


09.08.19

NC DEPARTMENT OF ENVIRONMENTAL QUALITY
DIVISION OF MITIGATION SERVICES

AS-BUILT PLANS
SHAWS RUN MITIGATION SITE


LOCATION: COLUMBUS COUNTY, NORTH CAROLINA

TYPE OF WORK: STREAM RESTORATION AND ENHANCEMENT (CLEARING, GRUBBING, GRADING, EROSION CONTROL AND PLANTING)

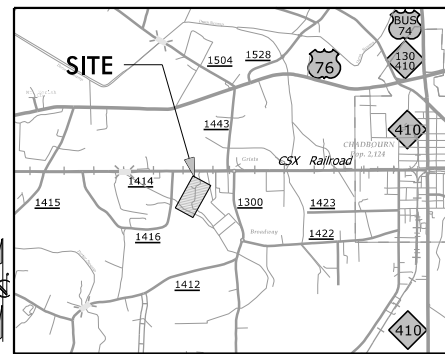

VICINITY MAP
Not to Scale

CONTRACT: SHAWS RUN MITIGATION SITE

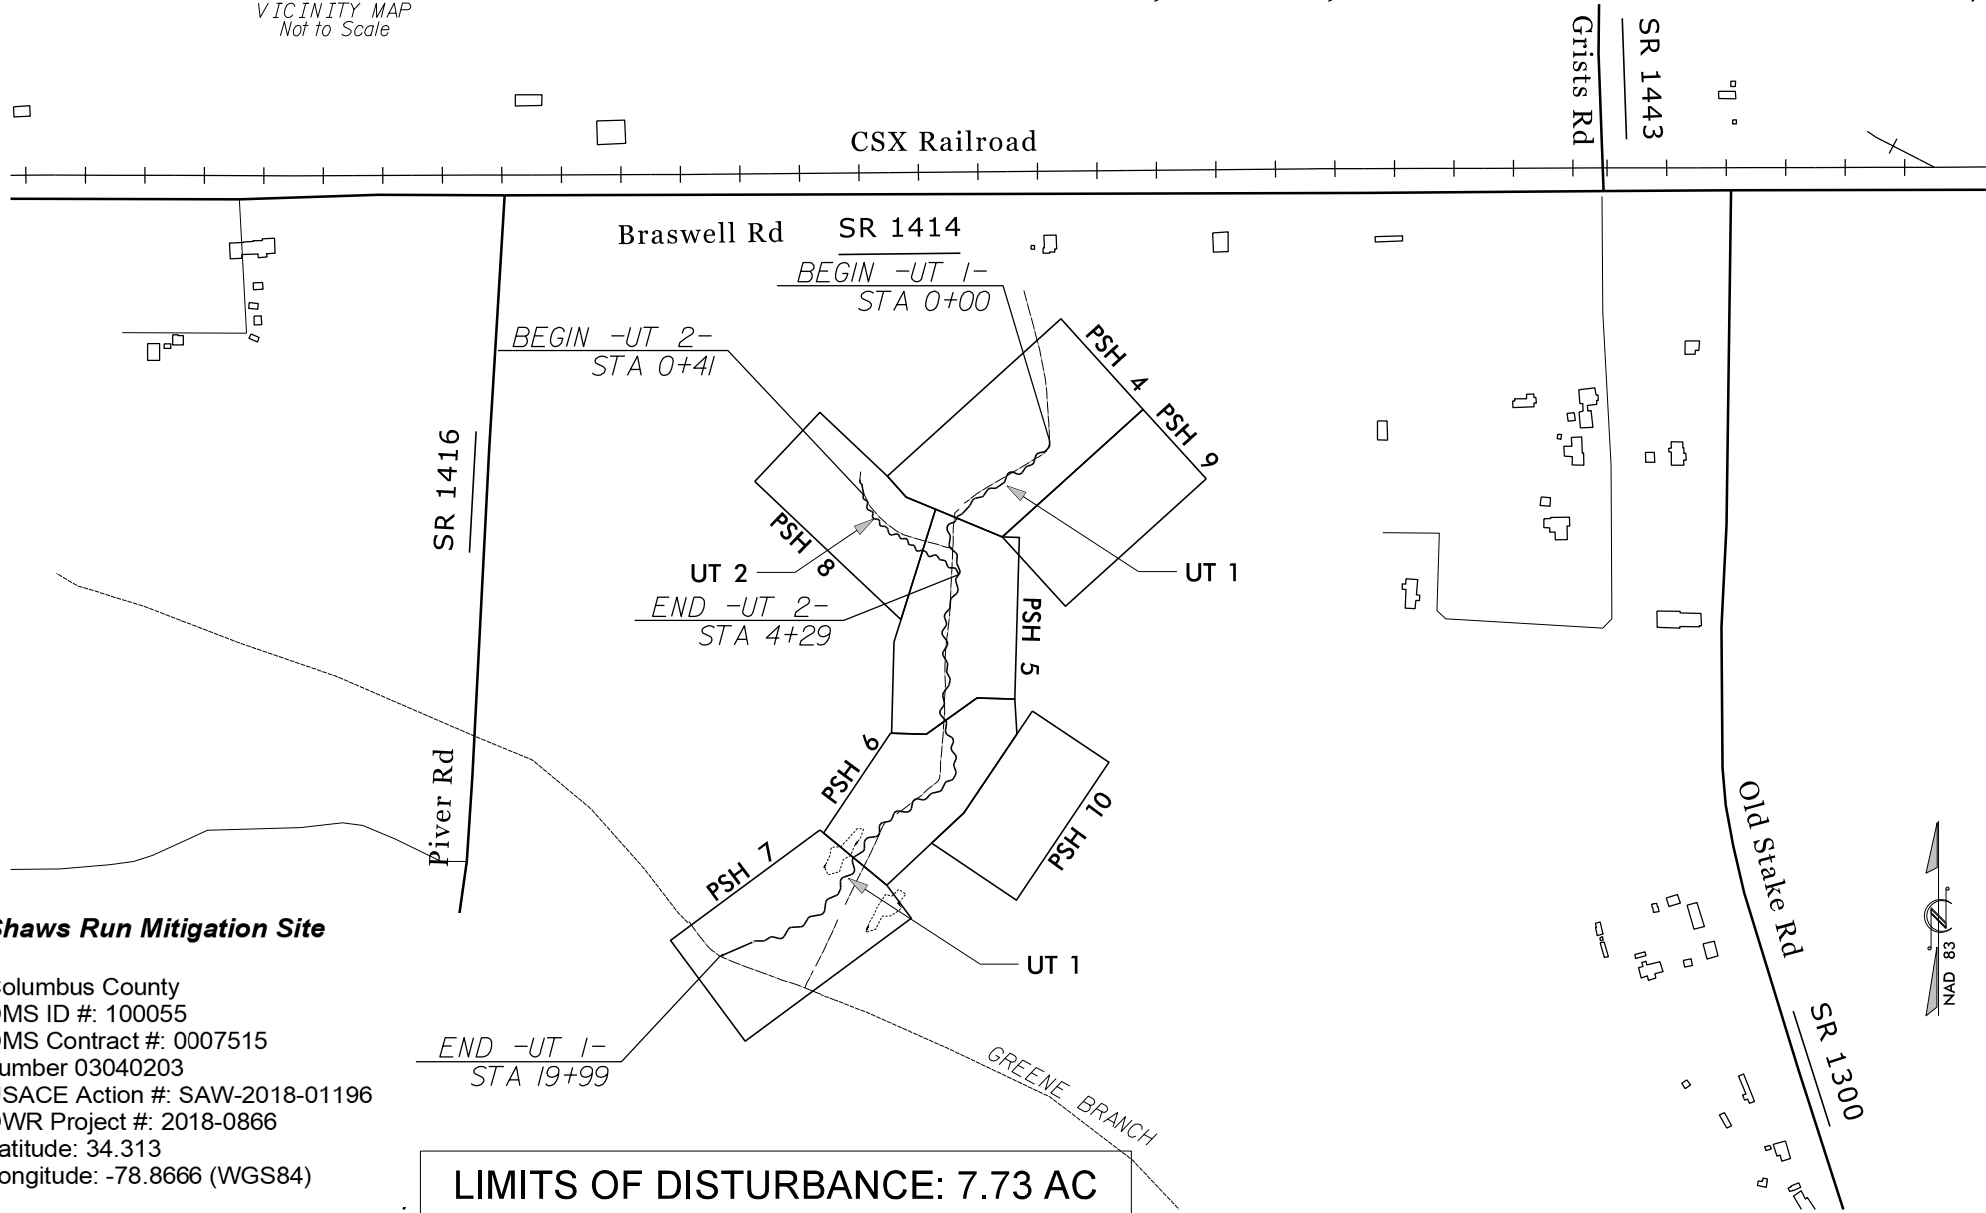

Shaws Run Mitigation Site

Columbus County
DMS ID #: 100055
DMS Contract #: 0007515
Lumber 03040203
USACE Action #: SAW-2018-01196
DWR Project #: 2018-0866
Latitude: 34.313
Longitude: -78.8666 (WGS84)

LIMITS OF DISTURBANCE: 7.73 AC

INDEX OF SHEETS

SHEET NUMBER	SHEET
01	Title Sheet
02	Symbology
03	Easement
04A THRU 4G	As-Built Structures
04H	As-Built Planting Table

SURVEYORS CERTIFICATION(S)

Surveyor's disclaimer: No attempt was made to locate any cemeteries, wetlands, hazardous material sites, underground utilities or any other features above, or below ground other than those shown. However, no visible evidence of cemeteries or utilities, aboveground or otherwise, was observed by the undersigned (other than those shown).


I certify that the survey is of an existing parcel or parcels of land or one or more existing easements and does not create a new street or change an existing street.

I, JOHN A. RUDOLPH, certify that this plat was prepared under my supervision from an actual field survey made under my supervision, of as-built conditions.

That the boundaries not surveyed are clearly indicated as such and were plotted from information as referenced hereon; That the ratio of precision as calculated was 1:7,500+ and that the global navigational satellite system (GNSS) was used to perform this survey and the following information was used:
 Class of Survey: CLASS B (HORIZONTAL) CLASS B (VERTICAL)
 Positional Accuracy: 0.12 feet (HORIZONTAL)
 Type of GPS field procedure: RTK
 Dates of survey: June & July 2020
 Datum/Epoch: NAD 1983(2011)
 Published/Fixed Control Use: OPUS
 Geoid Model: 2012B CONUS
 Combined Grid Factor: 0.99990680 GROUND TO GRID
 Units: US SURVEY FEET

That this plat meets the requirements of the standards of practice for land surveying in North Carolina. Witness my hand and seal this 04th day of November, 2020

SEAL OR STAMP

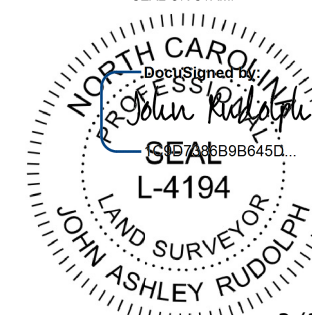


3/3/2021

Professional Land Surveyor License Number

RECORD DRAWING

GRAPHIC SCALES

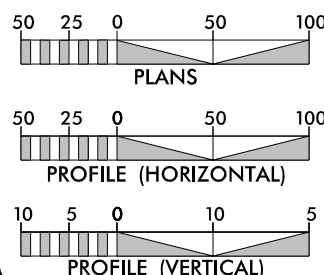

PROPOSED LENGTH OF -UT 1- = 1999 LF		PROPOSED LENGTH OF -UT 2- = 388 LF	
TOTAL STREAM LENGTH = 2428 LF			
RESTORATION LEVEL	STREAM (linear footage)	RIPARIAN WETLAND (acreage)	NONRIPARIAN WETLAND (acreage)
RESTORATION	2367	5.850	0.000
ENHANCEMENT	0	0.000	0.000
PRESERVATION	0	0.100	0.000
TOTALS	2367	5.950	0.000
MITIGATION UNITS	2367 SMUs	5.860 RIPARIAN WMUs	NONRIPARIAN WMUs

Axiom Environmental
218 Snow Ave
Raleigh, NC 27603

GRANT LEWIS
PROJECT DESIGNER


Restoration Systems
1101 Haynes St.
Suite 211
Raleigh, NC 27604

WORTH CREECH
SITE CONSTRUCTION MANAGER

Prepared in the Office of:
SUNGATE DESIGN GROUP, P.A.

905 JONES FRANKLIN ROAD
RALEIGH, NORTH CAROLINA 27606
TEL (919) 859-2243
ENG FIRM LICENSE NO. C-890

JOSHUA G. DALTON, P.E.
PROJECT ENGINEER

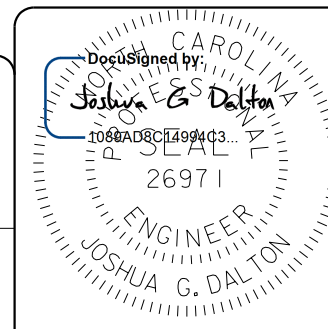

3/3/2021

DATE:

RECORD DRAWING

CONVENTIONAL PLAN SHEET SYMBOLS

Note: Not to Scale

*S.U.E. = Subsurface Utility Engineering

SHEET NAME		SHEET NUMBER
SYMBOLS		01A
PROJECT NAME: SHAW'S RUN MITIGATION SITE		
DMS ID #: 100055	COUNTY: COLUMBUS	DATE: 2021

BOUNDARIES AND PROPERTY:

- State Line
- County Line
- Township Line
- City Line
- Reservation Line
- Property Line
- Existing Iron Pin
- Computed Property Corner
- Property Monument
- Parcel/Sequence Number
- Existing Fence Line
- Proposed Fence Gate
- Proposed Barbed Wire Fence
- Existing Wetland Boundary
- Proposed Wetland Boundary
- Existing Endangered Animal Boundary
- Existing Endangered Plant Boundary
- Existing Historic Property Boundary

- Exist Permanent Easement Pin and Cap
- New Permanent Easement Pin and Cap
- Vertical Benchmark
- Existing Right of Way Marker
- Existing Right of Way Line
- New Right of Way Line
- New Right of Way Line with Pin and Cap
- New Right of Way Line with Concrete or Granite RW Marker
- New Control of Access Line with Concrete CA Marker
- Existing Control of Access
- New Control of Access
- Existing Easement Line
- New Conservation Easement
- New Temporary Drainage Easement
- New Permanent Drainage Easement
- New Permanent Drainage / Utility Easement
- New Permanent Utility Easement
- New Temporary Utility Easement
- New Aerial Utility Easement

- Pipe Culvert
- Footbridge
- Drainage Box: Catch Basin, DI or JB
- Paved Ditch Gutter
- Storm Sewer Manhole
- Storm Sewer

UTILITIES:

- POWER:
- Existing Power Pole
 - Proposed Power Pole
 - Existing Joint Use Pole
 - Proposed Joint Use Pole
 - Power Manhole
 - Power Line Tower
 - Power Transformer
 - U/G Power Cable Hand Hole
 - H-Frame Pole
 - U/G Power Line LOS B (S.U.E.*)
 - U/G Power Line LOS C (S.U.E.*)
 - U/G Power Line LOS D (S.U.E.*)
- TELEPHONE:
- Existing Telephone Pole
- WATER:
- Water Manhole
 - Water Meter
 - Water Valve
 - Water Hydrant
 - U/G Water Line LOS B (S.U.E.*)
 - U/G Water Line LOS C (S.U.E.*)
 - U/G Water Line LOS D (S.U.E.*)
 - Above Ground Water Line
- GAS:
- Gas Valve
 - Gas Meter
 - U/G Gas Line LOS B (S.U.E.*)
 - U/G Gas Line LOS C (S.U.E.*)
 - U/G Gas Line LOS D (S.U.E.*)
 - Above Ground Gas Line

ROADS AND RELATED FEATURES:

- Existing Edge of Pavement
- Existing Curb
- Proposed Slope Stakes Cut
- Proposed Slope Stakes Fill
- Proposed Curb Ramp
- Existing Metal Guardrail
- Proposed Guardrail
- Existing Cable Guiderail
- Proposed Cable Guiderail
- Equality Symbol
- Pavement Removal

VEGETATION:

- Single Tree
- Single Shrub
- Hedge
- Woods Line
- Orchard
- Vineyard

EXISTING STRUCTURES:

- MAJOR:
- Bridge, Tunnel or Box Culvert
 - Bridge Wing Wall, Head Wall and End Wall
- MINOR:
- Head and End Wall

BUILDINGS AND OTHER CULTURE:

- Gas Pump Vent or U/G Tank Cap
- Sign
- Well
- Small Mine
- Foundation
- Area Outline
- Cemetery
- Building
- School
- Church
- Dam

HYDROLOGY:

- Stream or Body of Water
- Hydro, Pool or Reservoir
- Jurisdictional Stream
- Buffer Zone 1
- Buffer Zone 2
- Flow Arrow
- Disappearing Stream
- Spring
- Wetland
- Proposed Lateral, Tail, Head Ditch


RIGHT OF WAY & PROJECT CONTROL:

- Secondary Horiz and Vert Control Point
- Primary Horiz Control Point
- Primary Horiz and Vert Control Point

- SS Forced Main Line LOS D (S.U.E.*)
- MISCELLANEOUS:
- Utility Pole
 - Utility Pole with Base
 - Utility Located Object
 - Utility Traffic Signal Box
 - Utility Unknown U/G Line LOS B (S.U.E.*)
 - U/G Tank; Water, Gas, Oil
 - Underground Storage Tank, Approx. Loc.
 - A/G Tank; Water, Gas, Oil
 - Geoenvironmental Boring
 - U/G Test Hole LOS A (S.U.E.*)
 - Abandoned According to Utility Records
 - End of Information
 - Riffle Rip Rap
 - Log Vane
 - Log Cross Vane
 - Step Pool Structure
 - Stream Plug
 - Floodplain Interceptor
 - Proposed Fence
 - Limits of Disturbance
- AS-BUILT:
- Stream Centerline
 - Stream Top of Bank
 - Stream Gauge
 - Groundwater Gauge
 - Benthic & Water Quality Station
 - Origin Point on CVS Plots
 - CVS Plots
 - Cross Section
 - Adjusted Stream Structure
 - Not Constructed

3/13/2021 Shaw's Run_Hyd_AB_PSH_02.dgn

RECORD DRAWING

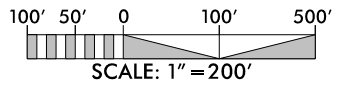


SURVEY INFORMATION PROPERTY/
EASEMENT PROVIDED BY:
K2 DESIGN GROUP, P.A.
5688 U.S. HIGHWAY 70 EAST
GOLDSBORO, NC 27534

SHEET NAME		SHEET NUMBER
EASEMENT		3
PROJECT NAME: SHAW'S RUN MITIGATION SITE		
DMS ID #: 100055	COUNTY: COLUMBUS	DATE: 2021



SUNGATE DESIGN GROUP, P.A.
 905 JONES FRANKLIN ROAD
 RALEIGH, NORTH CAROLINA 27606
 TEL: (919) 859-2243
 ENG FIRM LICENSE NO. C-890

Axiom Environmental, Inc.

**DOCUMENT NOT CONSIDERED FINAL
UNLESS ALL SIGNATURES COMPLETED**

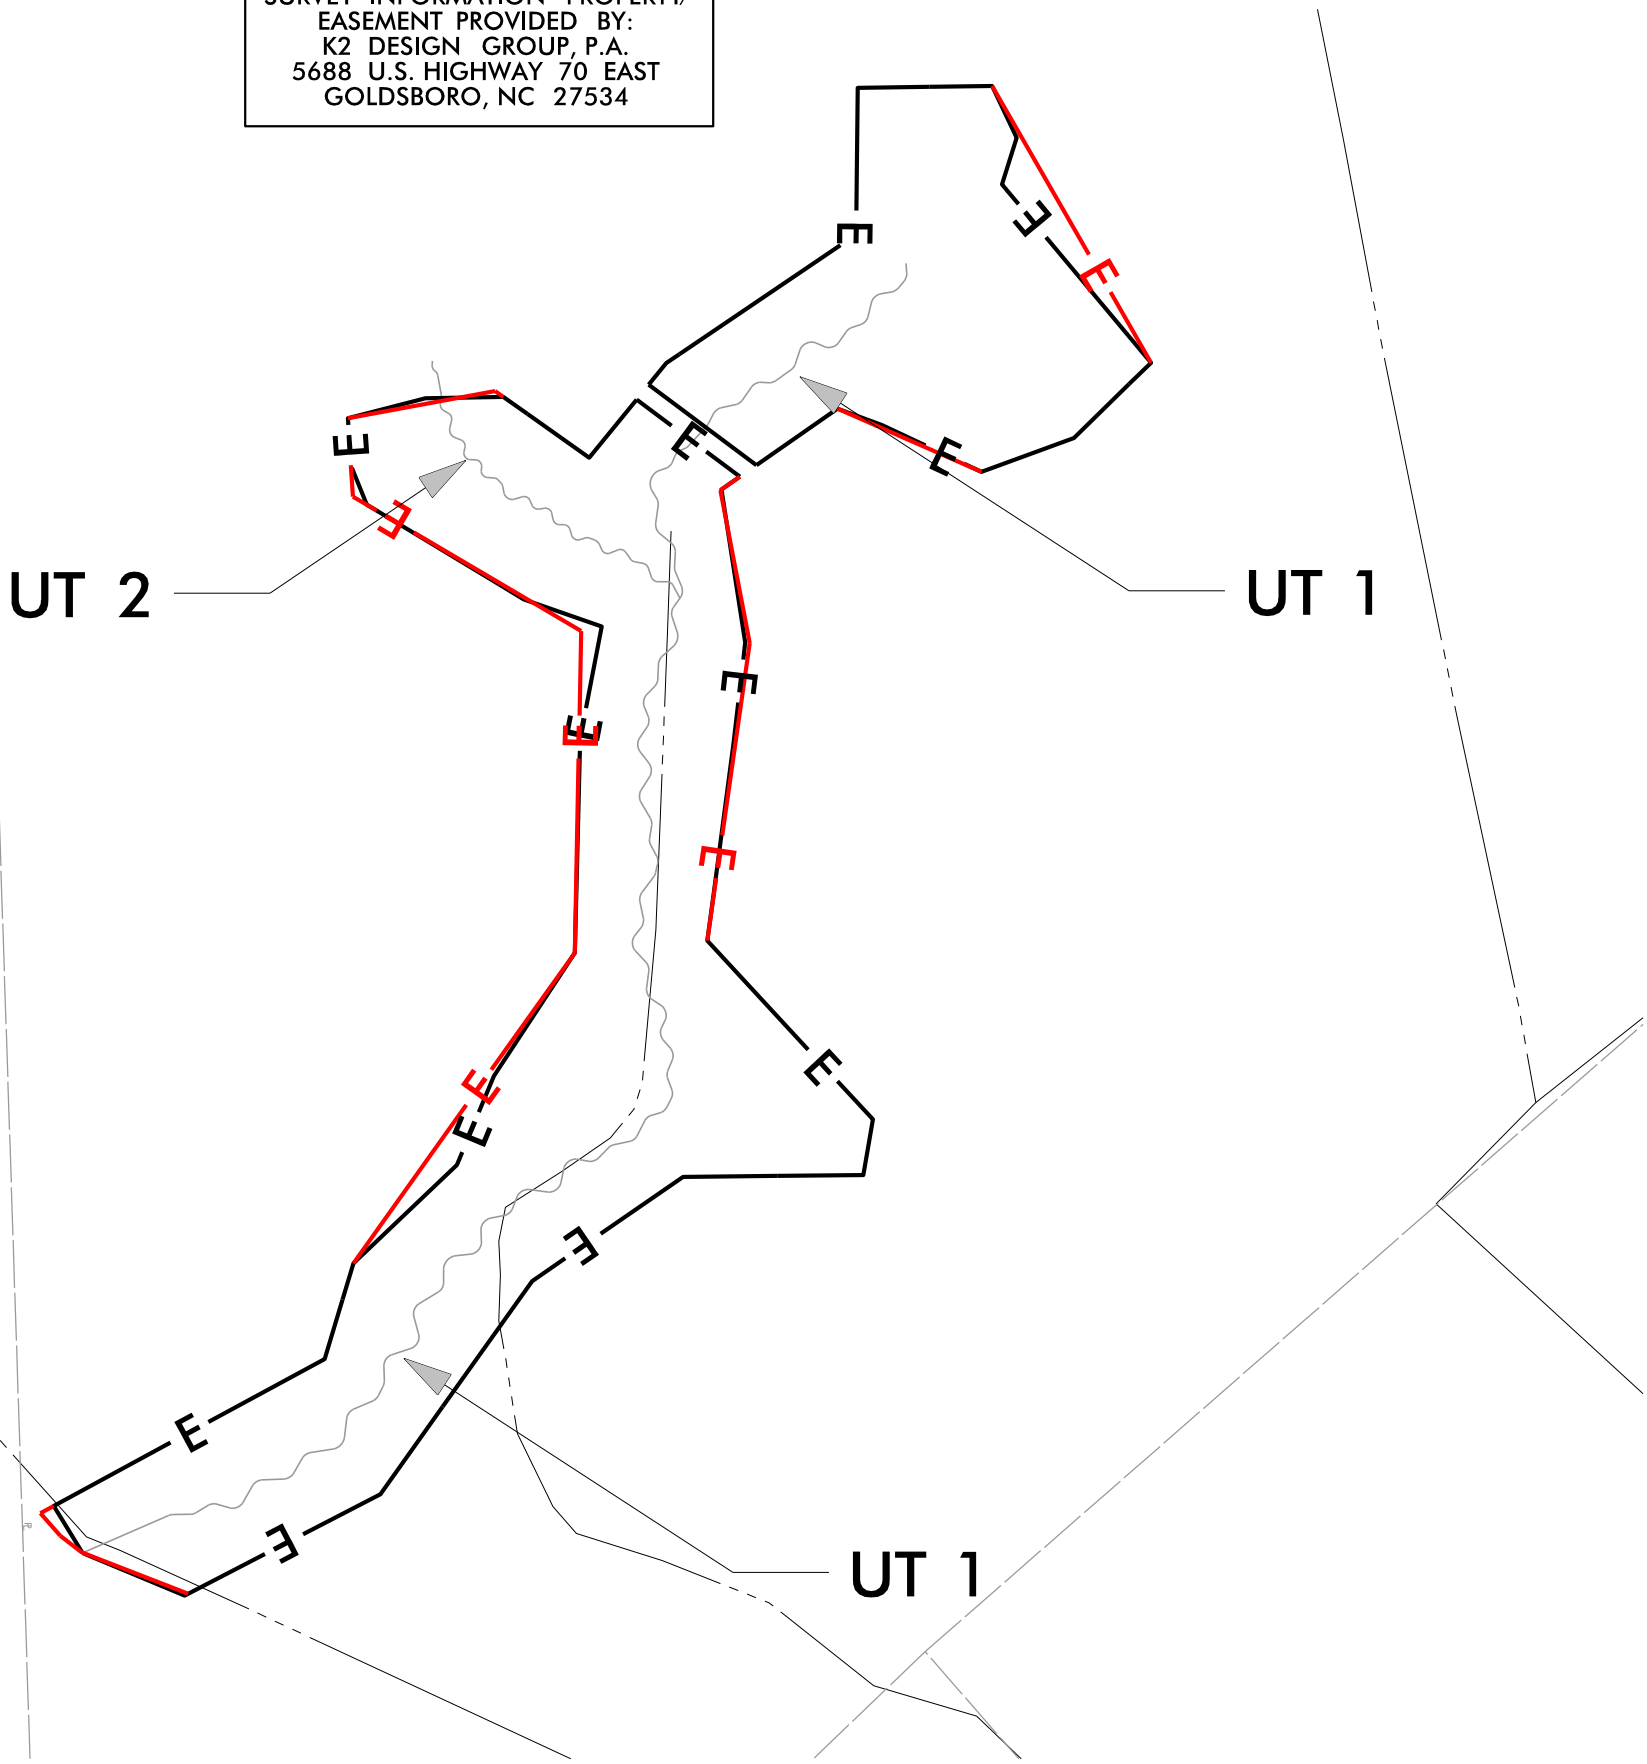


3/3/2021
Shaw's Run Hyd. AB_PSH_03.dgn
jbravey

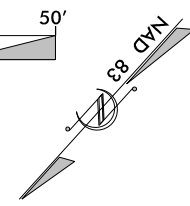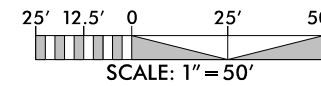

SHEET NAME		SHEET NUMBER
AS-BUILT STRUCTURES		4A
PROJECT NAME: SHAW'S RUN MITIGATION SITE		
DMS ID #: 100055	COUNTY: COLUMBUS	DATE: 2021

SUNGATE DESIGN GROUP, P.A.
 905 JONES FRANKLIN ROAD
 RALEIGH, NORTH CAROLINA 27606
 TEL (919) 859-2243
 ENG FIRM LICENSE NO. C-890

Axiom Environmental, Inc.

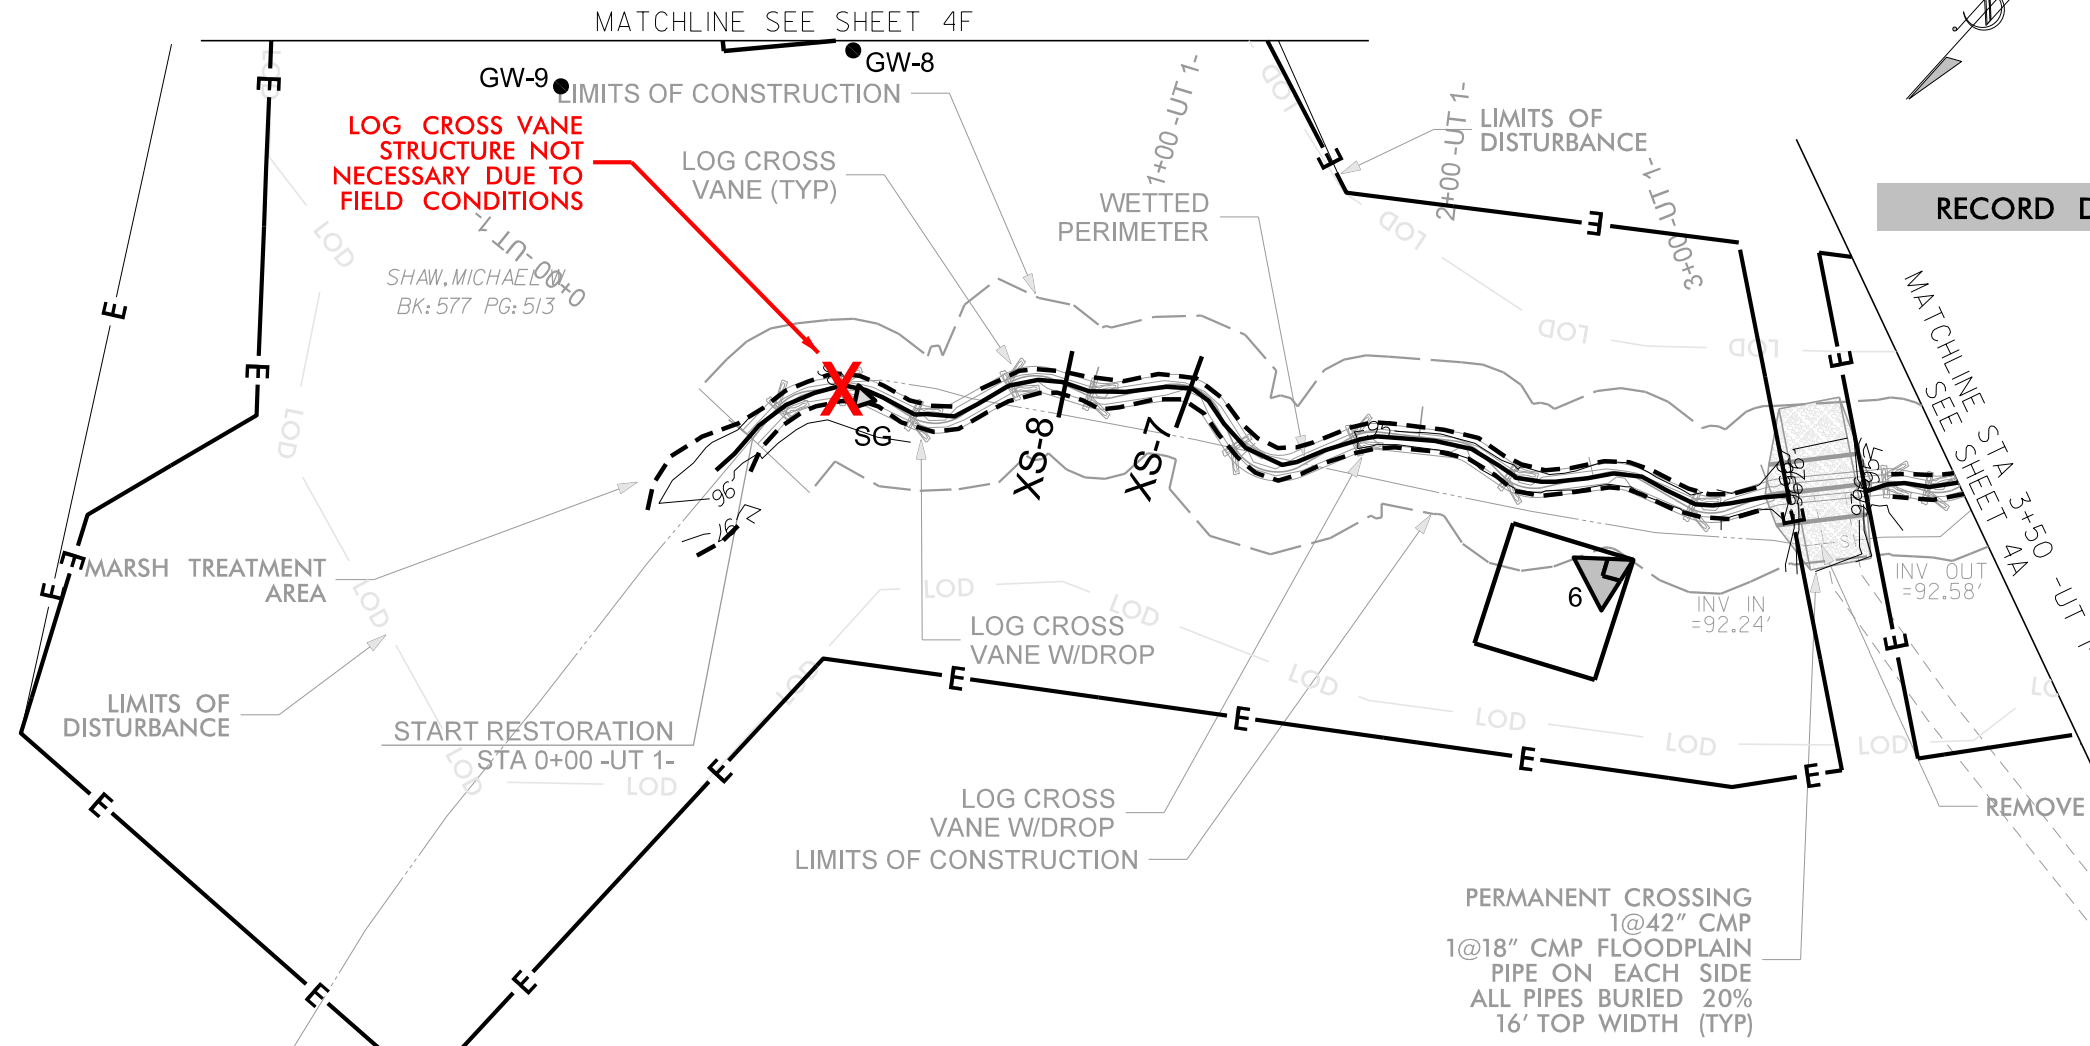

RECORD DRAWING

DOCUMENT NOT CONSIDERED FINAL UNLESS ALL SIGNATURES COMPLETED

DocuSigned by:
 Joshua G. Dalton
 1089AD6014994C3...
 PROFESSIONAL SEAL
 26971
 ENGINEER
 JOSHUA G. DALTON


3/3/2021
 DATE:

THE EASEMENT WILL NOT BE FENCED. THE EASEMENT BOUNDARY WILL BE MARKED APPROPRIATELY.

WOODY DEBRIS ADDED TO RIFFLES FOR HABITAT PURPOSES

TOPOGRAPHY OUTSIDE OF SURVEY LIMITS BASED ON NC SPATIAL DATA QL2 LIDAR


STR. TYPE	NORTHING	EASTING	Prop Elevation	AB Survey Elevation
LOG CROSS VANE	207,641.08	2,040,560.33	95.32	95.54
LOG CROSS VANE	207,626.66	2,040,552.22	95.29	
LOG CROSS VANE W/DROP	207,618.78	2,040,533.51	95.24	95.36
LOG CROSS VANE	207,596.19	2,040,520.06	95.08	95.26
LOG CROSS VANE	207,583.88	2,040,503.15	95.03	95.08
LOG CROSS VANE	207,568.02	2,040,465.84	94.93	95.11
LOG CROSS VANE W/DROP	207,546.55	2,040,444.04	94.86	95.03
LOG CROSS VANE	207,526.47	2,040,407.99	94.65	94.73
LOG CROSS VANE	207,500.08	2,040,367.42	94.52	94.66
LOG CROSS VANE	207,461.74	2,040,334.31	94.37	94.56
LOG CROSS VANE	207,455.58	2,040,325.06	94.29	94.41

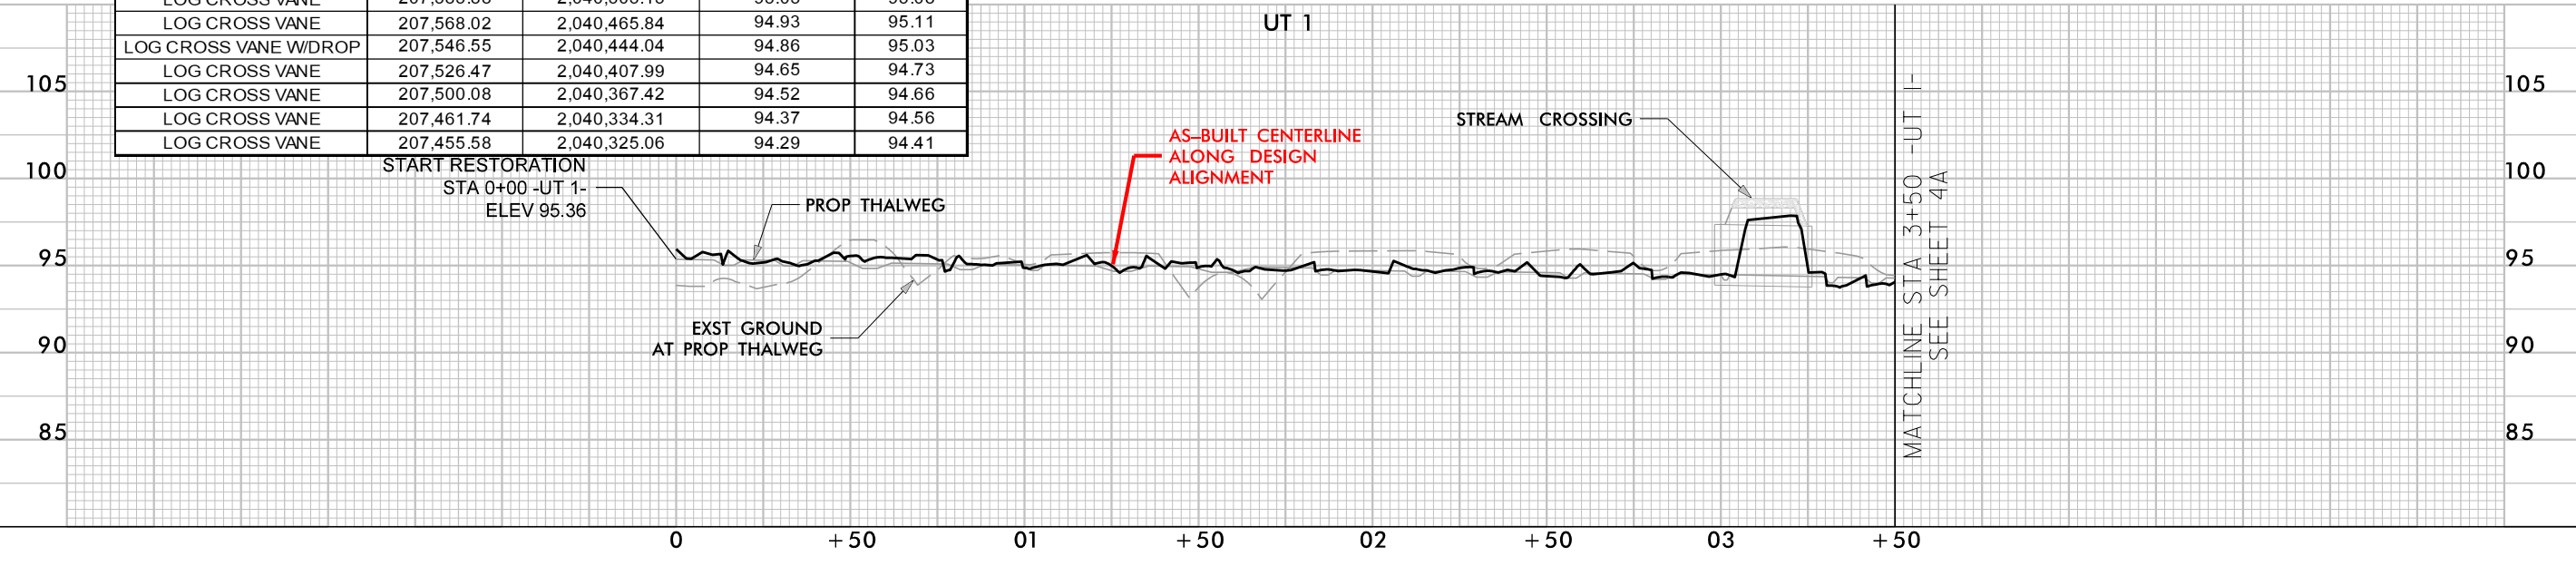

3/3/2021
 Shaw's Run_Mitigation_Hyd_AB_PSH_04A.dgn
 jbravey

-UT 1- STRUCTURE LOCATIONS				
STR. TYPE	NORTHING	EASTING	Prop Elevation	AB Survey Elevation
LOG CROSS VANE	207,443.71	2,040,316.03	94.26	94.24
LOG VANE ARM	207,434.62	2,040,302.82	94.22	94.33
LOG CROSS VANE W/DROP	207,405.43	2,040,300.39	94.16	94.45
LOG CROSS VANE	207,380.09	2,040,300.44	93.99	94.15
LOG CROSS VANE	207,359.29	2,040,315.16	93.93	94.10
LOG CROSS VANE W/DROP	207,314.62	2,040,325.79	93.80	94.09
LOG CROSS VANE	207,241.16	2,040,306.57	93.56	93.78
LOG CROSS VANE	207,217.36	2,040,300.71	93.50	93.78
LOG CROSS VANE	207,178.35	2,040,291.16	93.39	93.66

-UT 1- STRUCTURE LOCATIONS				
STR. TYPE	NORTHING	EASTING	Prop Elevation	AB Survey Elevation
LOG CROSS VANE	207,130.04	2,040,292.19	93.27	
LOG CROSS VANE	207,101.86	2,040,285.00	93.19	93.58
LOG CROSS VANE	207,072.92	2,040,293.28	93.12	
LOG CROSS VANE	207,051.40	2,040,294.03	93.06	93.36
LOG CROSS VANE	206,996.09	2,040,286.34	92.89	93.21
LOG CROSS VANE	206,968.31	2,040,285.74	92.82	93.10
LOG CROSS VANE	206,950.03	2,040,278.00	92.77	
LOG CROSS VANE	206,922.82	2,040,288.79	92.70	92.86

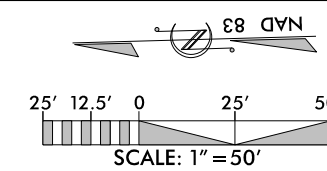

SHEET NAME		SHEET NUMBER
AS-BUILT STRUCTURES		4B
PROJECT NAME: SHAW'S RUN MITIGATION SITE		
DMS ID #: 100055	COUNTY: COLUMBUS	DATE: 2021

SUNGATE DESIGN GROUP, P.A.
 905 JONES FRANKLIN ROAD
 RALEIGH, NORTH CAROLINA 27606
 TEL: (919) 859-2243
 ENG FIRM LICENSE NO. C-890

Axiom Environmental, Inc.


**DOCUMENT NOT CONSIDERED FINAL
UNLESS ALL SIGNATURES COMPLETED**

DocuSigned by:

 1089A08C14994C3...
 NORTH CAROLINA
 PROFESSIONAL
 SEAL
 26971
 ENGINEER
 JOSHUA G. DALTON


DATE: 3/3/2021

THE EASEMENT WILL NOT BE FENCED.
THE EASEMENT BOUNDARY WILL BE MARKED APPROPRIATELY.

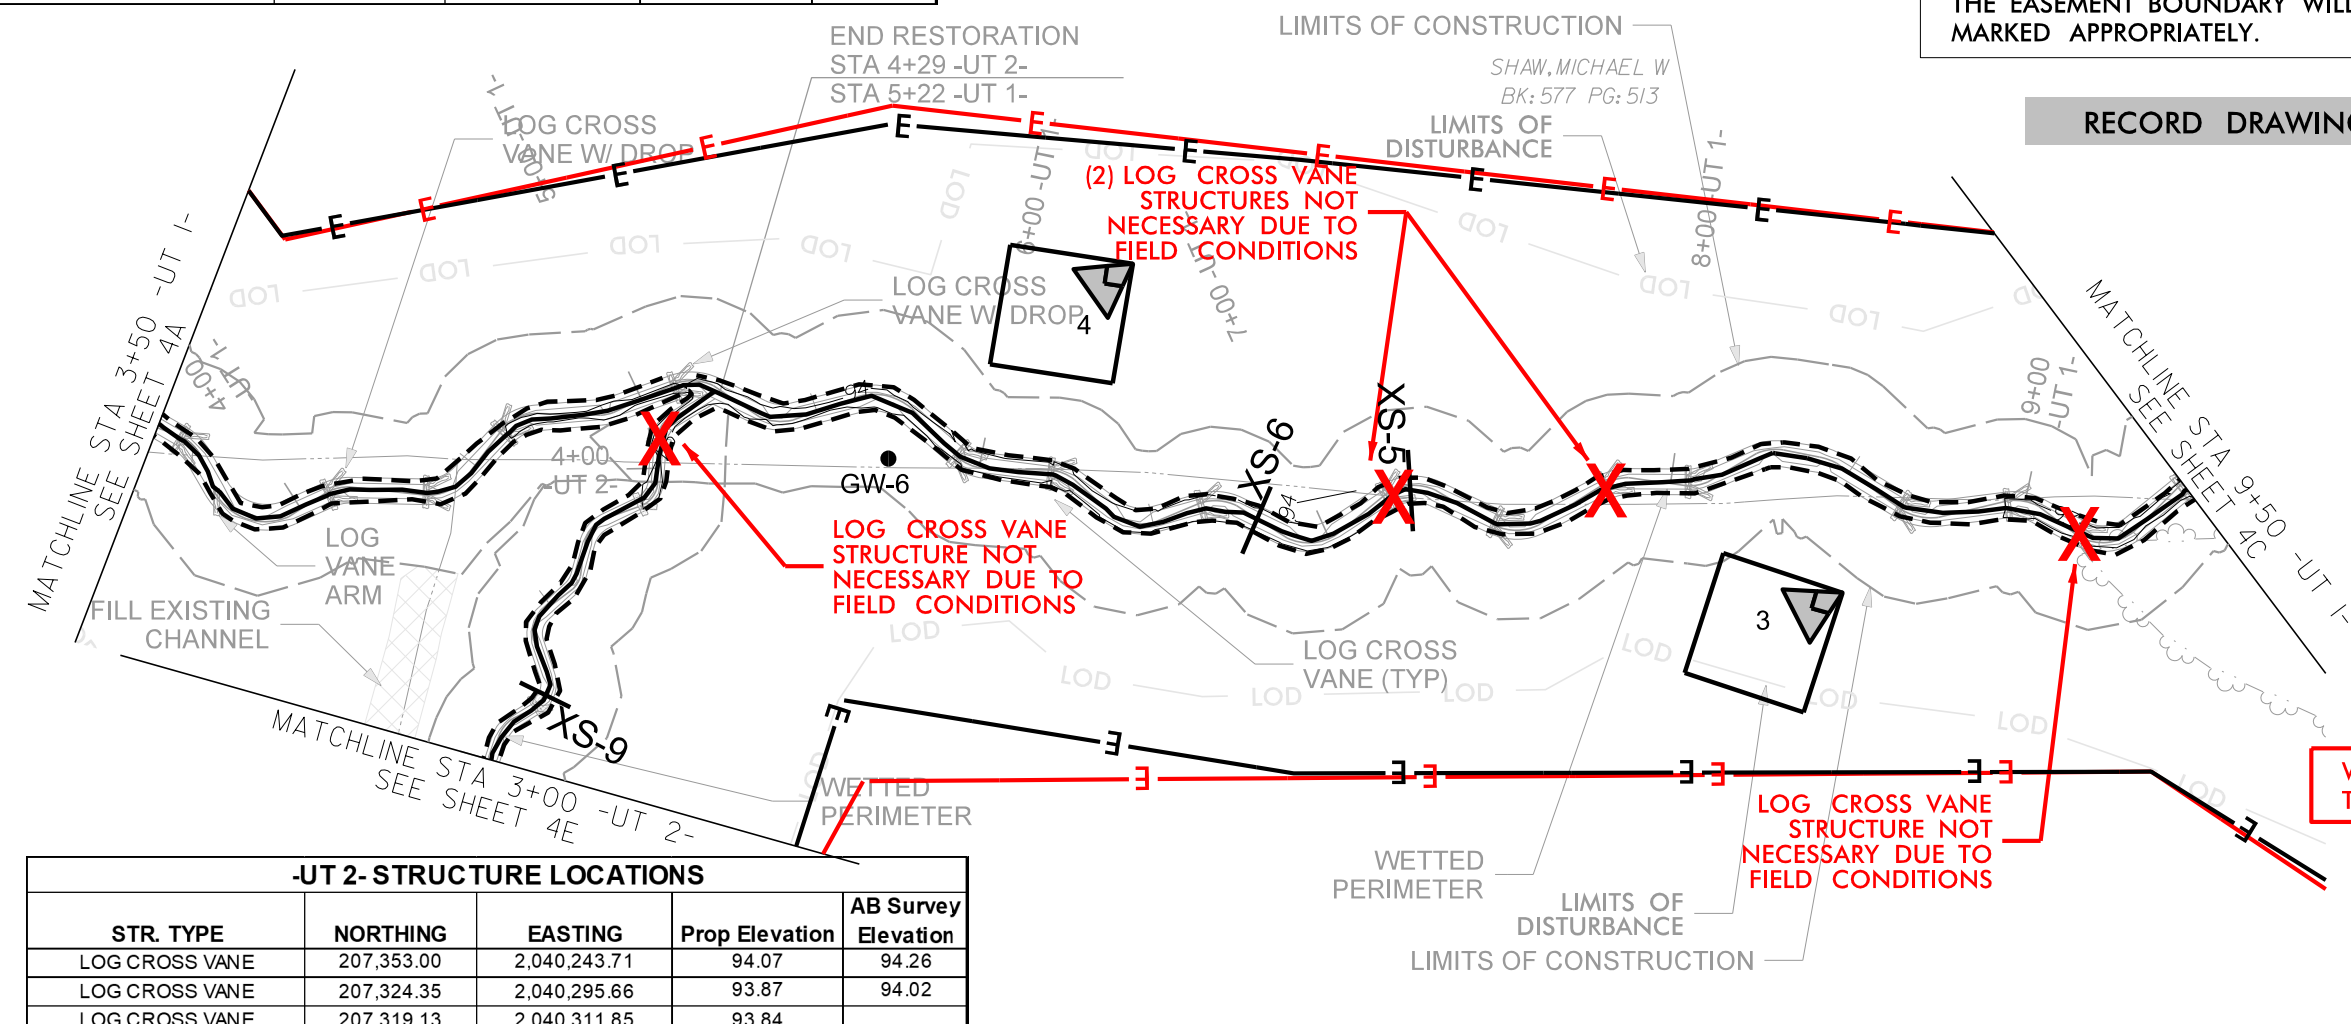


-UT 2- STRUCTURE LOCATIONS				
STR. TYPE	NORTHING	EASTING	Prop Elevation	AB Survey Elevation
LOG CROSS VANE	207,353.00	2,040,243.71	94.07	94.26
LOG CROSS VANE	207,324.35	2,040,295.66	93.87	94.02
LOG CROSS VANE	207,319.13	2,040,311.85	93.84	

TOPOGRAPHY OUTSIDE OF SURVEY LIMITS BASED ON NC SPATIAL DATA QL2 LIDAR

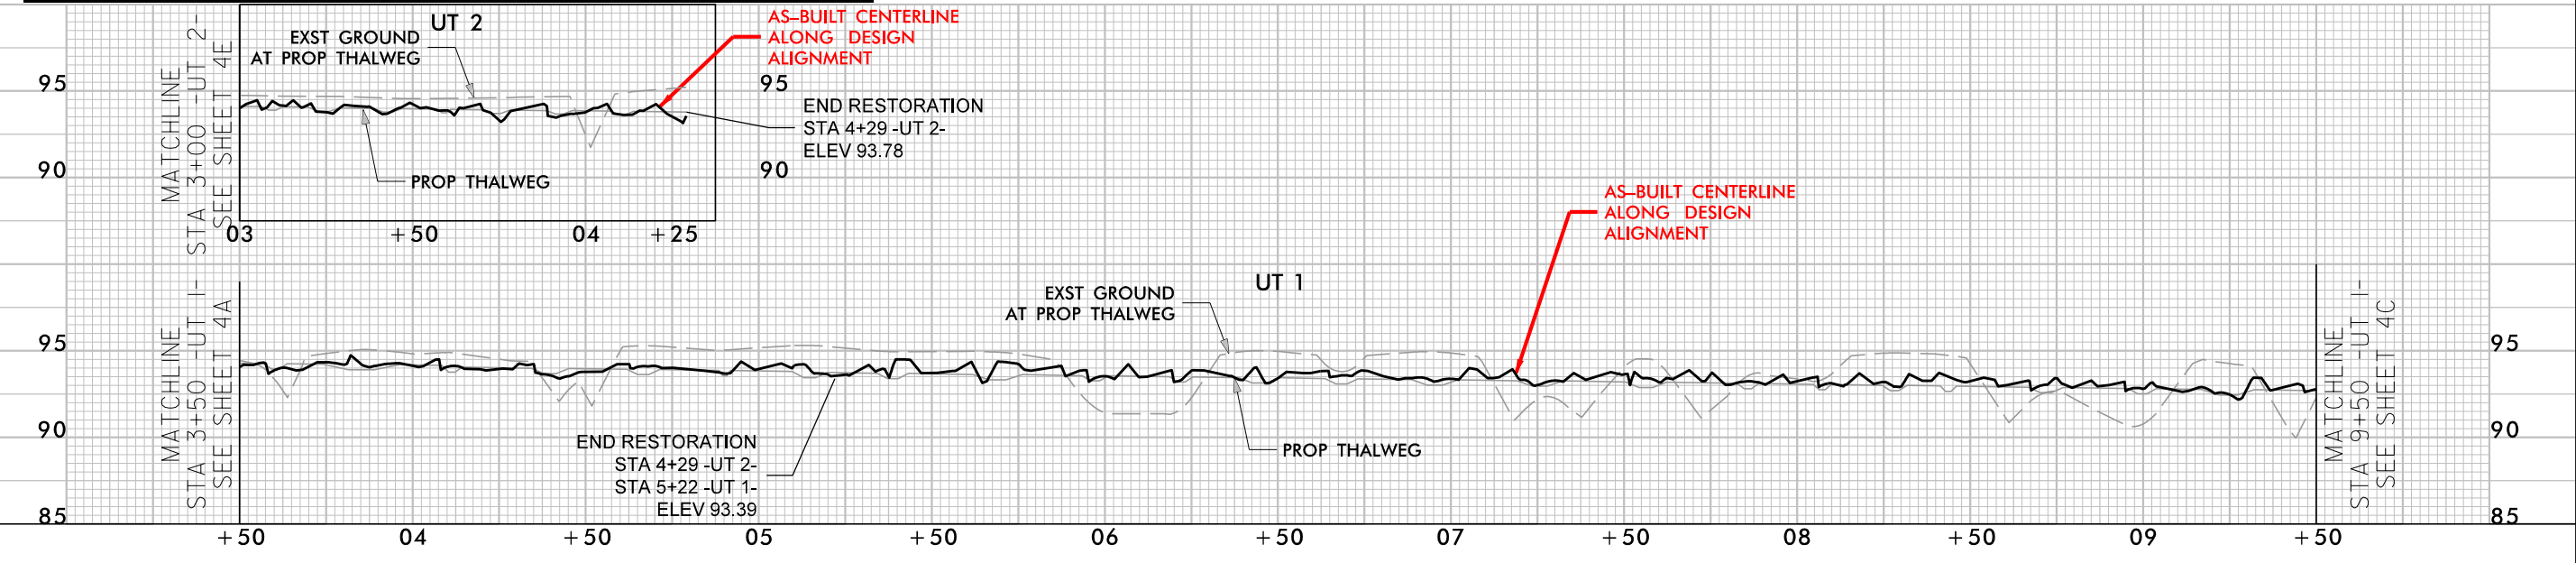

3/3/2021
Shaw's Run_Mitigation_Hydrology_PSH_04B.dgn

THE EASEMENT WILL NOT BE FENCED.
THE EASEMENT BOUNDARY WILL BE
MARKED APPROPRIATELY.

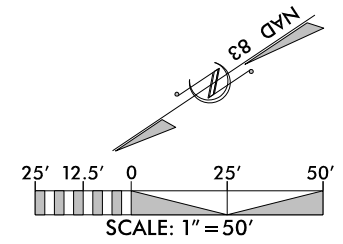

SHEET NAME		SHEET NUMBER
AS-BUILT STRUCTURES		4C
PROJECT NAME: SHAW'S RUN MITIGATION SITE		
DMS ID #: 100055	COUNTY: COLUMBUS	DATE: 2021

SUNGATE DESIGN GROUP, P.A.
905 JONES FRANKLIN ROAD
RALEIGH, NORTH CAROLINA 27606
TEL: (919) 859-2243
ENG FIRM LICENSE NO. C-890


Axiom Environmental, Inc.

RECORD DRAWING


**DOCUMENT NOT CONSIDERED FINAL
UNLESS ALL SIGNATURES COMPLETED**

DocuSigned by:
Joshua G. Dalton
1089AD8614994C3...
26971
ENGINEER
JOSHUA G. DALTON

3/3/2021
DATE:


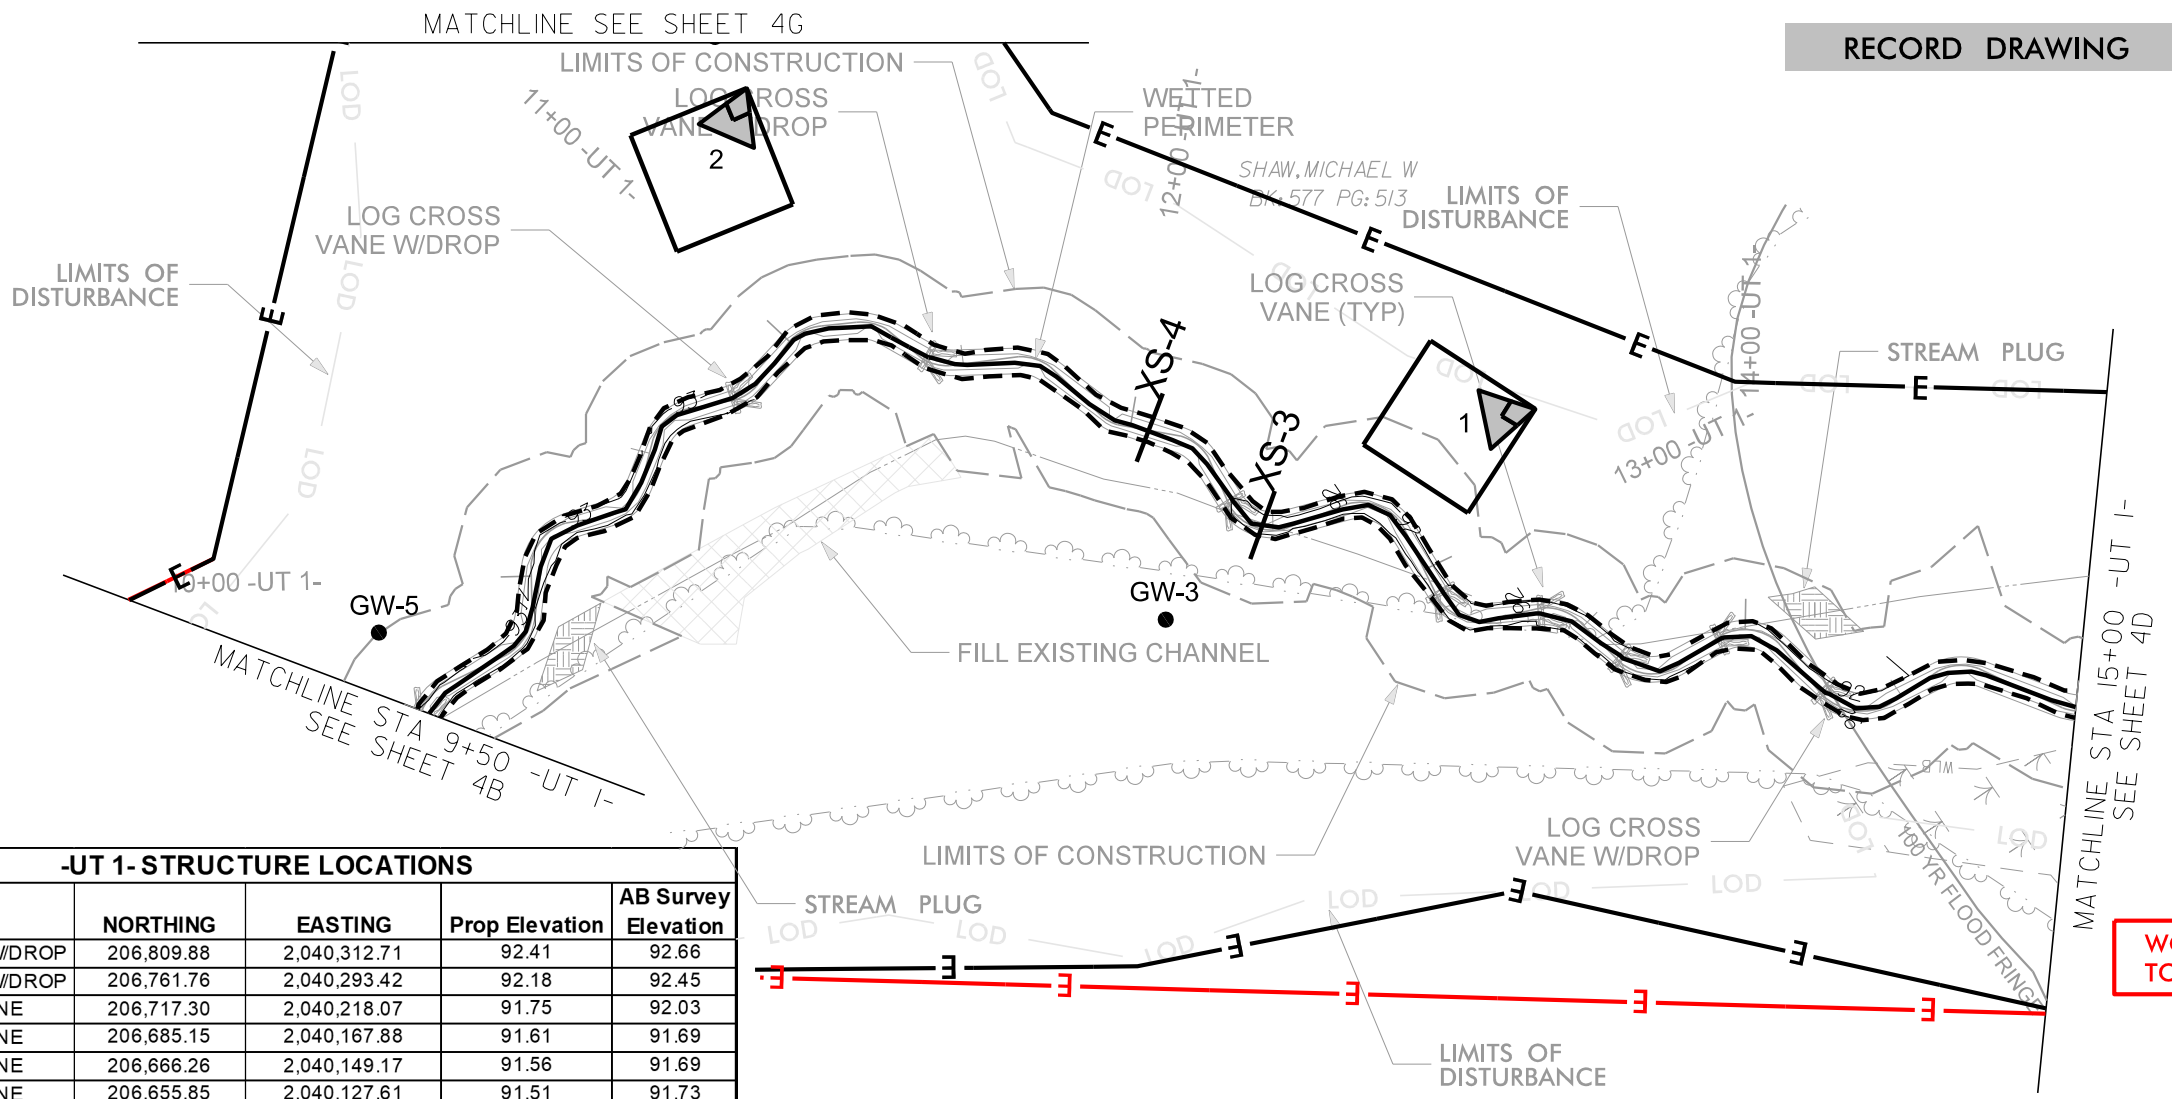


STR. TYPE	NORTHING	EASTING	Prop Elevation	AB Survey Elevation
LOG CROSS VANE W/DROP	206,809.88	2,040,312.71	92.41	92.66
LOG CROSS VANE W/DROP	206,761.76	2,040,293.42	92.18	92.45
LOG CROSS VANE	206,717.30	2,040,218.07	91.75	92.03
LOG CROSS VANE	206,685.15	2,040,167.88	91.61	91.69
LOG CROSS VANE	206,666.26	2,040,149.17	91.56	91.69
LOG CROSS VANE	206,655.85	2,040,127.61	91.51	91.73
LOG CROSS VANE	206,631.62	2,040,117.21	91.45	91.52
LOG CROSS VANE W/DROP	206,616.50	2,040,091.02	91.18	91.44

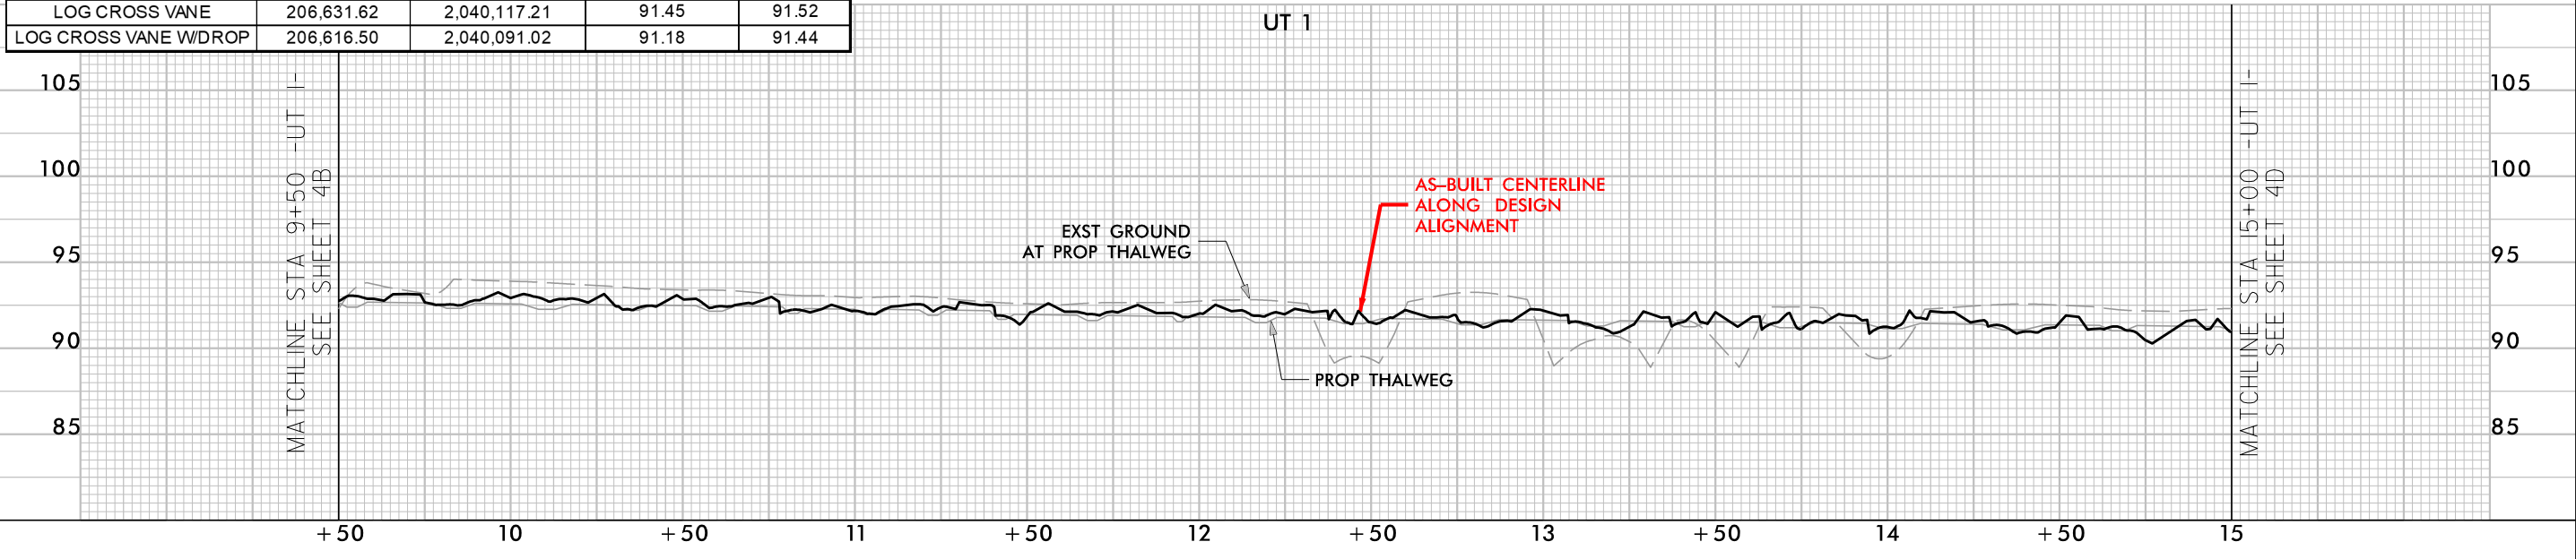

TOPOGRAHY OUTSIDE
OF SURVEY LIMITS BASED ON
NC SPATIAL DATA QL2 LIDAR

3/3/2021
Shaw's Run_Mitigation_Hyd_AB_PSH_04C.dgn
jbravey

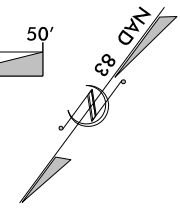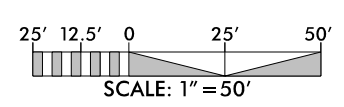


SHEET NAME AS-BUILT STRUCTURES		SHEET NUMBER 4D
PROJECT NAME: SHAW'S RUN MITIGATION SITE		
DMS ID #: 100055	COUNTY: COLUMBUS	DATE: 2021

SUNGATE DESIGN GROUP, P.A.
 905 JONES FRANKLIN ROAD
 RALEIGH, NORTH CAROLINA 27606
 TEL: (919) 859-2243
 ENG FIRM LICENSE NO. C-890

Axiom Environmental, Inc.

RECORD DRAWING


**DOCUMENT NOT CONSIDERED FINAL
UNLESS ALL SIGNATURES COMPLETED**

DocuSigned by:

 JOSHUA G. DALTON
 1089AD8C14994C3...
 PROFESSIONAL
 SEAL
 26971
 ENGINEER
 JOSHUA G. DALTON
 3/3/2021
 DATE:

THE EASEMENT WILL NOT BE FENCED.
 THE EASEMENT BOUNDARY WILL BE
 MARKED APPROPRIATELY.


**WOODY DEBRIS ADDED
 TO RIFFLES FOR HABITAT PURPOSES**

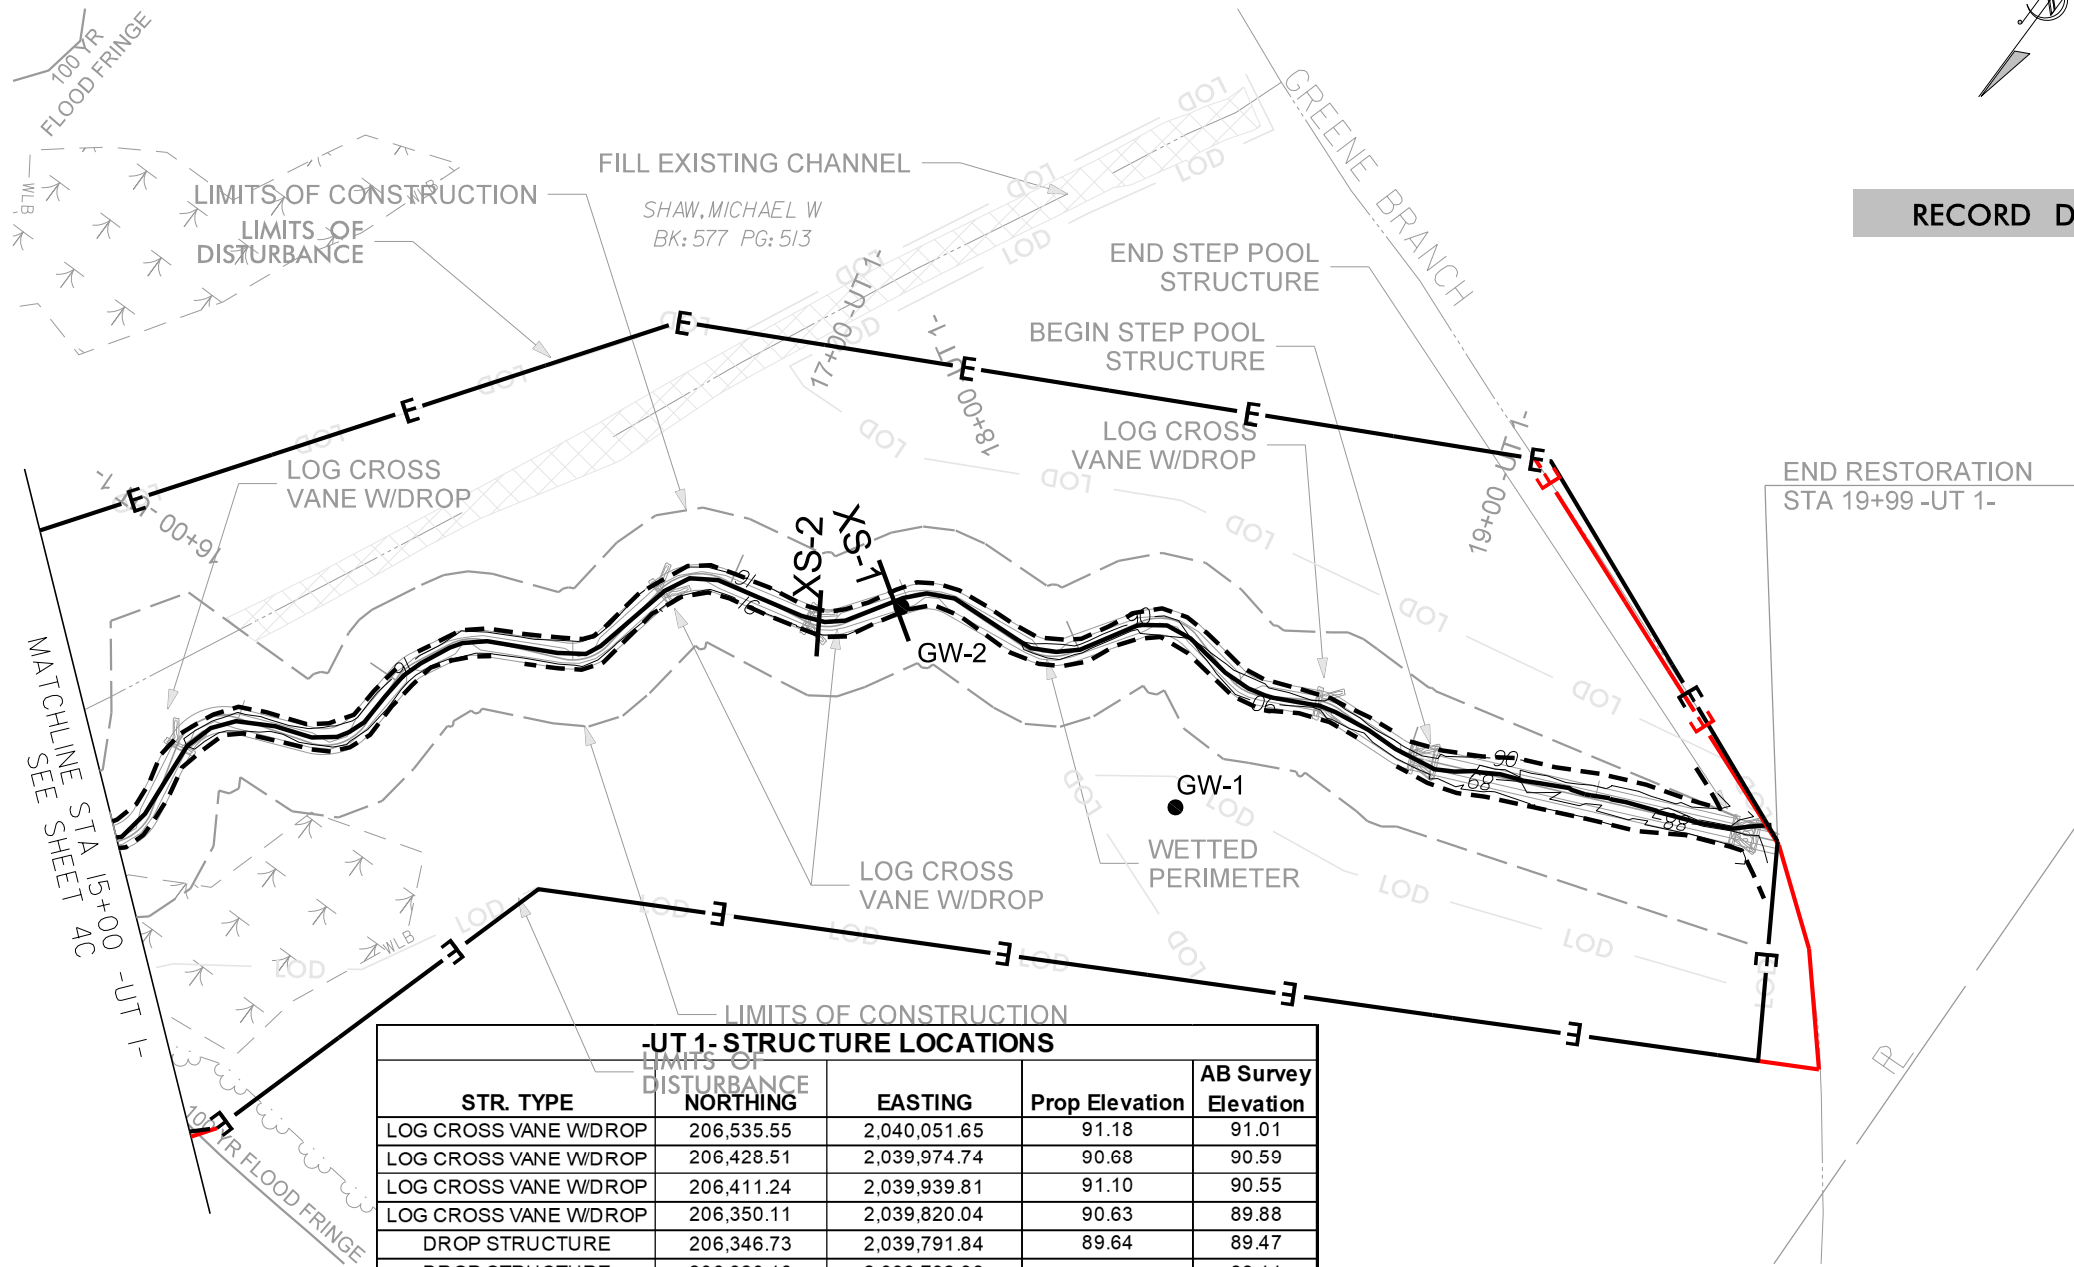TOPOGRAPHY OUTSIDE
 OF SURVEY LIMITS BASED ON
 NC SPATIAL DATA QL2 LIDAR




-UT 1- STRUCTURE LOCATIONS

STR. TYPE	NORTHING	EASTING	Prop Elevation	AB Survey Elevation
LOG CROSS VANE W/DROP	206,535.55	2,040,051.65	91.18	91.01
LOG CROSS VANE W/DROP	206,428.51	2,039,974.74	90.68	90.59
LOG CROSS VANE W/DROP	206,411.24	2,039,939.81	91.10	90.55
LOG CROSS VANE W/DROP	206,350.11	2,039,820.04	90.63	89.88
DROP STRUCTURE	206,346.73	2,039,791.84	89.64	89.47
DROP STRUCTURE	206,320.16	2,039,732.38		88.11

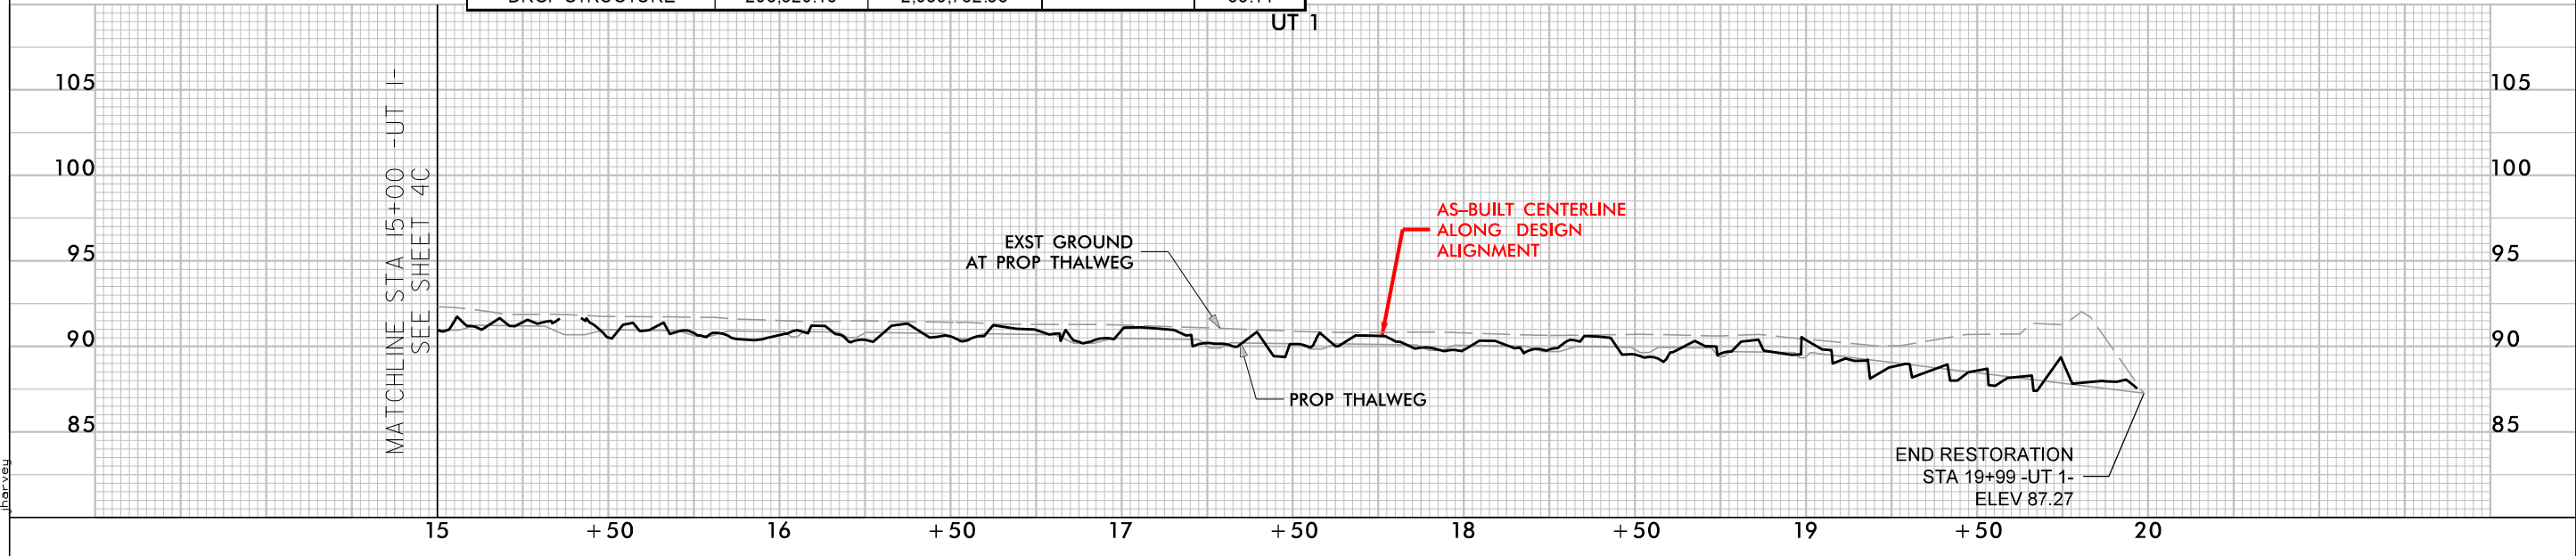

3/3/2021
 Shaw's Run Hyd. AB_PSH_04D.dgn

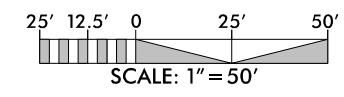


RECORD DRAWING

SHEET NAME AS-BUILT STRUCTURES		SHEET NUMBER 4E
PROJECT NAME: SHAW'S RUN MITIGATION SITE		
DMS ID #: 100055	COUNTY: COLUMBUS	DATE: 2021

SUNGATE DESIGN GROUP, P.A.
 905 JONES FRANKLIN ROAD
 RALEIGH, NORTH CAROLINA 27606
 TEL. (919) 859-2243
 ENG FIRM LICENSE NO. C-890

Axiom Environmental, Inc.


**DOCUMENT NOT CONSIDERED FINAL
UNLESS ALL SIGNATURES COMPLETED**

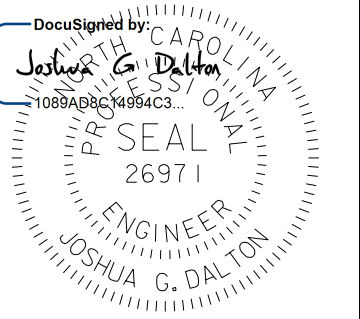

DocuSigned by:
Joshua G. Dalton
 1089A88C74994C3...
3/3/2021
 DATE:

THE EASEMENT WILL NOT BE FENCED.
 THE EASEMENT BOUNDARY WILL BE
 MARKED APPROPRIATELY.


**WOODY DEBRIS ADDED
 TO RIFFLES FOR HABITAT PURPOSES**

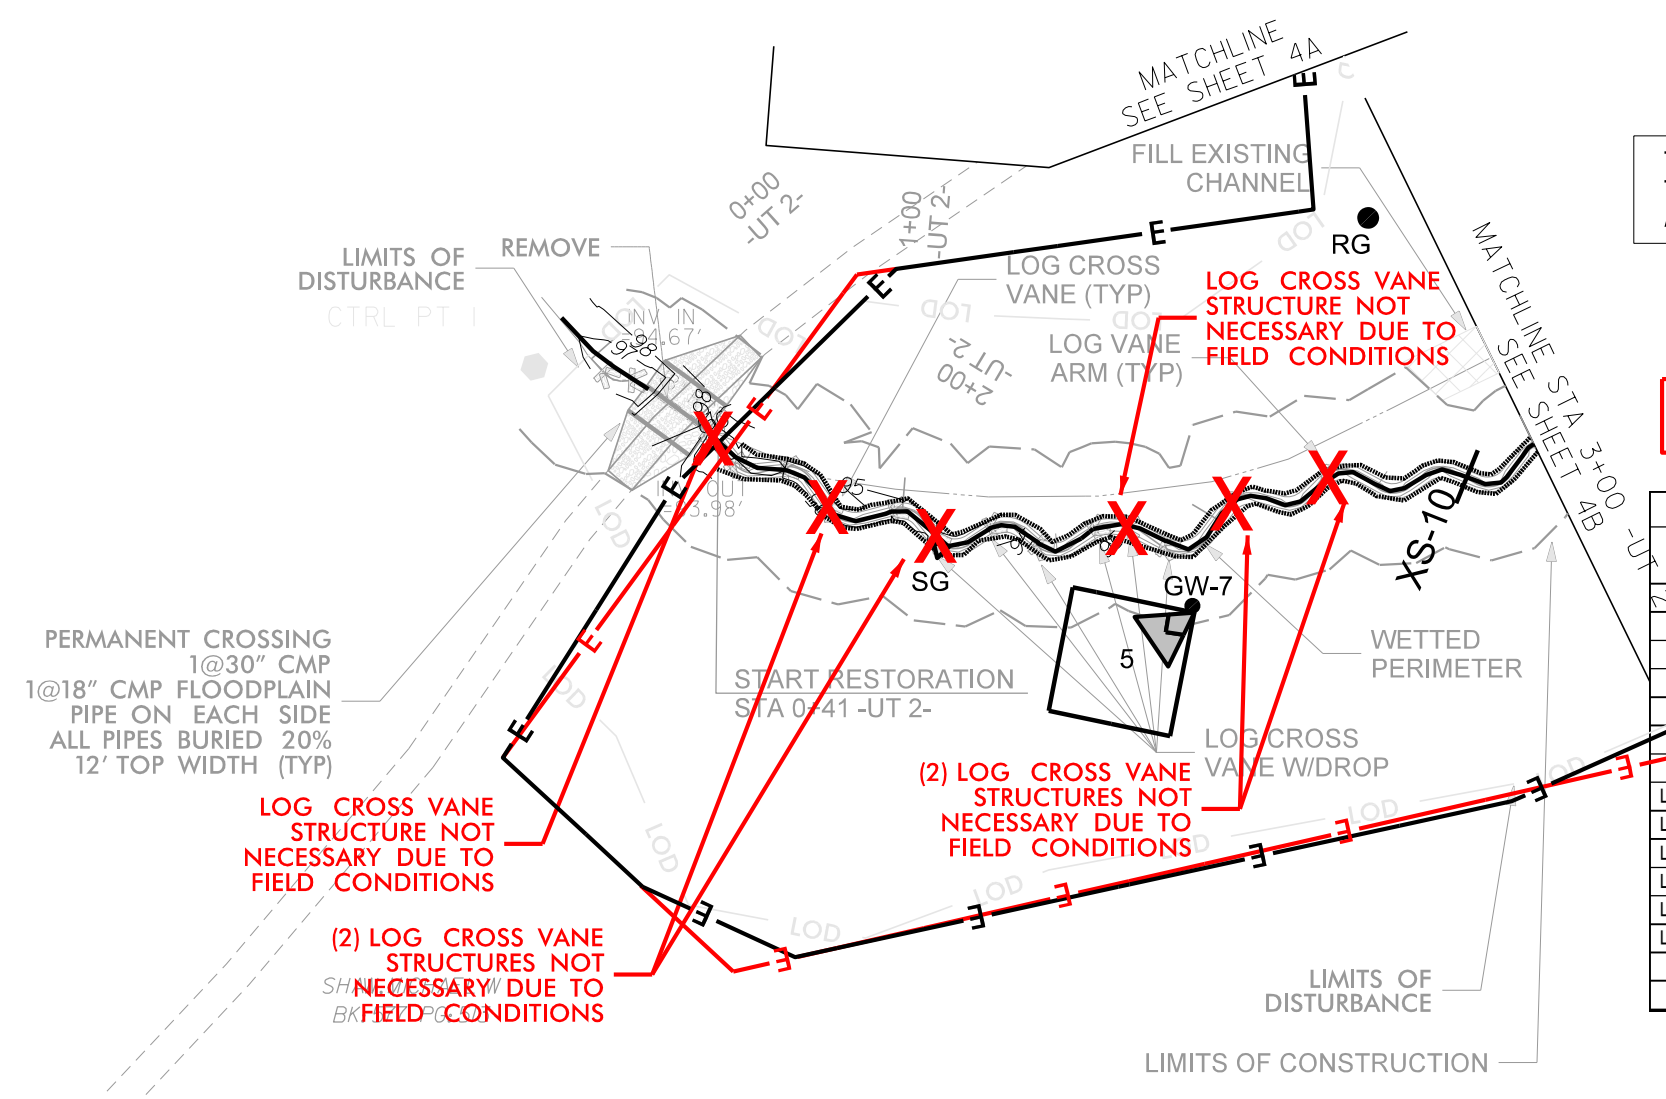



-UT 2- STRUCTURE LOCATIONS

STR. TYPE	NORTHING	EASTING	Prop Elevation	AB Survey Elevation
LOG CROSS VANE	207,545.16	2,040,070.07	95.01	96.49
LOG CROSS VANE	207,538.54	2,040,070.67	94.99	96.06
LOG CROSS VANE	207,515.43	2,040,076.09	94.92	
LOG CROSS VANE	207,504.87	2,040,075.57	94.89	94.95
LOG CROSS VANE	207,494.41	2,040,083.89	94.86	94.97
LOG CROSS VANE	207,479.89	2,040,085.33	94.82	
LOG CROSS VANE	207,467.04	2,040,096.75	94.78	94.90
LOG CROSS VANE W/DROP	207,454.70	2,040,100.05	94.75	
LOG CROSS VANE W/DROP	207,446.26	2,040,112.04	94.68	94.70
LOG CROSS VANE W/DROP	207,434.93	2,040,118.29	94.61	94.70
LOG CROSS VANE W/DROP	207,427.45	2,040,131.26	94.54	94.49
LOG CROSS VANE W/DROP	207,422.48	2,040,137.82	94.48	
LOG CROSS VANE W/DROP	207,412.23	2,040,141.97	94.40	94.35
LOG VANE ARM	207,407.84	2,040,161.05	94.33	
LOG VANE ARM	207,396.00	2,040,183.97	94.26	

TOPOGRAHY OUTSIDE
 OF SURVEY LIMITS BASED ON
 NC SPATIAL DATA QL2 LIDAR

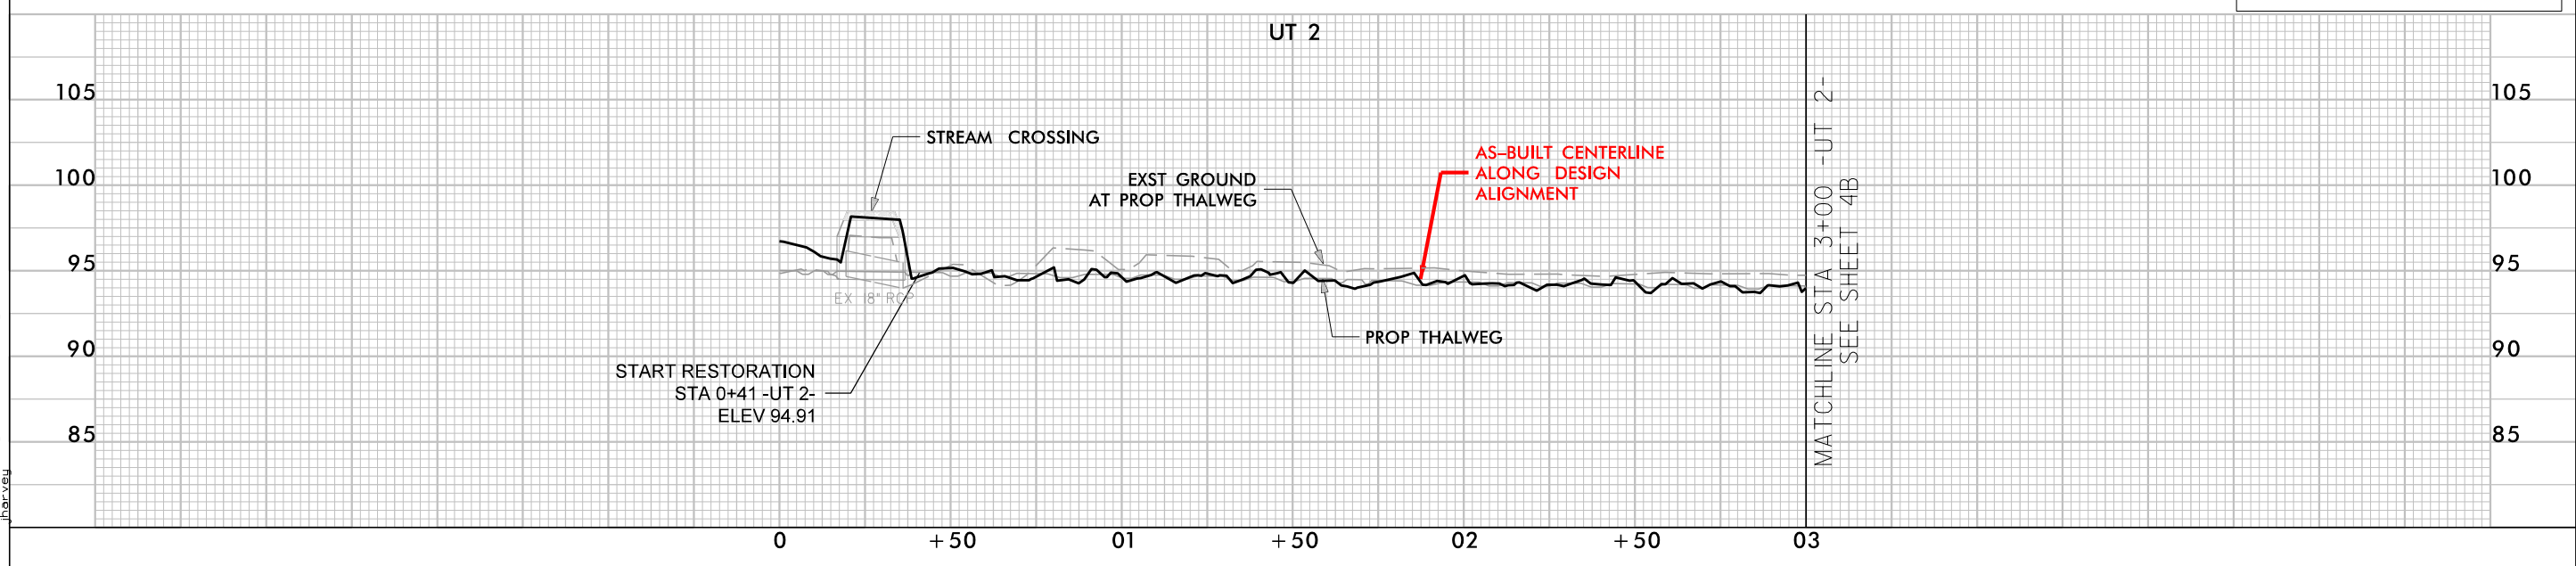


3/3/2021
 Shaw's Run_Mitigation_Hyd_AB_PSH_04E.dgn
 jbravey

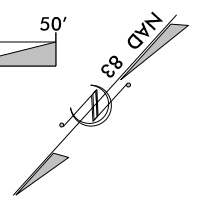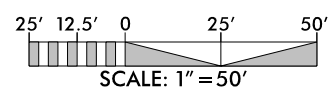

THE EASEMENT WILL NOT BE FENCED.
THE EASEMENT BOUNDARY WILL BE
MARKED APPROPRIATELY.


SHEET NAME		SHEET NUMBER
AS-BUILT STRUCTURES		4F
PROJECT NAME: SHAW'S RUN MITIGATION SITE		
DMS ID #: 100055	COUNTY: COLUMBUS	DATE: 2021

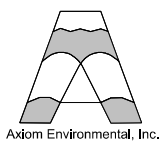

SUNGATE DESIGN GROUP, P.A.
 905 JONES FRANKLIN ROAD
 RALEIGH, NORTH CAROLINA 27606
 TEL: (919) 859-2243
 ENG FIRM LICENSE NO. C-890


RECORD DRAWING

**DOCUMENT NOT CONSIDERED FINAL
UNLESS ALL SIGNATURES COMPLETED**

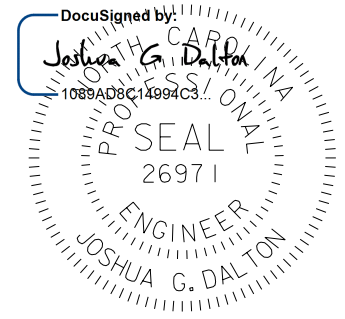



3/3/2021

DATE:

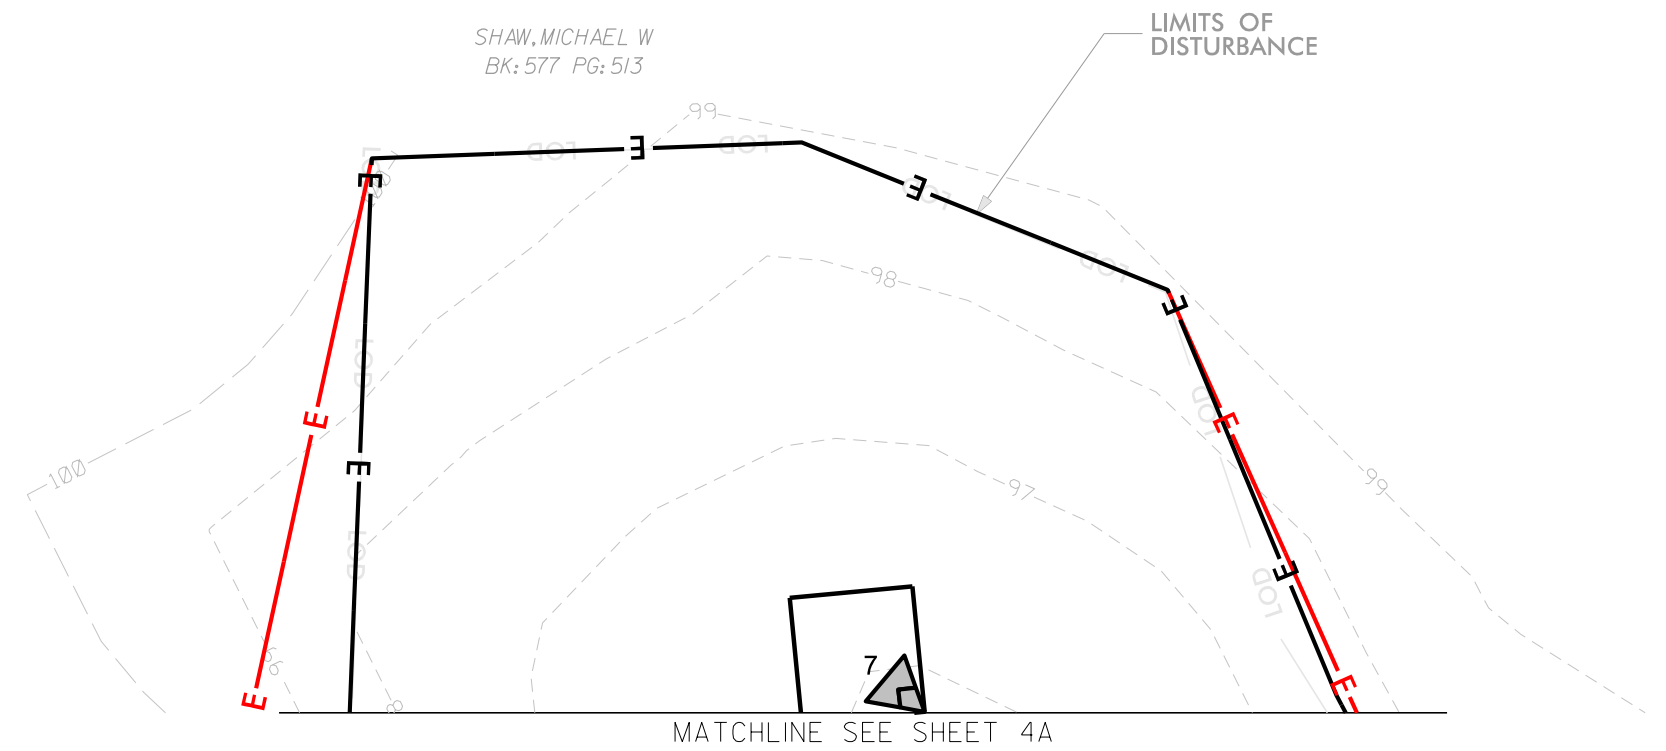

TOPOGRAHY OUTSIDE
OF SURVEY LIMITS BASED ON
NC SPATIAL DATA QL2 LIDAR

3/3/2021
Shaw's Run Hyd. AB_PSH_04F.dgn
jhervey

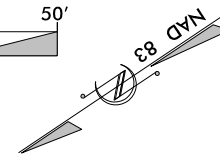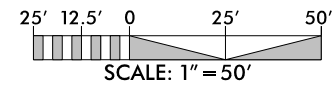

THE EASEMENT WILL NOT BE FENCED.
THE EASEMENT BOUNDARY WILL BE
MARKED APPROPRIATELY.

SHEET NAME		SHEET NUMBER
AS-BUILT STRUCTURES		4G
PROJECT NAME: SHAW'S RUN MITIGATION SITE		
DMS ID #:	COUNTY:	DATE:
100055	COLUMBUS	2021

SUNGATE DESIGN GROUP, P.A.
 905 JONES FRANKLIN ROAD
 RALEIGH, NORTH CAROLINA 27606
 TEL: (919) 859-2243
 ENG FIRM LICENSE NO. C-890


Axiom Environmental, Inc.

RECORD DRAWING

**DOCUMENT NOT CONSIDERED FINAL
UNLESS ALL SIGNATURES COMPLETED**


DocuSigned by:
 Joshua G. Dalton
 1089AD8C14994C3...

3/3/2021
DATE:

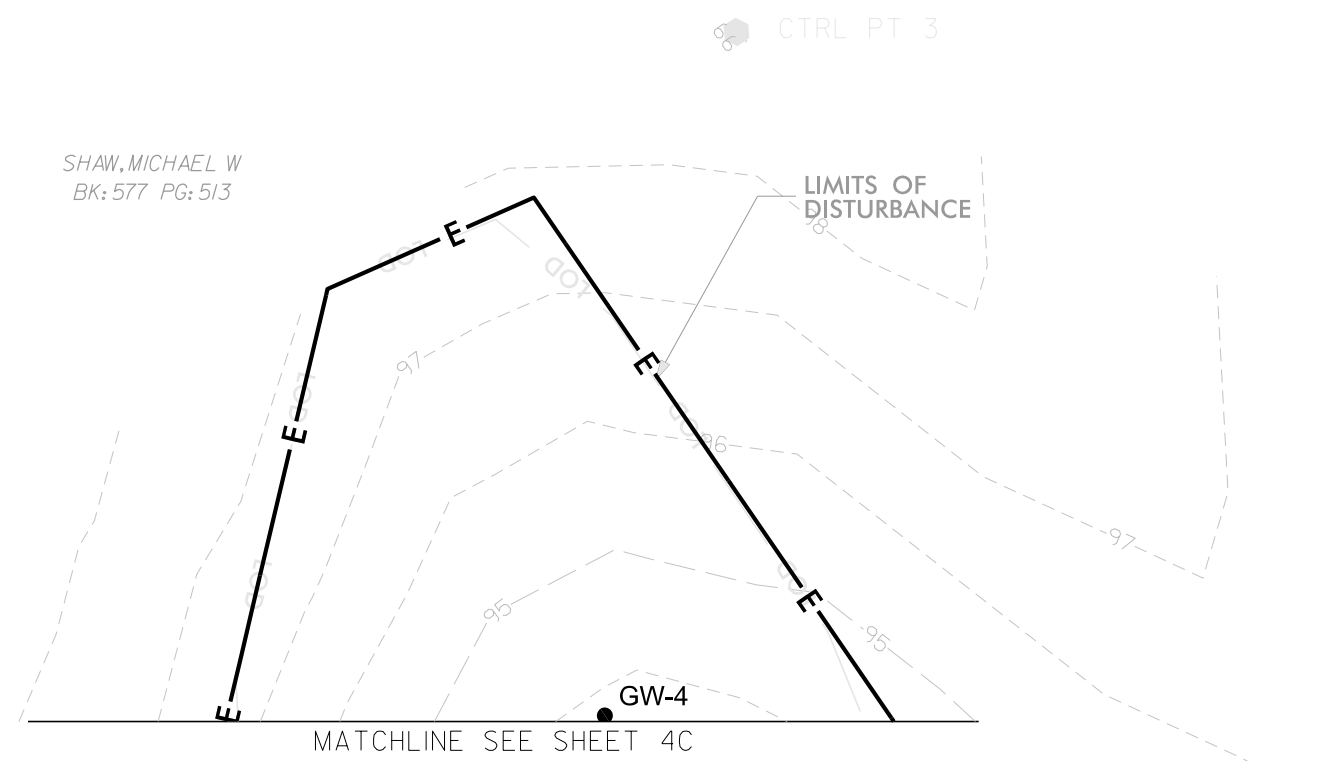

TOPOGRAHY OUTSIDE
OF SURVEY LIMITS BASED ON
NC SPATIAL DATA QL2 LIDAR

SHEET NAME		SHEET NUMBER
AS-BUILT PLANTING		4H
PROJECT NAME: SHAW'S RUN MITIGATION SITE		
DMS ID #: 100055	COUNTY: COLUMBUS	DATE: 2021



SUNGATE DESIGN GROUP, P.A.
 905 JONES FRANKLIN ROAD
 RALEIGH, NORTH CAROLINA 27606
 TEL: (919) 859-2243
 ENG FIRM LICENSE NO. C-890

**DOCUMENT NOT CONSIDERED FINAL
UNLESS ALL SIGNATURES COMPLETED**

RECORD DRAWING

DESIGN PLANTING LIST

Vegetation Association	Coastal Plain Small Stream Swamp Forest*		Mesic-Mixed Hardwood Forest*		Stream-side Assemblage**		TOTAL
	Area (acres)						
	3.7		2.1		1.5		7.3
Species	# planted*	% of total	# planted*	% of total	# planted**	% of total	# planted
Bald cypress (<i>Taxodium distichum</i>)	503	20	--	--	408	10	911
Black gum (<i>Nyssa sylvatica</i>)	503	20	--	--	408	10	911
Swamp chestnut oak (<i>Quercus michauxii</i>)	252	10	143	10	--	--	394
Laurel oak (<i>Quercus laurifolia</i>)	252	10	143	10	--	--	394
River birch (<i>Betula nigra</i>)	252	10	143	10	408	10	802
Tulip poplar (<i>Liriodendron tulipifera</i>)	252	10	143	10	--	--	394
Water oak (<i>Quercus nigra</i>)	--	--	143	10	--	--	143
Willow oak (<i>Quercus phellos</i>)	--	--	143	10	--	--	143
Green ash (<i>Fraxinus pennsylvanica</i>)	252	10	286	20	--	--	537
Sycamore (<i>Platanus occidentalis</i>)	252	10	286	20	408	10	945
Silky dogwood (<i>Cornus amomum</i>)	--	--	--	--	612	15	612
Black willow (<i>Salix nigra</i>)	--	--	--	--	612	15	612
Buttonbush (<i>Cephalanthus occidentalis</i>)	--	--	--	--	612	15	612
Elderberry (<i>Sambucus canadensis</i>)	--	--	--	--	612	15	612
TOTAL	2516	100	1428	100	4080	100	8024
* Planted at a density of 680 stems/acre.							
** Planted at a density of 2720 stems/acre.							

AS-BUILT PLANTING LIST

Species	# Planted
Bald cypress (<i>Taxodium distichum</i>)	1000
Black gum (<i>Nyssa sylvatica</i>)	1000
Swamp chestnut oak (<i>Quercus michauxii</i>)	
Laurel oak (<i>Quercus laurifolia</i>)	400
River birch (<i>Betula nigra</i>)	800
Tulip poplar (<i>Liriodendron tulipifera</i>)	500
Water oak (<i>Quercus nigra</i>)	300
Willow oak (<i>Quercus phellos</i>)	300
Green ash (<i>Fraxinus pennsylvanica</i>)	300
Sycamore (<i>Platanus occidentalis</i>)	1000
Silky dogwood (<i>Cornus amomum</i>)	700
Black willow (<i>Salix nigra</i>)	
Buttonbush (<i>Cephalanthus occidentalis</i>)	800
Elderberry (<i>Sambucus canadensis</i>)	
Sugarberry (<i>Celtis laevigata</i>)	100
Persimmon (<i>Diospyros virginiana</i>)	300
Overcup Oak (<i>Quercus lyrata</i>)	400
Cherrybark Oak (<i>Quercus pagoda</i>)	400

3/3/2021
Shaw's Run Hyd. AB_PSH_04H.dgn
jbravey