

**WHITTIER CREEK**

**PROJECT: 162039**


**NORTH CAROLINA  
DIVISION OF MITIGATION SERVICES**

**SURRY COUNTY**

**LOCATION: ROCK HILL CHURCH ROAD & NURSE ROAD**

**TYPE OF WORK: AS - BUILT PLAN**


STATE	BAKER PROJECT REFERENCE NO.	SHEET NO.	TOTAL SHEETS
NC	162039	1	19

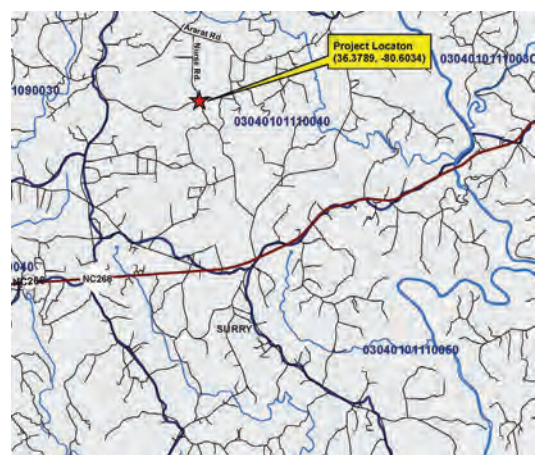


**VICINITY MAP**

**INDEX OF SHEETS**

- 1..... TITLE SHEET
- 1-A ..... STREAM CONVENTIONAL SYMBOLS  
GENERAL NOTES  
STANDARD SPECIFICATIONS  
VEGETATION SELECTION
- 1-B ..... NCDOT CONVENTIONAL SYMBOLS
- 2 - 2F ..... DETAILS
- 3 - 8 ..... PLAN VIEW
- 9 - 11 ..... PROFILES

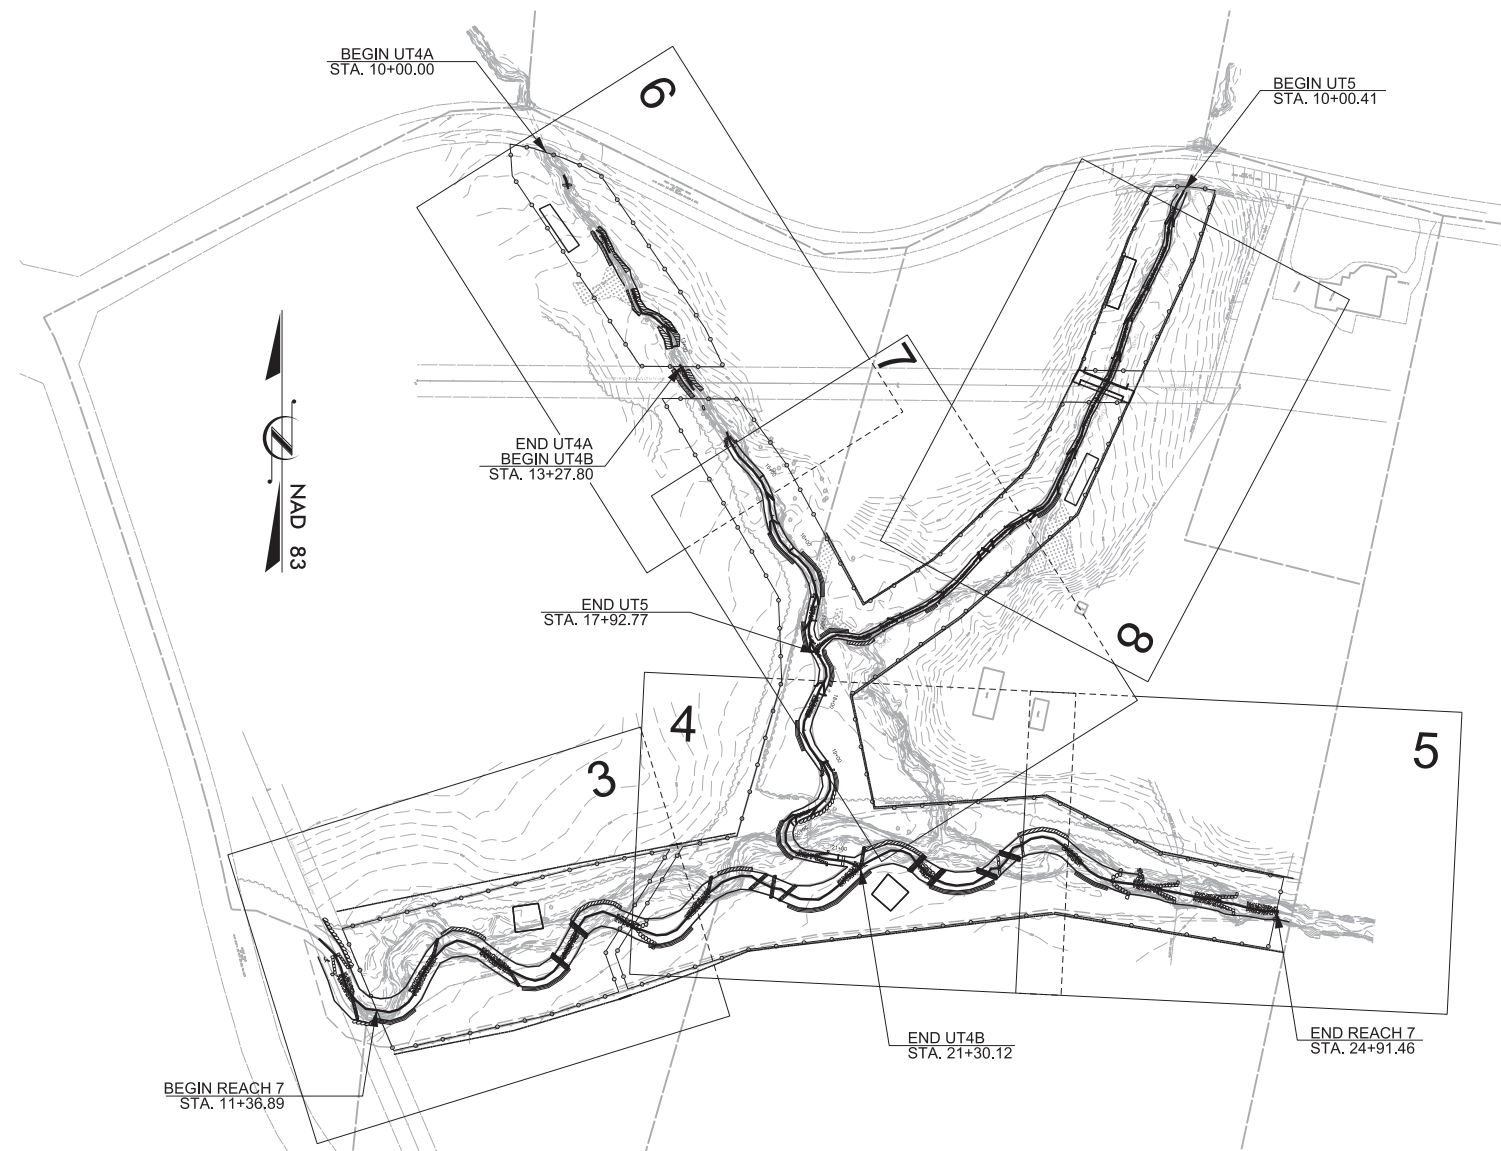

NCDMS ID NO. 100020

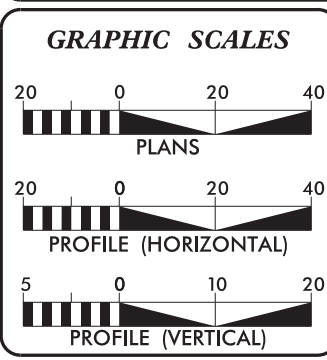

**REACH SUMMARY**

REACH	AS-BUILT LENGTHS
UT4A	327.80 LF
UT4B	753.57 LF
UT5	747.21 LF
R7	1,342.56 LF

**PREPARED FOR THE OFFICE OF:**

NCDEQ  
DIVISION OF MITIGATION SERVICES  
1652 MAIL SERVICE CENTER  
RALEIGH, NC 27699-1652

**CONTACT:** MATTHEW REID  
PROJECT MANAGER

**Michael Baker International**  
Michael Baker Engineering Inc.  
8000 Regency Parkway, Suite 600  
Cary, NORTH CAROLINA 27518  
Phone: 919.483.5488  
Fax: 919.483.5490  
License #: F-10584

**SPRING 2020**  
LETTING DATE:

**KATHLEEN M. MCKEITHAN, PE**  
PROJECT ENGINEER

**PROJECT ENGINEER**

2/22/2022

DocuSigned by:  
Kathleen M. McKeithan  
24E98DF4161473  
SIGNATURE: P.E.

2/26/2023

## STREAM CONVENTIONAL SYMBOLS SUPERCEDES SHEET 1-B

 J-HOOK VANE  ROCK VANE  OUTLET PROTECTION  ROCK CROSS VANE  DOUBLE DROP ROCK CROSS VANE  SINGLE WING DEFLECTOR  DOUBLE WING DEFLECTOR  TEMPORARY SILT CHECK  ROOT WAD  GRADE CONTROL LOG J-HOOK VANE  LOG VANE  LOG WEIR  LOG CROSS VANE  LOG ROLLER  GRADE CONTROL LOG JAM  CONSTRUCTED RIFFLE  BOULDER CLUSTER  BOULDER STEP  SAFETY FENCE  TAPE FENCE  100 YEAR FLOOD PLAIN  CONSERVATION EASEMENT	 PHOTO POINT  MONITORING WELL  FLOW GAUGE  IN-STREAM GAUGE  EXISTING MAJOR CONTOUR  EXISTING MINOR CONTOUR  LIMITS OF DISTURBANCE  PROPERTY LINE  FOOT BRIDGE  TEMPORARY STREAM CROSSING  ROCK FORD STREAM CROSSING  TRANSPLANTED VEGETATION  TREE REMOVAL  TREE PROTECTION  CHANNEL PLUG  CHANNEL FILL  BRUSH TOE WITH LIVE STAKES  GEOLIFT WITH BRUSH TOE  PROPOSED WETLAND RESTORATION  PROPOSED WETLAND ENHANCEMENT  JURISDICTIONAL WETLAND BOUNDARY
--	--

\*\*NOTE: ALL ITEMS ABOVE MAY NOT BE USED ON THIS PROJECT

## STANDARD SPECIFICATIONS

**NORTH CAROLINA  
EROSION AND SEDIMENT CONTROL PLANNING AND DESIGN MANUAL  
MARCH 2009 (REV 2013)**

- 6.06 TEMPORARY GRAVEL CONSTRUCTION ENTRANCE
- 6.24 RIPARIAN AREA SEEDING
- 6.62 TEMPORARY SILT FENCE
- 6.63 TEMPORARY ROCK DAM

PROJECT REFERENCE NO. <b>162039</b>	SHEET NO. <b>I-A</b>
PROJECT ENGINEER	
	
Approved by: <b>Kathleen M. McKeithan</b> 247840F4181473... APPROVED BY: _____ DATE: 2/22/2022	
<b>Michael Baker International</b> Michael Baker Engineering Inc. 8000 Regency Parkway, Suite 500 Cary, NORTH CAROLINA 27518 Phone: 919.463.5488 Fax: 919.463.5490 License #: F-1084	
NCDMS ID NO. 100020	

## GENERAL NOTES

1. THE CONTRACTOR IS REQUIRED TO INSTALL IN-STREAM STRUCTURES USING A TRACK HOE WITH A HYDRAULIC THUMB OF SUFFICIENT SIZE TO PLACE BOULDERS, LOGS AND ROOTWADS.
2. WORK IS BEING PERFORMED AS AN ENVIRONMENTAL RESTORATION PLAN. THE CONTRACTOR SHOULD MAKE ALL REASONABLE EFFORTS TO REDUCE SEDIMENT LOSS AND MINIMIZE DISTURBANCE OF THE SITE WHILE PERFORMING THE CONSTRUCTION WORK.
3. CONSTRUCTION IS SCHEDULED FOR THE SUMMER OF 2020.
4. CONTRACTOR SHOULD CALL NORTH CAROLINA "ONE-CALL" BEFORE EXCAVATION STARTS. (1-800-632-4949)
5. ALL ON-SITE ALLUVIUM SHALL BE HARVESTED AND STOCKPILED PRIOR TO FILLING ABANDONED CHANNELS.
6. TOPSOIL SHALL BE EXCAVATED TO A DEPTH OF 8" AND STOCKPILED SEPARATELY FROM UNDERCUT SOIL. 8" OF TOPSOIL SHALL BE PLACED ON ALL BANKFULL BENCHES AND AS DIRECTED BY THE ENGINEER.
7. ALL DISTURBED EMBANKMENTS SHALL BE MATTED WITH COIR FIBER MATTING OR AS DIRECTED BY THE ENGINEER.
8. ALL STREAM BANKS SHALL BE LIVE STAKED.
9. UNLESS THE ALIGNMENT IS BEING ALTERED, THE EXISTING CHANNEL DIMENSIONS ARE TO REMAIN UNLESS OTHERWISE NOTED.
10. CONTRACTOR WILL ENSURE THAT FENCING IS INSTALLED OUTSIDE THE CONSERVATION EASEMENT AS SHOWN ON THE PLANS BUT NO MORE THAN 1' OUTSIDE.
11. WHERE PROPOSED FENCE CROSSES EXISTING STREAMS, THE CONTRACTOR SHALL UTILIZE A SECTION OF BREAK AWAY FENCE, A FLOOD GATE, OR ELECTRIFIED CHAINS AS DIRECTED BY THE ENGINEER.

## PLANTING PLAN VEGETATION SELECTION

Permanent seed mixtures for the project site shall be planted throughout the floodplain and riparian buffer areas except the vernal pools. Permanent seed mixtures shall be applied with temporary seed, as defined in the construction specifications.

Scientific Name	Common Name	% Planted by Species	Wetland Tolerance
<b>All Buffer Plantings at 680 stems/acre using 8' X 8' spacing</b>			
<b>Riparian Zone – Overstory Species</b>			
<i>Betula nigra</i>	River Birch	10%	FACW
<i>Juglans nigra</i>	Black Walnut	5%	FACU
<i>Platanus occidentalis</i>	Sycamore	14%	FACW
<i>Liriodendron tulipifera</i>	Tulip Poplar	14%	FACU
<i>Fraxinus pennsylvanica</i>	Green Ash	5%	FACW
<i>Quercus lyrata</i>	Overcup Oak	10%	OBL
<i>Quercus phellos</i>	Willow Oak	10%	FAC
<i>Ulmus americana</i>	American Elm	5%	FACW
<i>Diospyros virginiana</i>	Persimmon	5%	FAC
<i>Nyssa sylvatica</i>	Blackgum	1%	FAC
<i>Quercus michauxii</i>	Swamp Chestnut Oak	1%	FACW
<i>Celtis laevigata</i>	Sugarberry	1%	FACW

Riparian Zone – Overstory Species			
<i>Betula nigra</i>	River Birch	10%	FACW
<i>Juglans nigra</i>	Black Walnut	5%	FACU
<i>Platanus occidentalis</i>	Sycamore	15%	FACW
<i>Liriodendron tulipifera</i>	Tulip Poplar	15%	FACU
<i>Fraxinus pennsylvanica</i>	Green Ash	5%	FACW
<i>Quercus lyrata</i>	Overcup Oak	10%	OBL
<i>Quercus phellos</i>	Willow Oak	10%	FAC
<i>Ulmus americana</i>	American Elm	5%	FACW
<i>Diospyros virginiana</i>	Persimmon	5%	FAC
<i>Hamamelis virginiana</i>	Witch Hazel	5%	FACU
<i>Lindera benzoin</i>	Spicebush	5%	FAC
<i>Carpinus caroliniana</i>	American Hornbeam	5%	FAC
<i>Acer negundo</i>	Box Elder	5%	FAC
<i>Amelanchier arborea</i>	Serviceberry	1%	FAC

Scientific Name	Common Name	Percent of Mixture	Seeding Density (lbs/acre)	Wetness Tolerance
<i>Agrostis alba</i>	Redtop	10%	1.5	FACW
<i>Elymus virginicus</i>	Virginia Wildrye	15%	2.25	FACW
<i>Panicum virgatum</i>	Switchgrass	15%	2.25	FAC
<i>Tripsacum dactyloides</i>	Eastern Gamma Grass	5%	0.75	FACW
<i>Polygonum pennsylvanicum</i>	Pennsylvania Smartweed	5%	0.75	FACW
<i>Schizachyrium scoparium</i>	Little Blue Stem	5%	0.75	FACU
<i>Juncus effusus</i>	Soft Rush	5%	0.75	FACW
<i>Bidens frondosa (or aristosa)</i>	Beggars Tick	5%	0.75	FACW
<i>Coreopsis lanceolata</i>	Lance-Leaved Tick Seed	10%	1.5	FACU
<i>Dichanthelium clandestinum</i>	Tioga Deer Tongue	15%	2.25	FAC
<i>Andropogon gerardii</i>	Big Blue Stem	5%	0.75	FAC
<i>Sorghastrum nutans</i>	Indian Grass	5%	0.75	FACU

TEMPORARY SEEDING SELECTION AND APPLICATION RATES				
Common Name	Scientific Name	Application Time	Application Rate	Total (lbs/acre)
Cereal rye	<i>Secale cereale</i>	Sept - March	3 lb/1,000 sq ft.	130 lbs/acre
Browntop millet	<i>Panicum ramosum</i>	April - Aug	1 lb/1,000 sq ft.	44 lbs/acre

R:\62039\_Whittier-Creek-Design\As-Built\Plans\162039\_ASB-PSH-01A.dgn

DocuSigned by:  
Kathleen M. McKishton  
DATE: 02/22/2022

APPROVED BY:  
2/22/2022

DATE:

STATE OF NORTH CAROLINA  
DIVISION OF HIGHWAYS

# CONVENTIONAL SYMBOLS

\*S.U.E = SUBSURFACE UTILITY ENGINEER

### BOUNDARIES AND PROPERTY:

State Line	-----
County Line	-----
Township Line	-----
City Line	-----
Reservation Line	-----
Property Line	-----
Existing Iron Pin	○ EP
Property Corner	-----
Property Monument	□ ECM
Parcel/Sequence Number	②③
Existing Fence Line	-x-x-x-
Proposed Woven Wire Fence	○
Proposed Chain Link Fence	□
Proposed Barbed Wire Fence	◇
Existing Wetland Boundary	---WLB---
Proposed Wetland Boundary	---WLB---
Existing Endangered Animal Boundary	---EAB---
Existing Endangered Plant Boundary	---EPB---

### BUILDINGS AND OTHER CULTURE:

Gas Pump Vent or U/G Tank Cap	○
Sign	○ S
Well	○ W
Small Mine	✕
Foundation	□
Area Outline	□
Cemetery	↑
Building	□
School	□
Church	□
Dam	▬

### HYDROLOGY:

Stream or Body of Water	-----
Hydro, Pool or Reservoir	□
Jurisdictional Stream	---JS---
Buffer Zone 1	---BZ 1---
Buffer Zone 2	---BZ 2---
Flow Arrow	←
Disappearing Stream	-----
Spring	○
Wetland	---WLB---
Proposed Lateral, Tail, Head Ditch	-----
False Sump	▽

### RAILROADS:

Standard Gauge	-----
RR Signal Milepost	○ MILEPOST 35
Switch	□ SWITCH
RR Abandoned	-----
RR Dismantled	-----

### RIGHT OF WAY:

Baseline Control Point	◆
Existing Right of Way Marker	△
Existing Right of Way Line	-----
Proposed Right of Way Line	-----
Proposed Right of Way Line with Iron Pin and Cap Marker	○ R W
Proposed Right of Way Line with Concrete or Granite Marker	△ R W
Existing Control of Access	○ C A
Proposed Control of Access	○ C A
Existing Easement Line	---E---
Proposed Temporary Construction Easement	---E---
Proposed Temporary Drainage Easement	---TDE---
Proposed Permanent Drainage Easement	---PDE---
Proposed Permanent Utility Easement	---PUE---
Proposed Temporary Utility Easement	---TUE---
Proposed Permanent Easement with Iron Pin and Cap Marker	◆

### ROADS AND RELATED FEATURES:

Existing Edge of Pavement	-----
Existing Curb	-----
Proposed Slope Stakes Cut	---C---
Proposed Slope Stakes Fill	---F---
Proposed Wheel Chair Ramp	○ WCR
Existing Metal Guardrail	-----
Proposed Guardrail	-----
Existing Cable Guiderail	-----
Proposed Cable Guiderail	-----
Equality Symbol	⊕
Pavement Removal	▨

### VEGETATION:

Single Tree	○
Single Shrub	○
Hedge	-----
Woods Line	-----
Orchard	-----
Vineyard	□ Vineyard

### EXISTING STRUCTURES:

MAJOR:	
Bridge, Tunnel or Box Culvert	-----
Bridge Wing Wall, Head Wall and End Wall	---) CONC WW (---
MINOR:	
Head and End Wall	---) CONC HW (---
Pipe Culvert	-----
Footbridge	-----
Drainage Box: Catch Basin, DI or JB	□ CB
Paved Ditch Gutter	-----
Storm Sewer Manhole	○ S
Storm Sewer	-----

### UTILITIES:

POWER:	
Existing Power Pole	●
Proposed Power Pole	○
Existing Joint Use Pole	●
Proposed Joint Use Pole	○
Power Manhole	○ P
Power Line Tower	□
Power Transformer	▭
U/G Power Cable Hand Hole	□ PH
H-Frame Pole	●
Recorded U/G Power Line	---P---
Designated U/G Power Line (S.U.E.*)	---P---

### TELEPHONE:

Existing Telephone Pole	●
Proposed Telephone Pole	○
Telephone Manhole	○ T
Telephone Booth	□
Telephone Pedestal	□
Telephone Cell Tower	⊕
U/G Telephone Cable Hand Hole	□ PH
Recorded U/G Telephone Cable	---T---
Designated U/G Telephone Cable (S.U.E.*)	---T---
Recorded U/G Telephone Conduit	---TC---
Designated U/G Telephone Conduit (S.U.E.*)	---TC---
Recorded U/G Fiber Optics Cable	---T FO---
Designated U/G Fiber Optics Cable (S.U.E.*)	---T FO---

### WATER:

Water Manhole	○ W
Water Meter	○
Water Valve	⊗
Water Hydrant	⊕
Recorded U/G Water Line	---W---
Designated U/G Water Line (S.U.E.*)	---W---
Above Ground Water Line	---A/G Water---

### TV:

TV Satellite Dish	⊕
TV Pedestal	□
TV Tower	⊗
U/G TV Cable Hand Hole	□ PH
Recorded U/G TV Cable	---TV---
Designated U/G TV Cable (S.U.E.*)	---TV---
Recorded U/G Fiber Optic Cable	---TV FO---
Designated U/G Fiber Optic Cable (S.U.E.*)	---TV FO---

### GAS:

Gas Valve	◇
Gas Meter	⊕
Recorded U/G Gas Line	---G---
Designated U/G Gas Line (S.U.E.*)	---G---
Above Ground Gas Line	---A/G Gas---

### SANITARY SEWER:


Sanitary Sewer Manhole	⊕
Sanitary Sewer Cleanout	⊕
U/G Sanitary Sewer Line	---SS---
Above Ground Sanitary Sewer	---A/G Sanitary Sewer---
Recorded SS Forced Main Line	---FSS---
Designated SS Forced Main Line (S.U.E.*)	---FSS---

### MISCELLANEOUS:

Utility Pole	●
Utility Pole with Base	□
Utility Located Object	○
Utility Traffic Signal Box	□
Utility Unknown U/G Line	---TUTL---
U/G Tank; Water, Gas, Oil	□
A/G Tank; Water, Gas, Oil	□
U/G Test Hole (S.U.E.*)	⊕
Abandoned According to Utility Records	AATUR
End of Information	E.O.I.


2/26/2023

### TYPICAL RIFFLE, POOL, AND BANKFULL BENCH CROSS SECTIONS

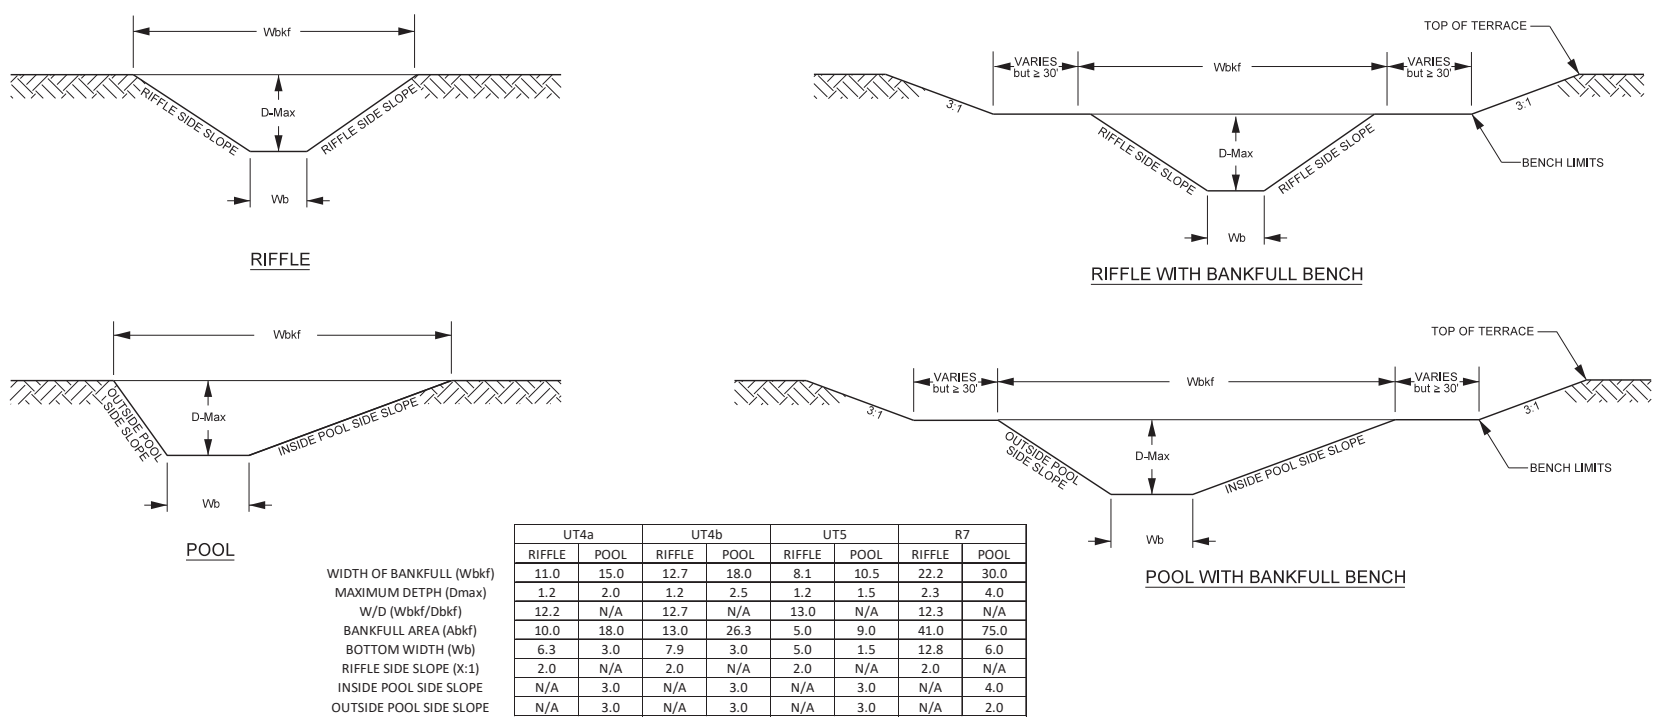

	UT4a		UT4b		UT5		R7	
	RIFFLE	POOL	RIFFLE	POOL	RIFFLE	POOL	RIFFLE	POOL
WIDTH OF BANKFULL (Wbkf)	11.0	15.0	12.7	18.0	8.1	10.5	22.2	30.0
MAXIMUM DETPH (Dmax)	1.2	2.0	1.2	2.5	1.2	1.5	2.3	4.0
W/D (Wbkf/Dmax)	12.2	N/A	12.7	N/A	13.0	N/A	12.3	N/A
BANKFULL AREA (Abkf)	10.0	18.0	13.0	26.3	5.0	9.0	41.0	75.0
BOTTOM WIDTH (Wb)	6.3	3.0	7.9	3.0	5.0	1.5	12.8	6.0
RIFFLE SIDE SLOPE (X:1)	2.0	N/A	2.0	N/A	2.0	N/A	2.0	N/A
INSIDE POOL SIDE SLOPE	N/A	3.0	N/A	3.0	N/A	3.0	N/A	4.0
OUTSIDE POOL SIDE SLOPE	N/A	3.0	N/A	3.0	N/A	3.0	N/A	2.0


### CHANNEL PLUG

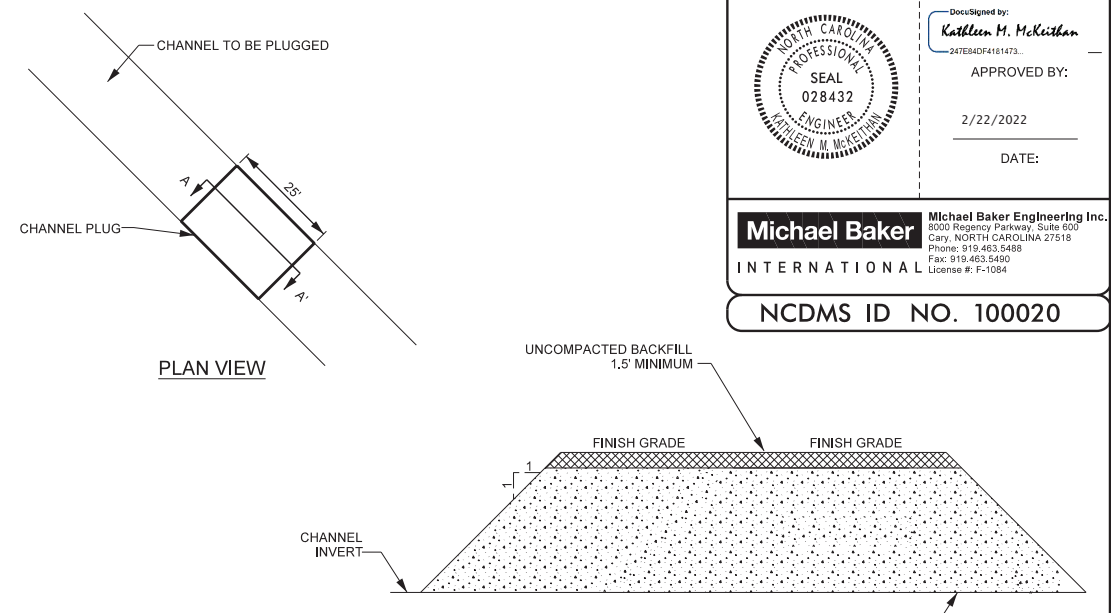

- NOTE:
- BACKFILL CONSISTING OF ON-SITE CLAY MATERIAL WILL BE COMPACTED USING HEAVY EQUIPMENT IN 10 INCH LIFTS.
  - THE REMAINDER OF THE EXISTING CHANNEL TO BE PLUGGED WILL BE COMPLETED FILLED TO THE NEW TOP-OF-BANK ELEVATION.


PROJECT REFERENCE NO. <b>162039</b>	SHEET NO. <b>2</b>
PROJECT ENGINEER	
DocuSigned by: <b>Kathleen M. McKeithan</b> 24784DF4181473...	
APPROVED BY:	
2/22/2022	
DATE:	
<b>Michael Baker International</b> Michael Baker Engineering Inc. 8020 Regency Parkway, Suite 600 Cary, NORTH CAROLINA 27518 Phone: 919.463.5485 Fax: 919.463.5490 License #: F-1084	
<b>NCDMS ID NO. 100020</b>	

### TYPICAL STRUCTURE PLACEMENT

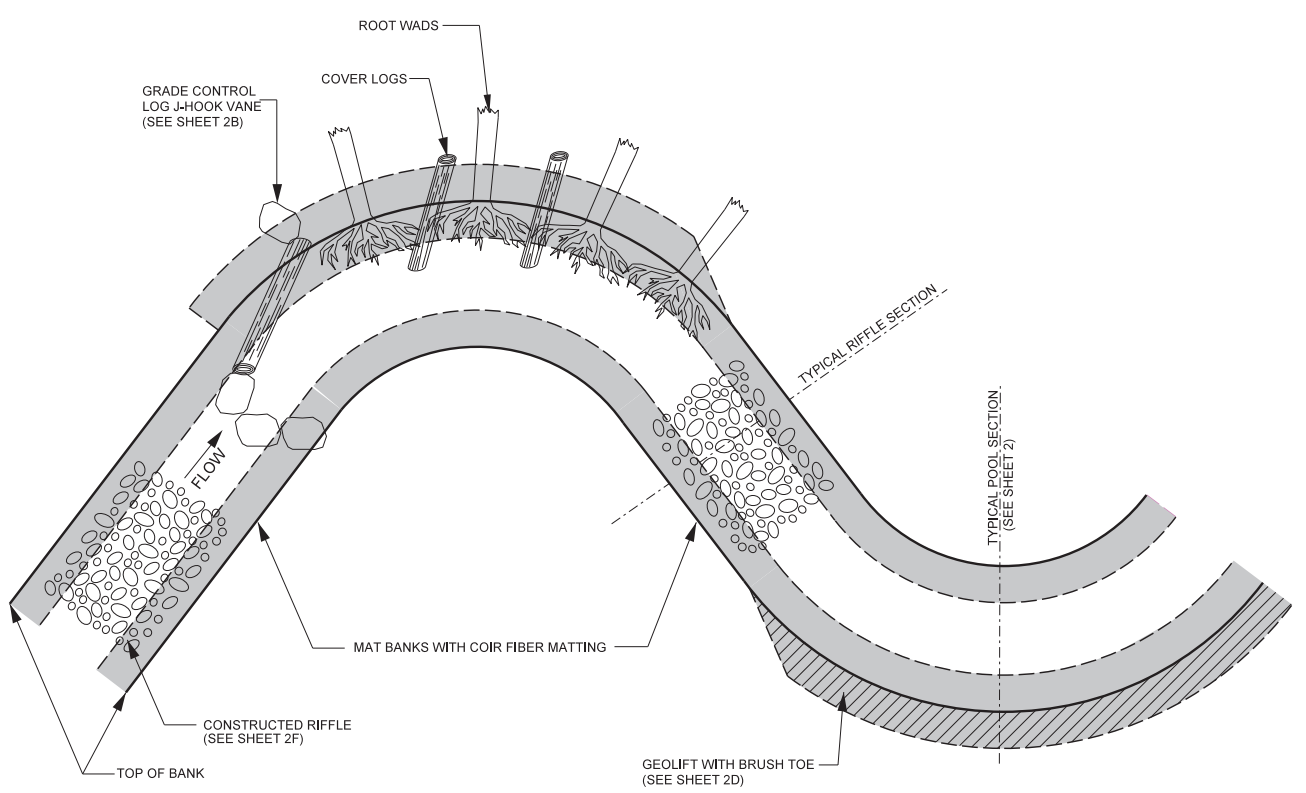

- STRUCTURE NOTES:
- GENERALLY CONSTRUCTED RIFFLES, ROOT WADS, LOG VANES AND COIR FIBER MATTING WILL BE INSTALLED IN THE LOCATION AND SEQUENCE AS SHOWN.
  - ANY CHANGES TO NUMBER OR LOCATION OF STRUCTURES DURING CONSTRUCTION MUST BE APPROVED BY THE DESIGN ENGINEER.
  - COIR FIBER MATTING TO BE INSTALLED ON ALL RESTORED STREAMBANKS, FLOODPLAIN BENCHING, AND TERRACE SLOPES AS DESCRIBED IN THE TECHNICAL SPECIFICATIONS.
  - ROOTWADS MAY BE REPLACED WITH GEOLIFT.

### ROCK CROSS VANE

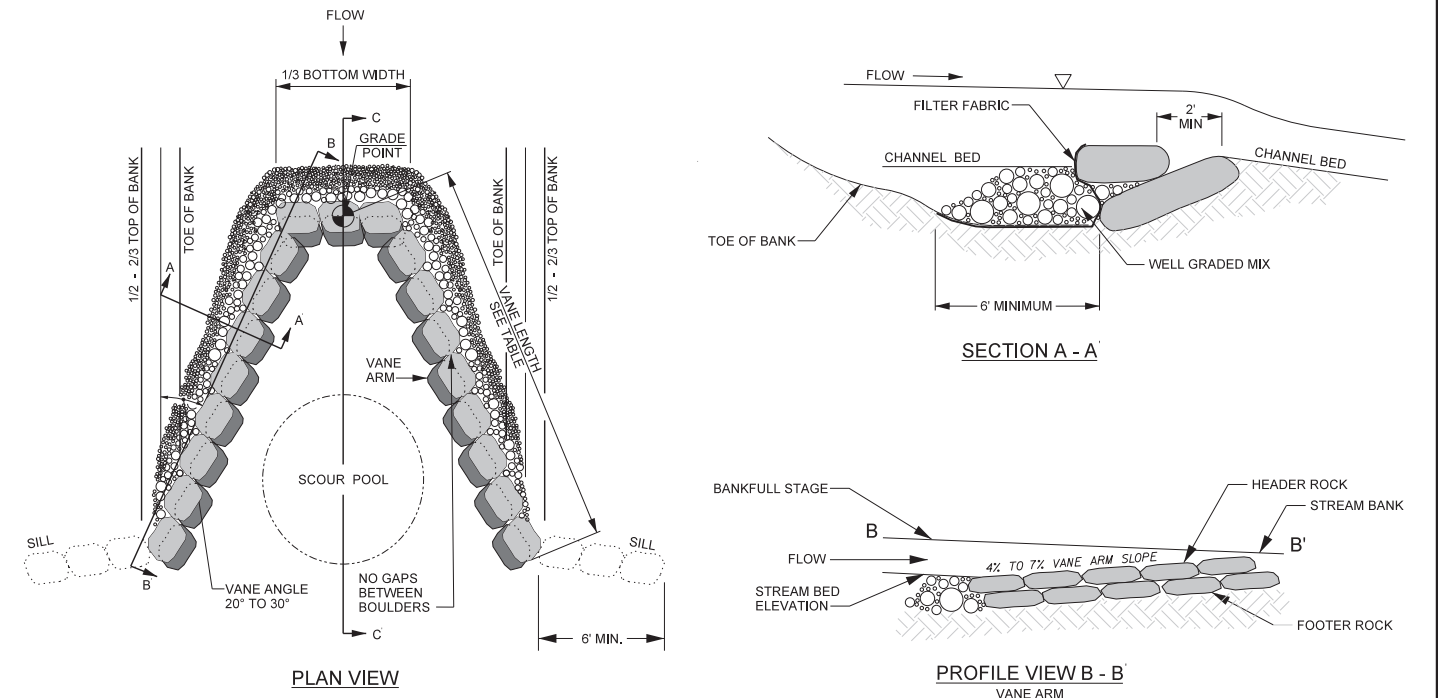


REACH	VANE LENGTH	BOULDER SIZE
UT4A	9'	1'x2'x3'
UT4B	10'	1'x2'x3'
UT5	7'	1'x2'x3'
REACH 7	18'	2'x3'x4'

- NOTES FOR ALL VANE STRUCTURES:
- INSTALL FILTER FABRIC FOR DRAINAGE BEGINNING AT THE MIDDLE OF THE HEADER ROCKS AND EXTEND DOWNWARD TO THE DEPTH OF THE BOTTOM FOOTER ROCK, AND THEN UPSTREAM TO A MINIMUM OF SIX FEET.
  - DIG A TRENCH BELOW THE BED FOR FOOTER ROCKS AND PLACE FILL ON UPSTREAM SIDE OF VANE ARM, BETWEEN THE ARM AND STREAMBANK.
  - CONSTRUCT ANGLE AND SLOPE SPECIFICATIONS AS SHOWN.
  - BACKFILL VANE ARMS AND INVERT WITH A WELL GRADED MIX OF CLASS B, A, AND #57 STONE.
  - ON-SITE ALLUVIUM SHALL BE INCORPORATED INTO THE STONE BACKFILL WHERE AVAILABLE.
  - BOULDER SILL MUST BE A MINIMUM OF 6' AND WILL INCLUDE FOOTER ROCKS.


R:\162039\_Whittier\_Creek\Design\As-Built\Plans\162039\_ASB-PSH-02.dgn  
 2/22/2023 10:00 AM  
 Michael Baker International

27/26/2023


### OUTLET PROTECTION

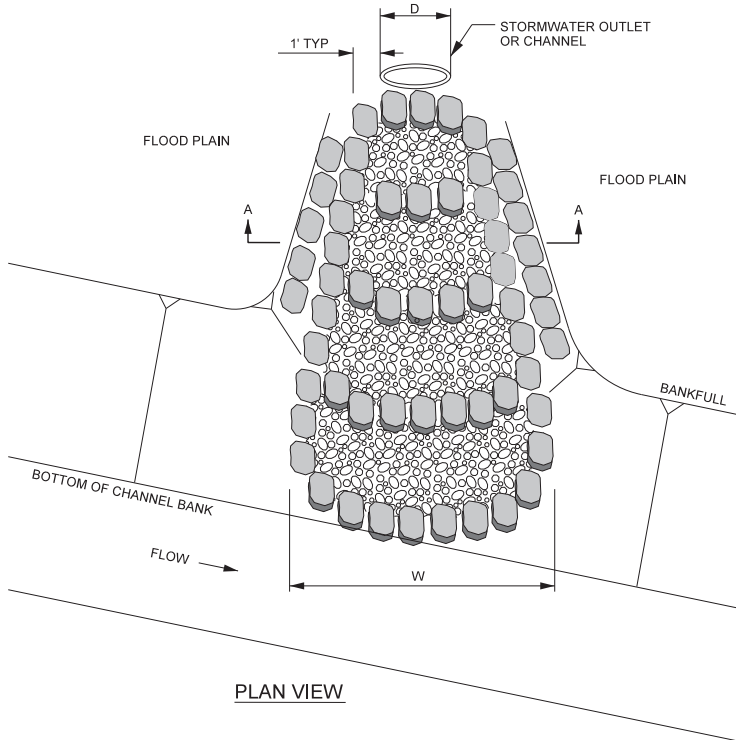

PLAN VIEW

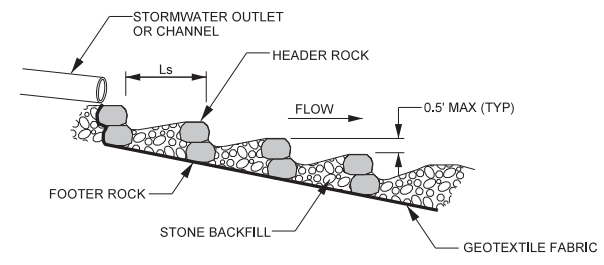


PROFILE VIEW

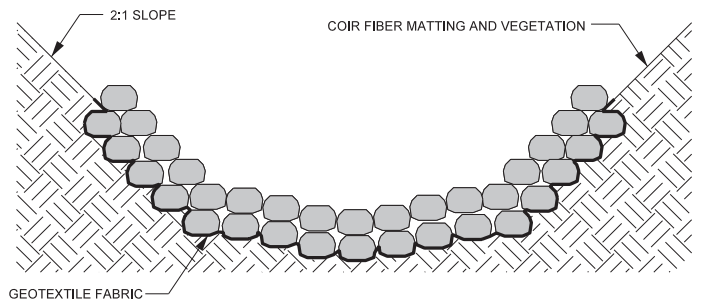

CROSS SECTION A - A


### ROCK VANE

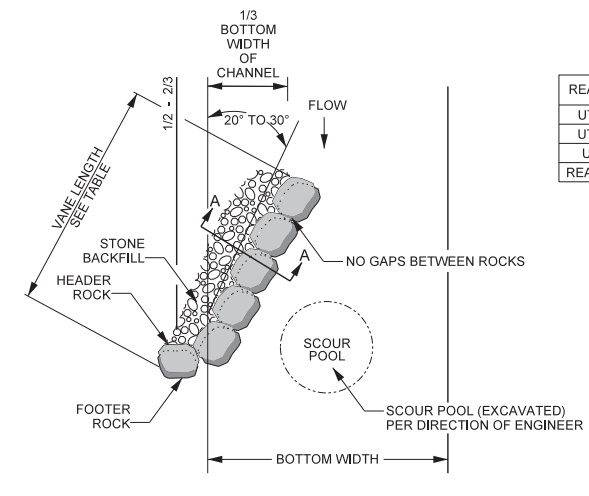


PLAN VIEW

REACH	VANE LENGTH	BOULDER SIZE
UT4A	9'	1'x2'x3'
UT4B	10'	1'x2'x3'
UT5	7'	1'x2'x3'
REACH 7	18'	2'x3'x4'

- NOTES FOR ALL VANE STRUCTURES:**
1. INSTALL GEOTEXTILE FABRIC BEGINNING AT THE TOP OF THE HEADER ROCKS AND EXTEND DOWNWARD TO THE DEPTH OF THE BOTTOM FOOTER ROCK, AND THEN UPSTREAM TO A MINIMUM OF TEN FEET.
  2. DIG A TRENCH BELOW THE BED FOR FOOTER ROCKS AND PLACE FILL ON UPSTREAM SIDE OF VANE ARM, BETWEEN THE ARM AND STREAMBANK.
  3. START AT BANK AND PLACE FOOTER ROCKS FIRST AND THEN HEADER (TOP) ROCK.
  4. CONTINUE WITH STRUCTURE, FOLLOWING ANGLE AND SLOPE SPECIFICATIONS.
  5. AN EXTRA ROCK CAN BE PLACED IN SCOUR POOL FOR HABITAT IMPROVEMENT.
  6. USE HAND PLACED STONE TO FILL GAPS ON UPSTREAM SIDE OF HEADER AND FOOTER ROCKS.
  7. AFTER ALL STONE BACKFILL HAS BEEN PLACED, FILL IN THE UPSTREAM SIDE OF THE STRUCTURE WITH WELL GRADED MIX OF CLASS B, CLASS A, & #57 STONE TO THE ELEVATION OF THE TOP OF THE HEADER ROCK. INCORPORATE ON-SITE ALLUVIUM WHERE AVAILABLE.
  8. START SLOPE AT 2/3 TO 3/4 TIMES THE BANKFULL STAGE.

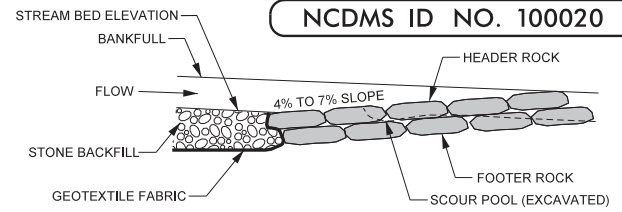


PROFILE VIEW

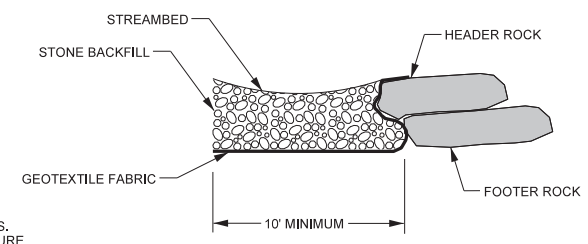


SECTION A - A


### GRADE CONTROL J-HOOK VANE

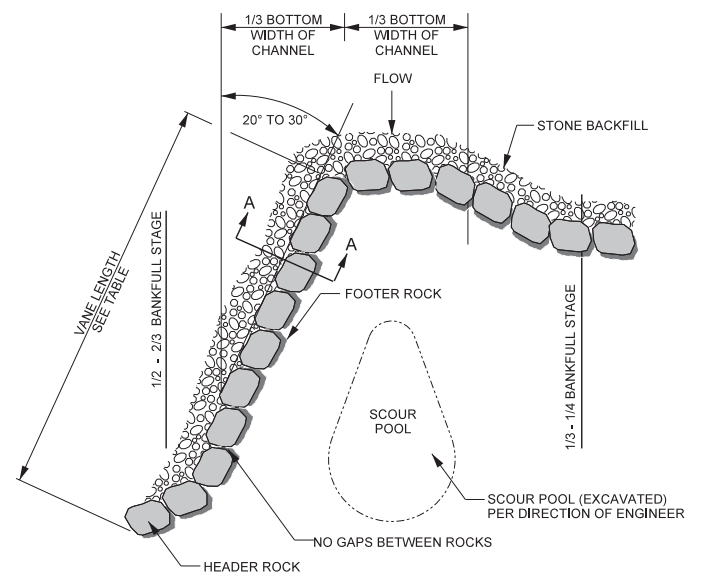

PLAN VIEW

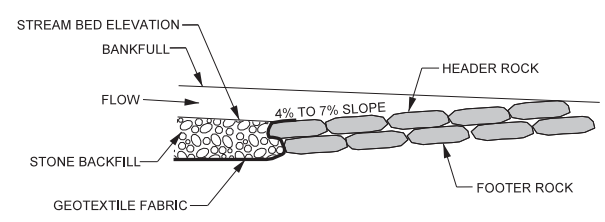

PROFILE VIEW

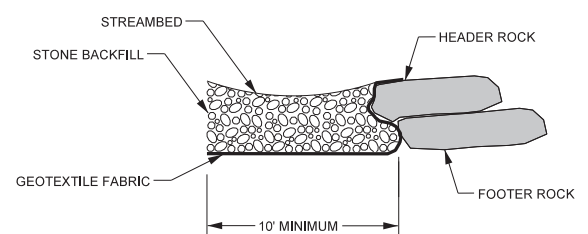


SECTION A - A


REACH	VANE LENGTH	BOULDER SIZE
UT4A	9'	1'x2'x3'
UT4B	10'	1'x2'x3'
UT5	7'	1'x2'x3'
REACH 7	18'	2'x3'x4'

- NOTES FOR ALL VANE STRUCTURES:**
1. INSTALL FILTER FABRIC FOR DRAINAGE BEGINNING AT THE MIDDLE OF THE HEADER ROCKS AND EXTEND DOWNWARD TO THE DEPTH OF THE BOTTOM FOOTER ROCK, AND THEN UPSTREAM TO A MINIMUM OF SIX FEET.
  2. DIG A TRENCH BELOW THE BED FOR FOOTER ROCKS AND PLACE FILL ON UPSTREAM SIDE OF VANE ARM, BETWEEN THE ARM AND STREAMBANK.
  3. CONSTRUCT ANGLE AND SLOPE SPECIFICATIONS AS SHOWN.
  4. BACKFILL VANE ARMS AND INVERT WITH A WELL GRADED MIX OF CLASS B, A, AND #57 STONE.
  5. ON-SITE ALLUVIUM SHALL BE INCORPORATED INTO THE STONE BACKFILL WHERE AVAILABLE.
  6. BOULDER SILL MUST BE A MINIMUM OF 6'.


### J-HOOK VANE

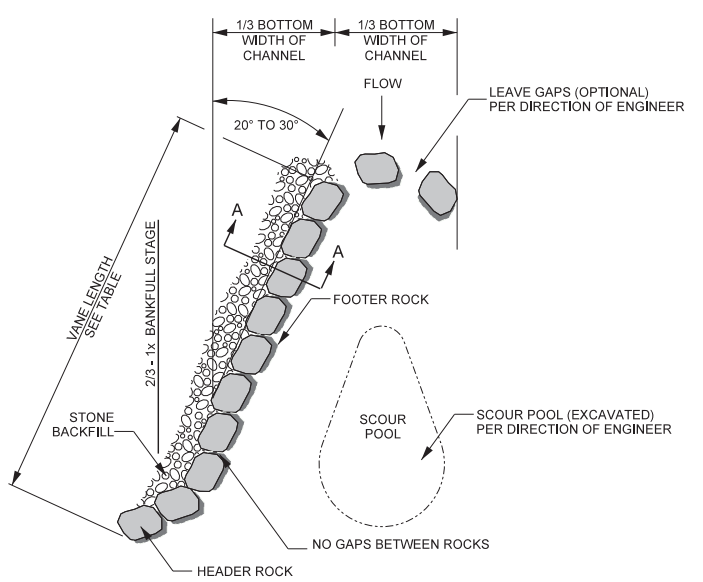

PLAN VIEW

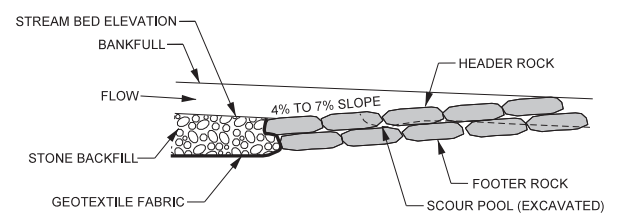

PROFILE VIEW

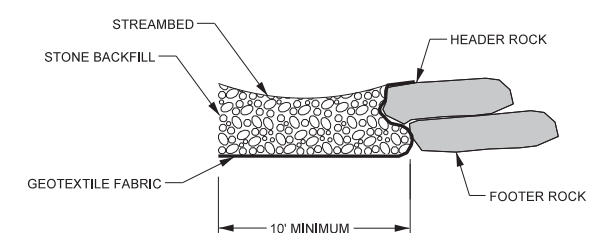

SECTION A - A




REACH	VANE LENGTH	BOULDER SIZE
UT4A	9'	1'x2'x3'
UT4B	10'	1'x2'x3'
UT5	7'	1'x2'x3'
REACH 7	18'	2'x3'x4'

- NOTES FOR ALL VANE STRUCTURES:**
1. INSTALL GEOTEXTILE FABRIC BEGINNING AT THE TOP OF THE HEADER ROCKS AND EXTEND DOWNWARD TO THE DEPTH OF THE BOTTOM FOOTER ROCK, AND THEN UPSTREAM TO A MINIMUM OF TEN FEET.
  2. DIG A TRENCH BELOW THE BED FOR FOOTER ROCKS AND PLACE FILL ON UPSTREAM SIDE OF VANE ARM, BETWEEN THE ARM AND STREAMBANK.
  3. START AT BANK AND PLACE FOOTER ROCKS FIRST AND THEN HEADER (TOP) ROCK.
  4. CONTINUE WITH STRUCTURE, FOLLOWING ANGLE AND SLOPE SPECIFICATIONS.
  5. AN EXTRA ROCK CAN BE PLACED IN SCOUR POOL FOR HABITAT IMPROVEMENT.
  6. USE HAND PLACED STONE TO FILL GAPS ON UPSTREAM SIDE OF HEADER AND FOOTER ROCKS.
  7. AFTER ALL STONE BACKFILL HAS BEEN PLACED, FILL IN THE UPSTREAM SIDE OF THE STRUCTURE WITH ON-SITE ALLUVIUM TO THE ELEVATION OF THE TOP OF THE HEADER ROCK.

R:\162039\_Whittier\_Creek\_Design\As-Built\Plans\162039\_ASB-PSH-02A.dgn

PROJECT REFERENCE NO. <b>162039</b>	SHEET NO. <b>2A</b>
PROJECT ENGINEER	
Documented by: <b>Kathleen M. McKeithan</b> 247840F4181473...	
APPROVED BY:	
DATE: 2/22/2022	
<b>Michael Baker International</b> Michael Baker Engineering Inc. 8000 Regency Parkway, Suite 600 Cary, NORTH CAROLINA 27518 Phone: 919.463.5485 Fax: 919.463.5490 License #: F-1084	
<b>NC DMS ID NO. 100020</b>	



### LOG AND ROCK STEP / POOL

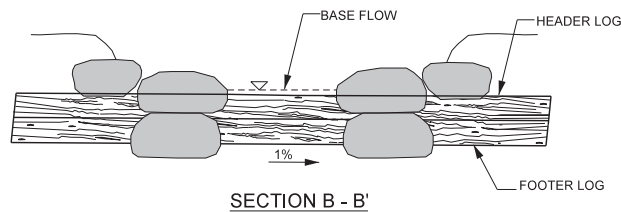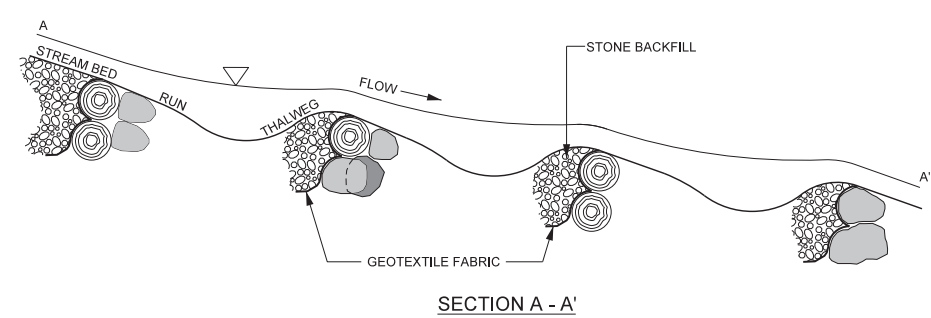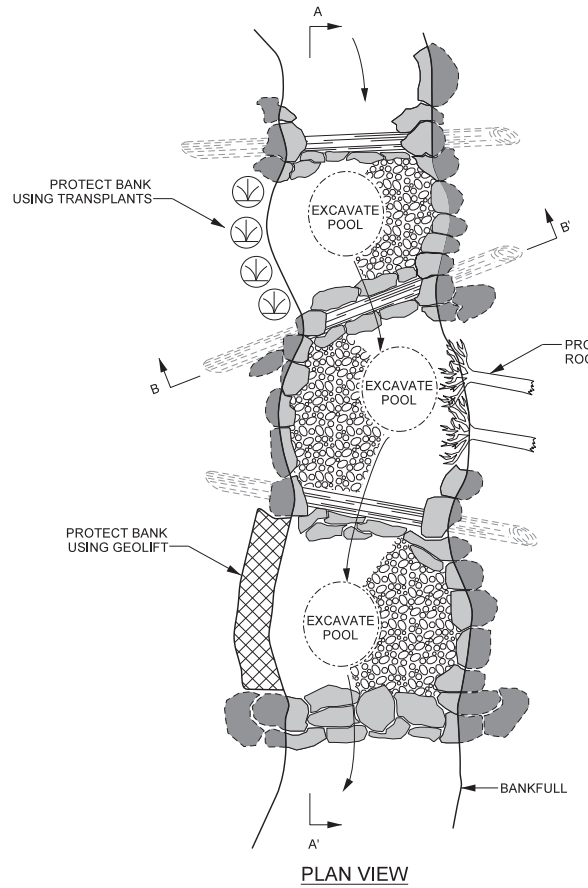

REACH	BOULDER SIZE
UT4A	1'x2'x3'
UT4B	1'x2'x3'
UT5	1'x2'x3'
REACH 7	2'x3'x4'

- NOTES:**
- LOGS SHOULD BE AT LEAST 10" IN DIAMETER, RELATIVELY STRAIGHT, HARDWOOD, AND RECENTLY HARVESTED AND EXTENDING INTO THE BANK 5' ON EACH SIDE.
  - SOIL SHOULD BE COMPACTED WELL AROUND BURIED PORTIONS OF LOG.
  - GEOTEXTILE FABRIC SHOULD BE NAILED TO THE LOG BELOW THE BACKFILL.
  - BOULDERS SHOULD BE PLACED ON TOP OF HEADER LOG FOR ANCHORING.
  - TRANSPLANTS CAN BE USED INSTEAD OF BOULDERS, PER DIRECTION OF ENGINEER.
  - AFTER ALL STONE BACKFILL HAS BEEN PLACED, FILL IN THE UPSTREAM SIDE OF THE STRUCTURE WITH WELL GRADED MIX OF CLASS B, CLASS A, & #57 STONE TO THE ELEVATION OF THE TOP OF THE HEADER ROCK. INCORPORATE ON-SITE ALLUVIUM WHERE AVAILABLE.




### BOULDER STEP

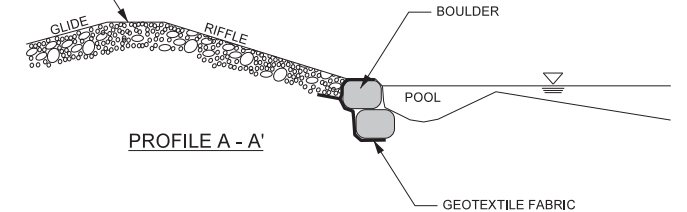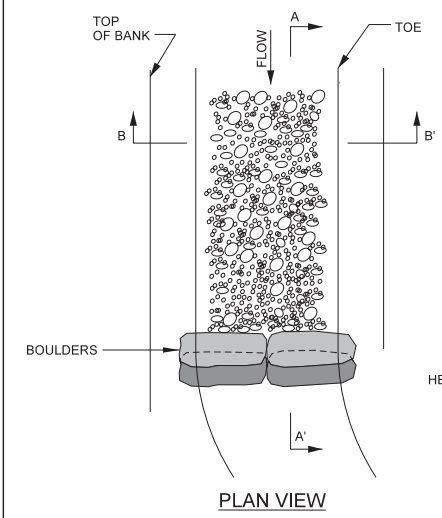

REACH	BOULDER SIZE
UT4A	1'x2'x3'
UT4B	1'x2'x3'
UT5	1'x2'x3'
REACH 7	2'x3'x4'

- NOTES:**
- FOOTERS SHALL BE INSTALLED SUCH THAT 1/4 TO 1/3 OF THE LENGTH IS DOWNSTREAM OF THE HEADER.
  - SOIL SHALL BE WELL COMPACTED AROUND BURIED PORTION OF FOOTERS WITH THE BUCKET OF EXCAVATOR.
  - INSTALL NON-WOVEN FILTER FABRIC UNDERNEATH FOOTER BOULDERS.
  - UNDERCUT THE RIFFLE ELEVATION 12 INCHES TO ALLOW FOR A LAYER OF STONE.
  - INSTALL EROSION CONTROL MATTING ALONG COMPLETED BANKS SUCH THAT THE EROSION CONTROL MATTING AT THE TOE OF THE BANK EXTENDS DOWN TO THE UNDERCUT ELEVATION.
  - FILL TRENCH WITH GRADED MIX OF CLASS A, CLASS B, AND #57 STONE TO THE BED ELEVATION OF THE CHANNEL.
  - BOULDER STEPS MUST BE EXTENDED TO A MINIMUM OF 2' INTO THE BANK. USE SILL BOULDERS IF NECESSARY.
  - THALWEG AND STEP INVERT WILL BE CONCAVE AND SHAPED PER DIRECTION OF THE DESIGNER.




### GRADE CONTROL LOG J-HOOK VANE

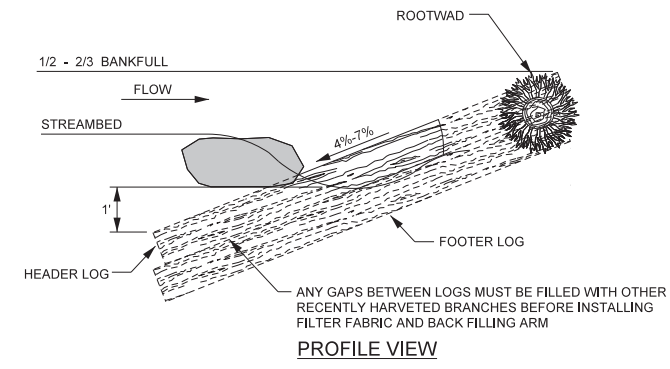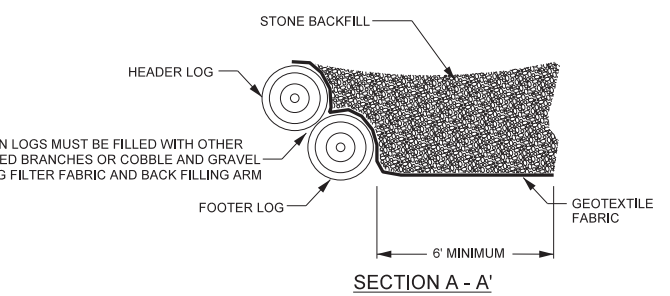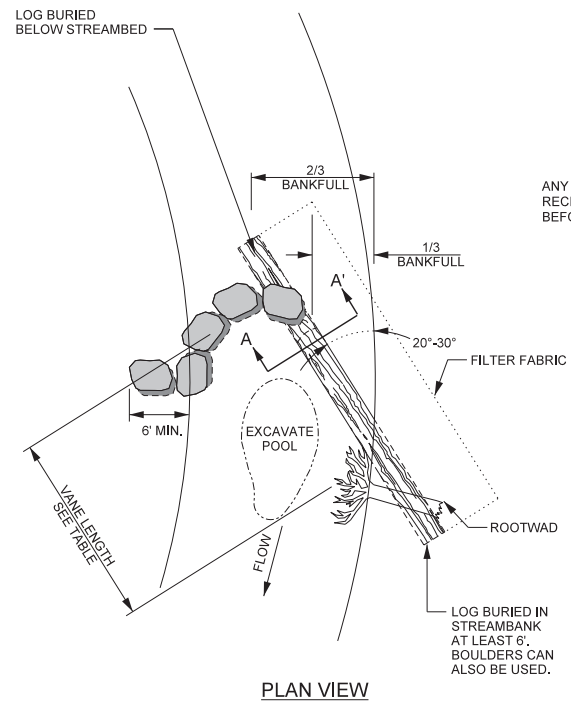

REACH	VANE LENGTH	BOULDER SIZE
UT4A	9'	1'x2'x3'
UT4B	10'	1'x2'x3'
UT5	7'	1'x2'x3'
REACH 7	18'	2'x3'x4'

- NOTES:**
- LOGS SHOULD BE AT LEAST 10" IN DIAMETER, RELATIVELY STRAIGHT, HARDWOOD, RECENTLY HARVESTED, AND FOOTERED.
  - BOULDERS MUST BE OF SUFFICIENT SIZE TO ANCHOR LOGS.
  - SOIL SHOULD BE COMPACTED WELL AROUND BURIED PORTIONS OF LOG.
  - ROOTWADS SHOULD BE PLACED BENEATH THE HEADER LOG AND PLACED SO THAT IT LOCKS THE HEADER LOG INTO THE BANK. SEE ROOTWAD DETAIL.
  - BOULDERS SHOULD BE PLACED ON TOP OF HEADER LOG FOR ANCHORING.
  - HEADER BOULDERS TO BE PLACED 0.5 TO 0.75 FEET APART.
  - FILTER FABRIC SHOULD BE NAILED TO THE LOG BELOW THE BACKFILL.
  - TRANSPLANTS OR BOULDERS CAN BE USED INSTEAD OF ROOTWADS, PER DIRECTION OF ENGINEER.
  - BOULDER SILL MUST BE A MINIMUM OF 6'.
  - AFTER ALL STONE BACKFILL HAS BEEN PLACED, FILL IN THE UPSTREAM SIDE OF THE STRUCTURE WITH WELL GRADED MIX OF CLASS B, CLASS A, & #57 STONE TO THE ELEVATION OF THE TOP OF THE HEADER ROCK. INCORPORATE ON-SITE ALLUVIUM WHERE AVAILABLE.

### LOG VANE

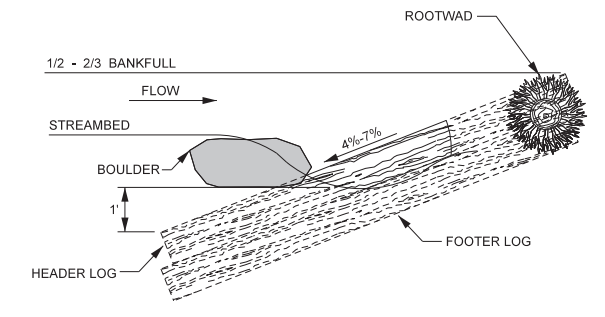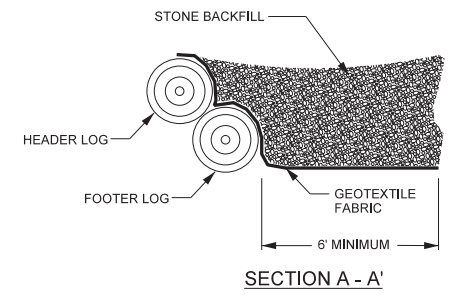
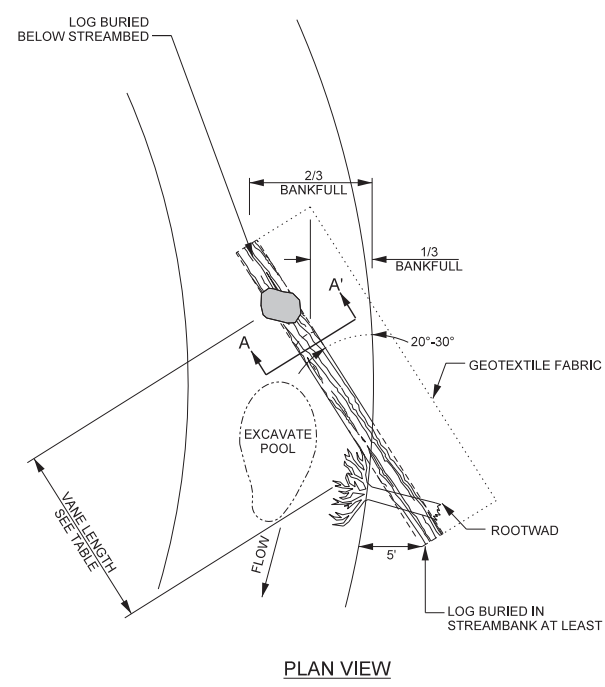


REACH	VANE LENGTH	BOULDER SIZE
UT4A	9'	1'x2'x3'
UT4B	10'	1'x2'x3'
UT5	7'	1'x2'x3'
REACH 7	18'	2'x3'x4'

- NOTES:**
- LOGS SHOULD BE AT LEAST 10" IN DIAMETER, RELATIVELY STRAIGHT, HARDWOOD, AND RECENTLY HARVESTED.
  - BOULDERS MUST BE OF SUFFICIENT SIZE TO ANCHOR LOGS.
  - SOIL SHOULD BE COMPACTED WELL AROUND BURIED PORTIONS OF LOGS.
  - ROOTWADS SHOULD BE PLACED BENEATH THE HEADER LOG AND PLACED SO THAT IT LOCKS THE HEADER LOG INTO THE BANK. SEE ROOTWAD DETAIL.
  - BOULDER SHOULD BE PLACED ON TOP OF HEADER LOG FOR ANCHORING.
  - GEOTEXTILE FABRIC SHOULD BE NAILED TO THE LOG BELOW THE BACKFILL.
  - TRANSPLANTS CAN BE USED INSTEAD OF ROOTWADS, PER DIRECTION OF ENGINEER.
  - AFTER ALL STONE BACKFILL HAS BEEN PLACED, FILL IN THE UPSTREAM SIDE OF THE STRUCTURE WITH WELL GRADED MIX OF CLASS B, CLASS A, & #57 STONE TO THE ELEVATION OF THE TOP OF THE HEADER ROCK. INCORPORATE ON-SITE ALLUVIUM WHERE AVAILABLE.



PROJECT REFERENCE NO. <b>162039</b>	SHEET NO. <b>2B</b>
PROJECT ENGINEER	
DocuSigned by: <b>Kathleen M. McKeithan</b> 247E84DF4181473...	
APPROVED BY:	
2/22/2022	
DATE:	
<b>Michael Baker International</b> Michael Baker Engineering Inc. 8000 Regency Parkway, Suite 600 Cary, NORTH CAROLINA 27518 Phone: 919.463.5488 Fax: 919.463.5490 License #: F-1084	
<b>NC DMS ID NO. 100020</b>	

### LIVE STAKING

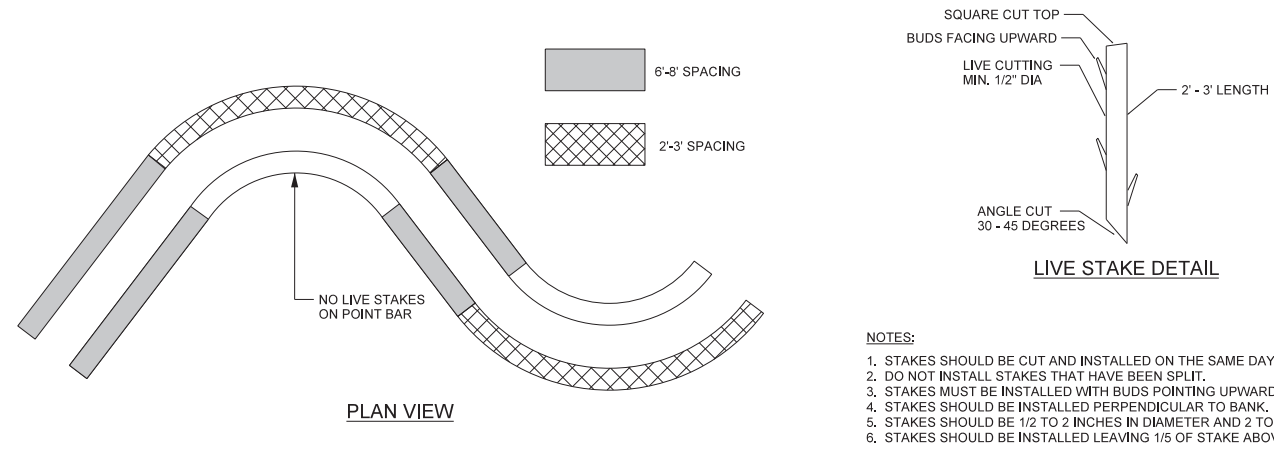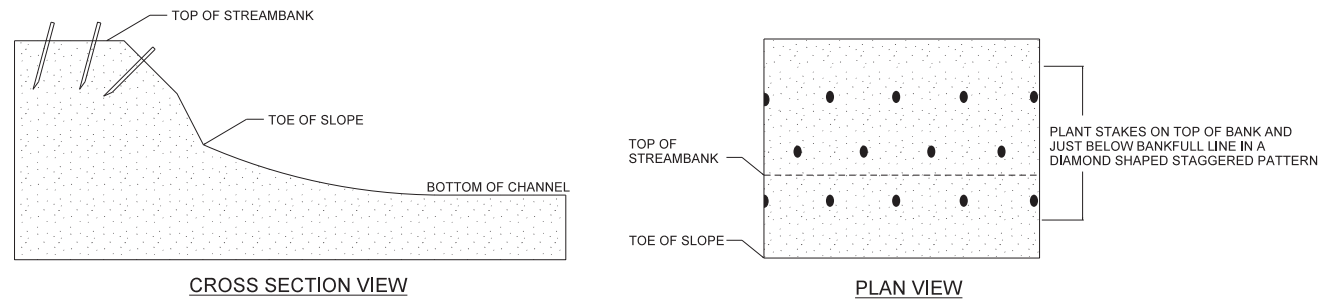

- NOTES:**
1. STAKES SHOULD BE CUT AND INSTALLED ON THE SAME DAY.
  2. DO NOT INSTALL STAKES THAT HAVE BEEN SPLIT.
  3. STAKES MUST BE INSTALLED WITH BUDS POINTING UPWARDS.
  4. STAKES SHOULD BE INSTALLED PERPENDICULAR TO BANK.
  5. STAKES SHOULD BE 1/2 TO 2 INCHES IN DIAMETER AND 2 TO 3 FT LONG.
  6. STAKES SHOULD BE INSTALLED LEAVING 1/5 OF STAKE ABOVE GROUND.


### TRANSPLANTED VEGETATION

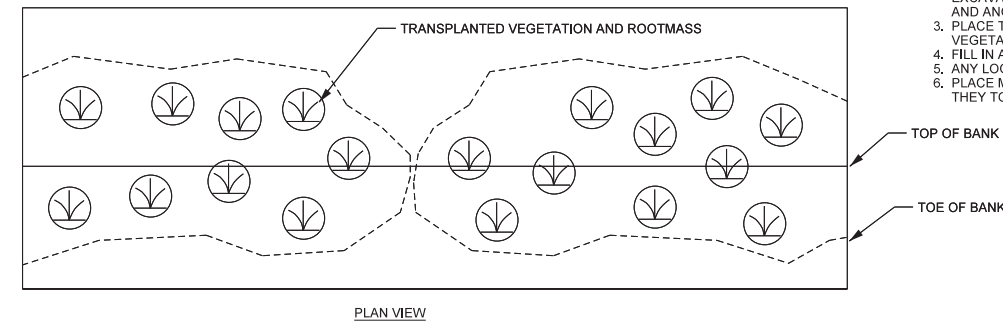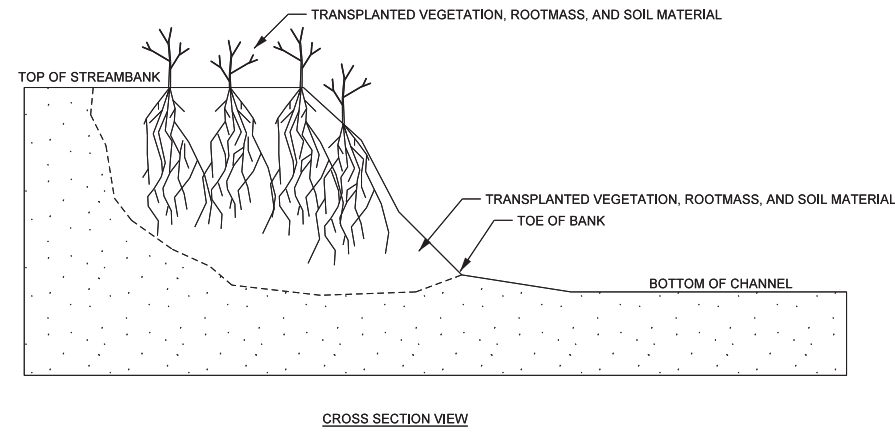


- NOTES:**
1. EXCAVATE A HOLE IN THE BANK TO BE STABILIZED THAT WILL ACCOMMODATE THE SIZE OF TRANSPLANT TO BE PLACED. BEGIN EXCAVATION AT THE TOE OF THE BANK.
  2. EXCAVATE TRANSPLANT USING A FRONT END LOADER. EXCAVATE THE ENTIRE ROOT MASS AND AS MUCH ADDITIONAL SOIL MATERIAL AS POSSIBLE. IF ENTIRE ROOT MASS CAN NOT BE EXCAVATED IN ONE BUCKET LOAD, THE TRANSPLANT IS TOO LARGE AND ANOTHER SHOULD BE SELECTED.
  3. PLACE TRANSPLANT IN THE BANK TO BE STABILIZED SO THAT VEGETATION IS ORIENTATED VERTICALLY.
  4. FILL IN ANY HOLES AROUND THE TRANSPLANT AND COMPACT.
  5. ANY LOOSE SOIL LEFT IN THE STREAM SHOULD BE REMOVED.
  6. PLACE MULTIPLE TRANSPLANTS CLOSE TOGETHER SUCH THAT THEY TOUCH.

PROJECT REFERENCE NO. <b>162039</b>	SHEET NO. <b>2C</b>
PROJECT ENGINEER	
DocuSigned by: <b>Kathleen M. McKeithan</b> 247E84DF4181473...	
APPROVED BY:	
DATE: 2/22/2022	
<b>Michael Baker International</b> 8000 Regency Parkway, Suite 600 Cary, NORTH CAROLINA 27518 Phone: 919.463.5485 Fax: 919.463.5490 License #: F-1084	
<b>NCDMS ID NO. 100020</b>	

### PLANTING SPECIFICATIONS

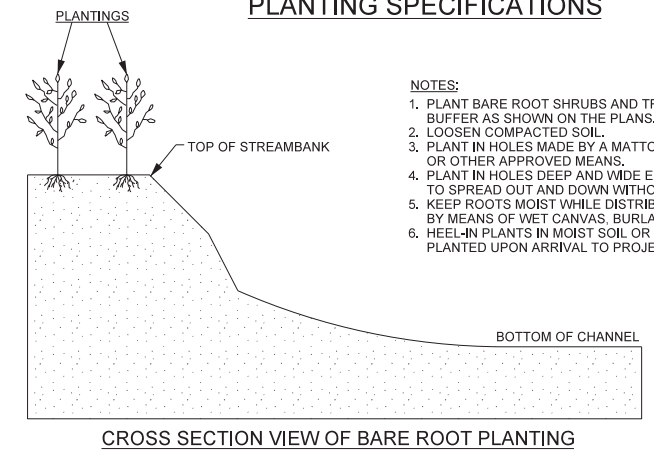


- NOTES:**
1. PLANT BARE ROOT SHRUBS AND TREES TO THE WIDTH OF THE BUFFER AS SHOWN ON THE PLANS.
  2. LOOSEN COMPACTED SOIL.
  3. PLANT IN HOLES MADE BY A MATTOCK, DIBBLE, PLANTING BAR, OR OTHER APPROVED MEANS.
  4. PLANT IN HOLES DEEP AND WIDE ENOUGH TO ALLOW THE ROOTS TO SPREAD OUT AND DOWN WITHOUT J-ROOTING.
  5. KEEP ROOTS MOIST WHILE DISTRIBUTING OR WAITING TO PLANT BY MEANS OF WET CANVAS, BURLAP, OR STRAW.
  6. HEEL-IN PLANTS IN MOIST SOIL OR SAWDUST IF NOT PROMPTLY PLANTED UPON ARRIVAL TO PROJECT SITE.

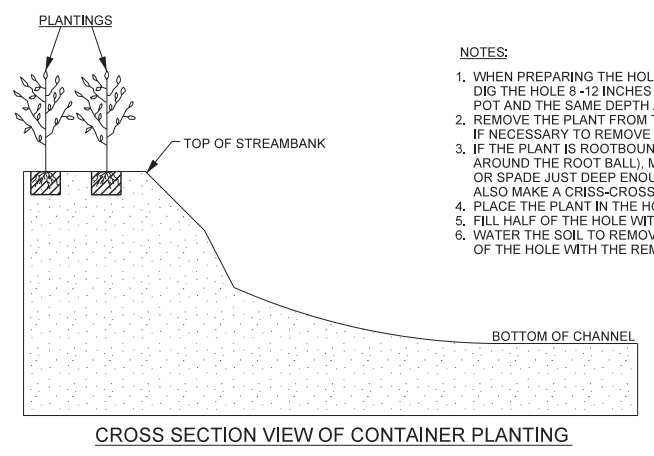


- NOTES:**
1. WHEN PREPARING THE HOLE FOR A POTTED PLANT OR SHRUB DIG THE HOLE 8-12 INCHES LARGER THAN THE DIAMETER OF THE POT AND THE SAME DEPTH AS THE POT.
  2. REMOVE THE PLANT FROM THE POT. LAY THE PLANT ON ITS SIDE IF NECESSARY TO REMOVE THE POT.
  3. IF THE PLANT IS ROOTBOUND (ROOTS GROWING IN A SPIRAL AROUND THE ROOT BALL), MAKE VERTICAL CUTS WITH A KNIFE OR SPADE JUST DEEP ENOUGH TO CUT THE NET OF ROOTS. ALSO MAKE A CRISS-CROSS CUT ACROSS THE BOTTOM OF THE BALL.
  4. PLACE THE PLANT IN THE HOLE.
  5. FILL HALF OF THE HOLE WITH SOIL (SAME SOIL REMOVED FOR BACKFILL).
  6. WATER THE SOIL TO REMOVE AIR POCKETS AND FILL THE REST OF THE HOLE WITH THE REMAINING SOIL.

### COIR FIBER MATTING

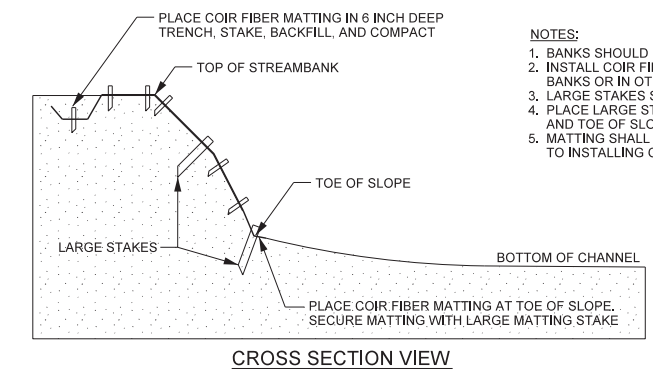


- NOTES:**
1. BANKS SHOULD BE SEEDED PRIOR TO PLACEMENT OF MATTING.
  2. INSTALL COIR FIBER MATTING PER SPECIFICATIONS ALONG STREAM BANKS OR IN OTHERS LOCATIONS SPECIFIED BY ENGINEER.
  3. LARGE STAKES SHOULD NOT BE SPACED FURTHER THAN 36" APART.
  4. PLACE LARGE STAKES ALONG ALL SEAMS, IN THE CENTER OF BANK, AND TOE OF SLOPE.
  5. MATTING SHALL BE PLACED ON BANKS, STAKED, AND TRENCHED PRIOR TO INSTALLING CONSTRUCTED RIFFLE MATERIAL.

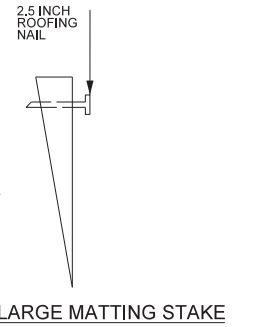

**TYPICAL LARGE MATTING STAKE**


LEG LENGTH	17.00 IN (43.18 CM) (TAPERED TO POINT)
WIDTH	1.5 IN (3.81 CM)
THICKNESS	1.5 IN (3.81 CM)

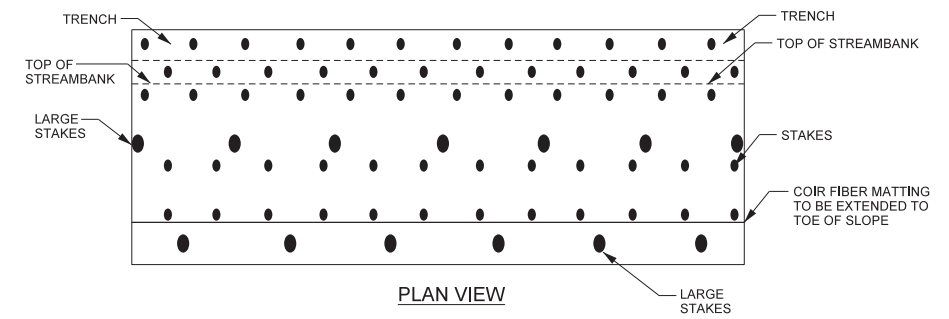


**TYPICAL SMALL MATTING STAKE**

LEG LENGTH	11.00 IN (27.94 CM)
HEAD WIDTH	1.25 IN (3.18 CM)
HEAD THICKNESS	0.40 IN (1.02 CM)
LEG WIDTH	0.60 IN (1.52 CM) (TAPERED TO POINT)
LEG THICKNESS	0.40 IN (1.02 CM)
TOTAL LENGTH	12.00 IN (30.48 CM)

### PLUNGE POOL

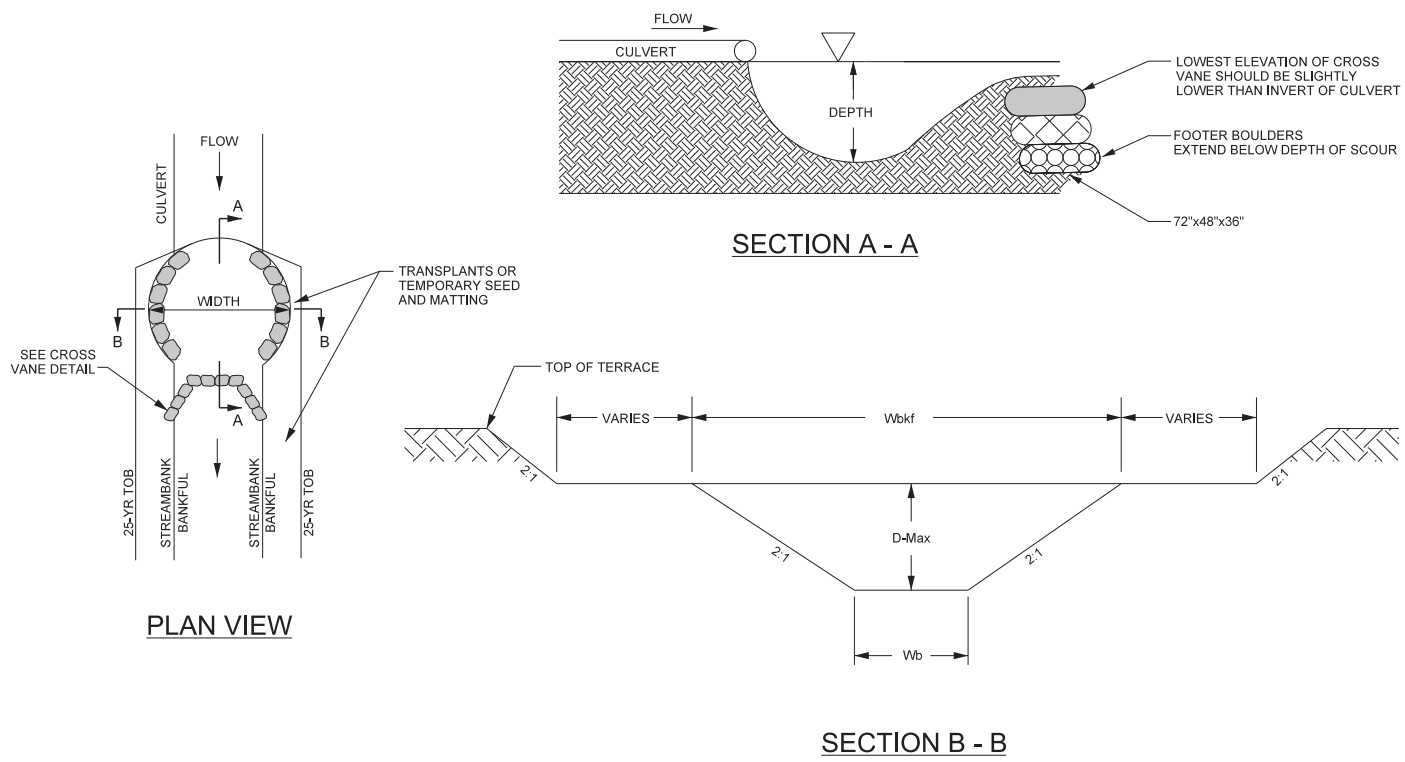


### GEOLIFT WITH BRUSH TOE

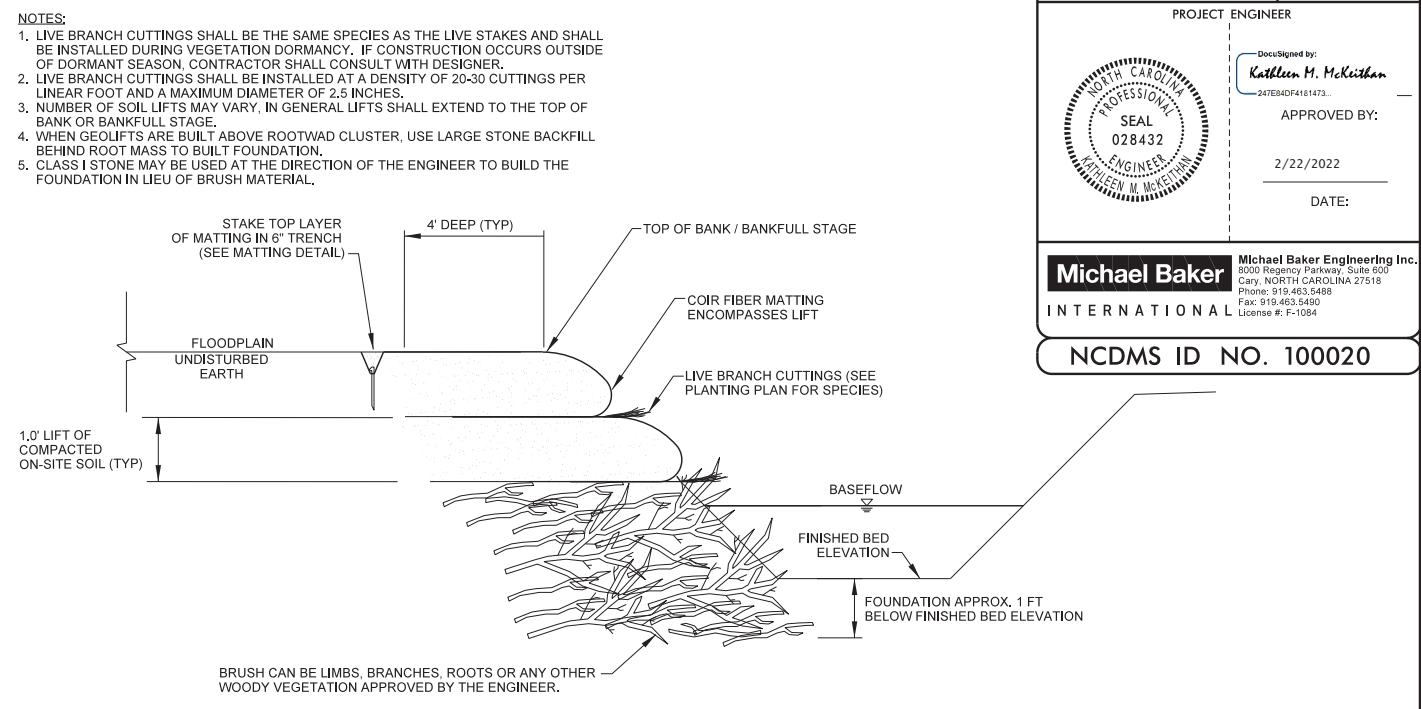


PROJECT REFERENCE NO. <b>162039</b>	SHEET NO. <b>2D</b>
PROJECT ENGINEER	
APPROVED BY:	
2/22/2022	
DATE:	
<b>Michael Baker International</b> Michael Baker Engineering Inc. 8020 Regency Parkway, Suite 600 Cary, NORTH CAROLINA 27518 Phone: 919.463.5485 Fax: 919.463.5490 License #: F-1084	
NCDMS ID NO. 100020	


### ROCK DAM

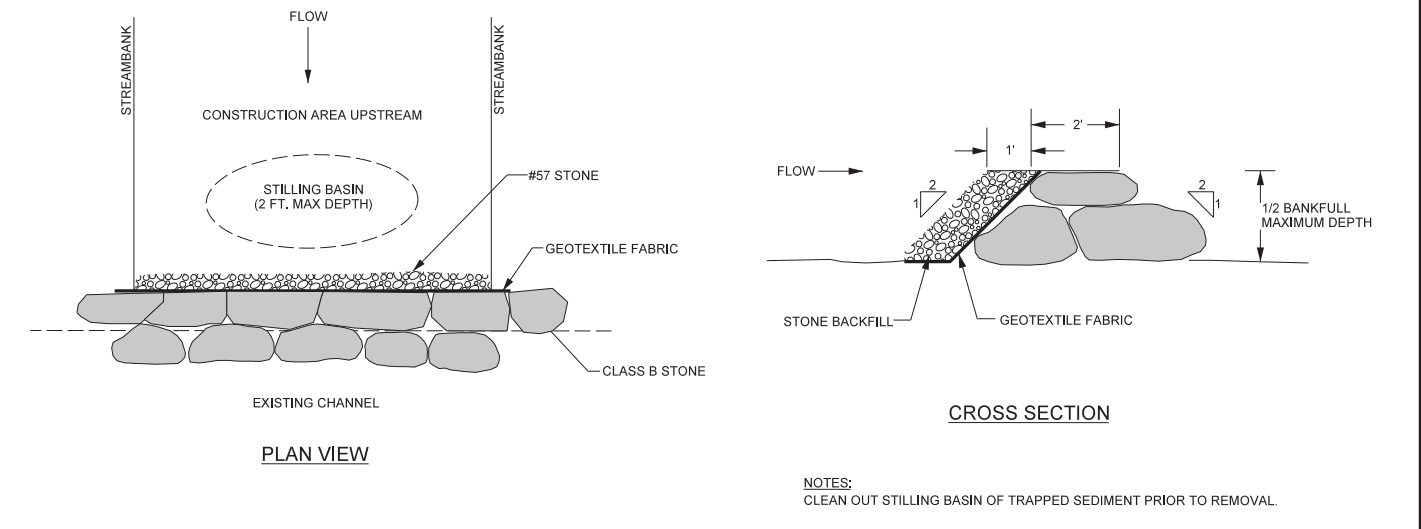

### ROCK TOE PROTECTION

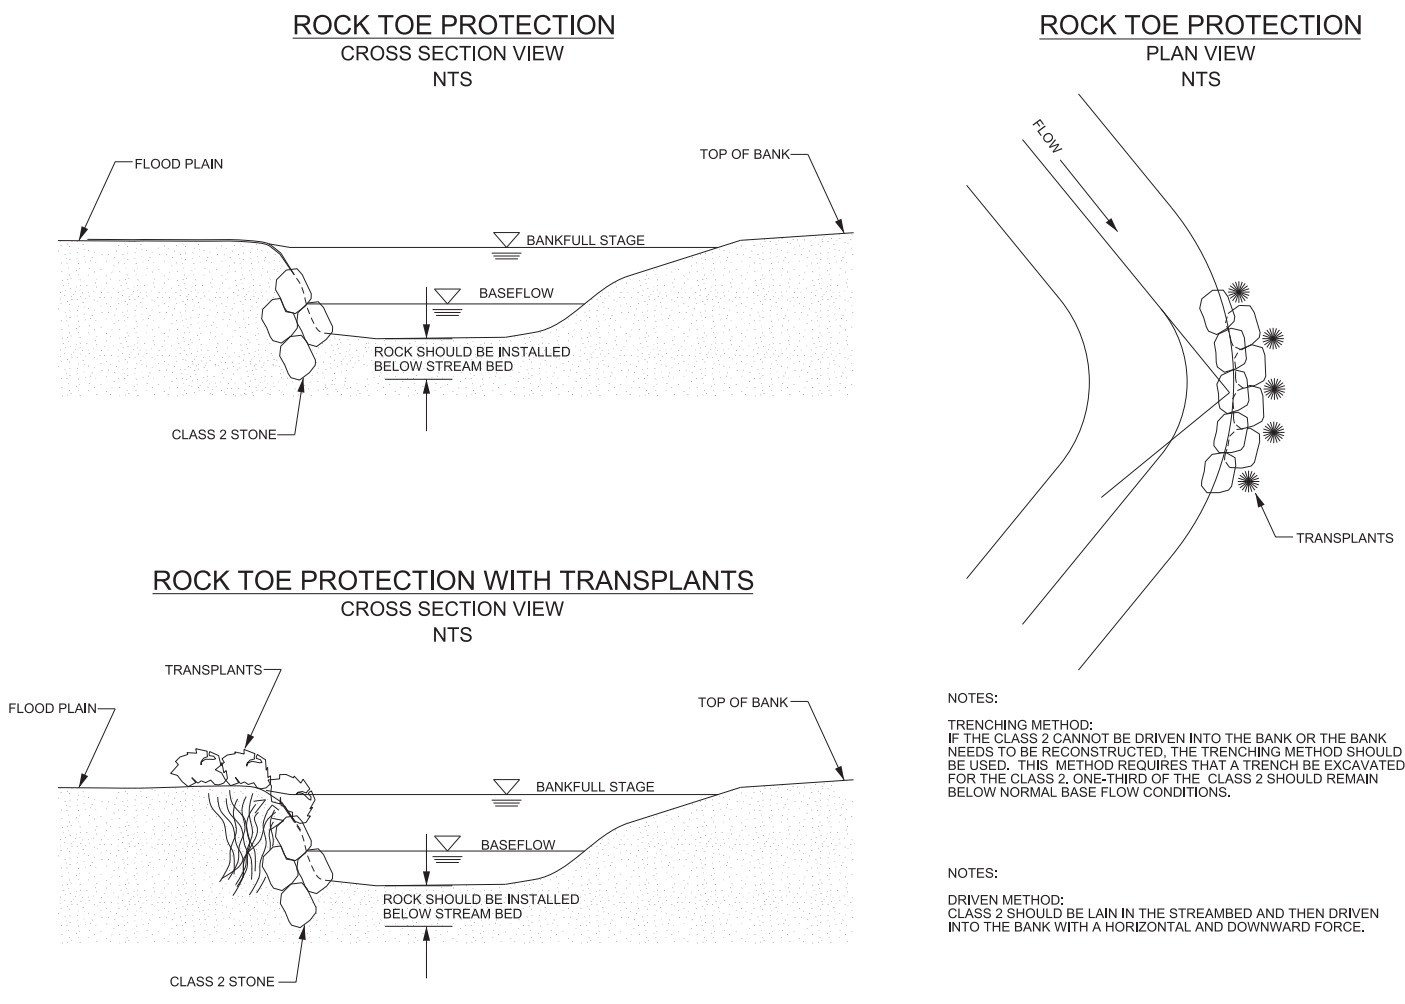


### ROCK FORD STREAM CROSSING

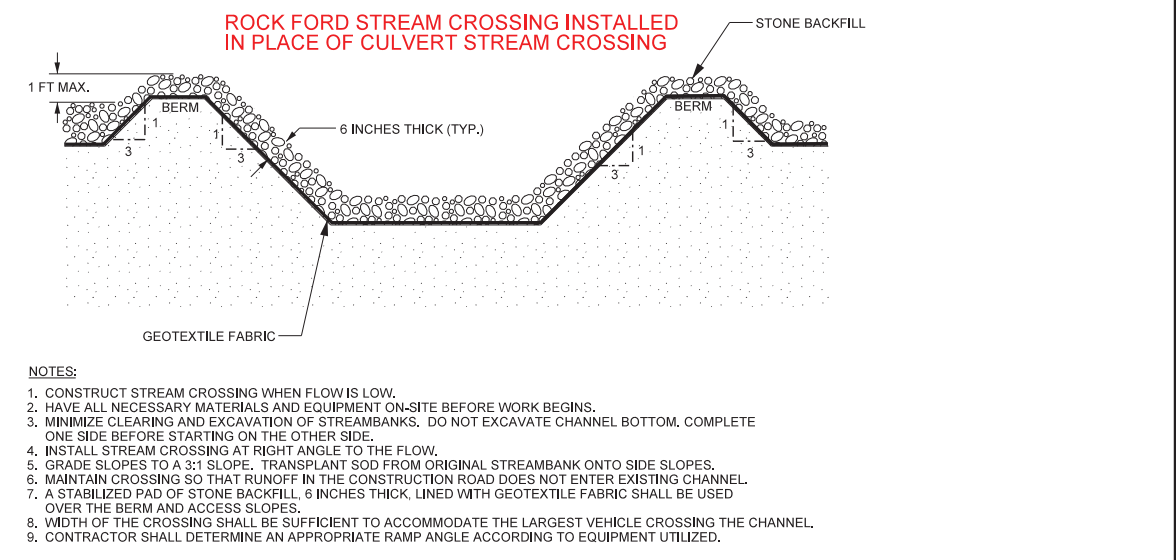




2/26/2023

### BARB WIRE FIELD FENCE

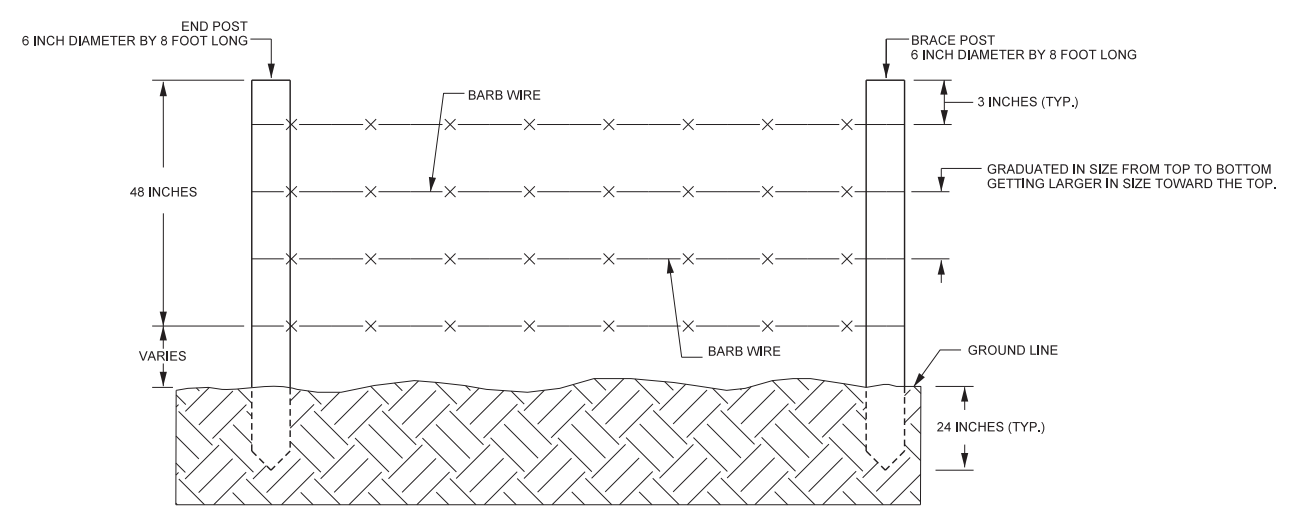


**NOTE:**  
1. END POSTS SHALL BE INSTALLED AT A SPACING OF 10-15 FEET.

### WOVEN WIRE FENCE

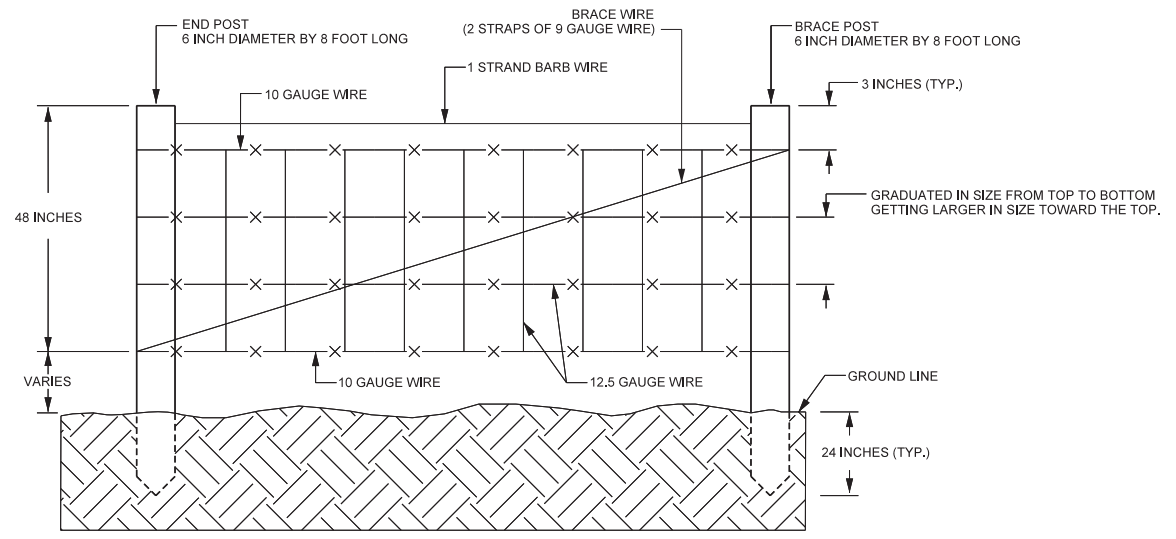


**NOTE:**  
1. END POSTS SHALL BE INSTALLED AT A SPACING OF 10-15 FEET.

### STEEL GATES

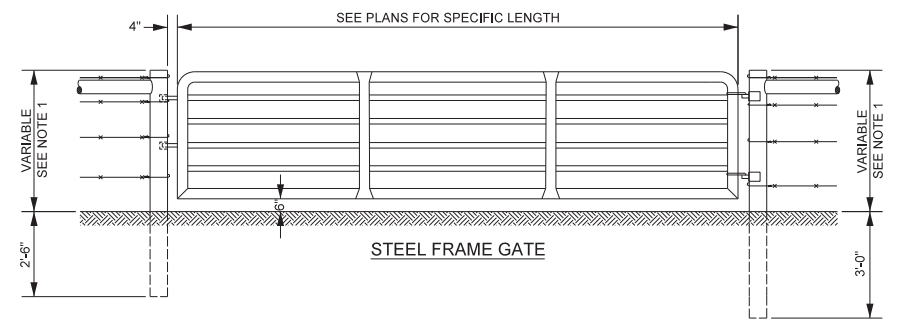


**NOTES:**  
1. POST HEIGHT DIMENSION SHALL BE THE SAME AS REQUIRED FOR THE ADJACENT FENCE.  
2. CONSTRUCT AN END OR STRESS PANEL, AS REQUIRED IN THE SPECIFICATION, ON EACH SIDE OF GATE.  
3. HINGES AND LOCKS SHALL BE INSTALLED AS SPECIFIED BY GATE MANUFACTURER.

### 4 STRAND - HIGH TENSILE FENCING

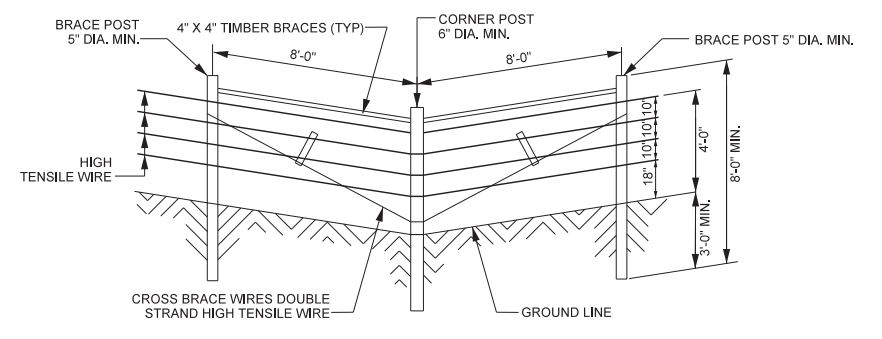


### CORNER AND VERTICAL CHANGE BRACING

INSTALL AT ALL POINTS WHERE FENCE ALIGNMENT CHANGES 15 DEGREES OR MORE

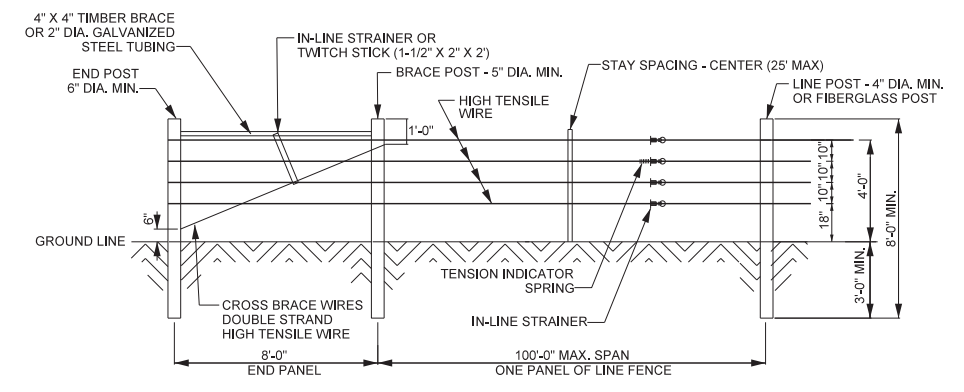


### END ASSEMBLY AND LINE FENCE SECTION

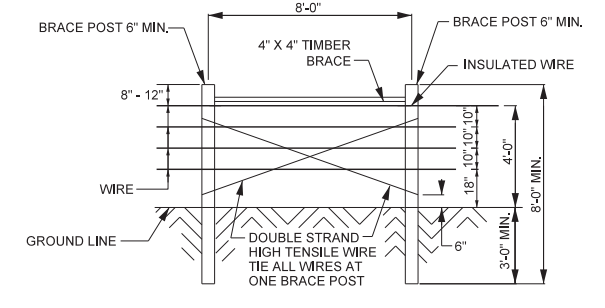

### PULL POST ASSEMBLY

PLACE IN FENCE LINE SO THAT MAXIMUM DISTANCE BETWEEN BRACED POSTS DOES NOT EXCEED 1320 FEET

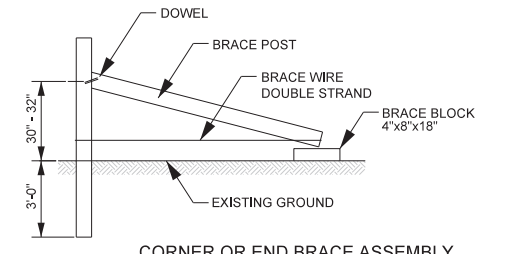

### CORNER OR END BRACE ASSEMBLY

OPTIONAL FIGURE 4




- NOTES:**
- NOTCH POSTS 3/4" FOR 4" X 4" TIMBER BRACES.
  - DOWELS TO BE 1/2" DIA. X 5" PLAIN STEEL RODS. DRIVE DOWELS IN 7/16" DIA. HOLES, 2-1/2" INTO EACH POST AND TIMBER BRACE.
  - STAPLE CROSS-BRACE WIRES TO BRACE AND CORNER POSTS AT QUARTER POINTS OF THE POSTS.
  - HIGH TENSILE WIRE WILL BE NEW AND SMOOTH AND WILL MEET THE FOLLOWING  
1) TENSILE STRENGTH - 110,000 PSI 2) GALVANIZING - TYPE III 3) GAGE - 12-1/2.
  - ALL CORNER POSTS, BRACE POSTS, BRACES, AND STAY SPACERS, SHALL BE PRESSURE TREATED. PRESSURE TREATMENT SHALL CONFORM TO FEDERAL SPECIFICATION TT-W-571. (1-1/4" LONG FOR HARD WOODS).
  - AT CORNER POSTS, STAPLE EACH WIRE AT QUARTER POINTS OF POSTS. AT BRACE POSTS, DOUBLE STAPLE EACH WIRE. AT LINE POSTS, SECURE EACH WIRE WITH STANDARD CLAMPS.
  - FIBERGLASS MAY BE USED FOR LINE POSTS. THESE WILL CONSIST OF MARBLE, FIBERGLASS, AND POLYMER RESINS WHICH HAVE BEEN TREATED BY THERMOSETTING (HEAT TREATMENT). POSTS MUST BE DRIVEN IN THE SOIL AT LEAST 18 INCHES.
  - 2" DIAMETER PIPE DIAGONAL BRACE MAY BE USED IN PLACE OF HORIZONTAL TIMBER BRACE AND DIAGONAL WIRES.
  - MINIMUM NET RETENTION OF CHROMATED COPPER ARSENATE (CCA) FOR WOOD FENCE POSTS SHALL BE 0.40 POUNDS PER CUBIC FOOT.
  - A SINGLE 12 FOOT LONG, 6 INCH MINIMUM DIAMETER POST MAY BE SUBSTITUTED FOR END PANEL, CORNER AND VERTICAL CHANGE BRACING, AND PULL POST ASSEMBLY. THE 12 FOOT LONG POSTS SHALL EXTEND A MINIMUM OF 7.5 FEET INTO THE GROUND AND BE BACKFILLED WITH GRAVEL.
  - FOR FURTHER DETAILS ON APPROVED METHODS OF FENCE INSTALLATION, SEE NATURAL RESOURCE SERVICE'S CONSERVATION PRACTICE MATERIALS AND CONSTRUCTION SPECIFICATIONS FOR FENCING (CODE 382) BY NRCS NORTH CAROLINA (FEBRUARY 2008).

PROJECT REFERENCE NO. <b>162039</b>	SHEET NO. <b>2E</b>
PROJECT ENGINEER	
APPROVED BY:	
2/22/2022	
DATE:	
<b>Michael Baker International</b> Michael Baker Engineering Inc. 8020 Regency Parkway, Suite 600 Cary, NORTH CAROLINA 27518 Phone: 919.463.5485 Fax: 919.463.5490 License #: F-1084	
NCDMS ID NO. 100020	

R:\2023\162039\_Whittier-Creek\Design\As-Built\Plans\162039\_ASB-PSH-02E.dgn

2/26/2023




**LOG DROP**

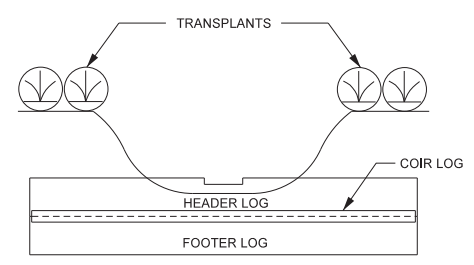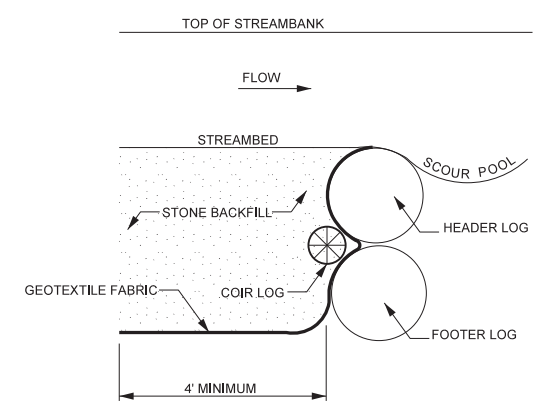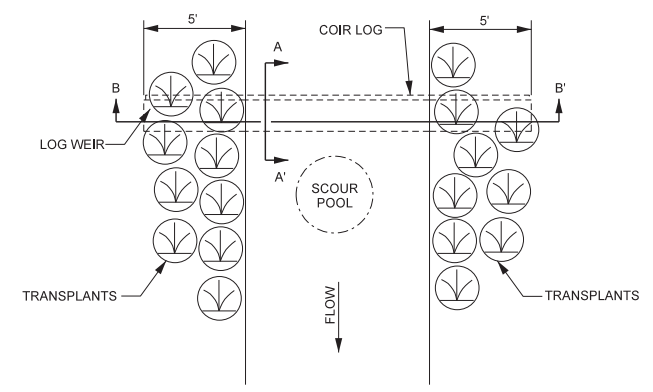

**NOTES:**

- LOGS SHOULD BE AT LEAST 10 INCHES IN DIAMETER, RELATIVELY STRAIGHT, HARDWOOD, AND RECENTLY HARVESTED.
- TOP OF HEADER LOG SHOULD BE SET AT SAME ELEVATION AS THE STREAMBED.
- DIAMETER OF COIR LOG SHOULD BE APPROXIMATELY 1/2 DIAMETER OF LOGS.
- USE GEOTEXTILE FABRIC WITH COIR LOGS TO SEAL GAPS BETWEEN LOGS.
- PLACE TRANSPLANTS ALONG BANKS TO PROTECT AGAINST BANK EROSION.
- THE HEADER LOG SHOULD BE NOTCHED 2 - 3 INCHES DEEP IN THE CENTER AND FOR 20 - 30% OF THE CHANNEL WIDTH.

**CONSTRUCTED RIFFLE**

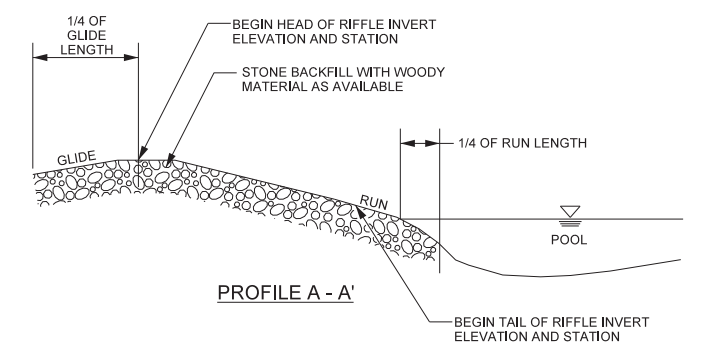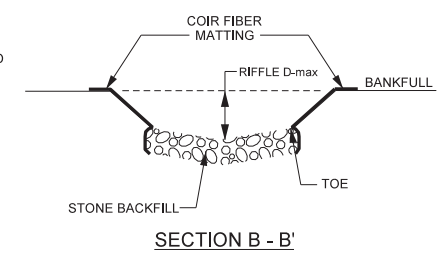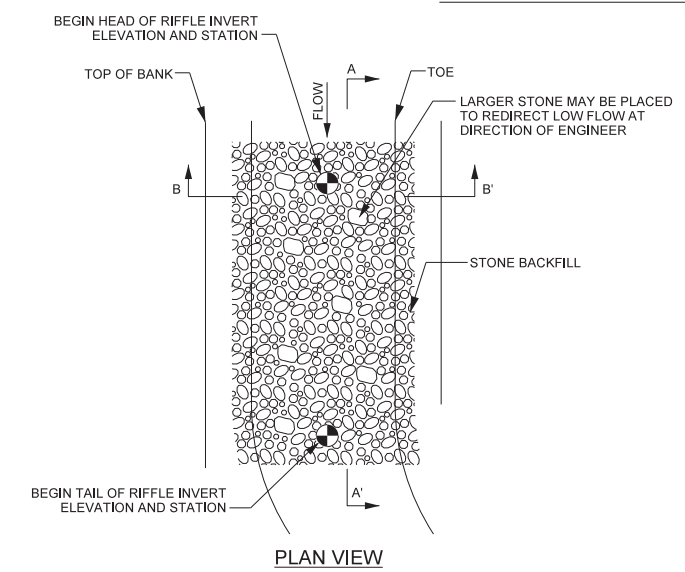




**NOTES:**

- UNDERCUT CHANNEL BED ELEVATION AS NEEDED TO ALLOW FOR LAYERS OF STONE TO ACHIEVE FINAL GRADE.
- INSTALL COIR FIBER MATTING ALONG COMPLETED BANKS SUCH THAT THE EROSION CONTROL MATTING AT THE TOE OF THE BANK EXTENDS DOWN TO THE UNDERCUT ELEVATION.
- INSTALL STONE BACKFILL, COMPACTED TO GRADE.
- FINAL CHANNEL BED SHAPE SHOULD BE ROUNDED, SMOOTH, AND CONCAVE, WITH THE ELEVATION OF THE BED 0.2 FT DEEPER IN THE CENTER THAN AT THE EDGES.
- CONSTRUCTED RIFFLES SHALL BE 12" THICK.
- CHANNEL BED SHALL INCLUDE WOODY MATERIAL AS AVAILABLE ON-SITE LAYERED IN WITH STONE BACKFILL.

PROJECT REFERENCE NO. <b>162039</b>	SHEET NO. <b>2F</b>
PROJECT ENGINEER <b>Kathleen M. McKeithan</b>	
APPROVED BY: <b>Michael Baker Engineering Inc.</b>	
DATE: <b>2/22/2022</b>	
<b>Michael Baker International</b> 8020 Regency Parkway, Suite 600 Cary, NORTH CAROLINA 27518 Phone: 919.463.5486 Fax: 919.463.5490 License #: F-1084	
NCDMS ID NO. 100020	

**CONSTRUCTED RIFFLE WITH WOOD**


**CONSTRUCTED RIFFLE WITH WOOD INSTALLED IN PLACE OF GRADE CONTROL LOG JAM**

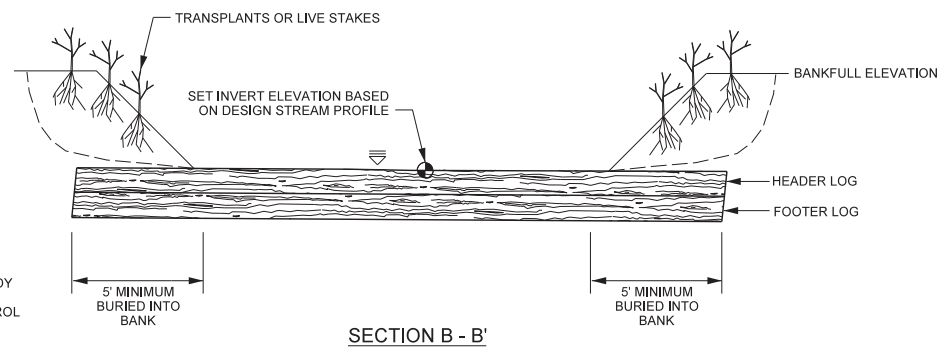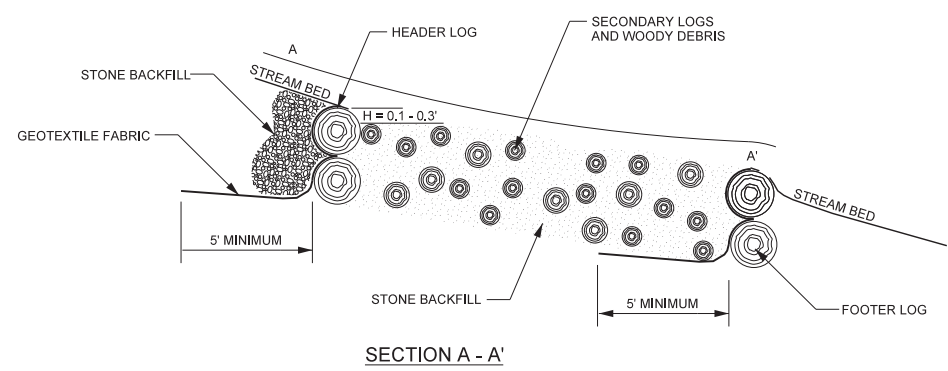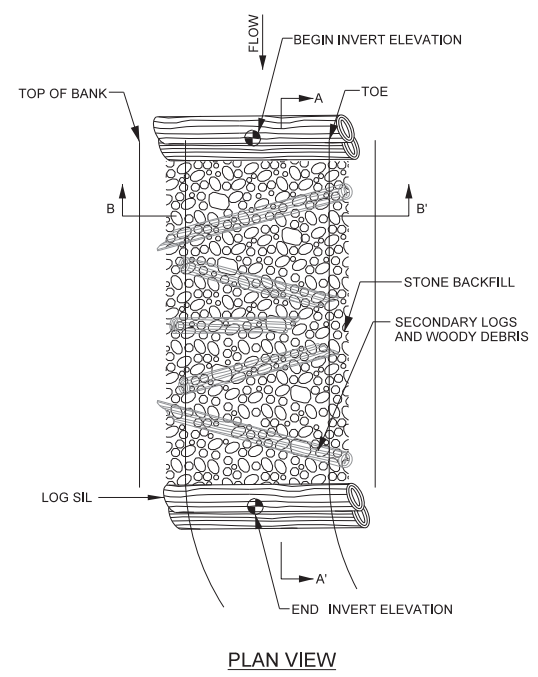

**NOTES:**


- UNDERCUT CHANNEL BED ELEVATION AS NEEDED TO ALLOW LAYERS OF STONE AND WOODY MATERIAL TO ACHIEVE FINAL GRADE.
- INSTALL COIR FIBER MATTING ALONG COMPLETED BANKS SUCH THAT THE EROSION CONTROL MATTING AT THE TOE OF THE BANK EXTENDS DOWN TO THE UNDERCUT ELEVATION.
- INSTALL STONE BACKFILL, COMPACTED TO GRADE.
- FINAL CHANNEL BED SHAPE SHOULD BE ROUNDED, SMOOTH, AND CONCAVE, WITH THE ELEVATION OF THE BED 0.2 FT DEEPER IN THE CENTER THAN AT THE EDGES.
- CONSTRUCTED RIFFLES SHALL BE 12" THICK.
- CHANNEL BED SHALL INCLUDE WOODY MATERIAL AS AVAILABLE ON-SITE LAYERED IN WITH STONE BACKFILL.

R:\162039\_Whittier\_Creek\_Design\As-Built\Plans\162039\_ASB-PSH-02F.dgn

BAKER PROJECT REFERENCE NO. <b>162039</b>	SHEET NO. <b>3</b>
PROJECT ENGINEER	
DocuSigned by: <i>Kathleen M. McKeithan</i> 247E8AD4161473 APPROVED BY:  2/22/2022 DATE:	
	
<b>Michael Baker International</b> Michael Baker Engineering Inc. 5000 Regency Parkway, Suite 500 Cary, NORTH CAROLINA 27518 Phone: 919.453.5488 Fax: 919.453.5490 License #: F-1084	
NCDMS ID NO. 100020	



NURSE ROAD  
SR 2023  
R/W WIDTH 50' PER DB: 426 Pg. 1263

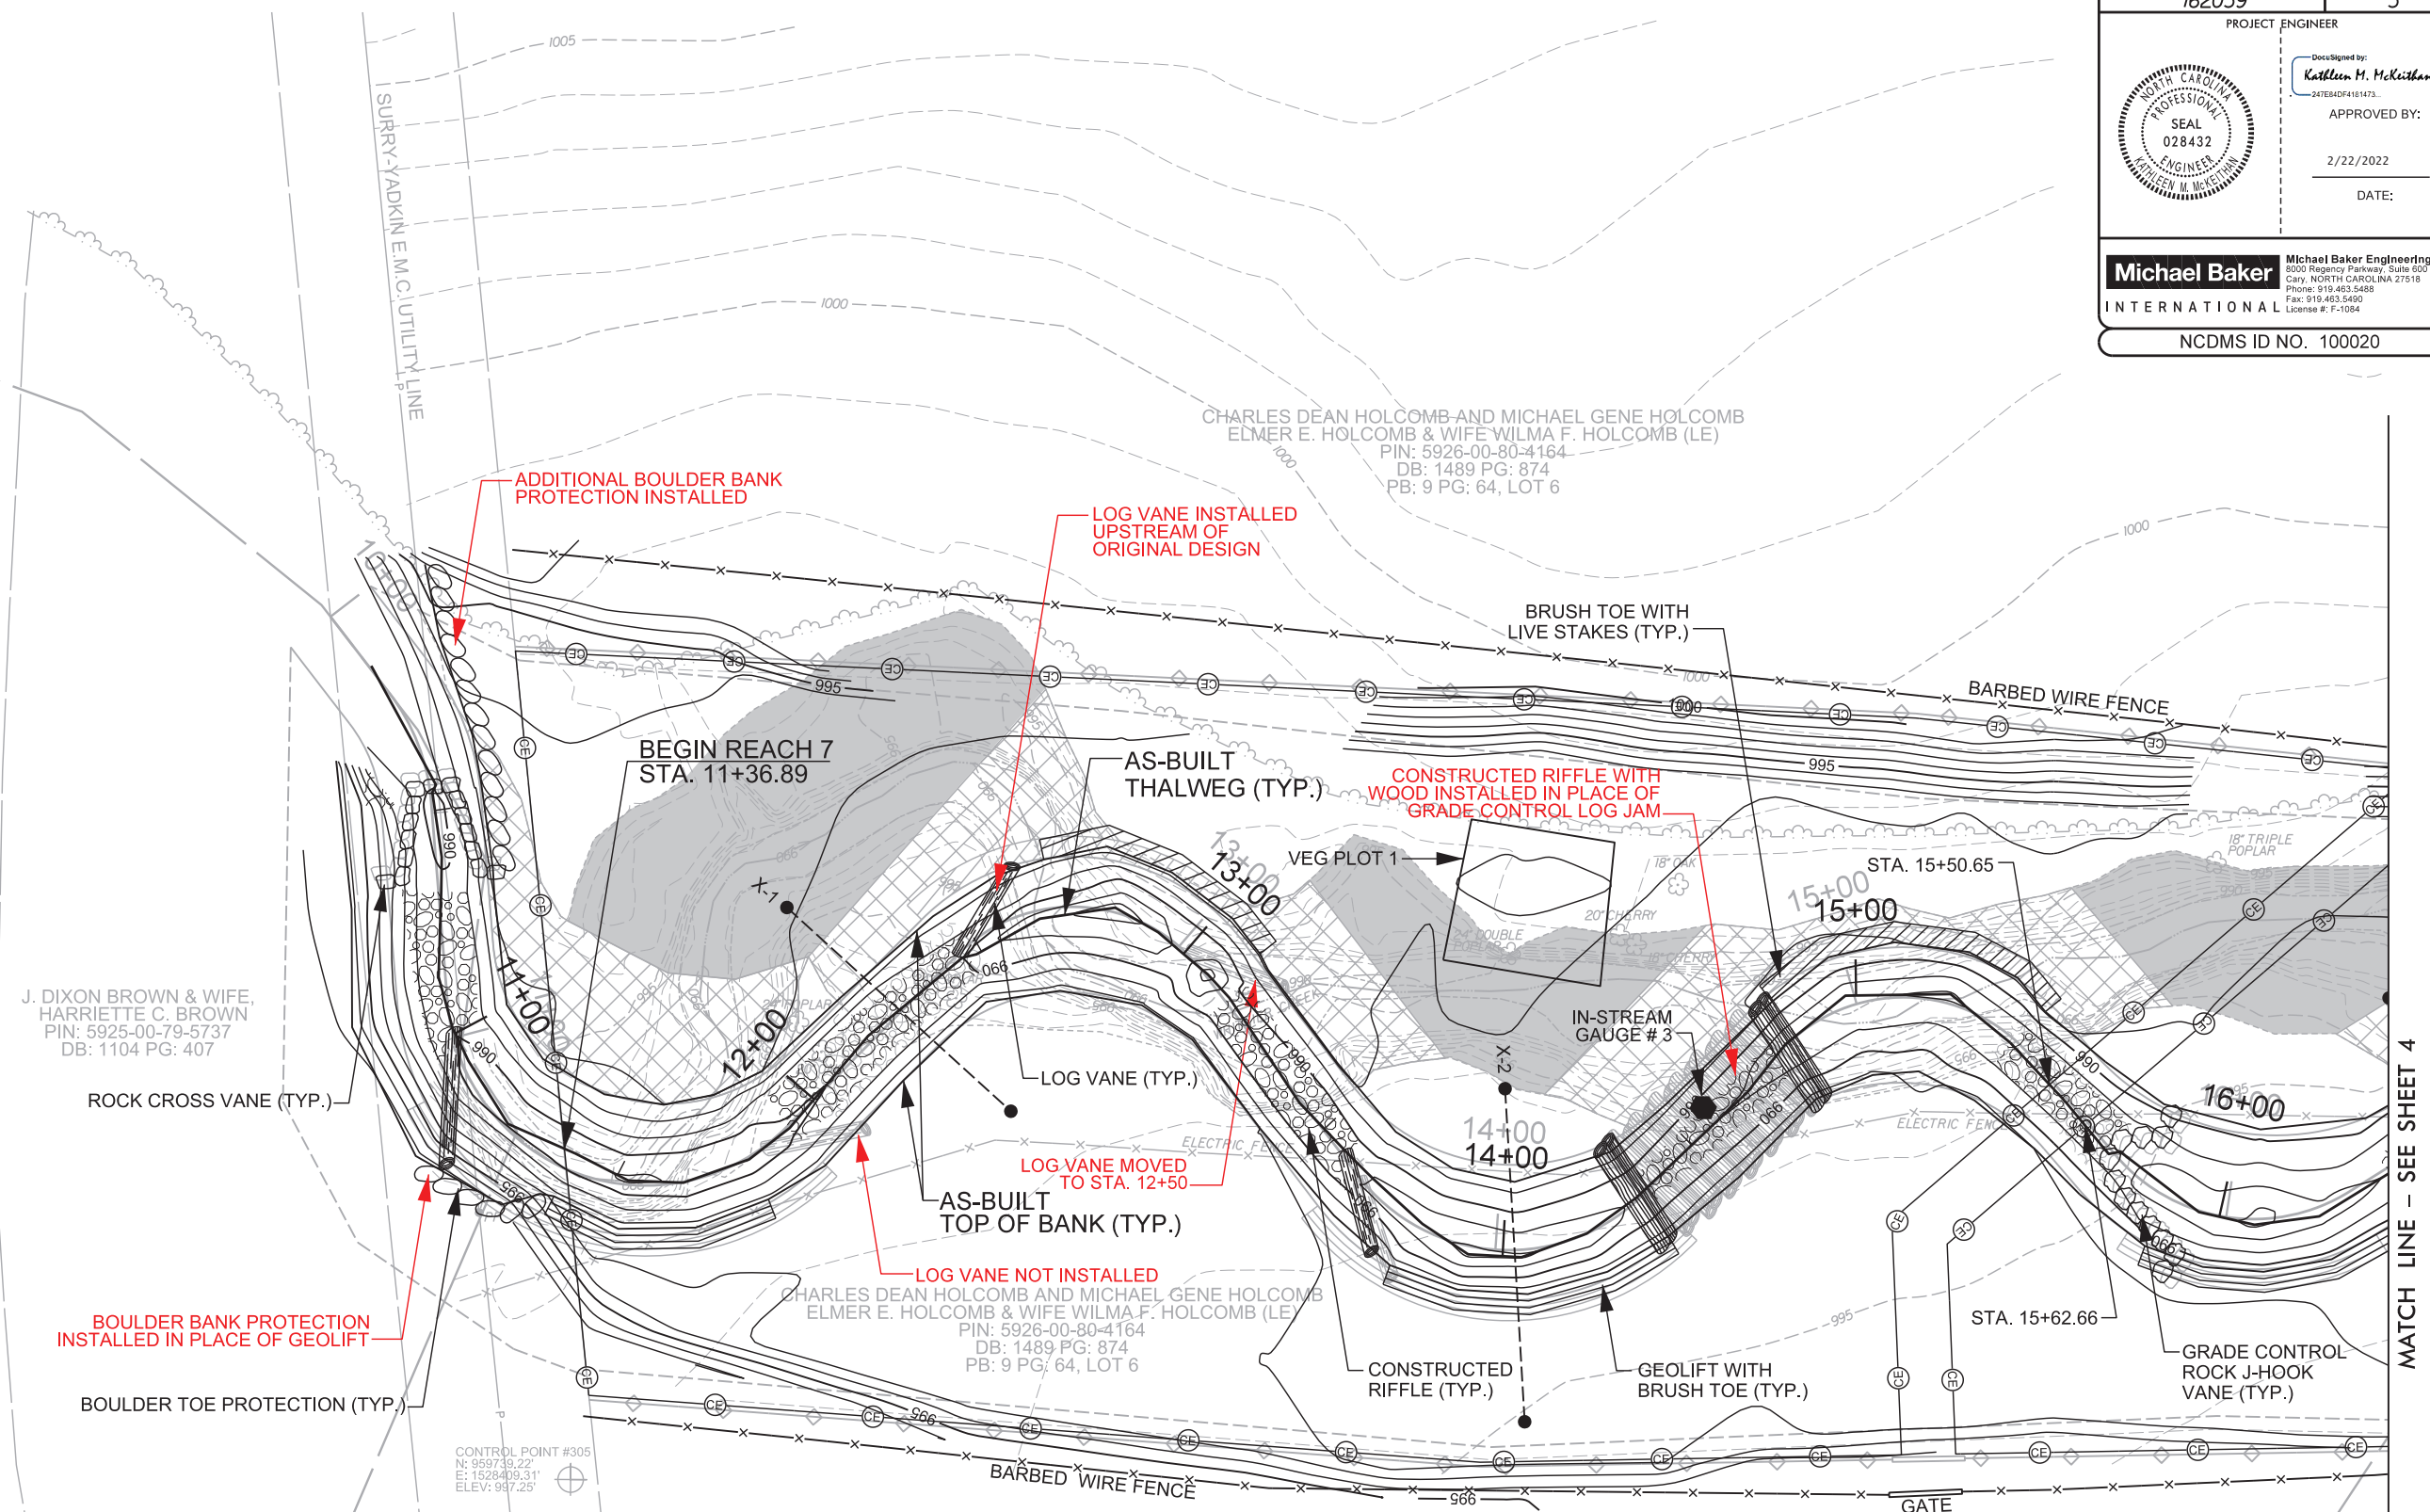

J. DIXON BROWN & WIFE,  
HARRIETTE C. BROWN  
PIN: 5925-00-79-5737  
DB: 1104 PG: 407

CHARLES DEAN HOLCOMB AND MICHAEL GENE HOLCOMB  
ELMER E. HOLCOMB & WIFE WILMA F. HOLCOMB (LE)  
PIN: 5926-00-80-4164  
DB: 1489 PG: 874  
PB: 9 PG: 64, LOT 6

CHARLES DEAN HOLCOMB AND MICHAEL GENE HOLCOMB  
ELMER E. HOLCOMB & WIFE WILMA F. HOLCOMB (LE)  
PIN: 5926-00-80-4164  
DB: 1489 PG: 874  
PB: 9 PG: 64, LOT 6


CONTROL POINT #305  
N: 959739.22'  
E: 1528409.31'  
ELEV: 997.25'

**AS-BUILT LEGEND**

- PROPOSED DESIGN
- - - AS-BUILT SURVEY BY  
KEE MAPPING & SURVEYING  
10/20/21 & 2/17/22
- RED LINE VARIATIONS FROM  
ORIGINAL DESIGN SEALED BY  
KATHLEEN M. MCKEITHAN, PE

- FILL EXISTING CHANNEL
- CHANNEL PLUG


**WHITTIER CREEK  
AS-BUILT PLAN VIEW**



SCALE (FT)


R:\162039\Whittier\_Creek\_Design\As-Built\Plans\162039\_ASB-PSH-03.dgn



MATCH LINE - SEE SHEET 4

BAKER PROJECT REFERENCE NO. <b>162039</b>	SHEET NO. <b>4</b>
PROJECT ENGINEER <b>Kathleen M. McKeithan</b> 247EADDF4181473	
APPROVED BY:  2/22/2022	
DATE:	
	
<b>Michael Baker International</b> Michael Baker Engineering Inc. 5020 Regency Parkway, Suite 500 Cary, NORTH CAROLINA 27518 Phone: 919.453.5488 Fax: 919.453.5490 License #: F-1084	
NCDMS ID NO. 100020	

**AS-BUILT LEGEND**

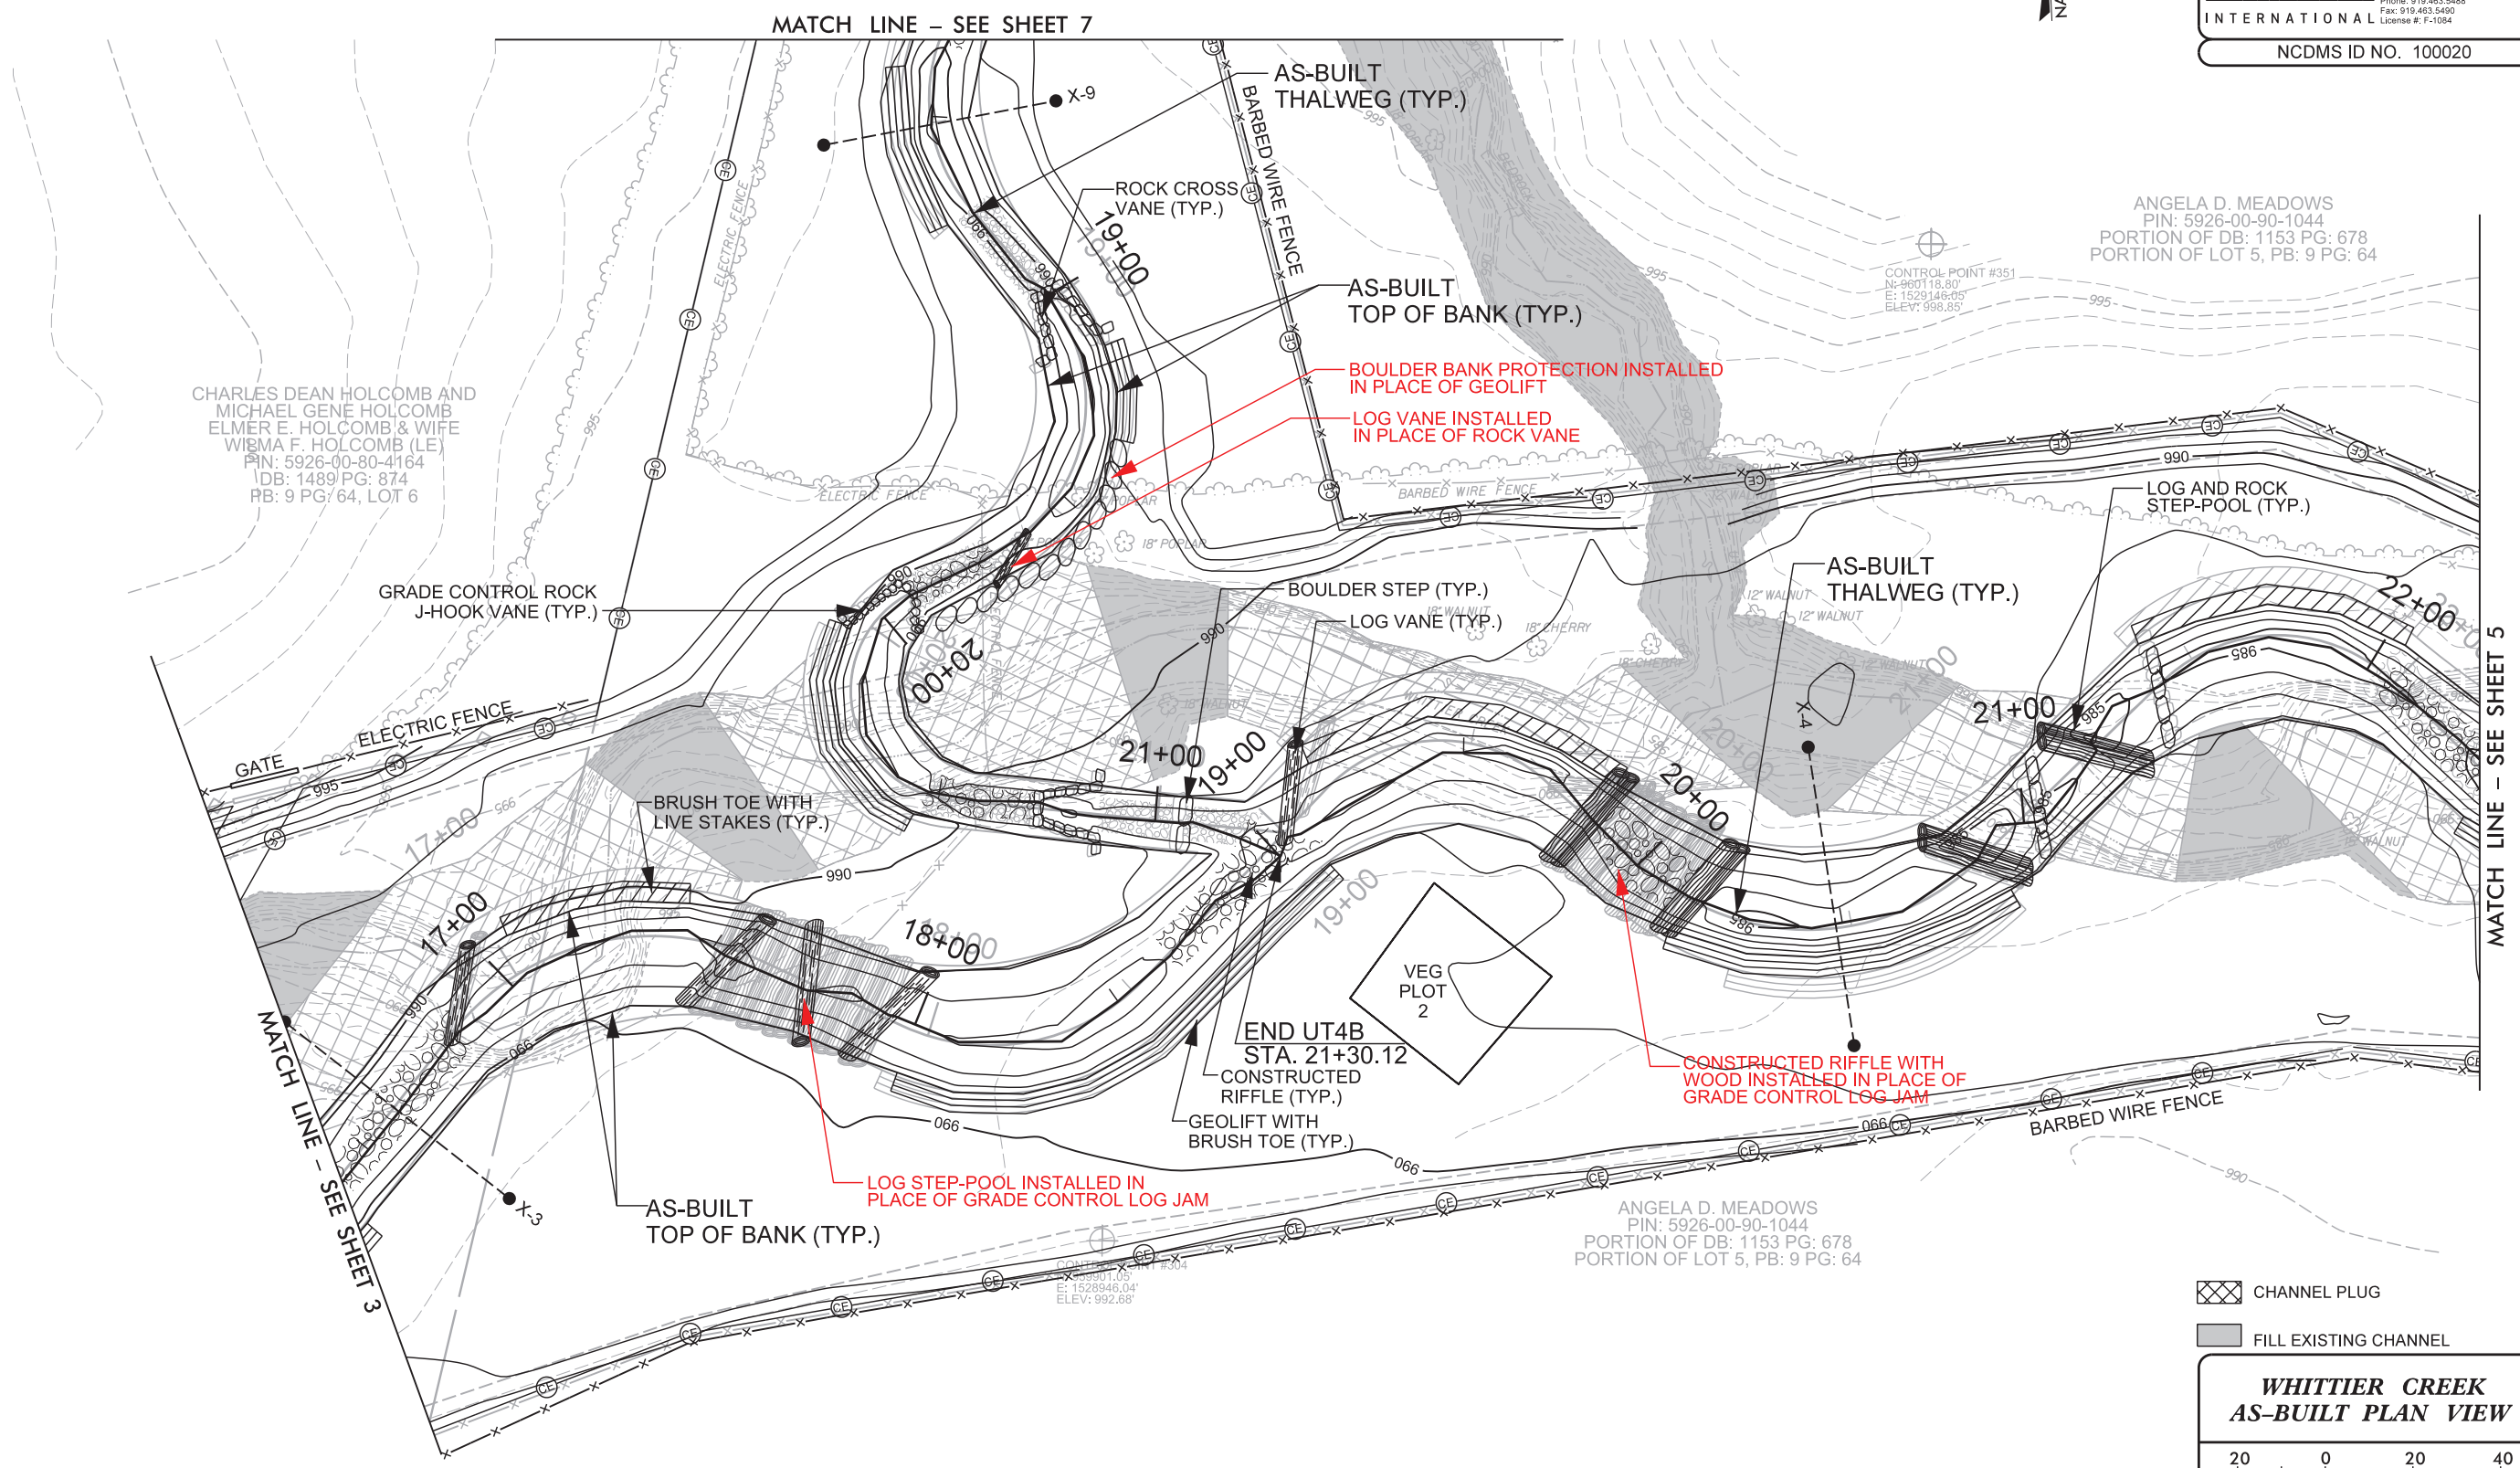- PROPOSED DESIGN
- AS-BUILT SURVEY BY KEE MAPPING & SURVEYING 10/20/21 & 2/17/22
- RED LINE VARIATIONS FROM ORIGINAL DESIGN SEALED BY KATHLEEN M. McKEITHAN, PE



 CHANNEL PLUG  
 FILL EXISTING CHANNEL

**WHITTIER CREEK AS-BUILT PLAN VIEW**

20 0 20 40  
SCALE (FT)


2/26/2023

BAKER PROJECT REFERENCE NO. <b>162039</b>	SHEET NO. <b>5</b>
PROJECT ENGINEER	
	
Approved by: <u>Kathleen M. McKeithan</u> <small>247EMDF4161473</small> APPROVED BY: _____ DATE: <u>2/22/2022</u> DATE: _____	
<b>Michael Baker International</b>	
<small>Michael Baker Engineering Inc.          5030 Regency Parkway, Suite 500          Cary, NORTH CAROLINA 27518          Phone: 919.453.5488          Fax: 919.453.5490          License #: F-1084</small>	
NCDMS ID NO. 100020	



**AS-BUILT LEGEND**

- PROPOSED DESIGN
- AS-BUILT SURVEY BY KEE MAPPING & SURVEYING 10/20/21 & 2/17/22
- RED LINE VARIATIONS FROM ORIGINAL DESIGN SEALED BY KATHLEEN M. MCKEITHAN, PE

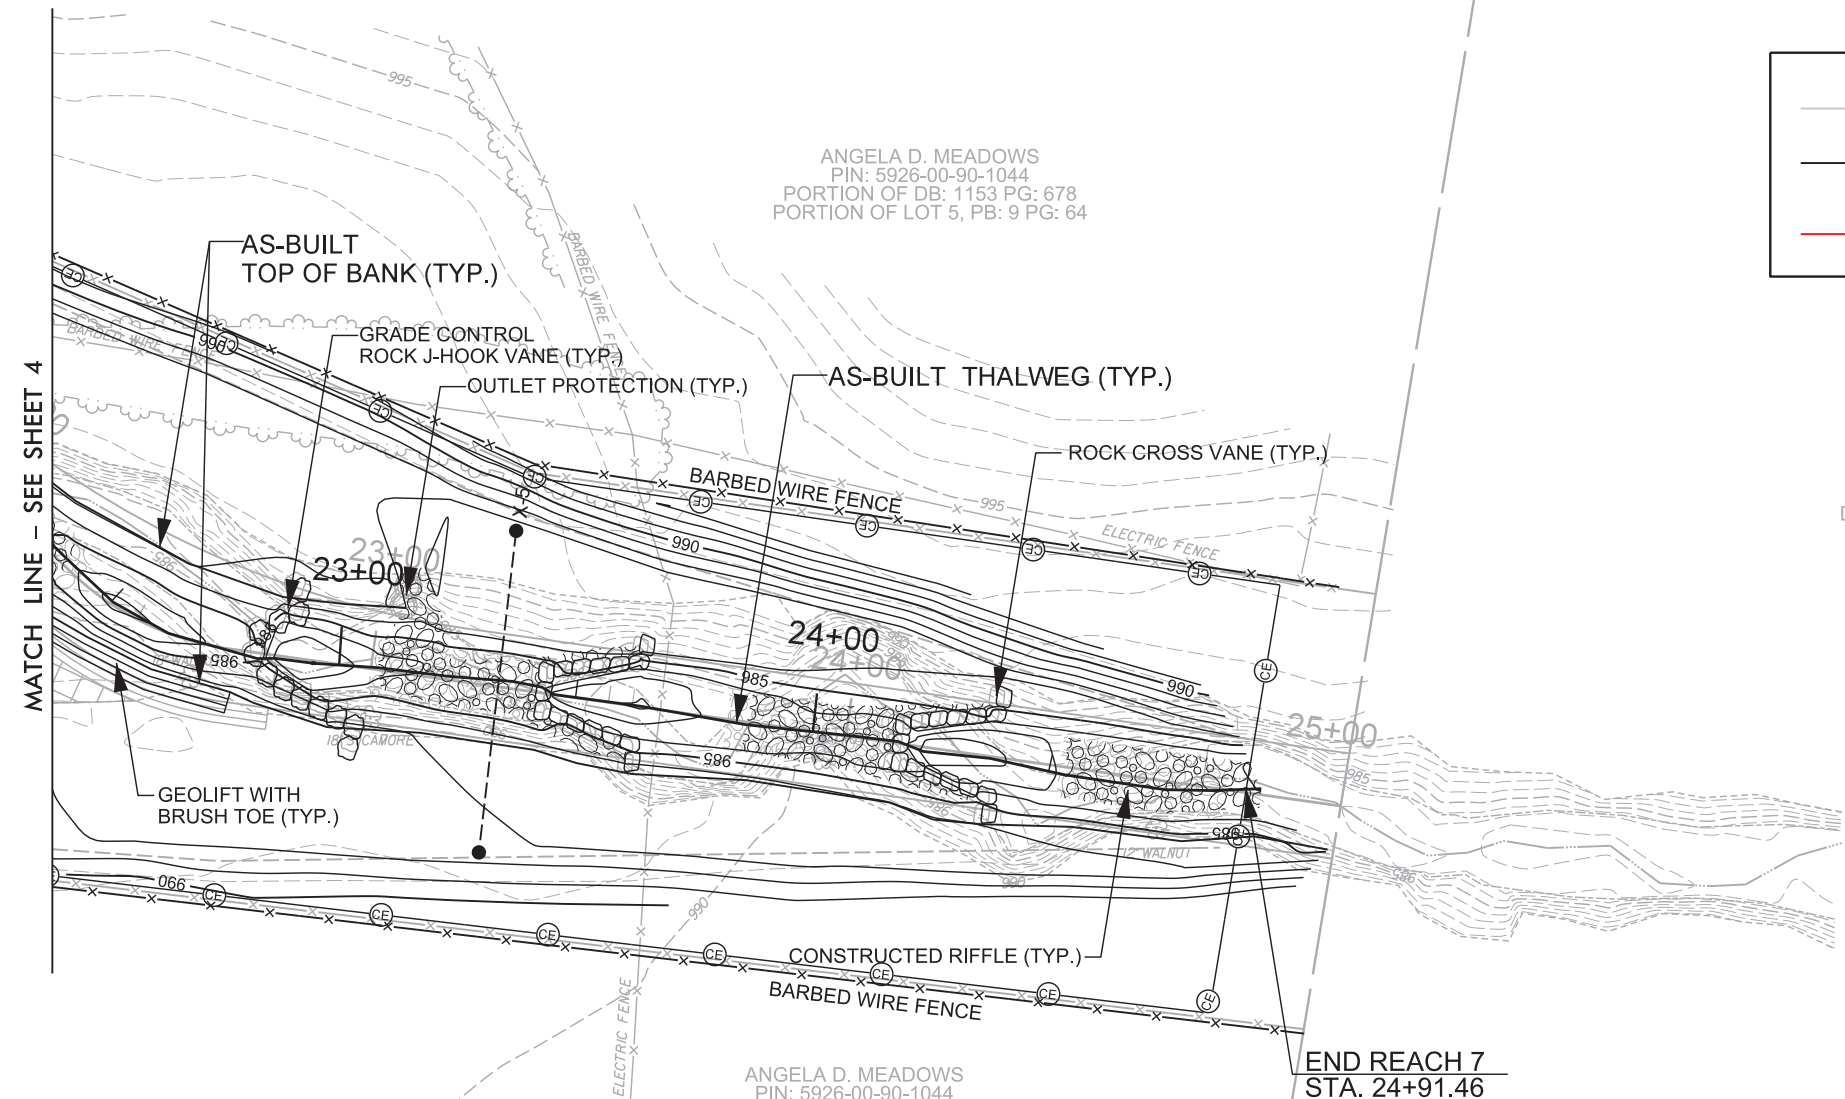



BEVERLY A. FULK  
 PIN: 5926-00-90-1044  
 DB: 1199 PG: 867, TRACT TWO  
 PB: 9 PG: 64, LOT 4 & LOT 1-B


CONTROL POINT #356  
 N: 959870.26'  
 E: 1529275.12'  
 ELEV: 990.34'

ANGELA D. MEADOWS  
 PIN: 5926-00-90-1044  
 PORTION OF DB: 1153 PG: 678  
 PORTION OF LOT 5, PB: 9 PG: 64

CONTROL POINT #357  
 N: 959857.42'  
 E: 1528946.04'  
 ELEV: 989.18'


-  FILL EXISTING CHANNEL
-  CHANNEL PLUG

**WHITTIER CREEK  
 AS-BUILT PLAN VIEW**




SCALE (FT)

R:\2023\Whittier-Creek-Design\As-Built\Plans\162039\_ASB-PSH-05.dgn  
 2/26/2023  
 Michael Baker International



BAKER PROJECT REFERENCE NO. <b>162039</b>	SHEET NO. <b>6</b>
PROJECT ENGINEER	
	
Approved By: <i>Kathleen M. McKeithan</i> 2/22/2022 DATE:	
<b>Michael Baker International</b>	
Michael Baker Engineering Inc. 5030 Regency Parkway, Suite 500 Cary, NORTH CAROLINA 27518 Phone: 919.453.5488 Fax: 919.453.5490 License #: F-1084	
NCDMS ID NO. 100020	

**AS-BUILT LEGEND**

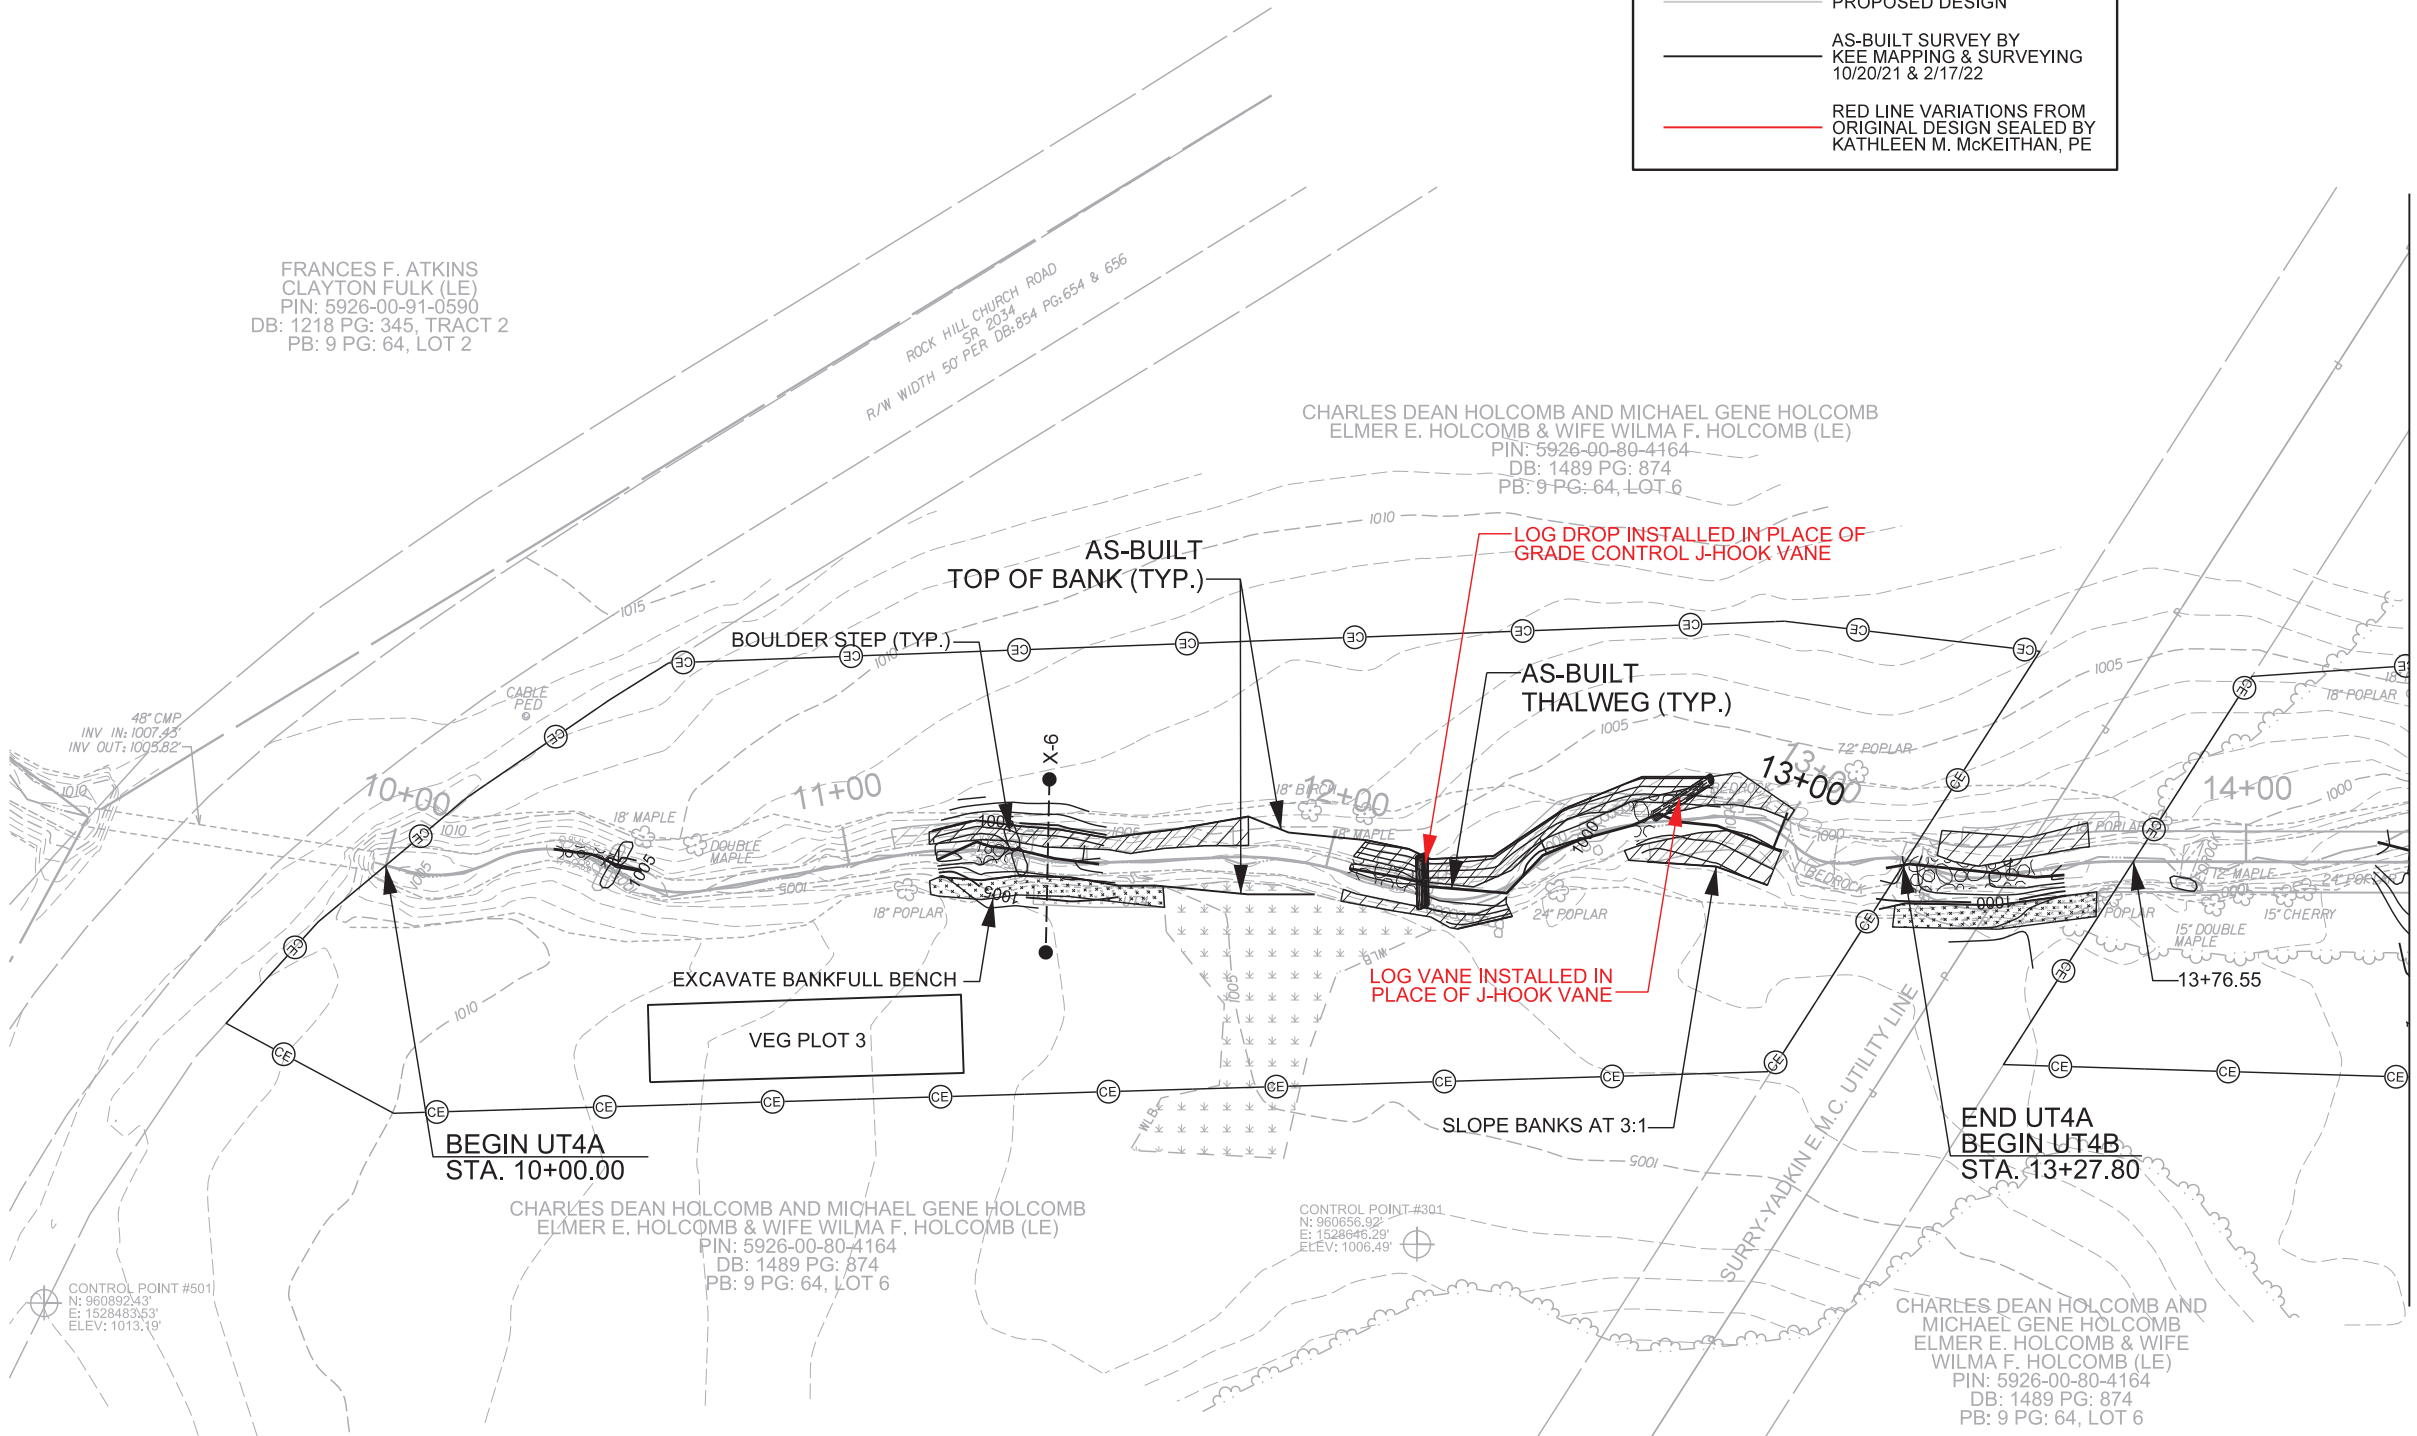
- PROPOSED DESIGN
- AS-BUILT SURVEY BY KEE MAPPING & SURVEYING 10/20/21 & 2/17/22
- RED LINE VARIATIONS FROM ORIGINAL DESIGN SEALED BY KATHLEEN M. McKEITHAN, PE



MATCH LINE - SEE SHEET 7


-  FILL EXISTING CHANNEL
-  CHANNEL PLUG



**WHITTIER CREEK  
AS-BUILT PLAN VIEW**



SCALE (FT)

R:\162039\Whittier\_Creek\_Design\As-Built\Plans\ASB-PSH-06.dgn

BAKER PROJECT REFERENCE NO. <b>162039</b>	SHEET NO. <b>7</b>
PROJECT ENGINEER	
DocuSigned by: <b>Kathleen M. McKeithan</b> <small>247E64DF4161473</small>	
APPROVED BY:	
2/22/2022	
DATE:	
	
<b>Michael Baker International</b> Michael Baker Engineering Inc. <small>5030 Regency Parkway, Suite 500          Cary, NORTH CAROLINA 27518          Phone: 919.453.5488          Fax: 919.453.5490          License #: F-1084</small>	
NCDMS ID NO. 100020	

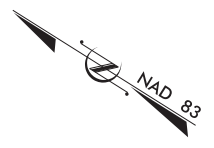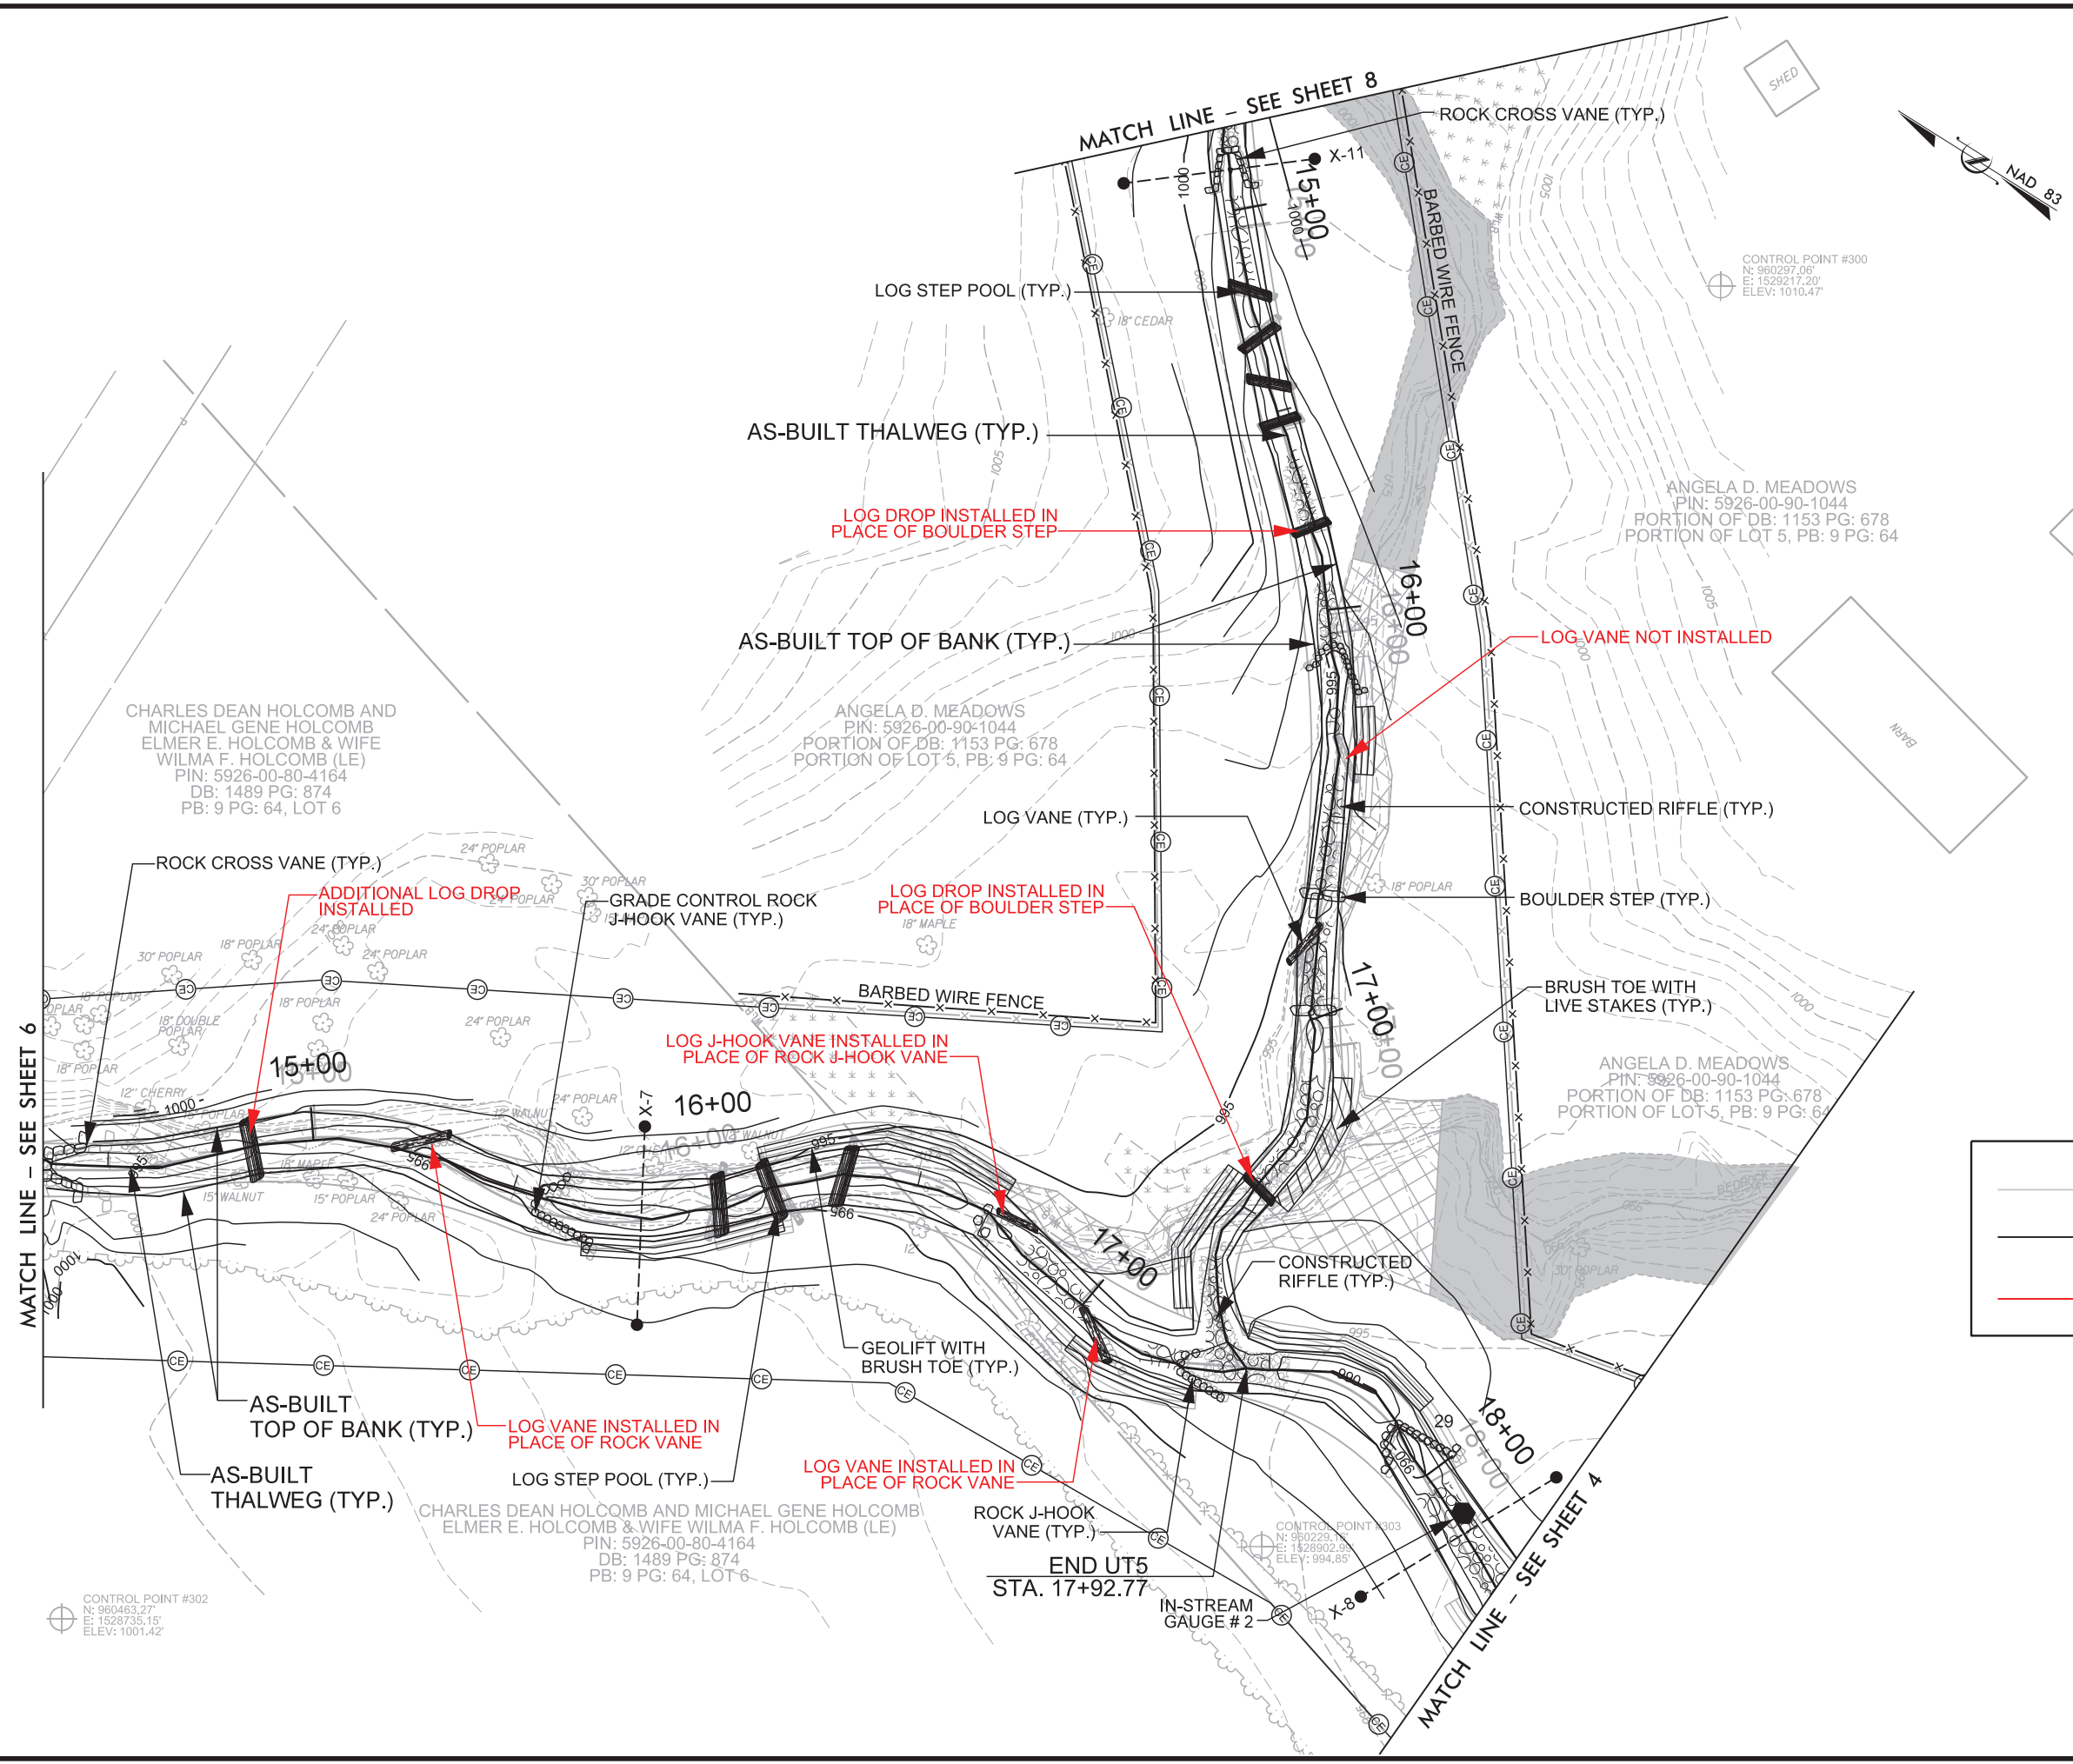

**AS-BUILT LEGEND**

- PROPOSED DESIGN
- AS-BUILT SURVEY BY KEE MAPPING & SURVEYING 10/20/21 & 2/17/22
- RED LINE VARIATIONS FROM ORIGINAL DESIGN SEALED BY KATHLEEN M. McKEITHAN, PE

- FILL EXISTING CHANNEL
- CHANNEL PLUG

**WHITTIER CREEK AS-BUILT PLAN VIEW**

SCALE (FT)

R:\2023\Whittier-Creek-Design\As-Built\Plans\162039\_ASB-PSH-07.dgn

CONTROL POINT #302  
 N: 960483.27  
 E: 1528735.15  
 ELEV: 1001.42'

CONTROL POINT #303  
 N: 930223.91  
 E: 1528902.92  
 ELEV: 994.85'

CHARLES DEAN HOLCOMB AND MICHAEL GENE HOLCOMB  
 ELMER E. HOLCOMB & WIFE WILMA F. HOLCOMB (LE)  
 PIN: 5926-00-80-4164  
 DB: 1489 PG: 874  
 PB: 9 PG: 64, LOT 6

ANGELA D. MEADOWS  
 PIN: 5926-00-90-1044  
 PORTION OF DB: 1153 PG: 678  
 PORTION OF LOT 5, PB: 9 PG: 64


ANGELA D. MEADOWS  
 PIN: 5926-00-90-1044  
 PORTION OF DB: 1153 PG: 678  
 PORTION OF LOT 5, PB: 9 PG: 64


CHARLES DEAN HOLCOMB AND  
 MICHAEL GENE HOLCOMB  
 ELMER E. HOLCOMB & WIFE  
 WILMA F. HOLCOMB (LE)  
 PIN: 5926-00-80-4164  
 DB: 1489 PG: 874  
 PB: 9 PG: 64, LOT 6

END UT5  
 STA. 17+92.77

IN-STREAM  
 GAUGE # 2

2/26/2023

BAKER PROJECT REFERENCE NO. <b>162039</b>	SHEET NO. <b>8</b>
PROJECT ENGINEER ANGELA D. MEADOWS PIN: 5926-00-90-5577 DB: 1332 PG: 199 PB: 24 PG: 57 PORTION OF LOT 5, PB: 9 PG: 64	
	DocuSigned by: <b>Kathleen M. McKeithan</b> 247E80F4F181473
	APPROVED BY:  2/22/2022
	DATE:
<b>Michael Baker International</b> Michael Baker Engineering Inc. 5000 Regency Parkway, Suite 500 Cary, NORTH CAROLINA 27518 Phone: 919.453.5488 Fax: 919.453.5490 License #: F-1084	
NCDMS ID NO. 100020	

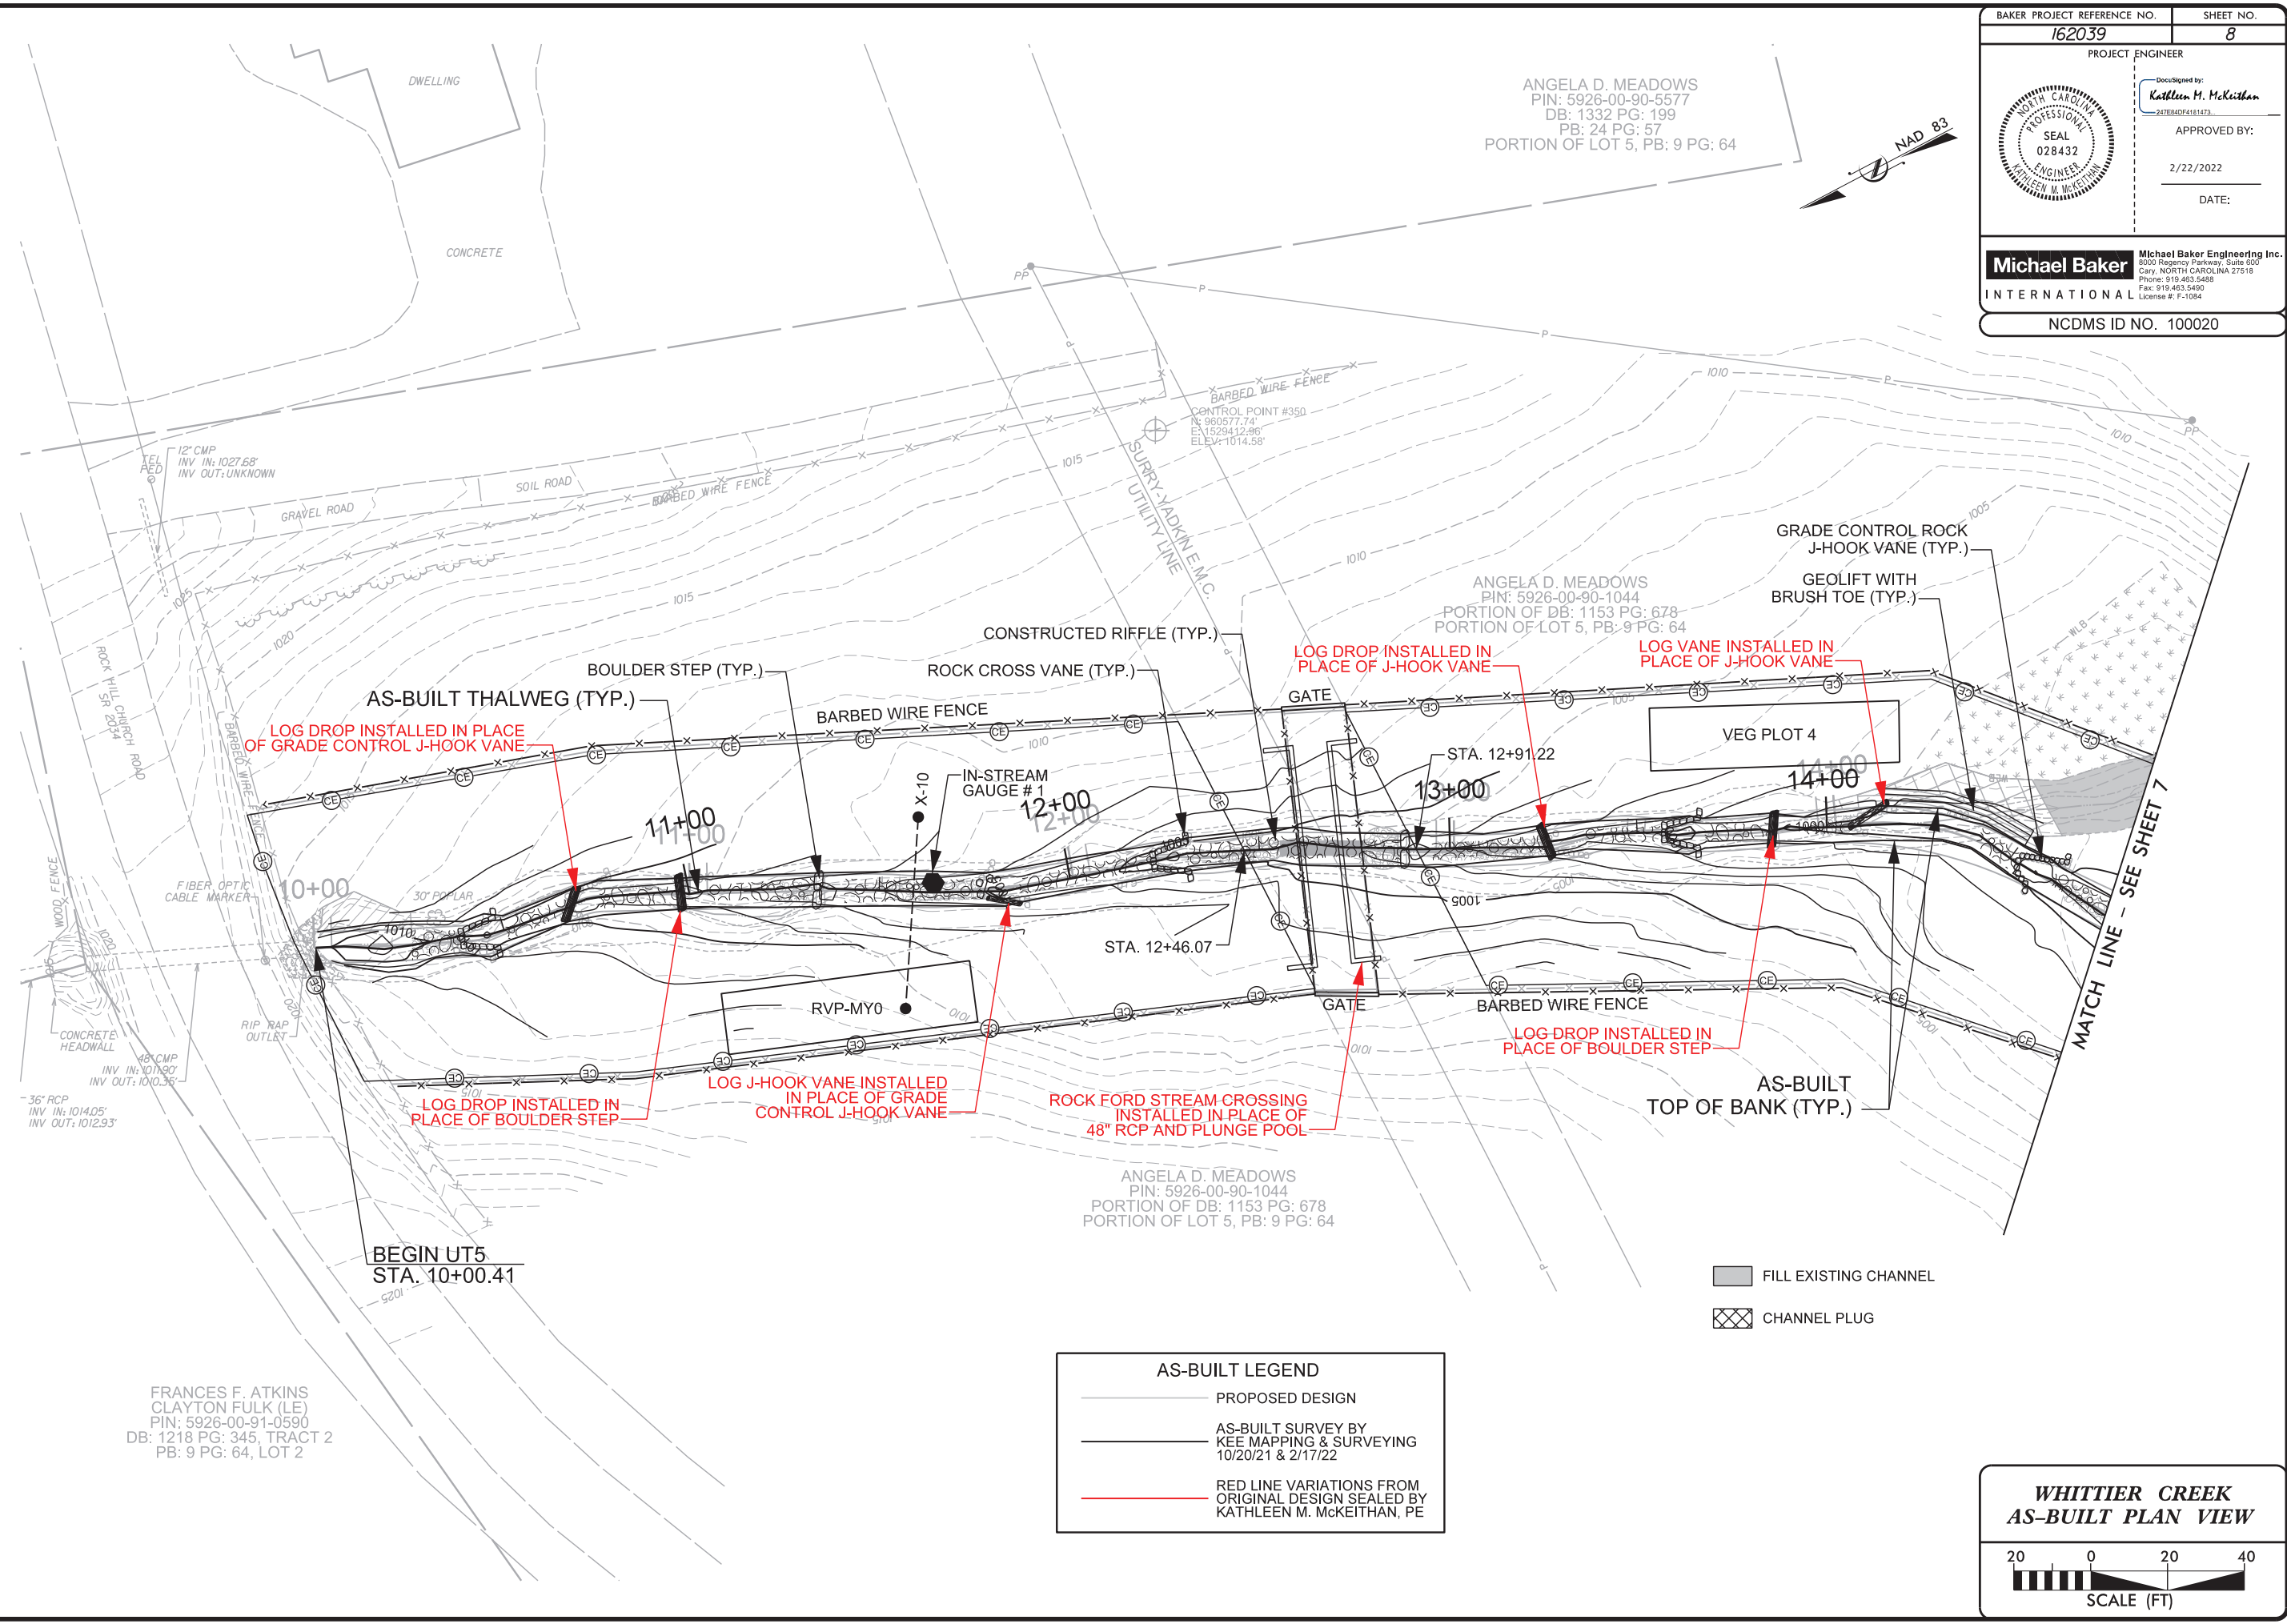


R:\162039\Whittier-Creek-Design\As-Built\Plans\162039\_ASB-PSH-08.dgn

FRANCES F. ATKINS  
 CLAYTON FULK (LE)  
 PIN: 5926-00-91-0590  
 DB: 1218 PG: 345, TRACT 2  
 PB: 9 PG: 64, LOT 2

AS-BUILT LEGEND	
	PROPOSED DESIGN
	AS-BUILT SURVEY BY KEE MAPPING & SURVEYING 10/20/21 & 2/17/22
	RED LINE VARIATIONS FROM ORIGINAL DESIGN SEALED BY KATHLEEN M. MCKEITHAN, PE

	FILL EXISTING CHANNEL
	CHANNEL PLUG


**WHITTIER CREEK  
AS-BUILT PLAN VIEW**






SCALE (FT)




2/26/2023

BAKER PROJECT REFERENCE NO. 162039	SHEET NO. 9
PROJECT ENGINEER	
	
Approved by: <i>Kathleen M. McKeithan</i> APPROVED BY: _____ DATE: 2/22/2022	
<b>Michael Baker International</b> <small>Michael Baker Engineering Inc.          3000 Regency Parkway, Suite 500          Cary, NORTH CAROLINA 27518          Phone: 919.453.5488          Fax: 919.453.5490          License #: F-1084</small>	
NCDMS ID NO. 100020	

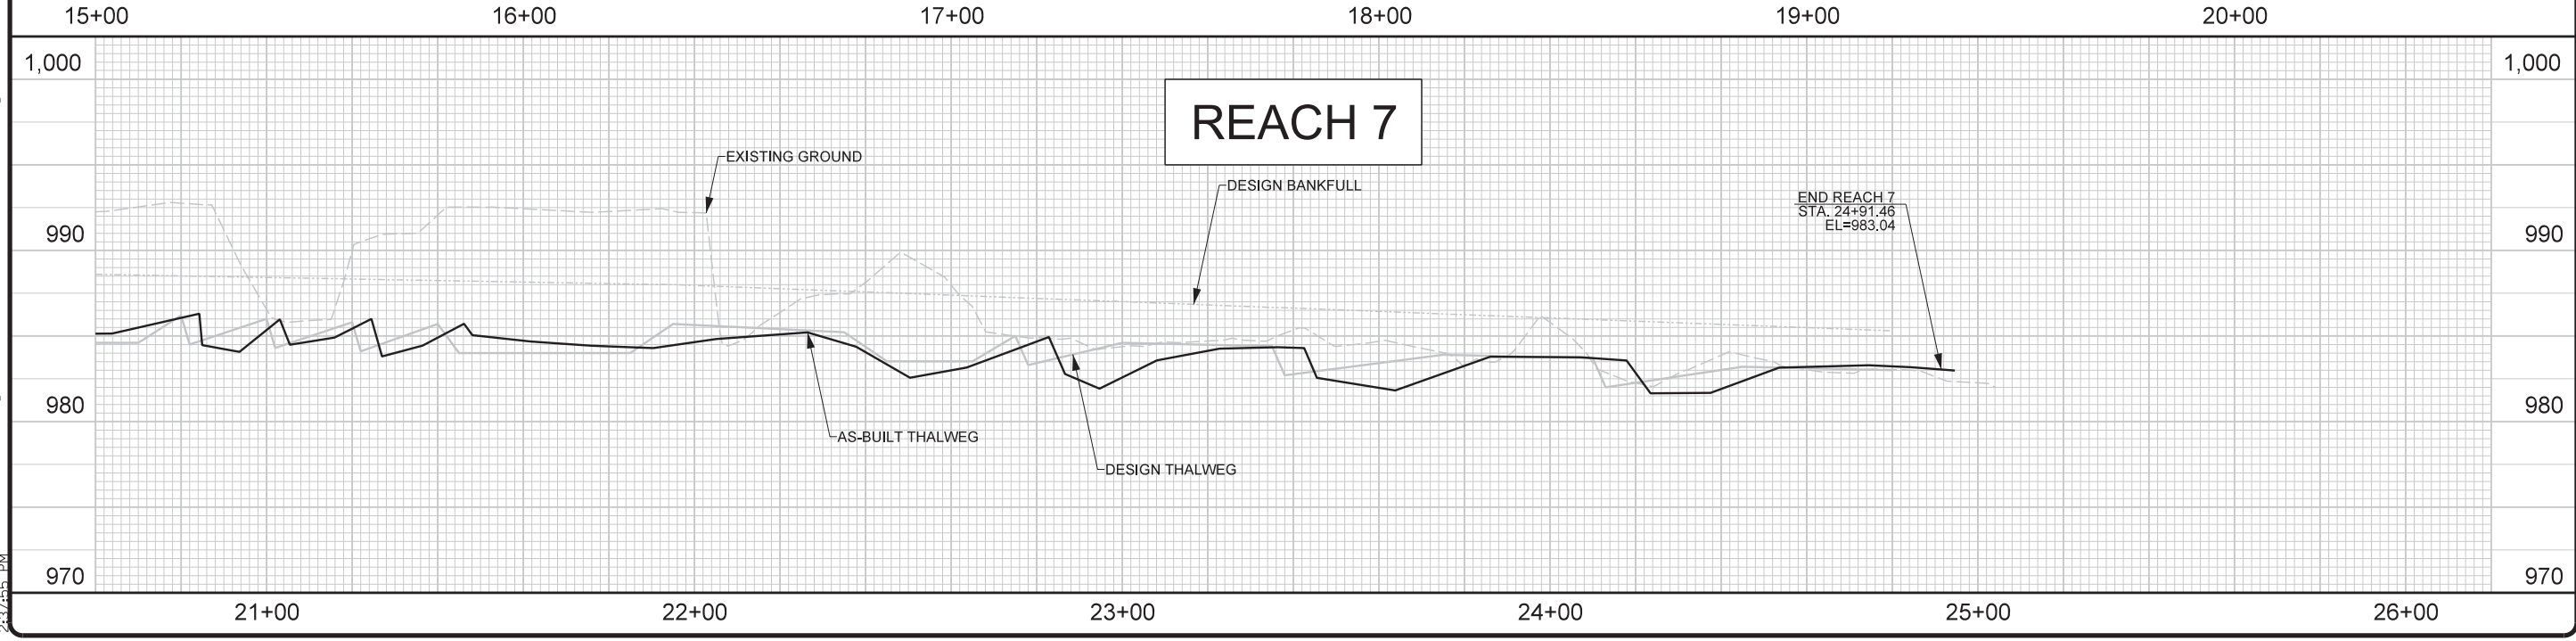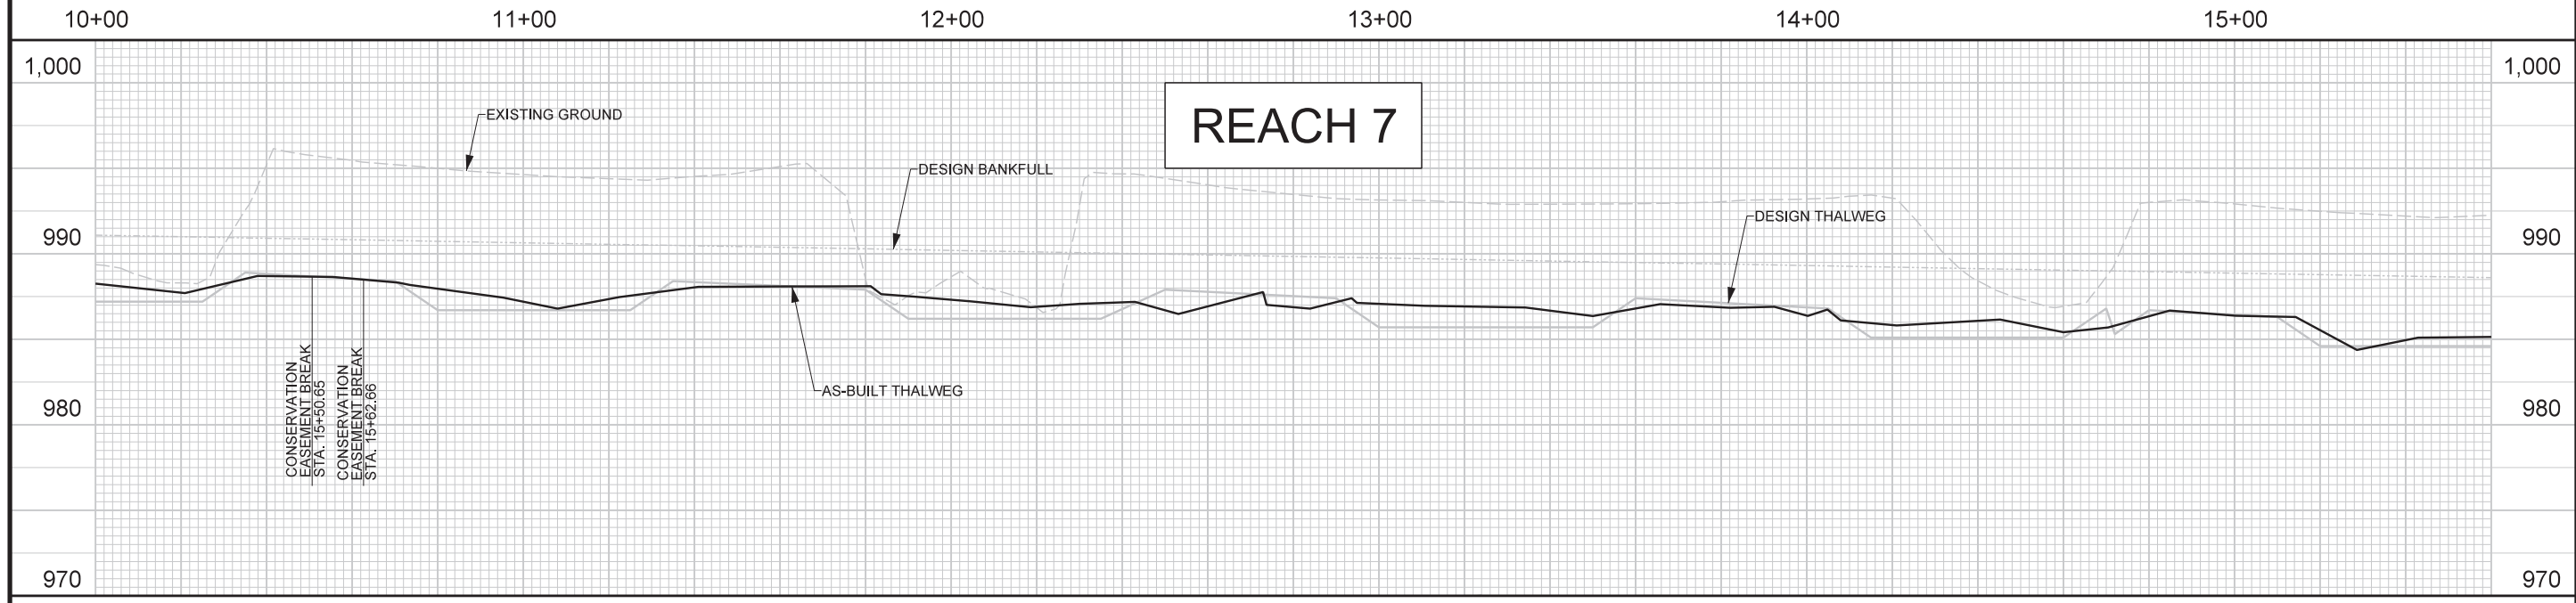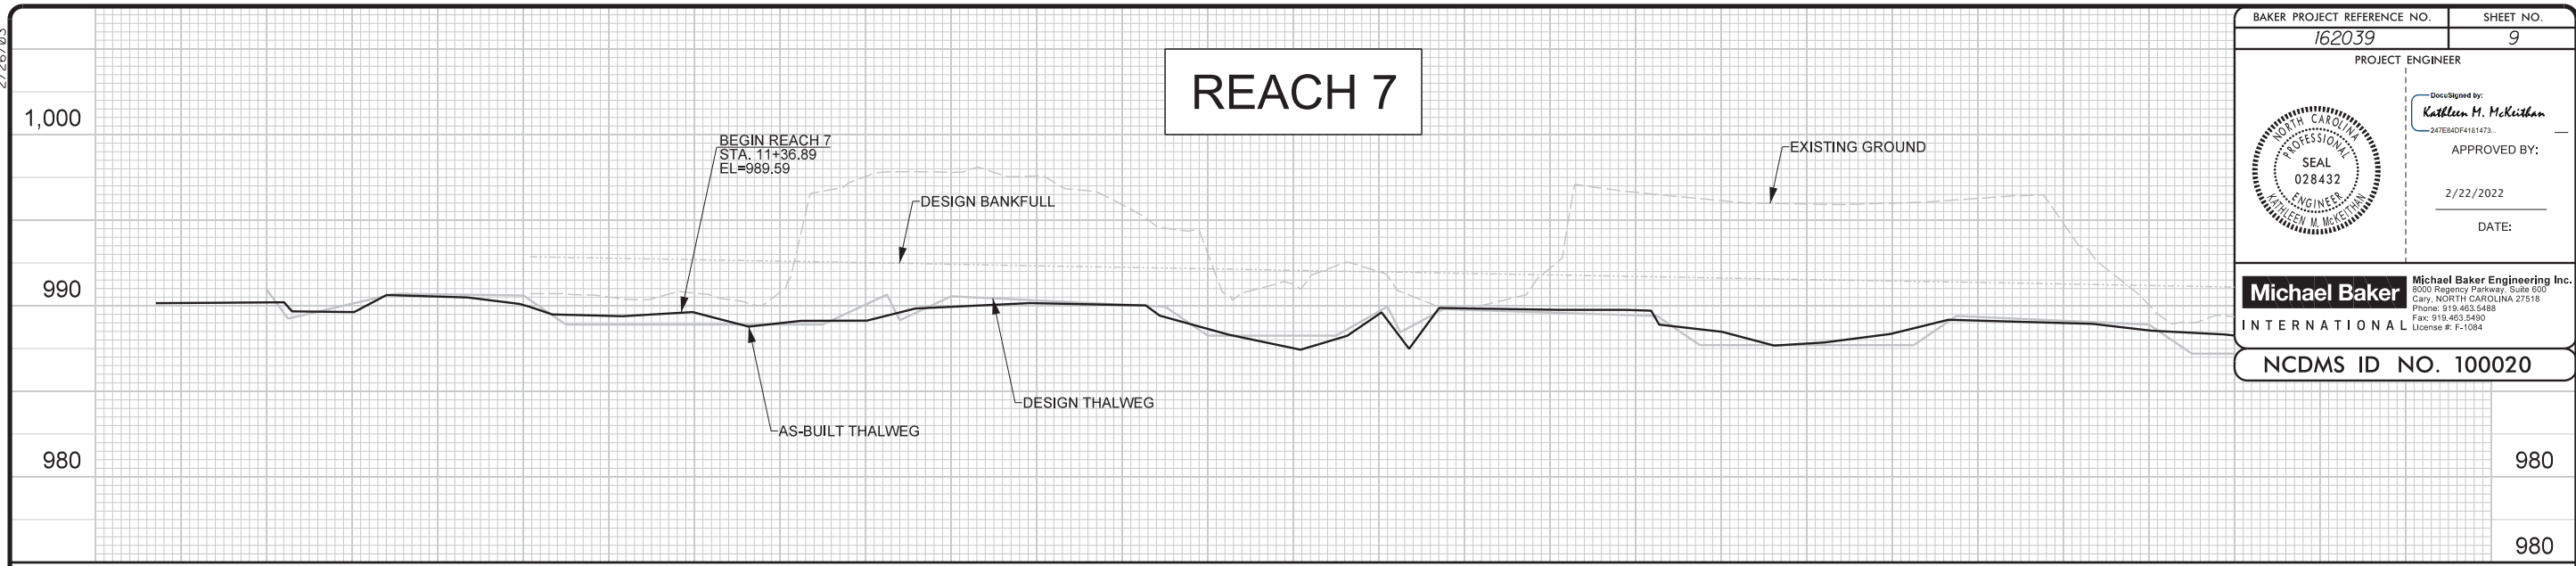


R:\162039\_Whittier\_Creek\Design\As-Built\Plans\162039\_ASB-PFL\_09.dgn


2/26/23

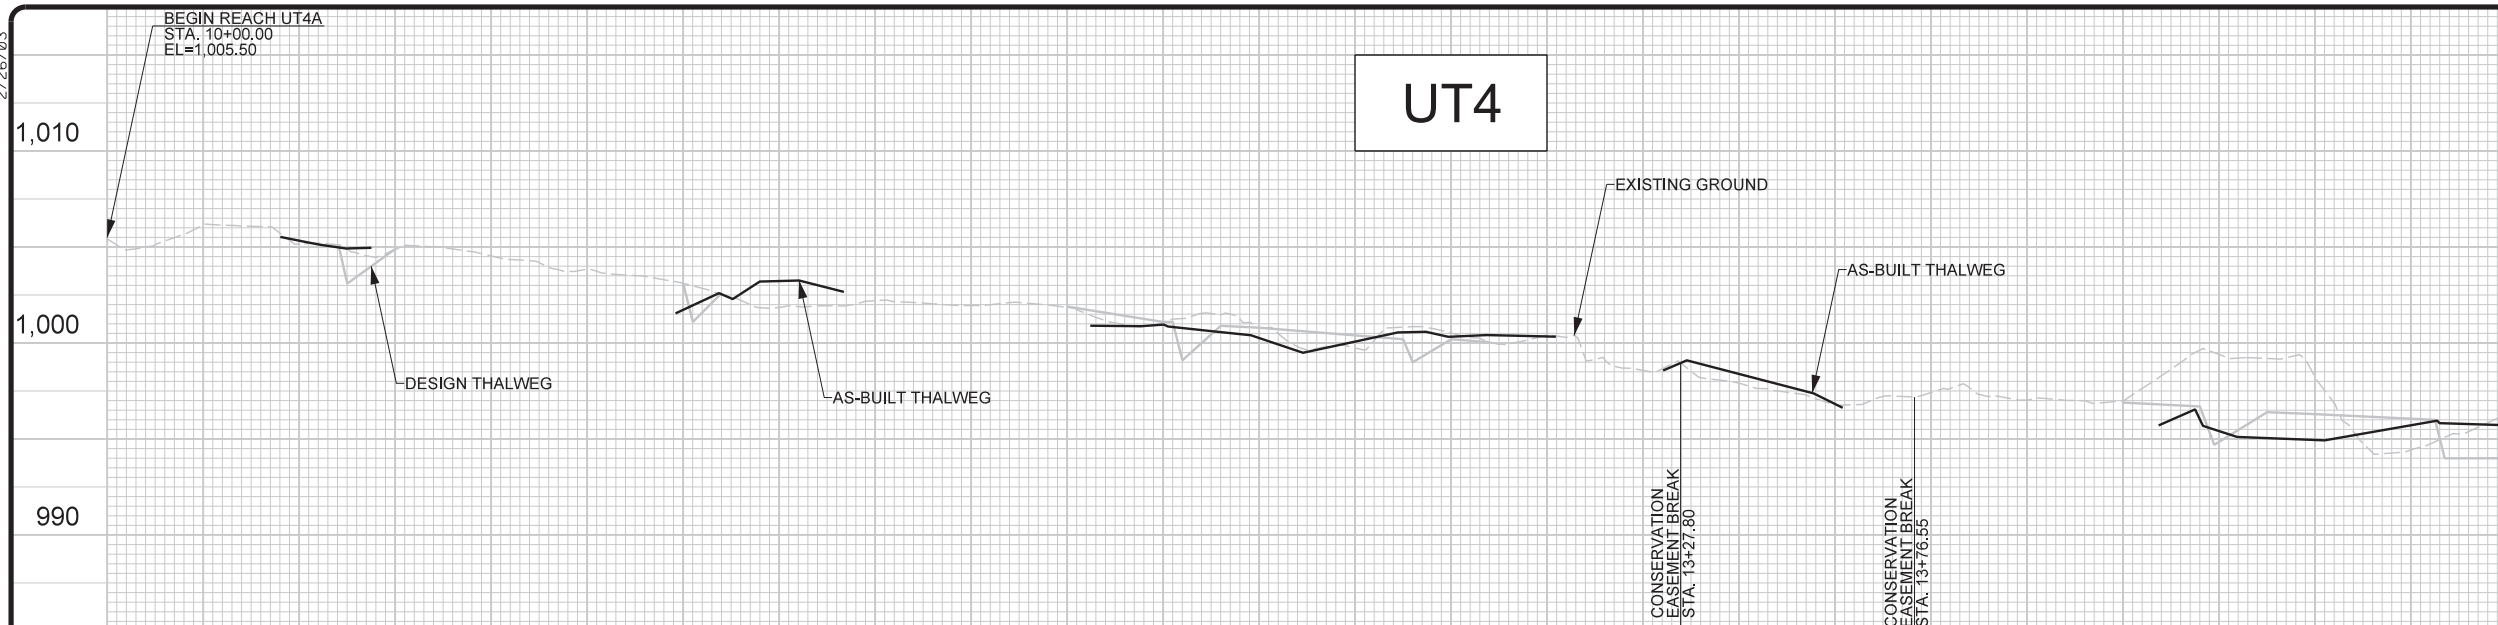

10+00 11+00 12+00 13+00 14+00 15+00

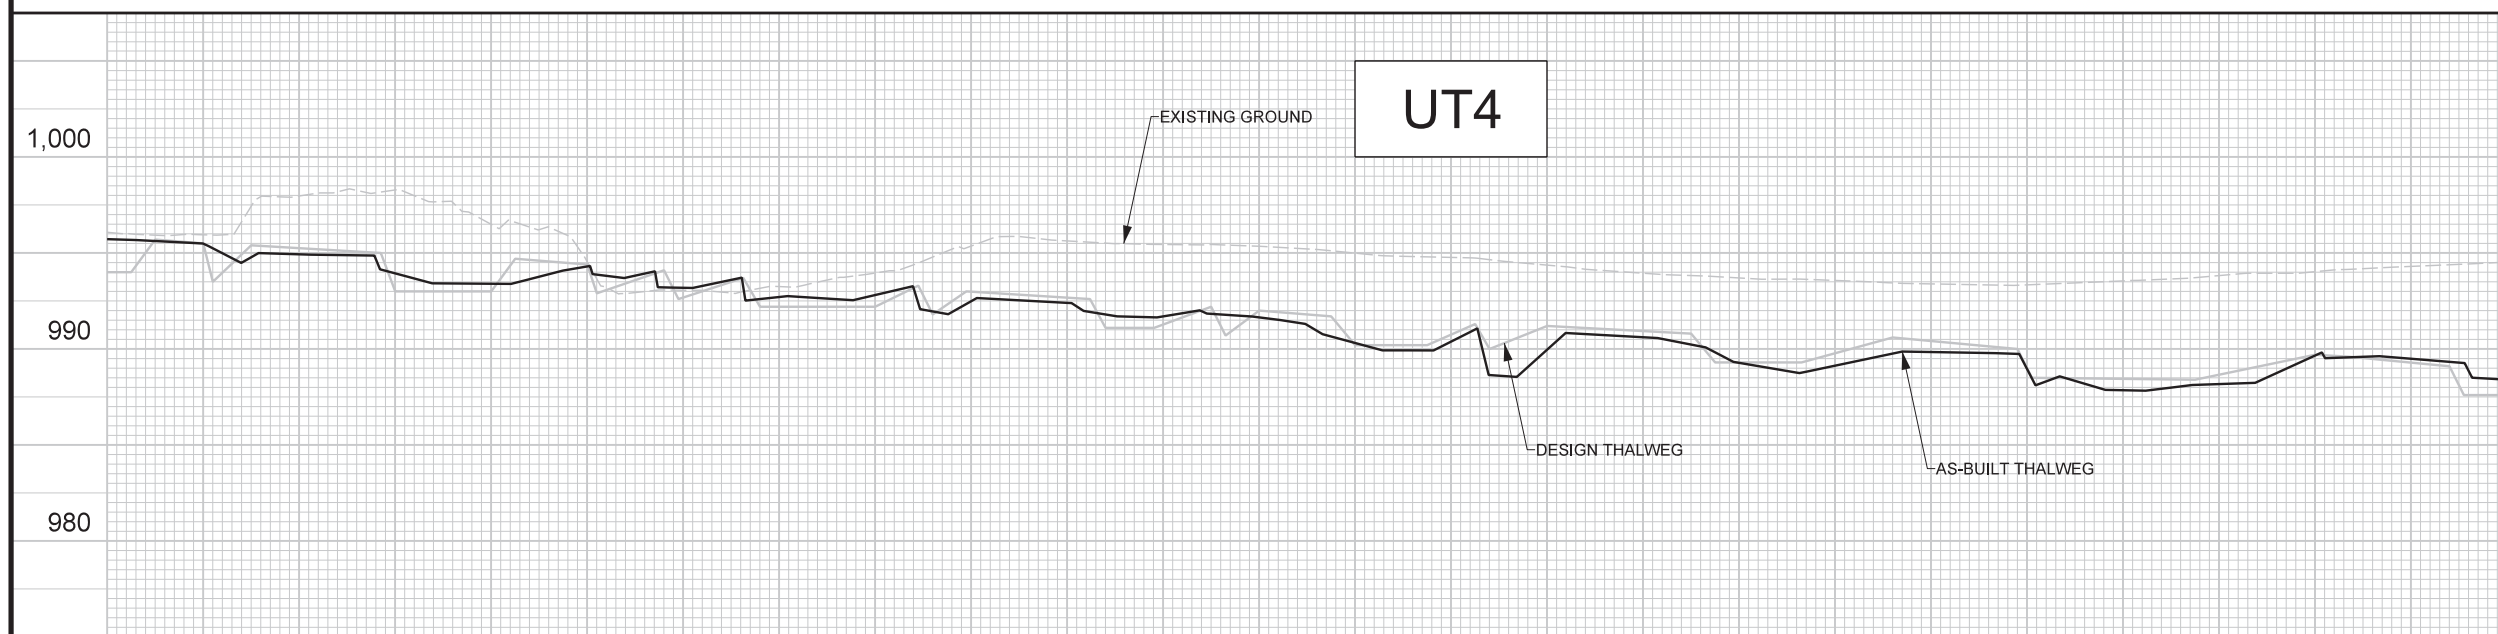

15+00 16+00 17+00 18+00 19+00 20+00

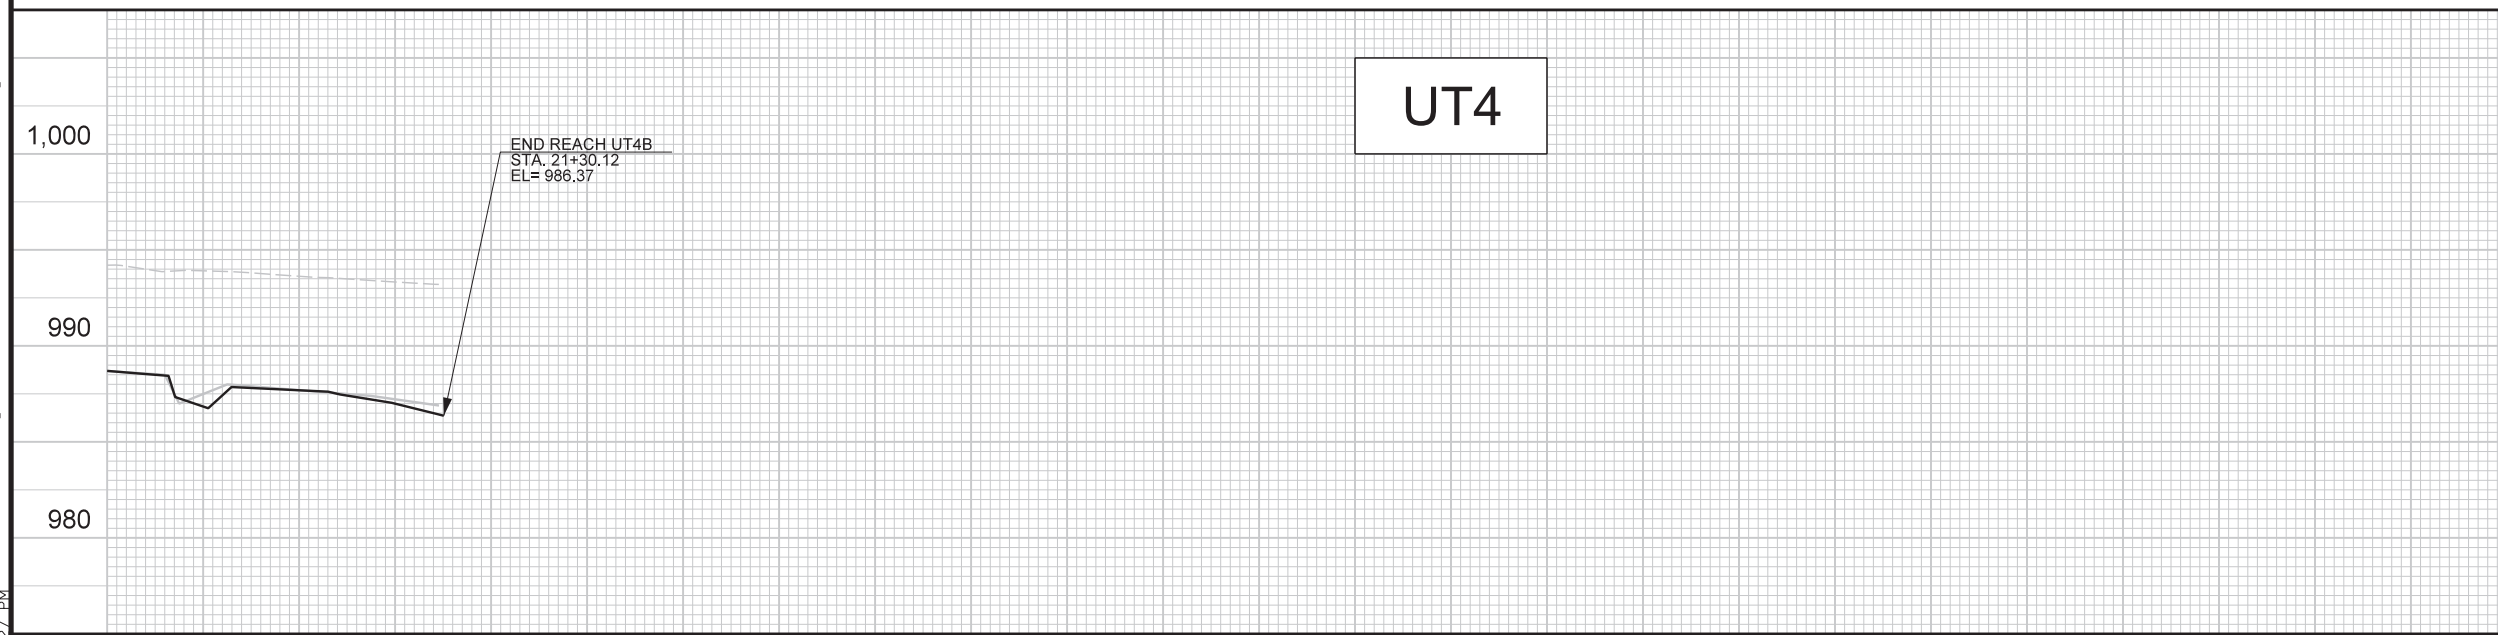


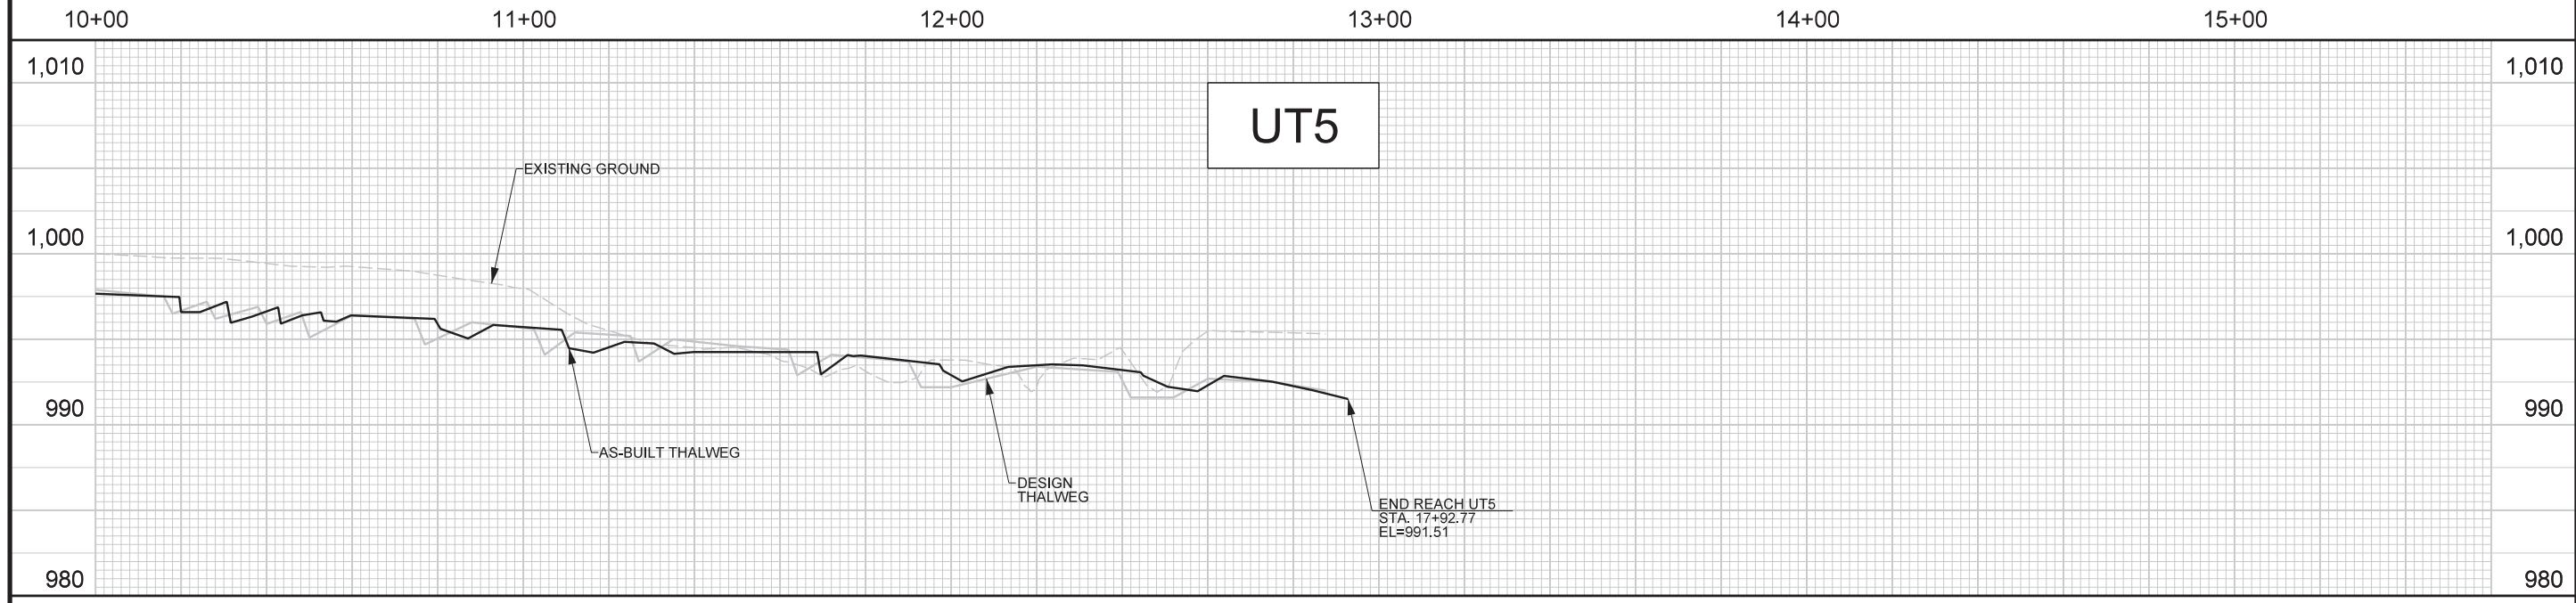
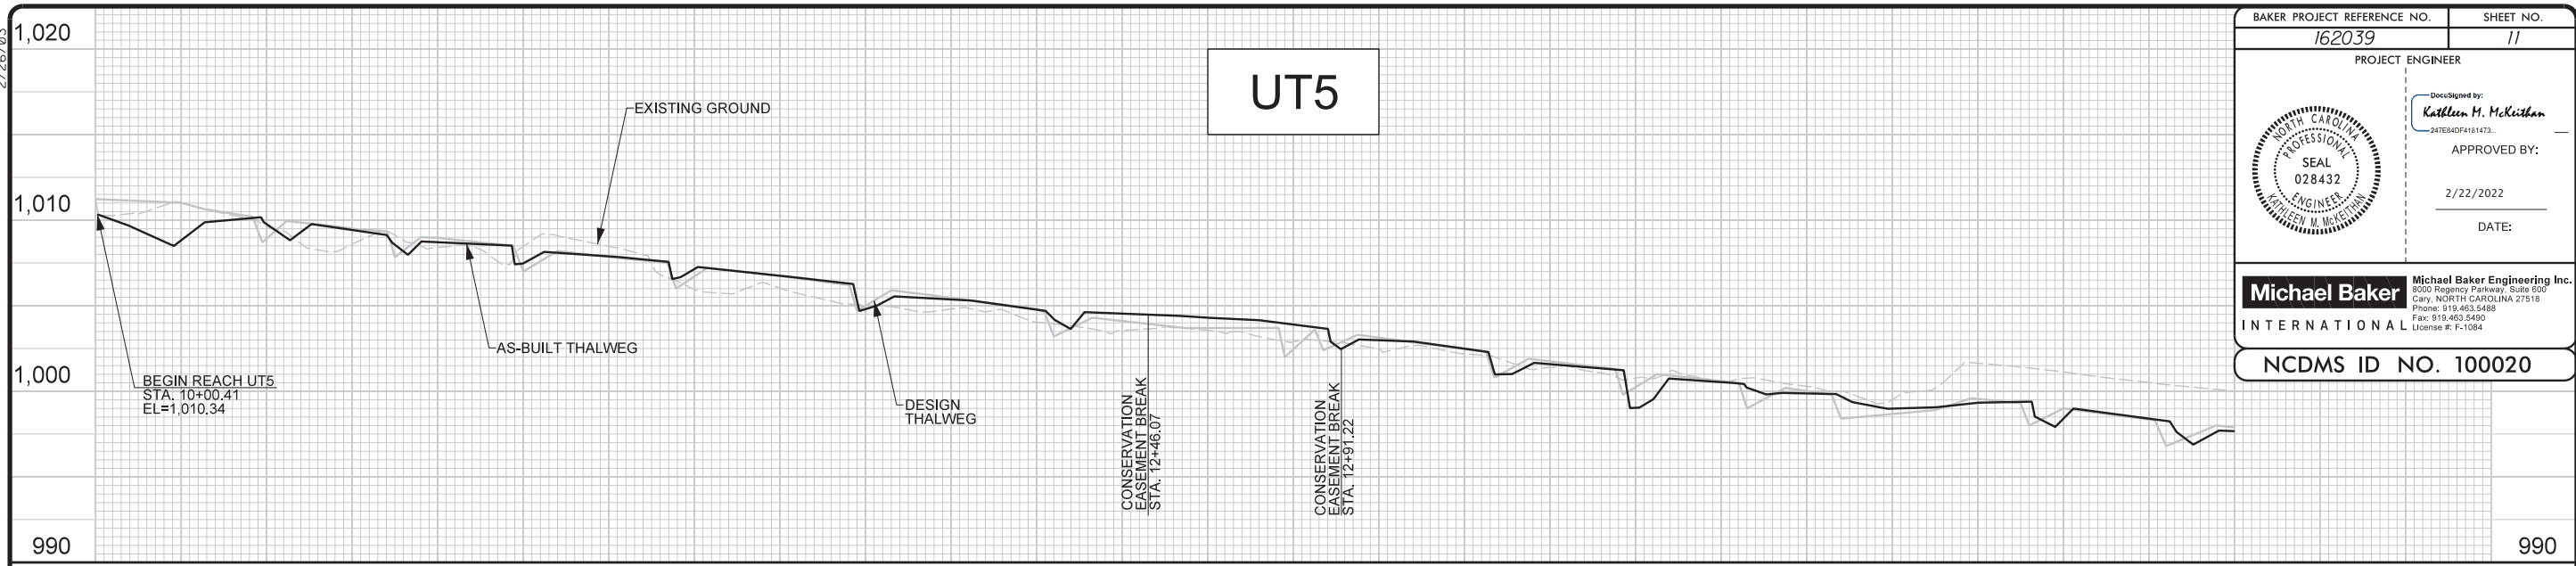
21+00

BAKER PROJECT REFERENCE NO. 162039	SHEET NO. 10
PROJECT ENGINEER	
DocuSigned by: <i>Kathleen M. McKeithan</i> 247E84DF4181473...	
APPROVED BY:	
2/22/2022	
DATE:	
<b>Michael Baker International</b> Michael Baker Engineering Inc. 3000 Regency Parkway, Suite 500 Cary, NORTH CAROLINA 27518 Phone: 919.453.6488 Fax: 919.453.6490 License #: F-1084	
NCDMS ID NO. 100020	

R:\162039\_Whittier\_Creek\Design\As-Built\Plans\162039\_ASB-PFL\_10.dgn  
2/26/23 2:40:27 PM

2/26/23

BAKER PROJECT REFERENCE NO. 162039	SHEET NO. 11
PROJECT ENGINEER	
	
APPROVED BY: Kathleen M. McKeithan	
DATE: 2/22/2022	
<b>Michael Baker International</b> <small>Michael Baker Engineering Inc. 3000 Regency Parkway, Suite 500 Cary, NORTH CAROLINA 27518 Phone: 919.463.6488 Fax: 919.463.6490 License #: F-1084</small>	
NCDMS ID NO. 100020	



R:\2023\Whittier\_Creek\_Design\As-Built\Plans\162039\_ASB-PFL\_11.dgn  
2/22/23 2:42:16 PM