

As-Built Baseline Monitoring Report FINAL

Whittier Creek Mitigation Project

Surry County, North Carolina

DMS Project ID No. 100020

DEQ Contract No. 7182

DWR# 17-1044

Yadkin River Basin: 03040101-1 10040

DMS RFP #16-006993 (Issued: 9/16/16)

USACE Action ID No. SAW-2017-01503

Baseline Data Collection Period: Survey August 2021, Vegetation January 2022



Submitted to/Prepared for:

NC Department of Environmental Quality
Division of Mitigation Services (DMS)
1652 Mail Service Center
Raleigh, North Carolina 27699-1652

Michael Baker

I N T E R N A T I O N A L

Submission Date: April 2022



This document was printed using 30% recycled paper.

April 6, 2022

Matthew Reid, PM
NCDEQ, Division of Mitigation Services (DMS)
5 Ravenscroft Dr. – Suite 102
Asheville, NC 28801

Subject: Response to DMS Comments for Draft MY0 Report Review
Whittier Creek Mitigation Project, Surry County
Yadkin River Basin: 03040101
DMS Project #100020, DEQ Contract #7182

Mr. Reid:

Please find enclosed our responses to the NC Division of Mitigation Services' review comments dated March 28, 2022 in reference to the Whittier Creek Mitigation Project's Draft MY0 Report. We have revised the Draft document in response to the referenced review comments as outlined below.

General Report Comments

- DMS recommends using the most current templates for monitoring reports. It is understood that this project was contracted in May 2017 and therefore templates from that time period are applicable. However, the most current templates provide the IRT and DMS with the needed information in a more streamlined and less verbose format.

Response: Given that the project has already been set up using the older baseline template version from June 2017 (along with our experience using that version), we are electing to stick with that format for this project. However, we are certainly open to any tweaks or simple modifications to the existing format or tables that would be of any help in streamlining the report.

- Recommend displaying project information (county, basin, project #, etc.) on title page in a vertical list format as opposed to horizontally separated by commas. Reduce photo size if necessary.

Response: The project information was rearranged into a two-column tabular format beneath the title. It appears to be much clearer and easier to read.

- 1.1 Project Description: Please update stream mitigation credits to 3,059.667 in the second paragraph. This is the official credit amount for the site and what is used on debit ledgers.

Response: Text revised as recommended. I have tried to be consistent in my reporting of stream credit and length numbers to avoid confusion but clearly missed this one.

- Table 2: Please add "Institution Date – May-17" as the first entry on the table.

Response: Table revised as requested.

- Table 2: Please add two lines below As-Built Baseline Monitoring Report (MY0) entry: “Vegetation Monitoring” and “Stream Survey” and the dates that these activities were completed. Please include this information for future monitoring reports.

Response: Table revised as requested.

- Table 5: Approved Mitigation Plan indicates CVS protocol will be used for vegetation monitoring. Please use the CVS output tables or the DMS vegetation tool and include all supporting data.

Response: The veg table provided is the required CVS output for this template version. However, we had revised it to remove the Volunteer and Total stem columns as there were no volunteers to be reported at this stage. In an attempt to streamline the table we inadvertently created confusion – our apologies. The veg table has been revised to replace the deleted columns so that it now looks like the standard output veg table we will use for the remaining monitoring period.

- Table 6: Please include grid lines in final submittal.

Response: Table 6 was revised to include grid lines.

- Table 7: Please include the baseline bankfull elevation used for the calculations. Include grid lines in final submittal. Consider using most current monitoring template. Only 6 parameters are required as opposed to the 11 currently shown.

Response: The baseline/as-built bankfull elevations are shown on the individual riffle cross-section graphs. In future monitoring years, these original as-built elevations will still be provided (both numerically and drawn onto the cross-section figure) along with the monitoring year bankfull elevations and the thalweg elevations. That allows the reviewer to do the calculations required to determine BHR as per DMS’ methodology and to more easily compare changes from the baseline condition. We feel placing this information on the graphs as opposed to Table 7 is much more useful as you can visually see what the data is telling you. Grid lines have been added to the table as requested.

- Please review and revise cross-section entrenchment ratios. Cross-section 1, 3, 5 and 10 graphs show different values than shown on Table 7.

Response: Those values were reviewed and have been corrected so they now all match. Our apologies for the confusion.

DMS conducted a field visit on March 24, 2022. The following comments/observations are a result of that visit:

- Overall, the site is in excellent condition. All structures are performing as intended, boundary marking is excellent, and all fences are intact. No conservation easement encroachments were identified.

Response: We’re glad you found in site in overall excellent condition!

- Please keep a watch on the right flood plain of UT4A near veg plot 3. There is an approximately 10-15’ wide strip that extends approximately 200’ of existing vegetation that contains of fescue and other pasture grasses. If this inhibits tree growth in this area, please consider ring spraying or other alternatives to prevent competition.

Response: We intend to treat the surviving fescue with ring-spraying around the planted stems this fall after the leaves have dropped and report as part of MY1 activities.

- Invasive populations consisting mainly of multiflora rose was identified in areas of undisturbed trees and existing vegetation along the left bank of UT4A. Please be sure to map these areas for MY1 and treat accordingly throughout the monitoring period.

Response: Absolutely. We are aware of those multiflora rose populations that survived initial treatments conducted during the first construction phase in the autumn of 2020 and are regrowing this year. We intend to treat them again this spring and report as part of MY1 activities.

Digital Deliverable Comments

- The submitted vegetation data does not meet the 2016 IRT requirements (e.g. x,y, stem height, etc.). Please reference the DMS vegetation table tool and either use the tool to replicate the output and include the supporting data. (https://ncdms.shinyapps.io/Veg_Table_Tool/)


Response: I failed to include the CVS database with the draft e-submission files but will do so for the final submission. It contains all the standard vegetation data (x/y location, stem heights and vigor, etc) that we collected in the field.

- If available, please include features representing the mitigation plan stream lengths.

Response: GIS shapefiles for the streams showing the mitigation plan design lengths have been included with the final e-submission.

As requested, one hardcopy of the final revised Baseline/MY0 report has been included with this response along with a full electronic copy on a USB drive. Please do not hesitate to contact me further should have any additional questions regarding our response submittal.

Sincerely,

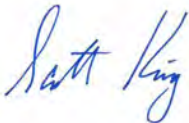

Scott King, LSS, PWS
Project Manager

TABLE OF CONTENTS

1.0	PROJECT SUMMARY.....	1
1.1	PROJECT DESCRIPTION.....	1
1.2	GOALS AND OBJECTIVES	1
1.3	PROJECT SUCCESS CRITERIA	2
1.4	MITIGATION COMPONENT SUMMARY	2
1.5	PROJECT TIMELINE.....	3
1.6	DESIGN CHANGE DEVIATIONS.....	3
1.7	FIGURE 1: VICINITY MAP.....	4
1.8	TECHNICAL AND METHODOLOGICAL DESCRIPTIONS AND REFERENCES.....	5

APPENDICES

Appendix	A	<i>Background Tables and Figures</i>
	Table 1	Project Components and Mitigation Credits
	Figure 2	Project Asset and Credit Map
	Table 2	Project Activity and Reporting History
	Table 3	Project Contacts
	Table 4	Project Attributes
Appendix	B	<i>Visual Assessment Data</i>
	Figure 3	Current Condition Plan View (CCPV)
		Stream Station Photo-Points
		Vegetation Plot Photographs
		Additional Project Photographs
Appendix	C	<i>Vegetation Plot Data</i>
	Table 5	As-Built Planted Stem Counts by Plot and Species
Appendix	D	<i>Stream Measurement and Geomorphology Data</i>
	Table 6	Baseline Stream Data Summary
	Table 7	Cross-Section Morphology Data Summary
	Figure 4	Longitudinal Profiles
	Figure 5	MY0 Cross-Sections
Appendix	E	<i>As-Built Plan Sheets</i>

1.0 PROJECT SUMMARY

1.1 Project Description

Michael Baker Engineering, Inc. (Michael Baker) restored approximately 2,844 linear feet of existing jurisdictional stream and enhanced 328 linear feet of stream along both the main stem of, and unnamed tributaries to, Whittier Creek. The project also reestablished roughly 5.5 acres of riparian buffer, though not for buffer credit. The project is located in the Yadkin River Basin, within the Hydrologic Unit Code (HUC) 03040101-110040 (the Bull Creek – Ararat River Watershed), which is identified as a Targeted Local Watershed (TLW) in DMS’s 2009 *Upper Yadkin Pee-Dee River Basin Restoration Priorities* (RBRP) report.

The Whittier Creek Mitigation Project is located on an active cattle farm in Surry County, North Carolina, approximately 7 miles west of the Town of Pilot Mountain (Figure 1). Historic agriculture uses on the project site have been predominantly cattle pasture and crop production (tobacco and hay). These activities had negatively impacted both water quality and streambank stability along the project streams and their tributaries (Table 4). The project is being conducted as part of the NCDMS Full Delivery In-Lieu Fee Program and is anticipated to generate at close-out a total of 3,059.667 cool stream mitigation credits (Table 1) and is protected by a 6.9-acre permanent conservation easement.

1.2 Goals and Objectives

The goals of this project are identified below:

- Reconnect stream reaches to their floodplains
- Improve stream stability
- Improve aquatic habitat
- Reestablish forested riparian buffers
- Permanently protect the project

To accomplish these goals, the following objectives were identified:

- To raise channel beds or excavate bankfull floodplains by utilizing either a Priority I or Priority II Restoration approach, or through an Enhancement Level I approach.
- To construct streams of appropriate dimensions, pattern, and profile in restored reaches, slope stream banks and provide bankfull benches on enhanced streams, and utilize bio-engineering to provide long-term stability.
- Construct an appropriate channel morphology for all streams, increasing the number and depths of pools, increasing the amount of woody debris with structures including geo-lifts, brush-toe, log vanes/weirs, root wads, woody riffles, and/or log J-hooks.
- Establish riparian buffers at a 30-foot minimum width along all stream reaches, planted with native tree and shrub species.
- Establish a permanent conservation easement restricting land use in perpetuity. This will prevent site disturbance and allow the project to mature and stabilize.

1.3 Project Success Criteria

The success criteria and performance standards for the project will follow the North Carolina Interagency Review Team (NCIRT) guidance document *Wilmington District Stream and Wetland Compensatory Mitigation Update* dated October 24, 2016 and as described in Section 7 of the approved Mitigation Plan. All specific monitoring activities will follow those outlined in detail in Section 8 of the approved Mitigation Plan and will be conducted for a period of 7 years unless otherwise noted. Annual monitoring reports will follow the DMS document *Annual Monitoring Report Format, Data Requirements, and Content Guidance* from June 2017.

1.4 Mitigation Component Summary

The project involved the restoration or enhancement of 4 reaches. Reach R7 (Whittier Creek) was restored to a Rosgen C-Type stream using a Priority Level II approach. The stream had been straightened and relocated, which caused it to become deeply incised with steep, bare, and heavily eroding banks. It also had substantial impacts from cattle access and lacked a forested riparian buffer. The channel was restored by excavating a wide new floodplain at the bankfull depth and by restoring an appropriate pattern back to the channel. Multiple in-stream structures were also installed throughout the reach to control grade, dissipate energy, protect streambanks, and create more diverse bedform/habitat diversity. Fencing was then installed to exclude cattle from the entire system.

Reach UT4a was improved using an Enhancement Level I approach to increase bank stability and promote bedform diversity of the channel. Sections of the reach had bankfull benches excavated while other sections of steep banks were graded back and stabilized. A few in-stream structures were also installed to control grade, protect streambanks, and promote habitat diversity. A full riparian buffer was then planted on both sides of the reach, though mature existing trees growing along the reach bank were preserved to the maximum extent possible.

Reach UT4b was restored to a Rosgen C-type stream using a Priority Level I approach. This reach was deeply incised, had been straightened, had substantial impacts from cattle access, and lacked a forested riparian buffer. The channel was raised to reconnect it with the adjacent floodplain, tying into an existing bedrock knickpoint at the top, and had a meandering riffle-pool morphology restored. Numerous in-stream structures were installed throughout the reach to control grade, promote bedform/habitat diversity, and protect streambanks. Fencing was then installed to exclude cattle from the reach.

Reach UT5 was restored to a Rosgen B-type stream using a Priority Level I approach. This reach was incised, had substantial impacts from cattle access, and lacked any forested riparian buffer. Due to existing valley slope and valley floor widths, the channel was restored with an appropriate riffle-step-pool morphology with minor pattern adjustments incorporated to ensure stability and promote habitat diversity. Overall, the valley acts to confine the stream, though there are a couple of exceptions; towards the top around the gated crossing, and at the bottom near its confluence with UT4b. In these locations the valley does flatten out or open up a bit for short sections (which increases the entrenchment ratio greater than 2.2) but given their relatively short lengths this will not cause any detrimental effects and the stream will function as designed. Channel dimensions and banks were graded to appropriate sizes and slopes, reconnecting the stream to the adjacent floodplain. Numerous in-stream structures were installed throughout the reach to control grade, promote bedform/habitat diversity, and protect streambanks. Fencing was then installed to exclude cattle from the reach, which included a gated rock ford crossing located at a break in the easement for an existing powerline.

A full, minimum 30-ft width riparian buffer was established around all project streams, resulting in the ultimate re-establishment of 5.5 acres of forested riparian buffer that had previously been used for pasture or crop production. The entire project area will be preserved in perpetuity in a 6.9-acre permanent conservation easement. A full summary of the project components and mitigation assets/credits is presented in Table 1 and shown in Figure 2.

1.5 Project Timeline

Project construction was originally initiated in April 2020 and was very close to completion in October 2020, before the remnants of Hurricane Zeta hit the site on October 29, 2020, dropping a substantial amount of rainfall over a relatively short timeframe. The resulting regional flooding blew out the two-lane NCDOT bridge at the top of the main stem (Reach R7) which resulted in substantial scouring and sediment deposition, leaving large sections of newly built channel buried (see photographs in Appendix B). Relatively minor damage was also observed along sections of the tributaries as well, particularly to lower portion of UT4b. The NCDOT requested that Michael Baker delay repair work until they could rebuild the bridge at the top of the project as well as remove the large chunks of the old bridge that had been washed down onto the project's floodplain. This request, along with the subsequent very wet winter and spring season delayed project repair work by several months, ultimately beginning in April and finishing up in June of 2021. The fencing and conservation boundary marking was completed shortly thereafter in July of 2021. All easement monuments were located at this time to confirm none had been lost or damaged during construction. The As-Built survey was completed in August of 2021. All 11 cross-sections (6 riffle and 5 pool) and 3 in-stream gauges were installed in June of 2021. Bareroot stems and livestakes were fully planted in January of 2022, while the vegetation plots (4 permanent and 1 random) were installed and vegetation data collected immediately thereafter, also in January of 2022. Thus, Monitoring Year 1 was delayed and is now scheduled for 2022 as shown in Table 2.


1.6 Design Change Deviations

During project construction, there were several relatively minor deviations from the original design plans as marked in red in the as-built plan sheets (Appendix E). They were mostly structure substitutions made in the field due to recent IRT feedback on this and other projects requesting more wood structures in the stream. In many locations, rock vanes were substituted with log vanes, rock sills with log sills, boulder-toe bank protection with brush/wood-toe, etc. The presence of bedrock in the bank and channel bed on Reach UT4a resulted in minor adjustments to the exact structure placement location. The pipe culvert crossing in upper Reach UT5 was replaced with a rock ford crossing to keep the stream daylighted. Additionally, after the damage caused by the storm in October of 2020 it was deemed prudent to install boulder-toe bank protection at the top of project along the outer banks of the first two meander bends (located outside of the conservation easement), and on the meander bend of UT4b at approximately Station 19+50. In each of those locations the extreme flooding had scoured the banks in these bends, thus additional protection was deemed prudent. But none of the changes described here should ultimately affect stream performance, function, or credit.

Additionally, after planting was completed in January of 2022, Michael Baker staff was informed by the contractor that their crew had planted a few extra stems leftover from another project. These were installed in addition to (not in substitution for) the proposed species list and density. There were approximately 50 stems each of swamp chestnut oak (*Quercus michauxii*), blackgum (*Nyssa sylvatica*), serviceberry (*Amelanchier arborea*), and sugarberry (*Celtis laevigata*) planted on site. This equates to just 1% each of the total planted stem numbers as shown on the revised planting plan tables on Sheet I-A of the as-built plan sheets (Appendix E).

1.7 Vicinity Map

Project Coordinates: 36.3779 N, -80.5999 W

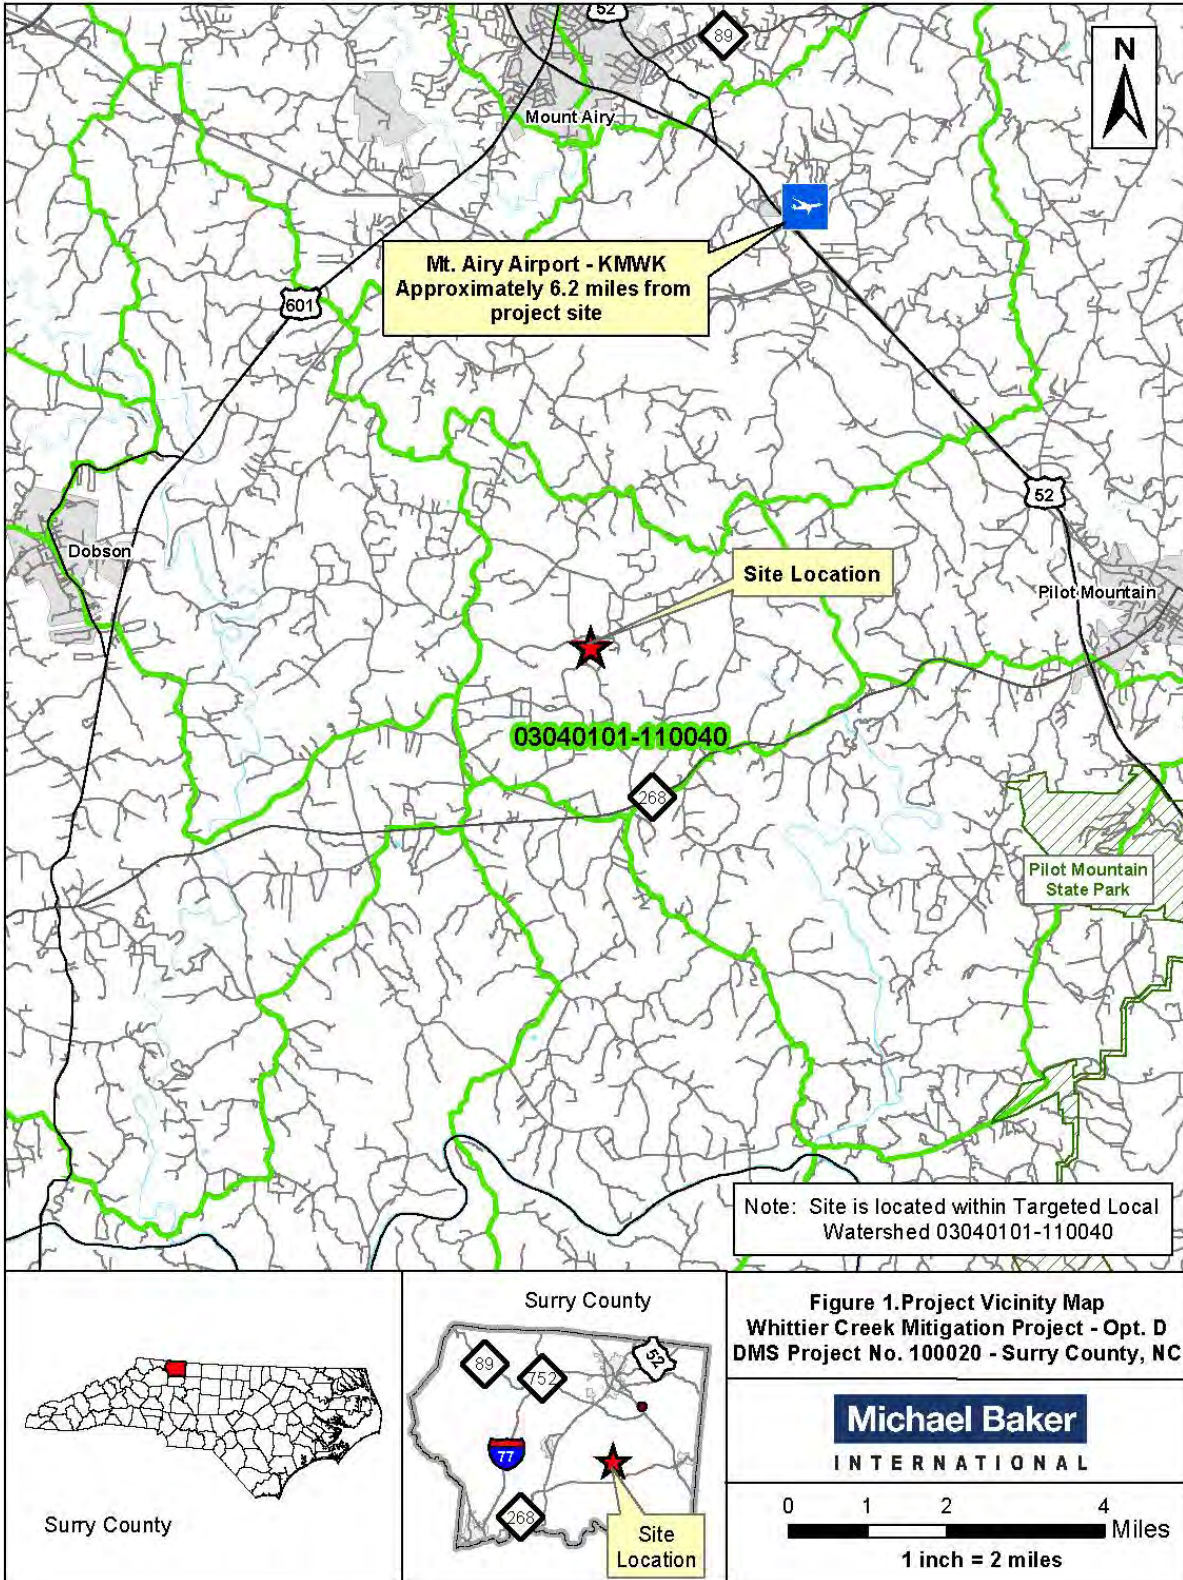

1.8 Technical and Methodological Descriptions and References

Stream survey data was collected to a minimum of Class C Vertical and Class A Horizontal Accuracy using a Leica TS06 Total Station and was georeferenced to the NAD83 State Plane Coordinate System, FIPS3200 in US Survey Feet. The survey data from the permanent project cross-sections were collected and classified using the Rosgen Stream Classification System to confirm design stream type (Rosgen 1994).

The vegetation-monitoring quadrants (plots) were installed across the site in accordance with the CVS-DMS Protocol for Recording Vegetation, Version 4.1 (Lee 2007) and the data collected from each was input into the CVS-DMS Data Entry Tool v. 2.3.1 (CVS 2012).

Three automated, in-stream continuous stage recorders were installed in Reaches UT4b, UT5, and R7 following suggestions and guidance from DMS Science and Analysis Section (G. Melia, personal communication, August 21, 2019). The gauges themselves are all In-Situ brand Rugged Troll 100 data loggers. The gauges will record flow depth to determine bankfull and near-bankfull events within each reach.

References:

Carolina Vegetation Survey (CVS) and NC Division of Mitigation Services (DMS). CVS-DMS Data Entry Tool v. 2.3.1. University of North Carolina, Raleigh, NC. 2012.

Lee, M., Peet R., Roberts, S., Wentworth, T. 2007. CVS-DMS Protocol for Recording Vegetation, Version 4.1.

North Carolina Division of Mitigation Services. 2009. Upper Yadkin Pee-Dee River Basin Restoration Priorities. NC Department of Environmental Quality. Raleigh, NC.

North Carolina Interagency Review Team (NCIRT). 2016. Guidance document “*Wilmington District Stream and Wetland Compensatory Mitigation Update*”. October 24, 2016

Rosgen, D.L. 1994. A Classification of Natural Rivers. *Catena* 22:169-199.

Rosgen, D.L. 1996. Applied River Morphology. Wildlands Hydrology. Pagosa Springs, CO.

APPENDIX A

Background Tables and Figures

Table 1.0 Project Components and Mitigation Credits
Whittier Creek Mitigation Project - NCDMS Project No. 100020

Project Component (reach ID, etc.)	Wetland Position and HydroType	Existing Footage or Acreage	Stationing	As-Built Restored Footage ¹	Mitigation Plan Designed Footage	Restoration Level	Approach Priority Level	Mitigation Ratio (X:1)	Mitigation Plan Credits ²
Reach R7 (Whittier Creek)		1,462	11+36 - 15+50, 15+62 - 24+91	1,343	1,332	R	P2	1	1,332.000
Reach UT4a		338	10+00 -13+27	328	328	E	L1	1.5	218.667
Reach UT4b		764	13+76 - 21+30	754	761	R	P1	1	761.000
Reach UT5		765	10+00 - 12+46, 12+91 - 17+92	747	748	R	P1	1	748.000
Wetland Group 1									
Buffer Group 1 (BG1)									

¹ All stream stationing and restored footage numbers reported here and shown in the as-built plan sheets use *thalweg* survey values and have had easement breaks removed.

² Credits reported here are derived from the design lengths as taken from the approved mitigation plan Table 11.1

Table 1.1
As-Built Centerline Length and Area Summations by Mitigation Category

Restoration Level	Stream (linear feet)	Riparian Wetland (acres)		Non-riparian Wetland (acres)	Credited Buffer (ft ²)
		Riverine	Non-Riverine		
Restoration	2,844				
Enhancement					
Enhancement I	328				
Enhancement II					
Creation					
Preservation					
High Quality Pres					

Table 1.2
Overall Assets Summary

Asset Category	Overall Credits
Stream (cool)	3,059.667
RP Wetland	
NR Wetland	
Buffer	

Conservation Easement

Stream Mitigation Type


Restoration (1:1)

Enhancement I (1.5:1)

No Credit



Whittier Creek Assets and Credits			
Reach	Mitigation Approach	Creditable Length (ft)	Credits (cool)
R7	R (1:1)	1,332	1,332.000
UT4a	EI (1.5:1)	328	218.667
UT4b	R (1:1)	761	761.000
UT5	R (1:1)	748	748.000
Total Design Footage		3,169	
Restoration		2,841	2,841.000
Enhancement I		328	218.667
Total Credits			3,059.667

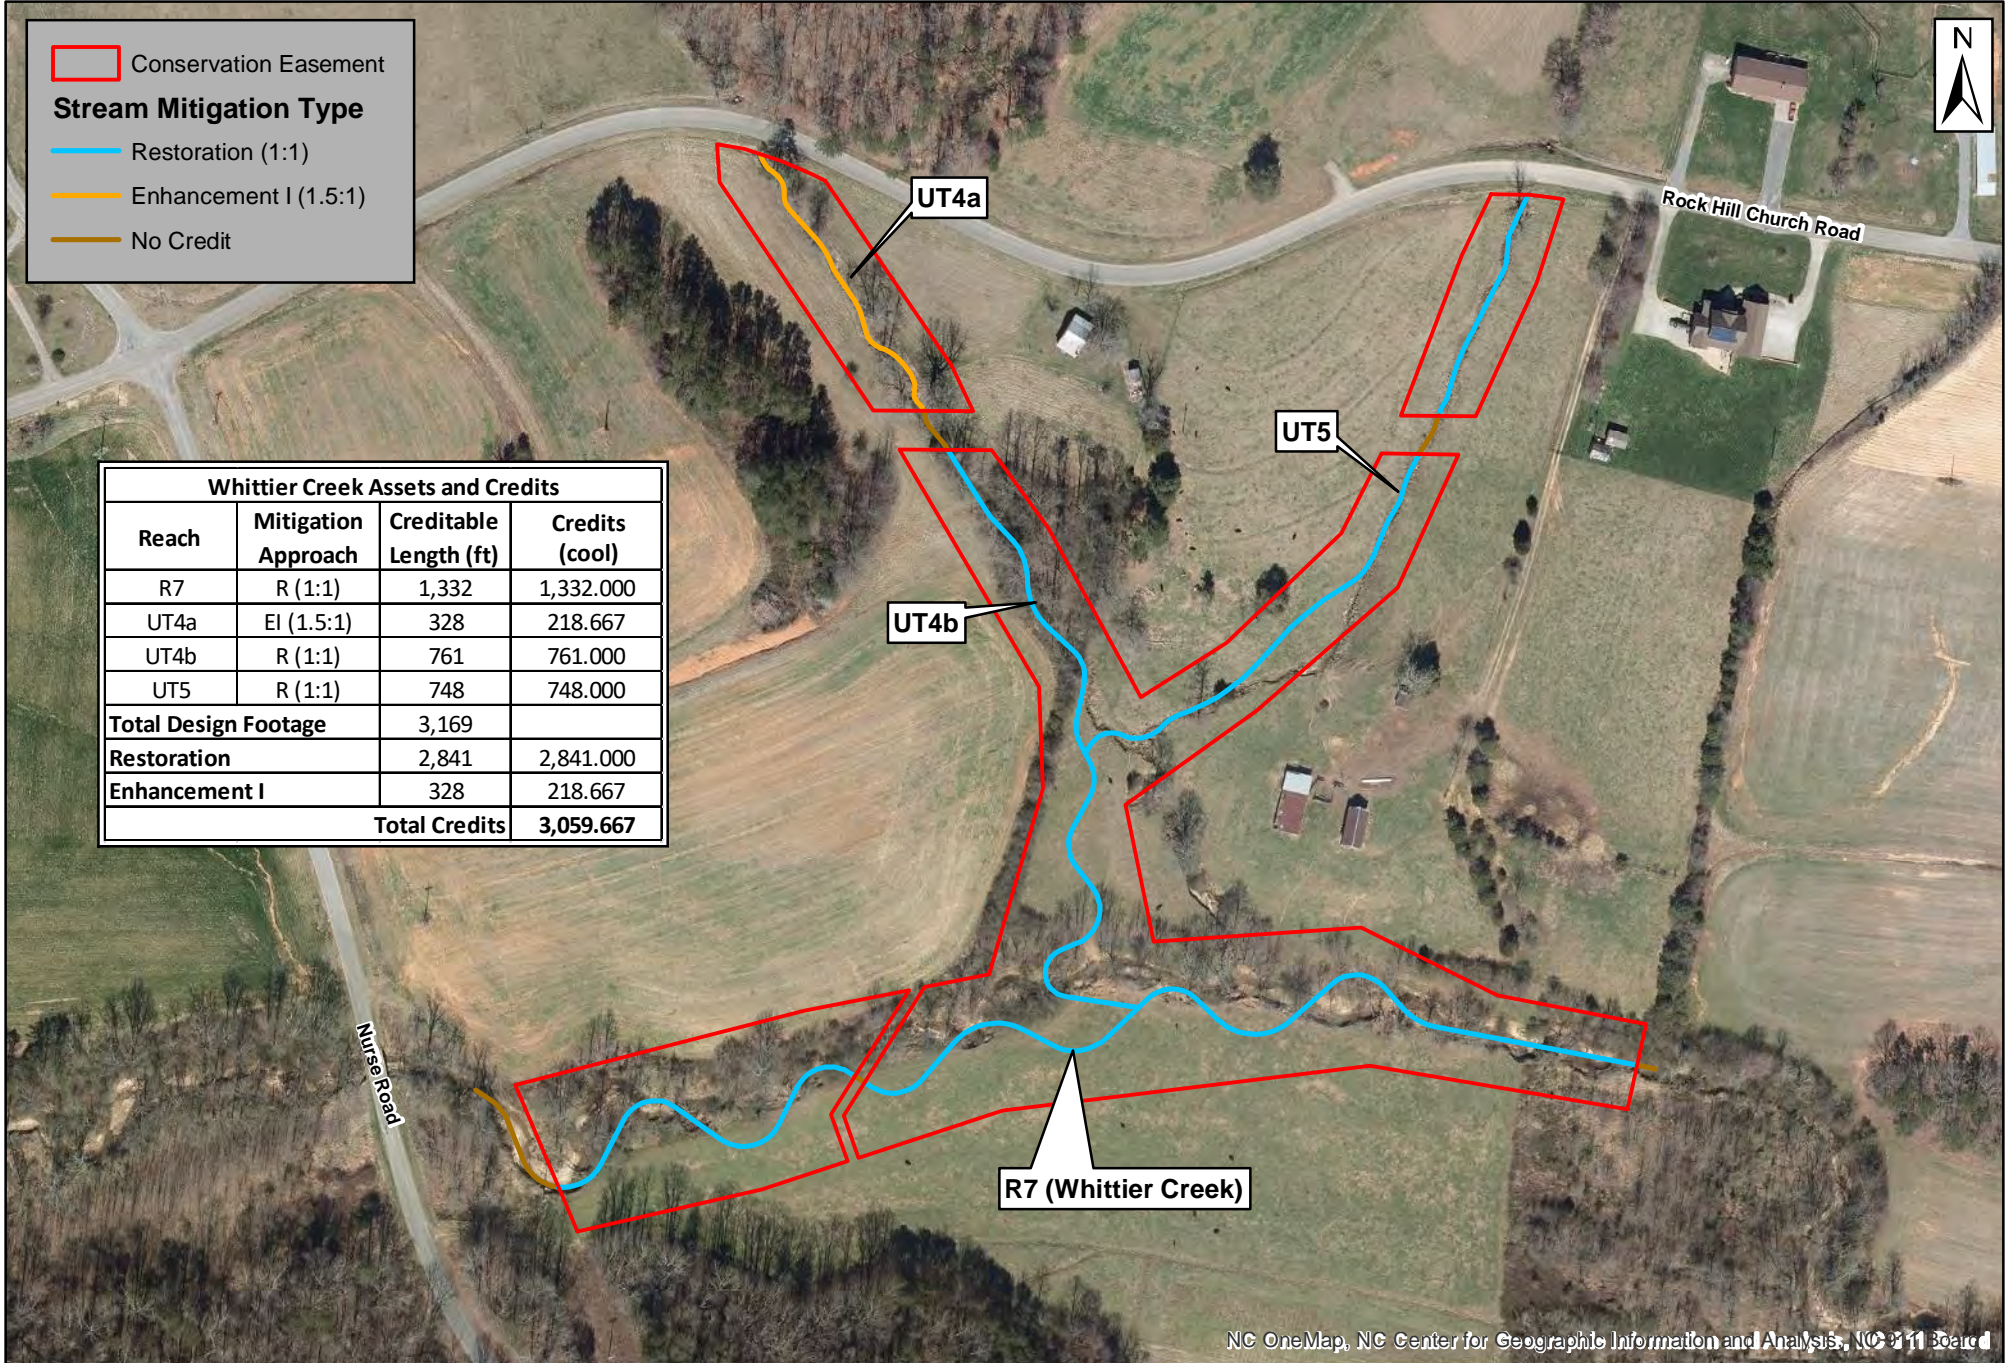

NC OneMap, NC Center for Geographic Information and Analysis, NC 911 Board

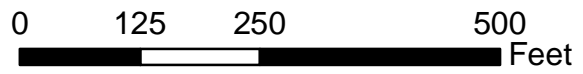


Figure 2. Project Asset and Credit Map
Whittier Creek Mitigation Project
DMS Project No. 100020

Table 2. Project Activity and Reporting History
Whittier Creek Mitigation Project - NCDMS Project No. 100020

Grading Completed in June 2021		
Elapsed Time Since grading complete:	8 months	
All Planting Completed in January 2022		
Elapsed Time Since planting complete:	1 month	
Number of Reporting Years¹:	0	
Activity or Deliverable	Data Collection Complete	Completion or Delivery
Institution date	N/A	May-17
404 permit date	N/A	May-20
Mitigation Plan	N/A	Mar-20
Final Design – Construction Plans	N/A	Jul-20
Construction Grading Completed	N/A	Jun-21
As-Built Survey	Aug-21	Aug-21
Livestake and Bareroot Planting Completed	N/A	Jan-22
As-Built Baseline Monitoring Report (MY0)	Jan-22	Feb-22
As-Built Stream Survey	Aug-21	N/A
As-Built Vegetation Monitoring	Jan-22	N/A
Year 1 Monitoring (anticipated)	Oct-22	Dec-22
Year 2 Monitoring (anticipated)	Oct-23	Dec-23
Year 3 Monitoring (anticipated)	Oct-24	Dec-24
Year 4 Monitoring (anticipated)	Oct-25	Dec-25
Year 5 Monitoring (anticipated)	Oct-26	Dec-26
Year 6 Monitoring (anticipoated)	Oct-27	Dec-27
Year 7 Monitoring (anticipated)	Oct-28	Dec-28

¹ = The number of monitoring reports excluding the as-built/baseline report

Table 3. Project Contacts
Whittier Creek Mitigation Project - NCDMS Project No. 100020

Designer	797 Haywood Rd, Suite 201 Asheville, NC 28806
Michael Baker Engineering, Inc.	Contact: Scott King, Tel. 828-412-6102
Construction Contractor	5616 Coble Church Rd Julian, NC 27283
KBS Earthworks, Inc.	Contact: Kory Strader, Tel. 336-362-0289
Survey Contractor	88 Central Avenue Asheville, NC 28801
Kee Mapping and Surveying	Contact: Brad Kee, Tel. 828-575-9021
Planting Contractor	5616 Coble Church Rd Julian, NC 27283
KBS Earthworks, Inc.	Contact: Kory Strader, Tel. 336-362-0289
Seeding Contractor	5616 Coble Church Rd Julian, NC 27283
KBS Earthworks, Inc.	Contact: Kory Strader, Tel. 336-362-0289
Seed Mix Sources	Telephone: 336-855-6363
Green Resources	
Nursery Stock Suppliers	Telephone: 919-742-1200 Telephone: 919-242-6555
Mellow Marsh Farm Bruton Natural Systems	
Monitoring Performers	797 Haywood Rd, Suite 201 Asheville, NC 28806
Michael Baker Engineering, Inc.	Stream Monitoring POC Vegetation Monitoring POC Scott King, Tel. 828-412-6102 Scott King, Tel. 828-412-6102

Table 4. Project Attributes for Existing Conditions
Whittier Creek Mitigation Project – NCDMS Project No. 100020


Project Information				
Project Name		Whittier Creek Site – Option D Mitigation Project		
County		Surry		
Project Area (acres)		6.97		
Project Coordinates (lat. and long.)		36.3779 N, -80.5999 W		
Project Watershed Summary Information				
Physiographic Province		Northern Inner Piedmont		
River Basin		Yadkin Pee-Dee		
USGS Hydrologic Unit 8-digit	3040101	USGS Hydrologic Unit 14-digit	03040101-110040	
DWR Sub-basin		03-07-03		
Project Drainage Area (acres)		1,722 acres / 2.69 square miles (at downstream end of R7)		
Stream Temperature Regime		cool		
Project Drainage Area Percentage of Impervious Area		0.95% impervious area		
USGS National Land Cover Database (NLCD) for 2011		8.2% developed (predominantly rural residential), 41.6% cultivated crops and hay, 6.9% grass/pasture, 4.8% shrub/scrub, and 38.3% forested.		
Reach Summary Information				
Parameters	Reach R7	UT4a	UT4b	UT5
Existing length of reach (linear feet)	1,462	338	764	765
Valley confinement (Confined, moderately confined, unconfined)	Unconfined	Moderately Confined	Unconfined	Moderately Confined
Drainage area (acres)	1,722	225	305	72
Perennial, Intermittent, Ephemeral	Perennial	Perennial	Perennial	Perennial
NCDWR Water Quality Classification	C	C	C	C
Stream Classification (existing / proposed)	G4&F4/C4	E4&B4/B4b	E4&G4c/C4	B4/B4
Evolutionary trend (Simon)	IV – Degradation and Widening	III – Degradation	IV – Degradation and Widening	III – Degrading
FEMA classification	Zone X	Zone X	Zone X	Zone X
Regulatory Considerations				
Parameters	Applicable?	Resolved?	Supporting Docs?	
Water of the United States - Section 404	Yes	Yes	PCN	
Water of the United States - Section 401	Yes	Yes	PCN	
Endangered Species Act	Yes	Yes	Categorical Exclusion	
Historic Preservation Act	Yes	Yes	Categorical Exclusion	
Coastal Zone Management Act (CAMA)	No	N/A	N/A	
FEMA Floodplain Compliance	No	N/A	N/A	
Essential Fisheries Habitat	No	N/A	N/A	

APPENDIX B

Visual Assessment Data



- Conservation Easement
- Fence
- Gate
- ▲ Photo-Point
- ⊕ Continuous Stage Recorder
- Cross-Sections
- Stream Structures
- Top-Of-Banks
- Reaches by Mitigation Type**
- Restoration
- Enhancement I
- Non-Credit
- Vegetation Plots**
- Permanent (4)
- Random (1)
- Jurisdictional Wetlands

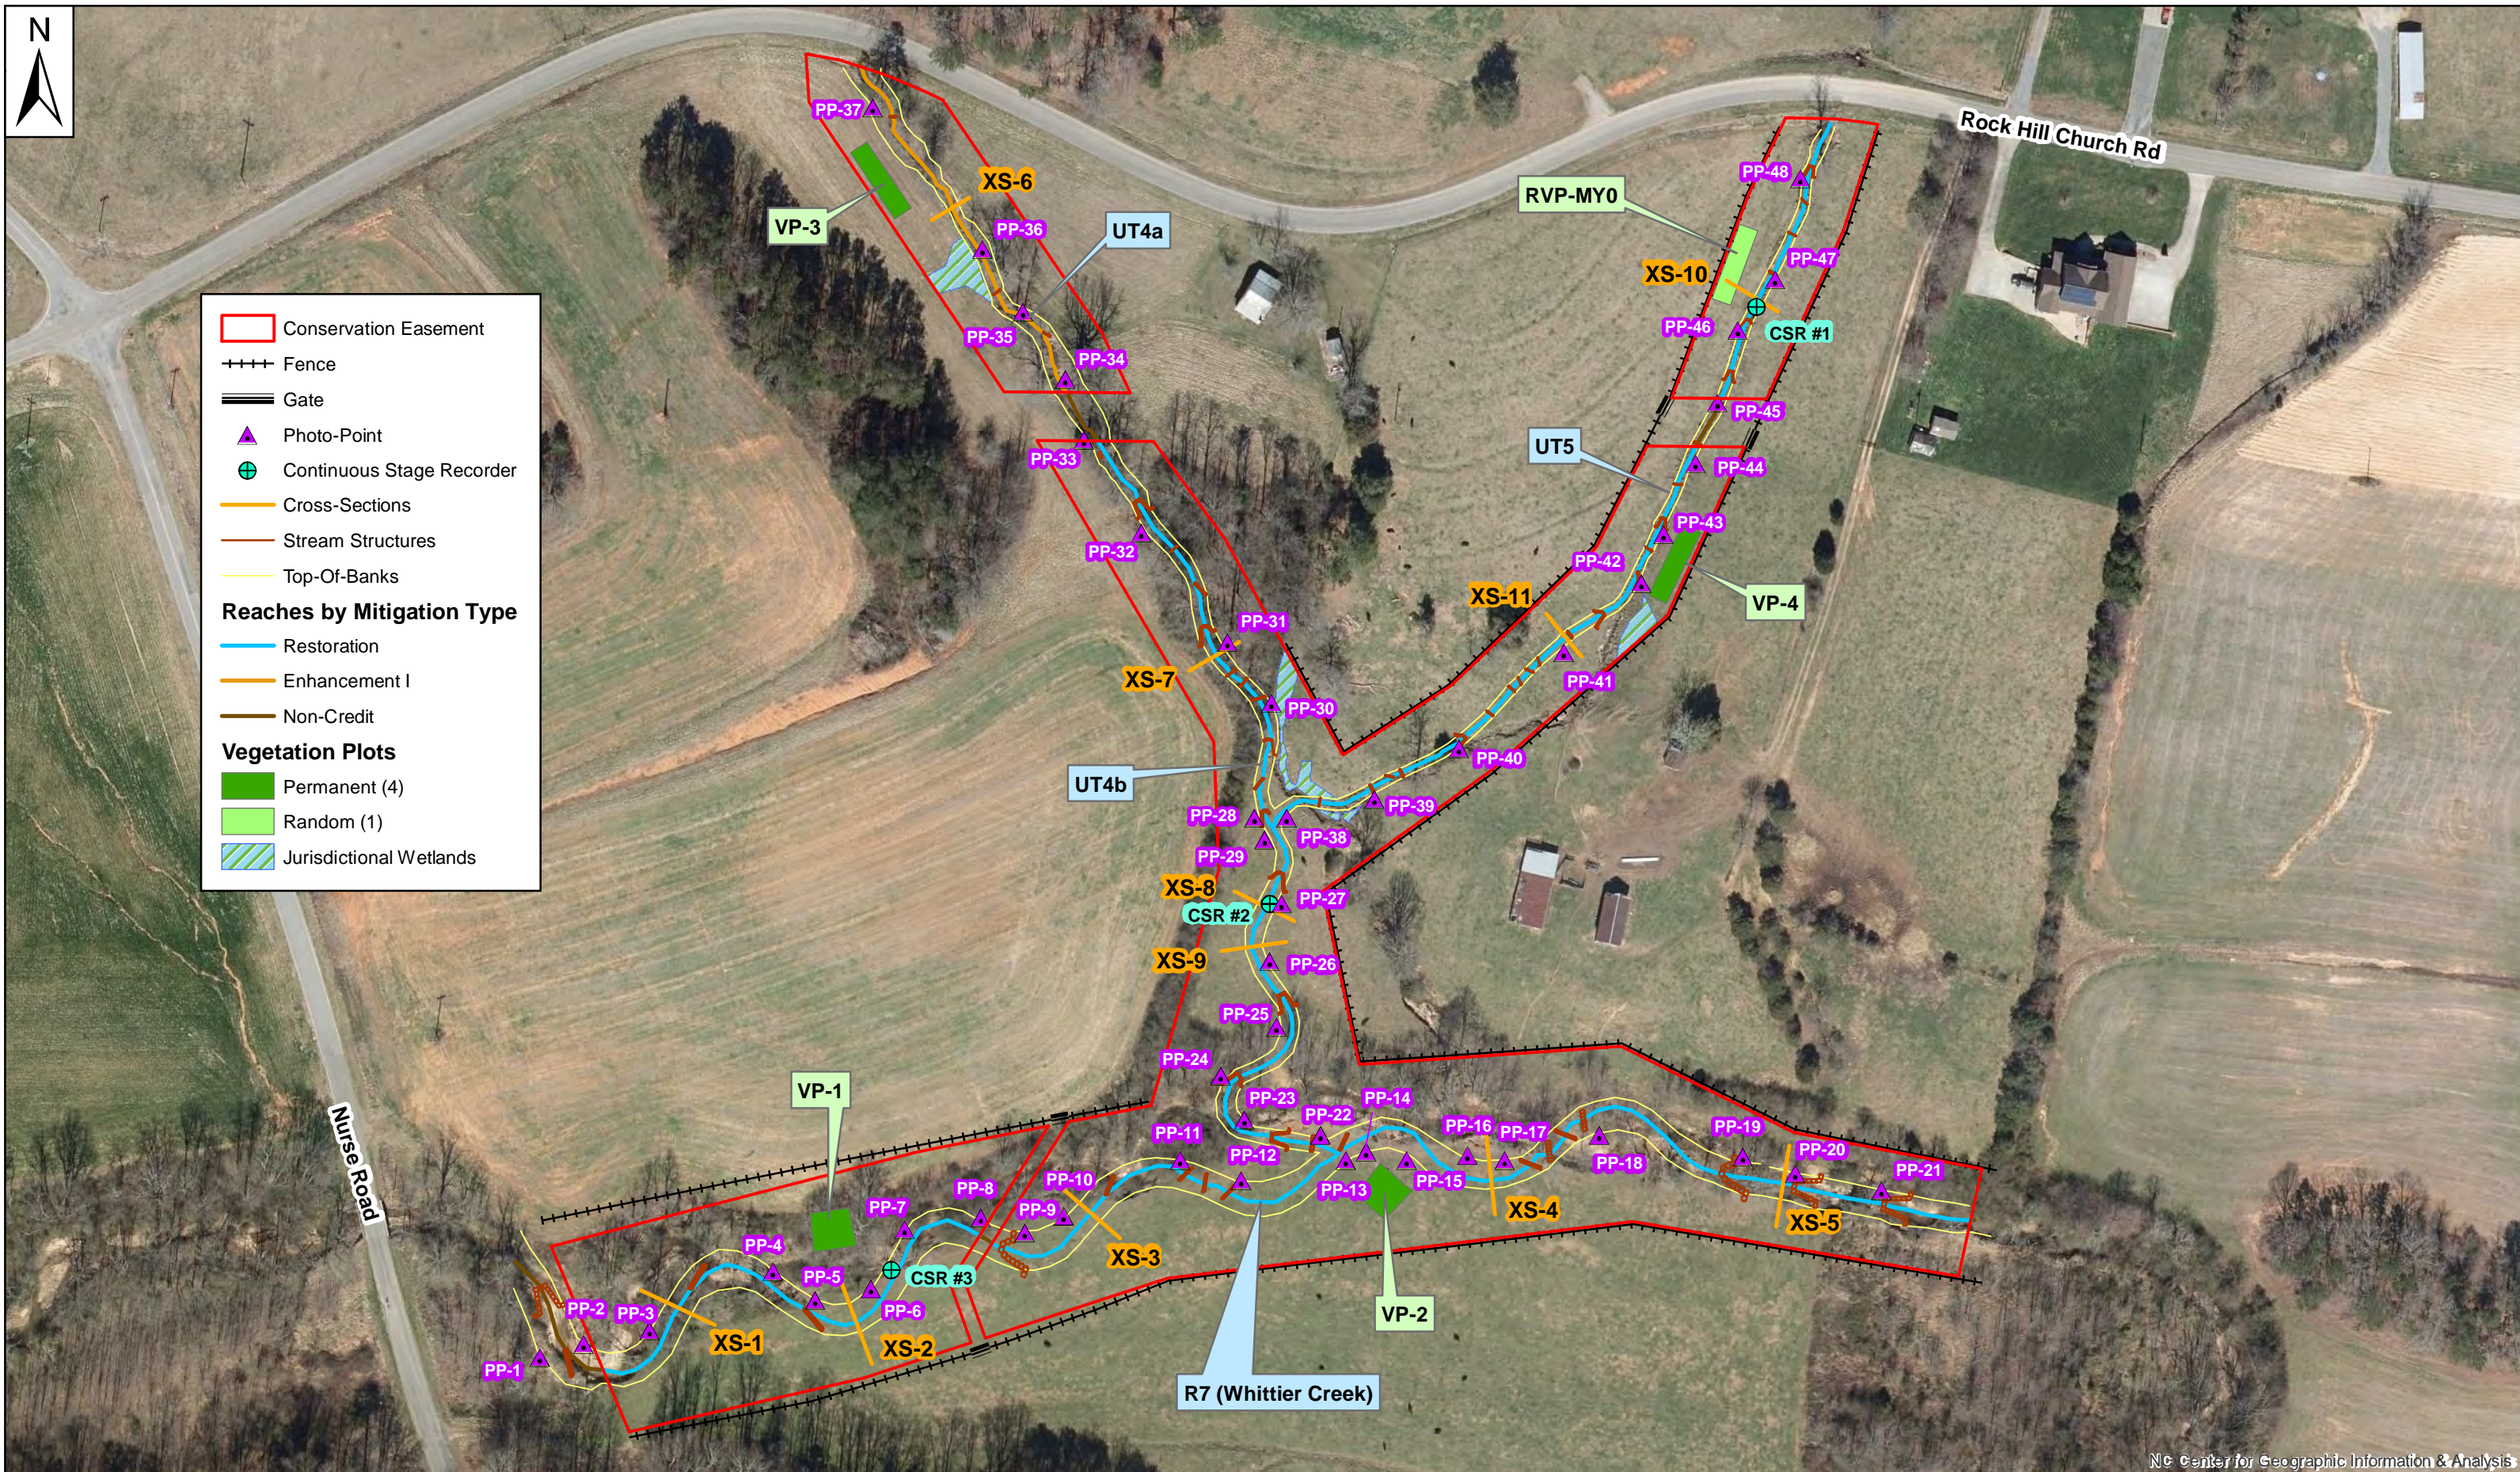

NC Center for Geographic Information & Analysis

Whittier Creek: As-Built MY0 Stream Station Photo-Points (taken 6/15/21)



PP-1: Reach 7, looking down valley from top of project



PP-2: Reach 7, downstream, Station 11+00



PP-3: Reach 7, downstream, Station 12+00



PP-4: Reach 7, downstream, Station 13+25



PP-5: Reach 7, downstream, Station 13+75



PP-6: Reach 7, downstream, Station 14+25

Whittier Creek: As-Built MY0 Stream Station Photo-Points (taken 6/15/21)



PP-7: Reach 7, downstream, Station 14+75



PP-8: Reach 7, downstream, Station 15+50



PP-9: Reach 7, downstream, Station 16+00



PP-10: Reach 7, downstream, Station 16+50



PP-11: Reach 7, downstream, Station 17+50



PP-12: Reach 7, downstream, Station 18+00

Whittier Creek: As-Built MY0 Stream Station Photo-Points (taken 6/15/21)



PP-13: Reach 7, upstream, Station 19+00 at confluence with Reach UT4B



PP-14: Reach 7, downstream, Station 19+25



PP-15: Reach 7, downstream, Station 19+75



PP-16: Reach 7, downstream, Station 20+25



PP-17: Reach 7, downstream, Station 20+75



PP-18: Reach 7, downstream, Station 21+50

Whittier Creek: As-Built MY0 Stream Station Photo-Points (taken 6/15/21)



PP-19: Reach 7, upstream, Station 22+75



PP-20: Reach 7, downstream, Station 23+25



PP-21: Reach 7, downstream, Station 24+00



PP-22: Reach UT4B, upstream, Station 21+10



PP-23: Reach UT4B, upstream, Station 20+50



PP-24: Reach UT4B, upstream, Station 20+00

Whittier Creek: As-Built MY0 Stream Station Photo-Points (taken 6/15/21)



PP-25: Reach UT4B, upstream, Station 19+25



PP-26: Reach UT4B, upstream, Station 18+75



PP-27: Reach UT4B, upstream, Station 18+00



PP-28: Reach UT4B, Station 17+50 at confluence with Reach UT5



PP-29: Reach UT4B, upstream, Station 17+25



PP-30: Reach UT4B, upstream, Station 16+50

Whittier Creek: As-Built MY0 Stream Station Photo-Points (taken 6/15/21)



PP-31: Reach UT4B, upstream, Station 15+75



PP-32: Reach UT4B, upstream, Station 15+50



PP-33: Reach UT4B, upstream, Station 13+75



PP-34: Reach UT4A, upstream, Station 13+25



PP-35: Reach UT4A, upstream, Station 12+50



PP-36: Reach UT4A, upstream, Station 11+75

Whittier Creek: As-Built MY0 Stream Station Photo-Points (taken 6/15/21)



PP-37: Reach UT4A, upstream, Station 10+25



PP-38: Reach UT5, upstream, Station 17+75



PP-39: Reach UT5, upstream, Station 17+00



PP-40: Reach UT5, upstream, Station 16+15



PP-41: Reach UT5, upstream, Station 15+00



PP-42: Reach UT5, upstream, Station 14+00

Whittier Creek: As-Built MY0 Stream Station Photo-Points (taken 6/15/21)



PP-43: Reach UT5, upstream, Station 13+60



PP-44: Reach UT5, upstream, Station 13+00 at ford crossing



PP-45: Reach UT5, upstream, Station 12+50



PP-46: Reach UT5, upstream, Station 11+75



PP-47: Reach UT5, upstream, Station 11+25



PP-48: Reach UT5, upstream, Station 10+50

Whittier Creek: As-Built MY0 Vegetation Plot Photos (taken 1/31/2022)



Vegetation Plot 1



Vegetation Plot 2



Vegetation Plot 3



Vegetation Plot 4



Random Vegetation Plot – MY0

Whittier Creek: As-Built MY0 Additional Project Photos



Continuous Stage Recorder #1 on UT5 (7/22/21)



Continuous Stage Recorder #2 on UT4b (7/22/21)



Continuous Stage Recorder #3 on R7 (7/22/21)



UT5 Rock Ford Crossing (6/15/21)



UT5 Rock Ford Crossing after fencing/gates installed (7/22/21)



UT5 Rock Ford Crossing after fencing/gates installed, looking upstream with interior wire (7/22/21)

Whittier Creek: As-Built MY0 Additional Project Photos



Fencing with CE marker (1/31/22)



Fencing with CE marker located inside (1/31/22)



Fencing with CE marker (1/31/22)



Fencing with CE marker located inside (by the gate at the break on R7) 1/31/22



Fencing with CE marker located inside (1/31/22)



Standalone CE marker on UT4b right bank (1/31/22)

Whittier Creek: As-Built MY0 Additional Project Photos



Flooding from Hurricane Zeta remnants on Upper R7 (10/29/20)



Flooding from Hurricane Zeta remnants on Upper R7 just below bridge (10/29/20)



Flooding from Zeta remnants above the bridge upstream of R7 (10/29/20)



Flooding from Zeta remnants collapsed the bridge immediately upstream of R7 (10/29/20)



The bridge after the flooding subsided (11/4/20)



Looking upstream of the bridge (11/4/20)

Whittier Creek: As-Built MY0 Additional Project Photos



Upper R7 Before Storm (10/14/20)



Upper R7 After Storm (11/4/20)



Upper R7 Before Storm (10/14/20)



Upper R7 After Storm (11/4/20)



Middle R7 Before Storm (10/14/20)



Middle R7 After Storm (11/4/20)

APPENDIX C

Vegetation Plot Data

Table 5. As-Built Planted Stem Counts by Plot and Species
Whittier Creek Mitigation Project - NCDMS Project No. 100020

Scientific Name	Common Name	Whittier Creek Vegetation Plots (MY0 2022)															Annual Means
		Veg Plot 1			Veg Plot 2			Veg Plot 3			Veg Plot 4			RVP-MY0 ¹			MY0 (2022)
		P	V	T	P	V	T	P	V	T	P	V	T	P	V	T	P
<i>Acer negundo</i>	Box Elder				6		6							3		3	9
<i>Betula nigra</i>	River Birch	4		4	6		6			1		1					11
<i>Carpinus caroliniana</i>	Iron Wood	1		1									1		1		2
<i>Celtis laevigata</i>	Sugarberry									1		1					1
<i>Diospyros virginiana</i>	Persimmon	5		5				2		2	1		1				8
<i>Fraxinus pennsylvanica</i>	Green Ash									2		2					2
<i>Hamamelis virginiana</i>	Witch Hazel				4		4			3		3	2		2		9
<i>Juglans nigra</i>	Black Walnut				1		1						1		1		2
<i>Lindera benzoin</i>	Northern Spicebush							1		1	1		1	2		2	4
<i>Liriodendron tulipifera</i>	Tulip Poplar	7		7	8		8	2		2				7		7	24
<i>Nyssa sylvatica</i>	Blackgum									1		1					1
<i>Platanus occidentalis</i>	Sycamore	3		3				2		2	1		1	1		1	7
<i>Quercus lyrata</i>	Overcup Oak	1		1	5		5	4		4	6		6	2		2	18
<i>Quercus michauxii</i>	Swamp Chestnut Oak							3		3							3
<i>Quercus phellos</i>	Willow Oak	4		4	1		1	6		6	9		9	3		3	23
<i>Ulmus americana</i>	American Elm	1		1										1		1	2
	Stems/Plot	26		26	31		31	20		20	26		26	23		23	126
	Plots (ares)	1			1			1			1			1			5
	Plot Size (Acres)	0.025			0.025			0.025			0.025			0.025			0.124
	Species Count	8		8	7		7	7		7	10		10	10		10	16
	Stems/Acre	1,052		1,052	1,255		1,255	809		809	1,052		1,052	931		931	1,020

Color for Stem Density
Exceeds requirements by >10%

P = Planted Stem
V = Volunteer Stem
T = Total Stems

¹ RVP-MY0 is a random vegetation plot that will move locations each monitoring year.

APPENDIX D

Stream Measurement and Geomorphology Data

Table 6. Baseline Stream Data Summary												
Whittier Creek Restoration Project: DMS Project No ID. 100020												
Reach 7 (Whittier Creek)												
Parameter	Pre-Existing Condition			Reference Reach(es) Data			Design			As-built		
				Composite								
Dimension and Substrate - Riffle	Min	Mean	Max	Min	Mean	Max	Min	Mean	Max	Min	Mean	Max
BF Width (ft)	18.5	20.1	21.7	-----	-----	-----	-----	22.2	----	20.5	22.0	22.9
Floodprone Width (ft)	22	23.0	24	-----	-----	-----	50	100	150	75	130	155
BF Mean Depth (ft)	1.8	1.8	1.8	-----	-----	-----	-----	1.8	----	1.6	1.7	1.8
BF Max Depth (ft)	2.2	2.3	2.3	-----	-----	-----	-----	2.3	----	2.4	2.5	2.6
BF Cross-sectional Area (ft²)	33.5	36.2	38.8	-----	-----	-----	-----	41.0	----	36.2	37.7	40.0
Width/Depth Ratio	10.2	11.2	12.1	12.0	13.5	15.0	-----	12.3	----	11.6	12.9	14.2
Entrenchment Ratio	1.1	1.2	1.2	-----	-----	-----	2.3	4.6	6.8	3.3	5.4	7.1
Bank Height Ratio	2.8	3.0	3.2	1.0	1.0	1.0	-----	1.0	----	1.0	1.0	1.0
d50 (mm)	6.4	16	26	-----	-----	-----	-----	-----	-----	44	48	50
Pattern												
Channel Beltwidth (ft)	45	55	65	-----	-----	-----	80	100	120	70	97	120
Radius of Curvature (ft)	25	39	53	-----	-----	-----	36	48	60	41	46	59
Rc/Bankfull width (ft/ft)	1.2	1.8	2.3	2.0	2.5	3.0	1.6	2.4	3.1	1.7	2.1	2.7
Meander Wavelength (ft)	61	125	188	-----	-----	-----	160	180	200	165	183	200
Meander Width Ratio	2.1	2.5	2.8	3.5	5.8	8.0	3.6	4.5	5.4	3.2	4.2	6.2
Profile												
Riffle Length (ft)	-----	-----	-----	-----	-----	-----	-----	-----	-----	21	37	55
Riffle Slope (ft/ft)	0.0030	0.0075	0.0120	-----	-----	-----	0.0057	0.0073	0.0089	0.0028	0.0072	0.0116
Pool Length (ft)	-----	-----	-----	-----	-----	-----	-----	-----	-----	37	65	91
Pool to Pool Spacing (ft)	36	104	172	-----	-----	-----	78	117	155	45	91	144
Pool Max Depth (ft)	3.3	4.15	5	-----	-----	-----	-----	4.0	-----	3.3	4.2	5.3
Substrate and Transport Parameters												
SC% / Sa% / G% / C% / Bo%	0% / 9% / 86% / 5% / 0%			-----	-----	-----	-----	-----	-----	0% / 2% / 63% / 33% / 2%		
d16 / d35 / d50 / d84 / d95	11 / 19 / 26 / 51 / 64			-----	-----	-----	-----	-----	-----	21 / 34 / 48 / 103 / 151		
Additional Reach Parameters												
Drainage Area (SM)	-----	2.69	-----	-----	-----	-----	-----	2.69	---	-----	2.69	-----
Impervious cover estimate (%)	-----	0.95%	-----	-----	-----	-----	-----	-----	-----	-----	-----	-----
Rosgen Classification	-----	G4/F4	-----	-----	C4	-----	-----	C4	-----	-----	C4	-----
BF Velocity (fps)	4.9	5.3	5.7	3.5	4.3	5.0	-----	4.6	-----	-----	-----	-----
BF Discharge (cfs)	-----	190	-----	-----	-----	-----	-----	190	-----	-----	190	-----
Valley Length	-----	1,153	-----	-----	-----	-----	-----	-----	-----	-----	-----	-----
Channel Length (ft)	-----	1,488	-----	-----	-----	-----	-----	1,484	-----	-----	1,495	-----
Sinuosity	-----	1.29	-----	-----	-----	-----	-----	1.21	-----	-----	1.22	-----
Water Surface Slope (Channel) (ft/ft)	-----	0.0051	-----	-----	-----	-----	-----	0.0056	-----	-----	0.0053	-----

Table 6. Baseline Stream Data Summary												
Whittier Creek Restoration Project: DMS Project No ID. 100020												
Reach UT4a												
Parameter	Pre-Existing Condition			Reference Reach(es) Data			Design			As-built		
				Composite								
Dimension and Substrate - Riffle	Min	Mean	Max	Min	Mean	Max	Min	Mean	Max	Min	Mean	Max
BF Width (ft)	----	7.3	----	----	----	----	----	11.0	----	----	10.6	----
Floodprone Width (ft)	----	20	----	----	----	----	----	30	----	----	18	----
BF Mean Depth (ft)	----	1.4	----	----	----	----	----	0.9	----	----	0.9	----
BF Max Depth (ft)	----	1.6	----	----	----	----	----	1.2	----	----	1.5	----
BF Cross-sectional Area (ft ²)	----	9.9	----	----	----	----	----	10.0	----	----	9.9	----
Width/Depth Ratio	----	5.4	----	10.0	12.5	15.0	----	12.2	----	----	12.0	----
Entrenchment Ratio	----	2.7	----	----	----	----	----	2.7	----	----	1.7	----
Bank Height Ratio	----	1.3	----	----	1.0	----	----	1.0	----	----	1.0	----
d50 (mm)	----	27	----	----	----	----	----	----	----	----	42	----
Pattern												
Channel Beltwidth (ft)	----	----	----	----	----	----	----	----	----	----	----	----
Radius of Curvature (ft)	----	----	----	----	----	----	----	----	----	----	----	----
Rc/Bankfull width (ft/ft)	----	----	----	----	----	----	----	----	----	----	----	----
Meander Wavelength (ft)	----	----	----	----	----	----	----	----	----	----	----	----
Meander Width Ratio	----	----	----	----	----	----	----	----	----	----	----	----
Profile												
Riffle Length (ft)	----	----	----	----	----	----	----	----	----	6	13	18
Riffle Slope (ft/ft)	0.026	0.035	0.043	----	----	----	0.026	0.035	0.043	----	0.031	----
Pool Length (ft)	----	----	----	----	----	----	----	----	----	17	33	48
Pool to Pool Spacing (ft)	35	58	80	35	53	70	38	58	77	30	33	35
Pool Max Depth (ft)	1.1	1.9	2.7	----	----	----	----	2.0	----	---	1.6	---
Substrate and Transport Parameters												
SC% / Sa% / G% / C% / B%	0% / 1% / 77% / 22% / 0%			----	----	----	----	----	----	0% / 1% / 69% / 29% / 1%		
d16 / d35 / d50 / d84 / d95	12 / 18 / 27 / 80 / 128			----	----	----	----	----	----	16 / 32 / 42 / 97 / 141		
Additional Reach Parameters												
Drainage Area (SM)	----	0.35	----	----	----	----	----	0.35	----	----	0.35	----
Impervious cover estimate (%)	----	1.28%	----	----	----	----	----	----	----	----	----	----
Rosgen Classification	----	E4/B4	----	----	C4/B4	----	----	B4	----	----	B4	----
BF Velocity (fps)	----	5.0	----	4.0	5.0	6.0	----	5.0	----	----	----	----
BF Discharge (cfs)	----	50	----	----	----	----	----	50	----	----	50	----
Valley Length	----	316	----	----	----	----	----	----	----	----	----	----
Channel Length (ft)	----	338	----	----	----	----	----	328	----	----	334	----
Sinuosity	----	1.1	----	1.1	1.2	1.2	----	1.1	----	----	1.1	----
Water Surface Slope (Channel) (ft/ft)	----	0.024	----	----	----	----	----	0.024	----	----	0.021	----

* The As-Built parameters shown here apply only to those surveyed sections of Reach UT4a where the channel was improved in its cross-section, profile, and in-stream structures.


Table 6. Baseline Stream Data Summary												
Whittier Creek Restoration Project: DMS Project No ID. 100020												
Reach UT4b												
Parameter	Pre-Existing Condition			Reference Reach(es) Data			Design			As-built		
				Composite								
Dimension and Substrate - Riffle	Min	Mean	Max	Min	Mean	Max	Min	Mean	Max	Min	Mean	Max
BF Width (ft)	9.5	9.8	10.1	-----	-----	-----	-----	12.7	-----	-----	13.7	-----
Floodprone Width (ft)	13	18.0	23	-----	-----	-----	30	45	60	-----	49	-----
BF Mean Depth (ft)	1.0	1.2	1.4	-----	-----	-----	-----	1.0	-----	-----	1.1	-----
BF Max Depth (ft)	1.2	1.7	2.2	-----	-----	-----	-----	1.2	-----	-----	1.6	-----
BF Cross-sectional Area (ft²)	9.5	11.8	14.0	-----	-----	-----	-----	13.0	-----	-----	14.9	-----
Width/Depth Ratio	7.3	8.5	9.6	12.0	13.5	15.0	-----	12.7	-----	-----	12.6	-----
Entrenchment Ratio	1.3	1.8	2.3	-----	-----	-----	2.4	3.6	4.7	-----	3.6	-----
Bank Height Ratio	2.0	2.1	2.1	-----	1.0	-----	-----	1.0	-----	-----	1.0	-----
d50 (mm)	----	26	----	-----	-----	-----	-----	-----	-----	-----	46	-----
Pattern												
Channel Beltwidth (ft)	-----	-----	-----	-----	-----	-----	45	48	50	36	46	53
Radius of Curvature (ft)	-----	-----	-----	-----	-----	-----	25	51	77	26	33	54
Rc/Bankfull width (ft/ft)	-----	-----	-----	2.0	2.5	3.0	2.0	4.1	6.1	2.0	3.1	4.1
Meander Wavelength (ft)	-----	-----	-----	-----	-----	-----	119	142	165	120	126	145
Meander Width Ratio	-----	-----	-----	3.5	5.8	8.0	3.5	3.7	3.9	2.8	3.6	4.1
Profile												
Riffle Length (ft)	-----	-----	-----	-----	-----	-----	-----	-----	-----	19	24	36
Riffle Slope (ft/ft)	0.015	0.028	0.040	-----	-----	-----	0.011	0.018	0.025	0.007	0.016	0.022
Pool Length (ft)	-----	-----	-----	-----	-----	-----	-----	-----	-----	13	39	62
Pool to Pool Spacing (ft)	30	60	90	-----	-----	-----	45	67	89	28	60	94
Pool Max Depth (ft)	2.4	3.4	4.3	-----	-----	-----	-----	2.5	-----	2.4	2.8	3.7
Substrate and Transport Parameters												
SC% / Sa% / G% / C% / B%	0% / 9% / 83% / 8% / 0%			-----	-----	-----	-----	-----	-----	0% / 3% / 66% / 27% / 4%		
d16 / d35 / d50 / d84 / d95	8.4 / 16 / 26 / 52 / 76			-----	-----	-----	-----	-----	-----	22 / 36 / 46 / 101 / 179		
Additional Reach Parameters												
Drainage Area (SM)	-----	0.48	-----	-----	-----	-----	-----	0.48	-----	-----	0.48	-----
Impervious cover estimate (%)	-----	1.30%	-----	-----	-----	-----	-----	-----	-----	-----	-----	-----
Rosgen Classification	-----	E4/G4	-----	-----	C4	-----	-----	C4	-----	-----	C4	-----
BF Velocity (fps)	4.7	5.8	6.9	3.5	4.3	5.0	-----	5.0	-----	-----	-----	-----
BF Discharge (cfs)	-----	65	-----	-----	-----	-----	-----	65	-----	-----	65	-----
Valley Length	-----	675	-----	-----	-----	-----	-----	622	-----	-----	622	-----
Channel Length (ft)	-----	764	-----	-----	-----	-----	-----	801	-----	-----	803	-----
Sinuosity	-----	1.13	-----	-----	-----	-----	-----	1.29	-----	-----	1.29	-----
Water Surface Slope (Channel) (ft/ft)	-----	0.0165	-----	-----	-----	-----	-----	0.0141	-----	-----	0.0136	-----


Table 6. Baseline Stream Data Summary												
Whittier Creek Restoration Project: DMS Project No ID. 100020												
Reach UT5												
Parameter	Pre-Existing Condition			Reference Reach(es) Data			Design			As-built		
				Composite								
Dimension and Substrate - Riffle	Min	Mean	Max	Min	Mean	Max	Min	Mean	Max	Min	Mean	Max
BF Width (ft)	7.8	7.9	8.0	-----	-----	-----	-----	8.1	----	-----	9.1	-----
Floodprone Width (ft)	15	17.0	19	-----	-----	-----	14	17	20	-----	31	-----
BF Mean Depth (ft)	0.7	0.7	0.7	-----	-----	-----	-----	0.6	----	-----	0.6	-----
BF Max Depth (ft)	2.3	2.6	2.8	1.2	1.4	1.5	-----	1.2	----	-----	0.9	-----
BF Cross-sectional Area (ft²)	5.1	5.3	5.5	-----	-----	-----	-----	5.0	----	-----	5.9	-----
Width/Depth Ratio	11.1	11.3	11.4	12	15	18	-----	13.0	----	-----	14.3	-----
Entrenchment Ratio	2.0	2.2	2.4	-----	-----	-----	1.7	2.1	2.5	-----	3.3	-----
Bank Height Ratio	1.4	1.8	2.2	-----	1.0	-----	-----	1.0	----	-----	1.0	-----
d50 (mm)	----	21	----	-----	-----	-----	-----	-----	-----	-----	44	-----
Pattern												
Channel Beltwidth (ft)	-----	-----	-----	-----	-----	-----	-----	-----	-----	15	16	20
Radius of Curvature (ft)	-----	-----	-----	-----	-----	-----	-----	-----	-----	-----	-----	-----
Rc/Bankfull width (ft/ft)	-----	-----	-----	-----	-----	-----	-----	-----	-----	-----	-----	-----
Meander Wavelength (ft)	-----	-----	-----	-----	-----	-----	-----	-----	-----	90	124	150
Meander Width Ratio	-----	-----	-----	-----	-----	-----	-----	-----	-----	-----	-----	-----
Profile												
Riffle Length (ft)	-----	-----	-----	-----	-----	-----	-----	-----	----	7	24	57
Riffle Slope (ft/ft)	0.026	0.034	0.041	-----	-----	-----	0.013	0.025	0.037	0.011	0.020	0.039
Pool Length (ft)	-----	-----	-----	-----	-----	-----	-----	-----	----	7	13	33
Pool to Pool Spacing (ft)	22	81	139	-----	-----	-----	15	28	40	24	33	44
Pool Max Depth (ft)	1.6	2.0	2.3	-----	-----	----	-----	1.5	----	0.8	1.7	2.7
Substrate and Transport Parameters												
SC% / Sa% / G% / C% / B%	3% / 11% / 72% / 14% / 0%			-----	-----	-----	-----	-----	-----	0% / 0% / 65% / 34% / 1%		
d16 / d35 / d50 / d84 / d95	5.6 / 12 / 21 / 57 / 104			-----	-----	-----	-----	-----	-----	23 / 33 / 44 / 109 / 169		
Additional Reach Parameters												
Drainage Area (SM)	-----	0.11	-----	-----	-----	-----	-----	0.11	-----	-----	0.11	-----
Impervious cover estimate (%)	-----	1.47%	-----	-----	-----	-----	-----	-----	-----	-----	-----	-----
Rosgen Classification	-----	B4	-----	-----	B4	-----	-----	B4	-----	-----	B4	-----
BF Velocity (fps)	3.6	3.8	3.9	4.0	5.0	6.0	-----	4.0	-----	-----	-----	-----
BF Discharge (cfs)	-----	20	-----	-----	-----	-----	-----	20	-----	-----	20	-----
Valley Length	-----	740	-----	-----	-----	-----	-----	740	-----	-----	740	-----
Channel Length (ft)	-----	765	-----	-----	-----	-----	-----	787	-----	-----	792	-----
Sinuosity	-----	1.03	-----	1.10	1.15	1.20	-----	1.06	-----	-----	1.07	-----
Water Surface Slope (Channel) (ft/ft)	-----	0.0250	-----	0.020	0.025	0.030	-----	0.024	-----	-----	0.024	-----

Table 7. Cross-Section Morphology Data Summary
Whittier Creek Restoration Project: DMS Project No ID. 100020

Stream Reach	Reach 7 (Whittier Creek)																												
	Cross-section X-1 (Riffle)							Cross-section X-2 (Pool)							Cross-section X-3 (Riffle)							Cross-section X-4 (Pool)							
Dimension and substrate	Base	MY1	MY2	MY3	MY4	MY5	MY+	Base	MY1	MY2	MY3	MY4	MY5	MY+	Base	MY1	MY2	MY3	MY4	MY5	MY+	Base	MY1	MY2	MY3	MY4	MY5	MY+	
Based on fixed baseline bankfull elevation																													
BF Width (ft)	20.5							26.4							22.9							23.7							
BF Mean Depth (ft)	1.8							1.9							1.6							1.8							
Width/Depth Ratio	11.6							14.0							14.2							13.0							
BF Cross-sectional Area (ft²)	36.2							49.5							36.9							43.0							
BF Max Depth (ft)	2.5							3.8							2.4							3.1							
Width of Floodprone Area (ft)	145							155							135							140							
Entrenchment Ratio	7.1							-							5.9							-							
Bank Height Ratio	1.0							-							1.0							-							
Wetted Perimeter (ft)	21.5							28.0							23.8							25.3							
Hydraulic Radius (ft)	1.7							1.8							1.6							1.7							
d50 (mm)	49							-							44							-							
Stream Reach	Reach 7 (Whittier Creek)							Reach UT4a							Reach UT4b														
Dimension and substrate	Cross-section X-5 (Riffle)							Cross-section X-6 (Riffle)							Cross-section X-7 (Pool)							Cross-section X-8 (Riffle)							
Based on fixed baseline bankfull elevation	Base	MY1	MY2	MY3	MY4	MY5	MY+	Base	MY1	MY2	MY3	MY4	MY5	MY+	Base	MY1	MY2	MY3	MY4	MY5	MY+	Base	MY1	MY2	MY3	MY4	MY5	MY+	
BF Width (ft)	22.6							10.6							14.6							13.7							
BF Mean Depth (ft)	1.8							0.9							1.5							1.1							
Width/Depth Ratio	12.8							12.0							9.9							12.6							
BF Cross-sectional Area (ft²)	40.0							9.9							21.5							14.9							
BF Max Depth (ft)	2.6							1.5							2.4							1.6							
Width of Floodprone Area (ft)	75							18							48							49							
Entrenchment Ratio	3.3							1.7							-							3.6							
Bank Height Ratio	1.0							1.0							-							1.0							
Wetted Perimeter (ft)	23.6							11.2							16.0							14.3							
Hydraulic Radius (ft)	1.7							0.9							1.4							1.0							
d50 (mm)	50							42							-							46							
Stream Reach	Reach UT4b							Reach UT5																					
Dimension and substrate	Cross-section X-9 (Pool)							Cross-section X-10 (Riffle)							Cross-section X-11 (Pool)														
Based on fixed baseline bankfull elevation	Base	MY1	MY2	MY3	MY4	MY5	MY+	Base	MY1	MY2	MY3	MY4	MY5	MY+	Base	MY1	MY2	MY3	MY4	MY5	MY+								
BF Width (ft)	13.5							9.1							7.9														
BF Mean Depth (ft)	1.6							0.6							1.3														
Width/Depth Ratio	8.4							14.3							6.0														
BF Cross-sectional Area (ft²)	21.7							5.9							10.4														
BF Max Depth (ft)	2.7							0.9							1.9														
Width of Floodprone Area (ft)	54							30							46														
Entrenchment Ratio	-							3.3							-														
Bank Height Ratio	-							1.0							-														
Wetted Perimeter (ft)	15.3							9.5							9.3														
Hydraulic Radius (ft)	1.4							0.6							1.1														
d50 (mm)	-							44							-														

Figure 4. Longitudinal Profiles

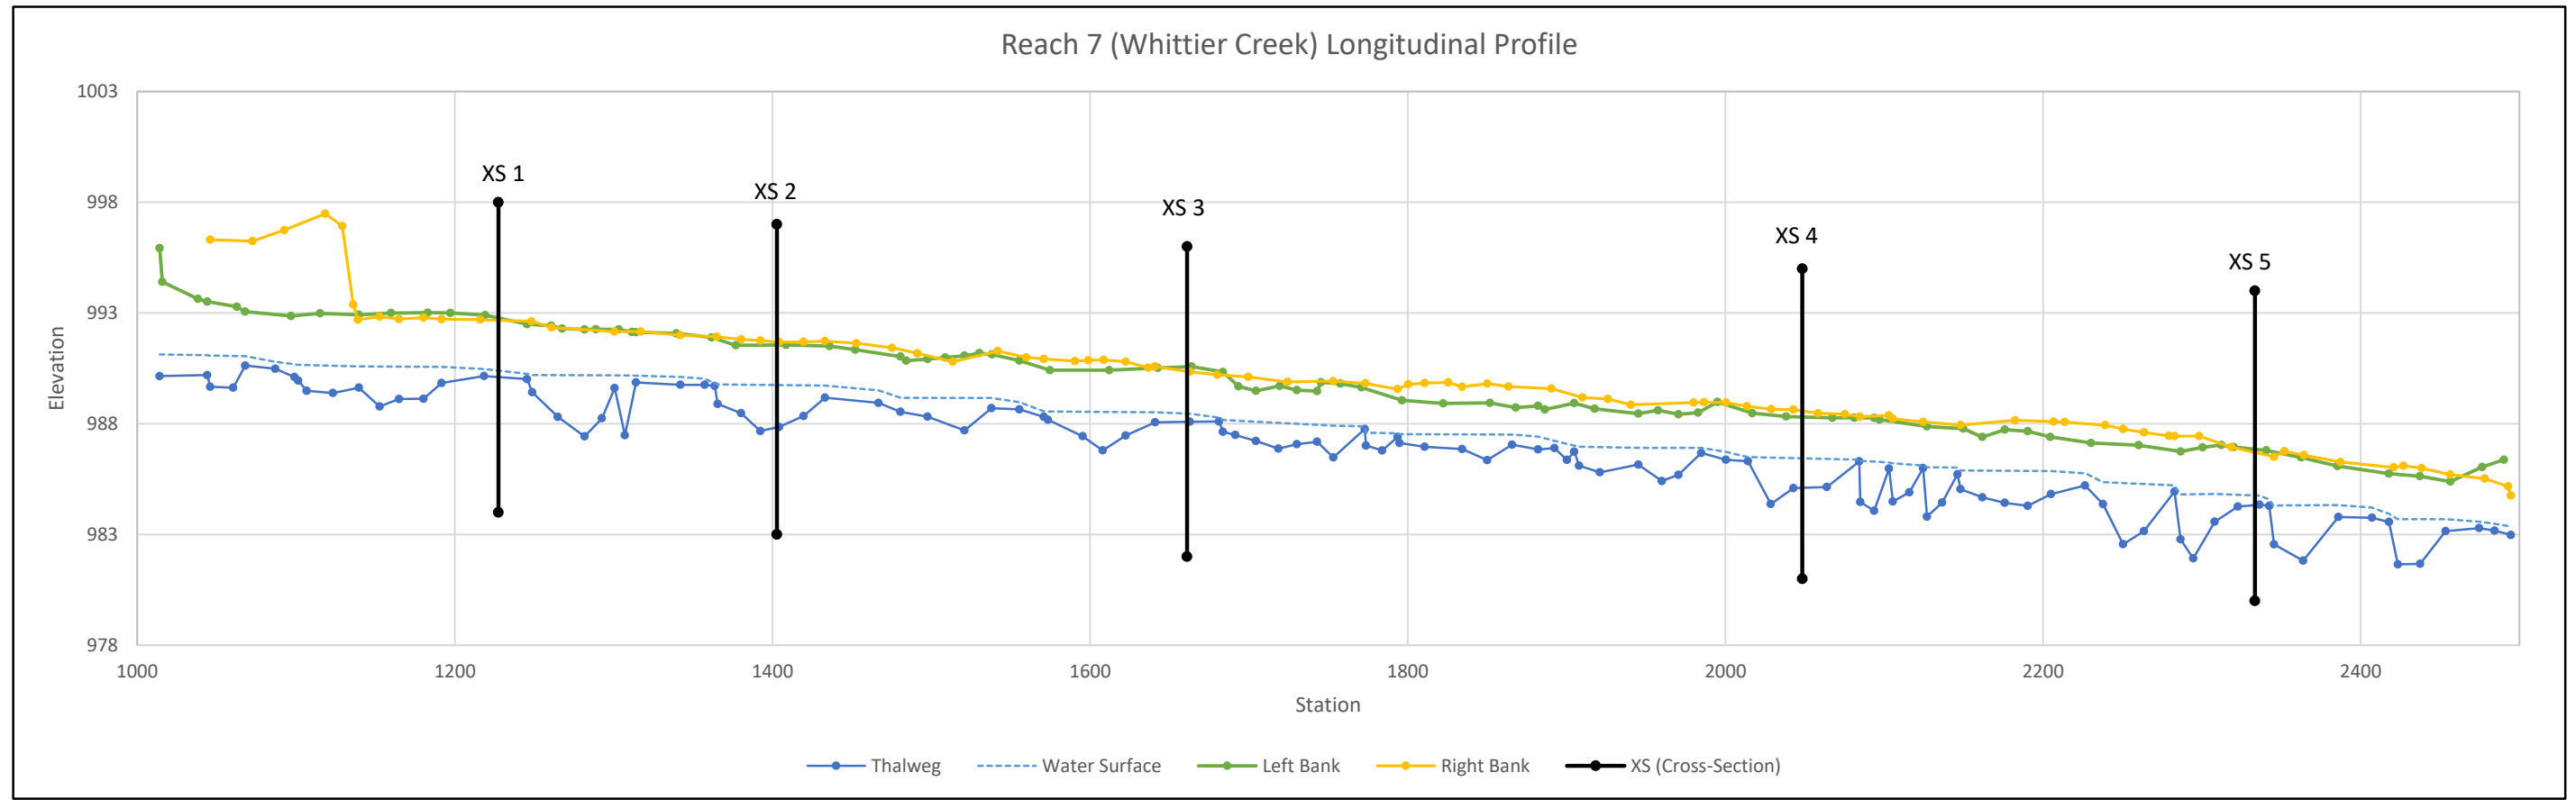

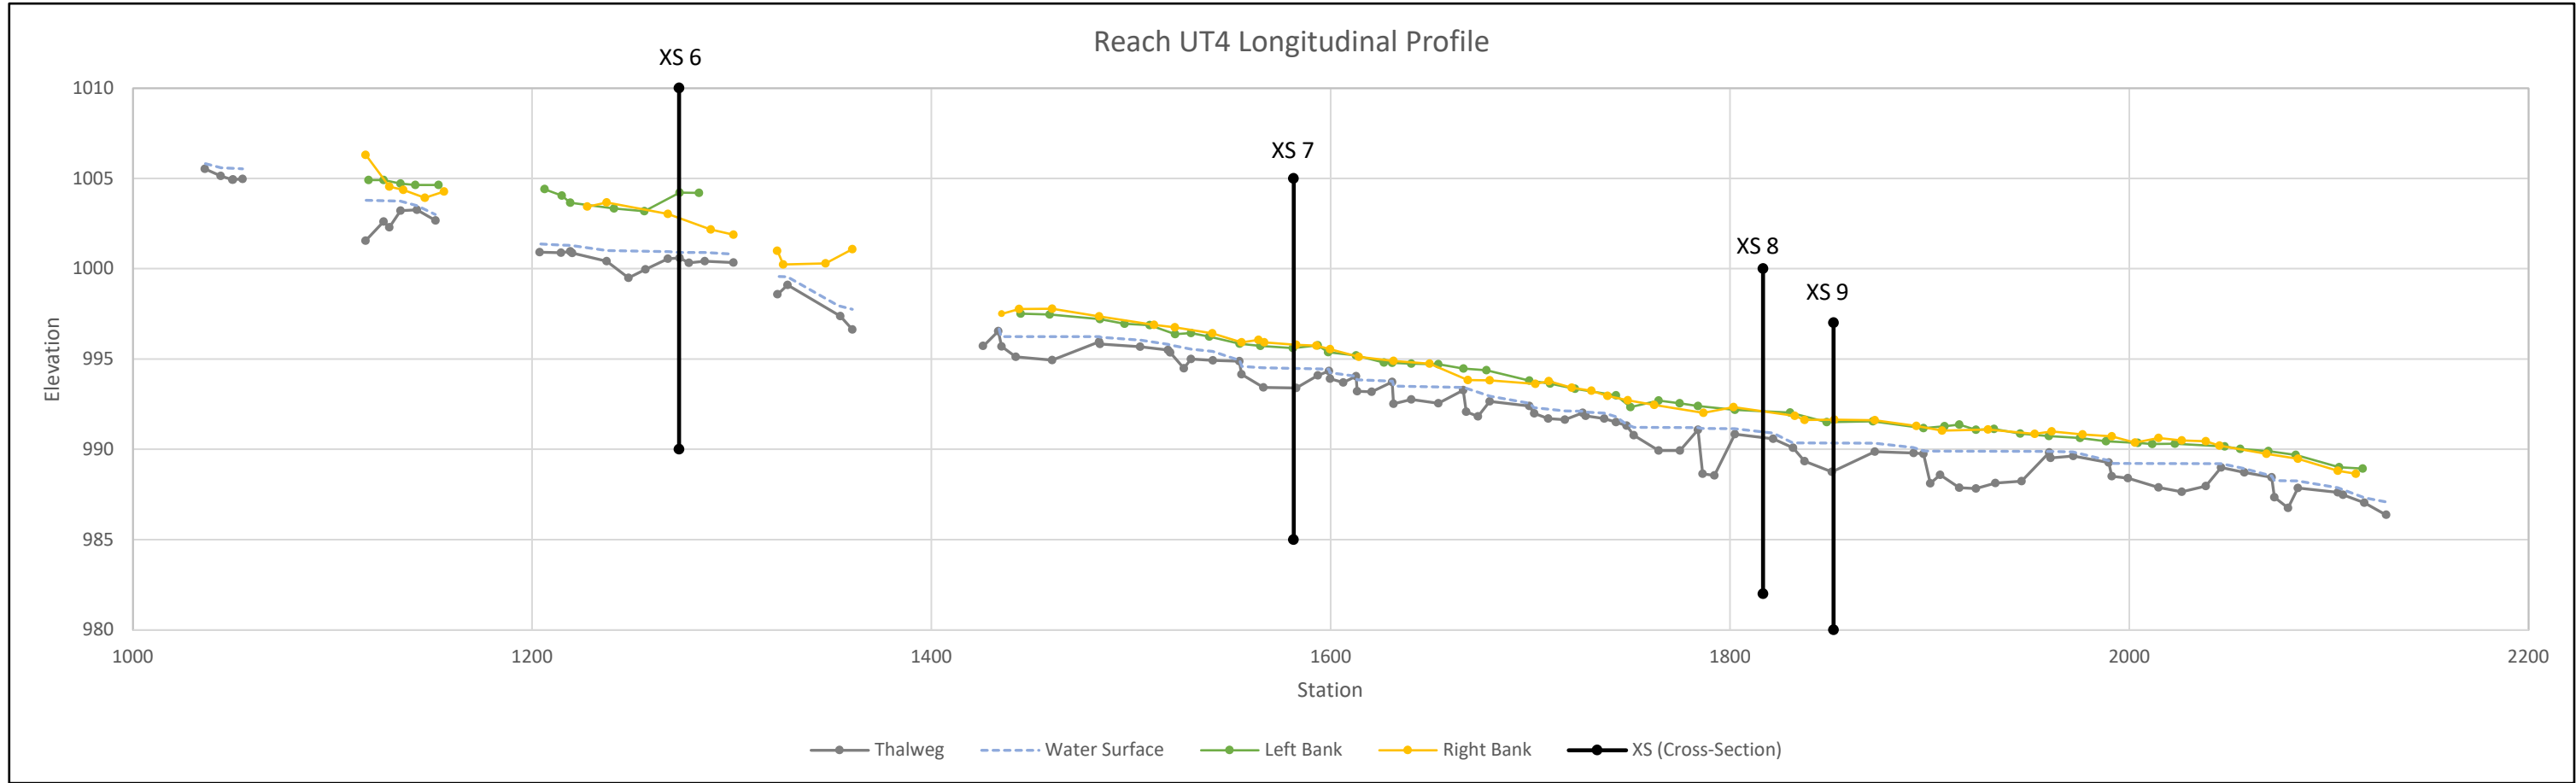

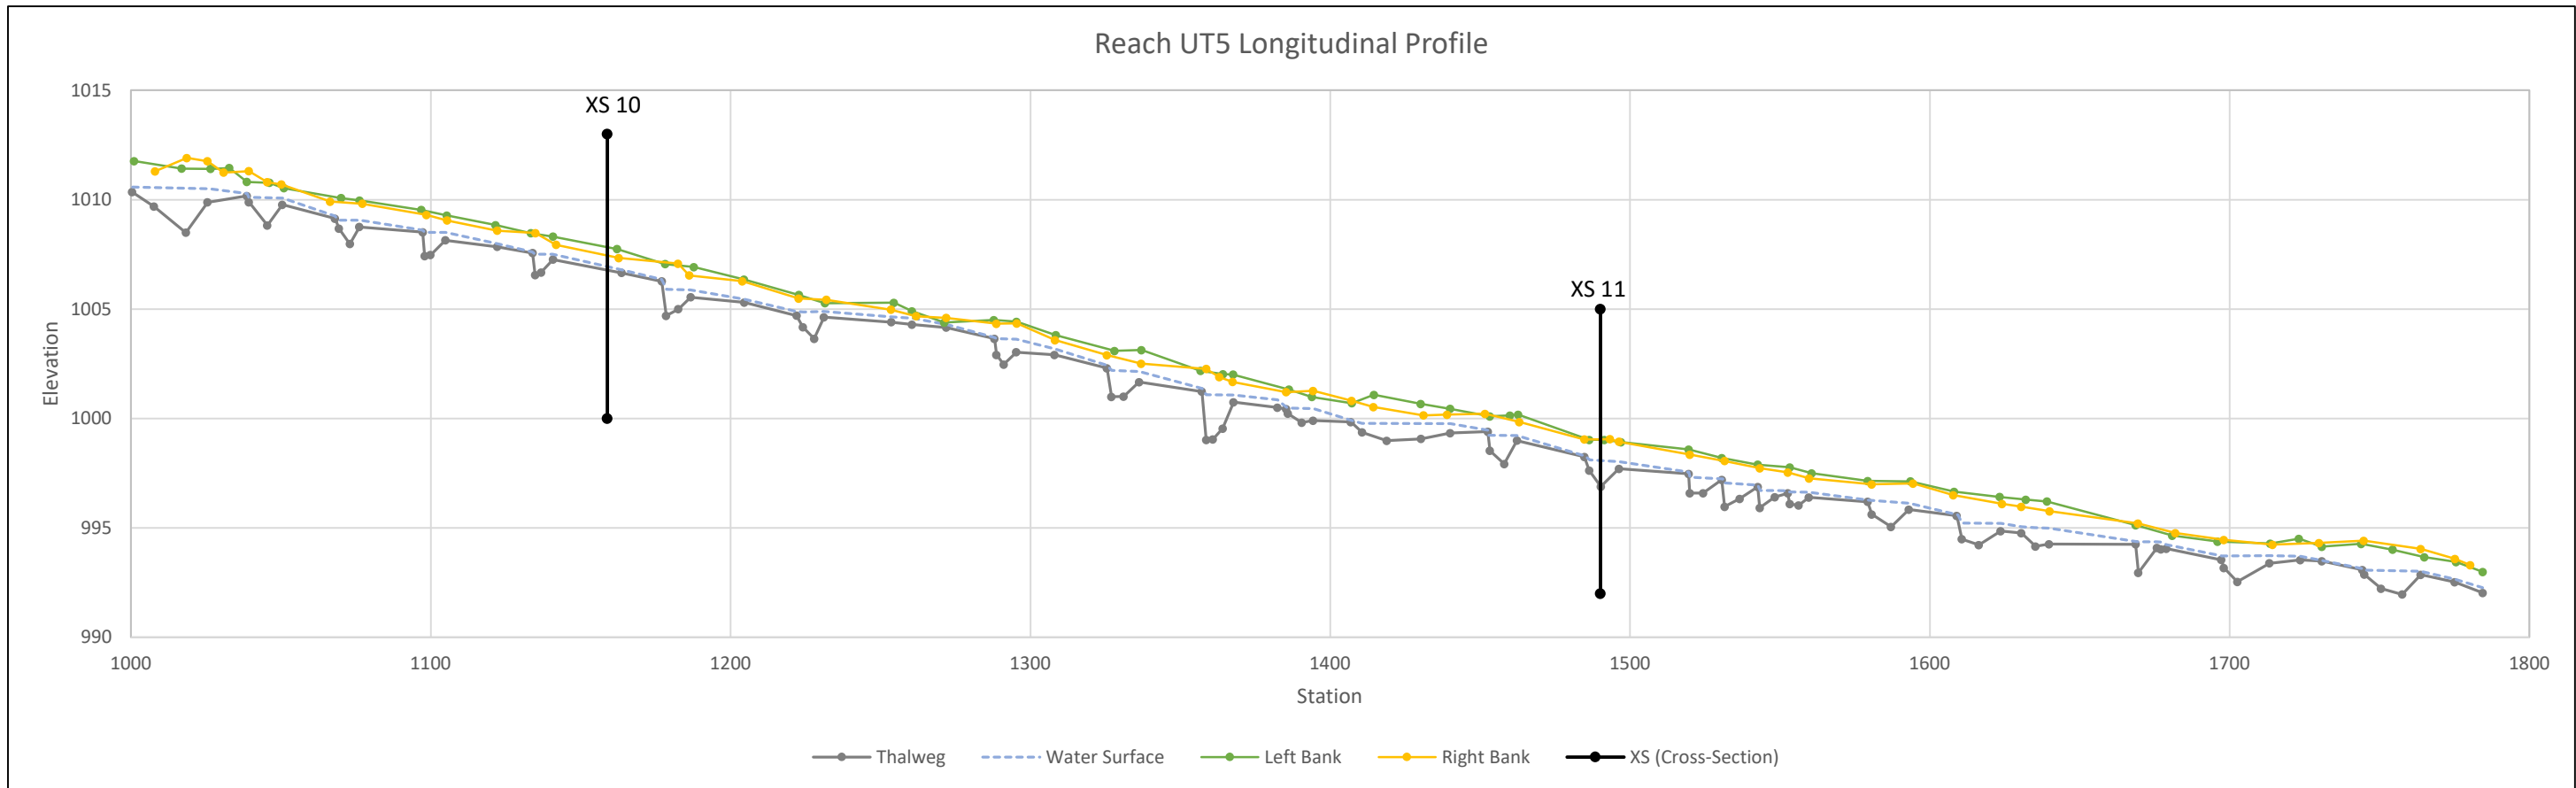


Figure 5. MY0 Cross-Sections

Permanent Cross-Section 1

(As-built Survey Data Collected: August 2021)




Looking at the Left Bank



Looking at the Right Bank

Feature	Stream Type	BKF Area	BKF Width	BKF Depth	Max BKF Depth	W/D	BH Ratio	ER	BKF Elev	TOB Elev
Riffle	C	36.2	20.5	1.8	2.5	11.6	1.0	7.1	992.48	992.48

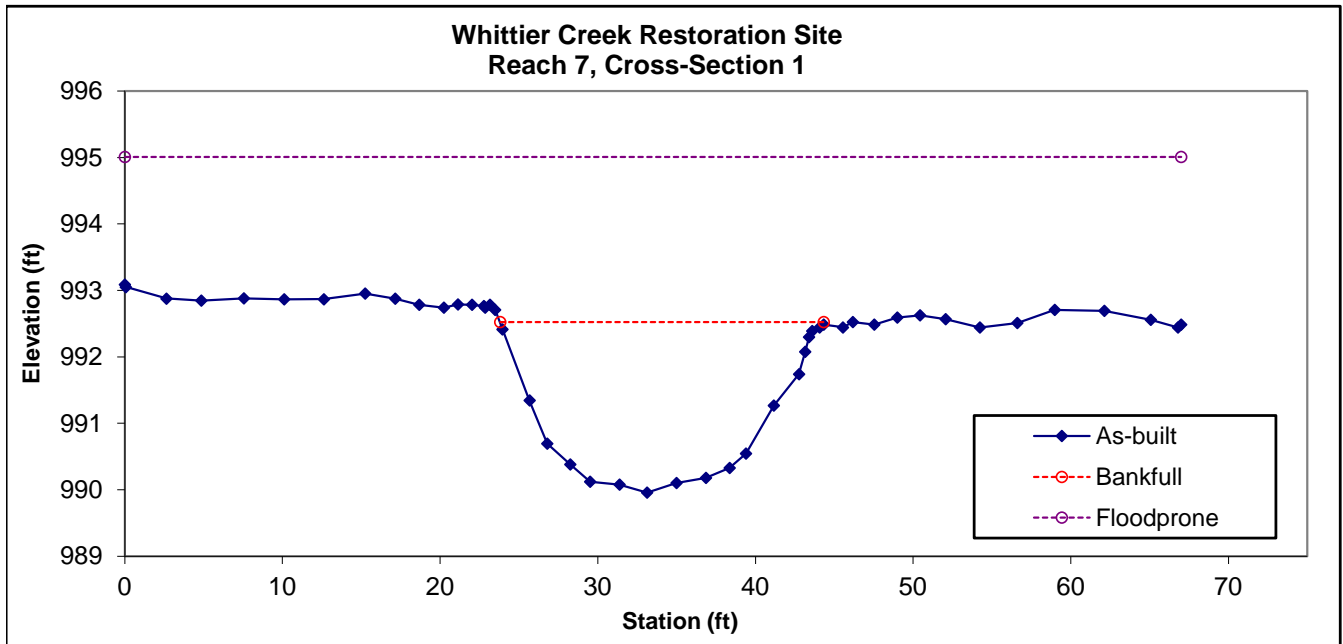

Permanent Cross-Section 2
(As-built Survey Data Collected: August 2021)




Looking at the Left Bank



Looking at the Right Bank

Feature	Stream Type	BKF Area	BKF Width	BKF Depth	Max BKF Depth	W/D	BH Ratio	ER	BKF Elev	TOB Elev
Pool	-	49.5	26.4	1.9	3.8	14.0	-	-	991.75	991.75

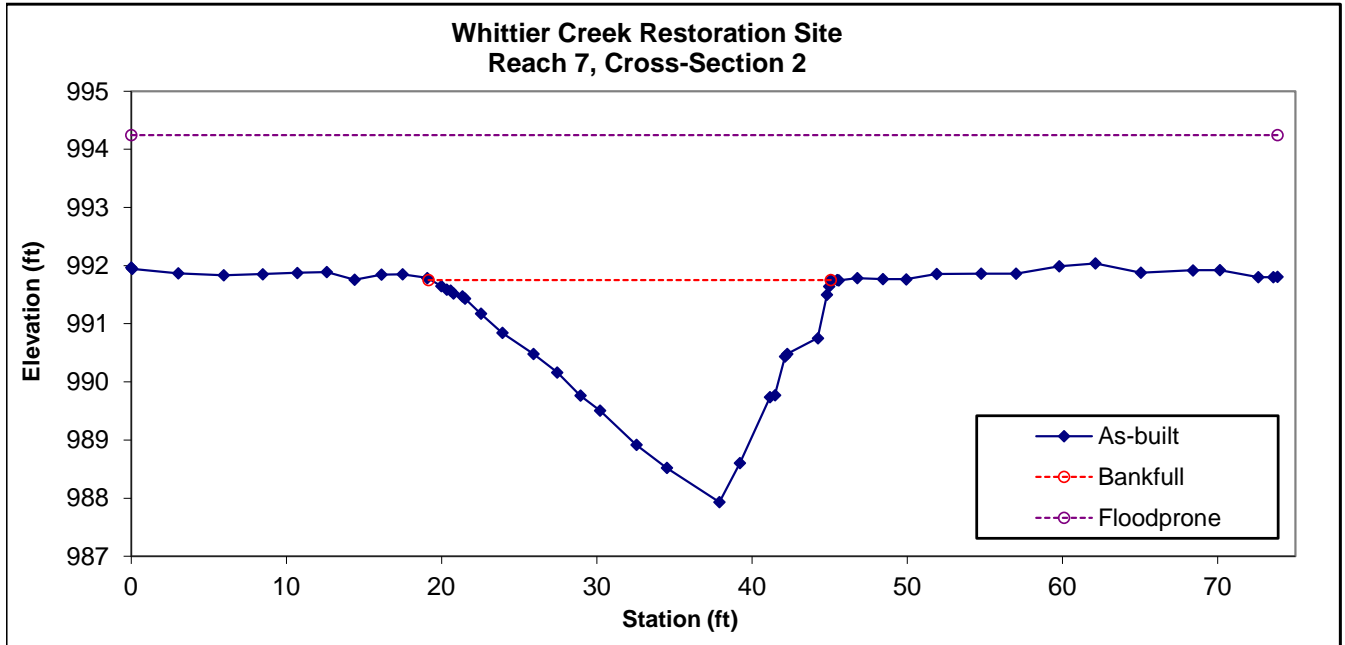

Permanent Cross-Section 3
 (As-built Survey Data Collected: August 2021)




Looking at the Left Bank



Looking at the Right Bank

Feature	Stream Type	BKF Area	BKF Width	BKF Depth	Max BKF Depth	W/D	BH Ratio	ER	BKF Elev	TOB Elev
Riffle	C	36.9	22.9	1.6	2.4	14.2	1.0	5.9	990.44	990.44

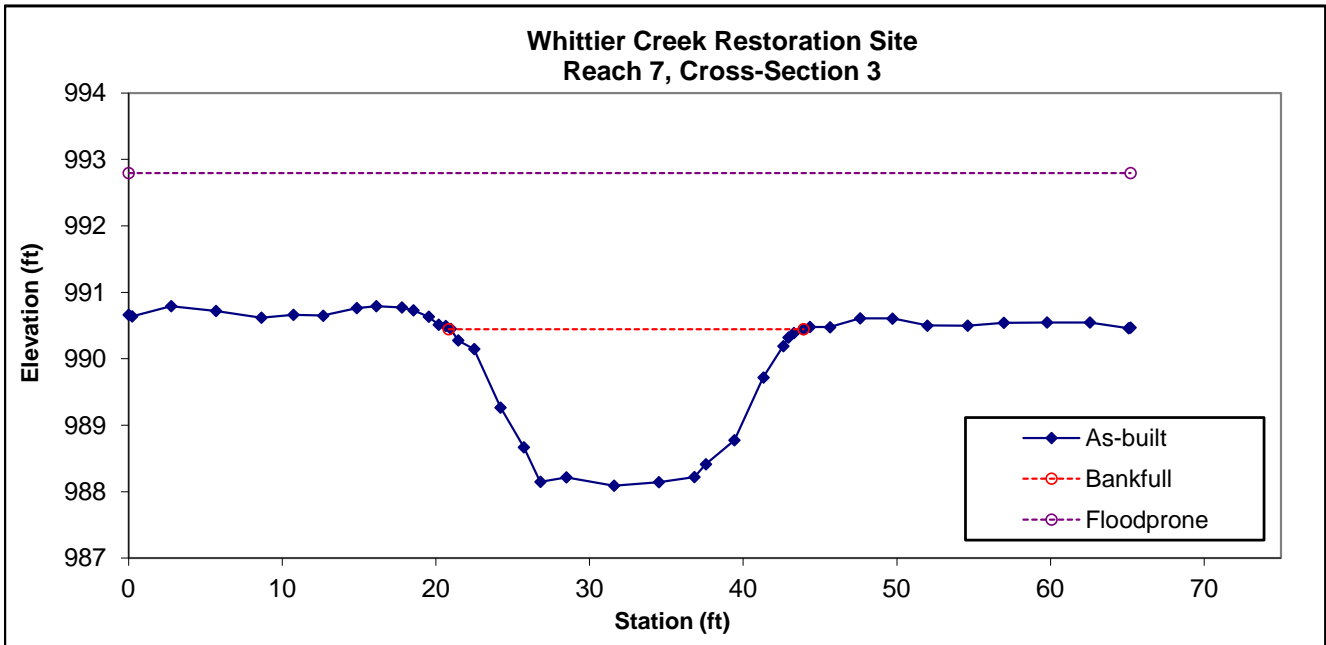

Permanent Cross-Section 4
 (As-built Survey Data Collected: August 2021)




Looking at the Left Bank



Looking at the Right Bank

Feature	Stream Type	BKF Area	BKF Width	BKF Depth	Max BKF Depth	W/D	BH Ratio	ER	BKF Elev	TOB Elev
Pool	-	43	23.7	1.8	3.1	13.0	-	-	988.47	988.47

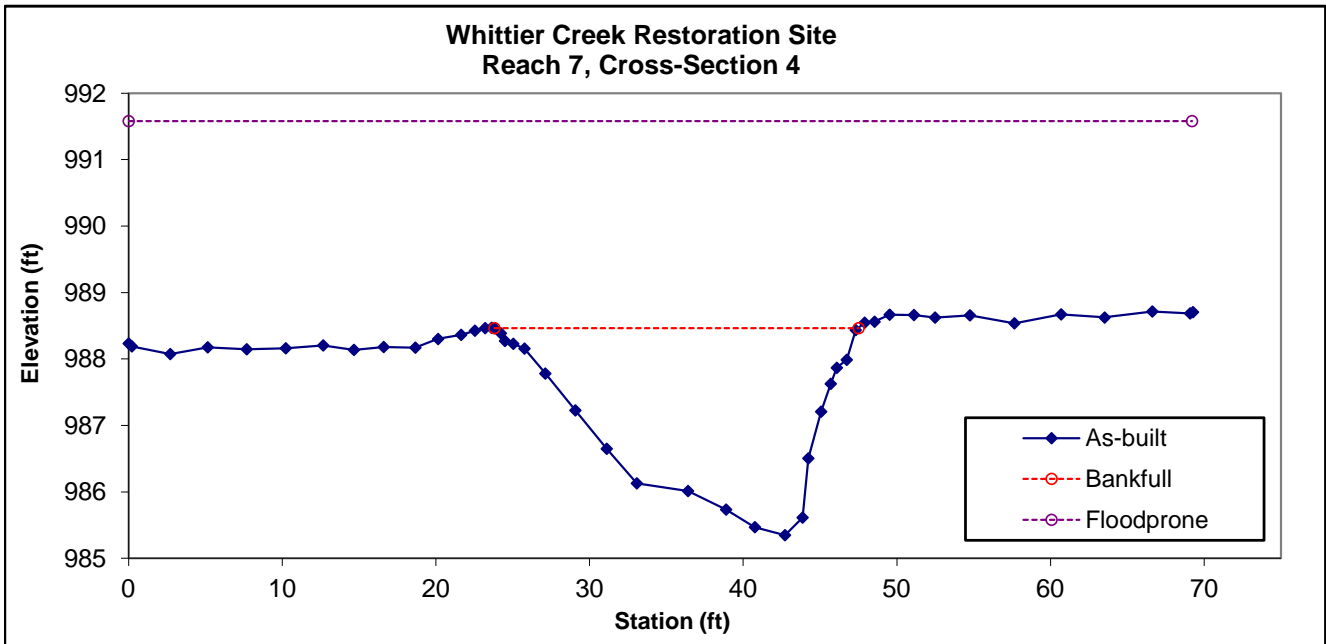

Permanent Cross-Section 5
(As-built Survey Data Collected: August 2021)




Looking at the Left Bank



Looking at the Right Bank

Feature	Stream Type	BKF Area	BKF Width	BKF Depth	Max BKF Depth	W/D	BH Ratio	ER	BKF Elev	TOB Elev
Riffle	C	40	22.6	1.8	2.6	12.8	1.0	3.3	986.8	986.8

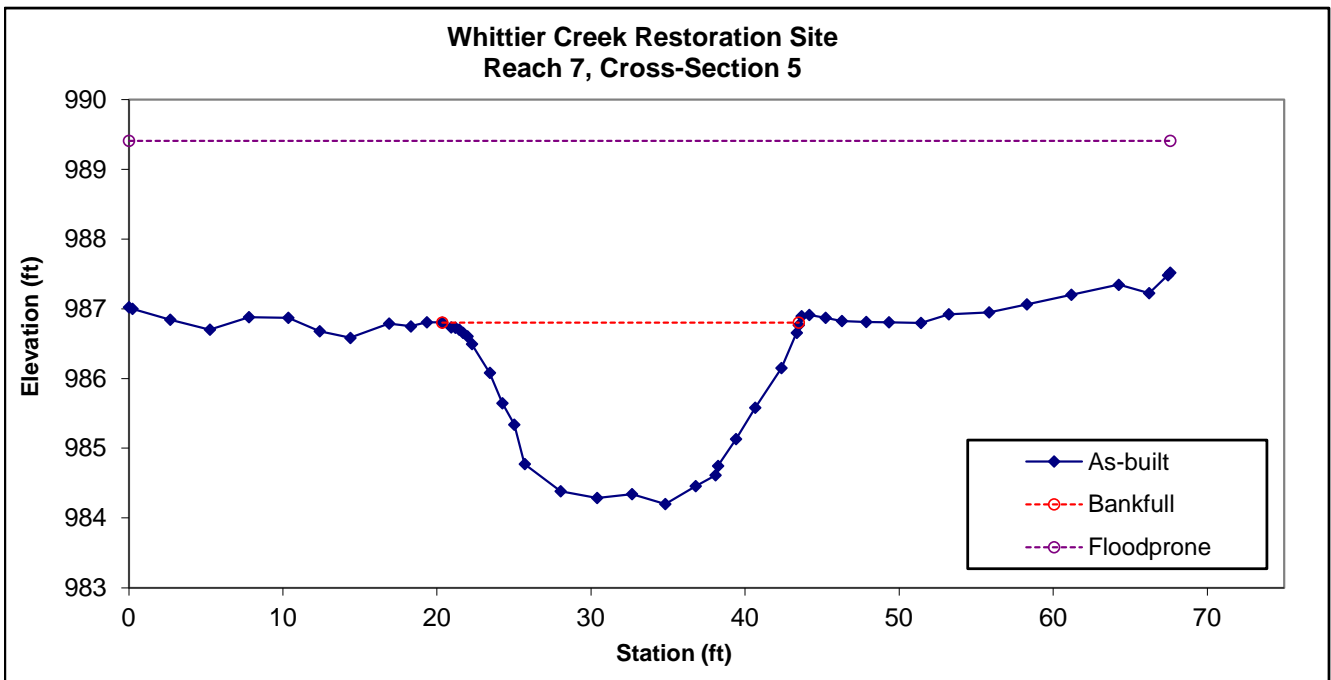

Permanent Cross-Section 6
(As-built Survey Data Collected: August 2021)




Looking at the Left Bank



Looking at the Right Bank

Feature	Stream Type	BKF Area	BKF Width	BKF Depth	Max BKF Depth	W/D	BH Ratio	ER	BKF Elev	TOB Elev
Riffle	B	9.9	10.6	0.9	1.5	12	1.0	1.7	1004.36	1004.36

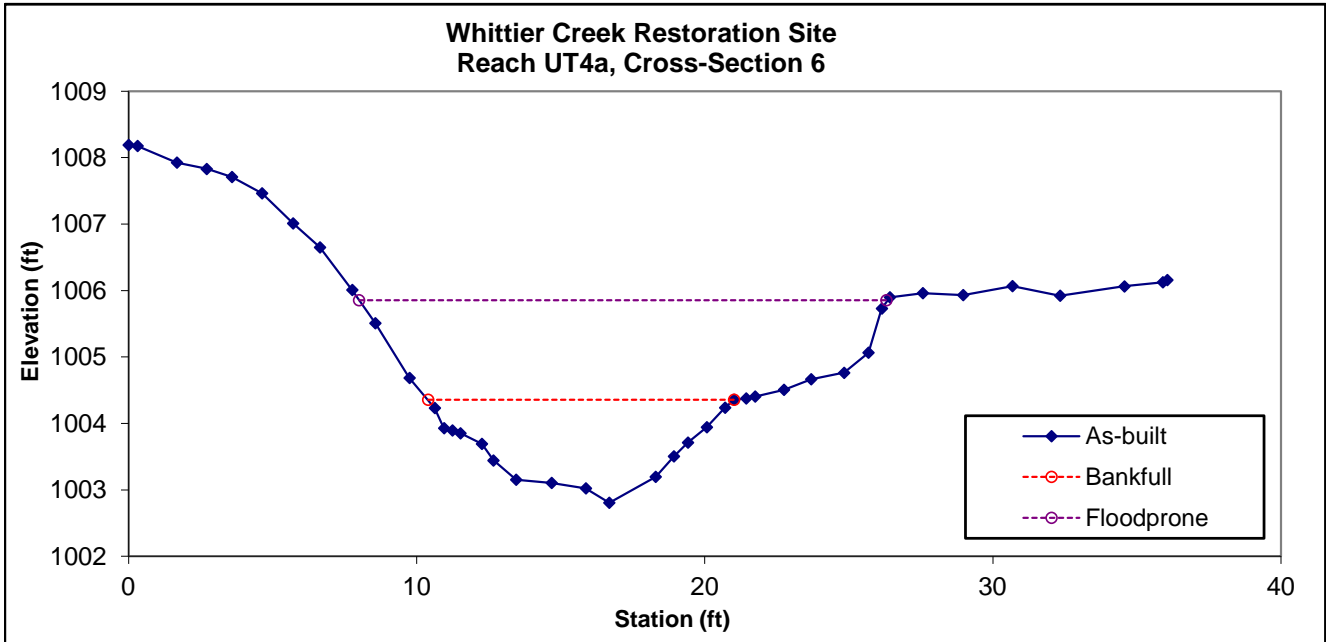

Permanent Cross-Section 7
 (As-built Survey Data Collected: August 2021)




Looking at the Left Bank



Looking at the Right Bank

Feature	Stream Type	BKF Area	BKF Width	BKF Depth	Max BKF Depth	W/D	BH Ratio	ER	BKF Elev	TOB Elev
Pool	-	21.5	14.6	1.5	2.4	9.9	-	-	995.72	995.72

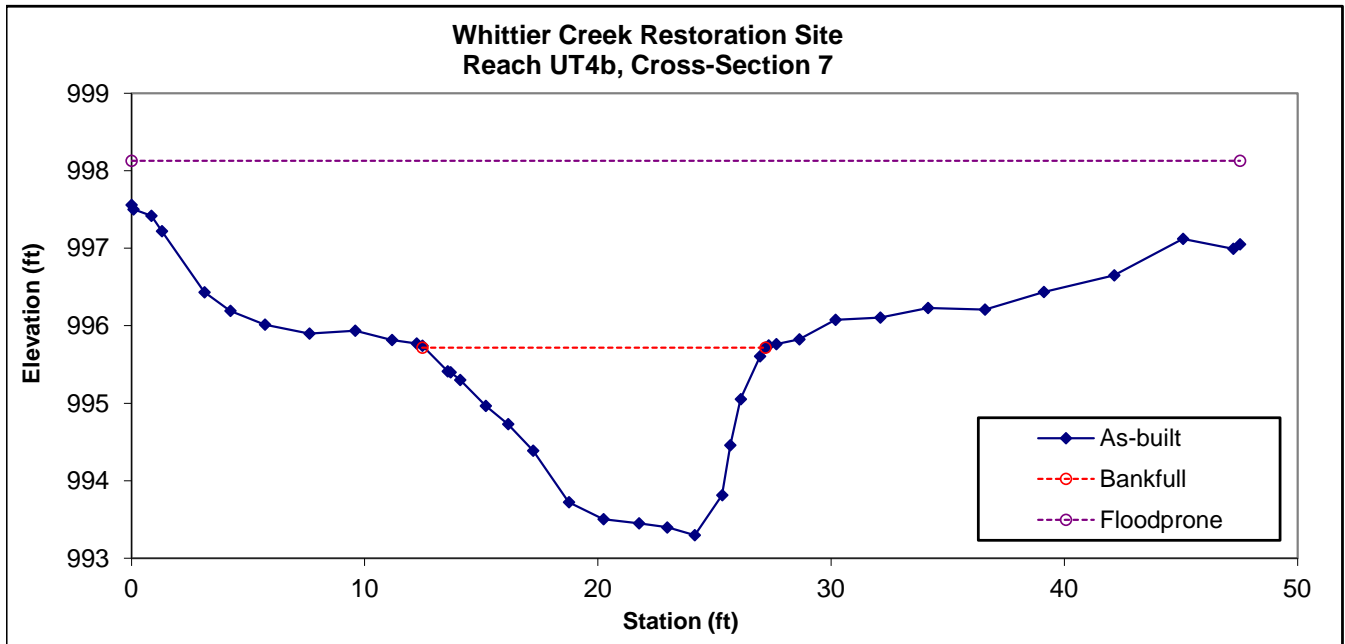

Permanent Cross-Section 8
 (As-built Survey Data Collected: August 2021)




Looking at the Left Bank



Looking at the Right Bank

Feature	Stream Type	BKF Area	BKF Width	BKF Depth	Max BKF Depth	W/D	BH Ratio	ER	BKF Elev	TOB Elev
Riffle	C	14.9	13.7	1.1	1.6	12.6	1.0	3.6	992.24	992.24

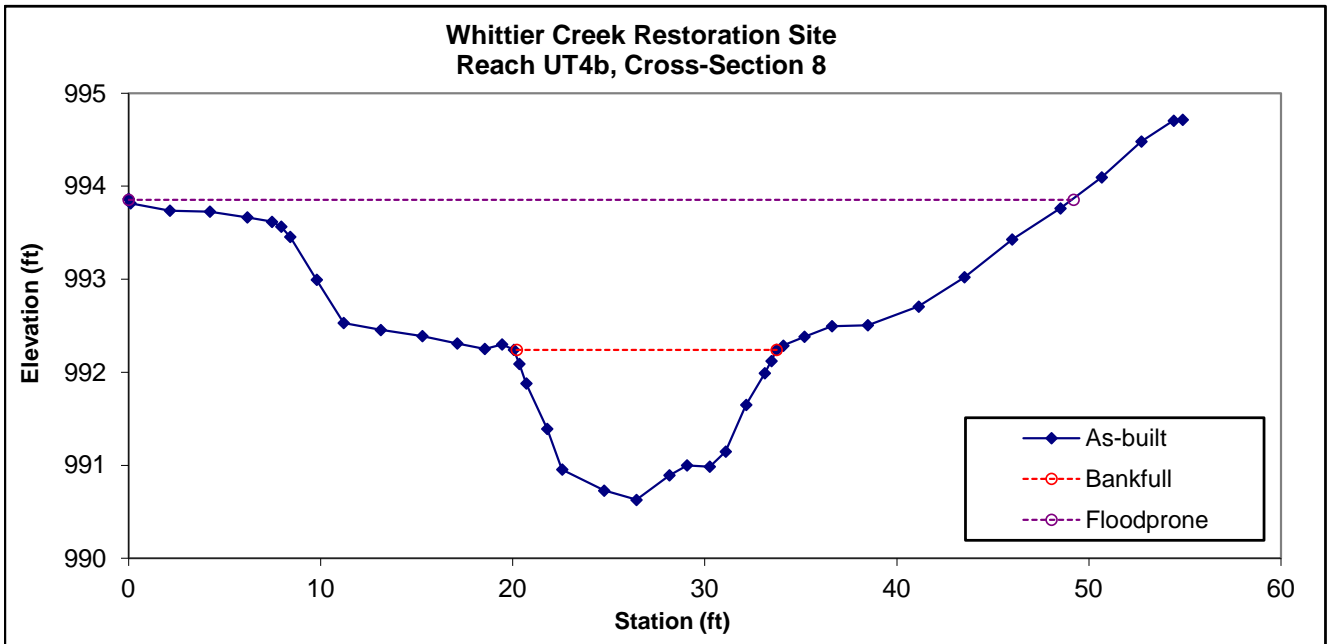

Permanent Cross-Section 9
 (As-built Survey Data Collected: August 2021)




Looking at the Left Bank



Looking at the Right Bank

Feature	Stream Type	BKF Area	BKF Width	BKF Depth	Max BKF Depth	W/D	BH Ratio	ER	BKF Elev	TOB Elev
Pool	-	21.7	13.5	1.6	2.7	8.4	-	-	991.50	991.50

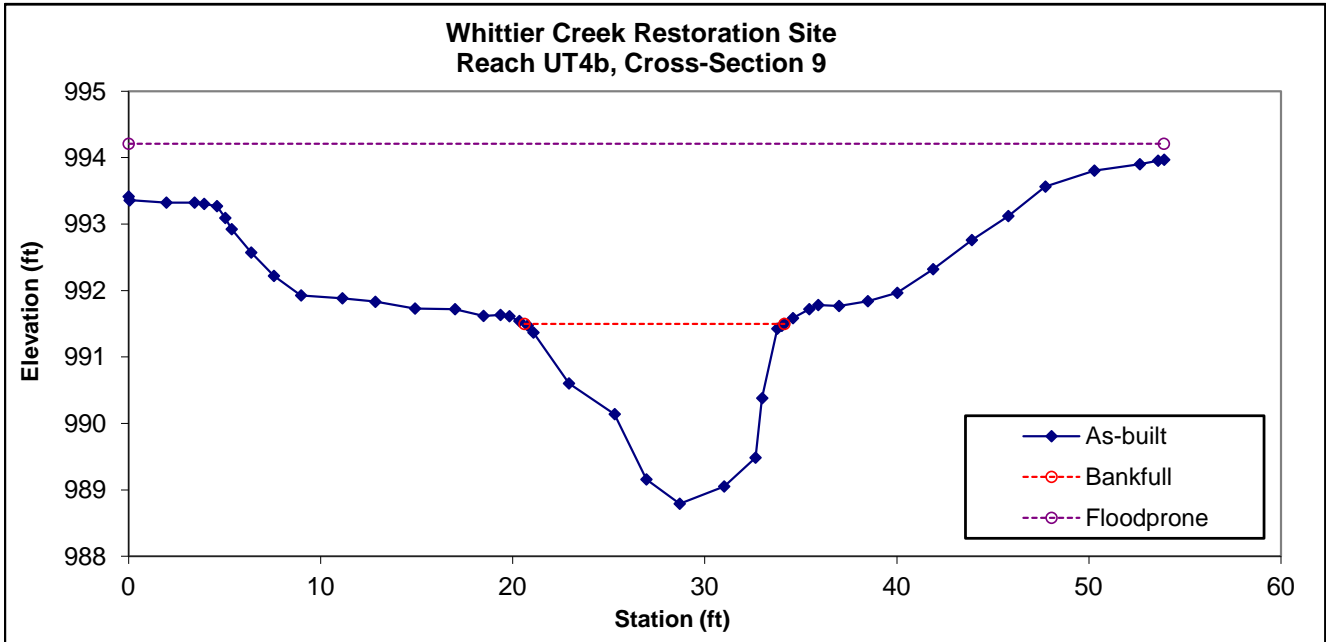

Permanent Cross-Section 10
 (As-built Survey Data Collected: August 2021)




Looking at the Left Bank



Looking at the Right Bank

Feature	Stream Type	BKF Area	BKF Width	BKF Depth	Max BKF Depth	W/D	BH Ratio	ER	BKF Elev	TOB Elev
Riffle	B	5.9	9.1	0.6	0.9	14.3	1.0	3.3	1007.70	1007.70

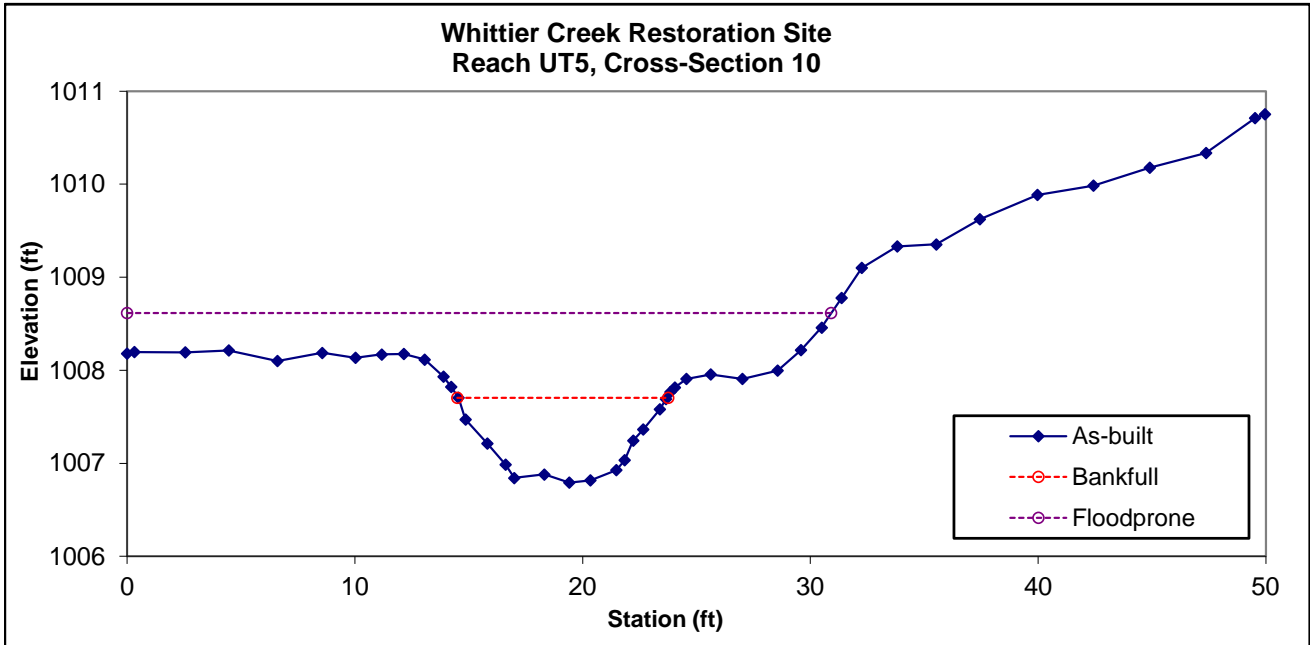

Permanent Cross-Section 11
 (As-built Survey Data Collected: August 2021)




Looking at the Left Bank



Looking at the Right Bank

Feature	Stream Type	BKF Area	BKF Width	BKF Depth	Max BKF Depth	W/D	BH Ratio	ER	BKF Elev	TOB Elev
Pool	-	10.4	7.9	1.3	1.9	6.0	-	-	998.87	998.87

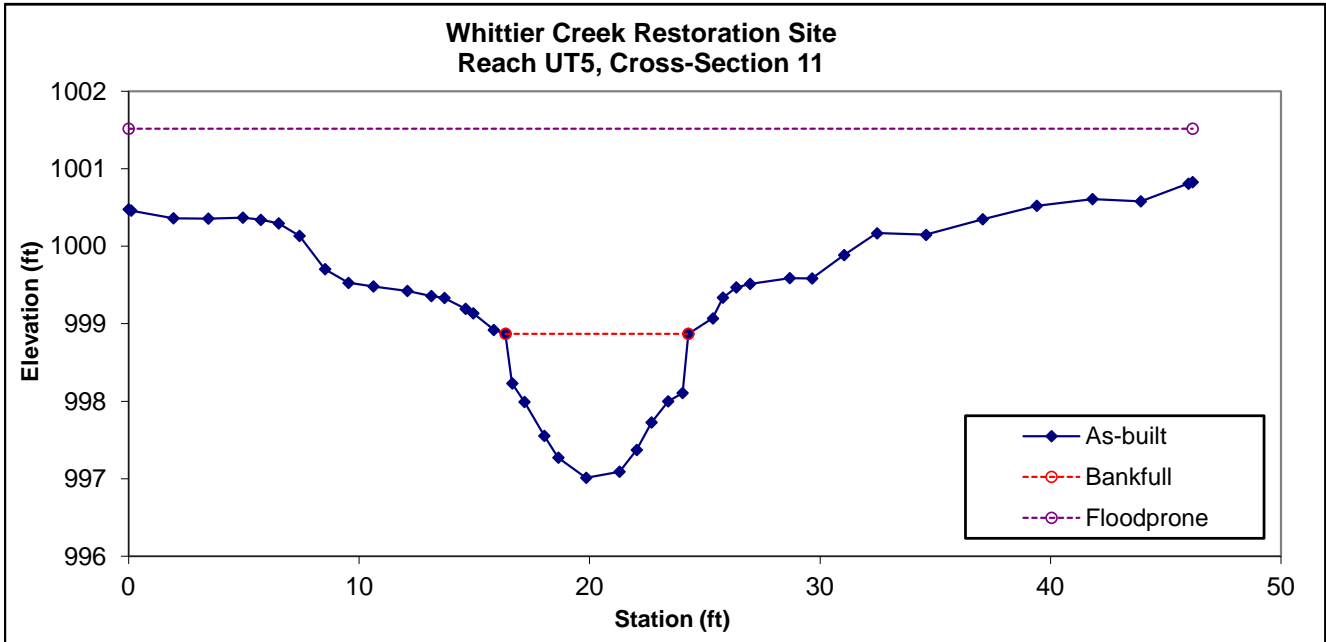

APPENDIX E

As-Built Plan Sheets

WHITTIER CREEK

PROJECT: 162039


**NORTH CAROLINA
DIVISION OF MITIGATION SERVICES**

SURRY COUNTY

LOCATION: ROCK HILL CHURCH ROAD & NURSE ROAD

TYPE OF WORK: AS - BUILT PLAN


STATE	BAKER PROJECT REFERENCE NO.	SHEET NO.	TOTAL SHEETS
NC	162039	1	19

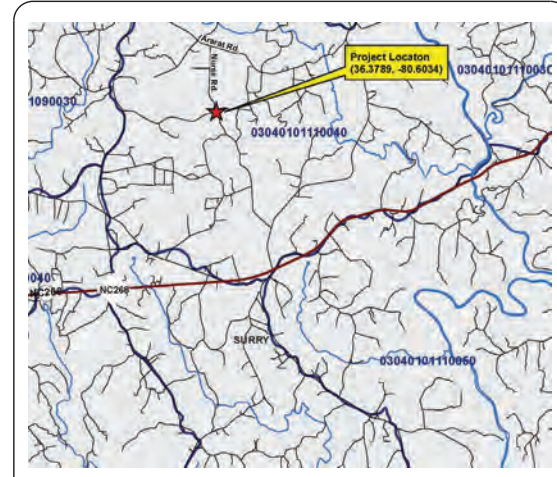


VICINITY MAP

INDEX OF SHEETS

- 1..... TITLE SHEET
- 1-A STREAM CONVENTIONAL SYMBOLS
GENERAL NOTES
STANDARD SPECIFICATIONS
VEGETATION SELECTION
- 1-B NCDOT CONVENTIONAL SYMBOLS
- 2 - 2F DETAILS
- 3 - 8 PLAN VIEW
- 9 - 11 PROFILES

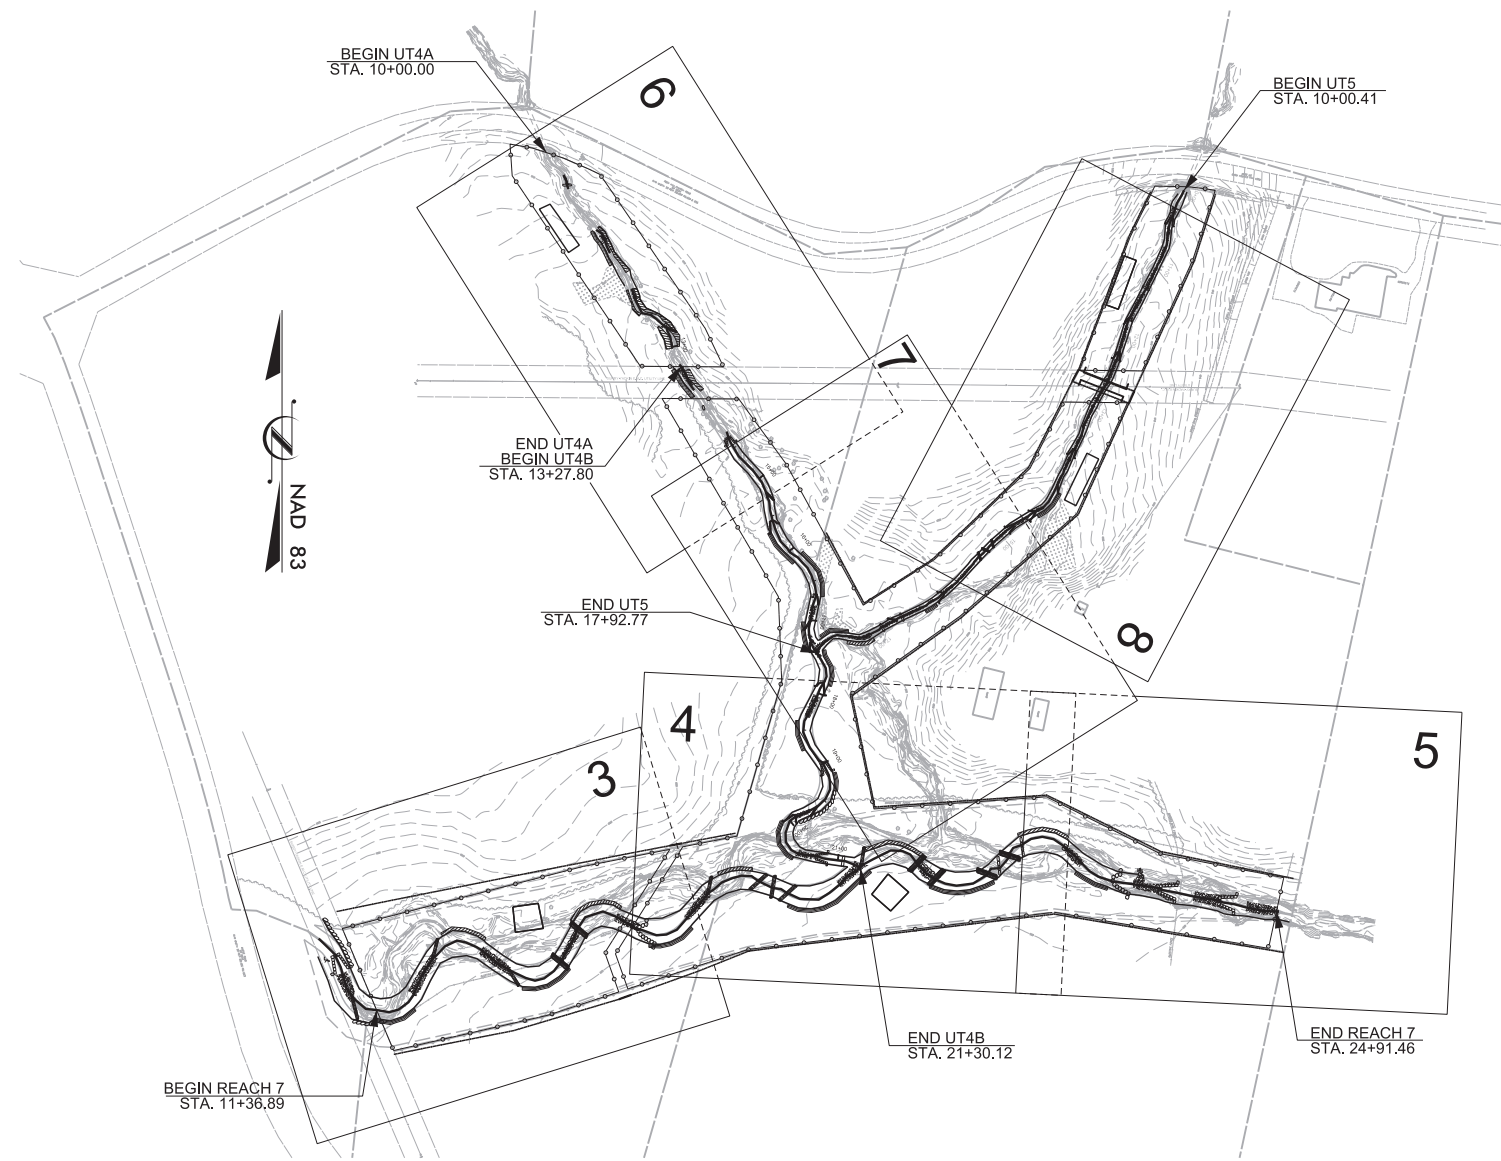

NCDMS ID NO. 100020

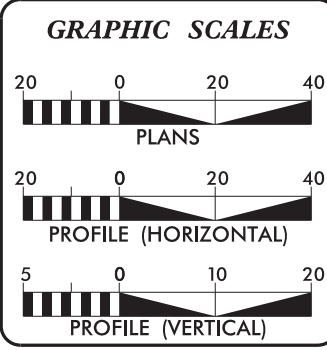

REACH SUMMARY

REACH	AS-BUILT LENGTHS
UT4A	327.80 LF
UT4B	753.57 LF
UT5	747.21 LF
R7	1,342.56 LF

PREPARED FOR THE OFFICE OF:

NCDEQ
DIVISION OF MITIGATION SERVICES
1652 MAIL SERVICE CENTER
RALEIGH, NC 27699-1652

CONTACT: MATTHEW REID
PROJECT MANAGER

Michael Baker International
Michael Baker Engineering Inc.
8000 Regency Parkway, Suite 600
Cary, NORTH CAROLINA 27518
Phone: 919.483.5488
Fax: 919.483.5490
License #: F-10584

Michael Baker International

SPRING 2020
LETTING DATE:

KATHLEEN M. MCKEITHAN, PE
PROJECT ENGINEER

PROJECT ENGINEER

2/22/2022

DocuSigned by:
Kathleen M. McKeithan
24E98DF4161473
SIGNATURE: P.E.

2/26/2023

STREAM CONVENTIONAL SYMBOLS SUPERCEDES SHEET 1-B

 J-HOOK VANE  ROCK VANE  OUTLET PROTECTION  ROCK CROSS VANE  DOUBLE DROP ROCK CROSS VANE  SINGLE WING DEFLECTOR  DOUBLE WING DEFLECTOR  TEMPORARY SILT CHECK  ROOT WAD  GRADE CONTROL LOG J-HOOK VANE  LOG VANE  LOG WEIR  LOG CROSS VANE  LOG ROLLER  GRADE CONTROL LOG JAM  CONSTRUCTED RIFFLE  BOULDER CLUSTER  BOULDER STEP  SAFETY FENCE  TAPE FENCE  100 YEAR FLOOD PLAIN  CONSERVATION EASEMENT	 PHOTO POINT  MONITORING WELL  FLOW GAUGE  IN-STREAM GAUGE  EXISTING MAJOR CONTOUR  EXISTING MINOR CONTOUR  LIMITS OF DISTURBANCE  PROPERTY LINE  FOOT BRIDGE  TEMPORARY STREAM CROSSING  ROCK FORD STREAM CROSSING  TRANSPLANTED VEGETATION  TREE REMOVAL  TREE PROTECTION  CHANNEL PLUG  CHANNEL FILL  BRUSH TOE WITH LIVE STAKES  GEOLIFT WITH BRUSH TOE  PROPOSED WETLAND RESTORATION  PROPOSED WETLAND ENHANCEMENT  JURISDICTIONAL WETLAND BOUNDARY
--	--

**NOTE: ALL ITEMS ABOVE MAY NOT BE USED ON THIS PROJECT

STANDARD SPECIFICATIONS

**NORTH CAROLINA
EROSION AND SEDIMENT CONTROL PLANNING AND DESIGN MANUAL
MARCH 2009 (REV 2013)**

- 6.06 TEMPORARY GRAVEL CONSTRUCTION ENTRANCE
- 6.24 RIPARIAN AREA SEEDING
- 6.62 TEMPORARY SILT FENCE
- 6.63 TEMPORARY ROCK DAM

PROJECT REFERENCE NO. 162039	SHEET NO. 1-A
PROJECT ENGINEER	
	
Approved by: Kathleen M. McKeithan APPROVED BY: _____ DATE: 2/22/2022	
Michael Baker International Michael Baker Engineering Inc. 8000 Regency Parkway, Suite 500 Cary, NORTH CAROLINA 27518 Phone: 919.463.5488 Fax: 919.463.5490 License #: F-1084	
NCDMS ID NO. 100020	

GENERAL NOTES

1. THE CONTRACTOR IS REQUIRED TO INSTALL IN-STREAM STRUCTURES USING A TRACK HOE WITH A HYDRAULIC THUMB OF SUFFICIENT SIZE TO PLACE BOULDERS, LOGS AND ROOTWADS.
2. WORK IS BEING PERFORMED AS AN ENVIRONMENTAL RESTORATION PLAN. THE CONTRACTOR SHOULD MAKE ALL REASONABLE EFFORTS TO REDUCE SEDIMENT LOSS AND MINIMIZE DISTURBANCE OF THE SITE WHILE PERFORMING THE CONSTRUCTION WORK.
3. CONSTRUCTION IS SCHEDULED FOR THE SUMMER OF 2020.
4. CONTRACTOR SHOULD CALL NORTH CAROLINA "ONE-CALL" BEFORE EXCAVATION STARTS. (1-800-632-4949)
5. ALL ON-SITE ALLUVIUM SHALL BE HARVESTED AND STOCKPILED PRIOR TO FILLING ABANDONED CHANNELS.
6. TOPSOIL SHALL BE EXCAVATED TO A DEPTH OF 8" AND STOCKPILED SEPARATELY FROM UNDERCUT SOIL. 8" OF TOPSOIL SHALL BE PLACED ON ALL BANKFULL BENCHES AND AS DIRECTED BY THE ENGINEER.
7. ALL DISTURBED EMBANKMENTS SHALL BE MATTED WITH COIR FIBER MATTING OR AS DIRECTED BY THE ENGINEER.
8. ALL STREAM BANKS SHALL BE LIVE STAKED.
9. UNLESS THE ALIGNMENT IS BEING ALTERED, THE EXISTING CHANNEL DIMENSIONS ARE TO REMAIN UNLESS OTHERWISE NOTED.
10. CONTRACTOR WILL ENSURE THAT FENCING IS INSTALLED OUTSIDE THE CONSERVATION EASEMENT AS SHOWN ON THE PLANS BUT NO MORE THAN 1' OUTSIDE.
11. WHERE PROPOSED FENCE CROSSES EXISTING STREAMS, THE CONTRACTOR SHALL UTILIZE A SECTION OF BREAK AWAY FENCE, A FLOOD GATE, OR ELECTRIFIED CHAINS AS DIRECTED BY THE ENGINEER.

PLANTING PLAN VEGETATION SELECTION

Permanent seed mixtures for the project site shall be planted throughout the floodplain and riparian buffer areas except the vernal pools. Permanent seed mixtures shall be applied with temporary seed, as defined in the construction specifications.

Scientific Name	Common Name	% Planted by Species	Wetland Tolerance
All Buffer Plantings at 680 stems/acre using 8' X 8' spacing			
Riparian Zone – Overstory Species			
<i>Betula nigra</i>	River Birch	10%	FACW
<i>Juglans nigra</i>	Black Walnut	5%	FACU
<i>Platanus occidentalis</i>	Sycamore	14%	FACW
<i>Liriodendron tulipifera</i>	Tulip Poplar	14%	FACU
<i>Fraxinus pennsylvanica</i>	Green Ash	5%	FACW
<i>Quercus lyrata</i>	Overcup Oak	10%	OBL
<i>Quercus phellos</i>	Willow Oak	10%	FAC
<i>Ulmus americana</i>	American Elm	5%	FACW
<i>Diospyros virginiana</i>	Persimmon	5%	FAC
<i>Nyssa sylvatica</i>	Blackgum	1%	FAC
<i>Quercus michauxii</i>	Swamp Chestnut Oak	1%	FACW
<i>Celtis laevigata</i>	Sugarberry	1%	FACW

Riparian Zone – Overstory Species			
<i>Betula nigra</i>	River Birch	10%	FACW
<i>Juglans nigra</i>	Black Walnut	5%	FACU
<i>Platanus occidentalis</i>	Sycamore	15%	FACW
<i>Liriodendron tulipifera</i>	Tulip Poplar	15%	FACU
<i>Fraxinus pennsylvanica</i>	Green Ash	5%	FACW
<i>Quercus lyrata</i>	Overcup Oak	10%	OBL
<i>Quercus phellos</i>	Willow Oak	10%	FAC
<i>Ulmus americana</i>	American Elm	5%	FACW
<i>Diospyros virginiana</i>	Persimmon	5%	FAC
<i>Hamamelis virginiana</i>	Witch Hazel	5%	FACU
<i>Lindera benzoin</i>	Spicebush	5%	FAC
<i>Carpinus caroliniana</i>	American Hornbeam	5%	FAC
<i>Acer negundo</i>	Box Elder	5%	FAC
<i>Amelanchier arborea</i>	Serviceberry	1%	FAC

Scientific Name	Common Name	Percent of Mixture	Seeding Density (lbs/acre)	Wetness Tolerance
<i>Agrostis alba</i>	Redtop	10%	1.5	FACW
<i>Elymus virginicus</i>	Virginia Wildrye	15%	2.25	FACW
<i>Panicum virgatum</i>	Switchgrass	15%	2.25	FAC
<i>Tripsacum dactyloides</i>	Eastern Gamma Grass	5%	0.75	FACW
<i>Polygonum pennsylvanicum</i>	Pennsylvania Smartweed	5%	0.75	FACW
<i>Schizachyrium scoparium</i>	Little Blue Stem	5%	0.75	FACU
<i>Juncus effusus</i>	Soft Rush	5%	0.75	FACW
<i>Bidens frondosa (or aristosa)</i>	Beggars Tick	5%	0.75	FACW
<i>Coreopsis lanceolata</i>	Lance-Leaved Tick Seed	10%	1.5	FACU
<i>Dichanthelium clandestinum</i>	Tioga Deer Tongue	15%	2.25	FAC
<i>Andropogon gerardii</i>	Big Blue Stem	5%	0.75	FAC
<i>Sorghastrum nutans</i>	Indian Grass	5%	0.75	FACU

TEMPORARY SEEDING SELECTION AND APPLICATION RATES				
Common Name	Scientific Name	Application Time	Application Rate	Total (lbs/acre)
Cereal rye	<i>Secale cereale</i>	Sept - March	3 lb/1,000 sq ft.	130 lbs/acre
Browntop millet	<i>Panicum ramosum</i>	April - Aug	1 lb/1,000 sq ft.	44 lbs/acre

R:\62039_Whittier-Creek-Design\As-Built\Plans\162039_ASB-PSH-01A.dgn

DocuSigned by:
Kathleen M. McKisken
2/26/2023 11:17:32

APPROVED BY:
2/22/2022

DATE:

STATE OF NORTH CAROLINA
DIVISION OF HIGHWAYS

CONVENTIONAL SYMBOLS

*S.U.E = SUBSURFACE UTILITY ENGINEER

BOUNDARIES AND PROPERTY:

State Line	-----
County Line	-----
Township Line	-----
City Line	-----
Reservation Line	-----
Property Line	-----
Existing Iron Pin	○ EP
Property Corner	-----
Property Monument	□ ECM
Parcel/Sequence Number	②③
Existing Fence Line	-x-x-x-
Proposed Woven Wire Fence	○
Proposed Chain Link Fence	□
Proposed Barbed Wire Fence	◇
Existing Wetland Boundary	-WLB-
Proposed Wetland Boundary	-WLB-
Existing Endangered Animal Boundary	-EAB-
Existing Endangered Plant Boundary	-EPB-

BUILDINGS AND OTHER CULTURE:

Gas Pump Vent or U/G Tank Cap	○
Sign	○ S
Well	○ W
Small Mine	✕
Foundation	□
Area Outline	□
Cemetery	↑
Building	□
School	□
Church	□
Dam	□

HYDROLOGY:

Stream or Body of Water	-----
Hydro, Pool or Reservoir	□
Jurisdictional Stream	-JS-
Buffer Zone 1	-BZ 1-
Buffer Zone 2	-BZ 2-
Flow Arrow	←
Disappearing Stream	-----
Spring	○
Wetland	-----
Proposed Lateral, Tail, Head Ditch	-----
False Sump	▽

RAILROADS:

Standard Gauge	-----
RR Signal Milepost	○ MILEPOST 35
Switch	□ SWITCH
RR Abandoned	-----
RR Dismantled	-----

RIGHT OF WAY:

Baseline Control Point	◆
Existing Right of Way Marker	△
Existing Right of Way Line	-----
Proposed Right of Way Line	-----
Proposed Right of Way Line with Iron Pin and Cap Marker	○ R W
Proposed Right of Way Line with Concrete or Granite Marker	△ R W
Existing Control of Access	○ C A
Proposed Control of Access	○ C A
Existing Easement Line	-E-
Proposed Temporary Construction Easement	-E-
Proposed Temporary Drainage Easement	-TDE-
Proposed Permanent Drainage Easement	-PDE-
Proposed Permanent Utility Easement	-PUE-
Proposed Temporary Utility Easement	-TUE-
Proposed Permanent Easement with Iron Pin and Cap Marker	◆

ROADS AND RELATED FEATURES:

Existing Edge of Pavement	-----
Existing Curb	-----
Proposed Slope Stakes Cut	-C-
Proposed Slope Stakes Fill	-F-
Proposed Wheel Chair Ramp	WCR
Existing Metal Guardrail	-----
Proposed Guardrail	-----
Existing Cable Guiderail	-----
Proposed Cable Guiderail	-----
Equality Symbol	⊕
Pavement Removal	XXXX

VEGETATION:

Single Tree	☼
Single Shrub	☼
Hedge	-----
Woods Line	-----
Orchard	☼ ☼ ☼ ☼
Vineyard	□ Vineyard

EXISTING STRUCTURES:

MAJOR:	
Bridge, Tunnel or Box Culvert	CONC
Bridge Wing Wall, Head Wall and End Wall	CONC WW
MINOR:	
Head and End Wall	CONC HW
Pipe Culvert	-----
Footbridge	-----
Drainage Box: Catch Basin, DI or JB	□ CB
Paved Ditch Gutter	-----
Storm Sewer Manhole	○ S
Storm Sewer	-S-

UTILITIES:

POWER:	
Existing Power Pole	●
Proposed Power Pole	○
Existing Joint Use Pole	●
Proposed Joint Use Pole	○
Power Manhole	○ P
Power Line Tower	□
Power Transformer	□
U/G Power Cable Hand Hole	□ PH
H-Frame Pole	●
Recorded U/G Power Line	-P-
Designated U/G Power Line (S.U.E.*)	-P-

TELEPHONE:

Existing Telephone Pole	●
Proposed Telephone Pole	○
Telephone Manhole	○ T
Telephone Booth	□
Telephone Pedestal	□
Telephone Cell Tower	☼
U/G Telephone Cable Hand Hole	□ PH
Recorded U/G Telephone Cable	-T-
Designated U/G Telephone Cable (S.U.E.*)	-T-
Recorded U/G Telephone Conduit	-TC-
Designated U/G Telephone Conduit (S.U.E.*)	-TC-
Recorded U/G Fiber Optics Cable	-T FO-
Designated U/G Fiber Optics Cable (S.U.E.*)	-T FO-

WATER:

Water Manhole	○ W
Water Meter	○
Water Valve	⊗
Water Hydrant	⊕
Recorded U/G Water Line	-W-
Designated U/G Water Line (S.U.E.*)	-W-
Above Ground Water Line	-A/G Water-

TV:

TV Satellite Dish	☼
TV Pedestal	□
TV Tower	⊗
U/G TV Cable Hand Hole	□ PH
Recorded U/G TV Cable	-TV-
Designated U/G TV Cable (S.U.E.*)	-TV-
Recorded U/G Fiber Optic Cable	-TV FO-
Designated U/G Fiber Optic Cable (S.U.E.*)	-TV FO-

GAS:

Gas Valve	◇
Gas Meter	⊕
Recorded U/G Gas Line	-G-
Designated U/G Gas Line (S.U.E.*)	-G-
Above Ground Gas Line	-A/G Gas-

SANITARY SEWER:


Sanitary Sewer Manhole	⊕
Sanitary Sewer Cleanout	⊕
U/G Sanitary Sewer Line	-SS-
Above Ground Sanitary Sewer	-A/G Sanitary Sewer-
Recorded SS Forced Main Line	-FSS-
Designated SS Forced Main Line (S.U.E.*)	-FSS-

MISCELLANEOUS:

Utility Pole	●
Utility Pole with Base	□
Utility Located Object	○
Utility Traffic Signal Box	□
Utility Unknown U/G Line	-TUTL-
U/G Tank; Water, Gas, Oil	□
A/G Tank; Water, Gas, Oil	□
U/G Test Hole (S.U.E.*)	⊕
Abandoned According to Utility Records	AATUR
End of Information	E.O.I.


2/26/2023

TYPICAL RIFFLE, POOL, AND BANKFULL BENCH CROSS SECTIONS

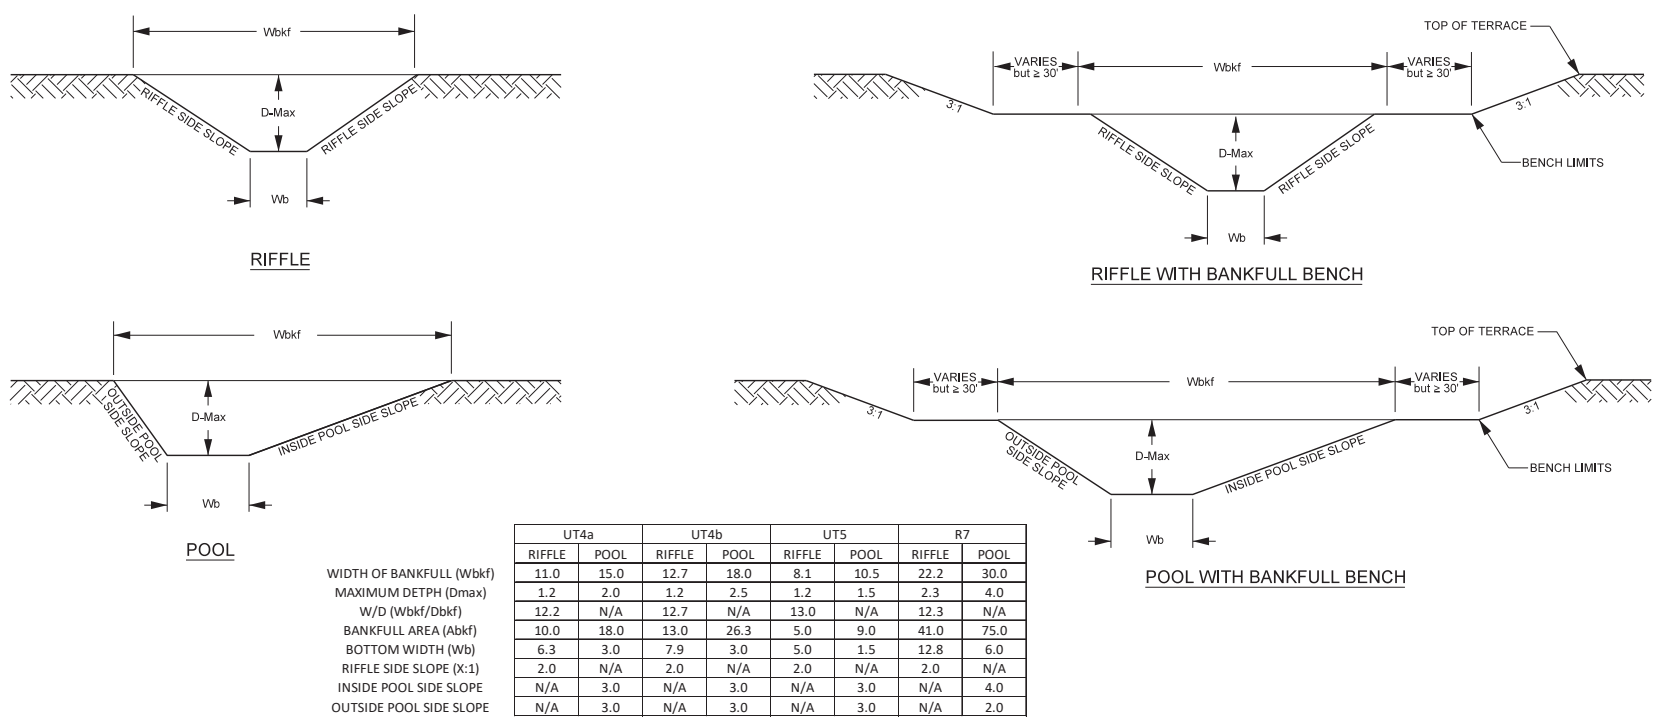

	UT4a		UT4b		UT5		R7	
	RIFFLE	POOL	RIFFLE	POOL	RIFFLE	POOL	RIFFLE	POOL
WIDTH OF BANKFULL (Wbkf)	11.0	15.0	12.7	18.0	8.1	10.5	22.2	30.0
MAXIMUM DETPH (Dmax)	1.2	2.0	1.2	2.5	1.2	1.5	2.3	4.0
W/D (Wbkf/Dmax)	12.2	N/A	12.7	N/A	13.0	N/A	12.3	N/A
BANKFULL AREA (Abkf)	10.0	18.0	13.0	26.3	5.0	9.0	41.0	75.0
BOTTOM WIDTH (Wb)	6.3	3.0	7.9	3.0	5.0	1.5	12.8	6.0
RIFFLE SIDE SLOPE (X:1)	2.0	N/A	2.0	N/A	2.0	N/A	2.0	N/A
INSIDE POOL SIDE SLOPE	N/A	3.0	N/A	3.0	N/A	3.0	N/A	4.0
OUTSIDE POOL SIDE SLOPE	N/A	3.0	N/A	3.0	N/A	3.0	N/A	2.0


CHANNEL PLUG

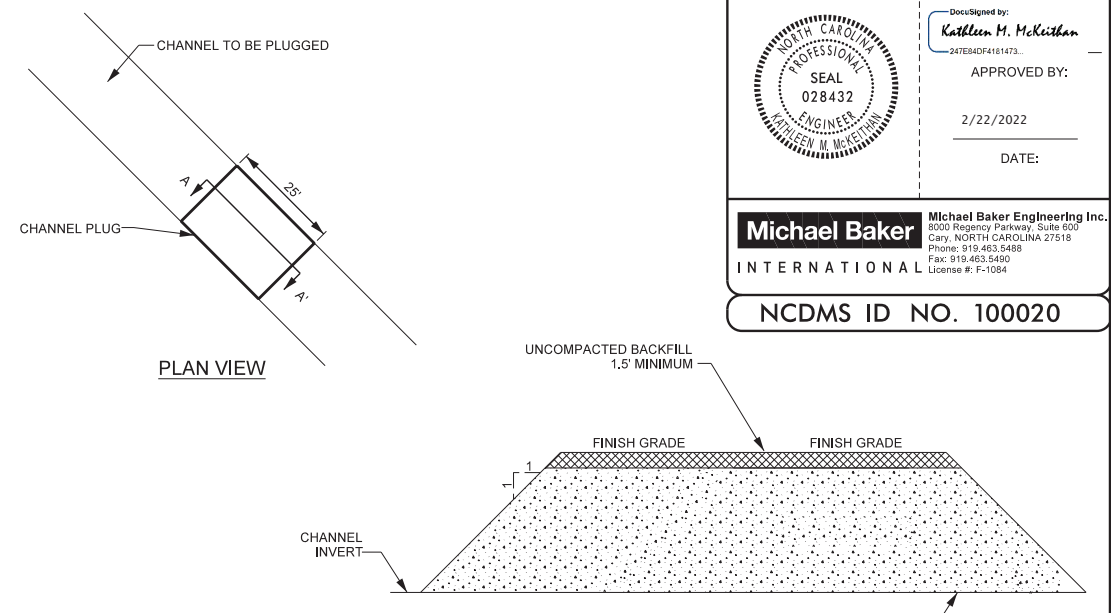

- NOTE:
- BACKFILL CONSISTING OF ON-SITE CLAY MATERIAL WILL BE COMPACTED USING HEAVY EQUIPMENT IN 10 INCH LIFTS.
 - THE REMAINDER OF THE EXISTING CHANNEL TO BE PLUGGED WILL BE COMPLETED FILLED TO THE NEW TOP-OF-BANK ELEVATION.


PROJECT REFERENCE NO. 162039	SHEET NO. 2
PROJECT ENGINEER	
APPROVED BY:	
2/22/2022	
DATE:	
Michael Baker International	
Michael Baker Engineering Inc. 8020 Regency Parkway, Suite 600 Cary, NORTH CAROLINA 27518 Phone: 919.463.5485 Fax: 919.463.5490 License #: F-1084	
NCDMS ID NO. 100020	

TYPICAL STRUCTURE PLACEMENT

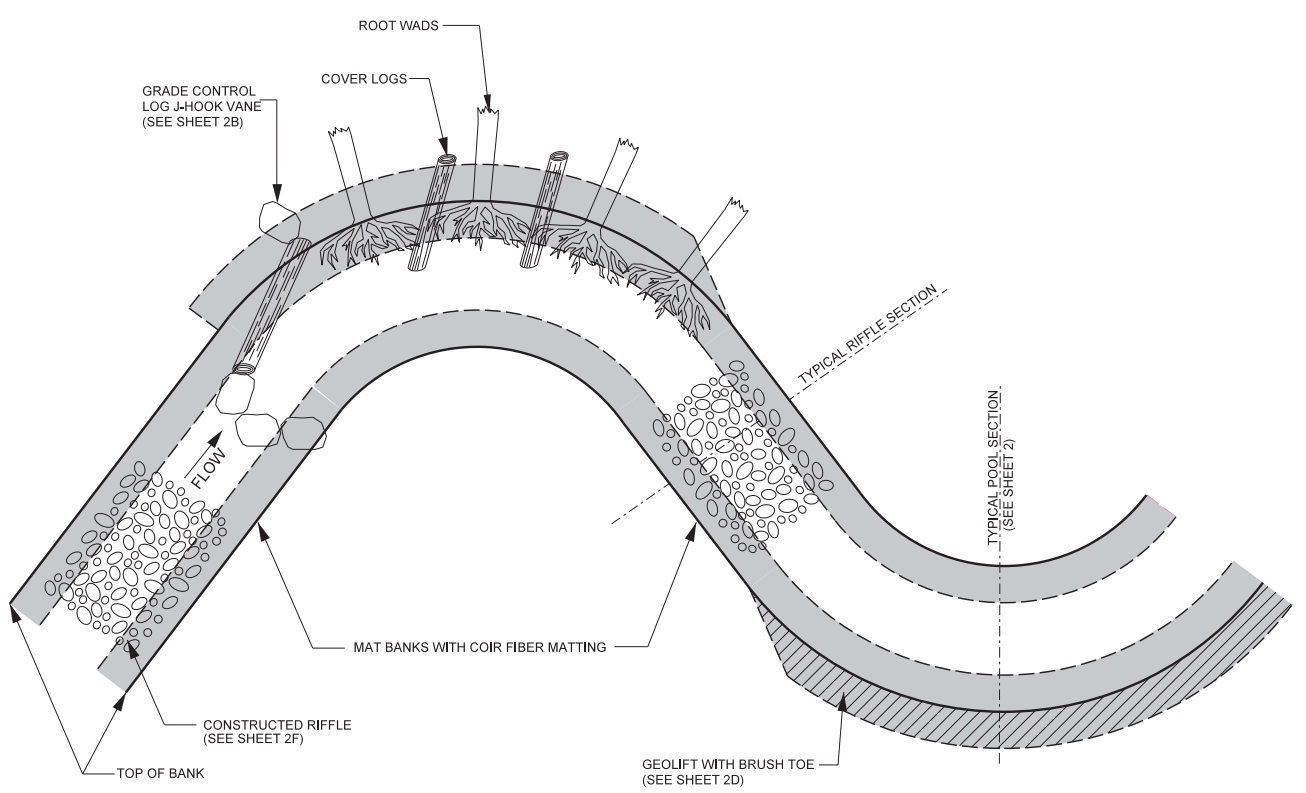

- STRUCTURE NOTES:
- GENERALLY CONSTRUCTED RIFFLES, ROOT WADS, LOG VANES AND COIR FIBER MATTING WILL BE INSTALLED IN THE LOCATION AND SEQUENCE AS SHOWN.
 - ANY CHANGES TO NUMBER OR LOCATION OF STRUCTURES DURING CONSTRUCTION MUST BE APPROVED BY THE DESIGN ENGINEER.
 - COIR FIBER MATTING TO BE INSTALLED ON ALL RESTORED STREAMBANKS, FLOODPLAIN BENCHING, AND TERRACE SLOPES AS DESCRIBED IN THE TECHNICAL SPECIFICATIONS.
 - ROOTWADS MAY BE REPLACED WITH GEOLIFT.

ROCK CROSS VANE

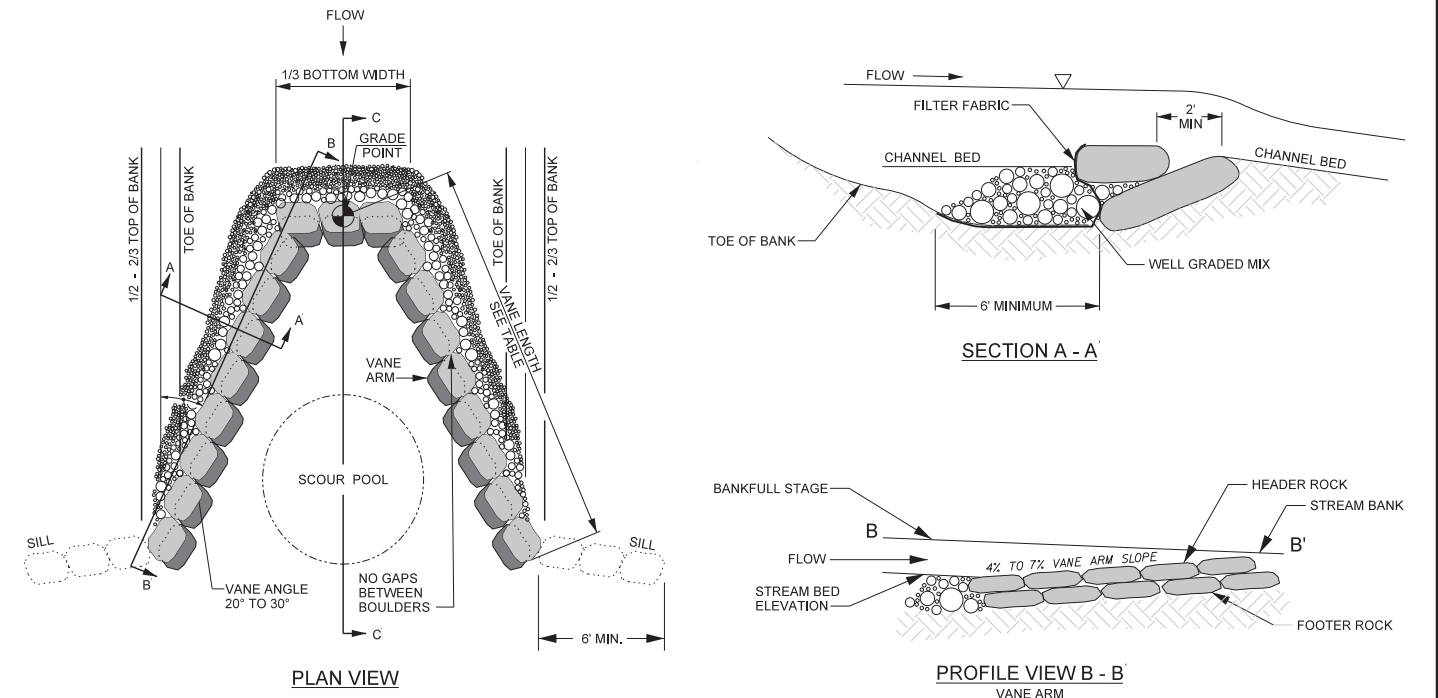


REACH	VANE LENGTH	BOULDER SIZE
UT4A	9'	1'x2'x3'
UT4B	10'	1'x2'x3'
UT5	7'	1'x2'x3'
REACH 7	18'	2'x3'x4'

- NOTES FOR ALL VANE STRUCTURES:
- INSTALL FILTER FABRIC FOR DRAINAGE BEGINNING AT THE MIDDLE OF THE HEADER ROCKS AND EXTEND DOWNWARD TO THE DEPTH OF THE BOTTOM FOOTER ROCK, AND THEN UPSTREAM TO A MINIMUM OF SIX FEET.
 - DIG A TRENCH BELOW THE BED FOR FOOTER ROCKS AND PLACE FILL ON UPSTREAM SIDE OF VANE ARM, BETWEEN THE ARM AND STREAMBANK.
 - CONSTRUCT ANGLE AND SLOPE SPECIFICATIONS AS SHOWN.
 - BACKFILL VANE ARMS AND INVERT WITH A WELL GRADED MIX OF CLASS B, A, AND #57 STONE.
 - ON-SITE ALLUVIUM SHALL BE INCORPORATED INTO THE STONE BACKFILL WHERE AVAILABLE.
 - BOULDER SILL MUST BE A MINIMUM OF 6' AND WILL INCLUDE FOOTER ROCKS.


R:\162039_Whittier_Creek\Design\As-Built\Plans\162039_ASB-PSH-02.dgn
 2/22/2023 10:00 AM
 Michael Baker International

27/26/2023


OUTLET PROTECTION

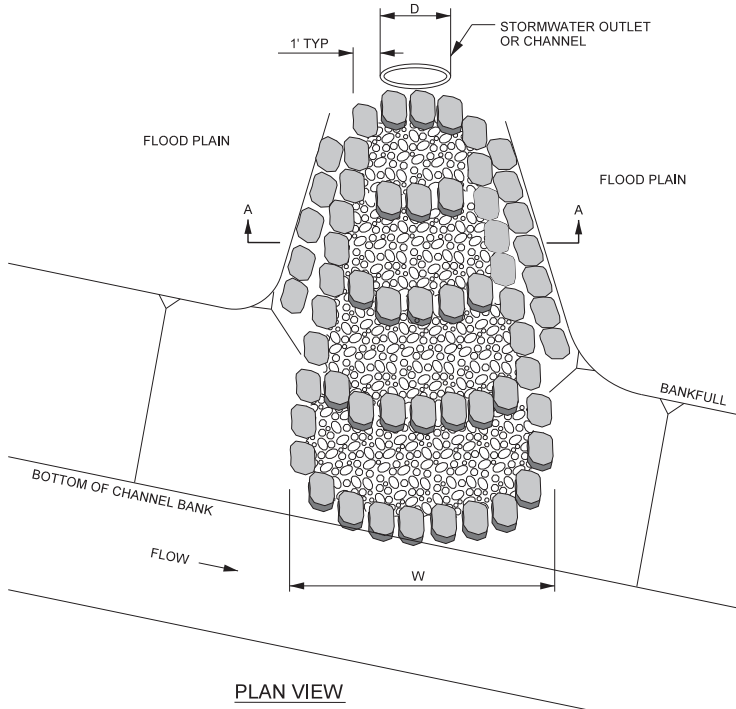

PLAN VIEW

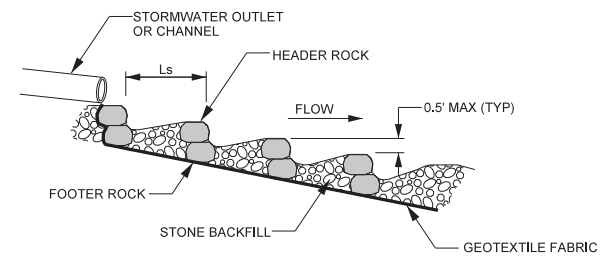


PROFILE VIEW

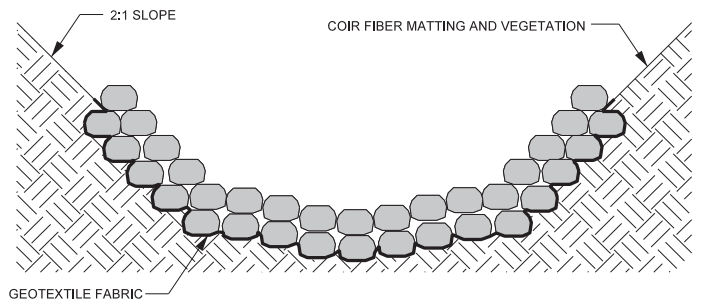

CROSS SECTION A - A


ROCK VANE

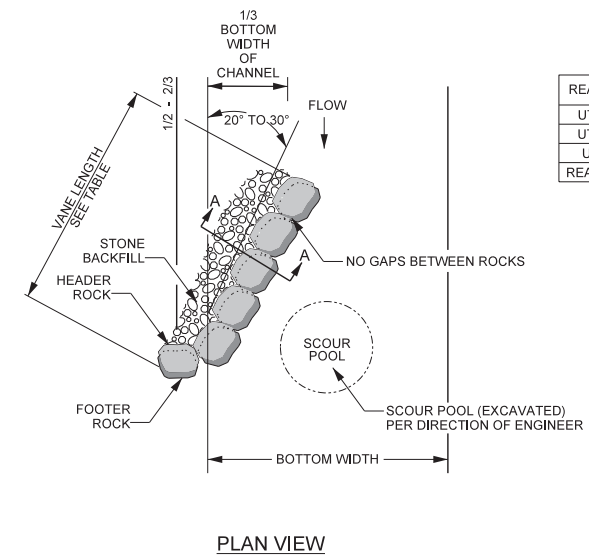


PLAN VIEW

REACH	VANE LENGTH	BOULDER SIZE
UT4A	9'	1'x2'x3'
UT4B	10'	1'x2'x3'
UT5	7'	1'x2'x3'
REACH 7	18'	2'x3'x4'

- NOTES FOR ALL VANE STRUCTURES:**
1. INSTALL GEOTEXTILE FABRIC BEGINNING AT THE TOP OF THE HEADER ROCKS AND EXTEND DOWNWARD TO THE DEPTH OF THE BOTTOM FOOTER ROCK, AND THEN UPSTREAM TO A MINIMUM OF TEN FEET.
 2. DIG A TRENCH BELOW THE BED FOR FOOTER ROCKS AND PLACE FILL ON UPSTREAM SIDE OF VANE ARM, BETWEEN THE ARM AND STREAMBANK.
 3. START AT BANK AND PLACE FOOTER ROCKS FIRST AND THEN HEADER (TOP) ROCK.
 4. CONTINUE WITH STRUCTURE, FOLLOWING ANGLE AND SLOPE SPECIFICATIONS.
 5. AN EXTRA ROCK CAN BE PLACED IN SCOUR POOL FOR HABITAT IMPROVEMENT.
 6. USE HAND PLACED STONE TO FILL GAPS ON UPSTREAM SIDE OF HEADER AND FOOTER ROCKS.
 7. AFTER ALL STONE BACKFILL HAS BEEN PLACED, FILL IN THE UPSTREAM SIDE OF THE STRUCTURE WITH WELL GRADED MIX OF CLASS B, CLASS A, & #57 STONE TO THE ELEVATION OF THE TOP OF THE HEADER ROCK. INCORPORATE ON-SITE ALLUVIUM WHERE AVAILABLE.
 8. START SLOPE AT 2/3 TO 3/4 TIMES THE BANKFULL STAGE.

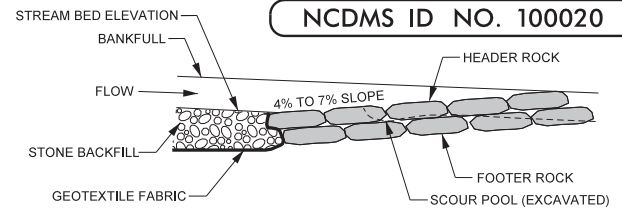


PROFILE VIEW

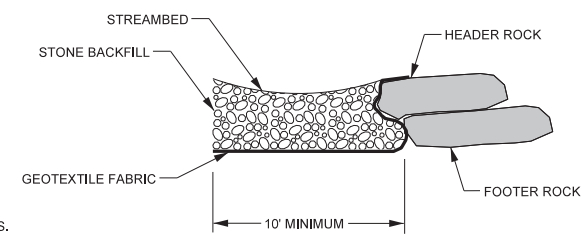


SECTION A - A


GRADE CONTROL J-HOOK VANE

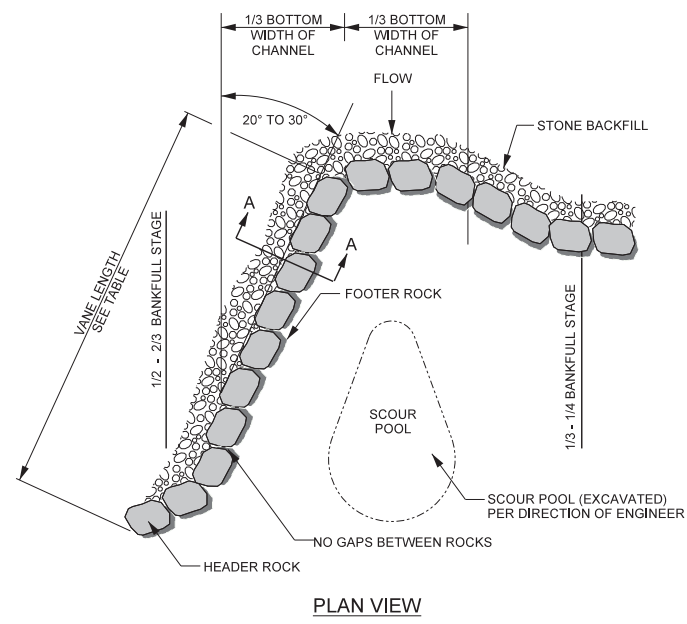

PLAN VIEW

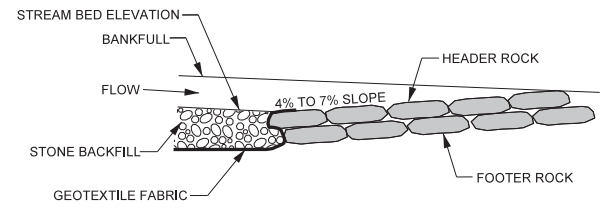

PROFILE VIEW

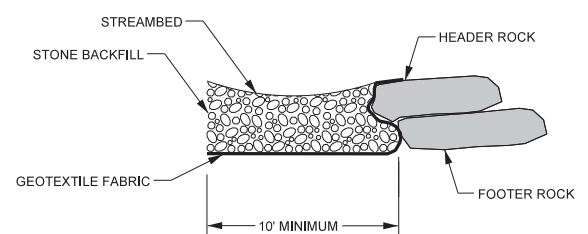


SECTION A - A


REACH	VANE LENGTH	BOULDER SIZE
UT4A	9'	1'x2'x3'
UT4B	10'	1'x2'x3'
UT5	7'	1'x2'x3'
REACH 7	18'	2'x3'x4'

- NOTES FOR ALL VANE STRUCTURES:**
1. INSTALL FILTER FABRIC FOR DRAINAGE BEGINNING AT THE MIDDLE OF THE HEADER ROCKS AND EXTEND DOWNWARD TO THE DEPTH OF THE BOTTOM FOOTER ROCK, AND THEN UPSTREAM TO A MINIMUM OF SIX FEET.
 2. DIG A TRENCH BELOW THE BED FOR FOOTER ROCKS AND PLACE FILL ON UPSTREAM SIDE OF VANE ARM, BETWEEN THE ARM AND STREAMBANK.
 3. CONSTRUCT ANGLE AND SLOPE SPECIFICATIONS AS SHOWN.
 4. BACKFILL VANE ARMS AND INVERT WITH A WELL GRADED MIX OF CLASS B, A, AND #57 STONE.
 5. ON-SITE ALLUVIUM SHALL BE INCORPORATED INTO THE STONE BACKFILL WHERE AVAILABLE.
 6. BOULDER SILL MUST BE A MINIMUM OF 6'.

J-HOOK VANE

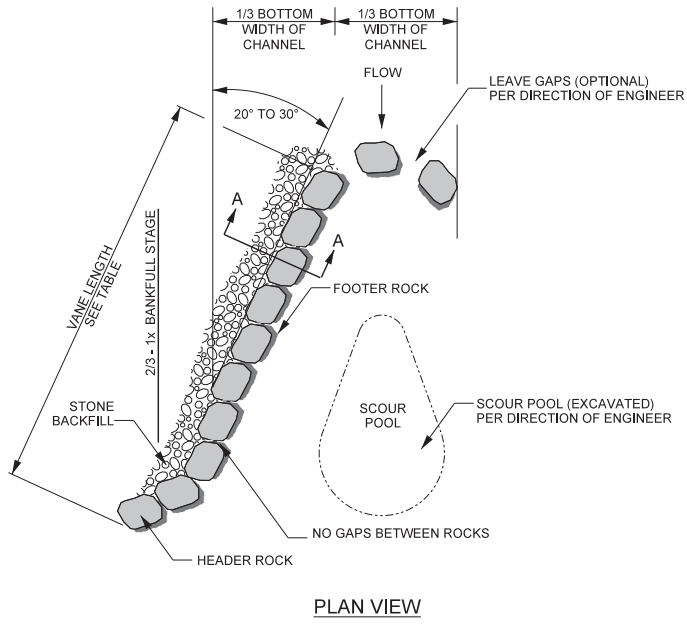


PLAN VIEW

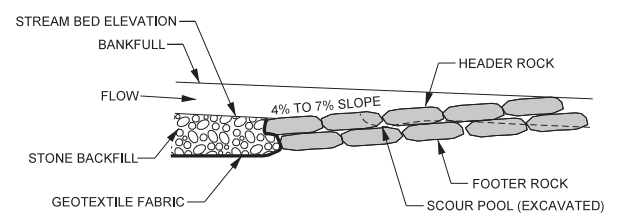

PROFILE VIEW

REACH	VANE LENGTH	BOULDER SIZE
UT4A	9'	1'x2'x3'
UT4B	10'	1'x2'x3'
UT5	7'	1'x2'x3'
REACH 7	18'	2'x3'x4'

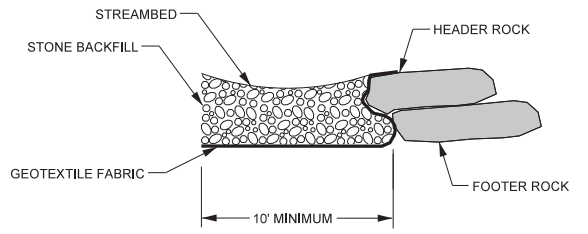




SECTION A - A

- NOTES FOR ALL VANE STRUCTURES:**
1. INSTALL GEOTEXTILE FABRIC BEGINNING AT THE TOP OF THE HEADER ROCKS AND EXTEND DOWNWARD TO THE DEPTH OF THE BOTTOM FOOTER ROCK, AND THEN UPSTREAM TO A MINIMUM OF TEN FEET.
 2. DIG A TRENCH BELOW THE BED FOR FOOTER ROCKS AND PLACE FILL ON UPSTREAM SIDE OF VANE ARM, BETWEEN THE ARM AND STREAMBANK.
 3. START AT BANK AND PLACE FOOTER ROCKS FIRST AND THEN HEADER (TOP) ROCK.
 4. CONTINUE WITH STRUCTURE, FOLLOWING ANGLE AND SLOPE SPECIFICATIONS.
 5. AN EXTRA ROCK CAN BE PLACED IN SCOUR POOL FOR HABITAT IMPROVEMENT.
 6. USE HAND PLACED STONE TO FILL GAPS ON UPSTREAM SIDE OF HEADER AND FOOTER ROCKS.
 7. AFTER ALL STONE BACKFILL HAS BEEN PLACED, FILL IN THE UPSTREAM SIDE OF THE STRUCTURE WITH ON-SITE ALLUVIUM TO THE ELEVATION OF THE TOP OF THE HEADER ROCK.

PROJECT REFERENCE NO. 162039	SHEET NO. 2A
PROJECT ENGINEER	
Documented by: Kathleen M. McKeithan 2478940F4181473...	
APPROVED BY:	
2/22/2022 DATE:	
Michael Baker International Michael Baker Engineering Inc. 8000 Regency Parkway, Suite 600 Cary, NORTH CAROLINA 27518 Phone: 919.463.5485 Fax: 919.463.5490 License #: F-1084	
NCDMS ID NO. 100020	

R:\162039_Whittier_Creek_Design\As-Built\Plans\162039_ASB-PSH-02A.dgn
 1/16/2023 10:00 AM
 27/26/2023



LOG AND ROCK STEP / POOL

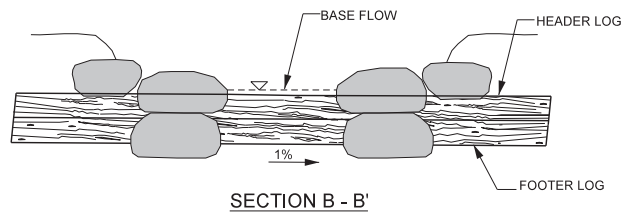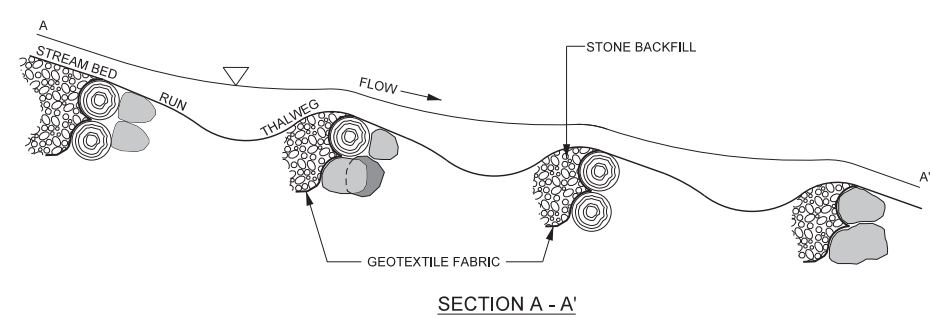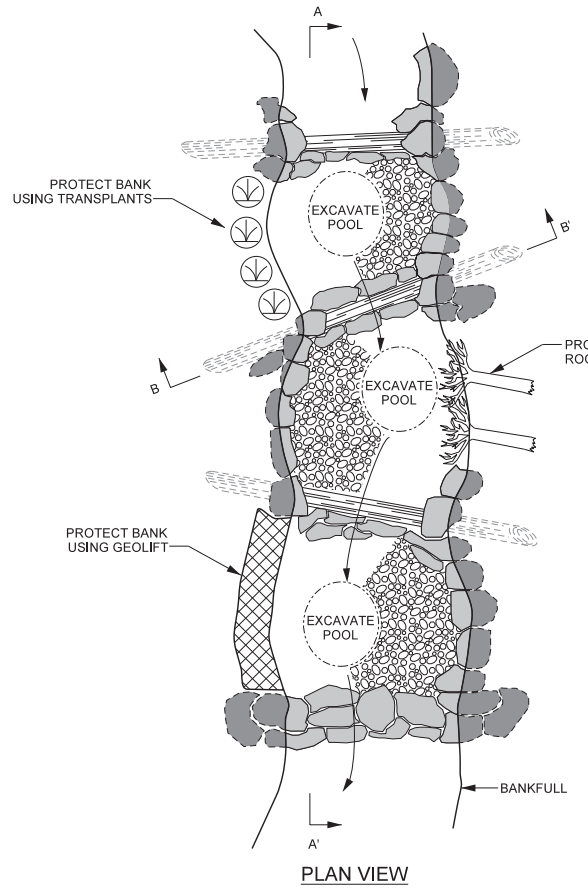

REACH	BOULDER SIZE
UT4A	1'x2'x3'
UT4B	1'x2'x3'
UT5	1'x2'x3'
REACH 7	2'x3'x4'

- NOTES:**
- LOGS SHOULD BE AT LEAST 10" IN DIAMETER, RELATIVELY STRAIGHT, HARDWOOD, AND RECENTLY HARVESTED AND EXTENDING INTO THE BANK 5' ON EACH SIDE.
 - SOIL SHOULD BE COMPACTED WELL AROUND BURIED PORTIONS OF LOG.
 - GEOTEXTILE FABRIC SHOULD BE NAILED TO THE LOG BELOW THE BACKFILL.
 - BOULDERS SHOULD BE PLACED ON TOP OF HEADER LOG FOR ANCHORING.
 - TRANSPLANTS CAN BE USED INSTEAD OF BOULDERS, PER DIRECTION OF ENGINEER.
 - AFTER ALL STONE BACKFILL HAS BEEN PLACED, FILL IN THE UPSTREAM SIDE OF THE STRUCTURE WITH WELL GRADED MIX OF CLASS B, CLASS A, & #57 STONE TO THE ELEVATION OF THE TOP OF THE HEADER ROCK. INCORPORATE ON-SITE ALLUVIUM WHERE AVAILABLE.




BOULDER STEP

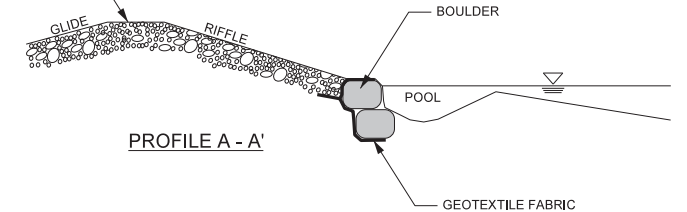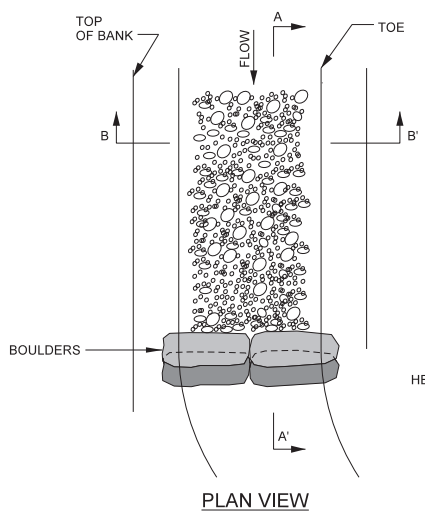

REACH	BOULDER SIZE
UT4A	1'x2'x3'
UT4B	1'x2'x3'
UT5	1'x2'x3'
REACH 7	2'x3'x4'

- NOTES:**
- FOOTERS SHALL BE INSTALLED SUCH THAT 1/4 TO 1/3 OF THE LENGTH IS DOWNSTREAM OF THE HEADER.
 - SOIL SHALL BE WELL COMPACTED AROUND BURIED PORTION OF FOOTERS WITH THE BUCKET OF EXCAVATOR.
 - INSTALL NON-WOVEN FILTER FABRIC UNDERNEATH FOOTER BOULDERS.
 - UNDERCUT THE RIFFLE ELEVATION 12 INCHES TO ALLOW FOR A LAYER OF STONE.
 - INSTALL EROSION CONTROL MATTING ALONG COMPLETED BANKS SUCH THAT THE EROSION CONTROL MATTING AT THE TOE OF THE BANK EXTENDS DOWN TO THE UNDERCUT ELEVATION.
 - FILL TRENCH WITH GRADED MIX OF CLASS A, CLASS B, AND #57 STONE TO THE BED ELEVATION OF THE CHANNEL.
 - BOULDER STEPS MUST BE EXTENDED TO A MINIMUM OF 2' INTO THE BANK. USE SILL BOULDERS IF NECESSARY.
 - THALWEG AND STEP INVERT WILL BE CONCAVE AND SHAPED PER DIRECTION OF THE DESIGNER.




GRADE CONTROL LOG J-HOOK VANE

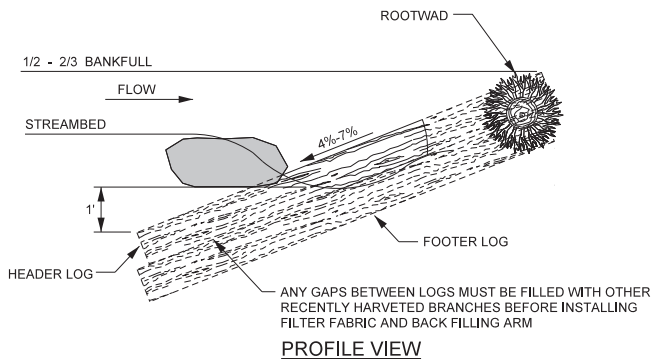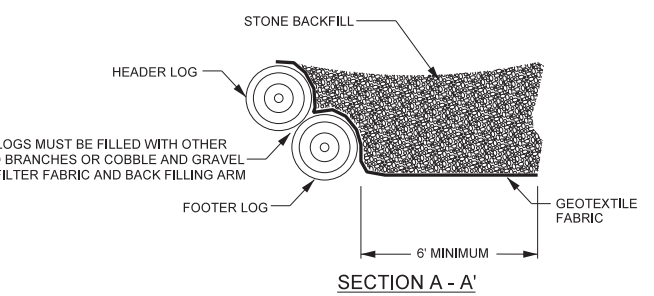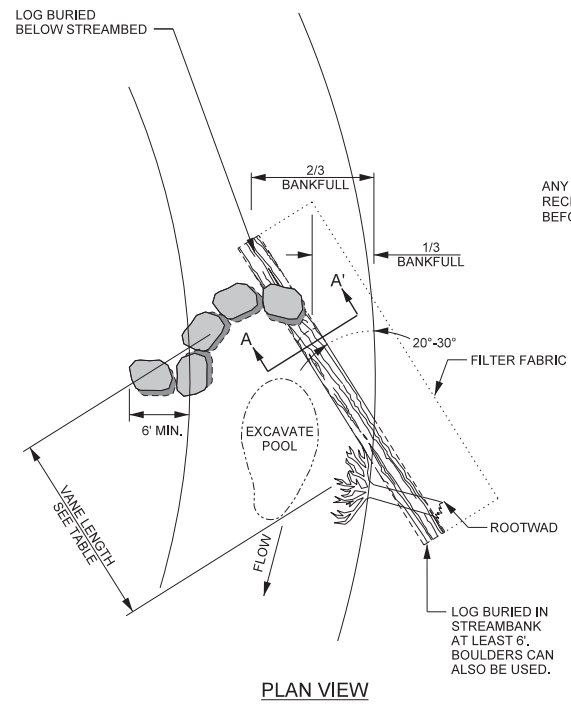

REACH	VANE LENGTH	BOULDER SIZE
UT4A	9'	1'x2'x3'
UT4B	10'	1'x2'x3'
UT5	7'	1'x2'x3'
REACH 7	18'	2'x3'x4'

- NOTES:**
- LOGS SHOULD BE AT LEAST 10" IN DIAMETER, RELATIVELY STRAIGHT, HARDWOOD, RECENTLY HARVESTED, AND FOOTERED.
 - BOULDERS MUST BE OF SUFFICIENT SIZE TO ANCHOR LOGS.
 - SOIL SHOULD BE COMPACTED WELL AROUND BURIED PORTIONS OF LOG.
 - ROOTWADS SHOULD BE PLACED BENEATH THE HEADER LOG AND PLACED SO THAT IT LOCKS THE HEADER LOG INTO THE BANK. SEE ROOTWAD DETAIL.
 - BOULDERS SHOULD BE PLACED ON TOP OF HEADER LOG FOR ANCHORING.
 - HEADER BOULDERS TO BE PLACED 0.5 TO 0.75 FEET APART.
 - FILTER FABRIC SHOULD BE NAILED TO THE LOG BELOW THE BACKFILL.
 - TRANSPLANTS OR BOULDERS CAN BE USED INSTEAD OF ROOTWADS, PER DIRECTION OF ENGINEER.
 - BOULDER SILL MUST BE A MINIMUM OF 6'.
 - AFTER ALL STONE BACKFILL HAS BEEN PLACED, FILL IN THE UPSTREAM SIDE OF THE STRUCTURE WITH WELL GRADED MIX OF CLASS B, CLASS A, & #57 STONE TO THE ELEVATION OF THE TOP OF THE HEADER ROCK. INCORPORATE ON-SITE ALLUVIUM WHERE AVAILABLE.

LOG VANE

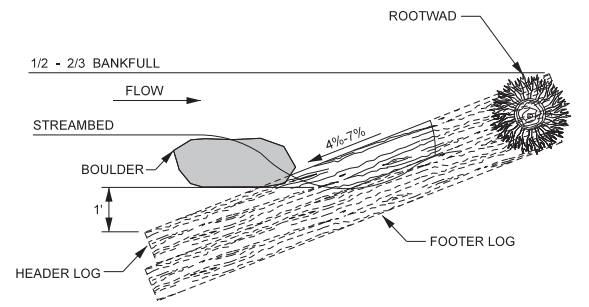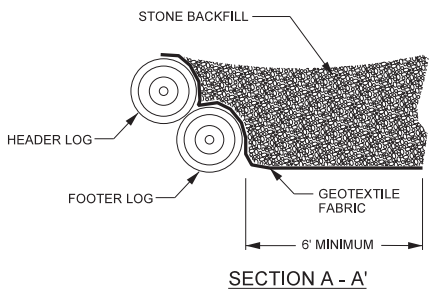
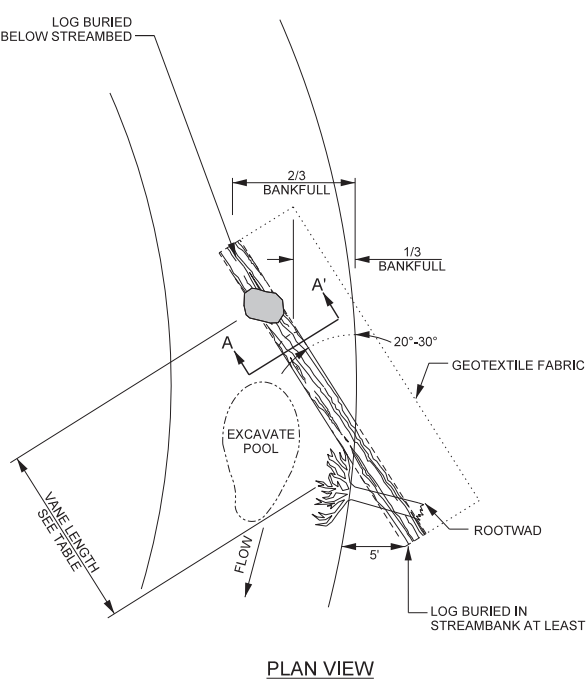


REACH	VANE LENGTH	BOULDER SIZE
UT4A	9'	1'x2'x3'
UT4B	10'	1'x2'x3'
UT5	7'	1'x2'x3'
REACH 7	18'	2'x3'x4'

- NOTES:**
- LOGS SHOULD BE AT LEAST 10" IN DIAMETER, RELATIVELY STRAIGHT, HARDWOOD, AND RECENTLY HARVESTED.
 - BOULDERS MUST BE OF SUFFICIENT SIZE TO ANCHOR LOGS.
 - SOIL SHOULD BE COMPACTED WELL AROUND BURIED PORTIONS OF LOGS.
 - ROOTWADS SHOULD BE PLACED BENEATH THE HEADER LOG AND PLACED SO THAT IT LOCKS THE HEADER LOG INTO THE BANK. SEE ROOTWAD DETAIL.
 - BOULDER SHOULD BE PLACED ON TOP OF HEADER LOG FOR ANCHORING.
 - GEOTEXTILE FABRIC SHOULD BE NAILED TO THE LOG BELOW THE BACKFILL.
 - TRANSPLANTS CAN BE USED INSTEAD OF ROOTWADS, PER DIRECTION OF ENGINEER.
 - AFTER ALL STONE BACKFILL HAS BEEN PLACED, FILL IN THE UPSTREAM SIDE OF THE STRUCTURE WITH WELL GRADED MIX OF CLASS B, CLASS A, & #57 STONE TO THE ELEVATION OF THE TOP OF THE HEADER ROCK. INCORPORATE ON-SITE ALLUVIUM WHERE AVAILABLE.



PROJECT REFERENCE NO. 162039	SHEET NO. 2B
PROJECT ENGINEER	
DocuSigned by: Kathleen M. McKeithan 247E84DF4181473...	
APPROVED BY:	
2/22/2022	
DATE:	
Michael Baker International Michael Baker Engineering Inc. 8000 Regency Parkway, Suite 600 Cary, NORTH CAROLINA 27518 Phone: 919.463.5488 Fax: 919.463.5490 License #: F-1084	
NC DMS ID NO. 100020	

LIVE STAKING

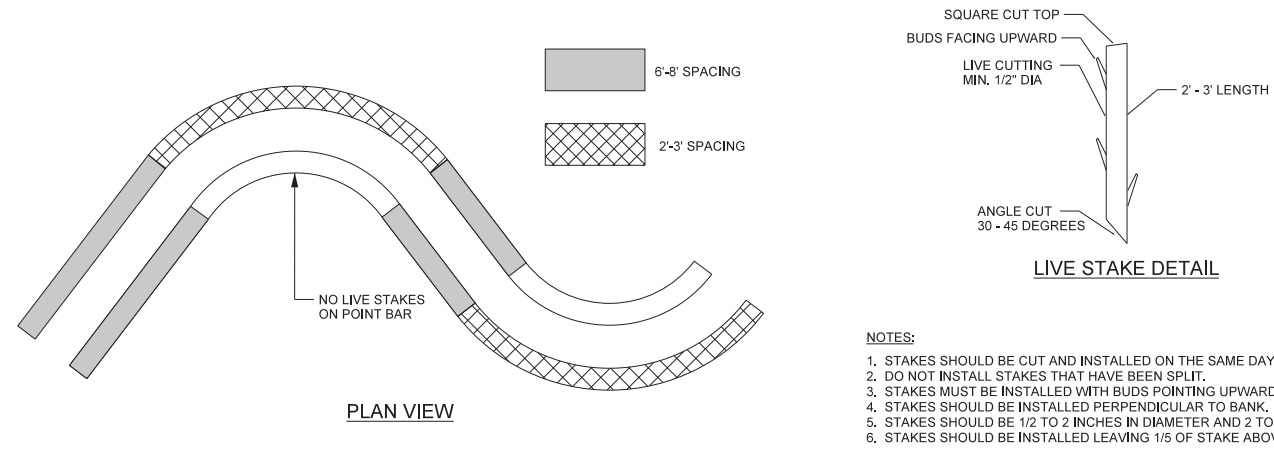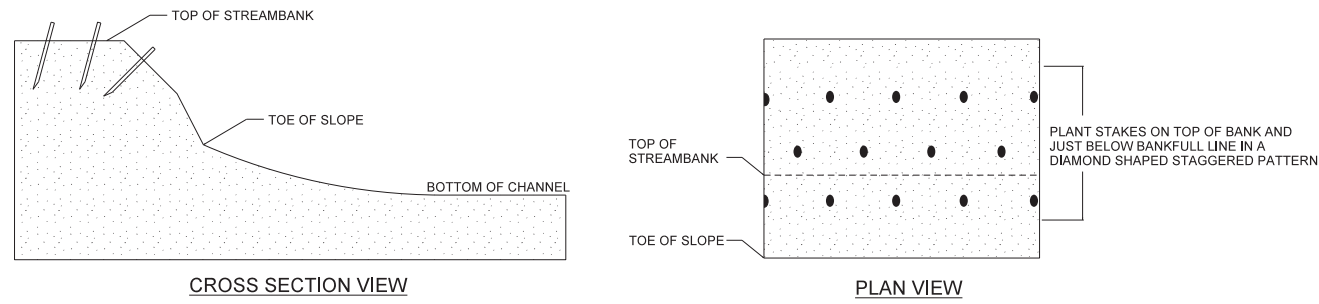

- NOTES:**
1. STAKES SHOULD BE CUT AND INSTALLED ON THE SAME DAY.
 2. DO NOT INSTALL STAKES THAT HAVE BEEN SPLIT.
 3. STAKES MUST BE INSTALLED WITH BUDS POINTING UPWARDS.
 4. STAKES SHOULD BE INSTALLED PERPENDICULAR TO BANK.
 5. STAKES SHOULD BE 1/2 TO 2 INCHES IN DIAMETER AND 2 TO 3 FT LONG.
 6. STAKES SHOULD BE INSTALLED LEAVING 1/5 OF STAKE ABOVE GROUND.


TRANSPLANTED VEGETATION

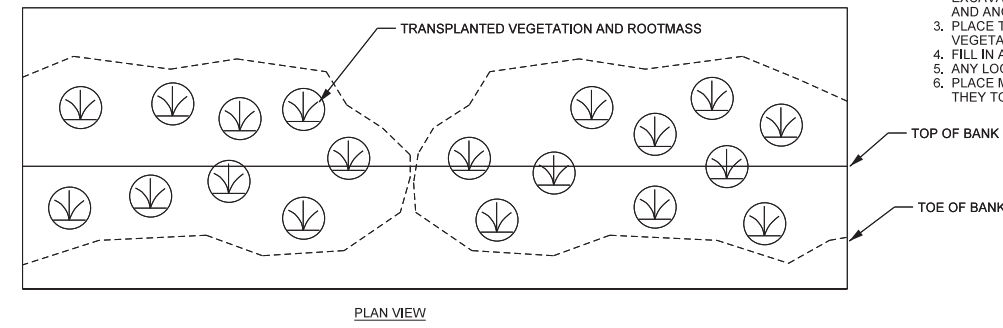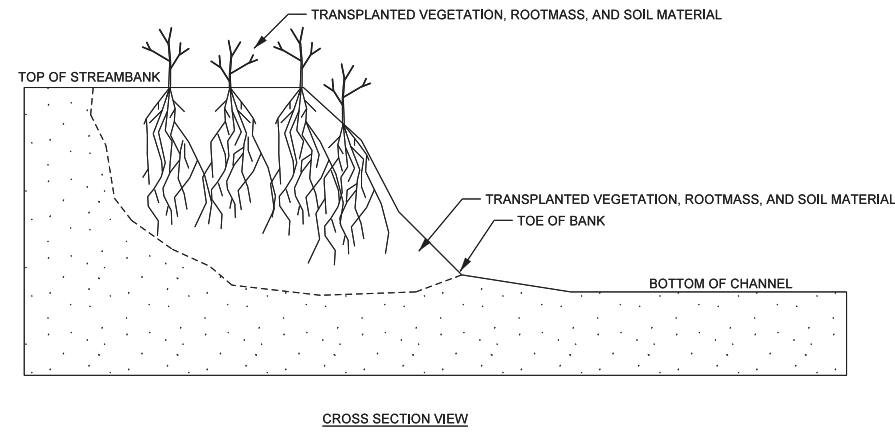


- NOTES:**
1. EXCAVATE A HOLE IN THE BANK TO BE STABILIZED THAT WILL ACCOMMODATE THE SIZE OF TRANSPLANT TO BE PLACED. BEGIN EXCAVATION AT THE TOE OF THE BANK.
 2. EXCAVATE TRANSPLANT USING A FRONT END LOADER. EXCAVATE THE ENTIRE ROOT MASS AND AS MUCH ADDITIONAL SOIL MATERIAL AS POSSIBLE. IF ENTIRE ROOT MASS CAN NOT BE EXCAVATED IN ONE BUCKET LOAD, THE TRANSPLANT IS TOO LARGE AND ANOTHER SHOULD BE SELECTED.
 3. PLACE TRANSPLANT IN THE BANK TO BE STABILIZED SO THAT VEGETATION IS ORIENTATED VERTICALLY.
 4. FILL IN ANY HOLES AROUND THE TRANSPLANT AND COMPACT.
 5. ANY LOOSE SOIL LEFT IN THE STREAM SHOULD BE REMOVED.
 6. PLACE MULTIPLE TRANSPLANTS CLOSE TOGETHER SUCH THAT THEY TOUCH.

PROJECT REFERENCE NO. 162039	SHEET NO. 2C
PROJECT ENGINEER	
DocuSigned by: Kathleen M. McKeithan 247E84DF4181473...	
APPROVED BY:	
DATE: 2/22/2022	
Michael Baker International 8000 Regency Parkway, Suite 600 Cary, NORTH CAROLINA 27518 Phone: 919.463.5485 Fax: 919.463.5490 License #: F-1084	
NCDMS ID NO. 100020	

PLANTING SPECIFICATIONS

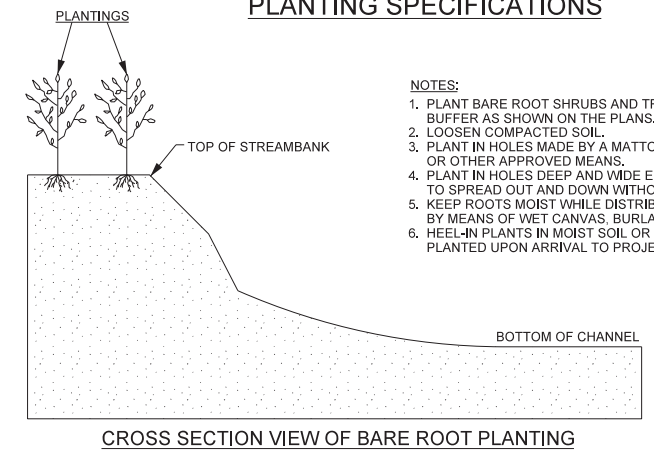


- NOTES:**
1. PLANT BARE ROOT SHRUBS AND TREES TO THE WIDTH OF THE BUFFER AS SHOWN ON THE PLANS.
 2. LOOSEN COMPACTED SOIL.
 3. PLANT IN HOLES MADE BY A MATTOCK, DIBBLE, PLANTING BAR, OR OTHER APPROVED MEANS.
 4. PLANT IN HOLES DEEP AND WIDE ENOUGH TO ALLOW THE ROOTS TO SPREAD OUT AND DOWN WITHOUT J-ROOTING.
 5. KEEP ROOTS MOIST WHILE DISTRIBUTING OR WAITING TO PLANT BY MEANS OF WET CANVAS, BURLAP, OR STRAW.
 6. HEEL-IN PLANTS IN MOIST SOIL OR SAWDUST IF NOT PROMPTLY PLANTED UPON ARRIVAL TO PROJECT SITE.

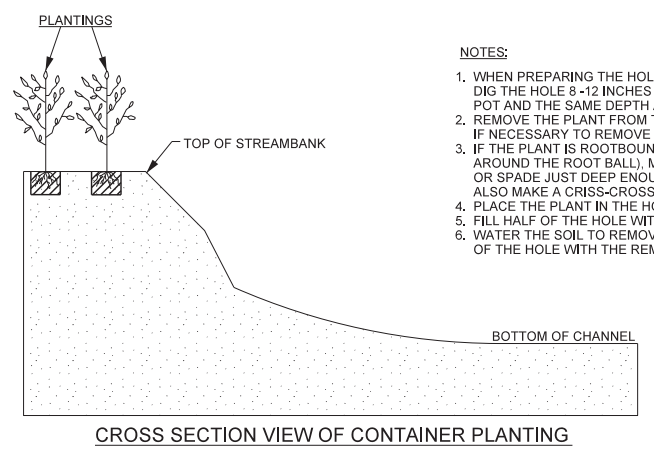


- NOTES:**
1. WHEN PREPARING THE HOLE FOR A POTTED PLANT OR SHRUB DIG THE HOLE 8 -12 INCHES LARGER THAN THE DIAMETER OF THE POT AND THE SAME DEPTH AS THE POT.
 2. REMOVE THE PLANT FROM THE POT. LAY THE PLANT ON ITS SIDE IF NECESSARY TO REMOVE THE POT.
 3. IF THE PLANT IS ROOTBOUND (ROOTS GROWING IN A SPIRAL AROUND THE ROOT BALL), MAKE VERTICAL CUTS WITH A KNIFE OR SPADE JUST DEEP ENOUGH TO CUT THE NET OF ROOTS. ALSO MAKE A CRISS-CROSS CUT ACROSS THE BOTTOM OF THE BALL.
 4. PLACE THE PLANT IN THE HOLE.
 5. FILL HALF OF THE HOLE WITH SOIL (SAME SOIL REMOVED FOR BACKFILL).
 6. WATER THE SOIL TO REMOVE AIR POCKETS AND FILL THE REST OF THE HOLE WITH THE REMAINING SOIL.

COIR FIBER MATTING

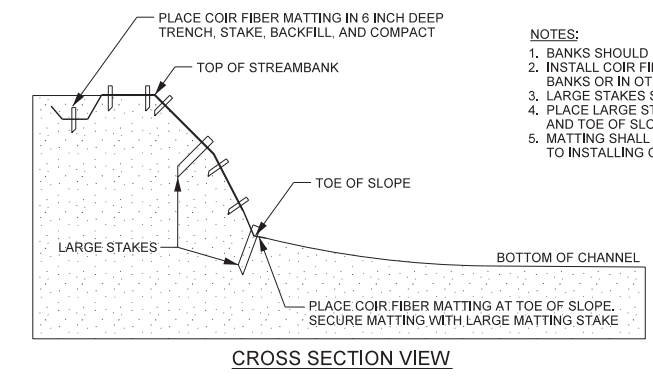


- NOTES:**
1. BANKS SHOULD BE SEEDED PRIOR TO PLACEMENT OF MATTING.
 2. INSTALL COIR FIBER MATTING PER SPECIFICATIONS ALONG STREAM BANKS OR IN OTHERS LOCATIONS SPECIFIED BY ENGINEER.
 3. LARGE STAKES SHOULD NOT BE SPACED FURTHER THAN 36" APART.
 4. PLACE LARGE STAKES ALONG ALL SEAMS, IN THE CENTER OF BANK, AND TOE OF SLOPE.
 5. MATTING SHALL BE PLACED ON BANKS, STAKED, AND TRENCHED PRIOR TO INSTALLING CONSTRUCTED RIFFLE MATERIAL.

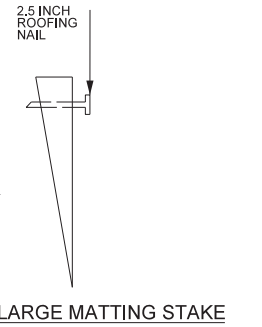

TYPICAL LARGE MATTING STAKE

LEG LENGTH	17.00 IN (43.18 CM) (TAPERED TO POINT)
WIDTH	1.5 IN (3.81 CM)
THICKNESS	1.5 IN (3.81 CM)

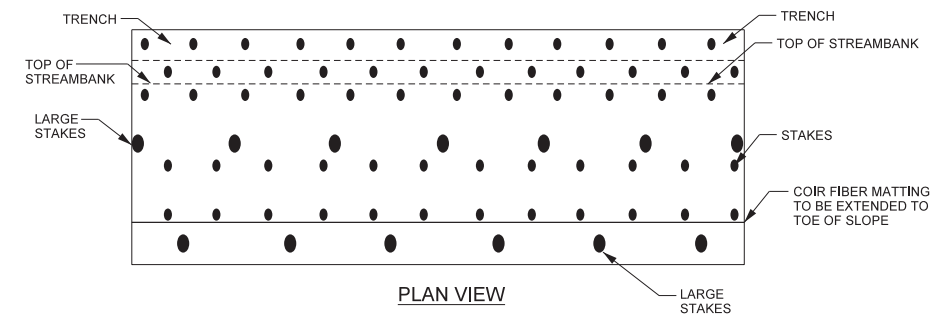


TYPICAL SMALL MATTING STAKE

LEG LENGTH	11.00 IN (27.94 CM)
HEAD WIDTH	1.25 IN (3.18 CM)
HEAD THICKNESS	0.40 IN (1.02 CM)
LEG WIDTH	0.60 IN (1.52 CM) (TAPERED TO POINT)
LEG THICKNESS	0.40 IN (1.02 CM)
TOTAL LENGTH	12.00 IN (30.48 CM)

2/26/2023


PLUNGE POOL

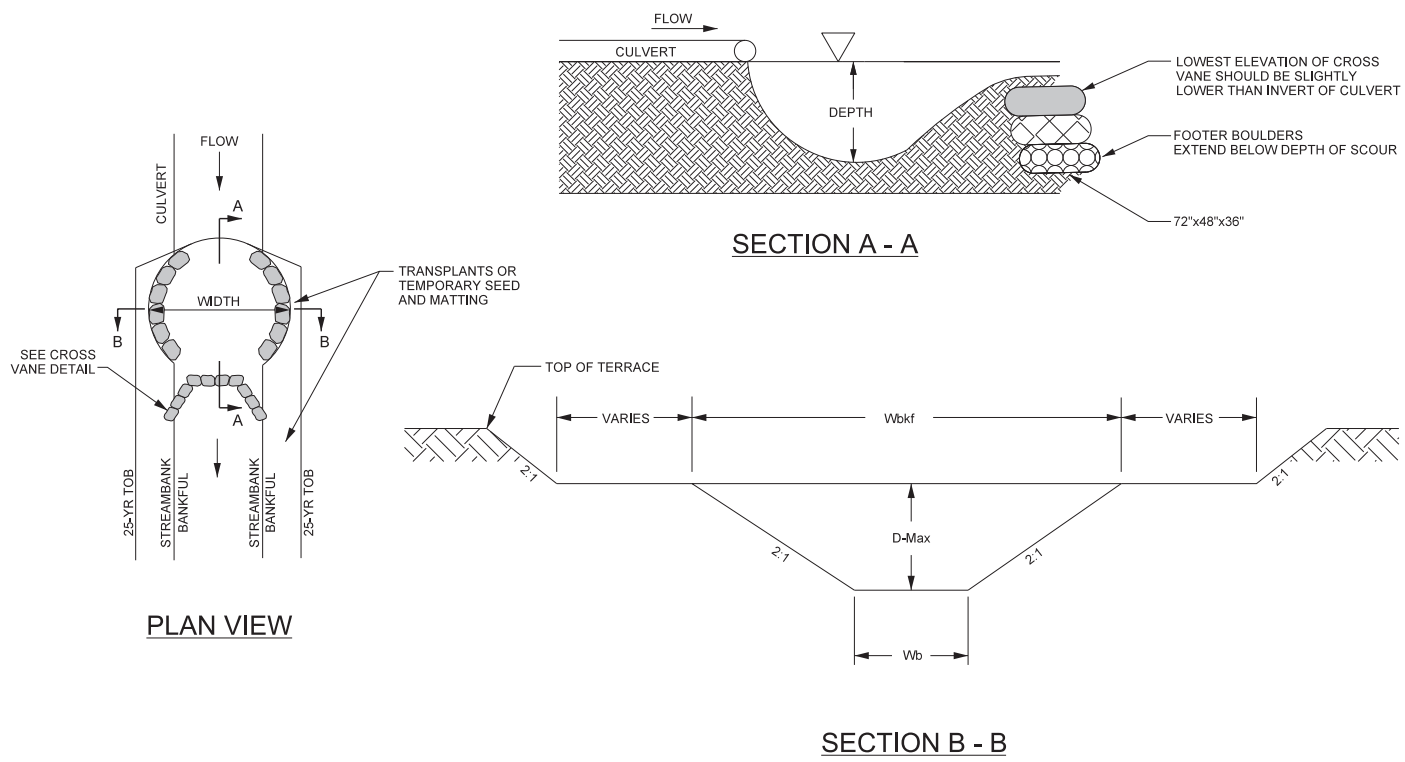

GEOLIFT WITH BRUSH TOE


NOTES:

1. LIVE BRANCH CUTTINGS SHALL BE THE SAME SPECIES AS THE LIVE STAKES AND SHALL BE INSTALLED DURING VEGETATION DORMANCY. IF CONSTRUCTION OCCURS OUTSIDE OF DORMANT SEASON, CONTRACTOR SHALL CONSULT WITH DESIGNER.
2. LIVE BRANCH CUTTINGS SHALL BE INSTALLED AT A DENSITY OF 20-30 CUTTINGS PER LINEAR FOOT AND A MAXIMUM DIAMETER OF 2.5 INCHES.
3. NUMBER OF SOIL LIFTS MAY VARY. IN GENERAL LIFTS SHALL EXTEND TO THE TOP OF BANK OR BANKFULL STAGE.
4. WHEN GEOLIFTS ARE BUILT ABOVE ROOTWAD CLUSTER, USE LARGE STONE BACKFILL BEHIND ROOT MASS TO BUILT FOUNDATION.
5. CLASS 1 STONE MAY BE USED AT THE DIRECTION OF THE ENGINEER TO BUILD THE FOUNDATION IN LIEU OF BRUSH MATERIAL.

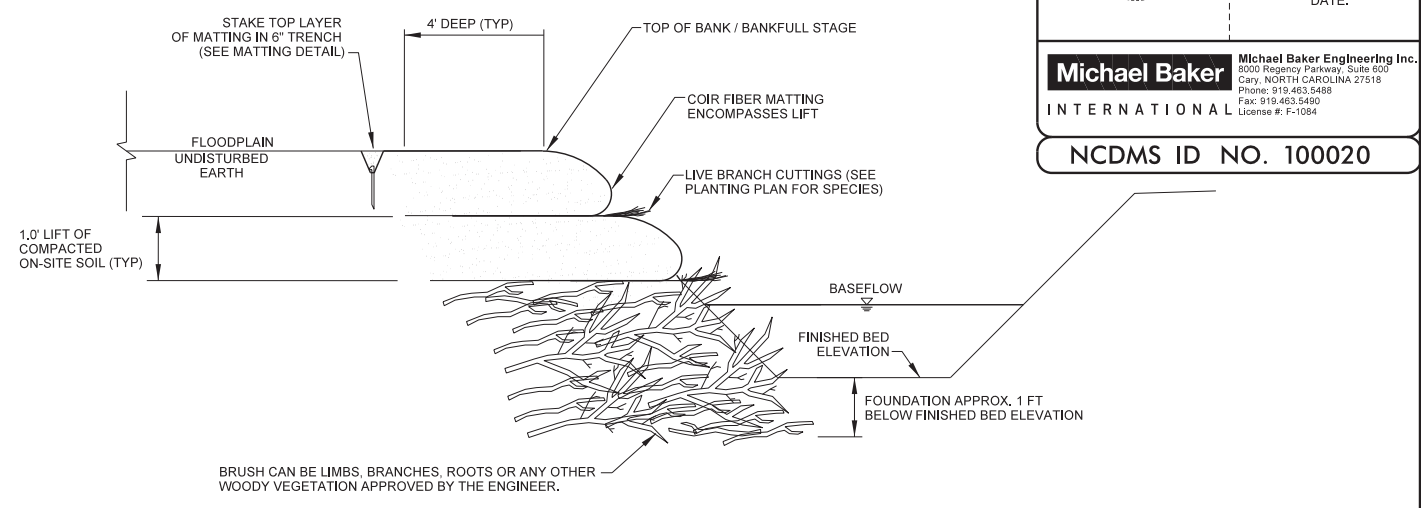


PROJECT REFERENCE NO. 162039	SHEET NO. 2D
PROJECT ENGINEER	
APPROVED BY:	
2/22/2022	
DATE:	
Michael Baker International Michael Baker Engineering Inc. 8020 Regency Parkway, Suite 600 Cary, NORTH CAROLINA 27518 Phone: 919.463.5485 Fax: 919.463.5490 License #: F-1084	
NCDMS ID NO. 100020	

ROCK DAM

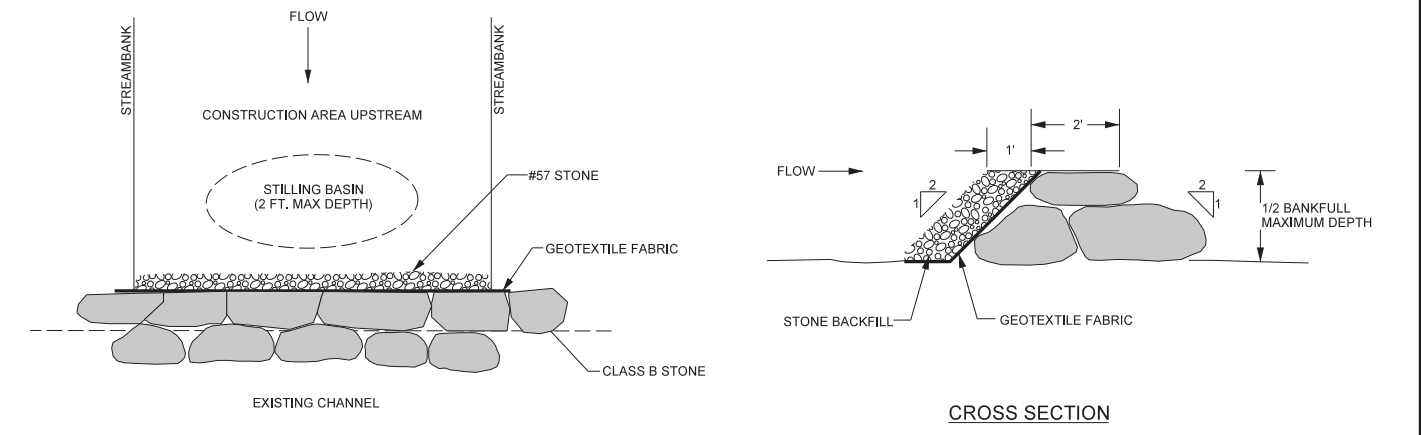


NOTES:
CLEAN OUT STILLING BASIN OF TRAPPED SEDIMENT PRIOR TO REMOVAL.

ROCK TOE PROTECTION

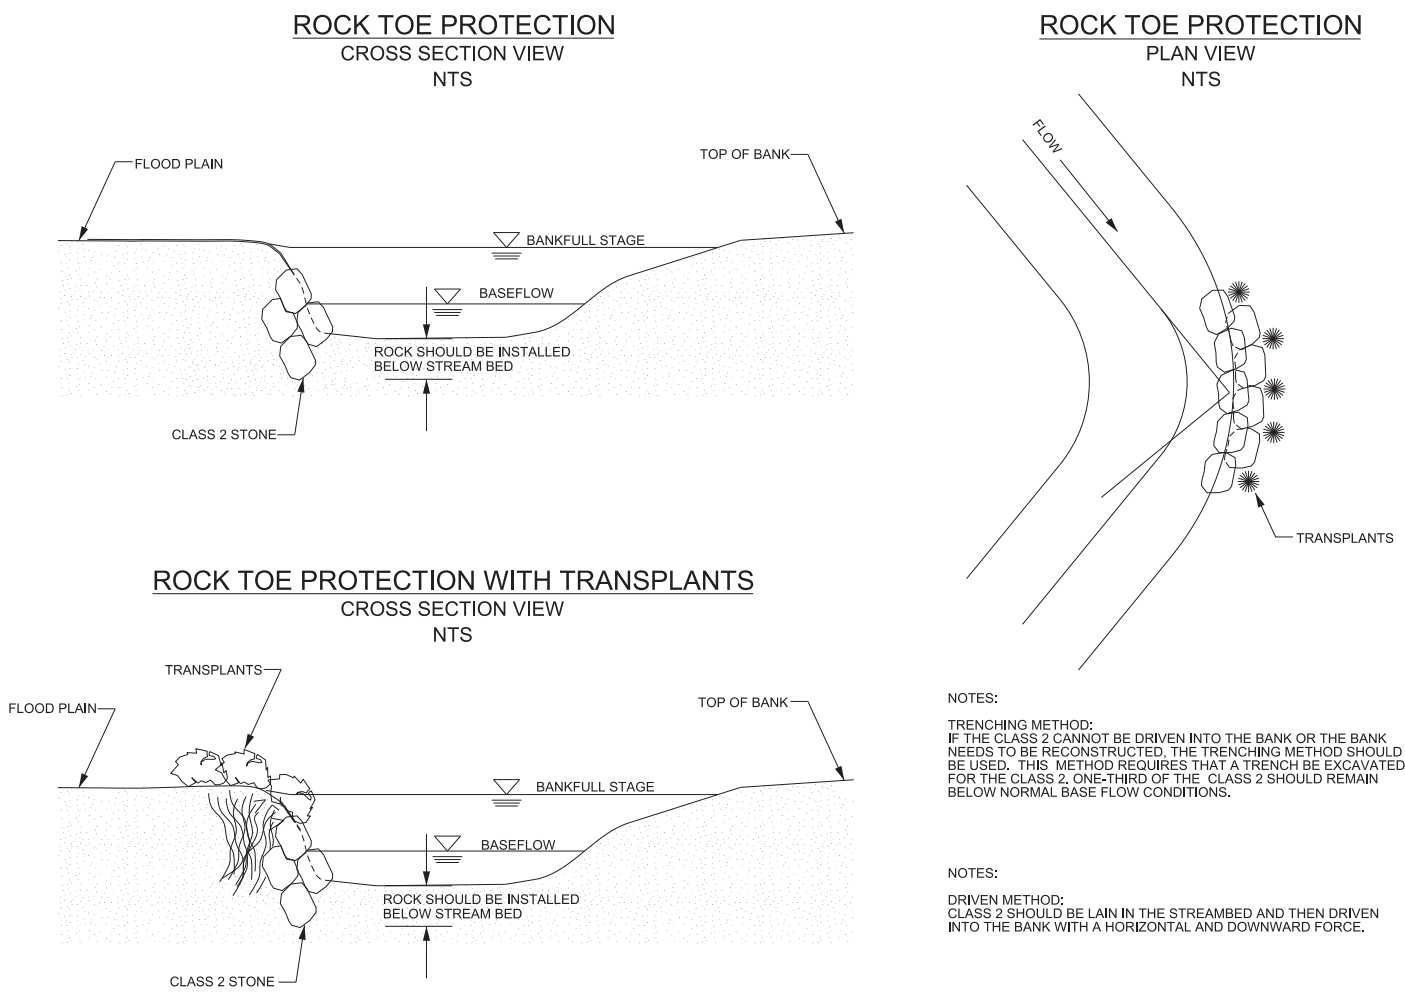

- NOTES:**
- TRENCHING METHOD:
IF THE CLASS 2 CANNOT BE DRIVEN INTO THE BANK OR THE BANK NEEDS TO BE RECONSTRUCTED, THE TRENCHING METHOD SHOULD BE USED. THIS METHOD REQUIRES THAT A TRENCH BE EXCAVATED FOR THE CLASS 2, ONE-THIRD OF THE CLASS 2 SHOULD REMAIN BELOW NORMAL BASE FLOW CONDITIONS.
- NOTES:**
- DRIVEN METHOD:
CLASS 2 SHOULD BE LAIN IN THE STREAMBED AND THEN DRIVEN INTO THE BANK WITH A HORIZONTAL AND DOWNWARD FORCE.

ROCK FORD STREAM CROSSING

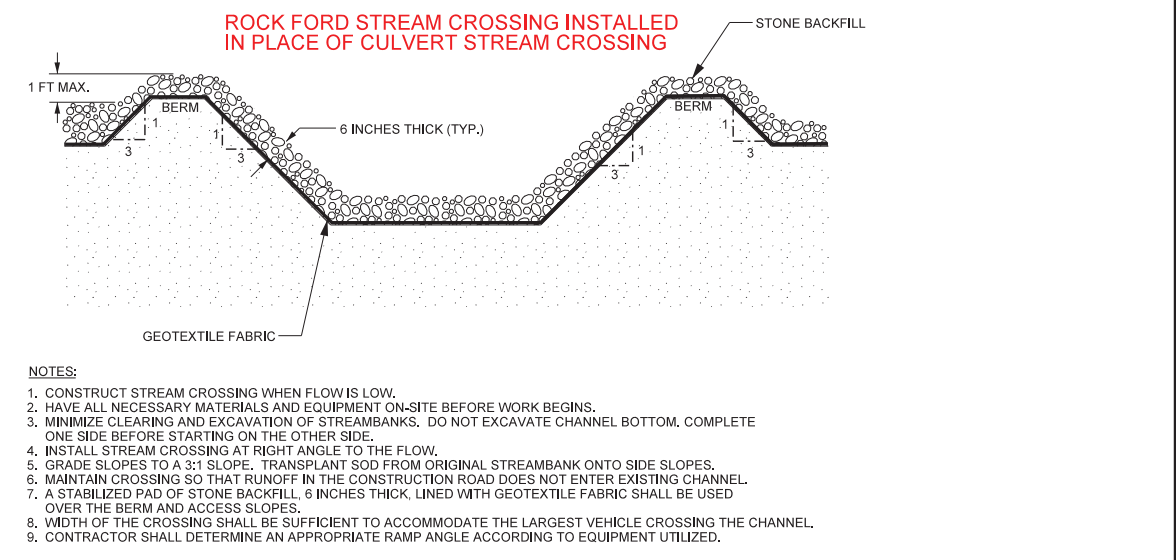


- NOTES:**
1. CONSTRUCT STREAM CROSSING WHEN FLOW IS LOW.
 2. HAVE ALL NECESSARY MATERIALS AND EQUIPMENT ON-SITE BEFORE WORK BEGINS.
 3. MINIMIZE CLEARING AND EXCAVATION OF STREAMBANKS. DO NOT EXCAVATE CHANNEL BOTTOM. COMPLETE ONE SIDE BEFORE STARTING ON THE OTHER SIDE.
 4. INSTALL STREAM CROSSING AT RIGHT ANGLE TO THE FLOW.
 5. GRADE SLOPES TO A 3:1 SLOPE. TRANSPLANT SOD FROM ORIGINAL STREAMBANK ONTO SIDE SLOPES.
 6. MAINTAIN CROSSING SO THAT RUNOFF IN THE CONSTRUCTION ROAD DOES NOT ENTER EXISTING CHANNEL.
 7. A STABILIZED PAD OF STONE BACKFILL, 6 INCHES THICK, LINED WITH GEOTEXTILE FABRIC SHALL BE USED OVER THE BERM AND ACCESS SLOPES.
 8. WIDTH OF THE CROSSING SHALL BE SUFFICIENT TO ACCOMMODATE THE LARGEST VEHICLE CROSSING THE CHANNEL.
 9. CONTRACTOR SHALL DETERMINE AN APPROPRIATE RAMP ANGLE ACCORDING TO EQUIPMENT UTILIZED.

R:\162039_Whittier_Creek_Design\As-Built\Plans\162039_ASB-PSH-02D.dgn


2/26/2023

BARB WIRE FIELD FENCE

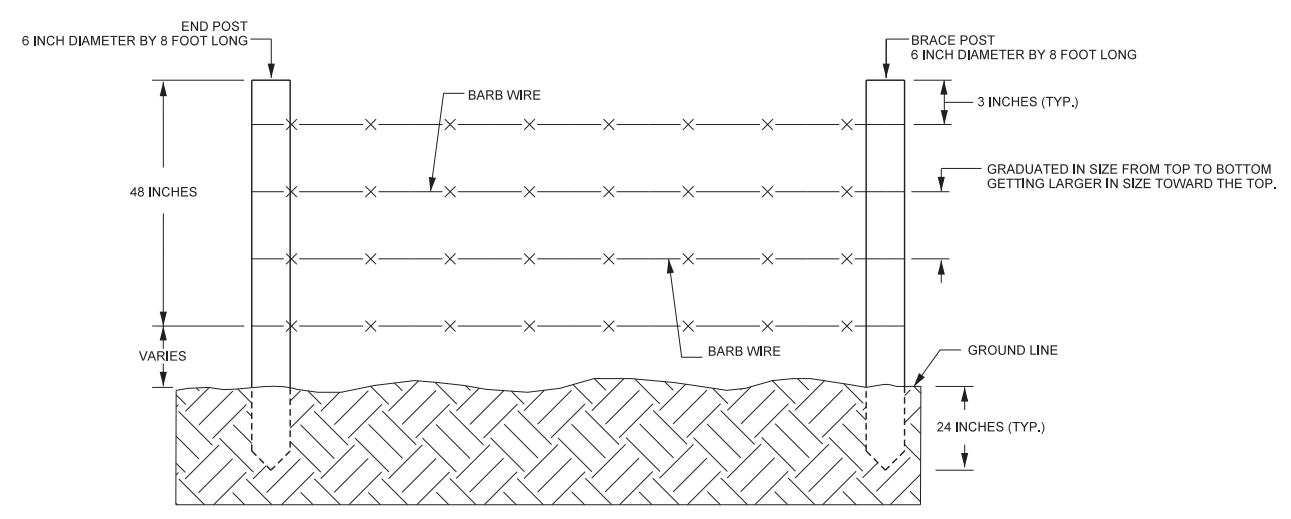


NOTE:
1. END POSTS SHALL BE INSTALLED AT A SPACING OF 10-15 FEET.

WOVEN WIRE FENCE

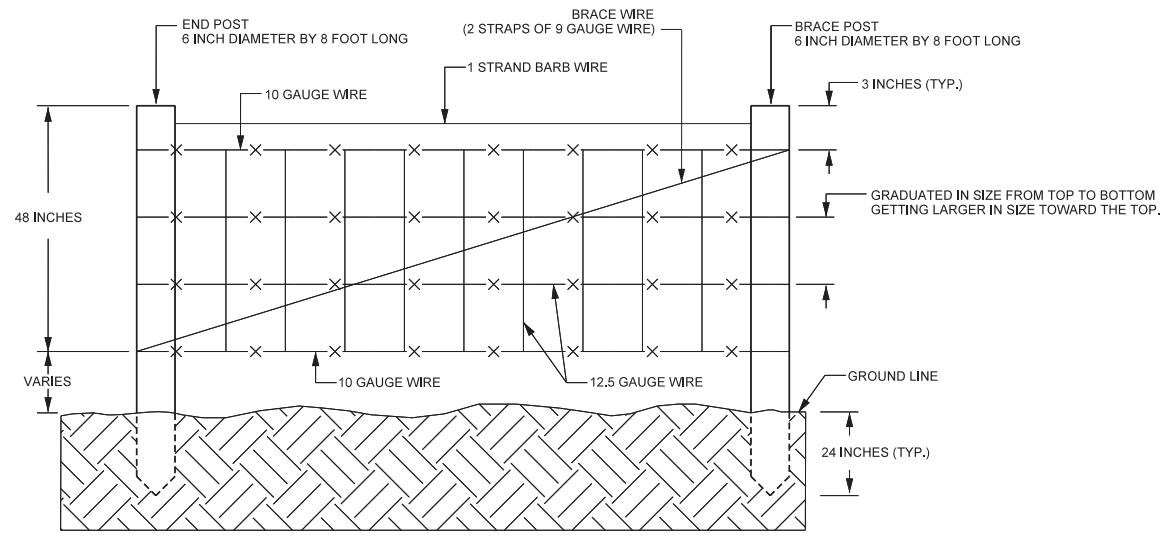


NOTE:
1. END POSTS SHALL BE INSTALLED AT A SPACING OF 10-15 FEET.

STEEL GATES

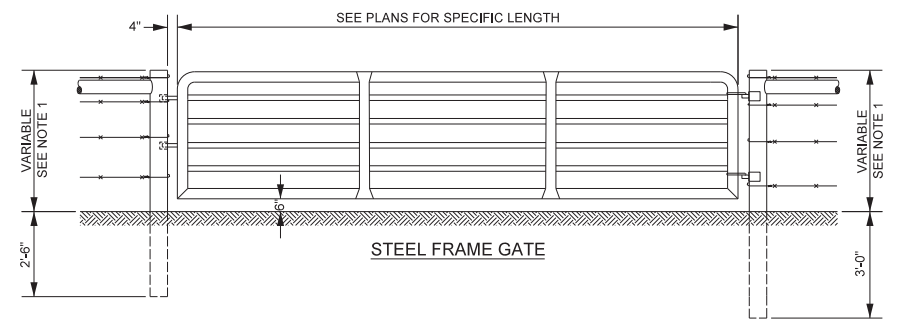


NOTES:
1. POST HEIGHT DIMENSION SHALL BE THE SAME AS REQUIRED FOR THE ADJACENT FENCE.
2. CONSTRUCT AN END OR STRESS PANEL, AS REQUIRED IN THE SPECIFICATION, ON EACH SIDE OF GATE.
3. HINGES AND LOCKS SHALL BE INSTALLED AS SPECIFIED BY GATE MANUFACTURER.


4 STRAND - HIGH TENSILE FENCING

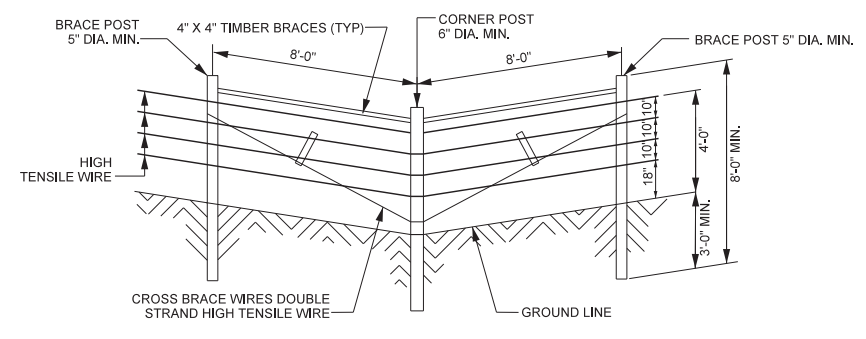


CORNER AND VERTICAL CHANGE BRACING
INSTALL AT ALL POINTS WHERE FENCE ALIGNMENT CHANGES 15 DEGREES OR MORE

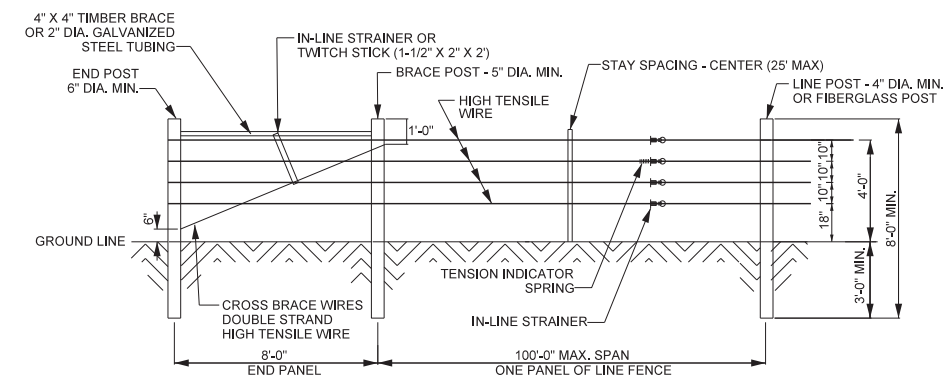

END ASSEMBLY AND LINE FENCE SECTION

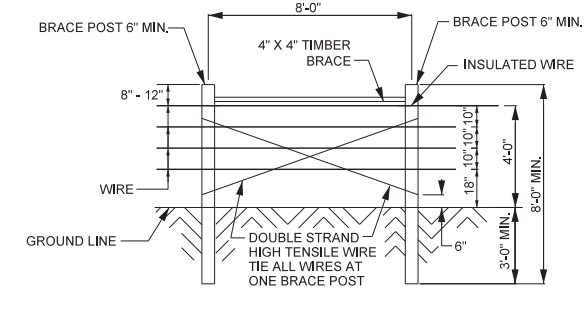

PULL POST ASSEMBLY

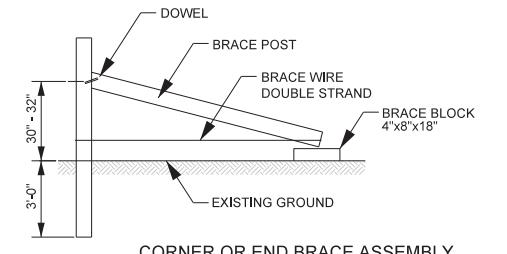

CORNER OR END BRACE ASSEMBLY

PLACE IN FENCE LINE SO THAT MAXIMUM DISTANCE BETWEEN BRACED POSTS DOES NOT EXCEED 1320 FEET

OPTIONAL FIGURE 4




- NOTES:**
- NOTCH POSTS 3/4" FOR 4" X 4" TIMBER BRACES.
 - DOWELS TO BE 1/2" DIA. X 5" PLAIN STEEL RODS. DRIVE DOWELS IN 7/16" DIA. HOLES, 2-1/2" INTO EACH POST AND TIMBER BRACE.
 - STAPLE CROSS-BRACE WIRES TO BRACE AND CORNER POSTS AT QUARTER POINTS OF THE POSTS.
 - HIGH TENSILE WIRE WILL BE NEW AND SMOOTH AND WILL MEET THE FOLLOWING
1) TENSILE STRENGTH - 110,000 PSI 2) GALVANIZING - TYPE III 3) GAGE - 12-1/2.
 - ALL CORNER POSTS, BRACE POSTS, BRACES, AND STAY SPACERS, SHALL BE PRESSURE TREATED. PRESSURE TREATMENT SHALL CONFORM TO FEDERAL SPECIFICATION TT-W-571. (1-1/4" LONG FOR HARD WOODS).
 - AT CORNER POSTS, STAPLE EACH WIRE AT QUARTER POINTS OF POSTS. AT BRACE POSTS, DOUBLE STAPLE EACH WIRE. AT LINE POSTS, SECURE EACH WIRE WITH STANDARD CLAMPS.
 - FIBERGLASS MAY BE USED FOR LINE POSTS. THESE WILL CONSIST OF MARBLE, FIBERGLASS, AND POLYMER RESINS WHICH HAVE BEEN TREATED BY THERMOSETTING (HEAT TREATMENT). POSTS MUST BE DRIVEN IN THE SOIL AT LEAST 18 INCHES.
 - 2" DIAMETER PIPE DIAGONAL BRACE MAY BE USED IN PLACE OF HORIZONTAL TIMBER BRACE AND DIAGONAL WIRES.
 - MINIMUM NET RETENTION OF CHROMATED COPPER ARSENATE (CCA) FOR WOOD FENCE POSTS SHALL BE 0.40 POUNDS PER CUBIC FOOT.
 - A SINGLE 12 FOOT LONG, 6 INCH MINIMUM DIAMETER POST MAY BE SUBSTITUTED FOR END PANEL, CORNER AND VERTICAL CHANGE BRACING, AND PULL POST ASSEMBLY. THE 12 FOOT LONG POSTS SHALL EXTEND A MINIMUM OF 7.5 FEET INTO THE GROUND AND BE BACKFILLED WITH GRAVEL.
 - FOR FURTHER DETAILS ON APPROVED METHODS OF FENCE INSTALLATION, SEE NATURAL RESOURCE SERVICE'S CONSERVATION PRACTICE MATERIALS AND CONSTRUCTION SPECIFICATIONS FOR FENCING (CODE 382) BY NRCS NORTH CAROLINA (FEBRUARY 2008).

PROJECT REFERENCE NO. 162039	SHEET NO. 2E
PROJECT ENGINEER	
Signed by: <i>Kathleen M. McKeithan</i> 247840F4181473... APPROVED BY: DATE: 2/22/2022	
Michael Baker International Michael Baker Engineering Inc. 8020 Regency Parkway, Suite 600 Cary, NORTH CAROLINA 27518 Phone: 919.463.5485 Fax: 919.463.5490 License #: F-1084	
NCDSM ID NO. 100020	

R:\2023\162039_Whittier-Creek\Design\As-Built\Plans\162039_ASB-PSH-02E.dgn

2/26/2023




LOG DROP

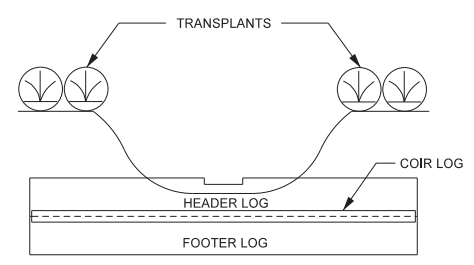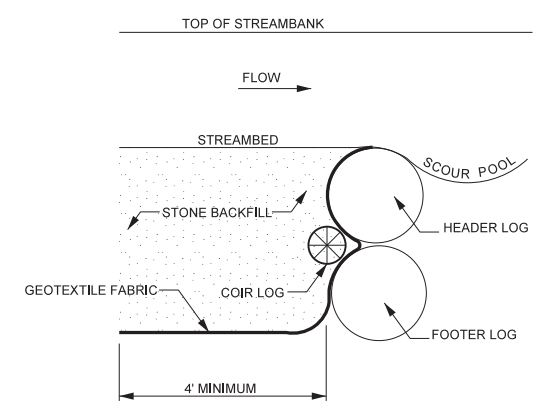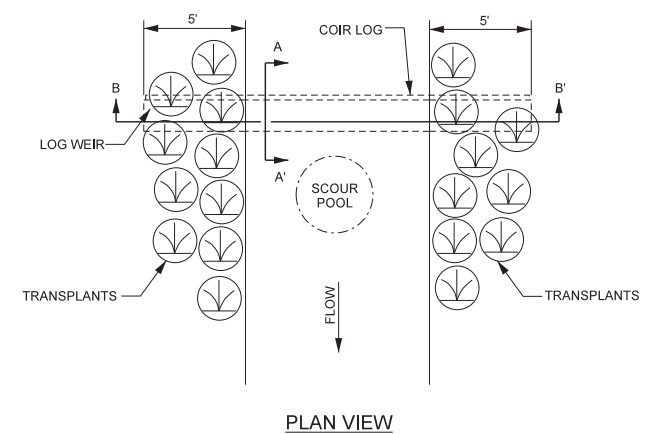

NOTES:

- LOGS SHOULD BE AT LEAST 10 INCHES IN DIAMETER, RELATIVELY STRAIGHT, HARDWOOD, AND RECENTLY HARVESTED.
- TOP OF HEADER LOG SHOULD BE SET AT SAME ELEVATION AS THE STREAMBED.
- DIAMETER OF COIR LOG SHOULD BE APPROXIMATELY 1/2 DIAMETER OF LOGS.
- USE GEOTEXTILE FABRIC WITH COIR LOGS TO SEAL GAPS BETWEEN LOGS.
- PLACE TRANSPLANTS ALONG BANKS TO PROTECT AGAINST BANK EROSION.
- THE HEADER LOG SHOULD BE NOTCHED 2 - 3 INCHES DEEP IN THE CENTER AND FOR 20 - 30% OF THE CHANNEL WIDTH.

CONSTRUCTED RIFFLE

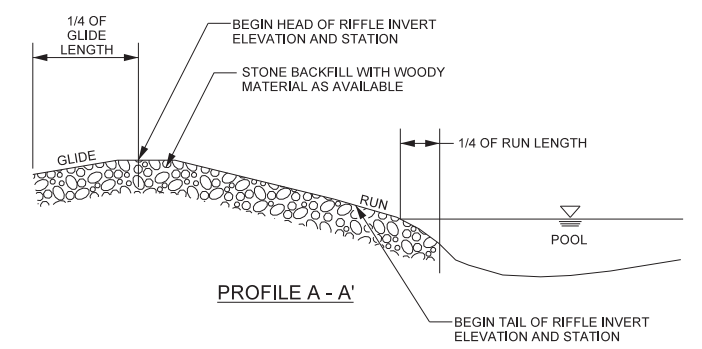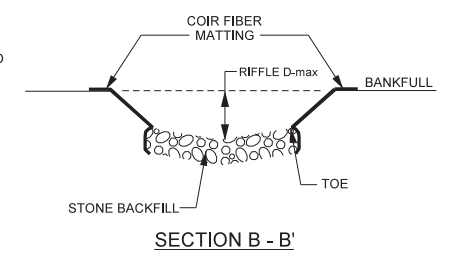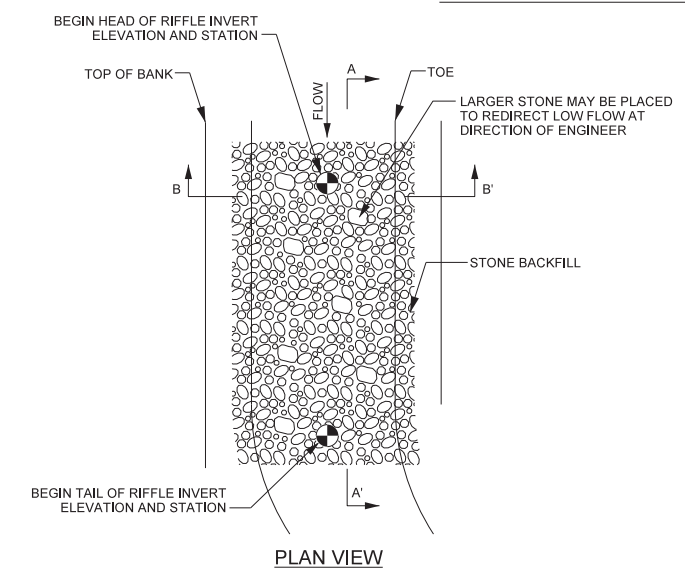

NOTES:

- UNDERCUT CHANNEL BED ELEVATION AS NEEDED TO ALLOW FOR LAYERS OF STONE TO ACHIEVE FINAL GRADE.
- INSTALL COIR FIBER MATTING ALONG COMPLETED BANKS SUCH THAT THE EROSION CONTROL MATTING AT THE TOE OF THE BANK EXTENDS DOWN TO THE UNDERCUT ELEVATION.
- INSTALL STONE BACKFILL, COMPACTED TO GRADE.
- FINAL CHANNEL BED SHAPE SHOULD BE ROUNDED, SMOOTH, AND CONCAVE, WITH THE ELEVATION OF THE BED 0.2 FT DEEPER IN THE CENTER THAN AT THE EDGES.
- CONSTRUCTED RIFFLES SHALL BE 12" THICK.
- CHANNEL BED SHALL INCLUDE WOODY MATERIAL AS AVAILABLE ON-SITE LAYERED IN WITH STONE BACKFILL.

REACH	STONE BACKFILL MIX
APPLIES TO ALL REACHES	10% CLASS I RIPRAP 20% CLASS B RIPRAP 40% CLASS A RIPRAP 30% ON-SITE ALLUVIUM

PROJECT REFERENCE NO. 162039 SHEET NO. 2F

PROJECT ENGINEER

DocuSigned by: *Kathleen M. McKeithan*
247E84DF4181473...

APPROVED BY: _____

2/22/2022




DATE: _____

Michael Baker International
8020 Regency Parkway, Suite 600
Cary, NORTH CAROLINA 27518
Phone: 919.463.5486
Fax: 919.463.5490
License #: F-1084

NCDMS ID NO. 100020

CONSTRUCTED RIFFLE WITH WOOD


CONSTRUCTED RIFFLE WITH WOOD INSTALLED IN PLACE OF GRADE CONTROL LOG JAM

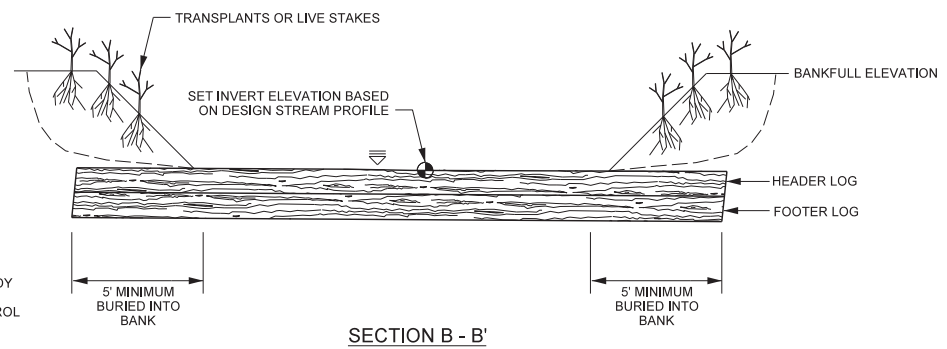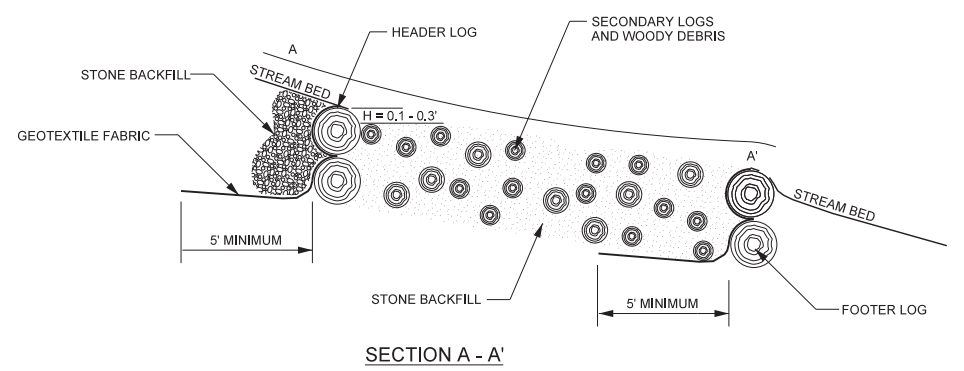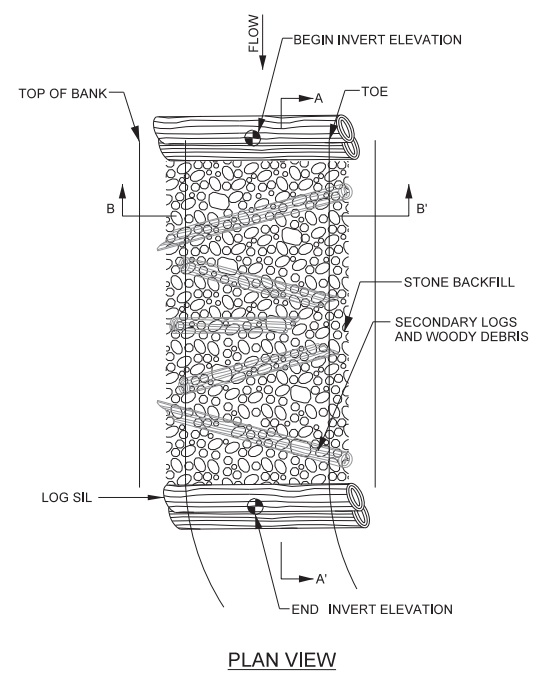

NOTES:


- UNDERCUT CHANNEL BED ELEVATION AS NEEDED TO ALLOW LAYERS OF STONE AND WOODY MATERIAL TO ACHIEVE FINAL GRADE.
- INSTALL COIR FIBER MATTING ALONG COMPLETED BANKS SUCH THAT THE EROSION CONTROL MATTING AT THE TOE OF THE BANK EXTENDS DOWN TO THE UNDERCUT ELEVATION.
- INSTALL STONE BACKFILL, COMPACTED TO GRADE.
- FINAL CHANNEL BED SHAPE SHOULD BE ROUNDED, SMOOTH, AND CONCAVE, WITH THE ELEVATION OF THE BED 0.2 FT DEEPER IN THE CENTER THAN AT THE EDGES.
- CONSTRUCTED RIFFLES SHALL BE 12" THICK.
- CHANNEL BED SHALL INCLUDE WOODY MATERIAL AS AVAILABLE ON-SITE LAYERED IN WITH STONE BACKFILL.

R:\162039_Whittier_Creek_Design\As-Built\Plans\162039_ASB-PSH-02F.dgn

BAKER PROJECT REFERENCE NO. 162039	SHEET NO. 3
PROJECT ENGINEER	
DocuSigned by: Kathleen M. McKeithan 247E8AD4161473 APPROVED BY: 2/22/2022 DATE:	
	
Michael Baker International Michael Baker Engineering Inc. 5000 Regency Parkway, Suite 600 Cary, NORTH CAROLINA 27518 Phone: 919.453.5488 Fax: 919.453.5490 License #: F-1084	
NCDMS ID NO. 100020	



NURSE ROAD
SR 2023
R/W WIDTH 50' PER DB: 426 Pg. 1263

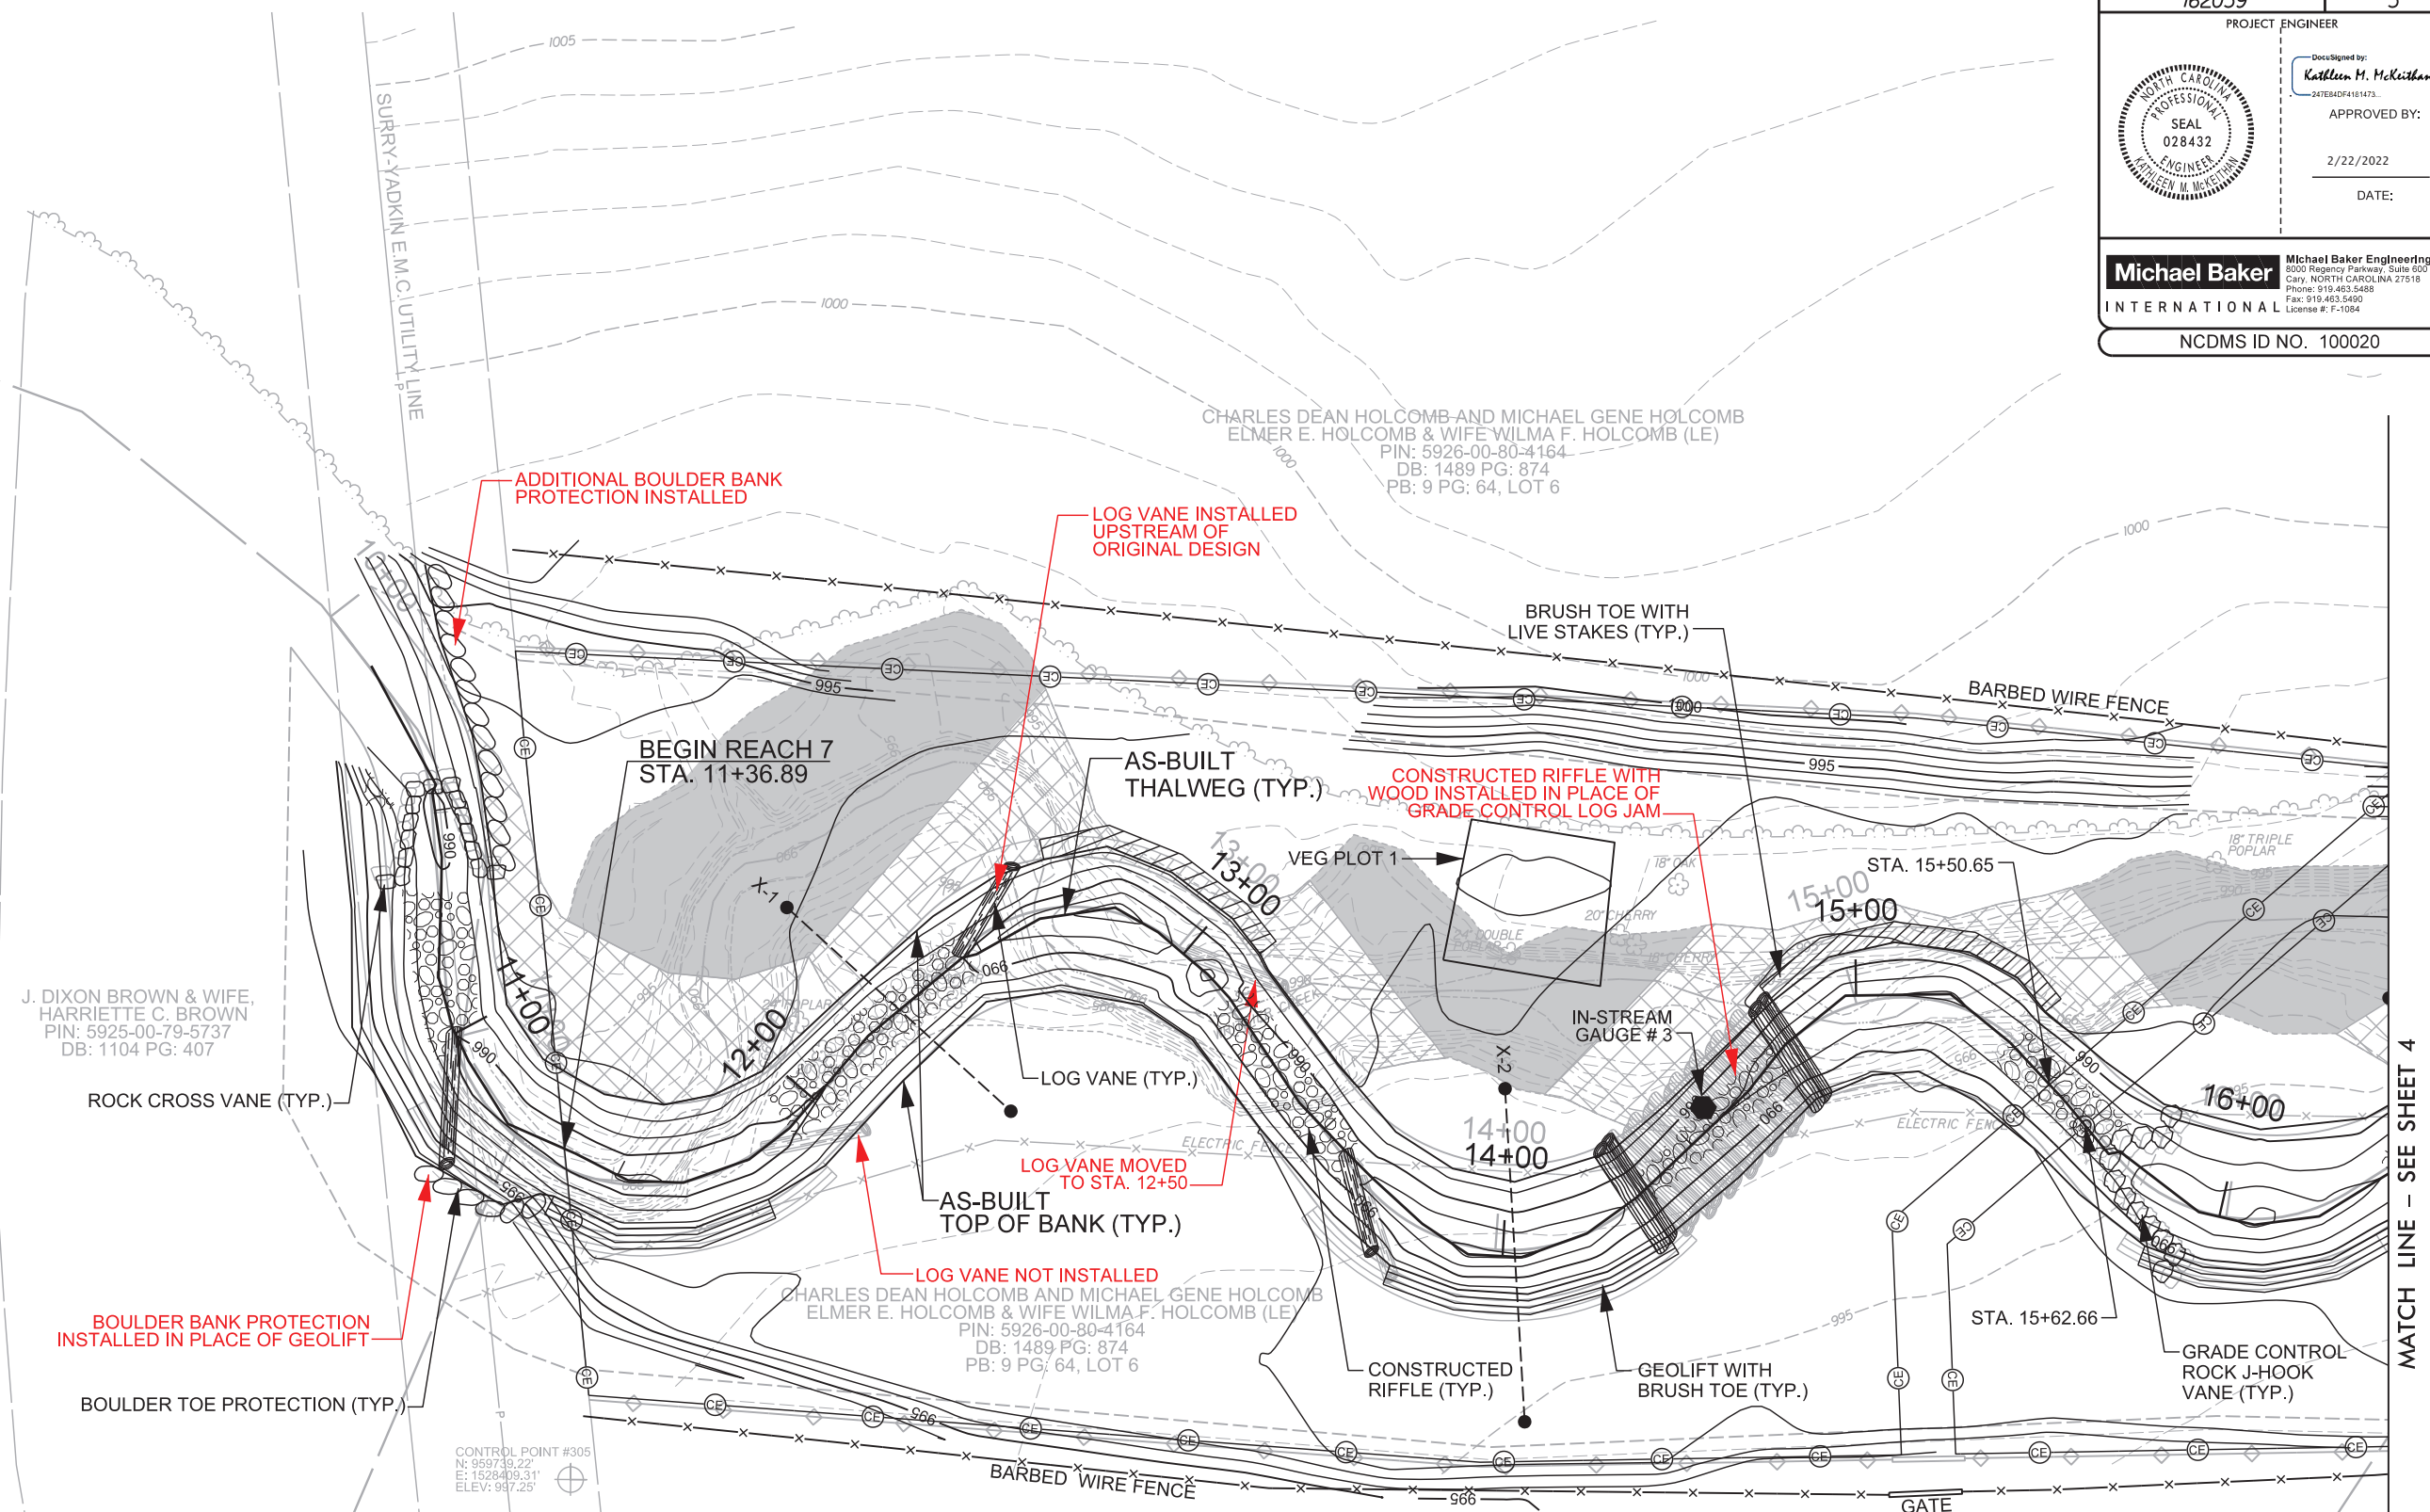

J. DIXON BROWN & WIFE,
HARRIETTE C. BROWN
PIN: 5925-00-79-5737
DB: 1104 PG: 407

CHARLES DEAN HOLCOMB AND MICHAEL GENE HOLCOMB
ELMER E. HOLCOMB & WIFE WILMA F. HOLCOMB (LE)
PIN: 5926-00-30-4164
DB: 1489 PG: 874
PB: 9 PG: 64, LOT 6


CONTROL POINT #305
N: 959739.22'
E: 1528409.31'
ELEV: 997.25'

AS-BUILT LEGEND

- PROPOSED DESIGN
- AS-BUILT SURVEY BY
KEE MAPPING & SURVEYING
10/20/21 & 2/17/22
- RED LINE VARIATIONS FROM
ORIGINAL DESIGN SEALED BY
KATHLEEN M. MCKEITHAN, PE

- FILL EXISTING CHANNEL
- CHANNEL PLUG

**WHITTIER CREEK
AS-BUILT PLAN VIEW**




SCALE (FT)

R:\2023\Whittier-Creek-Design\As-Built\Plans\162039_ASB-PSH-03.dgn


MATCH LINE - SEE SHEET 4



2/26/23

BAKER PROJECT REFERENCE NO. 162039	SHEET NO. 4
PROJECT ENGINEER	
DocuSigned by: <i>Kathleen M. McKeithan</i> 247EADDF4181473 APPROVED BY: 2/22/2022 DATE:	
	
Michael Baker International Michael Baker Engineering Inc. 5030 Regency Parkway, Suite 500 Cary, NORTH CAROLINA 27518 Phone: 919.453.5488 Fax: 919.453.5490 License #: F-1084	
NCDMS ID NO. 100020	

AS-BUILT LEGEND

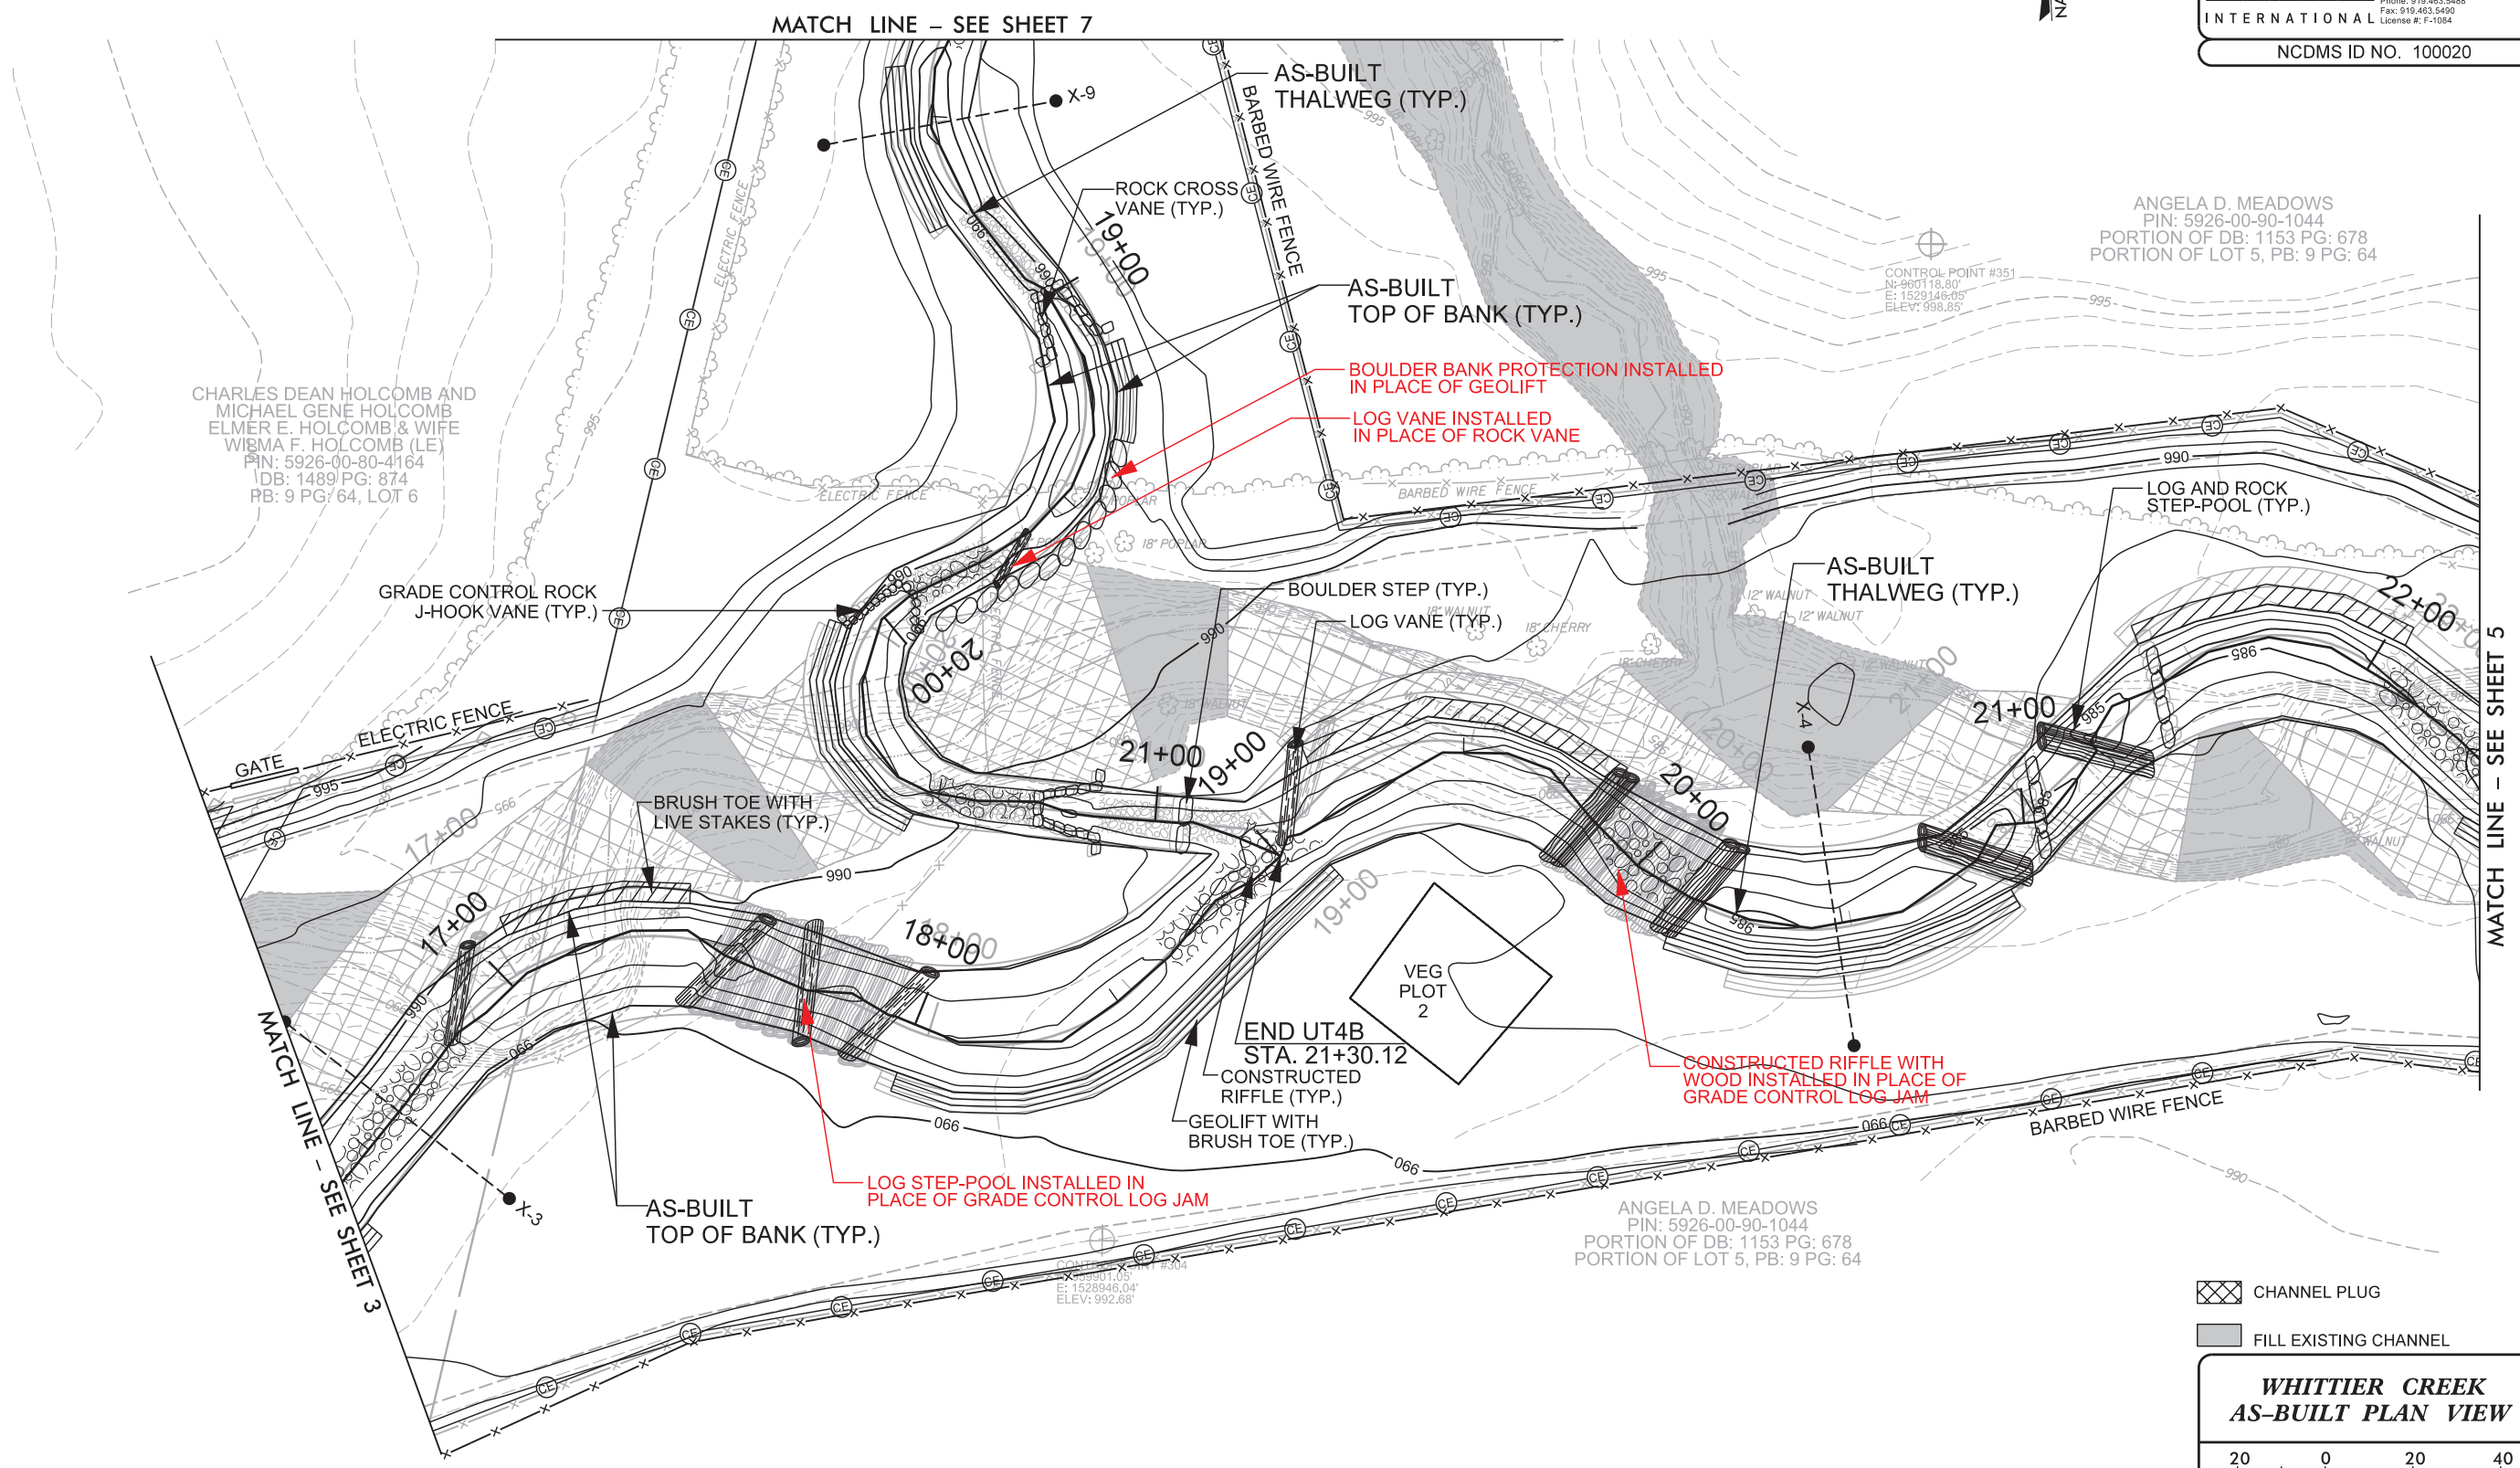- PROPOSED DESIGN
- AS-BUILT SURVEY BY KEE MAPPING & SURVEYING 10/20/21 & 2/17/22
- RED LINE VARIATIONS FROM ORIGINAL DESIGN SEALED BY KATHLEEN M. McKEITHAN, PE



 CHANNEL PLUG
 FILL EXISTING CHANNEL

**WHITTIER CREEK
AS-BUILT PLAN VIEW**

20 0 20 40
SCALE (FT)

R:\2023\Whittier-Creek-Design\As-Built\Plans\162039_ASB-PSH-04.dgn


2/26/2023

BAKER PROJECT REFERENCE NO. 162039	SHEET NO. 5
PROJECT ENGINEER	
	
Approved by: <i>Kathleen M. McKeithan</i> 247EMDF4161473. APPROVED BY: _____ DATE: 2/22/2022 DATE: _____	
Michael Baker International Michael Baker Engineering Inc. 5030 Regency Parkway, Suite 500 Cary, NORTH CAROLINA 27518 Phone: 919.453.5488 Fax: 919.453.5490 License #: F-1084	
NCDMS ID NO. 100020	



AS-BUILT LEGEND

- PROPOSED DESIGN
- AS-BUILT SURVEY BY KEE MAPPING & SURVEYING 10/20/21 & 2/17/22
- RED LINE VARIATIONS FROM ORIGINAL DESIGN SEALED BY KATHLEEN M. MCKEITHAN, PE

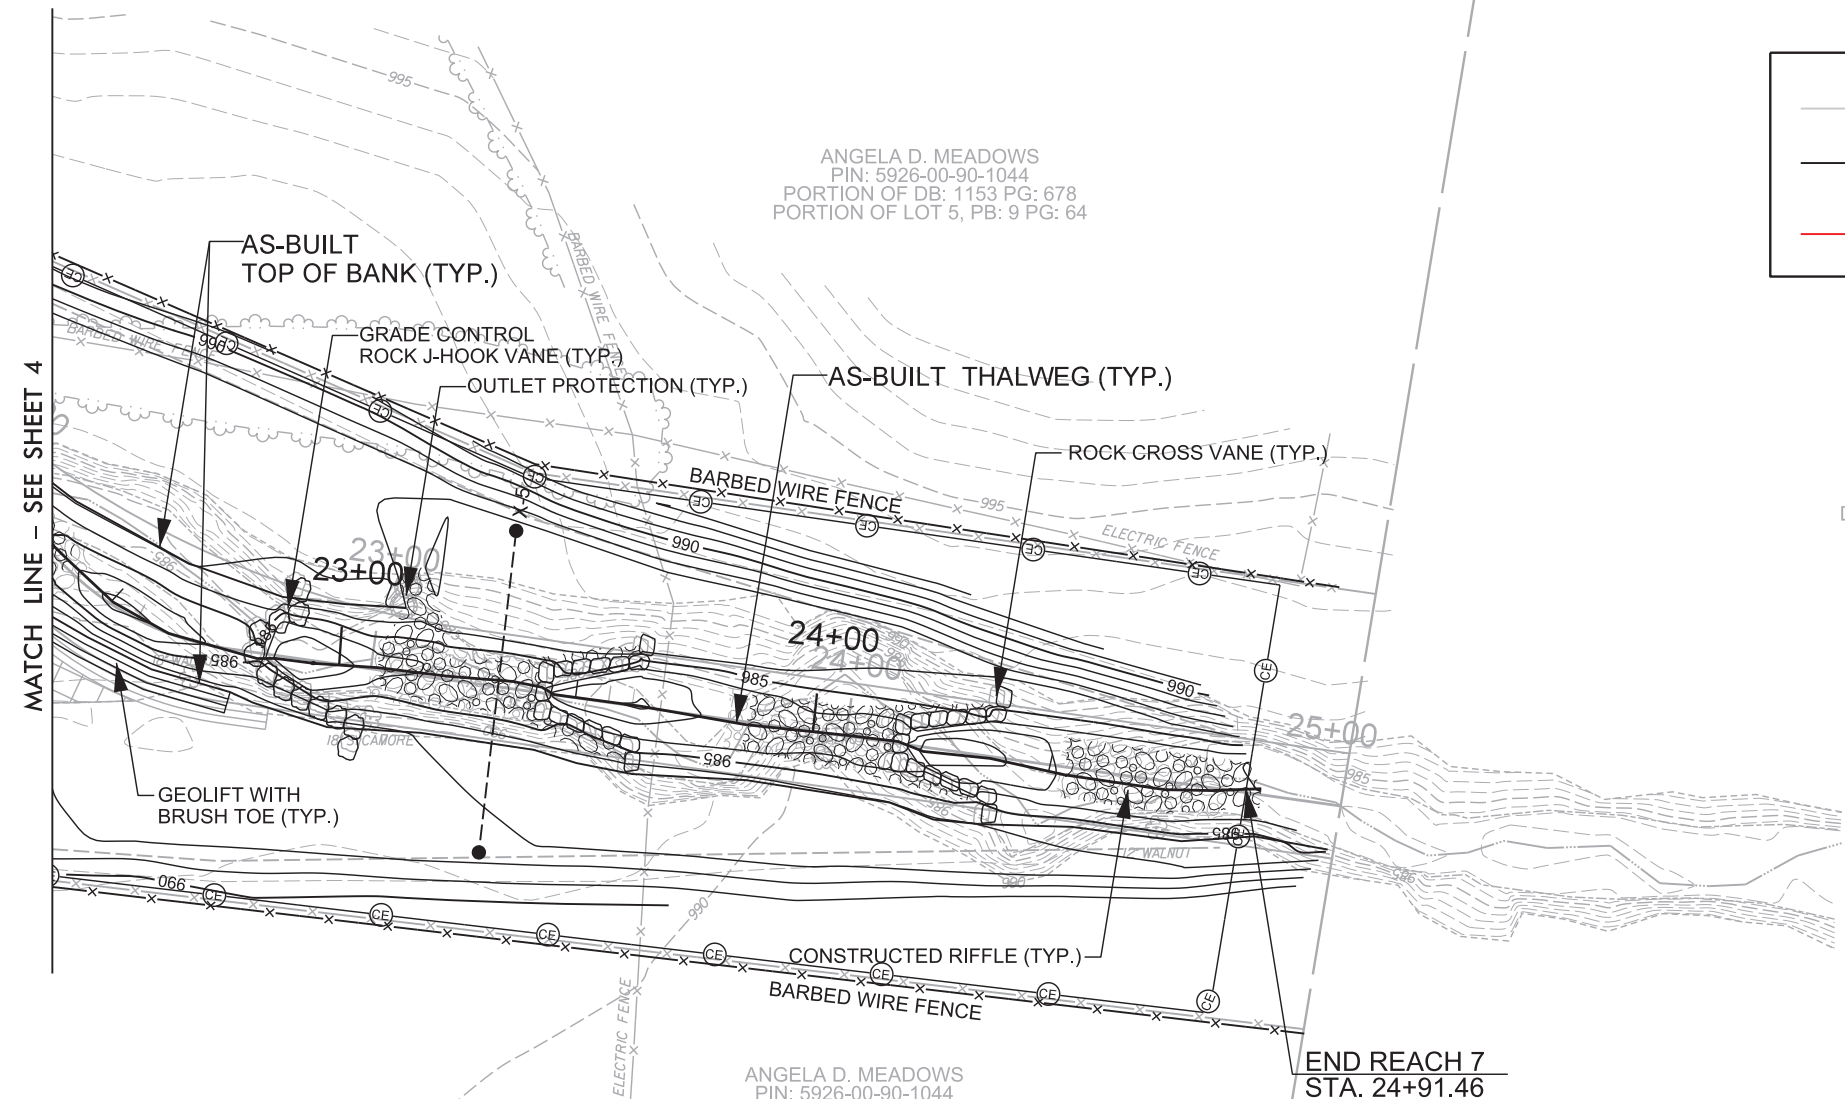



BEVERLY A. FULK
 PIN: 5926-00-90-1044
 DB: 1199 PG: 867, TRACT TWO
 PB: 9 PG: 64, LOT 4 & LOT 1-B

ANGELA D. MEADOWS
 PIN: 5926-00-90-1044
 PORTION OF DB: 1153 PG: 678
 PORTION OF LOT 5, PB: 9 PG: 64


ANGELA D. MEADOWS
 PIN: 5926-00-90-1044
 PORTION OF DB: 1153 PG: 678
 PORTION OF LOT 5, PB: 9 PG: 64

CONTROL POINT #356
 N: 959870.26'
 E: 1529275.12'
 ELEV: 990.34'

CONTROL POINT #357
 N: 959857.42'
 E: 1528946.04'
 ELEV: 989.18'


-  FILL EXISTING CHANNEL
-  CHANNEL PLUG

**WHITTIER CREEK
 AS-BUILT PLAN VIEW**




SCALE (FT)

R:\162039\Whittier_Creek_Design\As-Built\Plans\162039_ASB-PSH-05.dgn



BAKER PROJECT REFERENCE NO. 162039	SHEET NO. 6
PROJECT ENGINEER	
	
Approved By: <i>Kathleen M. McKeithan</i> 2/22/2022 DATE:	
Michael Baker International	
Michael Baker Engineering Inc. 5030 Regency Parkway, Suite 500 Cary, NORTH CAROLINA 27518 Phone: 919.453.5488 Fax: 919.453.5490 License #: F-1084	
NCDMS ID NO. 100020	

AS-BUILT LEGEND

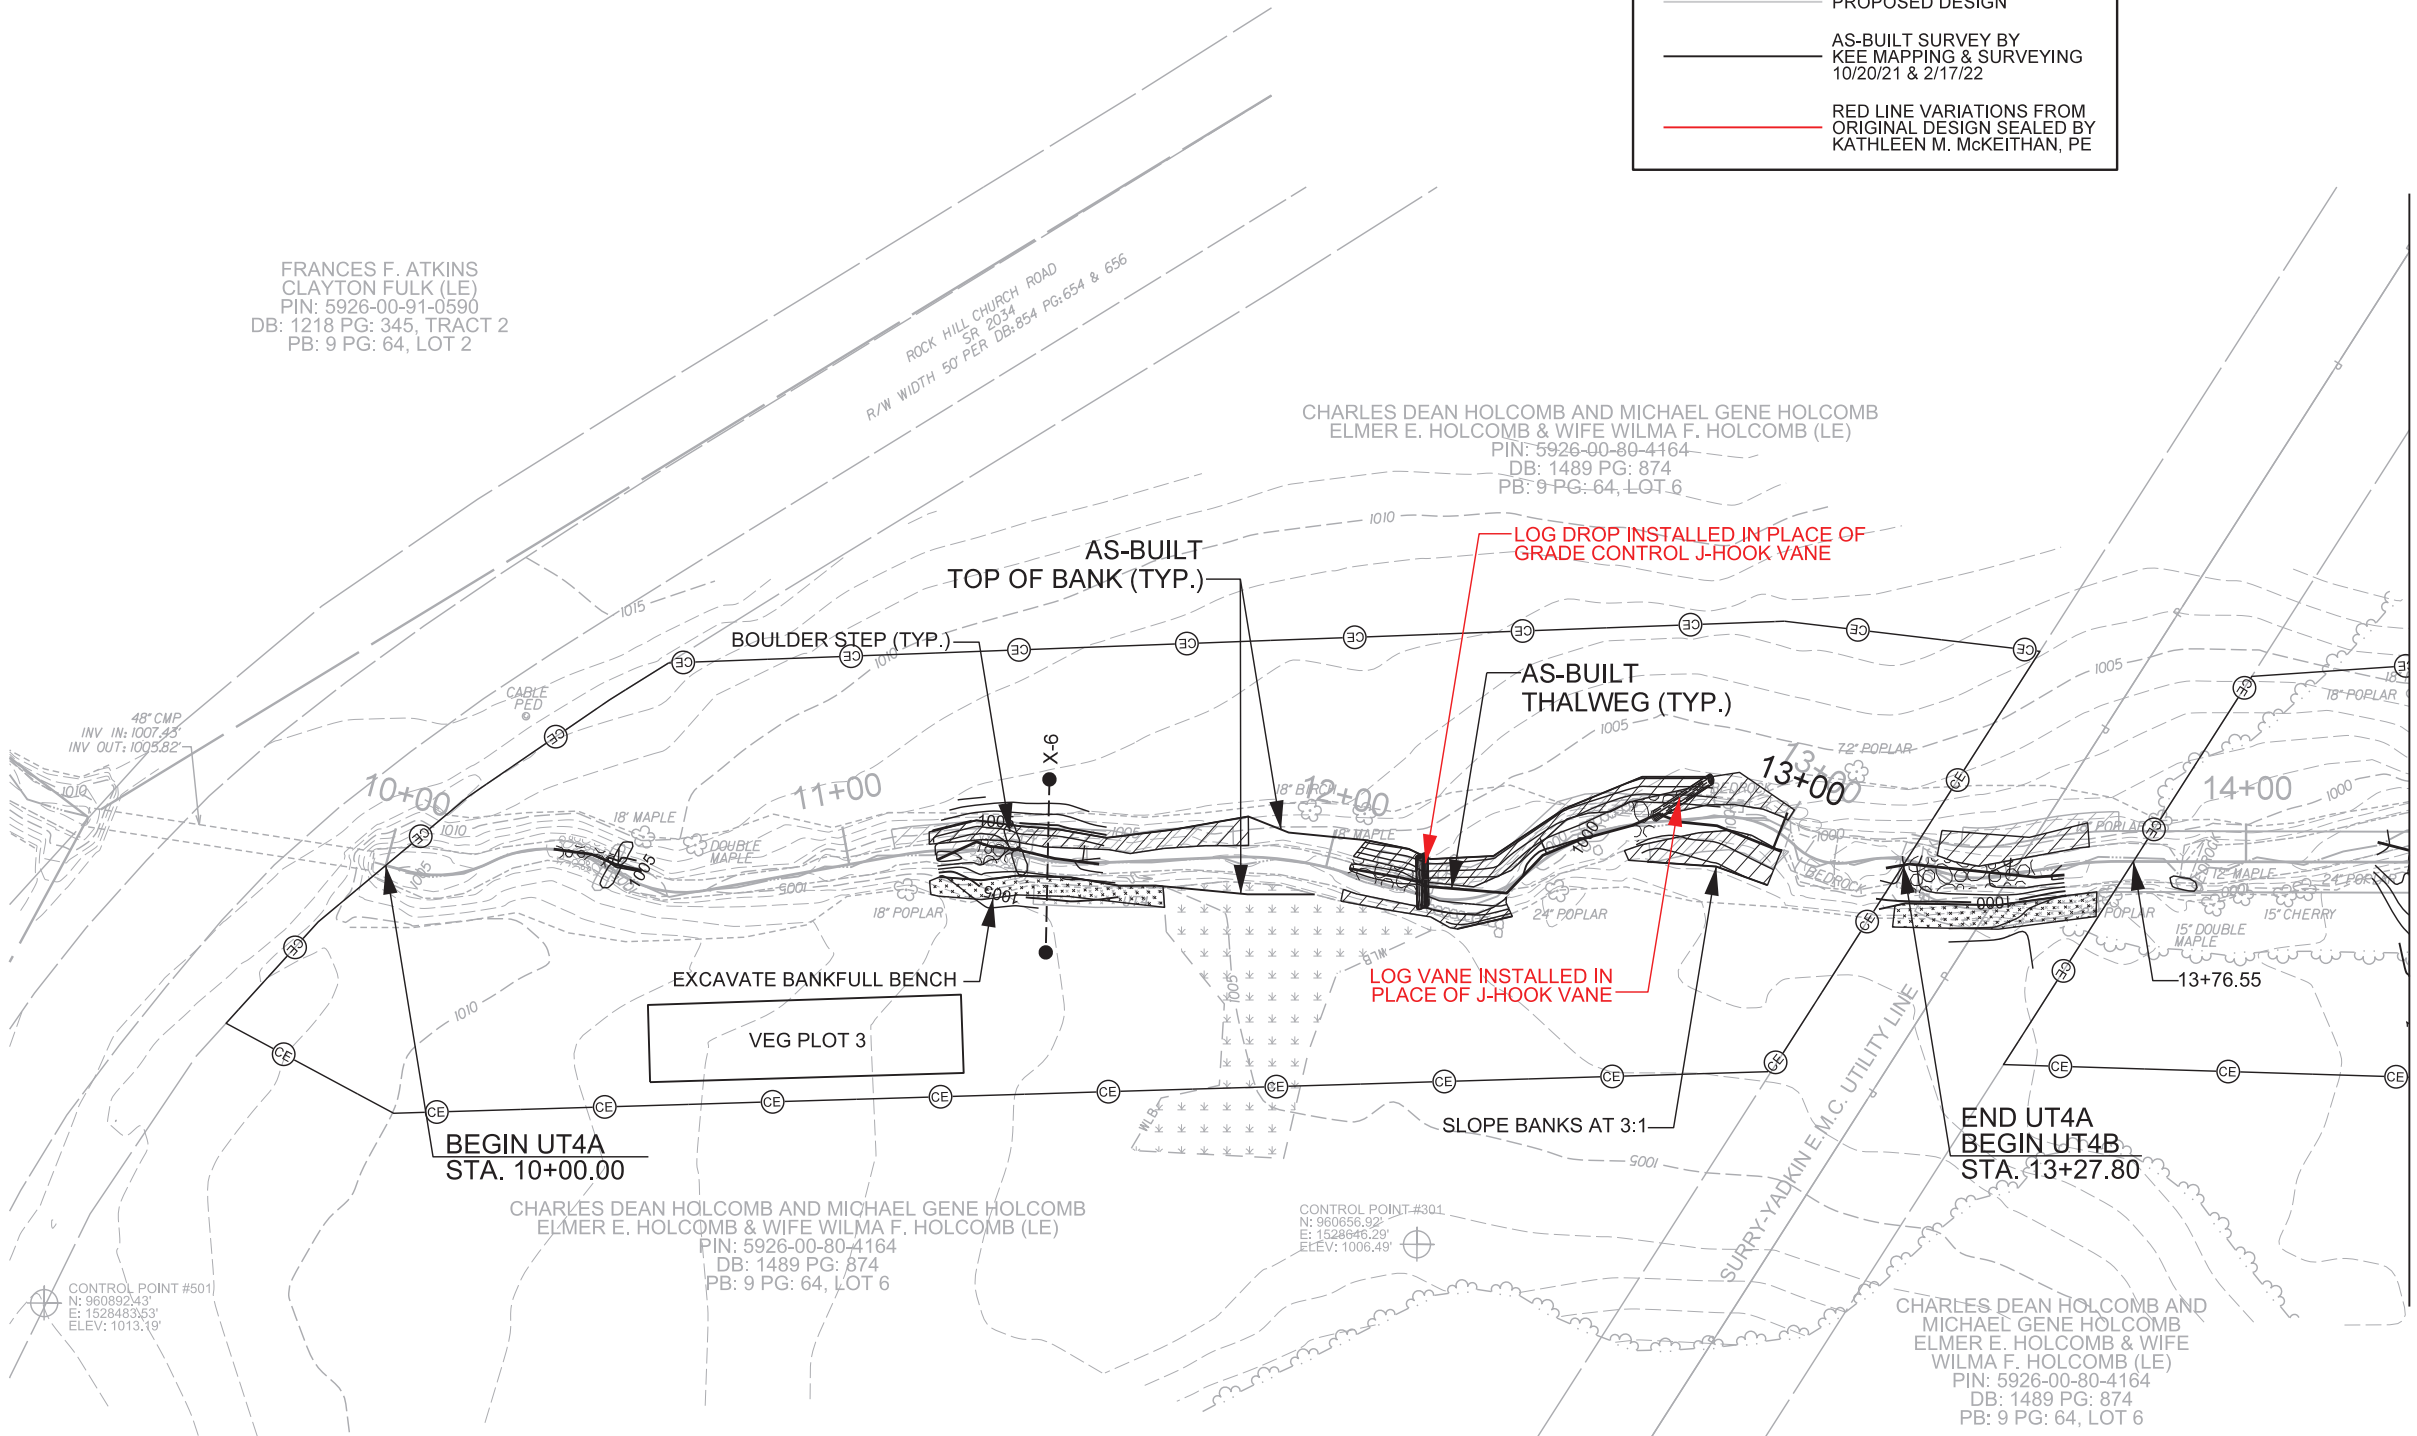
- PROPOSED DESIGN
- AS-BUILT SURVEY BY KEE MAPPING & SURVEYING 10/20/21 & 2/17/22
- RED LINE VARIATIONS FROM ORIGINAL DESIGN SEALED BY KATHLEEN M. McKEITHAN, PE



MATCH LINE - SEE SHEET 7


-  FILL EXISTING CHANNEL
-  CHANNEL PLUG


**WHITTIER CREEK
AS-BUILT PLAN VIEW**



SCALE (FT)

R:\162039\Whittier_Creek_Design\As-Built\Plans\ASB-PSH-06.dgn

BAKER PROJECT REFERENCE NO. 162039	SHEET NO. 7
PROJECT ENGINEER	
DocuSigned by:  Kathleen M. McKeithan 247E640F4161473 APPROVED BY: 2/22/2022 DATE:	
Michael Baker International Michael Baker Engineering Inc. 5000 Regency Parkway, Suite 500 Cary, NORTH CAROLINA 27518 Phone: 919.453.5488 Fax: 919.453.5490 License #: F-1084	
NCDMS ID NO. 100020	

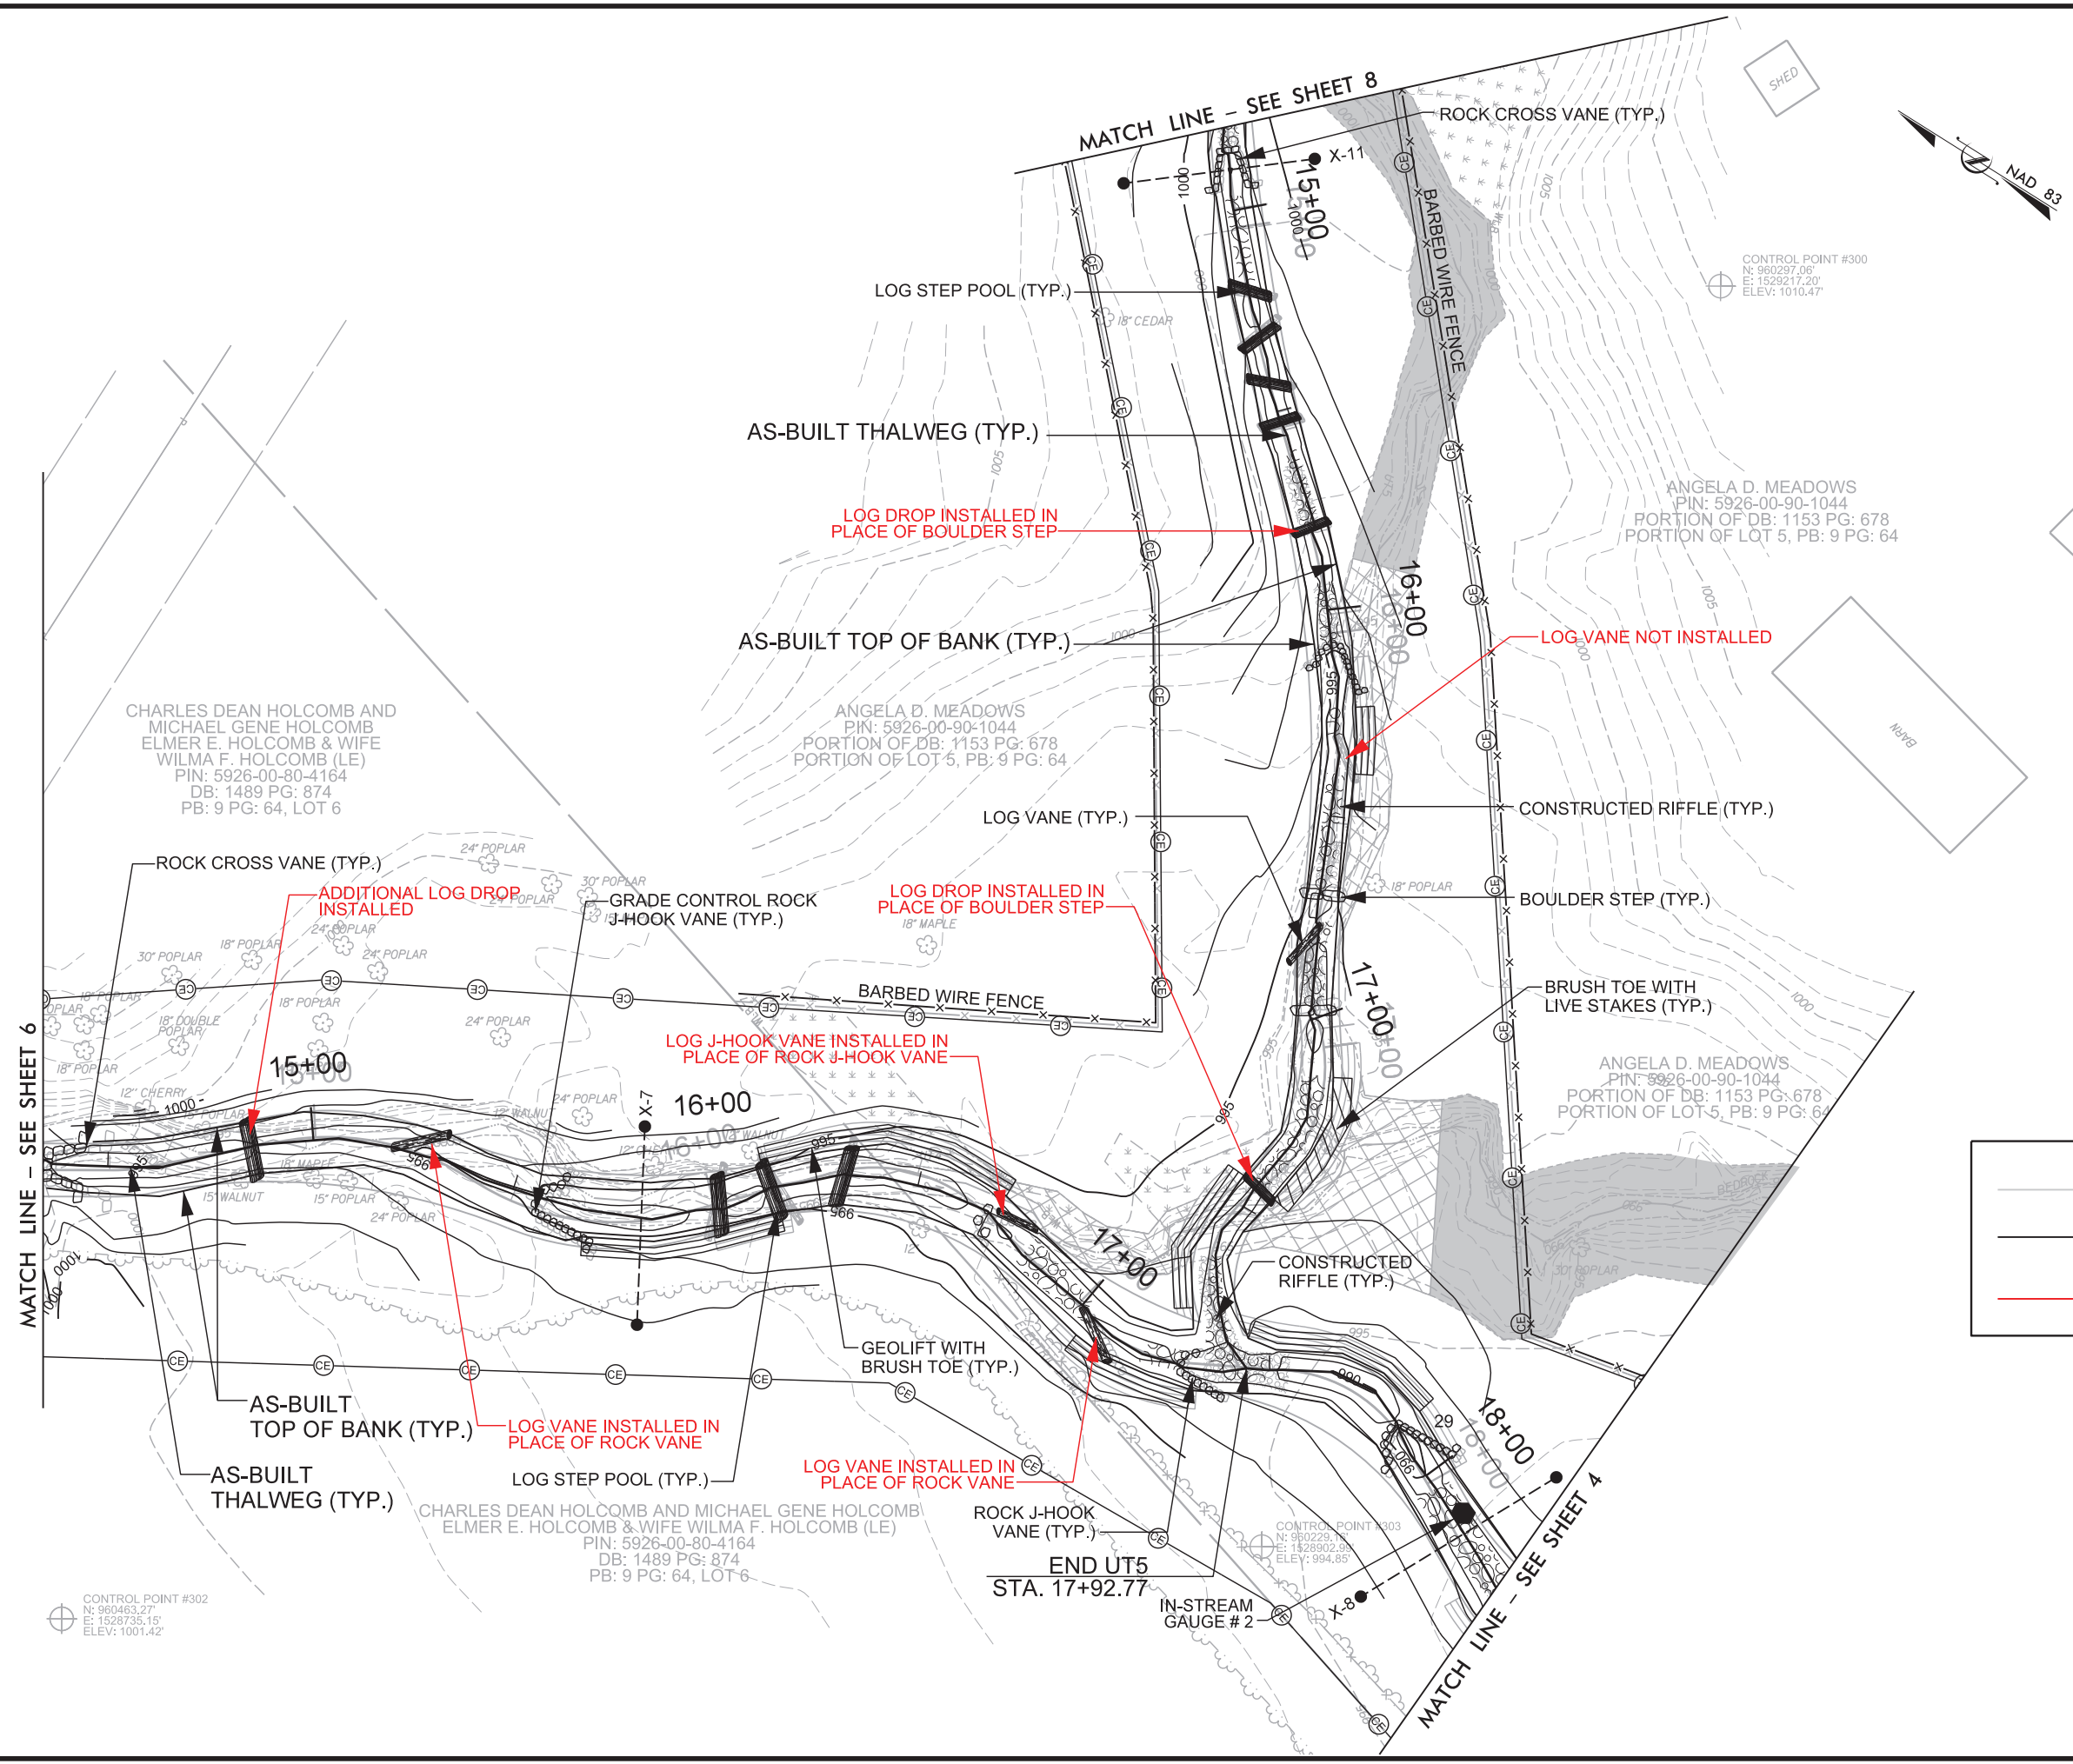


AS-BUILT LEGEND

- PROPOSED DESIGN
- AS-BUILT SURVEY BY KEE MAPPING & SURVEYING 10/20/21 & 2/17/22
- RED LINE VARIATIONS FROM ORIGINAL DESIGN SEALED BY KATHLEEN M. McKEITHAN, PE

- FILL EXISTING CHANNEL
- ⊗ CHANNEL PLUG


WHITTIER CREEK AS-BUILT PLAN VIEW




SCALE (FT)

R:\2023\Whittier-Creek-Design\As-Built\Plans\162039_ASB-PSH-07.dgn

2/26/2023

BAKER PROJECT REFERENCE NO. 162039	SHEET NO. 8
PROJECT ENGINEER <i>Kathleen M. McKeithan</i> 2478404F181473	
APPROVED BY: 2/22/2022	
DATE:	
	
Michael Baker International Michael Baker Engineering Inc. 5000 Regency Parkway, Suite 500 Cary, NORTH CAROLINA 27518 Phone: 919.453.5488 Fax: 919.453.5490 License #: F-1084	
NCDMS ID NO. 100020	

ANGELA D. MEADOWS
 PIN: 5926-00-90-5577
 DB: 1332 PG: 199
 PB: 24 PG: 57
 PORTION OF LOT 5, PB: 9 PG: 64

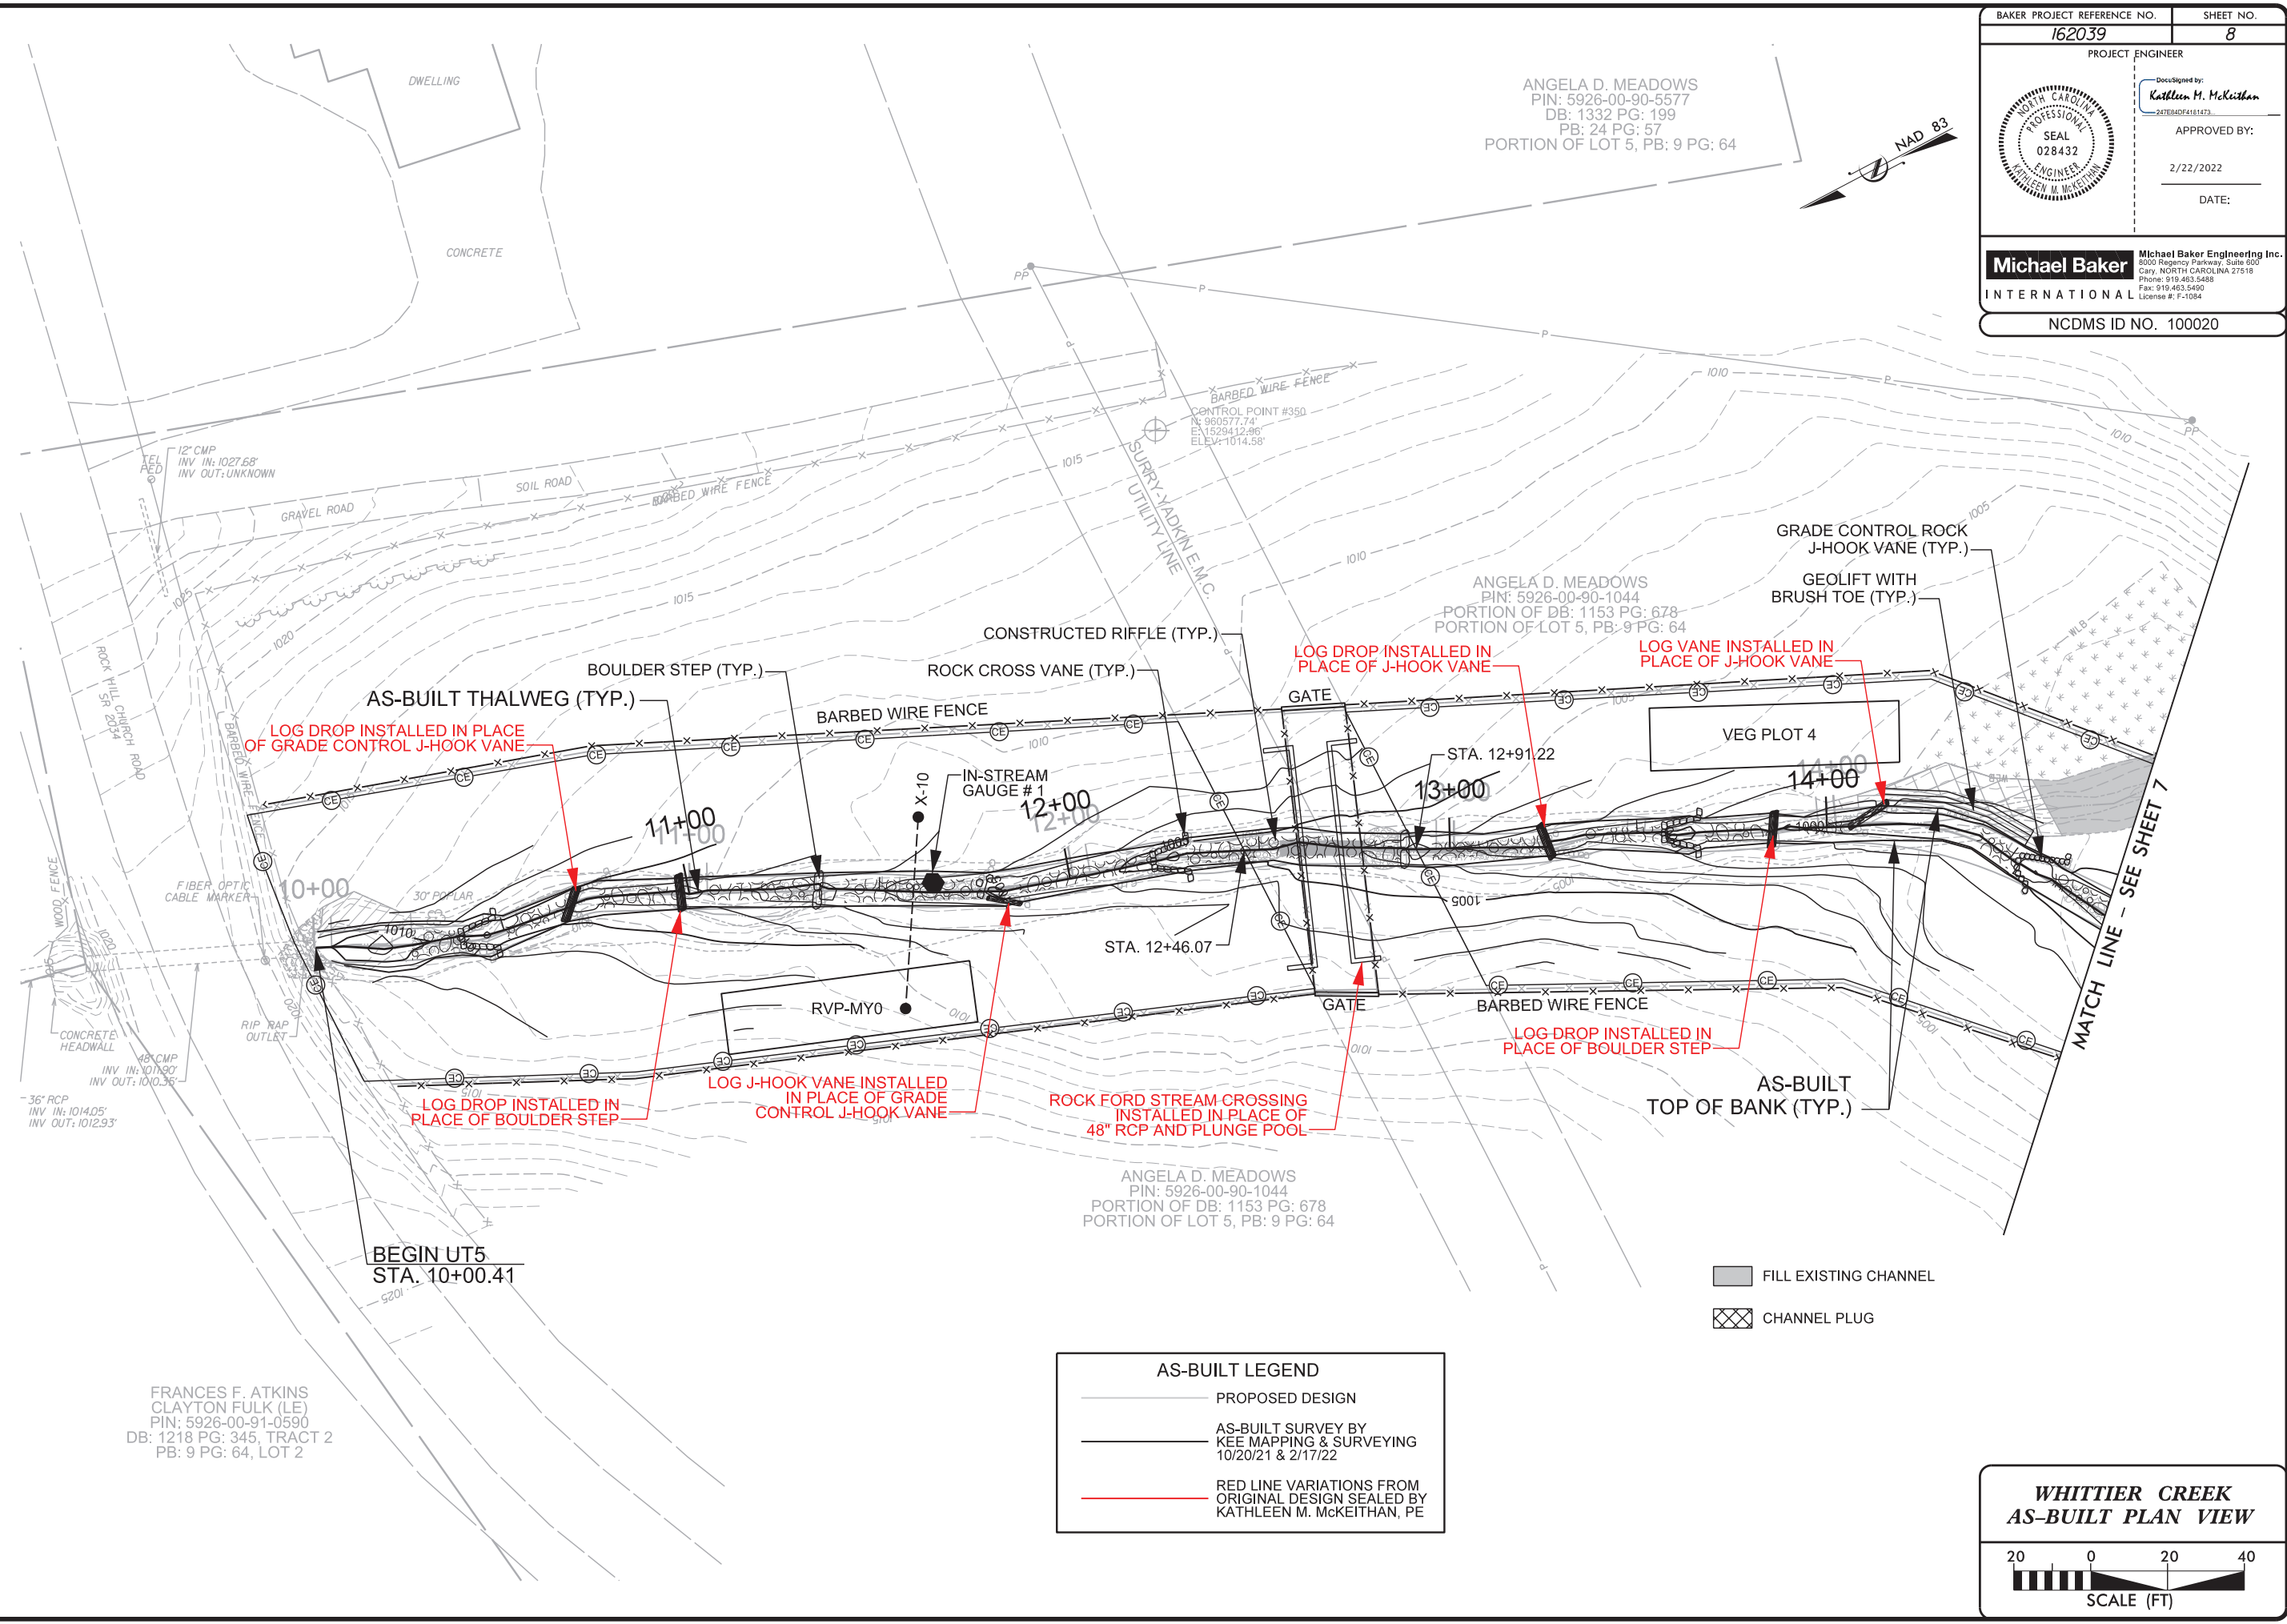

12" CMP
 INV IN: 1027.68'
 INV OUT: UNKNOWN

CONTROL POINT #350
 N: 960377.74'
 E: 1529412.96'
 ELEV: 1014.58'

ANGELA D. MEADOWS
 PIN: 5926-00-90-1044
 PORTION OF DB: 1153 PG: 678
 PORTION OF LOT 5, PB: 9 PG: 64

ANGELA D. MEADOWS
 PIN: 5926-00-90-1044
 PORTION OF DB: 1153 PG: 678
 PORTION OF LOT 5, PB: 9 PG: 64

FRANCES F. ATKINS
 CLAYTON FULK (LE)
 PIN: 5926-00-91-0590
 DB: 1218 PG: 345, TRACT 2
 PB: 9 PG: 64, LOT 2

AS-BUILT LEGEND	
	PROPOSED DESIGN
	AS-BUILT SURVEY BY KEE MAPPING & SURVEYING 10/20/21 & 2/17/22
	RED LINE VARIATIONS FROM ORIGINAL DESIGN SEALED BY KATHLEEN M. MCKEITHAN, PE


	FILL EXISTING CHANNEL
	CHANNEL PLUG




**WHITTIER CREEK
 AS-BUILT PLAN VIEW**

SCALE (FT)

R:\162039\Whittier-Creek-Design\As-Built\Plans\162039_ASB-PSH-08.dgn
 2/22/2023 10:00:00 AM
 KATHLEEN M. MCKEITHAN, PE


2/26/2023

BAKER PROJECT REFERENCE NO. 162039	SHEET NO. 9
PROJECT ENGINEER	
	
Approved by: <i>Kathleen M. McKeithan</i> APPROVED BY: _____ DATE: 2/22/2022	
Michael Baker International <small>Michael Baker Engineering Inc. 3000 Regency Parkway, Suite 500 Cary, NORTH CAROLINA 27518 Phone: 919.453.5488 Fax: 919.453.5490 License #: F-1084</small>	
NCDMS ID NO. 100020	

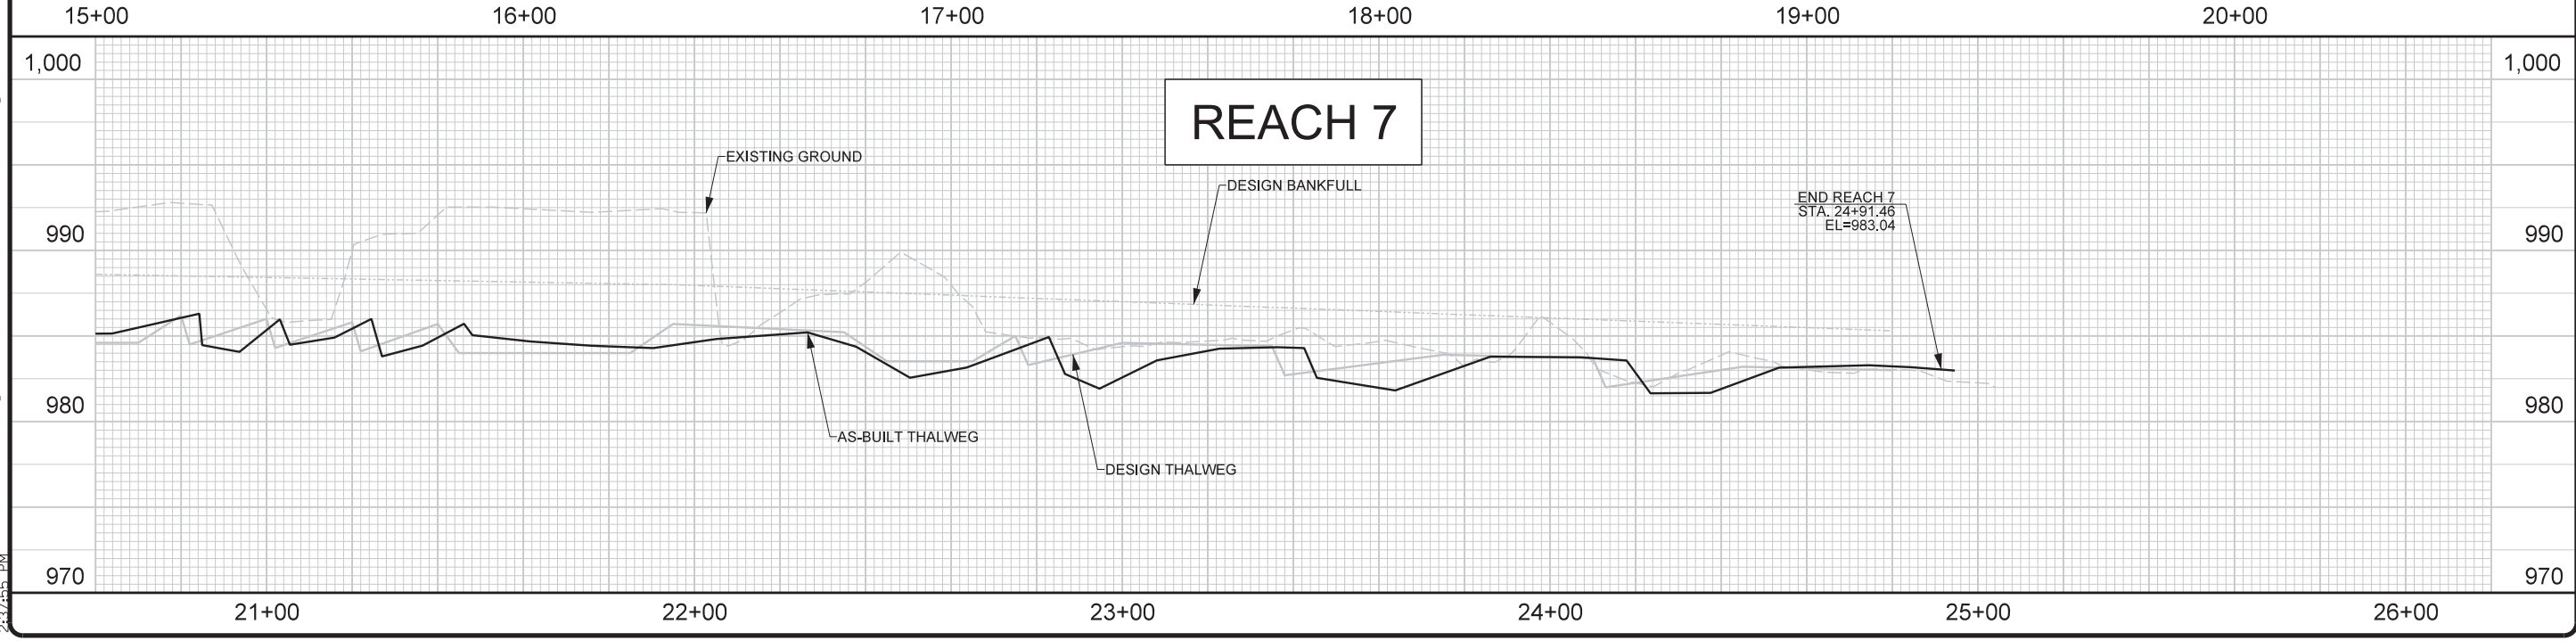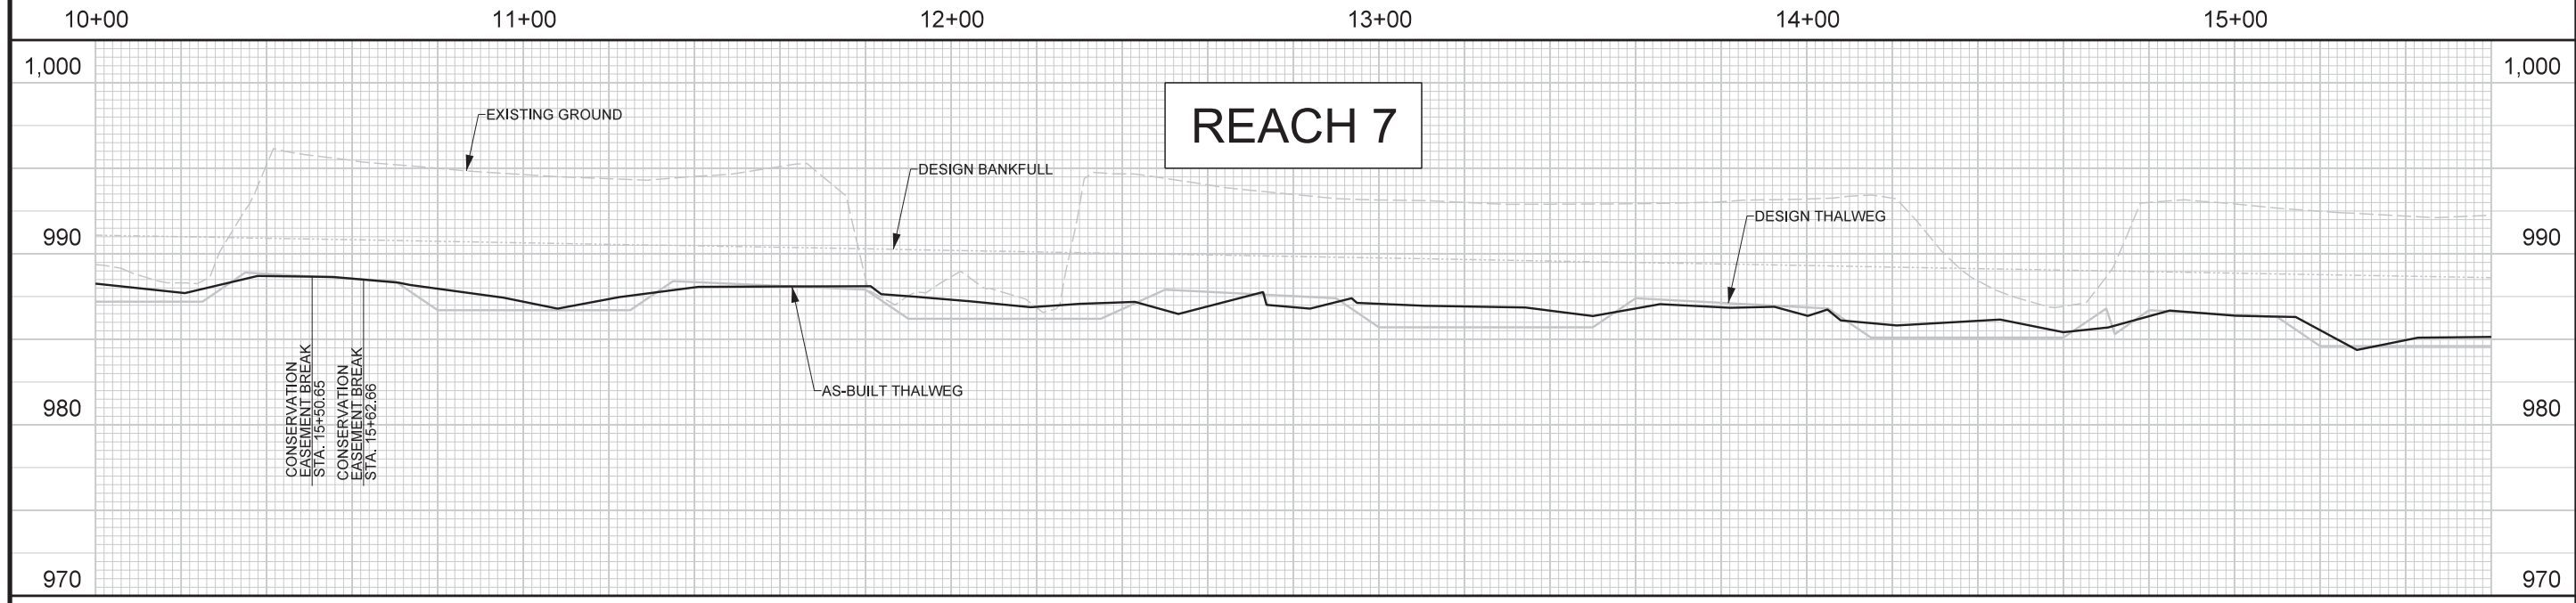
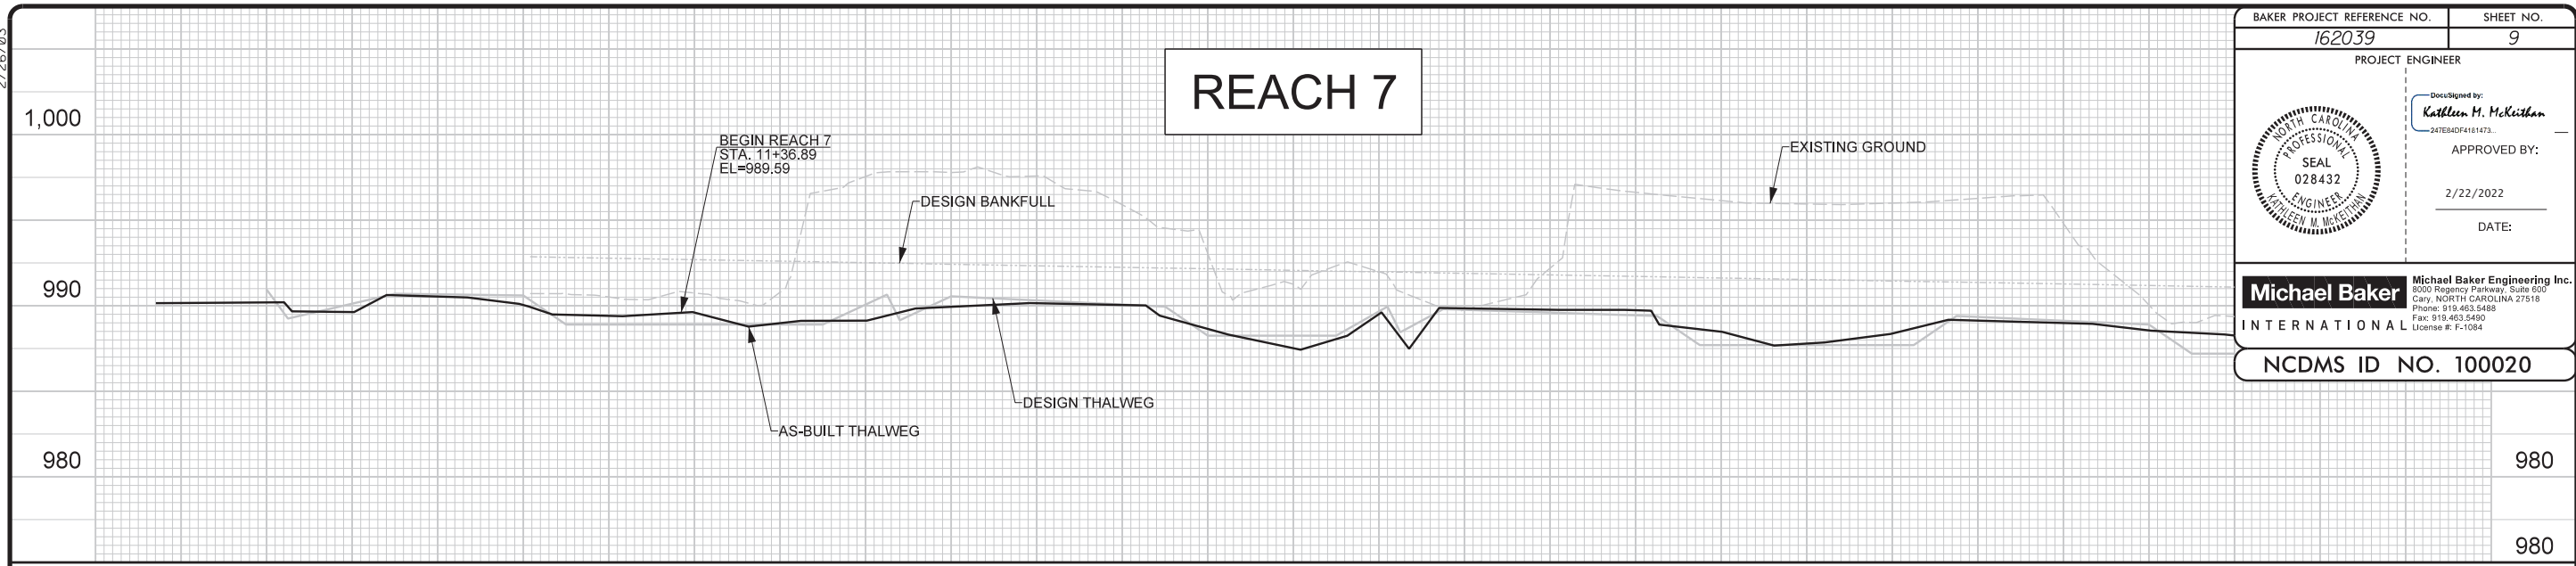


R:\2023\Whittier_Creek\Design\As-Built\Plans\162039_ASB-PFL_09.dgn 2/26/23 2:27:45 PM

2/26/23

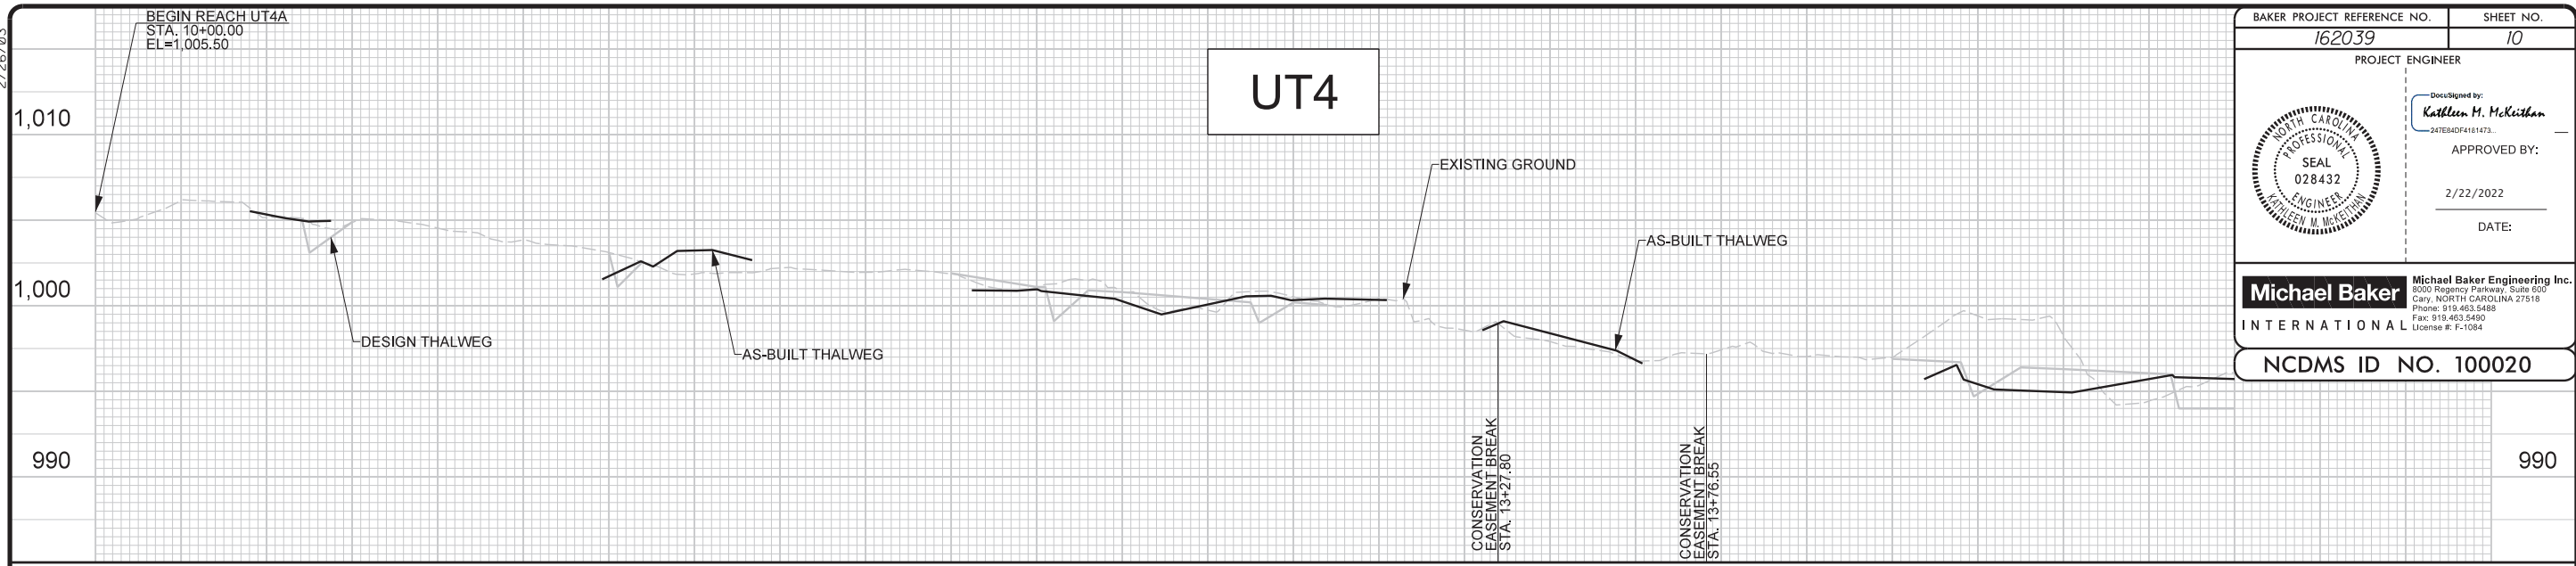


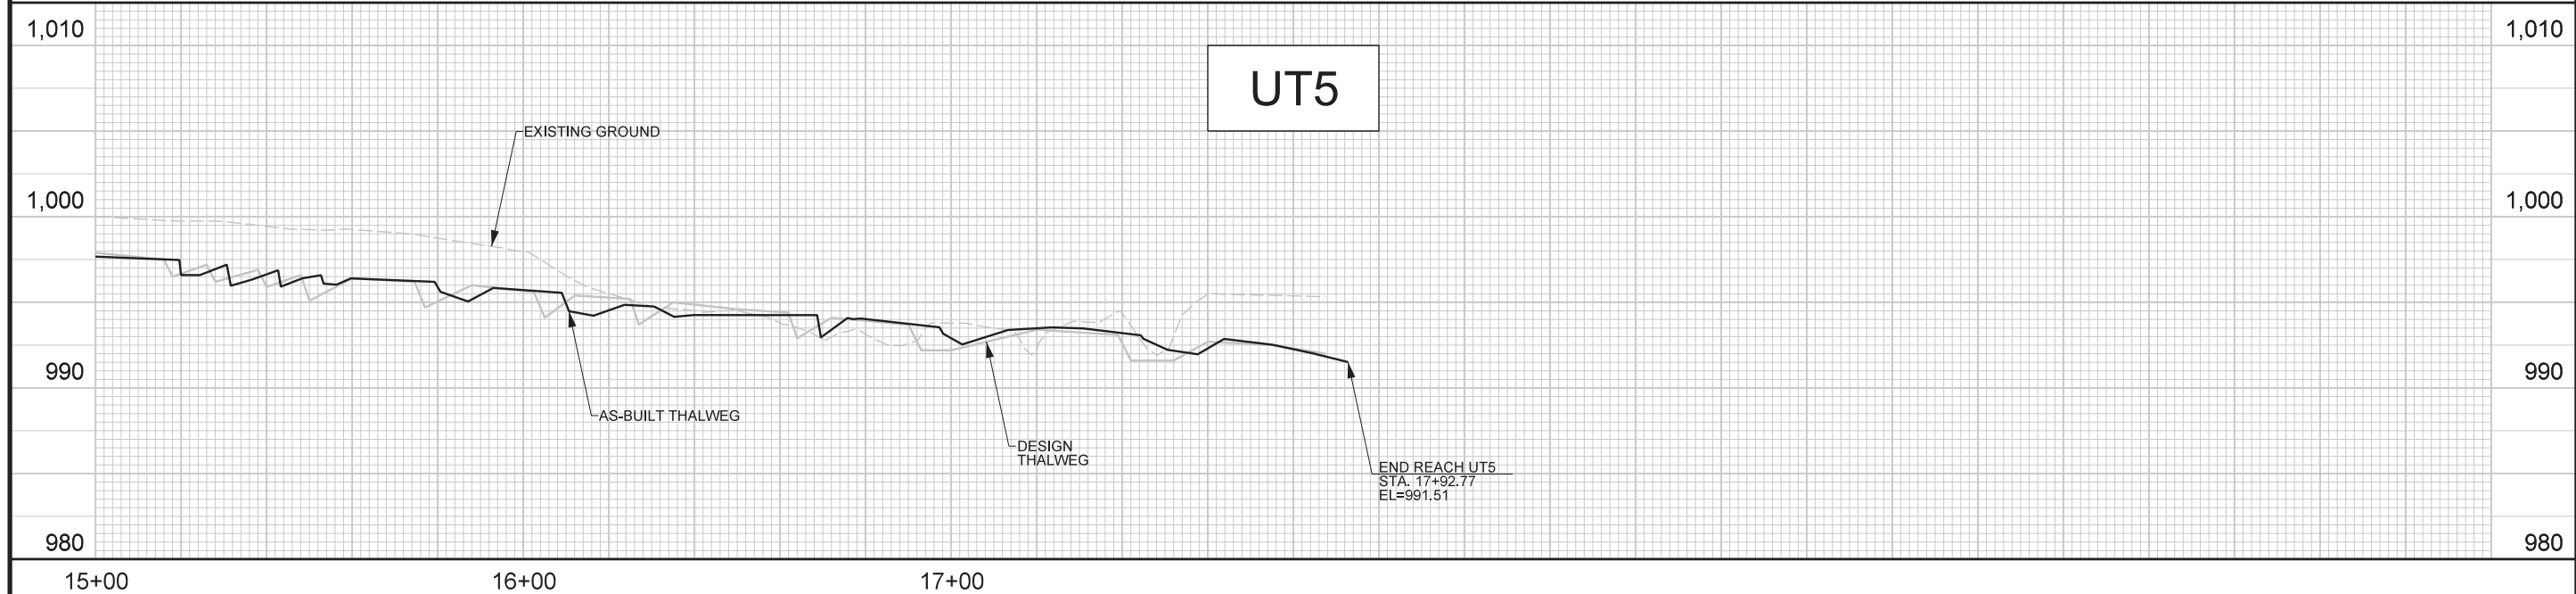
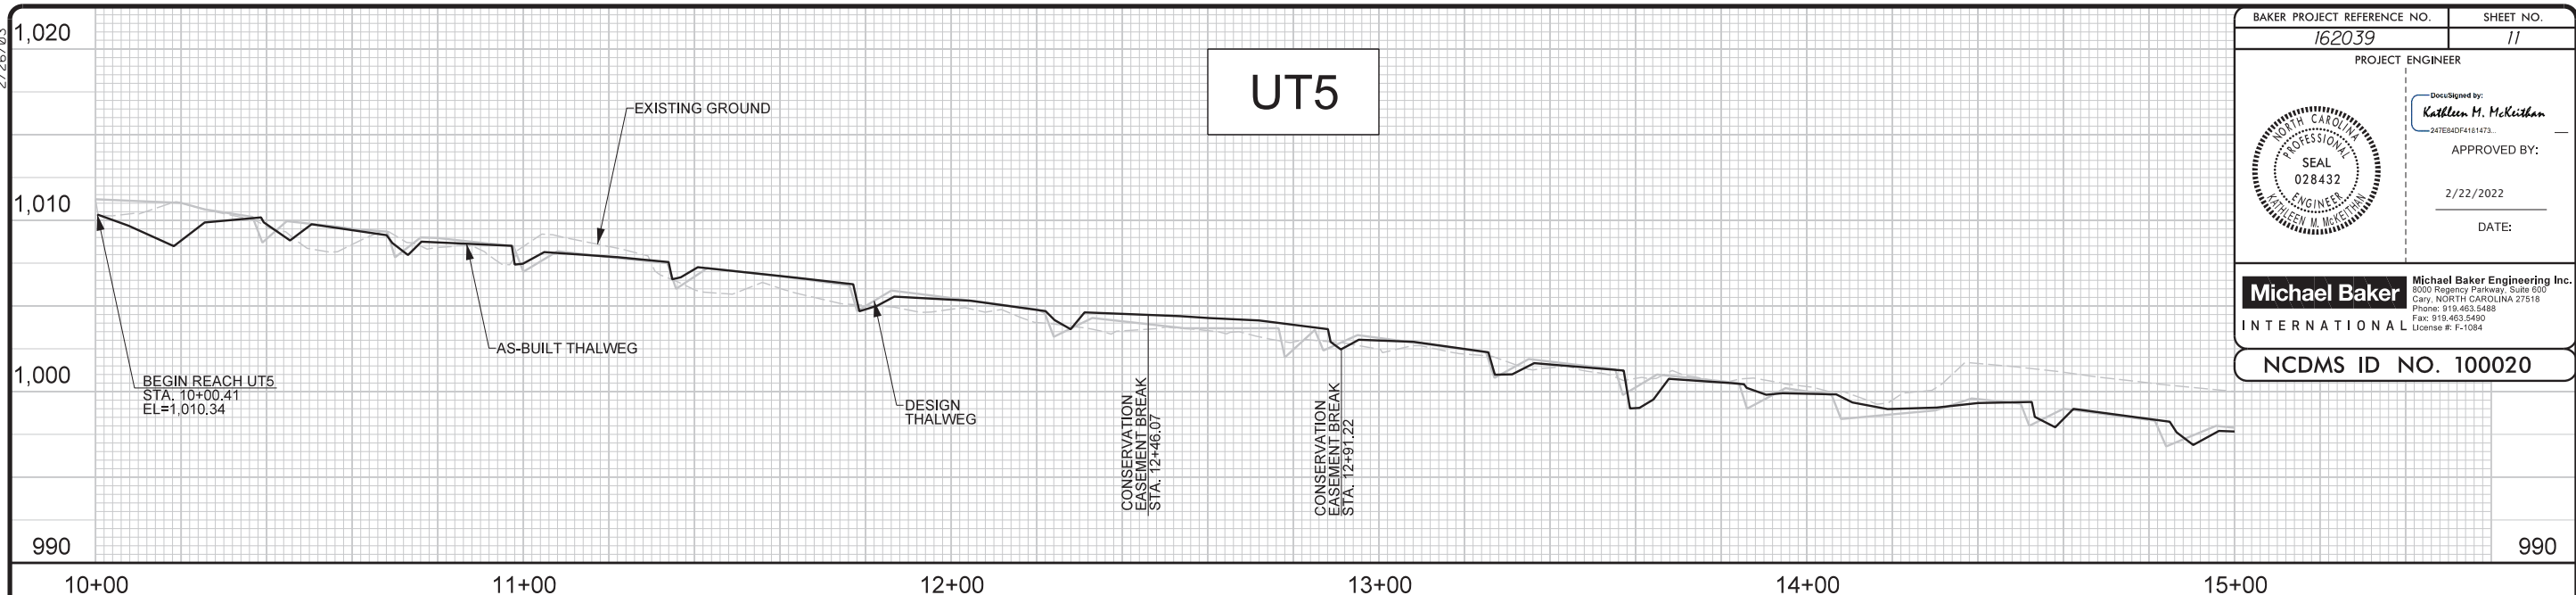
BAKER PROJECT REFERENCE NO. 162039	SHEET NO. 10
PROJECT ENGINEER	
DocuSigned by: <i>Kathleen M. McKeithan</i> 247E84DF4181473...	
APPROVED BY:	
2/22/2022	
DATE:	
Michael Baker International Michael Baker Engineering Inc. 3000 Regency Parkway, Suite 500 Cary, NORTH CAROLINA 27518 Phone: 919.453.6488 Fax: 919.453.6490 License #: F-1084	
NCDMS ID NO. 100020	

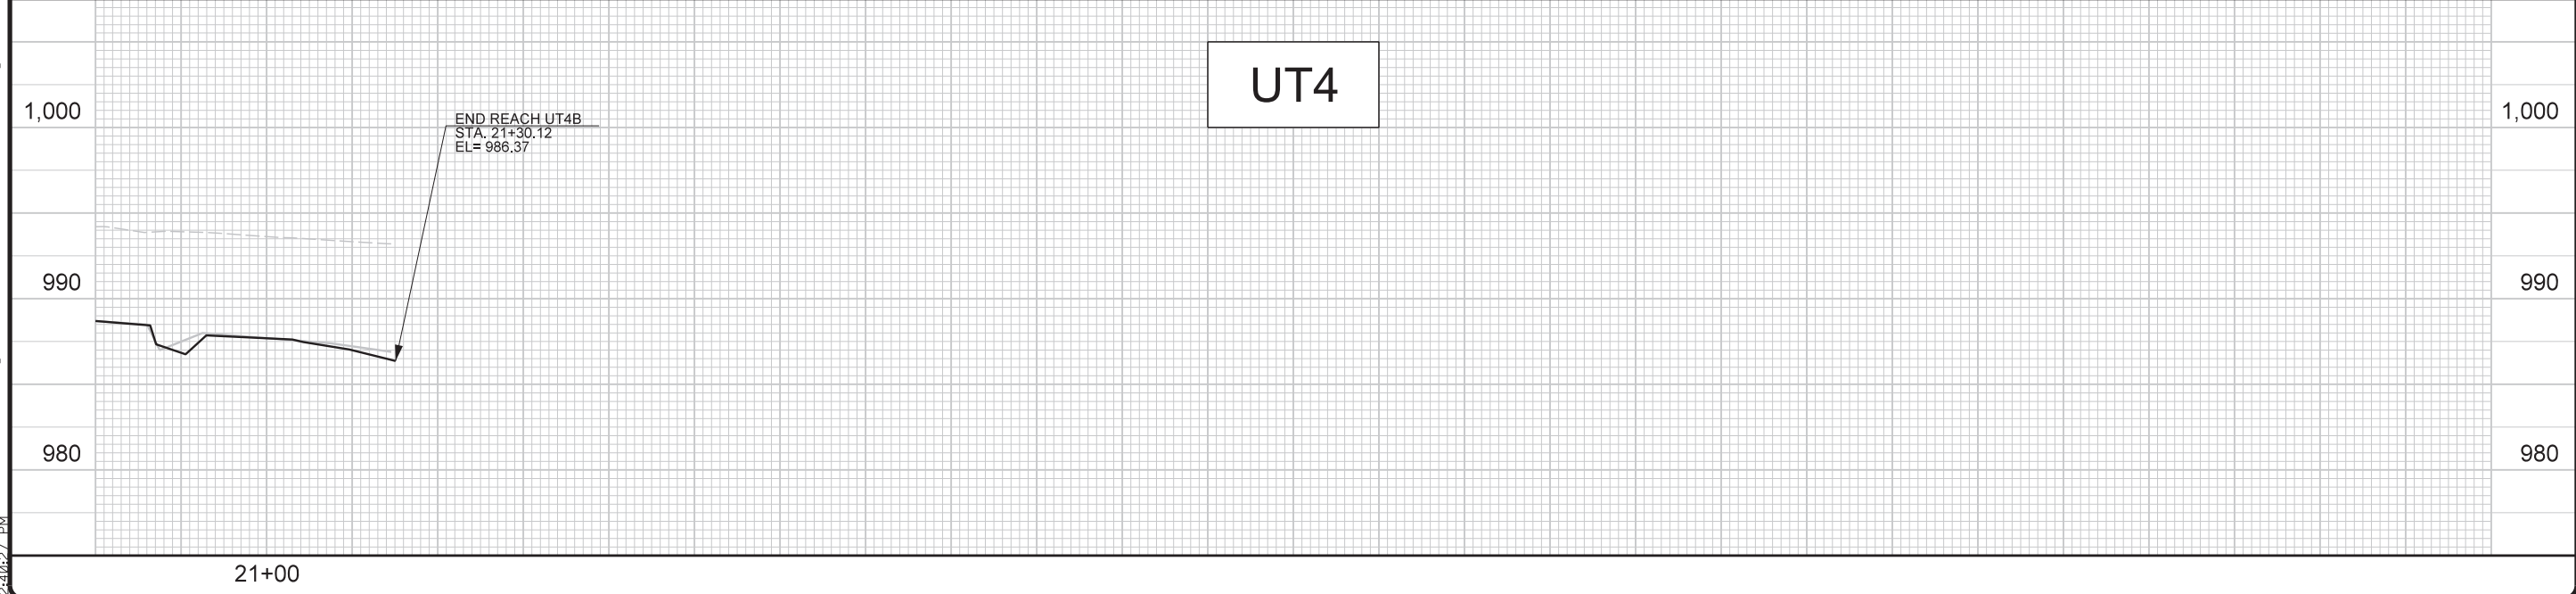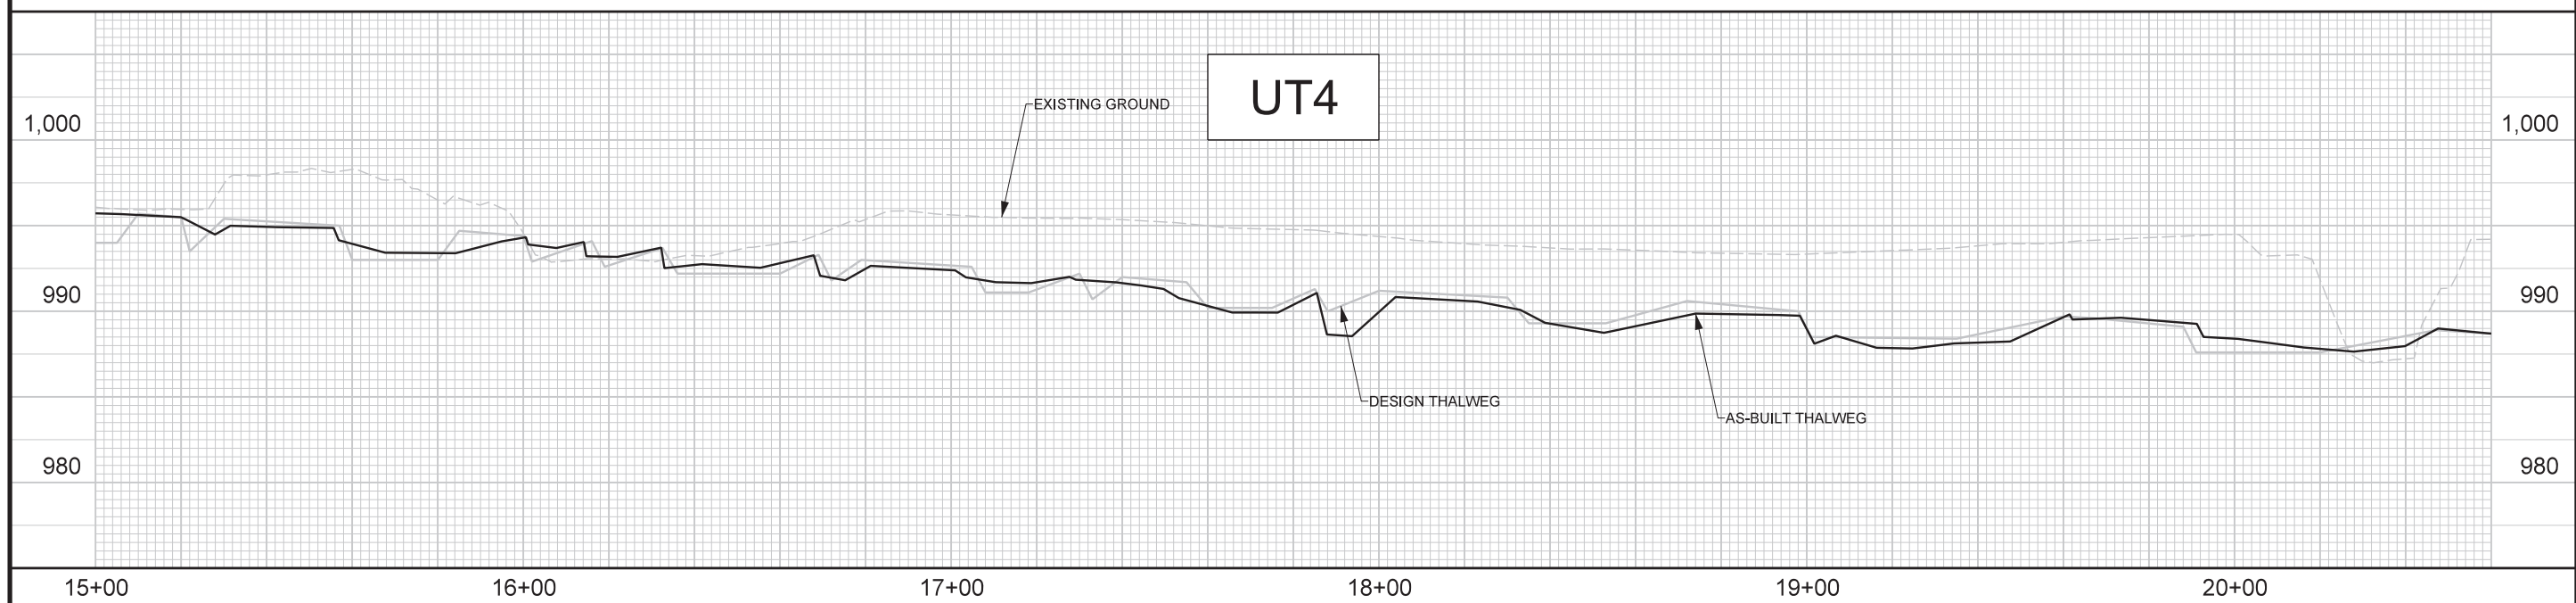

R:\2023\Whittier_Creek\Design\As-Built\Plans\162039_ASB-PFL_10.dgn
2/26/23 PM

2/26/23

BAKER PROJECT REFERENCE NO. 162039	SHEET NO. 11
PROJECT ENGINEER	
	
APPROVED BY: Kathleen M. McKeithan 2/22/2022	
DATE:	
Michael Baker International <small>Michael Baker Engineering Inc. 3000 Regency Parkway, Suite 500 Cary, NORTH CAROLINA 27518 Phone: 919.463.6488 Fax: 919.463.6490 License #: F-1084</small>	
NCDMS ID NO. 100020	



R:\2023\Whittier_Creek_Design\As-Built\Plans\162039_ASB-PFL_11.dgn
2/22/23 2:42:16 PM