



MONITORING YEAR 0 ANNUAL REPORT

Final

May 2022

BANNER FARM MITIGATION SITE

Henderson County, NC
French Broad River Basin
HUC 06010105

DMS Project No. 100062

DEQ Contract No. 7530

DMS RFP No. 16-007334

Date of Issue: September 8, 2017

USACE Action ID No. SAW-2018-01153

DWR Project No. 20181032

Data Collection Dates: December 2021 – March 2022

PREPARED FOR:



NC Department of Environmental Quality
Division of Mitigation Services
1652 Mail Service Center
Raleigh, NC 27699-1652

PREPARED BY:



Wildlands Engineering, Inc.
167-B Haywood Road
Asheville, NC 28806

Phone: 704.332.7754
Fax: 704.332.3306



May 27, 2022

Mr. Matthew Reid
Western Project Manager
Division of Mitigation Services
5 Ravenscroft Dr., Suite 102
Asheville, NC 28801

RE: **Banner Farm Draft MY0 Report Review**
French Broad River Basin – CU# 06010105
Henderson County
DMS Project ID No. 100062
Contract # 7530

Dear Mr. Reid:

Wildlands Engineering, Inc. (Wildlands) has reviewed the Division of Mitigation Services (DMS) comments from the Draft As-built Monitoring report for the Banner Farm Mitigation Site provided in bold type below and offers the following responses in italics.

Please add “Date of Issue: September 8, 2017” following RFP number on title page.

Wildlands Response: The date of issue has been added to the title page.

Table 1: Can you explain the changes in reach lengths for Banner Creek R1 and R2 and Banner Creek R4a and R4b. The total lengths are the same as the Mitigation Plan lengths but the individual reach lengths have changed (+/- 30' R1 and R2 and +/- 14' R4a and R4b). Did the reach breaks change?

Wildlands Response: The changes in reach lengths were due to a discrepancy in the reach break station callouts between the project overview sheet (sheet 0.2) and the stream plan and profile sheets (sheets 2.1.1 to 2.3.4) in the In the Preliminary Design Plans from the Mitigation Plan. The Mitigation Plan lengths were calculated referencing the project overview stationing. It was determined that the correct stationing was found in the stream plan and profile sheets and was thus updated in the as-built footage in Table 1. As noted above, the total lengths remain the same.

2.1 Asbuilt/Record Drawings: Thank you for the detailed list of all red line changes to the project. Approximately 13 rock sills, 17 brush toes, 4 cover logs and 6 log sills installed that were not part of the original design. Please add a short discussion to this section regarding the reasoning and need that lead to the field change for the additional structures.

Wildlands Response: Text was added to Section 2.1 discussing structures added between mitigation plan design and as built.

2.1.8 Encroachments: Please add a brief discussion regarding the need to amend the plat due to the farm entrance location. DMS met onsite with WEI in March to observe the issue. There were several



reasons that required the location of the farm entrance to be changed during construction. Proximity to DOT bridge, utility pole, existing trees and unsuitable slope all contributed to the need to move the entrance.

Wildlands Response: Text was added to Section 2.1.8 outlining field conditions which led to the relocation of the farm entrance and the associated minor easement encroachment to be resolved via plat amendment.

Table 4 and 5: Please add the date that the assessment work took place to the top of the tables. The IRT has requested this information be provided.

Wildlands Response: The date of the assessment work has been added to the top of tables 4 and 5.

Section 2 and Table 10: Section 2 indicates construction was completed in October and Table 2 shows November. Update as necessary.

Wildlands Response: Section 2 has been updated to be consistent with Table 10.

Table 10: The IRT approval letter for the mitigation plan is dated June 12, 2020. Please update the Mitigation Plan Approved line.

Wildlands Response: Table 10 has been updated.

Digital Deliverable Comments:

The As-built alignment is not segmented or attributed to enable verification of reach lengths, please resubmit this feature class with reach breaks and names and no credit sections identified.

Wildlands Response: The centerline alignment feature class named "Banner_AB_CL_Alignment" has been segmented and attributed to enable verification of reach lengths. This has been included in the geodatabase provided in the electronic support files.

Enclosed please find one hard copy of the Final As-built Monitoring Report and an electronic copy of the report and support files. Please contact me at (865) 207-8835 if you have any questions.

Sincerely,

A handwritten signature in black ink, appearing to read "Eric Neuhaus".

Eric Neuhaus, PE
Project Manager
eneuhaus@wildlandseng.com

BANNER FARM MITIGATION SITE
Monitoring Year 0 Annual Report

TABLE OF CONTENTS

Section 1: PROJECT OVERVIEW	1-1
1.1 Project Quantities and Credits	1-1
1.2 Project Goals and Objectives	1-2
1.3 Project Attributes.....	1-5
Section 2: As-Built Condition (Baseline)	2-1
2.1 As-Built/Record Drawings	2-1
2.1.1 Banner Creek Reach 1	2-1
2.1.2 Banner Creek Reach 2	2-2
2.1.3 Banner Creek Reach 3	2-2
2.1.4 Banner Creek Reach 4A.....	2-2
2.1.5 Banner Creek Reach 4B.....	2-2
2.1.6 UT1	2-2
2.1.7 UT2	2-3
2.1.8 Encroachments	2-3
2.1.9 Planting	2-3
2.1.10 Monitoring Device Locations	2-4
Section 3: Monitoring Year 0 Data Assessment	3-4
3.1 Vegetative Assessment	3-4
3.2 Vegetation Areas of Concern	3-5
3.3 Stream Assessment.....	3-5
3.4 Stream Areas of Concern	3-5
3.5 Hydrology Assessment.....	3-5
3.6 Wetland Assessment.....	3-5
3.7 Adaptive Management Plan	3-5
3.8 Monitoring Year 0 Summary.....	3-5
Section 4: METHODOLOGY	4-1
Section 5: REFERENCES.....	5-1

TABLES

Table 1: Project Quantities and Credits	1-1
Table 2: Goals, Performance Criteria, and Functional Improvements	1-3
Table 3: Project Attributes	1-6

FIGURES

Figure 1a-e	Monitoring Plan View Maps
-------------	---------------------------

APPENDICES

Appendix A	Visual Assessment Data
Table 4a-g	Visual Stream Morphology Stability Assessment Table
Table 5	Vegetation Condition Assessment Table
	Stream Photographs
	Wetland Photographs
	Groundwater Gage Photographs
	Groundwater Gage Soil Profile Photographs
	Culvert Crossing Photographs



Vegetation Plot Photographs

Appendix B

Table 6a-e
Table 7a-c

Vegetation Plot Data

Vegetation Plot Data
Vegetation Performance Standards Summary Table

Appendix C

Table 8a-c
Table 9a-b

Stream Geomorphology Data

Baseline Stream Data Summary
Cross-Section Morphology Monitoring Summary
Cross-Section Plots
Longitudinal Profile
Reachwide and Riffle Pebble Count Plots

Appendix D

Table 10
Table 11

Project Timeline and Contact Information

Project Activity and Reporting History
Project Contact Table
DMS Technical Workgroup Memo – October 19, 2021
Pebble Count Data Requirements Correspondence – M. Reid

Appendix E

Record Drawings and Sealed As-Built Survey

Appendix F

Other Data

Groundwater Gage Installation Sheets



Section 1: PROJECT OVERVIEW

The Banner Farm Mitigation Site (Site) is located in Henderson County, approximately five miles west of Hendersonville near Horse Shoe. The Site is positioned in the Blue Ridge Physiographic Province and project streams include Banner Creek and two associated tributaries which drain to the French Broad River. At the confluence with Banner Creek, the French Broad River is defined in the 2016 North Carolina Integrated Report as Class WS-IV waters. This classification of waters is protected for drinking, culinary, food processing, aquatic life, secondary recreation, and freshwater purposes.

1.1 Project Quantities and Credits

The site is located on 7 parcels under 4 different landowners and a conservation easement was recorded on 46.6 acres. Mitigation work within the Site included restoration of perennial stream channels and creation, re-establishment, and rehabilitation of wetland areas. Table 1 below shows stream and wetland credits and the total amount of credits expected at closeout.

Table 1: Project Quantities and Credits

Project Components							
Project Segment	Original Mitigation Plan Ft/Ac	As-Built Ft/Ac	Mitigation Category	Original Restoration Level	Original Mitigation Ratio (X:1)	Credits	Comments
Stream							
Banner Creek Reach 1	797	827	Cool	R	1.000	797.000	Restoring dimension, pattern, and profile, reconnecting channels with floodplains and wetlands, replanting buffers, protecting with conservation easement
Banner Creek Reach 2	866	836	Cool	R	1.000	866.000	
Banner Creek Reach 3	467	467	Cool	R	1.000	467.000	
Banner Creek Reach 4a	794	780	Cool	R	1.000	794.000	
Banner Creek Reach 4b	420	434	Cool	R	1.000	420.000	
UT1	1,071	1,071	Cool	R	1.000	1,071.000	
UT2	1,879	1,879	Cool	R	1.000	1,879.000	
Total:						6,294.000	
Wetland							
Wetland Re-Establishment	31.820	31.671	RR	REE	1.000	31.820	Re-establish hydrology via the plugging/filling of drainage features, stream grading, wetland planting, invasive species treatment, permanent conservation easement



Project Components							
Project Segment	Original Mitigation Plan Ft/Ac	As-Built Ft/Ac	Mitigation Category	Original Restoration Level	Original Mitigation Ratio (X:1)	Credits	Comments
Wetland Rehabilitation	2.760	2.746	RR	RH	2.000	1.380	Improve hydrology via the plugging/filling of drainage features, wetland planting, stream grading, invasive species treatment, permanent conservation easement
Wetland Creation	1.140	1.094	RR	C	3.000	0.380	Priority 2 stream grading, plugging/filling of drainage features, wetland planting, invasive species treatment, permanent conservation easement
Total:			33.580				

Project Credits							
Restoration Level	Stream			Riparian Wetland		Non-Riparian Wetland	Coastal Marsh
	Warm	Cool	Cold	Riverine	Non-Riv		
Restoration		6,294.000					
Re-establishment				31.820			
Rehabilitation				1.380			
Enhancement							
Enhancement I							
Enhancement II							
Creation				0.380			
Preservation							
Totals		6,294.000		33.580			

1.2 Project Goals and Objectives

The project is intended to provide numerous ecological benefits. Table 2 below describes expected outcomes to water quality and ecological processes and provides project goals and objectives.



Table 2: Goals, Performance Criteria, and Functional Improvements

Goal	Objective/ Treatment	Likely Functional Uplift	Performance Criteria	Measurement	Cumulative Monitoring Results
Stabilize eroding stream banks.	Reconstruct stream channels slated for restoration with stable dimensions. Add bank revetments and in-stream structures to reaches to protect restored streams.	Reduce erosion and sediment inputs.	Cross-sections should be stable and show little change in bankfull area and width-to-depth ratio.	Cross-section monitoring and visual inspections.	Cross-section dimensions are within the design parameters.
Improve the stability of stream channels.	Construct stream channels that will maintain a stable pattern and profile considering the hydrologic and sediment inputs to the system, landscape setting, and watershed conditions.	Reduce erosion and sediment inputs; maintain appropriate bedforms and sediment size distribution.	Entrenchment ratio (ER) stays over 2.2 and bank height ratio (BHR) below 1.2 with visual assessments showing progress toward stability.	Cross-section monitoring and visual inspections.	Cross-sections show streams are stable and functioning as designed. ERs are over 2.2 and BHRs are below 1.2.
Improve instream habitat.	Install habitat features including constructed riffles, cover logs, and brush toes into restored streams. Add woody materials to channel beds. Construct pools of varying depth.	Support biological communities and processes. Provide aquatic habitat for diverse populations of aquatic organisms.	There is no required performance standard for this metric.	N/A	N/A



Goal	Objective/ Treatment	Likely Functional Uplift	Performance Criteria	Measurement	Cumulative Monitoring Results
Reconnect channels with floodplains and riparian wetlands.	Reconstruct stream channels with appropriate bankfull dimensions and depth relative to the existing floodplain.	Reduce shear stress on channel, hydrate adjacent wetland areas, filter pollutants out of overbank flows, provide surface storage of water on floodplain, increase groundwater recharge while reducing outflow of stormwater, support water quality, and habitat goals.	Four bankfull events in separate years within the 7-year monitoring period.	Crest gages with transducers recording stage elevations.	Hydrology data will be reported in MY1.
Restore wetland hydrology, soils, and plant communities.	Restore and enhance riparian wetlands by raising stream beds, plug in existing ditches, removing berm material over relic hydric soils, and planting native wetland species.	Increase water storage, increase groundwater recharge, water quality treatment through retention, and increase habitat for aquatic and terrestrial species.	Free groundwater surface within 12 inches of the ground surface for 12% of the growing season.	Groundwater gages have been installed wetland re-establishment, creation, and rehabilitation areas and monitored annually.	Hydrology data will be reported in MY1.
Restore and enhance native floodplain vegetation.	Plant native tree species in riparian zone where they are currently insufficient.	Provide a canopy to shade streams and reduce thermal loading. Stabilize stream banks and floodplain. Support water quality habitat goals.	Survival rate of 320 stems per acre at MY3, 260 planted stems per acre at MY5, and 210 stems per acre at MY7. Average height of 6 feet in each plot at MY5 and 8 feet in each plot at MY7 for planted stems.	Vegetation plots measuring 100 square meters are established on 2% of the planted area are monitored annually.	All permanent and mobile vegetation plots have a planted stem density greater than 320 stems per acre.
Permanently protect the project Site from harmful uses	Establish conservation easements on the Site	Protect and enhance aquatic habitat, reduce sediments inputs, and protect any rare natural communities.	Prevent easement encroachment.	Visually inspect the perimeter of the Site to ensure no easement encroachment is occurring.	Minor encroachments along farm road to be resolved and discussed in MY1 report.



1.3 Project Attributes

The Site and adjoining properties have sustained predominantly rural characteristics for approximately 60 years. Portions of Site parcels were extensively ditched to drain and maintain adjacent agricultural fields for row crop production from 1964 to the commencement of project construction. Large segments of the ditches were determined to be modified streams including Banner Creek, UT1, and UT2.

Throughout the watershed, agricultural land use declined slightly from 1964 to 1994 as residential areas were established and fields were abandoned and allowed to reforest. The watershed has since remained relatively stable with only minor changes in land use. Table 3 below presents additional information on pre-restoration conditions.



Table 3: Project Attributes

Project Information					
Project Name	Banner Farm Mitigation Site				
County	Henderson				
Project Area (acres)	46.6				
Project Coordinates (latitude and longitude decimal)	35° 21' 7"N, 82° 33' 13" W				
Project Watershed Summary Information					
Physiographic Province	Blue Ridge				
River Basin	French Broad				
USGS Hydrologic Unit 8-digit	06010105				
DWR Sub-basin	04-03-02				
Project Drainage Area (acres)	722				
Project Drainage Area Percentage of Impervious Area	1.5%				
Land Use Classification	44% cultivated crops and hay, 27% forest, 2.5% shrub/grassland/herbaceous, 0.5% wetlands, 26% residential				
Reach Summary Information					
Parameters	Banner Creek				
	R1	R2	R3	R4a	R4b
Pre-project length (feet)	705	945	357	607	802
Post-project length (feet)	827	836	467	780	434
Valley confinement (Confined, moderately confined, unconfined)	Unconfined				
Drainage area (acres)	390	422	429	634	722
Perennial, Intermittent, Ephemeral	P				
NCDWR Water Quality Classification	WS-IV (WSW)				
Dominant Stream Classification (existing)	C4	C4	C4	C5/4	C5/4
Dominant Stream Classification (proposed)	C4	C4	C4	C5/4	C5/4
Dominant Evolutionary Classification (Simon) if applicable	V	IV	III	IV	IV
Parameters	UT1			UT2	
Pre-project length (feet)	620			2042	
Post-project length (feet)	1,071			1,879	
Valley confinement (Confined, moderately confined, unconfined)	Unconfined				
Drainage area (acres)	83			192	
Perennial, Intermittent, Ephemeral	P				
NCDWR Water Quality Classification	WS-IV (WSW)				
Dominant Stream Classification (existing)	E/C5			E/C5	
Dominant Stream Classification (proposed)	E5			C4	
Dominant Evolutionary Classification (Simon) if applicable	IV				



Regulatory Considerations

Regulation	Applicable ?	Resolved?	Supporting Docs?
USACE Public Notice - Section 404	Yes	Yes	SAW-2018-01153 ¹
Water of the United States - Section 404	Yes	No	PCN ²
Water of the United States - Section 401	Yes	No	PCN ²
Endangered Species Act	Yes	Yes	Final Mitigation Plan
Historic Preservation Act	Yes	Yes	Final Mitigation Plan
Coastal Zone Management Act	Yes	No	N/A
FEMA Floodplain Compliance	Yes	No	No Rise Certification
Essential Fisheries Habitat	Yes	N/A	N/A

¹Public Notice was issued on August 28, 2018.

²PCN was submitted to DMS with Final Mitigation Plan for IRT submittal.

Wetland Summary Information

Parameters	Wetland Rehabilitation Areas											
	A	D	E	F	H	I						
Post-project area (acres)	0.46	0.12	<0.01	0.03	0.06	<0.01						
Wetland Type (non-riparian, riparian)	Riparian											
Classification	Bottomland Hardwood Forest											
Mapped Soil Series	Toxaway/ Rosman	Toxaway/ Codorus	Toxaway	Toxaway	Codorus/ Delanco	Codorus						
Soil Hydric Status	Yes/No		Yes		No							
Restoration or enhancement method	Rehabilitation (Vegetative, hydrology)											
Parameters	Wetland Rehabilitation Areas											
	J	K	L	R	S	W						
Post-project area (acres)	0.05	0.11	<0.01	1.65		0.28						
Wetland Type (non-riparian, riparian)	Riparian											
Classification	Bottomland Hardwood Forest											
Mapped Soil Series	Codorus/ Delanco	Codorus/ Bradson	Codorus	Codorus/ Delanco	Codorus/ Bradson	Toxaway						
Soil Hydric Status	No											
Restoration or enhancement method	Rehabilitation (Vegetative, hydrology)											
Parameters												
Wetland Re-establishment Areas												
Post-project area (acres)	31.67											
Wetland Type (non-riparian, riparian)	Riparian											
Mapped Soil Series	Codorus/Delanco/Bradson/Toxaway/Rosman											
Soil Hydric Status	No											
Restoration or enhancement method	Re-establishment (Vegetative, hydrology)											
Parameters												
Wetland Creation Areas												
Post-project area (acres)	1.094											
Wetland Type (non-riparian, riparian)	Riparian											
Mapped Soil Series	Rosman											
Soil Hydric Status	No											
Restoration or enhancement method	Creation (Vegetative, hydrology)											



Section 2: As-Built Condition (Baseline)

The Site construction was completed in November 2021. The as-built survey, which included developing an as-built topographic surface; as well as, surveying the as-built channel centerlines, top of banks, structures, and cross-sections, was collected between 10/26/2021 – 01/25/2022 and completed in March 2022. The Site's construction planting was completed on 02/15/22. Monitoring device installation and vegetative and substrate data collection were completed by 02/17/2022. River cane planting was completed on 03/02/2022.

2.1 As-Built/Record Drawings

A sealed half-size set of the as-built survey and record drawing which includes the post-construction survey, alignments, structures, and monitoring features are in Appendix E. Field adjustments made during construction that differ from the preliminary design plans are shown as red lines on the record drawing. These adjustments were made during construction or final design, where needed, based on field evaluations, and are listed below. Overall, use of instream structure at the site was increased during final design and construction based on site conditions and material availability. An additional 13 rock sills, 17 brush toes, 4 cover logs and 6 log sills were installed at the site. The quantity of rock and log sills was increased along Banner Creek Reach 1 to raise bed elevations in the channel while preserving mature trees where possible. Additional brush toe installed along Banner Creek Reach 1 was intended to increase bank stability downstream of grade drops and through steeper sections of stream. Brush toes and cover logs installed in channels through proposed wetland areas were increased site wide to provide additional habitat and bedform diversity within long, low sloped pools. Encroachments are detailed in Section 2.1.9.

2.1.1 Banner Creek Reach 1

- STA 0+21 – Brush toe extended to provide additional bank protection.
- STA 0+75 – Brush toe installed to provide bank protection.
- STA 1+60 – Rock sill installed for stability.
- STA 1+77 – Brush toe installed to provide bank protection and habitat.
- STA 1+94 – 3+77 Profile adjustment to save existing trees.
- STA 2+24 – Length of riffle reduced to protect tree root mass.
- STA 2+63 – Riffles combined and location changed to protect trees.
- STA 2+79 – Rock sill installed for stability.
- STA 2+87 – Brush toe installed to provide bank protection.
- STA 3+09 – Riffle length reduced to protect trees.
- STA 3+17 – Rock sill installed for stability.
- STA 3+34 – Riffle added for profile adjustment to save trees.
- STA 3+39 – Rock sill installed for stability.
- STA 3+51 – Brush toe installed to provide bank protection.
- STA 3+71 – Riffle shortened to protect trees.
- STA 5+37 – Brush toe replaced by cover log based on site materials and channel conditions.
- STA 5+79 – Rock sill replaced by log still based on site materials and channel conditions.
- STA 5+85 – Cover log installed to provide habitat.
- STA 6+40 – Added stabilization at outlet.
- STA 6+56 – Rock sill replaced by log sill based on site materials and channel conditions.
- STA 7+23 – Boulder toe installed to provide bank protection downstream of existing crossing.
- STA 7+52 – Rock sill installed for stability.



- STA 7+61 – Brush toe installed to provide habitat.
- STA 9+24 – Added stabilization at drainage outlet with natural stone.

2.1.2 Banner Creek Reach 2

- STA 9+66 – Brush toe installed to provide bank protection and habitat.
- STA 10+44 – Added stabilization at outlet with natural stone.
- STA 11+78 – Added stabilization at outlet with natural stone.
- STA 13+48 – Cover log installed to provide bank protection.
- STA 14+90 – Rock sill installed for stability.
- STA 15+16 – Brush toe installed to provide bank stability and habitat.
- STA 16+42 – Log sill installed for stability.
- STA 16+71 – Brush toe installed to provide bank stability and habitat.
- STA 17+16 – Log sill installed for stability.
- STA 17+45 – Rock sill replaced by J-hook to protect bank.
- STA 17+47 – STA 18+34 – Profile adjusted to reduce slope at tie-out to existing stream bed.
- STA 17+66 – Riffle added due to change in profile.
- STA 17+71 – Log sill installed for stability due to change in profile.
- STA 17+81 – Riffle location changed due to change in profile.
- STA 17+89 – Log sill installed for stability due to change in profile.

2.1.3 Banner Creek Reach 3

- STA 18+20 – Riffle installed due to change in profile to tie to existing stream bed.
- STA 18+28 – Rock sill installed due to change in profile for stability.
- STA 20+40 – Rock sill not installed to refrain from encroaching on DOT right-of-way.
- STA 23+46 – Brush toe installed to provide bank protection and habitat.

2.1.4 Banner Creek Reach 4A

- STA 29+40 – Log sill installed for stability.
- STA 29+85 – Brush toe installed to provide bank protection and habitat.
- STA 31+81 – Cover log installed to provide bank protection and habitat.
- STA 32+00 – Brush toe installed to provide bank protection and habitat.

2.1.5 Banner Creek Reach 4B

- STA 33+79 – Rock sill installed for stability.
- STA 37+40 – Brush toe installed to provide bank protection.

2.1.6 UT1

- STA 100+37 – Rip rap headwall added during final design.
- STA 100+62 – Rip rap headwall added during final design.
- STA 100+69 – Rock sill installed for stability and aquatic organism passage.
- STA 101+77 – Rock sill installed for stability.
- STA 102+00 – Brush toe installed for bank protection and habitat.
- STA 103+63 – Brush toe installed to provide bank protection and habitat.
- STA 107+88 – Rip rap headwall added during final design.
- STA 108+09 – Rip rap headwall added during final design.
- STA 108+81 – Brush toe installed to provide bank protection and habitat.
- STA 109+39 – STA 112+82 – Stream profile adjustment to tie to Banner Creek stream bed.



- STA 109+39 – Rock sill installed for stability.
- STA 109+63 – Cover log installed to provide habitat.
- STA 110+79 – Rock sill installed for stability.
- STA 112+15 – Brush toe installed to provide bank protection and habitat.

2.1.7 UT2

- STA 200+52 – Rock sill replaced by log sill due to availability of logs.
- STA 201+95 – Brush toe installed to provide bank protection and habitat.
- STA 203+32 – Brush toe installed to provide bank protection and habitat.
- STA 207+69 – Cover log installed to provide habitat.
- STA 209+83 – Brush toe installed to provide bank protection and habitat.
- STA 210+57 – Brush toe installed to provide bank protection and habitat.
- STA 213+06 – Brush toe installed to provide bank protection and habitat.
- STA 214+64 – Cover log installed to provide bank protection and habitat.
- STA 218+38 – Cover log installed to provide bank protection and habitat.

2.1.8 Encroachments

Easement encroachments to be resolved:

Though the following encroachments will be corrected during MY1 maintenance activities, the areas were documented on the record drawings as red lines. They are as follows:

- Wetland grading sheet 2.2 – The constructed farm entrance is encroaching on the conservation easement but not on mitigation assets. During construction, the location of the farm entrance had to be modified. The entrance was proposed (and built) between two existing DOT bridges. An existing overhead electric guy wire pole and newly installed narrow bridge notification sign conflicted with the original proposed location of the farm entrance. Based on the field conditions including existing utilities, DOT signage, FEMA considerations, and landowner workability it was determined that the best course of action was to shift the entrance west, which resulted in the minor encroachment on the conservation easement. Wildlands is currently working to modify the recorded conservation easement to release the area and rectify the encroachment. The conservation easement modification will be completed in MY1.
- Wetland grading sheet 2.3 – 292 SQFT of constructed soil road is encroaching on conservation easement. In MY1, the area will be raked, seeded, and strawed. Horse tape will be added between marker boundaries in this area to keep vehicles and farm equipment from entering conservation easement. This work will be completed in MY1.
- Wetland grading sheet 2.4 – 2 SQFT of constructed soil road is encroaching on conservation easement. The area will be raked, seeded, and strawed. This work will be completed in MY1.

2.1.9 Planting

Changes within the planted riparian buffer were minimal and consisted of three species changes and planting density adjustments within the Wetland and Streambank Planting Zones. Species replacements and planting density adjustments were made due to availability of the species at the time of planting. All species replacements were approved species or alternate species within the Final Mitigation Plan's planting list (Wildlands, 2020), so no approval for the inclusion of the species is needed.

Open Area Planting Zone

- Sweet birch (*Betula lenta*) was replaced by silver maple (*Acer saccharinum*).

Wetland Planting Zone

- Persimmon (*Diospyros virginiana*) was replaced by American elm (*Ulmus americana*).



- Mountain doghobble (*Leucothoe fontanesiana*) was replaced by elderberry (*Sambucus canadensis*).
- Stem densities were updated from 15% to 15.5% for river birch (*Betula nigra*) and boxelder (*Acer negundo*). Tulip poplar (*Liriodendron tulipifera*) was reduced from 15% to 5%. Tag alder (*Alnus serrulate*) was increased from 2% to 3.5%. Spicebush (*Lindera benzoin*) and American holly (*Ilex opaca*) were increased from 2% to 2.5% and 1% to 2%, respectively.
- An additional density of 5% of American elm and 1% of elderberry were added to offset planting densities adjustments.

Streambank Planting Zone

- Planting densities for black willow (*Salix nigra*) was increased from 10% to 11%, while buttonbush (*Cephaelis occidentalis*) was reduced from 15% to 14.5% and elderberry was increased from 15% to 15.5%.

Planting Plan

- Sheet 3.3 – No bare roots were planted due to the depth of standing water.
- Sheet 3.3 – No bare roots were planted due to farm road encroachment.
- Sheet 3.4 – River cane planting areas replaced with wetland area plantings. Due to the availability of plant material.
- Sheet 3.4 – River cane planting areas replaced with open area buffer plantings. Due to the availability of plant material.
- Sheet 3.4 – River cane plantings concentrated towards the lower bench of the project. Due to the availability of plant material.
- Sheet 3.4 – Area not disturbed during construction. Existing vegetation is already established. No river cane or bare roots needed.

2.1.10 Monitoring Device Locations

Installed monitoring devices and plot locations closely mimic the locations of those proposed in the Site's Mitigation Plan. Minor deviations from these locations were made when professional judgement deemed them necessary to better represent as-built field conditions or when installation of the device in the proposed location was not physically feasible.

Section 3: Monitoring Year 0 Data Assessment

The as-built and MY0 data collection was conducted between December 2021 and March 2022 to assess the baseline condition of the project. The vegetation, stream, and wetland success criteria for the Site follow the approved Mitigation Plan (Wildlands, 2020).

Performance criteria for vegetation, stream, and hydrologic assessments are located in Section 1.2 Table 3: Goals, Performance Criteria, and Functional Improvements. The first annual monitoring assessment (MY1) will be completed in the fall of 2022, at least 6 months after the MY0 assessment. The Site will be monitored for a total of seven years, with the final monitoring activities scheduled for 2028.

3.1 Vegetative Assessment

The MY0 vegetative survey was completed in February 2022. Vegetation monitoring resulted in a stem density range of 405 to 850 planted stems per acre across vegetation plots which is above the interim requirement of 320 stems per acre required at MY3. The average stem density across vegetation plots is 565 planted stems per acre. All 24 permanent and 12 mobile vegetation plots exceeded the interim success criteria individually and are on track to meet the final success criteria required for MY7.



Herbaceous vegetation is establishing itself across the site. Refer to Appendix A for Vegetation Plot Photographs and the Vegetation Condition Assessment Table and Appendix B for Vegetation Plot Data.

3.2 Vegetation Areas of Concern

There are currently no vegetation areas of concern. Invasive species are not currently pervasive on the Site. Treatments of reed canary grass (*Phalaris arundinacea*) and golden bamboo (*Phyllostachys aurea*) occurred before construction to prevent the spread of invasive species that could compete with planted native species. Invasive species will continue to be monitored and managed as necessary throughout the monitoring period.

3.3 Stream Assessment

Morphological surveys for MY0 were completed in February 2022. All streams on Site are stable and functioning as designed. Cross-sections show dimensions within an acceptable range of the design parameters. Entrenchment ratios are greater than 2.2, and bank height ratios are less than 1.2. Reachwide and riffle 100-count substrate sampling was conducted during baseline condition assessment to classify the reach and characterize the riffle pavement.

Sediment analysis results show riffles along most reaches have a median particle size classification of coarse gravel to small cobble. As expected, and noted in the Mitigation Plan (Wildlands, 2020), the Banner Creek Reach 4b riffle count is showing a finer median particle size of fine sand due to backwater and high sand loads from the French Broad River. Based on a DMS Technical Workgroup memo from 10/19/21 and concurrence received on 10/27/2021 from the DMS project manager for the Site, pebble counts will not be conducted during the remaining monitoring years unless requested by the IRT or deemed necessary by best professional judgement. Refer to Appendix A for the Visual Stream Morphology Stability Assessment Table and Stream Photographs. Refer to Appendix C for Stream Geomorphology Data. Refer to Appendix D for the DMS Technical Workgroup memo and the email confirmation from the DMS project manager (Reid, 2021).

3.4 Stream Areas of Concern

No stream areas of concern were identified at this time.

3.5 Hydrology Assessment

In total, 3 automated crest gages (CG) were installed along Banner Creek Reach 2, UT1, and UT2 to monitor bankfull events. Hydrologic data will be collected and reported during MY1.

3.6 Wetland Assessment

In total, 18 groundwater gages and one soil temperature probe were installed across re-establishment, rehabilitation, creation wetland areas. Groundwater gage data will be collected and reported during MY1. Refer to Appendix A for Groundwater Gage and Soil Profile Photographs. Refer to Appendix F for Groundwater Gage Installation Sheets that contain soil profile descriptions and ground elevations.

3.7 Adaptive Management Plan

Site maintenance and adaptive measurement implementation will follow those outlined in the project's Final Mitigation Plan (Wildlands, 2020). No adaptive management plans are needed at this time.

3.8 Monitoring Year 0 Summary

Overall, the Site is performing as intended, and is on course to meet success criteria. Vegetation plot data shows an average density of 565 planted stems per acre across vegetation plots. All plots are on track to exceed the MY3 interim requirement of 320 planted stems per acre. All project streams are stable, functioning as intended, and meeting project goals. Herbaceous vegetation is



establishing itself across the site and the floodplain is stable. Stream and wetland hydrology data will be included in the MY1 annual report. Invasive species are not currently a concern, but they will be assessed and treated as necessary in future monitoring years.

Summary information and data related to the performance of various project and monitoring elements can be found in the tables and figures in the report appendices. All raw data supporting the tables and figures in the appendices are available from DMS upon request.



Section 4: METHODOLOGY

Annual monitoring will consist of collecting morphologic, vegetative, and hydrologic data to assess project success based on the goals outlined in the Site's Mitigation Plan (Wildlands, 2020). Monitoring requirements will follow guidelines outlined in the NC IRT Stream and Wetland Mitigation Guidance Update (2016). Installed monitoring devices and plot locations closely mimic the locations of those proposed in the Site's Mitigation Plan. Deviations from these locations were made when professional judgement deemed them necessary to better represent as-built field conditions or when installation of the device in the proposed location was not physically feasible.

Geomorphic data was collected following the standards outlined in *The Stream Channel Reference Site: An Illustrated Guide to Field Techniques* (Harrelson et al., 1994) and in *Stream Restoration: A Natural Channel Design Handbook* (Doll et al., 2003). All Integrated Current Condition Mapping was collected by either a professional licensed surveyor or an Arrow 100® Submeter GNSS Receiver and processed using ArcPro. Crest gages, using automated pressure transducers, were installed in riffle cross-sections to monitor stream hydrology throughout the year. Groundwater gages were installed using guidance from the USACE's *Technical Standard for Water-Table Monitoring of Potential Wetland Sites* (2005). Stream hydrology and vegetation monitoring protocols followed the Wilmington District Stream and Wetland Compensatory Mitigation Update (NCIRT, 2016). Vegetation installation data collection follow the Carolina Vegetation Survey-EEP Level 2 Protocol (Lee et al., 2008); however, vegetation data processing follows the NC DMS Vegetation Data Entry Tool and Vegetation Plot Data Table (NCDMS, 2020).





Section 5: REFERENCES

- Doll, B.A., Grabow, G.L., Hall, K.A., Halley, J., Harman, W.A., Jennings, G.D., and Wise, D.E. 2003. Stream Restoration A Natural Channel Design Handbook.
- Harrelson, C.C., Rawlins, C.L., Potyondy, J.P. 1994. *Stream Channel Reference Sites: An Illustrated Guide to Field Technique*. Gen. Tech. Rep. RM-245. Fort Collins, CO: U.S. Department of Agriculture, Forest Service, Rocky Mountain Forest and Range Experiment Station. 61 p.
- Lee, Michael T., Peet, Robert K., Steven D., Wentworth, Thomas R. 2008. CVS-EEP Protocol for Recording Vegetation Version 4.2. Retrieved: <http://cvs.bio.unc.edu/protocol/cvs-eep-protocol-v4.2-lev1-5.pdf>.
- North Carolina Division of Mitigation Services. 2009 (NC DMS). French Broad River Basin Restoration Priorities (RBRP). Raleigh, NC.
- NC DMS. 2020. Vegetation Data Entry Tool and Vegetation Plot Data Table. Raleigh, NC.
https://ncdms.shinyapps.io/Veg_Table_Tool/
- NC DMS and Interagency Review Team (IRT) Technical Workgroup. 2018. Standard Measurement of the BHR Monitoring Parameter. Raleigh, NC.
- NC DMS and IRT Technical Workgroup. 2021. Pebble Count Data Requirements. Raleigh, NC. October 19, 2021.
- North Carolina Division of Water Quality. 2016. Surface Water Classifications.
<http://portal.ncdenr.org/web/wq/ps/csu/classifications>
- North Carolina Geological Survey (NCGS), 1985, Geologic Map of North Carolina: Raleigh, North Carolina Department of Natural Resources and Community Development, Geological Survey Section, scale 1:500,00, in color.
- North Carolina Interagency Review Team (NCIRT). 2016. Wilmington District Stream and Wetland Compensatory Mitigation Update. Accessed at: <https://saw-reg.usace.army.mil/PN/2016/Wilmington-District-Mitigation-Update.pdf>
- Reid, M. 2021. Email Correspondence, Pebble Count Data Requirements. October 28, 2021.
- Rosgen, D. L. 1994. A classification of natural rivers. *Catena* 22:169-199.
- Rosgen, D.L. 1996. Applied River Morphology. Pagosa Springs, CO: Wildland Hydrology Books.
- Simon, A. 1989. A model of channel response in disturbed alluvial channels. *Earth Surface Processes and Landforms* 14(1):11-26.
- US Army Corps of Engineers (USACE). 2005. *Technical Standard for Water-Table Monitoring of Potential Wetland Sites*. ERDC TN-WRAP-05-2.
- United States Geological Survey (USGS). 1998. North Carolina Geology.
- Soil Survey Staff, Natural Resources Conservation Service, United States Department of Agriculture. 2019. <http://websoilsurvey.sc.egov.usda.gov/>. Accessed August 2019.
- Wildlands Engineering, Inc. (2020). Banner Farm Mitigation Site Final Mitigation Plan. DMS, Raleigh, NC.



Figures

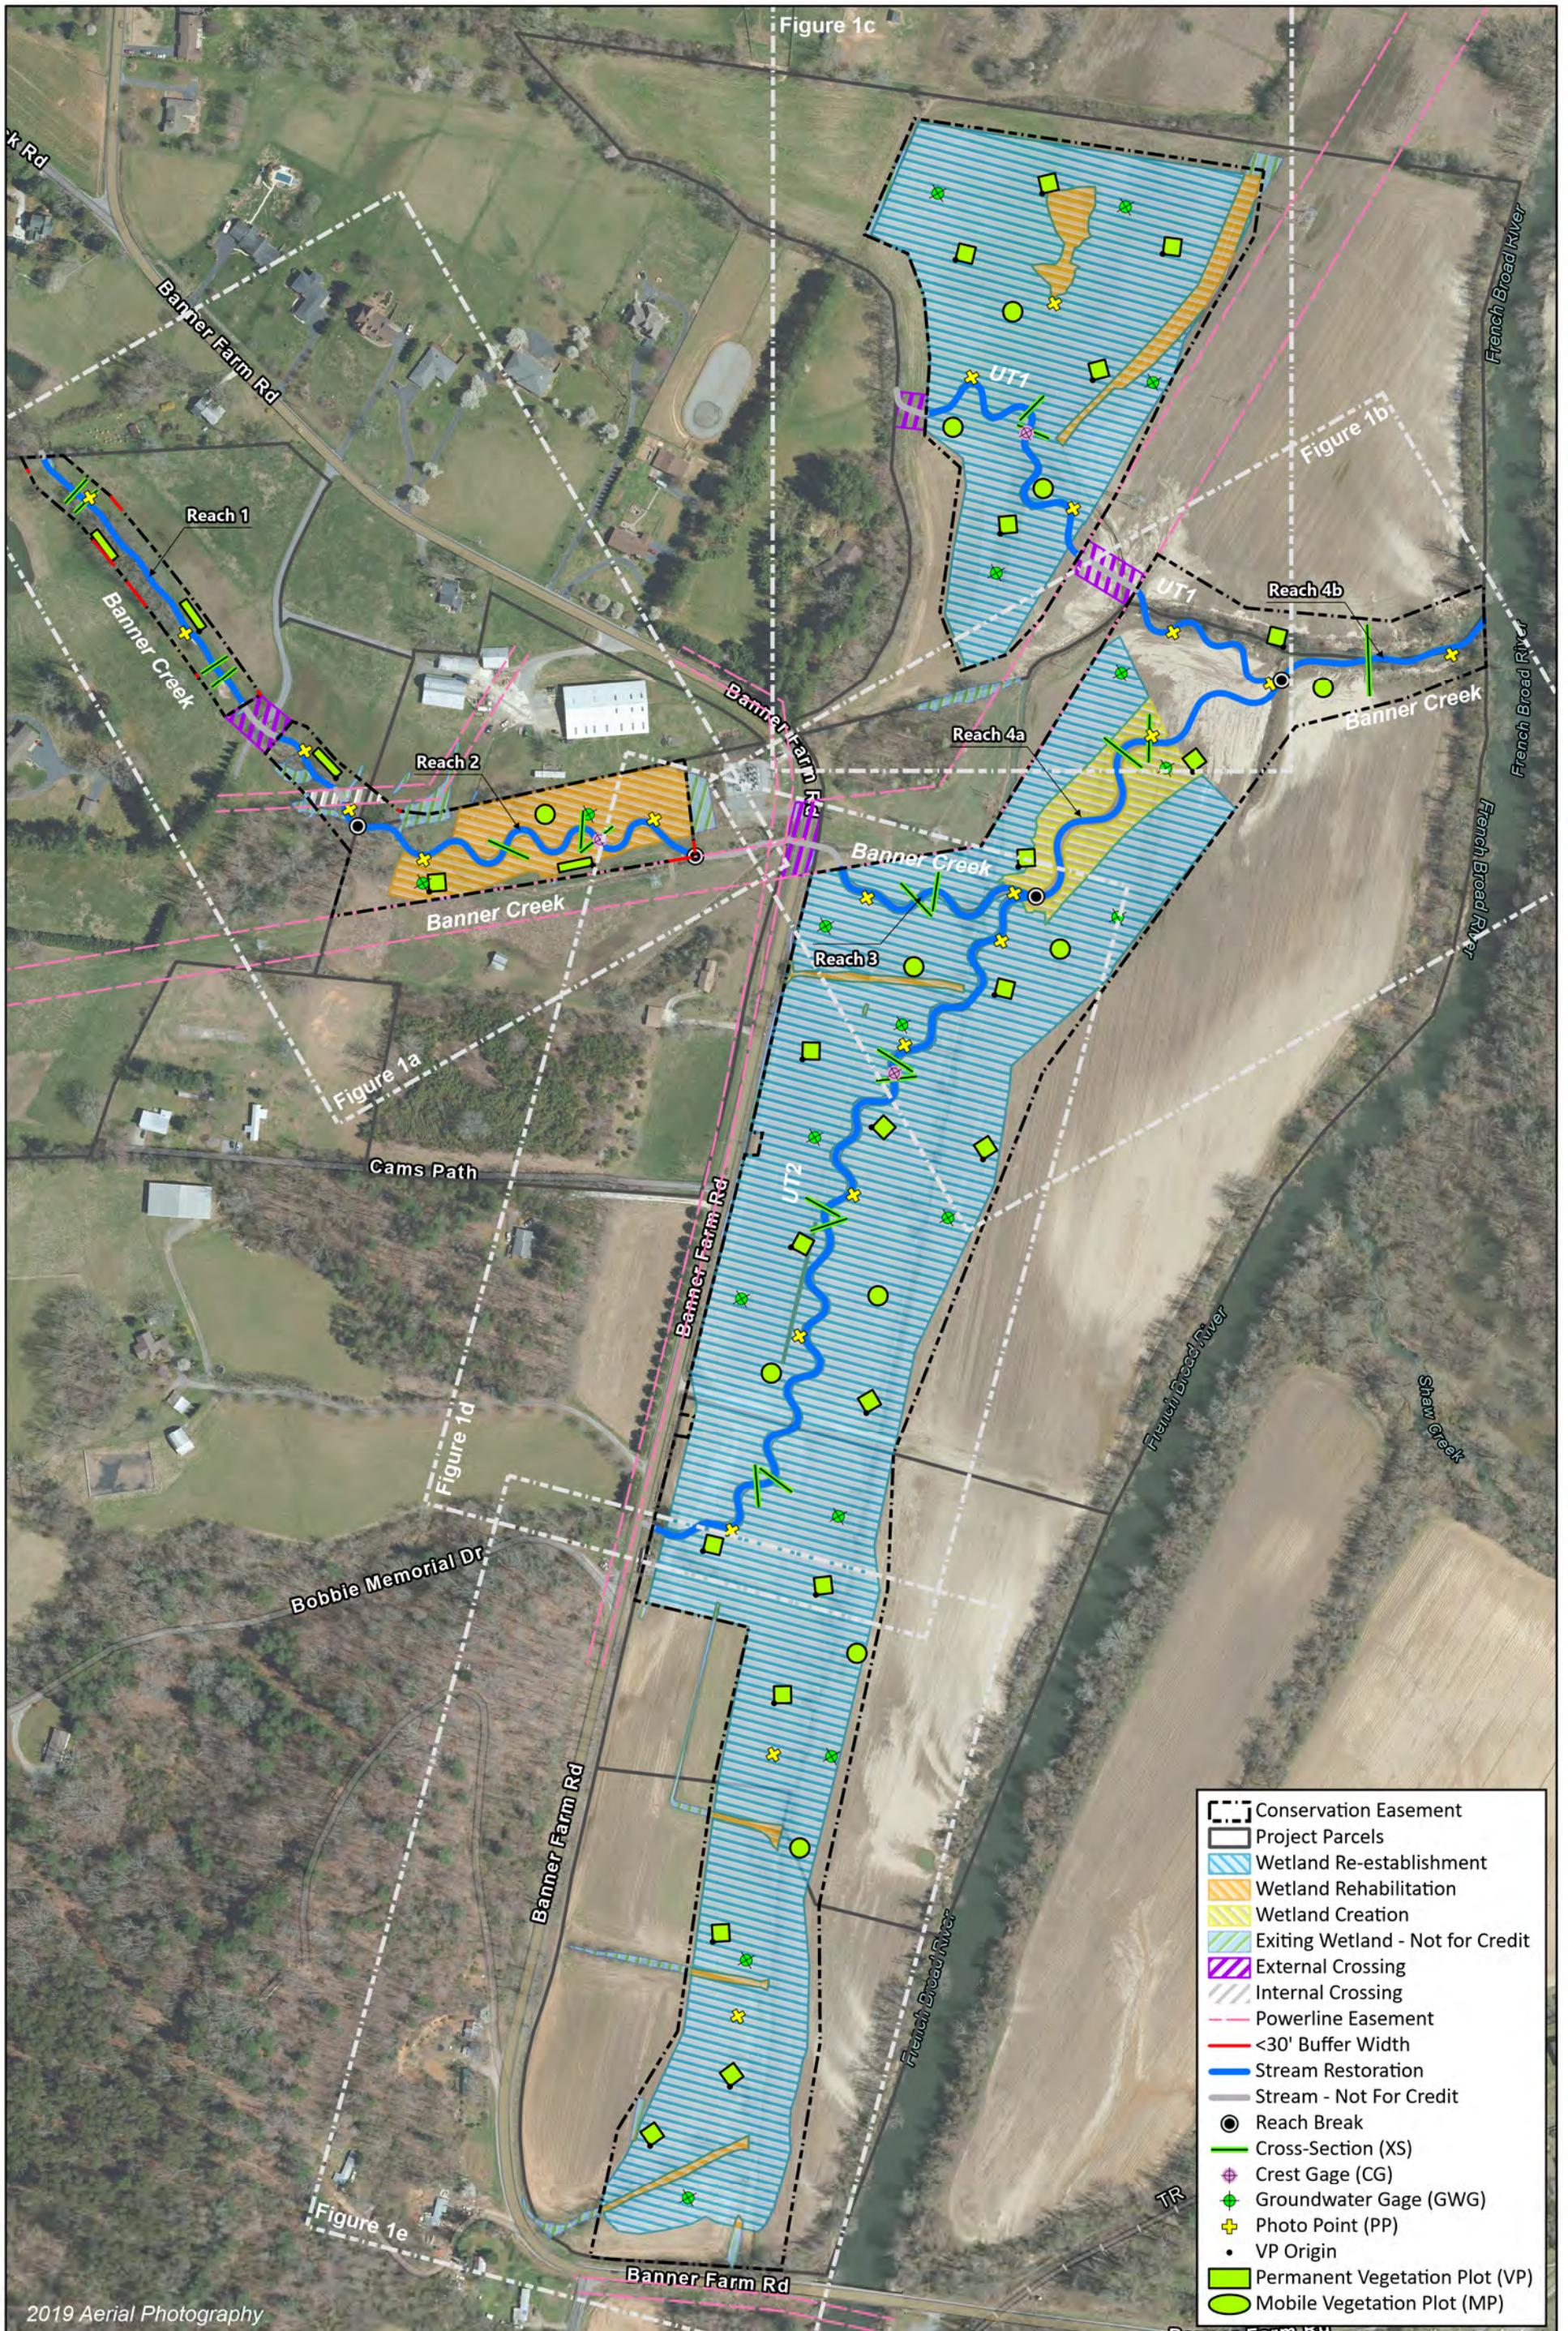

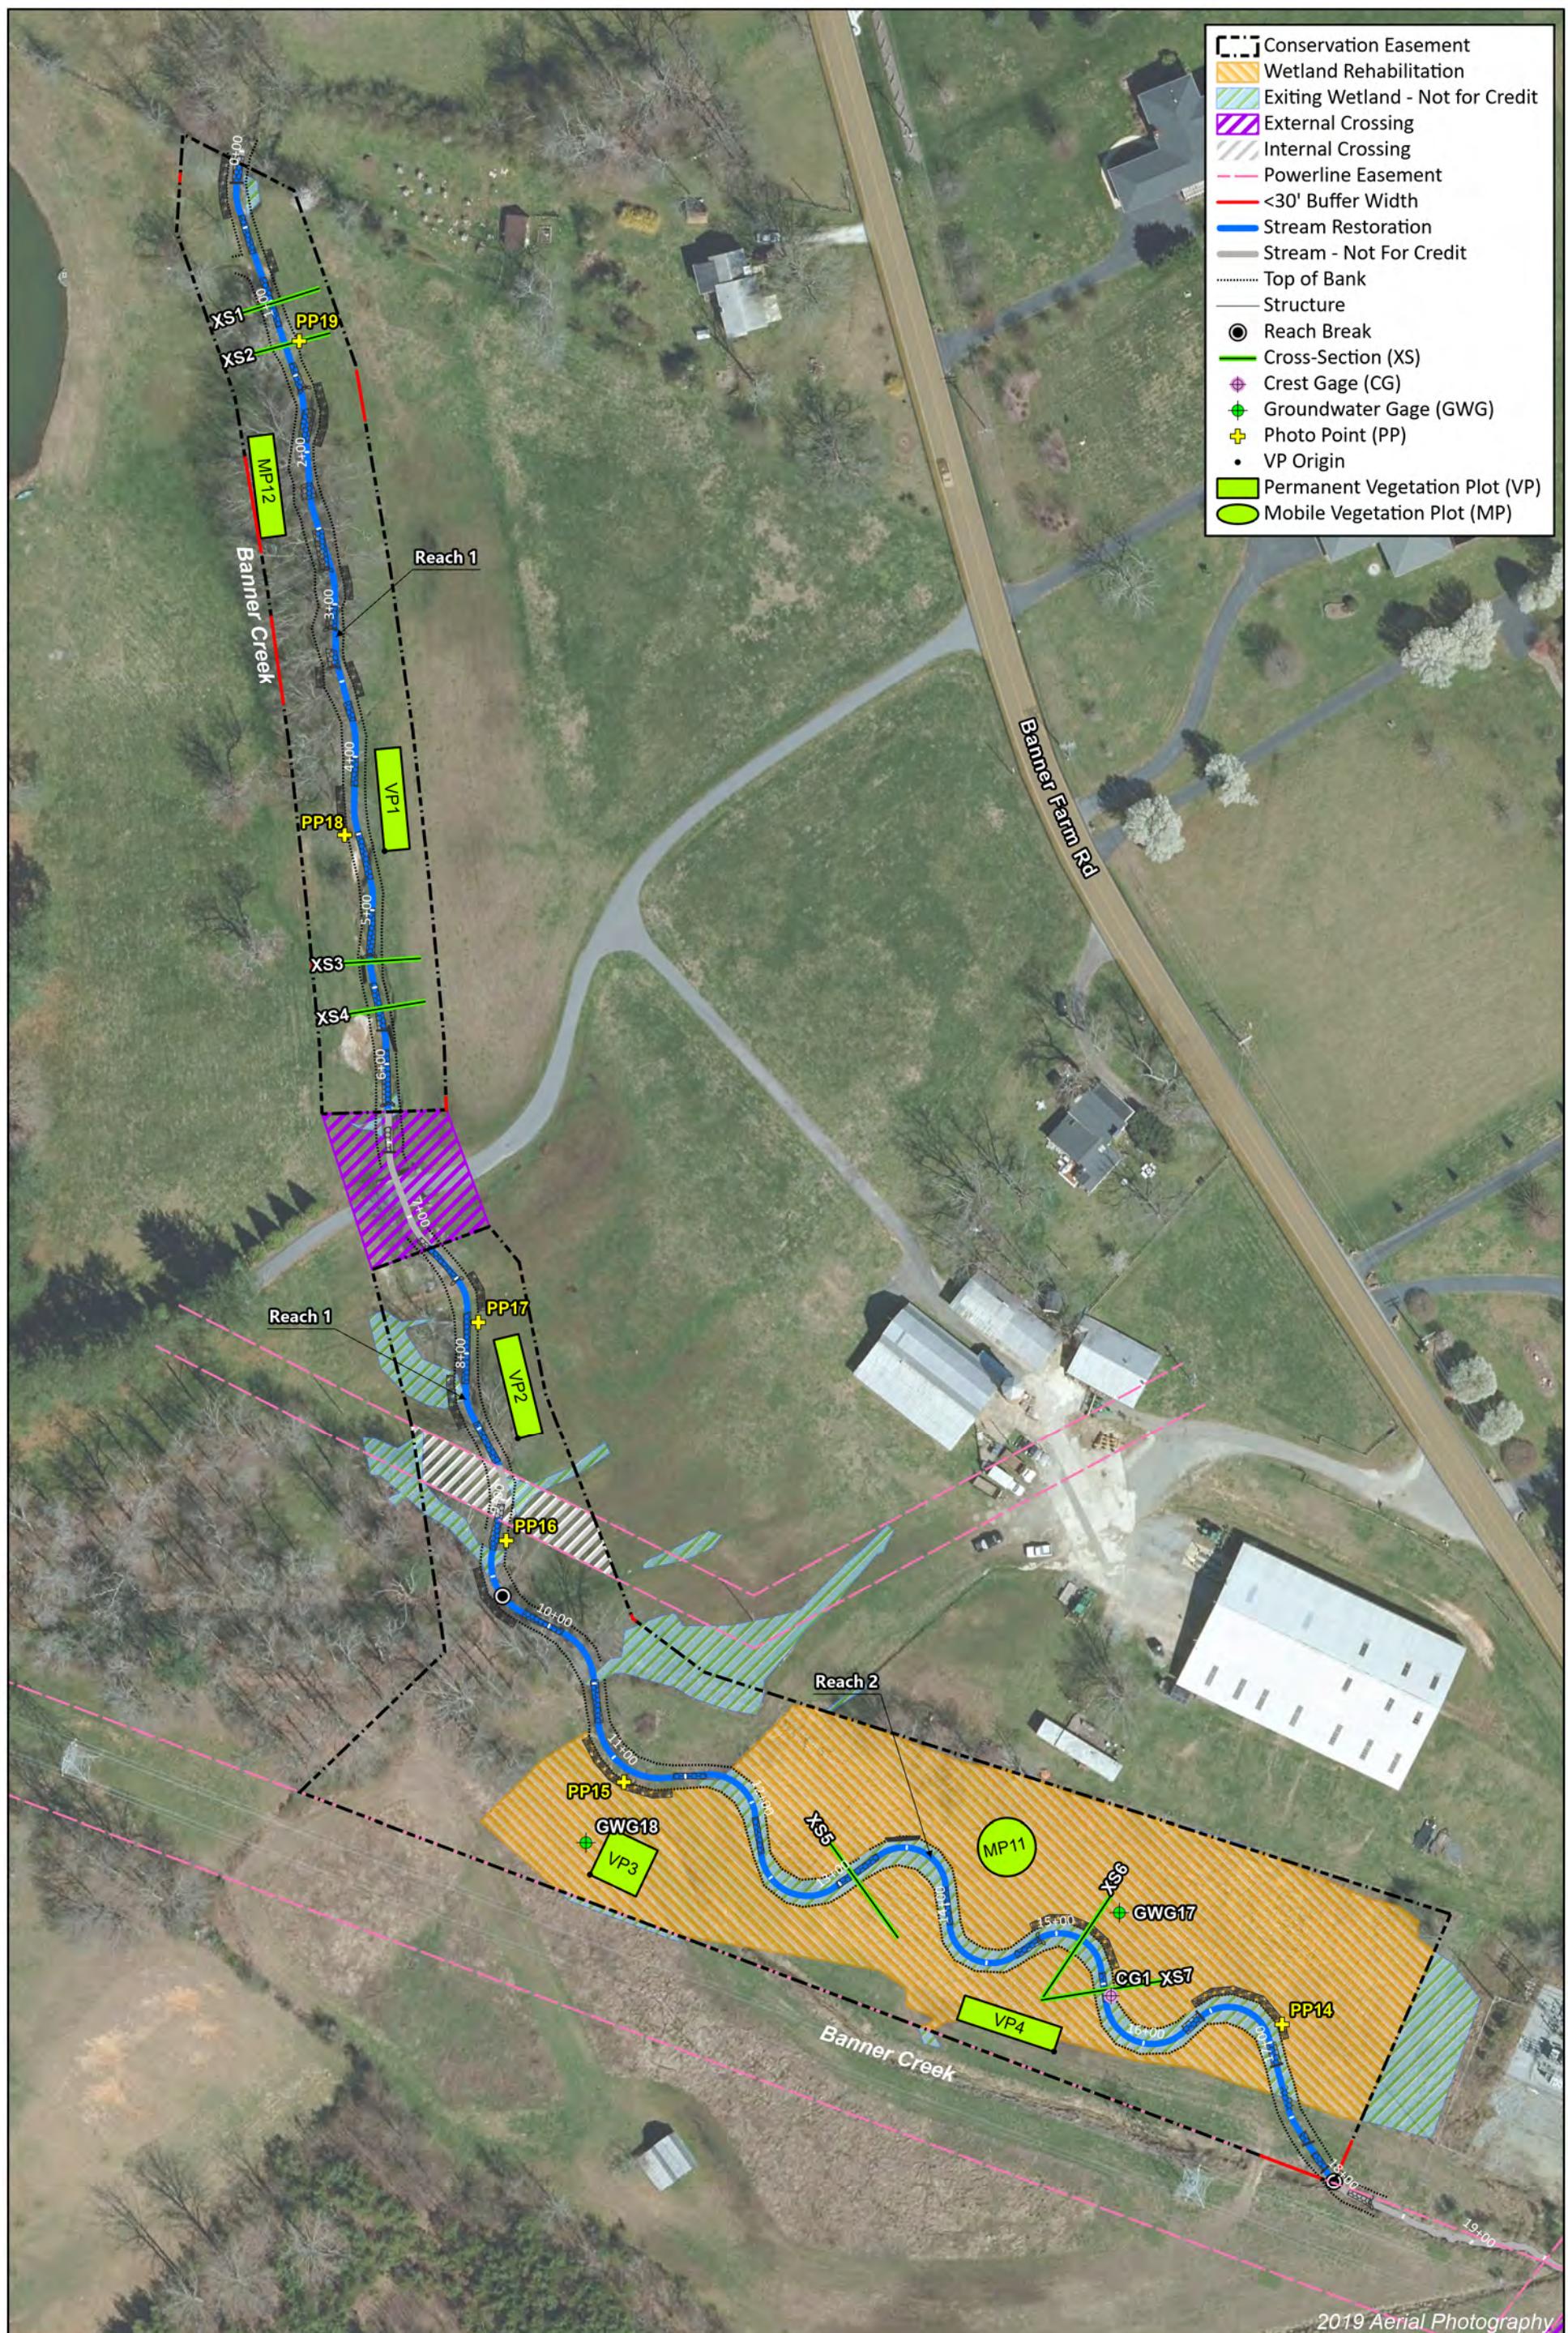

□ Conservation Easement
▨ Wetland Rehabilitation
▨ Existing Wetland - Not for Credit
▨ External Crossing
▨ Internal Crossing
- Powerline Easement
— <30' Buffer Width
— Stream Restoration
— Stream - Not For Credit
— Top of Bank
— Structure
● Reach Break
— Cross-Section (XS)
◆ Crest Gage (CG)
◆ Groundwater Gage (GWG)
◆ Photo Point (PP)
• VP Origin
■ Permanent Vegetation Plot (VP)
○ Mobile Vegetation Plot (MP)

Figure 1a Monitoring Plan View Map
Banner Farm Mitigation Site
DMS Project No. 100062
Monitoring Year 0 - 2022
Henderson County, NC

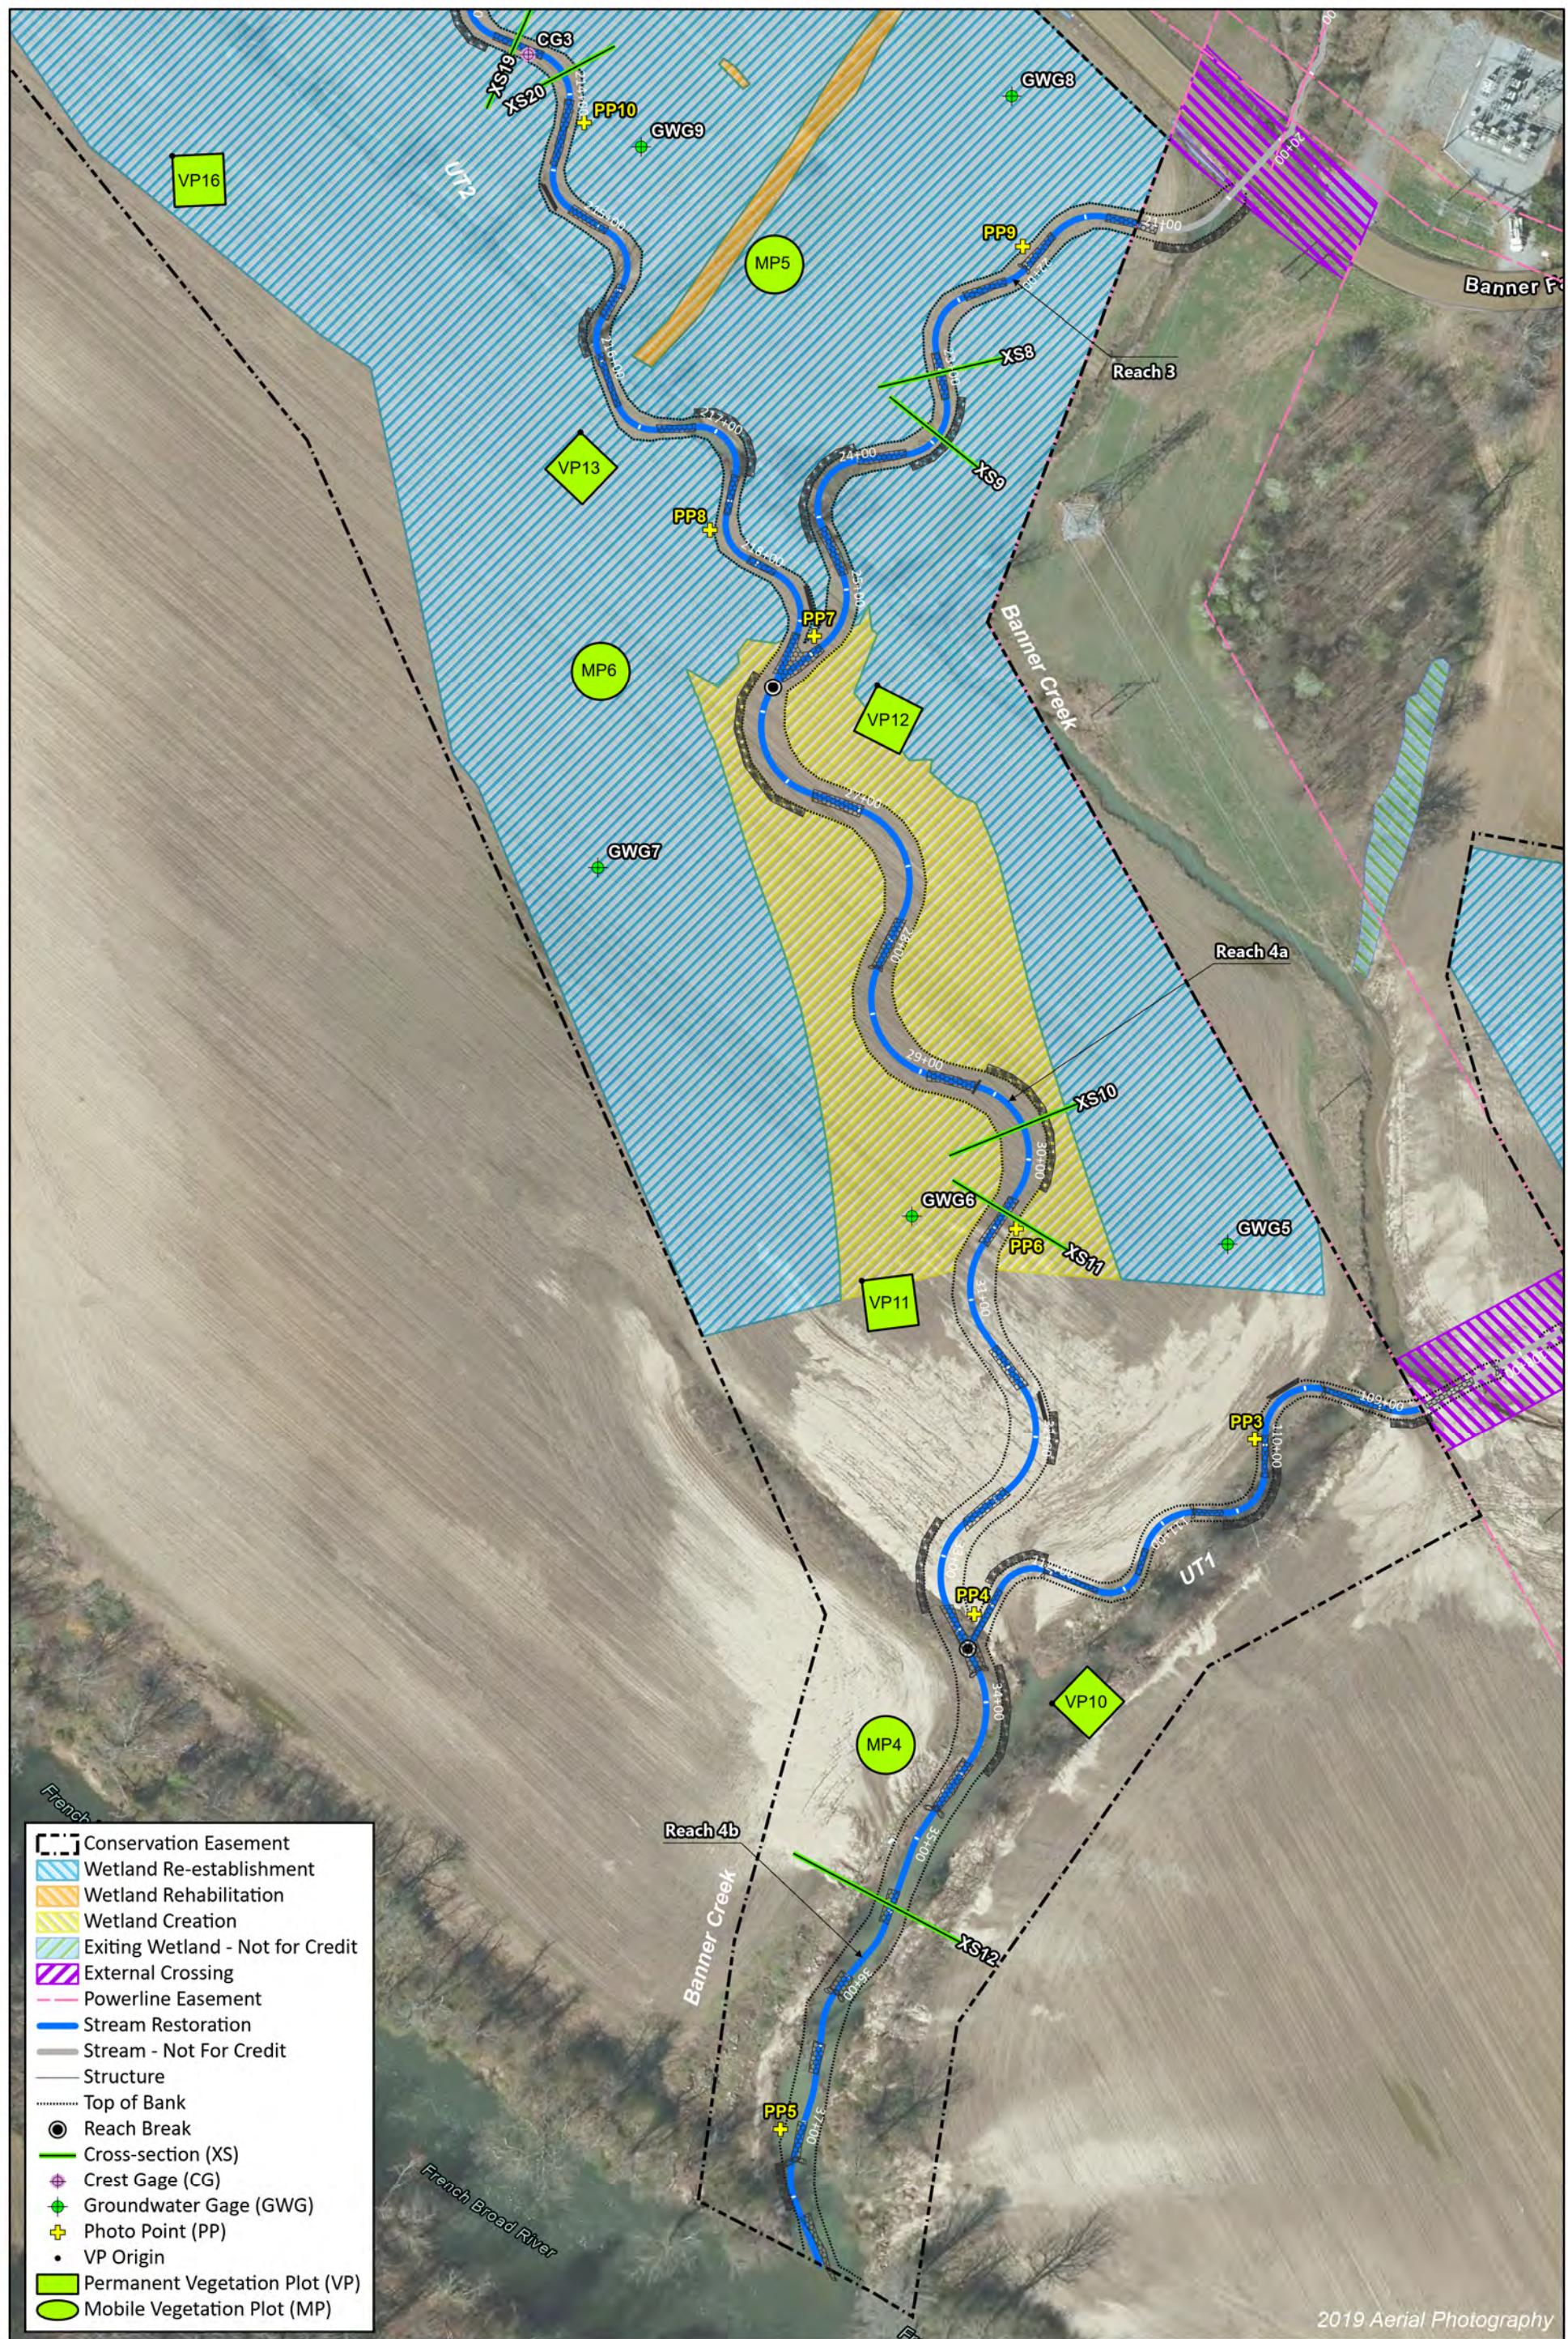
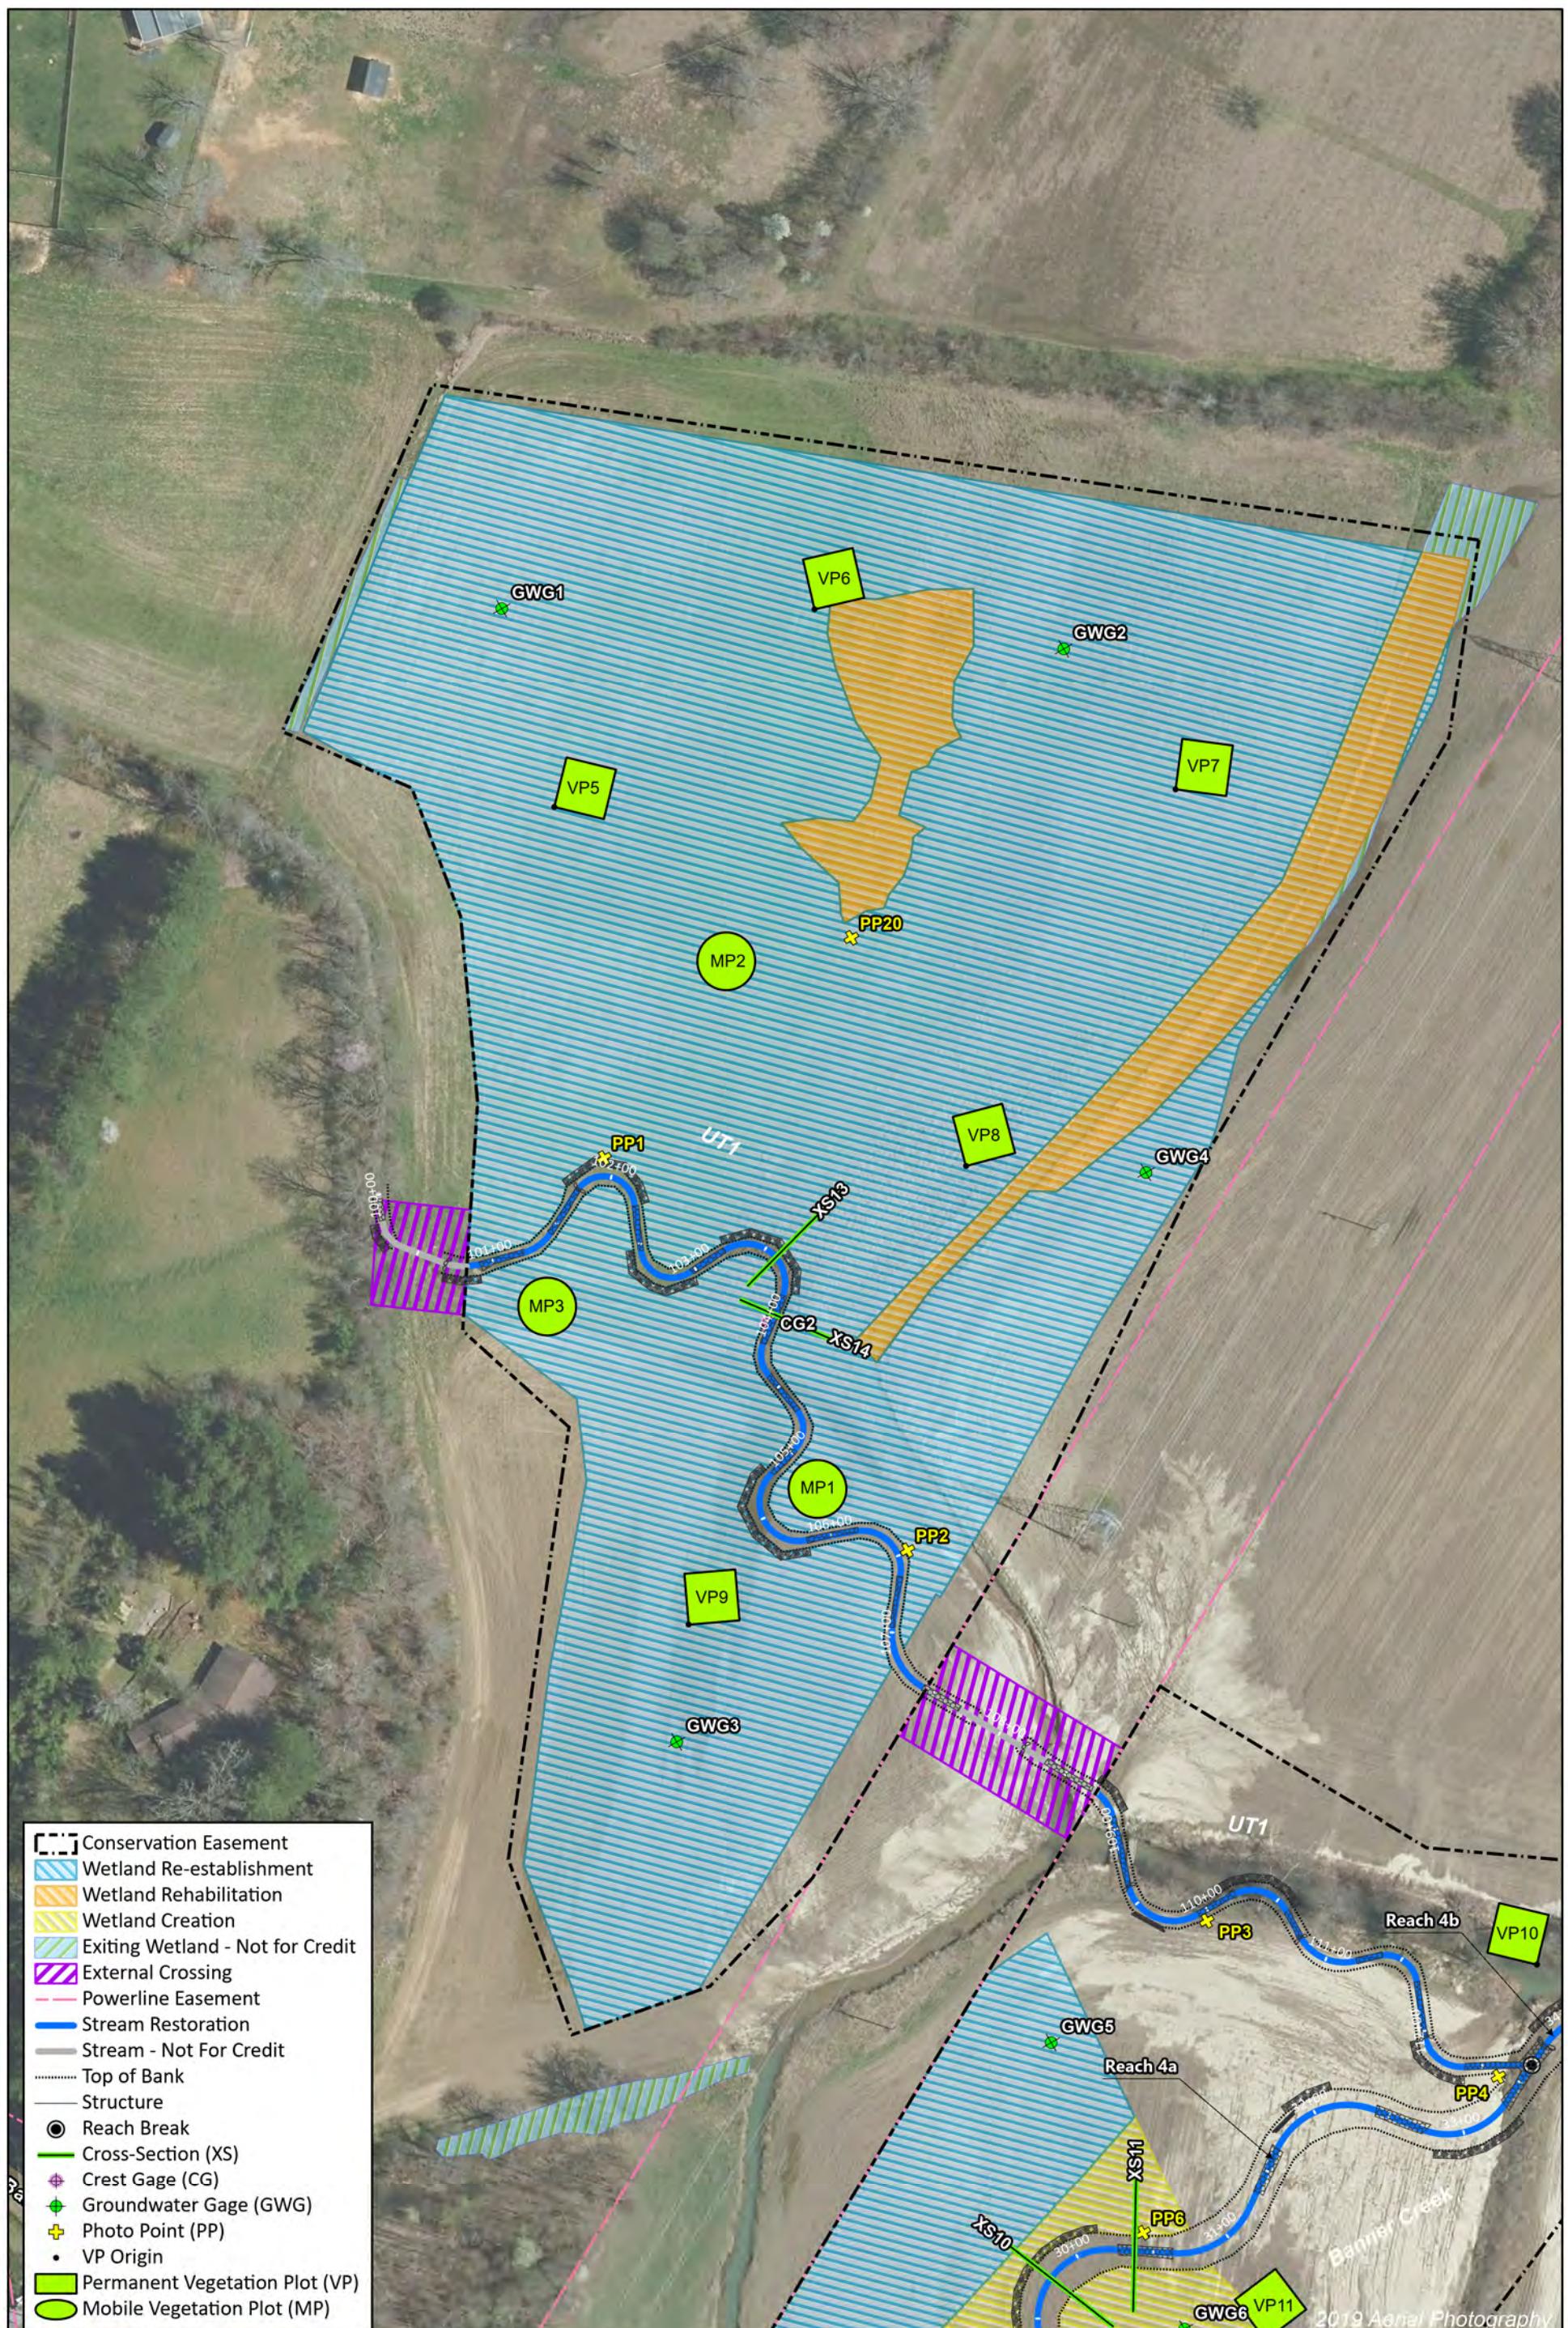


Figure 1b Monitoring Plan View Map
Banner Farm Mitigation Site
DMS Project No. 100062
Monitoring Year 0 - 2022

Henderson County, NC




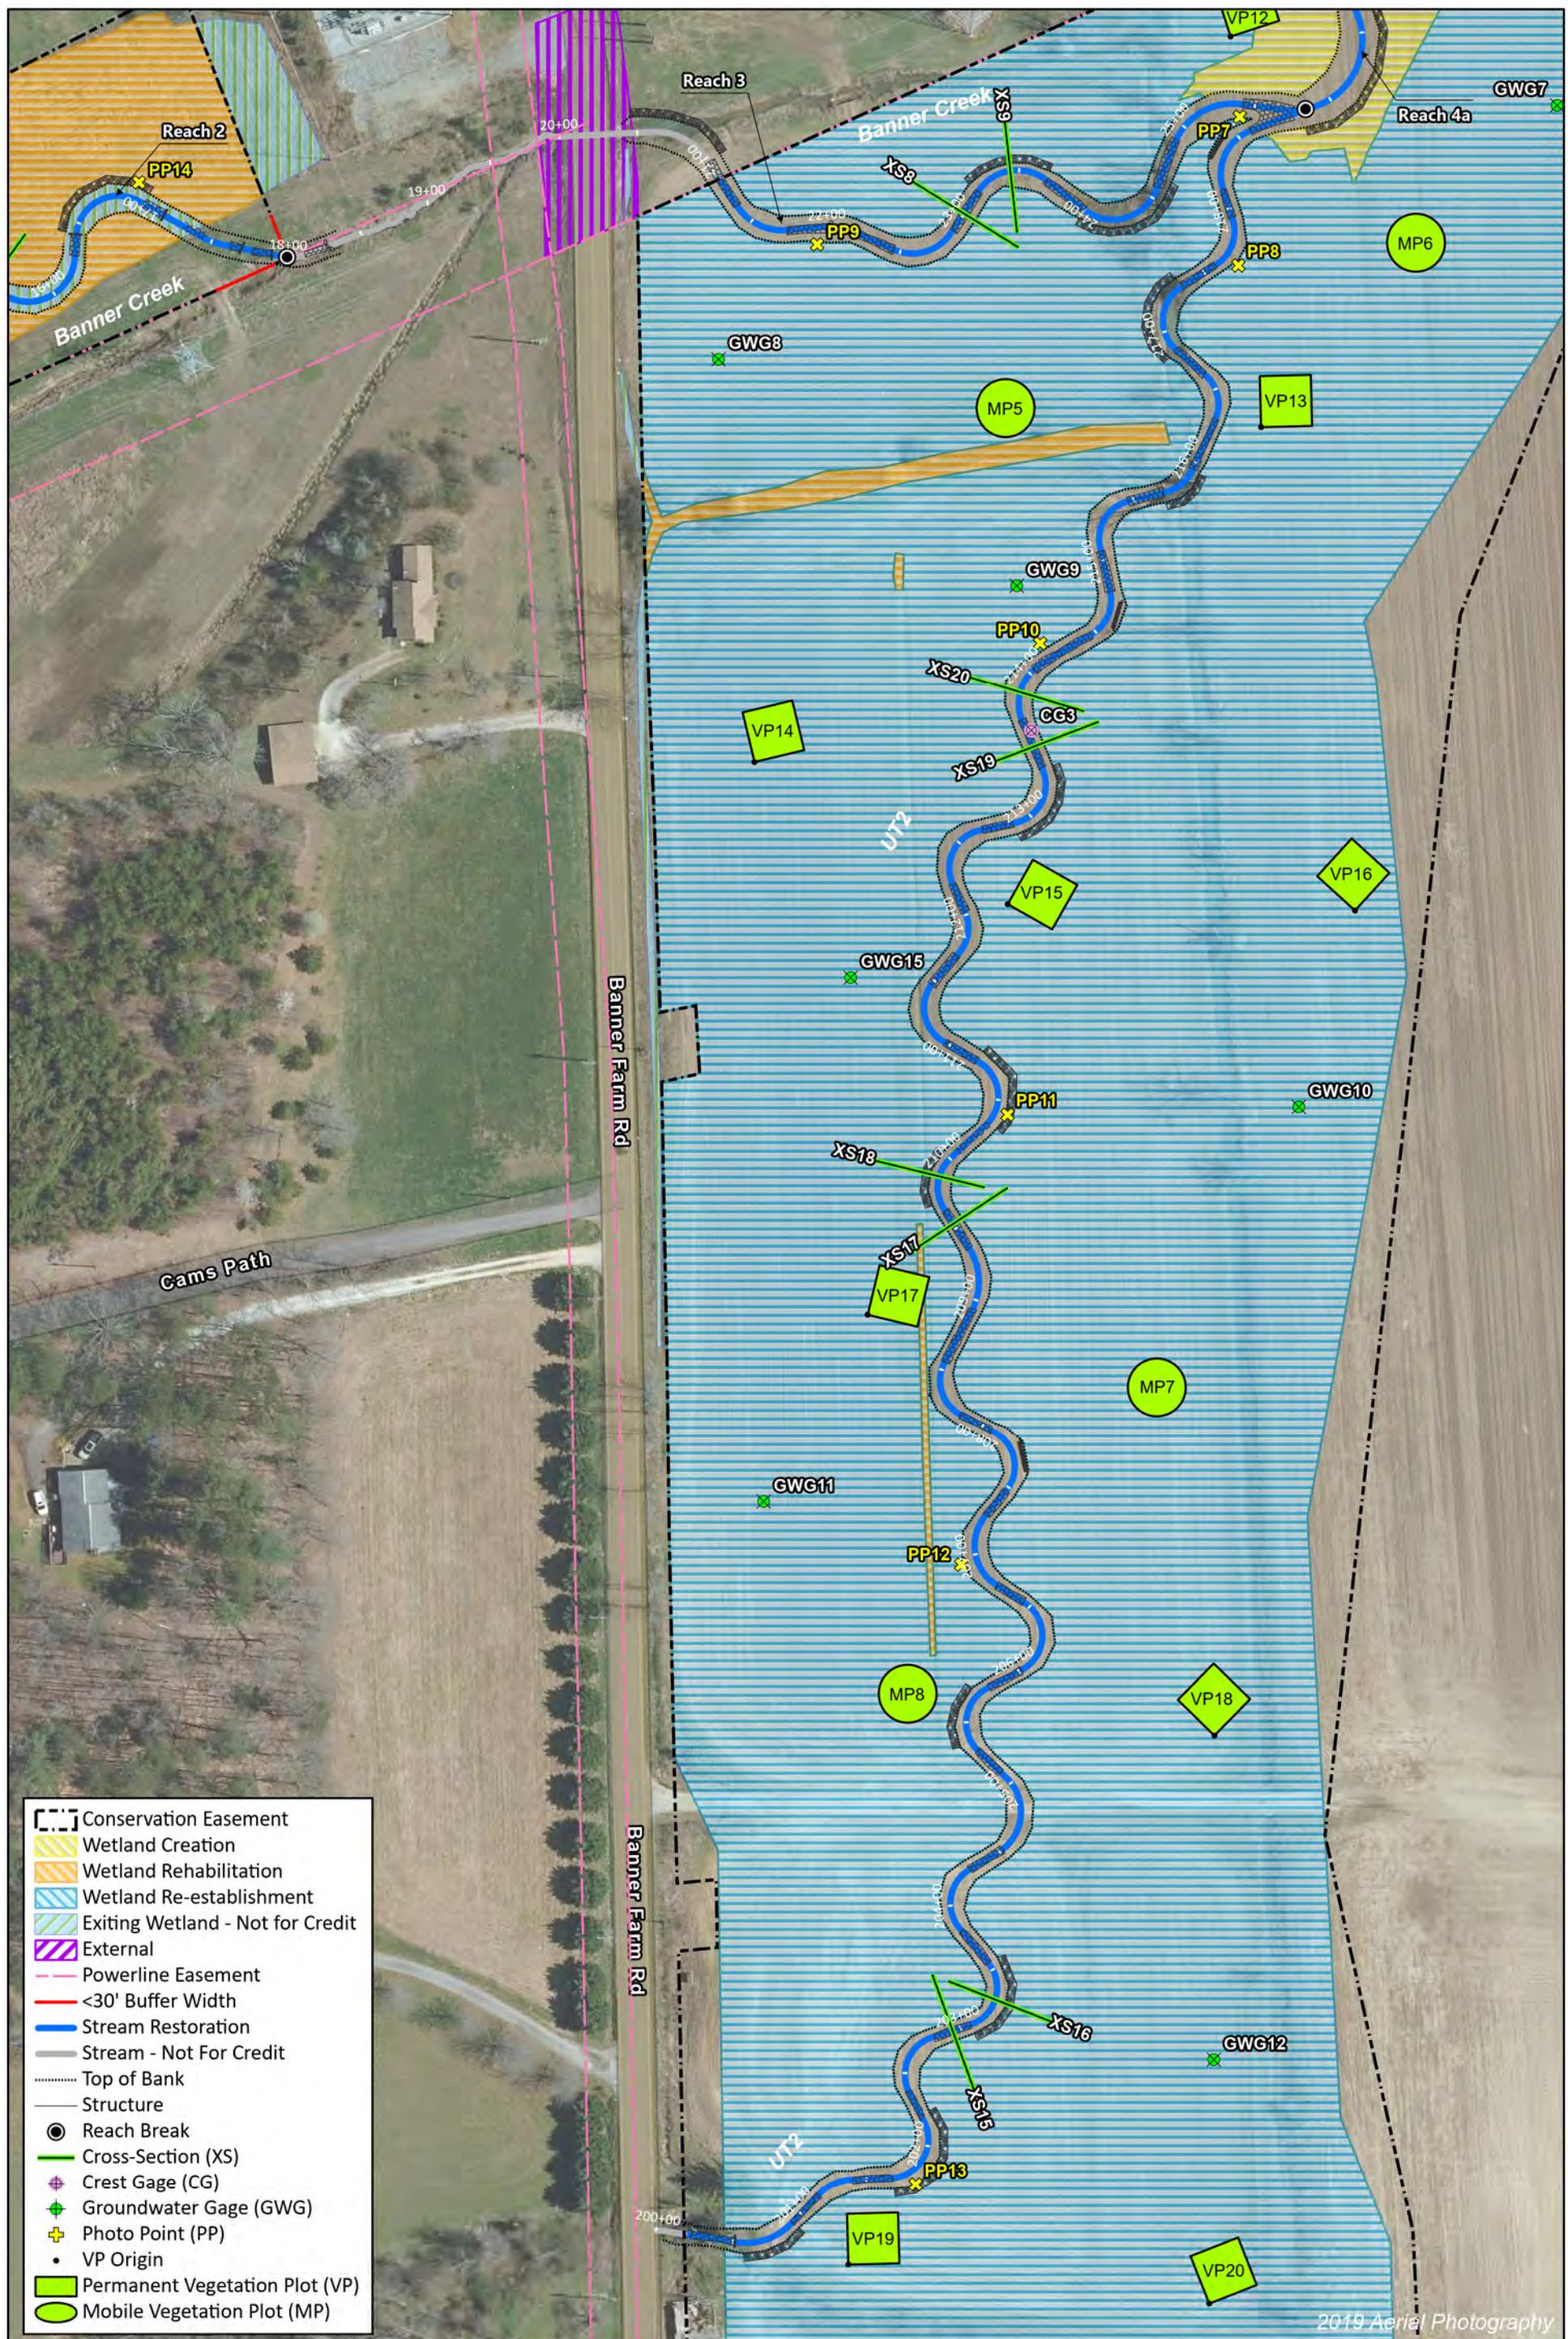


Figure 1d Monitoring Plan View Map
Banner Farm Mitigation Site
DMS Project No. 100062
Monitoring Year 0 - 2022

Henderson County, NC

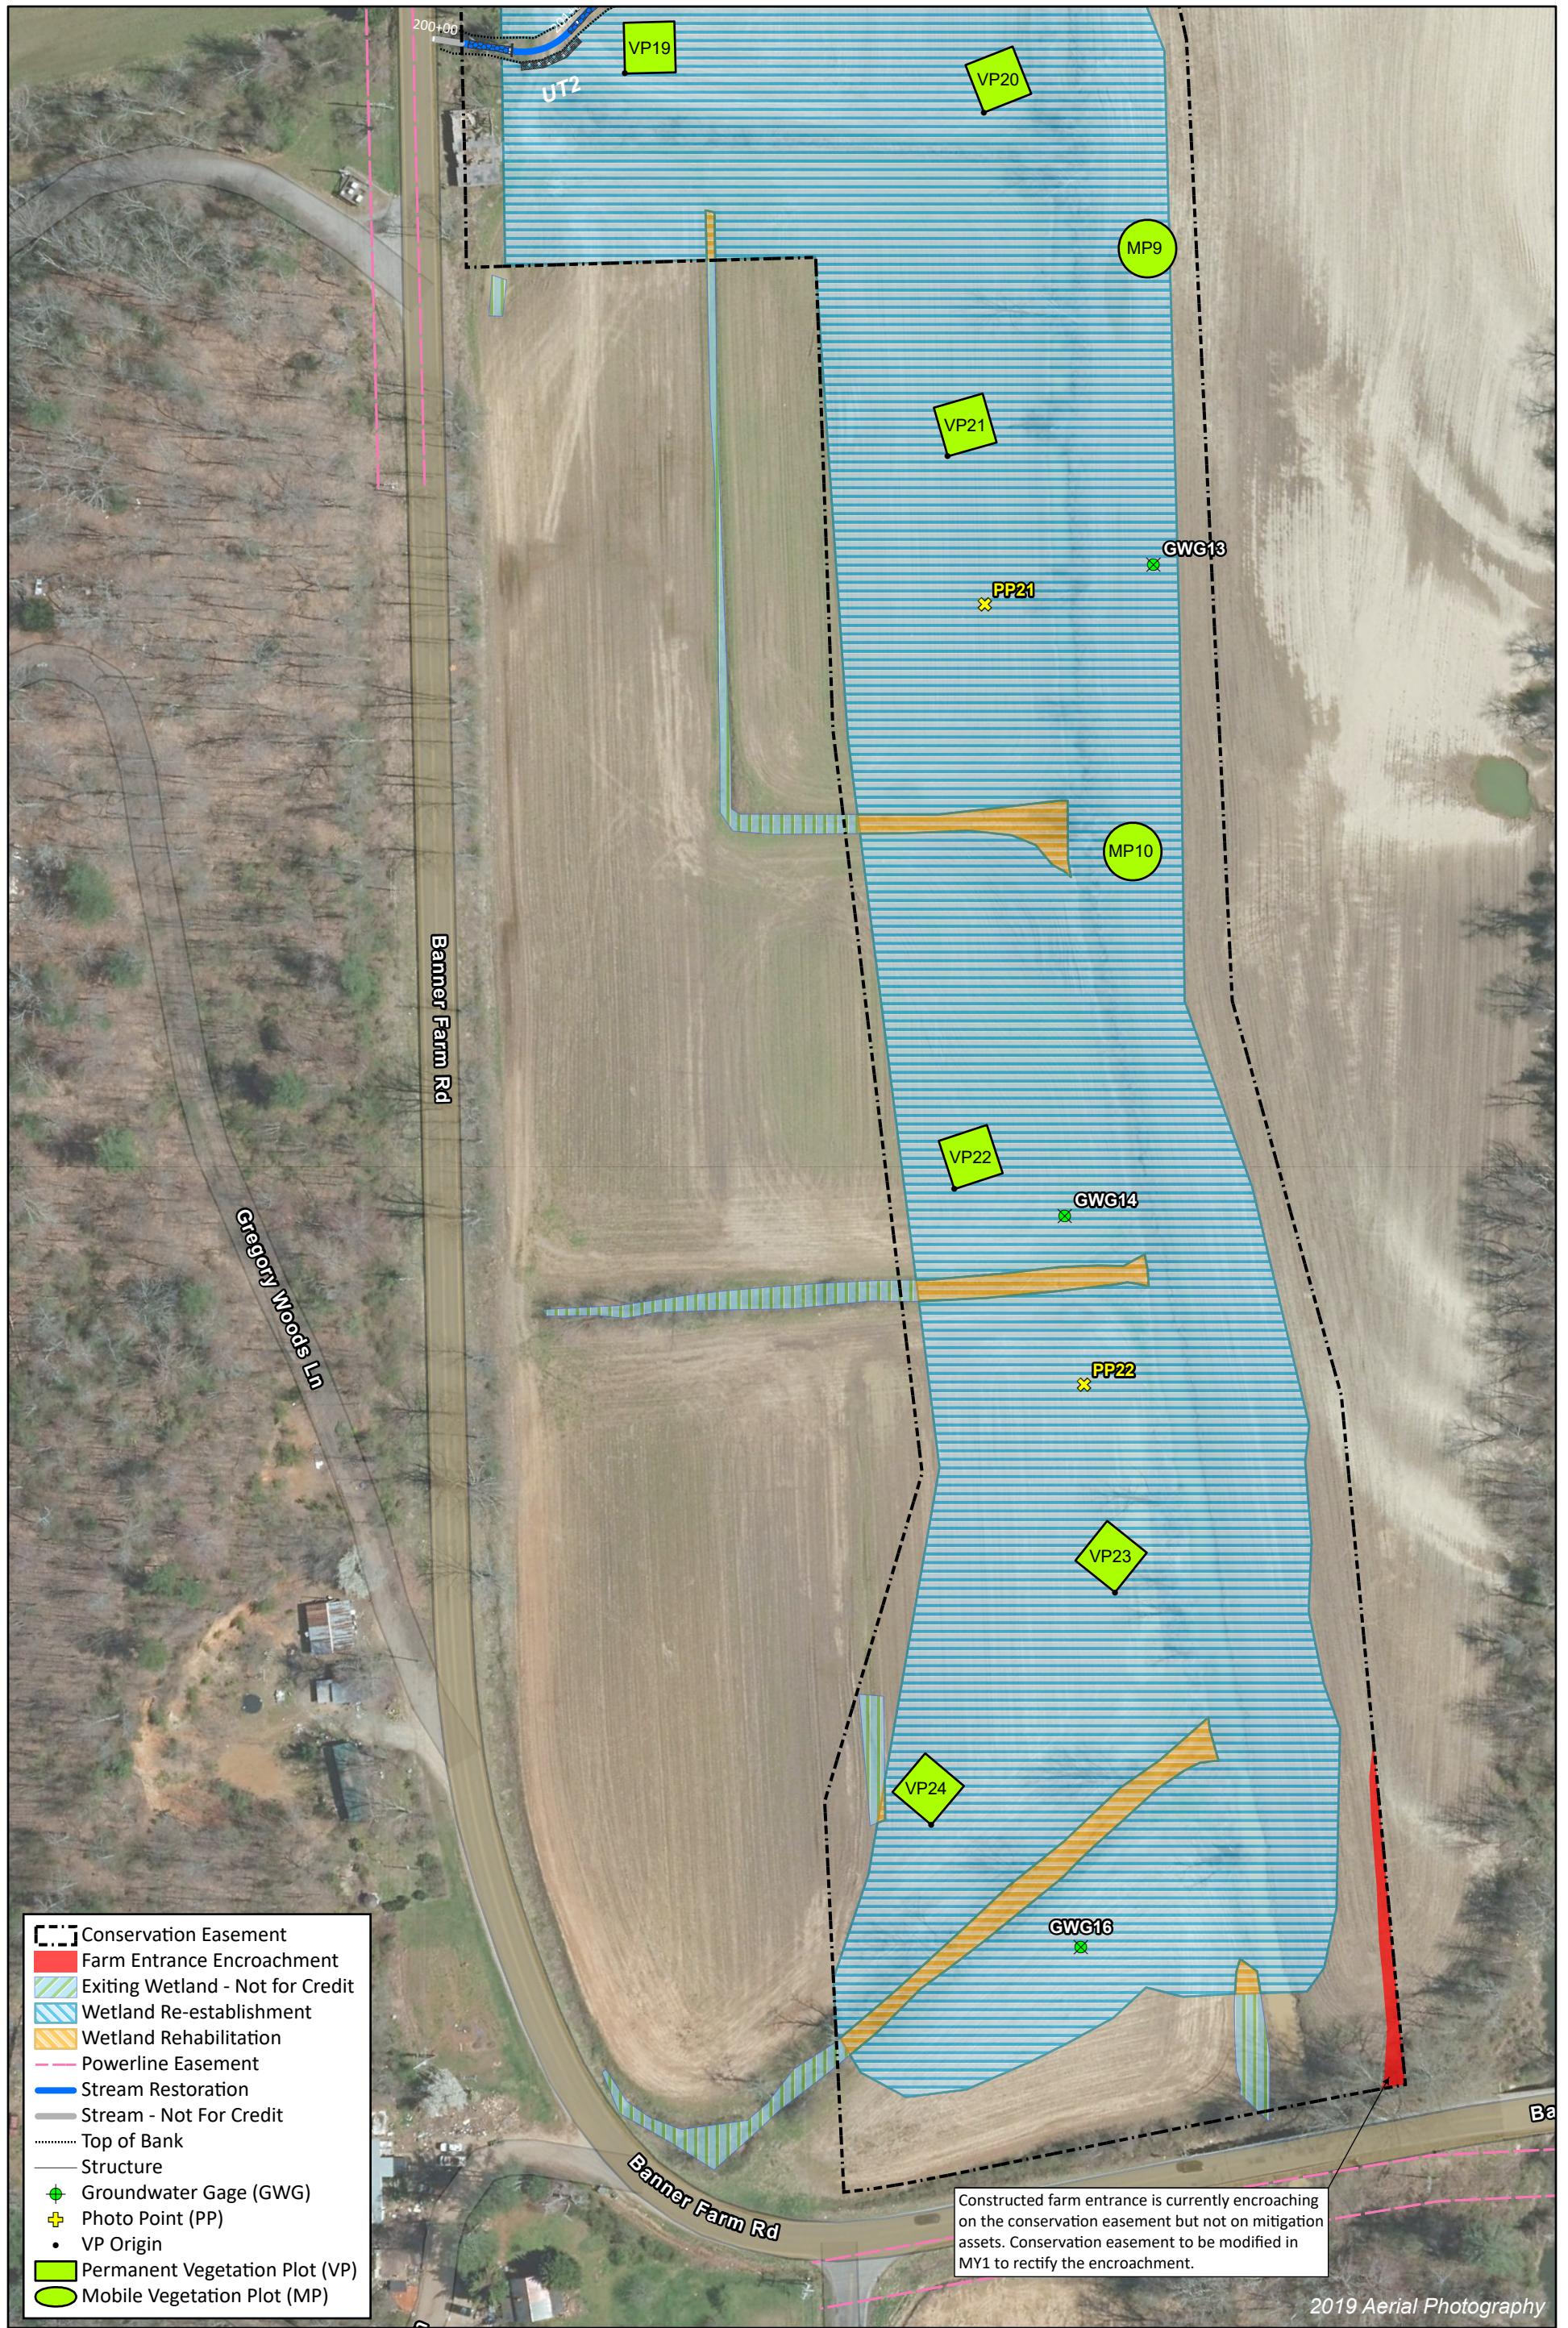

APPENDIX A. Visual Assessment Data

Table 4a-b. Visual Stream Morphology Stability Assessment Table

Banner Farm Mitigation Site

DMS Project No. 100062

Monitoring Year 0 - 2022

Table 4a: Banner Creek Reach 1

Date Last Assessed: 3/02/2022

Major Channel Category		Metric	Number Stable, Performing as Intended	Total Number in As-Built	Amount of Unstable Footage	% Stable, Performing as Intended
						Assessed Stream Length
						827
Bank	Surface Scour/ Bare Bank	Bank lacking vegetative cover resulting simply from poor growth and/or surface scour.			0	100%
	Toe Erosion	Bank toe eroding to the extent that bank failure appears likely. Does <u>NOT</u> include undercuts that are modest, appear sustainable and are providing habitat.			0	100%
	Bank Failure	Fluvial and geotechnical - rotational, slumping, calving, or collapse.			0	100%
						Totals: 0 100%
Structure	Grade Control	Grade control structures exhibiting maintenance of grade across the sill.	9	9		100%
	Bank Protection	Bank erosion within the structures extent of influence does <u>not</u> exceed 15%.	12	12		100%

Table 4b: Banner Creek Reach 2

Date Last Assessed: 3/02/2022

Major Channel Category		Metric	Number Stable, Performing as Intended	Total Number in As-Built	Amount of Unstable Footage	% Stable, Performing as Intended
						Assessed Stream Length
						836
						Assessed Bank Length
Bank	Surface Scour/ Bare Bank	Bank lacking vegetative cover resulting simply from poor growth and/or surface scour.			0	100%
	Toe Erosion	Bank toe eroding to the extent that bank failure appears likely. Does <u>NOT</u> include undercuts that are modest, appear sustainable and are providing habitat.			0	100%
	Bank Failure	Fluvial and geotechnical - rotational, slumping, calving, or collapse.			0	100%
						Totals: 0 100%
Structure	Grade Control	Grade control structures exhibiting maintenance of grade across the sill.	5	5		100%
	Bank Protection	Bank erosion within the structures extent of influence does <u>not</u> exceed 15%.	4	4		100%

Table 4c-d. Visual Stream Morphology Stability Assessment Table

Banner Farm Mitigation Site

DMS Project No. 100062

Monitoring Year 0 - 2022

Table 4c: Banner Creek Reach 3

Date Last Assessed: 3/02/2022

Major Channel Category		Metric	Number Stable, Performing as Intended	Total Number in As-Built	Amount of Unstable Footage	% Stable, Performing as Intended
						Assessed Stream Length
						934
Bank	Surface Scour/ Bare Bank	Bank lacking vegetative cover resulting simply from poor growth and/or surface scour.			0	100%
	Toe Erosion	Bank toe eroding to the extent that bank failure appears likely. Does <u>NOT</u> include undercuts that are modest, appear sustainable and are providing habitat.			0	100%
	Bank Failure	Fluvial and geotechnical - rotational, slumping, calving, or collapse.			0	100%
						Totals: 0 100%
Structure	Grade Control	Grade control structures exhibiting maintenance of grade across the sill.	1	1		100%
	Bank Protection	Bank erosion within the structures extent of influence does <u>not</u> exceed 15%.	2	2		100%

Table 4d: Banner Creek Reach 4a

Date Last Assessed: 3/02/2022

Major Channel Category		Metric	Number Stable, Performing as Intended	Total Number in As-Built	Amount of Unstable Footage	% Stable, Performing as Intended
						Assessed Stream Length
						780
Bank	Surface Scour/ Bare Bank	Bank lacking vegetative cover resulting simply from poor growth and/or surface scour.			0	100%
	Toe Erosion	Bank toe eroding to the extent that bank failure appears likely. Does <u>NOT</u> include undercuts that are modest, appear sustainable and are providing habitat.			0	100%
	Bank Failure	Fluvial and geotechnical - rotational, slumping, calving, or collapse.			0	100%
						Totals: 0 100%
Structure	Grade Control	Grade control structures exhibiting maintenance of grade across the sill.	2	2		100%
	Bank Protection	Bank erosion within the structures extent of influence does <u>not</u> exceed 15%.	5	5		100%

Table 4e-f. Visual Stream Morphology Stability Assessment Table

Banner Farm Mitigation Site

DMS Project No. 100062

Monitoring Year 0 - 2022

Table 4e: Banner Creek Reach 4b

Date Last Assessed: 3/02/2022

Major Channel Category		Metric	Number Stable, Performing as Intended	Total Number in As-Built	Amount of Unstable Footage	% Stable, Performing as Intended
						Assessed Stream Length
						434
Bank	Surface Scour/ Bare Bank	Bank lacking vegetative cover resulting simply from poor growth and/or surface scour.			0	100%
	Toe Erosion	Bank toe eroding to the extent that bank failure appears likely. Does <u>NOT</u> include undercuts that are modest, appear sustainable and are providing habitat.			0	100%
	Bank Failure	Fluvial and geotechnical - rotational, slumping, calving, or collapse.			0	100%
						Totals: 0 100%
Structure	Grade Control	Grade control structures exhibiting maintenance of grade across the sill.	3	3		100%
	Bank Protection	Bank erosion within the structures extent of influence does <u>not</u> exceed 15%.	2	2		100%

Table 4f: UT1

Date Last Assessed: 3/02/2022

Major Channel Category		Metric	Number Stable, Performing as Intended	Total Number in As-Built	Amount of Unstable Footage	% Stable, Performing as Intended
						Assessed Stream Length
						1,071
						Assessed Bank Length
Bank	Surface Scour/ Bare Bank	Bank lacking vegetative cover resulting simply from poor growth and/or surface scour.			0	100%
	Toe Erosion	Bank toe eroding to the extent that bank failure appears likely. Does <u>NOT</u> include undercuts that are modest, appear sustainable and are providing habitat.			0	100%
	Bank Failure	Fluvial and geotechnical - rotational, slumping, calving, or collapse.			0	100%
						Totals: 0 100%
Structure	Grade Control	Grade control structures exhibiting maintenance of grade across the sill.	4	4		100%
	Bank Protection	Bank erosion within the structures extent of influence does <u>not</u> exceed 15%.	8	8		100%

Table 4g. Visual Stream Morphology Stability Assessment Table

Banner Farm Mitigation Site

DMS Project No. 100062

Monitoring Year 0 - 2022**Table 4g: UT2**

Date Last Assessed: 3/02/2022

Major Channel Category		Metric	Number Stable, Performing as Intended	Total Number in As-Built	Amount of Unstable Footage	% Stable, Performing as Intended
			Assessed Stream Length		1,879	
			Assessed Bank Length		3,758	
Bank	Surface Scour/ Bare Bank	Bank lacking vegetative cover resulting simply from poor growth and/or surface scour.			0	100%
	Toe Erosion	Bank toe eroding to the extent that bank failure appears likely. Does <u>NOT</u> include undercuts that are modest, appear sustainable and are providing habitat.			0	100%
	Bank Failure	Fluvial and geotechnical - rotational, slumping, calving, or collapse.			0	100%
			Totals:		0	100%
Structure	Grade Control	Grade control structures exhibiting maintenance of grade across the sill.	1	1		100%
	Bank Protection	Bank erosion within the structures extent of influence does <u>not</u> exceed 15%.	12	12		100%

Table 5. Vegetation Condition Assessment Table

Banner Farm Mitigation Site

DMS Project No. 100062

Monitoring Year 0 - 2022

Planted Acreage 45.00

Date Last Assessed: 3/02/2022

Vegetation Category	Definitions	Mapping Threshold (ac)	Combined Acreage	% of Planted Acreage
Bare Areas	Very limited cover of both woody and herbaceous material.	0.10	0	0%
Low Stem Density Areas	Woody stem densities clearly below target levels based on current MY stem count criteria.	0.10	0	0%
		Total	0	0%
Areas of Poor Growth Rates	Planted areas where average height is not meeting current MY Performance Standard.	0.10	0	0%
		Cumulative Total	0.0	0%

Easement Acreage 46.60

Date Last Assessed: 3/02/2022

Vegetation Category	Definitions	Mapping Threshold (ac)	Combined Acreage	% of Easement Acreage
Invasive Areas of Concern	Invasives may occur outside of planted areas and within the easement and will therefore be calculated against the total easement acreage. Include species with the potential to directly outcompete native, young, woody stems in the short-term or community structure for existing communities. Invasive species included in summation above should be identified in report summary.	0.10	0	0%
Easement Encroachment Areas	Encroachment may be point, line, or polygon. Encroachment to be mapped consists of any violation of restrictions specified in the conservation easement. Common encroachments are mowing, cattle access, vehicular access. Encroachment has no threshold value as will need to be addressed regardless of impact area.	none	0 Encroachments Noted / 0 ac	

Stream Photographs
MY0



Photo Point 1 – UT1, view upstream (02/16/2022)



Photo Point 1 – UT1, view downstream (02/16/2022)



Photo Point 2 – UT1, view upstream (02/16/2022)



Photo Point 2 – UT1, view downstream (02/16/2022)



Photo Point 3 – UT1, view upstream (02/16/2022)



Photo Point 3 – UT1, view downstream (02/16/2022)



Photo Point 4 – UT1, view upstream (02/16/2022)



Photo Point 4 – Banner Creek R4a, view upstream (02/16/2022)



Photo Point 4 – Banner Creek R4b, view downstream (02/16/2022)



Photo Point 5 – Banner Creek R4b, view upstream (02/16/2022)



Photo Point 5 – Banner Creek R4b, view downstream (02/16/2022)



Photo Point 6 – Banner Creek R4a, view upstream (02/16/2022)



Photo Point 6 – Banner Creek R4a, view downstream (02/16/2022)



Photo Point 7 – UT2, view upstream (02/16/2022)



Photo Point 14 – Banner Creek R2, view downstream (02/16/2022)



Photo Point 15 – Banner Creek R2, view upstream (02/16/2022)



Photo Point 15 – Banner Creek R2, view downstream (02/16/2022)



Photo Point 16 – Banner Creek R1, view upstream (02/16/2022)



Photo Point 16 – Banner Creek R1, view downstream (02/16/2022)



Photo Point 17 – Banner Creek R1, view upstream (02/16/2022)



Photo Point 17 – Banner Creek R1, view downstream (02/16/2022)



Photo Point 18 – Banner Creek R1, view upstream (02/16/2022)



Photo Point 18 – Banner Creek R1, view downstream (02/16/2022)



Photo Point 19 – Banner Creek R1, view upstream (02/16/2022)



Photo Point 19 – Banner Creek R1, view downstream (02/16/2022)

Wetland Photographs
MY0



Photo Point 20 –
wetland rehabilitation/re-establishment area, view north (03/02/2022)

Photo Point 20 –
wetland rehabilitation/re-establishment area, view east (03/02/2022)



Photo Point 20 –
wetland re-establishment area, view south (03/02/2022)

Photo Point 20 –
wetland re-establishment area, view west (03/02/2022)



Photo Point 21 –
wetland re-establishment area, view north (03/02/2022)



Photo Point 21 –
wetland re-establishment area, view east (03/02/2022)



Photo Point 21 –
wetland re-establishment area, view south (03/02/2022)



Photo Point 21 –
wetland re-establishment area, view west (03/02/2022)



Photo Point 22 –
wetland re-establishment area, view north (03/02/2022)



Photo Point 22 –
wetland re-establishment area, view east (03/02/2022)



Photo Point 22 –
wetland re-establishment area, view south (03/02/2022)



Photo Point 22 –
wetland re-establishment area, view west (03/02/2022)

**Groundwater Gage Photographs
MY0**



GWG 1 – (02/16/2022)



GWG 2 – (02/16/2022)



GWG 3 – (02/16/2022)



GWG 4 – (02/16/2022)



GWG 5 – (02/16/2022)



GWG 6 – (02/16/2022)



GWG 7 – (02/16/2022)



GWG 8 – (02/16/2022)



GWG 9 – (02/16/2022)



GWG 10 – (06/29/2021)



GWG 11 – (02/16/2022)



GWG 12 – (02/16/2022)



GWG 13 – (02/16/2022)



GWG 14 – (02/16/2022)



GWG 15 – (02/16/2022)



GWG 16 – (02/16/2022)



GWG 17 – (02/16/2022)



GWG 18 – (02/16/2022)

**Groundwater Gage Soil Profile Photographs
MY0**



GWG 1 Soil Profile – (12/02/2021)



GWG 2 Soil Profile – (12/02/2021)



GWG 3 Soil Profile – (12/02/2021)



GWG 4 Soil Profile – (12/02/2021)



GWG 5 Soil Profile – (12/02/2021)



GWG 6 Soil Profile – (12/02/2021)



GWG 7 Soil Profile – (12/03/2021)



GWG 8 Soil Profile – (12/03/2021)



GWG 9 Soil Profile – (12/03/2021)



GWG 10 Soil Profile – (12/03/2021)



GWG 11 Soil Profile – (12/03/2021)



GWG 12 Soil Profile – (12/06/2021)



GWG 13 Soil Profile – (12/06/2021)



GWG 14 Soil Profile – (12/06/2021)



GWG 15 Soil Profile – (12/06/2021)



GWG 16 Soil Profile – (12/06/2021)



GWG 17 Soil Profile – (12/06/2021)



GWG 18 Soil Profile – (12/06/2021)

Culvert Crossing Photographs
MY0



Culvert Crossing – Upper UT1, view upstream (02/16/2022)



Culvert Crossing – Upper UT1, view downstream (02/16/2022)



Culvert Crossing – Lower UT1, view upstream (02/16/2022)



Culvert Crossing – Lower UT1, view downstream (02/16/2022)



Culvert Crossing – Banner Creek R1, view upstream (02/16/2022)



Culvert Crossing – Banner Creek R1, view downstream (02/16/2022)

Vegetation Photographs

MY0



Permanent Vegetation Plot 1 (02/16/2022)



Permanent Vegetation Plot 2 (02/16/2022)



Permanent Vegetation Plot 3 (02/16/2022)



Permanent Vegetation Plot 4 (02/16/2022)



Permanent Vegetation Plot 5 (02/15/2022)



Permanent Vegetation Plot 6 (02/15/2022)



Permanent Vegetation Plot 7 (02/15/2022)



Permanent Vegetation Plot 8 (02/15/2022)



Permanent Vegetation Plot 9 (02/15/2022)



Permanent Vegetation Plot 10 (02/15/2022)



Permanent Vegetation Plot 11 (02/15/2022)



Permanent Vegetation Plot 12 (02/15/2022)



Permanent Vegetation Plot 13 (02/15/2022)



Permanent Vegetation Plot 14 (02/15/2022)



Permanent Vegetation Plot 15 (02/15/2022)



Permanent Vegetation Plot 16 (02/15/2022)



Permanent Vegetation Plot 17 (02/15/2022)



Permanent Vegetation Plot 18 (02/15/2022)



Banner Farm Mitigation Site

DMS Project No. 100062

Monitoring Year 0 - 2022

Planted Acreage	45
Date of Initial Plant	2022-02-13
Date of Current Survey	2022-02-15
Plot size (ACRES)	0.0247

	Scientific Name	Common Name	Tree/ Shrub	Indicator Status	Veg Plot 1 F		Veg Plot 2 F		Veg Plot 3 F		Veg Plot 4 F		Veg Plot 5 F		Veg Plot 6 F	
					Planted	Total										
Species Included in Approved Mitigation Plan	Acer negundo	boxelder	Tree	FAC									2	2	2	2
	Acer saccharinum	silver maple	Tree	FACW			1	1	1	1						
	Alnus serrulata	hazel alder	Tree	OBL												
	Amelanchier arborea	common serviceberry	Tree	FAC	1	1			1	1						
	Asimina triloba	pawpaw	Tree	FAC											1	1
	Betula nigra	river birch	Tree	FACW	2	2	3	3	2	2	3	3	2	2	1	1
	Carpinus caroliniana	American hornbeam	Tree	FAC												
	Cornus florida	flowering dogwood	Tree	FACU	1	1										
	Diospyros virginiana	common persimmon	Tree	FAC	1	1	1	1	1	1						
	Fagus grandifolia	American beech	Tree	FACU			1	1	1	1						
	Fraxinus pennsylvanica	green ash	Tree	FACW	2	2	2	2								
	Hamamelis virginiana	American witchhazel	Tree	FACU					1	1						
	Ilex opaca	American holly	Tree	FACU											1	1
	Lindera benzoin	northern spicebush	Tree	FAC					1	1			1	1	1	1
	Liriodendron tulipifera	tuliptree	Tree	FACU			1	1			1	1	2	2		
	Nyssa sylvatica	blackgum	Tree	FAC	1	1	2	2	1	1	2	2	1	1	2	2
	Platanus occidentalis	American sycamore	Tree	FACW	1	1	2	2	3	3	1	1	1	1	1	2
	Prunus serotina	black cherry	Tree	FACU	3	3										
	Quercus falcata	southern red oak	Tree	FACU	2	2	2	2	2	2						
	Quercus rubra	northern red oak	Tree	FACU	2	2										
	Salix nigra	black willow	Tree	OBL							3	3	4	4	3	3
	Sambucus canadensis	American black elderberry	Tree								1	1				
	Ulmus americana	American elm	Tree	FACW							1	1	1	1	1	1
Sum	Performance Standard				16	16	15	15	14	14	14	14	14	14	15	15
Mitigation Plan Performance Standard	Current Year Stem Count				16		15		14		14		14			15
	Stems/Acre				648		607		567		567		567			607
	Species Count				10		9		10		8		8			9
	Dominant Species Composition (%)				19		20		21		21		29			20
	Average Plot Height (ft.)				2		2		2		3		3			3
	% Invasives				0		0		0		0		0			0
Post Mitigation Plan Performance Standard	Current Year Stem Count				16		15		14		14		14			15
	Stems/Acre				648		607		567		567		567			607
	Species Count				10		9		10		8		8			9
	Dominant Species Composition (%)				19		20		21		21		29			20
	Average Plot Height (ft.)				2		2		2		3		3			3
	% Invasives				0		0		0		0		0			0

1). Bolded species are proposed for the current monitoring year, italicized species are not approved, and a regular font indicates that the species has been approved.

2). The "Species Included in Approved Mitigation Plan" section contains only those species that were included in the original approved mitigation plan. The "Post Mitigation Plan Species" section includes species that are being proposed through a mitigation plan addendum for the current monitoring year (**bolded**) , species that have been approved in prior monitoring years through a mitigation plan addendum (*italicized* font), and species that are not approved (**regular** font).

3). The "Mitigation Plan Performance Standard" section is derived only from stems included in the original mitigation plan, whereas the "Post Mitigation Plan Performance Standard" includes data from mitigation plan approved, post mitigation plan approved, and proposed stems.

Table 7a. Vegetation Performance Standards Summary Table

Banner Farm Mitigation Site

DMS Project No. 100062

Monitoring Year 0 - 2022

	Veg Plot 1 F				Veg Plot 2 F				Veg Plot 3 F			
	Stems/Ac.	Av. Ht. (ft)	# Species	% Invasives	Stems/Ac.	Av. Ht. (ft)	# Species	% Invasives	Stems/Ac.	Av. Ht. (ft)	# Species	% Invasives
Monitoring Year 7												
Monitoring Year 5												
Monitoring Year 3												
Monitoring Year 2												
Monitoring Year 1												
Monitoring Year 0	648	2	10	0	607	2	9	0	567	2	10	0
	Veg Plot 4 F				Veg Plot 5 F				Veg Plot 6 F			
	Stems/Ac.	Av. Ht. (ft)	# Species	% Invasives	Stems/Ac.	Av. Ht. (ft)	# Species	% Invasives	Stems/Ac.	Av. Ht. (ft)	# Species	% Invasives
Monitoring Year 7												
Monitoring Year 5												
Monitoring Year 3												
Monitoring Year 2												
Monitoring Year 1												
Monitoring Year 0	567	3	8	0	567	3	8	0	607	3	9	0
	Veg Plot 7 F				Veg Plot 8 F				Veg Plot 9 F			
	Stems/Ac.	Av. Ht. (ft)	# Species	% Invasives	Stems/Ac.	Av. Ht. (ft)	# Species	% Invasives	Stems/Ac.	Av. Ht. (ft)	# Species	% Invasives
Monitoring Year 7												
Monitoring Year 5												
Monitoring Year 3												
Monitoring Year 2												
Monitoring Year 1												
Monitoring Year 0	648	3	8	0	607	3	9	0	567	2	7	0
	Veg Plot 10 F				Veg Plot 11 F				Veg Plot 12 F			
	Stems/Ac.	Av. Ht. (ft)	# Species	% Invasives	Stems/Ac.	Av. Ht. (ft)	# Species	% Invasives	Stems/Ac.	Av. Ht. (ft)	# Species	% Invasives
Monitoring Year 7												
Monitoring Year 5												
Monitoring Year 3												
Monitoring Year 2												
Monitoring Year 1												
Monitoring Year 0	607	2	10	0	607	2	9	0	607	3	9	0

*Each monitoring year represents a different plot for the random vegetation plot "groups". Random plots are denoted with an R, and fixed plots with an F.

Table 7b. Vegetation Performance Standards Summary Table

Banner Farm Mitigation Site

DMS Project No. 100062

Monitoring Year 0 - 2022

	Veg Plot 13 F				Veg Plot 14 F				Veg Plot 15 F			
	Stems/Ac.	Av. Ht. (ft)	# Species	% Invasives	Stems/Ac.	Av. Ht. (ft)	# Species	% Invasives	Stems/Ac.	Av. Ht. (ft)	# Species	% Invasives
Monitoring Year 7												
Monitoring Year 5												
Monitoring Year 3												
Monitoring Year 2												
Monitoring Year 1												
Monitoring Year 0	567	2	6	0	567	3	9	0	607	2	6	0
	Veg Plot 16 F				Veg Plot 17 F				Veg Plot 18 F			
	Stems/Ac.	Av. Ht. (ft)	# Species	% Invasives	Stems/Ac.	Av. Ht. (ft)	# Species	% Invasives	Stems/Ac.	Av. Ht. (ft)	# Species	% Invasives
Monitoring Year 7												
Monitoring Year 5												
Monitoring Year 3												
Monitoring Year 2												
Monitoring Year 1												
Monitoring Year 0	648	2	7	0	567	3	7	0	648	3	6	0
	Veg Plot 19 F				Veg Plot 20 F				Veg Plot 21 F			
	Stems/Ac.	Av. Ht. (ft)	# Species	% Invasives	Stems/Ac.	Av. Ht. (ft)	# Species	% Invasives	Stems/Ac.	Av. Ht. (ft)	# Species	% Invasives
Monitoring Year 7												
Monitoring Year 5												
Monitoring Year 3												
Monitoring Year 2												
Monitoring Year 1												
Monitoring Year 0	486	3	7	0	648	2	6	0	648	3	7	0
	Veg Plot 22 F				Veg Plot 23 F				Veg Plot 24 F			
	Stems/Ac.	Av. Ht. (ft)	# Species	% Invasives	Stems/Ac.	Av. Ht. (ft)	# Species	% Invasives	Stems/Ac.	Av. Ht. (ft)	# Species	% Invasives
Monitoring Year 7												
Monitoring Year 5												
Monitoring Year 3												
Monitoring Year 2												
Monitoring Year 1												
Monitoring Year 0	607	3	5	0	648	2	7	0	567	2	8	0

*Each monitoring year represents a different plot for the random vegetation plot "groups". Random plots are denoted with an R, and fixed plots with an F.

Table 7c. Vegetation Performance Standards Summary Table

Banner Farm Mitigation Site

DMS Project No. 100062

Monitoring Year 0 - 2022

	Veg Plot Group 1 R				Veg Plot Group 2 R				Veg Plot Group 3 R			
	Stems/Ac.	Av. Ht. (ft)	# Species	% Invasives	Stems/Ac.	Av. Ht. (ft)	# Species	% Invasives	Stems/Ac.	Av. Ht. (ft)	# Species	% Invasives
Monitoring Year 7												
Monitoring Year 5												
Monitoring Year 3												
Monitoring Year 2												
Monitoring Year 1												
Monitoring Year 0	405	3	6	0	486	2	7	0	445	3	6	0
	Veg Plot Group 4 R				Veg Plot Group 5 R				Veg Plot Group 6 R			
	Stems/Ac.	Av. Ht. (ft)	# Species	% Invasives	Stems/Ac.	Av. Ht. (ft)	# Species	% Invasives	Stems/Ac.	Av. Ht. (ft)	# Species	% Invasives
Monitoring Year 7												
Monitoring Year 5												
Monitoring Year 3												
Monitoring Year 2												
Monitoring Year 1												
Monitoring Year 0	486	2	8	0	445	2	5	0	526	2	6	0
	Veg Plot Group 7 R				Veg Plot Group 8 R				Veg Plot Group 9 R			
	Stems/Ac.	Av. Ht. (ft)	# Species	% Invasives	Stems/Ac.	Av. Ht. (ft)	# Species	% Invasives	Stems/Ac.	Av. Ht. (ft)	# Species	% Invasives
Monitoring Year 7												
Monitoring Year 5												
Monitoring Year 3												
Monitoring Year 2												
Monitoring Year 1												
Monitoring Year 0	445	2	6	0	405	2	7	0	405	2	5	0
	Veg Plot Group 10 R				Veg Plot Group 11 R				Veg Plot Group 12 R			
	Stems/Ac.	Av. Ht. (ft)	# Species	% Invasives	Stems/Ac.	Av. Ht. (ft)	# Species	% Invasives	Stems/Ac.	Av. Ht. (ft)	# Species	% Invasives
Monitoring Year 7												
Monitoring Year 5												
Monitoring Year 3												
Monitoring Year 2												
Monitoring Year 1												
Monitoring Year 0	486	2	9	0	526	2	7	0	850	2	12	0

*Each monitoring year represents a different plot for the random vegetation plot "groups". Random plots are denoted with an R, and fixed plots with an F.

APPENDIX C. Stream Geomorphology Data

Table 8a. Baseline Stream Data Summary

Banner Farm Mitigation Site

DMS Project No. 100062

Monitoring Year 0 - 2022

	PRE-EXISTING CONDITIONS			DESIGN		MONITORING BASELINE (MY0)		
Parameter	Banner Creek R1							
Riffle Only	Min	Max	n	Min	Max	Min	Max	n
Bankfull Width (ft)	9.8	1		13.5		12.8	14.0	2
Floodprone Width (ft)	25	1		30	68	61	62	2
Bankfull Mean Depth	1.2	1		1.0		1.1	1.2	2
Bankfull Max Depth	1.7	1		1.7		1.8	2.0	2
Bankfull Cross Sectional Area (ft ²)	12.0	1		14.0		15.9	15.9	2
Width/Depth Ratio	8.2	1		13.0		10.2	12.3	2
Entrenchment Ratio	2.5	1		2.2	5.0	4.4	4.7	2
Bank Height Ratio	2.2	1		1.0	1.1	1.0	1.0	2
Max part size (mm) mobilized at bankfull	-			33			-	
Rosgen Classification	C4			C4		C4		
Bankfull Discharge (cfs)	40.5	1		40.0	43.0	52.3	55.2	2
Sinuosity	1.08			1.20		1.20		
Water Surface/Channel Slope (ft/ft) ²	0.006			0.002		0.005		
Other	-			-		-	-	
Parameter	Banner Creek R2							
Riffle Only	Min	Max	n	Min	Max	Min	Max	n
Bankfull Width (ft)	10.4	1		13.5		10.2	13.3	2
Floodprone Width (ft)	58	1		30	68	81	86	2
Bankfull Mean Depth	1.1	1		1.0		0.9	1.1	2
Bankfull Max Depth	2.3	1		1.2	1.7	1.4	1.9	2
Bankfull Cross Sectional Area (ft ²)	11.6	1		14.0		9.6	14.6	2
Width/Depth Ratio	9.3	1		13.0		10.9	12.0	2
Entrenchment Ratio	14.4	1		2.2	5.0	6.5	7.9	2
Bank Height Ratio	1.4	1		1.0	1.1	1.0	1.0	2
Max part size (mm) mobilized at bankfull	-			33			-	
Rosgen Classification	C5/4			C4		C4		
Bankfull Discharge (cfs)	45.7	1		40.0	43.0	18.7	32.1	2
Sinuosity	1.01			1.20		1.20		
Water Surface/Channel Slope (ft/ft) ²	0.007			0.002		0.003		
Other	-			-		-	-	

Table 8b. Baseline Stream Data Summary

Banner Farm Mitigation Site

DMS Project No. 100062

Monitoring Year 0 - 2022

	PRE-EXISTING CONDITIONS			DESIGN		MONITORING BASELINE (MY0)		
Parameter	Banner Creek R3							
Riffle Only	Min	Max	n	Min	Max	Min	Max	n
Bankfull Width (ft)	7.4		1	14.8		14.9		1
Floodprone Width (ft)	31		1	33	74	88		1
Bankfull Mean Depth	1.6		1	1.0		1.4		1
Bankfull Max Depth	2.1		1	1.7		2.2		1
Bankfull Cross Sectional Area (ft ²)	11.9		1	17.3		20.6		1
Width/Depth Ratio	4.6		1	13.0		10.7		1
Entrenchment Ratio	4.2		1	2.2	5.0	5.9		1
Bank Height Ratio	1.7		1	1.0	1.1	1.0		1
Max part size (mm) mobilized at bankfull	-			33		-		
Rosgen Classification	C4			C4		C4		
Bankfull Discharge (cfs)	42.5		1	44.0		44.2		1
Sinuosity	1.00			1.30		1.30		
Water Surface/Channel Slope (ft/ft) ²	0.009			0.002		0.002		
Other	-			-		-		
Parameter	Banner Creek R4a							
Riffle Only	Min	Max	n	Min	Max	Min	Max	n
Bankfull Width (ft)	19.4		1	19.8		20.0		1
Floodprone Width (ft)	23		1	44	99	94		1
Bankfull Mean Depth	1.7		1	1.5		1.4		1
Bankfull Max Depth	2.6		1	2.5		2.5		1
Bankfull Cross Sectional Area (ft ²)	32.4		1	30.3		28.2		1
Width/Depth Ratio	11.4		1	13.0		14.2		1
Entrenchment Ratio	1.2		1	2.2	5.0	4.7		1
Bank Height Ratio	2.1		1	1.0		1.0		1
Max part size (mm) mobilized at bankfull	-			44		-		
Rosgen Classification	C4			C5/4		C5/4		
Bankfull Discharge (cfs)	57.5		1	60.0		60.1		1
Sinuosity	1.02			1.20		1.20		
Water Surface/Channel Slope (ft/ft) ²	0.001			0.001		0.002		
Other	-			-		-		

Table 8c. Baseline Stream Data Summary

Banner Farm Mitigation Site

DMS Project No. 100062

Monitoring Year 0 - 2022

	PRE-EXISTING CONDITIONS			DESIGN		MONITORING BASELINE (MY0)		
Parameter	Banner Creek Reach 4b							
Riffle Only	Min	Max	n	Min	Max	Min	Max	n
Bankfull Width (ft)	19.4	1		20.8		22.4		1
Floodprone Width (ft)	23	1		46	104	114		1
Bankfull Mean Depth	1.7	1		1.6		1.6		1
Bankfull Max Depth	2.6	1		1.9	2.7	2.7		1
Bankfull Cross Sectional Area (ft ²)	32.4	1		32.7		35.5		1
Width/Depth Ratio	11.4	1		13.0		14.2		1
Entrenchment Ratio	1.2	1		2.2	5.0	5.1		1
Bank Height Ratio	2.1	1		1.0		1.0		1
Max part size (mm) mobilized at bankfull	-			45		-		
Rosgen Classification	C4			C5/4		C5/4		
Bankfull Discharge (cfs)	57.5	1		70.0		145.3		1
Sinuosity	1.02			1.20		1.20		
Water Surface/Channel Slope (ft/ft) ²	0.001			0.002		0.005		
Other	-			-		-		
Parameter	UT1							
Riffle Only	Min	Max	n	Min	Max	Min	Max	n
Bankfull Width (ft)	5.2	10.0	1	9.0		9.2		1
Floodprone Width (ft)	15	24	1	20	72	66		1
Bankfull Mean Depth	0.7	0.8	1	0.9		1.0		1
Bankfull Max Depth	1.4	1.7	1	1.5		1.6		1
Bankfull Cross Sectional Area (ft ²)	3.6	7.8	1	8.4		9.6		1
Width/Depth Ratio	7.5	12.9	1	10.0		8.9		1
Entrenchment Ratio	2.4	2.9	1	2.2	8.0	7.2		1
Bank Height Ratio	2.0	2.1	1	1.0		1.0		1
Max part size (mm) mobilized at bankfull	-			30		-		
Rosgen Classification	E/C5			E5		E5		
Bankfull Discharge (cfs)	5.0	8.0	1	14.0		23.5		1
Sinuosity	1.10			1.30		1.30		
Water Surface/Channel Slope (ft/ft) ²	0.003			0.002		0.004		
Other	-			-		-		

Table 8d. Baseline Stream Data Summary

Banner Farm Mitigation Site

DMS Project No. 100062

Monitoring Year 0 - 2022

	PRE-EXISTING CONDITIONS			DESIGN		MONITORING BASELINE (MY0)		
Parameter	UT2							
Riffle Only	Min	Max	n	Min	Max	Min	Max	n
Bankfull Width (ft)	4.6		1	12.0		11.0	12.0	3
Floodprone Width (ft)	16		1	26	60	75	82	3
Bankfull Mean Depth	0.9		1	1.1		1.1	1.4	3
Bankfull Max Depth	1.2		1	1.7		1.6	2.0	3
Bankfull Cross Sectional Area (ft ²)	4.1		1	12.8		11.9	15.4	3
Width/Depth Ratio	5.1		1	11.0		7.8	10.5	3
Entrenchment Ratio	3.5		1	2.2	5.0	6.2	7.5	3
Bank Height Ratio	1.4		1	1.0		1.0	1.0	3
Max part size (mm) mobilized at bankfull	-			33		-	-	
Rosgen Classification	E/C5			C4	C4			
Bankfull Discharge (cfs)	10.0	13.0	1	25.0		14.8	22.5	3
Sinuosity	1.28			1.30	1.30			
Water Surface/Channel Slope (ft/ft) ²	0.005			0.002	0.001			
Other	-			-	-			

Table 9b. Cross-Section Morphology Monitoring Summary

Banner Farm Mitigation Site

DMS Project No. 100062

Monitoring Year 0 - 2022

	UT1														UT2																			
	Cross-Section 13 (Pool)							Cross-Section 14 (Riffle)							Cross-Section 15 (Riffle)							Cross-Section 16 (Pool)												
	MY0	MY1	MY2	MY3	MY5	MY7	MY0	MY1	MY2	MY3	MY5	MY7	MY0	MY1	MY2	MY3	MY5	MY7	MY0	MY1	MY2	MY3	MY5	MY7	MY0	MY1	MY2	MY3	MY5	MY7				
Bankfull Elevation (ft) - Based on AB-Bankfull ¹ Area	2056.51						2056.54						2057.14						2056.67															
Bank Height Ratio - Based on AB Bankfull ¹ Area	-						1.0						1.0						-															
Thalweg Elevation	2053.81						2054.96						2055.16						2053.10															
LTOB ² Elevation	2056.51						2056.54						2057.14						2056.67															
LTOB ² Max Depth (ft)	2.7						1.6						2.0						3.6															
LTOB ² Cross Sectional Area (ft ²)	16.8						9.6						15.4						28.4															
UT2																																		
Bankfull Elevation (ft) - Based on AB-Bankfull ¹ Area	2056.27						2055.93						2055.87						2055.80															
Bank Height Ratio - Based on AB Bankfull ¹ Area	1.0						-						1.0						-															
Thalweg Elevation	2054.31						2052.20						2054.24						2052.10															
LTOB ² Elevation	2056.27						2055.93						2055.87						2055.80															
LTOB ² Max Depth (ft)	2.0						3.7						1.6						3.7															
LTOB ² Cross Sectional Area (ft ²)	14.1						24.5						11.9						33.3															

¹Bank Height Ratio (BHR) takes the As-built bankfull area as the basis for adjusting each subsequent years bankfull elevation.

²LTOB Area and Max depth - These are based on the LTOB elevation for each years survey (The same elevation used for the LTOB in the BHR calculation). Area below the LTOB elevation will be used and tracked for each year as above. The difference between the LTOB elevation and the thalweg elevation (same as in the BHR calculation) will be recorded and tracked above as LTOB max depth.


Cross-Section Plots

Banner Farm Mitigation Site

DMS Project No. 100062

Monitoring Year 0 - 2022

Cross-Section 1-Banner Creek Reach 1

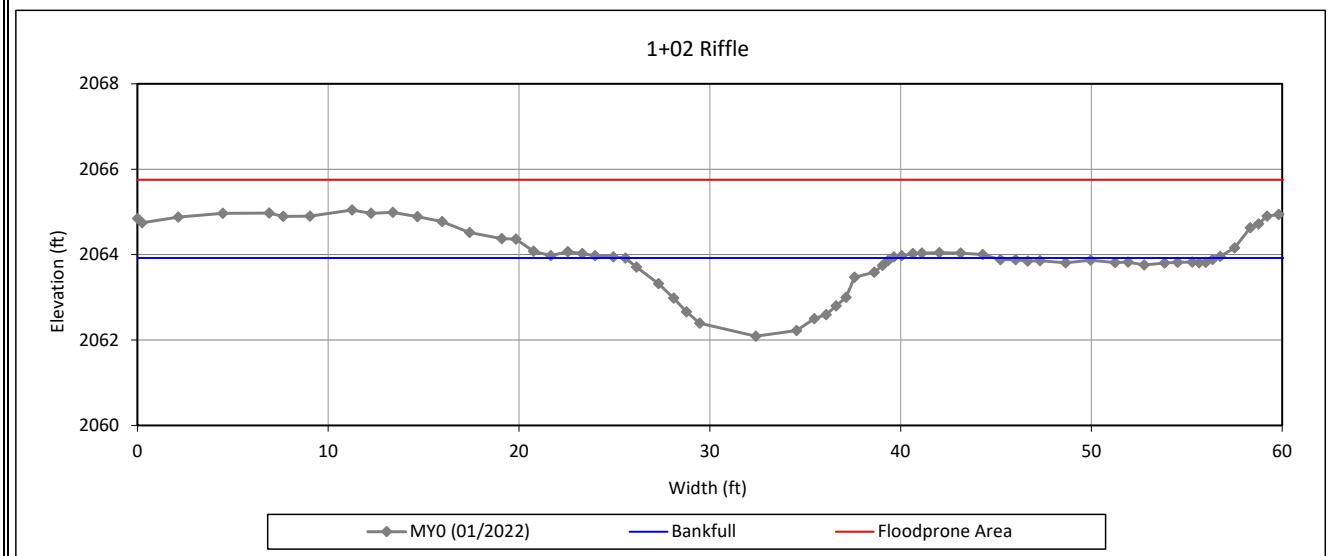

Bankfull Dimensions

15.9	x-section area (ft.sq.)
14.0	width (ft)
1.1	mean depth (ft)
1.8	max depth (ft)
14.7	wetted perimeter (ft)
1.1	hydraulic radius (ft)
12.3	width-depth ratio
61.7	W flood prone area (ft)
4.4	entrenchment ratio
1.0	low bank height ratio



View Downstream

Survey Date: 01/2022

Field Crew: Kee Mapping & Surveying


Cross-Section Plots

Banner Farm Mitigation Site

DMS Project No. 100062

Monitoring Year 0 - 2022

Cross-Section 2-Banner Creek Reach 1

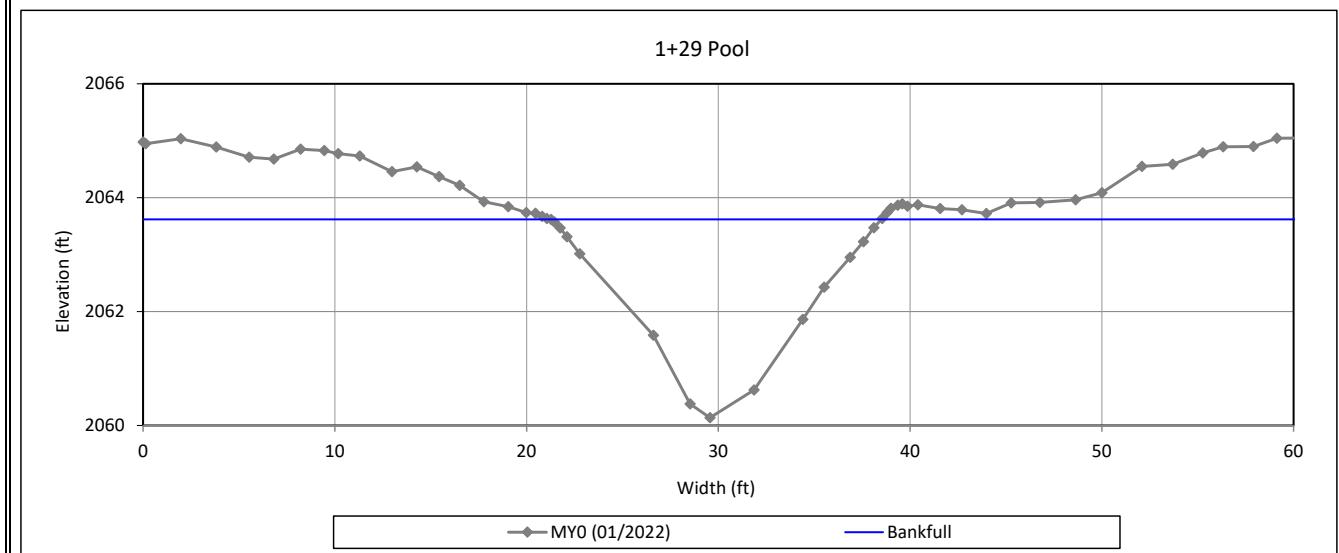

Bankfull Dimensions

31.0	x-section area (ft.sq.)
17.2	width (ft)
1.8	mean depth (ft)
3.5	max depth (ft)
18.7	wetted perimeter (ft)
1.7	hydraulic radius (ft)
9.6	width-depth ratio



View Downstream

Survey Date: 01/2022
Field Crew: Kee Mapping & Surveying


Cross-Section Plots

Banner Farm Mitigation Site

DMS Project No. 100062

Monitoring Year 0 - 2022

Cross-Section 3-Banner Creek Reach 1

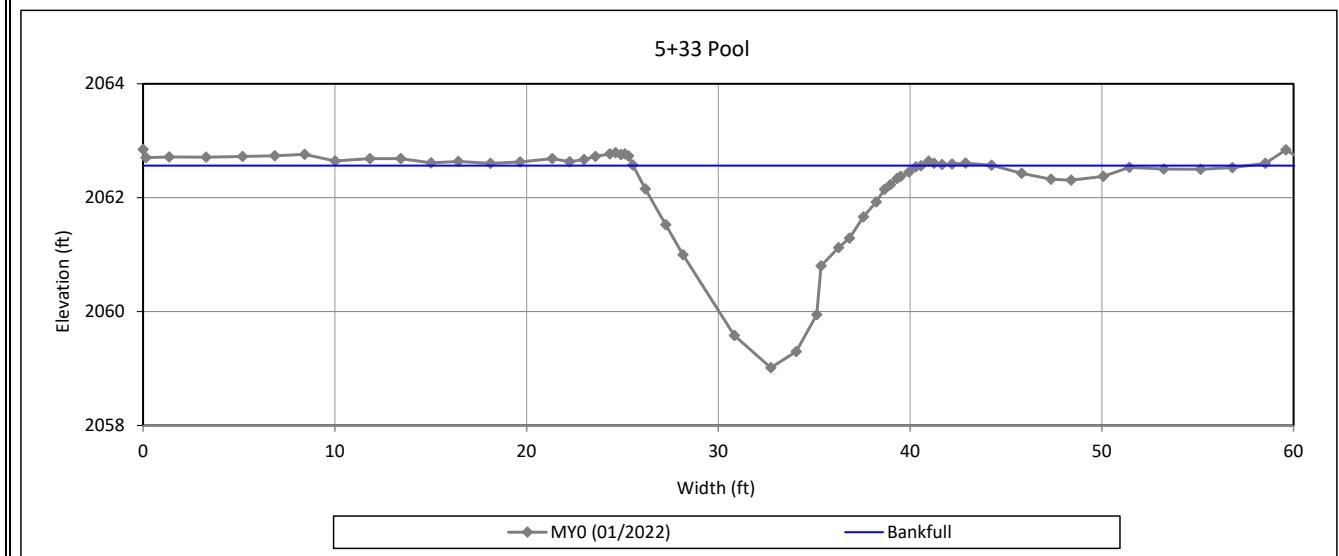

Bankfull Dimensions

26.6	x-section area (ft.sq.)
15.0	width (ft)
1.8	mean depth (ft)
3.5	max depth (ft)
17.1	wetted perimeter (ft)
1.6	hydraulic radius (ft)
8.5	width-depth ratio



View Downstream

Survey Date: 01/2022
Field Crew: Kee Mapping & Surveying


Cross-Section Plots

Banner Farm Mitigation Site

DMS Project No. 100062

Monitoring Year 0 - 2022

Cross-Section 4-Banner Creek Reach 1

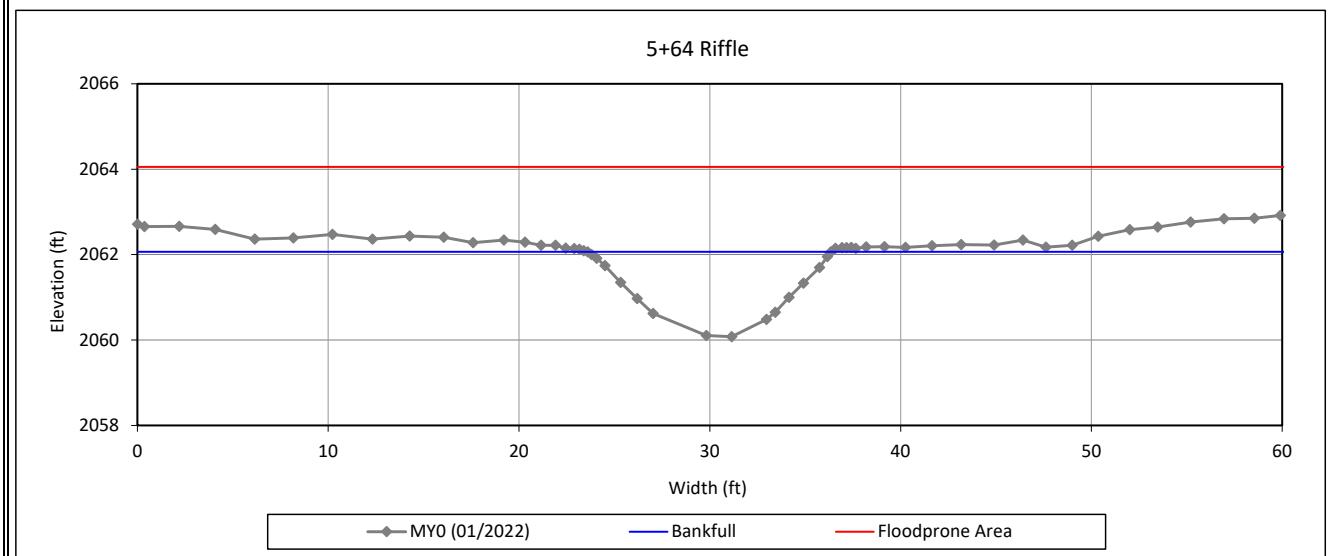

Bankfull Dimensions

15.9	x-section area (ft.sq.)
12.8	width (ft)
1.2	mean depth (ft)
2.0	max depth (ft)
13.5	wetted perimeter (ft)
1.2	hydraulic radius (ft)
10.2	width-depth ratio
60.5	W flood prone area (ft)
4.7	entrenchment ratio
1.0	low bank height ratio

Survey Date: 01/2022

Field Crew: Kee Mapping & Surveying



View Downstream


Cross-Section Plots

Banner Farm Mitigation Site

DMS Project No. 100062

Monitoring Year 0 - 2022

Cross-Section 5-Banner Creek Reach 2

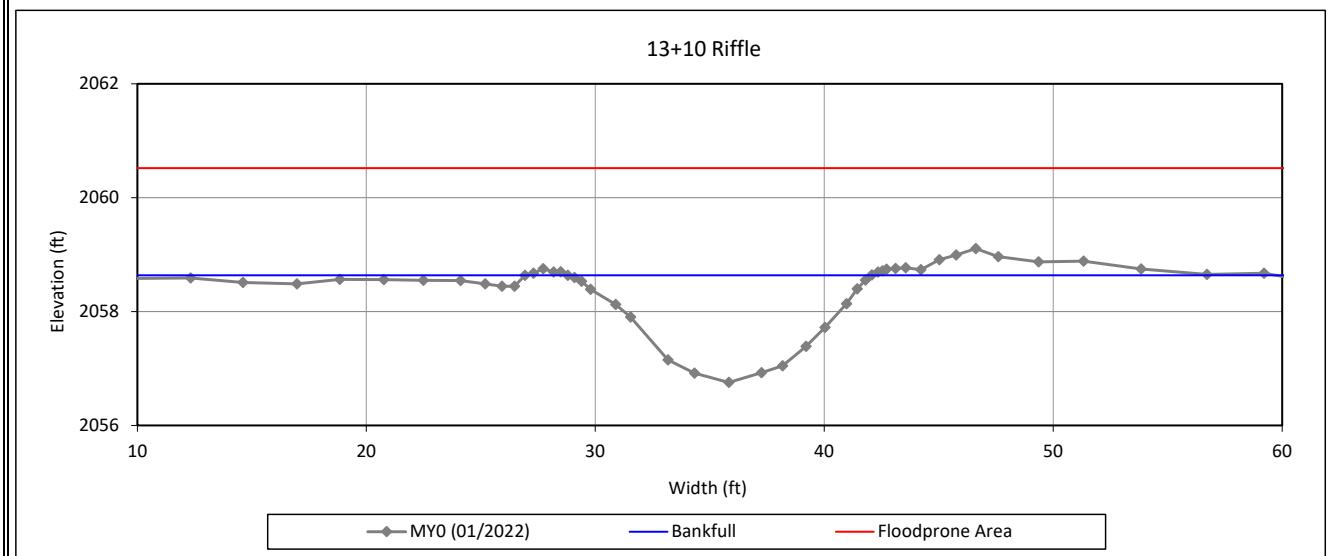

Bankfull Dimensions

14.6	x-section area (ft.sq.)
13.3	width (ft)
1.1	mean depth (ft)
1.9	max depth (ft)
13.9	wetted perimeter (ft)
1.1	hydraulic radius (ft)
12.0	width-depth ratio
85.8	W flood prone area (ft)
6.5	entrenchment ratio
1.0	low bank height ratio



View Downstream

Survey Date: 01/2022

Field Crew: Kee Mapping & Surveying


Cross-Section Plots

Banner Farm Mitigation Site

DMS Project No. 100062

Monitoring Year 0 - 2022

Cross-Section 6-Banner Creek Reach 2

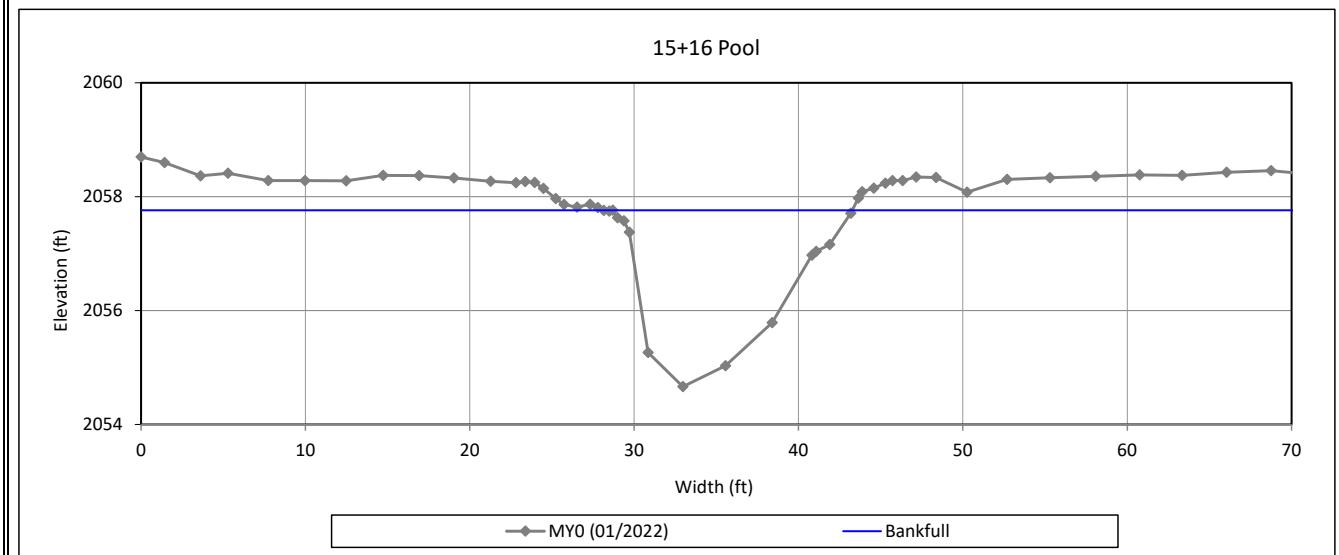

Bankfull Dimensions

26.5	x-section area (ft.sq.)
14.6	width (ft)
1.8	mean depth (ft)
3.1	max depth (ft)
16.5	wetted perimeter (ft)
1.6	hydraulic radius (ft)
8.0	width-depth ratio



View Downstream

Survey Date: 01/2022
Field Crew: Kee Mapping & Surveying


Cross-Section Plots

Banner Farm Mitigation Site

DMS Project No. 100062

Monitoring Year 0 - 2022

Cross-Section 7-Banner Creek Reach 2

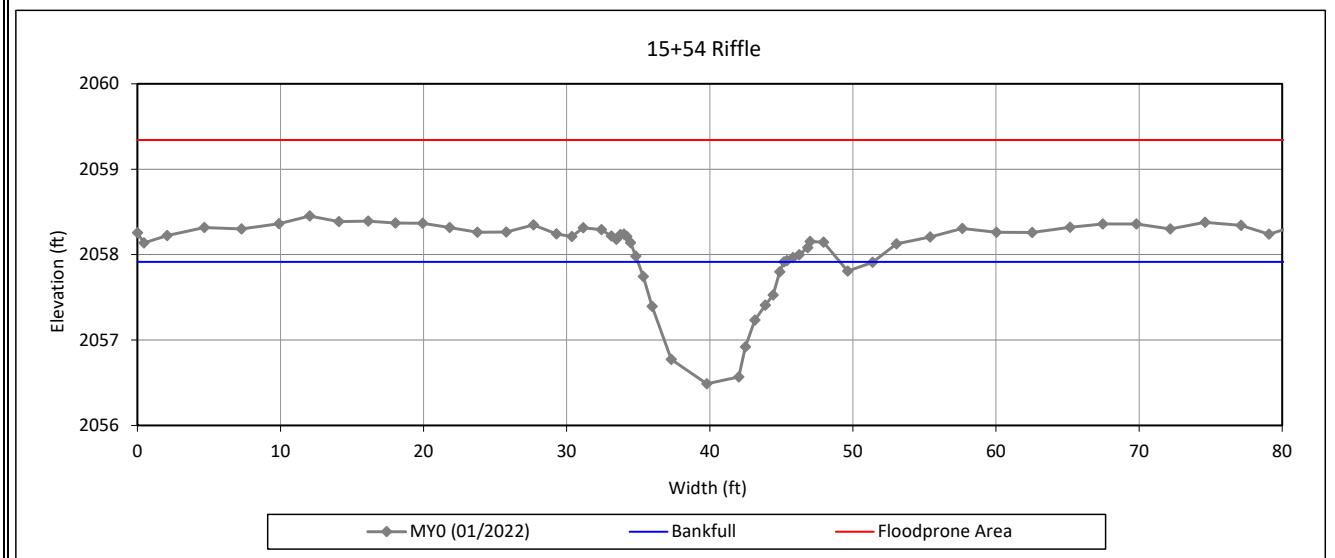

Bankfull Dimensions

9.6	x-section area (ft.sq.)
10.2	width (ft)
0.9	mean depth (ft)
1.4	max depth (ft)
10.8	wetted perimeter (ft)
0.9	hydraulic radius (ft)
10.9	width-depth ratio
80.8	W flood prone area (ft)
7.9	entrenchment ratio
1.0	low bank height ratio



View Downstream

Survey Date: 01/2022

Field Crew: Kee Mapping & Surveying


Cross-Section Plots

Banner Farm Mitigation Site

DMS Project No. 100062

Monitoring Year 0 - 2022

Cross-Section 8-Banner Creek Reach 3

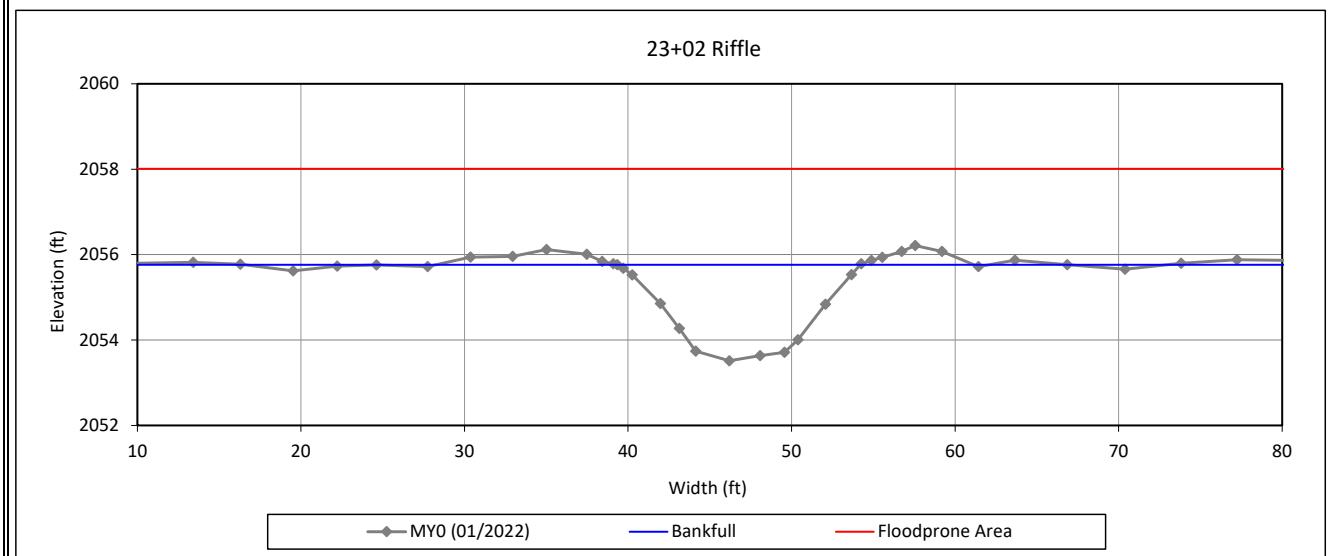

Bankfull Dimensions

20.6	x-section area (ft.sq.)
14.9	width (ft)
1.4	mean depth (ft)
2.2	max depth (ft)
15.7	wetted perimeter (ft)
1.3	hydraulic radius (ft)
10.7	width-depth ratio
87.5	W flood prone area (ft)
5.9	entrenchment ratio
1.0	low bank height ratio

Survey Date: 01/2022

Field Crew: Kee Mapping & Surveying



View Downstream


Cross-Section Plots

Banner Farm Mitigation Site

DMS Project No. 100062

Monitoring Year 0 - 2022

Cross-Section 9-Banner Creek Reach 3

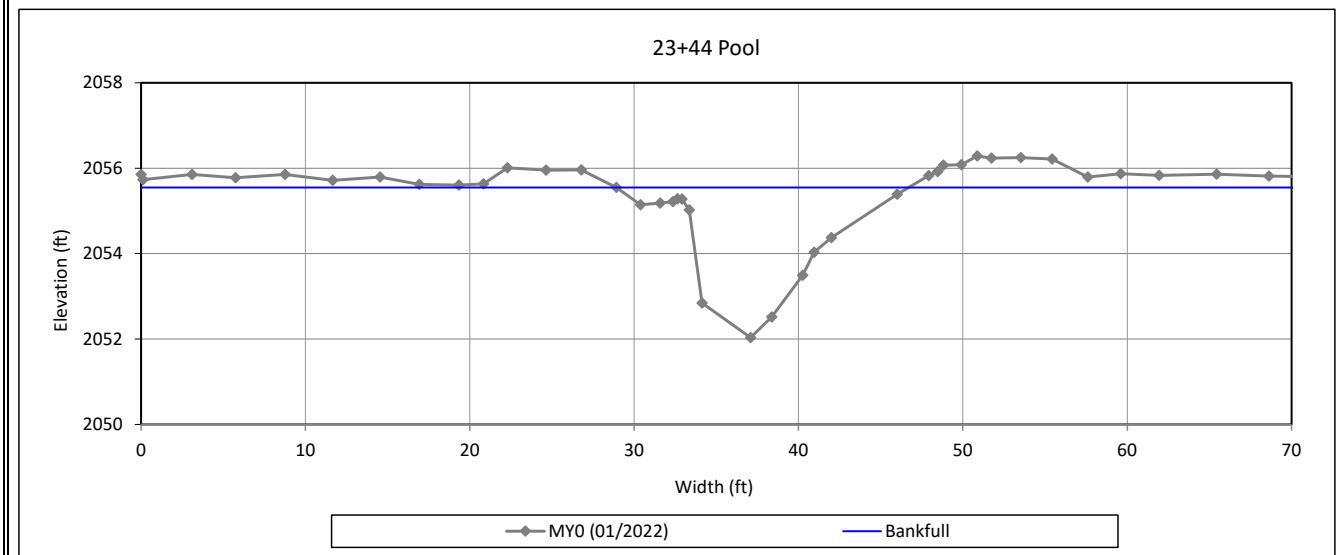

Bankfull Dimensions

26.2	x-section area (ft.sq.)
17.8	width (ft)
1.5	mean depth (ft)
3.5	max depth (ft)
20.3	wetted perimeter (ft)
1.3	hydraulic radius (ft)
12.1	width-depth ratio



Survey Date: 01/2022
Field Crew: Kee Mapping & Surveying

View Downstream


Cross-Section Plots

Banner Farm Mitigation Site

DMS Project No. 100062

Monitoring Year 0 - 2022

Cross-Section 10-Banner Creek Reach 4a

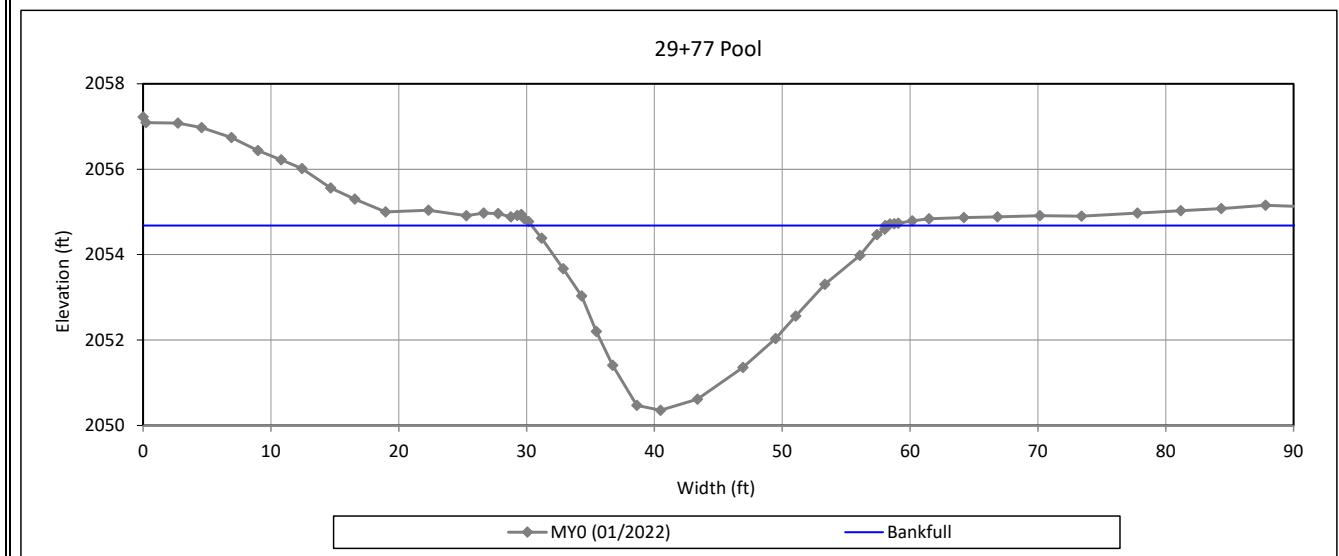

Bankfull Dimensions

68.4	x-section area (ft.sq.)
27.7	width (ft)
2.5	mean depth (ft)
4.3	max depth (ft)
29.3	wetted perimeter (ft)
2.3	hydraulic radius (ft)
11.2	width-depth ratio



Survey Date: 01/2022
Field Crew: Kee Mapping & Surveying

View Downstream


Cross-Section Plots

Banner Farm Mitigation Site

DMS Project No. 100062

Monitoring Year 0 - 2022

Cross-Section 11-Banner Creek Reach 4a

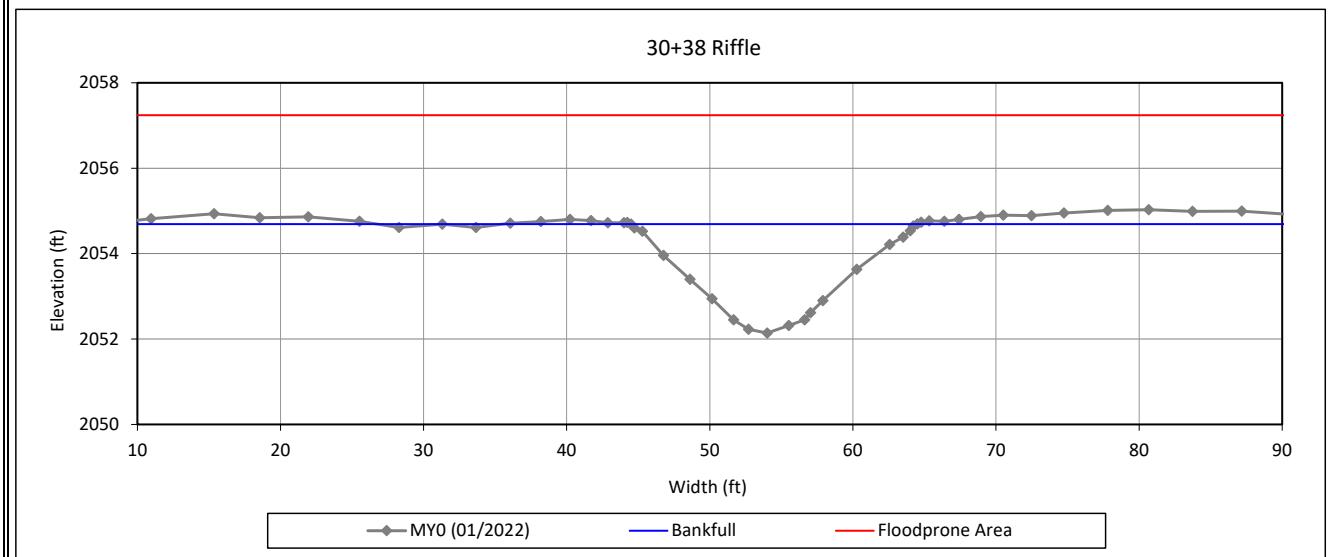

Bankfull Dimensions

28.2	x-section area (ft.sq.)
20.0	width (ft)
1.4	mean depth (ft)
2.5	max depth (ft)
20.7	wetted perimeter (ft)
1.4	hydraulic radius (ft)
14.2	width-depth ratio
93.5	W flood prone area (ft)
4.7	entrenchment ratio
1.0	low bank height ratio

Survey Date: 01/2022

Field Crew: Kee Mapping & Surveying



View Downstream


Cross-Section Plots

Banner Farm Mitigation Site

DMS Project No. 100062

Monitoring Year 0 - 2022

Cross-Section 12-Banner Creek Reach 4b

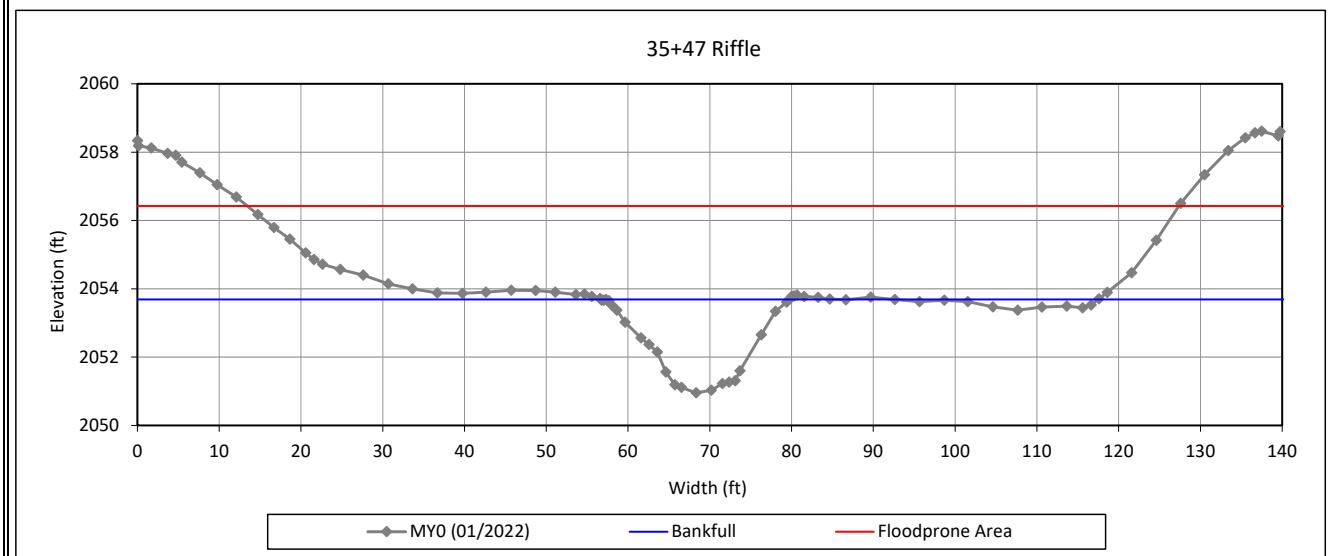

Bankfull Dimensions

35.5	x-section area (ft.sq.)
22.4	width (ft)
1.6	mean depth (ft)
2.7	max depth (ft)
23.3	wetted perimeter (ft)
1.5	hydraulic radius (ft)
14.2	width-depth ratio
114.0	W flood prone area (ft)
5.1	entrenchment ratio
1.0	low bank height ratio



View Downstream

Survey Date: 01/2022

Field Crew: Kee Mapping & Surveying


Cross-Section Plots

Banner Farm Mitigation Site

DMS Project No. 100062

Monitoring Year 0 - 2022

Cross-Section 13-UT1

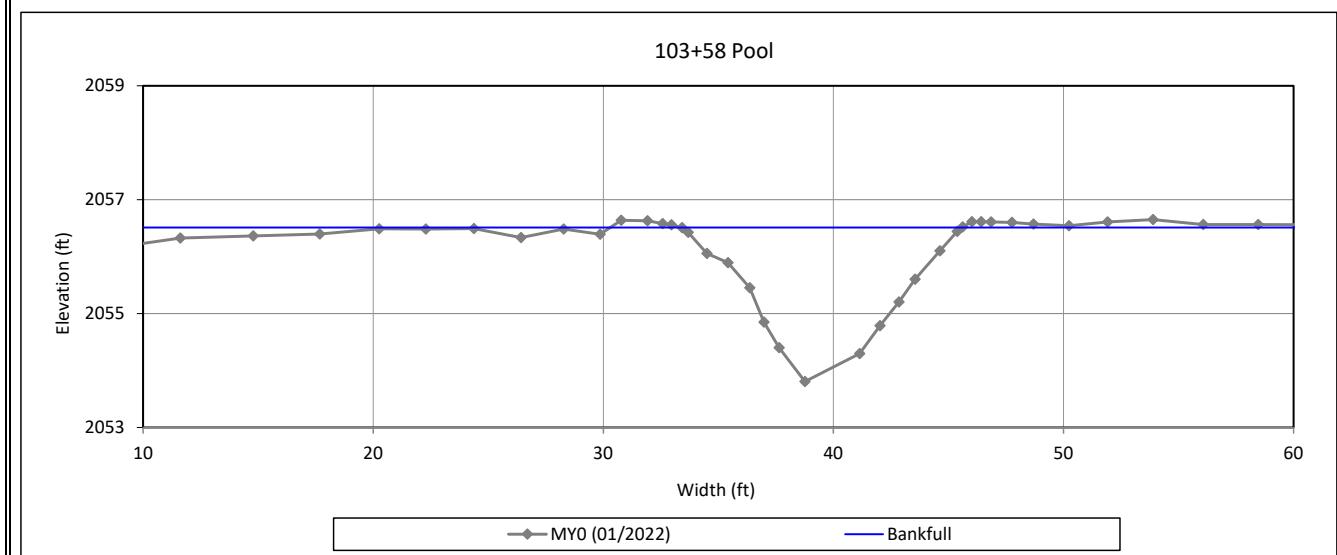

Bankfull Dimensions

16.8	x-section area (ft.sq.)
12.2	width (ft)
1.4	mean depth (ft)
2.7	max depth (ft)
13.5	wetted perimeter (ft)
1.2	hydraulic radius (ft)
8.8	width-depth ratio



Survey Date: 01/2022
Field Crew: Kee Mapping & Surveying

View Downstream


Cross-Section Plots

Banner Farm Mitigation Site

DMS Project No. 100062

Monitoring Year 0 - 2022

Cross-Section 14-UT1

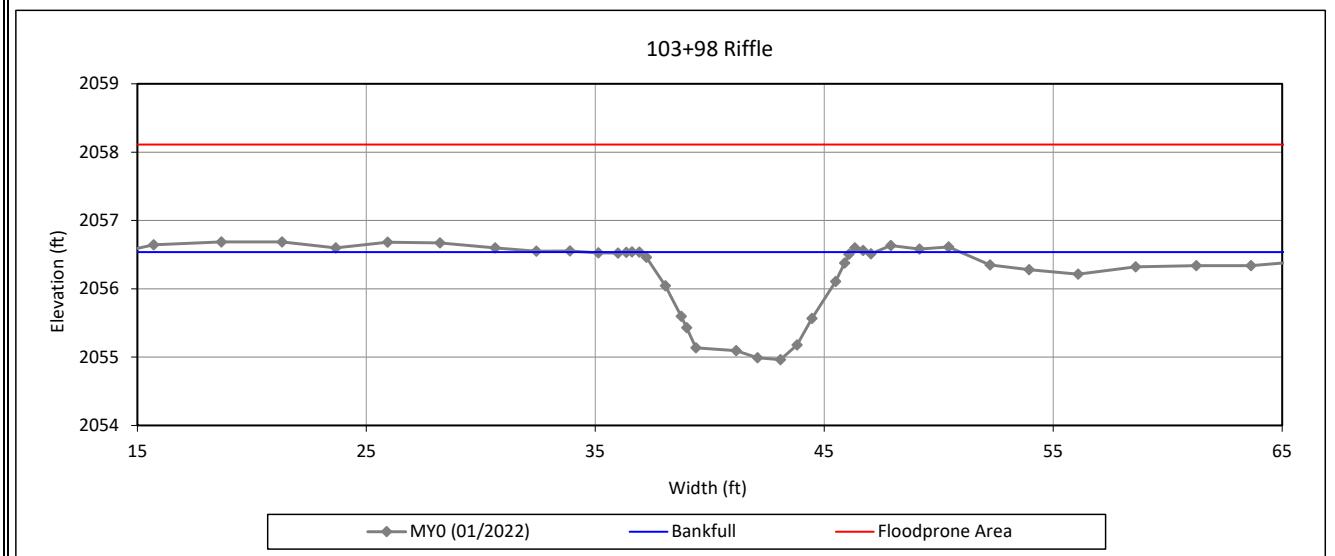

Bankfull Dimensions

9.6	x-section area (ft.sq.)
9.2	width (ft)
1.0	mean depth (ft)
1.6	max depth (ft)
10.0	wetted perimeter (ft)
1.0	hydraulic radius (ft)
8.9	width-depth ratio
66.4	W flood prone area (ft)
7.2	entrenchment ratio
1.0	low bank height ratio

Survey Date: 01/2022

Field Crew: Kee Mapping & Surveying



View Downstream


Cross-Section Plots

Banner Farm Mitigation Site

DMS Project No. 100062

Monitoring Year 0 - 2022

Cross-Section 15-UT2

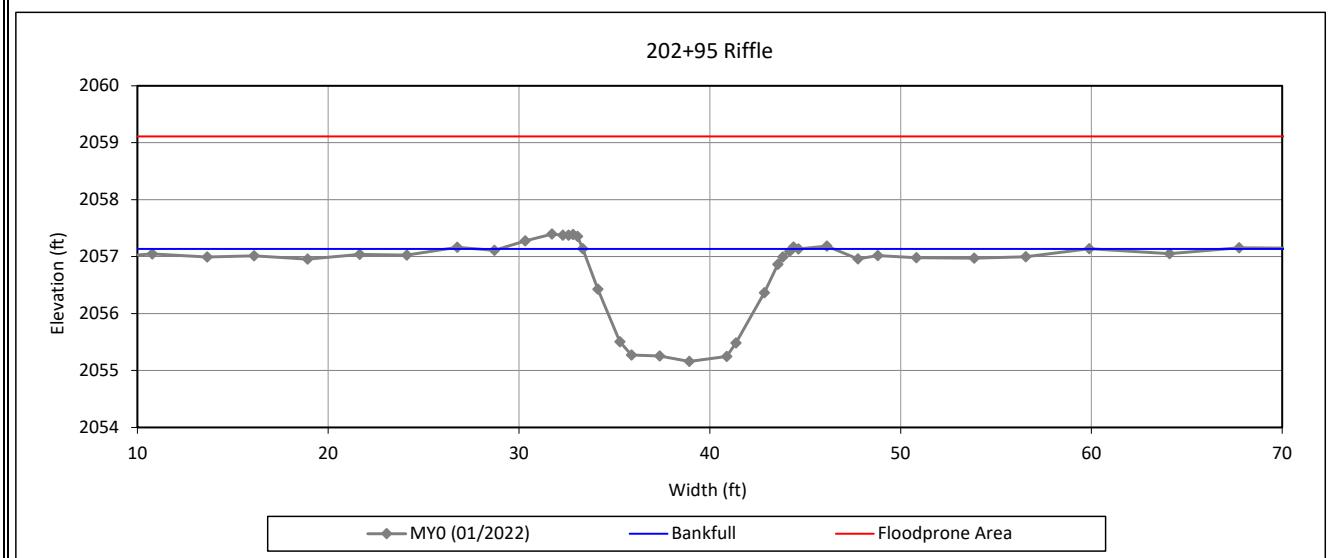

Bankfull Dimensions

15.4	x-section area (ft.sq.)
11.0	width (ft)
1.4	mean depth (ft)
2.0	max depth (ft)
12.1	wetted perimeter (ft)
1.3	hydraulic radius (ft)
7.8	width-depth ratio
81.9	W flood prone area (ft)
7.5	entrenchment ratio
1.0	low bank height ratio

Survey Date: 01/2022

Field Crew: Kee Mapping & Surveying



View Downstream


Cross-Section Plots

Banner Farm Mitigation Site

DMS Project No. 100062

Monitoring Year 0 - 2022

Cross-Section 16-UT2

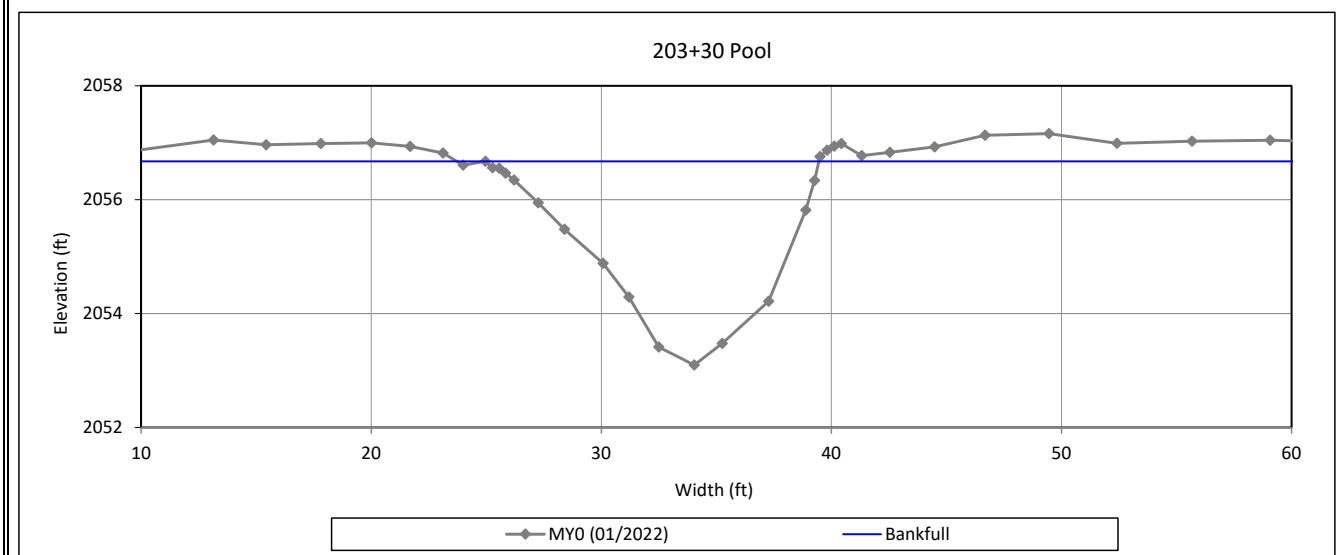

Bankfull Dimensions

28.4	x-section area (ft.sq.)
14.5	width (ft)
2.0	mean depth (ft)
3.6	max depth (ft)
16.6	wetted perimeter (ft)
1.7	hydraulic radius (ft)
7.4	width-depth ratio



View Downstream

Survey Date: 01/2022
Field Crew: Kee Mapping & Surveying


Cross-Section Plots

Banner Farm Mitigation Site

DMS Project No. 100062

Monitoring Year 0 - 2022

Cross-Section 17-UT2

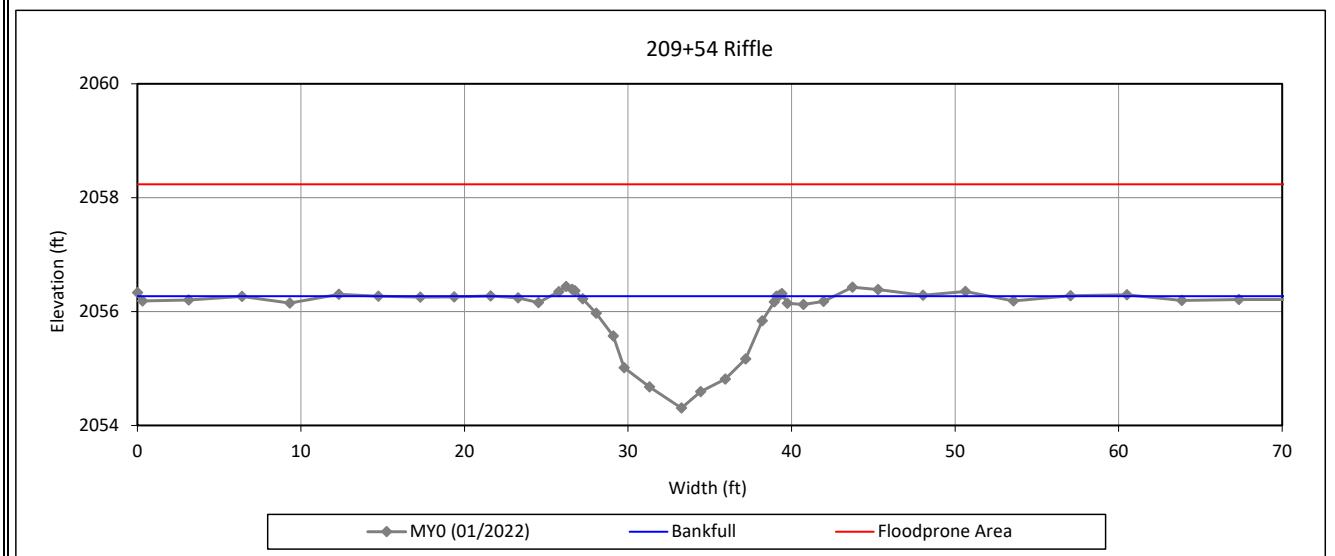

Bankfull Dimensions

- 14.1 x-section area (ft.sq.)
- 12.0 width (ft)
- 1.2 mean depth (ft)
- 2.0 max depth (ft)
- 12.8 wetted perimeter (ft)
- 1.1 hydraulic radius (ft)
- 10.2 width-depth ratio
- 74.8 W flood prone area (ft)
- 6.2 entrenchment ratio
- 1.0 low bank height ratio

Survey Date: 01/2022
Field Crew: Kee Mapping & Surveying



View Downstream


Cross-Section Plots

Banner Farm Mitigation Site

DMS Project No. 100062

Monitoring Year 0 - 2022

Cross-Section 18-UT2

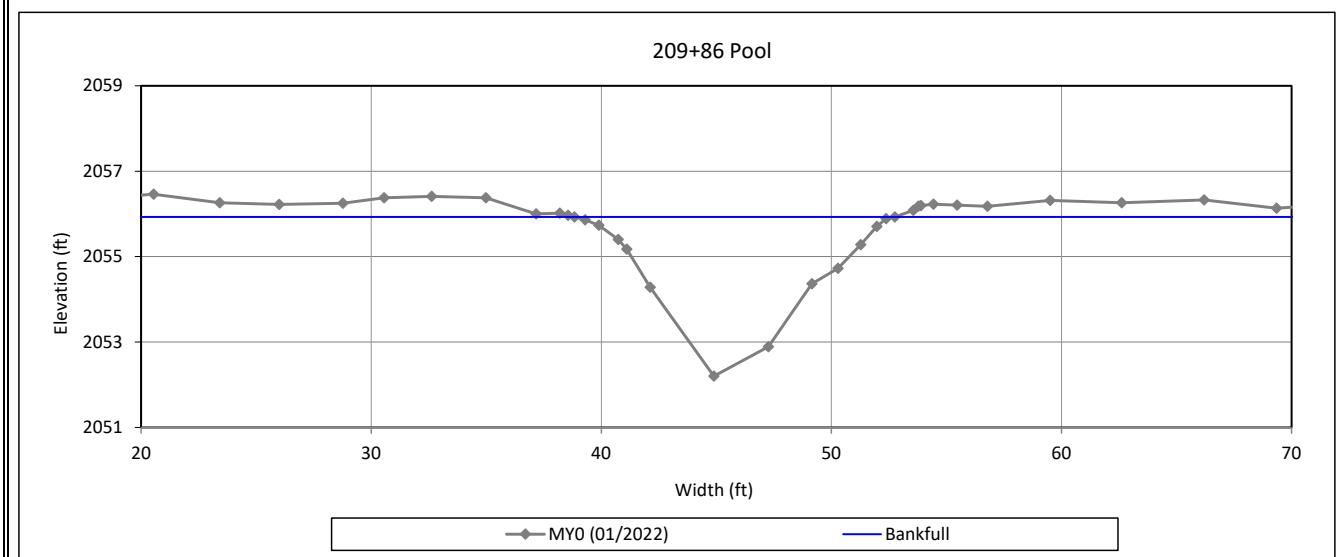

Bankfull Dimensions

24.5	x-section area (ft.sq.)
13.9	width (ft)
1.8	mean depth (ft)
3.7	max depth (ft)
16.1	wetted perimeter (ft)
1.5	hydraulic radius (ft)
7.9	width-depth ratio



View Downstream

Survey Date: 01/2022

Field Crew: Kee Mapping & Surveying


Cross-Section Plots

Banner Farm Mitigation Site

DMS Project No. 100062

Monitoring Year 0 - 2022

Cross-Section 19-UT2

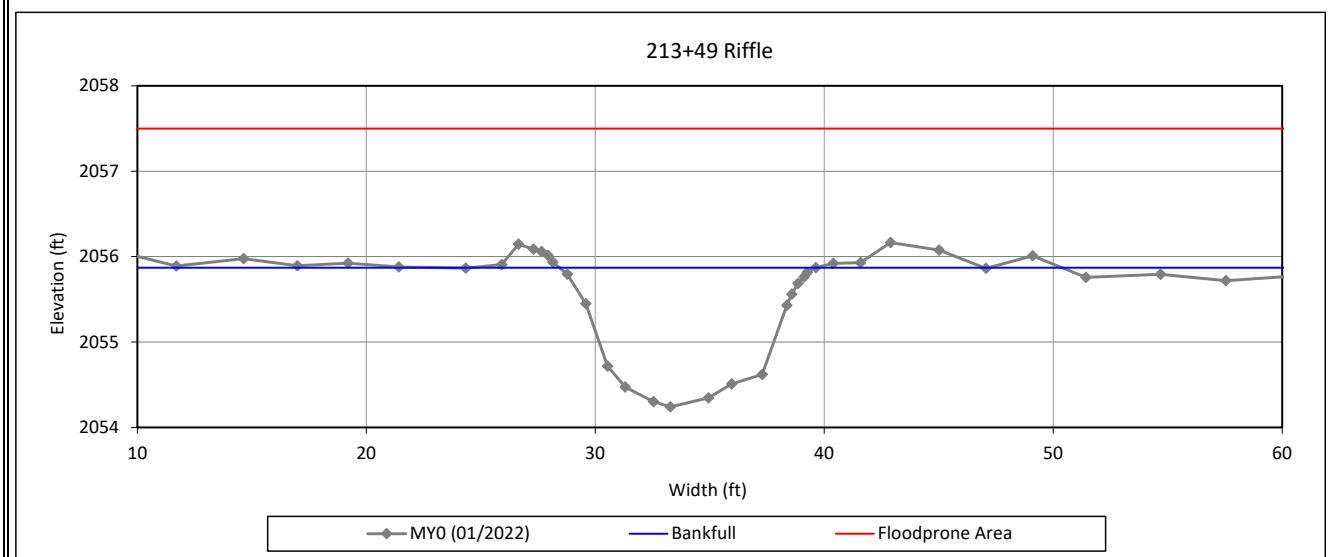

Bankfull Dimensions

11.9	x-section area (ft.sq.)
11.2	width (ft)
1.1	mean depth (ft)
1.6	max depth (ft)
12.0	wetted perimeter (ft)
1.0	hydraulic radius (ft)
10.5	width-depth ratio
79.0	W flood prone area (ft)
7.1	entrenchment ratio
1.0	low bank height ratio



View Downstream

Survey Date: 01/2022

Field Crew: Kee Mapping & Surveying


Cross-Section Plots

Banner Farm Mitigation Site

DMS Project No. 100062

Monitoring Year 0 - 2022

Cross-Section 20-UT2

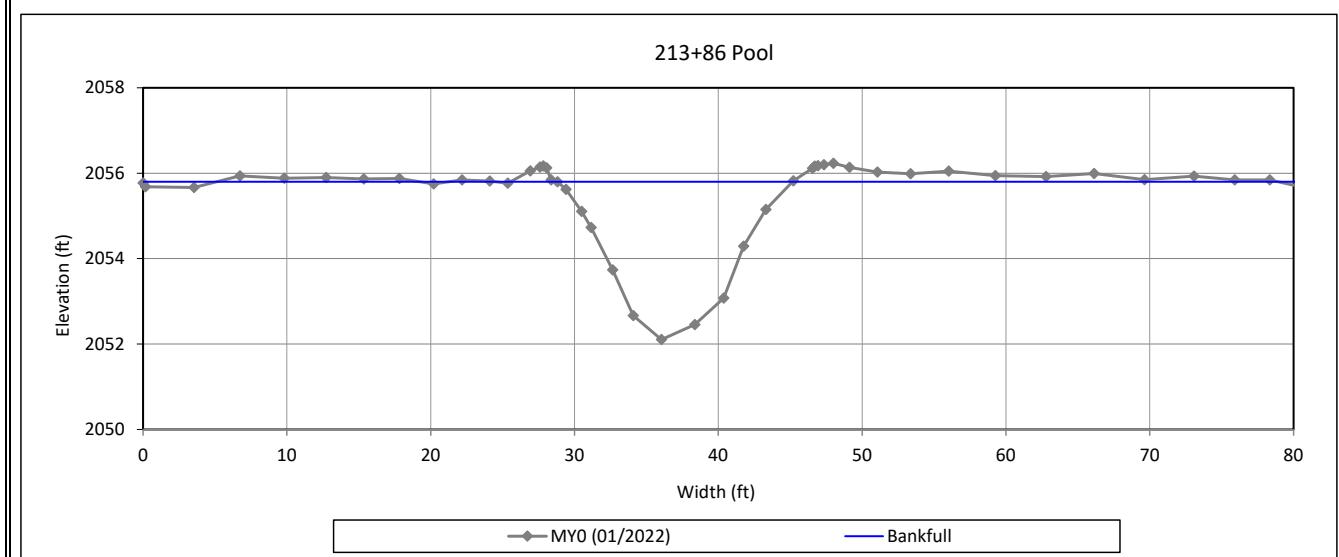

Bankfull Dimensions

33.3	x-section area (ft.sq.)
16.3	width (ft)
2.0	mean depth (ft)
3.7	max depth (ft)
18.2	wetted perimeter (ft)
1.8	hydraulic radius (ft)
8.0	width-depth ratio



Survey Date: 01/2022
Field Crew: Kee Mapping & Surveying

View Downstream


Longitudinal Profile Plots

Banner Creek Mitigation Site

DMS ID No. 100062

Monitoring Year 0 - 2022

Banner Creek (STA 0+08 to 37+97)

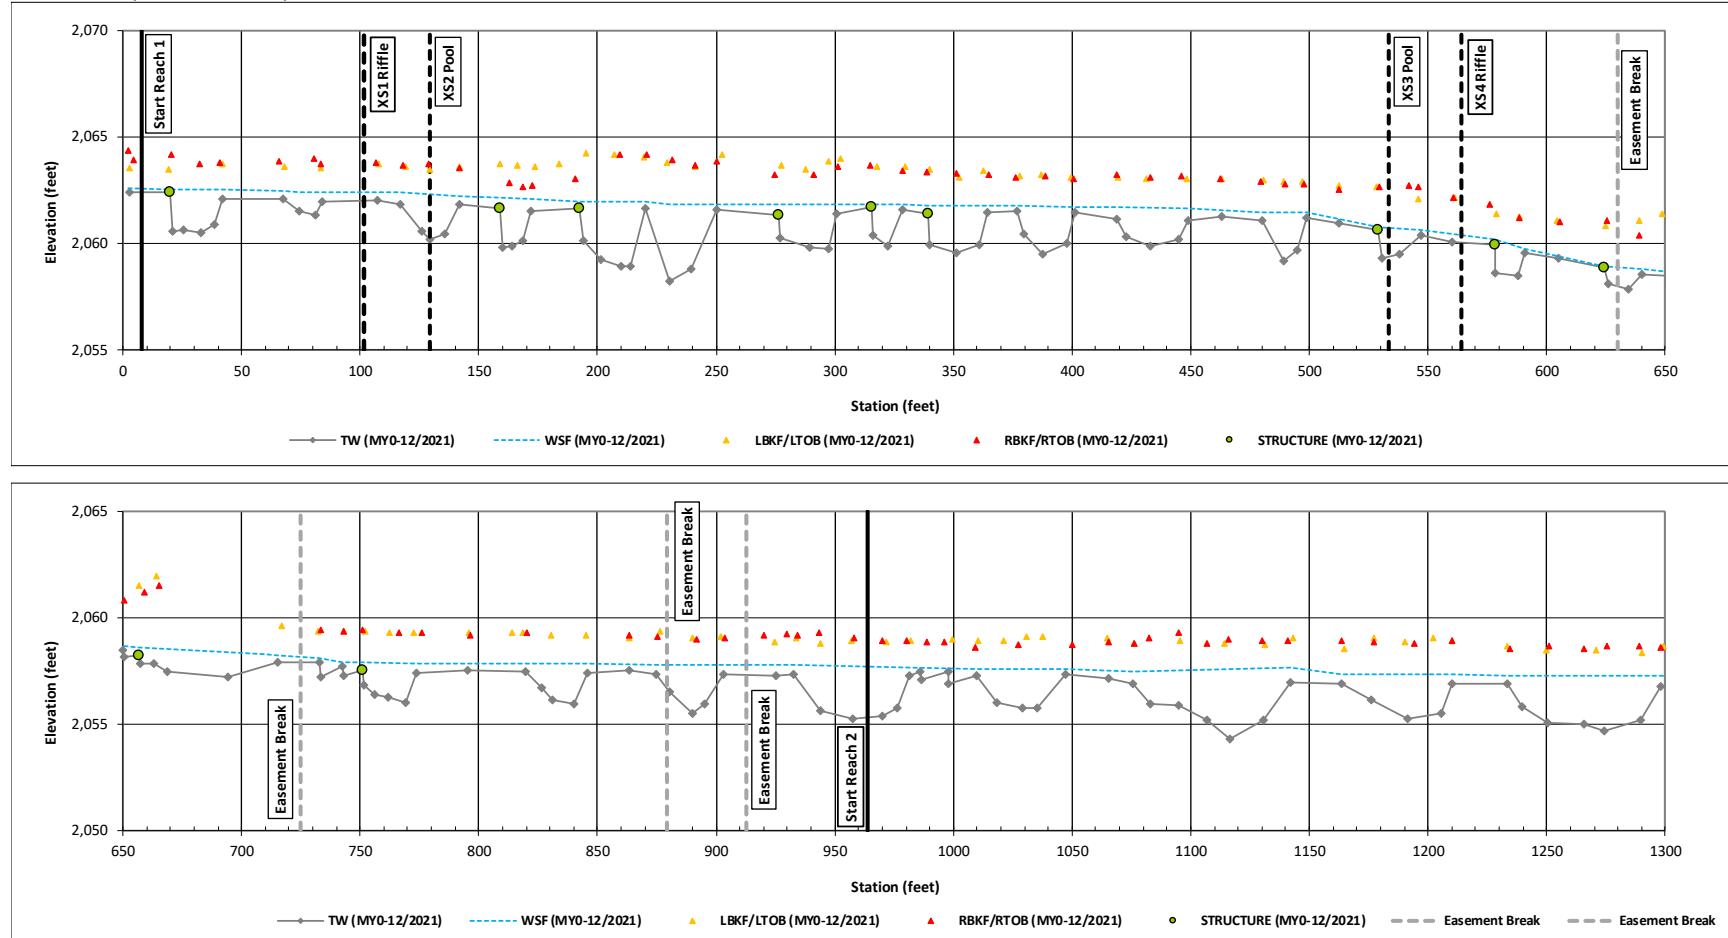



Longitudinal Profile Plots

Banner Creek Mitigation Site

DMS ID No. 100062

Monitoring Year 0 - 2022

Banner Creek (STA 0+08 to 37+97)

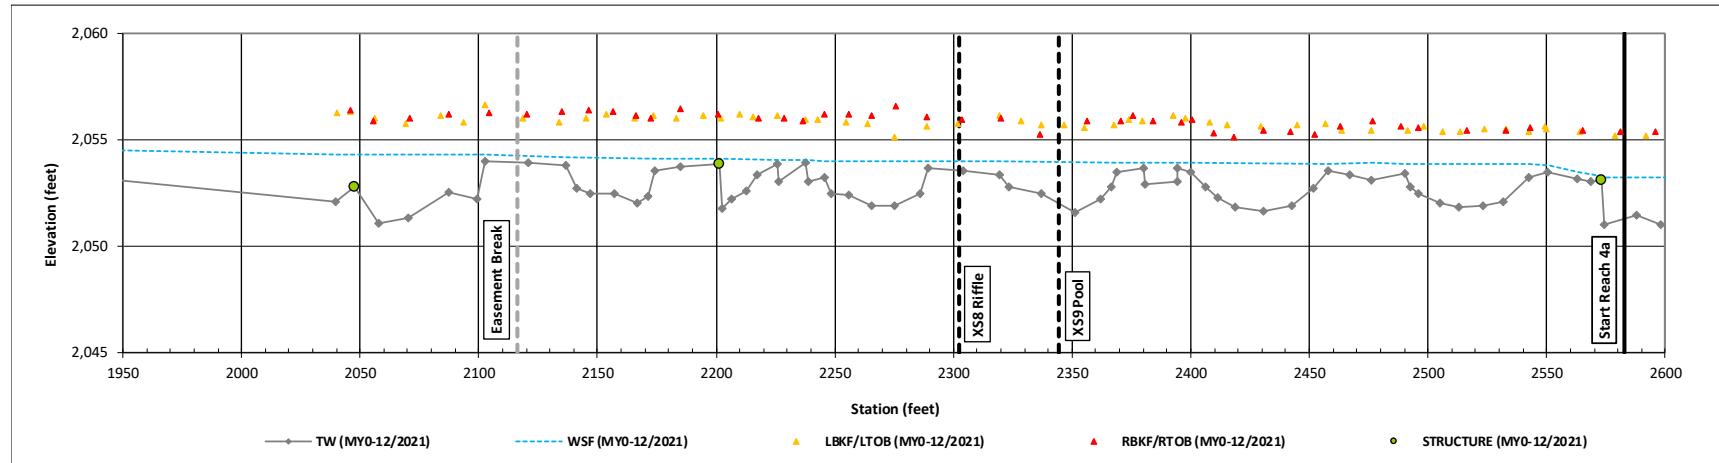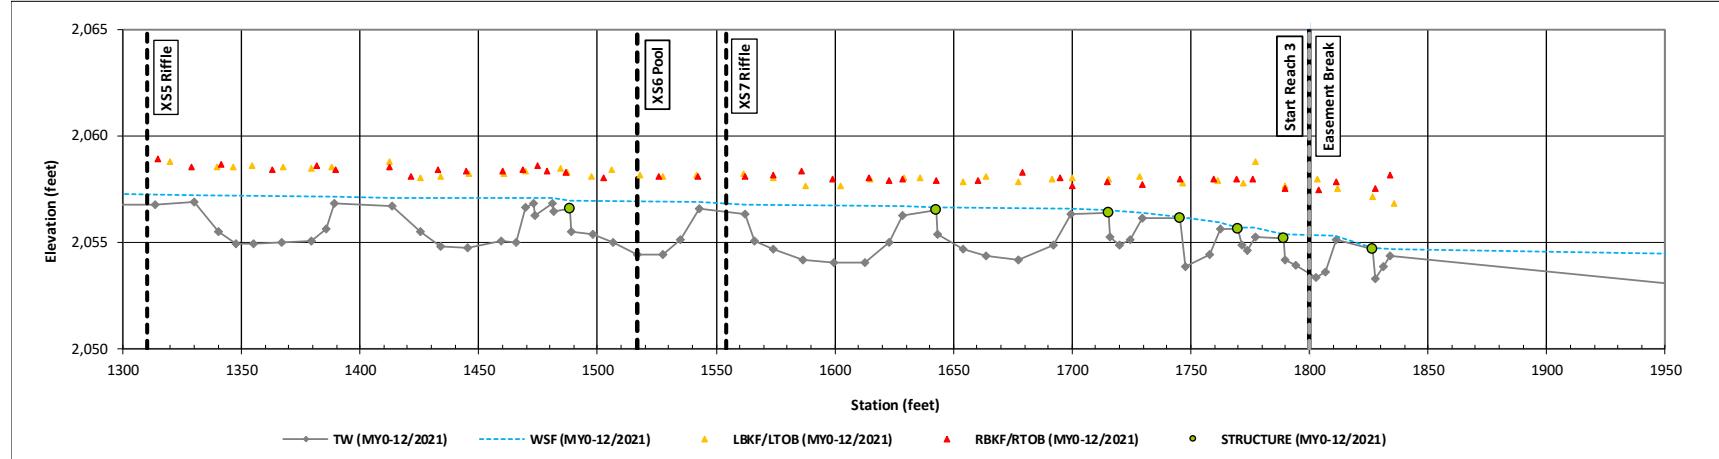



Longitudinal Profile Plots

Banner Creek Mitigation Site

DMS ID No. 100062

Monitoring Year 0 - 2022

Banner Creek (STA 0+08 to 37+97)

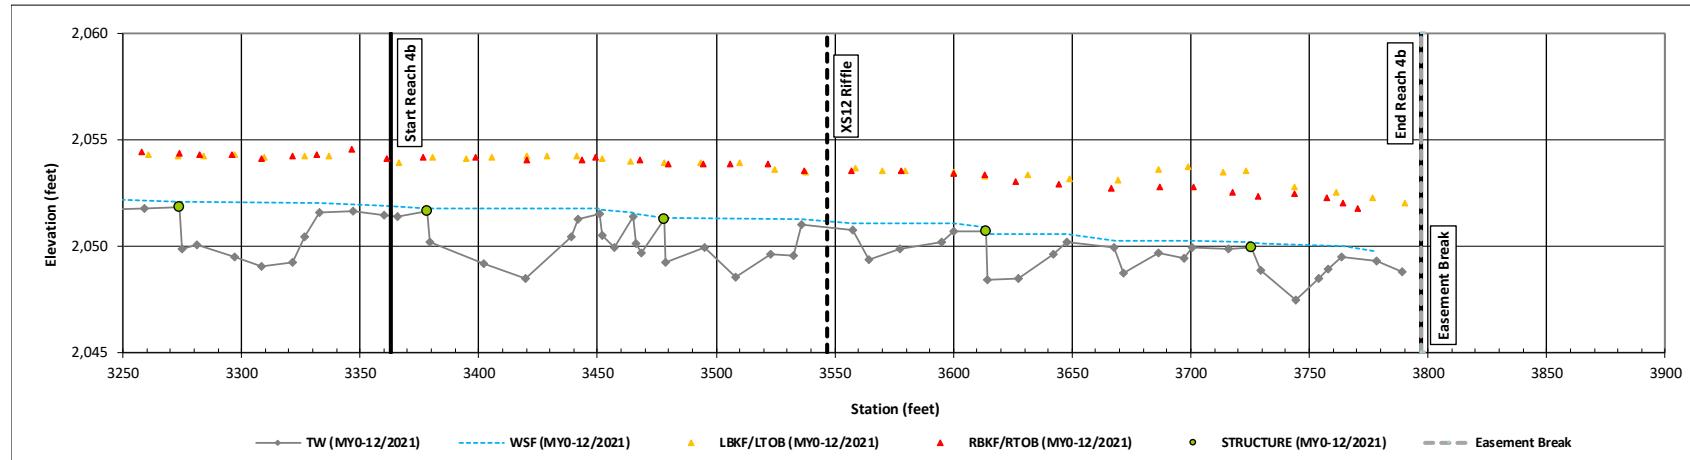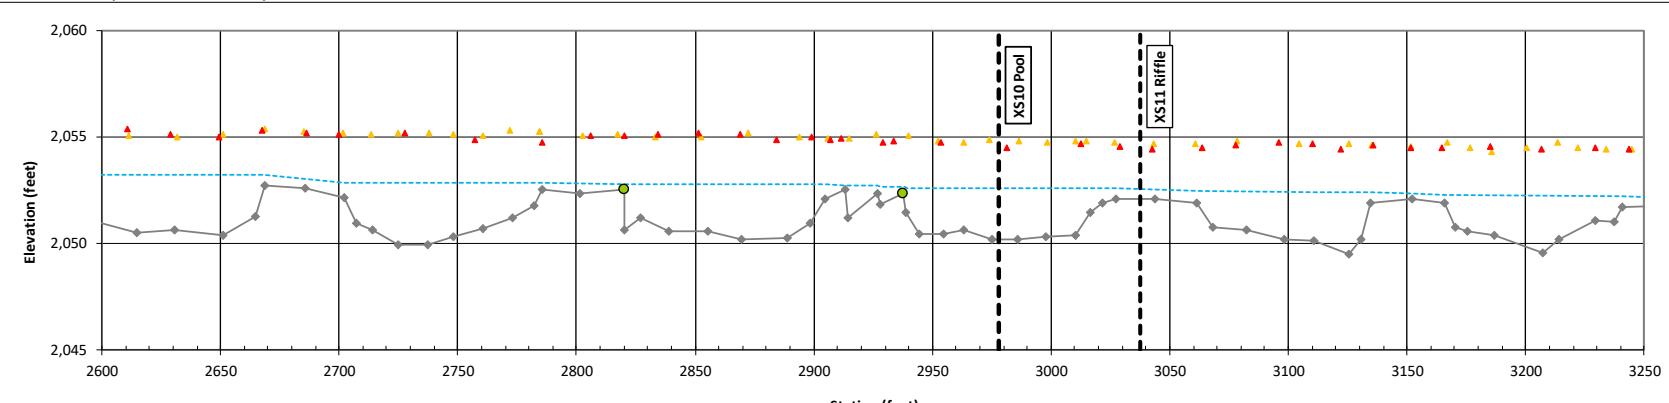



Longitudinal Profile Plots

Banner Creek Mitigation Site

DMS ID No. 100062

Monitoring Year 0 - 2022

UT1 (STA 100+83 to 112+82)

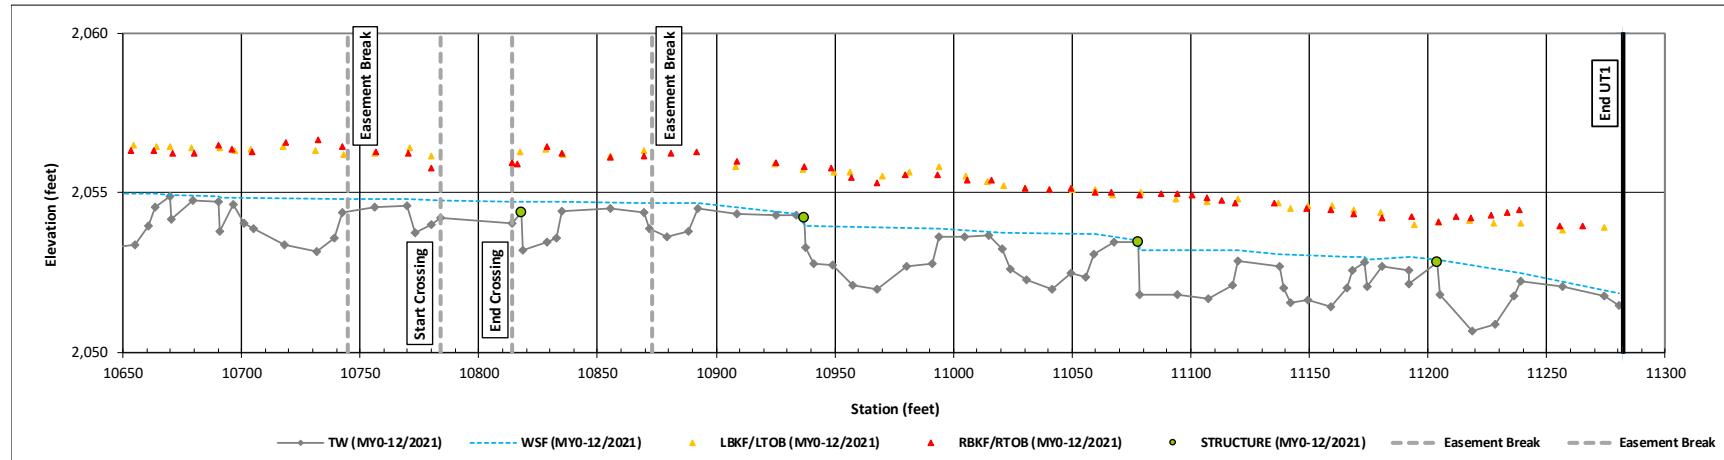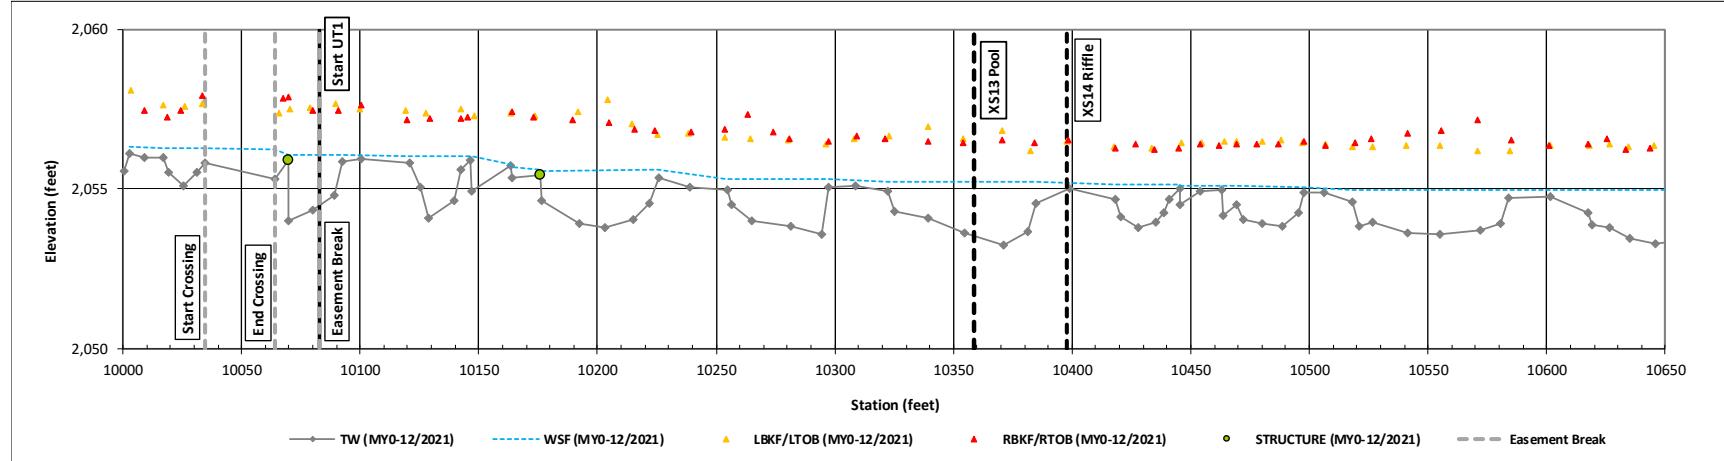



Longitudinal Profile Plots

Banner Creek Mitigation Site

DMS ID No. 100062

Monitoring Year 0 - 2022

UT2 (STA 200+18 to 218+97)

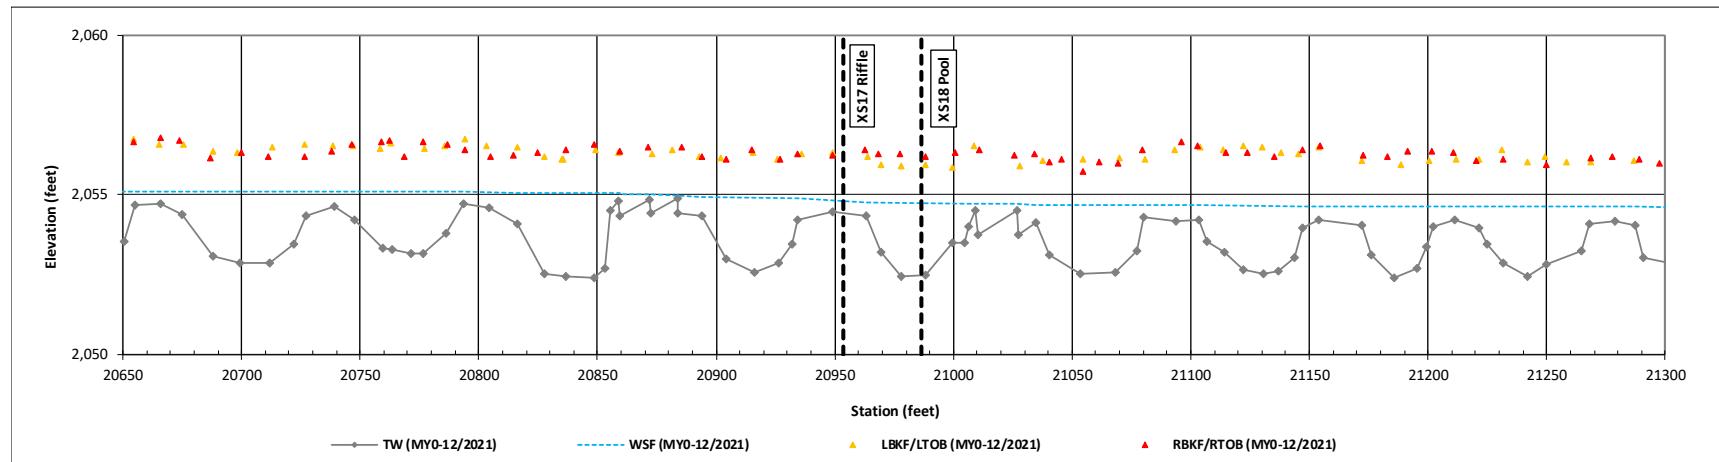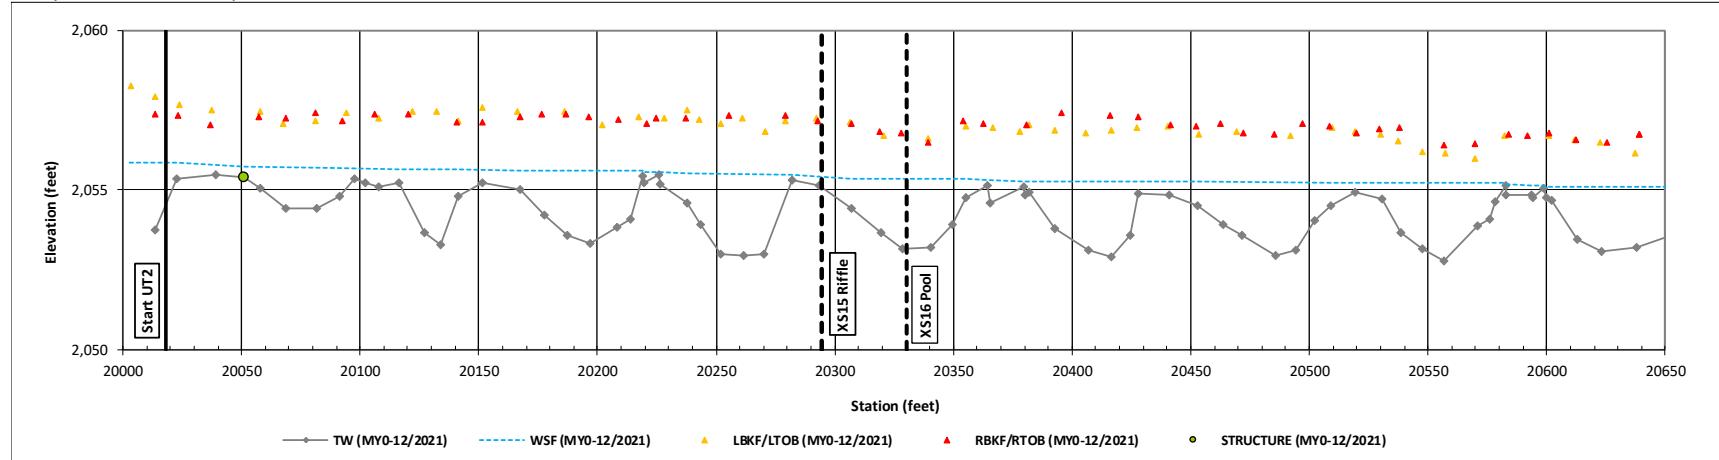


Longitudinal Profile Plots

Banner Creek Mitigation Site

DMS ID No. 100062

Monitoring Year 0 - 2022

UT2 (STA 200+18 to 218+97)

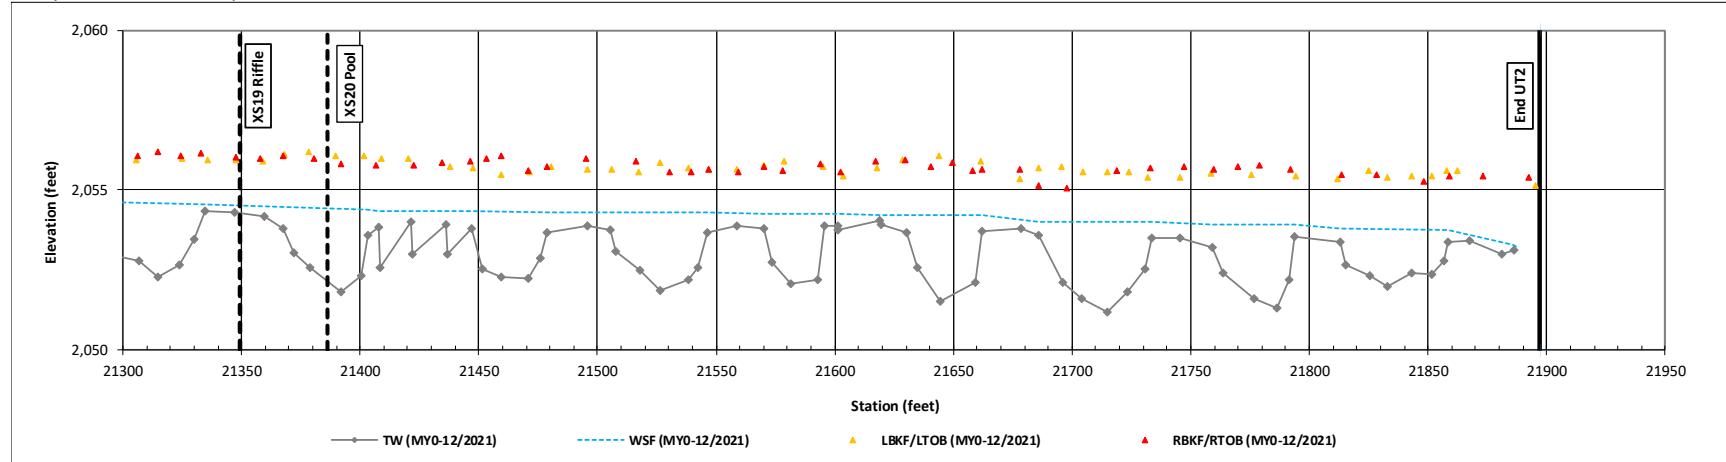

Reachwide Pebble Count Plots

Banner Creek Mitigation Site


DMS Project No. 100062

Monitoring Year 0 - 2022

BC R1, Reachwide

Particle Class	Diameter (mm)		Particle Count			Reach Summary		
	min	max	Riffle	Pool	Total	Class Percentage	Percent Cumulative	
SILT/CLAY	Silt/Clay	0.000	0.062		24	24	24	24
SAND	Very fine	0.062	0.125		1	1	1	25
	Fine	0.125	0.250		1	1	1	26
	Medium	0.25	0.50		2	2	2	28
	Coarse	0.5	1.0		3	3	3	31
	Very Coarse	1.0	2.0		3	3	3	34
	Very Fine	2.0	2.8					34
GRAVEL	Very Fine	2.8	4.0		1	1	1	35
	Fine	4.0	5.6		3	3	3	38
	Fine	5.6	8.0		7	7	7	45
	Medium	8.0	11.0		1	1	1	46
	Medium	11.0	16.0	1	1	2	2	48
	Coarse	16.0	22.6	3	3	6	6	54
	Coarse	22.6	32	3		3	3	57
	Very Coarse	32	45	10		10	10	67
	Very Coarse	45	64	8		8	8	75
	Small	64	90	17		17	17	92
COBBLE	Small	90	128	7		7	7	99
	Large	128	180					99
	Large	180	256					99
	Small	256	362					99
BOULDER	Small	362	512	1		1	1	100
	Medium	512	1024					100
	Large/Very Large	1024	2048					100
	Bedrock	2048	>2048					100
		Total	50	50	100	100	100	

Reachwide	
Channel materials (mm)	
D ₁₆ =	Silt/Clay
D ₃₅ =	4.0
D ₅₀ =	18.0
D ₈₄ =	76.7
D ₉₅ =	104.7
D ₁₀₀ =	512.0

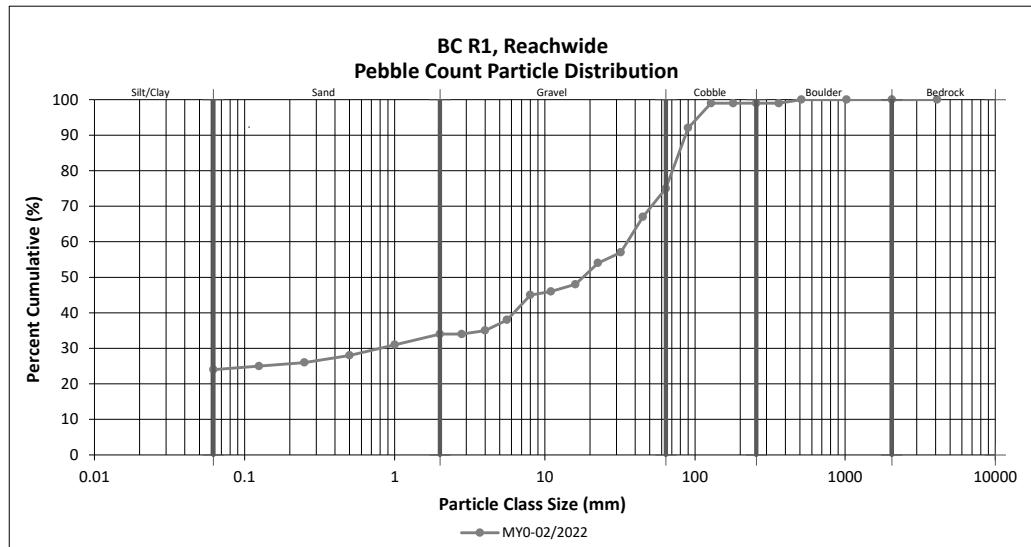

Reachwide Pebble Count Plots

Banner Creek Mitigation Site


DMS Project No. 100062

Monitoring Year 0 - 2022

BC R2, Reachwide

Particle Class	Diameter (mm)		Particle Count			Reach Summary		
	min	max	Riffle	Pool	Total	Class Percentage	Percent Cumulative	
SILT/CLAY	Silt/Clay	0.000	0.062	2	26	28	28	28
SAND	Very fine	0.062	0.125		6	6	6	34
	Fine	0.125	0.250	1	8	9	9	43
	Medium	0.25	0.50					43
	Coarse	0.5	1.0	2	1	3	3	46
	Very Coarse	1.0	2.0					46
	Very Fine	2.0	2.8					46
GRAVEL	Very Fine	2.8	4.0		1	1	1	47
	Fine	4.0	5.6		3	3	3	50
	Fine	5.6	8.0		2	2	2	52
	Medium	8.0	11.0	1		1	1	53
	Medium	11.0	16.0					53
	Coarse	16.0	22.6		2	2	2	55
	Coarse	22.6	32	2		2	2	57
	Very Coarse	32	45	8	1	9	9	66
	Very Coarse	45	64	10		10	10	76
	Small	64	90	13		13	13	89
COBBLE	Small	90	128	9		9	9	98
	Large	128	180	1		1	1	99
	Large	180	256					99
	Small	256	362	1		1	1	100
BOULDER	Small	362	512					100
	Medium	512	1024					100
	Large/Very Large	1024	2048					100
	Bedrock	2048	>2048					100
		Total	50	50	100	100	100	

Reachwide	
Channel materials (mm)	
D ₁₆ =	Silt/Clay
D ₃₅ =	0.1
D ₅₀ =	5.6
D ₈₄ =	78.9
D ₉₅ =	113.8
D ₁₀₀ =	362.0

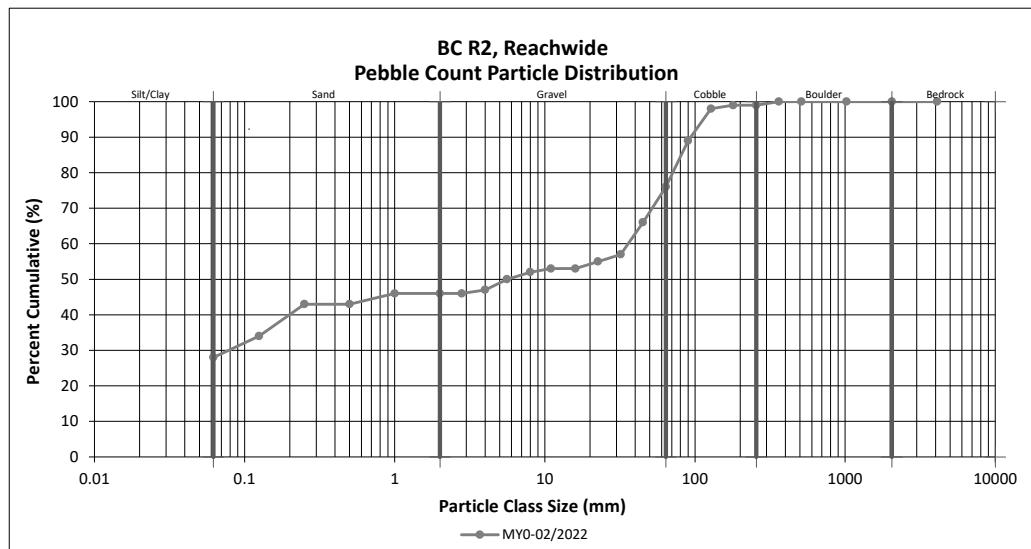

Reachwide Pebble Count Plots

Banner Creek Mitigation Site


DMS Project No. 100062

Monitoring Year 0 - 2022

BC R3, Reachwide

Particle Class	Diameter (mm)		Particle Count			Reach Summary		
	min	max	Riffle	Pool	Total	Class Percentage	Percent Cumulative	
SILT/CLAY	Silt/Clay	0.000	0.062	2	30	32	32	32
SAND	Very fine	0.062	0.125		2	2	2	34
	Fine	0.125	0.250					34
	Medium	0.25	0.50		1	1	1	35
	Coarse	0.5	1.0					35
	Very Coarse	1.0	2.0					35
	Very Fine	2.0	2.8					35
GRAVEL	Very Fine	2.8	4.0		1	1	1	36
	Fine	4.0	5.6		3	3	3	39
	Fine	5.6	8.0		2	2	2	41
	Medium	8.0	11.0		2	2	2	43
	Medium	11.0	16.0		4	4	4	47
	Coarse	16.0	22.6	1	2	3	3	50
	Coarse	22.6	32	6		6	6	56
	Very Coarse	32	45	7	2	9	9	65
	Very Coarse	45	64	16		16	16	81
	Small	64	90	9	1	10	10	91
COBBLE	Small	90	128	9		9	9	100
	Large	128	180					100
	Large	180	256					100
	Small	256	362					100
BOULDER	Small	362	512					100
	Medium	512	1024					100
	Large/Very Large	1024	2048					100
	Bedrock	2048	>2048					100
		Total	50	50	100	100	100	

Reachwide	
Channel materials (mm)	
D ₁₆ =	Silt/Clay
D ₃₅ =	0.5
D ₅₀ =	22.6
D ₈₄ =	70.9
D ₉₅ =	105.3
D ₁₀₀ =	128.0

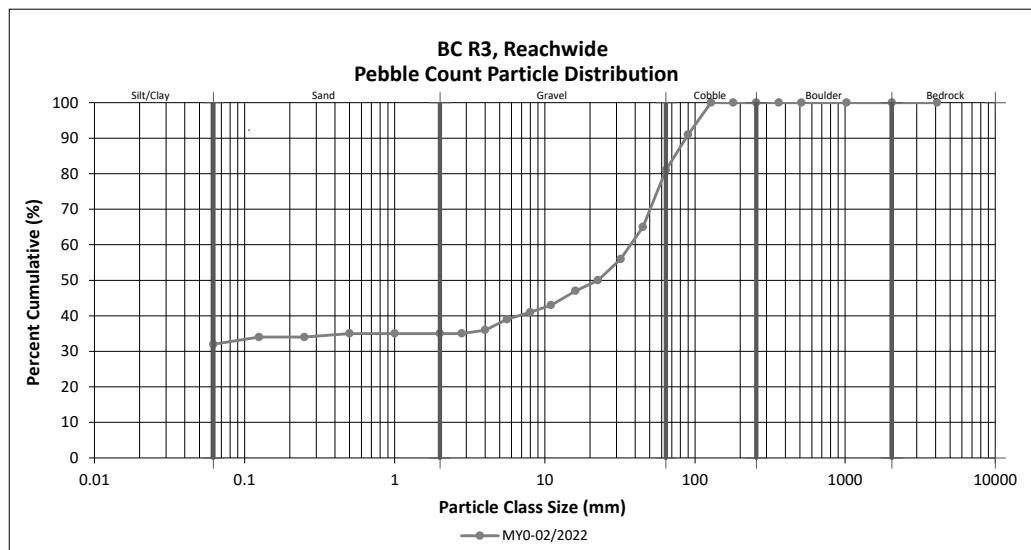

Reachwide Pebble Count Plots

Banner Creek Mitigation Site


DMS Project No. 100062

Monitoring Year 0 - 2022

BC R4a, Reachwide

Particle Class	Diameter (mm)		Particle Count			Reach Summary		
	min	max	Riffle	Pool	Total	Class Percentage	Percent Cumulative	
SILT/CLAY	Silt/Clay	0.000	0.062		22	22	22	22
SAND	Very fine	0.062	0.125		7	7	7	29
	Fine	0.125	0.250		6	6	6	35
	Medium	0.25	0.50		3	3	3	38
	Coarse	0.5	1.0		1	1	1	39
	Very Coarse	1.0	2.0		1	1	1	40
	Very Fine	2.0	2.8		1	1	1	41
GRAVEL	Very Fine	2.8	4.0		1	1	1	42
	Fine	4.0	5.6		5	5	5	47
	Fine	5.6	8.0					47
	Medium	8.0	11.0		1	1	1	48
	Medium	11.0	16.0					48
	Coarse	16.0	22.6		1	1	1	49
	Coarse	22.6	32	2	1	3	3	51
	Very Coarse	32	45	2		2	2	53
	Very Coarse	45	64	27		27	27	80
	Small	64	90	13		13	13	93
COBBLE	Small	90	128	3		3	3	96
	Large	128	180	3		3	3	99
	Large	180	256	1		1	1	100
	Small	256	362					100
BOULDER	Small	362	512					100
	Medium	512	1024					100
	Large/Very Large	1024	2048					100
	Bedrock	2048	>2048					100
		Total	51	50	101	100	100	

Reachwide	
Channel materials (mm)	
D ₁₆ =	Silt/Clay
D ₃₅ =	0.3
D ₅₀ =	26.9
D ₈₄ =	70.8
D ₉₅ =	113.2
D ₁₀₀ =	256.0

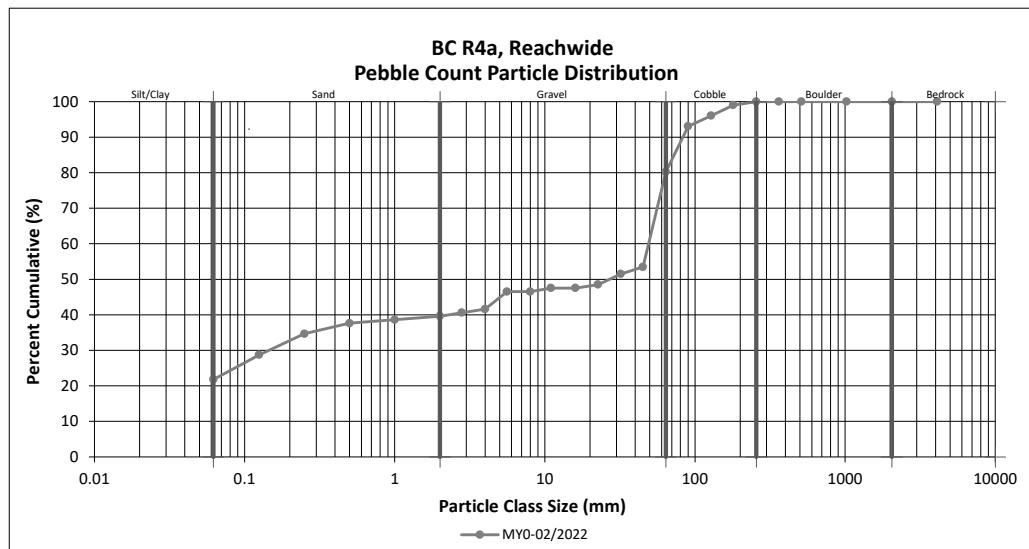

Reachwide Pebble Count Plots

Banner Creek Mitigation Site


DMS Project No. 100062

Monitoring Year 0 - 2022

BC R4b, Reachwide

Particle Class	Diameter (mm)		Particle Count			Reach Summary		
	min	max	Riffle	Pool	Total	Class Percentage	Percent Cumulative	
SILT/CLAY	Silt/Clay	0.000	0.062	7	26	33	33	33
SAND	Very fine	0.062	0.125		13	13	13	46
	Fine	0.125	0.250	2	7	9	9	55
	Medium	0.25	0.50		2	2	2	57
	Coarse	0.5	1.0					57
	Very Coarse	1.0	2.0					57
	Very Fine	2.0	2.8		1	1	1	58
GRAVEL	Very Fine	2.8	4.0					58
	Fine	4.0	5.6					58
	Fine	5.6	8.0					58
	Medium	8.0	11.0					58
	Medium	11.0	16.0					58
	Coarse	16.0	22.6					58
	Coarse	22.6	32	1		1	1	59
	Very Coarse	32	45	1		1	1	60
	Very Coarse	45	64	10		10	10	70
	Small	64	90	14	1	15	15	85
COBBLE	Small	90	128	12		12	12	97
	Large	128	180	3		3	3	100
	Large	180	256					100
	Small	256	362					100
BOULDER	Small	362	512					100
	Medium	512	1024					100
	Large/Very Large	1024	2048					100
	Bedrock	2048	>2048					100
		Total	50	50	100	100	100	

Reachwide	
Channel materials (mm)	
D ₁₆ =	Silt/Clay
D ₃₅ =	0.1
D ₅₀ =	0.2
D ₈₄ =	88.0
D ₉₅ =	120.7
D ₁₀₀ =	180.0

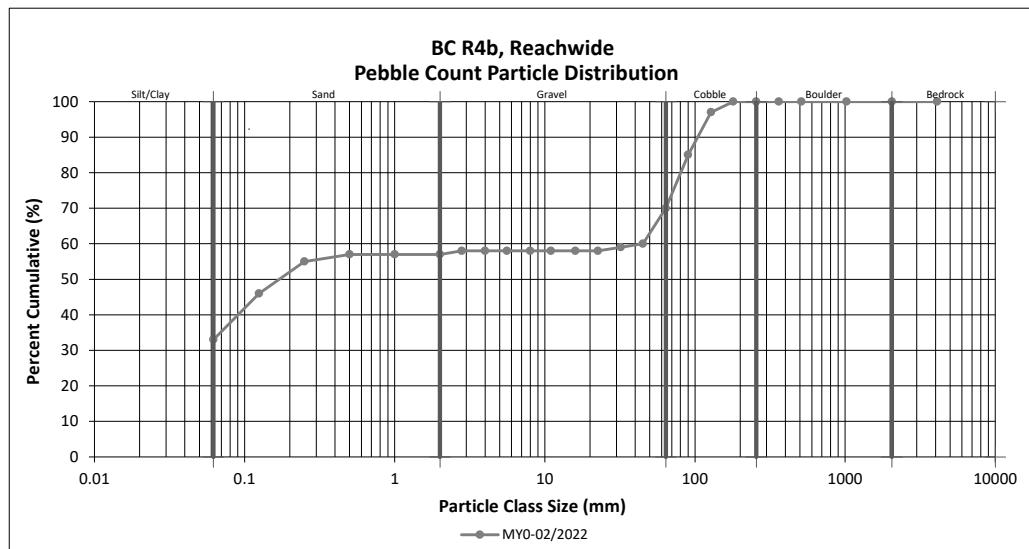

Reachwide Pebble Count Plots

Banner Creek Mitigation Site


DMS Project No. 100062

Monitoring Year 0 - 2022

UT1, Reachwide

Particle Class	Diameter (mm)		Particle Count			Reach Summary		
	min	max	Riffle	Pool	Total	Class Percentage	Percent Cumulative	
SILT/CLAY	Silt/Clay	0.000	0.062		16	16	16	16
SAND	Very fine	0.062	0.125		11	11	11	27
	Fine	0.125	0.250		9	9	9	36
	Medium	0.25	0.50		5	5	5	41
	Coarse	0.5	1.0		2	2	2	43
	Very Coarse	1.0	2.0	4	3	7	7	50
	Very Fine	2.0	2.8	1	1	2	2	52
GRAVEL	Very Fine	2.8	4.0		2	2	2	54
	Fine	4.0	5.6	2	1	3	3	57
	Fine	5.6	8.0					57
	Medium	8.0	11.0					57
	Medium	11.0	16.0	1		1	1	58
	Coarse	16.0	22.6					58
	Coarse	22.6	32					58
	Very Coarse	32	45	8		8	8	66
	Very Coarse	45	64	13		13	13	79
	Small	64	90	13		13	13	92
COBBLE	Small	90	128	7		7	7	99
	Large	128	180	1		1	1	100
	Large	180	256					100
	Small	256	362					100
BOULDER	Small	362	512					100
	Medium	512	1024					100
	Large/Very Large	1024	2048					100
	Bedrock	2048	>2048					100
		Total	50	50	100	100	100	

Reachwide	
Channel materials (mm)	
D ₁₆ =	Silt/Clay
D ₃₅ =	0.2
D ₅₀ =	2.0
D ₈₄ =	73.0
D ₉₅ =	104.7
D ₁₀₀ =	180.0

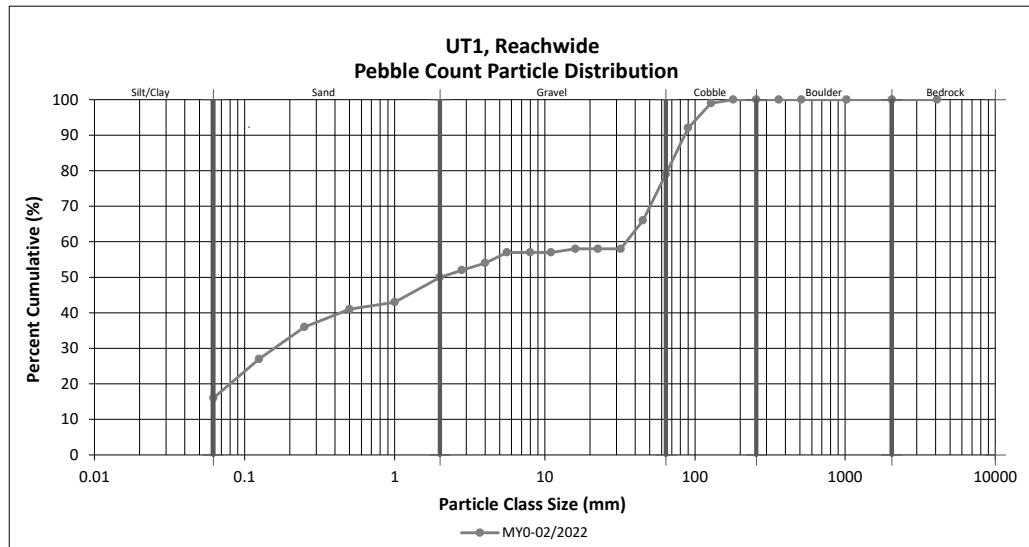

Reachwide Pebble Count Plots

Banner Creek Mitigation Site


DMS Project No. 100062

Monitoring Year 0 - 2022

UT2, Reachwide

Particle Class	Diameter (mm)		Particle Count			Reach Summary	
	min	max	Riffle	Pool	Total	Class Percentage	Percent Cumulative
SILT/CLAY	Silt/Clay	0.000	0.062		34	34	34
SAND	Very fine	0.062	0.125		3	3	3
	Fine	0.125	0.250		1	1	37
	Medium	0.25	0.50		2	2	40
	Coarse	0.5	1.0				40
	Very Coarse	1.0	2.0				40
	Very Fine	2.0	2.8				40
GRAVEL	Very Fine	2.8	4.0		1	1	41
	Fine	4.0	5.6	1	5	6	47
	Fine	5.6	8.0		3	3	50
	Medium	8.0	11.0		1	1	51
	Medium	11.0	16.0				51
	Coarse	16.0	22.6				51
	Coarse	22.6	32	1		1	52
	Very Coarse	32	45	14		14	66
	Very Coarse	45	64	9		9	75
	Small	64	90	15		15	90
COBBLE	Small	90	128	8		8	98
	Large	128	180	1		1	99
	Large	180	256				99
	Small	256	362				99
BOULDER	Small	362	512	1		1	100
	Medium	512	1024				100
	Large/Very Large	1024	2048				100
	Bedrock	2048	>2048				100
		Total	50	50	100	100	100

Reachwide	
Channel materials (mm)	
D ₁₆ =	Silt/Clay
D ₃₅ =	0.1
D ₅₀ =	8.0
D ₈₄ =	78.5
D ₉₅ =	112.2
D ₁₀₀ =	512.0

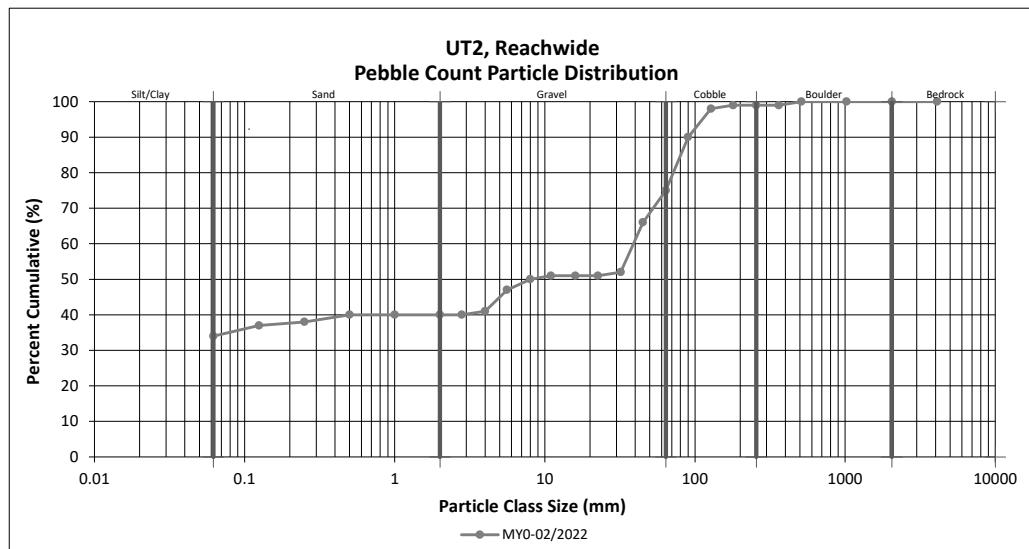

Riffle Pebble Count Plots

Banner Farm Mitigation Site


DMS Project No. 100062

Monitoring Year 0 - 2022

BC R1, Cross-Section 1

Particle Class	Diameter (mm)		Riffle 100-Count	Summary	
	min	max		Class Percentage	Percent Cumulative
SILT/CLAY	Silt/Clay	0.000	0.062		0
SAND	Very fine	0.062	0.125		0
	Fine	0.125	0.250		0
	Medium	0.25	0.50		0
	Coarse	0.5	1.0		0
	Very Coarse	1.0	2.0		0
GRAVEL	Very Fine	2.0	2.8		0
	Very Fine	2.8	4.0		0
	Fine	4.0	5.6		0
	Fine	5.6	8.0		0
	Medium	8.0	11.0		0
	Medium	11.0	16.0		0
	Coarse	16.0	22.6	1	1
	Coarse	22.6	32		1
	Very Coarse	32	45	11	11
	Very Coarse	45	64	32	44
COBBLE	Small	64	90	33	33
	Small	90	128	20	20
	Large	128	180	2	2
	Large	180	256	1	1
BOULDER	Small	256	362		100
	Small	362	512		100
	Medium	512	1024		100
	Large/Very Large	1024	2048		100
BEDROCK	Bedrock	2048	>2048		100
		Total	100	100	100

Cross-Section 1	
Channel materials (mm)	
$D_{16} =$	47.0
$D_{35} =$	58.0
$D_{50} =$	68.1
$D_{84} =$	101.8
$D_{95} =$	123.6
$D_{100} =$	256.0

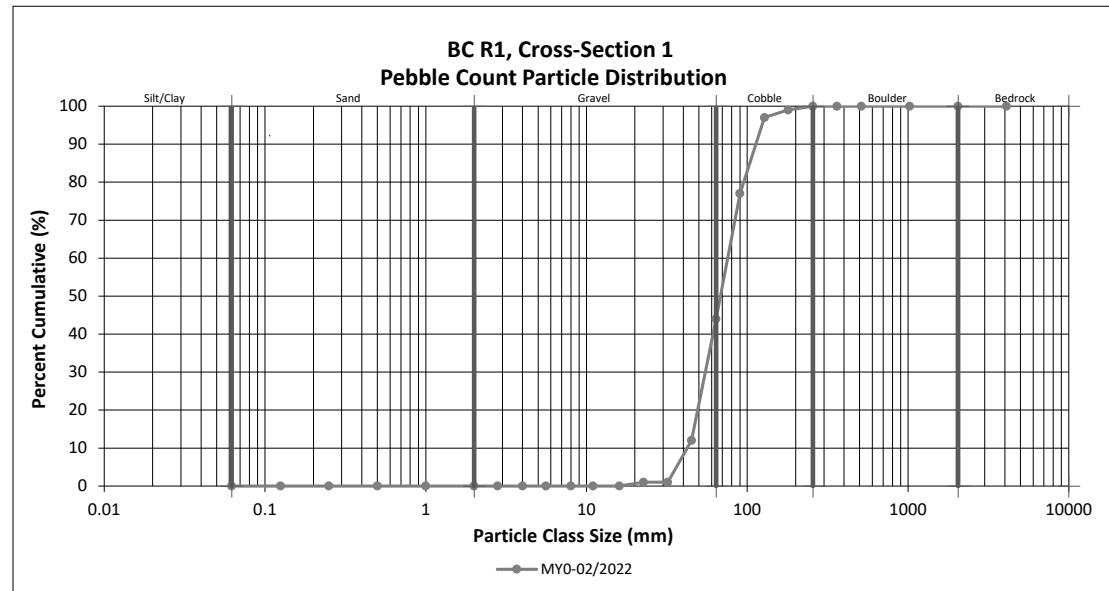

Riffle Pebble Count Plots

Banner Farm Mitigation Site


DMS Project No. 100062

Monitoring Year 0 - 2022

BC R1, Cross-Section 4

Particle Class	Diameter (mm)		Riffle 100-Count	Summary	
	min	max		Class Percentage	Percent Cumulative
SILT/CLAY	Silt/Clay	0.000	0.062	3	3
SAND	Very fine	0.062	0.125		3
	Fine	0.125	0.250		3
	Medium	0.25	0.50		3
	Coarse	0.5	1.0		3
	Very Coarse	1.0	2.0		3
GRAVEL	Very Fine	2.0	2.8		3
	Very Fine	2.8	4.0		3
	Fine	4.0	5.6		3
	Fine	5.6	8.0		3
	Medium	8.0	11.0		3
	Medium	11.0	16.0		3
	Coarse	16.0	22.6		3
	Coarse	22.6	32	11	14
	Very Coarse	32	45	22	36
	Very Coarse	45	64	26	62
COBBLE	Small	64	90	22	22
	Small	90	128	11	11
	Large	128	180	2	2
	Large	180	256		97
BOULDER	Small	256	362	1	1
	Small	362	512	1	1
	Medium	512	1024	1	1
	Large/Very Large	1024	2048		100
BEDROCK	Bedrock	2048	>2048		100
		Total	100	100	100

Cross-Section 4	
Channel materials (mm)	
$D_{16} =$	33.0
$D_{35} =$	44.3
$D_{50} =$	54.4
$D_{84} =$	90.0
$D_{95} =$	128.0
$D_{100} =$	1024.0

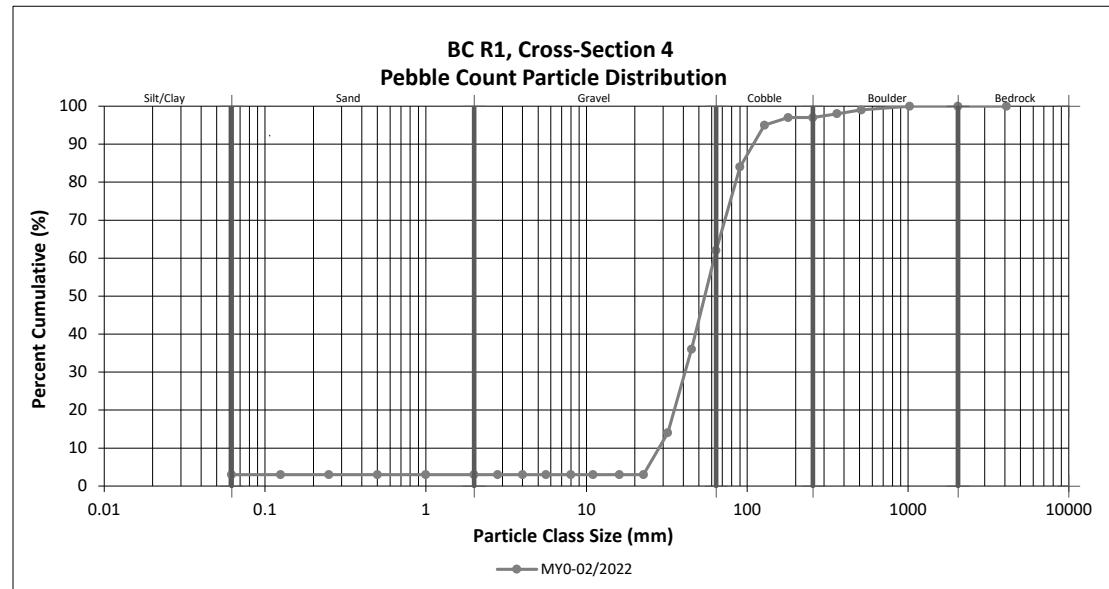

Riffle Pebble Count Plots

Banner Farm Mitigation Site


DMS Project No. 100062

Monitoring Year 0 - 2022

BC R2, Cross-Section 5

Particle Class	Diameter (mm)		Riffle 100-Count	Summary	
	min	max		Class Percentage	Percent Cumulative
SILT/CLAY	Silt/Clay	0.000	0.062	3	3
SAND	Very fine	0.062	0.125		3
	Fine	0.125	0.250		3
	Medium	0.25	0.50		3
	Coarse	0.5	1.0	3	6
	Very Coarse	1.0	2.0	2	8
GRAVEL	Very Fine	2.0	2.8		8
	Very Fine	2.8	4.0	1	9
	Fine	4.0	5.6	1	10
	Fine	5.6	8.0		10
	Medium	8.0	11.0	2	12
	Medium	11.0	16.0		12
	Coarse	16.0	22.6		12
	Coarse	22.6	32	4	16
	Very Coarse	32	45	12	28
	Very Coarse	45	64	25	53
COBBLE	Small	64	90	31	31
	Small	90	128	13	13
	Large	128	180	3	3
	Large	180	256		100
BOULDER	Small	256	362		100
	Small	362	512		100
	Medium	512	1024		100
	Large/Very Large	1024	2048		100
BEDROCK	Bedrock	2048	>2048		100
		Total	100	100	100

Cross-Section 5	
Channel materials (mm)	
$D_{16} =$	32.0
$D_{35} =$	49.7
$D_{50} =$	61.4
$D_{84} =$	90.0
$D_{95} =$	121.2
$D_{100} =$	180.0

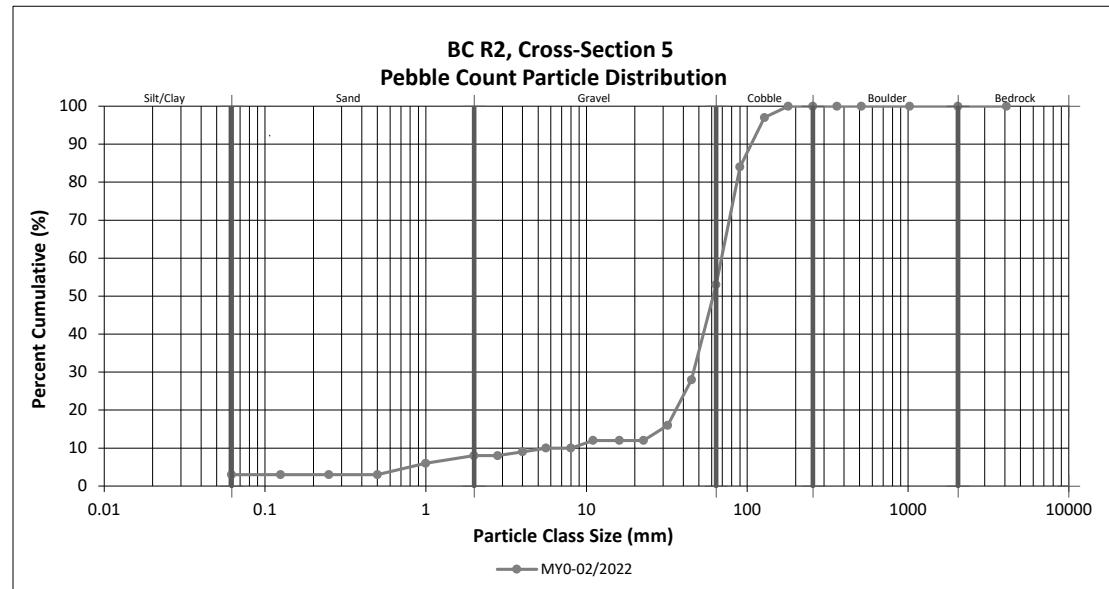

Riffle Pebble Count Plots

Banner Farm Mitigation Site


DMS Project No. 100062

Monitoring Year 0 - 2022

BC R2, Cross-Section 7

Particle Class	Diameter (mm)		Riffle 100-Count	Summary	
	min	max		Class Percentage	Percent Cumulative
SILT/CLAY	Silt/Clay	0.000	0.062	3	3
SAND	Very fine	0.062	0.125		3
	Fine	0.125	0.250		3
	Medium	0.25	0.50		3
	Coarse	0.5	1.0		3
	Very Coarse	1.0	2.0		3
GRAVEL	Very Fine	2.0	2.8		3
	Very Fine	2.8	4.0	1	1
	Fine	4.0	5.6		4
	Fine	5.6	8.0	1	1
	Medium	8.0	11.0	1	1
	Medium	11.0	16.0	2	2
	Coarse	16.0	22.6		8
	Coarse	22.6	32	5	13
	Very Coarse	32	45	19	32
	Very Coarse	45	64	36	68
COBBLE	Small	64	90	24	24
	Small	90	128	5	5
	Large	128	180	3	3
	Large	180	256		100
BOULDER	Small	256	362		100
	Small	362	512		100
	Medium	512	1024		100
	Large/Very Large	1024	2048		100
BEDROCK	Bedrock	2048	>2048		100
		Total	100	100	100

Cross-Section 7	
Channel materials (mm)	
$D_{16} =$	33.8
$D_{35} =$	46.3
$D_{50} =$	53.7
$D_{84} =$	80.3
$D_{95} =$	111.2
$D_{100} =$	180.0

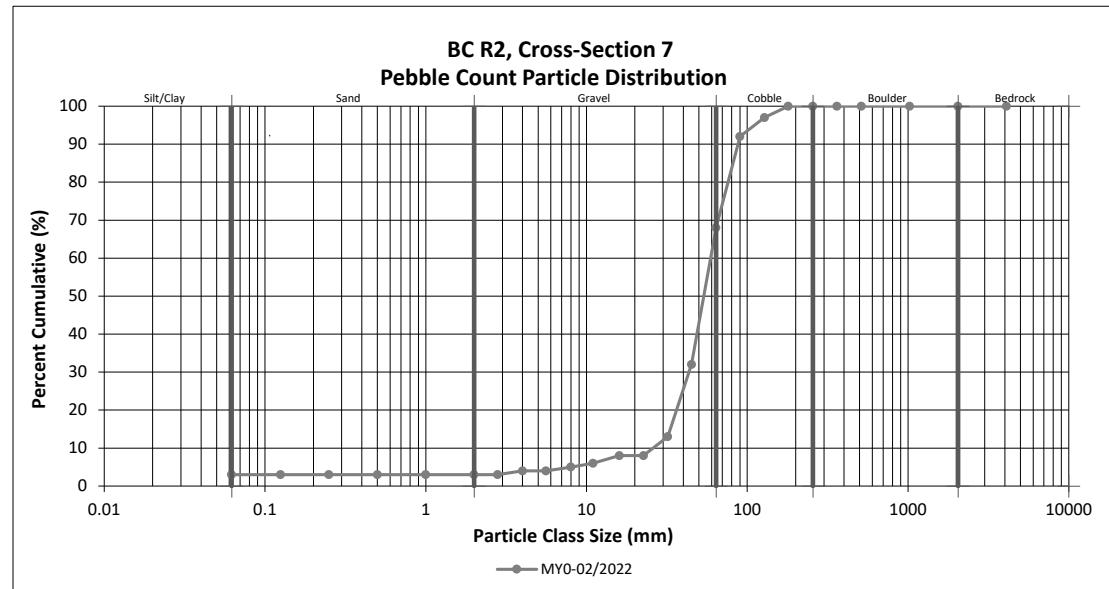

Riffle Pebble Count Plots

Banner Farm Mitigation Site


DMS Project No. 100062

Monitoring Year 0 - 2022

BC R3, Cross-Section 8

Particle Class	Diameter (mm)		Riffle 100-Count	Summary	
	min	max		Class Percentage	Percent Cumulative
SILT/CLAY	Silt/Clay	0.000	0.062	2	2
SAND	Very fine	0.062	0.125		2
	Fine	0.125	0.250		2
	Medium	0.25	0.50		2
	Coarse	0.5	1.0		2
	Very Coarse	1.0	2.0		2
GRAVEL	Very Fine	2.0	2.8		2
	Very Fine	2.8	4.0	2	4
	Fine	4.0	5.6	4	8
	Fine	5.6	8.0		8
	Medium	8.0	11.0		8
	Medium	11.0	16.0		8
	Coarse	16.0	22.6	2	10
	Coarse	22.6	32	10	20
	Very Coarse	32	45	15	35
	Very Coarse	45	64	30	65
COBBLE	Small	64	90	28	28
	Small	90	128	7	7
	Large	128	180		100
	Large	180	256		100
BOULDER	Small	256	362		100
	Small	362	512		100
	Medium	512	1024		100
	Large/Very Large	1024	2048		100
BEDROCK	Bedrock	2048	>2048		100
		Total	100	100	100

Cross-Section 8	
Channel materials (mm)	
$D_{16} =$	27.8
$D_{35} =$	45.0
$D_{50} =$	53.7
$D_{84} =$	80.7
$D_{95} =$	99.5
$D_{100} =$	128.0

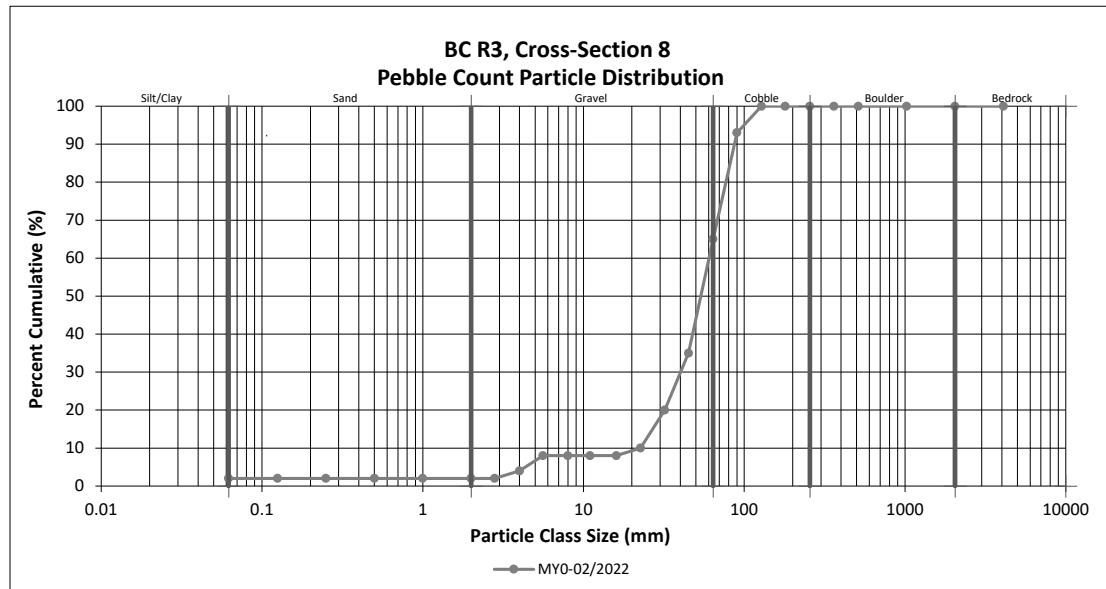

Riffle Pebble Count Plots

Banner Farm Mitigation Site


DMS Project No. 100062

Monitoring Year 0 - 2022

BC R4a, Cross-Section 11

Particle Class	Diameter (mm)		Riffle 100-Count	Summary	
	min	max		Class Percentage	Percent Cumulative
SILT/CLAY	Silt/Clay	0.000	0.062	2	2
SAND	Very fine	0.062	0.125		2
	Fine	0.125	0.250		2
	Medium	0.25	0.50		2
	Coarse	0.5	1.0		2
	Very Coarse	1.0	2.0	2	4
GRAVEL	Very Fine	2.0	2.8		4
	Very Fine	2.8	4.0		4
	Fine	4.0	5.6	2	6
	Fine	5.6	8.0		6
	Medium	8.0	11.0	2	8
	Medium	11.0	16.0		8
	Coarse	16.0	22.6	4	12
	Coarse	22.6	32	6	18
	Very Coarse	32	45	10	28
	Very Coarse	45	64	24	52
COBBLE	Small	64	90	26	78
	Small	90	128	10	88
	Large	128	180	7	95
	Large	180	256	5	100
BOULDER	Small	256	362		100
	Small	362	512		100
	Medium	512	1024		100
	Large/Very Large	1024	2048		100
BEDROCK	Bedrock	2048	>2048		100
		Total	100	100	100

Cross-Section 11	
Channel materials (mm)	
$D_{16} =$	28.5
$D_{35} =$	49.9
$D_{50} =$	62.1
$D_{84} =$	111.2
$D_{95} =$	180.0
$D_{100} =$	256.0

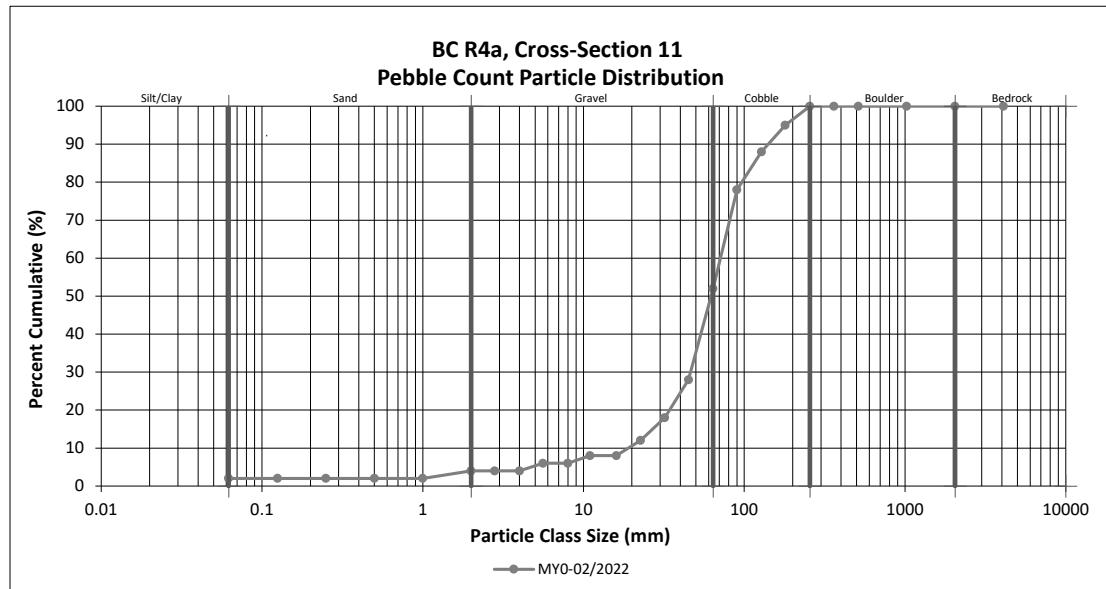

Riffle Pebble Count Plots

Banner Farm Mitigation Site


DMS Project No. 100062

Monitoring Year 0 - 2022

BC R4b, Cross-Section 12

Particle Class	Diameter (mm)		Riffle 100-Count	Summary	
	min	max		Class Percentage	Percent Cumulative
SILT/CLAY	Silt/Clay	0.000	0.062	20	20
SAND	Very fine	0.062	0.125	14	14
	Fine	0.125	0.250	31	31
	Medium	0.25	0.50		66
	Coarse	0.5	1.0		66
	Very Coarse	1.0	2.0		66
GRAVEL	Very Fine	2.0	2.8		66
	Very Fine	2.8	4.0		66
	Fine	4.0	5.6		66
	Fine	5.6	8.0		66
	Medium	8.0	11.0		66
	Medium	11.0	16.0		66
	Coarse	16.0	22.6	6	72
	Coarse	22.6	32	2	74
	Very Coarse	32	45		74
	Very Coarse	45	64	8	82
COBBLE	Small	64	90	4	4
	Small	90	128	4	4
	Large	128	180	10	10
	Large	180	256		100
BOULDER	Small	256	362		100
	Small	362	512		100
	Medium	512	1024		100
	Large/Very Large	1024	2048		100
BEDROCK	Bedrock	2048	>2048		100
		Total	99	100	100

Cross-Section 12	
Channel materials (mm)	
D ₁₆ =	Silt/Clay
D ₃₅ =	0.1
D ₅₀ =	0.2
D ₈₄ =	76.9
D ₉₅ =	152.0
D ₁₀₀ =	180.0

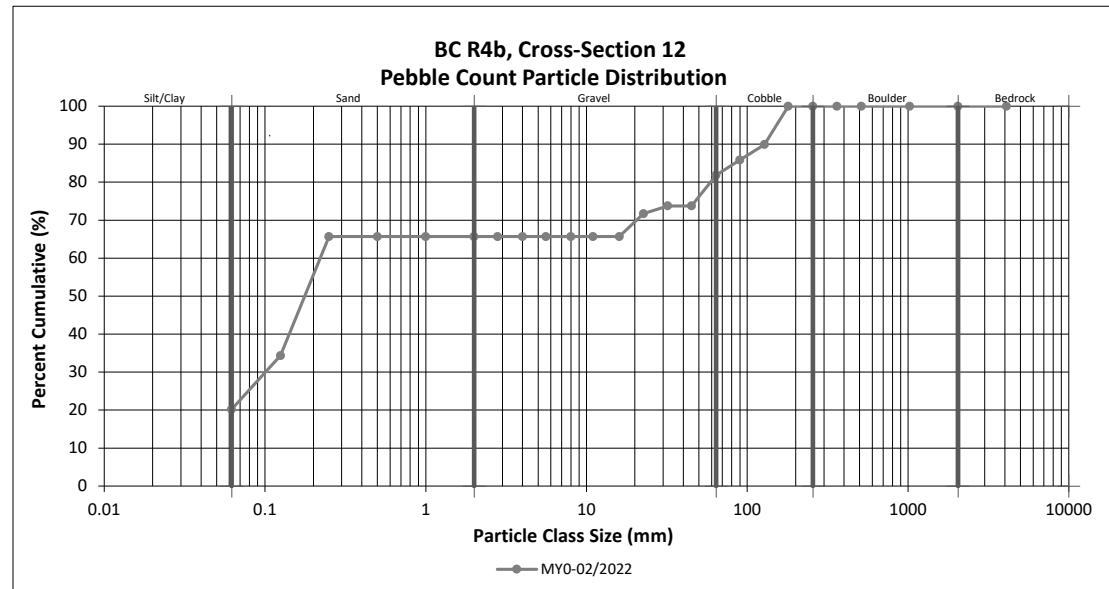

Riffle Pebble Count Plots

Banner Farm Mitigation Site


DMS Project No. 100062

Monitoring Year 0 - 2022

UT1, Cross-Section 14

Particle Class	Diameter (mm)		Riffle 100-Count	Summary	
	min	max		Class Percentage	Percent Cumulative
SILT/CLAY	Silt/Clay	0.000	0.062		0
SAND	Very fine	0.062	0.125		0
	Fine	0.125	0.250		0
	Medium	0.25	0.50		0
	Coarse	0.5	1.0		0
	Very Coarse	1.0	2.0		0
GRAVEL	Very Fine	2.0	2.8		0
	Very Fine	2.8	4.0		0
	Fine	4.0	5.6		0
	Fine	5.6	8.0		0
	Medium	8.0	11.0		0
	Medium	11.0	16.0		0
	Coarse	16.0	22.6		0
	Coarse	22.6	32	4	4
	Very Coarse	32	45	12	12
	Very Coarse	45	64	35	50
COBBLE	Small	64	90	30	30
	Small	90	128	16	16
	Large	128	180	2	2
	Large	180	256	2	2
BOULDER	Small	256	362		100
	Small	362	512		100
	Medium	512	1024		100
	Large/Very Large	1024	2048		100
BEDROCK	Bedrock	2048	>2048		100
		Total	101	100	100

Cross-Section 14	
Channel materials (mm)	
$D_{16} =$	45.1
$D_{35} =$	54.7
$D_{50} =$	63.7
$D_{84} =$	97.9
$D_{95} =$	125.1
$D_{100} =$	256.0

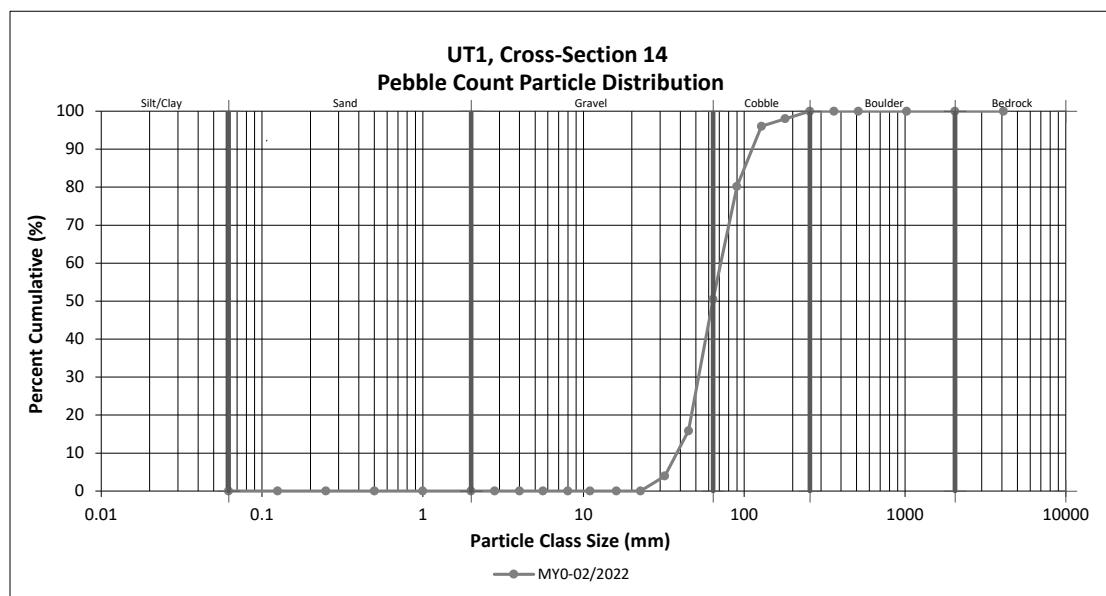

Riffle Pebble Count Plots

Banner Farm Mitigation Site


DMS Project No. 100062

Monitoring Year 0 - 2022

UT2, Cross-Section 15

Particle Class	Diameter (mm)		Riffle 100-Count	Summary	
	min	max		Class Percentage	Percent Cumulative
SILT/CLAY	Silt/Clay	0.000	0.062		0
SAND	Very fine	0.062	0.125		0
	Fine	0.125	0.250		0
	Medium	0.25	0.50		0
	Coarse	0.5	1.0		0
	Very Coarse	1.0	2.0		0
GRAVEL	Very Fine	2.0	2.8		0
	Very Fine	2.8	4.0		0
	Fine	4.0	5.6		0
	Fine	5.6	8.0		0
	Medium	8.0	11.0		0
	Medium	11.0	16.0		0
	Coarse	16.0	22.6		0
	Coarse	22.6	32		0
	Very Coarse	32	45	31	31
	Very Coarse	45	64	34	65
COBBLE	Small	64	90	25	25
	Small	90	128	6	6
	Large	128	180	2	2
	Large	180	256	1	1
BOULDER	Small	256	362	1	1
	Small	362	512		100
	Medium	512	1024		100
	Large/Very Large	1024	2048		100
BEDROCK	Bedrock	2048	>2048		100
		Total	100	100	100

Cross-Section 15	
Channel materials (mm)	
$D_{16} =$	38.2
$D_{35} =$	46.9
$D_{50} =$	54.8
$D_{84} =$	82.9
$D_{95} =$	120.7
$D_{100} =$	362.0

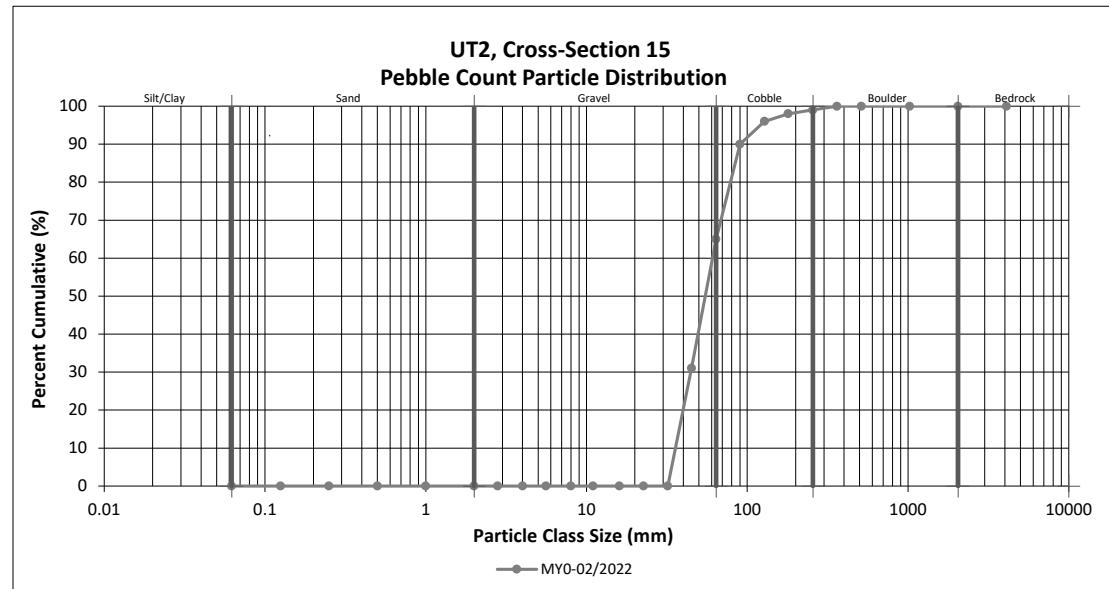

Riffle Pebble Count Plots

Banner Farm Mitigation Site


DMS Project No. 100062

Monitoring Year 0 - 2022

UT2, Cross-Section 17

Particle Class	Diameter (mm)		Riffle 100-Count	Summary	
	min	max		Class Percentage	Percent Cumulative
SILT/CLAY	Silt/Clay	0.000	0.062		0
SAND	Very fine	0.062	0.125		0
	Fine	0.125	0.250		0
	Medium	0.25	0.50		0
	Coarse	0.5	1.0		0
	Very Coarse	1.0	2.0		0
GRAVEL	Very Fine	2.0	2.8		0
	Very Fine	2.8	4.0	2	2
	Fine	4.0	5.6		2
	Fine	5.6	8.0		2
	Medium	8.0	11.0		2
	Medium	11.0	16.0		2
	Coarse	16.0	22.6	1	3
	Coarse	22.6	32	6	9
	Very Coarse	32	45	18	27
	Very Coarse	45	64	26	53
COBBLE	Small	64	90	26	26
	Small	90	128	21	21
	Large	128	180		100
	Large	180	256		100
BOULDER	Small	256	362		100
	Small	362	512		100
	Medium	512	1024		100
	Large/Very Large	1024	2048		100
BEDROCK	Bedrock	2048	>2048		100
		Total	100	100	100

Cross-Section 17	
Channel materials (mm)	
$D_{16} =$	36.5
$D_{35} =$	50.2
$D_{50} =$	61.5
$D_{84} =$	97.9
$D_{95} =$	117.7
$D_{100} =$	128.0

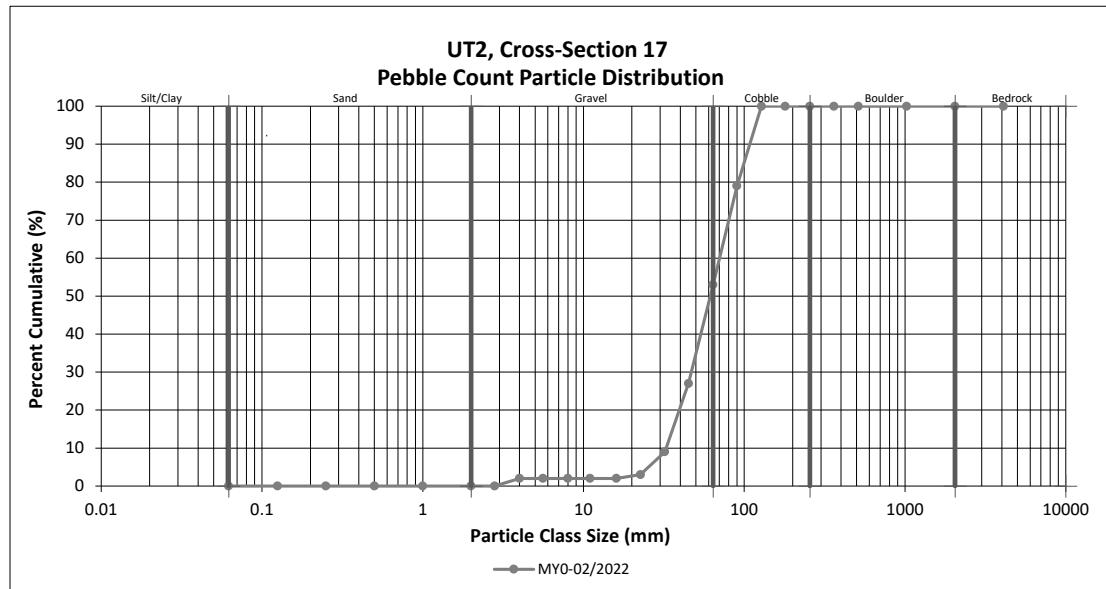

Riffle Pebble Count Plots

Banner Farm Mitigation Site


DMS Project No. 100062

Monitoring Year 0 - 2022

UT2, Cross-Section 19

Particle Class	Diameter (mm)		Riffle 100-Count	Summary	
	min	max		Class Percentage	Percent Cumulative
SILT/CLAY	Silt/Clay	0.000	0.062		0
SAND	Very fine	0.062	0.125		0
	Fine	0.125	0.250		0
	Medium	0.25	0.50		0
	Coarse	0.5	1.0		0
	Very Coarse	1.0	2.0		0
GRAVEL	Very Fine	2.0	2.8		0
	Very Fine	2.8	4.0		0
	Fine	4.0	5.6	2	2
	Fine	5.6	8.0		2
	Medium	8.0	11.0		2
	Medium	11.0	16.0		2
	Coarse	16.0	22.6		2
	Coarse	22.6	32	6	8
	Very Coarse	32	45	22	30
	Very Coarse	45	64	30	60
COBBLE	Small	64	90	22	22
	Small	90	128	16	16
	Large	128	180	1	1
	Large	180	256		99
BOULDER	Small	256	362	1	1
	Small	362	512		100
	Medium	512	1024		100
	Large/Very Large	1024	2048		100
BEDROCK	Bedrock	2048	>2048		100
		Total	100	100	100

Cross-Section 19	
Channel materials (mm)	
$D_{16} =$	36.2
$D_{35} =$	47.7
$D_{50} =$	56.9
$D_{84} =$	94.1
$D_{95} =$	119.8
$D_{100} =$	362.0

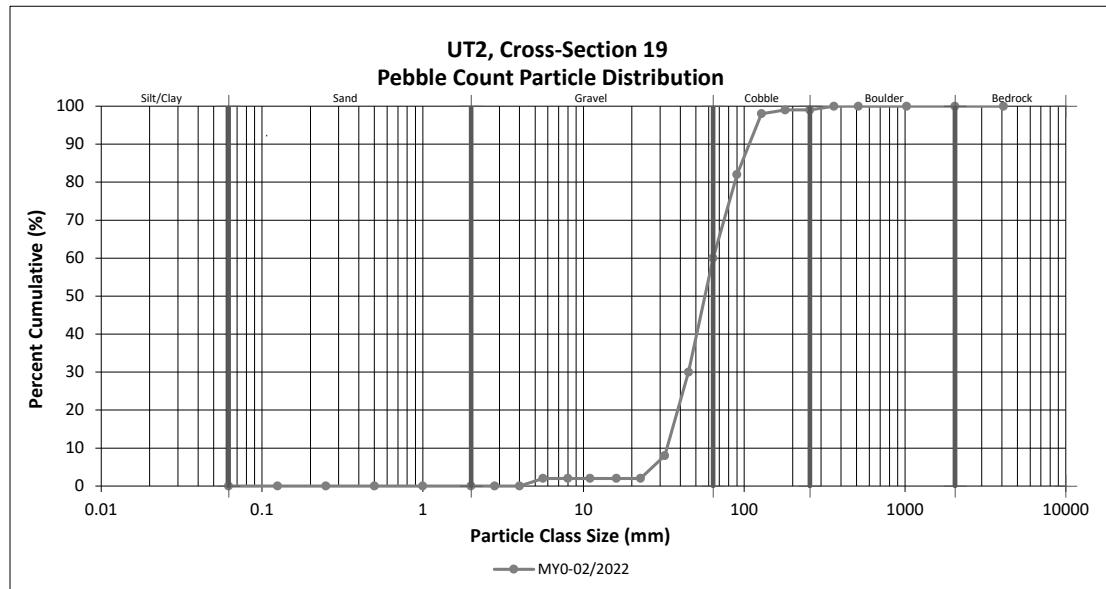

APPENDIX D. Project Timeline and Contact Information

Table 10. Project Activity and Reporting History

Banner Farm Mitigation Site

DMS Project No. 100062

Monitoring Year 0 - 2022

Activity or Deliverable		Data Collection Complete	Task Completion or Deliverable Submission
Project Instituted		N/A	April 2018
Mitigation Plan Approved		June 2020	June 2020
Construction (Grading) Completed		N/A	November 2021
Planting Completed		N/A	February 2022
As-Built Survey Completed		February 2022	February 2022
Baseline Monitoring Document (Year 0)	Stream Survey	February - March 2022	April 2022
	Vegetation Survey	February 2022	
Year 1 Monitoring	Stream Survey		
	Vegetation Survey		
Year 2 Monitoring	Stream Survey		
	Vegetation Survey		
Year 3 Monitoring	Stream Survey		
	Vegetation Survey		
Year 4 Monitoring			
Year 5 Monitoring	Stream Survey		
	Vegetation Survey		
Year 6 Monitoring			
Year 7 Monitoring	Stream Survey		
	Vegetation Survey		

Table 11. Project Contact Table

Banner Farm Mitigation Site

DMS Project No. 100062

Monitoring Year 0 - 2022

Designer Eric Neuhaus, PE	Wildlands Engineering, Inc. 167-B Haywood Rd. Asheville, NC 28806 828-774-5547
Construction Contractor	Main Stream Earthwork, Inc. 631 Camp Dan Valley Rd Reidsville, NC 27320
Monitoring Performers Monitoring, POC	Wildlands Engineering, Inc. Kristi Suggs 704-332-7754 x 110



To: DMS Technical Workgroup, DMS operations staff
From: Periann Russell, Division of Mitigation Services (DMS)
RE: Pebble count data requirements
Date: October 19, 2021

The DMS Technical Work Group met September 29, 2021 to discuss Interagency Review Team (IRT) and DMS requirements for collecting pebble count data as part of monitoring (MY0-MYx). Agreement was reached between all attending parties that pebble count data will not be required during the monitoring period for all future projects.

Sediment data and particle distribution will still be required for the mitigation plan as part of the proposed design explanation and justification.

Pebble counts and/or particle distributions currently being conducted by providers for annual monitoring may be discontinued at the discretion of the DMS project manager. If particle distribution was listed as a performance standard in the project mitigation plan, the provider is required to communicate the intent to cease data collection with the DMS project manager. The absence of pebble count data in future monitoring reports where pebble count data was listed as part of monitoring in the mitigation plan must be documented in the monitoring report. The September 29, 2021 Technical Work Group meeting may be cited as the source of the new policy.

The IRT reserves the right to request pebble count data/particle distributions if deemed necessary during the monitoring period.

Kristi Suggs

From: Reid, Matthew <matthew.reid@ncdenr.gov>
Sent: Wednesday, October 27, 2021 1:26 PM
To: Kristi Suggs
Cc: Mimi Caddell
Subject: RE: [External] FW: Pebble Count Data Requirements

I am absolutely OK with not doing pebble counts anymore!

As stated in the memo, please add a statement in the monitoring reports citing the policy.

Thanks!

Matthew Reid

Project Manager – Western Region
North Carolina Department of Environmental Quality
Division of Mitigation Services

828-231-7912 Mobile
matthew.reid@ncdenr.gov

Western DMS Field Office
5 Ravenscroft Dr
Suite 102
Asheville, NC 28801



Email correspondence to and from this address is subject to the North Carolina Public Records Law and may be disclosed to third parties.

From: Kristi Suggs [mailto:ksuggs@wildlandseng.com]
Sent: Wednesday, October 27, 2021 1:24 PM
To: Reid, Matthew <matthew.reid@ncdenr.gov>
Cc: Mimi Caddell <mcaddell@wildlandseng.com>
Subject: [External] FW: Pebble Count Data Requirements

CAUTION: External email. Do not click links or open attachments unless you verify. Send all suspicious email as an attachment to [Report Spam](#).

Matthew,

Jason Lorch in our Raleigh Office forwarded this meeting memo to me. It says that conducting pebble counts for DMS monitoring (MY0 – MY7) projects is no longer needed as long as it has been okayed by the DMS PM. Moving forward, are you going to allow us to stop doing them on your projects? If so, will DBB projects be treated the same? Please let me know. Thank you!

Kristi

Kristi Suggs | Senior Environmental Scientist
O: 704.332.7754 x110 M: 704.579.4828

Wildlands Engineering, Inc.

1430 S. Mint St, Suite 104

Charlotte, NC 28203

From: Jason Lorch <jlorch@wildlandseng.com>

Sent: Monday, October 25, 2021 9:05 AM

To: Kristi Suggs <ksuggs@wildlandseng.com>

Subject: FW: Pebble Count Data Requirements

FYI!

Jason Lorch, GISP | Senior Environmental Scientist

O: 919.851.9986 x107 M: 919.413.1214

Wildlands Engineering, Inc.

312 West Millbrook Road, Suite 225

Raleigh, NC 27609

From: Russell, Periann <periann.russell@ncdenr.gov>

Sent: Thursday, October 21, 2021 10:05 AM

To: King, Scott <Scott.King@mbakerintl.com>; Catherine Manner <catherine@waterlandsolutions.com>; Tugwell, Todd J CIV USARMY CESAW (US) <Todd.J.Tugwell@usace.army.mil>; adam.spiller@kci.com; Brad Breslow <bbreslow@res.us>; Davis, Erin B <erin.davis@ncdenr.gov>; gginn@wolfcreekeng.com; grant lewis <glewis@axiomenvironmental.org>; Jeff Keaton <jkeaton@wildlandseng.com>; katie mckeithan <Katie.McKeithan@mbakerintl.com>; Kayne Van Stell <kayne@waterlandsolutions.com>; Kevin Tweedy <ktweedy@eprusa.net>; Reid, Matthew <matthew.reid@ncdenr.gov>; Ryan Smith <rsmith@lmggroup.net>; Melia, Gregory <gregory.melia@ncdenr.gov>; Allen, Melonie <melonie.allen@ncdenr.gov>; Famularo, Joseph T <Joseph.Famularo@ncdenr.gov>; Rich@mogmit.com; Bryan Dick <Bryan.Dick@freese.com>; Ryan Medric <rmedric@res.us>; Kim Browning <Kimberly.D.Browning@usace.army.mil>; Kayne Van Stell <kayne@waterlandsolutions.com>; Worth Creech <worth@restorationsystems.com>; Jason Lorch <jlorch@wildlandseng.com>

Cc: Crocker, Lindsay <Lindsay.Crocker@ncdenr.gov>; Wiesner, Paul <paul.wiesner@ncdenr.gov>; Tsomides, Harry <harry.tsomides@ncdenr.gov>; Reid, Matthew <matthew.reid@ncdenr.gov>; Dow, Jeremiah J <jeremiah.dow@ncdenr.gov>; Horton, Jeffrey <jeffrey.horton@ncdenr.gov>; Ullman, Kirsten J <Kirsten.Ullman@NCDENR.gov>; Ackerman, Anjie <anjie.ackerman@ncdenr.gov>; Blackwell, Jamie D <james.blackwell@ncdenr.gov>; Xu, Lin <lin.xu@ncdenr.gov>; Mir, Danielle <Danielle.Mir@ncdenr.gov>; Corson, Kristie <kristie.corson@ncdenr.gov>; Russell, Periann <periann.russell@ncdenr.gov>; Sparks, Kimberly L <Kim.sparks@ncdenr.gov>

Subject: Pebble Count Data Requirements

Please review the attached memo documenting the agreed upon policy for pebble count data requirements.

Please reply (me only) to this email if accept that this memo represents (or misrepresents) our discussion on Sept 29.

Thank you.

Periann Russell
Geomorphologist
Division of Mitigation Services, Science and Analysis
NC Department of Environmental Quality

919 707 8306 office
919 208 1426 mobile

periann.russell@ncdenr.gov

Mailing: 1652 Mail Service Center Raleigh, NC 27699-1652

Physical: 217 West Jones Street Raleigh, NC 27603

APPENDIX E. Record Drawings and Sealed As-Built Survey


Banner Farm Mitigation Site Record Drawings

Henderson County, North Carolina

for

NCDEQ

Division of Mitigation Services

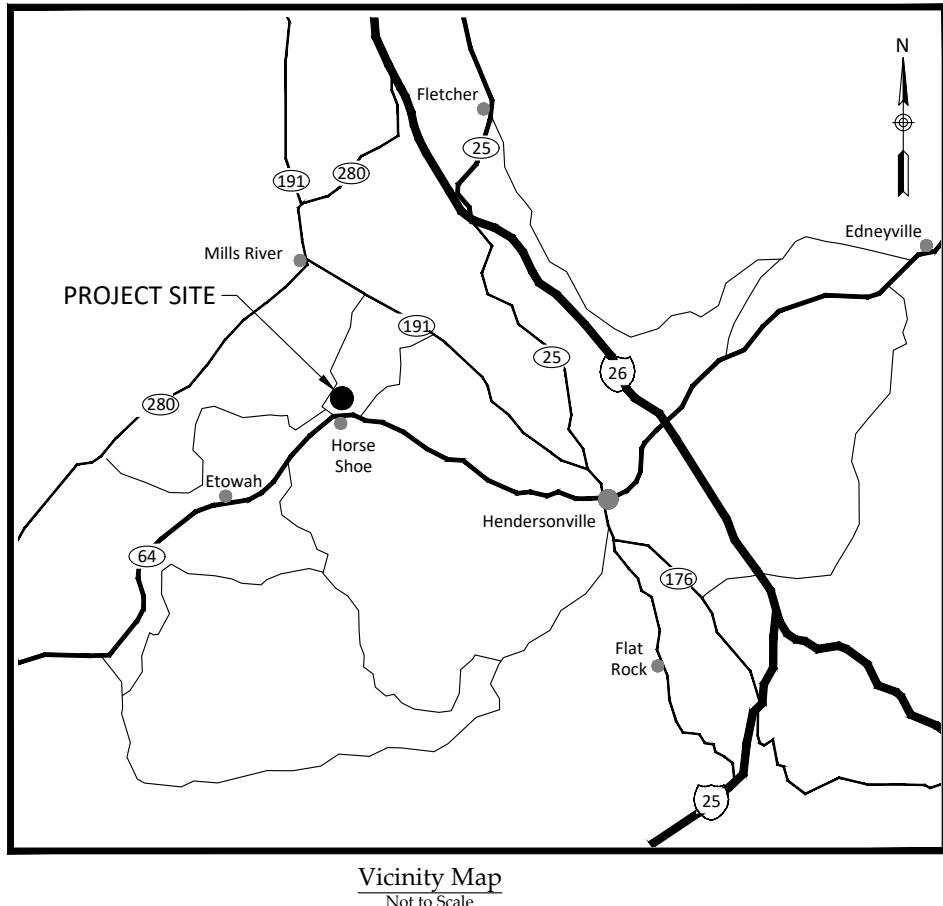

RECORD DRAWINGS ISSUED
APRIL 18, 2022

Sheet Index

Title Sheet	0.1
Project Overview	0.2
General Notes and Symbols	0.3
Stream Plan and Profile	
Banner Creek	1.1.1-1.1.9
UT 1	1.2.1-1.2.3
UT 2	1.3.1-1.3.4
Wetland Grading Plan	2.1-2.5
Planting	3.1-3.5

Project Directory


Engineering:
Wildlands Engineering, Inc
License No. F-0831
167-B Haywood Road
Asheville, NC 28806
Eric Neuhaus, PE
865-207-8835

Surveying:
Kee Mapping and Surveying
P.O. Box 2566
Asheville, NC 28802
Brad Kee, PLS
828-575-9021

Owner:
NCDEQ
Division of Mitigation Services
1652 Mail Service Center
Raleigh, NC 27699
Matthew Reid
828-231-7912

DMS Project No. 100062
French Broad River Basin
HUC 06010105
NCDWR#: 20181032
USACE Action ID:
SAW-2018-01153


WILDLANDS
ENGINEERING
167-B Haywood Road
Asheville, NC 28806
Tel: 828.774.5547
Fax: 828.332.3306
Firm license No. F-0831

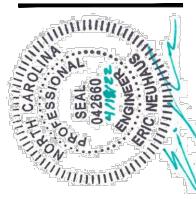

Banner Farm Mitigation Site Record Drawings
Henderson County, North Carolina

Title Sheet

04-18-22	W021752	Revision:	
Date:	Job Number:	Project Engineer:	
		Drawn By:	
		Checked By:	
0.1			

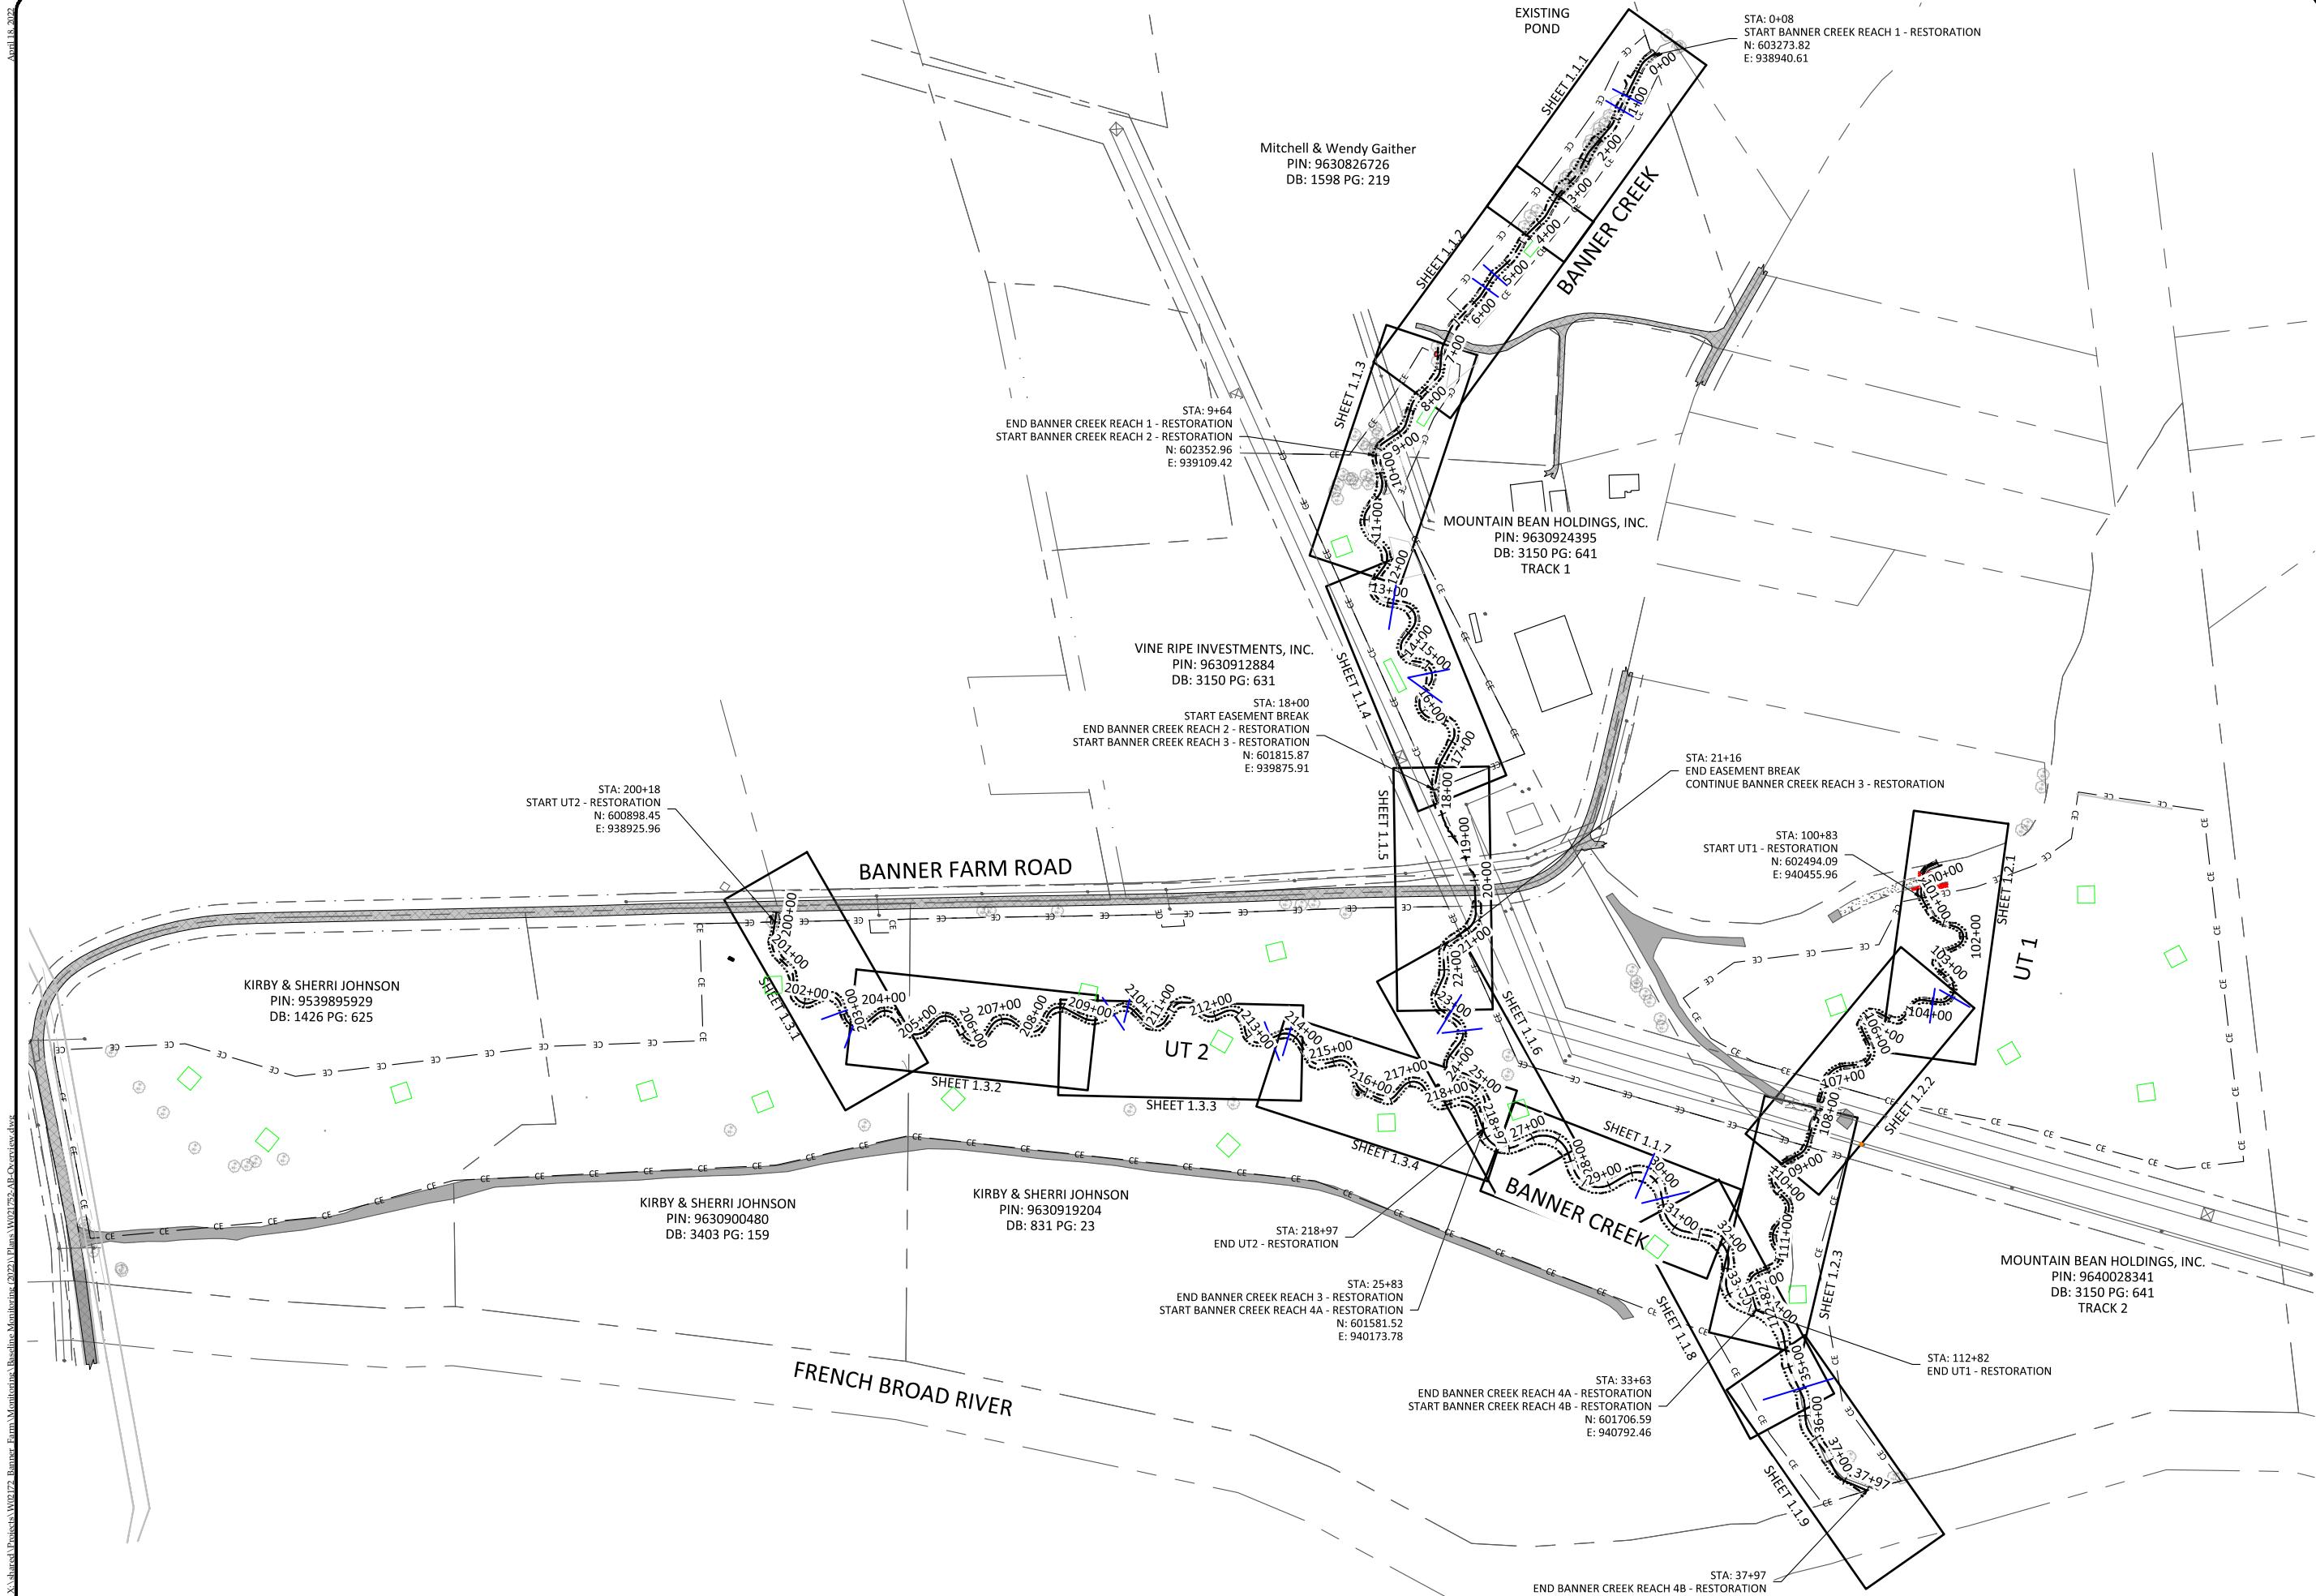

Project Overview

04-18-22

W02172

Revision:

EN JH JK

Banner Farm Mitigation Site Record Drawings

Henderson County, North Carolina

0.2


Date: 04-18-22

Job Number: W02172






Project Engineer: EN

Drawn By: JH



Checked By: JK

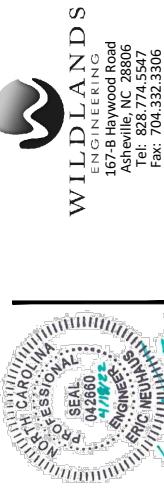







Pre-construction Features

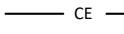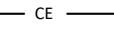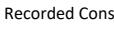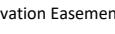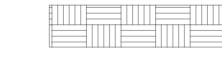-  CE Recorded Conservation Easement
-  Pre-construction Property Boundary
-  Pre-construction Overhead Wire/Utility
-  Pre-construction Utility Right-of-Way
-  Pre-construction Road Right-of-Way
-  Pre-construction Pole/Utility Tower/Guy Wire
-  Pre-construction tree
-  Pre-construction Jurisdictionally Delineated Wetlands
-  Pre-construction Asphalt Roads

Design Features

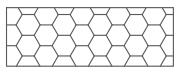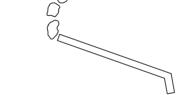- 10+00 Stream Design Alignment
 100 Design Grading Contour 5' Major
 Design Grading Contour 1' Major
 Design Bankfull
 Design Culvert
-  Design Brush Toe
 Design Riffle
 Design Log Sill
 Design Rock Sill
 Design Log J-Hook
 Design Cover Log

As-Built Features

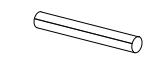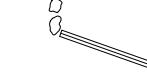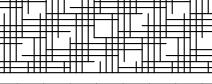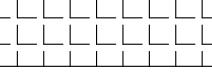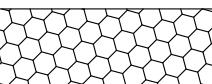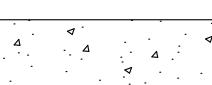- As-Built Thalweg
 As-Built Bankfull
 100 As-Built Major Contour
 As-Built Minor Contour
 > As-Built Cross Section
 As-Built Culvert
-  As-Built Log Sill
 As-Built Rock Sill
 As-Built Log J-Hook
 As-Built Cover Log
-  As-Built Brush Toe
 As-Built Boulder Toe
 As-Built Riffle
 As-Built Crossing
 As-Built Soil Bed Farm Road

Monitoring Features

- VEG VP# VEG
 VEG CG# VEG
 VEG GWG# VEG
 VEG BT# VEG
 VEG PP# VEG
- As-Built Vegetation Monitoring Plot
 Crest Gage
 Groundwater Gage
 Barotroll
 Photo Point

Banner Farm Mitigation Site Record Drawings
 Henderson County, North Carolina


General Notes and Symbols

Date:	04-18-22	Revisions:	
Job Number:	W021752		
Project Engineer:	JH		
Drawn By:	JK		
Checked By:			

0.3

NOTE:
 Deviations shown in red.

WILL DLANDS
 ENGINEERING
 167-B Hawwood Road
 Asheville, NC 28806
 Tel: 828.771.5547
 Fax: 704.332.3306
 Firm License No. F-0831

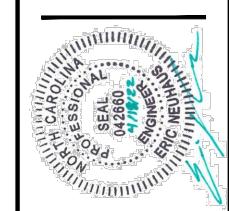




Banner Farm Mitigation Site Record Drawings
Henderson County, North Carolina

Stream Plan and Profile
Banner Creek

1.1.1

Sheet

WILDLANDS
ENGINEERING
167-B Hawwood Road
Asheville, NC 28806
Tel: 828.774.5547
Fax: 828.332.3306
Firm license No. E-0831

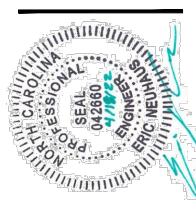

0' 2' 4' 6'
(VERTICAL)



0' 20' 40' 60'
(HORIZONTAL)



Sheet Index

Revision:	
04-18-22	
W021752	
EN	
JH	
JK	

Date:	
Job Number:	
Project Engineer:	
Drawn By:	
Checked By:	

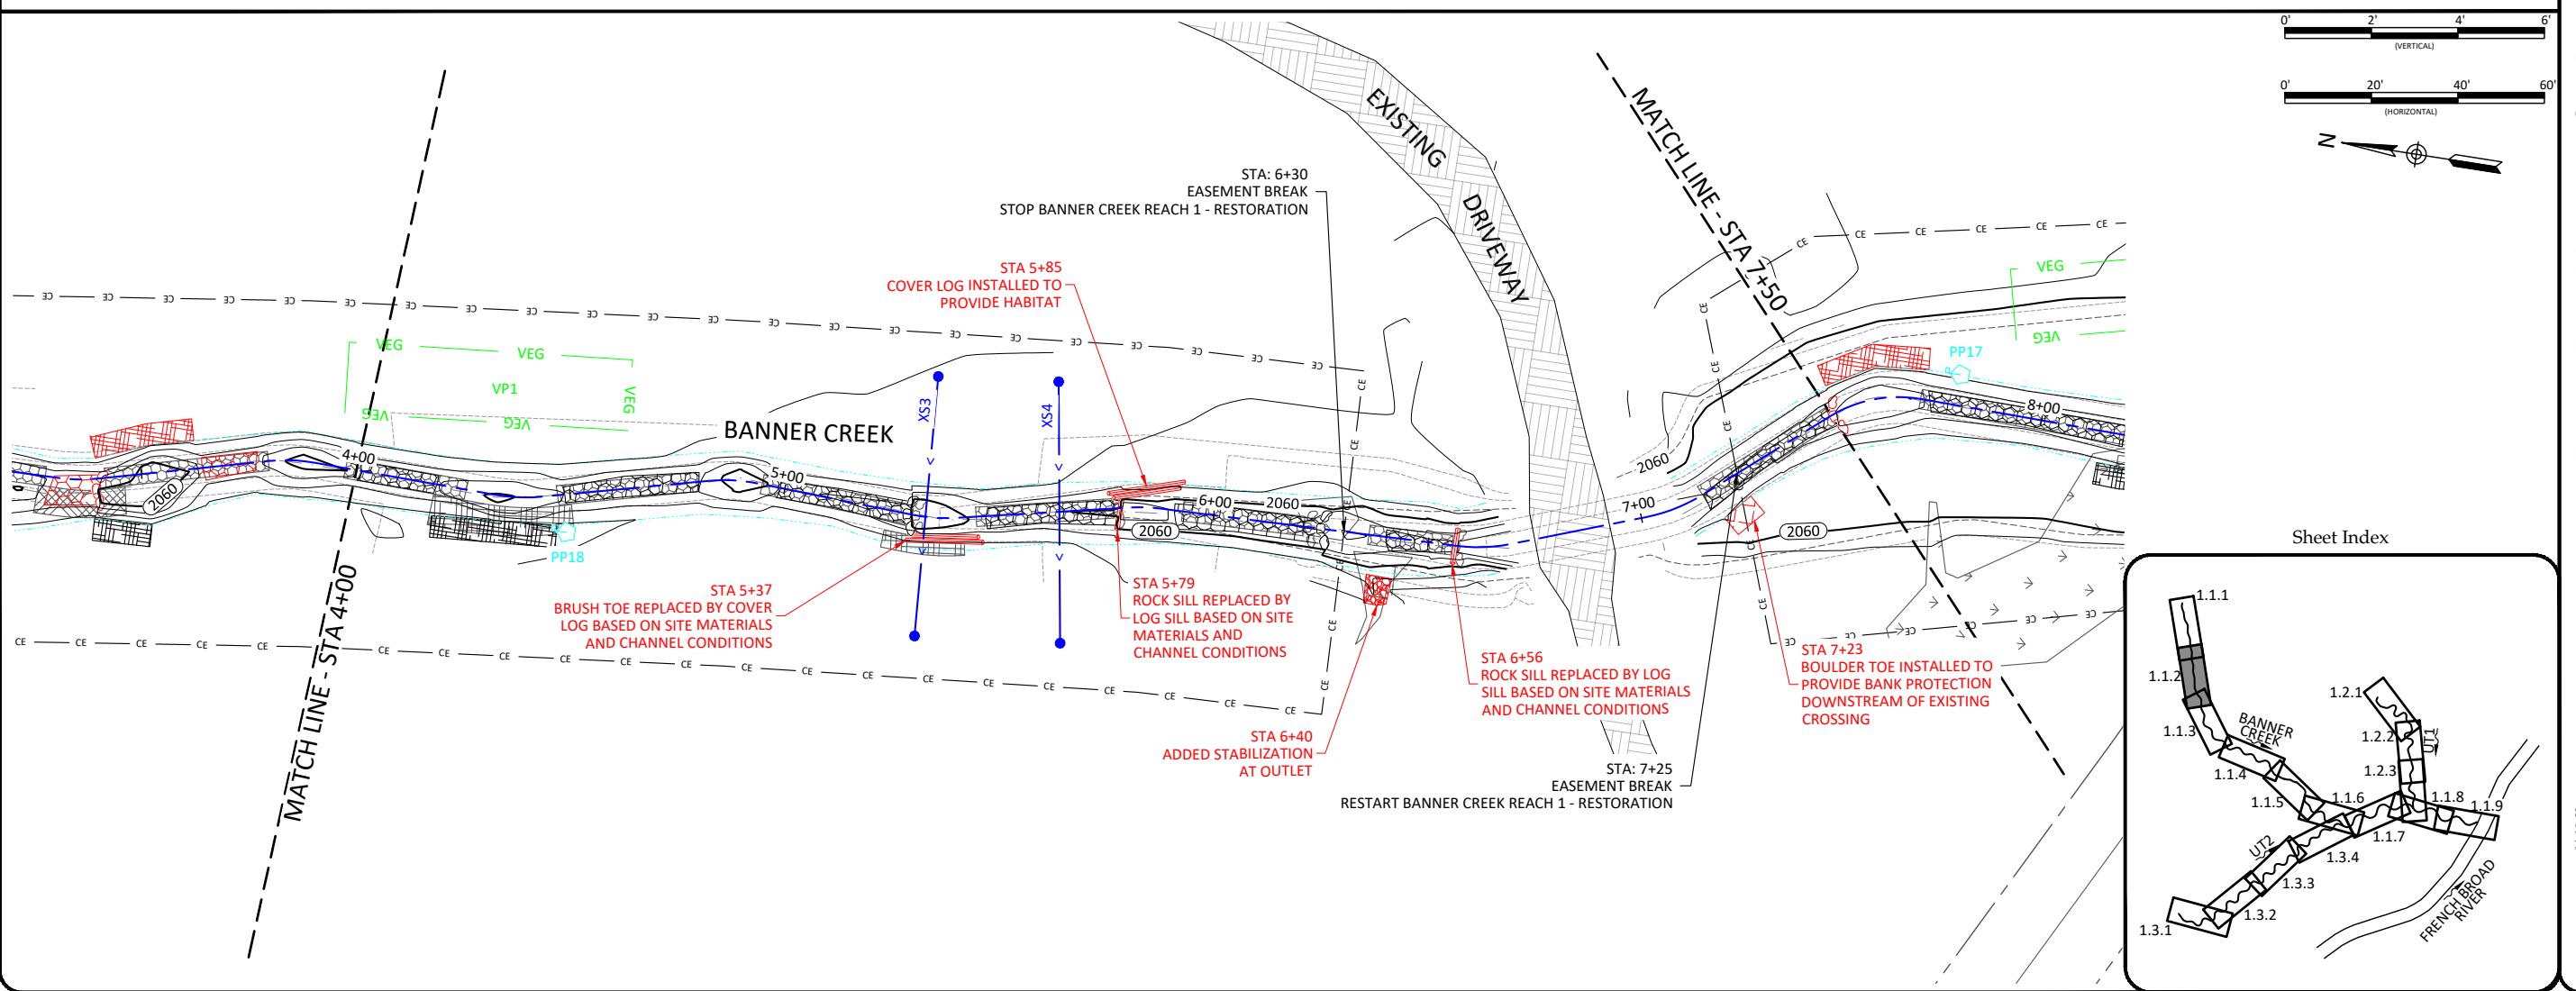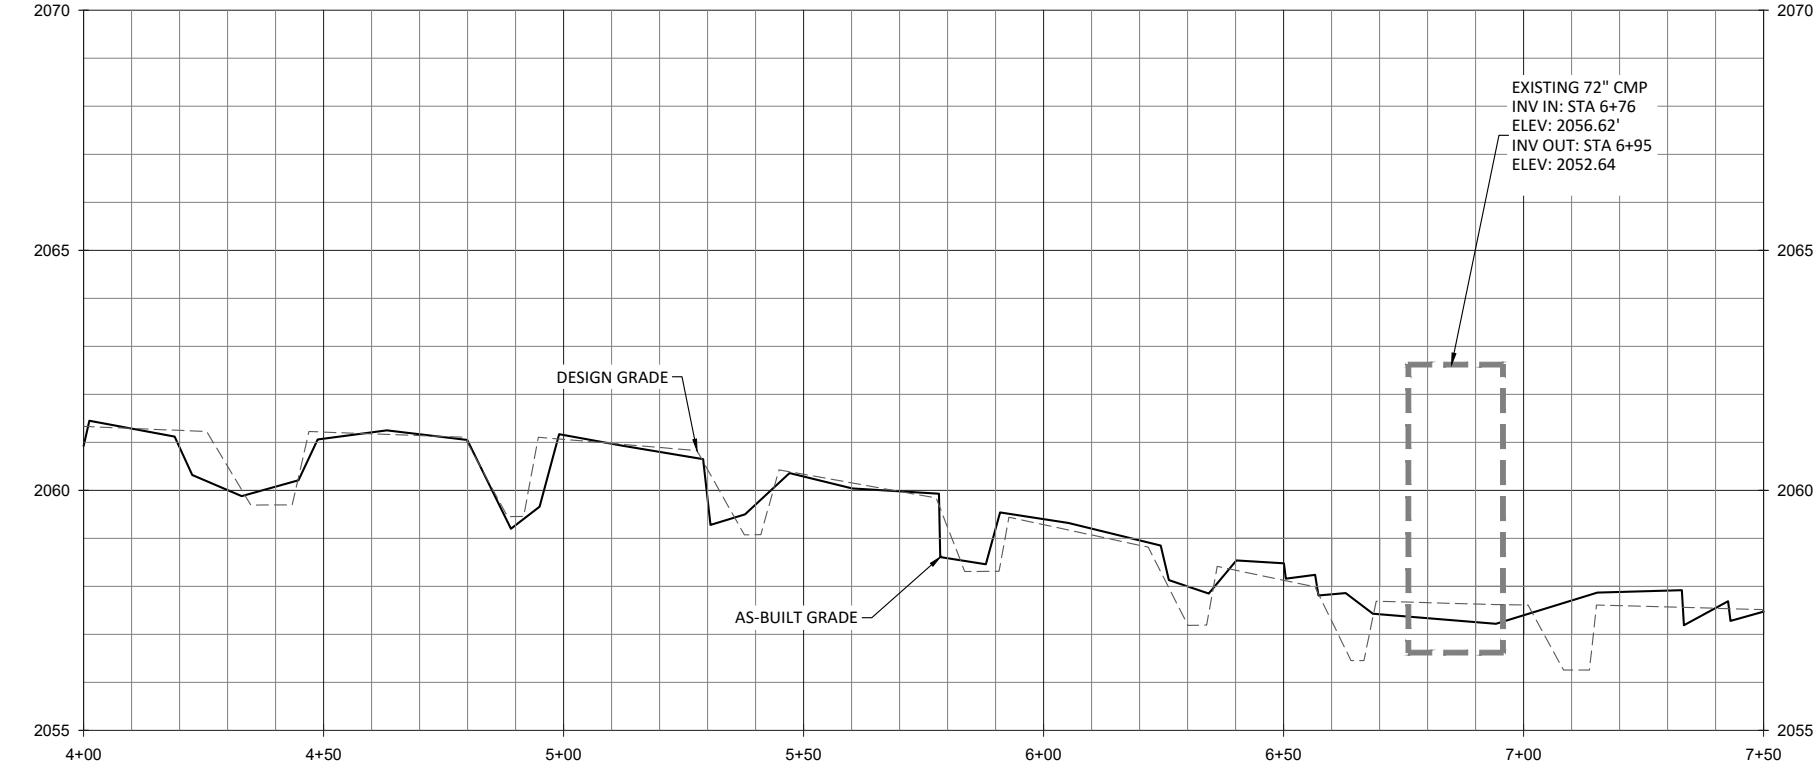

Banner Farm Mitigation Site Record Drawings

Henderson County, North Carolina

WILD LANDS
ENGINEERING
167-B Hawwood Road
Asheville, NC 28806
Tel: 828.774.5547
Fax: 828.332.3306
Firm license No. E-0831

04/18/22
W02172




EN

JH

JK


1.1.2

Sheet

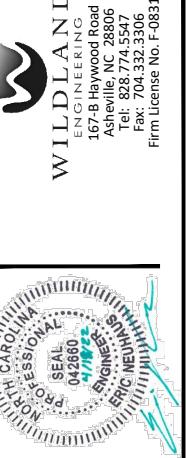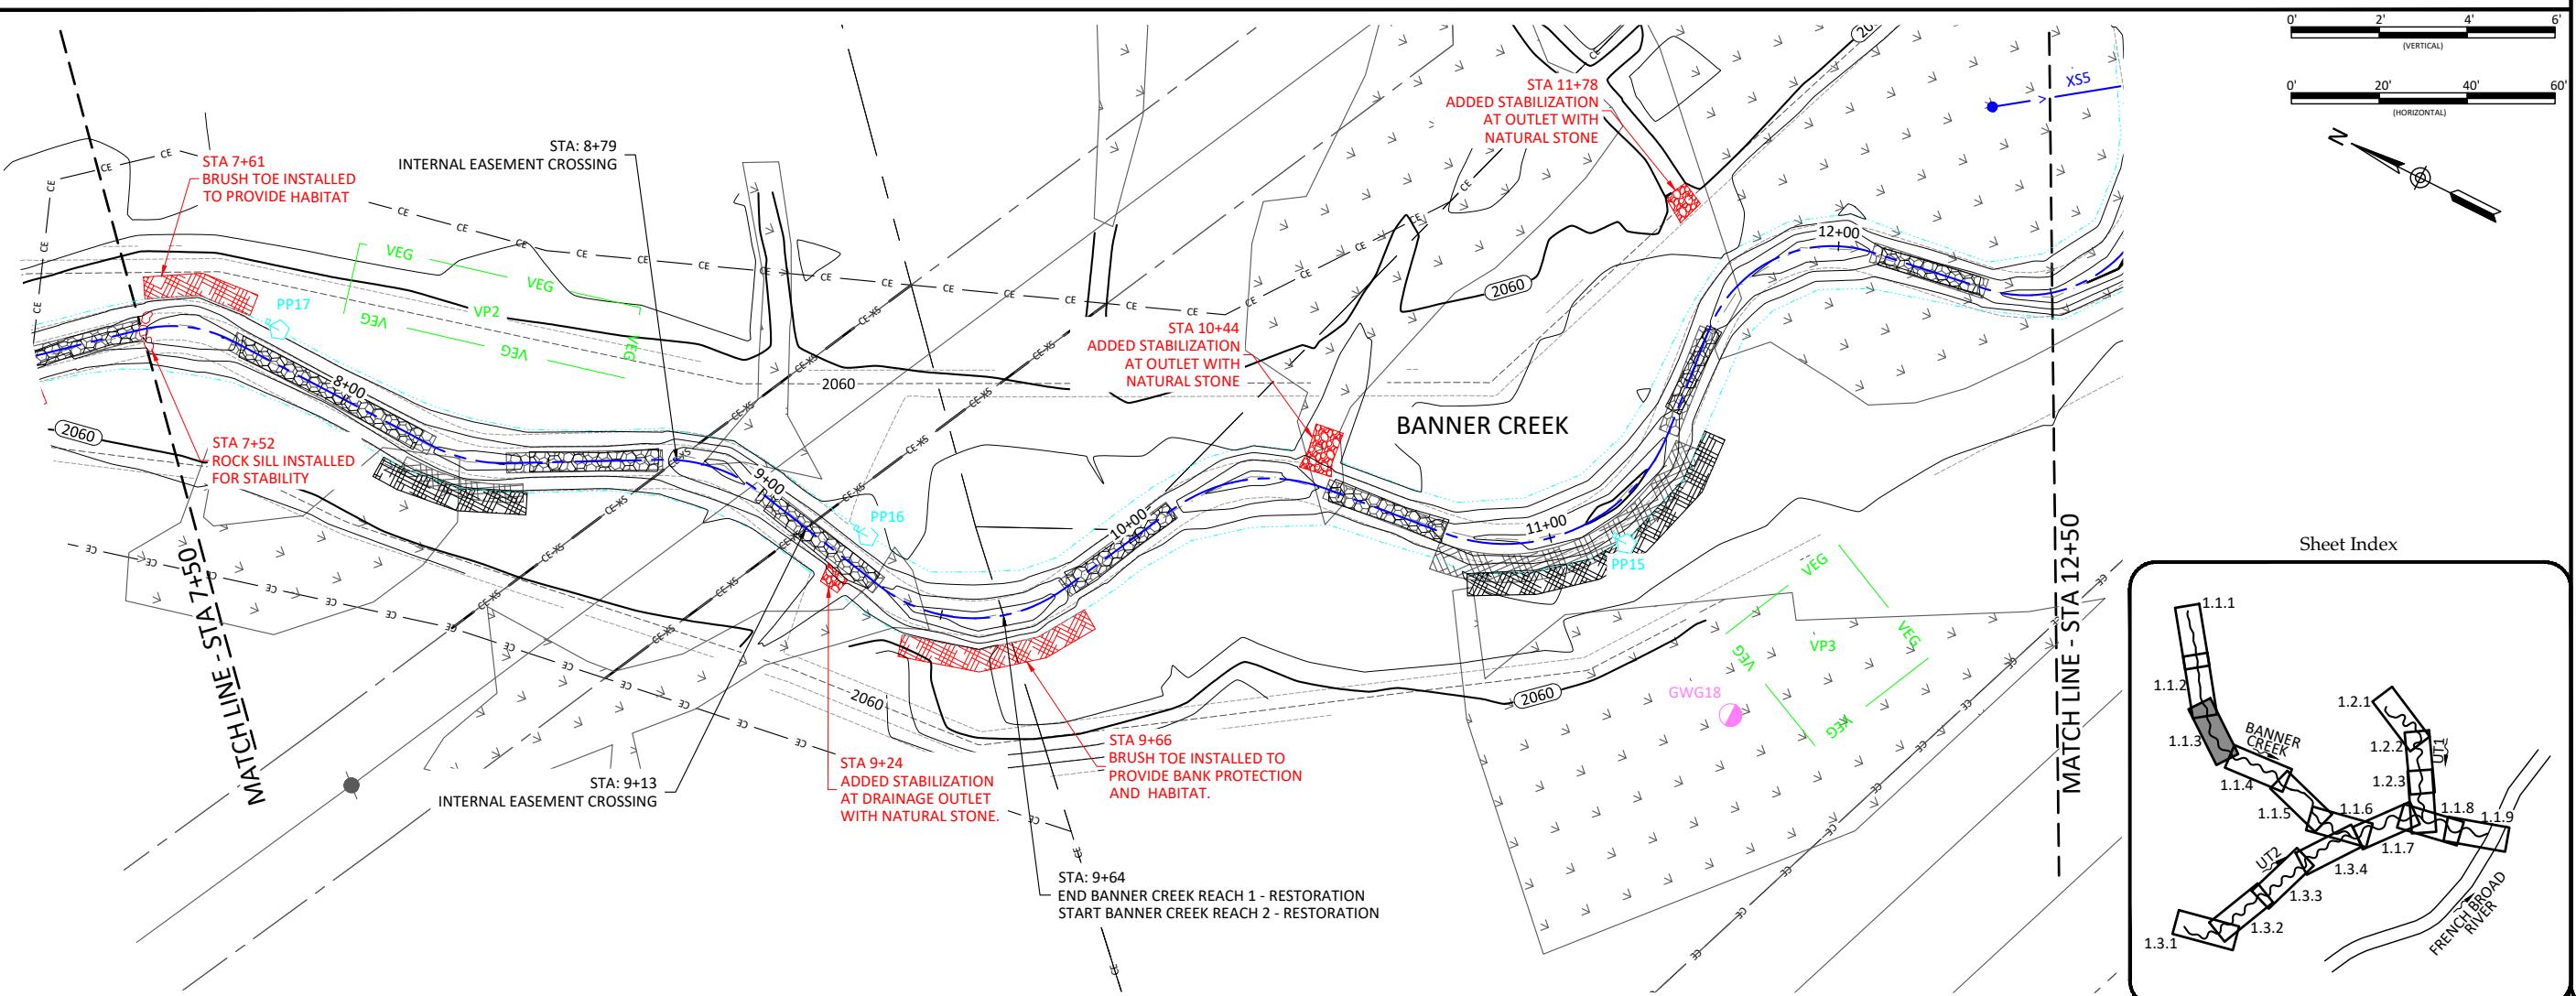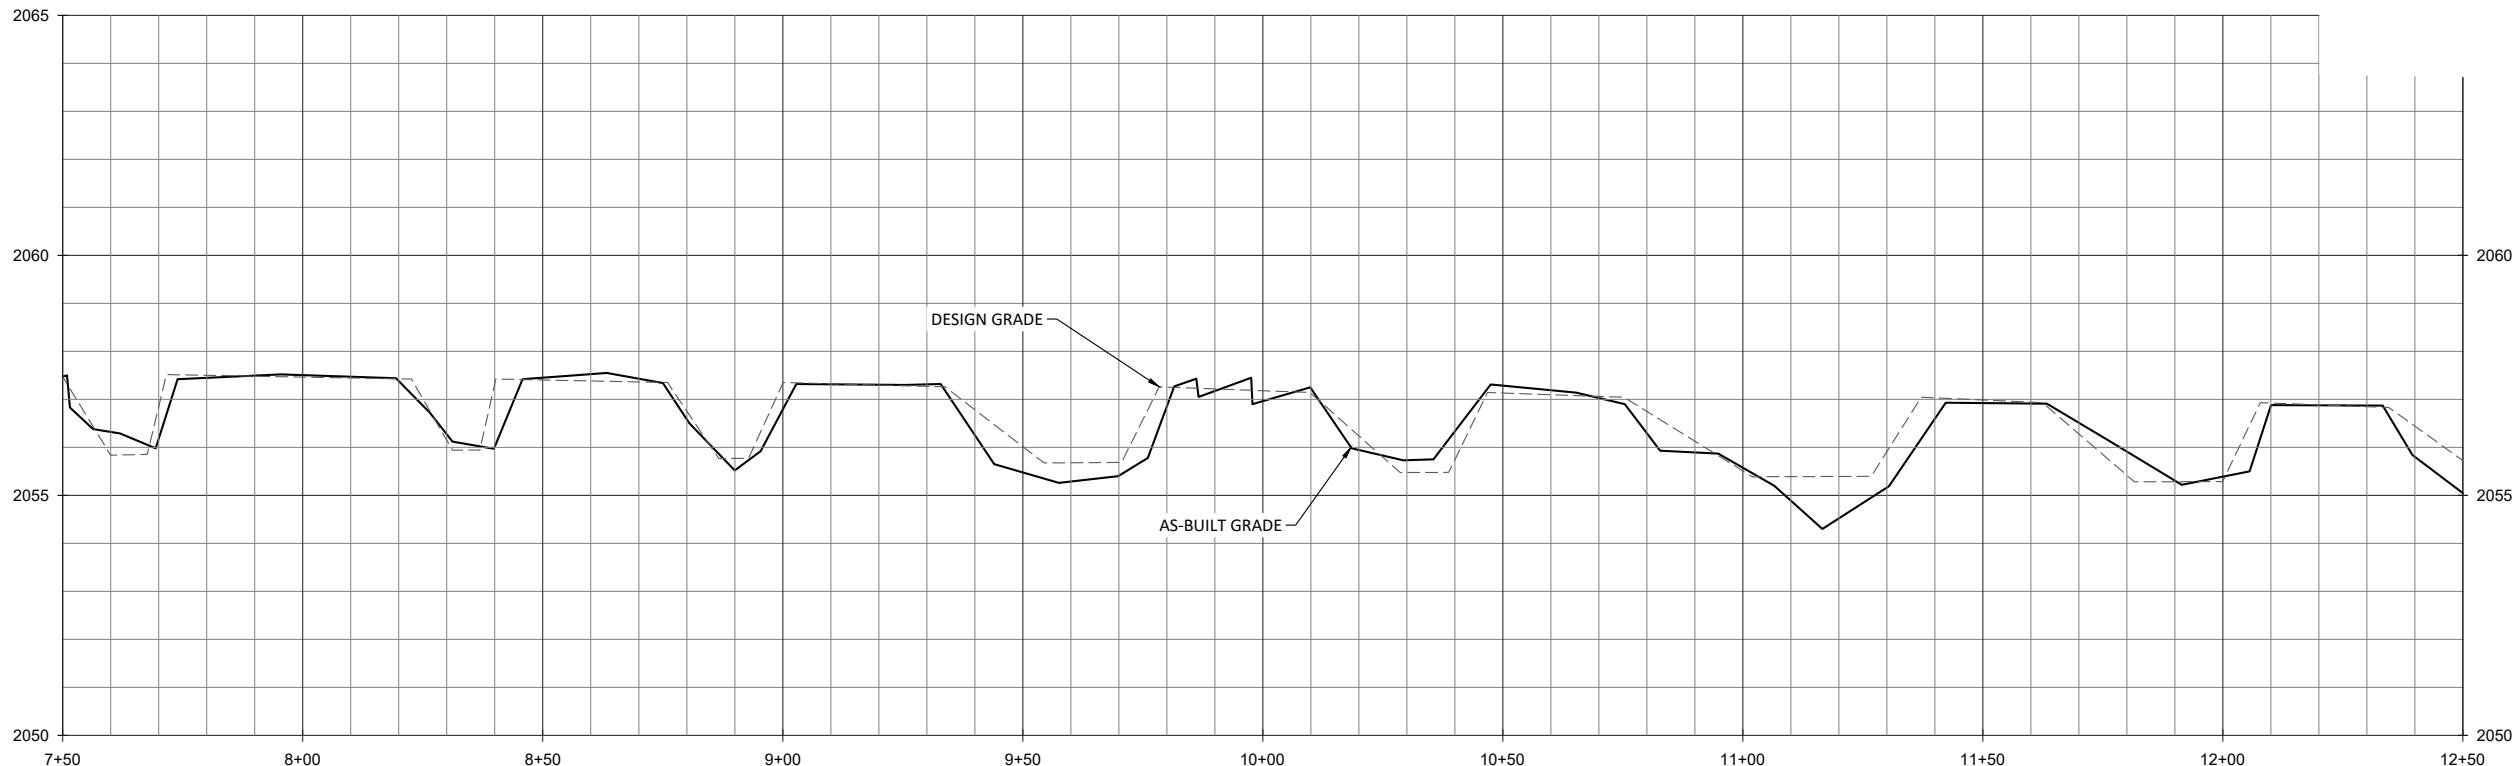


Banner Farm Mitigation Site Record Drawings
Henderson County, North Carolina

Stream Plan and Profile
Banner Creek

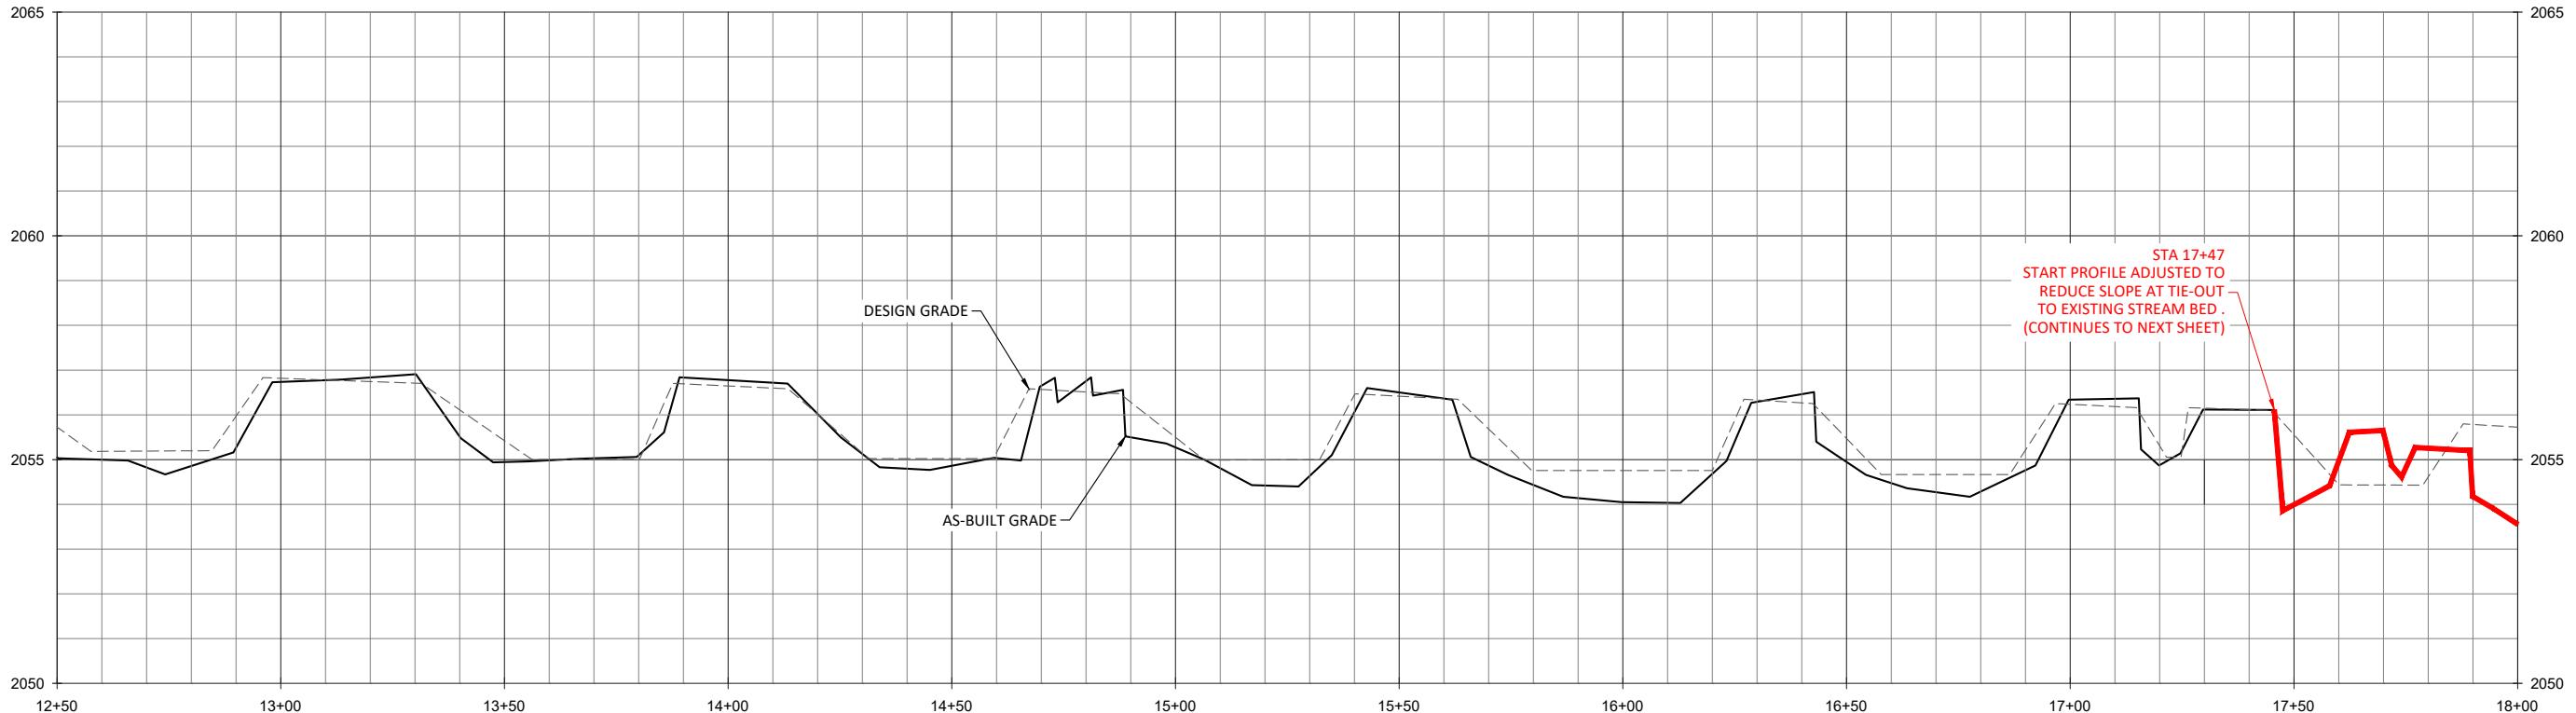

Stream Plan and Profile
Banner Creek

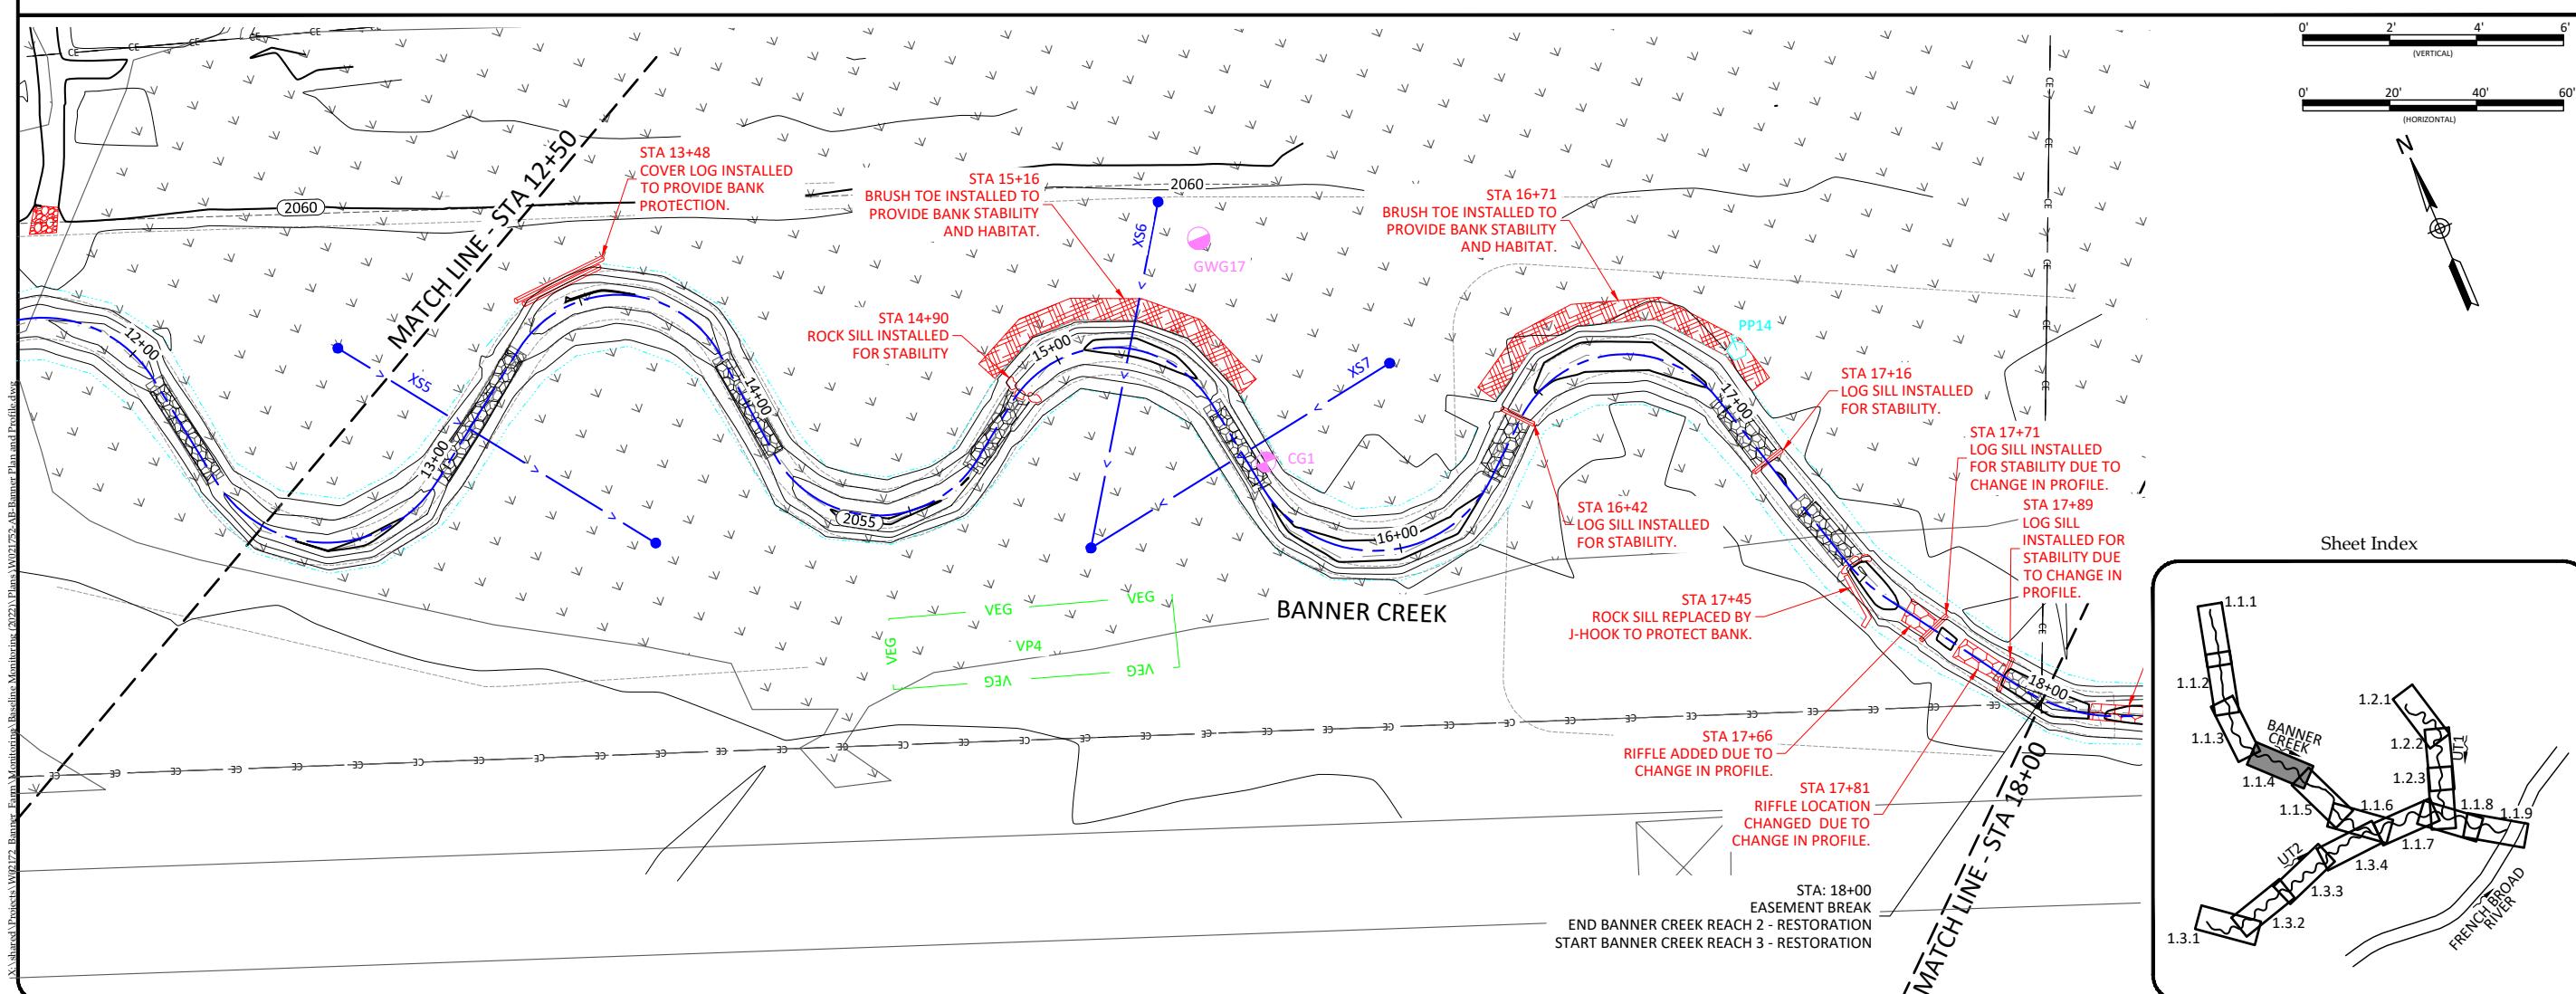




Banner Farm Mitigation Site Record Drawings
Henderson County, North Carolina

Date:	04-18-22
Job Number:	W021752
Project Engineer:	EN
Drawn By:	JH
Checked By:	JK

1.1.4

WILDLANDS
ENGINEERING
167-B Hawwood Road
Asheville, NC 28806
Tel: 828.774.5547
Fax: 828.332.3306
Firm license No. E-0831

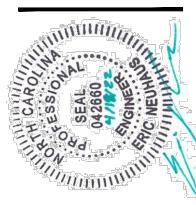

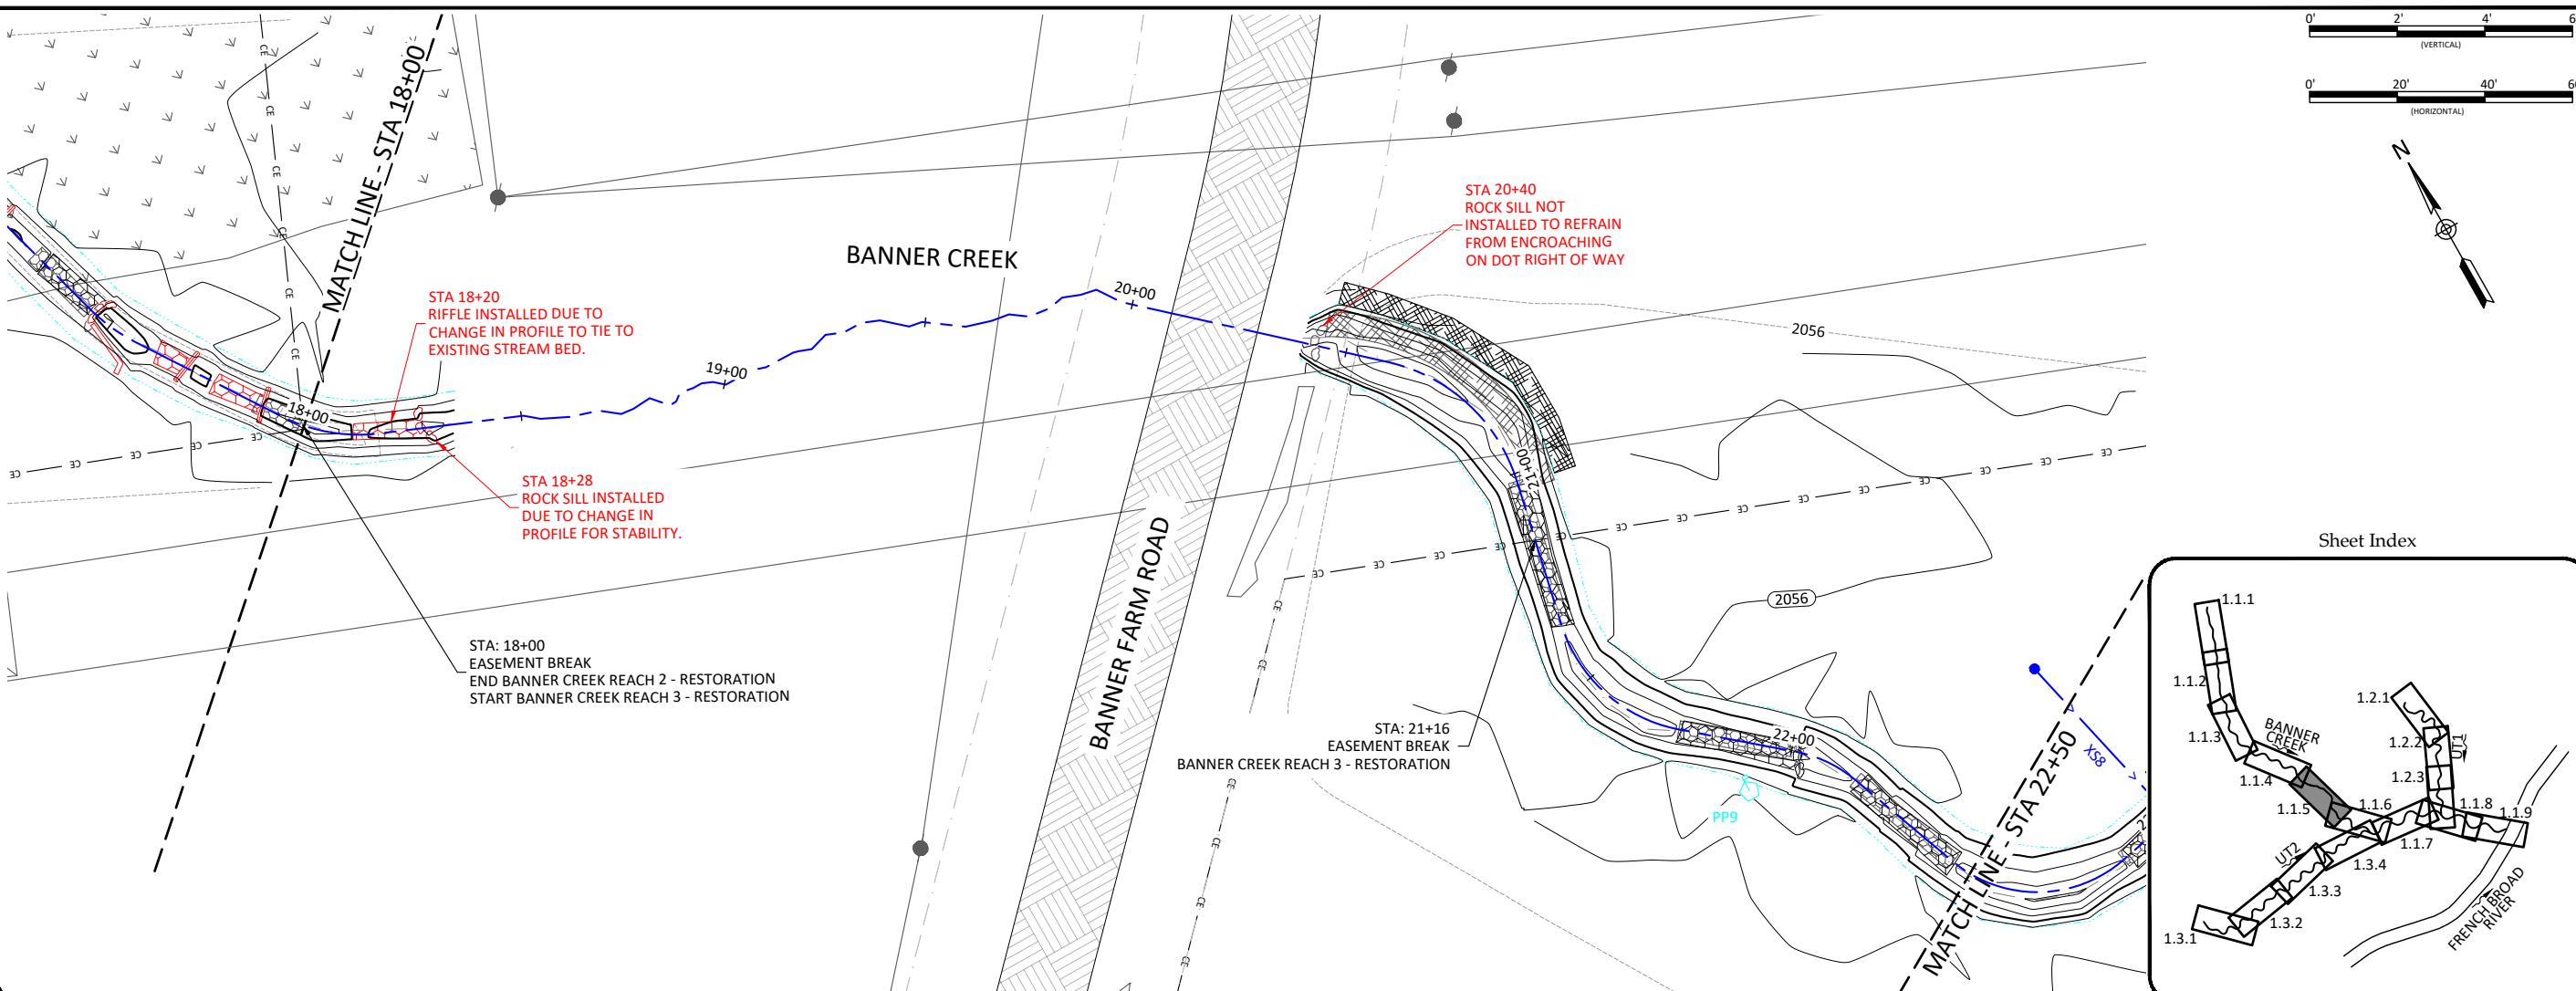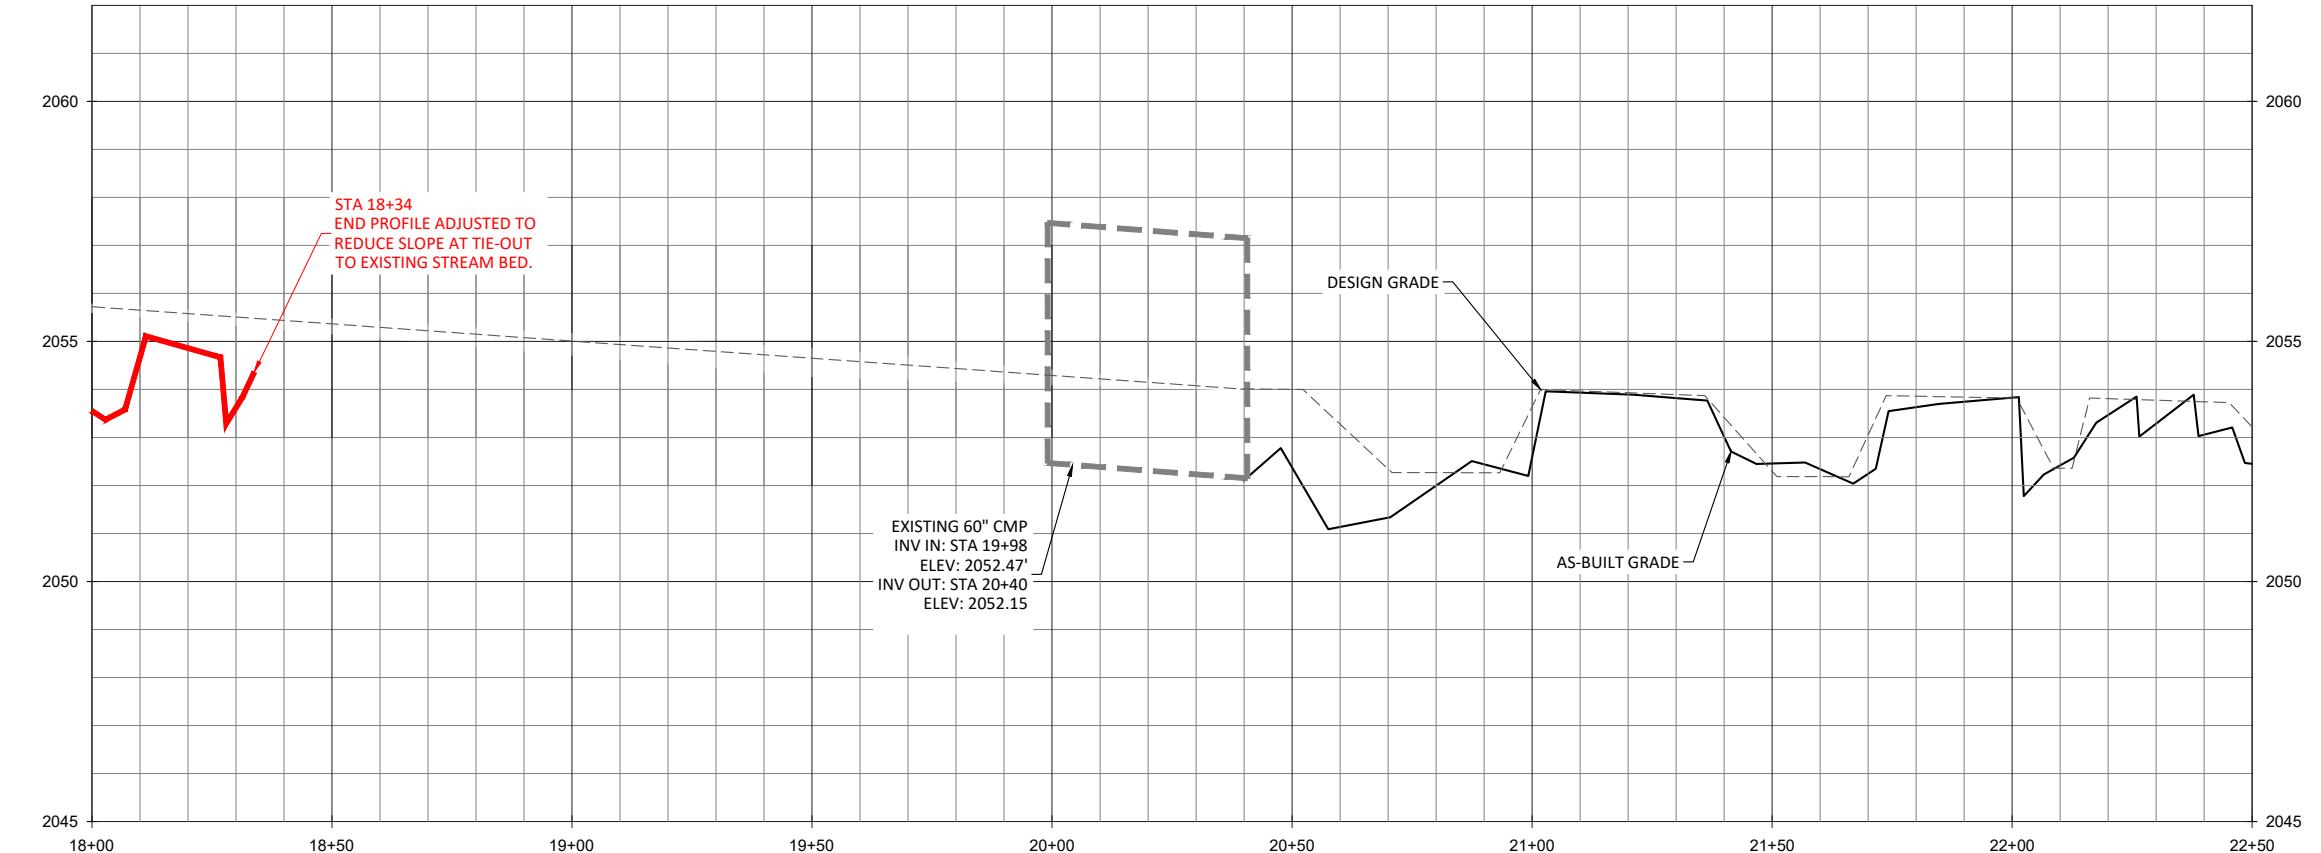

Date: 04-18-22
Job Number: W02172
Project Engineer: EN
Drawn By: JH
Checked By: JK

Revision:

1.1.5

Sheet


Banner Farm Mitigation Site Record Drawings



Henderson County, North Carolina




Stream Plan and Profile

Banner Creek

WILDLANDS
ENGINEERING
167-B Hawwood Road
Asheville, NC 28806
Tel: 828.774.5547
Fax: 704.332.3306
Firm license No. E-0831

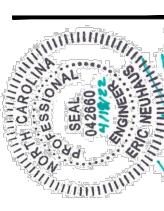

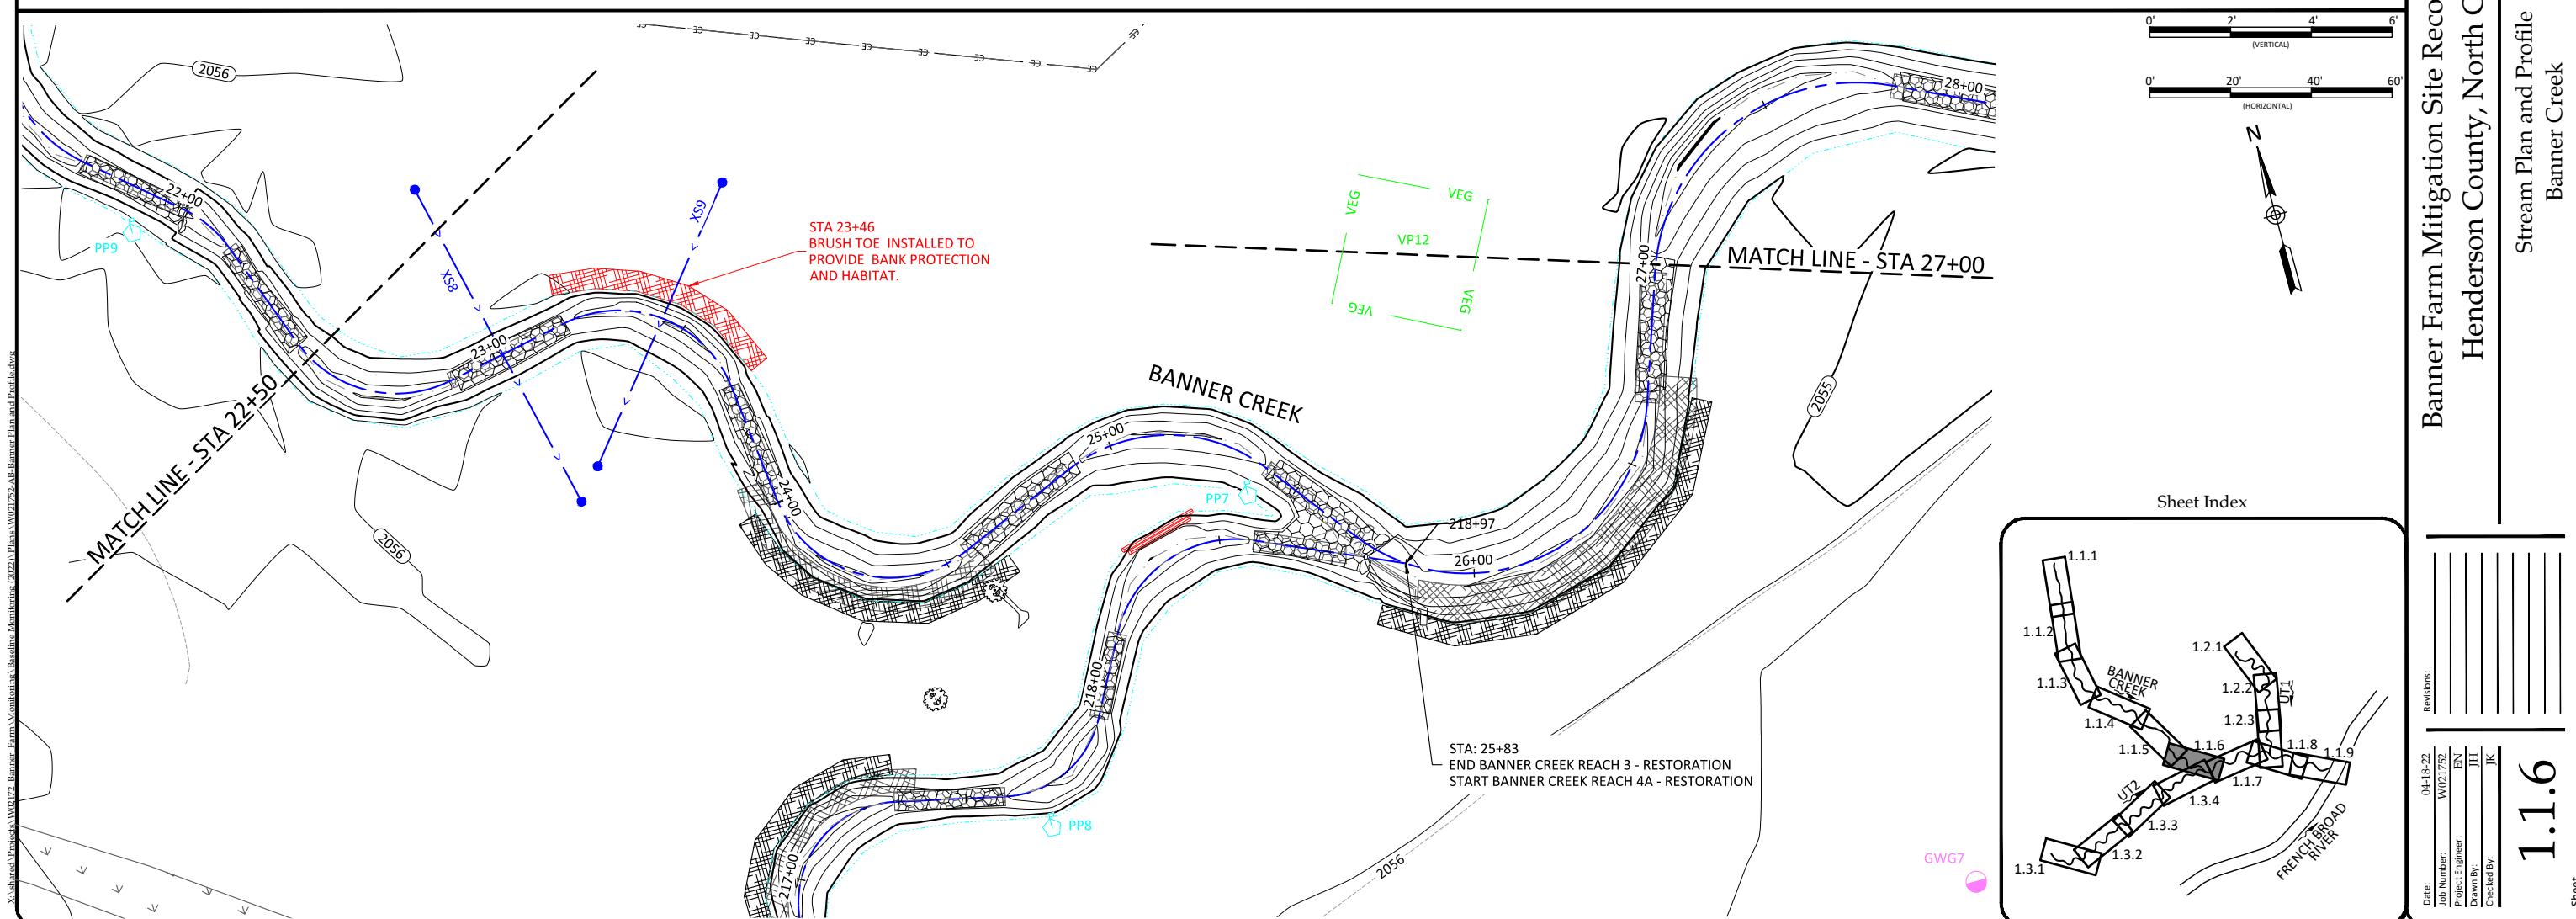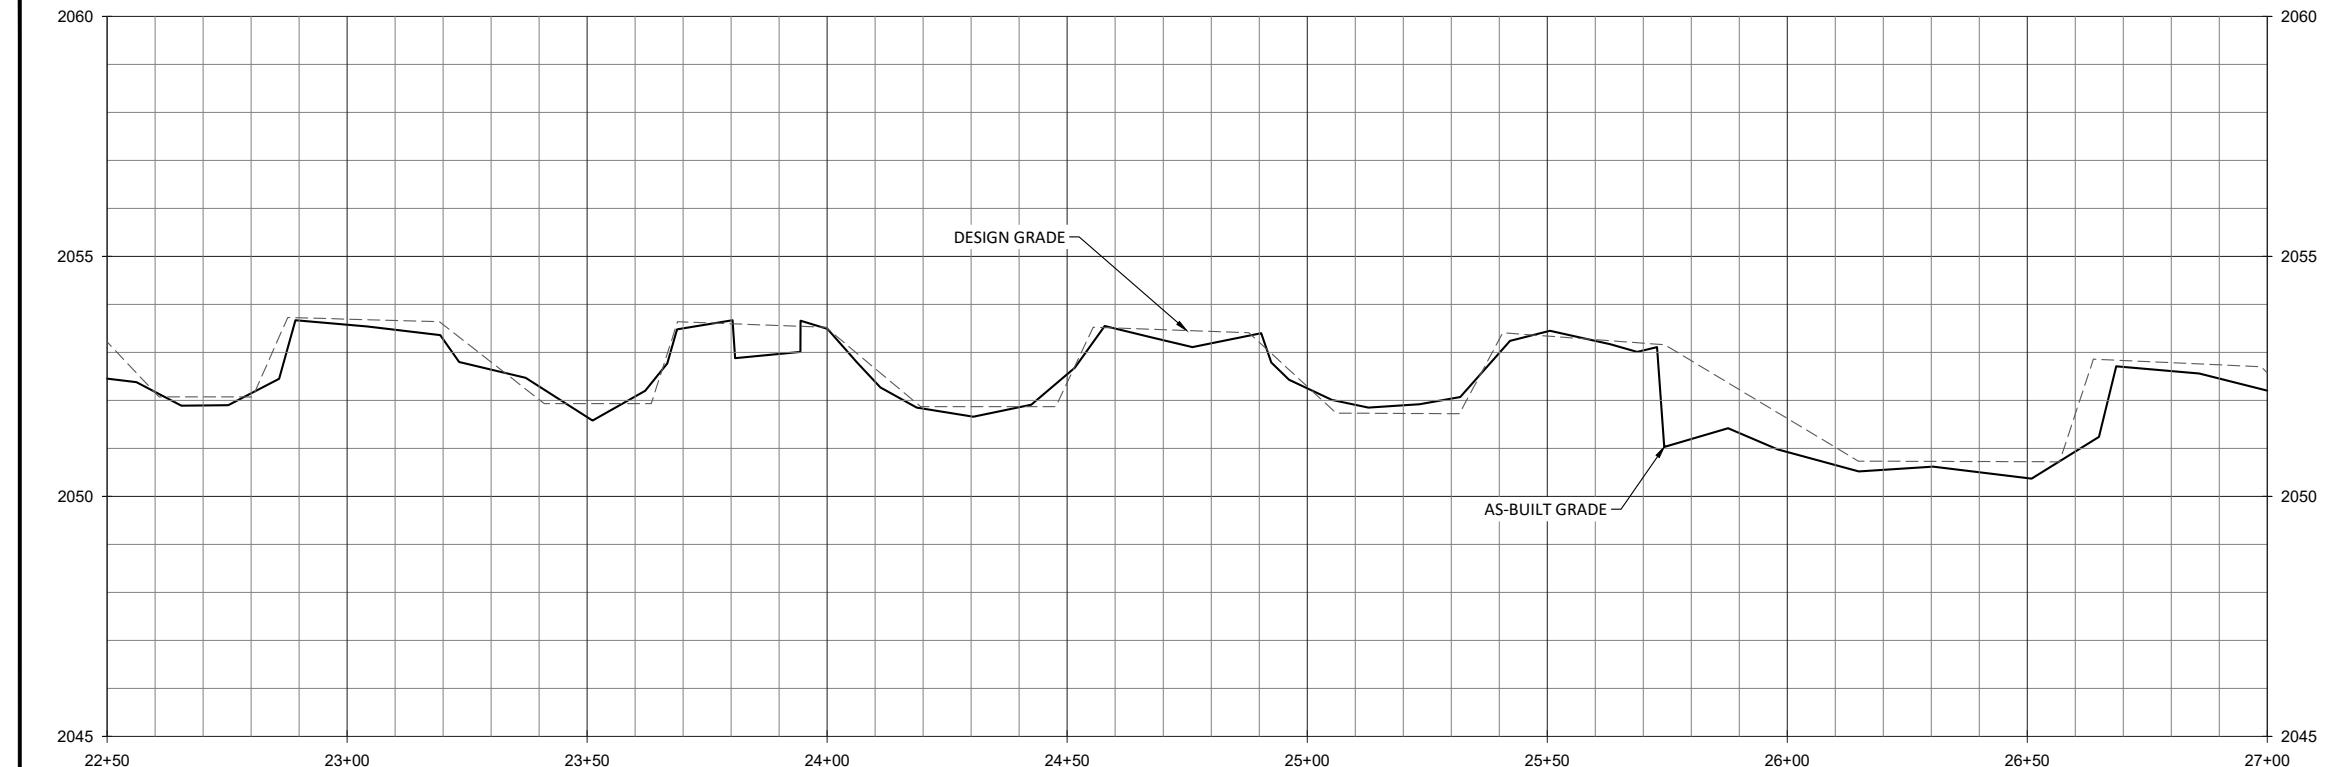

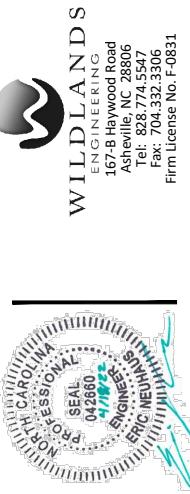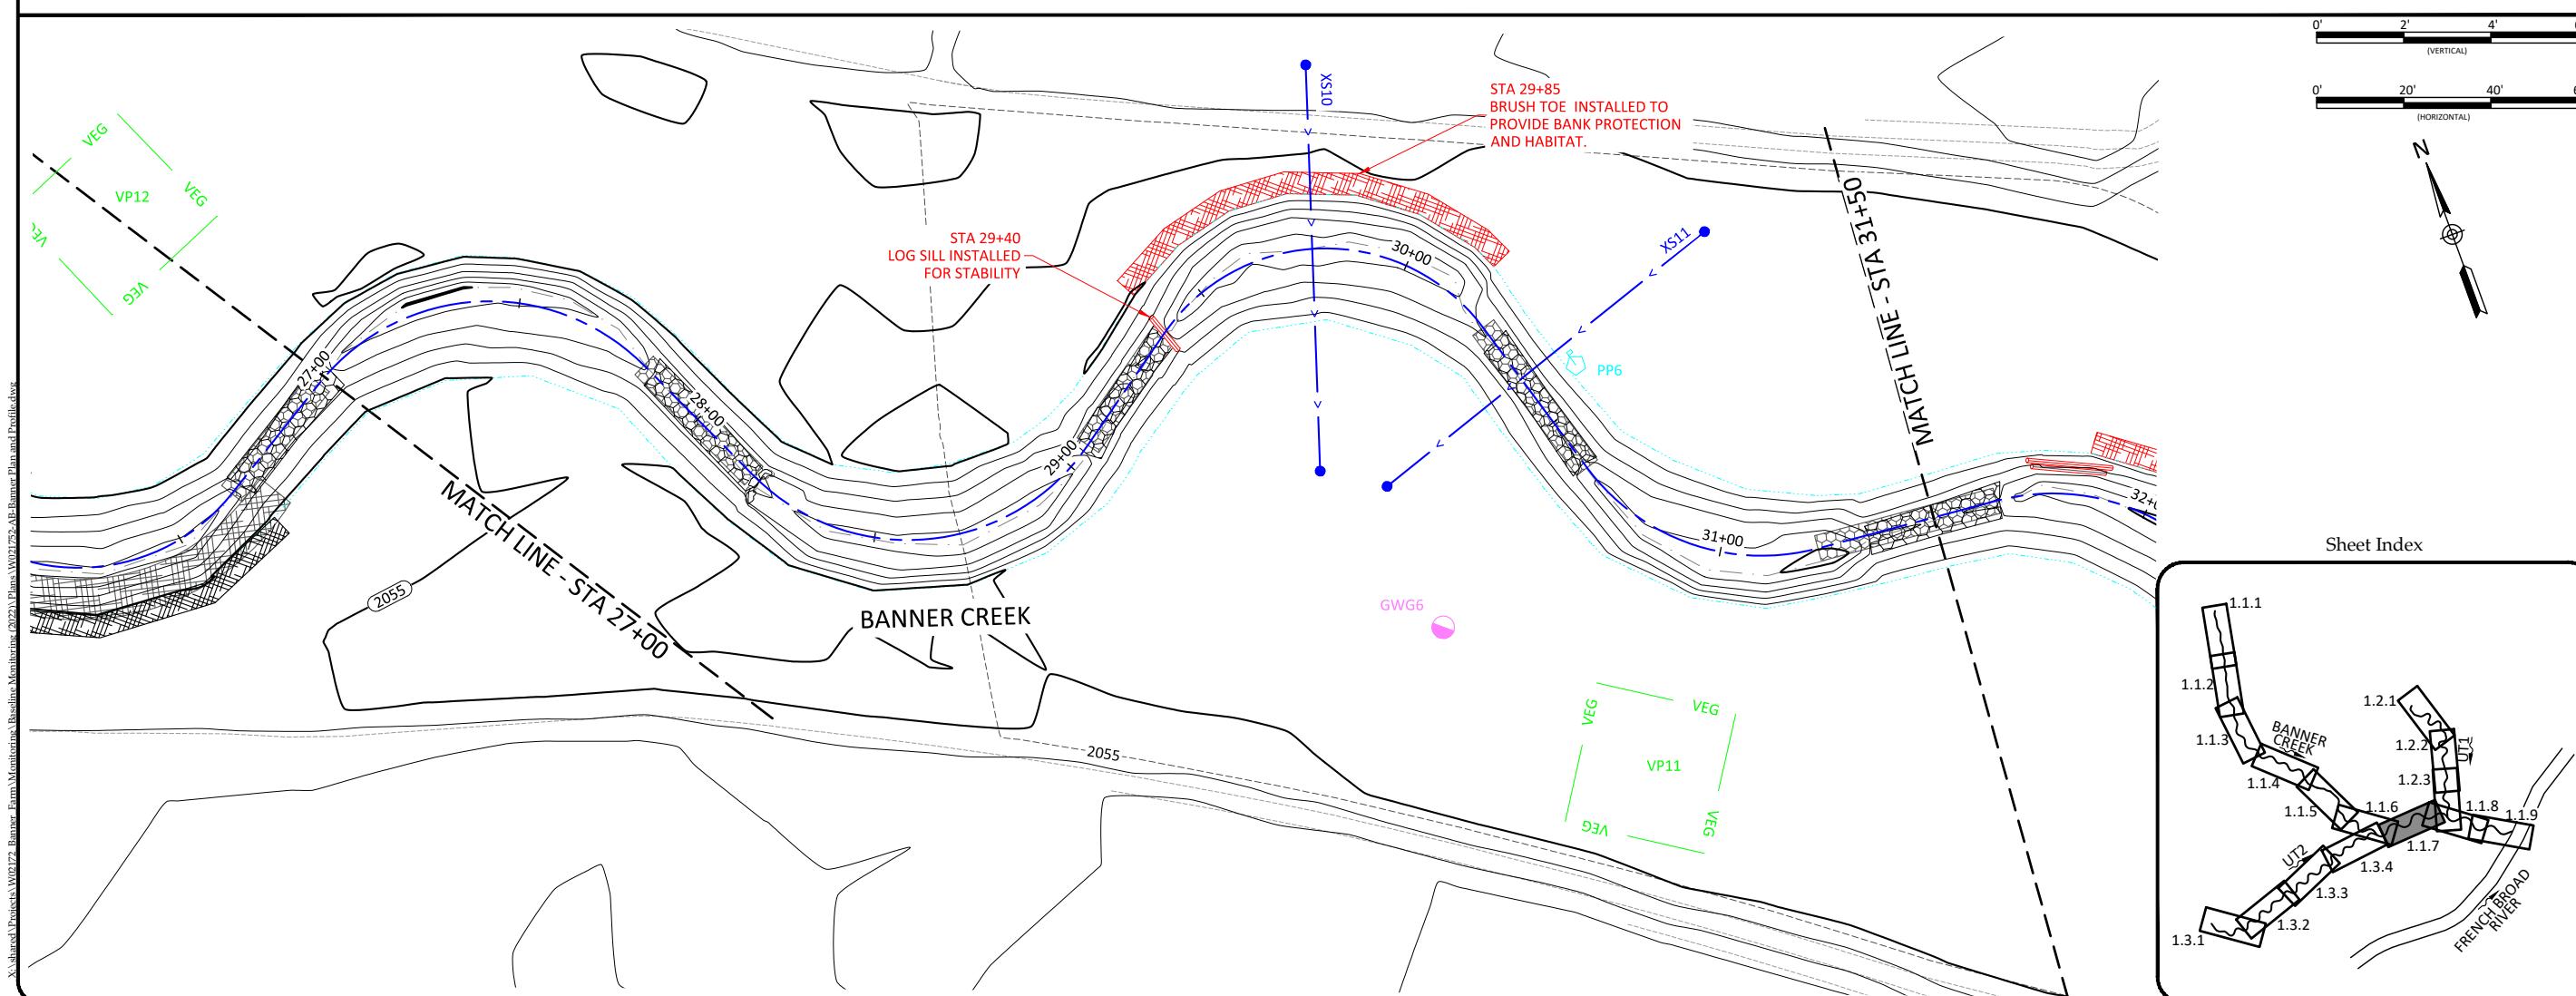
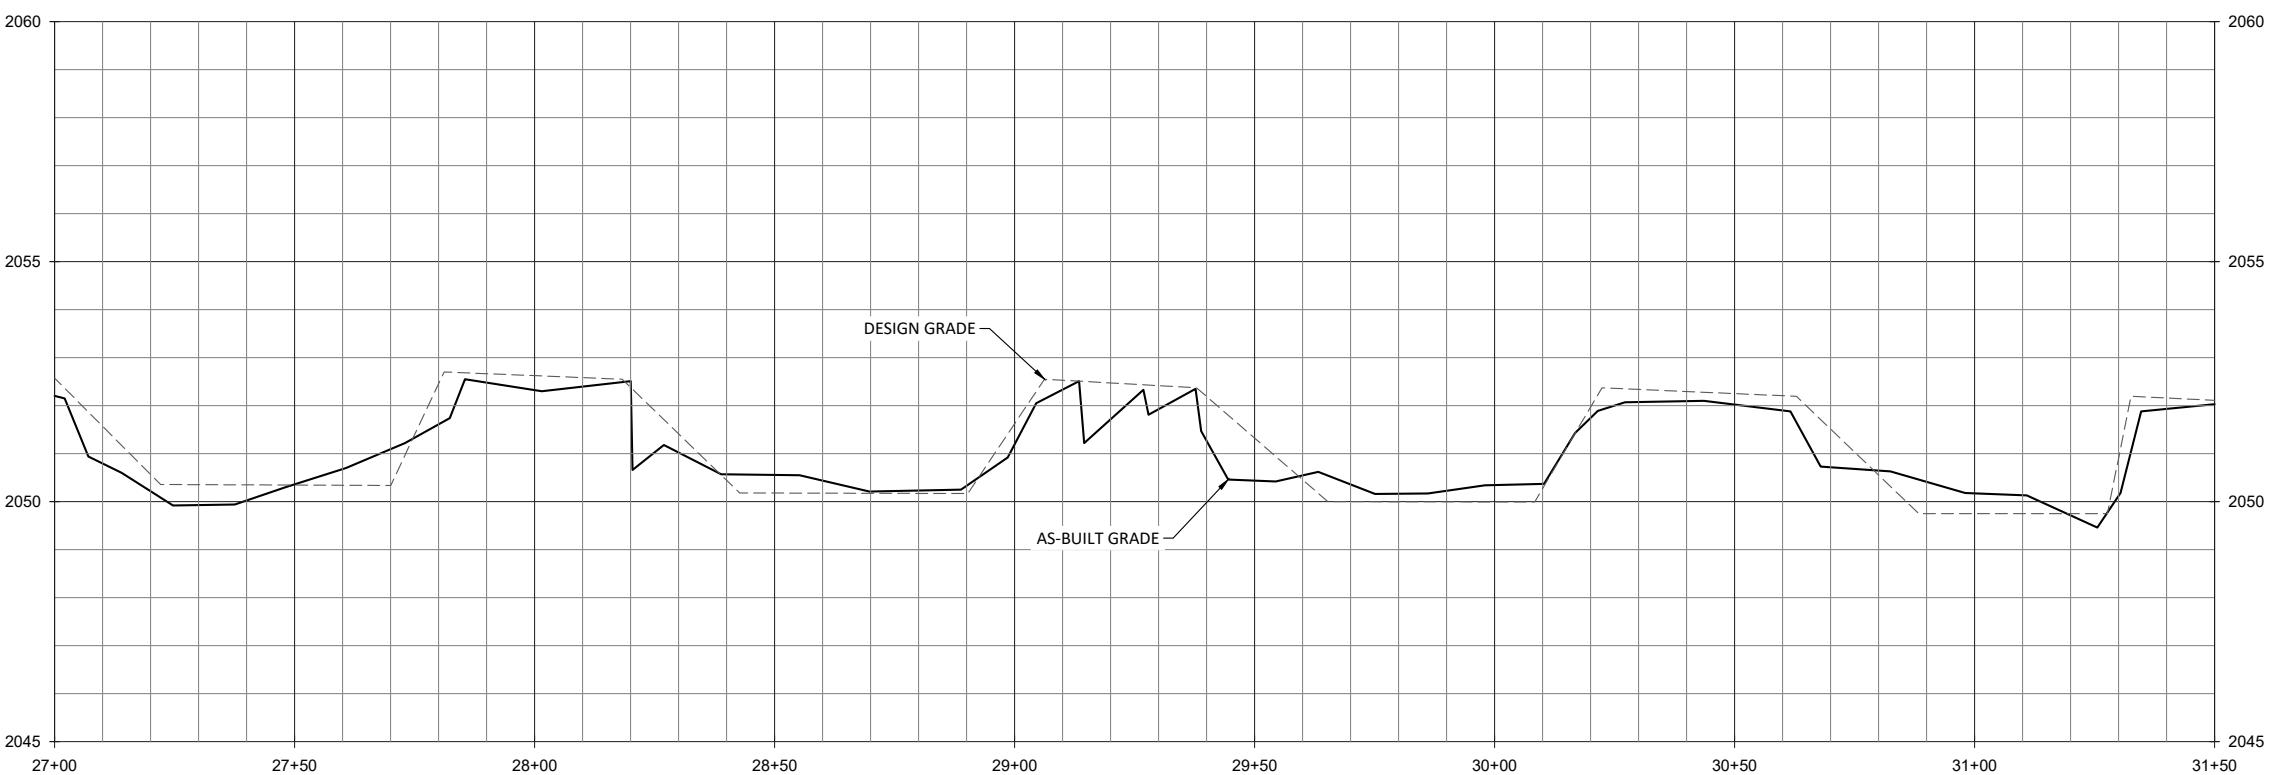


Banner Farm Mitigation Site Record Drawings
Henderson County, North Carolina

Stream Plan and Profile
Banner Creek


04-18-22
W02172
EN
JH
JK



1.1.7

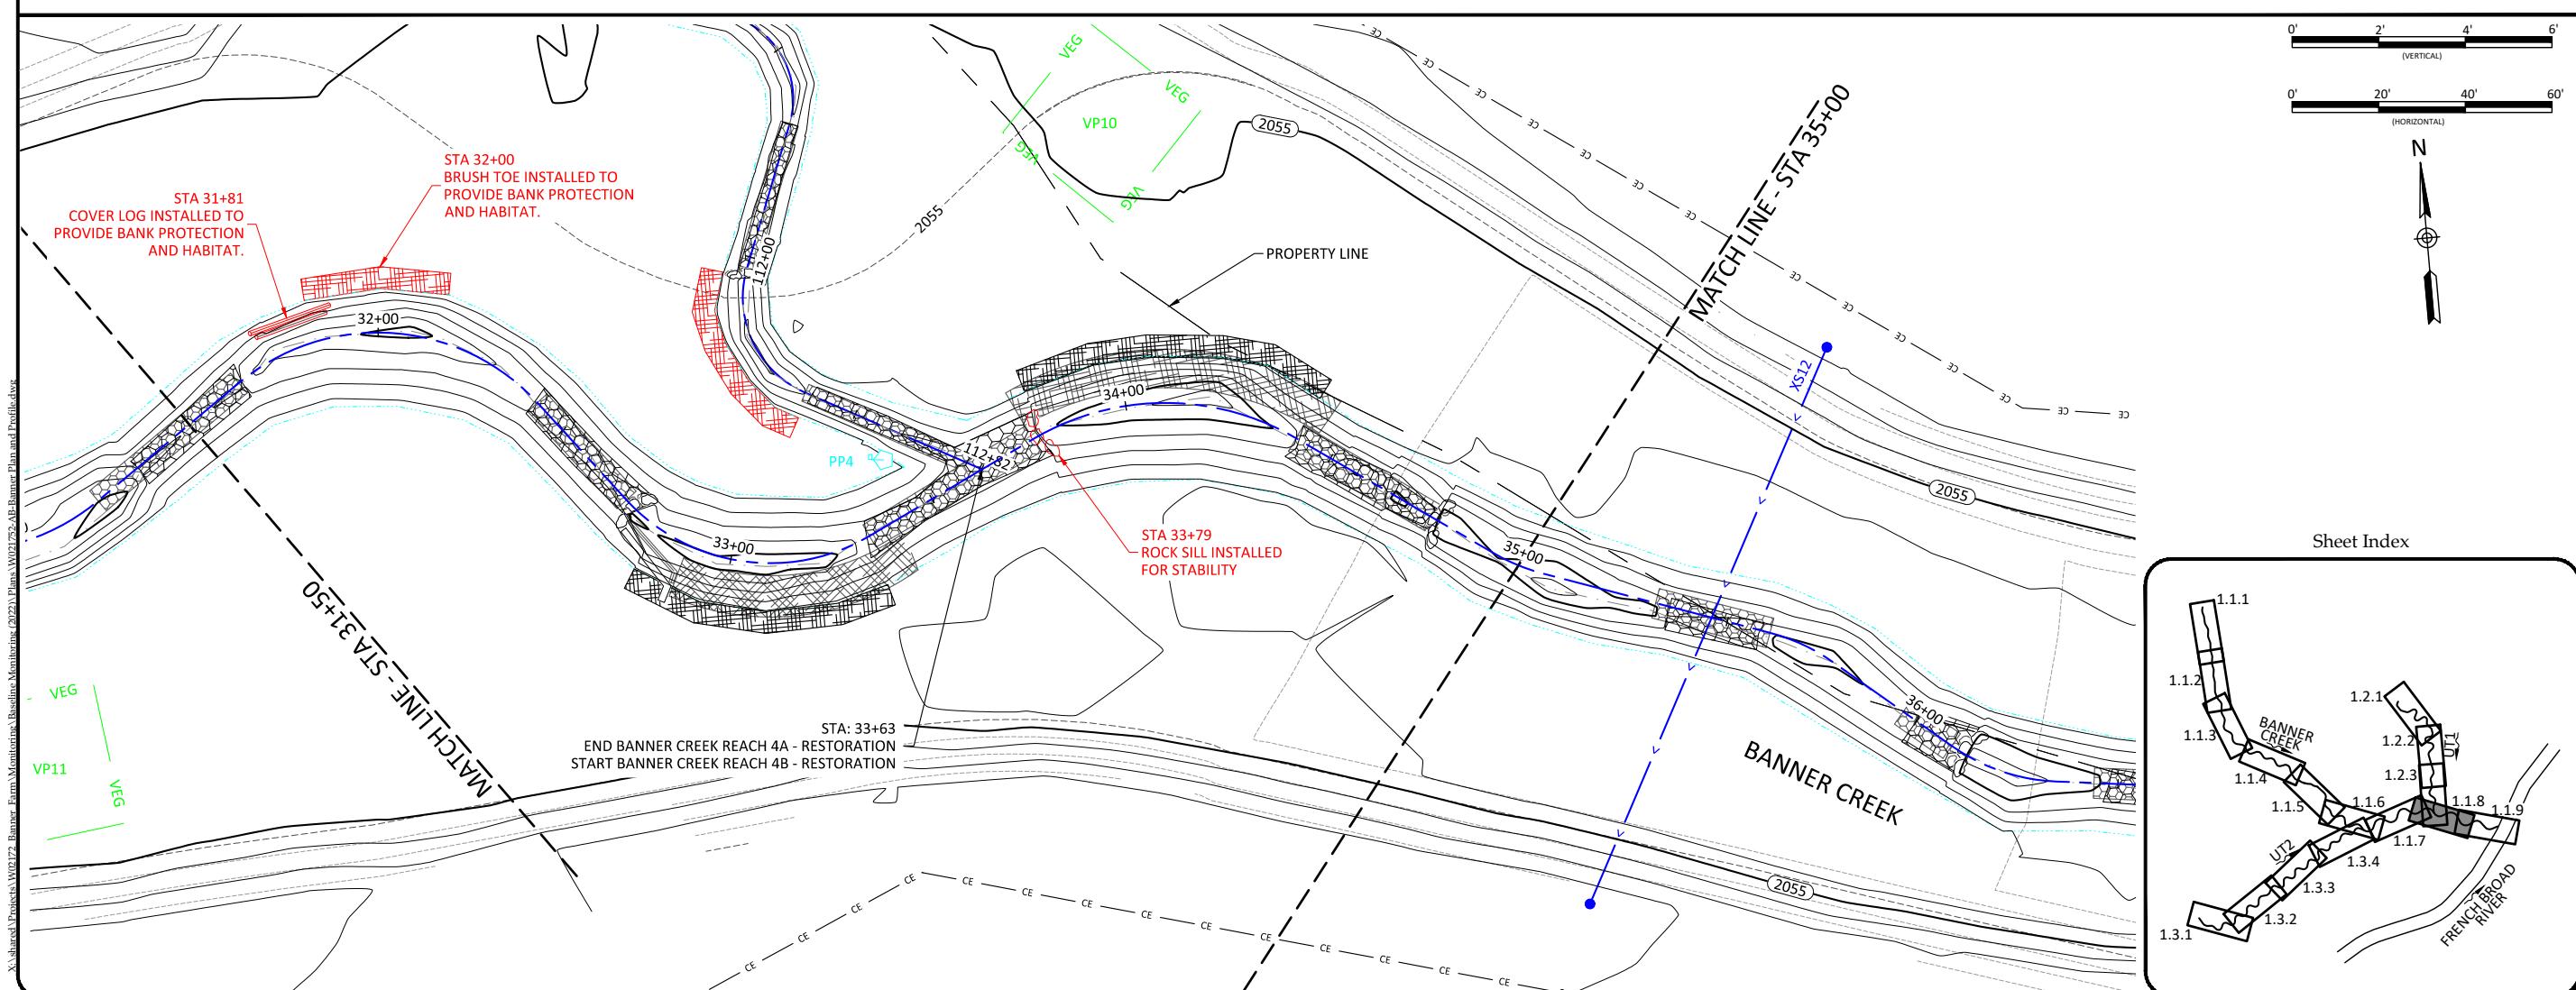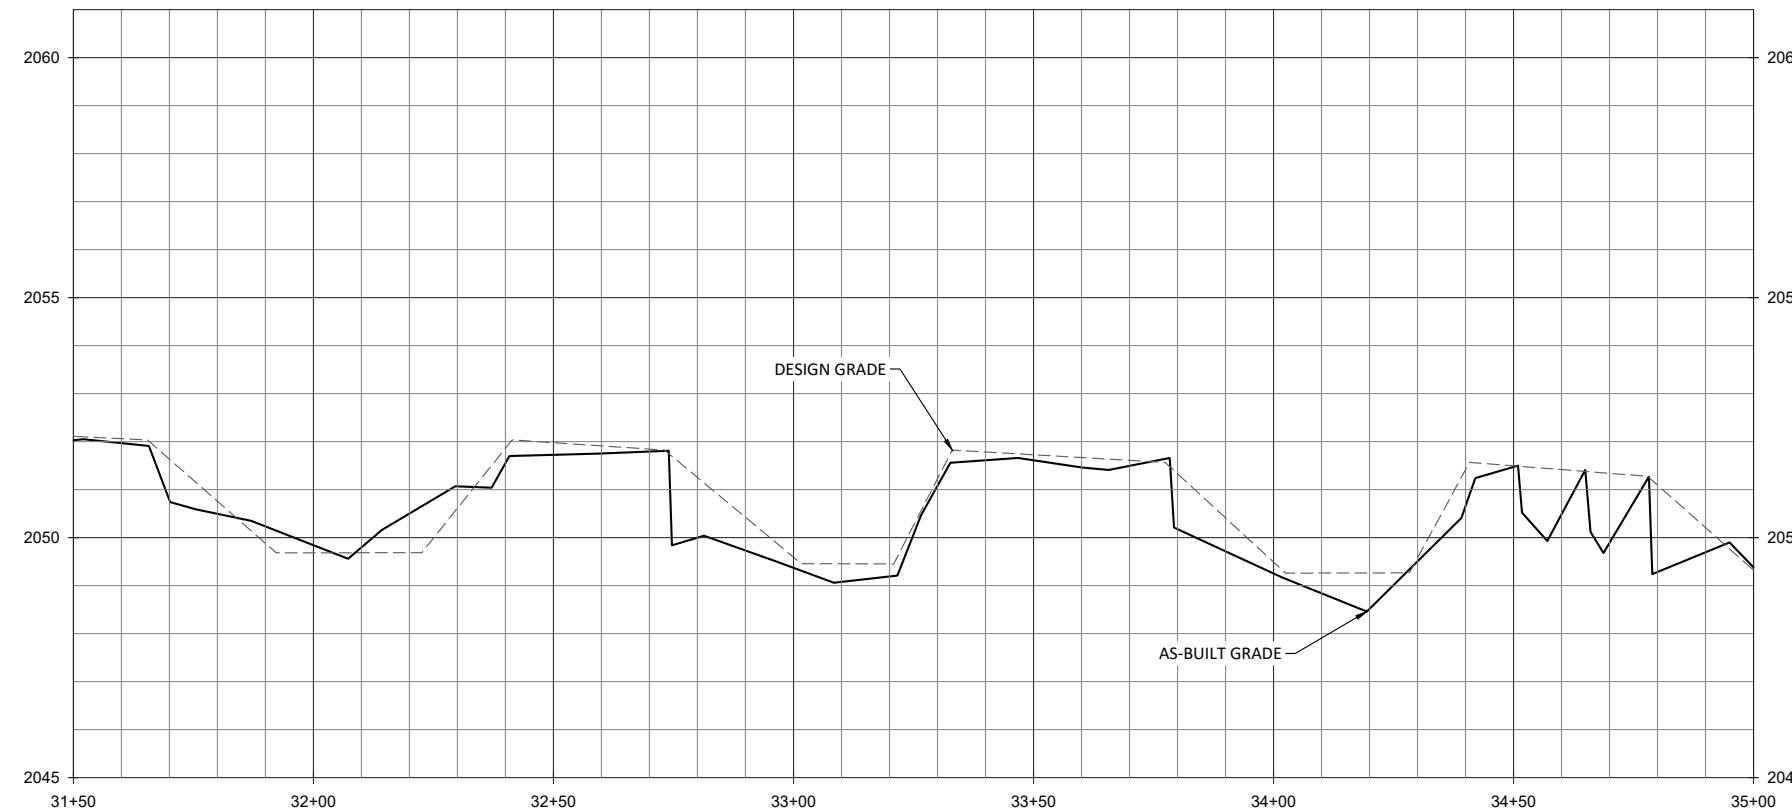

WILDLANDS
ENGINEERING
167-B Hawwood Road
Asheville, NC 28806
Tel: 828.774.5547
Fax: 828.332.3306
Firm license No. E-0831






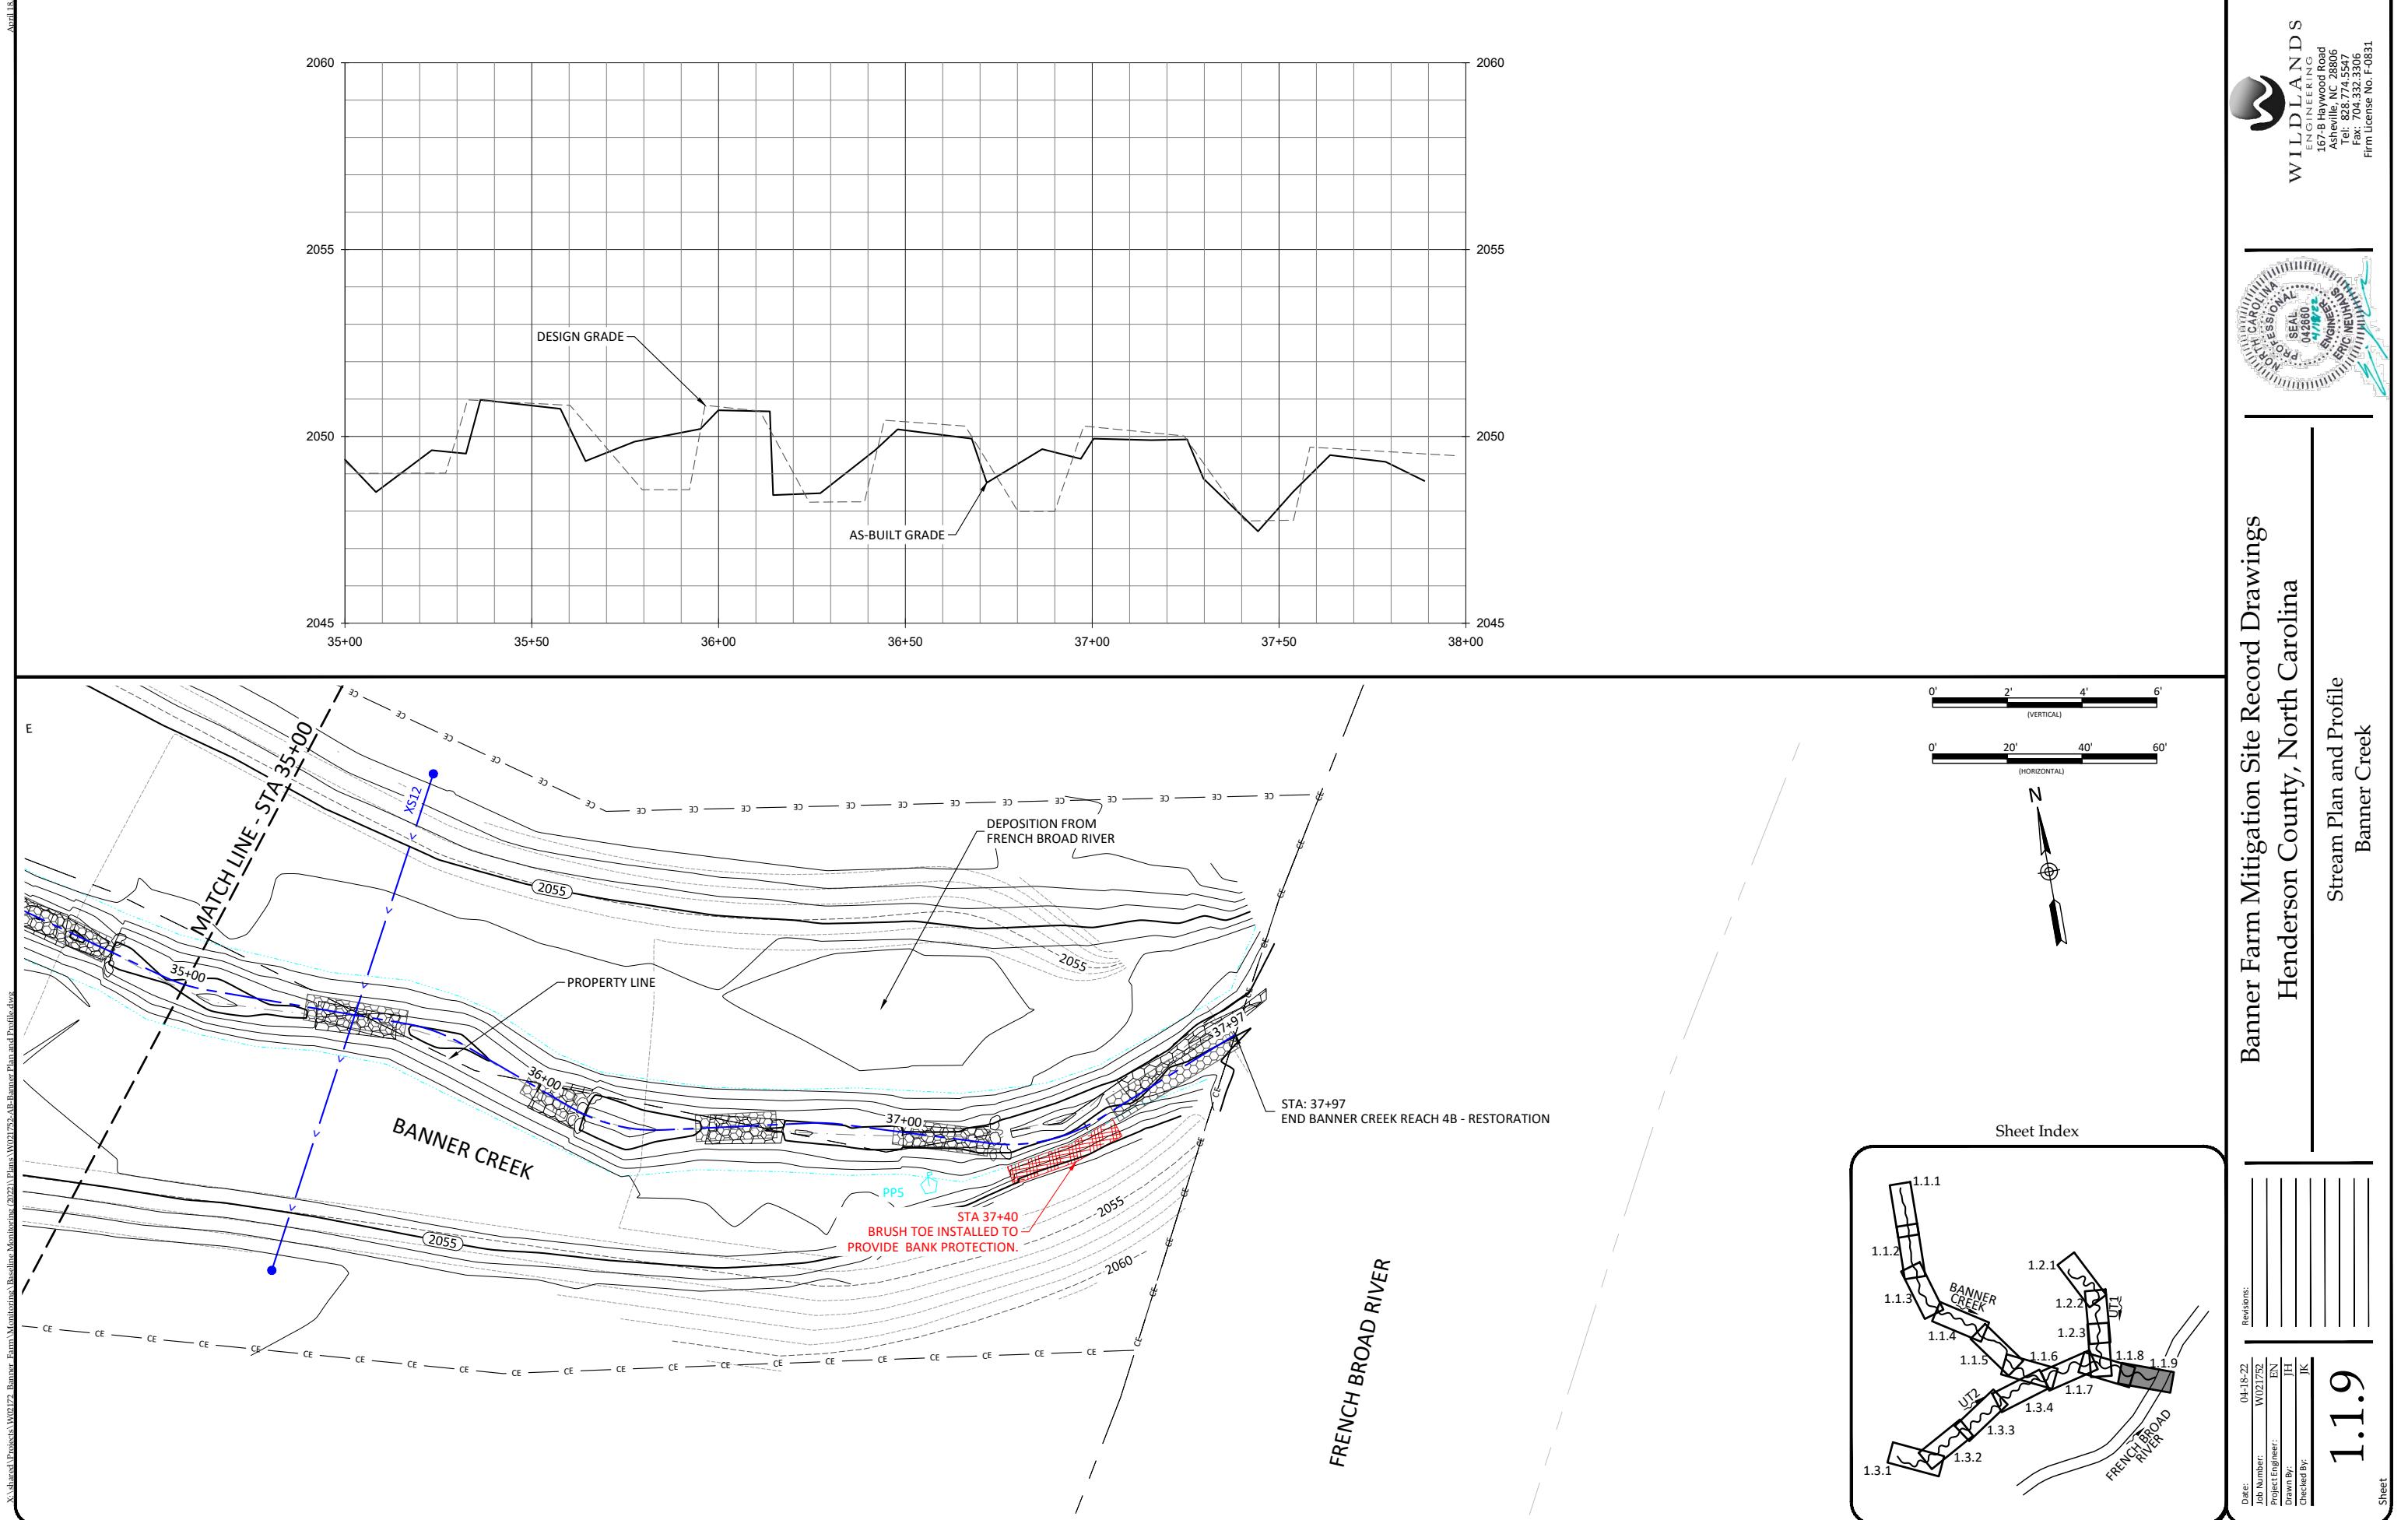


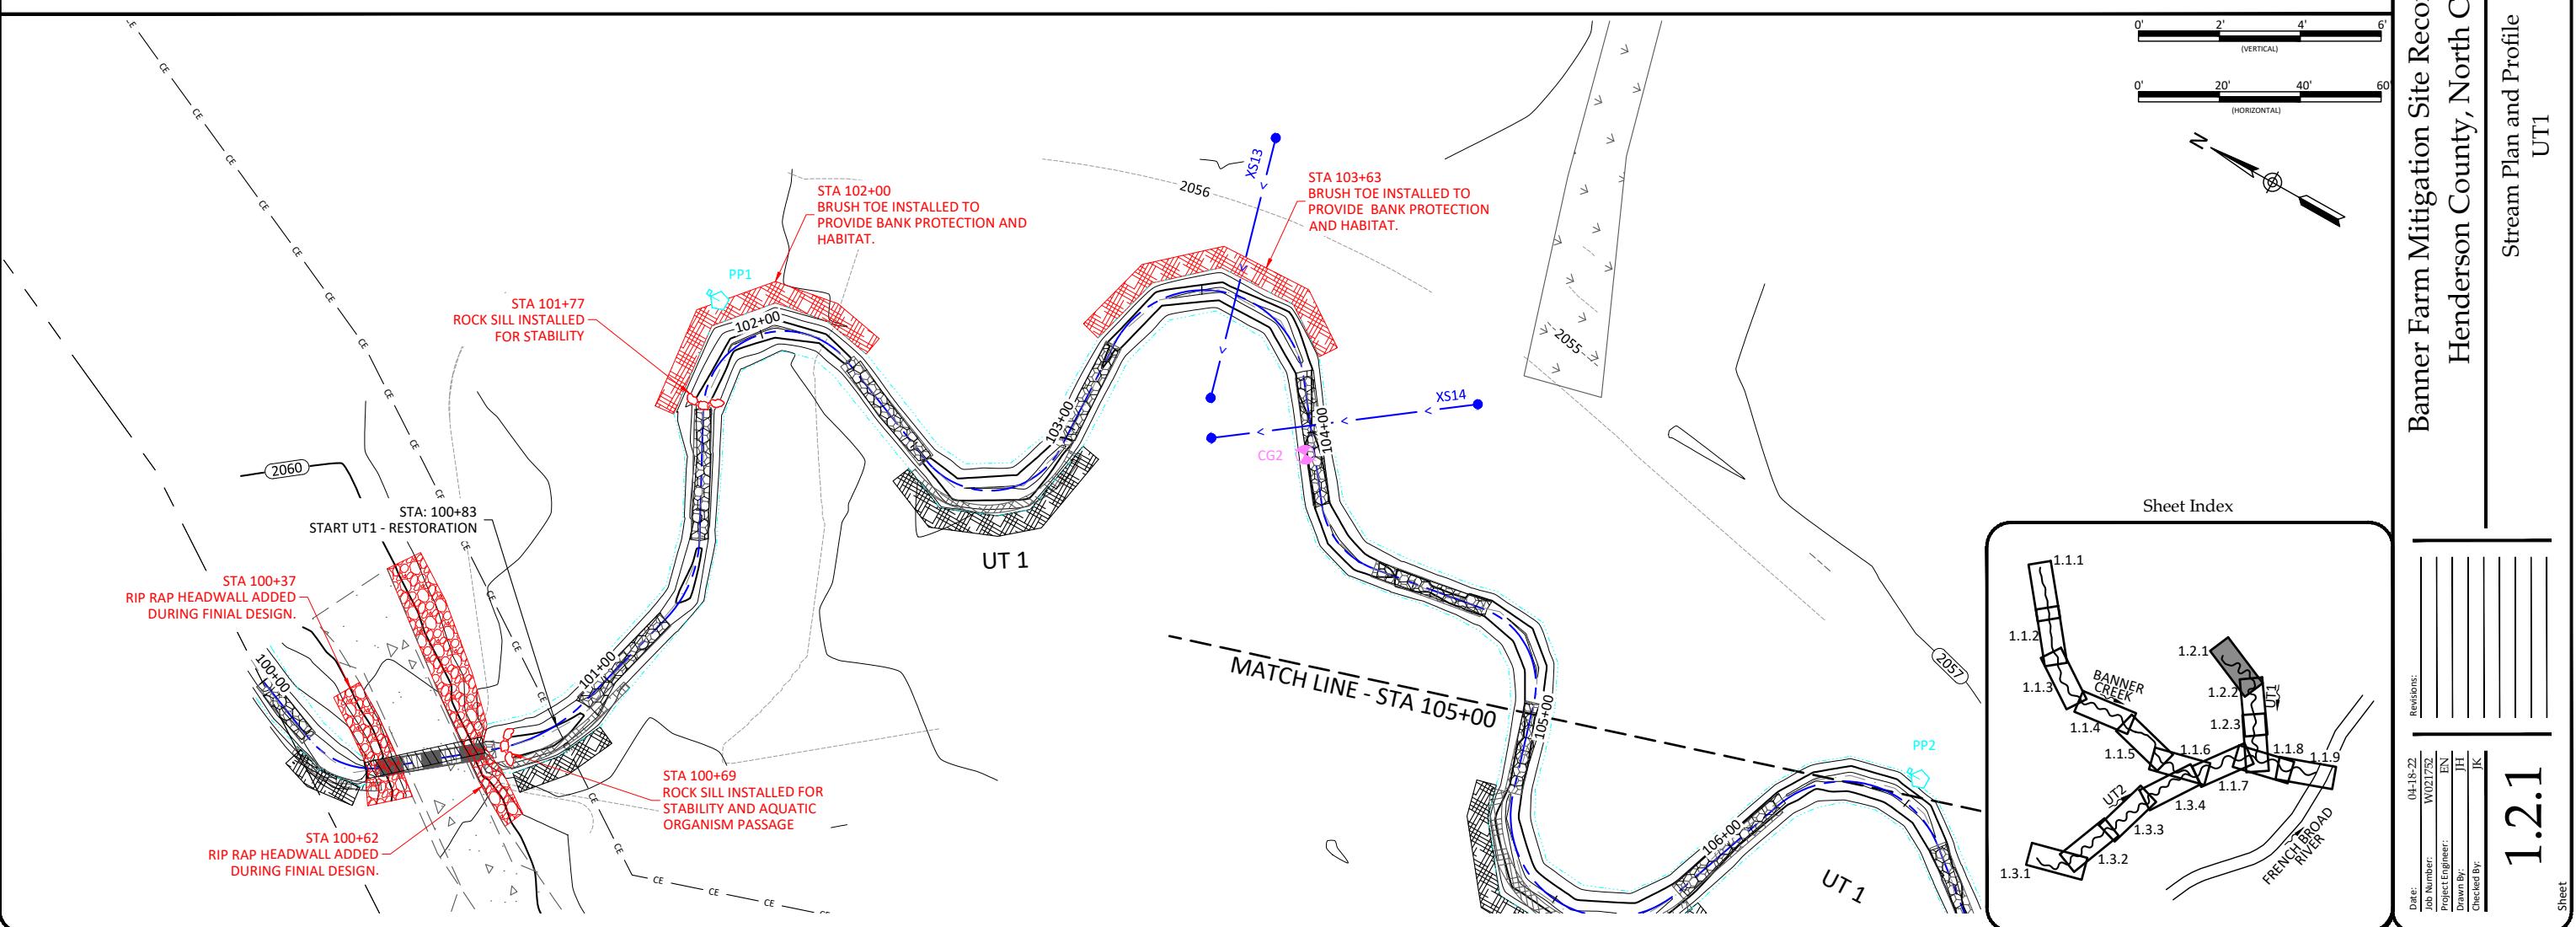
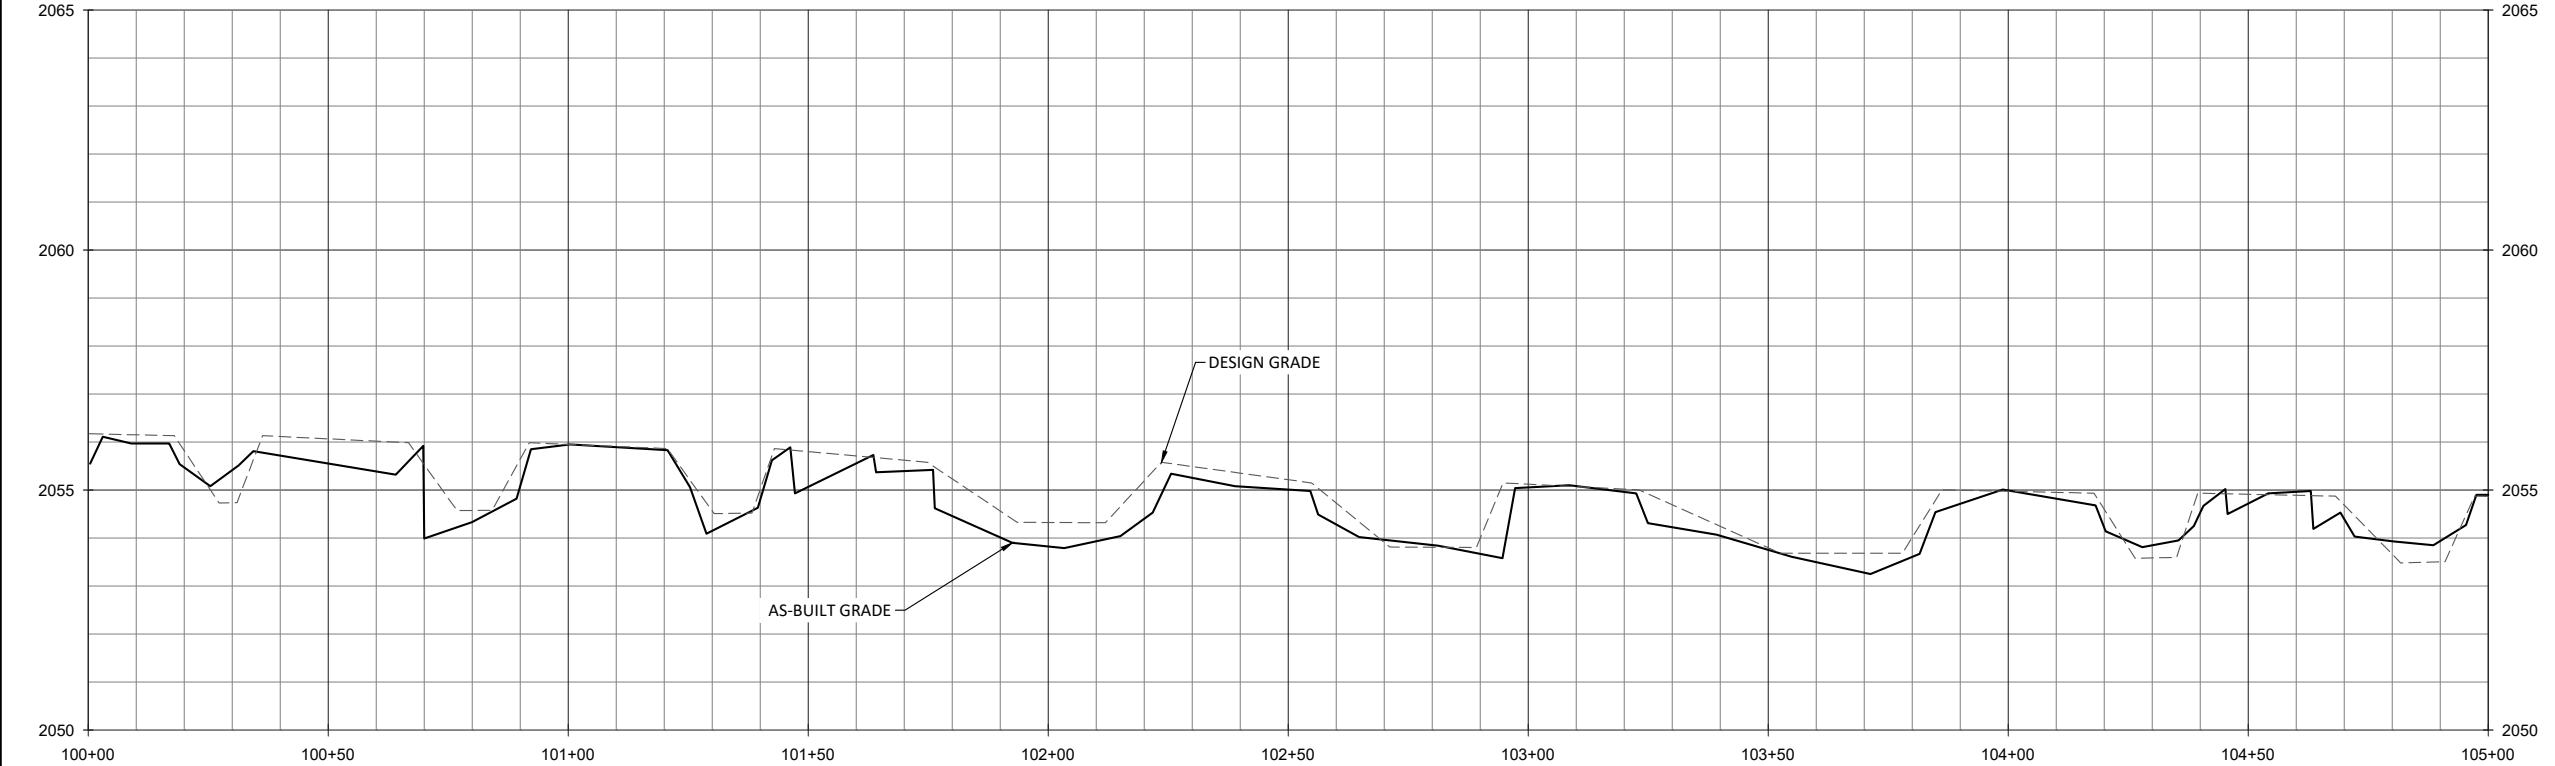




Banner Farm Mitigation Site Record Drawings
Henderson County, North Carolina

Stream Plan and Profile
UT1

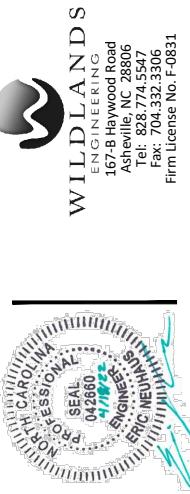

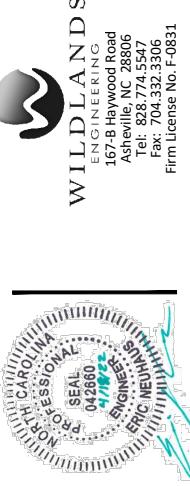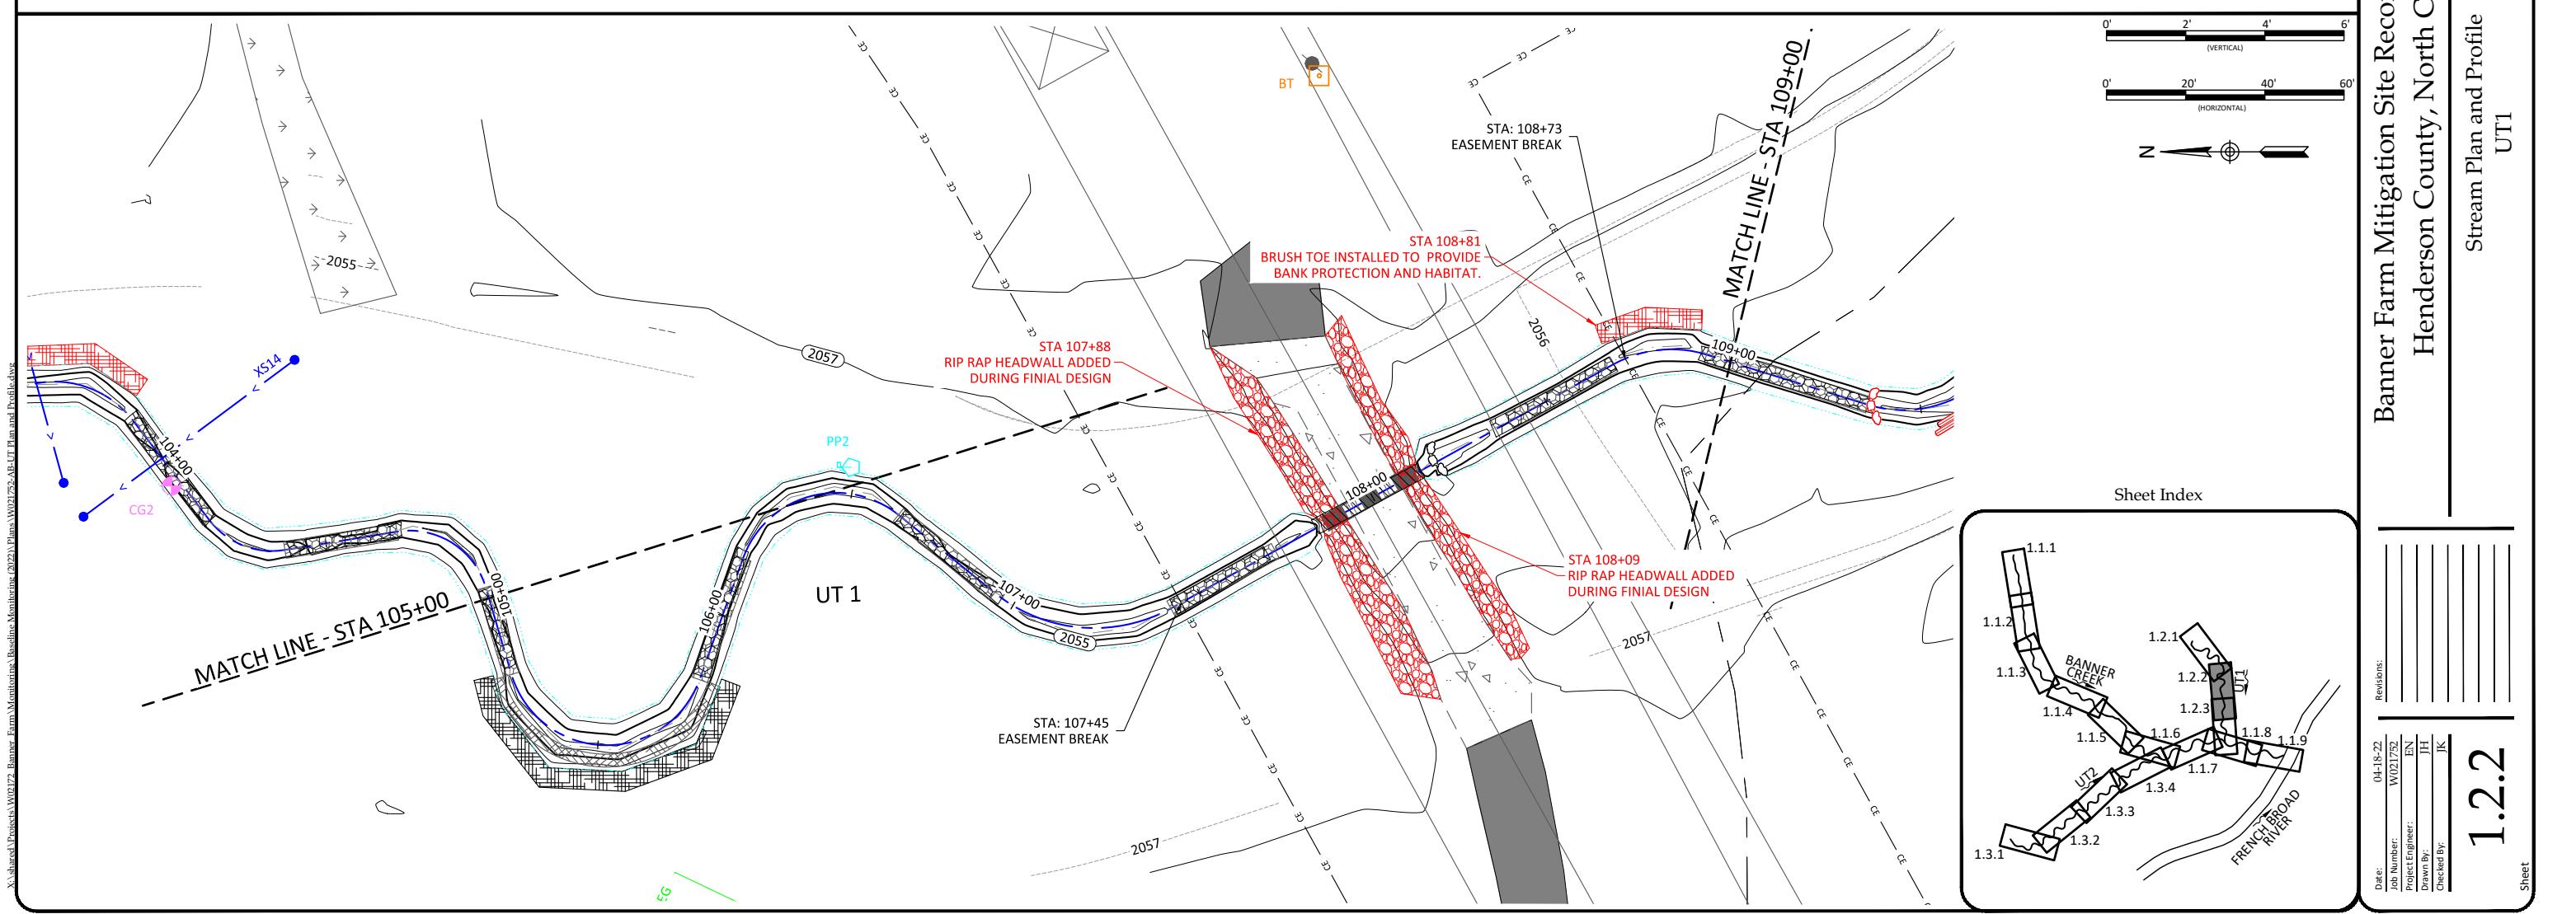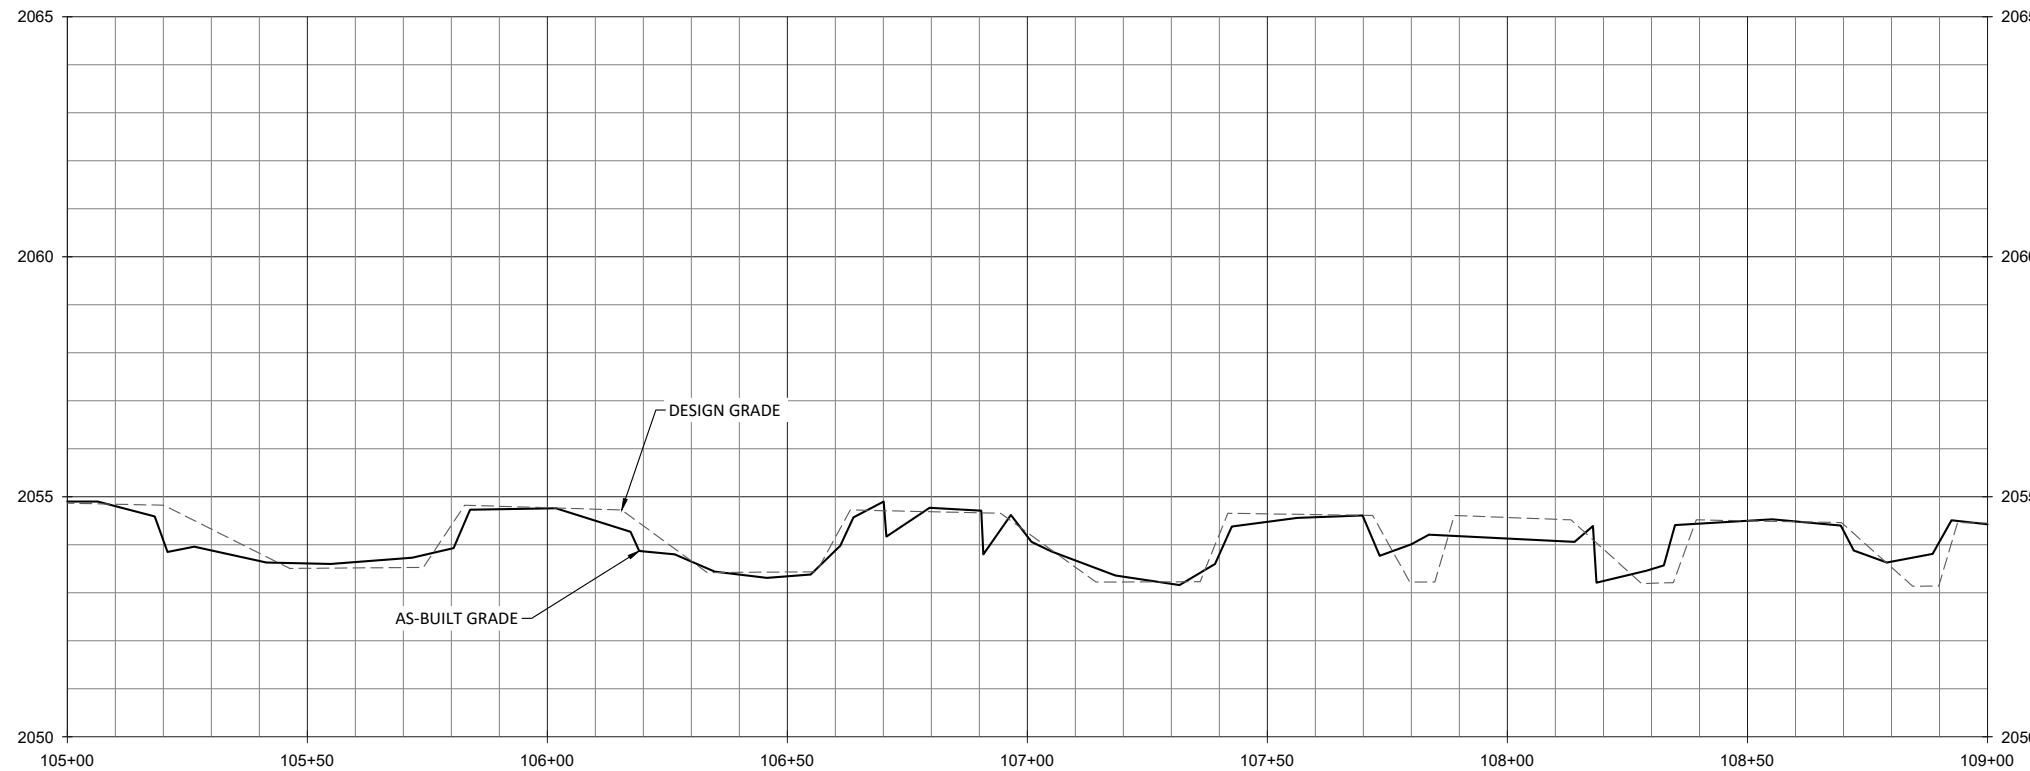


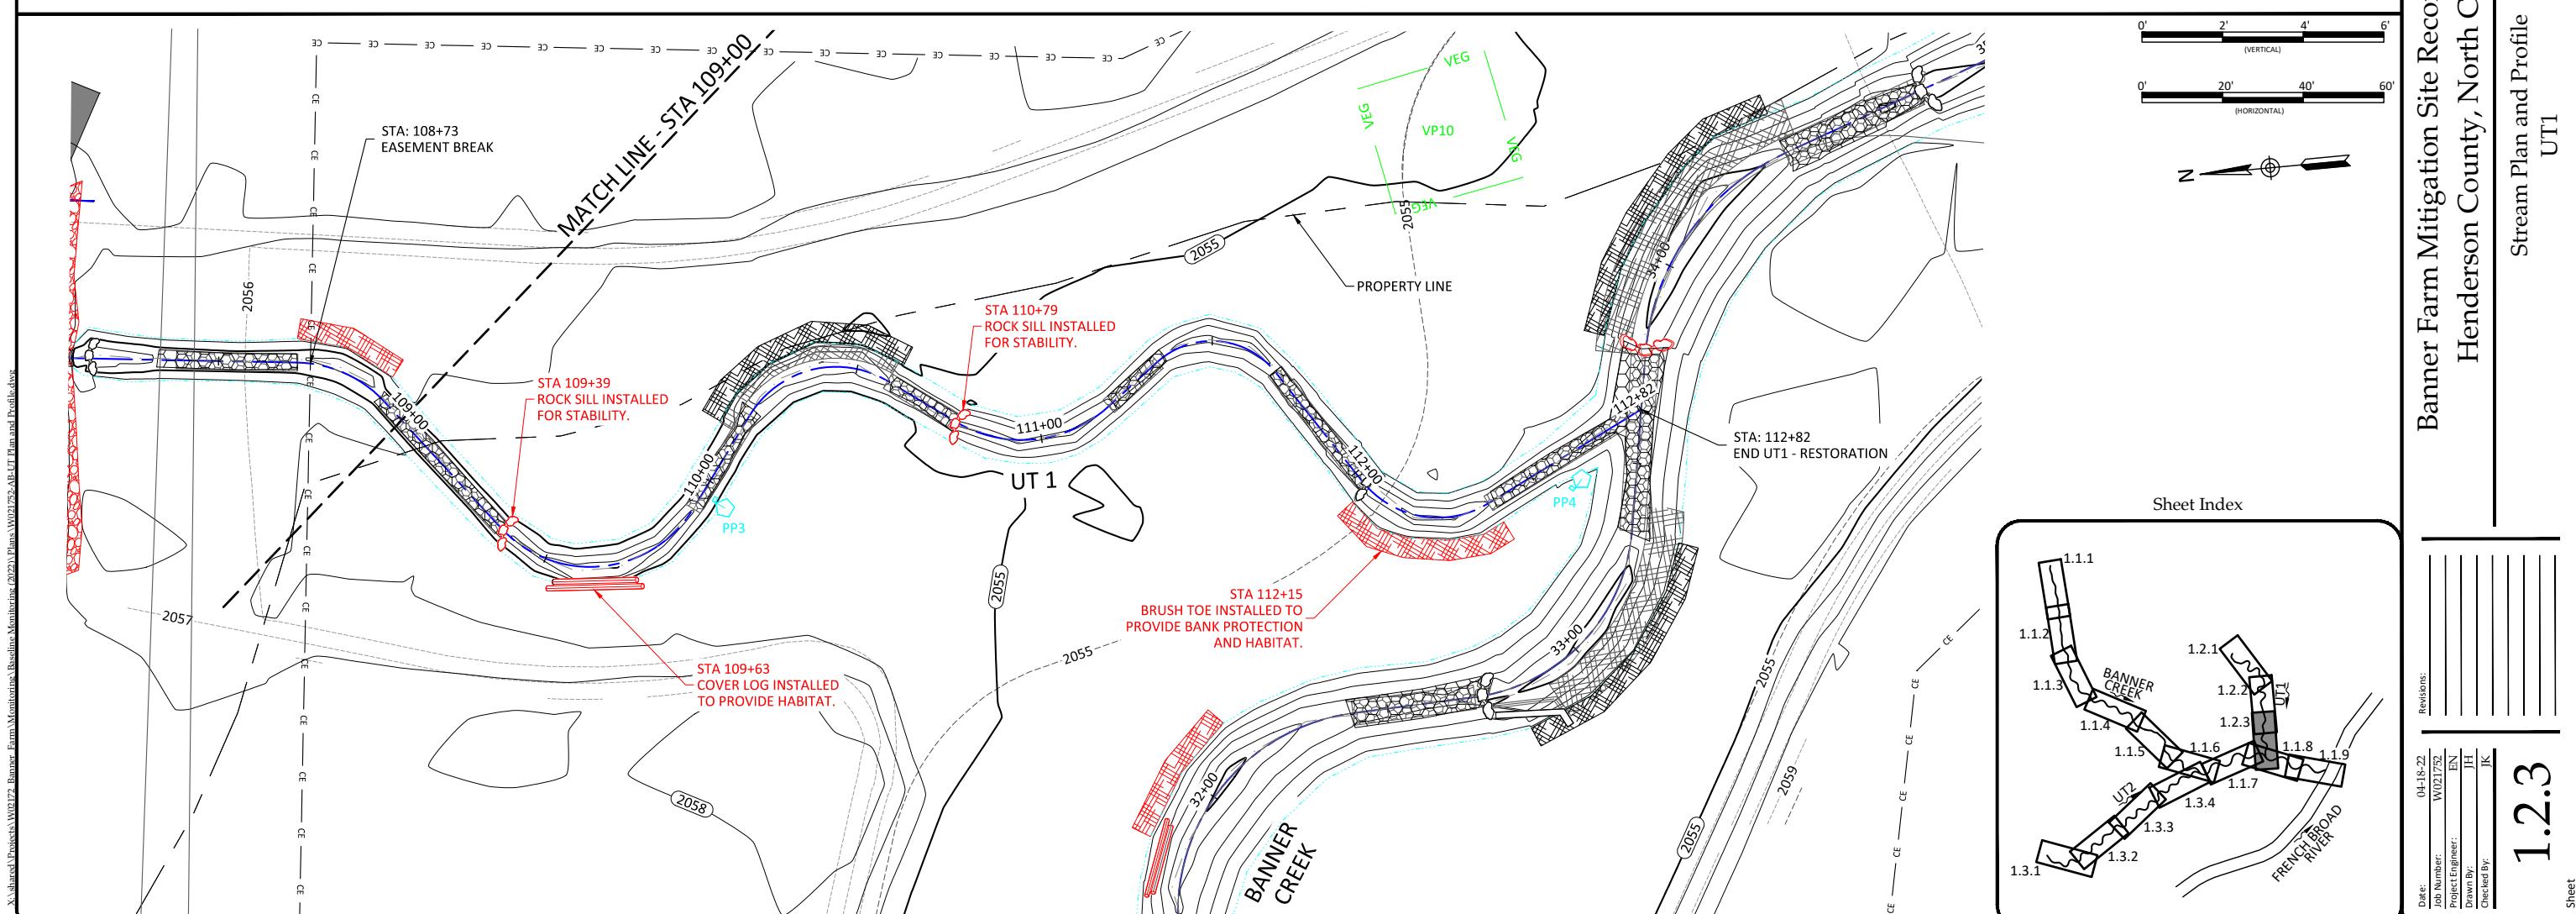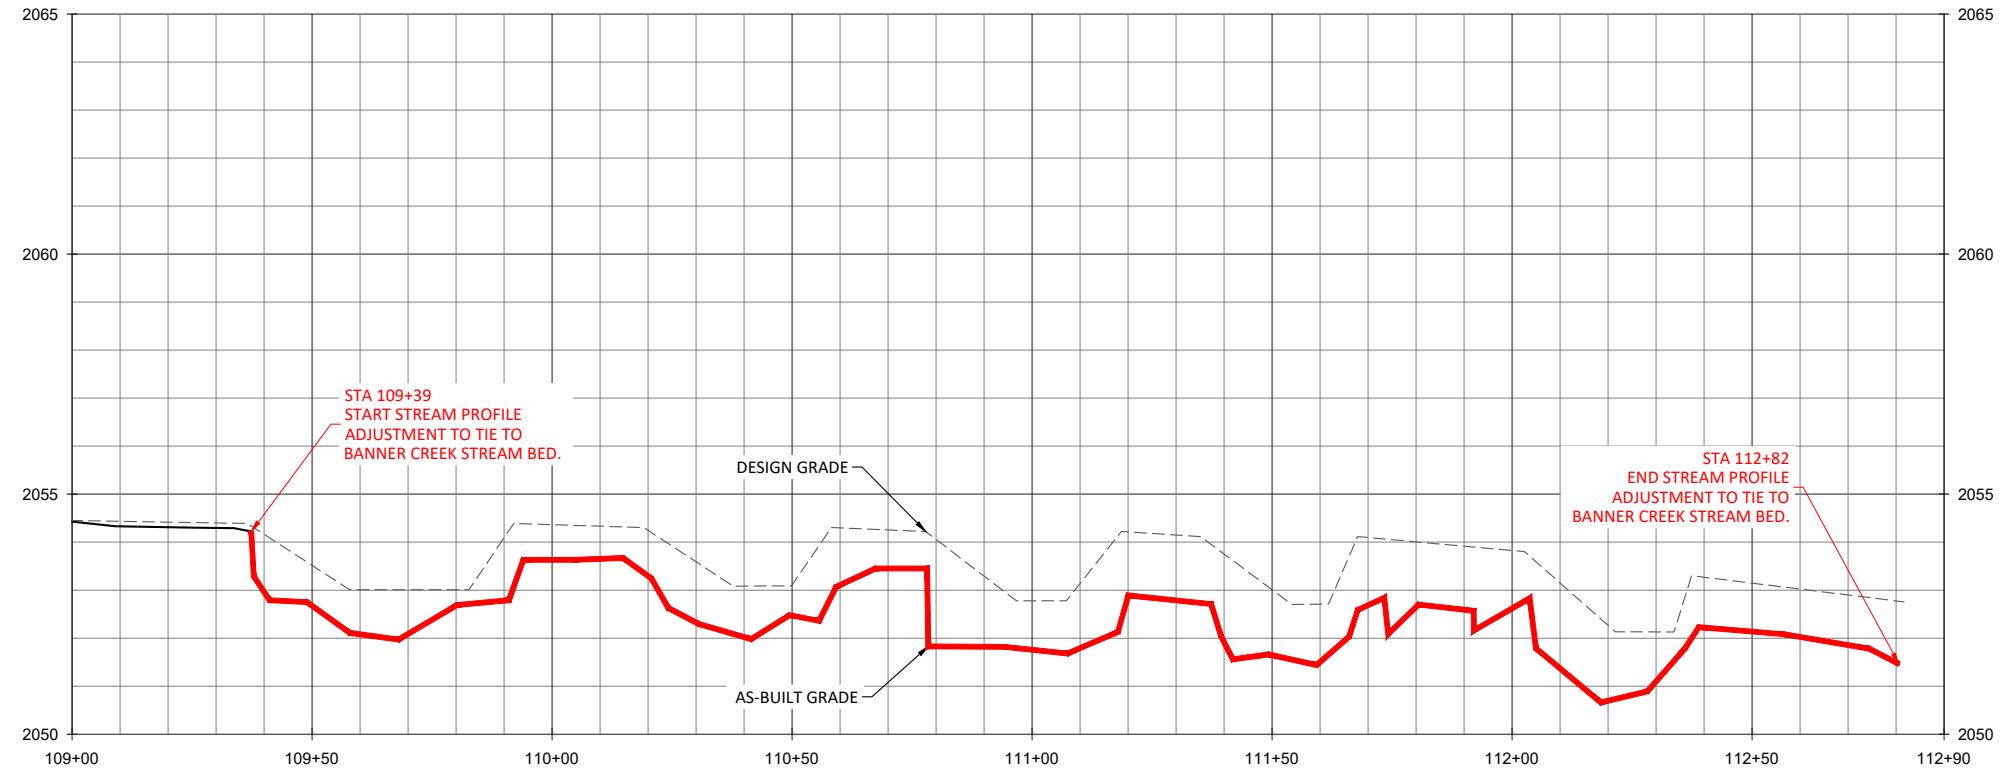

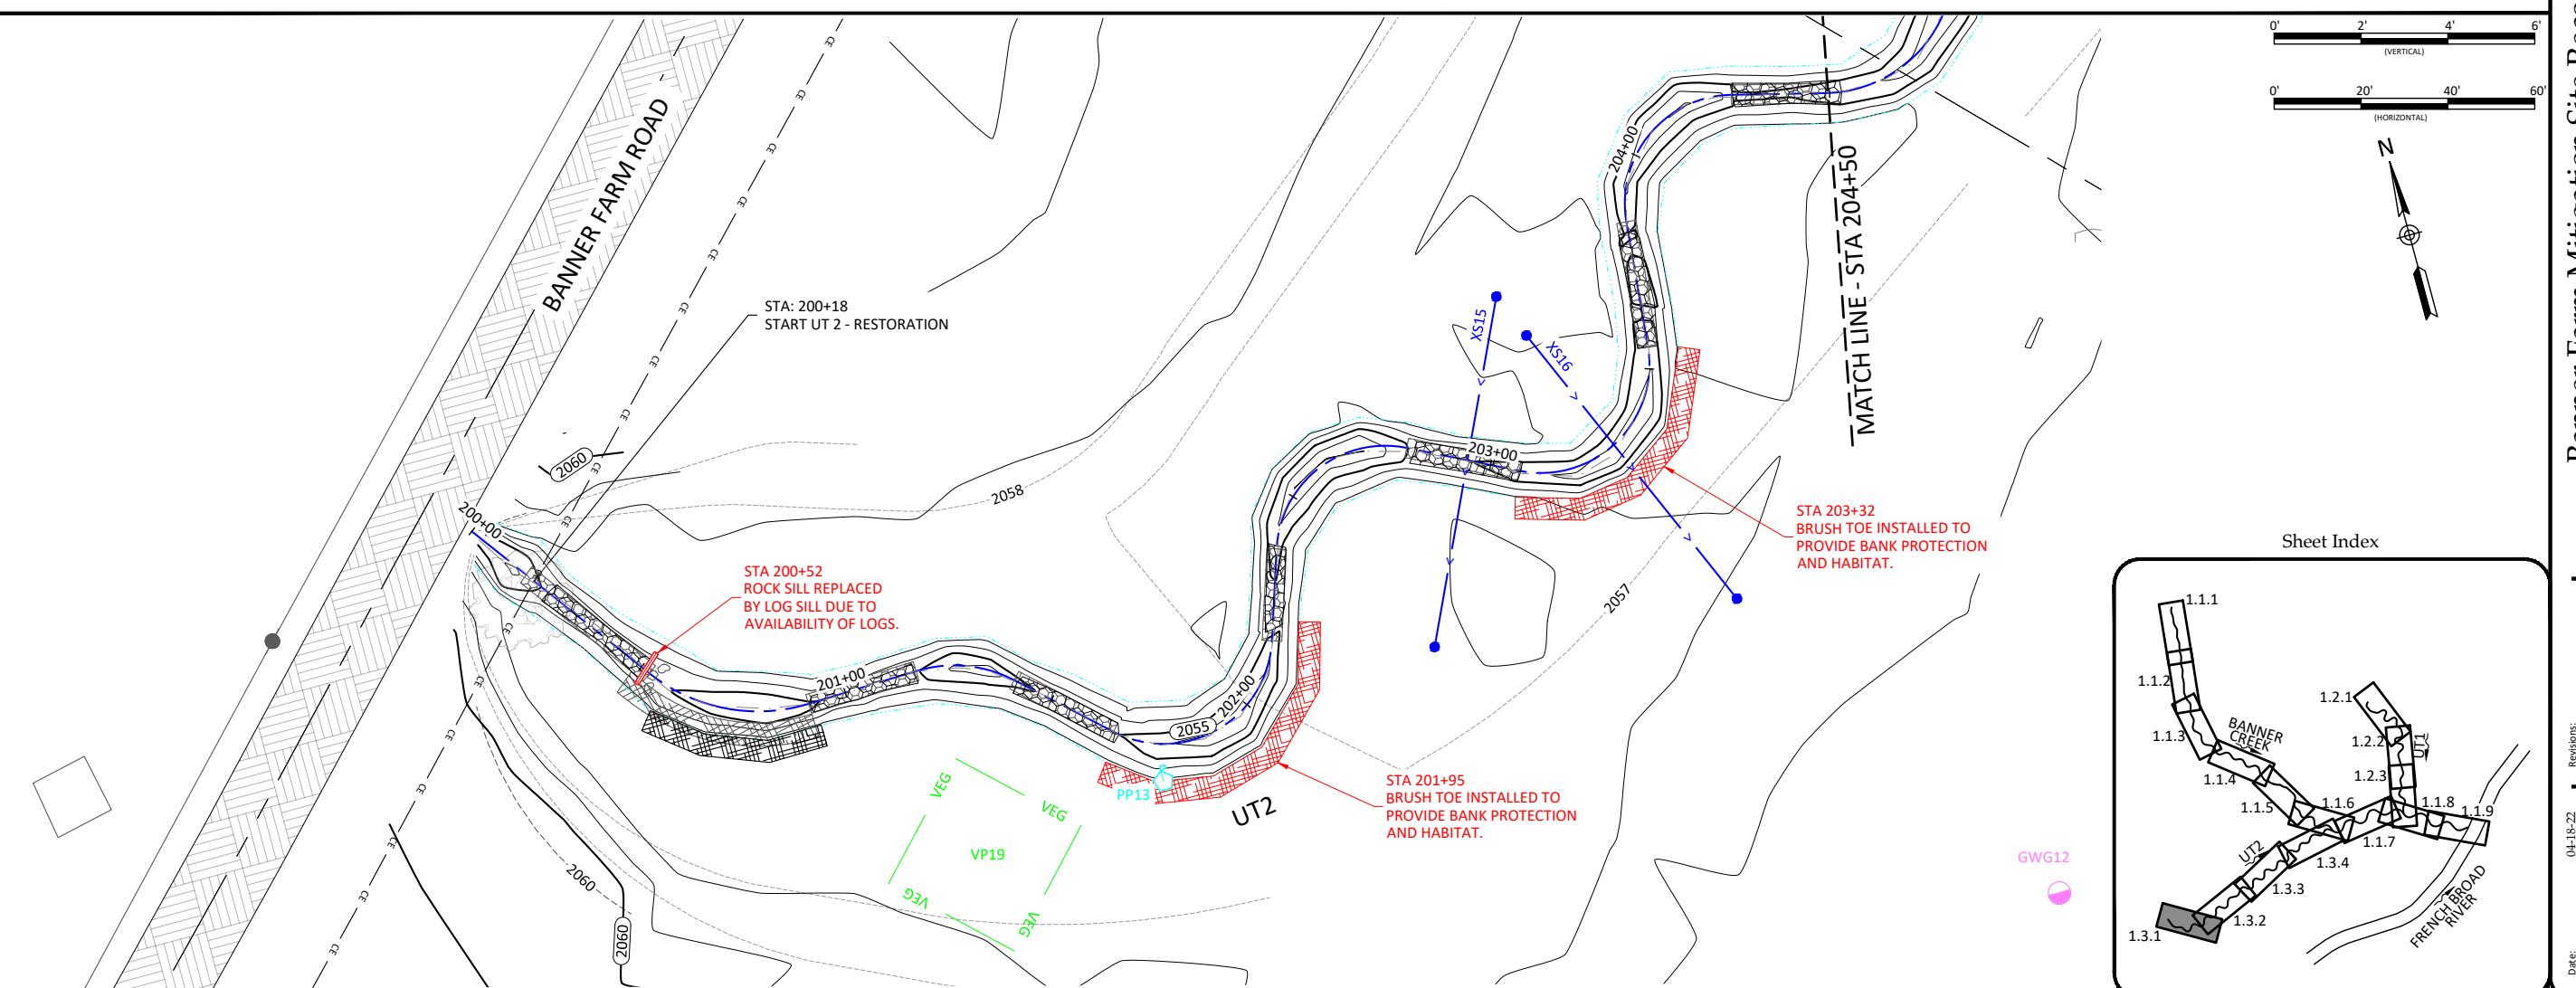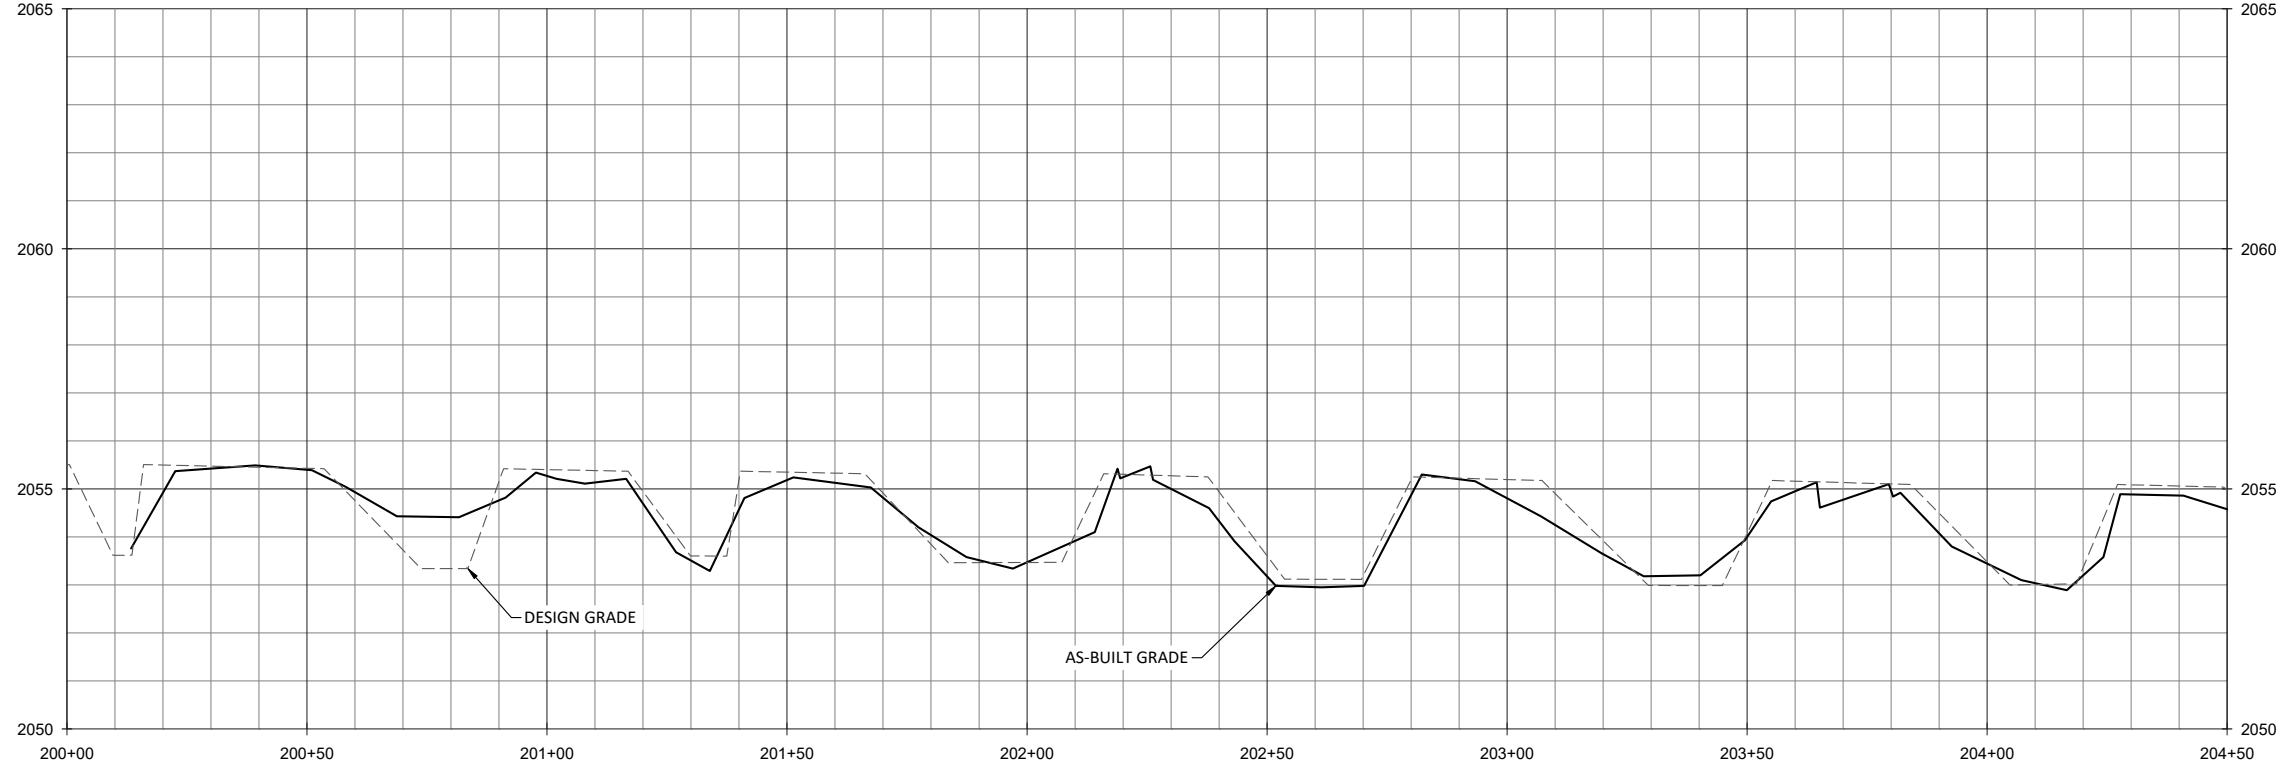




Banner Farm Mitigation Site Record Drawings

Henderson County, North Carolina

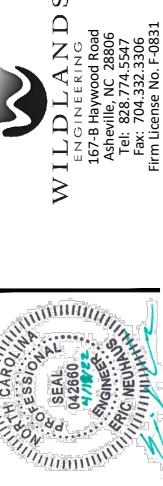Stream Plan and Profile
UT2

Date:	04-18-22
Job Number:	W02172
Project Engineer:	
Drawn By:	JH
Checked By:	JK




1.3.1

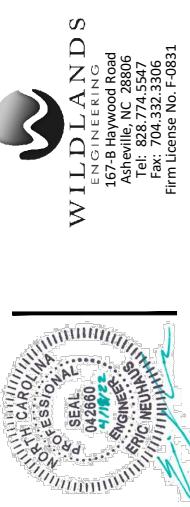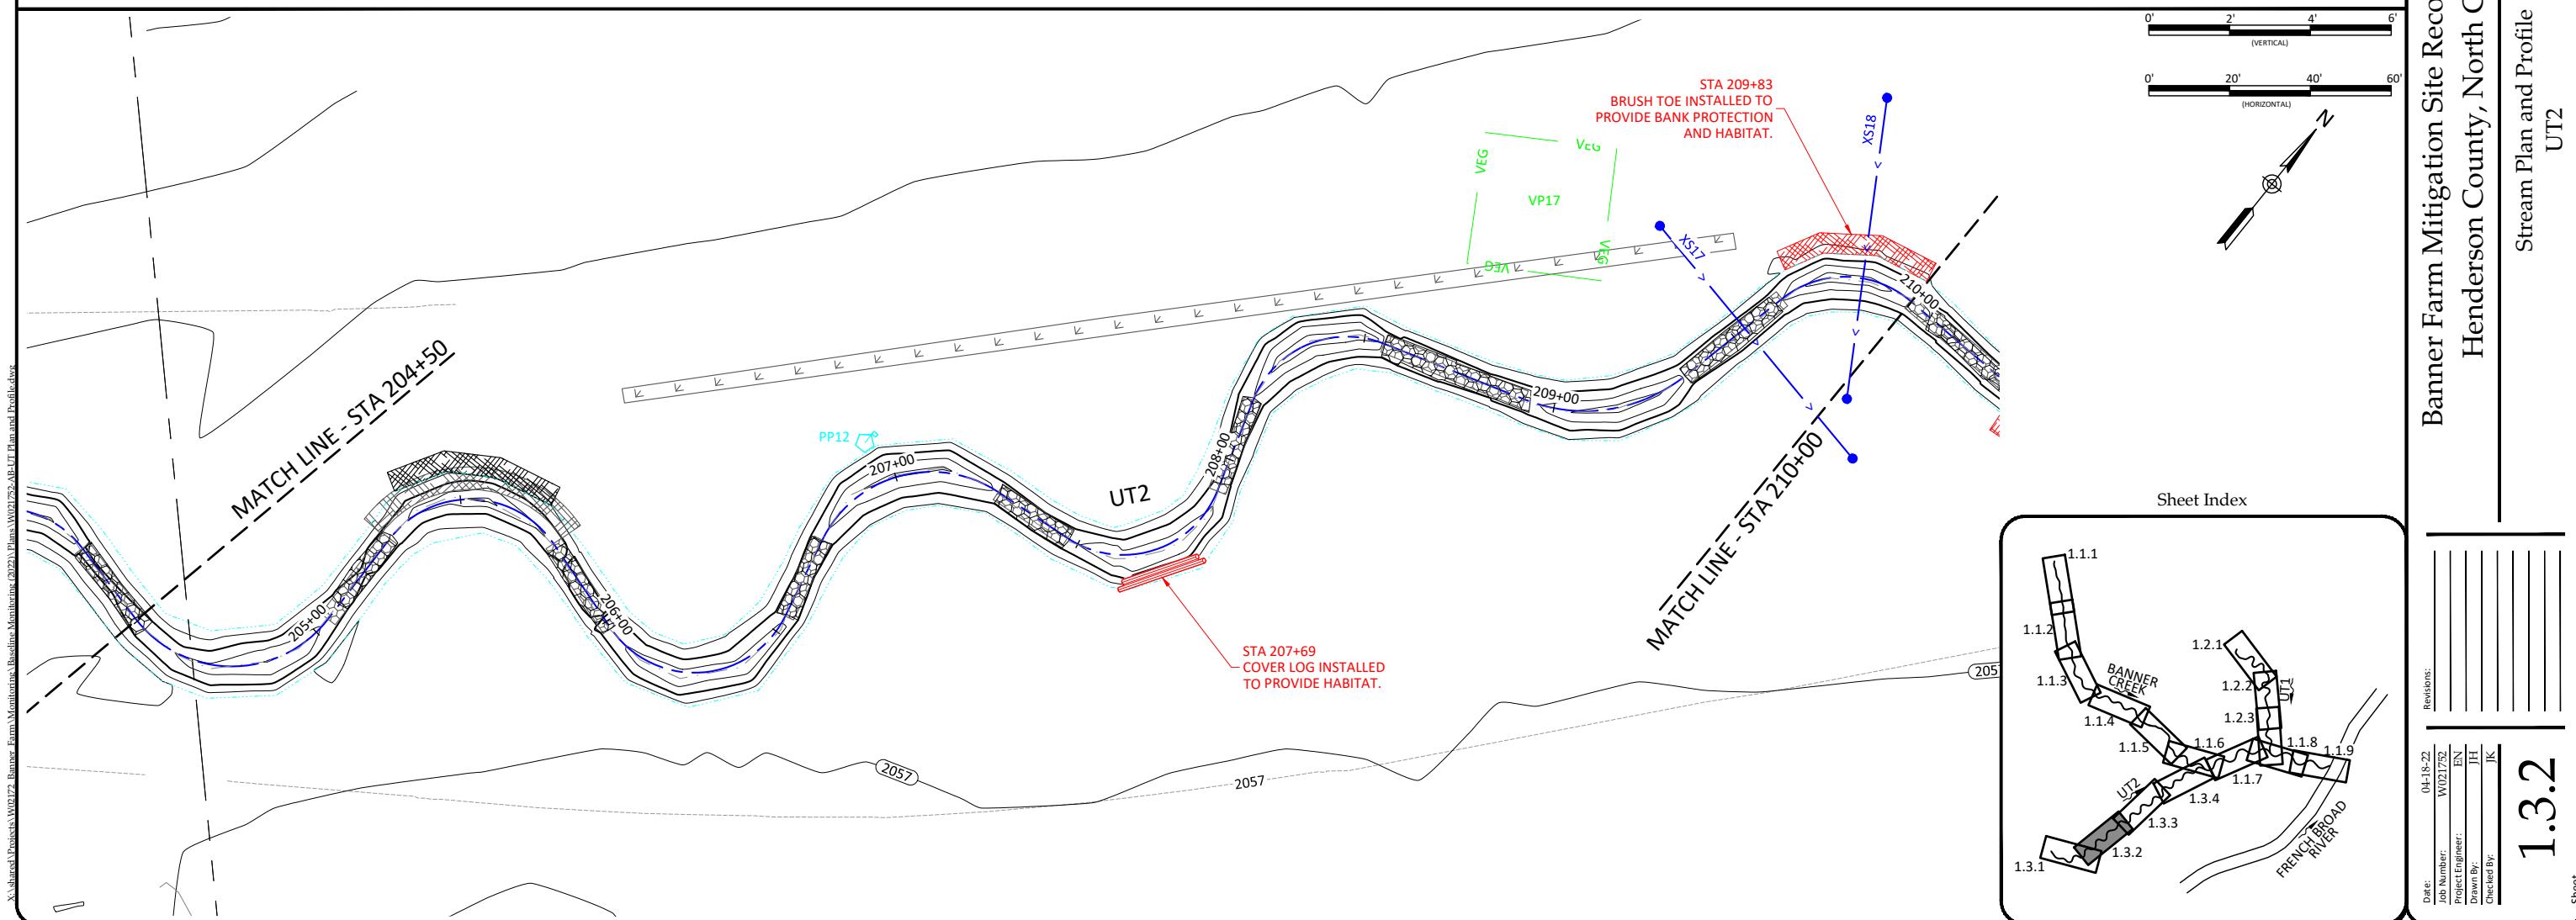
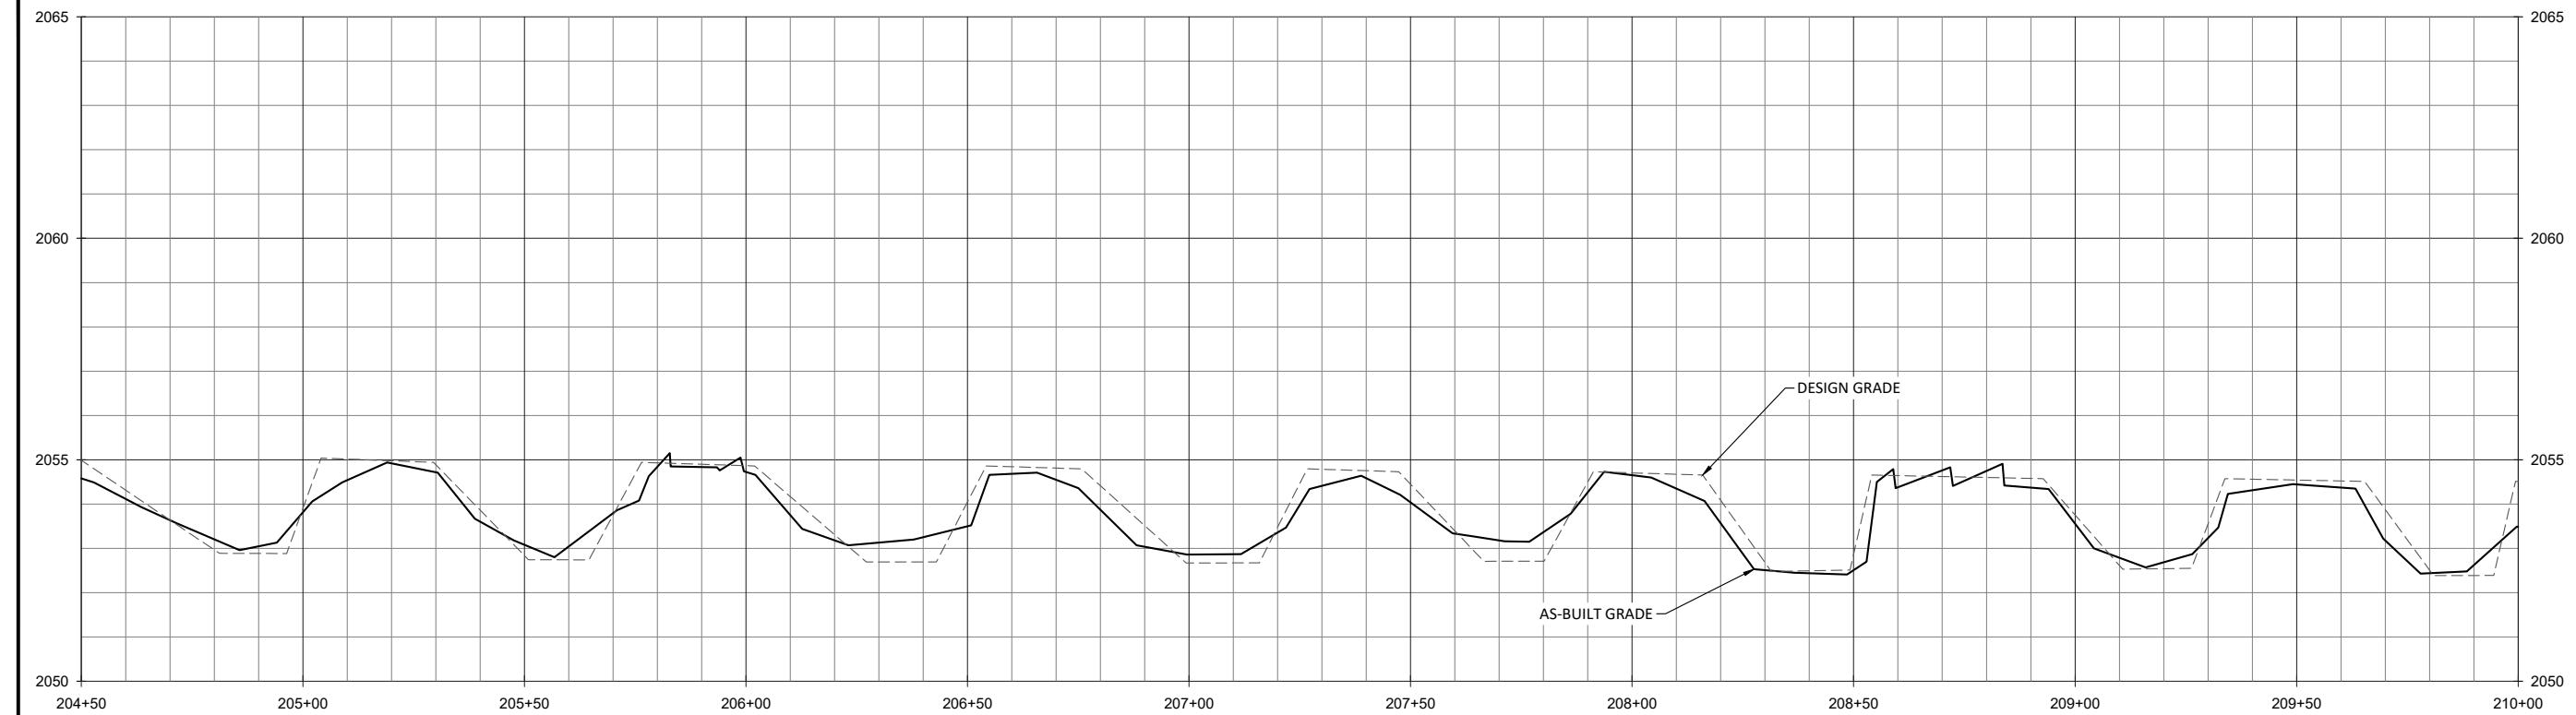


Banner Farm Mitigation Site Record Drawings
Henderson County, North Carolina

Stream Plan and Profile
UT2

Sheet Index

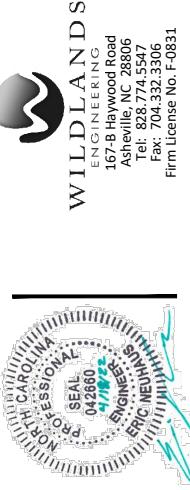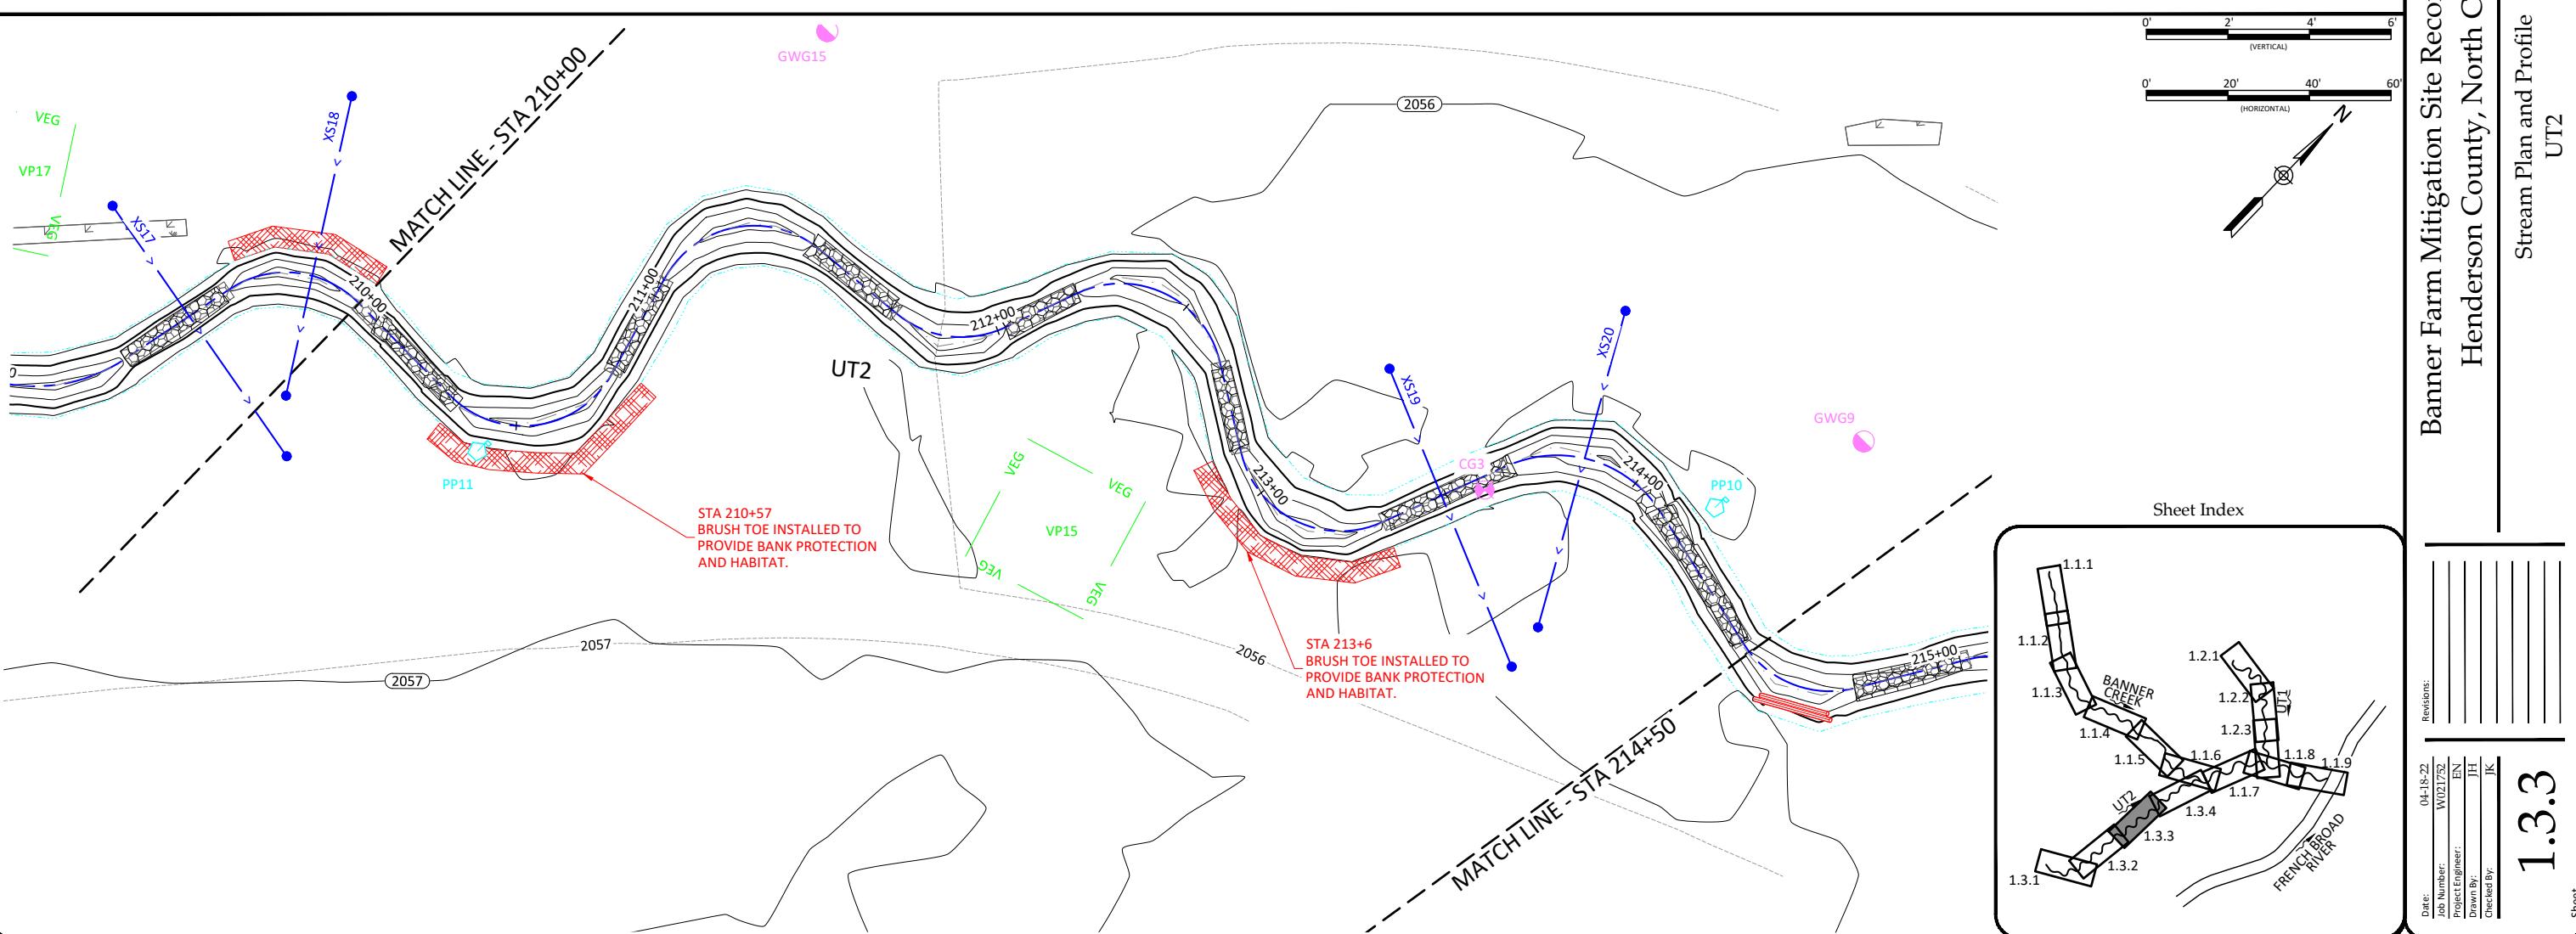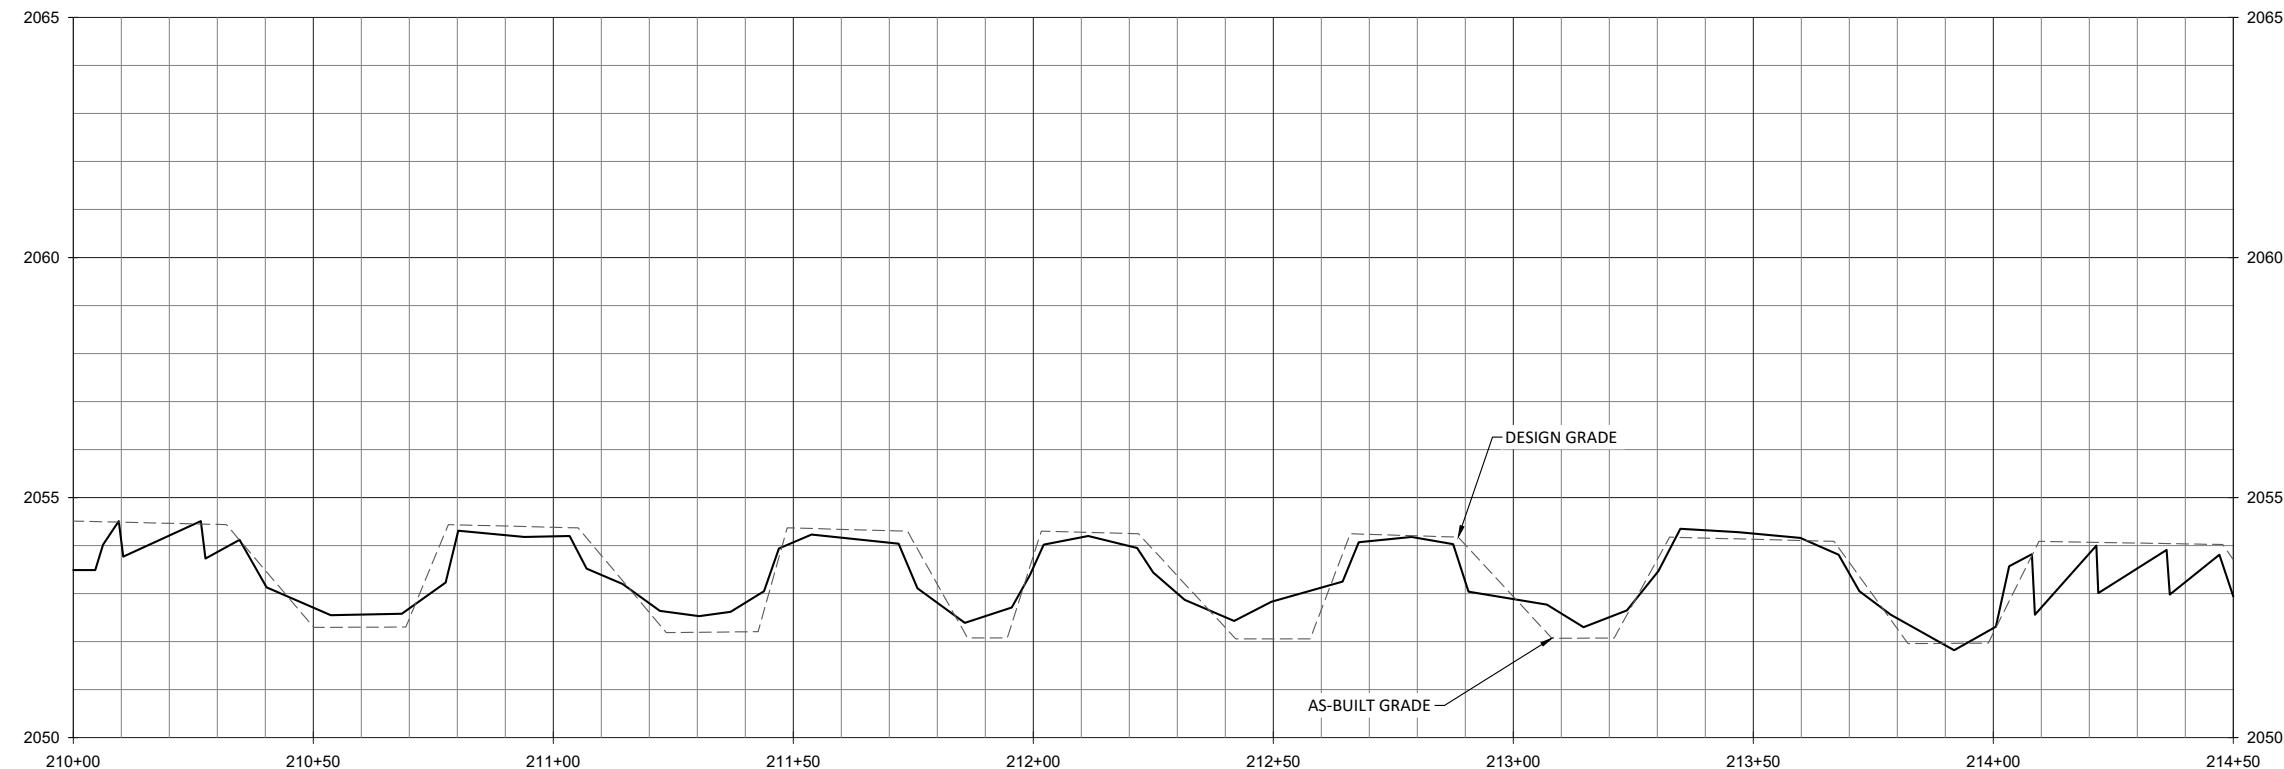

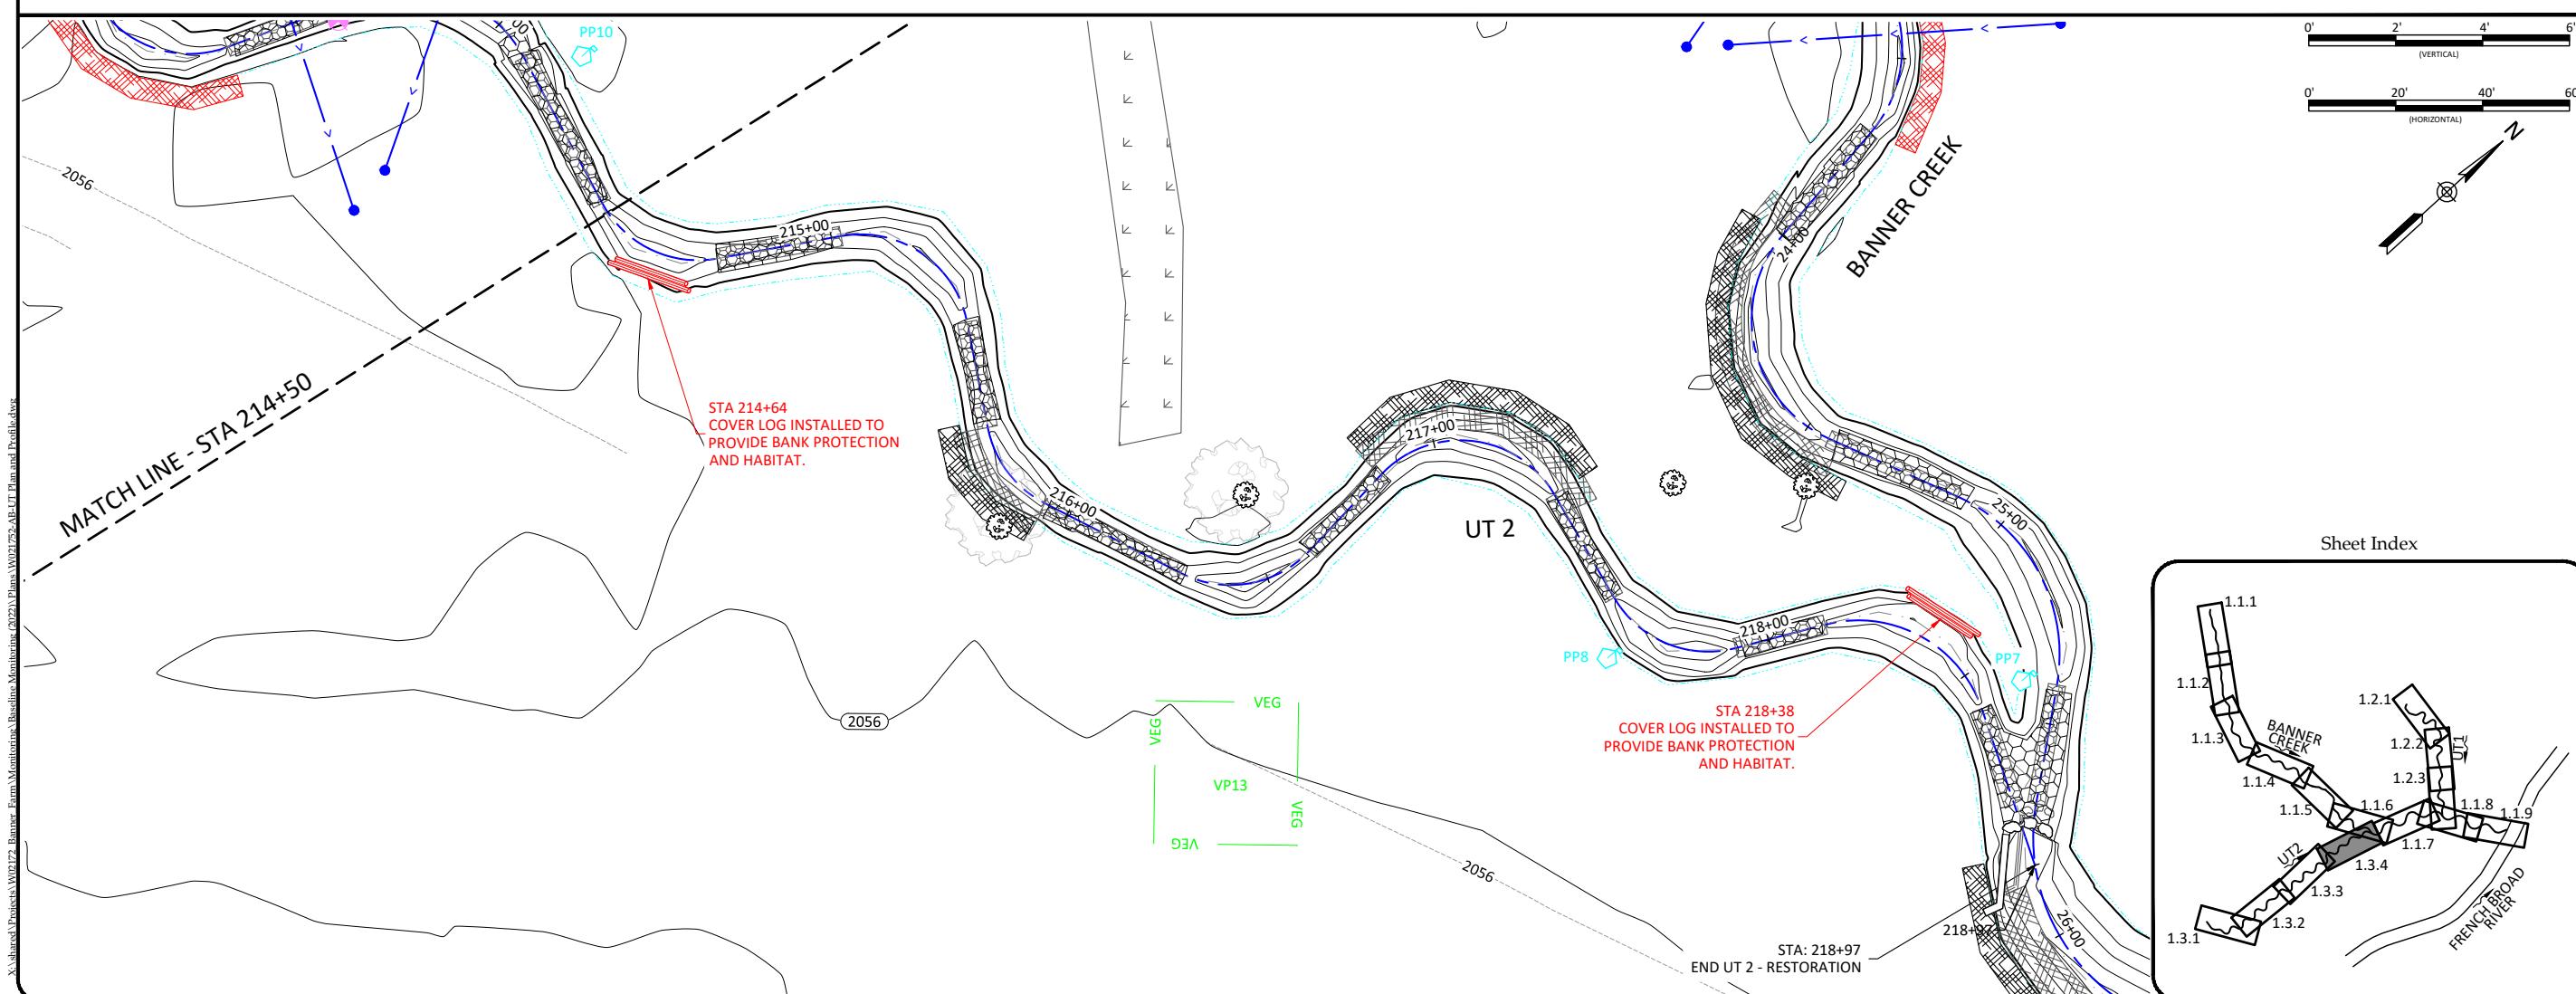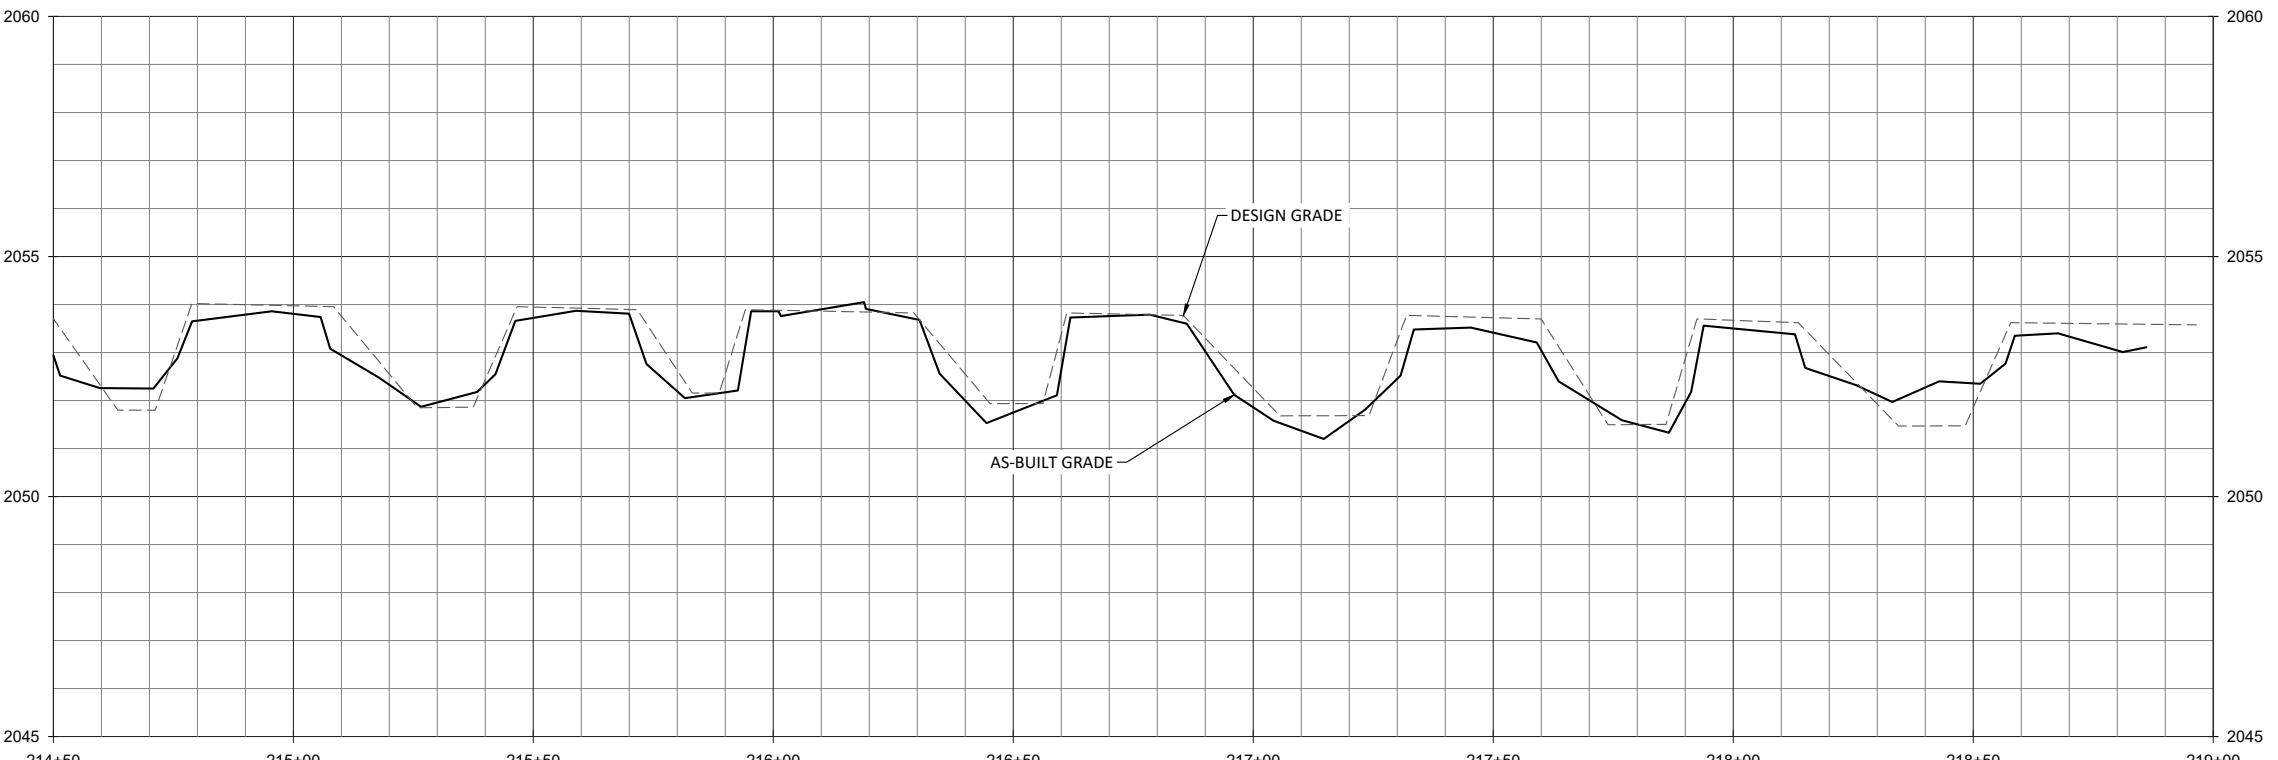


Banner Farm Mitigation Site Record Drawings

Henderson County, North Carolina

Stream Plan and Profile

1.3.4

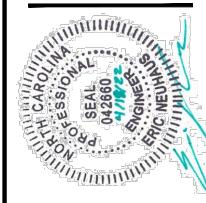

WILDLANDS
ENGINEERING
167-B Hawwood Road
Asheville, NC 28806
Tel: 828.774.5547
Fax: 828.774.3306
Firm license No. E-0831




04-18-22
W02172
EN
JH
JK
Date: Job Number: Project Engineer: Drawn By: Checked By:

Revision:



Overview
Wetland Grading Plan

Banner Farm Mitigation Site Record Drawings Henderson County, North Carolina

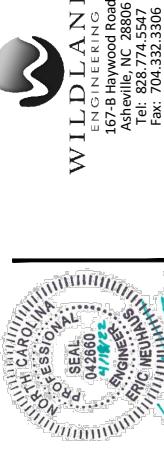

April 18, 2022

X:\Shared\Projects\W02172\Banner Farm Monitoring\Baseline Monitoring\2022\Plans\W02172-A-B-Wetland Grading.dwg

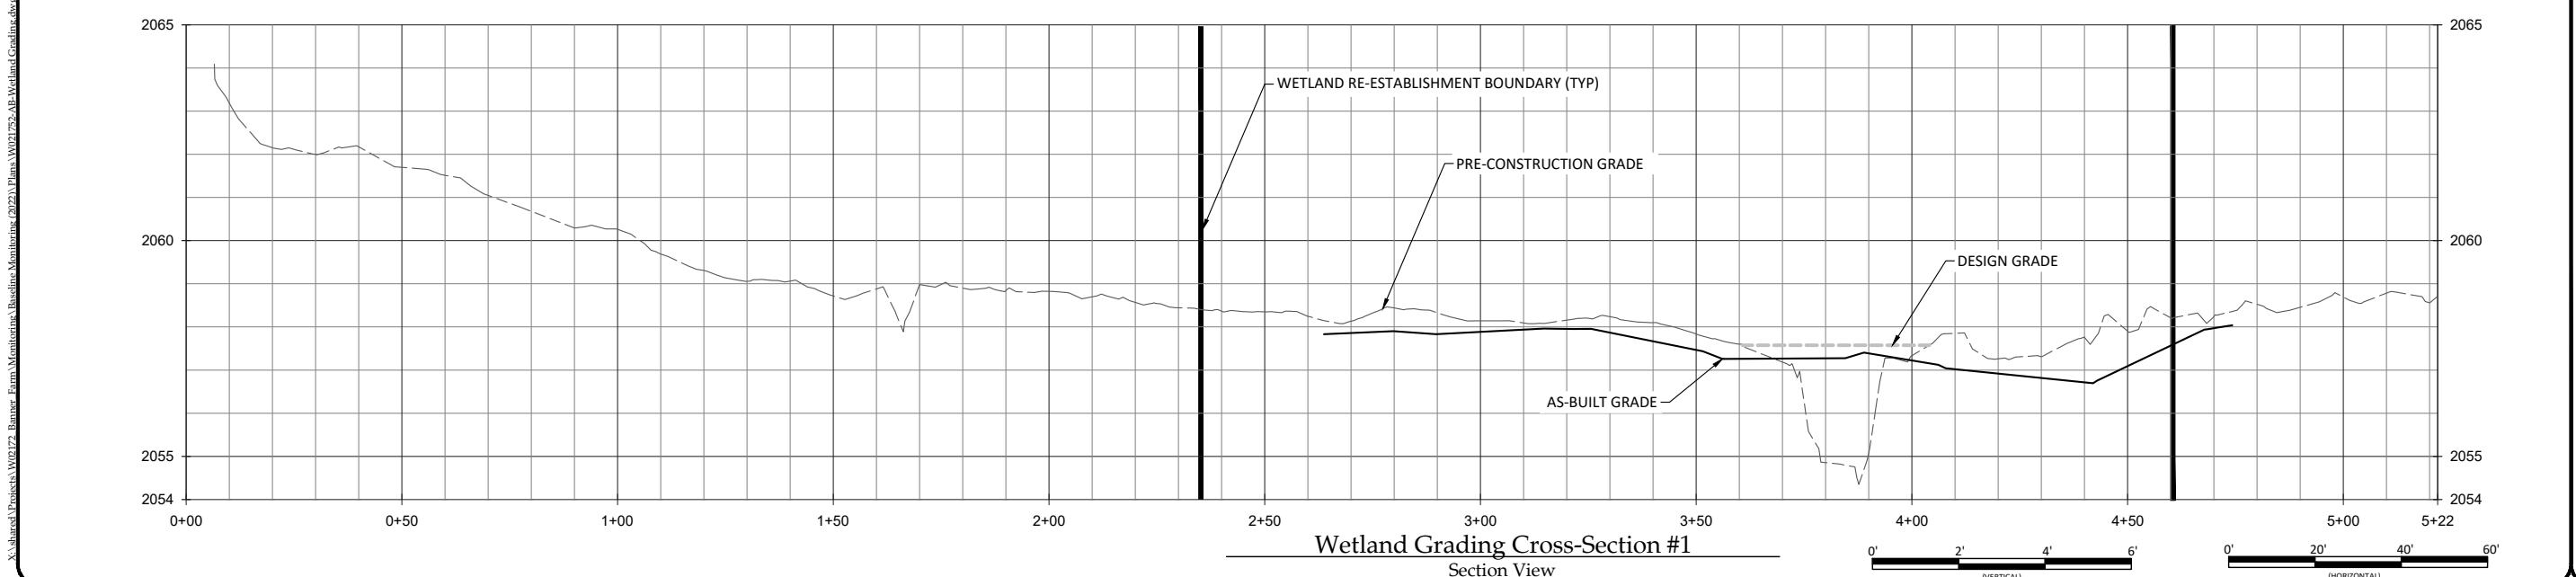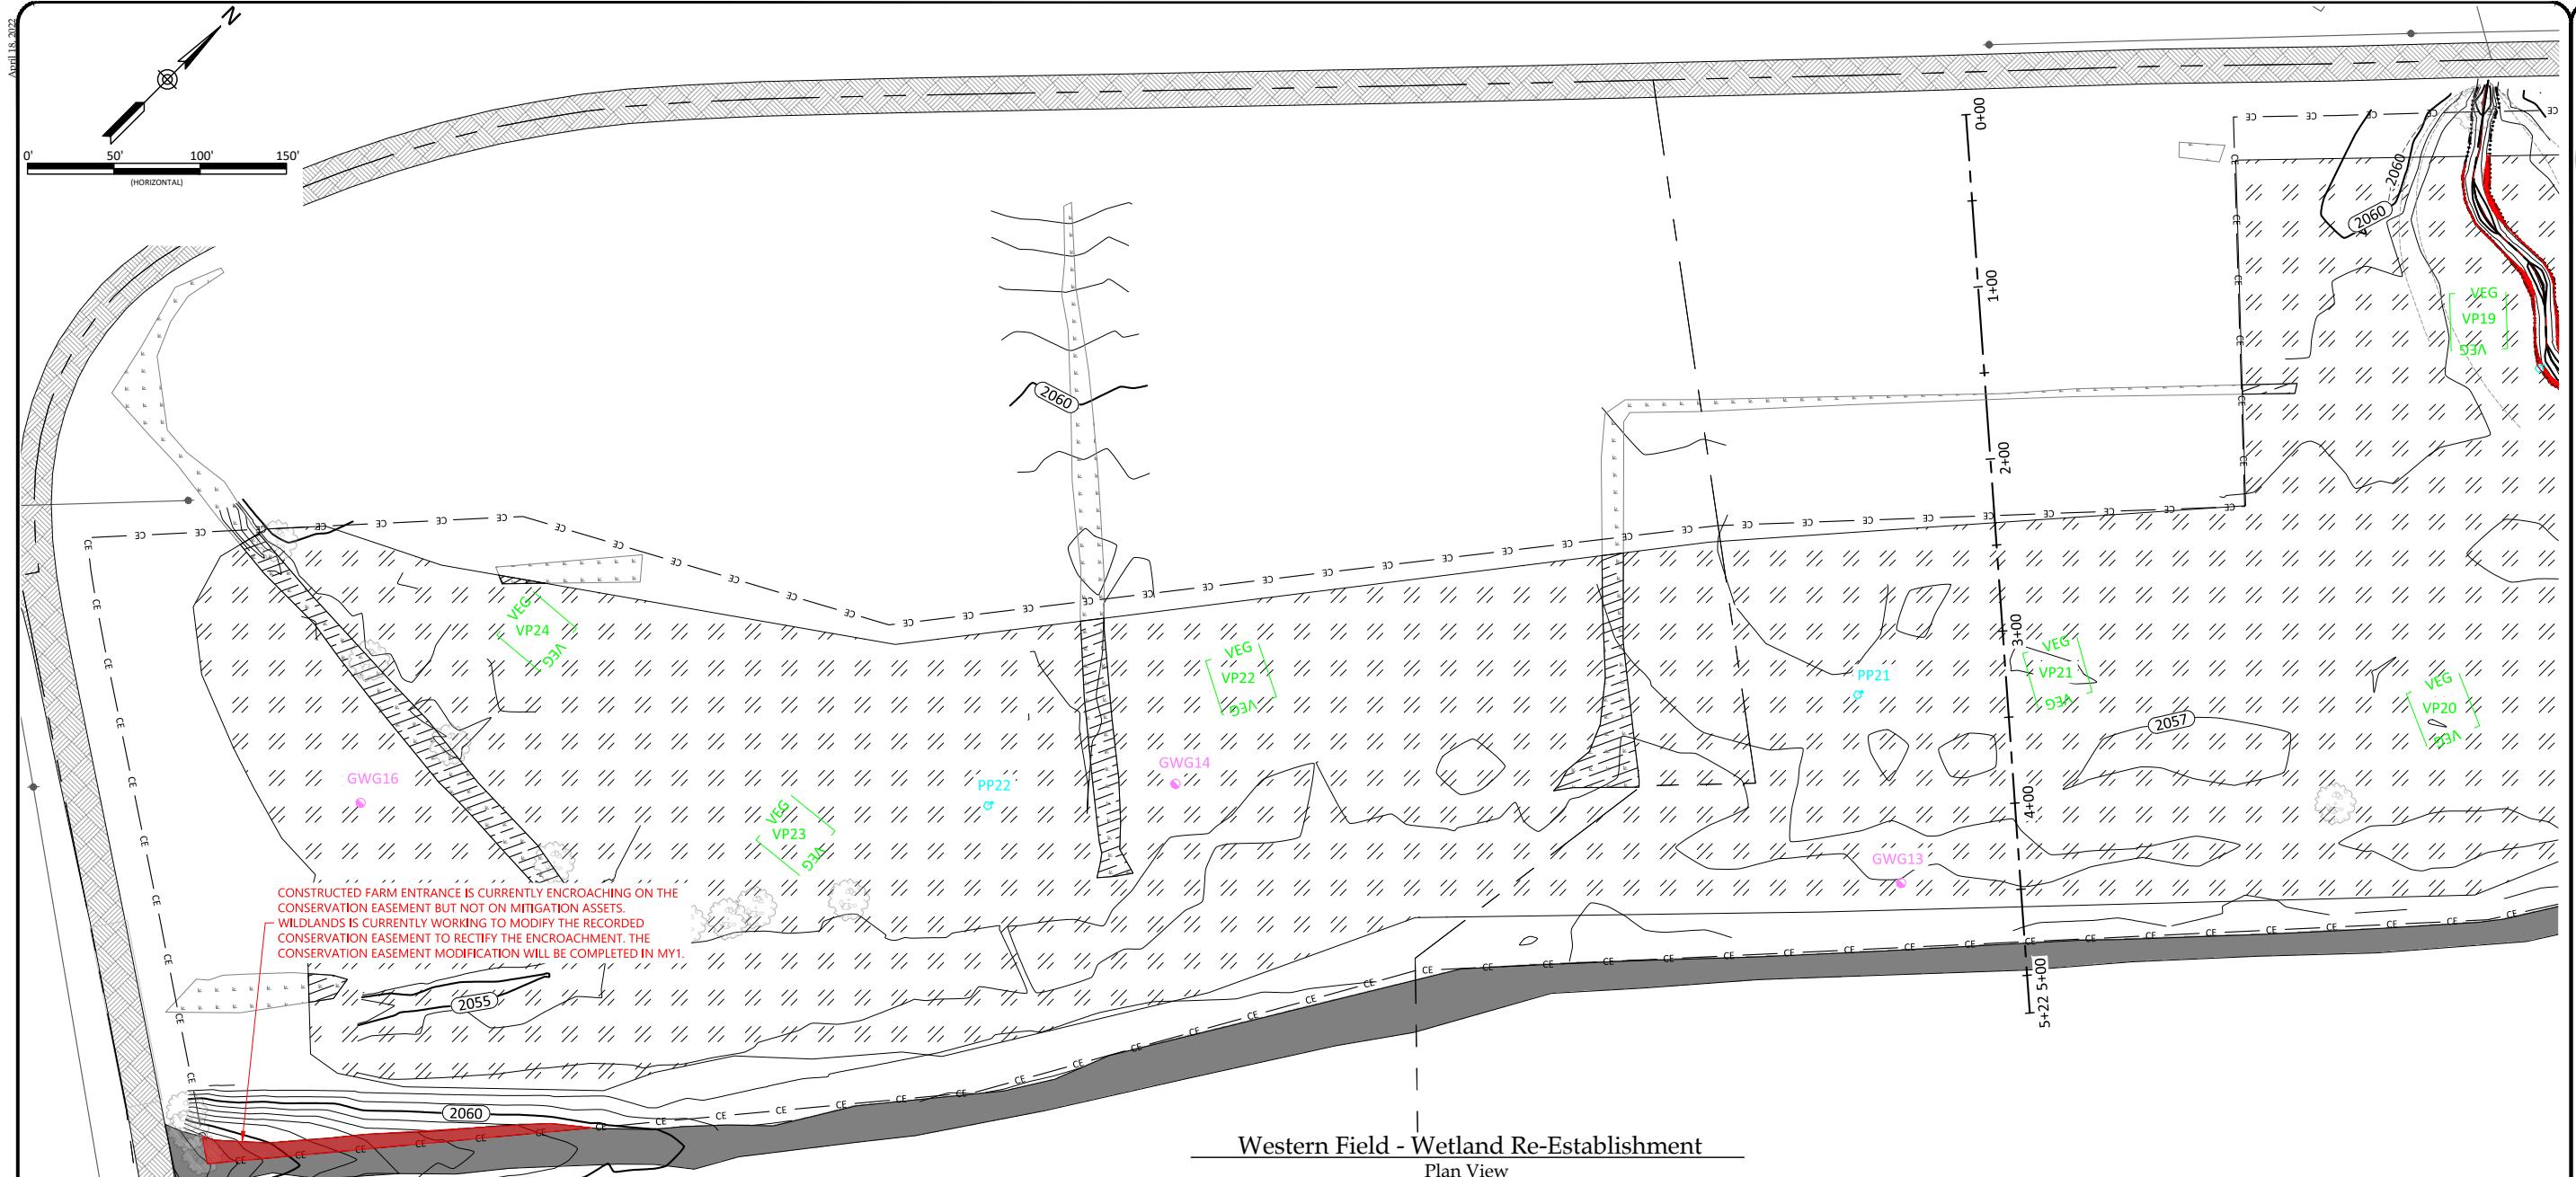



2.2

Date: 04-18-22
Revision: W02172
Job Number: EN
Project Engineer: JH
Drawn By: JK
Checked By:


Banner Farm Mitigation Site Record Drawings**Henderson County, North Carolina****Western Field****Wetland Grading Plan**

WILDLANDS
ENGINEERING
167-B Hawwood Road
Asheville, NC 28806
Tel: 828.774.5547
Fax: 828.332.3306
Firm license No. E-0831

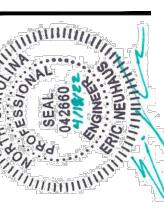


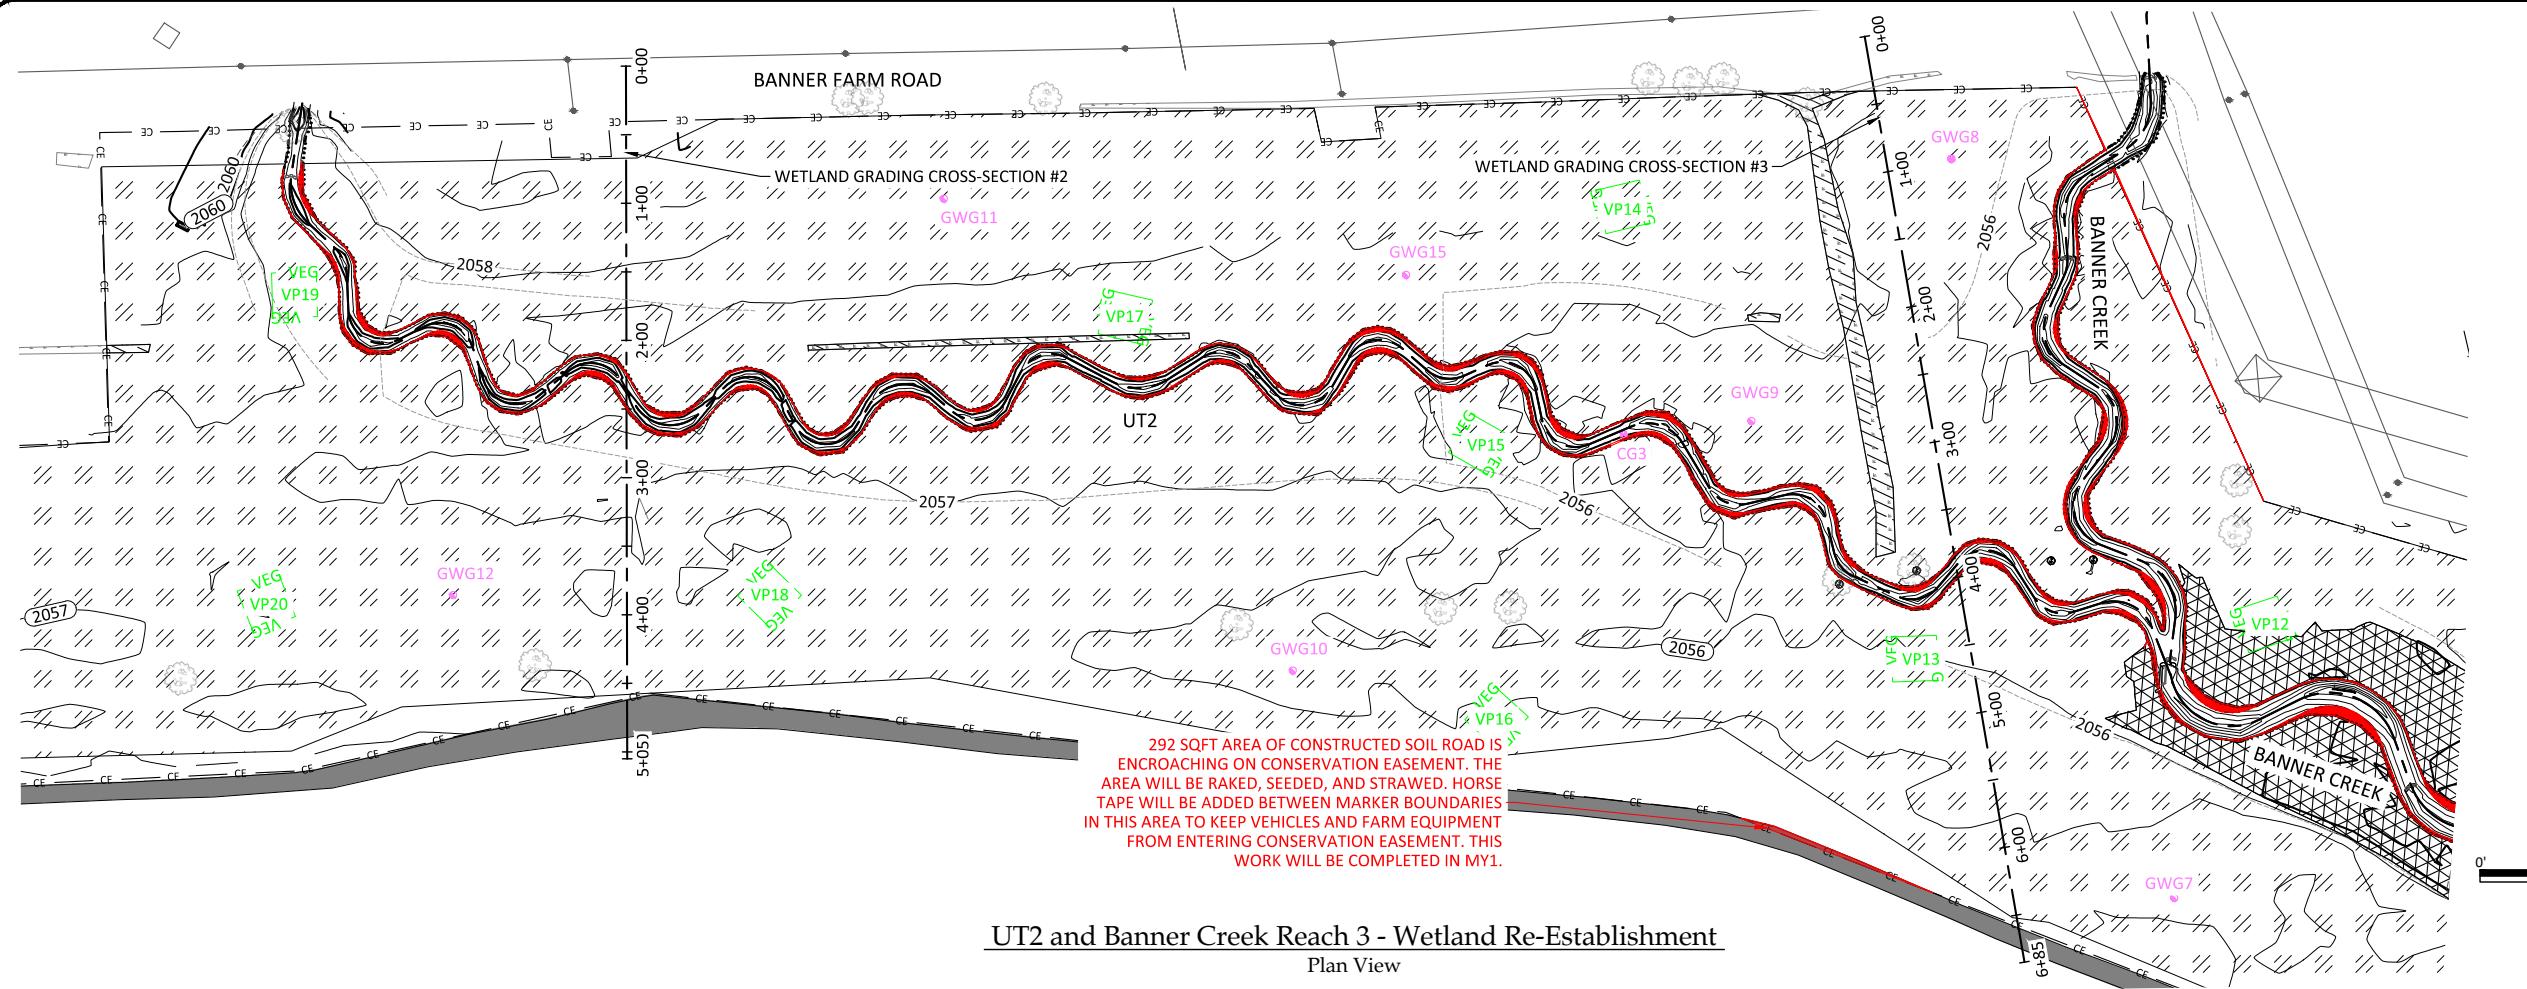UT2 and Banner Creek Reach 3 - Wetland Re-Establishment

Plan View

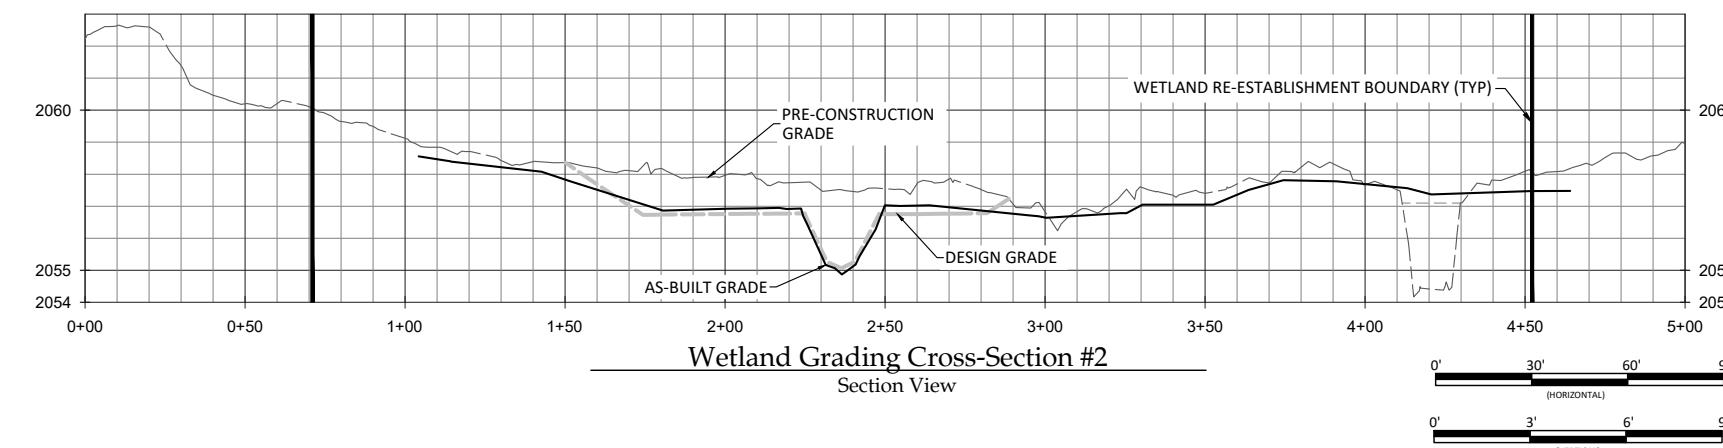Wetland Grading Cross-Section #2

Section View

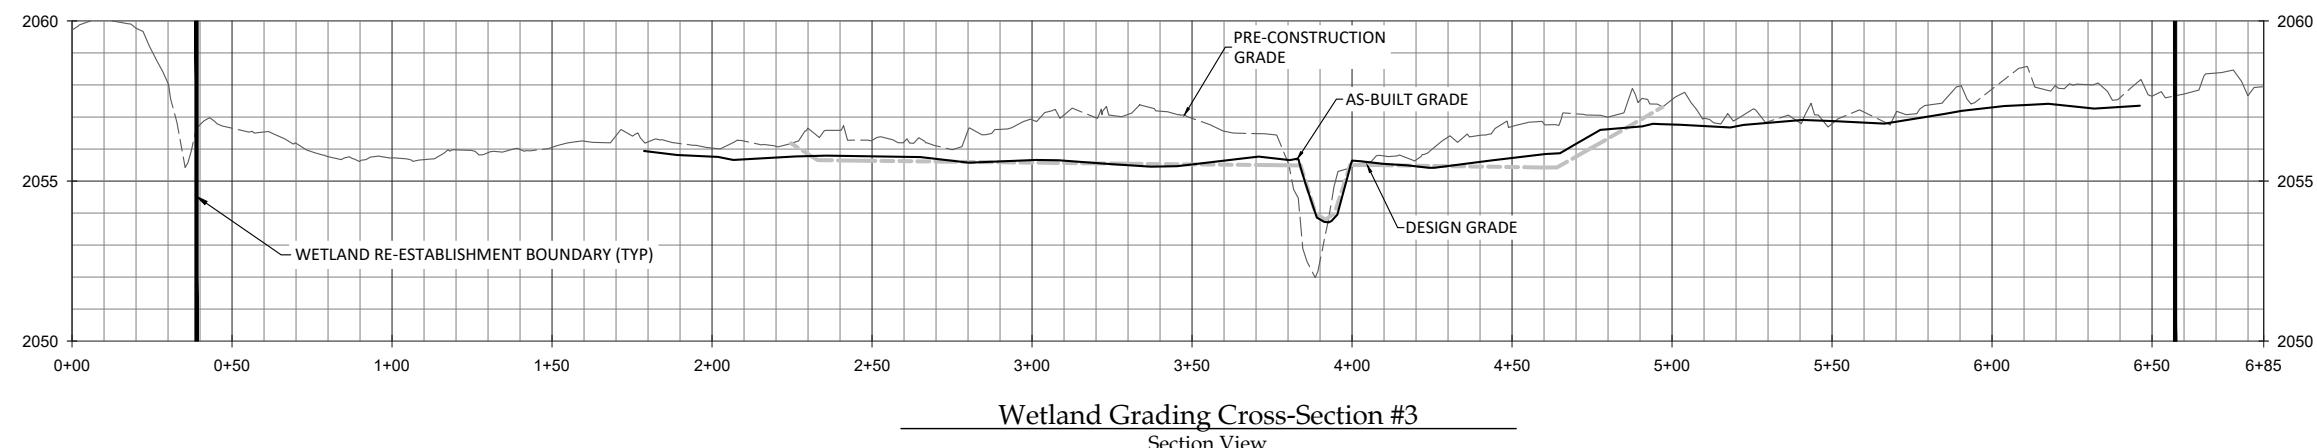Wetland Grading Cross-Section #3

Section View


Banner Farm Mitigation Site Record Drawings**Henderson County, North Carolina****Banner Creek & UT2
Wetland Grading Plan**

Revision:




01-18-22
W021752
EN
JH
JK**2.3**Date:
Job Number:
Project Engineer:
Drawn By:
Checked By:

Sheet

WILDLANDS
ENGINEERING
167-B Hawwood Road
Asheville, NC 28806
Tel: 828.774.5547
Fax: 704.332.3306
Firm license No. E-0831

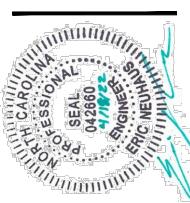

Ann18.2022

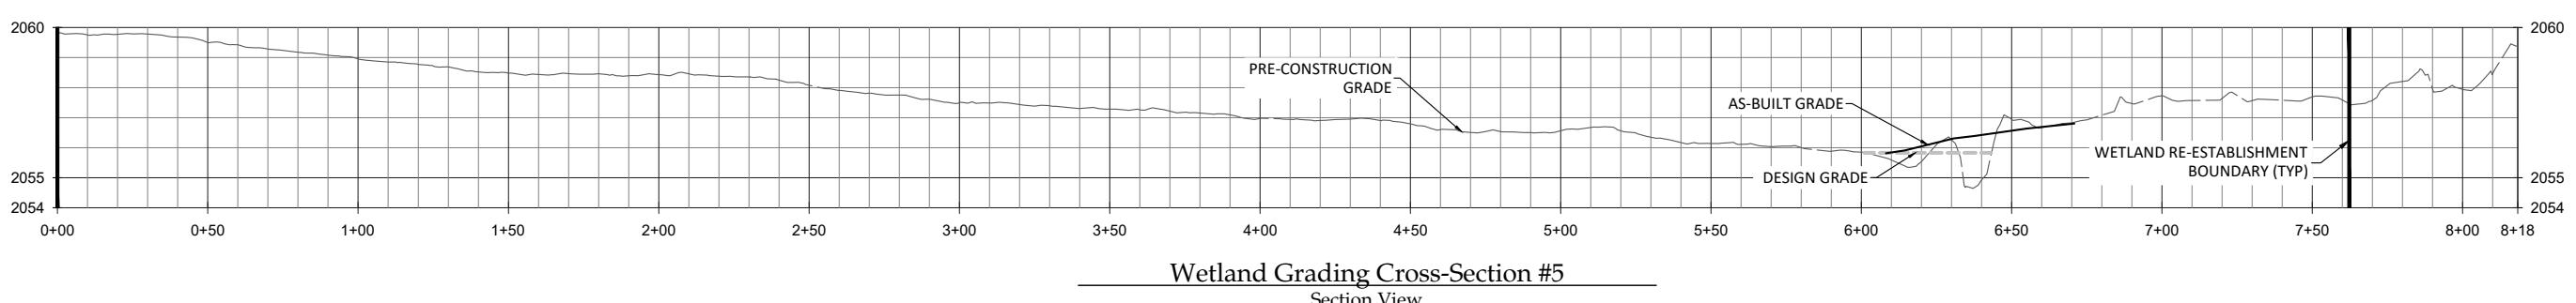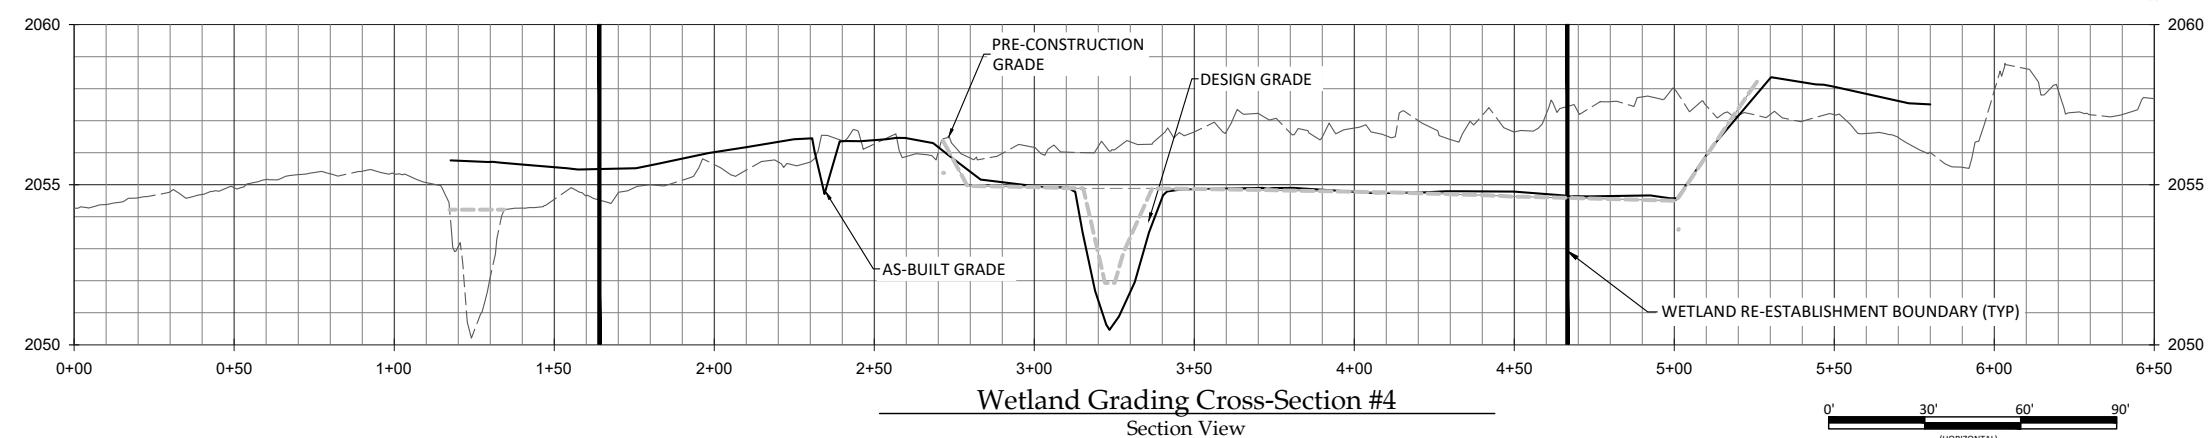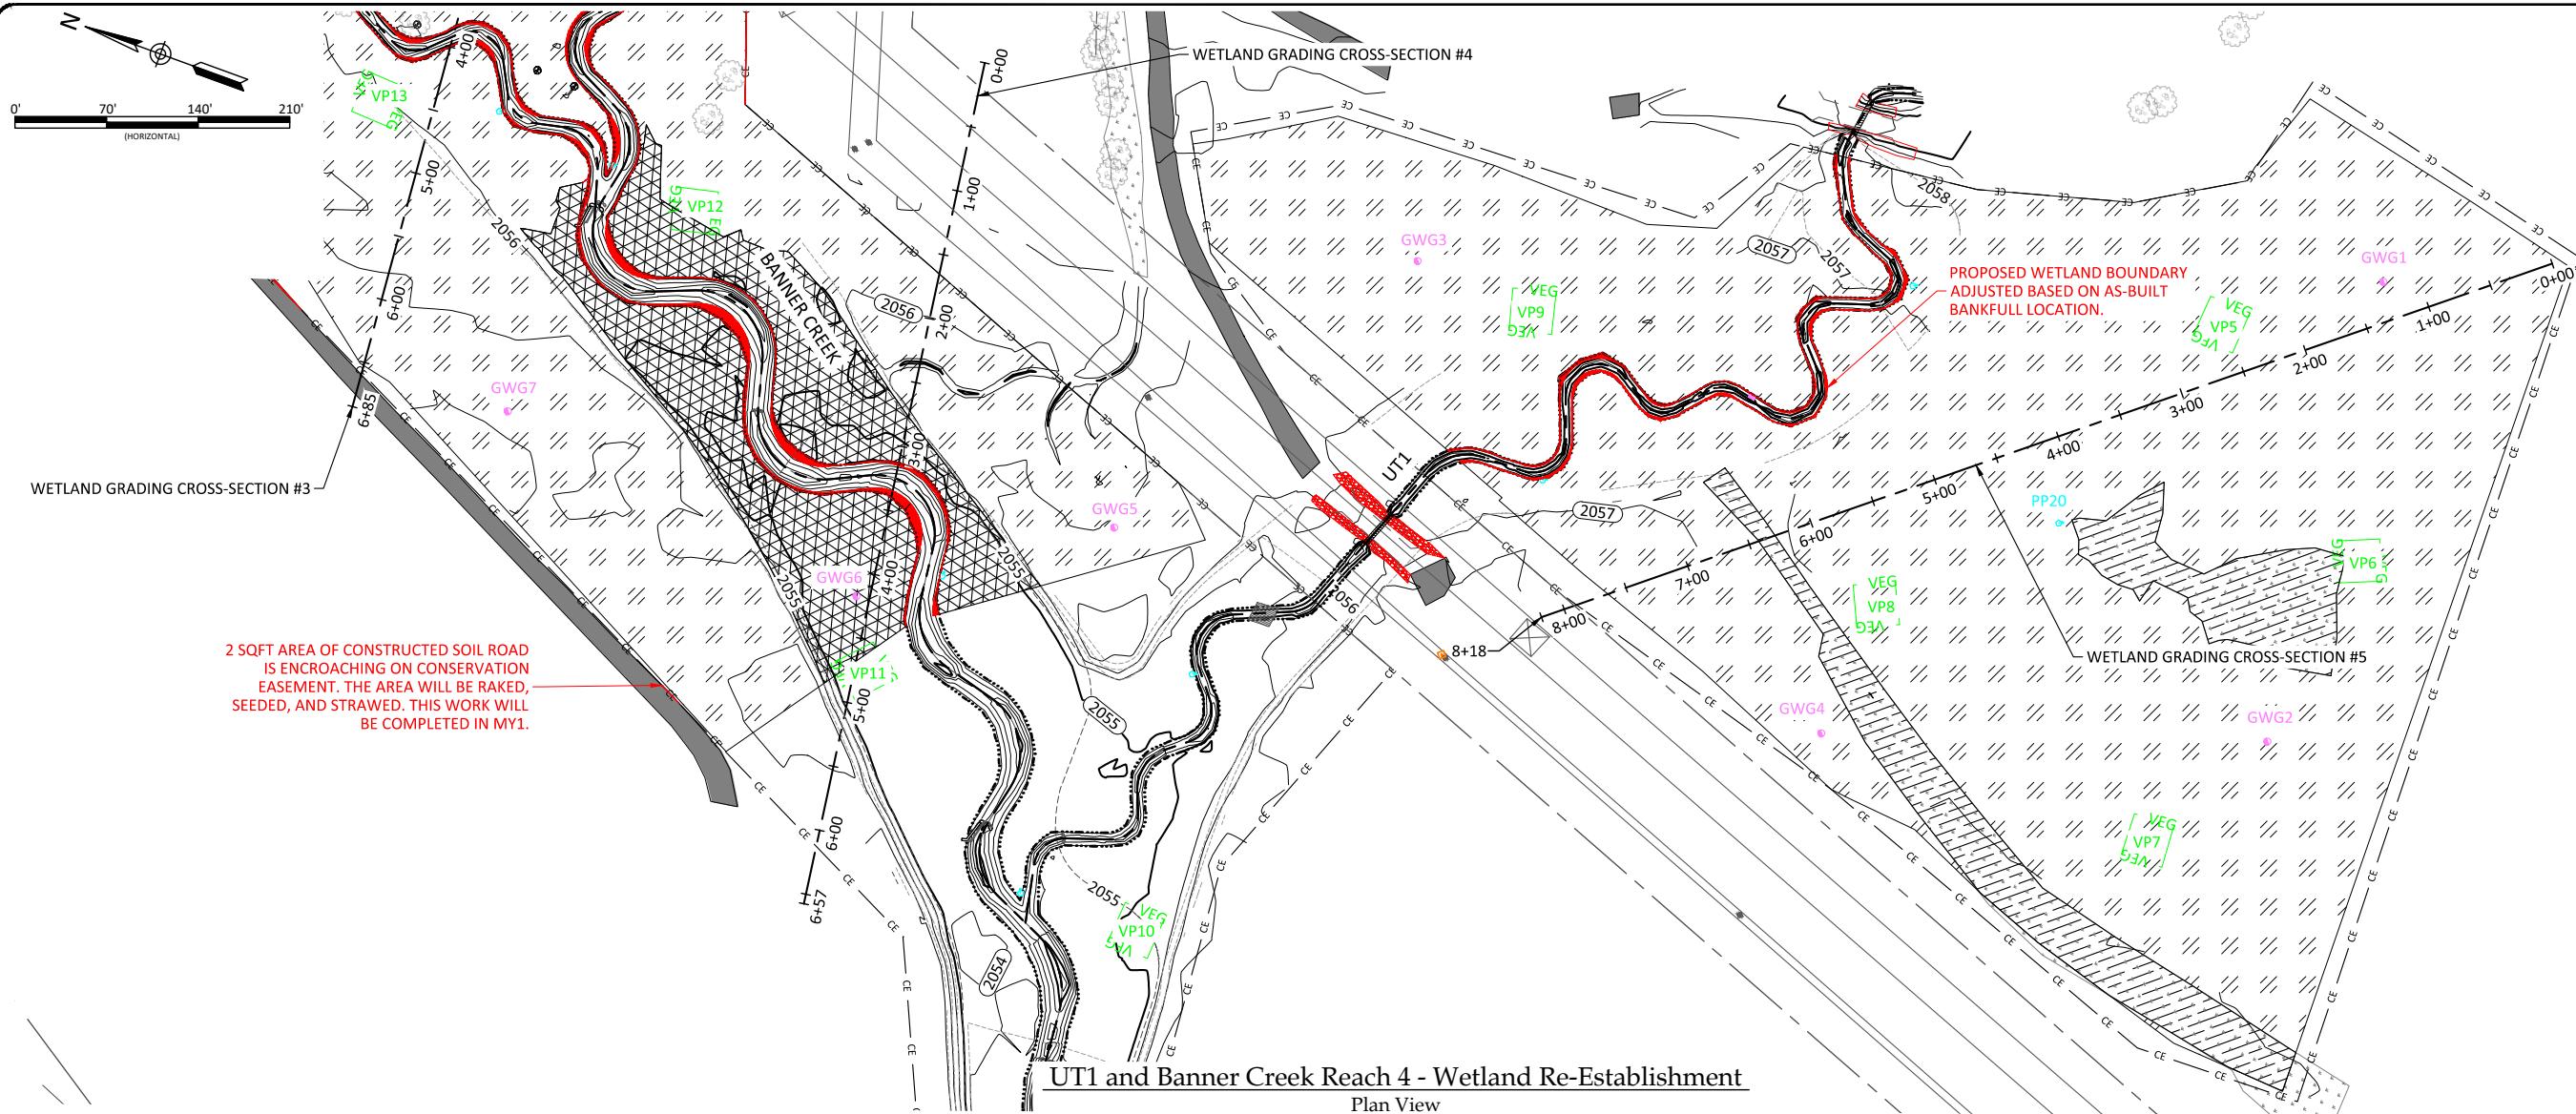

Banner Farm Mitigation Site Record Drawings


Henderson County, North Carolina


UT1 and Banner Creek Reach 4

Wetland Grading Plan



Date: 01-18-22
Job Number: W021752
Project Engineer: EN
Drawn By: JH
Checked By: JK

2.4

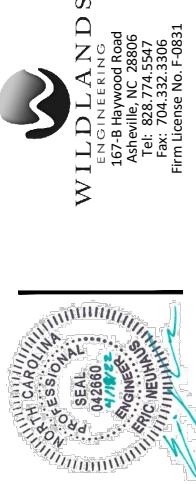

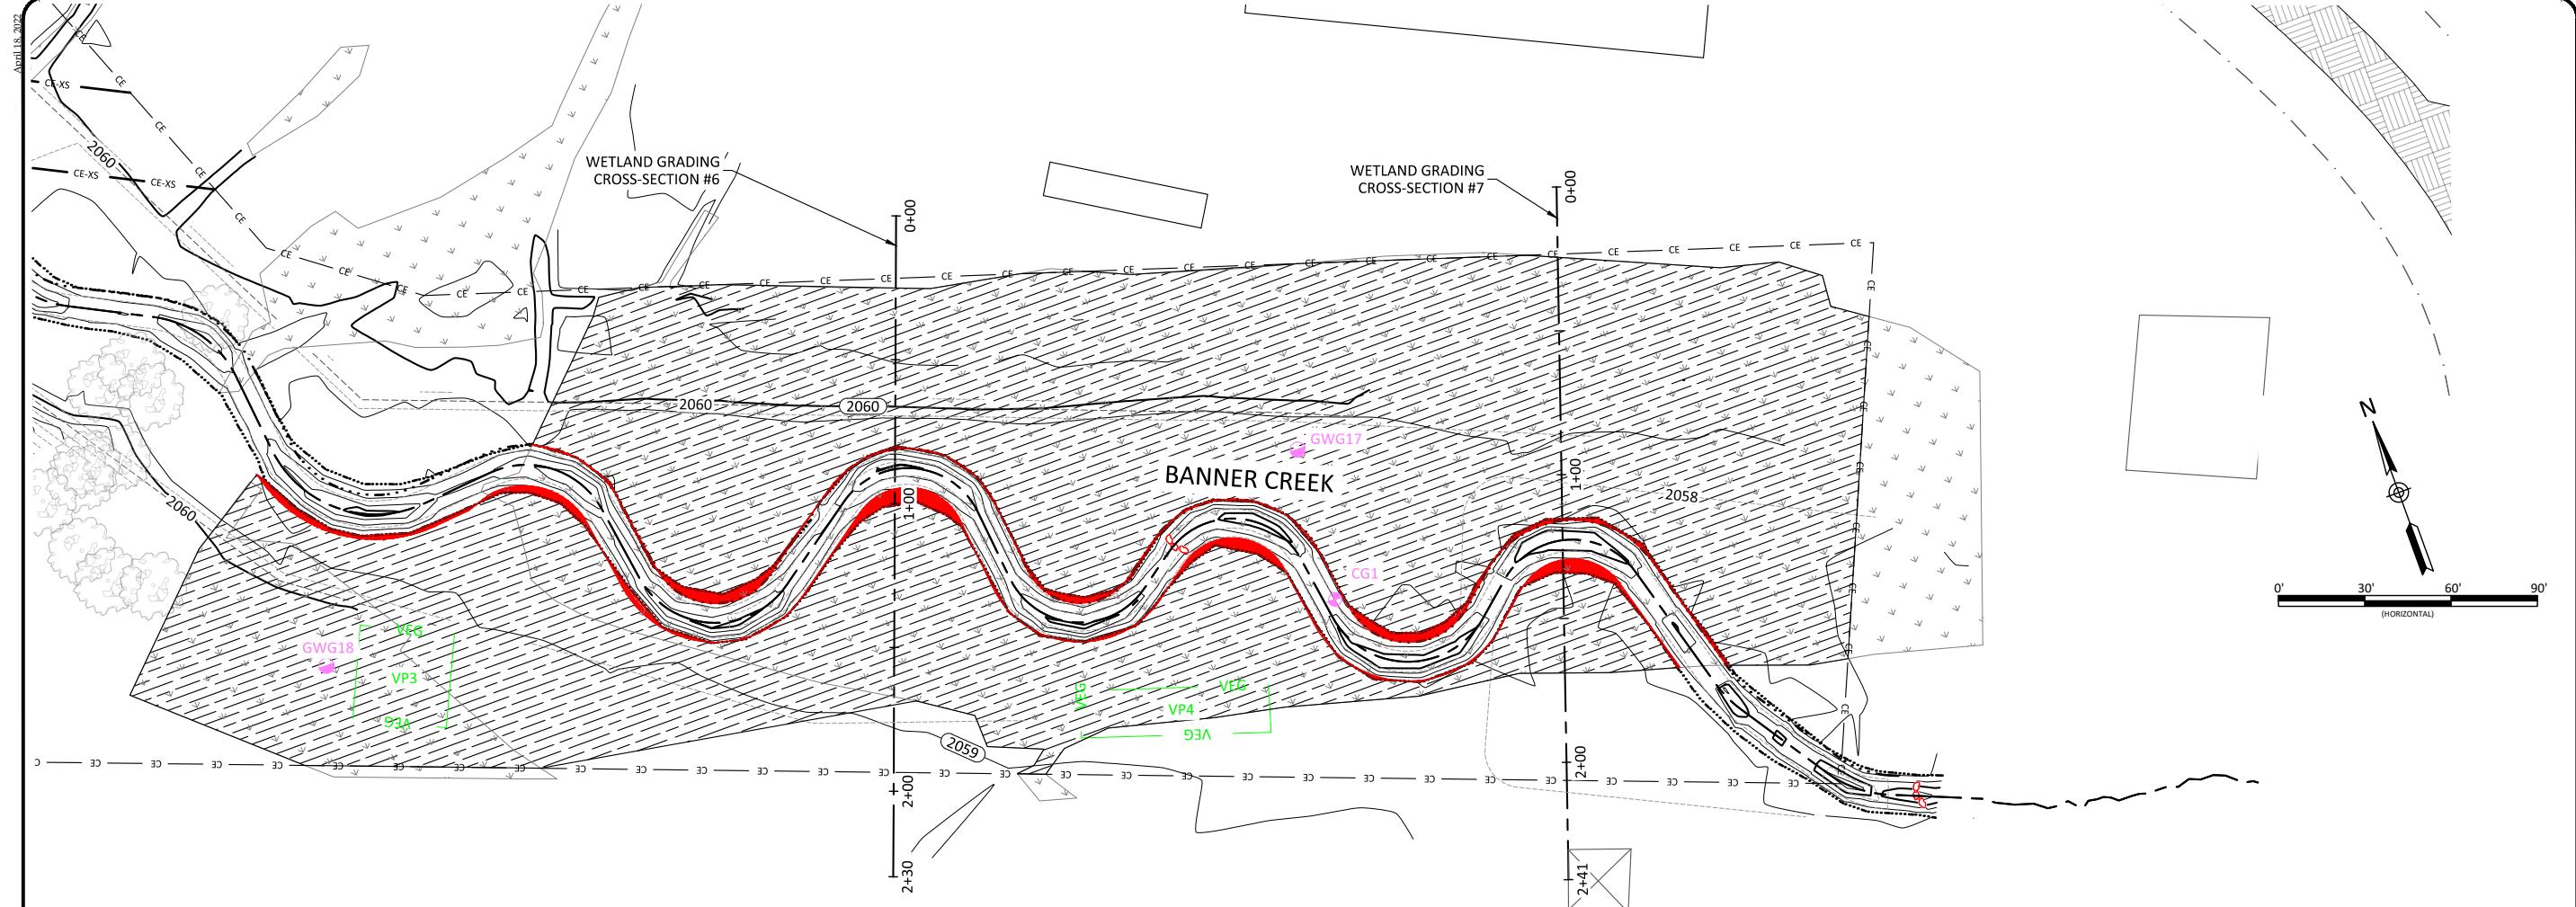

Banner Creek Reach 2 - Wetland Rehabilitation
Plan View

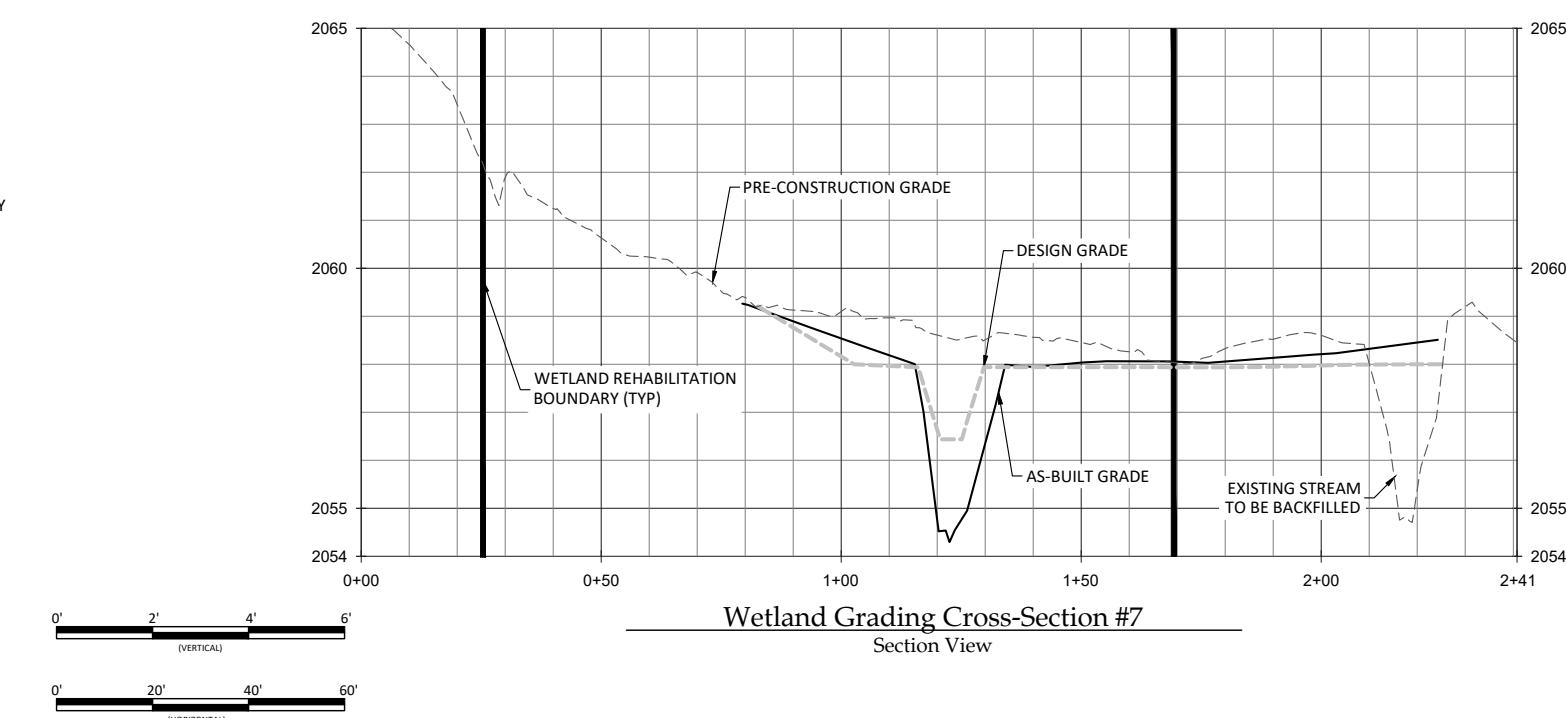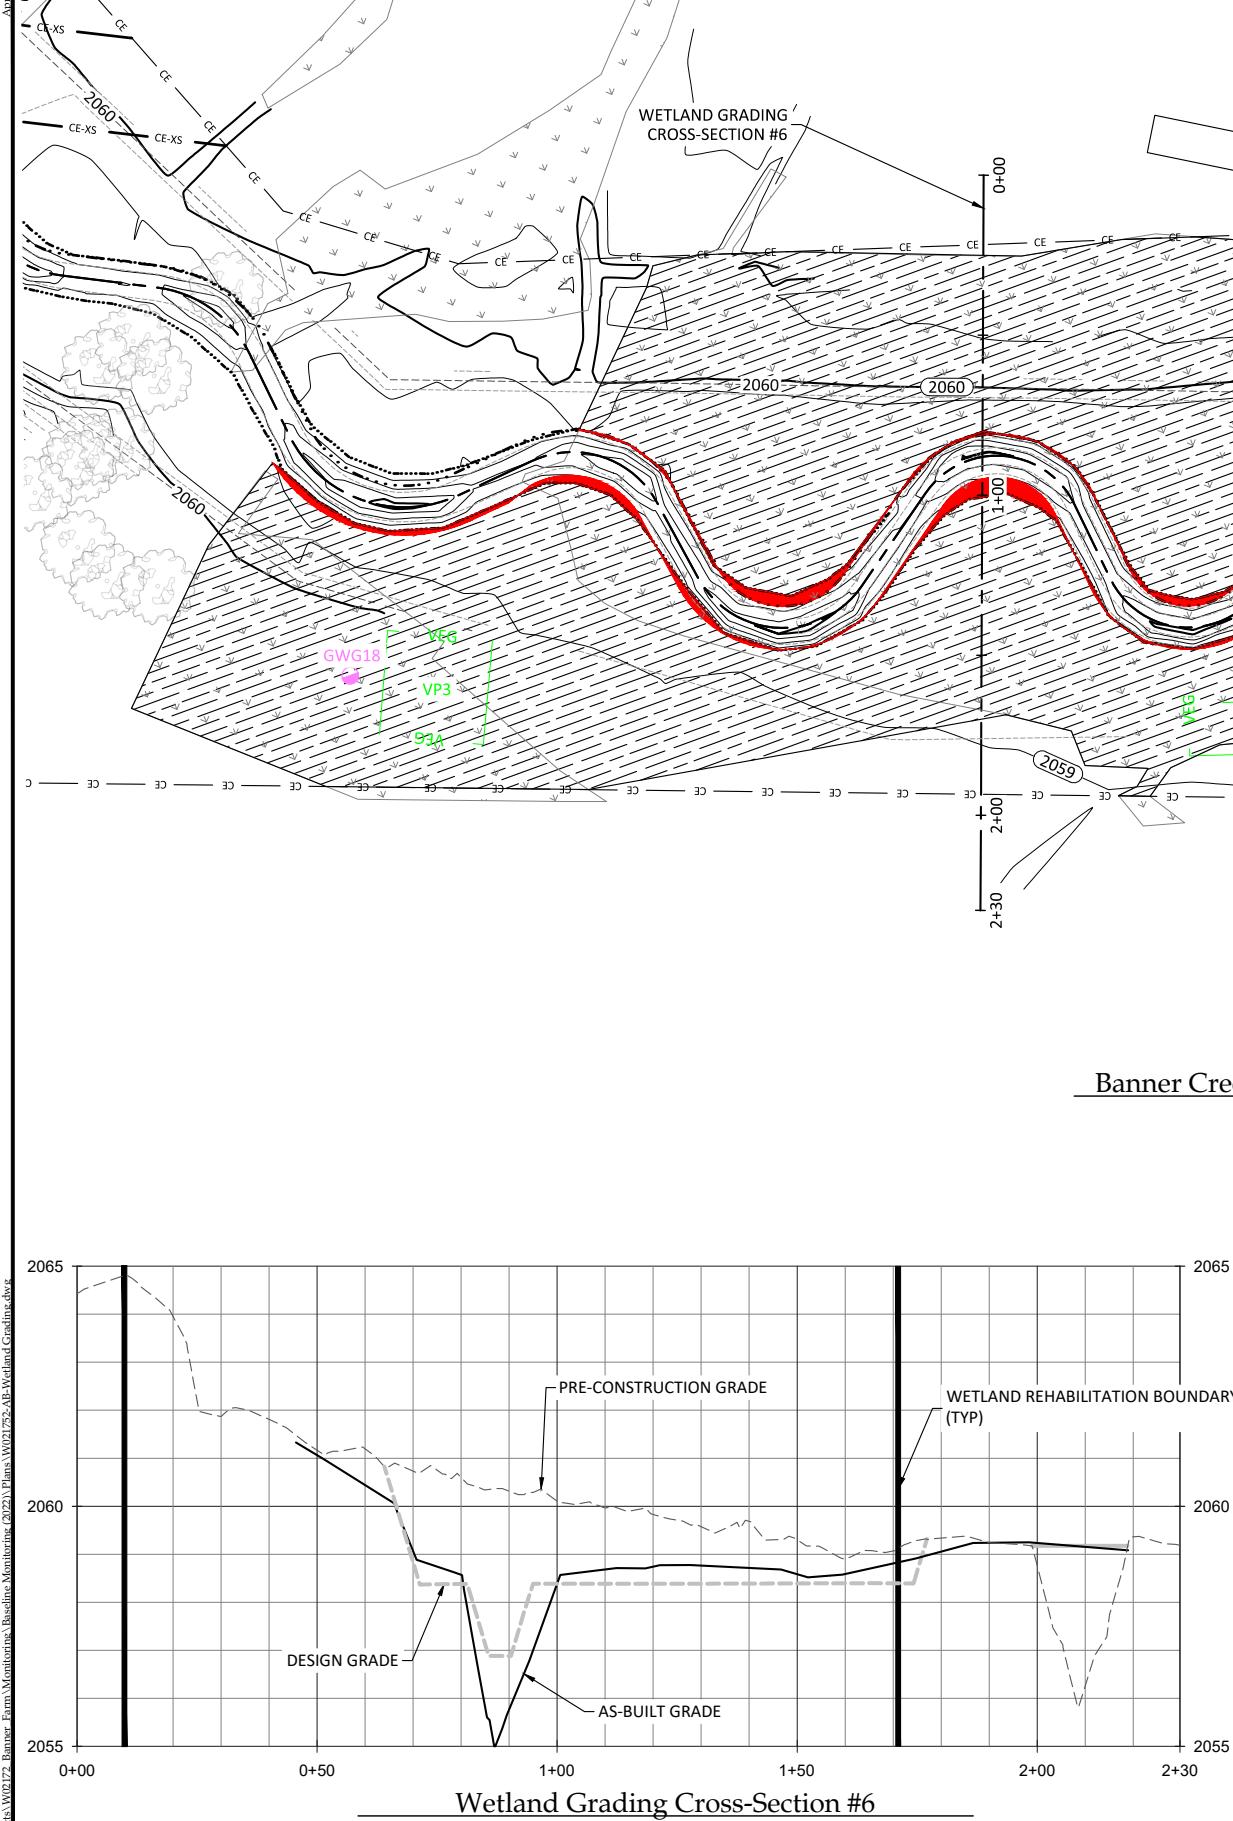


Banner Farm Mitigation Site Record Drawings

Henderson County, North Carolina


**Banner Creek Reach 2
Wetland Grading Plan**

WILDLANDS
ENGINEERING
167-B Hawwood Road
Asheville, NC 28806
Tel: 828.774.5547
Fax: 828.332.3306
Firm license No. E-0831

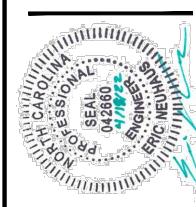

Revision: 04-18-22
Job Number: W021752
Project Engineer: EN
Drawn By: JH
Checked By: JK
Date: 04-18-22
Sheet: 2.5

Open Area Buffer Planting

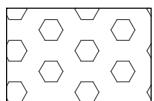

Open Buffer Planting Zone Trees										
Bare Root										
Species	Common Name	Max Spacing	Indiv. Spacing	Min. Caliper Size	Stratum	# of Stems	Wetland Indicator			
<i>Nyssa sylvatica</i>	Black Gum	12 ft.	6-12 ft.	0.25"-1.0"	Canopy	5%	FAC			
<i>Platanus occidentalis</i>	Sycamore	12 ft.	6-12 ft.	0.25"-1.0"	Canopy	15%	FACW			
<i>Betula nigra</i>	River Birch	12 ft.	6-12 ft.	0.25"-1.0"	Canopy	12%	FACW			
<i>Liriodendron tulipifera</i>	Tulip Poplar	12 ft.	6-12 ft.	0.25"-1.0"	Canopy	10%	FACU			
<i>Fraxinus pennsylvanica</i>	Green Ash	12 ft.	6-12 ft.	0.25"-1.0"	Canopy	4%	FACW			
<i>Prunus serotina</i>	Black Cherry	12 ft.	6-12 ft.	0.25"-1.0"	Canopy	9%	FACU			
<i>Quercus rubra</i>	Red Oak	12 ft.	6-12 ft.	0.25"-1.0"	Canopy	10%	FACU			
<i>Betula lenta</i>	Sweet Birch	12 ft.	6-12 ft.	0.25"-1.0"	Canopy	8%	FACU			
<i>Quercus falcata</i>	Southern Red Oak	12 ft.	6-12 ft.	0.25"-1.0"	Canopy	10%	FACU			
<i>Diospyros virginiana</i>	Persimmon	12 ft.	6-12 ft.	0.25"-1.0"	Canopy	5%	FAC			
<i>Fagus grandifolia</i>	American Beech	12 ft.	6-12 ft.	0.25"-1.0"	Canopy	2%	FACU			
Total						-90%	82%			
Alternates										
<i>Acer saccharinum</i>	Silver Maple	12 ft.	6-12 ft.	0.25"-1.0"	Canopy	-0% 8%	FACW			
<i>Halesia caroliniana</i>	Carolina Silverbell	12 ft.	6-12 ft.	0.25"-1.0"	Canopy	0%	FAC			
<i>Fraxinus americana</i>	White Ash	12 ft.	6-12 ft.	0.25"-1.0"	Canopy	0%	FACU			
Total						-0% 8%				
Open Buffer Planting Zone Small Trees / Shrubs										
Bare Root										
Species	Common Name	Max Spacing	Indiv. Spacing	Min. Caliper Size	Stratum	# of Stems	Wetland Indicator			
<i>Alnus serrulata</i>	Tag Alder	12 ft.	6-12 ft.	0.25"-1.0"	Sub-Canopy	2%	OBL			
<i>Hamamelis virginiana</i>	Witch Hazel	12 ft.	6-12 ft.	0.25"-1.0"	Sub-Canopy	2%	FACU			
<i>Cornus florida</i>	Flowering Dogwood	12 ft.	6-12 ft.	0.25"-1.0"	Sub-Canopy	2%	FACU			
<i>Lindera benzoin</i>	Spicebush	12 ft.	6-12 ft.	0.25"-1.0"	Shrub	2%	FAC			
<i>Amelanchier arborea</i>	Serviceberry	12 ft.	6-12 ft.	0.25"-1.0"	Shrub	2%	FAC			
Total						10%				

Notes:
Transplants from on-site to be used at Designer's discretion for streambank and floodplain planting.
Percentages of each species may be varied at Designer's discretion but shall not exceed 20% per each species.
Designer may substitute container plantings or other plantings for bare roots.

Partially Vegetated Buffer Area Planting



Notes:
used open area buffer planting list and percentages.

Wetland Planting



Wetland Planting Zone Trees								
Bare Root								
Species	Common Name	Max Spacing	Indiv. Spacing	Min. Caliper Size	Stratum	# of Stems	Wetland Indicator	
<i>Platanus occidentalis</i>	Sycamore	12 ft.	6-12 ft.	0.25"-1.0"	Canopy	15%	FACW	
<i>Betula nigra</i>	River Birch	12 ft.	6-12 ft.	0.25"-1.0"	Canopy	15%	15.5%	
<i>Liriodendron tulipifera</i>	Tulip Poplar	12 ft.	6-12 ft.	0.25"-1.0"	Canopy	15%	5%	
<i>Diospyros virginiana</i>	Persimmon	12 ft.	6-12 ft.	0.25"-1.0"	Canopy	5%	FAC	
<i>Acer negundo</i>	Box elder	12 ft.	6-12 ft.	0.25"-1.0"	Canopy	-15% 15.5%	FAC	
<i>Nyssa sylvatica</i>	Black gum	12 ft.	6-12 ft.	0.25"-1.0"	Canopy	10%	FAC	
<i>Salix nigra</i>	Black Willow	12 ft.	6-12 ft.	0.25"-1.0"	Canopy	15%	OBL	
Total						90%	76%	
Alternates								
<i>Acer saccharinum</i>	Silver Maple	12 ft.	6-12 ft.	0.25"-1.0"	Canopy	0%	FACW	
<i>Acer Rubrum</i>	Red Maple	12 ft.	6-12 ft.	0.25"-1.0"	Canopy	0%	FAC	
<i>Ulmus americana</i>	American elm	12 ft.	6-12 ft.	0.25"-1.0"	Canopy	-0% 10%	FACW	
Total						-0%	10%	



Wetland Planting Zone Small Trees/Shrubs						
Bare Root						
Species	Common Name	Max Spacing	Indiv. Spacing	Min. Caliper Size	Stratum	# of Stems
<i>Alnus serrulata</i>	Tag Alder	12 ft.	6-12 ft.	0.25"-1.0"	Sub-Canopy	-2% 3.5%
<i>Carpinus caroliniana</i>	Ironwood	12 ft.	6-12 ft.	0.25"-1.0"	Shrub	2%
<i>Lindera benzoin</i>	Spicebush	12 ft.	6-12 ft.	0.25"-1.0"	Shrub	-2% 2.5%
<i>Asimina triloba</i>	Pawpaw	12 ft.	6-12 ft.	0.25"-1.0"	Sub-Canopy	2%
<i>Leucothoe fontanesiana</i>	Mountain doghobble	12 ft.	6-12 ft.	0.25"-1.0"	Shrub	1%
<i>Ilex opaca</i>	American Holly	12 ft.	6-12 ft.	0.25"-1.0"	shrub	-1% 2%
<i>Sambucus canadensis</i>	Elderberry	12 ft.	6-12 ft.	0.25"-1.0"	shrub	2%
Total						-10% 14%

Notes:
Transplants from on-site to be used at Designer's discretion for streambank and floodplain planting.
Percentages of each species may be varied at Designer's discretion but shall not exceed 20% per each species.
Designer may substitute container plantings or other plantings for bare roots.

Riparian Corridor Planting (Streambanks)



Streambank Planting Zone								
Live Stakes								
Species	Common Name	Max Spacing	Indiv. Spacing	Min. Size	Stratum	% of Stems	Wetland Indicator	
<i>Salix nigra</i>	Black Willow	8 ft.	6-8 ft.	0.5"-1.5" cal.	Shrub	-10% 11%	OBL	
<i>Cornus amomum</i>	Silky Dogwood	8 ft.	6-8 ft.	0.5"-1.5" cal.	Shrub	20%	FACW	
<i>Salix sericea</i>	Silky Willow	8 ft.	6-8 ft.	0.5"-1.5" cal.	Shrub	20%	OBL	
<i>Physocarpus opulifolius</i>	Ninebark	8 ft.	6-8 ft.	0.5"-1.5" cal.	Shrub	20%	FACW	
<i>Cephaelathus occidentalis</i>	Buttonbush	8 ft.	6-8 ft.	0.				

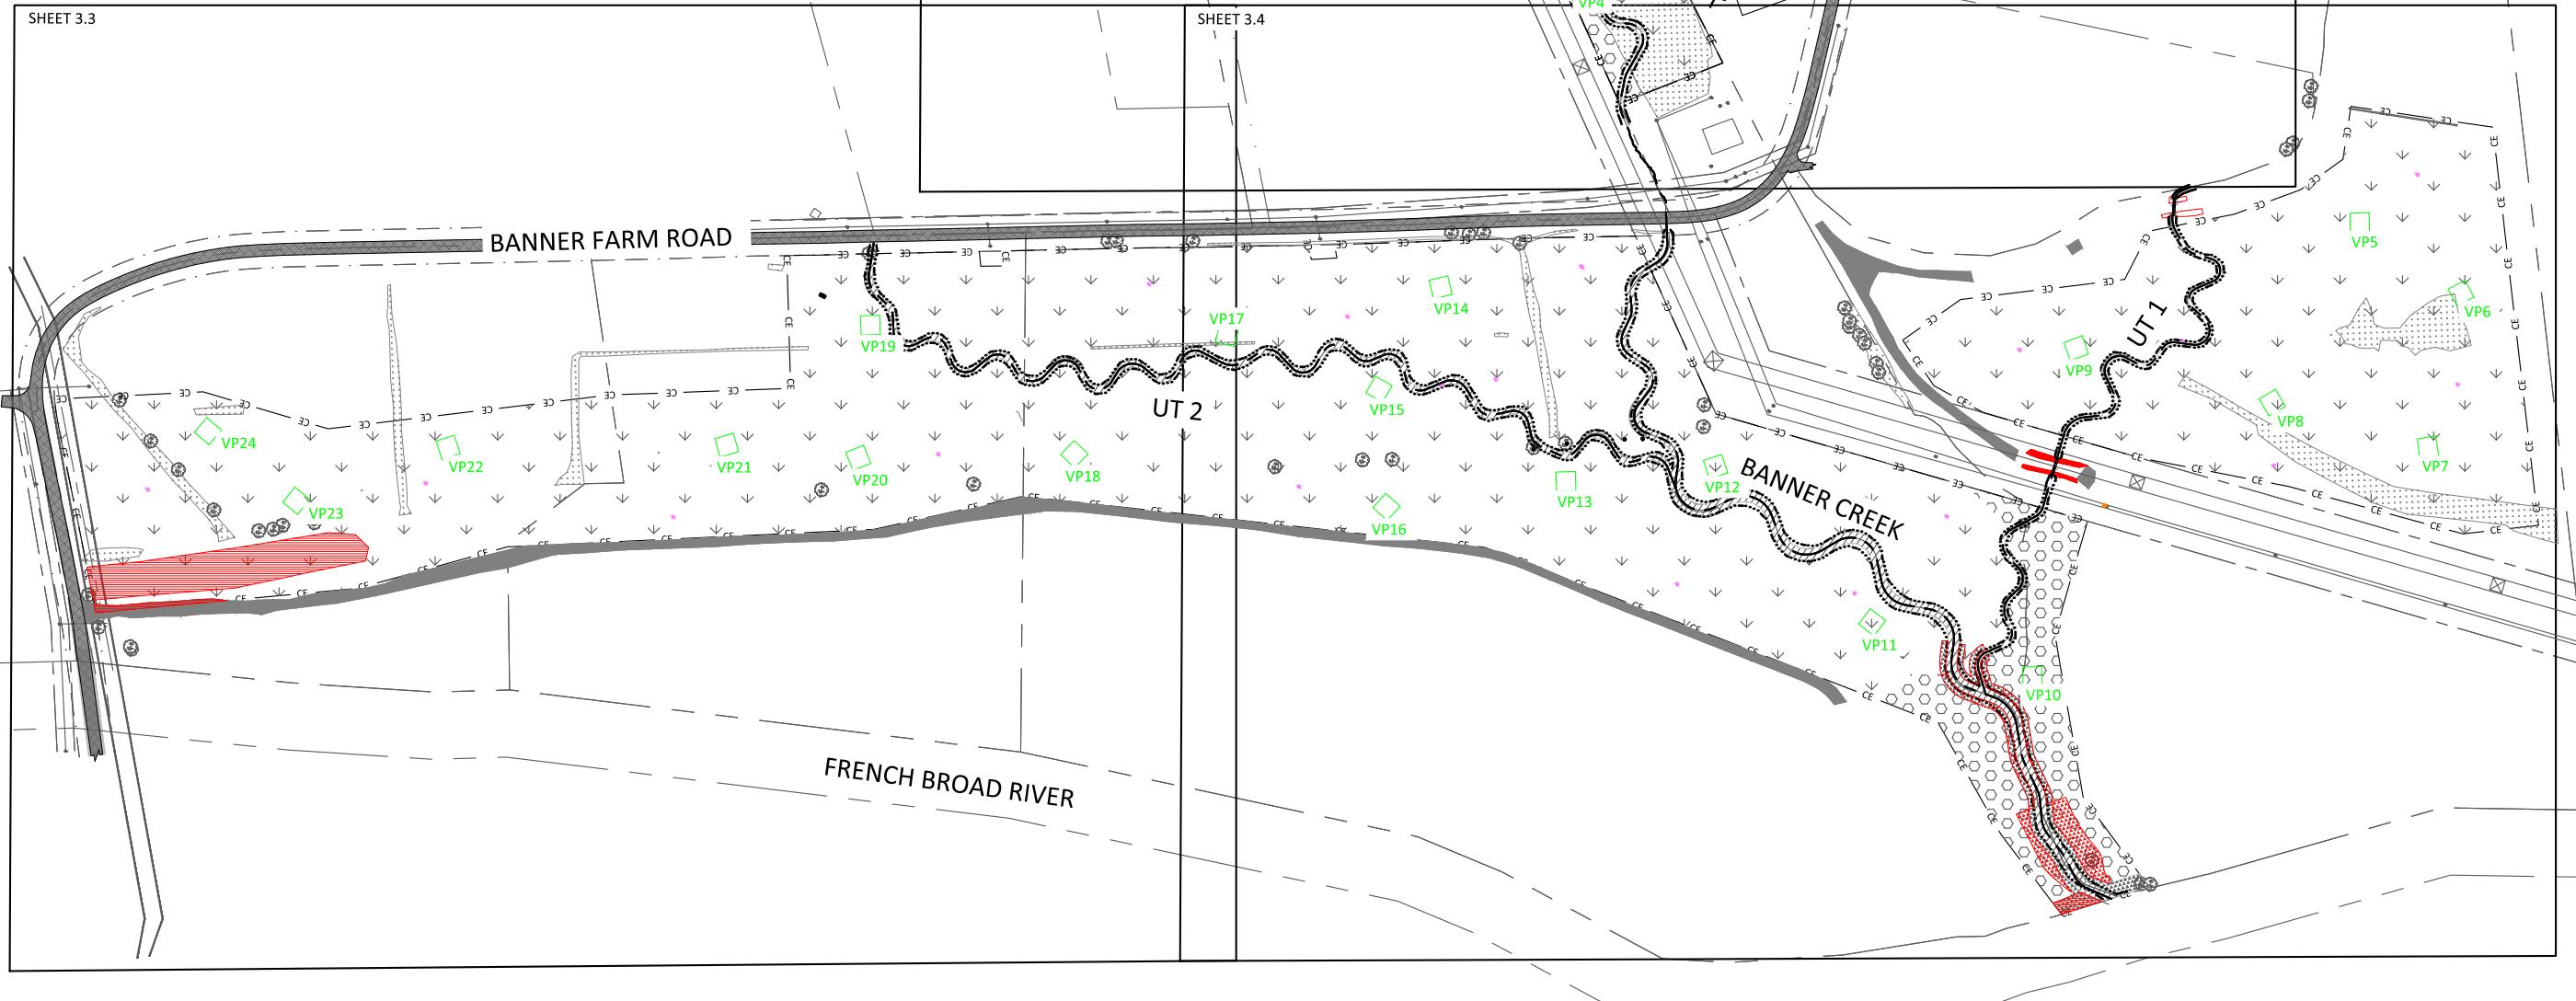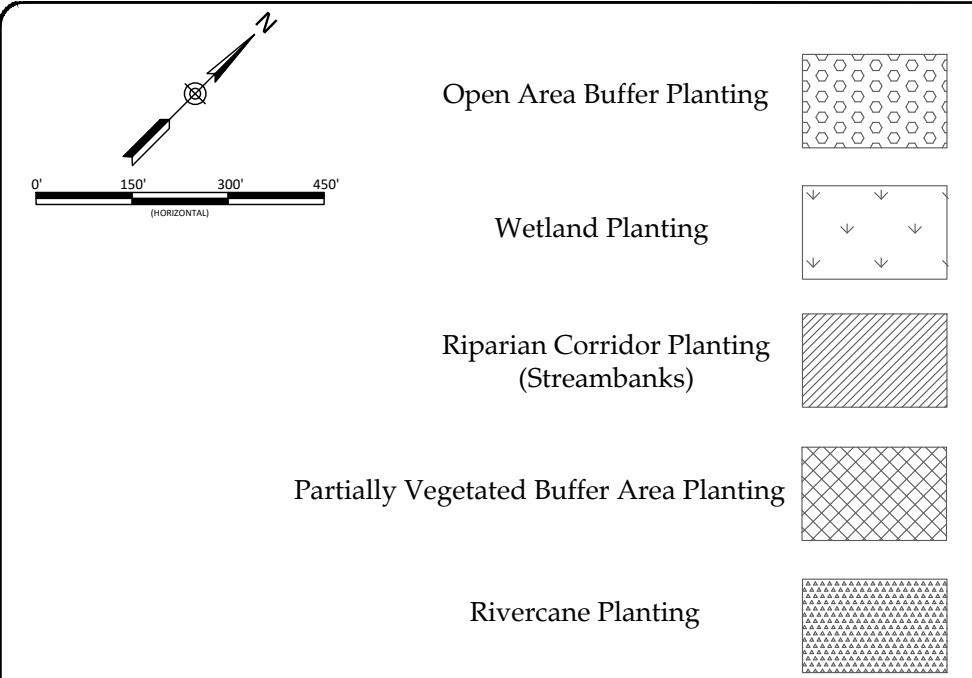


Revision: _____
 Job Number: W021752
 Project Engineer: EN JH JK
 Drawn By: _____
 Checked By: _____

3.2

Banner Farm Mitigation Site Record Drawings

Henderson County, North Carolina

Planting Overview
Planting Plan

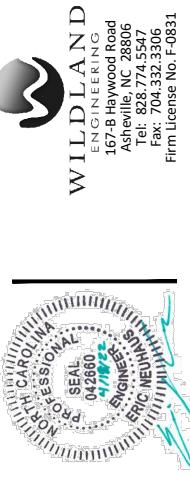





Date: 04-18-22
Job Number: W021752
Project Engineer: EN
Drawn By: JH
Checked By: JK

Sheet 3.3

Banner Farm Mitigation Site Record Drawings
Henderson County, North Carolina

WILDLANDS
ENGINEERING
167-B Hawwood Road
Asheville, NC 28806
Tel: 828.774.5547
Fax: 704.332.3306
Firm license No. E-0831

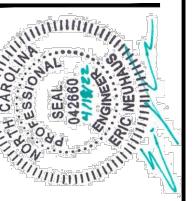

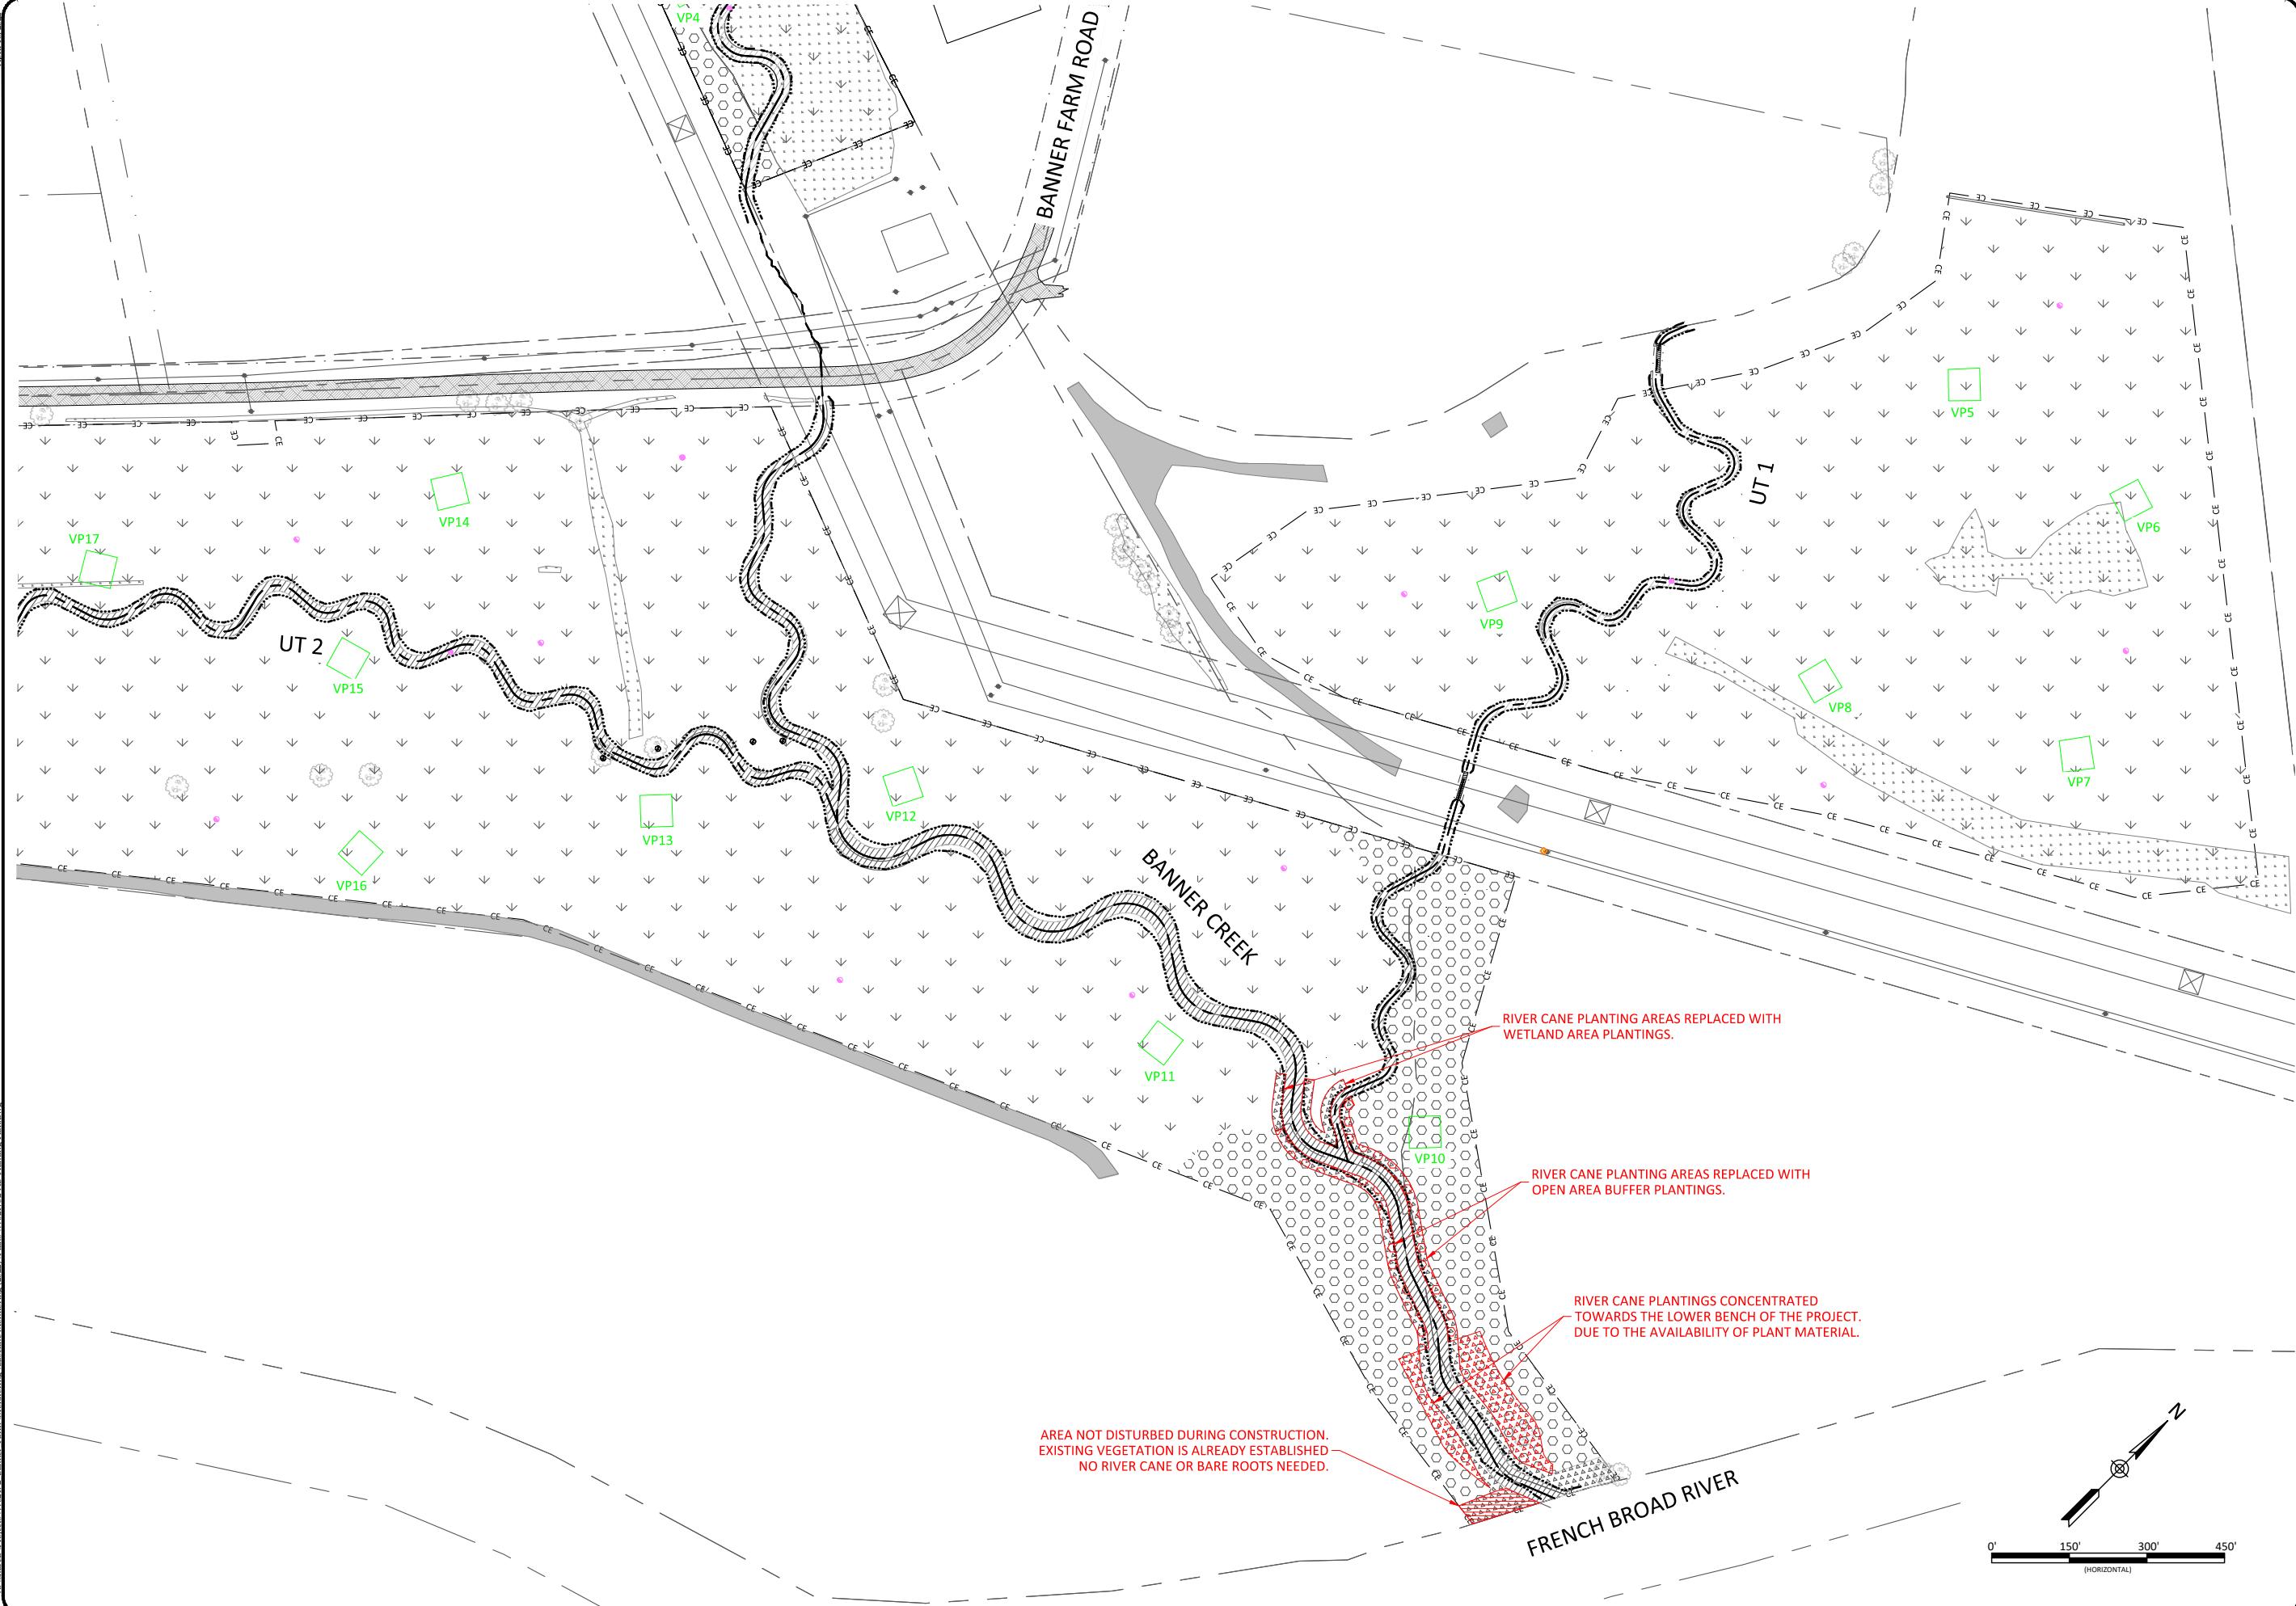

04-18-22
W02172
EN
JH
JK
Date:
Job Number:
Project Engineer:
Drawn By:
Checked By:

Sheet 3.4

Banner Farm Mitigation Site Record Drawings
Henderson County, North Carolina

Wetland UT1, UT2, and Banner Creek
Planting Plan

WILDLANDS
ENGINEERING
167-B Hawwood Road
Asheville, NC 28806
Tel: 828.774.5547
Fax: 704.332.3306
Firm license No. E-0831





04-18-22
W02172
EN
JH
JK
Date:
Job Number:
Project Engineer:
Drawn By:
Checked By:

3.5

Revised:

04-18-22

W02172

EN

JH

JK

Banner Farm Mitigation Site Record Drawings
Henderson County, North Carolina

Banner Creek Reach 2



WILDLANDS
ENGINEERING
167-B Hawwood Road
Asheville, NC 28806
Tel: 828.774.5547
Fax: 704.332.3306
Firm license No. E-0831

CERTIFICATE OF SURVEY AND ACCURACY

I, PHILLIP B. KEE, CERTIFY THAT THE GROUND TOPOGRAPHIC SURVEY PORTION OF THIS PROJECT WAS COMPLETED UNDER MY DIRECT SUPERVISION FROM AN ACTUAL SURVEY MADE UNDER MY DIRECT SUPERVISION; THAT THIS SURVEY WAS PERFORMED AT THE 95% CONFIDENCE LEVEL TO MEET THE FEDERAL GEOGRAPHIC DATA COMMITTEE STANDARDS; THAT THIS SURVEY WAS PERFORMED TO THE CLASS A HORIZONTAL AND CLASS C VERTICAL WHERE APPLICABLE; THAT THE ORIGINAL DATA WAS OBTAINED BETWEEN THE DATES OF 10/26/21-01/25/22; THAT THE CONTOURS SHOWN AS BROKEN LINES MAY NOT MEET THE STATED STANDARD AND ALL COORDINATES ARE BASED ON NAD 83 (NSRS 2011) AND ALL ELEVATIONS ARE BASED ON NAVD 88; THAT THE GPS PORTION OF THIS PROJECT WAS TO PERFORM A GRID TIE TO THE NC STATE PLANE COORDINATE SYSTEM AND THE INFORMATION USED IS SHOWN & NOTED HEREON; THAT THIS MAP MEETS THE SPECIFICATIONS FOR TOPOGRAPHIC SURVEYS AS STATED IN TITLE 21, CHAPTER 56, SECTION .1606; THAT THIS MAP WAS NOT PREPARED IN ACCORDANCE WITH G.S. 47-30, AS AMENDED AND DOES NOT REPRESENT AN OFFICIAL BOUNDARY SURVEY.

GPS METADATA
SEE SURVEY CONTROL WILDLANDS ENGINEERING, INC. BY KEE MAPPING & SURVEYING, PA (LICENSE # C-3039); SIGNED, SEALED AND DATED ON JULY 24, 2019 BY PHILLIP B. KEE, NC PLS (LICENSE #4647).

WITNESS MY ORIGINAL SIGNATURE, LICENSE NUMBER, AND SEAL THIS 31ST DAY OF MARCH, 2022, A.D.




DocuSigned by:



PHILLIP B. KEE, PLS L-4647
D965004A7692407...

SURVEYOR'S NOTES:

- ALL DISTANCES AND COORDINATES ARE GROUND MEASUREMENTS IN US SURVEY FEET UNLESS OTHERWISE NOTED.
- PROPERTY SUBJECT TO ALL EASEMENTS, RIGHT OFWAYS AND RESTRICTIONS THAT ARE RECORDED, UNRECORDED, WRITTEN AND UNWRITTEN.
- CONSERVATION EASEMENT BOUNDARIES SHOWN HEREON WERE TAKEN FROM PLATS OF SURVEY ENTITLED: "A CONSERVATION EASEMENT SURVEY FOR THE STATE OF NORTH CAROLINA, DIVISION OF MITIGATION SERVICES, "BANNER FARMS MITIGATION SITE" AND RECORDED IN BOOK: 2020 SLIDES: 12507-12511 DATED APRIL 28, 2020, RECORDED IN THE HENDERSON COUNTY REGISTRY.
- HENDERSON COUNTY GIS WEBSITE USED TO IDENTIFY ADJOINING PROPERTY OWNERS.
- BY GRAPHIC DETERMINATION, A PORTION OF THE SUBJECT PROPERTY APPEARS TO LIE WITHIN A SPECIAL FLOOD HAZARD AREA (SFHA) AS DETERMINED BY THE FIRM MAP# 3700953900J, 3700963000J, 3700964000J DATED 10/02/2008
- STATE PLANE COORDINATES AND ELEVATIONS WERE DERIVED FROM THE CONTROL SURVEY PREPARED BY KEE MAPPING & SURVEYING. THE HORIZONTAL DATUM IS NAD 83 (2011) AND THE VERTICAL DATUM IS NAVD 88. ALL COORDINATES SHOWN HEREON ARE GROUND MEASUREMENTS IN US SURVEY FEET.
- UTILITIES WERE LOCATED BASED ON VISIBLE ABOVE GROUND STRUCTURES, THEREFORE THE LOCATION OF UNDERGROUND UTILITIES ARE APPROXIMATE OR MAY BE PRESENT AND NOT SHOWN HEREON. CALL 1-800-632-4949 BEFORE DIGGING.
- STATIONING AND STREAM LABELS FOR PLAN AND PROFILES ARE BASED OFF OF FINAL PLANS AND DESIGN CENTERLINES PROVIDED BY WILDLANDS ENGINEERING, INC.
- CONTOUR INTERVAL: 1 FOOT
VERTICAL DATUM: NAVD 88
- AREA OF LIMITS OF DISTURBANCE: 34.88 ACRES
- WETLANDS SHOWN HEREON WERE PROVIDED BY WILDLANDS ENGINEERING, INC.

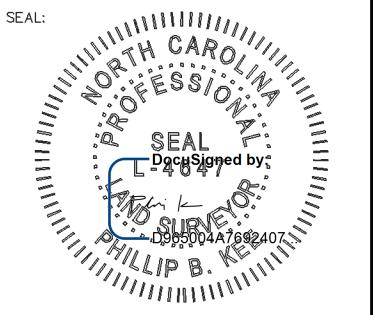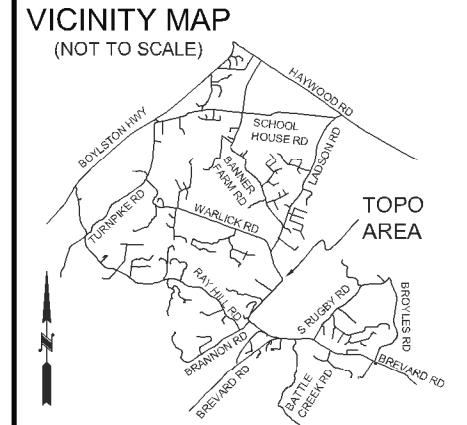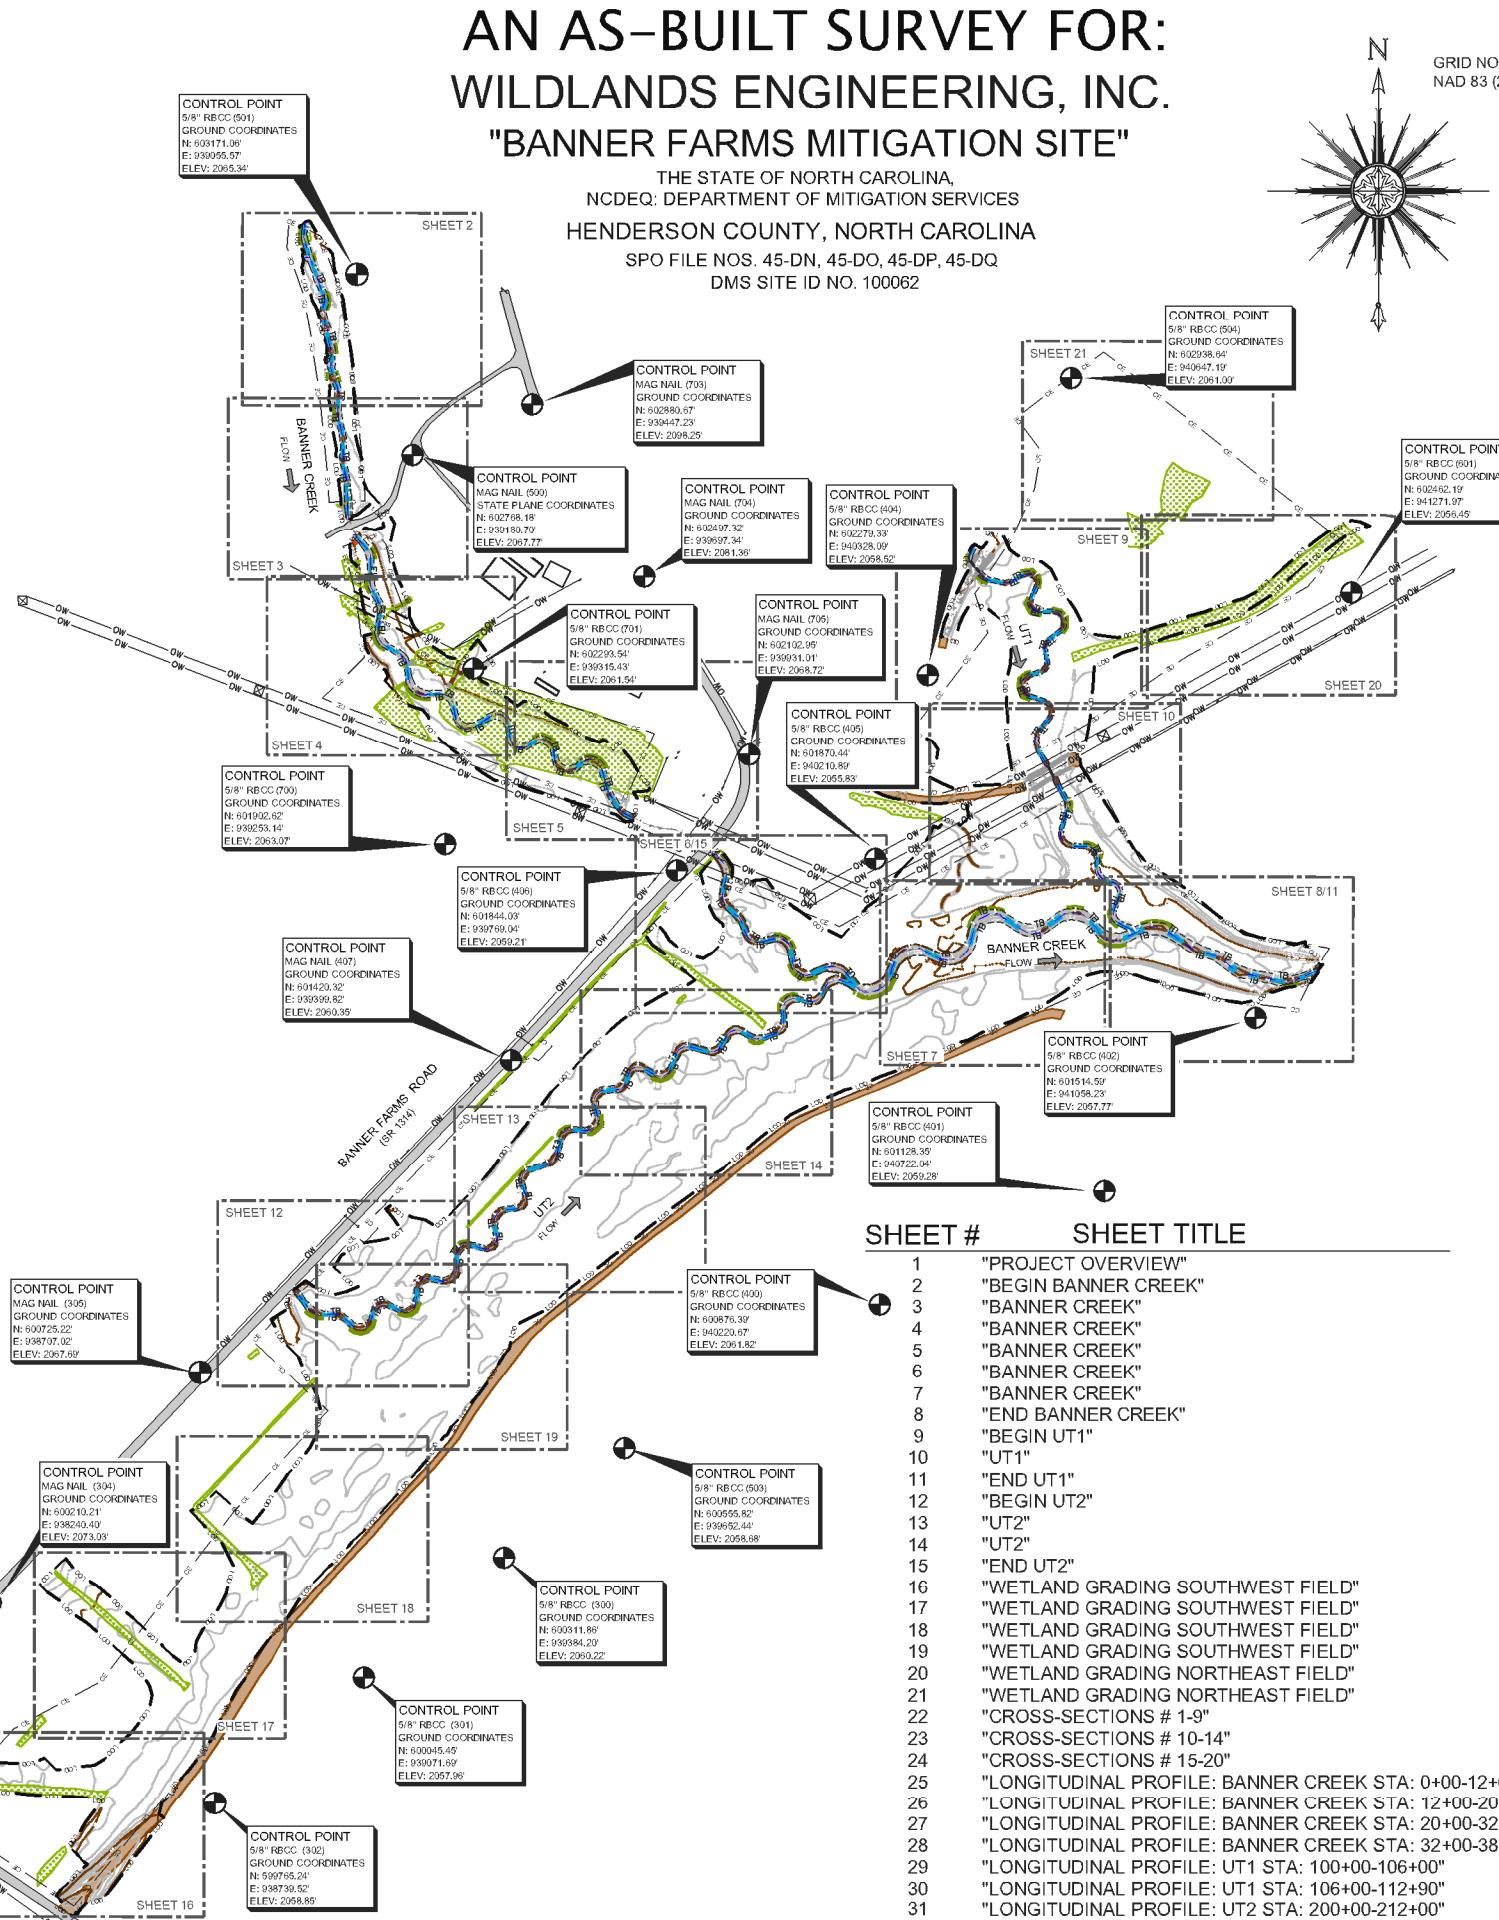

NOTE: SEE SHEET 1 FOR SURVEYOR'S NOTES, LEGEND & STATEMENT OF CERTIFICATION

ELEVATION DATUM: NAVD 88
CONTOUR INTERVAL: 1 FOOT

THIS IS A TOPOGRAPHIC SURVEY FOR INFORMATIONAL AND DESIGN PURPOSES ONLY. IT SHOULD NOT BE USED FOR CONVEYANCE OR LEGAL PURPOSES.

**AN AS-BUILT SURVEY FOR:
WILDLANDS
ENGINEERING, INC.**

SPO FILE NOS. 45-DN, 45-DO,
45-DP, 45-DQ
DMS SITE ID NO. 100062

**PROJECT:
BANNER FARMS
MITIGATION SITE**




**SHEET TITLE:
PROJECT OVERVIEW**

TOWNSHIP: MILLS RIVER	COUNTY: HENDERSON	STATE: NORTH CAROLINA
DRAWN BY: NH	CHECKED BY: PBK	SURVEY BY: JB, PD, HW, ZC, KP, AC
SCALE: AS SHOWN	SURVEY DATE: 03/31/22	JOB: #2110100-AB SHEET SIZE: 11" X 17" (HALF SIZE)
# DATE	REVISIONS	

Sheet:

1 OF 32

Kee
MAPPING & SURVEYING
P.O. Box 2566
Asheville, NC 28802
(828) 575-9021
www.keemap.com
License # C-3039

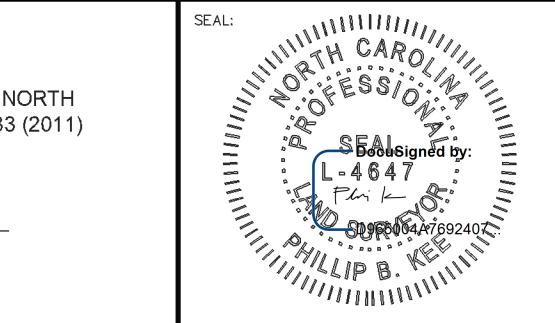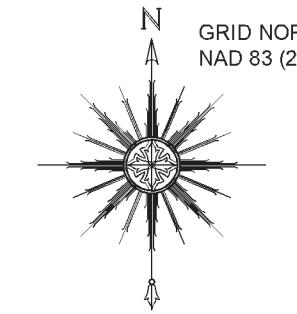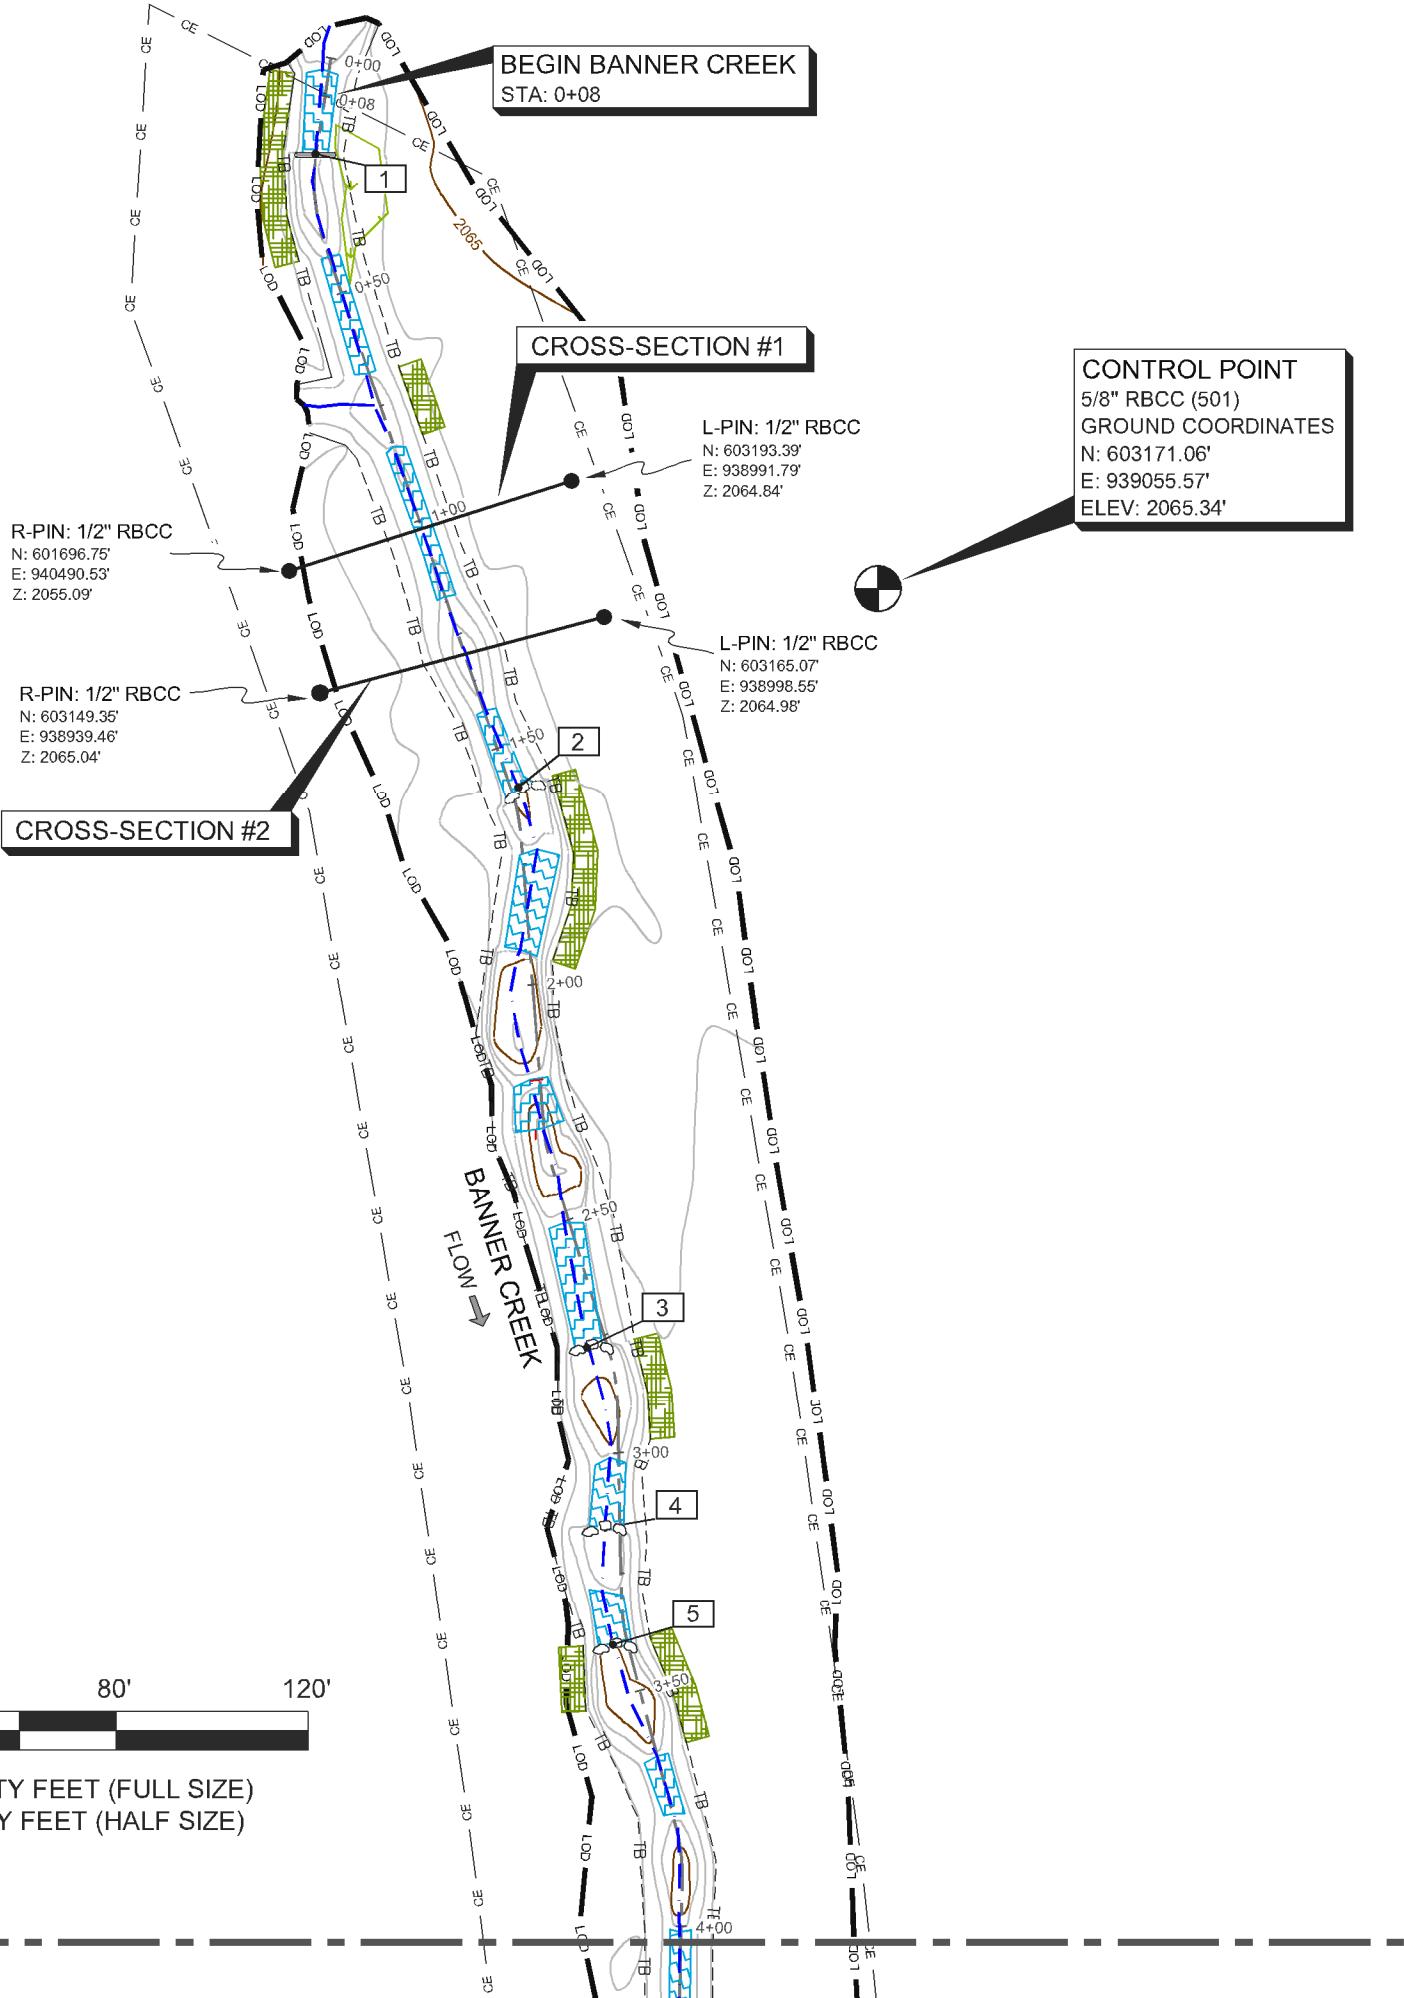

NOTE: SEE SHEET 1 FOR SURVEYOR'S NOTES, LEGEND & STATEMENT OF CERTIFICATION

ELEVATION DATUM: NAVD 88
CONTOUR INTERVAL: 1 FOOT

THIS IS A TOPOGRAPHIC SURVEY FOR INFORMATIONAL AND DESIGN PURPOSES ONLY. IT SHOULD NOT BE USED FOR CONVEYANCE OR LEGAL PURPOSES.

AN AS-BUILT SURVEY FOR:
WILDLANDS ENGINEERING, INC

SPO FILE NOS. 45-DN, 45-DO,
45-DP, 45-DQ
DMS SITE ID NO. 100062

PROJECT:
BANNER FARMS MITIGATION SITE

SHEET TITLE:
**BEGIN
BANNER CREEK**

TOWNSHIP:	COUNTY:	STATE:
MILLS RIVER	HENDERSON	NORTH CAROLINA
DRAWN BY:	CHECKED BY:	SURVEY BY:
NH	PKB	JB, PD, HW, ZC, KP, AC
SCALE:	SURVEY DATE:	
AS SHOWN	03/31/22	
JOB:	Sheet Size:	
#2110100-AB	11" X 17" (HALF SIZE)	
#	DATE	REVISIONS

Sheet:



2 **OF** **32**

BANNER CREEK STRUCTURE TABLE		
#	DESCRIPTION	ELEVATION
1	LOG SILL	2062.37
2	ROCK SILL	2061.64
3	ROCK SILL	2061.35
4	ROCK SILL	2061.68
5	ROCK SILL	2061.41

SHEET 2

SHEET 3

BANNER CREEK STRUCTURE TABLE		
#	DESCRIPTION	ELEVATION
6	ROCK SILL	2060.65
7	LOG SILL	2059.93
8	ROCK SILL	2058.85
9	LOG SILL	2058.24
10	ROCK SILL	2057.50

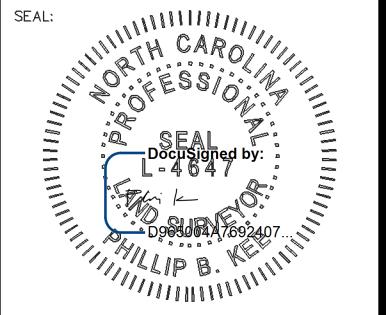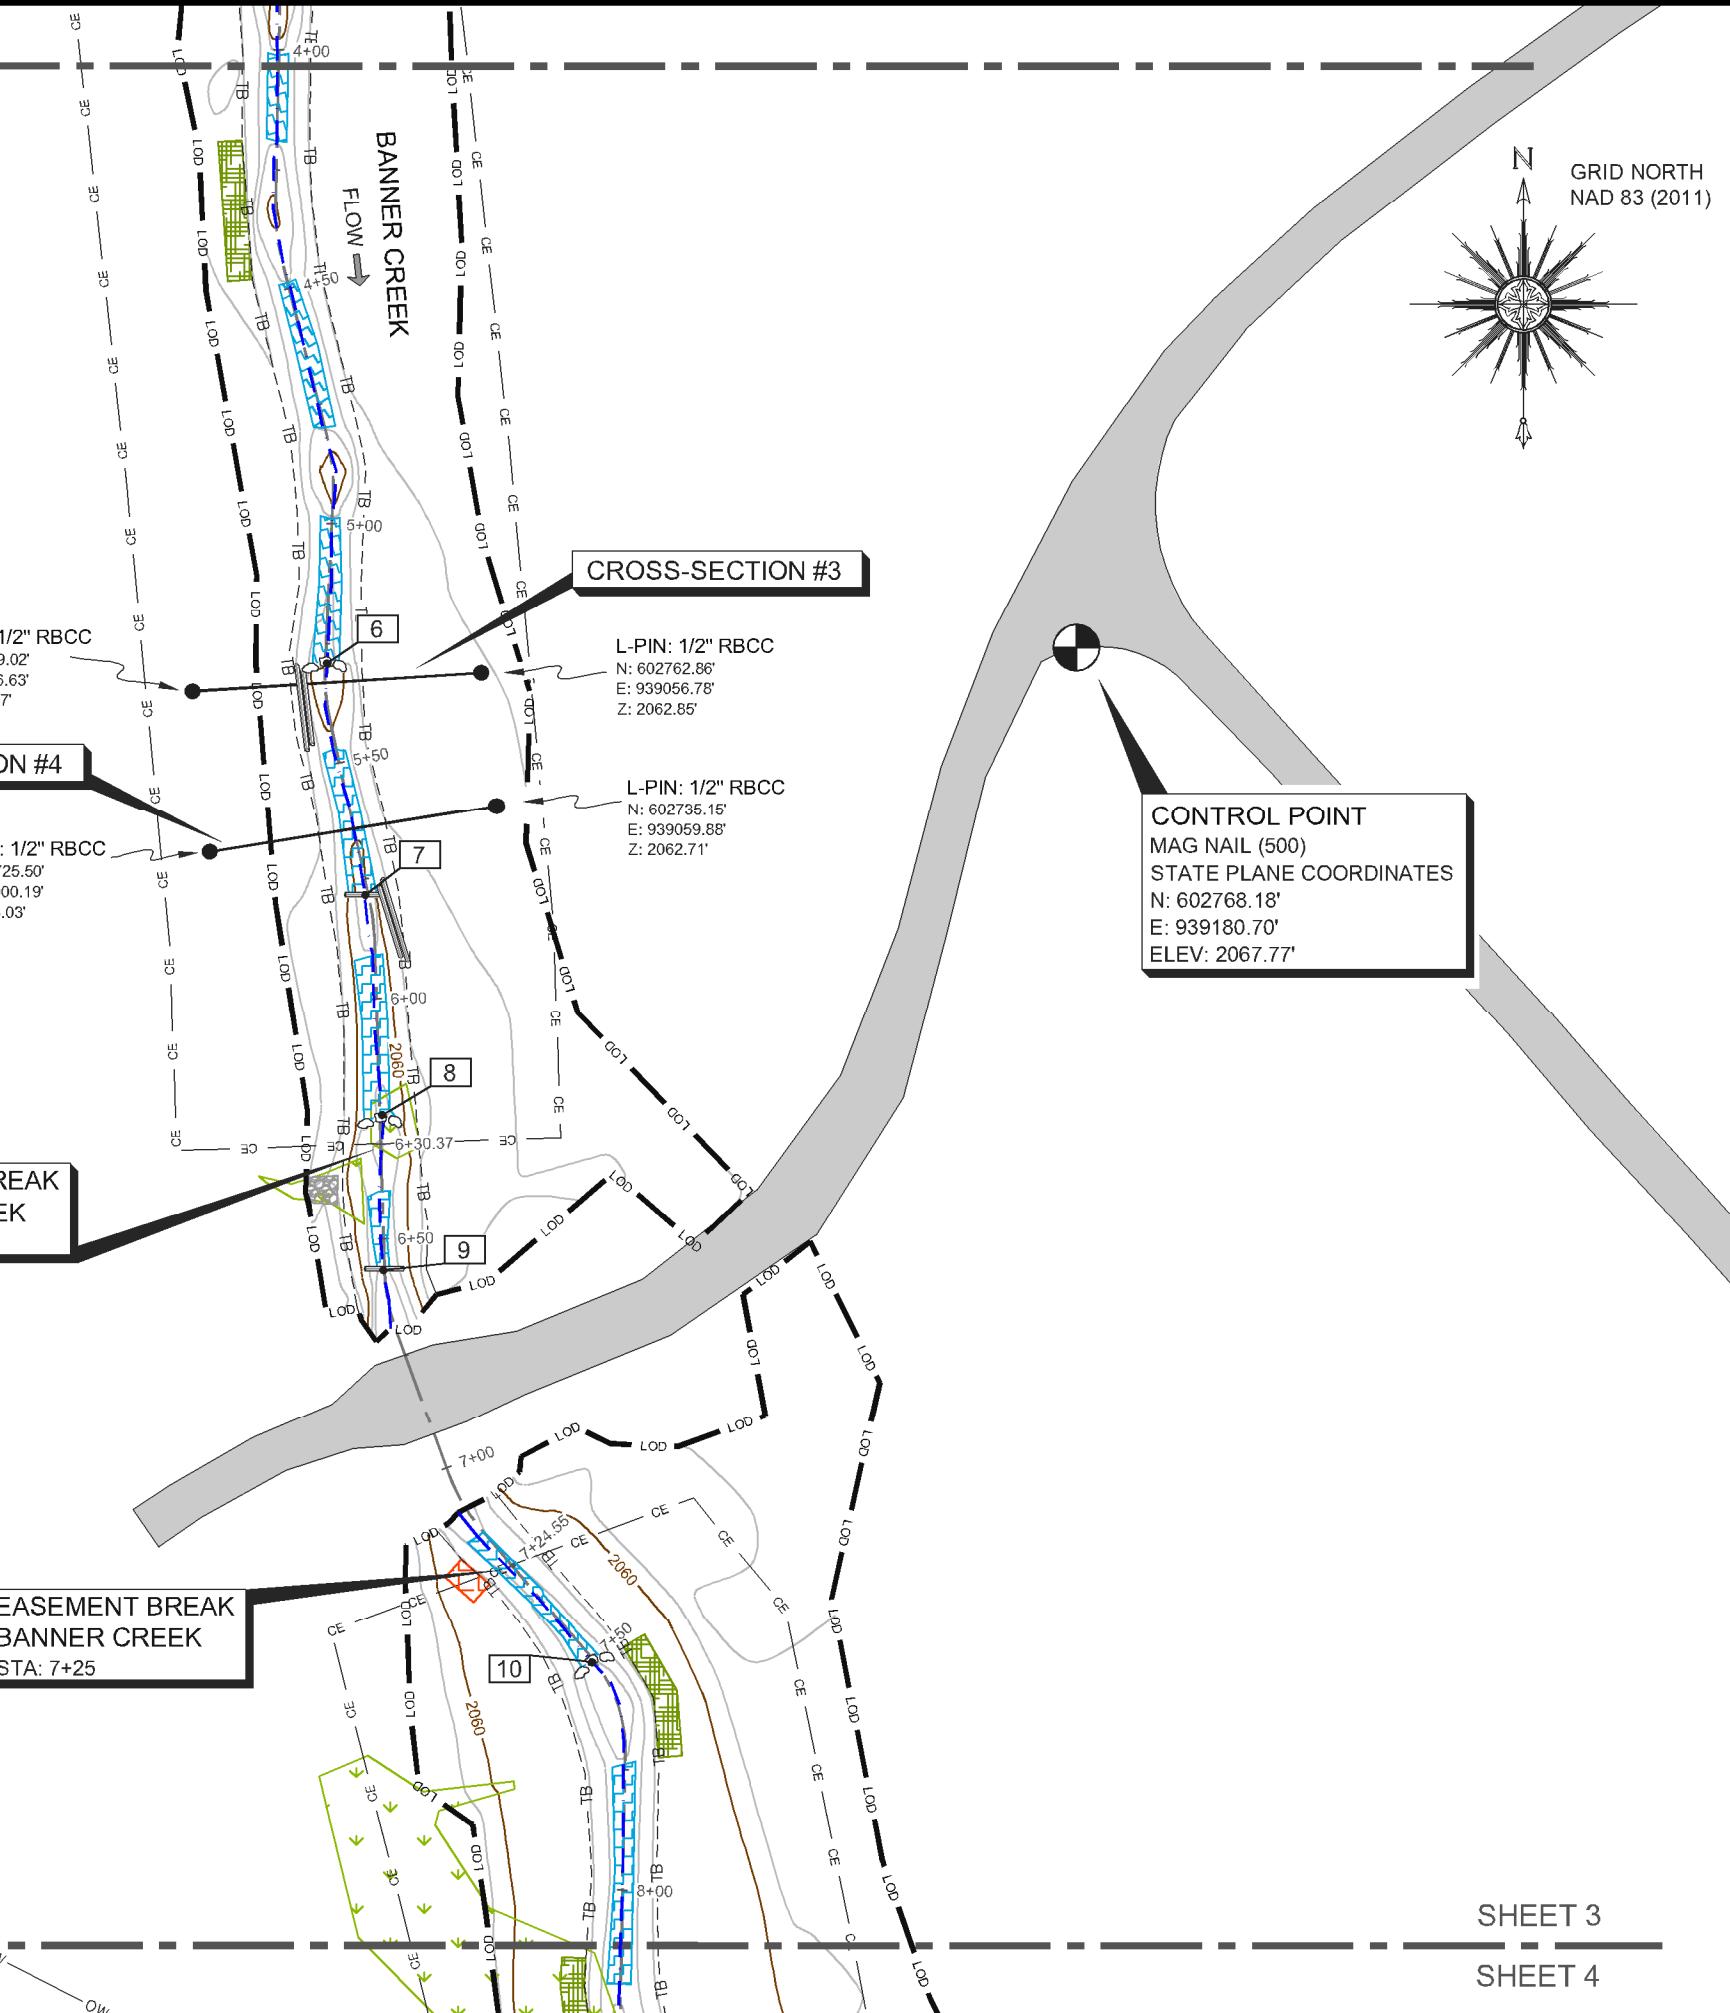

NOTE: SEE SHEET 1 FOR SURVEYOR'S NOTES, LEGEND & STATEMENT OF CERTIFICATION

ELEVATION DATUM: NAVD 88
CONTOUR INTERVAL: 1 FOOT

THIS IS A TOPOGRAPHIC SURVEY FOR INFORMATIONAL AND DESIGN PURPOSES ONLY. IT SHOULD NOT BE USED FOR CONVEYANCE OR LEGAL PURPOSES.

AN AS-BUILT SURVEY FOR:
WILDLANDS ENGINEERING, INC

SPO FILE NOS. 45-DN, 45-DO,
45-DP, 45-DQ
DMS SITE ID NO. 100062

PROJECT:
BANNER FARMS MITIGATION SITE

SHEET TITLE:
BANNER CREEK


TOWNSHIP: MILLS RIVER	COUNTY: HENDERSON	STATE: NORTH CAROLINA
DRAWN BY: NH	CHECKED BY: PBK	SURVEY BY: JB, PD, HW, ZC, KP, AC
SCALE: AS SHOWN	SURVEY DATE: 03/31/22	
JOB: #2110100-AB	SHOOT SIZE: 11" X 17" (HALF SIZE)	
# DATE	REVISIONS	

SHEET:

3 OF 32

SHEET 3

SHEET 4

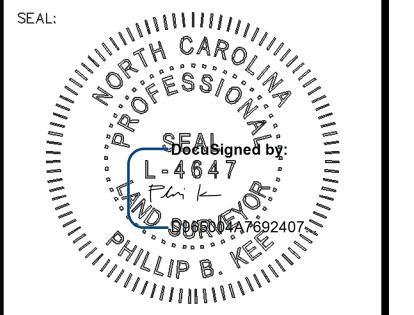

NOTE: SEE SHEET 1 FOR
SURVEYOR'S NOTES, LEGEND &
STATEMENT OF CERTIFICATION

ELEVATION DATUM: NAVD 88
CONTOUR INTERVAL: 1 FOOT

THIS IS A TOPOGRAPHIC
SURVEY FOR INFORMATIONAL
AND DESIGN PURPOSES
ONLY. IT SHOULD NOT BE
USED FOR CONVEYANCE OR
LEGAL PURPOSES.

AN AS-BUILT SURVEY FOR:
**WILDLANDS
ENGINEERING, INC**

SPO FILE NOS. 45-DN, 45-DO,
45-DP, 45-DQ
DMS SITE ID NO. 100062

PROJECT:
**BANNER FARMS
MITIGATION SITE**

SHEET TITLE:
BANNER CREEK

TOWNSHIP:	MILLS RIVER	COUNTY:	HENDERSON	STATE:	NORTH CAROLINA
DRAWN BY:	NH	CHECKED BY:	PK	SURVEY BY:	JB, PD, HW, ZC, KP, AC
SCALE:	AS SHOWN	SURVEY DATE:	03/31/22		
JOB:	#2110100-AB	Sheet Size:	11" X 17" (HALF SIZE)		
#	DATE	REVISIONS			

4 OF 32

INTERNAL EASEMENT CROSSING
BANNER CREEK
STA: 9+13

INTERNAL EASEMENT CROSSING
BANNER CREEK
STA: 8+79

CONTROL POINT
5/8" RBCC (701)
GROUND COORDINATES
N: 602293.54'
E: 939315.43'
ELEV: 2061.54'

CROSS-SECTION #5

BANNER CREEK
FLOW →

GROUND WATER GAUGE
BOLT ELEV: 2062.02'


L-PIN: 1/2" RBCC
N: 602203.36'
E: 939313.50'
Z: 2058.77'

R-PIN: 1/2" RBCC
N: 602133.72'
E: 939363.61'
Z: 2058.71'

ONE INCH = TWENTY FEET (FULL SIZE)
ONE INCH = FORTY FEET (HALF SIZE)

0' 40' 80' 120'

BANNER CREEK STRUCTURE TABLE		
#	DESCRIPTION	ELEVATION
11	ROCK SILL	2056.56
12	LOG SILL	2056.51
13	LOG SILL	2056.37
14	ROCK J-HOOK	2056.11
15	LOG SILL	2055.65
16	LOG SILL	2055.20
17	ROCK SILL	2054.67

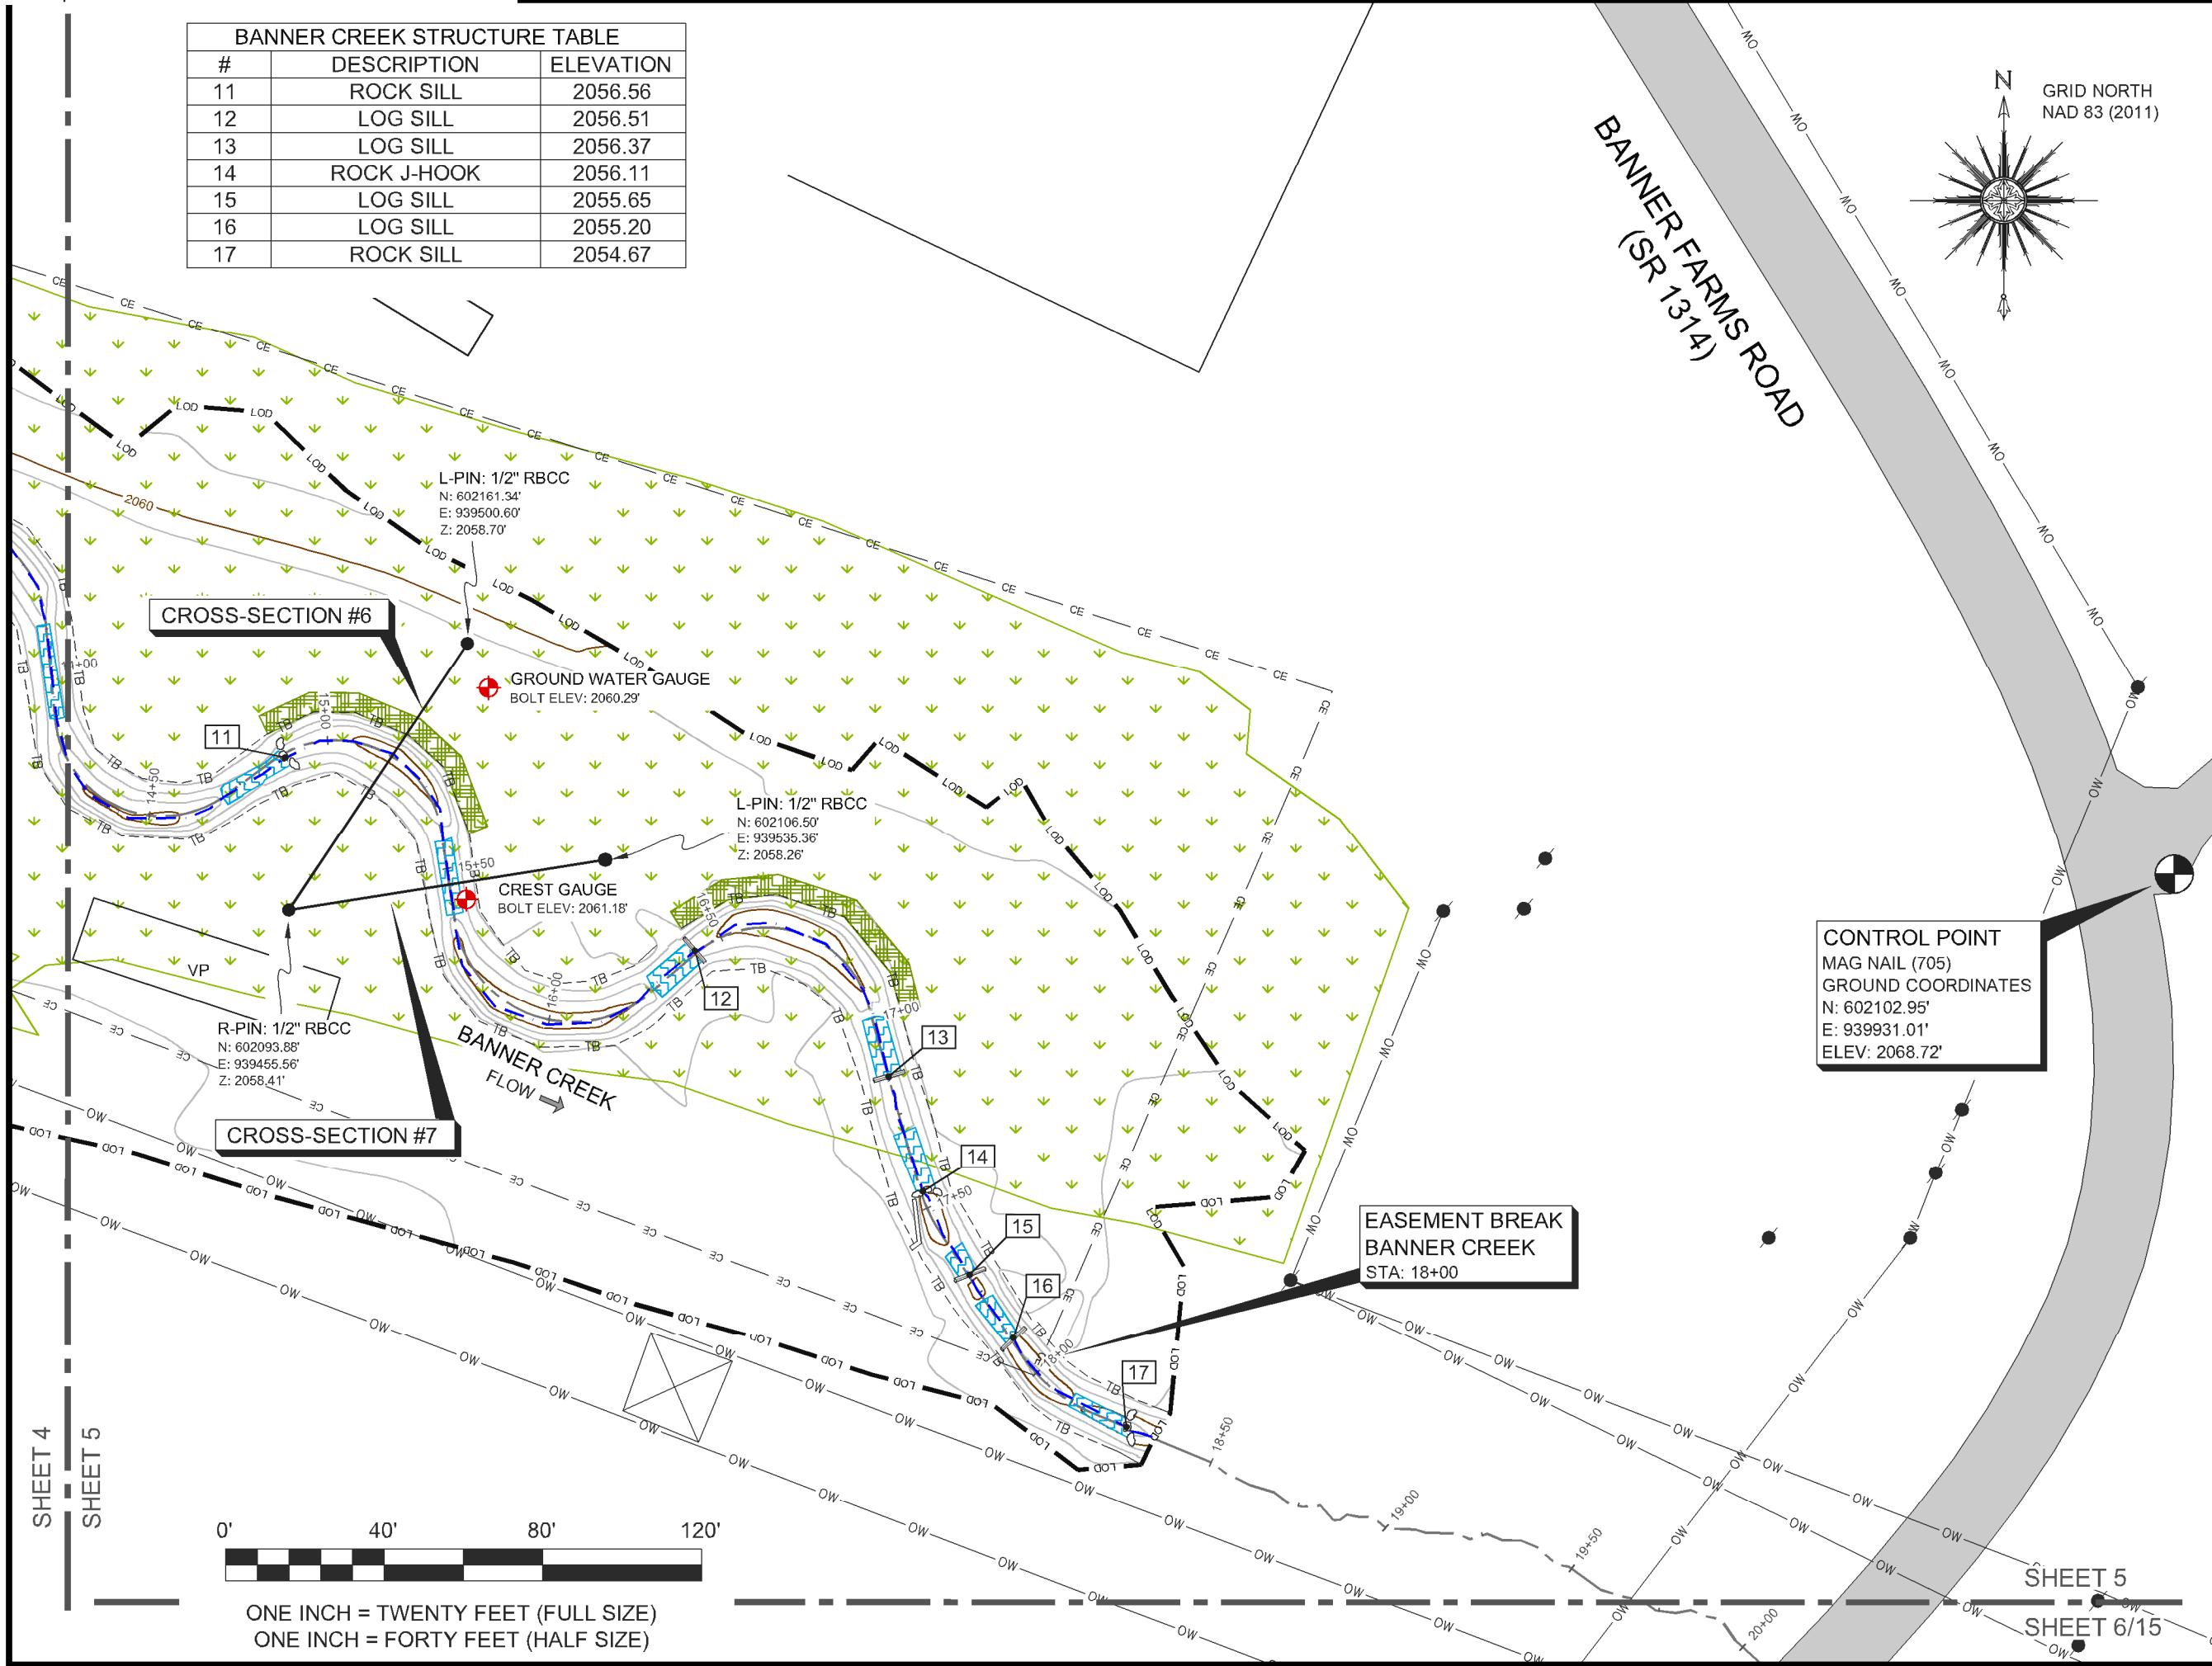

SEAL:
NORTH CAROLINA
PROFESSIONAL
LAND SURVEYOR
PHILLIP B. KEE
DocuSigned by:
L-464
D965014AT892407

NOTE: SEE SHEET 1 FOR SURVEYOR'S NOTES, LEGEND & STATEMENT OF CERTIFICATION

ELEVATION DATUM: NAVD 88
CONTOUR INTERVAL: 1 FOOT

THIS IS A TOPOGRAPHIC SURVEY FOR INFORMATIONAL AND DESIGN PURPOSES ONLY. IT SHOULD NOT BE USED FOR CONVEYANCE OR LEGAL PURPOSES.

AN AS-BUILT SURVEY FOR:
WILDLANDS ENGINEERING, INC


SPO FILE NOS. 45-DN, 45-DO, 45-DP, 45-DQ
DMS SITE ID NO. 100062


PROJECT:
BANNER FARMS MITIGATION SITE

SHEET TITLE:
BANNER CREEK

TOWNSHIP: MILLS RIVER	COUNTY: HENDERSON	STATE: NORTH CAROLINA
DRAWN BY: NH	CHECKED BY: PBK	SURVEY BY: JB, PD, HW, ZC, KP, AC
SCALE: AS SHOWN	SURVEY DATE: 03/31/22	
JOB: #2110100-AB	sheet size: 11" X 17" (HALF SIZE)	REVISIONS
#	DATE	

Sheet: 5 of 32

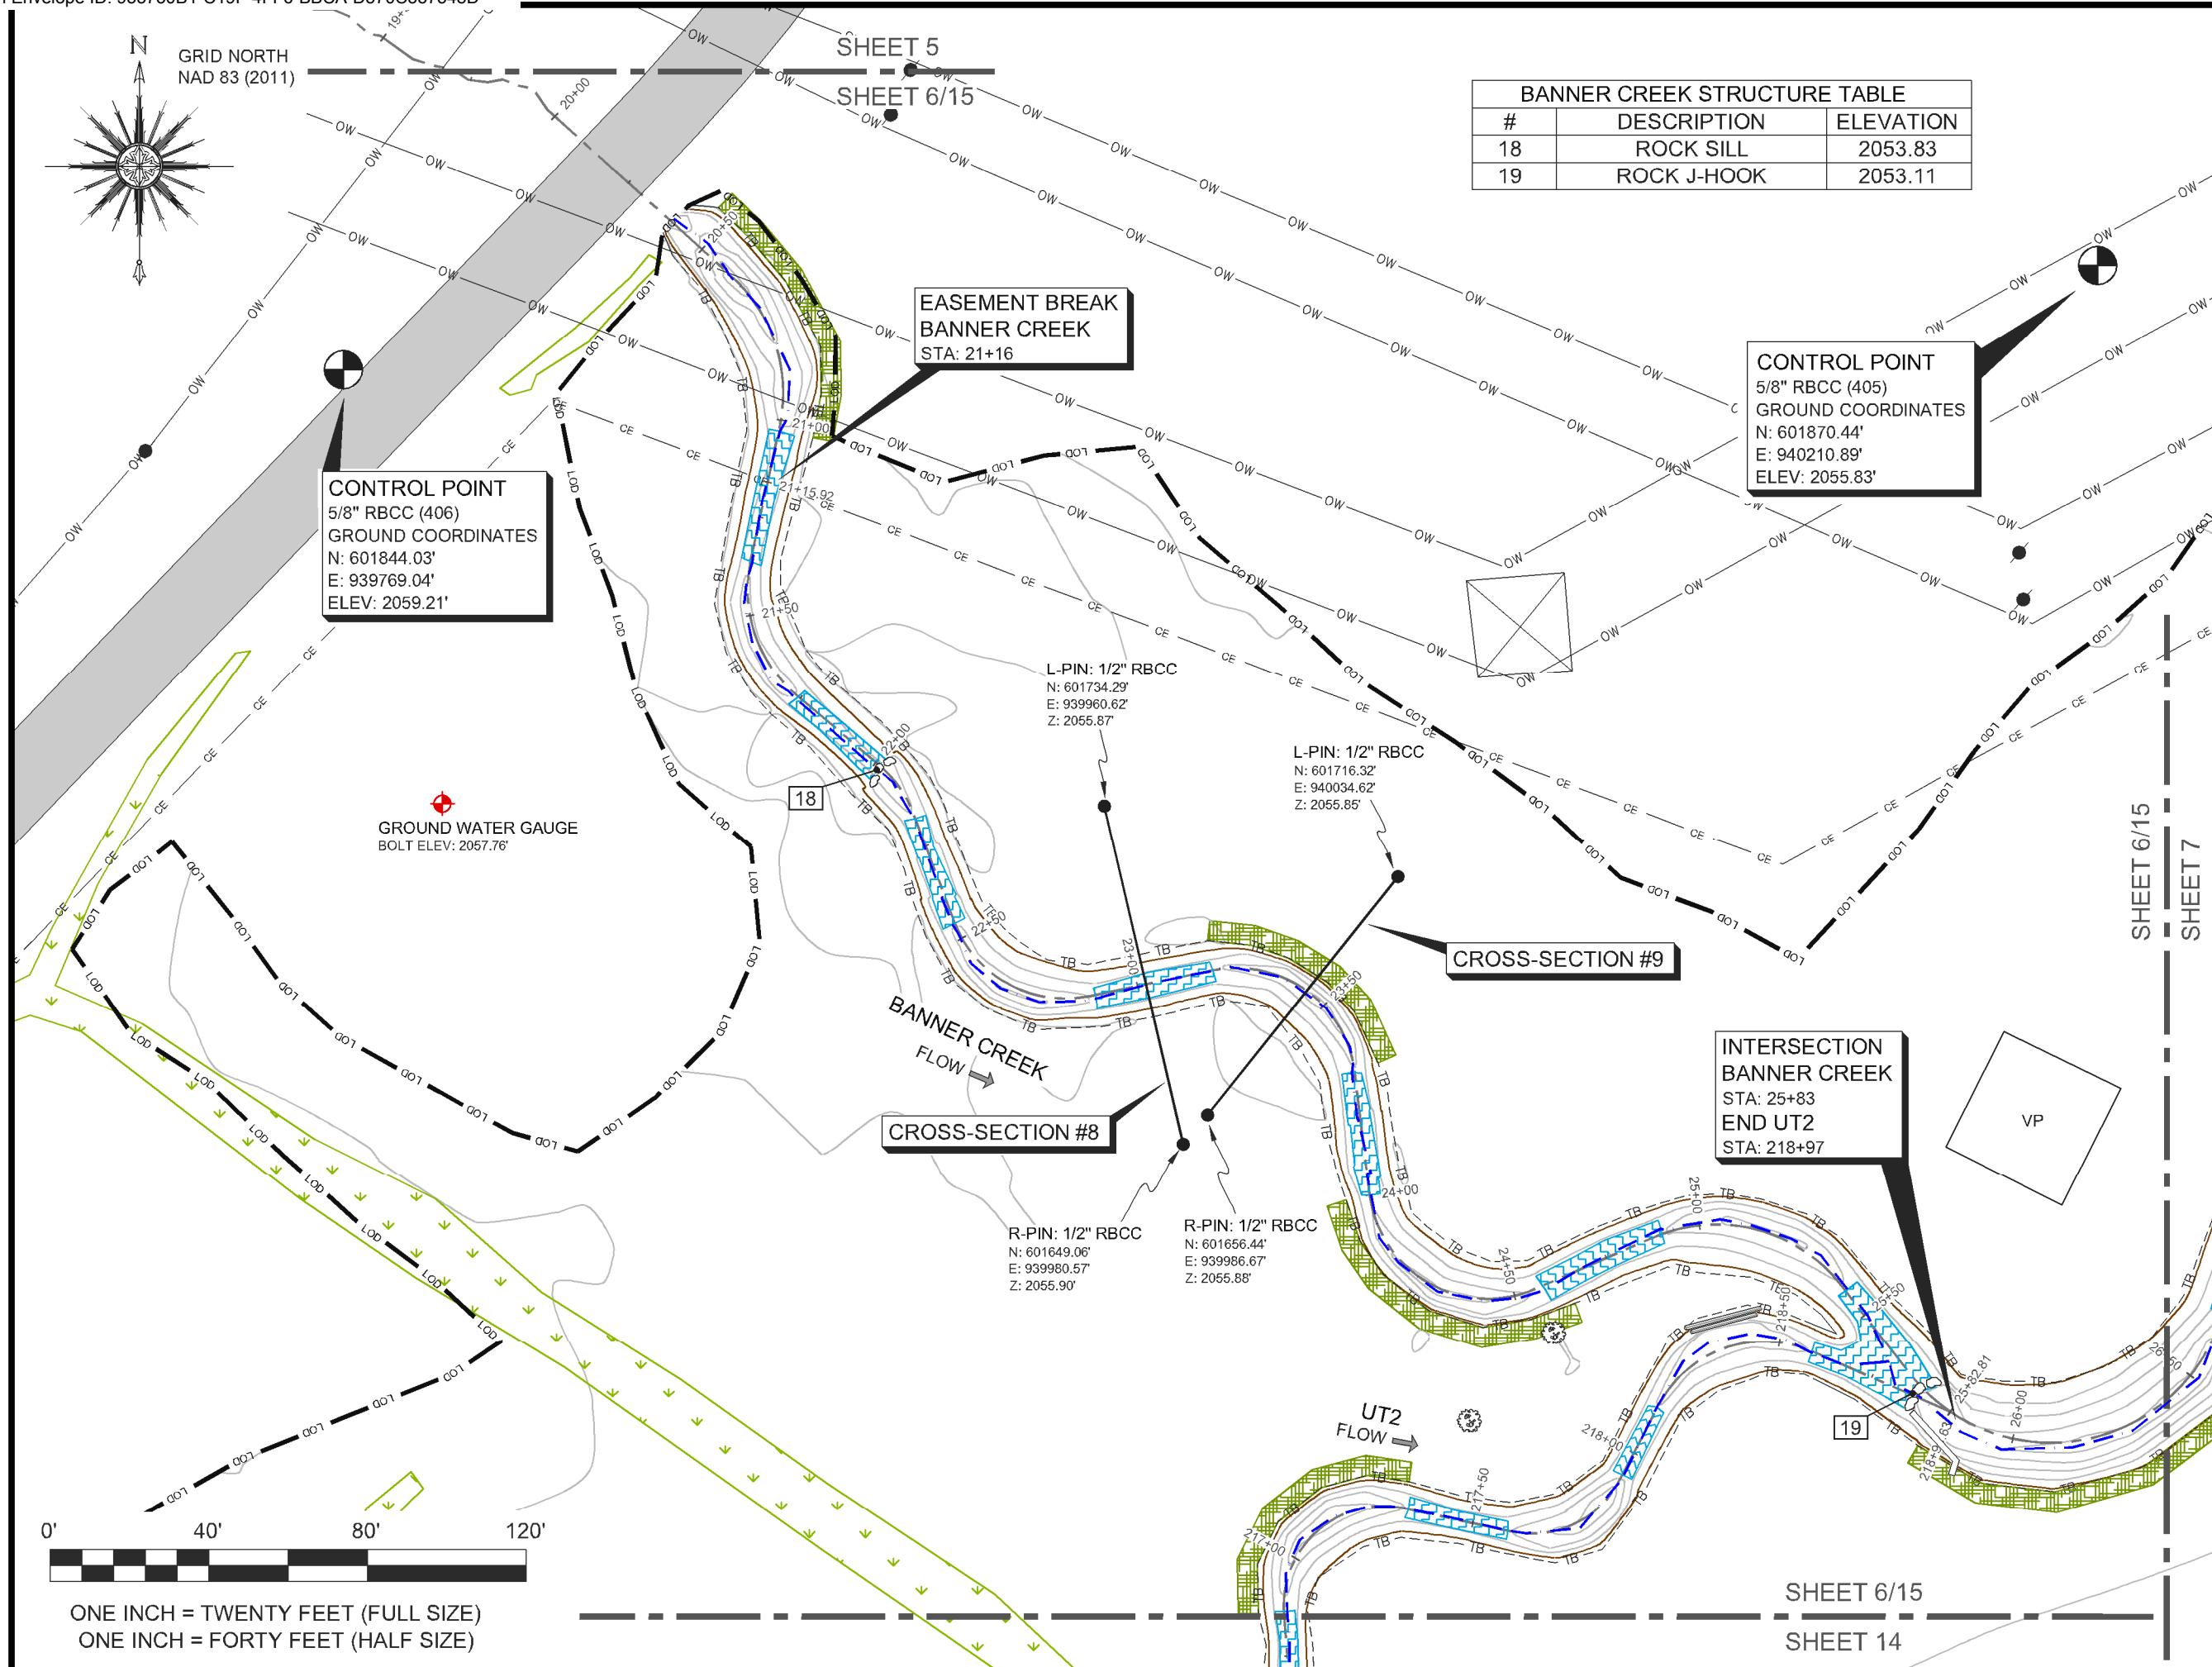

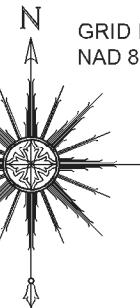GRID NORTH
NAD 83 (2011)

SHEET 6/15

SHEET 7

GROUND WATER GAUGE
BOLT ELEV: 2058.89'

L-PIN: 1/2" RBCC
N: 601781.31'
E: 940439.88'
Z: 2057.23'


CROSS-SECTION #10

L-PIN: 1/2" RBCC
N: 601776.65'
E: 940539.03'
Z: 2054.65'

CROSS-SECTION #11

R-PIN: 1/2" RBCC
N: 601694.75'
E: 940490.53'
Z: 2055.09'

GROUND WATER GAUGE
BOLT ELEV: 2058.77'

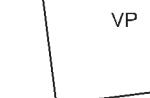


VP

BANNER CREEK STRUCTURE TABLE		
#	DESCRIPTION	ELEVATION
20	ROCK SILL	2052.51
21	LOG SILL	2052.35
22	ROCK J-HOOK	2051.81

0' 40' 80' 120'

ONE INCH = TWENTY FEET (FULL SIZE)
ONE INCH = FORTY FEET (HALF SIZE)

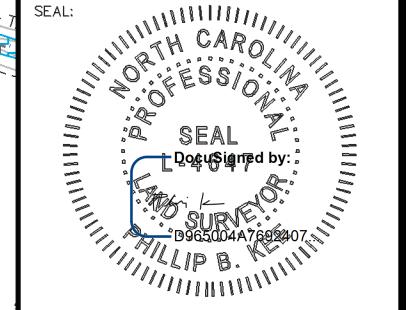

NOTE: SEE SHEET 1 FOR
SURVEYOR'S NOTES, LEGEND &
STATEMENT OF CERTIFICATION

ELEVATION DATUM: NAVD 88
CONTOUR INTERVAL: 1 FOOT

THIS IS A TOPOGRAPHIC
SURVEY FOR INFORMATIONAL
AND DESIGN PURPOSES
ONLY. IT SHOULD NOT BE
USED FOR CONVEYANCE OR
LEGAL PURPOSES.

AN AS-BUILT SURVEY FOR:

WILDLANDS
ENGINEERING, INCSPO FILE NOS. 45-DN, 45-DO,
45-DP, 45-DQ

DMS SITE ID NO. 100062


PROJECT:
BANNER FARMS
MITIGATION SITESHEET TITLE:
BANNER CREEK

TOWNSHIP: MILLS RIVER	COUNTY: HENDERSON	STATE: NORTH CAROLINA
DRAWN BY: NH	CHECKED BY: PBK	SURVEY BY: JB, PD, HW, ZC, KP, AC
SCALE: AS SHOWN	SURVEY DATE: 03/31/22	
JOB: #2110100-AB	SHEET SIZE: 11" X 17" (HALF SIZE)	REVISIONS
#	DATE	

SHEET:

7 OF 32

N
Kee
MAPPING & SURVEYING
P.O. Box 2566
Asheville, NC 28802
(828) 575-9021
www.kee-map.com
License # C-3039

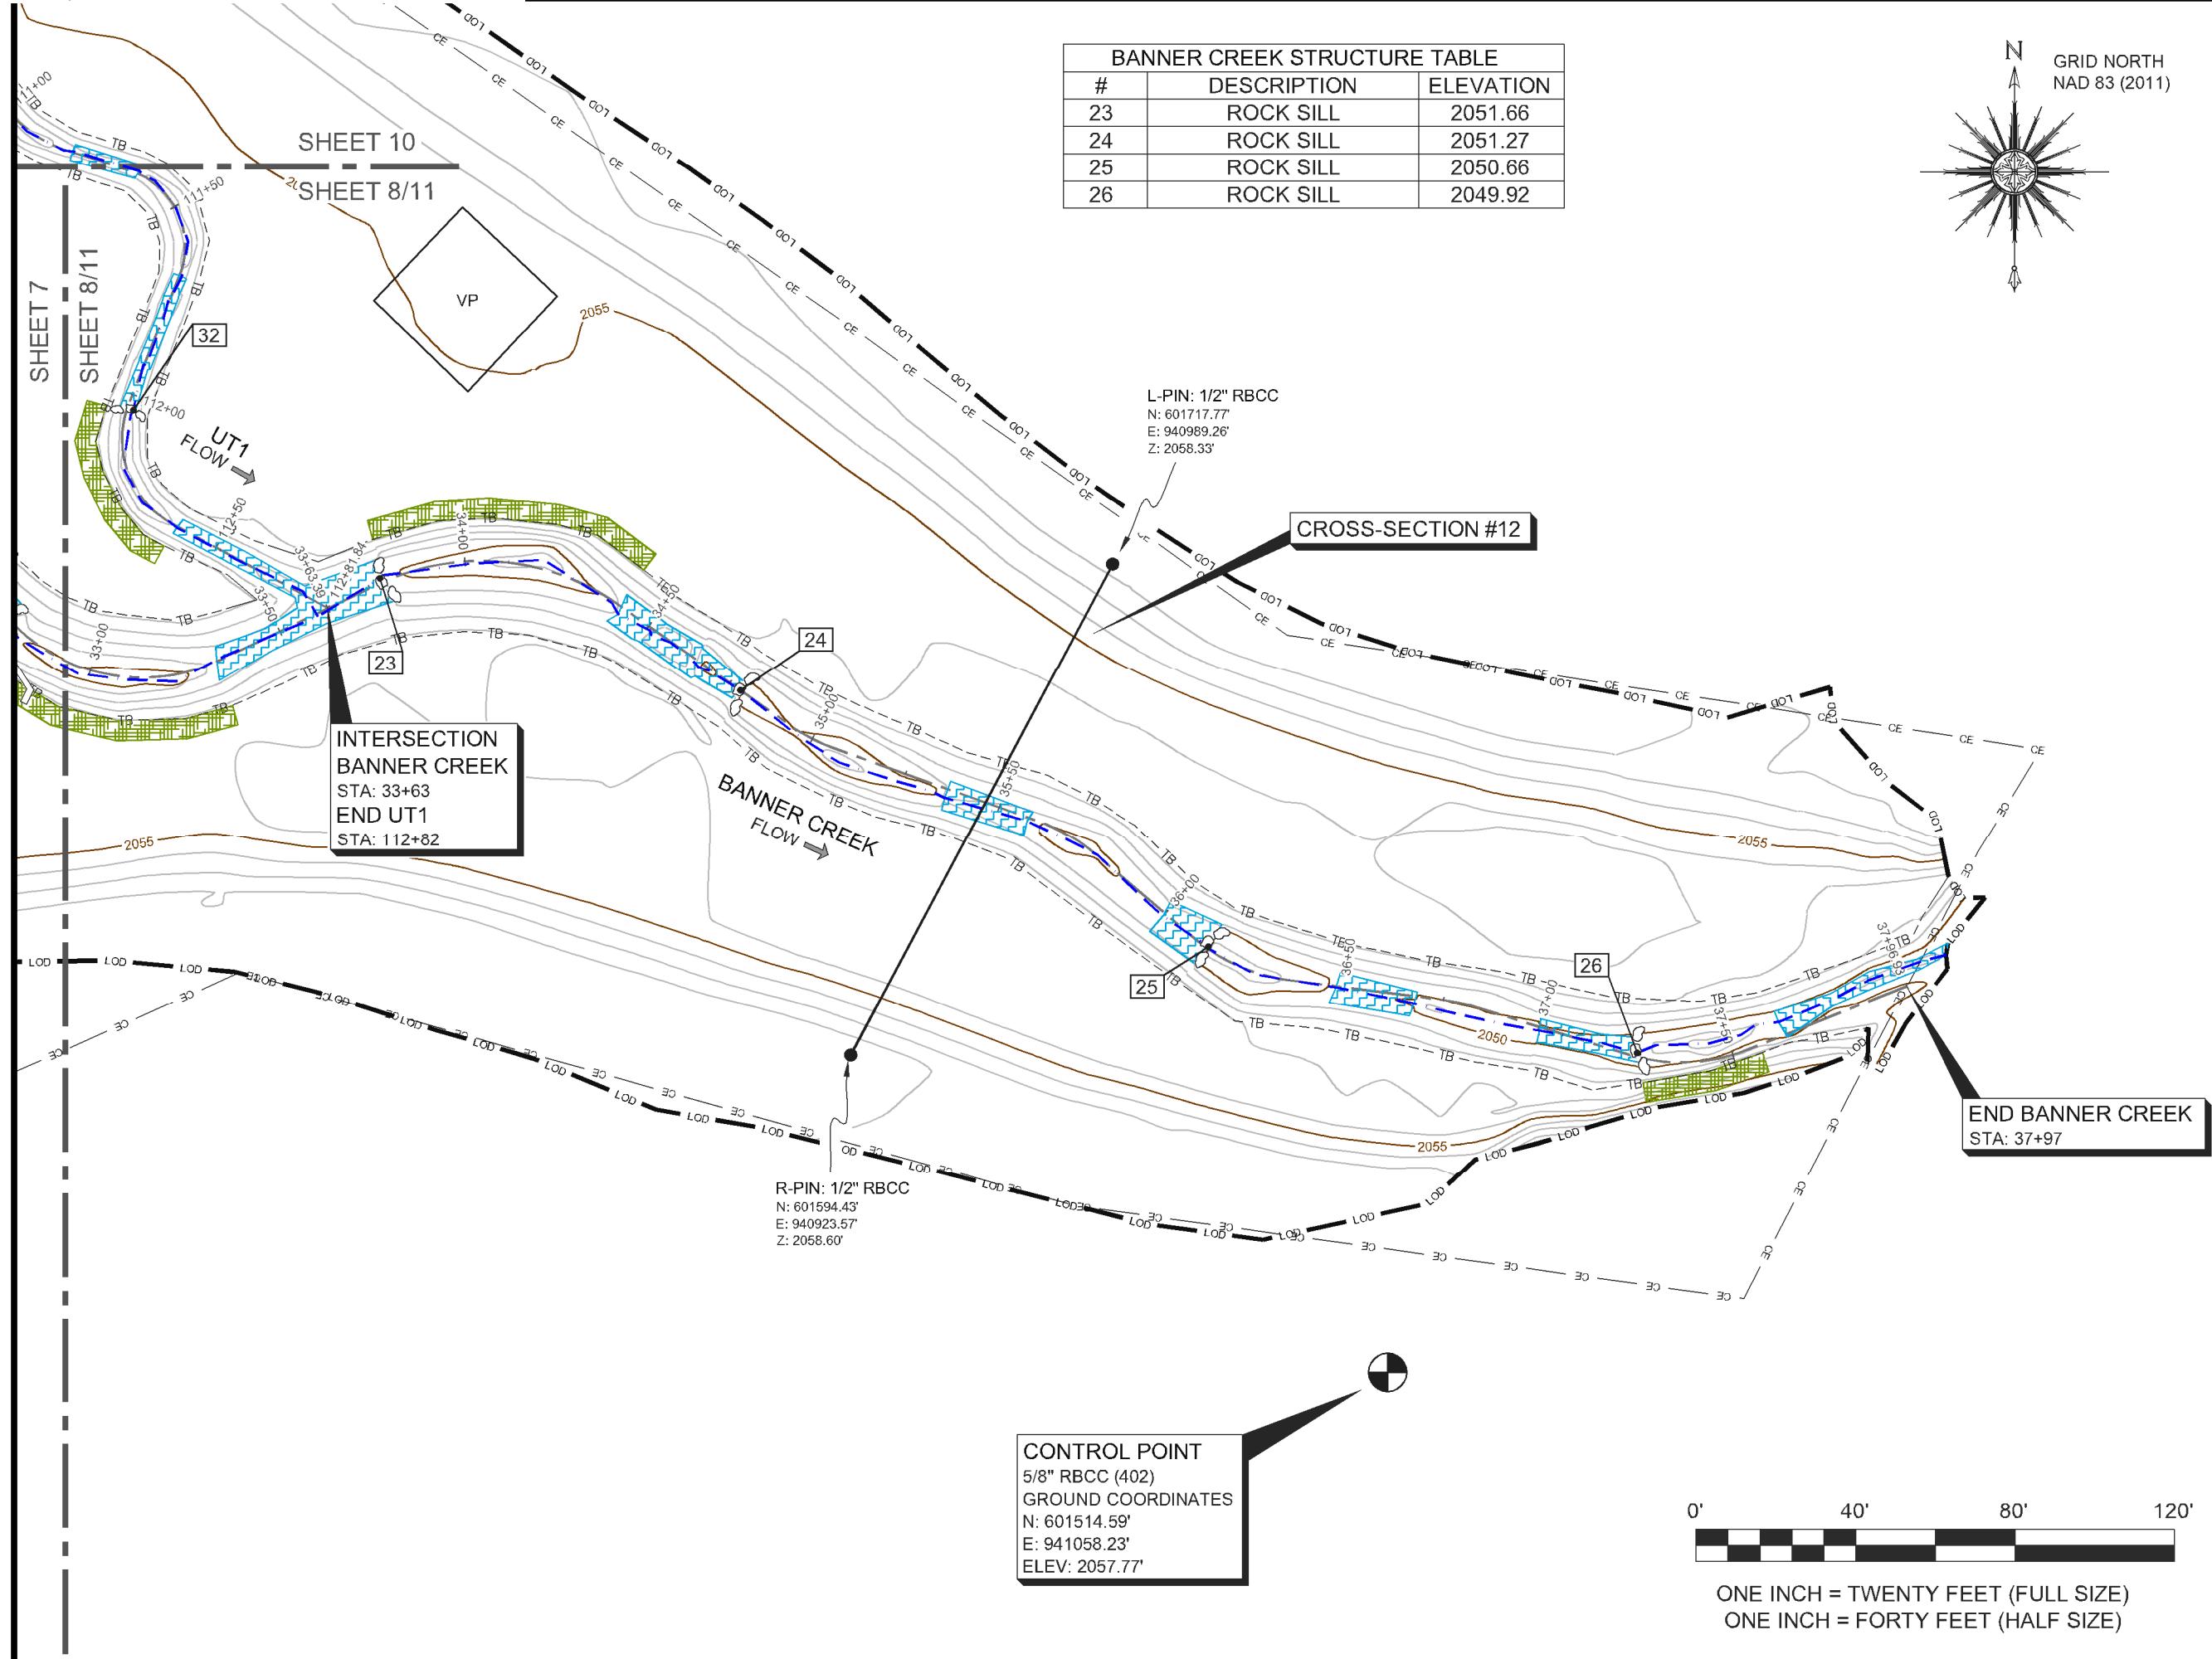

SEAL:

Designed by:
L-4647
B065004747692407

PHILLIP B. KEE

NOTE: SEE SHEET 1 FOR SURVEYOR'S NOTES, LEGEND & STATEMENT OF CERTIFICATION

ELABORATION DATUM: NAVD 88
CONTOUR INTERVAL: 1 FOOT

THIS IS A TOPOGRAPHIC SURVEY FOR INFORMATIONAL AND DESIGN PURPOSES ONLY. IT SHOULD NOT BE USED FOR CONVEYANCE OR LEGAL PURPOSES.

AN AS-BUILT SURVEY FOR:
WILDLANDS ENGINEERING, INC

SPO FILE NOS. 45-DN, 45-DO,
45-DP, 45-DQ

DMS SITE ID NO. 100062



PROJECT:
BANNER FARMS MITIGATION SITE

SHEET TITLE:
END BANNER CREEK



TOWNSHIP: MILLS RIVER	COUNTY: HENDERSON	STATE: NORTH CAROLINA
DRAWN BY: NH	CHECKED BY: PBK	SURVEY BY: JB, PD, HW, ZC, KP, AC
SCALE: AS SHOWN	SURVEY DATE: 03/31/22	
JOB: #2110100-AB	SHEET SIZE: 11" X 17" (HALF SIZE)	
#	DATE	REVISIONS

SHEET:

8 OF 32

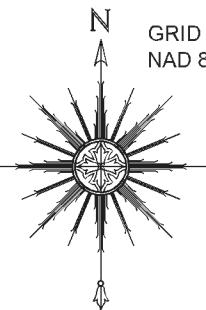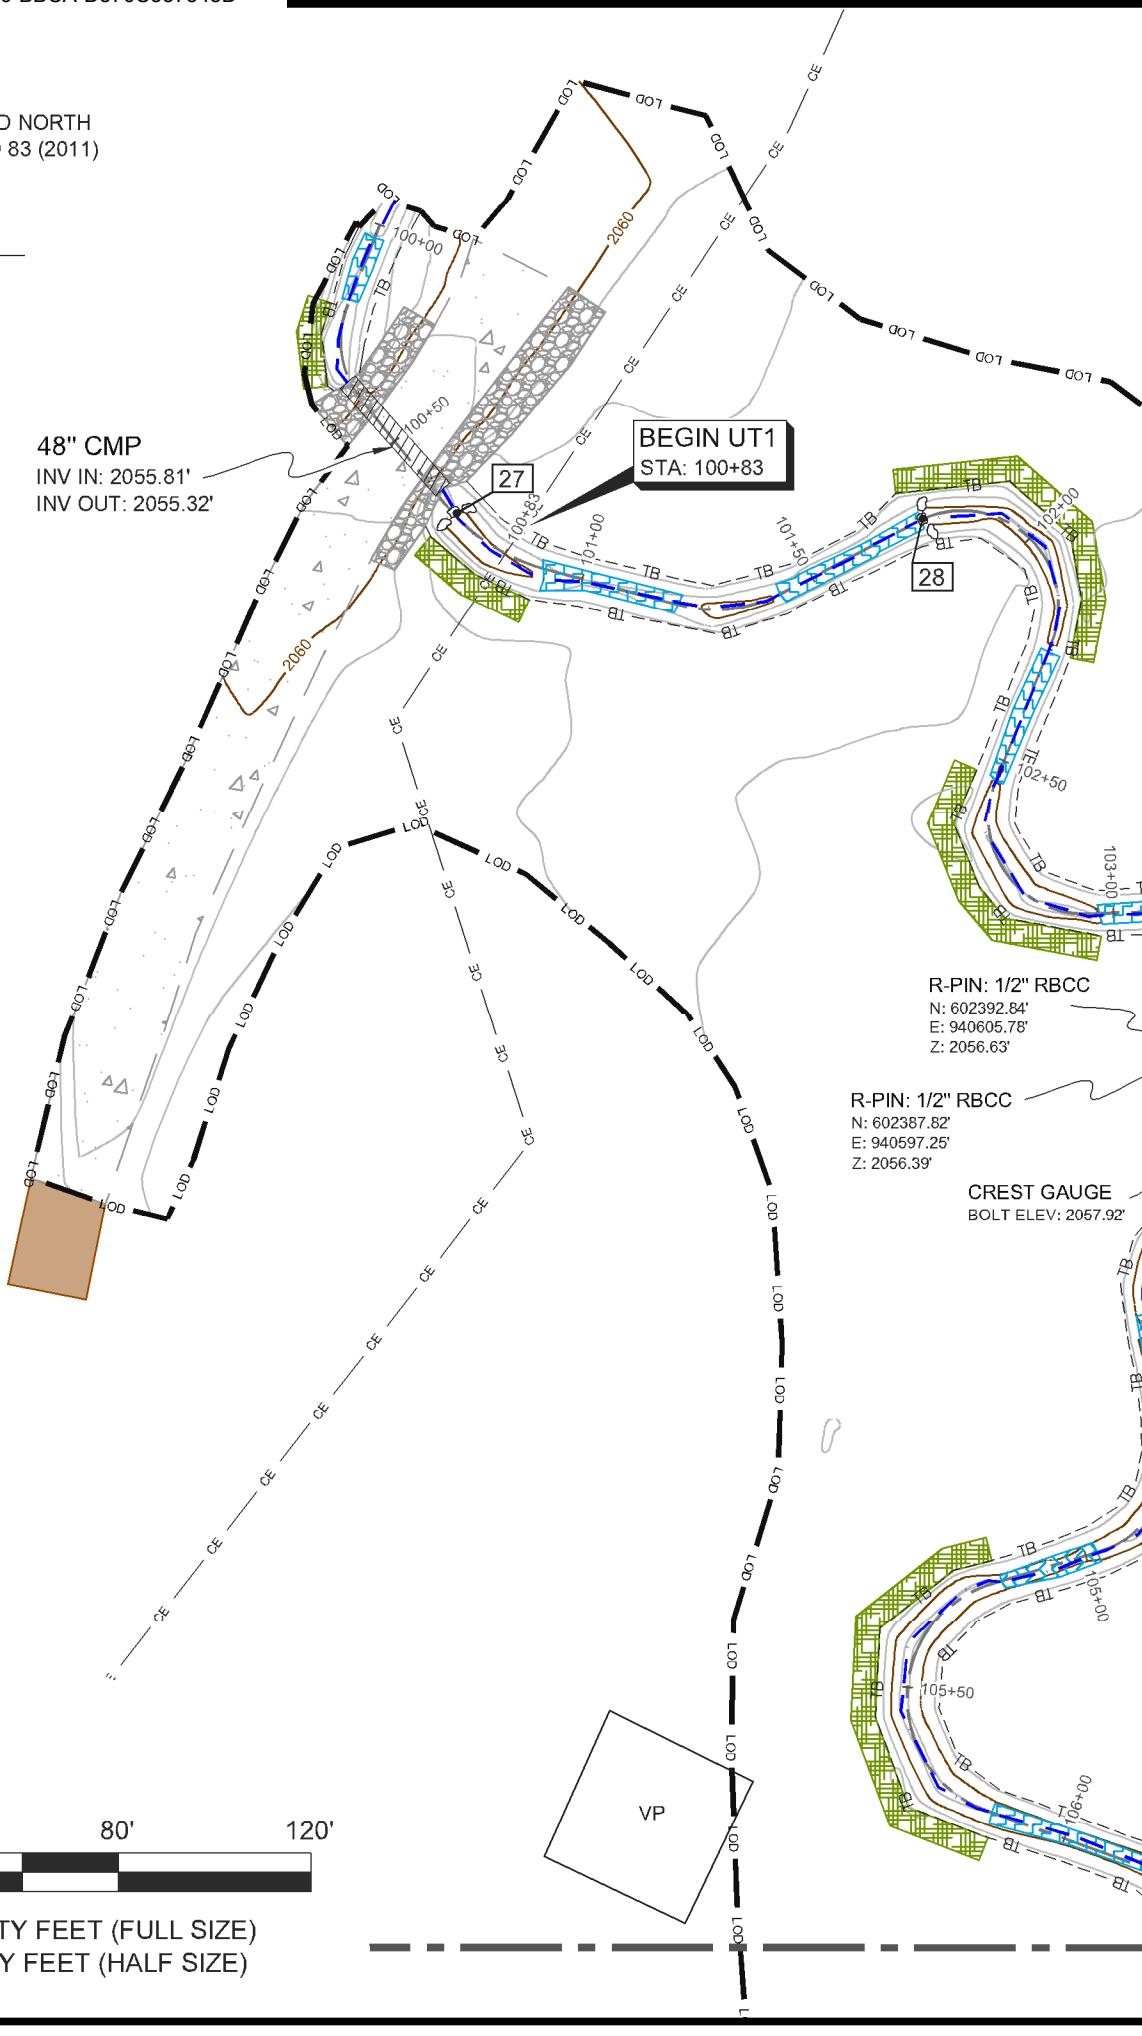GRID NORTH
NAD 83 (2011)48" CMP
INV IN: 2055.81'
INV OUT: 2055.32'

UT1 STRUCTURE TABLE		
#	DESCRIPTION	ELEVATION
27	ROCK SILL	2055.92
28	ROCK SILL	2055.42

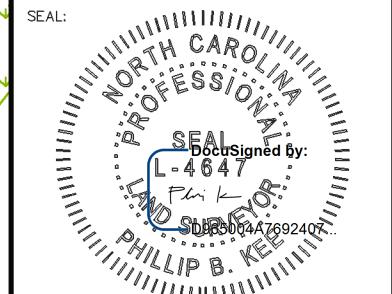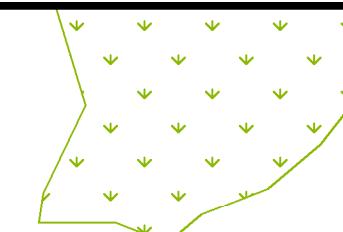
NOTE: SEE SHEET 1 FOR
SURVEYOR'S NOTES, LEGEND &
STATEMENT OF CERTIFICATIONELEVATION DATUM: NAVD 88
CONTOUR INTERVAL: 1 FOOTTHIS IS A TOPOGRAPHIC
SURVEY FOR INFORMATIONAL
AND DESIGN PURPOSES
ONLY. IT SHOULD NOT BE
USED FOR CONVEYANCE OR
LEGAL PURPOSES.AN AS-BUILT SURVEY FOR:
**WILDLANDS
ENGINEERING, INC**SPO FILE NOS. 45-DN, 45-DO,
45-DP, 45-DQ
DMS SITE ID NO. 100062PROJECT:
**BANNER FARMS
MITIGATION SITE**SHEET TITLE:
BEGIN UT1


TOWNSHIP:	COUNTY:	STATE:
MILLS RIVER	HENDERSON	NORTH CAROLINA
DRAWN BY:	CHECKED BY:	SURVEY BY:
NH	PK	JB, PD, HW, ZC, KP, AC
SCALE:	SURVEY DATE:	
AS SHOWN	03/31/22	
JOB:	SHEET SIZE:	
#2110100-AB	11" X 17" (HALF SIZE)	
#	DATE	REVISIONS

SHEET:

9 OF 32

Kee
MAPPING & SURVEYING
P.O. Box 2566
Asheville, NC 28802
(828) 575-9021
www.keemap.com
License # C-3039

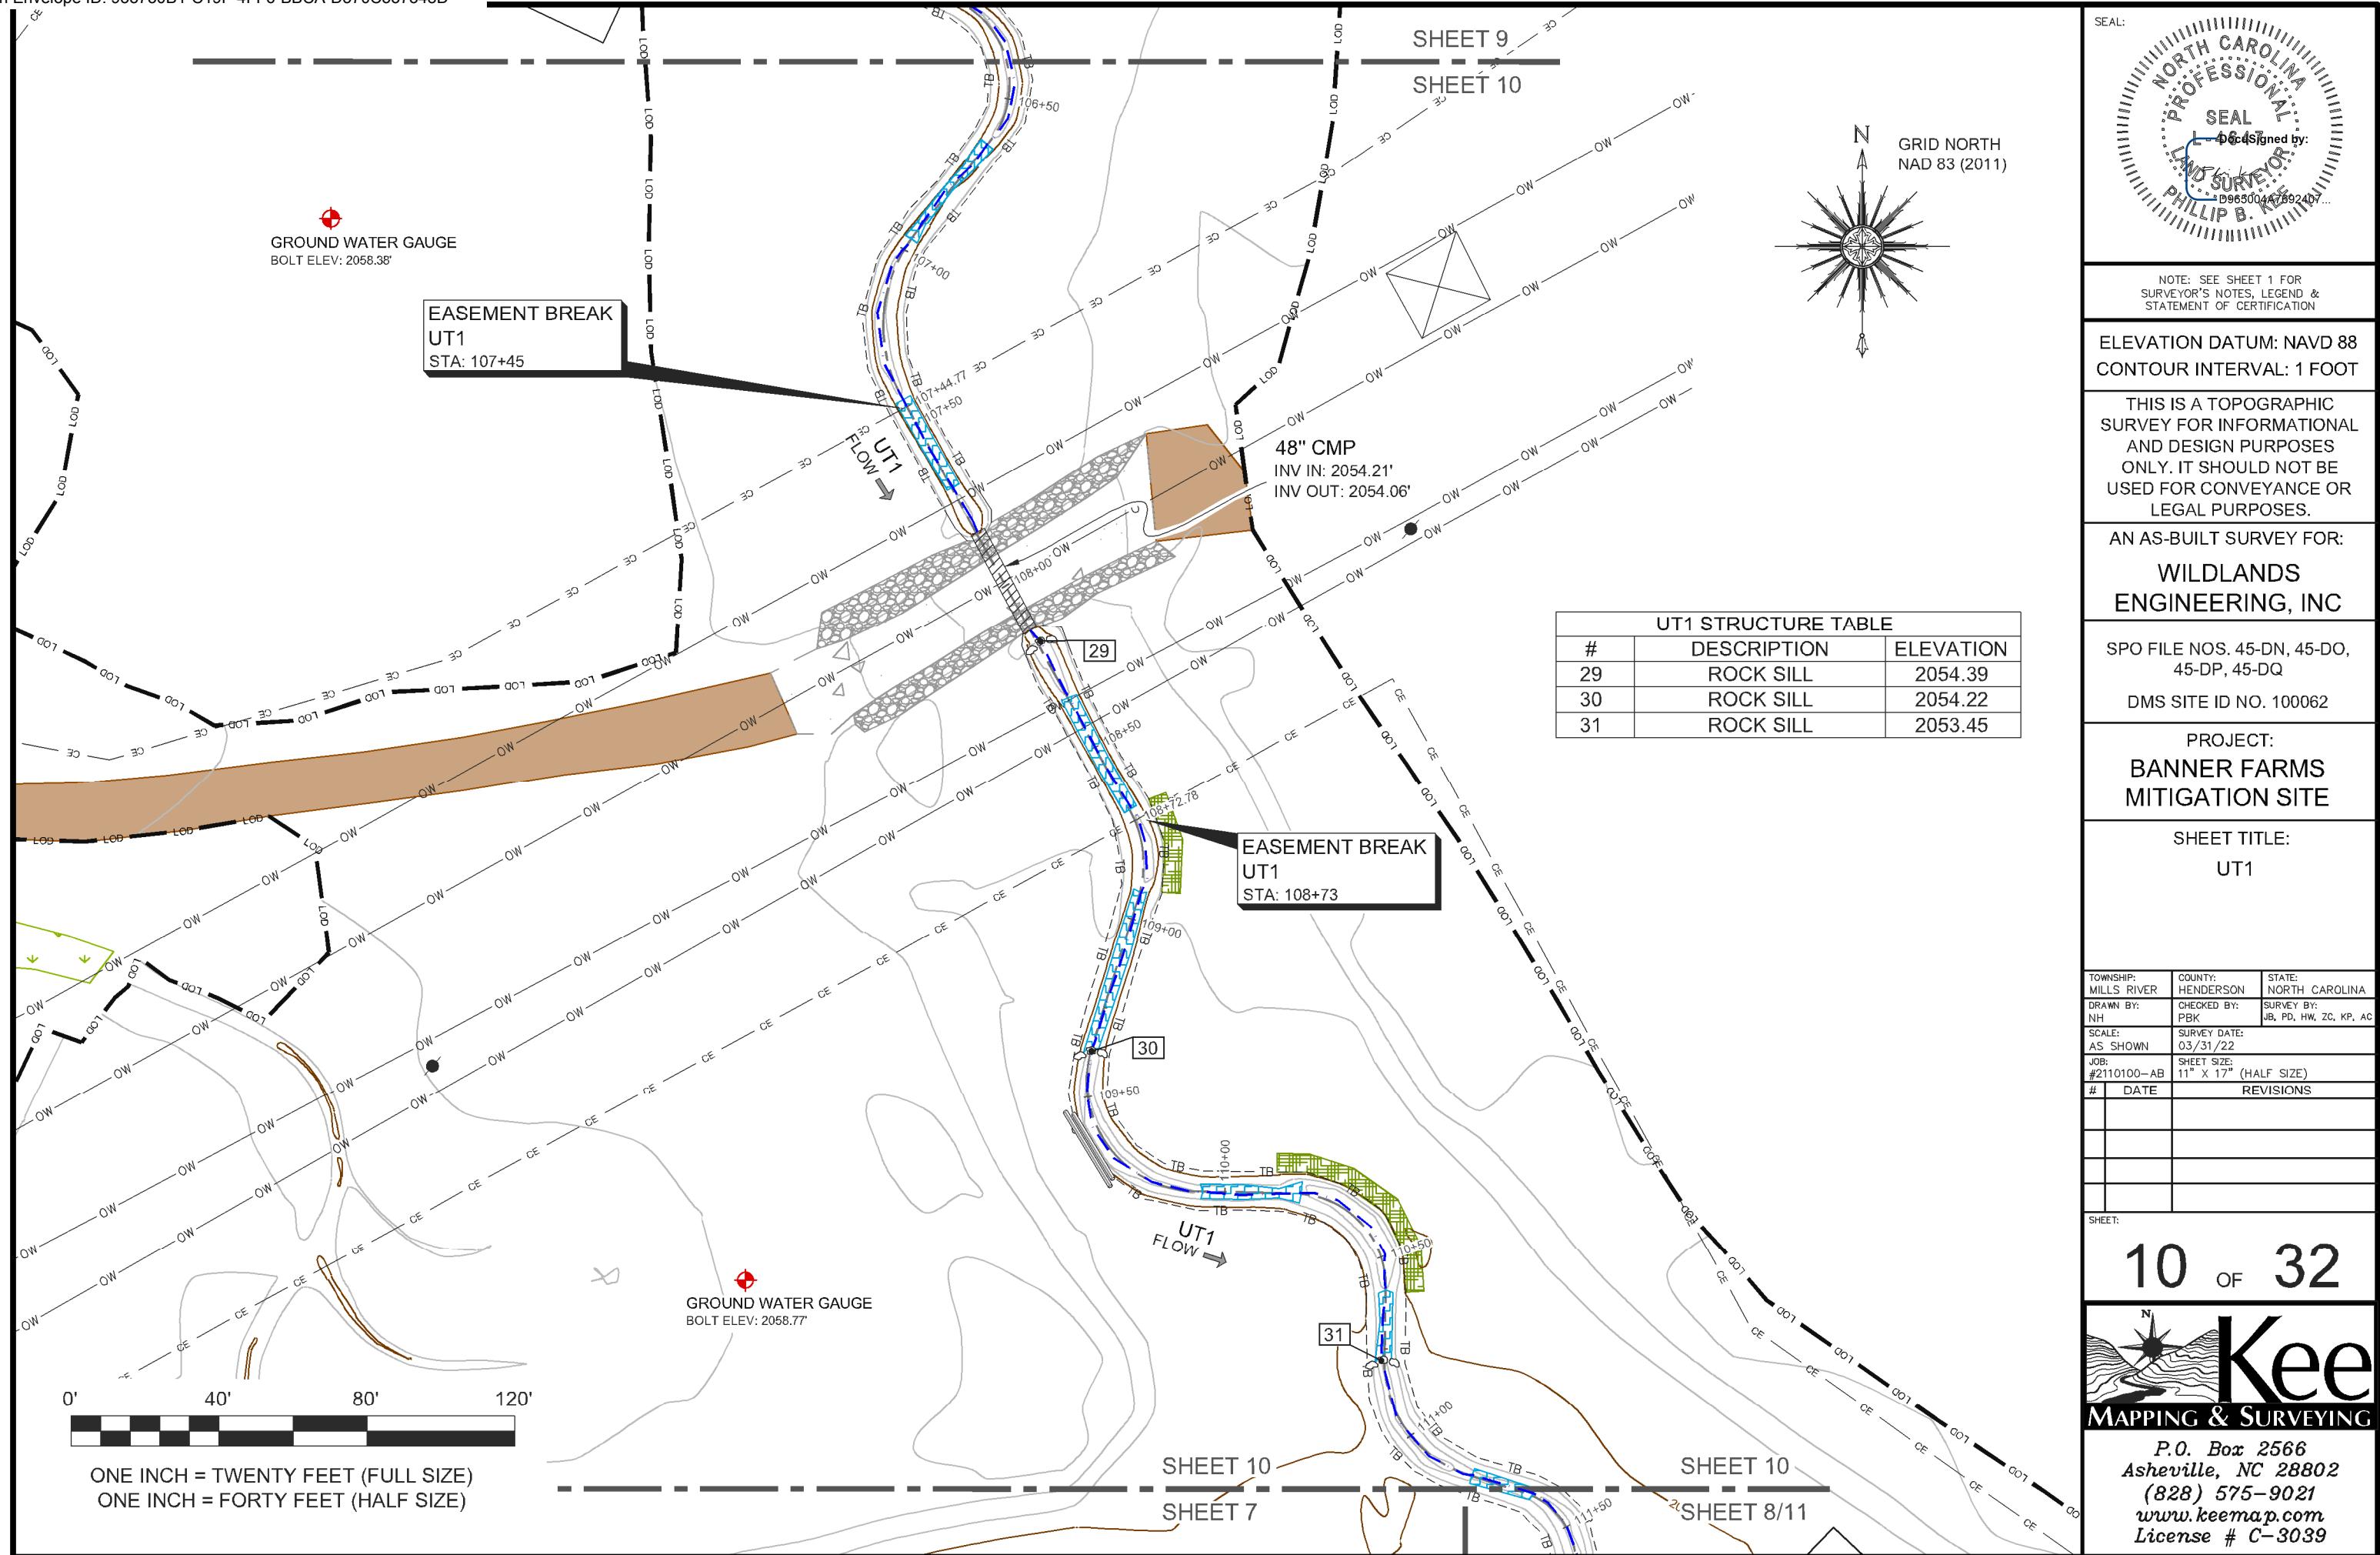

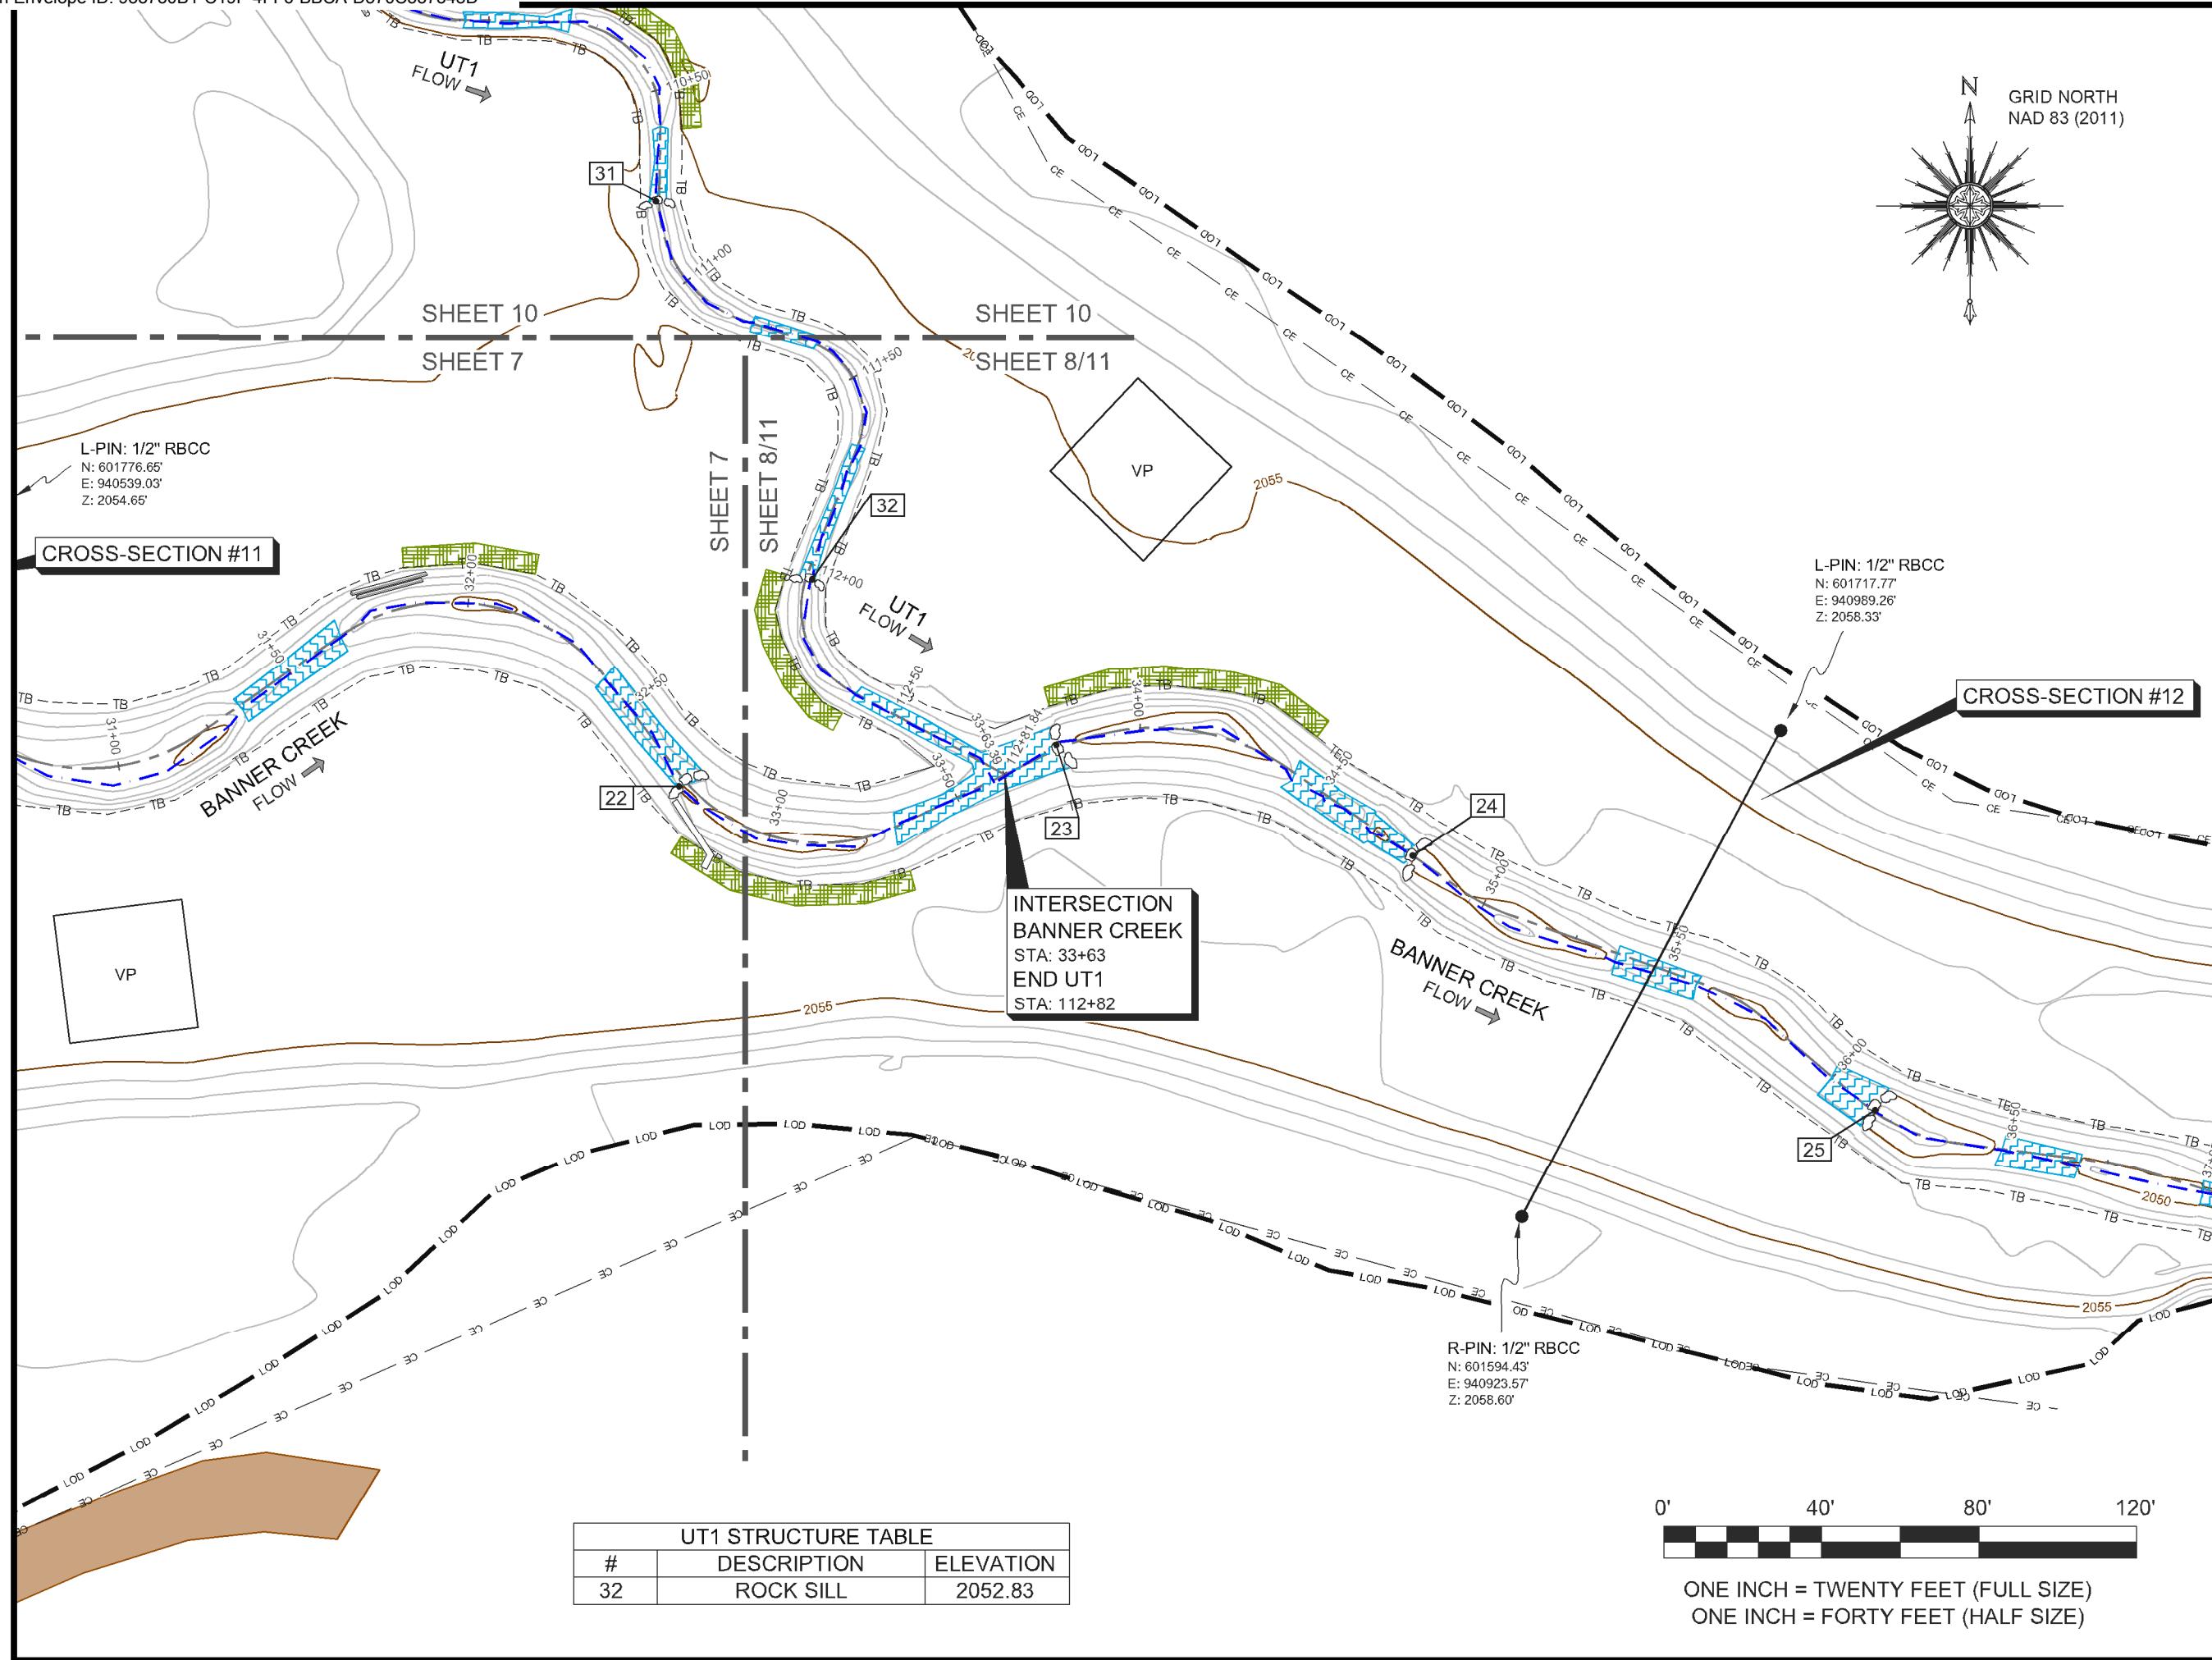

NOTE: SEE SHEET 1 FOR SURVEYOR'S NOTES, LEGEND & STATEMENT OF CERTIFICATION

ELEVATION DATUM: NAVD 88
CONTOUR INTERVAL: 1 FOOT

THIS IS A TOPOGRAPHIC SURVEY FOR INFORMATIONAL AND DESIGN PURPOSES ONLY. IT SHOULD NOT BE USED FOR CONVEYANCE OR LEGAL PURPOSES.

AN AS-BUILT SURVEY FOR:
WILDLANDS ENGINEERING, INC

SPO FILE NOS. 45-DN, 45-DO,
45-DP, 45-DQ
DMS SITE ID NO. 100062


PROJECT:
BANNER FARMS MITIGATION SITE


SHEET TITLE:
END UT1


TOWNSHIP:	COUNTY:	STATE:
MILLS RIVER	HENDERSON	NORTH CAROLINA
DRAWN BY:	CHECKED BY:	SURVEY BY:
NH	PKB	JB, PD, HW, ZC, KP, AC
SCALE:	SURVEY DATE:	
AS SHOWN	03/31/22	
JOB:	SHEET SIZE:	REVISIONS
#2110100-AB	11" X 17" (HALF SIZE)	
#	DATE	


11 OF 32


Kee
MAPPING & SURVEYING
P.O. Box 2566
Asheville, NC 28802
(828) 575-9021
www.kee-map.com
License # C-3039


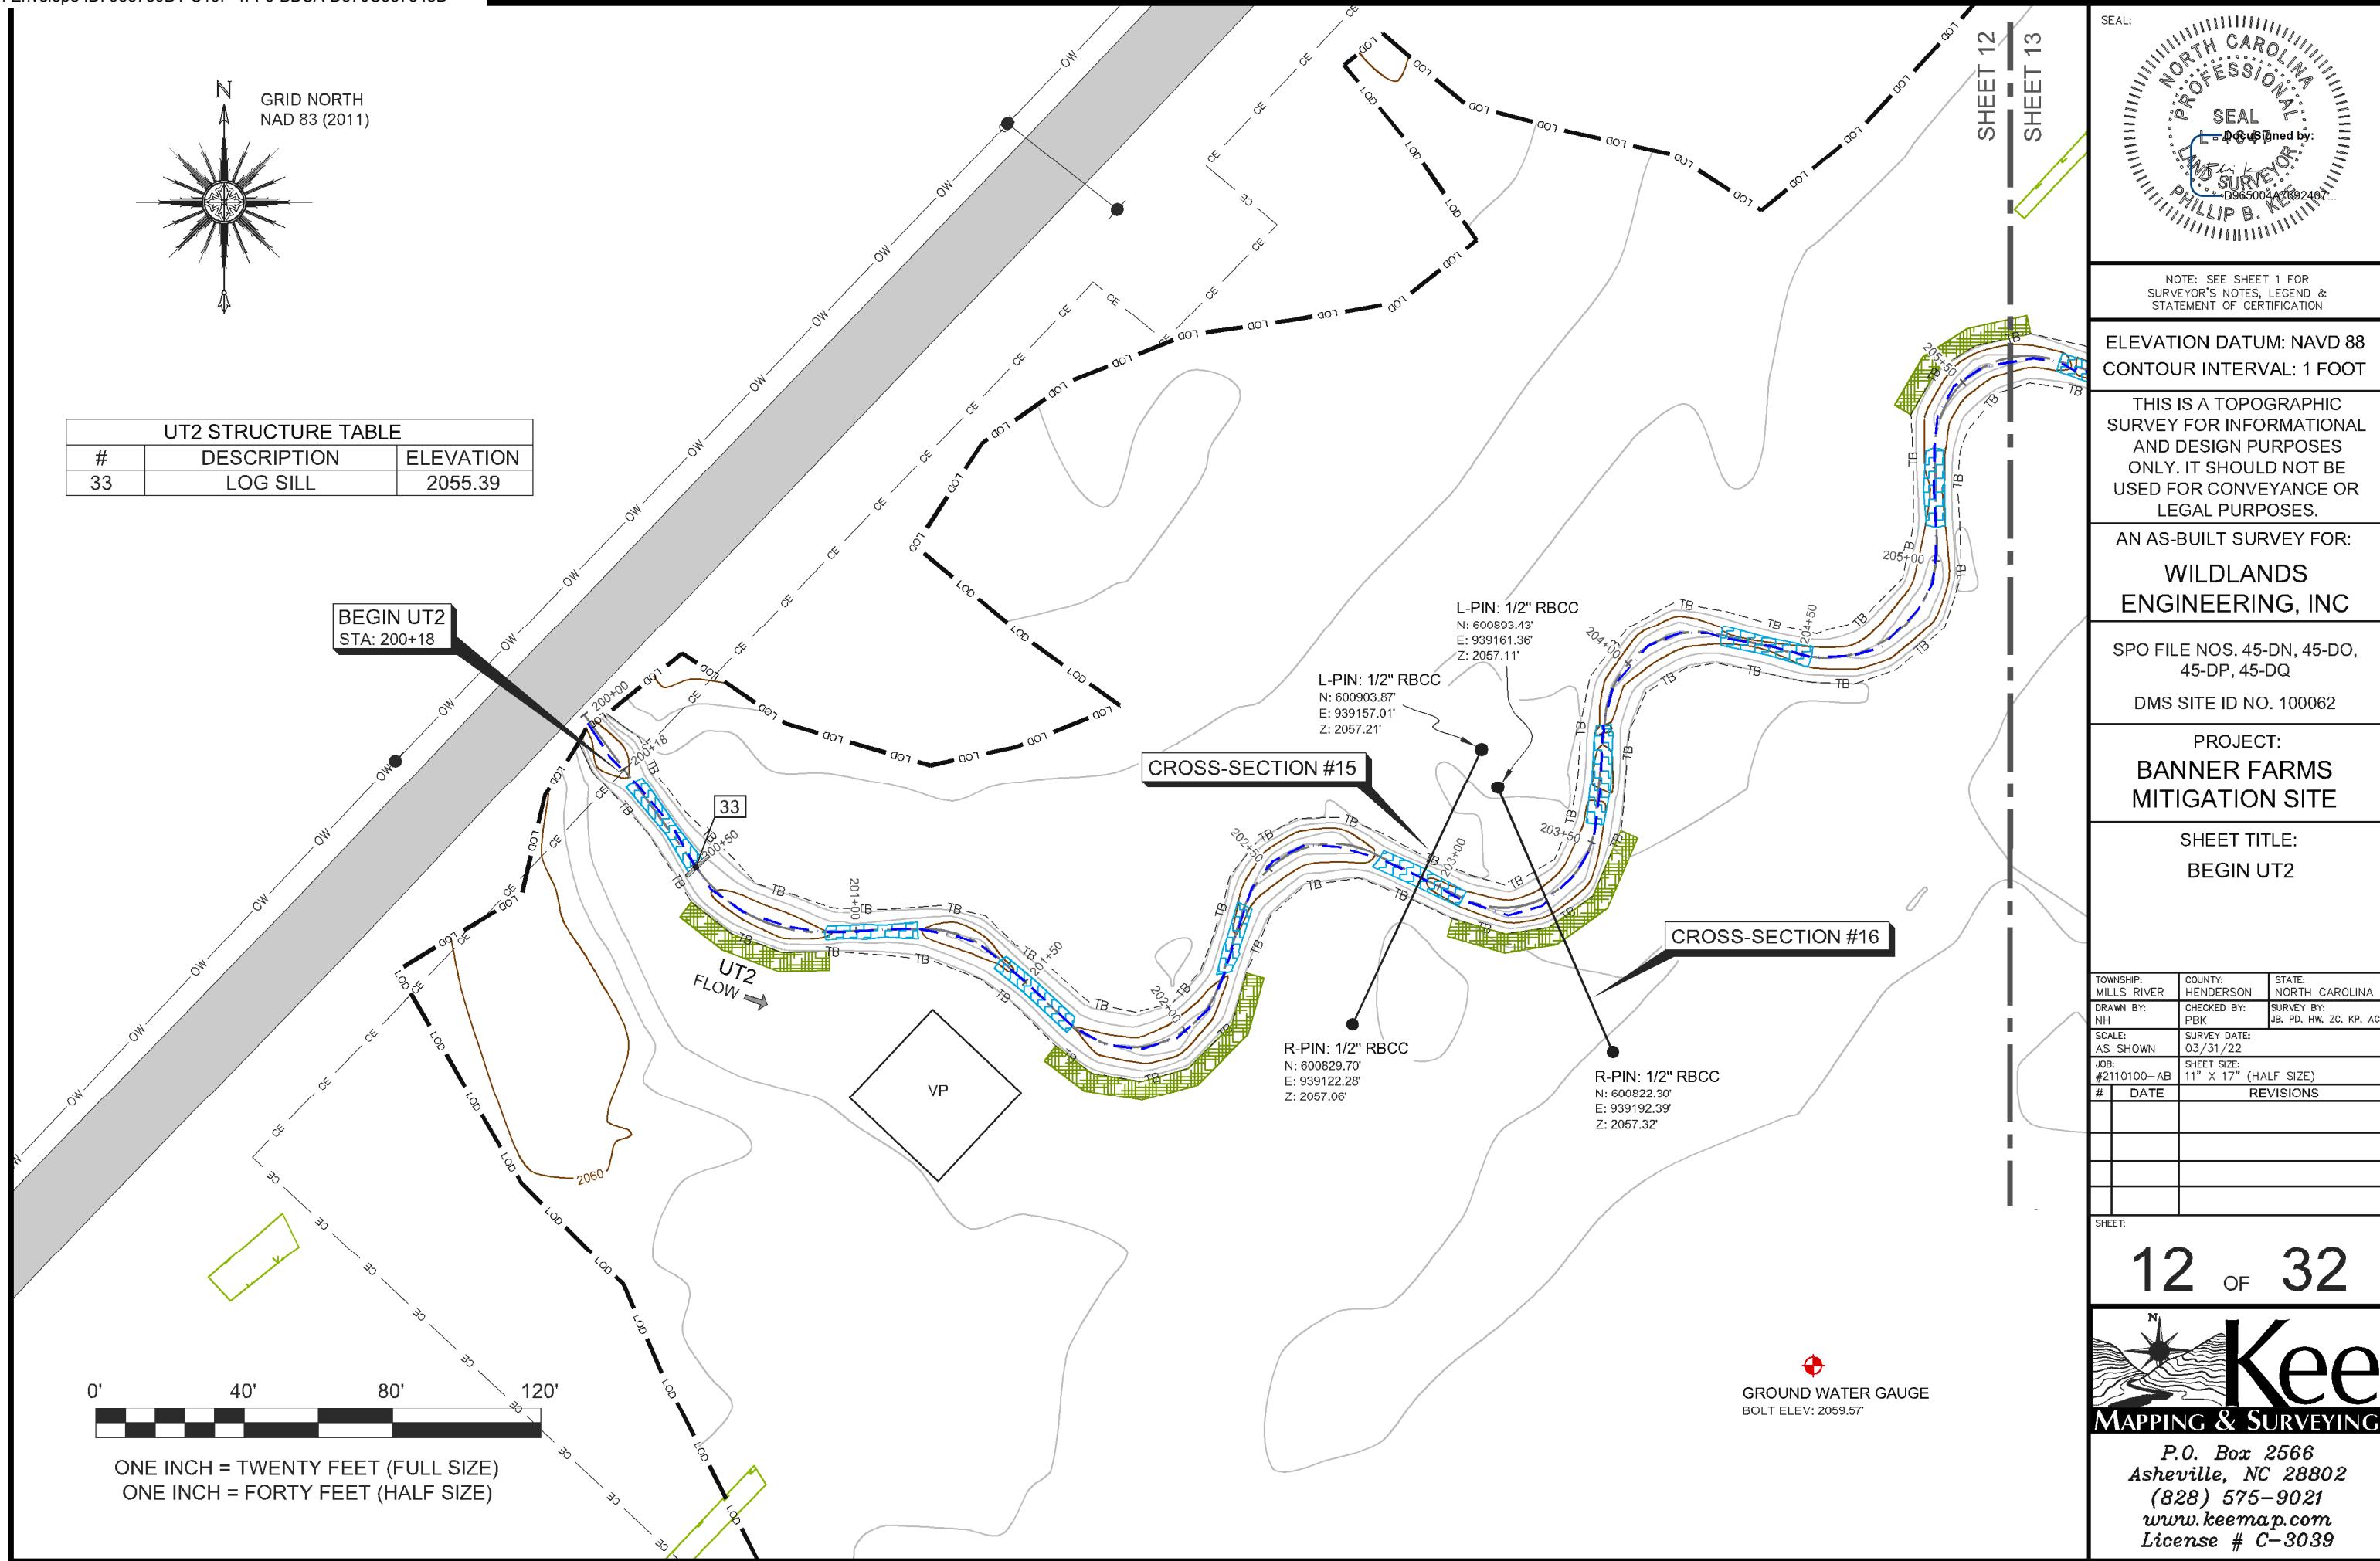


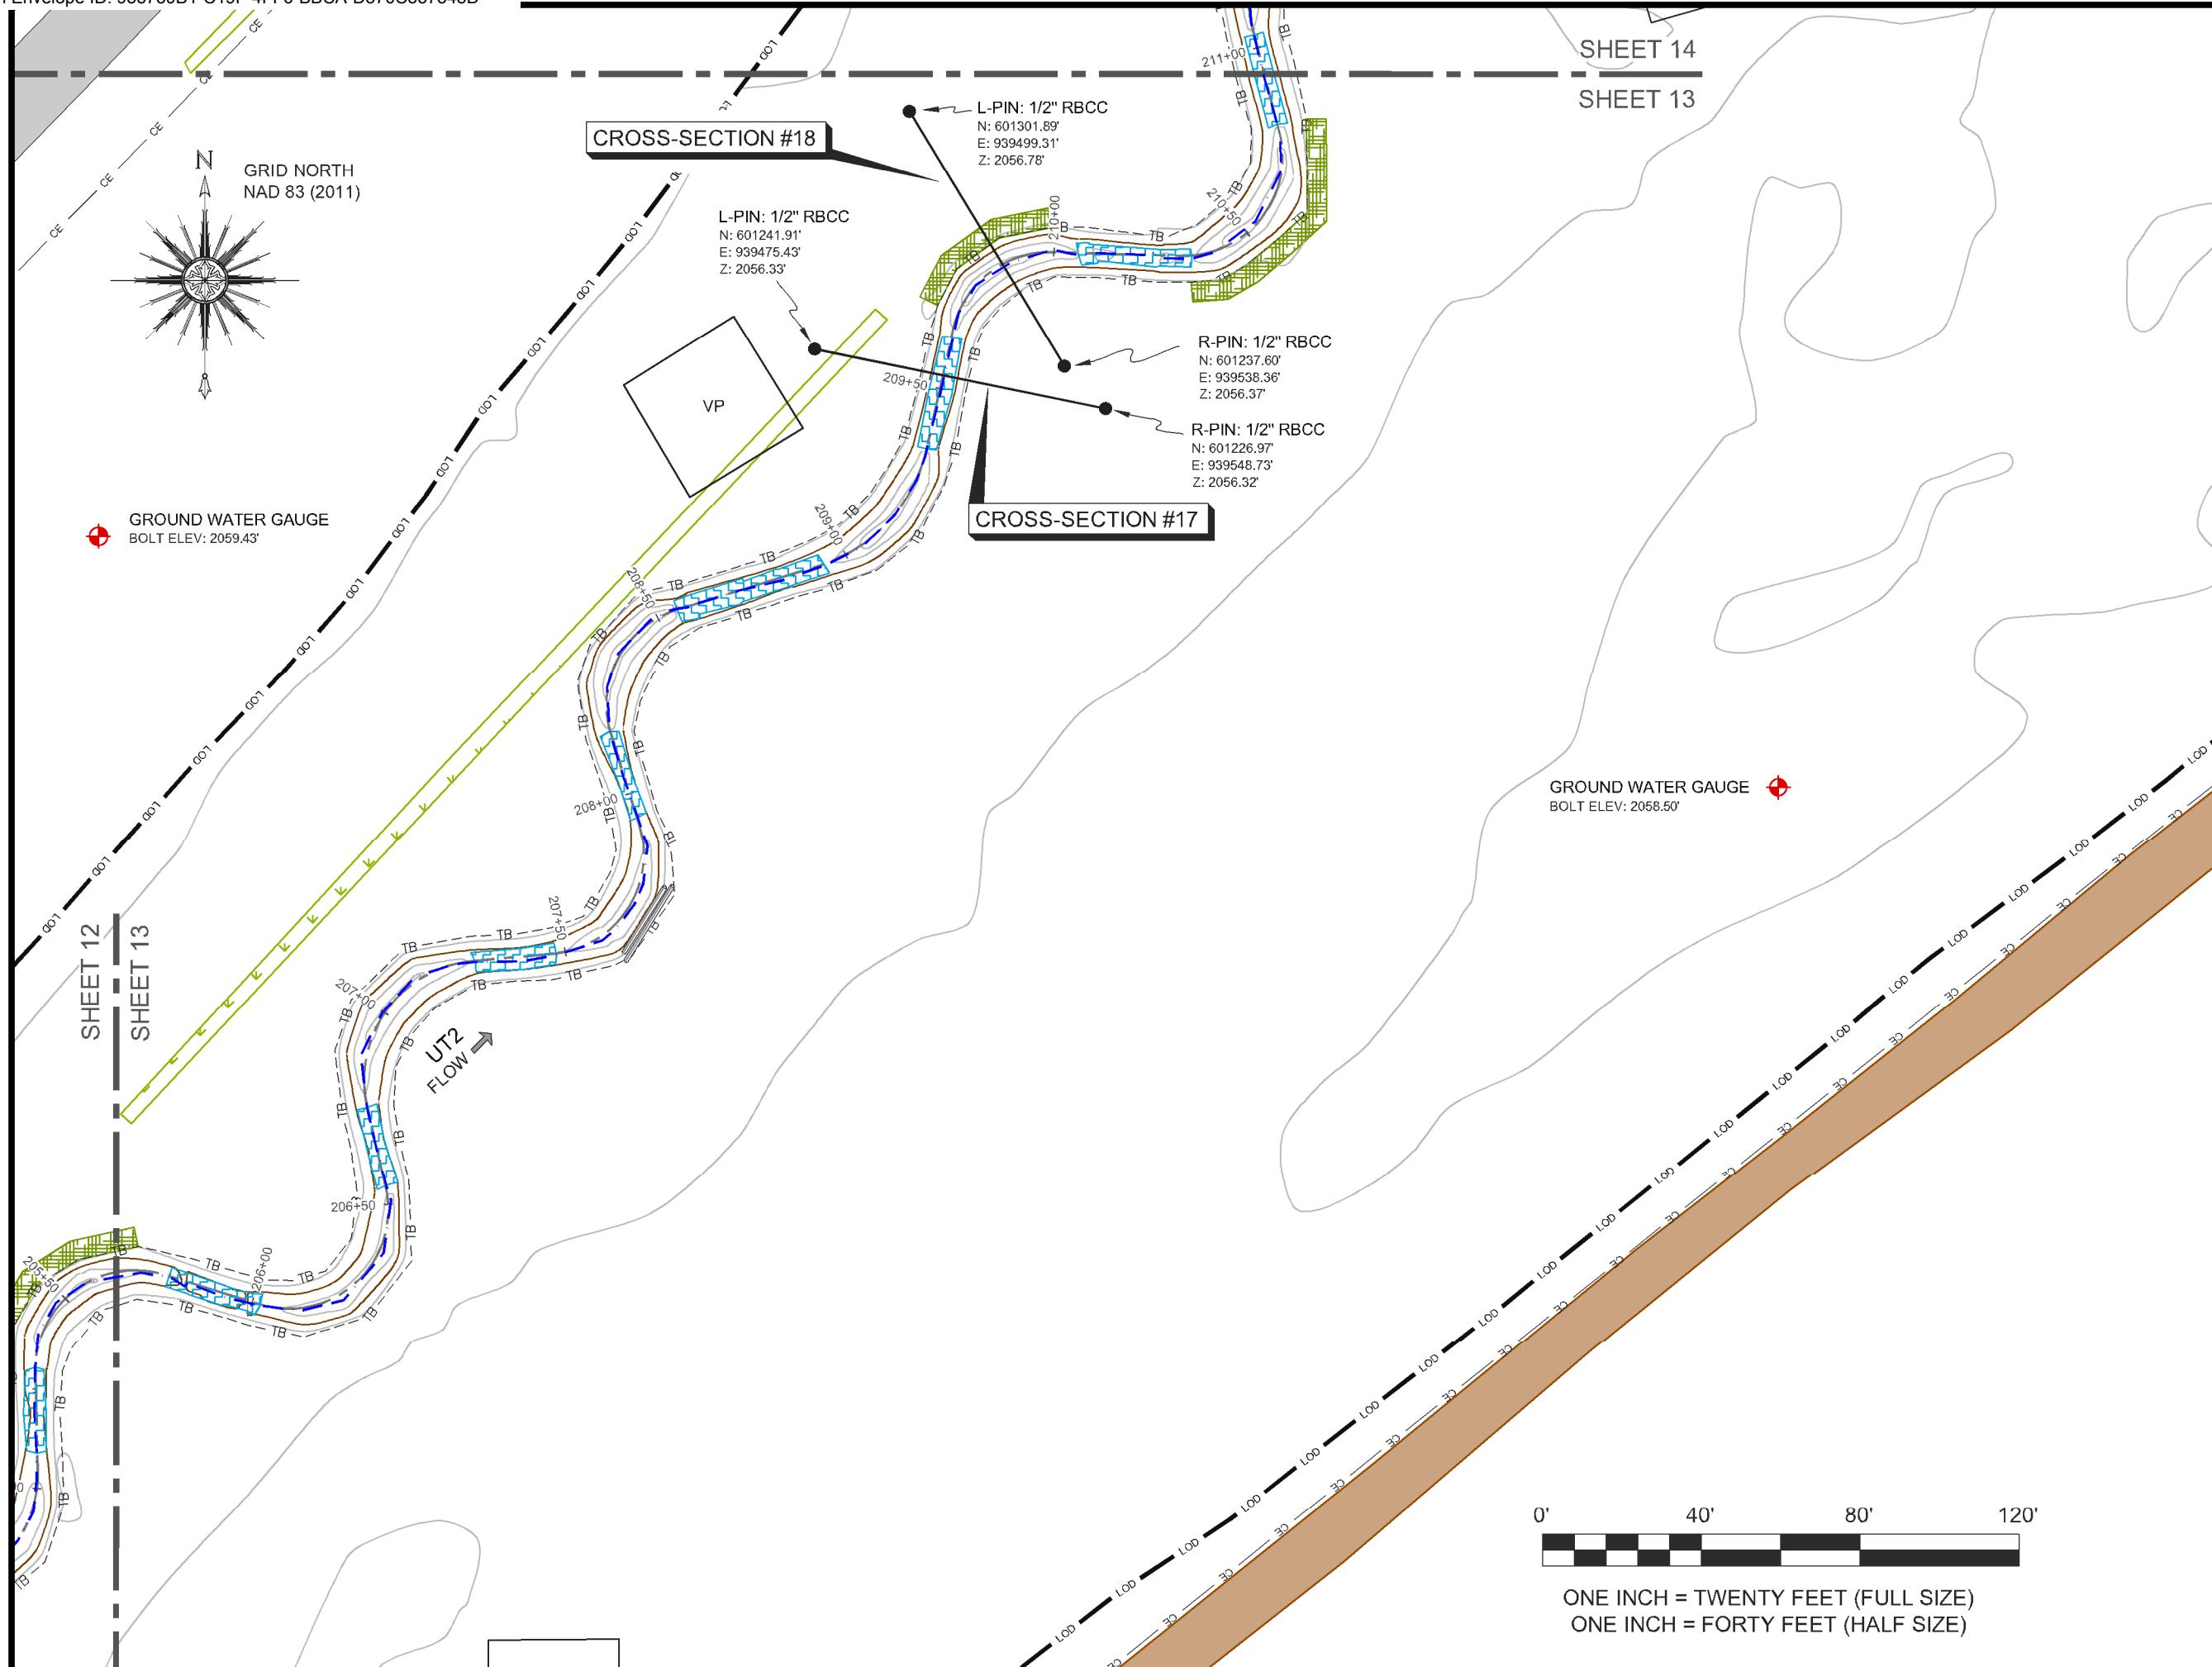

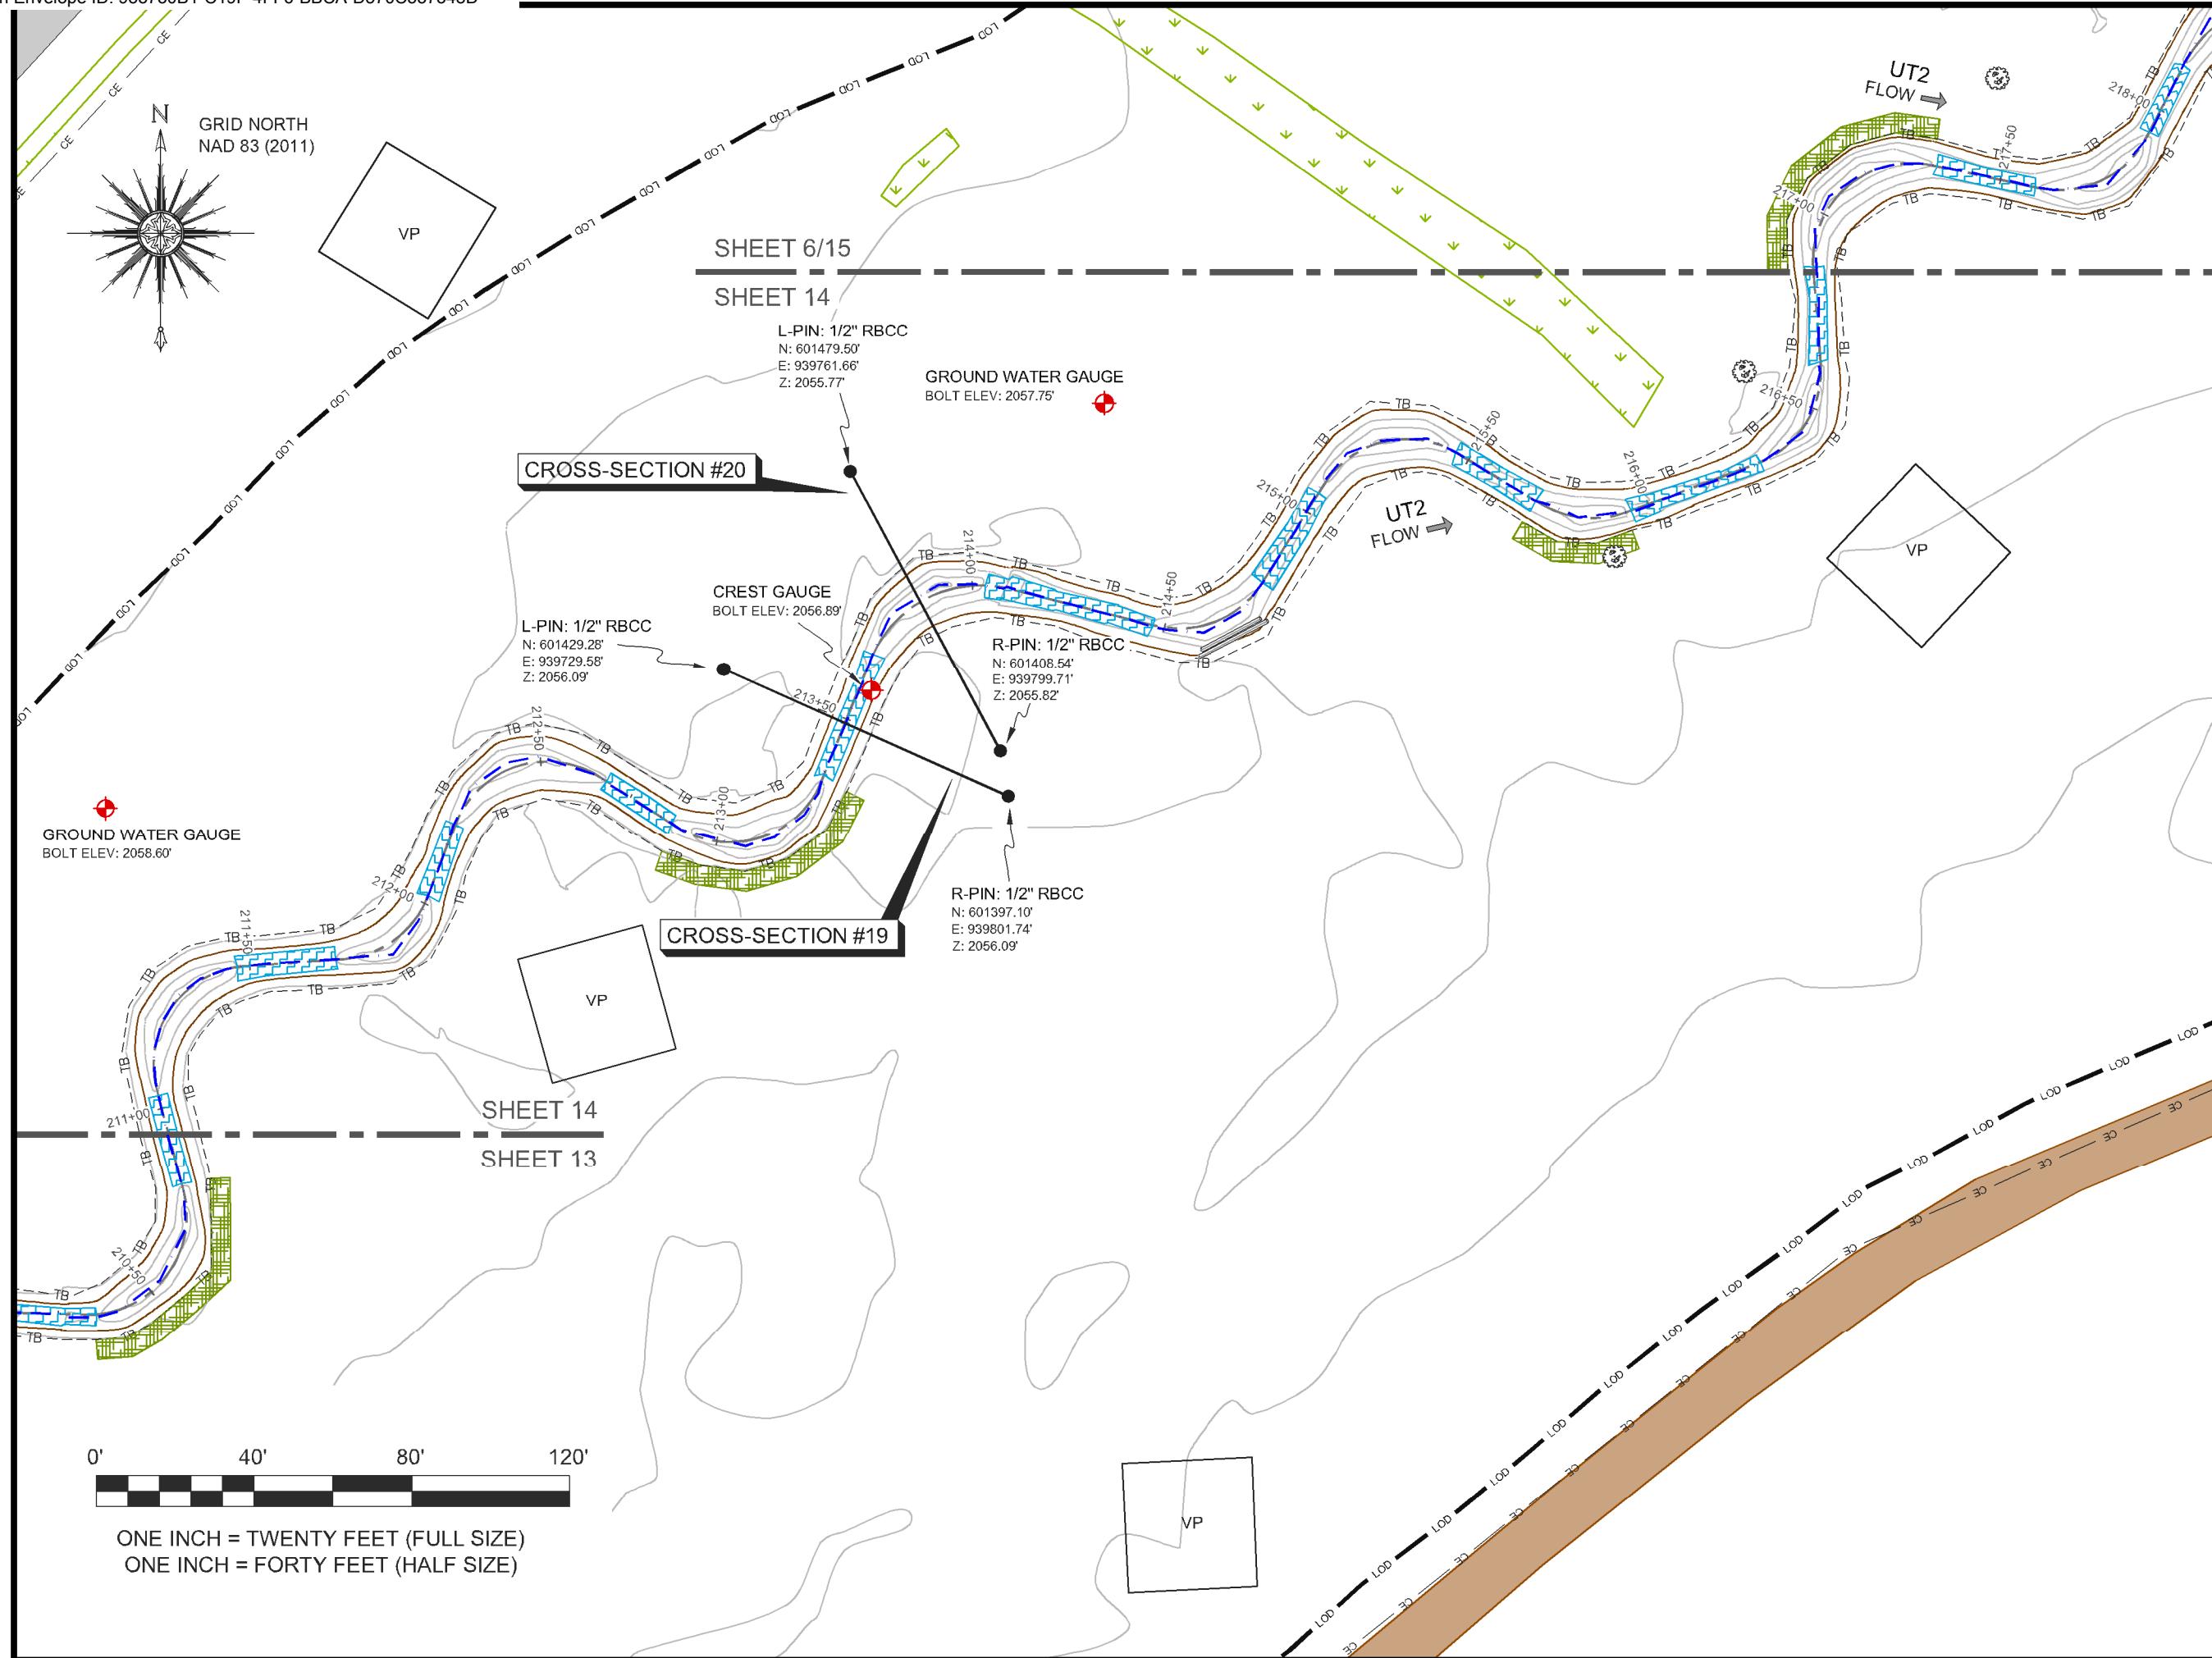

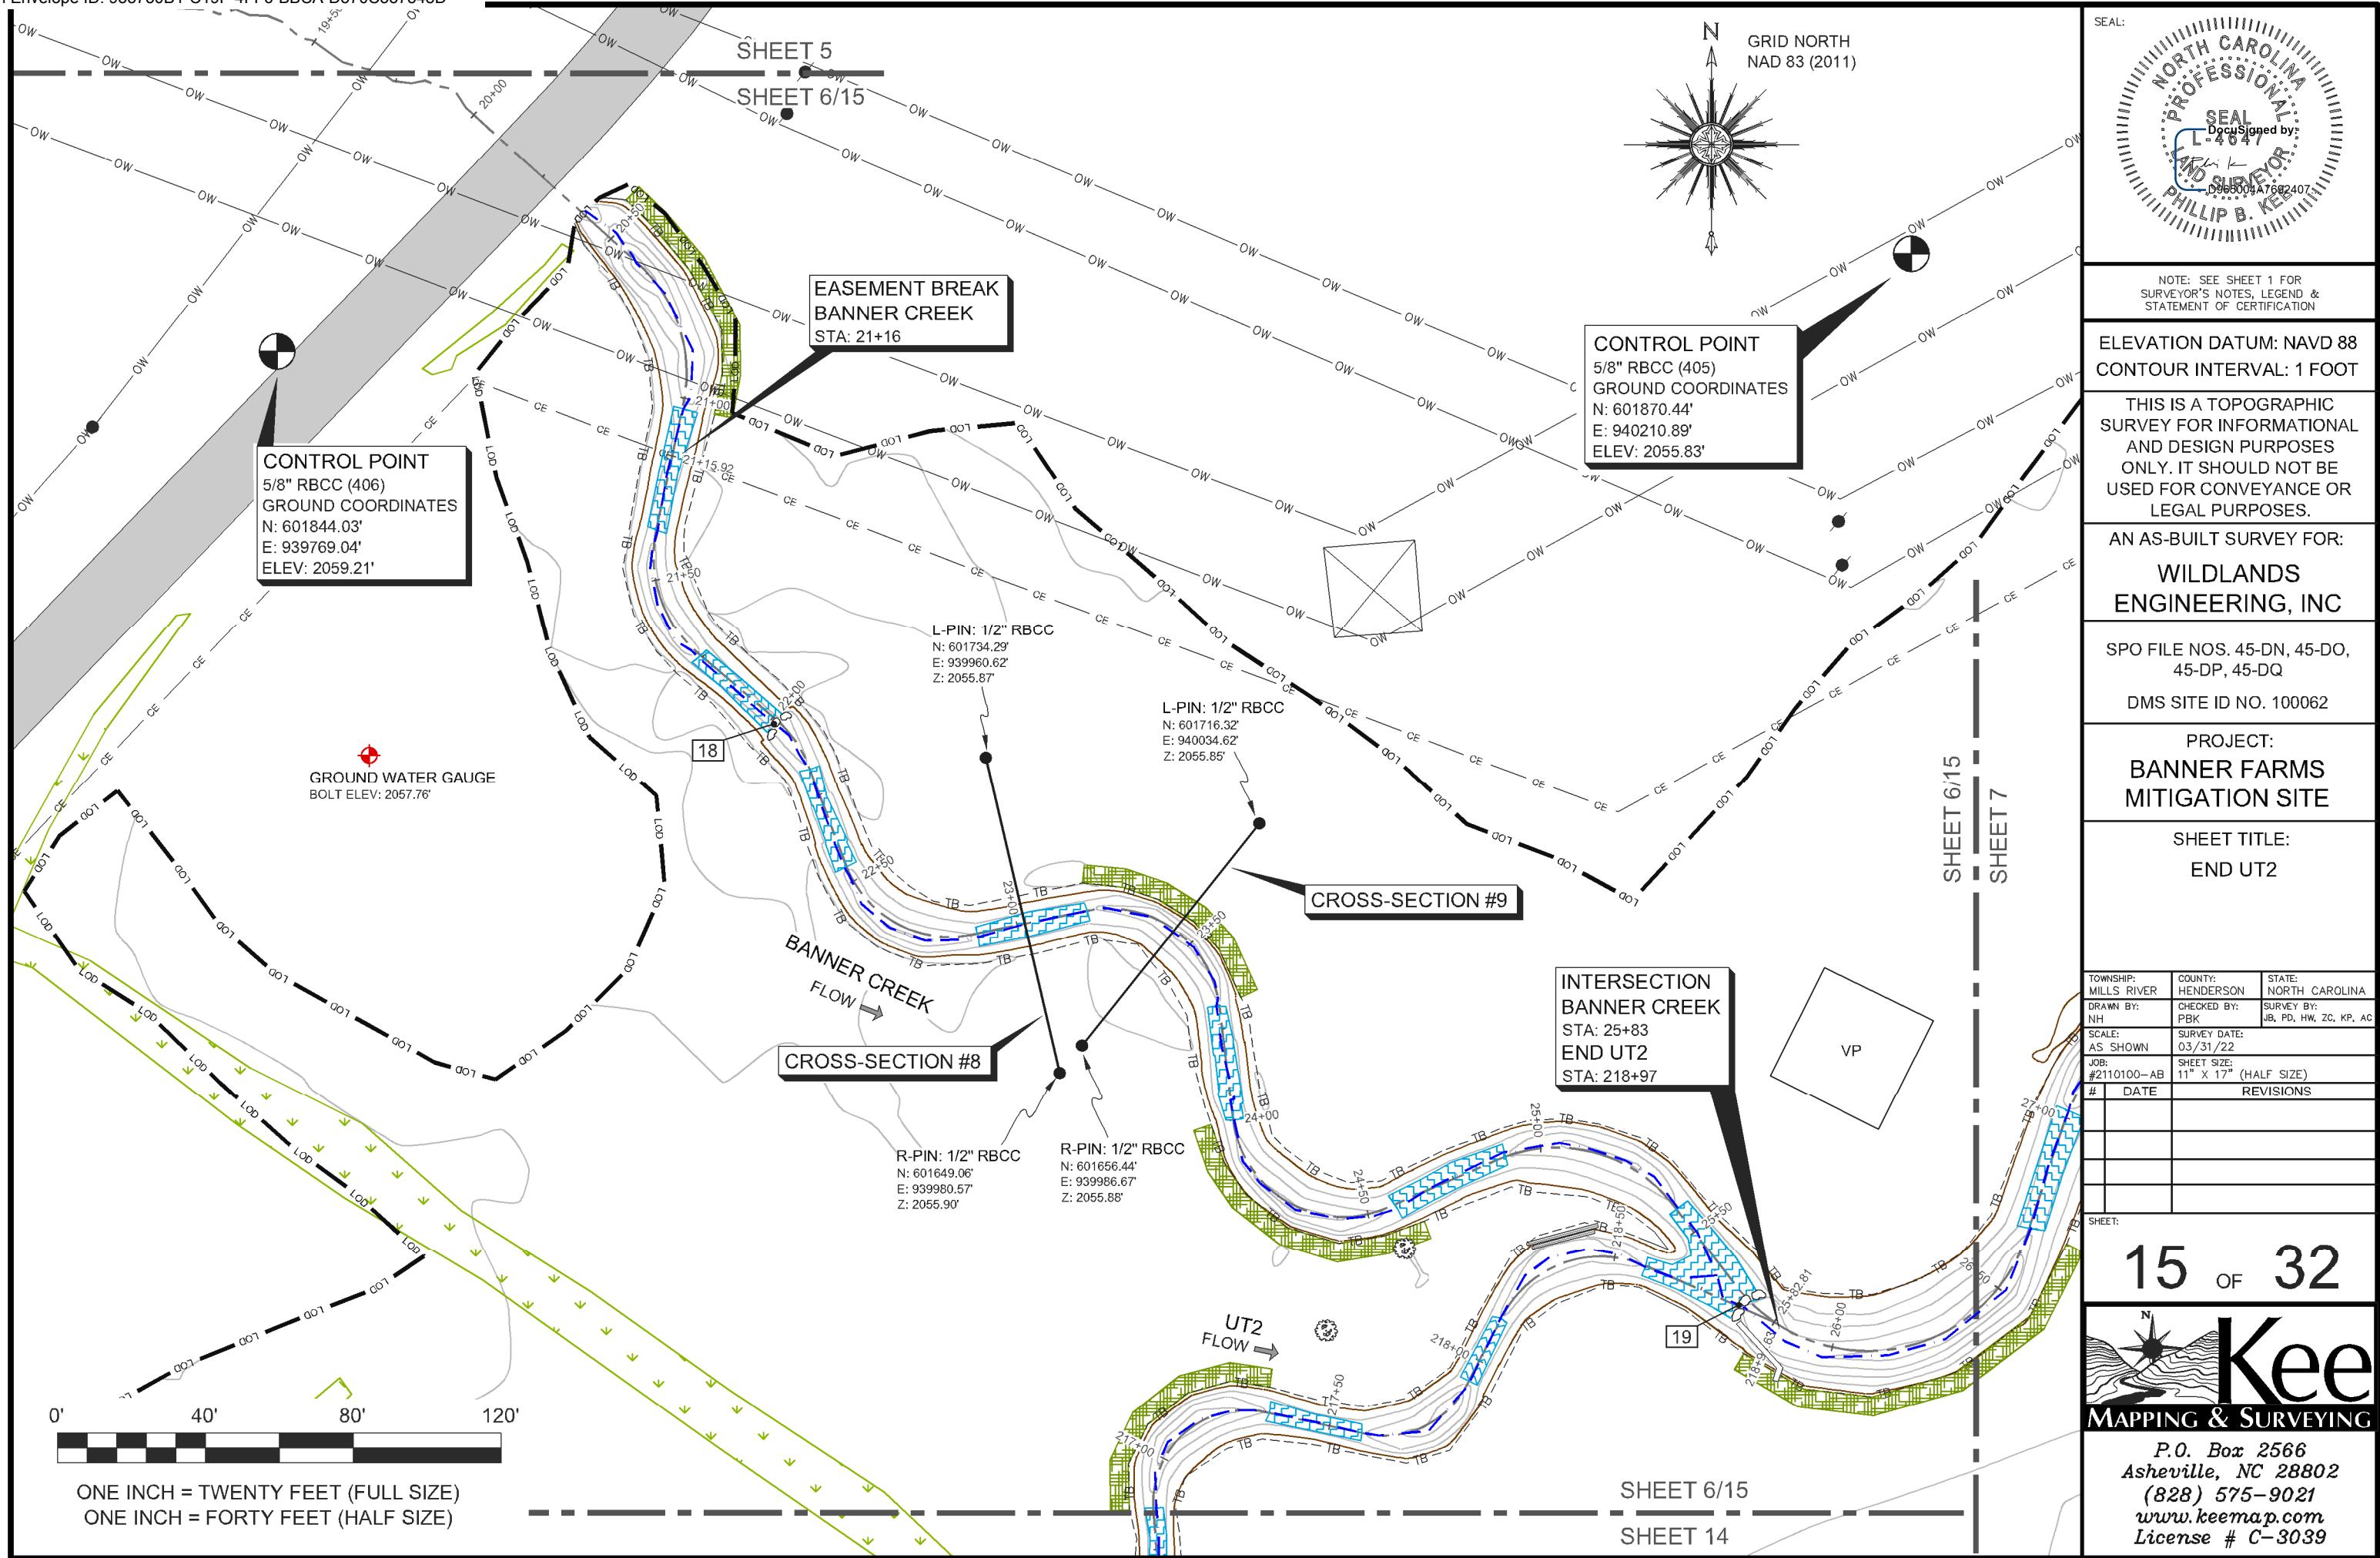

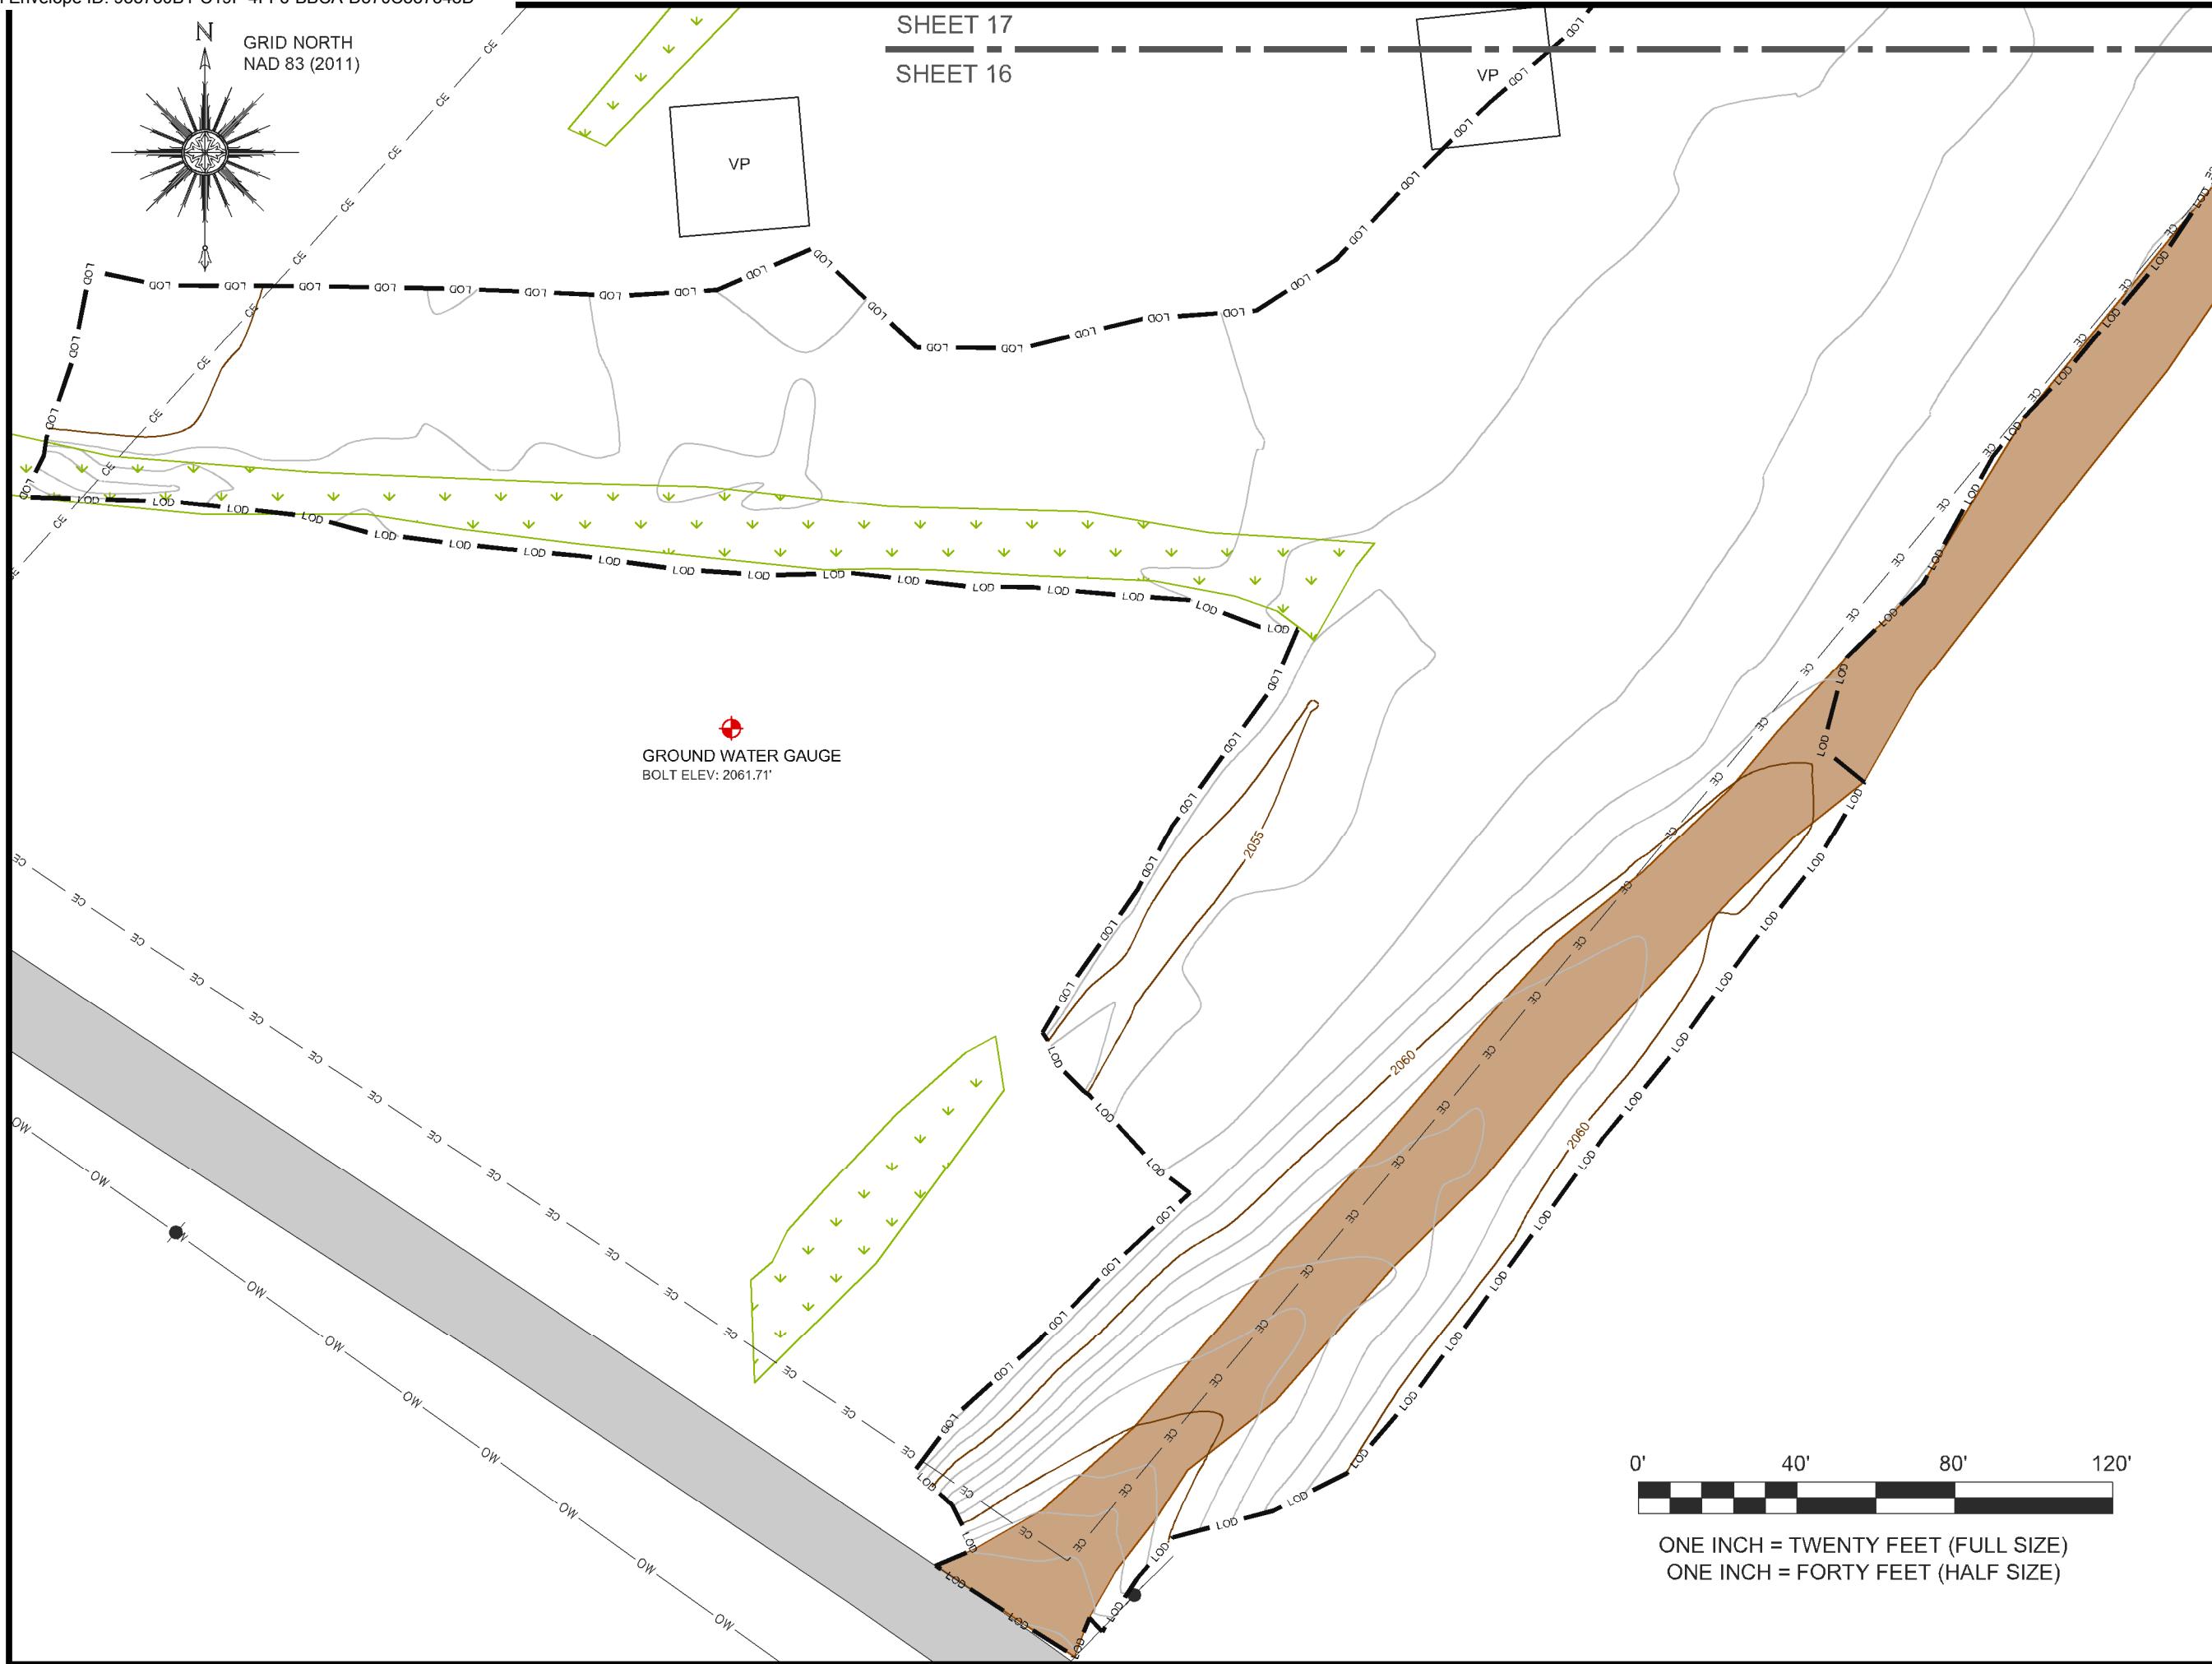

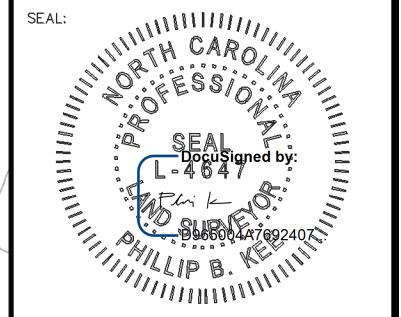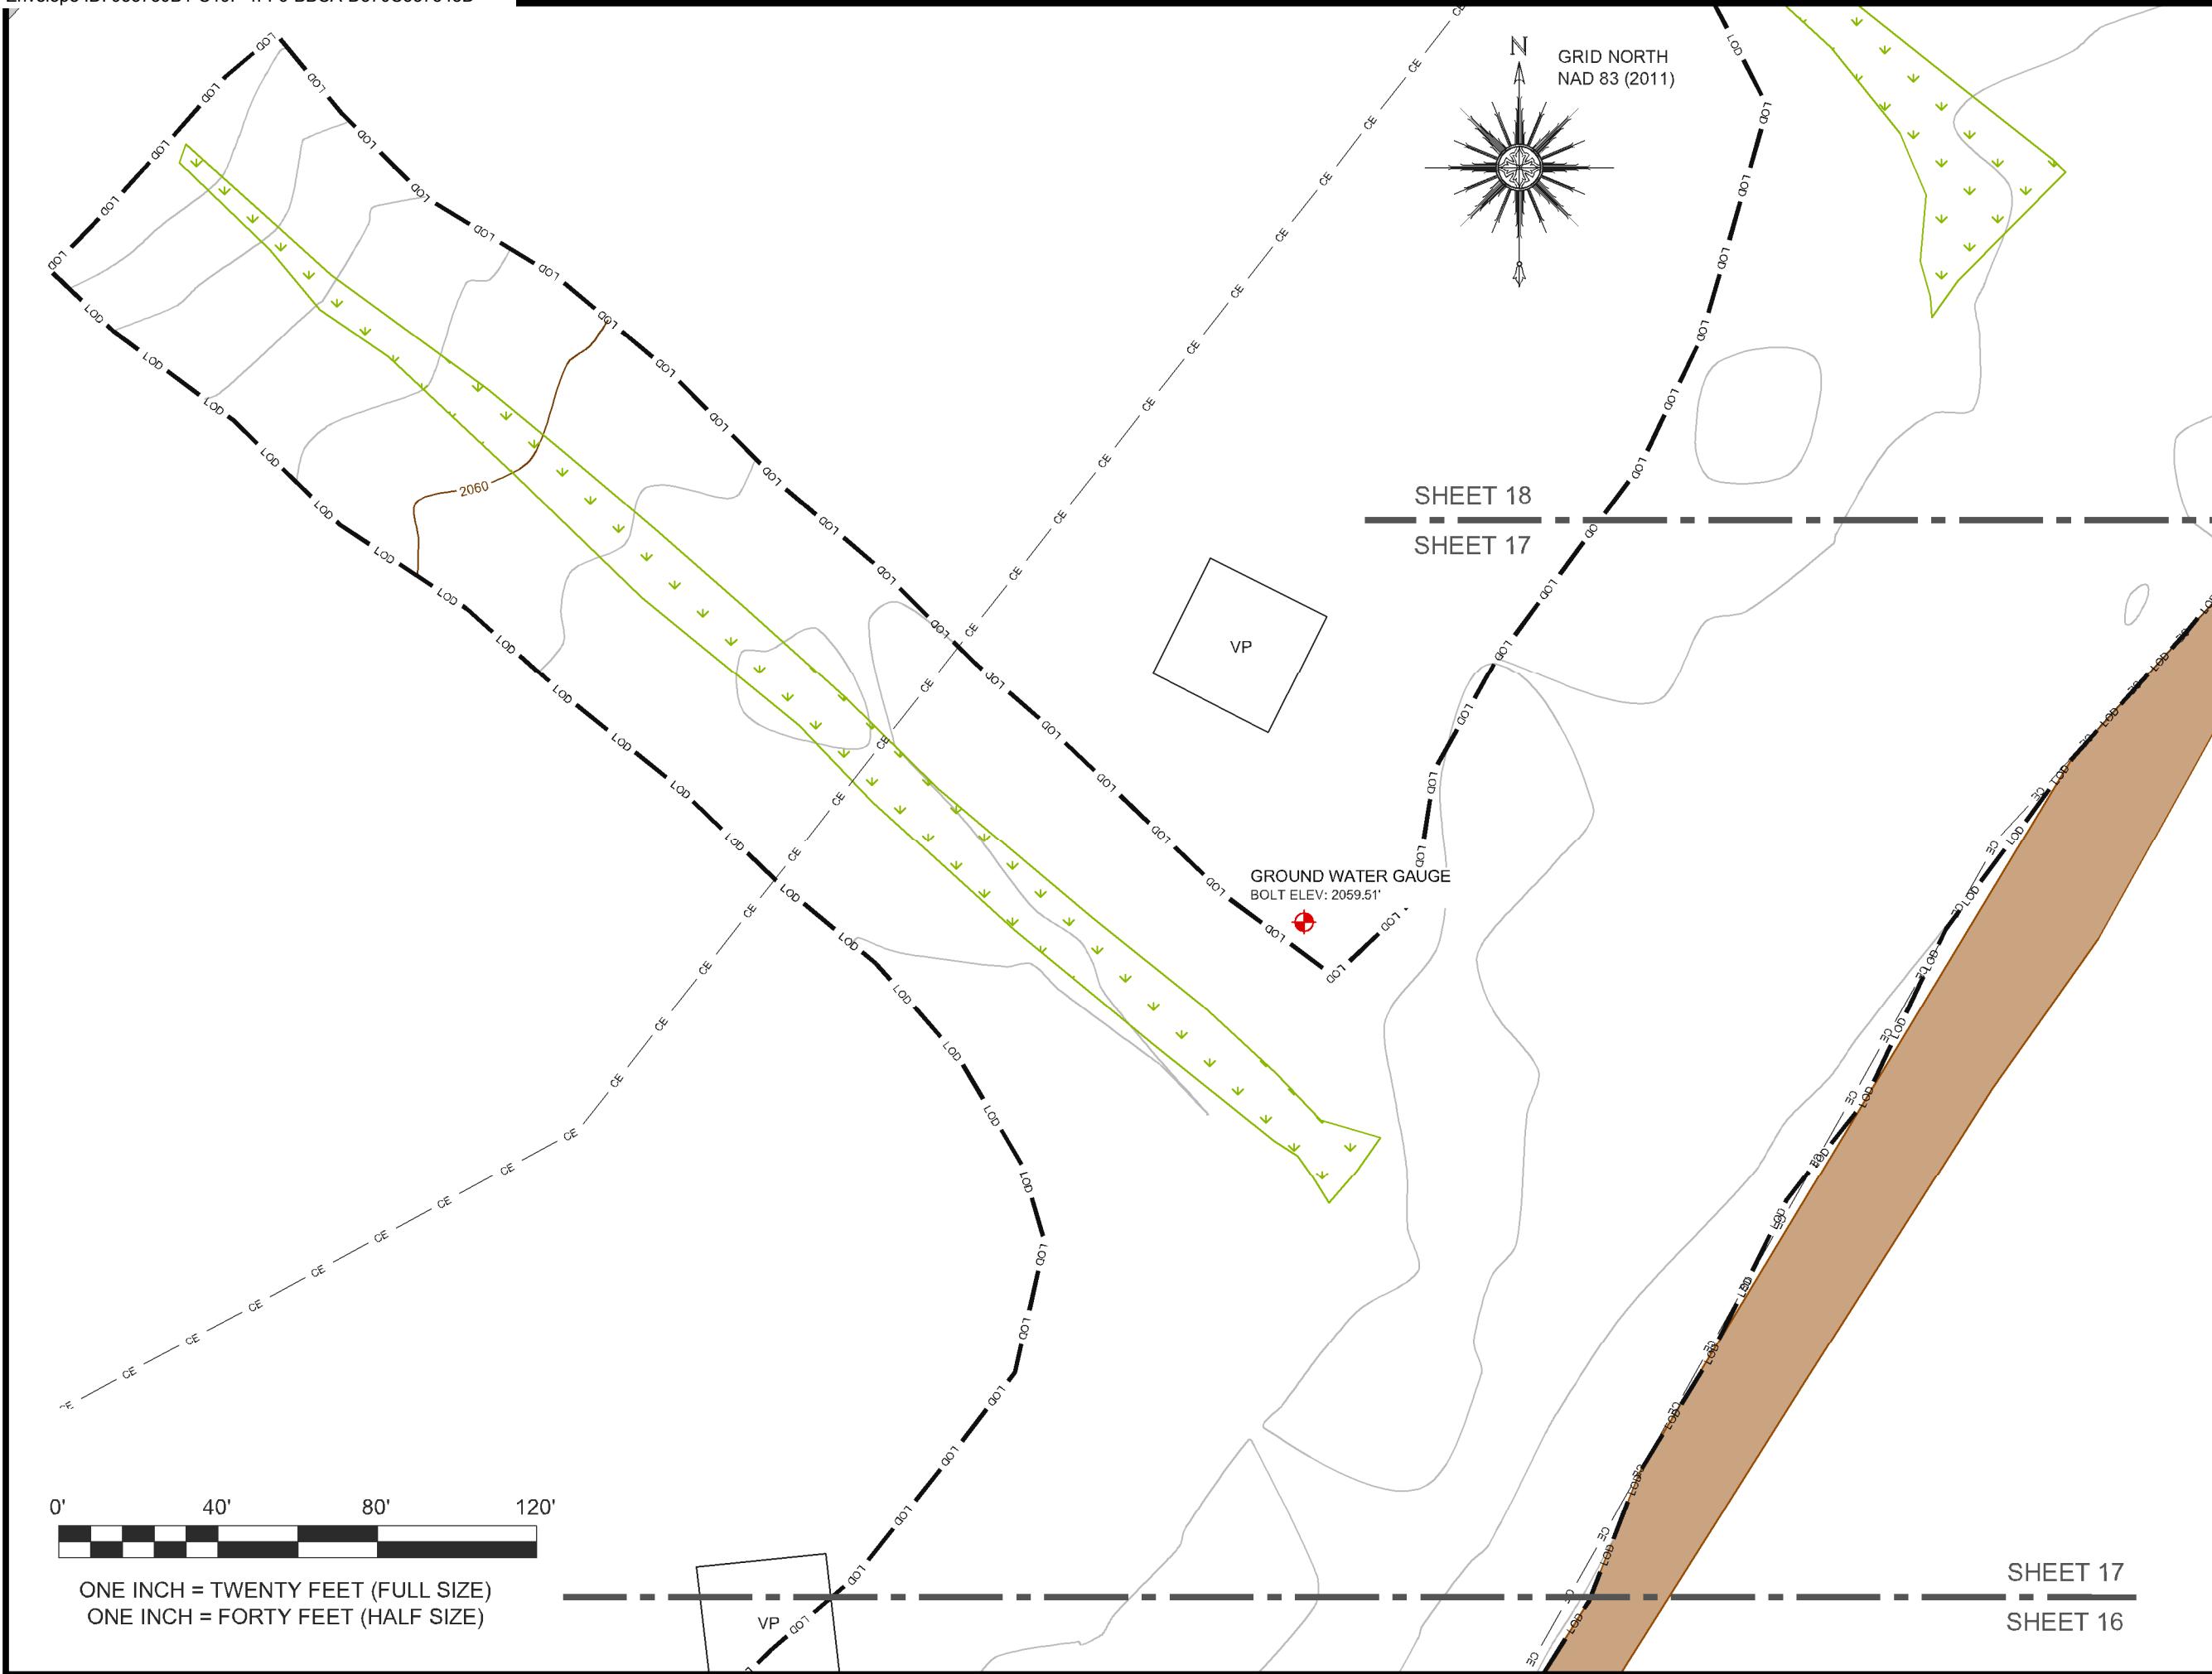

NOTE: SEE SHEET 1 FOR SURVEYOR'S NOTES, LEGEND & STATEMENT OF CERTIFICATION

ELEVATION DATUM: NAVD 88
CONTOUR INTERVAL: 1 FOOT

THIS IS A TOPOGRAPHIC SURVEY FOR INFORMATIONAL AND DESIGN PURPOSES ONLY. IT SHOULD NOT BE USED FOR CONVEYANCE OR LEGAL PURPOSES.

AN AS-BUILT SURVEY FOR:
WILDLANDS ENGINEERING, INC

SPO FILE NOS. 45-DN, 45-DO,
45-DP, 45-DQ
DMS SITE ID NO. 100062

PROJECT:
BANNER FARMS MITIGATION SITE

SHEET TITLE:
WETLAND GRADING SOUTHWEST FIELD


TOWNSHIP:	COUNTY:	STATE:
MILLS RIVER	HENDERSON	NORTH CAROLINA
DRAWN BY:	CHECKED BY:	SURVEY BY:
NH	PK	JB, PD, HW, ZC, KP, AC
SCALE:	SURVEY DATE:	
AS SHOWN	03/31/22	
JOB:	SHEET SIZE:	
#2110100-AB	11" X 17" (HALF SIZE)	
#	DATE	REVISIONS

SHEET:

17 OF 32



P.O. Box 2566
Asheville, NC 28802
(828) 575-9021
www.keemaps.com
License # C-3039

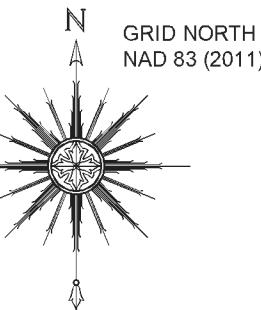GRID NORTH
NAD 83 (2011)

SHEET 19

SHEET 18

SHEET 17

SHEET 16

SHEET 15

SHEET 14

SHEET 13

SHEET 12

SHEET 11

SHEET 10

SHEET 9

SHEET 8

SHEET 7

SHEET 6


SHEET 5

SHEET 4


SHEET 3

SHEET 2

SHEET 1

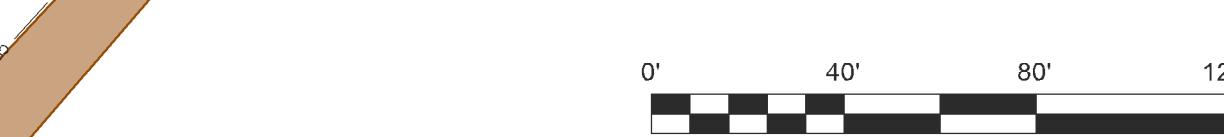

ONE INCH = TWENTY FEET (FULL SIZE)
ONE INCH = FORTY FEET (HALF SIZE)

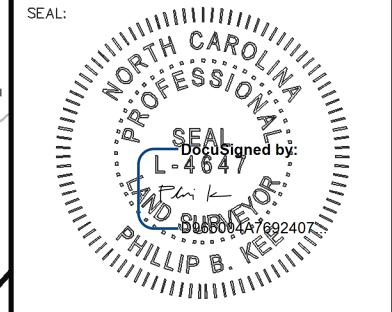NOTE: SEE SHEET 1 FOR
SURVEYOR'S NOTES, LEGEND &
STATEMENT OF CERTIFICATIONELEVATION DATUM: NAVD 88
CONTOUR INTERVAL: 1 FOOTTHIS IS A TOPOGRAPHIC
SURVEY FOR INFORMATIONAL
AND DESIGN PURPOSES
ONLY. IT SHOULD NOT BE
USED FOR CONVEYANCE OR
LEGAL PURPOSES.AN AS-BUILT SURVEY FOR:
**WILDLANDS
ENGINEERING, INC**SPO FILE NOS. 45-DN, 45-DO,
45-DP, 45-DQ
DMS SITE ID NO. 100062PROJECT:
**BANNER FARMS
MITIGATION SITE**SHEET TITLE:
**WETLAND GRADING
SOUTHWEST FIELD**


TOWNSHIP:	COUNTY:	STATE:
MILLS RIVER	HENDERSON	NORTH CAROLINA
DRAWN BY:	CHECKED BY:	SURVEY BY:
NH	PBK	JB, PD, HW, ZC, KP, AC
SCALE:	SURVEY DATE:	
AS SHOWN	03/31/22	
JOB:	SHEET SIZE:	
#2110100-AB	11" X 17" (HALF SIZE)	
#	DATE	REVISIONS

SHEET:

18 OF 32





P.O. Box 2566
Asheville, NC 28802
(828) 575-9021
www.keemap.com
License # C-3039

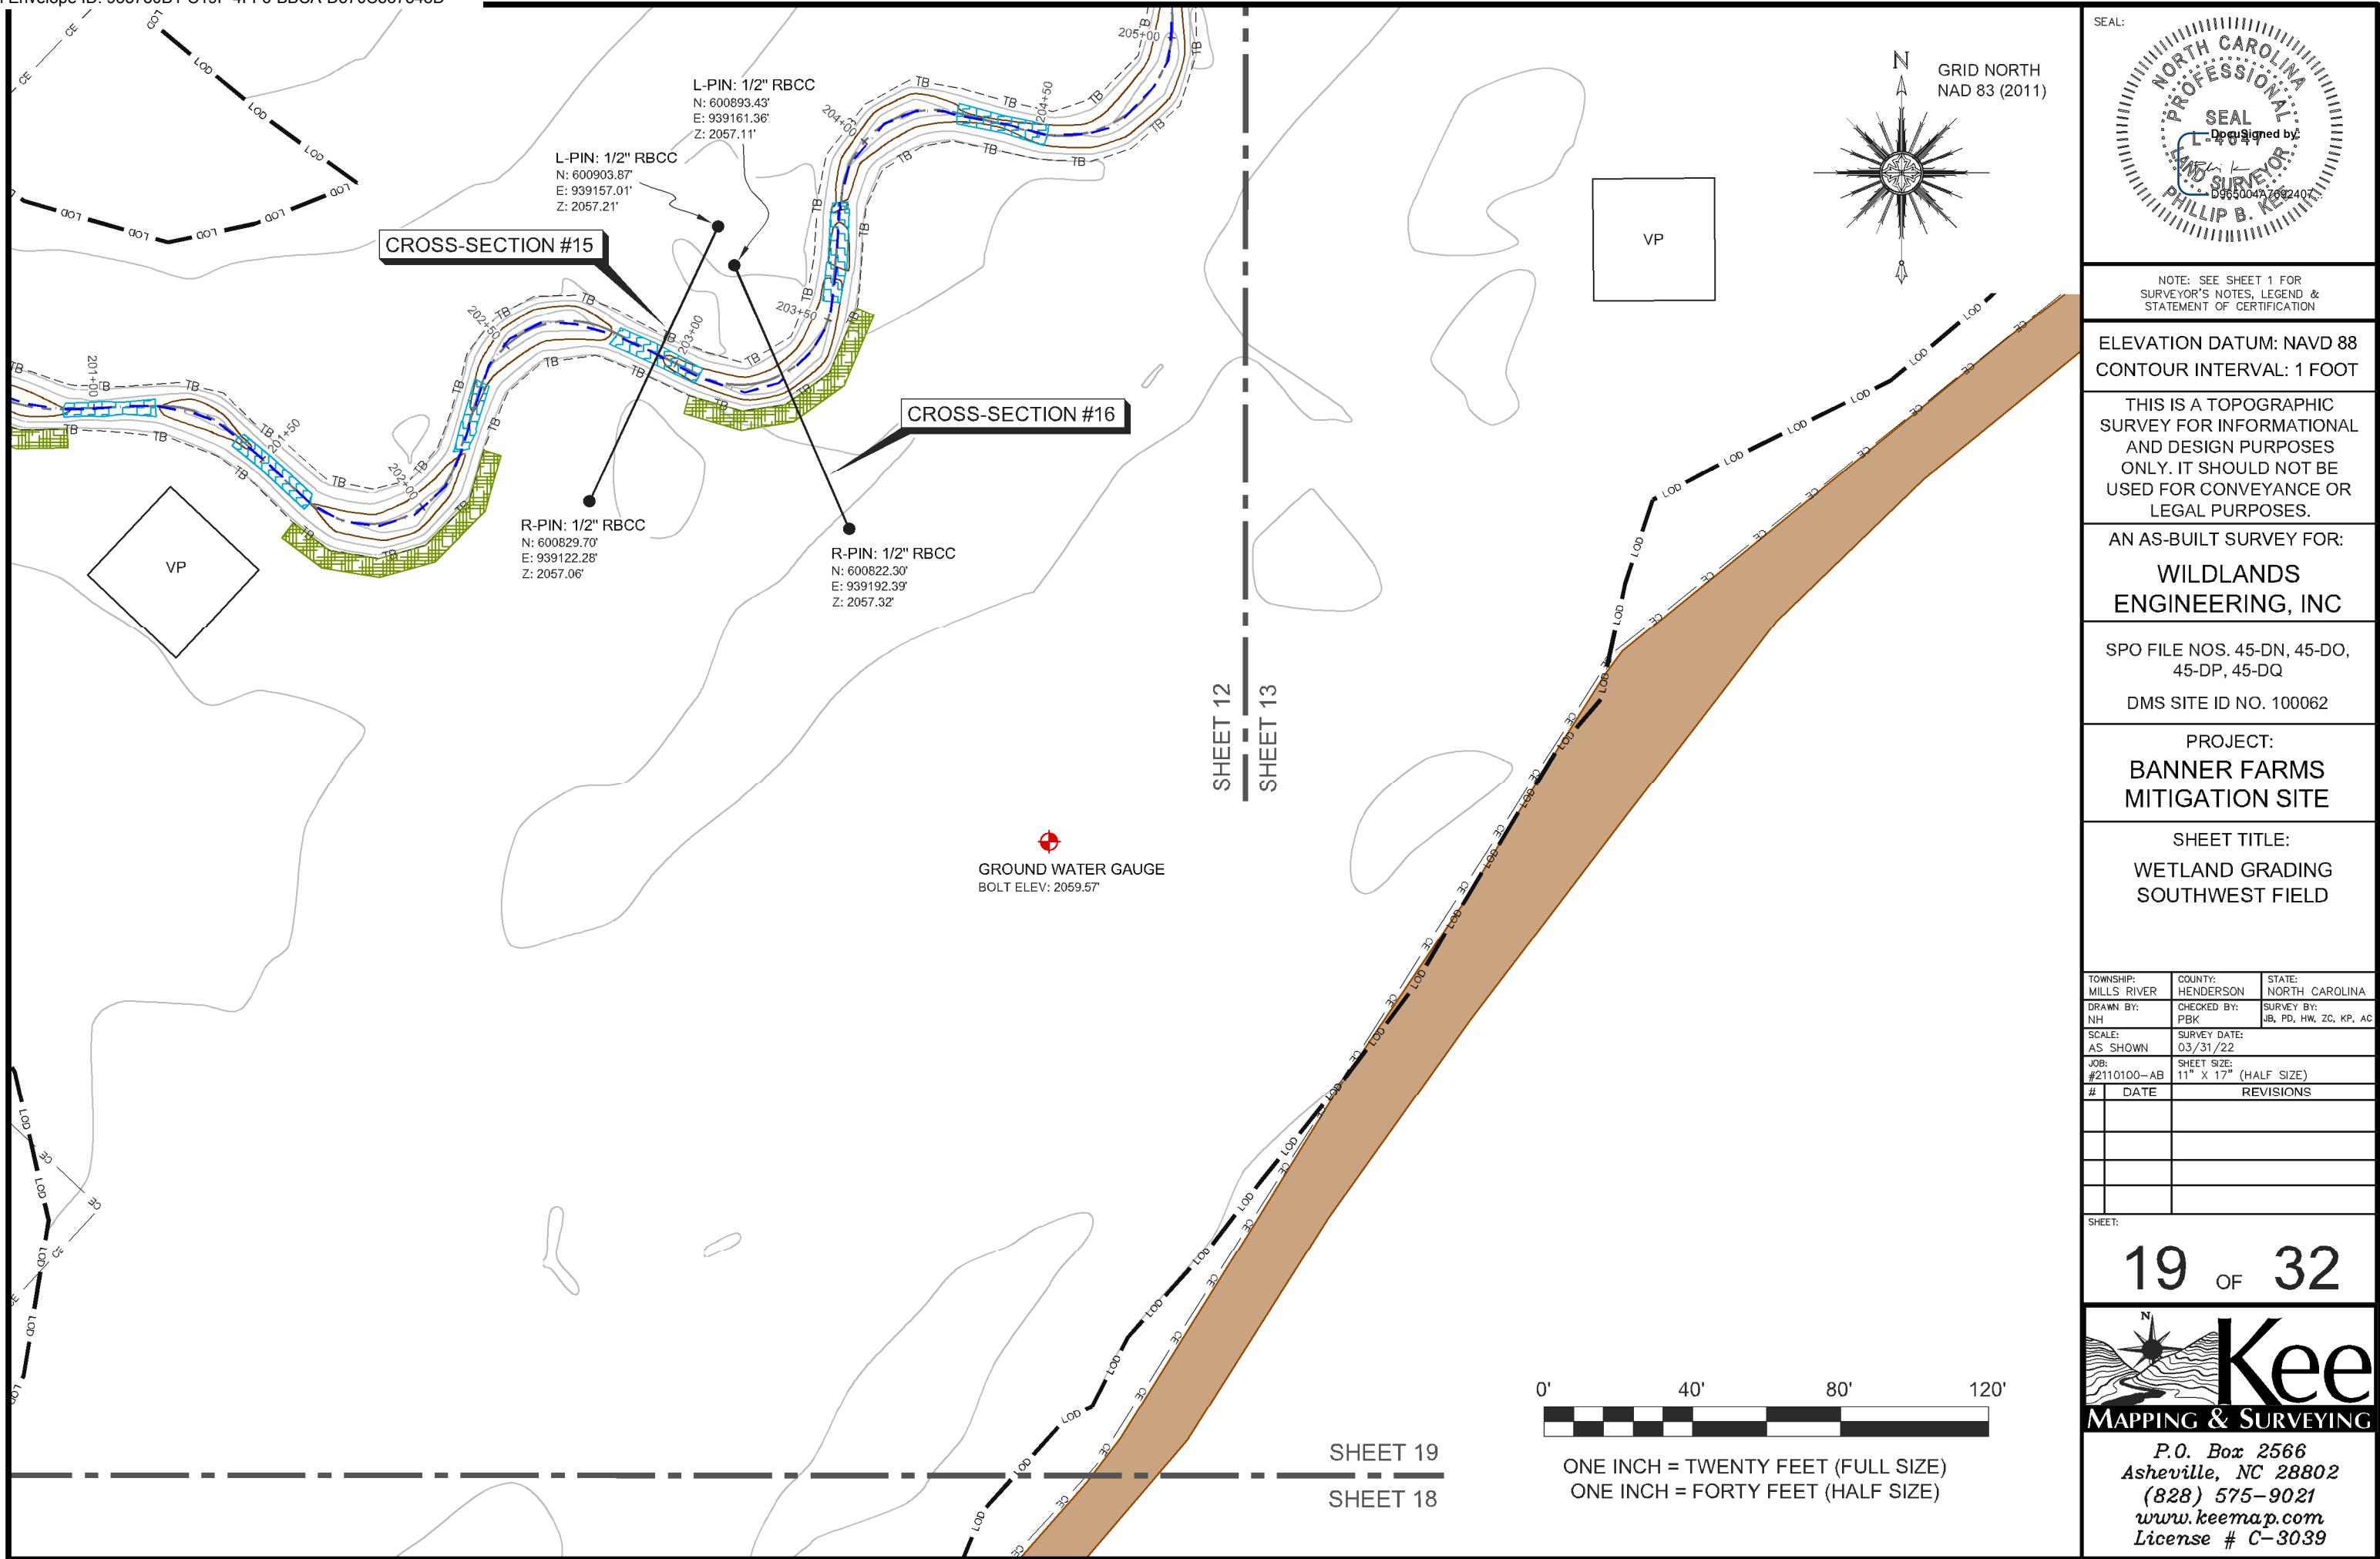

SHEET 21

SHEET 20

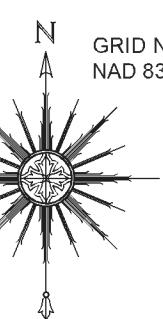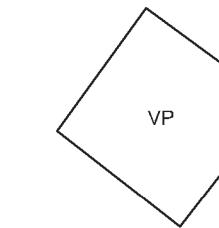
GRID NORTH
NAD 83 (2011)SHEET 9
SHEET 20

CONTROL POINT
5/8" RBCC (601)
GROUND COORDINATES
N: 602462.19'
E: 941271.97'
ELEV: 2056.45'

GROUND WATER GAUGE
BOLT ELEV: 2058.20'



ONE INCH = TWENTY FEET (FULL SIZE)
ONE INCH = FORTY FEET (HALF SIZE)

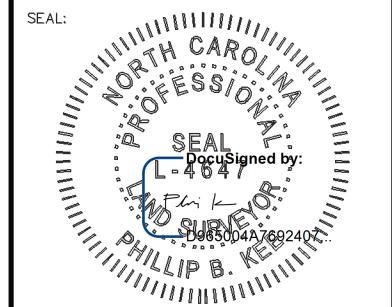

NOTE: SEE SHEET 1 FOR
SURVEYOR'S NOTES, LEGEND &
STATEMENT OF CERTIFICATION

ELEVATION DATUM: NAVD 88
CONTOUR INTERVAL: 1 FOOT

THIS IS A TOPOGRAPHIC
SURVEY FOR INFORMATIONAL
AND DESIGN PURPOSES
ONLY. IT SHOULD NOT BE
USED FOR CONVEYANCE OR
LEGAL PURPOSES.

AN AS-BUILT SURVEY FOR:
**WILDLANDS
ENGINEERING, INC**

SPO FILE NOS. 45-DN, 45-DO,
45-DP, 45-DQ
DMS SITE ID NO. 100062


PROJECT:
**BANNER FARMS
MITIGATION SITE**


SHEET TITLE:
**WETLAND GRADING
NORTHEAST FIELD**

TOWNSHIP:	COUNTY:	STATE:
MILLS RIVER	HENDERSON	NORTH CAROLINA
DRAWN BY:	CHECKED BY:	SURVEY BY:
NH	PBK	JB, PD, HW, ZC, KP, AC
SCALE:	SURVEY DATE:	
AS SHOWN	03/31/22	
JOB:	SHEET SIZE:	
#2110100-AB	11" X 17" (HALF SIZE)	
#	DATE	REVISIONS


SHEET:

20 OF 32

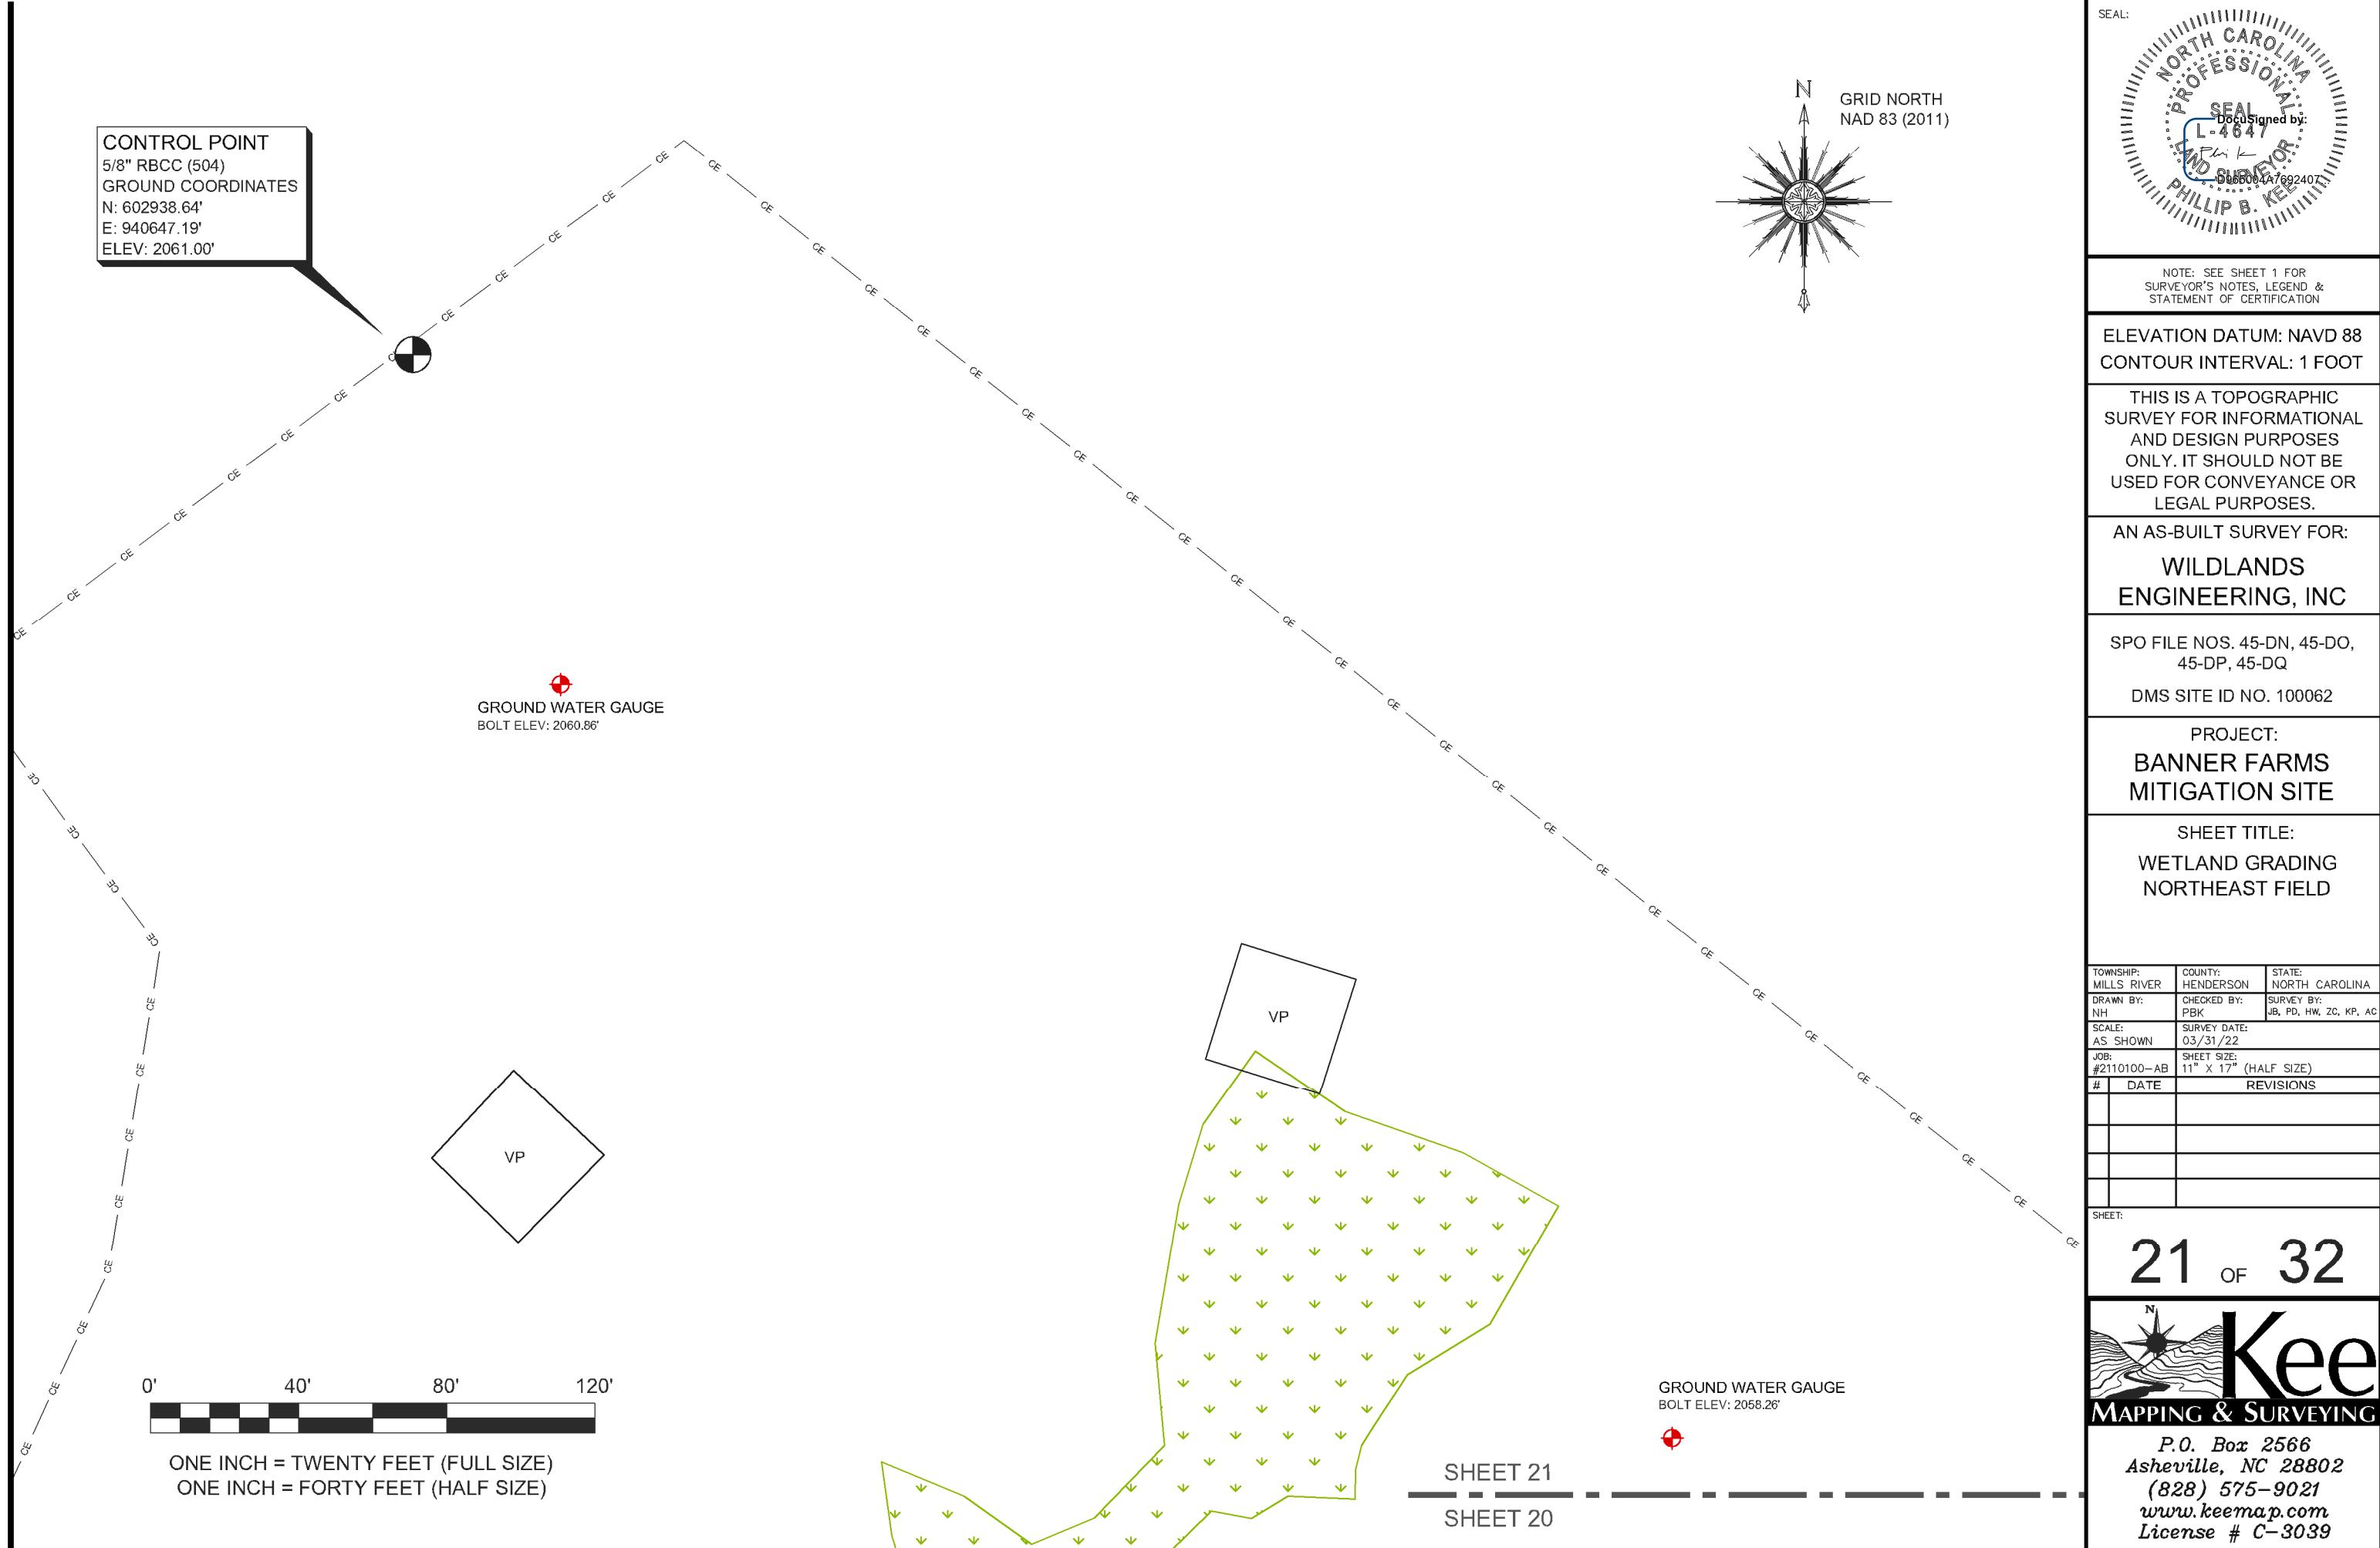


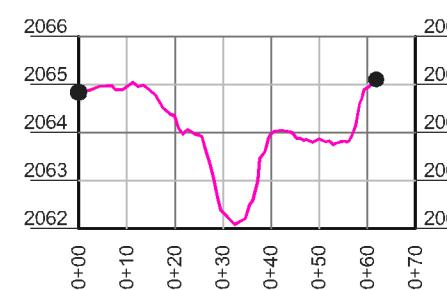


CROSS-SECTION #1 - BANNER CREEK
HORIZONTAL SCALE: 1" = 20' FULL SIZE, 1" = 40' HALF SIZE
VERTICAL SCALE: 1" = 2' FULL SIZE, 1" = 4' HALF SIZE

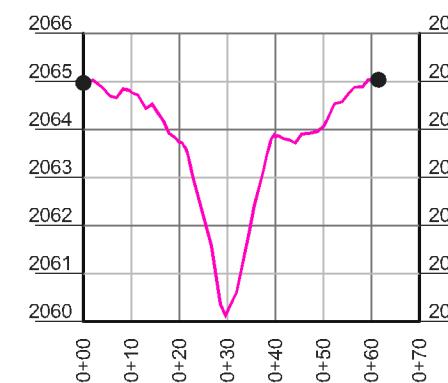


CROSS-SECTION #2 - BANNER CREEK
HORIZONTAL SCALE: 1" = 20' FULL SIZE, 1" = 40' HALF SIZE
VERTICAL SCALE: 1" = 2' FULL SIZE, 1" = 4' HALF SIZE

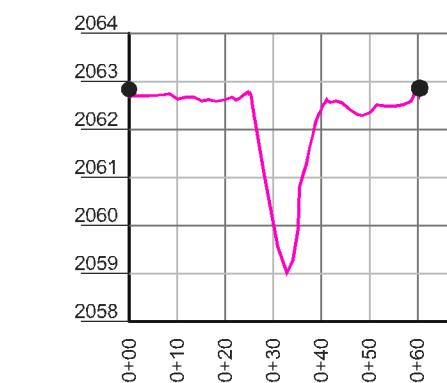


CROSS-SECTION #3 - BANNER CREEK
HORIZONTAL SCALE: 1" = 20' FULL SIZE, 1" = 40' HALF SIZE
VERTICAL SCALE: 1" = 2' FULL SIZE, 1" = 4' HALF SIZE

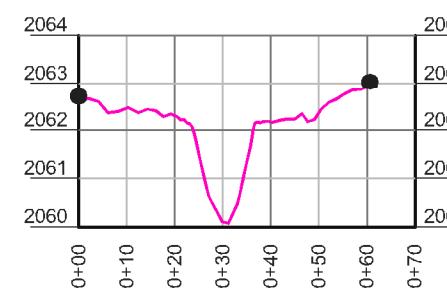


CROSS-SECTION #4 - BANNER CREEK
HORIZONTAL SCALE: 1" = 20' FULL SIZE, 1" = 40' HALF SIZE
VERTICAL SCALE: 1" = 2' FULL SIZE, 1" = 4' HALF SIZE

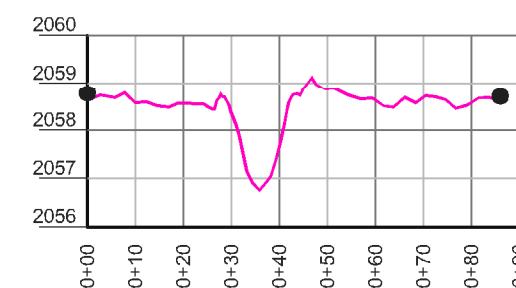


CROSS-SECTION #5 - BANNER CREEK
HORIZONTAL SCALE: 1" = 20' FULL SIZE, 1" = 40' HALF SIZE
VERTICAL SCALE: 1" = 2' FULL SIZE, 1" = 4' HALF SIZE

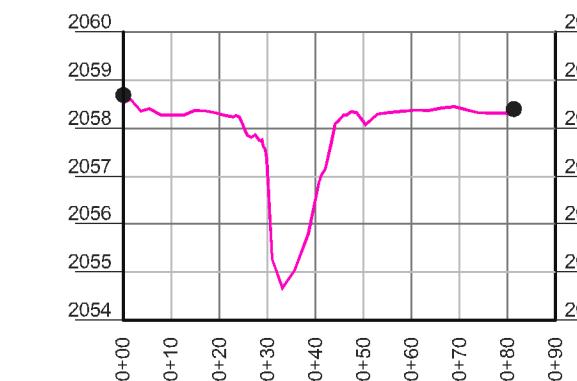


CROSS-SECTION #6 - BANNER CREEK
HORIZONTAL SCALE: 1" = 20' FULL SIZE, 1" = 40' HALF SIZE
VERTICAL SCALE: 1" = 2' FULL SIZE, 1" = 4' HALF SIZE

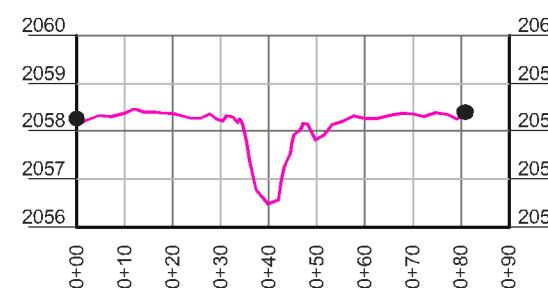

CROSS-SECTION #7 - BANNER CREEK
HORIZONTAL SCALE: 1" = 20' FULL SIZE, 1" = 40' HALF SIZE
VERTICAL SCALE: 1" = 2' FULL SIZE, 1" = 4' HALF SIZE

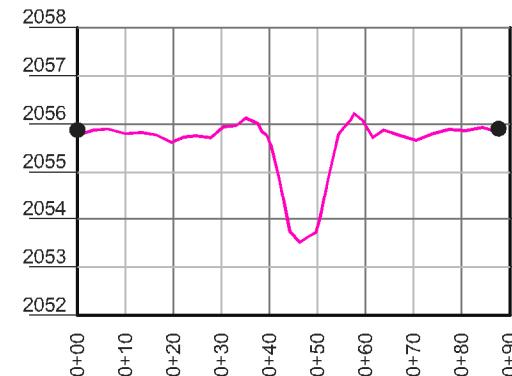


CROSS-SECTION #8 - BANNER CREEK
HORIZONTAL SCALE: 1" = 20' FULL SIZE, 1" = 40' HALF SIZE
VERTICAL SCALE: 1" = 2' FULL SIZE, 1" = 4' HALF SIZE

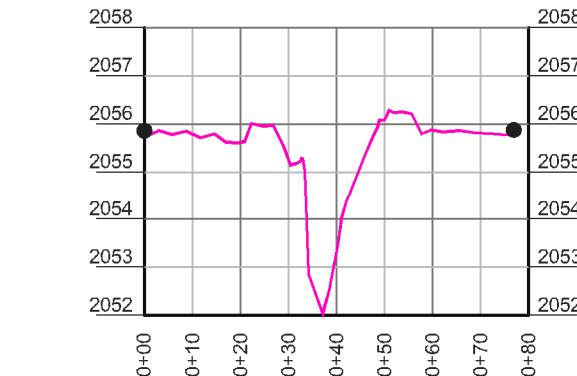

CROSS-SECTION #9 - BANNER CREEK
HORIZONTAL SCALE: 1" = 20' FULL SIZE, 1" = 40' HALF SIZE
VERTICAL SCALE: 1" = 2' FULL SIZE, 1" = 4' HALF SIZE

LEGEND

- CROSS-SECTION REBAR

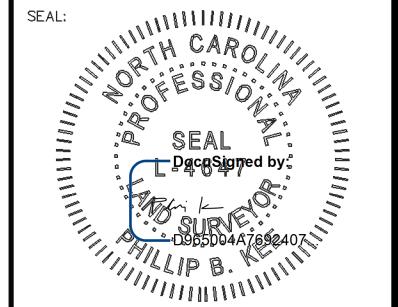

NOTE: SEE SHEET 1 FOR SURVEYOR'S NOTES, LEGEND & STATEMENT OF CERTIFICATION

ELEVATION DATUM: NAVD 88
CONTOUR INTERVAL: 1 FOOT

THIS IS A TOPOGRAPHIC SURVEY FOR INFORMATIONAL AND DESIGN PURPOSES ONLY. IT SHOULD NOT BE USED FOR CONVEYANCE OR LEGAL PURPOSES.

AN AS-BUILT SURVEY FOR:

WILDLANDS ENGINEERING, INC

SPO FILE NOS. 45-DN, 45-DO,
45-DP, 45-DQ
DMS SITE ID NO. 100062

PROJECT:
BANNER FARMS MITIGATION SITE

SHEET TITLE:
CROSS-SECTIONS # 1-9



TOWNSHIP:	MILLS RIVER	COUNTY:	HENDERSON	STATE:	NORTH CAROLINA
DRAWN BY:		CHECKED BY:	PK	SURVEY BY:	JB, PD, HW, ZC, KP, AC
SCALE:	AS SHOWN	SURVEY DATE:	03/31/22		
JOB:	#2110100-AB	SHEET SIZE:	11" X 17" (HALF SIZE)		
#		DATE		REVISIONS	

SHEET:


22 OF 32



P.O. Box 2566
Asheville, NC 28802
(828) 575-9021
www.keemap.com
License # C-3039

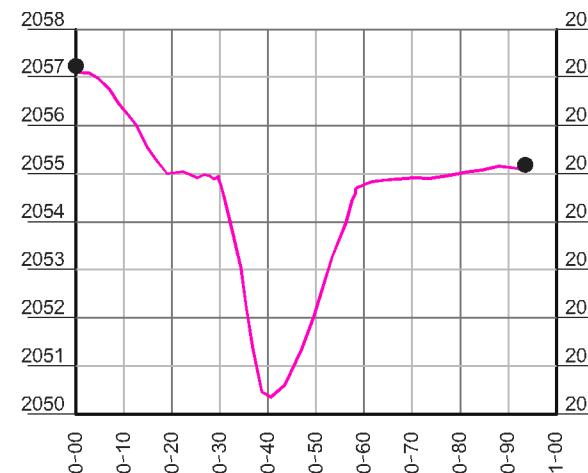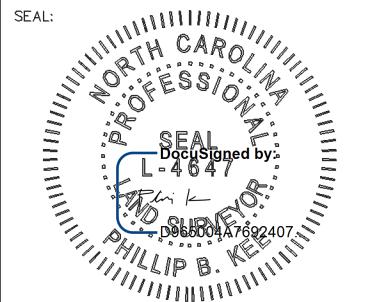CROSS-SECTION #10 -BANNER CREEK


HORIZONTAL SCALE: 1" = 20' FULL SIZE, 1" = 40' HALF SIZE
VERTICAL SCALE: 1" = 2' FULL SIZE, 1" = 4' HALF SIZE

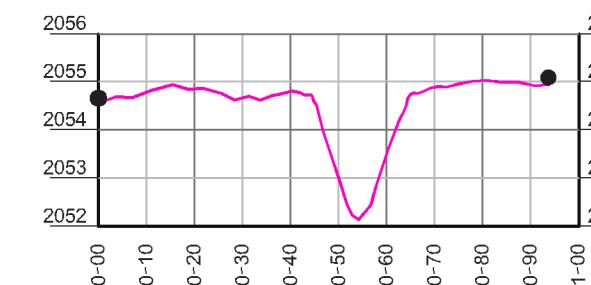CROSS-SECTION #11 -BANNER CREEK


HORIZONTAL SCALE: 1" = 20' FULL SIZE, 1" = 40' HALF SIZE
VERTICAL SCALE: 1" = 2' FULL SIZE, 1" = 4' HALF SIZE

CROSS-SECTION #12 -BANNER CREEK

HORIZONTAL SCALE: 1" = 20' FULL SIZE, 1" = 40' HALF SIZE
VERTICAL SCALE: 1" = 2' FULL SIZE, 1" = 4' HALF SIZE

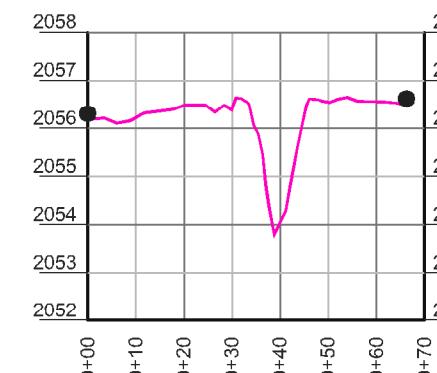CROSS-SECTION #13 -UT1

HORIZONTAL SCALE: 1" = 20' FULL SIZE, 1" = 40' HALF SIZE
VERTICAL SCALE: 1" = 2' FULL SIZE, 1" = 4' HALF SIZE

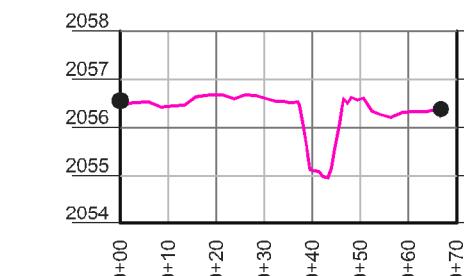CROSS-SECTION #14 -UT1

HORIZONTAL SCALE: 1" = 20' FULL SIZE, 1" = 40' HALF SIZE
VERTICAL SCALE: 1" = 2' FULL SIZE, 1" = 4' HALF SIZE

LEGEND

● CROSS-SECTION REBAR

NOTE: SEE SHEET 1 FOR SURVEYOR'S NOTES, LEGEND & STATEMENT OF CERTIFICATION

ELEVATION DATUM: NAVD 88
CONTOUR INTERVAL: 1 FOOT

THIS IS A TOPOGRAPHIC SURVEY FOR INFORMATIONAL AND DESIGN PURPOSES ONLY. IT SHOULD NOT BE USED FOR CONVEYANCE OR LEGAL PURPOSES.

AN AS-BUILT SURVEY FOR:
WILDLANDS ENGINEERING, INC

SPO FILE NOS. 45-DN, 45-DO,
45-DP, 45-DQ

DMS SITE ID NO. 100062

PROJECT:
BANNER FARMS MITIGATION SITE

SHEET TITLE:
**CROSS-SECTIONS #
10-14**







TOWNSHIP:	COUNTY:	STATE:
MILLS RIVER	HENDERSON	NORTH CAROLINA
DRAWN BY:	CHECKED BY:	SURVEY BY:
NH	PK	JB, PD, HW, ZC, KP, AC
SCALE:	SURVEY DATE:	
AS SHOWN	03/31/22	
JOB:	SHEET SIZE:	
#2110100-AB	11" X 17" (HALF SIZE)	
#	DATE	REVISIONS

SHEET:

23 OF 32



P.O. Box 2566
Asheville, NC 28802
(828) 575-9021
www.keemap.com
License # C-3039

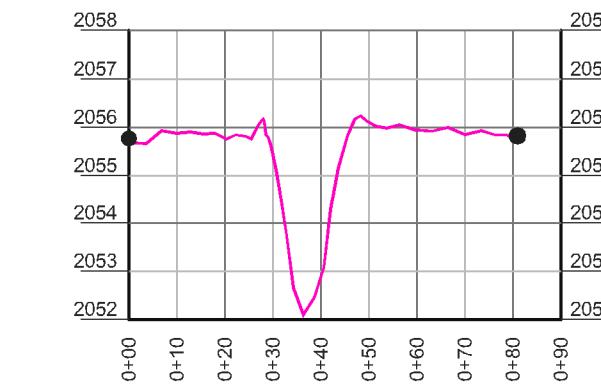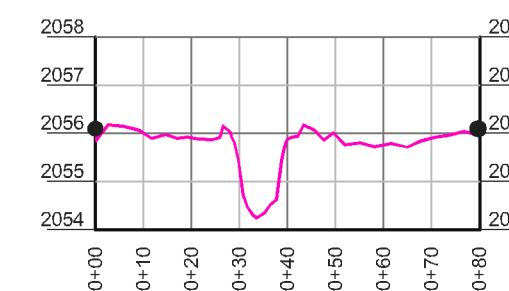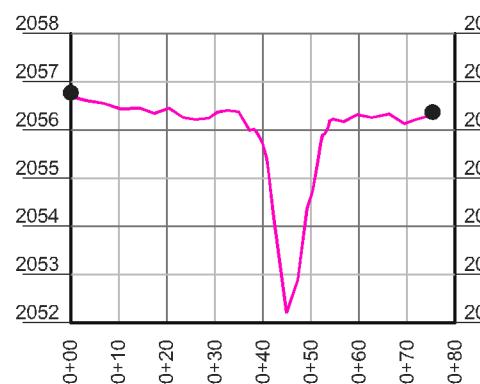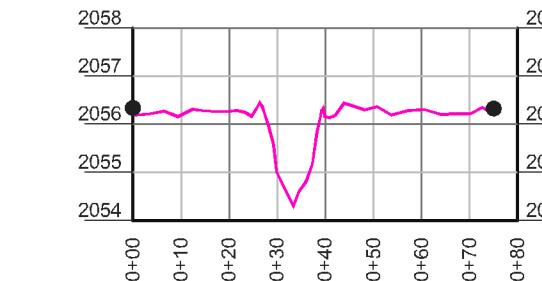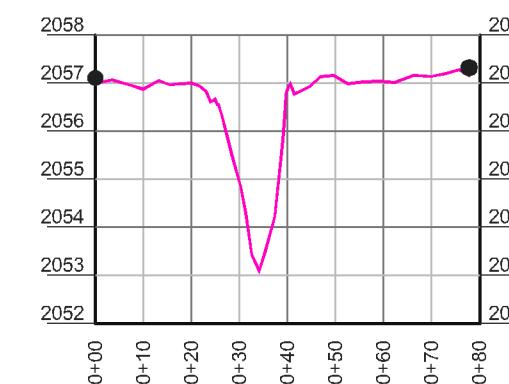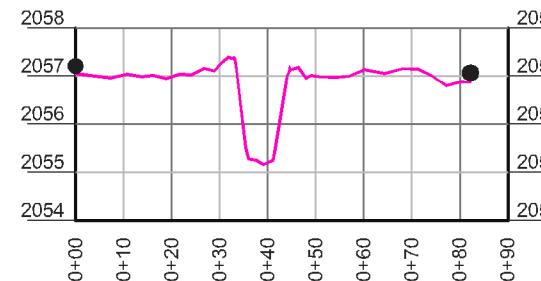

LEGEND

- CROSS-SECTION REBAR

SEAL:
Searched by:
L-4647
0965004A7692407
Signed by:
PHILLIP B. KEE

NOTE: SEE SHEET 1 FOR SURVEYOR'S NOTES, LEGEND & STATEMENT OF CERTIFICATION

ELEVATION DATUM: NAVD 88
CONTOUR INTERVAL: 1 FOOT

THIS IS A TOPOGRAPHIC SURVEY FOR INFORMATIONAL AND DESIGN PURPOSES ONLY. IT SHOULD NOT BE USED FOR CONVEYANCE OR LEGAL PURPOSES.

AN AS-BUILT SURVEY FOR:
WILDLANDS ENGINEERING, INC

SPO FILE NOS. 45-DN, 45-DO,
45-DP, 45-DQ

DMS SITE ID NO. 100062




PROJECT:
BANNER FARMS MITIGATION SITE

SHEET TITLE:
CROSS-SECTIONS # 15-20

TOWNSHIP: MILLS RIVER	COUNTY: HENDERSON	STATE: NORTH CAROLINA
DRAWN BY: NH	CHECKED BY: PBK	SURVEY BY: JB, PD, HW, ZC, KP, AC
SCALE: AS SHOWN	SURVEY DATE: 03/31/22	
JOB: #2110100-AB	SHEET SIZE: 11" X 17" (HALF SIZE)	
#	DATE	REVISIONS

SHEET:


24 OF 32

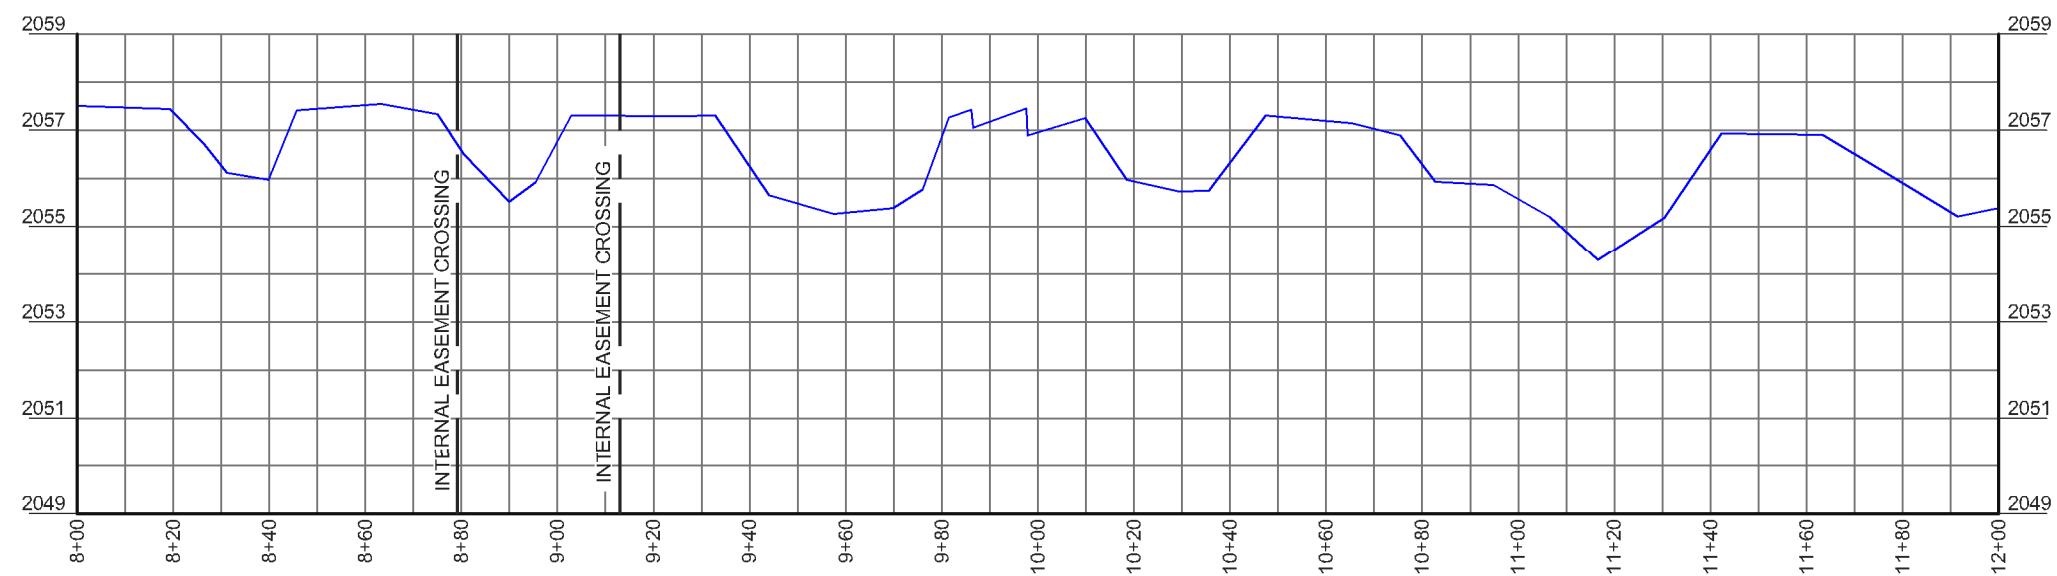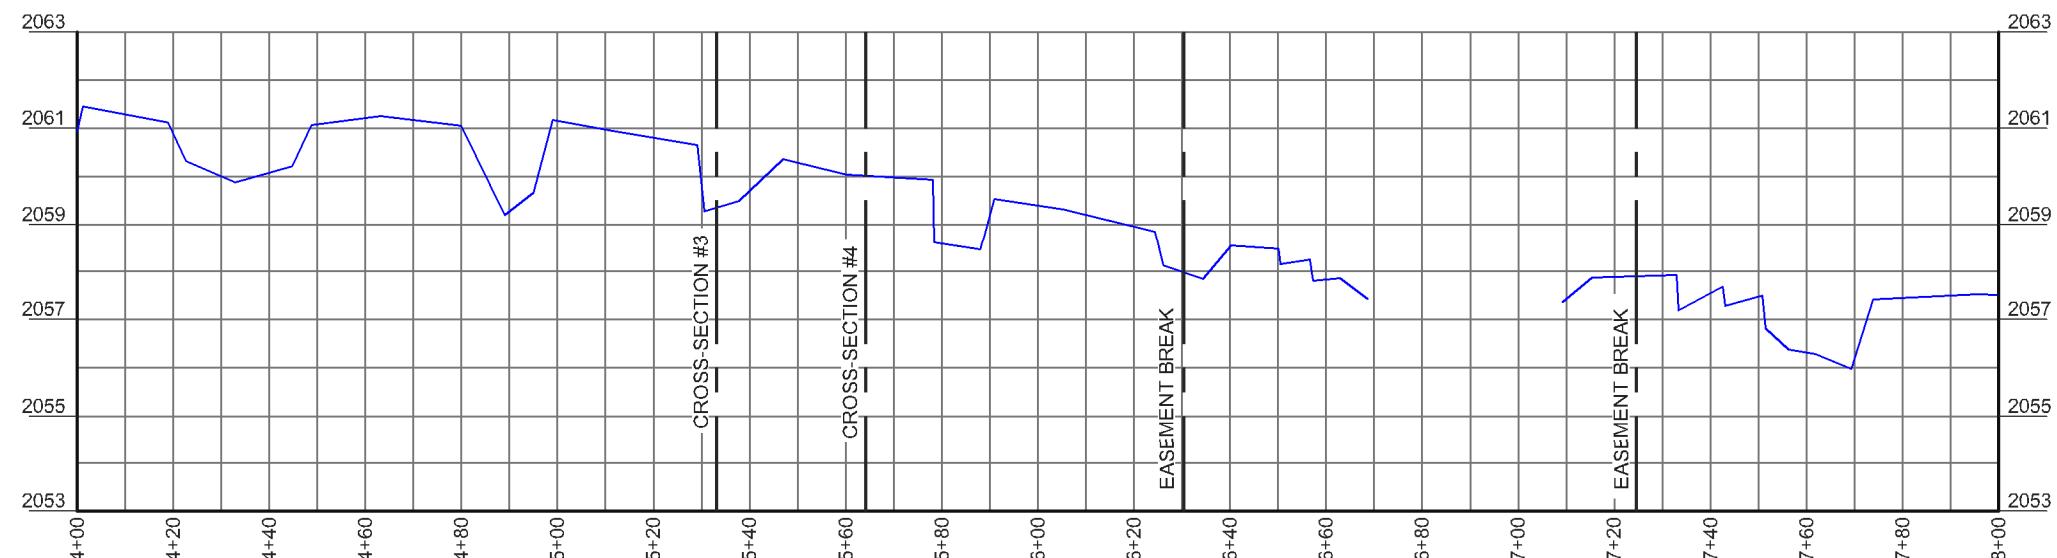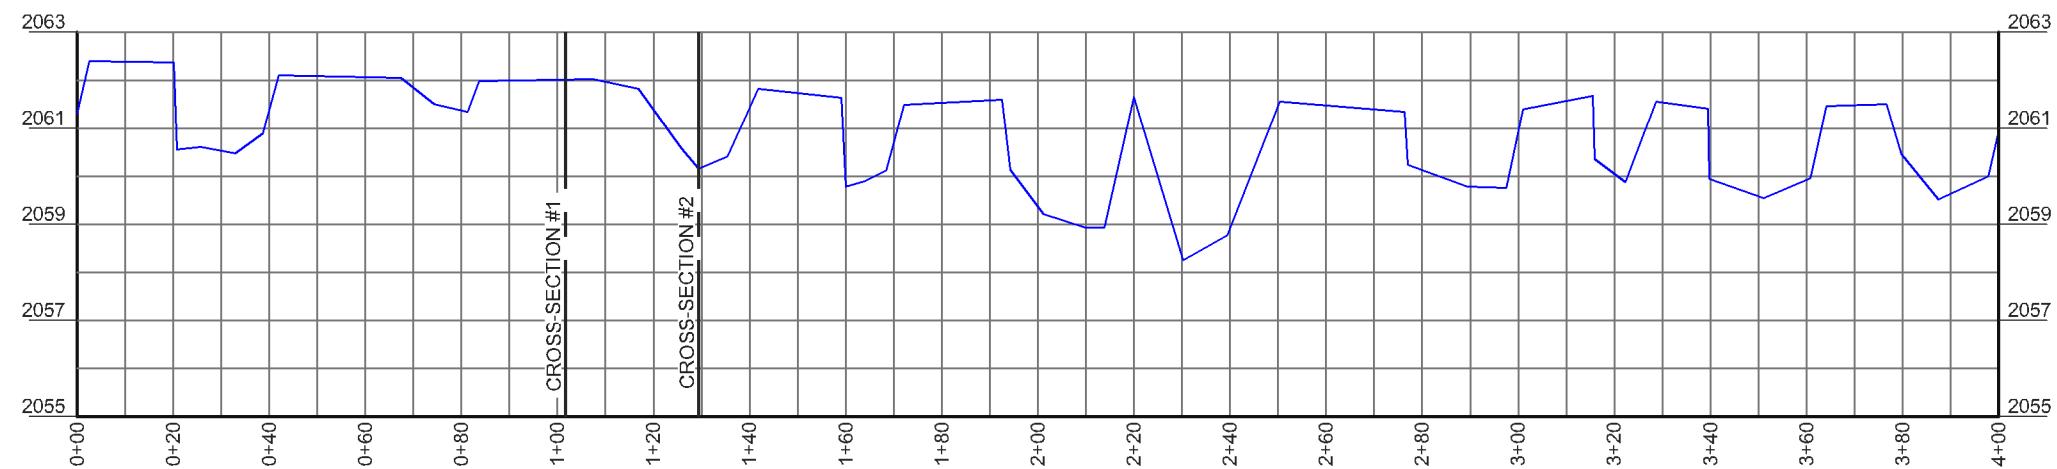

LONGITUDINAL PROFILE- BANNER CREEK
HORIZONTAL SCALE: 1" = 20' FULL SIZE, 1" = 40' HALF SIZE
VERTICAL SCALE: 1" = 2' FULL SIZE, 1" = 4' HALF SIZE

LEGEND

THALWEG

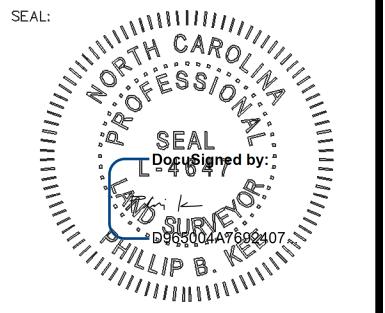

NOTE: SEE SHEET 1 FOR SURVEYOR'S NOTES, LEGEND & STATEMENT OF CERTIFICATION

ELEVATION DATUM: NAVD 88
CONTOUR INTERVAL: 1 FOOT

THIS IS A TOPOGRAPHIC SURVEY FOR INFORMATIONAL AND DESIGN PURPOSES ONLY. IT SHOULD NOT BE USED FOR CONVEYANCE OR LEGAL PURPOSES.

AN AS-BUILT SURVEY FOR:
WILDLANDS ENGINEERING, INC

SPO FILE NOS. 45-DN, 45-DO,
45-DP, 45-DQ
DMS SITE ID NO. 100062




PROJECT:
BANNER FARMS MITIGATION SITE

SHEET TITLE:
LONGITUDINAL PROFILE:
BANNER CREEK
STA: 0+00-12+00

TOWNSHIP:	MILLS RIVER	COUNTY:	HENDERSON	STATE:	NORTH CAROLINA
DRAWN BY:	NH	CHECKED BY:	PBK	SURVEY BY:	JB, PD, HW, ZC, KP, AC
SCALE:	AS SHOWN	SURVEY DATE:	03/31/22		
JOB:	#2110100-AB	SHEET SIZE:	11" X 17" (HALF SIZE)		
#	DATE	REVISIONS			

SHEET:

25 OF 32

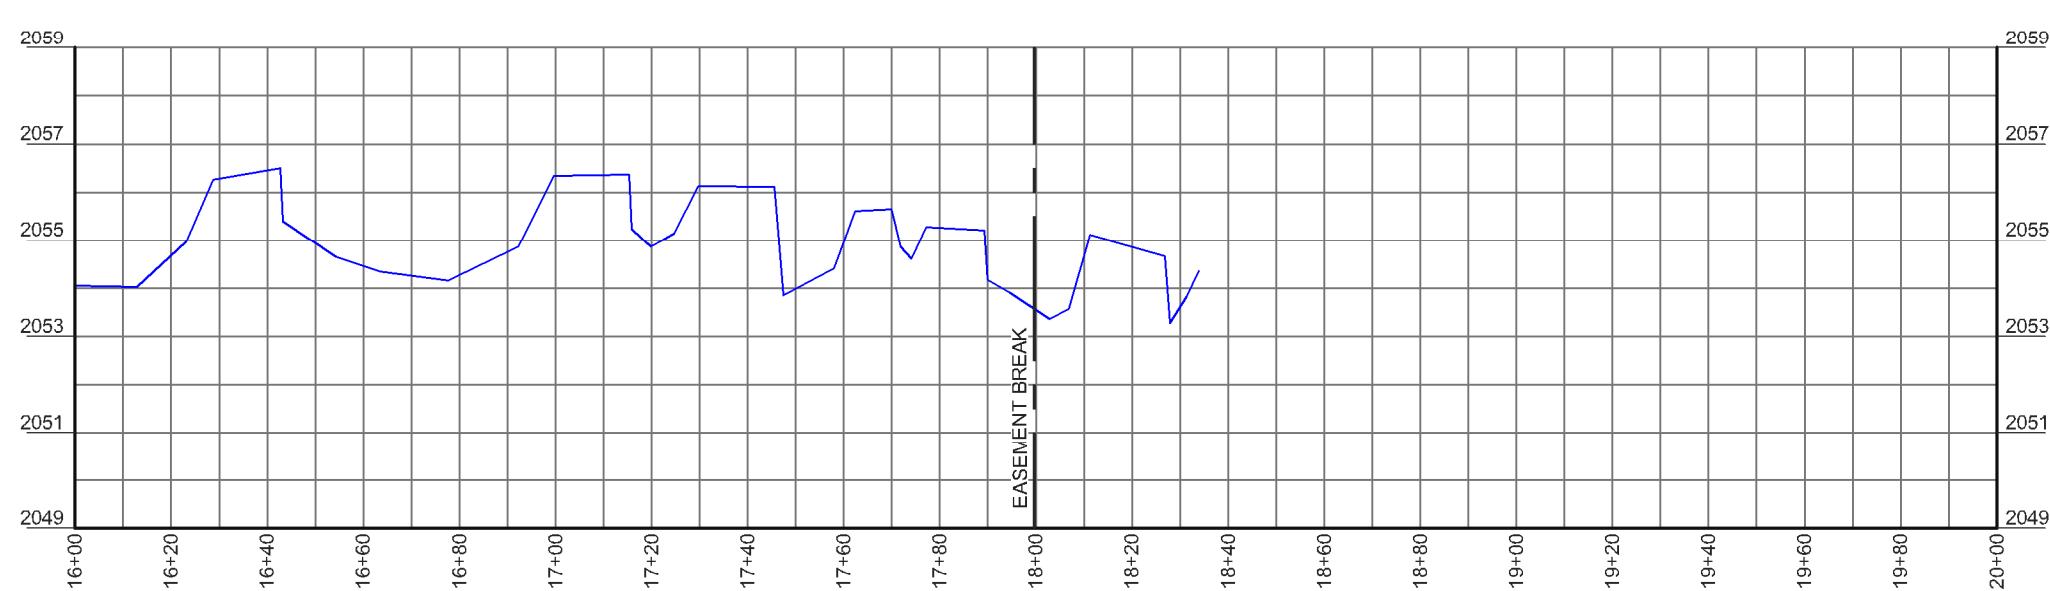
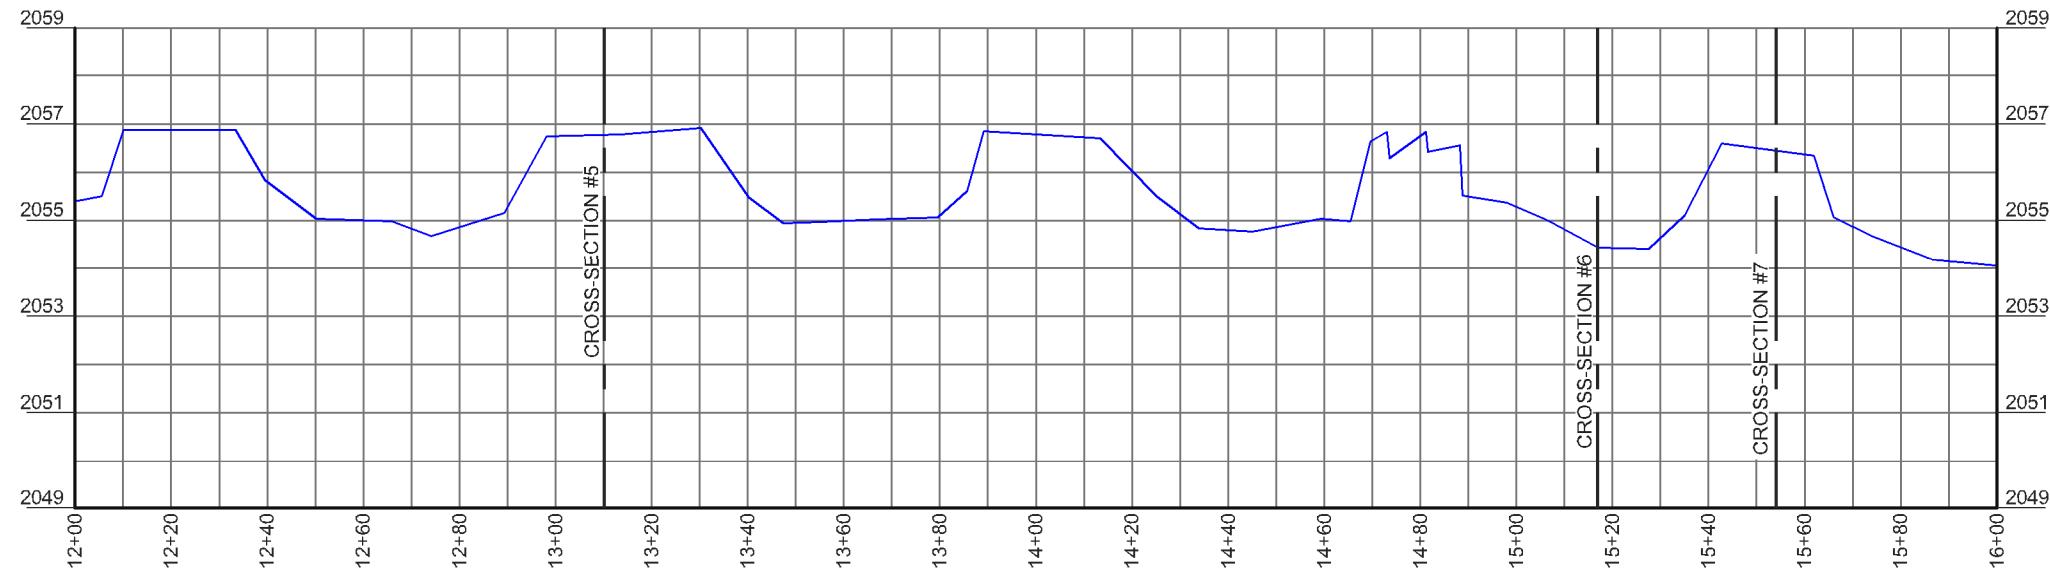
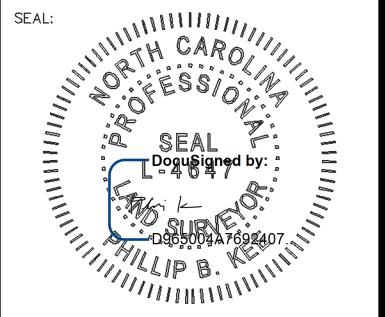


LONGITUDINAL PROFILE- BANNER CREEK
HORIZONTAL SCALE: 1" = 20' FULL SIZE, 1" = 40' HALF SIZE
VERTICAL SCALE: 1" = 2' FULL SIZE, 1" = 4' HALF SIZE

LEGEND

— THALWEG

26 OF 32

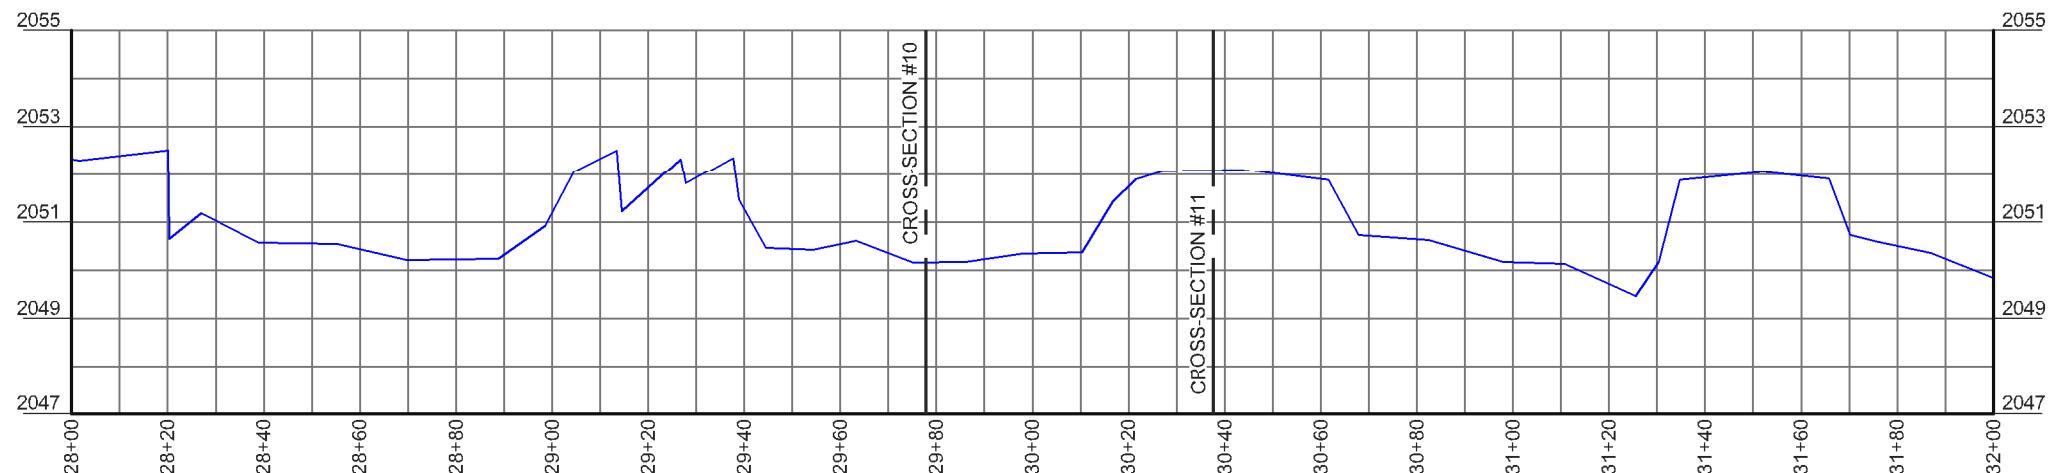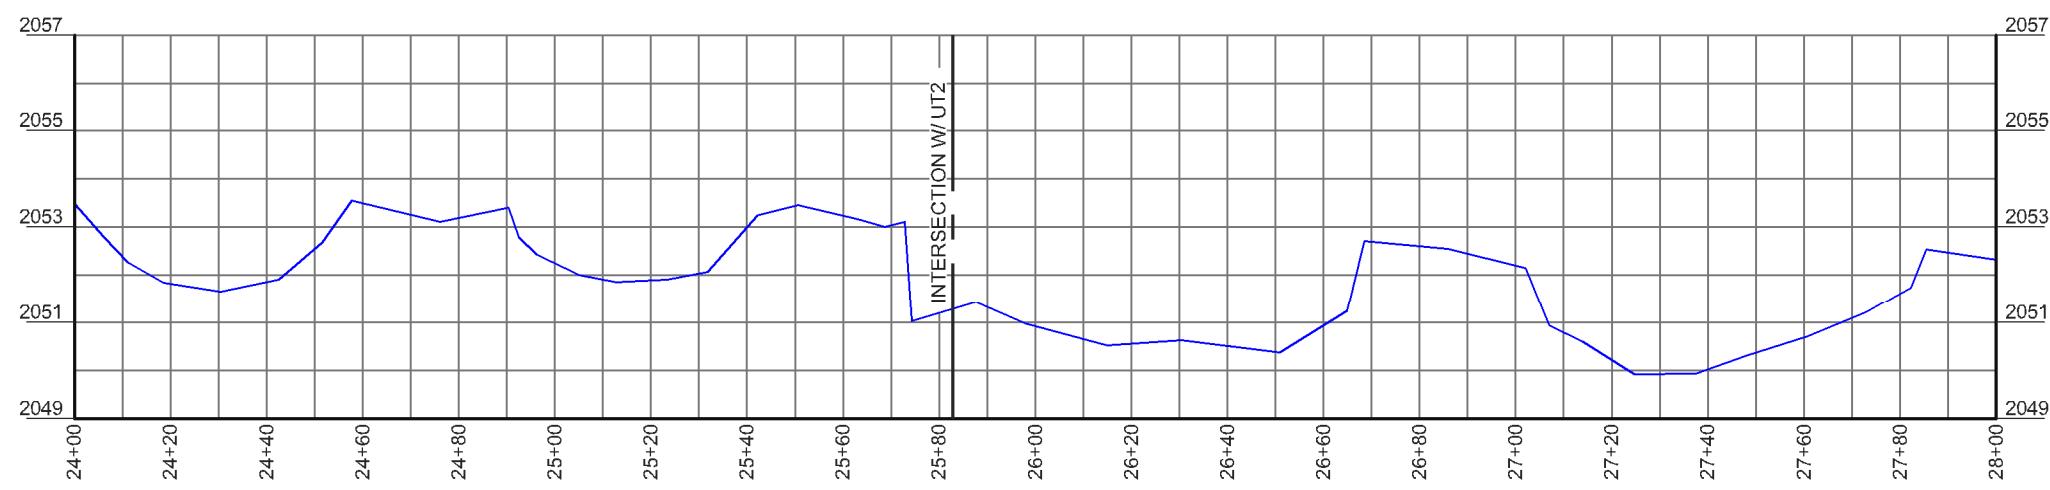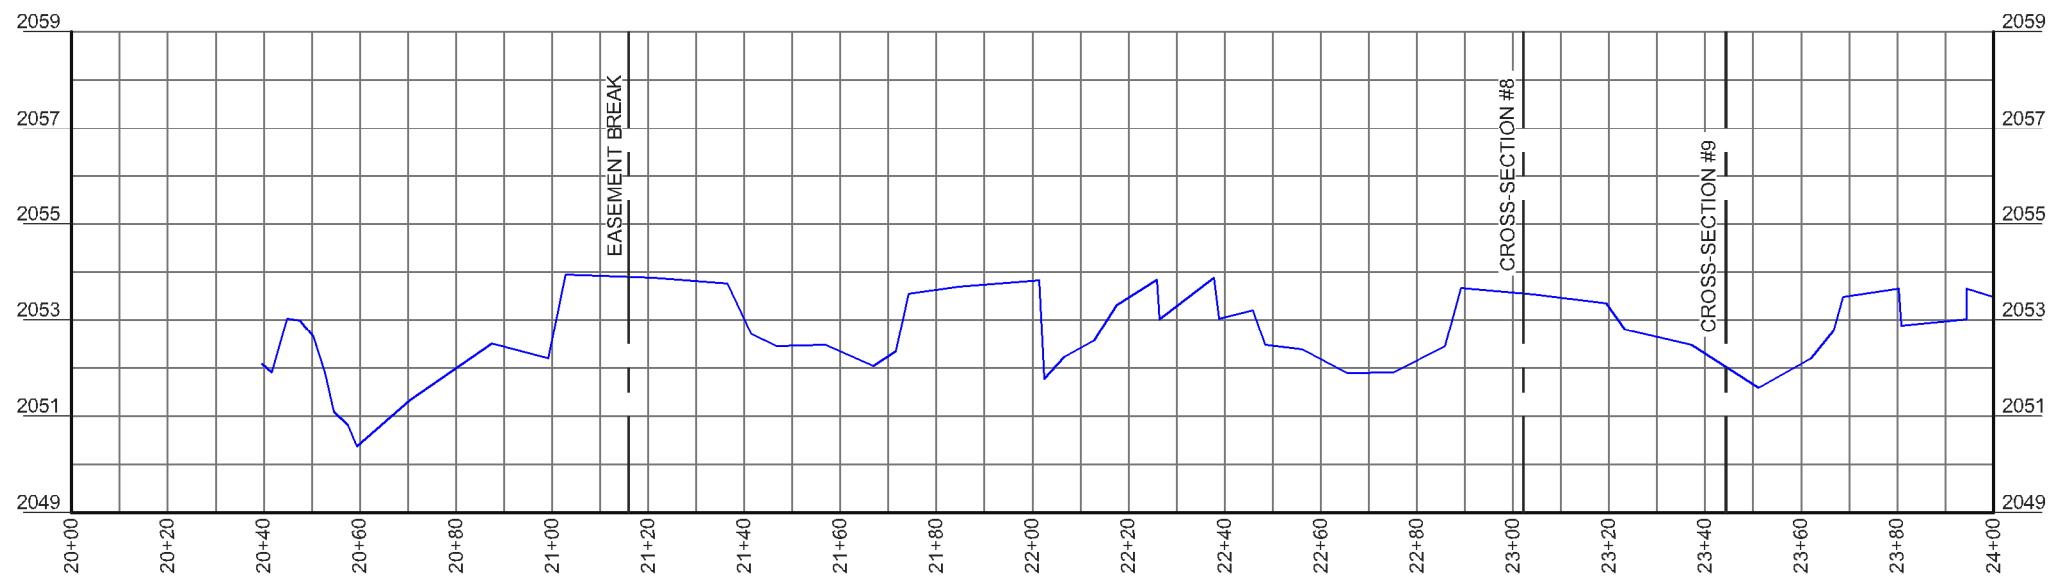
LONGITUDINAL PROFILE- BANNER CREEK

HORIZONTAL SCALE: 1" = 20' FULL SIZE, 1" = 40' HALF SIZE

VERTICAL SCALE: 1" = 2' FULL SIZE, 1" = 4' HALF SIZE

LEGEND

THALWEG

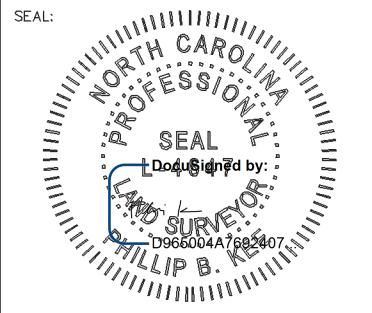NOTE: SEE SHEET 1 FOR
SURVEYOR'S NOTES, LEGEND &
STATEMENT OF CERTIFICATIONELEVATION DATUM: NAVD 88
CONTOUR INTERVAL: 1 FOOTTHIS IS A TOPOGRAPHIC
SURVEY FOR INFORMATIONAL
AND DESIGN PURPOSES
ONLY. IT SHOULD NOT BE
USED FOR CONVEYANCE OR
LEGAL PURPOSES.AN AS-BUILT SURVEY FOR:
**WILDLANDS
ENGINEERING, INC**SPO FILE NOS. 45-DN, 45-DO,
45-DP, 45-DQ
DMS SITE ID NO. 100062PROJECT:
**BANNER FARMS
MITIGATION SITE**SHEET TITLE:
LONGITUDINAL PROFILE:
BANNER CREEK
STA: 20+00-32+00


TOWNSHIP:	COUNTY:	STATE:
MILLS RIVER	HENDERSON	NORTH CAROLINA
DRAWN BY:	CHECKED BY:	SURVEY BY:
NH	PBK	JB, PD, HW, ZC, KP, AC
SCALE:	SURVEY DATE:	
AS SHOWN	03/31/22	
JOB:	SHEET SIZE:	
#2110100-AB	11" X 17" (HALF SIZE)	
#	DATE	REVISIONS

SHEET:

27 OF 32



P.O. Box 2566
Asheville, NC 28802
(828) 575-9021
www.keemap.com
License # C-3039

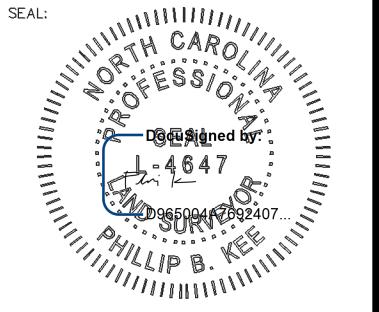

NOTE: SEE SHEET 1 FOR SURVEYOR'S NOTES, LEGEND & STATEMENT OF CERTIFICATION

ELEVATION DATUM: NAVD 88
CONTOUR INTERVAL: 1 FOOT

THIS IS A TOPOGRAPHIC SURVEY FOR INFORMATIONAL AND DESIGN PURPOSES ONLY. IT SHOULD NOT BE USED FOR CONVEYANCE OR LEGAL PURPOSES.

AN AS-BUILT SURVEY FOR:
WILDLANDS ENGINEERING, INC

SPO FILE NOS. 45-DN, 45-DO,
45-DP, 45-DQ
DMS SITE ID NO. 100062



PROJECT:
BANNER FARMS MITIGATION SITE

SHEET TITLE:
LONGITUDINAL PROFILE:
BANNER CREEK
STA: 32+00-38+00

TOWNSHIP:	MILLS RIVER	COUNTY:	HENDERSON	STATE:	NORTH CAROLINA
DRAWN BY:	NH	CHECKED BY:	PBK	SURVEY BY:	JB, PD, HW, ZC, KP, AC
SCALE:	AS SHOWN	SURVEY DATE:	03/31/22		
JOB:	#2110100-AB	SHEET SIZE:	11" X 17" (HALF SIZE)		
#	DATE	REVISIONS			

SHEET:

28 OF 32

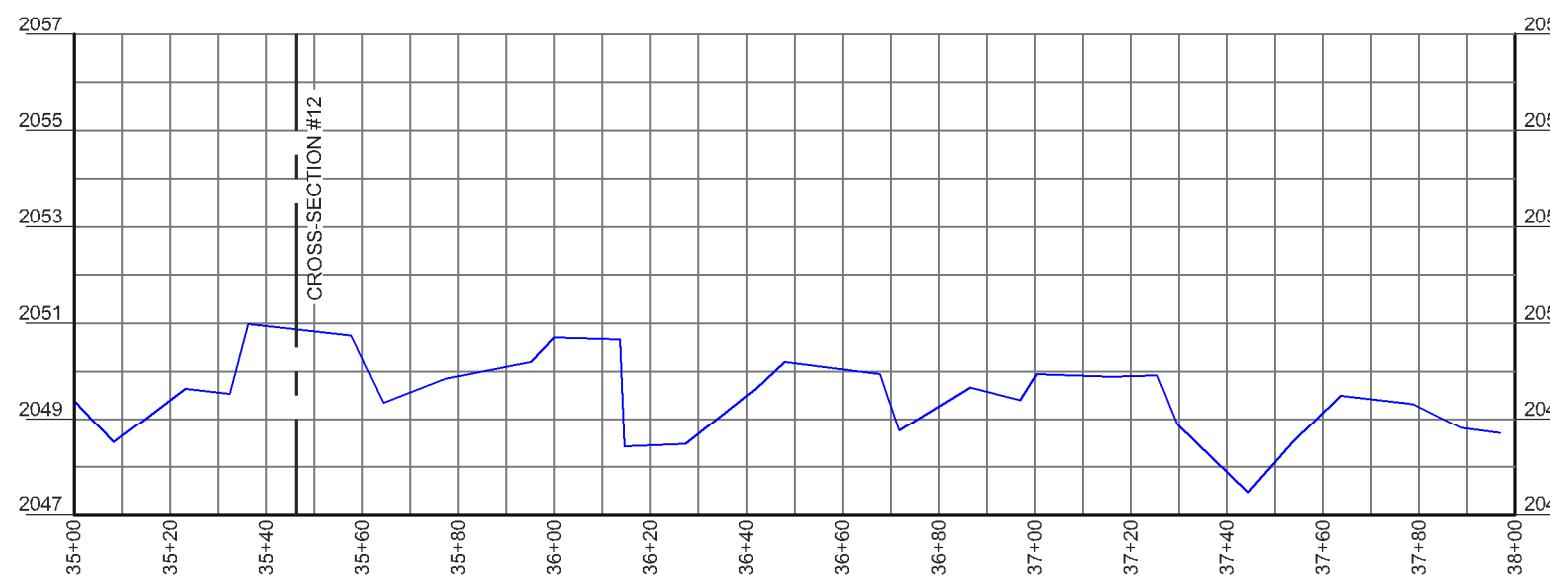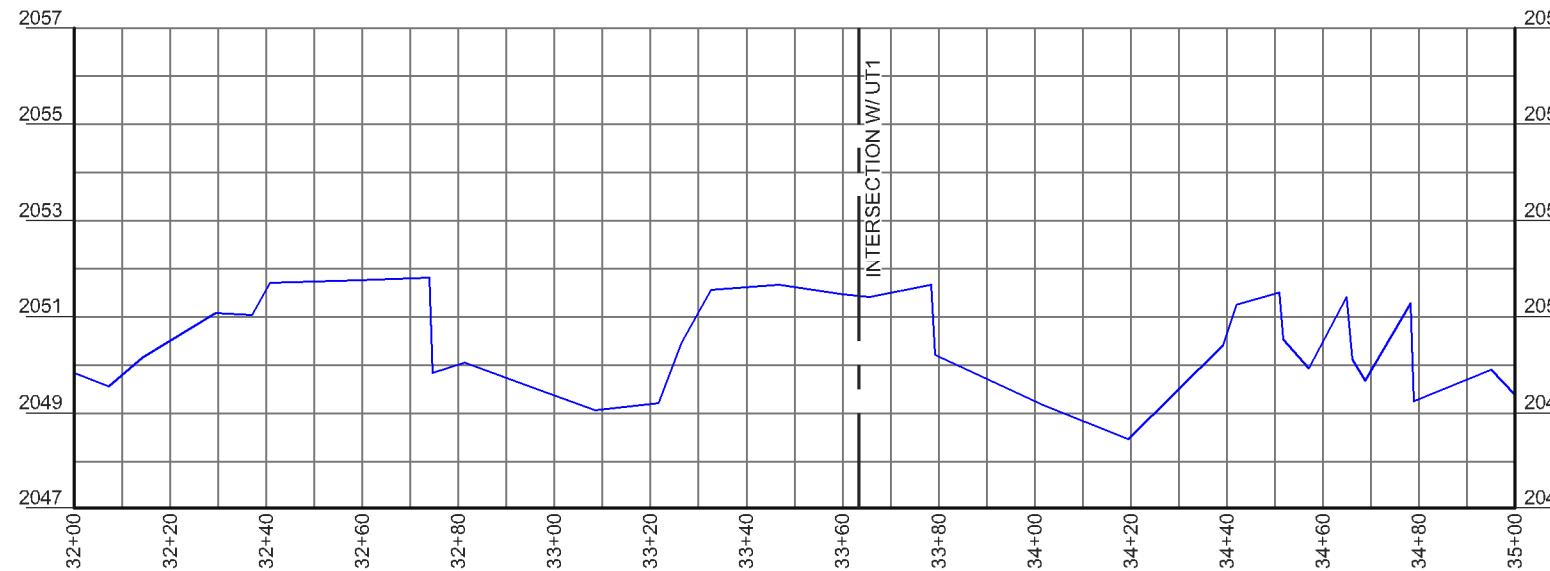


LONGITUDINAL PROFILE - BANNER CREEK

HORIZONTAL SCALE: 1" = 20' FULL SIZE, 1" = 40' HALF SIZE
VERTICAL SCALE: 1" = 2' FULL SIZE, 1" = 4' HALF SIZE

LEGEND

 THALWEG

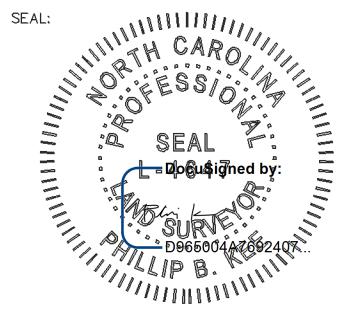

NOTE: SEE SHEET 1 FOR SURVEYOR'S NOTES, LEGEND & STATEMENT OF CERTIFICATION

ELEVATION DATUM: NAVD 88
CONTOUR INTERVAL: 1 FOOT

THIS IS A TOPOGRAPHIC SURVEY FOR INFORMATIONAL AND DESIGN PURPOSES ONLY. IT SHOULD NOT BE USED FOR CONVEYANCE OR LEGAL PURPOSES.

AN AS-BUILT SURVEY FOR:
WILDLANDS ENGINEERING, INC

SPO FILE NOS. 45-DN, 45-DO,
45-DP, 45-DQ
DMS SITE ID NO. 100062



PROJECT:
BANNER FARMS MITIGATION SITE

SHEET TITLE:
LONGITUDINAL PROFILE:
UT1
STA: 100+00-106+00

TOWNSHIP:	MILLS RIVER	COUNTY:	HENDERSON	STATE:	NORTH CAROLINA
DRAWN BY:	NH	CHECKED BY:	PK	SURVEY BY:	JB, PD, HW, ZC, KP, AC
SCALE:	AS SHOWN	SURVEY DATE:	03/31/22		
JOB:	#2110100-AB	SHEET SIZE:	11" X 17" (HALF SIZE)		
#	DATE	REVISIONS			

SHEET:

29 OF 32

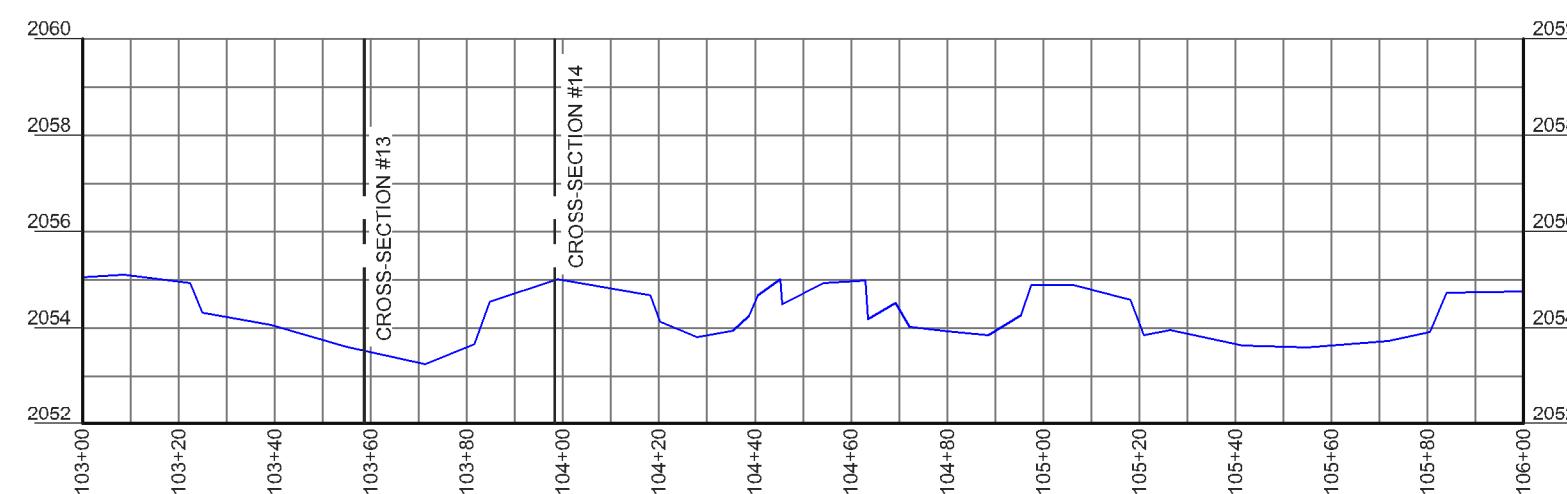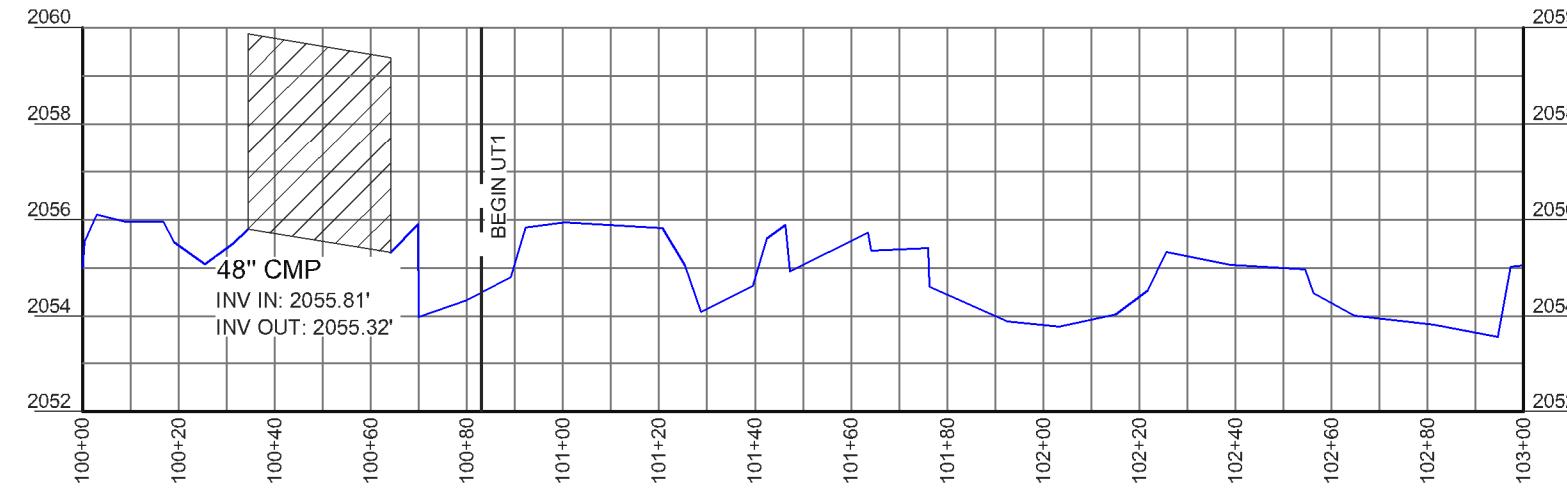

LONGITUDINAL PROFILE- UT1
HORIZONTAL SCALE: 1" = 20' FULL SIZE, 1" = 40' HALF SIZE
VERTICAL SCALE: 1" = 2' FULL SIZE, 1" = 4' HALF SIZE

LEGEND

THALWEG



NOTE: SEE SHEET 1 FOR SURVEYOR'S NOTES, LEGEND & STATEMENT OF CERTIFICATION

ELEVATION DATUM: NAVD 88
CONTOUR INTERVAL: 1 FOOT

THIS IS A TOPOGRAPHIC SURVEY FOR INFORMATIONAL AND DESIGN PURPOSES ONLY. IT SHOULD NOT BE USED FOR CONVEYANCE OR LEGAL PURPOSES.

AN AS-BUILT SURVEY FOR:
WILDLANDS ENGINEERING, INC

SPO FILE NOS. 45-DN, 45-DO,
45-DP, 45-DQ
DMS SITE ID NO. 100062

PROJECT:
BANNER FARMS MITIGATION SITE

SHEET TITLE:
LONGITUDINAL PROFILE:
UT1
STA: 106+00-112+90



TOWNSHIP:	COUNTY:	STATE:
MILLS RIVER	HENDERSON	NORTH CAROLINA
DRAWN BY:	CHECKED BY:	SURVEY BY:
NH	PK	JB, PD, HW, ZC, KP, AC
SCALE:	SURVEY DATE:	
AS SHOWN	03/31/22	
JOB:	SHEET SIZE:	
#2110100-AB	11" X 17" (HALF SIZE)	
#	DATE	REVISIONS

SHEET:

30 OF **32**




P.O. Box 2566
Asheville, NC 28802
(828) 575-9021
www.keemap.com
License # C-3039

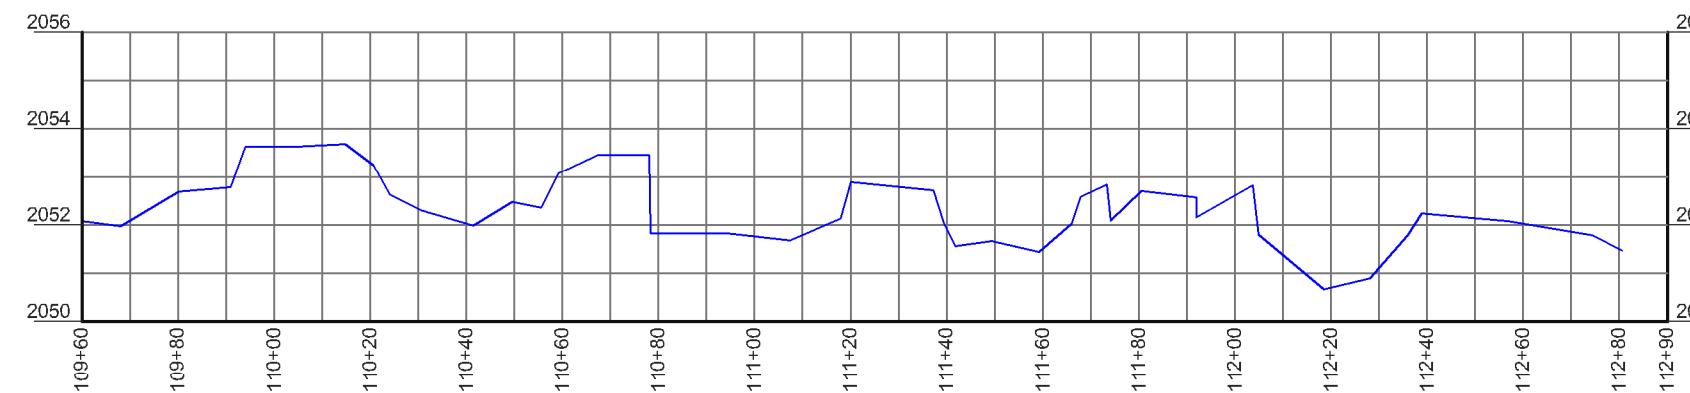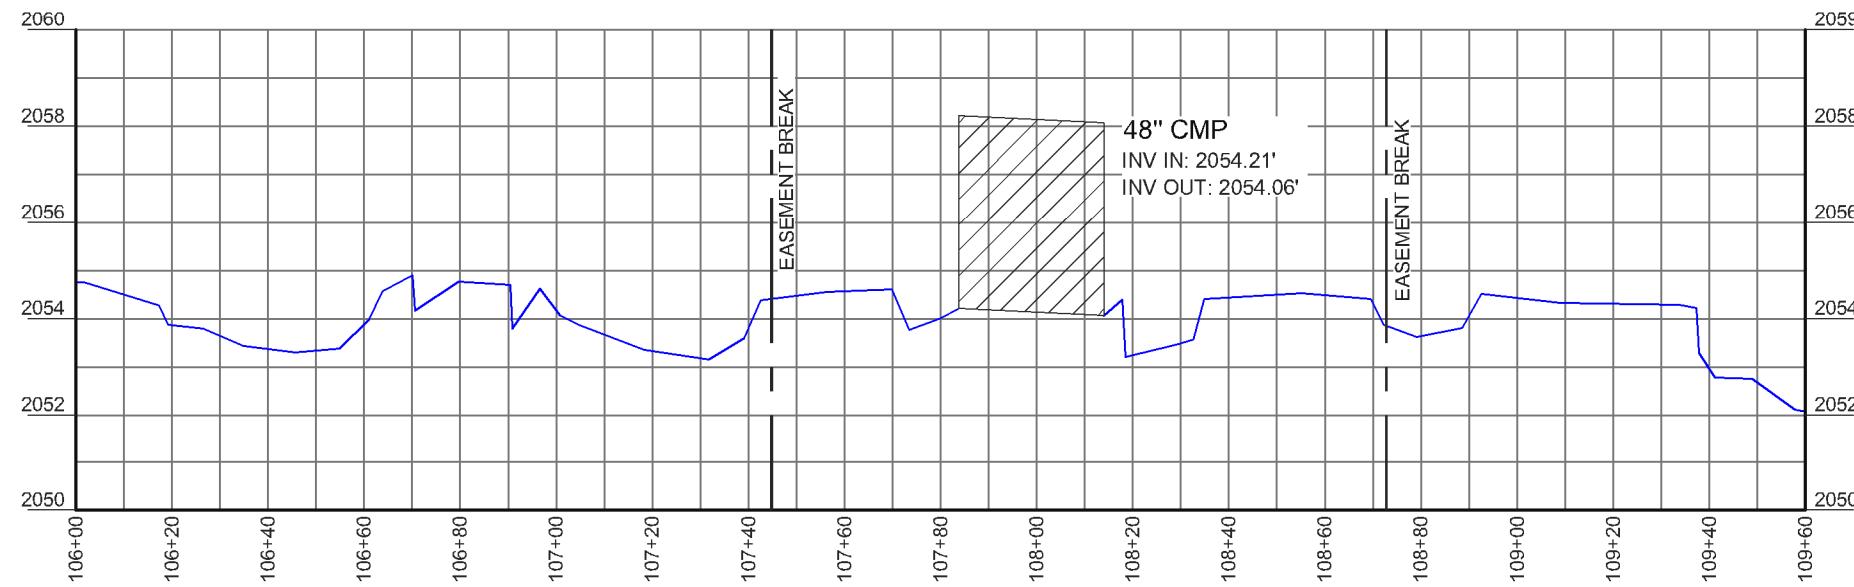

LONGITUDINAL PROFILE- UT1
HORIZONTAL SCALE: 1" = 20' FULL SIZE, 1" = 40' HALF SIZE
VERTICAL SCALE: 1" = 2' FULL SIZE, 1" = 4' HALF SIZE

LEGEND

THALWEG

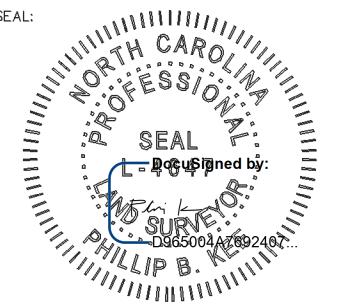

NOTE: SEE SHEET 1 FOR
SURVEYOR'S NOTES, LEGEND &
STATEMENT OF CERTIFICATION

ELEVATION DATUM: NAVD 88
CONTOUR INTERVAL: 1 FOOT

THIS IS A TOPOGRAPHIC
SURVEY FOR INFORMATIONAL
AND DESIGN PURPOSES
ONLY. IT SHOULD NOT BE
USED FOR CONVEYANCE OR
LEGAL PURPOSES.

AN AS-BUILT SURVEY FOR:

**WILDLANDS
ENGINEERING, INC**

SPO FILE NOS. 45-DN, 45-DO,
45-DP, 45-DQ
DMS SITE ID NO. 100062

PROJECT:
**BANNER FARMS
MITIGATION SITE**

SHEET TITLE:
LONGITUDINAL PROFILE:
UT2
STA: 200+00-212+00


TOWNSHIP:	MILLS RIVER	COUNTY:	HENDERSON	STATE:	NORTH CAROLINA
DRAWN BY:	NH	CHECKED BY:	PK	SURVEY BY:	JB, PD, HW, ZC, KP, AC
SCALE:	AS SHOWN	SURVEY DATE:	03/31/22		
JOB:	#2110100-AB	SHEET SIZE:	11" X 17" (HALF SIZE)		
#	DATE	REVISIONS			

SHEET:

31 OF **32**



P.O. Box 2566
Asheville, NC 28802
(828) 575-9021
www.keemap.com
License # C-3039

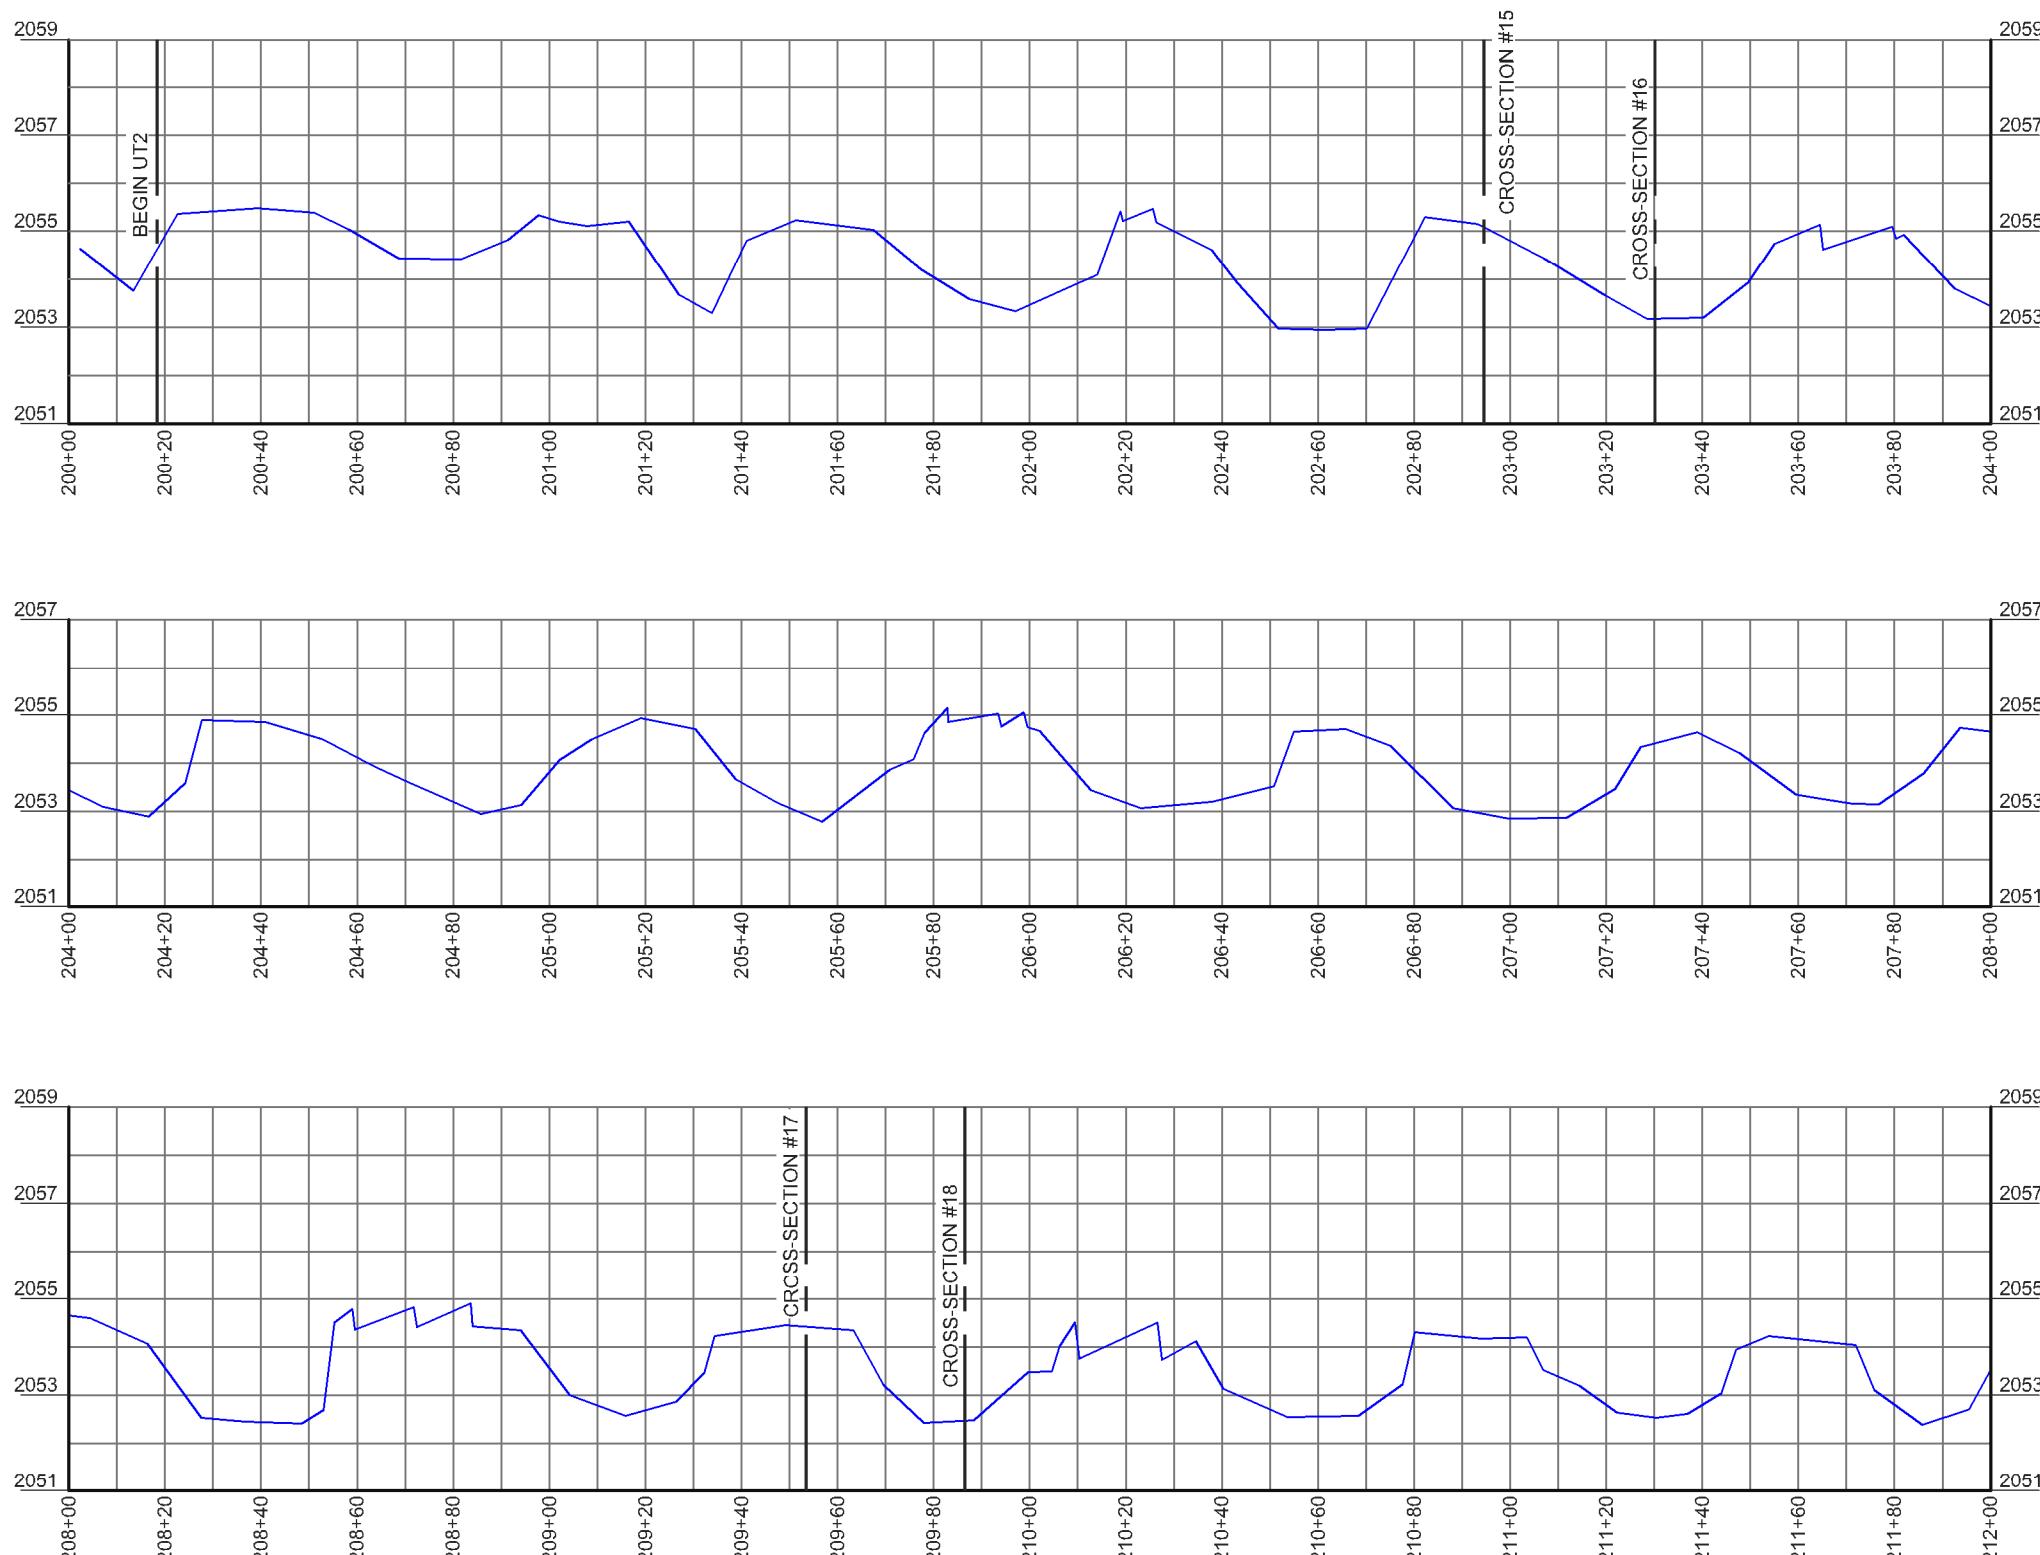


LONGITUDINAL PROFILE- UT2

HORIZONTAL SCALE: 1" = 20' FULL SIZE, 1" = 40' HALF SIZE

VERTICAL SCALE: 1" = 2' FULL SIZE, 1" = 4' HALF SIZE

LEGEND

THALWEG

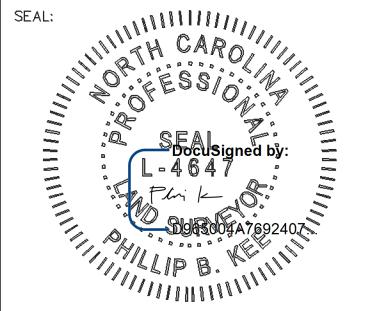

NOTE: SEE SHEET 1 FOR SURVEYOR'S NOTES, LEGEND & STATEMENT OF CERTIFICATION

ELEVATION DATUM: NAVD 88
CONTOUR INTERVAL: 1 FOOT

THIS IS A TOPOGRAPHIC SURVEY FOR INFORMATIONAL AND DESIGN PURPOSES ONLY. IT SHOULD NOT BE USED FOR CONVEYANCE OR LEGAL PURPOSES.

AN AS-BUILT SURVEY FOR:
WILDLANDS ENGINEERING, INC

SPO FILE NOS. 45-DN, 45-DO,
45-DP, 45-DQ
DMS SITE ID NO. 100062

PROJECT:
BANNER FARMS MITIGATION SITE

SHEET TITLE:
LONGITUDINAL PROFILE:
UT2
STA: 212+00-219+00



TOWNSHIP:	MILLS RIVER	COUNTY:	HENDERSON	STATE:	NORTH CAROLINA
DRAWN BY:	NH	CHECKED BY:	PK	SURVEY BY:	JB, PD, HW, ZC, KP, AC
SCALE:	AS SHOWN	SURVEY DATE:	03/31/22		
JOB:	#2110100-AB	SHEET SIZE:	11" X 17" (HALF SIZE)		
#	DATE	REVISIONS			

SHEET:

32 OF 32



P.O. Box 2566
Asheville, NC 28802
(828) 575-9021
www.keemap.com
License # C-3039

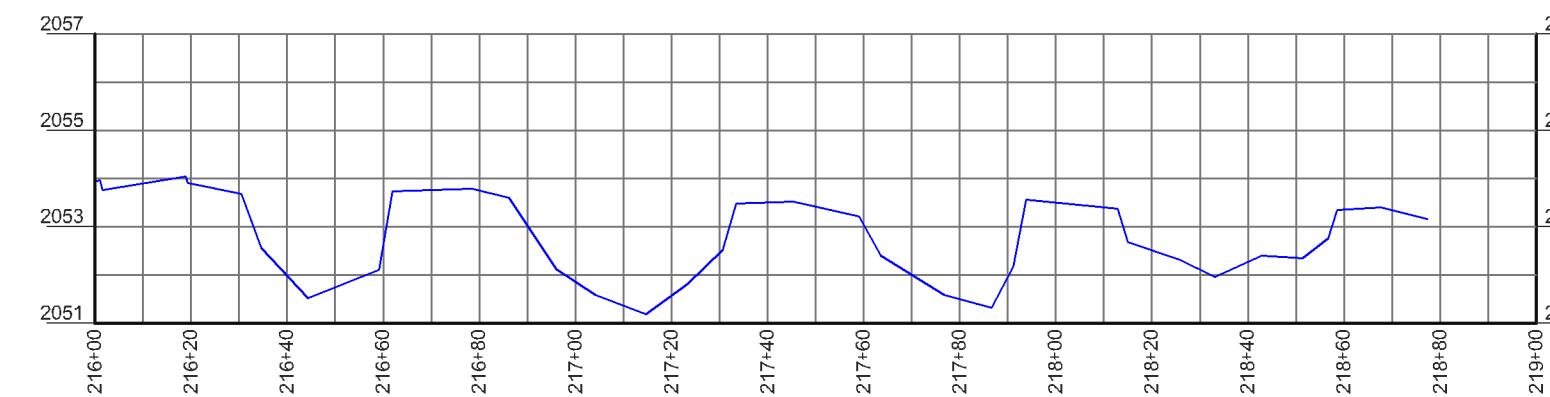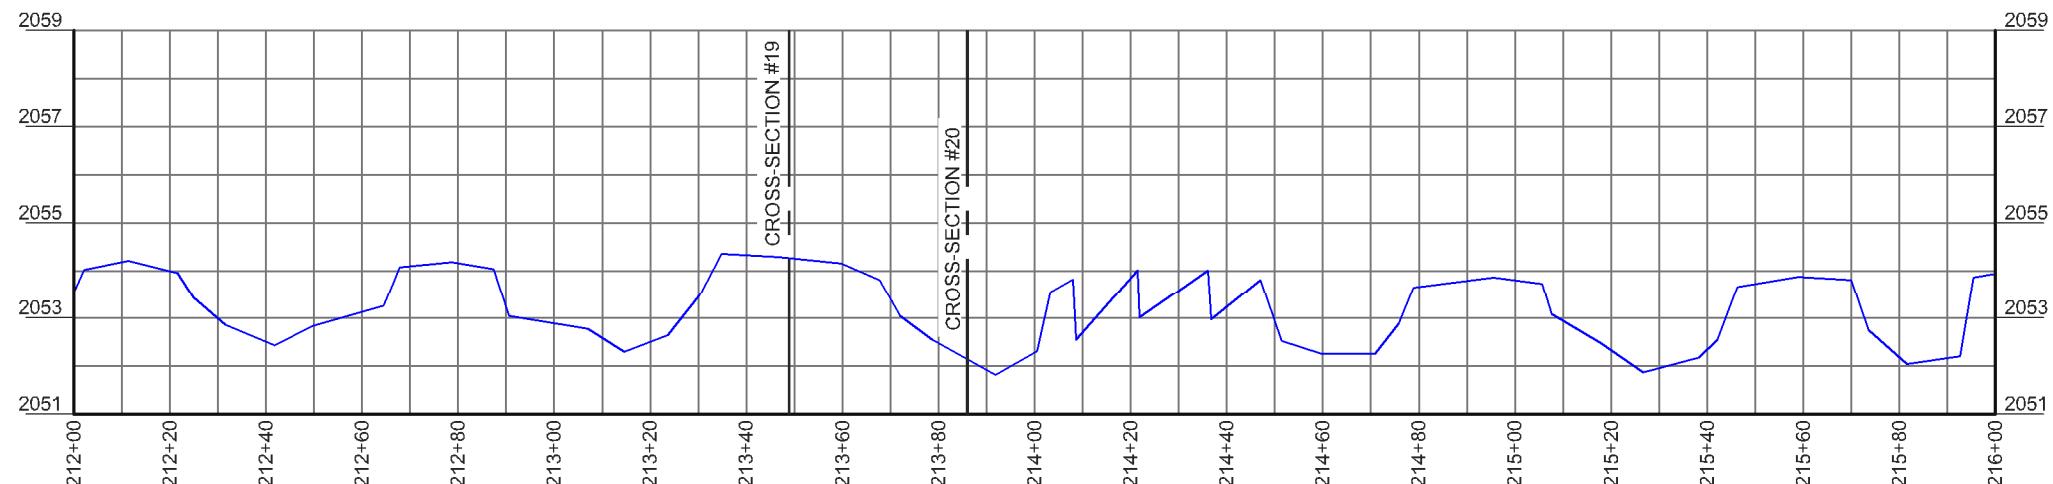

LONGITUDINAL PROFILE- UT2
HORIZONTAL SCALE: 1" = 20' FULL SIZE, 1" = 40' HALF SIZE
VERTICAL SCALE: 1" = 2' FULL SIZE, 1" = 4' HALF SIZE

LEGEND

THALWEG

APPENDIX F. Other Data

MONITORING GAUGE INSTALLATION DATA SHEET

12/2/2021

Project Name:
Project Location:
Purpose of Gauge:

Banner Farm
Henderson County
Water Table Monitoring

Gauge Description:


Gauge ID:	GWG 2
Serial Number:	650095
Total Well Casing Length (A):	~
Well Casing Height Above Ground (B):	1.83
Distance From Eye Bolt To Probe Sensor:	6.30
Material:	2" PVC Well Screen
Type of Measurement:	Pressure, Temperature, & Depth
Type of Logger:	In-Situ Level TROLL 100
Gauge Location:	35.354374, -80.553519

Ground Elevation = 2059.0015

Notes:

Soil Profile Description at Location of Well:

Depth Range (in.)	Color	Redox	Texture	Notes
0 - 13	10YR 4/2	d.5YR 4/8.3%	clay	
0 - 50	10YR 5/1	10YR 6/8.30%	clay	
50 - 60	10YR 4/1	10YR 5/8.10%	silty clay	

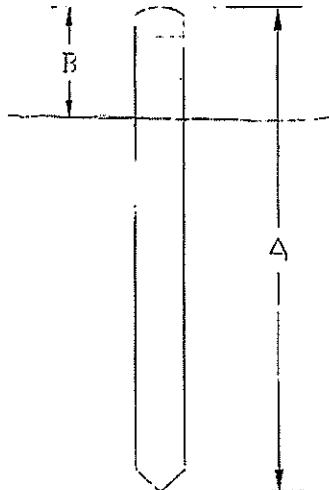

MONITORING GAUGE INSTALLATION DATA SHEET

12/2/2021

Project Name:
Project Location:
Purpose of Gauge:

Banner Farms
Henderson County
Water Table Monitoring

Gauge Description:


Gauge ID:
Serial Number:
Total Well Casing Length (A):
Well Casing Height Above Ground (B):
Distance From Eye Bolt To Probe Sensor:
Material:
Type of Measurement:
Type of Logger:
Gauge Location:

GW/G 2
611012
—
2.12
5.74
2" PVC Well Screen
Pressure, Temperature, & Depth
In-Situ Level TROLL 100
35.353831, -82.552493
Ground elevation (ft): 2056.169

Notes:

Soil Profile Description at Location of Well:

Depth Range (in.)	Color	Redox	Texture	Notes
0 - 30	10YR 2/1	10YR 5/8, 2%	Silt Clay Loam	
30 - 38	10YR 3/1	10YR 5/8, 15%	Silt/Loam	
38 - 60	10YR 5/1	10YR 5/8, 50%	Silt Clay Loam	

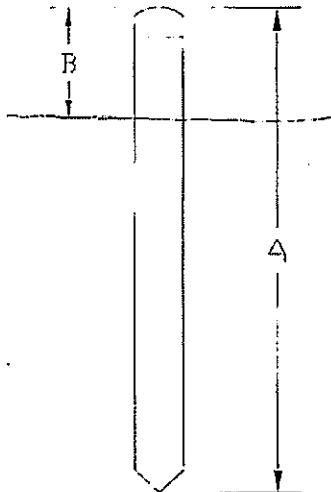

MONITORING GAUGE INSTALLATION DATA SHEET

Project Name:
Project Location:
Purpose of Gauge:

Banner Farm
Henderson Farmland
Water Table Monitoring

12/2/2021


Gauge Description:

Gauge ID:	GWG 3
Serial Number:	611013
Total Well Casing Length (A):	—
Well Casing Height Above Ground (B):	2.11
Distance From Eye Bolt To Probe Sensor:	6.18
Material:	2' PVC Well Screen
Type of Measurement:	Pressure, Temperature, & Depth
Type of Logger:	In-Situ Level Troll 100
Gauge Location:	35°35'24.55", -80°55'43.4"
Ground Elevation (H):	2056.279

Notes:

Soil Profile Description at Location of Well:

Depth Range (in.)	Color	Redox	Texture	Notes
0-34	10 YK 3/2		clayey	
34-38	10 YR 4/2		stony clay	
38-52	10 YR 4/1	10 YR 6/8, 50%	stony clay	

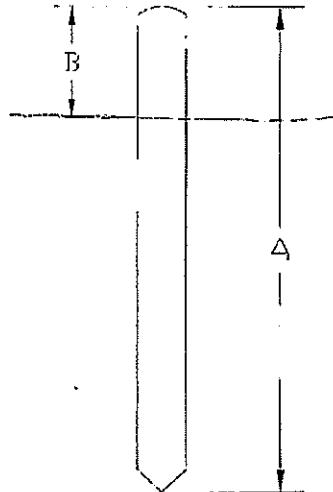

MONITORING GAUGE INSTALLATION DATA SHEET

Project Name:
Project Location:
Purpose of Gauge:

Banner farms
Henderson County
Water Table Monitoring

12/2/2021


Gauge Description:

Gauge ID:	GWG 4
Serial Number:	61332-3
Total Well Casing Length (A):	
Well Casing Height Above Ground (B):	1.75
Distance From Eye Bolt To Probe Sensor	0.10
Material:	2" PVC Well Screen
Type of Measurement:	Pressure, Temperature, & Depth
Type of Logger:	In-Situ Level Troll 100
Gauge Location:	35.352426, -80.550844
Ground Elevation (ft):	2056.456

Notes:

Soil Profile Description at Location of Well:

Depth Range (in.)	Color	Redox	Texture	Notes
0 - 25	10YR 3/2	I	Clay	
25 - 38	10YR 4/2	I	Silty Clay	
38 - 45	10YR 5/2	10YR 5/8 (10% sand)	Sandy Clay	
45 - 50	10YR 5/2	10YR 4/8, 50% silty clay	Silty Clay	

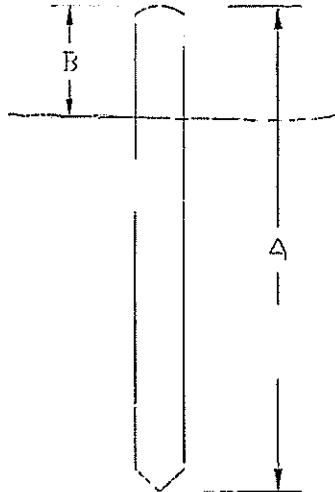

MONITORING GAUGE INSTALLATION DATA SHEET

Project Name:
Project Location:
Purpose of Gauge:

BANNER FARM
HENDERSON COUNTY
Water Table Monitoring

Gauge Description:


Gauge ID: Serial Number:	GWG 5 610995
Total Well Casing Length (A):	
Well Casing Height Above Ground (B):	1.78
Distance From Eye Bolt To Probe Sensor	6.50
Material:	2" PVC Well Screen
Type of Measurement:	Pressure, Temperature, & Depth
Type of Logger:	In-Situ Level Troll 100
Gauge Location:	35.351670, -82.553925
Ground Elevation (H):	2056.853

12/2/2021

Notes:

Soil Profile Description at Location of Well:

Depth Range (in.)	Color	Redox	Texture	Notes
0 - 15	UVR 2/2		SILTY CLAY LOAM	
15 - 33	UVR 2/1		SILTY CLAY LOAM	
33 - 44	UVR 2/2		SILTY CLAY LOAM	
44 - 60	UVR 4/3		SILTY CLAY LOAM	

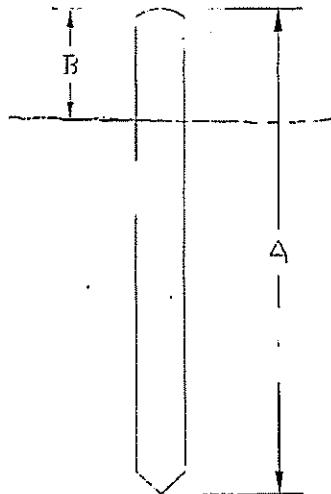

MONITORING GAUGE INSTALLATION DATA SHEET

Project Name:
Project Location:
Purpose of Gauge:

Banner Farm
Henderson County
Water Table Monitoring

Gauge Description:


Gauge ID:	GWG b
Serial Number:	650686
Total Well Casing Length (A):	
Well Casing Height Above Ground (B):	1.98
Distance From Eye Bolt To Probe Sensor	5.99
Material:	2" PVC Well Screen
Type of Measurement:	Pressure, Temperature, & Depth
Type of Logger:	In-Situ Level TROLL 100
Gauge Location:	35.351100, -80.553462
Ground Elevation (ft):	2054.827'

12/2/2021

Notes:

Soil Profile Description at Location of Well:

Depth Range (in.)	Color	Redox	Texture	Notes
0-25	15 YR 4/4	=	Clean loam	
25-48	10 YR 4/4	=	Sand loam	

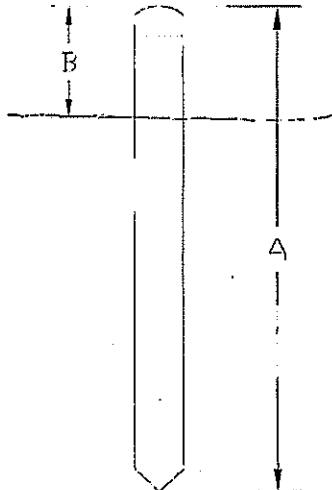

MONITORING GAUGE INSTALLATION DATA SHEET

Project Name:
Project Location:
Purpose of Gauge:

Banner farm
Henderson County
Water Table Monitoring

Gauge Description:

Gauge ID:	GWG 7
Serial Number:	650497
Total Well Casing Length (A):	6.50
Well Casing Height Above Ground (B):	1.70
Distance From Eye Bolt To Probe Sensor:	3.76
Material:	2" PVC Well Screen
Type of Measurement:	Pressure, Temperature, & Depth
Type of Logger:	In-Situ Level Troll 100
Gauge Location:	35.350209 128.554718


Ground elevation (ft): 2057.227

12/3/2021

Notes:

Soil Profile Description at Location of Well:

Depth Range (in.)	Color	Redox	Texture	Notes
0 - 20	10YR 3/2		Silt	
21 - 42	10YR 4/4		Silt clay	
43 - 60	10YR 5/5		Silt clay	

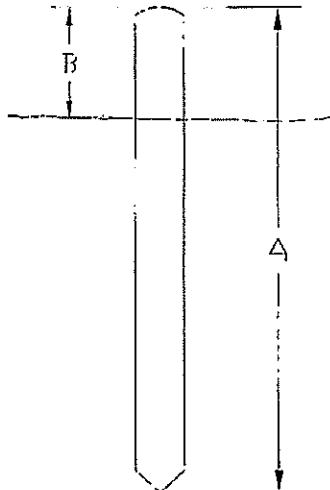

MONITORING GAUGE INSTALLATION DATA SHEET

Project Name:
Project Location:
Purpose of Gauge:

<i>Banner Inn (Y)</i>
<i>Hennepin County</i>
Water Table Monitoring

Gauge Description:


Gauge ID:	<i>G-WC-82</i>
Serial Number:	<i>6500941</i>
Total Well Casing Length (A):	<i>62.08</i>
Well Casing Height Above Ground (B):	<i>6.28</i>
Distance From Eye Bolt To Probe Sensor:	
Material:	2" PVC Well Screen
Type of Measurement:	Pressure, Temperature, & Depth
Type of Logger:	In-Situ Level Troll 100
Gauge Location:	<i>35351202 - 82.556364</i>
Ground elevation (ft):	<i>2055.74</i>

12/03/2021

Notes:

Soil Profile Description at Location of Well:

Depth Range (in.)	Color	Redox	Texture	Notes
0 - 8	10YR 4/1 4%	7SY 4/6 1w	Silt loam	
9 - 18	10YR 2/1		loam	
19 - 50	6YR 5/1 2%	7SY 5/8 2%	Clay loam	
51 - 60	2 SY 6/1 3%	7SP 5/8 2%	(Silt)	

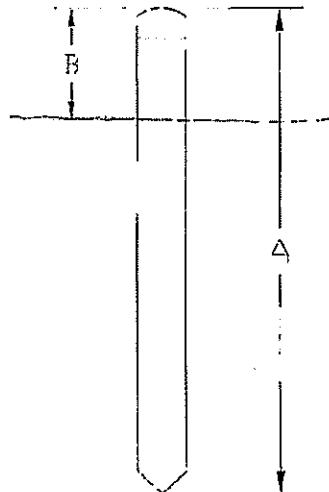

MONITORING GAUGE INSTALLATION DATA SHEET

Project Name:
Project Location:
Purpose of Gauge:

Bonell farm
Henderson County
Water Table Monitoring

Gauge Description:


Gauge ID:	GVG-9
Serial Number:	867904
Total Well Casing Length (A):	
Well Casing Height Above Ground (B):	1.48
Distance From Eye Bolt To Probe Sensor:	6.31
Material:	2" PVC Well Screen
Type of Measurement:	Pressure, Temperature, & Depth
Type of Logger:	In-Situ Level Troll 100
Gauge Location:	35.350888, -82.586243
(Ground elevation (ft)):	2055.854

12/3/2021

Notes:

Soil Profile Description at Location of Well:

Depth Range (in.)	Color	Redox	Texture	Notes
0-4	7.5 YR 3/2		10cm	
5-12	10YR 3/1 9%	7.5 YR 3/4 13%	5.1 + 10cm	
13-29	10 YR 2/1		5.1 + 10cm	
30-46	10 YR 4/1 78%	7.5 YR 4/6 25%	Clay 10cm	
47-50	10 YR 2/1		Clay 16cm	

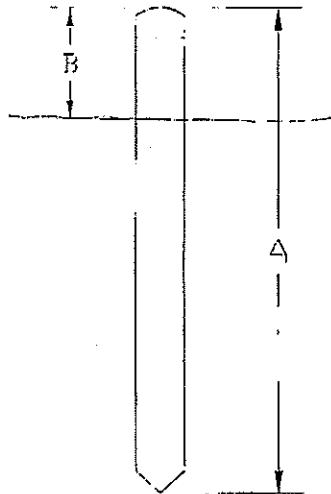

MONITORING GAUGE INSTALLATION DATA SHEET

Project Name:
Project Location:
Purpose of Gauge:

Brunner Foxx	
Underground Facility	
Water Table Monitoring	

Gauge Description:


<u>Gauge ID:</u>	GWES 10
<u>Serial Number:</u>	369193
<u>Total Well Casing Length (A):</u>	1.90
<u>Well Casing Height Above Ground (B):</u>	6.50
<u>Distance From Eye Bolt To Probe Sensor:</u>	2" PVC Well Screen
<u>Material:</u>	Pressure, Temperature, & Depth
<u>Type of Measurement:</u>	In-Situ Level Troll 100
<u>Type of Logger:</u>	
<u>Gauge Location:</u>	35.349525, -84.556553
<u>Ground Elevation (ft):</u>	2056.58

12/3/2021

Notes:

Soil Profile Description at Location of Well:

Depth Range (in.)	Color	Redox	Texture	Notes
0 - 12	10YR 3/2		FIRM	
13 - 20	10YR 3/3		FIRM	
21 - 42	10YR 3/3 45%	ZSYR 5/6 S	FIRM	
43 - 60	10YR 5/2 70%	ZSYR 5/8 W	clayey FIRM	

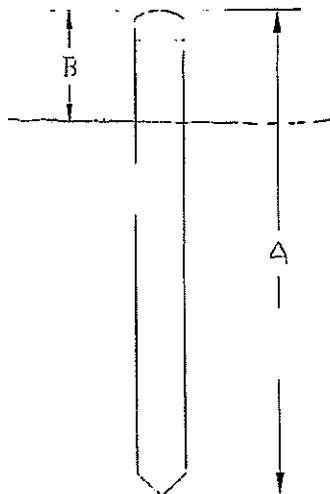

MONITORING GAUGE INSTALLATION DATA SHEET

Project Name:
Project Location:
Purpose of Gauge:

Branner Farm
Henderson County

Water Table Monitoring

Gauge Description:


Gauge ID:	(EWG-11)
Serial Number:	C50672
Total Well Casing Length (A):	
Well Casing Height Above Ground (B):	
Distance From Eye Bolt To Probe Sensor Material:	1.83
Type of Measurement:	2" PVC Well Screen
Type of Logger:	Pressure, Temperature, & Depth
Gauge Location:	In-Situ Level Troll 100
Ground Elevation (ft):	35.349682, -82.534981

12/3/2021

Notes:

Soil Profile Description at Location of Well:

Depth Range (in.)	Color	Redox S.	Texture	Notes
0 - 12	12YR 4/1 9%	Z5YR Y/6	1 mm	
14 - 21	10YR 4/1 8%	Z5YR 4/6 16	1 mm	
21 - 60	10YR 3/1 7%	Z5YR 4/6 25	5-14 mm	

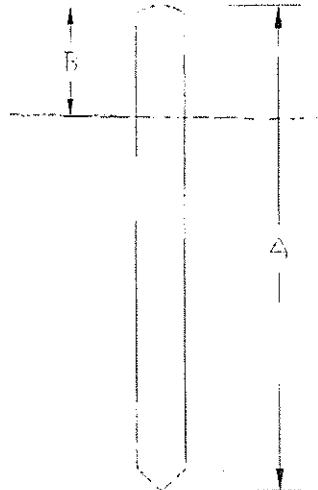

MONITORING GAUGE INSTALLATION DATA SHEET

Project Name:
Project Location:
Purpose of Gauge:

Banner Farm
Henderson County
Water Table Monitoring

12/16/2021


Gauge Description:

Gauge ID:	GWG 12
Serial Number:	0500600
Total Well Casing Length (A):	
Well Casing Height Above Ground (B):	1.97
Distance From Eye Bolt To Probe Sensor	0.00
Material:	2" PVC Well Screen
Type of Measurement:	Pressure, Temperature, & Depth
Type of Logger:	In-Situ Level Troll 100
Gauge Location:	35.348438, -82.558076
Ground elevation (ft):	2097.603

Notes:

Soil Profile Description at Location of Well:

Depth Range (in.)	Color	Redox	Texture	Notes
0-25	DVR 2/2		Silt loam	
25-100	DVR 5/2	10YRL 1/1, 10Z	Clay loam	

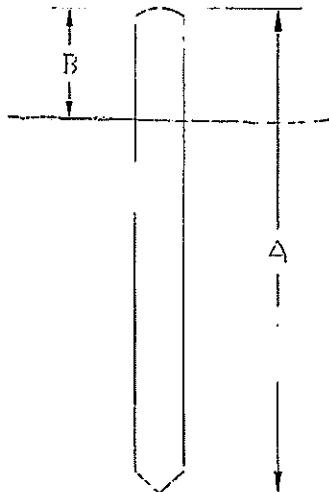

MONITORING GAUGE INSTALLATION DATA SHEET

Project Name:
Project Location:
Purpose of Gauge:

Rainiver Farm
Henderson County
Water Table Monitoring

12/06/2021

Gauge Description:


Gauge ID:	GWP713
Serial Number:	150668
Total Well Casing Length (A):	
Well Casing Height Above Ground (B):	1.80
Distance From Eye Bolt To Probe Sensor:	5.95
Material:	2" PVC Well Screen
Type of Measurement:	Pressure, Temperature, & Depth
Type of Logger:	In-Situ Level TROLL 100
Gauge Location:	35.347333, -82.558854
Ground elevation (E):	2057.27'

Ground elevation (E): 2057.27'

Notes:

Soil Profile Description at Location of Well:

Depth Range (in.)	Color	Redox	Texture	Notes
0-10	TOYR 41/2	A	5811 loam	
11-24	TOYR 41/1	TOYR 41/2 57/041 loam		
24-39	TOYR 51/2	TOYR 41/8 49/11 loam		
39-60	TOYR 51/2	TOYR 41/8 001 loam		
		B		
		B'		
		C		

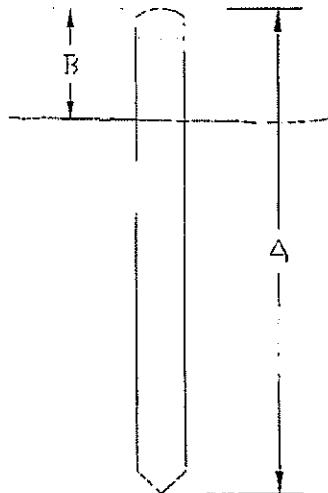

MONITORING GAUGE INSTALLATION DATA SHEET

Project Name:
Project Location:
Purpose of Gauge:

Ranner Farm
Henderson County
Water Table Monitoring

12/6/2001


Gauge Description:

Gauge ID:	GWG714
Serial Number:	6503100
Total Well Casing Length (A):	11.2
Well Casing Height Above Ground (B):	5.90
Distance From Eye Bolt To Probe Sensor:	2" PVC Well Screen
Material:	Pressure, Temperature, & Depth
Type of Measurement:	In-Situ Level TROLL 100
Type of Logger:	
Gauge Location:	35.346553, -82.559953
Ground Elevation (ft):	2057.595

Notes:

Soil Profile Description at Location of Well:

Depth Range (in.)	Color	Redox	Texture	Notes
0 - 27	(U) YR 4/12	5YR 4/16 2/20	C (1) L (1) M (1)	
27 - 41	(U) YR 5/12	10YR 5/16 30%	C (1) L (1) M (1)	
41 - 51	(U) YR 4/11	10YR 4/16 5/2	C (1) L (1) M (1)	
51 - 60	(U) YR 6/12	10YR 4/16 4/16 2/16	S (1) + V	

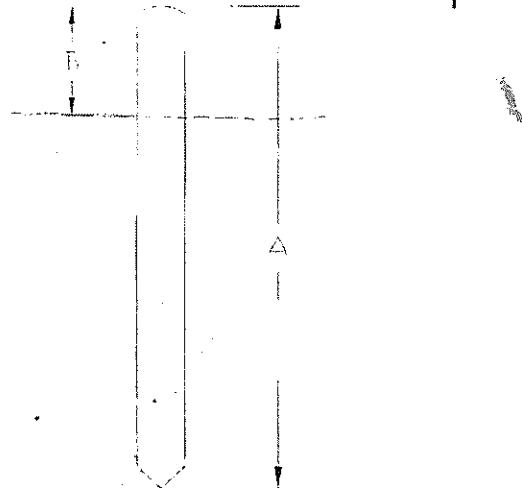

MONITORING GAUGE INSTALLATION DATA SHEET

Project Name:
Project Location:
Purpose of Gauge:

Danville Farm
Henderson County
Water Table Monitoring

Gauge Description:


Gauge ID:	6VVV715
Serial Number:	W13834
Total Well Casing Length (A):	1,837
Well Casing Height Above Ground (B):	1,058
Distance From Eye Bolt To Probe Sensor	2" PVC Well Screen
Material:	Pressure, Temperature, & Depth
Type of Measurement:	In-Situ Level Troll 100
Type of Logger:	35.360249, -82.551099
Gauge Location:	Ground elevation (ft): 2056.733

18/6/2021

Notes:

Soil Profile Description at Location of Well:

Depth Range (in.)	Color	Redox	Texture	Notes
0-16	OYR 2/1	11111111111111111111	SANDY LOAM	
16-47	IVP 5/2	11111111111111111111	SANDY LOAM	
47-110	DSY 10/3	11111111111111111111	SANDY CLAY	

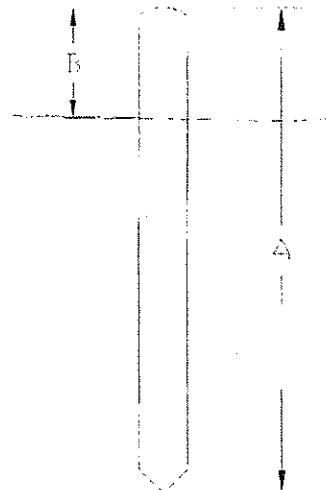

MONITORING GAUGE INSTALLATION DATA SHEET

Project Name:
Project Location:
Purpose of Gauge:

Banner Farm
Henderson County
Water Table Monitoring

(12/06/2021)


Gauge Description:

Gauge ID:	GW718
Serial Number:	W13841
Total Well Casing Length (A):	
Well Casing Height Above Ground (B):	2.11
Distance From Eye Bolt To Probe Sensor	b.10
Material:	2" PVC Well Screen
Type of Measurement:	Pressure, Temperature, & Depth
Type of Logger:	In-Situ Level Troll 100
Gauge Location:	35.395592, -82.541015
Ground elevation (ft m):	2059.602

Notes:

Soil Profile Description at Location of Well:

Depth Range (in.)	Color	Redox	Texture	Notes
0-9	10YR 3/2	5 YR 6/8 2-7	Clean	
9-29	10YR 6/1	10YR 6/8 3-5	1-2% Silt	
29-43	2.5Y 5/1	10YR 6/8 1-9	Silt / 1-2% sand	
43-60	2.5Y 5/1	10YR 6/8 1-5%	Sand	

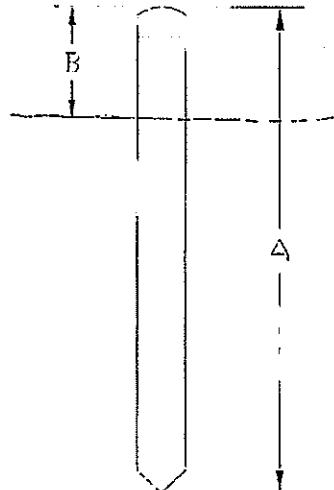

MONITORING GAUGE INSTALLATION DATA SHEET

Project Name:
Project Location:
Purpose of Gauge:

Banner Farm
Henderson County
Water Table Monitoring

12/06/2021


Gauge Description:

Gauge ID:	GWG 17
Serial Number:	013815
Total Well Casing Length (A):	
Well Casing Height Above Ground (B):	1.96
Distance From Eye Bolt To Probe Sensor	5.10
Material:	2" PVC Well Screen
Type of Measurement:	Pressure, Temperature, & Depth
Type of Logger:	In-Situ Level Troll 100
Gauge Location:	35.352285, -80.657371
Ground elevation (ft):	2058.3643

Notes:

Soil Profile Description at Location of Well:

Depth Range (in.)	Color	Redox	Texture	Notes
0-15	D.SY 6/11	DYK 6/8, 202	Silt loam	
15-25	D.SY 6/12	DYK 3/4, 57	Silt loam	
25-40	SY 6/1	DYK 1/8, 151	Sandy loam	

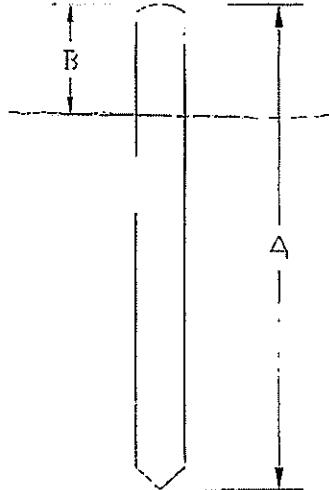

MONITORING GAUGE INSTALLATION DATA SHEET

Project Name:
Project Location:
Purpose of Gauge:

Banner farm
HENDERSON COUNTY
Water Table Monitoring

Gauge Description:

Gauge ID:	GWG IX
Serial Number:	8109171
Total Well Casing Length (A):	1.78
Well Casing Height Above Ground (B):	10.48
Distance From Eve Bolt To Probe Sensor	2' PVC Well Screen
Material:	Pressure, Temperature, & Depth
Type of Measurement:	In-Situ Level Troll 100
Type of Logger:	
Gauge Location:	35.352400, -82.65X554
Ground Elevation (ft):	2060.27

12/6/2021

Notes:

Soil Profile Description at Location of Well:

Depth Range (in.)	Color	Redox	Texture	Notes
0-15	2.5 41.0	10VR5IX 10	Silt loam	
15-33	2.5 41	10VR518.2%	Silt loam	
33-41	10VR3/1		Silt loam	
41-50	10VR2/2		Silt loam	Lots of organic material semi-composted

