


Oak Hill Dairy Mitigation Site Record Drawing

Gaston County, North Carolina

for

NCDEQ

Division of Mitigation Services

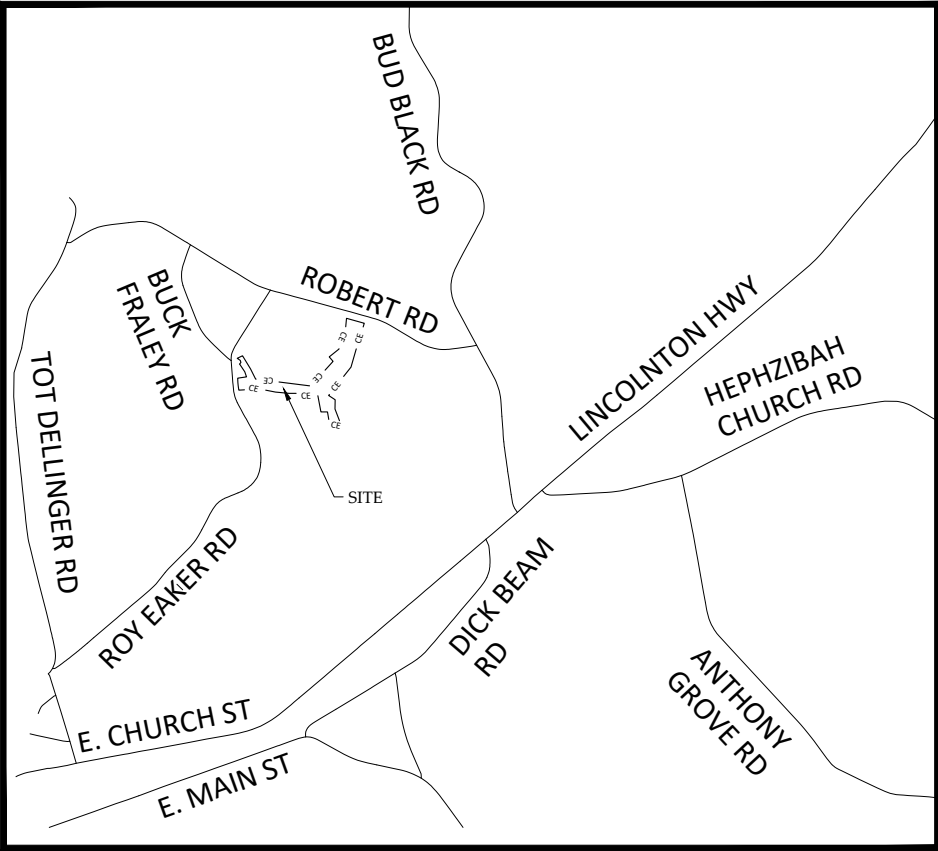

Vicinity Map
Not to Scale

STREAM ORIGINS		
NAME	NORTHING	EASTING
OAK HILL CREEK	609299	1299430
UT1	610055	1297694
UT1A	610499	1297711
UT1B	609941	1297705
UT2	610266	1299747
UT3	610616	1299891



PRELIMINARY PLANS
ISSUED May 12, 2022

Sheet Index

Title Sheet	0.1
Project Overview	0.2
General Notes and Symbols	0.3
Stream Plan and Profile	
Oak Hill Creek	1.1-1.6
UT1	1.7-1.11
UT1A	1.12
UT1B	1.13
UT2	1.14
UT3	1.15
Wetland Grading	2.1-2.4
Planting Sheets	3.1-3.5
Fencing and Gate Plan	4.1

Project Directory


Engineering:
Wildlands Engineering, Inc
License No. F-0831
167-B Haywood Rd
Asheville, NC 28806
Jake Mclean, PE, CFM
828-774-5547

Surveying:
Kee Mapping and Surveying, PA
88 Central Avenue
Asheville, NC 28801
Phillip B. Kee, PLS
828-645-8275


Owner:
NCDEQ - NC DMS
1652 Mail Service Center
Raleigh, NC 27699
Mathew Reid
828-231-7912

NCDEQ Contract No. 7867
DMS ID No. 100120


NC DWR#20190863
Catawba River Basin 03050102

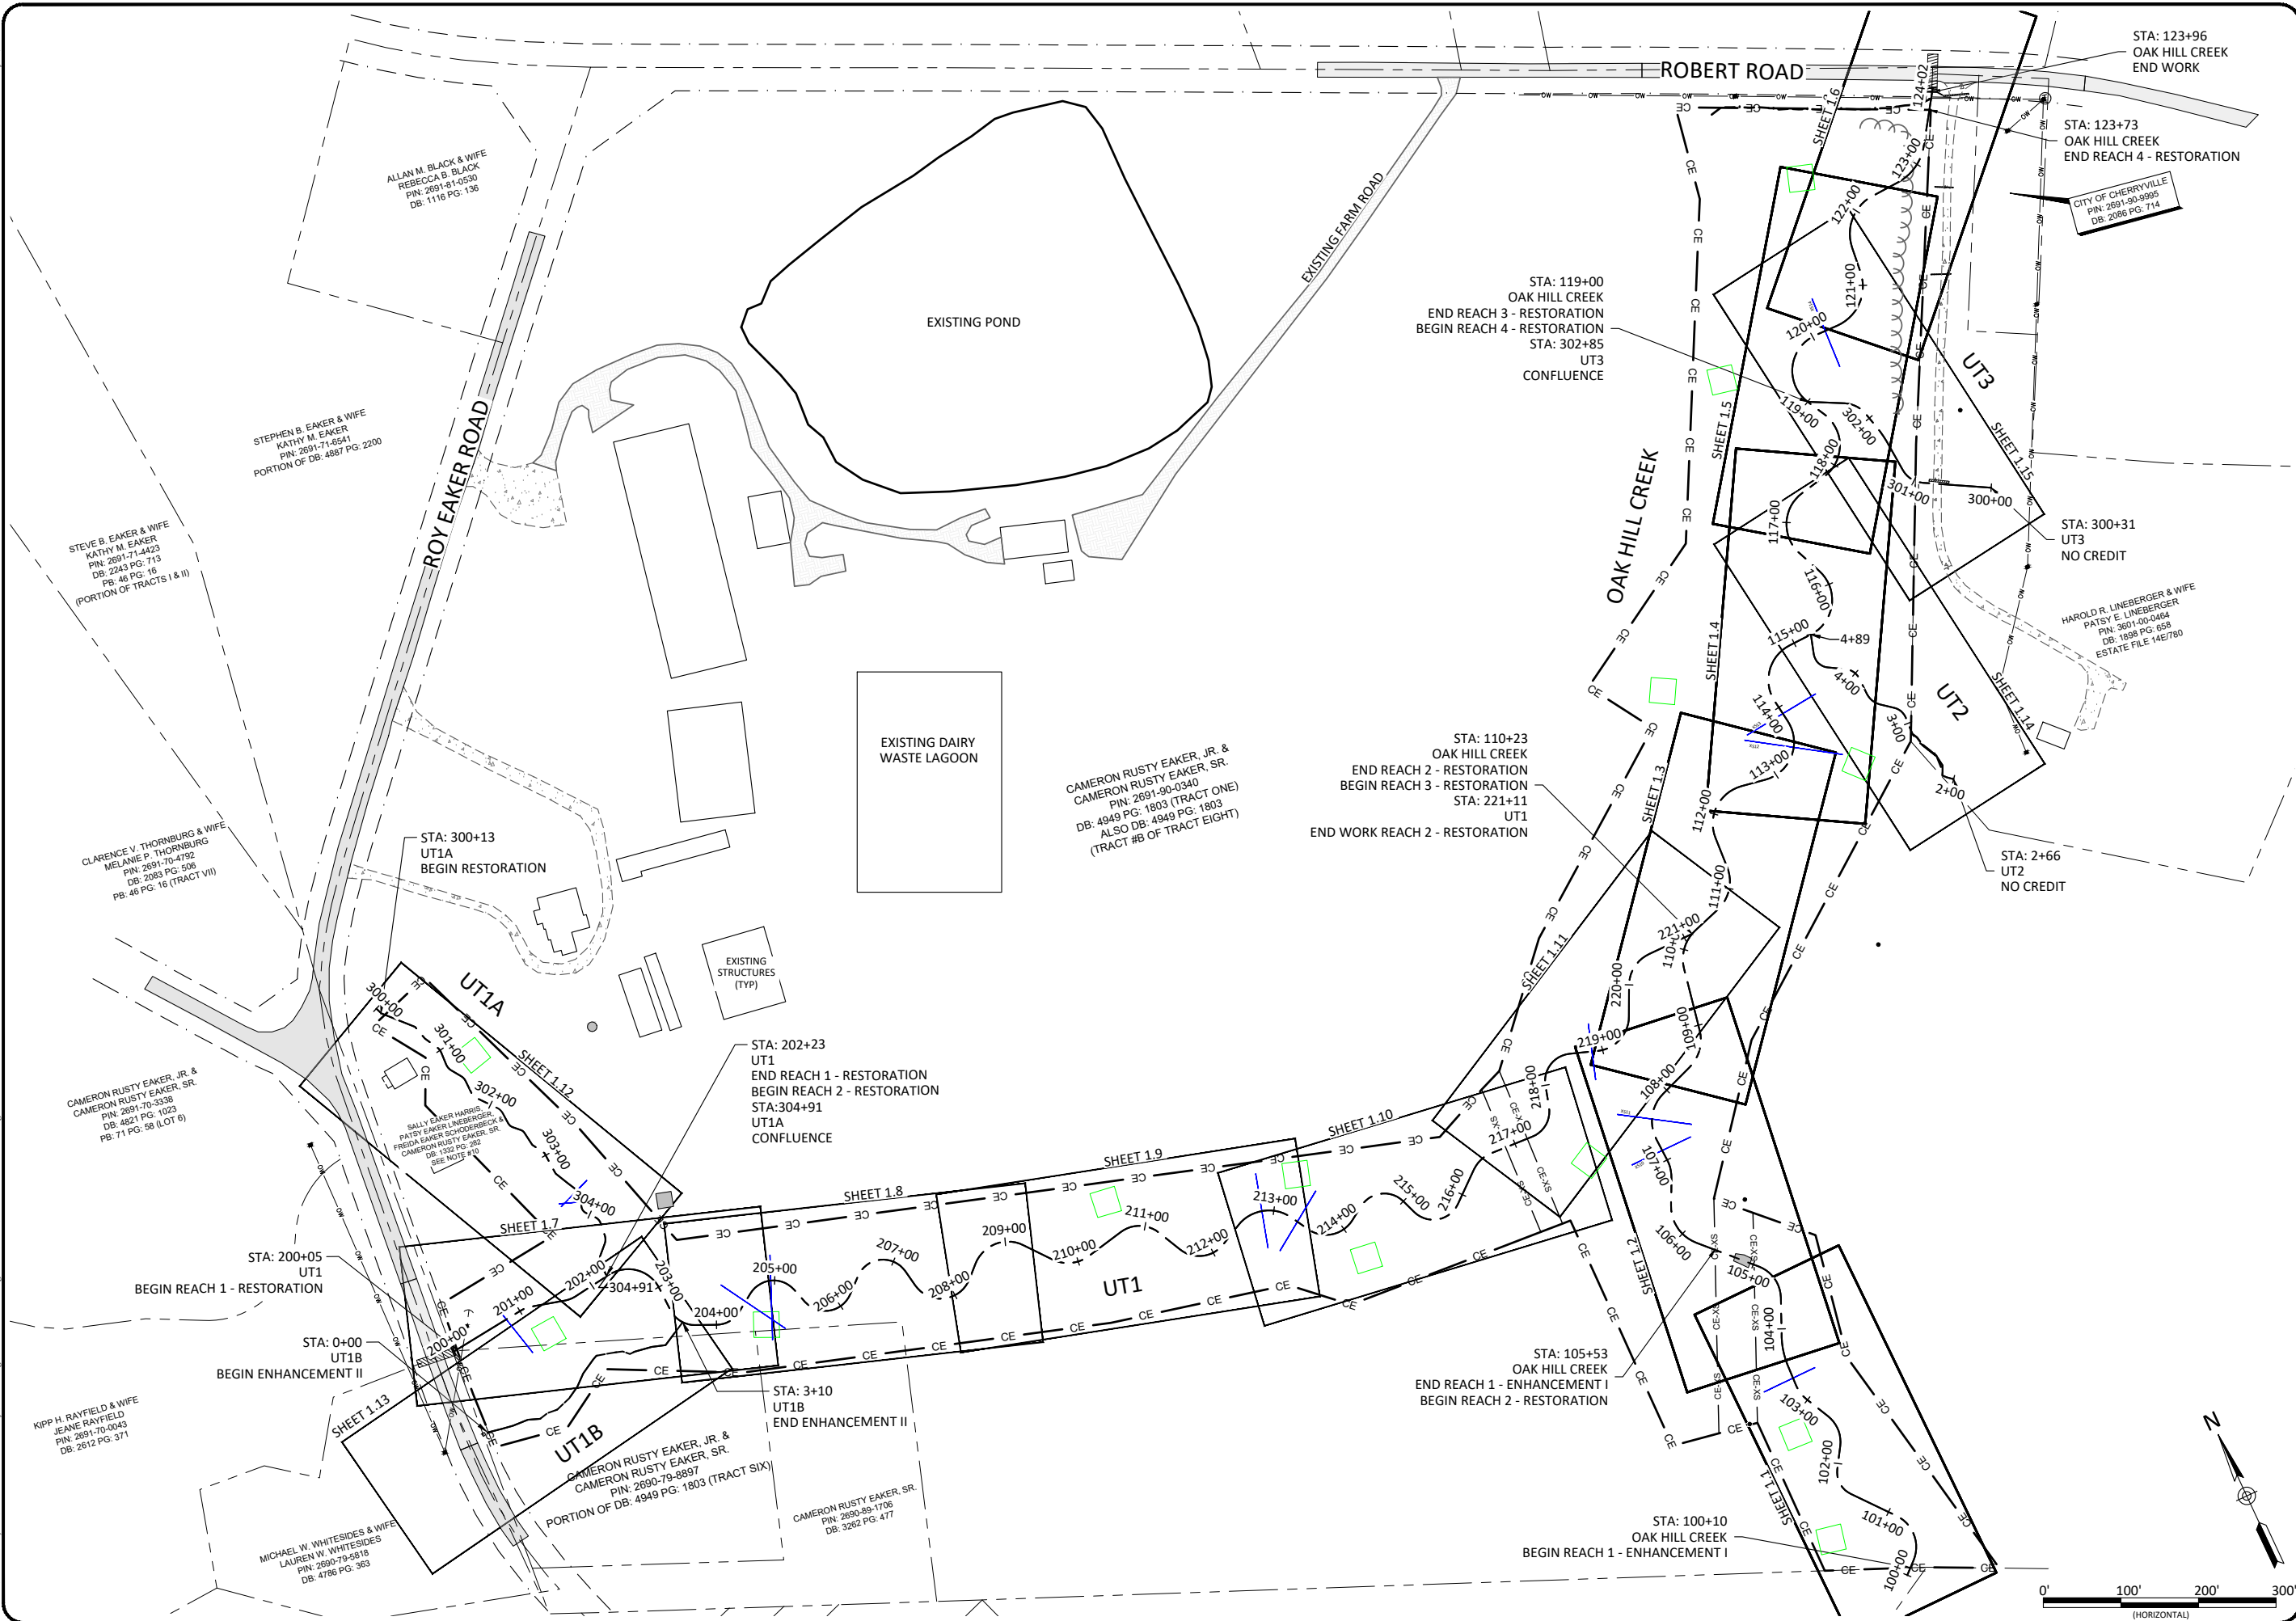


Pre-Construction Features

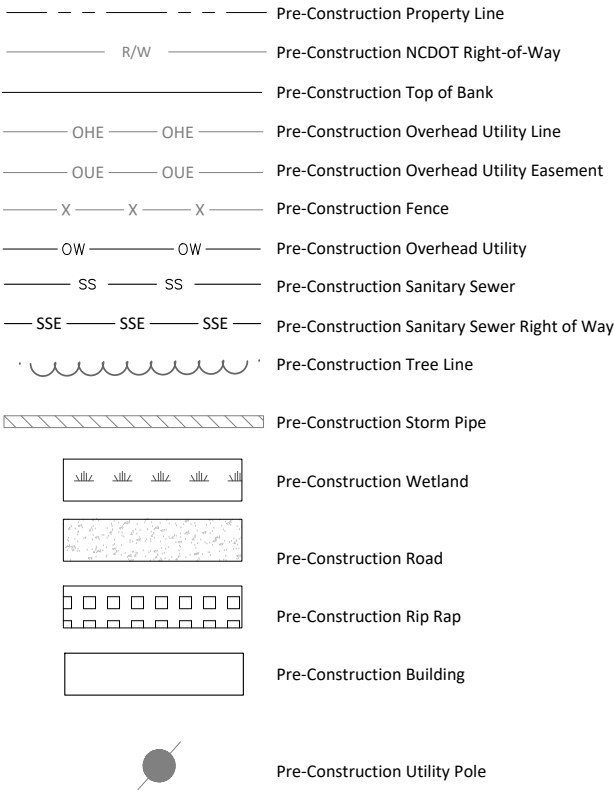


Design Features

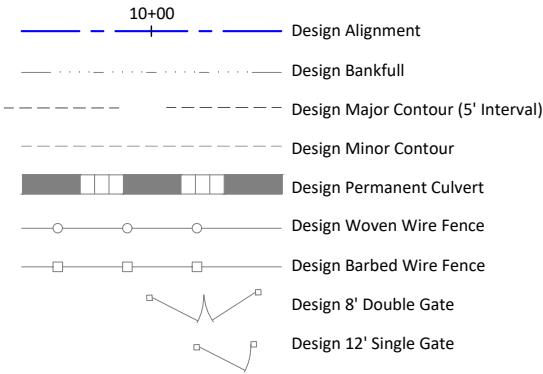


Design Structures

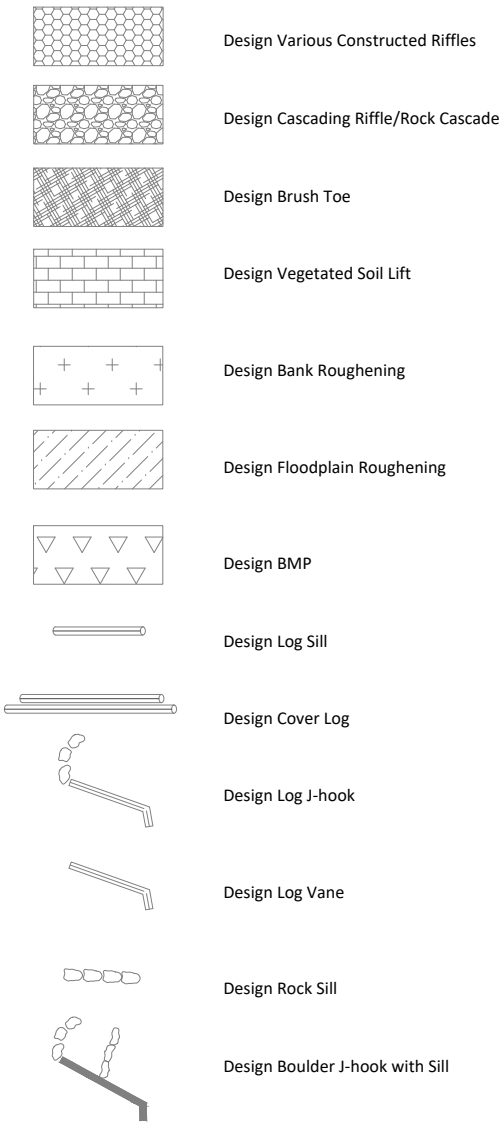

Asbuilt Features

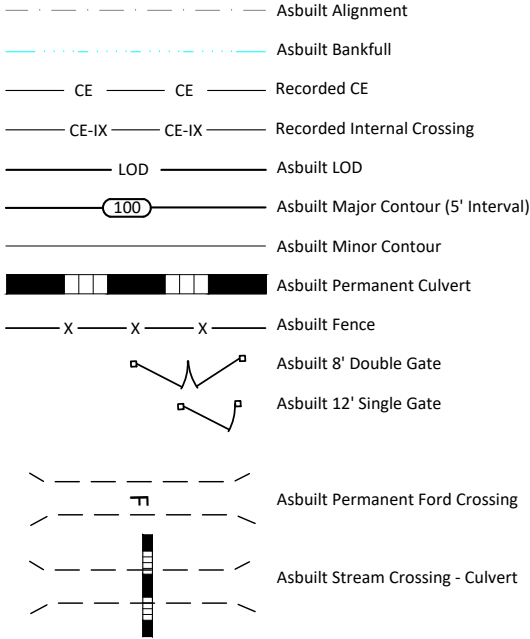

Asbuilt Structures

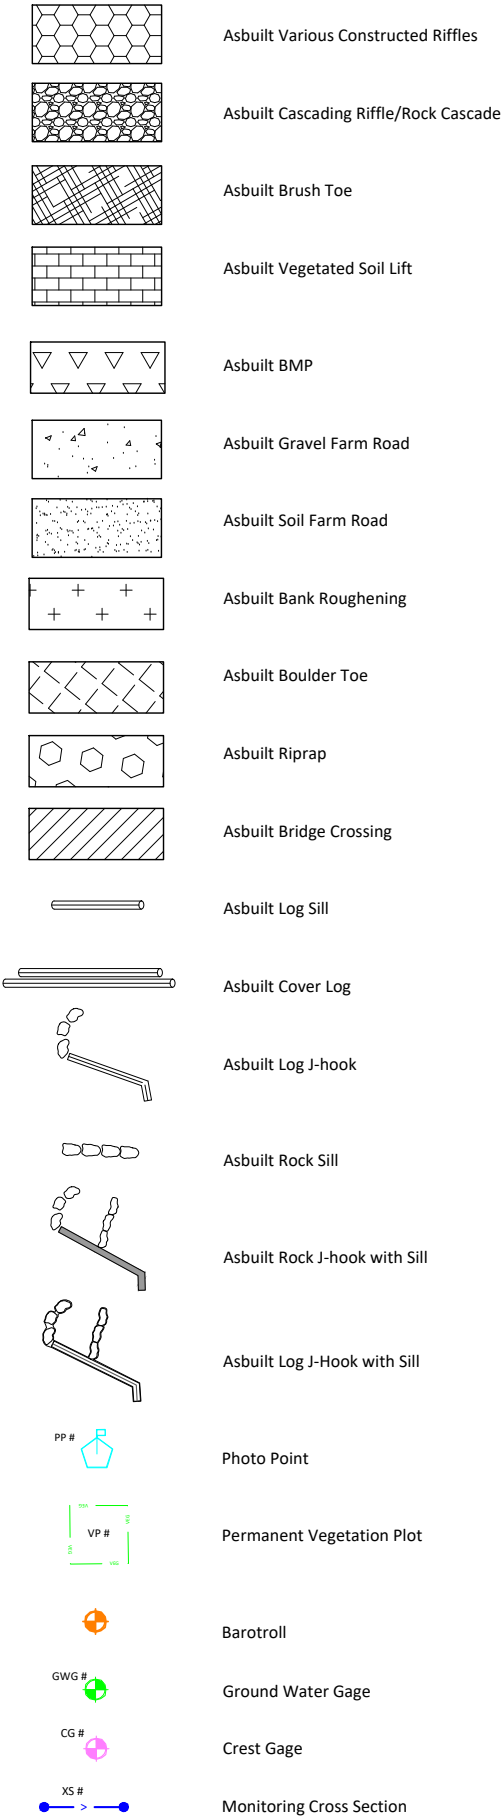

PROJECT NOTES:

Topographic survey was completed by Kee Mapping and Surveying, PA in July 2019.

Parcel boundary survey completed by Kee Mapping and Surveying, PA in October 2019.




Conservation easement survey completed by Kee Mapping and Surveying, PA in October 2020.

Topographic data supplemented with Lidar data from Feb - April 2017.

Riffle selection varied based on available materials at the Engineers' discretion. Field coordination will be required.

Project Notes:

1. DEVIATIONS FROM THE DESIGN WILL BE SHOWN IN RED.

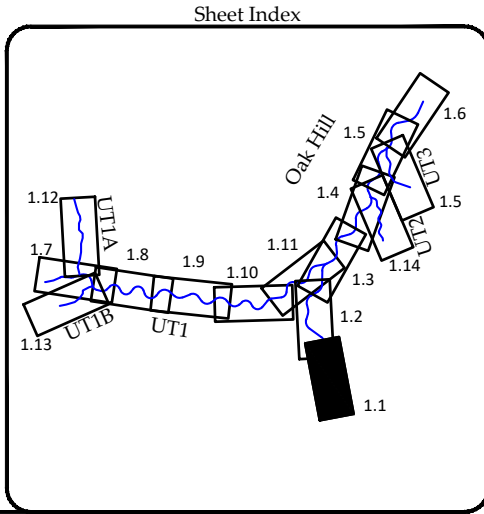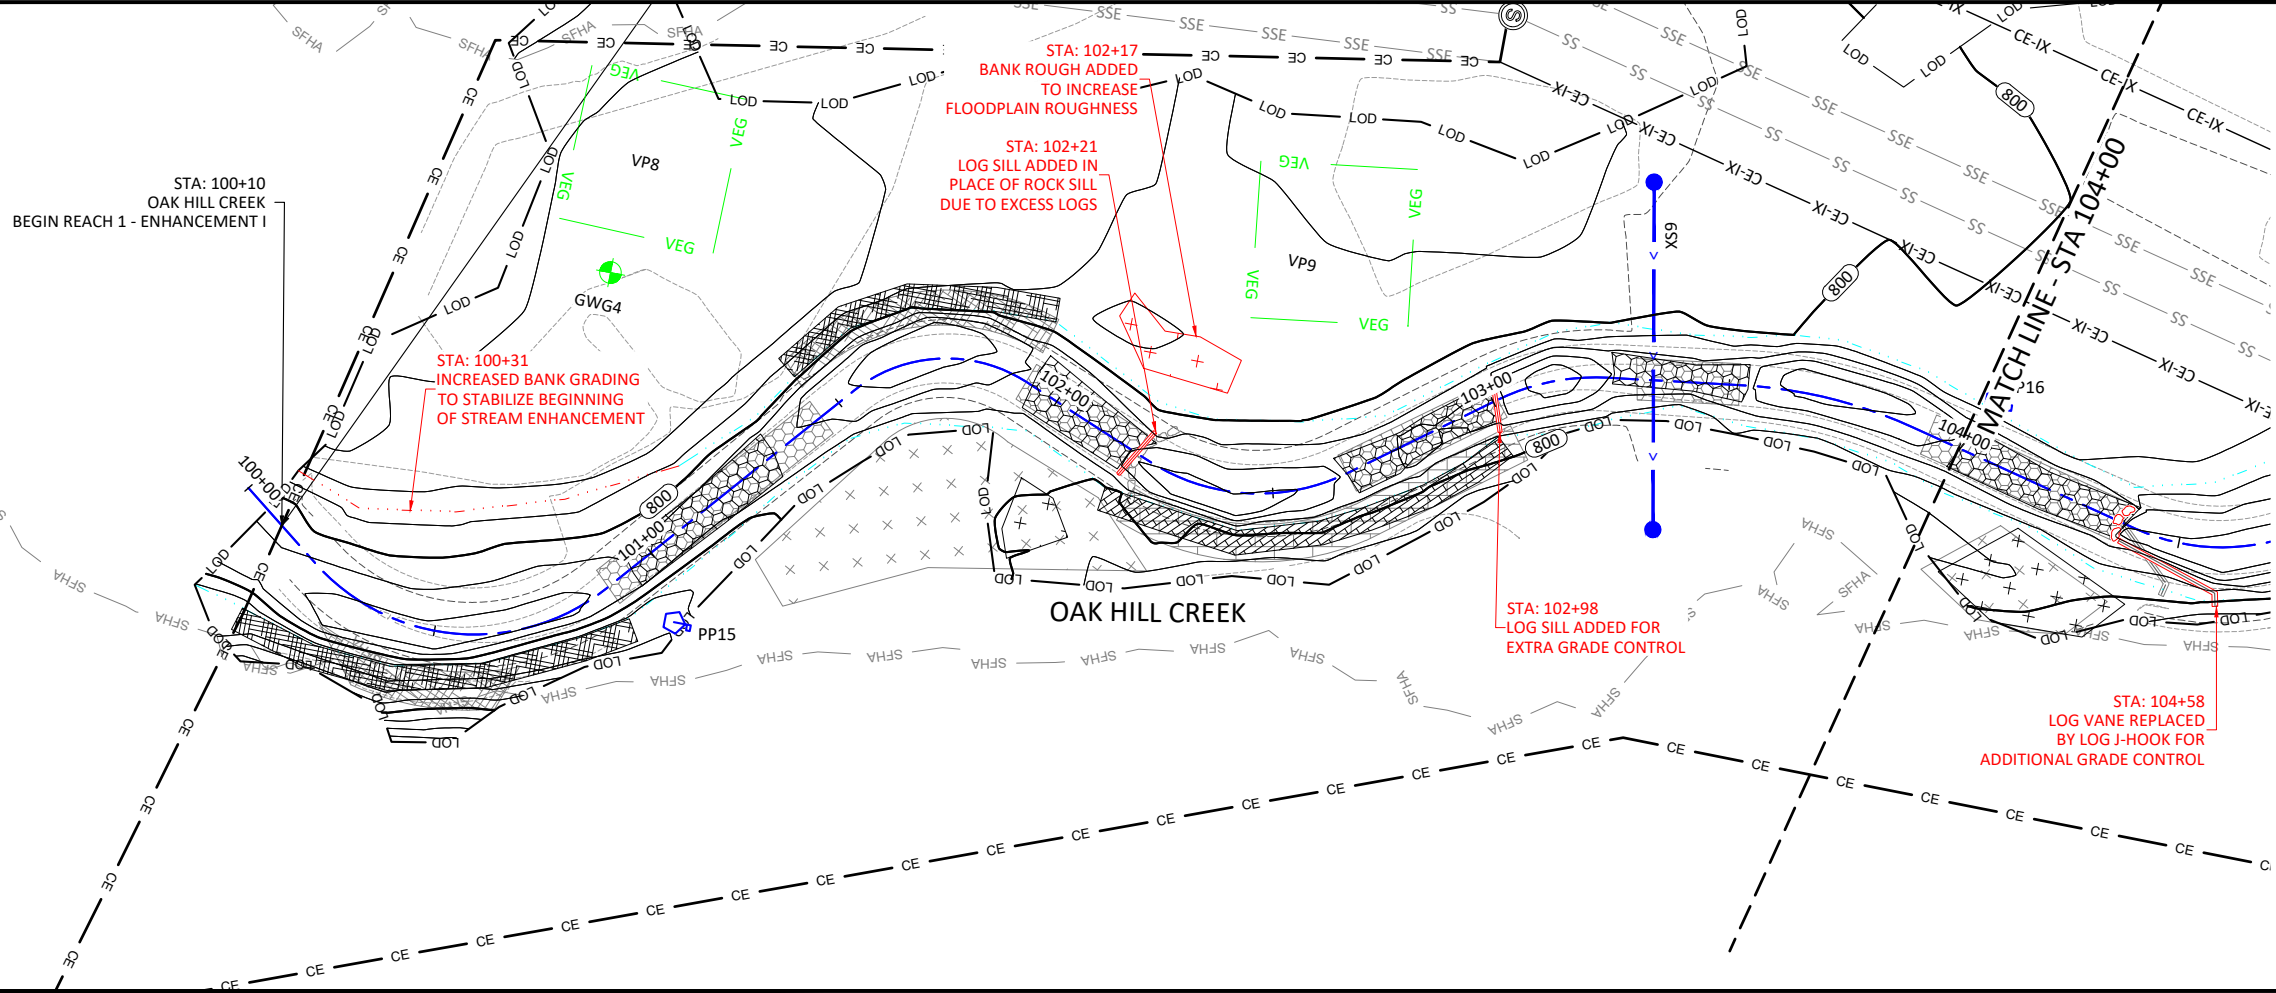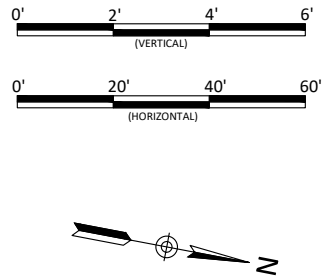

Oak Hill Dairy Mitigation Site Record Drawings
Gaston County, North Carolina

Oak Hill Creek
Stream Plan and Profiles

Revisions:	





Date:	May 12, 2022
Job Number:	005-02182
Project Engineer:	IM
Drawn By:	AMR
Checked By:	JCK

1.1

Sheet



WILDLANDS
ENGINEERING
167-B Haywood Rd
Asheville, NC 28806
Tel: 828.774.5547
License No. F-0831

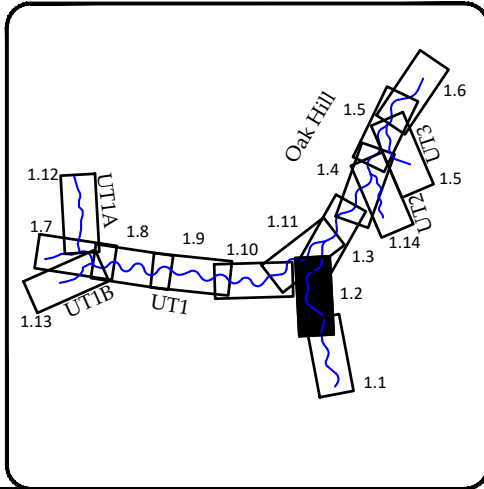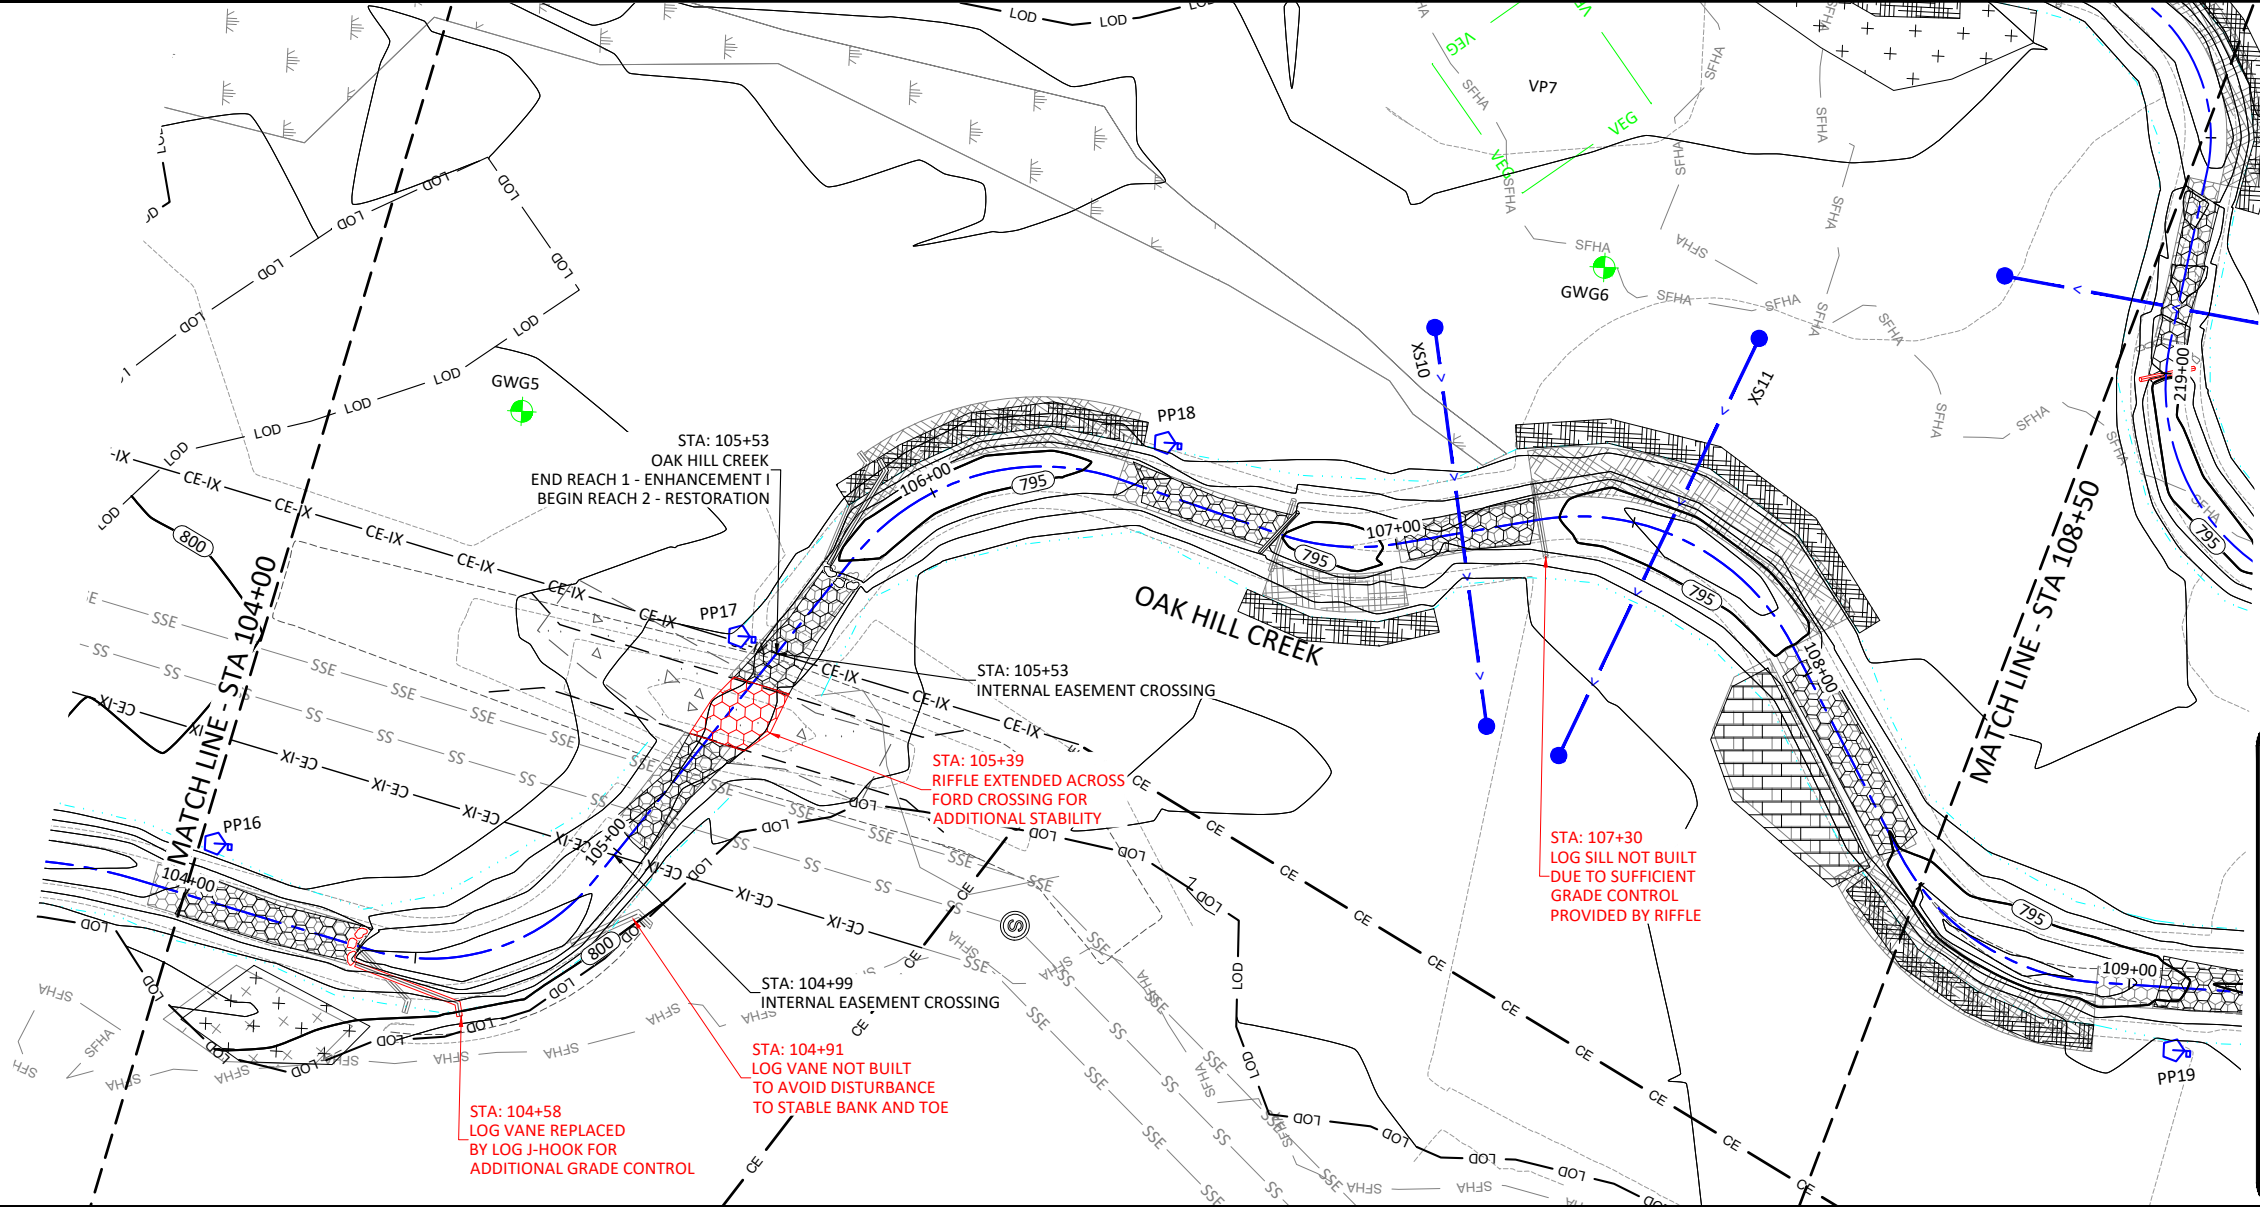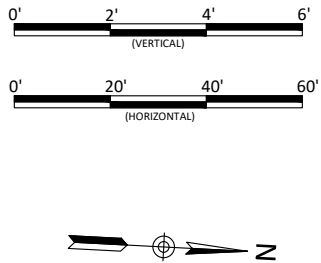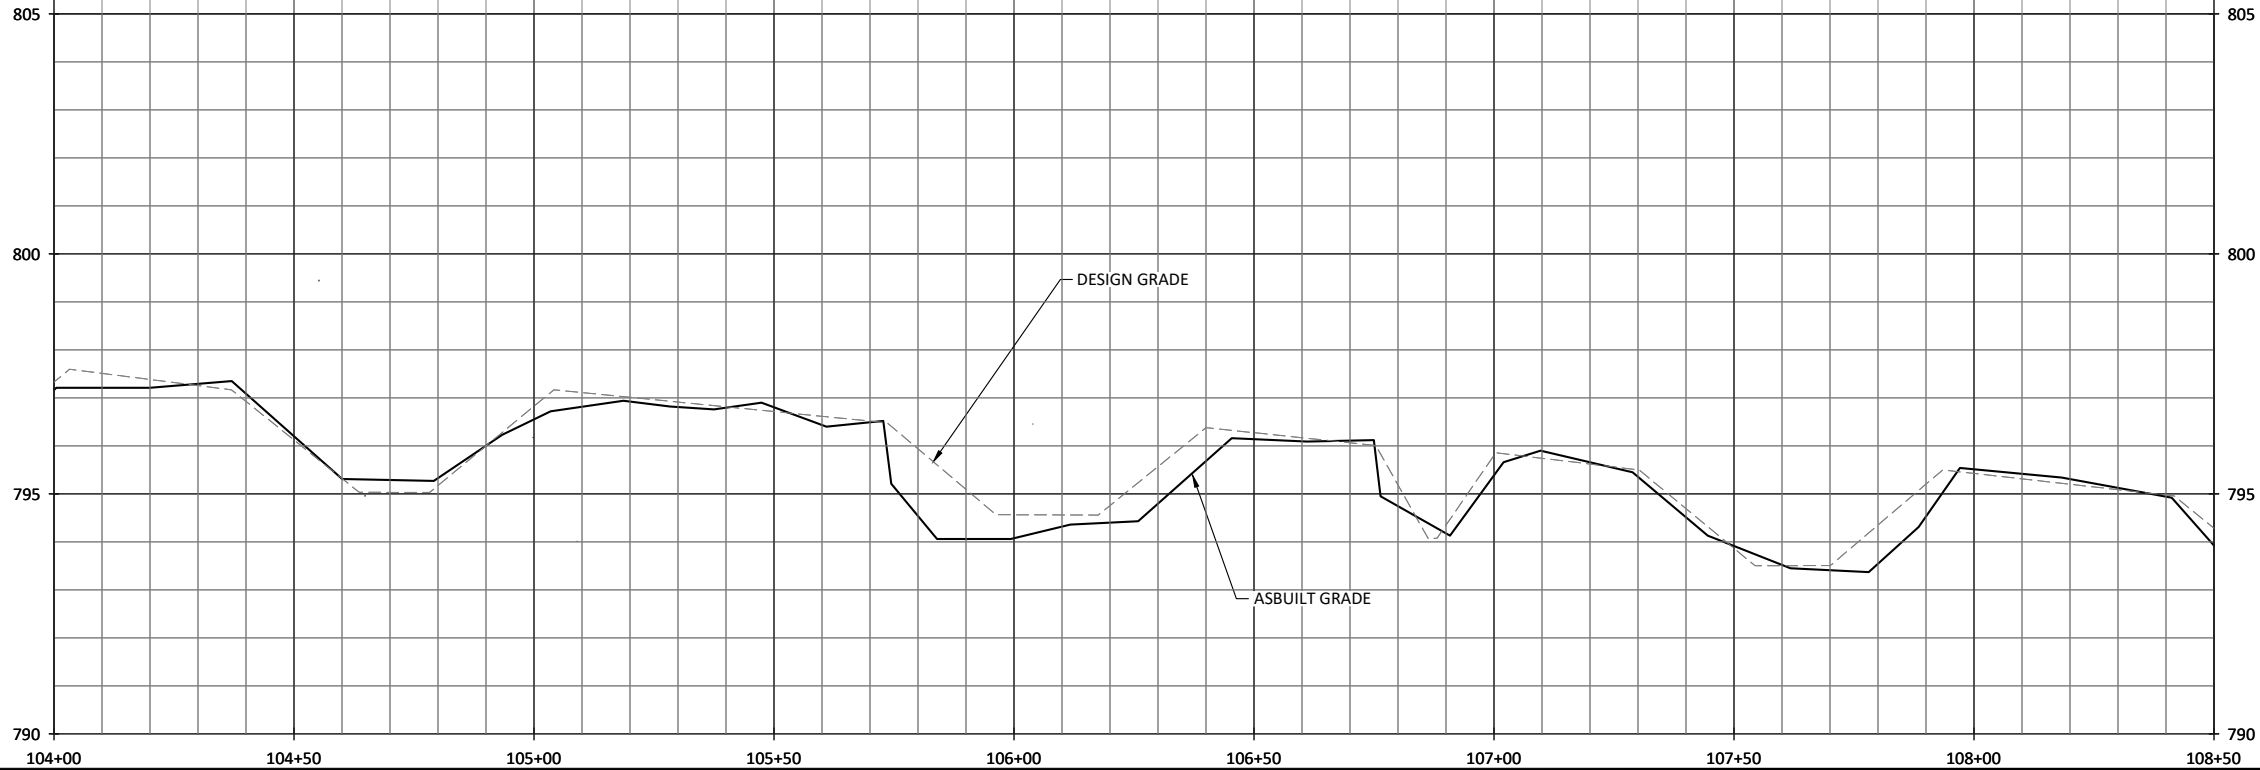

Oak Hill Dairy Mitigation Site Record Drawings
Gaston County, North Carolina

Oak Hill Creek
Stream Plan and Profiles





Revisions:

Date:	May 12, 2022
Job Number:	005-02182
Project Engineer:	JM
Drawn By:	AMR
Checked By:	JCK

1.2



May 13, 2022
X:\Shared Projects\005-02182 Oak Hill Dairy Monitoring Baseline Monitoring - 2021 Plans\AB-02182 Profiles.dwg

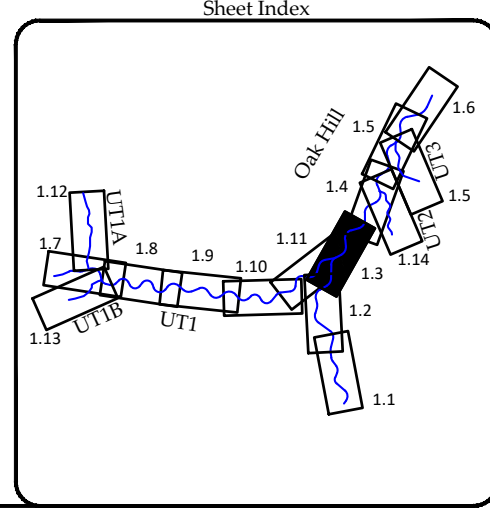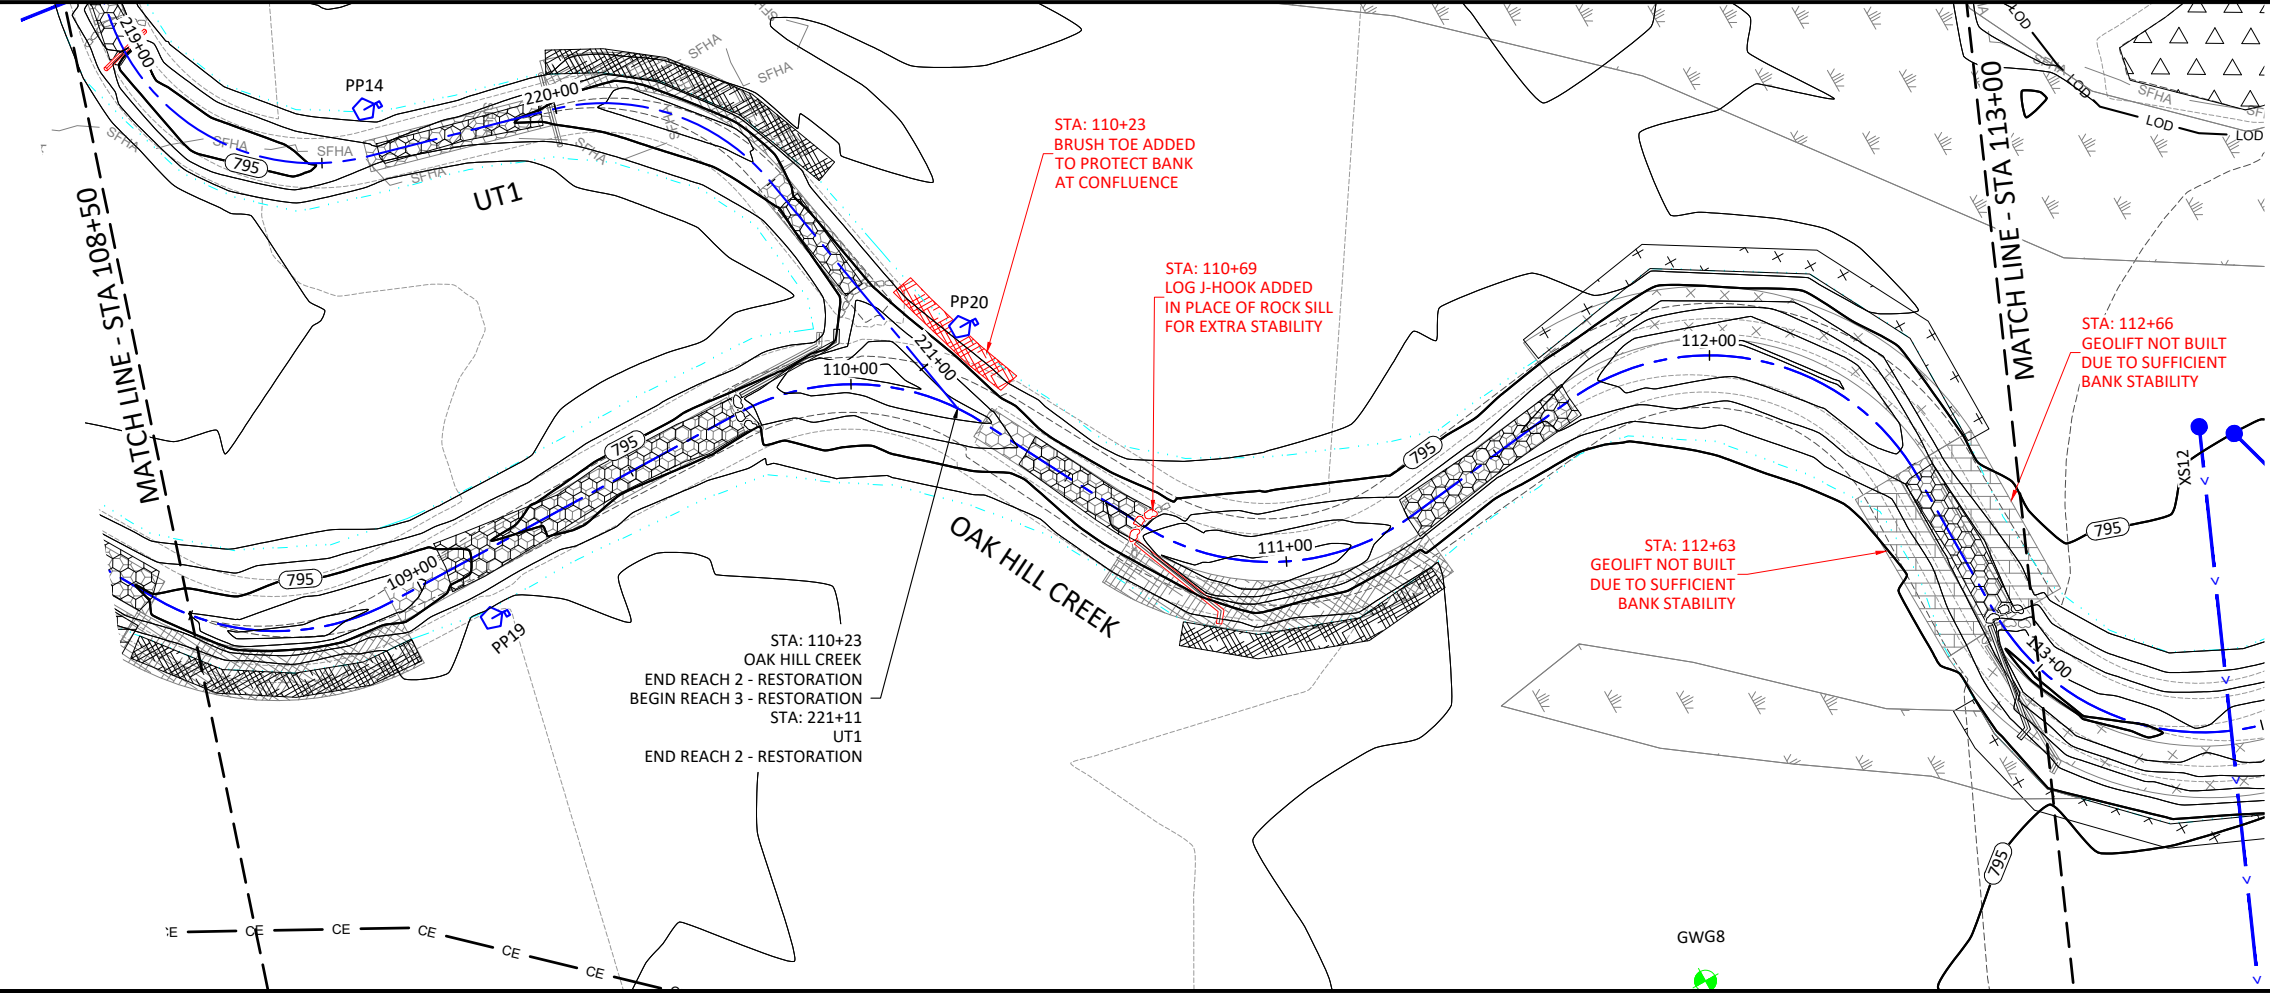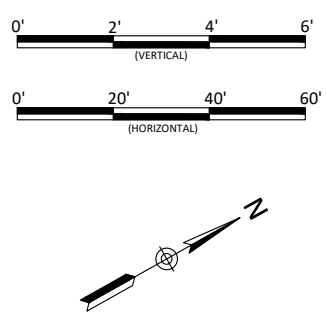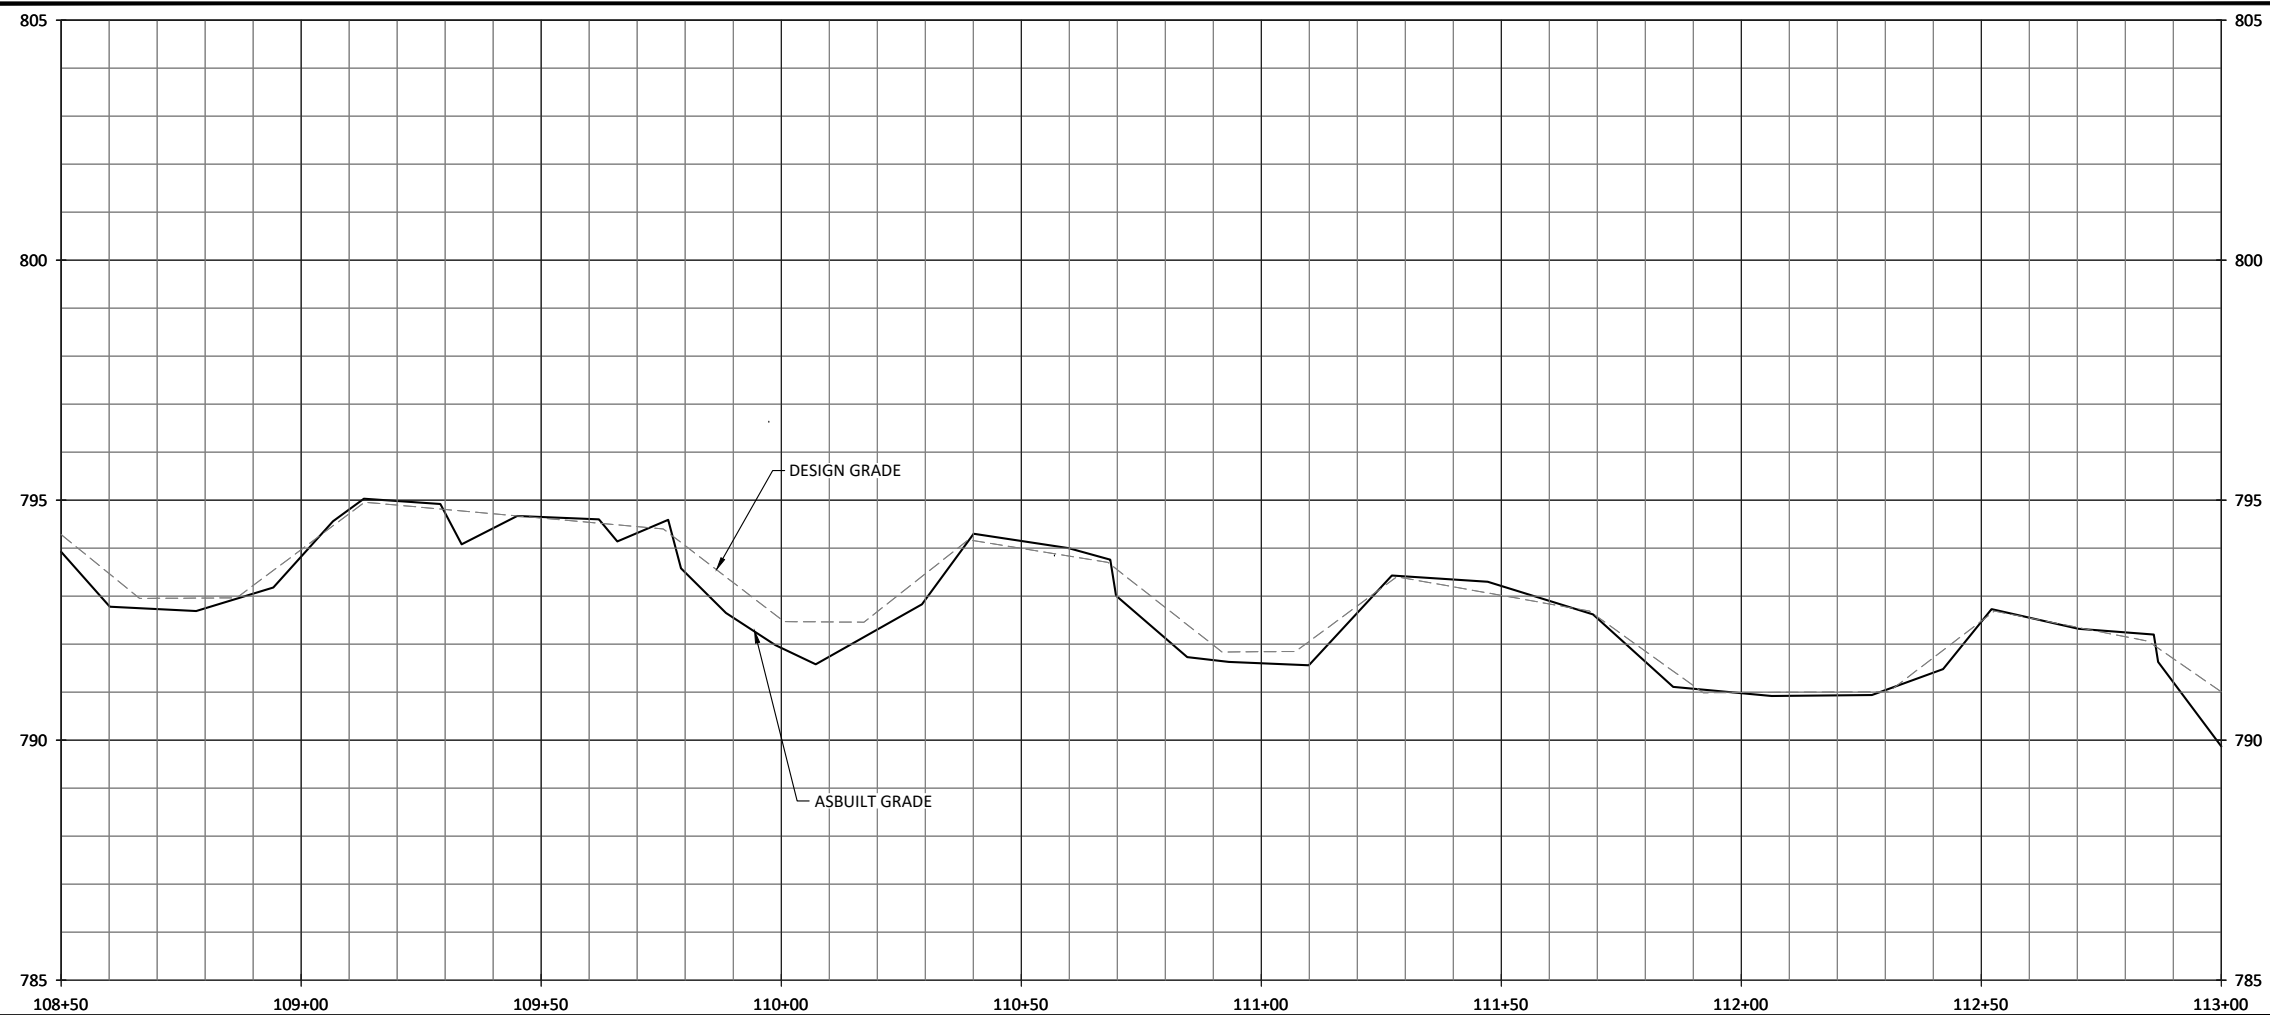

WILDLANDS
ENGINEERING
167-B Haywood Rd
Asheville, NC 28806
Tel: 828.774.5547
License No. F-0831





Oak Hill Dairy Mitigation Site Record Drawings
Gaston County, North Carolina

Oak Hill Creek
Stream Plan and Profiles

Revisions:

Date: May 12, 2022
Job Number: 005-02182
Project Engineer: JMK
Drawn By: AMR
Checked By: JCK

1.3
Sheet

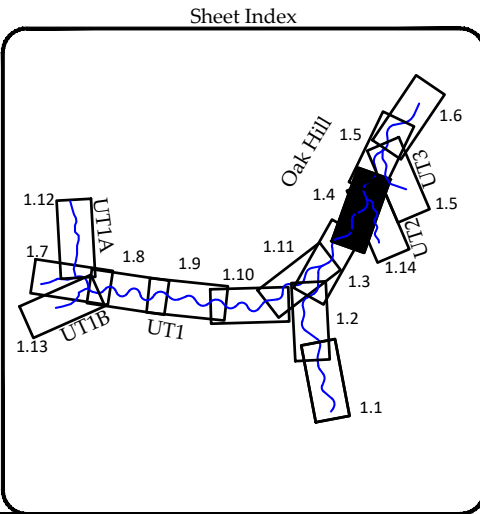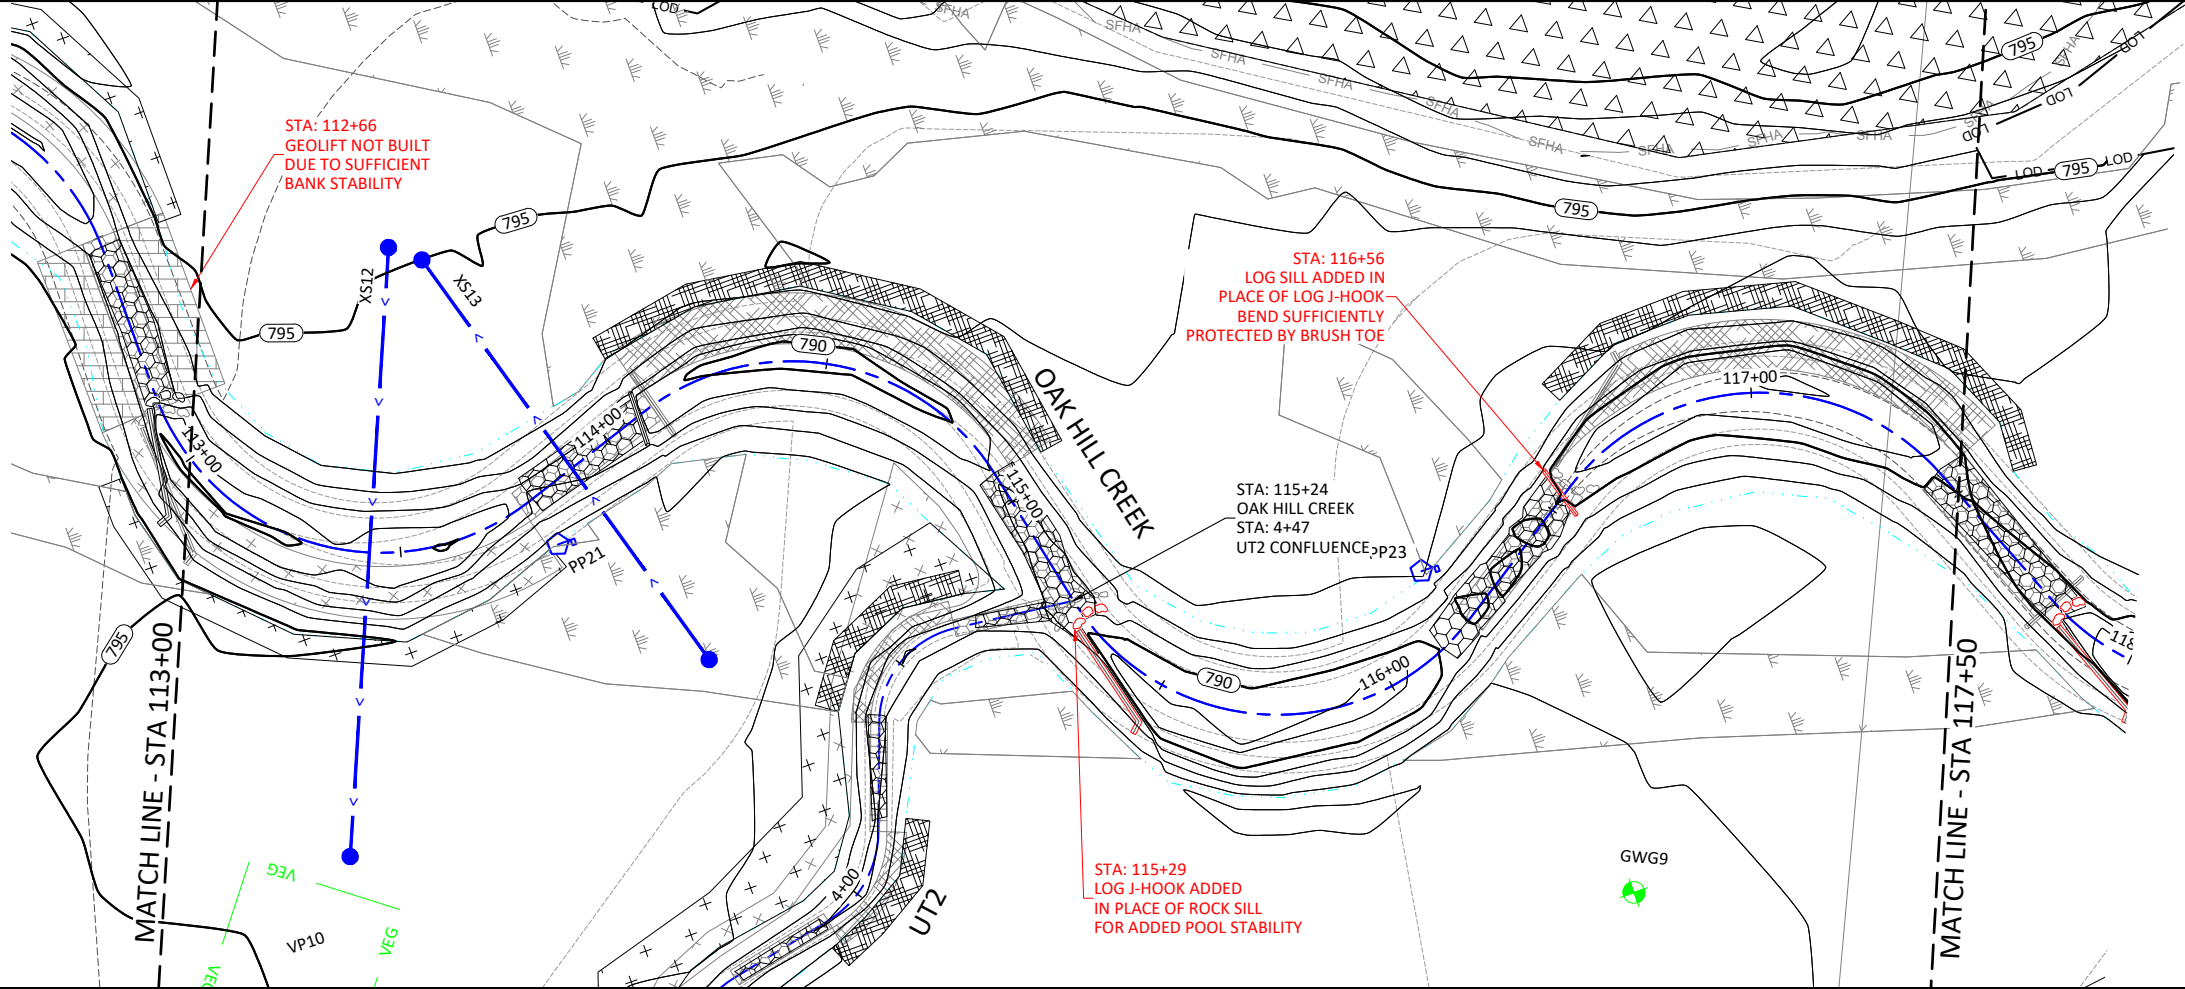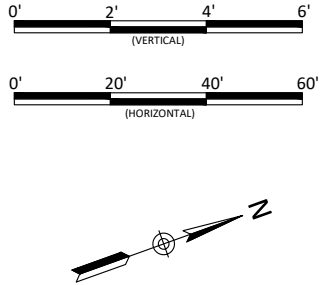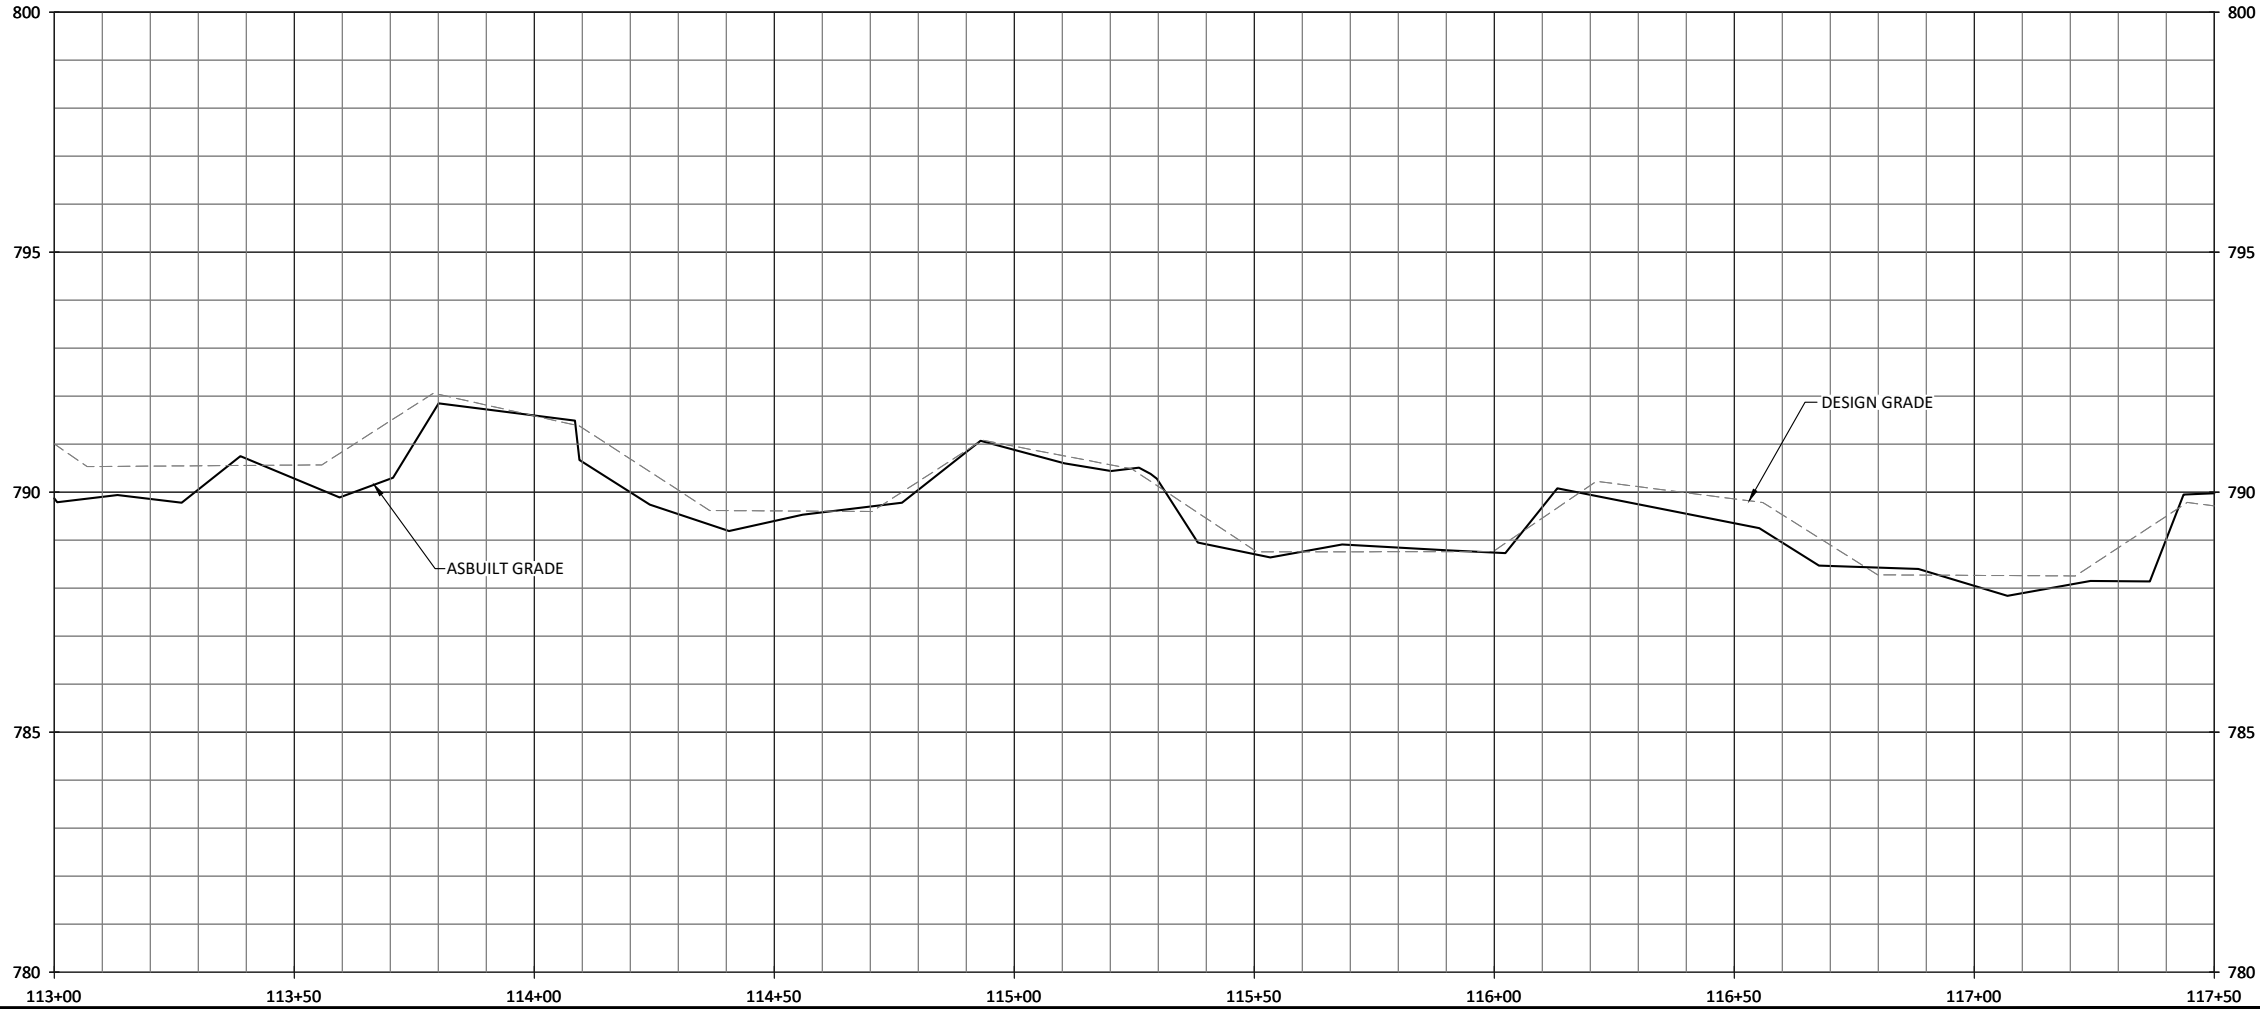

Oak Hill Dairy Mitigation Site Record Drawings
Gaston County, North Carolina

Oak Hill Creek
Stream Plan and Profiles

Revisions:





Date:	May 12, 2022
Job Number:	005-02182
Project Engineer:	IM
Drawn By:	AMR
Checked By:	JCK

1.4




May 13, 2022

X:\Shared Projects\005-02182 Oak Hill Dairy Monitoring Baseline Monitoring - 2021 Plans\AB-02182 Profiles.dwg

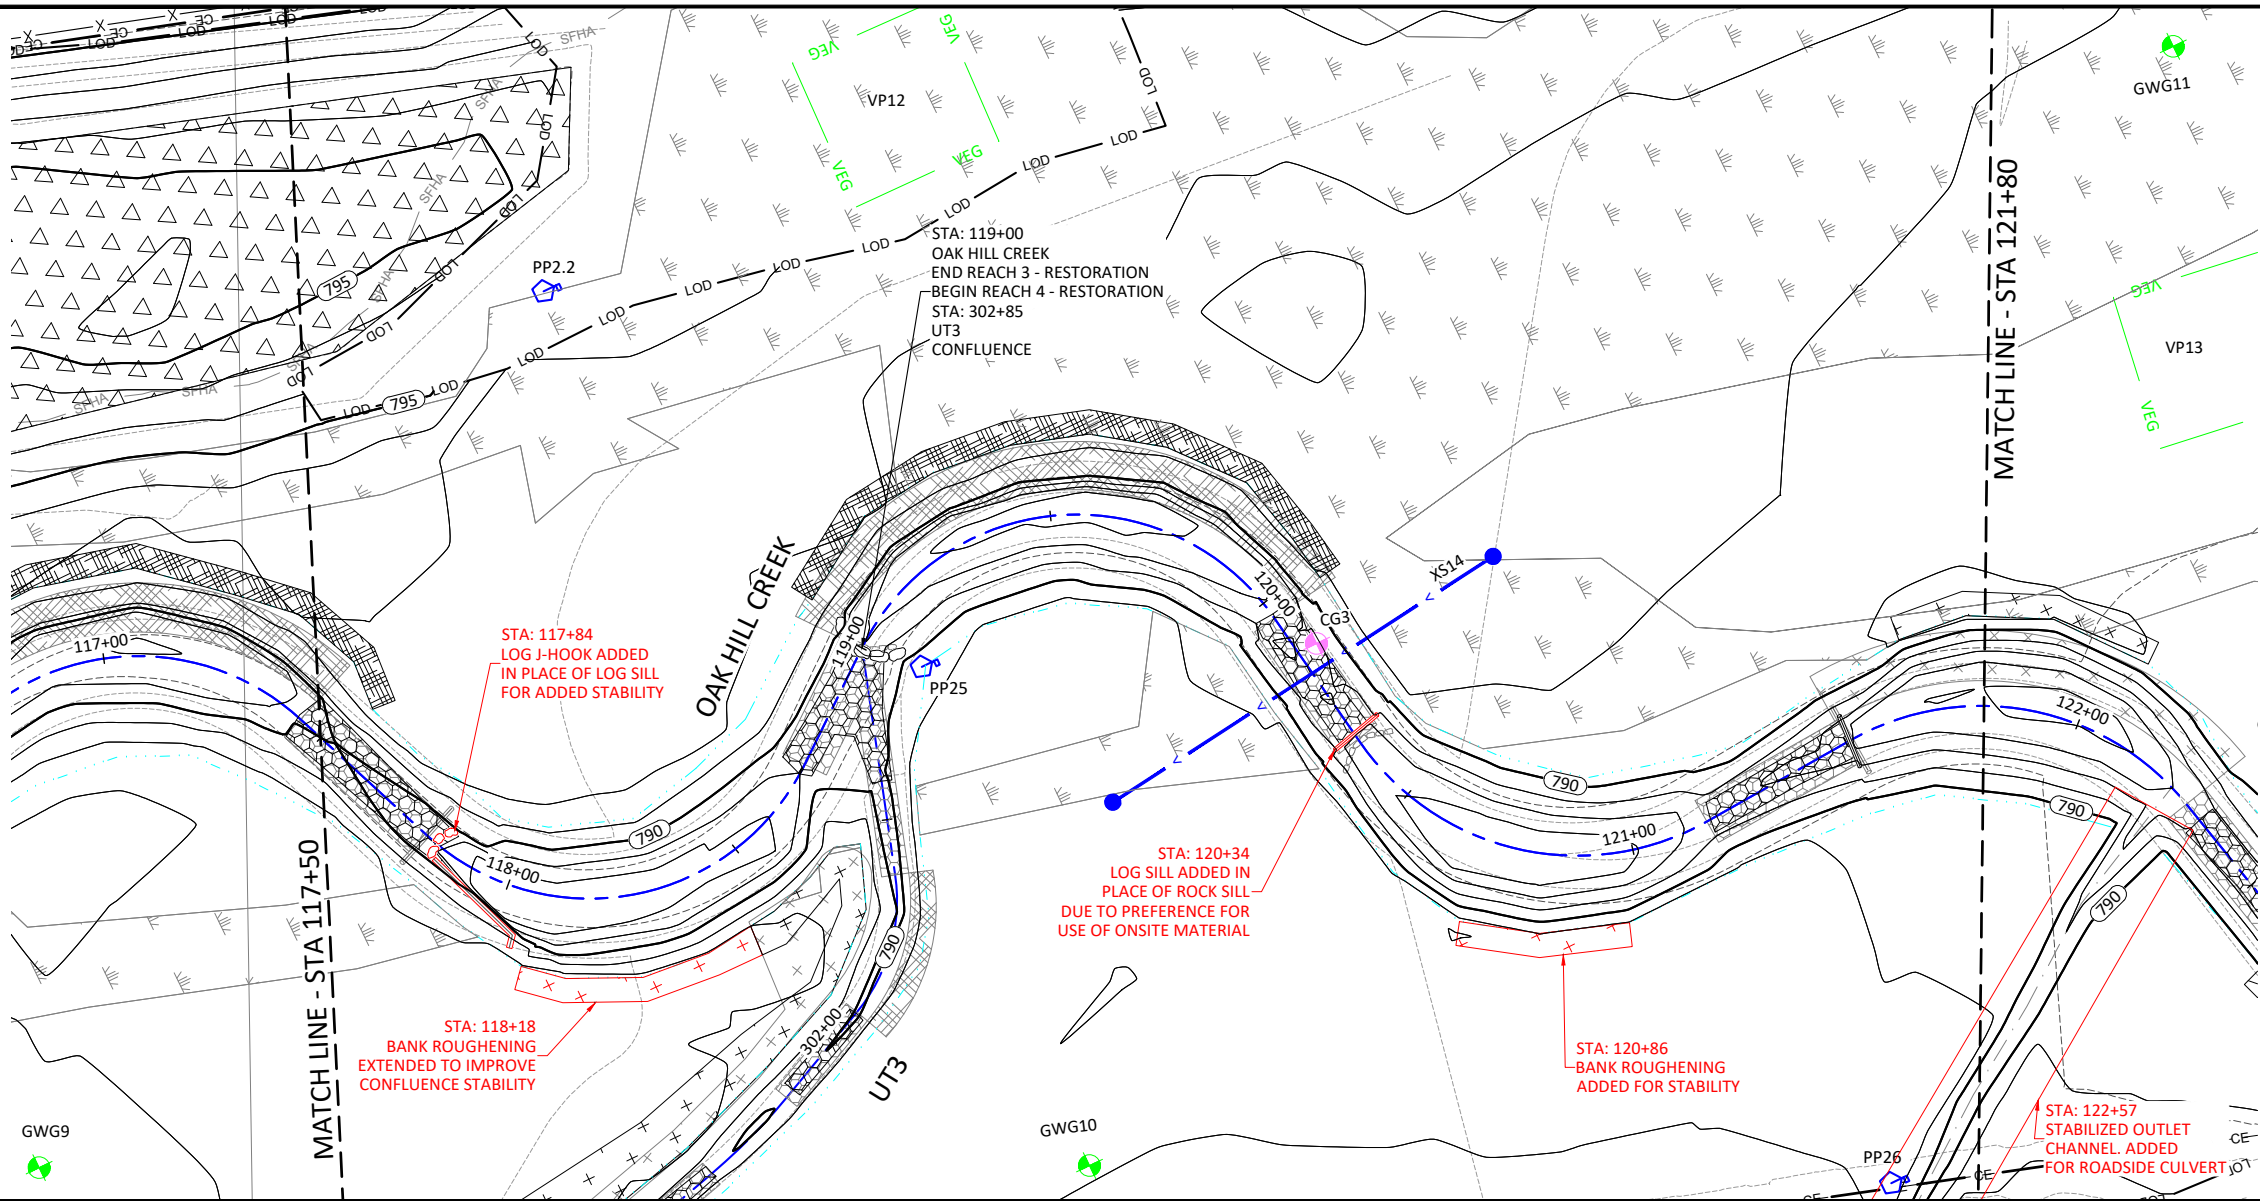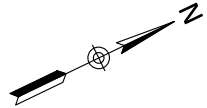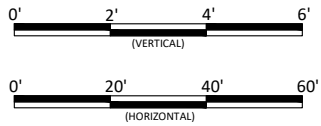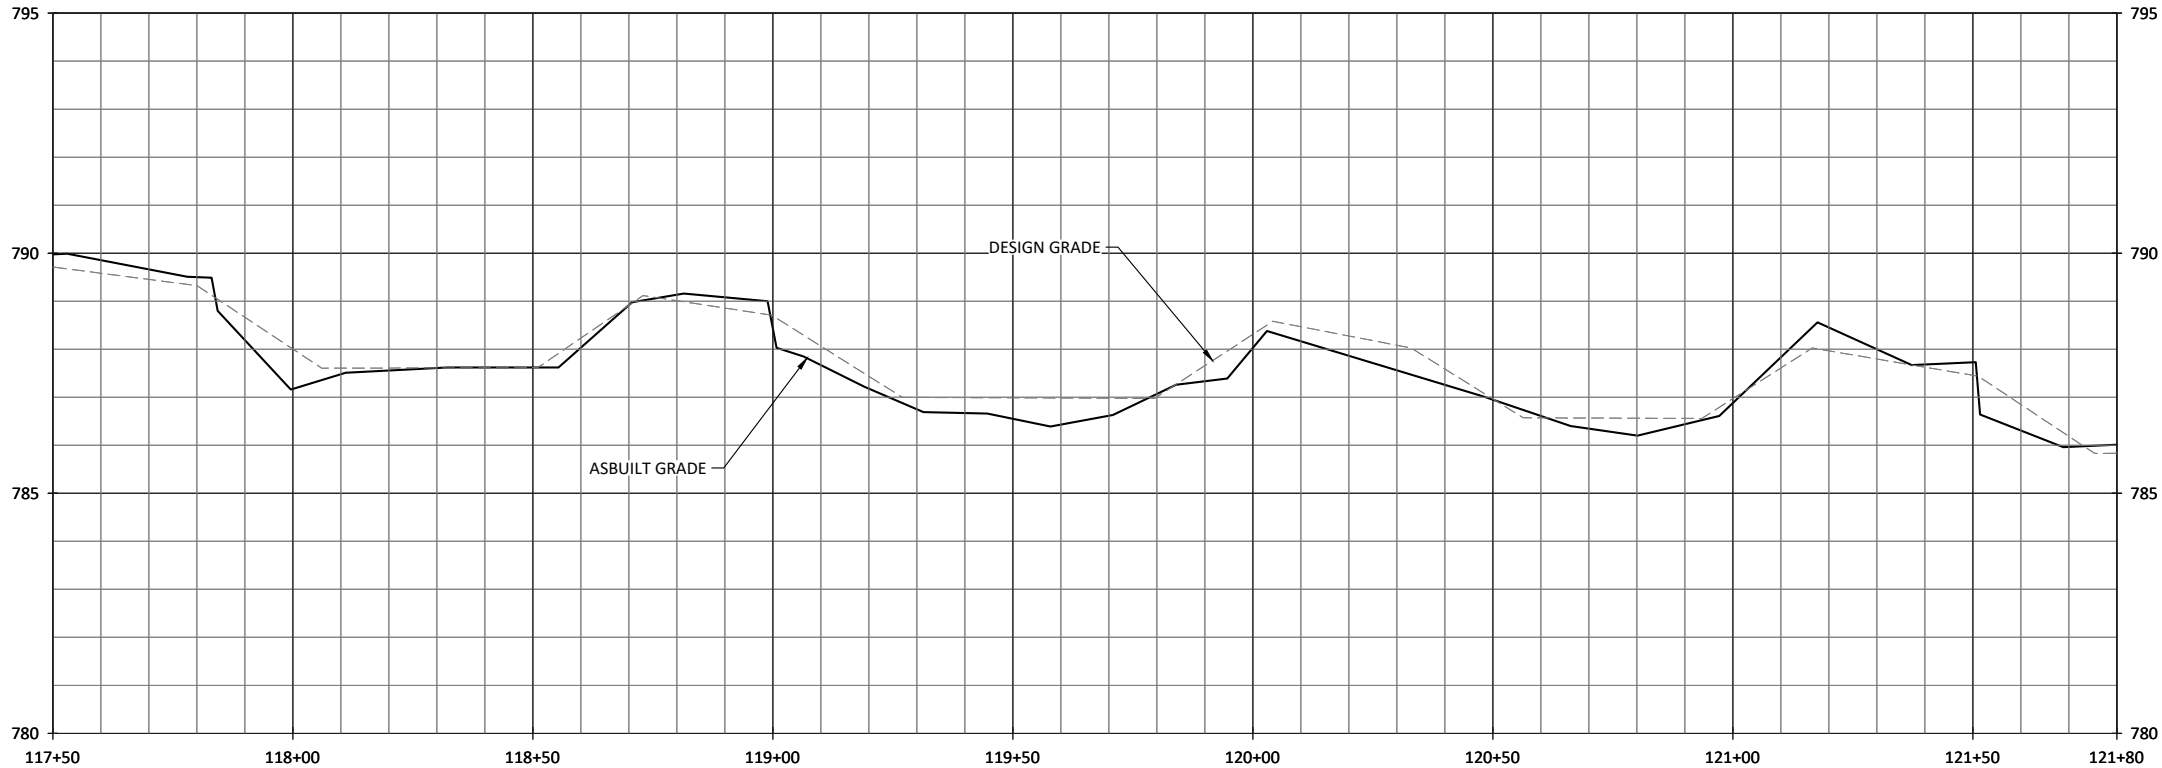

Sheet Index

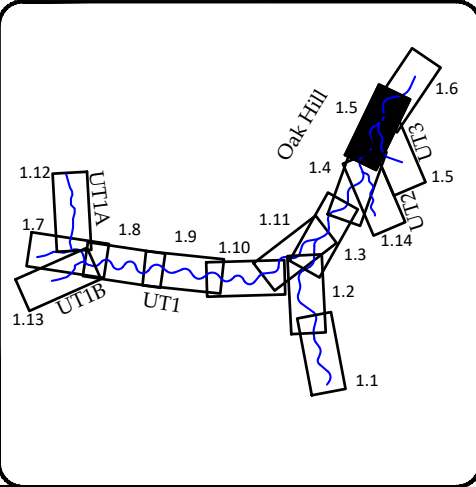

Oak Hill Dairy Mitigation Site Record Drawings

Gaston County, North Carolina

Oak Hill Creek
Stream Plan and Profiles



WILDLANDS
ENGINEERING
167-B Haywood Rd
Asheville, NC 28806
Tel: 828.774.5547
License No. F-0831

Revisions:





Date:	May 12, 2022
Job Number:	005-02182
Project Engineer:	JM
Drawn By:	AMR
Checked By:	JCK

1.5

Sheet

X:\Shared Projects\005-02182 Oak Hill Dairy Monitoring Baseline Monitoring - 2021 Plans\AB-02182 Profiles.dwg

May 13, 2022

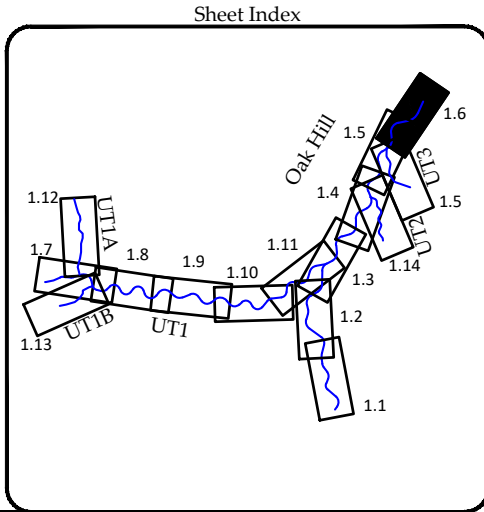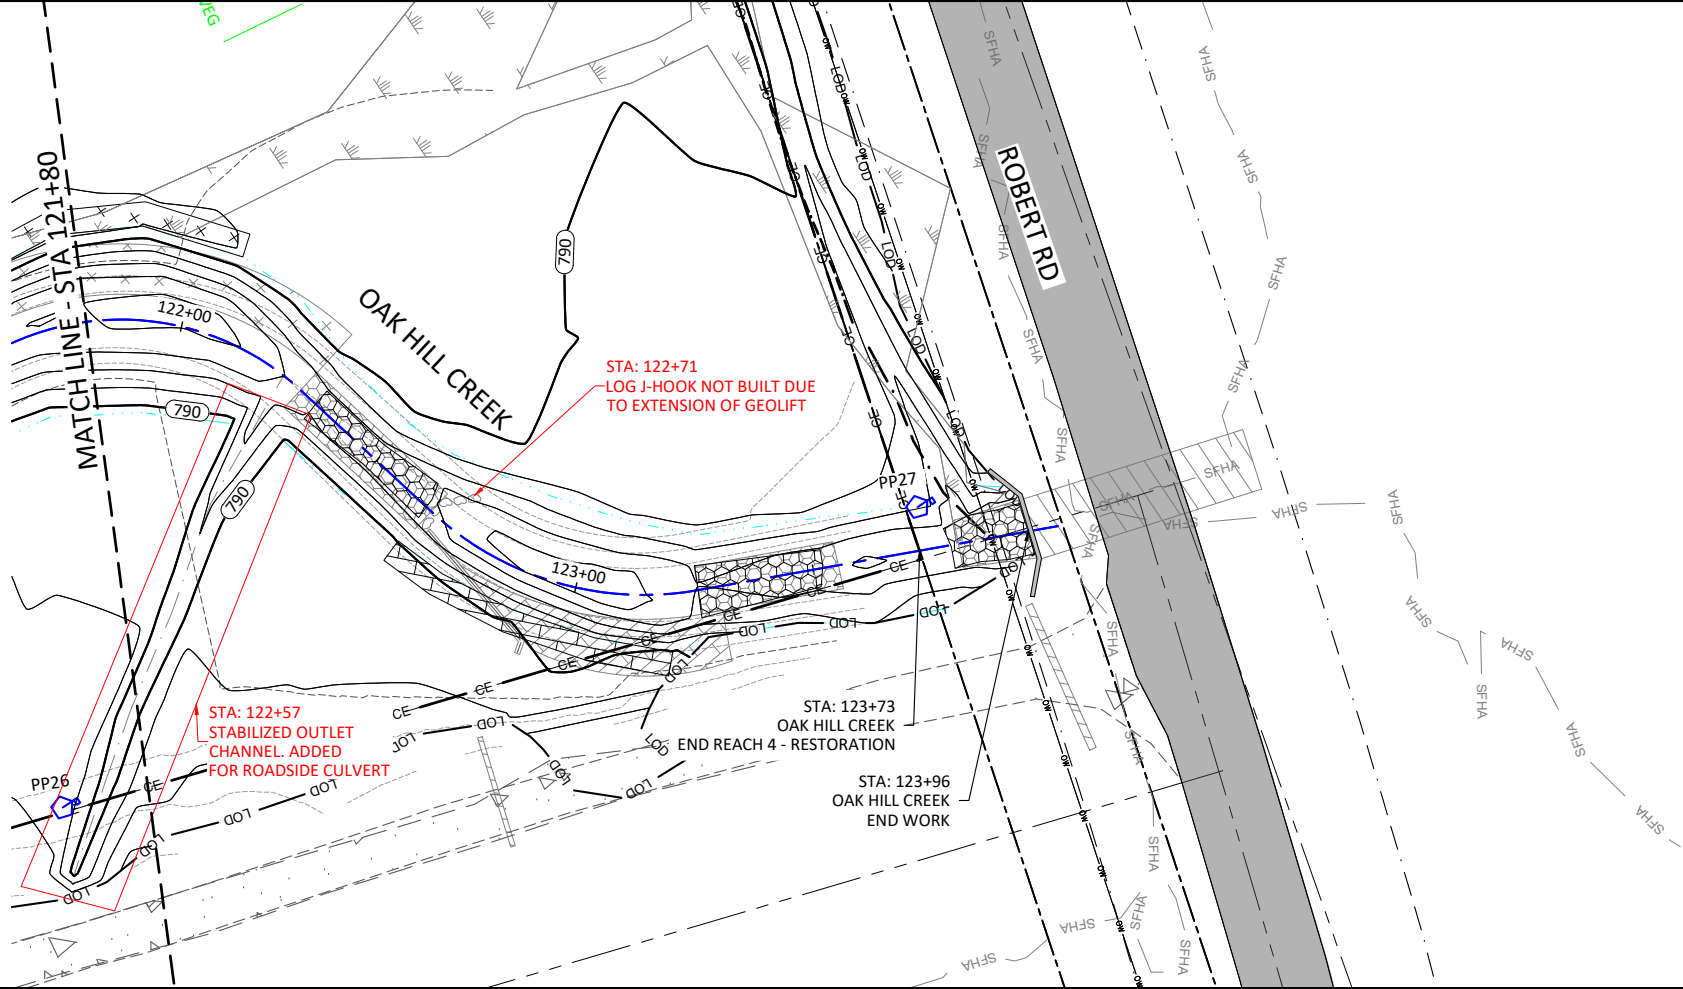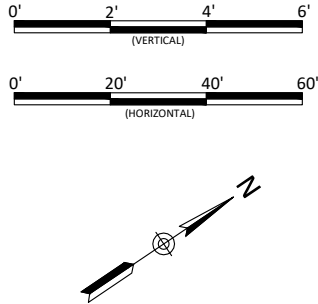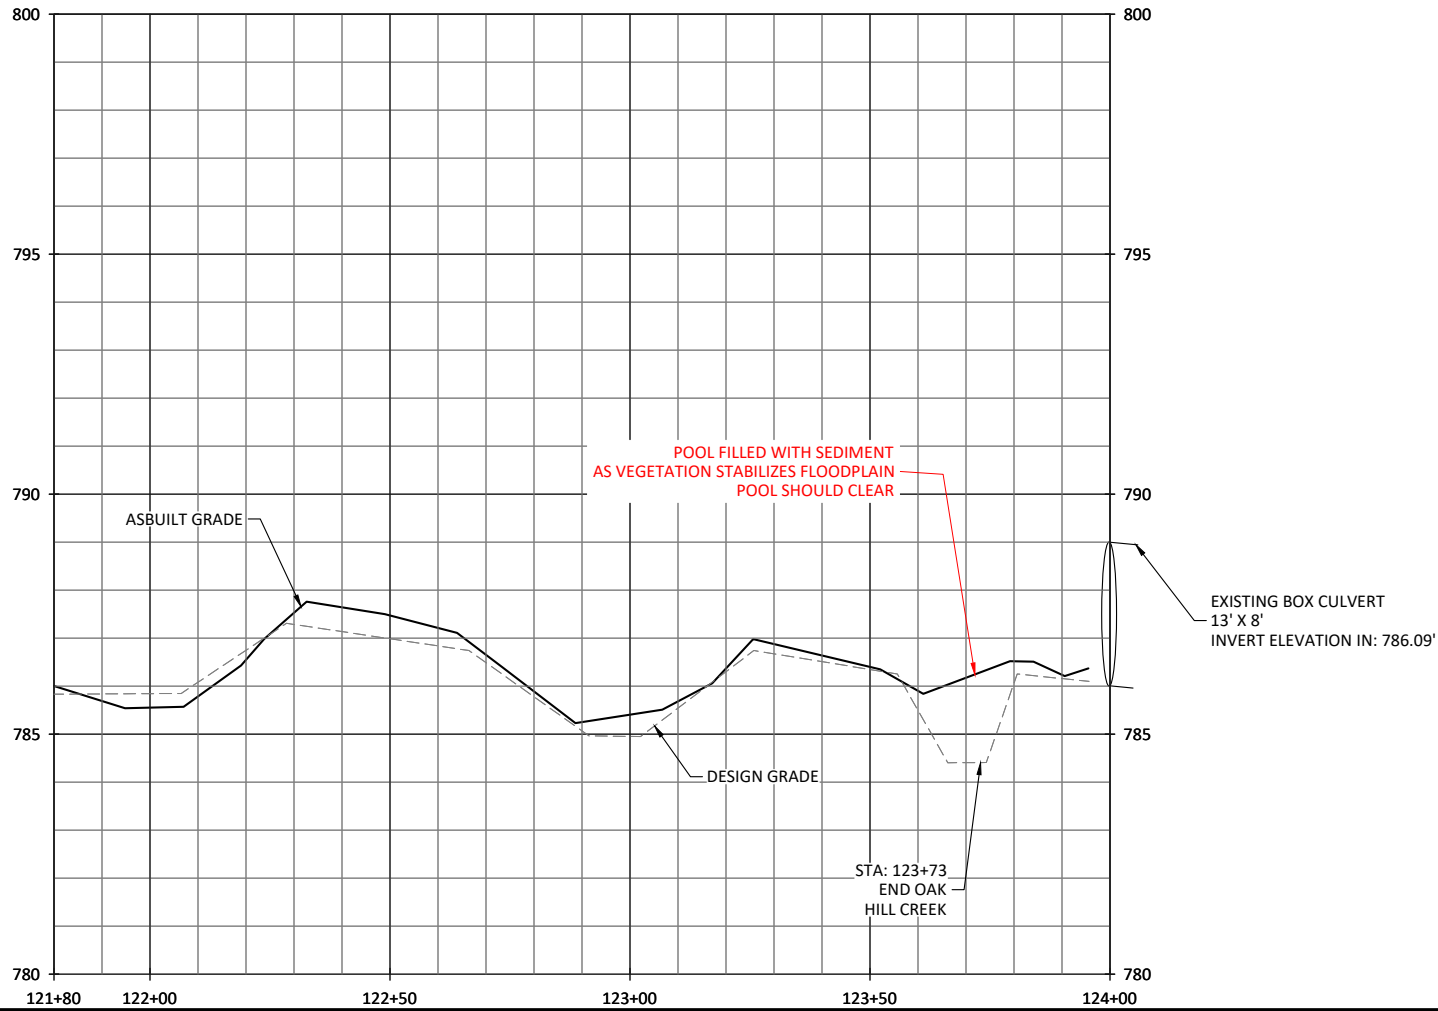

Oak Hill Dairy Mitigation Site Record Drawings
Gaston County, North Carolina

Oak Hill Creek
Stream Plan and Profiles

Revisions:	





Date:	May 12, 2022
Job Number:	005-02182
Project Engineer:	AMR
Drawn By:	AMR
Checked By:	JCK

1.6

Sheet



WILDLANDS
ENGINEERING
167-B Haywood Rd
Asheville, NC 28806
Tel: 828.774.5547
License No. F-0831

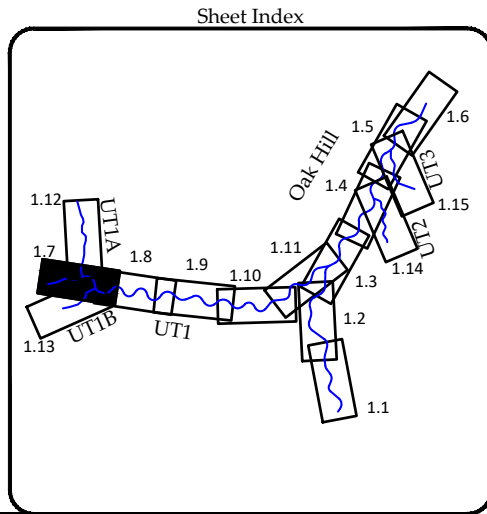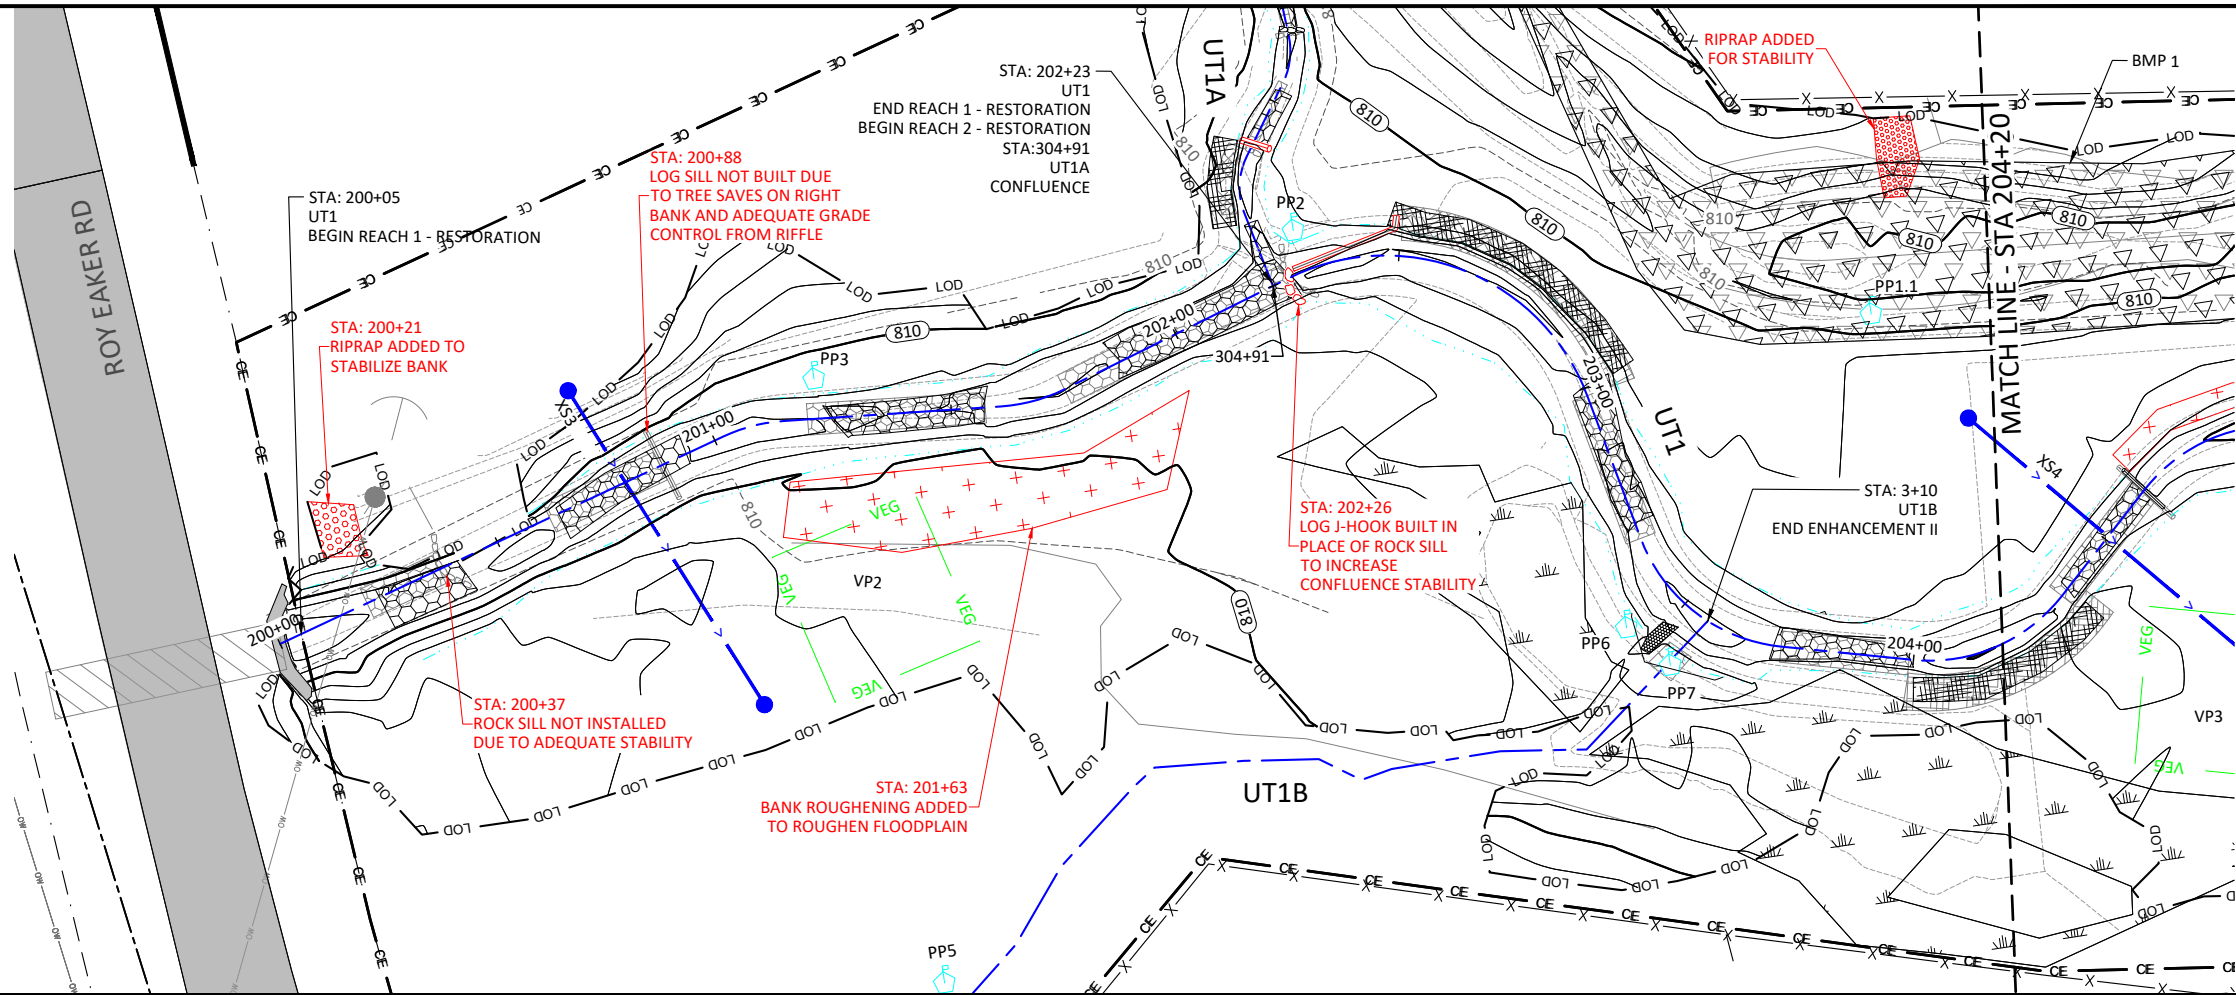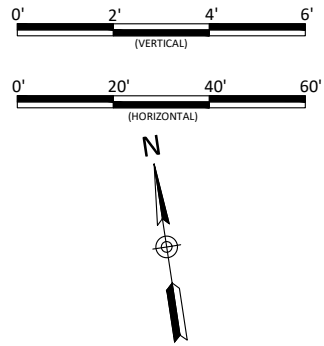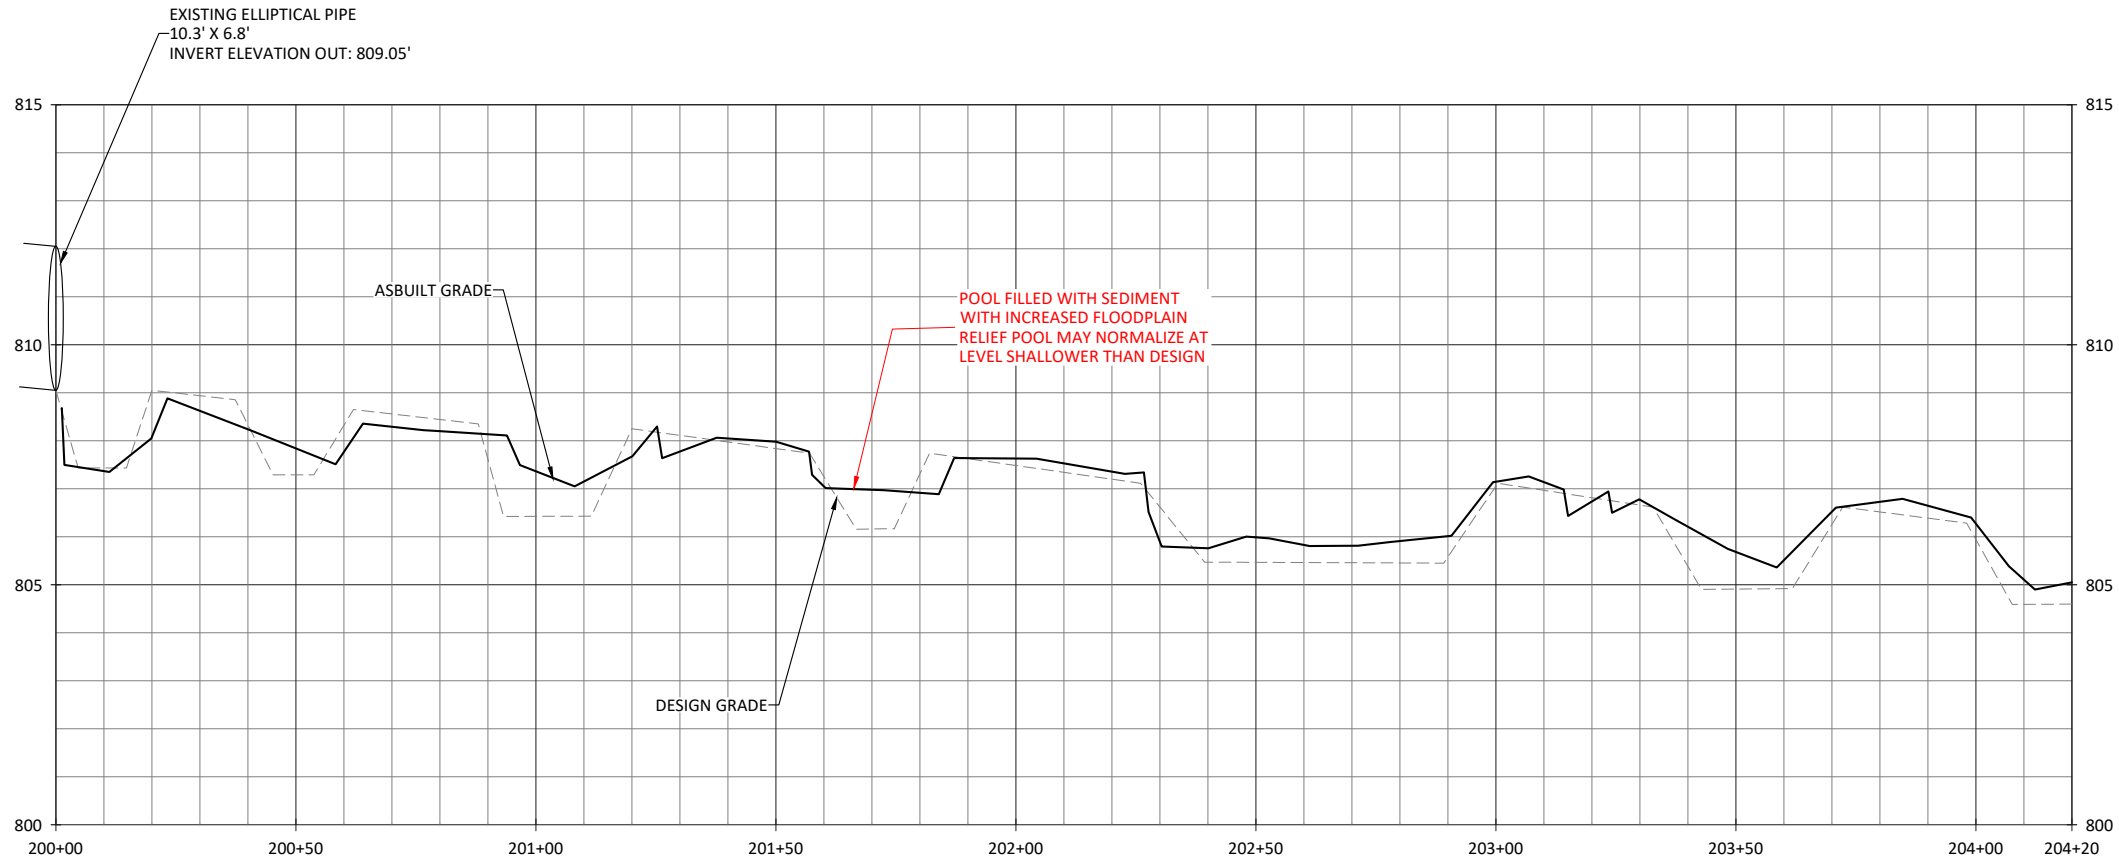

Oak Hill Dairy Mitigation Site Record Drawings
Gaston County, North Carolina

UT1
Stream Plan and Profiles





Revisions:

Date:	May 12, 2022
Job Number:	005-02182
Project Engineer:	JM
Drawn By:	AMR
Checked By:	JCK

1.7

Sheet



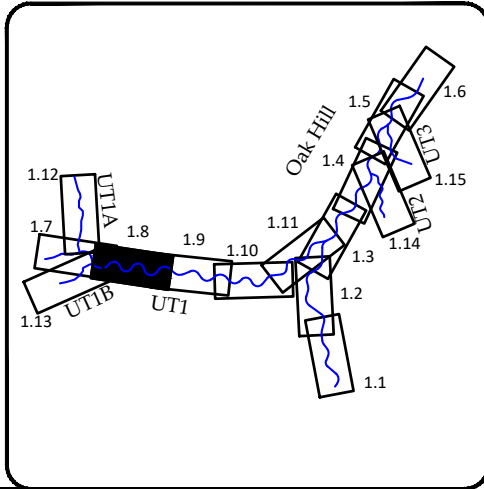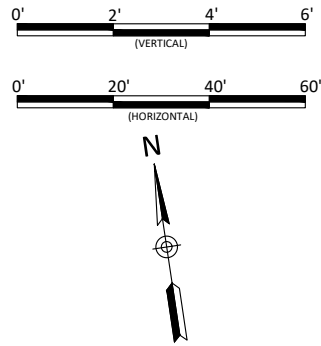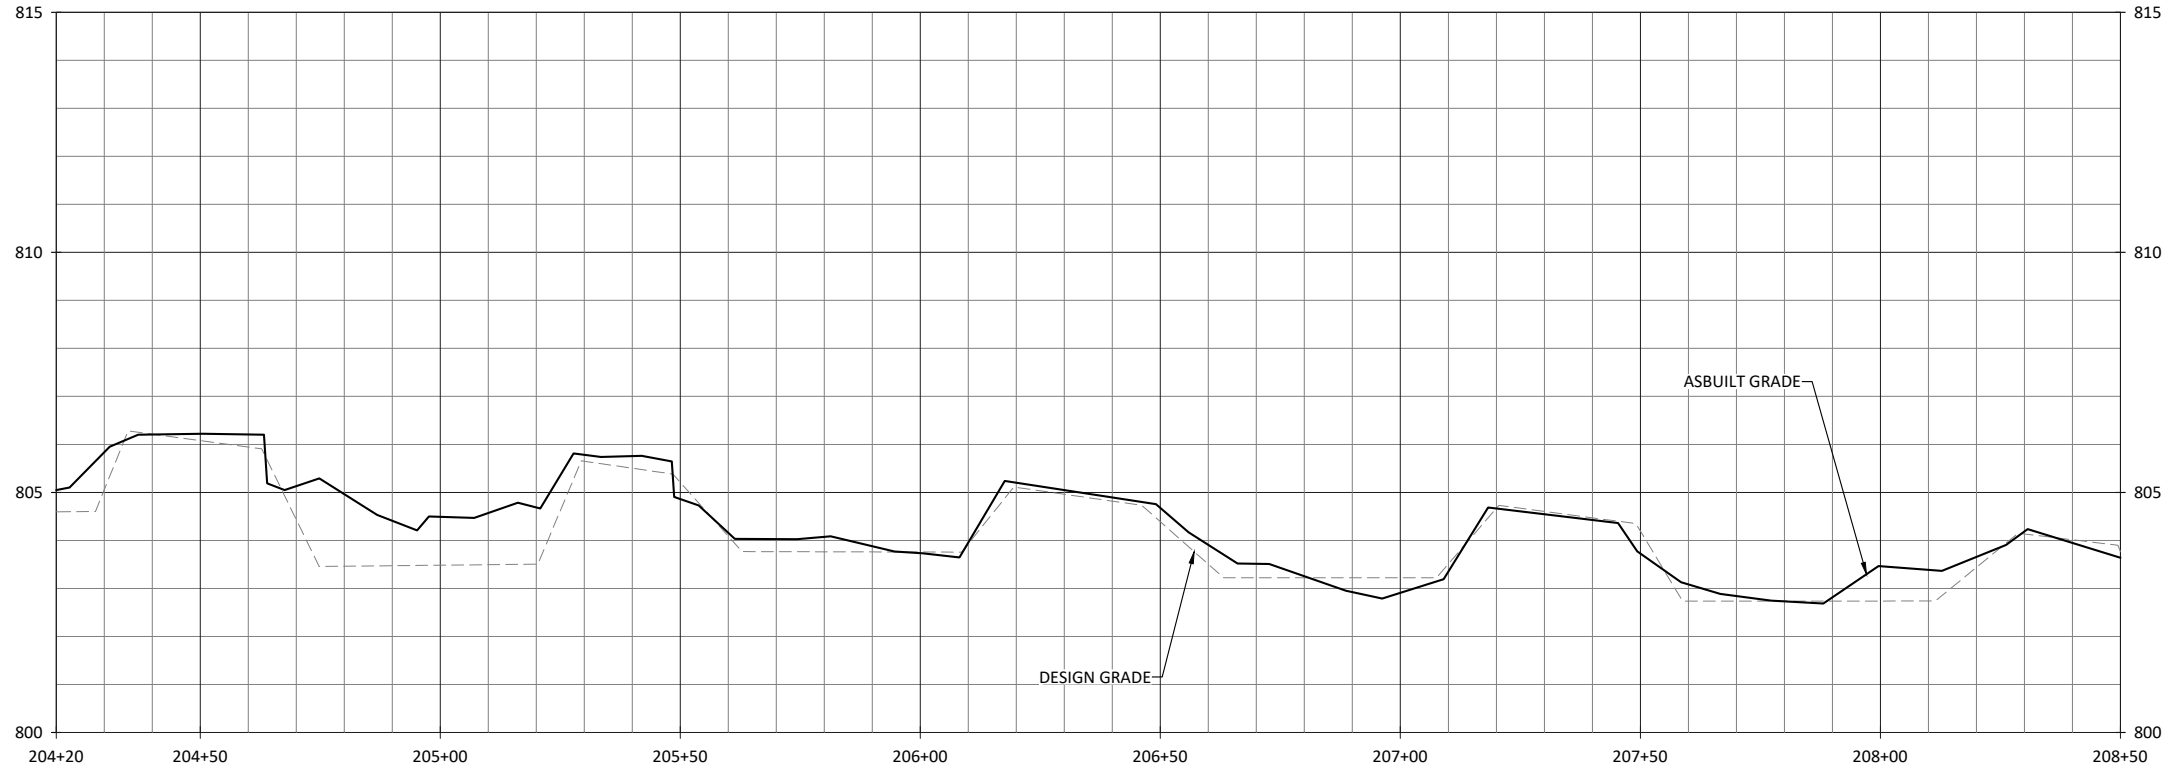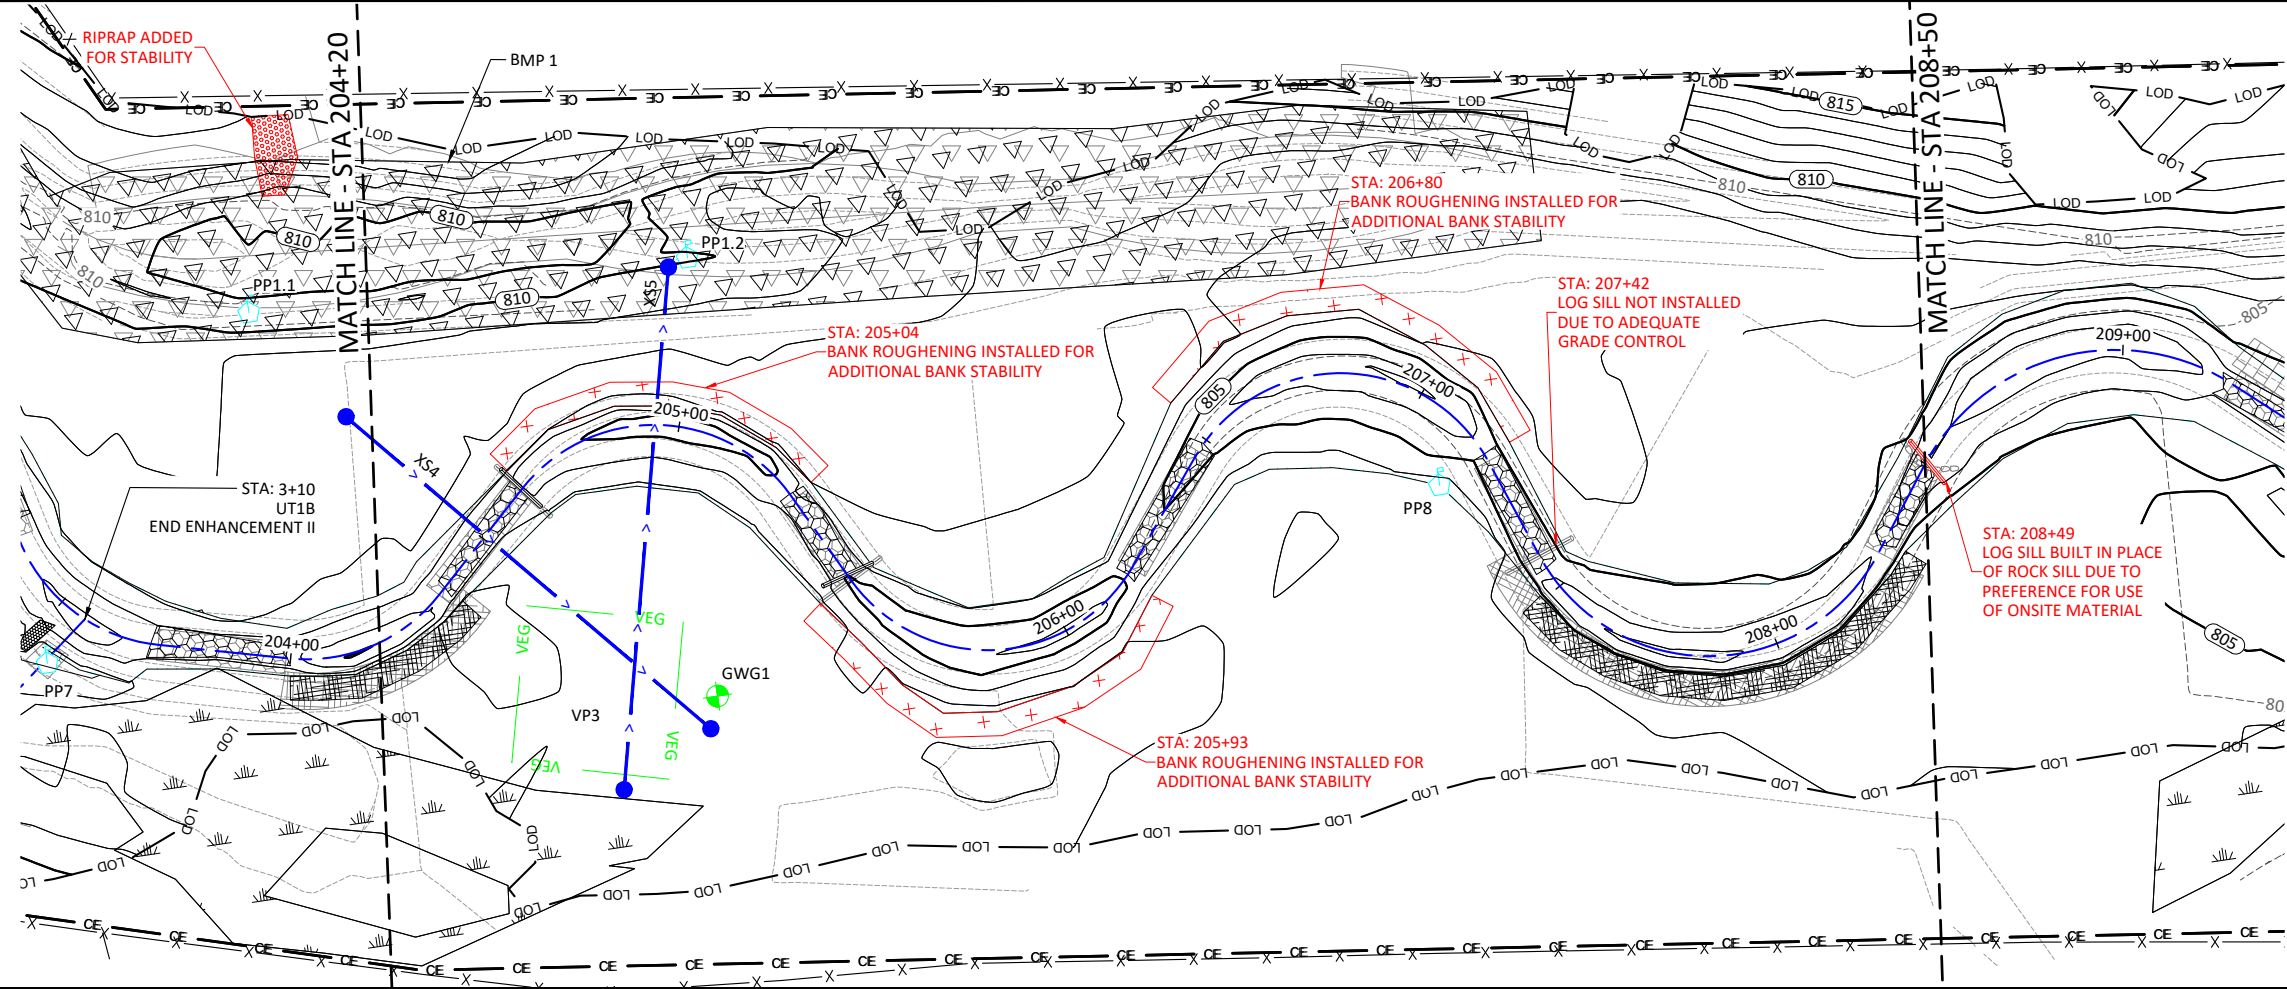

Oak Hill Dairy Mitigation Site Record Drawings
Gaston County, North Carolina

UT1
Stream Plan and Profiles



Revisions:	
Date:	May 12, 2022
Job Number:	005-02182
Project Engineer:	AM
Drawn By:	AMR
Checked By:	JCK





1.8

Sheet



WILDLANDS
ENGINEERING
167-B Haywood Rd
Asheville, NC 28806
Tel: 828.774.5547
License No. F-0831

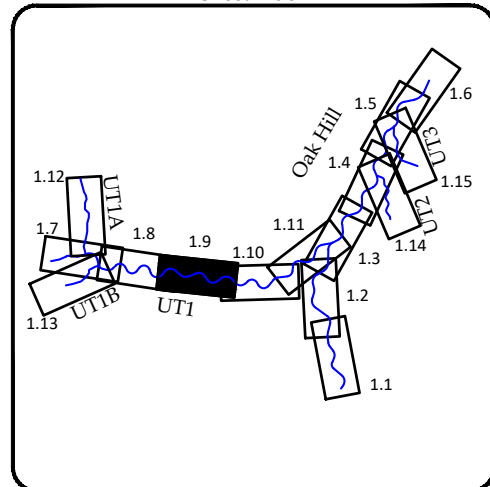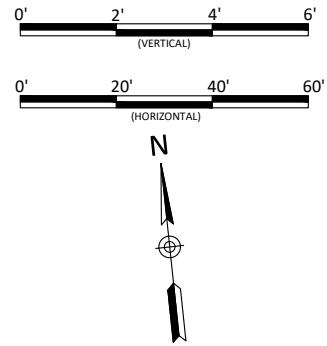

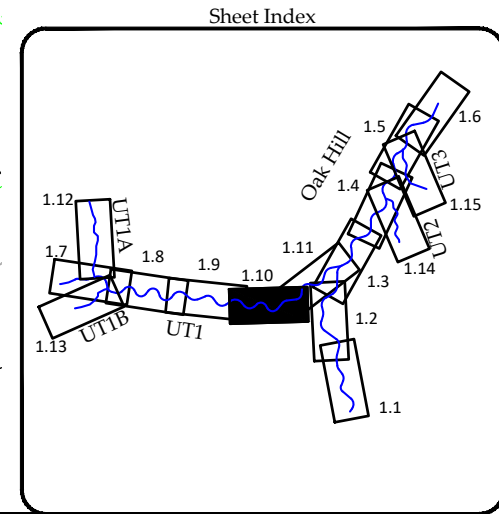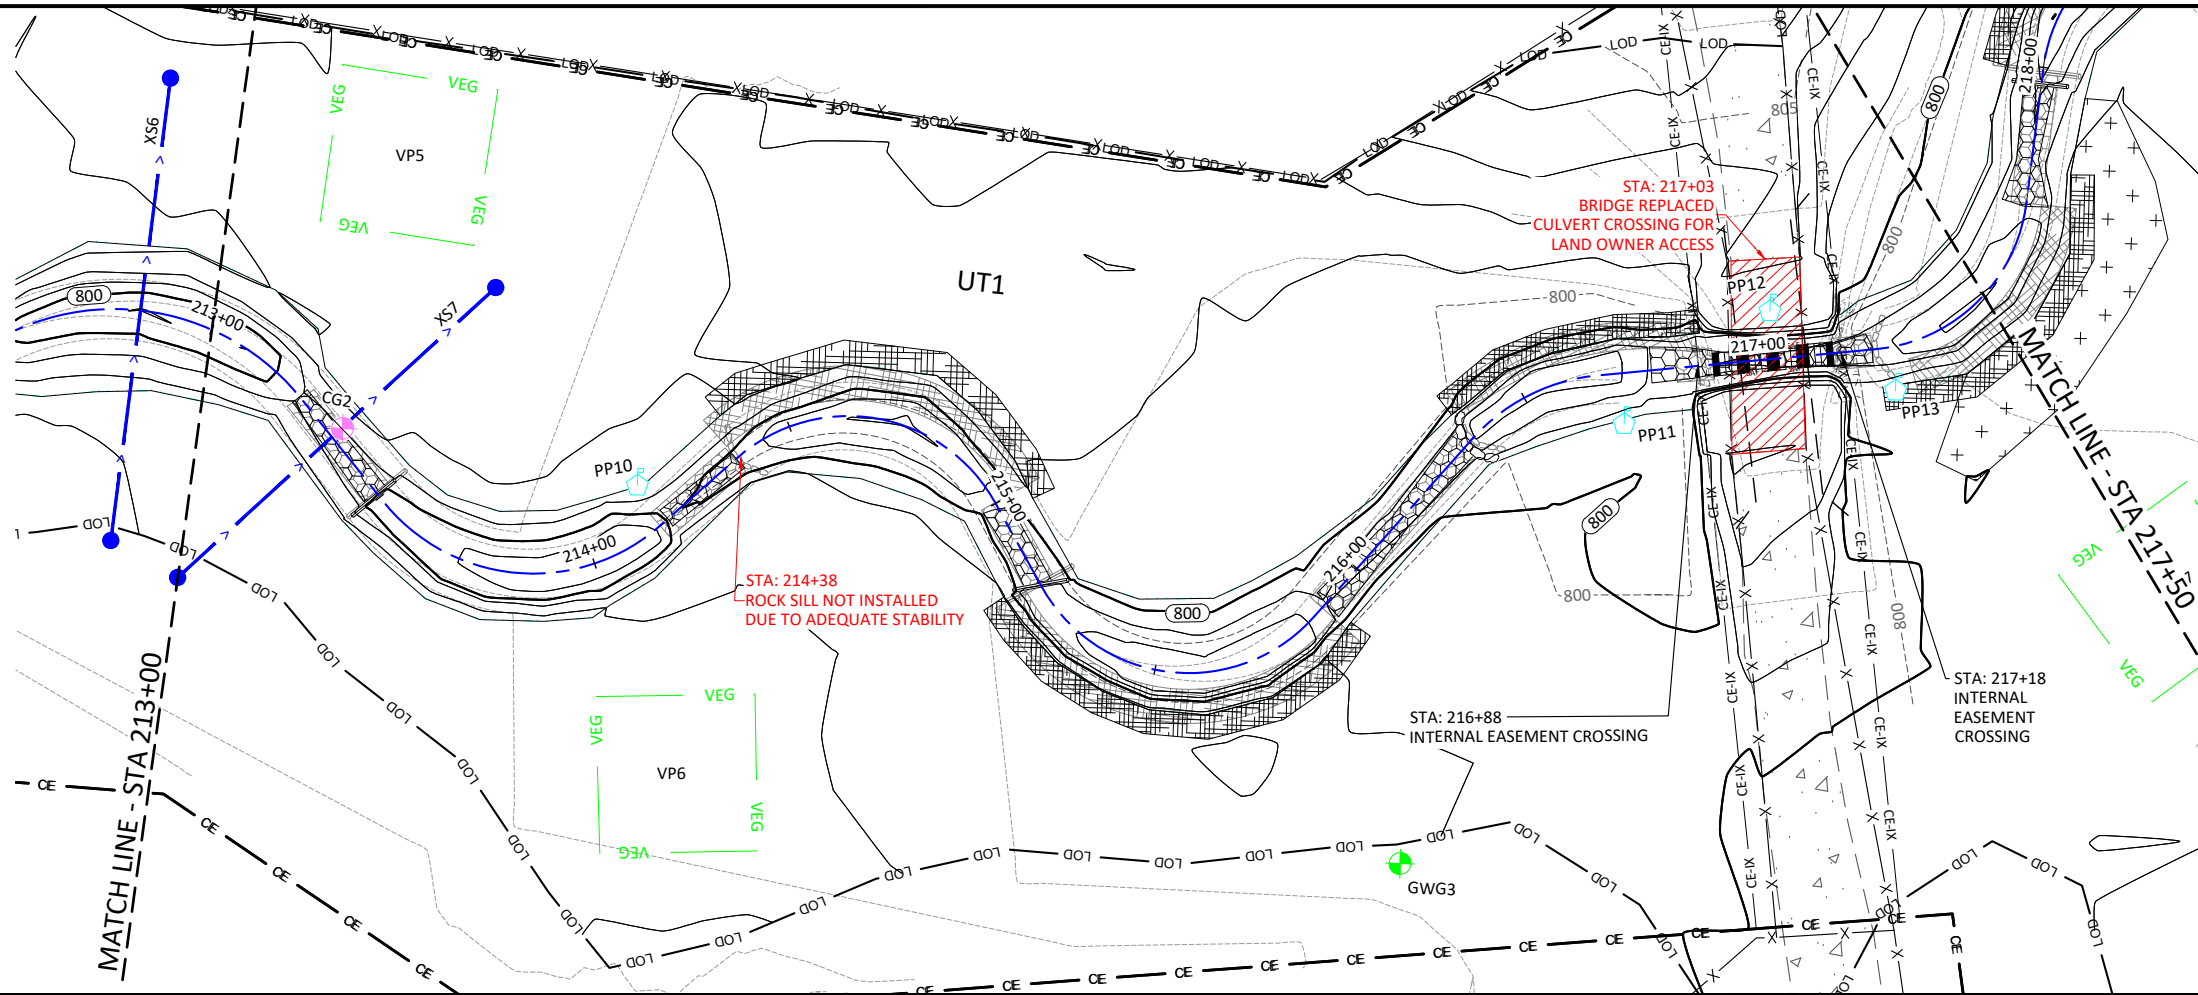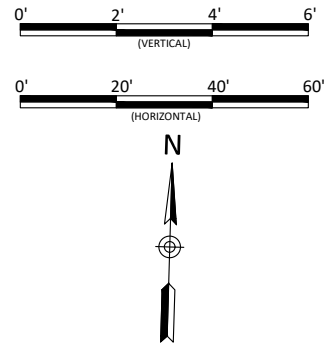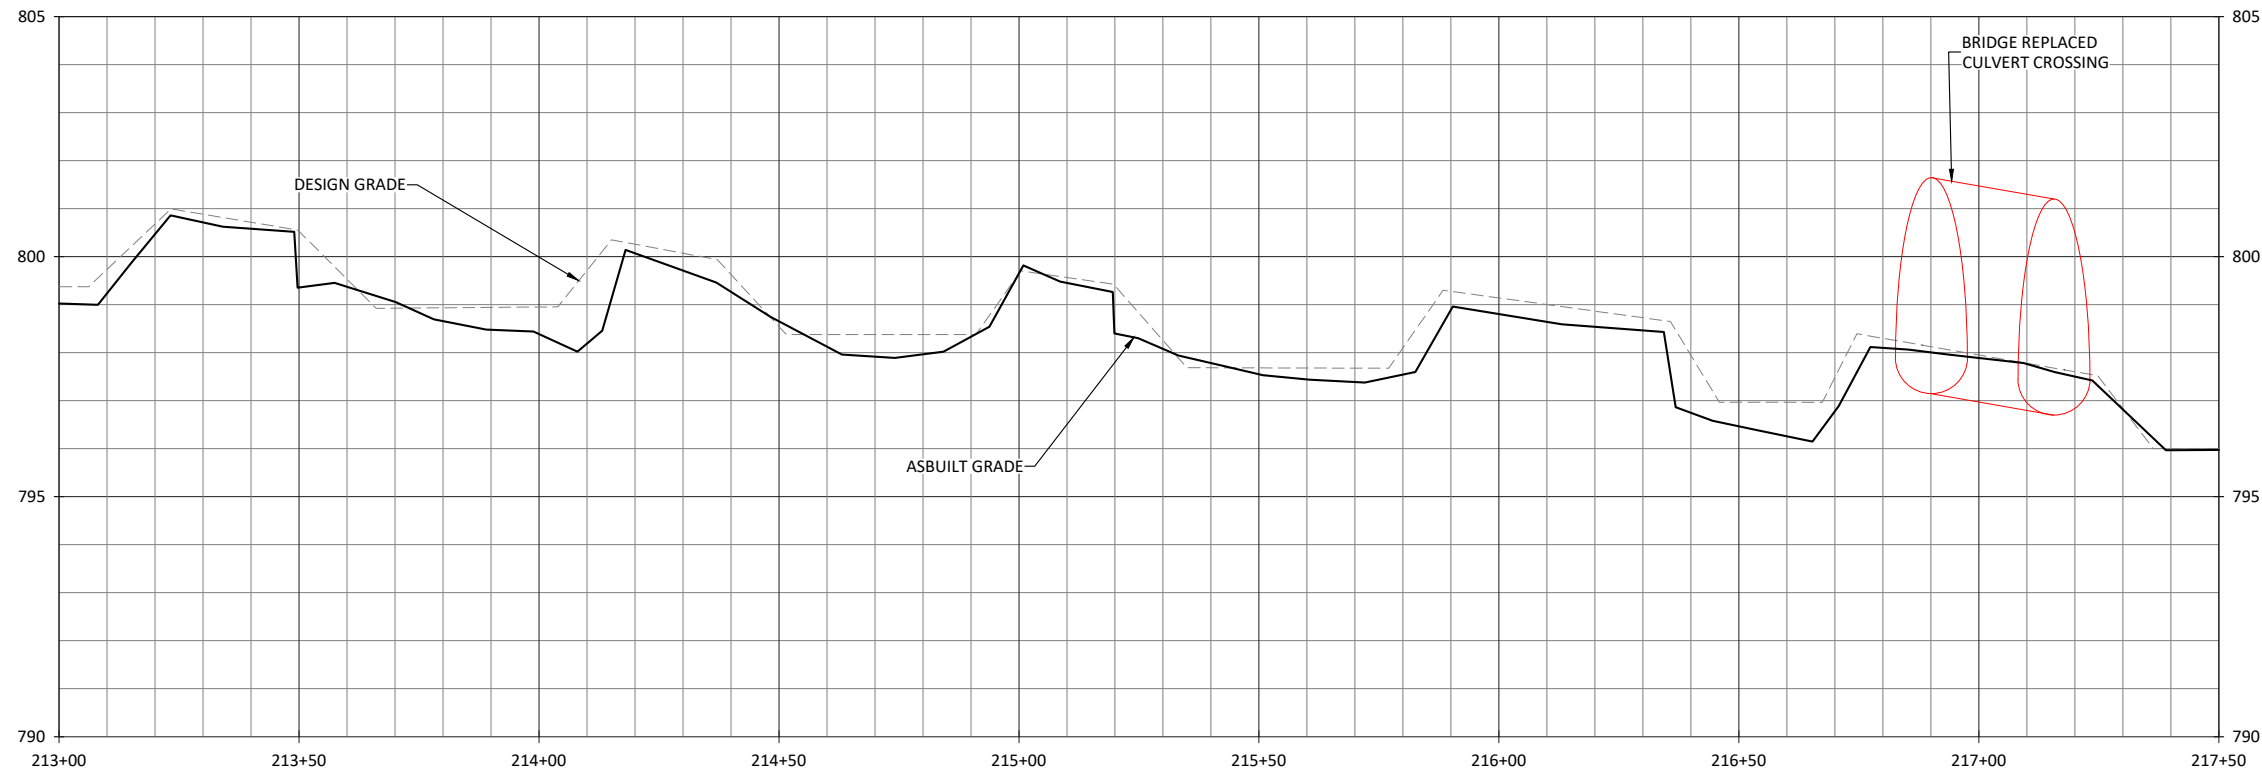

Oak Hill Dairy Mitigation Site Record Drawings
Gaston County, North Carolina

UT1
Stream Plan and Profiles





Revisions:	

Date:	May 12, 2022
Job Number:	005-02182
Project Engineer:	JM
Drawn By:	AMR
Checked By:	JCK

1.10

Sheet



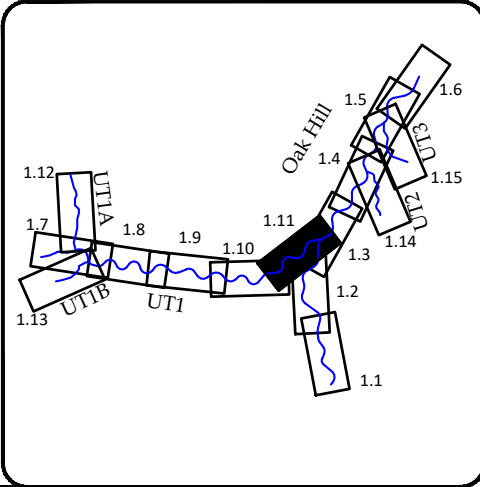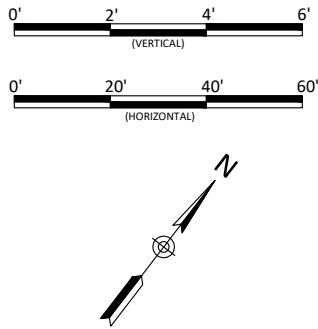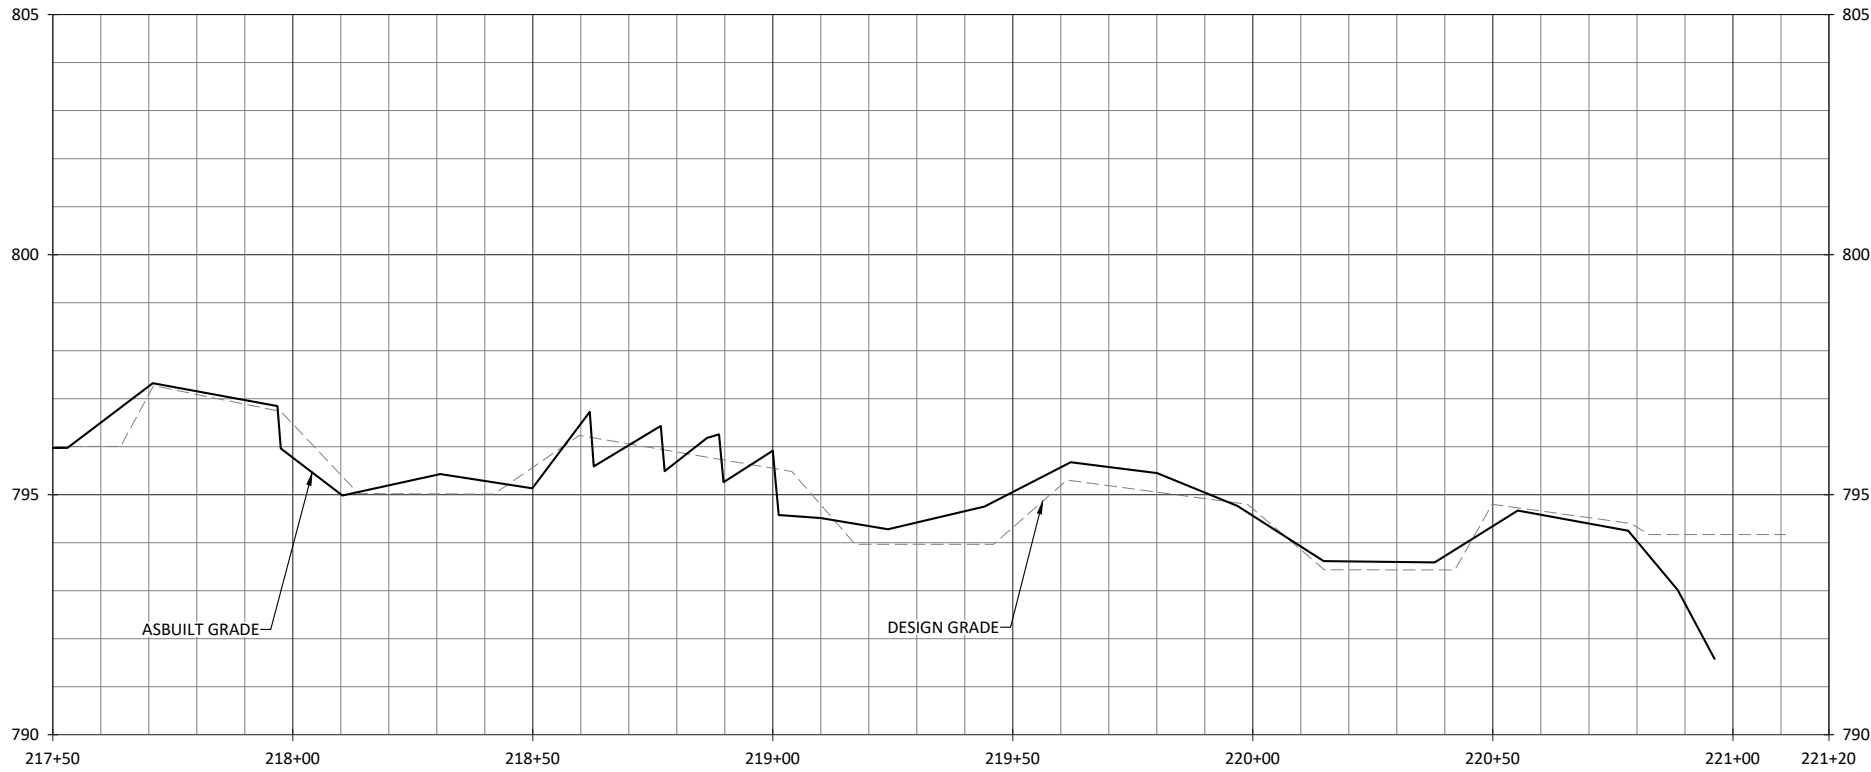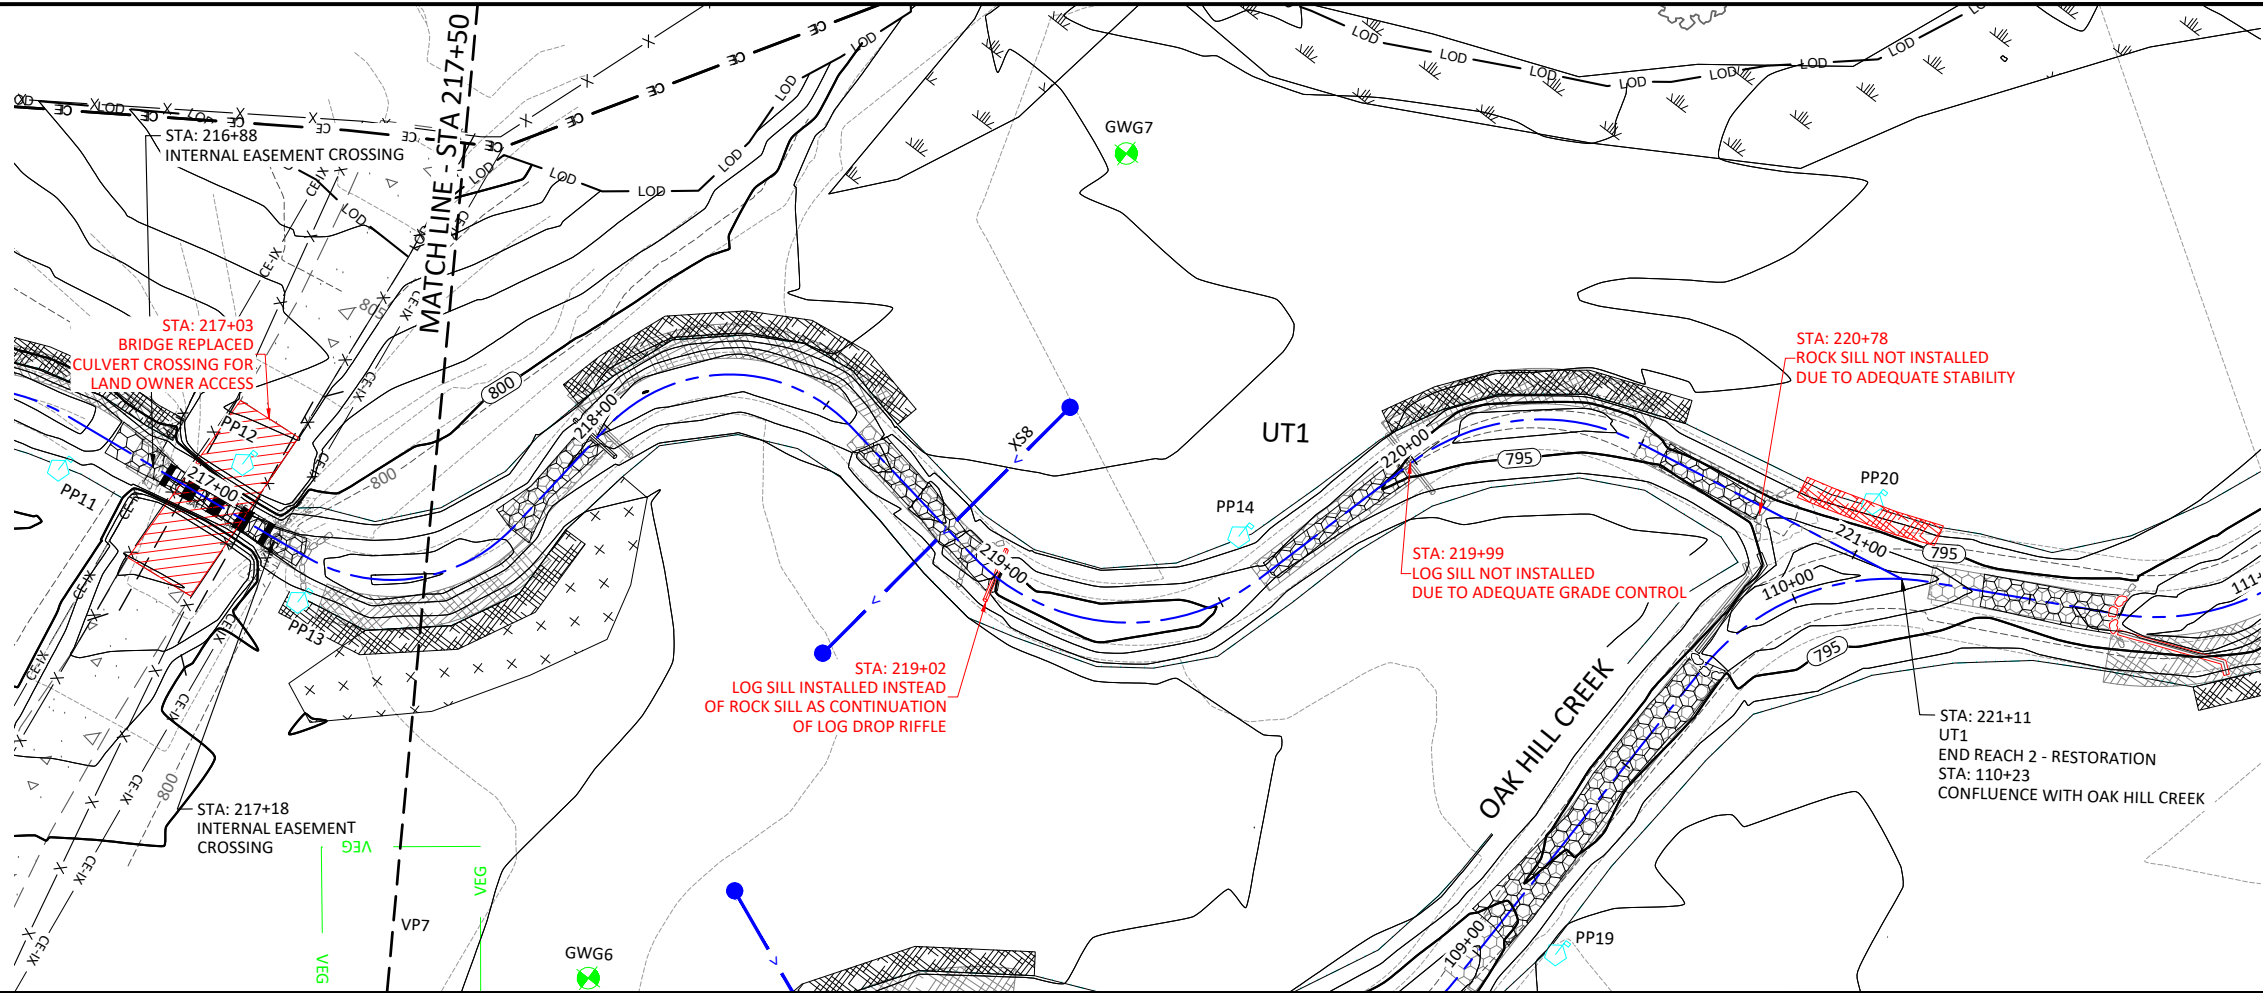

Oak Hill Dairy Mitigation Site Record Drawings
Gaston County, North Carolina

UT1
Stream Plan and Profiles

Revisions:	

Date:	May 12, 2022
Job Number:	005-02182
Project Engineer:	JM
Drawn By:	AMR
Checked By:	JCK

1.11



Sheet



WILDLANDS
ENGINEERING
167-B Haywood Rd
Asheville, NC 28806
Tel: 828.774.5547
License No. F-0831


May 13, 2022

X:\Shared Projects\005-02182 Oak Hill Dairy Monitoring\Baseline Monitoring - 2021 Plans\AB-02182 Profiles-T11b.dwg

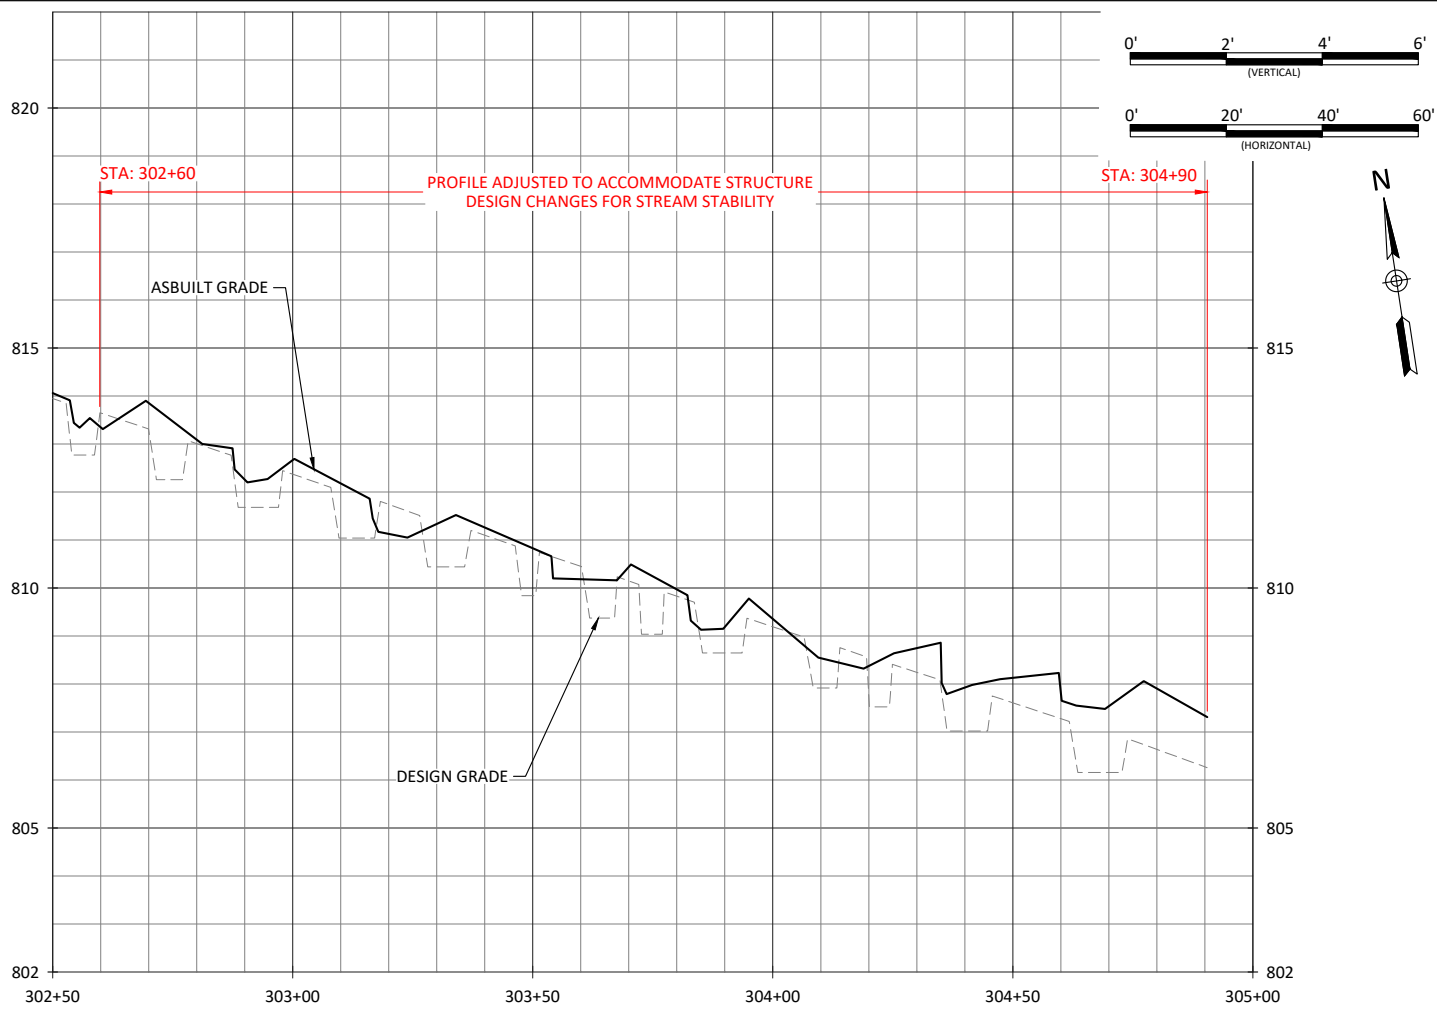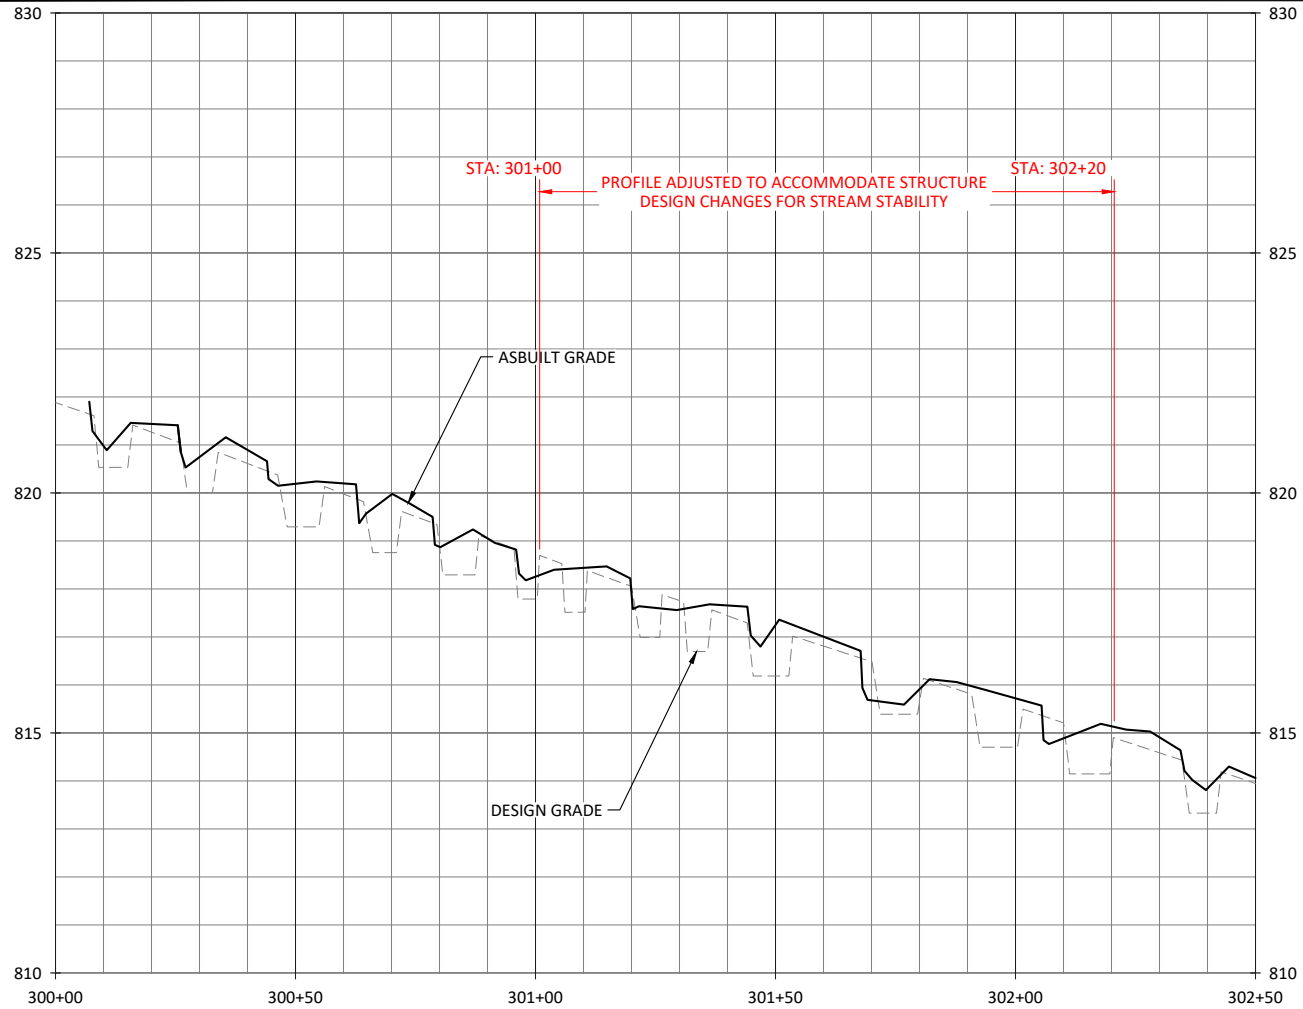


0' 2' 4' 6'
(VERTICAL)

0' 20' 40' 60'
(HORIZONTAL)

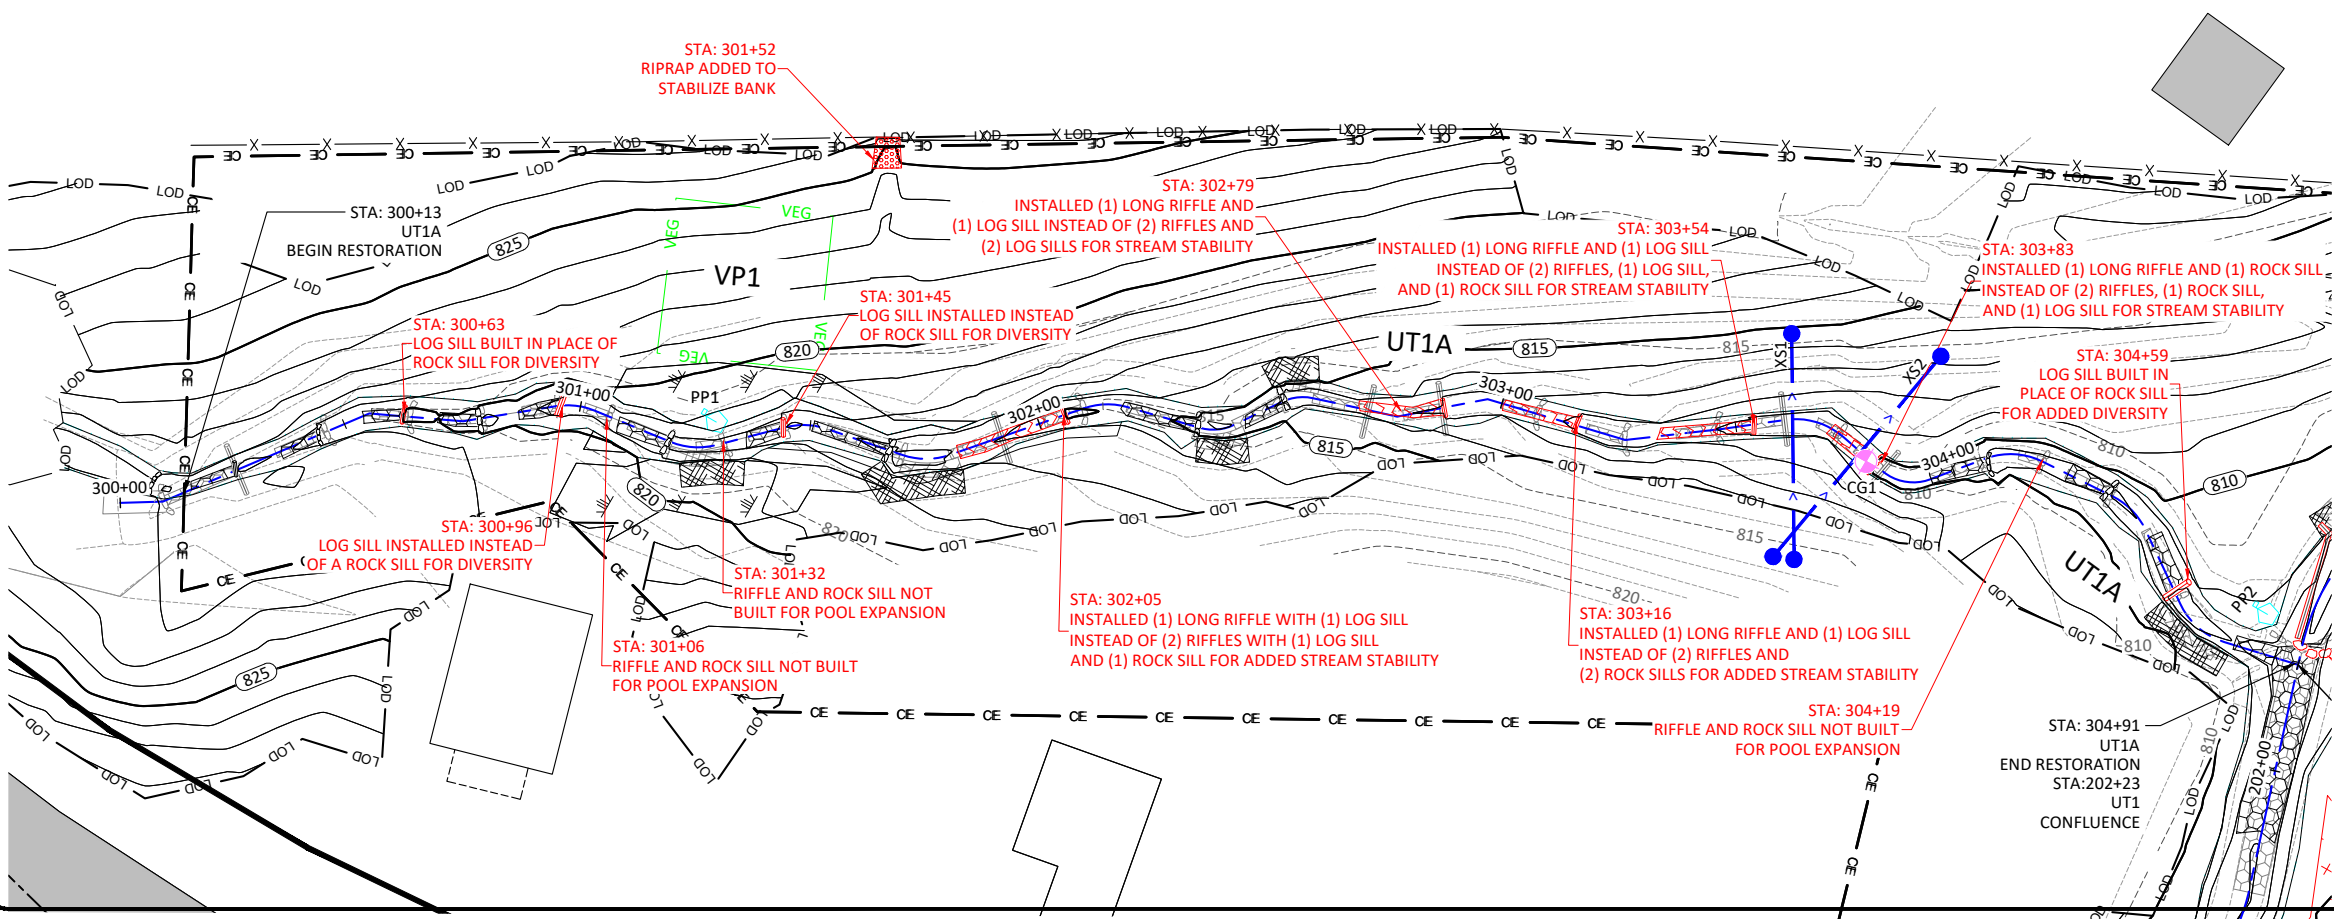

Sheet Index

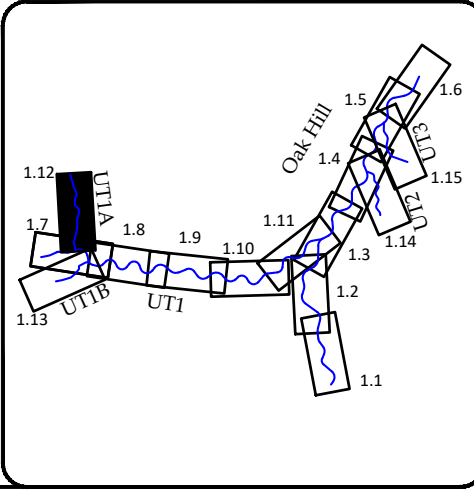

Oak Hill Dairy Mitigation Site Record Drawings

Gaston County, North Carolina

UT1A
Stream Plan and Profiles






Revisions:

Date: May 12, 2022
Job Number: 005-02182
Project Engineer: JIM
Drawn By: AMR
Checked By: JCK

1.12

Sheet

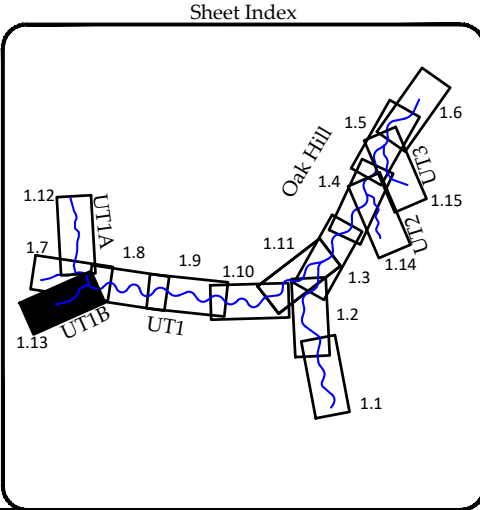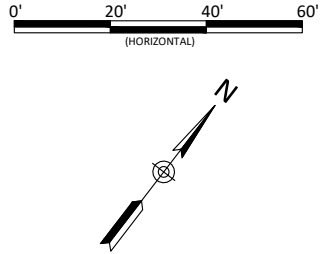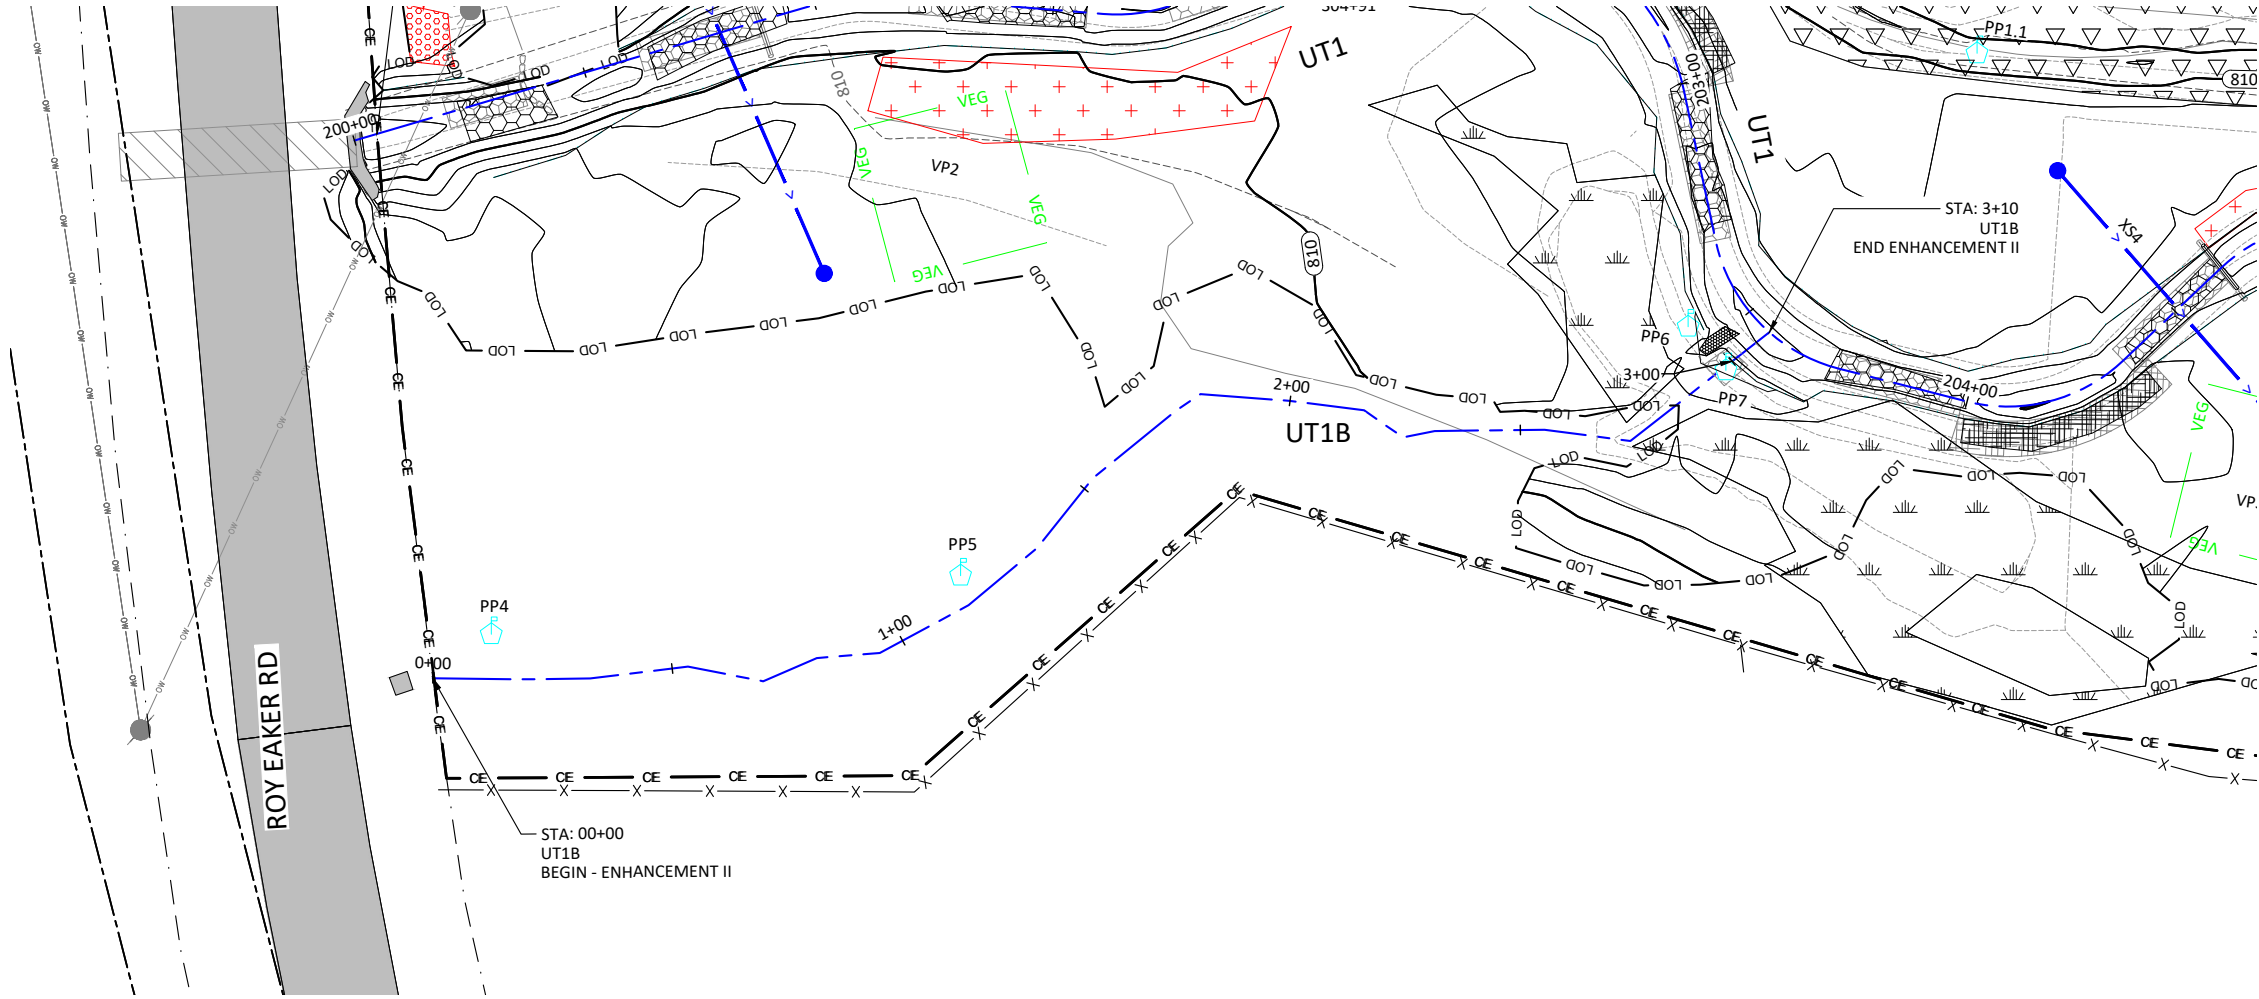

Oak Hill Dairy Mitigation Site Record Drawings
Gaston County, North Carolina

UT1B
Stream Plan and Profiles






Revisions:	

Date:	May 12, 2022
Job Number:	005-02182
Project Engineer:	AMR
Drawn By:	AMR
Checked By:	JCK

1.13

Sheet



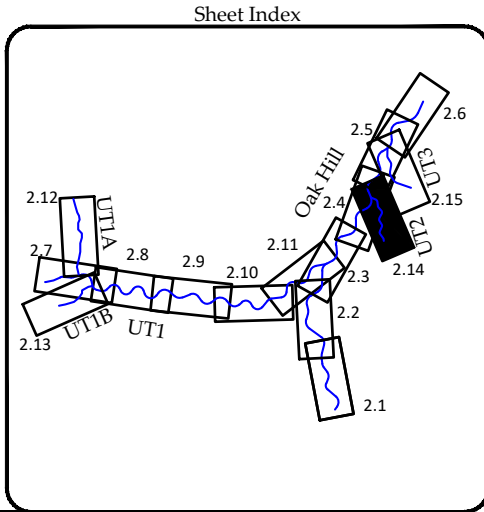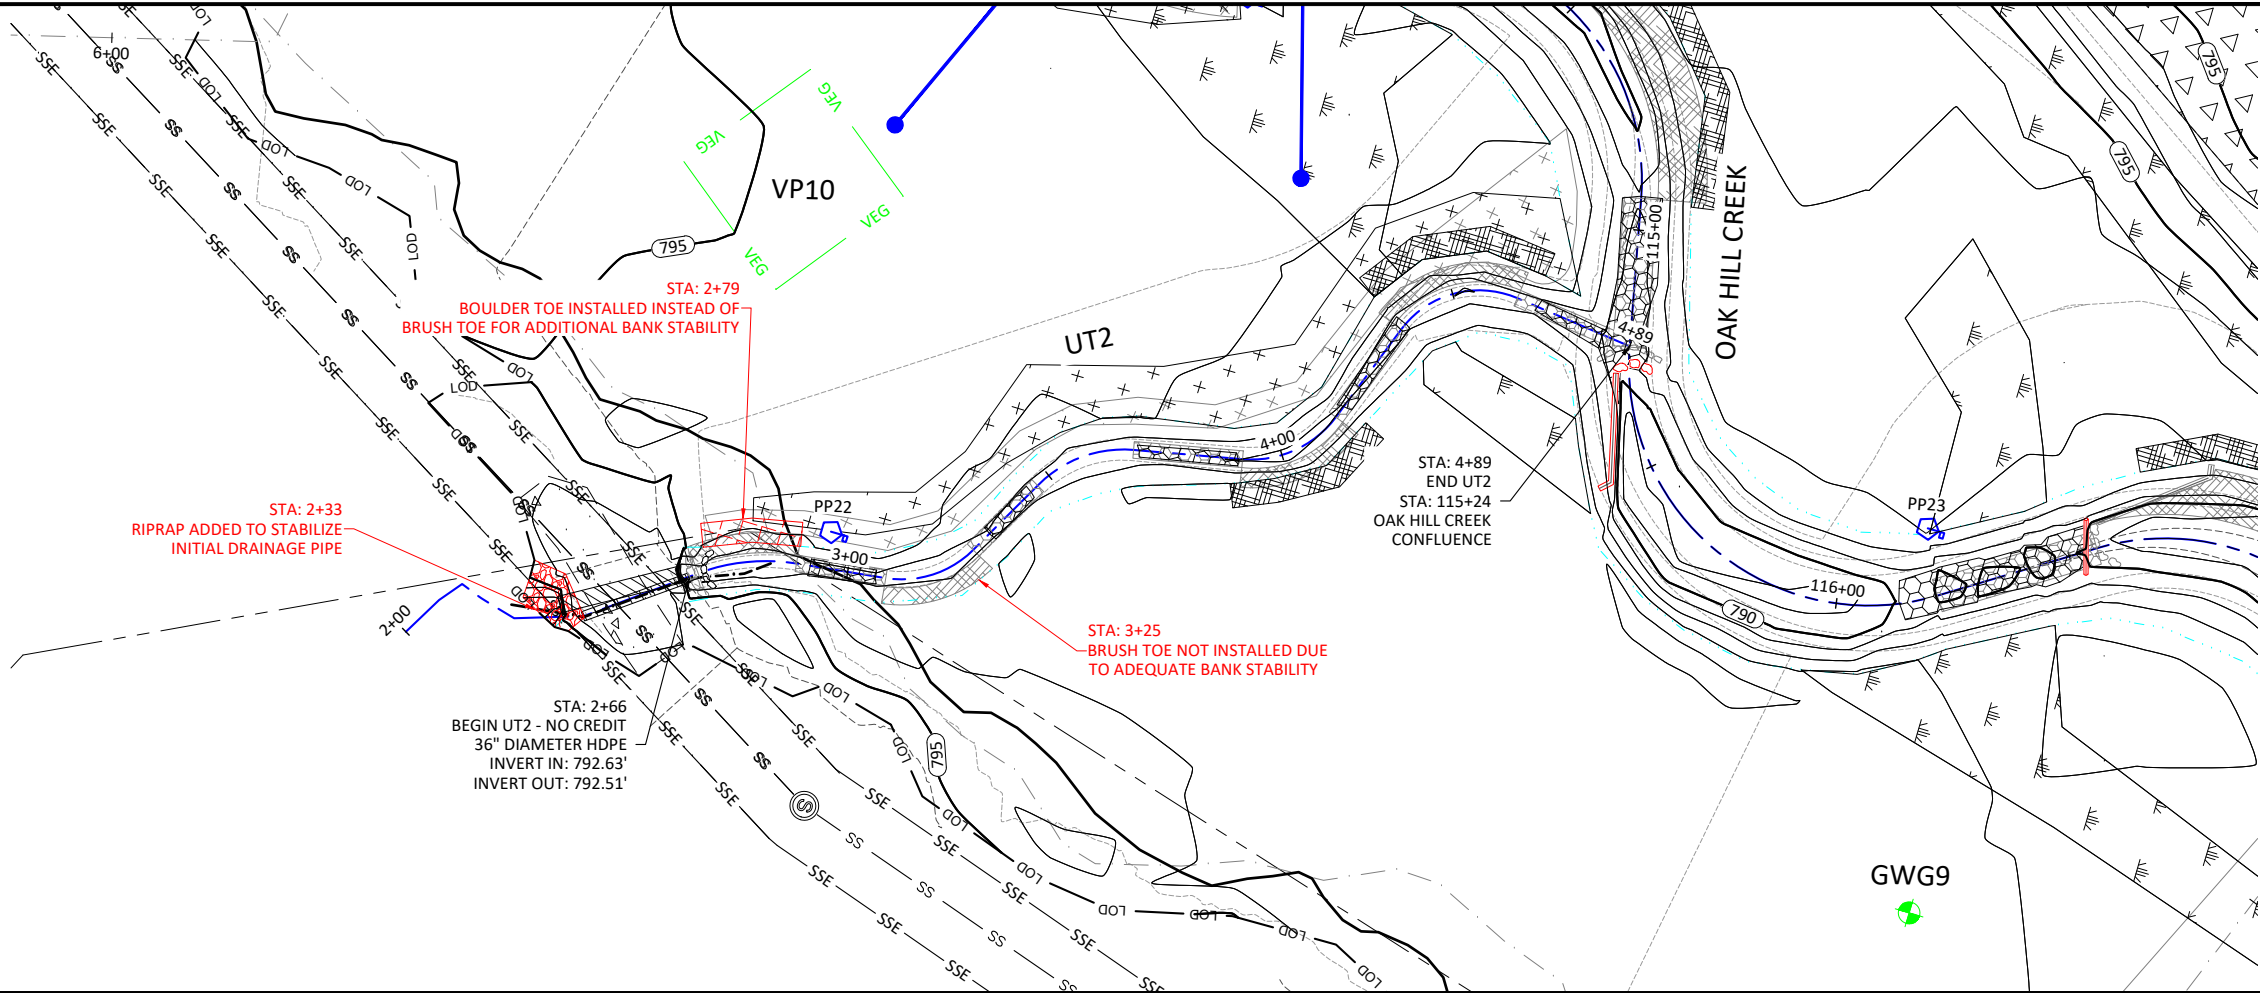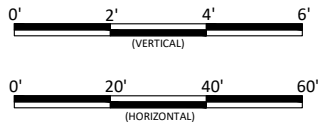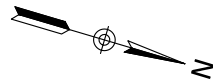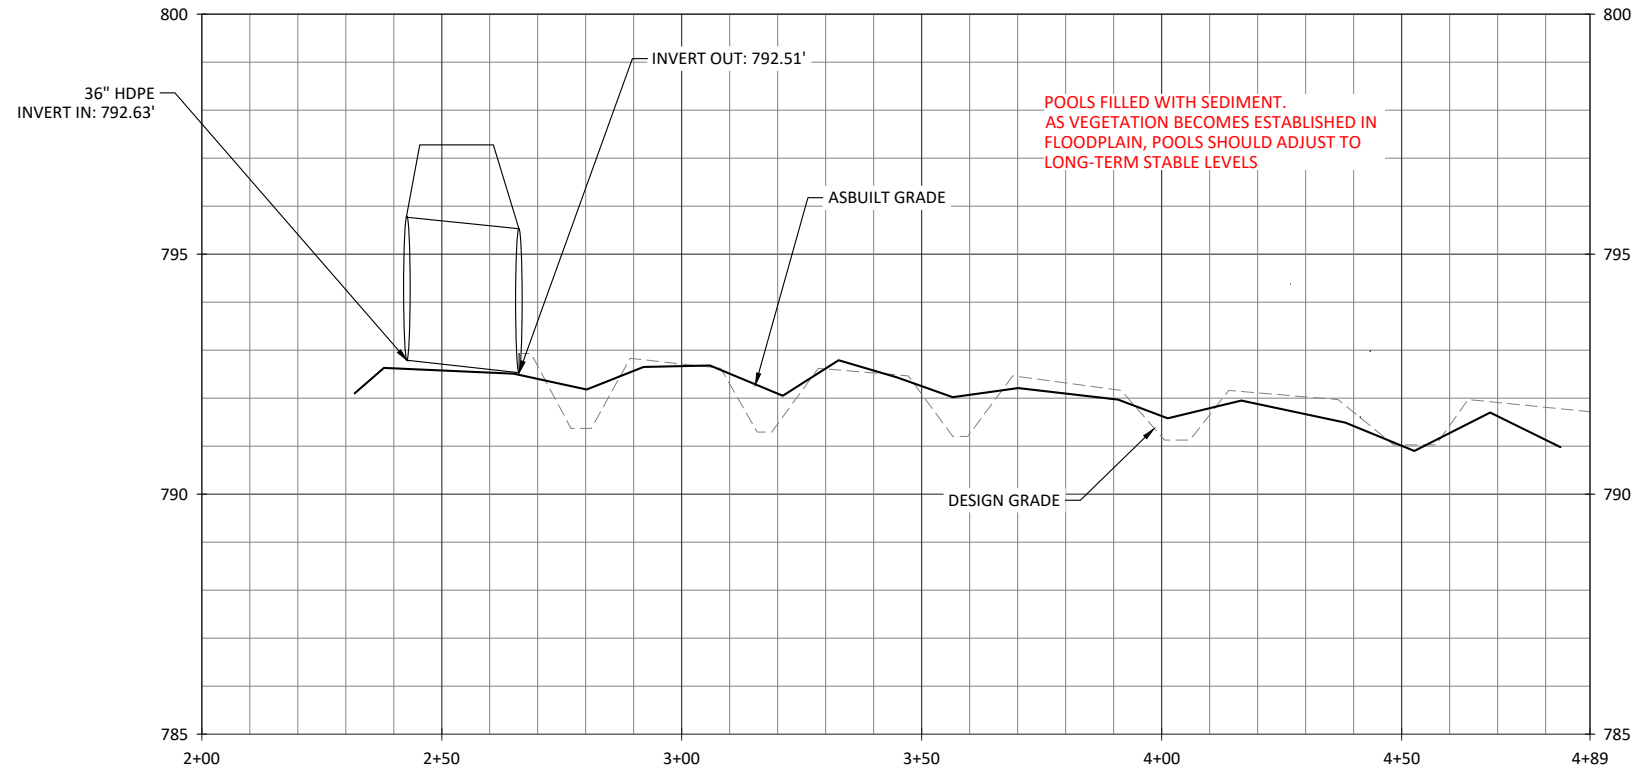

Oak Hill Dairy Mitigation Site Record Drawings
Gaston County, North Carolina
Uncredited-Tribs - UT2
Stream Plan and Profiles






Revisions:

Date:	May 12, 2022
Job Number:	005-02182
Project Engineer:	JM
Drawn By:	AMR
Checked By:	JCK

1.14

Sheet



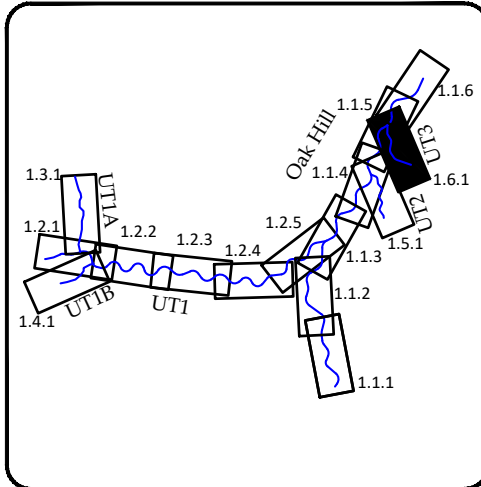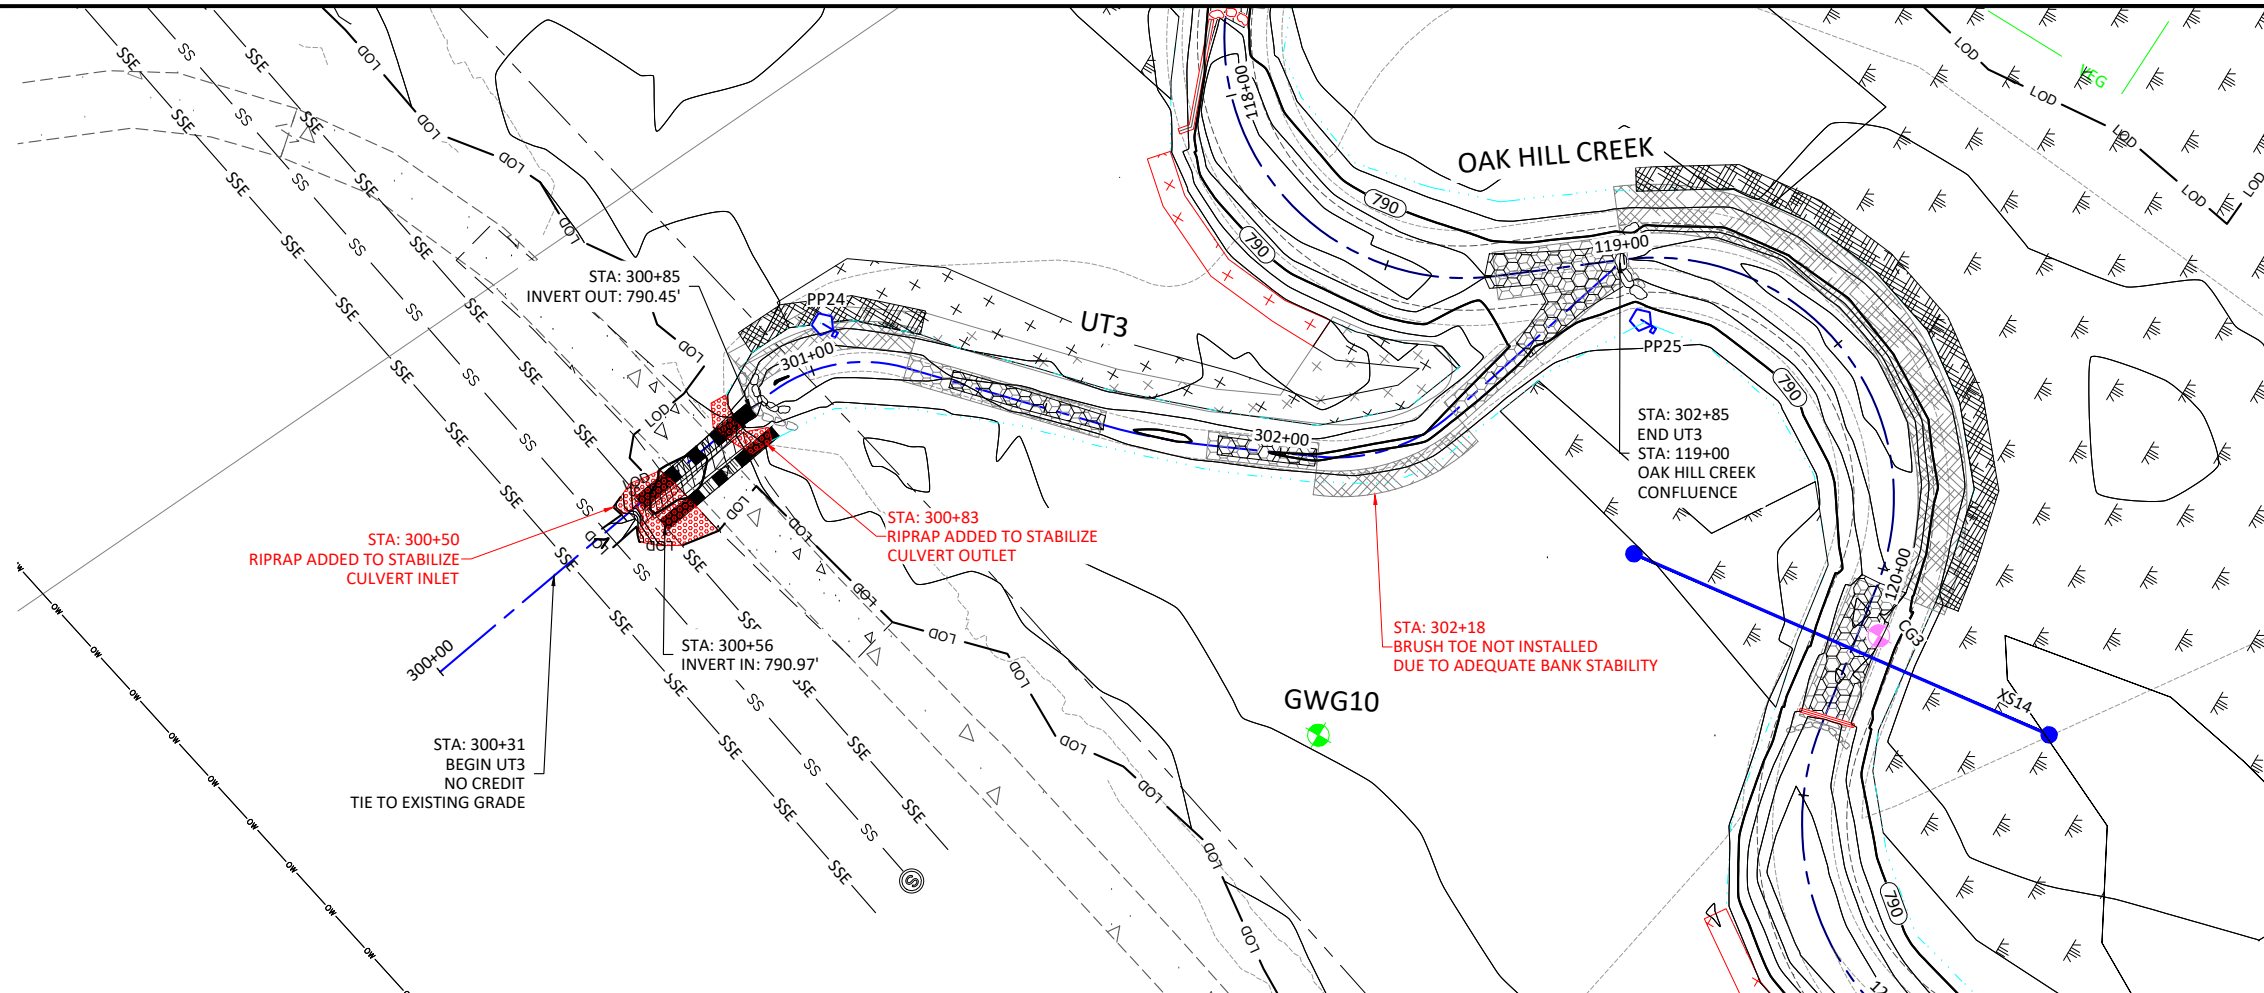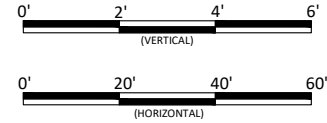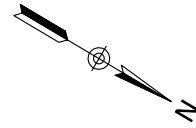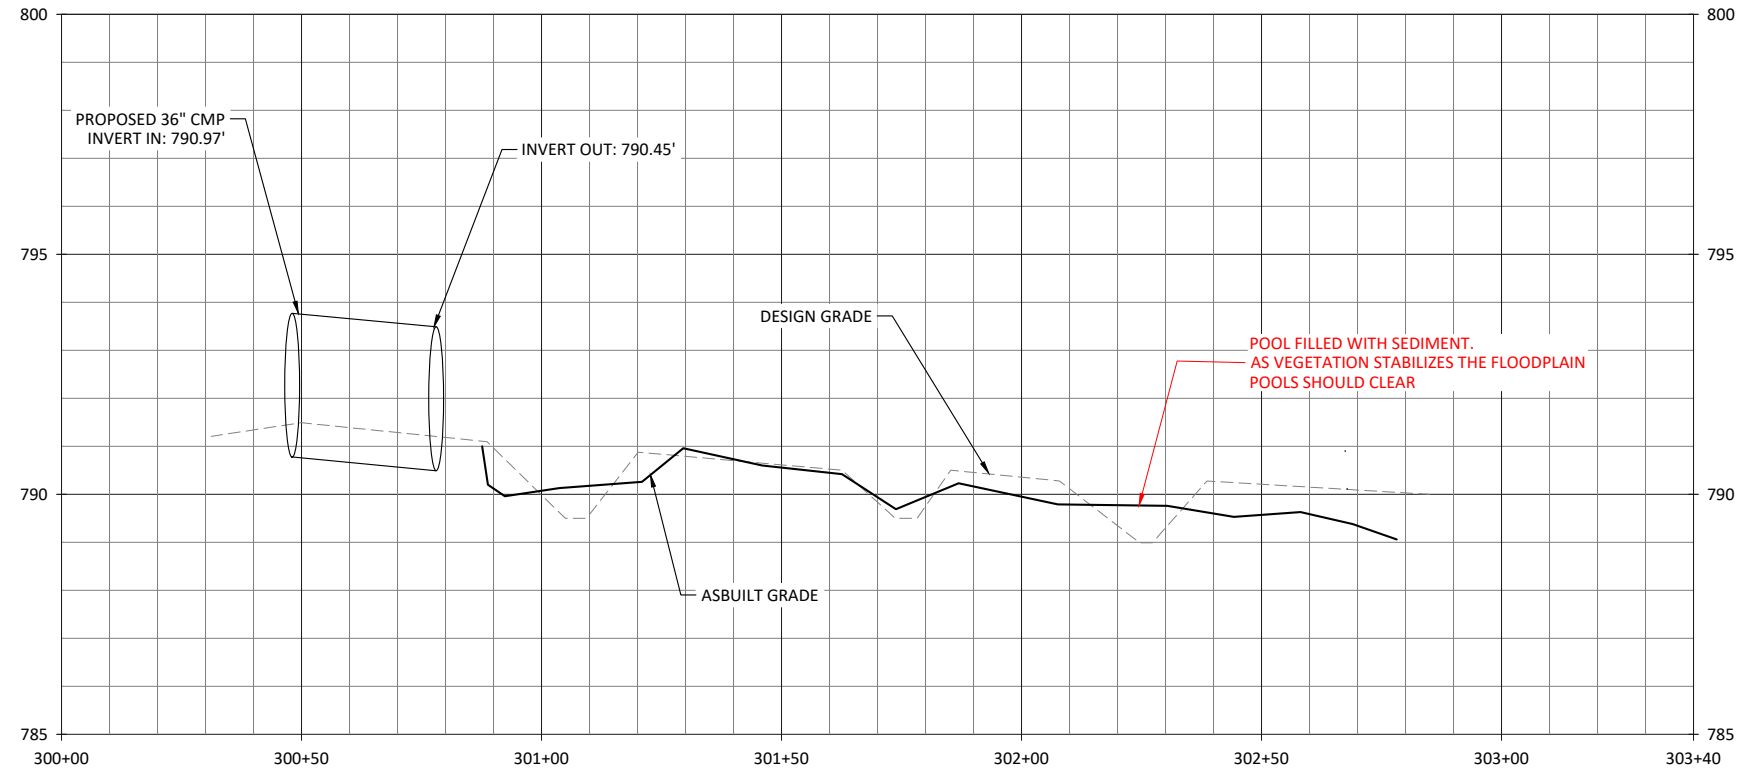

Oak Hill Dairy Mitigation Site Record Drawings

Gaston County, North Carolina

Uncredited-Tribs - UT3
Stream Plan and Profiles




Revisions:	

Date:	May 12, 2022
Job Number:	005-02182
Project Engineer:	IM
Drawn By:	AMR
Checked By:	JCK



May 13, 2022





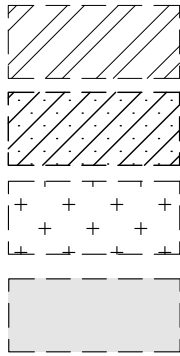


WETLAND RE-ESTABLISHMENT
PROPOSED AT A 1:1 CREDIT RATIO

WETLAND REHABILITATION
PROPOSED AT A 1:1 CREDIT RATIO

WETLAND REHABILITATION
PROPOSED AT A 1.5:1 CREDIT RATIO

WETLAND CREATION
PROPOSED AT A 3:1 CREDIT RATIO

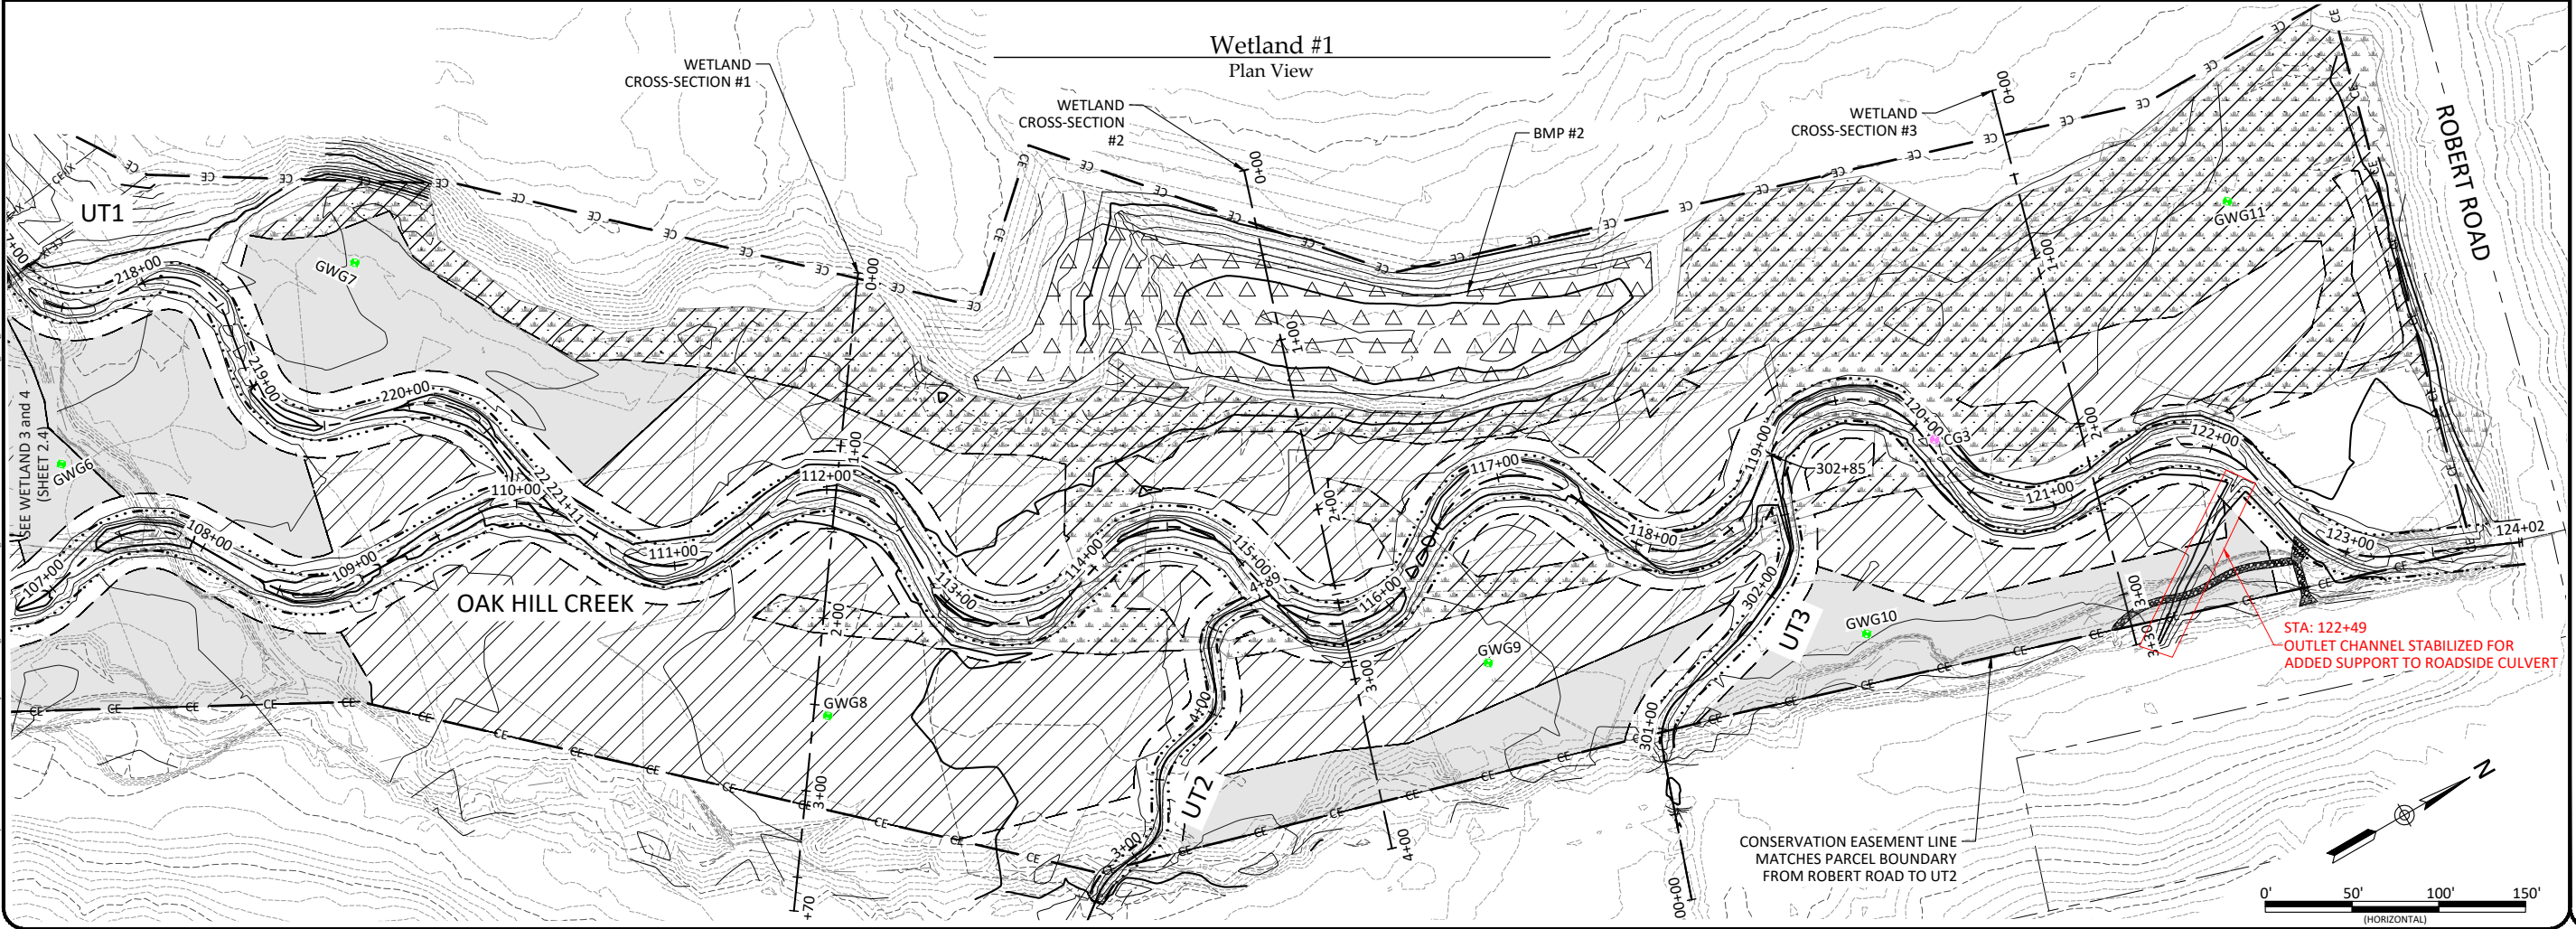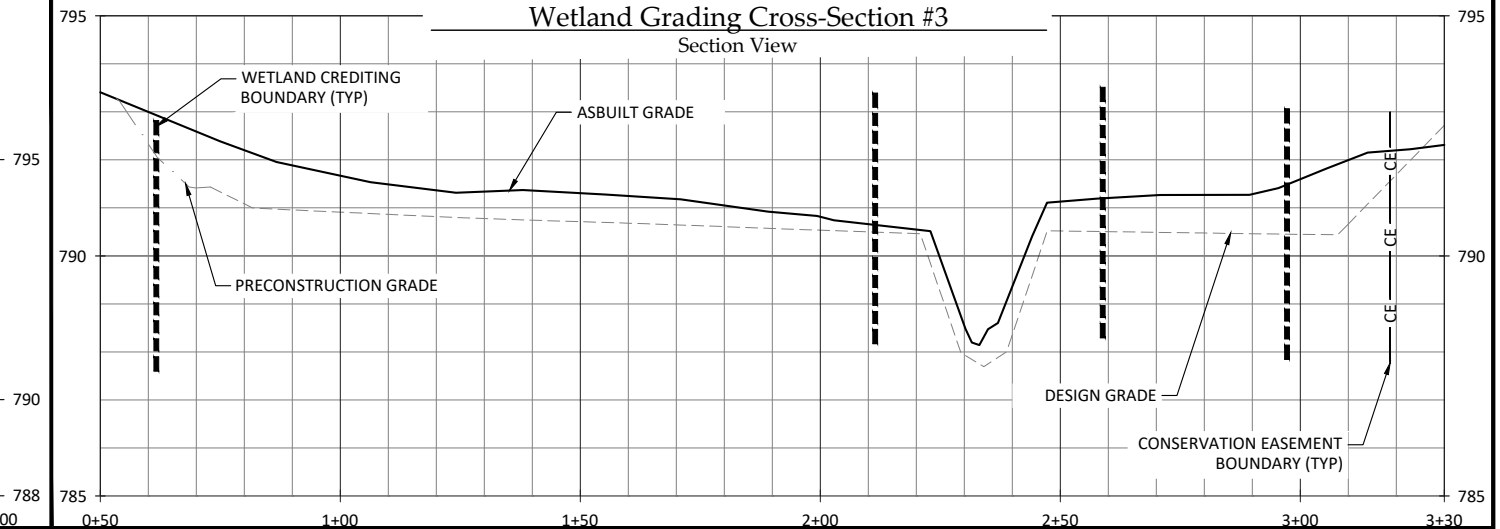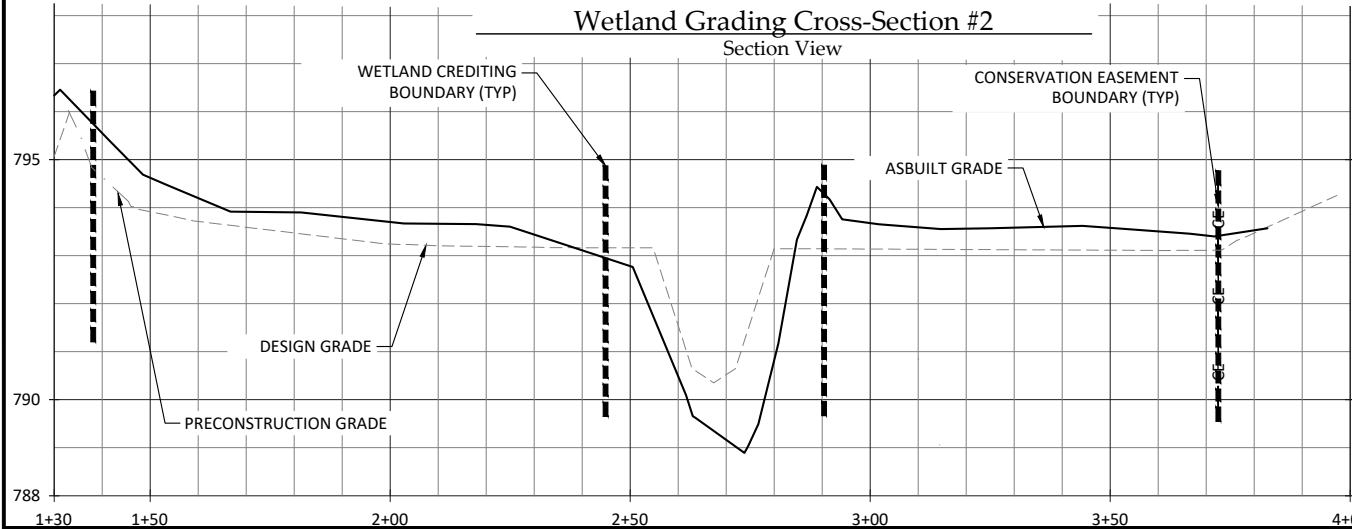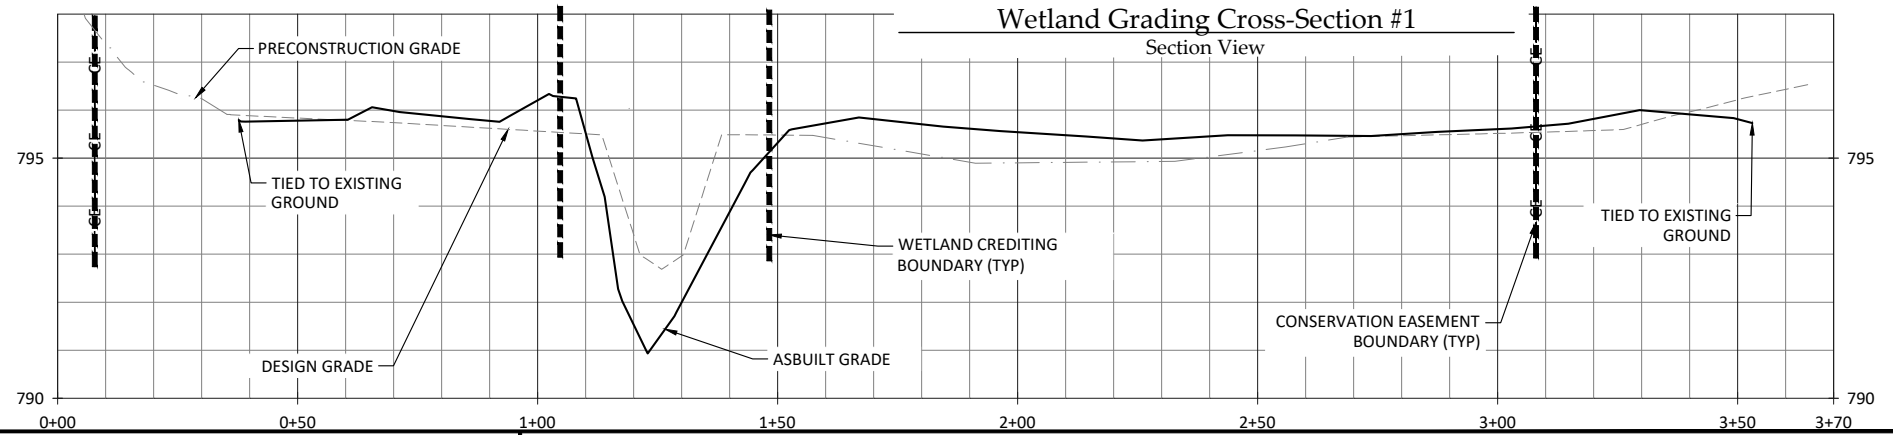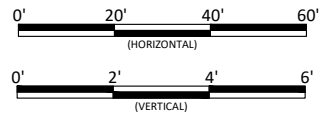

Oak Hill Dairy Mitigation Site Record Drawings

Gaston County, North Carolina

Wetland Grading - Wetland 1

Wetland Grading

Revisions:


Date:	May 12, 2022
Job Number:	005-02182
Project Engineer:	AMR
Drawn By:	AMR
Checked By:	JCK

2.2


Sheet





WILDLANDS
ENGINEERING
167-B Haywood Rd
Asheville, NC 28806
Tel: 828.774.5547
License No. F-0831

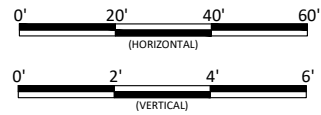

Wetland Grading Cross-Section #4
Section View

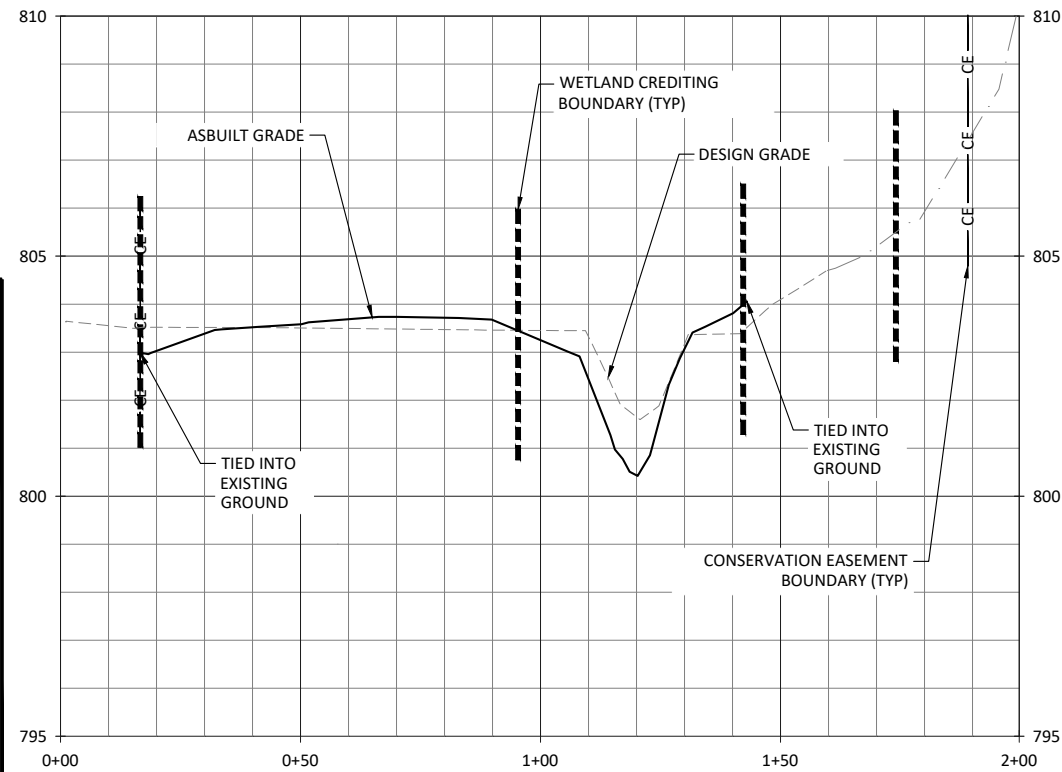

Wetland Grading Cross-Section #5
Section View

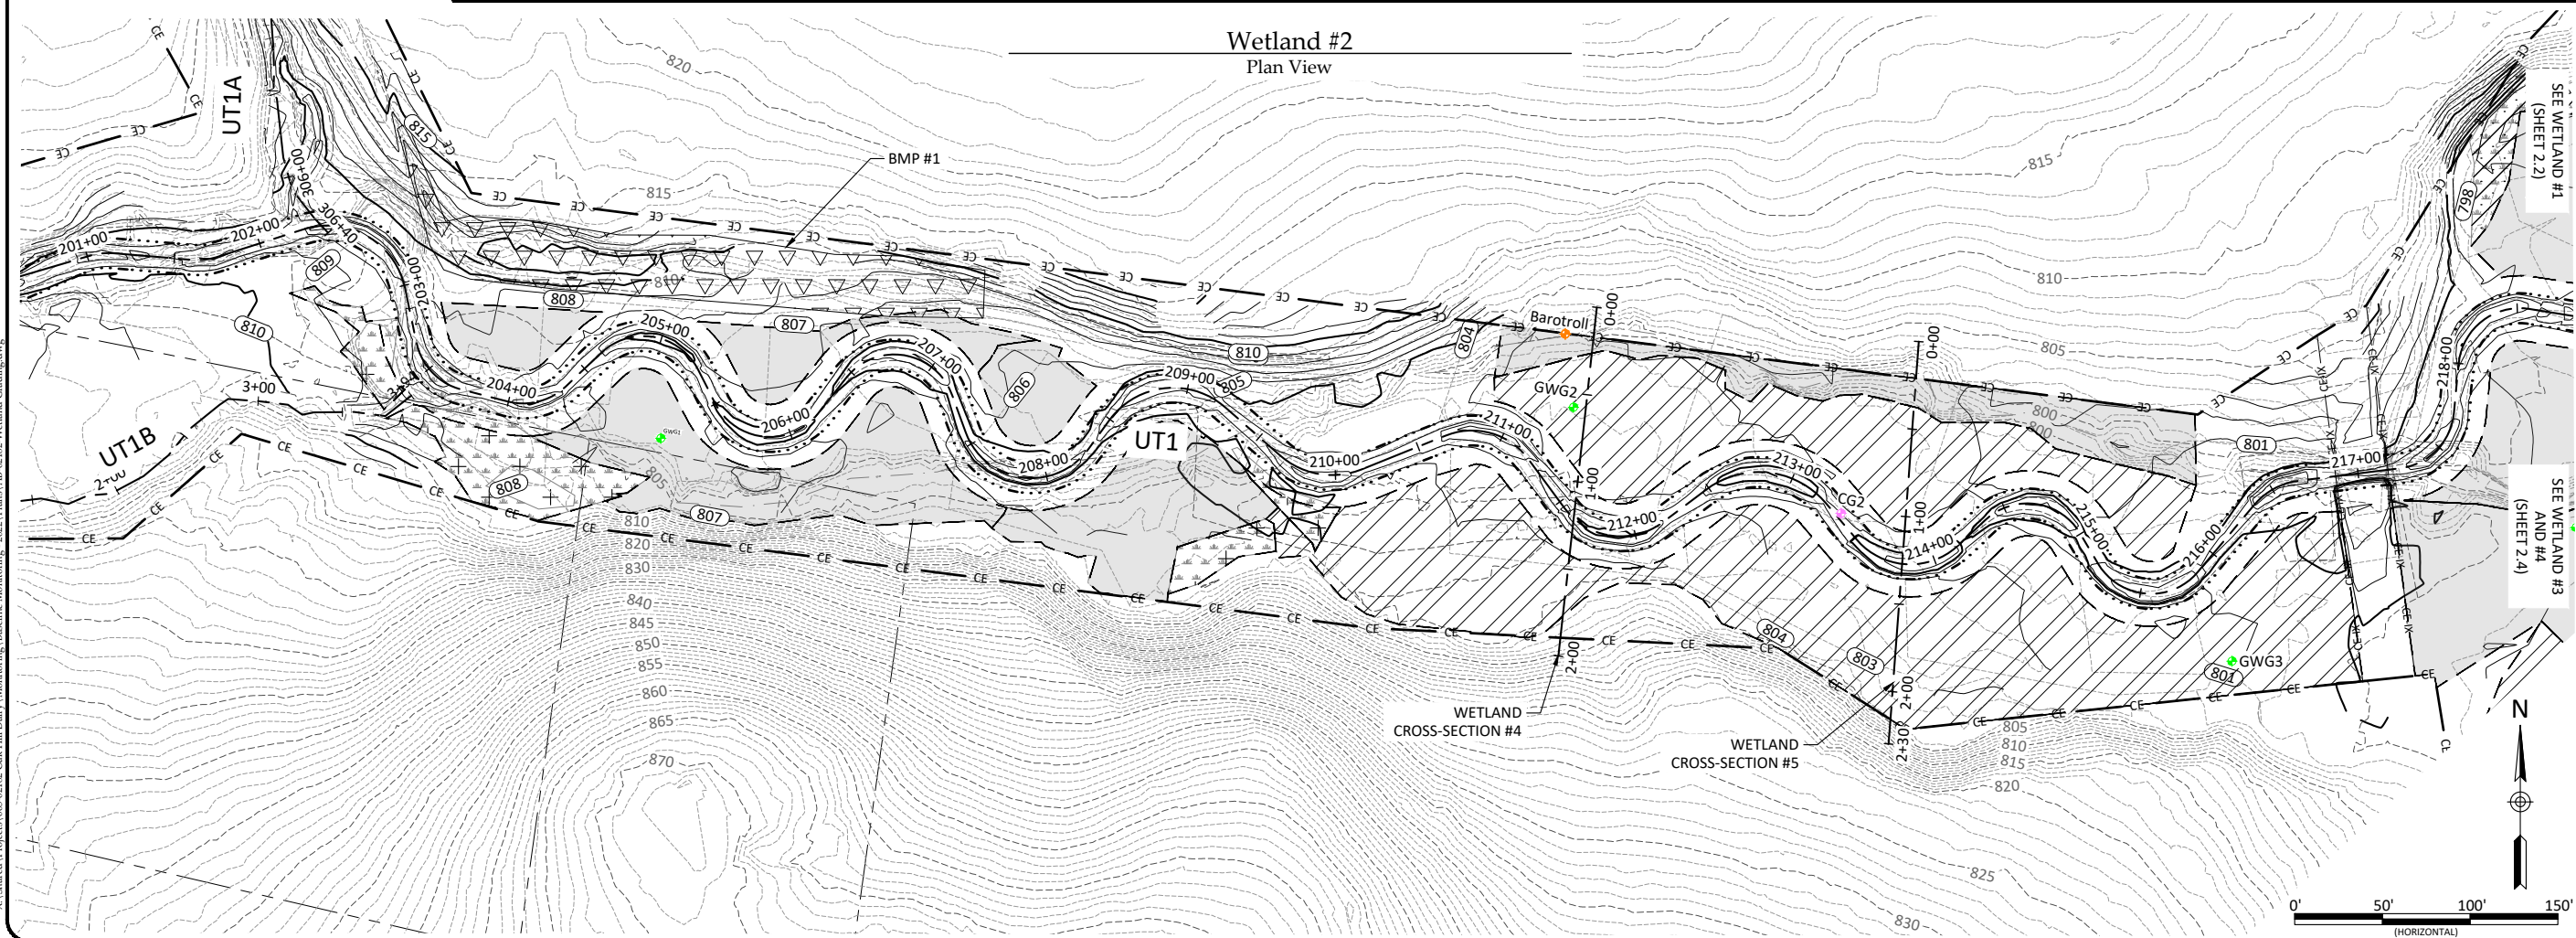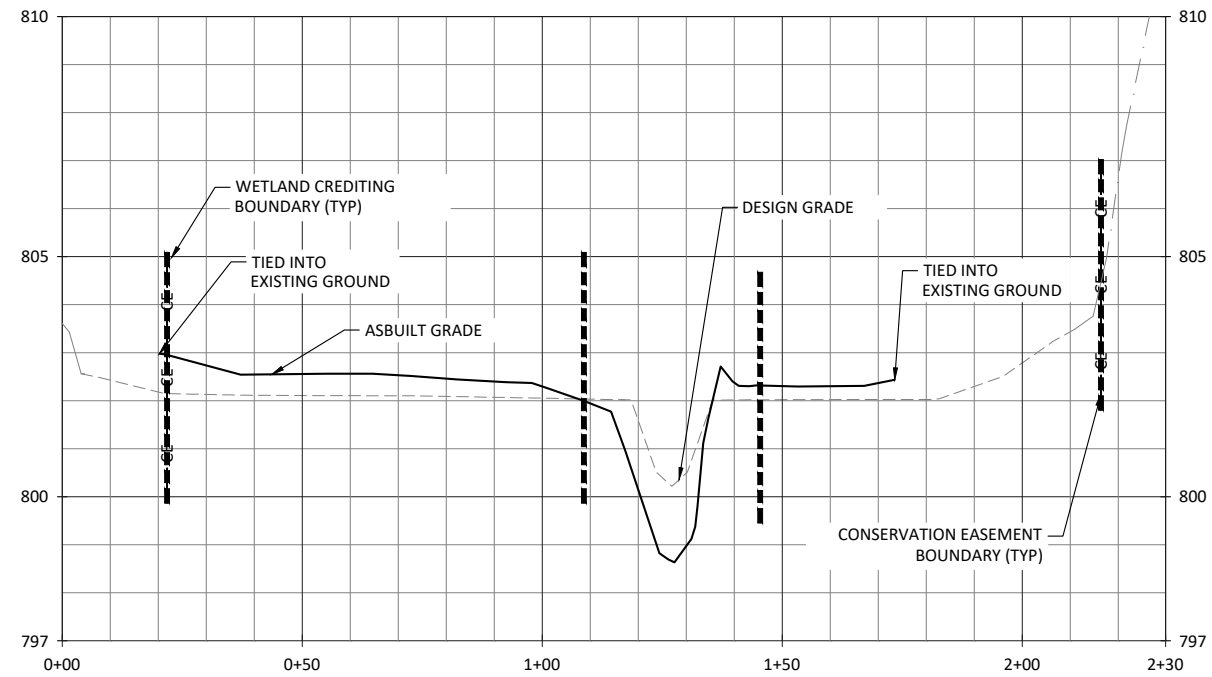

Oak Hill Dairy Mitigation Site Record Drawings

Gaston County, North Carolina

Wetland Grading - Wetland 2
Wetland Grading

Date:	May 12, 2022
Job Number:	005-02182
Project Engineer:	JM
Drawn By:	AMR
Checked By:	JCK

2.3





May 13, 2022

X:\Shared Projects\005-02182 Oak Hill Dairy Monitoring Baseline Monitoring - 2021 Plans\AB-02182 Wetland Grading.dwg


Wetland Grading Cross-Section #6

Section View

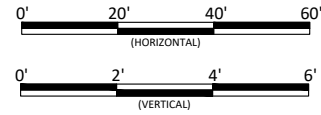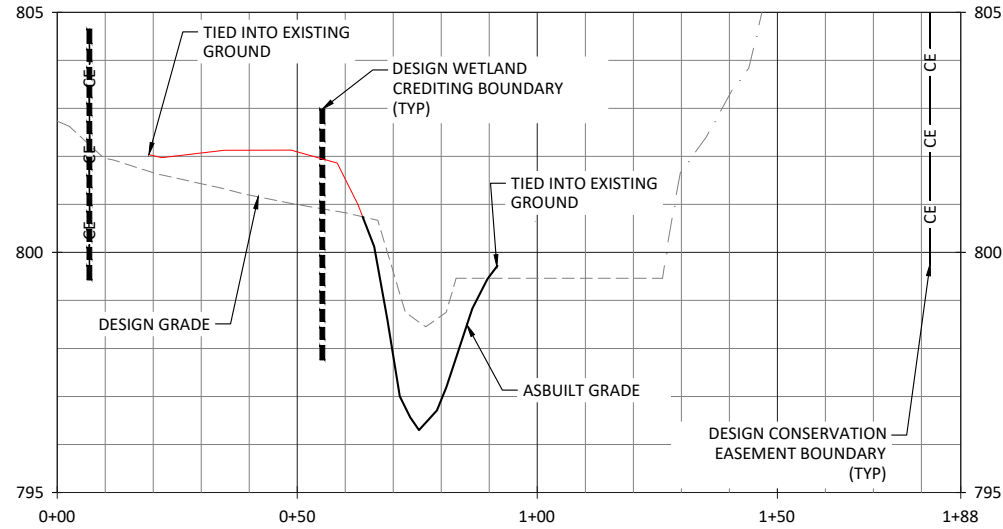




Wetland Grading Cross-Section #7

Section View

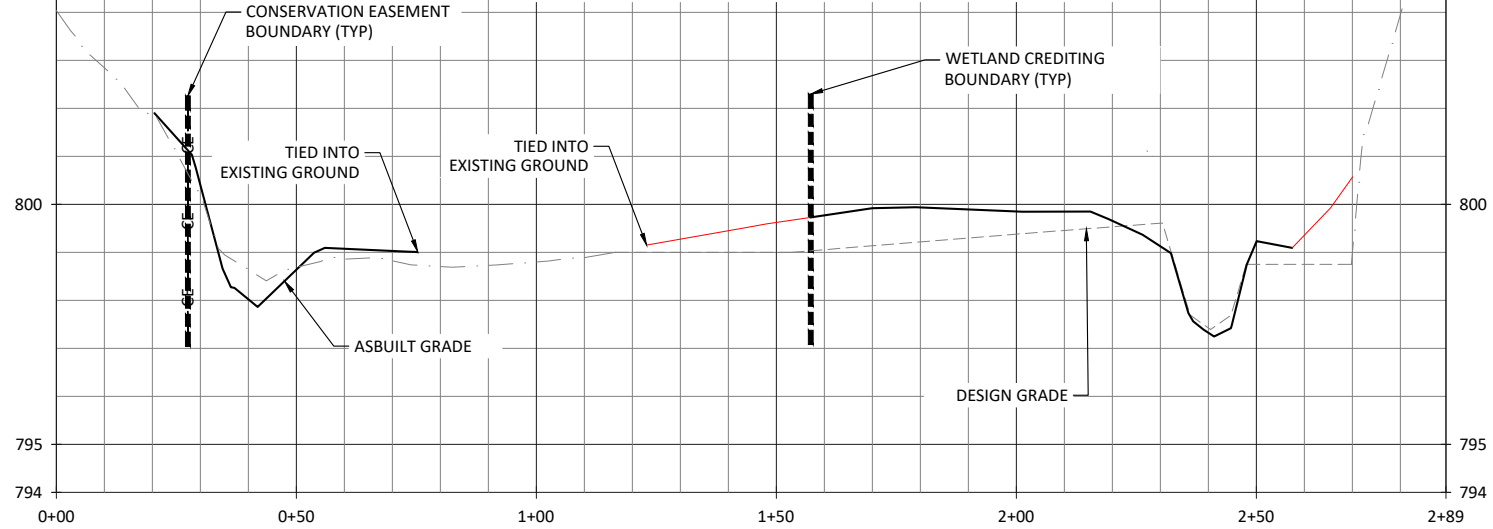

Wetland #3 and #4


Plan View

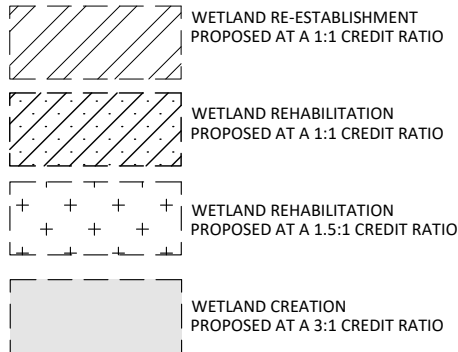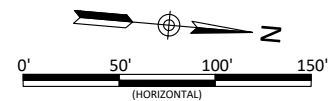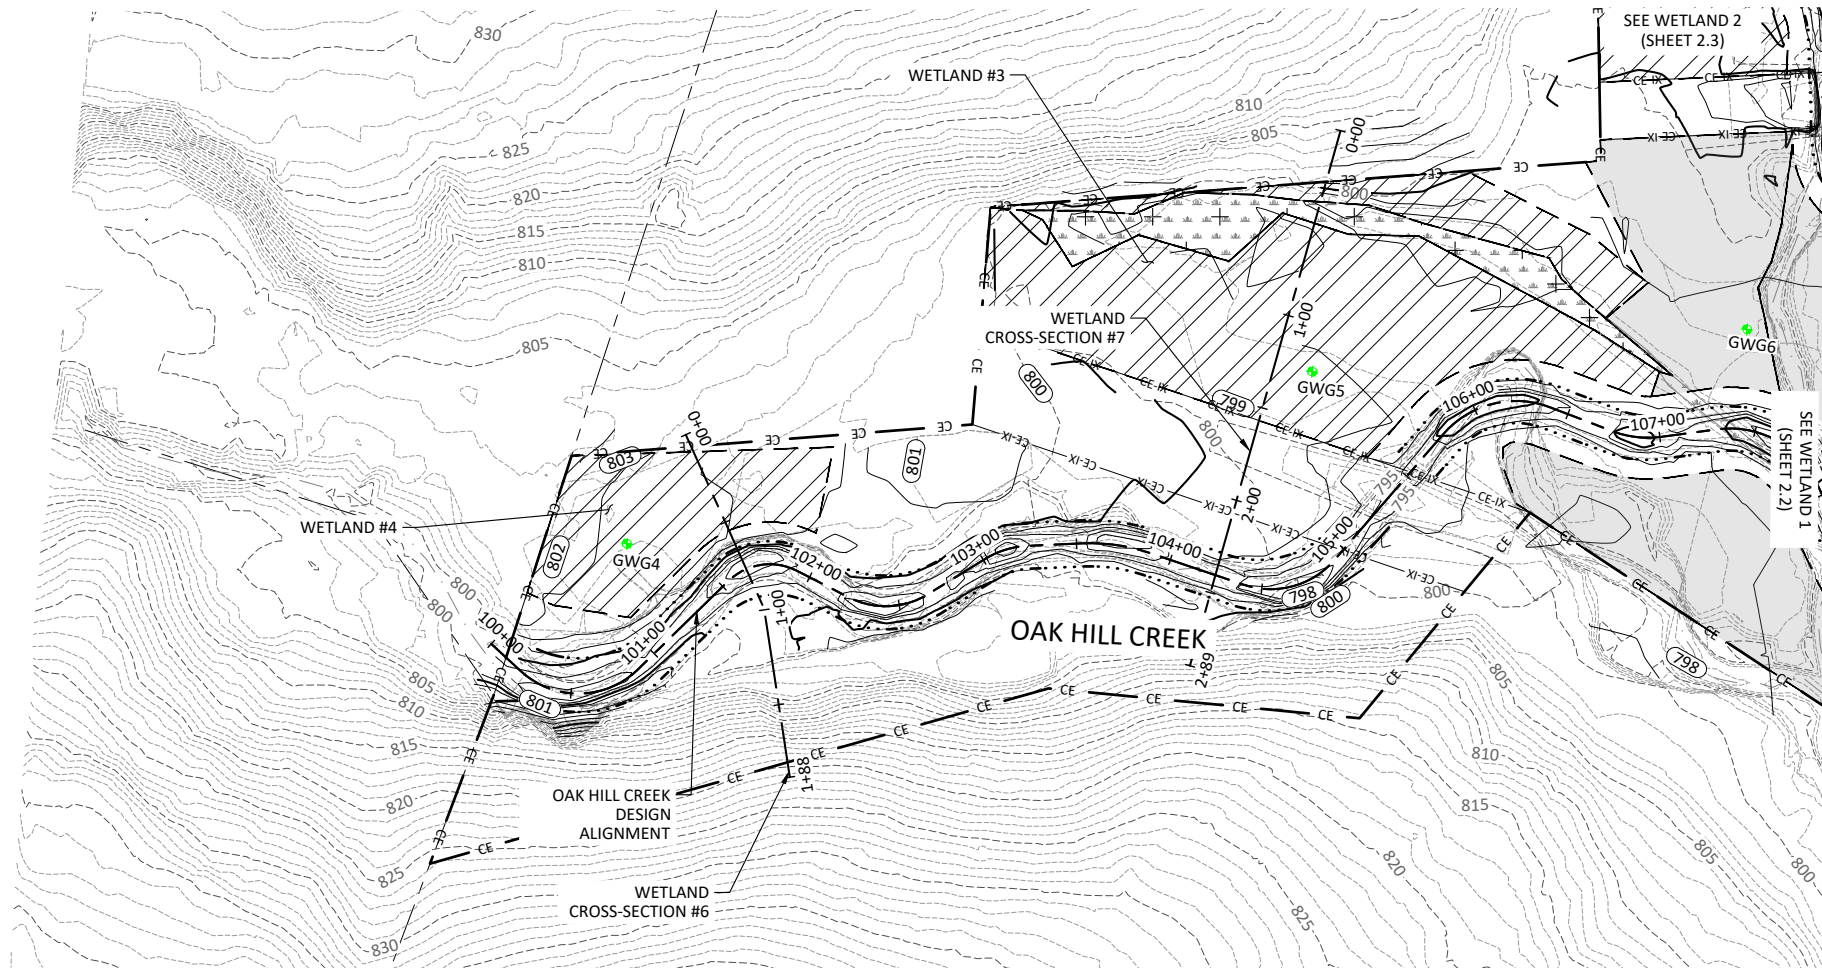

Revisions:

Date:	May 12, 2022
Job Number:	005-02182
Project Engineer:	JM
Drawn By:	AMK
Checked By:	JCK

Open Area Buffer Planting

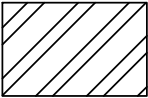

Open Buffer Planting Zone Trees							
Bare Root							
Species	Common Name	Max Spacing	Indiv. Spacing	Min. Caliper Size	Stratum	Wetland Indicator	# of Stems
<i>Acer negundo</i>	Boxelder	12 ft.	6-12 ft.	0.25"-1.0"	Canopy	FAC	10%
<i>Platanus occidentalis</i>	Sycamore	12 ft.	6-12 ft.	0.25"-1.0"	Canopy	FACW	15%
<i>Betula nigra</i>	River Birch	12 ft.	6-12 ft.	0.25"-1.0"	Canopy	FACW	15%
<i>Liriodendron tulipifera</i>	Tulip Poplar	12 ft.	6-12 ft.	0.25"-1.0"	Canopy	FACU	2%
<i>Quercus phellos</i>	Willow Oak	12 ft.	6-12 ft.	0.25"-1.0"	Canopy	FAC	10%
<i>Oxydendrum arboreum</i>	Sourwood	12 ft.	6-12 ft.	0.25"-1.0"	Canopy	UPL	5%
<i>Diospyros virginiana</i>	Persimmon	12 ft.	6-12 ft.	0.25"-1.0"	Canopy	FAC	6%
<i>Populus deltoides</i>	Eastern Cottonwood	12 ft.	6-12 ft.	0.25"-1.0"	Canopy	FAC	10%
<i>Carya cordiformis</i>	Bitternut Hickory	12 ft.	6-12 ft.	0.25"-1.0"	Canopy	FACU	5%
<i>Quercus alba</i>	White Oak	12 ft.	6-12 ft.	0.25"-1.0"	Canopy	FACU	5%
<i>Quercus rubra</i>	Northern Red Oak	12 ft.	6-12 ft.	0.25"-1.0"	Canopy	FACU	5%
<i>Ulmus rubra</i>	Slippery Elm	12 ft.	6-12 ft.	0.25"-1.0"	Canopy	FACU	1%
Total							89%


Open Buffer Planting Zone Small Trees / Shrubs							
Bare Root							
Species	Common Name	Max Spacing	Indiv. Spacing	Min. Caliper Size	Stratum	Wetland Indicator	# of Stems
<i>Ainus serrulata</i>	Tag Alder	12 ft.	6-12 ft.	0.25"-1.0"	Sub-Canopy	OBL	2%
<i>Hamamelis virginiana</i>	Witch Hazel	12 ft.	6-12 ft.	0.25"-1.0"	Shrub	FACU	2%
<i>Cornus florida</i>	Flowering Dogwood	12 ft.	6-12 ft.	0.25"-1.0"	Sub-Canopy	FACU	2%
<i>Lindera benzoin</i>	Spicebush	12 ft.	6-12 ft.	0.25"-1.0"	Shrub	FAC	2%
<i>Amelanchier arborea</i>	Serviceberry	12 ft.	6-12 ft.	0.25"-1.0"	Shrub	FAC	2%
<i>Calycanthus floridus</i>	Sweet Shrub	12 ft.	6-12 ft.	0.25"-1.0"	Shrub	FACW	1%
<i>Sambucus canadensis</i>	Elderberry	12 ft.	6-12 ft.	0.25"-1.0"	Shrub	FAC	2%
Total							11%

- Notes:
- (1) Substitute species: Sweetshrub, northern red oak, slippery elm.
 - (2) Transplants from on-site to be used at Designer's discretion for streambank and floodplain planting.
 - (3) Percentages of each species may be varied at Designer's discretion but shall not exceed 20% per each species.
 - (4) Designer may substitute container plantings or other plantings for bare roots.

TEMPORARY SEEDING		
APPROVED DATE	TYPE	PLANTING RATE (lbs/acre)
Jan 1 – May 1	Rye Grain (<i>Secale Cereale</i>)	120
	Ladino clover (<i>Trifolium Repens</i>)	5
	Crimson Clover (<i>Trifolium incarnatum</i>)	5
	Straw Mulch	4,000
May 1 – Aug 15	German Millet (<i>Setaria italica</i>)	40
	Ladino clover (<i>Trifolium Repens</i>)	5
	Crimson Clover (<i>Trifolium incarnatum</i>)	5
	Straw Mulch	4,000
Aug 15 – Dec 31	Rye Grain (<i>Secale Cereale</i>)	120
	Ladino clover (<i>Trifolium Repens</i>)	5
	Crimson Clover (<i>Trifolium incarnatum</i>)	5
	Straw Mulch	4,000

Note:
Rates of fertilizer and lime if necessary can be found in the site preparation plan included in the specification documents.

Wetland Planting

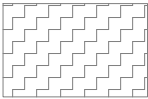

Wetland Planting Zone Trees							
Bare Root							
Species	Common Name	Max Spacing	Indiv. Spacing	Min. Caliper Size	Stratum	Wetland Indicator	# of Stems
<i>Platanus occidentalis</i>	Sycamore	12 ft.	6-12 ft.	0.25"-1.0"	Canopy	FACW	15%
<i>Betula nigra</i>	River Birch	12 ft.	6-12 ft.	0.25"-1.0"	Canopy	FACW	15%
<i>Quercus phellos</i>	Willow Oak	12 ft.	6-12 ft.	0.25"-1.0"	Canopy	FAC	10%
<i>Ulmus americana</i>	American Elm	12 ft.	6-12 ft.	0.25"-1.0"	Canopy	FACW	10%
<i>Nyssa sylvatica</i>	Black Gum	12 ft.	6-12 ft.	0.25"-1.0"	Canopy	FAC	5%
<i>Quercus michauxii</i>	Swamp Chestnut Oak	12 ft.	6-12 ft.	0.25"-1.0"	Canopy	FACW	8%
<i>Acer negundo</i>	Boxelder	12 ft.	6-12 ft.	0.25"-1.0"	Canopy	FAC	5%
<i>Quercus nigra</i>	Water Oak	12 ft.	6-12 ft.	0.25"-1.0"	Canopy	FACW	7%
<i>Celtis laevigata</i>	Sugarberry	12 ft.	6-12 ft.	0.25"-1.0"	Canopy	FACW	5%
Total							80%

Wetland Planting Zone Small Trees/Shrubs							
Bare Root							
Species	Common Name	Max Spacing	Indiv. Spacing	Min. Caliper Size	Stratum	Wetland Indicator	# of Stems
<i>Alnus serrulata</i>	Tag Alder	12 ft.	6-12 ft.	0.25"-1.0"	Sub-Canopy	OBL	1%
<i>Lindera benzoin</i>	Spicebush	12 ft.	6-12 ft.	0.25"-1.0"	Shrub	FAC	5%
<i>Cephalanthus occidentalis</i>	Buttonbush	12 ft.	6-12 ft.	0.25"-1.0"	Shrub	OBL	5%
<i>Sambucus canadensis</i>	Elderberry	12 ft.	6-12 ft.	0.25"-1.0"	Shrub	FAC	5%
<i>Cornus amomum</i>	Silky Dogwood	12 ft.	6-12 ft.	0.25"-1.0"	Shrub	FACW	1%
<i>Salix sericea</i>	Silky Willow	12 ft.	6-12 ft.	0.25"-1.0"	Shrub	OBL	2%
Livestakes							
<i>Salix nigra</i>	Black Willow	8 ft	6-8 ft.	0.5"-1.5"	Shrub	OBL	1%
Total							20%


- Notes:
- (1) Substitute species: Silky willow, silky dogwood.
 - (2) Tag Alder shall be limited to Wetland 1 or other wetter areas of the site as designated by Designer.
 - (3) Transplants from on-site to be used at Designer's discretion for streambank and floodplain planting.
 - (4) Percentages of each species may be varied at Designer's discretion but shall not exceed 20% per each species.
 - (5) Designer may substitute container plantings or other plantings for bare roots.

Partially Vegetated Buffer Area Planting



Open Buffer Planting Zone Trees							
Bare Root							
Species	Common Name	Max Spacing	Indiv. Spacing	Min. Caliper Size	Stratum	Wetland Indicator	# of Stems
<i>Carpinus caroliniana</i>	American Hornbeam	12 ft.	6-12 ft.	0.25"-1.0"	Sub-Canopy	FAC	14%
<i>Euonymus americana</i>	Strawberry Bush	12 ft.	6-12 ft.	0.25"-1.0"	Shrub	FAC	14%
<i>Lindera benzoin</i>	Spicebush	12 ft.	6-12 ft.	0.25"-1.0"	Shrub	FAC	8%
<i>Fagus grandifolia</i>	American Beech	12 ft.	6-12 ft.	0.25"-1.0"	Canopy	FACU	14%
<i>Ulmus rubra</i>	Slippery Elm	12 ft.	6-12 ft.	0.25"-1.0"	Canopy	FAC	7%
<i>Hamamelis virginiana</i>	Witchhazel	12 ft.	6-12 ft.	0.25"-1.0"	Shrub	FACU	7%
<i>Calycanthus floridus</i>	Sweetshrub	12 ft.	6-12 ft.	0.25"-1.0"	Shrub	FACU	7%
<i>Cornus florida</i>	Flowering Dogwood	12 ft.	6-12 ft.	0.25"-1.0"	Sub-Canopy	FACU	7%
<i>Asimina triloba</i>	Pawpaw	12 ft.	6-12 ft.	0.25"-1.0"	Sub-Canopy	FAC	14%
<i>Quercus rubra</i>	Northern Red Oak	12 ft.	6-12 ft.	0.25"-1.0"	Canopy	FACU	8%
Total							100%

Riparian Corridor and Inundated Wetland Planting

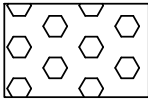

Streambank Planting Zone							
Live Stakes							
Species	Common Name	Max Spacing	Indiv. Spacing	Min. Size	Stratum	Wetland Indicator	% of Stems
<i>Salix nigra</i>	Black Willow	8 ft.	6-8 ft.	0.5"-1.5" cal.	Shrub	OBL	25%
<i>Cornus amomum</i>	Silky Dogwood	8 ft.	6-8 ft.	0.5"-1.5" cal.	Shrub	FACW	20%
<i>Salix sericea</i>	Silky Willow	8 ft.	6-8 ft.	0.5"-1.5" cal.	Shrub	OBL	25%
<i>Cephalanthus occidentalis</i>	Buttonbush	8 ft.	6-8 ft.	0.5"-1.5" cal.	Shrub	OBL	15%
<i>Sambucus canadensis</i>	Elderberry	8 ft.	6-8 ft.	0.5"-1.5" cal.	Shrub	FAC	15%
Total							100%
Herbaceous Plugs							
<i>Juncus effusus</i>	Common Rush	5 ft.	3-5 ft.	1.0"-2.0" plug	Herb	FACW	40%
<i>Carex crinita</i>	Fringed Sedge	5 ft.	3-5 ft.	1.0"-2.0" plug	Herb	OBL	10%
<i>Carex lurida</i>	Lurid Sedge	5 ft.	3-5 ft.	1.0"-2.0" plug	Herb	OBL	20%
<i>Carex lupulina</i>	Hop Sedge	5 ft.	3-5 ft.	1.0"-2.0" plug	Herb	OBL	15%
<i>Scirpus cyperinus</i>	Woolgrass	5 ft	3-5 ft.	1.0"-2.0" plug	Herb	FACW	15%
Total							100%

Note: See live staking and herbaceous plugs detail.

Permanent Seeding

Riparian Seeding - Open Canopy					
Pure Live Seed (21 lbs/ acre)					
Approved Date	Species Name	Common Name	Stratum	Wetland Indicator	Density (lbs/acre)
All Year	<i>Schizachyrium scoparium</i>	Little Bluestem	Herb	FACU	4.0
All Year	<i>Panicum virgatum</i>	Switchgrass	Herb	FAC	2.0
All Year	<i>Panicum rigidulum</i>	Redtop Panicgrass	Herb	FACW	1.0
All Year	<i>Rudbeckia hirta</i>	Blackeyed Susan	Herb	FACU	1.0
All Year	<i>Coreopsis lanceolata</i>	Lanceleaf Coreopsis	Herb	FACU	1.0
All Year	<i>Echinacea purpurea</i>	Purple coneflower	Herb	UPL	1.0
All Year	<i>Panicum clandestinum</i>	Deertongue	Herb	FAC	2.0
All Year	<i>Elymus virginicus</i>	Virginia Wild Rye	Herb	FACW	2.0
All Year	<i>Sorghastrum nutans</i>	Indiangrass	Herb	FACU	3.0
All Year	<i>Bidens aristosa</i>	Bur-Marigold	Herb	FACW	1.0
All Year	<i>Helianthus angustifolia</i>	Narrowleaf Sunflower	Herb	FACW	1.0
All Year	<i>Coreopsis tinctoria</i>	Plains coreopsis	Herb	FAC	1.0
All Year	<i>Achillea millefolium</i>	Common yarrow	Herb	FACU	1.0

Wetland Seeding - Open Canopy					
Pure Live Seed (19 lbs/ acre)					
Approved Date	Species Name	Common Name	Stratum	Wetland Indicator	Density (lbs/acre)
All Year	<i>Coleataenia anceps</i>	Beaked Panicgrass	Herb	FAC	3.0
All Year	<i>Carex vulpinoidea</i>	Fox Sedge	Herb	OBL	2.0
All Year	<i>Elymus virginicus</i>	Virginia Wild Rye	Herb	FACW	4.0
All Year	<i>Bidens aristosa</i>	Bur-Marigold	Herb	FACW	3.0
All Year	<i>Panicum cirgatum</i>	Switchgrass	Herb	FAC	2.0
All Year	<i>Polygonum pensylvanicum</i>	Smartweed	Herb	FACW	0.5
All Year	<i>Juncus effusus</i>	Common Rush	Herb	OBL	1.5
All Year	<i>Panicum dichotomiflorum</i>	Panicgrass	Herb	FACW	2.0
All Year	<i>Helianthus augustifolia</i>	Narrowleaf sunflower	Herb	FACW	1.0

- Notes:
- (1) Apply Permanent Riparian seeding in all disturbed areas within Conservation Easement.
 - (2) Apply Permanent seeding in all other disturbed areas outside of Easement per specification.

Stabilization Seeding

Stabilization Seeding		
Pure Live Seed (32 lbs/ac)		
Species Name	Common Name	lbs/acre
<i>Festuca arundinacea</i>	Fescue (KY 31)	20
<i>Dactylis glomerata</i>	Orchard Grass	12

- Notes:
- (1) Apply Pasture Seeding for grading outside Conservation Easement, utility easements, and stream crossings.
 - (2) Install temporary seed and mulch with all permanent seed.

Oak Hill Dairy Mitigation Site Record Drawings

Gaston County, North Carolina

Planting List

Revisions:

Date:	May 12, 2022
Job Number:	005-02182
Project Engineer:	JM
Drawn By:	AMR
Checked By:	JCK

3.1

Sheet



X:\Shared Projects\005-02182 Oak Hill Dairy\Monitoring\Baseline Monitoring - 2021\Plans\AB-02182 Planting.dwg
May 13, 2022


OPEN BUFFER PLANTING

BMP PLANTING

RIPARIAN CORRIDOR AND INUNDATED WETLAND PLANTING

WETLAND PLANTING

PARTIALLY VEGETATED BUFFER PLANTING

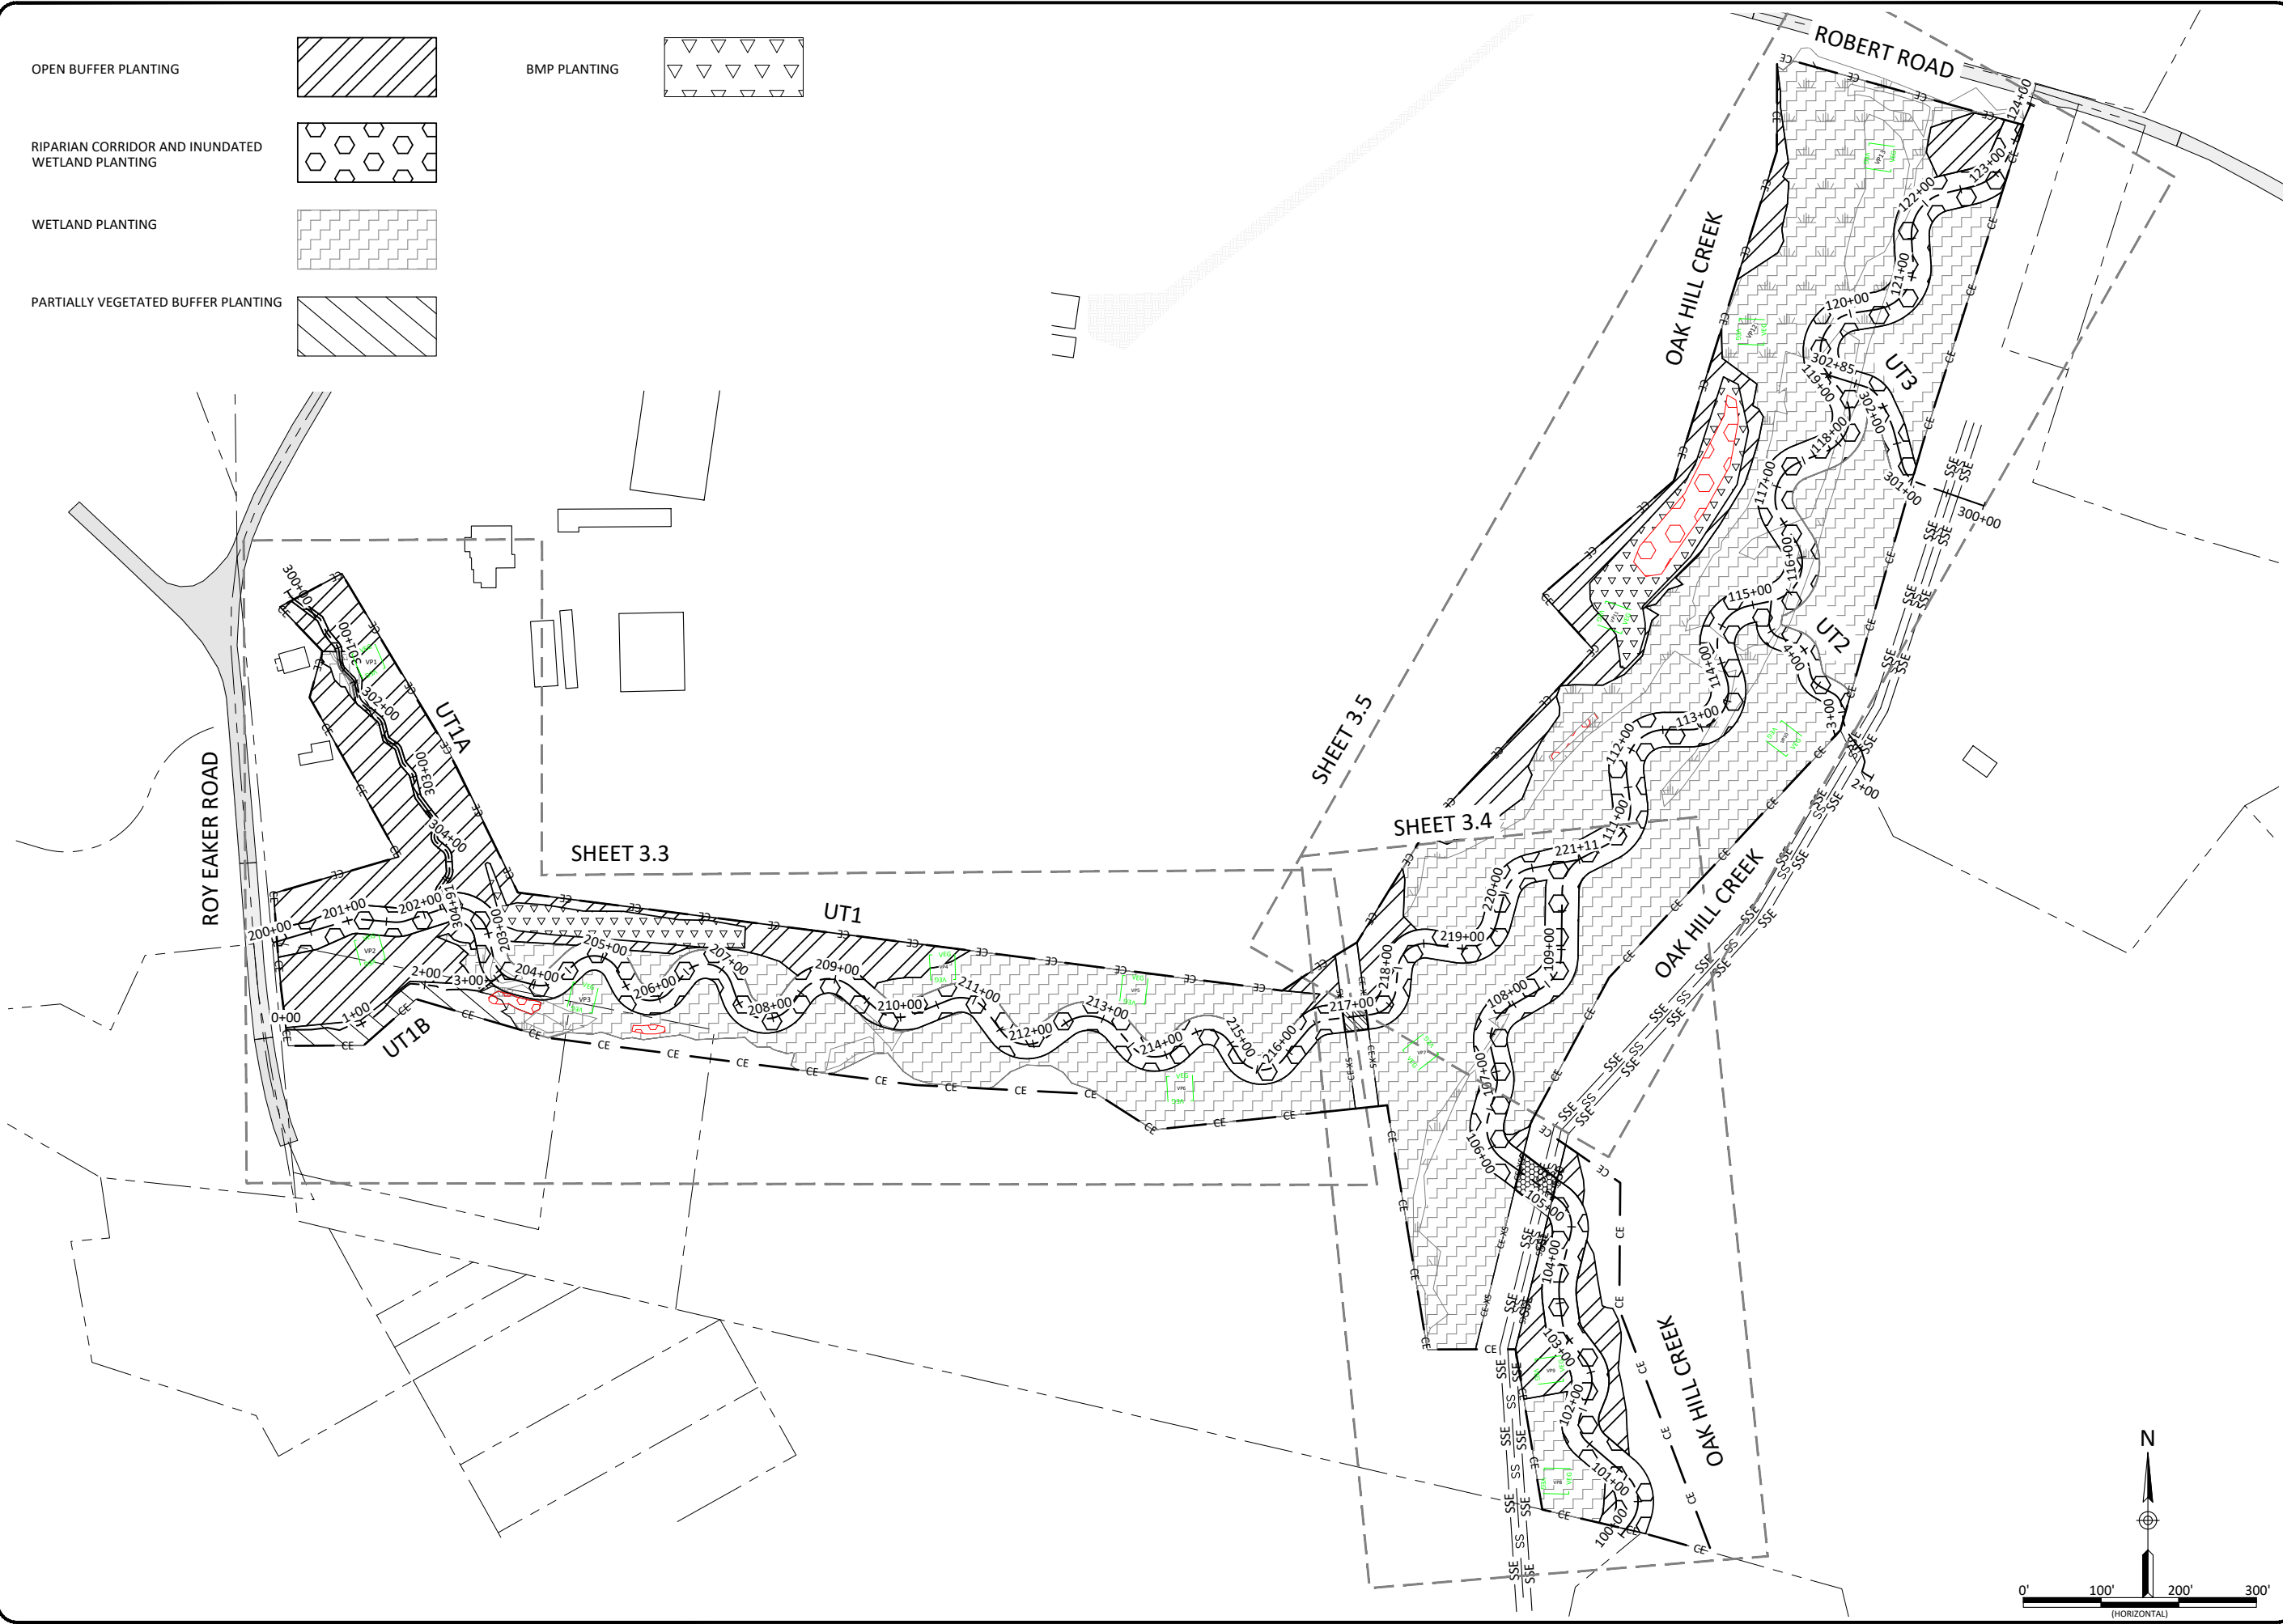

Oak Hill Dairy Mitigation Site Record Drawings
Gaston County, North Carolina

Date:	May 12, 2022
Job Number:	005-02182
Project Engineer:	JM
Drawn By:	AMR
Checked By:	JCK

Revisions:

3.2

Sheet




WILDLANDS

ENGINEERING

167-B Haywood Rd
Asheville, NC 28806
Tel: 828.774.5547
License No. F-0831

Planting Overview

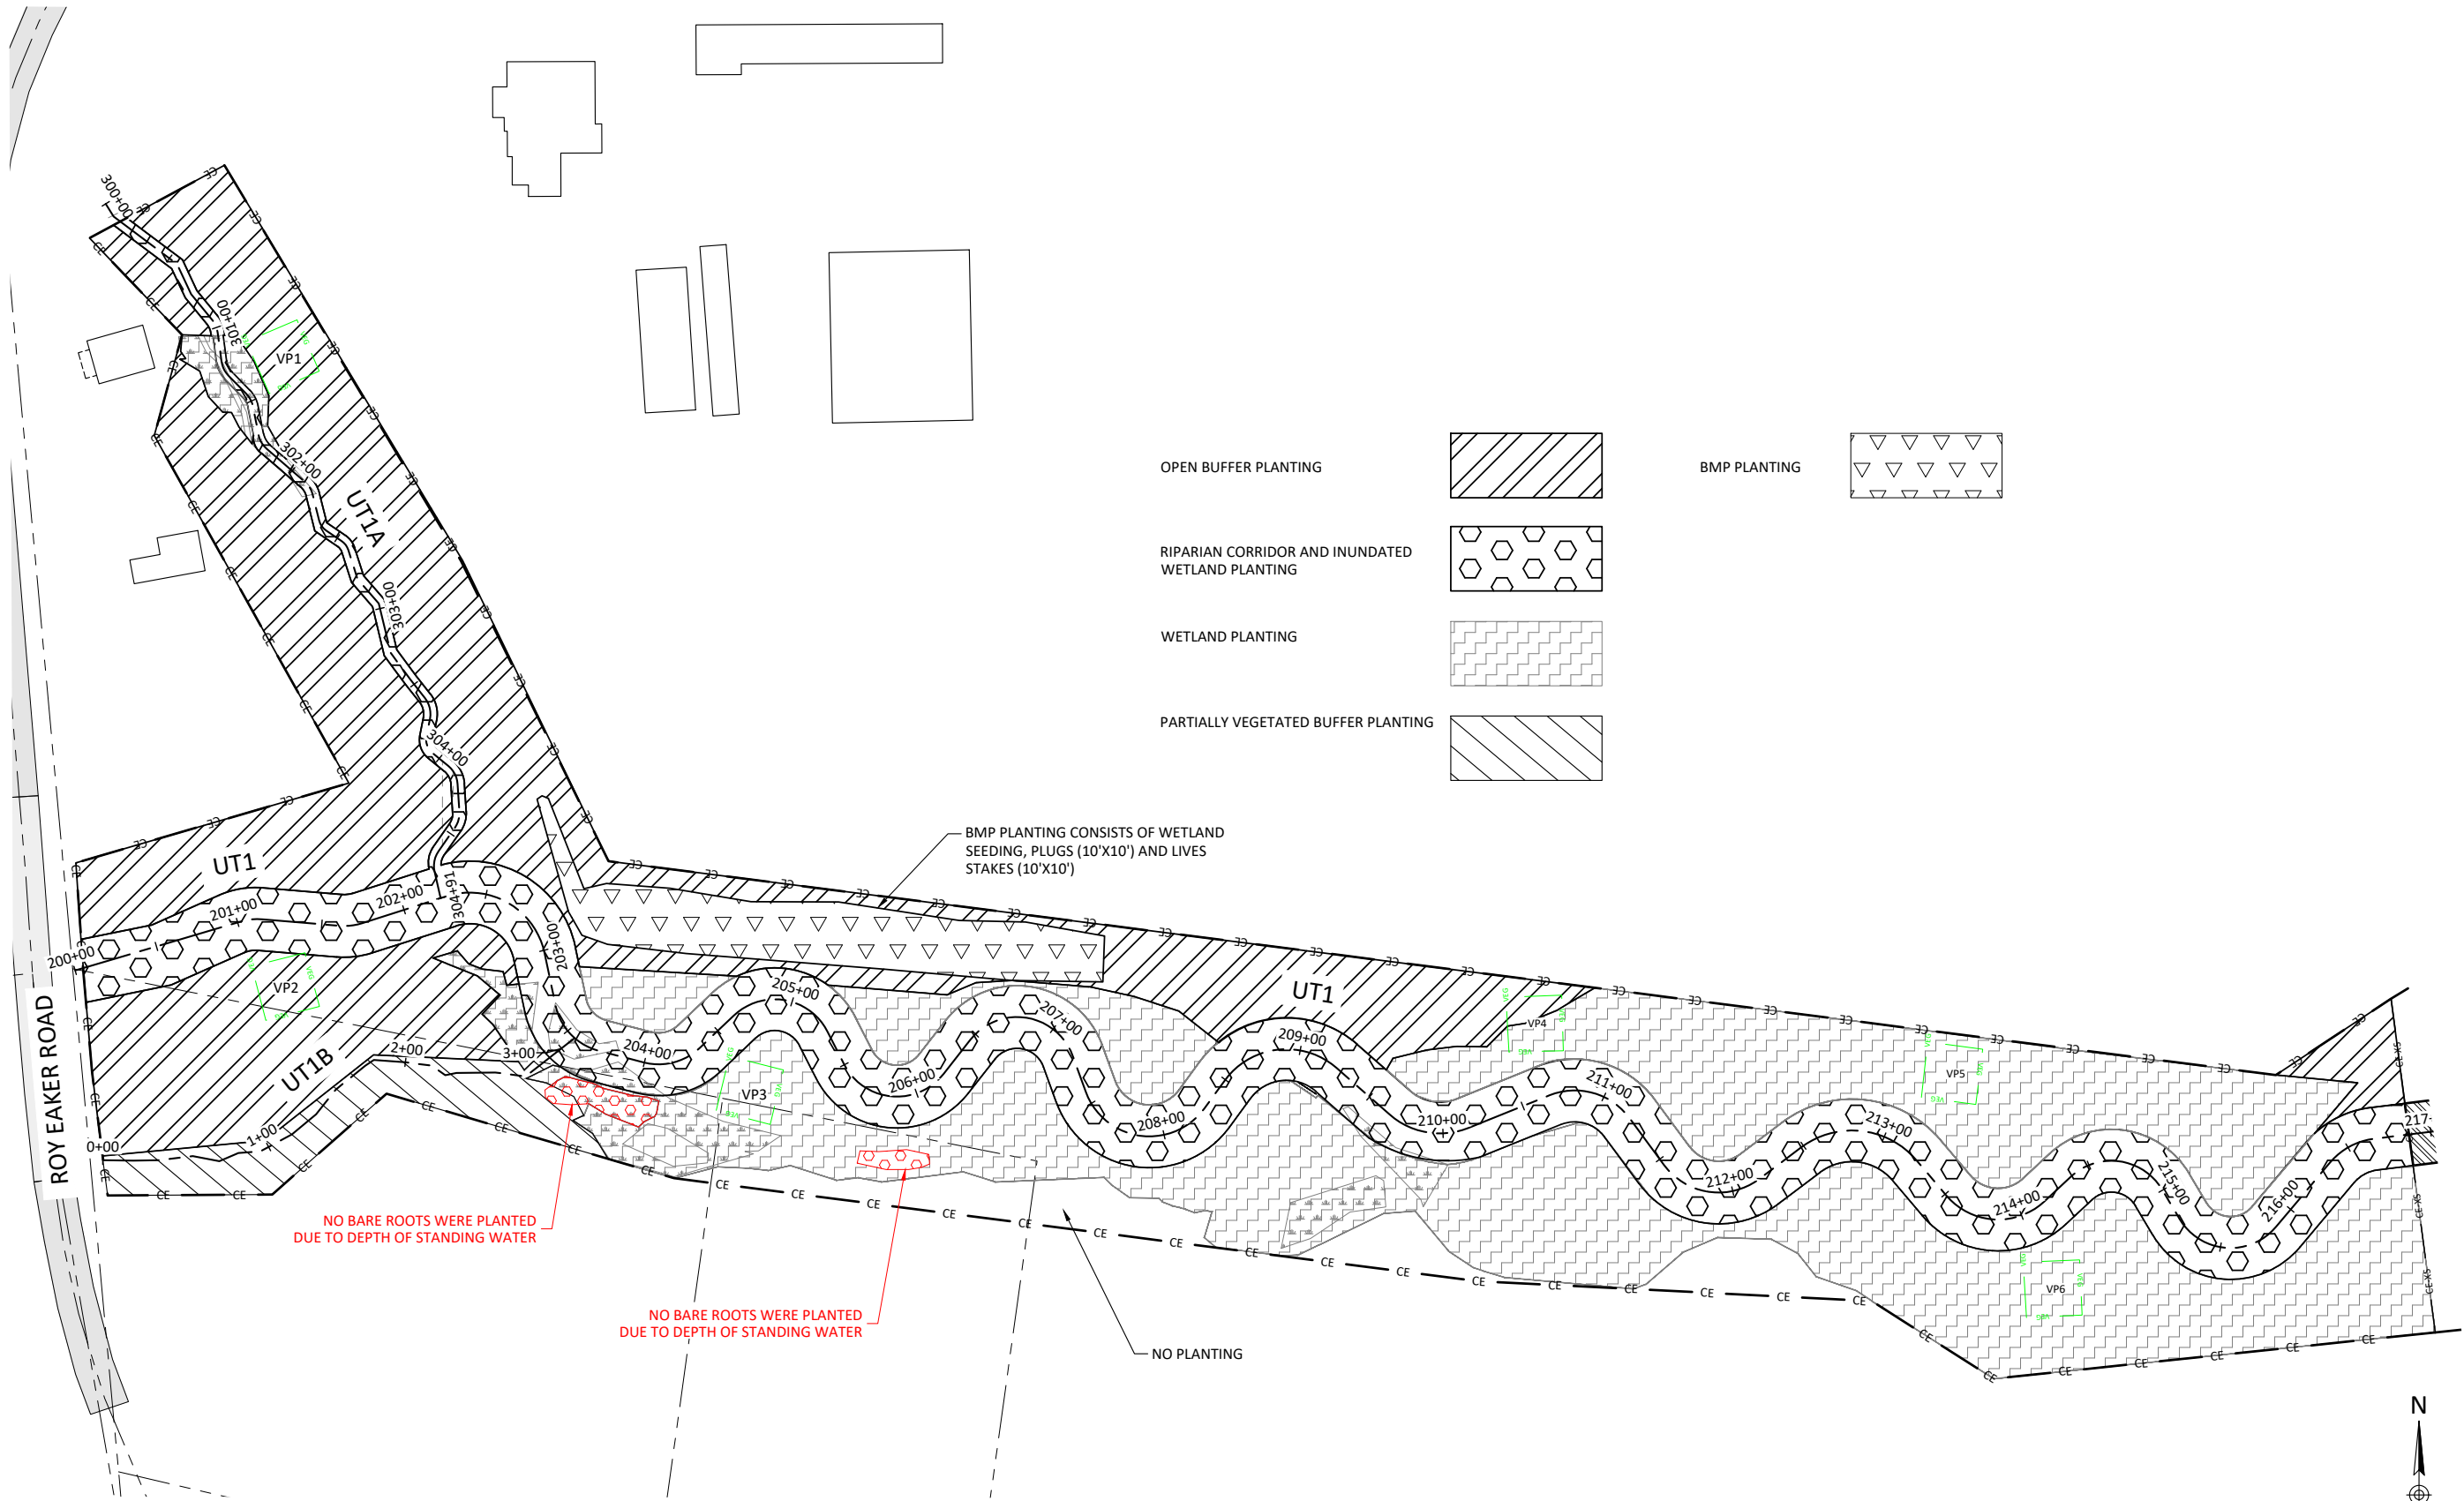

Oak Hill Dairy Mitigation Site Record Drawings
Gaston County, North Carolina

Planting Plan

Revisions:

Date:	May 12, 2022
Job Number:	005-02182
Project Engineer:	JM
Drawn By:	AMR
Checked By:	JCK

3.3

Sheet





OPEN BUFFER PLANTING

BMP PLANTING

RIPARIAN CORRIDOR AND INUNDATED WETLAND PLANTING

WETLAND PLANTING

PARTIALLY VEGETATED BUFFER PLANTING

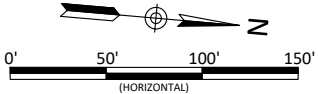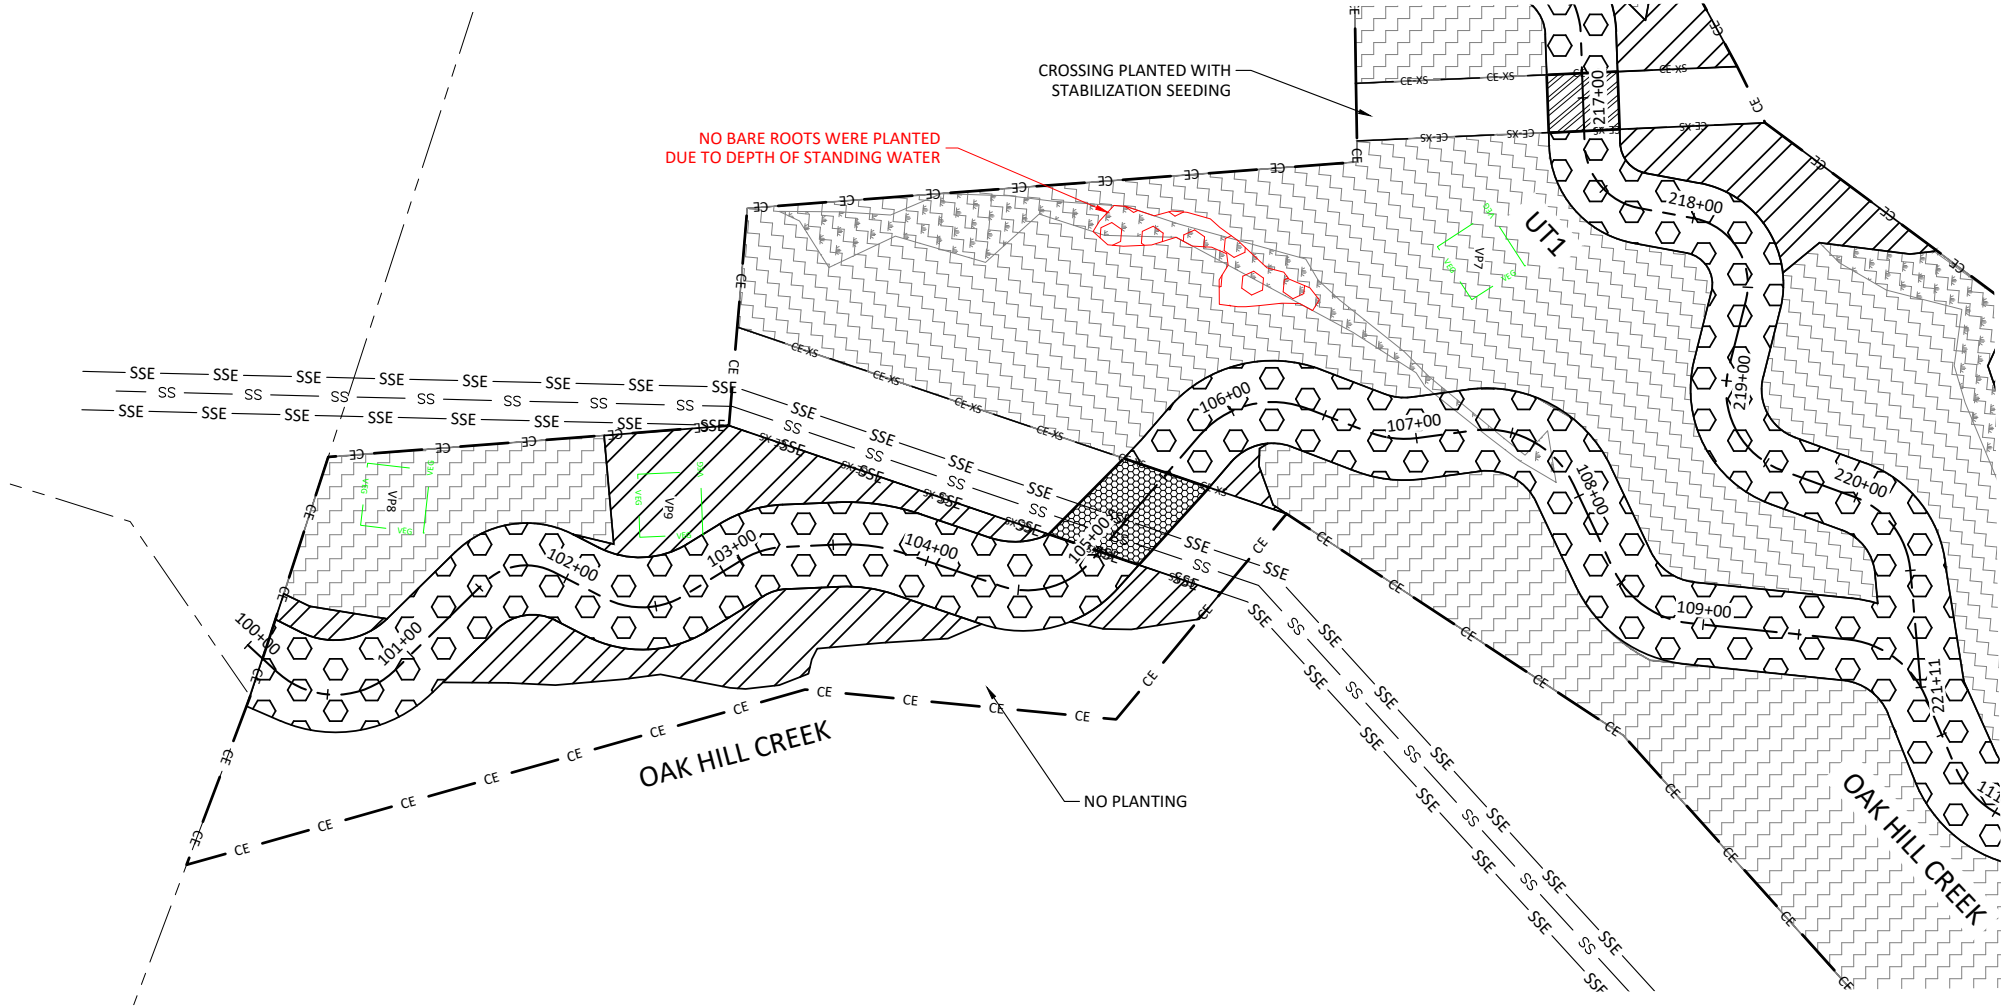

Oak Hill Dairy Mitigation Site Record Drawings
Gaston County, North Carolina

Revisions:

Date:	May 12, 2022
Job Number:	005-02182
Project Engineer:	JM
Drawn By:	AMR
Checked By:	JCK

3.4




WILDLANDS


ENGINEERING

167-B Haywood Rd
Asheville, NC 28806
Tel: 828.774.5547
License No. F-0831

Planting Plan

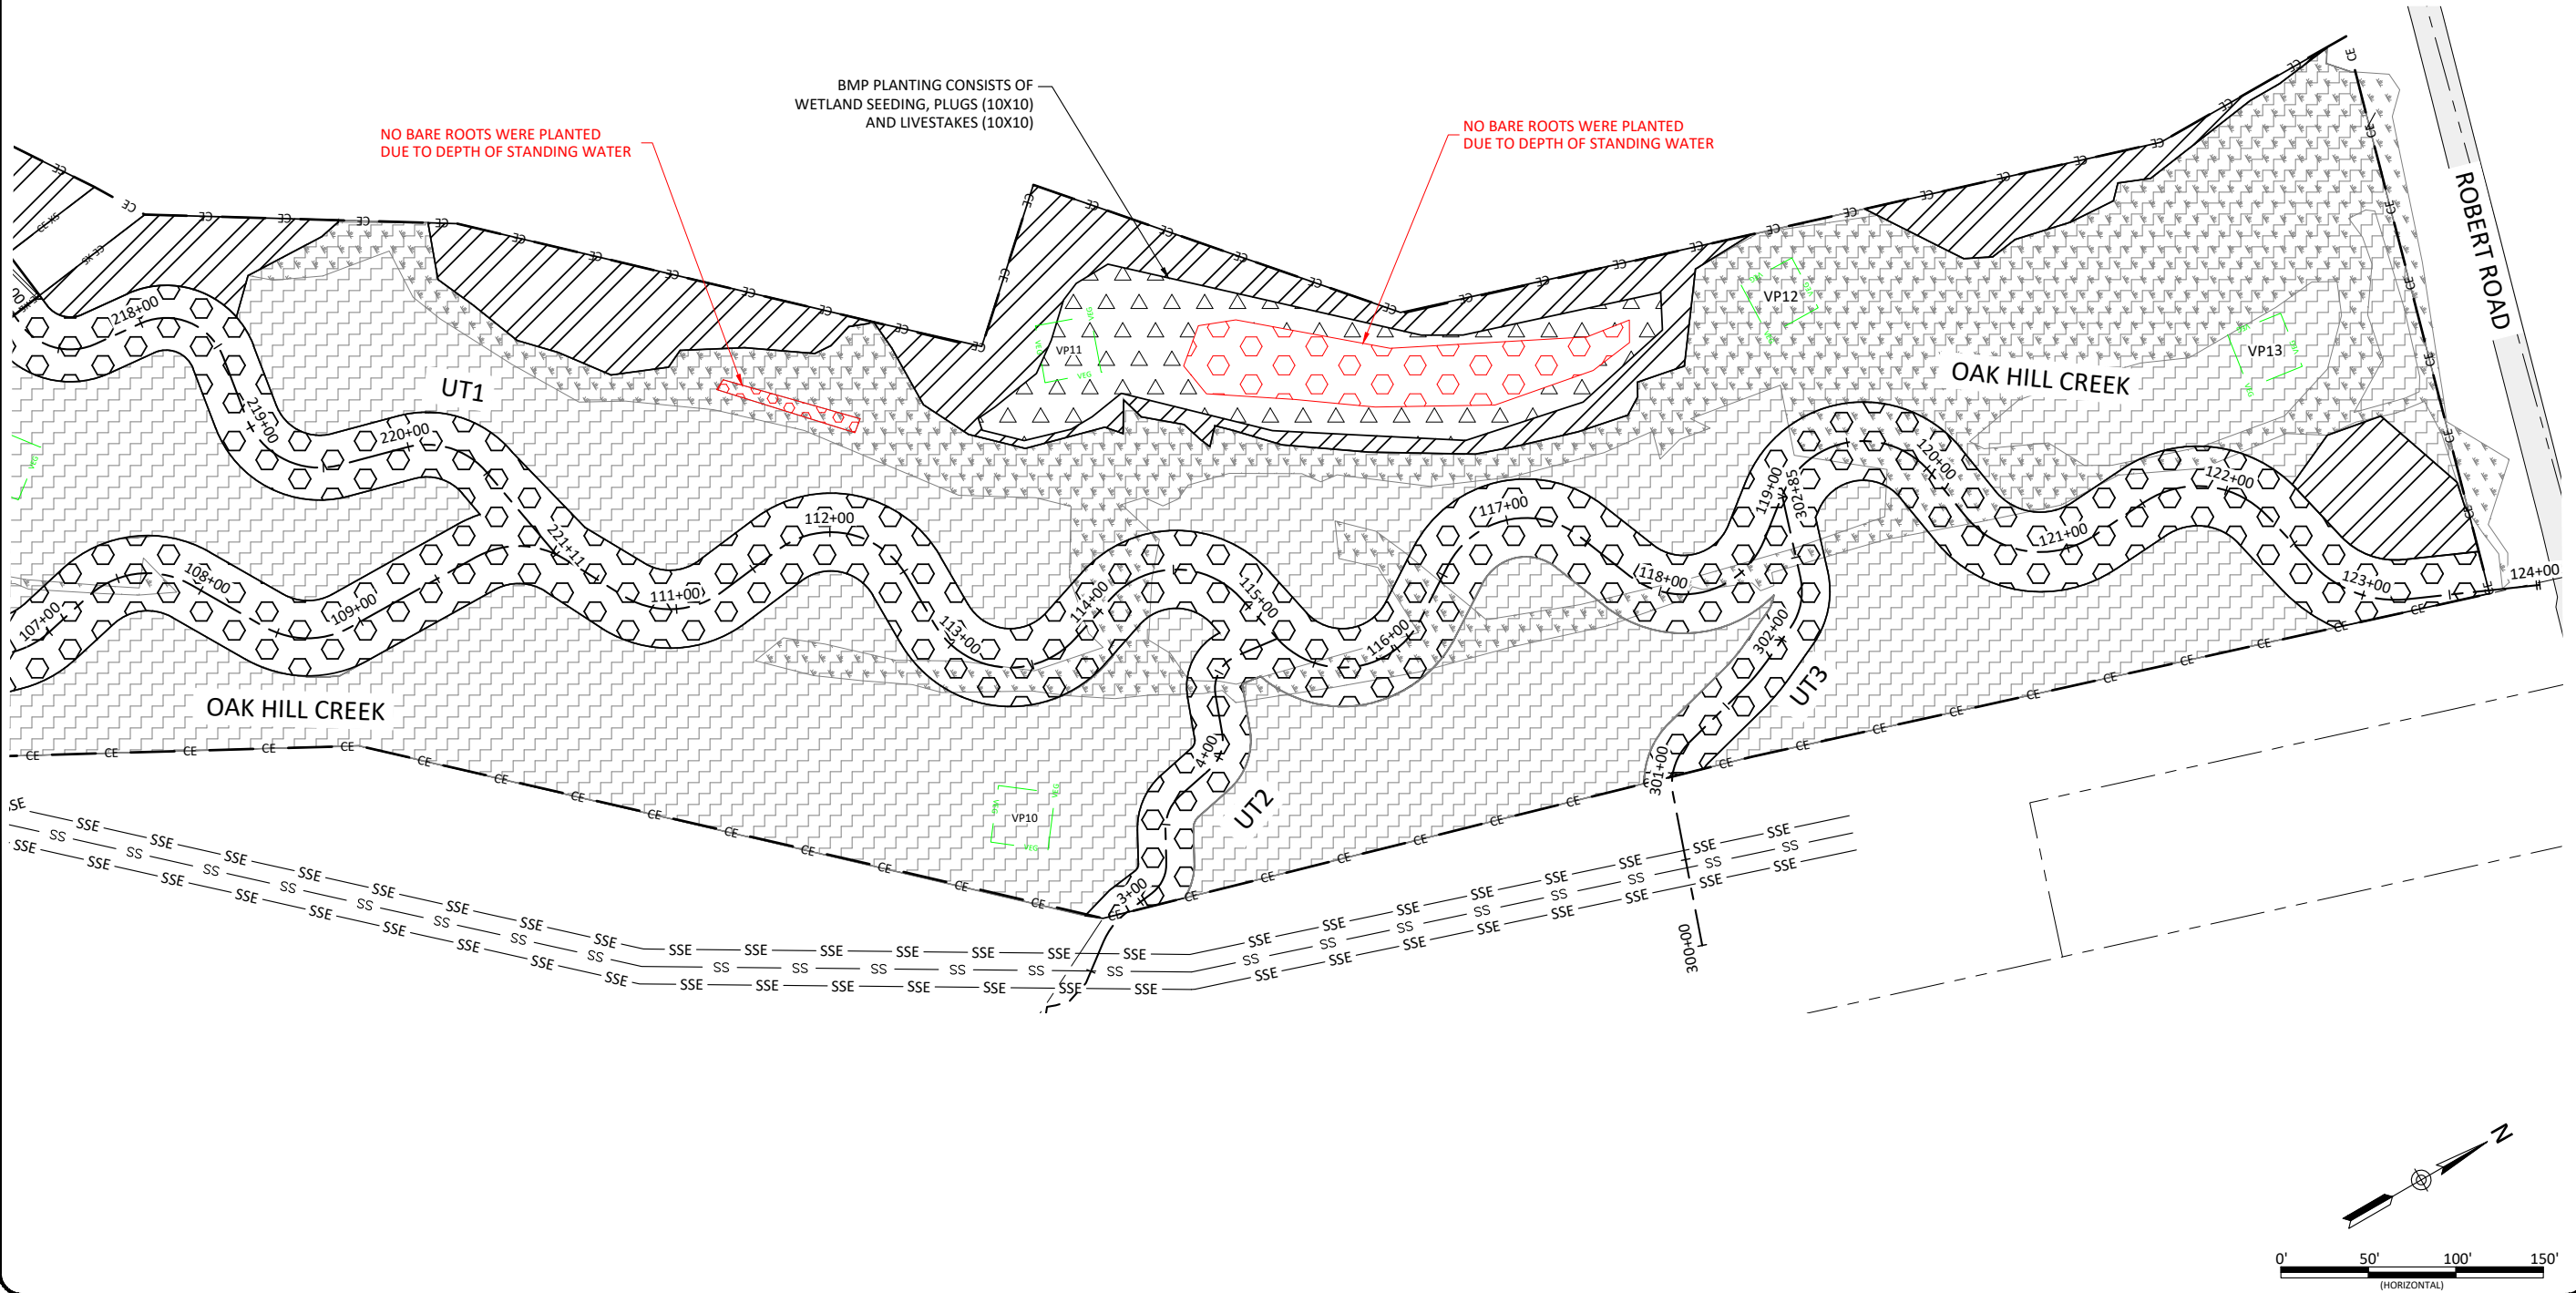

A:\Shared Projects\005-02162 Oak Hill Dairy\Monitoring\Baseline Monitoring - ZUZZ\Plans\05-02162 - Farm Fencing

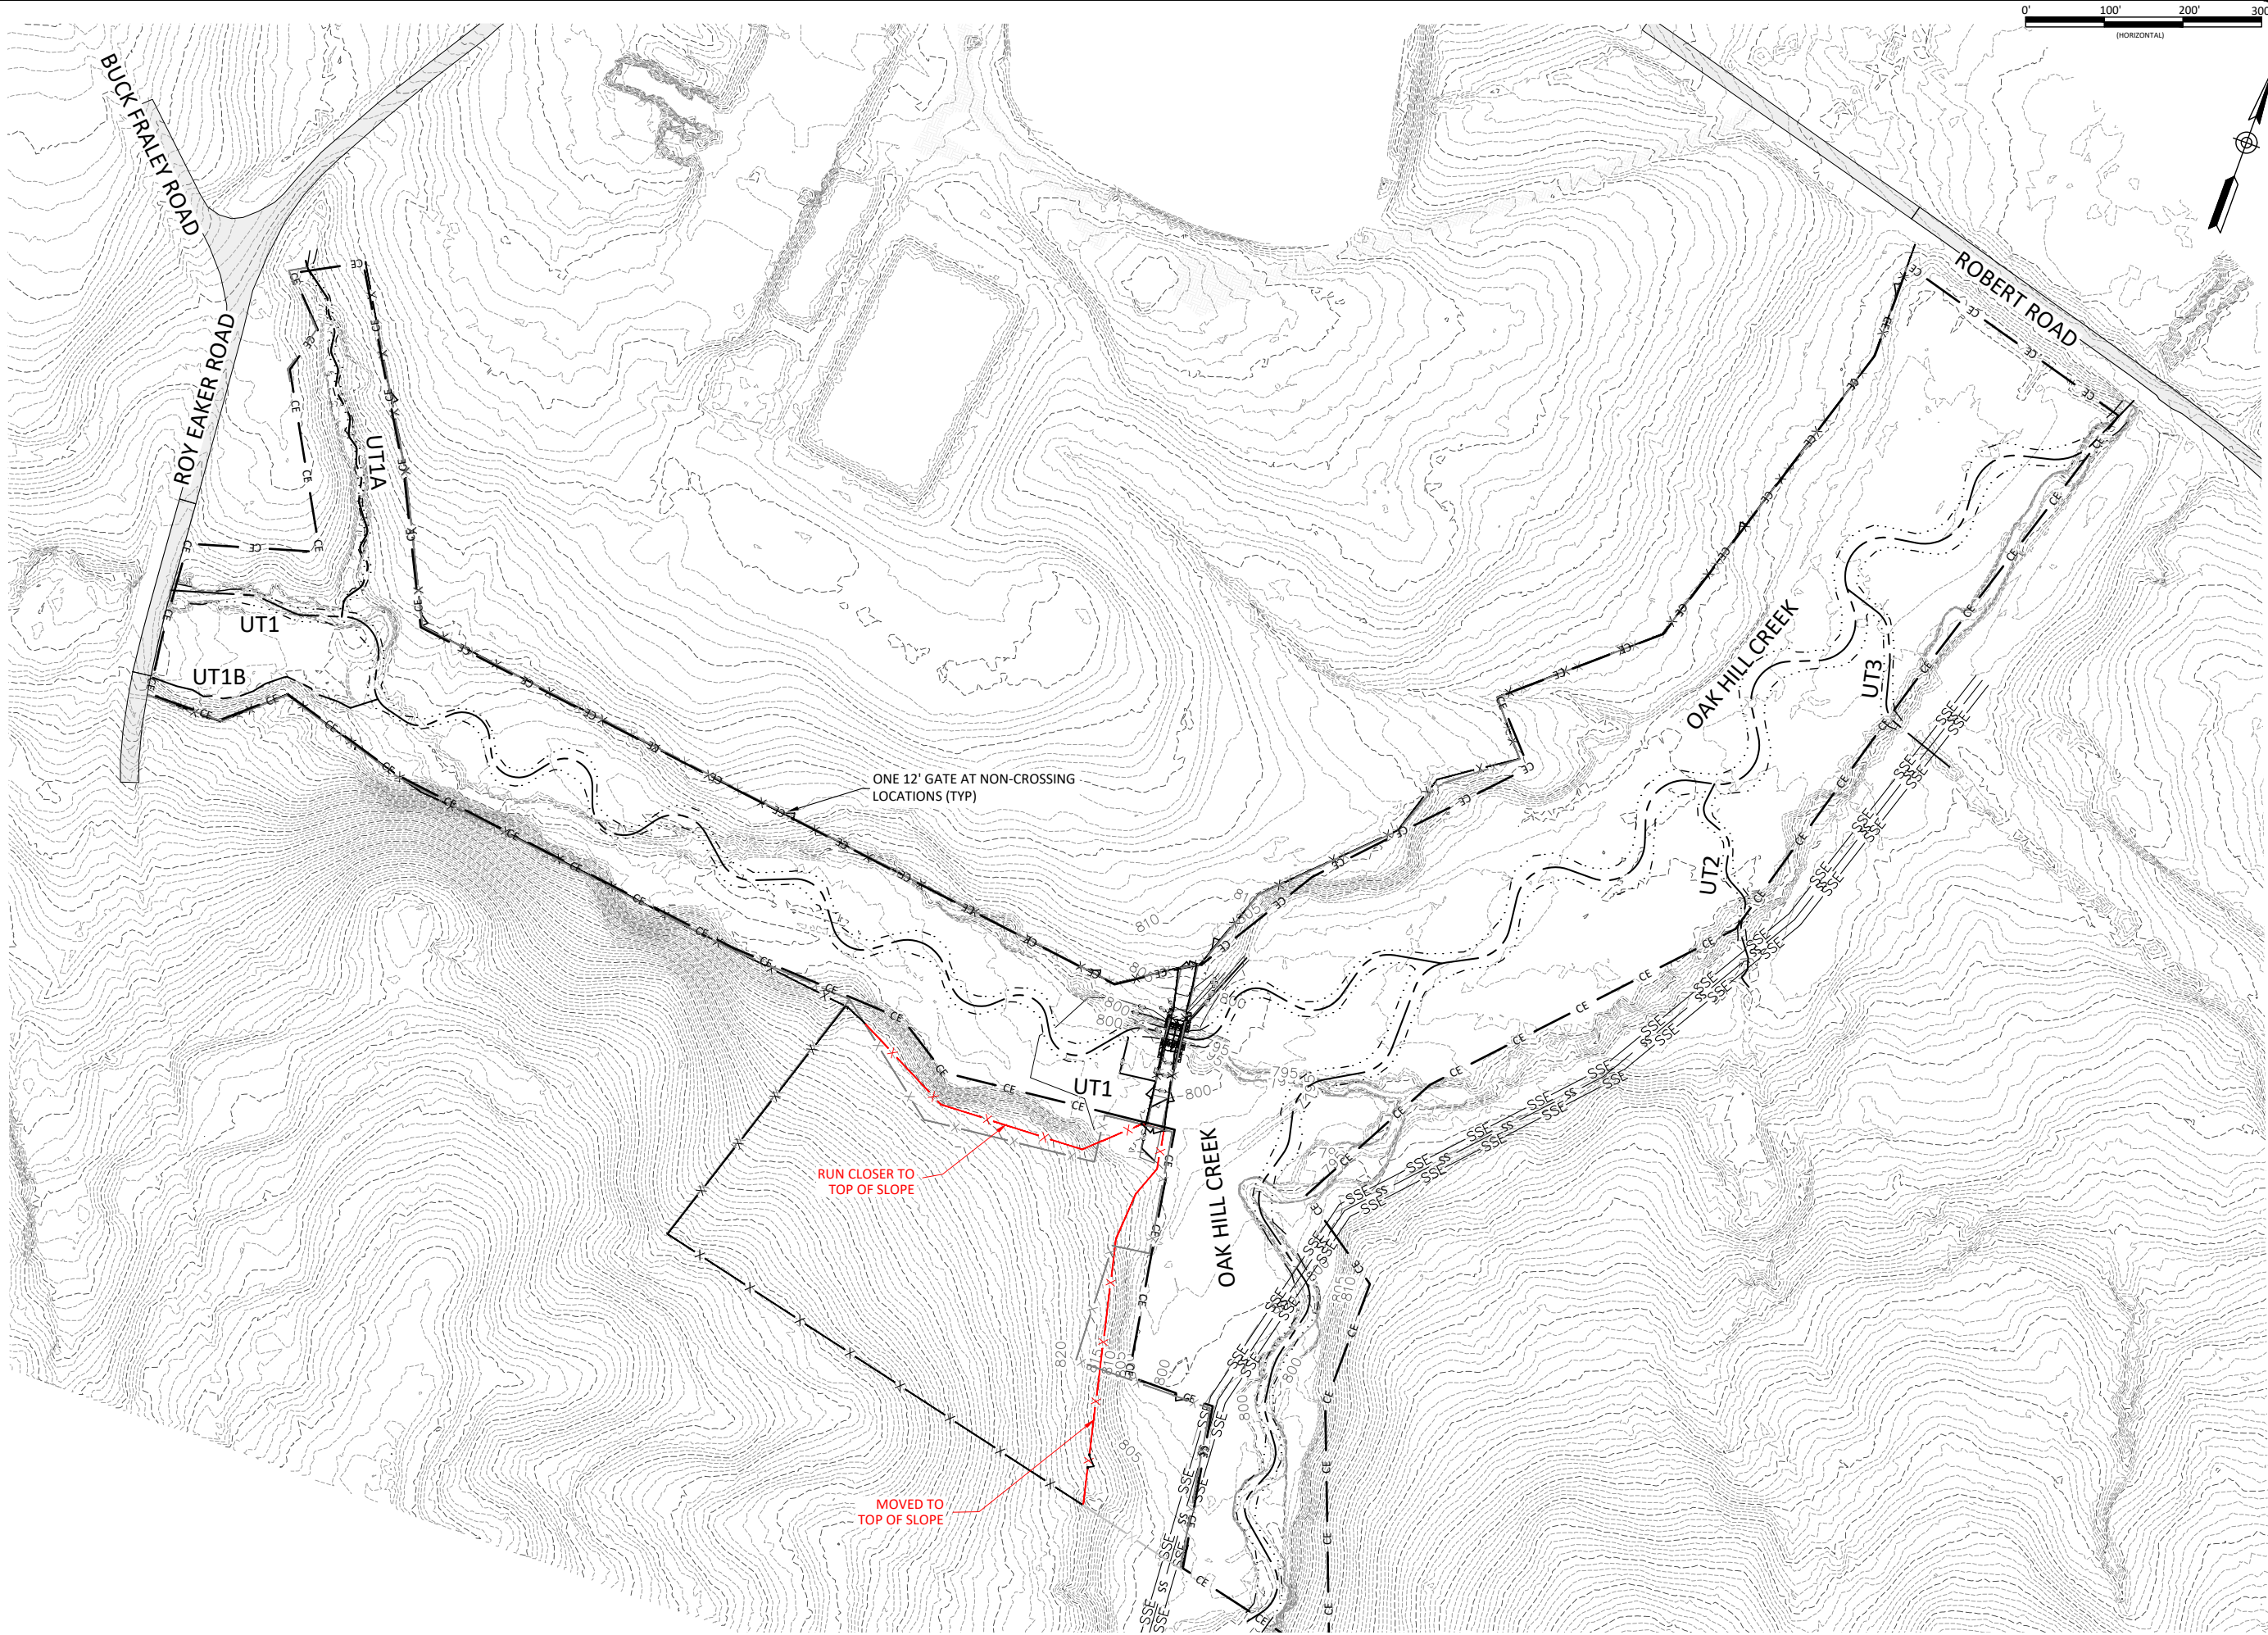

Oak Hill Dairy Mitigation Site Record Drawings
Gaston County, North Carolina

Fencing Plan

Date:	May 12, 2022
Job Number:	005-02162
Project Engineer:	JM
Drawn By:	AMR
Checked By:	JCK



WILDLANDS
ENGINEERING
167-B Haywood Rd
Asheville, NC 28806
Tel: 828.774.5547
License No. F-0831