

PROJECT: 166680 **UT to RUSH FORK**


STATE	BAKER PROJECT REFERENCE NO.	SHEET NO.	TOTAL SHEETS
NC	166680	1	24

NORTH CAROLINA
DIVISION OF MITIGATION SERVICES

HAYWOOD COUNTY


LOCATION: FROM EXIT 24 ON INTERSTATE 40, TRAVEL NORTH FOR 5.75 MILES ON NC HWY 209 RUSH FORK ROAD

TYPE OF WORK: RECORD DRAWINGS

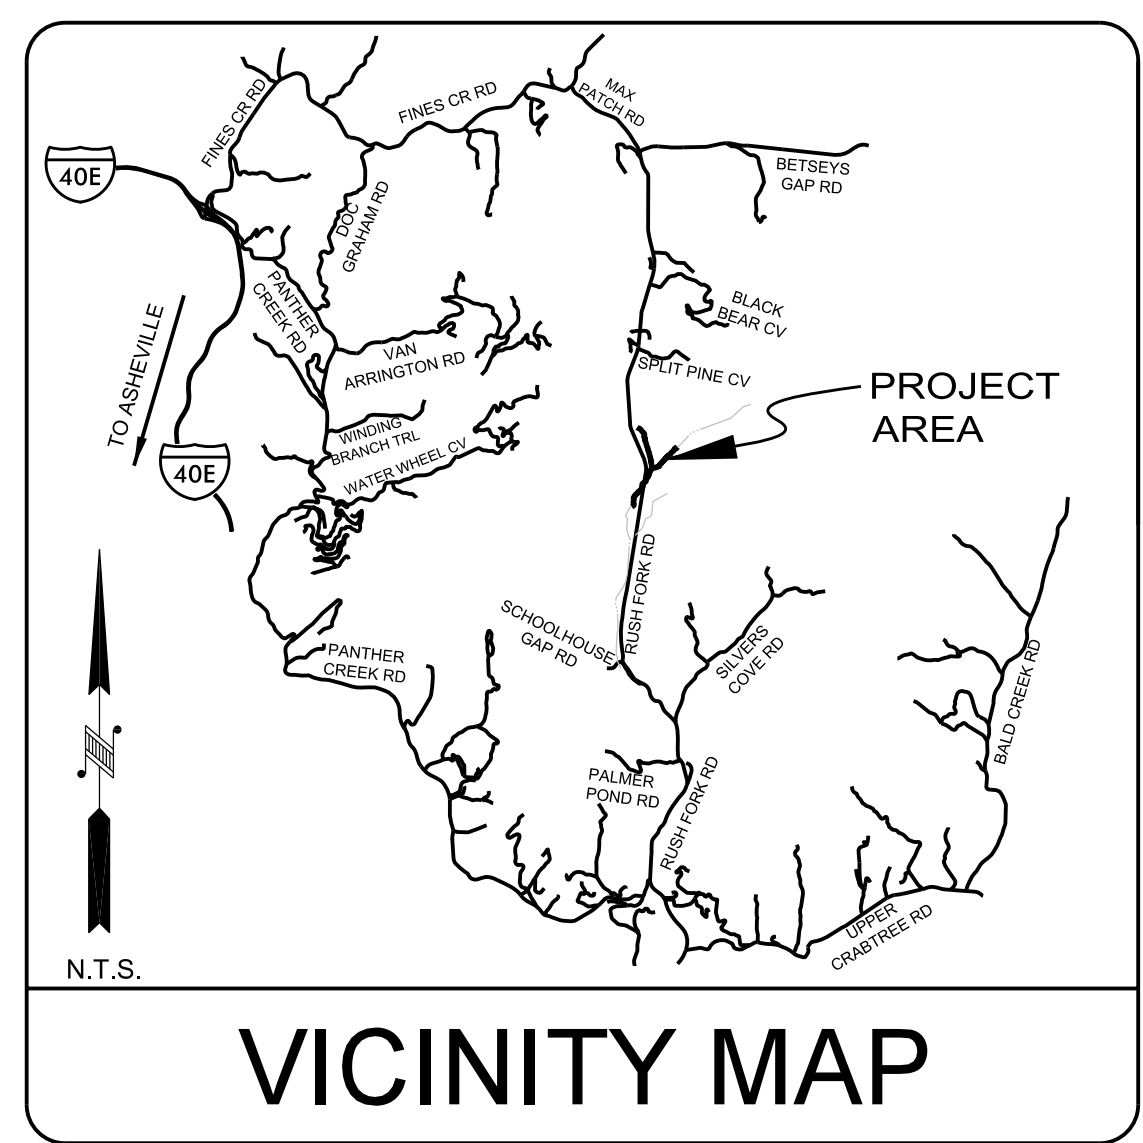


INDEX OF SHEETS

1	TITLE SHEET
1-A	STREAM CONVENTIONAL SYMBOLS GENERAL NOTES STANDARD SPECIFICATIONS VEGETATION SELECTION
1-B	NCDOT CONVENTIONAL SYMBOLS
2 - 2F	DETAILS
3 - 10	PLAN VIEW
11 - 15	PROFILES
16	BMP DETAIL

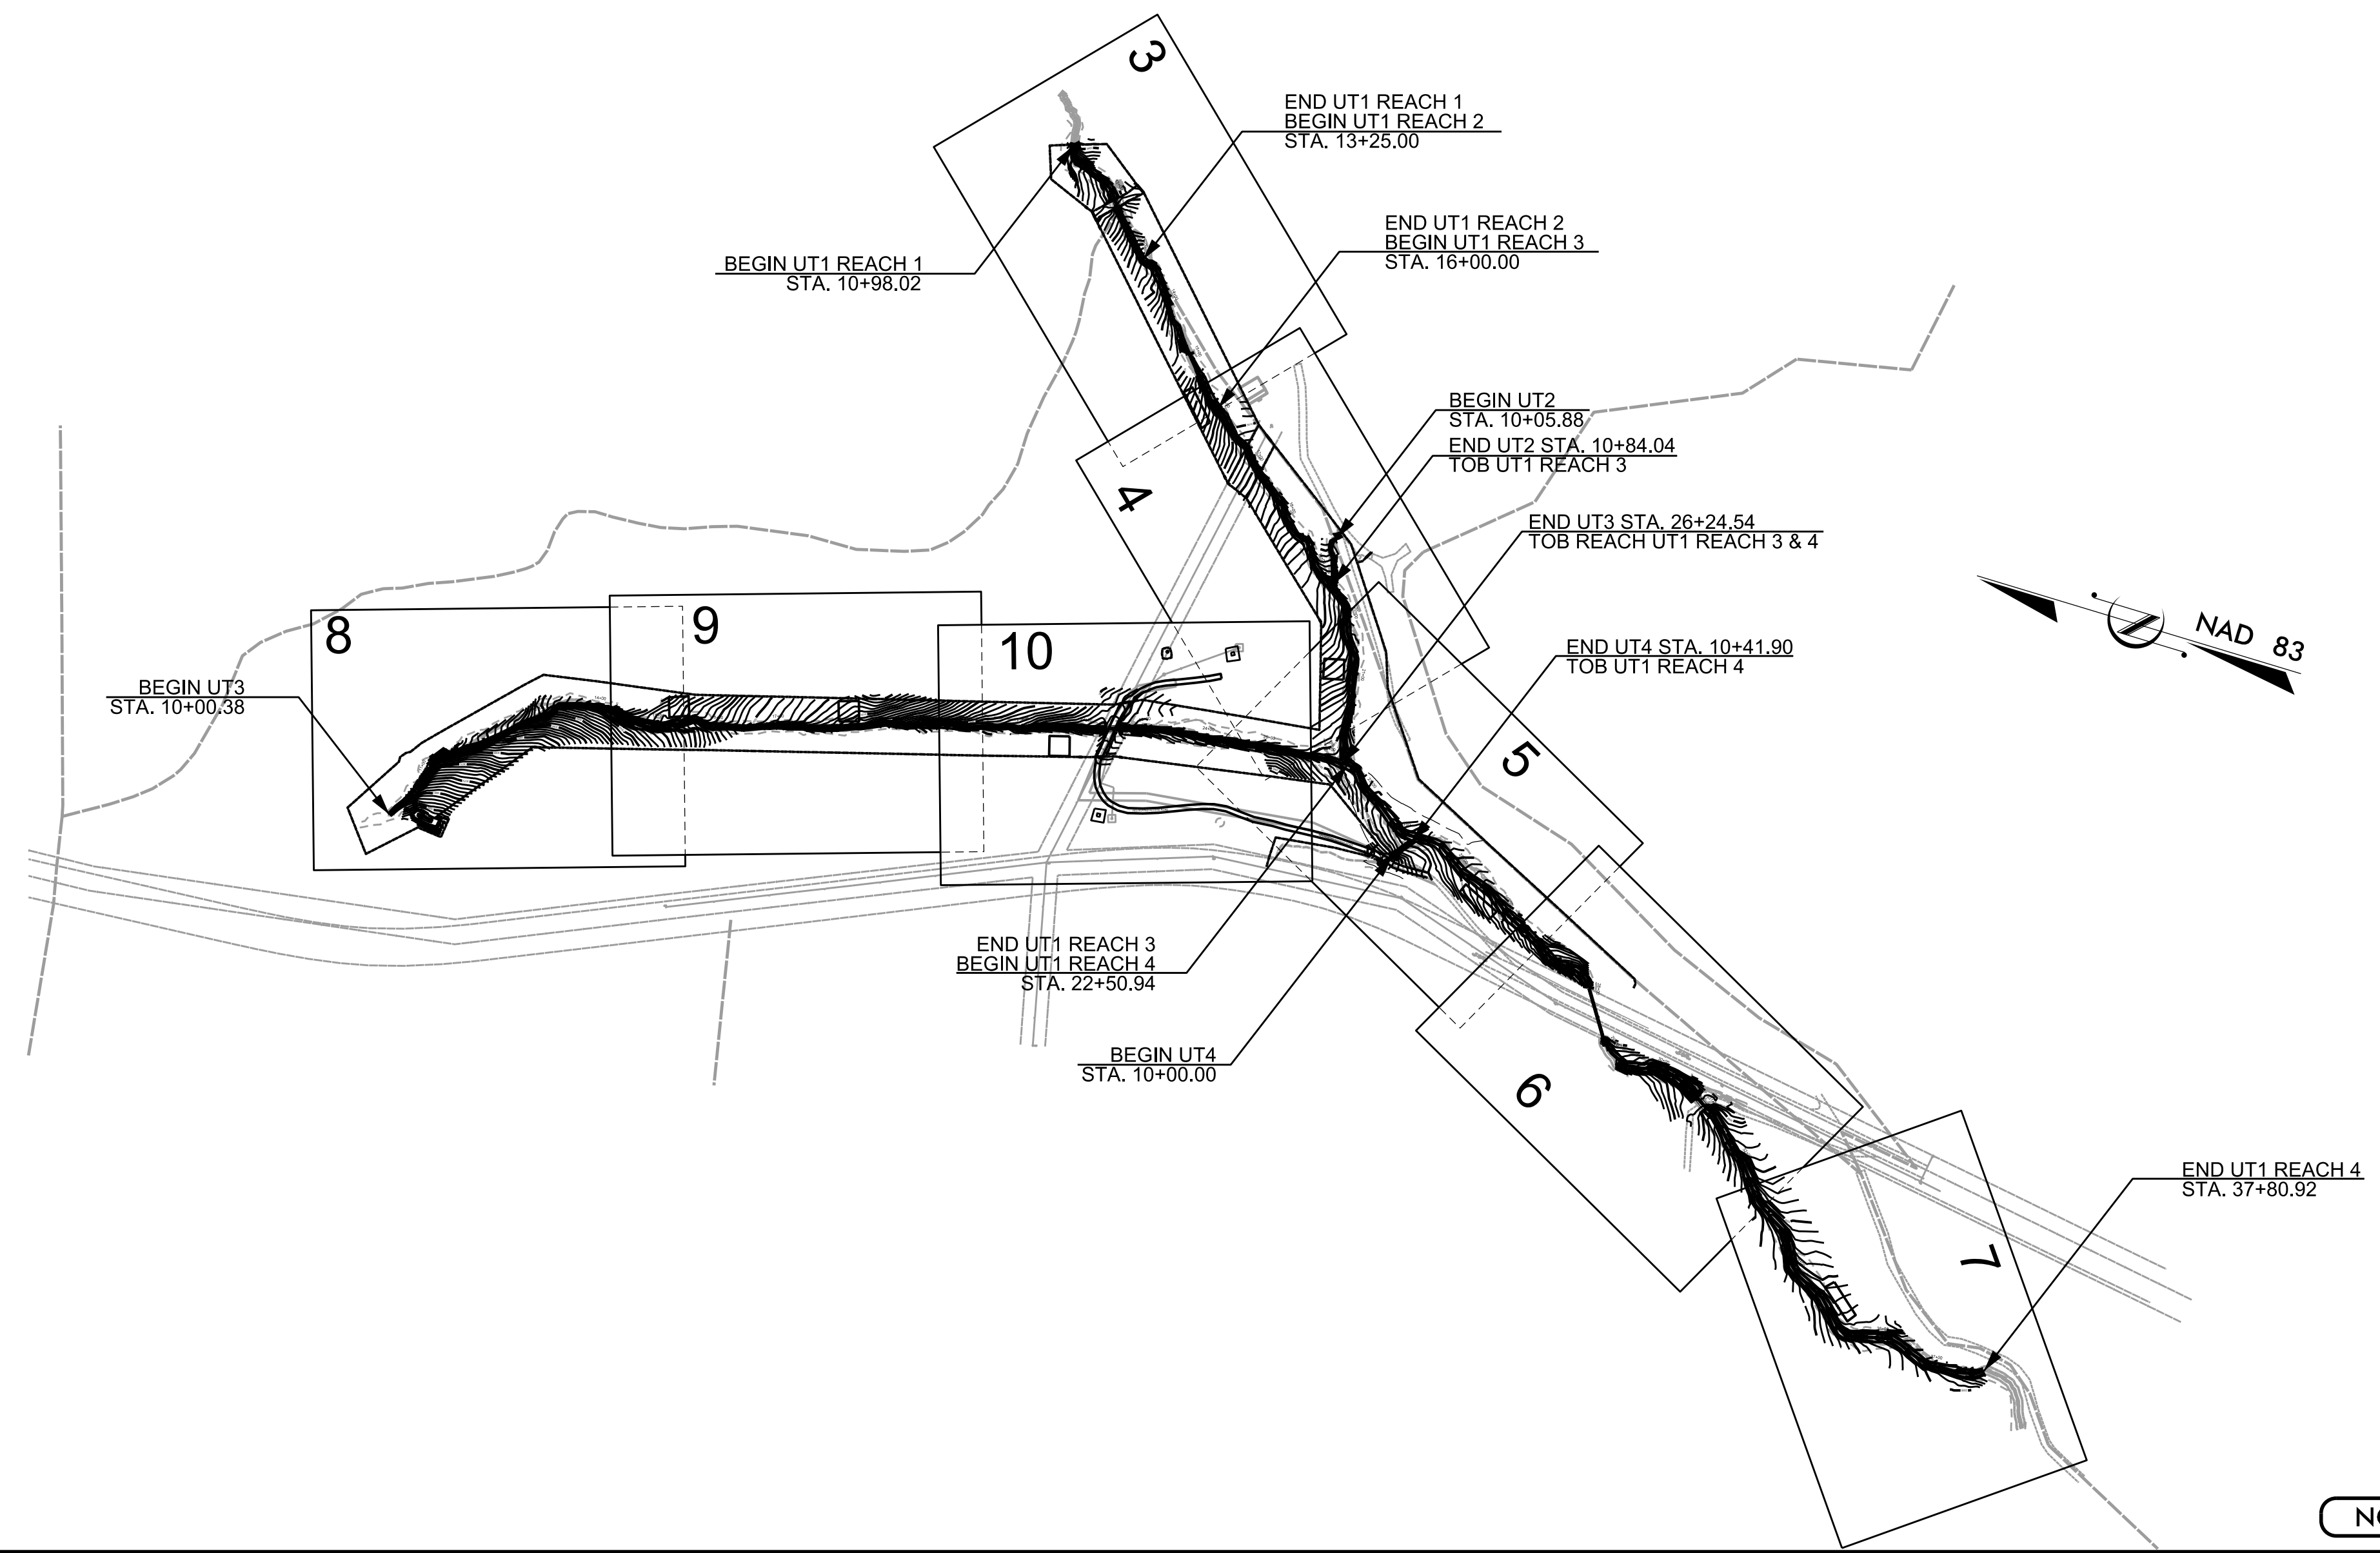

NCDMS ID NO. 100068

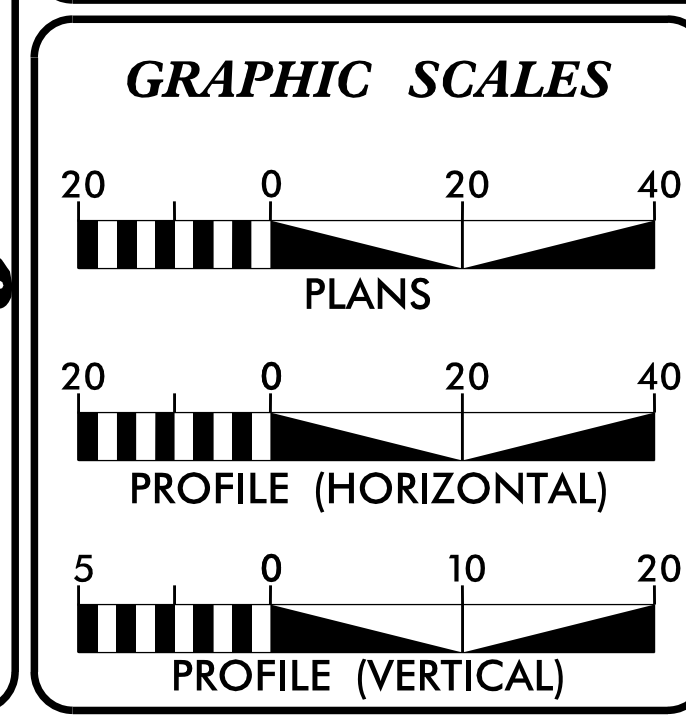

MITIGATION SUMMARY

REACH	STREAM RESTORATION	STREAM ENHANCEMENT I	STREAM ENHANCEMENT II
UT1 R1	0	206.41	0
UT1 R2	0	0	275.00
UT1 R3	0	600.86	0
UT1 R4	1224.37	0	0
UT2	0	0	78.16
UT3	1577.53	0	0
UT4	41.90	0	0
TOTAL	2843.80	807.27	353.16

PREPARED FOR THE OFFICE OF:
 NCDEQ
 NC DIVISION OF MITIGATION SERVICES
 217 WEST JONES STREET, SUITE 3000a
 RALEIGH, NC 27603

CONTACT: PAUL WIESNER
 PROJECT MANAGER

Michael Baker International
 Michael Baker Engineering Inc.
 8000 Regency Parkway, Suite 600
 Cary, NORTH CAROLINA 27518
 Phone: 919.463.5488
 Fax: 919.463.5490
 License #: F-1084

LETTING DATE: _____

KATHLEEN M. MCKEITHAN, PE
 PROJECT ENGINEER

PROJECT ENGINEER

SIGNATURE: _____ P.E.

STREAM CONVENTIONAL SYMBOLS SUPERCEDES SHEET 1-B

J-HOOK VANE	100 YEAR FLOOD PLAIN	
GRADE CONTROL J-HOOK VANE	CONSERVATION EASEMENT	
ROCK VANE	EXISTING MAJOR CONTOUR	
OUTLET PROTECTION	EXISTING MINOR CONTOUR	
ROCK CROSS VANE	LIMITS OF DISTURBANCE	
DOUBLE DROP ROCK CROSS VANE	PROPERTY LINE	
LOG AND ROCK STEP / POOL	FOOT BRIDGE	
TEMPORARY ROCK DAM	TEMPORARY STREAM CROSSING	
ROOT WAD	PERMANENT STREAM CROSSING	
LOG J-HOOK VANE	TRANSPLANTED VEGETATION	
GRADE CONTROL LOG J-HOOK VANE	TREE REMOVAL	
LOG VANE	TREE PROTECTION	MONITORING WELL
LOG STEP	DITCH PLUG	RAIN GAUGE
LOG CROSS VANE	CHANNEL FILL	CREST GAUGE
LOG ROLLER	SOD MAT WITH WOOD TOE	IN STREAM FLOW GAUGE
CONSTRUCTED RIFFLE	GEOLIFT WITH BRUSH TOE	
BOULDER CLUSTER	ROOT WAD REVETMENT WITH LIVE BRUSH	
BOULDER STEP	BOULDER TOE PROTECTION	
SAFETY FENCE	PROPOSED WETLAND RE-ESTABLISHMENT	
TAPE FENCE	PROPOSED WETLAND ENHANCEMENT	
JURISDICTIONAL WETLAND BOUNDARY	PROPOSED WETLAND REHABILITATION	

**NOTE: ALL ITEMS ABOVE MAY NOT BE USED ON THIS PROJECT

STANDARD SPECIFICATIONS

NORTH CAROLINA EROSION AND SEDIMENT CONTROL PLANNING AND DESIGN MANUAL MARCH 2009 (REV 2013)

- 6.06 TEMPORARY GRAVEL CONSTRUCTION ENTRANCE
- 6.24 RIPARIAN AREA SEEDING
- 6.60 TEMPORARY SEDIMENT TRAP
- 6.62 TEMPORARY SILT FENCE
- 6.63 TEMPORARY ROCK DAM
- 6.70 TEMPORARY STREAM CROSSING

PROJECT REFERENCE NO. 166680	SHEET NO. 1-A
PROJECT ENGINEER	
APPROVED BY:	
DATE:	
Michael Baker International	
Michael Baker Engineering Inc. 8000 Regency Parkway, Suite 500 Cary, NORTH CAROLINA 27518 Phone: 919.463.5488 Fax: 919.463.5490 License #: F-1084	
NCDMS ID NO. 100068	

GENERAL NOTES

1. THE CONTRACTOR IS REQUIRED TO INSTALL IN-STREAM STRUCTURES USING A TRACK HOE WITH A HYDRAULIC THUMB OF SUFFICIENT SIZE TO PLACE BOULDERS (3'x2'x2), LOGS AND ROOTWADS.
2. WORK IS BEING PERFORMED AS AN ENVIRONMENTAL RESTORATION PLAN. THE CONTRACTOR SHOULD MAKE ALL REASONABLE EFFORTS TO REDUCE SEDIMENT LOSS AND MINIMIZE DISTURBANCE OF THE SITE WHILE PERFORMING THE CONSTRUCTION WORK.
3. CONSTRUCTION IS SCHEDULED FOR THE SPRING OF 2020.
4. CONTRACTOR SHOULD CALL NORTH CAROLINA "ONE-CALL" BEFORE EXCAVATION STARTS. (1-800-632-4949)
5. BOULDER SIZES FOR IN-STREAM STRUCTURES SHALL BE A MINIMUM OF 3'x2'x1' AND CAN BE CHANGED PER STRUCTURE OR THE DIRECTION OF THE ENGINEER.
6. ALL ON-SITE ALLUVIUM SHALL BE HARVESTED AND STOCKPILED PRIOR TO FILLING ABANDONED CHANNELS.
7. TOPSOIL SHALL BE EXCAVATED TO A DEPTH OF 8" AND STOCKPILED SEPARATELY FROM UNDERCUT SOIL. 8" OF TOPSOIL SHALL BE PLACED ON ALL BANKFULL BENCHES AND AS DIRECTED BY THE ENGINEER.
8. ALL DISTURBED EMBANKMENTS SHALL BE MATTED WITH COIR FIBER MATTING OR AS DIRECTED BY THE ENGINEER.
9. ALL STREAM BANKS SHALL BE LIVE STAKED.
10. UNLESS THE ALIGNMENT IS BEING ALTERED, THE EXISTING CHANNEL DIMENSIONS ARE TO REMAIN UNLESS OTHERWISE NOTED.
11. CONTRACTOR WILL ENSURE THAT FENCING IS INSTALLED ON OR OUTSIDE THE CONSERVATION EASEMENT AS SHOWN ON THE PLANS BUT NO MORE THAN 1' OUTSIDE.
12. WHERE PROPOSED FENCE CROSSES EXISTING STREAMS, THE CONTRACTOR SHALL UTILIZE A SECTION OF BREAK AWAY FENCE, A FLOOD GATE, OR ELECTRIFIED CHAINS AS DIRECTED BY THE ENGINEER.
13. ANY BORROW OR WASTE ASSOCIATED WITH THIS PROJECT MUST COME FROM OR GO TO A PERMITTED SITE AND/OR FACILITY.

VEGETATION SELECTION


Proposed Bare-Root and Live Stake Species UT to Rush Fork Mitigation Project - NCDMS Project No. 100068			
Botanical Name	Common Name	% Planted by Species	Wetland Tolerance
All Buffer Plantings at 680 stems/acre using 8' X 8' spacing			
General Riparian Zone – Overstory/Canopy Species			
<i>Betula nigra</i>	River Birch	10%	FACW
<i>Platanus occidentalis</i>	Sycamore	10%	FACW
<i>Liriodendron tulipifera</i>	Tulip Poplar	10%	FACU
<i>Betula lenta</i>	Sweet Birch	10%	FAC
<i>Quercus alba</i>	White Oak	10%	FACU
<i>Tilia americana</i>	American Basswood	0%	FACU
<i>Aesculus flava</i>	Yellow Buckeye	7.5%	FACU
<i>Nyssa sylvatica</i>	Blackgum	5%	FAC
<i>Fraxinus americana</i>	White Ash	5%	FACU
<i>Diospyros virginiana</i>	Persimmon	7.5%	FAC
<i>Ulmus americana</i>	American Elm	5%	FACW
General Riparian Zone – Understory/Shrub Species			
<i>Rhododendron maximum</i>	Rosebay	0%	FAC
<i>Lindera benzoin</i>	Spicebush	2.5%	FAC
<i>Ilex verticillata</i>	Winterberry	5%	FACW
<i>Carpinus caroliniana</i>	American Hornbeam	5%	FAC
<i>Sambucus canadensis</i>	Elderberry	2.5%	FAC
<i>Magnolia tripetala</i>	Umbrella Tree	0%	FACU
<i>Halesia carolina</i>	Carolina Silverbell	5%	FAC

Wetland Zone – Overstory/Canopy Species			
<i>Betula nigra</i>	River Birch	15%	FACW
<i>Platanus occidentalis</i>	Sycamore	15%	FACW
<i>Betula alleghaniensis</i>	Yellow Birch	10%	FAC
<i>Quercus imbricaria</i>	Shingle Oak	5%	FAC
<i>Nyssa sylvatica</i>	Blackgum	5%	FAC
<i>Acer negundo</i>	Box Elder	5%	FAC
<i>Fraxinus pennsylvanica</i>	Green Ash	5%	FACW
<i>Ulmus americana</i>	American Elm	5%	FACW
Wetland Zone – Understory/Shrub Species			
<i>Alnus serrulata</i>	Tag Alder	15%	OBL
<i>Ilex verticillata</i>	Winterberry	5%	FACW
<i>Lindera benzoin</i>	Spicebush	5%	FAC
<i>Cephalanthus occidentalis</i>	Buttonbush	2.5%	OBL
<i>Cornus amomum</i>	Silky Dogwood	2.5%	FACW
<i>Xanthorhiza simplicissima</i>	Yellow-root	2.5%	FACW
<i>Aronia arbutifolia</i>	Red Chokeberry	2.5%	FACW
Streambank Live Stake Plantings			
<i>Salix sericea</i>	Silky Willow	25%	OBL
<i>Sambucus canadensis</i>	Elderberry	20%	FACW
<i>Cephalanthus occidentalis</i>	Buttonbush	10%	OBL
<i>Cornus amomum</i>	Silky Dogwood	25%	FACW
<i>Salix nigra</i>	Black Willow	20%	OBL

Proposed Permanent Seed Mixture UT to Rush Fork Stream Mitigation Project – NCDMS Project No. 100068				
Botanical Name	Common Name	% Planted by Species	Density (lbs/ac)	Wetland Tolerance
<i>Agrostis perennans</i>	Autumn Bentgrass	10%	1.5	FACU
<i>Elymus virginicus</i>	Virginia Wildrye	15%	2.25	FACW
<i>Panicum virgatum</i>	Switchgrass	15%	2.25	FAC
<i>Tripsacum dactyloides</i>	Eastern Gamma Grass	5%	0.75	FACW
<i>Polygonum pennsylvanicum</i>	Pennsylvania Smartweed	5%	0.75	FACW
<i>Schizachyrium scoparium</i>	Little Blue Stem	5%	0.75	FACU
<i>Juncus effusus</i>	Soft Rush	5%	0.75	FACW
<i>Bidens frondosa (or aristosa)</i>	Beggars Tick	5%	0.75	FACW
<i>Coreopsis lanceolata</i>	Lance-Leaved Tick Seed	10%	1.5	FACU
<i>Dichanthelium clandestinum</i>	Tioga Deer Tongue	15%	2.25	FAC
<i>Andropogon gerardii</i>	Big Blue Stem	5%	0.75	FAC
<i>Sorghastrum nutans</i>	Indian Grass	5%	0.75	FACU
Total		100%	15	

Note: Final species selection may change due to refinement of site conditions or to availability at the time of planting. If species substitution is required, the planting Contractor will submit a revised planting list to Baker for approval prior to the procurement of plant stock.

PERCENTAGES SHOWN IN RED ARE THE CONSTRUCTED PLANTED PERCENTATGE.

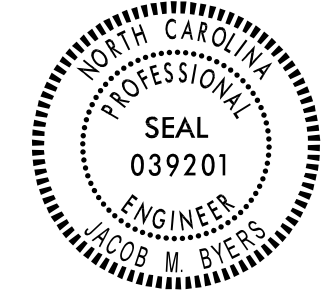

APPROVED BY: _____
DATE: _____

STATE OF NORTH CAROLINA
DIVISION OF HIGHWAYS

CONVENTIONAL SYMBOLS

*S.U.E = SUBSURFACE UTILITY ENGINEER

BOUNDARIES AND PROPERTY:

State Line	-----
County Line	-----
Township Line	-----
City Line	-----
Reservation Line	-----
Property Line	-----
Existing Iron Pin	○ EP
Property Corner	-----
Property Monument	□ ECM
Parcel/Sequence Number	②③
Existing Fence Line	-x-x-x-
Proposed Woven Wire Fence	○
Proposed Chain Link Fence	□
Proposed Barbed Wire Fence	◇
Existing Wetland Boundary	-WLB-
Proposed Wetland Boundary	-WLB-
Existing Endangered Animal Boundary	-EAB-
Existing Endangered Plant Boundary	-EPB-

BUILDINGS AND OTHER CULTURE:

Gas Pump Vent or U/G Tank Cap	○
Sign	○ S
Well	○ W
Small Mine	⊗
Foundation	□
Area Outline	□
Cemetery	□ †
Building	□
School	□
Church	□
Dam	□

HYDROLOGY:

Stream or Body of Water	-----
Hydro, Pool or Reservoir	□
Jurisdictional Stream	----- JS
Buffer Zone 1	----- BZ 1
Buffer Zone 2	----- BZ 2
Flow Arrow	←
Disappearing Stream	-----
Spring	○
Wetland	-----
Proposed Lateral, Tail, Head Ditch	----- FLOW
False Sump	▽

RAILROADS:

Standard Gauge	-----
RR Signal Milepost	○ MILEPOST 35
Switch	□ SWITCH
RR Abandoned	-----
RR Dismantled	-----

RIGHT OF WAY:

Baseline Control Point	◆
Existing Right of Way Marker	△
Existing Right of Way Line	-----
Proposed Right of Way Line	-----
Proposed Right of Way Line with Iron Pin and Cap Marker	○ R W
Proposed Right of Way Line with Concrete or Granite Marker	○ R W
Existing Control of Access	○ C A
Proposed Control of Access	○ C A
Existing Easement Line	----- E
Proposed Temporary Construction Easement	----- E
Proposed Temporary Drainage Easement	----- TDE
Proposed Permanent Drainage Easement	----- PDE
Proposed Permanent Utility Easement	----- PUE
Proposed Temporary Utility Easement	----- TUE
Proposed Permanent Easement with Iron Pin and Cap Marker	◆

ROADS AND RELATED FEATURES:

Existing Edge of Pavement	-----
Existing Curb	-----
Proposed Slope Stakes Cut	----- C
Proposed Slope Stakes Fill	----- F
Proposed Wheel Chair Ramp	□ WCR
Existing Metal Guardrail	-----
Proposed Guardrail	-----
Existing Cable Guiderail	-----
Proposed Cable Guiderail	-----
Equality Symbol	⊕
Pavement Removal	□

VEGETATION:

Single Tree	○
Single Shrub	○
Hedge	-----
Woods Line	-----
Orchard	-----
Vineyard	□ Vineyard

EXISTING STRUCTURES:

MAJOR:	
Bridge, Tunnel or Box Culvert	----- CONC
Bridge Wing Wall, Head Wall and End Wall	-----) CONC WW (
MINOR:	
Head and End Wall	----- CONC HW
Pipe Culvert	-----
Footbridge	-----
Drainage Box: Catch Basin, DI or JB	□ CB
Paved Ditch Gutter	-----
Storm Sewer Manhole	○ S
Storm Sewer	----- S

UTILITIES:

POWER:	
Existing Power Pole	●
Proposed Power Pole	○
Existing Joint Use Pole	●
Proposed Joint Use Pole	○
Power Manhole	○ P
Power Line Tower	□
Power Transformer	□
U/G Power Cable Hand Hole	□ PH
H-Frame Pole	●
Recorded U/G Power Line	----- P
Designated U/G Power Line (S.U.E.*)	----- P

TELEPHONE:

Existing Telephone Pole	●
Proposed Telephone Pole	○
Telephone Manhole	○ T
Telephone Booth	□
Telephone Pedestal	□
Telephone Cell Tower	□
U/G Telephone Cable Hand Hole	□ PH
Recorded U/G Telephone Cable	----- T
Designated U/G Telephone Cable (S.U.E.*)	----- T
Recorded U/G Telephone Conduit	----- TC
Designated U/G Telephone Conduit (S.U.E.*)	----- TC
Recorded U/G Fiber Optics Cable	----- T FO
Designated U/G Fiber Optics Cable (S.U.E.*)	----- T FO

WATER:

Water Manhole	○ W
Water Meter	○
Water Valve	⊗
Water Hydrant	⊕
Recorded U/G Water Line	-----
Designated U/G Water Line (S.U.E.*)	-----
Above Ground Water Line	----- A/G Water

TV:

TV Satellite Dish	⊗
TV Pedestal	□
TV Tower	⊗
U/G TV Cable Hand Hole	□ PH
Recorded U/G TV Cable	----- TV
Designated U/G TV Cable (S.U.E.*)	----- TV
Recorded U/G Fiber Optic Cable	----- TV FO
Designated U/G Fiber Optic Cable (S.U.E.*)	----- TV FO

GAS:

Gas Valve	◇
Gas Meter	⊕
Recorded U/G Gas Line	----- G
Designated U/G Gas Line (S.U.E.*)	----- G
Above Ground Gas Line	----- A/G Gas

SANITARY SEWER:


Sanitary Sewer Manhole	⊕
Sanitary Sewer Cleanout	⊕
U/G Sanitary Sewer Line	----- SS
Above Ground Sanitary Sewer	----- A/G Sanitary Sewer
Recorded SS Forced Main Line	----- FSS
Designated SS Forced Main Line (S.U.E.*)	----- FSS

MISCELLANEOUS:


Utility Pole	●
Utility Pole with Base	□
Utility Located Object	○
Utility Traffic Signal Box	□
Utility Unknown U/G Line	----- TUTL
U/G Tank; Water, Gas, Oil	□
A/G Tank; Water, Gas, Oil	□
U/G Test Hole (S.U.E.*)	⊕
Abandoned According to Utility Records	AATUR
End of Information	E.O.I.

2/26/2023
5/24/2022
M:\Projects\166680_Rush_Fork\Design\As-Built\Plans\166680_ASB-FSH_01B.dgn


TYPICAL RIFFLE, POOL, AND BANKFULL BENCH CROSS SECTIONS

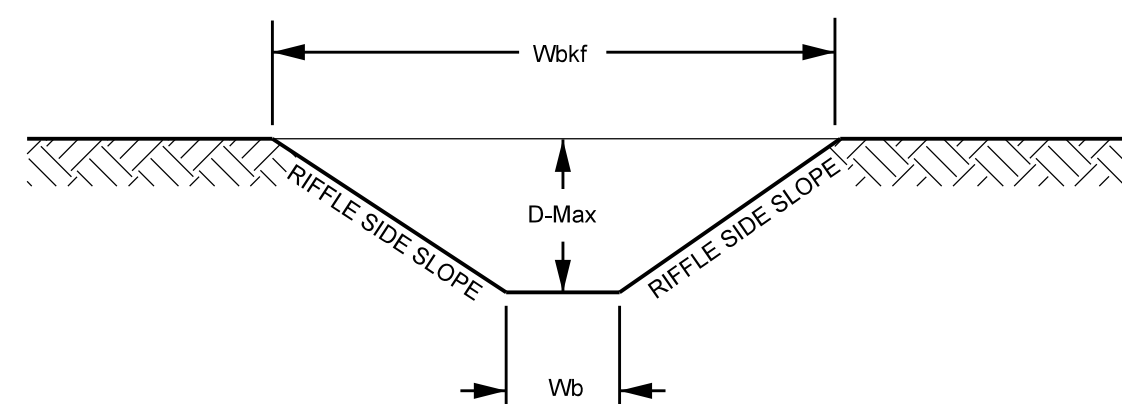


RIFFLE or PLUNGE POOL

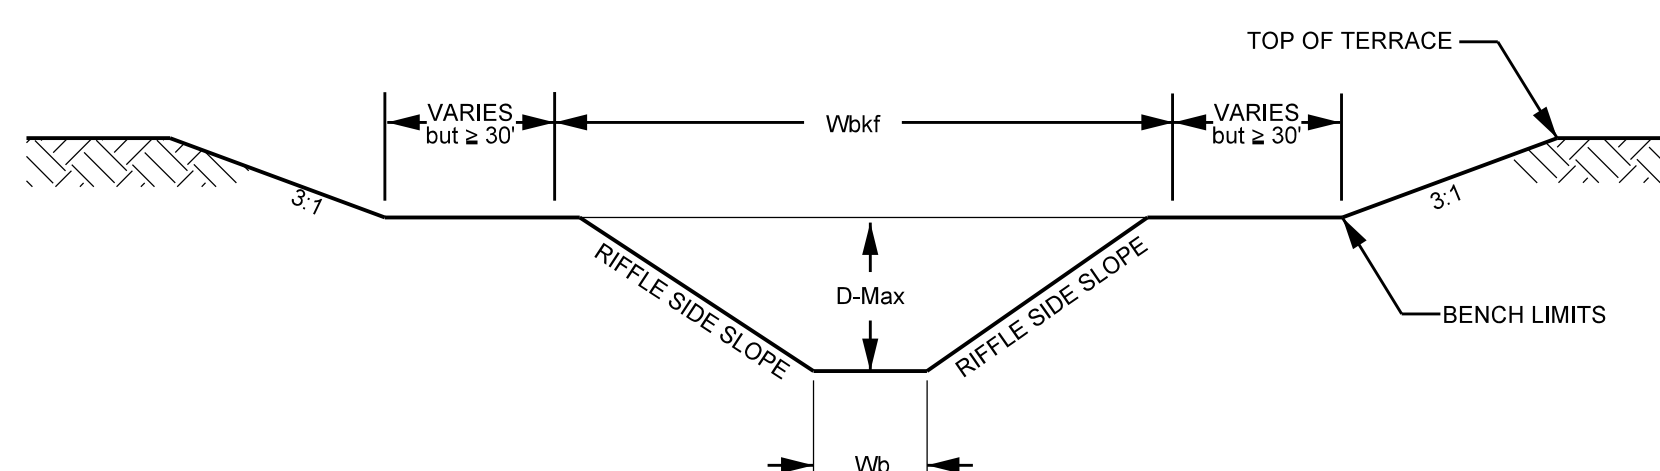

RIFFLE WITH BANKFULL BENCH

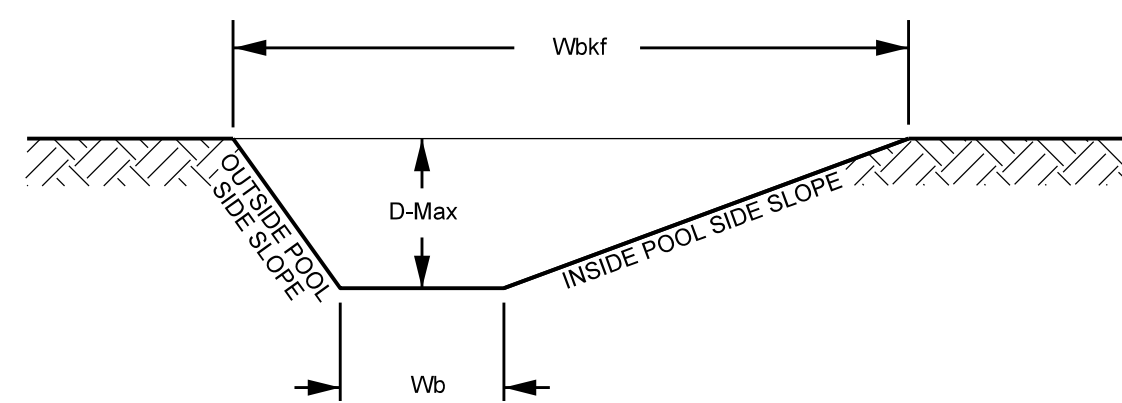

POOL (MEANDER)

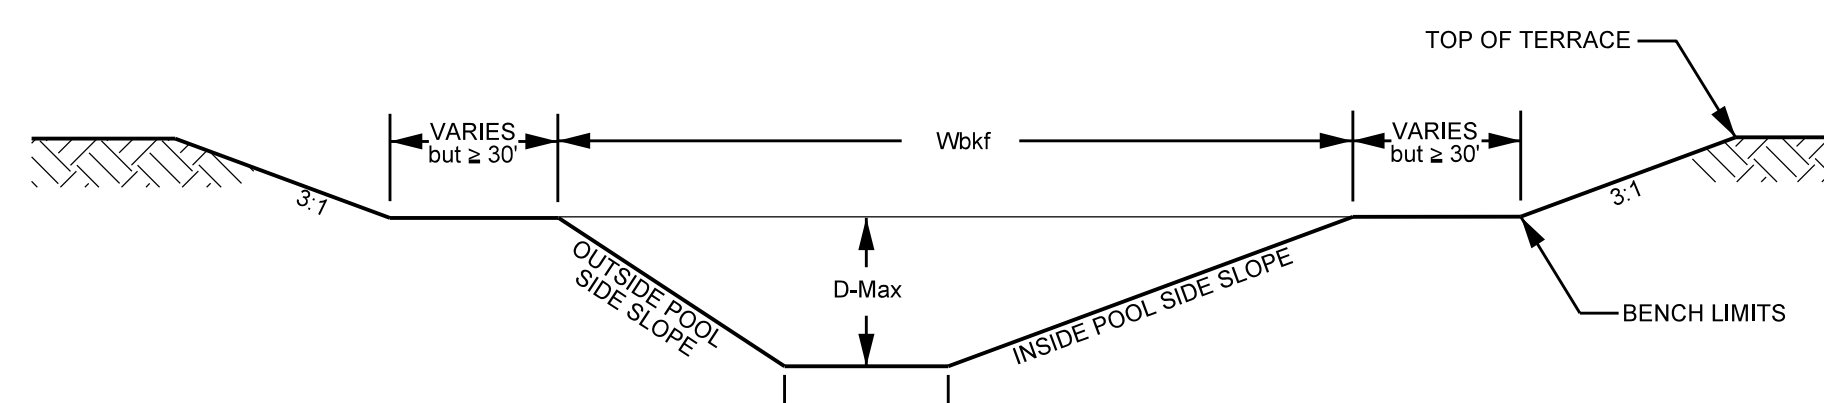


POOL WITH BANKFULL BENCH

WIDTH OF BANKFULL (Wbkf)
 AVERAGE DEPTH
 MAXIMUM DEPTH (Dmax)
 W/D (Wbkf/Dmax)
 BANKFULL AREA (Abkf)
 BOTTOM WIDTH (Wb)
 RIFFLE SIDE SLOPE (X:1)
 INSIDE POOL SIDE SLOPE
 OUTSIDE POOL SIDE SLOPE

UT1 R1, R2, & R3 UPPER 10+00 - 19+50		UT1 R3 LOWER 19+50 - 22+61		UT1 R4 UPPER 22+61 - 28+00		UT1 R4 LOWER 28+00 - 37+95		UT2		UT3 UPPER 11+50 - 16+50		UT3 LOWER 16+50 - 26+45		UT4	
RIFFLE	POOL	RIFFLE	POOL	RIFFLE	POOL	RIFFLE	POOL	RIFFLE	POOL	RIFFLE	POOL	RIFFLE	POOL	RIFFLE	POOL
9.00	11.50	10.00	12.50	12.50	16.50	13.00	17.50	4.50	6.60	7.50	10.00	8.50	12.00	5.80	7.50
0.65	1.11	0.70	1.40	0.90	1.70	0.95	1.80	0.45	0.70	0.57	1.10	0.65	1.30	0.45	0.70
0.80	1.50	1.00	2.00	1.20	2.50	1.30	2.50	0.60	1.00	0.70	1.70	0.85	1.80	0.50	1.00
13.80	10.40	14.30	9.20	13.90	9.50	13.70	9.80	13.00	9.50	13.10	8.90	13.10	9.50	12.90	10.30
5.90	12.80	7.00	17.00	11.30	28.80	12.10	31.30	2.20	4.60	4.30	11.20	6.00	15.10	2.60	5.50
5.80	5.50	5.00	4.50	8.10	6.50	8.50	7.50	4.00	2.60	4.70	3.20	4.90	4.80	3.60	3.50
2.00	N/A	2.00	N/A	2.00	N/A	2.00	N/A	2.00	N/A	2.00	N/A	2.00	N/A	2.00	N/A
N/A	2.00	N/A	2.00	N/A	2.00	N/A	2.00	N/A	2.00	N/A	2.00	N/A	2.00	N/A	2.00
N/A	2.00	N/A	2.00	N/A	2.00	N/A	2.00	N/A	2.00	N/A	2.00	N/A	2.00	N/A	2.00


TYPICAL STRUCTURE PLACEMENT

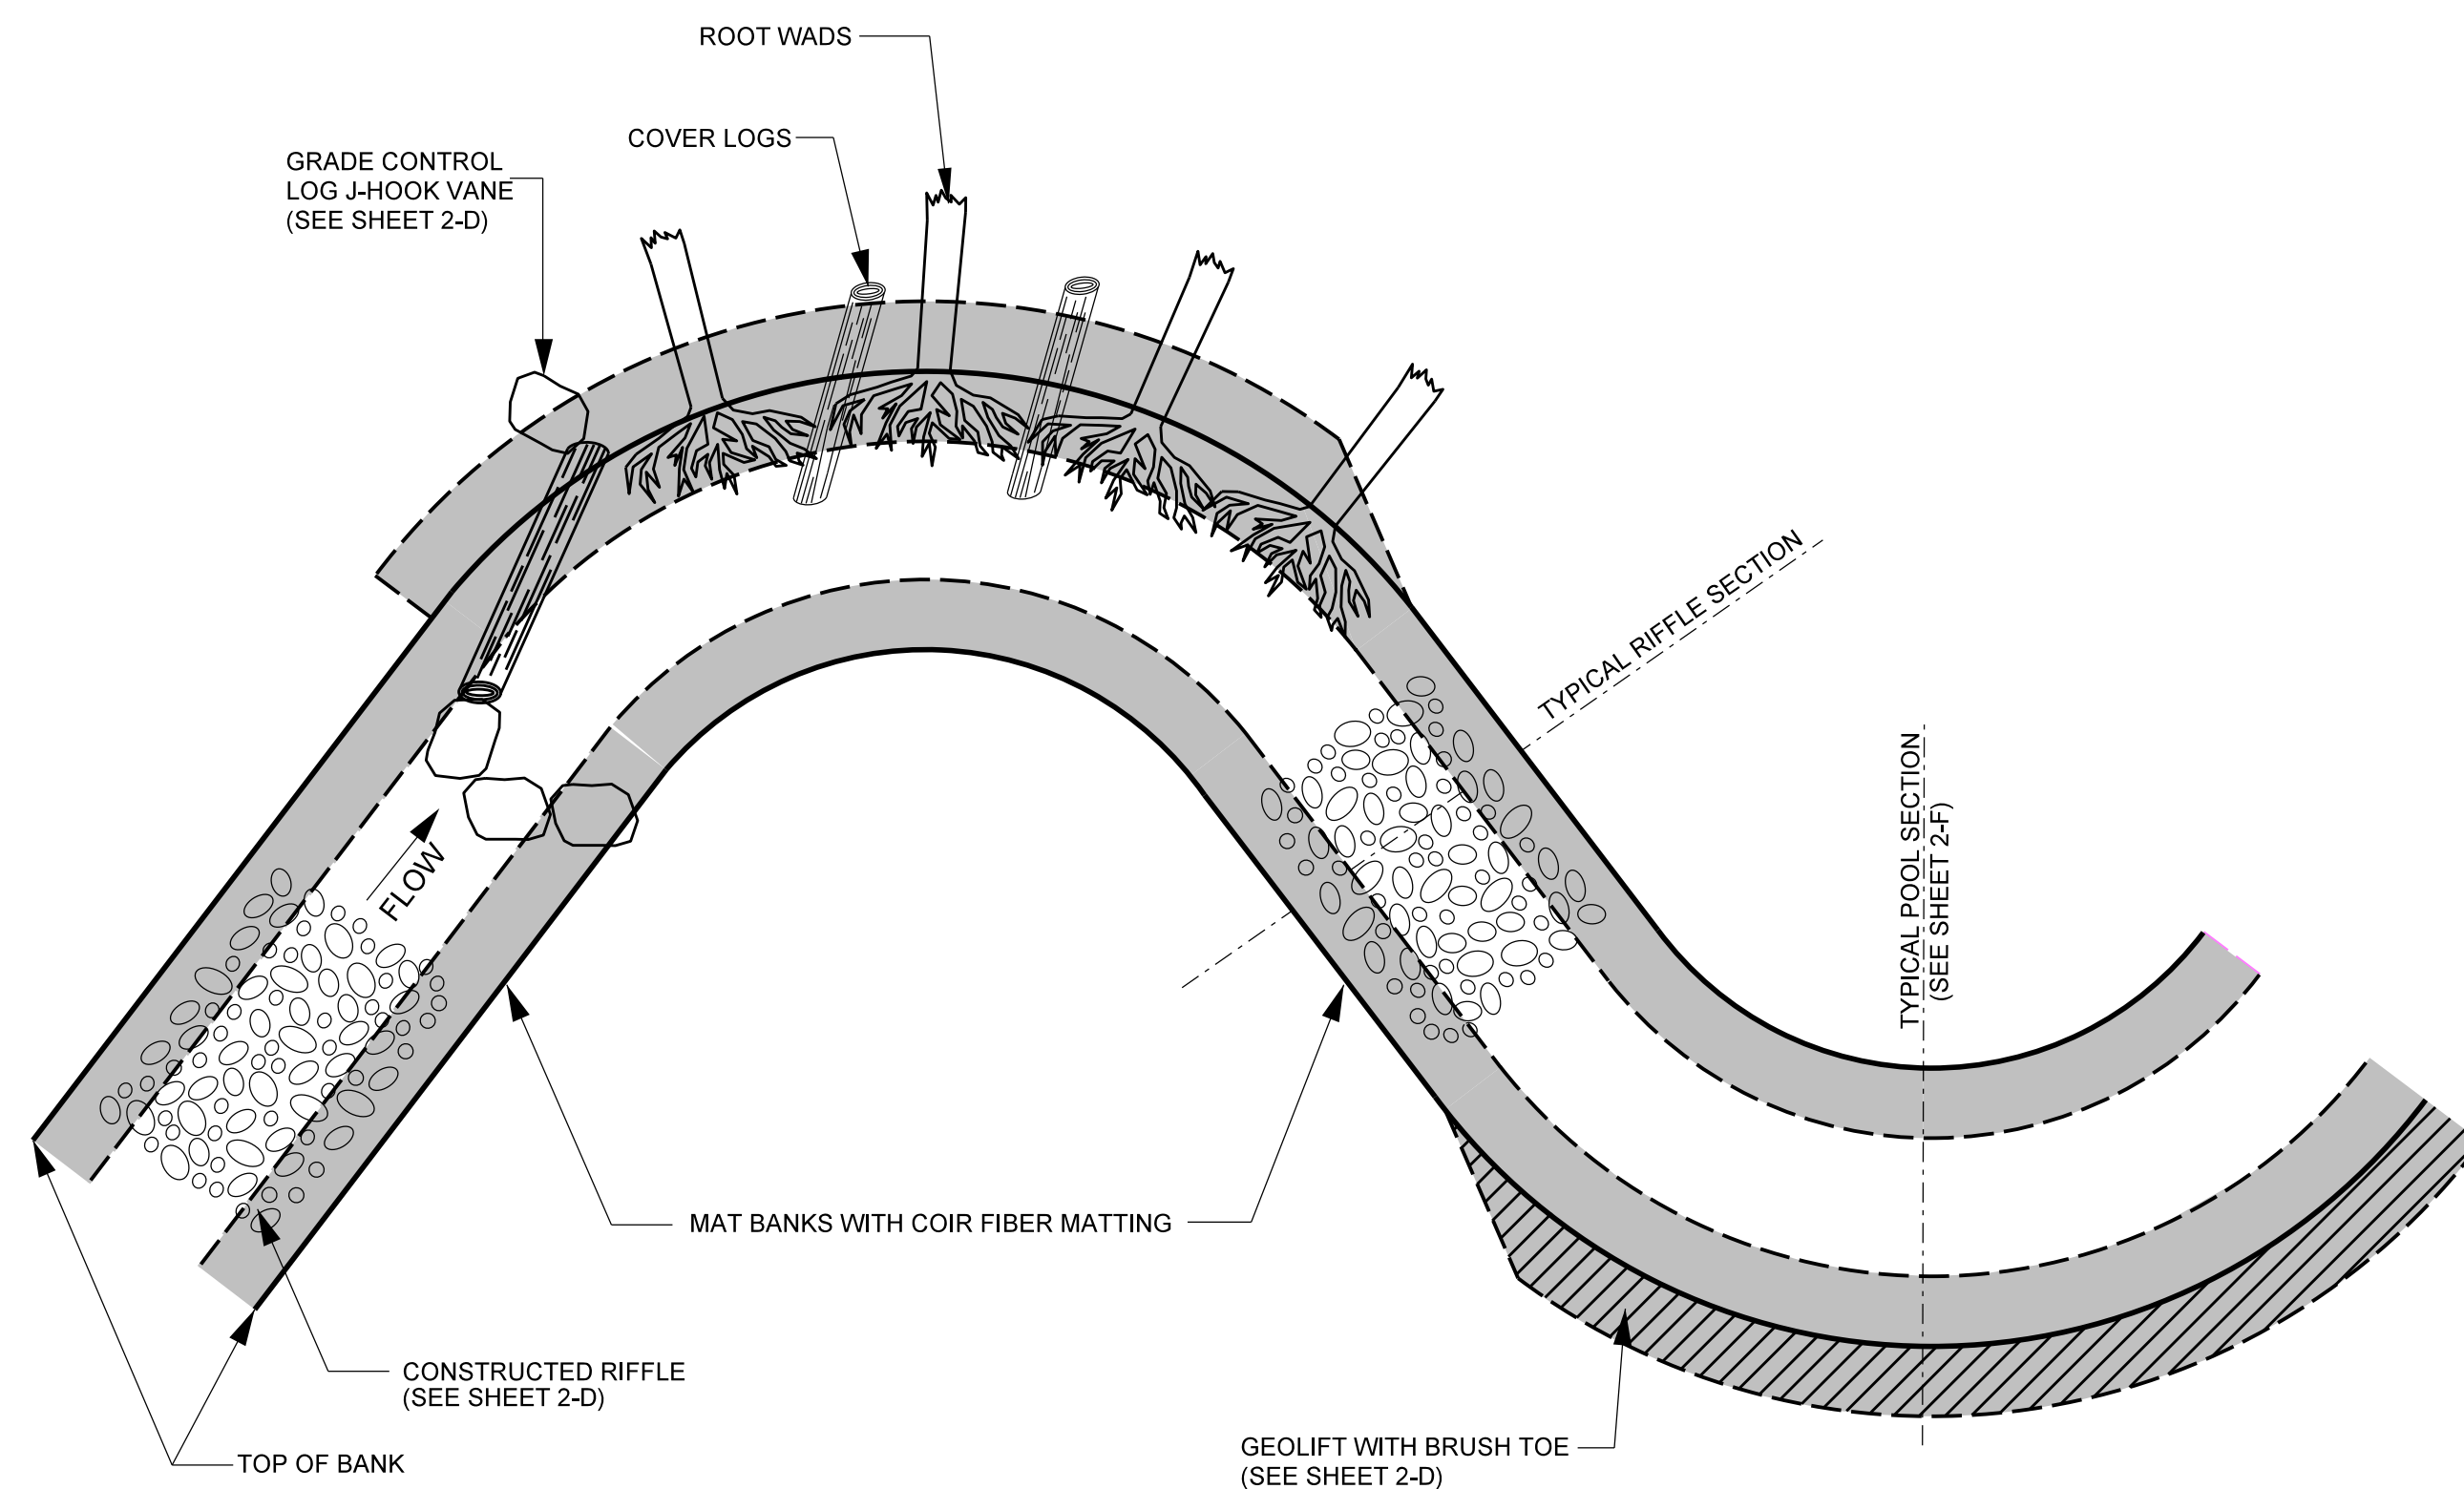


STRUCTURE NOTES:

1. GENERALLY CONSTRUCTED RIFFLES, ROOT WADS, LOG VANES AND COIR FIBER MATTING WILL BE INSTALLED IN THE LOCATION AND SEQUENCE AS SHOWN.
2. ANY CHANGES TO NUMBER OR LOCATION OF STRUCTURES DURING CONSTRUCTION MUST BE APPROVED BY THE DESIGN ENGINEER.
3. COIR FIBER MATTING TO BE INSTALLED ON ALL RESTORED STREAMBANKS, FLOODPLAIN BENCHING, AND TERRACE SLOPES AS DESCRIBED IN THE TECHNICAL SPECIFICATIONS.
4. ROOTWADS MAY BE REPLACED WITH GEOLIFT.


ROCK CROSS VANE

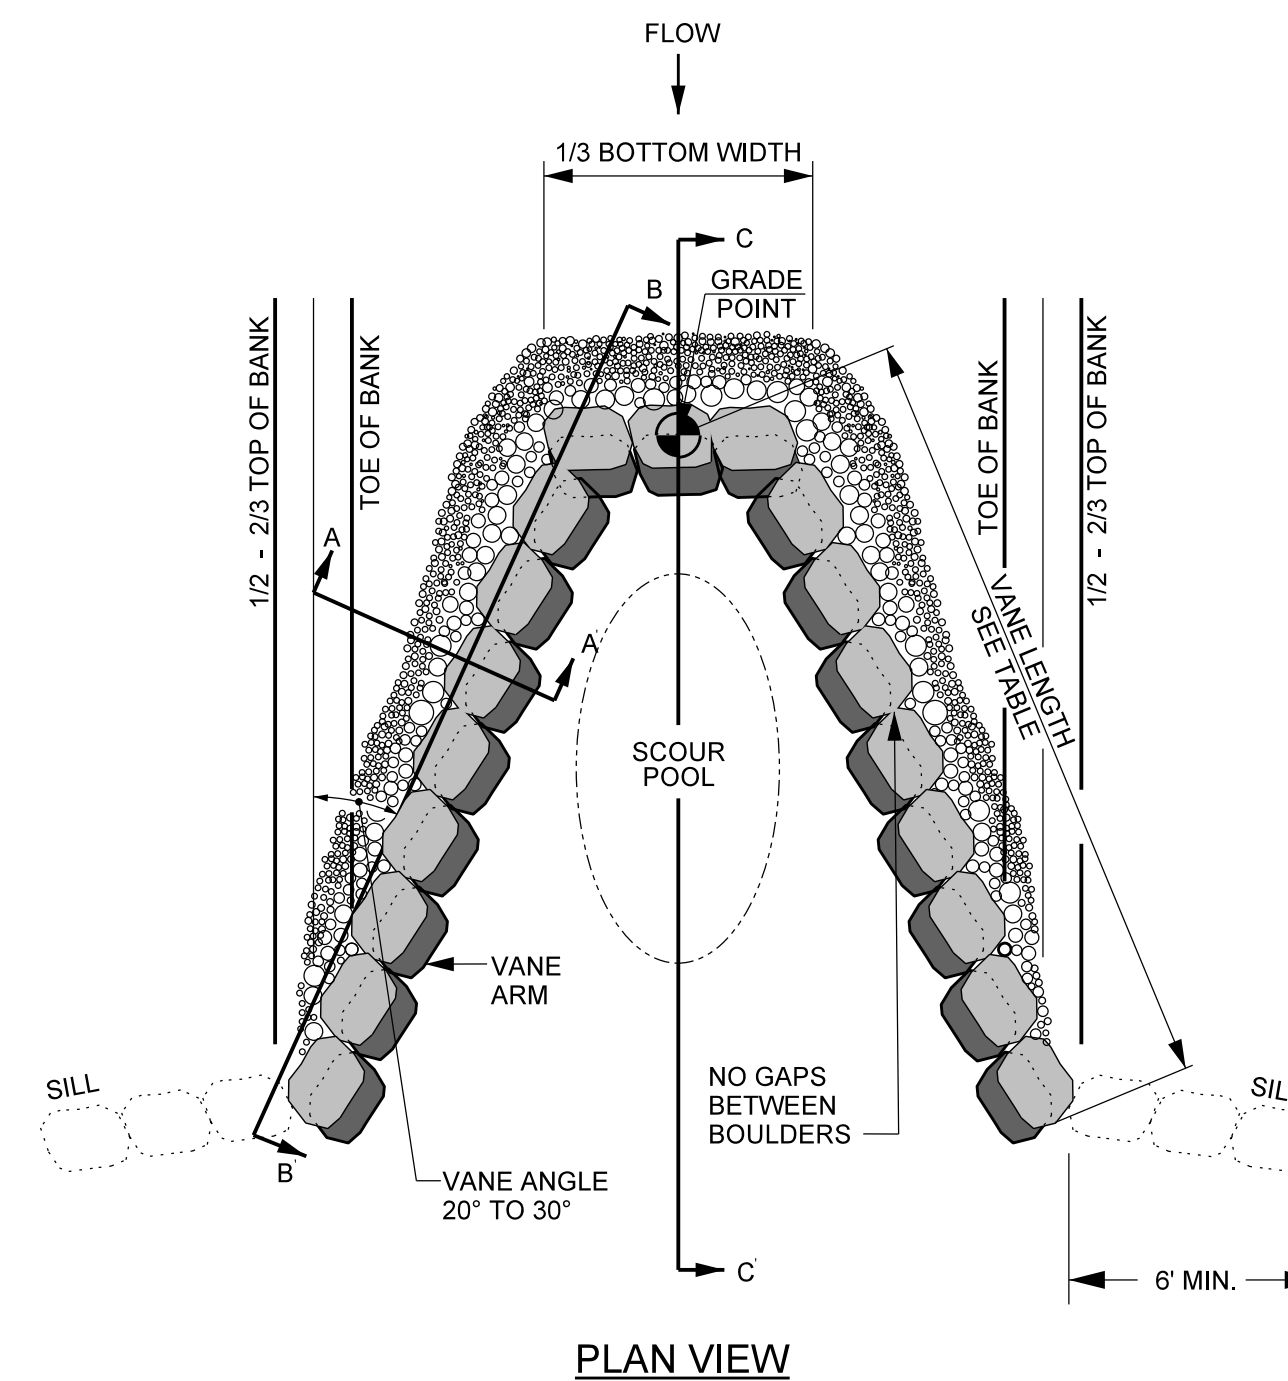


PLAN VIEW

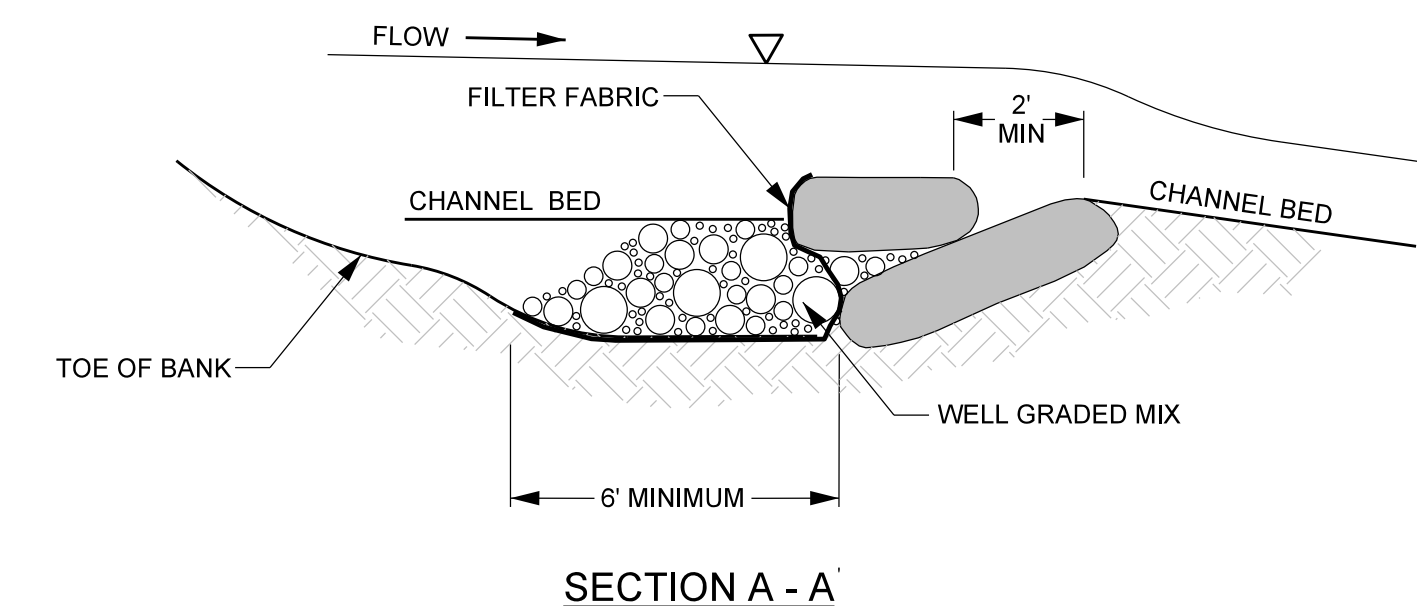

SECTION A - A

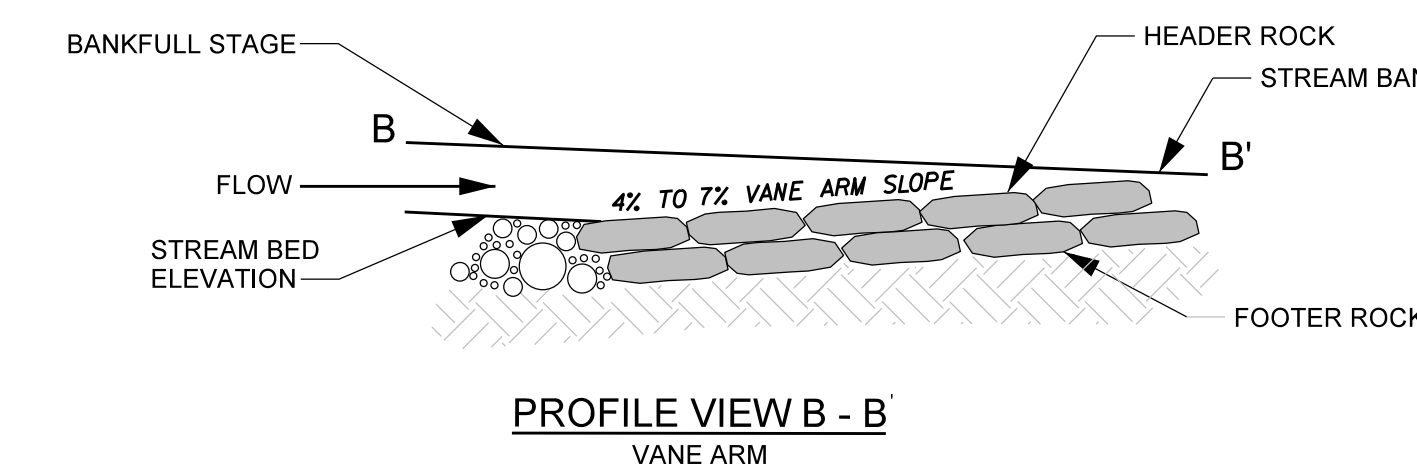

PROFILE VIEW B - B
VANE ARM

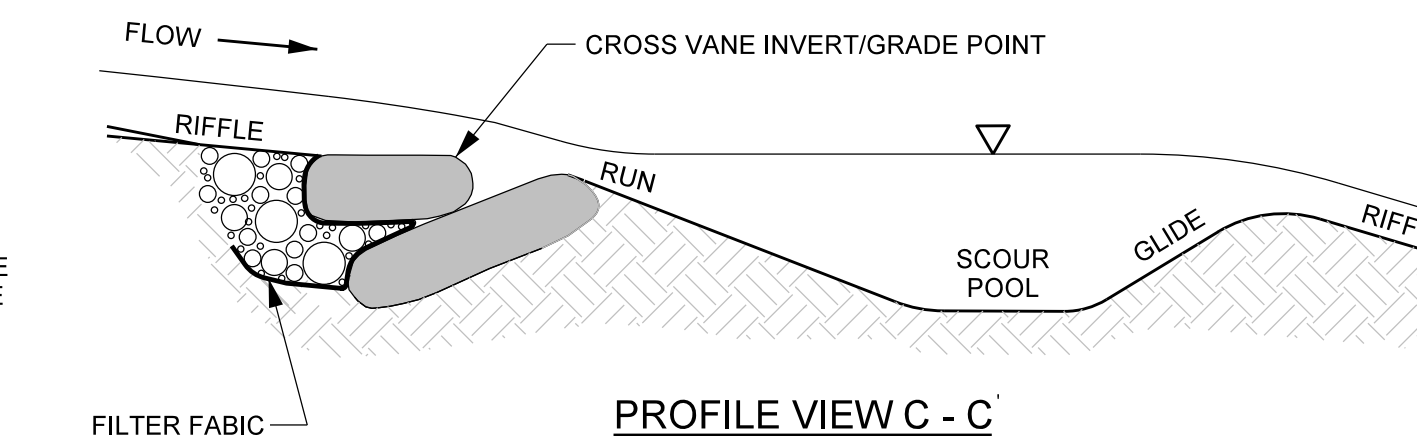




PROFILE VIEW C - C

NOTES FOR ALL VANE STRUCTURES:

1. DIG A TRENCH BELOW THE BED FOR FOOTER ROCKS.
2. START AT BANK AND PLACE FOOTER ROCKS FIRST AND THEN HEADER (TOP) ROCK.
3. CONSTRUCT ANGLE AND SLOPE SPECIFICATIONS AS SHOWN.
4. AN EXTRA ROCK CAN BE PLACED IN SCOUR POOL FOR HABITAT IMPROVEMENT.
5. USE HAND PLACED STONE TO FILL GAPS ON UPSTREAM SIDE OF HEADER AND FOOTER ROCKS.
6. INSTALL GEOTEXTILE FABRIC BEGINNING AT THE TOP OF THE HEADER ROCKS AND EXTEND DOWNWARD TO THE DEPTH OF THE BOTTOM FOOTER ROCK, AND THEN UPSTREAM TO A MINIMUM OF SIX FEET.
7. AFTER ALL STONE BACKFILL HAS BEEN PLACED, FILL IN THE UPSTREAM SIDE OF THE STRUCTURE WITH WELL GRADED MIX OF CLASS B, CLASS A, & #57 STONE TO THE ELEVATION 2'-4" BELOW THE THE HEADER ROCK. INCORPORATE ON-SITE ALLUVIUM WHERE AVAILABLE. FILL SHOULD BE CONCAVE BEHIND THE VANE ARM TO ALLOW POOLING OF FLOW.
8. ON-SITE ALLUVIUM SHALL BE INCORPORATED INTO THE STONE BACKFILL WHERE AVAILABLE.
9. START SLOPE AT 2/3 TO 3/4 TIMES THE BANKFULL STAGE.
10. ALL REACHES, BOULDER SIZE 1' x 2' x 3' TO 2' x 2' x 4'.

PROJECT REFERENCE NO. 166680	SHEET NO. 2
PROJECT ENGINEER	
APPROVED BY:	
DATE:	
Michael Baker International 8000 Regency Parkway, Suite 600 Cary, NORTH CAROLINA 27518 Phone: 919.463.5488 Fax: 919.463.5490 License #: F-1084	
NCDMS ID NO. 100068	



ROCK VANE

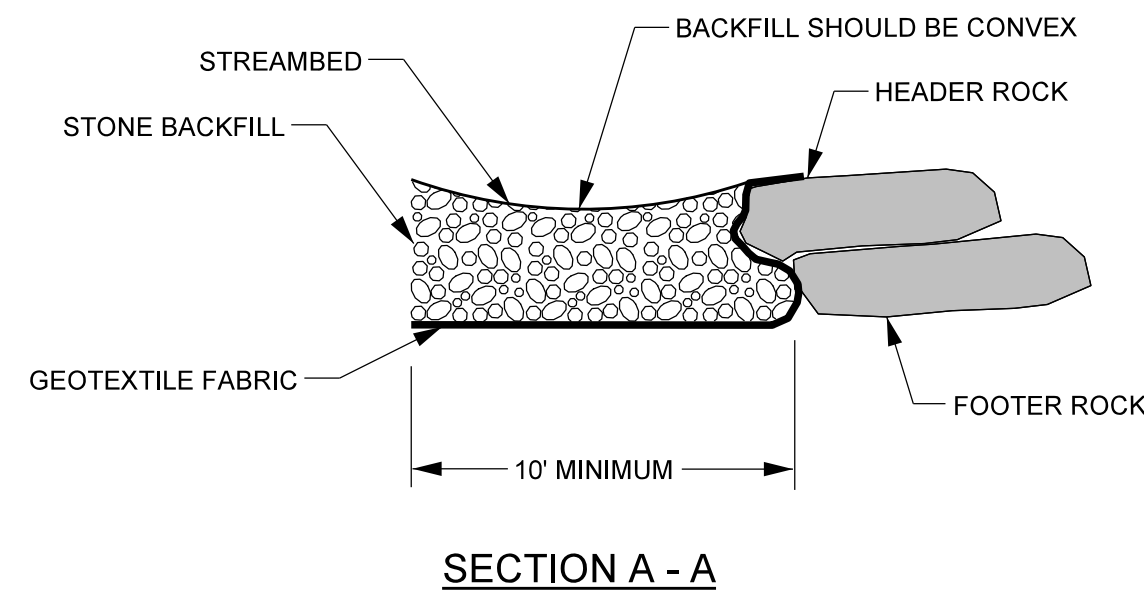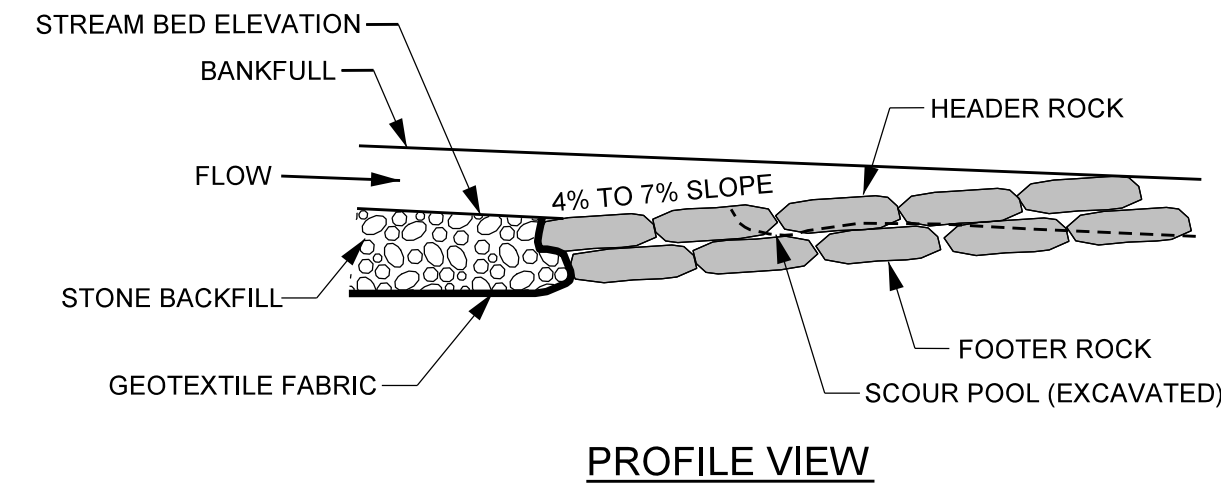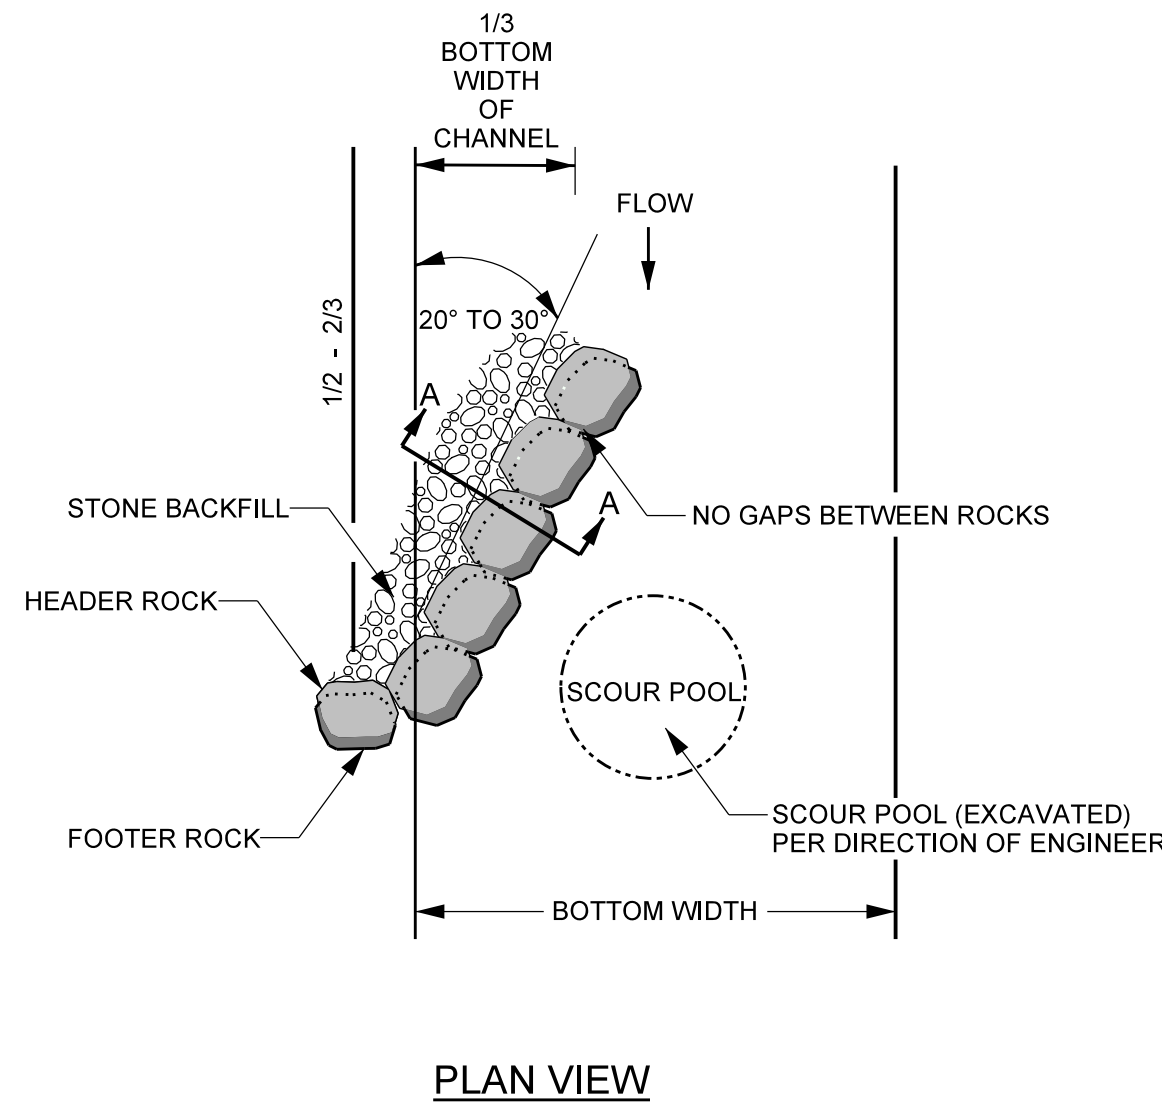

NOTES FOR ALL VANE STRUCTURES:

1. DIG A TRENCH BELOW THE BED FOR FOOTER ROCKS.
2. START AT BANK AND PLACE FOOTER ROCKS FIRST AND THEN HEADER (TOP) ROCK.
3. CONTINUE WITH STRUCTURE, FOLLOWING ANGLE AND SLOPE SPECIFICATIONS.
4. AN EXTRA ROCK CAN BE PLACED IN SCOUR POOL FOR HABITAT IMPROVEMENT.
5. USE HAND PLACED STONE TO FILL GAPS ON UPSTREAM SIDE OF HEADER AND FOOTER ROCKS.
6. INSTALL GEOTEXTILE FABRIC BEGINNING AT THE TOP OF THE HEADER ROCKS AND EXTEND DOWNWARD TO THE DEPTH OF THE BOTTOM FOOTER ROCK, AND THEN UPSTREAM TO A MINIMUM OF SIX FEET.
7. AFTER ALL STONE BACKFILL HAS BEEN PLACED, FILL IN THE UPSTREAM SIDE OF THE STRUCTURE WITH WELL GRADED MIX OF CLASS B, CLASS A, & #57 STONE TO THE ELEVATION 2"-4" BELOW THE HEADER ROCK. INCORPORATE ON-SITE ALLUVIUM WHERE AVAILABLE. FILL SHOULD BE CONCAVE BEHIND THE VANE ARM TO ALLOW POOLING OF FLOW.
8. START SLOPE AT 2/3 TO 3/4 TIMES THE BANKFULL STAGE.
9. ALL REACHES, BOULDER SIZE 1' x 2' x 3' TO 2' x 2' x 4'.




BOULDER STEP

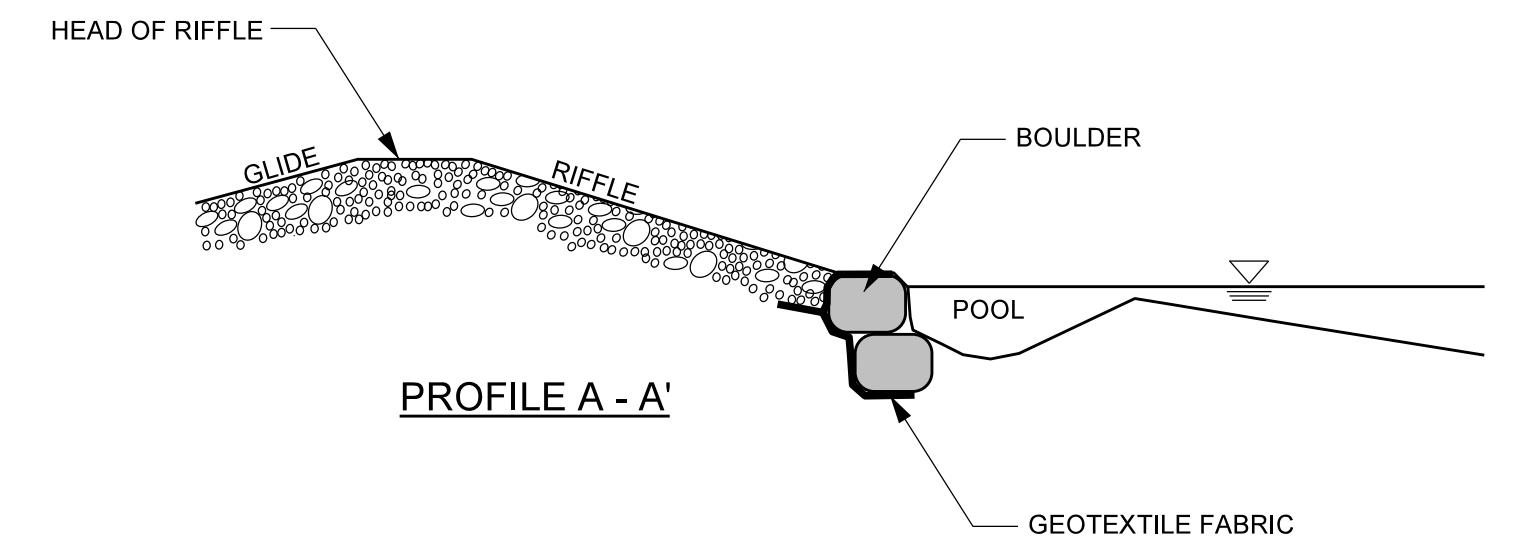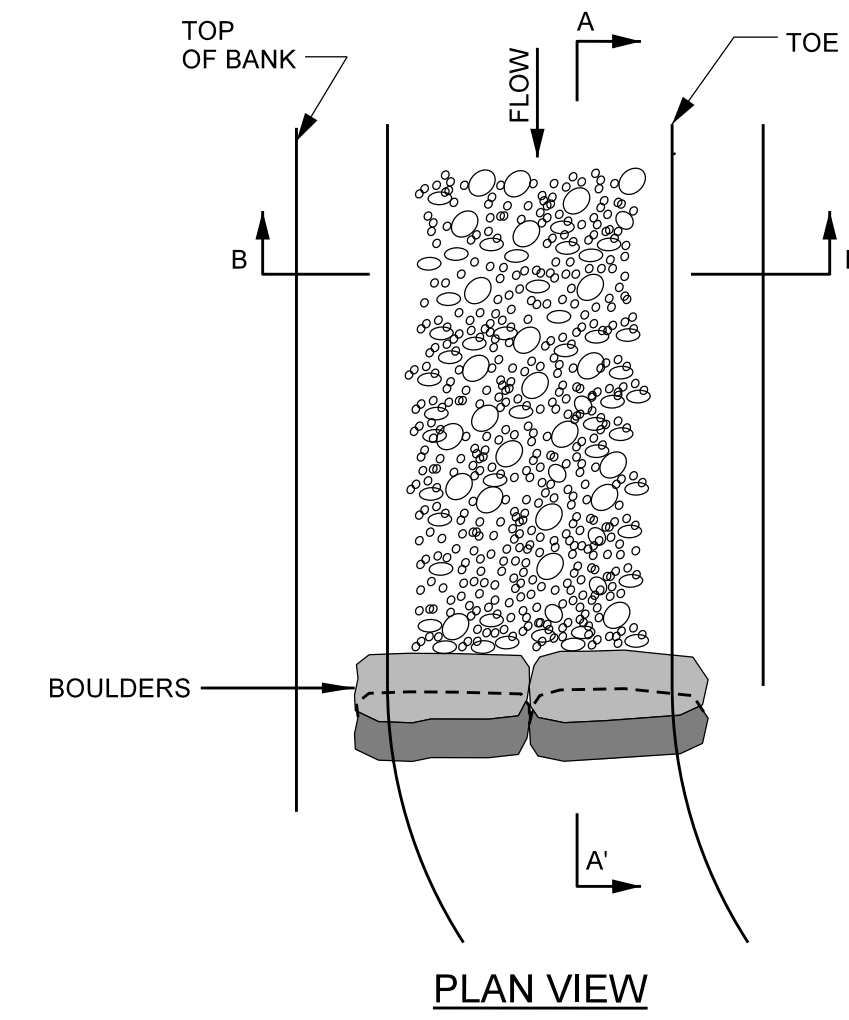

NOTES:

1. HEADER AND FOOTER BOULDERS MUST BE AT LEAST 1' X 2' X 3'.
2. FOOTERS SHALL BE INSTALLED SUCH THAT 1/4 TO 1/3 OF THE LENGTH IS DOWNSTREAM OF THE HEADER.
3. SOIL SHALL BE WELL COMPACTED AROUND BURIED PORTION OF FOOTERS WITH THE BUCKET OF EXCAVATOR.
4. INSTALL NON-WOVEN FILTER FABRIC UNDERNEATH FOOTER BOULDERS.
5. UNDERCUT THE RIFFLE ELEVATION 12 INCHES TO ALLOW FOR A LAYER OF STONE.
6. INSTALL EROSION CONTROL MATTING ALONG COMPLETED BANKS SUCH THAT THE EROSION CONTROL MATTING AT THE TOE OF THE BANK EXTENDS DOWN TO THE UNDERCUT ELEVATION.
7. FILL TRENCH WITH GRADED MIX OF CLASS A, CLASS B, AND #57 STONE TO THE BED ELEVATION OF THE CHANNEL.
8. BOULDER STEPS MUST BE EXTENDED TO A MINIMUM OF 2' INTO THE BANK. USE SILL BOULDERS IF NECESSARY.
9. THALWEG AND STEP INVERT WILL BE CONCAVE AND SHAPED PER DIRECTION OF THE DESIGNER.
10. ALL REACHES, BOULDER SIZE 1' x 2' x 3' TO 2' x 2' x 4'.




GRADE CONTROL ROCK J-HOOK VANE

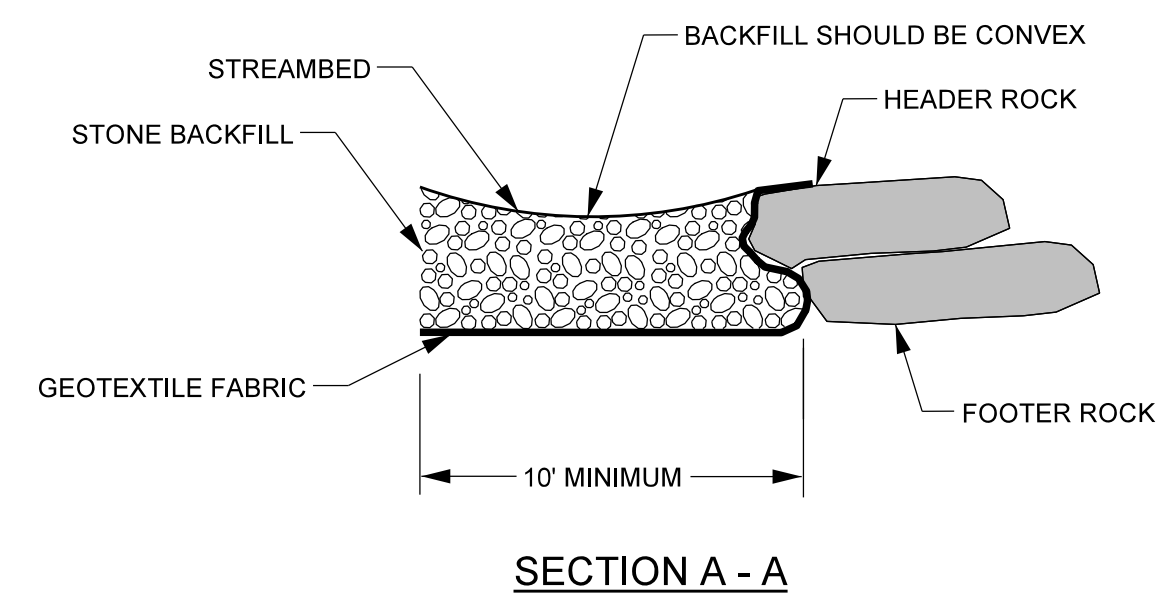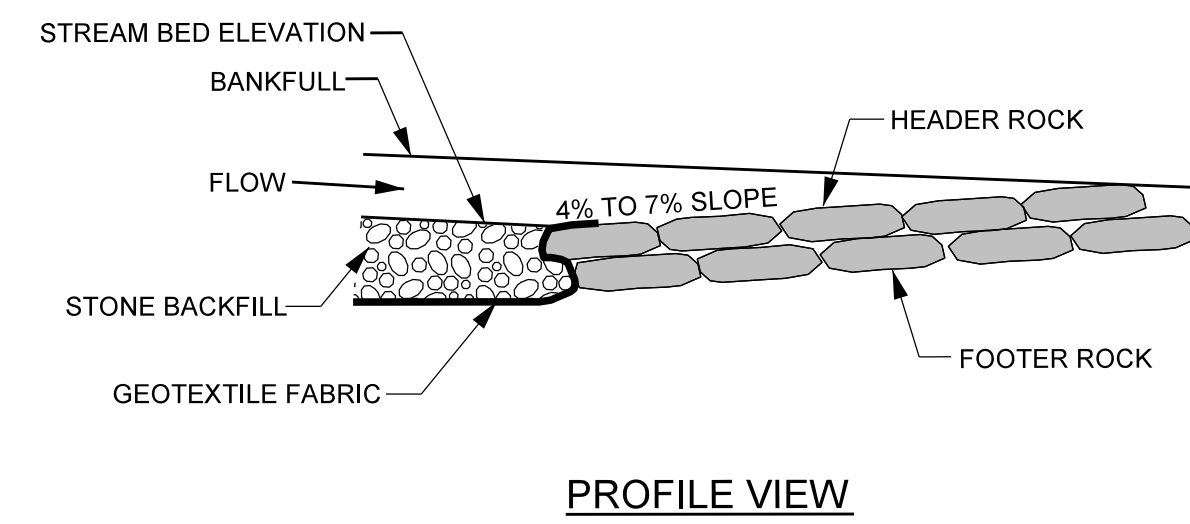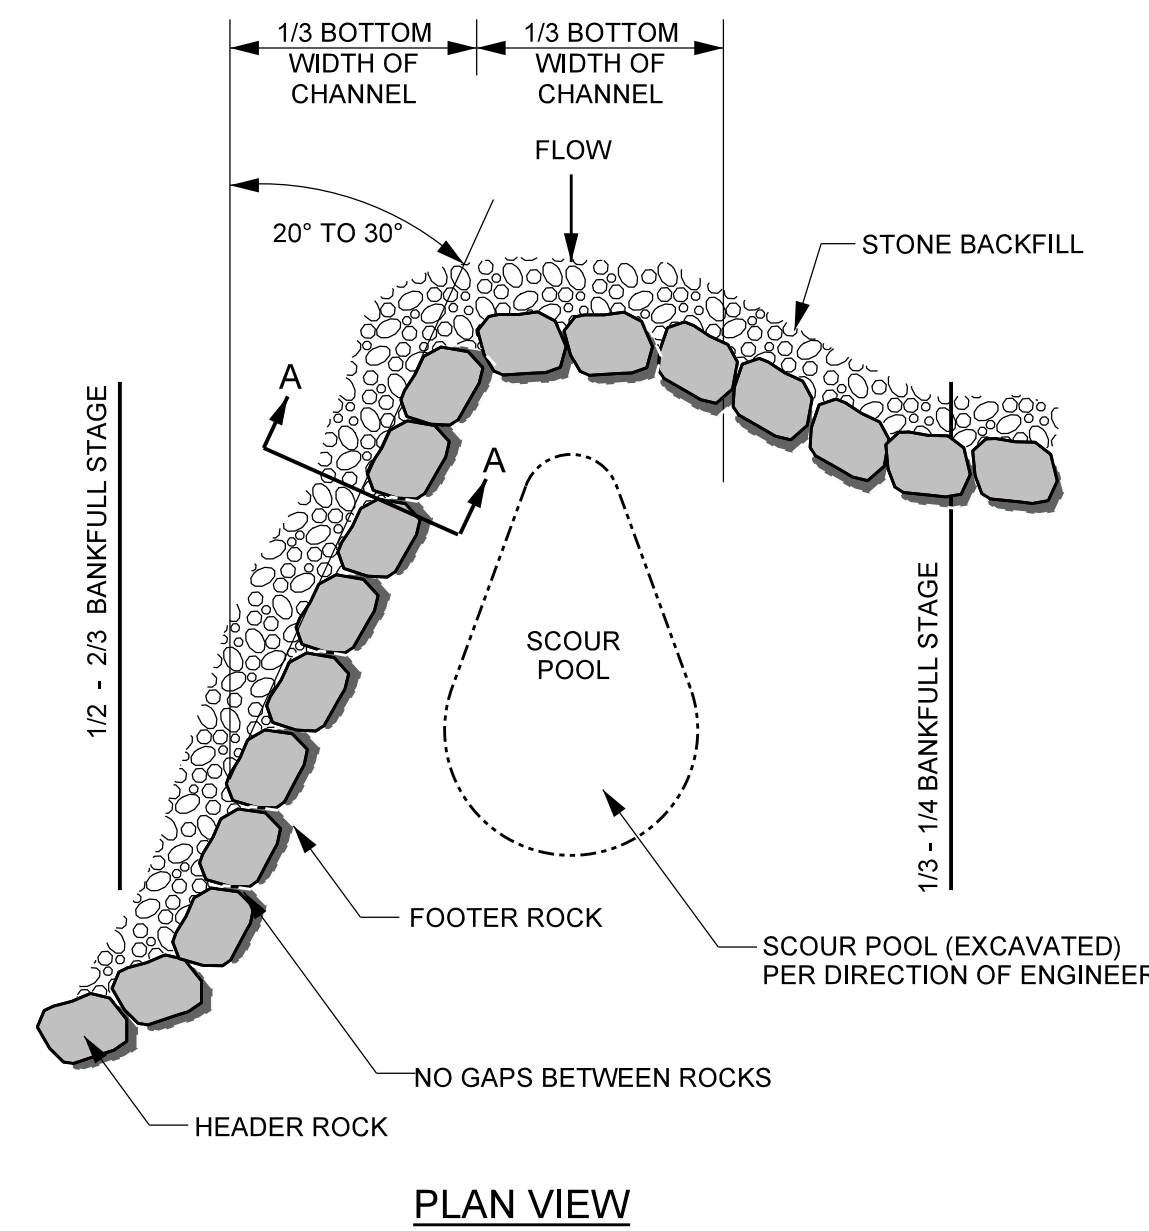

NOTES FOR ALL VANE STRUCTURES:


1. DIG A TRENCH BELOW THE BED FOR FOOTER ROCKS.
2. START AT BANK AND PLACE FOOTER ROCKS FIRST AND THEN HEADER (TOP) ROCK.
3. CONTINUE WITH STRUCTURE, FOLLOWING ANGLE AND SLOPE SPECIFICATIONS.
4. AN EXTRA ROCK CAN BE PLACED IN SCOUR POOL FOR HABITAT IMPROVEMENT.
5. USE HAND PLACED STONE TO FILL GAPS ON UPSTREAM SIDE OF HEADER AND FOOTER ROCKS.
6. INSTALL GEOTEXTILE FABRIC BEGINNING AT THE TOP OF THE HEADER ROCKS AND EXTEND DOWNWARD TO THE DEPTH OF THE BOTTOM FOOTER ROCK, AND THEN UPSTREAM TO A MINIMUM OF SIX FEET.
7. AFTER ALL STONE BACKFILL HAS BEEN PLACED, FILL IN THE UPSTREAM SIDE OF THE STRUCTURE WITH WELL GRADED MIX OF CLASS B, CLASS A, & #57 STONE TO THE ELEVATION 2"-4" BELOW THE HEADER ROCK. INCORPORATE ON-SITE ALLUVIUM WHERE AVAILABLE. FILL SHOULD BE CONCAVE BEHIND THE VANE ARM TO ALLOW POOLING OF FLOW.
8. START SLOPE AT 2/3 TO 3/4 TIMES THE BANKFULL STAGE.
9. ALL REACHES, BOULDER SIZE 1' x 2' x 3' TO 2' x 2' x 4'.

ROCK J-HOOK VANE

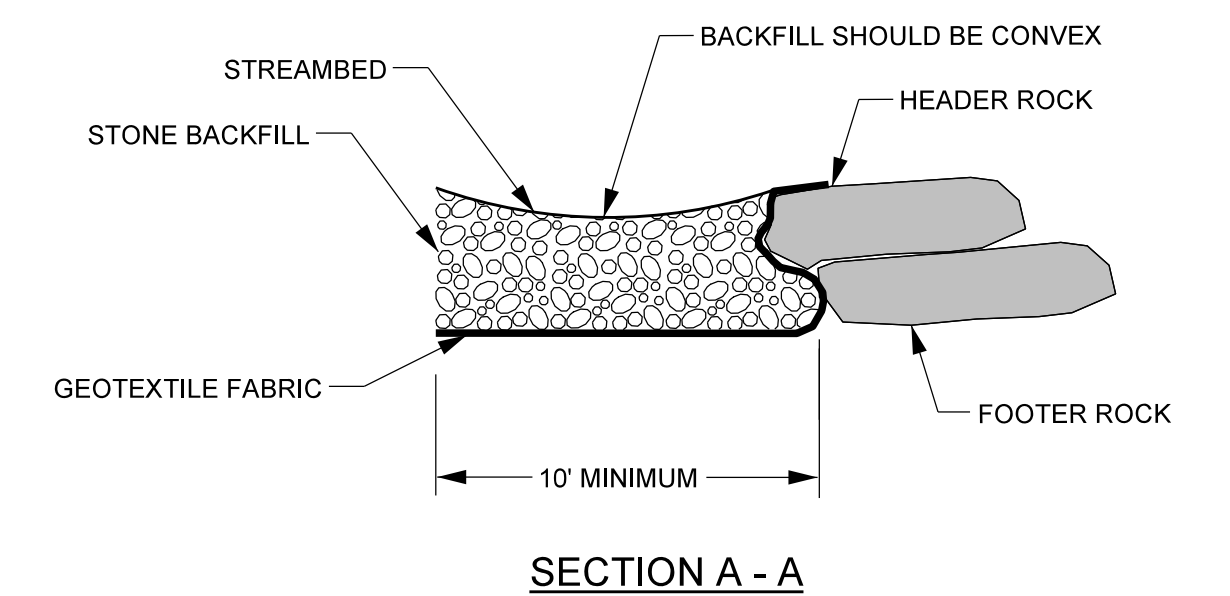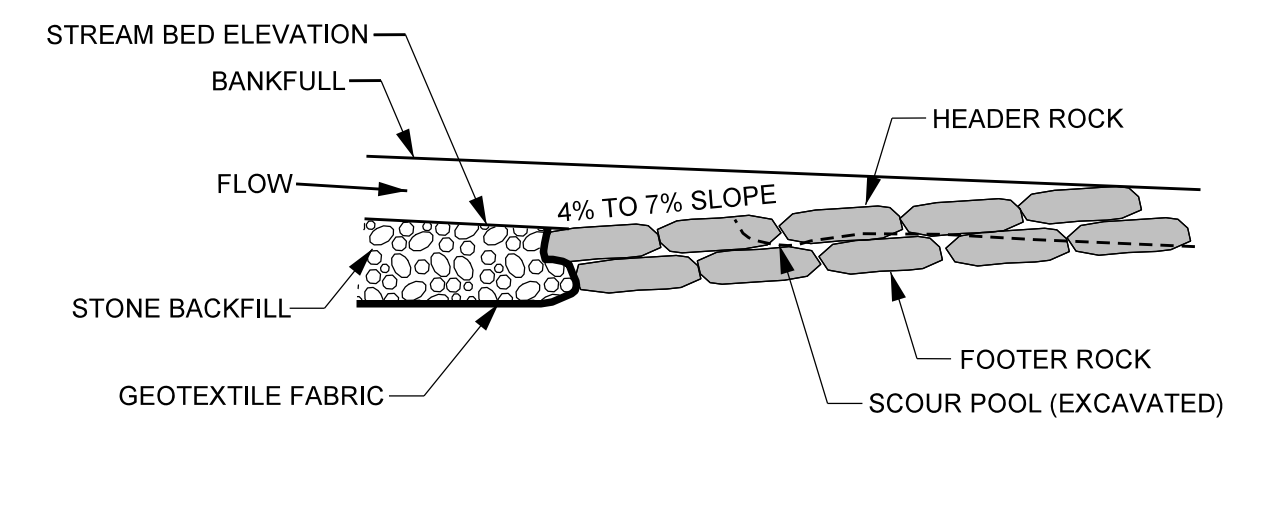
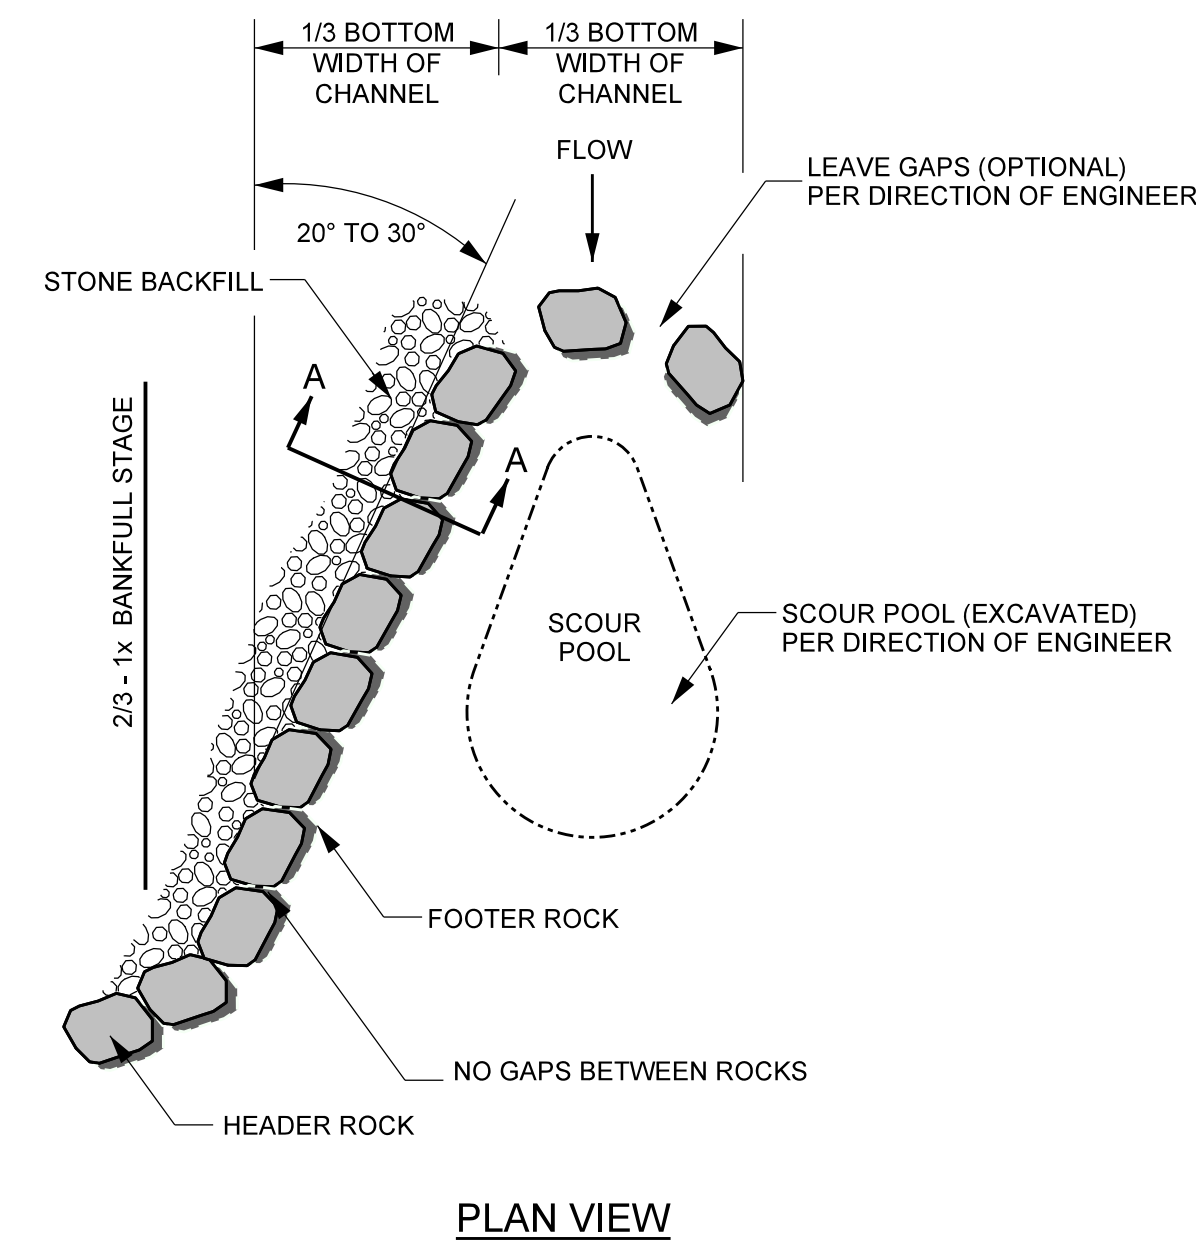


NOTES FOR ALL VANE STRUCTURES:


1. DIG A TRENCH BELOW THE BED FOR FOOTER ROCKS.
2. START AT BANK AND PLACE FOOTER ROCKS FIRST AND THEN HEADER (TOP) ROCK.
3. CONTINUE WITH STRUCTURE, FOLLOWING ANGLE AND SLOPE SPECIFICATIONS.
4. AN EXTRA ROCK CAN BE PLACED IN SCOUR POOL FOR HABITAT IMPROVEMENT.
5. USE HAND PLACED STONE TO FILL GAPS ON UPSTREAM SIDE OF HEADER AND FOOTER ROCKS.
6. INSTALL GEOTEXTILE FABRIC BEGINNING AT THE TOP OF THE HEADER ROCKS AND EXTEND DOWNWARD TO THE DEPTH OF THE BOTTOM FOOTER ROCK, AND THEN UPSTREAM TO A MINIMUM OF SIX FEET.
7. AFTER ALL STONE BACKFILL HAS BEEN PLACED, FILL IN THE UPSTREAM SIDE OF THE STRUCTURE WITH WELL GRADED MIX OF CLASS B, CLASS A, & #57 STONE TO THE ELEVATION 2"-4" BELOW THE HEADER ROCK. INCORPORATE ON-SITE ALLUVIUM WHERE AVAILABLE. FILL SHOULD BE CONCAVE BEHIND THE VANE ARM TO ALLOW POOLING OF FLOW.
8. START SLOPE AT 2/3 TO 3/4 TIMES THE BANKFULL STAGE.
9. ALL REACHES, BOULDER SIZE 1' x 2' x 3' TO 2' x 2' x 4'.

PROJECT REFERENCE NO. 166680	SHEET NO. 2A
PROJECT ENGINEER	
	
APPROVED BY:	
DATE:	
Michael Baker International	
<small>Michael Baker Engineering Inc. 8000 Regency Parkway, Suite 600 Cary, NORTH CAROLINA 27518 Phone: 919.463.5486 Fax: 919.463.5490 License #: F-1084</small>	
NCDMS ID NO. 100068	

LOG AND ROCK STEP / POOL

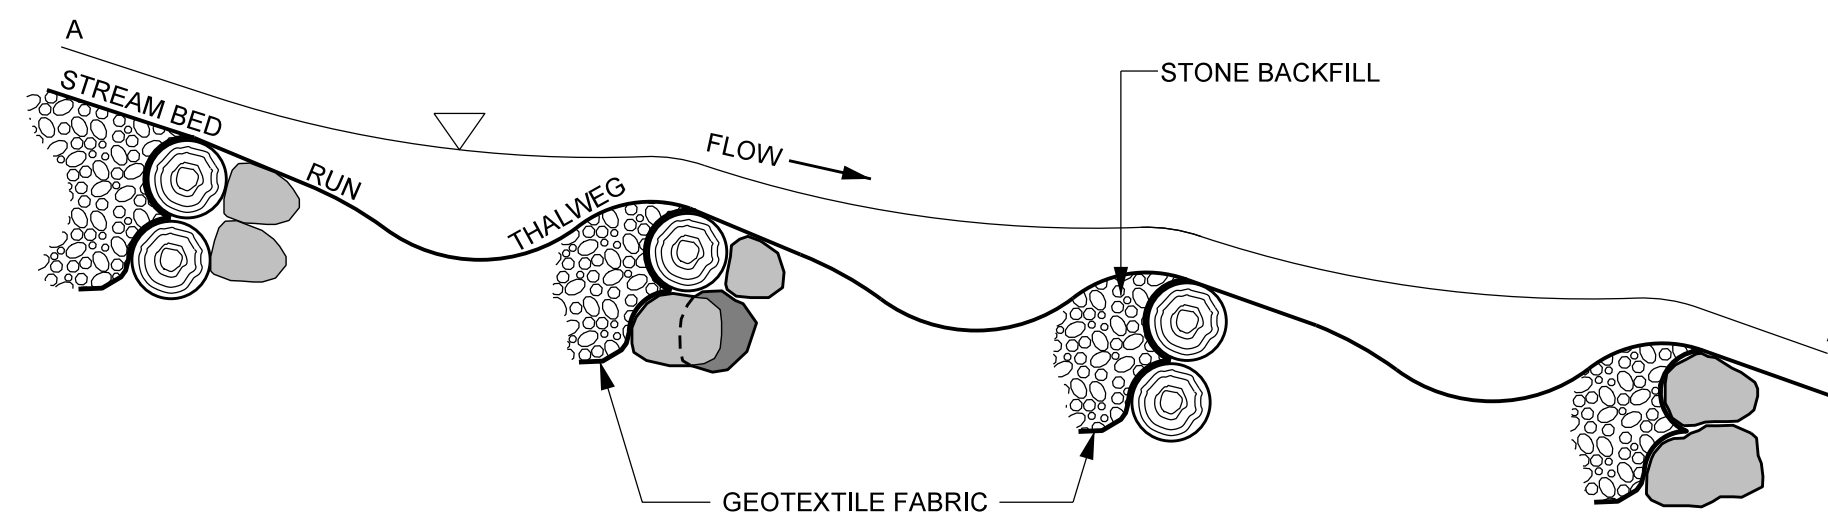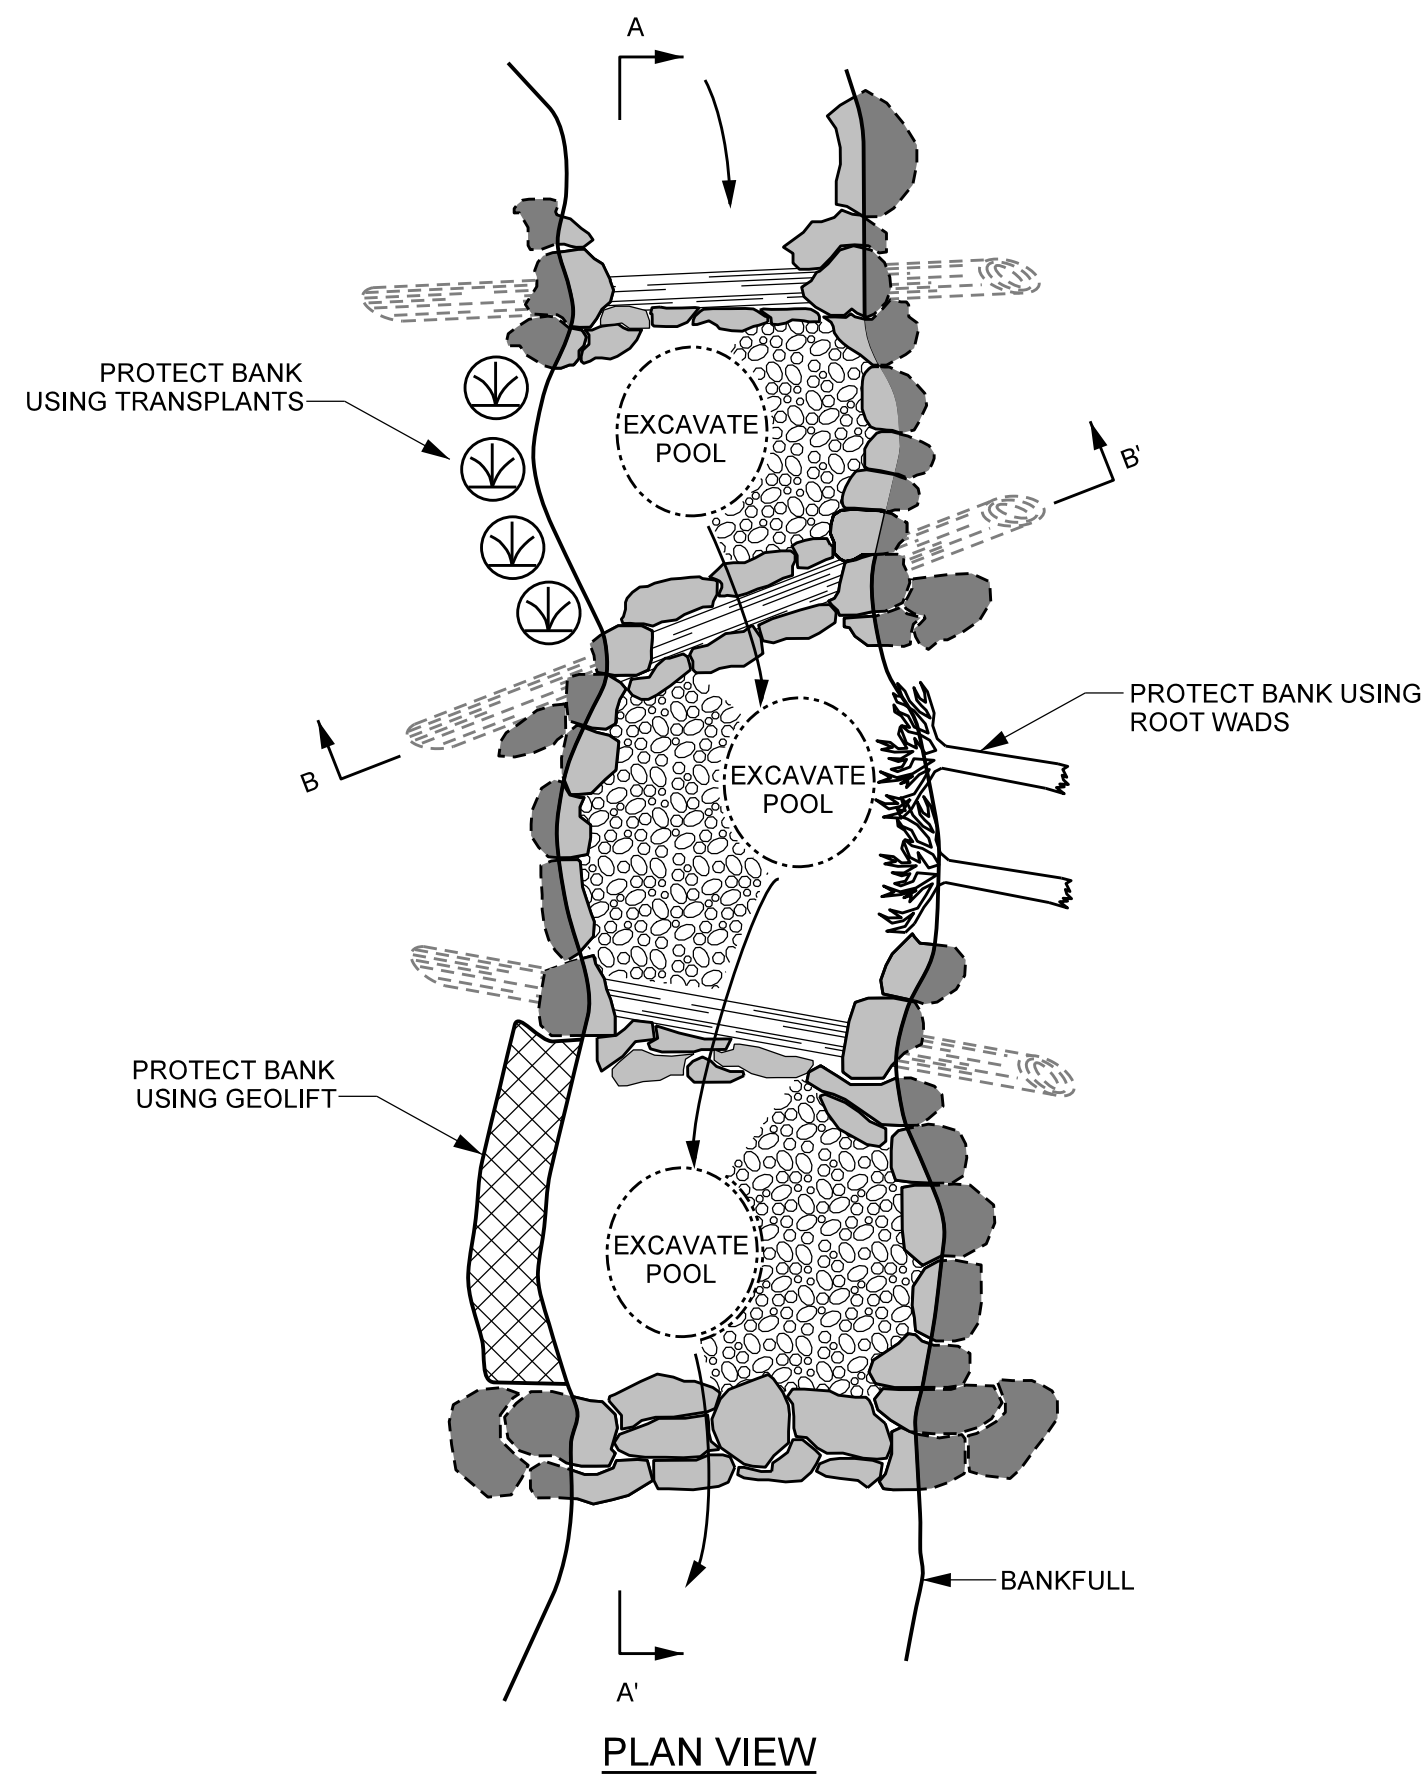

SECTION A - A'

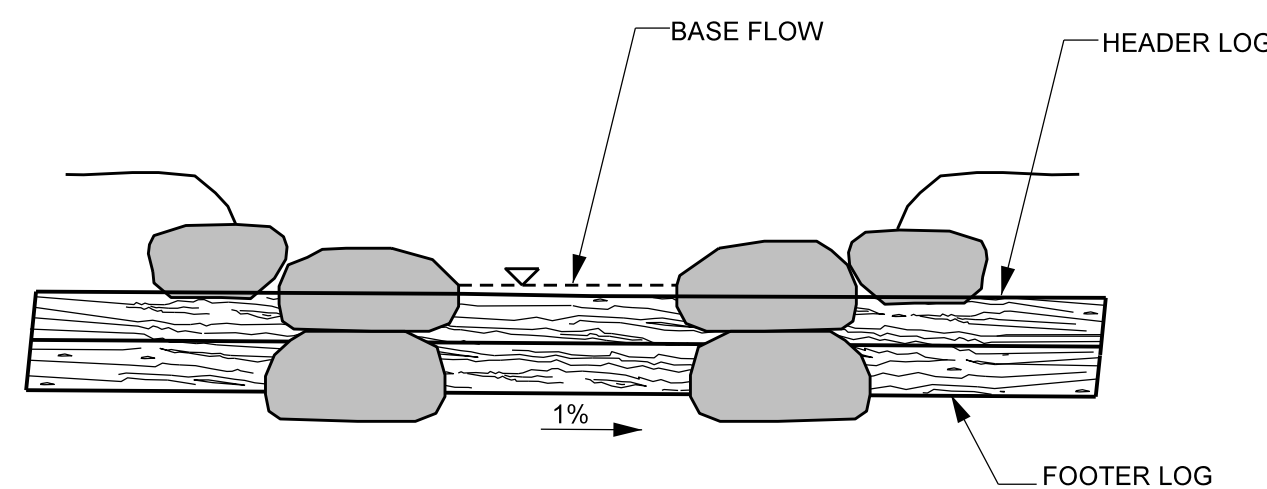


SECTION B - B'

NOTES:


- LOGS SHOULD BE AT LEAST 8" IN DIAMETER, RELATIVELY STRAIGHT, HARDWOOD, AND RECENTLY HARVESTED AND EXTENDING INTO THE BANK 3' ON EACH SIDE.
- SOIL SHOULD BE COMPACTED WELL AROUND BURIED PORTIONS OF LOG.
- GEOTEXTILE FABRIC SHOULD BE NAILED TO THE LOG BELOW THE BACKFILL.
- BOULDERS SHOULD BE 1' X 2' X 3' AND PLACED ON TOP OF HEADER LOG FOR ANCHORING.
- TOEWOOD OR TRANSPLANTS CAN BE USED INSTEAD OF BOULDERS, PER DIRECTION OF ENGINEER.
- AFTER ALL STONE BACKFILL HAS BEEN PLACED, FILL IN THE UPSTREAM SIDE OF THE STRUCTURE WITH WELL GRADED MIX OF CLASS B, CLASS A, & #57 STONE TO THE ELEVATION OF THE TOP OF THE HEADER ROCK. INCORPORATE ON-SITE ALLUVIUM WHERE AVAILABLE.

PROJECT REFERENCE NO. 166680	SHEET NO. 2B
PROJECT ENGINEER	
APPROVED BY:	
DATE:	
Michael Baker International	
NC DMS ID NO. 100068	


GRADE CONTROL LOG J-HOOK VANE

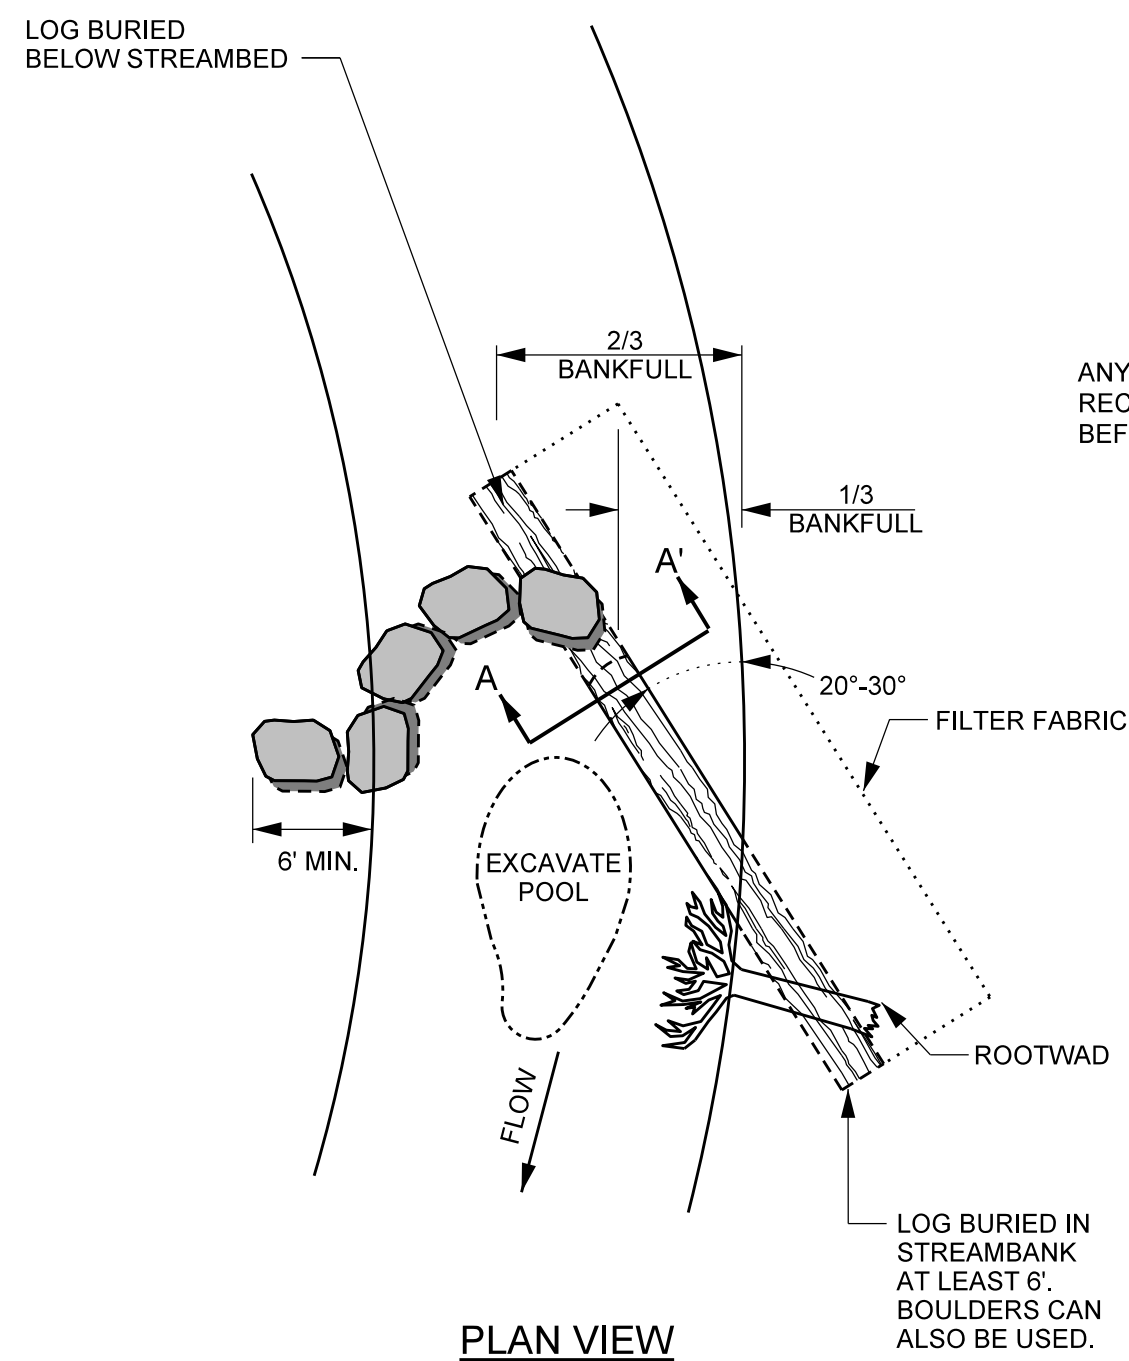

PLAN VIEW

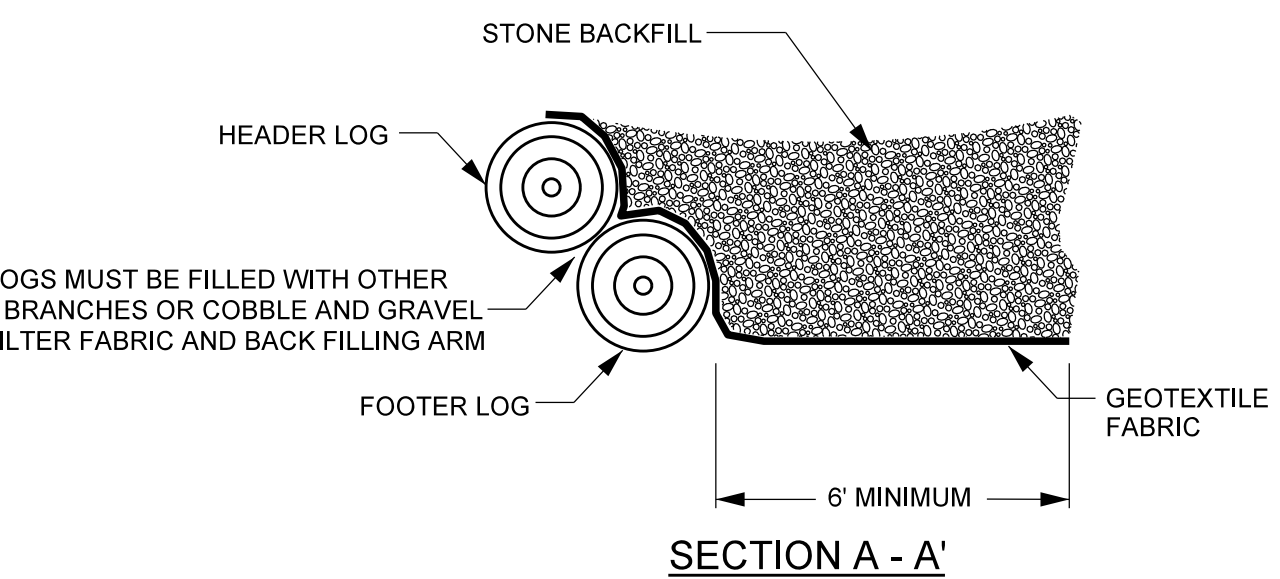

SECTION A - A'

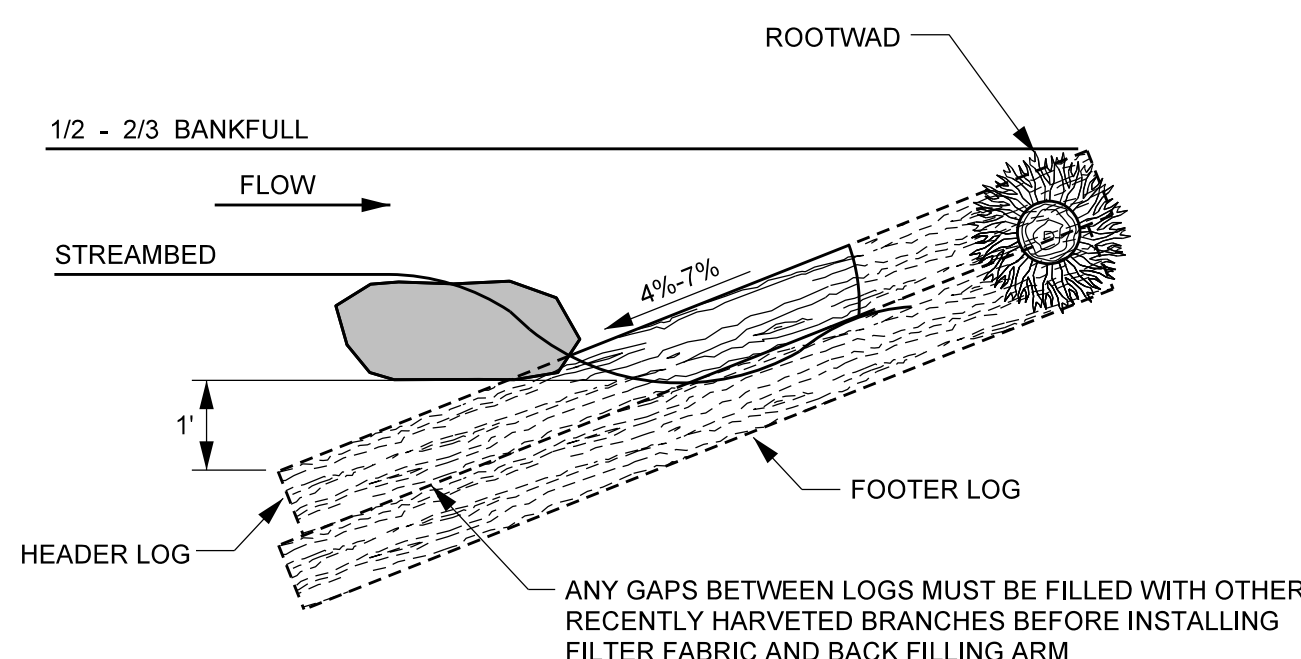


PROFILE VIEW


NOTES:

- LOGS SHOULD BE AT LEAST 10" IN DIAMETER, RELATIVELY STRAIGHT, HARDWOOD, RECENTLY HARVESTED, AND FOOTERED.
- BOULDERS MUST BE AT LEAST 2' X 2' X 1'.
- SOIL SHOULD BE COMPACTED WELL AROUND BURIED PORTIONS OF LOG.
- ROOTWADS SHOULD BE PLACED BENEATH THE HEADER LOG AND PLACED SO THAT IT LOCKS THE HEADER LOG INTO THE BANK. SEE ROOTWAD DETAIL.
- BOULDERS SHOULD BE PLACED ON TOP OF HEADER LOG FOR ANCHORING.
- HEADER BOULDERS TO BE PLACED 0.5 TO 0.75 FEET APART.
- FILTER FABRIC SHOULD BE NAILED TO THE LOG BELOW THE BACKFILL.
- TRANSPLANTS OR BOULDERS CAN BE USED INSTEAD OF ROOTWADS, PER DIRECTION OF ENGINEER.
- BOULDER SILL MUST BE A MINIMUM OF 6'.
- AFTER ALL STONE BACKFILL HAS BEEN PLACED, FILL IN THE UPSTREAM SIDE OF THE STRUCTURE WITH WELL GRADED MIX OF CLASS B, CLASS A, & #57 STONE TO THE ELEVATION OF THE TOP OF THE HEADER ROCK. INCORPORATE ON-SITE ALLUVIUM WHERE AVAILABLE.

LOG VANE

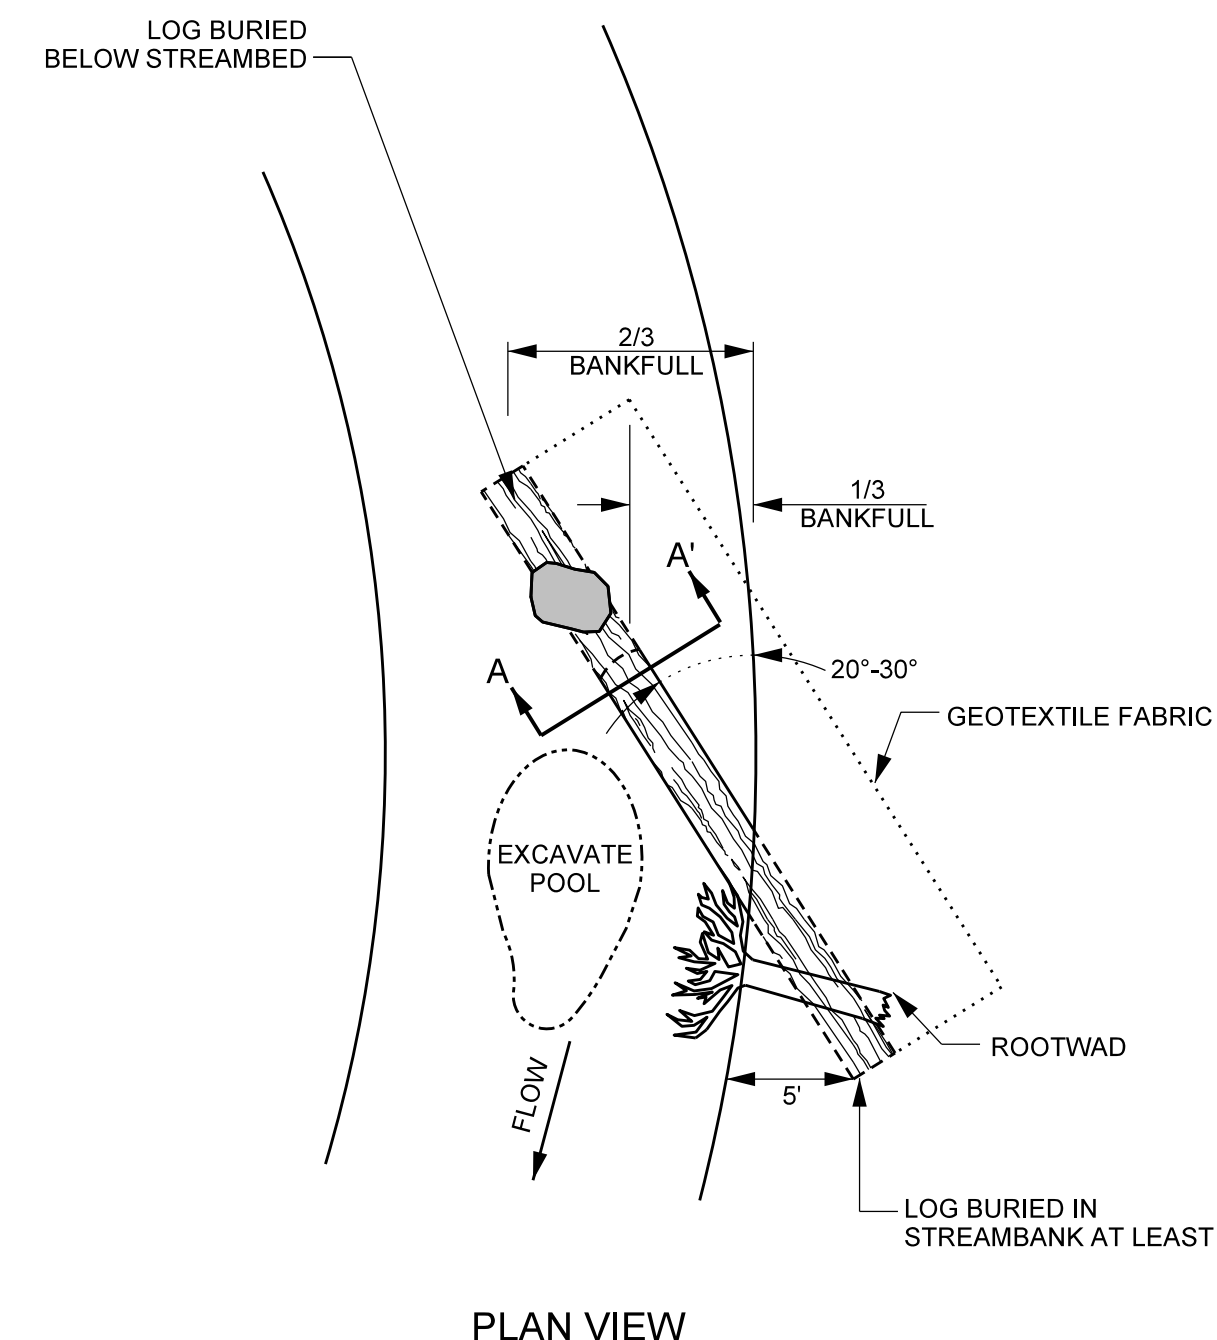

PLAN VIEW

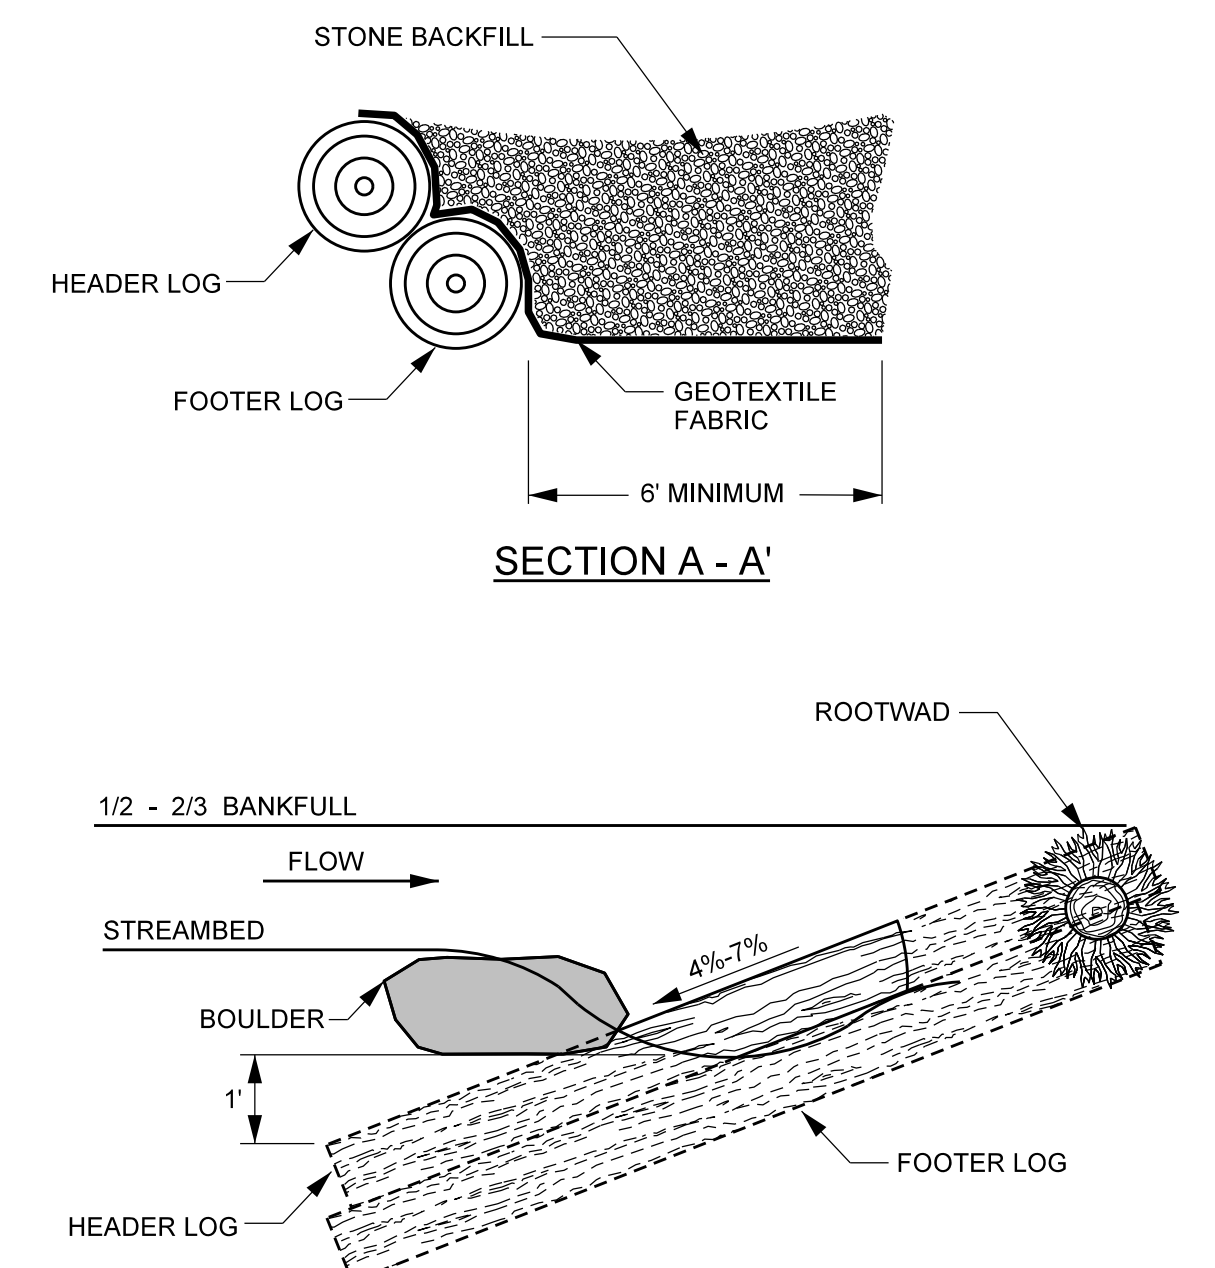


PROFILE VIEW

NOTES:

- LOGS SHOULD BE AT LEAST 10" IN DIAMETER, RELATIVELY STRAIGHT, HARDWOOD, AND RECENTLY HARVESTED.
- BOULDERS MUST BE OF SUFFICIENT SIZE TO ANCHOR LOGS.
- SOIL SHOULD BE COMPACTED WELL AROUND BURIED PORTIONS OF LOGS.
- ROOTWADS SHOULD BE PLACED BENEATH THE HEADER LOG AND PLACED SO THAT IT LOCKS THE HEADER LOG INTO THE BANK. SEE ROOTWAD DETAIL.
- BOULDER SHOULD BE PLACED ON TOP OF HEADER LOG FOR ANCHORING.
- GEOTEXTILE FABRIC SHOULD BE NAILED TO THE LOG BELOW THE BACKFILL.
- TOEWOOD OR TRANSPLANTS CAN BE USED INSTEAD OF ROOTWADS, PER DIRECTION OF ENGINEER.
- AFTER ALL STONE BACKFILL HAS BEEN PLACED, FILL IN THE UPSTREAM SIDE OF THE STRUCTURE WITH WELL GRADED MIX OF CLASS B, CLASS A, & #57 STONE TO THE ELEVATION OF THE TOP OF THE HEADER ROCK. INCORPORATE ON-SITE ALLUVIUM WHERE AVAILABLE.

ROCK DOUBLE DROP CROSS VANE

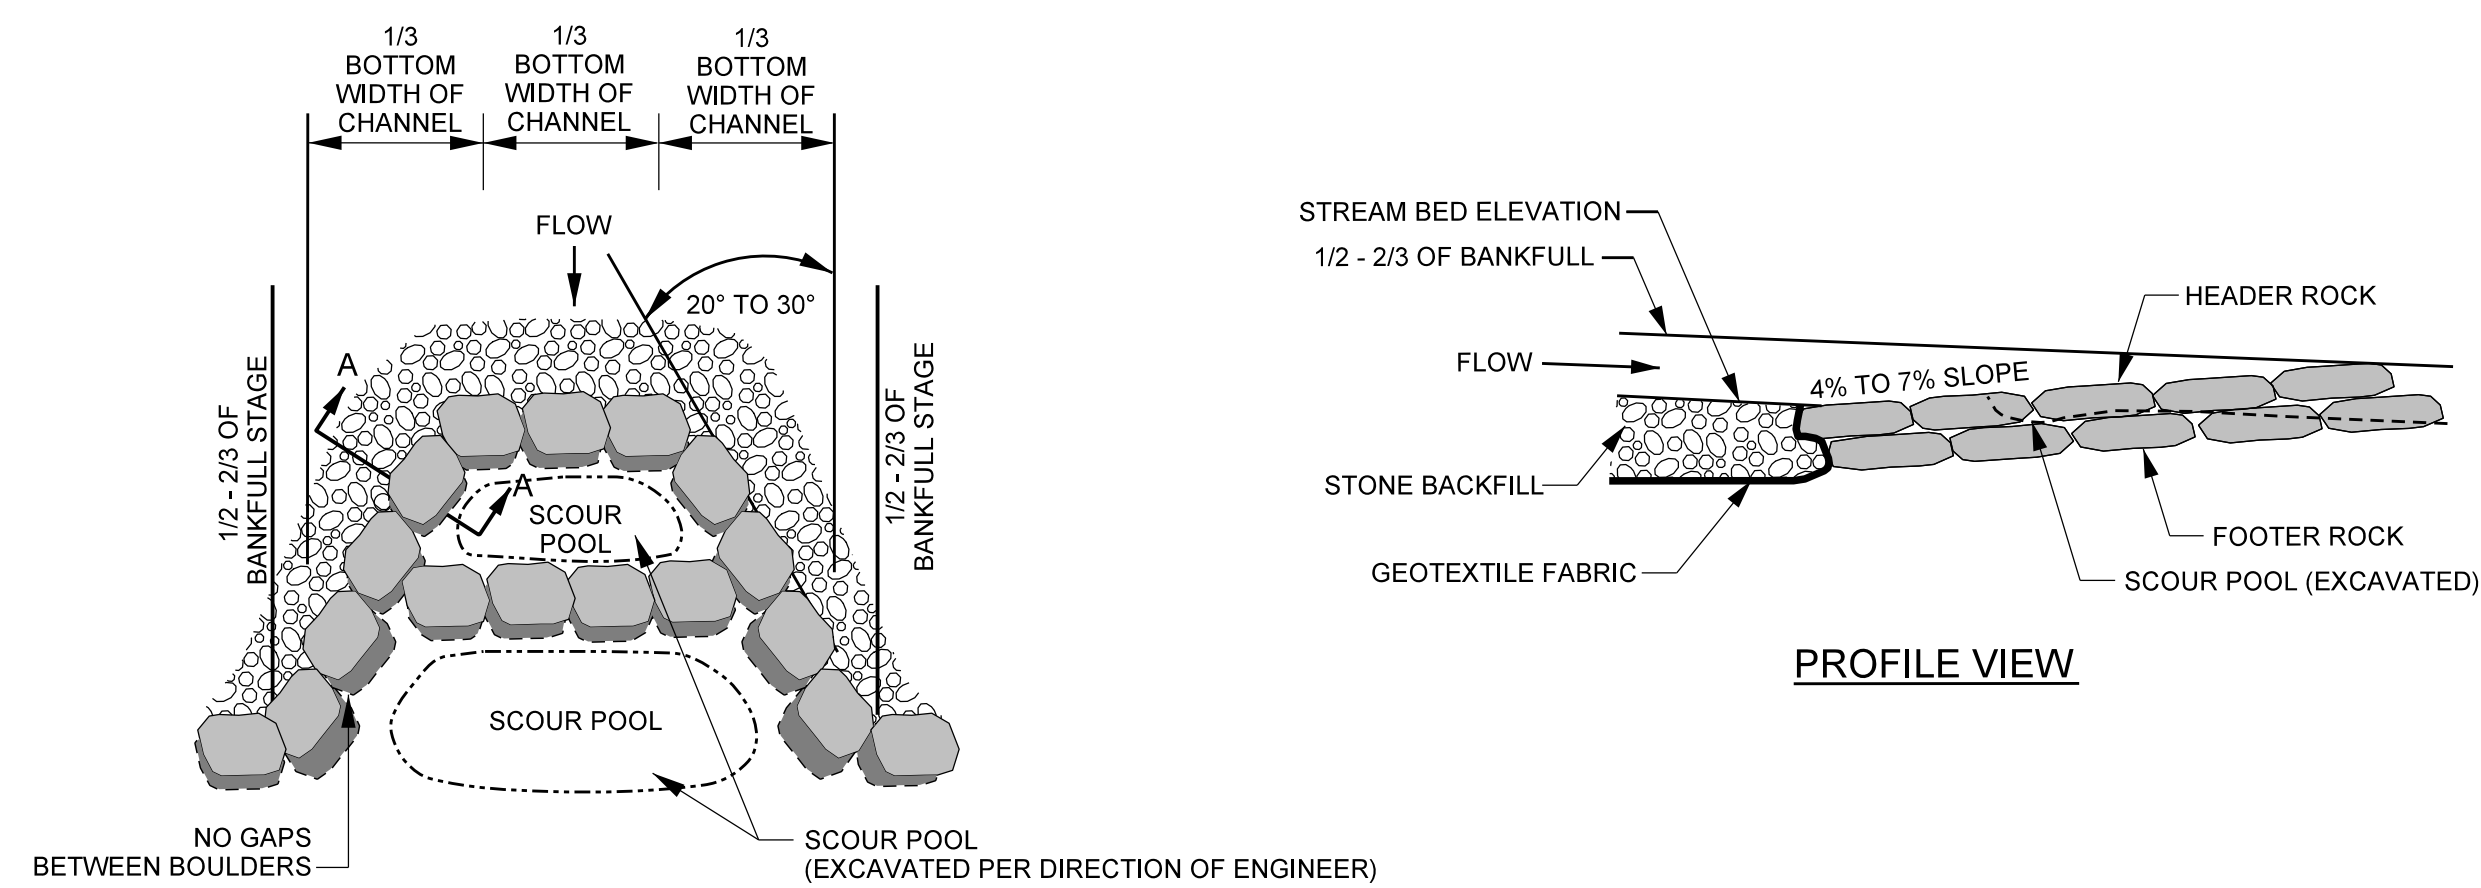


PLAN VIEW

PROFILE VIEW


NOTES FOR ALL VANE STRUCTURES:

1. DIG A TRENCH BELOW THE BED FOR FOOTER ROCKS.
2. START AT BANK AND PLACE FOOTER ROCKS FIRST AND THEN HEADER (TOP) ROCK.
3. CONTINUE WITH STRUCTURE FOLLOWING ANGLE AND SLOPE SPECIFICATIONS.
4. AN EXTRA ROCK CAN BE PLACED IN SCOUR POOL FOR HABITAT IMPROVEMENT.
5. USE HAND PLACED STONE TO FILL GAPS ON UPSTREAM SIDE OF HEADER AND FOOTER ROCKS.
6. INSTALL GEOTEXTILE FABRIC BEGINNING AT THE TOP OF THE HEADER ROCKS AND EXTEND DOWNWARD TO THE DEPTH OF THE BOTTOM FOOTER ROCK, AND THEN UPSTREAM TO A MINIMUM OF SIX FEET.
7. AFTER ALL STONE BACKFILL HAS BEEN PLACED, FILL IN THE UPSTREAM SIDE OF THE STRUCTURE WITH WELL GRADED MIX OF CLASS B, CLASS A, & #57 STONE TO THE ELEVATION 2'-4" BELOW THE THE HEADER ROCK. INCORPORATE ON-SITE ALLUVIUM WHERE AVAILABLE. FILL SHOULD BE CONCAVE BEHIND THE VANE ARM TO ALLOW POOLING OF FLOW.
8. START SLOPE AT 2/3 TO 3/4 TIMES THE BANKFULL STAGE.
9. ALL REACHES, BOULDER SIZE 1' x 2' x 3' TO 2' x 2' x 4'.

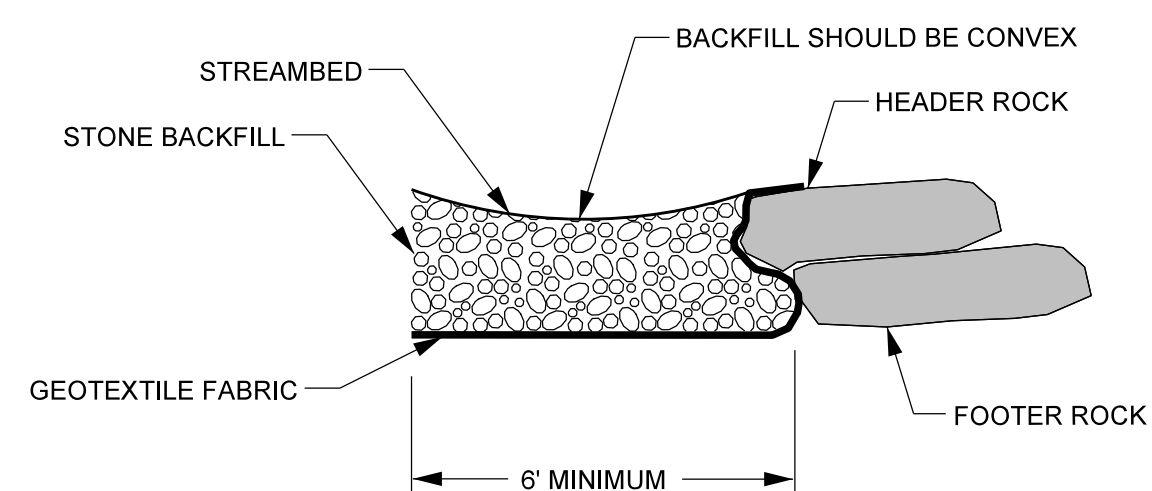

SECTION A - A

CONSTRUCTED RIFFLE

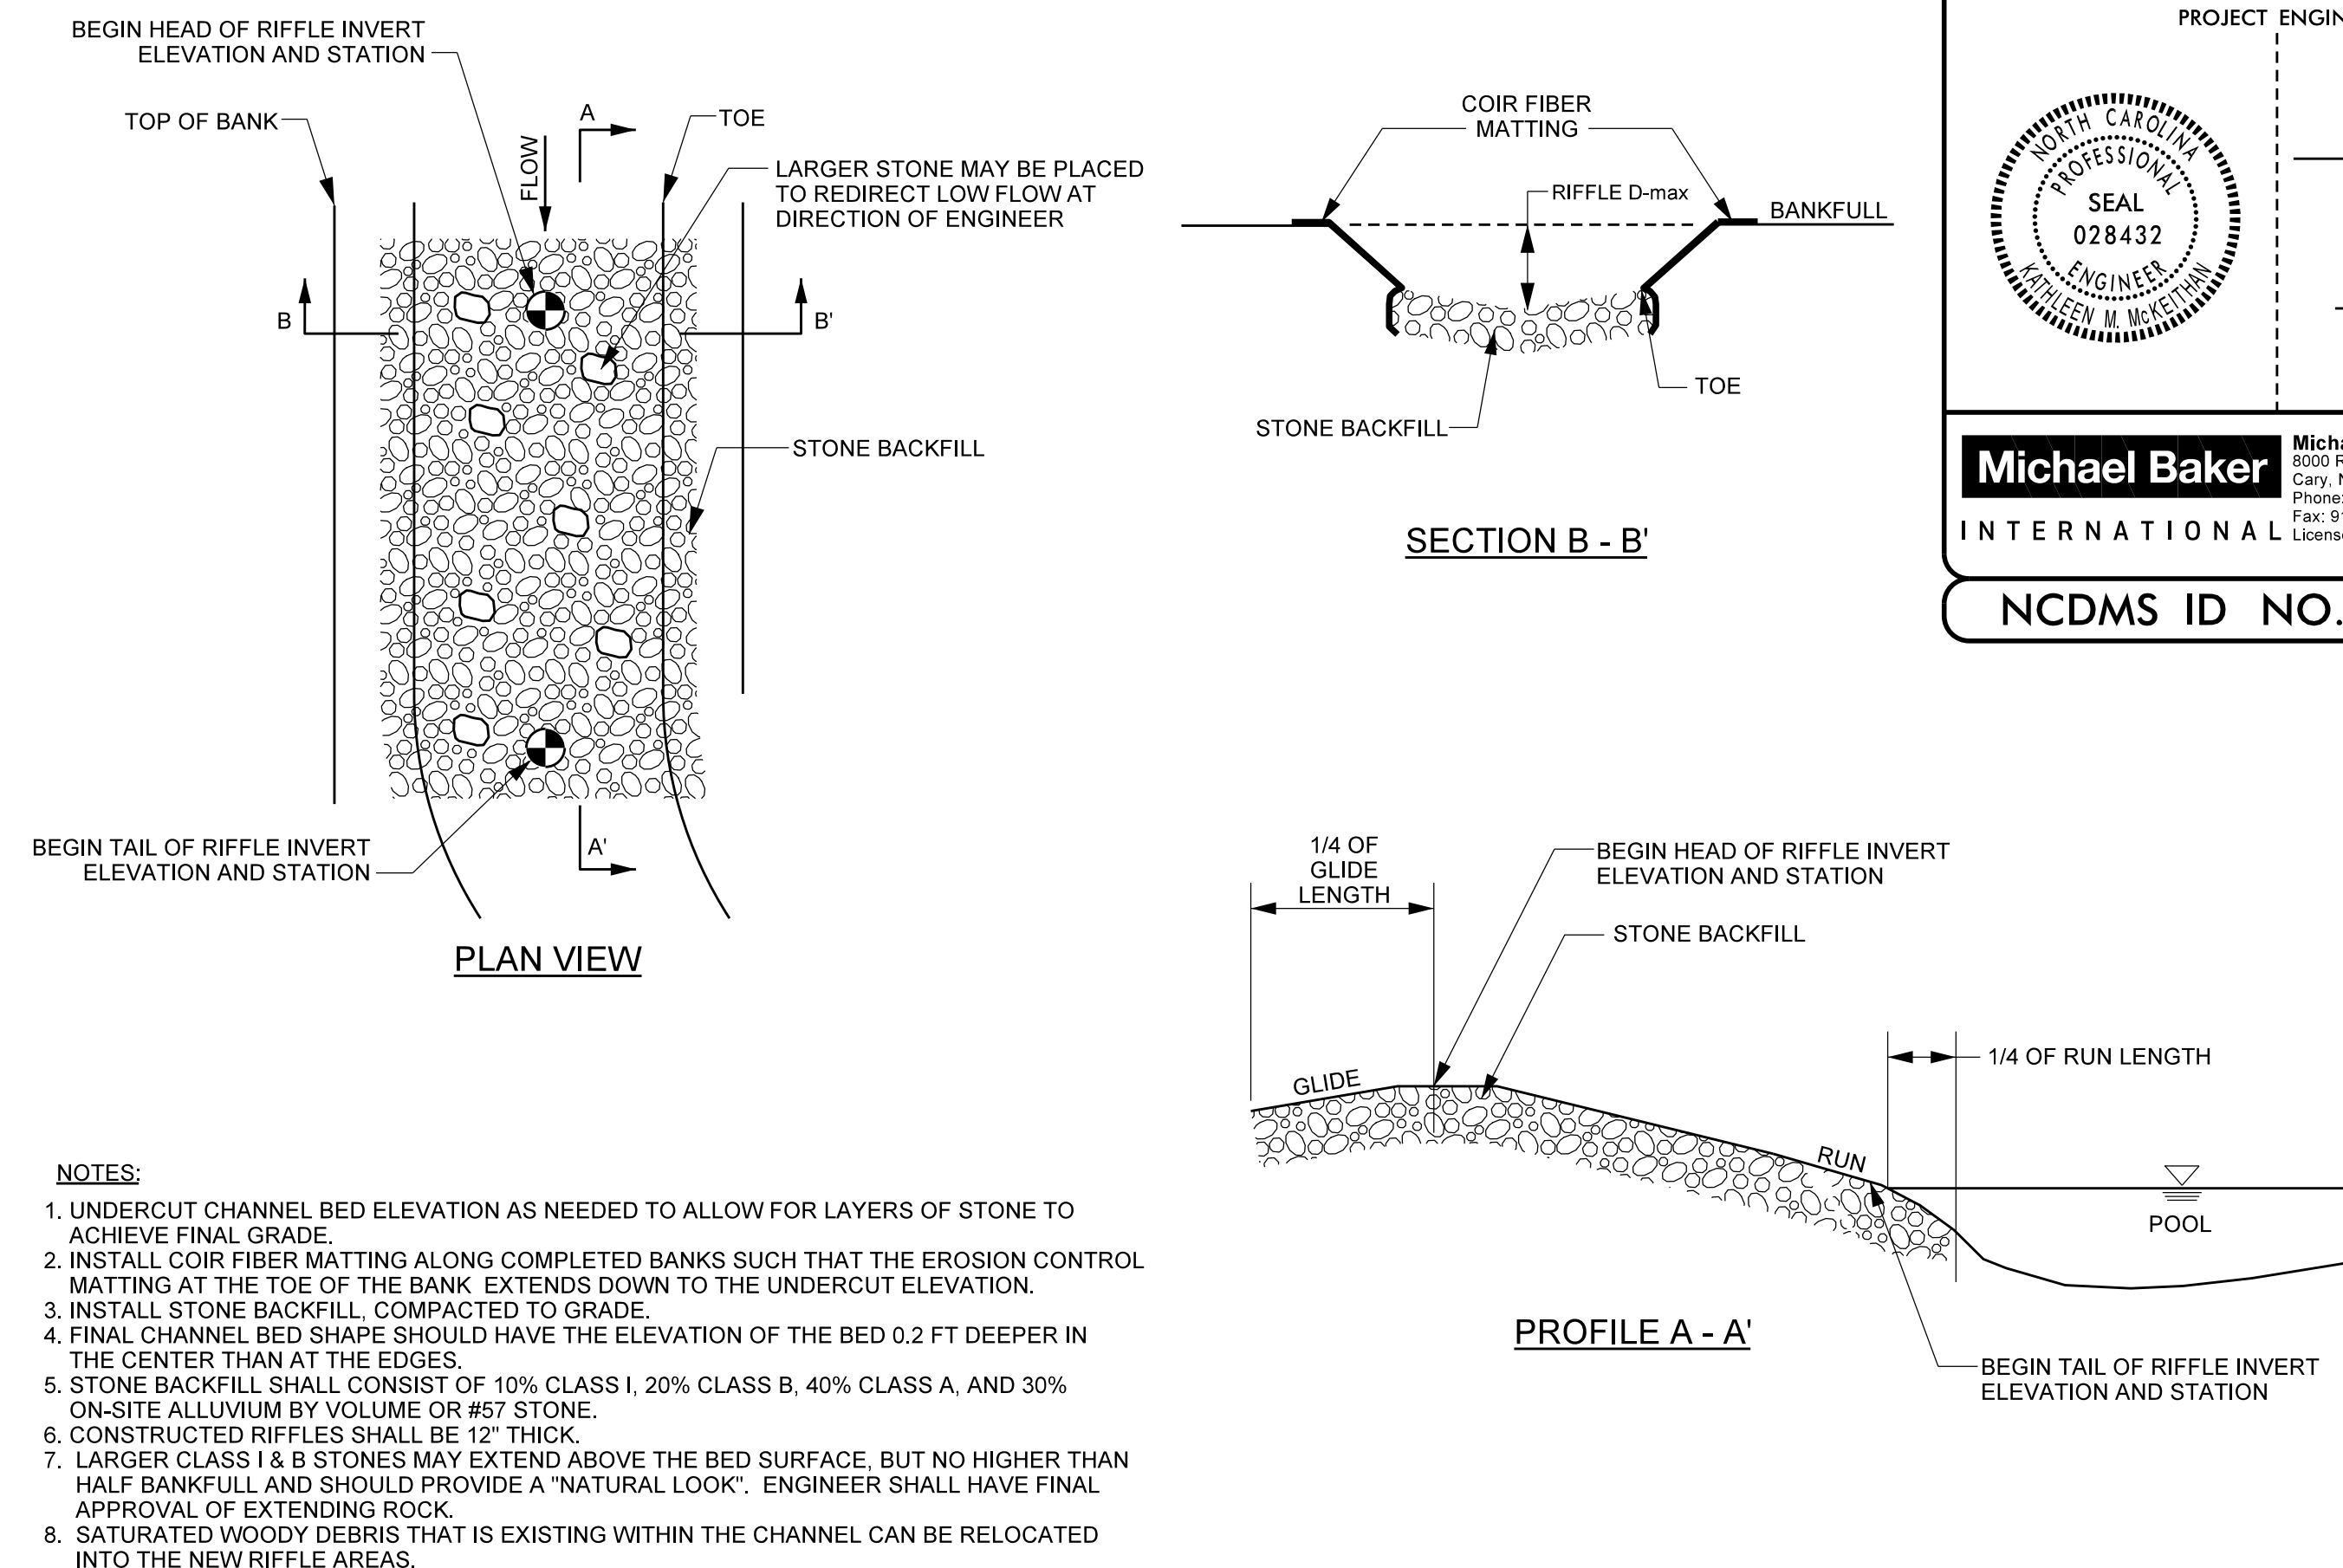

PLAN VIEW


SECTION B - B'

PROFILE A - A'

NOTES:

1. UNDERCUT CHANNEL BED ELEVATION AS NEEDED TO ALLOW FOR LAYERS OF STONE TO ACHIEVE FINAL GRADE.
2. INSTALL COIR FIBER MATTING ALONG COMPLETED BANKS SUCH THAT THE EROSION CONTROL MATTING AT THE TOE OF THE BANK EXTENDS DOWN TO THE UNDERCUT ELEVATION.
3. INSTALL STONE BACKFILL, COMPACTED TO GRADE.
4. FINAL CHANNEL BED SHAPE SHOULD HAVE THE ELEVATION OF THE BED 0.2 FT DEEPER IN THE CENTER THAN AT THE EDGES.
5. STONE BACKFILL SHALL CONSIST OF 10% CLASS I, 20% CLASS B, 40% CLASS A, AND 30% ON-SITE ALLUVIUM BY VOLUME OR #57 STONE.
6. CONSTRUCTED RIFFLES SHALL BE 12" THICK.
7. LARGER CLASS I & B STONES MAY EXTEND ABOVE THE BED SURFACE, BUT NO HIGHER THAN HALF BANKFULL AND SHOULD PROVIDE A "NATURAL LOOK". ENGINEER SHALL HAVE FINAL APPROVAL OF EXTENDING ROCK.
8. SATURATED WOODY DEBRIS THAT IS EXISTING WITHIN THE CHANNEL CAN BE RELOCATED INTO THE NEW RIFFLE AREAS.


CHANNEL PLUG

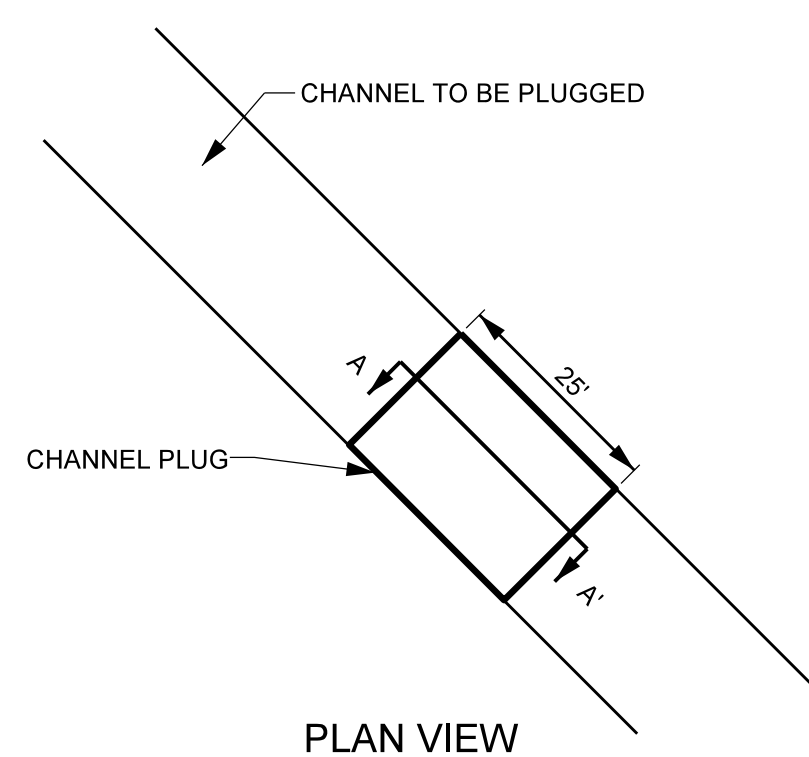

PLAN VIEW


NOTES:

1. COMPACT BACKFILL USING ON-SITE HEAVY EQUIPMENT IN 10 INCH LIFTS.
2. BACKFILL OF PLUGS SHOULD INCORPORATE ANY OF-SITE CLAY AVAILABLE.

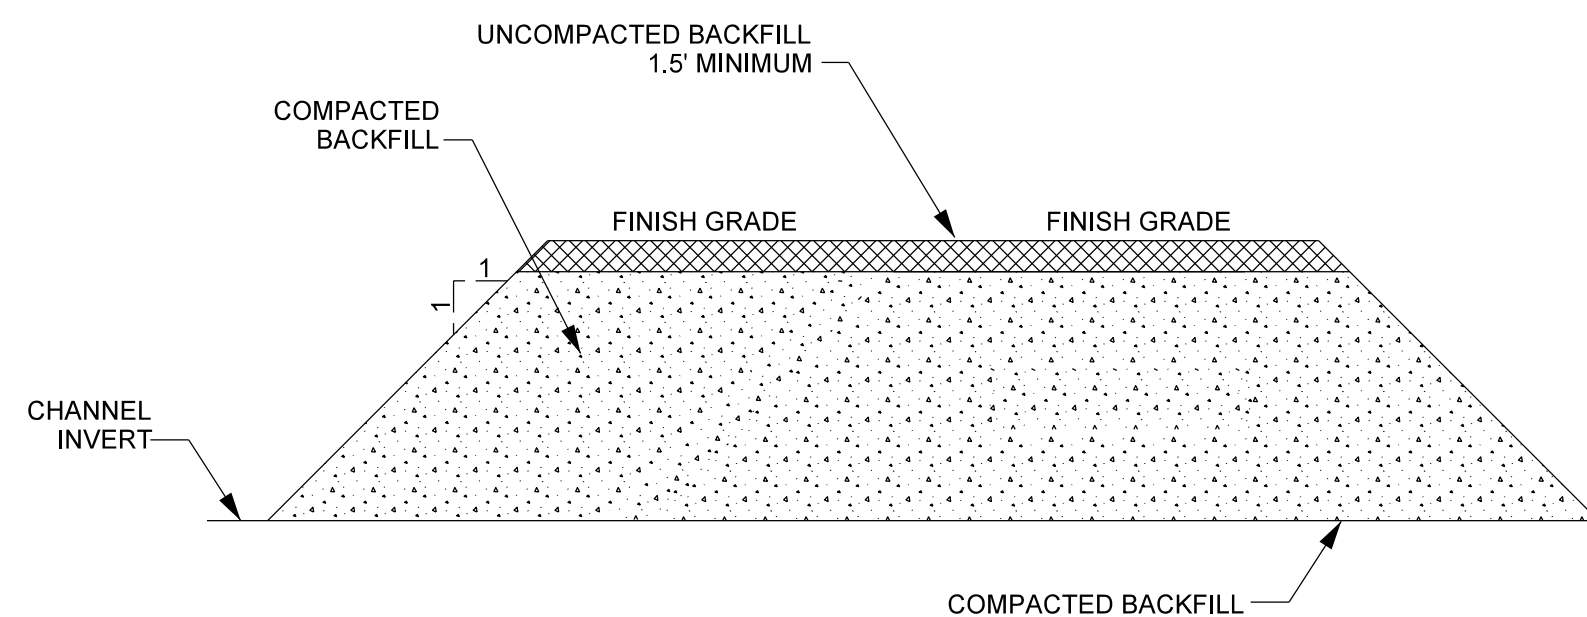


SECTION A - A'

LOG DROP

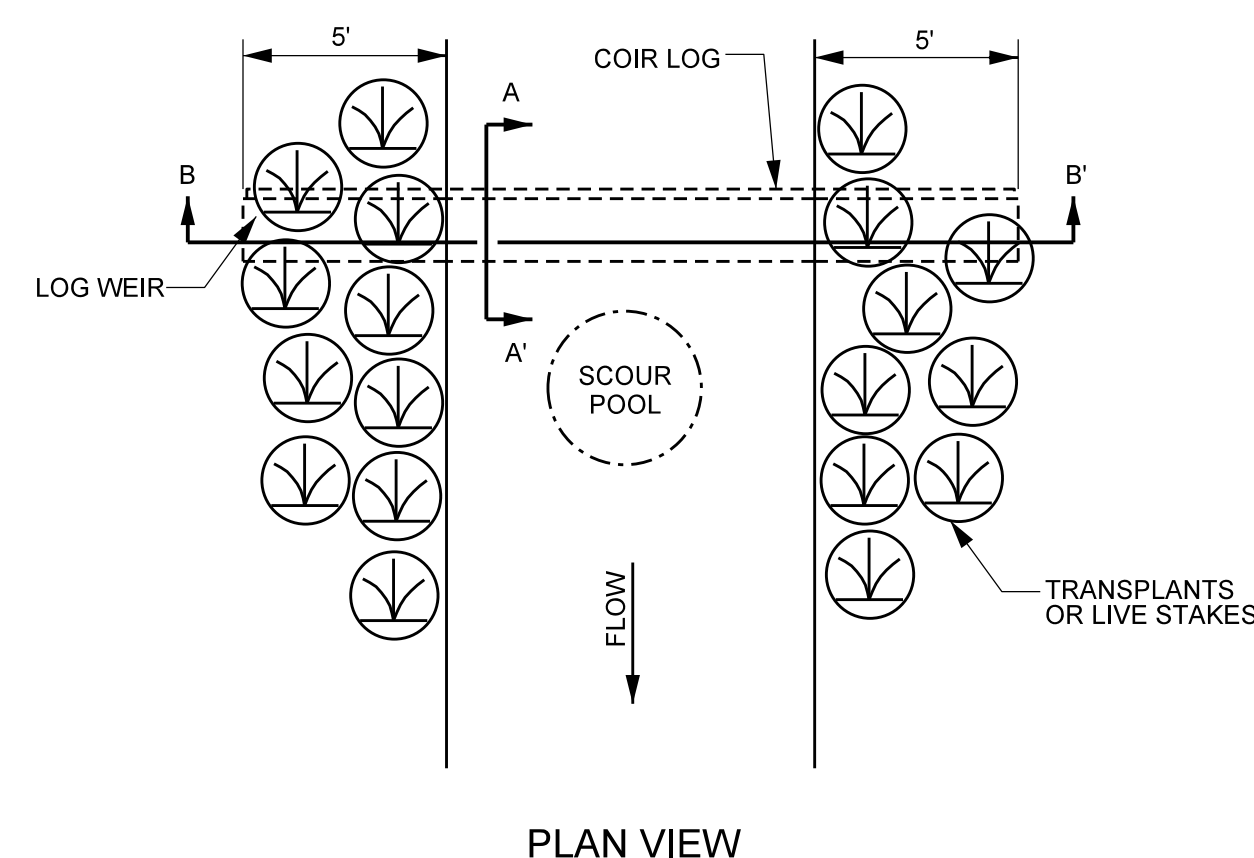


PLAN VIEW

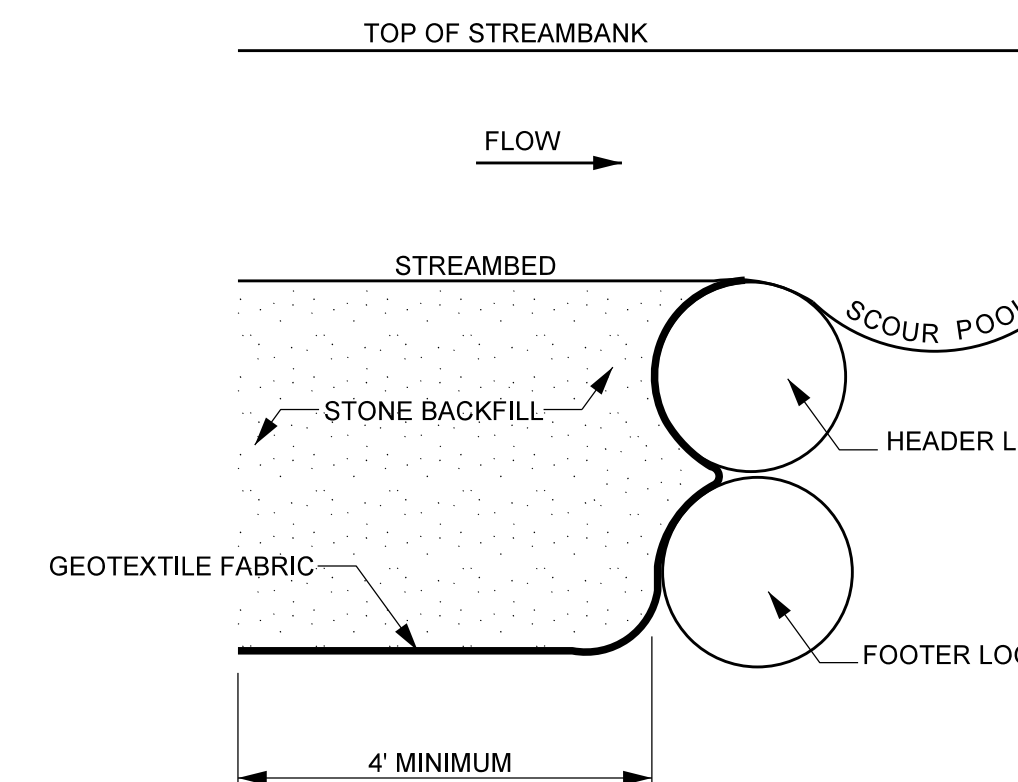

SECTION A - A'

NOTES:


1. LOGS SHOULD BE AT LEAST 10 INCHES IN DIAMETER, RELATIVELY STRAIGHT, HARDWOOD, AND RECENTLY HARVESTED.
2. TOP OF HEADER LOG SHOULD BE SET AT SAME ELEVATION AS THE STREAMBED.
3. USE GEOTEXTILE FABRIC WITH COIR LOGS TO SEAL GAPS BETWEEN LOGS.
4. PLACE TRANSPLANTS ALONG BANKS TO PROTECT AGAINST BANK EROSION.
5. THE HEADER LOG SHOULD BE NOTCHED 2 - 3 INCHES DEEP IN THE CENTER AND FOR 20 - 30% OF THE CHANNEL WIDTH.

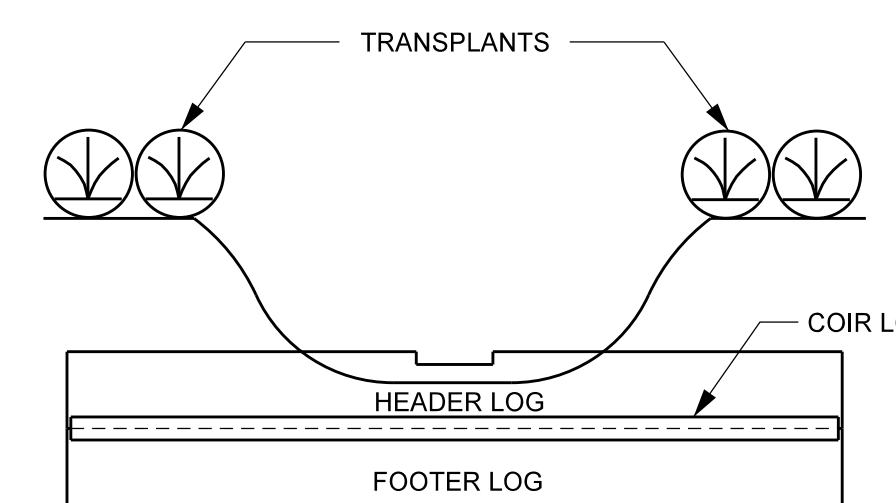

CROSS SECTION VIEW B - B'

PROJECT REFERENCE NO. 166680	SHEET NO. 2C
PROJECT ENGINEER	
APPROVED BY:	
DATE:	
Michael Baker International	
NCDMS ID NO. 100068	


PLUNGE POOL

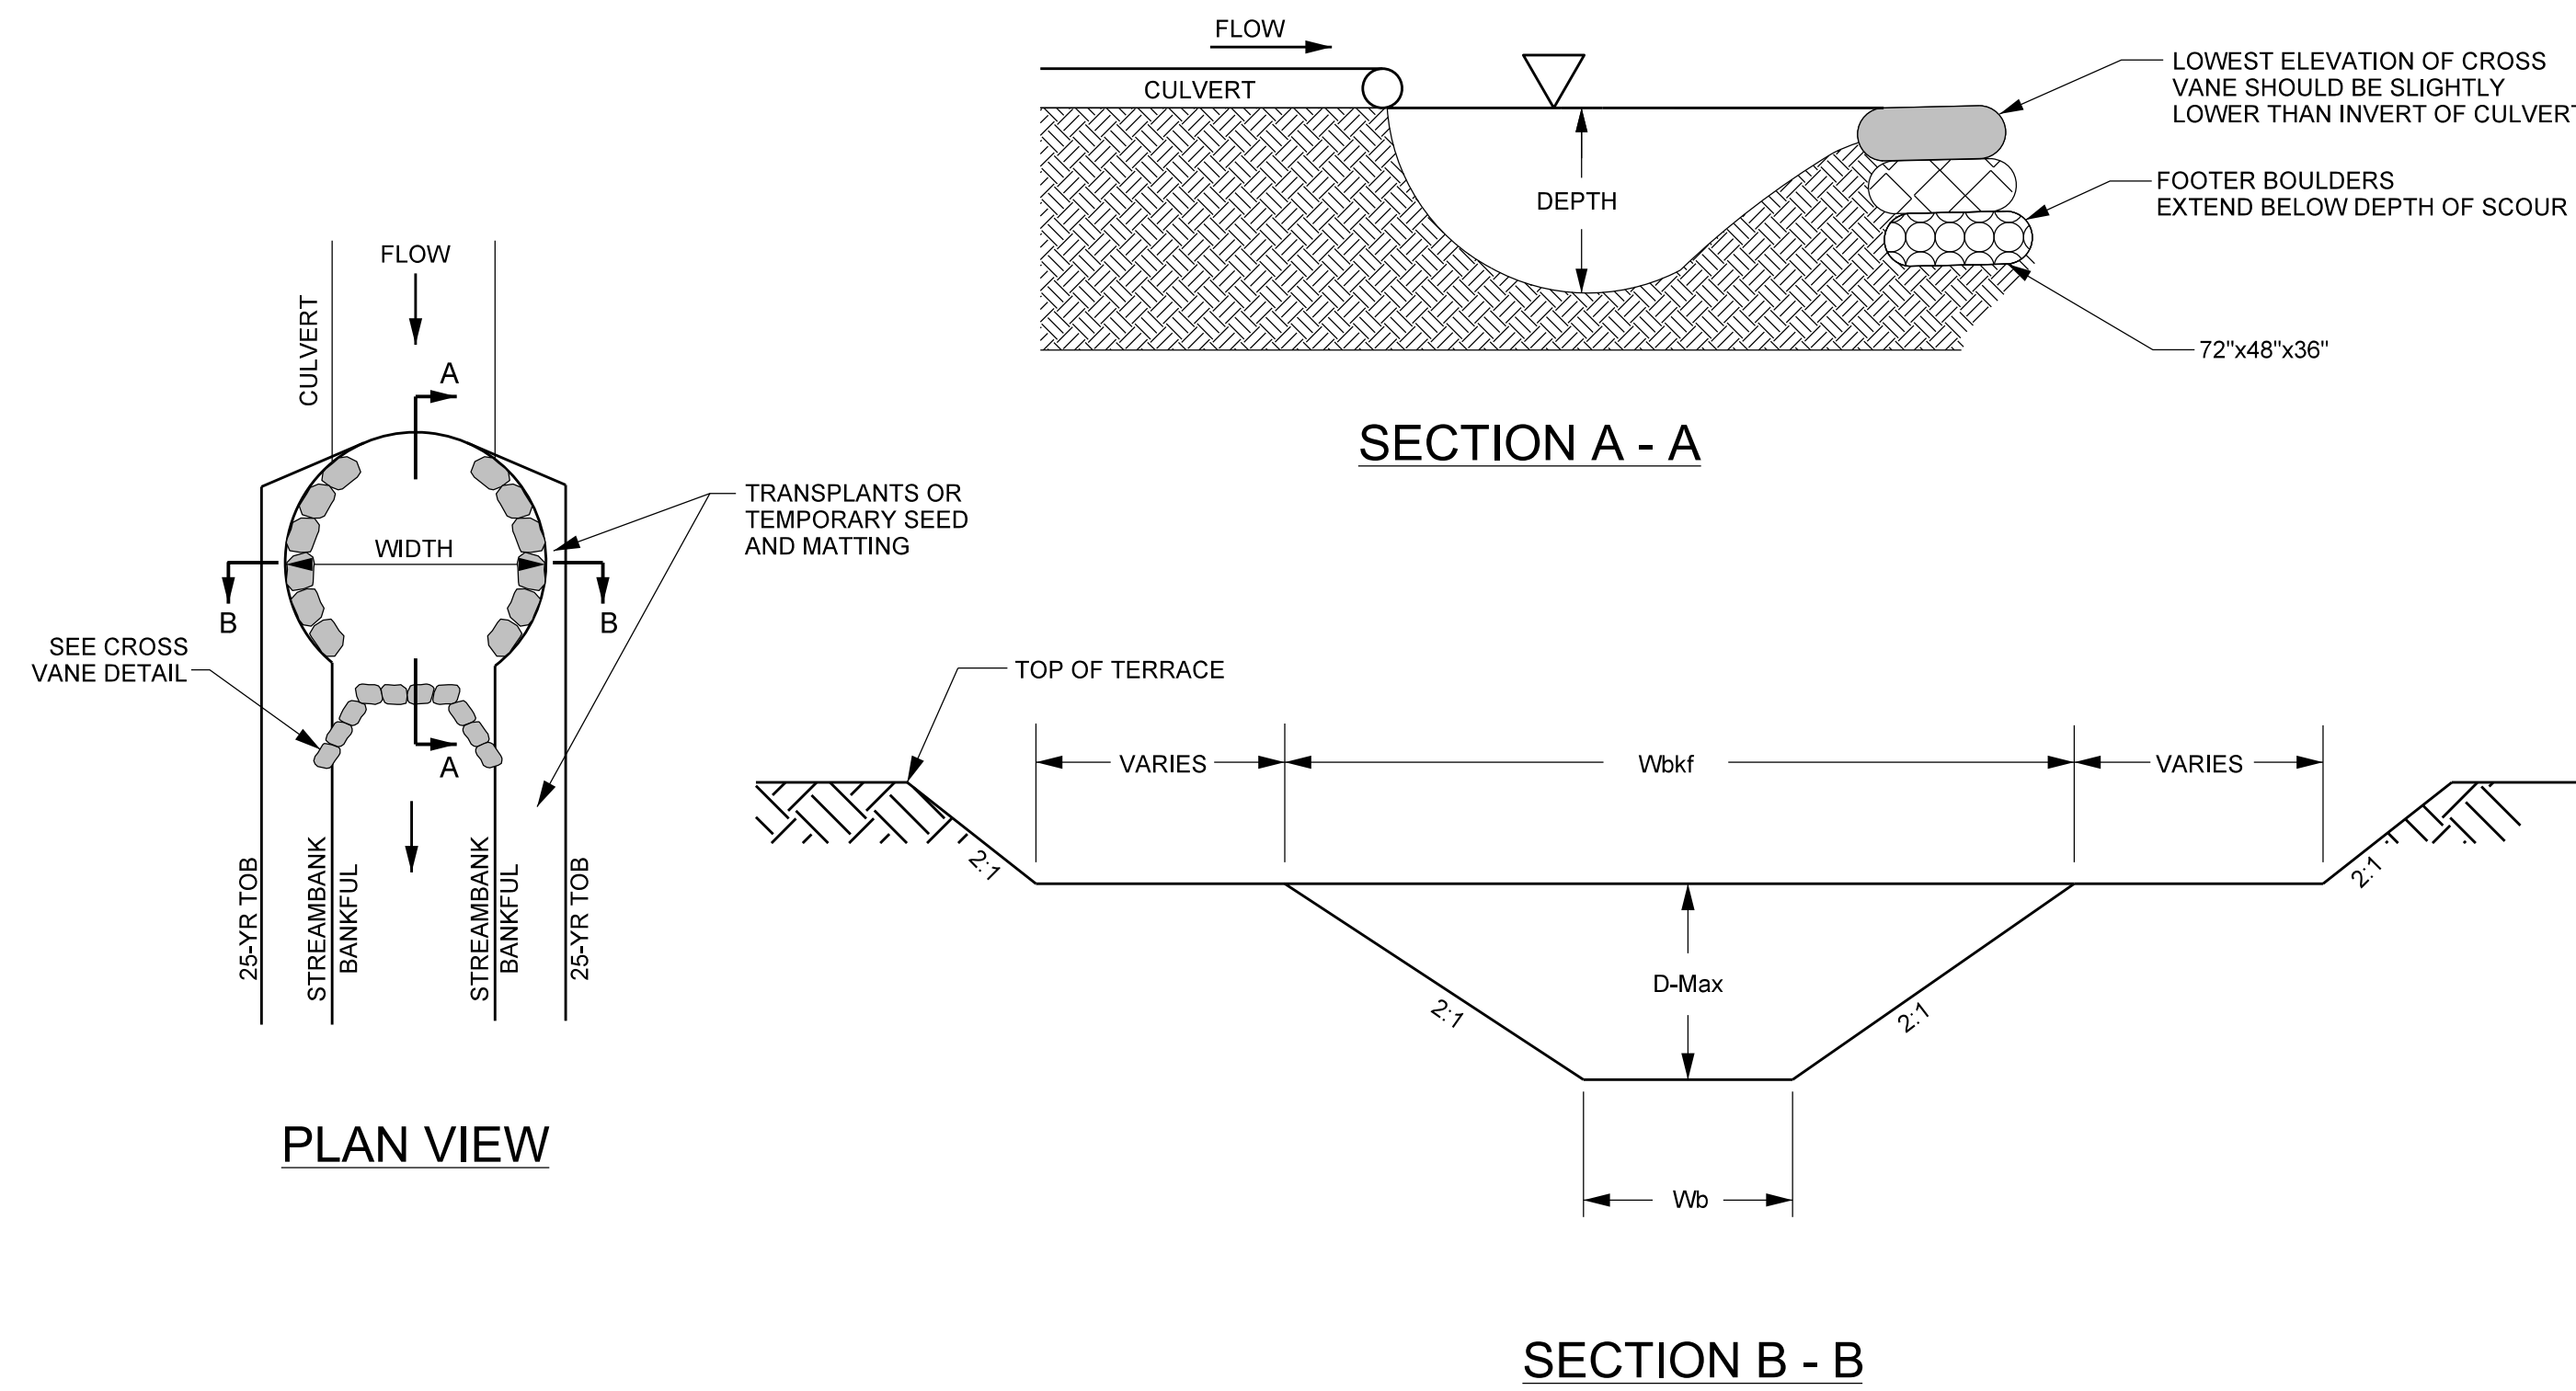


GEOLIFT WITH BRUSH TOE


NOTES:

1. LIVE BRANCH CUTTINGS SHALL BE THE SAME SPECIES AS THE LIVE STAKES AND SHALL BE INSTALLED DURING VEGETATION DORMANCY.
2. LIVE BRANCH CUTTINGS SHALL BE INSTALLED AT A DENSITY OF 20-30 CUTTINGS PER LINEAR FOOT AND A MAXIMUM DIAMETER OF 2.5 INCHES.
3. NUMBER OF SOIL LIFTS MAY VARY, IN GENERAL LIFTS SHALL EXTEND TO THE TOP OF BANK OR BANKFULL STAGE.

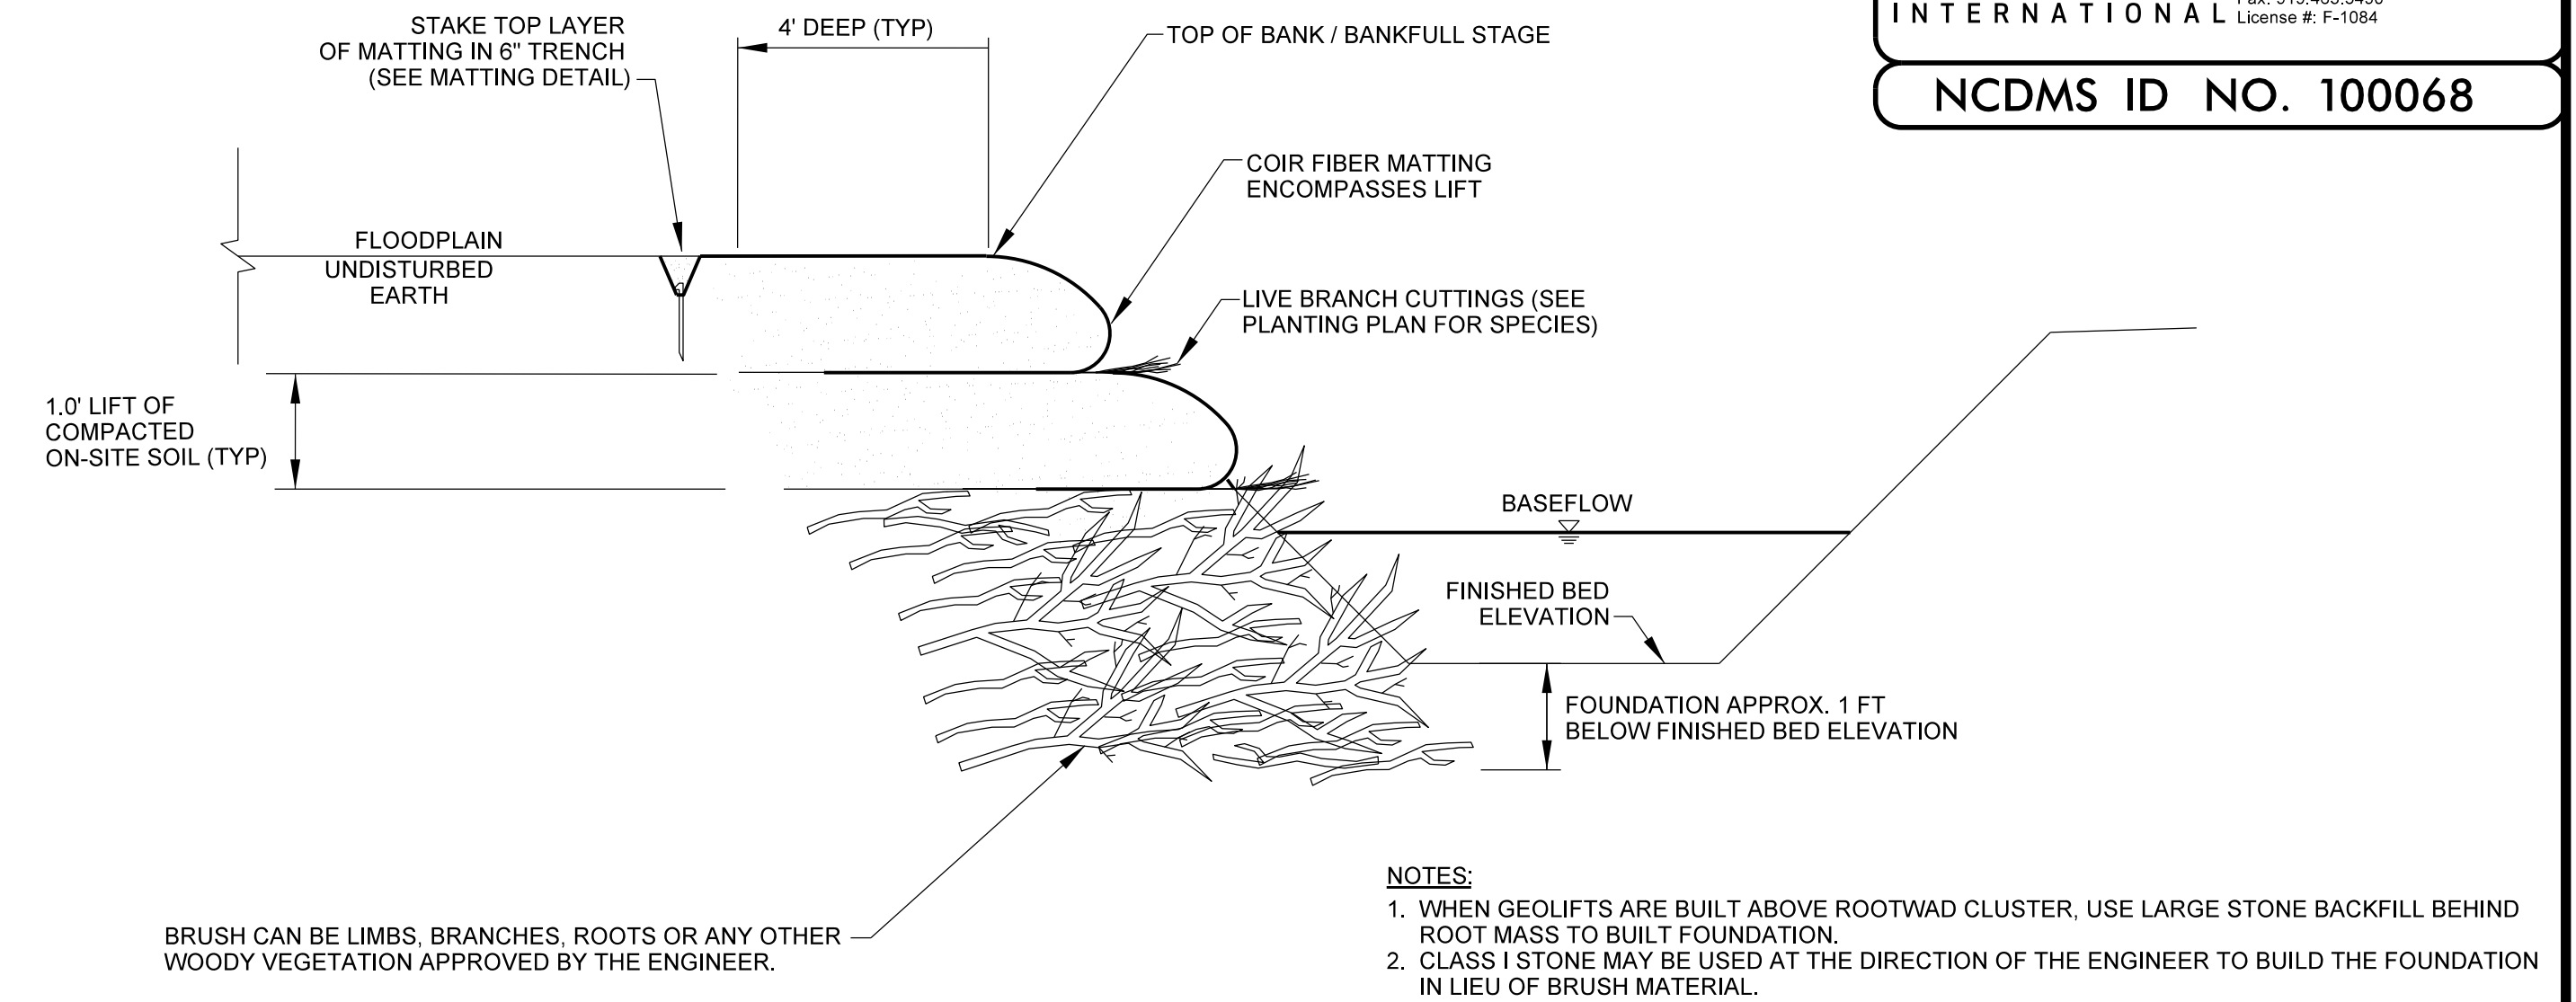

PROJECT REFERENCE NO. 166680	SHEET NO. 2D
PROJECT ENGINEER	
	
APPROVED BY:	
DATE:	
Michael Baker International	
NCDMS ID NO. 100068	


PERMANENT STREAM CROSSING

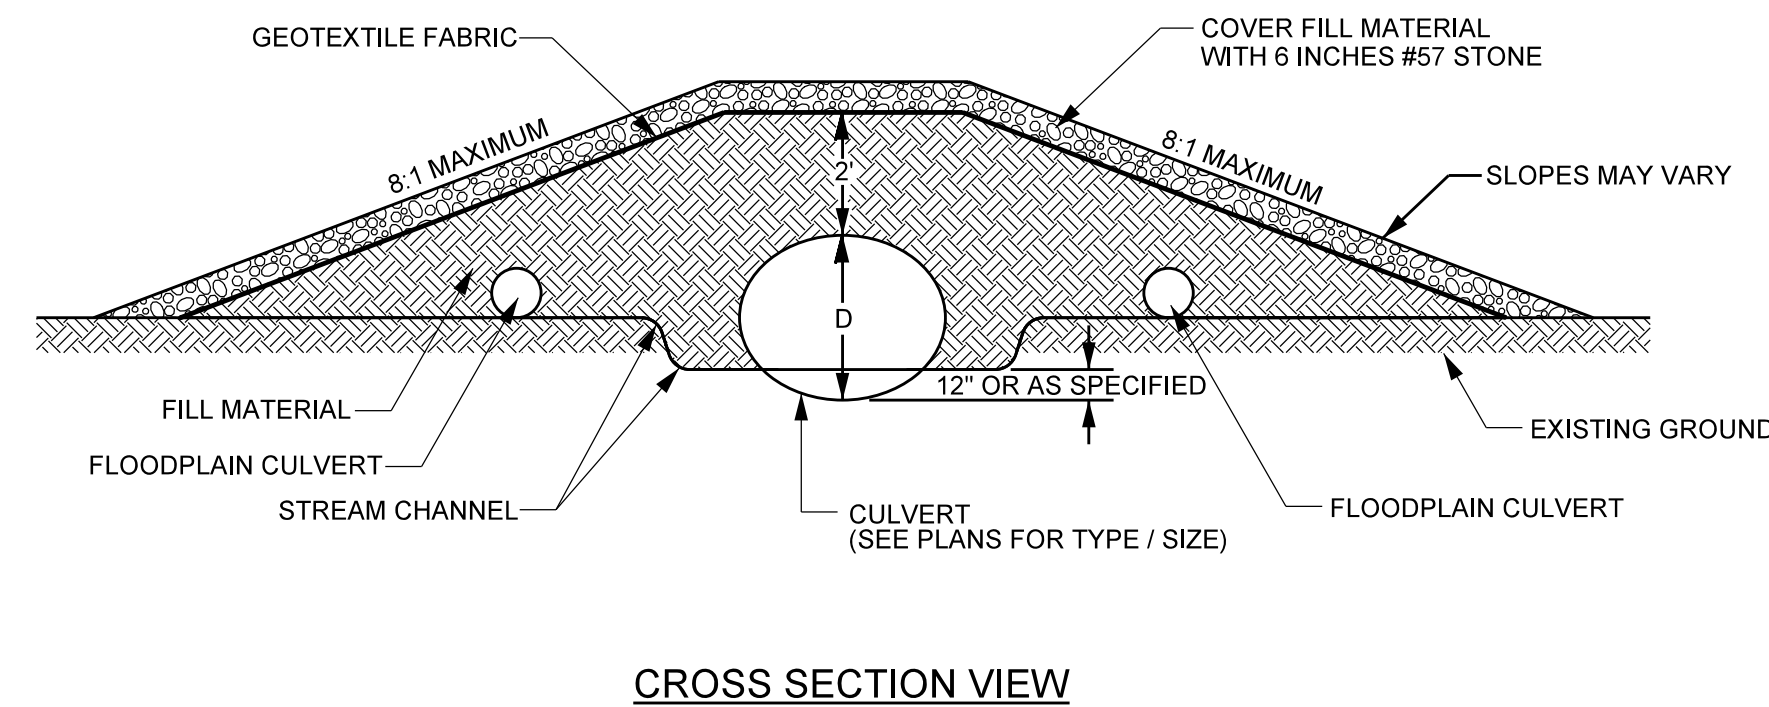

NOTES:

1. SIZE DIMENSIONS SHOWN ON PLANS.
2. APPLY SUFFICIENT FILL (2 MIN) OVER CULVERT TO PREVENT COLLAPSE.
3. STABILIZE SIDE SLOPES WITH EROSION CONTROL MATTING AND FILL AROUND CULVERTS WITH CLASS II STONE.
4. INSTALL HEADWALLS AND ENDWALLS AS SHOWN ON THE PLANS AND IN THE DETAILS.
5. PRIMARY CULVERT SHOULD BE INSTALLED 12" OR AS SPECIFIED BELOW CHANNEL ELEVATION.



BOULDER HEADWALL / ENDWALL

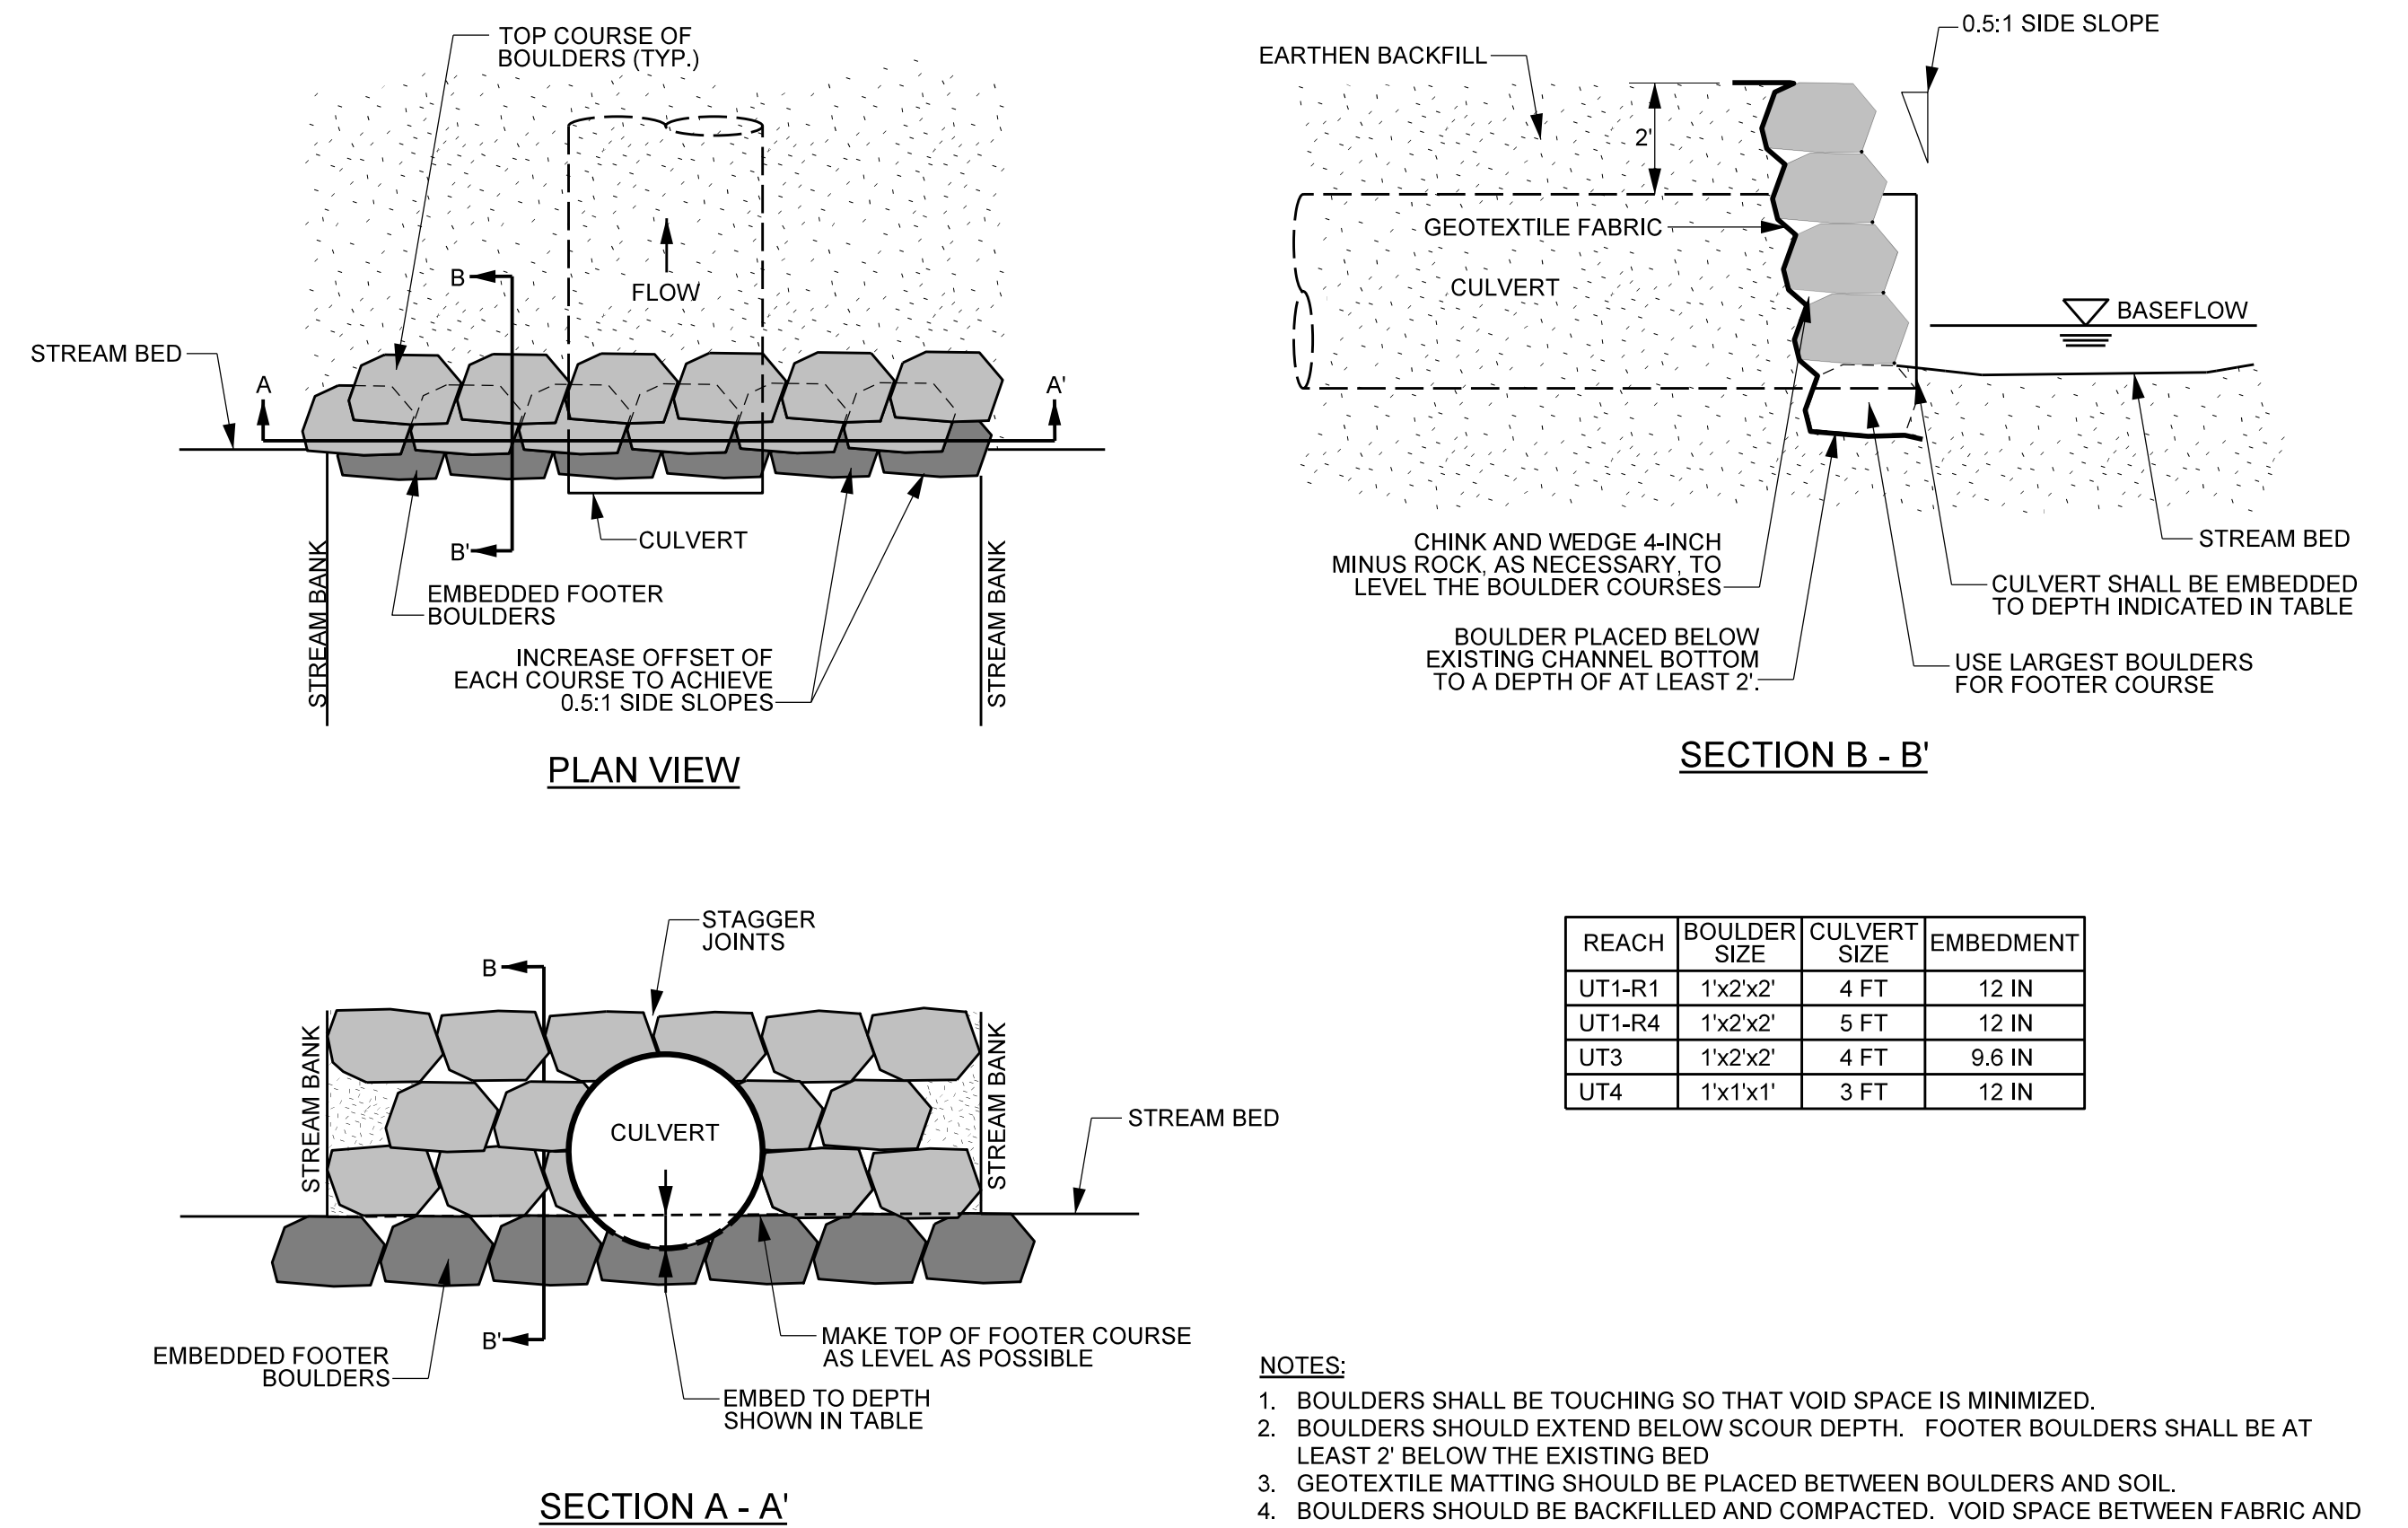

NOTES:



1. BOULDERS SHALL BE TOUCHING SO THAT VOID SPACE IS MINIMIZED.
2. BOULDERS SHOULD EXTEND BELOW SCOUR DEPTH. FOOTER BOULDERS SHALL BE AT LEAST 2' BELOW THE EXISTING BED.
3. GEOTEXTILE MATTING SHOULD BE PLACED BETWEEN BOULDERS AND SOIL.
4. BOULDERS SHOULD BE BACKFILLED AND COMPACTED. VOID SPACE BETWEEN FABRIC AND BOULDER OR ROCK FILL MATERIAL, SHOULD BE MINIMIZED.
5. BOULDERS SHOULD NOT BE HIGHER THAN THE TOP OF CROSSING ELEVATION.
6. FILTER FABRIC SHOULD BE PLACED BEHIND BOULDERS, BURIED BELOW BOULDER DEPTH, AND EXTEND INTO THE BANK.

LIVE STAKING

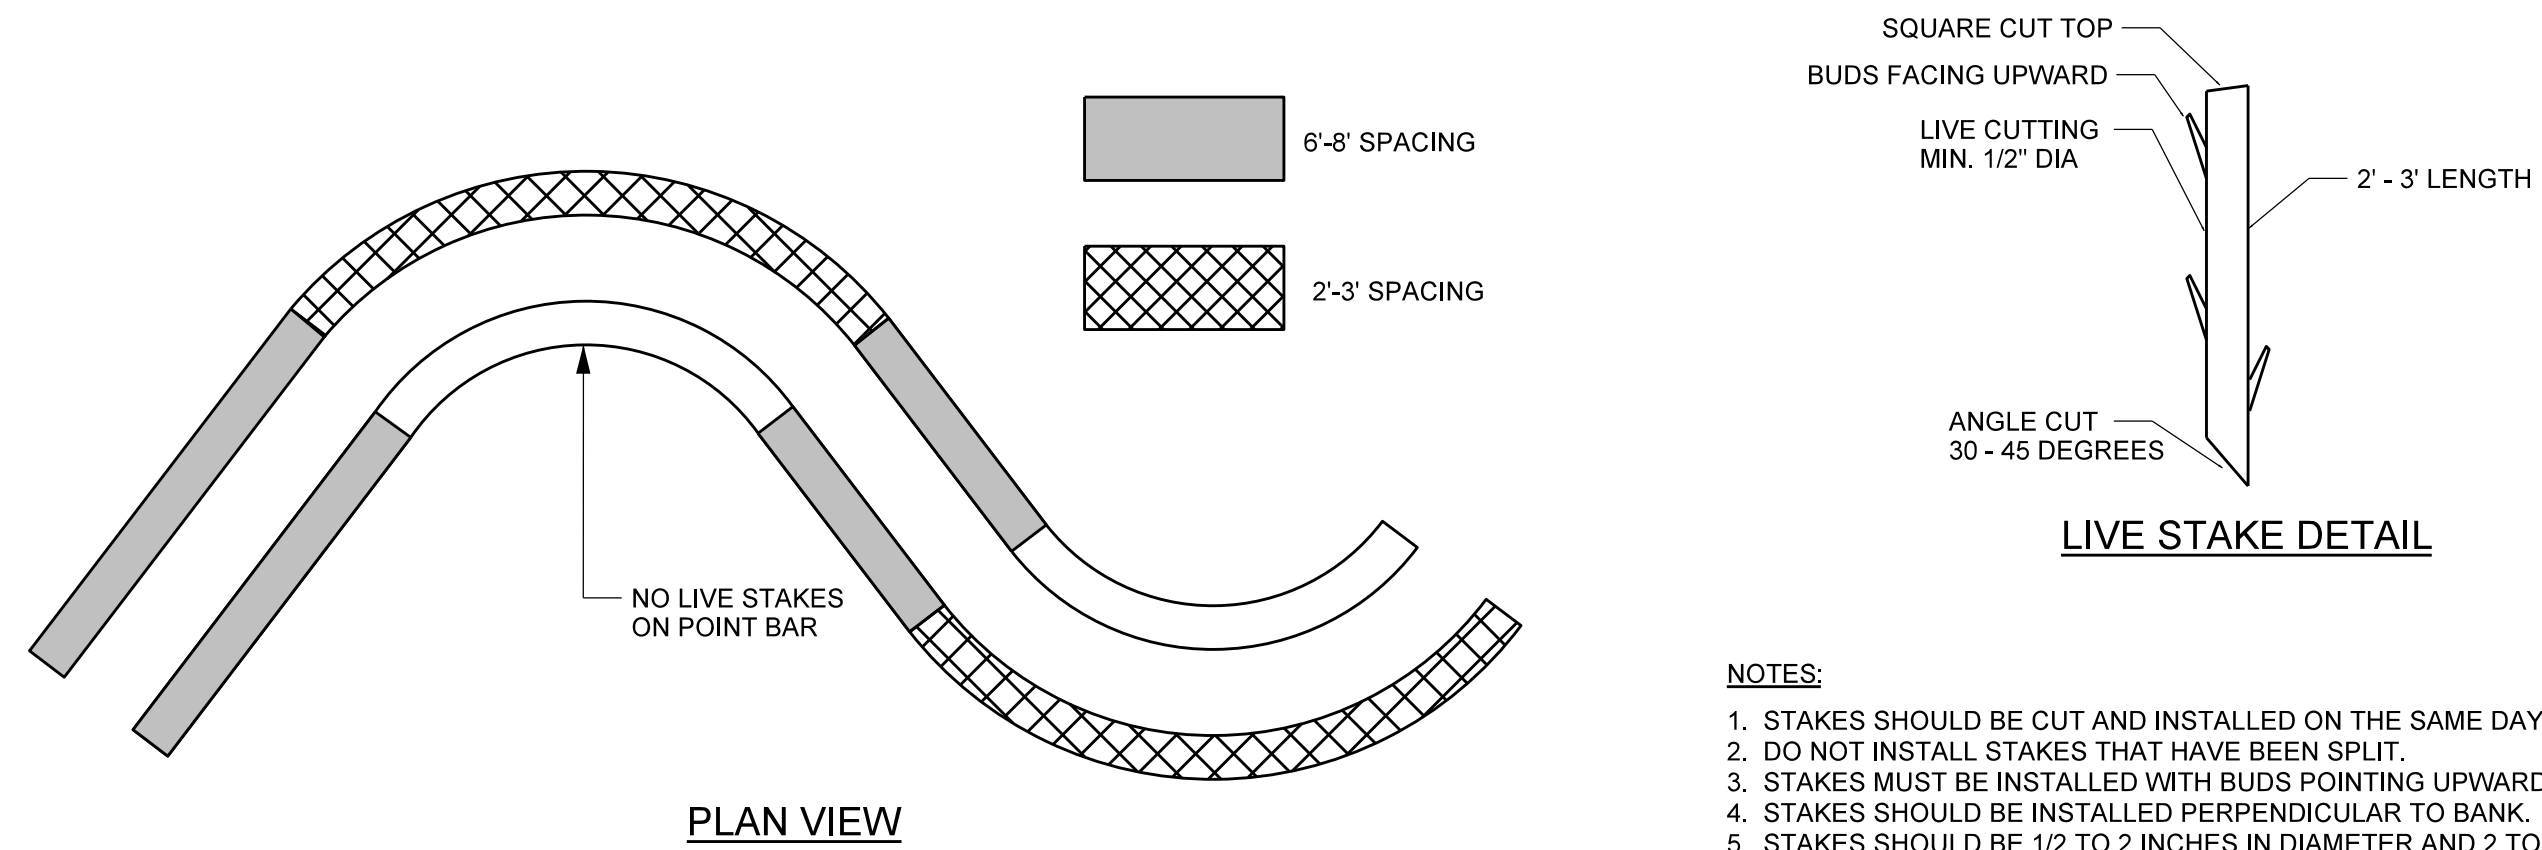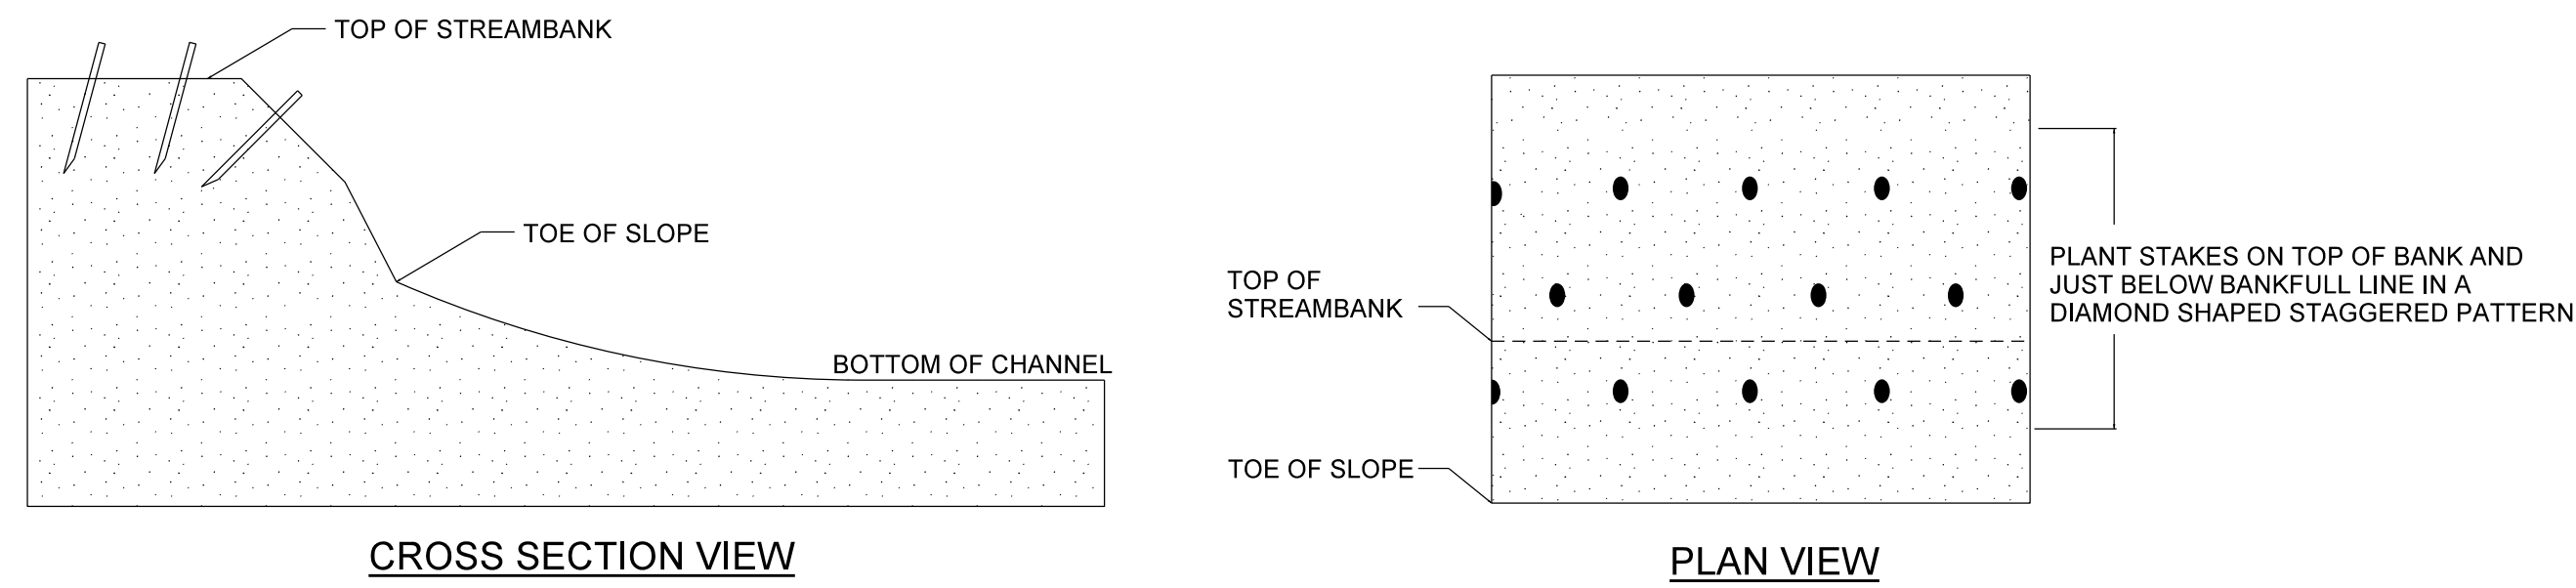


- NOTES:**
1. STAKES SHOULD BE CUT AND INSTALLED ON THE SAME DAY.
 2. DO NOT INSTALL STAKES THAT HAVE BEEN SPLIT.
 3. STAKES MUST BE INSTALLED WITH BUDS POINTING UPWARDS.
 4. STAKES SHOULD BE INSTALLED PERPENDICULAR TO BANK.
 5. STAKES SHOULD BE 1/2 TO 2 INCHES IN DIAMETER AND 2 TO 3 FT LONG.
 6. STAKES SHOULD BE INSTALLED LEAVING 1/5 OF STAKE ABOVE GROUND.

TRANSPLANTED VEGETATION

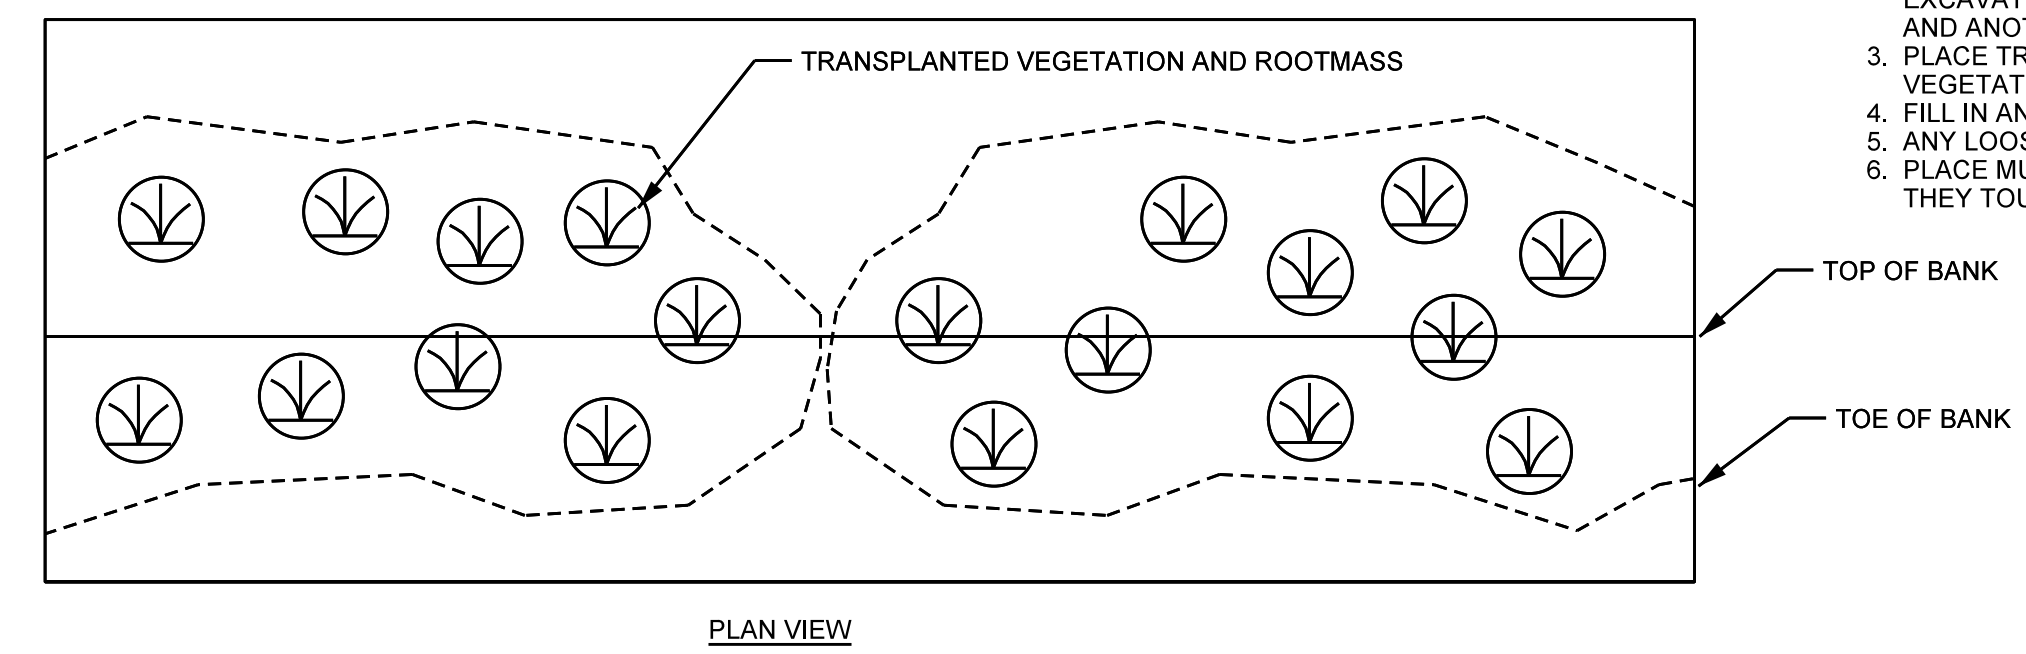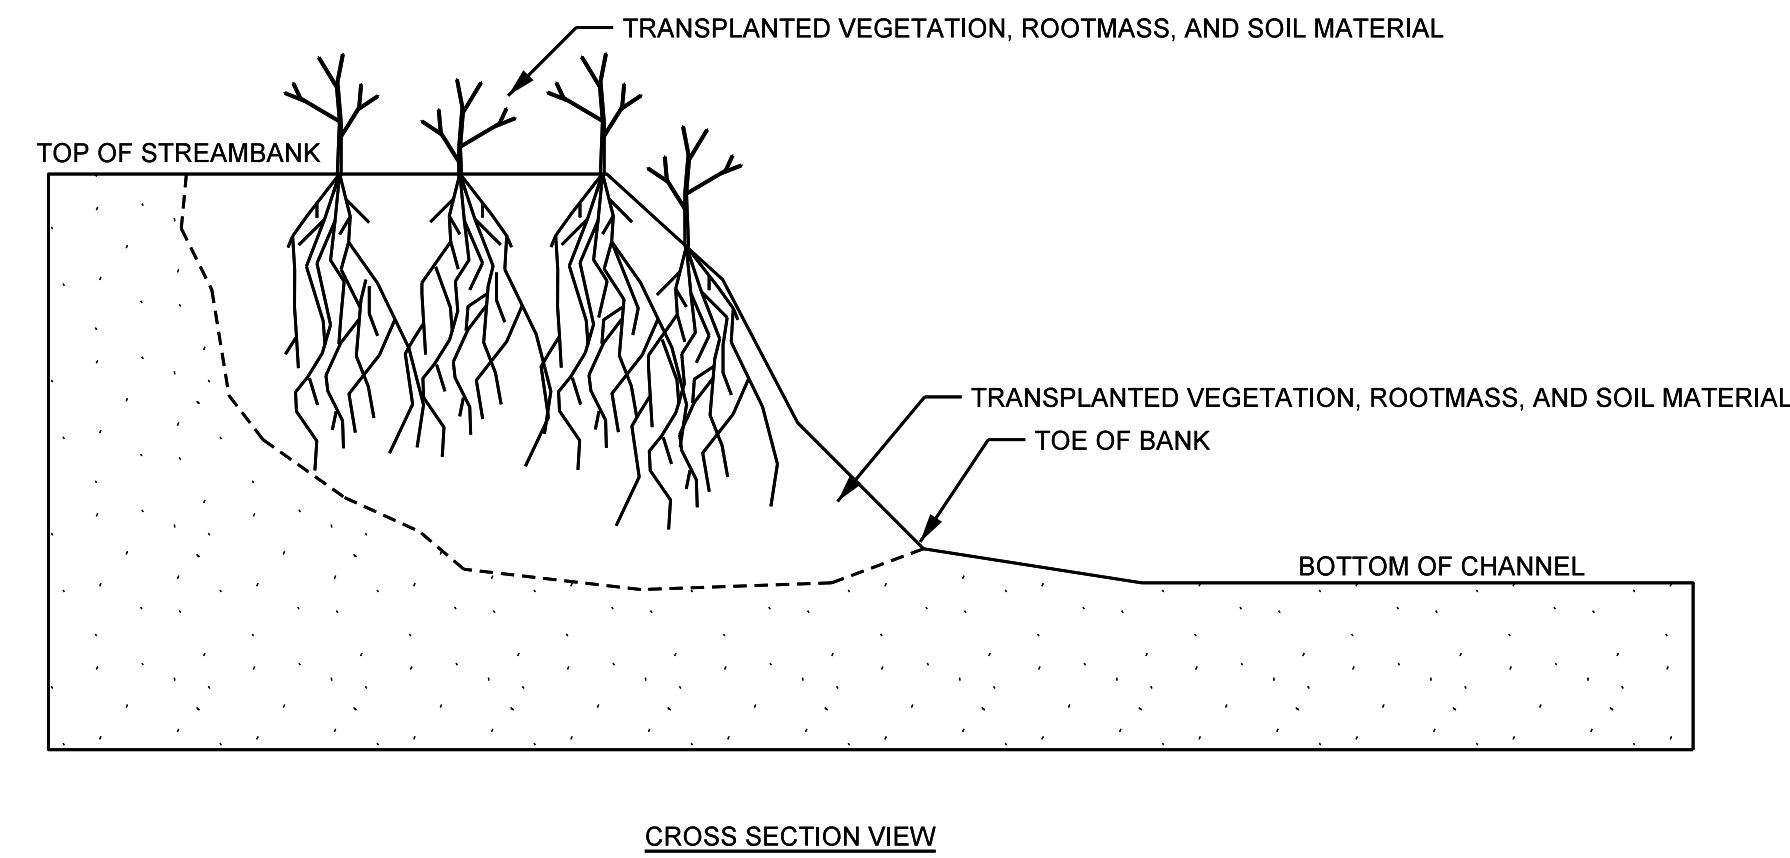


- NOTES:**
1. EXCAVATE A HOLE IN THE BANK TO BE STABILIZED THAT WILL ACCOMMODATE THE SIZE OF TRANSPLANT TO BE PLACED. BEGIN EXCAVATION AT THE TOE OF THE BANK.
 2. EXCAVATE TRANSPLANT USING A FRONT END LOADER. EXCAVATE THE ENTIRE ROOT MASS AND AS MUCH ADDITIONAL SOIL MATERIAL AS POSSIBLE. IF ENTIRE ROOT MASS CAN NOT BE EXCAVATED IN ONE BUCKET LOAD, THE TRANSPLANT IS TOO LARGE AND ANOTHER SHOULD BE SELECTED.
 3. PLACE TRANSPLANT IN THE BANK TO BE STABILIZED SO THAT VEGETATION IS ORIENTATED VERTICALLY.
 4. FILL IN ANY HOLES AROUND THE TRANSPLANT AND COMPACT.
 5. ANY LOOSE SOIL LEFT IN THE STREAM SHOULD BE REMOVED.
 6. PLACE MULTIPLE TRANSPLANTS CLOSE TOGETHER SUCH THAT THEY TOUCH.

PLANTING SPECIFICATIONS

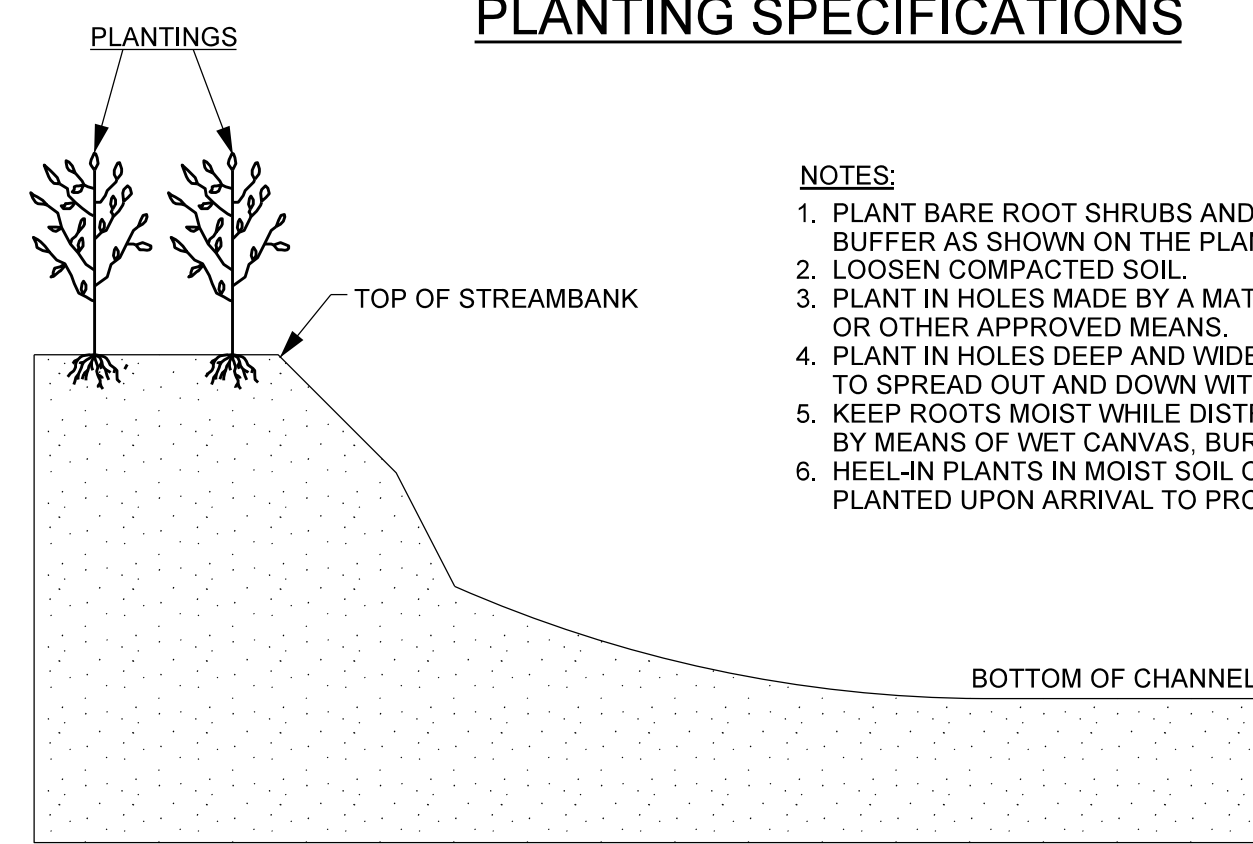


- NOTES:**
1. PLANT BARE ROOT SHRUBS AND TREES TO THE WIDTH OF THE BUFFER AS SHOWN ON THE PLANS.
 2. LOOSEN COMPACTED SOIL.
 3. PLANT IN HOLES MADE BY A MATTOCK, DIBBLE, PLANTING BAR, OR OTHER APPROVED MEANS.
 4. PLANT IN HOLES DEEP AND WIDE ENOUGH TO ALLOW THE ROOTS TO SPREAD OUT AND DOWN WITHOUT J-ROOTING.
 5. KEEP ROOTS MOIST WHILE DISTRIBUTING OR WAITING TO PLANT BY MEANS OF WET CANVAS, BURLAP, OR STRAW.
 6. HEEL-IN PLANTS IN MOIST SOIL OR SAWDUST IF NOT PROMPTLY PLANTED UPON ARRIVAL TO PROJECT SITE.

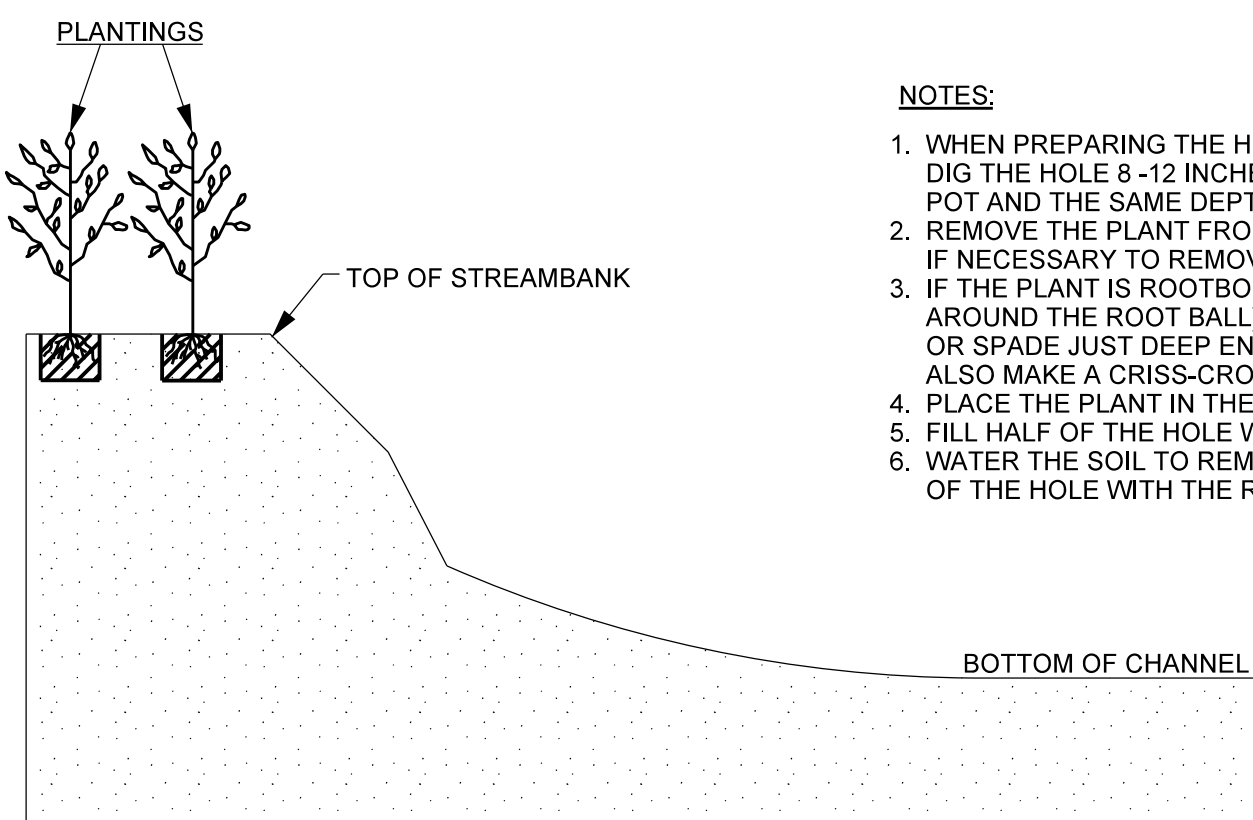


- NOTES:**
1. WHEN PREPARING THE HOLE FOR A POTTED PLANT OR SHRUB DIG THE HOLE 8 - 12 INCHES LARGER THAN THE DIAMETER OF THE POT AND THE SAME DEPTH AS THE POT.
 2. REMOVE THE PLANT FROM THE POT. LAY THE PLANT ON ITS SIDE IF NECESSARY TO REMOVE THE POT.
 3. IF THE PLANT IS ROOTBOUND (ROOTS GROWING IN A SPIRAL AROUND THE ROOT BALL), MAKE VERTICAL CUTS WITH A KNIFE OR SPADE JUST DEEP ENOUGH TO CUT THE NET OF ROOTS. ALSO MAKE A CRISS-CROSS CUT ACROSS THE BOTTOM OF THE BALL.
 4. PLACE THE PLANT IN THE HOLE.
 5. FILL HALF OF THE HOLE WITH SOIL (SAME SOIL REMOVED FOR BACKFILL).
 6. WATER THE SOIL TO REMOVE AIR POCKETS AND FILL THE REST OF THE HOLE WITH THE REMAINING SOIL.


COIR FIBER MATTING

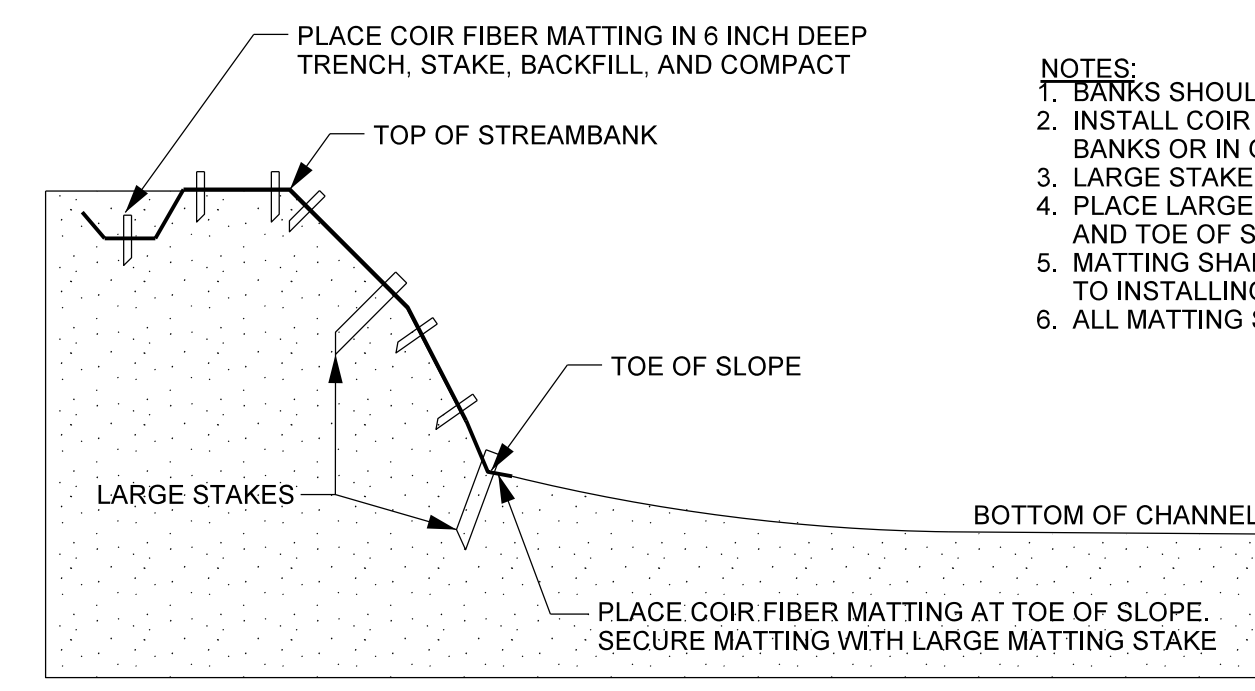

- NOTES:**
1. BANKS SHOULD BE SEEDED PRIOR TO PLACEMENT OF MATTING.
 2. INSTALL COIR FIBER MATTING PER SPECIFICATIONS ALONG STREAM BANKS OR IN OTHERS LOCATIONS SPECIFIED BY ENGINEER.
 3. LARGE STAKES SHOULD NOT BE SPACED FURTHER THAN 36" APART.
 4. PLACE LARGE STAKES ALONG ALL SEAMS, IN THE CENTER OF BANK, AND TOE OF SLOPE.
 5. MATTING SHALL BE PLACED ON BANKS, STAKED, AND TRENCHED PRIOR TO INSTALLING CONSTRUCTED RIFFLE MATERIAL.
 6. ALL MATTING STAKES MUST BE 100% BIODEGRADABLE.

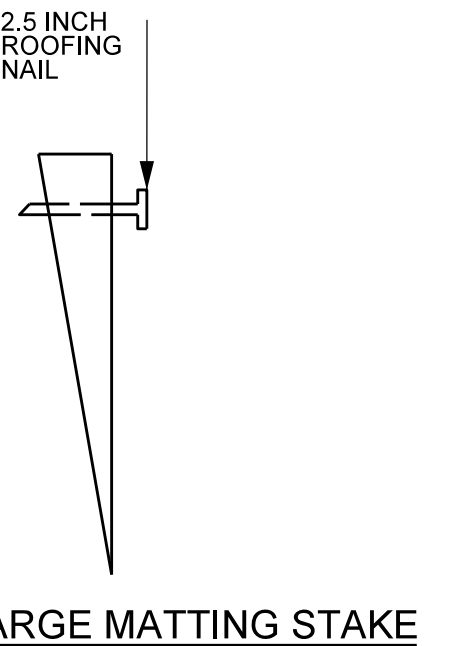


LEG LENGTH	17.00 IN (43.18 CM) (TAPERED TO POINT)
WIDTH	1.5 IN (3.81 CM)
THICKNESS	1.5 IN (3.81 CM)

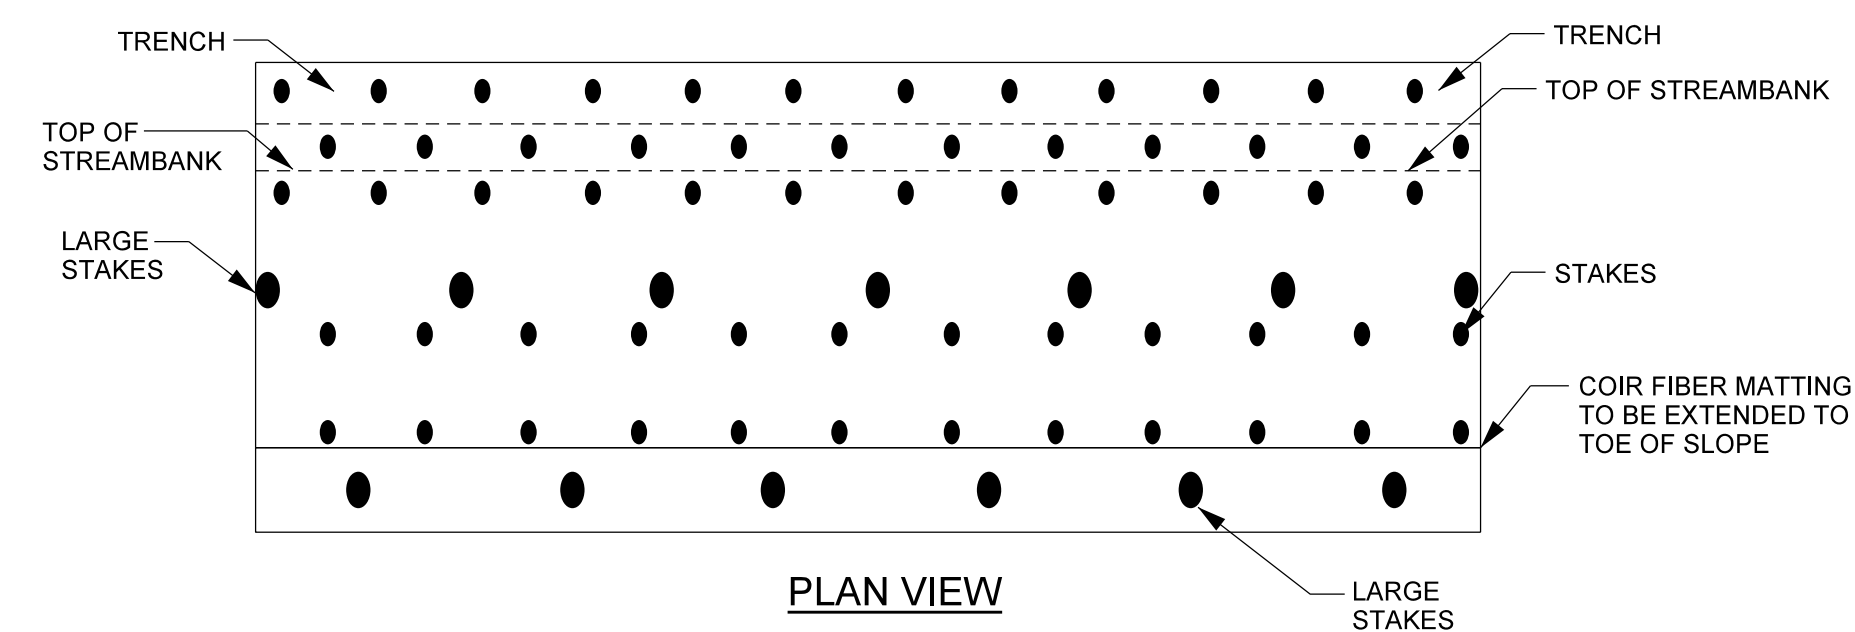

LEG LENGTH	11.00 IN (27.94 CM)
HEAD WIDTH	1.25 IN (3.18 CM)
HEAD THICKNESS	0.40 IN (1.02 CM)
LEG WIDTH	0.60 IN (1.52 CM) (TAPERED TO POINT)
LEG THICKNESS	0.40 IN (1.02 CM)
TOTAL LENGTH	12.00 IN (30.48 CM)

PROJECT REFERENCE NO. 166680	SHEET NO. 2E
PROJECT ENGINEER	
APPROVED BY:	
DATE:	
Michael Baker International <small>8000 Regency Parkway, Suite 600 Cary, NORTH CAROLINA 27518 Phone: 919.463.5486 Fax: 919.463.5490 License #: F-1084</small>	
NCDMS ID NO. 100068	


BARB WIRE FIELD FENCE

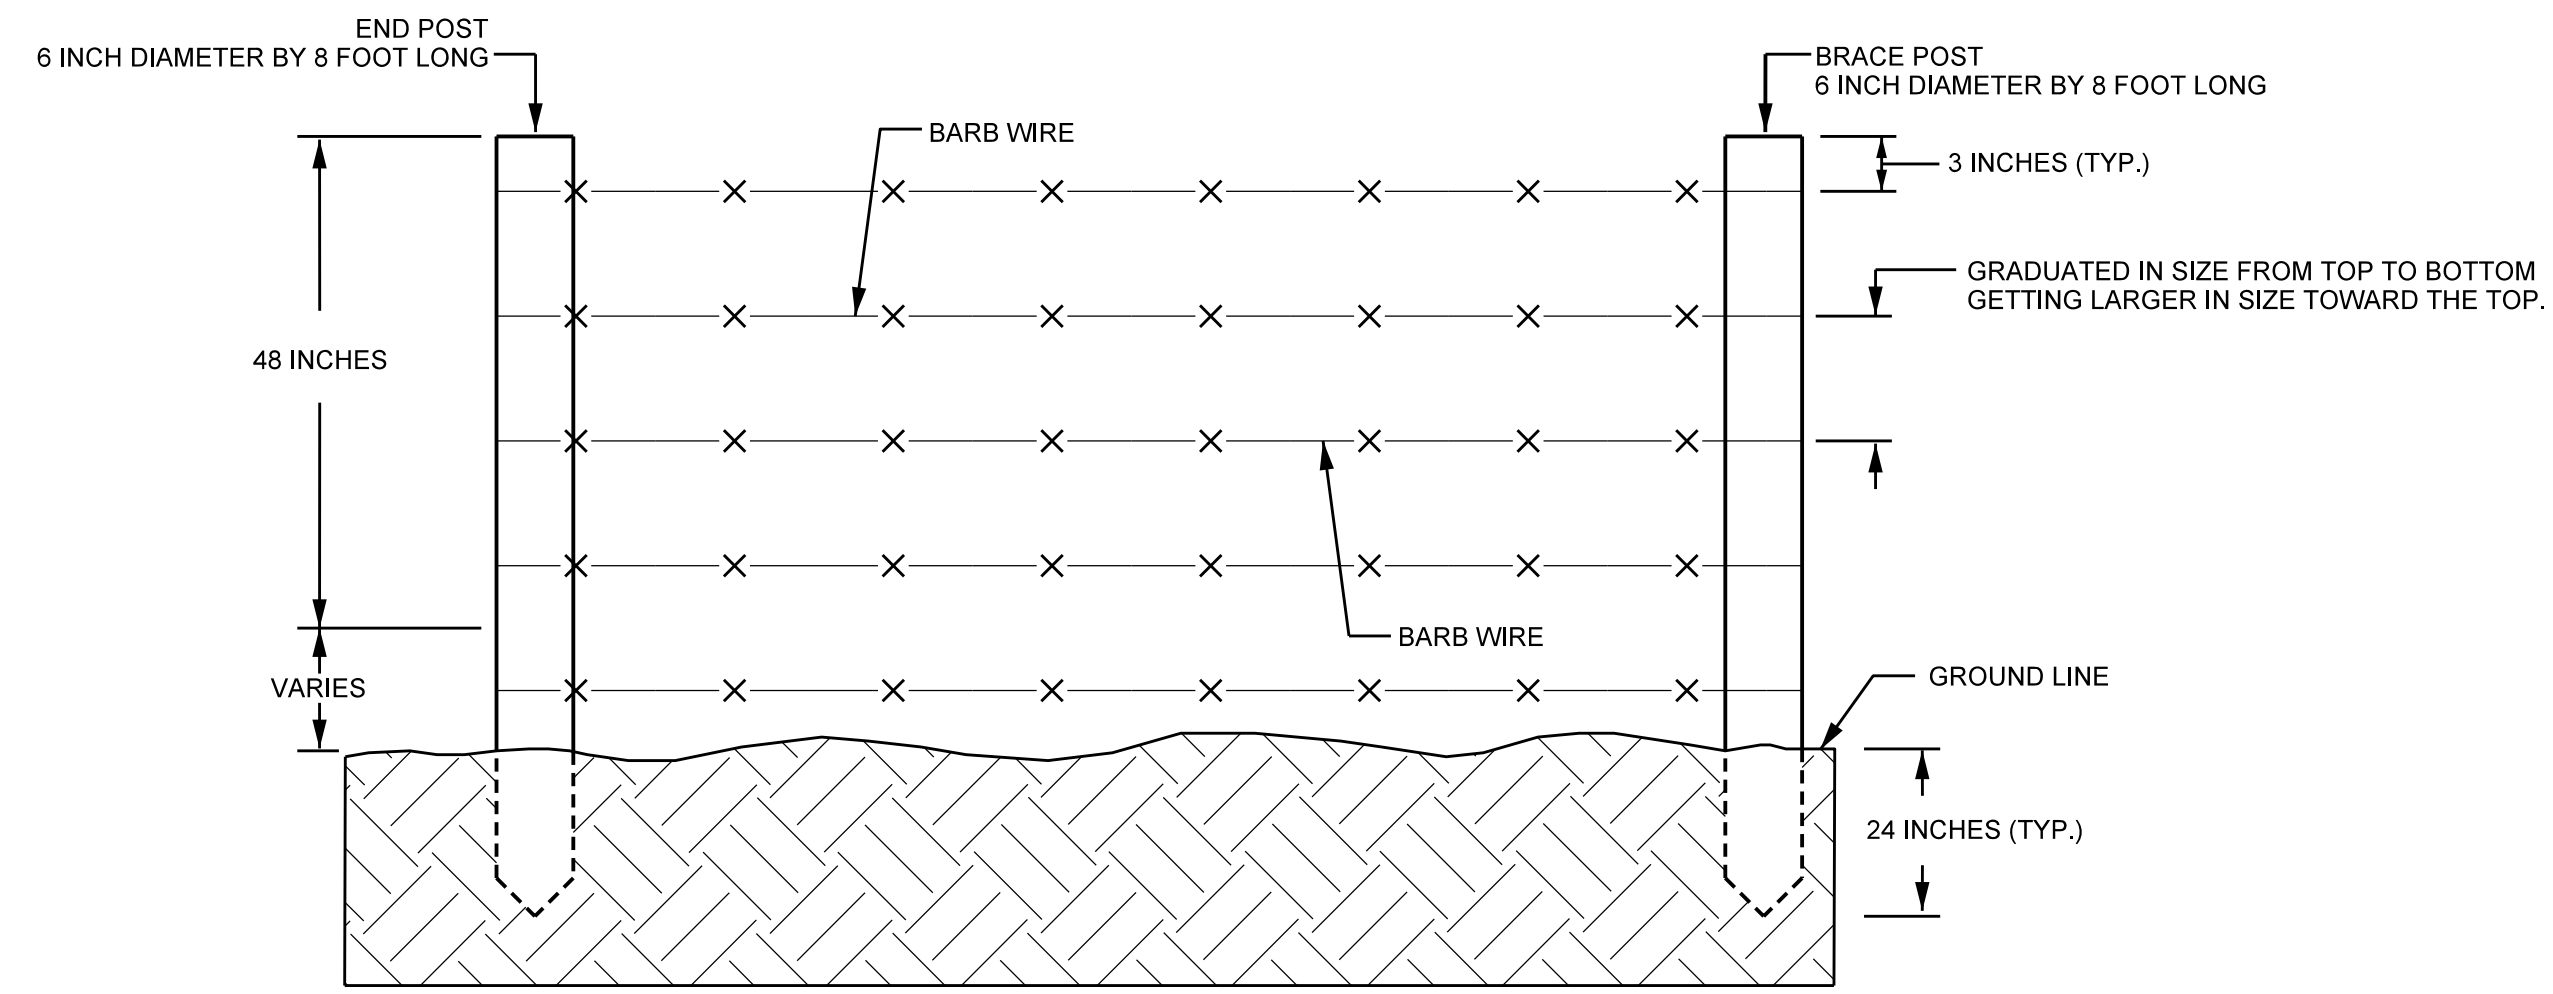

NOTE:

1. END POSTS SHALL BE INSTALLED AT A SPACING OF 10-15 FEET.
2. ALL FENCING AND FENCE POSTS SHOULD BE SET 1-2 FEET OUTSIDE OF THE CONSERVATION EASEMENT FOR FENCE LINE MAINTENANCE (LIKE HERBICIDE SPRAYING).

STEEL GATES

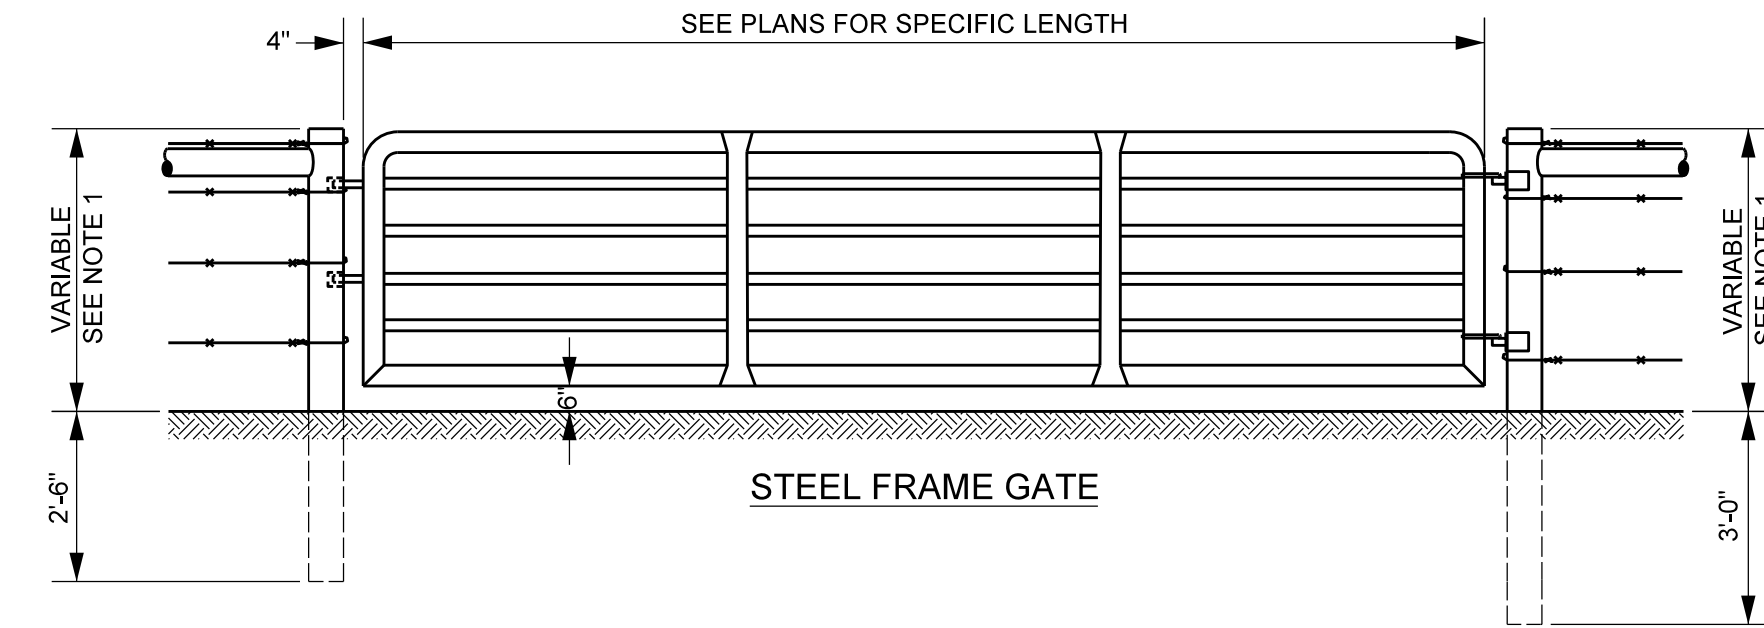




NOTES:

1. POST HEIGHT DIMENSION SHALL BE THE SAME AS REQUIRED FOR THE ADJACENT FENCE.
2. CONSTRUCT AN END OR STRESS PANEL, AS REQUIRED IN THE SPECIFICATION, ON EACH SIDE OF GATE.
3. HINGES AND LOCKS SHALL BE INSTALLED AS SPECIFIED BY GATE MANUFACTURER.

PROJECT REFERENCE NO. 166680	SHEET NO. 2F
PROJECT ENGINEER	
APPROVED BY:	
DATE:	
Michael Baker International <small>Michael Baker Engineering Inc. 8000 Regency Parkway, Suite 600 Cary, NORTH CAROLINA 27518 Phone: 919.463.5486 Fax: 919.463.5490 License #: F-1084</small>	
NCDMS ID NO. 100068	

2/26/2023

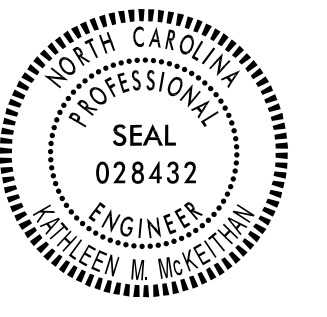BAKER PROJECT REFERENCE NO. 166680	SHEET NO. 3
PROJECT ENGINEER	
APPROVED BY:	
DATE:	
	
Michael Baker International Michael Baker Engineering Inc. 5030 Regency Parkway, Suite 600 Cary, NORTH CAROLINA 27518 Phone: 919.453.5488 Fax: 919.453.5490 License #: F-1084	
NCDMS ID NO. 100068	

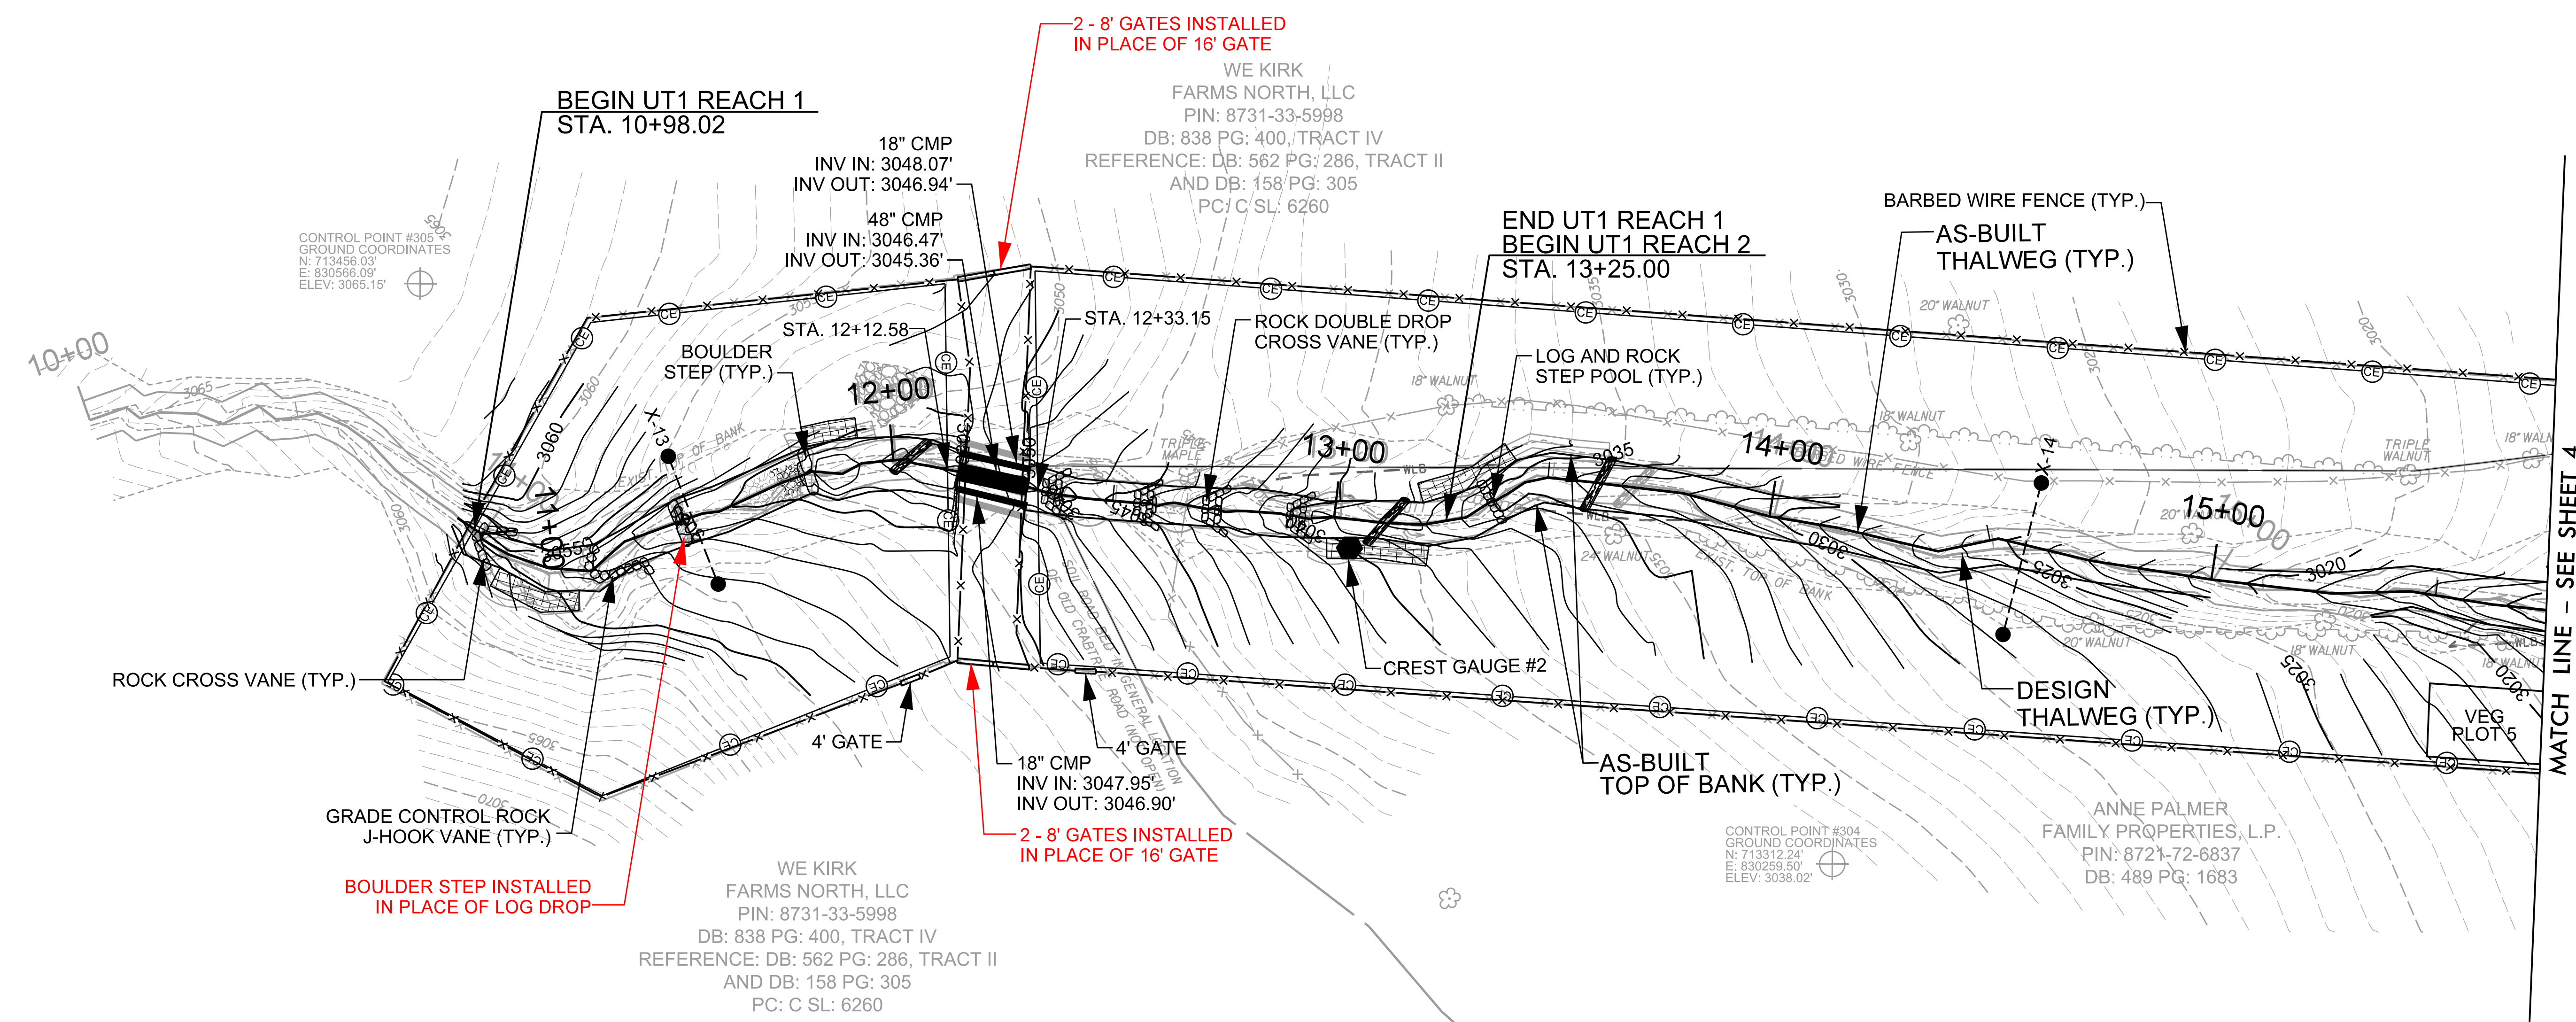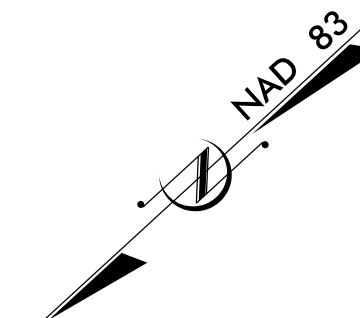

RECORD DRAWING LEGEND	
	PROPOSED DESIGN
	AS-BUILT SURVEY BY KEE MAPPING & SURVEYING 4/14/22
	RED LINE VARIATIONS FROM ORIGINAL DESIGN SUBMITTED WITH THE MITIGATION PLAN

- FILL EXISTING CHANNEL
- CHANNEL PLUG

UT to RUSH FORK UTI RECORD DRAWING

SCALE (FT)

5/24/2022
 M:\Projects\166680_Rush_Fork_Design\As-Built\Plans\166680-ASB-PSH-03.dgn
 Michael Baker International

2/26/2023

PROJECT ENGINEER

APPROVED BY:

DATE:



Michael Baker International Michael Baker Engineering Inc.
 5000 Regency Parkway, Suite 800
 Cary, NORTH CAROLINA 27518
 Phone: 919.453.5488
 Fax: 919.453.5490
 License #: F-1084

NCDMS ID NO. 100068

WE KIRK
 FARMS NORTH, LLC
 PIN: 8731-33-5998
 DB: 838 PG: 400, TRACT IV
 REFERENCE: DB: 562 PG: 286, TRACT II
 AND DB: 158 PG: 305
 PC: C SL: 6260

WE KIRK
 PIN: 8730-09-3258
 DB: 838 PG: 404
 REFERENCE: DB: 562 PG: 286, TRACT II
 AND DB: 158 PG: 305
 PC: C SL: 6260 & PC: C SL: 7314

SOUTHERN APPALACHIAN
 HIGHLANDS CONSERVANCY
 (CONSERVATION EASEMENT)
 DB: 917 PG: 978
 PC: C SL: 7314

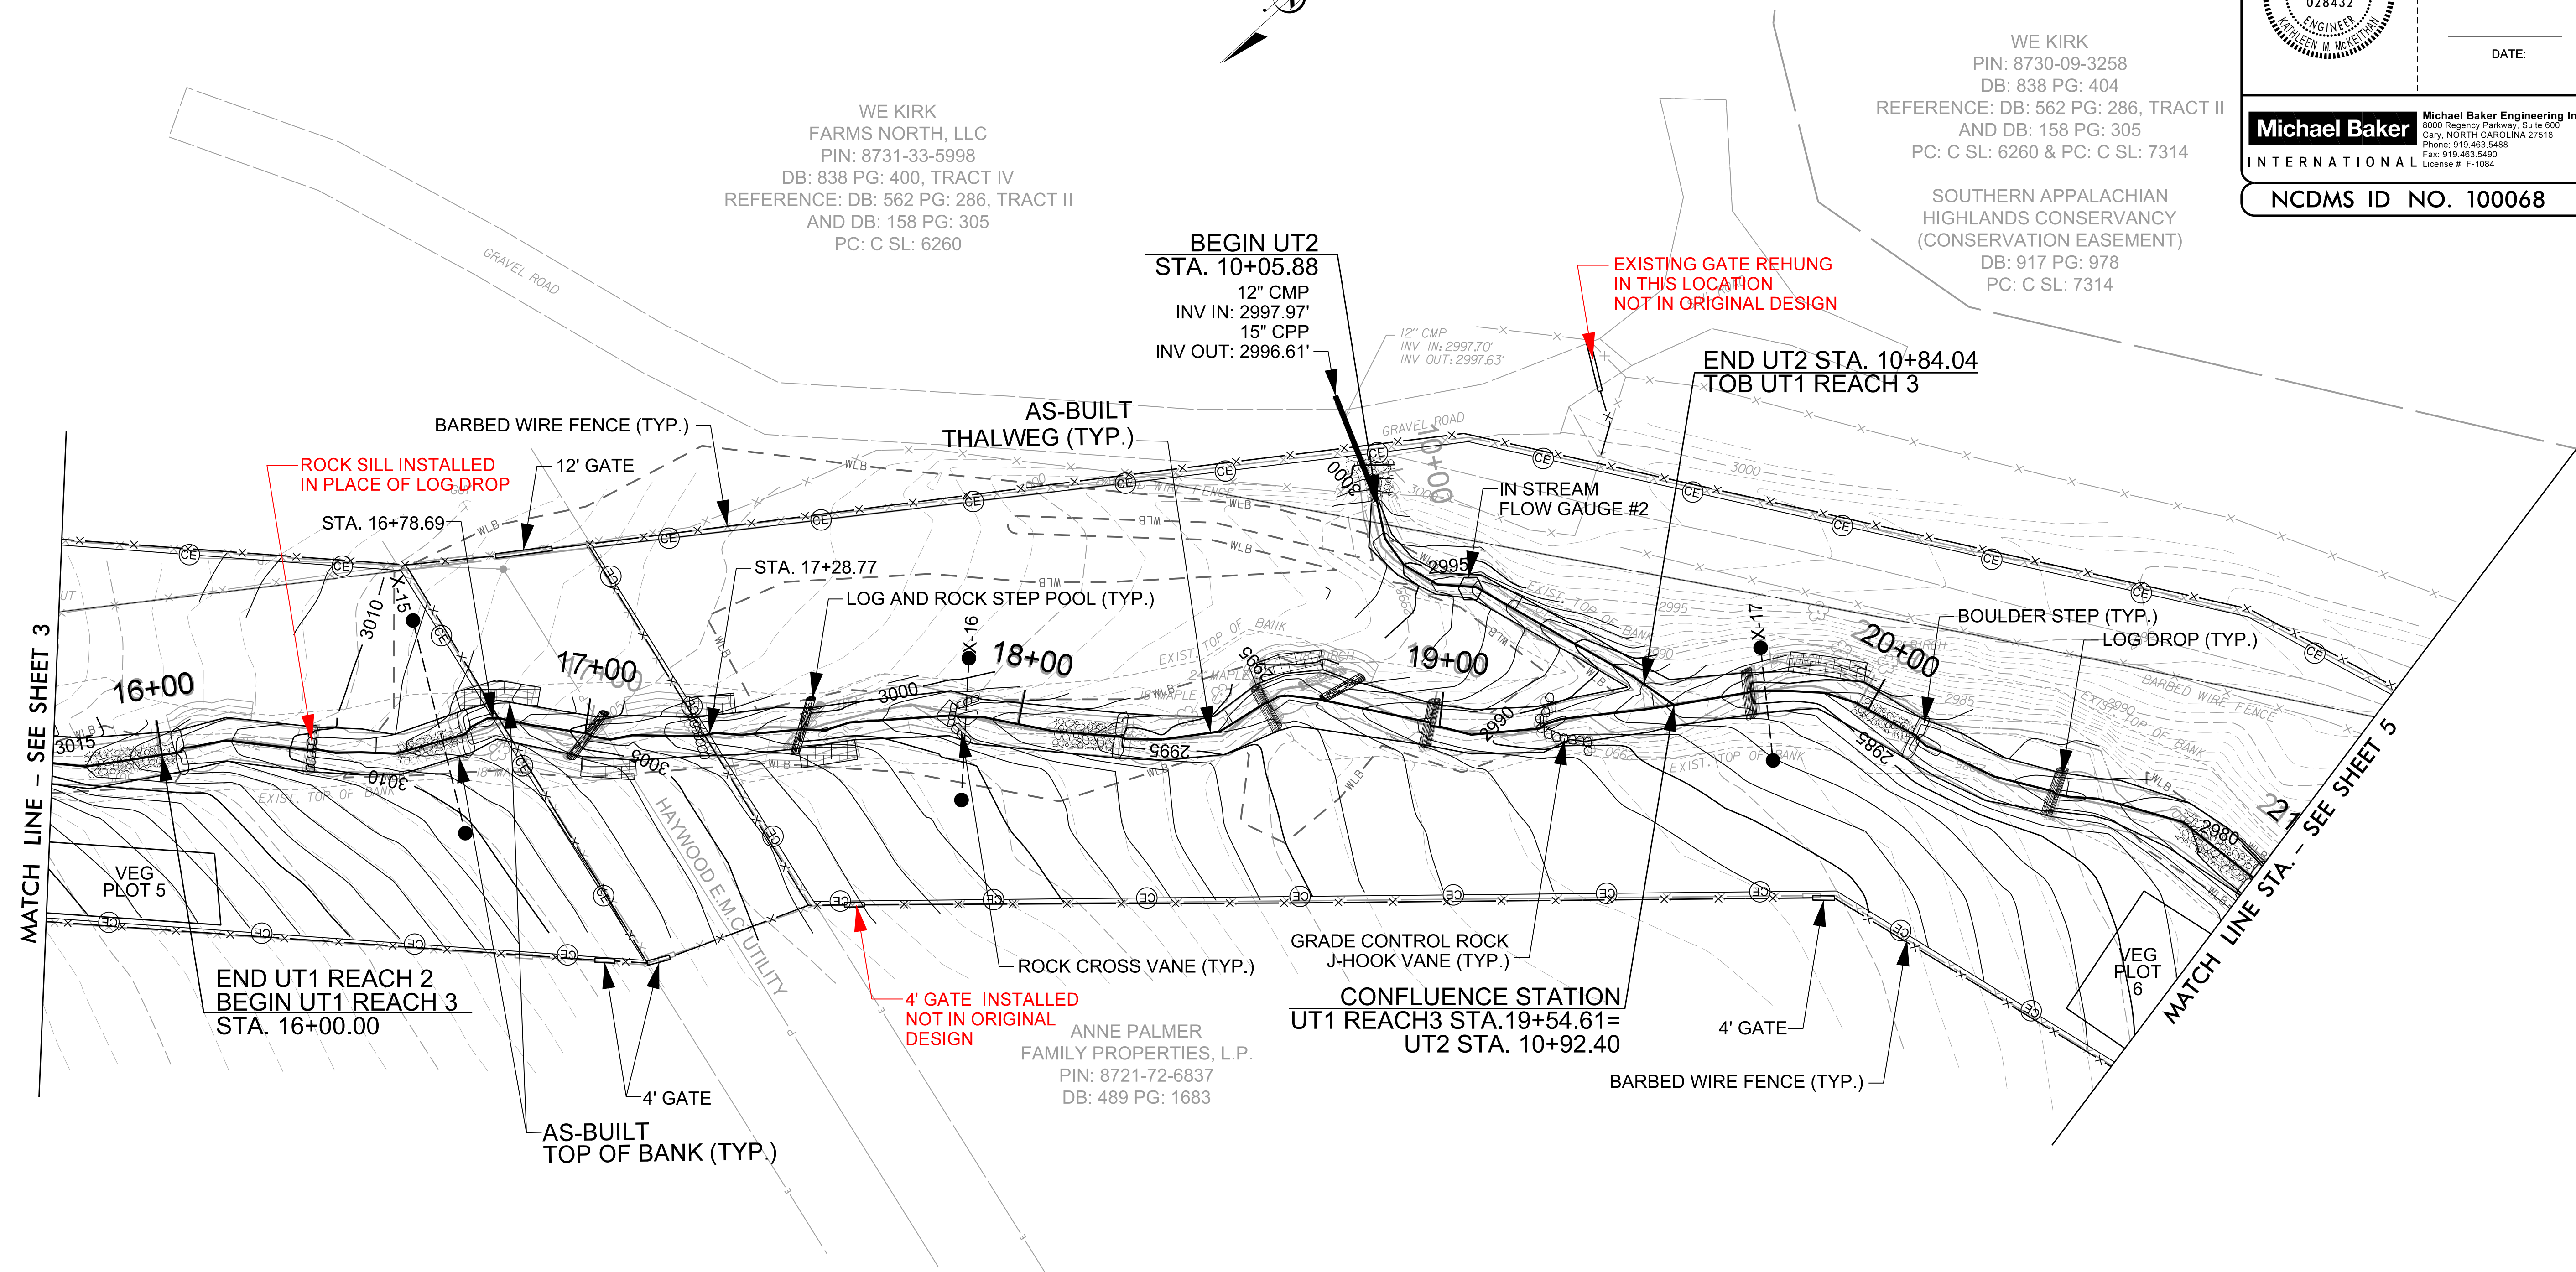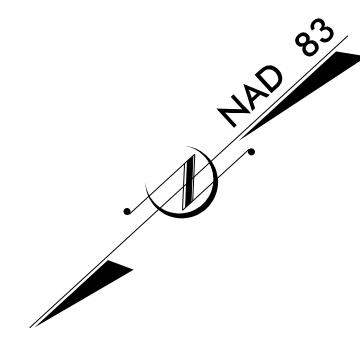

MATCH LINE - SEE SHEET 3

MATCH LINE STA. - SEE SHEET 5

RECORD DRAWING LEGEND

- PROPOSED DESIGN
- AS-BUILT SURVEY BY KEE MAPPING & SURVEYING 4/14/22
- RED LINE VARIATIONS FROM ORIGINAL DESIGN SUBMITTED WITH THE MITIGATION PLAN

- FILL EXISTING CHANNEL
- ▣ CHANNEL PLUG

UT to RUSH FORK UTI RECORD DRAWING

SCALE (FT)


5/31/2022
 M:\projects\166680_Rush_Fork\Design\As-Built\Plans\166680_ASB-P5H_04.dgn

2/26/2023


5/31/2022
M:\projects\166680_Rush_Fork\Design\As-Built\Plots\166680_ASB-PSH_05.dgn

WE KIRK
PIN: 8730-09-3258
DB: 838 PG: 404
REFERENCE: DB: 562 PG: 286, TRACT II
AND DB: 158 PG: 305
PC: C SL: 6260 & PC: C SL: 7314

SOUTHERN APPALACHIAN
HIGHLANDS CONSERVANCY
(CONSERVATION EASEMENT)
DB: 917 PG: 978
PC: C SL: 7314

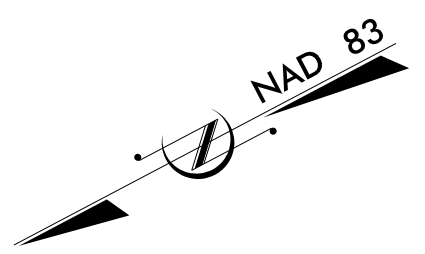

BAKER PROJECT REFERENCE NO. 166680	SHEET NO. 5
PROJECT ENGINEER	
APPROVED BY:	
DATE:	
Michael Baker International	
Michael Baker Engineering Inc. 5030 Regency Parkway, Suite 500 Cary, NORTH CAROLINA 27518 Phone: 919.453.5488 Fax: 919.453.5490 License #: F-1084	
NCDMS ID NO. 100068	

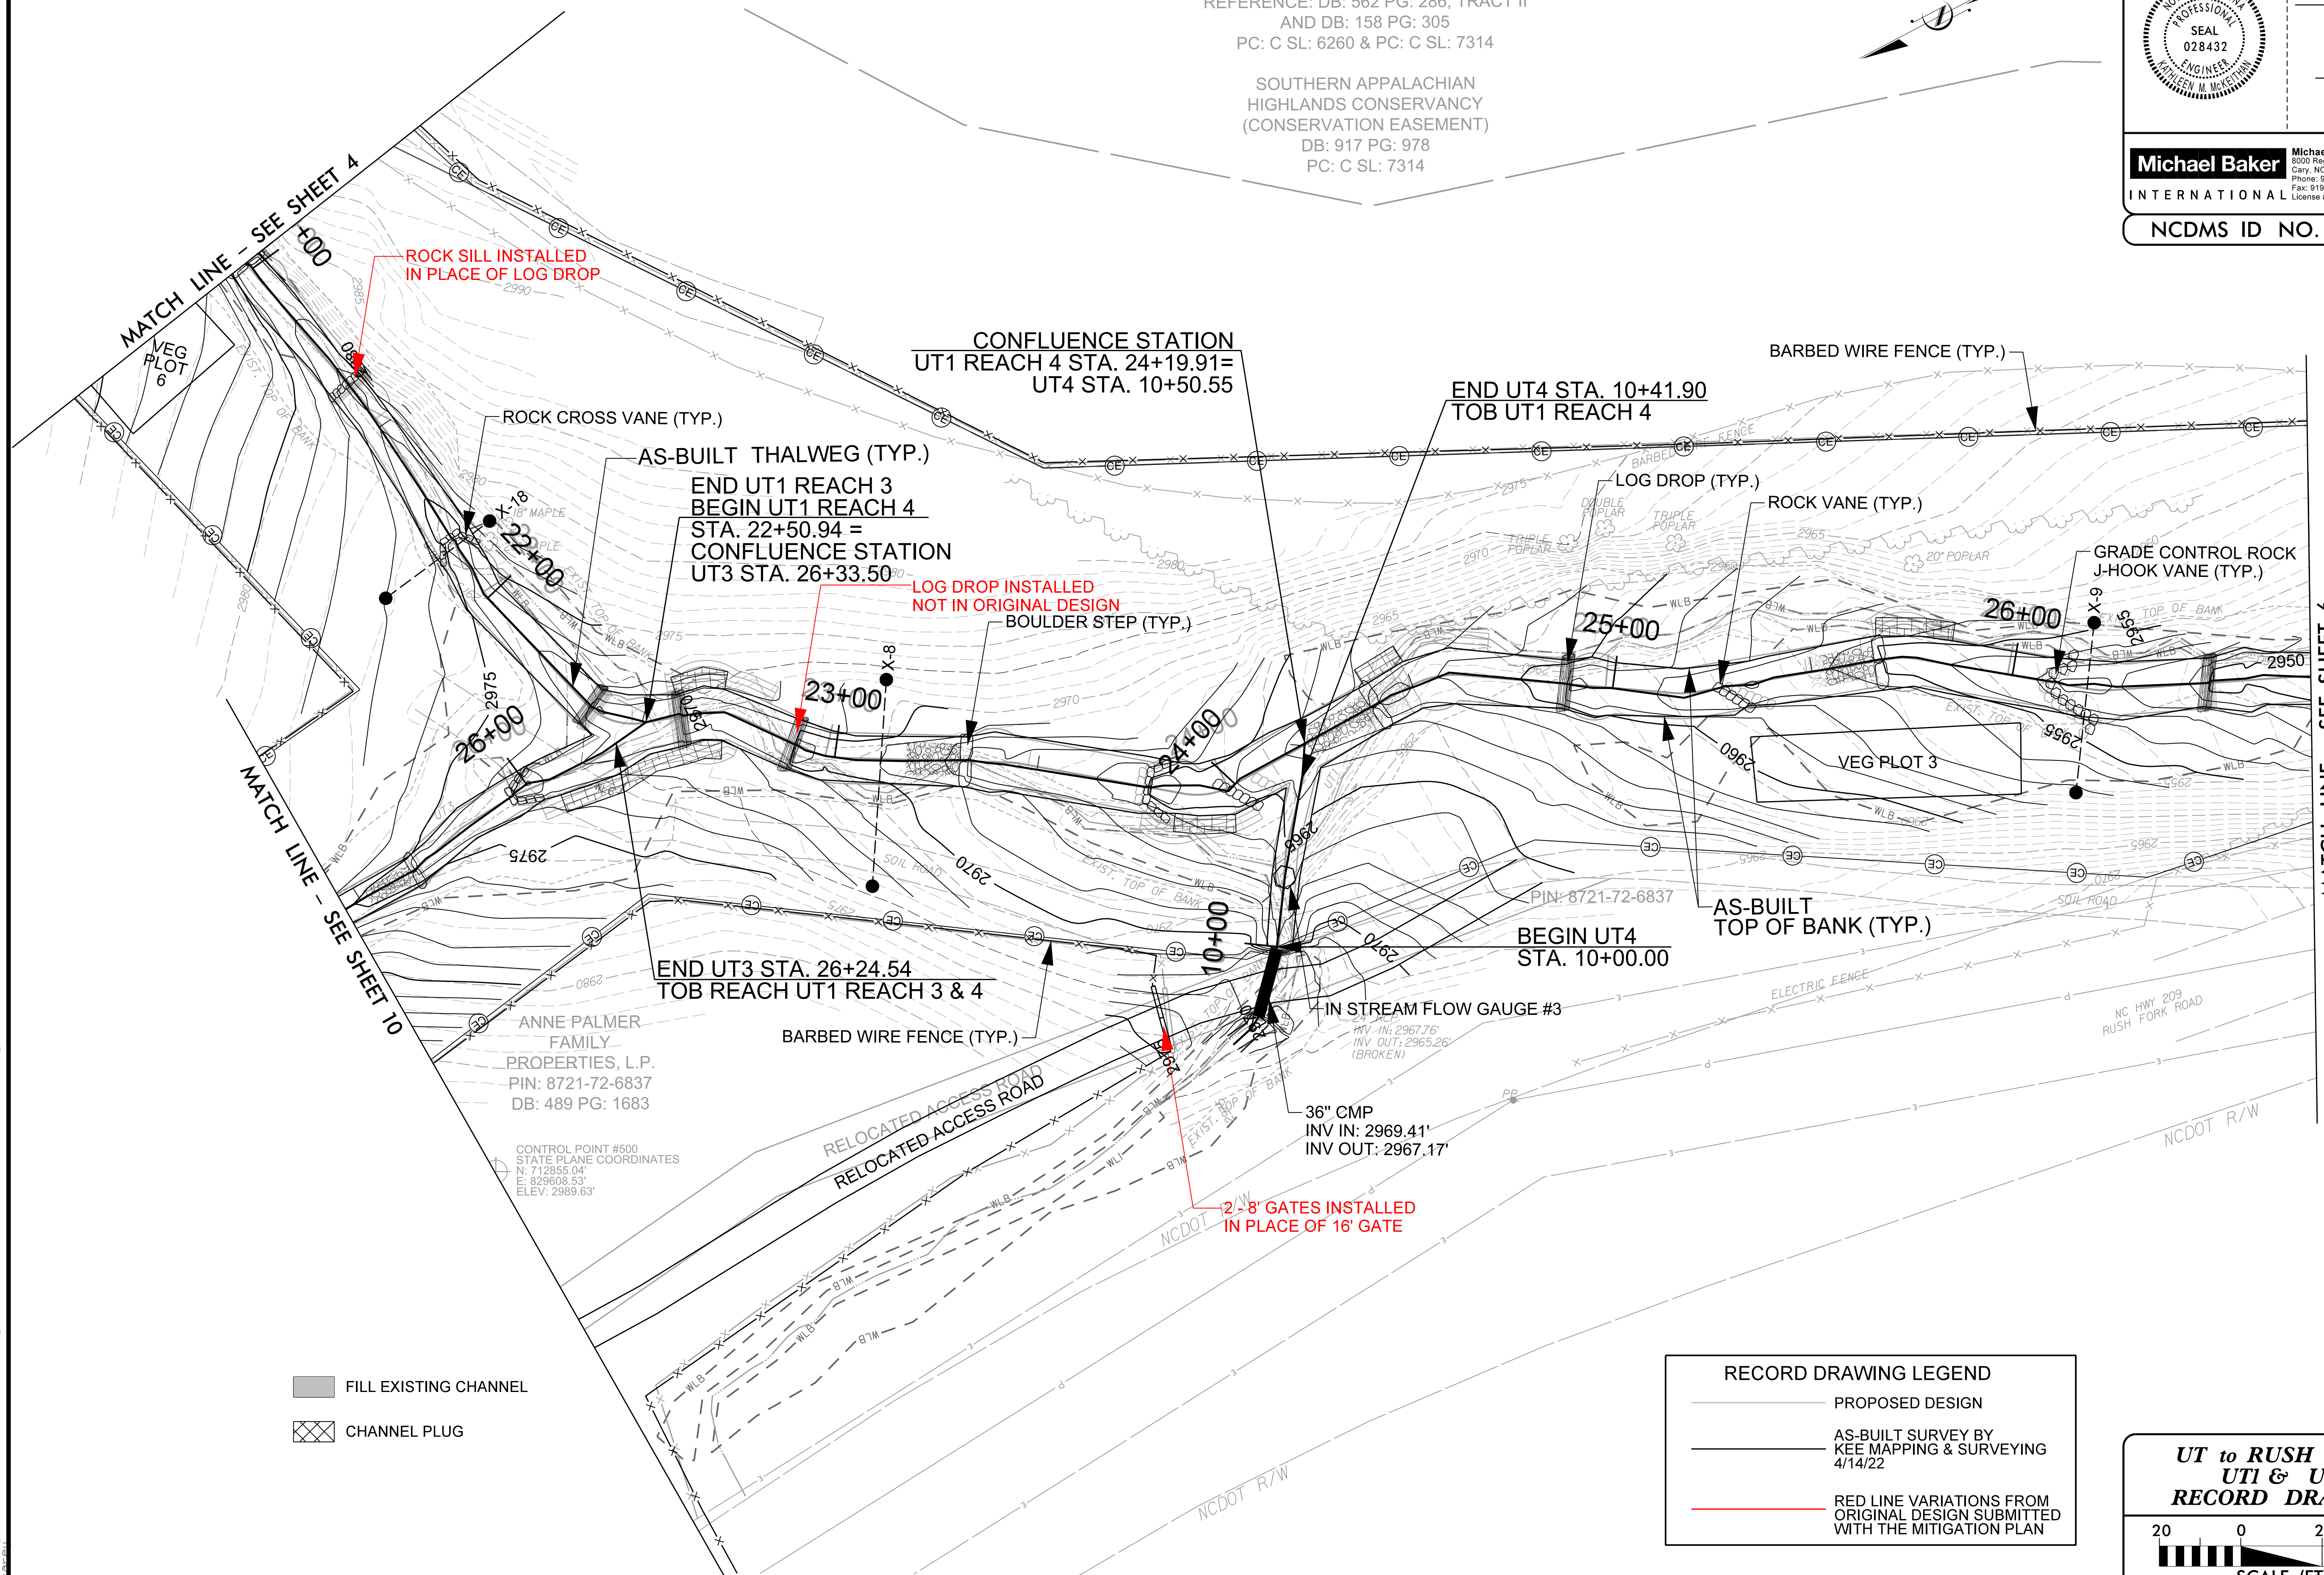


- FILL EXISTING CHANNEL
- CHANNEL PLUG


RECORD DRAWING LEGEND

- PROPOSED DESIGN
- AS-BUILT SURVEY BY
KEE MAPPING & SURVEYING
4/14/22
- RED LINE VARIATIONS FROM
ORIGINAL DESIGN SUBMITTED
WITH THE MITIGATION PLAN




**UT to RUSH FORK
UT1 & UT4
RECORD DRAWING**

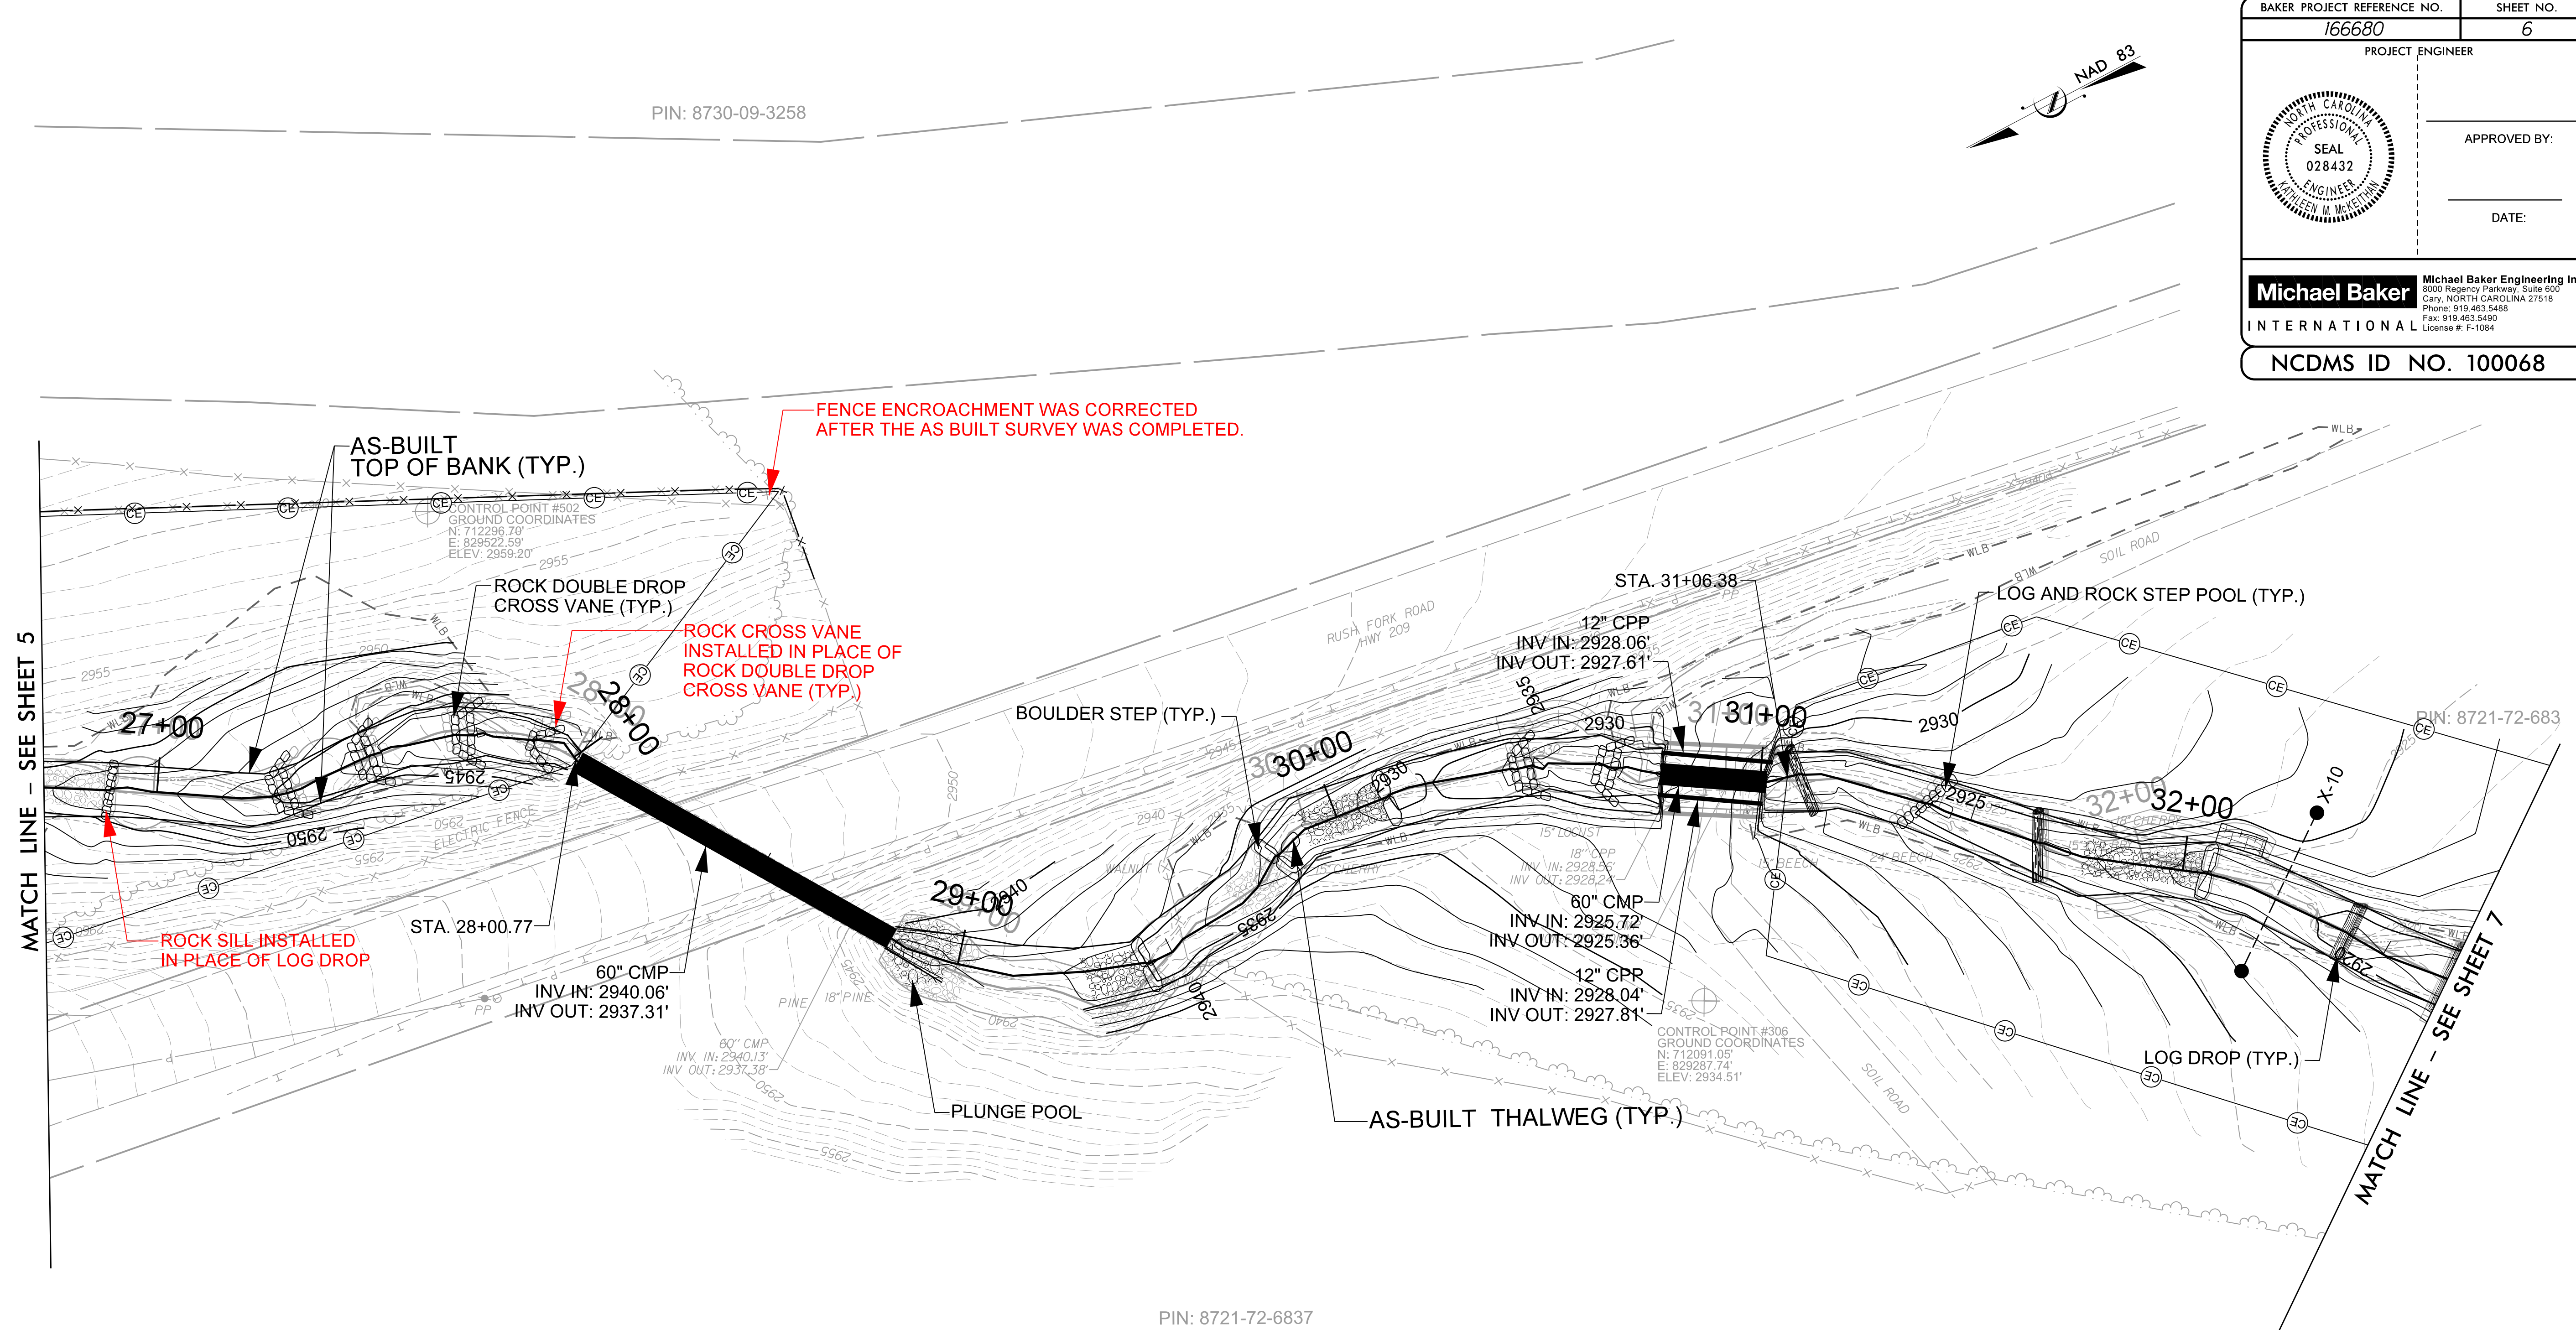

SCALE (FT)

BAKER PROJECT REFERENCE NO. 166680	SHEET NO. 6
PROJECT ENGINEER 	
APPROVED BY: 	
DATE: 	
	
Michael Baker INTERNATIONAL	
Michael Baker Engineering Inc. 5030 Regency Parkway, Suite 600 Cary, NORTH CAROLINA 27518 Phone: 919.453.5488 Fax: 919.453.5490 License #: F-1084	
NCDMS ID NO. 100068	




RECORD DRAWING LEGEND

-  PROPOSED DESIGN
-  AS-BUILT SURVEY BY KEE MAPPING & SURVEYING 4/14/22
-  RED LINE VARIATIONS FROM ORIGINAL DESIGN SUBMITTED WITH THE MITIGATION PLAN

-  FILL EXISTING CHANNEL
-  CHANNEL PLUG


**UT to RUSH FORK
UTI
RECORD DRAWING**



SCALE (FT)

2/26/2023

PROJECT ENGINEER


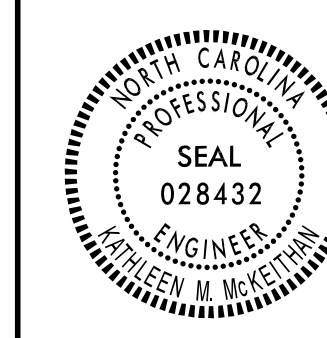


APPROVED BY:

DATE:

Michael Baker International
 Michael Baker Engineering Inc.
 5000 Regency Parkway, Suite 800
 Cary, NORTH CAROLINA 27518
 Phone: 919.453.5488
 Fax: 919.453.5490
 License #: F-1084

NC DMS ID NO. 100068

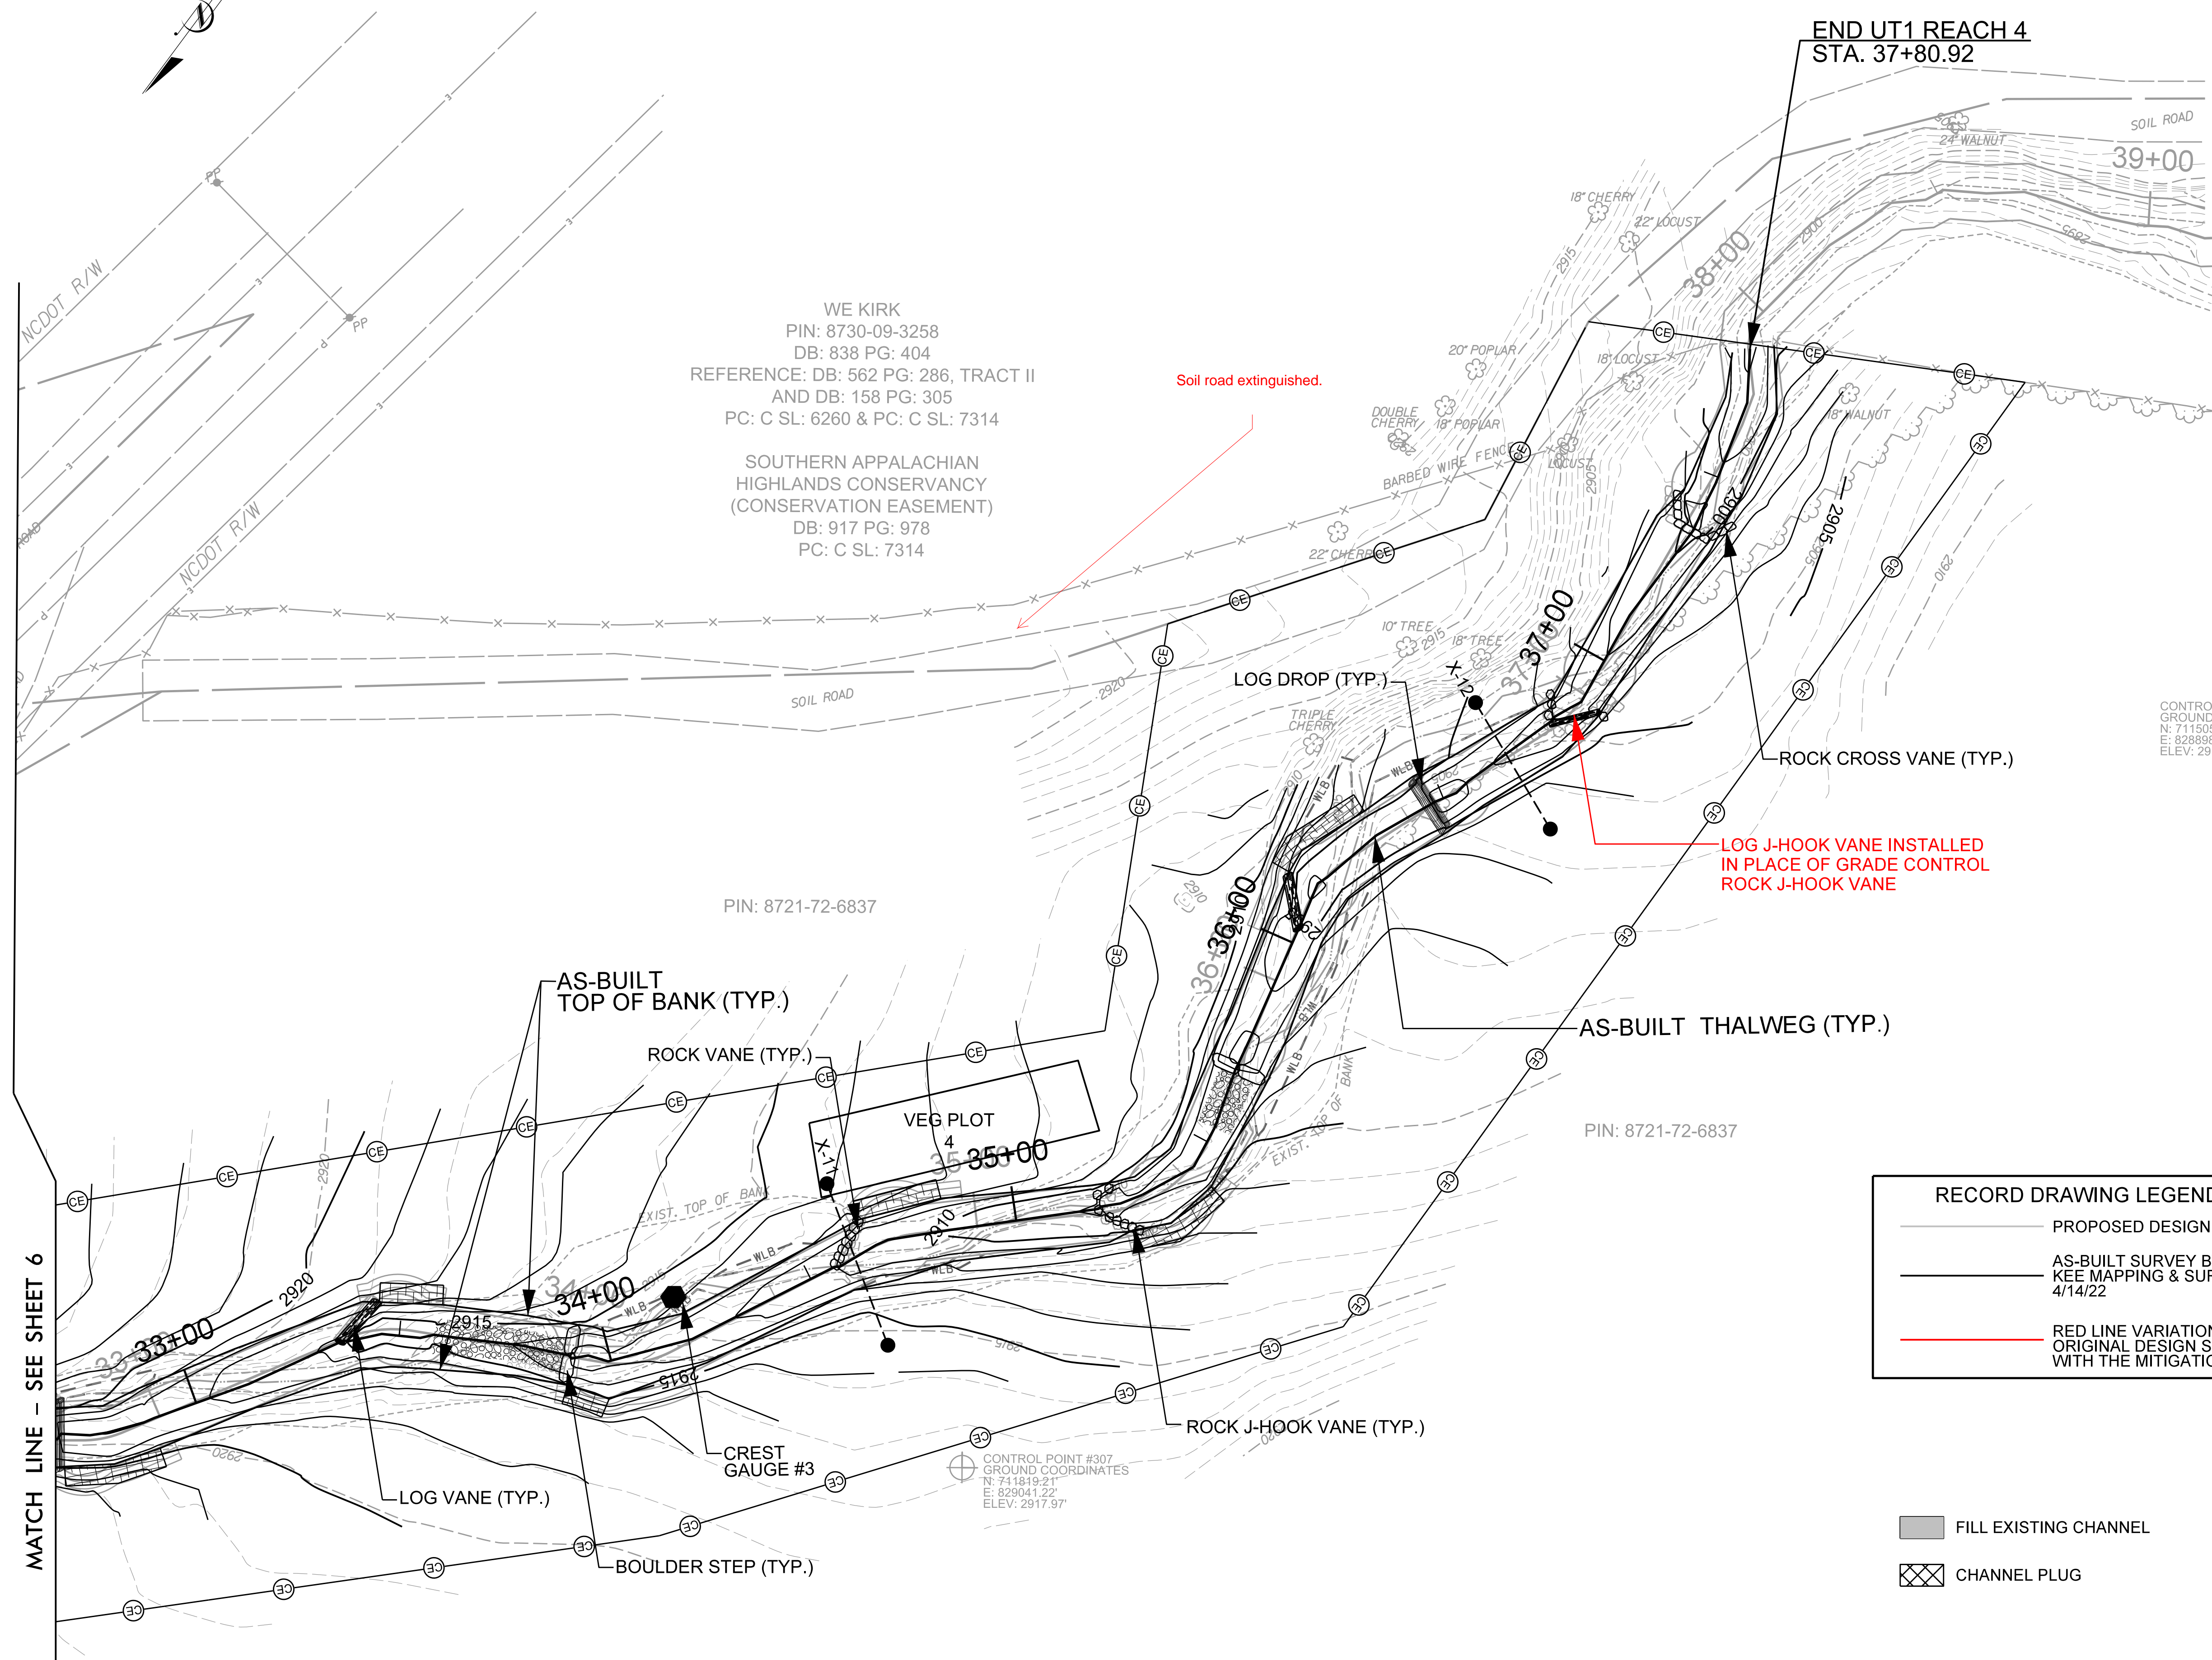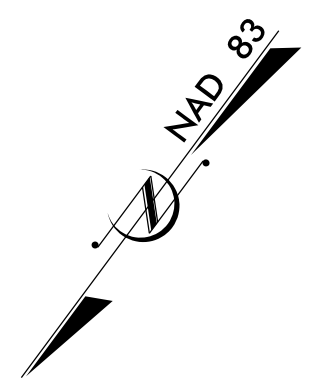

WE KIRK
 PIN: 8730-09-3258
 DB: 838 PG: 404
 REFERENCE: DB: 562 PG: 286, TRACT II
 AND DB: 158 PG: 305
 PC: C SL: 6260 & PC: C SL: 7314

SOUTHERN APPALACHIAN
 HIGHLANDS CONSERVANCY
 (CONSERVATION EASEMENT)
 DB: 917 PG: 978
 PC: C SL: 7314

Soil road extinguished.

CONTROL POINT #308
 GROUND COORDINATES
 N: 711505.47
 E: 828898.77
 ELEV: 2918.81'

PIN: 8721-72-6837

PIN: 8721-72-6837

RECORD DRAWING LEGEND

- PROPOSED DESIGN
- AS-BUILT SURVEY BY KEE MAPPING & SURVEYING 4/14/22
- RED LINE VARIATIONS FROM ORIGINAL DESIGN SUBMITTED WITH THE MITIGATION PLAN

- FILL EXISTING CHANNEL
- ⊗ CHANNEL PLUG


**UT to RUSH FORK
 UTI
 RECORD DRAWING**

SCALE (FT)






MATCH LINE - SEE SHEET 6

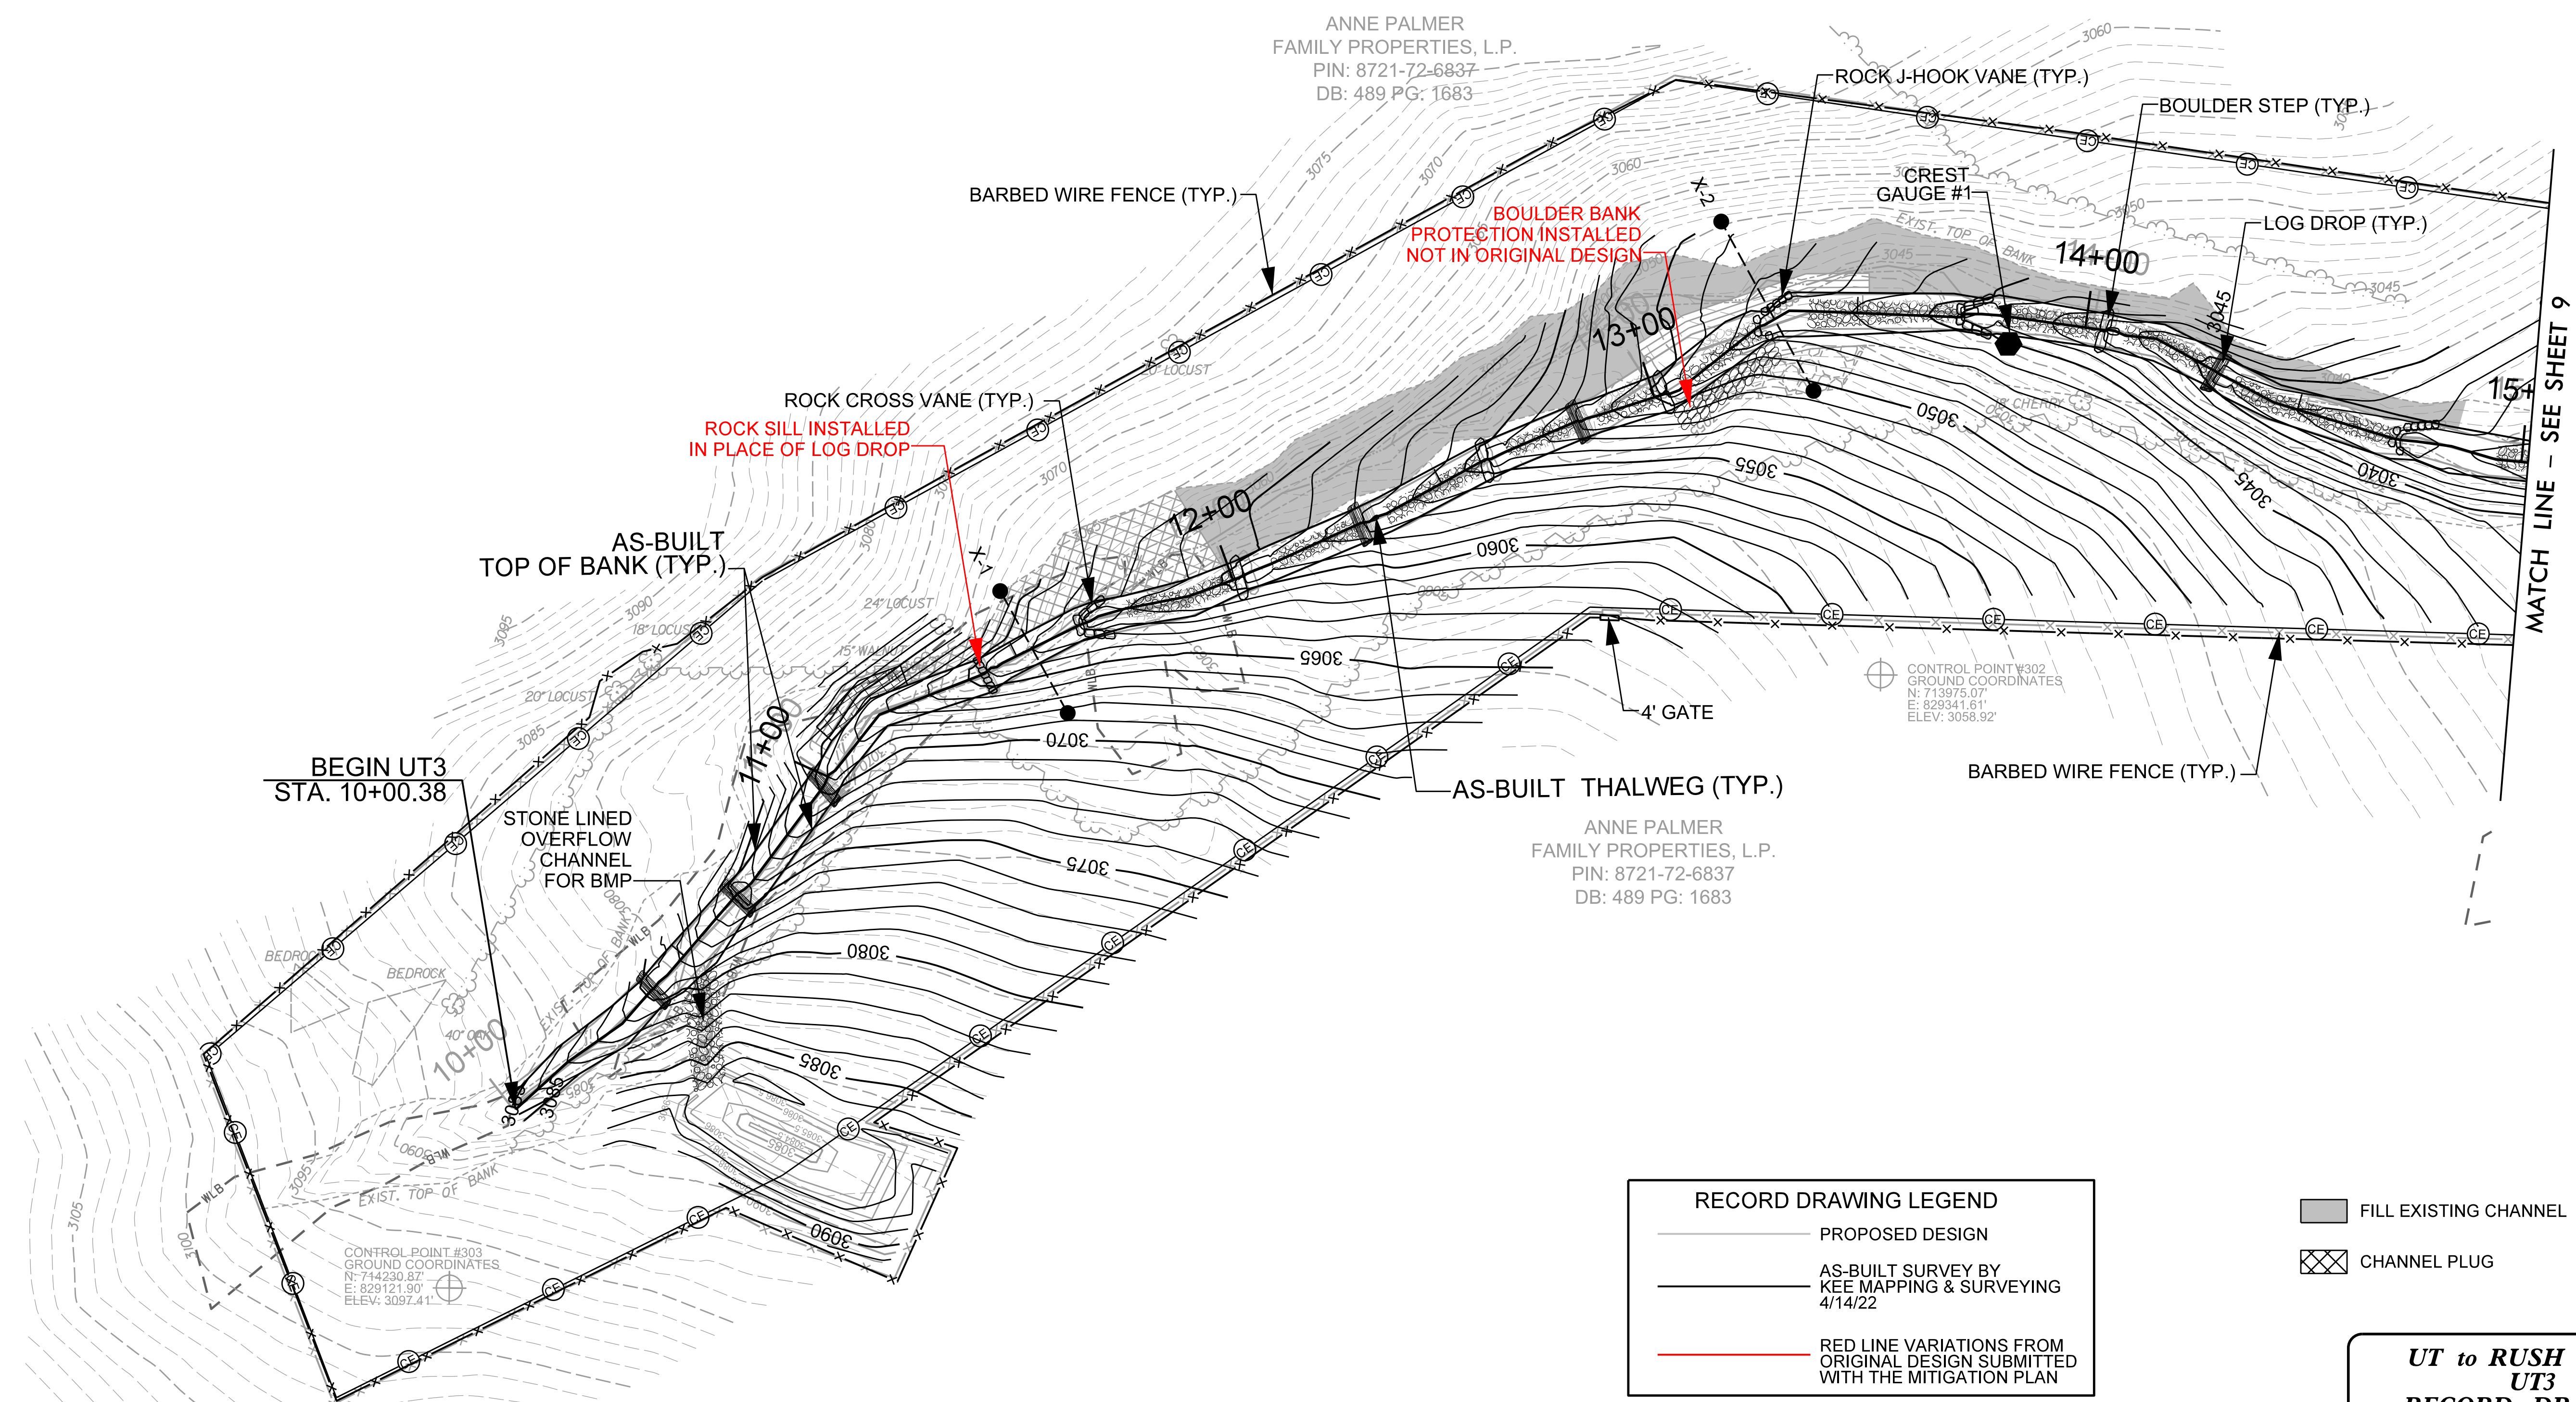5/24/2022
 M:\Projects\166680_Rush_Fork_Design\As-Built\Plans\166680_ASB-FSH_07.dgn

 2/26/2023



RECORD DRAWING LEGEND

-  PROPOSED DESIGN
-  AS-BUILT SURVEY BY KEE MAPPING & SURVEYING 4/14/22
-  RED LINE VARIATIONS FROM ORIGINAL DESIGN SUBMITTED WITH THE MITIGATION PLAN
-  FILL EXISTING CHANNEL
-  CHANNEL PLUG

**UT to RUSH FORK
UT3
RECORD DRAWING**


SCALE (FT)

5/24/2022
 M:\Projects\166680_Rush_Fork\Design\As-Built\Plans\166680_ASB-FSH-08.dgn
 Michael Keenan

2/26/23



ANNE PALMER
 FAMILY PROPERTIES, L.P.
 PIN: 8721-72-6837
 DB: 489 PG: 1683

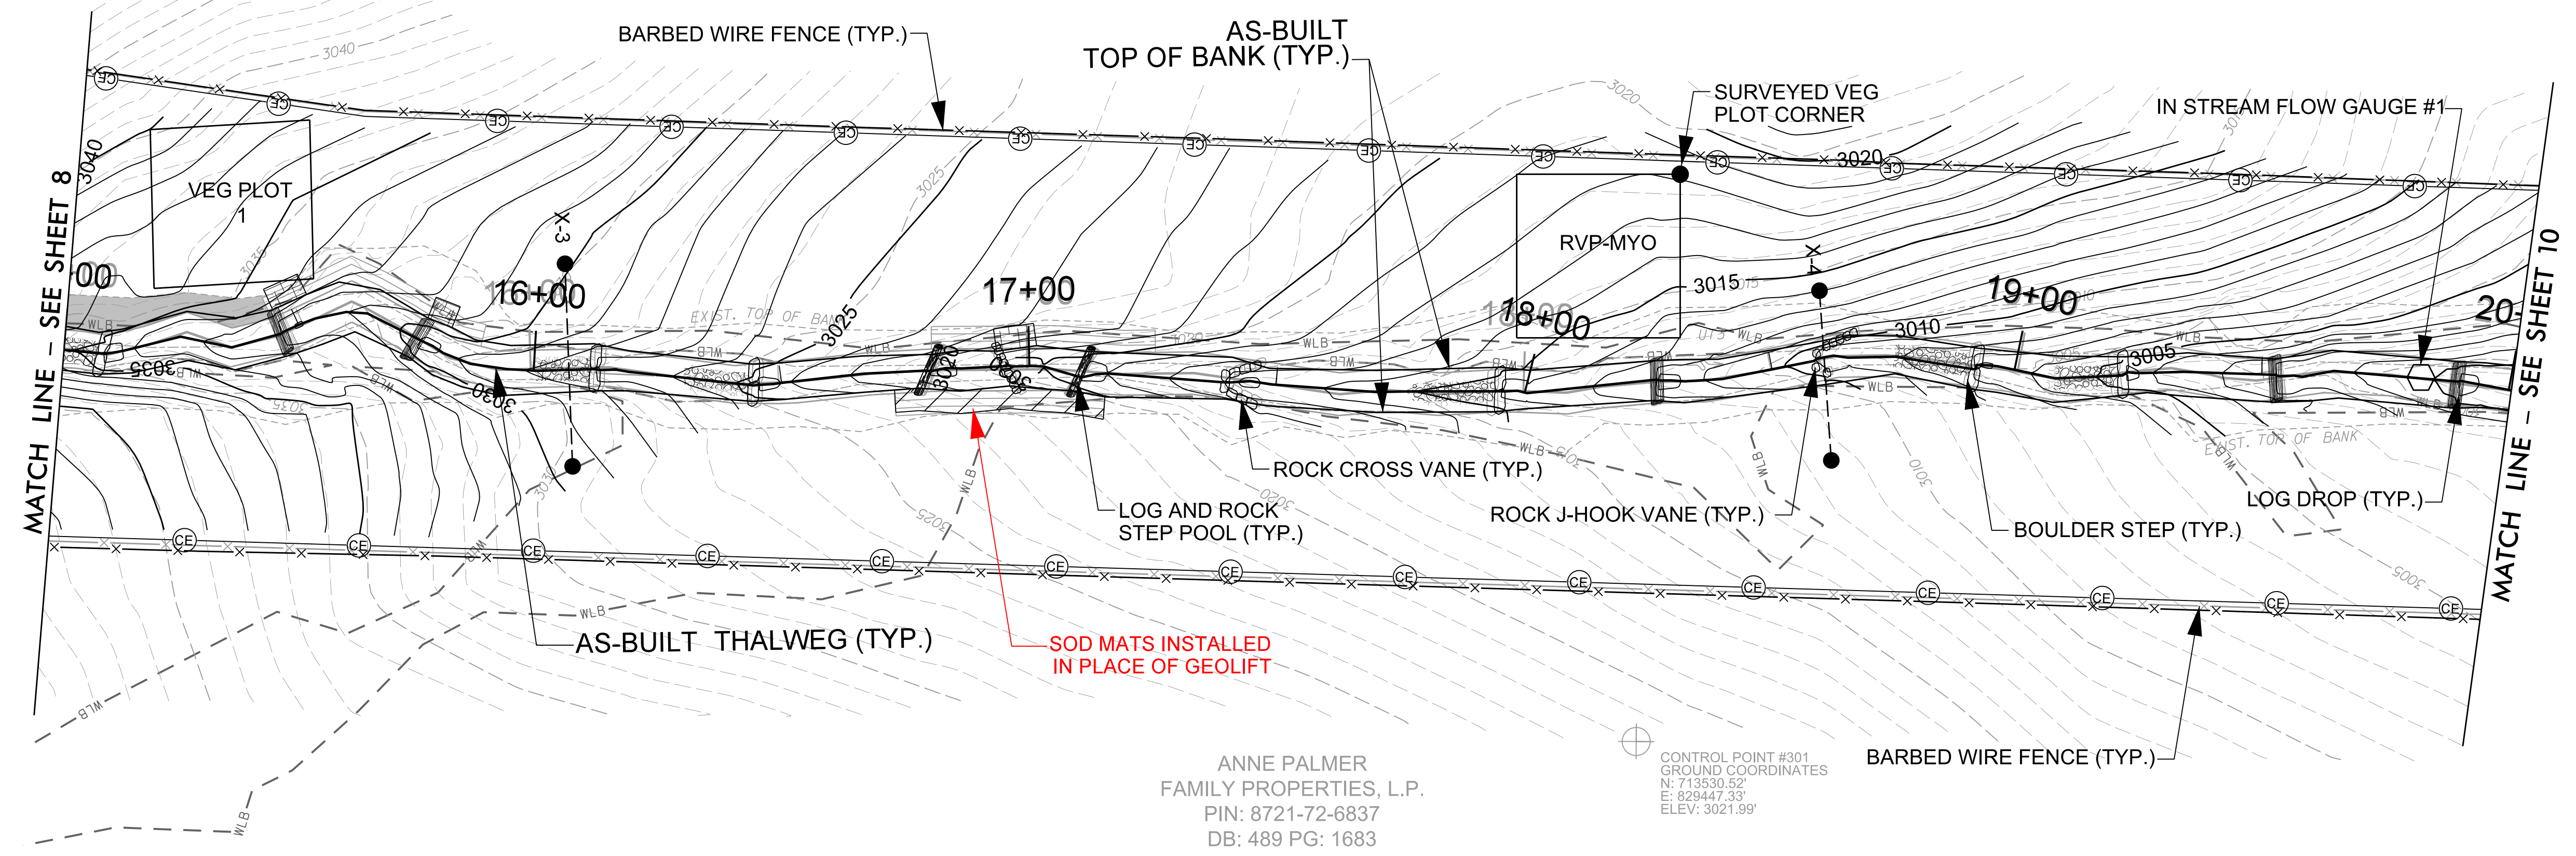

RECORD DRAWING LEGEND	
	PROPOSED DESIGN
	AS-BUILT SURVEY BY KEE MAPPING & SURVEYING 4/14/22
	RED LINE VARIATIONS FROM ORIGINAL DESIGN SUBMITTED WITH THE MITIGATION PLAN

- FILL EXISTING CHANNEL
- CHANNEL PLUG

**UT to RUSH FORK
 UT3
 RECORD DRAWING**

SCALE (FT)

6/6/2022
 C:\Users\jts\OneDrive\Documents\Projects\166680\ASB-PSH-09.dgn


2/26/2023

BAKER PROJECT REFERENCE NO. 166680 SHEET NO. 10

PROJECT ENGINEER
APPROVED BY:
DATE:

Michael Baker International
Michael Baker Engineering Inc.
5000 Regency Parkway, Suite 600
Cary, NORTH CAROLINA 27518
Phone: 919.453.5488
Fax: 919.453.5490
License #: F-1084

NCDMS ID NO. 100068

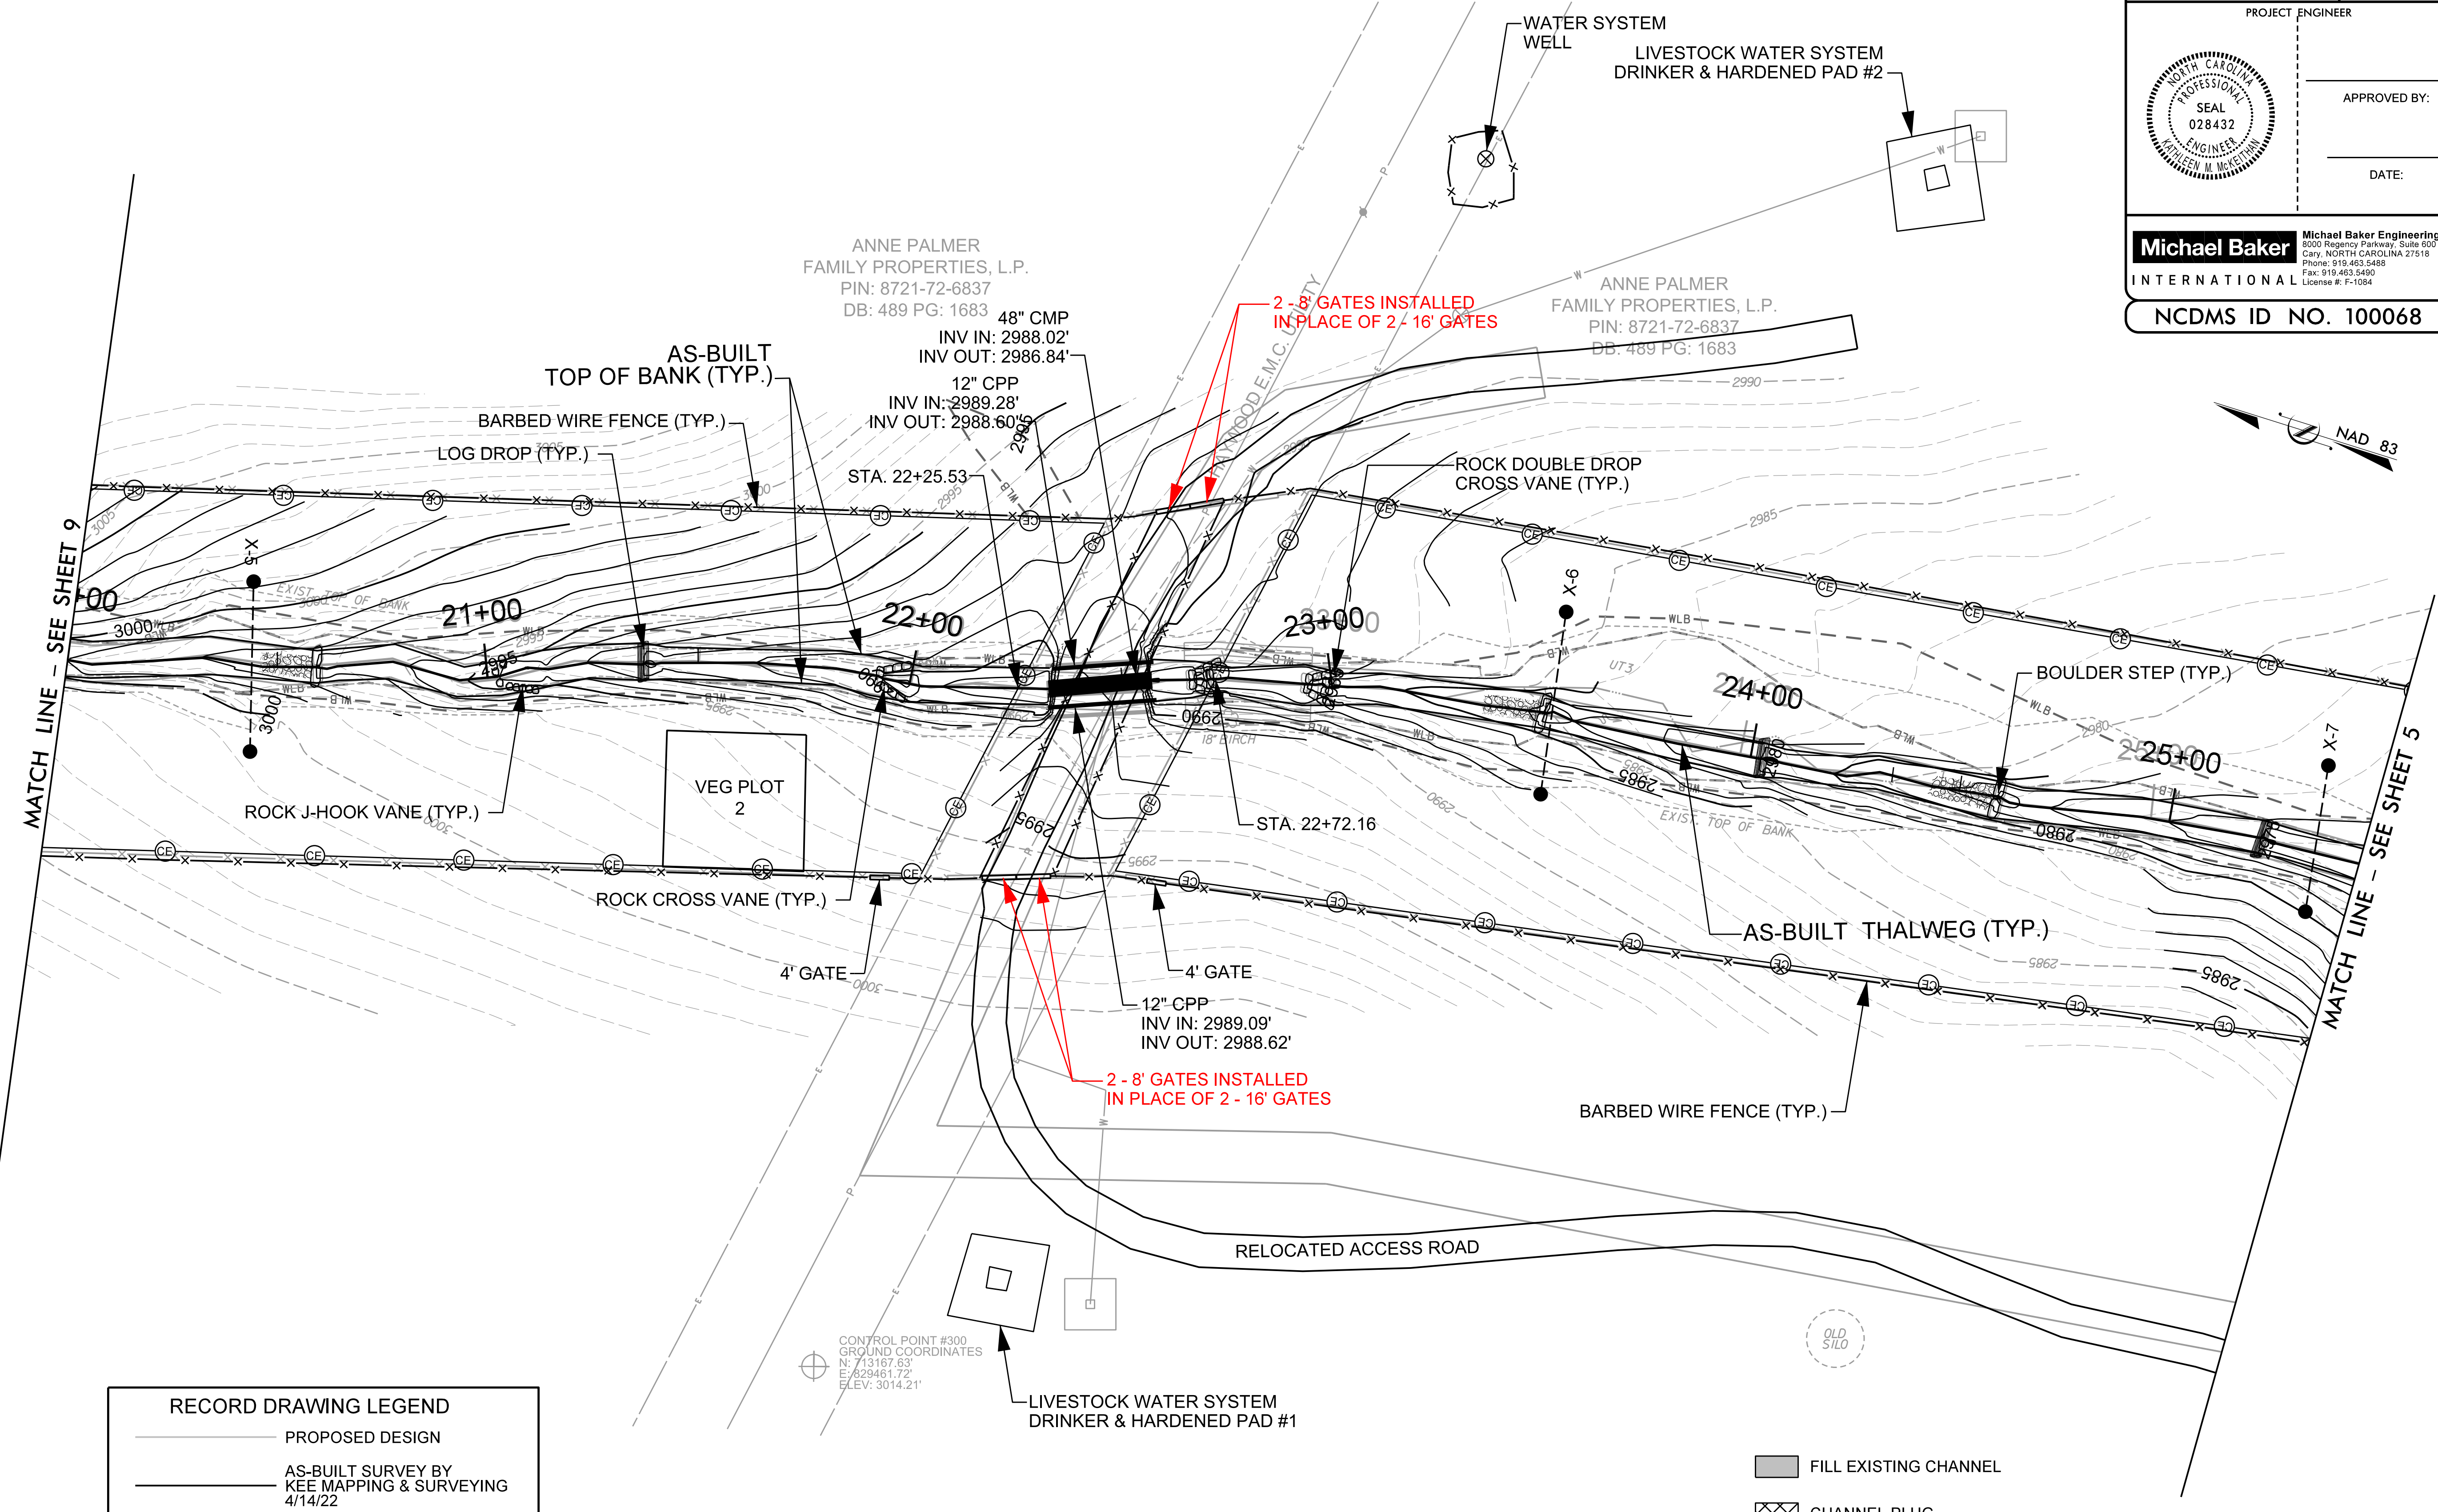

RECORD DRAWING LEGEND
— PROPOSED DESIGN
— AS-BUILT SURVEY BY KEE MAPPING & SURVEYING 4/14/22
— RED LINE VARIATIONS FROM ORIGINAL DESIGN SUBMITTED WITH THE MITIGATION PLAN

FILL EXISTING CHANNEL
CHANNEL PLUG

CONTROL POINT #300
GROUND COORDINATES
N: 713187.63
E: 829461.72
ELEV: 3014.21'



ANNE PALMER
FAMILY PROPERTIES, L.P.
PIN: 8721-72-6837
DB: 489 PG: 1683

**UT to RUSH FORK
UT3
RECORD DRAWING**
20 0 20 40
SCALE (FT)

5/24/2022
M:\Projects\166680_Rush_Fork\Design\As-Built\Plans\166680_ASB-FSH-10.dgn

2/26/03



BAKER PROJECT REFERENCE NO. 166680	SHEET NO. 11
PROJECT ENGINEER	
	
DATE:	
Michael Baker International	
<small>Michael Baker Engineering Inc. 3000 Regency Parkway, Suite 500 Cary, NORTH CAROLINA 27518 Phone: 919.463.5488 Fax: 919.463.5490 License #: F-1084</small>	
NCDMS ID NO. 100068	

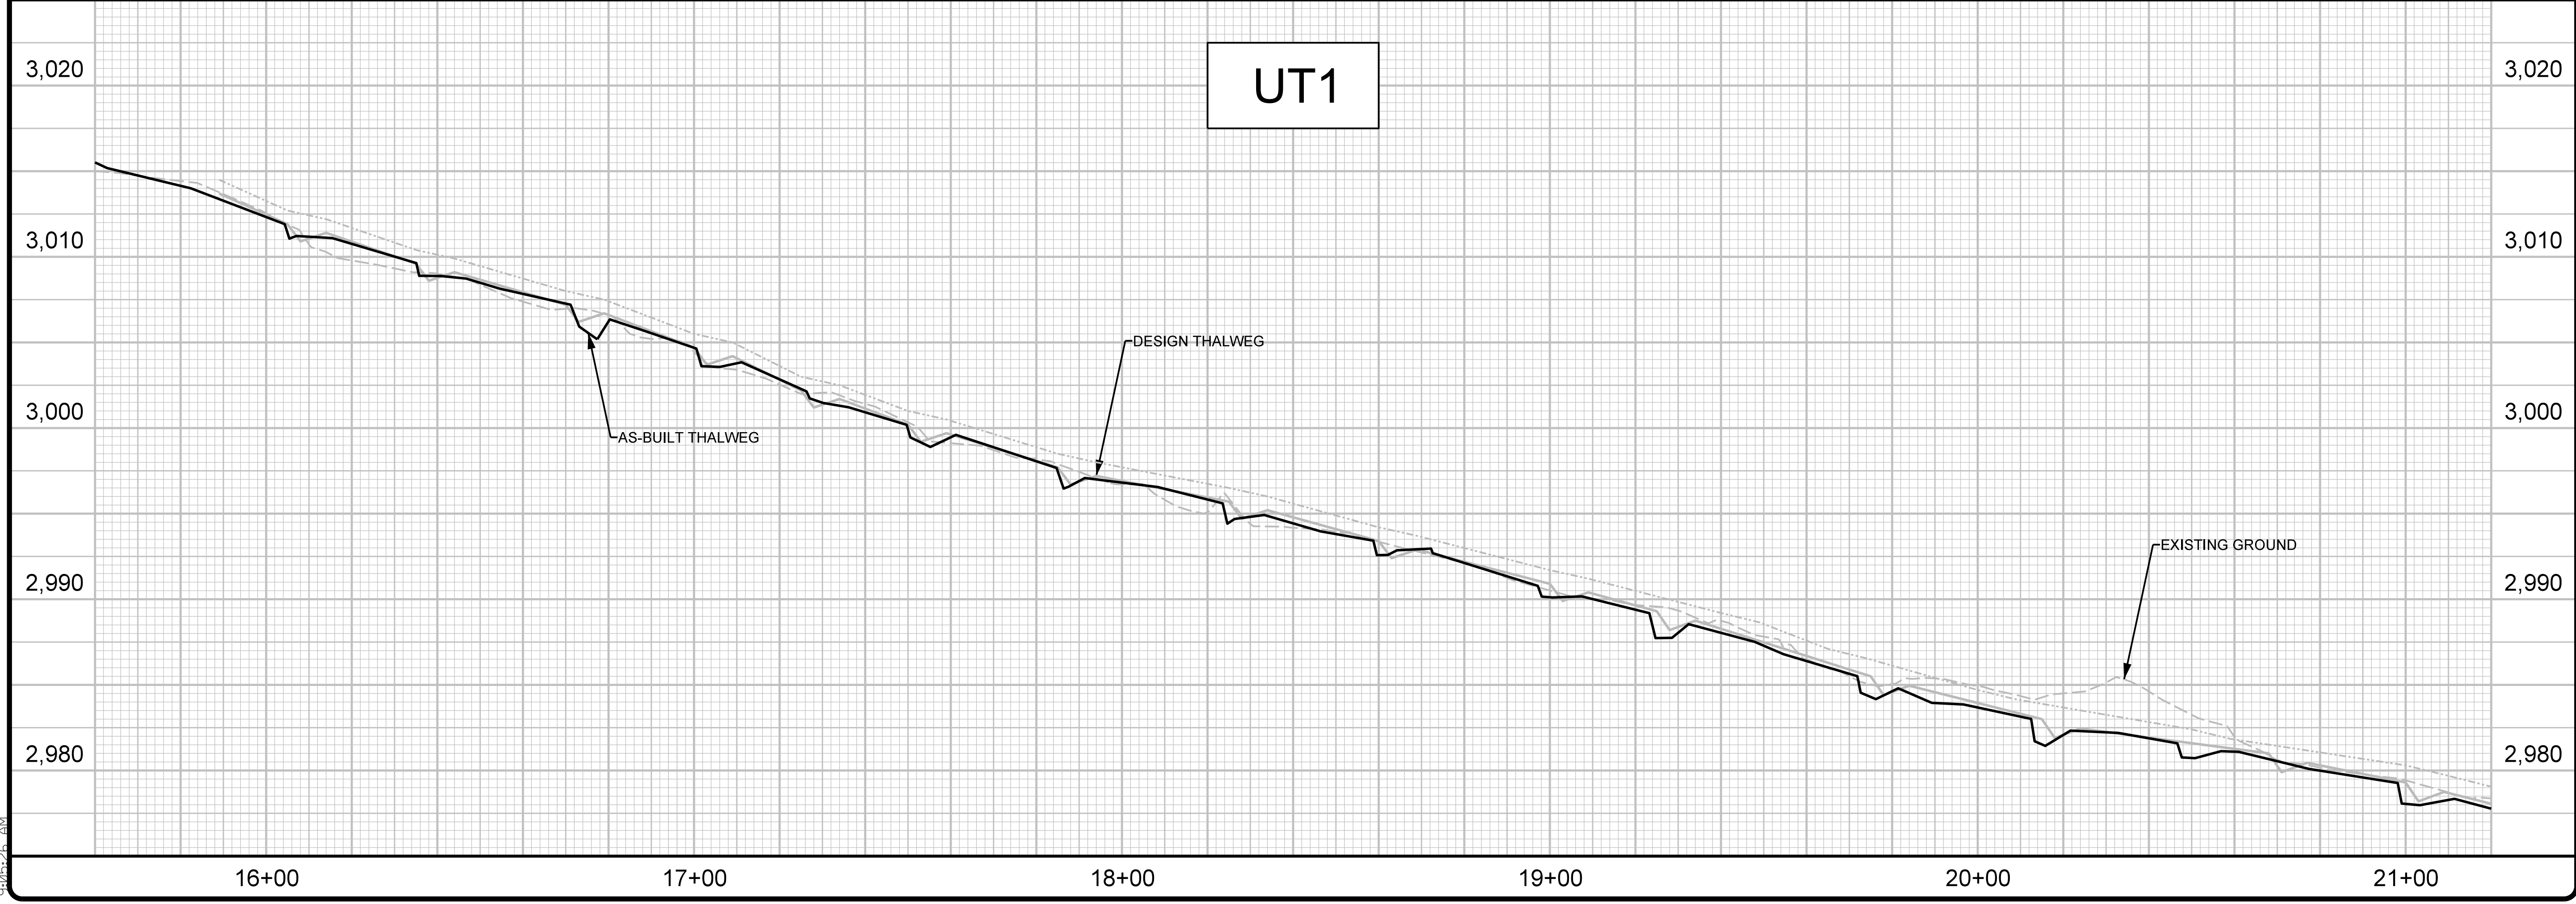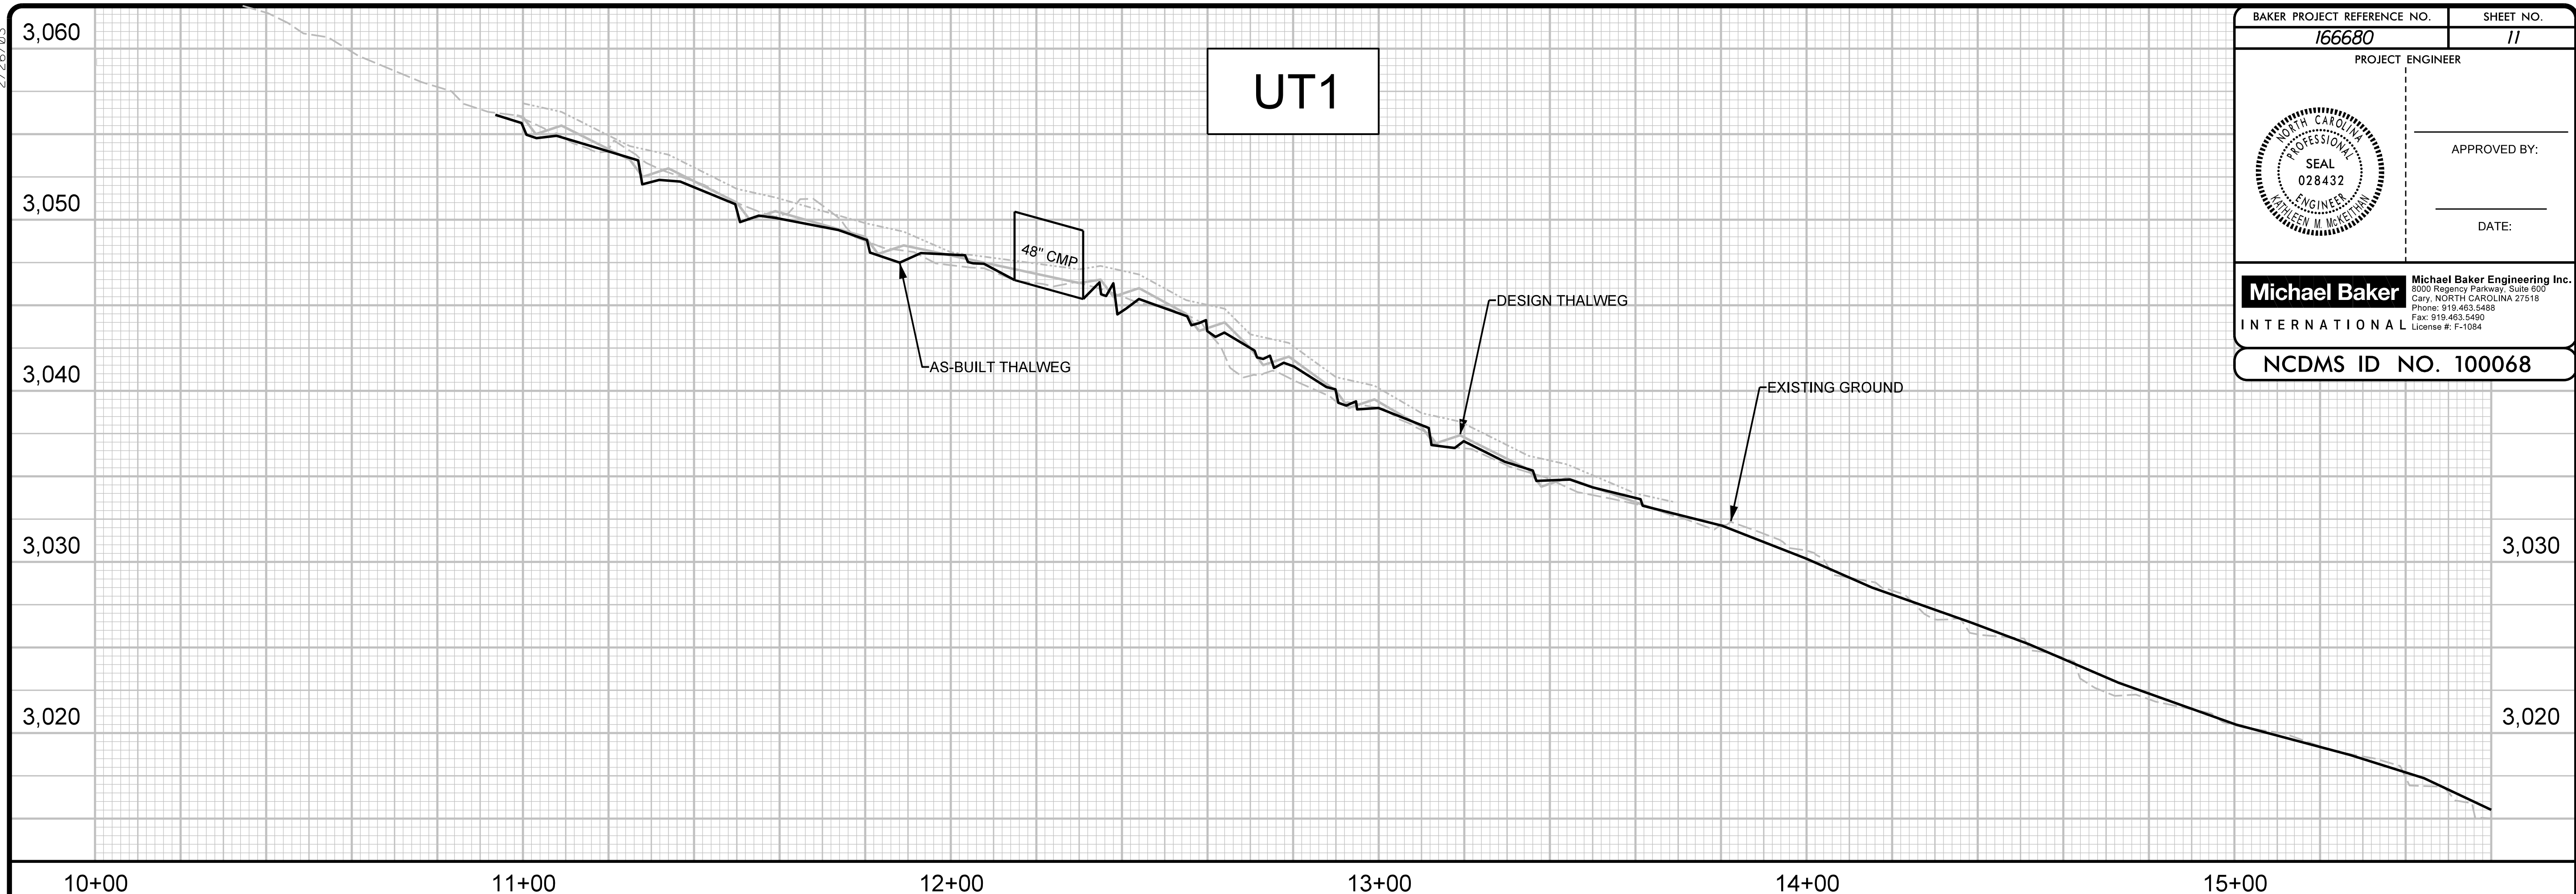

F:\24\2022\Projects\166680_Rush_Fork\Design\As-Built\Plans\166680_ASB-PFL-11.dgn

2/26/03

BAKER PROJECT REFERENCE NO. 166680	SHEET NO. 12
PROJECT ENGINEER	
	
DATE:	
Michael Baker International	
<small>Michael Baker Engineering Inc. 5000 Regency Parkway, Suite 500 Cary, NORTH CAROLINA 27518 Phone: 919.463.5488 Fax: 919.463.5490 License #: F-1084</small>	
NCDMS ID NO. 100068	

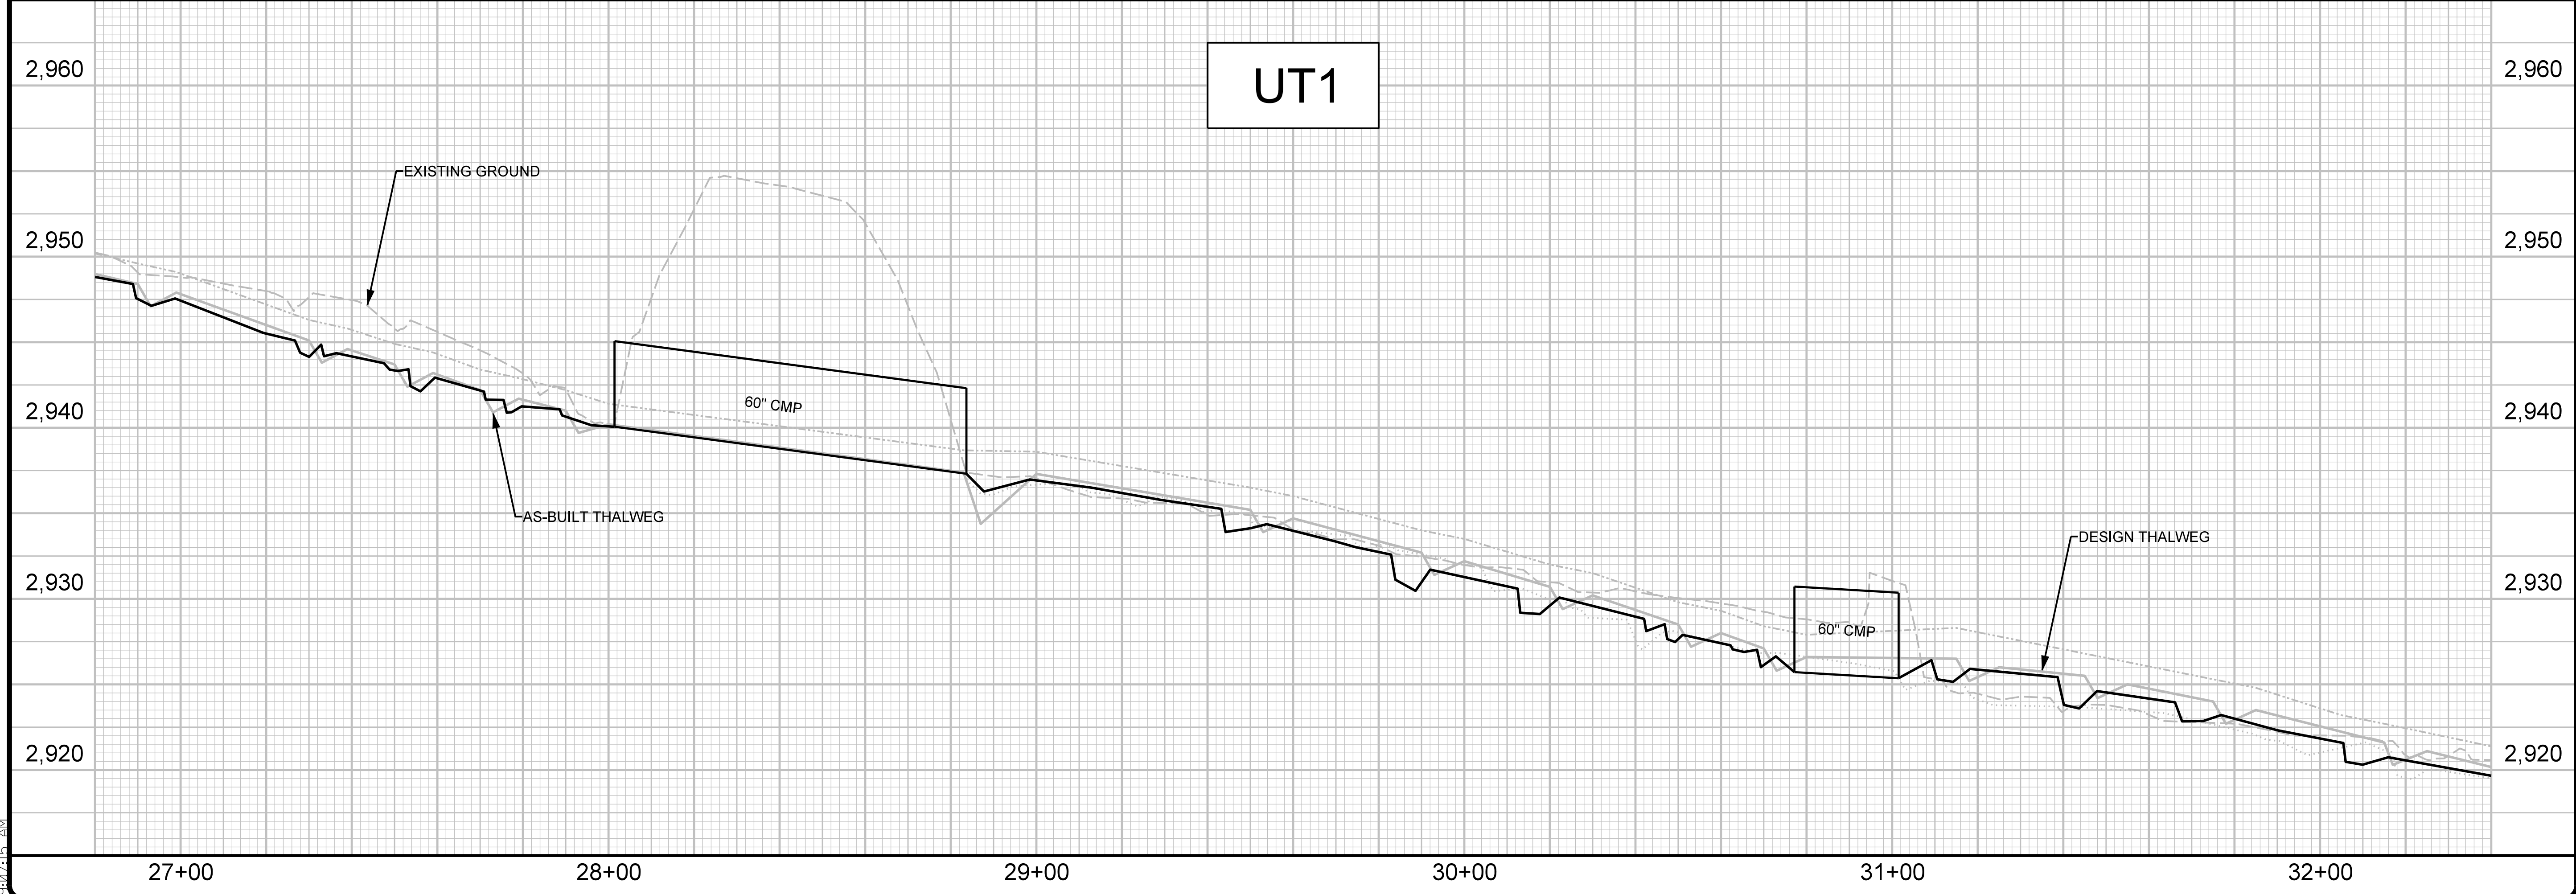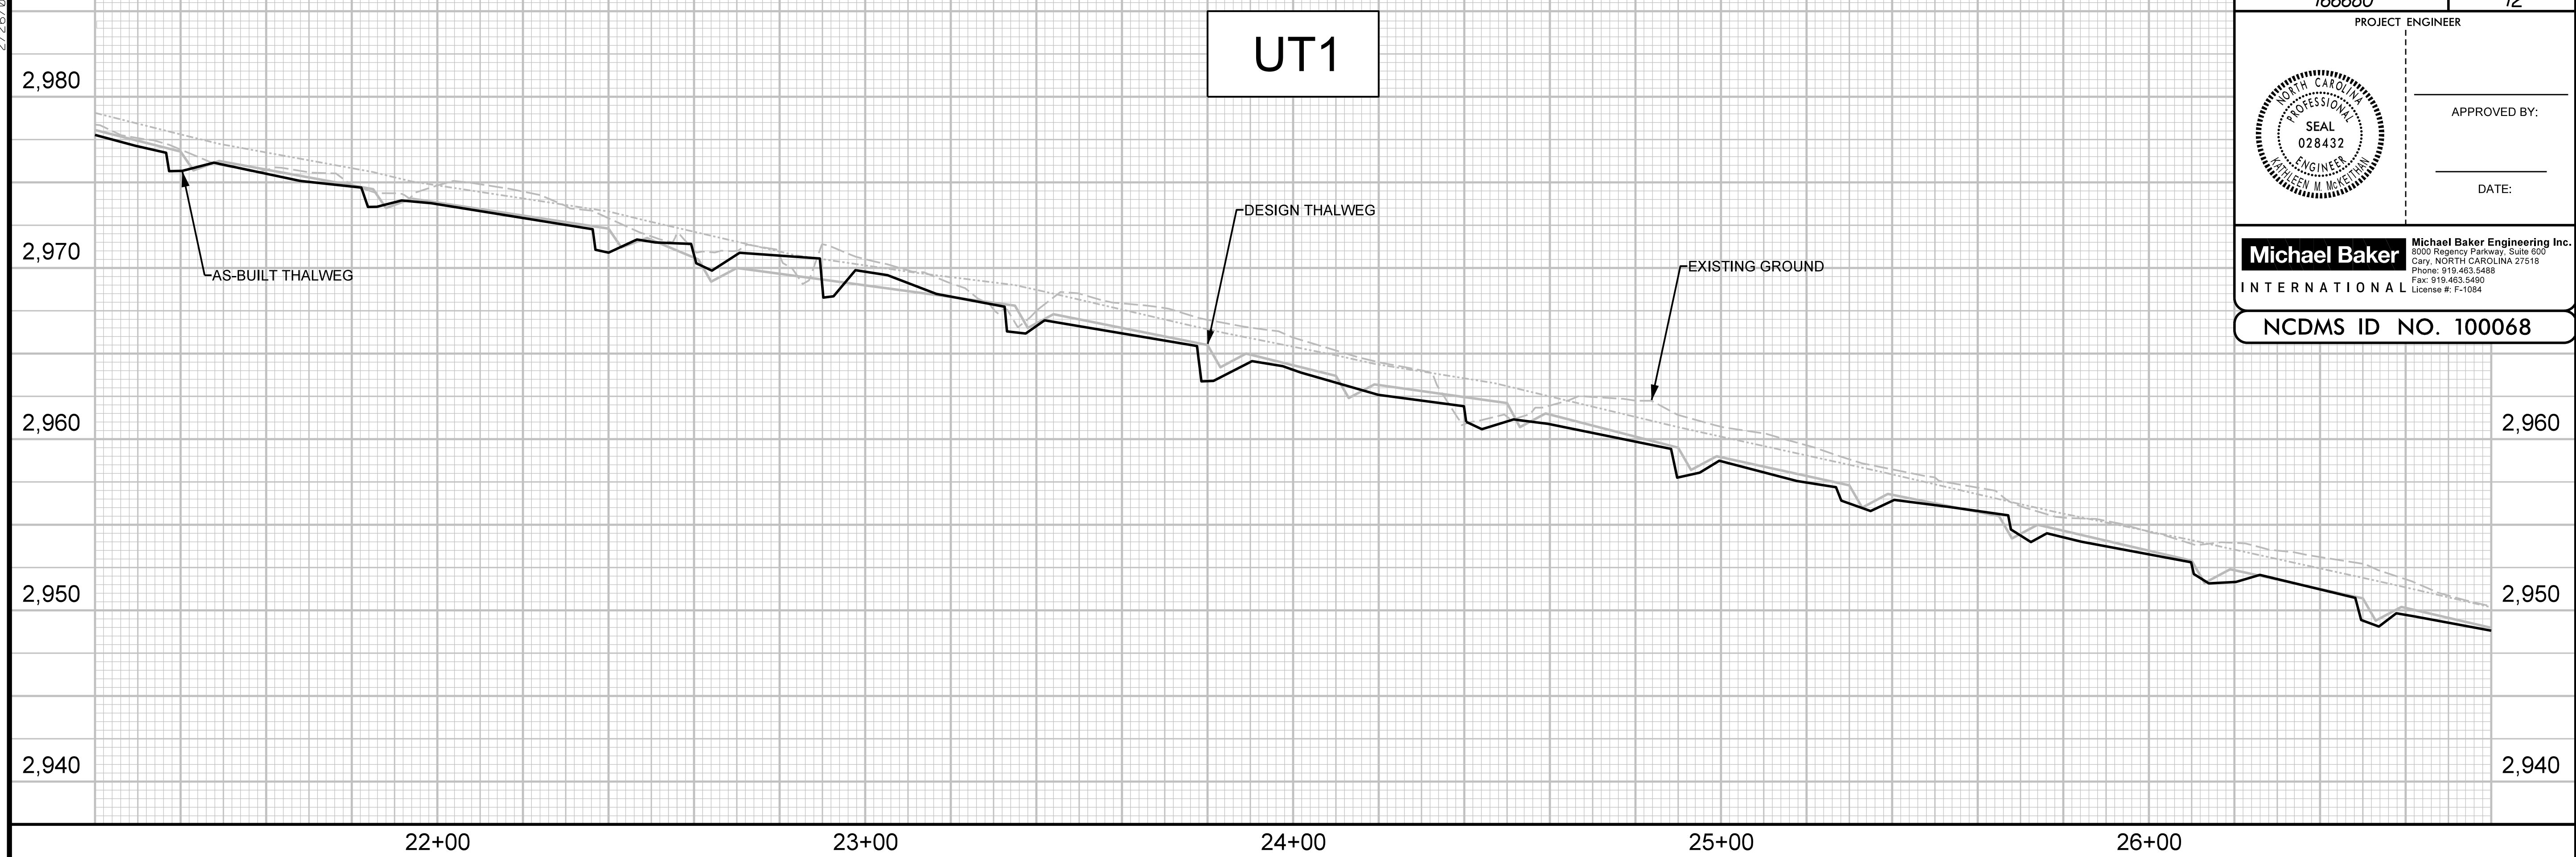

F:\24\2022\Projects\166680_Rush_Fork\Design\As-Built\Plans\166680_ASB-PFL-12.dgn

2/26/03

UT1



BAKER PROJECT REFERENCE NO. 166680	SHEET NO. 13
PROJECT ENGINEER	
	
DATE:	
Michael Baker International	
<small>Michael Baker Engineering Inc. 5000 Regency Parkway, Suite 500 Cary, NORTH CAROLINA 27518 Phone: 919.463.5498 Fax: 919.463.5490 License #: F-1084</small>	
NCDMS ID NO. 100068	



F:\24\2022\Projects\166680_Rush_Fork_Design\As-Built\Plans\166680_ASB-PFL-13.dgn

2/26/03



BAKER PROJECT REFERENCE NO. 166680	SHEET NO. 14
PROJECT ENGINEER	
	
APPROVED BY:	
DATE:	
Michael Baker International	
<small>Michael Baker Engineering Inc. 3000 Regency Parkway, Suite 500 Cary, NORTH CAROLINA 27518 Phone: 919.463.5488 Fax: 919.463.5490 License #: F-1084</small>	
NCDMS ID NO. 100068	

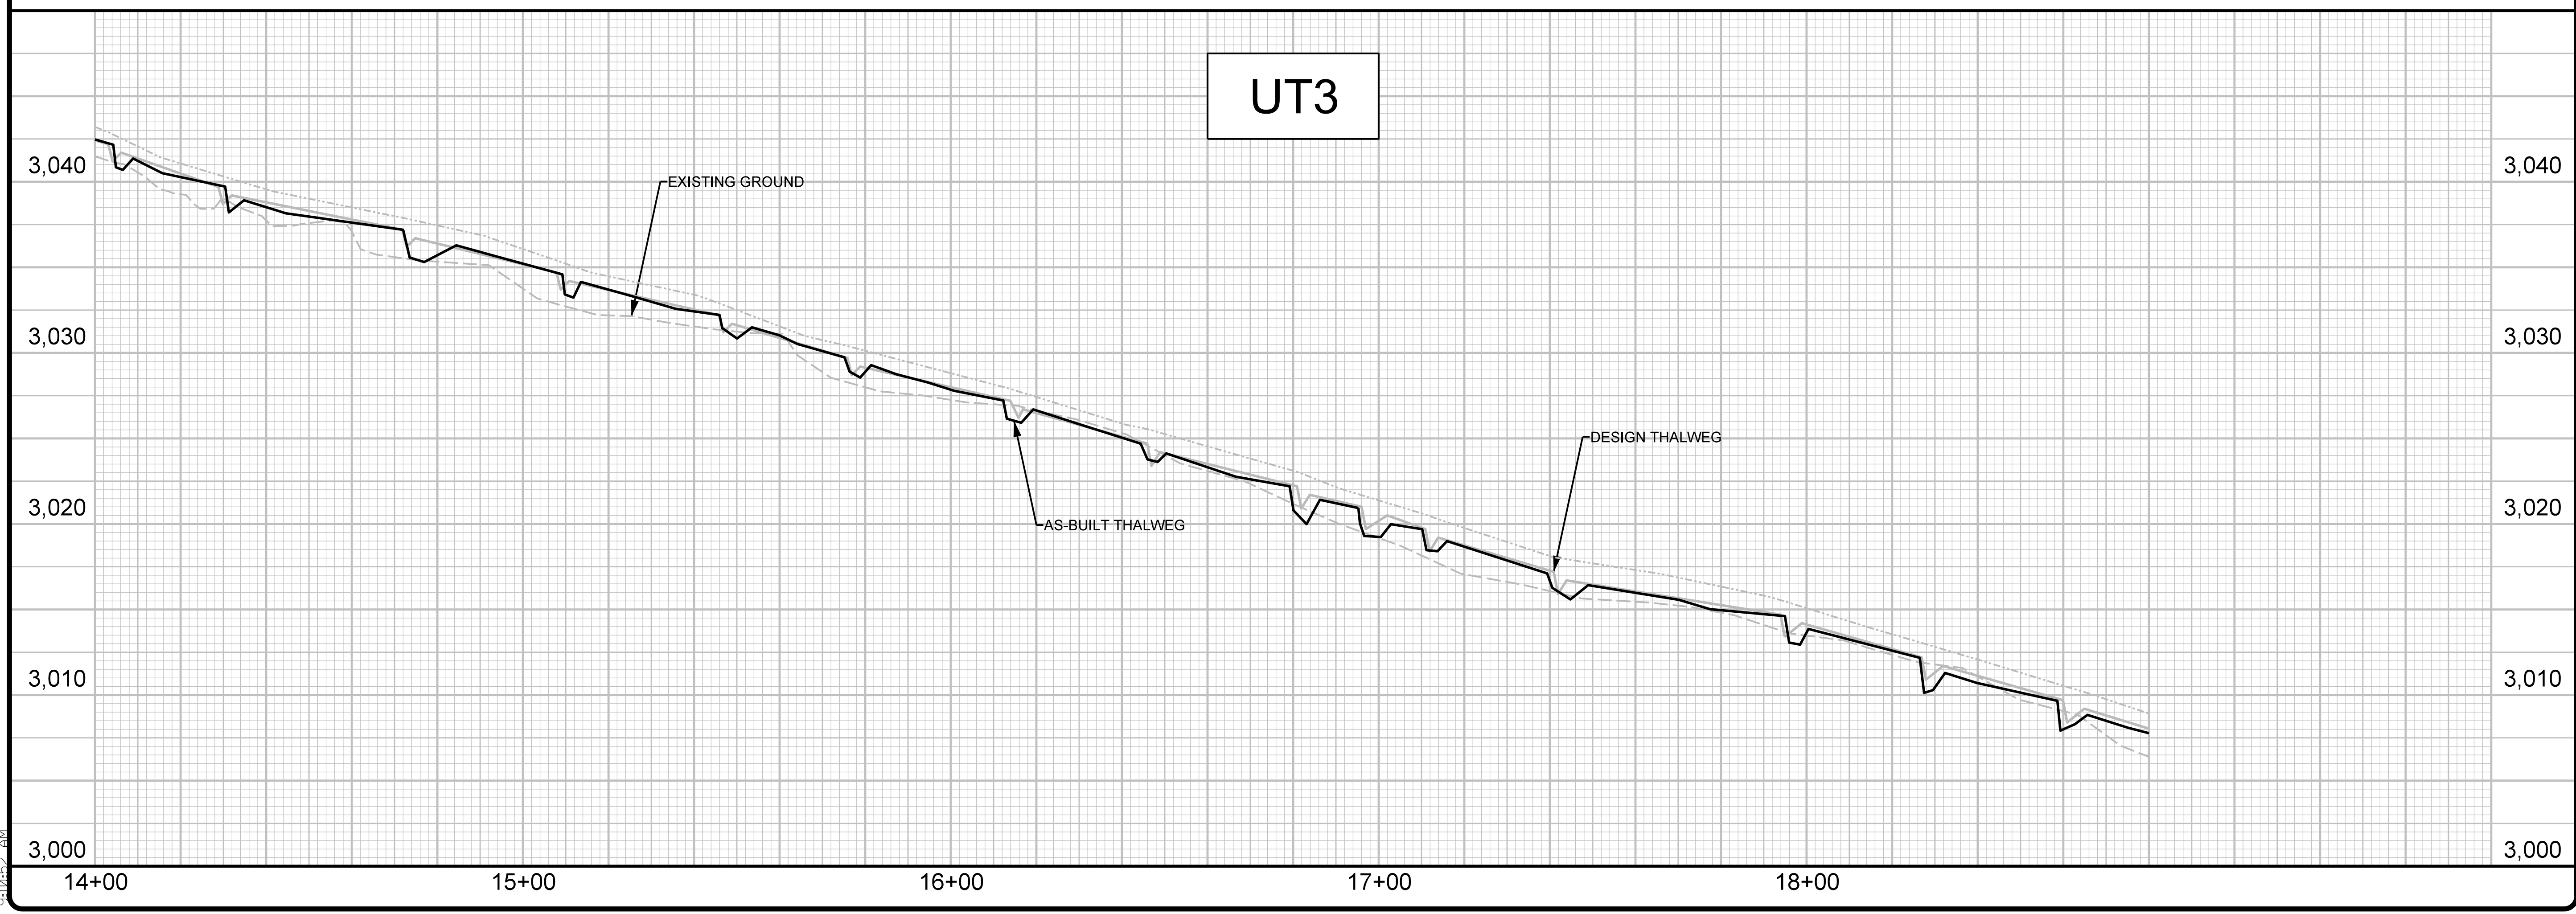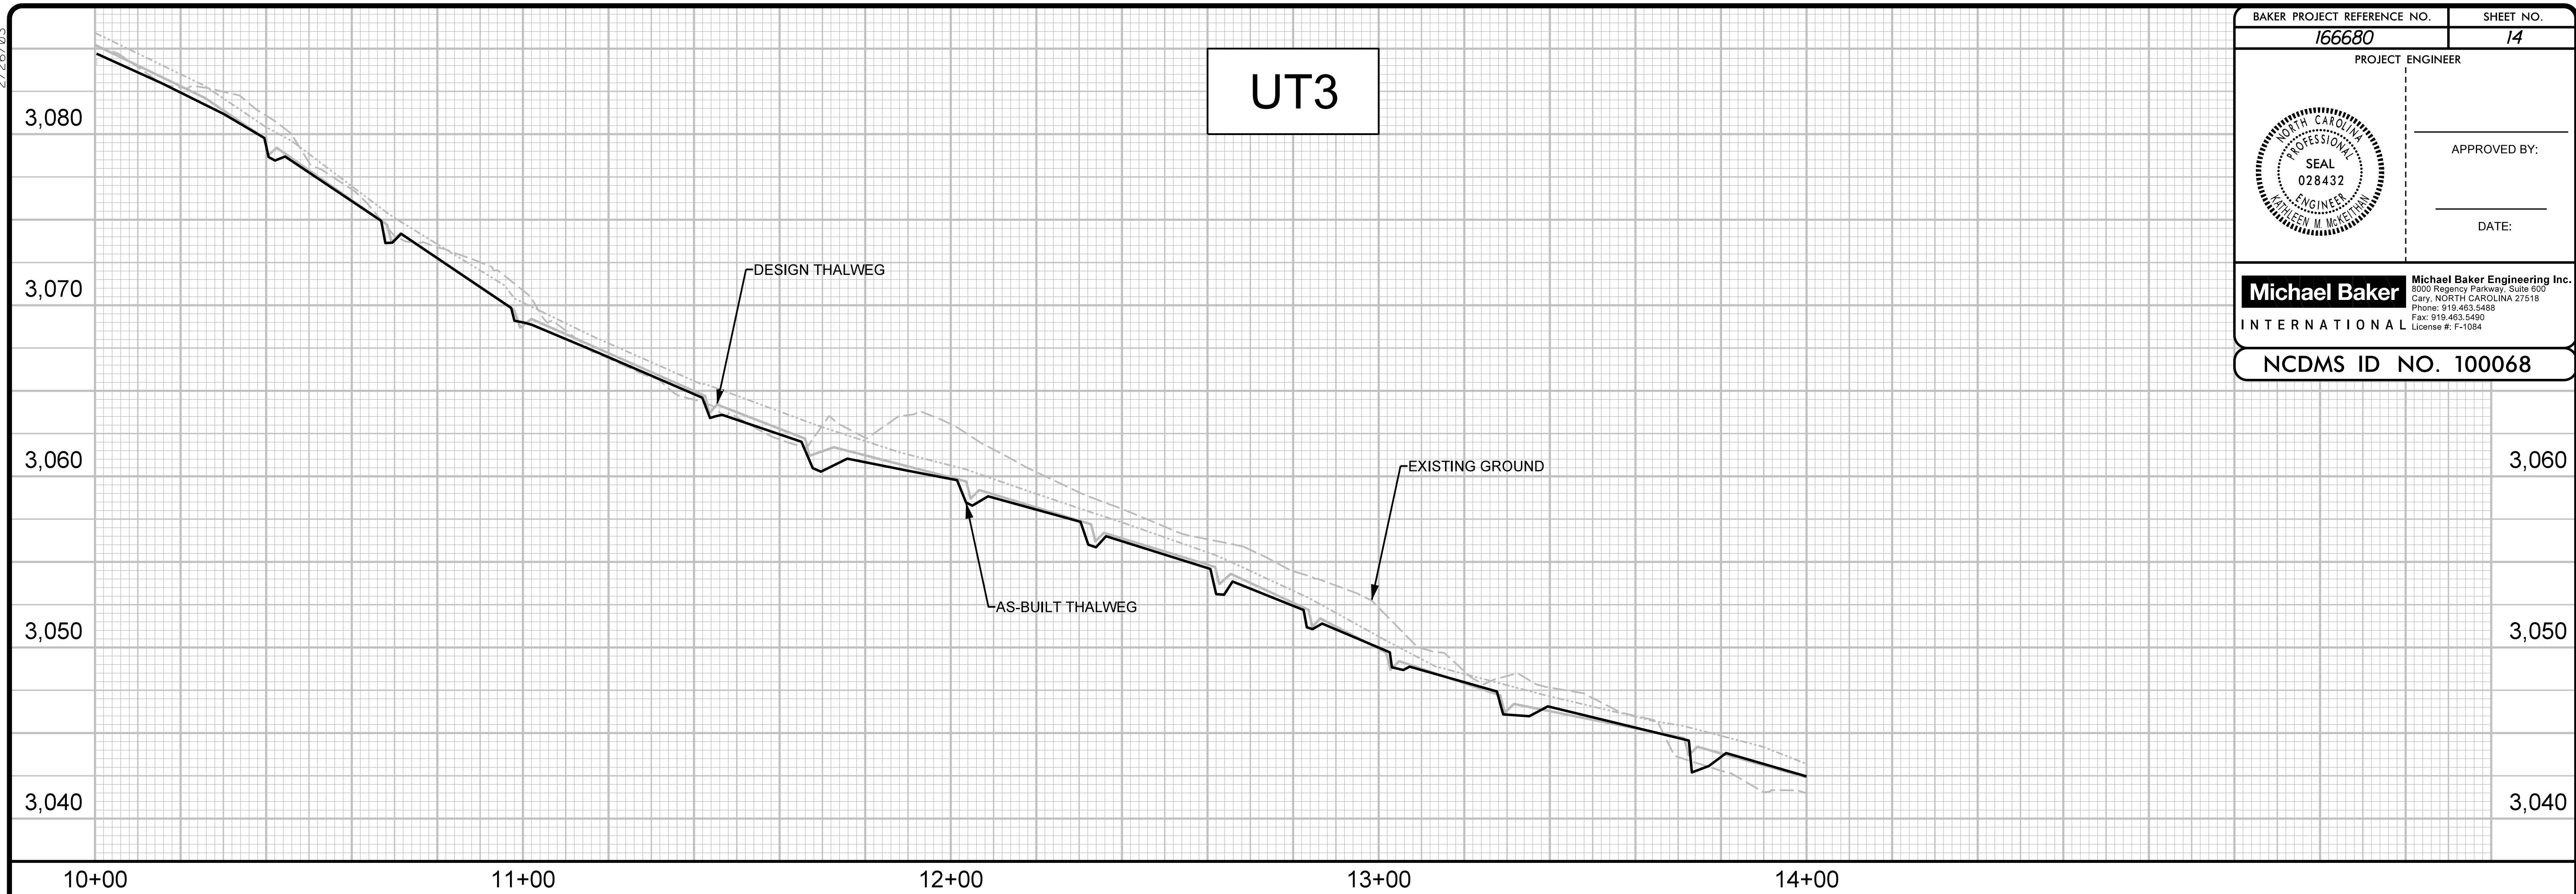

F:\24\2022\Projects\166680\166680_Rush_Fork\Design\As-Built\Plans\166680_ASB-PFL-14.dgn

2/26/03

BAKER PROJECT REFERENCE NO. 166680	SHEET NO. 15
PROJECT ENGINEER	
	
DATE:	
Michael Baker International	
<small>Michael Baker Engineering Inc. 3000 Regency Parkway, Suite 500 Cary, NORTH CAROLINA 27518 Phone: 919.463.5488 Fax: 919.463.5490 License #: F-1084</small>	
NCDMS ID NO. 100068	

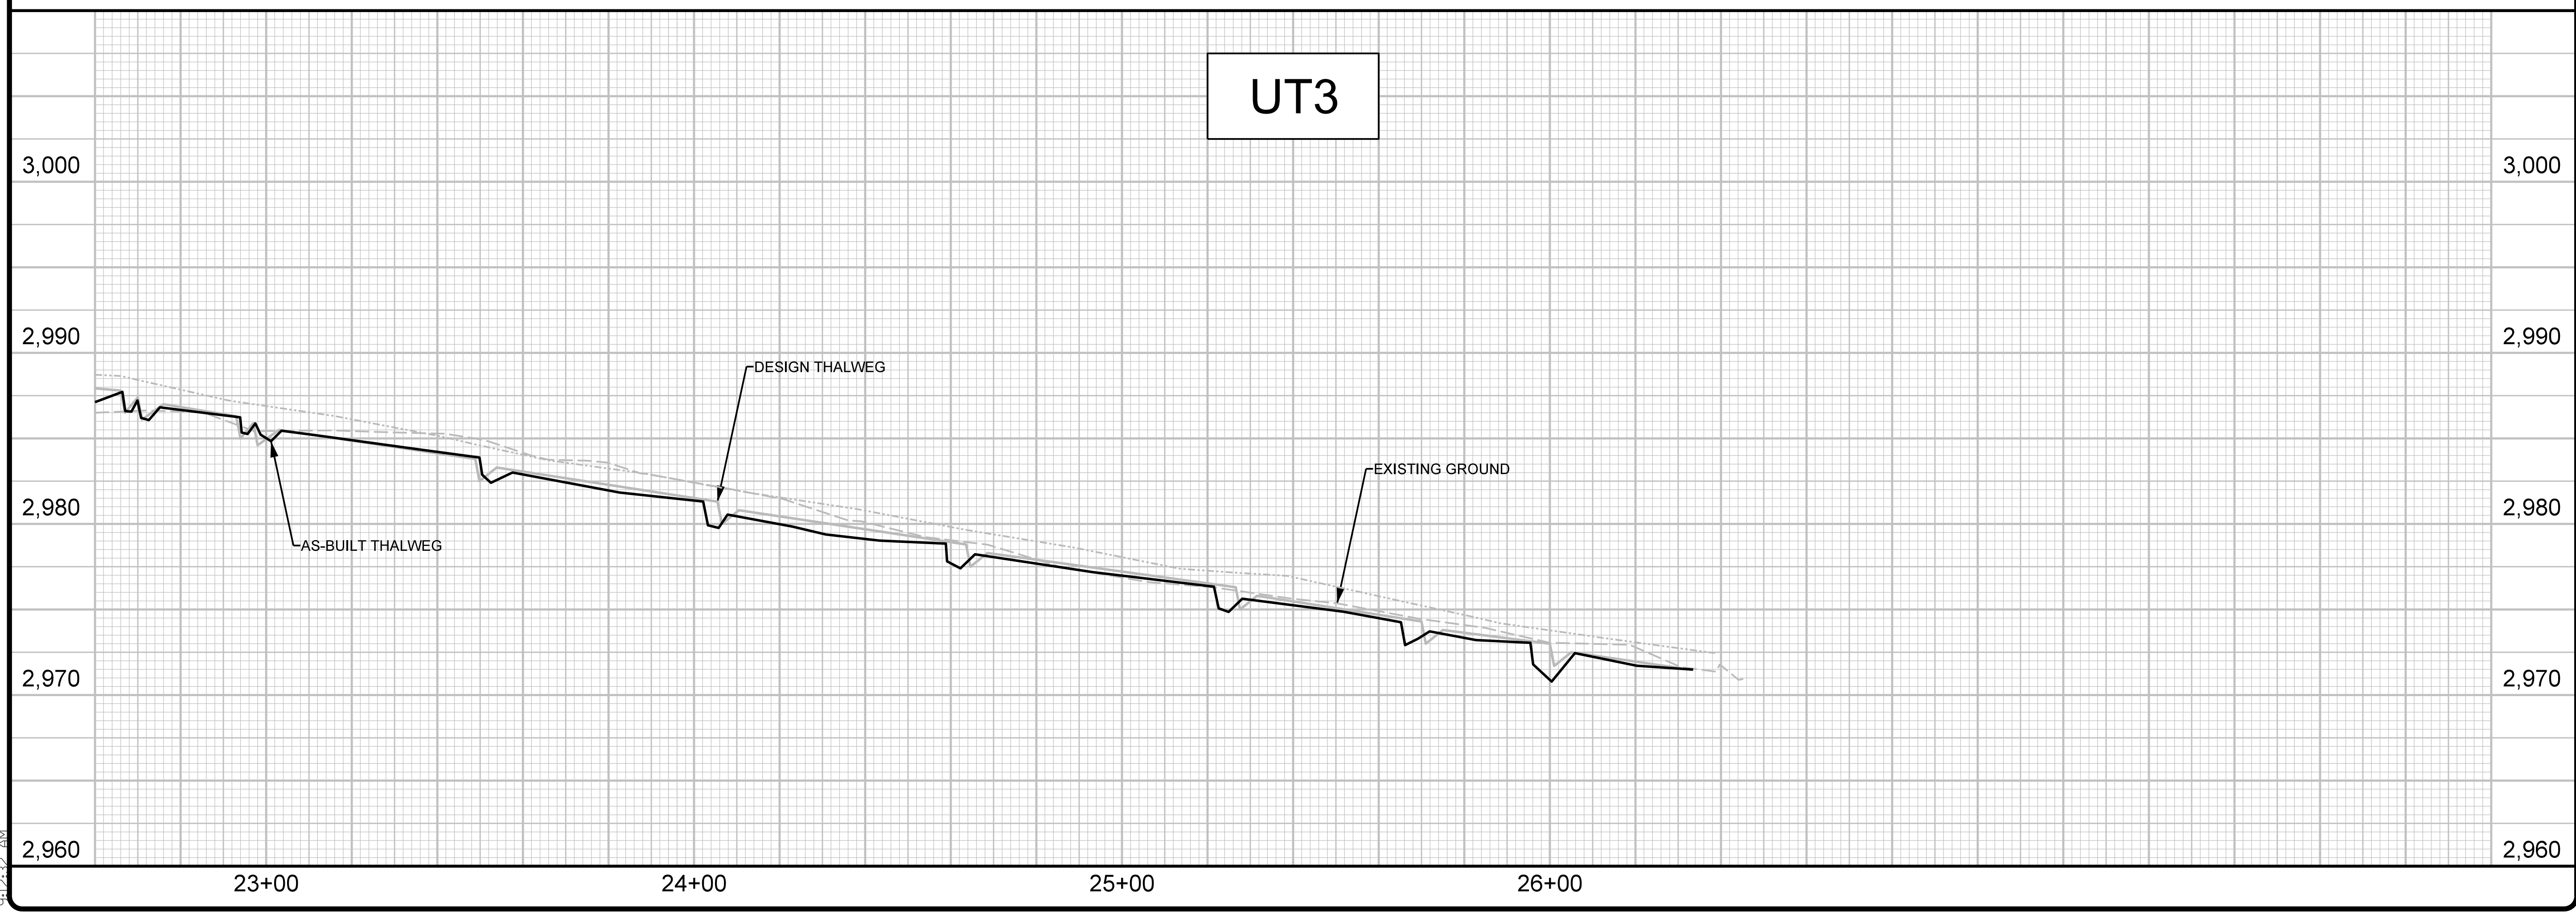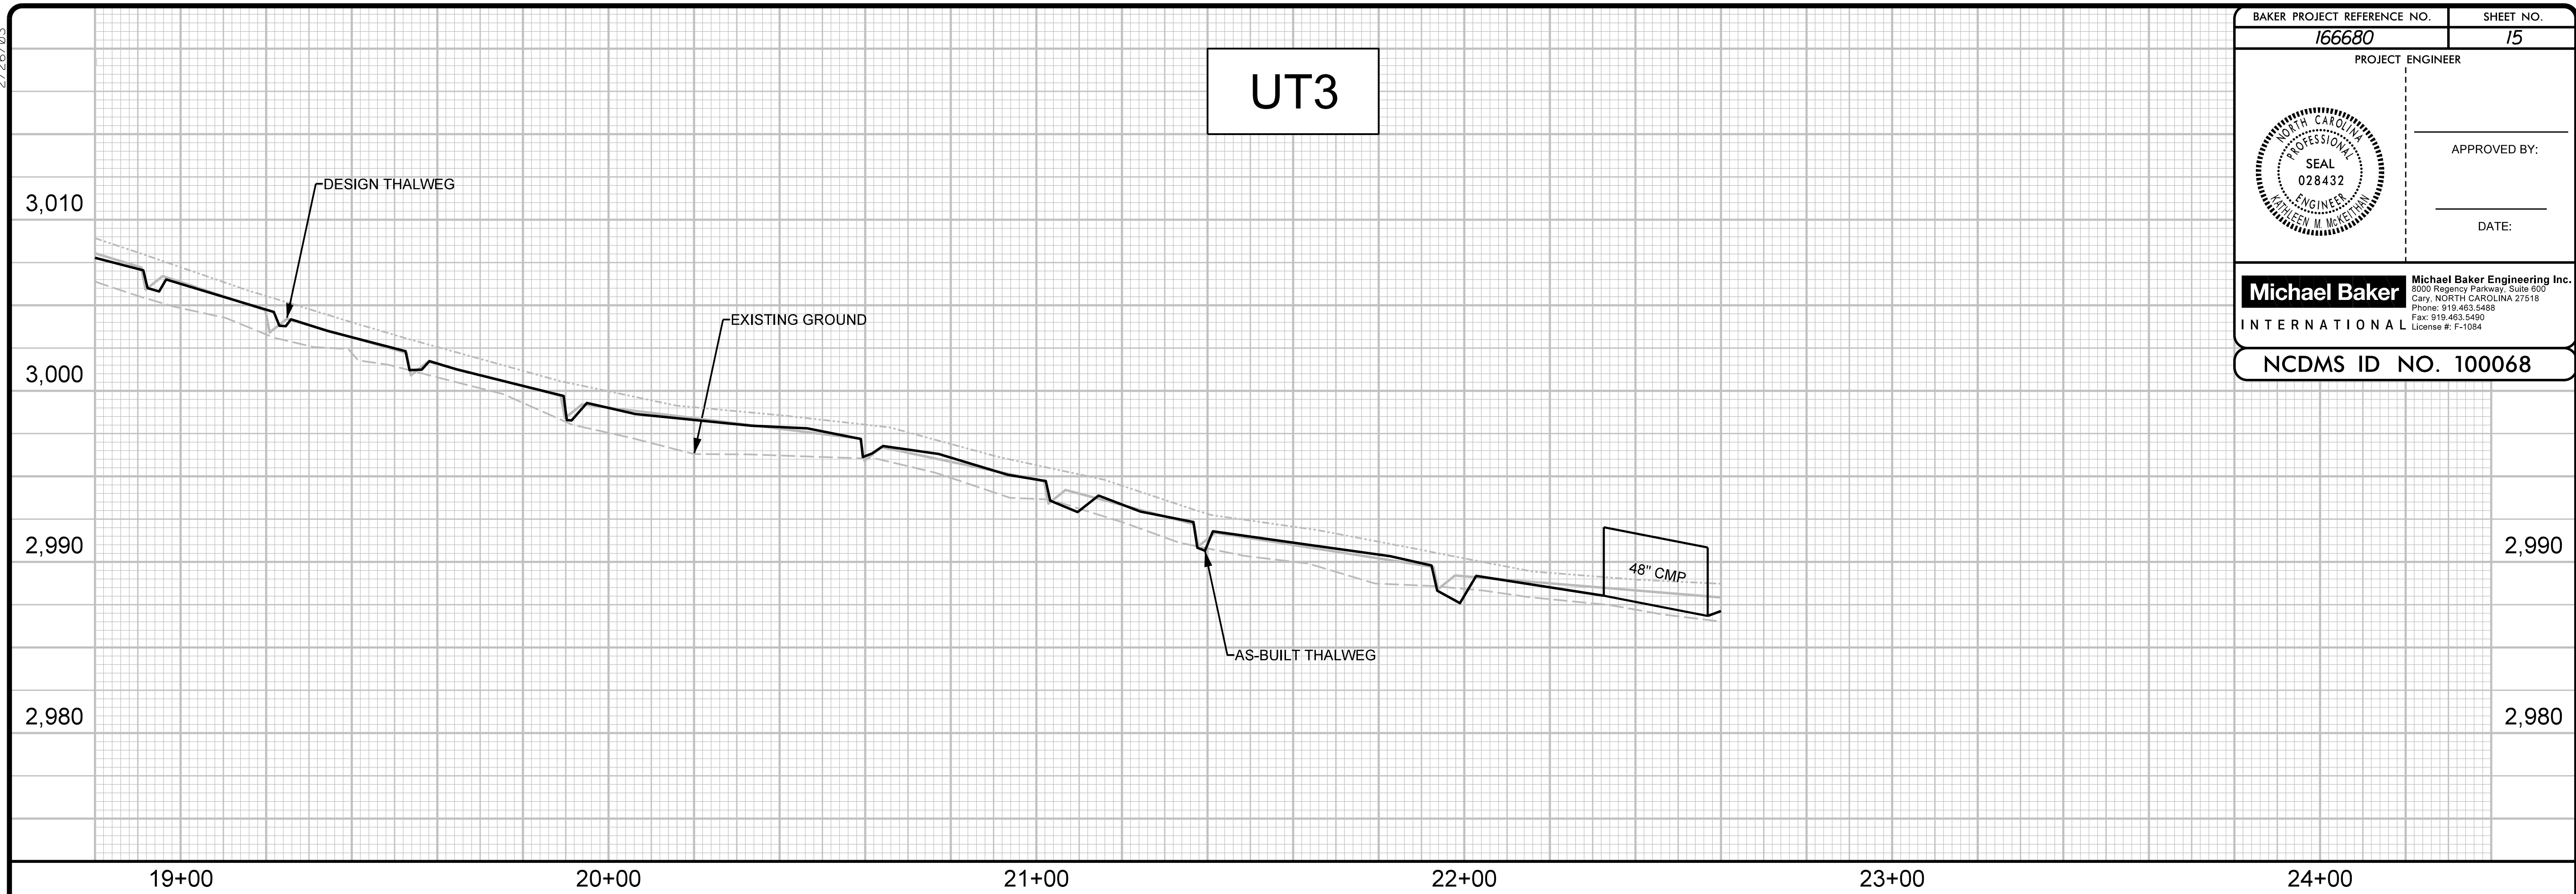

F:\24\2022\Projects\166680\As-Built\Plans\As-Built\166680_ASB-PFL-15.dgn


PROJECT ENGINEER

APPROVED BY: _____

DATE: _____

Michael Baker International Michael Baker Engineering Inc.
 5030 Regency Parkway, Suite 500
 Cary, NORTH CAROLINA 27518
 Phone: 919.453.5488
 Fax: 919.453.5490
 License #: F-1084

NCDMS ID NO. 100068

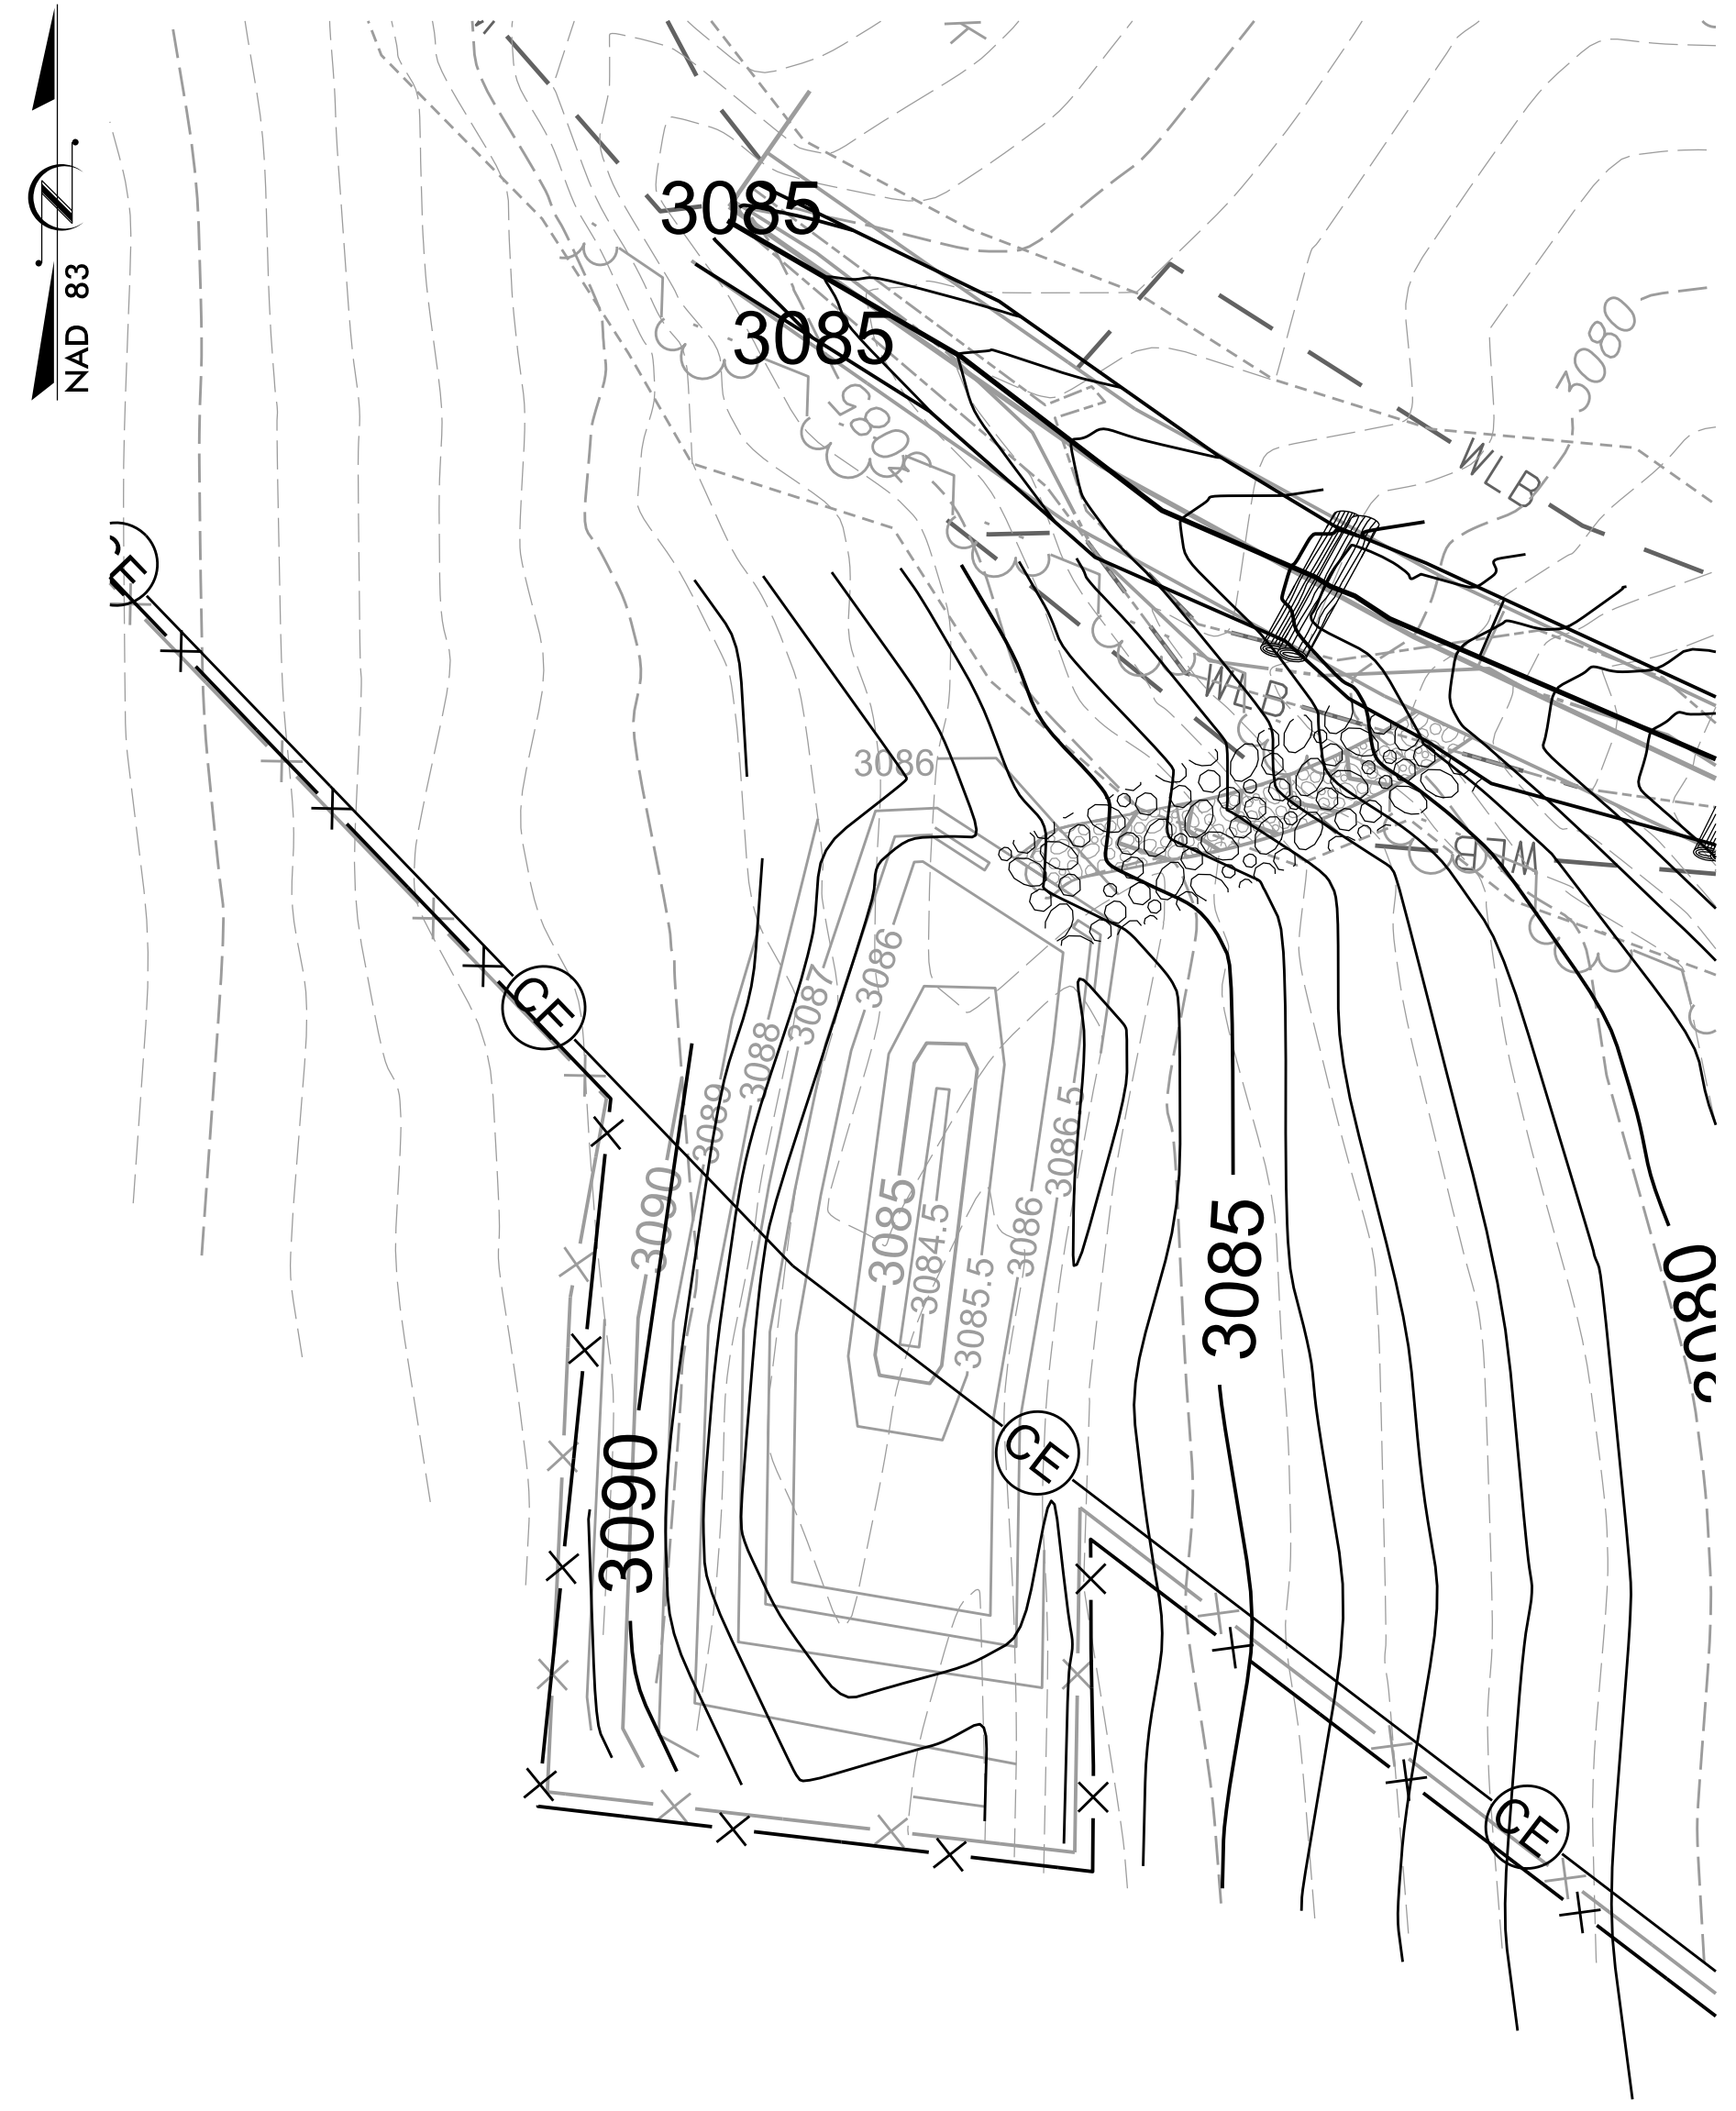

Proposed BMP Planted Species
 UT to Rush Fork Mitigation Project - NCDMS Project No. 100068

Botanical Name	Common Name	% Planted by Species	Wetland Tolerance
Shallow Water Zone (50 Herbaceous Plants per 200 ft²)			
<i>Juncus effusus</i>	Common Rush	10%	FACW
<i>Peltandra virginica</i>	Arrow Arum	10%	OBL
<i>Pontederia cordata</i>	Pickernelweed	10%	OBL
<i>Sagittaria latifolia</i>	Broadleaf Arrowhead	10%	OBL
<i>Saururus cernuus</i>	Lizard's Tail	10%	OBL
<i>Scirpus cyperinus</i>	Woolgrass	10%	FACW
<i>Carex vulpinoidea</i>	Fox Sedge	10%	OBL
<i>Sparganium americanum</i>	Bur-reed	10%	FAC
<i>Carex lurida</i>	Shallow Sedge	10%	OBL
<i>Polygonum pensylvanicum</i>	Smartweed	10%	FACW
Temporary Inundation Zone (8 shrubs per 200 ft²)			
<i>Alnus serrulata</i>	Tag Alder	10%	OBL
<i>Cephalanthus occidentalis</i>	Buttonbush	10%	OBL
<i>Cornus amomum</i>	Silky Dogwood	10%	FACW
<i>Ilex verticillata</i>	Winterberry	10%	FACW
<i>Rhododendron viscosum</i>	Swamp Azalea	10%	FACW
<i>Physocarpus opulifolius</i>	Ninebark	10%	FACW
<i>Sambucus canadensis</i>	Elderberry	10%	FACW
<i>Leucothoe fontanesiana</i>	Highland Doghobble	10%	FACW
<i>Vaccinium corymbosum</i>	Highbush Blueberry	10%	FACW
<i>Xanthorhiza simplicissima</i>	Yellowroot	10%	FACW

Notes: -Final species selection may change due to refinement of site conditions or to availability at the time of planting. If species substitution is required, the planting Contractor will submit a revised planting list to Baker for approval prior to the procurement of plant stock.

-Shallow Water planting zone is from basin bottom to elevation 3085.5' while Temporary Inundation planting zone is from elevation 3085.5' to 3086.5'.

-Embankments and perimeter fill slopes will be planted with non-clumping turf grasses (no trees or woody shrubs).

**UT to RUSH FORK
 AS - BUILT
 RECORD DRAWING**

SCALE (FT)