

As-built Baseline Monitoring Report FINAL

UT to Rush Fork Stream Mitigation Project



Haywood County, North Carolina

French Broad River Basin: 06010106

DMS Project ID No. 100068

DMS RFP #16-007335 (Issued 9/8/2017)

DEQ Contract No. 7535

USACE Action ID No. SAW-2018-01171

DWR# 2018-1034

Baseline Data Collection Period:
March 2022

Submitted to/Prepared for:

NC Department of Environmental Quality
Division of Mitigation Services (DMS)
1652 Mail Service Center
Raleigh, North Carolina 27699-1652

Michael Baker

INTERNATIONAL

Submission Date: August 2022

August 8, 2022

Paul Wiesner, PM
NCDENR, Division of Mitigation Services
5 Ravenscroft Dr. – Suite 102
Asheville, NC 28801

Subject: Response to DMS Comments (June 24, 2022) for Draft As-Built Baseline Monitoring Report. UT to Rush Fork Stream Mitigation Project, Haywood County
French Broad River Basin: 06010106
DMS Project #100068

Dear Mr. Wiesner,

Please find below our responses to the NC Division of Mitigation Services (DMS) review comments dated June 24, 2022 in reference to the Rush Fork Stream Mitigation Project's As-Built Baseline Monitoring Report. We have revised the Draft document in response to review comments as outlined below.

- Cover Page: Please update the cover page to; UT to Rush Fork Stream Mitigation Project, so the project name matches the DMS accounting system (CRM) and the project's Credit Ledger. Please update the project name report wide as necessary.

RESPONSE: Revision made as requested.

- Section 1.1 Project Description: This section notes; *"Michael Baker Engineering, Inc. (Michael Baker) restored approximately 2,865 linear feet and enhanced an additional 1,185 linear feet of stream along seven reaches of unnamed tributaries (UT) to Rush Fork creek."* These footages do not appear to match Table 1. Please review and update the report accordingly. Please also review and confirm the uncredited wetland acreage noted in the report.

RESPONSE: Revisions and review made as requested.

- Section 1.6 Design Change Deviations: In this section, please also note and discuss any monitoring device location changes from the IRT approved mitigation plan.

RESPONSE: Two monitoring changes were noted: the addition of a flow gauge on UT4 and the relocation of one vegetation plot from the right floodplain to the left floodplain on UT1-R4.

- General: Based on recent IRT feedback and requests, DMS recommends including upstream and downstream project crossing photos in all future monitoring reports (MY1-MY7).

RESPONSE: Additional photos of upstream and downstream project crossings will be included in future monitoring reports (MY1-MY7).

- Appendix E: This appendix should be labeled “Record Drawing Plan Sheets”.

RESPONSE: Revision made as requested.

- Appendix E - Record Drawing Sheet 5: Sheet 5 shows a portion of the crossing infrastructure (pipe and headwall) installed inside the conservation easement. This infrastructure encroachment was confirmed in the field by DMS and Baker on 6/14/2022. The crossing infrastructure should be moved outside of the recorded conservation easement, or a conservation easement modification will be required. Any conservation easement modification costs will be the responsibility of the full delivery provider (Baker). Please discuss a proposed resolution in the comment responses. The proposed resolution will need to be reviewed and approved by the IRT as part of the MY0/ As-built IRT review prior to implementation.

RESPONSE: Baker has worked with the contractor to move the crossing infrastructure just upstream of the CE line. This modification was completed on July 25, 2022.

- Appendix E - Record Drawing Sheet 7: Please confirm that the pre-existing soil road shown within the conservation easement has been either moved or extinguished as part of the project construction. In the revised record drawings, the sheet should be updated to show the soil road relocation area or a call out should be provided noting that the soil road was extinguished as part of project construction and implementation.

RESPONSE: We acknowledge the soil road is shown on Sheet 7; however, this is only intended to describe a topographical and historic feature on the landscape. The road has long been abandoned for any use and is currently vegetated with mature trees and lacks any connection to any usable roadways. Moreover, there is no existing Right of Way, and the old roadbed was not used during construction of this project.

- Appendix E - Record Drawing Sheet 8: Sheet 8 shows a portion of the project BMP located within the conservation easement and a portion of the BMP located outside of the conservation easement. Please explain why the BMP is partially located in the conservation easement and indicate if BMP maintenance will be required in the monitoring term or in long term Stewardship. If a conservation easement modification is required based on the comment above and IRT review, DMS and DEQ Stewardship highly recommend including the entire BMP and associated infrastructure inside the modified conservation easement. Please discuss a proposed resolution. As noted above, this should be reviewed and approved by the IRT as part of the MY0/ As-built IRT review prior to implementation.

RESPONSE: The capacity of the designed BMP needed to increase to function as intended. This design was implemented after the establishment of the conservation easement,

resulting in a portion of the BMP being located outside the conservation easement boundary. It should be noted that livestock fencing surrounds the entire BMP with permission and cooperation from the landowner. This arrangement was shown in the approved Mitigation Plan on Sheet 9 of the included project plans, thus review and approvals have already taken place. Functionality of the BMP will be assessed in future monitoring years to determine if maintenance will be required; although no maintenance outside the conservation easement boundary is anticipated.

DMS conducted a field visit on June 14, 2022. The following comments/observations are a result of that visit:

- Areas of multiflora rose were noted within the conservation easement at the upstream portion of UT3. Please treat the existing invasives within the entire conservation easement during MY1 (2022) and through the monitoring term. Please provide invasive treatment details in the MY1 (2022) report.

RESPONSE: Multiflora rose was treated on June 29th, 2022, at the upstream portion of UT3 and invasive plants will continue to be treated as needed in future monitoring years. Details of these treatments will be included in all monitoring reports.

- The conservation easement corners along the unfenced section of UT1-R4 from stations 24+00 – 28+00 (soil farm road) are not currently marked. Each conservation easement corner must be marked with a durable witness post and signage. Conservation easement corners greater than 200 feet in distance or stretches that cannot be seen by direct line of sight should be supplementally marked between the easement corners. All conservation easement marking must be complete prior to approval and payment for Task 6 (MY0).

RESPONSE: Signs were added to these posts on June 29, 2022. Additional durable witness posts were added on August 16, 2022.

- Signed durable wooden posts mark the conservation easement corners on reach UT1-R4 (stations 31+00 – 38+00). Metal t-posts are installed between conservation easement corners but are not currently signed. DMS recommends adding signs to the t-posts to clearly mark the conservation easement boundary. While not required, Baker should consider adding PVC poles on this reach to avoid easement encroachment and easement scalloping.

RESPONSE: Signs were added to these t-posts on June 29, 2022. Additional signage and/or t-posts may be added along with PVC poles to clearly delineate the conservation easement boundary.

Digital Deliverable Comments:

- The MY0 2022 Background Tables file - Table 5 vegetation table, is incorrect/ not complete.

The data sheets and individual vegetation tables submitted appear to be complete and accurate. Please verify that Table 5 should be deleted from this submission or submit a revised and accurate Table 5 with data as presented in vegetation data files.

RESPONSE: This revision has been made as requested. Table 5 has been changed to Table 6 due to the addition of the new Table 2, Summary: Goals, Performances and Results and is in the Background Tables file. The blank file has been deleted. An accurate Table 6 is included in the vegetation data files.

- The cross-section morphology table used is not the current version of the template and is missing attributes required for baseline morphology summary, please see the current (2020) version of the DMS Monitoring Table templates and include all missing attributes noted on the morph table template.

RESPONSE: The cross-section morphology table has been updated to the current DMS monitoring template and missing attributes have been added. The revised table is Table 8 in Appendix D.

- The goals table (table 2 of DMS template) is missing from the submission.

RESPONSE: The goals table has been included as Table 2 in Appendix A.

- The cross section and longitudinal profile raw data is incomplete, please refer to the DMS monitoring digital data templates, XS Raw Survey and Raw Long Pro Data, for features requiring annotation and revise the submission to include missing features.

RESPONSE: Grade control structures have been added to the profile and a note has been added to the XS graphs indicating the location of the left and right pins. A table has been added to the Geomorphology folder in the digital deliverables indicating the type of structure, it's stationing and elevation by reach.

- Photo Point 58 is missing from the RushFork_As_Photo_Points file. Please update accordingly.

RESPONSE: Photo Point 58 is included the Stream Station Photo Points within the As Built report and is also included in the digital submission files under Support Files – 2 Visual Assessment – Photos – Stream. Photo Point 58 is the last file in this folder.

- Please provide a .PDF of the standalone PLS sealed project as-built drawings in the revised digital submittal.

RESPONSE: A standalone copy of the PLS sealed project as-built drawings has been included as requested.

- Please verify the soil road indicated as having been relocated on the As-built and the fencing previously identified in the conservation easement plat in the vicinity of veg plot 3 have both been relocated outside the conservation easement.

RESPONSE: Both the soil road and the fencing previously identified in the conservation easement have been relocated outside of the conservation easement in these areas.

As requested, one hardcopy of the revised Final As-Built Baseline Monitoring report has been included with this response. A full electronic copy with support files is also included on a USB drive. Please do not hesitate to contact me should you have any questions regarding our response submittal.

Sincerely,

A handwritten signature in black ink, appearing to read "Jason York". The signature is fluid and cursive, with a large initial "J" and "Y".

Jason York
Environmental Scientist

TABLE OF CONTENTS

1.0	PROJECT SUMMARY	3
1.1	PROJECT DESCRIPTION.....	3
1.2	GOALS AND OBJECTIVES.....	3
1.3	PROJECT SUCCESS CRITERIA	4
1.4	MITIGATION COMPONENT SUMMARY	4
1.5	PROJECT TIMELINE.....	6
1.6	DESIGN CHANGE DEVIATIONS	6
1.7	VICINITY MAP	7
1.8	TECHNICAL AND METHODOLOGICAL DESCRIPTIONS AND REFERENCES	8

APPENDICES

Appendix A	<i>Background Tables and Figures</i>	
	Table 1	Project Mitigation Quantities and Credits
	Figure 2	Project Asset Map and Credit Map
	Table 2	Summary: Goals, Performances and Results
	Table 3	Project Activity and Reporting History
	Table 4	Project Contacts
	Table 5	Project Baseline Information and Attributes
Appendix B	<i>Visual Assessment Data</i>	
	Figure 3	Current Condition Plan View (CCPV) Map
	Figure 4	As Built Stream Station Photo-Points
	Figure 5	As Built Vegetation Photo Log
	Figure 6	Monitoring Device Photo Log
Appendix C	<i>Vegetation Plot Data</i>	
	Table 6	Planted Stem Counts by Plot and Species
Appendix D	<i>Stream Measurement and Geomorphology Data</i>	
	Table 7	Baseline Stream Data Summary
	Table 8	Cross-Section Morphology Data Summary
	Figure 7	Longitudinal Profiles
	Figure 8	As Built Cross-Sections
Appendix E	<i>Record Drawing Plan Sheets</i>	

1.0 PROJECT SUMMARY

1.1 Project Description

Michael Baker Engineering, Inc. (Michael Baker) restored approximately 2,843.58 linear feet and enhanced an additional 1160.43 linear feet of stream along seven reaches of unnamed tributaries (UT) to Rush Fork creek. Additionally, 0.996 uncredited acres of adjacent riparian wetlands were enhanced and protected within the conservation easement of the project. The project lies within the French Broad River Basin, Hydrologic Unit Code (HUC) 06010106-020010 (named the Pigeon River/Crabtree Creek Watershed), which is identified as a Targeted Local Watershed (TLW) in the NC Division of Mitigation Services' (DMS 2009) *French Broad River Basin Restoration Priorities* (RBRP) report. The project is located in the Blue Ridge Physiographic Region, within the Southern Crystalline and Mountains Level IV ecoregion. The project watershed drains into Rush Fork Creek, which flows for approximately 2.8 miles to its confluence with Crabtree Creek which continues for approximately 0.7 miles where it flows into the Pigeon River. These tributaries and streams are designated as Class C waters by the surface water classification system of the NC Division of Water Resources (DWR).

The UT to Rush Fork Stream Mitigation Project (project) is located on two adjacent parcels of an active cattle farm in Haywood County, North Carolina, halfway between the unincorporated communities of Crabtree and Fines Creek as shown on the Project Vicinity Map (Figure 1). The project site entrance is 5.9 miles down Route 209 from exit 24 off of I-40, on the right at 9503 Rush Fork Road. Coordinates for the approximate center of the project are 35.644607 N Latitude, -82.940170 W Longitude. Current agricultural use on the project site is predominantly livestock pasture; however, past use may have included row crops and apple production. These activities have negatively impacted both water quality and streambank stability along the project stream reaches. The resulting observed stressors include streambank erosion, sedimentation, excess nutrient input, channel modification, and the loss of riparian buffers.

The project is being conducted as part of the DMS Full Delivery In-Lieu Fee Program and is anticipated to generate a total of 3,533.610 cold-water stream mitigation credits and the site will be protected by an 8.26-acre permanent conservation easement (Appendix B).

1.2 Goals and Objectives

The goals of this project are identified below:

- Reconnect stream reaches to their floodplains,
- Improve stream stability,
- Improve aquatic habitat,
- Reestablish forested riparian buffers, and
- Permanently protect the project in a conservation easement.

To accomplish these goals, the following objectives were identified:

- To restore appropriate bankfull dimensions, and/or raise channel beds, by utilizing either a Priority I Restoration approach or an Enhancement Level I approach.
- Stabilize eroding channel banks and arrest incision by utilizing an Enhancement Level II approach.
- To construct streams of appropriate dimensions, pattern, and profile in restored reaches, slope stream banks and provide bankfull benches on enhanced reaches and utilize bio-engineering to provide long-term stability.

- Construct the correct channel morphology along all stream channels, increasing the number and depth of pools utilizing structures including geo-lifts with brush toe, log vanes/weirs, root wads, and/or J-hooks.
- Establish riparian buffers at a 30 foot minimum width along all stream reaches, planted with native tree and shrub species.
- Establish a permanent conservation easement restricting land use in perpetuity. This will prevent site disturbance and allow the project to mature and stabilize.

1.3 Project Success Criteria

The success criteria and performance standards for the project will follow the NCDMS's templates As-Built Baseline Monitoring Report Format, Data Requirements, and Content Guidance (June 2017), and the Annual Monitoring Report Format, Data Requirements, and Content Guidance (June 2017), and as described in Section 7 of the approved Mitigation Plan. All specific monitoring activities will follow those outlined in detail in Section 8 of the approved Mitigation Plan and will be conducted for a period of 7 years unless otherwise noted.

1.4 Mitigation Component Summary

The project involved the restoration or enhancement of seven reaches, all unnamed tributaries to Rush Fork. Reach UT1-R1, is a steep, 206-foot long perennial reach that had been impacted historically through the removal of riparian vegetation, channelization, and agricultural activities (most recently livestock). The channel had been experiencing active erosion on over 50 percent of the streambank upstream of a degraded old ford crossing. An Enhancement Level 1 approach was implemented on this reach, which involved rebuilding new, stable channel dimensions as a B-type stream, raising the channel elevation to allow floodplain access, installing in-stream structures, and building a stable culverted crossing just upstream of the old, degraded ford.

Reach UT1-R2 is a steep, roughly 275-ft reach that was not as impacted by the historic land use as the reaches above and below it. A narrow line of established walnut trees growing along the banks of this reach provide greater stability to this section. As a result, the channel is not deeply incised here, and bank erosion along R2 was minimal in spite of the fact that livestock had access to the reach. As such, an Enhancement Level II approach was implemented here. This involved the reestablishment of a full riparian buffer, the rebuilding of new channel dimensions along most of the reach (stabilizing the few sections of eroding banks), and the installation of three in-stream structures. Some of the black walnut trees were removed in the buffer to reduce their impact on other vegetation and an abandoned cabin within the conservation easement was also removed.

Reach UT1-R3 is a steep, roughly 601-ft reach that had been impacted historically through the removal of riparian vegetation, channelization, and agricultural activities (most recently livestock). As a result, the channel is experiencing active erosion for well over 50 percent of the streambank length, and the absence of woody vegetation along the banks also contributes to the instability. An Enhancement Level I approach was selected for this reach, which involved rebuilding new, stable channel dimensions as a B-type stream, raising the channel elevation to allow floodplain access, and installing in-stream structures, several of which act as grade control features. Additionally, areas of multiflora rose (*Rosa multiflora*) were removed and treated during and after construction. There is also a 40-ft conservation easement break for a powerline right-of-way located near the top of this reach. Stream enhancement work was conducted through this break, though no trees were planted here.

Reach UT1-R4 is a steep, roughly 1,530-ft long perennial channel, though only 1,224-ft are located within the conservation easement due to the break from NC Route 209 and associated utility lines. The reach had been quite incised and had exhibited bank scour ranging from 50-60% over its length, and mass wasting

along an additional 15-20%, with numerous headcuts present. Reach R4 was accessed by livestock and had little or no vegetated buffer with only a few scattered trees found along the stream, predominantly Chinese privet (*Ligustrum sinense*). A Priority Level I Restoration approach was implemented on R4 in order to fully restore the stream and its associated buffer functions. A channel of appropriate dimensions was constructed and was raised to reconnect the reach to its historic sloping floodplain as a B-type stream. This will promote more frequent overbank flooding thus reducing erosive stream energies during storm events greater than the bankfull discharge and will also improve adjacent groundwater hydrology. Numerous in-stream structures were installed along the reach to promote bank stability, improve habitat, and provide grade control. A full, 30-ft riparian buffer of native species was planted, and the Chinese privet was removed and treated during and after construction. The reach also has extensive wetland areas on the right bank above Route 209, which are now protected within the conservation easement. Livestock have subsequently been excluded from this reach. A fence encroachment was corrected after the As Built survey was completed.

Reach UT2 a roughly 78-ft intermittent channel that flows into UT1-R3 from a culvert that carries drainage from a small field and the hill slope to the east of R3. It had been incised in the lower portion as the channel cut down to meet R3 and it had a pronounced hydrologic disconnect at the culvert outlet. The channel also lacked a full riparian buffer, especially an herbaceous layer, due to livestock impacts. An Enhancement Level II approach was selected for this reach. A full buffer of native species was planted, and the channel was raised in the lowermost section to ensure a stable tie-in with R3. Additionally, areas of multiflora rose were removed and treated during and after construction.

Reach UT3 is a steep, roughly 1,577-ft perennial channel that begins as a series of springs just upstream of the project boundary. It had been impacted historically through the removal of riparian vegetation, channelization, and agricultural activities (most recently livestock). UT3 had been incised over most of its length, with varying degrees of bank scour, including sections of mass wasting where the stream flowed up against a steep bank or where cattle trails crossed the stream. The reach only had a few pools primarily associated with headcuts in the channel. The uppermost section of UT3 began with a partially buffered forested area, mostly along the left bank, consisting of a narrow row of crabapple (*Malus* sp.) trees. However, the vast majority of the reach buffer consisted primarily of herbaceous pasture grasses. A Priority Level I Restoration approach was implemented on UT3 in order to fully restore the stream and its associated buffer functions. A new channel with the appropriate dimensions was constructed and was raised to reconnect the reach to its historic sloping floodplain as a B-type stream. This will promote more frequent overbank flooding thus reducing erosive stream energies during storm events greater than the bankfull discharge and will also improve adjacent groundwater hydrology. Numerous in-stream structures were installed along the reach to promote bank stability, improve habitat, and provide grade control. A full, 30-ft riparian buffer of native species was planted, and the pasture grasses were treated around the planted stems after construction (ring-spraying) to help with tree establishment. A degraded ford crossing was also rebuilt as a stable culvert crossing and relocated to coincide with an existing powerline easement, thus allowing for only one CE break on this reach. UT3 also has extensive wetland areas along both banks, which are now protected within the CE and livestock have been fully excluded.

Reach UT4 is a roughly 42-ft intermittent channel that begins from an existing culvert flowing under and then paralleling Route 209 before turning through a culvert under the access road and onto the project tying into UT1-R4. This short section of channel was nevertheless highly degraded, mostly due to the presence of livestock. It was incised as it cut down to meet the similarly incised UT1-R4, had eroding banks, and lacked a riparian buffer. As such, Restoration was implemented on this reach, wherein a new channel was built of appropriate dimensions, which was also raised to meet the restored R4 channel. A full buffer of native species was planted along the reach. And while only the lowermost section is included within the project easement, the upper portion between the access road culvert and Highway 209, also had fencing installed to exclude livestock, thus protecting the entire reach.

Additionally, a small BMP was installed at the top of UT3 to capture and treat the runoff from a vegetated swale (an old abandoned roadbed) that had conveyed stormwater from its 4.3-acre drainage area directly into the reach. The BMP was sized for a 1-inch design storm and has been planted with native shrub and herbaceous vegetation to ensure stability. It also has a stable rock outlet feature to convey overflow into UT3.

1.5 Project Timeline

The Rush Fork Mitigation Project was instituted in April 2018. The Mitigation Plan was approved by the IRT in April 2021. Project construction of the streams was initiated in October 2021 and completed in February 2022. Planting of live stakes and bareroot stems was completed in February 2022 and the vegetation plots were installed in March 2022. The As-Built survey was completed in March of 2022. All monitoring devices including 18 cross-sections, 3 crest gauges, and 3 flow gauges were installed in March 2022. All crest gauges and flow gauges are continuous logging Van Essen DIVER gauges. Livestock exclusion fencing and gates were fully installed by March 2022. The CE pins were located and the boundary fully marked by March 2022 as well. Monitoring Year 1 is on schedule for 2022 as shown in Table 2.


1.6 Design Change Deviations

During project construction, there were a few, relatively minor deviations from the original design plans as marked in red in the as-built plans (Appendix E). Primarily these were a few substitutions made on in-stream structures replacing log structures with rock/boulder structures due to material availability. In two cases, an additional structure was added to the channel not originally in the plans. Additionally, the sizing of several of the crossing and access gates were changed from the proposed due to landowner preference, and a few extra gates were installed for improved easement access.

There were a few minor deviations from the approved planting plan due to lack of species availability. American basswood (*Tilia americana*), rosebay (*Rhododendron maximum*), and umbrella tree (*Magnolia tripetala*) were unavailable and were replaced by planting additional stems of several other species on the approved list; yellow buckeye (*Aesculus flava*), persimmon (*Diospyros virginiana*), winterberry (*Ilex verticillata*), American hornbeam (*Carpinus caroliniana*), and Carolina silverbell (*Halesia carolina*).

One additional flow gauge was added to UT4 following the IRT approval of the mitigation plan. Additionally, a vegetation monitoring plot shown on the right floodplain of UT1-R4 in the approved mitigation plan was moved to the left floodplain of UT1-R4.

1.7 Vicinity Map

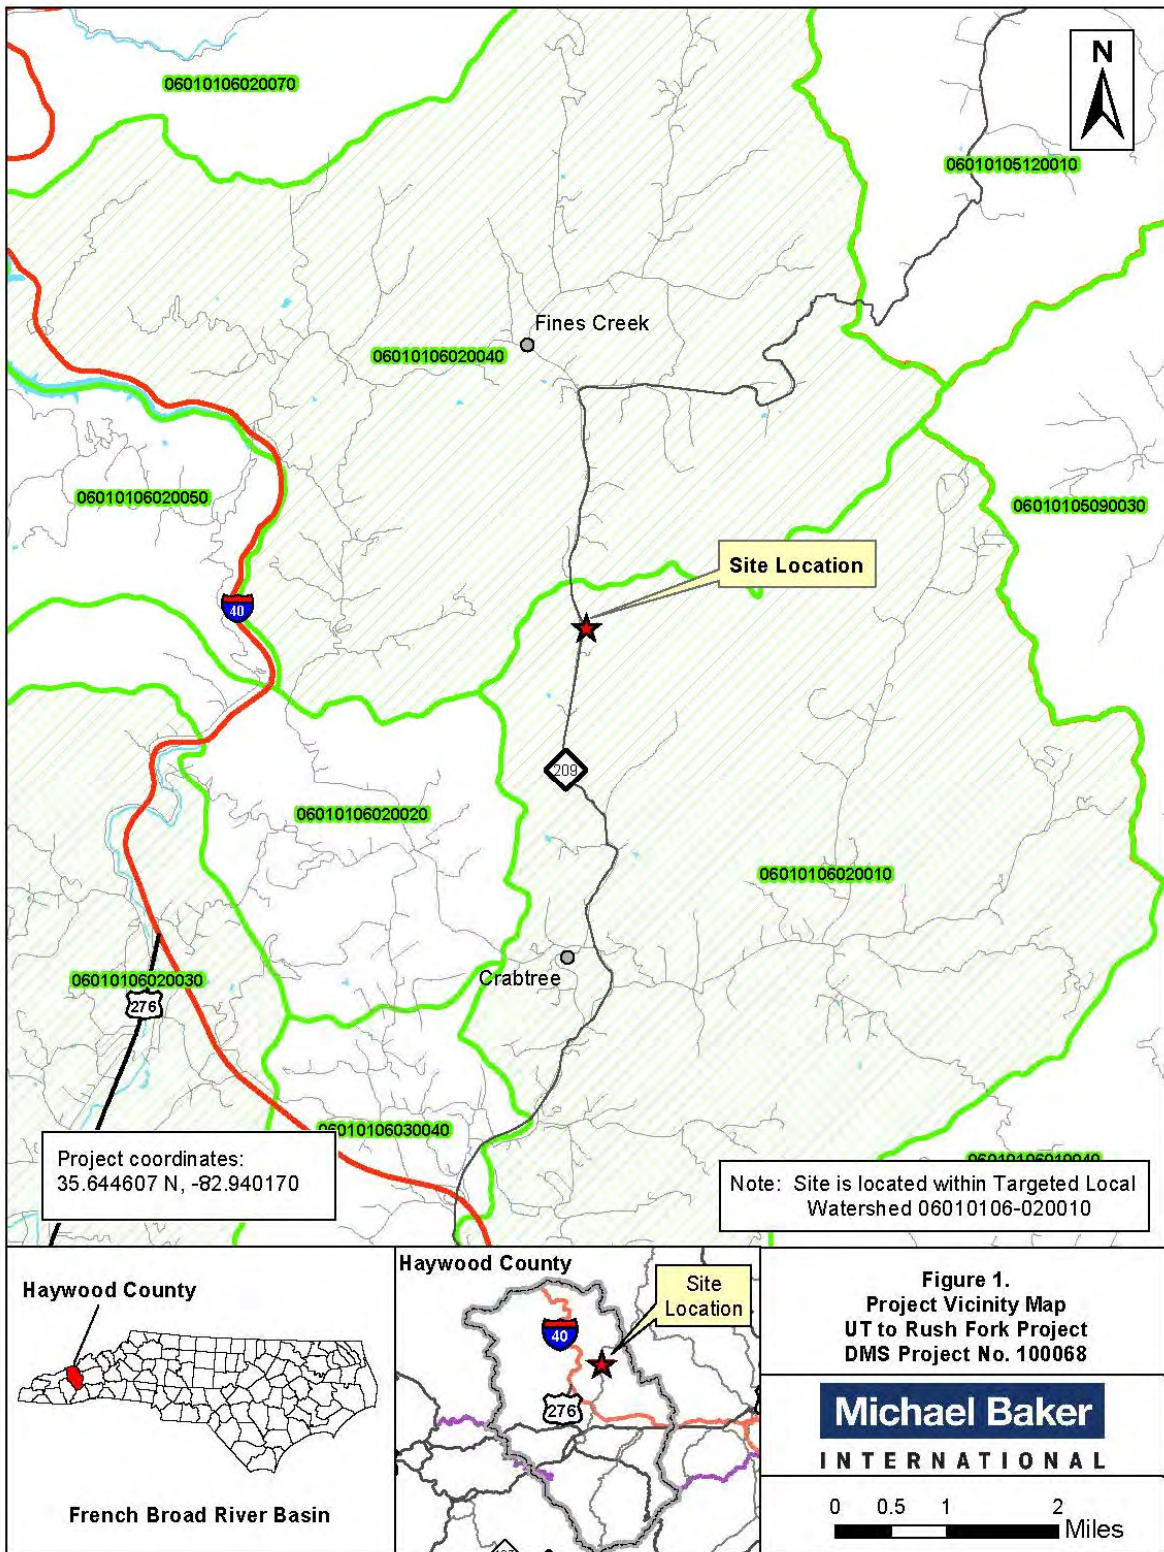

1.8 Technical and Methodological Descriptions and References

Stream survey data was collected to a minimum of Class C Vertical and Class A Horizontal Accuracy using a Leica TS06 Total Station and was georeferenced to the NAD83 State Plane Coordinate System, FIPS3200 in US Survey Feet, which was derived from the As-built Survey. The survey data from the permanent project cross-sections were collected and classified using the Rosgen Stream Classification System to confirm design stream type (Rosgen 1994).

The six permanent vegetation-monitoring quadrants (plots) were installed across the site in accordance with the CVS-DMS Protocol for Recording Vegetation, Version 4.1 (Lee 2007) and the data collected from each was input into the DMS Veg Table Production Tool (2021).

All of the crest gauges and flow gauges are Van Essen brand Baro-Diver data loggers.

References:

- Lee, M., Peet R., Roberts, S., Wentworth, T. 2007. CVS-DMS Protocol for Recording Vegetation, Version 4.1.
- North Carolina Division of Water Resources. 2011 French Broad River Basin Classification Schedule. NC Department of Environmental Quality. Raleigh, NC. Available at: <https://deq.nc.gov/river-basin-classification-schedule>
- North Carolina Division of Mitigation Services. 2021. DMS Vegetation Table Production Tool. NC Department of Environmental Quality. Raleigh, NC.
- North Carolina Division of Mitigation Services. 2009. French Broad River Basin Restoration Priorities. NC Department of Environmental Quality. Raleigh, NC.
- Rosgen, D.L. 1994. A Classification of Natural Rivers. *Catena* 22:169-199.
- ____. 1996. Applied River Morphology. Wildland Hydrology Books, Pagosa Springs, Colo.

APPENDIX A

Background Tables and Figures

Table 1. Project Mitigation Quantities and Credits


UT to Rush Fork Stream Mitigation Project - NCDMS Project No. 100068

Project Segment	Original Mitigation Plan* Ft/Ac	As-Built Ft/Ac	Original Mitigation Category	Original Restoration Level	Original Mitigation Ratio (X:1)	Credits
Stream						
Reach UT1-R1	206.20	206.410	Cold	EI	1.5	137.467
Reach UT1-R2	275.00	275.000	Cold	EII	2.5	110.000
Reach UT1-R3	612.10	600.860	Cold	EI	1.5	408.067
Reach UT1-R4	1,216.33	1,224.370	Cold	R	1.0	1,216.330
Reach UT2	86.24	78.160	Cold	EII	2.5	34.496
Reach UT3	1,584.45	1,577.530	Cold	R	1.0	1,584.450
Reach UT4	42.80	41.900	Cold	R	1.0	42.800
					Total:	3,533.610
Wetland						
N/A	0.996	0.996	-	E	-	-
					Total:	N/A

*The lengths shown for each reach are the creditable lengths and were calculated after all exclusions were accounted for, such as easement breaks, utility impacts, stream crossings, etc.

Project Credits

Restoration Level	Stream			Riparian	Non-Rip	Coastal
	Warm	Cool	Cold	Wetland	Wetland	Marsh
Restoration	-	-	2,843.580	-	-	-
Re-establishment				-	-	-
Rehabilitation				-	-	-
Enhancement				-	-	-
Enhancement I	-	-	545.534			
Enhancement II	-	-	144.496			
Creation				-	-	-
Preservation	-	-	-	-	-	-
Totals			3,533.610			

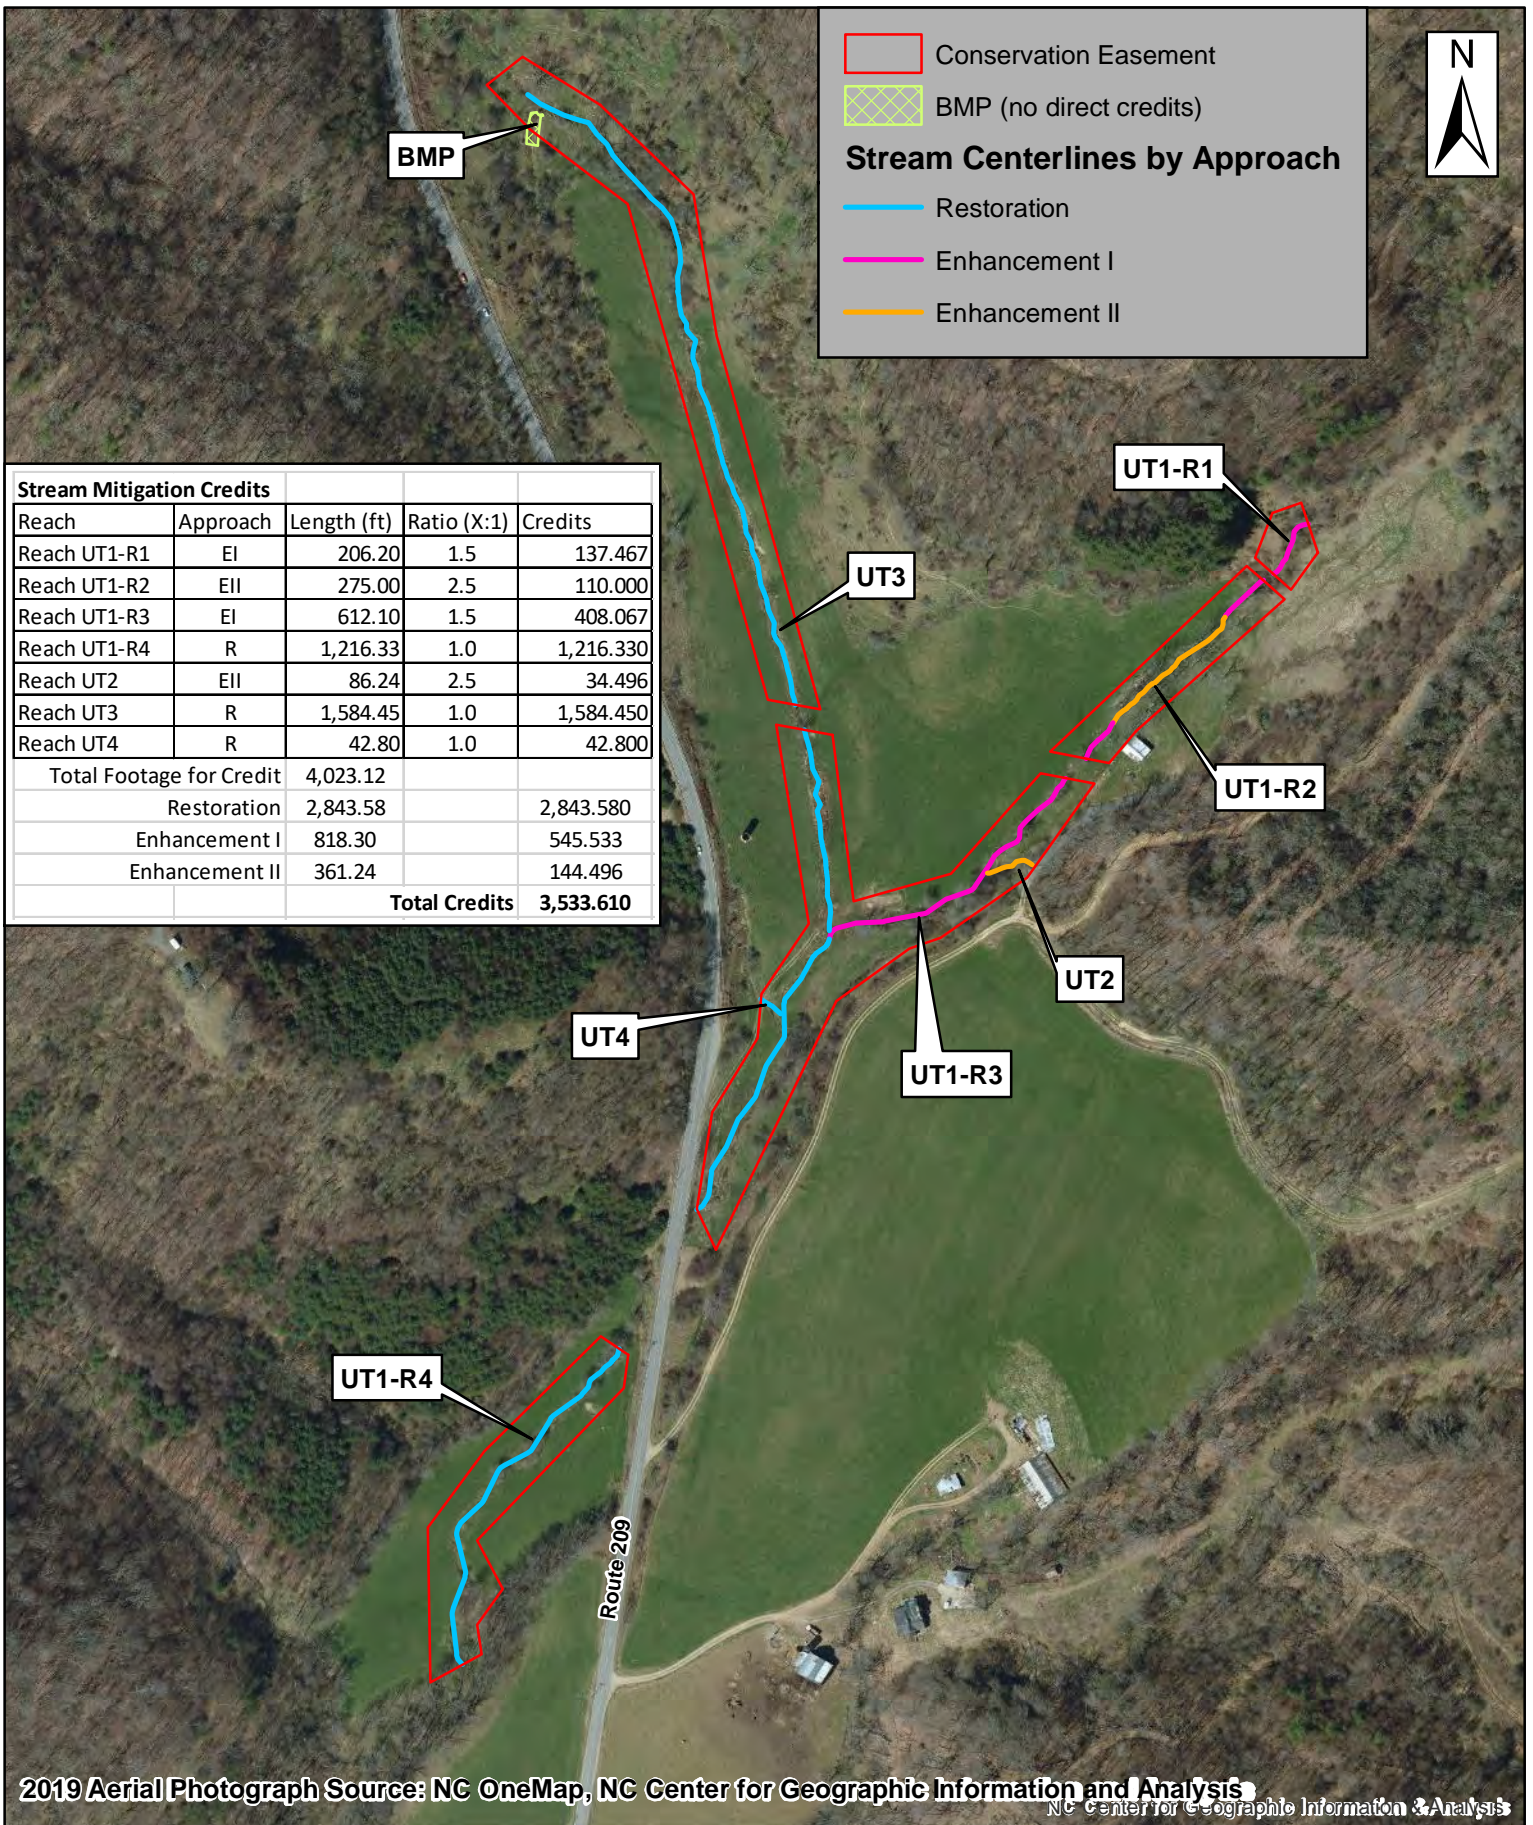

Conservation Easement
 BMP (no direct credits)

Stream Centerlines by Approach

— Restoration
— Enhancement I
— Enhancement II

Stream Mitigation Credits				
Reach	Approach	Length (ft)	Ratio (X:1)	Credits
Reach UT1-R1	EI	206.20	1.5	137.467
Reach UT1-R2	EII	275.00	2.5	110.000
Reach UT1-R3	EI	612.10	1.5	408.067
Reach UT1-R4	R	1,216.33	1.0	1,216.330
Reach UT2	EII	86.24	2.5	34.496
Reach UT3	R	1,584.45	1.0	1,584.450
Reach UT4	R	42.80	1.0	42.800
Total Footage for Credit		4,023.12		
Restoration		2,843.58		2,843.580
Enhancement I		818.30		545.533
Enhancement II		361.24		144.496
Total Credits				3,533.610

2019 Aerial Photograph Source: NC OneMap, NC Center for Geographic Information and Analysis

	<p>North Carolina Division of Mitigation Services DMS Proj. No. 100068</p>	<p>0 125 250 500 Feet</p>	<p>Figure 2. Project Asset and Credit Map UT to Rush Fork Project Haywood County</p>
--	----------------------------------------------------------------------------------------	-------------------------------	---------------------------------------------------------------------------------------------------------

Table 2. Summary: Goals, Performances and Results
UT to Rush Fork Stream Mitigation Project - NCDMS Project No. 100068

Goals	Objectives	Functional Level	Performance Criteria	Monitoring Measurement Tool	Cumulative Monitoring Results
Reconnect stream channels to their floodplains	To raise channel beds and/or slope stream banks which serve as floodplains as is appropriate for a B stream type by utilizing either a Priority I Restoration approach or an Enhancement Level I approach.	Hydraulics	Four bankfull events within monitoring period.	Stage recorders located upstream on UT3, UT1-R1, and middle of UT1-R4. Supplemental data from flow gauges on UT3, UT2, UT4.	N/A
Improve stream stability	To construct streams with the appropriate dimension, pattern, and profile in Restored reaches or dimension and profile on Enhanced I reaches. Also slope stream banks, install grade control structures with plunge pools, and utilize bio-engineering to provide long term stability.	Geomorphology	Restored streams will maintain bank-height ratios of less than 1.2 and entrenchment ratios greater than 1.4 (B-type) or 2.2 (C-type) provided visual inspections also reveal stabilization.	Cross-Sectional Survey Visual Inspection	N/A
Improve aquatic habitat	Increase the heterogeneity of habitat by increasing the number and depth of pools, increasing the amount of woody debris, utilizing structures including geo- lifts with brush toe, log vanes/weirs, cross-vanes, and/or J-hooks.	Geomorphology	Inventory comparisons of in-stream structures and features from existing conditions and as-built project surveys and assessments. Increased number of pools and woody structures and debris compared to the existing conditions.	Profile Survey Visual Inspection	N/A
Reestablish forested riparian buffers	Establish riparian buffers at a 30-ft minimum width along all stream reaches, planted with native tree, shrub and herbaceous species.	Geomorphology	Survival rate of 320 stems per acre at MY3, 260 planted stems per acre at MY5, and 210 stems per acre at MY7.	Vegetation Plots Visual Inspection	N/A
Permanently protect the project	Establish a permanent conservation easement restricting land use in perpetuity. This will prevent site disturbance and allow the project to mature and stabilize.	Biology	Conservation Easement documents. Visual inspections to confirm no encroachments into CE.	Visual Inspection	N/A

Table 3. Project Activity and Reporting History
UT to Rush Fork Stream Mitigation Project - NCDMS Project No. 100068

Grading Completed in	February 2022	
Elapsed Time Since grading complete:	3 months	
All Planting Completed in	February 2022	
Elapsed Time Since planting complete:	3 months	
Number of Reporting Years¹:	0	
Activity or Deliverable	Data Collection Complete	Completion or Delivery
Project Institution Date	N/A	April 2018
Mitigation Plan Approved by IRT	N/A	April 2021
Final Design – Construction Plans	N/A	October 2021
Construction Grading Completed	N/A	February 2022
Livestake and Bareroot Planting Completed	N/A	February 2022
As-Built Baseline Monitoring Report (MY0)	March 2022	June 2022
As-Built Stream Survey	March 2022	N/A
As-Built Vegetation Monitoring	March 2022	N/A
Year 1 Monitoring	-----	-----
Year 2 Monitoring	-----	-----
Year 3 Monitoring	-----	-----
Year 4 Monitoring	-----	-----
Year 5 Monitoring	-----	-----
Year 6 Monitoring	-----	-----
Year 7 Monitoring	-----	-----

¹ = The number of monitoring reports excluding the as-built/baseline report

Table 4. Project Contacts**UT to Rush Fork Stream Mitigation Project - NCDMS Project No. 100068**

Designer	
Michael Baker Engineering, Inc.	8000 Regency Parkway, Suite 600 Cary, NC 27518 Contact: Katie McKeithan, Tel. 919-481-5703
Construction Contractor	
Baker Grading & Landscaping, Inc.	1000 Bat Cave Road, Old Fort, NC 28762 Contact: Charles Baker, Tel. 828-668-5060 x. 11
Survey Contractor	
Kee Mapping and Surveying	88 Central Avenue Asheville, NC 28801 Contact: Brad Kee, Tel. 828-575-9021
Planting Contractor	
Baker Grading & Landscaping, Inc.	1000 Bat Cave Road, Old Fort, NC 28762 Contact: Charles Baker, Tel. 828-668-5060 x. 11
Seeding Contractor	
Baker Grading & Landscaping, Inc.	1000 Bat Cave Road, Old Fort, NC 28762 Contact: Charles Baker, Tel. 828-668-5060 x. 11
Seed Mix Sources	
Roundstone Native Seed, LLC	9764 Raider Hollow Road, Upton, KY 42784 Telephone: 270-531-3034
Nursery Stock Suppliers	
Foggy Mountain Nursery (livestakes)	797 Helton Creek Road, Lansing, NC 28643 Telephone: 336-384-5323
Dykes and Son Nursery	825 Maude Etter Road, McMinnville, TN 37110 Telephone: 843-528-3204
Monitoring Performers	
Michael Baker Engineering, Inc.	8000 Regency Parkway, Suite 600 Cary, NC 27518
Stream Monitoring POC	Katie McKeithan, Tel. 919-481-5703
Vegetation Monitoring POC	Katie McKeithan, Tel. 919-481-5703

Table 5. Project Baseline Information and Attributes
UT to Rush Fork Stream Mitigation Project - NCDMS Project No. 100068

Table 4. Project Background Information				
Project Name		UT to Rush Fork Stream Mitigation Project		
County		Haywood County		
Project Area (acres)		8.26		
Project Coordinates (latitude and longitude)		35.644607 N, -82.940170 W		
Planted Acreage (Acres of Woody Stems Planted)		7.3		
Project Watershed Summary Information				
Physiographic Province		Blue Ridge		
River Basin		French Broad		
USGS Hydrologic Unit 8-digit	6010106	USGS Hydrologic Unit 14-digit	06010106-020010	
DWR Sub-basin		04-03-05		
Project Drainage Area (Acres and Square Miles)		308 acres/0.48 square miles (at downstream end of UT1)		
Project Drainage Area Percentage of Impervious Area		0.18% impervious area		
CGIA Land Use Classification		79,8% forested, 17.1% hay/pasture, and 2.9% developed (open space).		
Reach Summary Information				
Parameters	UT1	UT2	UT3	UT4
Length of reach (linear feet)	2,464	99	1,618	18
Valley confinement (Confined, moderately confined, unconfined)	Moderately Confined	Unconfined	Moderately Confined	Unconfined
Drainage area (Acres)	308	24	98	27
Perennial, Intermittent, Ephemeral	Perennial	Intermittent	Perennial	Intermittent
NCDWR Water Quality Classification	C	C	C	C
Stream Classification (existing)	B4a	B	A to B4	B
Stream Classification (proposed)	B4a	B	A to B4	Cb
Evolutionary trend (Simon)	IV – Degradation and Widening	III – Degrading	IV – Degradation and Widening	III – Degrading
FEMA classification	Zone X	Zone X	Zone X	Zone X
Regulatory Considerations				
Parameters	Applicable?	Resolved?	Supporting Docs?	
Water of the United States - Section 404	Yes	No	PCN	
Water of the United States - Section 401	Yes	No	PCN	
Endangered Species Act	Yes	Yes	Categorical Exclusion	
Historic Preservation Act	Yes	Yes	Categorical Exclusion	
Coastal Zone Management Act (CZMA or CAMA)	No	N/A	N/A	
FEMA Floodplain Compliance	No	N/A	N/A	
Essential Fisheries Habitat	No	N/A	N/A	
Notes:				
¹ Source: USGS National Land Cover Database (NLCD) for 2016				

APPENDIX B

Visual Assessment Data



Fig. 3A

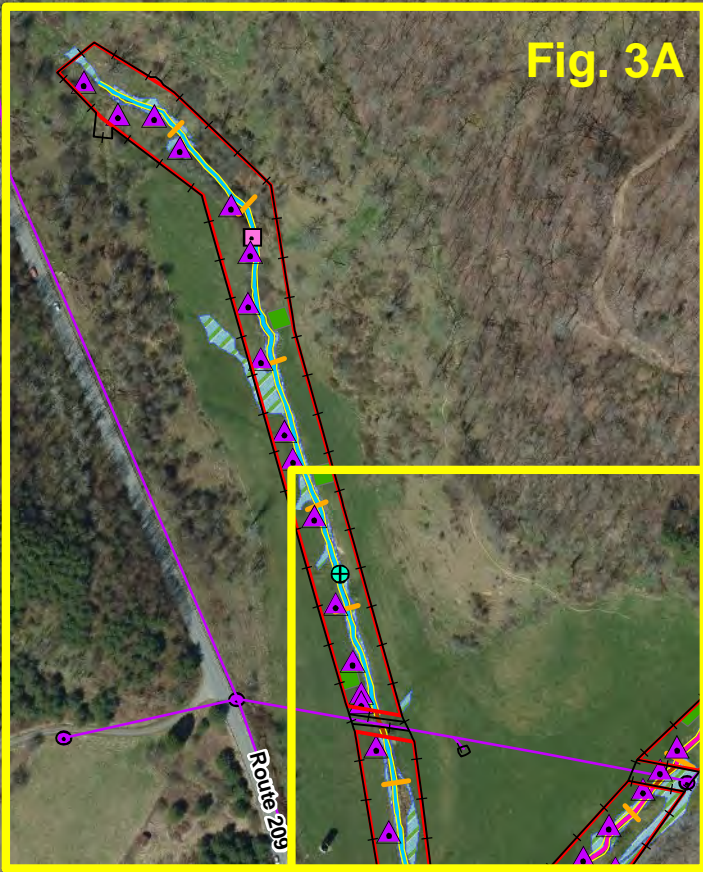


Fig. 3B


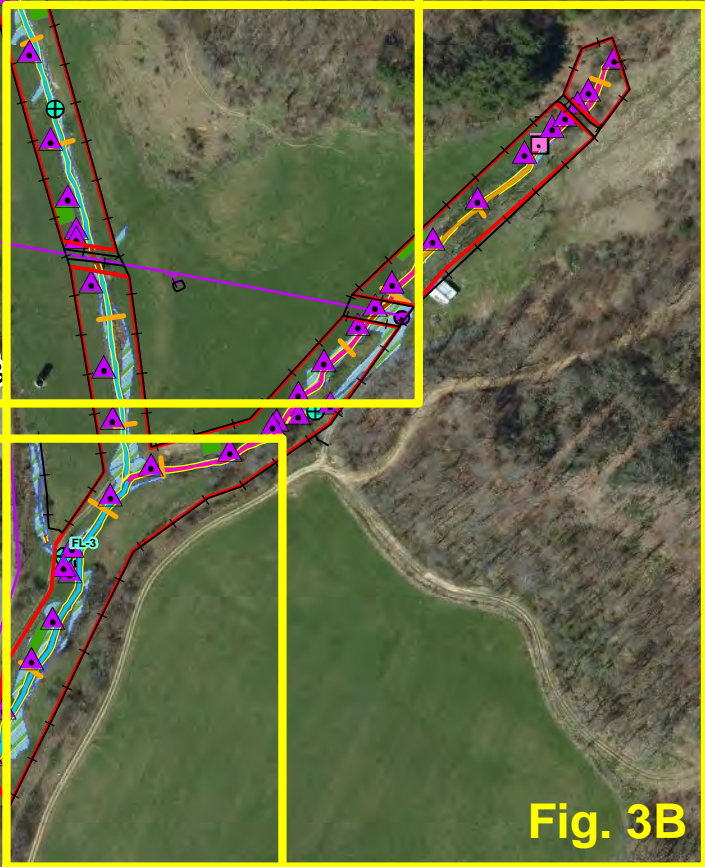



Fig. 3C

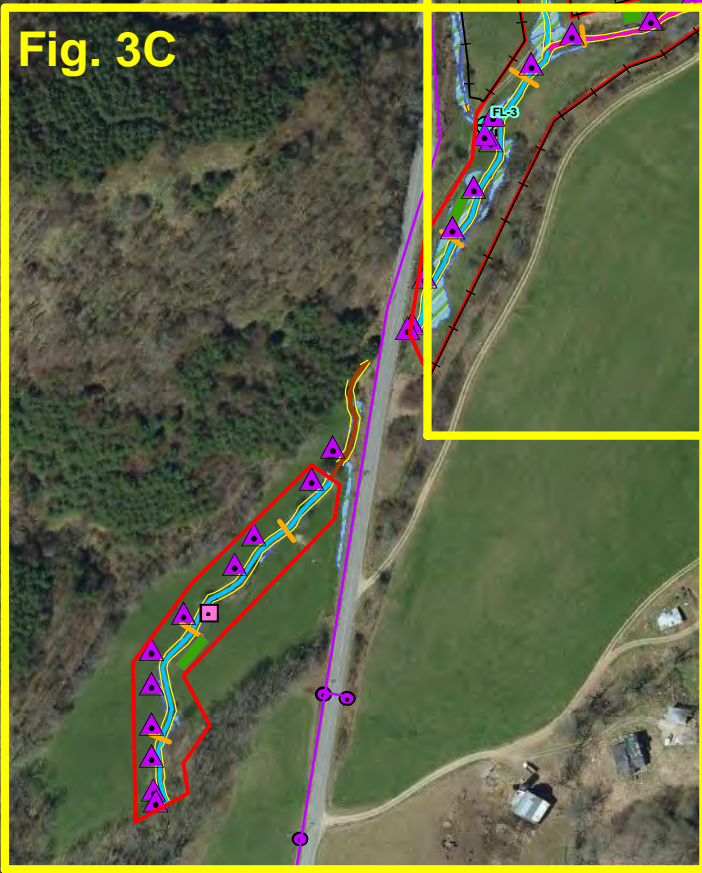


NC Center for Geographic Information & Analysis

Michael Baker
INTERNATIONAL

North Carolina
Division of
Mitigation Services
DMS Proj. No. 100068

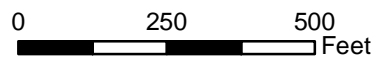


Overview Map: Current Condition
Plan View (CCPV) MY0
UT to Rush Fork Project
Haywood County

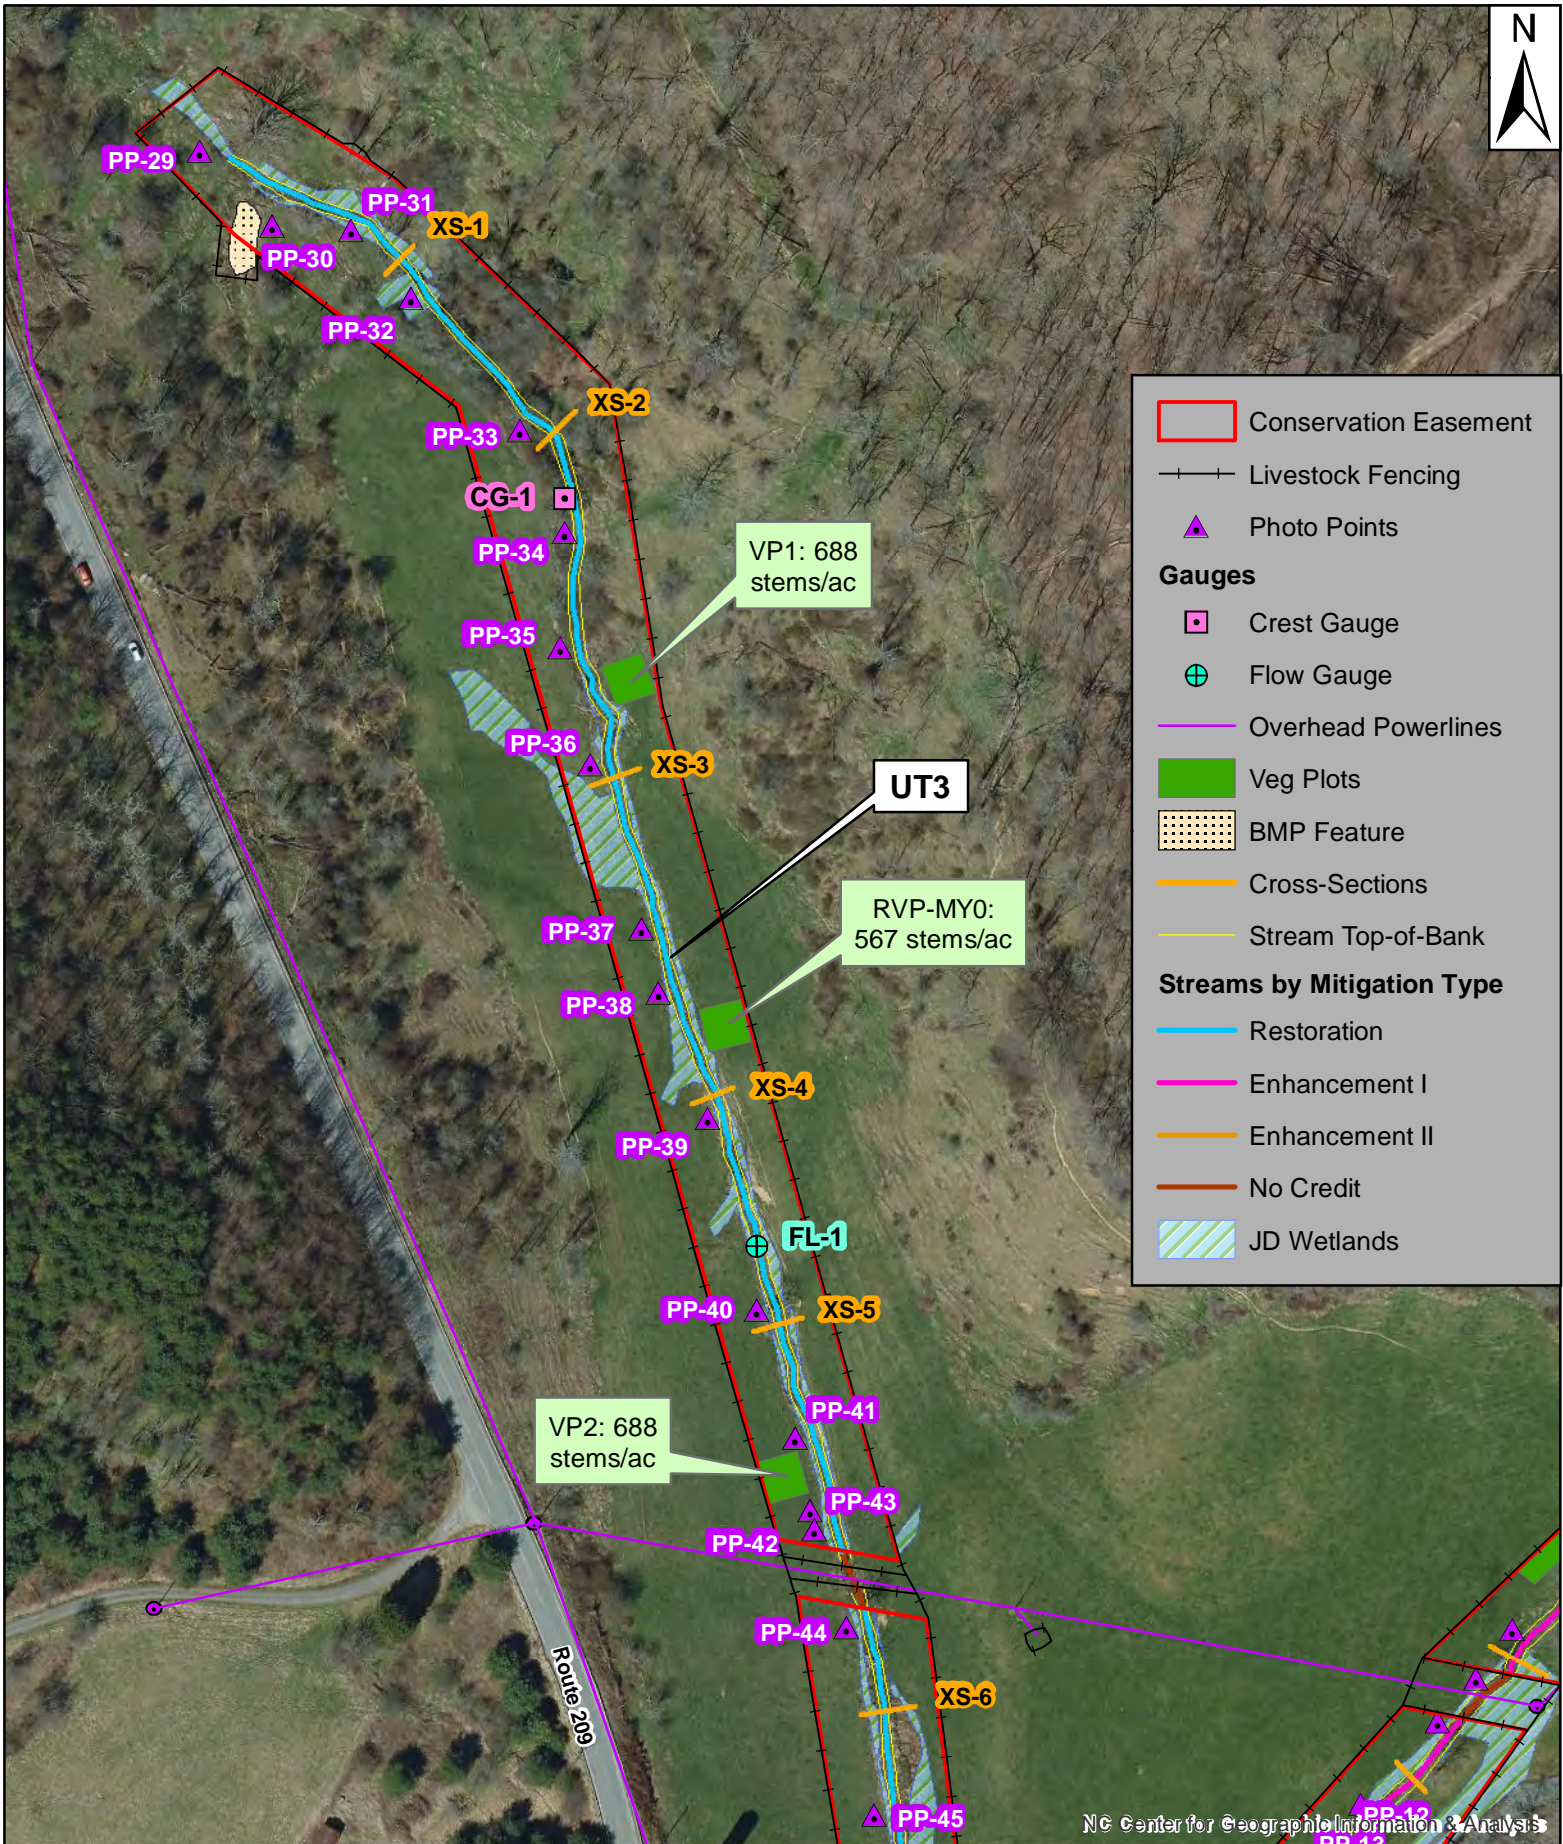


NC Center for Geographic Information & Analysis

Michael Baker
INTERNATIONAL


North Carolina
Division of
Mitigation Services
DMS Proj. No. 100068

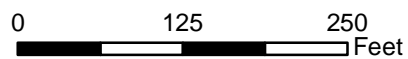


**Figure 3A. Current Condition
Plan View (CCPV) MY0
UT to Rush Fork Project
Haywood County**

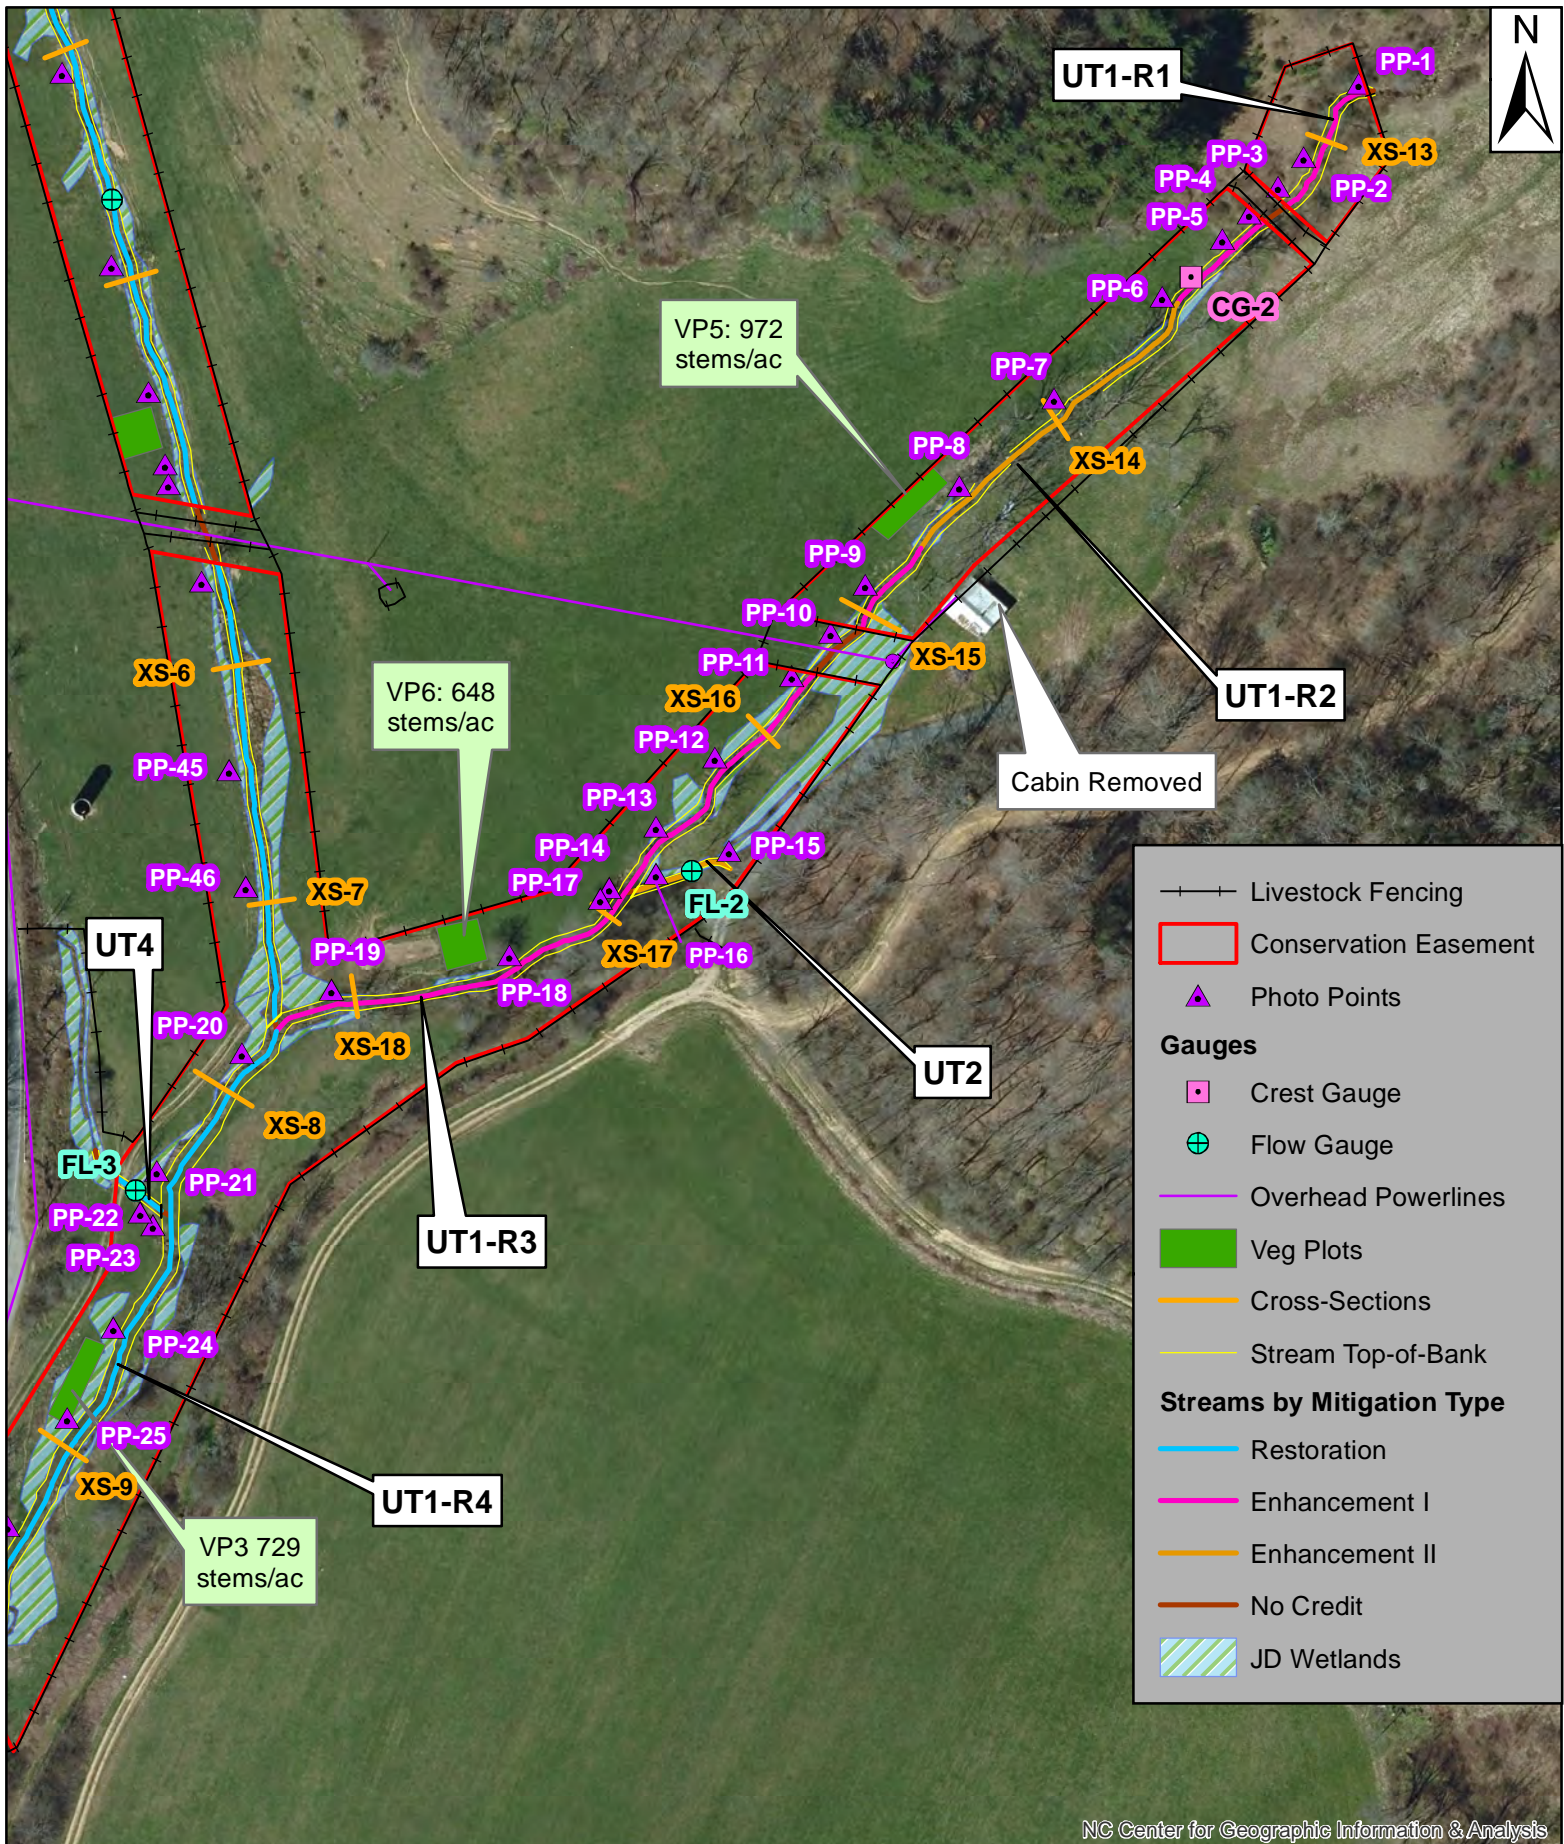

NC Center for Geographic Information & Analysis

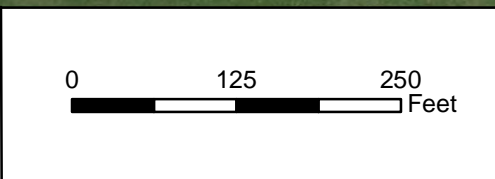

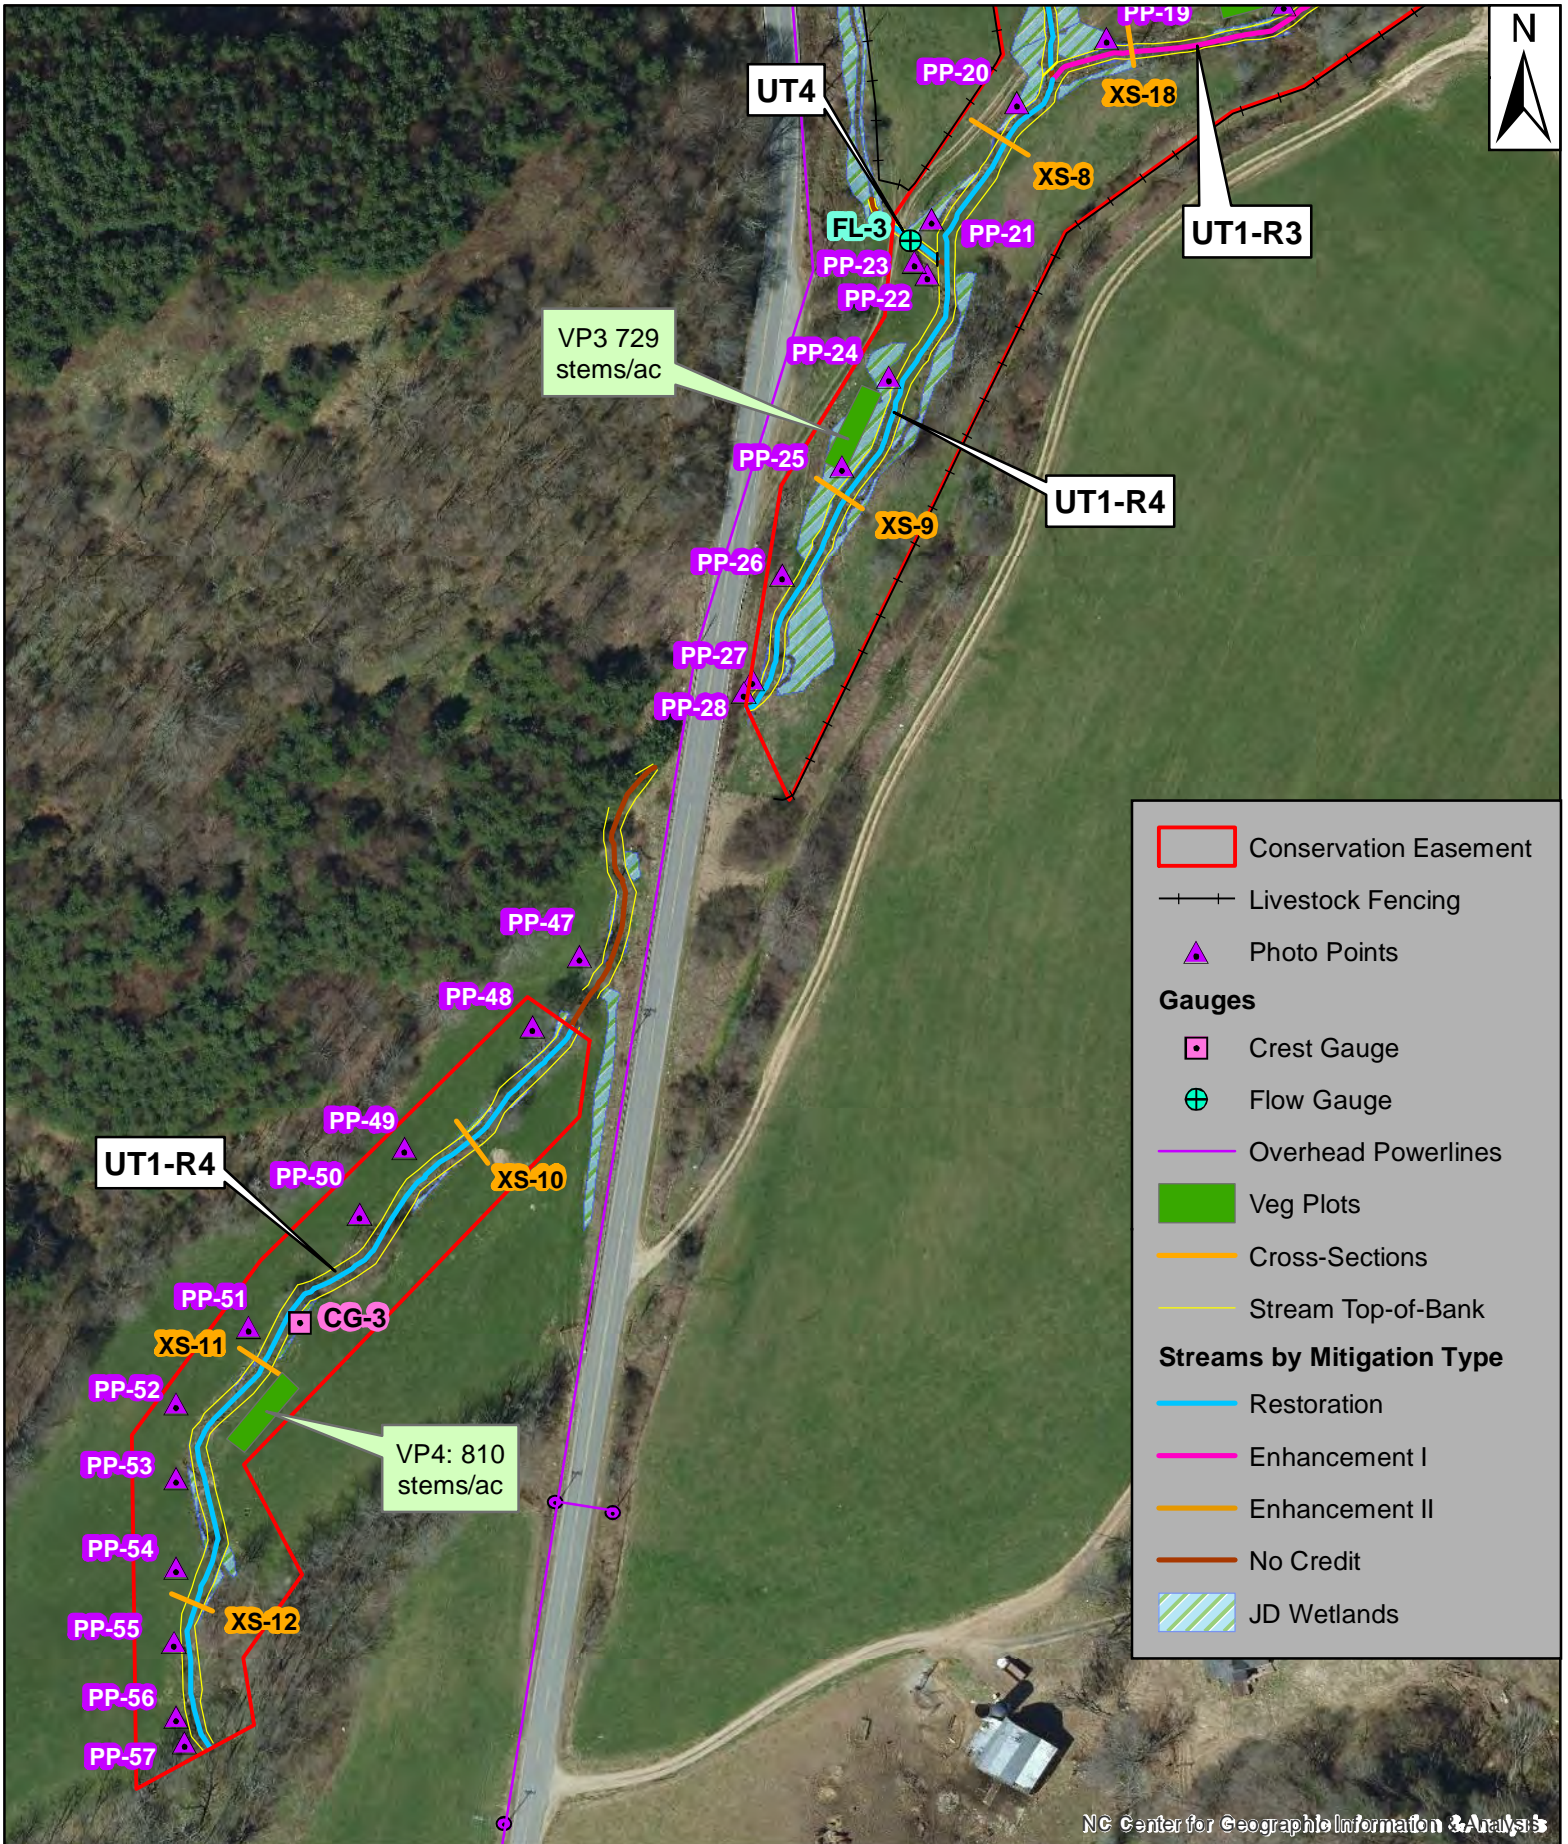

NC Center for Geographic Information & Analysis



Figure 3C. Current Condition Plan View (CCPV) MY0 UT to Rush Fork Project Haywood County

**Figure 4: Rush Fork: MY0 As-Built Stream Station Photo-Points
NCDMS Project No. #100068**



PP-1: UT1, Reach 1, Station 11+00. Facing Upstream.



PP-2: UT1, Reach 1, Station 11+80. Facing Upstream.



PP-3: UT1, Reach 1, Station 12+10
Facing Downstream



PP-4: UT1, Reach 1, Station 12+33
Facing Downstream



PP-6: UT1, Reach 2, Station 13+25. Facing Upstream.



PP-7: UT1, Reach 2, Station 14+60. Facing Upstream.

**Figure 4: Rush Fork: MY0 As-Built Stream Station Photo-Points
NCDMS Project No. #100068**



PP-7: UT1, Reach 2, Station 14+60. Facing Upstream.



PP-8: UT1, Reach 2, Station 15+50. Facing Upstream.



PP-9: UT1, Reach 3, Station 16+50. Facing Upstream.



PP-10: UT1, Reach 3, 16+80. Facing Upstream.



P-11: UT1, Reach 3, Station 17+35. Facing Upstream.




PP-12: UT1, Reach 3, Station 18+25. Facing Upstream.

**Figure 4: Rush Fork: MY0 As-Built Stream Station Photo-Points
NCDMS Project No. #100068**



PP-13: UT1, Reach 3, Station 18+90. Facing Upstream.

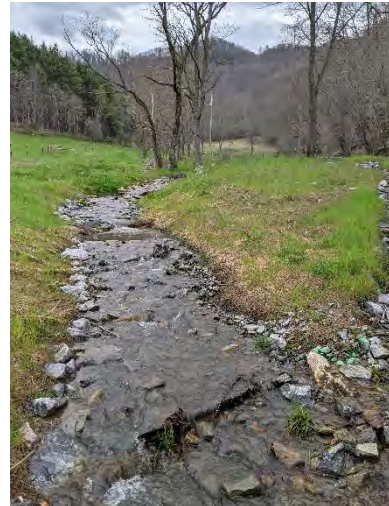

PP-14: UT1 Reach 3, Station 19+55. Facing Upstream.



PP-15: UT2, Station 10+15. Facing Upstream.



PP-16: UT2, Station 10+85. Facing Upstream.



PP-17: UT1, Reach3, Station 19+70. Facing Upstream.



PP-18: UT1, Reach 3, Station 20+60. Facing Upstream.

**Figure 4: Rush Fork: MY0 As-Built Stream Station Photo-Points
NCDMS Project No. #100068**




PP-19: UT1, Reach 3, Station 22+00. Facing Upstream.



PP-20: UT1, Reach 4, Station 22+75. Facing Upstream.



PP-21: UT1, Reach 4, Station 23+90. Facing Upstream.

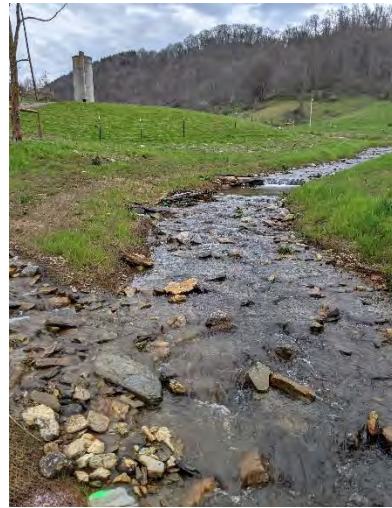

PP-22: UT1, Reach 4, Station 24+20. Facing Upstream.



PP-23: UT4, Station 10+50. Facing Upstream.



PP-24: UT1, Reach 4, Station 25+25. Facing Upstream.

**Figure 4: Rush Fork: MY0 As-Built Stream Station Photo-Points
NCDMS Project No. #100068**



PP-25: UT1, Reach 4, Station 26+00. Facing Upstream.



PP-26: UT1, Reach 4, Station 27+00. Facing Upstream.



PP-27: UT1, Reach 4, Station 27+75. Facing Upstream.



PP-28: UT1, Reach 4, Station 27+90. Facing Downstream.



PP-29: BMP at Top of UT3.



PP-30: UT3, Station 10+00. Facing Upstream.

**Figure 4: Rush Fork: MY0 As-Built Stream Station Photo-Points
NCDMS Project No. #100068**



PP-31: UT3, Station 11+10. Facing Upstream.



PP-32: UT3, Station 11+75. Facing Upstream.



PP-33: UT3, Station 13+15. Facing Upstream.



PP-34: UT3, Station 14+15. Facing Upstream.



PP-35: UT3, Station 14+85. Facing Upstream.



PP-36: UT3, Station 15+95. Facing Upstream.

**Figure 4: Rush Fork: MY0 As-Built Stream Station Photo-Points
NCDMS Project No. #100068**



PP-37: UT3, Station 17+35. Facing Upstream.



PP-38: UT3, Station 17+65. Facing Upstream.



PP-39: UT3, Station 18+75. Facing Upstream.



PP-40: UT3, Station 20+40. Facing Upstream.



PP-41: UT3, Station 21+20. Facing Upstream.



PP-42: UT3, Station 22+10. Facing Upstream.

**Figure 4: Rush Fork: MY0 As-Built Stream Station Photo-Points
NCDMS Project No. #100068**



PP-43: UT3, Station 22+15. Facing Downstream.



PP-44: UT3, Station 23+15 Facing Upstream.



PP-45: UT3, Station 24+40. Facing Upstream.



PP-46: UT3, Station 25+35. Facing Upstream.




PP-47: UT3, Station 26+30. Facing Upstream at confluence.



PP-48: UT1, Reach 4, Station 30+50. Facing Downstream.

**Figure 4: Rush Fork: MY0 As-Built Stream Station Photo-Points
NCDMS Project No. #100068**

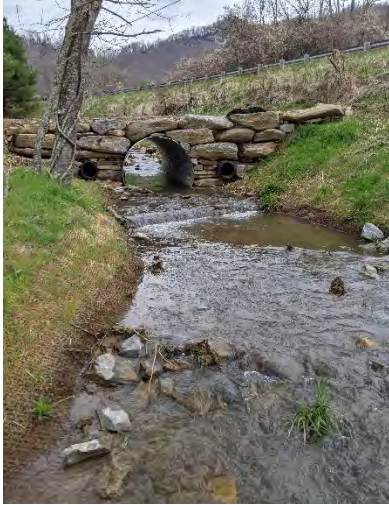

PP-49: UT1, Reach 4, Station 31+20. Facing Upstream.



PP-50: UT1, Reach 4, Station 32+50. Facing Upstream.



PP-51: UT1, Reach 4, Station 33+10. Facing Upstream.



PP-52: UT1, Reach 4, Station 34+30. Facing Upstream.



PP-53: UT1, Reach 4, Station 35+00. Facing Upstream.



PP-54: UT1, Reach 4, Station 35+60. Facing Upstream.

**Figure 4: Rush Fork: MY0 As-Built Stream Station Photo-Points
NCDMS Project No. #100068**



PP-55: UT1, Reach 4, Station 36+15. Facing Upstream



PP-56: UT1, Reach 4, Station 37+00. Facing Upstream.



PP-57: UT1, Reach 4, Station 37+50. Facing Upstream.



PP-58: UT1, Reach 4, Station 37+60. Facing Downstream. End of Project.

Figure 5: Rush Fork: MY0 As-Built Vegetation Photo Log
NCDMS Project No. 100068



Vegetation Plot #1: Photo 3-17-22



Vegetation Plot #2: Photo 3-17-22



Vegetation Plot #3: Photo 3-22-22



Vegetation Plot #4: Photo 3-17-22



Vegetation Plot #5: Photo 3-22-22



Vegetation Plot #6: Photo 3-17-22

**Figure 5: Rush Fork: MY0 As-Built Vegetation Photo Log
NCDMS Project No. 100068**



Random Vegetation Plot #1: Photo
3-17-22

Figure 6: Rush Fork: MY0 As-Built Monitoring Device Photo Log



Crest Gauge #1, UT3



Crest Gauge #2, UT1 Reach 2



Crest Gauge #3, UT1 Reach 4



Flow Gauge #1, UT3



Flow Gauge #2, UT2



Flow Gauge #3, UT4

APPENDIX C

Vegetation Plot Data

TABLE 6. PLANTED STEM COUNTS BY PLOT AND SPECIES

Planted Acreage	7.3
Date of Initial Plant	2022-02-23
Date(s) of Supplemental Plant(s)	NA
Date(s) Mowing	2022-03-22
Date of Current Survey	2022-03-22
Plot size (ACRES)	0.0247

	Scientific Name	Common Name	Tree/Shrub	Indicator Status	Veg Plot 1 F		Veg Plot 2 F		Veg Plot 3 F		Veg Plot 4 F		Veg Plot 5 F		Veg Plot 6 F		Veg Plot 1 R
					Planted	Total	Planted	Total	Planted	Total	Planted	Total	Planted	Total	Planted	Total	Total
Species Included in Approved Mitigation Plan	<i>Acer negundo</i>	boxelder	Tree	FAC									1	1			
	<i>Aesculus flava</i>	yellow buckeye	Tree	FACU							1	1	1	1	2	2	2
	<i>Betula lenta</i>	sweet birch	Tree	FACU	1	1	1	1	4	4	3	3	2	2	1	1	1
	<i>Betula nigra</i>	river birch	Tree	FACW	2	2	3	3	2	2	3	3	8	8	4	4	2
	<i>Carpinus caroliniana</i>	American hornbeam	Tree	FAC			2	2	1	1	1	1	1	1	1	1	
	<i>Cephalanthus occidentalis</i>	common buttonbush	Shrub	OBL					2	2							1
	<i>Cornus amomum</i>	silky dogwood	Shrub	FACW			3	3	2	2	3	3	1	1	1	1	
	<i>Diospyros virginiana</i>	common persimmon	Tree	FAC			1	1	1	1							
	<i>Fraxinus americana</i>	white ash	Tree	FACU	2	2	1	1					1	1			1
	<i>Fraxinus pennsylvanica</i>	green ash	Tree	FACW	3	3											
	<i>Halesia carolina</i>	Carolina silverbell	Tree	FAC	1	1				1	1					2	2
	<i>Ilex verticillata</i>	common winterberry	Tree	FACW	2	2											
	<i>Liriodendron tulipifera</i>	tuliptree	Tree	FACU	2	2	2	2						3	3		2
	<i>Nyssa sylvatica</i>	blackgum	Tree	FAC									1	1			2
	<i>Platanus occidentalis</i>	American sycamore	Tree	FACW							4	4	2	2	2	2	
	<i>Quercus alba</i>	white oak	Tree	FACU					2	2	1	1	2	2	2	2	1
	<i>Quercus imbricaria</i>	shingle oak	Tree	FAC	3	3	1	1	1	1	1	1					
	<i>Sambucus canadensis</i>	American black elderberry	Tree	FACW			1	1								1	1
<i>Ulmus americana</i>	American elm	Tree	FACW	1	1	2	2	2	2	2	2					1	
<i>Xanthorrhiza simplicissima</i>	yellowroot	Shrub	FACW									1	1				
Sum	Performance Standard				17	17	17	17	18	18	20	20	24	24	16	16	14
Post Mitigation	<i>Prunus serotina</i>	black cherry	Tree	FACU					1								
Sum	Proposed Standard				17	17	17	17	18	18	20	20	24	24	16	16	14
Mitigation Plan Performance Standard	Current Year Stem Count				17	17	17	17	18	18	20	20	24	24	16	16	14
	Stems/Acre				688	688	688	688	729	729	810	810	972	972	648	648	567
	Species Count				9	10	10	10	10	10	10	10	12	12	9	10	10
	Dominant Species Composition (%)				18	17	17	17	22	22	20	20	33	33	25	25	14
	Average Plot Height (ft.)				2	2	2	2	2	2	2	2	2	2	2	2	2
% Invasives				0	0	0	0	0	0	0	0	0	0	0	0	0	
Post Mitigation Plan Performance Standard	Current Year Stem Count				17	17	17	17	18	18	20	20	24	24	16	16	14
	Stems/Acre				688	688	688	688	729	729	810	810	972	972	648	648	567
	Species Count				9	10	10	10	10	10	10	10	12	12	9	10	10
	Dominant Species Composition (%)				18	17	17	17	22	22	20	20	33	33	25	25	14
	Average Plot Height (ft.)				2	2	2	2	2	2	2	2	2	2	2	2	2
% Invasives				0	0	0	0	0	0	0	0	0	0	0	0	0	

- 1). Bolded species are proposed for the current monitoring year, italicized species are not approved, and a regular font indicates that the species has been approved.
- 2). The "Species Included in Approved Mitigation Plan" section contains only those species that were included in the original approved mitigation plan. The "Post Mitigation Plan Species" section includes species that are being proposed through a mitigation plan addendum for the current monitoring year (bolded), species that have been approved in prior monitoring years through a mitigation plan addendum (regular font), and species that are not approved (italicized).
- 3). The "Mitigation Plan Performance Standard" section is derived only from stems included in the original mitigation plan, whereas the "Post Mitigation Plan Performance Standard" includes data from mitigation plan approved, post mitigation plan approved, and proposed stems.

TABLE 6. PLANTED STEM COUNTS BY PLOT AND SPECIES

Vegetation Performance Standards Summary Table												
	Veg Plot 1 F				Veg Plot 2 F				Veg Plot 3 F			
	Stems/Ac.	Av. Ht. (ft)	# Species	% Invasives	Stems/Ac.	Av. Ht. (ft)	# Species	% Invasives	Stems/Ac.	Av. Ht. (ft)	# Species	% Invasives
Monitoring Year 7												
Monitoring Year 5												
Monitoring Year 3												
Monitoring Year 2												
Monitoring Year 1												
Monitoring Year 0	688		9	0	688		10	0	729		10	0
	Veg Plot 4 F				Veg Plot 5 F				Veg Plot 6 F			
	Stems/Ac.	Av. Ht. (ft)	# Species	% Invasives	Stems/Ac.	Av. Ht. (ft)	# Species	% Invasives	Stems/Ac.	Av. Ht. (ft)	# Species	% Invasives
Monitoring Year 7												
Monitoring Year 5												
Monitoring Year 3												
Monitoring Year 2												
Monitoring Year 1												
Monitoring Year 0	810		10	0	972		12	0	648		9	0
	Veg Plot Group 1 R											
	Stems/Ac.	Av. Ht. (ft)	# Species	% Invasives								
Monitoring Year 7												
Monitoring Year 5												
Monitoring Year 3												
Monitoring Year 2												
Monitoring Year 1												
Monitoring Year 0	567		10	0								

*Each monitoring year represents a different plot for the random vegetation plot "groups". Random plots are denoted with an R, and fixed plots with an F.

APPENDIX D

Stream Measurement and Geomorphology Data

Table 7. Baseline Stream Data Summary																
Rush Fork Stream Mitigation Project: DMS Project No ID. 100068																
UT1 - Reach 1-3 (Enhancement)																
Parameter	Pre-Existing Condition				Reference Reach(es) Data				Design				As-built			
					Composite											
Dimension and Substrate - Riffle	Min	Mean	Med	Max	Min	Mean	Med	Max	Min	Mean	Med	Max	Min	Mean	Med	Max
BF Width (ft)	7.1000	9.65	-----	12.2000	9.90	11.39	-----	12.88	9.00	9.50	-----	10.00	7.79	9.28	9.28	10.76
Floodprone Width (ft)	-----	-----	-----	-----	-----	-----	-----	-----	-----	-----	-----	-----	15.09	27.03	15.09	38.96
BF Mean Depth (ft)	0.2700	0.58	-----	0.8900	0.55	0.86	-----	1.16	0.65	0.68	-----	0.70	0.59	0.65	0.65	0.70
BF Max Depth (ft)	-----	-----	-----	-----	-----	-----	-----	-----	0.80	0.90	-----	1.00	0.96	0.98	0.98	0.99
BF Cross-sectional Area (ft²)	3.3300	4.85	-----	6.4	5.4	8.76	-----	12.1	5.9	6.45	-----	7.00	5.44	5.90	5.90	6.36
Width/Depth Ratio	7.9800	26.62	-----	45.2600	8.97	13.49	-----	18.00	13.80	14.05	-----	14.30	11.13	14.69	14.69	18.24
Entrenchment Ratio	1.1500	1.43	-----	1.7100	1.70	1.67	-----	1.63	1.40	-----	-----	2.20	1.94	2.78	2.78	3.62
Bank Height Ratio	1.0000	1.43	-----	1.8600	1.00	1.19	-----	1.38	1.10	-----	-----	1.10	1.00	1.00	1.00	1.00
d50 (mm)	-----	-----	-----	-----	-----	-----	-----	-----	-----	-----	-----	-----	-----	-----	-----	-----
Pattern																
Channel Beltwidth (ft)	-----	N/A	-----	-----	-----	N/A	-----	-----	-----	N/A	-----	-----	-----	N/A	-----	-----
Radius of Curvature (ft)	-----	N/A	-----	-----	-----	N/A	-----	-----	-----	N/A	-----	-----	-----	N/A	-----	-----
Rc/Bankfull width (ft/ft)	-----	N/A	-----	-----	-----	N/A	-----	-----	-----	N/A	-----	-----	-----	N/A	-----	-----
Meander Wavelength (ft)	-----	N/A	-----	-----	-----	N/A	-----	-----	-----	N/A	-----	-----	-----	N/A	-----	-----
Meander Width Ratio	-----	N/A	-----	-----	-----	N/A	-----	-----	-----	N/A	-----	-----	-----	N/A	-----	-----
Profile																
Riffle Length (ft)	-----	-----	-----	-----	-----	-----	-----	-----	-----	-----	-----	-----	4.30	14.60	15.40	20.50
Riffle Slope (ft/ft)	-----	-----	-----	-----	-----	-----	-----	-----	-----	-----	-----	-----	-0.0950	-0.0680	-0.0630	-0.0400
Pool Length (ft)	-----	-----	-----	-----	-----	-----	-----	-----	-----	-----	-----	-----	2.00	9.50	10.00	14.00
Pool to Pool Spacing (ft)	-----	-----	-----	-----	-----	-----	-----	-----	-----	-----	-----	-----	14.00	42.10	35.00	240.00
Pool Max Depth (ft)	-----	-----	-----	-----	-----	-----	-----	-----	1.50	1.75	-----	2.00	2.33	2.46	2.47	2.55
Substrate and Transport Parameters																
SC% / Sa% / G% / C% / Bo%	-----	-----	-----	-----	-----	-----	-----	-----	-----	-----	-----	-----	-----	-----	-----	-----
d16 / d35 / d50 / d84 / d95	-----	168.14/256/80	-----	-----	-----	-----	-----	-----	-----	-----	-----	-----	-----	-----	-----	-----
Additional Reach Parameters																
Drainage Area (SM)	-----	0.21	-----	-----	0.15	0.32	-----	0.49	0.15	-----	-----	0.21	0.15	-----	-----	0.21
Impervious cover estimate (%)	-----	-----	-----	-----	-----	-----	-----	-----	-----	-----	-----	-----	-----	-----	-----	-----
Rosgen Classification	-----	B4a	-----	-----	-----	B4a - B4 - Ba	-----	-----	-----	B4a	-----	-----	-----	B	-----	-----
BF Velocity (fps)	3.00	3.82	-----	4.64	3.42	5.11	-----	6.80	2.15	3.58	-----	5.00	-----	-----	-----	-----
BF Discharge (cfs)	10.00	19.75	-----	29.50	23.90	31.16	-----	38.41	12.60	14.95	-----	17.30	-----	-----	-----	-----
Valley Length	-----	-----	-----	-----	-----	-----	-----	-----	-----	-----	-----	-----	-----	-----	-----	-----
Channel Length (ft)	-----	1,164	-----	-----	-----	-----	-----	-----	-----	1,093.30	-----	-----	-----	1,082.27	-----	-----
Sinuosity	1.06	1.07	-----	1.07	1.02	1.08	-----	1.14	-----	1.05	-----	-----	-----	-----	-----	-----

Table 7. Baseline Stream Data Summary																
Rush Fork Stream Mitigation Project: DMS Project No ID. 100068																
UT1 - Reach 4 (Restoration)																
Parameter	Pre-Existing Condition				Reference Reach(es) Data				Design				As-built			
					Composite											
Dimension and Substrate - Riffle	Min	Mean	Med	Max	Min	Mean	Med	Max	Min	Mean	Med	Max	Min	Mean	Med	Max
BF Width (ft)	8.7300	11.07	-----	13.4000	9.90	11.39	-----	12.88	12.50	12.75	-----	13.00	12.93	14.21	13.36	15.90
Floodprone Width (ft)	-----	-----	-----	-----	-----	-----	-----	-----	-----	-----	-----	-----	21.96	30.86	24.30	46.32
BF Mean Depth (ft)	0.7300	1.01	-----	1.2800	0.55	0.86	-----	1.16	0.90	0.93	-----	0.95	0.69	0.71	0.87	1.11
BF Max Depth (ft)	-----	-----	-----	-----	-----	-----	-----	-----	1.20	1.25	-----	1.30	1.35	1.46	1.43	1.60
BF Cross-sectional Area (ft²)	9.8600	10.48	-----	11.1	5.4	8.76	-----	12.1	11.3	11.70	-----	12.10	11.01	13.27	14.33	14.48
Width/Depth Ratio	6.8200	12.59	-----	18.3600	8.97	13.49	-----	18.00	12.00	15.00	-----	18.00	11.65	15.94	13.13	13.13
Entrenchment Ratio	1.4800	2.45	-----	3.4200	1.70	1.67	-----	1.63	1.40	1.80	-----	2.20	1.59	2.13	1.88	1.88
Bank Height Ratio	1.0000	1.31	-----	1.6200	1.00	1.19	-----	1.38	1.00	-----	-----	1.62	1.00	1.00	1.00	1.00
d50 (mm)	-----	-----	-----	-----	-----	-----	-----	-----	-----	-----	-----	-----	-----	-----	-----	-----
Pattern																
Channel Beltwidth (ft)	-----	N/A	-----	-----	-----	N/A	-----	-----	-----	N/A	-----	-----	-----	N/A	-----	-----
Radius of Curvature (ft)	-----	N/A	-----	-----	-----	N/A	-----	-----	-----	N/A	-----	-----	-----	N/A	-----	-----
Rc/Bankfull width (ft/ft)	-----	N/A	-----	-----	-----	N/A	-----	-----	-----	N/A	-----	-----	-----	N/A	-----	-----
Meander Wavelength (ft)	-----	N/A	-----	-----	-----	N/A	-----	-----	-----	N/A	-----	-----	-----	N/A	-----	-----
Meander Width Ratio	-----	N/A	-----	-----	-----	N/A	-----	-----	-----	N/A	-----	-----	-----	N/A	-----	-----
Profile																
Riffle Length (ft)	-----	-----	-----	-----	-----	-----	-----	-----	-----	-----	-----	-----	12.30	19.30	17.70	19.30
Riffle Slope (ft/ft)	-----	-----	-----	-----	-----	-----	-----	-----	-----	-----	-----	-----	-0.5800	-0.0220	-0.0377	-0.0790
Pool Length (ft)	-----	-----	-----	-----	-----	-----	-----	-----	-----	-----	-----	-----	2.00	13.40	14.00	22.00
Pool to Pool Spacing (ft)	-----	-----	-----	-----	-----	-----	-----	-----	-----	-----	-----	-----	18.00	44.80	40.00	117.00
Pool Max Depth (ft)	-----	-----	-----	-----	-----	-----	-----	-----	-----	2.50	-----	-----	2.55	2.72	2.72	2.89
Substrate and Transport Parameters																
SC% / Sa% / G% / C% / Bo%	-----	-----	-----	-----	-----	-----	-----	-----	-----	-----	-----	-----	-----	-----	-----	-----
d16 / d35 / d50 / d84 / d95	-----	156/180/100.3	-----	-----	-----	-----	-----	-----	-----	-----	-----	-----	-----	-----	-----	-----
Additional Reach Parameters																
Drainage Area (SM)	-----	0.48	-----	-----	0.15	0.32	-----	0.49	-----	-----	-----	-----	-----	-----	-----	-----
Impervious cover estimate (%)	-----	-----	-----	-----	-----	-----	-----	-----	-----	-----	-----	-----	-----	-----	-----	-----
Rosgen Classification	-----	B4	-----	-----	-----	B4a - B4 - Ba	-----	-----	-----	B4	-----	-----	-----	B4	-----	-----
BF Velocity (fps)	3.17	3.61	-----	4.04	3.42	5.11	-----	6.80	4.00	5.00	-----	6.00	-----	-----	-----	-----
BF Discharge (cfs)	31.24	38.03	-----	44.81	23.90	-----	38.41	37.88	38.13	-----	38.37	-----	-----	-----	-----	-----
Valley Length	-----	-----	-----	-----	-----	-----	-----	-----	-----	-----	-----	-----	-----	-----	-----	-----
Channel Length (ft)	-----	1,300.00	-----	-----	-----	-----	-----	-----	-----	1,216.33	-----	-----	-----	1,224.37	-----	-----
Sinuosity	1.08	1.11	-----	1.14	1.02	1.08	-----	1.14	1.10	1.15	-----	1.20	-----	-----	-----	-----

Table 7. Baseline Stream Data Summary																
Rush Fork Stream Mitigation Project: DMS Project No ID. 100068																
UT3 - Restoration																
Parameter	Pre-Existing Condition				Reference Reach(es) Data				Design				As-built			
					Composite											
Dimension and Substrate - Riffle	Min	Mean	Med	Max	Min	Mean	Med	Max	Min	Mean	Med	Max	Min	Mean	Med	Max
BF Width (ft)	----	6.58	----	----	9.90	11.39	----	12.88	7.50	8.00	----	8.50	7.04	8.29	7.60	10.92
Floodprone Width (ft)	----		----	----	----	----	----	----	----	----	----	----	11.96	15.37	14.41	20.71
BF Mean Depth (ft)	----	0.82	----	----	0.55	0.86	----	1.16	0.57	0.61	----	0.65	0.52	0.61	0.58	0.77
BF Max Depth (ft)	----		----	----	----	----	----	----	0.70	0.78	----	0.85	0.71	0.89	0.89	1.07
BF Cross-sectional Area (ft ²)	----	5.4	----	----	5.4	8.76	----	12.1	4.6	5.30	----	6.00	3.64	5.05	5.16	6.23
Width/Depth Ratio	----	8.02	----	----	8.97	13.49	----	18.00	----	13.10	----	----	10.32	13.88	13.02	19.16
Entrenchment Ratio	----	2.17	----	----	1.70	1.67	----	1.63	1.40	1.80	----	2.20	1.70	1.85	1.86	1.97
Bank Height Ratio	----	1.83	----	----	1.00	1.19	----	1.38	----	1.00	----	----	1.00	1.00	1.00	1.00
d50 (mm)	----	----	----	----	----	----	----	----	----	----	----	----	----	----	----	----
Pattern																
Channel Beltwidth (ft)	----	N/A	----	----	----	N/A	----	----	----	N/A	----	----	----	N/A	----	----
Radius of Curvature (ft)	----	N/A	----	----	----	N/A	----	----	----	N/A	----	----	----	N/A	----	----
Rc/Bankfull width (ft/ft)	----	N/A	----	----	----	N/A	----	----	----	N/A	----	----	----	N/A	----	----
Meander Wavelength (ft)	----	N/A	----	----	----	N/A	----	----	----	N/A	----	----	----	N/A	----	----
Meander Width Ratio	----	N/A	----	----	----	N/A	----	----	----	N/A	----	----	----	N/A	----	----
Profile																
Riffle Length (ft)	----	----	----	----	----	----	----	----	----	----	----	----	10.20	18.70	16.90	37.20
Riffle Slope (ft/ft)	----	----	----	----	----	----	----	----	----	----	----	----	-0.1400	-0.0660	-0.0649	-0.0330
Pool Length (ft)	----	----	----	----	----	----	----	----	----	----	----	----	2.00	5.70	6.00	12.00
Pool to Pool Spacing (ft)	----	----	----	----	----	----	----	----	----	----	----	----	10.00	37.00	34.00	70.00
Pool Max Depth (ft)	----	----	----	----	----	----	----	----	1.70	1.75	----	1.80	2.16	2.54	2.53	2.94
Substrate and Transport Parameters																
SC% / Sa% / G% / C% / Bo%	----	----	----	----	----	----	----	----	----	----	----	----	----	----	----	----
d16 / d35 / d50 / d84 / d95	----	----	----	----	----	----	----	----	----	----	----	----	----	----	----	----
Additional Reach Parameters																
Drainage Area (SM)	----	0.15	----	----	0.15	0.32	----	0.49	----	0.15	----	----	----	0.15	----	----
Impervious cover estimate (%)	----	----	----	----	----	----	----	----	----	----	----	----	----	----	----	----
Rosgen Classification	----	Ba	----	----		B4a - B4 - Ba	----	----	----	Ba	----	----	----	B4	----	----
BF Velocity (fps)	----	3.48	----	----	3.42	5.11	----	6.80	4.42	4.71	----	5.00	----	----	----	----
BF Discharge (cfs)	----	18.8	----	----	23.90	31.16	----	38.41	19.00	24.50	----	30.00	----	----	----	----
Valley Length	----	1,541	----	----	----	----	----	----	----	----	----	----	----	----	----	----
Channel Length (ft)	----	1,618	----	----	----	----	----	----	----	1,584.45	----	----	----	1,577.53	----	----
Sinuosity	----	1.05	----	----	1.02	1.08	----	1.14	----	1.02	----	----	----	----	----	----


Table 8. Cross-Section Morphology Data Summary
UT to Rush Fork Restoration Project: DMS Project No ID. 100068

Stream Reach	UT3																												
	Cross-section X-1 (Riffle)							Cross-section X-2 (Pool)							Cross-section X-3 (Riffle)							Cross-section X-4 (Pool)							
Dimension and substrate	Base	MY1	MY2	MY3	MY4	MY5	MY+	Base	MY1	MY2	MY3	MY4	MY5	MY+	Base	MY1	MY2	MY3	MY4	MY5	MY+	Base	MY1	MY2	MY3	MY4	MY5	MY+	
Based on fixed baseline bankfull elevation																													
Bankfull Elevation (ft) - Based on AB-Bankfull ¹ Area	3063.86							3048.03							3028.13							3010.84							
Bank Height Ratio - Based on AB Bankfull ¹ Area	1.00							1.00							1.00							1.00							
Thalweg Elevation	3062.99							3045.87							3027.42							3007.90							
LTOB ² Elevation	3063.86							3048.03							3028.13							3010.84							
LTOB ² Max Depth (ft)	0.87							2.16							0.71							2.94							
LTOB ² Cross Sectional Area (ft ²)	4.20							11.12							3.64							15.11							
Stream Reach	UT3																												
	Cross-section X-5 (Riffle)							Cross-section X-6 (Pool)							Cross-section X-7 (Riffle)							Cross-section X-8 (Riffle)							
Dimension and substrate	Base	MY1	MY2	MY3	MY4	MY5	MY+	Base	MY1	MY2	MY3	MY4	MY5	MY+	Base	MY1	MY2	MY3	MY4	MY5	MY+	Base	MY1	MY2	MY3	MY4	MY5	MY+	
Based on fixed baseline bankfull elevation																													
Bankfull Elevation (ft) - Based on AB-Bankfull ¹ Area	2998.75							2985.03							2976.51							2970.37							
Bank Height Ratio - Based on AB Bankfull ¹ Area	1.00							1.00							1.00							1.00							
Thalweg Elevation	2997.84							2982.50							2975.44							2969.02							
LTOB ² Elevation	2998.75							2985.03							2976.51							2970.37							
LTOB ² Max Depth (ft)	0.91							2.53							1.07							1.35							
LTOB ² Cross Sectional Area (ft ²)	6.23							15.51							6.11							11.01							
Stream Reach	UT1 Reach 4																												
	Cross-section X-9 (Pool)							Cross-section X-10 (Riffle)							Cross-section X-11 (Pool)							Cross-section X-12 (Riffle)							
Dimension and substrate	Base	MY1	MY2	MY3	MY4	MY5	MY+	Base	MY1	MY2	MY3	MY4	MY5	MY+	Base	MY1	MY2	MY3	MY4	MY5	MY+	Base	MY1	MY2	MY3	MY4	MY5	MY+	
Based on fixed baseline bankfull elevation																													
Bankfull Elevation (ft) - Based on AB-Bankfull ¹ Area	2954.14							2922.10							2913.15							2904.41							
Bank Height Ratio - Based on AB Bankfull ¹ Area	1.00							1.00							1.00							1.00							
Thalweg Elevation	2951.59							2920.67							2910.26							2902.81							
LTOB ² Elevation	2954.14							2922.10							2913.15							2904.41							
LTOB ² Max Depth (ft)	2.55							1.43							2.89							1.60							
LTOB ² Cross Sectional Area (ft ²)	27.56							14.50							31.24							14.33							


Table 8. Cross-Section Morphology Data Summary
UT to Rush Fork Restoration Project: DMS Project No ID. 100068

Stream Reach	UT1 Reach 1							UT1 Reach 2							UT1 Reach 3														
	Cross-section X-13 (Pool)							Cross-section X-14 (Riffle)							Cross-section X-15 (Riffle)							Cross-section X-16 (Pool)							
Dimension and substrate	Base	MY1	MY2	MY3	MY4	MY5	MY+	Base	MY1	MY2	MY3	MY4	MY5	MY+	Base	MY1	MY2	MY3	MY4	MY5	MY+	Base	MY1	MY2	MY3	MY4	MY5	MY+	
Based on fixed baseline bankfull elevation																													
Bankfull Elevation (ft) - Based on AB-Bankfull ¹ Area	3051.49							3025.48							3008.35							2998.87							
Bank Height Ratio - Based on AB Bankfull ¹ Area	1.00							1.00							1.00							1.00							
Thalweg Elevation	3049.01							3024.52							3007.37							2996.54							
LTOB ² Elevation	3051.49							3025.48							3008.35							2998.87							
LTOB ² Max Depth (ft)	2.48							0.96							0.98							2.33							
LTOB ² Cross Sectional Area (ft ²)	12.13							5.44							6.36							12.06							
Stream Reach	UT1 Reach 3																												
	Cross-section X-17 (Pool)							Cross-section X-18 (Pool)																					
Dimension and substrate	Base	MY1	MY2	MY3	MY4	MY5	MY+	Base	MY1	MY2	MY3	MY4	MY5	MY+															
Based on fixed baseline bankfull elevation																													
Bankfull Elevation (ft) - Based on AB-Bankfull ¹ Area	2986.75							2976.03																					
Bank Height Ratio - Based on AB Bankfull ¹ Area	1.00							1.00																					
Thalweg Elevation	2984.29							2973.48																					
LTOB ² Elevation	2986.75							2976.03																					
LTOB ² Max Depth (ft)	2.46							2.55																					
LTOB ² Cross Sectional Area (ft ²)	17.60							17.29																					


Figure 7. Longitudinal Profiles

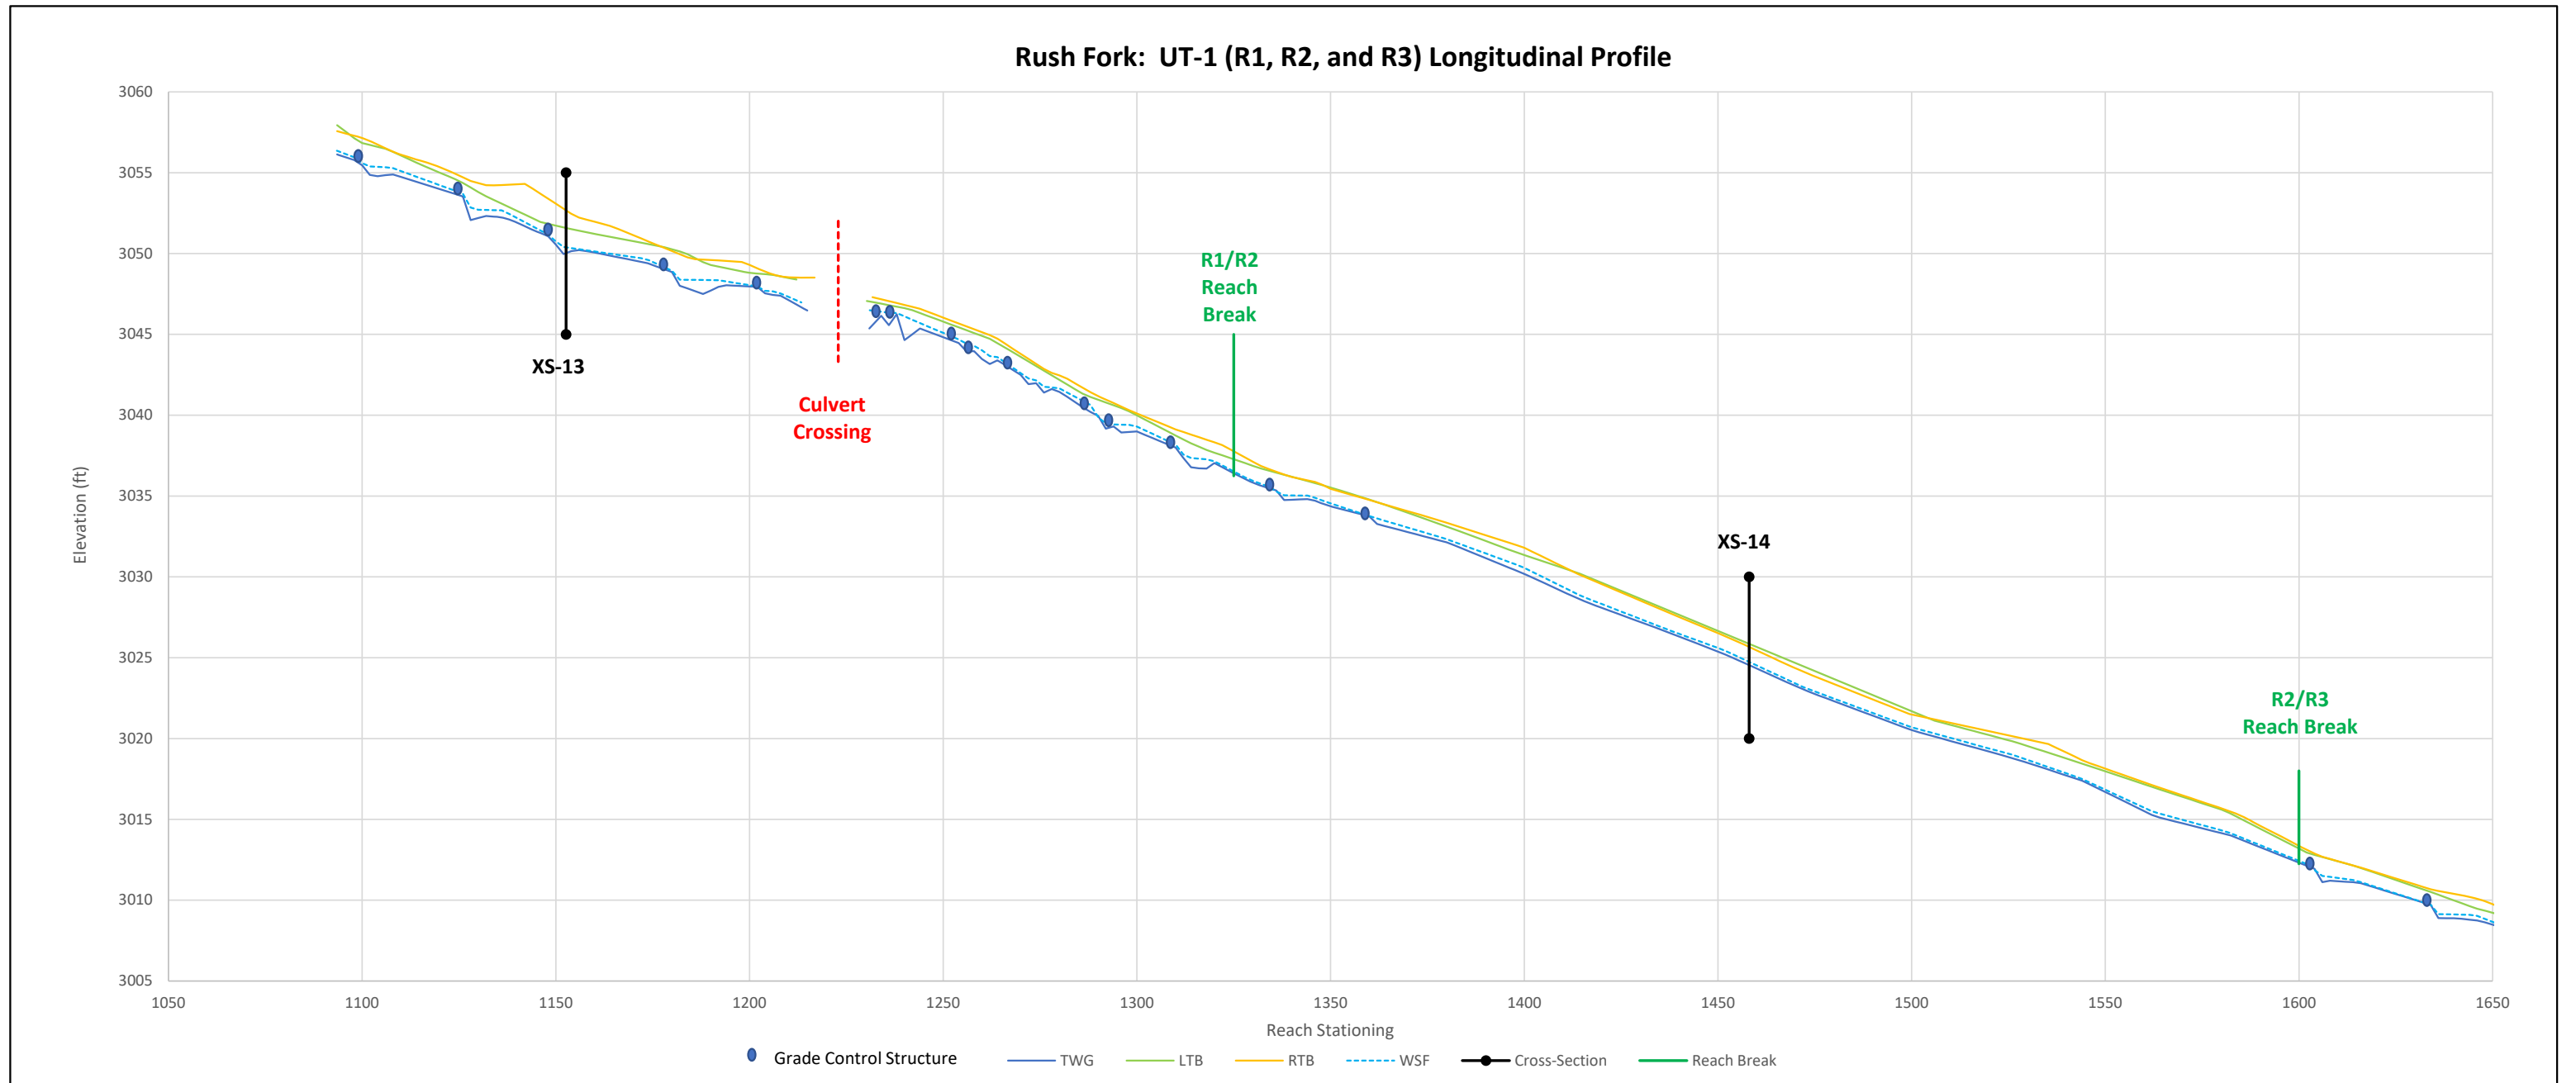


Rush Fork: UT-1 (R1, R2, and R3) Longitudinal Profile (cont.)

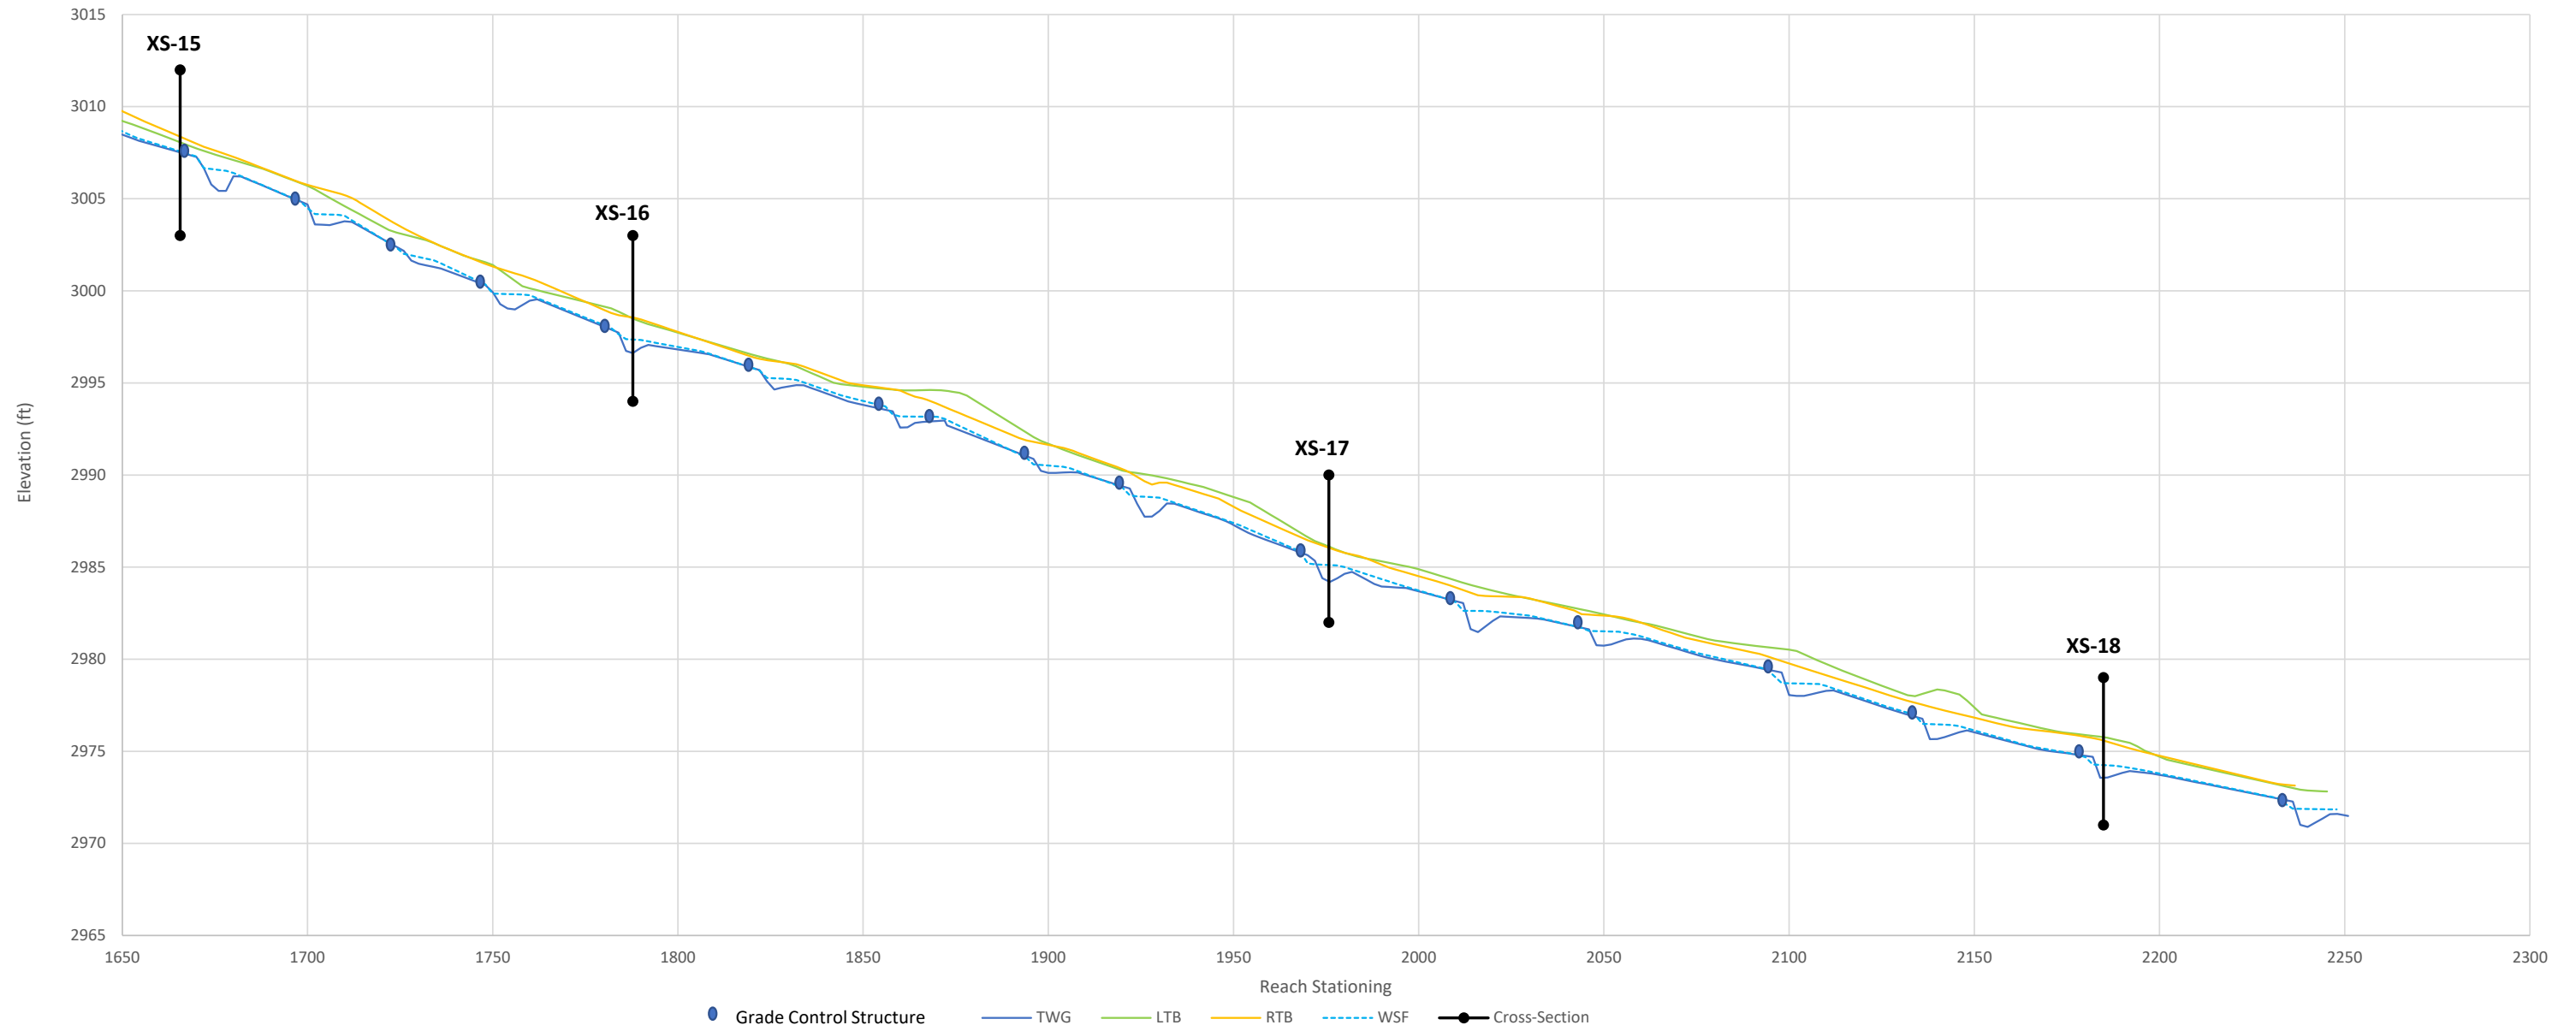


Rush Fork: UT1 (R4) Longitudinal Profile

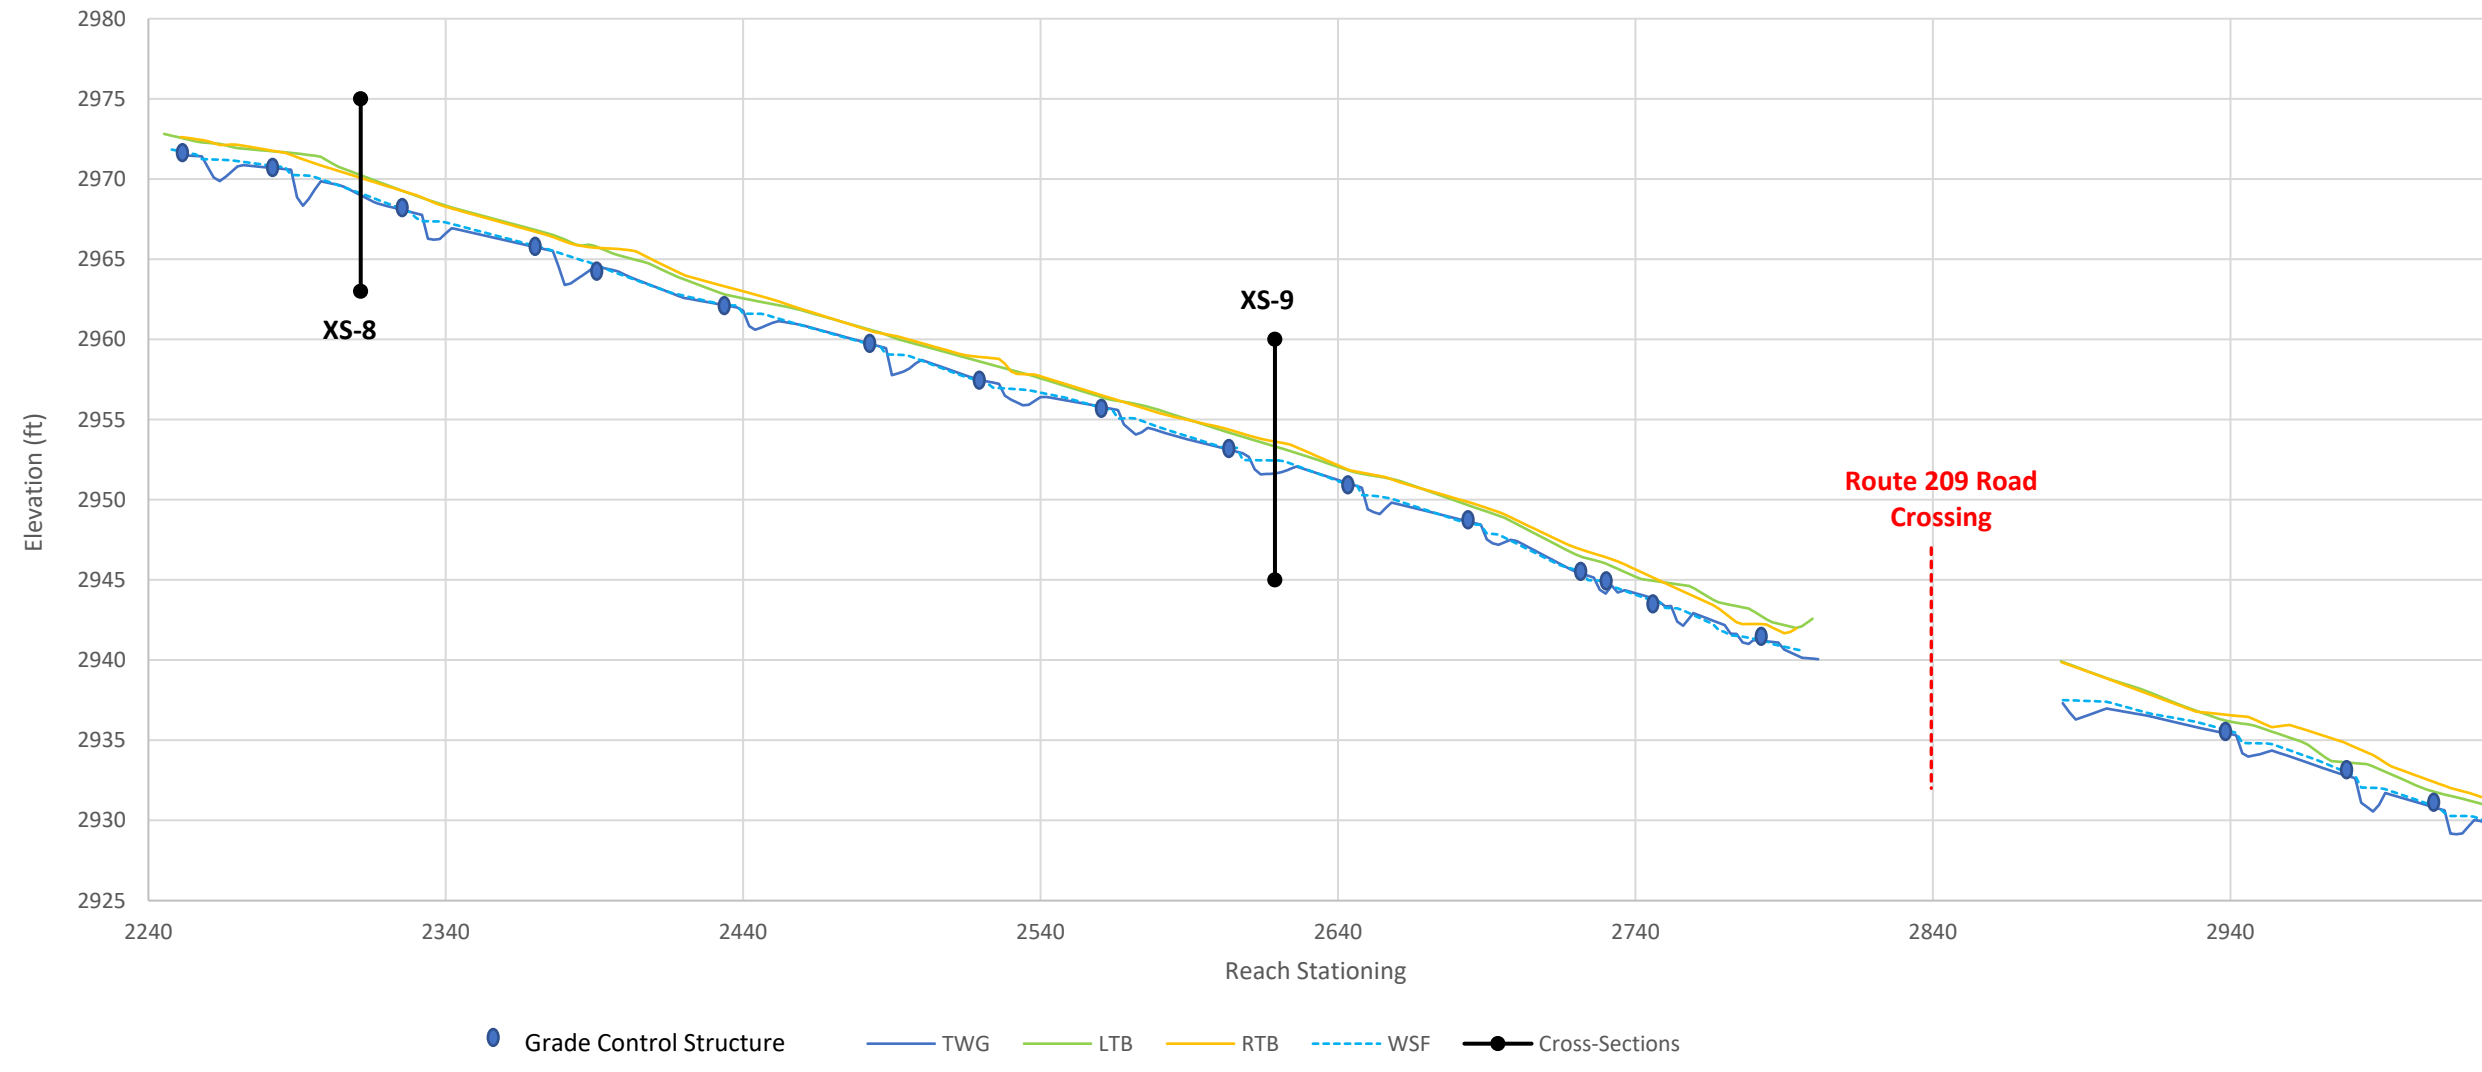


Rush Fork: UT1 (R4) Longitudinal Profile (cont.)

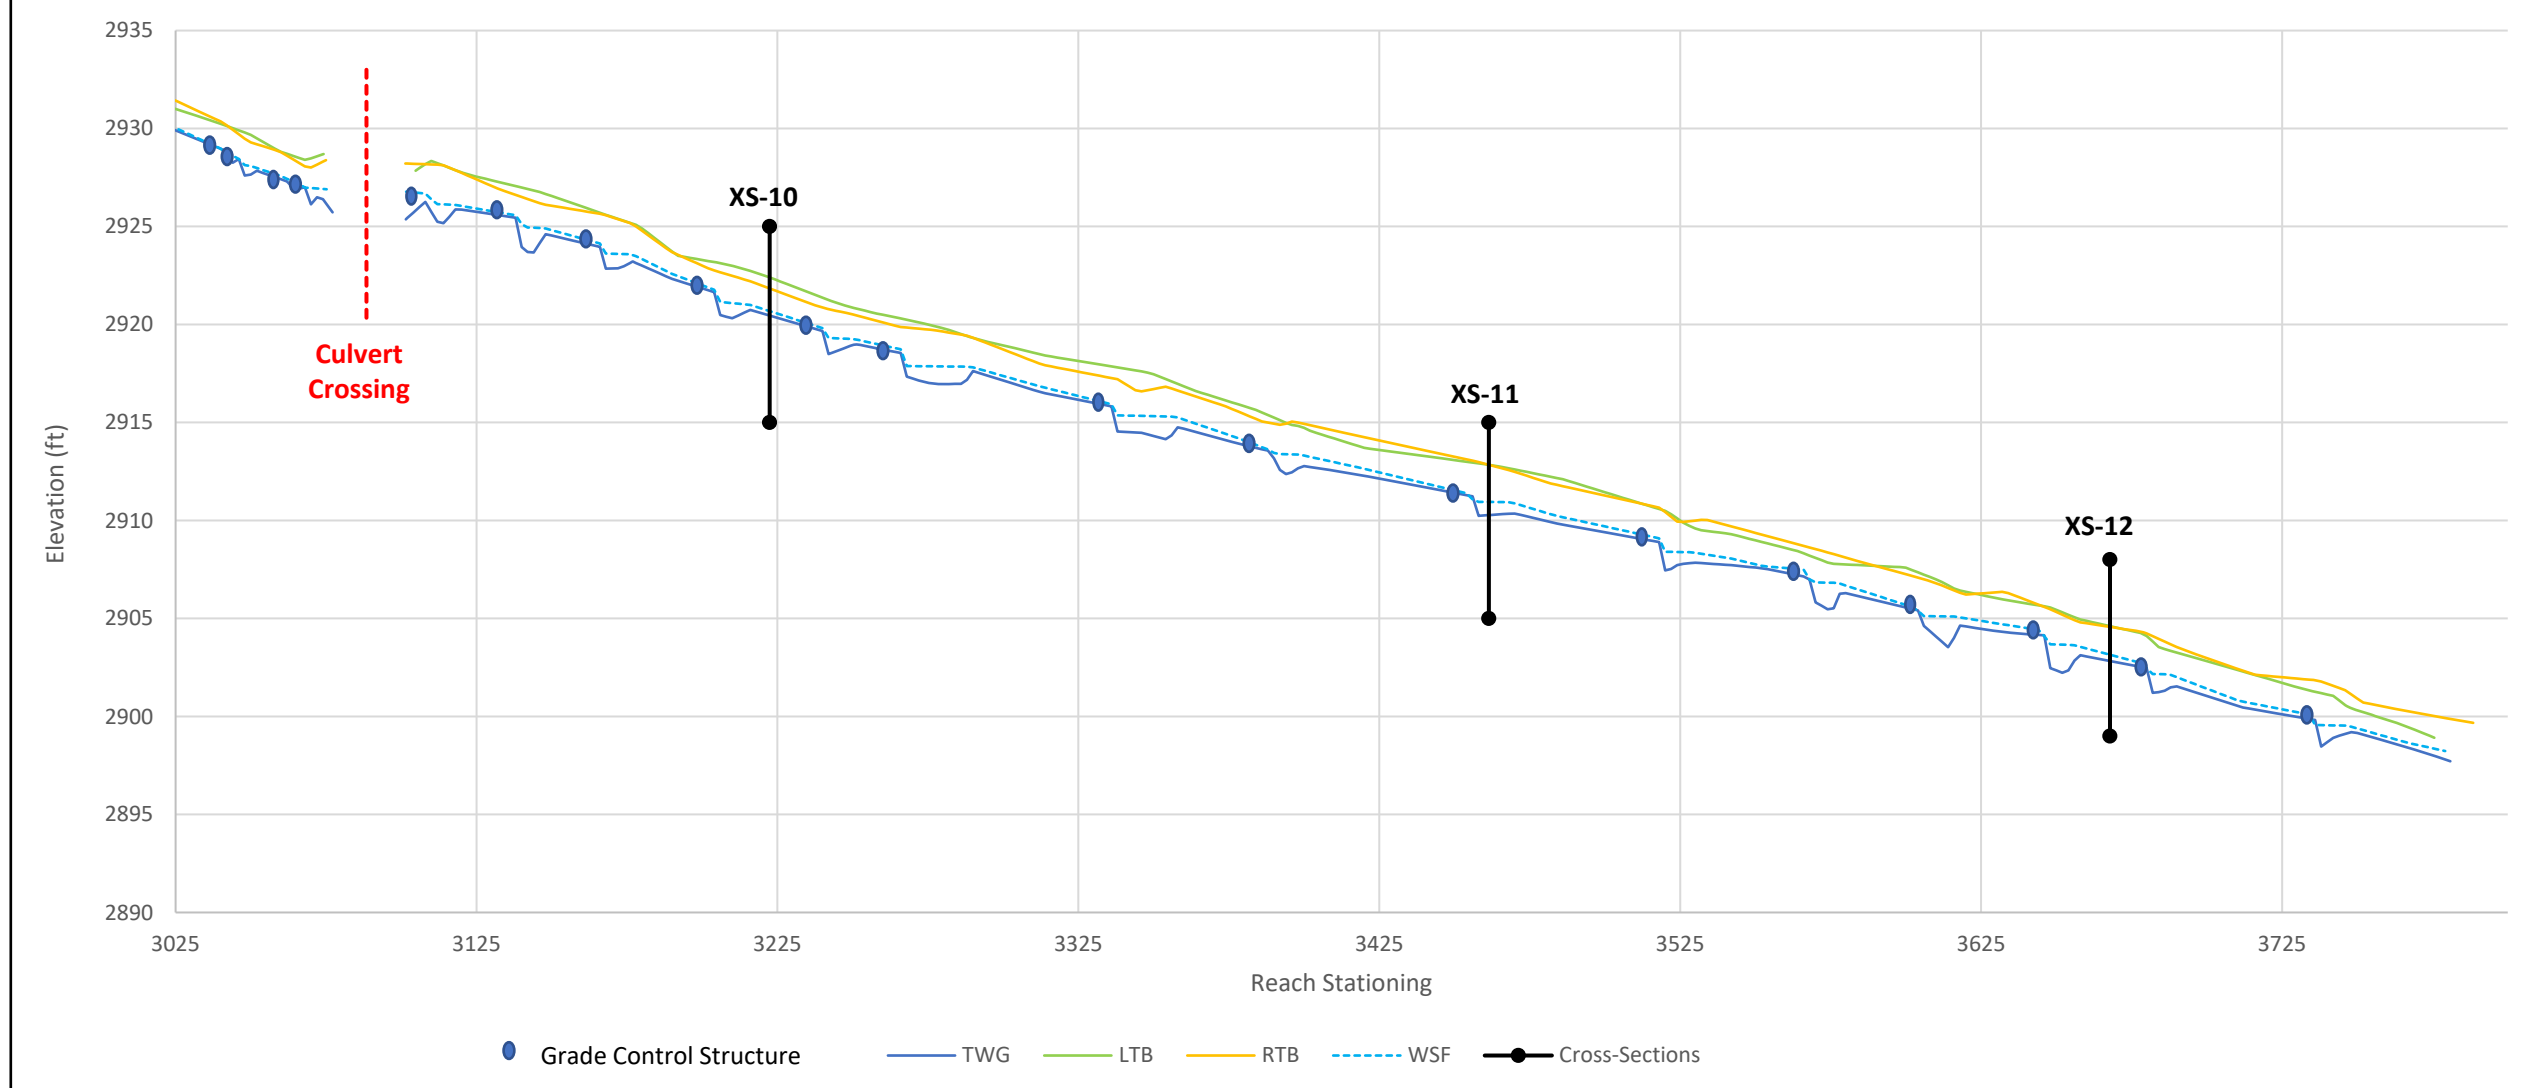


Rush Fork: Reach UT2 Longitudinal Profile

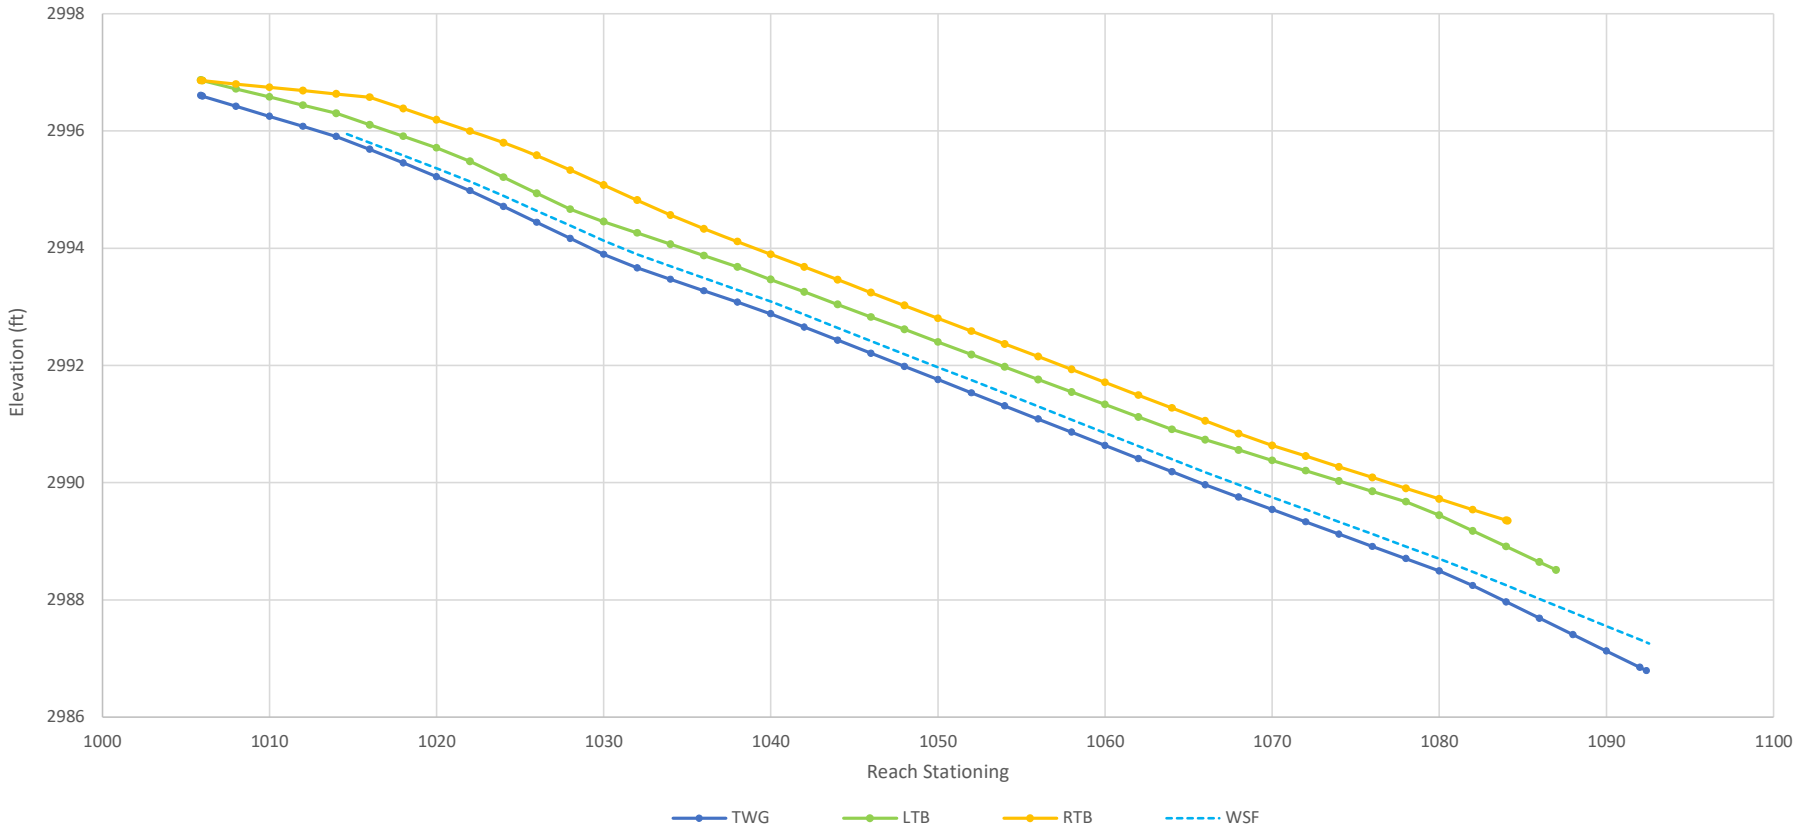


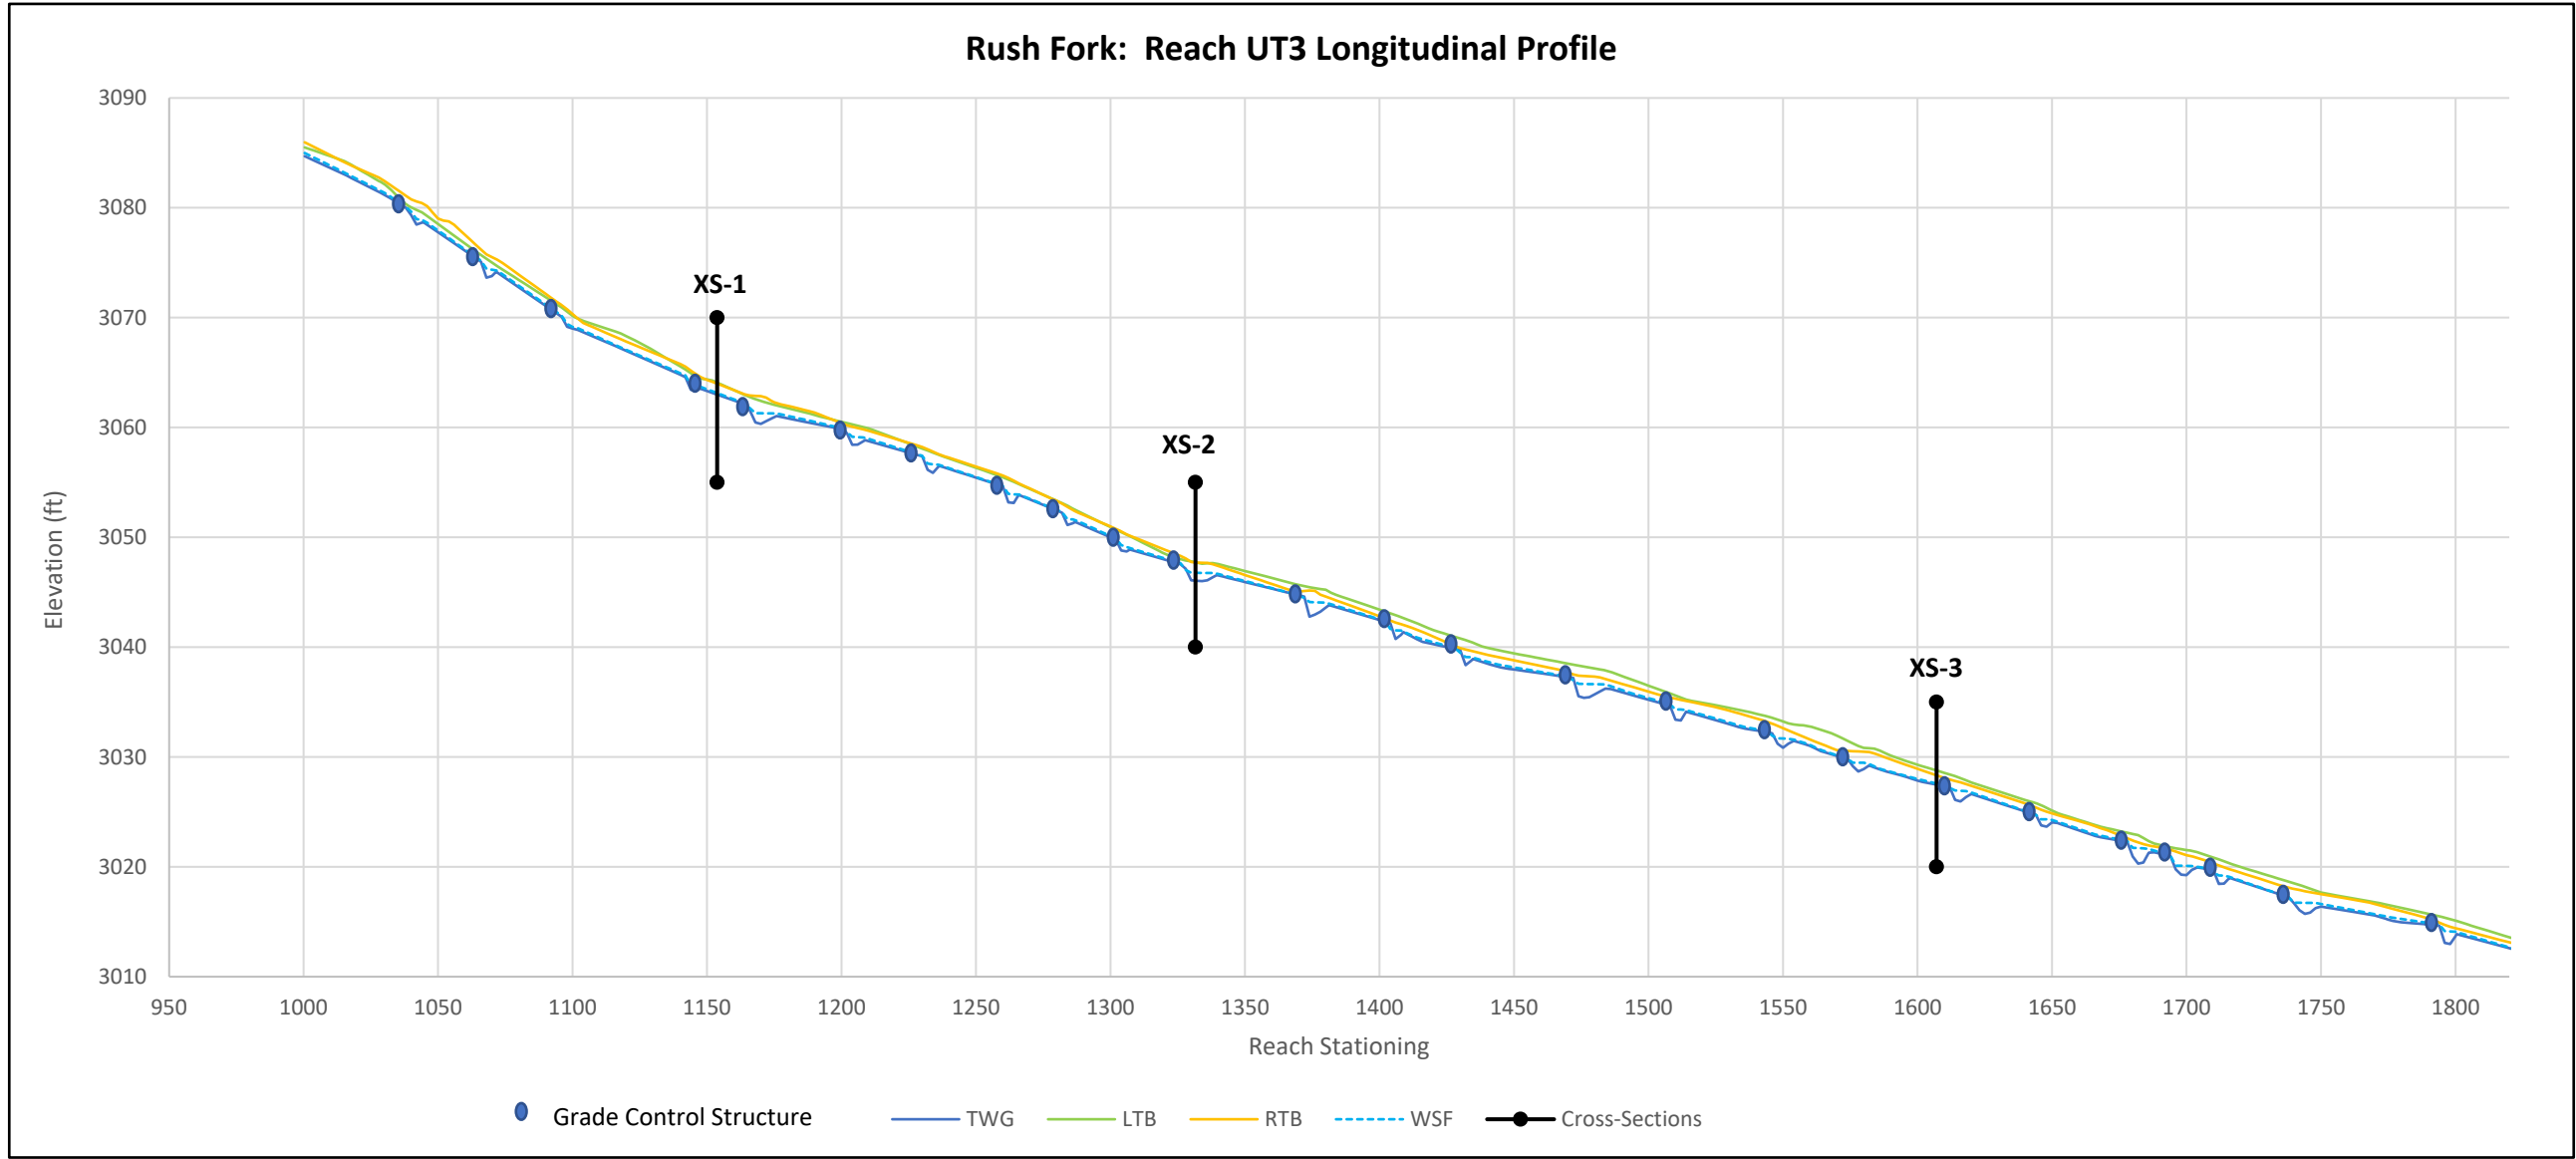

Rush Fork: Reach UT3 Longitudinal Profile (cont.)

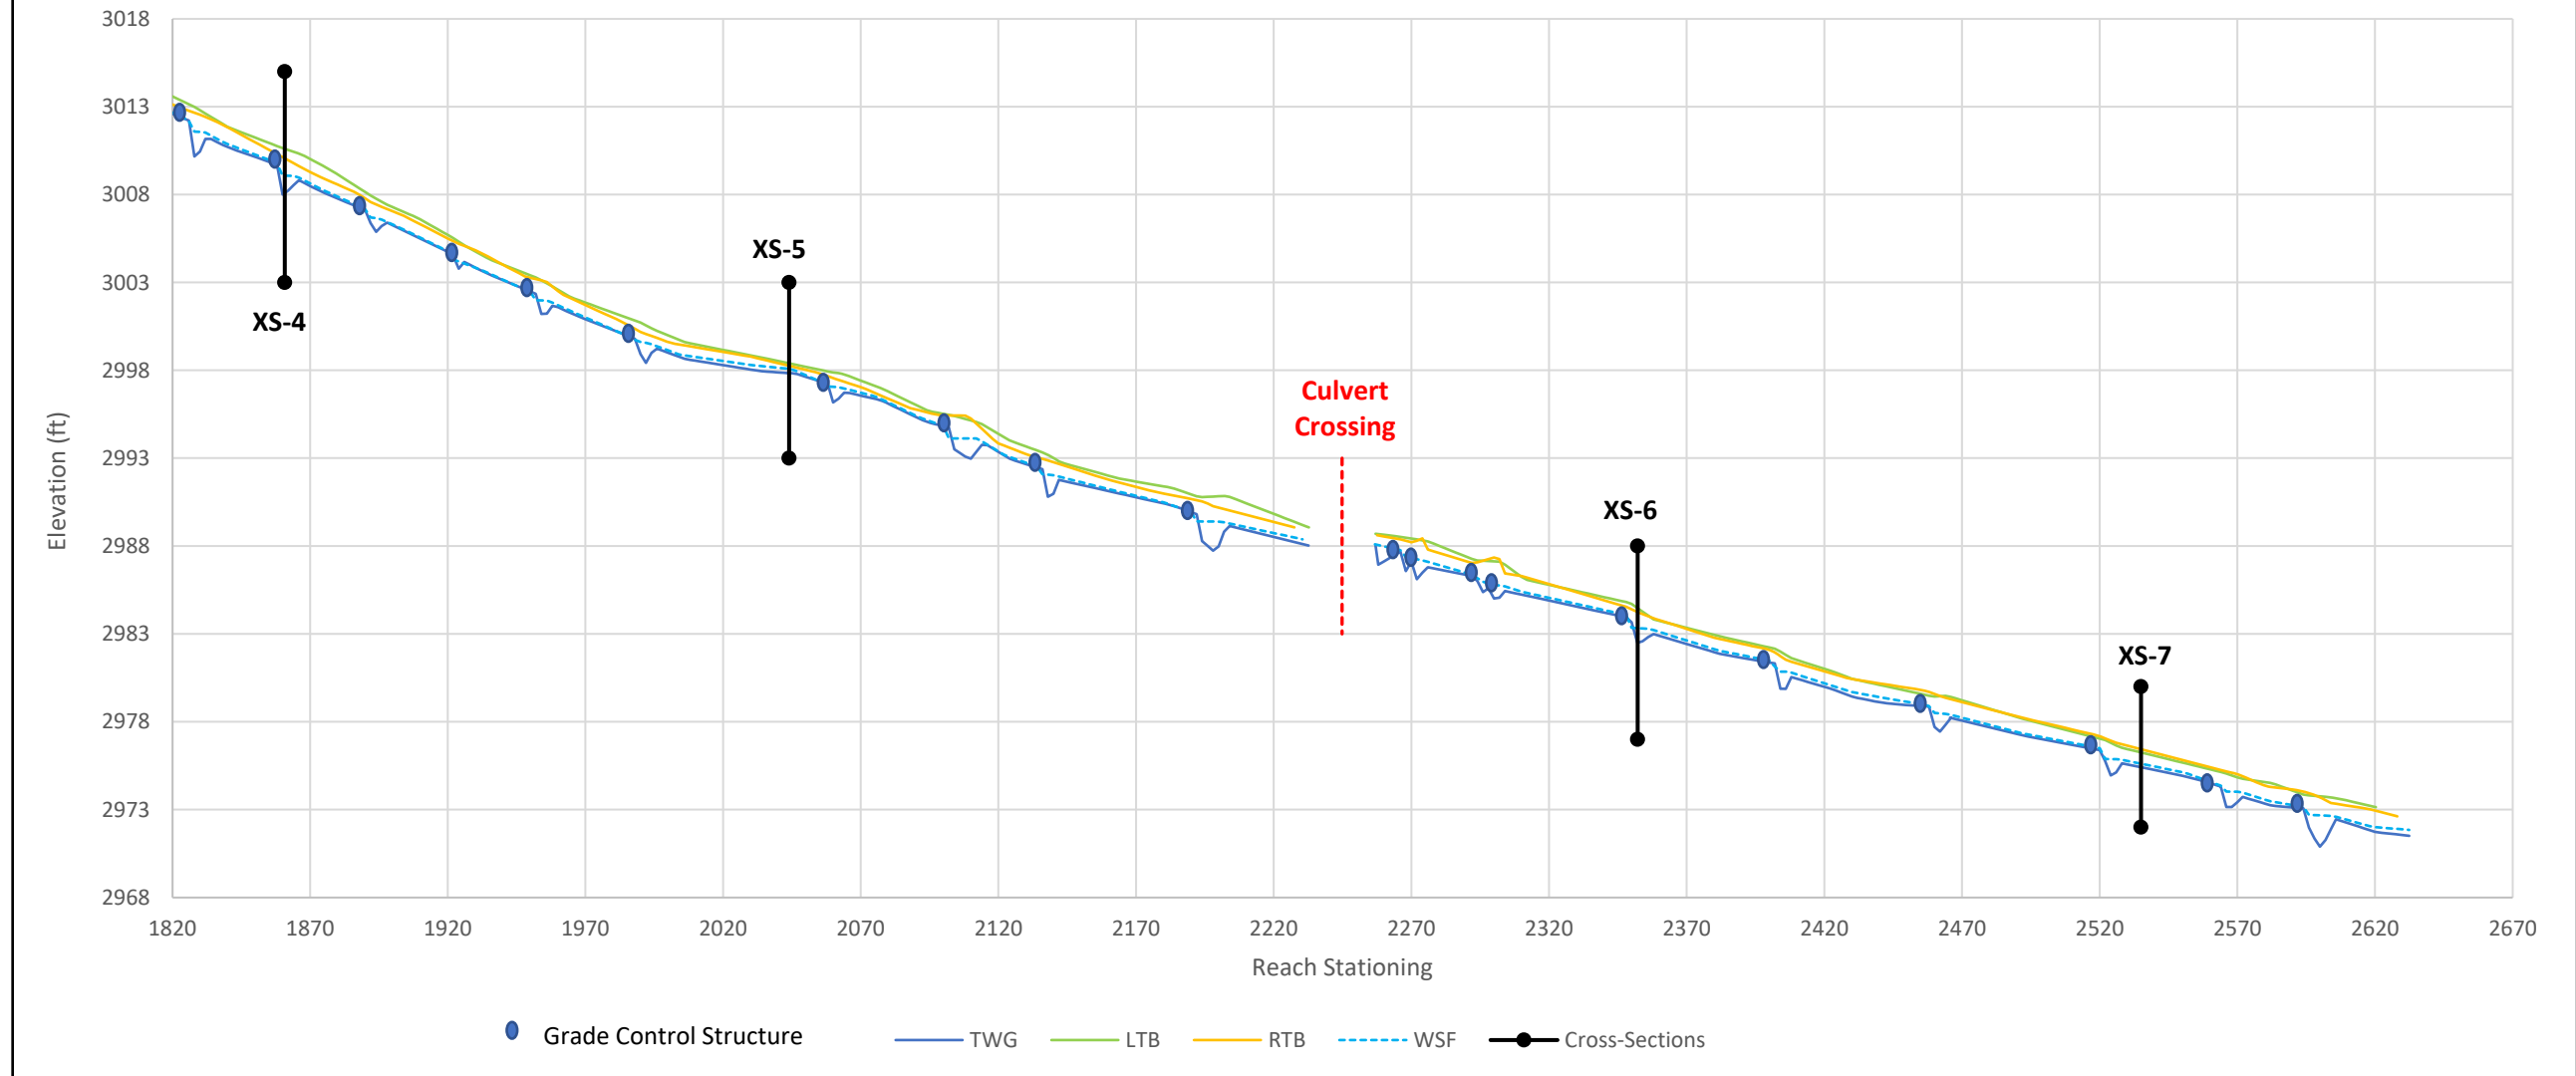

Rush Fork: Reach UT4 Longitudinal Profile

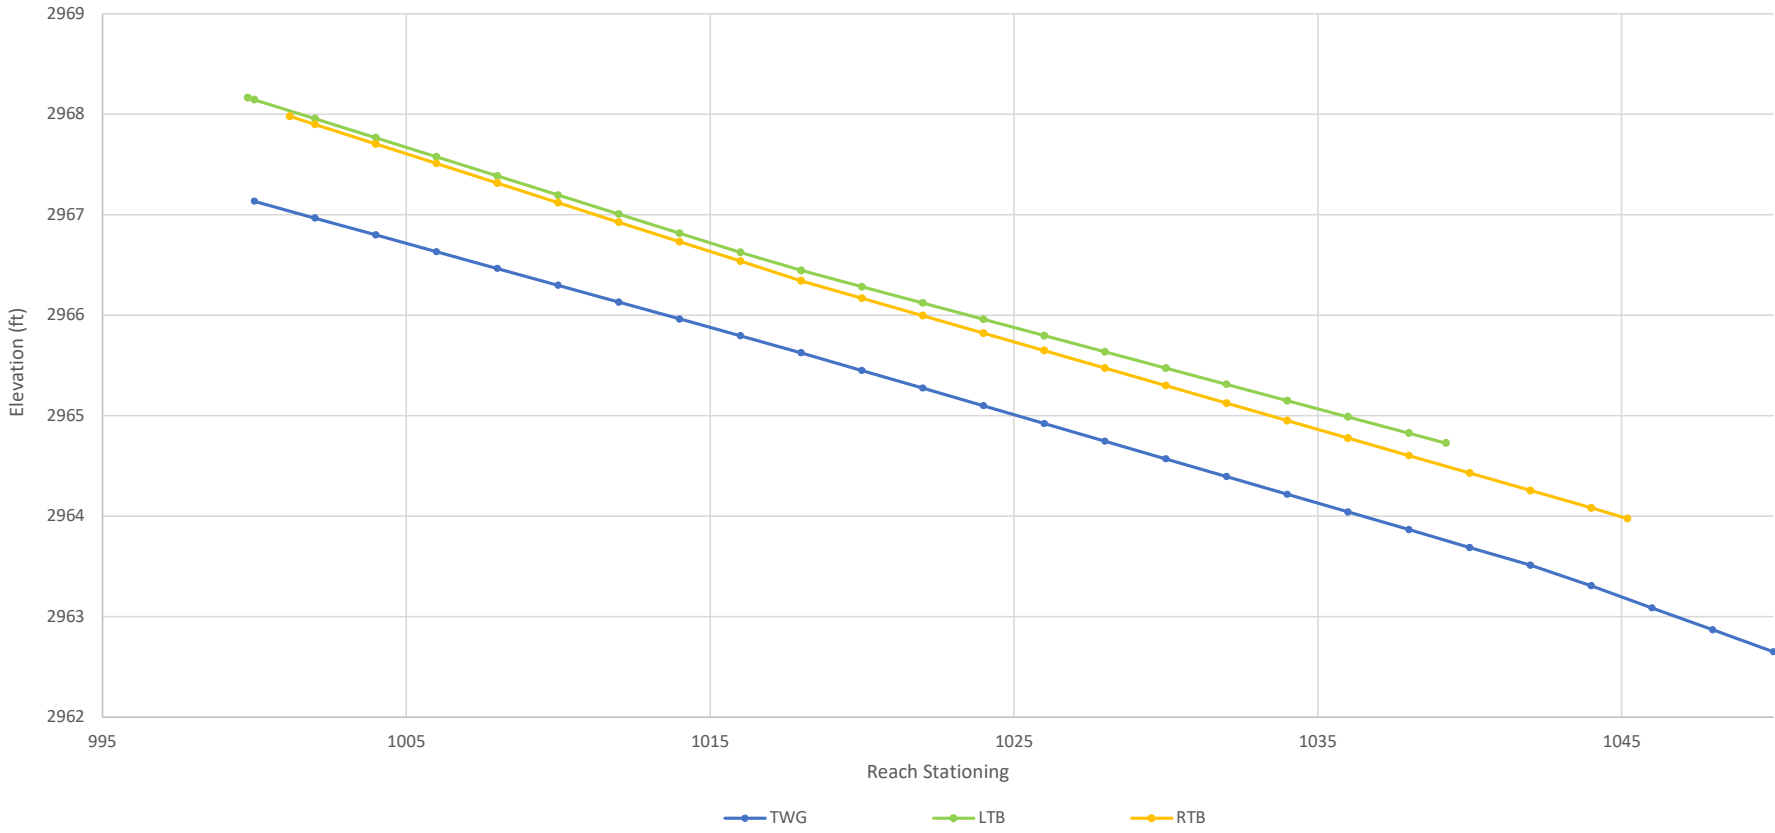

Permanent Cross-Section 1

(As-built Survey Data Collected: March 2022)
Restoration




Looking at the Left Bank



Looking at the Right Bank

Feature	Stream Type	BKF Area	BKF Width	BKF Depth	Max BKF Depth	W/D	BH Ratio	ER	BKF Elev	TOB Elev
Riffle	B	4.2	7.25	0.58	0.87	12.5	1.0	1.81	3063.86	3063.86

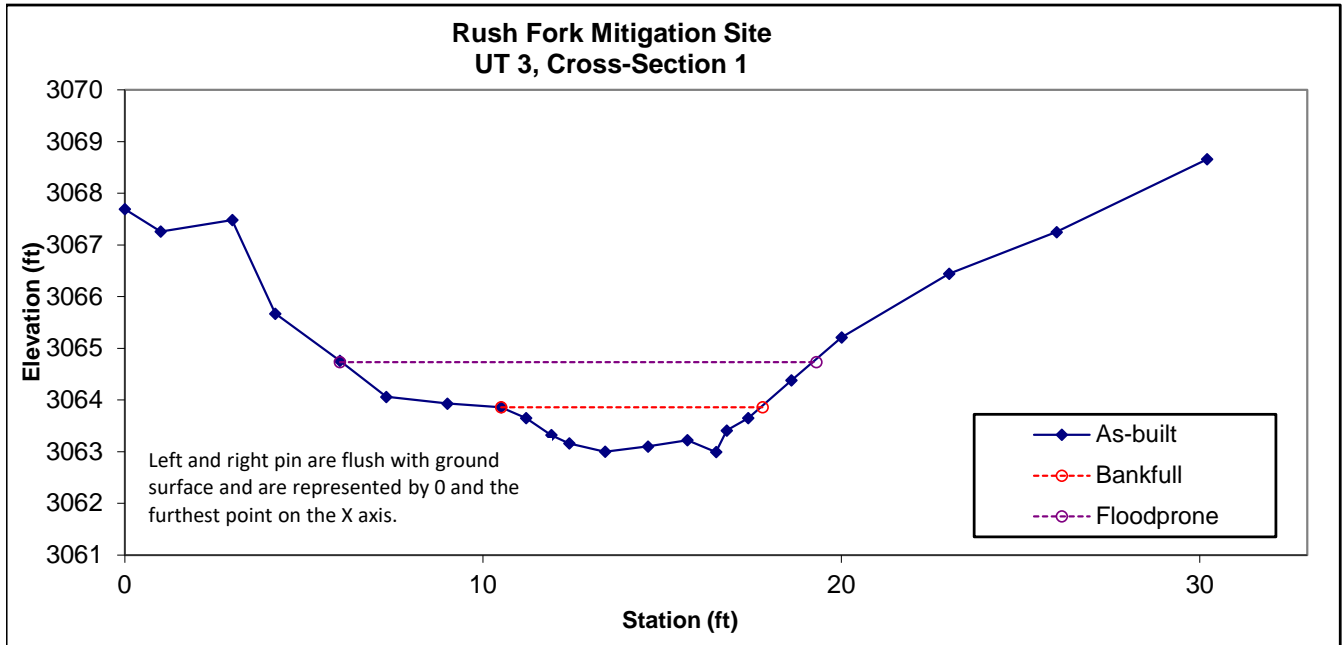

Permanent Cross-Section 2

(As-built Survey Data Collected: March 2022)
Restoration




Looking at the Left Bank



Looking at the Right Bank

Feature	Stream Type	BKF Area	BKF Width	BKF Depth	Max BKF Depth	W/D	BH Ratio	ER	BKF Elev	TOB Elev
Pool	C	11.12	14.64	0.76	2.16	19.26	----	----	3048.03	3048.03

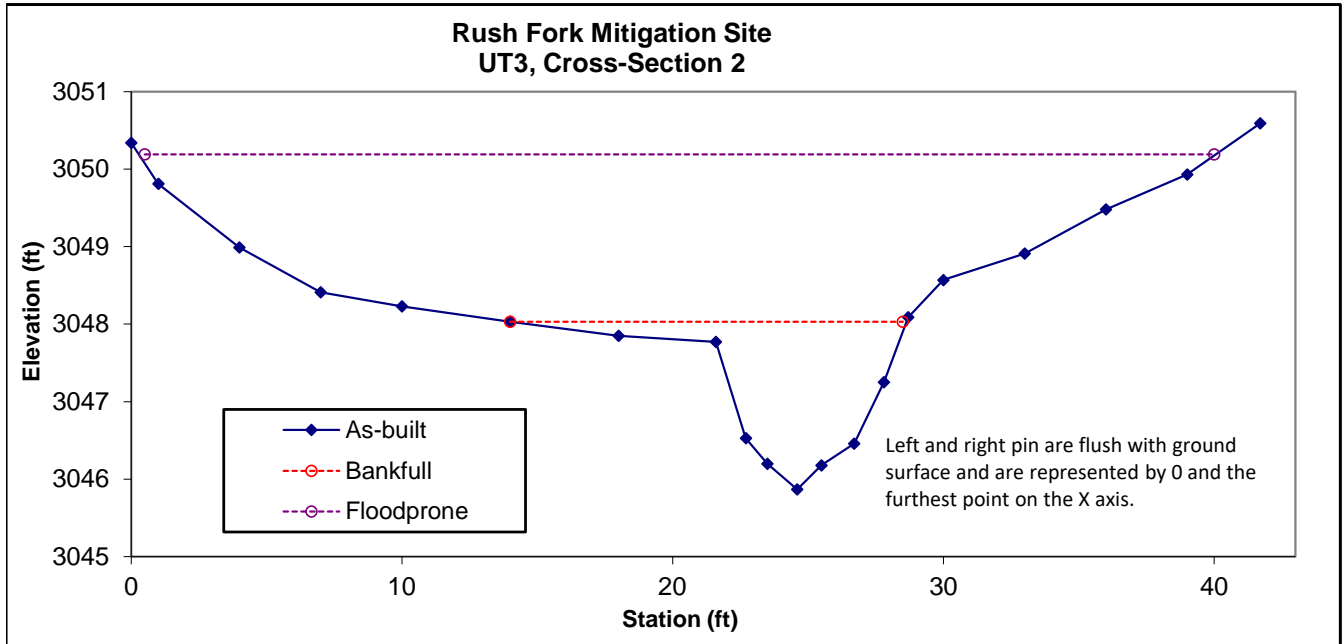

Permanent Cross-Section 3

(As-built Survey Data Collected: March 2022)
Restoration




Looking at the Left Bank



Looking at the Right Bank

Feature	Stream Type	BKF Area	BKF Width	BKF Depth	Max BKF Depth	W/D	BH Ratio	ER	BKF Elev	TOB Elev
Riffle	B	3.64	7.04	0.52	0.71	13.54	1.0	1.7	3028.13	3028.13

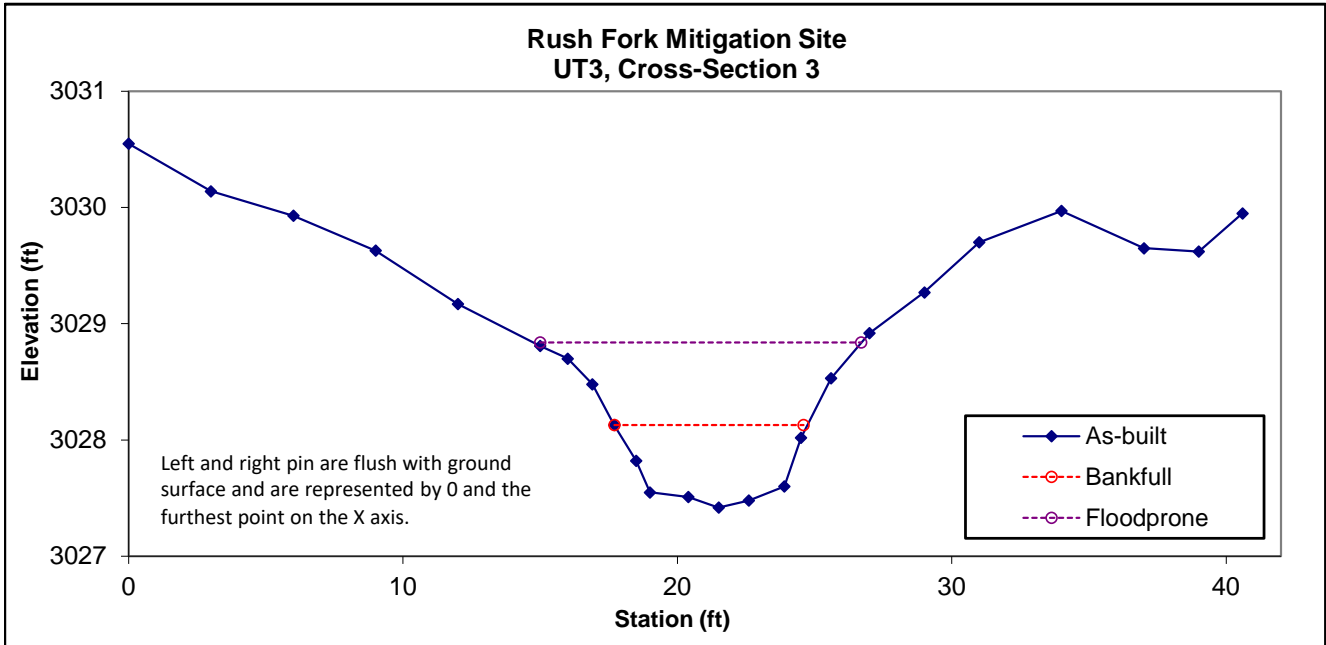

Permanent Cross-Section 4

(As-built Survey Data Collected: March 2022)
Restoration




Looking at the Left Bank




Looking at the Right Bank

Feature	Stream Type	BKF Area	BKF Width	BKF Depth	Max BKF Depth	W/D	BH Ratio	ER	BKF Elev	TOB Elev
Pool	E	15.11	13.05	1.16	2.94	11.25	----	----	3010.84	3010.84

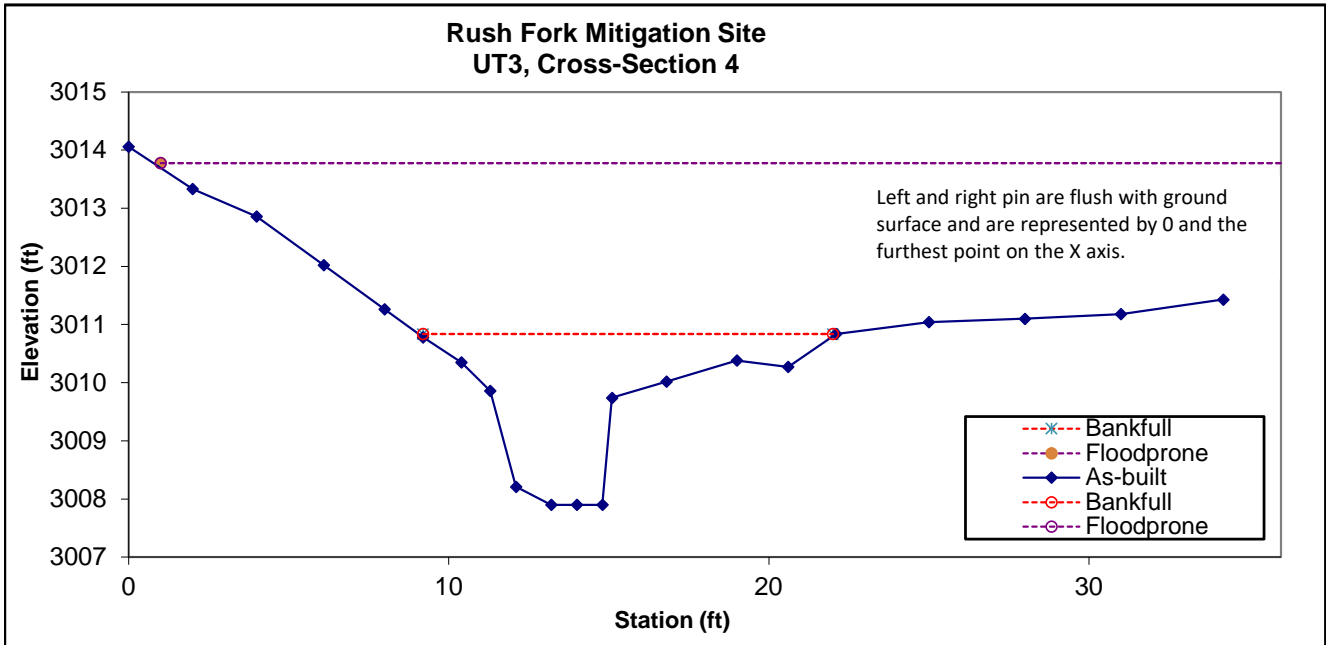

Permanent Cross-Section 5

(As-built Survey Data Collected: March 2022)
Restoration

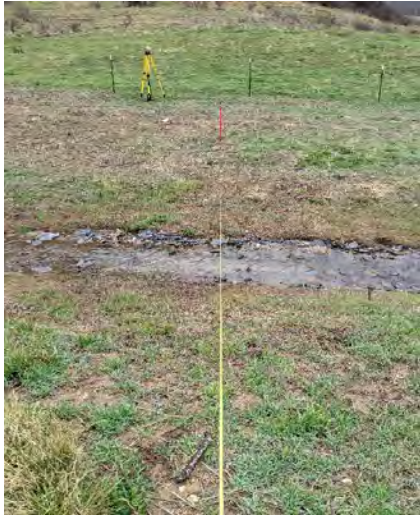


Looking at the Left Bank



Looking at the Right Bank

Feature	Stream Type	BKF Area	BKF Width	BKF Depth	Max BKF Depth	W/D	BH Ratio	ER	BKF Elev	TOB Elev
Riffle	B	6.23	10.92	0.57	0.91	19.16	1.0	1.9	2998.75	2998.75

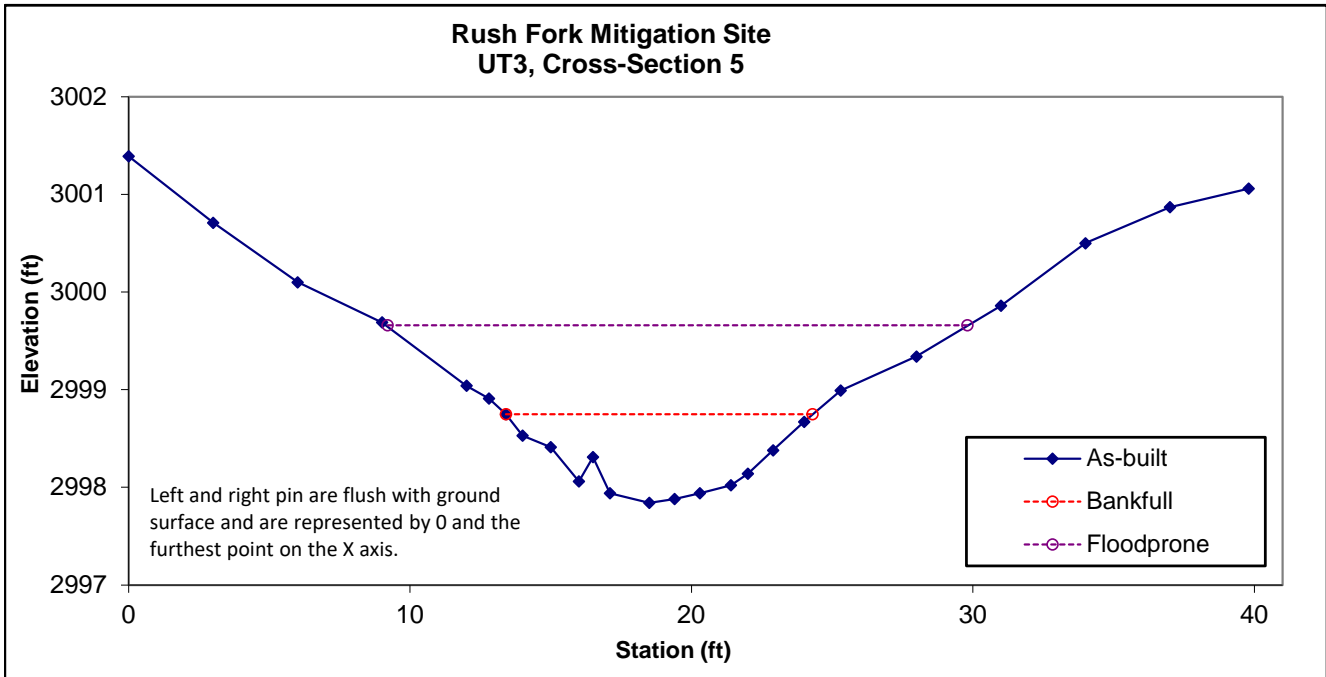

Permanent Cross-Section 6

(As-built Survey Data Collected: March 2022)
Restoration




Looking at the Left Bank



Looking at the Right Bank

Feature	Stream Type	BKF Area	BKF Width	BKF Depth	Max BKF Depth	W/D	BH Ratio	ER	BKF Elev	TOB Elev
Pool	E	15.51	12.07	1.29	2.53	9.36	----	----	2985.03	2985.03

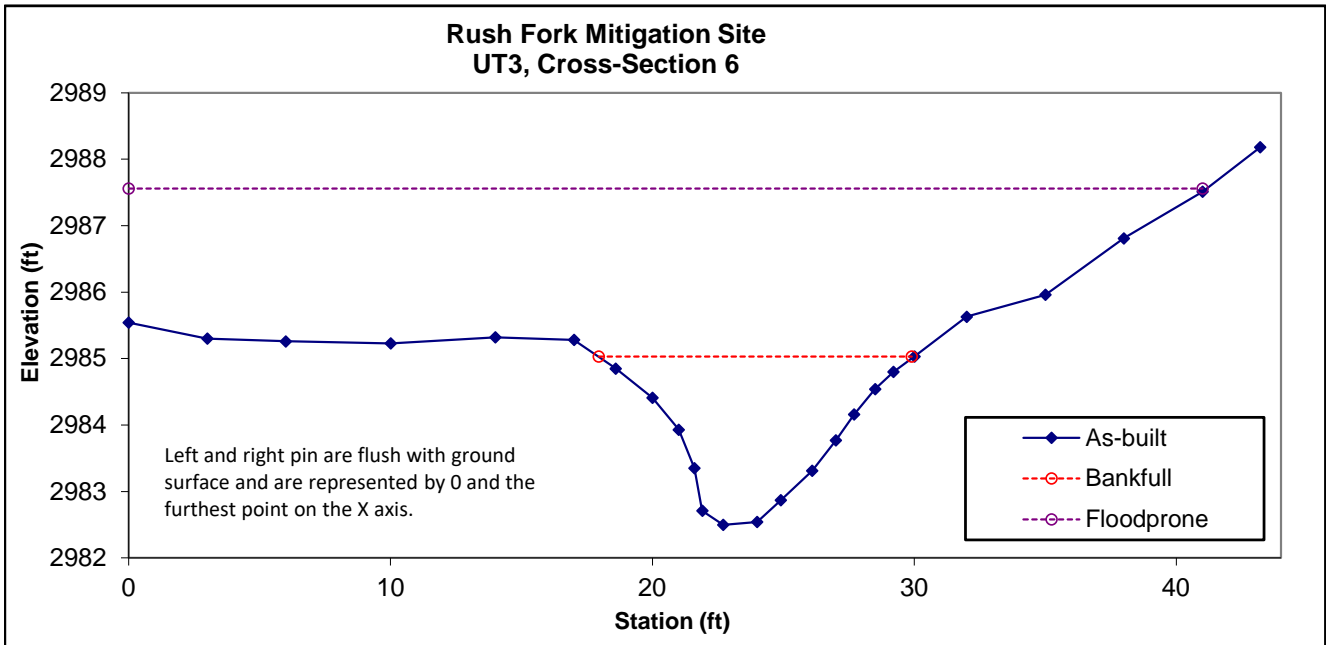

Permanent Cross-Section 7


(As-built Survey Data Collected: March 2022)
Restoration



Looking at the Left Bank

Looking at the Right Bank

Feature	Stream Type	BKF Area	BKF Width	BKF Depth	Max BKF Depth	W/D	BH Ratio	ER	BKF Elev	TOB Elev
Riffle	B	6.11	7.95	0.77	1.07	10.32	1.0	1.97	2976.51	2976.51

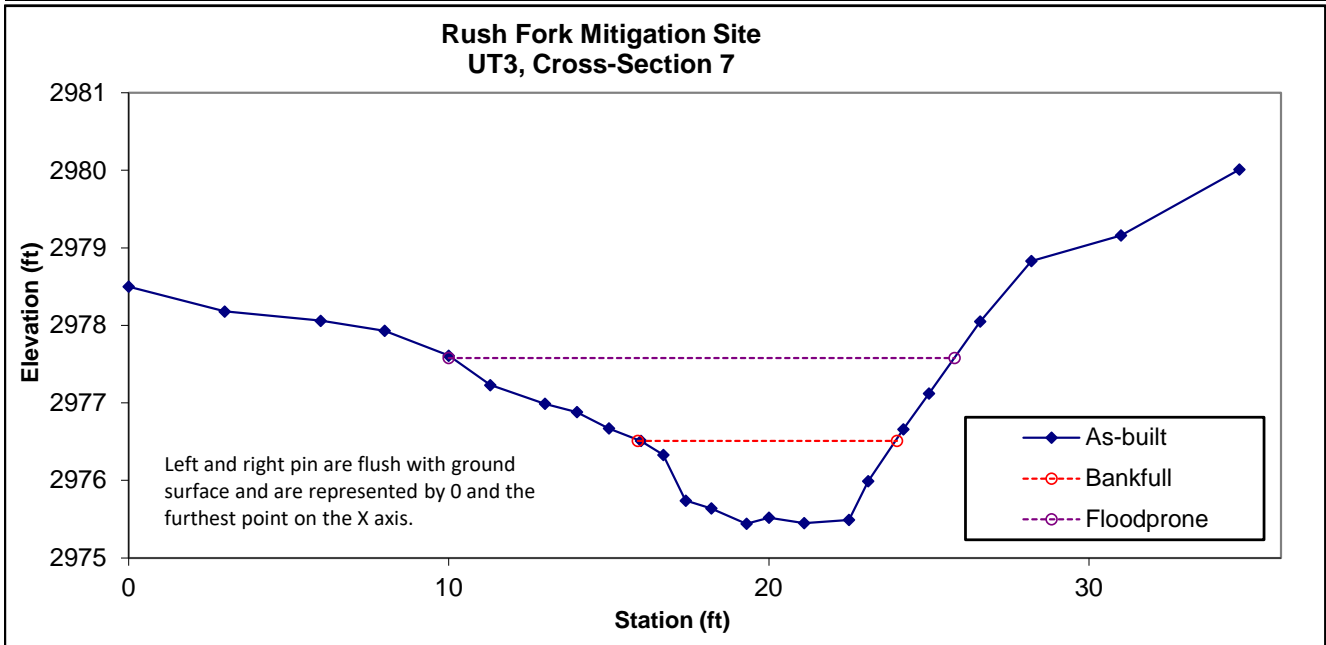

Permanent Cross-Section 8

(As-built Survey Data Collected: March 2022)
Restoration




Looking at the Left Bank



Looking at the Right Bank

Feature	Stream Type	BKF Area	BKF Width	BKF Depth	Max BKF Depth	W/D	BH Ratio	ER	BKF Elev	TOB Elev
Riffle	C	11.01	15.9	0.69	1.35	23.04	1.0	2.91	2970.37	2970.37

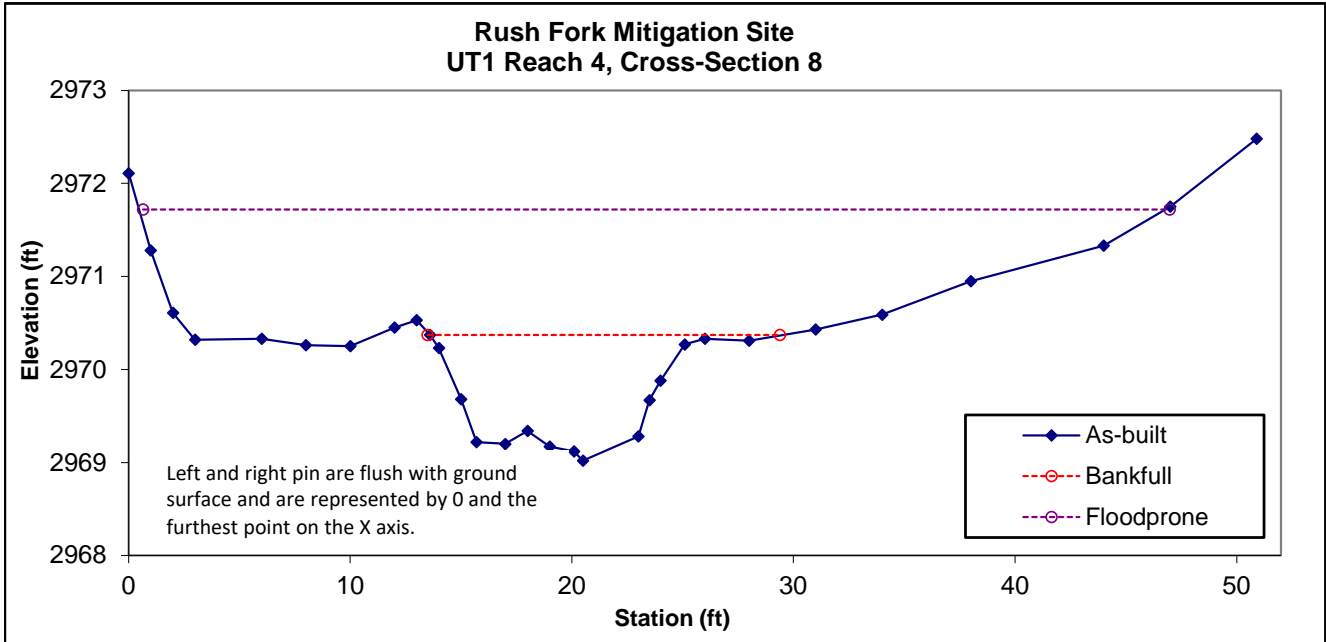

Permanent Cross-Section 9

(As-built Survey Data Collected: March 2022)
Restoration




Looking at the Left Bank



Looking at the Right Bank

Feature	Stream Type	BKF Area	BKF Width	BKF Depth	Max BKF Depth	W/D	BH Ratio	ER	BKF Elev	TOB Elev
Pool	B	27.56	19.55	1.41	2.55	13.87	----	----	2954.14	2954.14

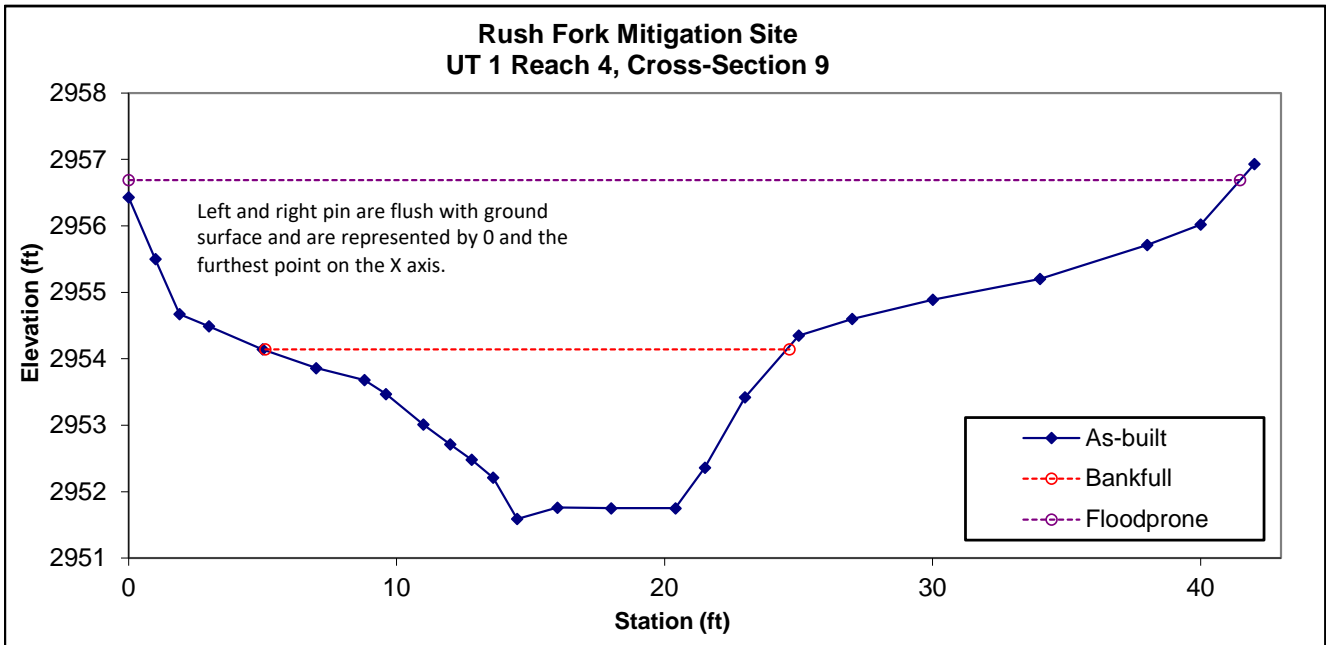

Permanent Cross-Section 10

(As-built Survey Data Collected: March 2022)
Restoration




Looking at the Left Bank



Looking at the Right Bank

Feature	Stream Type	BKF Area	BKF Width	BKF Depth	Max BKF Depth	W/D	BH Ratio	ER	BKF Elev	TOB Elev
Riffle	B	14.5	13.79	1.05	1.43	13.13	1.0	1.59	2922.1	2922.1

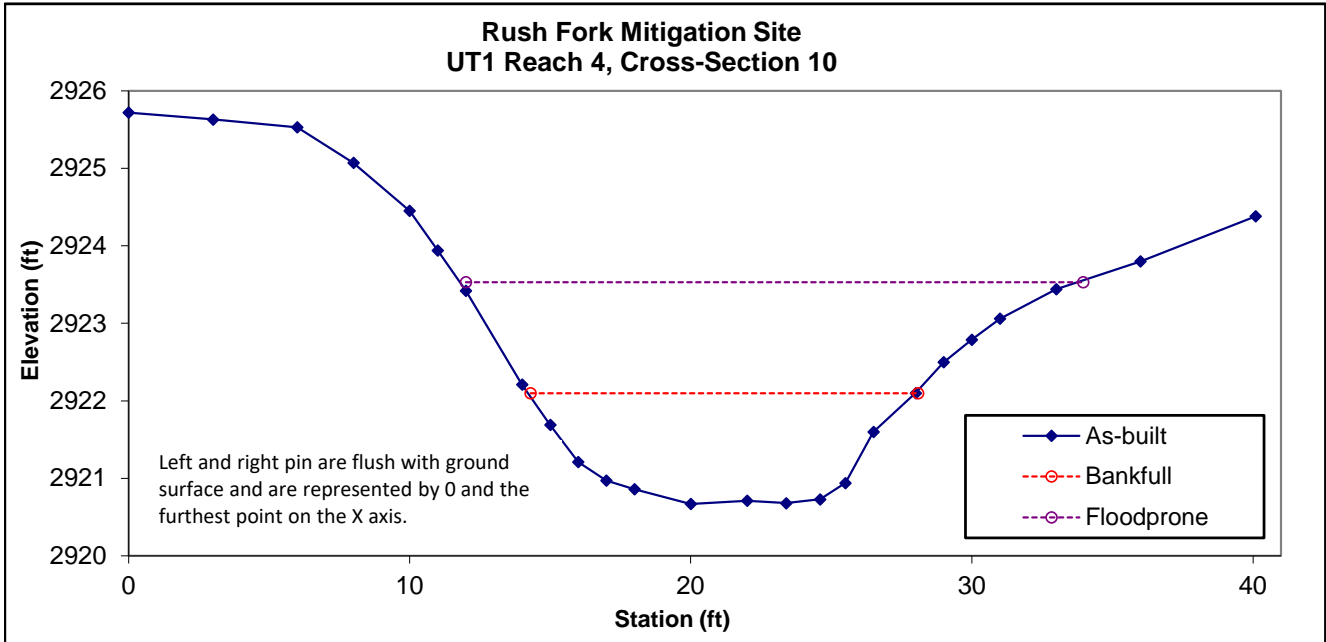

Permanent Cross-Section 11

(As-built Survey Data Collected: March 2022)
Restoration




Looking at the Left Bank



Looking at the Right Bank

Feature	Stream Type	BKF Area	BKF Width	BKF Depth	Max BKF Depth	W/D	BH Ratio	ER	BKF Elev	TOB Elev
Pool	E	31.24	17.43	1.79	2.89	9.74	----	----	2913.15	2913.15

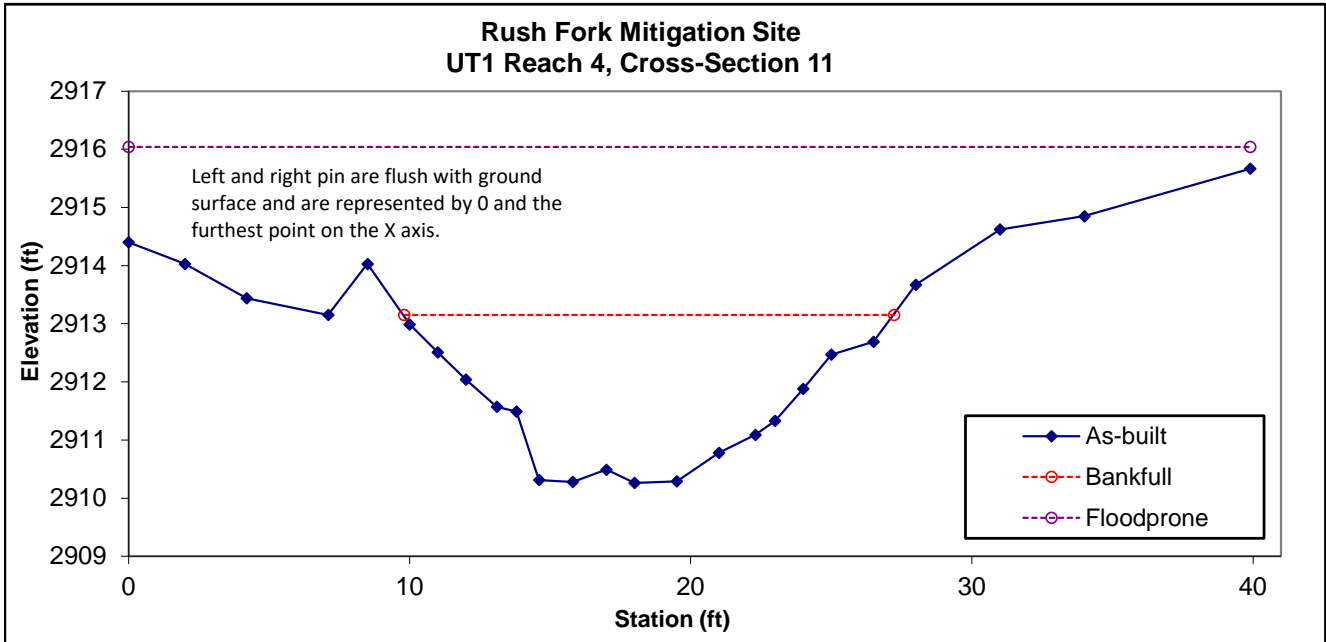

Permanent Cross-Section 12

(As-built Survey Data Collected: March 2022)
Restoration




Looking at the Left Bank



Looking at the Right Bank

Feature	Stream Type	BKF Area	BKF Width	BKF Depth	Max BKF Depth	W/D	BH Ratio	ER	BKF Elev	TOB Elev
Riffle	B	14.33	12.93	1.11	1.6	11.65	1.0	1.88	2904.41	2904.41

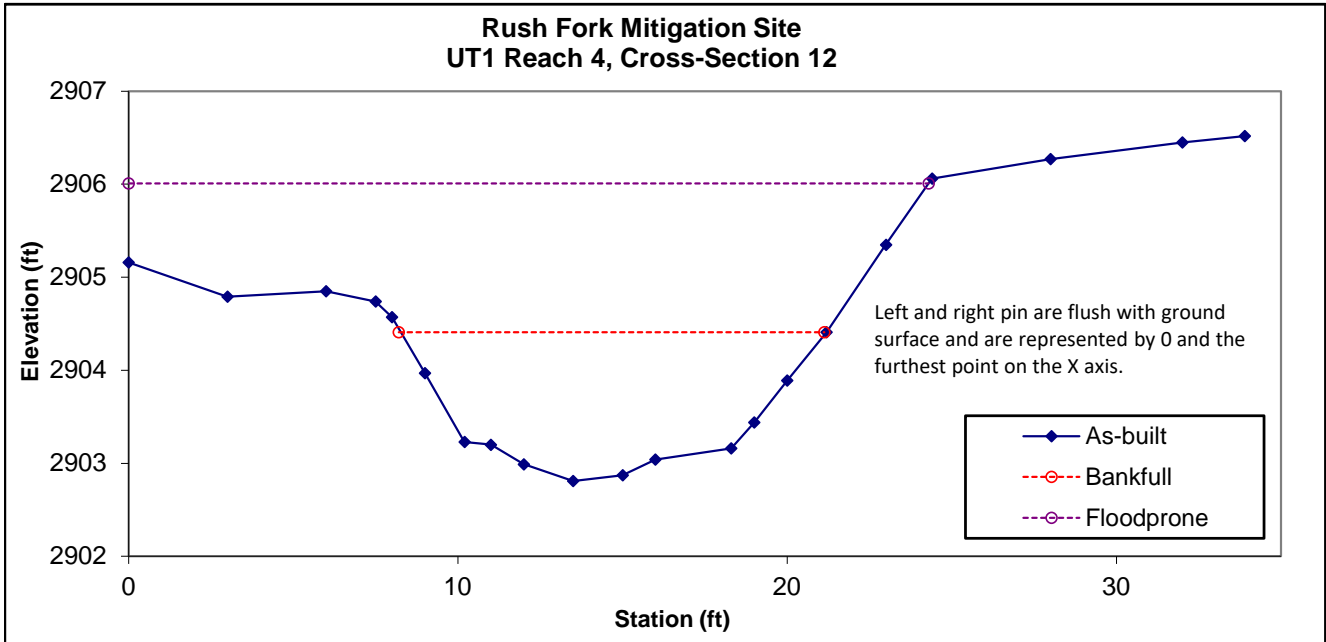

Permanent Cross-Section 13

(As-built Survey Data Collected: March 2022)
Enhancement




Looking at the Left Bank



Looking at the Right Bank

Feature	Stream Type	BKF Area	BKF Width	BKF Depth	Max BKF Depth	W/D	BH Ratio	ER	BKF Elev	TOB Elev
Pool	E	12.13	9.45	1.28	2.48	7.38	----	----	3051.49	3051.49

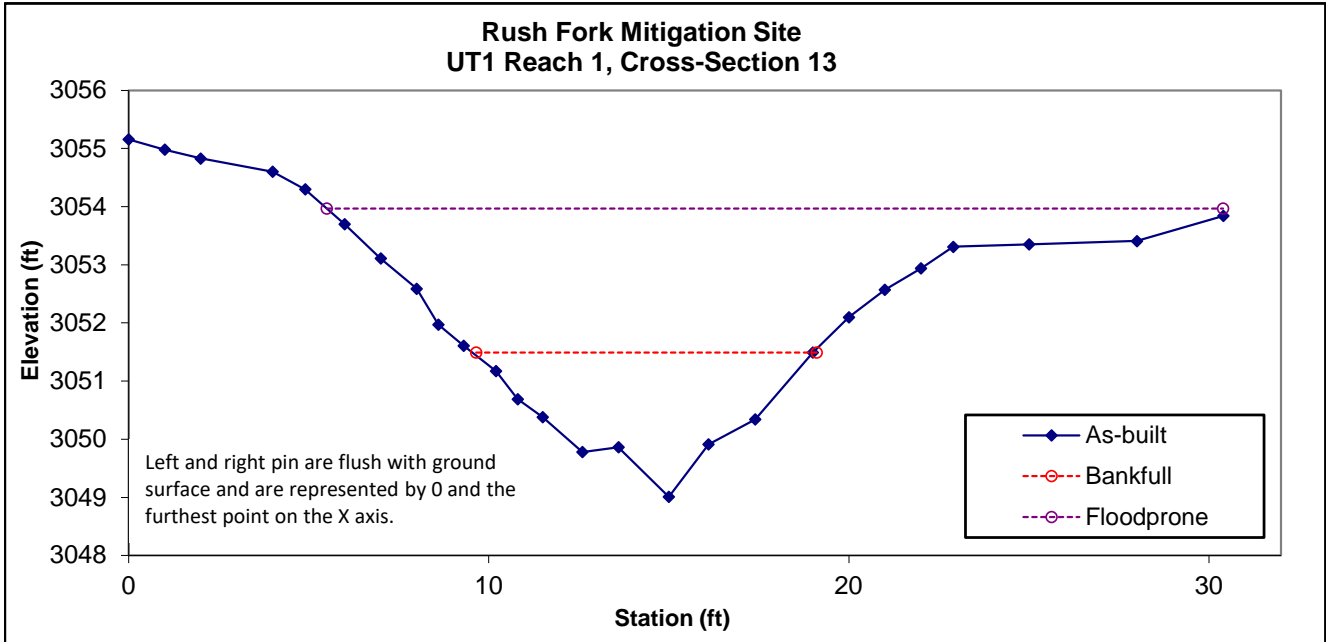

Permanent Cross-Section 14

(As-built Survey Data Collected: March 2022)
Enhancement




Looking at the Left Bank



Looking at the Right Bank

Feature	Stream Type	BKF Area	BKF Width	BKF Depth	Max BKF Depth	W/D	BH Ratio	ER	BKF Elev	TOB Elev
Riffle	B	5.44	7.79	0.7	0.96	11.13	1.0	1.94	3025.48	3025.48

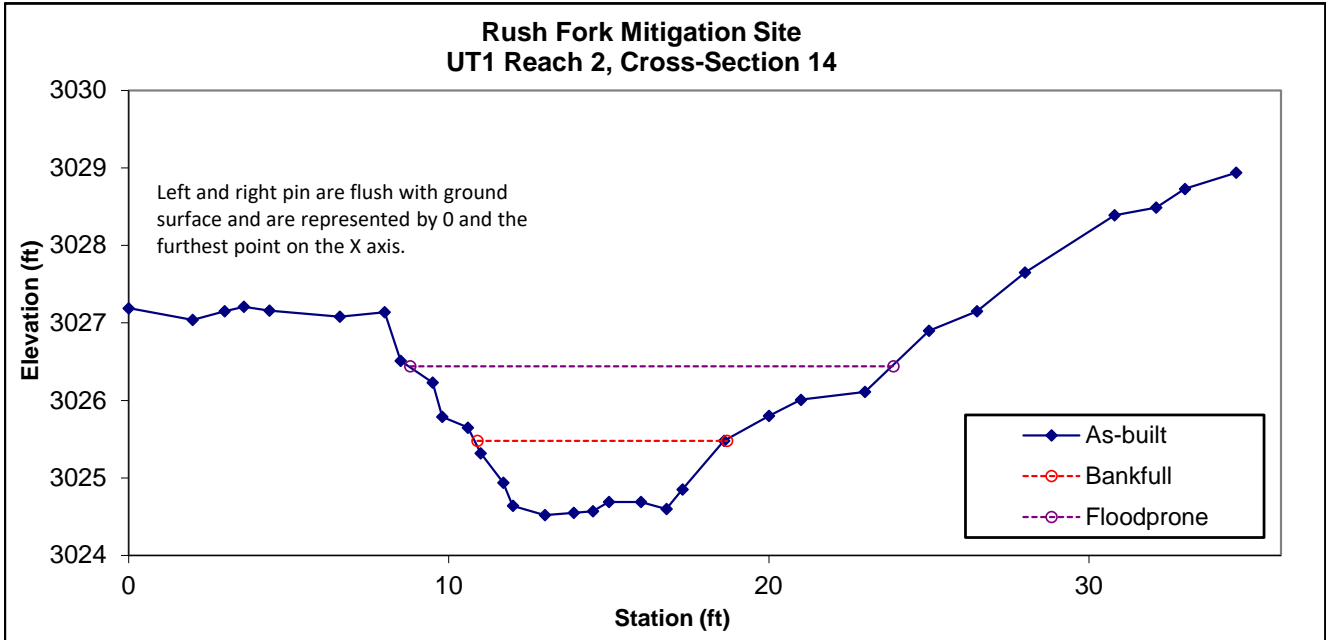

Permanent Cross-Section 15

(As-built Survey Data Collected: March 2022)


Enhancement



Looking at the Left Bank

Looking at the Right Bank

Feature	Stream Type	BKF Area	BKF Width	BKF Depth	Max BKF Depth	W/D	BH Ratio	ER	BKF Elev	TOB Elev
Riffle	C	6.36	10.76	0.6	0.99	18.24	1.0	3.62	3008.35	3008.35

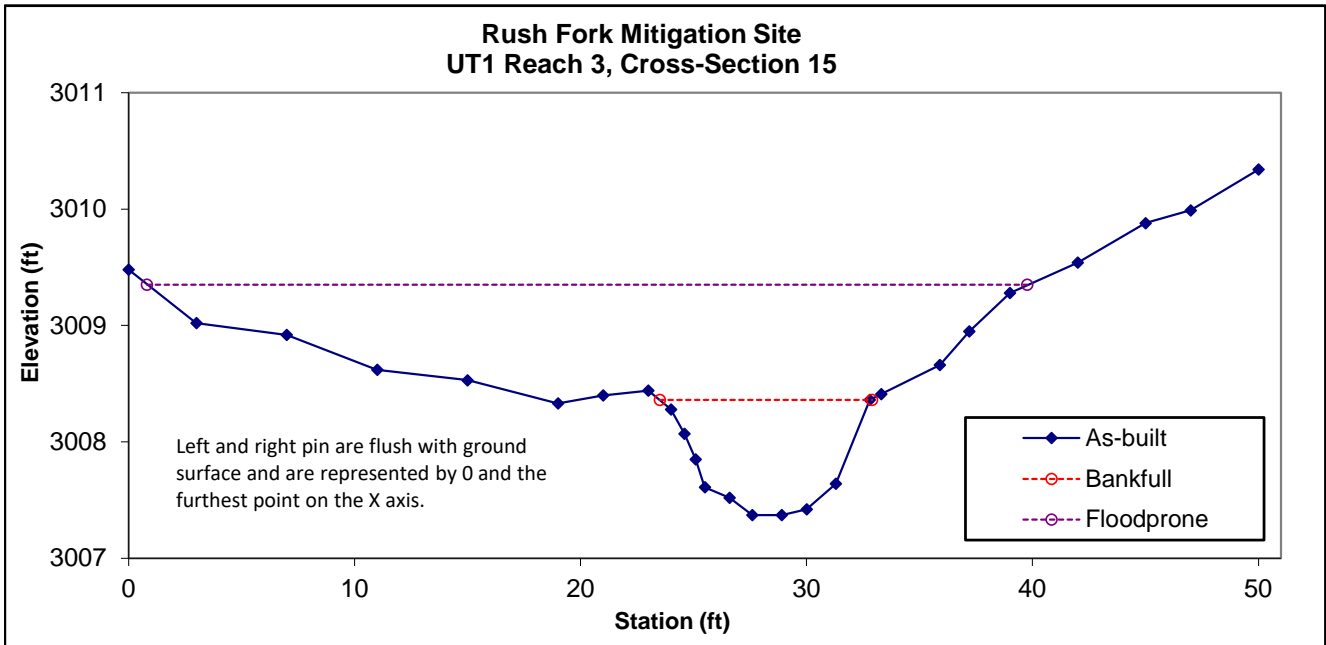

Permanent Cross-Section 16

(As-built Survey Data Collected: March 2022)
Enhancement




Looking at the Left Bank



Looking at the Right Bank

Feature	Stream Type	BKF Area	BKF Width	BKF Depth	Max BKF Depth	W/D	BH Ratio	ER	BKF Elev	TOB Elev
Pool	--	12.06	11.68	1.03	2.33	11.34	--	--	2998.87	2998.87

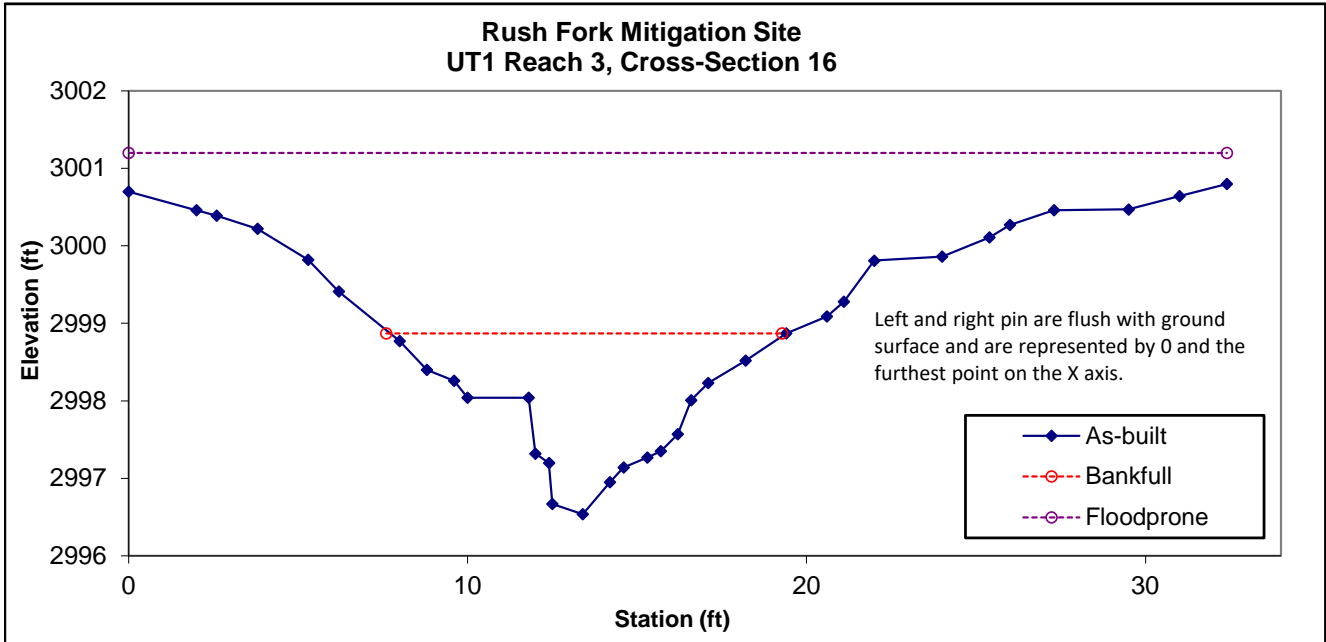

Permanent Cross-Section 17

(As-built Survey Data Collected: March 2022)


Enhancement



Looking at the Left Bank

Looking at the Right Bank

Feature	Stream Type	BKF Area	BKF Width	BKF Depth	Max BKF Depth	W/D	BH Ratio	ER	BKF Elev	TOB Elev
Pool	B	17.6	12.06	1.5	2.46	8.26	----	----	2986.75	2986.75

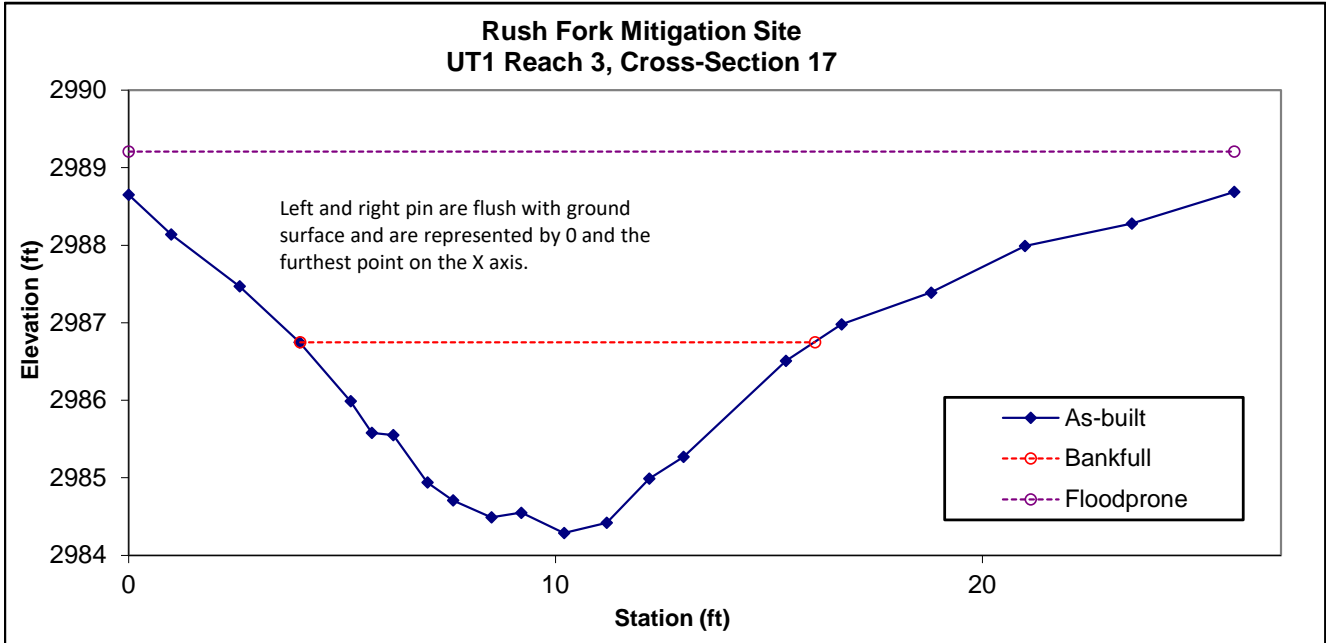

Permanent Cross-Section 18

(As-built Survey Data Collected: March 2022)
Enhancement




Looking at the Left Bank



Looking at the Right Bank

Feature	Stream Type	BKF Area	BKF Width	BKF Depth	Max BKF Depth	W/D	BH Ratio	ER	BKF Elev	TOB Elev
Pool	B	17.29	15.15	1.14	2.55	13.29	----	----	2976.03	2976.03

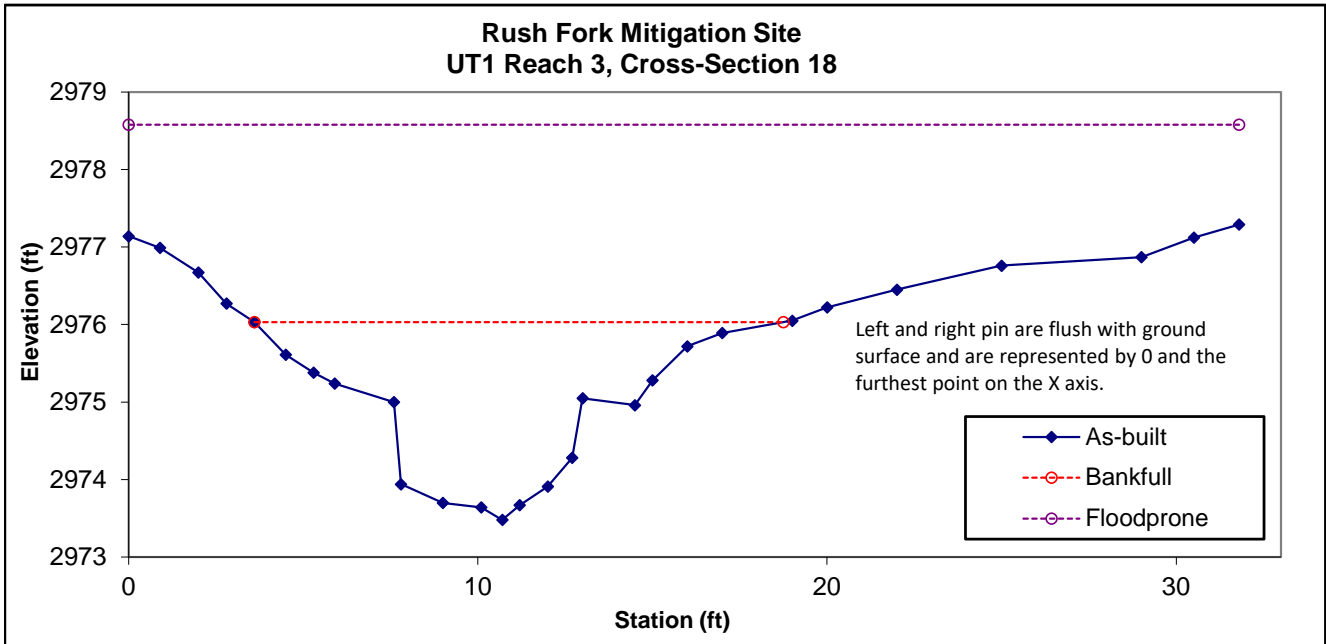

APPENDIX E

Record Drawing Plan Sheets

PROJECT: 166680 **UT to RUSH FORK**


STATE	BAKER PROJECT REFERENCE NO.	SHEET NO.	TOTAL SHEETS
NC	166680	1	24

NORTH CAROLINA
DIVISION OF MITIGATION SERVICES

HAYWOOD COUNTY


LOCATION: FROM EXIT 24 ON INTERSTATE 40, TRAVEL NORTH FOR 5.75 MILES ON NC HWY 209 RUSH FORK ROAD

TYPE OF WORK: RECORD DRAWINGS

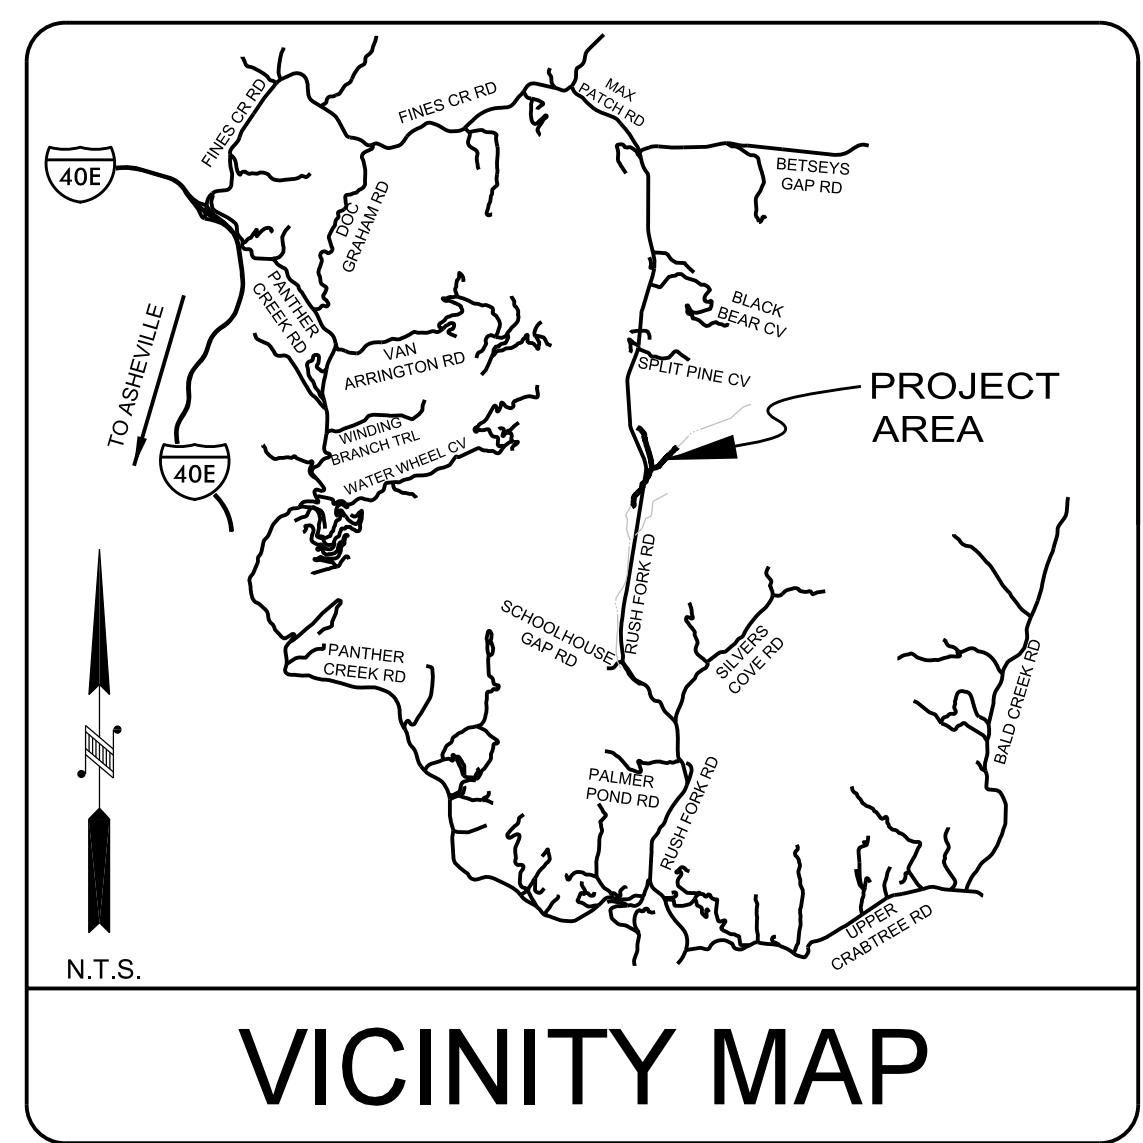


INDEX OF SHEETS

1	TITLE SHEET
1-A	STREAM CONVENTIONAL SYMBOLS GENERAL NOTES STANDARD SPECIFICATIONS VEGETATION SELECTION
1-B	NCDOT CONVENTIONAL SYMBOLS
2 - 2F	DETAILS
3 - 10	PLAN VIEW
11 - 15	PROFILES
16	BMP DETAIL

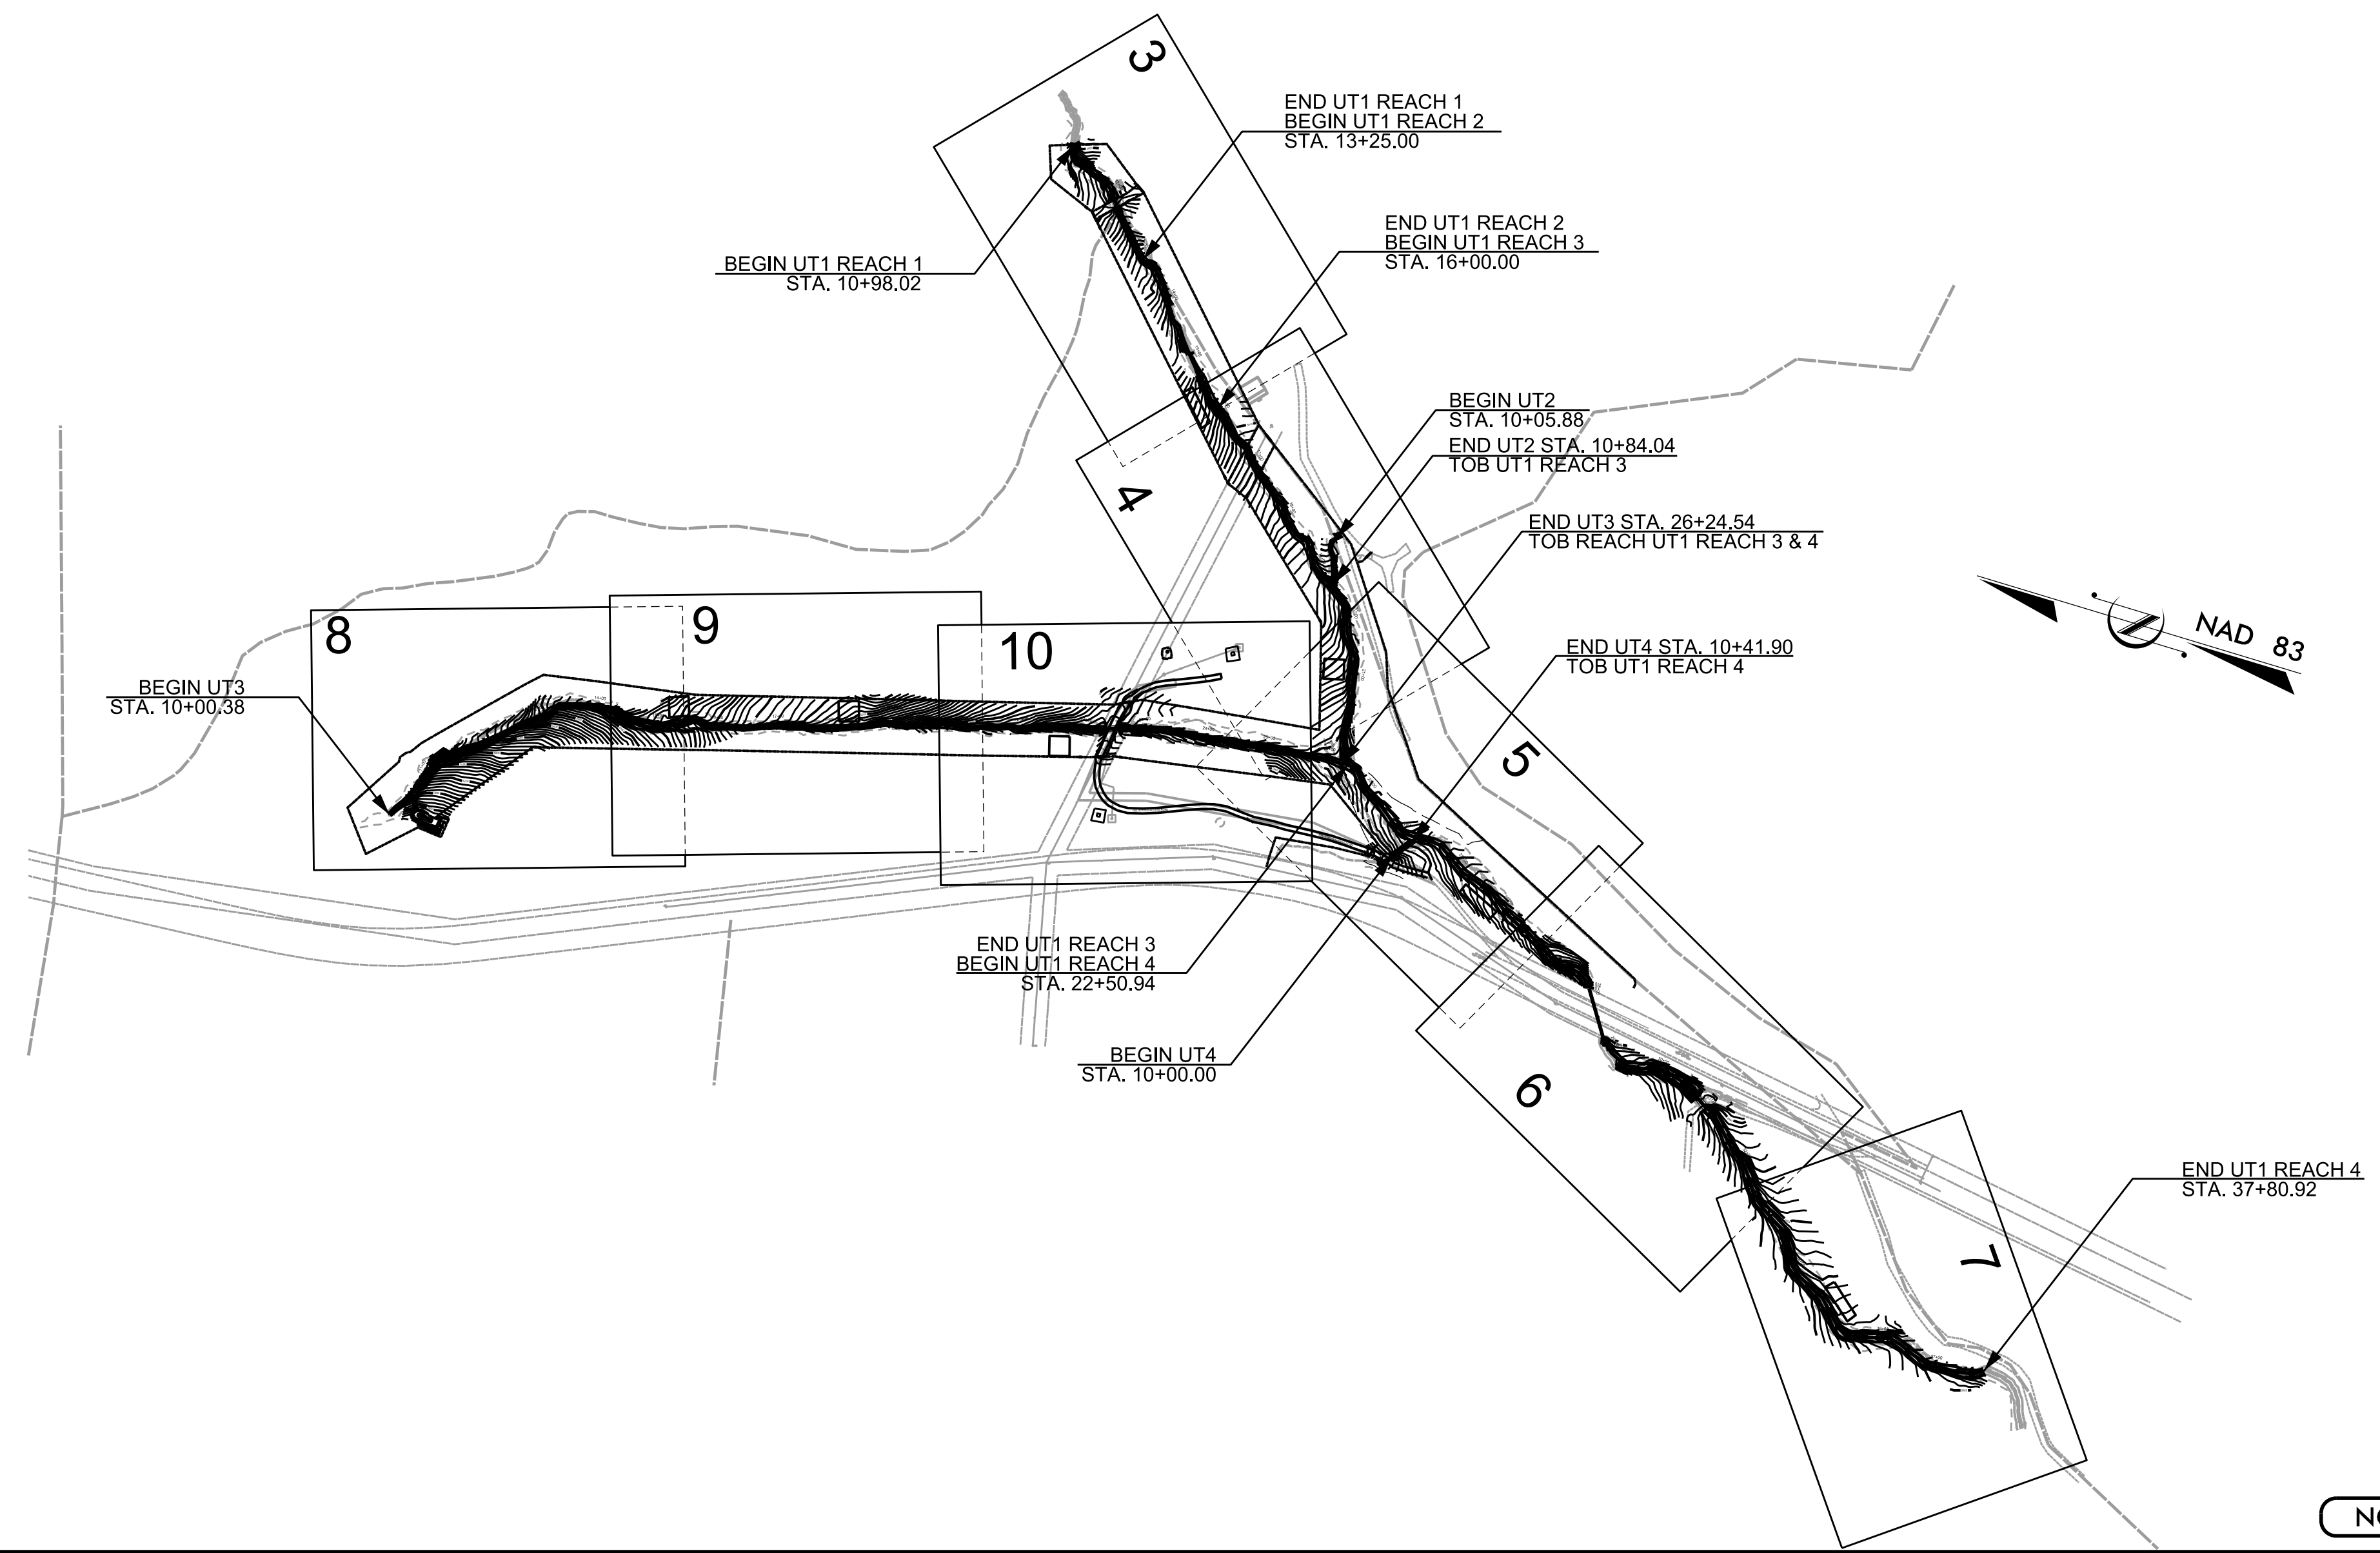

NCDMS ID NO. 100068

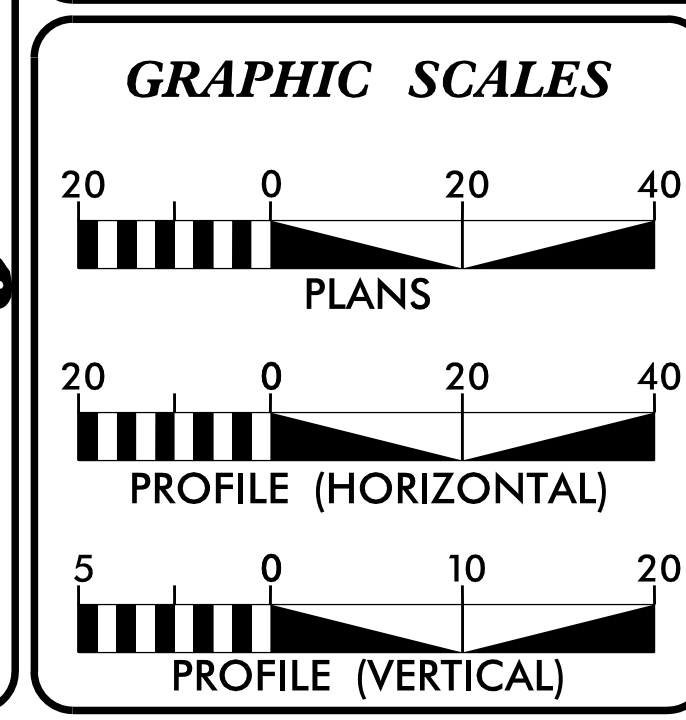

MITIGATION SUMMARY

REACH	STREAM RESTORATION	STREAM ENHANCEMENT I	STREAM ENHANCEMENT II
UT1 R1	0	206.41	0
UT1 R2	0	0	275.00
UT1 R3	0	600.86	0
UT1 R4	1224.37	0	0
UT2	0	0	78.16
UT3	1577.53	0	0
UT4	41.90	0	0
TOTAL	2843.80	807.27	353.16

PREPARED FOR THE OFFICE OF:

 NCDEQ
 NC DIVISION OF MITIGATION SERVICES
 217 WEST JONES STREET, SUITE 3000a
 RALEIGH, NC 27603

CONTACT: PAUL WIESNER
 PROJECT MANAGER

Michael Baker INTERNATIONAL
Michael Baker Engineering Inc.
 8000 Regency Parkway, Suite 600
 Cary, NORTH CAROLINA 27518
 Phone: 919.463.5488
 Fax: 919.463.5490
 License #: F-1084

LETTING DATE: _____

KATHLEEN M. MCKEITHAN, PE
 PROJECT ENGINEER

PROJECT ENGINEER

SIGNATURE: _____ P.E.

STREAM CONVENTIONAL SYMBOLS SUPERCEDES SHEET 1-B

J-HOOK VANE	100 YEAR FLOOD PLAIN	
GRADE CONTROL J-HOOK VANE	CONSERVATION EASEMENT	
ROCK VANE	EXISTING MAJOR CONTOUR	
OUTLET PROTECTION	EXISTING MINOR CONTOUR	
ROCK CROSS VANE	LIMITS OF DISTURBANCE	
DOUBLE DROP ROCK CROSS VANE	PROPERTY LINE	
LOG AND ROCK STEP / POOL	FOOT BRIDGE	
TEMPORARY ROCK DAM	TEMPORARY STREAM CROSSING	
ROOT WAD	PERMANENT STREAM CROSSING	
LOG J-HOOK VANE	TRANSPLANTED VEGETATION	
GRADE CONTROL LOG J-HOOK VANE	TREE REMOVAL	
LOG VANE	TREE PROTECTION	MONITORING WELL
LOG STEP	DITCH PLUG	RAIN GAUGE
LOG CROSS VANE	CHANNEL FILL	CREST GAUGE
LOG ROLLER	SOD MAT WITH WOOD TOE	IN STREAM FLOW GAUGE
CONSTRUCTED RIFFLE	GEOLIFT WITH BRUSH TOE	
BOULDER CLUSTER	ROOT WAD REVETMENT WITH LIVE BRUSH	
BOULDER STEP	BOULDER TOE PROTECTION	
SAFETY FENCE	PROPOSED WETLAND RE-ESTABLISHMENT	
TAPE FENCE	PROPOSED WETLAND ENHANCEMENT	
JURISDICTIONAL WETLAND BOUNDARY	PROPOSED WETLAND REHABILITATION	

**NOTE: ALL ITEMS ABOVE MAY NOT BE USED ON THIS PROJECT

STANDARD SPECIFICATIONS

NORTH CAROLINA EROSION AND SEDIMENT CONTROL PLANNING AND DESIGN MANUAL MARCH 2009 (REV 2013)

- 6.06 TEMPORARY GRAVEL CONSTRUCTION ENTRANCE
- 6.24 RIPARIAN AREA SEEDING
- 6.60 TEMPORARY SEDIMENT TRAP
- 6.62 TEMPORARY SILT FENCE
- 6.63 TEMPORARY ROCK DAM
- 6.70 TEMPORARY STREAM CROSSING

PROJECT REFERENCE NO. 166680	SHEET NO. 1-A
PROJECT ENGINEER	
APPROVED BY:	
DATE:	
Michael Baker International	
Michael Baker Engineering Inc. 8000 Regency Parkway, Suite 500 Cary, NORTH CAROLINA 27518 Phone: 919.463.5488 Fax: 919.463.5490 License #: F-1084	
NCDMS ID NO. 100068	

GENERAL NOTES

1. THE CONTRACTOR IS REQUIRED TO INSTALL IN-STREAM STRUCTURES USING A TRACK HOE WITH A HYDRAULIC THUMB OF SUFFICIENT SIZE TO PLACE BOULDERS (3'x2'x2), LOGS AND ROOTWADS.
2. WORK IS BEING PERFORMED AS AN ENVIRONMENTAL RESTORATION PLAN. THE CONTRACTOR SHOULD MAKE ALL REASONABLE EFFORTS TO REDUCE SEDIMENT LOSS AND MINIMIZE DISTURBANCE OF THE SITE WHILE PERFORMING THE CONSTRUCTION WORK.
3. CONSTRUCTION IS SCHEDULED FOR THE SPRING OF 2020.
4. CONTRACTOR SHOULD CALL NORTH CAROLINA "ONE-CALL" BEFORE EXCAVATION STARTS. (1-800-632-4949)
5. BOULDER SIZES FOR IN-STREAM STRUCTURES SHALL BE A MINIMUM OF 3'x2'x1' AND CAN BE CHANGED PER STRUCTURE OR THE DIRECTION OF THE ENGINEER.
6. ALL ON-SITE ALLUVIUM SHALL BE HARVESTED AND STOCKPILED PRIOR TO FILLING ABANDONED CHANNELS.
7. TOPSOIL SHALL BE EXCAVATED TO A DEPTH OF 8" AND STOCKPILED SEPARATELY FROM UNDERCUT SOIL. 8" OF TOPSOIL SHALL BE PLACED ON ALL BANKFULL BENCHES AND AS DIRECTED BY THE ENGINEER.
8. ALL DISTURBED EMBANKMENTS SHALL BE MATTED WITH COIR FIBER MATTING OR AS DIRECTED BY THE ENGINEER.
9. ALL STREAM BANKS SHALL BE LIVE STAKED.
10. UNLESS THE ALIGNMENT IS BEING ALTERED, THE EXISTING CHANNEL DIMENSIONS ARE TO REMAIN UNLESS OTHERWISE NOTED.
11. CONTRACTOR WILL ENSURE THAT FENCING IS INSTALLED ON OR OUTSIDE THE CONSERVATION EASEMENT AS SHOWN ON THE PLANS BUT NO MORE THAN 1' OUTSIDE.
12. WHERE PROPOSED FENCE CROSSES EXISTING STREAMS, THE CONTRACTOR SHALL UTILIZE A SECTION OF BREAK AWAY FENCE, A FLOOD GATE, OR ELECTRIFIED CHAINS AS DIRECTED BY THE ENGINEER.
13. ANY BORROW OR WASTE ASSOCIATED WITH THIS PROJECT MUST COME FROM OR GO TO A PERMITTED SITE AND/OR FACILITY.

VEGETATION SELECTION


Proposed Bare-Root and Live Stake Species UT to Rush Fork Mitigation Project - NCDMS Project No. 100068			
Botanical Name	Common Name	% Planted by Species	Wetland Tolerance
All Buffer Plantings at 680 stems/acre using 8' X 8' spacing			
General Riparian Zone – Overstory/Canopy Species			
<i>Betula nigra</i>	River Birch	10%	FACW
<i>Platanus occidentalis</i>	Sycamore	10%	FACW
<i>Liriodendron tulipifera</i>	Tulip Poplar	10%	FACU
<i>Betula lenta</i>	Sweet Birch	10%	FAC
<i>Quercus alba</i>	White Oak	10%	FACU
<i>Tilia americana</i>	American Basswood	0%	FACU
<i>Aesculus flava</i>	Yellow Buckeye	7.5%	FACU
<i>Nyssa sylvatica</i>	Blackgum	5%	FAC
<i>Fraxinus americana</i>	White Ash	5%	FACU
<i>Diospyros virginiana</i>	Persimmon	7.5%	FAC
<i>Ulmus americana</i>	American Elm	5%	FACW
General Riparian Zone – Understory/Shrub Species			
<i>Rhododendron maximum</i>	Rosebay	0%	FAC
<i>Lindera benzoin</i>	Spicebush	2.5%	FAC
<i>Ilex verticillata</i>	Winterberry	5%	FACW
<i>Carpinus caroliniana</i>	American Hornbeam	5%	FAC
<i>Sambucus canadensis</i>	Elderberry	2.5%	FAC
<i>Magnolia tripetala</i>	Umbrella Tree	0%	FACU
<i>Halesia carolina</i>	Carolina Silverbell	5%	FAC

Wetland Zone – Overstory/Canopy Species			
<i>Betula nigra</i>	River Birch	15%	FACW
<i>Platanus occidentalis</i>	Sycamore	15%	FACW
<i>Betula alleghaniensis</i>	Yellow Birch	10%	FAC
<i>Quercus imbricaria</i>	Shingle Oak	5%	FAC
<i>Nyssa sylvatica</i>	Blackgum	5%	FAC
<i>Acer negundo</i>	Box Elder	5%	FAC
<i>Fraxinus pennsylvanica</i>	Green Ash	5%	FACW
<i>Ulmus americana</i>	American Elm	5%	FACW
Wetland Zone – Understory/Shrub Species			
<i>Alnus serrulata</i>	Tag Alder	15%	OBL
<i>Ilex verticillata</i>	Winterberry	5%	FACW
<i>Lindera benzoin</i>	Spicebush	5%	FAC
<i>Cephalanthus occidentalis</i>	Buttonbush	2.5%	OBL
<i>Cornus amomum</i>	Silky Dogwood	2.5%	FACW
<i>Xanthorhiza simplicissima</i>	Yellow-root	2.5%	FACW
<i>Aronia arbutifolia</i>	Red Chokeberry	2.5%	FACW
Streambank Live Stake Plantings			
<i>Salix sericea</i>	Silky Willow	25%	OBL
<i>Sambucus canadensis</i>	Elderberry	20%	FACW
<i>Cephalanthus occidentalis</i>	Buttonbush	10%	OBL
<i>Cornus amomum</i>	Silky Dogwood	25%	FACW
<i>Salix nigra</i>	Black Willow	20%	OBL

Proposed Permanent Seed Mixture UT to Rush Fork Stream Mitigation Project – NCDMS Project No. 100068				
Botanical Name	Common Name	% Planted by Species	Density (lbs/ac)	Wetland Tolerance
<i>Agrostis perennans</i>	Autumn Bentgrass	10%	1.5	FACU
<i>Elymus virginicus</i>	Virginia Wildrye	15%	2.25	FACW
<i>Panicum virgatum</i>	Switchgrass	15%	2.25	FAC
<i>Tripsacum dactyloides</i>	Eastern Gamma Grass	5%	0.75	FACW
<i>Polygonum pennsylvanicum</i>	Pennsylvania Smartweed	5%	0.75	FACW
<i>Schizachyrium scoparium</i>	Little Blue Stem	5%	0.75	FACU
<i>Juncus effusus</i>	Soft Rush	5%	0.75	FACW
<i>Bidens frondosa (or aristosa)</i>	Beggars Tick	5%	0.75	FACW
<i>Coreopsis lanceolata</i>	Lance-Leaved Tick Seed	10%	1.5	FACU
<i>Dichanthelium clandestinum</i>	Tioga Deer Tongue	15%	2.25	FAC
<i>Andropogon gerardii</i>	Big Blue Stem	5%	0.75	FAC
<i>Sorghastrum nutans</i>	Indian Grass	5%	0.75	FACU
Total		100%	15	

Note: Final species selection may change due to refinement of site conditions or to availability at the time of planting. If species substitution is required, the planting Contractor will submit a revised planting list to Baker for approval prior to the procurement of plant stock.

PERCENTAGES SHOWN IN RED ARE THE CONSTRUCTED PLANTED PERCENTATGE.

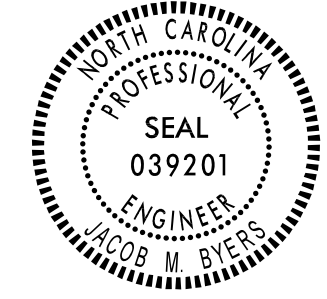

APPROVED BY: _____
DATE: _____

STATE OF NORTH CAROLINA
DIVISION OF HIGHWAYS

CONVENTIONAL SYMBOLS

*S.U.E = SUBSURFACE UTILITY ENGINEER

BOUNDARIES AND PROPERTY:

State Line	-----
County Line	-----
Township Line	-----
City Line	-----
Reservation Line	-----
Property Line	-----
Existing Iron Pin	○ EP
Property Corner	-----
Property Monument	□ ECM
Parcel/Sequence Number	②③
Existing Fence Line	-x-x-x-
Proposed Woven Wire Fence	○
Proposed Chain Link Fence	□
Proposed Barbed Wire Fence	◇
Existing Wetland Boundary	-WLB-
Proposed Wetland Boundary	-WLB-
Existing Endangered Animal Boundary	-EAB-
Existing Endangered Plant Boundary	-EPB-

BUILDINGS AND OTHER CULTURE:

Gas Pump Vent or U/G Tank Cap	○
Sign	○ S
Well	○ W
Small Mine	✕
Foundation	□
Area Outline	□
Cemetery	□ †
Building	□
School	□
Church	□
Dam	□

HYDROLOGY:

Stream or Body of Water	-----
Hydro, Pool or Reservoir	□
Jurisdictional Stream	----- JS
Buffer Zone 1	----- BZ 1
Buffer Zone 2	----- BZ 2
Flow Arrow	←
Disappearing Stream	-----
Spring	○
Wetland	-----
Proposed Lateral, Tail, Head Ditch	----- FLOW
False Sump	▽

RAILROADS:

Standard Gauge	-----
RR Signal Milepost	○ MILEPOST 35
Switch	□ SWITCH
RR Abandoned	-----
RR Dismantled	-----

RIGHT OF WAY:

Baseline Control Point	◆
Existing Right of Way Marker	△
Existing Right of Way Line	-----
Proposed Right of Way Line	-----
Proposed Right of Way Line with Iron Pin and Cap Marker	○ R W
Proposed Right of Way Line with Concrete or Granite Marker	○ R W
Existing Control of Access	○ C A
Proposed Control of Access	○ C A
Existing Easement Line	----- E
Proposed Temporary Construction Easement	----- E
Proposed Temporary Drainage Easement	----- TDE
Proposed Permanent Drainage Easement	----- PDE
Proposed Permanent Utility Easement	----- PUE
Proposed Temporary Utility Easement	----- TUE
Proposed Permanent Easement with Iron Pin and Cap Marker	◆

ROADS AND RELATED FEATURES:

Existing Edge of Pavement	-----
Existing Curb	-----
Proposed Slope Stakes Cut	----- C
Proposed Slope Stakes Fill	----- F
Proposed Wheel Chair Ramp	□ WCR
Existing Metal Guardrail	-----
Proposed Guardrail	-----
Existing Cable Guiderail	-----
Proposed Cable Guiderail	-----
Equality Symbol	⊕
Pavement Removal	□ X X X X

VEGETATION:

Single Tree	○
Single Shrub	○
Hedge	-----
Woods Line	-----
Orchard	-----
Vineyard	□ Vineyard

EXISTING STRUCTURES:

MAJOR:	
Bridge, Tunnel or Box Culvert	----- CONC
Bridge Wing Wall, Head Wall and End Wall	----- } CONC WW {
MINOR:	
Head and End Wall	----- CONC HW
Pipe Culvert	-----
Footbridge	-----
Drainage Box: Catch Basin, DI or JB	□ CB
Paved Ditch Gutter	-----
Storm Sewer Manhole	○ S
Storm Sewer	----- S

UTILITIES:

POWER:	
Existing Power Pole	●
Proposed Power Pole	○
Existing Joint Use Pole	●
Proposed Joint Use Pole	○
Power Manhole	○ P
Power Line Tower	□
Power Transformer	□
U/G Power Cable Hand Hole	□ PH
H-Frame Pole	●
Recorded U/G Power Line	----- P
Designated U/G Power Line (S.U.E.*)	----- P

TELEPHONE:

Existing Telephone Pole	●
Proposed Telephone Pole	○
Telephone Manhole	○ T
Telephone Booth	□
Telephone Pedestal	□
Telephone Cell Tower	□
U/G Telephone Cable Hand Hole	□ PH
Recorded U/G Telephone Cable	----- T
Designated U/G Telephone Cable (S.U.E.*)	----- T
Recorded U/G Telephone Conduit	----- TC
Designated U/G Telephone Conduit (S.U.E.*)	----- TC
Recorded U/G Fiber Optics Cable	----- T FO
Designated U/G Fiber Optics Cable (S.U.E.*)	----- T FO

WATER:

Water Manhole	○ W
Water Meter	○
Water Valve	⊗
Water Hydrant	⊕
Recorded U/G Water Line	-----
Designated U/G Water Line (S.U.E.*)	-----
Above Ground Water Line	----- A/G Water

TV:

TV Satellite Dish	⋈
TV Pedestal	□
TV Tower	⊗
U/G TV Cable Hand Hole	□ PH
Recorded U/G TV Cable	----- TV
Designated U/G TV Cable (S.U.E.*)	----- TV
Recorded U/G Fiber Optic Cable	----- TV FO
Designated U/G Fiber Optic Cable (S.U.E.*)	----- TV FO

GAS:

Gas Valve	◇
Gas Meter	⊕
Recorded U/G Gas Line	----- G
Designated U/G Gas Line (S.U.E.*)	----- G
Above Ground Gas Line	----- A/G Gas

SANITARY SEWER:


Sanitary Sewer Manhole	⊕
Sanitary Sewer Cleanout	⊕
U/G Sanitary Sewer Line	----- SS
Above Ground Sanitary Sewer	----- A/G Sanitary Sewer
Recorded SS Forced Main Line	----- FSS
Designated SS Forced Main Line (S.U.E.*)	----- FSS

MISCELLANEOUS:


Utility Pole	●
Utility Pole with Base	□
Utility Located Object	○
Utility Traffic Signal Box	□
Utility Unknown U/G Line	----- TUTL
U/G Tank; Water, Gas, Oil	□
A/G Tank; Water, Gas, Oil	□
U/G Test Hole (S.U.E.*)	⊕
Abandoned According to Utility Records	AATUR
End of Information	E.O.I.

2/26/2023
5/24/2022
M:\Projects\166680_Rush_Fork\Design\As-Built\Plans\166680_ASB-FSH_01B.dgn


TYPICAL RIFFLE, POOL, AND BANKFULL BENCH CROSS SECTIONS

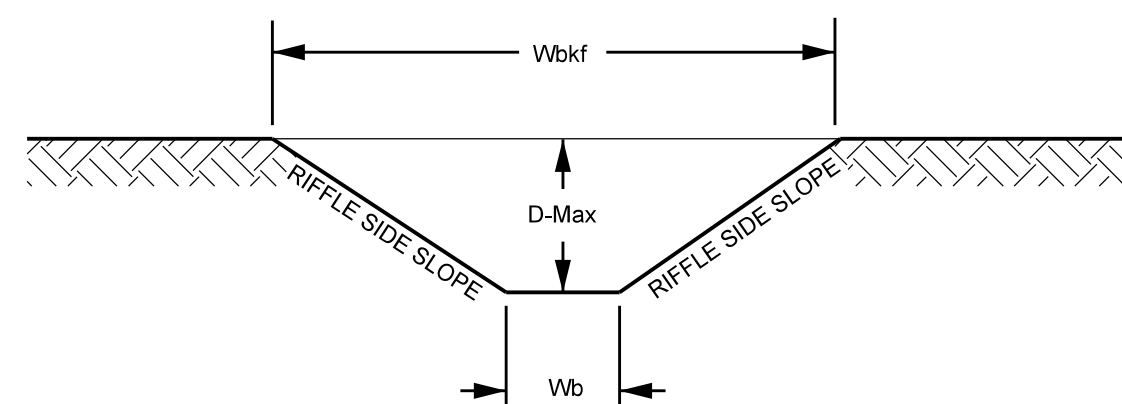


RIFFLE or PLUNGE POOL

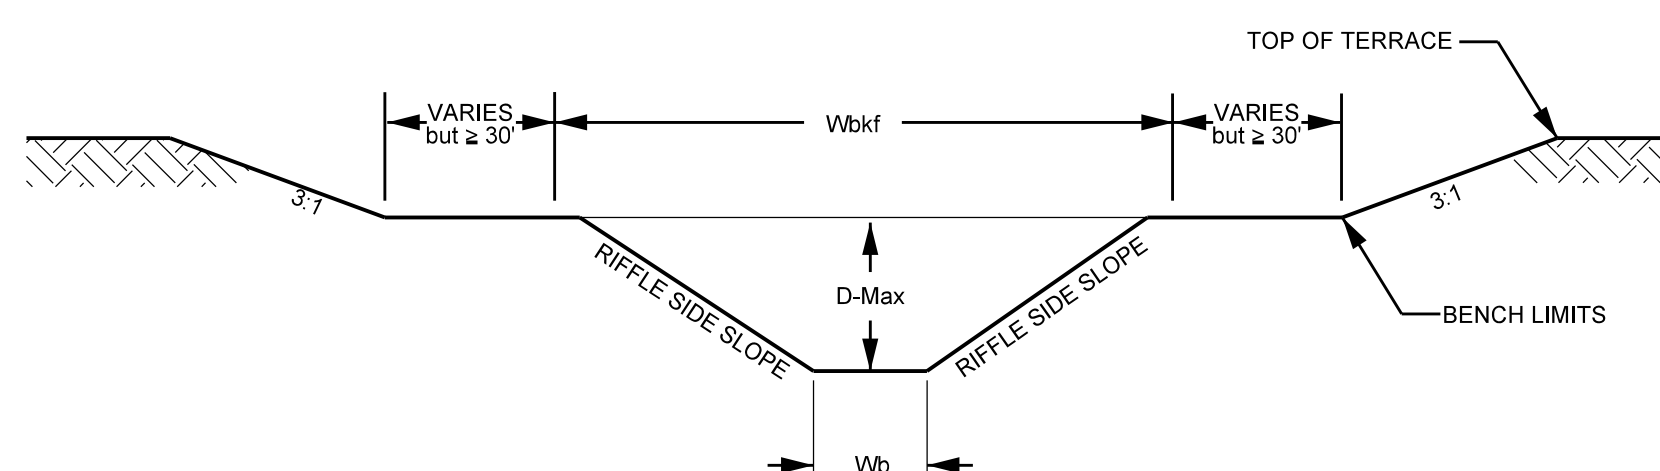

RIFFLE WITH BANKFULL BENCH

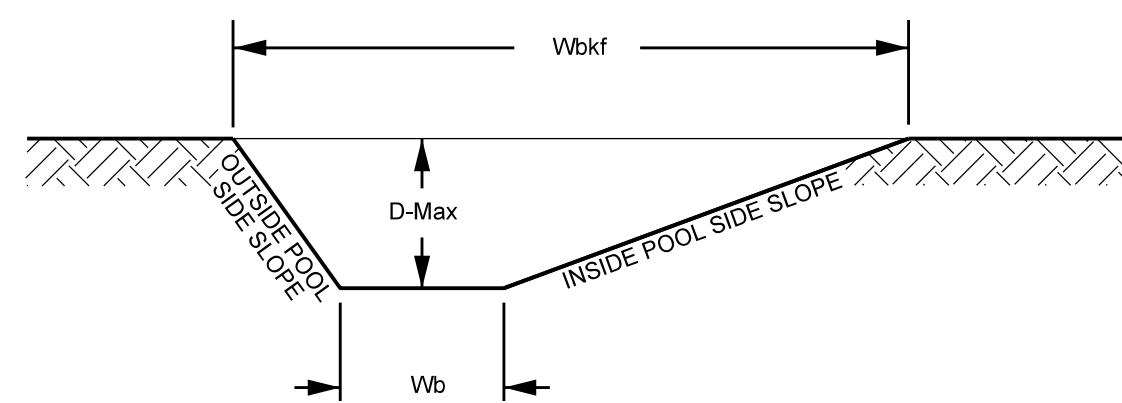

POOL (MEANDER)

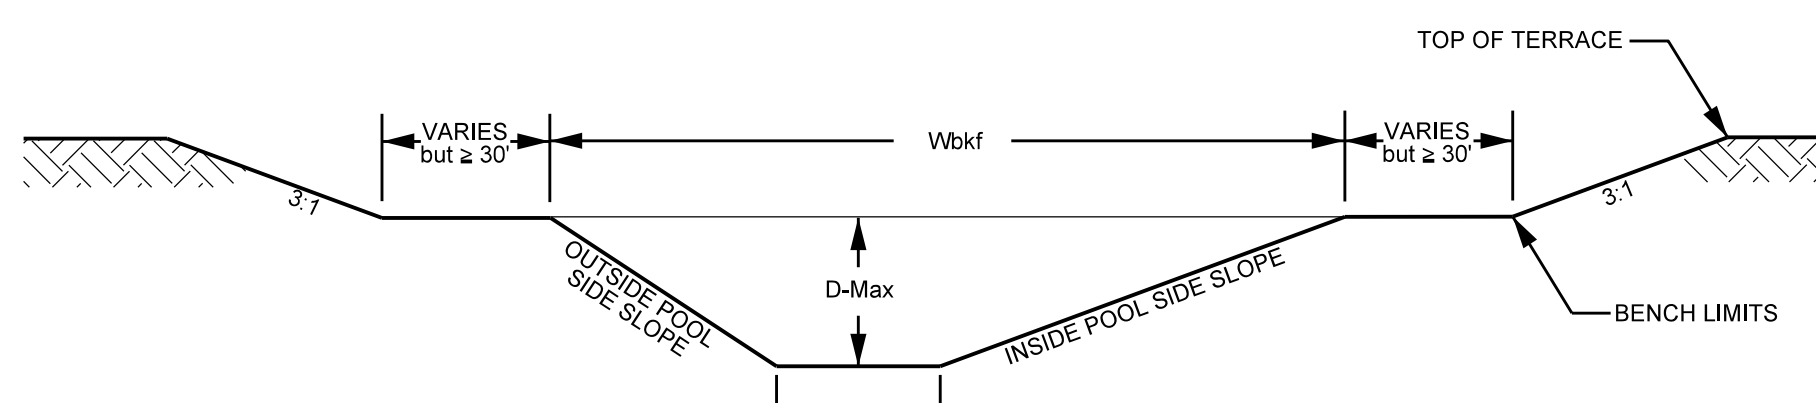


POOL WITH BANKFULL BENCH

WIDTH OF BANKFULL (Wbkf)
 AVERAGE DEPTH
 MAXIMUM DEPTH (Dmax)
 W/D (Wbkf/Dmax)
 BANKFULL AREA (Abkf)
 BOTTOM WIDTH (Wb)
 RIFFLE SIDE SLOPE (K-1)
 INSIDE POOL SIDE SLOPE
 OUTSIDE POOL SIDE SLOPE

UT1 R1, R2, & R3 UPPER 10+00 - 19+50		UT1 R3 LOWER 19+50 - 22+61		UT1 R4 UPPER 22+61 - 28+00		UT1 R4 LOWER 28+00 - 37+95		UT2		UT3 UPPER 11+50 - 16+50		UT3 LOWER 16+50 - 26+45		UT4	
RIFFLE	POOL	RIFFLE	POOL	RIFFLE	POOL	RIFFLE	POOL	RIFFLE	POOL	RIFFLE	POOL	RIFFLE	POOL	RIFFLE	POOL
9.00	11.50	10.00	12.50	12.50	16.50	13.00	17.50	4.50	6.60	7.50	10.00	8.50	12.00	5.80	7.50
0.65	1.11	0.70	1.40	0.90	1.70	0.95	1.80	0.45	0.70	0.57	1.10	0.65	1.30	0.45	0.70
0.80	1.50	1.00	2.00	1.20	2.50	1.30	2.50	0.60	1.00	0.70	1.70	0.85	1.80	0.50	1.00
13.80	10.40	14.30	9.20	13.90	9.50	13.70	9.80	13.00	9.50	13.10	8.90	13.10	9.50	12.90	10.30
5.90	12.80	7.00	17.00	11.30	28.80	12.10	31.30	2.20	4.60	4.30	11.20	6.00	15.10	2.60	5.50
5.80	5.50	5.00	4.50	8.10	6.50	8.50	7.50	4.00	2.60	4.70	3.20	4.90	4.80	3.60	3.50
2.00	N/A	2.00	N/A	2.00	N/A	2.00	N/A	2.00	N/A	2.00	N/A	2.00	N/A	2.00	N/A
N/A	2.00	N/A	2.00	N/A	2.00	N/A	2.00	N/A	2.00	N/A	2.00	N/A	2.00	N/A	2.00
N/A	2.00	N/A	2.00	N/A	2.00	N/A	2.00	N/A	2.00	N/A	2.00	N/A	2.00	N/A	2.00


TYPICAL STRUCTURE PLACEMENT

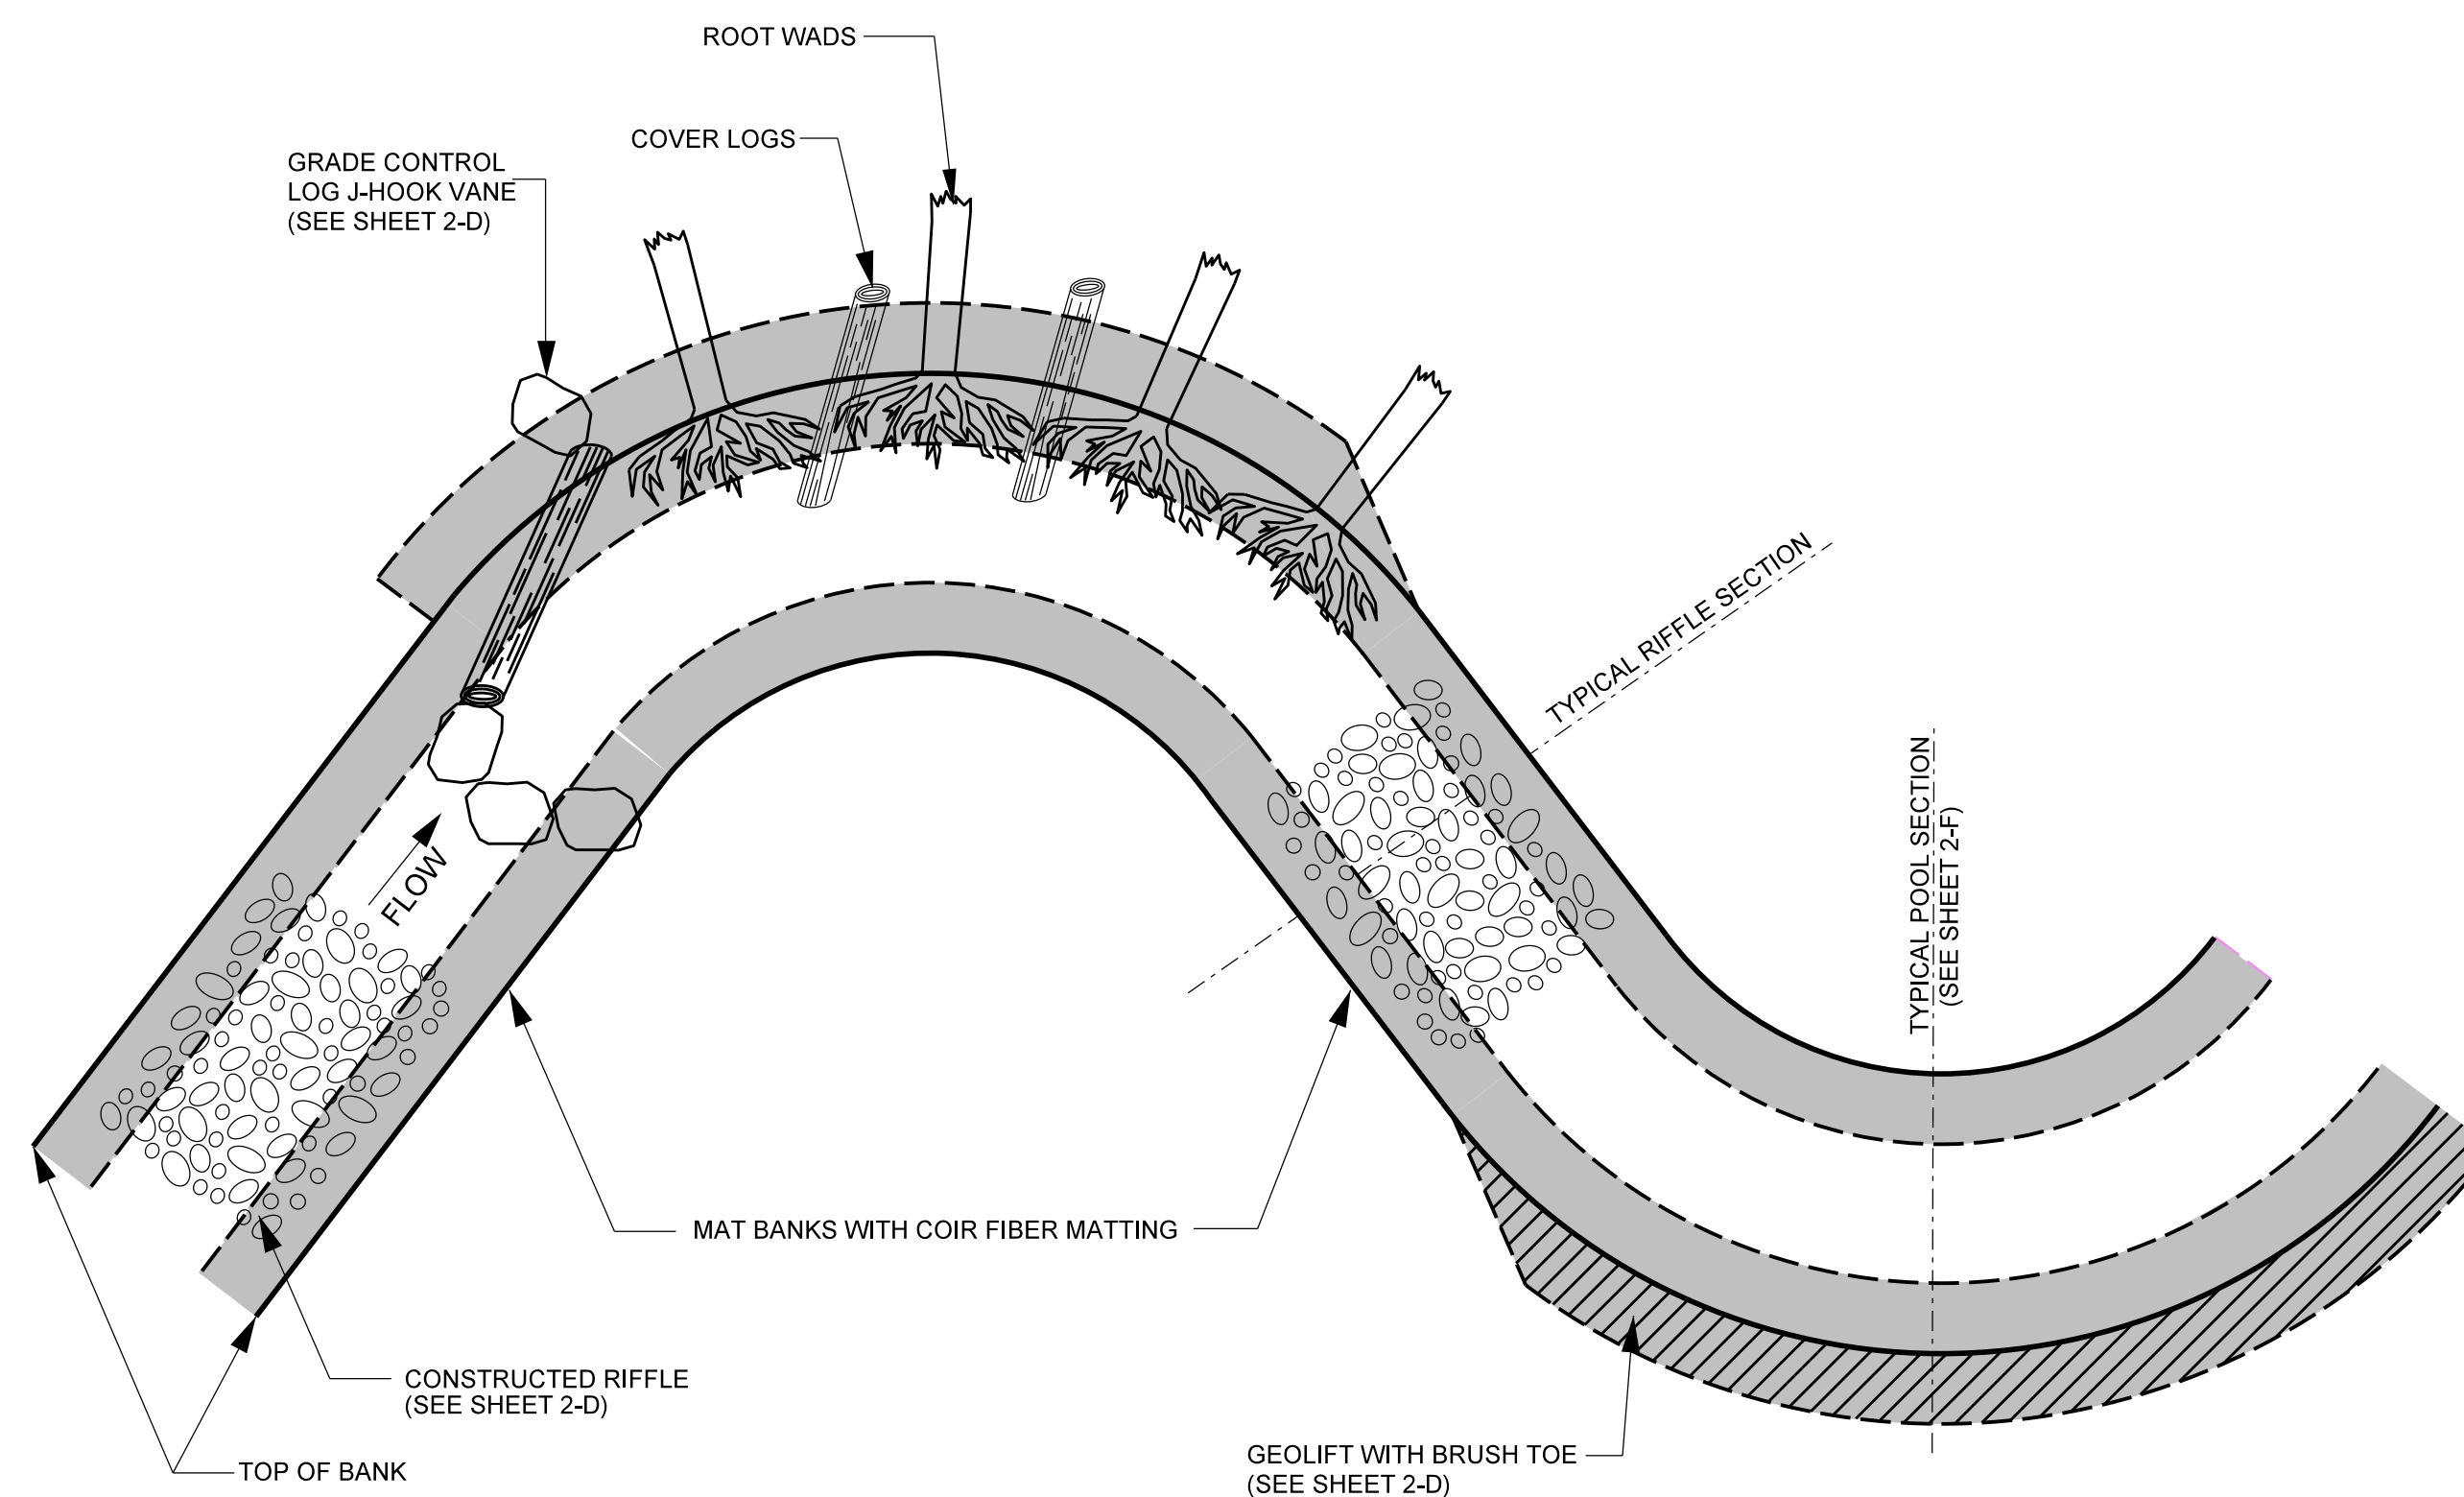

STRUCTURE NOTES:




1. GENERALLY CONSTRUCTED RIFFLES, ROOT WADS, LOG VANES AND COIR FIBER MATTING WILL BE INSTALLED IN THE LOCATION AND SEQUENCE AS SHOWN.
2. ANY CHANGES TO NUMBER OR LOCATION OF STRUCTURES DURING CONSTRUCTION MUST BE APPROVED BY THE DESIGN ENGINEER.
3. COIR FIBER MATTING TO BE INSTALLED ON ALL RESTORED STREAMBANKS, FLOODPLAIN BENCHING, AND TERRACE SLOPES AS DESCRIBED IN THE TECHNICAL SPECIFICATIONS.
4. ROOTWADS MAY BE REPLACED WITH GEOLIFT.

ROCK CROSS VANE

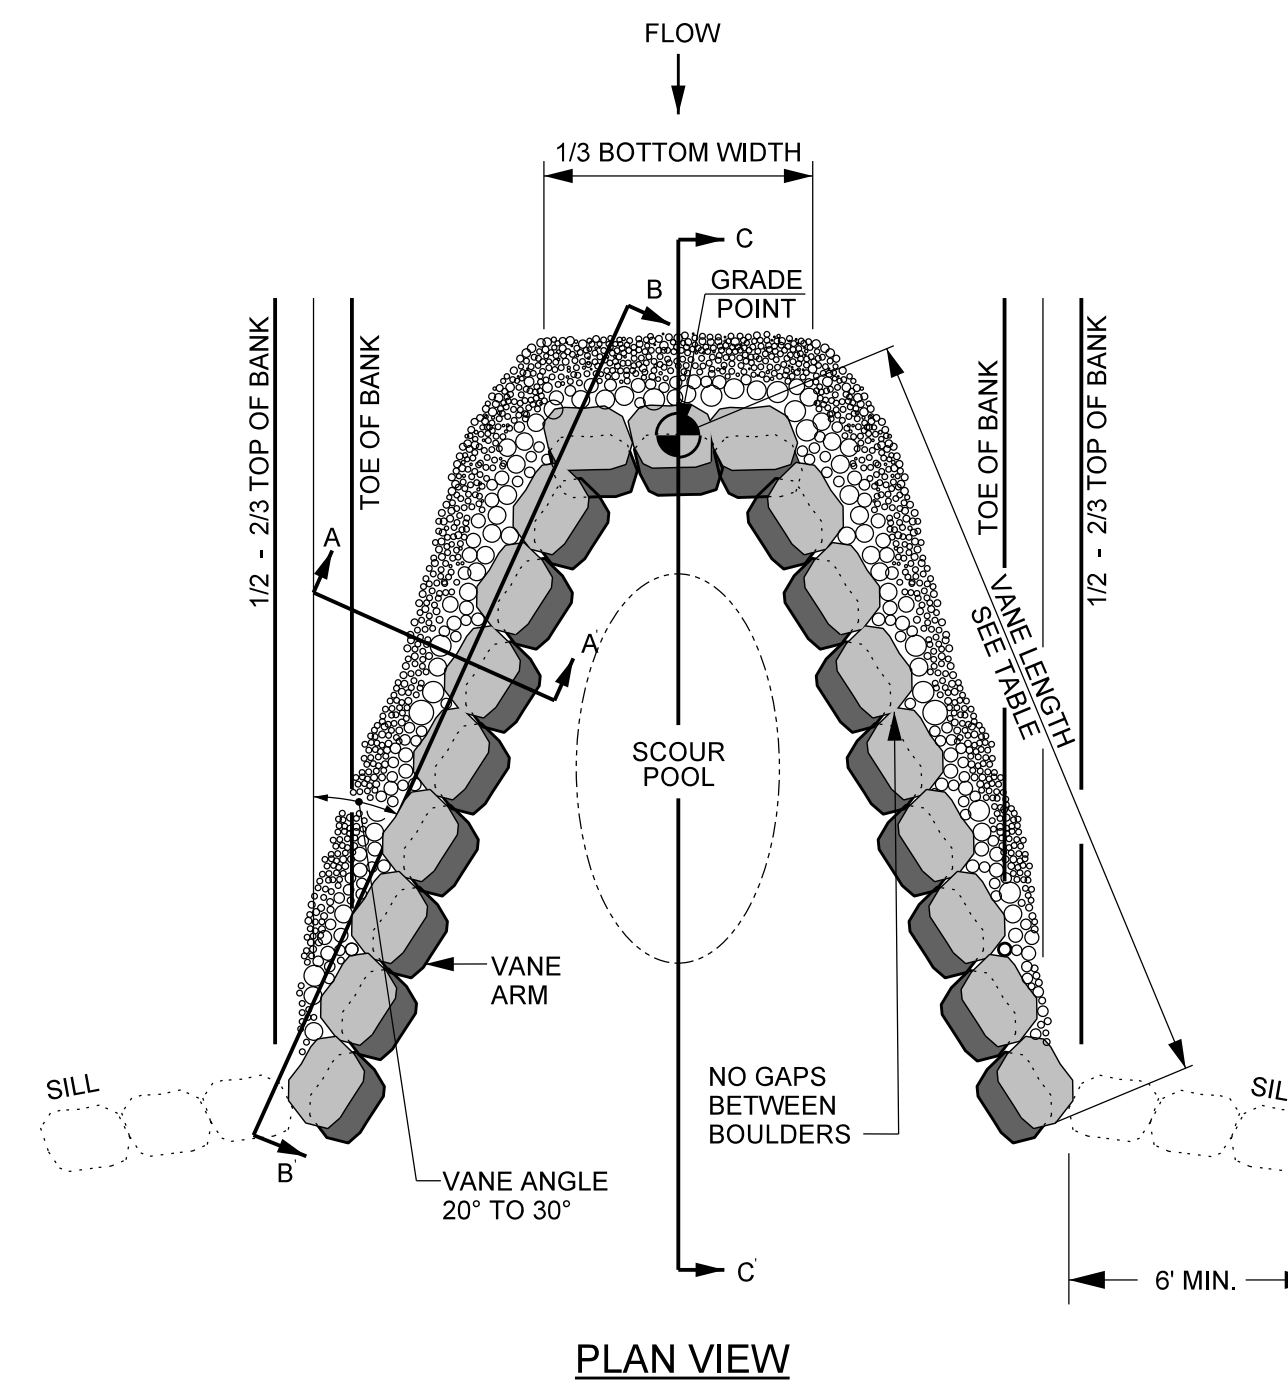


NOTES FOR ALL VANE STRUCTURES:

1. DIG A TRENCH BELOW THE BED FOR FOOTER ROCKS.
2. START AT BANK AND PLACE FOOTER ROCKS FIRST AND THEN HEADER (TOP) ROCK.
3. CONSTRUCT ANGLE AND SLOPE SPECIFICATIONS AS SHOWN.
4. AN EXTRA ROCK CAN BE PLACED IN SCOUR POOL FOR HABITAT IMPROVEMENT.
5. USE HAND PLACED STONE TO FILL GAPS ON UPSTREAM SIDE OF HEADER AND FOOTER ROCKS.
6. INSTALL GEOTEXTILE FABRIC BEGINNING AT THE TOP OF THE HEADER ROCKS AND EXTEND DOWNWARD TO THE DEPTH OF THE BOTTOM FOOTER ROCK, AND THEN UPSTREAM TO A MINIMUM OF SIX FEET.
7. AFTER ALL STONE BACKFILL HAS BEEN PLACED, FILL IN THE UPSTREAM SIDE OF THE STRUCTURE WITH WELL GRADED MIX OF CLASS B, CLASS A, & #57 STONE TO THE ELEVATION 2'-4" BELOW THE THE HEADER ROCK. INCORPORATE ON-SITE ALLUVIUM WHERE AVAILABLE. FILL SHOULD BE CONCAVE BEHIND THE VANE ARM TO ALLOW POOLING OF FLOW.
8. ON-SITE ALLUVIUM SHALL BE INCORPORATED INTO THE STONE BACKFILL WHERE AVAILABLE.
9. START SLOPE AT 2/3 TO 3/4 TIMES THE BANKFULL STAGE.
10. ALL REACHES, BOULDER SIZE 1' x 2' x 3' TO 2' x 2' x 4'.

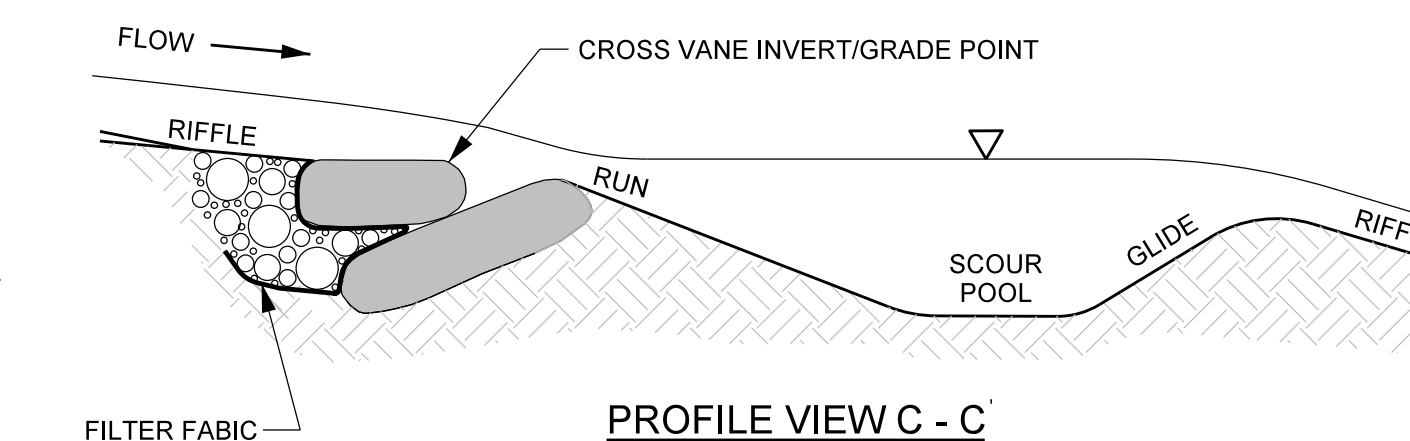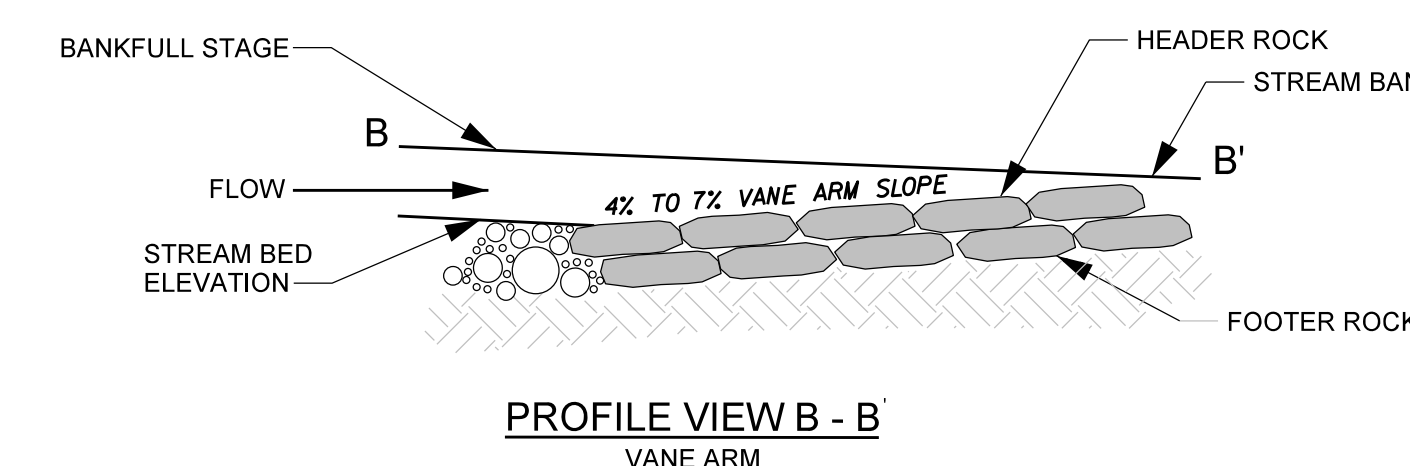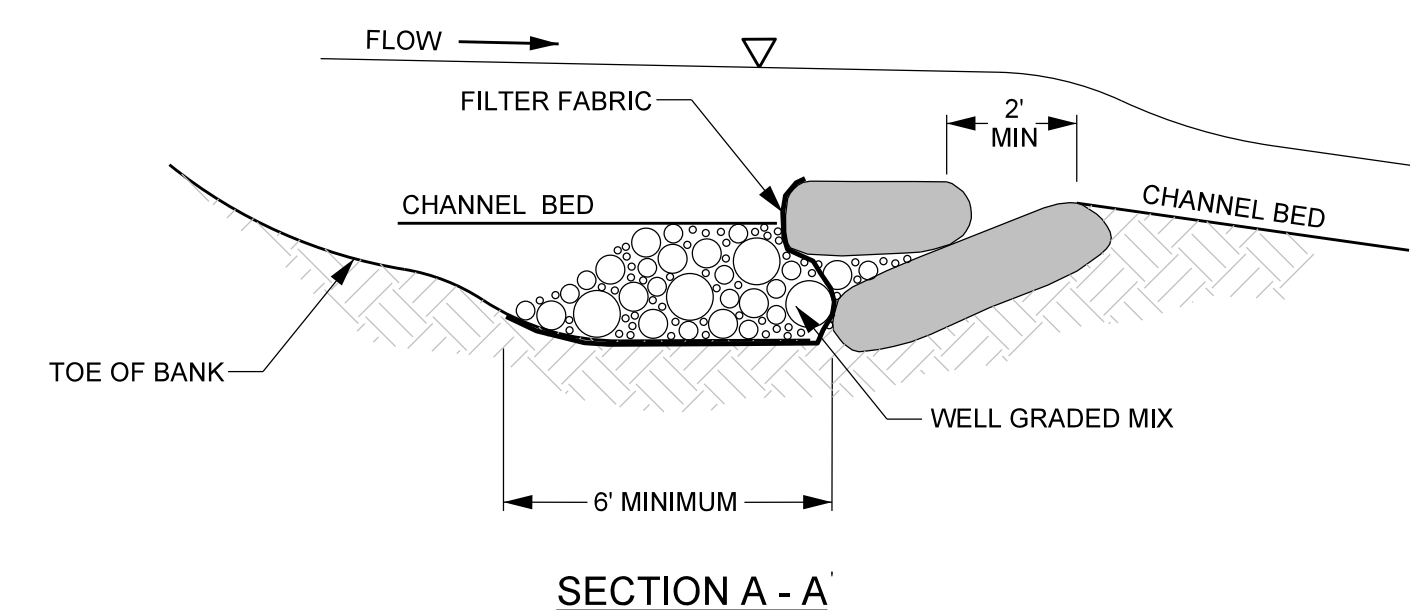


PROJECT REFERENCE NO. 166680	SHEET NO. 2
PROJECT ENGINEER	
APPROVED BY:	
DATE:	
Michael Baker International 8000 Regency Parkway, Suite 600 Cary, NORTH CAROLINA 27518 Phone: 919.463.5488 Fax: 919.463.5490 License #: F-1084	
NCDMS ID NO. 100068	


ROCK VANE

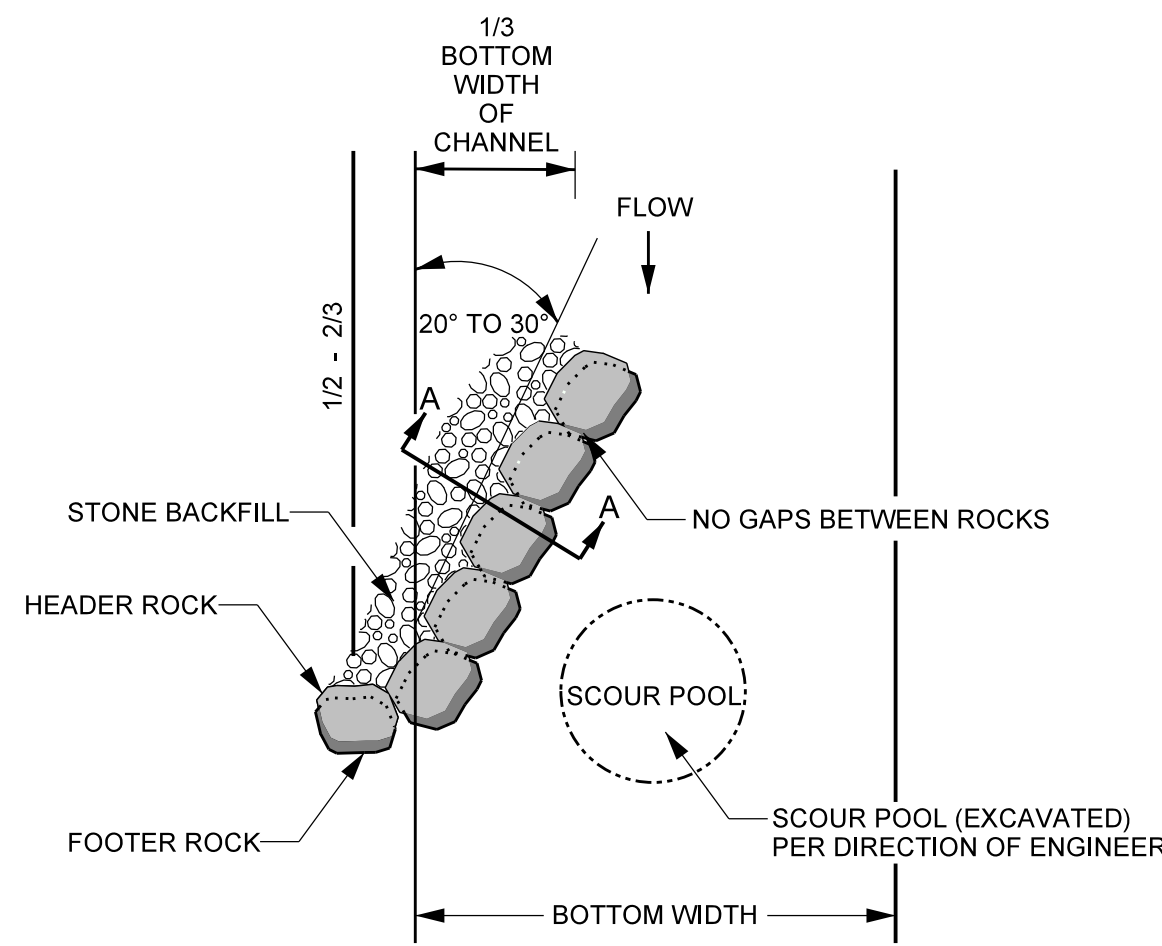

PLAN VIEW

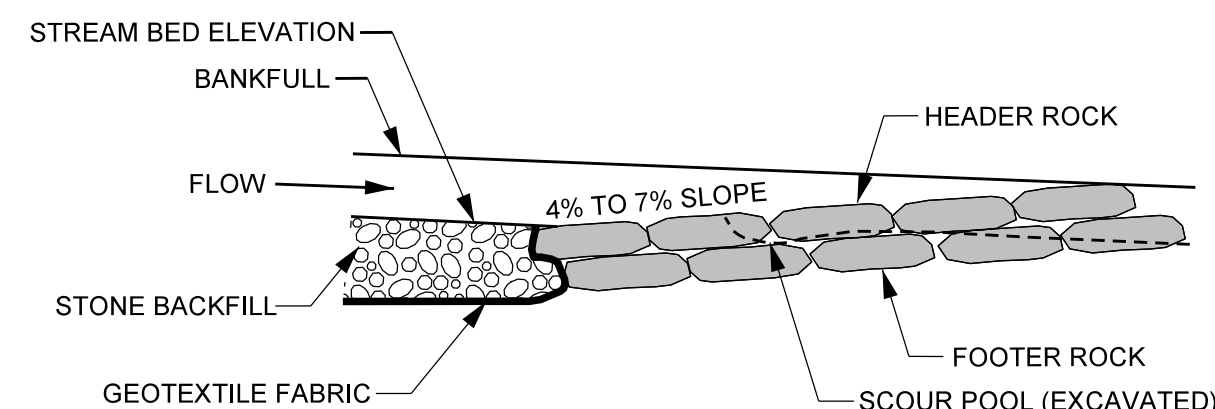

PROFILE VIEW

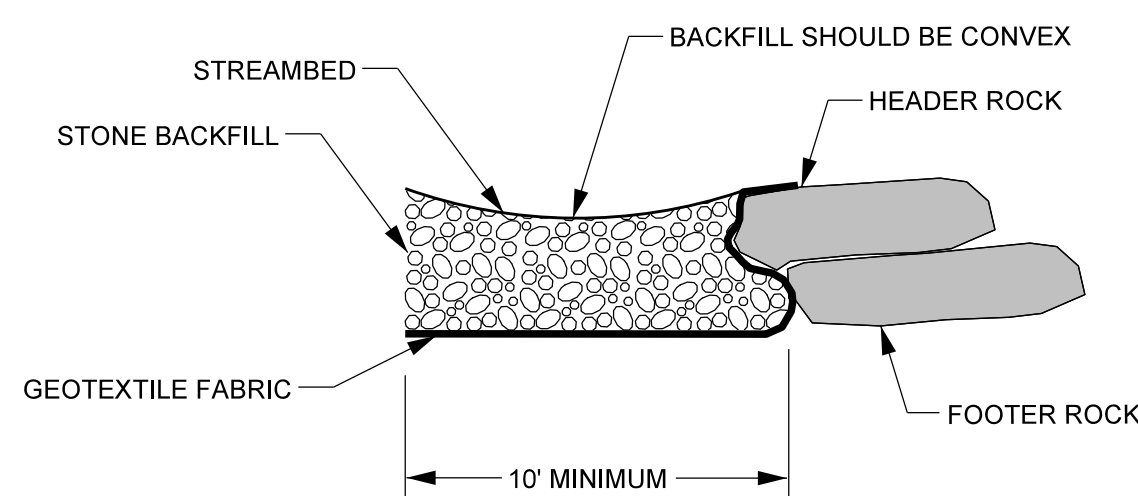


SECTION A - A


NOTES FOR ALL VANE STRUCTURES:

1. DIG A TRENCH BELOW THE BED FOR FOOTER ROCKS.
2. START AT BANK AND PLACE FOOTER ROCKS FIRST AND THEN HEADER (TOP) ROCK.
3. CONTINUE WITH STRUCTURE, FOLLOWING ANGLE AND SLOPE SPECIFICATIONS.
4. AN EXTRA ROCK CAN BE PLACED IN SCOUR POOL FOR HABITAT IMPROVEMENT.
5. USE HAND PLACED STONE TO FILL GAPS ON UPSTREAM SIDE OF HEADER AND FOOTER ROCKS.
6. INSTALL GEOTEXTILE FABRIC BEGINNING AT THE TOP OF THE HEADER ROCKS AND EXTEND DOWNWARD TO THE DEPTH OF THE BOTTOM FOOTER ROCK, AND THEN UPSTREAM TO A MINIMUM OF SIX FEET.
7. AFTER ALL STONE BACKFILL HAS BEEN PLACED, FILL IN THE UPSTREAM SIDE OF THE STRUCTURE WITH WELL GRADED MIX OF CLASS B, CLASS A, & #57 STONE TO THE ELEVATION 2'-4" BELOW THE HEADER ROCK. INCORPORATE ON-SITE ALLUVIUM WHERE AVAILABLE. FILL SHOULD BE CONCAVE BEHIND THE VANE ARM TO ALLOW POOLING OF FLOW.
8. START SLOPE AT 2/3 TO 3/4 TIMES THE BANKFULL STAGE.
9. ALL REACHES, BOULDER SIZE 1' x 2' x 3' TO 2' x 2' x 4'.

BOULDER STEP

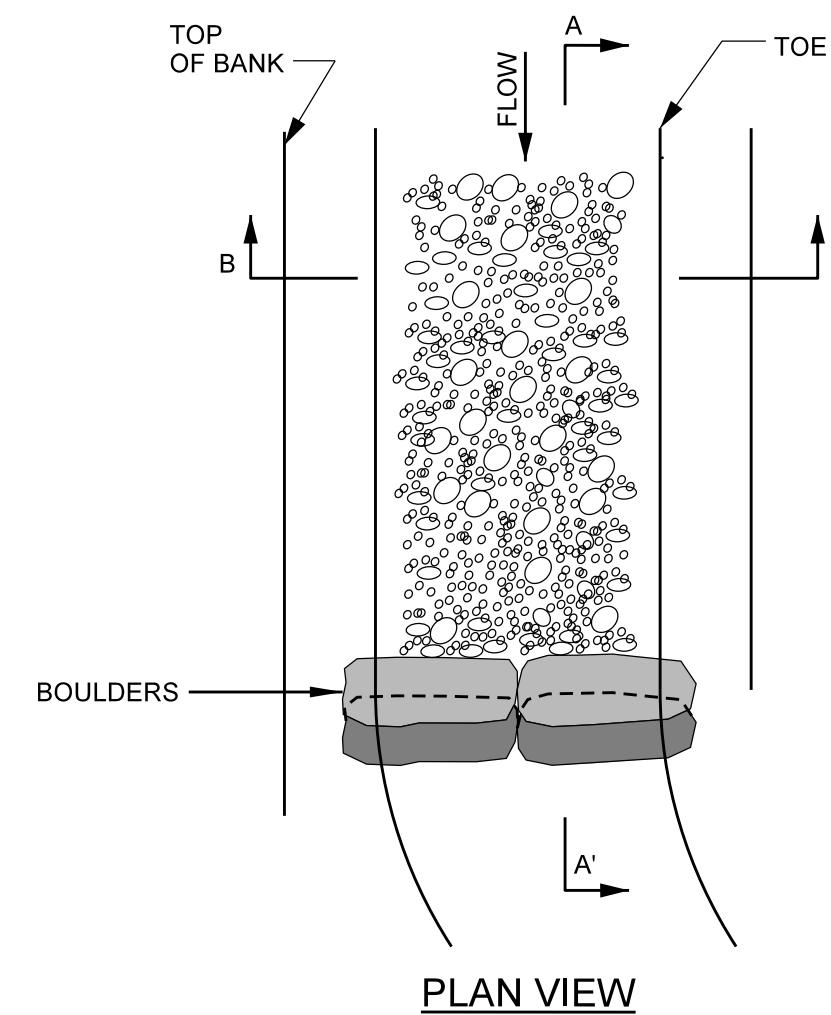

PLAN VIEW

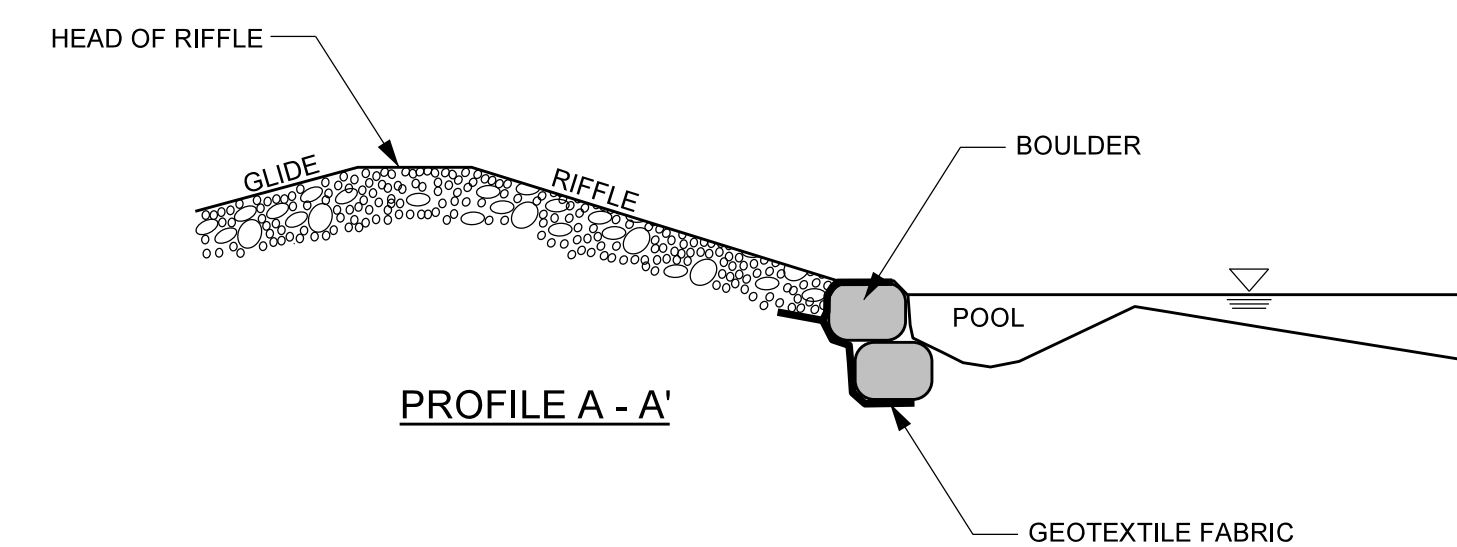


PROFILE A - A'


NOTES:

1. HEADER AND FOOTER BOULDERS MUST BE AT LEAST 1' X 2' X 3'.
2. FOOTERS SHALL BE INSTALLED SUCH THAT 1/4 TO 1/3 OF THE LENGTH IS DOWNSTREAM OF THE HEADER.
3. SOIL SHALL BE WELL COMPACTED AROUND BURIED PORTION OF FOOTERS WITH THE BUCKET OF EXCAVATOR.
4. INSTALL NON-WOVEN FILTER FABRIC UNDERNEATH FOOTER BOULDERS.
5. UNDERCUT THE RIFFLE ELEVATION 12 INCHES TO ALLOW FOR A LAYER OF STONE.
6. INSTALL EROSION CONTROL MATTING ALONG COMPLETED BANKS SUCH THAT THE EROSION CONTROL MATTING AT THE TOE OF THE BANK EXTENDS DOWN TO THE UNDERCUT ELEVATION.
7. FILL TRENCH WITH GRADED MIX OF CLASS A, CLASS B, AND #57 STONE TO THE BED ELEVATION OF THE CHANNEL.
8. BOULDER STEPS MUST BE EXTENDED TO A MINIMUM OF 2' INTO THE BANK. USE SILL BOULDERS IF NECESSARY.
9. THALWEG AND STEP INVERT WILL BE CONCAVE AND SHAPED PER DIRECTION OF THE DESIGNER.
10. ALL REACHES, BOULDER SIZE 1' x 2' x 3' TO 2' x 2' x 4'.


GRADE CONTROL ROCK J-HOOK VANE

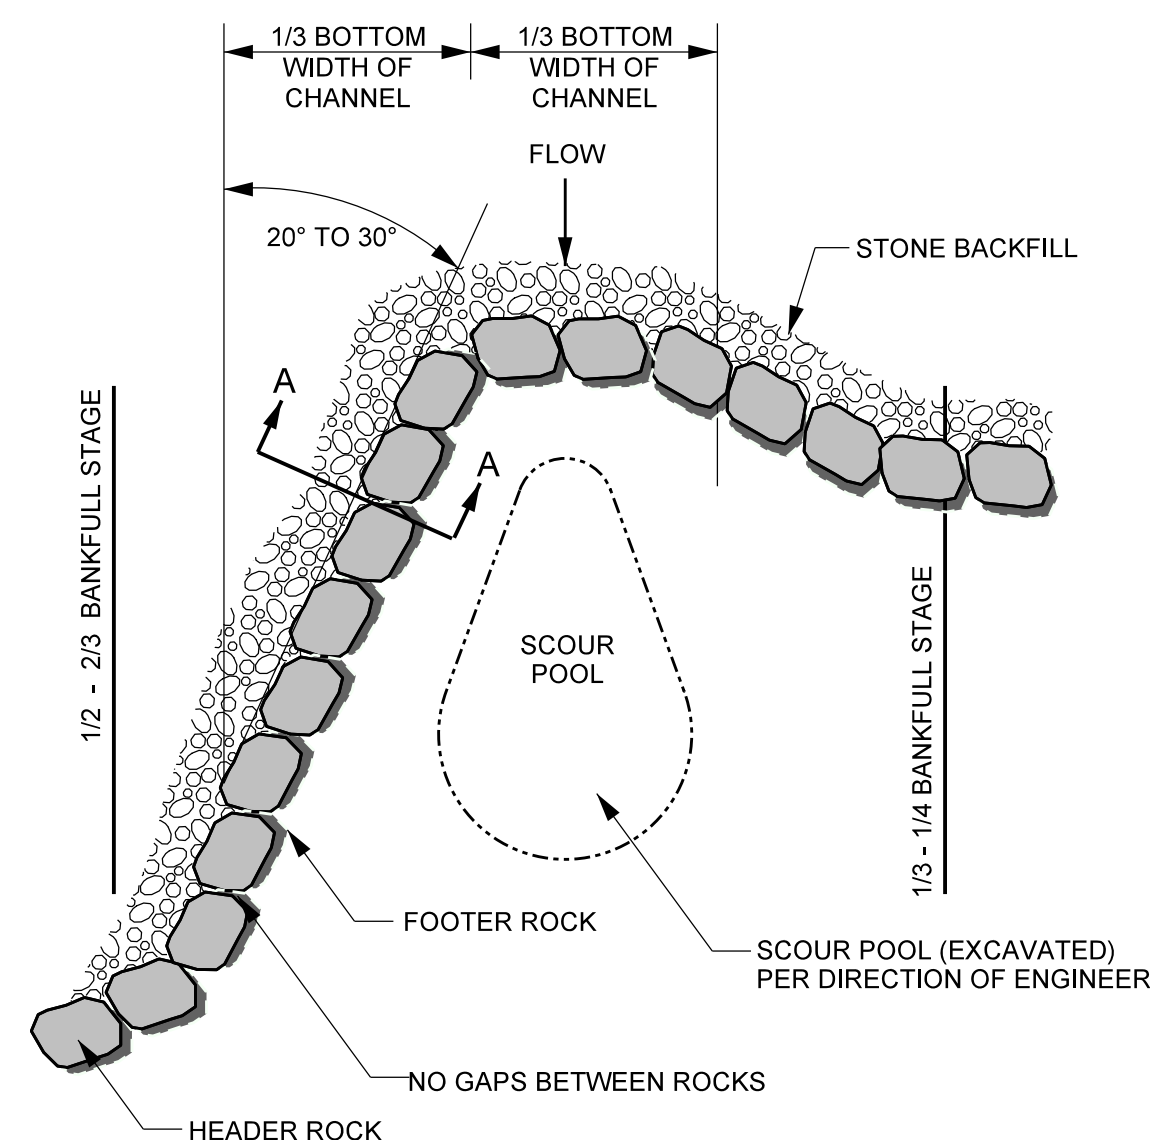

PLAN VIEW

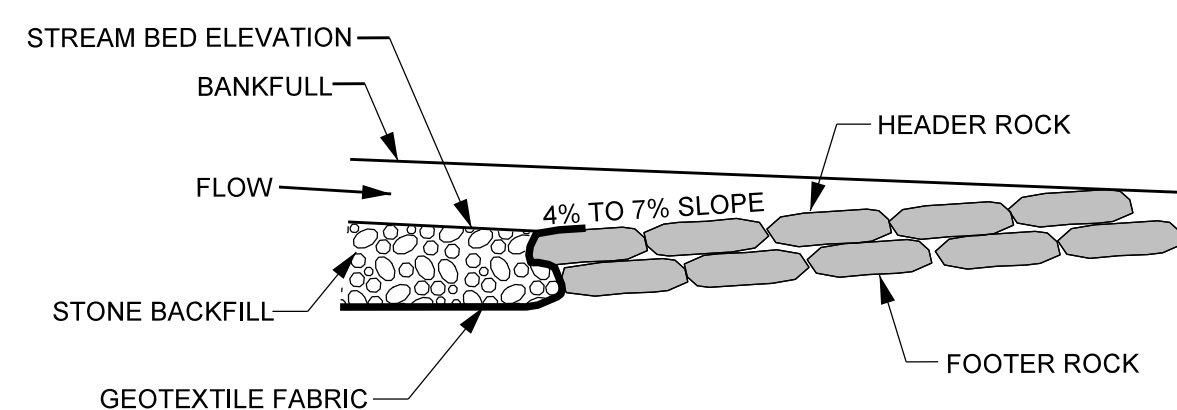

PROFILE VIEW

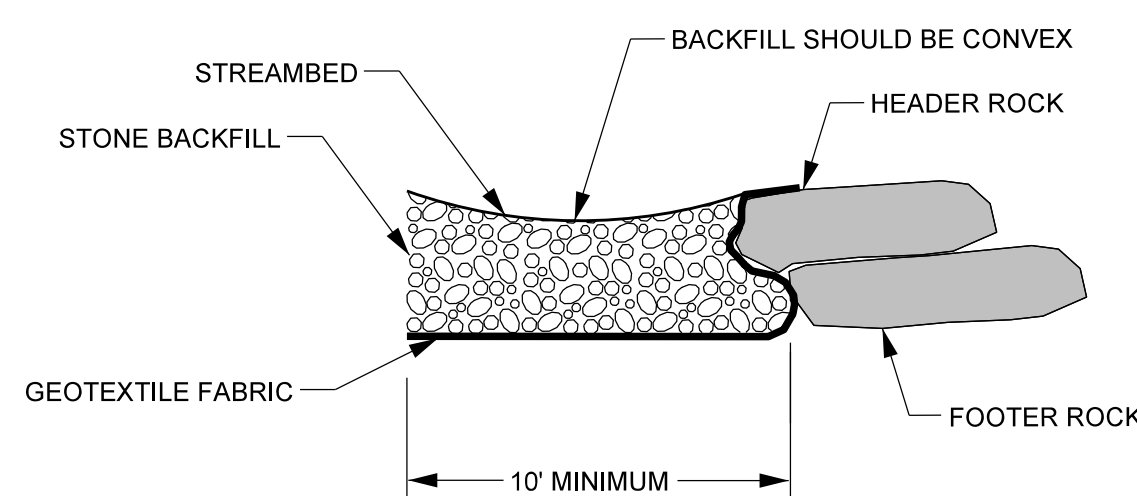


SECTION A - A


NOTES FOR ALL VANE STRUCTURES:

1. DIG A TRENCH BELOW THE BED FOR FOOTER ROCKS.
2. START AT BANK AND PLACE FOOTER ROCKS FIRST AND THEN HEADER (TOP) ROCK.
3. CONTINUE WITH STRUCTURE, FOLLOWING ANGLE AND SLOPE SPECIFICATIONS.
4. AN EXTRA ROCK CAN BE PLACED IN SCOUR POOL FOR HABITAT IMPROVEMENT.
5. USE HAND PLACED STONE TO FILL GAPS ON UPSTREAM SIDE OF HEADER AND FOOTER ROCKS.
6. INSTALL GEOTEXTILE FABRIC BEGINNING AT THE TOP OF THE HEADER ROCKS AND EXTEND DOWNWARD TO THE DEPTH OF THE BOTTOM FOOTER ROCK, AND THEN UPSTREAM TO A MINIMUM OF SIX FEET.
7. AFTER ALL STONE BACKFILL HAS BEEN PLACED, FILL IN THE UPSTREAM SIDE OF THE STRUCTURE WITH WELL GRADED MIX OF CLASS B, CLASS A, & #57 STONE TO THE ELEVATION 2'-4" BELOW THE HEADER ROCK. INCORPORATE ON-SITE ALLUVIUM WHERE AVAILABLE. FILL SHOULD BE CONCAVE BEHIND THE VANE ARM TO ALLOW POOLING OF FLOW.
8. START SLOPE AT 2/3 TO 3/4 TIMES THE BANKFULL STAGE.
9. ALL REACHES, BOULDER SIZE 1' x 2' x 3' TO 2' x 2' x 4'.


ROCK J-HOOK VANE

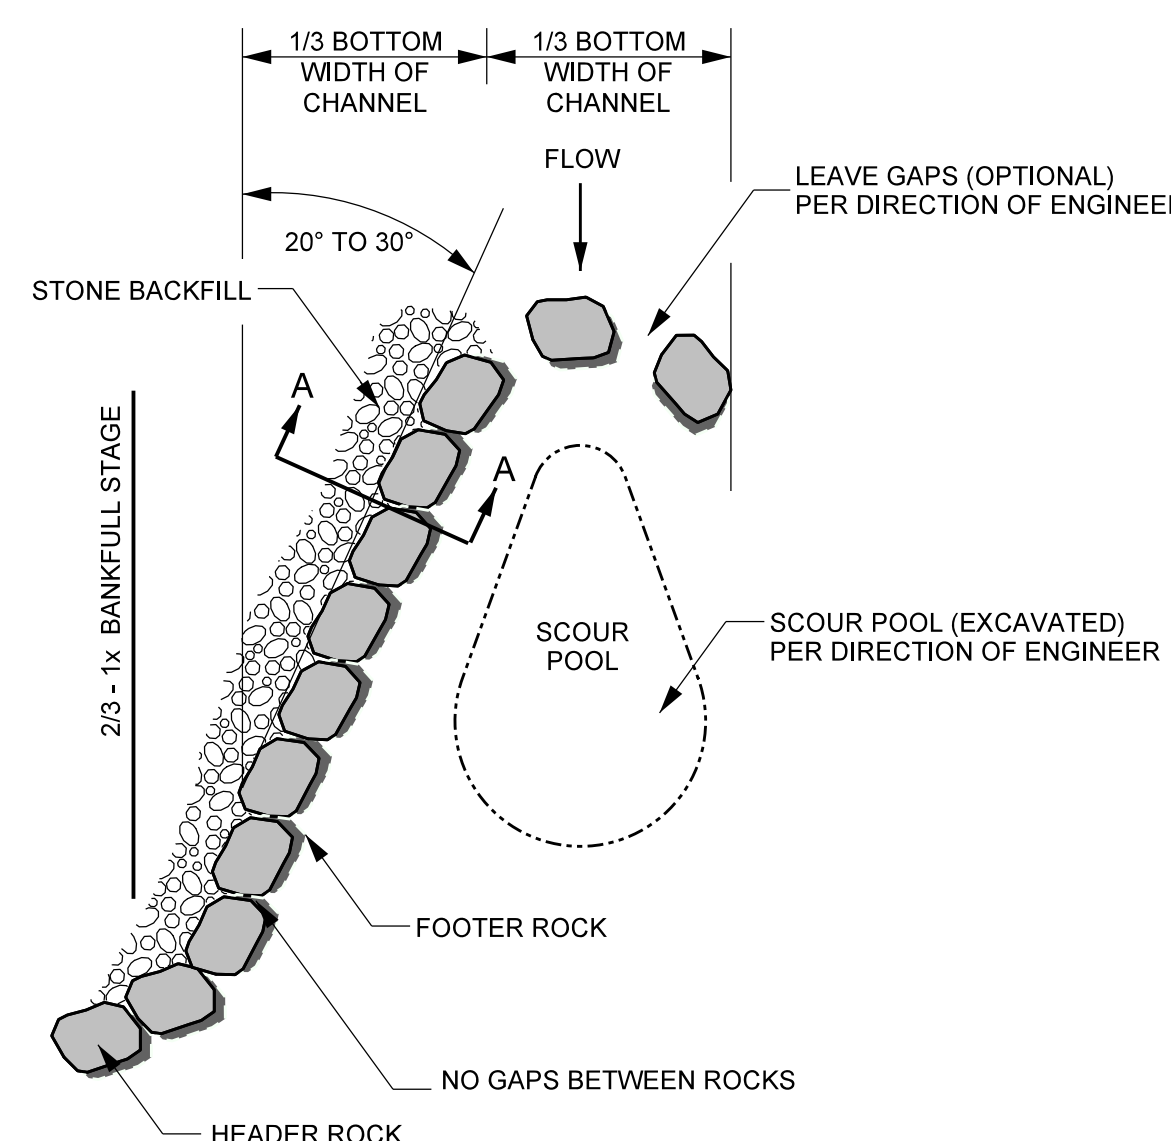

PLAN VIEW

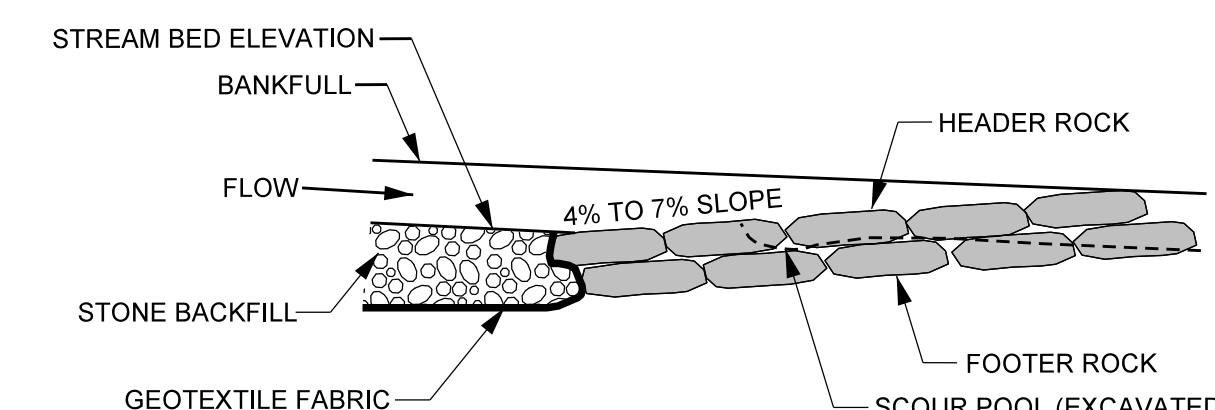


PROFILE VIEW

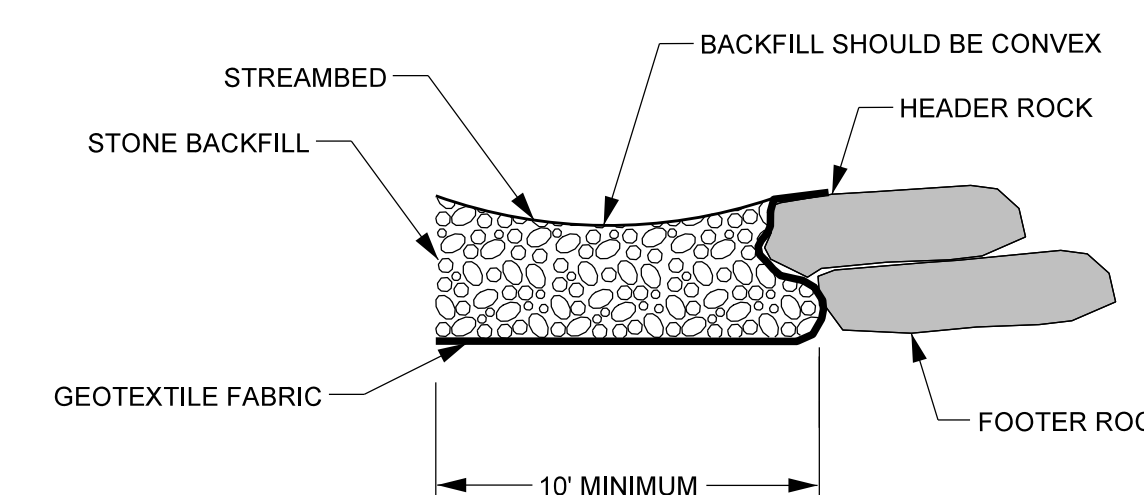




SECTION A - A

NOTES FOR ALL VANE STRUCTURES:

1. DIG A TRENCH BELOW THE BED FOR FOOTER ROCKS.
2. START AT BANK AND PLACE FOOTER ROCKS FIRST AND THEN HEADER (TOP) ROCK.
3. CONTINUE WITH STRUCTURE, FOLLOWING ANGLE AND SLOPE SPECIFICATIONS.
4. AN EXTRA ROCK CAN BE PLACED IN SCOUR POOL FOR HABITAT IMPROVEMENT.
5. USE HAND PLACED STONE TO FILL GAPS ON UPSTREAM SIDE OF HEADER AND FOOTER ROCKS.
6. INSTALL GEOTEXTILE FABRIC BEGINNING AT THE TOP OF THE HEADER ROCKS AND EXTEND DOWNWARD TO THE DEPTH OF THE BOTTOM FOOTER ROCK, AND THEN UPSTREAM TO A MINIMUM OF SIX FEET.
7. AFTER ALL STONE BACKFILL HAS BEEN PLACED, FILL IN THE UPSTREAM SIDE OF THE STRUCTURE WITH WELL GRADED MIX OF CLASS B, CLASS A, & #57 STONE TO THE ELEVATION 2'-4" BELOW THE HEADER ROCK. INCORPORATE ON-SITE ALLUVIUM WHERE AVAILABLE. FILL SHOULD BE CONCAVE BEHIND THE VANE ARM TO ALLOW POOLING OF FLOW.
8. START SLOPE AT 2/3 TO 3/4 TIMES THE BANKFULL STAGE.
9. ALL REACHES, BOULDER SIZE 1' x 2' x 3' TO 2' x 2' x 4'.

PROJECT REFERENCE NO. 166680	SHEET NO. 2A
PROJECT ENGINEER	
	
APPROVED BY:	
DATE:	
Michael Baker International	
<small>Michael Baker Engineering Inc. 8000 Regency Parkway, Suite 600 Cary, NORTH CAROLINA 27518 Phone: 919.463.5486 Fax: 919.463.5490 License #: F-1084</small>	
NCDMS ID NO. 100068	

LOG AND ROCK STEP / POOL

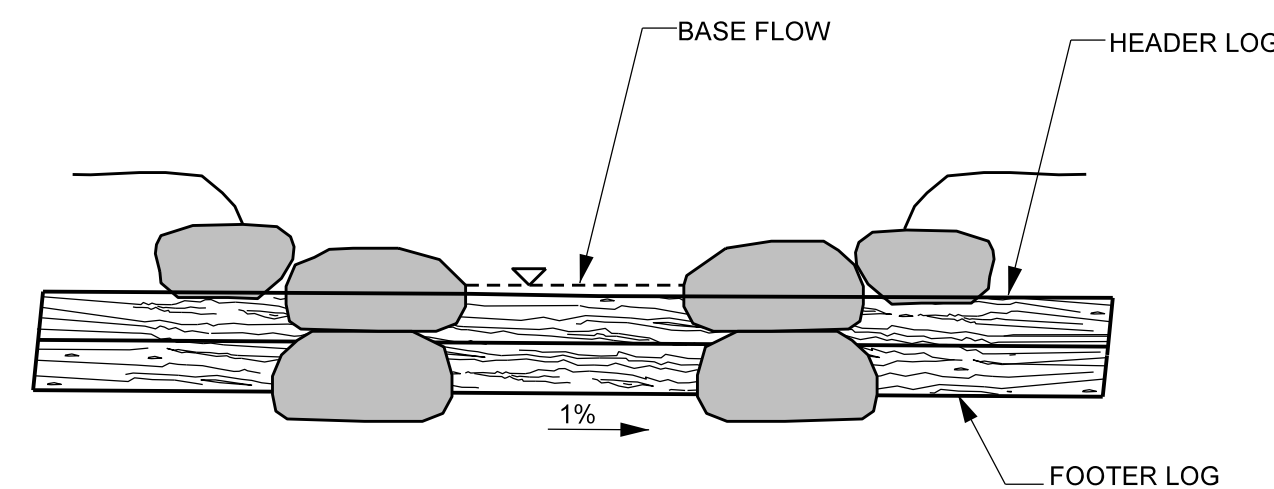
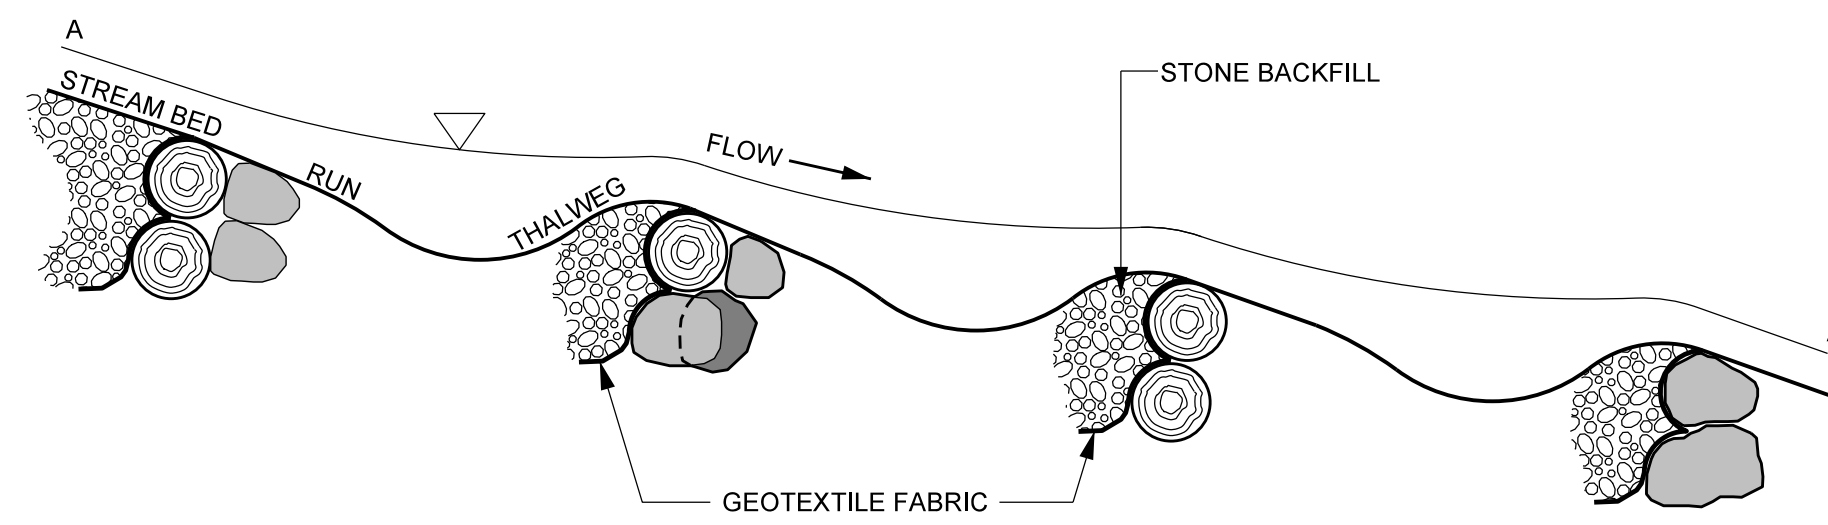
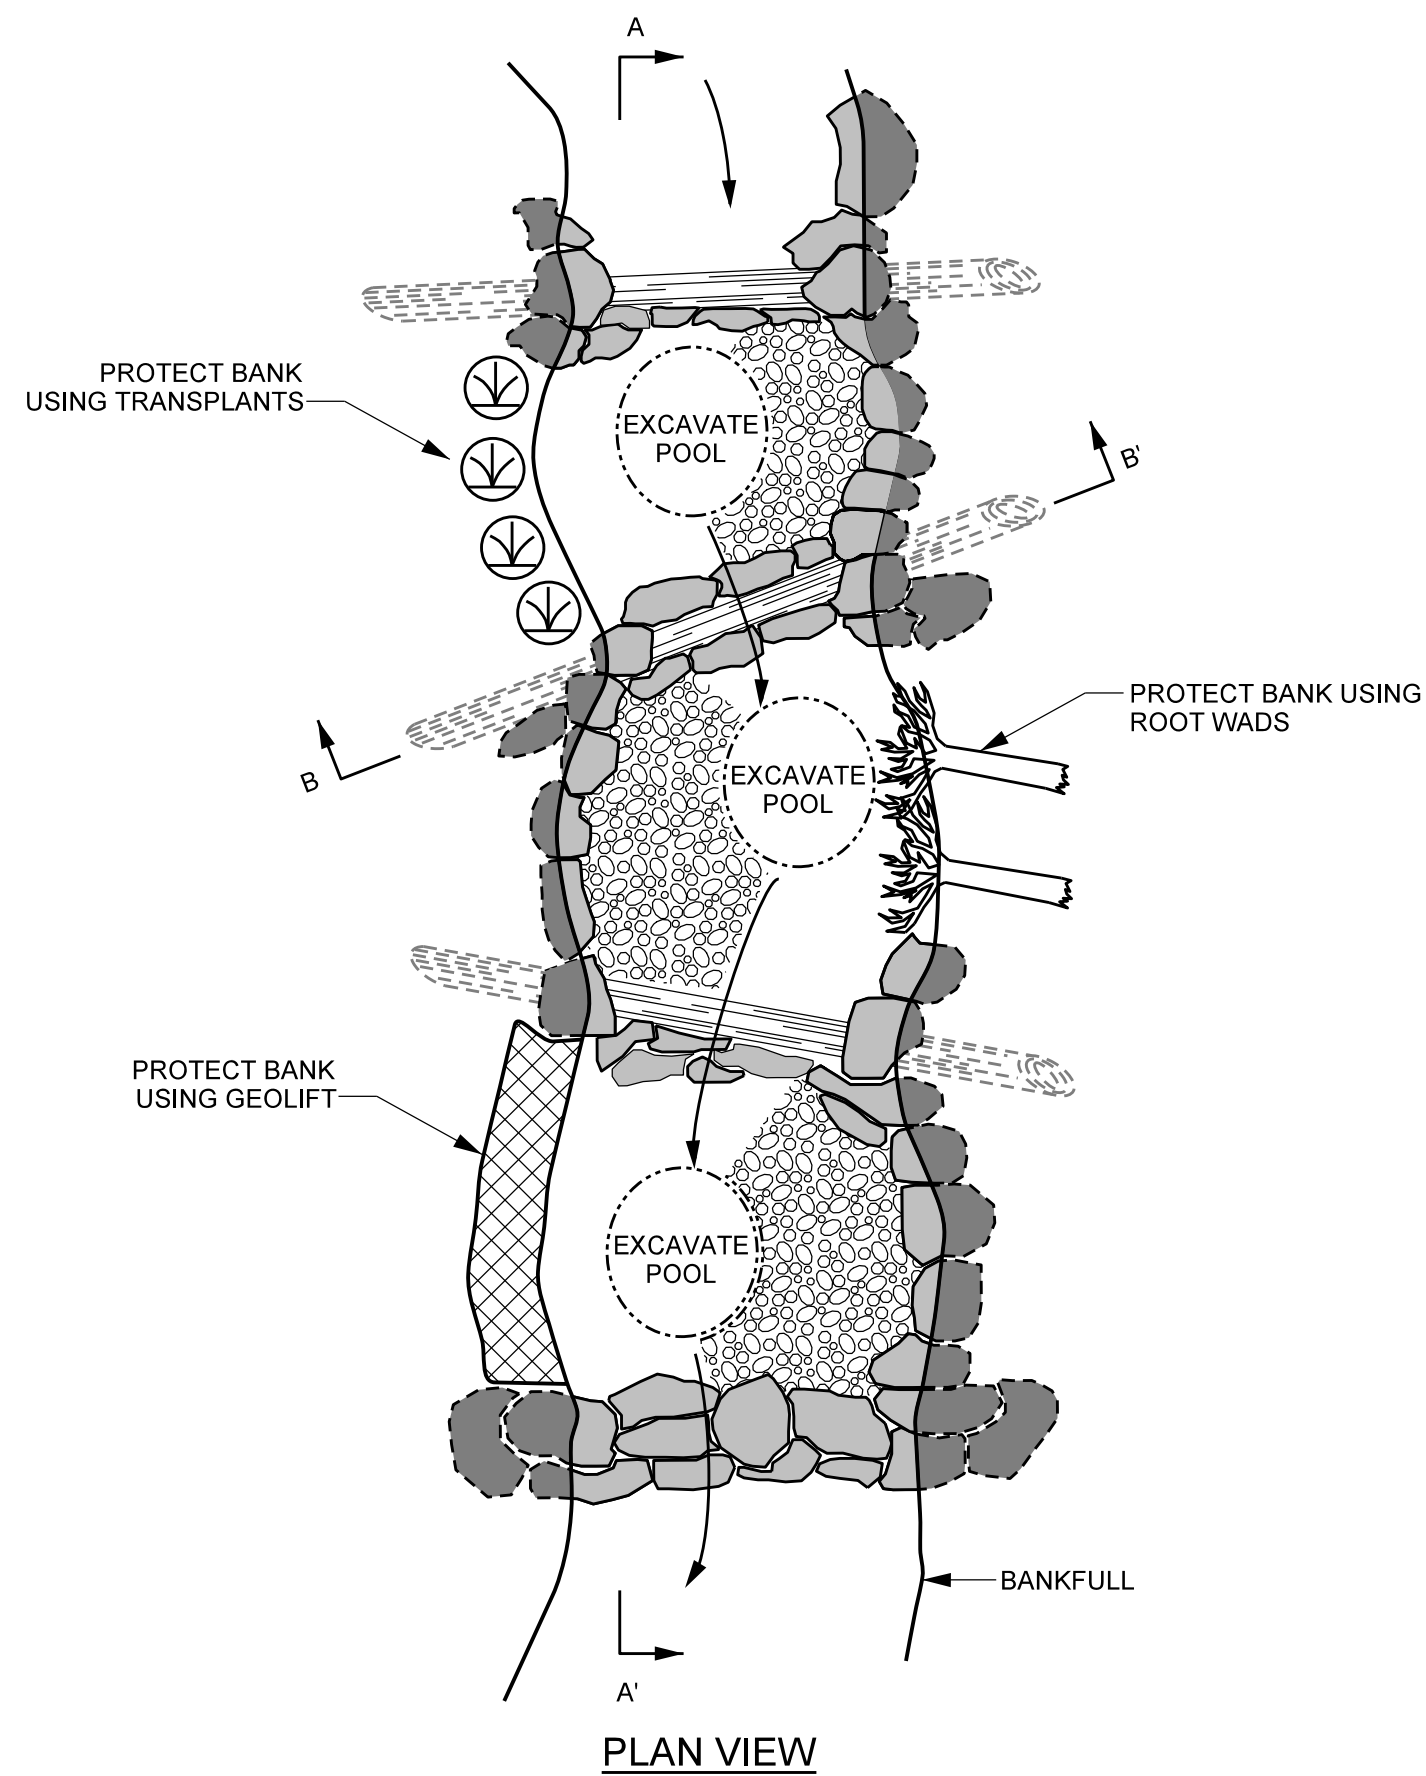


NOTES:

- LOGS SHOULD BE AT LEAST 8" IN DIAMETER, RELATIVELY STRAIGHT, HARDWOOD, AND RECENTLY HARVESTED AND EXTENDING INTO THE BANK 3' ON EACH SIDE.
- SOIL SHOULD BE COMPACTED WELL AROUND BURIED PORTIONS OF LOG.
- GEOTEXTILE FABRIC SHOULD BE NAILED TO THE LOG BELOW THE BACKFILL.
- BOULDERS SHOULD BE 1' X 2' X 3' AND PLACED ON TOP OF HEADER LOG FOR ANCHORING.
- TOEWOOD OR TRANSPLANTS CAN BE USED INSTEAD OF BOULDERS, PER DIRECTION OF ENGINEER.
- AFTER ALL STONE BACKFILL HAS BEEN PLACED, FILL IN THE UPSTREAM SIDE OF THE STRUCTURE WITH WELL GRADED MIX OF CLASS B, CLASS A, & #57 STONE TO THE ELEVATION OF THE TOP OF THE HEADER ROCK. INCORPORATE ON-SITE ALLUVIUM WHERE AVAILABLE.

PROJECT REFERENCE NO. 166680	SHEET NO. 2B
PROJECT ENGINEER	
APPROVED BY:	
DATE:	
Michael Baker International	
NC DMS ID NO. 100068	




GRADE CONTROL LOG J-HOOK VANE

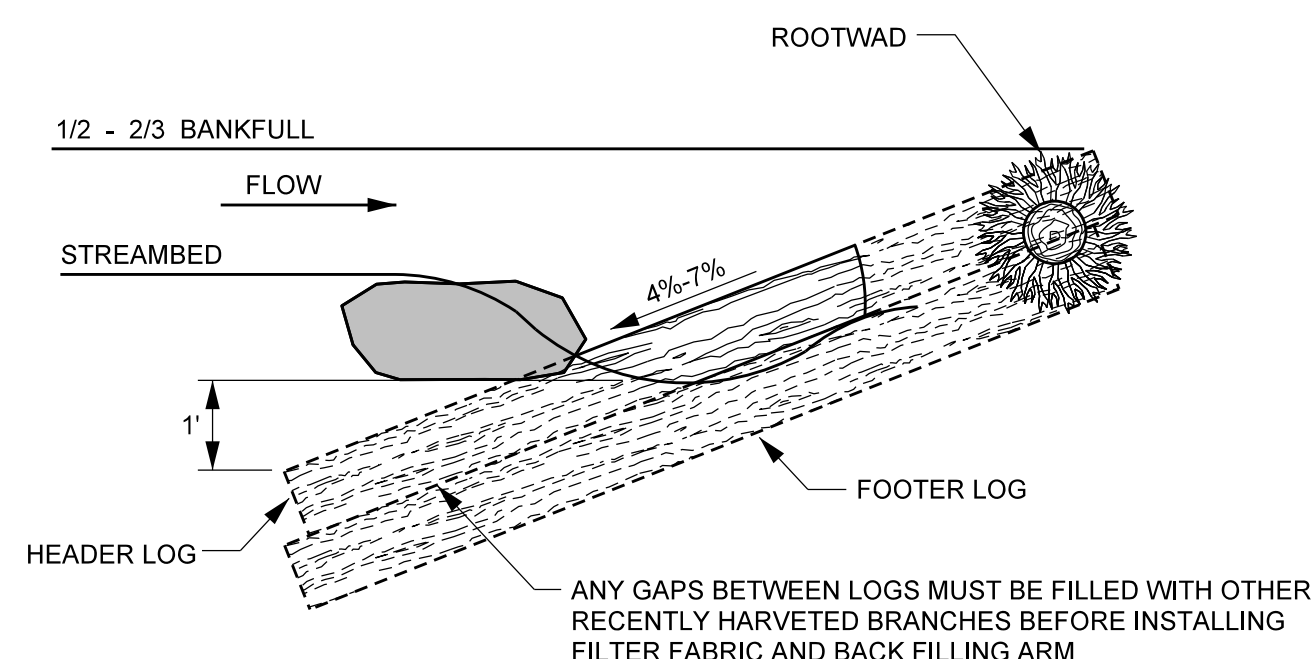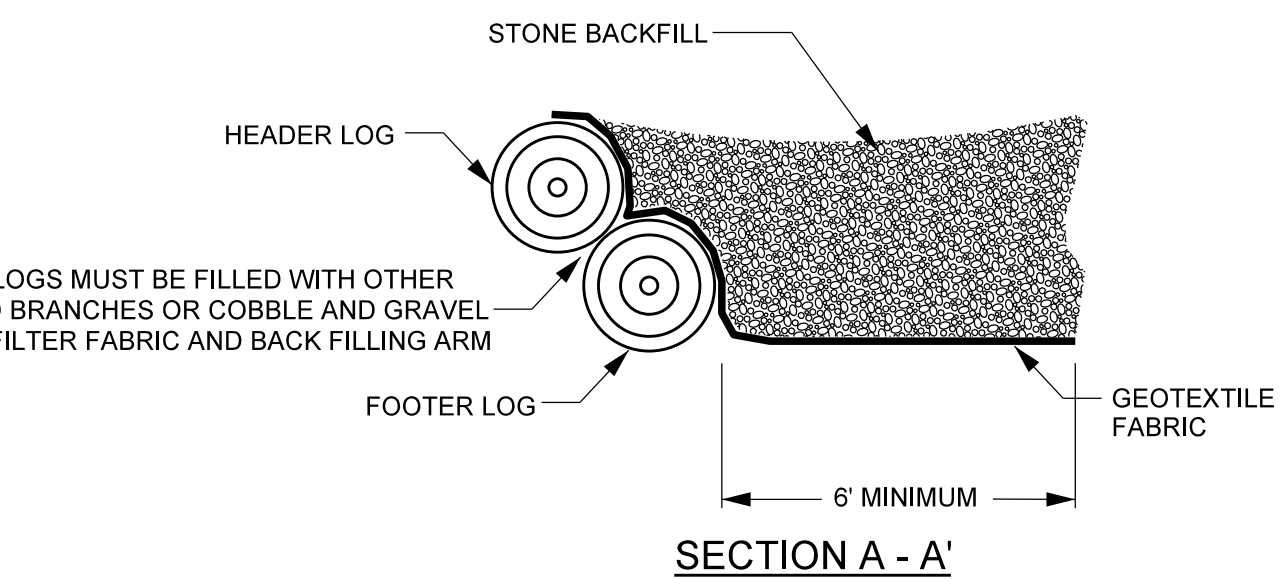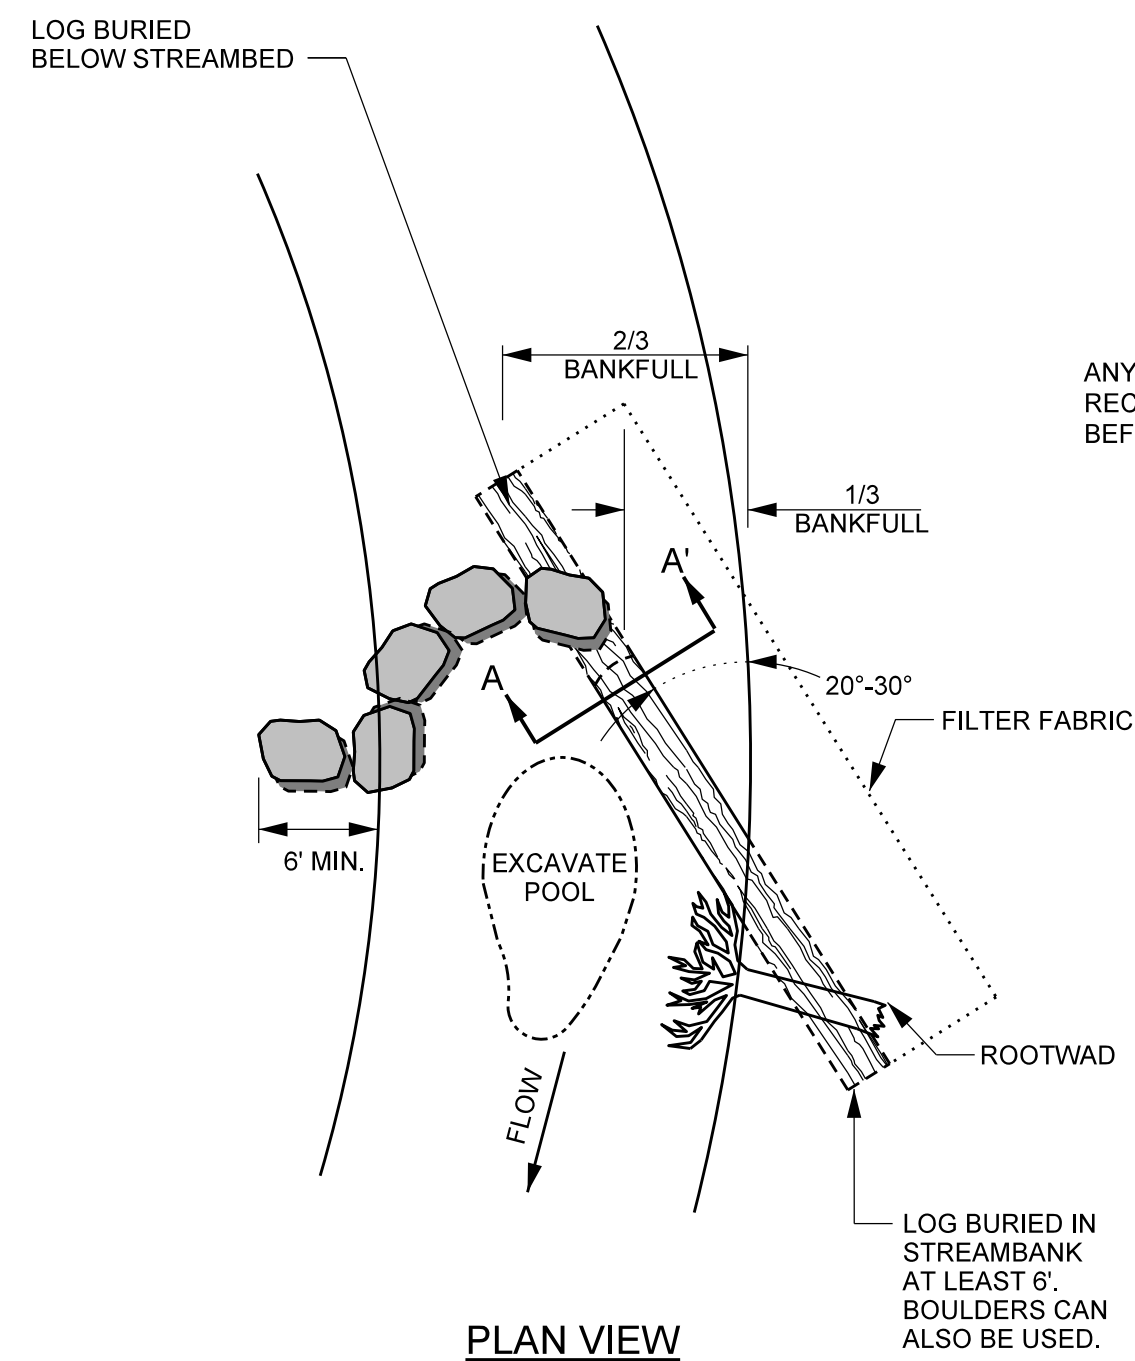

NOTES:

- LOGS SHOULD BE AT LEAST 10" IN DIAMETER, RELATIVELY STRAIGHT, HARDWOOD, RECENTLY HARVESTED, AND FOOTERED.
- BOULDERS MUST BE AT LEAST 2' X 2' X 1'.
- SOIL SHOULD BE COMPACTED WELL AROUND BURIED PORTIONS OF LOG.
- ROOTWADS SHOULD BE PLACED BENEATH THE HEADER LOG AND PLACED SO THAT IT LOCKS THE HEADER LOG INTO THE BANK. SEE ROOTWAD DETAIL.
- BOULDERS SHOULD BE PLACED ON TOP OF HEADER LOG FOR ANCHORING.
- HEADER BOULDERS TO BE PLACED 0.5 TO 0.75 FEET APART.
- FILTER FABRIC SHOULD BE NAILED TO THE LOG BELOW THE BACKFILL.
- TRANSPLANTS OR BOULDERS CAN BE USED INSTEAD OF ROOTWADS, PER DIRECTION OF ENGINEER.
- BOULDER SILL MUST BE A MINIMUM OF 6'.
- AFTER ALL STONE BACKFILL HAS BEEN PLACED, FILL IN THE UPSTREAM SIDE OF THE STRUCTURE WITH WELL GRADED MIX OF CLASS B, CLASS A, & #57 STONE TO THE ELEVATION OF THE TOP OF THE HEADER ROCK. INCORPORATE ON-SITE ALLUVIUM WHERE AVAILABLE.



LOG VANE

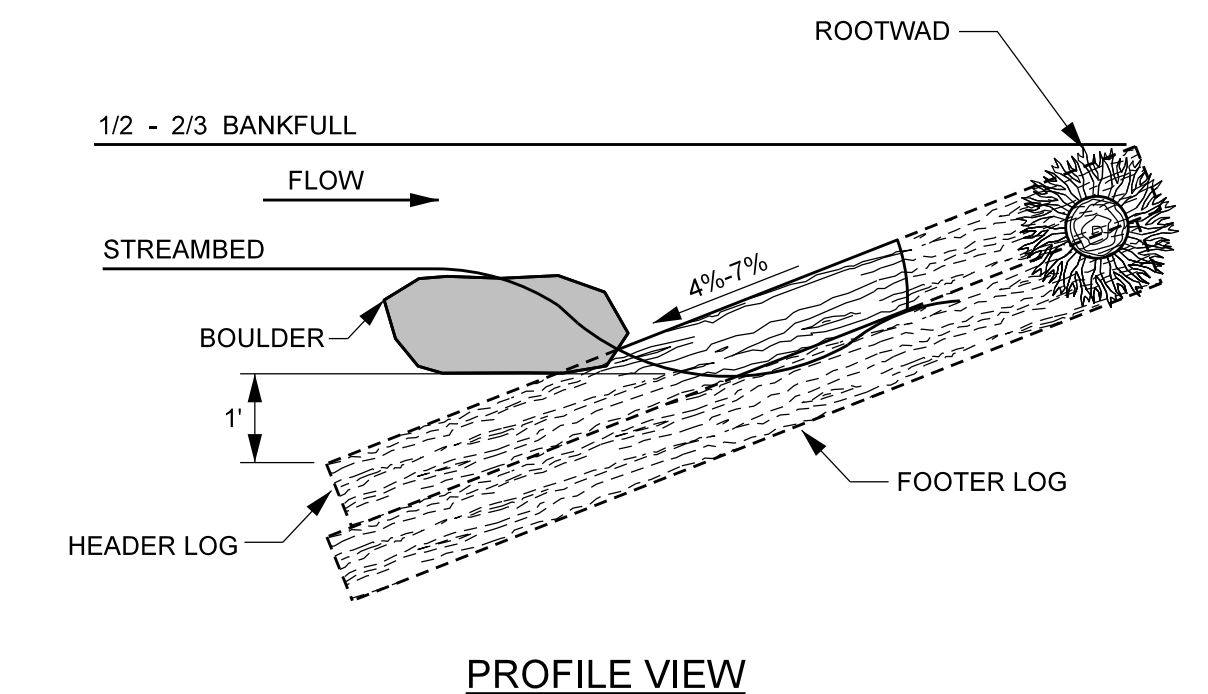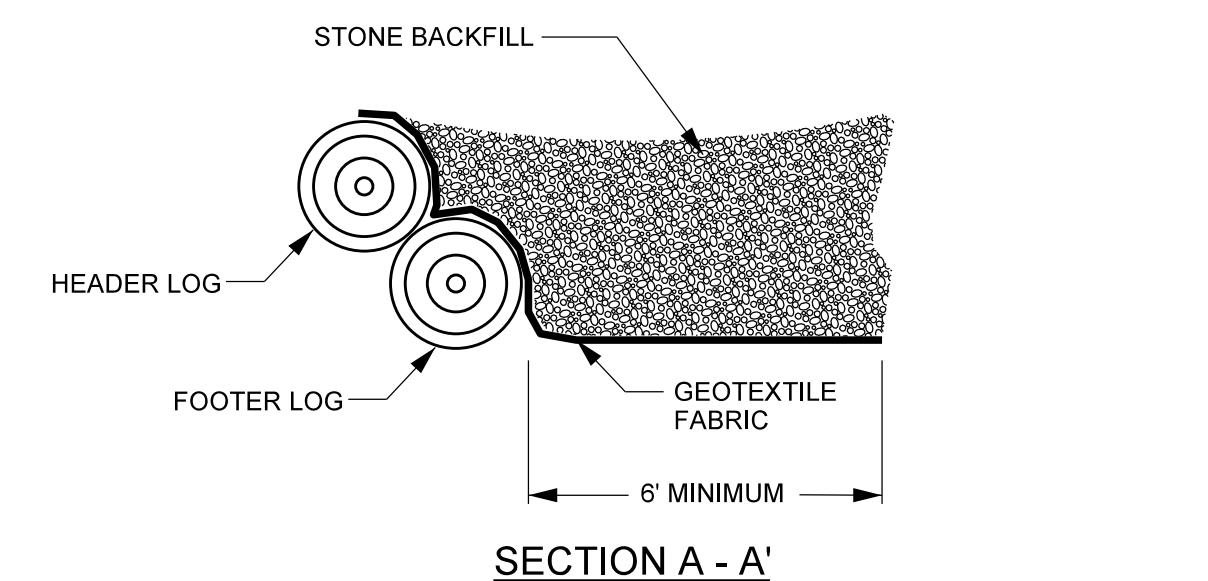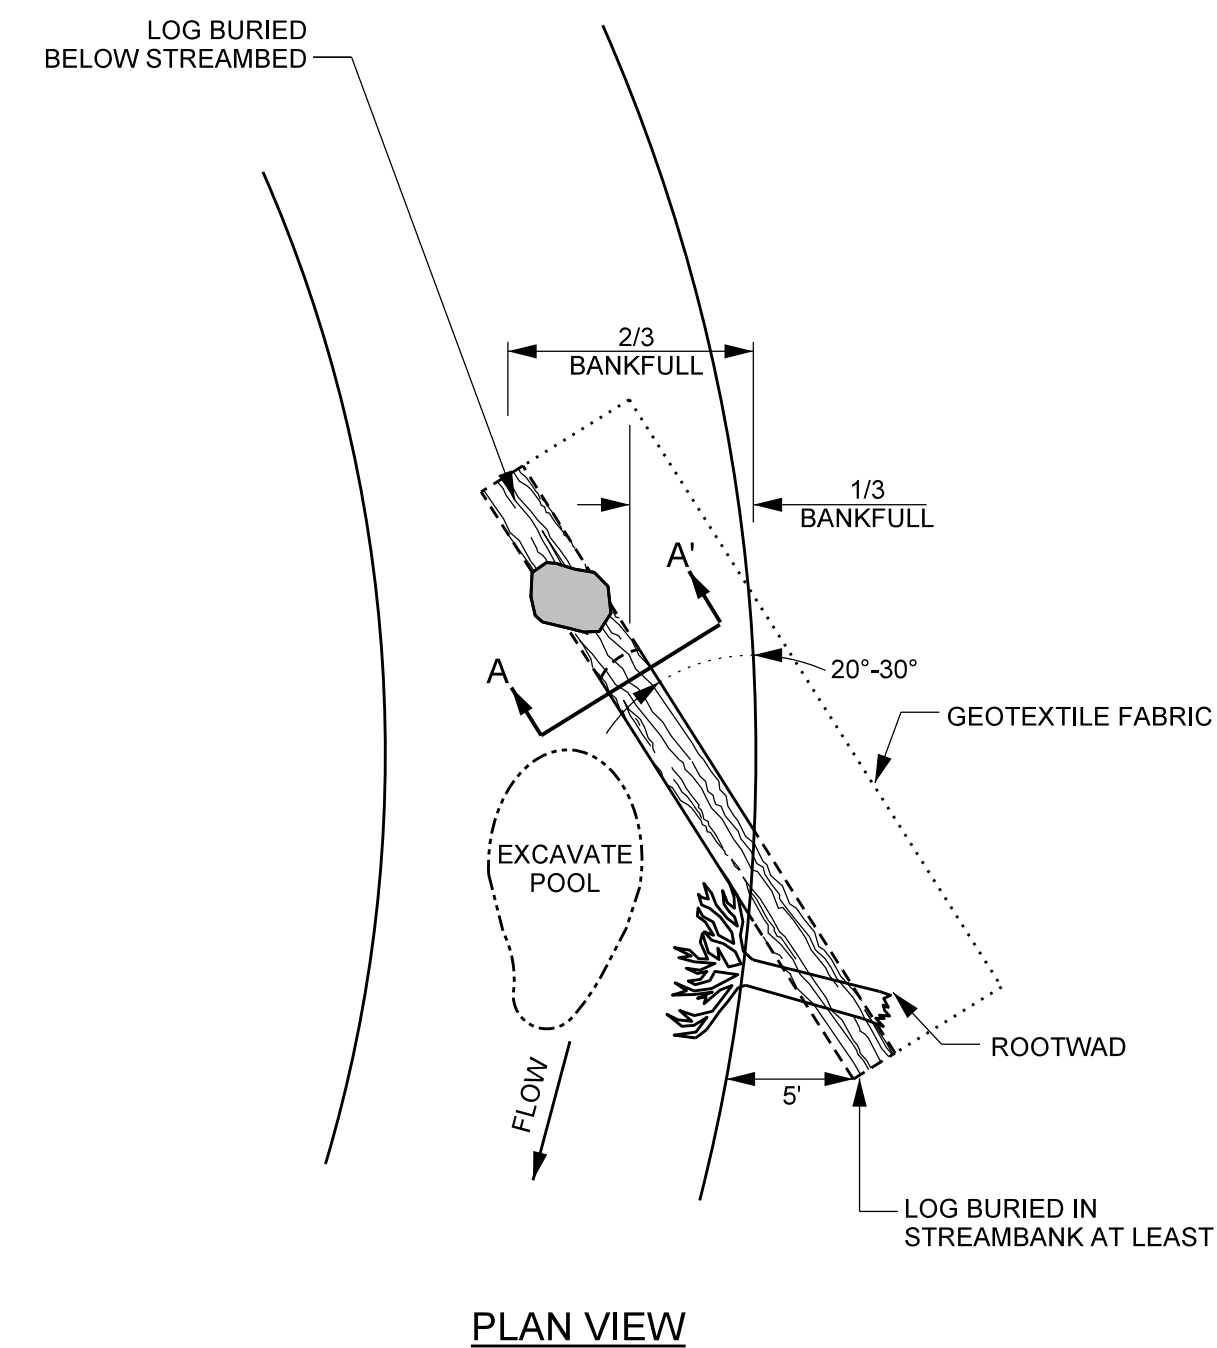


NOTES:

- LOGS SHOULD BE AT LEAST 10" IN DIAMETER, RELATIVELY STRAIGHT, HARDWOOD, AND RECENTLY HARVESTED.
- BOULDERS MUST BE OF SUFFICIENT SIZE TO ANCHOR LOGS.
- SOIL SHOULD BE COMPACTED WELL AROUND BURIED PORTIONS OF LOGS.
- ROOTWADS SHOULD BE PLACED BENEATH THE HEADER LOG AND PLACED SO THAT IT LOCKS THE HEADER LOG INTO THE BANK. SEE ROOTWAD DETAIL.
- BOULDER SHOULD BE PLACED ON TOP OF HEADER LOG FOR ANCHORING.
- GEOTEXTILE FABRIC SHOULD BE NAILED TO THE LOG BELOW THE BACKFILL.
- TOEWOOD OR TRANSPLANTS CAN BE USED INSTEAD OF ROOTWADS, PER DIRECTION OF ENGINEER.
- AFTER ALL STONE BACKFILL HAS BEEN PLACED, FILL IN THE UPSTREAM SIDE OF THE STRUCTURE WITH WELL GRADED MIX OF CLASS B, CLASS A, & #57 STONE TO THE ELEVATION OF THE TOP OF THE HEADER ROCK. INCORPORATE ON-SITE ALLUVIUM WHERE AVAILABLE.

ROCK DOUBLE DROP CROSS VANE

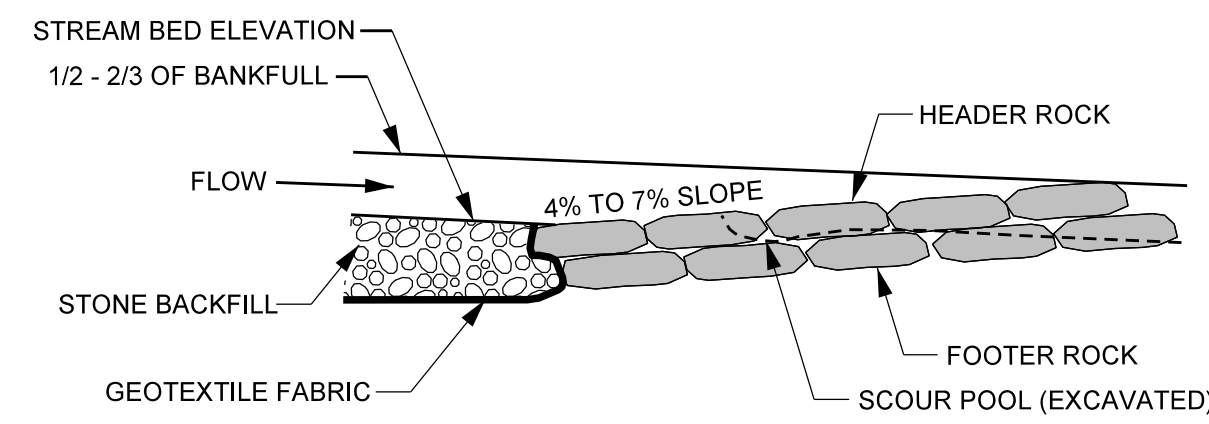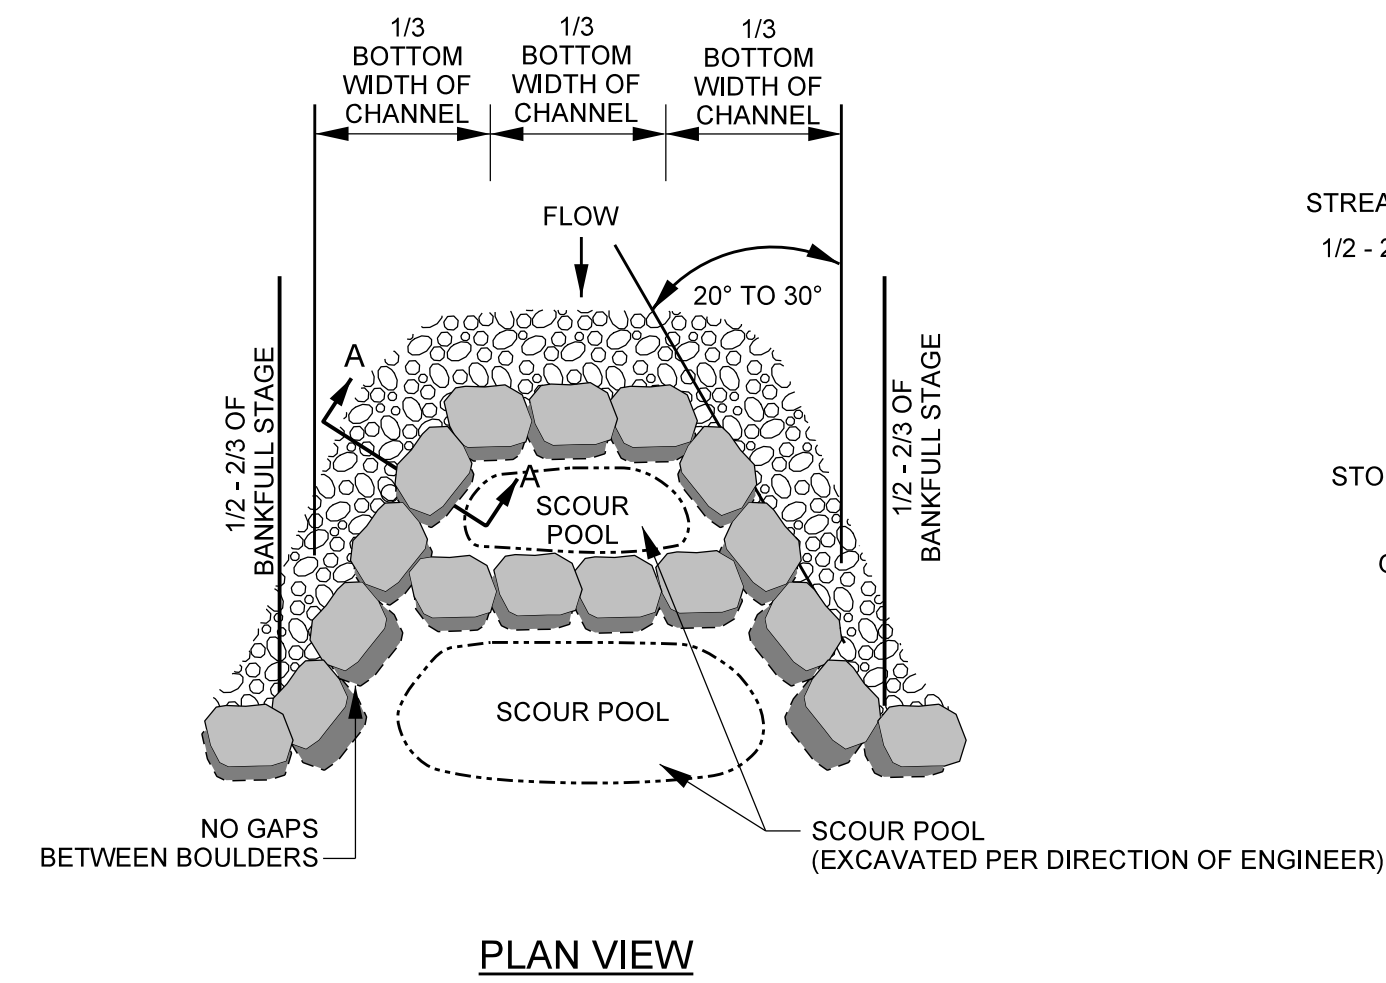

PROFILE VIEW

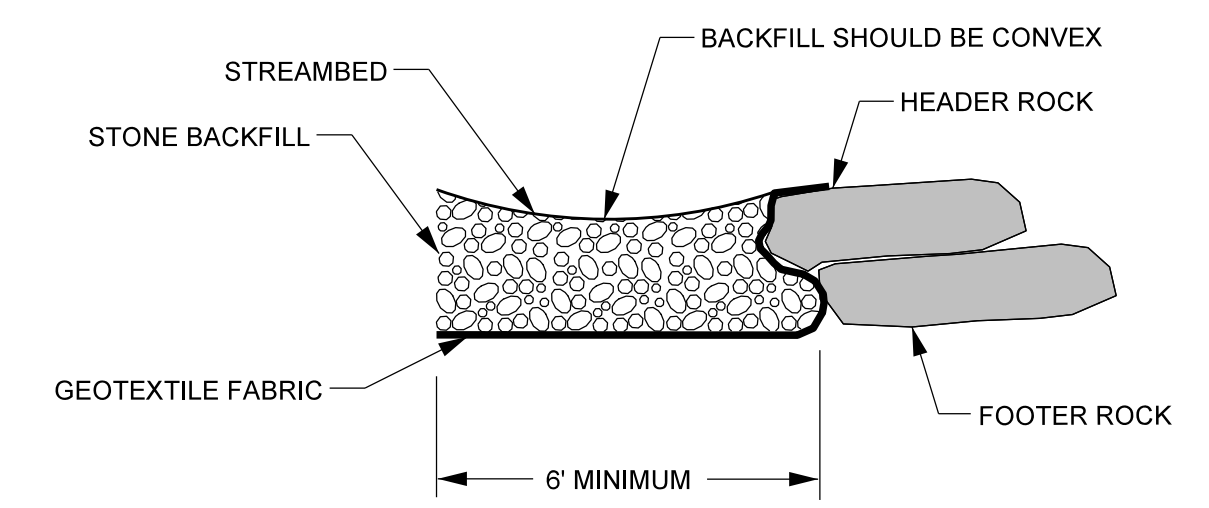


SECTION A - A


NOTES FOR ALL VANE STRUCTURES:

1. DIG A TRENCH BELOW THE BED FOR FOOTER ROCKS.
2. START AT BANK AND PLACE FOOTER ROCKS FIRST AND THEN HEADER (TOP) ROCK.
3. CONTINUE WITH STRUCTURE FOLLOWING ANGLE AND SLOPE SPECIFICATIONS.
4. AN EXTRA ROCK CAN BE PLACED IN SCOUR POOL FOR HABITAT IMPROVEMENT.
5. USE HAND PLACED STONE TO FILL GAPS ON UPSTREAM SIDE OF HEADER AND FOOTER ROCKS.
6. INSTALL GEOTEXTILE FABRIC BEGINNING AT THE TOP OF THE HEADER ROCKS AND EXTEND DOWNWARD TO THE DEPTH OF THE BOTTOM FOOTER ROCK, AND THEN UPSTREAM TO A MINIMUM OF SIX FEET.
7. AFTER ALL STONE BACKFILL HAS BEEN PLACED, FILL IN THE UPSTREAM SIDE OF THE STRUCTURE WITH WELL GRADED MIX OF CLASS B, CLASS A, & #57 STONE TO THE ELEVATION 2'-4" BELOW THE THE HEADER ROCK. INCORPORATE ON-SITE ALLUVIUM WHERE AVAILABLE. FILL SHOULD BE CONCAVE BEHIND THE VANE ARM TO ALLOW POOLING OF FLOW.
8. START SLOPE AT 2/3 TO 3/4 TIMES THE BANKFULL STAGE.
9. ALL REACHES, BOULDER SIZE 1' x 2' x 3' TO 2' x 2' x 4'.


CONSTRUCTED RIFFLE

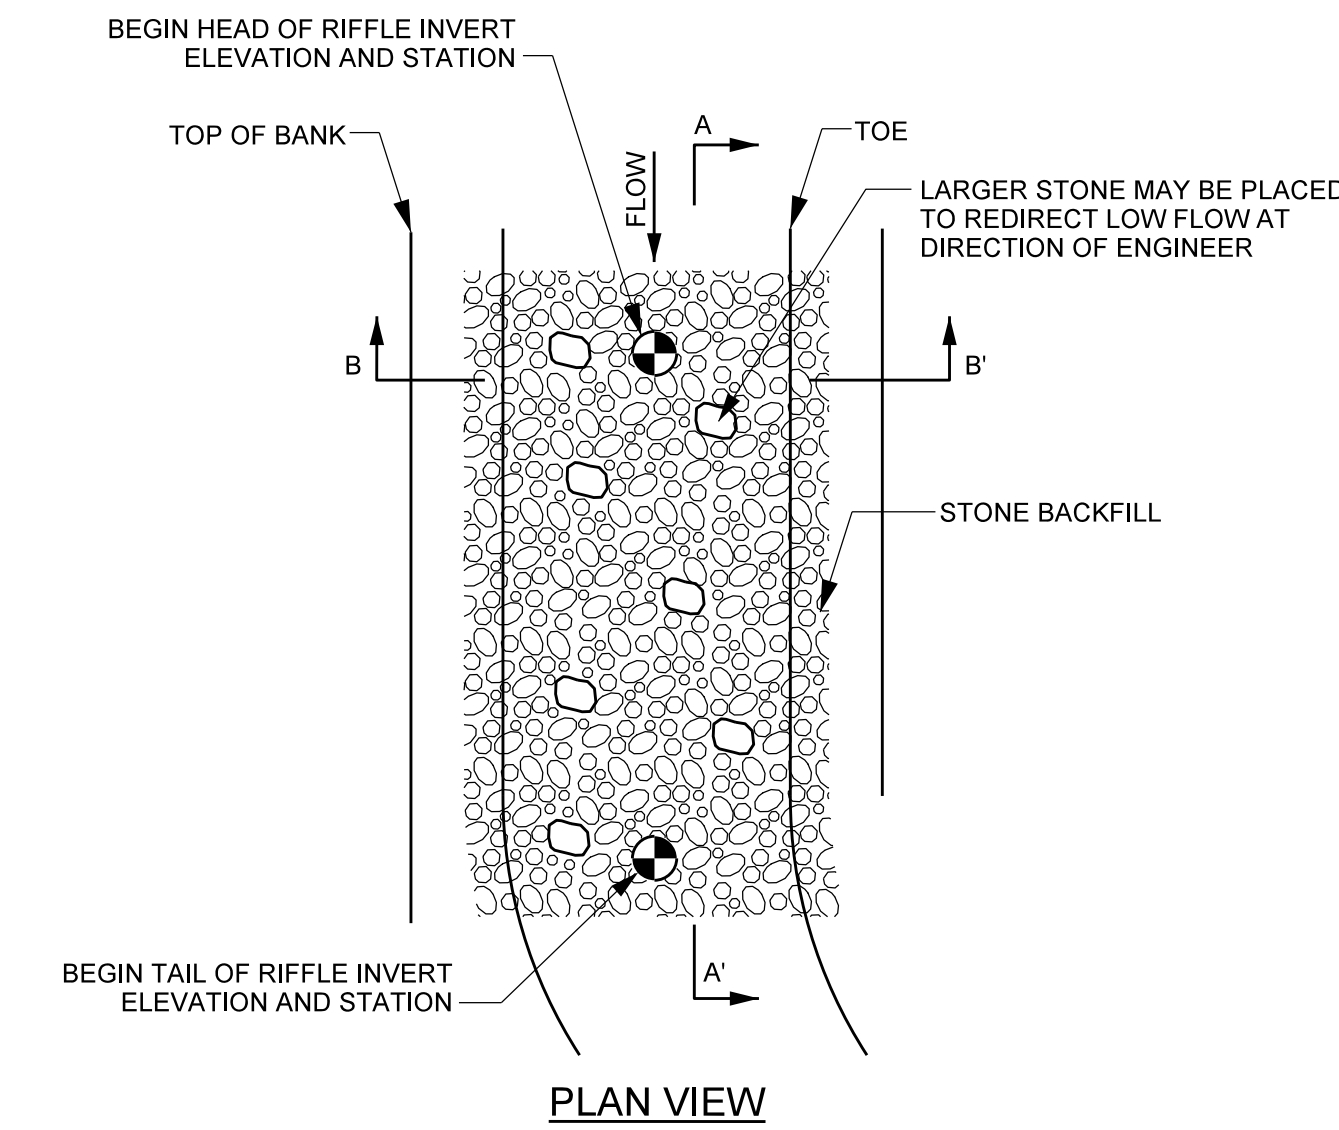

PLAN VIEW

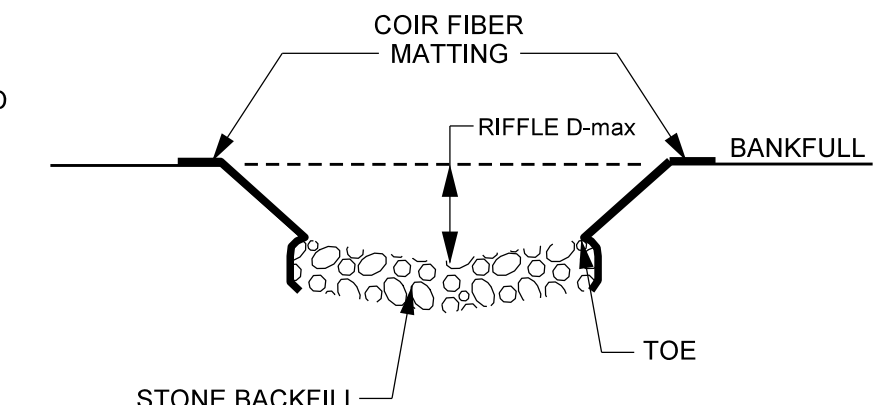

SECTION B - B'

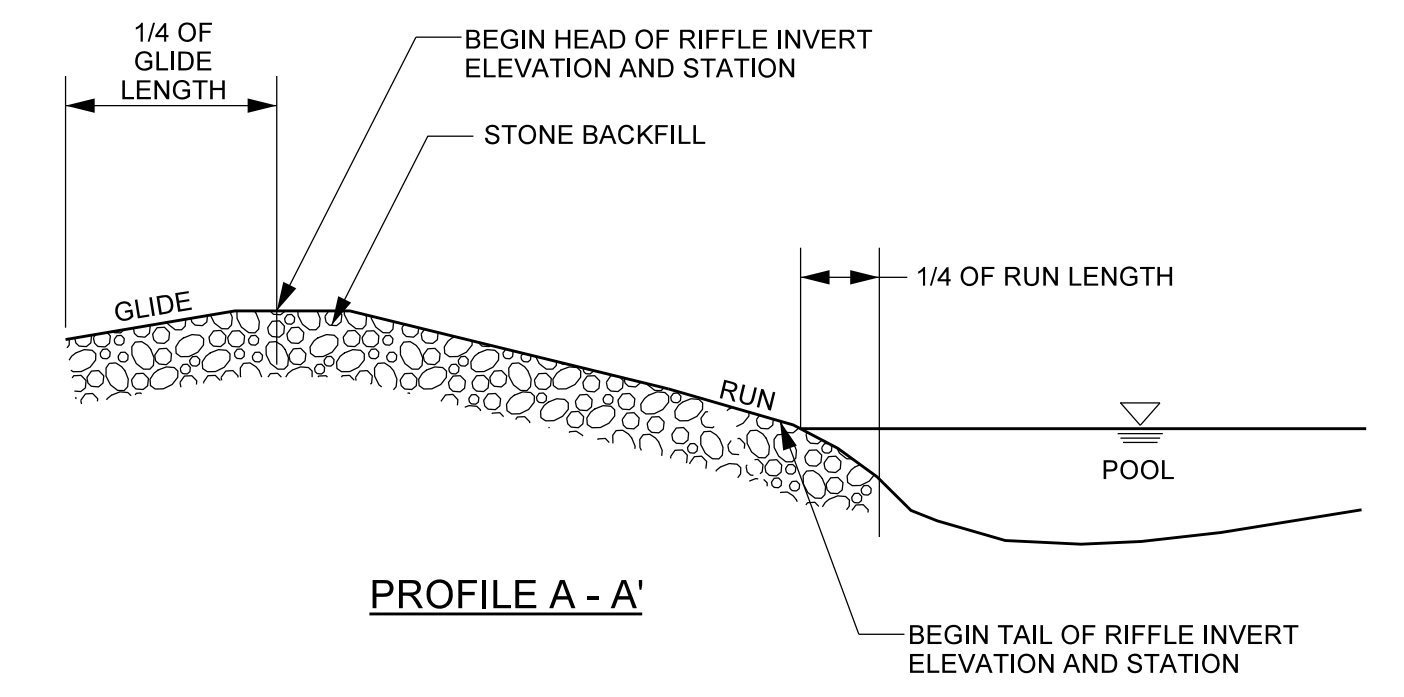


PROFILE A - A'

NOTES:

1. UNDERCUT CHANNEL BED ELEVATION AS NEEDED TO ALLOW FOR LAYERS OF STONE TO ACHIEVE FINAL GRADE.
2. INSTALL COIR FIBER MATTING ALONG COMPLETED BANKS SUCH THAT THE EROSION CONTROL MATTING AT THE TOE OF THE BANK EXTENDS DOWN TO THE UNDERCUT ELEVATION.
3. INSTALL STONE BACKFILL, COMPACTED TO GRADE.
4. FINAL CHANNEL BED SHAPE SHOULD HAVE THE ELEVATION OF THE BED 0.2 FT DEEPER IN THE CENTER THAN AT THE EDGES.
5. STONE BACKFILL SHALL CONSIST OF 10% CLASS I, 20% CLASS B, 40% CLASS A, AND 30% ON-SITE ALLUVIUM BY VOLUME OR #57 STONE.
6. CONSTRUCTED RIFFLES SHALL BE 12" THICK.
7. LARGER CLASS I & B STONES MAY EXTEND ABOVE THE BED SURFACE, BUT NO HIGHER THAN HALF BANKFULL AND SHOULD PROVIDE A "NATURAL LOOK". ENGINEER SHALL HAVE FINAL APPROVAL OF EXTENDING ROCK.
8. SATURATED WOODY DEBRIS THAT IS EXISTING WITHIN THE CHANNEL CAN BE RELOCATED INTO THE NEW RIFFLE AREAS.


CHANNEL PLUG

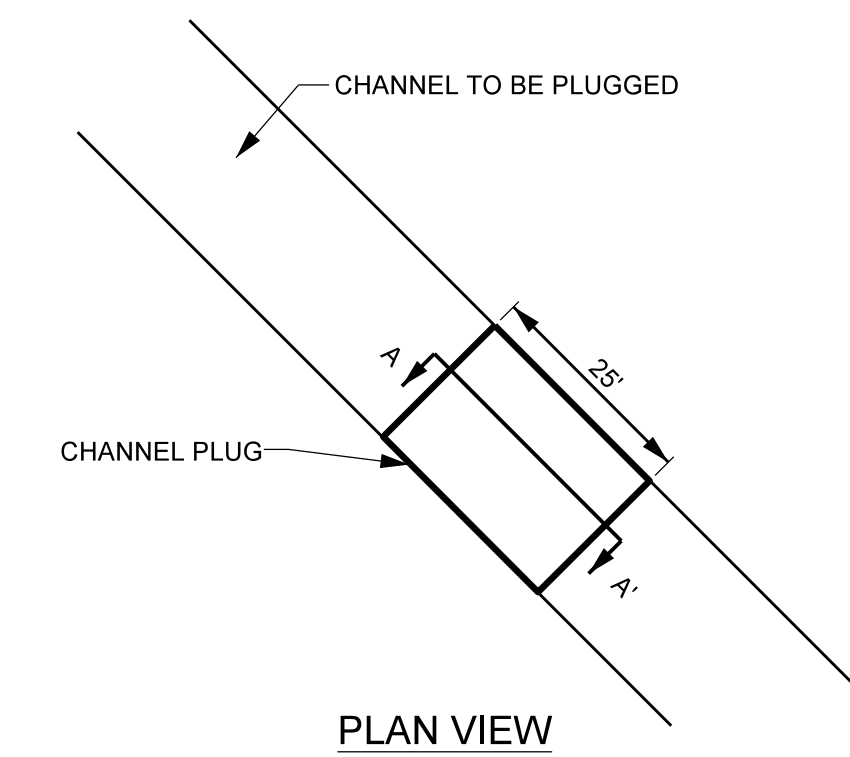

PLAN VIEW


NOTES:

1. COMPACT BACKFILL USING ON-SITE HEAVY EQUIPMENT IN 10 INCH LIFTS.
2. BACKFILL OF PLUGS SHOULD INCORPORATE ANY OF-SITE CLAY AVAILABLE.

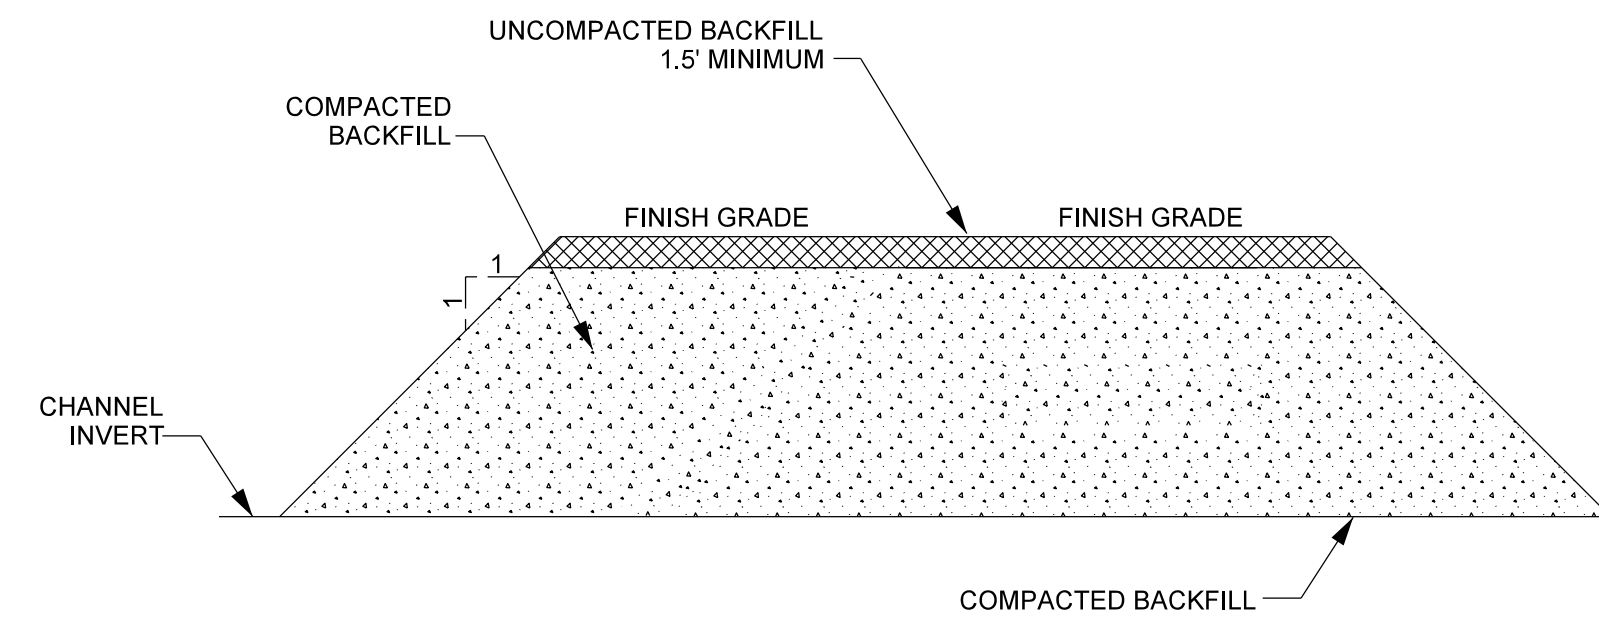


SECTION A - A'

LOG DROP

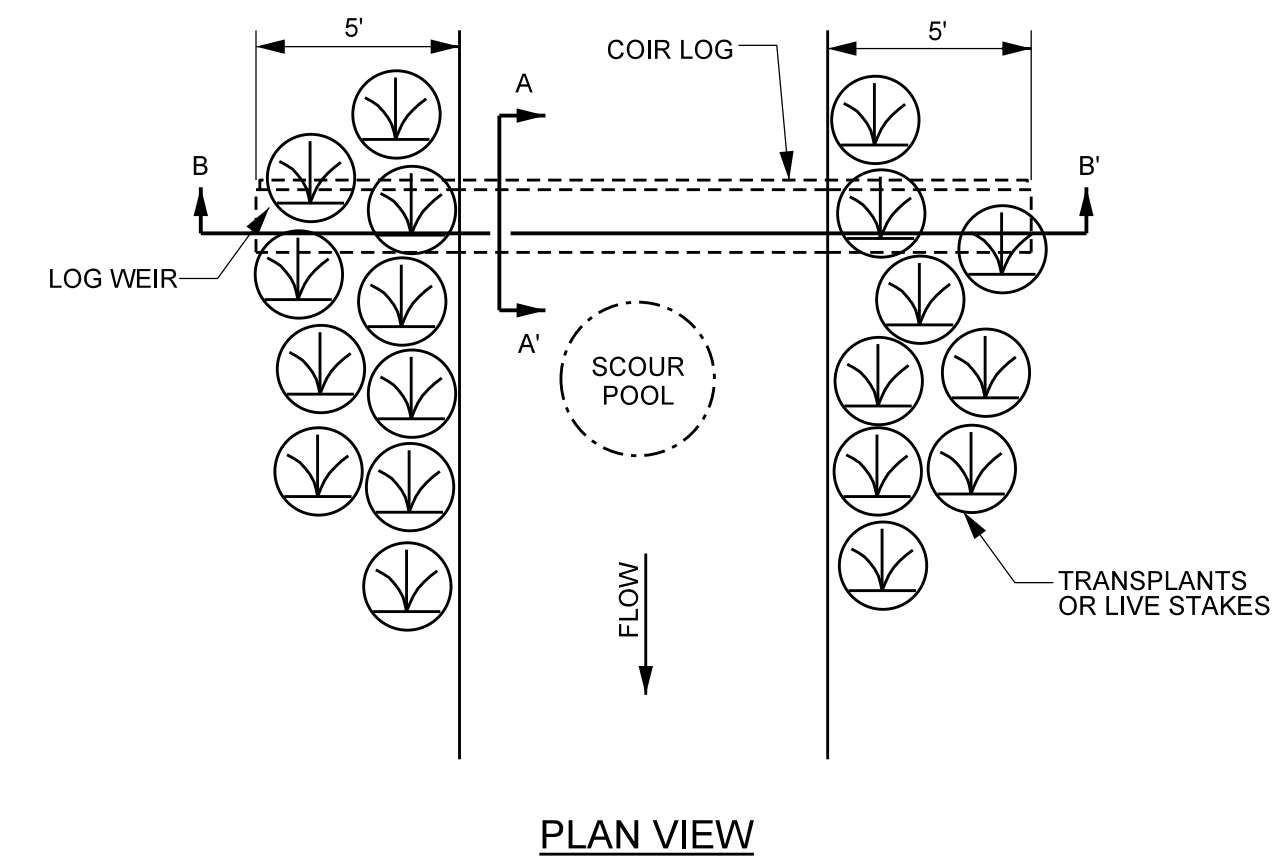


PLAN VIEW

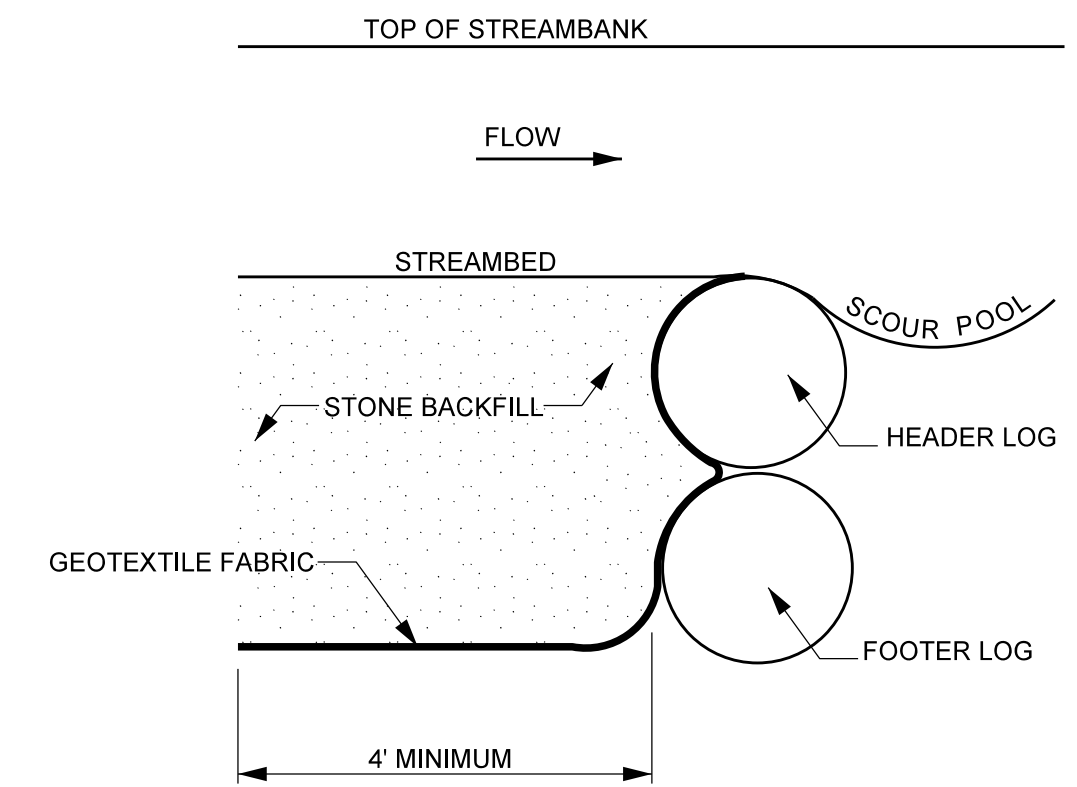

SECTION A - A'

NOTES:


1. LOGS SHOULD BE AT LEAST 10 INCHES IN DIAMETER, RELATIVELY STRAIGHT, HARDWOOD, AND RECENTLY HARVESTED.
2. TOP OF HEADER LOG SHOULD BE SET AT SAME ELEVATION AS THE STREAMBED.
3. USE GEOTEXTILE FABRIC WITH COIR LOGS TO SEAL GAPS BETWEEN LOGS.
4. PLACE TRANSPLANTS ALONG BANKS TO PROTECT AGAINST BANK EROSION.
5. THE HEADER LOG SHOULD BE NOTCHED 2 - 3 INCHES DEEP IN THE CENTER AND FOR 20 - 30% OF THE CHANNEL WIDTH.

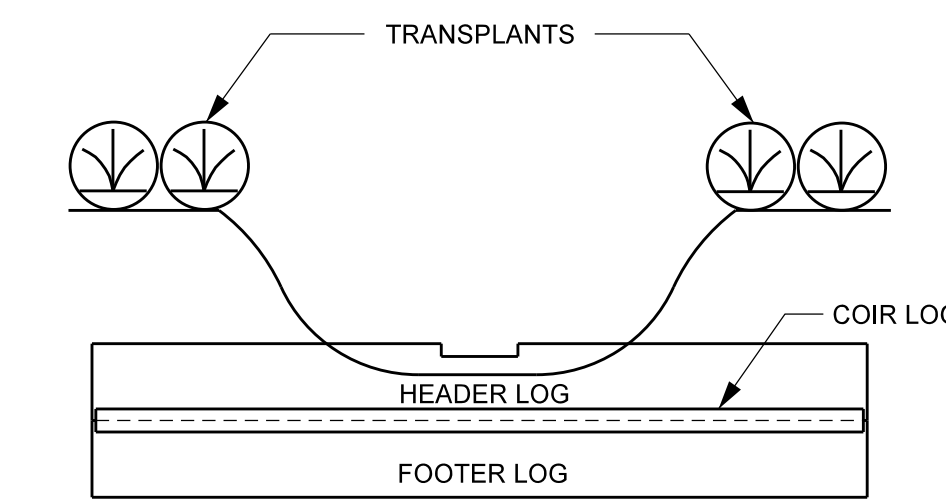

CROSS SECTION VIEW B - B'

PROJECT REFERENCE NO. 166680	SHEET NO. 2C
PROJECT ENGINEER	
APPROVED BY:	
DATE:	
Michael Baker International	
NCDMS ID NO. 100068	


PLUNGE POOL

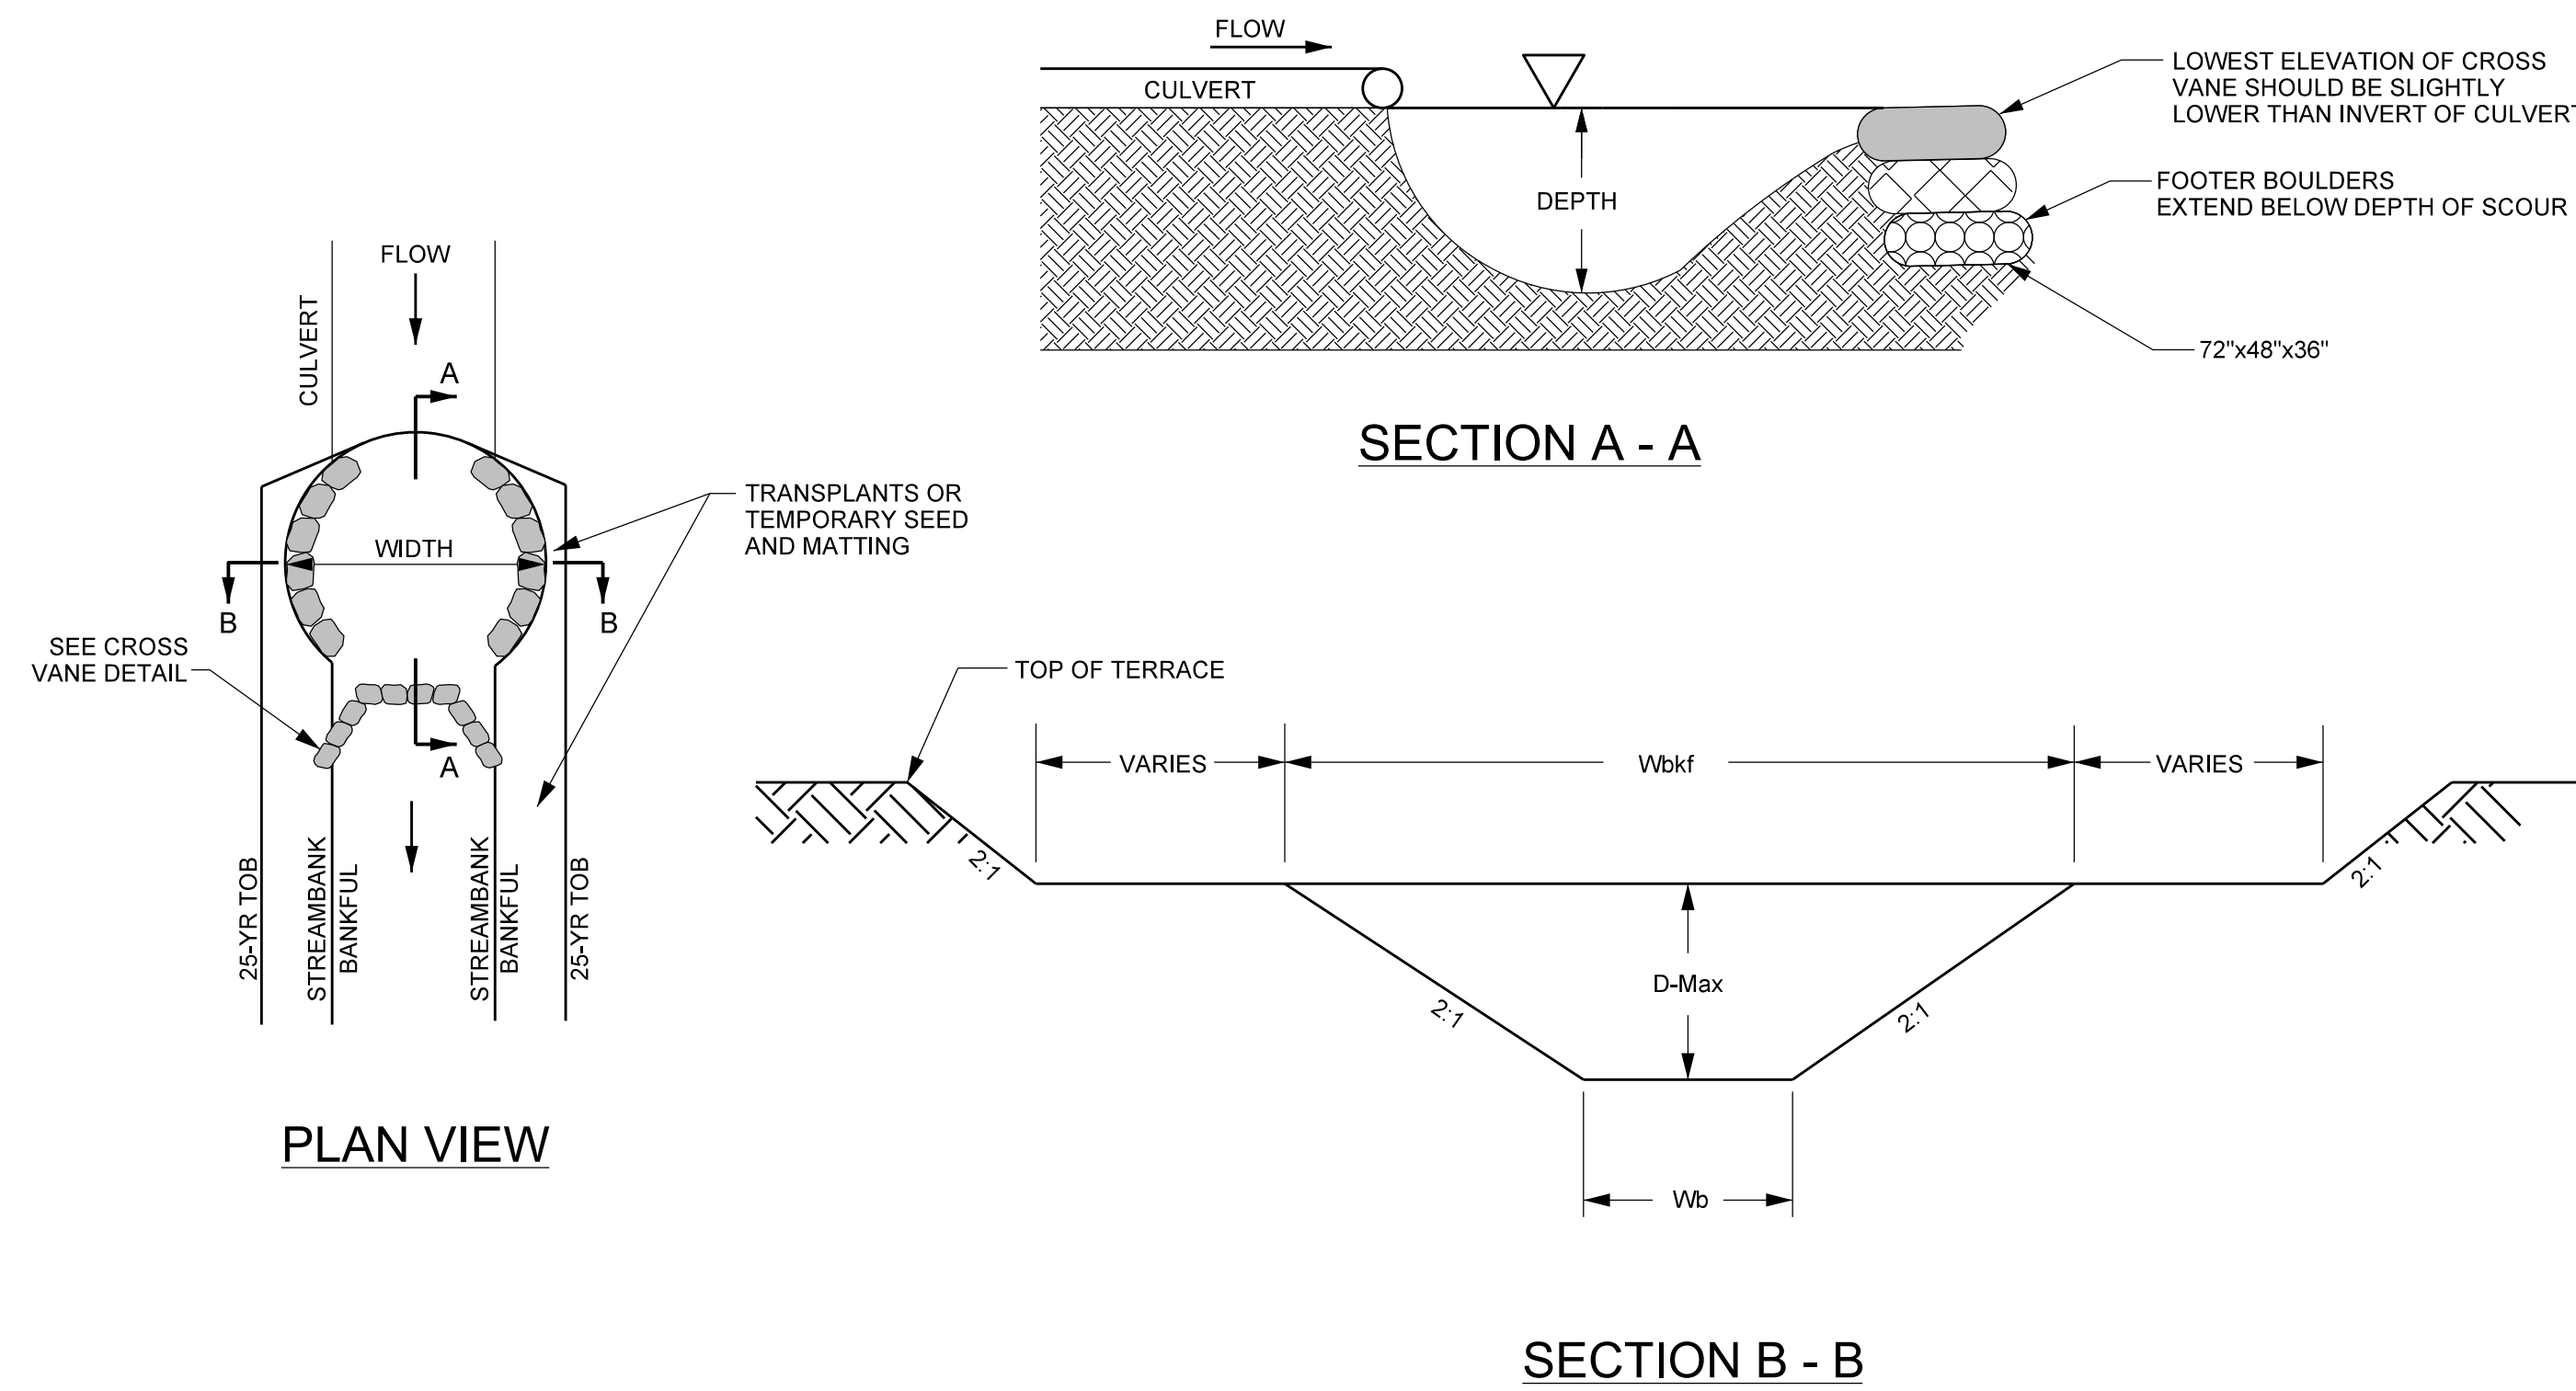


GEOLIFT WITH BRUSH TOE


NOTES:

1. LIVE BRANCH CUTTINGS SHALL BE THE SAME SPECIES AS THE LIVE STAKES AND SHALL BE INSTALLED DURING VEGETATION DORMANCY.
2. LIVE BRANCH CUTTINGS SHALL BE INSTALLED AT A DENSITY OF 20-30 CUTTINGS PER LINEAR FOOT AND A MAXIMUM DIAMETER OF 2.5 INCHES.
3. NUMBER OF SOIL LIFTS MAY VARY, IN GENERAL LIFTS SHALL EXTEND TO THE TOP OF BANK OR BANKFULL STAGE.

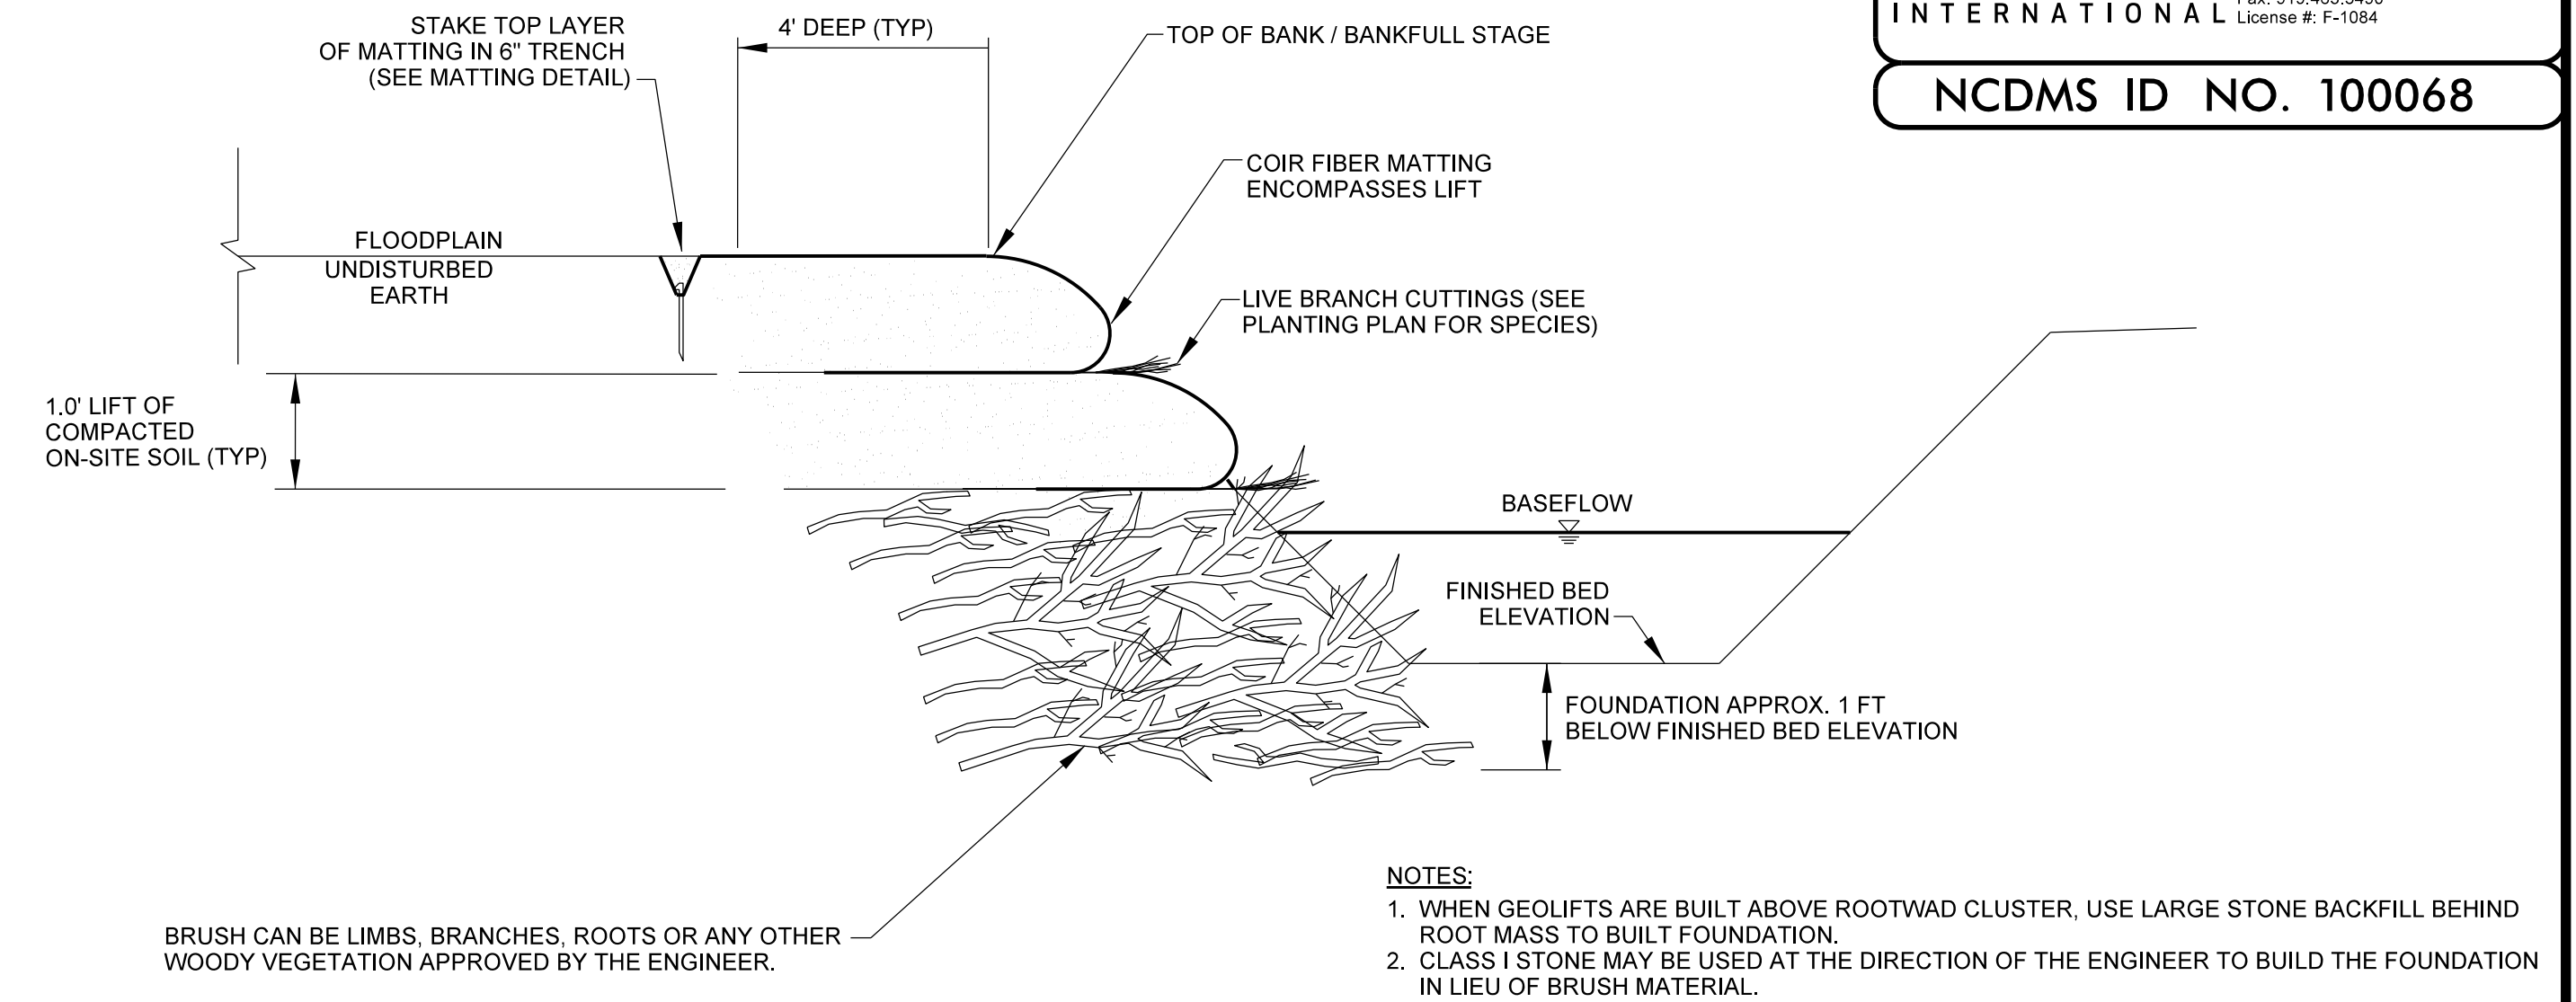

PROJECT REFERENCE NO. 166680	SHEET NO. 2D
PROJECT ENGINEER	
	
APPROVED BY:	
DATE:	
Michael Baker International	
NCDMS ID NO. 100068	


PERMANENT STREAM CROSSING

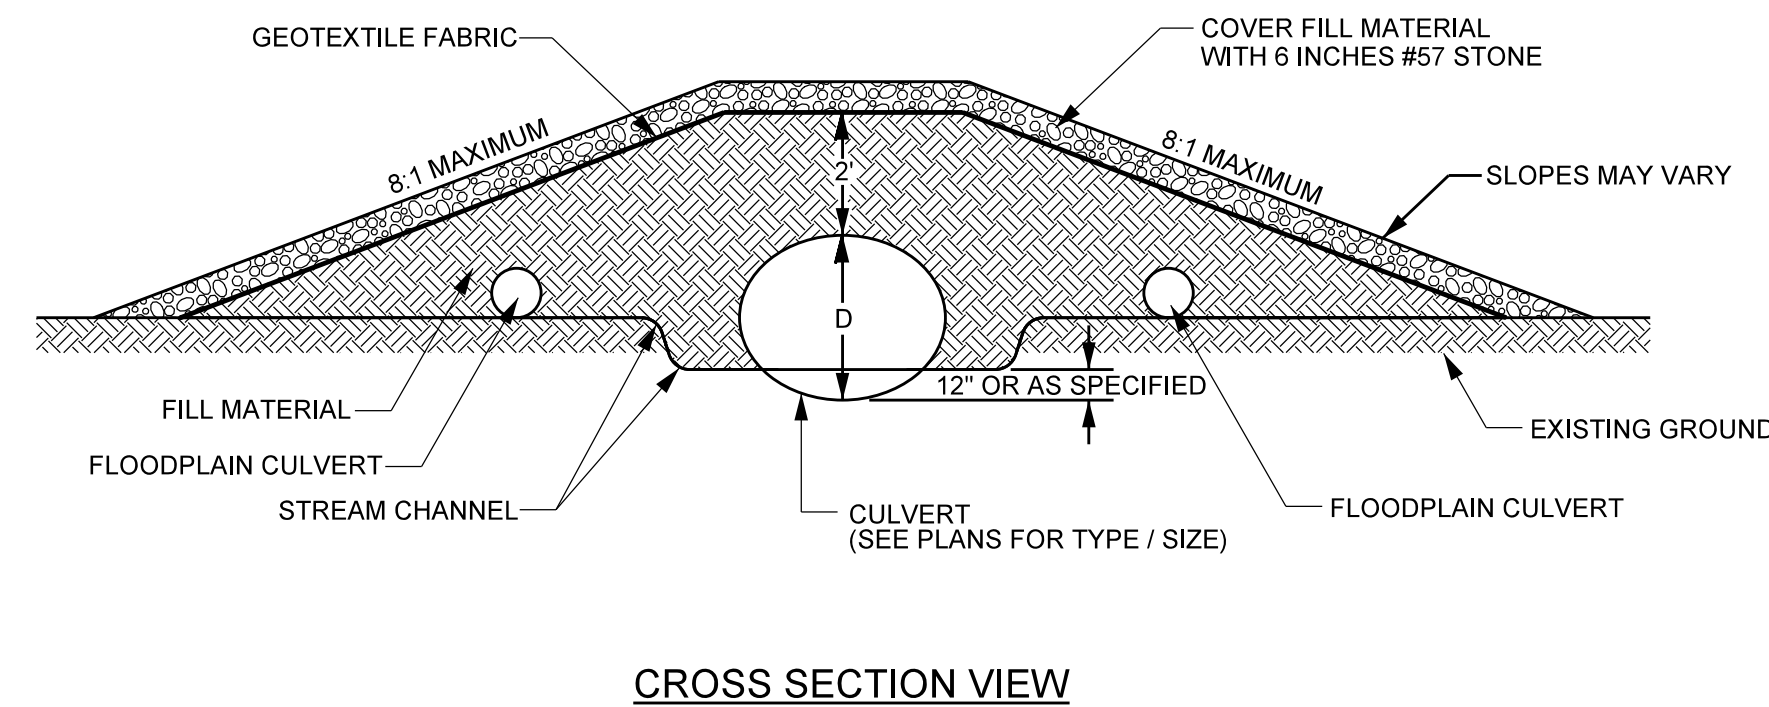

NOTES:

1. SIZE DIMENSIONS SHOWN ON PLANS.
2. APPLY SUFFICIENT FILL (2 MIN) OVER CULVERT TO PREVENT COLLAPSE.
3. STABILIZE SIDE SLOPES WITH EROSION CONTROL MATTING AND FILL AROUND CULVERTS WITH CLASS II STONE.
4. INSTALL HEADWALLS AND ENDWALLS AS SHOWN ON THE PLANS AND IN THE DETAILS.
5. PRIMARY CULVERT SHOULD BE INSTALLED 12" OR AS SPECIFIED BELOW CHANNEL ELEVATION.


BOULDER HEADWALL / ENDWALL

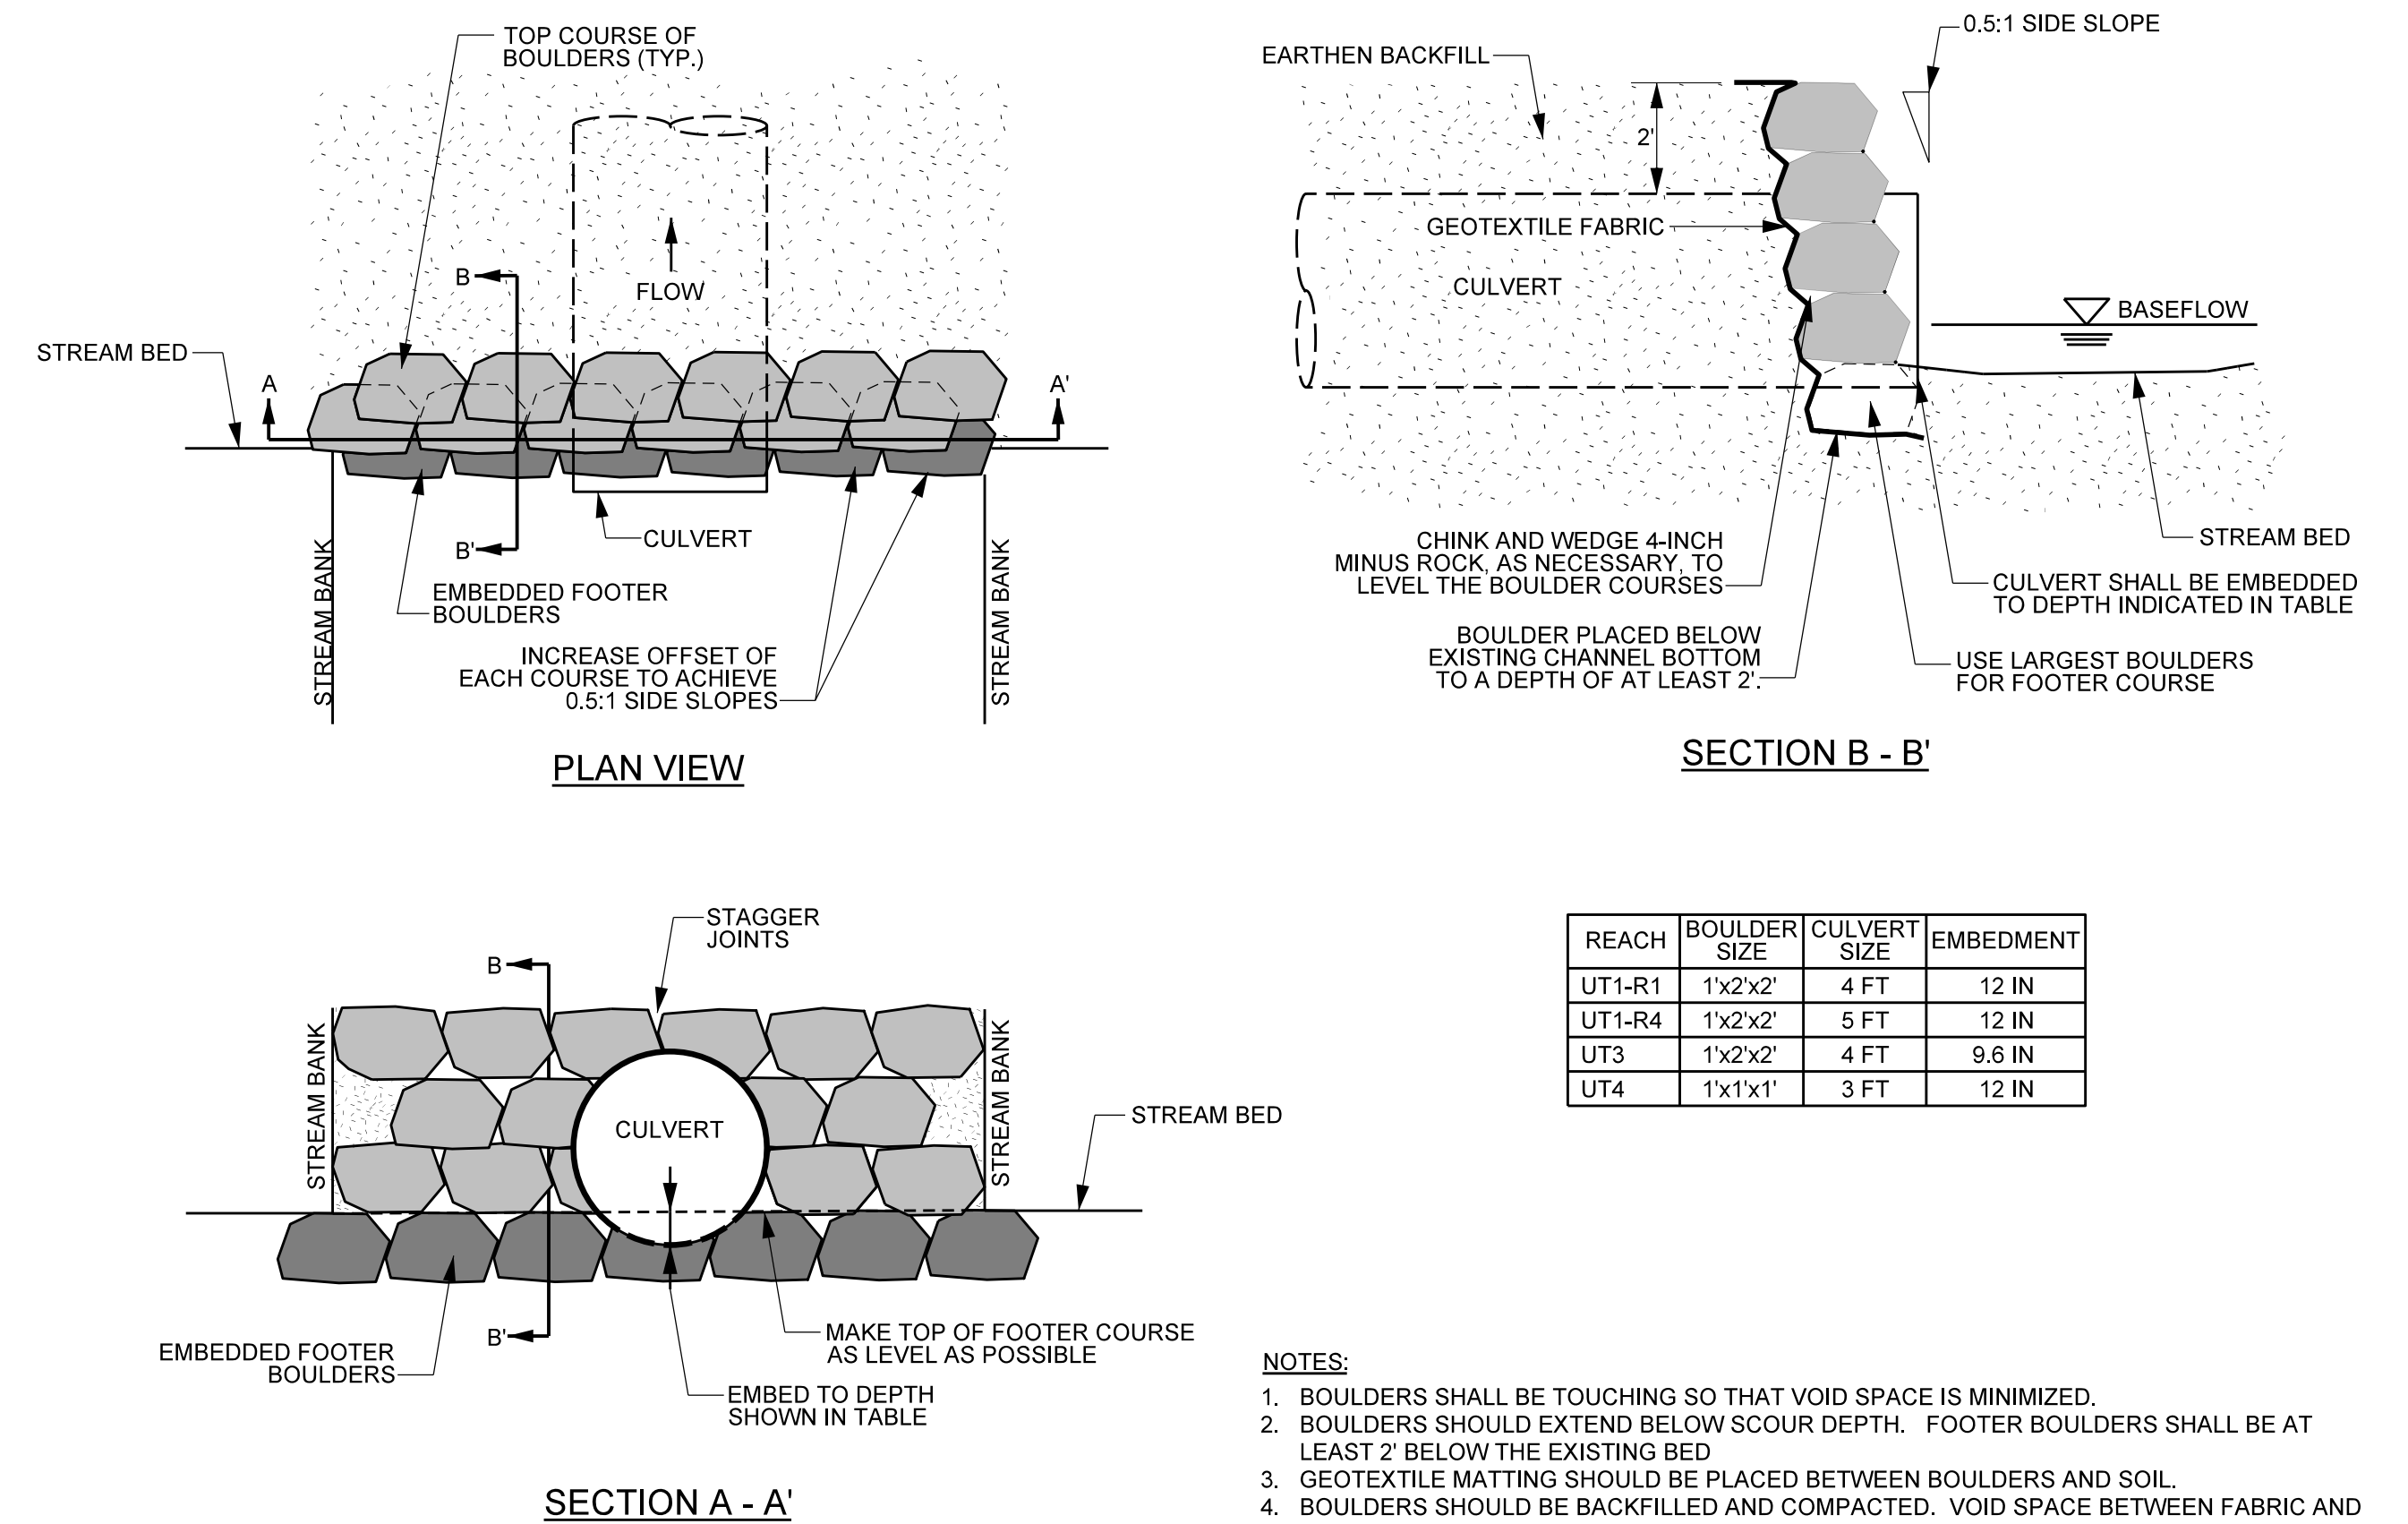

NOTES:


1. BOULDERS SHALL BE TOUCHING SO THAT VOID SPACE IS MINIMIZED.
2. BOULDERS SHOULD EXTEND BELOW SCOUR DEPTH. FOOTER BOULDERS SHALL BE AT LEAST 2' BELOW THE EXISTING BED.
3. GEOTEXTILE MATTING SHOULD BE PLACED BETWEEN BOULDERS AND SOIL.
4. BOULDERS SHOULD BE BACKFILLED AND COMPACTED. VOID SPACE BETWEEN FABRIC AND BOULDER OR ROCK FILL MATERIAL, SHOULD BE MINIMIZED.
5. BOULDERS SHOULD NOT BE HIGHER THAN THE TOP OF CROSSING ELEVATION.
6. FILTER FABRIC SHOULD BE PLACED BEHIND BOULDERS, BURIED BELOW BOULDER DEPTH, AND EXTEND INTO THE BANK.

LIVE STAKING

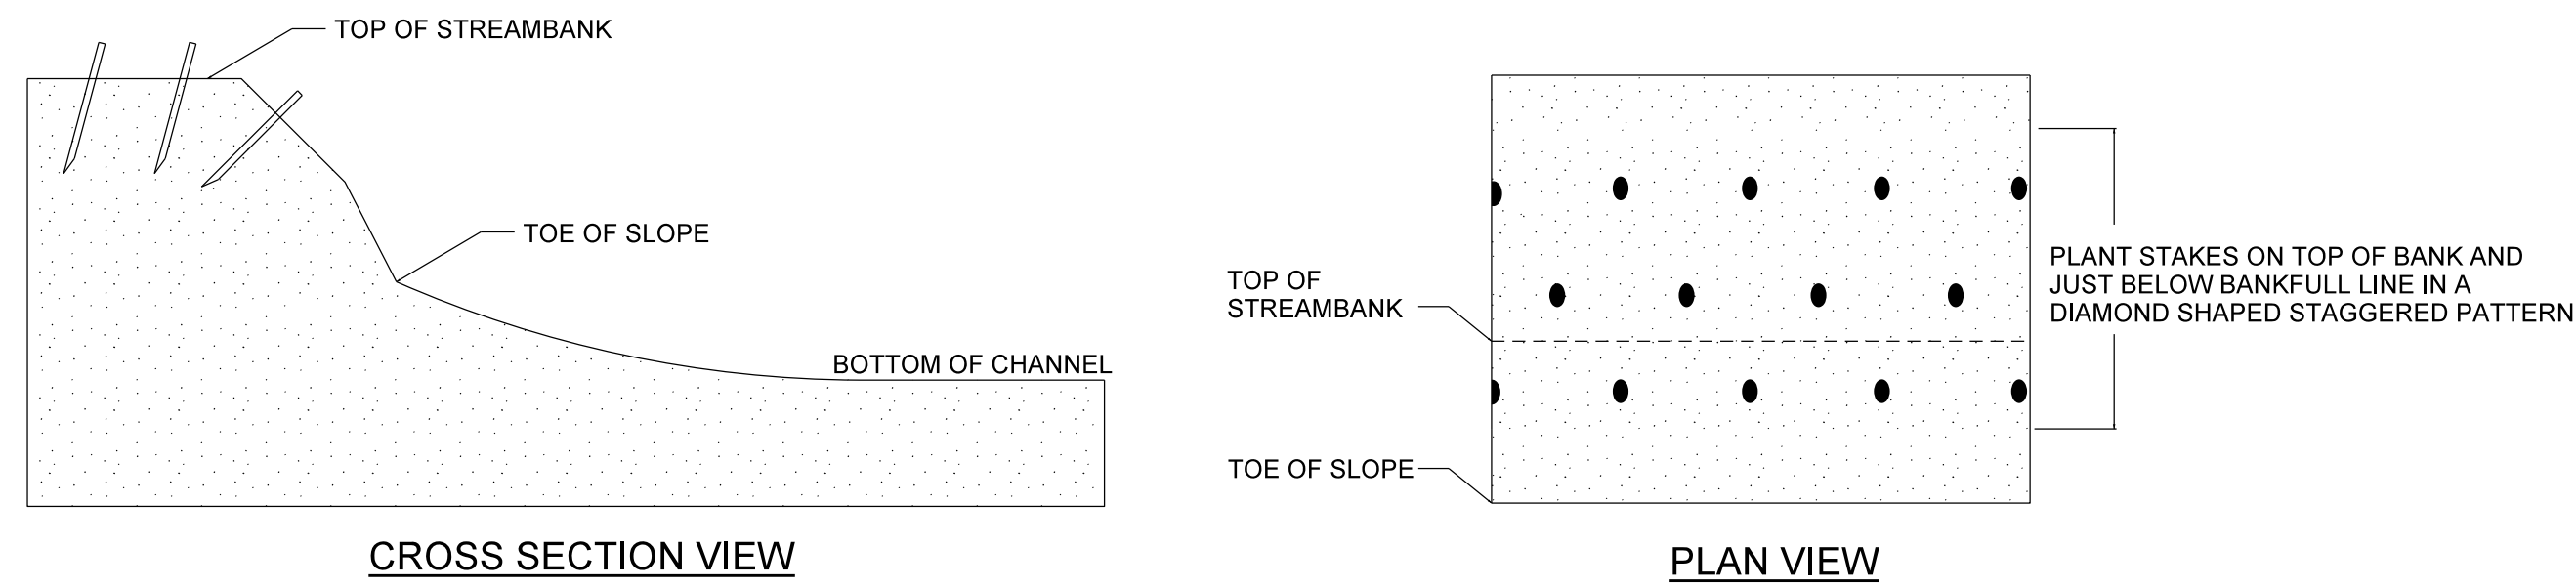

CROSS SECTION VIEW

PLAN VIEW

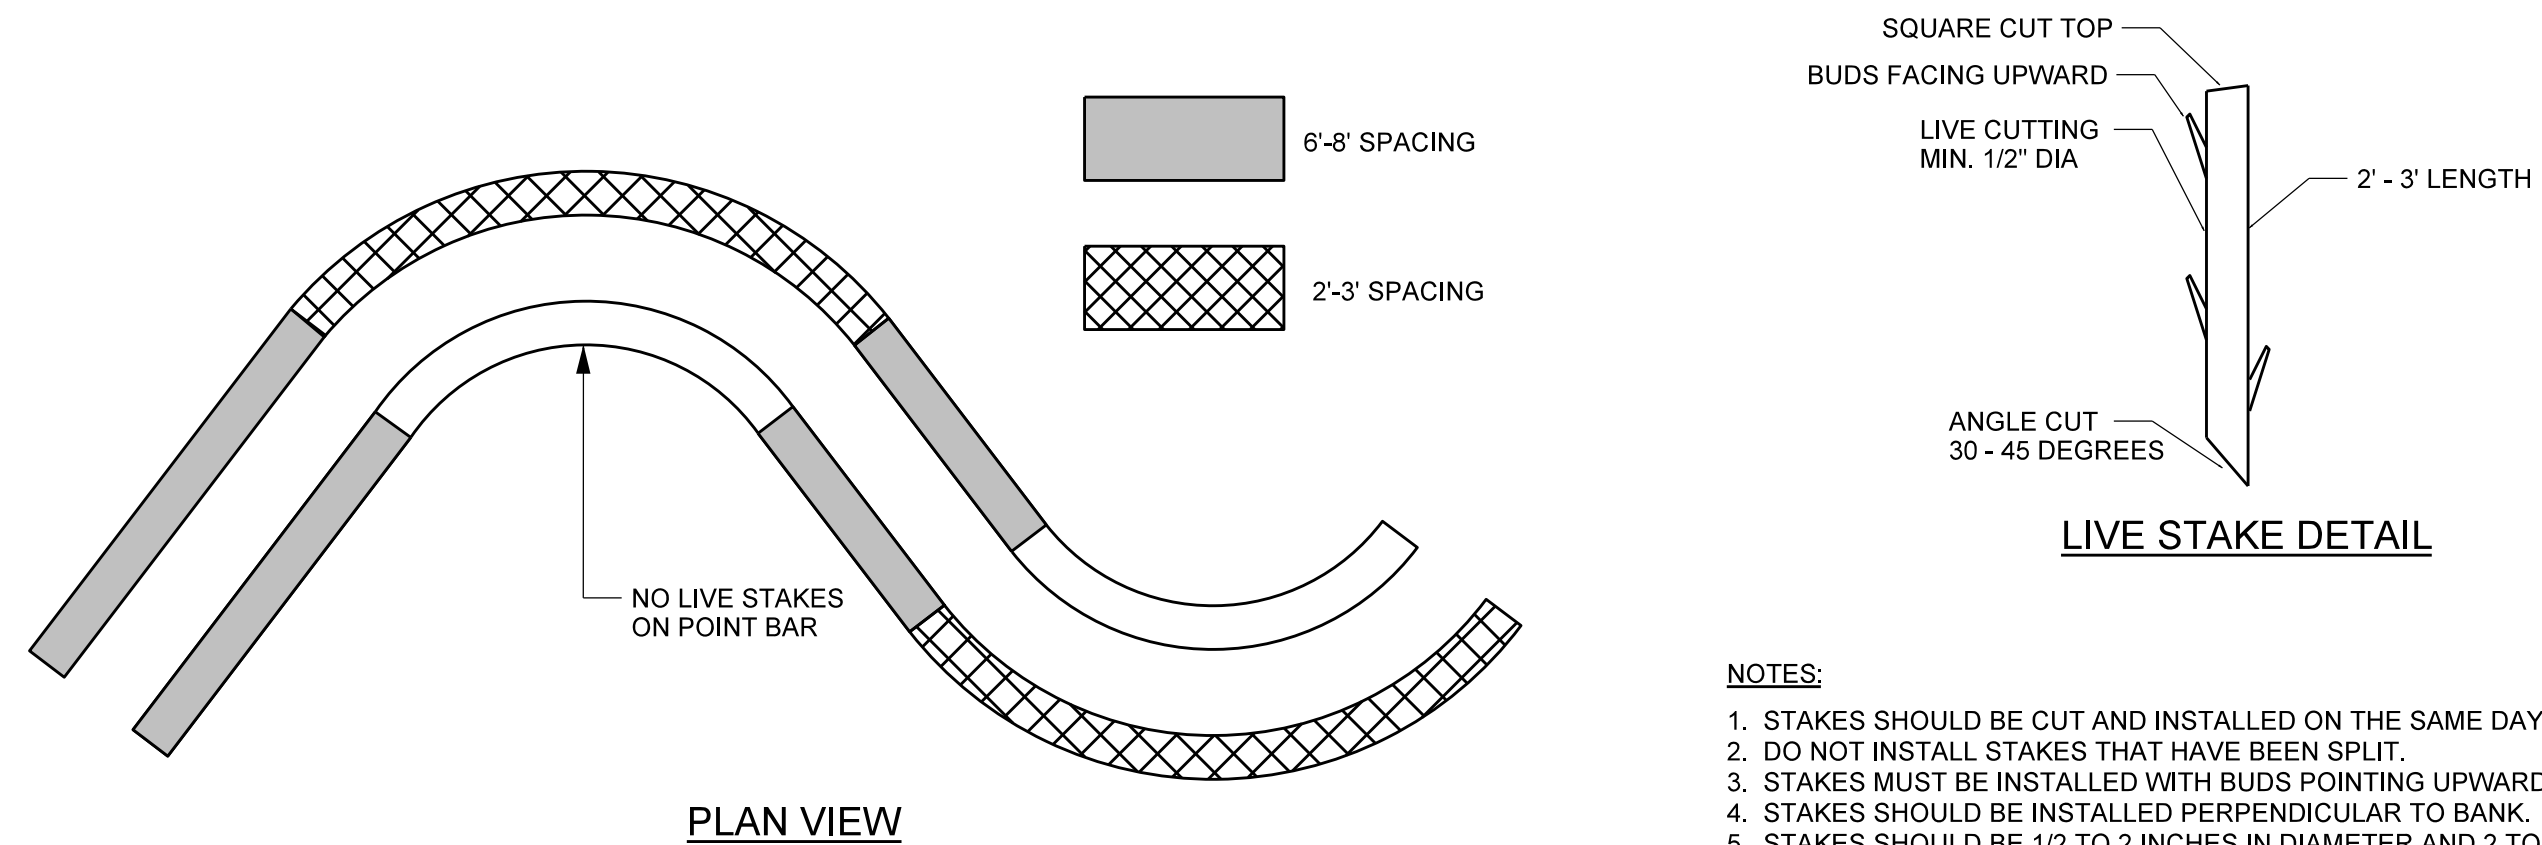


PLAN VIEW


LIVE STAKE DETAIL

- NOTES:**
1. STAKES SHOULD BE CUT AND INSTALLED ON THE SAME DAY.
 2. DO NOT INSTALL STAKES THAT HAVE BEEN SPLIT.
 3. STAKES MUST BE INSTALLED WITH BUDS POINTING UPWARDS.
 4. STAKES SHOULD BE INSTALLED PERPENDICULAR TO BANK.
 5. STAKES SHOULD BE 1/2 TO 2 INCHES IN DIAMETER AND 2 TO 3 FT LONG.
 6. STAKES SHOULD BE INSTALLED LEAVING 1/5 OF STAKE ABOVE GROUND.

TRANSPLANTED VEGETATION

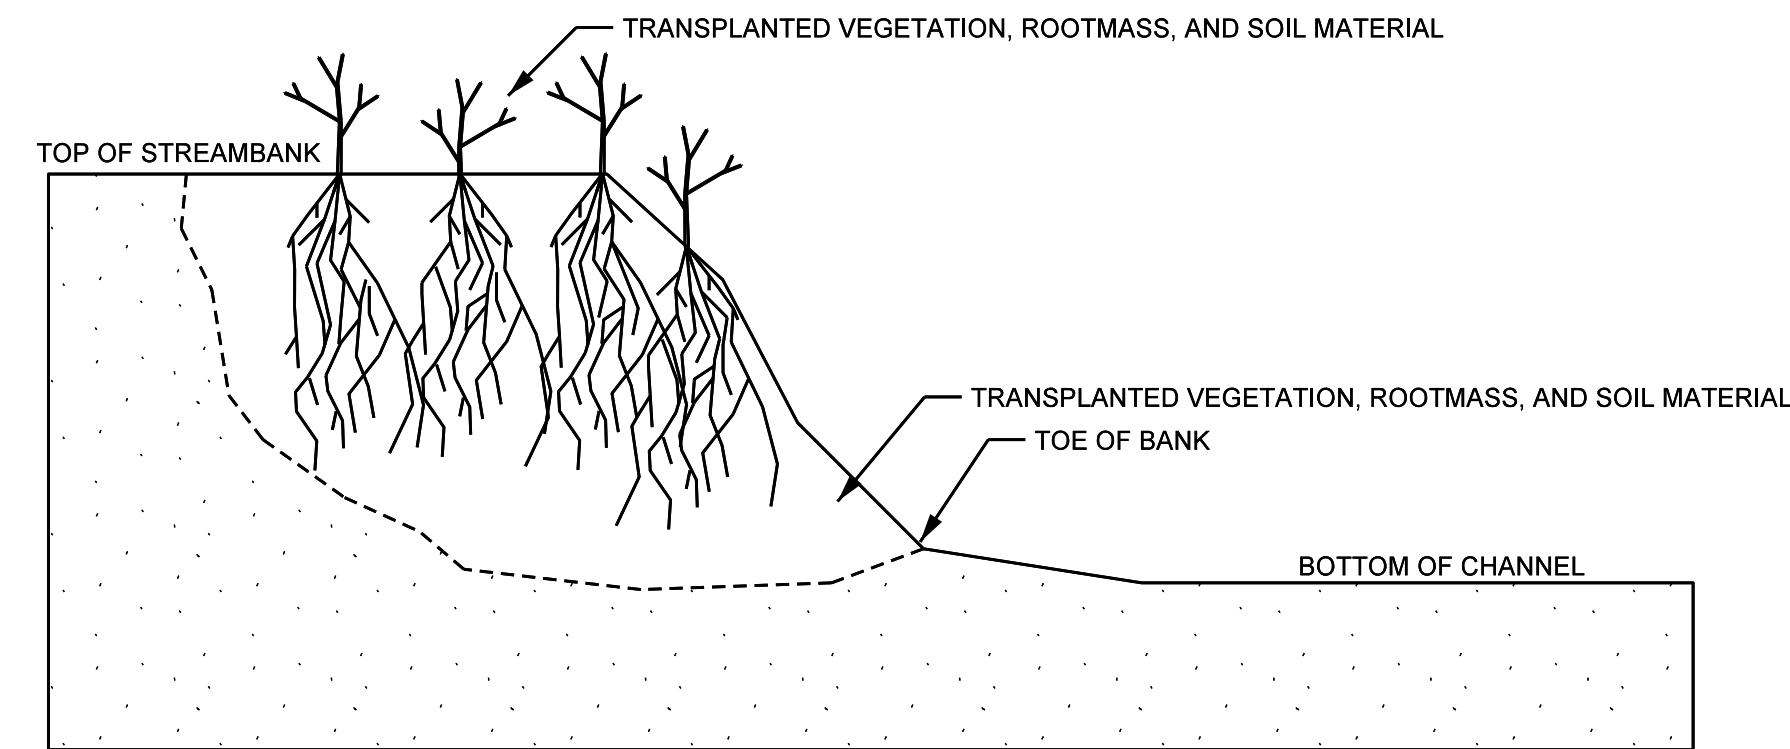

CROSS SECTION VIEW

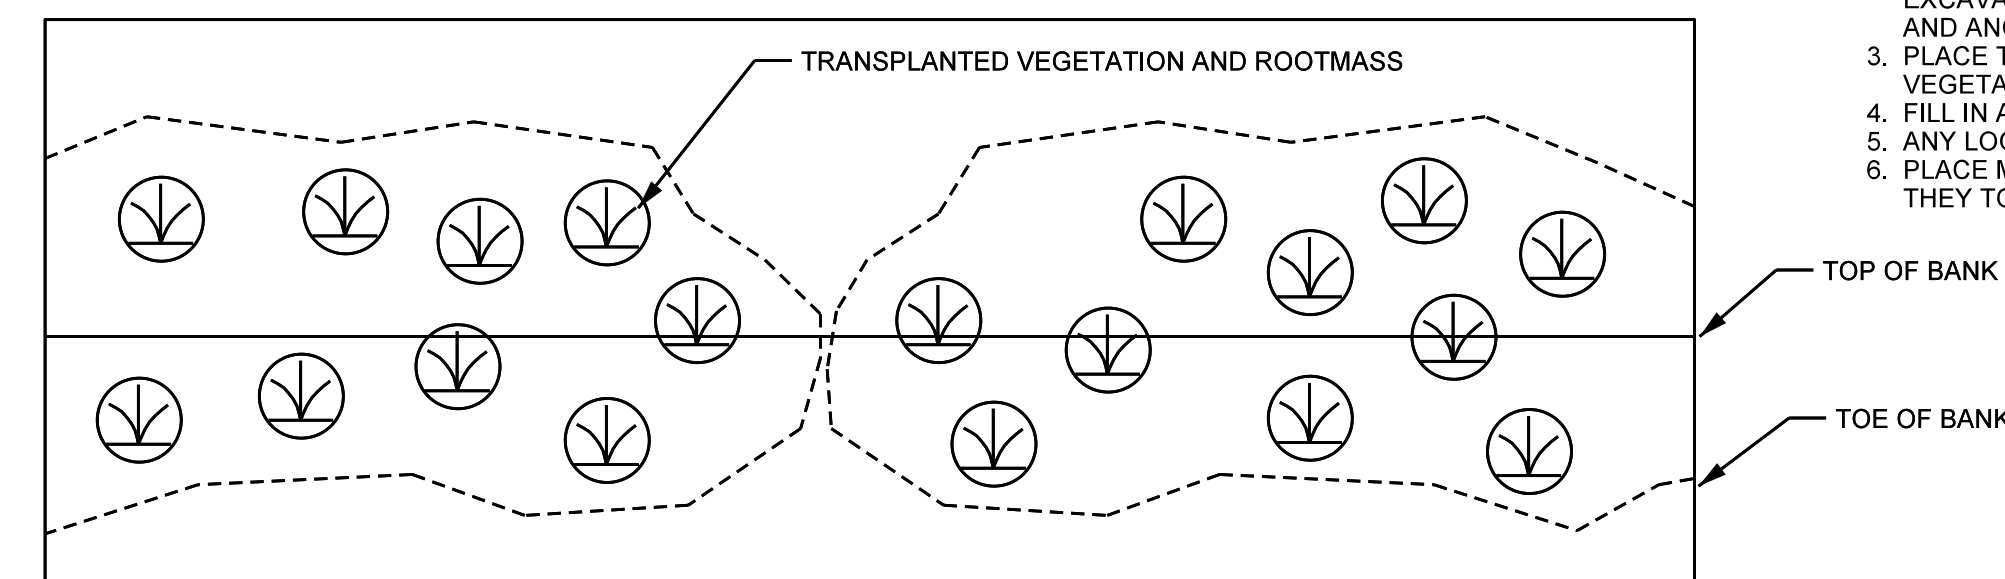


PLAN VIEW

NOTES:

1. EXCAVATE A HOLE IN THE BANK TO BE STABILIZED THAT WILL ACCOMMODATE THE SIZE OF TRANSPLANT TO BE PLACED. BEGIN EXCAVATION AT THE TOE OF THE BANK.
2. EXCAVATE TRANSPLANT USING A FRONT END LOADER. EXCAVATE THE ENTIRE ROOT MASS AND AS MUCH ADDITIONAL SOIL MATERIAL AS POSSIBLE. IF ENTIRE ROOT MASS CAN NOT BE EXCAVATED IN ONE BUCKET LOAD, THE TRANSPLANT IS TOO LARGE AND ANOTHER SHOULD BE SELECTED.
3. PLACE TRANSPLANT IN THE BANK TO BE STABILIZED SO THAT VEGETATION IS ORIENTATED VERTICALLY.
4. FILL IN ANY HOLES AROUND THE TRANSPLANT AND COMPACT.
5. ANY LOOSE SOIL LEFT IN THE STREAM SHOULD BE REMOVED.
6. PLACE MULTIPLE TRANSPLANTS CLOSE TOGETHER SUCH THAT THEY TOUCH.


PROJECT REFERENCE NO. 166680	SHEET NO. 2E
PROJECT ENGINEER	
APPROVED BY:	
DATE:	
Michael Baker International <small>8000 Regency Parkway, Suite 600 Cary, NORTH CAROLINA 27518 Phone: 919.463.5486 Fax: 919.463.5490 License #: F-1084</small>	
NCDMS ID NO. 100068	

PLANTING SPECIFICATIONS

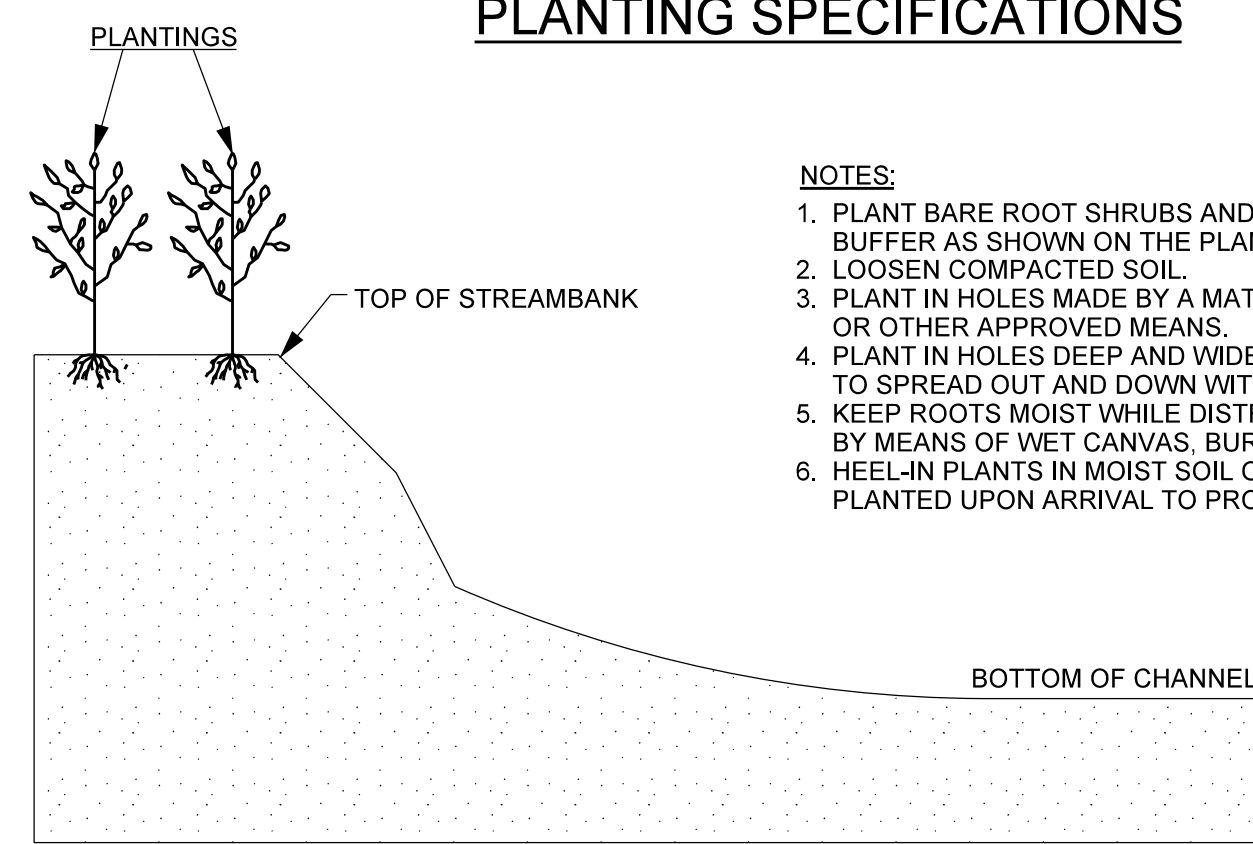

CROSS SECTION VIEW OF BARE ROOT PLANTING


- NOTES:**
1. PLANT BARE ROOT SHRUBS AND TREES TO THE WIDTH OF THE BUFFER AS SHOWN ON THE PLANS.
 2. LOOSEN COMPACTED SOIL.
 3. PLANT IN HOLES MADE BY A MATTOCK, DIBBLE, PLANTING BAR, OR OTHER APPROVED MEANS.
 4. PLANT IN HOLES DEEP AND WIDE ENOUGH TO ALLOW THE ROOTS TO SPREAD OUT AND DOWN WITHOUT J-ROOTING.
 5. KEEP ROOTS MOIST WHILE DISTRIBUTING OR WAITING TO PLANT BY MEANS OF WET CANVAS, BURLAP, OR STRAW.
 6. HEEL-IN PLANTS IN MOIST SOIL OR SAWDUST IF NOT PROMPTLY PLANTED UPON ARRIVAL TO PROJECT SITE.

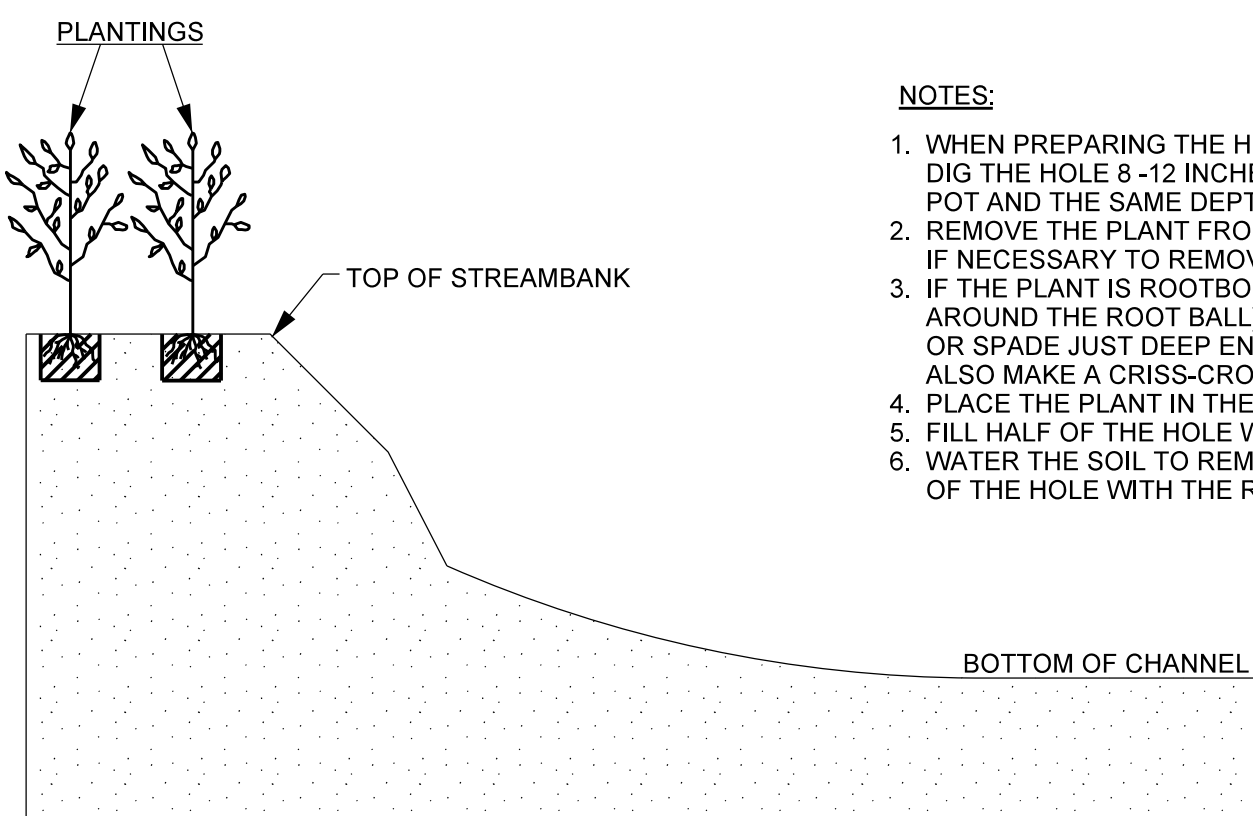


CROSS SECTION VIEW OF CONTAINER PLANTING

- NOTES:**
1. WHEN PREPARING THE HOLE FOR A POTTED PLANT OR SHRUB DIG THE HOLE 8 - 12 INCHES LARGER THAN THE DIAMETER OF THE POT AND THE SAME DEPTH AS THE POT.
 2. REMOVE THE PLANT FROM THE POT. LAY THE PLANT ON ITS SIDE IF NECESSARY TO REMOVE THE POT.
 3. IF THE PLANT IS ROOTBOUND (ROOTS GROWING IN A SPIRAL AROUND THE ROOT BALL), MAKE VERTICAL CUTS WITH A KNIFE OR SPADE JUST DEEP ENOUGH TO CUT THE NET OF ROOTS. ALSO MAKE A CRISS-CROSS CUT ACROSS THE BOTTOM OF THE BALL.
 4. PLACE THE PLANT IN THE HOLE.
 5. FILL HALF OF THE HOLE WITH SOIL (SAME SOIL REMOVED FOR BACKFILL).
 6. WATER THE SOIL TO REMOVE AIR POCKETS AND FILL THE REST OF THE HOLE WITH THE REMAINING SOIL.

COIR FIBER MATTING

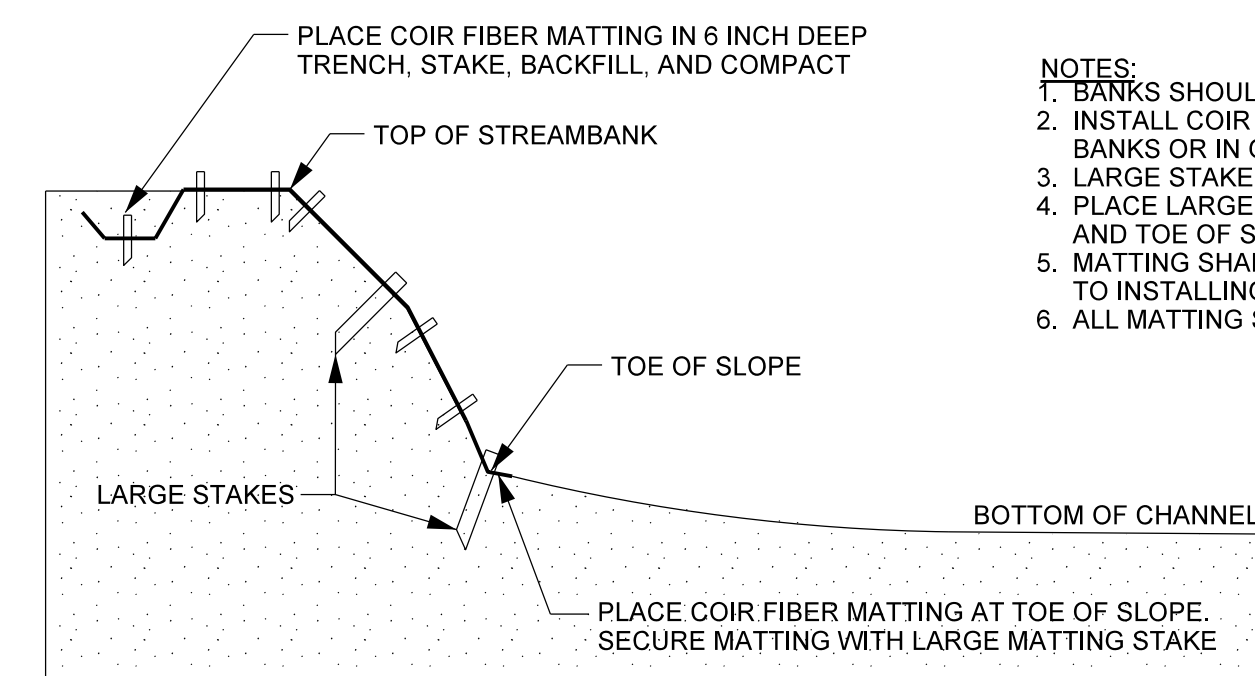


CROSS SECTION VIEW

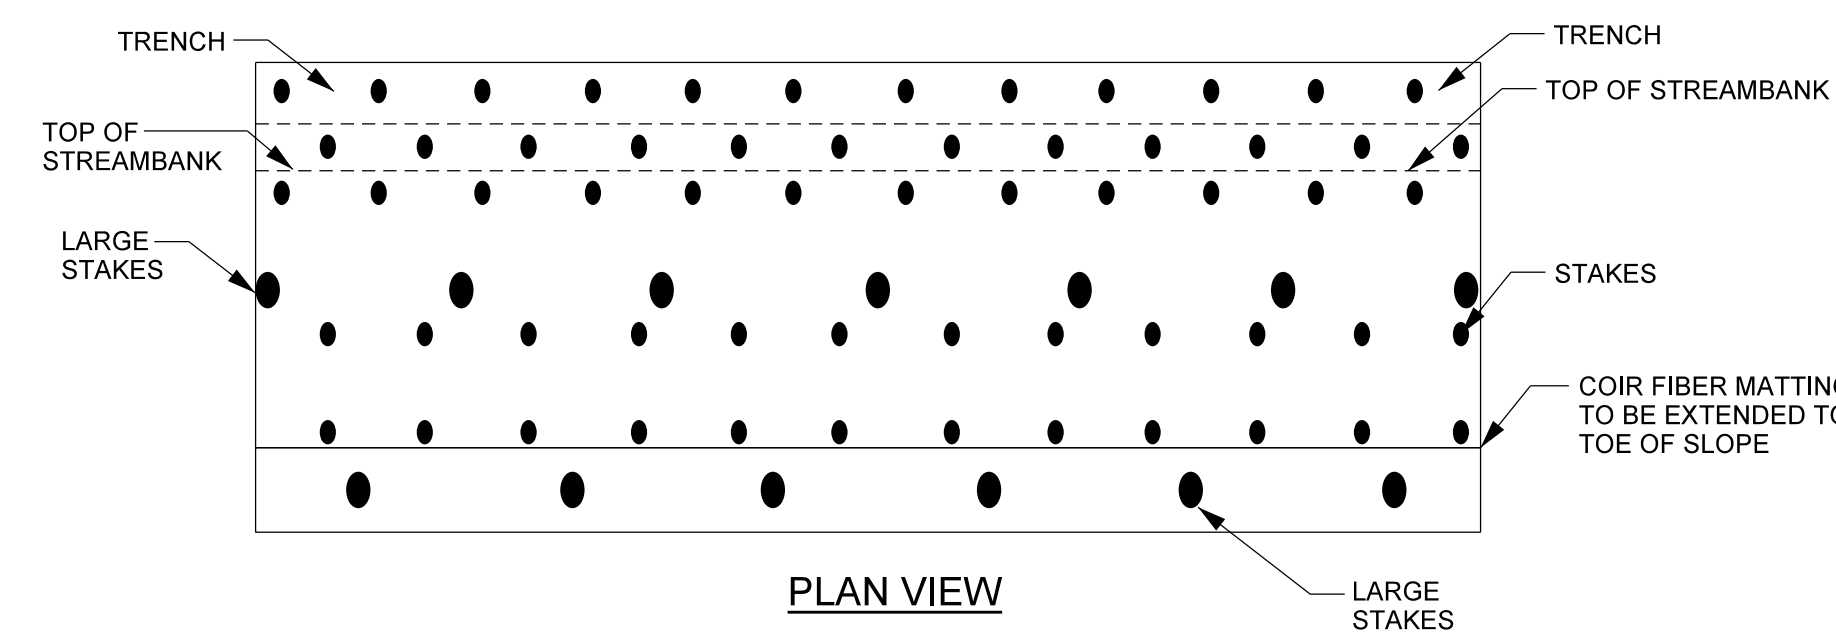


PLAN VIEW

- NOTES:**
1. BANKS SHOULD BE SEEDED PRIOR TO PLACEMENT OF MATTING.
 2. INSTALL COIR FIBER MATTING PER SPECIFICATIONS ALONG STREAM BANKS OR IN OTHERS LOCATIONS SPECIFIED BY ENGINEER.
 3. LARGE STAKES SHOULD NOT BE SPACED FURTHER THAN 36" APART.
 4. PLACE LARGE STAKES ALONG ALL SEAMS, IN THE CENTER OF BANK, AND TOE OF SLOPE.
 5. MATTING SHALL BE PLACED ON BANKS, STAKED, AND TRENCHED PRIOR TO INSTALLING CONSTRUCTED RIFFLE MATERIAL.
 6. ALL MATTING STAKES MUST BE 100% BIODEGRADABLE.

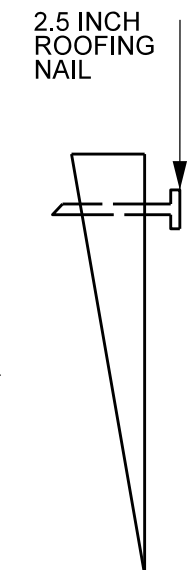

TYPICAL LARGE MATTING STAKE

LEG LENGTH	17.00 IN (43.18 CM) (TAPERED TO POINT)
WIDTH	1.5 IN (3.81 CM)
THICKNESS	1.5 IN (3.81 CM)

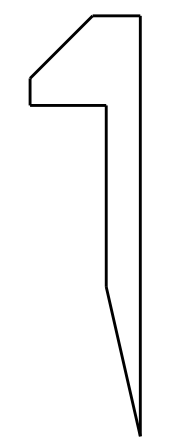


TYPICAL SMALL MATTING STAKE

LEG LENGTH	11.00 IN (27.94 CM)
HEAD WIDTH	1.25 IN (3.18 CM)
HEAD THICKNESS	0.40 IN (1.02 CM)
LEG WIDTH	0.60 IN (1.52 CM) (TAPERED TO POINT)
LEG THICKNESS	0.40 IN (1.02 CM)
TOTAL LENGTH	12.00 IN (30.48 CM)

2/26/203


BARB WIRE FIELD FENCE

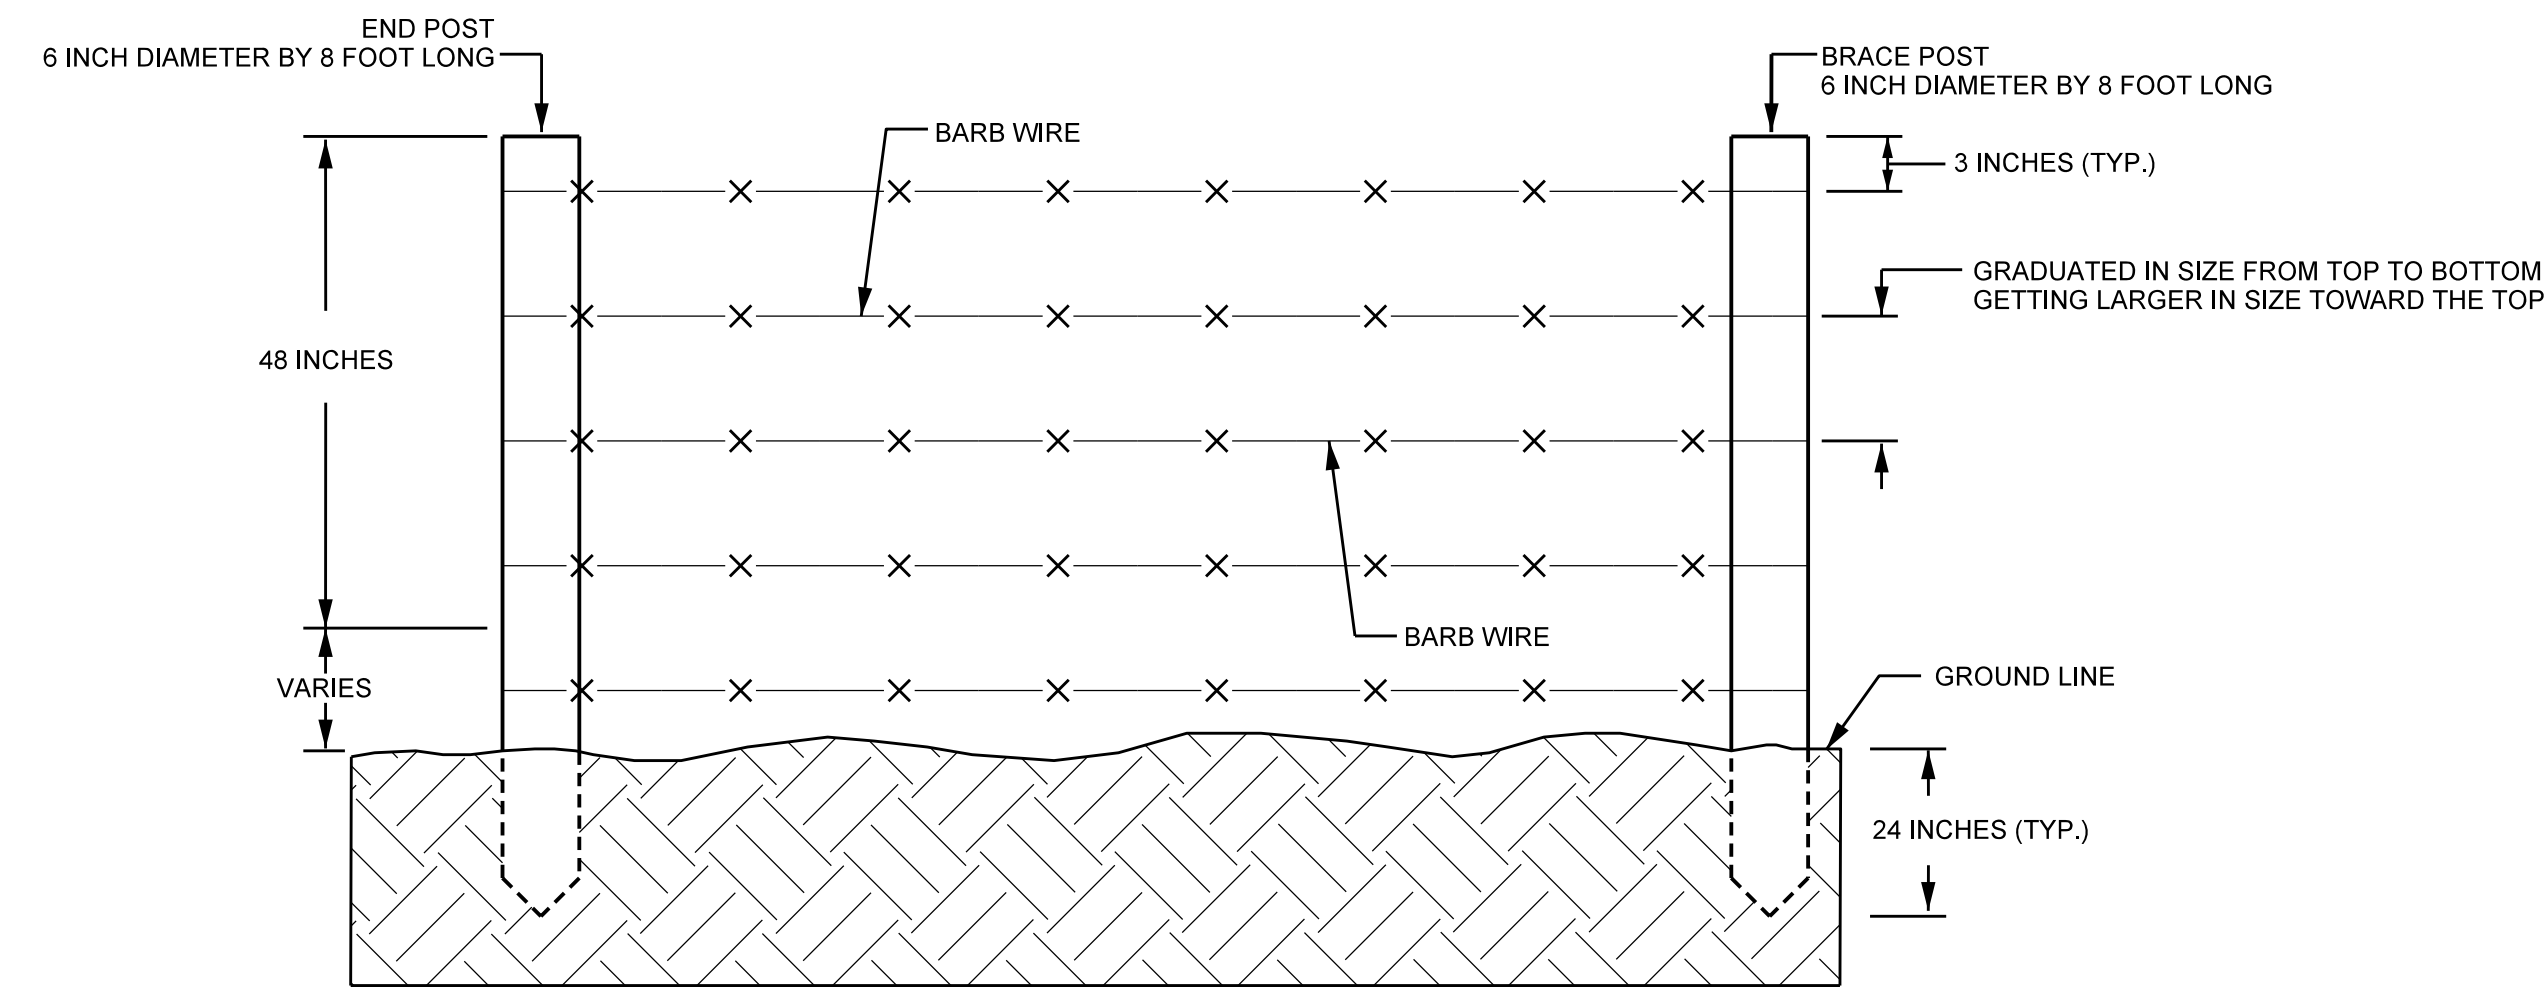

NOTE:

1. END POSTS SHALL BE INSTALLED AT A SPACING OF 10-15 FEET.
2. ALL FENCING AND FENCE POSTS SHOULD BE SET 1-2 FEET OUTSIDE OF THE CONSERVATION EASEMENT FOR FENCE LINE MAINTENANCE (LIKE HERBICIDE SPRAYING).

STEEL GATES

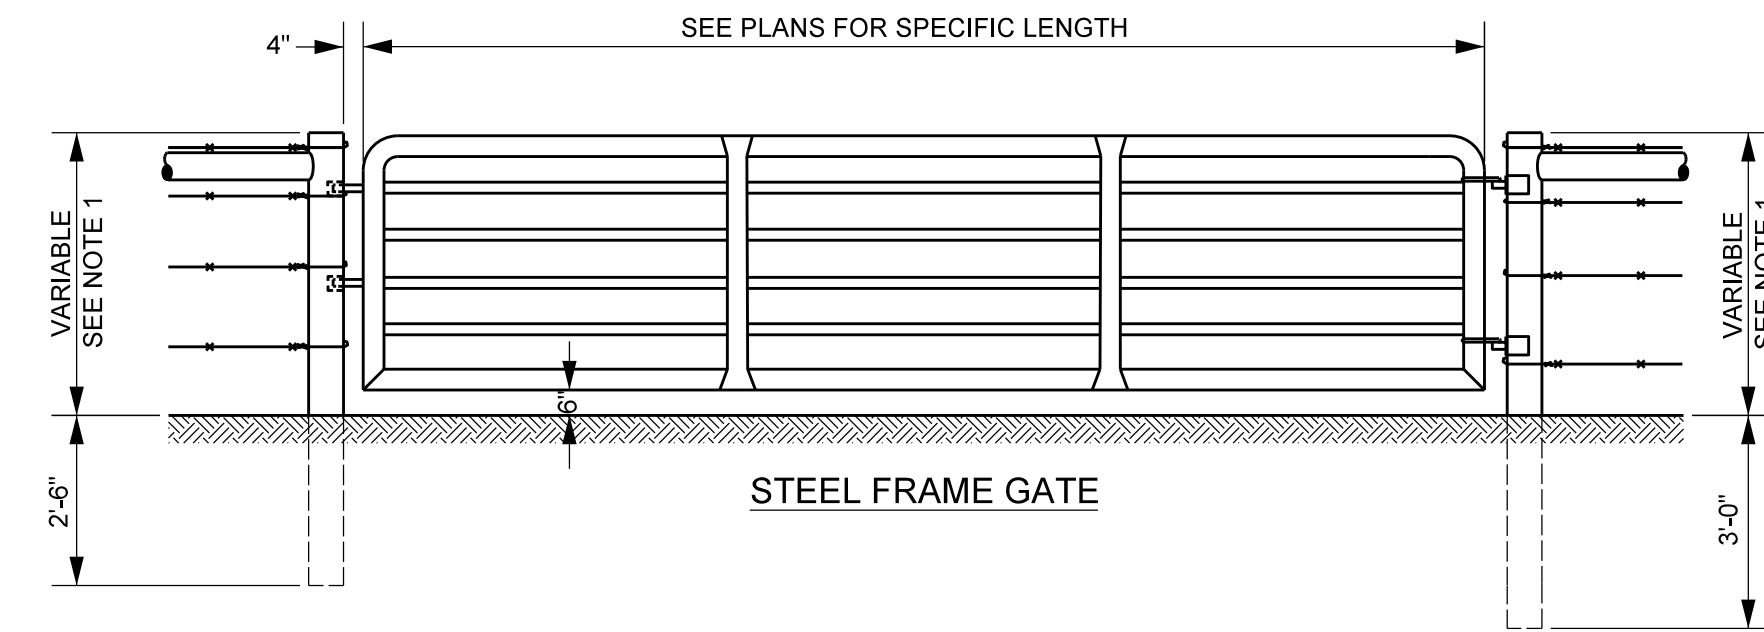


NOTES:



1. POST HEIGHT DIMENSION SHALL BE THE SAME AS REQUIRED FOR THE ADJACENT FENCE.
2. CONSTRUCT AN END OR STRESS PANEL, AS REQUIRED IN THE SPECIFICATION, ON EACH SIDE OF GATE.
3. HINGES AND LOCKS SHALL BE INSTALLED AS SPECIFIED BY GATE MANUFACTURER.

PROJECT REFERENCE NO. 166680	SHEET NO. 2F
PROJECT ENGINEER	
APPROVED BY:	
DATE:	
Michael Baker International <small>Michael Baker Engineering Inc. 8000 Regency Parkway, Suite 600 Cary, NORTH CAROLINA 27518 Phone: 919.463.5486 Fax: 919.463.5490 License #: F-1084</small>	
NCDMS ID NO. 100068	

5/24/2022
M:\Projects\166680_Rush_Fork_Design\As-Built\Plans\166680_ASB-FSH-02F.dgn
Michael Baker International

2/26/2023

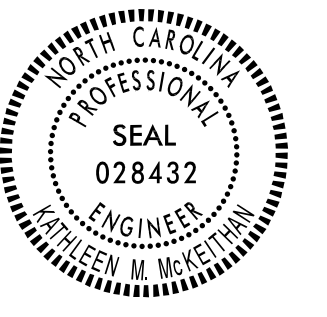BAKER PROJECT REFERENCE NO. 166680	SHEET NO. 3
PROJECT ENGINEER	
APPROVED BY:	
DATE:	
	
Michael Baker International Michael Baker Engineering Inc. 5030 Regency Parkway, Suite 600 Cary, NORTH CAROLINA 27518 Phone: 919.453.5488 Fax: 919.453.5490 License #: F-1084	
NCDMS ID NO. 100068	

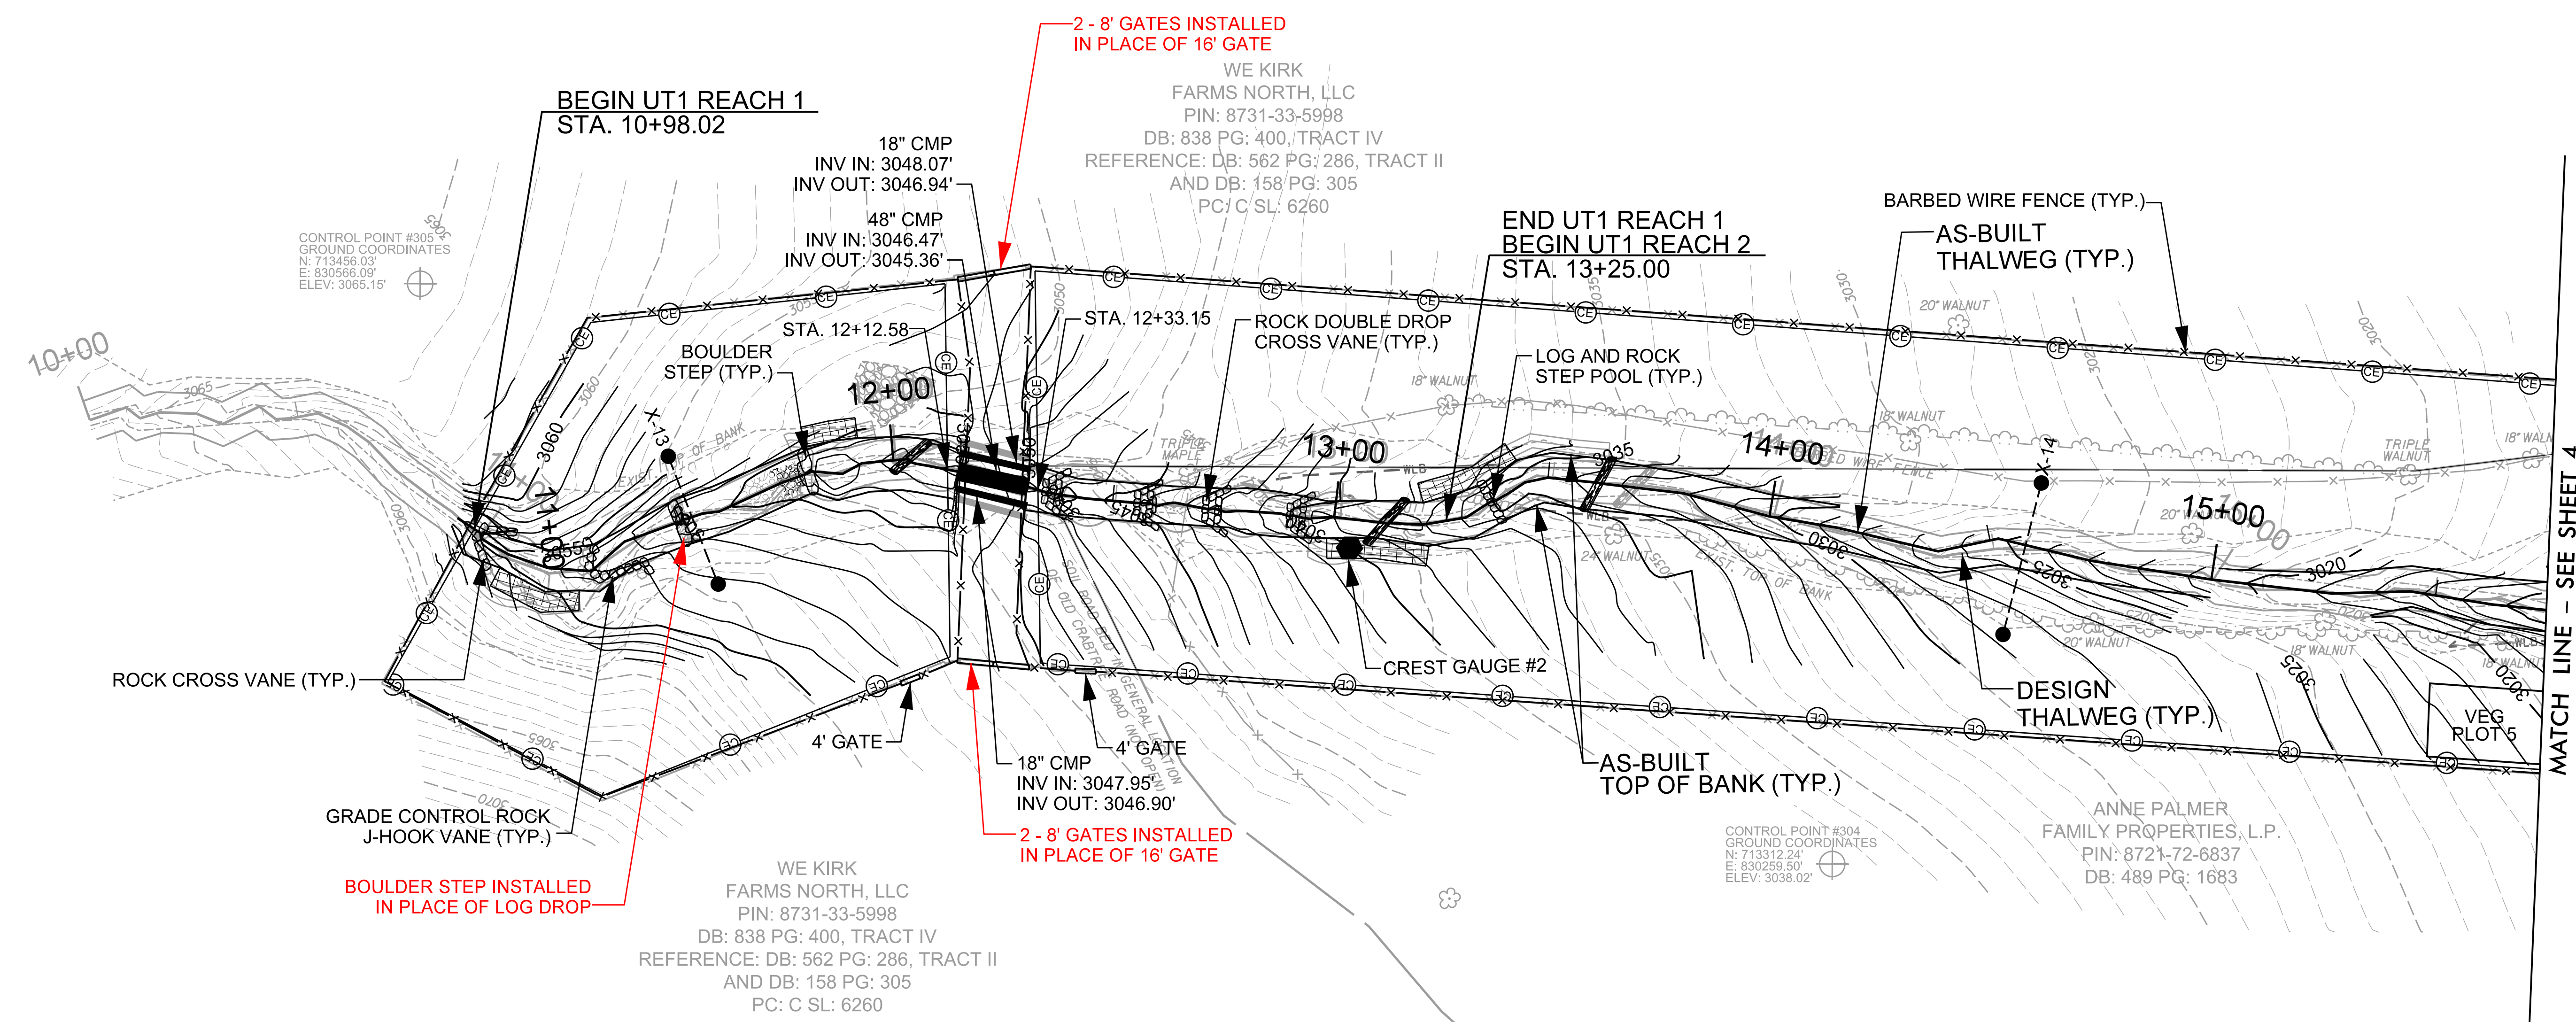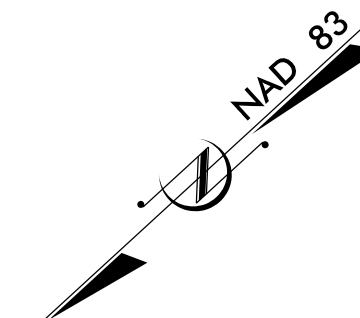

RECORD DRAWING LEGEND	
	PROPOSED DESIGN
	AS-BUILT SURVEY BY KEE MAPPING & SURVEYING 4/14/22
	RED LINE VARIATIONS FROM ORIGINAL DESIGN SUBMITTED WITH THE MITIGATION PLAN

- FILL EXISTING CHANNEL
- CHANNEL PLUG

**UT to RUSH FORK
 UTI
 RECORD DRAWING**

SCALE (FT)



5/24/2022
 M:\Projects\166680_Rush_Fork_Design\As-Built\Plans\166680-ASB-PSH-03.dgn
 Michael Baker Engineering Inc.

2/26/2023

WE KIRK
 FARMS NORTH, LLC
 PIN: 8731-33-5998
 DB: 838 PG: 400, TRACT IV
 REFERENCE: DB: 562 PG: 286, TRACT II
 AND DB: 158 PG: 305
 PC: C SL: 6260

WE KIRK
 PIN: 8730-09-3258
 DB: 838 PG: 404
 REFERENCE: DB: 562 PG: 286, TRACT II
 AND DB: 158 PG: 305
 PC: C SL: 6260 & PC: C SL: 7314

SOUTHERN APPALACHIAN
 HIGHLANDS CONSERVANCY
 (CONSERVATION EASEMENT)
 DB: 917 PG: 978
 PC: C SL: 7314

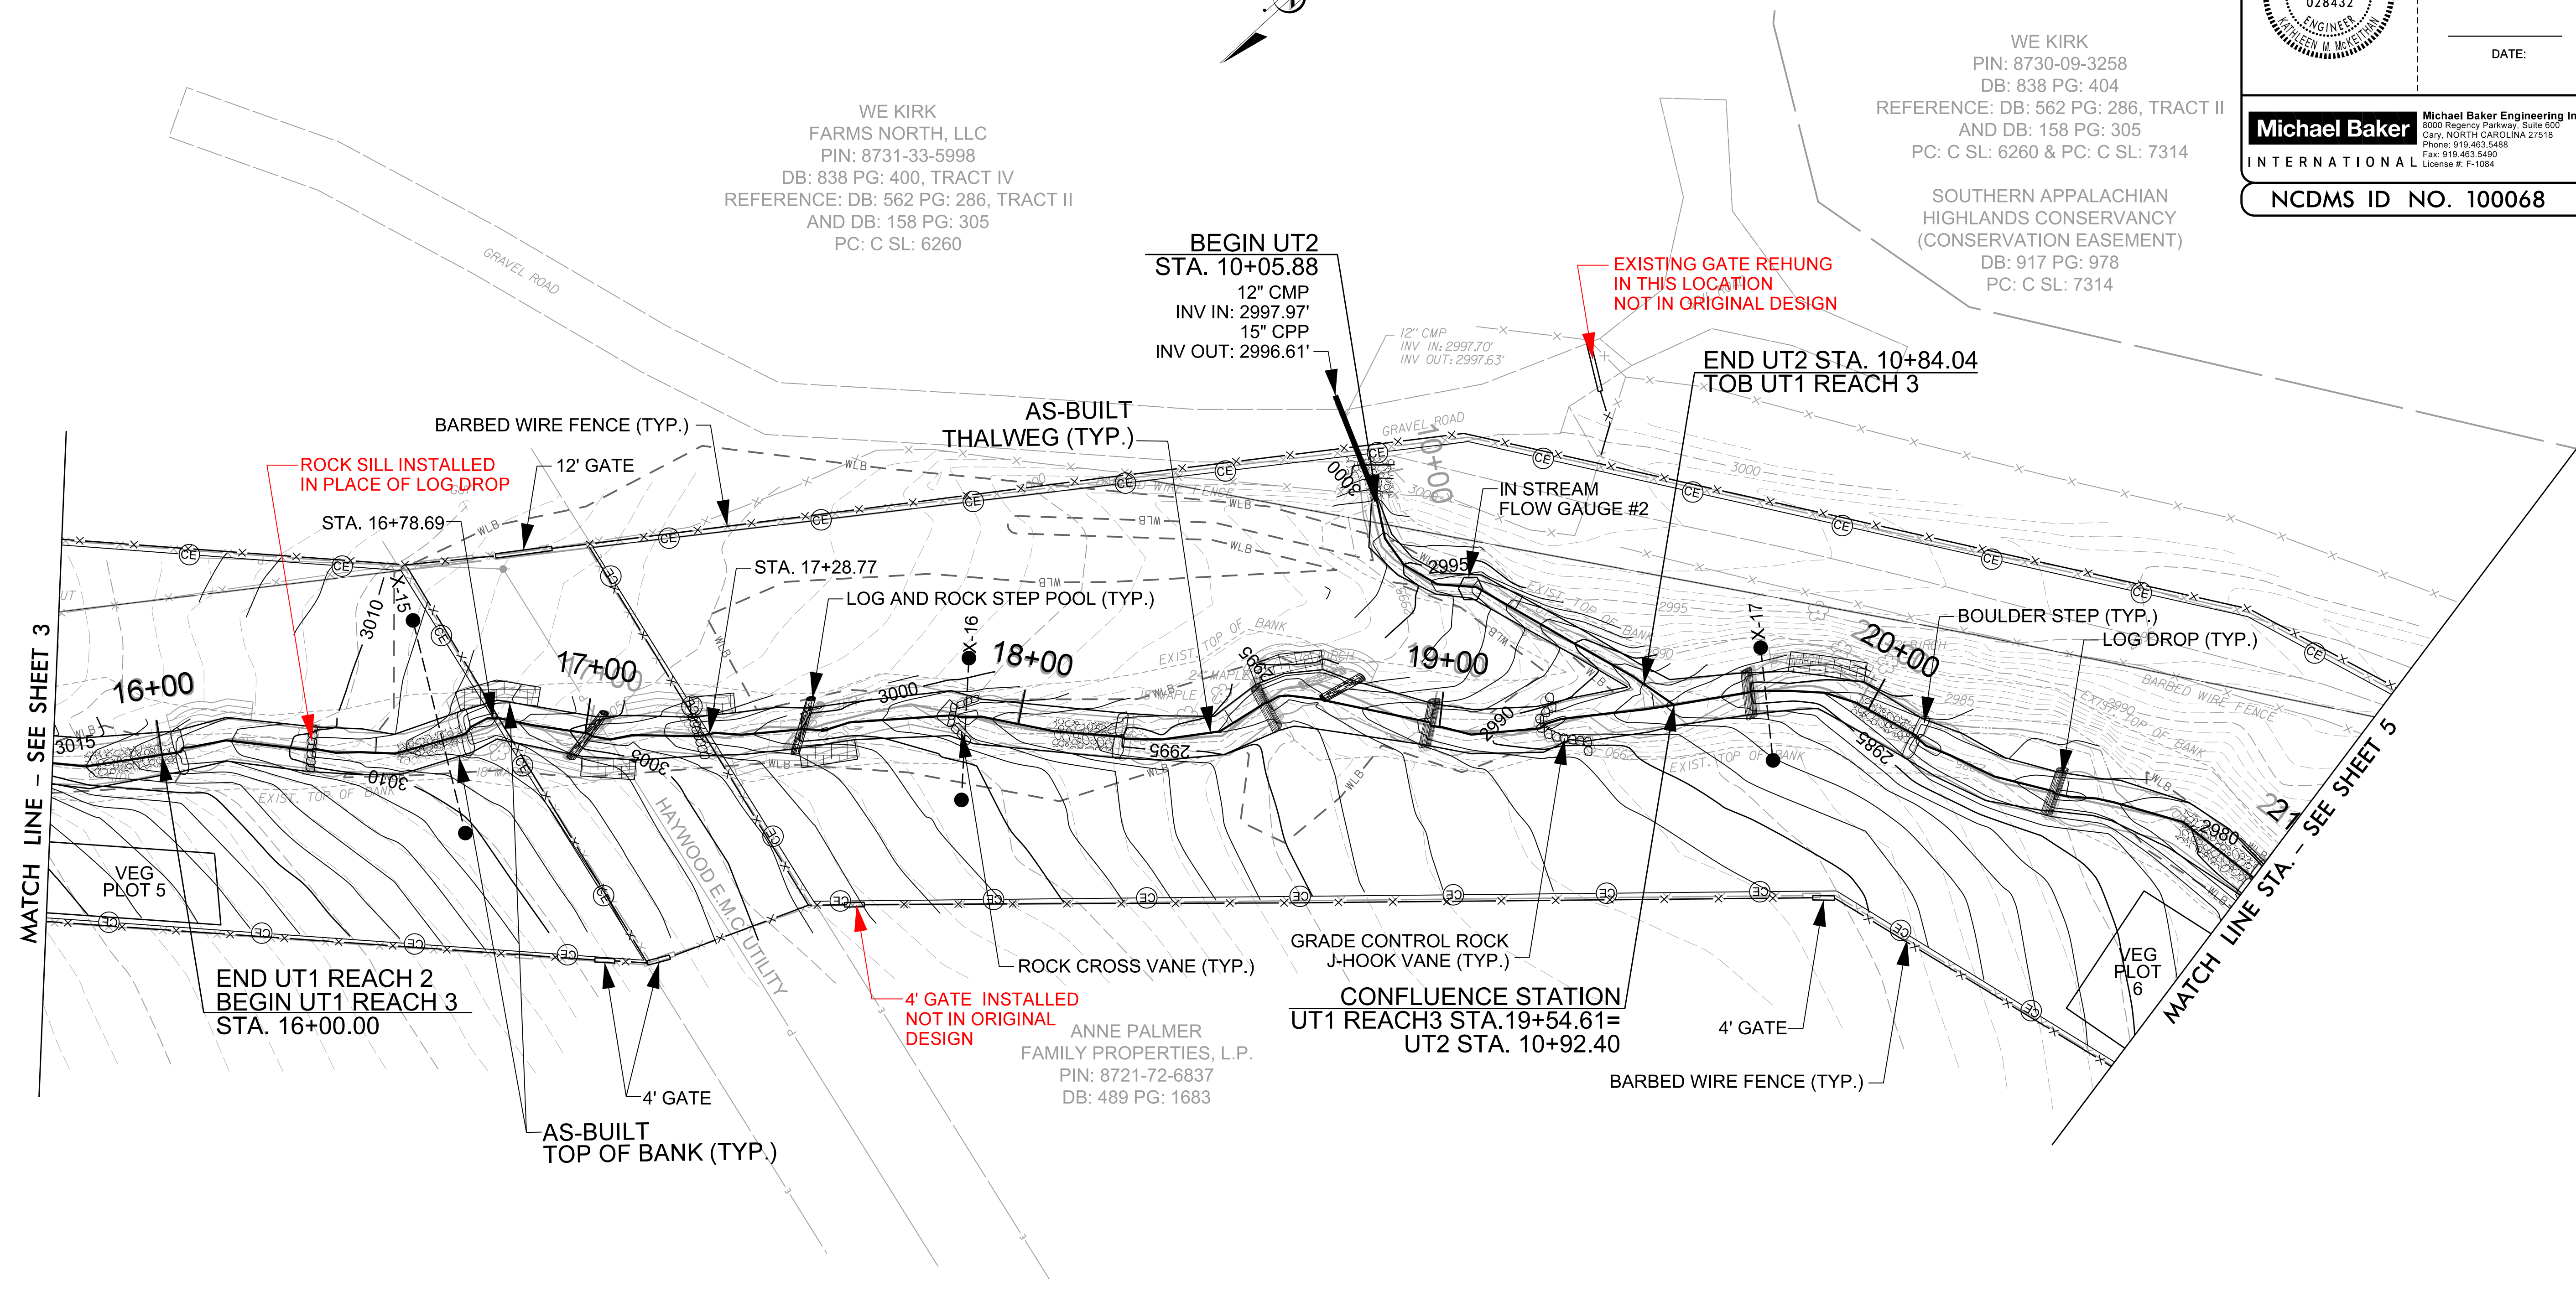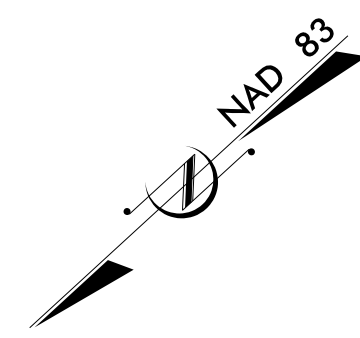

MATCH LINE - SEE SHEET 3

MATCH LINE STA. - SEE SHEET 5

RECORD DRAWING LEGEND	
	PROPOSED DESIGN
	AS-BUILT SURVEY BY KEE MAPPING & SURVEYING 4/14/22
	RED LINE VARIATIONS FROM ORIGINAL DESIGN SUBMITTED WITH THE MITIGATION PLAN

- FILL EXISTING CHANNEL
- CHANNEL PLUG

**UT to RUSH FORK
 UTI
 RECORD DRAWING**

SCALE (FT)


5/31/2022
 M:\projects\166680_Rush_Fork\Design\As-Built\Plots\166680_ASB-PSH_04.dgn

2/26/2023


5/31/2022
M:\projects\166680_Rush_Fork\Design\As-Built\Plots\166680_ASB-P5H_05.dgn

WE KIRK
PIN: 8730-09-3258
DB: 838 PG: 404
REFERENCE: DB: 562 PG: 286, TRACT II
AND DB: 158 PG: 305
PC: C SL: 6260 & PC: C SL: 7314

SOUTHERN APPALACHIAN
HIGHLANDS CONSERVANCY
(CONSERVATION EASEMENT)
DB: 917 PG: 978
PC: C SL: 7314

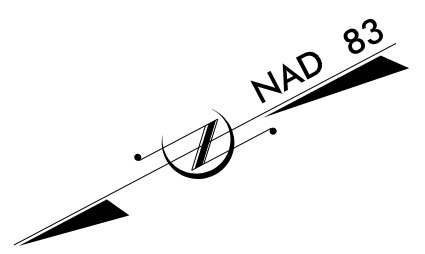

BAKER PROJECT REFERENCE NO. 166680	SHEET NO. 5
PROJECT ENGINEER	
APPROVED BY:	
DATE:	
Michael Baker International	
Michael Baker Engineering Inc. 5030 Regency Parkway, Suite 500 Cary, NORTH CAROLINA 27518 Phone: 919.453.5488 Fax: 919.453.5490 License #: F-1084	
NCDMS ID NO. 100068	

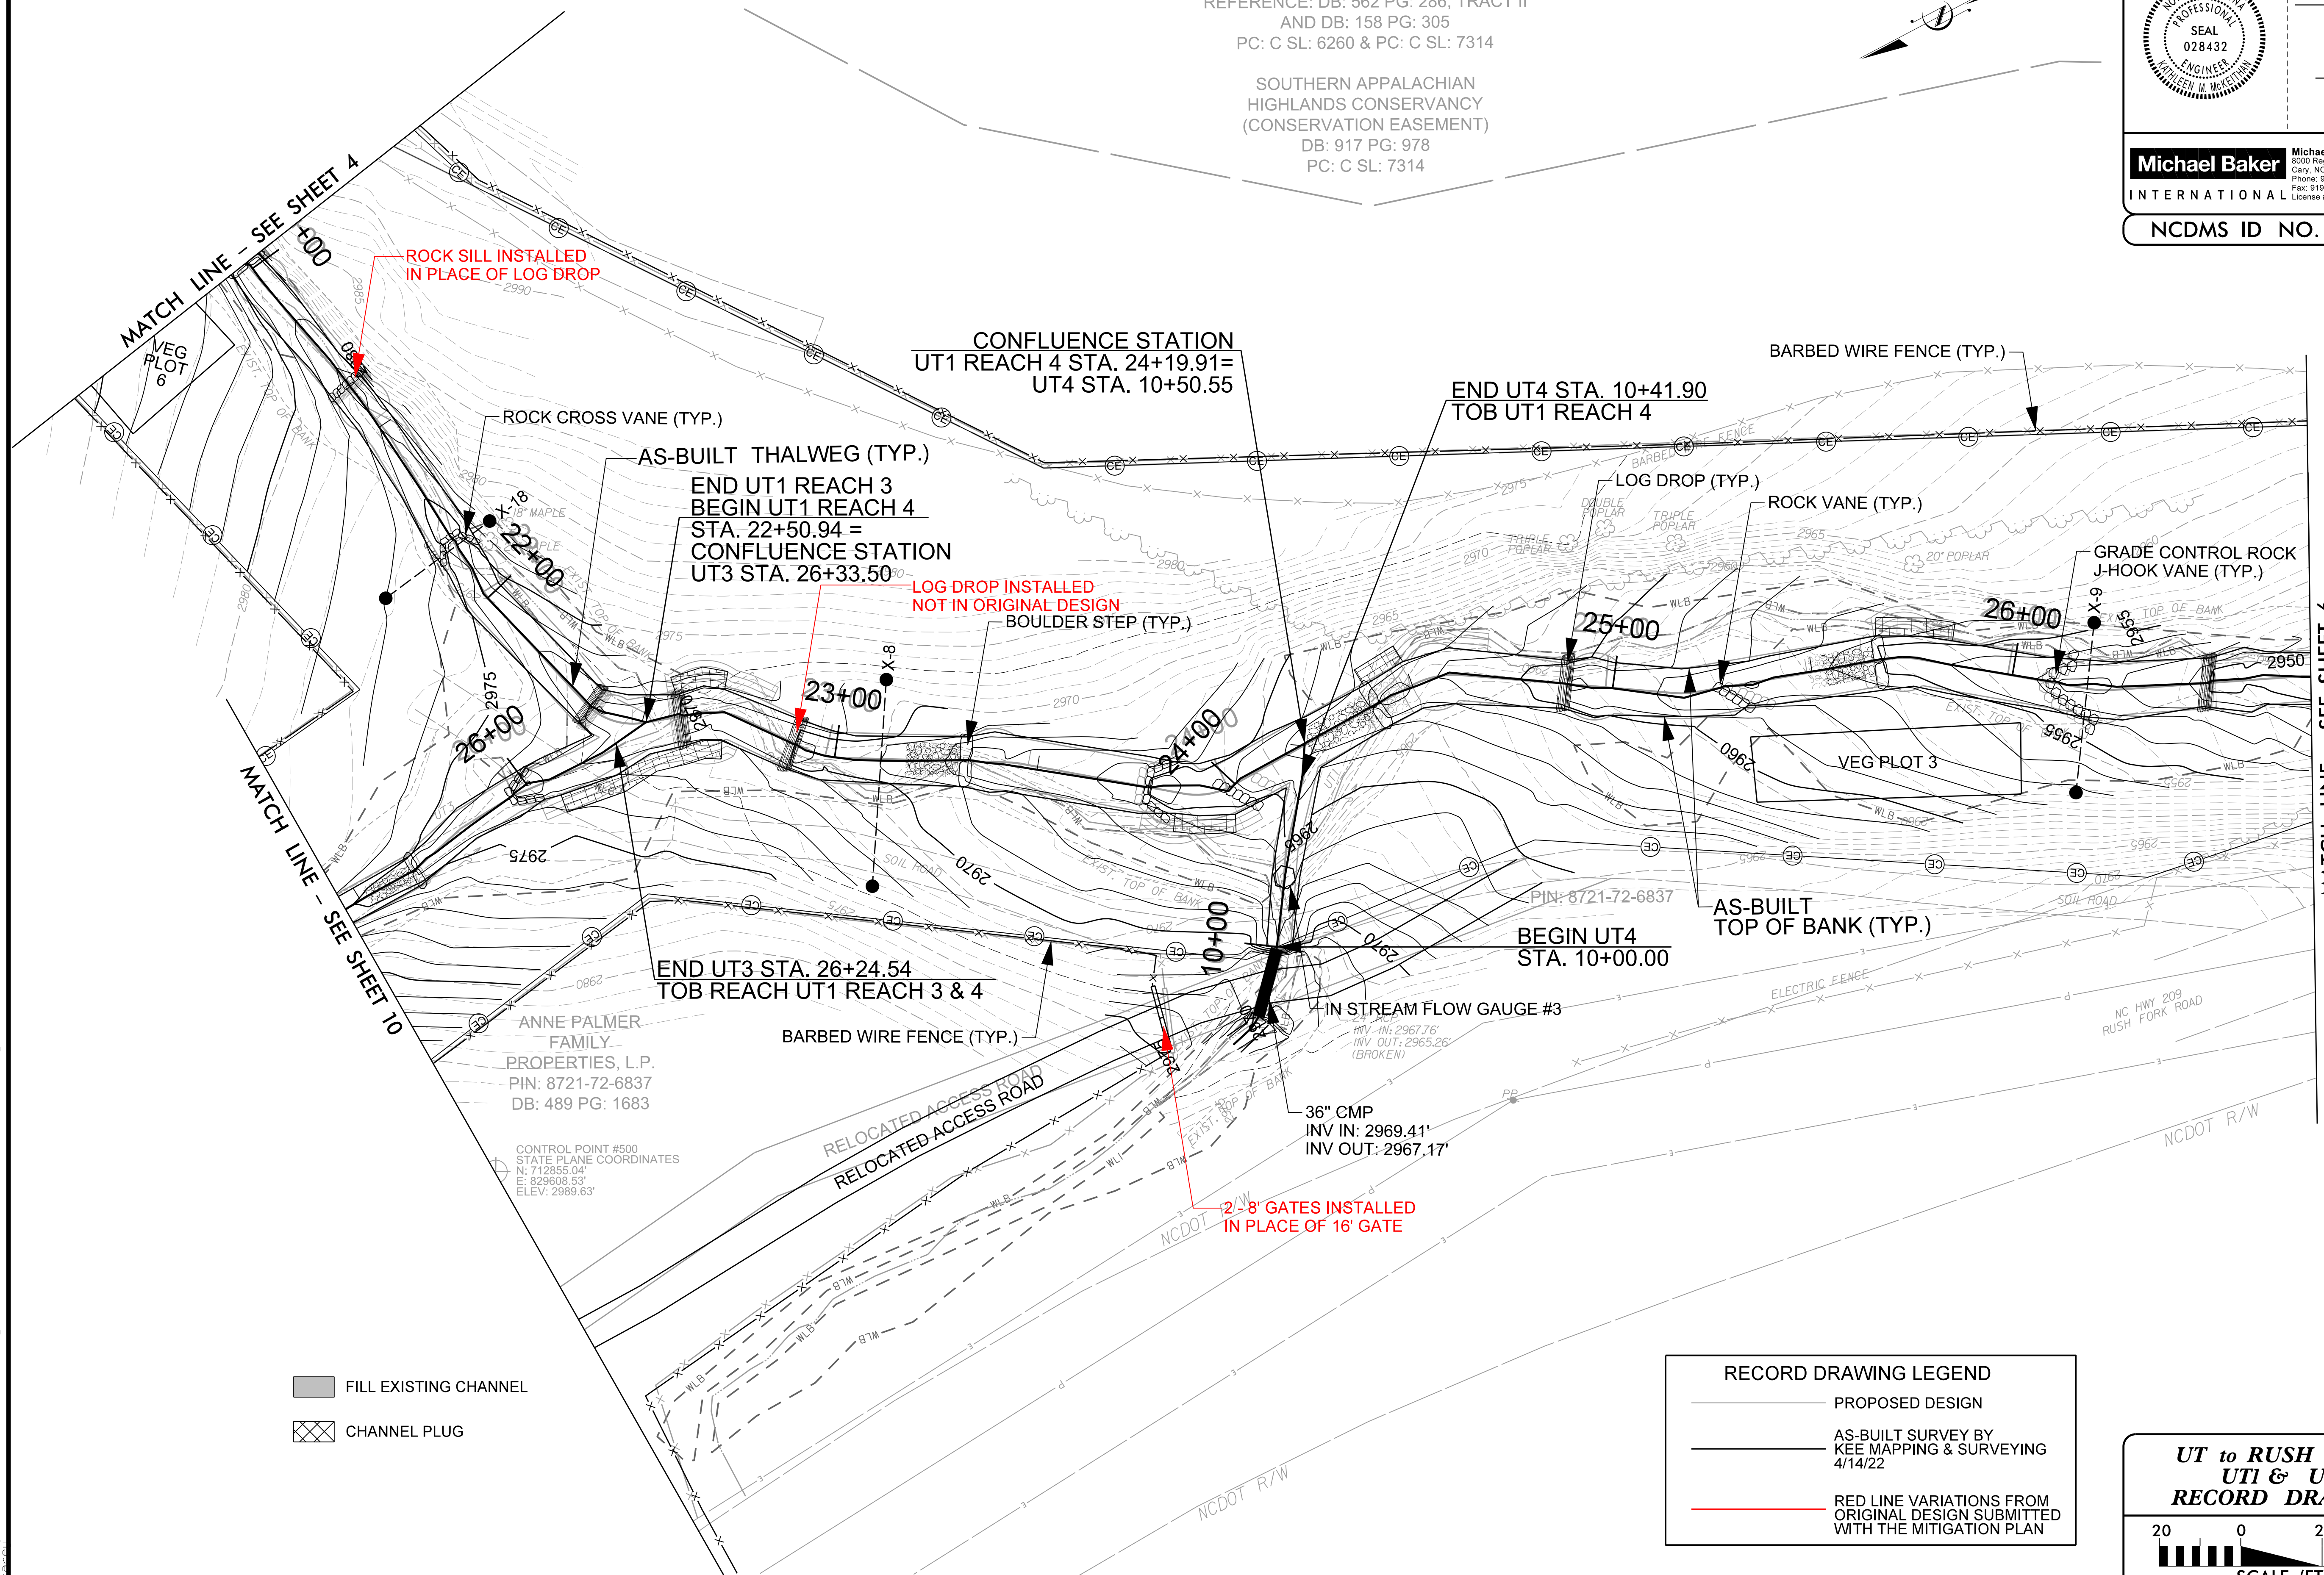

- FILL EXISTING CHANNEL
- CHANNEL PLUG

RECORD DRAWING LEGEND

- PROPOSED DESIGN
- AS-BUILT SURVEY BY
KEE MAPPING & SURVEYING
4/14/22
- RED LINE VARIATIONS FROM
ORIGINAL DESIGN SUBMITTED
WITH THE MITIGATION PLAN


**UT to RUSH FORK
UT1 & UT4
RECORD DRAWING**

SCALE (FT)

2/26/2023

BAKER PROJECT REFERENCE NO. 166680 SHEET NO. 6

PROJECT ENGINEER

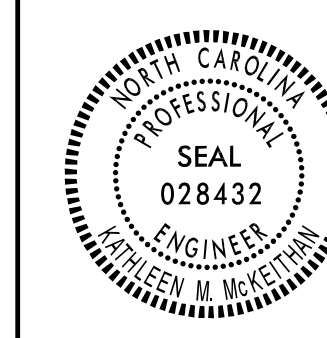



APPROVED BY:

DATE:

Michael Baker International
Michael Baker Engineering Inc.
5030 Regency Parkway, Suite 600
Cary, NORTH CAROLINA 27518
Phone: 919.453.5488
Fax: 919.453.5490
License #: F-1084

NCDMS ID NO. 100068

PIN: 8730-09-3258

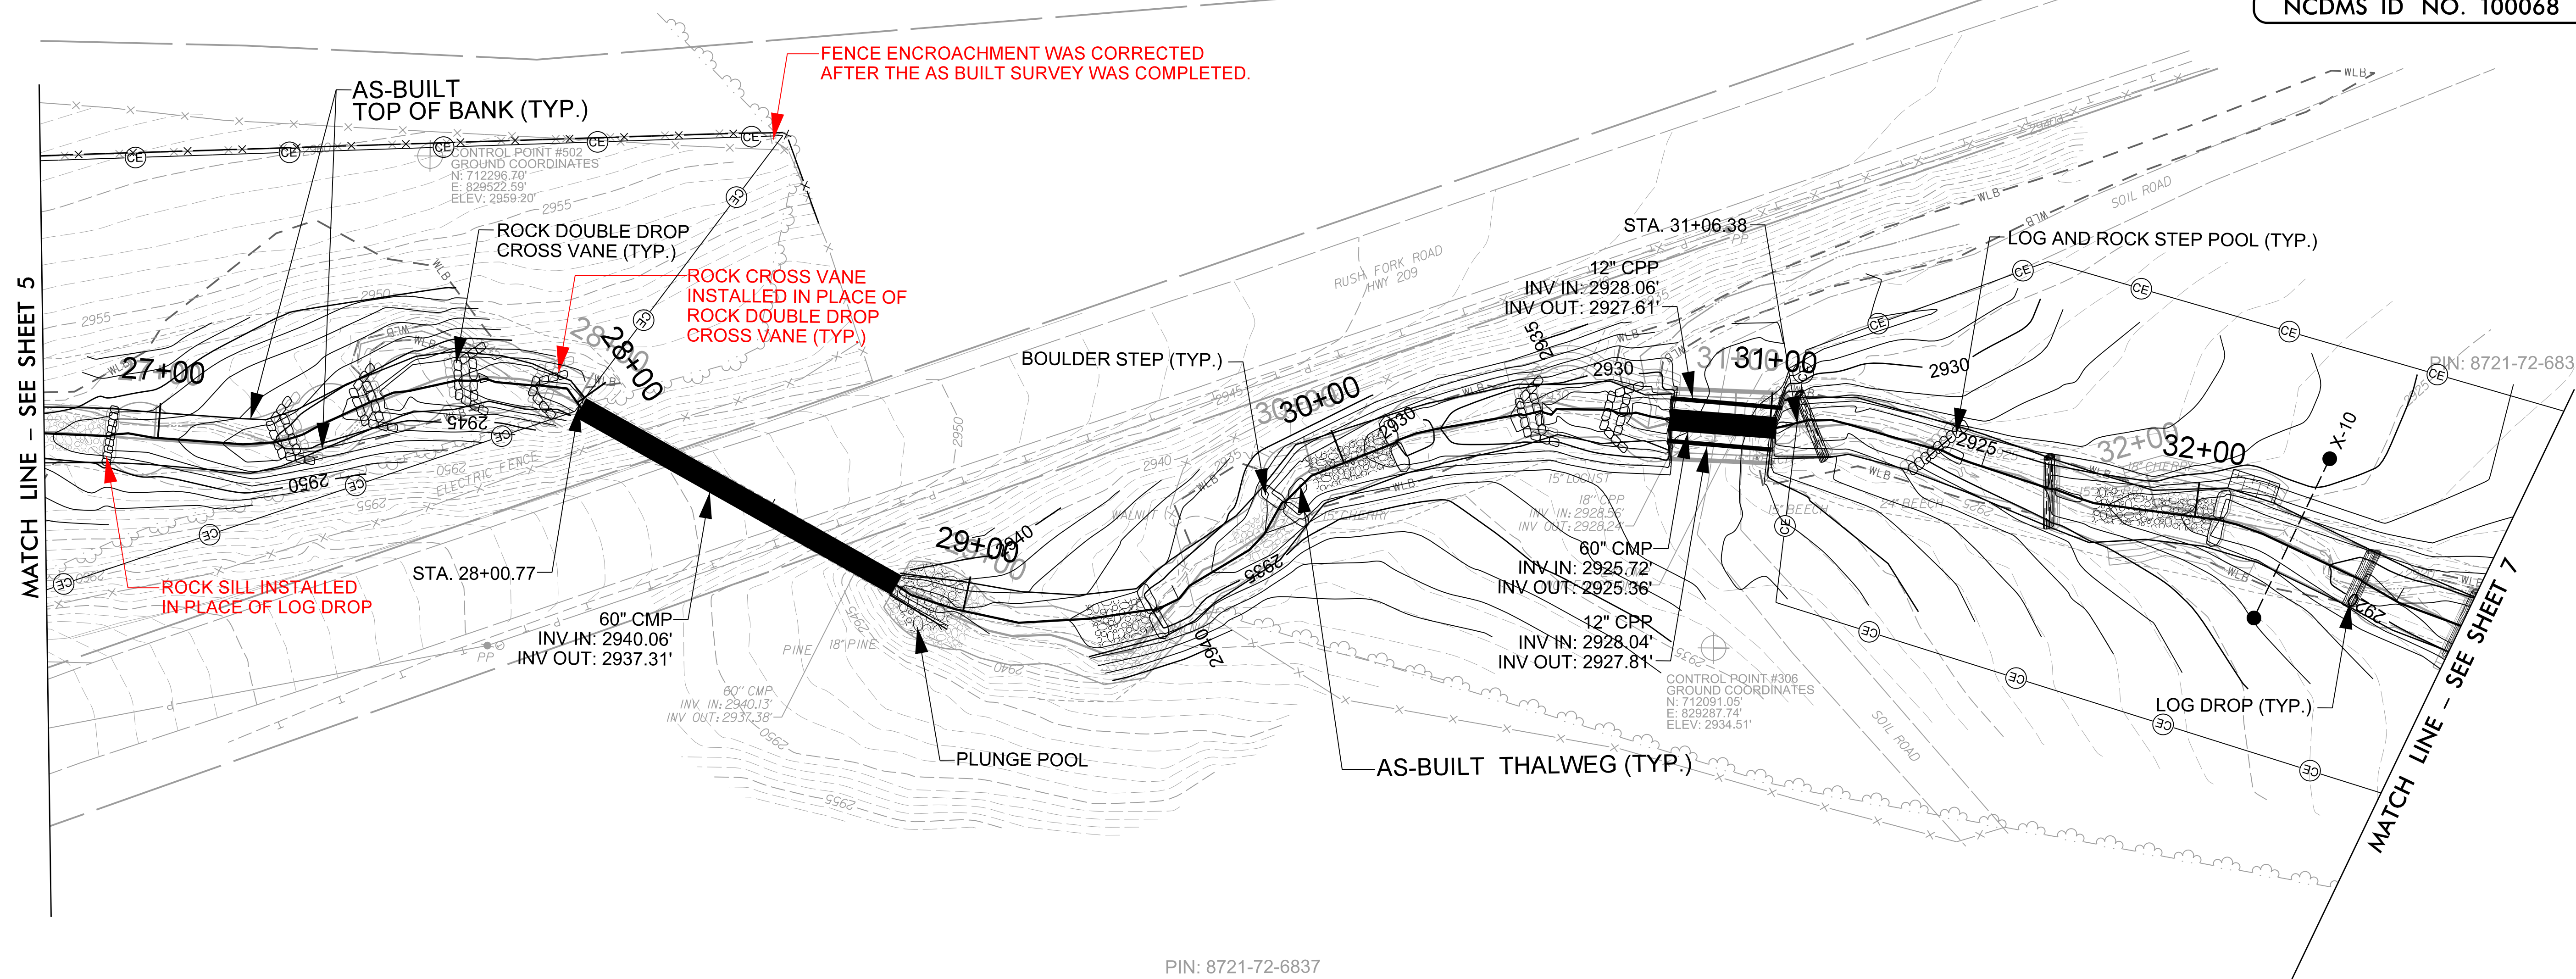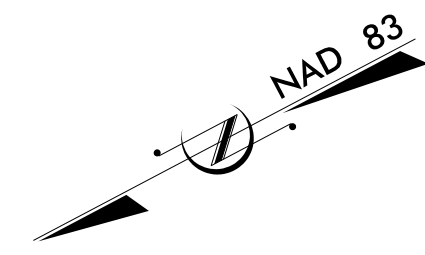

MATCH LINE - SEE SHEET 5

MATCH LINE - SEE SHEET 7

PIN: 8721-72-6837

RECORD DRAWING LEGEND	
	PROPOSED DESIGN
	AS-BUILT SURVEY BY KEE MAPPING & SURVEYING 4/14/22
	RED LINE VARIATIONS FROM ORIGINAL DESIGN SUBMITTED WITH THE MITIGATION PLAN

- FILL EXISTING CHANNEL
- CHANNEL PLUG


**UT to RUSH FORK
UTI
RECORD DRAWING**

SCALE (FT)

5/31/2022
C:\Users\ts\OneDrive\ts\166680_Rush_Fork_Design\As-Built\Plans\166680_ASB-PH_06.dgn

2/26/2023

PROJECT ENGINEER


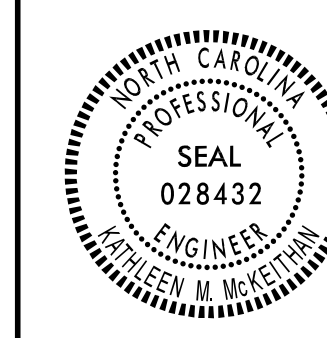


APPROVED BY:

DATE:

Michael Baker International
 Michael Baker Engineering Inc.
 5000 Regency Parkway, Suite 800
 Cary, NORTH CAROLINA 27518
 Phone: 919.453.5488
 Fax: 919.453.5490
 License #: F-1084

NC DMS ID NO. 100068

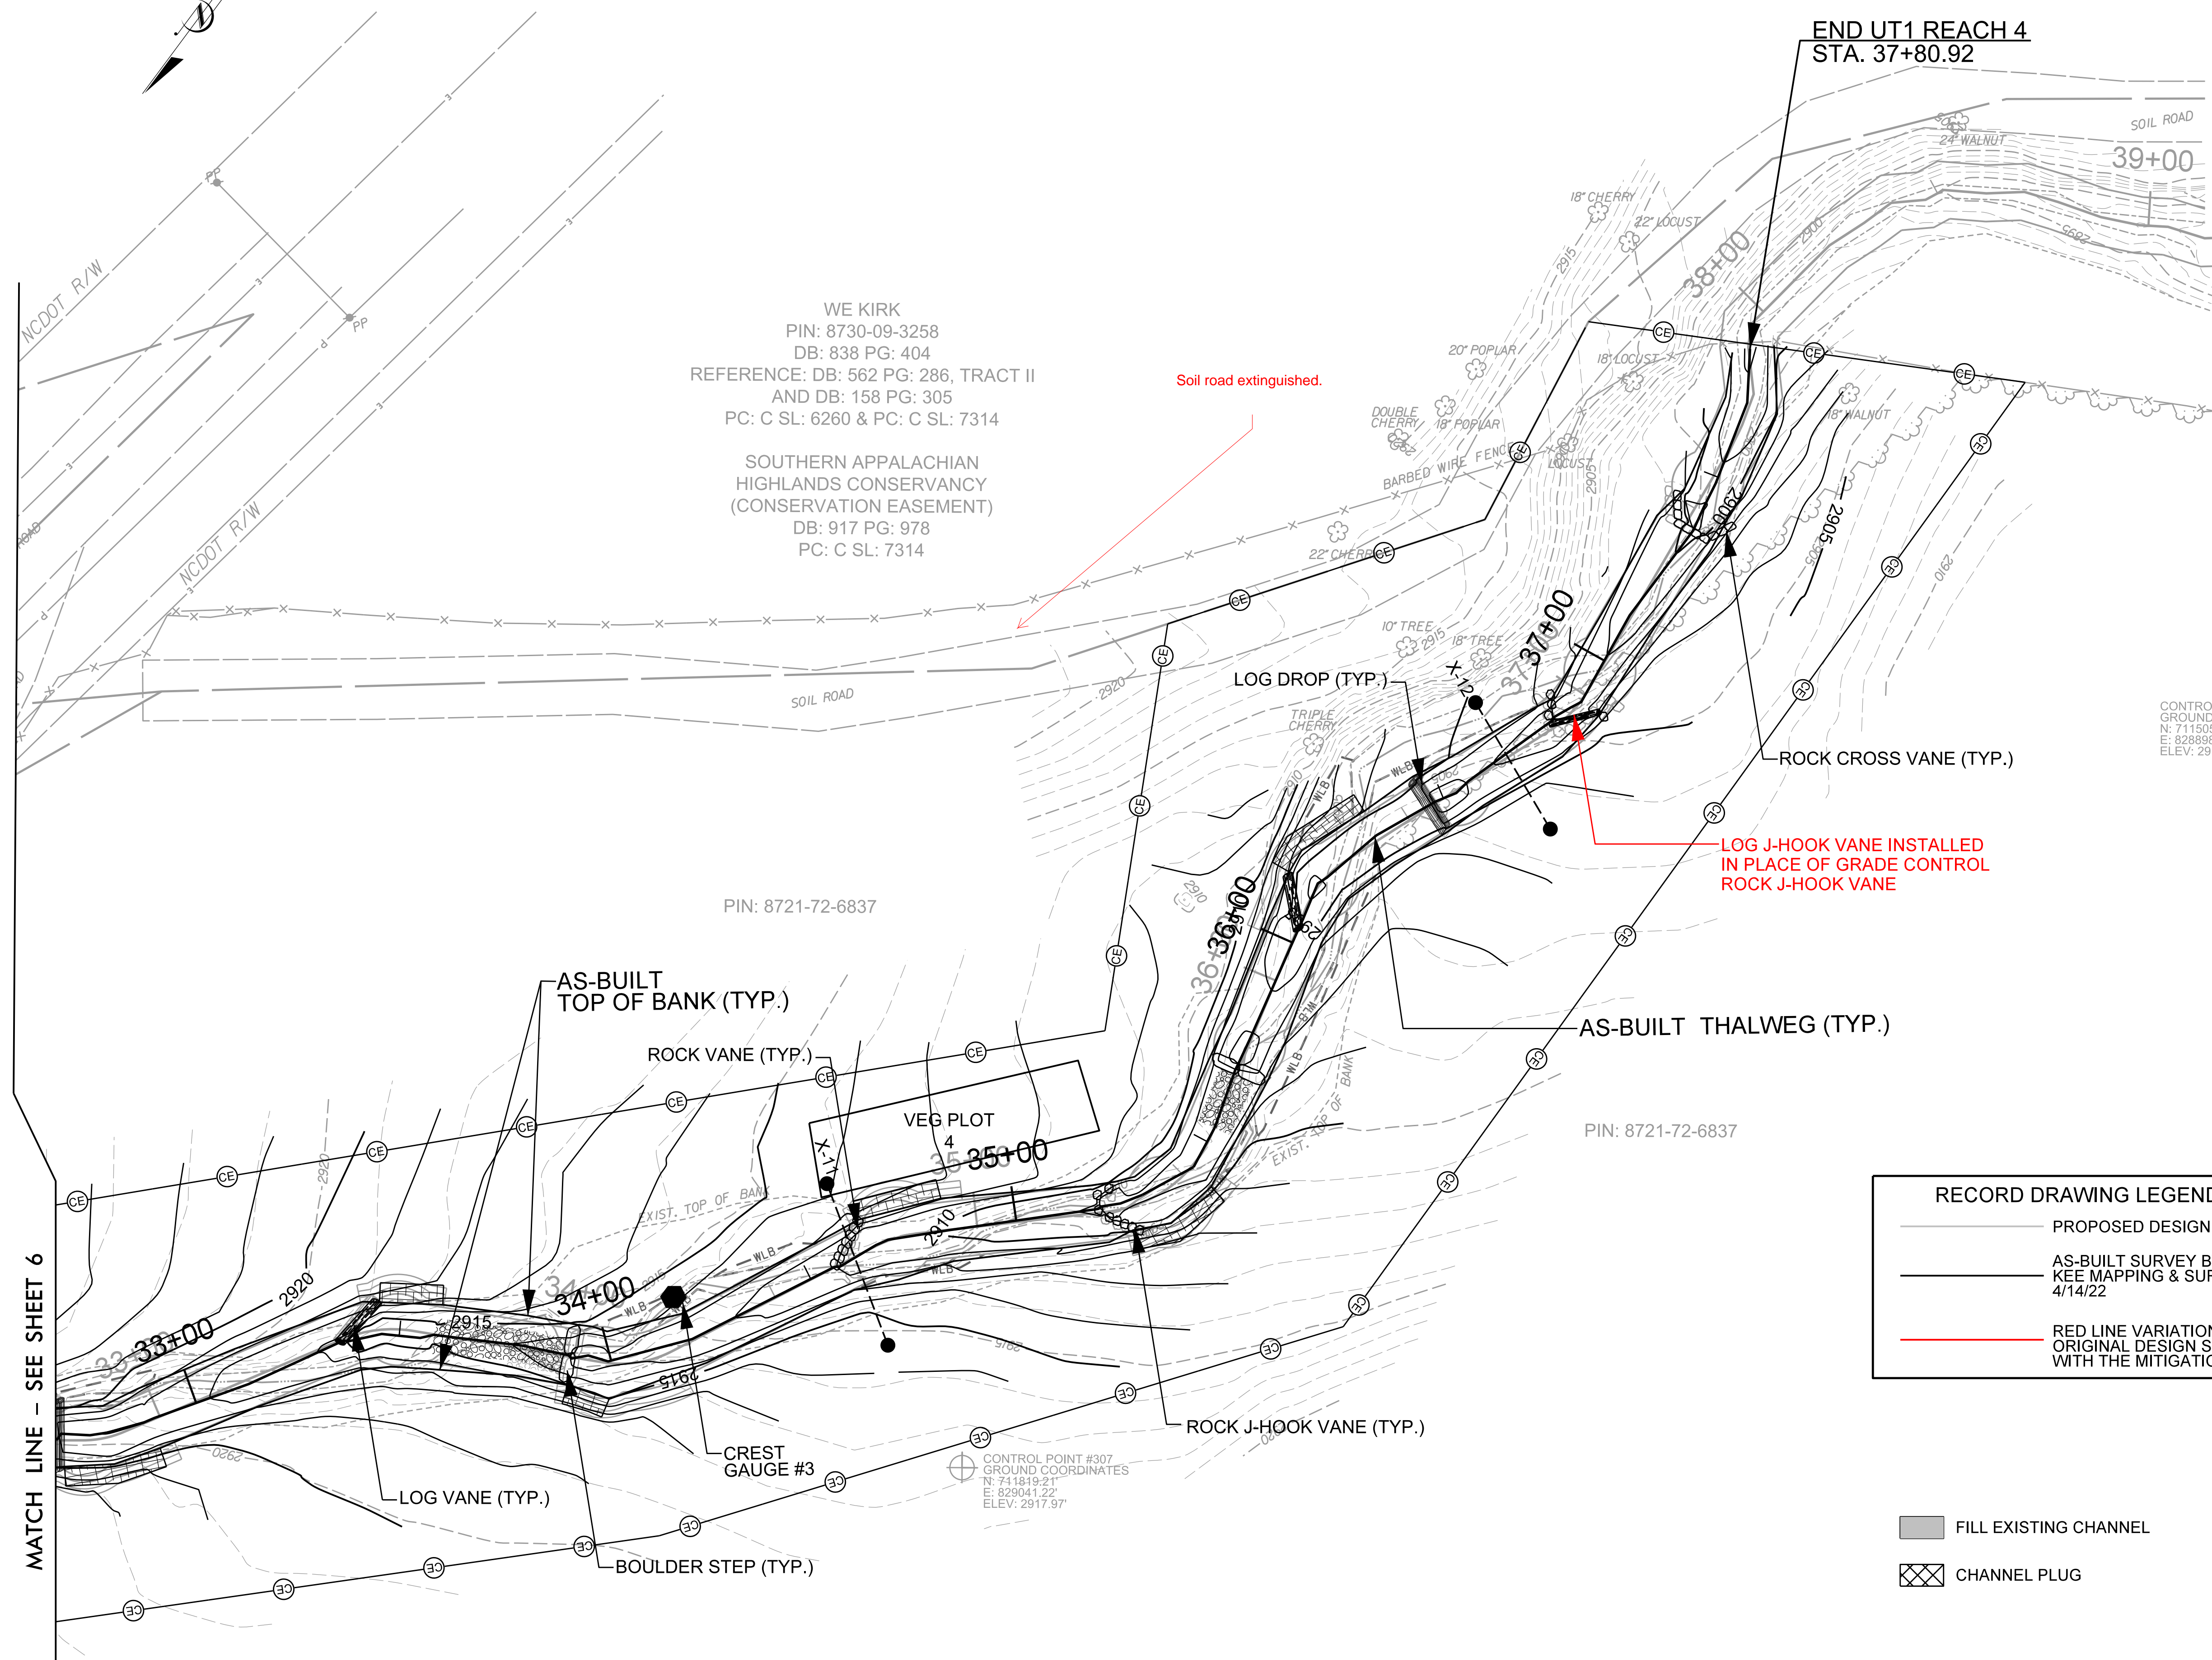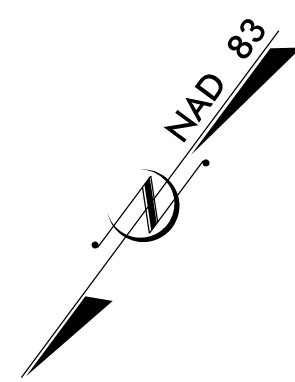

WE KIRK
 PIN: 8730-09-3258
 DB: 838 PG: 404
 REFERENCE: DB: 562 PG: 286, TRACT II
 AND DB: 158 PG: 305
 PC: C SL: 6260 & PC: C SL: 7314

SOUTHERN APPALACHIAN
 HIGHLANDS CONSERVANCY
 (CONSERVATION EASEMENT)
 DB: 917 PG: 978
 PC: C SL: 7314

CONTROL POINT #308
 GROUND COORDINATES
 N: 711505.47
 E: 828898.77
 ELEV: 2918.81'

PIN: 8721-72-6837

PIN: 8721-72-6837

RECORD DRAWING LEGEND

- PROPOSED DESIGN
- AS-BUILT SURVEY BY KEE MAPPING & SURVEYING 4/14/22
- RED LINE VARIATIONS FROM ORIGINAL DESIGN SUBMITTED WITH THE MITIGATION PLAN

- FILL EXISTING CHANNEL
- ⊠ CHANNEL PLUG


**UT to RUSH FORK
 UTI
 RECORD DRAWING**




SCALE (FT)



MATCH LINE - SEE SHEET 6

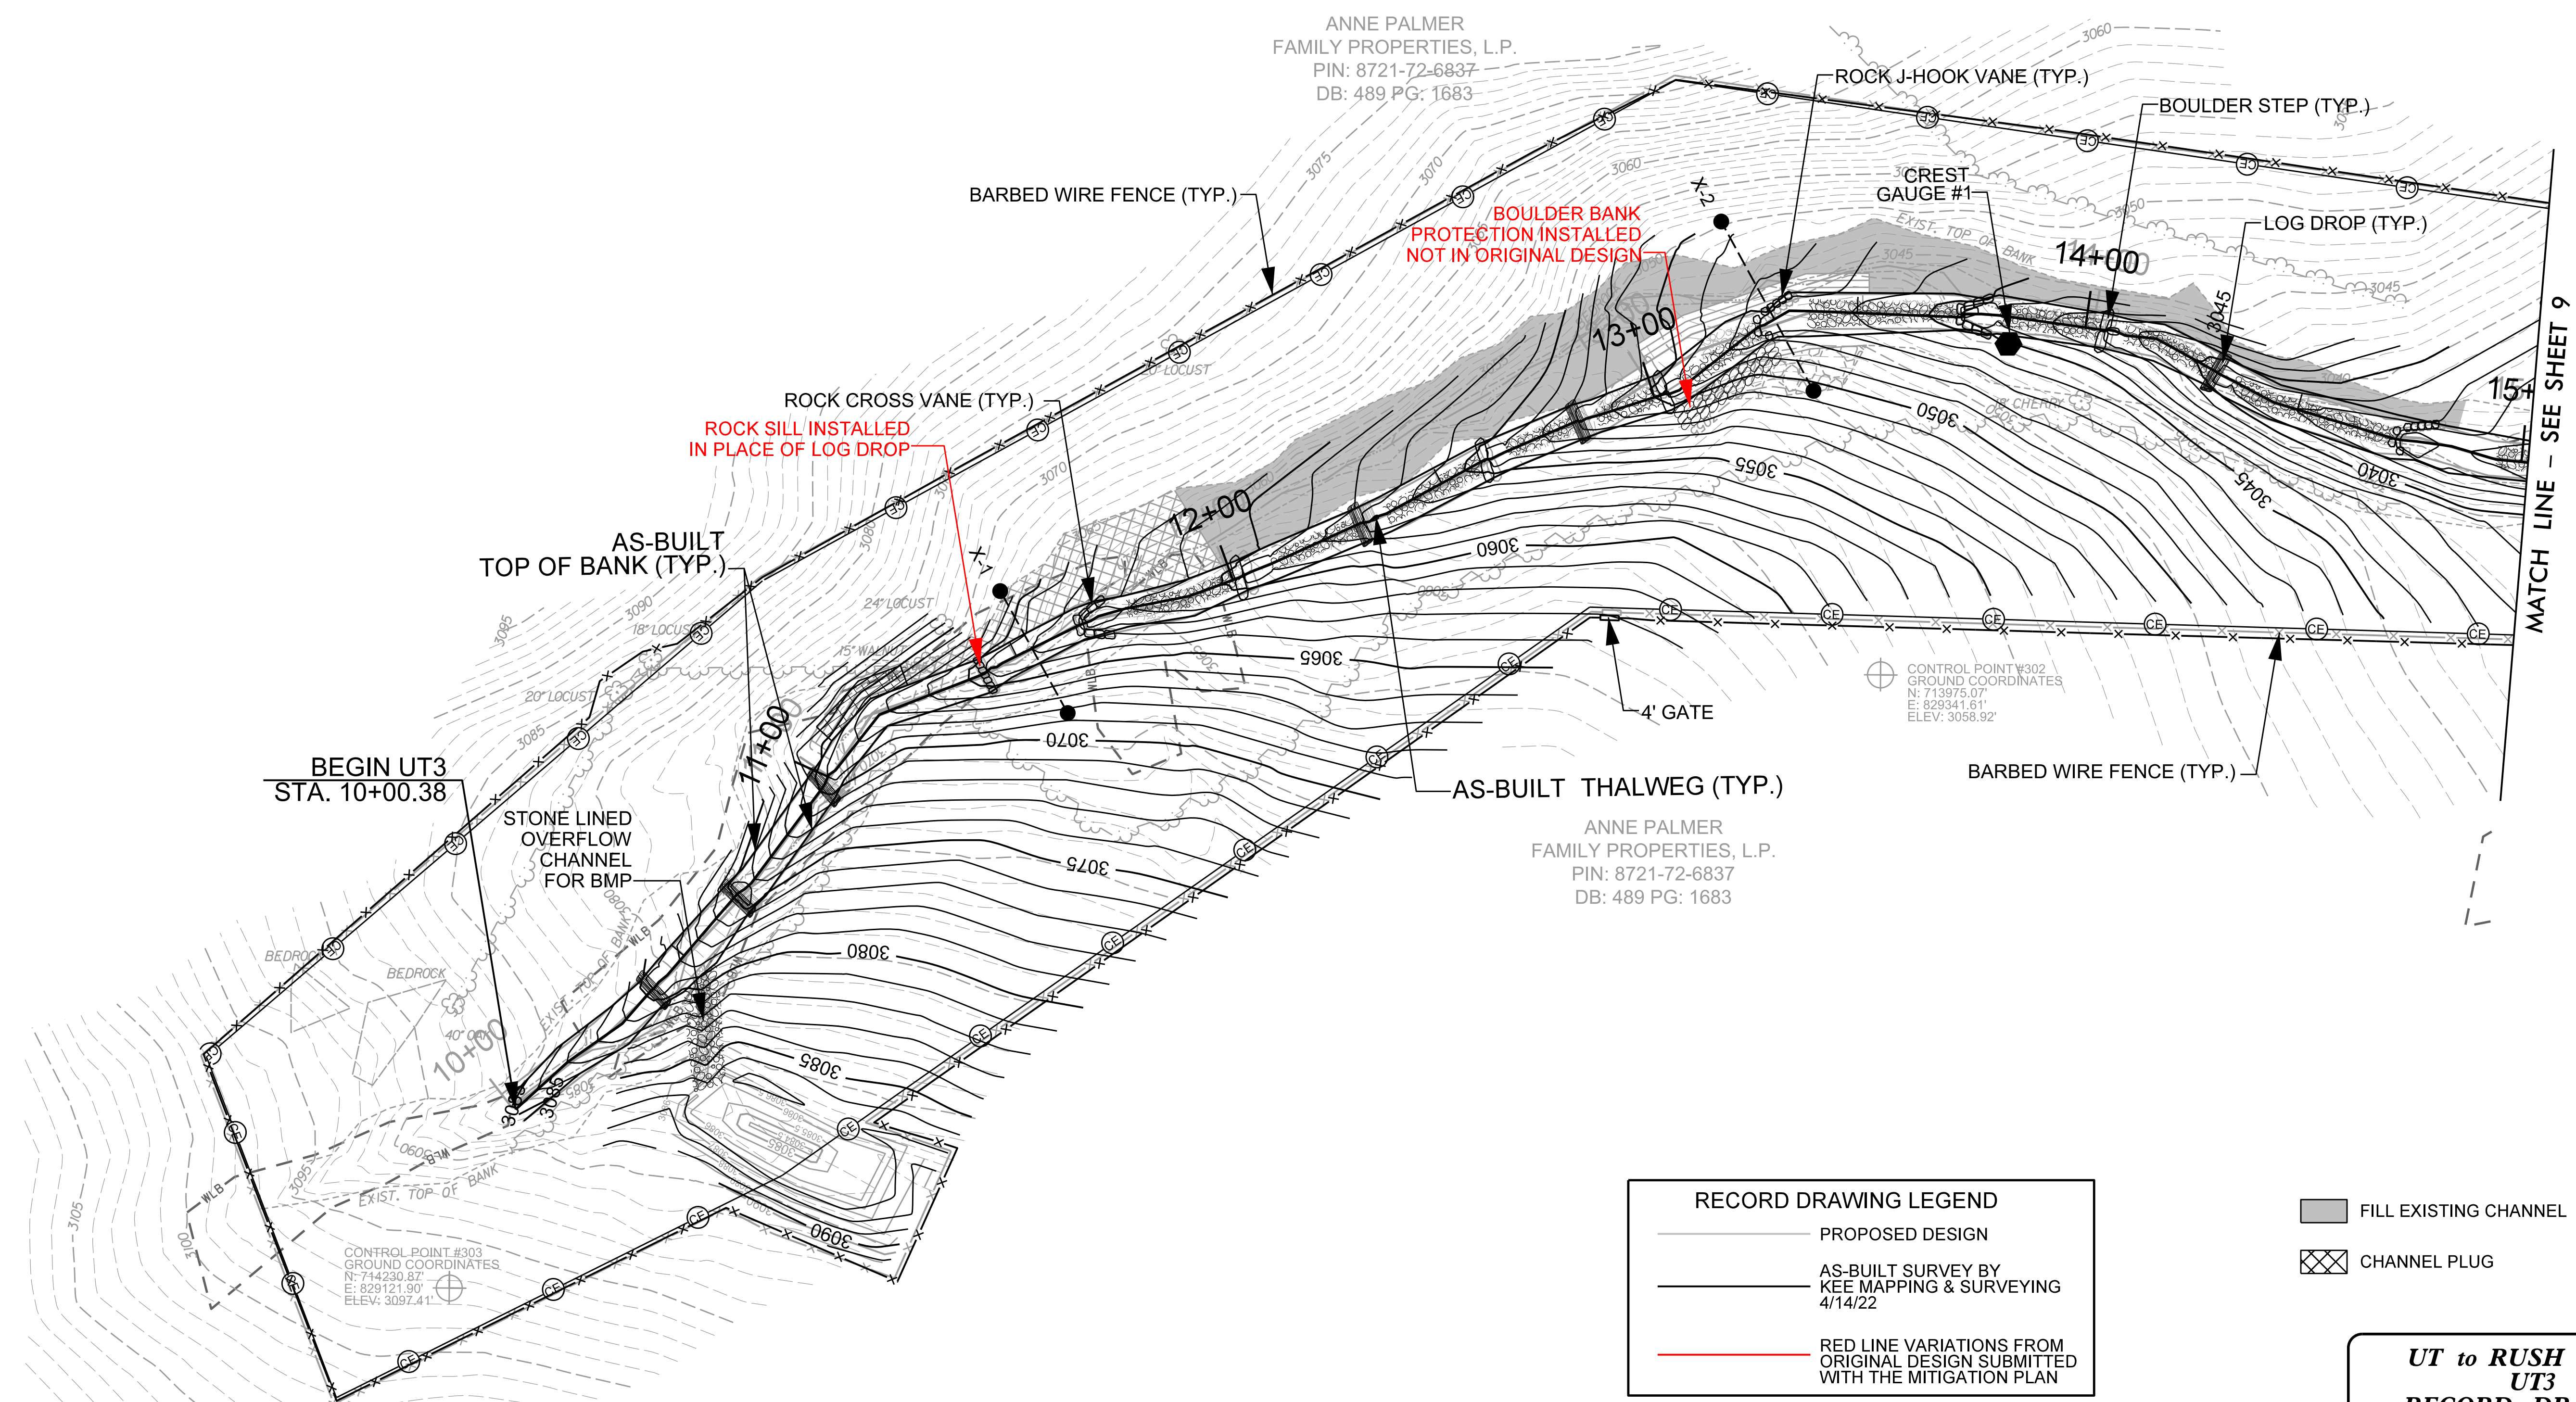
5/24/2022
 M:\Projects\166680_Rush_Fork_Design\As-Built\Plans\166680-ASB-FSH-07.dgn

2/26/2023



RECORD DRAWING LEGEND	
	PROPOSED DESIGN
	AS-BUILT SURVEY BY KEE MAPPING & SURVEYING 4/14/22
	RED LINE VARIATIONS FROM ORIGINAL DESIGN SUBMITTED WITH THE MITIGATION PLAN


-  FILL EXISTING CHANNEL
-  CHANNEL PLUG

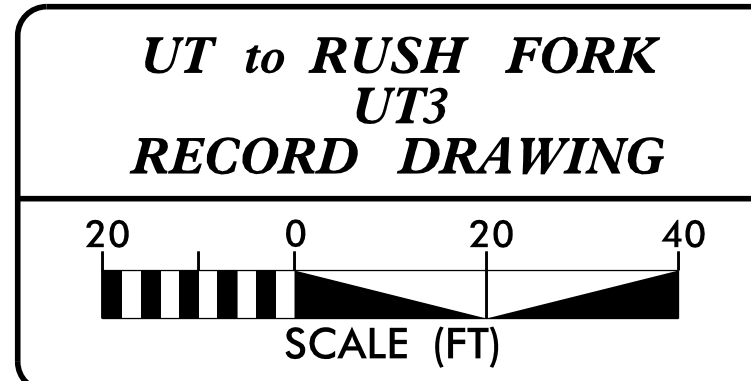

5/24/2022
 M:\Projects\166680_Rush_Fork\Design\As-Built\Plans\166680-ASB-FSH-08.dgn
 Michael Baker Engineering Inc.

2/26/23

ANNE PALMER
 FAMILY PROPERTIES, L.P.
 PIN: 8721-72-6837
 DB: 489 PG: 1683

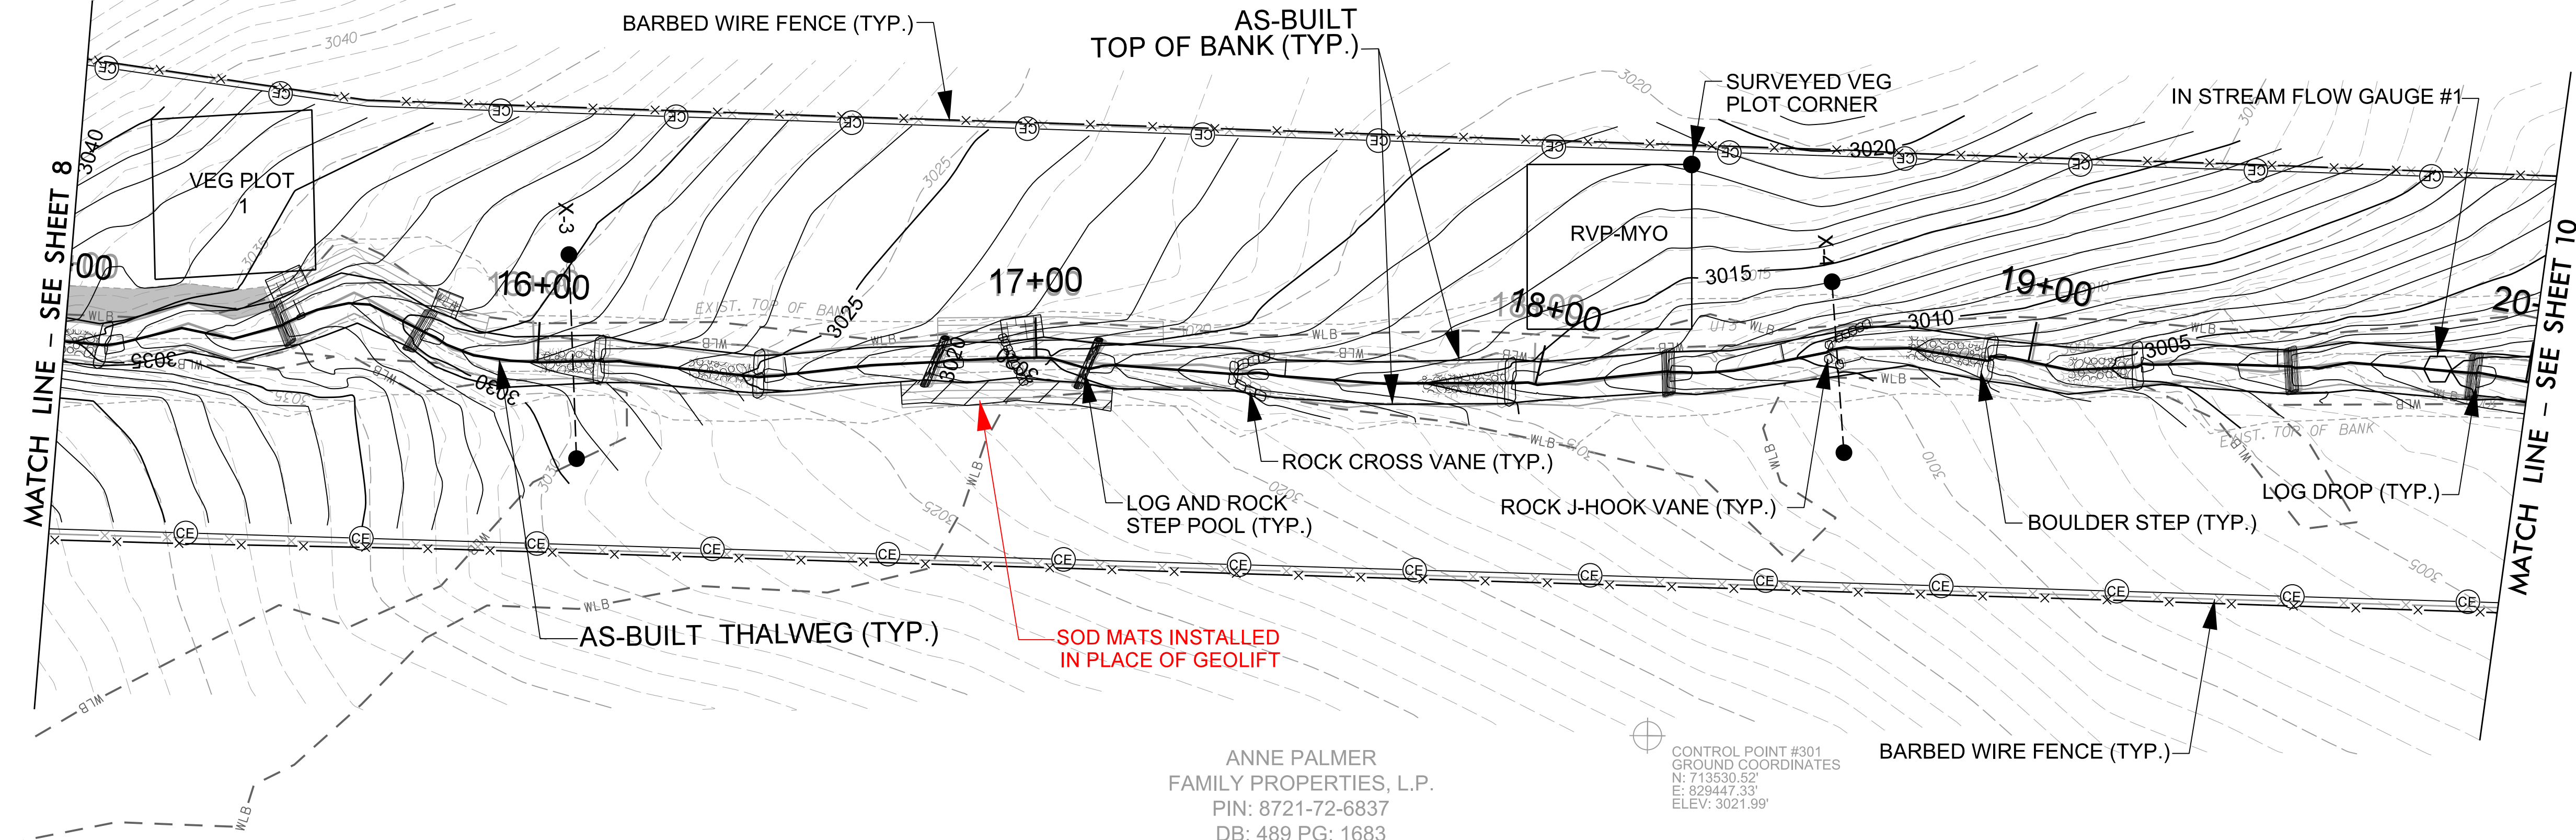

ANNE PALMER
 FAMILY PROPERTIES, L.P.
 PIN: 8721-72-6837
 DB: 489 PG: 1683

RECORD DRAWING LEGEND	
	PROPOSED DESIGN
	AS-BUILT SURVEY BY KEE MAPPING & SURVEYING 4/14/22
	RED LINE VARIATIONS FROM ORIGINAL DESIGN SUBMITTED WITH THE MITIGATION PLAN


	FILL EXISTING CHANNEL
	CHANNEL PLUG


**UT to RUSH FORK
 UT3
 RECORD DRAWING**

SCALE (FT)

6/6/2022
 C:\Users\jts\OneDrive\Documents\Projects\166680\ASB-PSH-09.dgn

2/26/2023

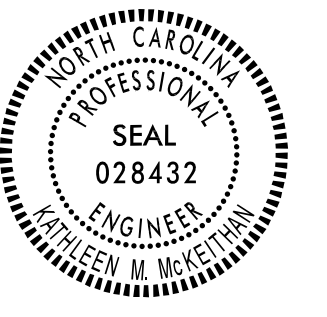BAKER PROJECT REFERENCE NO. 166680	SHEET NO. 10
PROJECT ENGINEER	
	
DATE:	
Michael Baker International	
Michael Baker Engineering Inc. 5030 Regency Parkway, Suite 500 Cary, NORTH CAROLINA 27518 Phone: 919.453.5488 Fax: 919.453.5490 License #: F-1084	
NC DMS ID NO. 100068	

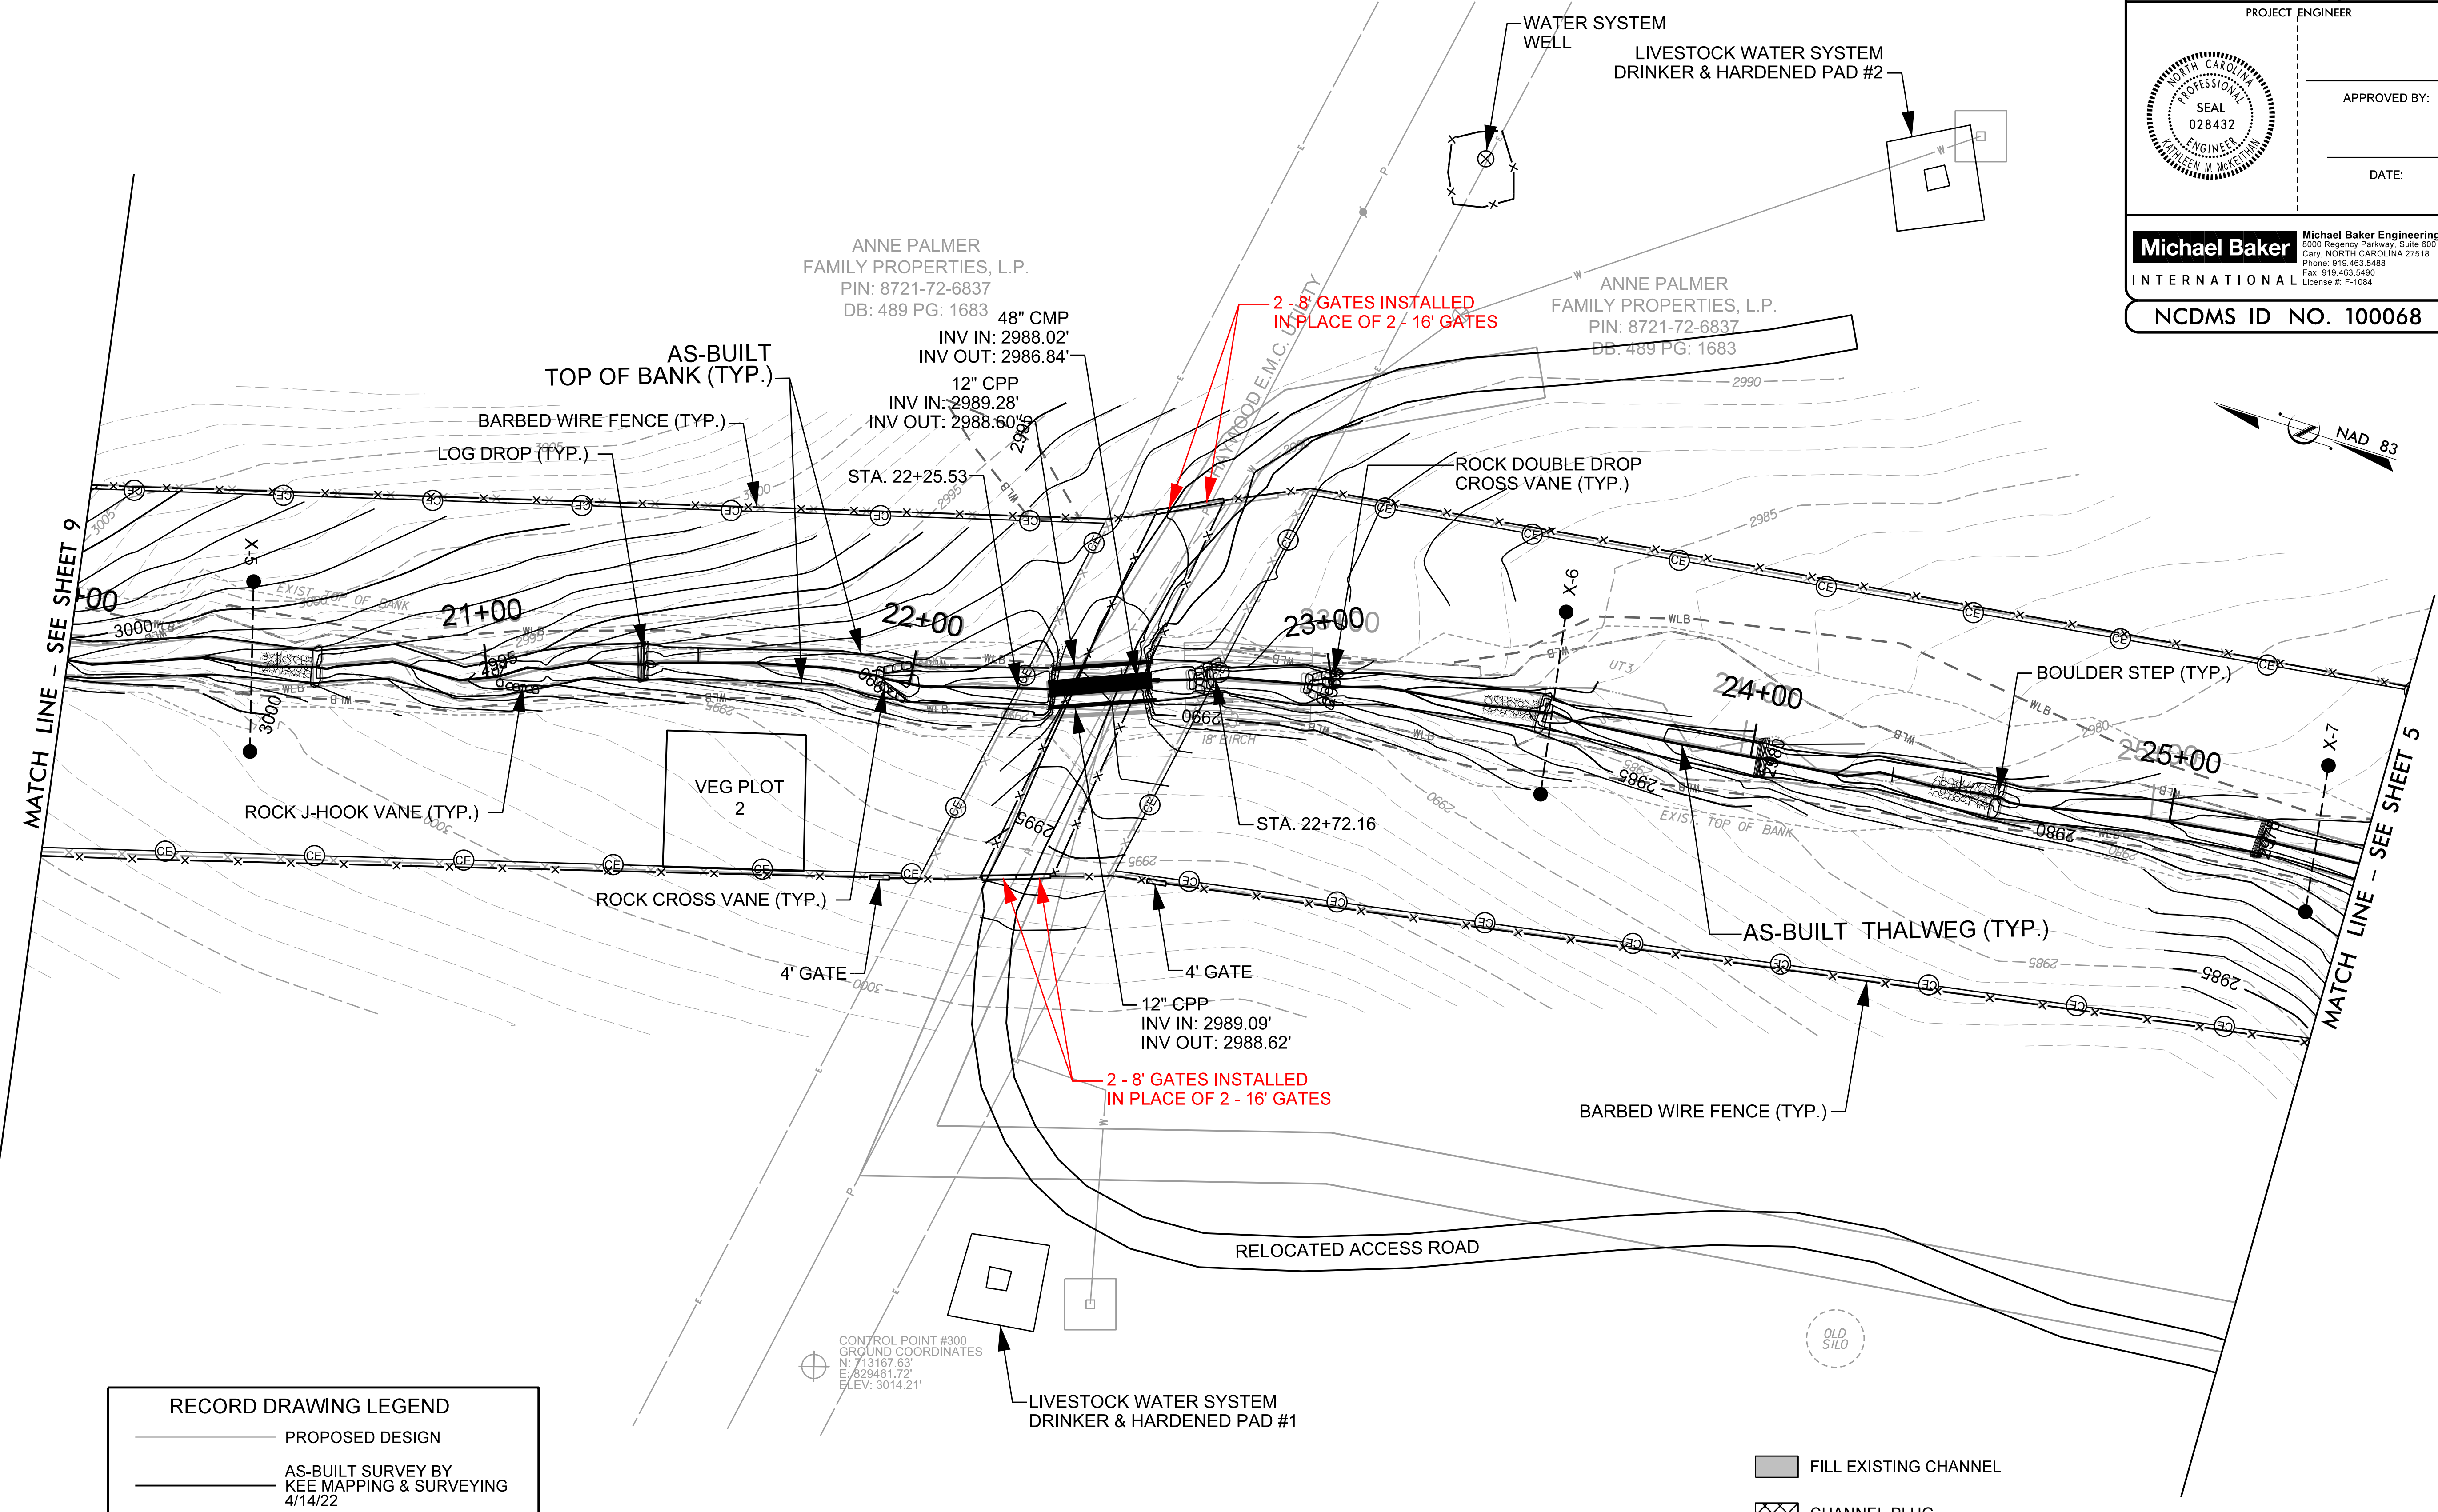

RECORD DRAWING LEGEND

- PROPOSED DESIGN
- - - AS-BUILT SURVEY BY KEE MAPPING & SURVEYING 4/14/22
- RED LINE VARIATIONS FROM ORIGINAL DESIGN SUBMITTED WITH THE MITIGATION PLAN

- FILL EXISTING CHANNEL
- ⊗ CHANNEL PLUG

ANNE PALMER
 FAMILY PROPERTIES, L.P.
 PIN: 8721-72-6837
 DB: 489 PG: 1683



**UT to RUSH FORK
 UT3
 RECORD DRAWING**

20 0 20 40
 SCALE (FT)

5/24/2022
 M:\Projects\166680_Rush_Fork\Design\As-Built\Plans\166680_ASB-FSH-10.dgn
 Michael Keeth

2/26/03



BAKER PROJECT REFERENCE NO. 166680	SHEET NO. 11
PROJECT ENGINEER	
APPROVED BY:	
DATE:	
Michael Baker International	
<small>Michael Baker Engineering Inc. 3000 Regency Parkway, Suite 500 Cary, NORTH CAROLINA 27518 Phone: 919.463.5488 Fax: 919.463.5490 License #: F-1084</small>	
NCDMS ID NO. 100068	

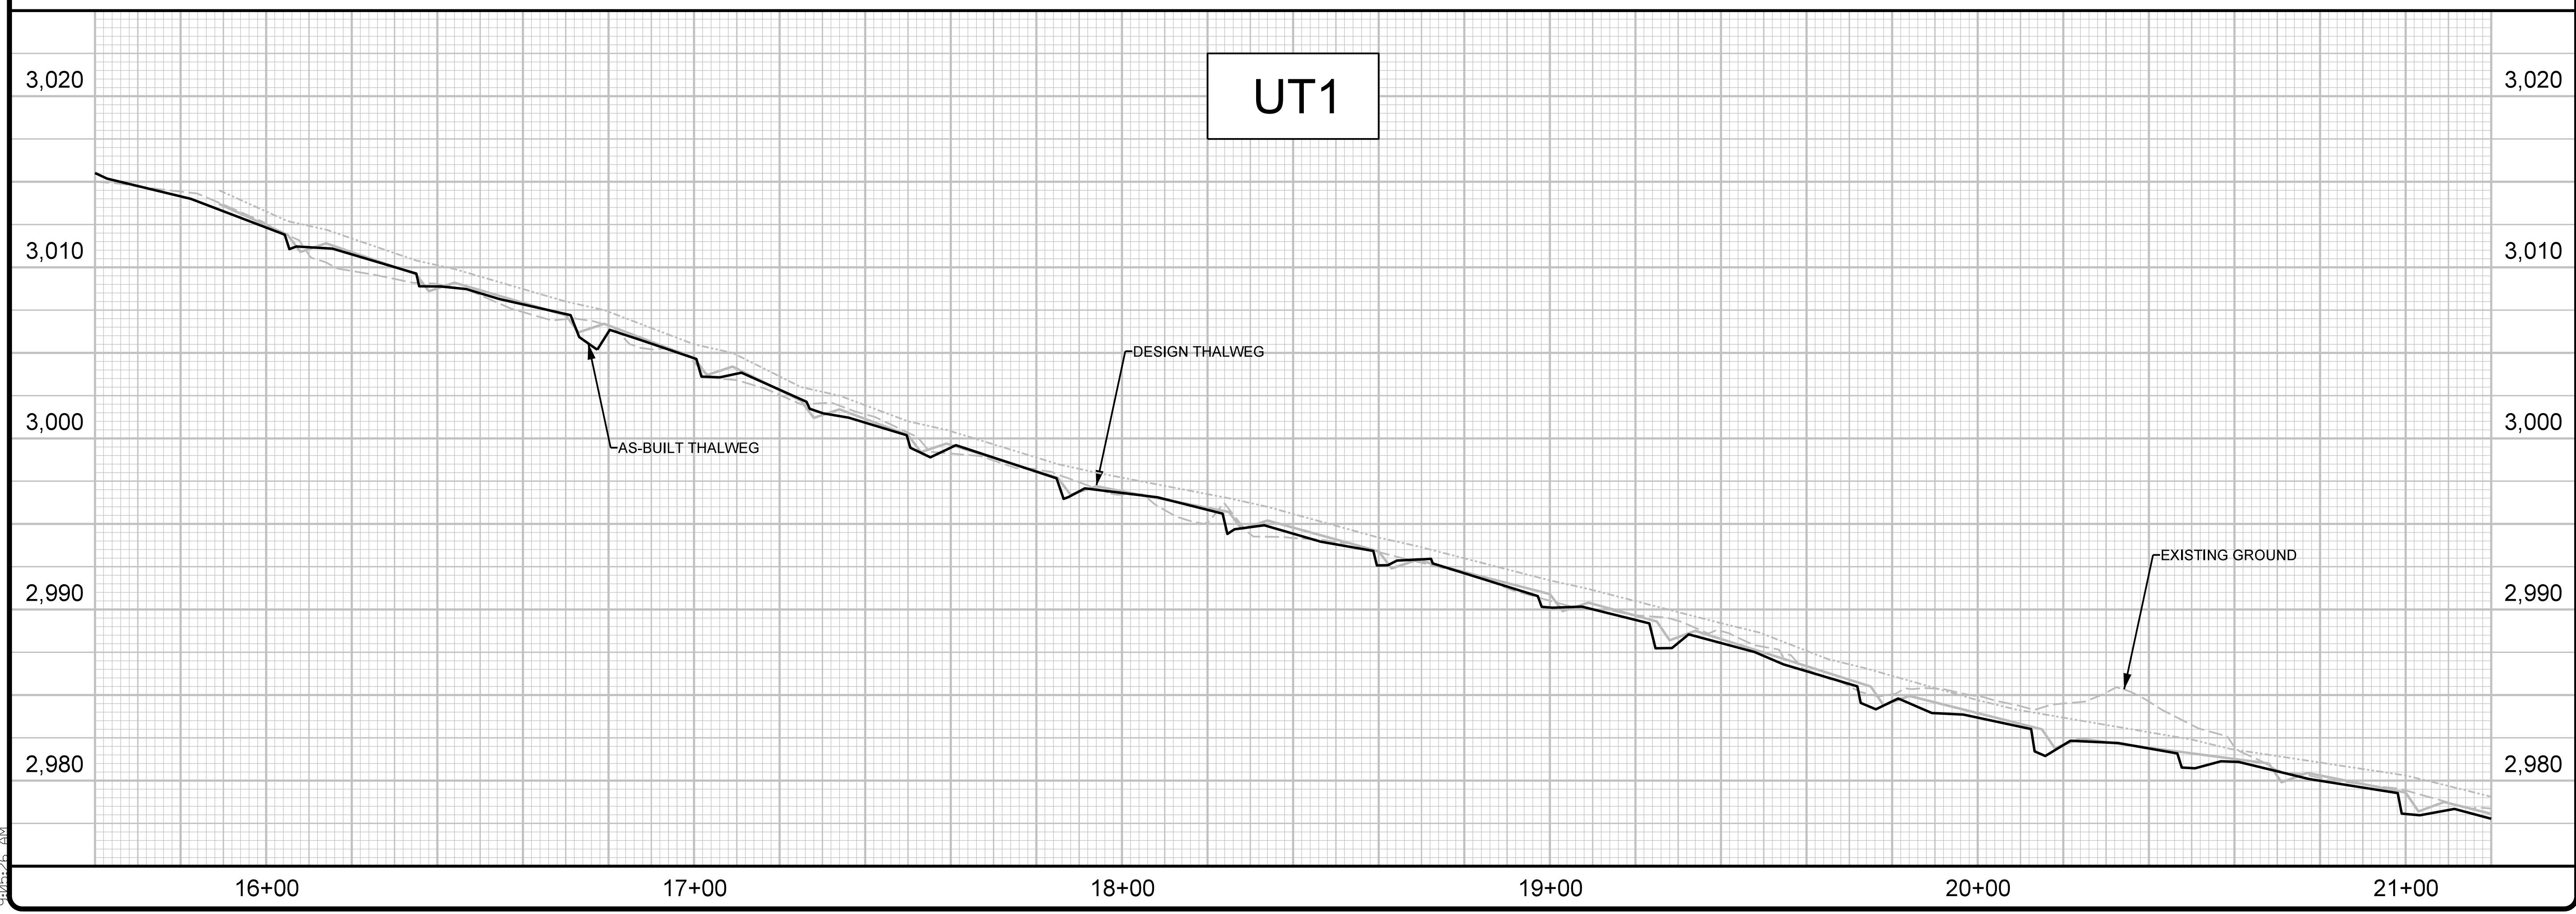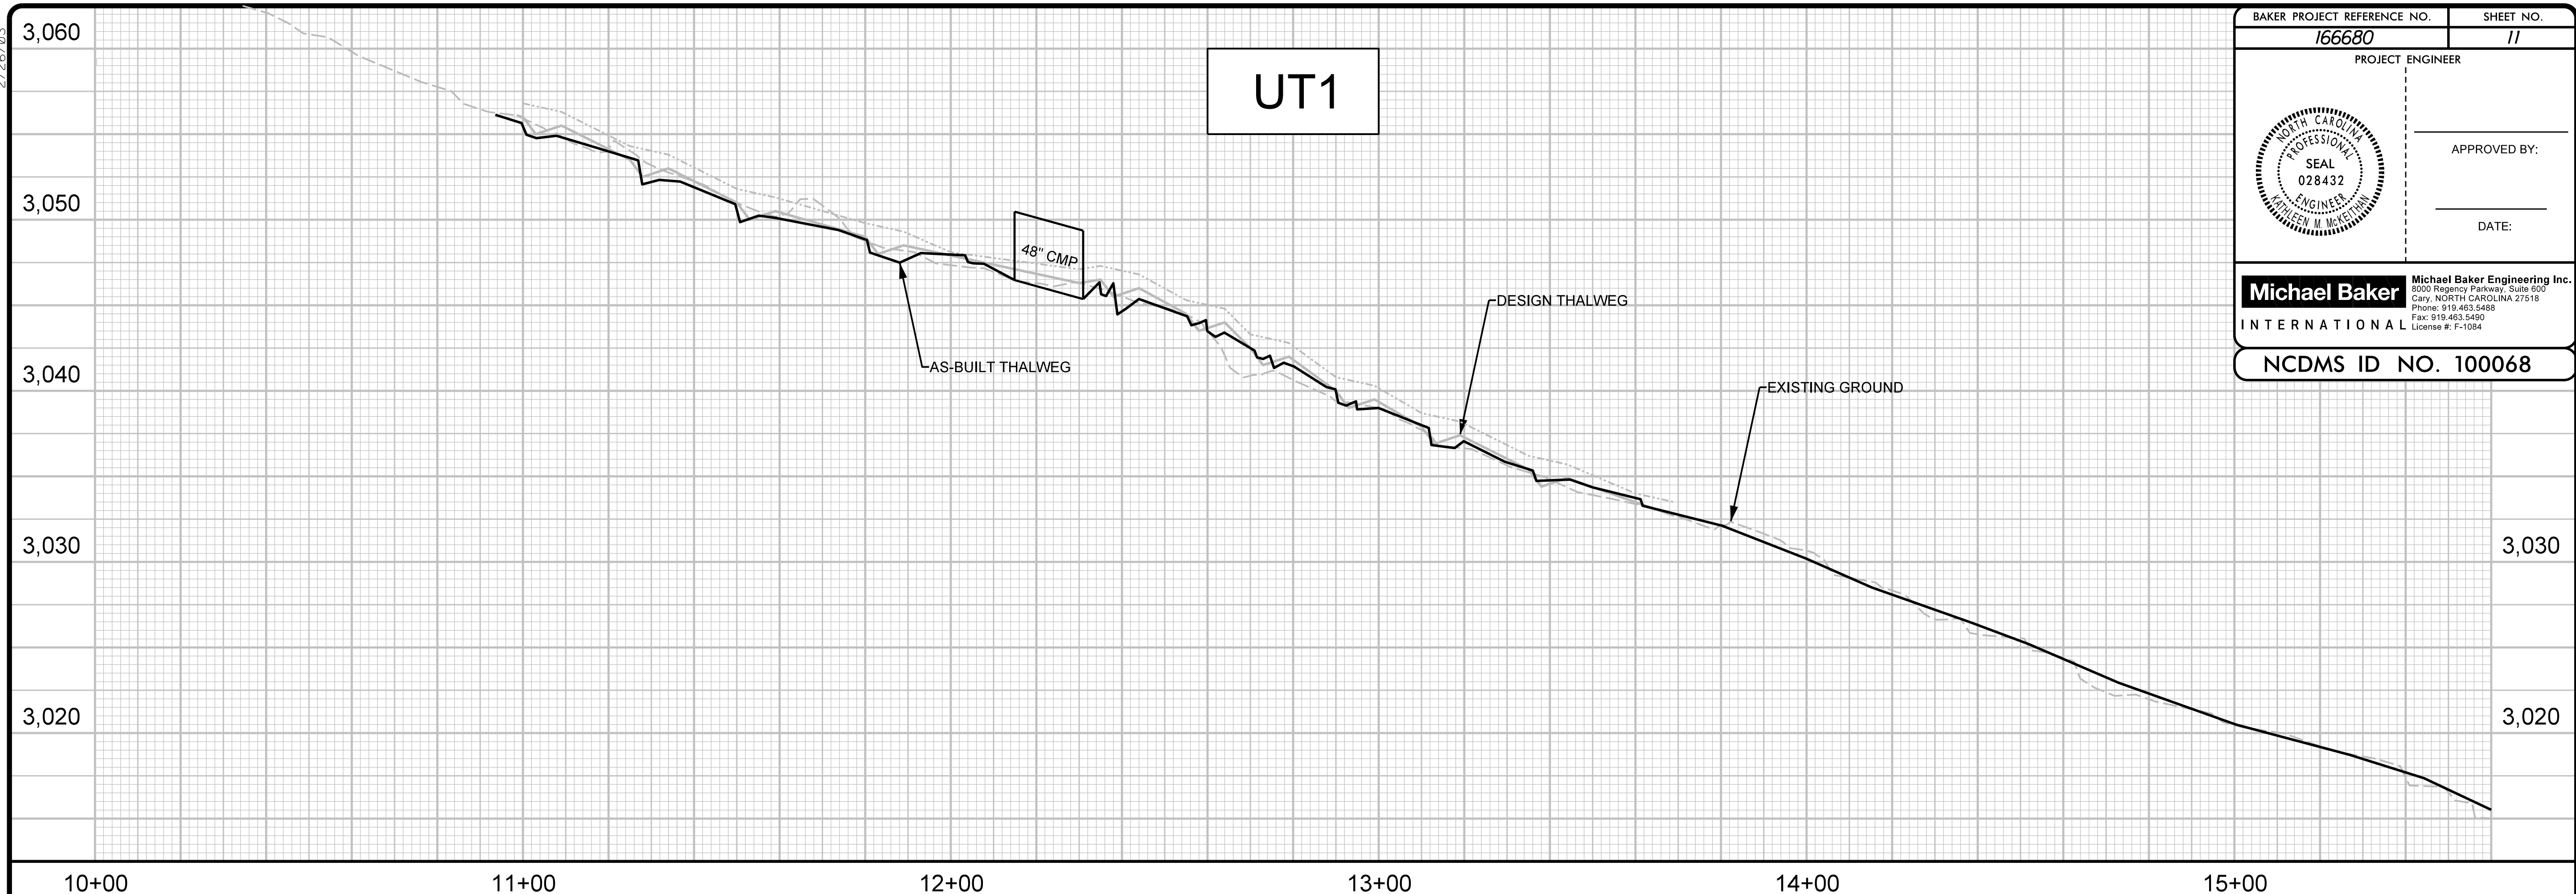

F:\24\2022\Projects\166680_Rush_Fork_Design\As-Built\Plans\166680_ASB-PFL-11.dgn

2/26/03
5/24/2022
F:\Projects\166680_Rush_Fork_Design\As-Built\Plans\166680_ASB-PFL-12.dgn

BAKER PROJECT REFERENCE NO. 166680	SHEET NO. 12
PROJECT ENGINEER	
APPROVED BY:	
DATE:	
	
Michael Baker International Michael Baker Engineering Inc. 3000 Regency Parkway, Suite 500 Cary, NORTH CAROLINA 27518 Phone: 919.463.5488 Fax: 919.463.5490 License #: F-1084	
NCDMS ID NO. 100068	

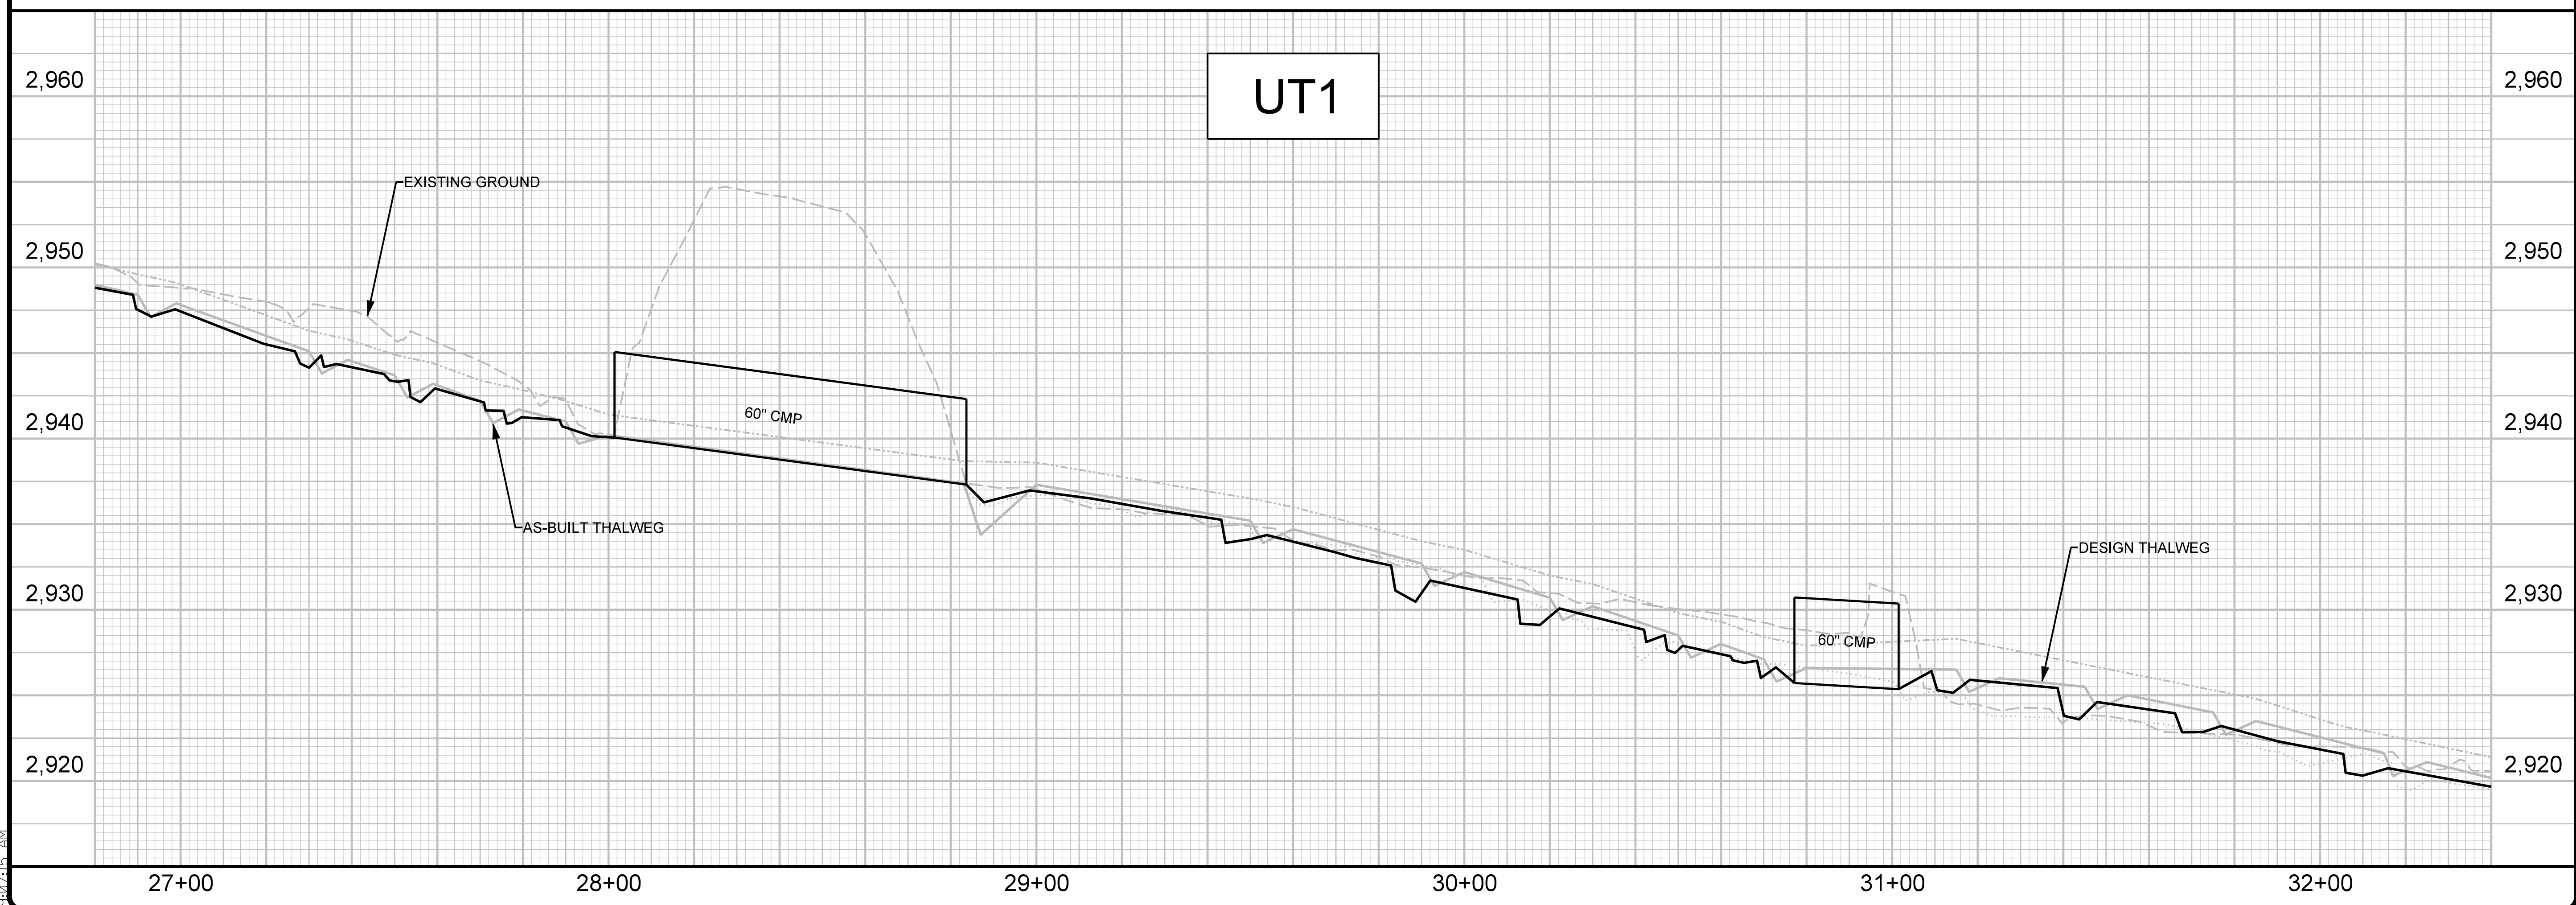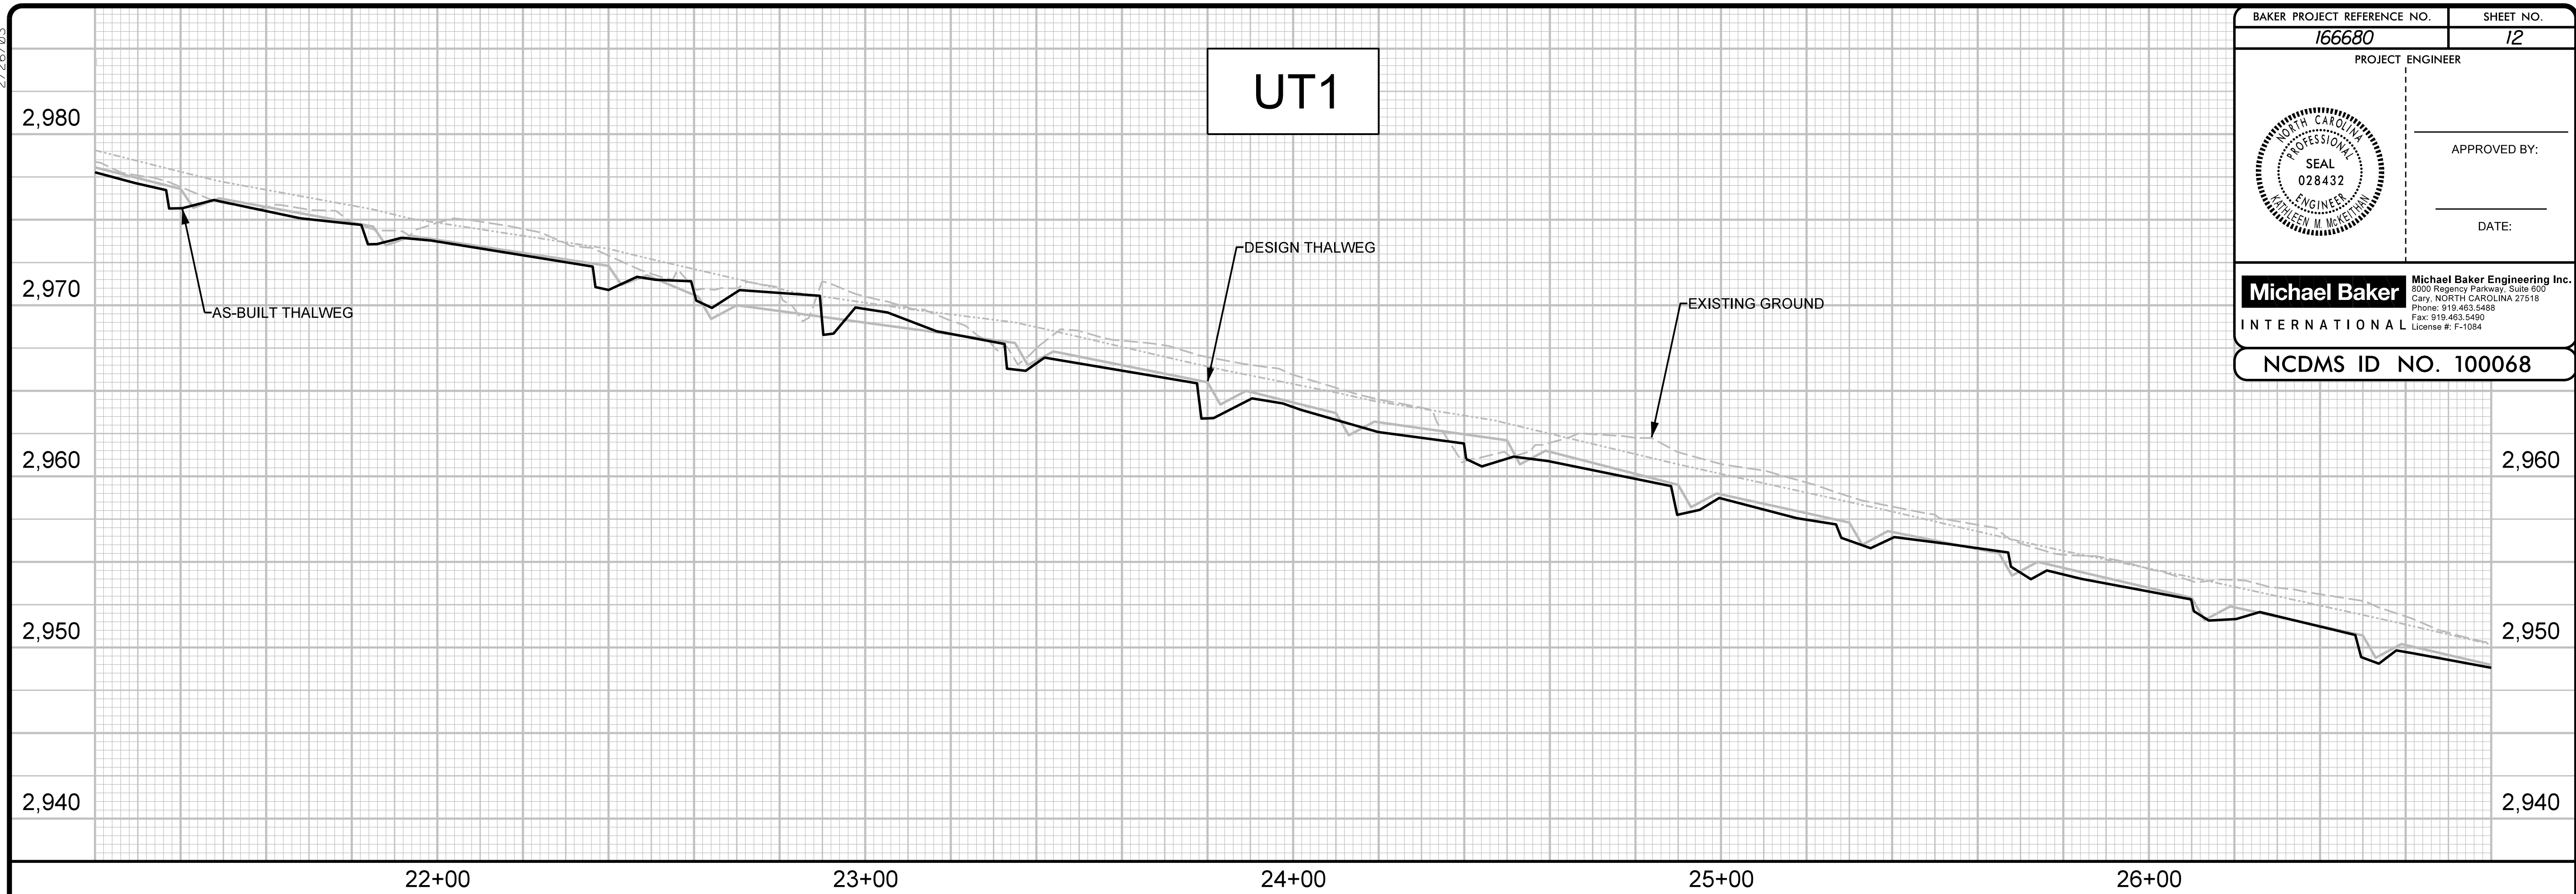

2/26/03

UT1



BAKER PROJECT REFERENCE NO. 166680	SHEET NO. 13
PROJECT ENGINEER	
	
DATE:	
Michael Baker International	
<small>Michael Baker Engineering Inc. 5000 Regency Parkway, Suite 500 Cary, NORTH CAROLINA 27518 Phone: 919.463.5498 Fax: 919.463.5490 License #: F-1084</small>	
NCDMS ID NO. 100068	



F:\24\2022\Projects\166680_Rush_Fork_Design\As-Built\Plans\166680_ASB-PFL-13.dgn

2/26/03

BAKER PROJECT REFERENCE NO. 166680	SHEET NO. 14
PROJECT ENGINEER	
	
DATE:	
Michael Baker International	
<small>Michael Baker Engineering Inc. 3000 Regency Parkway, Suite 500 Cary, NORTH CAROLINA 27518 Phone: 919.463.5498 Fax: 919.463.5490 License #: F-1084</small>	
NCDMS ID NO. 100068	

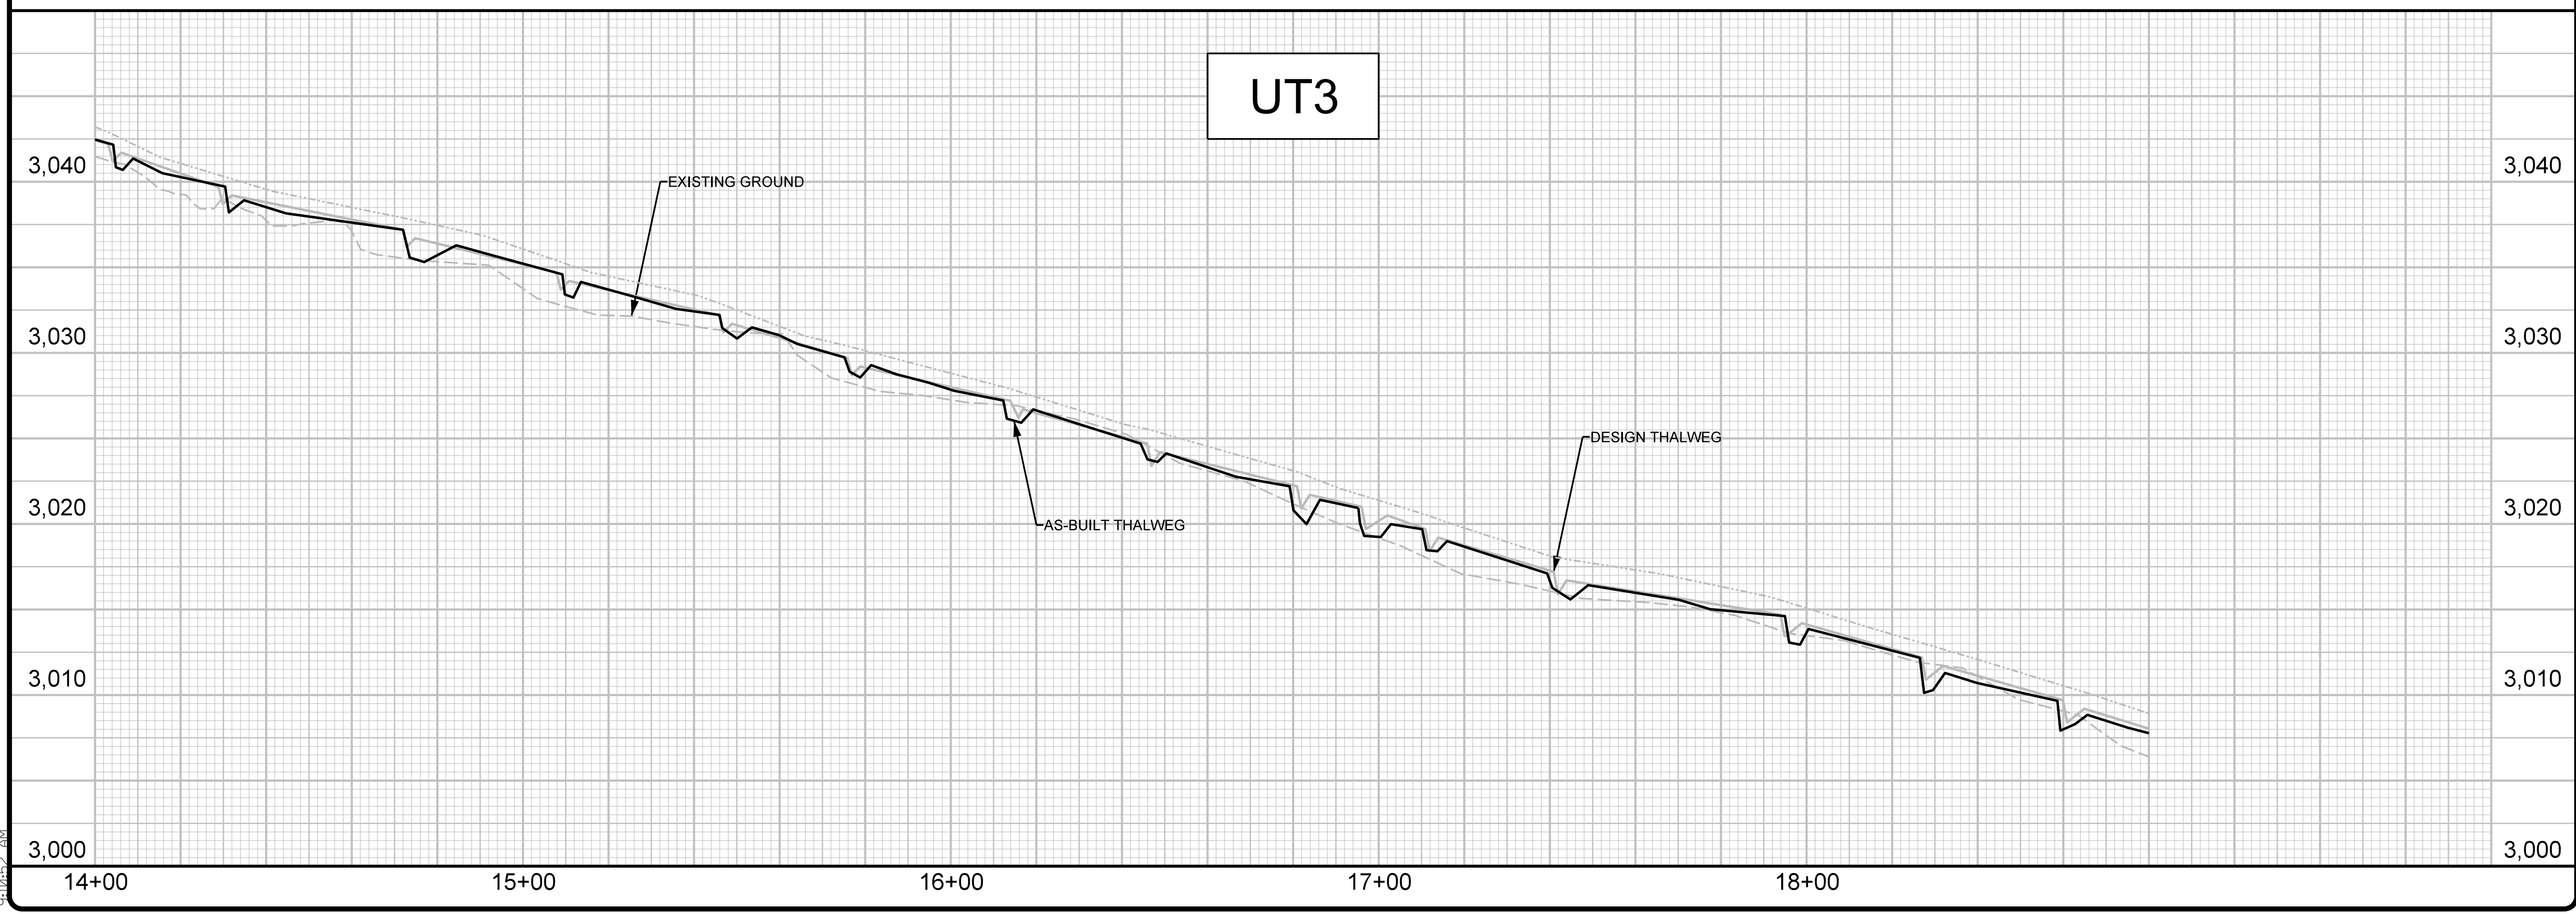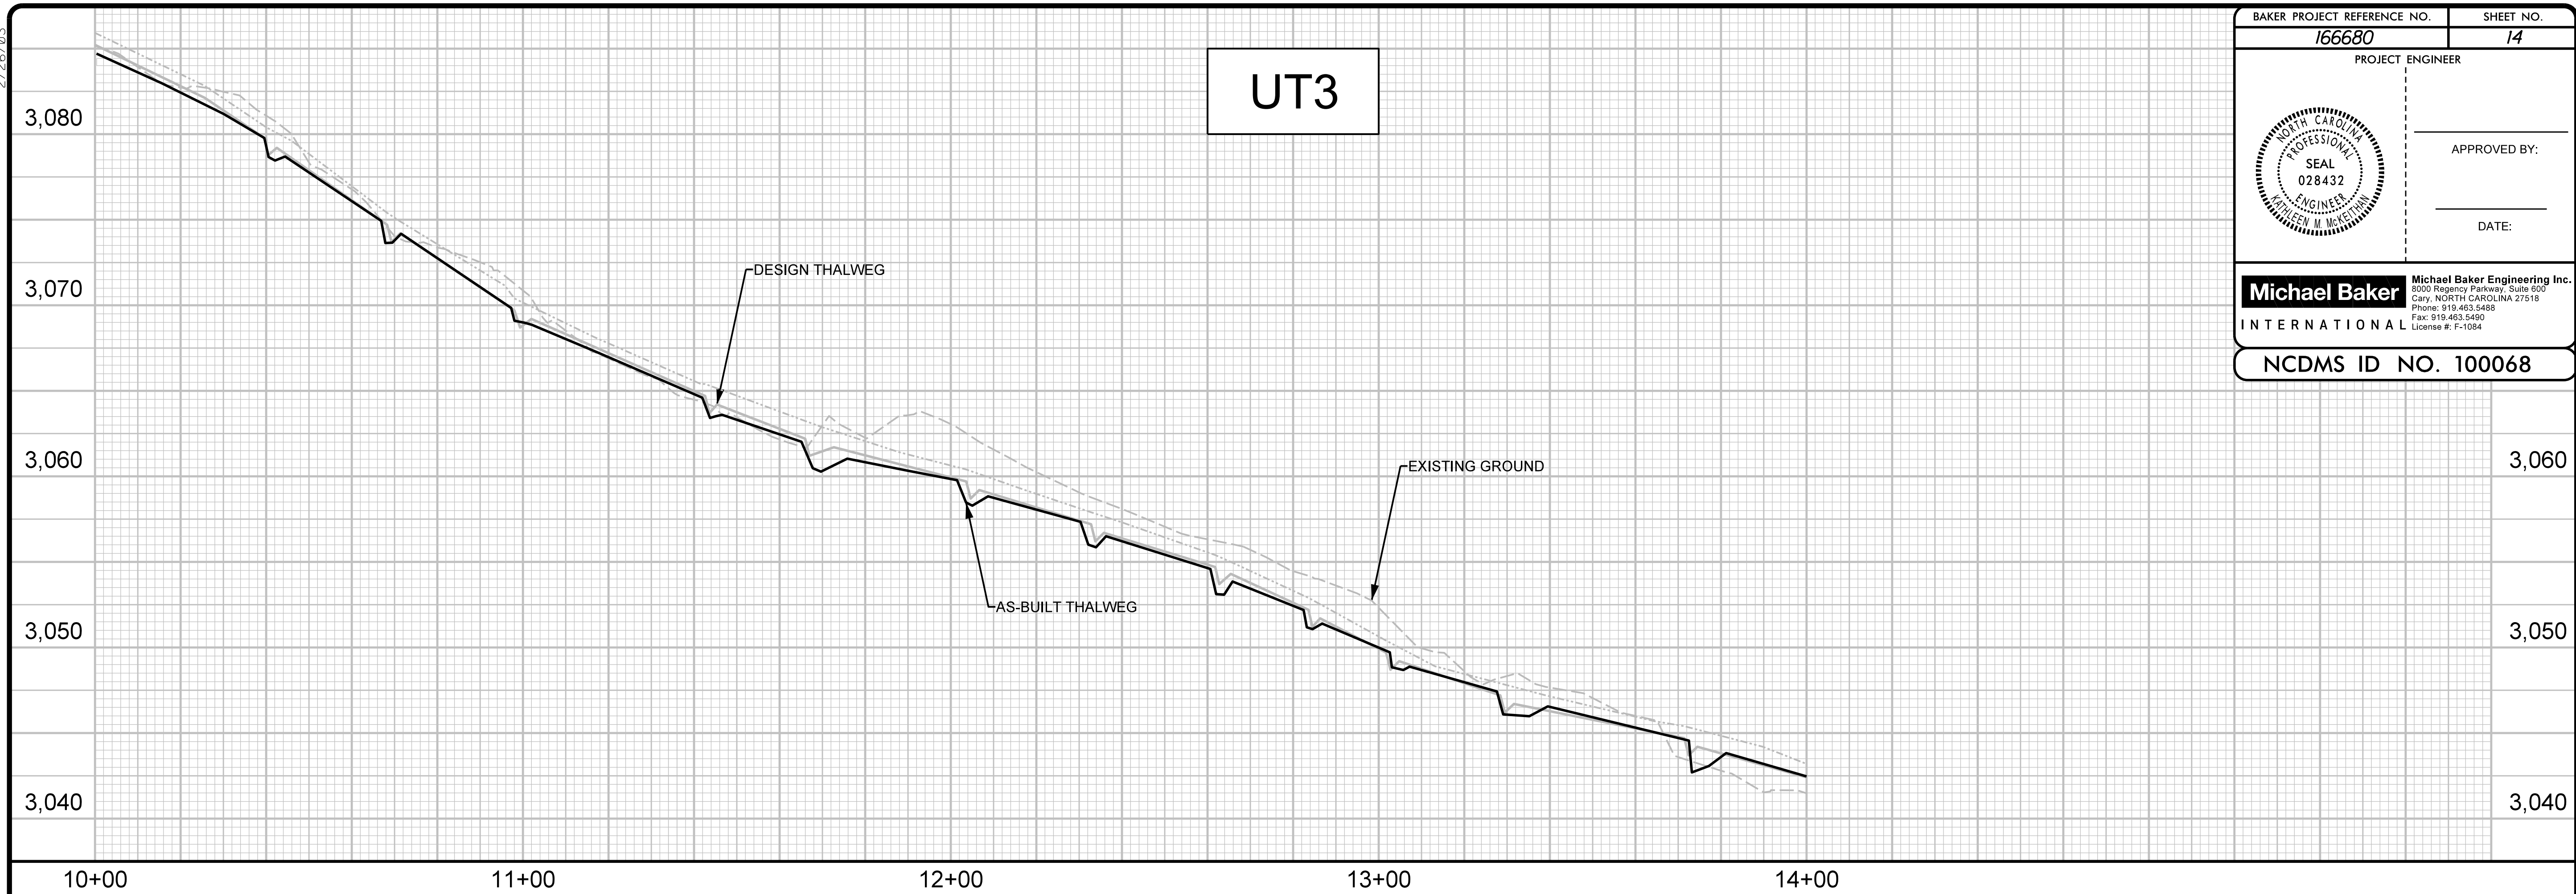


F:\24\2022\Projects\166680_Rush_Fork\Design\As-Built\Plans\166680_ASB-PFL-14.dgn

2/26/03

PROJECT ENGINEER



APPROVED BY:

DATE:




Michael Baker International Michael Baker Engineering Inc.
 3000 Regency Parkway, Suite 500
 Cary, NORTH CAROLINA 27518
 Phone: 919.463.5488
 Fax: 919.463.5490
 License #: F-1084

NCDMS ID NO. 100068

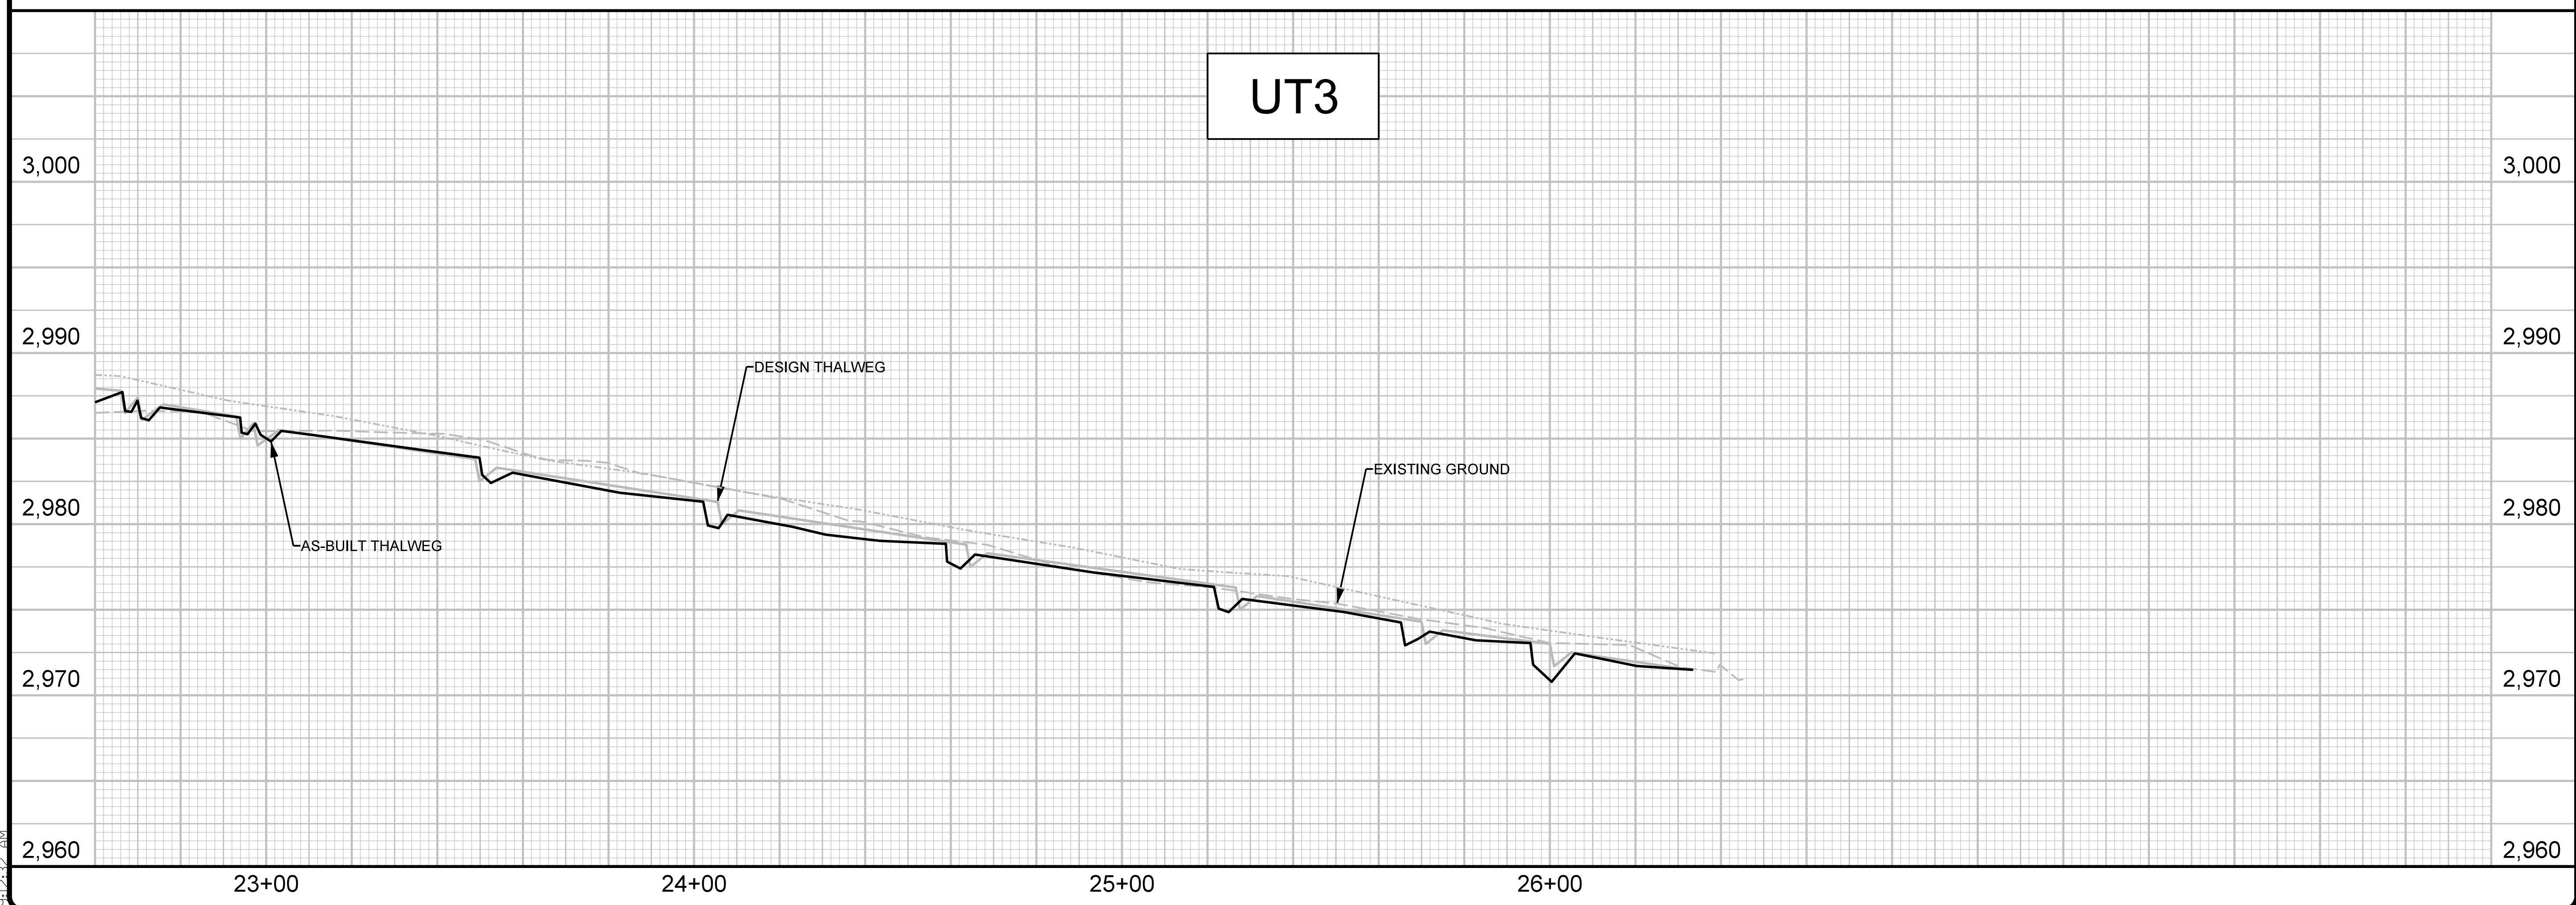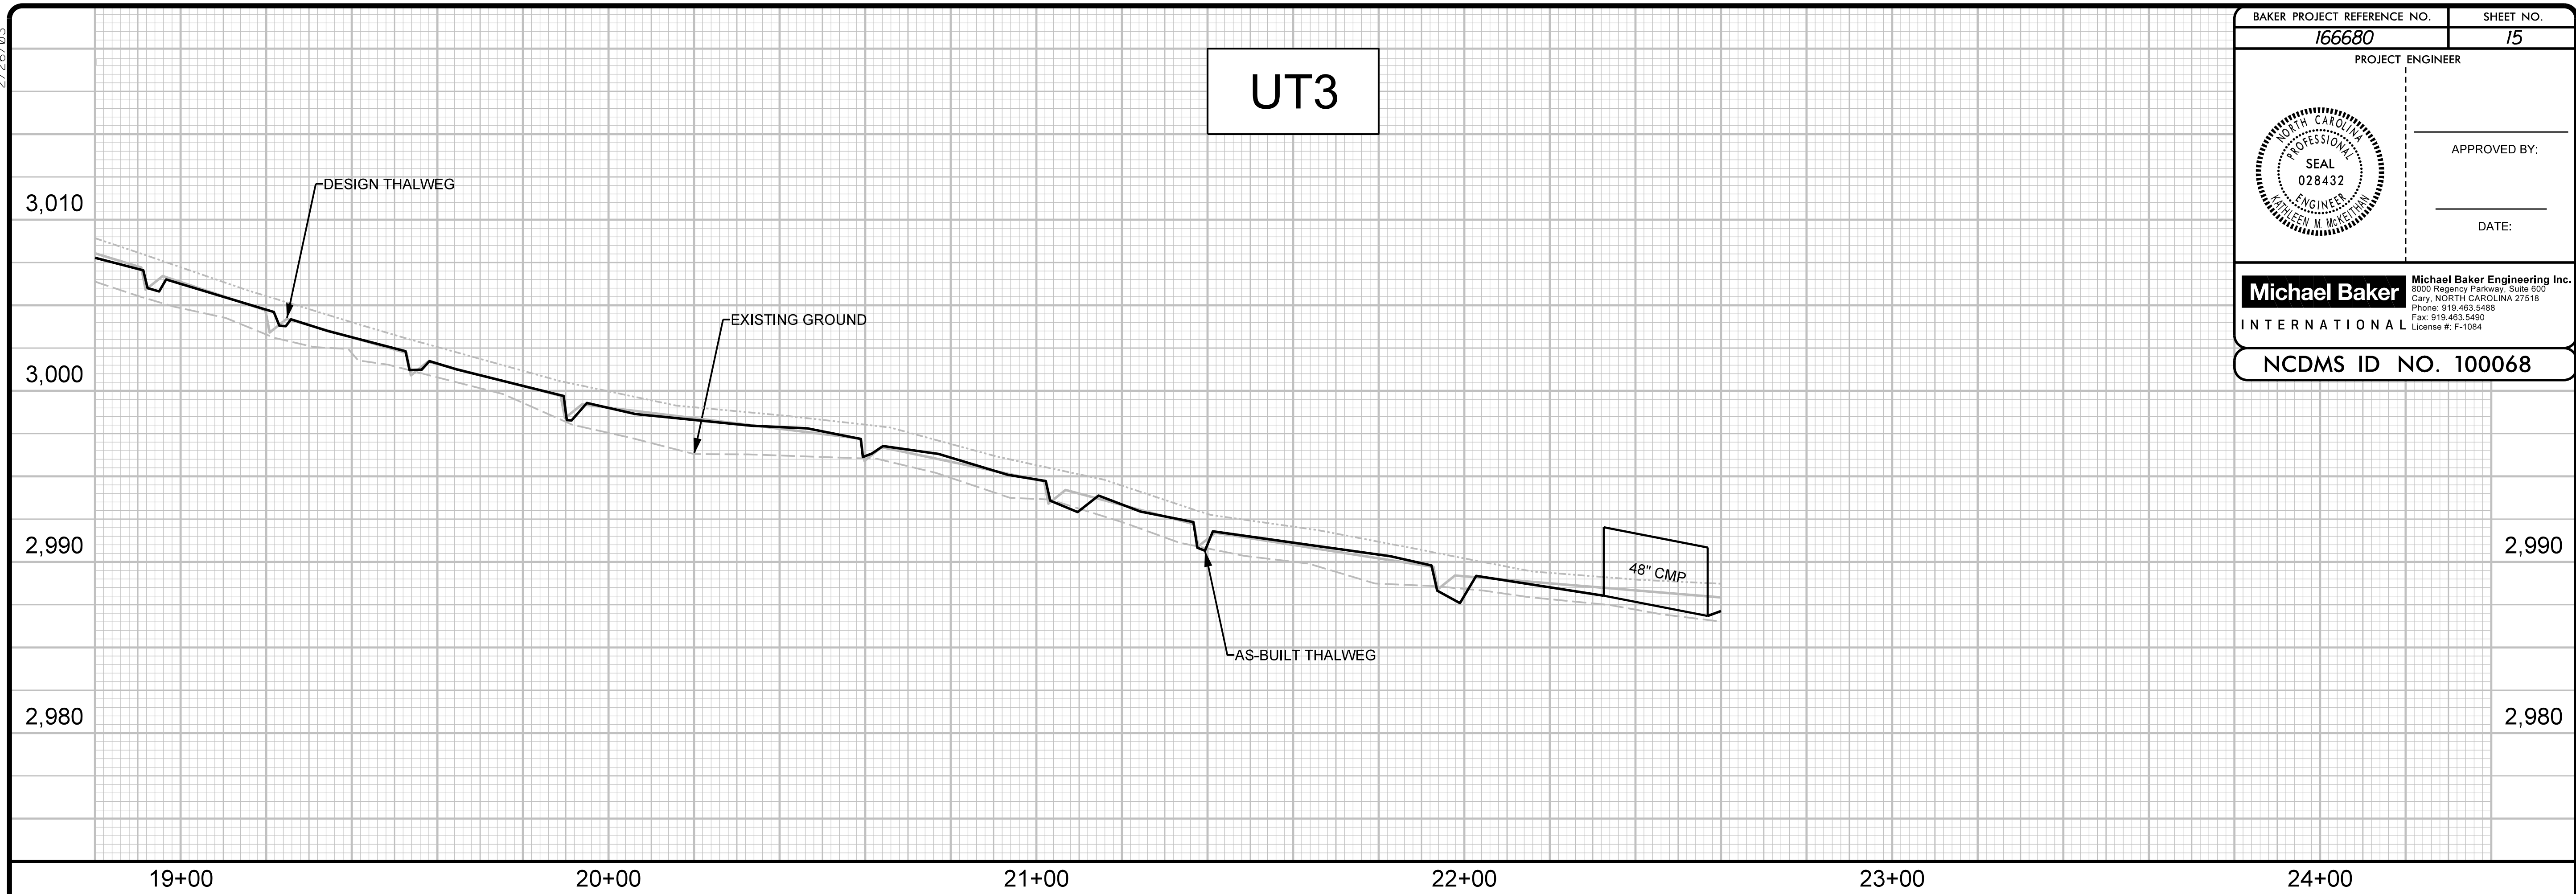

F:\24\2022\Projects\166680\As-Built\Plans\166680_ASB-PFL-15.dgn
 2/26/03
 10:35 AM

2/26/2023
 F:\24\2022\Projects\166680_Rush_Fork_Design\As-Built\Plots\166680_ASB-FSH_16_BMP.dgn

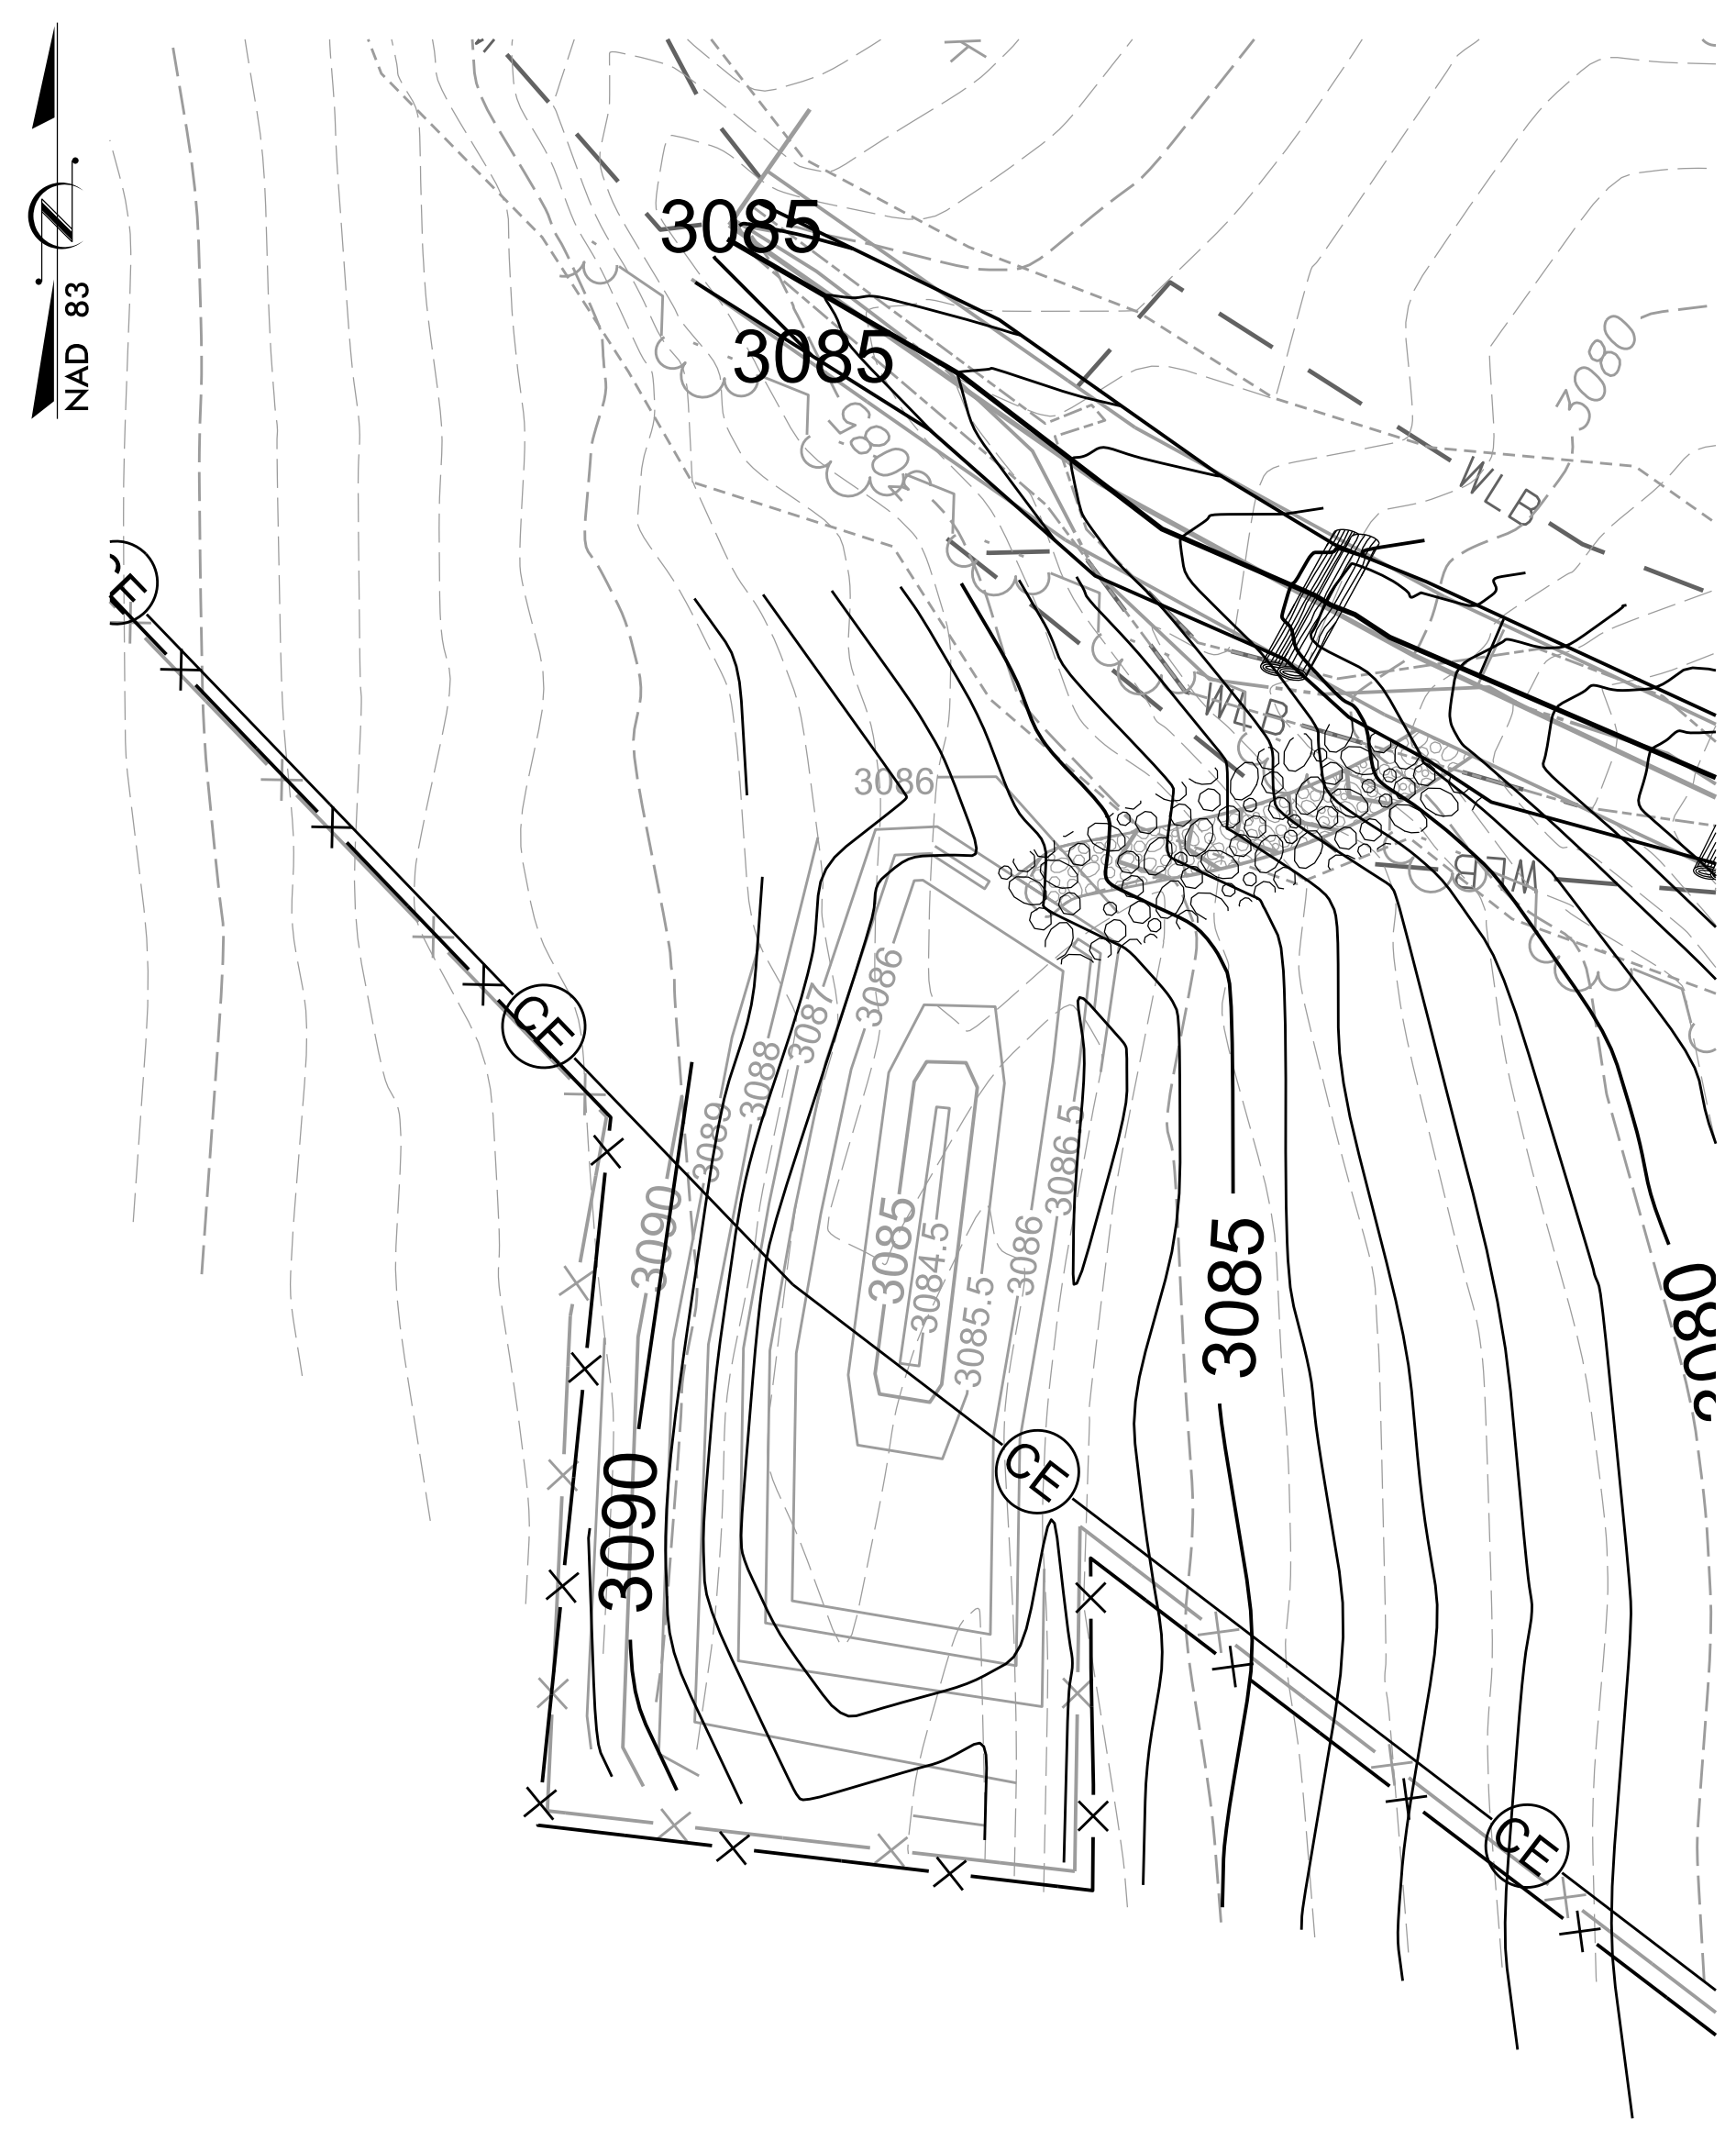

Proposed BMP Planted Species
 UT to Rush Fork Mitigation Project - NCDMS Project No. 100068

Botanical Name	Common Name	% Planted by Species	Wetland Tolerance
Shallow Water Zone (50 Herbaceous Plants per 200 ft²)			
<i>Juncus effusus</i>	Common Rush	10%	FACW
<i>Peltandra virginica</i>	Arrow Arum	10%	OBL
<i>Pontederia cordata</i>	Pickernelweed	10%	OBL
<i>Sagittaria latifolia</i>	Broadleaf Arrowhead	10%	OBL
<i>Saururus cernuus</i>	Lizard's Tail	10%	OBL
<i>Scirpus cyperinus</i>	Woolgrass	10%	FACW
<i>Carex vulpinoidea</i>	Fox Sedge	10%	OBL
<i>Sparganium americanum</i>	Bur-reed	10%	FAC
<i>Carex lurida</i>	Shallow Sedge	10%	OBL
<i>Polygonum pensylvanicum</i>	Smartweed	10%	FACW
Temporary Inundation Zone (8 shrubs per 200 ft²)			
<i>Alnus serrulata</i>	Tag Alder	10%	OBL
<i>Cephalanthus occidentalis</i>	Buttonbush	10%	OBL
<i>Cornus amomum</i>	Silky Dogwood	10%	FACW
<i>Ilex verticillata</i>	Winterberry	10%	FACW
<i>Rhododendron viscosum</i>	Swamp Azalea	10%	FACW
<i>Physocarpus opulifolius</i>	Ninebark	10%	FACW
<i>Sambucus canadensis</i>	Elderberry	10%	FACW
<i>Leucothoe fontanesiana</i>	Highland Doghobble	10%	FACW
<i>Vaccinium corymbosum</i>	Highbush Blueberry	10%	FACW
<i>Xanthorhiza simplicissima</i>	Yellowroot	10%	FACW

Notes: -Final species selection may change due to refinement of site conditions or to availability at the time of planting. If species substitution is required, the planting Contractor will submit a revised planting list to Baker for approval prior to the procurement of plant stock.

-Shallow Water planting zone is from basin bottom to elevation 3085.5' while Temporary Inundation planting zone is from elevation 3085.5' to 3086.5'.

-Embankments and perimeter fill slopes will be planted with non-clumping turf grasses (no trees or woody shrubs).

BAKER PROJECT REFERENCE NO. 166680	SHEET NO. 16
PROJECT ENGINEER	
	APPROVED BY:
	DATE:
Michael Baker International	
<small>Michael Baker Engineering Inc. 5030 Regency Parkway, Suite 500 Cary, NORTH CAROLINA 27518 Phone: 919.453.5488 Fax: 919.453.5490 License #: F-1084</small>	
NCDMS ID NO. 100068	

**UT to RUSH FORK
 AS - BUILT
 RECORD DRAWING**

SCALE (FT)