

601 East Stream Restoration Site
(EEP Project #95756)
Union County, North Carolina



Baseline Monitoring Document and As-Built Baseline Report Final

Data Collected from December 2014 – February 2015

Submitted May 12, 2015



Prepared for:
North Carolina Department of Environment and Natural Resources
Ecosystem Enhancement Program
217 West Jones Street
Suite 3000A
Raleigh, NC 27603

[This page intentionally left blank.]

Submitted by:



Environmental Banc & Exchange
909 Capability Drive, Suite 3100
Raleigh, NC 27606

Phone Number: (919) 829-9909

Fax Number: (919) 829-9913

Project Manager: David Godley

Stream Data Collected & Prepared by:



Ward Consulting Engineers, P.C.
4805 Green Road, Suite 100
Raleigh, NC 27616-2848

Phone Number: (919) 870-0526

Fax Number: (919) 870-5359

Project Manager: Becky Ward, PE

Vegetation Data Collected & Prepared by:



The Catena Group
410-B Millstone Drive
Hillsborough, NC 27278

Phone Number: (919) 732-1300

Fax Number: (919) 417-2732

Project Manager: Chris Sheats, PWS

[This page intentionally left blank.]

Table of Contents

1.0	Executive Summary.....	7
2.0	Background	8
2.1	Location and Setting.....	8
3.0	Project Structure, Restoration Type, and Approach	8
4.0	Project History, Contacts, and Attribute Data	8
5.0	Modifications to the Mitigation Plan and Construction Plan Summary	8
6.0	Success Criteria	9
6.1	Morphologic Parameters and Channel Stability.....	9
6.1.1	Dimension.....	9
6.1.2	Pattern and Profile	9
6.1.3	Substrate	9
6.1.4	Sediment Transport.....	9
6.2	Vegetation	9
6.2.1	Streams	9
7.0	Monitoring Plan Guidelines.....	10
7.1	Hydrology	10
7.1.1	Stream.....	10
7.2	Stream Channel Stability and Geomorphology.....	10
7.2.1	Dimension.....	11
7.2.2	Profile and Pattern	11
7.2.3	Visual Assessment	11
7.2.4	Bank Stability Assessments	11
7.2.5	Vegetation.....	12
7.2.6	Digital Photos	12
7.3	Maintenance and Contingency Plans	12
8.0	Documenting the As-Built Conditions (Baseline).....	12
8.1	As-Built/Record Drawings	12
8.2	Installation and Marking of Monitoring Features	12
9.0	Report and Data Submission Format.....	13
10.0	References	13

Appendicies

Appendix A: General Tables and Figures

Exhibit Figure 1: Vicinity Map

Exhibit Figure 2: Hydrologic Features

Exhibit Figure 3: Monitoring Features

Table 1: Project Components and Mitigation Credits

Table 2: Project Activity and Reporting History

Table 3: Project Contact Table

Table 4: Project Baseline Information and Attributes

Appendix B: Morphological Summary Data and Plots

Table 5: Baseline Stream Data Summary

Table 6: Morphology and Hydraulic Monitoring Summary

Longitudinal Profile Data

Cross Sections

Appendix C: Vegetation Data

Vegetation Plot Photos

Table 7: Planted and Total Stem Counts

CVS Output Tables

Appendix D: Record Drawing Plan Sheets

1.0 Executive Summary

The 601 East Stream Restoration Site is located within the sub-basin 03-04-14 of the Yadkin River Basin in Union County, North Carolina and contains Tanyard Branch. The restoration of Tanyard Branch generated 3,713 stream mitigation credits. The project site is owned by one property owner Mr. Frank W. Howey, Jr. The project is located with the HUC 03040105081010 (Upper Lanes Creek). In 2009, nine (9) percent of the streams in the watershed were listed as impaired for Aquatic Life by the North Carolina Division of Water Quality (NCDWQ). The 601 East Stream Restoration Site was identified as a stream restoration opportunity to improve water quality and habitat within the Upper Lane's Creek Target Local Watershed (TLW). The 0.56 square mile watershed contributing drainage to the stream is primarily used for agricultural practices and angle family development. Vegetation typical of a Piedmont Alluvial Forest was planted throughout the conservation easement.

The project goals address the stressors identified in the TLW and include the following:

- Reduce water quality stressors originating in and around the project area affecting the project reaches and downstream watercourses, which included populations of the Savannah Lilliput (*Toxolasma pullus*) and the Carolina Creekshell (*Vilosa vaughiana*), both listed species of concern. Specifically, involving:
 - Reducing turbidity and sediment loading
 - Input reductions of nutrients and crop protection chemicals
 - Improving thermoregulation
- Improving aquatic habitat quality and diversity within the project reaches
- Improving recruitment of instream fine organic matter (FOM) in the near term and both FOM and large wood in the long term
- Improving terrestrial habitat diversity and quality in the vicinity of project reaches
- Establishing habitat continuity between the reach headwaters and Lanes Creek
- Improving flood flow attenuation and floodplain interaction

The project goals will be addressed through the project objectives:

- Restore or enhance reach pattern, dimension, and profile
- Stabilize eroding stream banks
- Install stream structures to maintain grade and improve bed form complexity
- Implement BMP detention devices on lateral agricultural drainages
- Install a diverse native riparian buffer
- Remove of invasive and/or exotic plant species
- Secure a protective conservation easement and establish fencing as needed

Construction was completed in December 2014. As-built surveys and plantings were completed in January 2015. In January 2015, ten (10) vegetation plots were established and baseline vegetation data was collected, excluding natural stems in accordance with the EEP/CVS protocol (Version 4.2). Data collected for these plots are included in Appendix C. The success criterion for planted woody species in the restoration areas is based on annual and cumulative survival and growth over seven (7) years. Survival on preferred species must be at a minimum of 320 stems/acre at the end of three years of monitoring and 260 stems/acre after five years. At year 7, density must be no less than 210 seven year-old planted stems/acre. Level II of the CVS protocol, which includes natural stems and planted stems, will be followed for monitoring year 2 and subsequent years until the project close out year.

2.0 Background

2.1 Location and Setting

The project area is located within the United States Geological Survey (USGS) Hydrologic Unit 03040105 (Rocky River Basin) of the greater Yadkin Pee-Dee River Basin. The project stream on the property is named Tanyard Branch which is a tributary to Lanes Creek. The Site is located on predominately agricultural land. The Site lies within the Carolina Slate Belt system of the Piedmont Geographical Province and is composed of gently sloping terrain with parent material consisting of a Metamudstone and Meta-Argillic metamorphic rock. The landowner to the northeast of the lower reach utilizes his land for livestock grazing. The livestock on this property is contained by fencing and does not have access to Tanyard Branch. The Vicinity Map can be found in Appendix A.

3.0 Project Structure, Restoration Type, and Approach

The historic land use at the Site has consisted primarily of agriculture use. Additional land use practices, including the maintenance and removal of riparian vegetation and the relocating and straightening of on-site streams have contributed to unstable channel characteristics and degraded water quality. Historic wetlands were likely drained in order to maximize agricultural production.

The streams were restored and enhanced using a combination of Rosgen priority 1 and 2 restoration techniques. The riparian buffer was planted with native vegetation. The mitigation work at the project site resulted in the restoration of 4023 linear feet of stream including 215 linear feet of ephemeral channel with buffer restoration and best management practices to filter sediment; 3,396 linear feet of Priority I restoration; and 412 linear feet of Stream Enhancement Level I. The project component breakdown and components can be found in Table 1.

4.0 Project History, Contacts, and Attribute Data

Stream construction began in November 2014 and concluded in December 2014. Live stakes and bare root planting of the site occurred in January 2015. Baseline stream data collection coincided with the as-built survey and was an ongoing process that took place throughout construction and concluded in January 2015. Vegetation monitoring baseline data was established and collected in January 2015. Significant milestone dates for the project can be found in Table 2. The project designer, construction contractor and all other consultants, contractors and suppliers contact information can be found in Table 3. The drainage area of Tanyard Branch to the culvert at Landsford Road is 0.27 square miles and 0.56 square miles to the downstream end at Lanes Creek. Land use within the watershed consists of primarily agricultural use with some single family residential. Impervious area covers less than 2 percent of the total watershed. Land use changes are not anticipated in the watershed of this headwater stream in the near future as the watershed consists of primarily active agricultural crop production. Low density residential development is a possibility for the watershed due to the sites proximity to US 601.

5.0 Modifications to the Mitigation Plan and Construction Plan Summary

The following is a summary of changes implemented during construction that differ from the Construction Drawings.

Reach 1: Native rock was excavated on site and used for the constructed riffles. The farm crossing in this reach was installed to a length of 48 feet.

Reach 2: Native rock was excavated on site and used for the constructed riffles. No work was done in the conservation easement exclusion at the brick pump house. Brush toe was not installed on the right bank from station 22+70 to 23+10. The stone and log riffles were not installed due to the concerns with the wet soils in this area. The riffles were constructed only with stone.

Reach 3: The twin 42 inch pipe crossing was constructed to a length of 48 feet. Native rock was excavated on site and used for the constructed riffles. Native rock was added to dress the top of all of the riffles in this reach to stabilize the riffles that were not constructed as some erosion was observed.

Reach 4: Native rock was excavated on site and used for the constructed riffles. Stone was placed to dress the top of the riffle not constructed at station 53+70. The grade of the stream was changed from the end of the riffle at station 57+15 to the tie in at Lanes Creek at 58+50. The plans had called for a tie in location of 484.0 feet. To better tie into the existing elevation of Lanes Creek the elevation of the end of the riffle at station 58+50 was raised two feet to elevation 486 feet. The riffle elevations were changed accordingly:

HR Station 56+90 Elevation 487.4; no change
ER Station 57+15 Elevation 487.0; +0.25 feet
HR Station 57+50 Elevation 487.0; + 0.28 feet
ER Station 57+80 Elevation 486.5; +0.54 feet
HR Station 58+20 Elevation 486.5; +0.58 feet
ER Station 58+50 Elevation 486.0; +2.0 feet

6.0 **Success Criteria**

6.1 *Morphologic Parameters and Channel Stability*

6.1.1 *Dimension*

The dimension parameters of the restored channel should remain stable throughout the monitoring period. Cross sectional overlays should show modest changes from year to year. The channel should not show a trend towards widening or increases in cross sectional area. Riffle depths should maintain a low bank height ratio (<1.2).

6.1.2 *Pattern and Profile*

The longitudinal profile should not indicate significant aggradation or degradation over any substantial continuous lengths of channel. The bedform should develop or be maintained during the monitoring period and be consistent with the reference and design reaches. Variation within bedform parameters is acceptable as long as they are within design distributions. Pattern parameters should show little change over the monitoring period.

6.1.3 *Substrate*

The substrate should maintain or progress towards the design distribution. Particle size distribution within riffles should coarsen throughout the monitoring period.

6.1.4 *Sediment Transport*

The success of parameters described above should be demonstrated by the lack on any significant aggradation or deposition within the channel. Point bar and inner berms should not encroach excessively into the channel. Mid-channel bars should not be present.

6.2 Vegetation

Vegetation success is based on the criteria established in the *Ecosystem Enhancement Program Monitoring Requirements and Performance Standards for Stream and/or Wetland Mitigation* dated November 7, 2011. Survival on preferred species must be at a minimum 320 stems/acre at the end of the three years of monitoring and 260 stems/acre after five years. At year 7, density must be no less than 210 seven year-old planted stems/acre. Level II of the CVS protocol, which includes natural stems and planted stems, will be followed for the monitoring year 2 and subsequent years until the project close out year. Invasive exotic

species were observed before construction. Additional treatments will be conducted where deemed necessary if regeneration of these invasive exotic species is observed.

6.2.1 *Streams*

Two bankfull storm events must be recorded during the standard 7-year monitoring period. For the monitoring to be completed, these events must occur in separate monitoring years.

7.0 **Monitoring Plan Guidelines**

Monitoring protocol will follow that outlined within the EEP Monitoring Report guidelines and detailed in the U.S. Army Corps of Engineers (USACE) Stream Mitigation Guidelines for Monitoring Level I. Monitoring shall occur annually for a minimum of seven years and consist of the collection and analysis of stream stability and riparian/stream bank vegetation survivability data to support the evaluation of the project in meeting established restoration objectives. Monitoring shall include measurements and visual assessments of stream dimension, profile, pattern, bed materials, photo documentation, vegetation survivability sampling, and stream bankfull return interval.

7.1 *Hydrology*

7.1.1 *Stream*

Two crest gages have been installed one in the upper and one in the lower reach on the site to document bankfull events (See Figure 3 for locations). The gauges shall be checked, documented, and reset during each site visit by the monitoring performer.

7.2 **Stream Channel Stability and Geomorphology**

This project consisted of four restoration reaches on Tanyard Branch. Two reaches are located above Landsford Road and two below the road. Eighteen permanent cross sections on both riffles and pools were established on the site as detailed below:

Reach 1: Station 7+60 - 22+00

- Cross Section 1: Station 8+32 (Pool)
- Cross Section 2: Station 10+95 (Riffle)
- Cross Section 3: Station 12+20 (Pool)
- Cross Section 4: Station 14+68 (Riffle)
- Cross Section 5: Station 16+23 (Pool)
- Cross Section 6: Station 17+66 (Riffle)
- Cross Section 7: Station 19+30 (Pool)
- Cross Section 8: Station 20+59 (Riffle)

Reach 2: Station 22+00 - 24+02

- Cross Section 9: Station 24+25 (Riffle)
- Cross Section 10: Station 26+16 (Pool)
- Cross Section 11: Station 27+15 (Riffle)
- Cross Section 12: Station 29+67 (Pool)

Reach 3: Station 42+92 - 53+70

- Cross Section 13: Station 44+45 (Riffle)
- Cross Section 14: Station 48+78 (Pool)
- Cross Section 15: Station 50+93 (Pool)
- Cross Section 16: Station 52+29 (Riffle)

Reach 4: Station 53+70 - 58+65

- Cross Section 17: Station 56+15 (Pool)
- Cross Section 18: Station 56+42 (Riffle)

7.2.1 Dimension

The permanent cross sections shall be monitored for seven years, with monitoring events occurring in years 1, 2, 3, 5, and 7 during the monitoring period. These sections should be overlaid to allow for comparison. Dimension parameters shall be calculated from the surveyed cross sections and compared to previous monitoring periods. The dimension data is detailed by section in Tables 6a, 6b, 6c, and 6d.

7.2.2 Profile and Pattern

The entire project length of was surveyed for this baseline monitoring plan. The MY-00 pattern and profile data for each reach is summarized in Tables 5a, 5b, 5c and 5d. For subsequent monitoring years, profile data will be visually monitored. Pebble counts were collected on two constructed riffles on in the upper and one in the lower reach and are included in the digital support files in the stream subfolder.

7.2.3 Visual Assessment

An annual visual assessment shall be conducted twice each monitoring year per NCEEP morphometric monitoring guidelines. At least 5 months shall separate each visual monitoring event.

7.2.4 Bank Stability Assessments

Bank pins have been installed at all pool permanent monitoring sections and marked with pink flagging. The length of exposed pin shall be measured and reported during each cross-section monitoring event. Once the exposure has been measured, the pin should be hammered flush with the face of the bank. Three rebar bank pins were installed in an array approximately 6 inches above the normal water surface in three locations and installed flush with the to the face of the stream bank as detailed below:

Reach 1: Station 7+60 – 22+00

Pool Cross Section	River Station of Pin		
	Upstream Cross Section	At Cross Section	Downstream Cross Section
Cross Section 1	8+24.5	8+32	8+37.5
Cross Section 3	12+16	12+20	12+23.5
Cross Section 5	16+18.5	16+23	16+28
Cross Section 7	19+26	19+30	19+35

Reach 2: Station 22+00 – 24+02

Pool Cross Section	River Station of Pin		
	Upstream Cross Section	At Cross Section	Downstream Cross Section
Cross Section 10	26+08	26+16	26+24.5
Cross Section 12	29+61	29+67	29+73.5

Reach 3: Station 42+92 – 53+70

Pool Cross Section	River Station of Pin		
	Upstream Cross Section	At Cross Section	Downstream Cross Section
Cross Section 14	48+70.5	48+78	48+85
Cross Section 15	50+87.5	50+93	50+99

Reach 4: Station 53+70 – 58+65

Pool Cross Section	River Station of Pin		
	Upstream Cross Section	At Cross Section	Downstream Cross Section
Cross Section 17	56+07.5	56+15	56+22.5

7.2.5 Vegetation

Ten (10) vegetation plots were installed along Tanyard Branch. Vegetation data collection for the baseline monitoring report follows the CVS-EEP Protocol for Recording Vegetation Version 4.2 (Lee et al. 2008). The baseline vegetation monitoring was conducted according to the Level I: Inventory of Planted Stems. Level I will also be used for MY-01 data collection. However, from MY-02 and through the remainder of the monitoring period, vegetation monitoring data collection will follow Level II of the CVS-EEP protocol which includes planted and natural stems. Plant identification will be verified according to Alan Weakley’s, *Flora of the Carolinas, Virginia, Georgia, and Surrounding Areas* (Weakley 2012).

7.2.6 Digital Photos

Photo points were established at the start/end of the project, at each vegetation monitoring plot, and at each cross section. For each subsequent monitoring period, photos shall be taken at the same location and, preferably, within the same two-month window between monitoring periods. The cross section photos can be found on their corresponding cross section sheets located in Appendix B. The vegetation monitoring plot photo log is located in Appendix C.

7.3 Maintenance and Contingency Plans

If deemed necessary, recommendations for increased monitoring, maintenance, or repair shall be made in the annual monitoring reports. Problem areas shall be located on the monitoring report plan view and tabulated noting the severity and possible causes.

8.0 Documenting the As-Built Conditions (Baseline)

8.1 As-Built/Record Drawings

The project as-built survey was conducted in December of 2014 on reaches 3 & 4 and January 2015 on reaches 1 & 2 upon completion of construction. The entire project length of Tanyard Branch as-built data was collected by the staff of the Designer/Monitoring Performer. The Record Drawings (including red-line markups) were completed on February 19, 2015. Baseline vegetative data was collected January 26, 2015.

8.2 Installation and Marking of Monitoring Features

Monitoring features installation and the baseline monitoring data collection occurred in January 2015. Cross Section pins were set at each end of the cross section left and right and are 1/2” rebar marked with wooden stakes with pink flagging. Stream crest gauges located in both the upper and lower reaches are black plastic tubes set with 48” green T posts. Vegetation monitoring plots were established as 10mX10m

squares with each corner marked with 2' long ½" diameter PVC pipes with pink flagging marking the plot origin. Plants within the plot were marked with pink flagging.

9.0 Report and Data Submission Format

Refer to the NCEEP Monitoring Report guidelines for report and data submission requirements, formats and procedures.

10.0 References

USACOE (2003) *Stream Mitigation Guidelines*. USACOE, NCDENR-DWQ, USEPA, NCWRC,




USACOE (1987) *Corps of Engineering Wetlands Delineation Manual*. Tech report Y-87-1. AD/A176

Lee, Michael T. Peet, Robert K. Roberts, Steven D., Wentworth, Thomas R. (2008). *CVS-EEP Protocol for Recording Vegetation Version 4.2*.

Weakley, Alan (2012). *Flora of the Carolinas, Virginia, Georgia, and Surrounding Areas*.
<http://www.herbarium.unc.edu/flora.htm>.

Appendix A – General Tables and Figures


[This page intentionally left blank.]

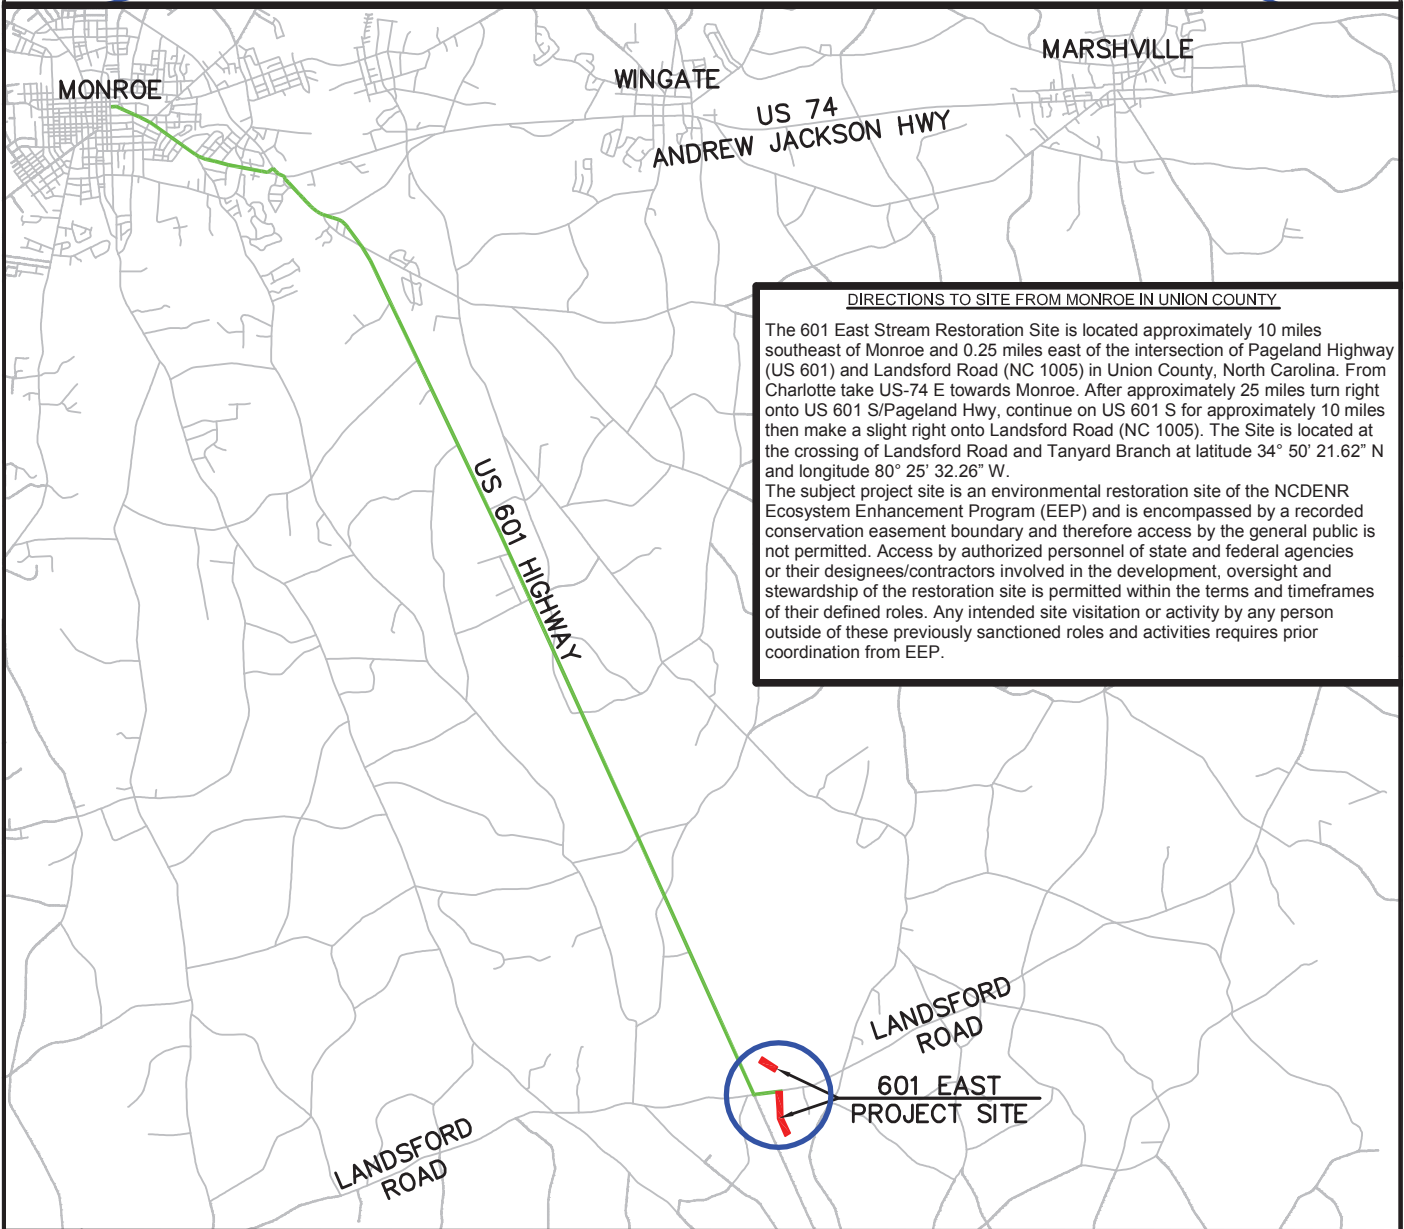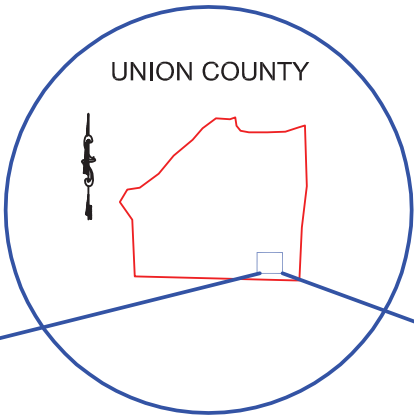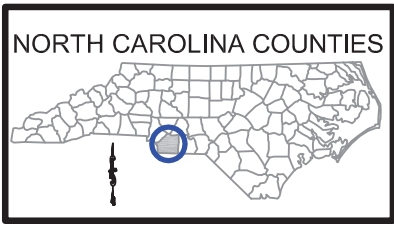

DIRECTIONS TO SITE FROM MONROE IN UNION COUNTY

The 601 East Stream Restoration Site is located approximately 10 miles southeast of Monroe and 0.25 miles east of the intersection of Pageland Highway (US 601) and Landsford Road (NC 1005) in Union County, North Carolina. From Charlotte take US-74 E towards Monroe. After approximately 25 miles turn right onto US 601 S/Pageland Hwy, continue on US 601 S for approximately 10 miles then make a slight right onto Landsford Road (NC 1005). The Site is located at the crossing of Landsford Road and Tanyard Branch at latitude 34° 50' 21.62" N and longitude 80° 25' 32.26" W.

The subject project site is an environmental restoration site of the NCDENR Ecosystem Enhancement Program (EEP) and is encompassed by a recorded conservation easement boundary and therefore access by the general public is not permitted. Access by authorized personnel of state and federal agencies or their designees/contractors involved in the development, oversight and stewardship of the restoration site is permitted within the terms and timeframes of their defined roles. Any intended site visitation or activity by any person outside of these previously sanctioned roles and activities requires prior coordination from EEP.

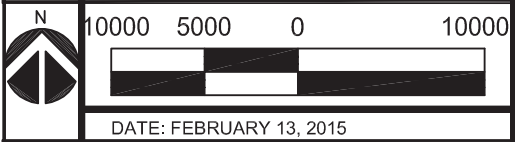

**FIGURE 1: 601 EAST
SITE LOCATION VICINITY MAP
EEP PROJECT #95756**



[This page intentionally left blank.]


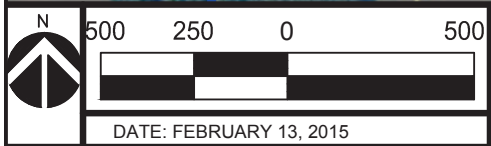


FIGURE 2 HYDROLOGIC FEATURES
 601 EAST STREAM RESTORATION SITE
 UNION COUNTY, NC
 EEP PROJECT #95756

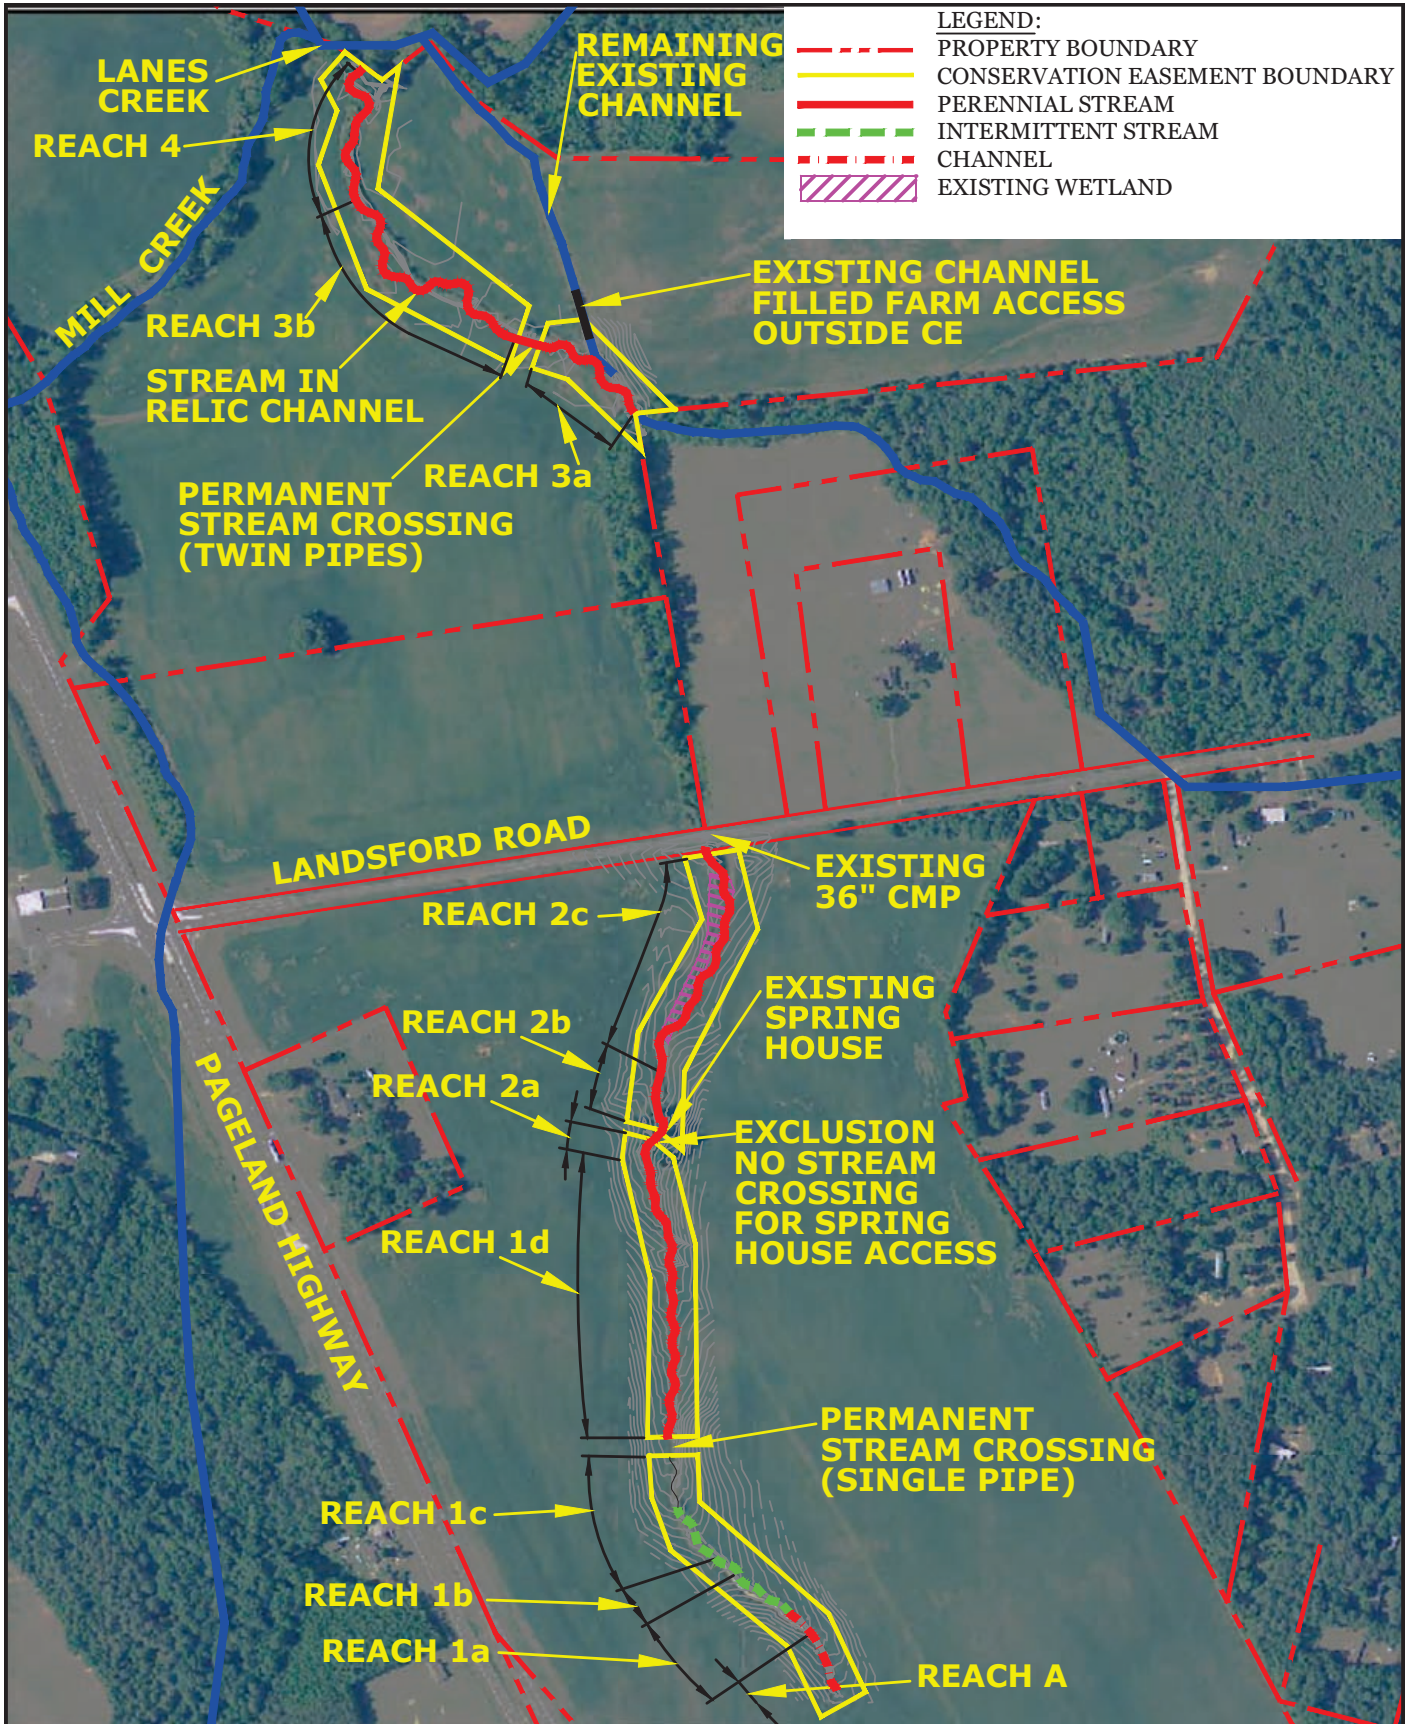

2011 Aerial from NCOneMap.org

WARD CONSULTING ENGINEERS, PC

[This page intentionally left blank.]

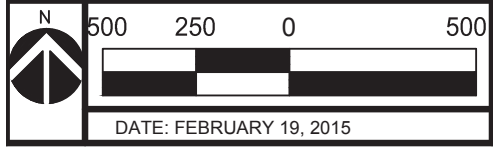
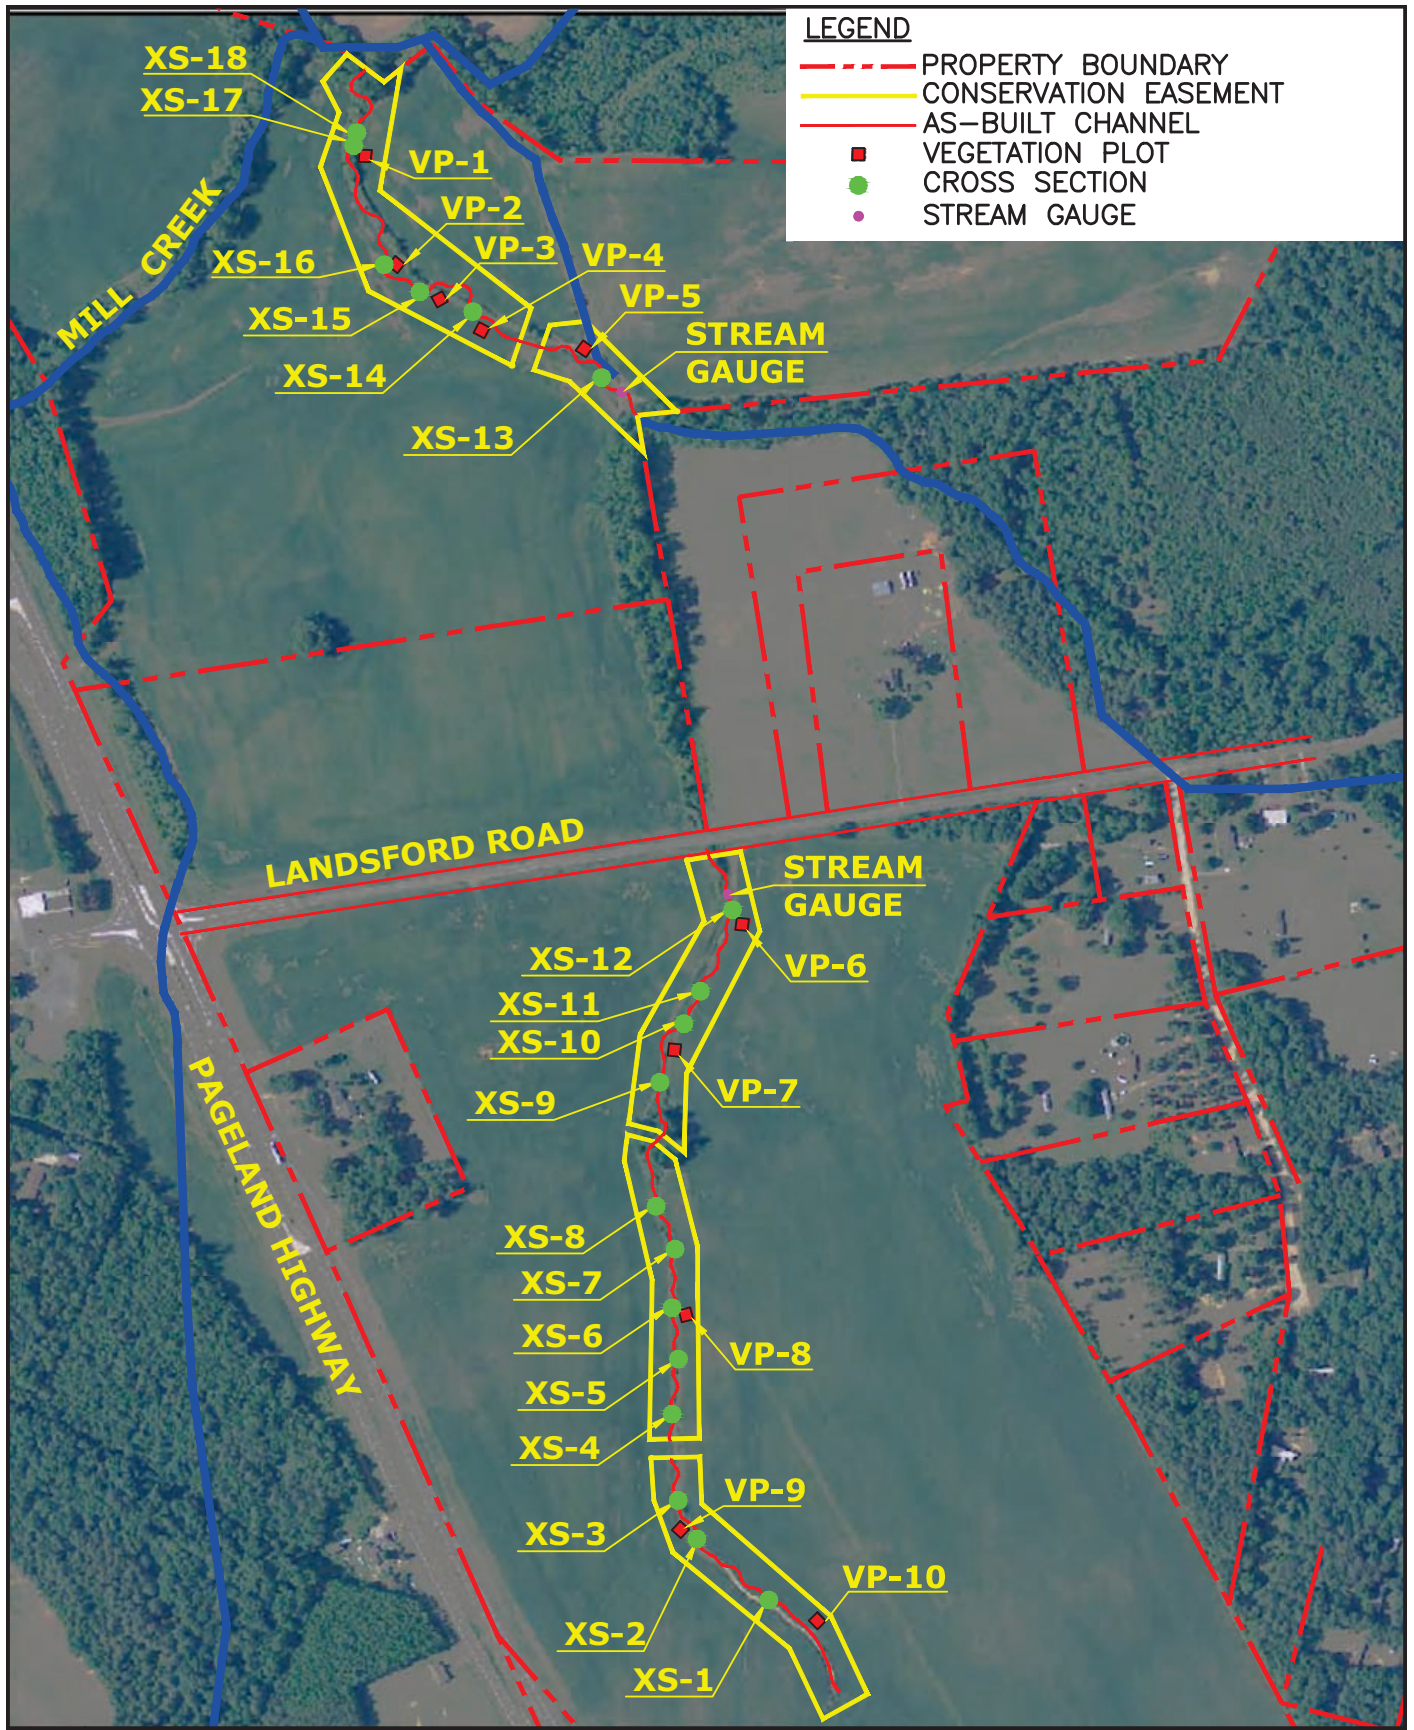


FIGURE 3 MONITORING FEATURES
 601 EAST STREAM RESTORATION SITE
 UNION COUNTY, NC
EPP PROJECT #95756

WARD CONSULTING ENGINEERS, PC

2011 Aerial from NCOneMap.org

[This page intentionally left blank.]

**Table 1: 601 East Stream Restoration, Union County
EEP Project Number 95756**

Mitigation Credits									
	Stream		Riparian Wetland		Non-riparian Wetland		Buffer	Nitrogen Nutrient Offset	Phosphorous Nutrient Offset
Type	R	RE	R	RE	R	RE			
Totals	3671	43							
Project Components									
Project Component -or- Reach ID	Stationing/Location	Existing Footage/Acreage	Approach (PI, PII etc.)	Restoration -or- Restoration Equivalent	Restoration Footage or Acreage	Mitigation			
						Ratio	Credits		
Reach A Ephemeral	5+45 – 7+60	215		Buffer establishment and BMP sediment import reduction	215	1:5	43		
Reach 1a Intermittent	7+60 – 11+10	336	P1	R	350	1:1	350		
Reach 1b Intermittent	11+10 – 11+95	85	Enhancement	E1	85	1:1.5	57		
Reach 1c Perennial	11+95 – 13+47	136	Enhancement	E1	155	1:1.5	103		
Reach 1d Perennial	13+97 – 22+00	790	P1	R	803	1:1	803		
Reach 2a Perennial	22+00 – 22+45	40	Enhancement	E1	45	1:1.5	30		
Reach 2b Perennial	22+75 – 24+02	125	Enhancement	E1	127	1:1.5	85		
Reach 2c Perennial	24+02 – 31+32	669	P1	R	730	1:1	730		
Reach 3a Perennial	42+92 – 46+61	80' active channel 112' relic channel	P1	R	369	1:1	369		
Reach 3b Perennial	47+21 – 53+70	502' relic channel	P1	R	649	1:1	649		
Reach 4 Perennial	53+70 – 58+65	470' relic channel	P3	R	495	1:1	495		
Component Summation									
Restoration Level	Stream (linear feet)	Riparian Wetland (acres)		Non-riparian Wetland (acres)	Buffer (square feet)	Upland (acres)	Mitigation Credits		
		Riverine	Non-Riverine						
Restoration	3396						3396		
Enhancement									
Enhancement I	412						275		
Enhancement II									
Creation									
Preservation/Other	215						43		
HQ Preservation									
BMP Elements									
Element	Location		Purpose/Function			Notes			
FB, LS, S, FS	Ephemeral Channel 5+45 – 7+60		Slowing the water down for settling and filtering excess sediment			Sediment expected from future degradation upstream			
<u>BMP Elements</u>									
BR = Bioretention cell; SF = Sand Filter; SW = Stormwater Wetland; WDP = Wet Detention Pond; DDP = Dry Detention Pond; FS = Filter Strip; S = Grassed Swale; LS = Level Spread; NI = Natural Infiltration Area; FB = Forested Buffer									

**Table 2. Project Activity and Reporting History
601 East Stream Restoration- EEP #95756**

Activity or Deliverable	Data Collection Complete	Completion or Delivery
Restoration Plan	May 2013	Jan 2014
Final Design – Construction Plans	Sept 2013	Jan 2014
Construction	-	Dec 2014
Containerized, bare root and B&B plantings	-	Jan 2015
Mitigation Plan / As-built (Year 0 Monitoring – baseline)	Feb 2015	Feb 2015
Year 1 Monitoring		
Year 2 Monitoring		
Year 3 Monitoring		
Year 4 Monitoring		
Year 5 Monitoring		

Bolded items are examples of those items that are not standard, but may come up and should be included

Non-bolded items represent events that are standard components over the course of a typical project.

The above are obviously not the extent of potential relevant project activities, but are just provided as example as part of this exhibit.

If planting and morphology are on split monitoring schedules that should be made clear in the table

**Table 3. Project Contact Table
601 East Stream Restoration- EEP #95756**

Designer	Ward Consulting Engineers, P.C. (WCE) 4805 Green Road, Suite 100, Raleigh, NC 27616 Becky Ward (919) 870-0526
Primary project design POC	
Construction Contractor	Wright Contracting P.O. Box 545, Siler City, NC 27344 Joseph Wright (919) 663-0810
Construction contractor POC	
Planting Contractor	H & J Forest Services 1416 Ocean Boulevard, Holly Ridge, NC 28445 (910) 512-6754
Planting contractor POC	
Construction Survey Contractor	Turner Land Survey, PLLC 3719 Benson Drive, Raleigh, NC 27629 Elizabeth Turner (919) 827-0745
Survey contractor POC	
Seeding Contractor	Wright Contracting P.O. Box 545, Siler City, NC 27344 Andrew Dimmette (919) 663-0810
Construction contractor POC	
Seed Mix Sources	Green Resource - Raleigh, NC As Purchased by EBX (919) 829-9909 x 213
Nursery Stock Suppliers	Arbor Gen - Blenheim, SC (800) 222-1290 NC Forest Service Nursery - Goldsboro, NC (888) 628-7337
[Baseline] Monitoring Performers	Ward Consulting Engineers, P.C. 4805 Green Road, Suite 100, Raleigh, NC 27616
Stream Monitoring POC	Rachael Zigler - WCE - (919) 870-0526
Vegetation Monitoring POC	Chris Sheats - The Cantena Group - (919) 732-1300

Table 4. Project Baseline Information and Attributes

Project Information				
Project Name		601 East Stream Restoration Site		
County		Union County		
Project Area (acres)		12.78		
Project Coordinates (latitude and longitude)		34° 50' 21.62" N, 80° 25' 32.26"N		
Project Watershed Summary Information				
Physiographic Province		Piedmont		
River Basin		Yadkin River Basin		
USGS Hydrologic Unit 8-Digit		USGS Hydrologic Unit 14-digit	03040105081010	
DWQ Sub-basin		03-04-14		
Project Drainage Area (acres)		361.33		
Project drainage Area Percentage of Impervious Area		2%		
CGIA Land Use Classification		2.01.01.07 Annual Row Crop Rotation		
Reach Summary Information				
Parameters	Reach 1	Reach 2	Reach 3	Reach 4
Length of reach (LF)	1418, 1393 LF Restored	906, 902 LF Restored	1080, 1018 LF Restored	Relic Channel, 495 LF Restored
Valley Classification	II	II	VIII	VIII
Drainage area (acres)	109	135	333	359
NCDWQ stream identification score	Intermittent: 19.5 Perennial: 33.5	33.5	33.5	33.5
NCDWQ Water Quality Classification	13-17-40-(1)	13-17-40-(1)	13-17-40-(1)	13-17-40-(1)
Morphological Description (stream type)	G4/B4/C4b	C4/E4/DA	C4/G4	G4
Evolutionary trend (reference channel evolution model used)	G	C/DA	G	G
Underlying mapped soils	Intermittent: Tatum gravelly silty clay loam Perennial: Cid channery silt loam	Cid channery silt loam, Tatum gravelly silt loam	Chewacla silt loam	Chewacla silt loam
Drainage class	Well Drained	Moderately Well Drained	Somewhat Poorly Drained	Somewhat Poorly Drained
Soil Hydric status	Non Hydric	Non Hydric	Non Hydric	Non Hydric
Slope	2%	0.84%	0.67%	1.25%
FEMA classification	N/A	N/A	N/A	N/A
Native vegetation community	Agriculture along upstream portion of Intermittent channel. The remaining stream buffer within this reach is composed of Willow Oak, Red Maple, River Birch, Black Willow, Elderberry, and Blackberry.	Canopy species include Willow Oak, Black Willow, Red Maple, Sweetgum, Eastern Red Cedar, Tag Alder, and Silky Dogwood. Wetland A is composed of Cattails, spike rush arrow-arum, and duckweed.	Canopy species include Red Maple, Hackberry, Willow Oak, and Sweetgum. The presence of Chinese privet outcompete any shrub and herb layer.	Canopy species include Red Maple, Hackberry, Willow oak, and Sweetgum. The presence of Chinese privet outcompete any shrub and herb layer.
Percent composition of exotic invasive vegetation	0%	50% of Parrot feather	5% of Japanese stilt grass, 80% Chinese privet, and kudzu	80% Chinese privet

Table 4. Project Baseline Information and Attributes

Wetland Summary Information			
Parameters	Wetland 1		
Size of Wetland (acres)	0.43 ac		
Wetland Type (non-riparian, riparian riverine, or riparian non-riverine)	Non-Tidal Freshwater Marsh		
Mapped Soil Series	Cid channery Silt Loam		
Drainage class	Moderately Well Drained to Somewhat Poorly Drained		
Soil Hydric Status	Non-Hydric		
Source of Hydrology	Tanyard Branch headwaters, groundwater, and adjacent runoff		
Hydrologic Impairment	Wetland A formed from accumulating sediments filling the channel resulting in a braided channel system through the wetland.		
Native vegetation community	Herbaceous -Vegetation is dominated by herbaceous vegetation such as Cattail (<i>Typha latifolia</i>), Bulrush (<i>Scirpus cyperinus</i>), Common Rush (<i>Juncus effuses</i>). Some tree species such as Black Willow (<i>Salix nigra</i>), and Red Maple (<i>Acer rubrum</i>) are present in the wetland margins.		
Percent composition of exotic invasive vegetation	95% -The invasive Parrot Feather (<i>Miriophyllum aquaticum</i>) is dominant throughout the wetland where there is standing water.		
Regulatory Considerations			
Regulation	Applicable?	Resolved?	Supporting Documentation
Waters of the United States-Section 404	Yes	SAW 2013-00265; EEP IMS #95756	
Waters of the United States – Section 401	Yes	DWR# 14-0547	
Endangered Species Act	No	Yes	ERTR
Historic Preservation Act	No	Yes	ERTR
Coastal Zone Management Act (CZMA)/Costal Area Management Act (CAMA)	No	N/A	
FEMA Floodplain Compliance	No	N/A	
Essential Fisheries Habitat	No	N/A	

Appendix B – Morphological Summary Data and Plots

[This page intentionally left blank.]

Table 5a. Baseline Stream Data Summary
601 East Stream Restoration, EEP Project Number 95756 - Reach 1 (1393 feet)

Parameter	Gauge ³	Regional Curve			Pre- Existing Conditions						Reference Reach(es) Data						Design			As-built / Baseline						
		LL	UL	Eq.	Min	Mean	Med	Max	SD	n	Min	Mean	Med	Max	SD	n	Min	Med	Max	Min	Mean	Med	Max	SD	n	
Dimension and Substrate - Riffle																										
Bankfull Width (ft)					7	21		60			7.42	9.88		11.61				10		8.82	11.45	10.77	15.13	2.23	8	
Floodprone Width (ft)					8	60		101			18.51	26.43		33.59				22	28	35	40.00	74.38	69.00	154.00	35.32	8
Bankfull Mean Depth (ft)					0.2	0.5		0.9			0.68	0.79		0.97				0.72		0.50	0.81	0.77	1.20	0.26	8	
¹ Bankfull Max Depth (ft)					0.7	1		1.4			1.28	1.78		2.16				1.2		0.87	1.53	1.54	2.07	0.49	8	
Bankfull Cross Sectional Area (ft ²)					8	1		1.4			0.97	1.39		1.82				7.2		4.45	9.27	8.85	14.07	3.48	8	
Width/Depth Ratio					1.1	27		47			8.14	12.95		16.82				13.9		8.56	15.45	14.89	25.33	5.40	8	
Entrenchment Ratio					0.4	2.4		9.5			2.02	2.4		3.24				2.2	2.8	3.5	3.30	6.90	5.62	16.40	4.19	8
¹ Bank Height Ratio						0.34		2			0.97	1.39		1.82				1		0.93	0.98	1.00	1.00	0.03	8	
d50 (mm)																										
Profile																										
Riffle Length (ft)					2.7	24.9		107.3			5.97	11.26		26.78				14	23	90	10.04	22.09	18.54	95.26	14.52	32
Riffle Slope (ft/ft)					0.0007	1.7		40			0.015	0.031		0.05				0.021	0.036	0.046	0.015	0.034	0.032	0.064	0.012	32
Pool Length (ft)					9.03	16.89		56.86			13.6	20.13		31.74				14	22	29	13.38	24.28	21.23	65.67	11.47	33
Pool Max depth (ft)					1	2.4		3.9			1.4	1.83		2.2					2.2		1.16	2.19	2.17	3.15	0.38	33
Pool Spacing (ft)					15.5	50		128			23.5	36.2		57.4				24	36.7	58	31.42	44.63	40.18	116.51	16.87	32
³ Pool Volume (ft ³)																										
Pattern																										
Channel Beltwidth (ft)					10	19.6		25			13	17.33		20				13	18	21	13		18	21		
Radius of Curvature (ft)					14.5	84		118			16	33		53				16	32.1	52	16		32.1	52		
Rc: Bankfull width (ft/ft)					1.7	4.6		11.5			4.35	6.04		8.9				4.3	6.1	8.9	4.3		6.1	8.9		
Meander Wavelength (ft)					36	96		240			43	59.67		88				43	61	89	43		61	89		
Meander Width Ratio					0.5	0.94		1.7			1.32	1.76		2.03				1.3	1.8	2.1	1.3		1.8	2.1		
Substrate, bed and transport parameters																										
⁴ Ri%/Ru%/P%/G%/S%					45.5%			53.6%			0.0%			26.8%	17.2%	47.9%	8.1%	0.0%			44.3%		55.7%		0.0%	
⁴ SC%/Sa%/G%/C%/B%/Be%					4.1%	27.3%		67.6%	1.0%	0.0%	0.0%															
⁴ d16/d35/d50/d84/d95/di ^p /di ^{sp} (mm)					2.71	6.72		10.56	24.89	38.23																
Reach Shear Stress (competency) lb/ft ²																										
Max part size (mm) Mobilized at bankfull																										
Stream Power (transport capacity) W/m ²																										
Additional Reach Parameters																										
Drainage Area (SM)								0.166						0.144												
Impervious cover estimate (%)																										
Rosgen Classification								G4/B4/C4b						B4/C4						B4/C4b					B4/C4b	
Bankfull Velocity (fps)								3.2												3.2						
Bankfull Discharge (cfs)								24																		
Valley length (ft)								1425						378												
Channel Thalweg length (ft)								1479						440						1438					1438	
Sinuosity (ft)								1.04						1.16						1.17					1.17	
Water Surface Slope (Channel) (ft/ft)								0.0196												0.017					0.017	
BF slope (ft/ft)																				0.017					0.017	
⁵ Bankfull Floodplain Area (acres)																										
⁶ Proportion over wide (%)																										
Entrenchment Class (ER Range)																										
Incision Class (BHR Range)																										
BEHI VL%/L%/M%/H%/VH%/E%																										
Channel Stability or Habitat Metric																										
Biological or Other																										

1 = The distributions for these parameters can include information from both the cross-section surveys and the longitudinal profile. 2 = Methodology should be described/cited. 3 = For projects with a proximal USGS gauge in-line with the project reach (added bankfull verification - rare). 4 = Riffle, Run, Pool, Glide, Step; Silt/Clay, Sand, Gravel, Cobble, Boulder, Bedrock, di^p=max pave, di^{sp}=max subpave. Shaded cells indicate that these will typically not be filled in. 5. Utilizing survey data produce and estimate of the bankfull floodplain area in acres, which should be the area from the top of bank to the toe of the terrace rise/slope. 6 = Proportion of reach determined to be over-wide based on the visual survey using the regional curve UL for width (see monitoring methodology document -pending); 7 = Entrenchment Class (ER ranges (see monitoring methodology document -pending). 8 = Incision Class (BHR ranges - see monitoring methodology document -pending) Footnotes 6, 7, 8 involve planning pre-construction monitoring for future projects. If the referenced monitoring methodology document is not available at the time of contracting or RFP review, the provider is not expected to address these parameters.

Table 5b. Baseline Stream Data Summary

601 East Stream Restoration, EEP Project Number 95756 - Reach 2 (902 feet)

Parameter	Gauge ³	Regional Curve			Pre- Existing Conditions							Reference Reach(es) Data						Design			As-built / Baseline					
		LL	UL	Eq.	Min	Mean	Med	Max	SD	n	Min	Mean	Med	Max	SD	n	Min	Med	Max	Min	Mean	Med	Max	SD	n	
Dimension and Substrate - Riffle																										
Bankfull Width (ft)					7	21		19			10	12.2		14.3			12		15.50	19.73	19.63	24.18	3.56	4		
Floodprone Width (ft)					40	60		214			42	77		11			48	91.5	135	62.00	108.75	102.50	168.00	50.05	4	
Bankfull Mean Depth (ft)					0.5	0.5		1.33			0.92	1.12		1.34			0.9		0.61	0.93	0.90	1.31	0.32	4		
¹ Bankfull Max Depth (ft)					0.7	1		1.9			1.2	1.6		2.2			1.5		1.49	2.01	2.02	2.53	0.58	4		
Bankfull Cross Sectional Area (ft ²)					6	1		21			12.2	13		13.4			10.7		9.43	18.42	19.49	25.26	6.75	4		
Width/Depth Ratio					6.1	27		38			7.7	11.3		15.6			13.3		14.64	23.00	22.13	33.10	8.07	4		
Entrenchment Ratio					2.2	2.4		10			2.9	6.5		8.6			3.6	7.6	10	2.56	5.63	5.79	8.39	2.54	4	
¹ Bank Height Ratio					0.9	0.34		1.7			1.1	1.5		1.7			1		0.90	0.96	0.96	1.00	0.05	4		
d50 (mm)																										
Profile																										
Riffle Length (ft)					10.9	24.9		19.7			4.03	14.18		13.61			14	23	90	12.13	23.38	18.96	50.22	10.70	18	
Riffle Slope (ft/ft)					0.00	1.7		0.04			0.006	0.02		0.05			0.021	0.036	0.046	0.004	0.02	0.02	0.04	0.01	17	
Pool Length (ft)					11.1	16.89		525.4			18.51	32.11		58.03			14	22	29	15.06	32.87	29.14	74.26	14.68	17	
Pool Max depth (ft)					1.9	2.4		4.2			1.7	2.47		3.1			2.5		1.91	2.87	2.67	4.03	0.59	17		
Pool Spacing (ft)					20	50		512			29	48		84			38	57	85	32.94	55.57	47.60	110.28	20.48	17	
³ Pool Volume (ft ³)																										
Pattern																										
Channel Beltwidth (ft)					12	32		42			25	40		65			25	40	65	25		40	65			
Radius of Curvature (ft)					68	75		77			20	31		65			38	47	58	38		47	58			
Rc: Bankfull width (ft/ft)					5.2	5.7		5.9			3.2	3.9		4.8			3.2	3.9	4.8	3.2		3.9	4.8			
Meander Wavelength (ft)					46	70		97			61	84		97			61	84	97	61		84	97			
Meander Width Ratio					0.9	2.4		3.2			2.1	3.3		5.4			2.1	3.3	5.4	2.1		3.3	5.4			
Substrate, bed and transport parameters																										
⁴ R%/Ru%/P%/G%/S%					12.6%			87.4%			27.2%	3.7%		61.5%			7.6%		0%			39.5%		60.5%		0.0%
⁴ SC%/Sa%/G%/C%/B%/Be%					0.0%	33.7%		66.3%	0.0%	0.0%	0.0%	0.0%														
⁴ d16/d35/d50/d84/d95/d ¹⁰ /d ⁹⁰ (mm)					0.90	4.57		8.92	24.42	47.93																
Reach Shear Stress (competency) lb/ft ²																										
Max part size (mm) Mobilized at bankfull																										
Stream Power (transport capacity) W/m ²																										
Additional Reach Parameters																										
Drainage Area (SM)								0.212						0.5												
Impervious cover estimate (%)																										
Rosgen Classification								C4/E4/DA						C4					C4/E4					C4/E4		
Bankfull Velocity (fps)								2.1											2.6							
Bankfull Discharge (cfs)								27																		
Valley length (ft)								830						378												
Channel Thalweg length (ft)								1479						440												
Sinuosity (ft)								1.01						1.1					1.34					1.34		
Water Surface Slope (Channel) (ft/ft)																			0.0069					0.0069		
BF slope (ft/ft)																			0.0069					0.0069		
⁵ Bankfull Floodplain Area (acres)																										
⁶ Proportion over wide (%)																										
Entrenchment Class (ER Range)																										
Incision Class (BHR Range)																										
BEHI VL%/L%/M%/H%/VH%/E%																										
Channel Stability or Habitat Metric																										
Biological or Other																										

1 = The distributions for these parameters can include information from both the cross-section surveys and the longitudinal profile. 2 = Methodology should be described/cited. 3 = For projects with a proximal USGS gauge in-line with the project reach (added bankfull verification - rare). 4 = Riffle, Run, Pool, Glide, Step; Silt/Clay, Sand, Gravel, Cobble, Boulder, Bedrock, di¹⁰=max pave, di⁹⁰=max subpave. Shaded cells indicate that these will typically not be filled in. 5. Utilizing survey data produce and estimate of the bankfull floodplain area in acres, which should be the area from the top of bank to the toe of the terrace rise/slope. 6 = Proportion of reach determined to be over-wide based on the visual survey using the regional curve UL for width (see monitoring methodology document -pending); 7 = Entrenchment Class (ER ranges (see monitoring methodology document -pending); 8 = Incision Class (BHR ranges - see monitoring methodology document -pending)Footnotes 6, 7, 8 involve planning pre-construction monitoring for future projects. If the referenced monitoring methodology document is not available at the time of contracting or RFP review, the provider is not expected to address these parameters.

Table 5c. Baseline Stream Data Summary

601 East Stream Restoration, EEP Project Number 95756 - Reach 3 (1018 feet)

Parameter	Gauge ³	Regional Curve			Pre- Existing Conditions						Reference Reach(es) Data						Design			As-built / Baseline					
		LL	UL	Eq.	Min	Mean	Med	Max	SD	n	Min	Mean	Med	Max	SD	n	Min	Med	Max	Min	Mean	Med	Max	SD	n
Dimension and Substrate - Riffle																									
Bankfull Width (ft)					65	15.7		29			10	12.2		14.3			17		15.86	17.69	17.66	19.58	1.52	4	
Floodprone Width (ft)					150	200		2601.26			42	77		11		150	200	300	75.00	231.25	250.00	350.00	140.50	4	
Bankfull Mean Depth (ft)					0.5	0.9		2.1			0.92	1.12		1.34			1.18		0.79	1.26	1.21	1.84	0.54	4	
¹ Bankfull Max Depth (ft)					1.28	1.7		19.4			1.2	1.6		2.2		2			1.58	2.51	2.52	3.44	1.06	4	
Bankfull Cross Sectional Area (ft ²)					10.5	14.5		31			12.2	13		13.4		21			12.85	22.79	21.12	36.08	11.26	4	
Width/Depth Ratio					12.8	17.5		16.5			7.7	11.3		15.6		14.4			10.62	15.88	15.27	22.36	5.98	4	
Entrenchment Ratio					9.6	12.7		4			2.9	6.5		8.6		8.8	11.8	17.6	4.73	12.74	13.17	19.90	7.31	4	
¹ Bank Height Ratio					1.3	2.2		1.7			1.1	1.5		1.7			1		0.99	1.00	1.00	1.00	0.01	4	
d50 (mm)																									
Profile																									
Riffle Length (ft)					0.97	10.58		23.77			4.03	14.18		13.61		15	25	103	10.12	24.10	16.77	110.25	22.07	19	
Riffle Slope (ft/ft)					0	0.2		0.6			0.006	0.02		0.05		0.008	0.018	0.03	0.00	0.02	0.02	0.04	0.01	17	
Pool Length (ft)					7.83	20.87		64.91			18.51	32.11		58.03		25	35	50	27.38	35.18	35.18	49.71	6.68	18	
Pool Max depth (ft)					1.8	2.7		3.4			1.7	2.47		3.1			3.4		1.93	2.91	2.98	3.50	0.36	18	
Pool Spacing (ft)					8	48		125			29	48		84		39	66	117	41.11	58.55	54.44	137.89	20.86	18	
³ Pool Volume (ft ³)																									
Pattern																									
Channel Beltwidth (ft)					13	41		58			25	40		65		35	56	92	35		56	92			
Radius of Curvature (ft)					22.5	49.7		78			20	31		65		27	43	63	27		43	63			
Rc: Bankfull width (ft/ft)					1.4	3.2		4.9			3.2	3.9		4.8		1.6	2.5	3.7	1.6		2.5	3.7			
Meander Wavelength (ft)					32	57		89			61	84		97		87	119	134	87		119	134			
Meander Width Ratio					1.3	2.6		3.7			2.1	3.3		5.4		2.1	3.3	5.4	2.1		3.3	5.4			
Substrate, bed and transport parameters																									
⁴ Ri%/Ru%/P%/G%/S%					38.0%		62.0%		0.0%		27.2%	3.7%	61.5%	7.6%	0.0%				43.0%		57.0%		0.0%		
⁴ SC%/Sa%/G%/C%/B%/Be%					4.0%	51.9%	44.1%	0.0%	0.0%	0%															
⁴ d16/d35/d50/d84/d95/d ¹⁰⁰ (mm)					0.8	3.5	5.4	12.8	19.6																
Reach Shear Stress (competency) lb/ft ²																									
Max part size (mm) Mobilized at bankfull																									
Stream Power (transport capacity) W/m ²																									
Additional Reach Parameters																									
Drainage Area (SM)							0.52						0.5												
Impervious cover estimate (%)																									
Rosgen Classification							C4-G4						E4/C4					C4				C4			
Bankfull Velocity (fps)							3.2											3				3			
Bankfull Discharge (cfs)							55																		
Valley length (ft)																									
Channel Thalweg length (ft)																		1064				1064			
Sinuosity (ft)							1.05						1.2												
Water Surface Slope (Channel) (ft/ft)																		0.0056				0.0056			
BF slope (ft/ft)																		0.0056				0.0056			
⁵ Bankfull Floodplain Area (acres)																									
⁶ Proportion over wide (%)																									
Entrenchment Class (ER Range)																									
Incision Class (BHR Range)																									
BEHI VL%/L%/M%/H%/VH%/E%																									
Channel Stability or Habitat Metric																									
Biological or Other																									

1 = The distributions for these parameters can include information from both the cross-section surveys and the longitudinal profile. 2 = Methodology should be described/cited. 3 = For projects with a proximal USGS gauge in-line with the project reach (added bankfull verification - rare). 4 = Riffle, Run, Pool, Glide, Step; Silt/Clay, Sand, Gravel, Cobble, Boulder, Bedrock, di¹⁰⁰=max pave, di⁵⁰=max subpave. Shaded cells indicate that these will typically not be filled in. 5. Utilizing survey data produce and estimate of the bankfull floodplain area in acres, which should be the area from the top of bank to the toe of the terrace rise/slope. 6 = Proportion of reach determined to be over-wide based on the visual survey using the regional curve UL for width (see monitoring methodology document -pending); 7 = Entrenchment Class (ER ranges (see monitoring methodology document -pending); 8 = Incision Class (BHR ranges - see monitoring methodology document -pending)Footnotes 6, 7, 8. Involve planning pre-construction monitoring for future projects. If the referenced monitoring methodology document is not available at the time of contracting or RFP review, the provider is not expected to address these parameters.

Table 5d. Baseline Stream Data Summary

601 East Stream Restoration, EEP Project Number 95756 - Reach 4 (495 feet)

Parameter	Gauge ³	Regional Curve			Pre- Existing Conditions						Reference Reach(es) Data						Design			As-built / Baseline						
		LL	UL	Eq.	Min	Mean	Med	Max	SD	n	Min	Mean	Med	Max	SD	n	Min	Med	Max	Min	Mean	Med	Max	SD	n	
Dimension and Substrate - Riffle																										
Bankfull Width (ft)					5.2	11.6		20			7.42	9.88		11.61				16		14.93	15.92	15.92	16.91	1.40	2	
Floodprone Width (ft)					16	20		25			18.51	26.43		33.59				30	35	40	30.39	36.19	36.19	42.00	8.21	2
Bankfull Mean Depth (ft)					0.76	0.9		1.1			0.68	0.79		0.97				0.98		0.98	1.37	1.37	1.76	0.55	2	
¹ Bankfull Max Depth (ft)						1.2		1.33			1.28	1.78		2.16				1.8		1.49	2.11	2.11	2.72	0.87	2	
Bankfull Cross Sectional Area (ft ²)					12.3	15		16			0.97	1.39		1.82				15.7		14.70	22.25	22.25	29.81	10.68	2	
Width/Depth Ratio					7	12.9		18			8.14	12.95		16.82				16.3		9.60	12.38	12.38	15.16	3.93	2	
Entrenchment Ratio					1.4	1.7		2.2			2.02	2.4		3.24				1.9	2.2	2.5	2.04	2.26	2.26	2.48	0.32	2
³ Bank Height Ratio					3.3	3.5		4.2			0.97	1.39		1.82				1		1.00	1.10	1.10	1.20	0.14	2	
d50 (mm)																										
Profile																										
Riffle Length (ft)					0.79	10.58		23.7			5.97	11.26		26.78				15	23	103	15.84	20.829	18.18	28.96	4.7764	9
Riffle Slope (ft/ft)					0	0.02		0.06			0.015	0.031		0.05				0.021	0.036	0.03	0.018	0.0274	0.0298	0.0382	0.0068	9
Pool Length (ft)					7.83	20.7		64.91			13.6	20.13		31.74				14	22	42	30.82	35.01	35.78	38.85	3.1243	9
Pool Max depth (ft)					2	2.5		3.2			1.4	1.83		2.2				2.2		1.997	2.8154	2.753	3.392	0.3909	9	
Pool Spacing (ft)					12	29		55			23.5	36.2		57.4				38	59	93	49.77	56.111	54.805	69.26	6.2441	8
³ Pool Volume (ft ³)																										
Pattern																										
Channel Beltwidth (ft)					12	32		82			13	17.33		20				21	28	32	21		28	32		
Radius of Curvature (ft)					18	34.9		61			16	33		53				26	52	84	26		52	84		
Rc: Bankfull width (ft/ft)					1.6	3		5.3			4.35	6.04		8.9				162	3.25	5.25	162		3.25	5.25		
Meander Wavelength (ft)					30	56		113			43	59.67		88				69	97	142	69		97	142		
Meander Width Ratio					1.1	2.8		7.2			1.32	1.76		2.03				1.32	1.76	2.03	1.32		1.76	2.03		
Substrate, bed and transport parameters																										
⁴ Ri%/Ru%/P%/G%/S%					19.9%			80.1%			0.0%			26.8%	17.2%	47.9%	8.1%	0.0%						39.1%	65.6%	0.0%
⁴ Sc%/Sa%/G%/C%/B%/Be%																										
⁴ d16/d35/d50/d84/d95/di ¹⁰ /di ¹⁰ (mm)																										
Reach Shear Stress (competency) lb/ft ²																										
Max part size (mm) Mobilized at bankfull																										
Stream Power (transport capacity) W/m ²																										
Additional Reach Parameters																										
Drainage Area (SM)							0.56							0.144												
Impervious cover estimate (%)																										
Rosgen Classification							G4							B4/C4						B4				B4		
Bankfull Velocity (fps)							4													3.27				3.27		
Bankfull Discharge (cfs)							55																			
Valley length (ft)														378												
Channel Thalweg length (ft)														440										465		465
Sinuosity (ft)							1.04							1.16										1.13		1.13
Water Surface Slope (Channel) (ft/ft)																				0.0114				0.0114		
BF slope (ft/ft)																				0.0114				0.0114		
⁵ Bankfull Floodplain Area (acres)																										
⁶ Proportion over wide (%)																										
Entrenchment Class (ER Range)																										
Incision Class (BHR Range)																										
BEHI VL%/L%/M%/H%/VH%/E%																										
Channel Stability or Habitat Metric																										
Biological or Other																										

1 = The distributions for these parameters can include information from both the cross-section surveys and the longitudinal profile. 2 = Methodology should be described/cited. 3 = For projects with a proximal USGS gauge in-line with the project reach (added bankfull verification - rare). 4 = Riffle, Run, Pool, Glide, Step; Silt/Clay, Sand, Gravel, Cobble, Boulder, Bedrock, di¹⁰=max pave, di¹⁰=max subpave. Shaded cells indicate that these will typically not be filled in. 5. Utilizing survey data produce and estimate of the bankfull floodplain area in acres, which should be the area from the top of bank to the toe of the terrace rise/slope. 6 = Proportion of reach determined to be over-wide based on the visual survey using the regional curve UL for width (see monitoring methodology document -pending); 7 = Entrenchment Class (ER ranges (see monitoring methodology document -pending). 8 = Incision Class (BHR ranges - see monitoring methodology document -pending) Footnotes 6, 7, 8 involve planning pre-construction monitoring for future projects. If the referenced monitoring methodology document is not available at the time of contracting or RFP review, the provider is not expected to address these parameters.

Table 6a. Morphology and Hydraulic Monitoring Summary (Dimensional Parameters-Cross Section)

601 East Stream Restoration, EEP Project Number 95756 - Reach 1 (1393 feet)

	Cross Section 1 (Pool)							Cross Section 2 (Riffle)							Cross Section 3 (Pool)							Cross Section 4 (Riffle)						
Based on fixed baseline bankfull elevation ¹	Base	MY1	MY2	MY3	MY4	MY5	MY+	Base	MY1	MY2	MY3	MY4	MY5	MY+	Base	MY1	MY2	MY3	MY4	MY5	MY+	Base	MY1	MY2	MY3	MY4	MY5	MY+
Bankfull Width (ft)	13.64							15.13							9.39							8.82						
Floodprone Width (ft)	45							77							154							75						
Bankfull Mean Depth (ft)	1.03							0.60							0.92							0.50						
Bankfull Max Depth (ft)	2.07							1.20							1.76							0.87						
Bankfull Cross Sectional Area (ft ²)	14.07							9.04							8.67							4.45						
Bankfull Width/Depth Ratio	13.22							25.33							10.17							17.48						
Bankfull Entrenchment Ratio	10.26							9.25							14.91							15.87						
Bankfull Bank Height Ratio	1.00							1.00							1.00							0.93						
Based on current/developing bankfull feature²																												
Bankfull Width (ft)																												
Floodprone Width (ft)																												
Bankfull Mean Depth (ft)																												
Bankfull Max Depth (ft)																												
Bankfull Cross Sectional Area (ft ²)																												
Bankfull Width/Depth Ratio																												
Bankfull Entrenchment Ratio																												
Bankfull Bank Height Ratio																												
Cross Sectional Area between end pins (ft ²)	22.967525							14.25679							14.58241							8.58						
d50 (mm)																												
	Cross Section 5 (Pool)							Cross Section 6 (Riffle)							Cross Section 7 (Pool)							Cross Section 8 (Riffle)						
Based on fixed baseline bankfull elevation ¹	Base	MY1	MY2	MY3	MY4	MY5	MY+	Base	MY1	MY2	MY3	MY4	MY5	MY+	Base	MY1	MY2	MY3	MY4	MY5	MY+	Base	MY1	MY2	MY3	MY4	MY5	MY+
Bankfull Width (ft)	12.92							11.29							10.25							10.13						
Floodprone Width (ft)	61							80							63							40						
Bankfull Mean Depth (ft)	0.99							0.59							1.20							0.61						
Bankfull Max Depth (ft)	2.02							1.31							1.98							1.01						
Bankfull Cross Sectional Area (ft ²)	12.84							6.62							12.27							6.20						
Bankfull Width/Depth Ratio	12.99							19.26							8.56							16.55						
Bankfull Entrenchment Ratio	17.42							9.74							10.73							10.86						
Bankfull Bank Height Ratio	0.94							1.00							1.00							1.00						
Based on current/developing bankfull feature²																												
Bankfull Width (ft)																												
Floodprone Width (ft)																												
Bankfull Mean Depth (ft)																												
Bankfull Max Depth (ft)																												
Bankfull Cross Sectional Area (ft ²)																												
Bankfull Width/Depth Ratio																												
Bankfull Entrenchment Ratio																												
Bankfull Bank Height Ratio																												
Cross Sectional Area between end pins (ft ²)	20.51714							16.673495							24.88571							11.37						
d50 (mm)																												

1 = Widths and depths for monitoring resurvey will be based on the baseline bankfull datum regardless of dimensional/depositional development. Input the elevation used as the datum, which should be consistent and based on the baseline datum established. If the
 2 = Based on the elevation of any dominant depositional feature that develops and is observed at the time of survey. If the baseline datum remains the only significant depositional feature then these two sets of dimensional parameters will be

**Table 6b. Morphology and Hydraulic Monitoring Summary (Dimensional Parameters-Cross Section)
601 East Stream Restoration, EEP Project Number 95756 - Reach 2 (902 feet)**

	Cross Section 9 (Riffle)							Cross Section 10 (Pool)							Cross Section 11 (Riffle)							Cross Section 12 (Pool)						
Based on fixed baseline bankfull elevation¹	Base	MY1	MY2	MY3	MY4	MY5	MY+	Base	MY1	MY2	MY3	MY4	MY5	MY+	Base	MY1	MY2	MY3	MY4	MY5	MY+	Base	MY1	MY2	MY3	MY4	MY5	MY+
Bankfull Width (ft)	24.18							19.23							15.50							20.02						
Floodprone Width (ft)	62							132							73							168						
Bankfull Mean Depth (ft)	0.73							1.31							0.61							1.06						
Bankfull Max Depth (ft)	1.54							2.53							1.49							2.50						
Bankfull Cross Sectional Area (ft ²)	17.66							25.26							9.43							21.33						
Bankfull Width/Depth Ratio	33.10							14.64							25.45							18.80						
Bankfull Entrenchment Ratio	5.79							11.70							7.10							6.99						
Bankfull Bank Height Ratio	1.00							1.00							0.90							0.93						
Based on current/developing bankfull feature²																												
Bankfull Width (ft)																												
Floodprone Width (ft)																												
Bankfull Mean Depth (ft)																												
Bankfull Max Depth (ft)																												
Bankfull Cross Sectional Area (ft ²)																												
Bankfull Width/Depth Ratio																												
Bankfull Entrenchment Ratio																												
Bankfull Bank Height Ratio																												
Cross Sectional Area between end pins (ft ²)	30.35249							44.920645							28.42963							37.27						
d50 (mm)																												

¹ = Widths and depths for monitoring resurvey will be based on the baseline bankfull datum regardless of dimensional/depositional development. Input the elevation used as the datum, which should be consistent and based on the baseline datum established. If the

² = Based on the elevation of any dominant depositional feature that develops and is observed at the time of survey. If the baseline datum remains the only significant depositional feature then these two sets of dimensional parameters will be equal, however, if another depositional feature of significance develops above or below the baseline bankfull datum then this should be tracked and quantified in these cells.

Table 6c. Morphology and Hydraulic Monitoring Summary (Dimensional Parameters-Cross Section)
601 East Stream Restoration, EEP Project Number 95756 - Reach 3 (1018 feet)

	Cross Section 13 (Riffle)							Cross Section 14 (Pool)							Cross Section 15 (Pool)							Cross Section 16 (Riffle)						
Based on fixed baseline bankfull elevation¹	Base	MY1	MY2	MY3	MY4	MY5	MY+	Base	MY1	MY2	MY3	MY4	MY5	MY+	Base	MY1	MY2	MY3	MY4	MY5	MY+	Base	MY1	MY2	MY3	MY4	MY5	MY+
Bankfull Width (ft)	15.86							17.58							19.58							17.74						
Floodprone Width (ft)	75							350							350							150						
Bankfull Mean Depth (ft)	0.81							1.60							1.84							0.79						
Bankfull Max Depth (ft)	1.61							3.43							3.44							1.58						
Bankfull Cross Sectional Area (ft ²)	12.85							28.18							36.08							14.07						
Bankfull Width/Depth Ratio	19.57							10.97							10.62							22.36						
Bankfull Entrenchment Ratio	8.83							12.80							5.62							7.89						
Bankfull Bank Height Ratio	1.00							1.00							1.00							0.99						
Based on current/developing bankfull feature²																												
Bankfull Width (ft)																												
Floodprone Width (ft)																												
Bankfull Mean Depth (ft)																												
Bankfull Max Depth (ft)																												
Bankfull Cross Sectional Area (ft ²)																												
Bankfull Width/Depth Ratio																												
Bankfull Entrenchment Ratio																												
Bankfull Bank Height Ratio																												
Cross Sectional Area between end pins (ft ²)	21.49233							34.1507							39.69315							18.87						
d50 (mm)																												

1 = Widths and depths for monitoring resurvey will be based on the baseline bankfull datum regardless of dimensional/depositional development. Input the elevation used as the datum, which should be consistent and based on the baseline datum established. If the

2 = Based on the elevation of any dominant depositional feature that develops and is observed at the time of survey. If the baseline datum remains the only significant depositional feature then these two sets of dimensional parameters will be equal, however, if another depositional feature of significance develops above or below the baseline bankfull datum then this should be tracked and quantified in these cells.

Table 6d. Morphology and Hydraulic Monitoring Summary (Dimensional Parameters-Cross Section)

601 East Stream Restoration, EEP Project Number 95756 - Reach 4 (495 feet)


	Cross Section 17 (Pool)							Cross Section 18 (Riffle)							Cross Section 3 (Riffle)							
Based on fixed baseline bankfull elevation¹	Base	MY1	MY2	MY3	MY4	MY5	MY+	Base	MY1	MY2	MY3	MY4	MY5	MY+	Base	MY1	MY2	MY3	MY4	MY5	MY+	
Bankfull Width (ft)	16.91							14.93														
Floodprone Width (ft)	42							30.3896229														
Bankfull Mean Depth (ft)	1.76							0.98														
Bankfull Max Depth (ft)	2.72							1.49														
Bankfull Cross Sectional Area (ft ²)	29.81							14.70														
Bankfull Width/Depth Ratio	9.60							15.16														
Bankfull Entrenchment Ratio	2.48							2.04														
Bankfull Bank Height Ratio	1.20							1.00														
Based on current/developing bankfull feature²																						
Bankfull Width (ft)																						
Floodprone Width (ft)																						
Bankfull Mean Depth (ft)																						
Bankfull Max Depth (ft)																						
Bankfull Cross Sectional Area (ft ²)																						
Bankfull Width/Depth Ratio																						
Bankfull Entrenchment Ratio																						
Bankfull Bank Height Ratio																						
Cross Sectional Area between end pins (ft ²)	99.86796							86.17401														
d50 (mm)																						

1 = Widths and depths for monitoring resurvey will be based on the baseline bankfull datum regardless of dimensional/depositional development. Input the elevation used as the datum, which should be consistent and based on the baseline datum established. If the

2 = Based on the elevation of any dominant depositional feature that develops and is observed at the time of survey. If the baseline datum remains the only significant depositional feature then these two sets of dimensional parameters will be equal, however, if another depositional feature of significance develops above or below the baseline bankfull datum then this should be tracked and quantified in these cells.


**601 East: Reach 1
Longitudinal Profile
Main Channel: Station 7+60 - 22+00**

— TW MY-00 □ BKF MY-00 - WS MY-00

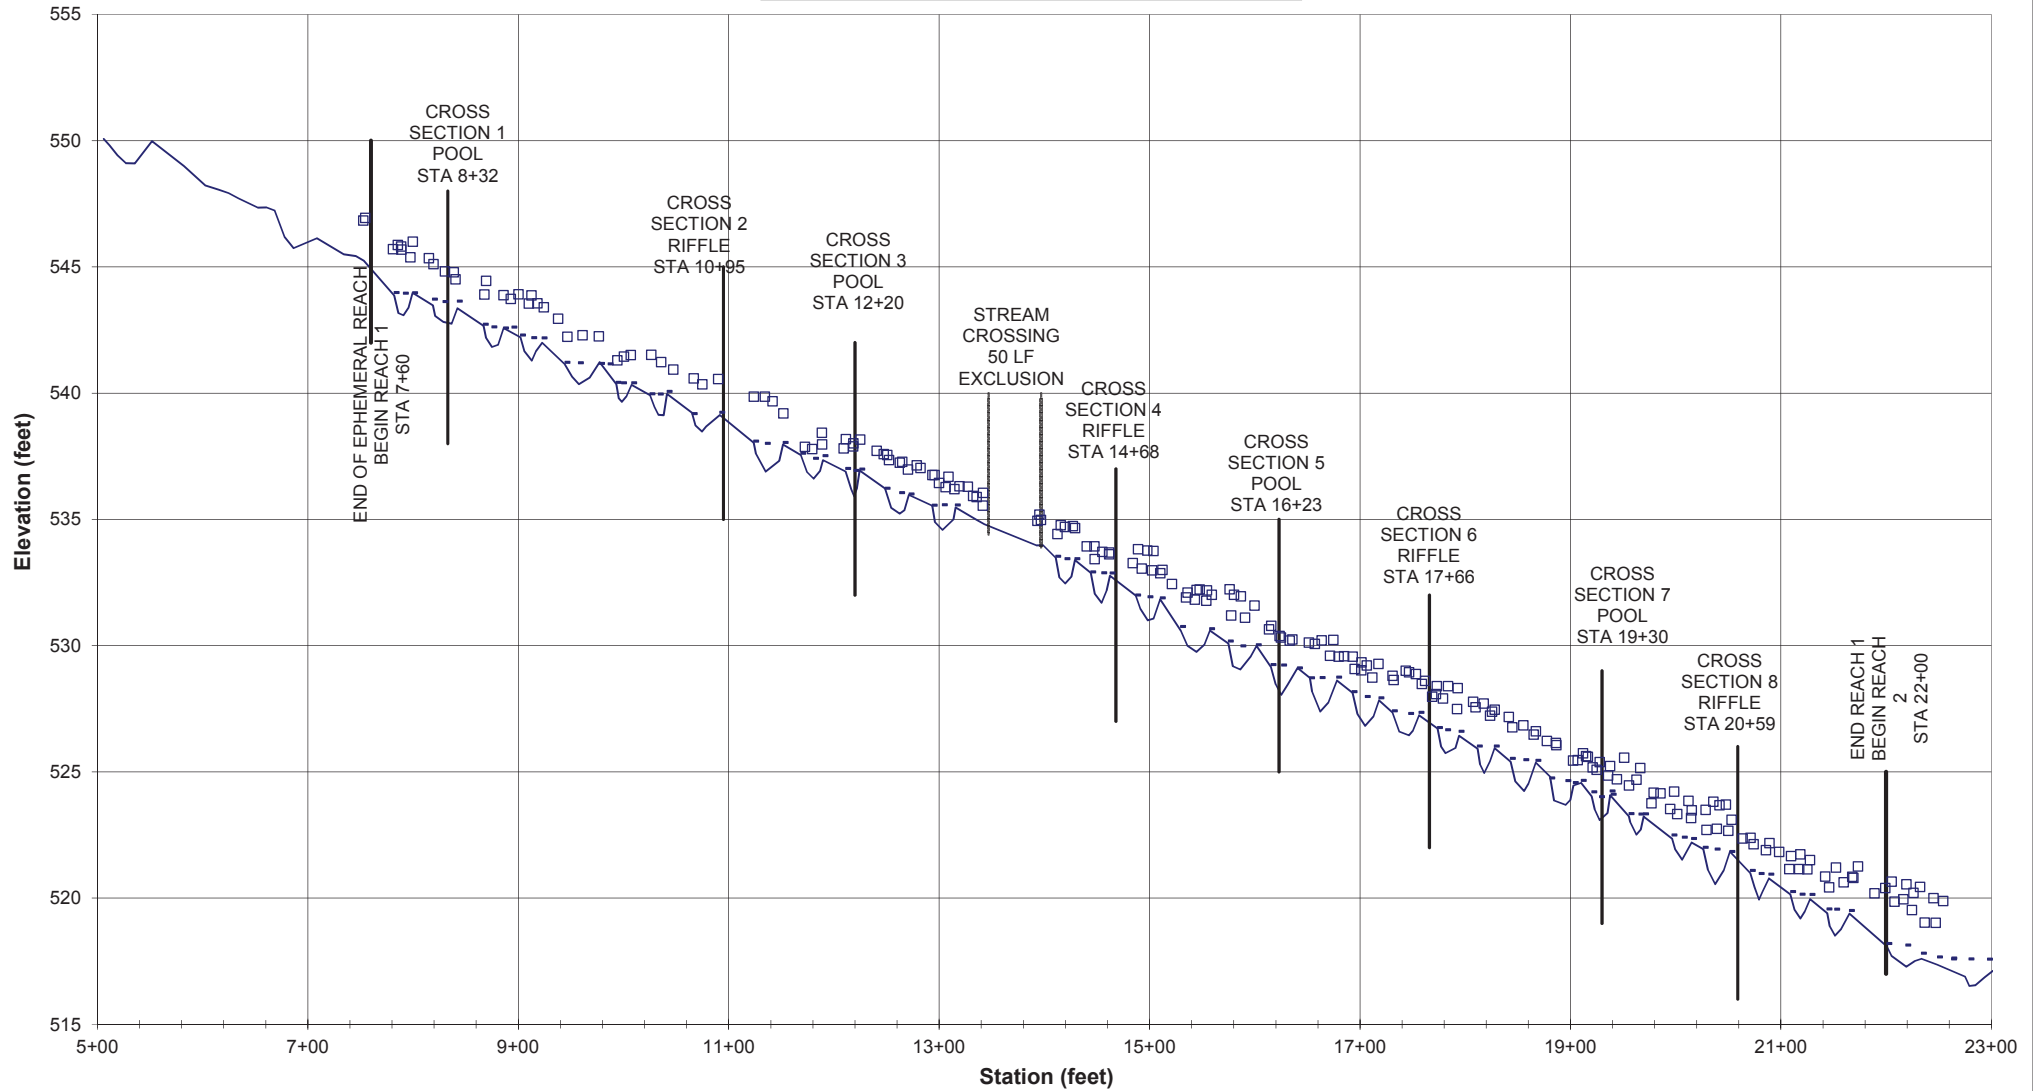


601 East: Reach 2
Longitudinal Profile
Main Channel: Station 22+00 - 31+32

— TW MY-00 □ BKF MY-00 - WS MY-00

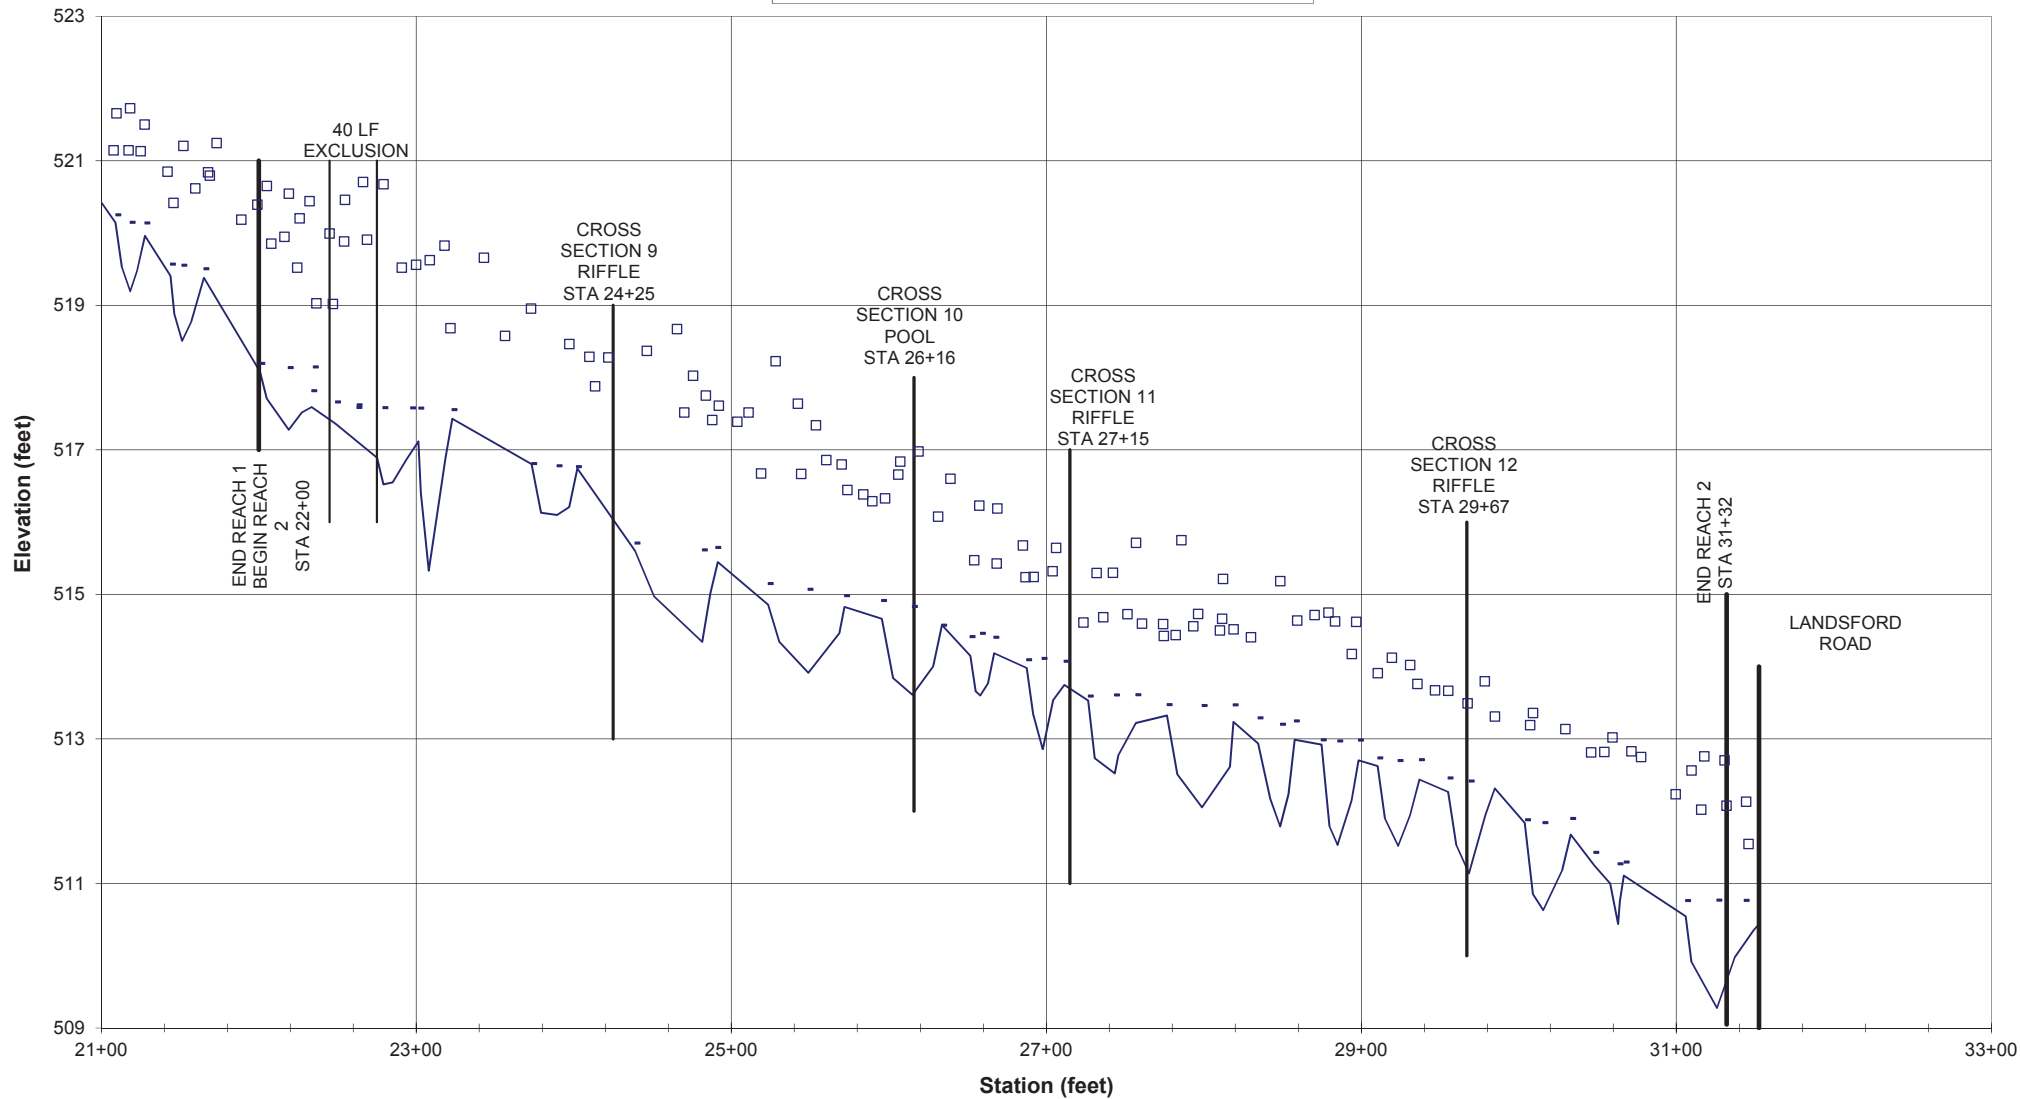


601 East: Reach 3
Longitudinal Profile
Main Channel: Station 42+92 - 53+70

— TW MY-00 □ BKF MY-00 - WS MY-00

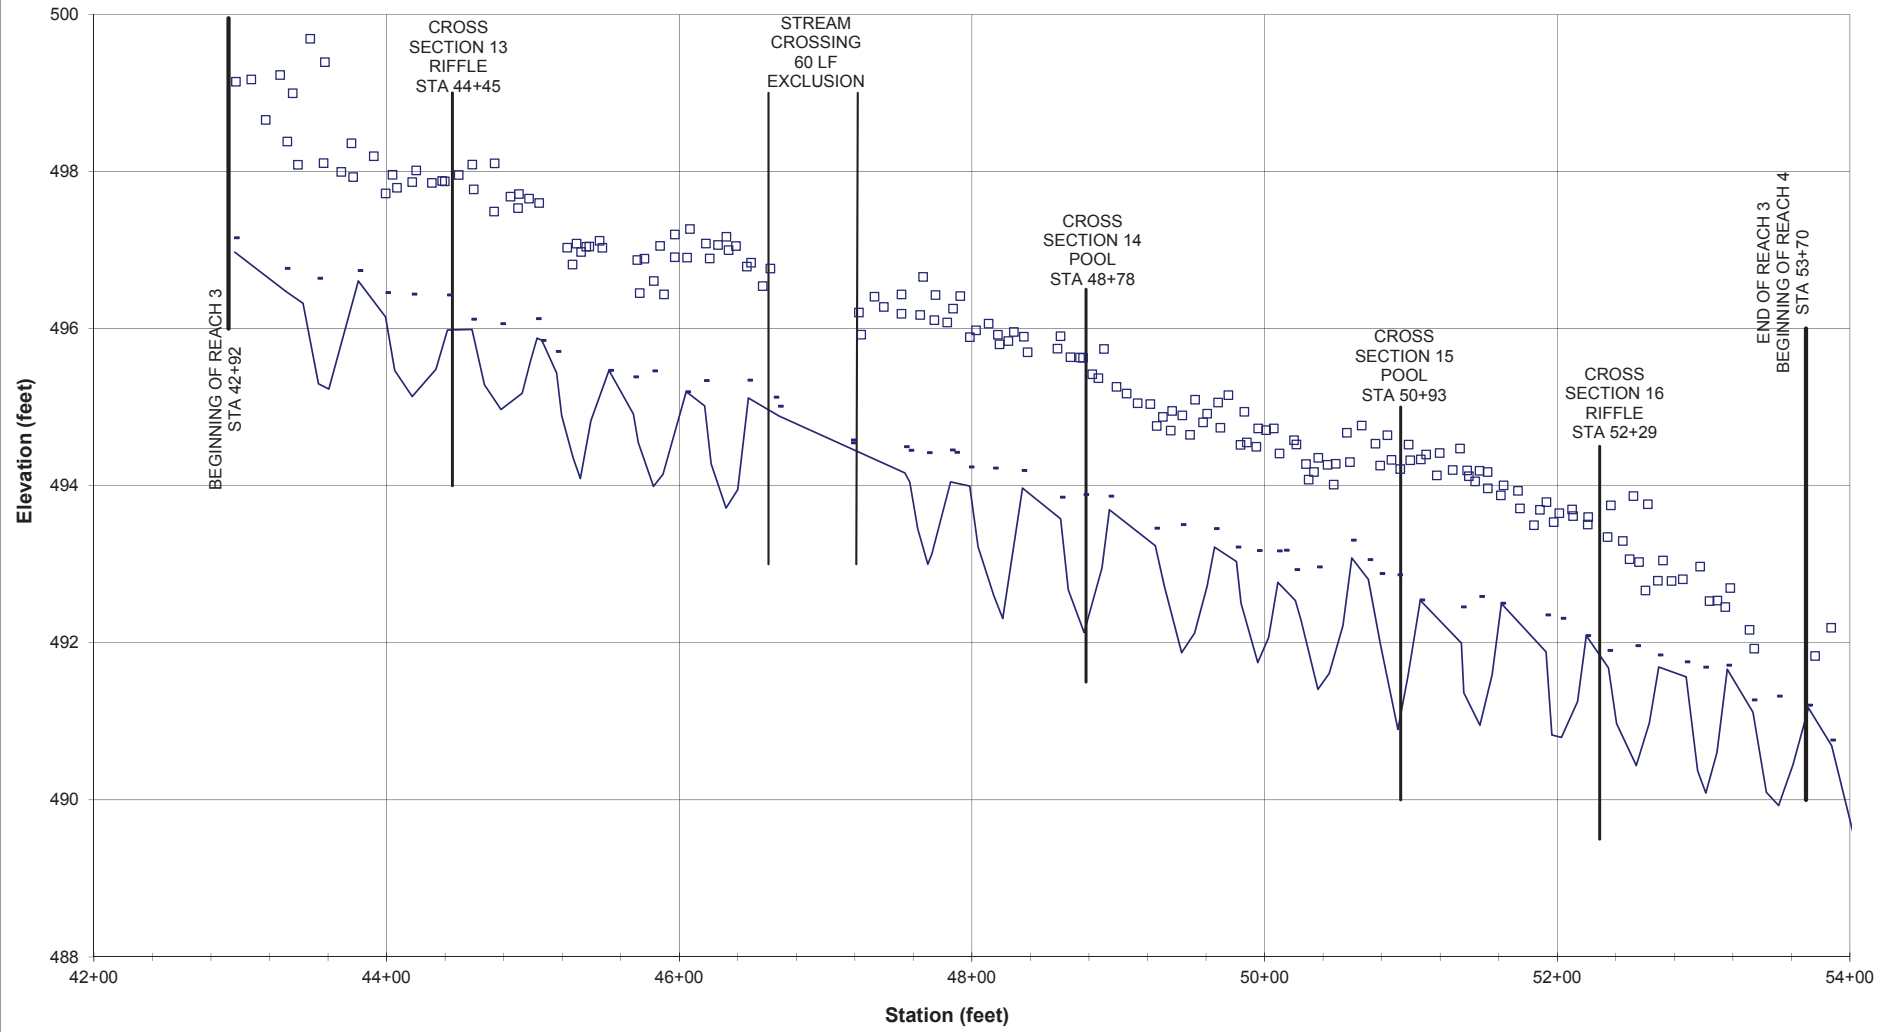

**601 East: Reach 4
Longitudinal Profile
Main Channel: Station 53+70- 58+65**

— TW MY-00 □ BKF MY-00 - WS MY-00

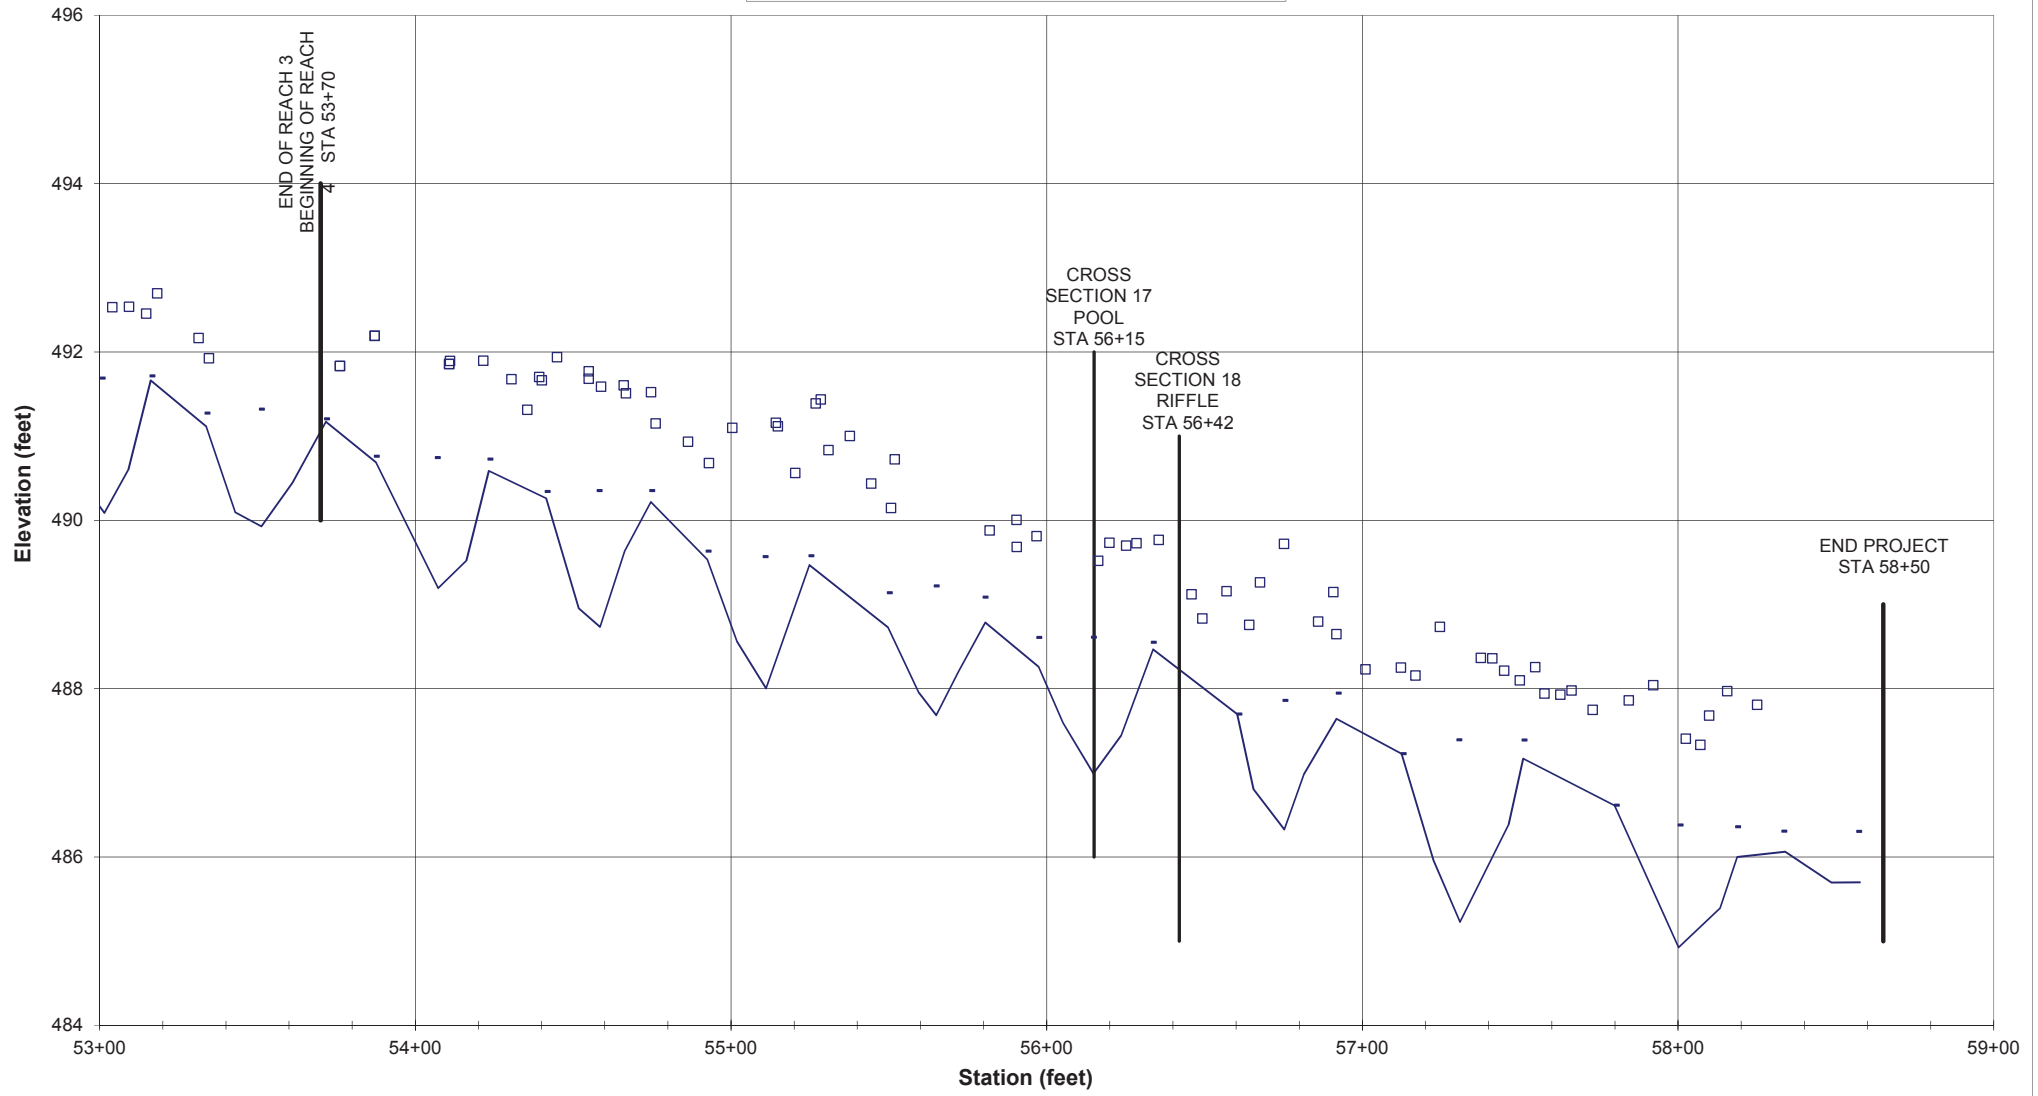


Project:	601 East	Summary (bankfull)						
Cross Section:	Cross Section 1	A (BKF)	MY0	MY1	MY2	MY3	MY4	MY5
Feature:	Pool	W (BKF)	14.1					
Station:	8+32	Max d	13.6					
Date:	1/29/15	Mean d	2.1					
Crew:	SV, RZ	W/D	1.0					
			13.2					

MY00-YEAR			MY01-Year			MY02-Year			MY03-Year			MY04-Year	
Station	Elevation	Notes	Station	Elevation	Notes	Station	Elevation	Notes	Station	Elevation	Notes	Station	Elevation
	545.33	LPIN											
0.34	545.26												
5.00	544.80												
6.04	544.82	Bankfull left TOBL											
9.13	543.31												
10.18	542.76	TOE L											
10.95	542.75	TW											
11.53	542.75												
12.63	543.20	TOE R											
14.31	543.69												
15.43	544.07												
17.35	544.35												
19.84	544.85												
21.70	545.28	Bankfull right TOBR											
21.74	545.27	RPIN											



Photo of XS-1, looking in the downstream direction

601 East, Reach 1: Cross Section 1

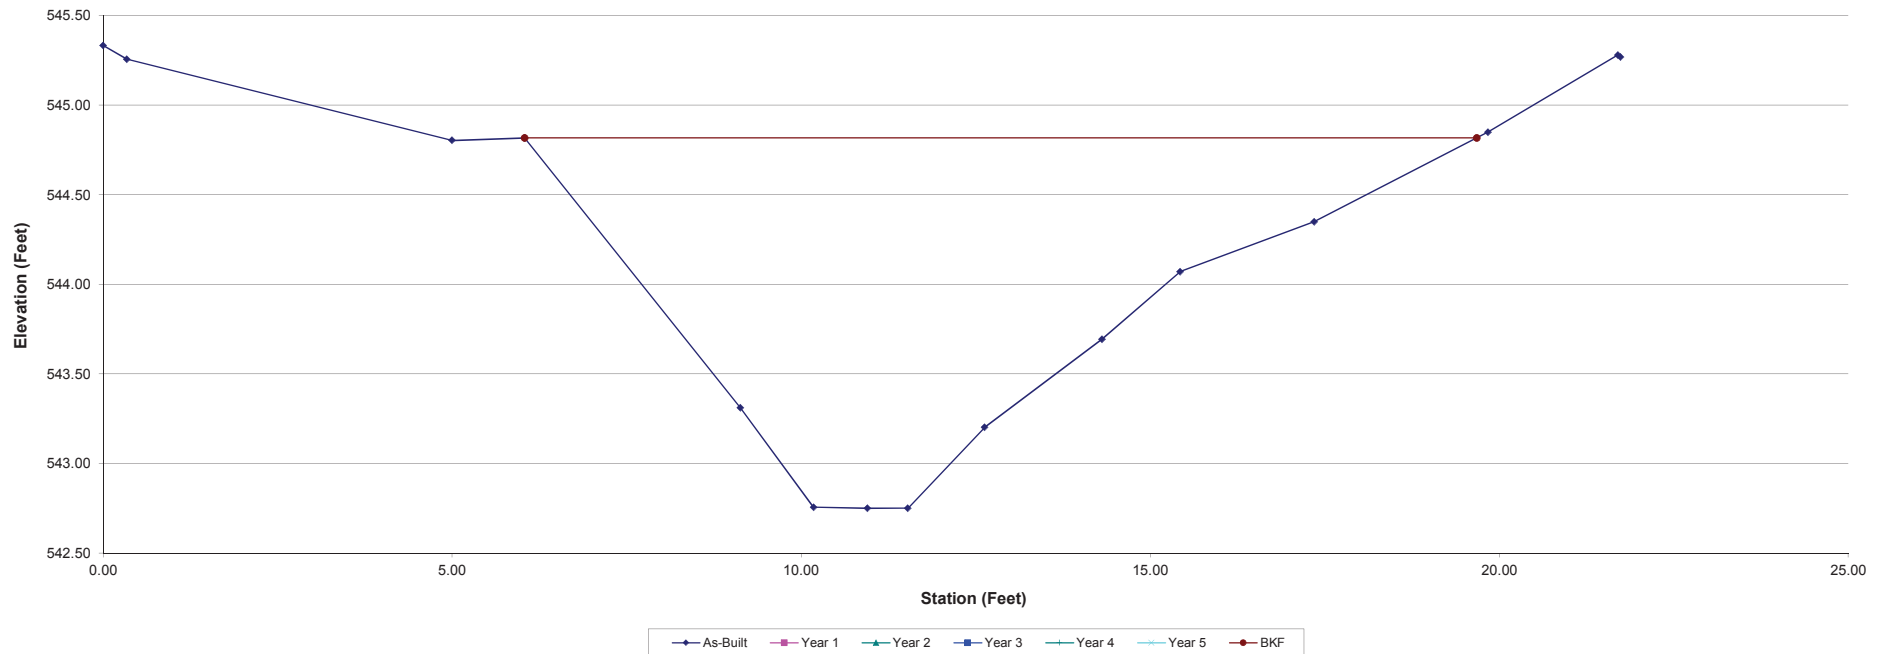


Project:	601 East	Summary (bankfull)					
Cross Section:	Cross Section 2	MY0	MY1	MY2	MY3	MY4	MY5
Feature:	Riffle	A (BKF)					
Station:	10+95	W (BKF)					
Date:	1/29/15	Max d					
Crew:	SV, RZ	Mean d					
		W/D	25.3				

MY00-YEAR			MY01-Year			MY02-Year			MY03-Year			MY04-Year	
Station	Elevation	Notes	Station	Elevation	Notes	Station	Elevation	Notes	Station	Elevation	Notes	Station	Elevation
	540.72	LPIN											
0.12	540.64												
0.75	540.40	TOBL Bankfull left											
1.44	540.14												
4.26	539.91												
7.46	539.82												
9.65	539.34												
10.27	539.21	TOE L											
10.48	539.20	TW											
11.25	539.30	TOE R											
11.58	539.29												
12.68	539.46												
12.81	539.77												
15.59	540.34												
16.47	540.52	TOBR Bankfull right											
18.33	540.48												
19.40	540.46												
19.40	540.66	Rpin											



Photo of XS-2, looking in the downstream direction

601 East, Reach 1: Cross Section 2

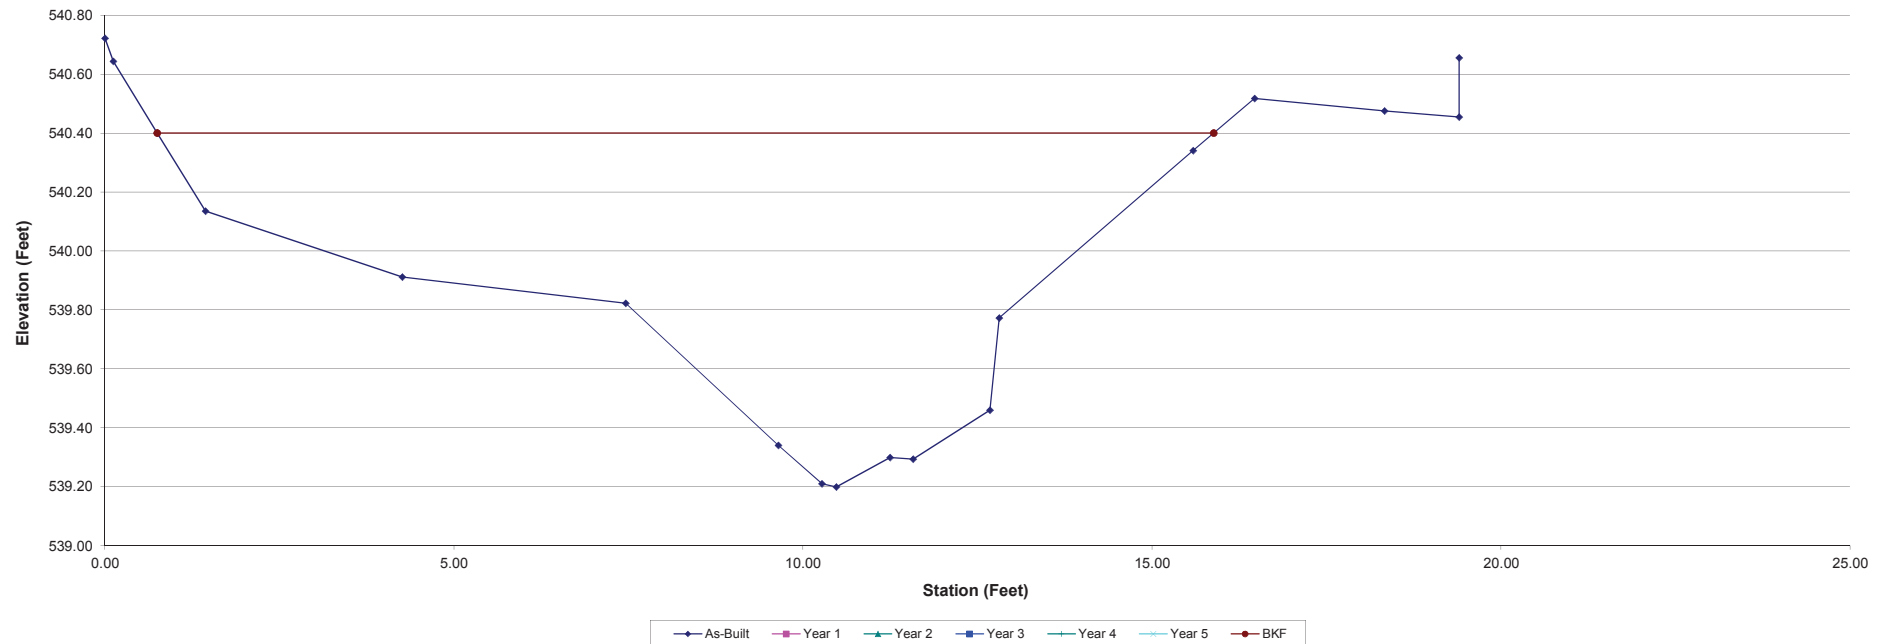


Project:	601 East	Summary (bankfull)						
Cross Section:	Cross Section 3	A (BKF)	MY0	MY1	MY2	MY3	MY4	MY5
Feature:	Pool	W (BKF)	8.7					
Station:	12+20	Max d	9.4					
Date:	1/29/15	Mean d	1.8					
Crew:	SV, RZ	W/D	0.9					
			10.2					

MY00-YEAR			MY01-Year			MY02-Year			MY03-Year			MY04-	
Station	Elevation	Notes	Station	Elevation	Notes	Station	Elevation	Notes	Station	Elevation	Notes	Station	Eleva
	538.55												
	538.44	LPIN											
0.70	538.07												
6.42	538.06												
6.80	537.87	TOBL BANKFULL LEFT											
7.27	537.64												
8.72	537.27												
10.21	536.30	TOE L											
10.46	536.13												
11.58	536.10	TW											
12.31	536.13												
13.06	536.21	TOE R											
13.92	537.21												
15.28	537.82												
16.19	537.87	TOBR BANKFULL RIGHT											
17.31	537.82												
17.38	538.01	RPIN											



Photo of XS-3, looking in the downstream direction

601 East, Reach 1: Cross Section 3

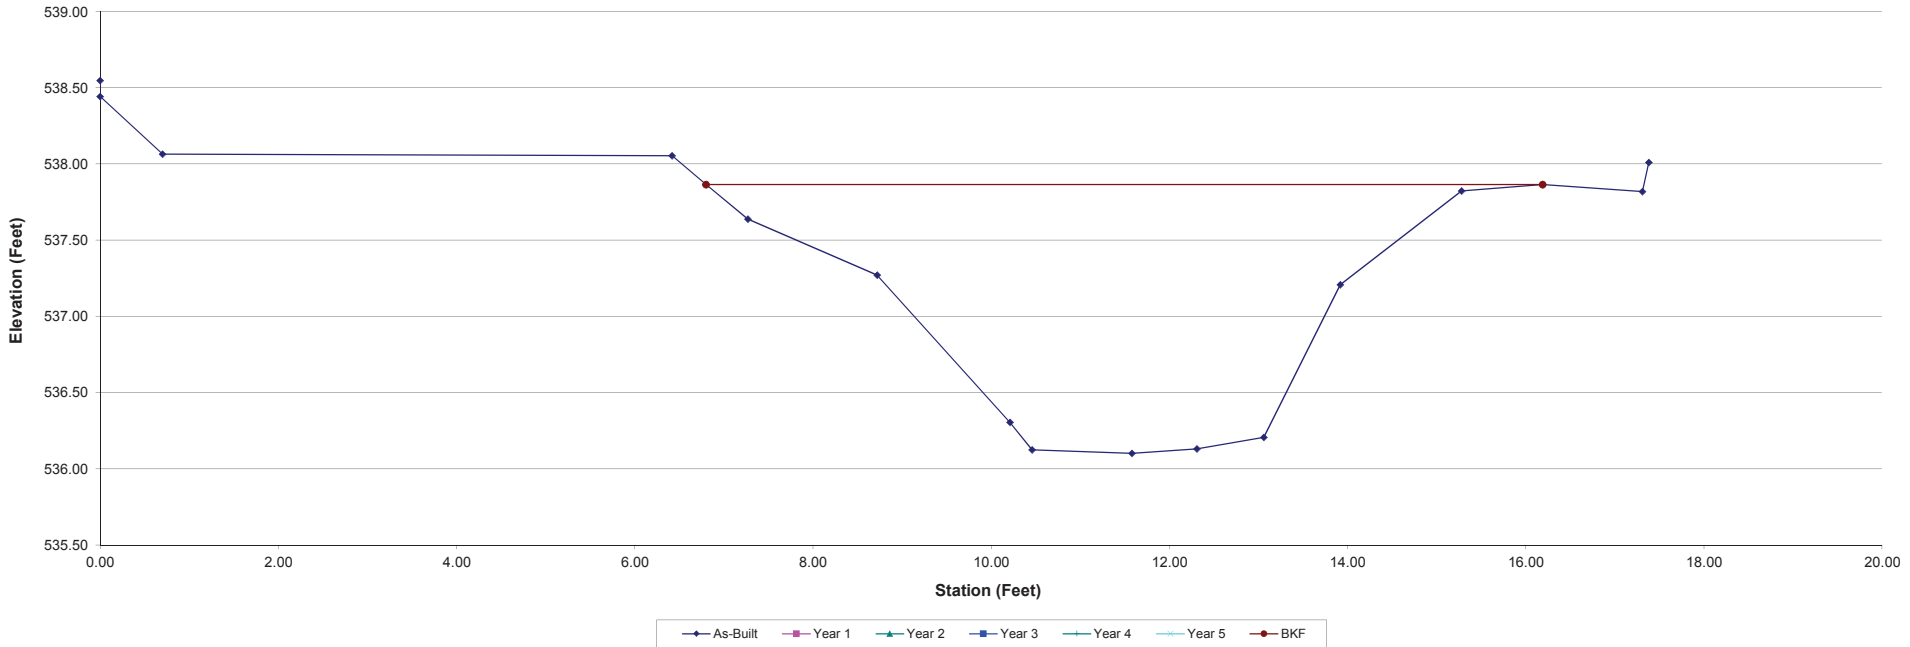


Project:	601 East	Summary (bankfull)											
Cross Section:	Cross Section 4	MY0	MY1	MY2	MY3	MY4	MY5						
Feature:	Riffle	A (BKF)	4.5										
Station:	14+68	W (BKF)	8.8										
Date:	1/29/15	Max d	0.9										
Crew:	SV, RZ	Mean d	0.5										
		W/D	17.5										
MY00-YEAR			MY01-Year			MY02-Year			MY03-Year			MY04	
Station	Elevation	Notes	Station	Elevation	Notes	Station	Elevation	Notes	Station	Elevation	Notes	Station	Elev
0.20	534.09	LPIN											
2.50	533.90												
3.79	533.87												
4.78	533.70												
6.09	533.74												
7.52	533.89												
8.04	533.79												
10.48	533.69	BANKFULL LEFT											
10.70	533.24												
11.39	533.09												
12.36	532.93	TOE L											
12.46	532.89												
14.22	532.88	TW											
14.79	532.82	TOE R											
15.89	533.25												
16.86	533.43												
18.93	533.69	BANKFULL RIGHT											
20.88	533.50												
22.21	533.37												
22.21	533.57												
22.21	533.67	RPIN											



Photo of XS-4, looking in the downstream direction

601 East, Reach 1: Cross Section 4

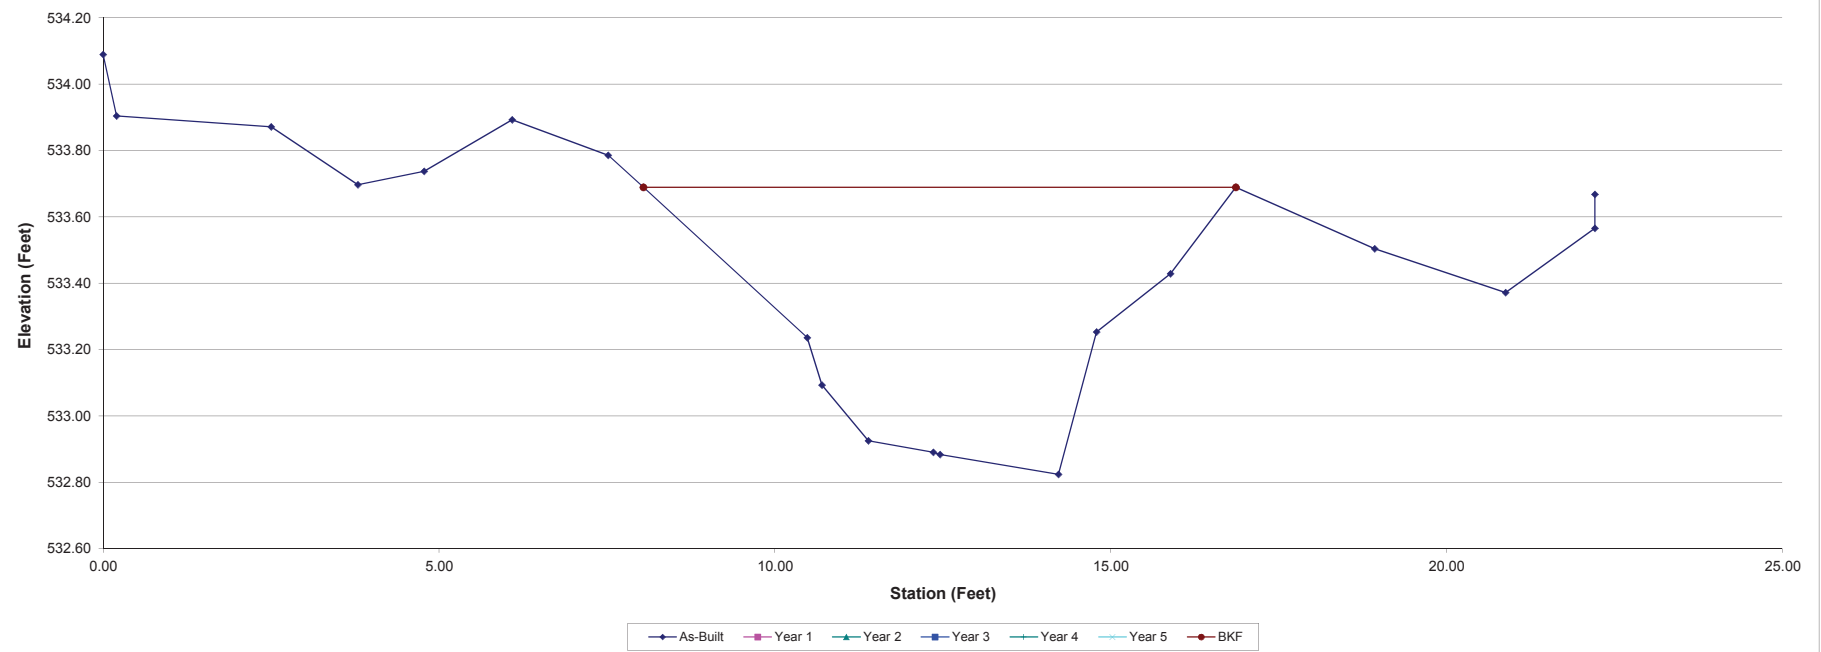


Project:	601 East	Summary (bankfull)						
Cross Section:	Cross Section 5	A (BKF)	MY0	MY1	MY2	MY3	MY4	MY5
Feature:	Pool	W (BKF)	12.8					
Station:	16+23	Max d	12.9					
Date:	1/29/15	Mean d	2.0					
Crew:	SV, RZ	W/D	1.0					
			13.0					

MY00-Year			MY01-Year			MY02-Year			MY03-Year			Station
Station	Elevation	Notes	Station	Elevation	Notes	Station	Elevation	Notes	Station	Elevation	Notes	Station
	530.83	LPIN										
0.11	530.54											
0.31	530.47											
0.94	530.49	TOBL BANKFULL LEFT										
1.22	530.33											
2.81	529.74											
5.27	529.67											
5.86	528.93											
6.76	528.86	TOE L										
7.67	528.59	TW										
8.76	528.47	TOE R										
10.31	529.26											
11.23	529.81											
14.01	530.53											
15.11	530.64	TOBR BANKFULL RIGHT										
17.77	530.56											
18.35	530.47											
19.89	530.52											
22.20	530.72											
22.53	530.90	RPIN										



Photo of XS-5, looking in the downstream direction

601 East, Reach 1: Cross Section 5

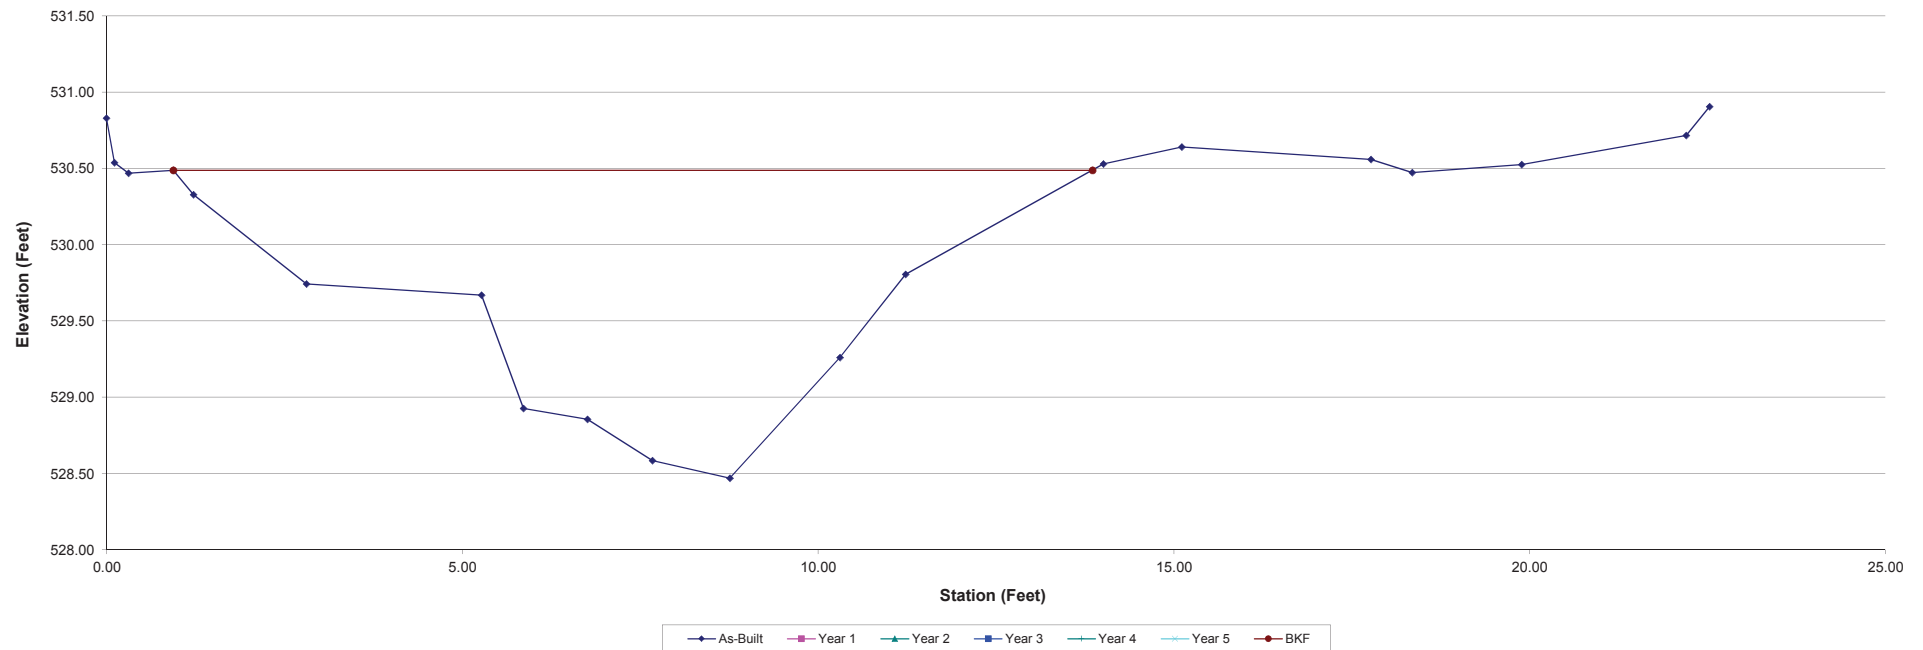


Project:	601 East	Summary (bankfull)						
Cross Section:	Cross Section 6	MY0	MY1	MY2	MY3	MY4	MY5	
Feature:	Riffle	A (BKF)						
Station:	17+66	W (BKF)						
Date:	1/29/15	Max d						
Crew:	SV, RZ	Mean d						
		W/D						

MY00-YEAR			MY01-Year			MY02-Year			MY03-Year			Station
Station	Elevation	Notes	Station	Elevation	Notes	Station	Elevation	Notes	Station	Elevation	Notes	Station
	528.49	LPIN										
0.28	528.34											
3.97	528.31											
8.62	528.11	BANKFULL LEFT										
10.76	527.96											
13.19	527.22											
13.81	526.82	TOE L										
14.78	526.80	TW										
15.29	527.10											
16.10	527.10	TOE R										
16.65	527.23											
18.94	527.91											
20.84	528.30											
22.69	528.77	BANKFULL RIGHT										
22.72	528.80	RPIN										



Photo of XS-6 looking in the downstream direction

601 East, Reach 1: Cross Section 6

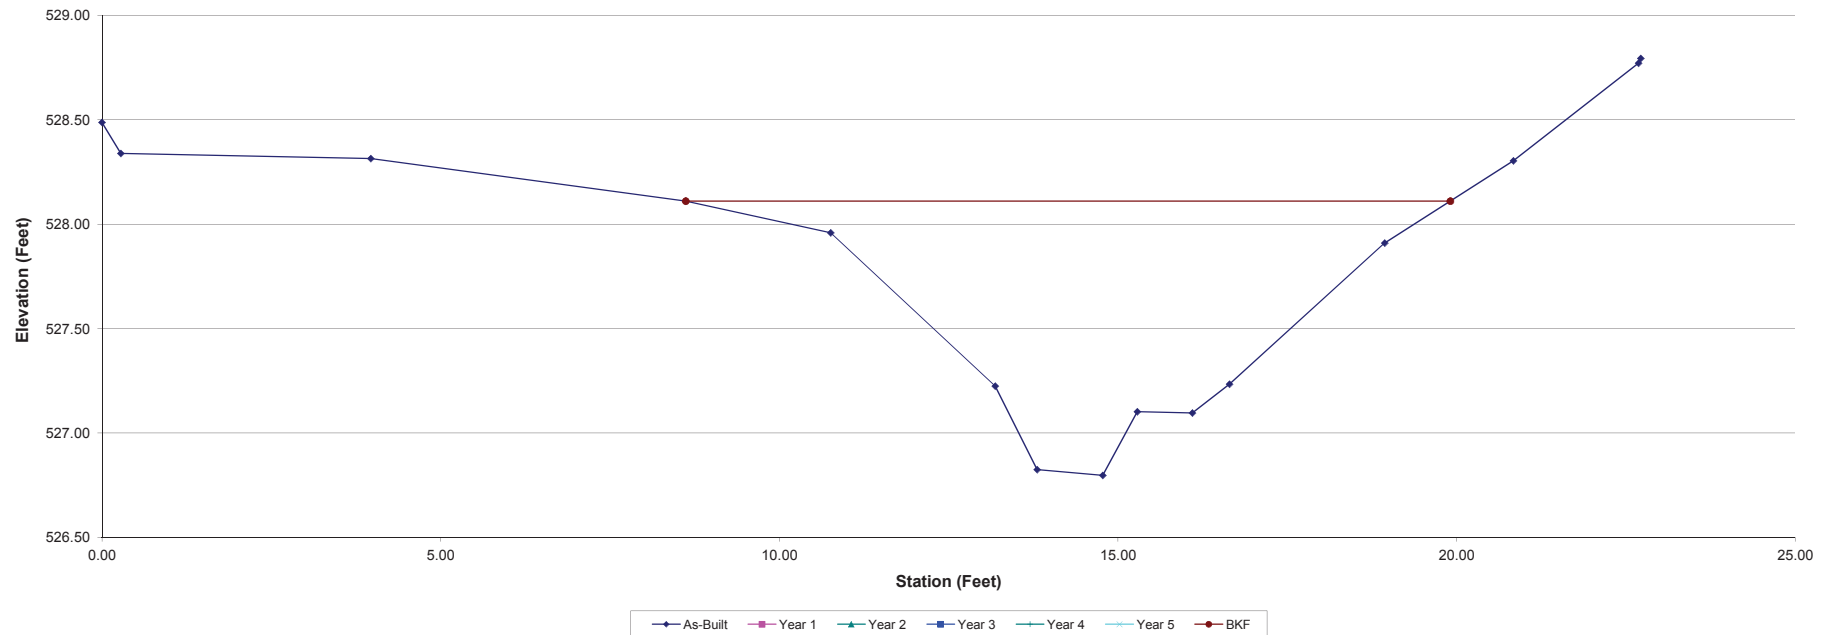


Project: 601 East		Summary (bankfull)											
Cross Section: Cross Section 7		A (BKF)	MY0	MY1	MY2	MY3	MY4	MY5					
Feature: Pool		W (BKF)	12.3										
Station: 19+30		Max d	10.3										
Date: 1/29/15		Mean d	2.0										
Crew: SV, RZ		W/D	1.2										
			8.6										
MY00-Year			MY01-Year			MY02-Year			MY03-Year			MY04-Year	
Station	Elevation	Notes	Station	Elevation	Notes	Station	Elevation	Notes	Station	Elevation	Notes	Station	Elevation
	525.41	LPIN											
0.26	525.06												
1.89	525.02	TOBL BANKFULL LEFT											
2.79	524.64												
4.97	524.16												
6.28	523.46	TOE L											
6.56	523.08												
8.37	523.04	TW											
9.13	523.04	TOE R											
11.19	523.97												
12.34	525.24												
14.33	525.21												
16.36	525.62	TOBR BANKFULL RIGHT											
19.31	526.02												
19.63	526.25	RPIN											



Photo of XS-7 looking in the downstream direction

601 East, Reach 1: Cross Section 7

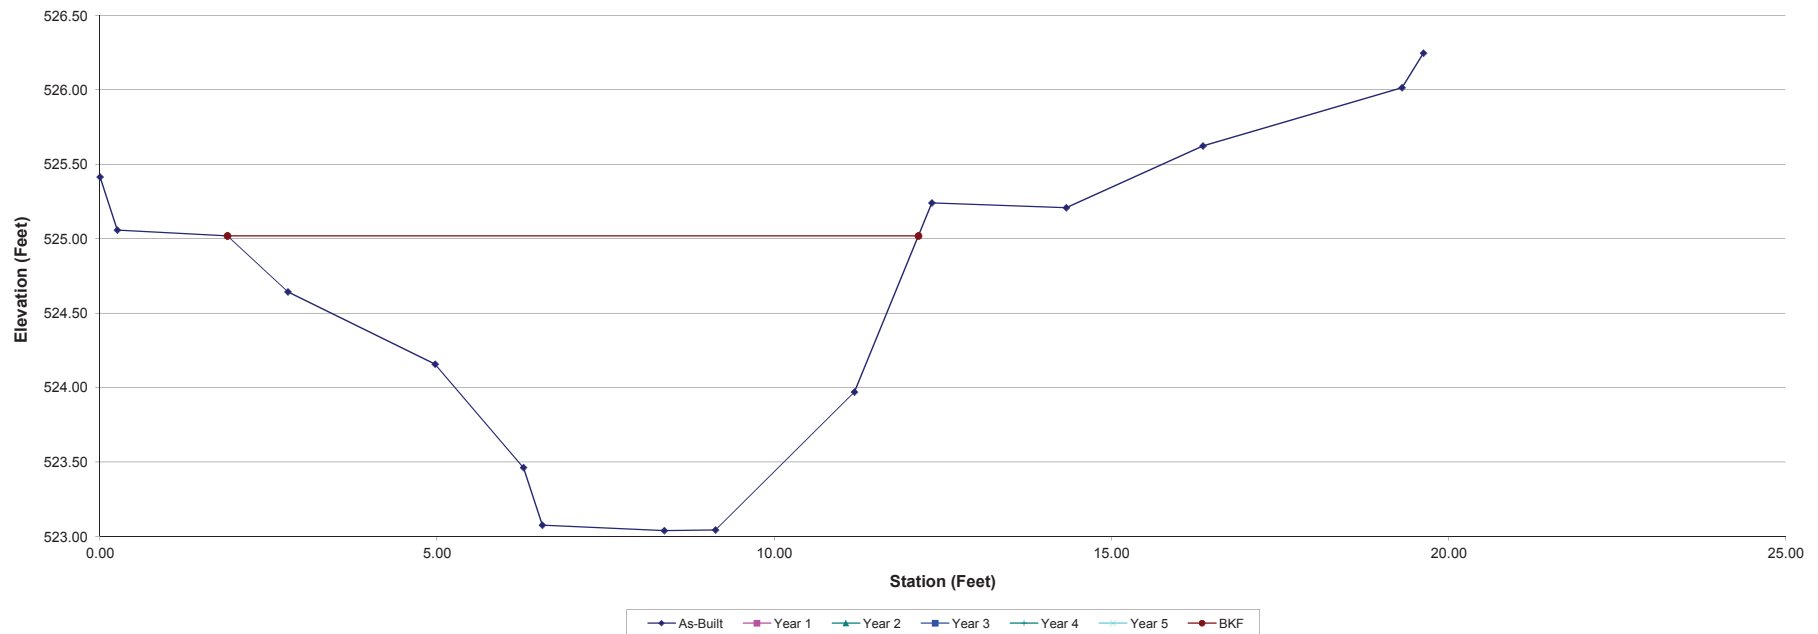


Project:	601 East	Summary (bankfull)						
Cross Section:	Cross Section 8	A (BKF)	MY0	MY1	MY2	MY3	MY4	MY5
Feature:	Riffle	W (BKF)	10.1					
Station:	20+59	Max d	1.0					
Date:	1/29/15	Mean d	0.6					
Crew:	SV, RZ	W/D	16.6					

MY00-YEAR			MY01-Year			MY02-Year			MY03-Year		
Station	Elevation	Notes	Station	Elevation	Notes	Station	Elevation	Notes	Station	Elevation	Notes
	523.06	LPIN									
0.05	522.87										
5.85	522.67										
8.81	522.71										
9.35	522.48	BANKFULL LEFT TOBL									
11.48	521.65	TOE L									
12.86	521.62										
13.42	521.47	TW									
15.22	521.48	TOE R									
15.94	521.84										
18.31	522.23										
19.48	522.48	TOBR BANKFULL RIGHT									
21.32	522.49										
21.56	522.55	RPIN									



Photo of XS-8 looking in the downstream direction

601 East, Reach 1: Cross Section 8

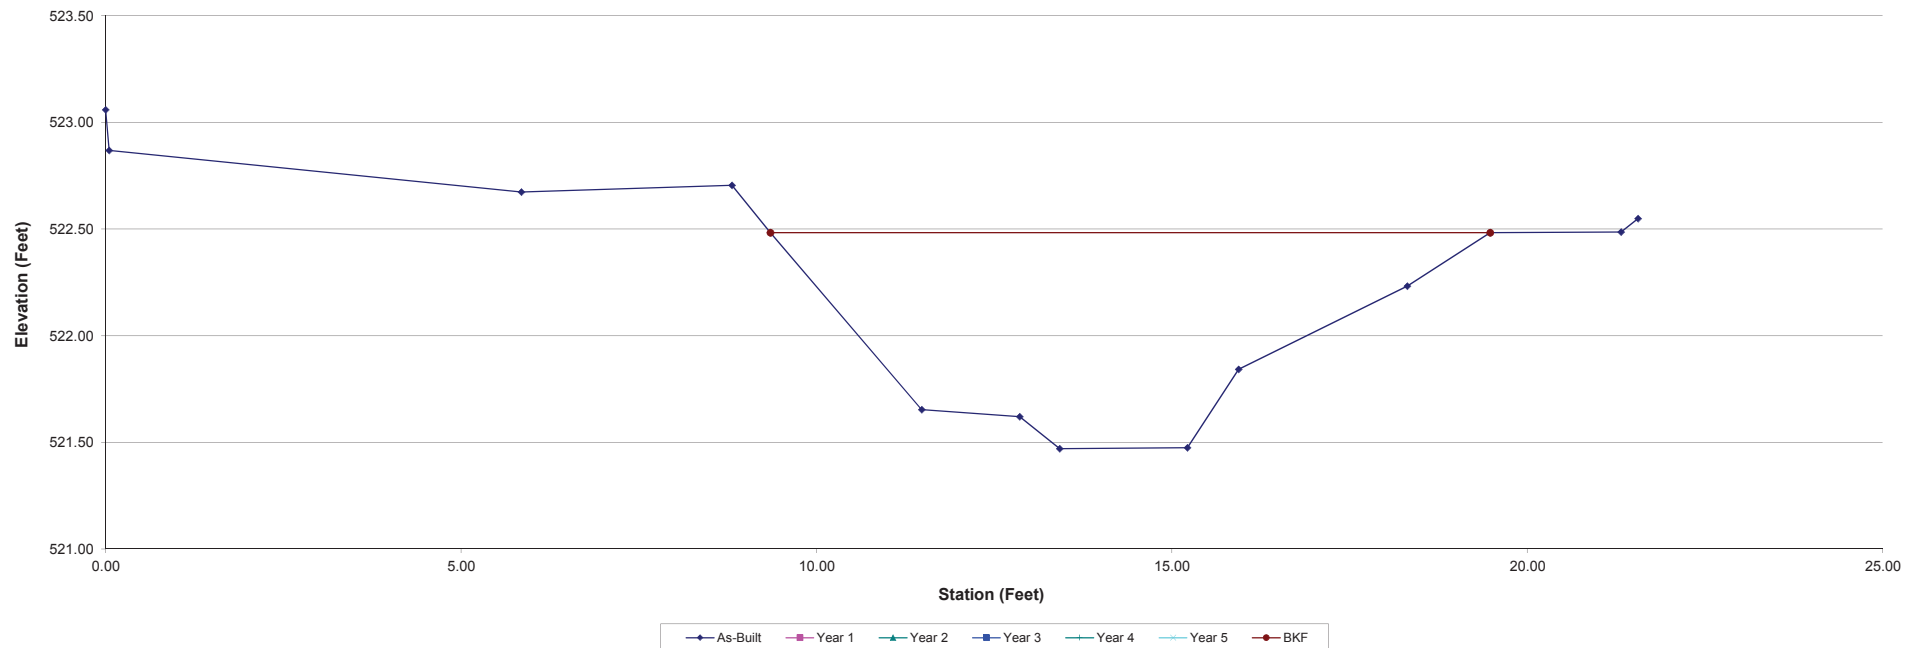


Project:	601 East	Summary (bankfull)						
Cross Section:	Cross Section 9	A (BKF)	MY0	MY1	MY2	MY3	MY4	MY5
Feature:	Riffle	W (BKF)	17.7					
Station:	24+25	Max d	24.2					
Date:	1/29/15	Mean d	1.5					
Crew:	RZ, SV	W/D	0.7					
			33.1					



Photo of XS-9, looking in the downstream direction

MY00-Year			MY01-Year			MY02-Year			MY03-Year			MY04	
Station	Elevation	Notes	Station	Elevation	Notes	Station	Elevation	Notes	Station	Elevation	Notes	Station	Elevation
	518.25	LPIN											
0.05	517.95												
1.02	517.99												
1.81	517.93												
3.41	517.73												
4.52	517.50	BANKFULL LEFT TOBL											
5.53	517.29												
6.22	517.15												
8.74	516.56												
10.33	516.26												
11.10	516.17	TOE L											
12.35	515.96	TW											
13.23	516.07												
14.49	515.99	TOE R											
17.71	516.78												
22.52	517.08												
27.74	517.29												
29.24	517.62	ULL RIGHT TOBR											
29.40	517.72	RPIN											

601 East, Reach 2: Cross Section 9

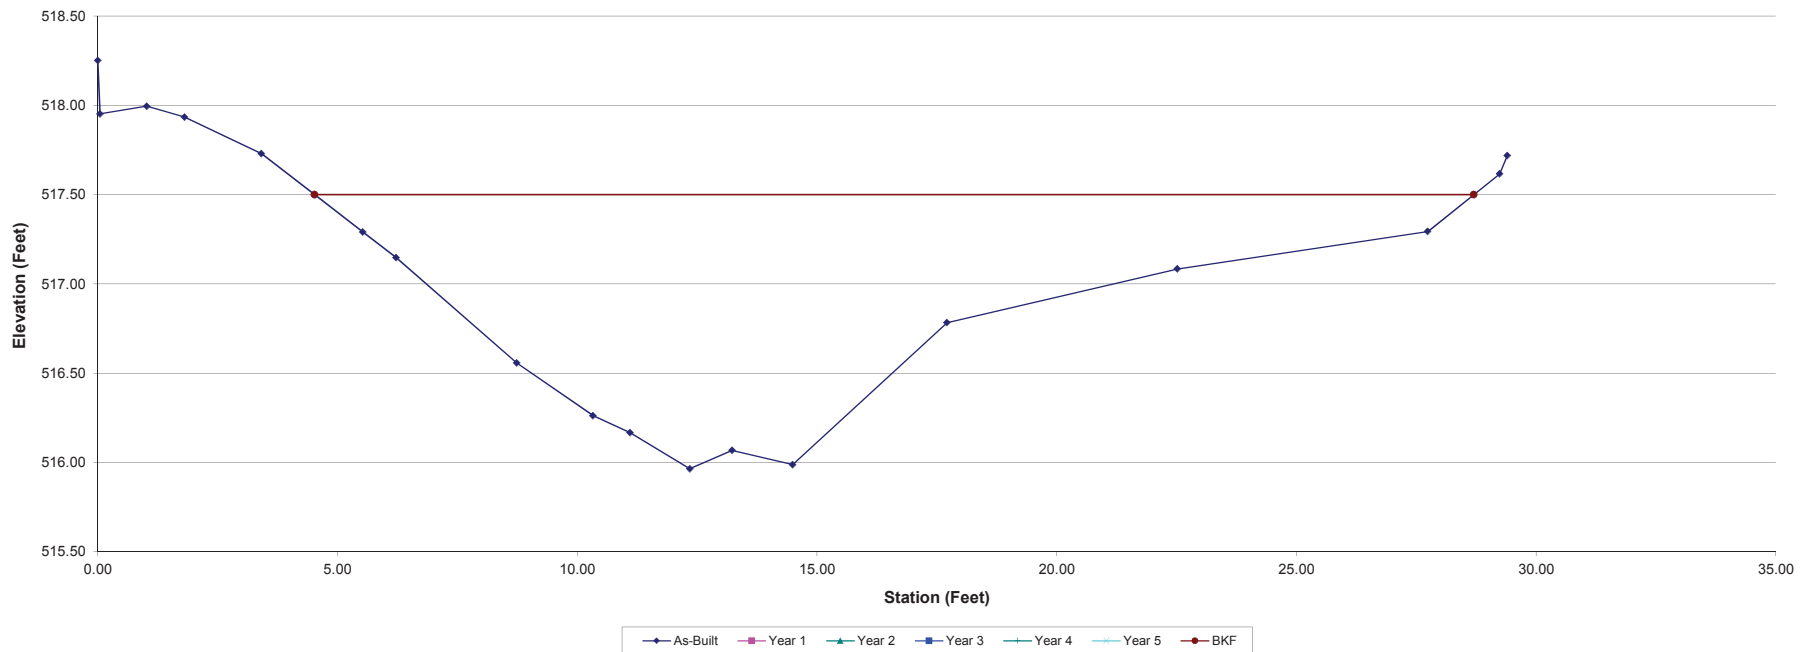


Project:	601 East	Summary (bankfull)						
Cross Section:	Cross Section 10	A (BKF)	MY0	MY1	MY2	MY3	MY4	MY5
Feature:	Pool	W (BKF)	25.3					
Station:	26+16	Max d	19.2					
Date:	1/29/15	Mean d	2.5					
Crew:	RZ, SV	W/D	1.3					
			14.6					

MY00-Year			MY01-Year			MY02-Year			MY03-Year			Station
Station	Elevation	Notes	Station	Elevation	Notes	Station	Elevation	Notes	Station	Elevation	Notes	Station
	516.93	LPIN										
0.17	516.72											
1.27	516.70											
1.49	516.40											
3.50	516.22	BANKFULL LEFT TOBL										
5.22	515.80											
9.31	514.70											
11.15	514.04	TOE L										
13.08	513.70	TW										
15.11	513.70	TOE R										
17.69	515.01											
23.86	516.49	BANKFULL RIGHT TOBR										
27.75	517.05											
27.93	517.15	RPIN										



Photo of XS-10, looking in the downstream direction

601 East, Reach 2: Cross Section 10

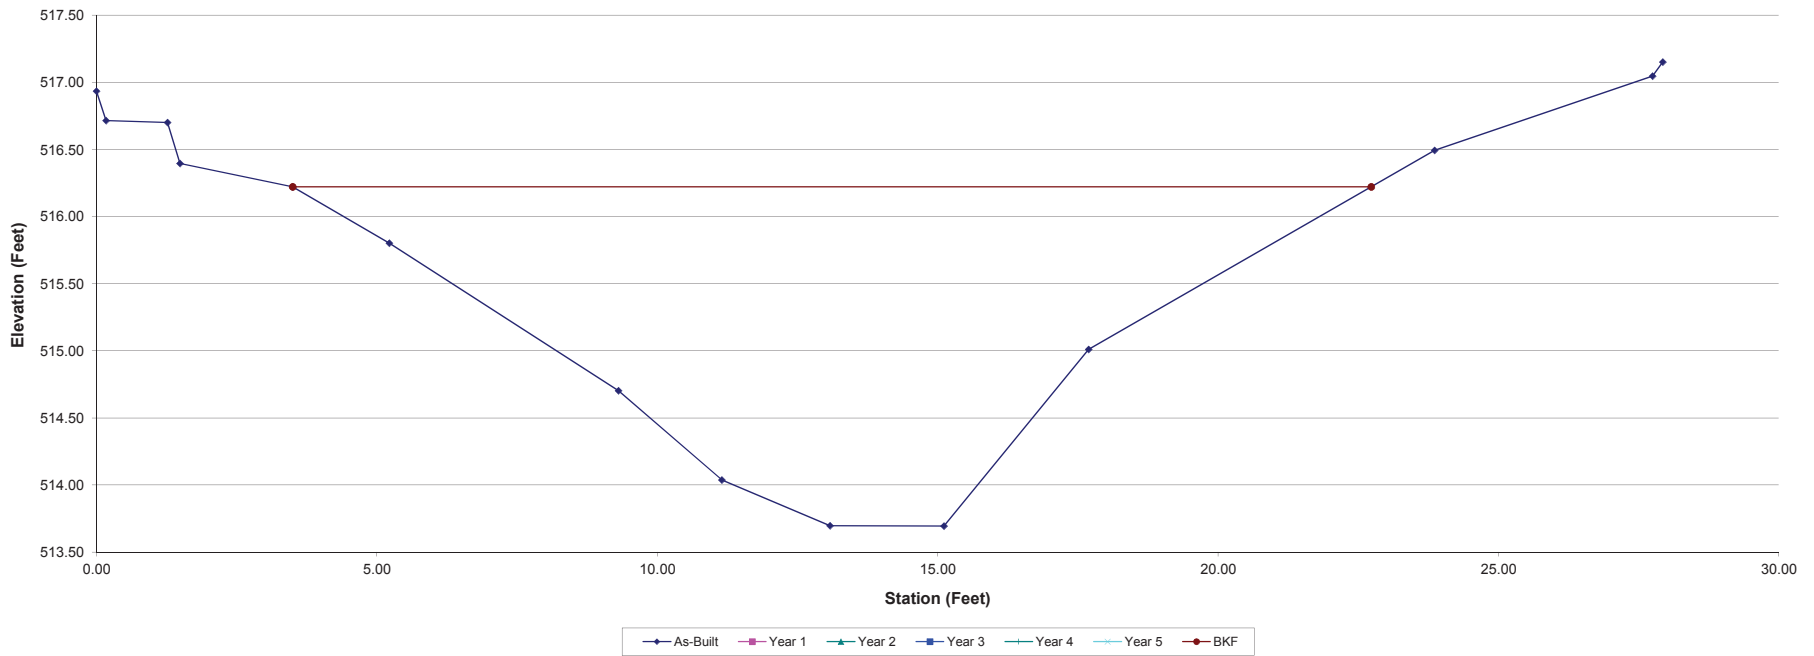


Project:	601 East	Summary (bankfull)					
Cross Section:	Cross Section 11	MY0	MY1	MY2	MY3	MY4	MY5
Feature:	Riffle	A (BKF)	9.4				
Station:	27+15	W (BKF)	15.5				
Date:	1/29/15	Max d	1.5				
Crew:	RZ, SV	Mean d	0.6				
		W/D	25.5				



Photo of XS-11 looking in the downstream direction

MY00-YEAR			MY01-Year			MY02-Year			MY03-Year			Station
Station	Elevation	Notes	Station	Elevation	Notes	Station	Elevation	Notes	Station	Elevation	Notes	Station
	516.43	LPIN										
0.41	516.19											
0.84	515.84											
3.60	515.47											
4.65	515.16	BANKFULL LEFT TOBL										
7.20	514.68											
8.66	514.17											
10.10	513.72	TOE L										
11.07	513.67	TW										
11.71	513.71	TOE R										
12.33	513.77											
14.40	514.78											
15.32	514.95											
18.27	515.02	BANKFULL RIGHT TOBR										
24.96	515.53											
24.96	515.65	RPIN										

601 East, Reach 2: Cross Section 11

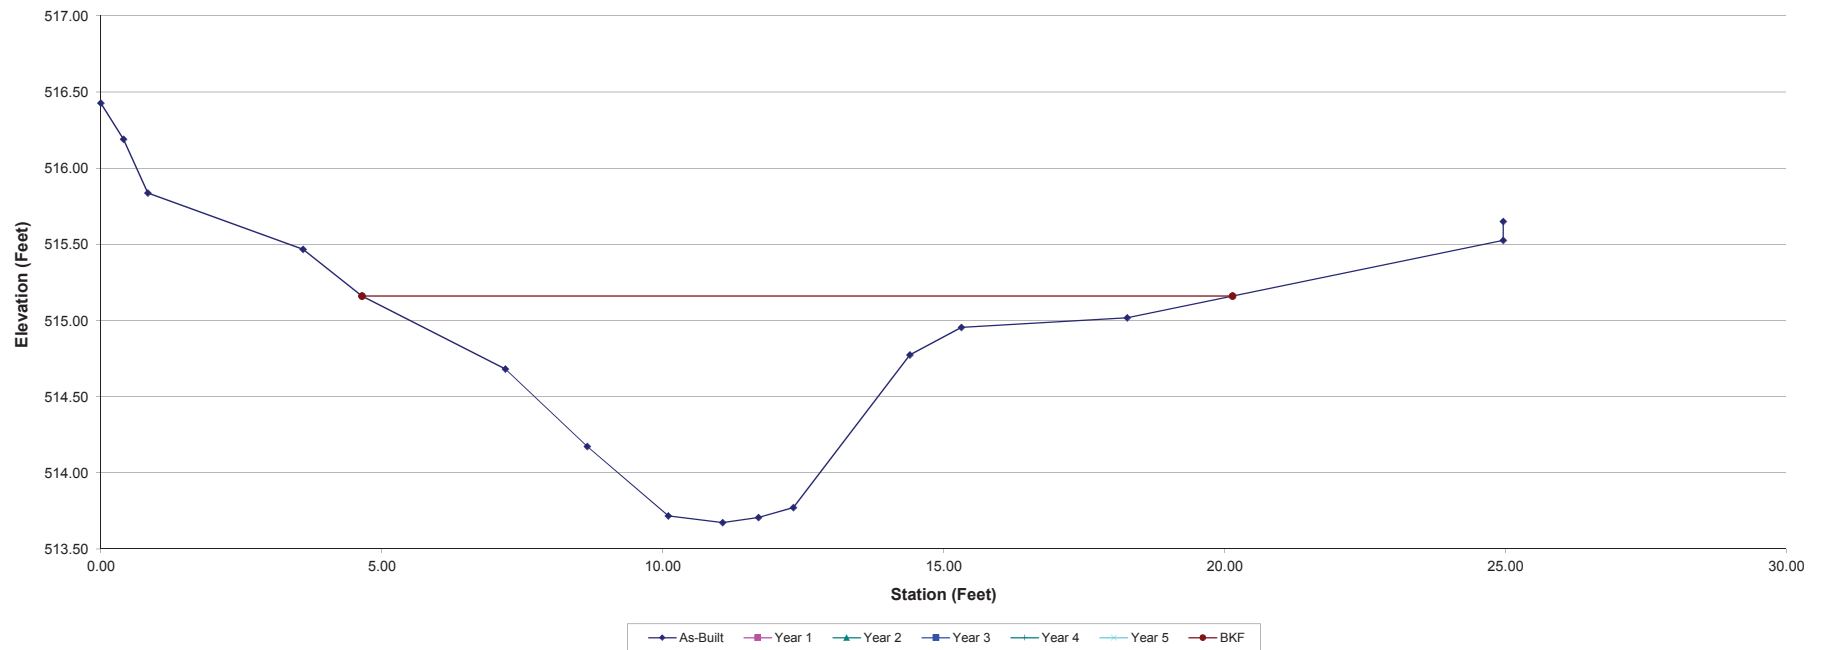


Project:	601 East	Summary (bankfull)					
Cross Section:	Cross Section 12	MY0	MY1	MY2	MY3	MY4	MY5
Feature:	Pool	A (BKF)	21.3				
Station:	29+67	W (BKF)	20.0				
Date:	1/29/15	Max d	2.5				
Crew:	RZ, SV	Mean d	1.1				
		W/D	18.8				

MY00-YEAR			MY01-Year			MY02-Year			MY03-Year			MY04
Station	Elevation	Notes	Station	Elevation	Notes	Station	Elevation	Notes	Station	Elevation	Notes	Station
	514.54	LPIN										
0.15	514.33											
1.61	514.12											
2.08	513.82											
2.48	513.68	TOBL, BANKFULL LEFT										
2.95	513.50											
4.14	512.90											
5.35	512.80											
8.01	511.51											
8.68	511.33	TOE L										
9.63	511.18	TW										
10.30	511.20	TOE R										
12.28	512.22											
13.92	512.34											
16.51	513.14											
20.18	513.50	TOBR, BANKFULL RIGHT										
26.50	513.99											
26.50	514.15	RPIN										



Photo of XS-12, looking in the downstream direction

601 East, Reach 2: Cross Section 12

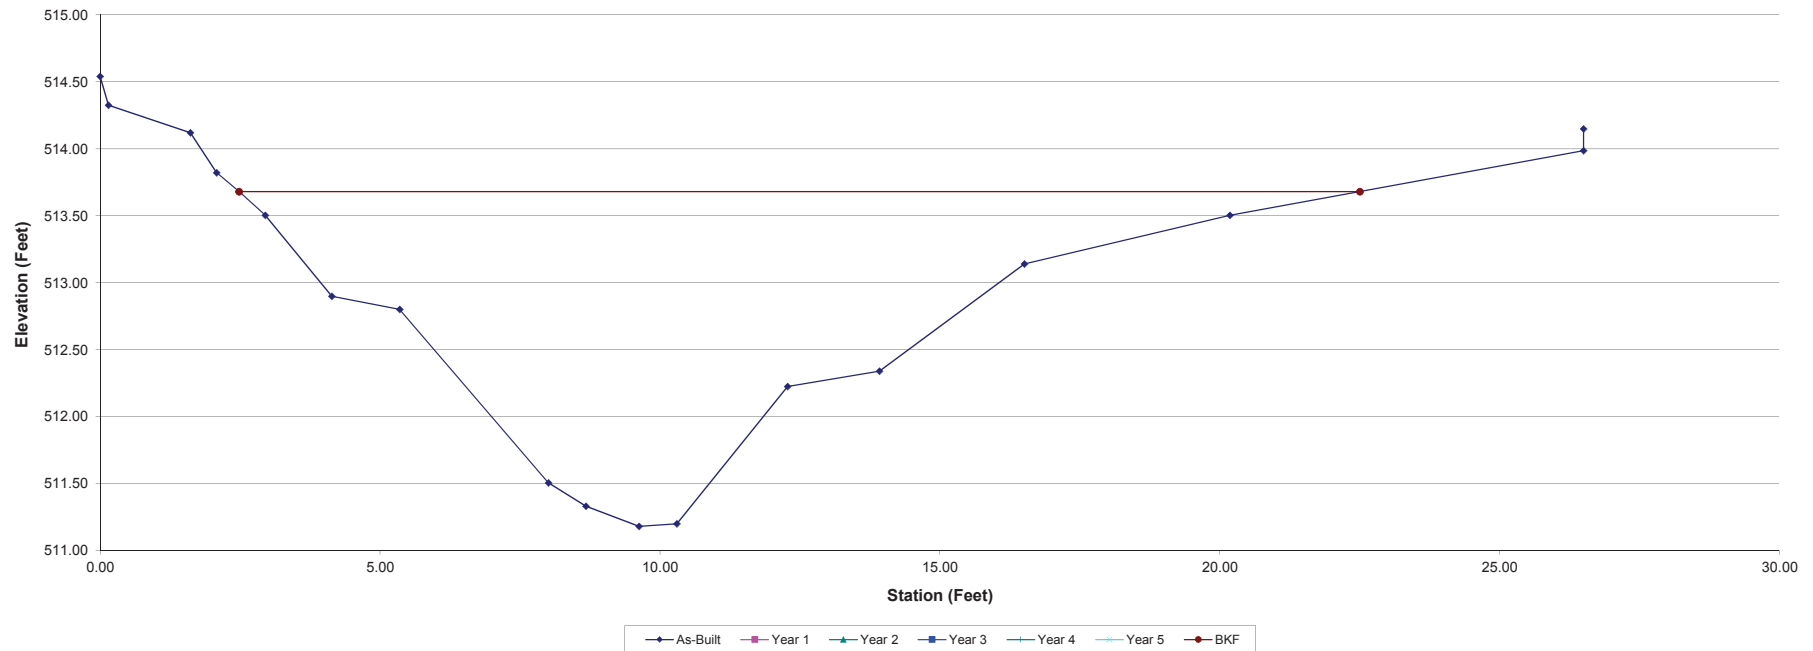


Project:	601 East	Summary (bankfull)					
Cross Section:	Cross Section 13	MY0	MY1	MY2	MY3	MY4	MY5
Feature:	Riffle	A (BKF)					
Station:	44+45	W (BKF)					
Date:	1/28/15	Max d					
Crew:	RZ, SV	Mean d					
		W/D	12.8				
			15.9				
			1.6				
			0.8				
			19.6				



Photo of XS-13, looking in the downstream direction

601 East, Reach 3: Cross Section 13

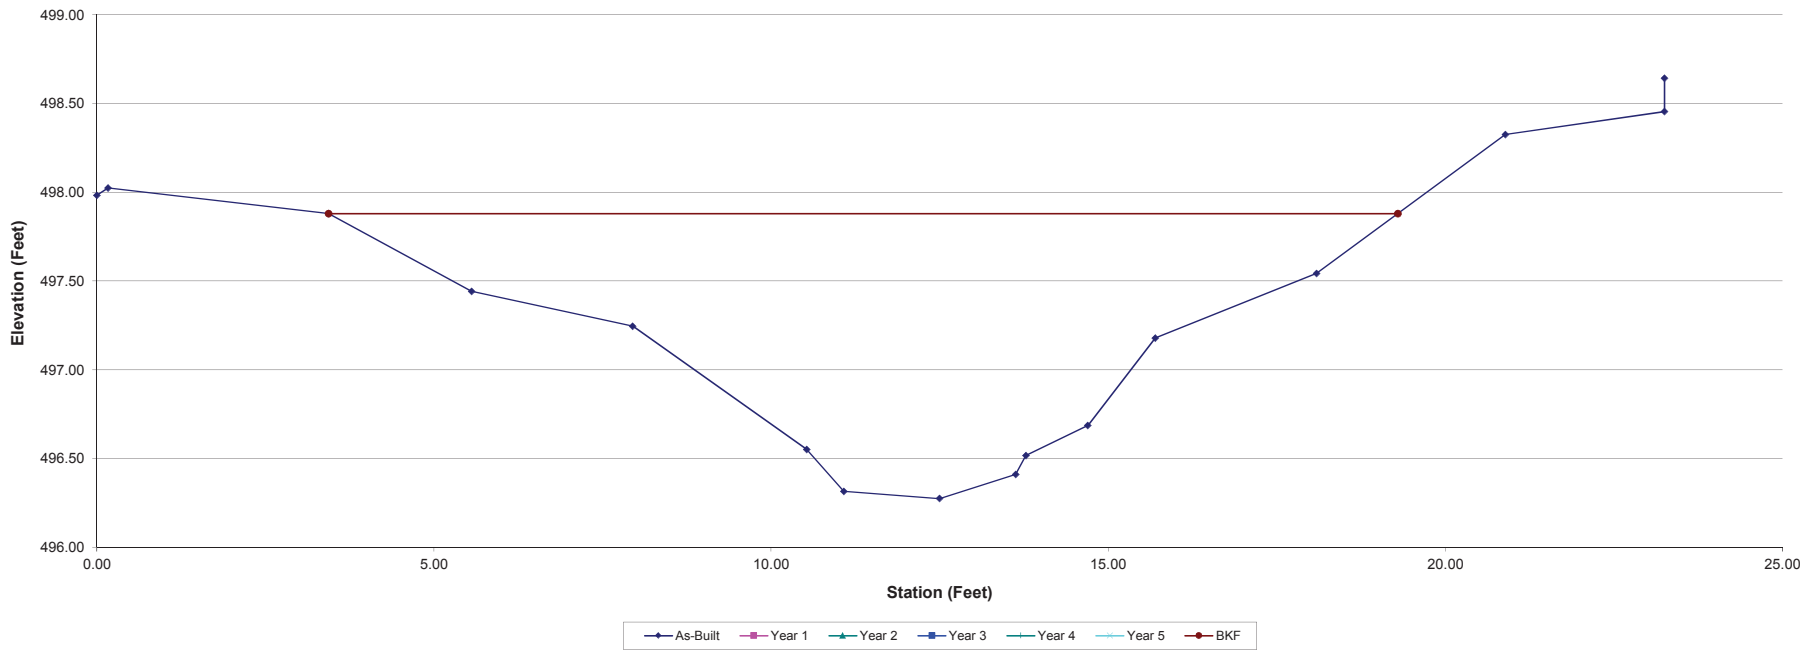


Project:	601 East	Summary (bankfull)					
Cross Section:	Cross Section 14	MY0	MY1	MY2	MY3	MY4	MY5
Feature:	Pool	A (BKF)					
Station:	48+78	W (BKF)					
Date:	1/28/15	Max d					
Crew:	RZ, SV	Mean d					
		W/D	28.2				
			17.6				
			3.4				
			1.6				
			11.0				



Photo of XS-14, looking in the downstream direction

MY00-Year			MY01-Year			MY02-Year			MY03-Year			MY04	
Station	Elevation	Notes	Station	Elevation	Notes	Station	Elevation	Notes	Station	Elevation	Notes	Station	Elev
	495.69	LPIN											
	495.55												
1.95	495.82												
3.11	495.50	BANKFULL LEFT											
4.65	495.08												
6.86	494.11												
7.85	493.58												
9.95	492.73	TOE L											
11.19	492.09												
12.09	492.08	TW											
13.08	492.79	TOE R											
16.13	494.12												
20.57	495.48												
22.09	495.69	BANKFULL RIGHT											
23.90	495.72												
23.93	495.89	RPIN											

601 East, Reach 3: Cross Section 14

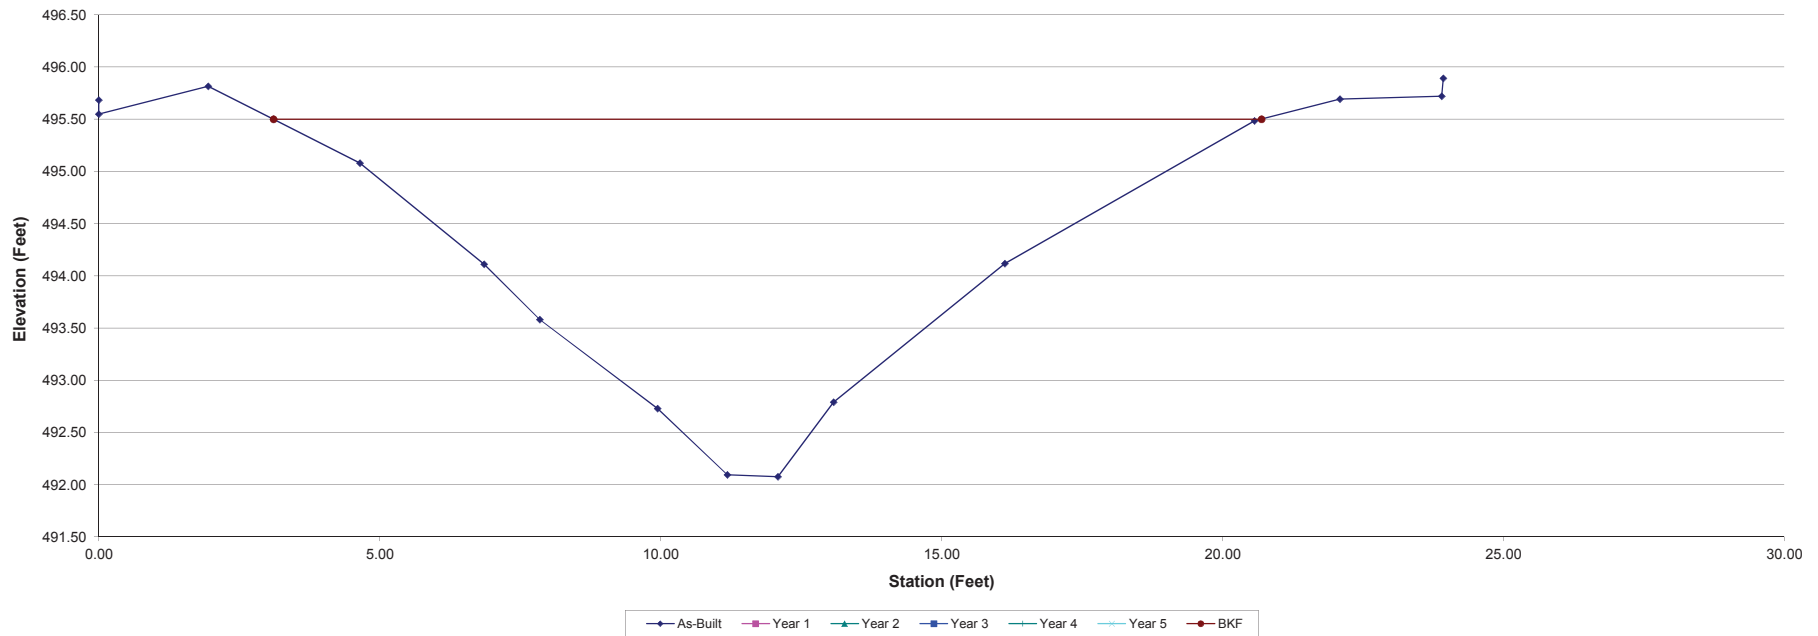


Project:	601 East	Summary (bankfull)					
Cross Section:	Cross Section 15	MY0	MY1	MY2	MY3	MY4	MY5
Feature:	Pool	A (BKF)					
Station:	50+93	W (BKF)					
Date:	1/28/15	Max d					
Crew:	RZ, SV	Mean d					
		W/D	10.6				



Photo of XS-15 looking in the downstream direction

MY00-YEAR			MY01-Year			MY02-Year			MY03-Year			MY04	
Station	Elevation	Notes	Station	Elevation	Notes	Station	Elevation	Notes	Station	Elevation	Notes	Station	Elev
	494.50	LPIN											
0.07	494.33												
3.46	494.42	TOBL, BANKFULL LEFT											
3.88	493.72												
4.43	493.35												
6.22	492.78												
9.21	491.73	TOE L											
10.75	491.00												
11.63	490.98	TW											
12.73	491.11												
13.53	491.72												
13.69	491.65	TOE R											
16.39	492.69												
18.20	492.91												
20.42	493.68												
21.39	494.11												
23.72	494.55	TOBR, BANKFULL RIGHT											
24.93	494.53												
24.93	494.63	RPIN											

601 East, Reach 3: Cross Section 15

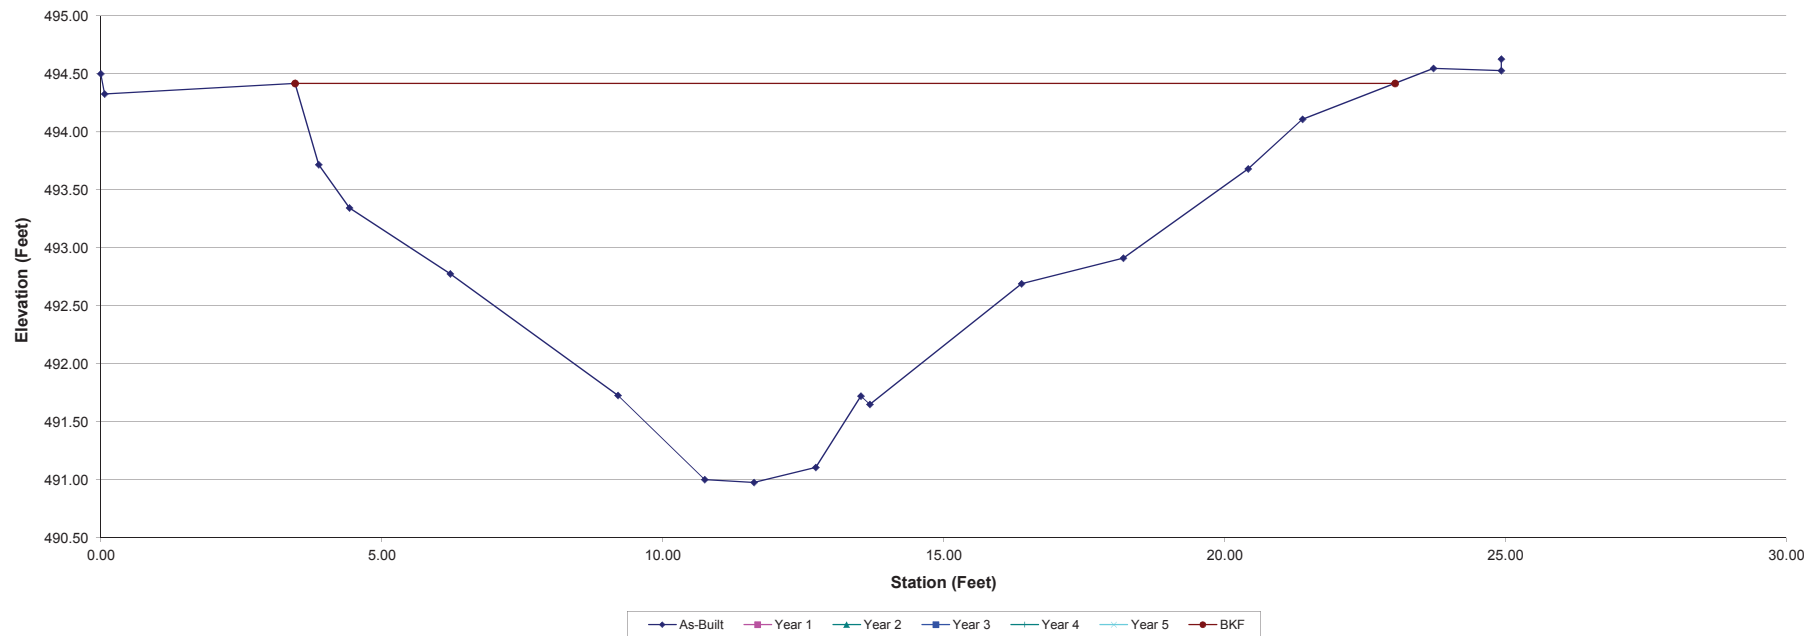


Project:	601 East	Summary (bankfull)					
Cross Section:	Cross Section 16	MY0	MY1	MY2	MY3	MY4	MY5
Feature:	Riffle	A (BKF)	14.1				
Station:	52+29	W (BKF)	17.7				
Date:	1/28/15	Max d	1.6				
Crew:	RZ, SV	Mean d	0.8				
		W/D	22.4				



Photo of XS-16, looking in the downstream direction

MY00-YEAR			MY01-Year			MY02-Year			MY03-Year			MY04-Year	
Station	Elevation	Notes	Station	Elevation	Notes	Station	Elevation	Notes	Station	Elevation	Notes	Station	Elevation
	493.92	LPIN											
0.08	493.73	BANKFULL LEFT											
1.92	493.58												
3.21	493.16												
5.35	493.19												
7.88	492.15	TOE L											
8.99	492.18	TW											
10.50	492.20	TOE R											
11.77	492.47												
13.03	492.83												
15.34	493.09												
15.91	493.38												
18.00	493.76	BANKFULL RIGHT											
20.28	493.80												
20.28	494.03	RPIN											

601 East, Reach 3: Cross Section 16

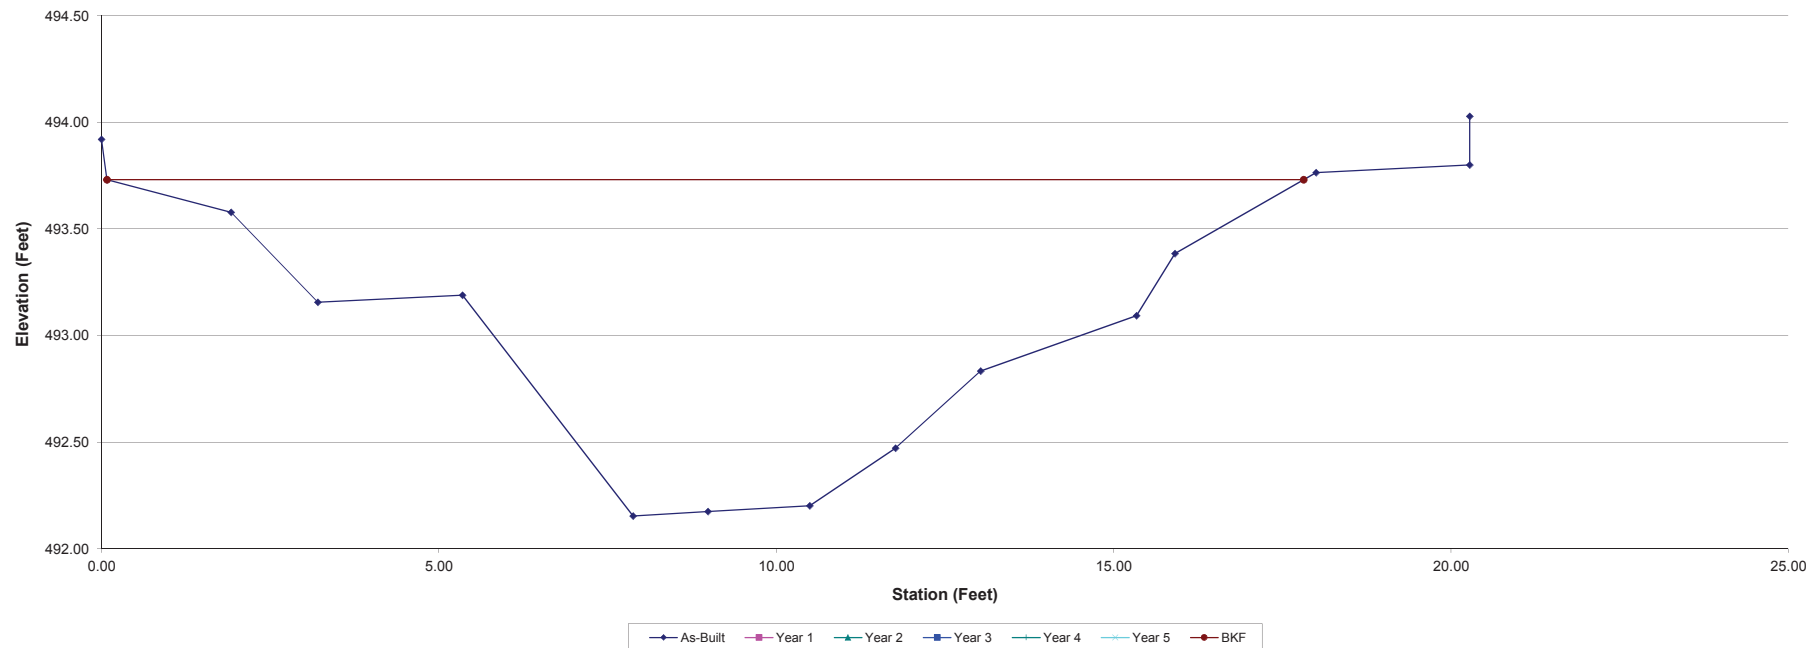


Project:	601 East	Summary (bankfull)						
Cross Section:	Cross Section 17	A (BKF)	MY0	MY1	MY2	MY3	MY4	MY5
Feature:	Pool	W (BKF)	29.8					
Station:	56+51	Max d	16.9					
Date:	1/28/15	Mean d	2.7					
Crew:	RZ, SV	W/D	1.8					
			9.6					



Photo of XS-17, looking in the downstream direction

MY00-Year			MY01-Year			MY02-Year			MY03-Year			MY0	
Station	Elevation	Notes	Station	Elevation	Notes	Station	Elevation	Notes	Station	Elevation	Notes	Station	Elevation
	492.63	LPIN											
0.12	492.50												
2.25	492.53	TOBL											
3.93	492.23												
8.68	491.16												
12.45	489.91	BANKFULL LEFT											
15.39	488.87												
16.21	487.77	TOE L											
17.87	487.57												
17.99	487.57												
20.56	487.19	TW											
23.63	487.24												
25.67	488.07												
26.76	488.47	TOE R											
27.92	489.17												
29.77	490.12	BANKFULL RIGHT											
30.94	490.54												
34.61	491.58												
39.54	492.51	TOBR											
41.48	492.54												
41.50	492.55	RPIN											

601 East, Reach 4: Cross Section 17

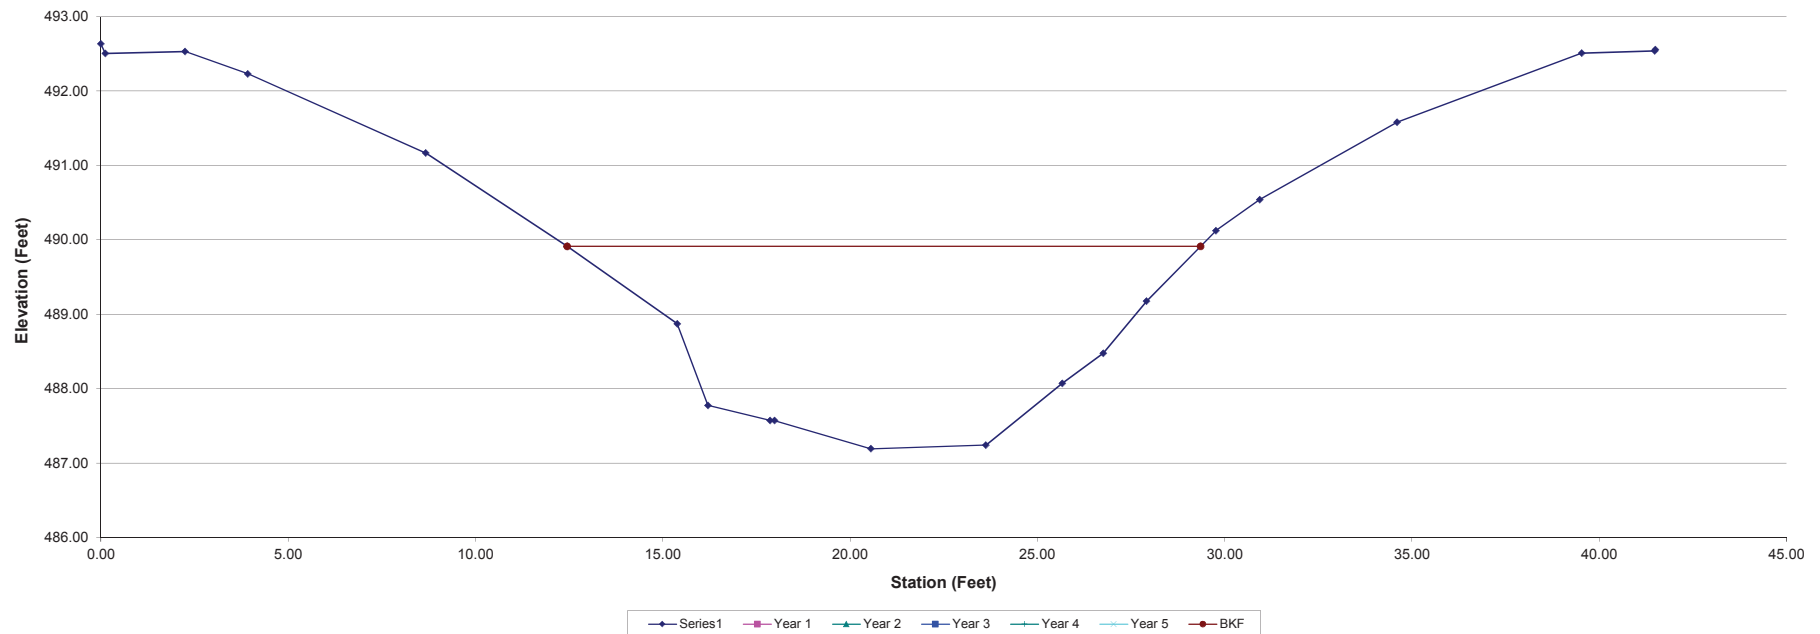


Project:	601 East	Summary (bankfull)					
Cross Section:	Cross Section 18	MY0	MY1	MY2	MY3	MY4	MY5
Feature:	Riffle	A (BKF)	14.7				
Station:	56+42	W (BKF)	14.9				
Date:	1/28/15	Max d	1.5				
Crew:	RZ, SV	Mean d	1.0				
		W/D	15.2				



Photo of XS-18, looking in the downstream direction

601 East, Reach 4: Cross Section 18

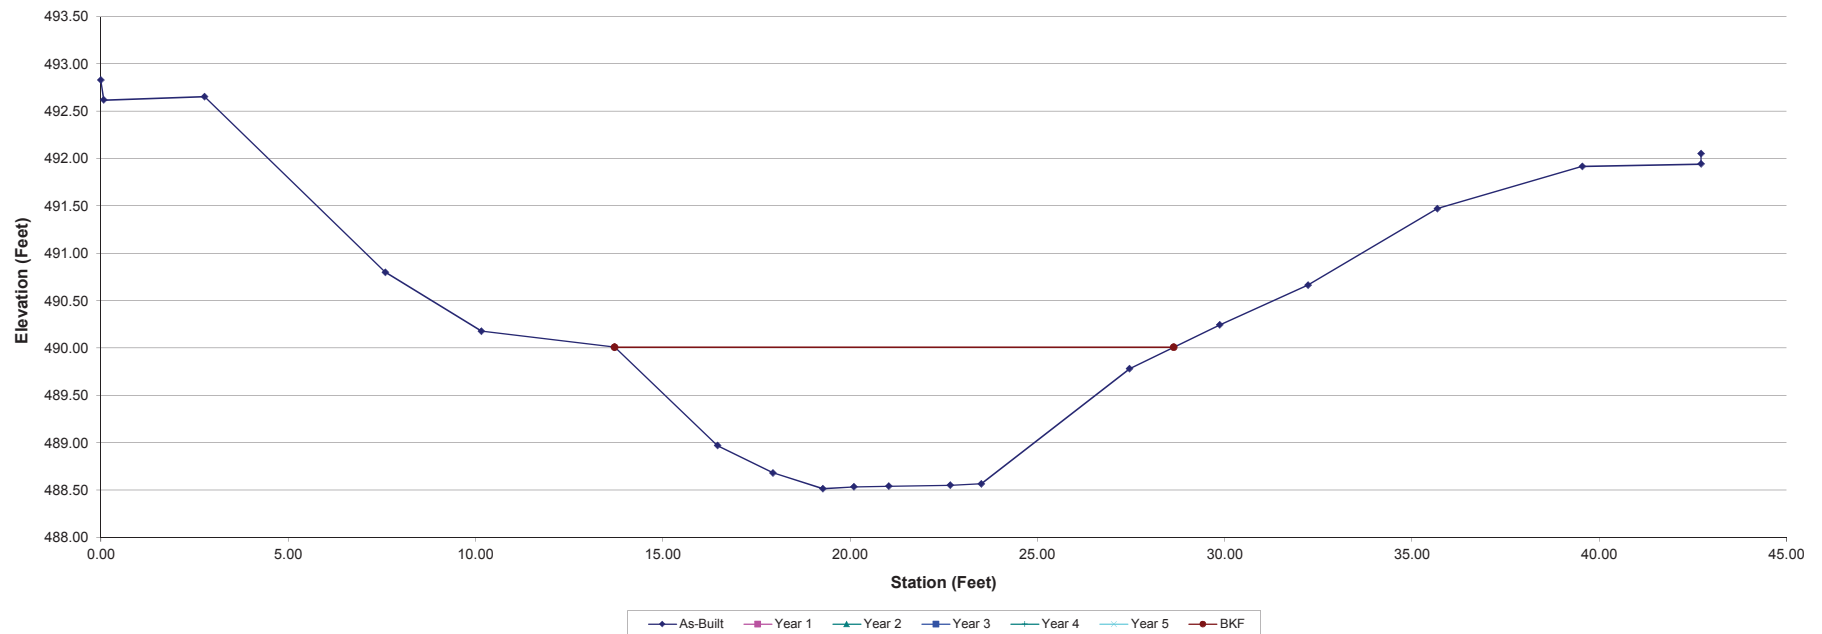

Appendix C – Vegetation Data

[This page intentionally left blank.]

Vegetation Plot Photos




Veg Plot 1



Veg Plot 5



Veg Plot 2

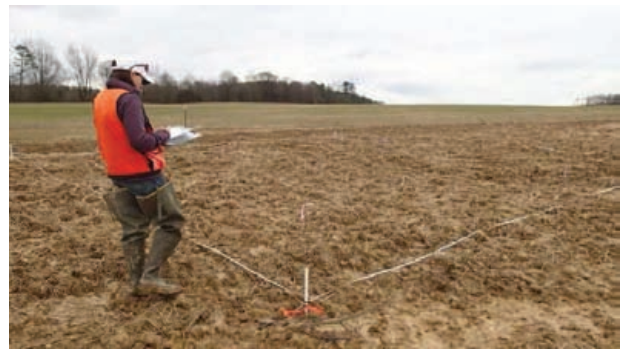


Veg Plot 6



Veg Plot 3



Veg Plot 7

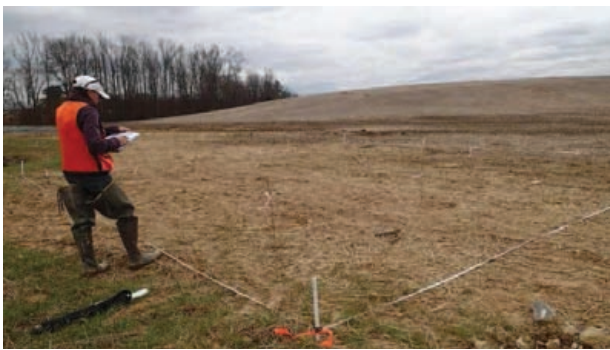

Veg Plot 4




Veg Plot 8

Vegetation Plot Photos



Veg Plot 9

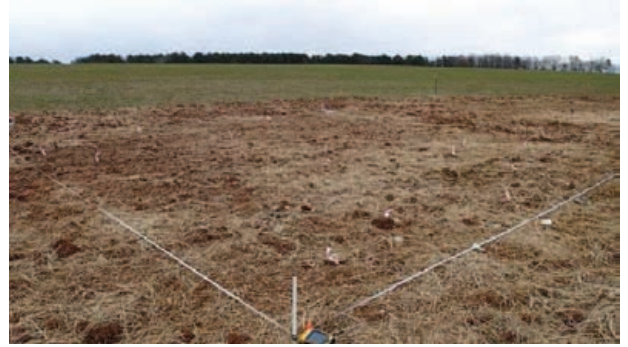

Veg Plot 10

Report Prepared By	Catena
Date Prepared	
database name	cv5-eep-entrytool-v2.3.1.mdb
file size	59482112

DESCRIPTION OF WORKSHEETS IN THIS DOCUMENT-----

Metadata	Description of database file, the report worksheets, and a summary of project(s) and project data.
Proj, planted	Each project is listed with its PLANTED stems per acre, for each year. This excludes live stakes.
Proj, total stems	Each project is listed with its TOTAL stems per acre, for each year. This includes live stakes, all planted stems, and all natural/volunteer stems.
Plots	List of plots surveyed with location and summary data (live stems, dead stems, missing, etc.).
Vigor	Frequency distribution of vigor classes for stems for all plots.
Vigor by Spp	Frequency distribution of vigor classes listed by species.
Damage	List of most frequent damage classes with number of occurrences and percent of total stems impacted by each.
Damage by Spp	Damage values tallied by type for each species.
Damage by Plot	Damage values tallied by type for each plot.
Planted Stems by Plot and Spp	A matrix of the count of PLANTED living stems of each species for each plot; dead and missing stems are excluded.

PROJECT SUMMARY-----

Project Code		1
project Name	601 East	
Description		
River Basin	Yadkin-Pee Dee	
length(ft)		
stream-to-edge width (ft)		
area (sq m)		
Required Plots (calculated)		
Sampled Plots		10

CVS Proj, planted

Living planted stems, excluding live stakes, per acre: Negative (red) numbers indicate the project failed to reach requirements in a particular year.

Project Code	Project Name	River Basin	Year 0 (baseline)
1	601 East	Yadkin-Pee Dee	809

CVS Proj, total stems

Total stems, including planted stems of all kinds (including live stakes) and natural/volunteer stems:

Project Code	Project Name	River Basin	Year 0 (baseline)
1	601 East	Yadkin-Pee Dee	838

CVS Vigor

vigor	Count	Percent
3	207	100

CVS Vigor by Spp

	Species	CommonName	4	3	2	1	0	Missing	Unknown
	Asimina triloba	pawpaw		2					
	Betula nigra	river birch		24					
	Cephalanthus occidentalis	common buttonbush		6					
	Fraxinus pennsylvanica	green ash		3					
	Liriodendron tulipifera var. tulipifera	Tulip-tree, Yellow Poplar, Whitewood		30					
	Nyssa sylvatica	blackgum		18					
	Platanus occidentalis var. occidentalis	Sycamore, Plane-tree		58					
	Populus deltoides var. deltoides	eastern cottonwood		8					
	Quercus michauxii	swamp chestnut oak		20					
	Quercus phellos	willow oak		26					
	Quercus	oak		12					
TOT:	11	11		207					

CVS Damage

Damage	Count	Percent Of Stems
(no damage)	207	100

CVS Damage by Spp

Species	Common Name	Count of Damage Categories	(no damage)
Asimina triloba	pawpaw	0	2
Betula nigra	river birch	0	24
Cephalanthus occidentalis	common buttonbush	0	6
Fraxinus pennsylvanica	green ash	0	3
Liriodendron tulipifera var. tulipifera	Tulip-tree, Yellow Poplar, Whitewood	0	30
Nyssa sylvatica	blackgum	0	18
Platanus occidentalis var. occidentalis	Sycamore, Plane-tree	0	58
Populus deltoides var. deltoides	eastern cottonwood	0	8
Quercus	oak	0	12
Quercus michauxii	swamp chestnut oak	0	20
Quercus phellos	willow oak	0	26
TOT: 11	11	0	207

CVS Damage by Plot

Plot	Count of Damage Categories	(no damage)
001-01-0001	0	20
001-01-0002	0	22
001-01-0003	0	26
001-01-0004	0	19
001-01-0005	0	19
001-01-0006	0	21
001-01-0007	0	23
001-01-0008	0	18
001-01-0009	0	16
001-01-0010	0	23
TOT: 10	0	207

CVS Steams by Plot and Spp

Comment	Species	Sp/Type	Common Name	Total Planted Steams																			
				# Plots	avg # stems	Plot 001-01-0001	Plot 001-01-0002	Plot 001-01-0003	Plot 001-01-0004	Plot 001-01-0005	Plot 001-01-0006	Plot 001-01-0007	Plot 001-01-0008	Plot 001-01-0009									
	Asimina triloba	Shrub Tree	pawpaw	2	1	2																	
	Betula nigra	Tree	river birch	24	7	3.4	4					3	1	1	2	4	9						
	Cephalanthus occidentalis	Shrub Tree	common buttonbush	6	3	2									1	3							2
	Fraxinus pennsylvanica	Tree	green ash	3	2	1.5							1										2
	Liriodendron tulipifera var. tulipifera	Tree	Tulip-tree, Yellow Poplar, Whitewood	30	9	3.3	1	2	7	4	4	4	1	7	1								3
	Nyssa sylvatica	Tree	blackgum	18	8	2.3	2		1	5	2	2			1	3	2						2
	Platanus occidentalis var. occidentalis	Tree	Sycamore, Plane-tree	58	9	6.4	6	13	10	5	5	3	3	5									8
	Populus deltoides var. deltoides		eastern cottonwood	8	2	4		1	7														
	Quercus	Shrub Tree	oak	12	7	1.7	3		1				4	1	1	1	1						1
	Quercus michauxii	Tree	swamp chestnut oak	20	7	2.9	2	6					2	3	5								1
	Quercus phellos	Tree	willow oak	26	7	3.7	2			2	4	6	2	6									4
TOT: 0	11	10	11	207	11		20	22	26	19	19	21	23	18	16	23							

Appendix D – Record Drawing Plan Sheets


[This page intentionally left blank.]

RECORD DRAWINGS


601 EAST

STREAM AND WETLAND RESTORATION PROJECT

UNION COUNTY, NORTH CAROLINA
EEP CONTRACT DENR NO:004925
EEP PROJECT NO:95756
RFP 16-004110

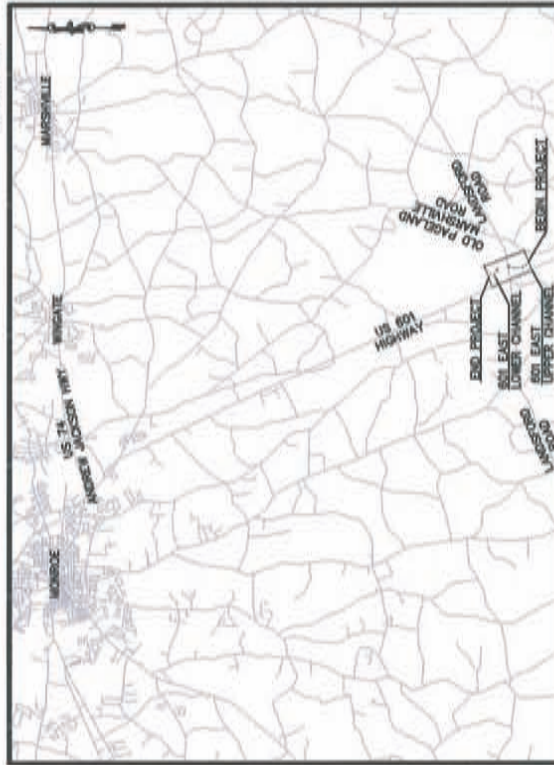

VICINITY MAP

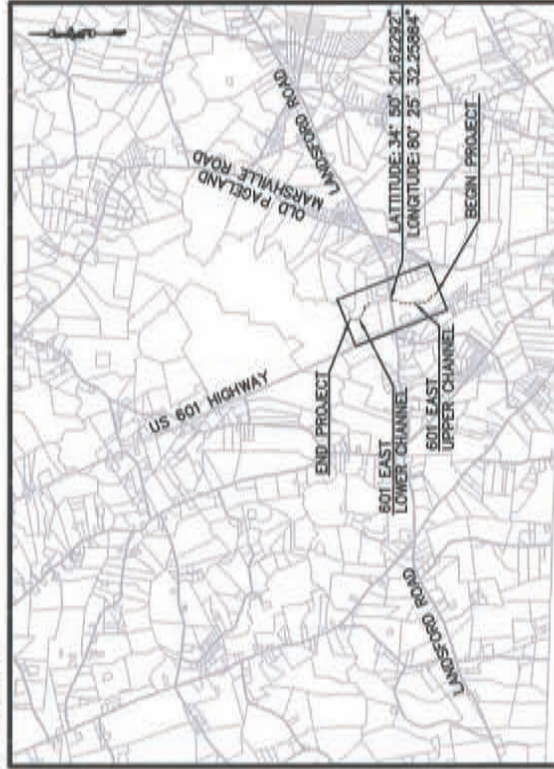

LOCATION MAP

STREAM DESIGNER AND AS-BUILT SURVEY:

Word Consulting Engineers
4805 Green Road
Raleigh, NC 27616
NC LICENSE NO: C-2619
PH: 919-870-0526
FAX: 919-870-5359

FULL DELIVERY PROVIDER:

Environmental Banc & Exchange
909 Capability Drive, Suite 3100
Raleigh, NC 27606
PH: 919-829-9809
FAX: 919-229-9913



NATURAL SYSTEMS INVESTIGATION:

The Cartena Group Inc.
410-B Millstone Drive
Hillsborough, NC 27278
PH: 919-732-1300
FAX: 919-732-1303



NCEEP CONTACT: PAUL WESNER (828) 273-1673
WARD CONSULTING ENGINEERS CONTACT: BECKY WARD, PE (919) 870-0526
ENVIRONMENTAL BANC AND EXCHANGE CONTACT: (919) 829-9909

INDEX OF SHEETS

SHEET NO.	DESCRIPTION
T1	TITLE SHEET
LI	LEGENDS SYMBOLS AND SHEET KEY
TCS1-TCS2	TYPICAL CONSTRUCTED CROSS SECTIONS
PLAN-PLUG	PLAN VIEWS
PT1-PT5	LONGITUDINAL PROFILES
VP1	PLANTING NOTES
VP2-VP9	PLANTING PLANS

601 EAST
AS-BUILT
TITLE SHEET
UNION COUNTY, NORTH CAROLINA

Ward Consulting Engineers, P.C.
Firm License No. C-8619
4805 Green Rd., Suite 100
Raleigh, NC 27616-2048 FAX (919) 870-0526
Environmental Banc & Exchange
909 Capability Drive, Suite 3100
Raleigh, NC 27606 Phone: (919) 829-9909
Fax: (919) 229-9913



DATE: 08/28/2003	RECORD DRAWINGS
PROJECT NAME: 601 East Stream	PROJECT NO: 95756
DRAWN BY: [Blank]	SCALE: As Shown
CHECKED BY: [Blank]	DATE: 08/28/2003

UNION COUNTY, NORTH CAROLINA

AS-BUILT


LEGENDS, SYMBOLS AND SHEET KEY

RECORD DRAWINGS
SHEET NO.
L1

DATE: 10/28/2015
DRAWN BY: [unintelligible]
CHECKED BY: [unintelligible]
SCALE: [unintelligible]
PROJECT NO: [unintelligible]
PROJECT NAME: [unintelligible]
PROJECT LOCATION: [unintelligible]
PROJECT OWNER: [unintelligible]
PROJECT PHASE: [unintelligible]
PROJECT STATUS: [unintelligible]




Ward Consulting Engineers, P.C.
 Environmental Data & Exchange
 809 Capaldi Drive, Suite 3100
 Raleigh, NC 27605 Phone: (919) 870-0000
 Fax: (919) 229-0913
 4000 Green Rd., Suite 100
 Raleigh, NC 27616-8049 FAX (919) 870-0888
 TRIAL LICENSE NO. C-8619
 (919) 870-0888

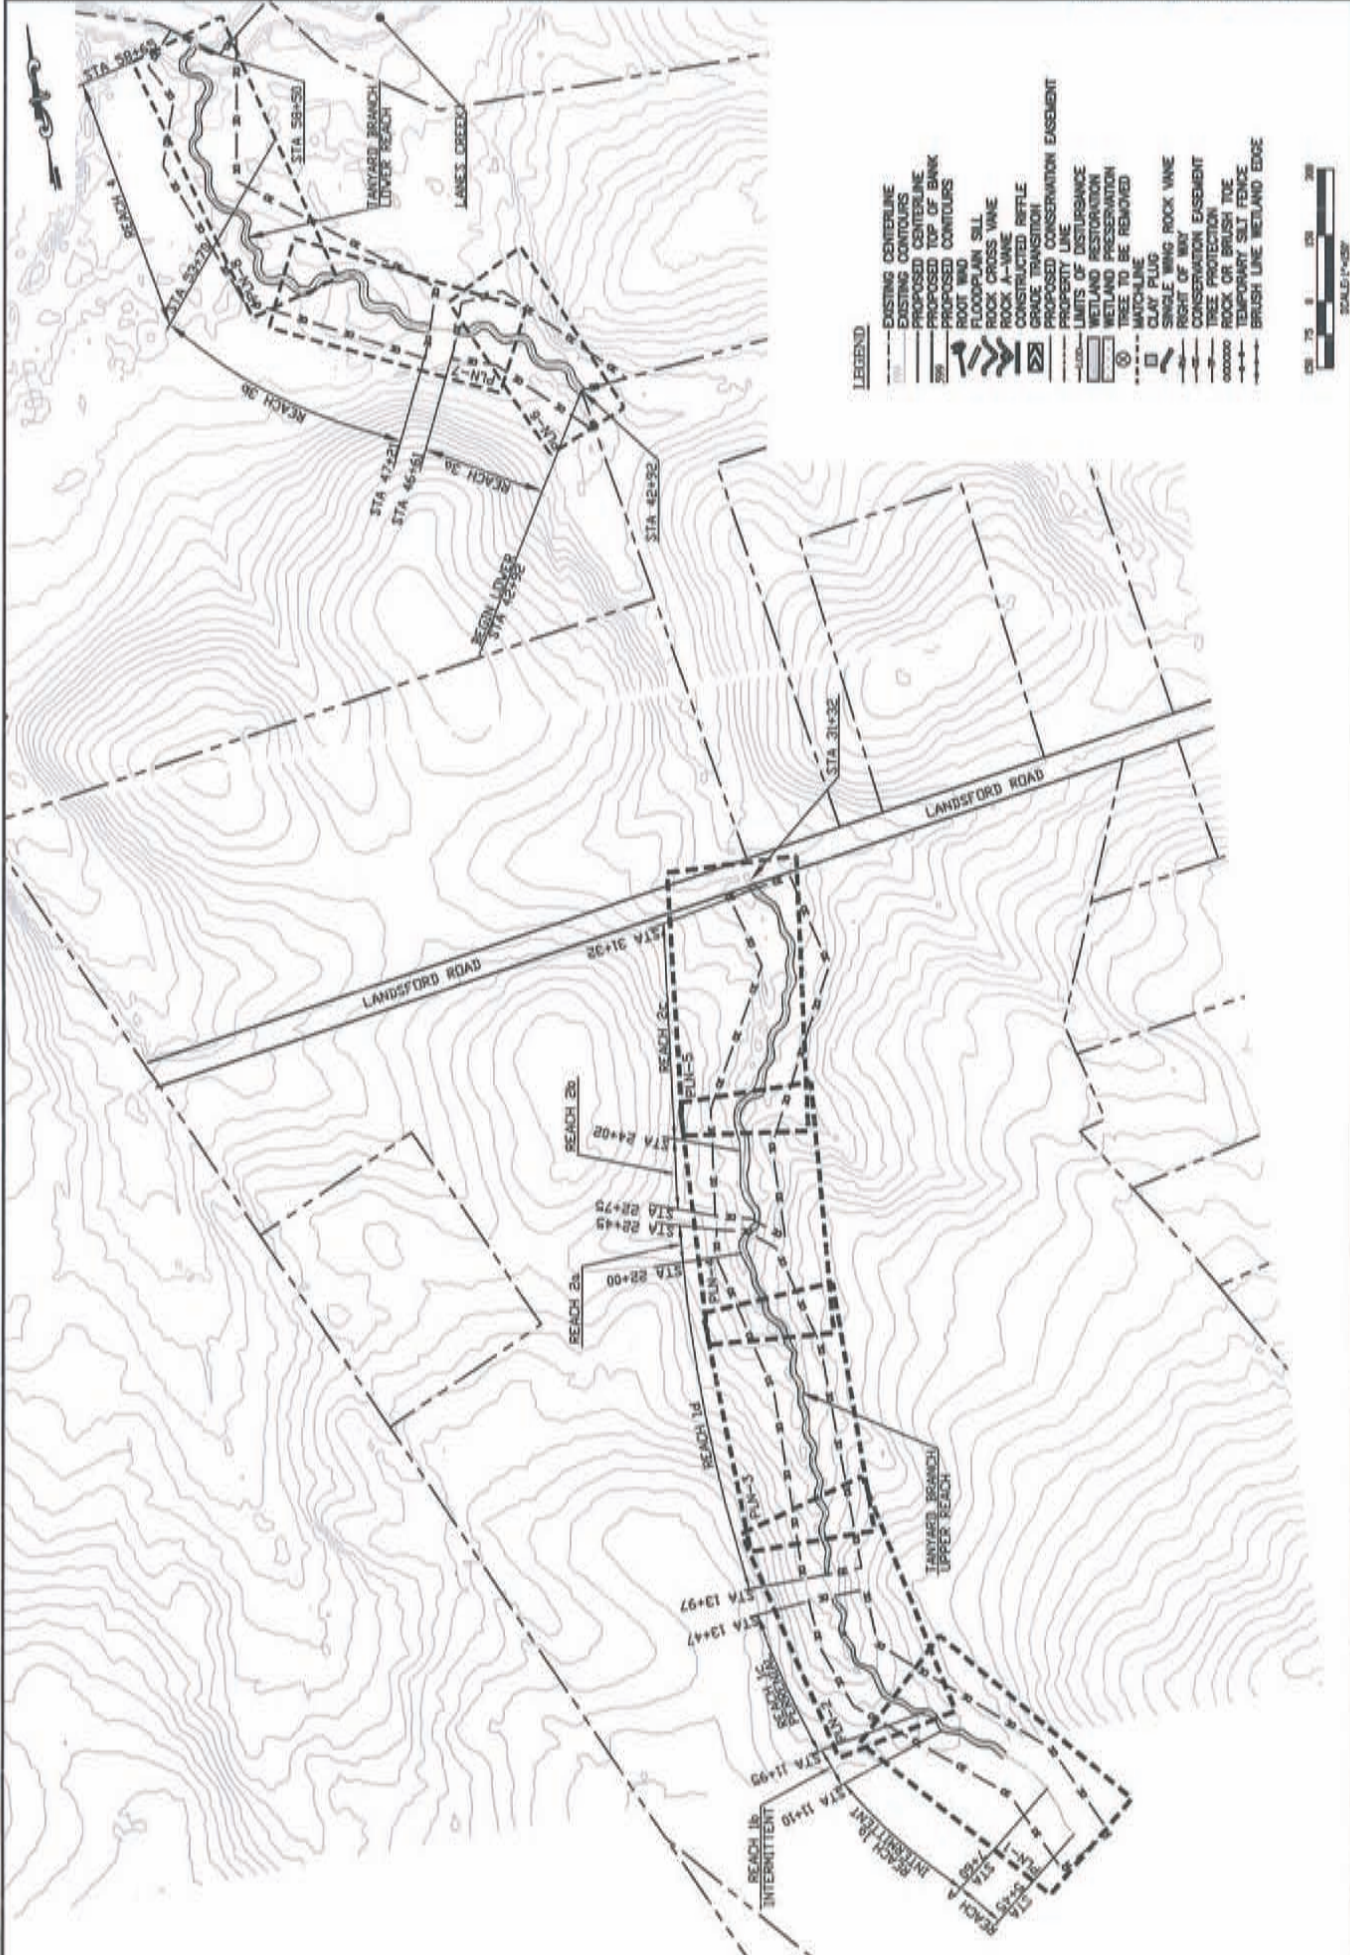


- LEGEND**
- EXISTING CENTERLINE
 - - - EXISTING CONTOURS
 - - - PROPOSED CENTERLINE
 - - - PROPOSED TOP OF BANK
 - - - PROPOSED CONTOURS
 - ███ FLOODPLAIN SILL
 - ███ ROCK CROSS VANE
 - ███ ROCK A-VANE
 - ███ CONSTRUCTED BRITTLE
 - ███ GRADE TRANSITION
 - ███ PROPOSED CONSERVATION EASEMENT
 - ███ PROPERTY LINE
 - ███ LIMITS OF DISTURBANCE
 - ███ WETLAND RESTORATION
 - ███ WETLAND PRESERVATION
 - ███ TREE TO BE REMOVED
 - ███ MATCHLINE
 - ███ SLUR PLUG ROCK VANE
 - ███ RIGHT OF WAY
 - ███ CONSERVATION EASEMENT
 - ███ TREE PROTECTION
 - ███ ROCK OR BRUSH TOE
 - ███ TEMPORARY SILT FENCE
 - ███ BRUSH LINE WETLAND EDGE




- NOTES:
1. CONTRACTOR TO PROVIDE A SMOOTH TRANSITION BETWEEN THE RIFFLE AND POOL SECTIONS SHOWN BELOW.
 2. INDICATES THE STREAM CENTERLINE ALIGNMENT AS IDENTIFIED ON THE PLAN AND PROFILE SHEETS.
 3. 1' OF STREAM FOR HORIZONTAL LAYOUT AND 1/4" OF THALWEG MAYBE AT DIFFERENT LOCATIONS IN POOL SECTIONS.
 4. USE 700 GRAM COIR FIBER MATTING BLANKET WESTERN EXCELSIOR CORPORATION COIR MAT 700 OR APPROVED EQUAL.

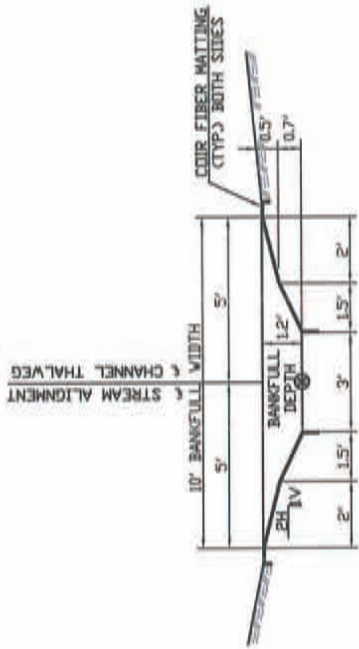


1 PROPOSED RIFFLE SECTION (REACH 1)
SCALE: NOT TO SCALE

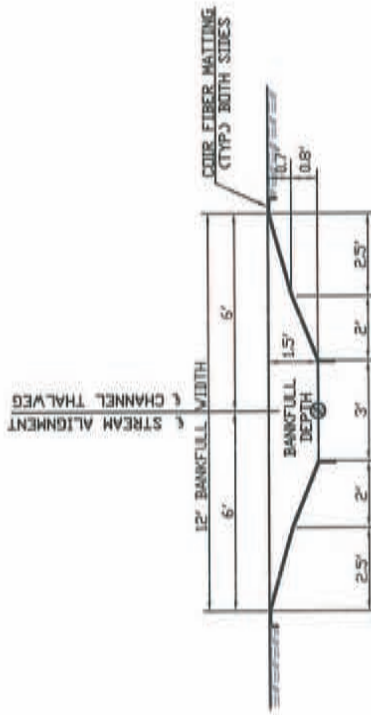






3 PROPOSED RIFFLE SECTION (REACH 2)
SCALE: NOT TO SCALE

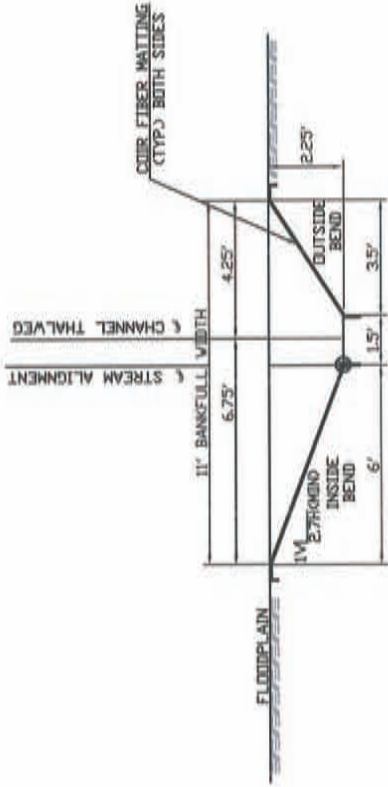

2 PROPOSED POOL SECTION (REACH 1)
SCALE: NOT TO SCALE

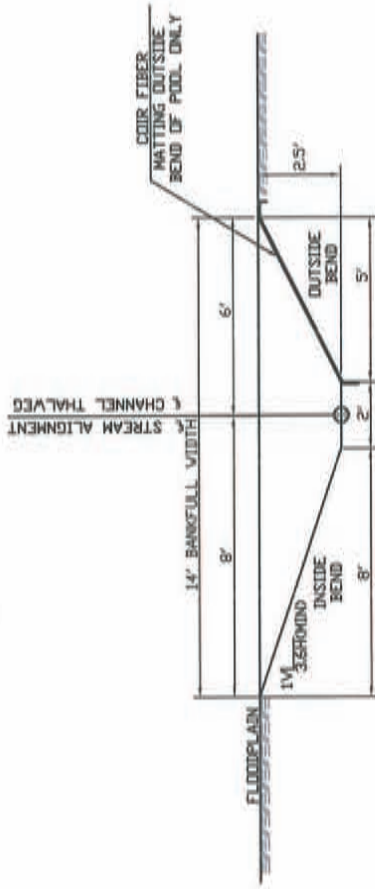

4 PROPOSED POOL SECTION (REACH 2)
SCALE: NOT TO SCALE

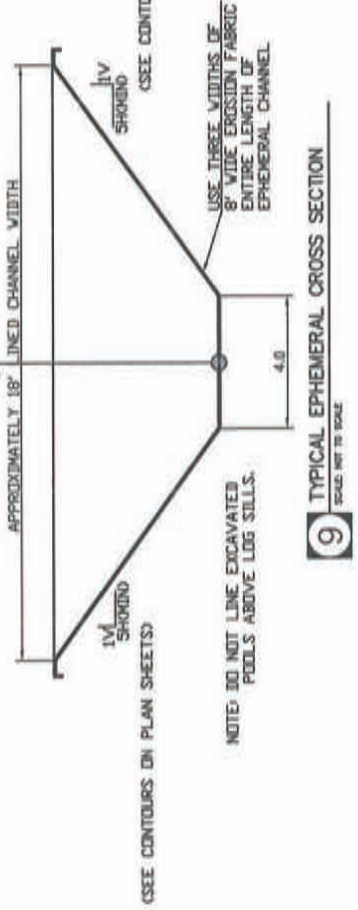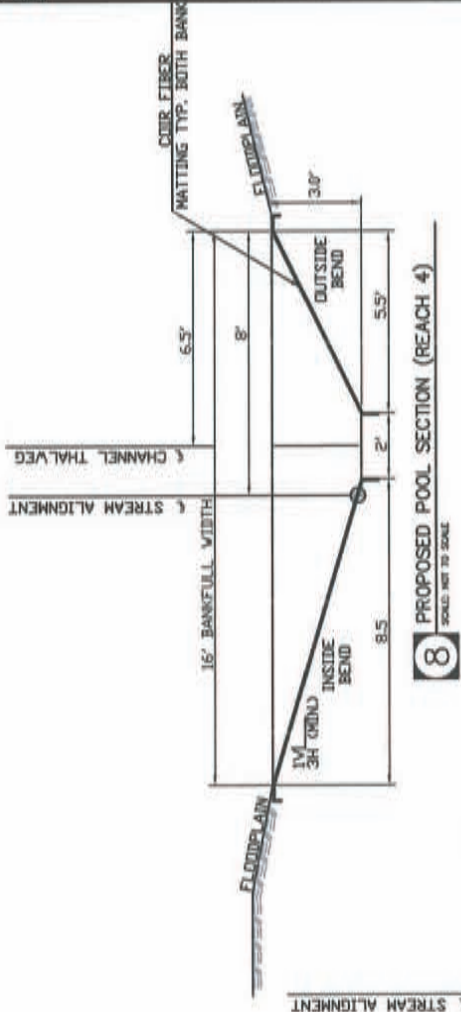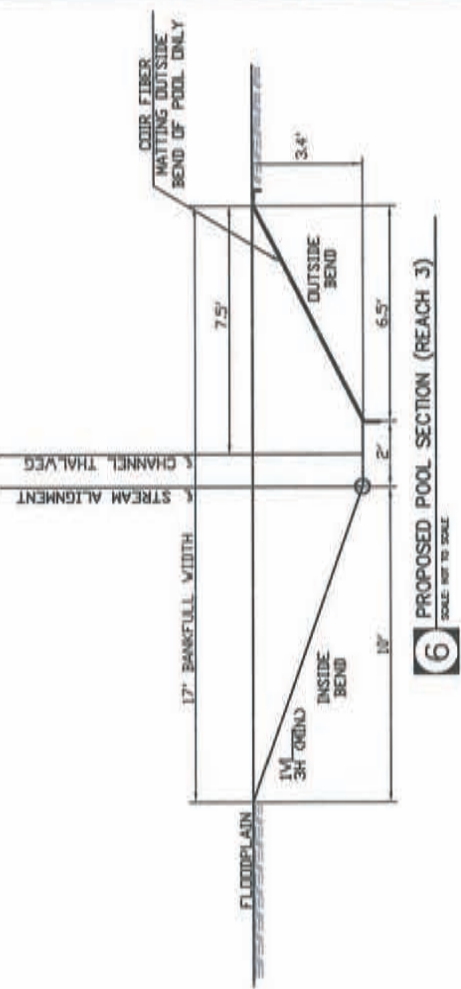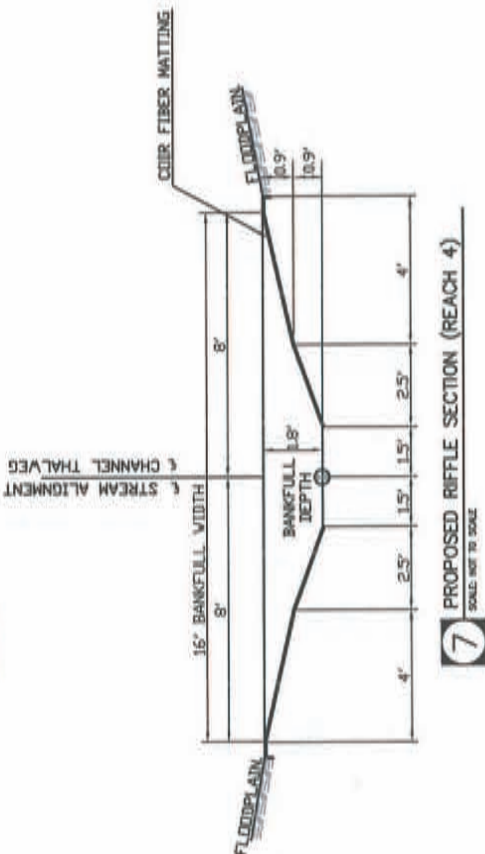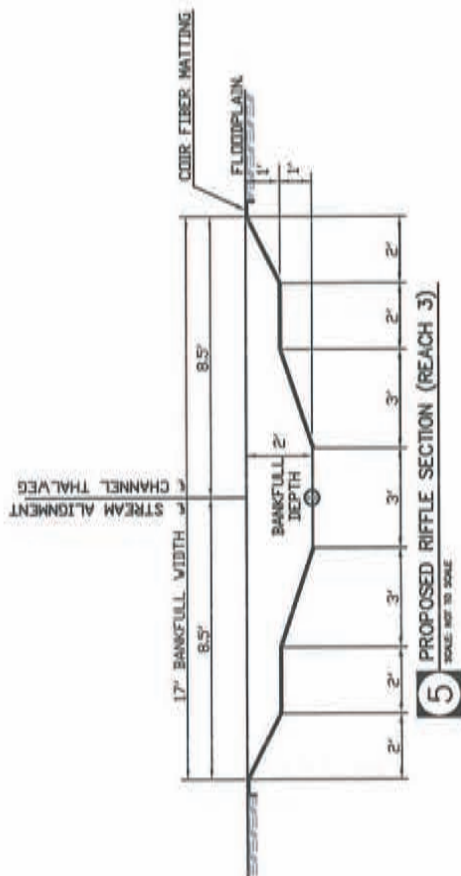

Ward Consulting Engineers, P.C.
Environmental Data & Exchange
4805 Green Rd, Suite 100
Raleigh, NC 27616
(919) 870-0586
FAX (919) 870-5339



601 EAST
TYPICAL CONSTRUCTED
CROSS SECTIONS WITH LEGENDS
UNION COUNTY, NORTH CAROLINA


DATE	1/12/2010
DESIGNER	
CHECKED	
APPROVED	
SCALE	AS SHOWN
PROJECT	
RECORD DRAWINGS	
DATE	
BY	
SCALE	
PROJECT	

TCS2

INTERMITTENT REACH 1A
CHANNEL TYPE "B"

REACH A
EPHEMERAL CHANNEL

RIPRAP CHANNEL

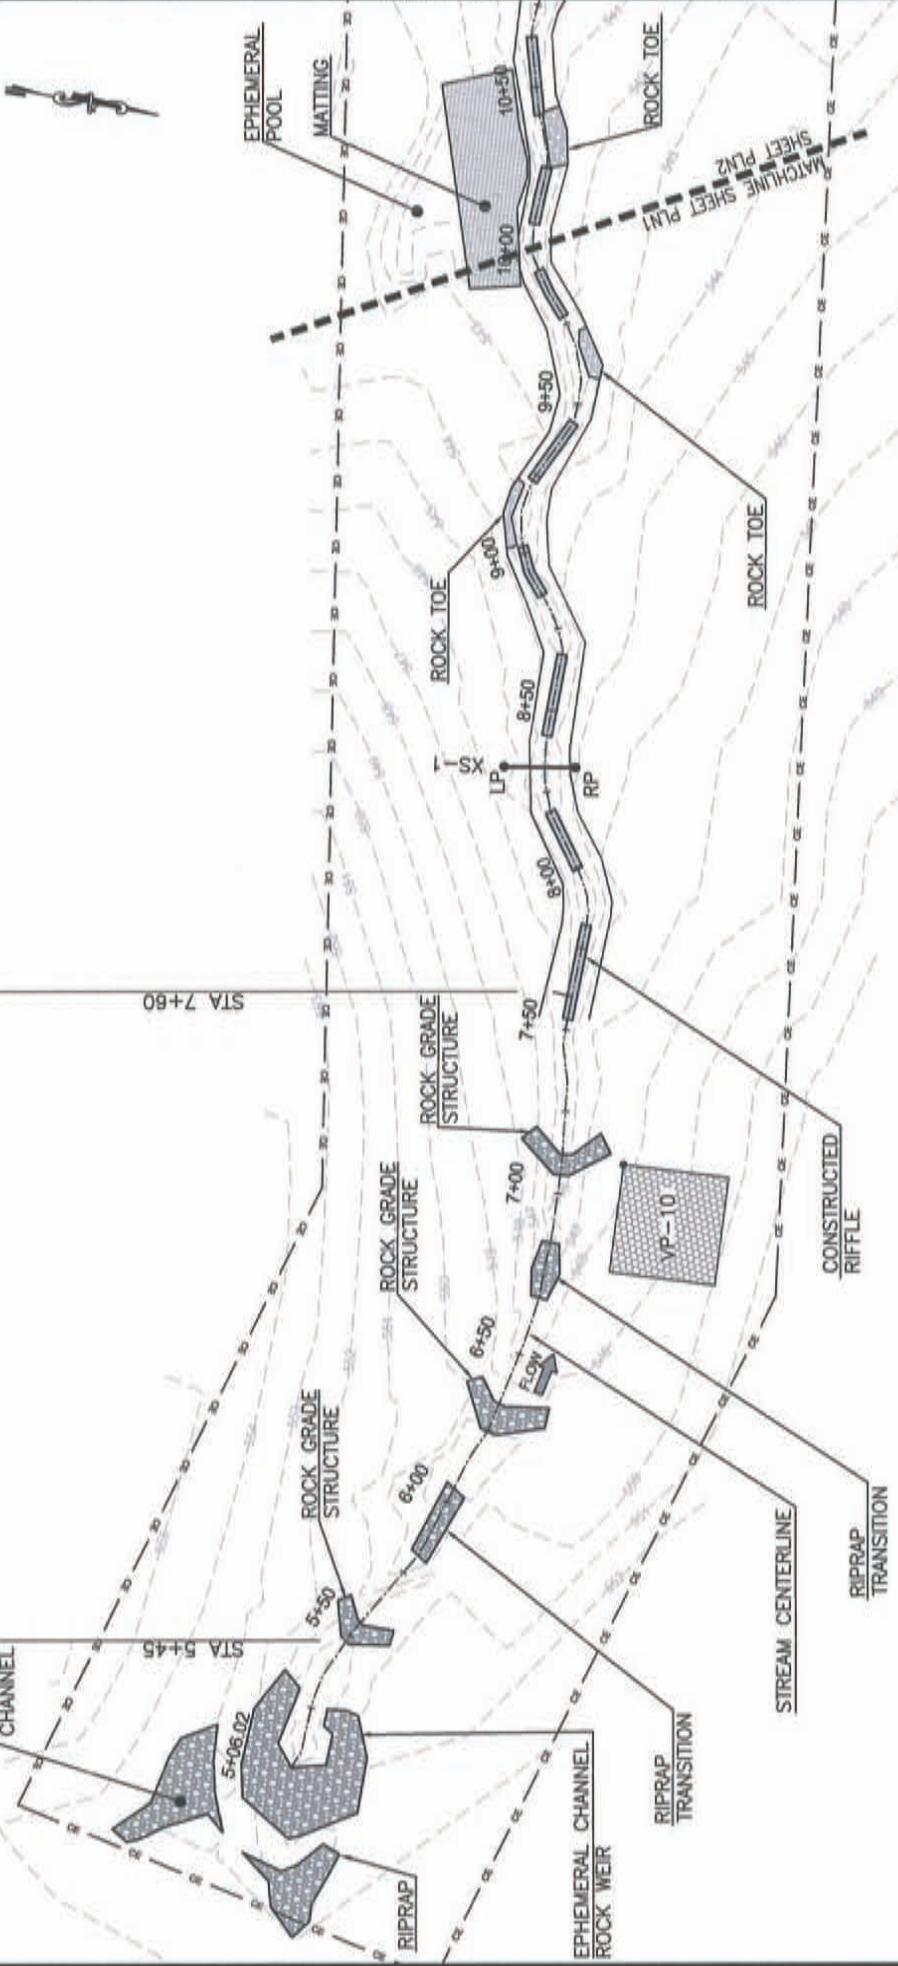

- LEGEND**
- AS-BUILT SURFACE
 - AS-BUILT STREAM THALWEG
 - AS-BUILT TOP OF BANK
 - AS-BUILT CONSERVATION EASEMENT
 - PERMANENT CROSS SECTION
 - AS-BUILT CONSTRUCTED ROCK RIFFLE
 - AS-BUILT ROCK TOE
 - AS-BUILT BRUSH TOE
 - VEGETATION PLOT

Veg Plot	Elevation	Northing	Eastings
VP-10	547.894	397465.1603	1572520.7387
Cross Section	Elevation	Northing	Eastings
XS-1 LP	545.333	397511.7551	1572403.9924
XS-1 RP	545.268	397528.5731	1572417.7687



- NOTE:**
1. BLACK DOT IN CORNER OF PLANT PLOT INDICATES PLOT CORNER LABELED IN TABLE.
 2. BENCH MARKERS SHOWN FROM CONSTRUCTION CONTROL SURVEY SET BY TURNER LAND SURVEYING, PLLC. (LABELED TLS) 3719 BENSON DRIVE RALEIGH, NC 27629 (919)827-0745
 3. AS-BUILT SURVEY AND MONITORING FEATURES SET BASED ON TURNER SITE BENCHMARKS.

Ward Consulting Engineers, P.C.
 Environmental, Survey & Exchange
 809 Capellity Drive, Suite 3100
 Raleigh, NC 27608 Phone: (919) 829-0008
 Fax: (919) 229-6613

Professional Seal: Ward Consulting Engineers, P.C. No. 28017 State of North Carolina




601 EAST
AS-BUILT PLAN VIEW
STATION 5+00 TO 10+00
UNION COUNTY, NORTH CAROLINA

DATE: 08/20/2018
 DRAWING NO.: 601E-AS-BUILT-PLAN-VIEW
 PROJECT NAME:
 SITE NO.:
 FILE NAME:
 PLOT NUMBER:
 DRAWN BY: PAB
 CHECKED BY:
 RECORDED DRAWINGS
 SHEET NO.

PLN1



601 EAST
 AS-BUILT PLAN VIEW
 STATION 10+00 TO 15+00
 UNION COUNTY, NORTH CAROLINA

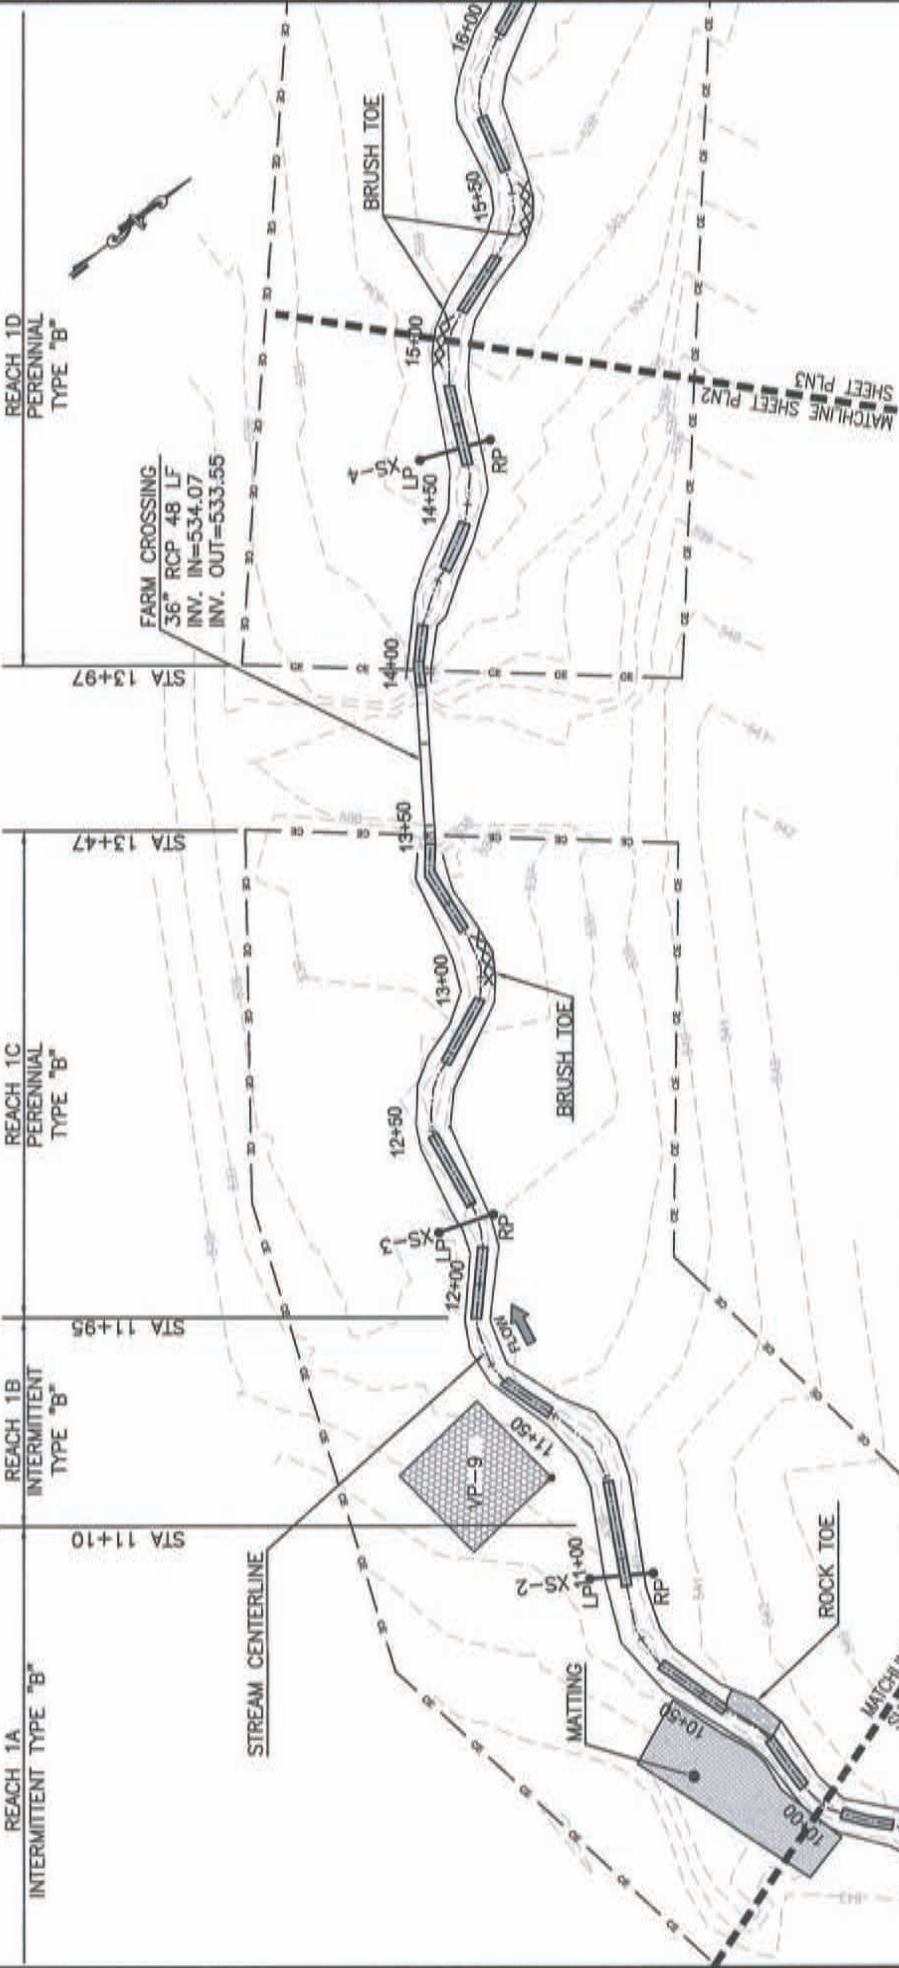

LEGEND

- AS-BUILT SURFACE
- AS-BUILT STREAM THALWEG
- AS-BUILT TOP OF BANK
- AS-BUILT CONSERVATION EASEMENT
- PERMANENT CROSS SECTION
- AS-BUILT CONSTRUCTED ROCK RIFFLE
- AS-BUILT ROCK TOE
- AS-BUILT BRUSH TOE
- VEGETATION PLOT

57+50

XS-1


VP-9

Scale: 1"=40'

Veg Plot	Elevation	Northing	Easting
VP9	539.428	397709.5938	1572200.0227

Cross Section	Elevation	Northing	Easting
XS-2 LP	540.722	397679.7631	1572213.2727
XS-2 RP	540.656	397682.4762	1572232.4822
XS-3 LP	538.548	397782.1264	1572162.3670
XS-3 RP	538.011	397788.4308	1572178.5801
XS-4 LP	534.089	398015.1829	1572144.7317
XS-4 RP	533.668	398022.3468	1572165.7573

REACH 1D
PERENNIAL TYPE "B"

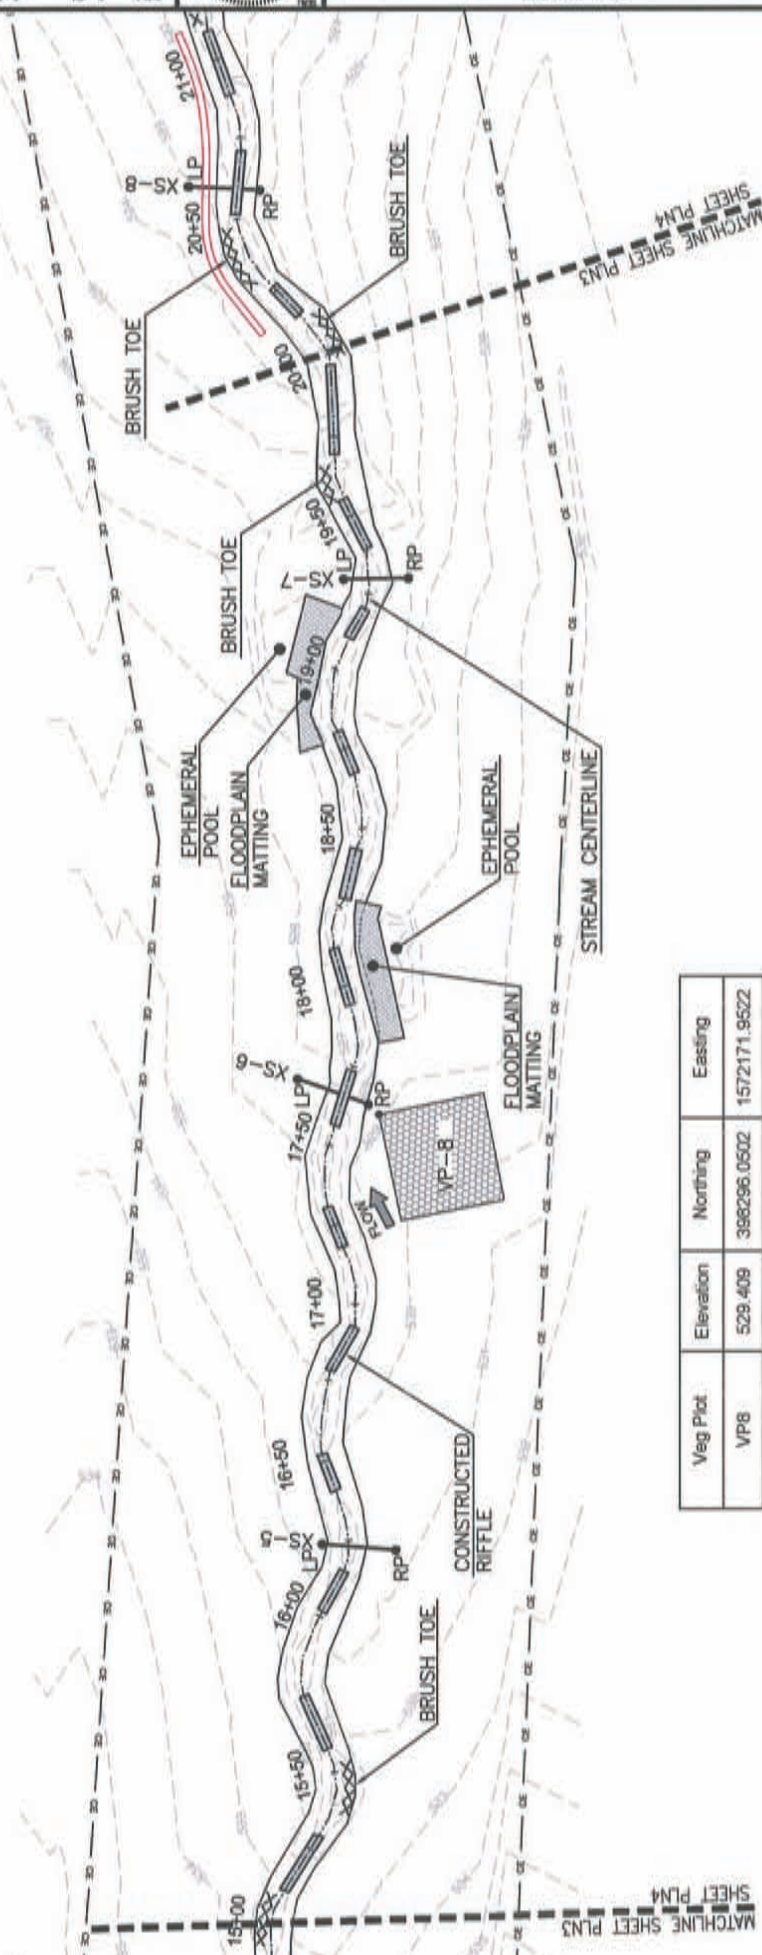

LEGEND

- AS-BUILT SURFACE
- AS-BUILT STREAM THALWEG
- AS-BUILT TOP OF BANK
- AS-BUILT CONSERVATION EASEMENT
- PERMANENT CROSS SECTION
- AS-BUILT CONSTRUCTED ROCK RIFFLE
- AS-BUILT ROCK TOE
- AS-BUILT BRUSH TOE
- VEGETATION PLOT

Veg Plot	Elevation	Northing	Easting
VP8	529.409	398296.0502	1572171.9522

Cross Section	Elevation	Northing	Easting
XS-5 LP	530.829	398165.3735	1572161.2797
XS-5 RP	530.904	398164.7815	1572183.7985
XS-6 LP	528.487	398305.6269	1572146.9679
XS-6 RP	528.795	398298.9918	1572188.6957
XS-7 LP	525.414	398457.1783	1572153.2354
XS-7 RP	526.247	398458.5135	1572172.8233



Ward Consulting Engineers, P.C.
 FIRM LICENSE NO. C-2819
 4805 Owen Rd, Suite 100
 Raleigh, NC 27616-2848
 FAX (919) 870-0526

Environmental Bank & Exchange
 900 Capital Dr., Suite 3100
 Raleigh, NC 27606
 Phone: (919) 820-9000
 Fax: (919) 229-0013





601 EAST
 AS-BUILT PLAN VIEW
 STATION 15+00 TO 20+00
 UNION COUNTY, NORTH CAROLINA

DATE: 11/13/2013
 DRAWING NO.:
 PROJECT NAME:
 SHEET NO.:
 SHEET TOTAL:
 RECORD DRAWINGS
 SHEET NO.:
 SHEET TOTAL:
 PLIN3



DATE	10/18/2018
PROJECT NAME	601 EAST
PROJECT NO.	18-001
SCALE	1"=40'
TIME	
RECORD DRAWINGS	
SHEET NO.	PLN4

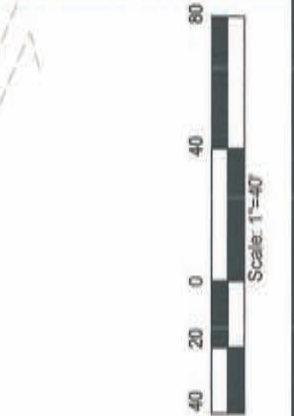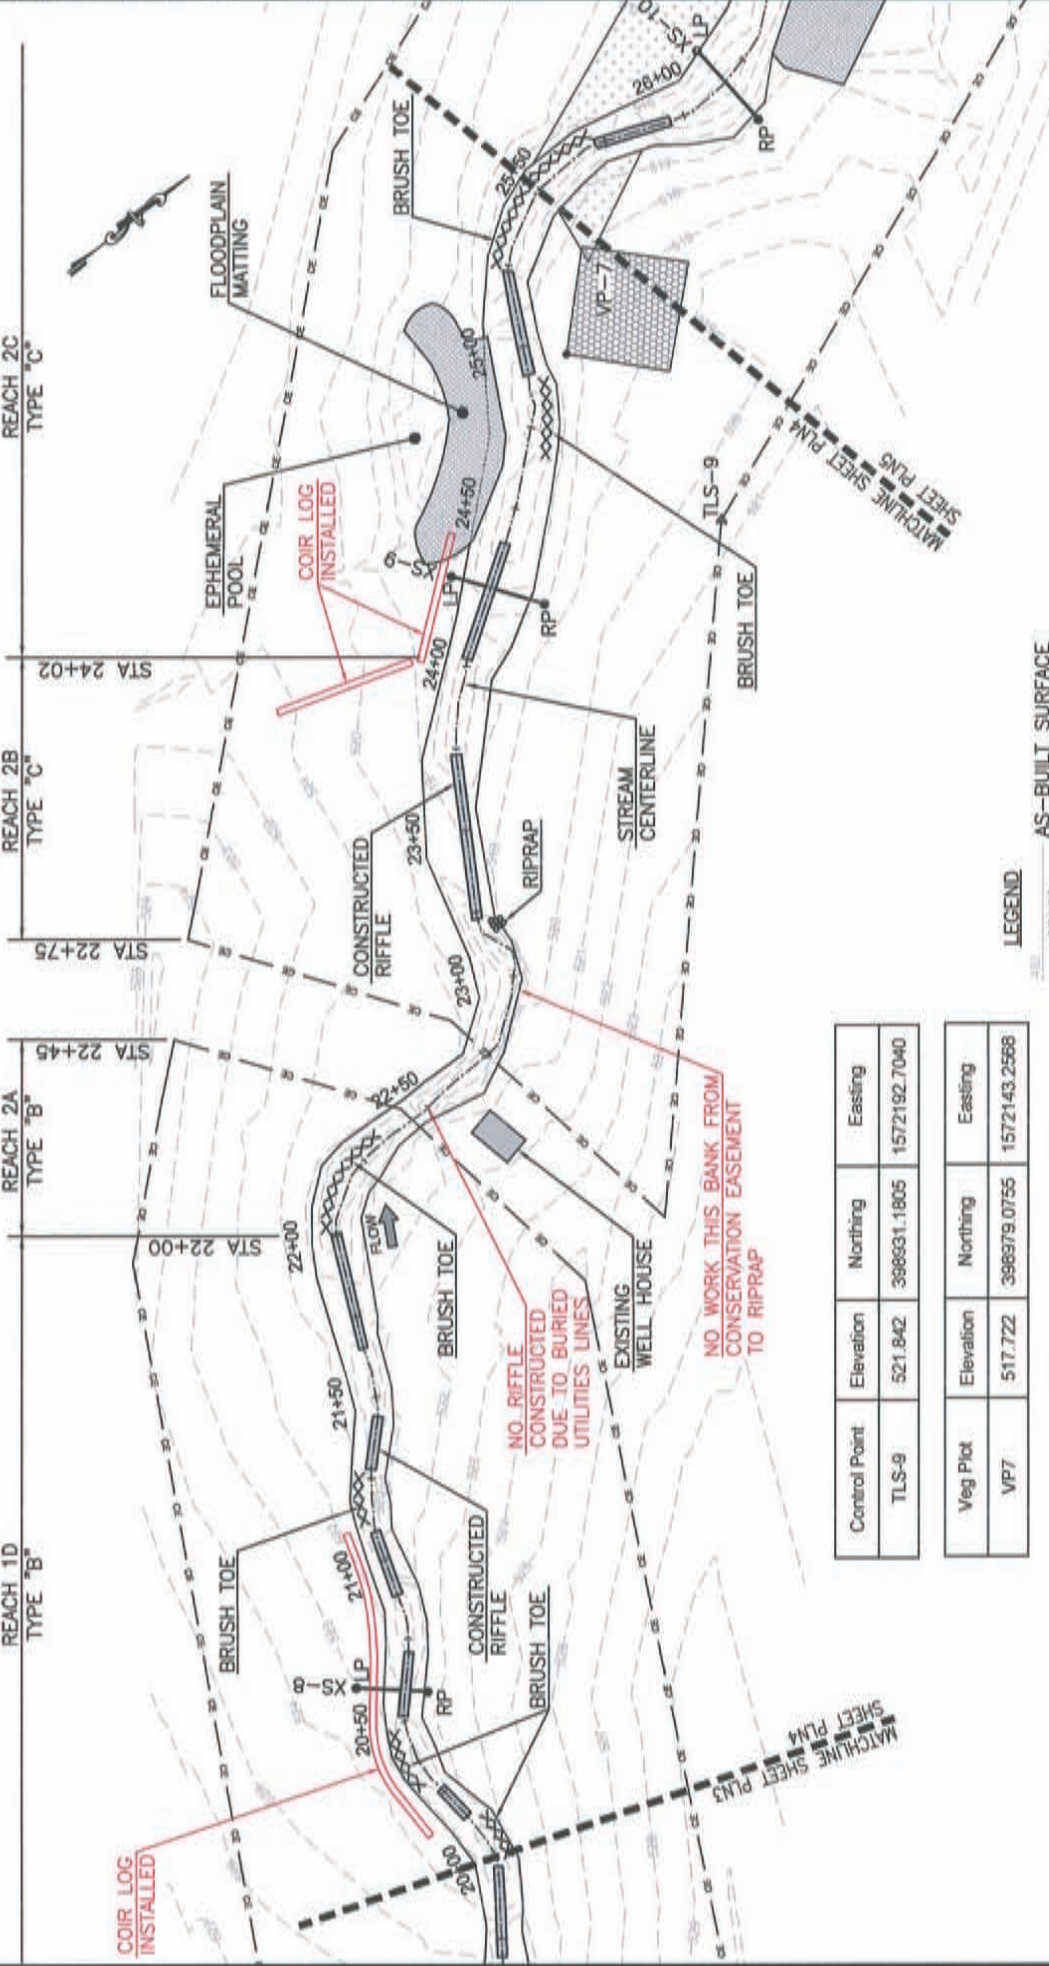

- LEGEND**
- 57+50 AS-BUILT SURFACE
 - AS-BUILT STREAM THALWEG
 - AS-BUILT TOP OF BANK
 - AS-BUILT CONSERVATION EASEMENT
 - XS-1 PERMANENT CROSS SECTION
 - AS-BUILT CONSTRUCTED ROCK RIFFLE
 - AS-BUILT ROCK TOE
 - AS-BUILT BRUSH TOE
 - VP-16 VEGETATION PLOT
 - A CONTROL POINT

Control Point	Elevation	Northing	Easting
TLS-9	521.842	398631.1805	1572192.7040

Veg Plot	Elevation	Northing	Easting
VP7	517.722	398679.0755	1572143.2568

Cross Section	Elevation	Northing	Easting
XS-8 LP	523.059	398573.4555	1572100.3479
XS-8 RP	522.549	398573.3919	1572121.9122
XS-9 LP	518.250	398910.1715	1572111.9904
XS-9 RP	517.718	398903.3405	1572140.5639

Ward Consulting Engineers, P.C.
 FIRM LICENSE NO. C-2610
 4805 Green Mt. Blvd. 100
 Raleigh, NC 27616-2948
 FAX: (919) 870-0326
 Environmental Services & Exchange
 800 Capital Dr., Suite 3100
 Raleigh, NC 27608
 Phone: (919) 820-0000
 Fax: (919) 229-8913




601 EAST
 AS-BUILT PLAN VIEW
 STATION 25+50 TO 31+50
 UNION COUNTY, NORTH CAROLINA

DATE	
DESCRIPTION	
PROJECT NAME	
FILE NAME	
DATE PLOTTED	
SCALE	
TITLE	

RECORD DRAWINGS
 SHEET NO. _____

PLANS

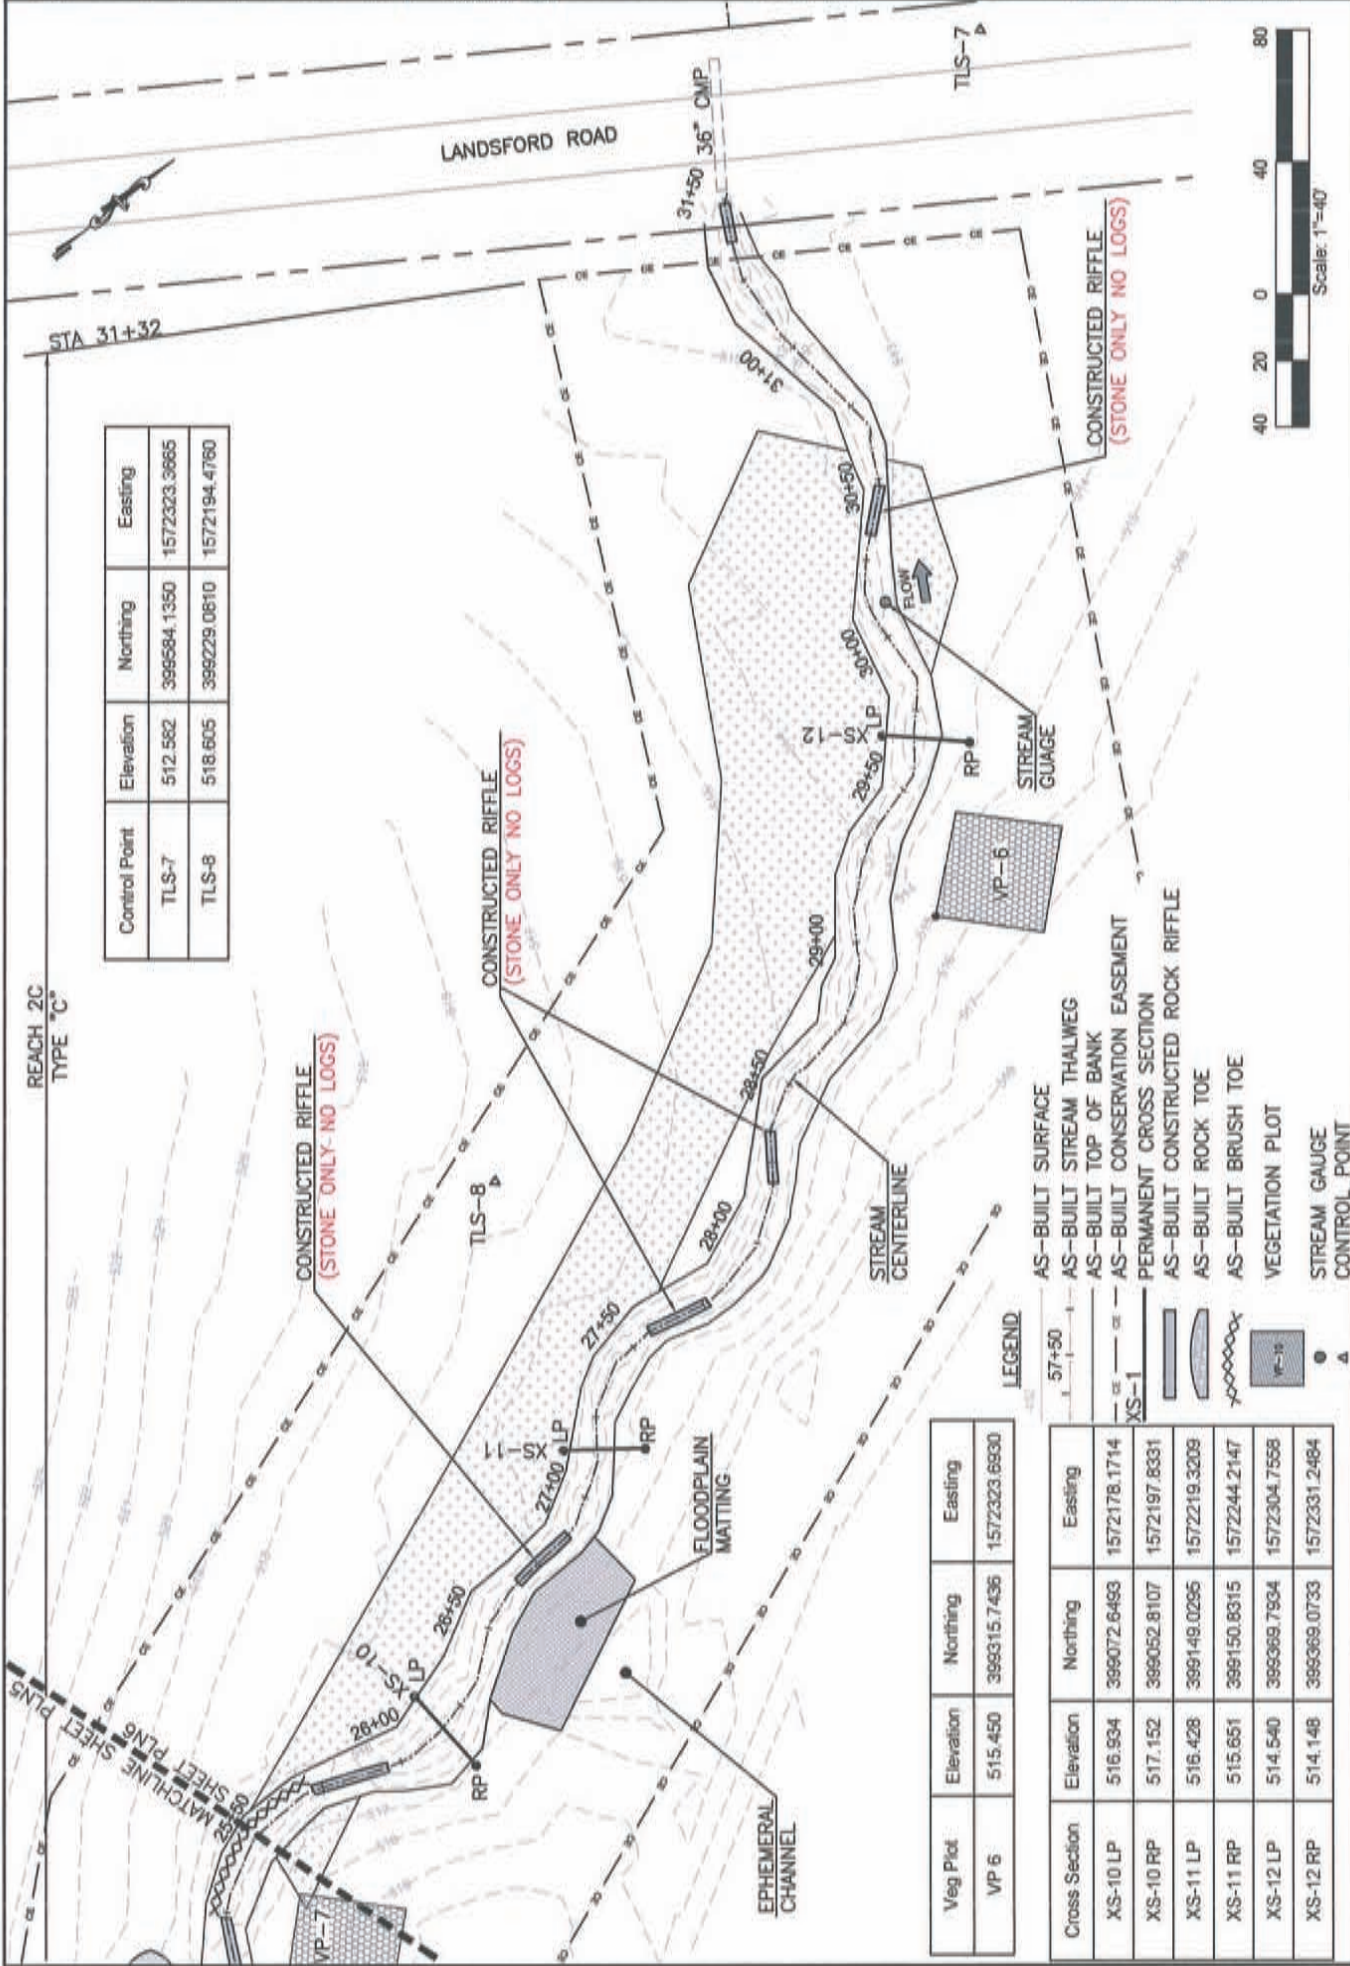

REACH 2C
 TYPE "C"


Control Point	Elevation	Northing	Easting
TLS-7	512.582	399584.1350	1572323.3665
TLS-8	518.605	399229.0610	1572194.4760



- LEGEND**
- 57+50 AS-BUILT SURFACE
 - AS-BUILT STREAM THALWEG
 - AS-BUILT TOP OF BANK
 - AS-BUILT CONSERVATION EASEMENT
 - PERMANENT CROSS SECTION
 - AS-BUILT CONSTRUCTED ROCK RIFFLE
 - AS-BUILT ROCK TOE
 - AS-BUILT BRUSH TOE
 - VEGETATION PLOT
 - STREAM GAUGE
 - CONTROL POINT

Veg Plot	Elevation	Northing	Easting
VP 6	515.450	399315.7436	1572323.6930

Cross Section	Elevation	Northing	Easting
XS-10 LP	516.934	399072.6493	1572178.1714
XS-10 RP	517.152	399052.8107	1572197.8331
XS-11 LP	516.428	399149.0295	1572219.3209
XS-11 RP	515.651	399150.8315	1572244.2147
XS-12 LP	514.540	399369.7934	1572304.7598
XS-12 RP	514.148	399369.0733	1572331.2484

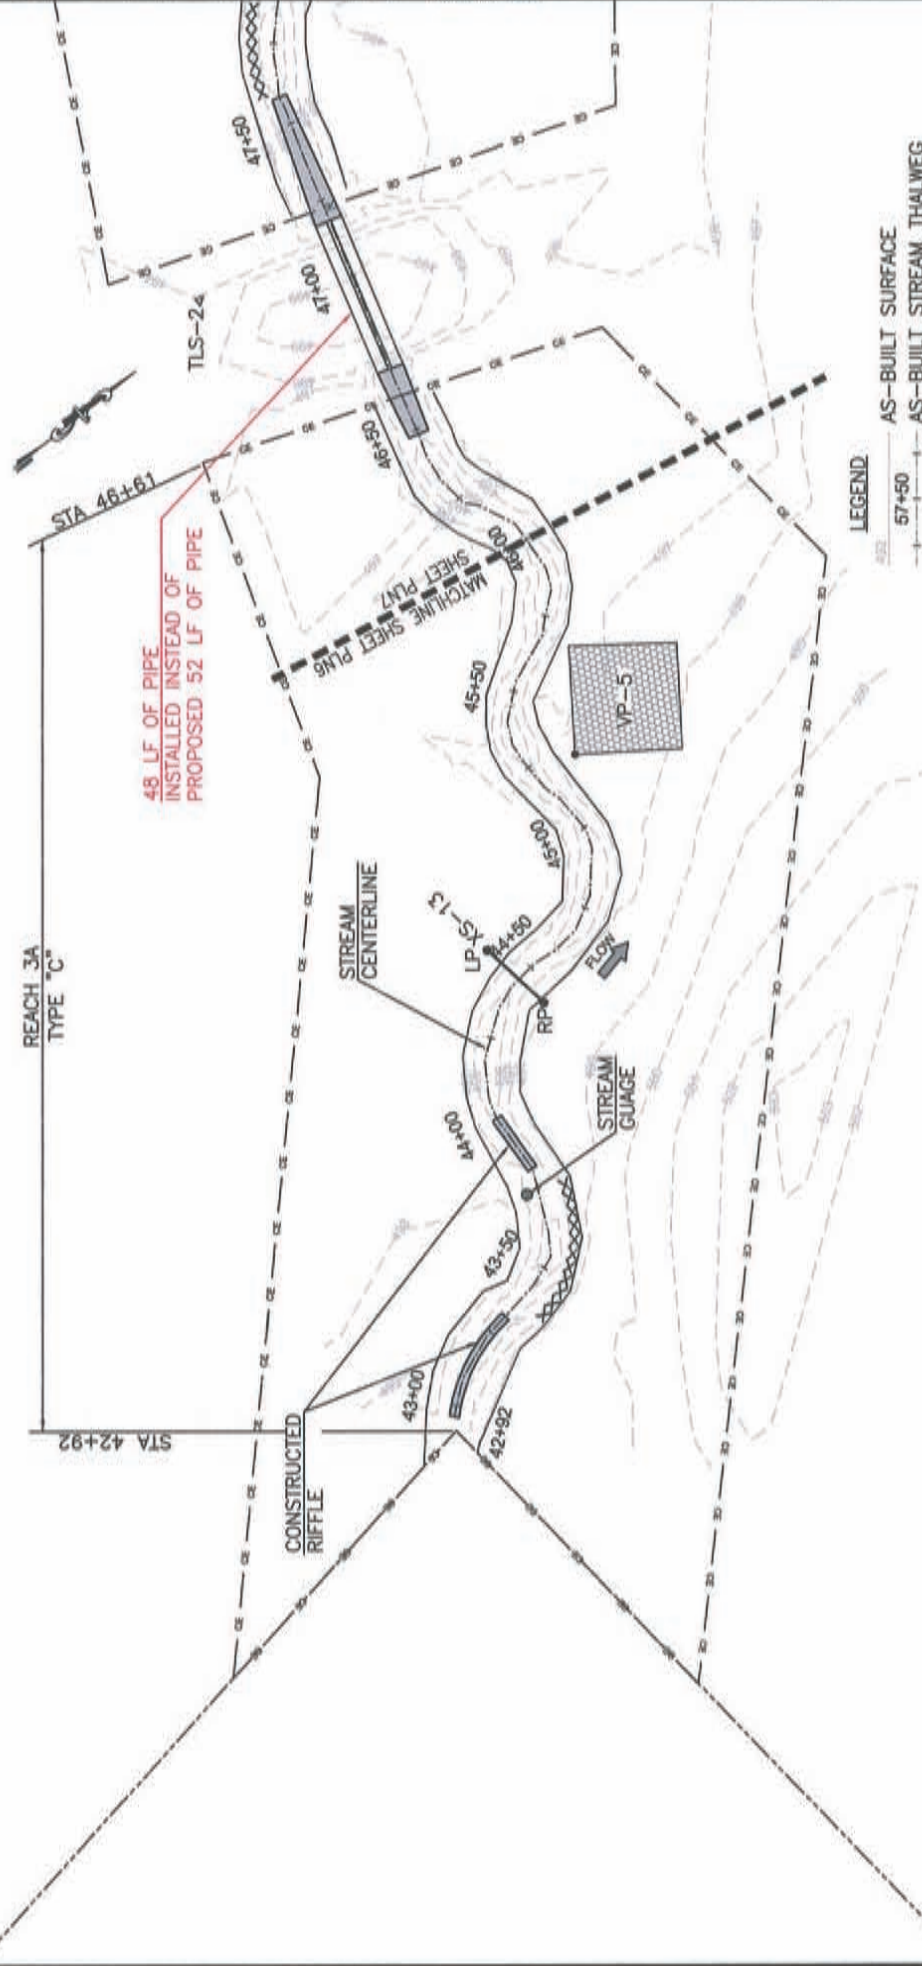

48 LF OF PIPE
 INSTALLED INSTEAD OF
 PROPOSED 52 LF OF PIPE

- LEGEND**
- AS-BUILT SURFACE
 - AS-BUILT STREAM THALWEG
 - AS-BUILT TOP OF BANK
 - PERMANENT CROSS SECTIONS
 - AS-BUILT CONSERVATION EASEMENT
 - AS-BUILT CONSTRUCTED ROCK RIFFLE
 - AS-BUILT ROOT WAD
 - AS-BUILT LOG WANE
 - AS-BUILT BRUSH TOE
 - VEGETATION PLOT
 - STREAM GAUGE
 - CONTROL POINT

NOTE:
 ALL RIFFLES NOT CONSTRUCTED
 TOP DRESSED WITH NATIVE ROCK THIS SHEET.

Veg Plot	Elevation	Northing	Easting
VP-5	497.138	400848.7936	1571923.3215

Cross Section	Elevation	Northing	Easting
XS-13 LP	497.982	400791.3334	1571953.3928
XS-13 RP	498.641	400794.8559	1571976.3664

Control Point	Elevation	Northing	Easting
TLS-2	466.742	400844.9925	1571745.0270




REACH 3B
TYPE "C"

Ward Consulting Engineers, P.C.
 Environmental Services & Exchange
 800 Capability Drive, Suite 3100
 Raleigh, NC 27606 Phone: (919) 829-9000
 Fax: (919) 229-0013

4805 Green Rd, Suite 100
 Raleigh, NC 27616-2948
 Phone: (919) 870-0326
 Fax: (919) 870-0326

Professional Engineer
 License No. 10000
 State of North Carolina

601 EAST
 AS-BUILT PLAN VIEW
 STATION 46+00 TO 52+50
 UNION COUNTY, NORTH CAROLINA

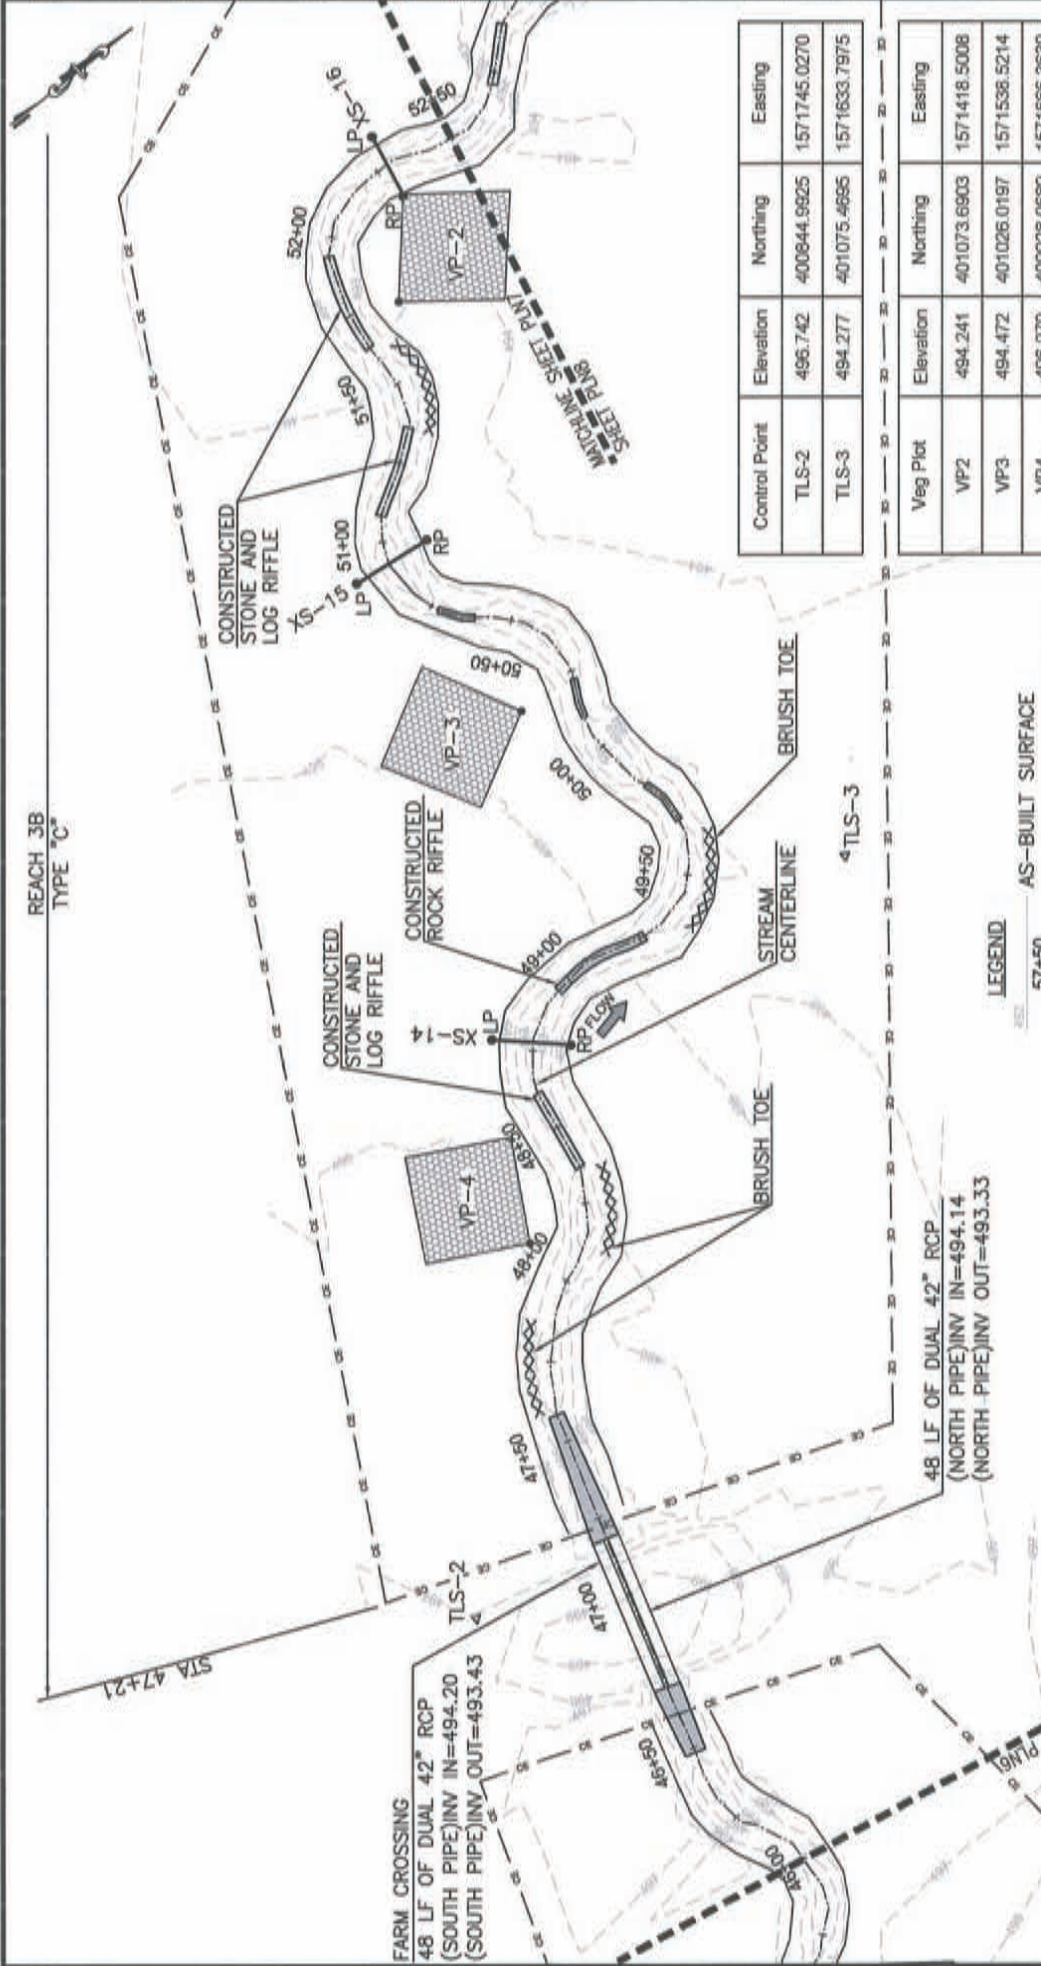

Cross Section	Elevation	Northing	Eastng
XS-14 LP	495.686	400957.4293	1571610.9769
XS-14 RP	495.891	400975.1539	1571627.0500
XS-15 LP	494.501	401010.9149	1571477.5248
XS-15 RP	494.627	401035.6978	1571480.2542
XS-16 LP	493.920	401098.4135	1571374.4520
XS-16 RP	494.028	401094.7191	1571394.3939

LEGEND

- 57+50 AS-BUILT SURFACE
- AS-BUILT STREAM THALWEG
- AS-BUILT TOP OF BANK
- XS-1 PERMANENT CROSS SECTION
- AS-BUILT CONSERVATION EASEMENT
- AS-BUILT CONSTRUCTED ROCK RIFFLE
- AS-BUILT STONE AND LOG RIFFLE
- AS-BUILT ROOT WAD
- AS-BUILT LOG VANE
- AS-BUILT BRUSH TOE
- VEGETATION PLOT
- CONTROL POINT

Control Point	Elevation	Northing	Eastng
TLS-2	496.742	400844.9625	1571745.0270
TLS-3	494.277	401075.4695	1571633.7975

Veg Plot	Elevation	Northing	Eastng
VP2	494.241	401073.6903	1571418.5008
VP3	494.472	401026.0197	1571536.5214
VP4	496.079	400928.0689	1571666.3630

NOTE:
 ALL RIFFLES NOT CONSTRUCTED
 TOP DRESSED WITH NATIVE ROCK THIS SHEET.




PLN17

MATCHING SHEET
 SHEET PLAN16

FARM CROSSING
 48 LF OF DUAL 42" RCP
 (SOUTH PIPE)INV IN=494.20
 (SOUTH PIPE)INV OUT=493.43

48 LF OF DUAL 42" RCP
 (NORTH PIPE)INV IN=494.14
 (NORTH PIPE)INV OUT=493.33

STA 47+21

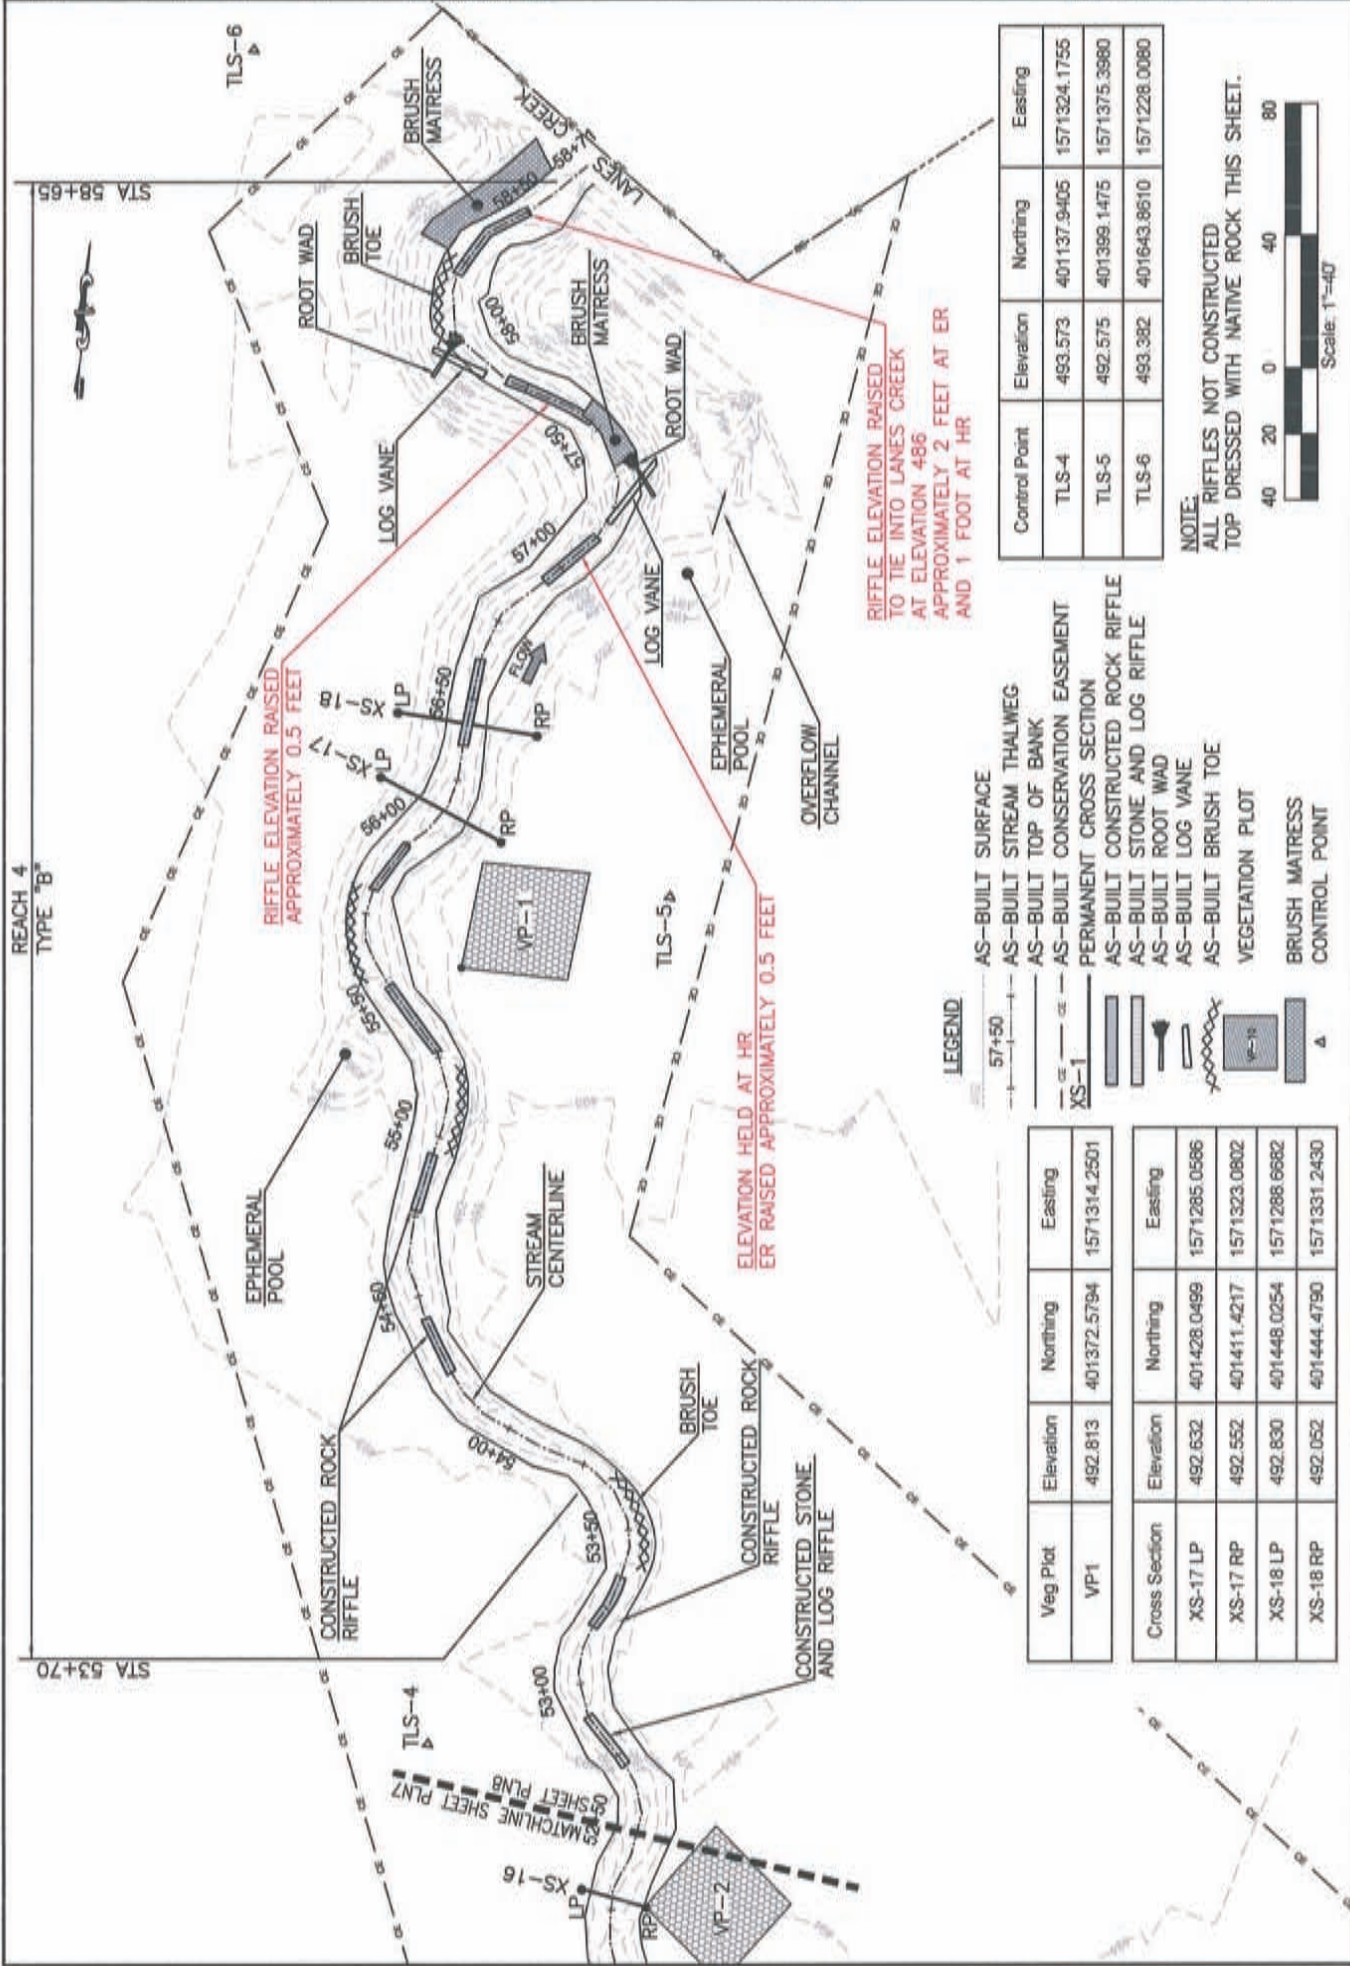

Control Point	Elevation	Northing	Easting
TLS-4	493.573	401137.9405	1571324.1755
TLS-5	492.575	401399.1475	1571375.3980
TLS-6	493.382	401643.8610	1571228.0080

NOTE:
 ALL RIFFLES NOT CONSTRUCTED
 TOP DRESSED WITH NATIVE ROCK THIS SHEET.

40 20 0 40 80
 Scale: 1"=40'

- LEGEND**
- 57+50 AS-BUILT SURFACE
 - AS-BUILT STREAM THALWEG
 - AS-BUILT TOP OF BANK
 - AS-BUILT CONSERVATION EASEMENT
 - PERMANENT CROSS SECTION
 - AS-BUILT CONSTRUCTED ROCK RIFFLE
 - AS-BUILT STONE AND LOG RIFFLE
 - AS-BUILT ROOT WAD
 - AS-BUILT LOG VANE
 - AS-BUILT BRUSH TOE
 - VEGETATION PLOT
 - BRUSH MATTRESS
 - CONTROL POINT

Veg Plot	Elevation	Northing	Easting
VP-1	492.813	401372.5794	1571314.2501

Cross Section	Elevation	Northing	Easting
XS-17 LP	492.632	401428.0499	1571285.0586
XS-17 RP	492.552	401411.4217	1571323.0802
XS-18 LP	492.830	401448.0254	1571288.6682
XS-18 RP	492.052	401444.4790	1571331.2430

REACH 4
 TYPE "B"

STA 53+70

STA 58+65


SMOOTHLINE SHEET PLAN7
 SHEET PLAN8

Ward Consulting Engineers, P.C.
 Environmental Data & Exchange
 4805 Green Rd, Suite 100
 Raleigh, NC 27616-2948 FAX (919) 870-0326
 809 Capital Dr, Suite 3100
 Raleigh, NC 27606 Phone (919) 820-0000
 Fax: (919) 229-0913



601 EAST AS-BUILT REACH 1 LONGITUDINAL PROFILE
 UNION COUNTY, NORTH CAROLINA

DATE: 01/18/2011
 PROJECT NAME: 601 East Stream
 SHEET NO.: 022
 RECORD DRAWINGS
 SHEET NO.

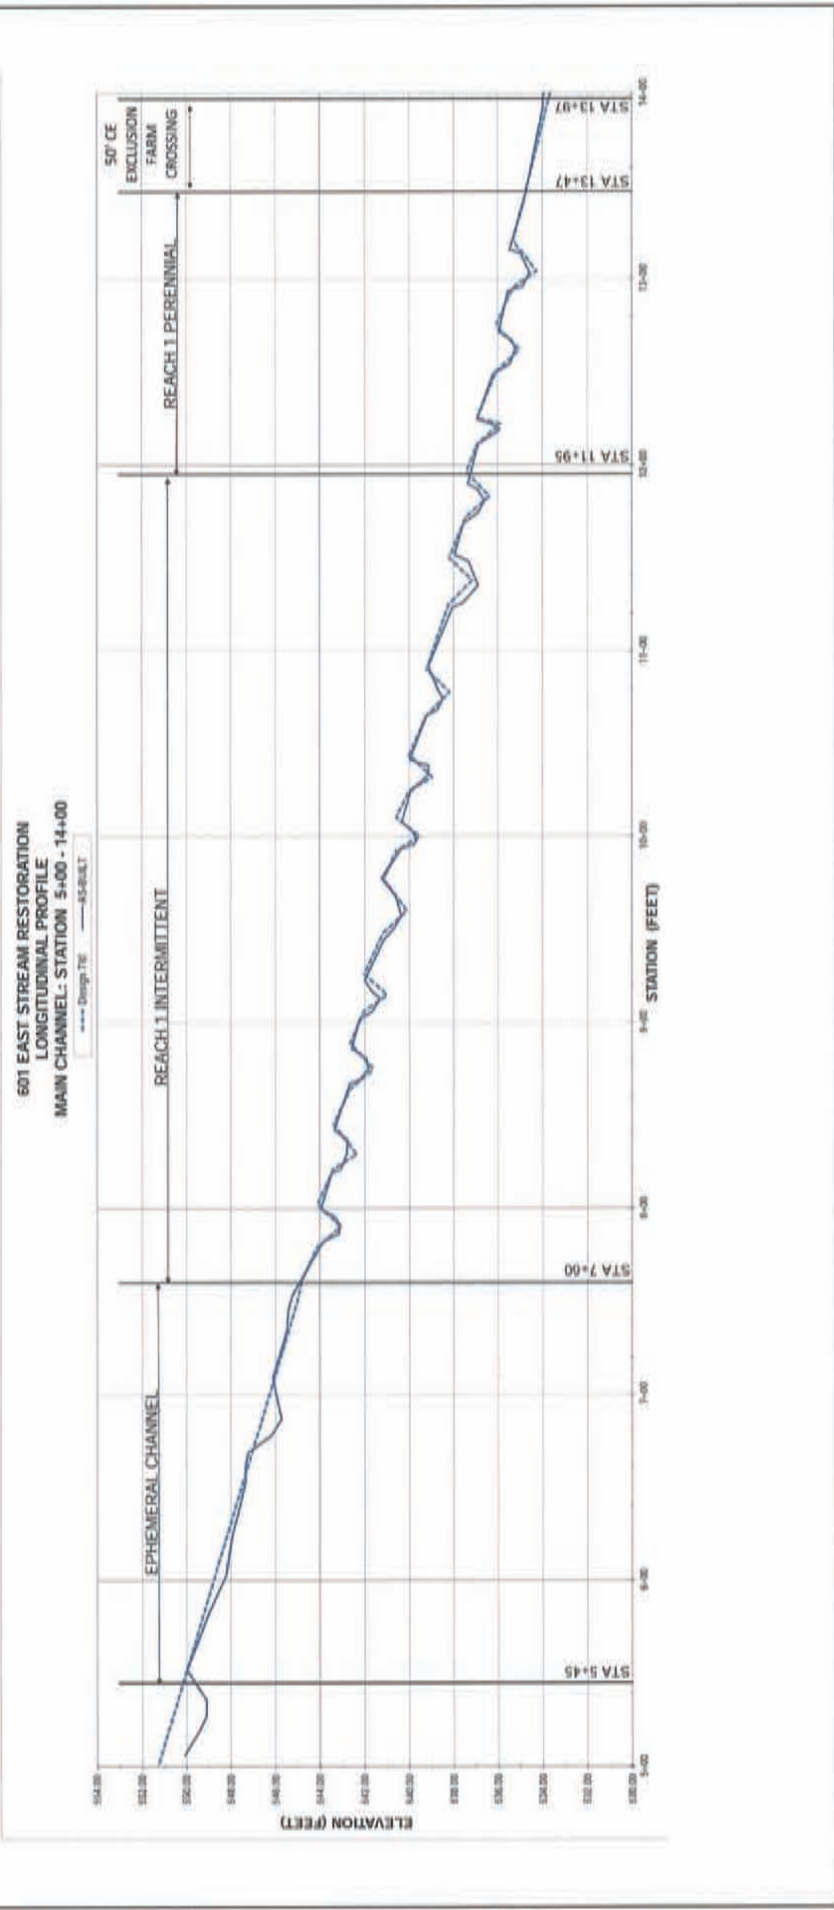


DATE: 10/13/2010
 PROJECT NAME:
 SHEET NO.:
 RECORD DRAWINGS
 SHEET NO.:

601 EAST
 AS-BUILT
 REACH 1 LONGITUDINAL PROFILE
 UNION COUNTY, NORTH CAROLINA



Ward Consulting Engineers, P.C.
 Environmental Services & Exchange
 909 Capability Drive, Suite 3100
 Raleigh, NC 27608 Phone: (919) 820-0000
 Fax: (919) 229-0013
 4805 Green Rd, Suite 100
 Raleigh, NC 27616-2848 Fax: (919) 870-0286
 (919) 870-0286
 FIRM LICENSE NO. C-6619

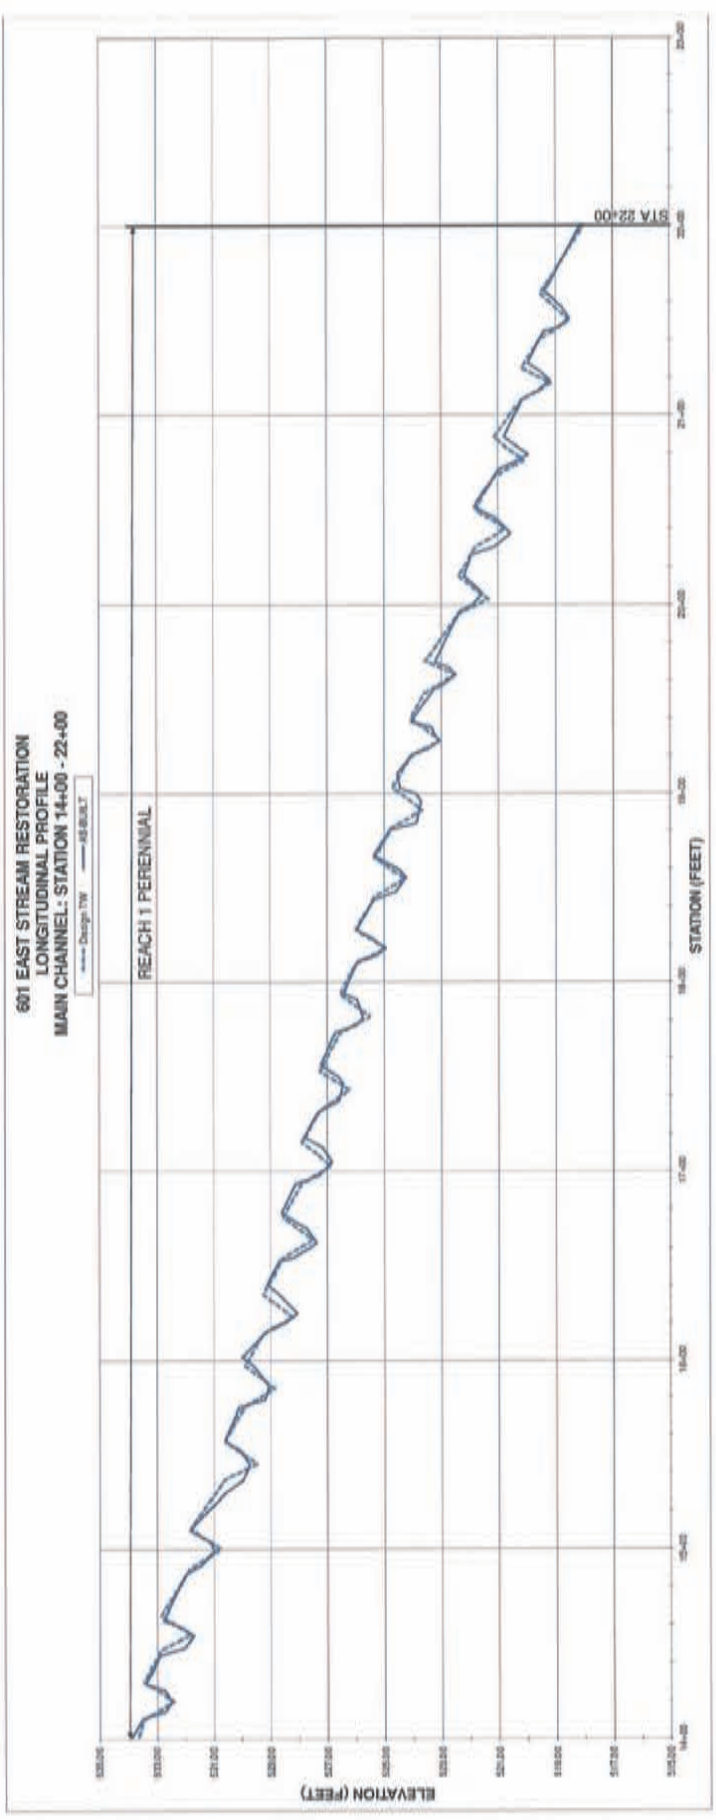


RECORD DRAWINGS
DATE: 01/23/2013
DRAWING NO. 21-00-03

PROJECT NAME: 601 East Stream
SHEET NO.: 03
SHEET TOTAL: 03
DATE: 01/23/2013

601 EAST
AS-BUILT
REACH 2 LONGITUDINAL PROFILE
UNION COUNTY, NORTH CAROLINA



Ward Consulting Engineers, P.C.
Firm License No. C-8619
4805 Green Rd, Suite 100
Raleigh, NC 27616-8848 FAX (919) 870-0566
Environmental Services & Exchange
609 Capital Drive, Suite 3100
Raleigh, NC 27606 Phone: (919) 829-8800
Fax: (919) 229-8813

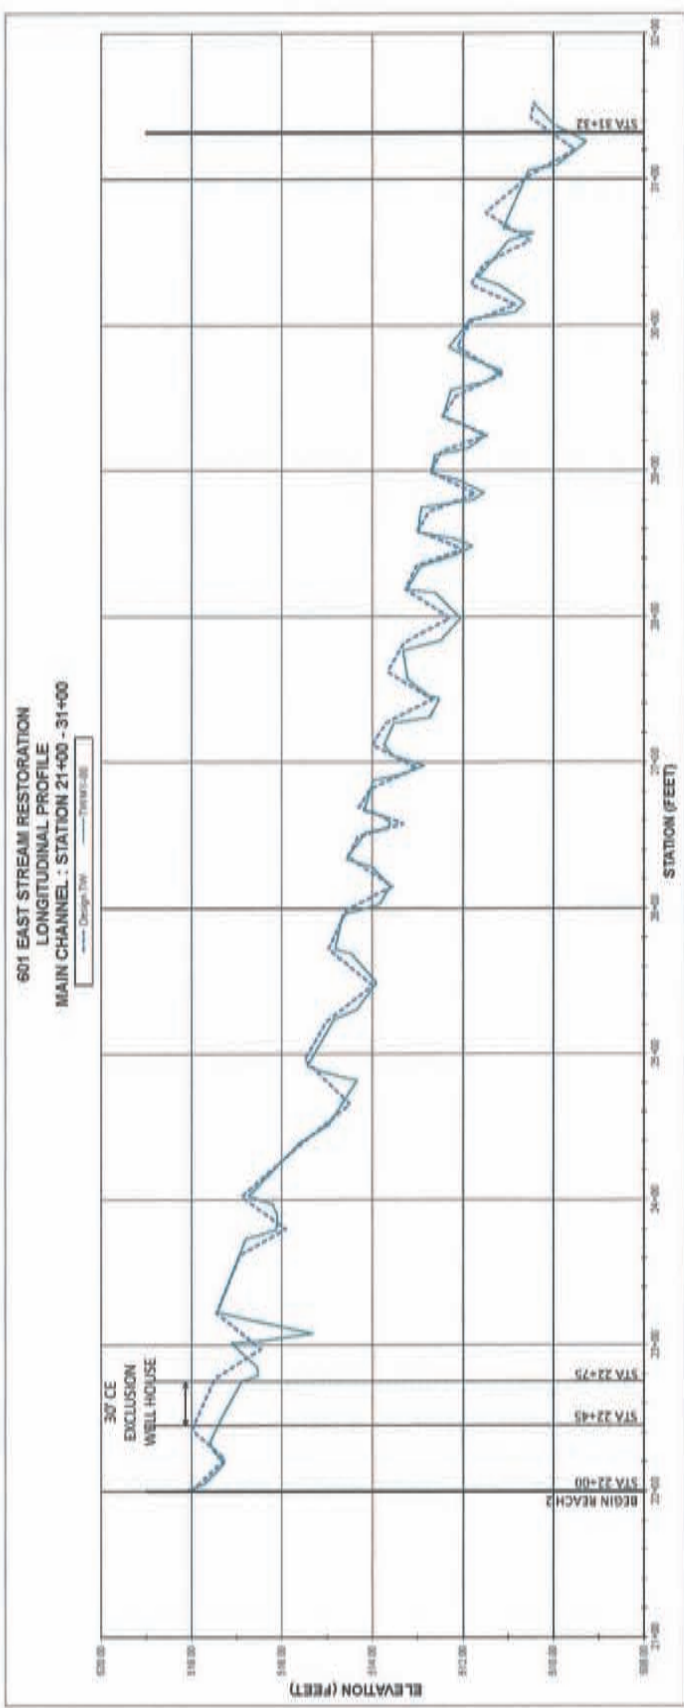

Ward Consulting Engineers, P.C.
 Environmental Services & Exchange
 809 Capaldi Drive, Suite 3100
 Raleigh, NC 27603 Phone: (919) 870-8000
 Fax: (919) 229-9913




601 EAST AS-BUILT REACH 3 LONGITUDINAL PROFILE
 UNION COUNTY, NORTH CAROLINA

PROJECT NAME	601 East Drive
DRAWN BY	Engineering
CHECKED BY	Engineering
DATE	08/20/13
RECORD DRAWINGS	08/20/13

601 EAST STREAM RESTORATION
 LONGITUDINAL PROFILE
 MAIN CHANNEL STATION 42+00 - 54+00

--- Design TW --- AS-BUILT

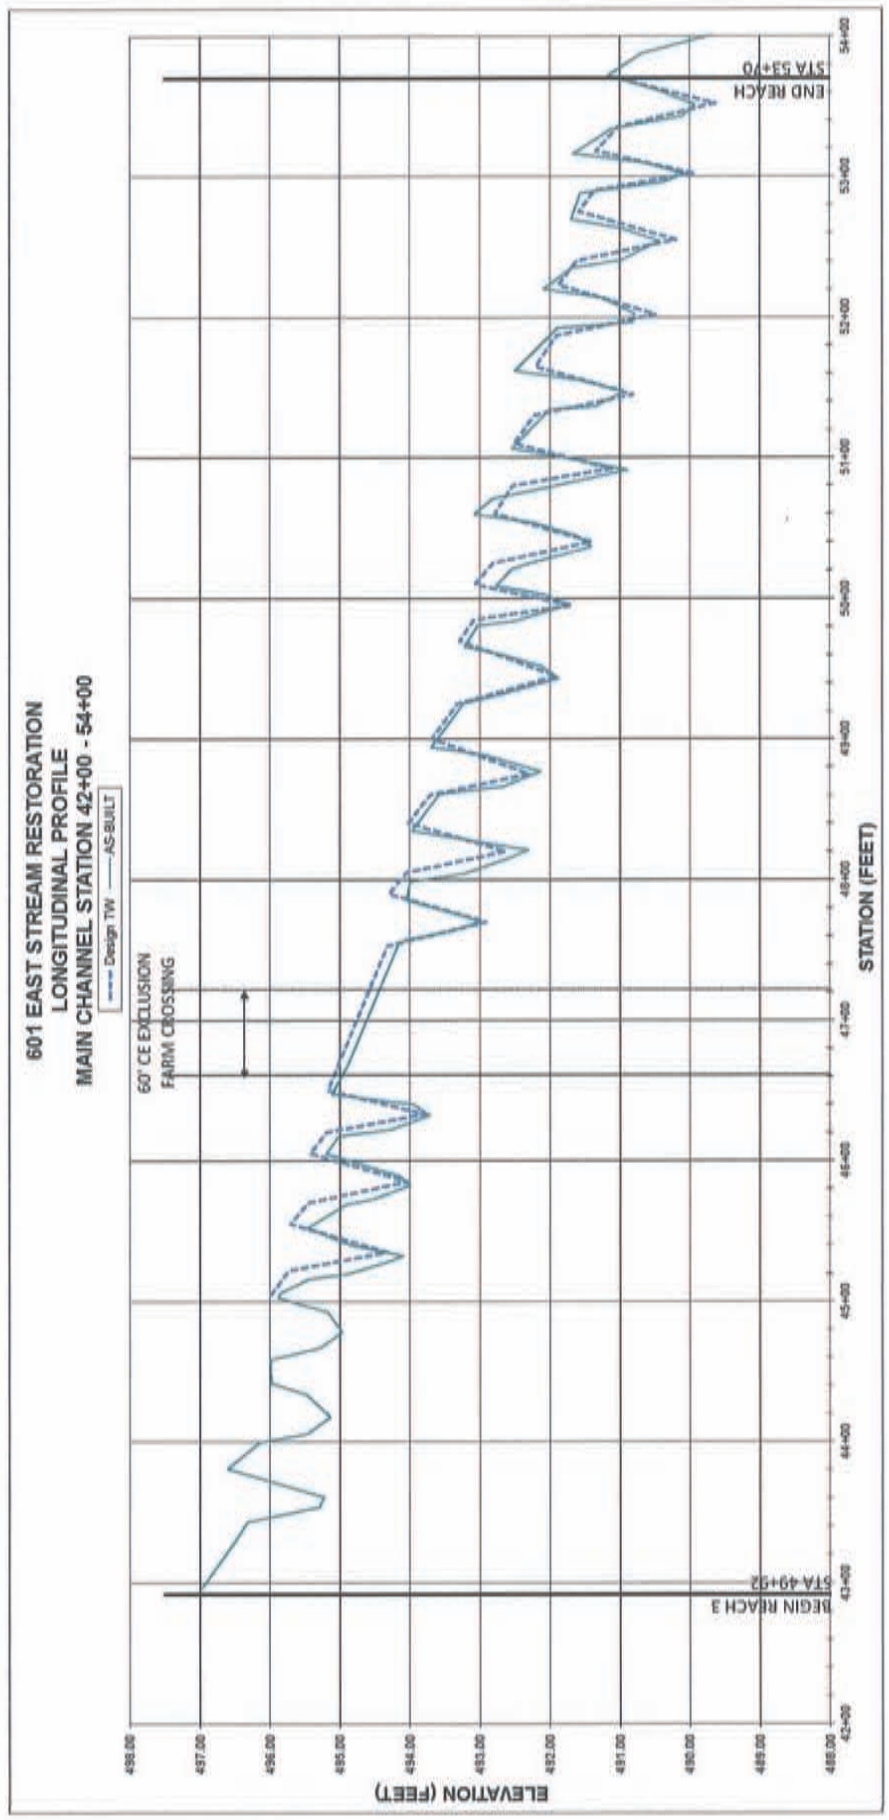

RECORD DRAWINGS
SHEET NO.

PROJECT NAME
601 East Stream
SHEET NO.
602


DATE
10/20/2010

601 EAST
AS-BUILT
REACH 4 LONGITUDINAL PROFILE
UNION COUNTY, NORTH CAROLINA



Ward Consulting Engineers, P.C.
FIRM LICENSE NO. C-8619
4005 Green Rd, Suite 100
Raleigh, NC 27616-2048 FAX (919) 870-0086
Environmental Services & Exchange
809 Capital City Drive, Suite 3100
Raleigh NC 27608 Phone: (919) 870-8000
Fax: (919) 229-9913

601 EAST STREAM RESTORATION
LONGITUDINAL PROFILE
MAIN CHANNEL - STATION 53+00 - 58+70

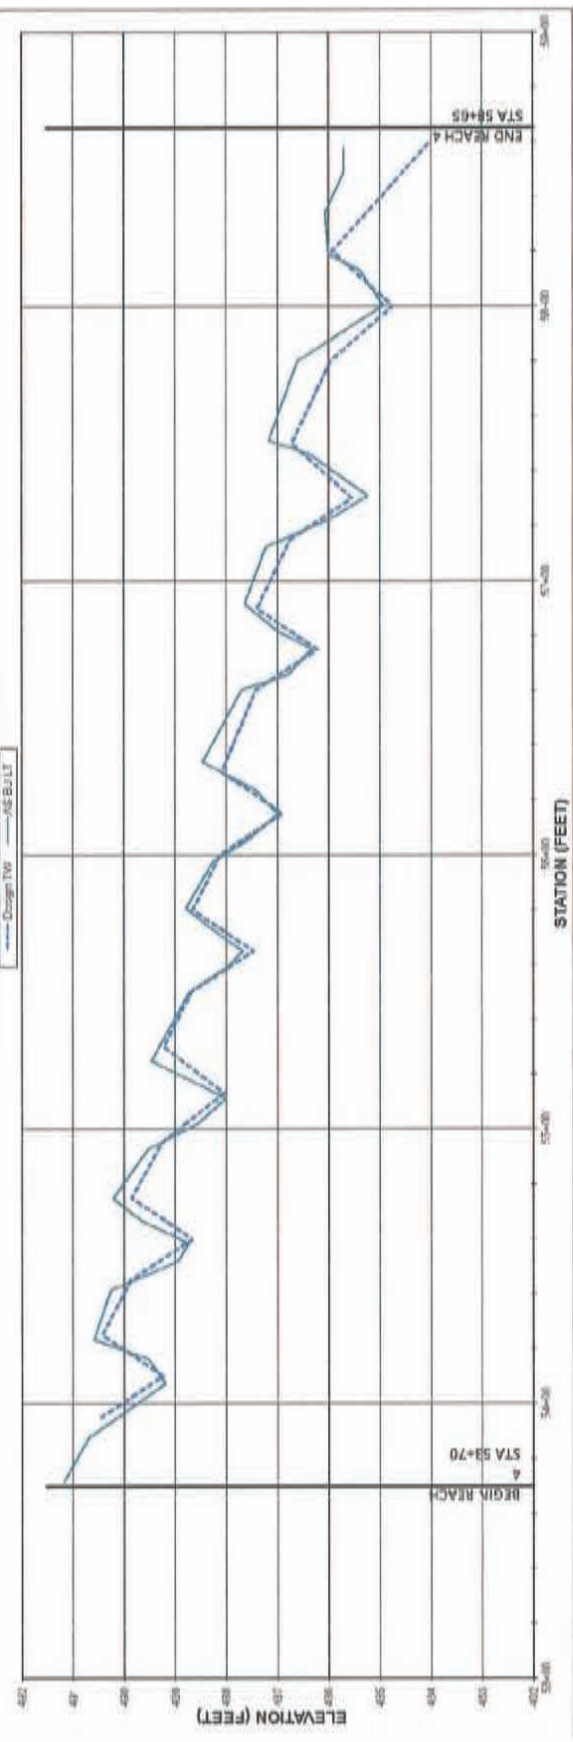


REGIN. REACH
A
STA 58+70

END REACH 4
STA 58+65



ZONE 2 FLOODPLAIN ZONE 3 WETLAND ZONE 1 STREAM BANK ZONE 2 FLOODPLAIN

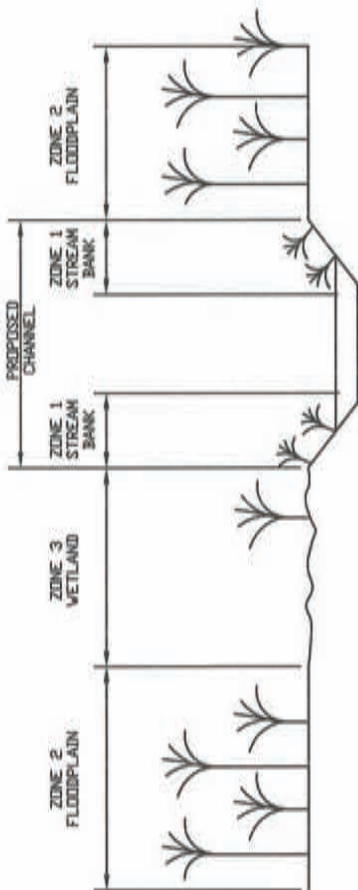

**PLANTING ZONE PROFILE SCHEMATIC
NOT TO SCALE**

Wetland Planting Zones - Permanent Seed Mix

Scientific Name	Common Name	Percent
<i>Sparganium angustifolium</i>	Wetland sparganium	35
<i>Carex virginica</i>	Blue sedge	25
<i>Elymus virginicus</i>	Virginia wild ryegrass	35
<i>Juncus effusus</i>	Soft Rush	5
<i>Rudbeckia hirta</i>	Black-eyed susan	5
<i>Verbena hastata</i>	Blue vervain	5
Total		100

0.37 Total Acres
20 lbs./acre
8 Tons/lbs.

Stream Buffer and Stream Banks Planting Zones-Permanent Seed Mix

Scientific Name	Common Name	Percent
<i>Elymus virginicus</i>	Virginia wild ryegrass	20
<i>Panicum virginicum</i>	Switchgrass	20
<i>Agrivis stolonifera</i>	Creeping bentgrass	15
<i>Carex lasiocarpa</i>	Carriacou	10
<i>Panicum columbianum</i>	Deer tongue	10
<i>Andropogon gerardii</i>	Big bluestem	5
<i>Juncus effusus</i>	Soft rush	5
<i>Panicum pennsylvanicum</i>	Penn. smartweed	5
<i>Schwartzia americana</i>	Little bluestem	5
<i>Styragnum natans</i>	Indian grass	5
Total		100

10.37 Total Acres
20 lbs./acre
208 Total lbs.

- GENERAL NOTES:**
- TEMPORARY PLANTING WILL OCCUR IMMEDIATELY AFTER CONSTRUCTION TO STABILIZE AREAS OF BARE SOIL. PERMANENT PLANTING AND SEEDINGS SHALL BEGIN IN SEASON OF FALL BETWEEN 10 NOVEMBER 15 AND APRIL 15. SOILS SHALL BE PREPARED FOR PLANTING, WHERE NEEDED THE SOILS SHOULD BE PLOWED OR RIPPED TO IMPROVE COMPACTED SOILS AND ELIMINATE CHANNELIZED FLOW FROM NON-TARGET AREAS. IF NECESSARY SOILS SHALL BE AMENDED WITH STORED SITE TOPSOIL TO FACILITATE VIGOROUS PLANT GROWTH.
 - SOILIC AND PLANTING PLANTERS SHALL BE TRAINED AND REMOVED.
 - PLANTS AT INSTALLATION WITHIN CHART SIZE REFERS TO THE SIZE OF THE PLANTS AT THE TIME OF PLANTING.
 - THE SPACING OF THE PLANTS SHALL BE 3' ON CENTER FOR SMALL PLANTS, WETLAND FORBES, AND ON STREAM BANK ZONES FOR TREES AND SHRUBS. SPACING SHALL BE 10 FEET ALONG ROWS WITH 10 FOOT ROW SPACING. FOR TREES AND SHRUBS PLANTING DENSITY IS TO BE 640 PLANTS/ACRE. PLANTS SHALL BE PLANTED IN ROWS SPACED 10 FEET APART TO MAINTAIN HEALTHY, VIGOROUS CONDITION PRIOR TO PLANTING.
 - PERMANENT SEED MIX REQUIRES ADVANCE PRE-ORDER AND SHIPMENT.
 - ALL PLANT MATERIAL SHALL CONFORM TO OR EXCEED THE AMERICAN STANDARD FOR NURSERY STOCK (LATEST EDITION) AS PUBLISHED BY THE AMERICAN ASSOCIATION OF NURSERYMEN.
 - THE SEED MIXES FOR THE TREES, SHRUBS, AND FORBES ARE LISTED ON SHEETS WITH SPECIES LISTED IN THE PLANTING TABLE.
 - PLANTING ZONE DESCRIPTIONS:
 - ZONE 1 - STREAM BANK**
THE STREAM BANK ZONE INCLUDES THE STREAM CHANNEL FROM BASE FLOW TO THE BANKFULL ELEVATION.
 - ZONE 2A - FLOODPLAIN**
THE STREAM BUFFER INCLUDES THE AREA FROM THE BANKFULL ELEVATION TO THE CONSERVATION EASEMENT LIMIT.
 - ZONE 4 - WETLAND**
THE WETLAND ZONES INCLUDE POCKETS OF ENHANCED WETLANDS AND WETLANDS THAT ARE NOT ADJACENT TO THE STREAM.
 - ZONE 5 - TEMPORARY ACCESS AREA TO BE REVEGETATED WITH TEMPORARY SEED ONLY WITHIN CROPPED PRODUCTION AREAS.**

- 488 Earthbuilding Summary**
January 25 - January 25, 2023
WLP Forest Service
- Other Sites low 40' high 40' 1/2", lateral ground position for 100%
700 Swamp Chestnut Oak were used (total 1400) for 60' 1/2" x 100' 1/2" x 100' 1/2" (60' 1/2" x 100' 1/2" x 100' 1/2")
Sufficient to replace a 1400 area (1400 acres) that were used at 60' East.

Species	Quantity
Blackburn	
Buckeye	400
Bursera	200
Sourwood Red Oak	200
Swamp Chestnut Oak	200
White Oak	400
Willow Oak	2,100 (200 1400 from 60' 1/2" x 100' 1/2")
Red Pine	700
Parrotwood	100
Yellow Poplar	1,300
Red Pine	100 + 100 (200 1400 from 60' 1/2" x 100' 1/2")
Planting	700 (700 1400)
Seeds	2,100 (200 1400)
Total Earthbuilding	3,800
Materials	3,800
Construction	3,800
Stock	4,200
Total Livestock	6,300

Planting by Site (Total)

Materials were planted 100' on the Red Pine to use for a follow up planting of Sycamores, Blue Birch and Other Air air an appropriate 100' 1/2" x 100' 1/2" to be able to include a rough 100' 1/2" diameter area, that will be along the stream banks to the edge of the stream and roughly 2' 1/2" high. The trees were planted in rows spaced 10' 1/2" apart. The trees were planted in the field at the end of the stream, 100' 1/2" x 100' 1/2". The trees were planted in the field at the end of the stream, 100' 1/2" x 100' 1/2". The trees were planted in the field at the end of the stream, 100' 1/2" x 100' 1/2".

UNION COUNTY, NORTH CAROLINA
AS-BUILT PLANTING NOTES
601 EAST

Ward Consulting Engineers, P.C.
4805 Green Rd, Suite 100
Raleigh, NC 27616-2949 FAX (919) 870-0299
Environmental Services & Exchange
600 Capital Blvd, Suite 3100
Raleigh NC 27606 Phone: (919) 829-9909 Fax: (919) 229-9913

VP1


601 EAST
AS-BUILT PLANTING PLAN
STATION 5+00 TO 10+00
UNION COUNTY, NORTH CAROLINA

Ward Consulting Engineers, P.C.
Firm License No. C-2819
4805 Owen Rd., Suite 100
Raleigh, NC 27616-2848
(919) 870-0536
FAX (919) 870-0535

Environmental Bar & Exchange
509 Capital Dr., Suite 9100
Raleigh, NC 27606
(919) 229-0913
Fax: (919) 229-0913



DATE	11/28/2019
DESCRIPTION	
DESIGNED BY	
CHECKED BY	
IN CHARGE	
PROJECT NAME	601 East
FILE NAME	601 East Planting Plan
SCALE	As Shown
SECOND DRAWINGS	
SHEET NO.	VP2

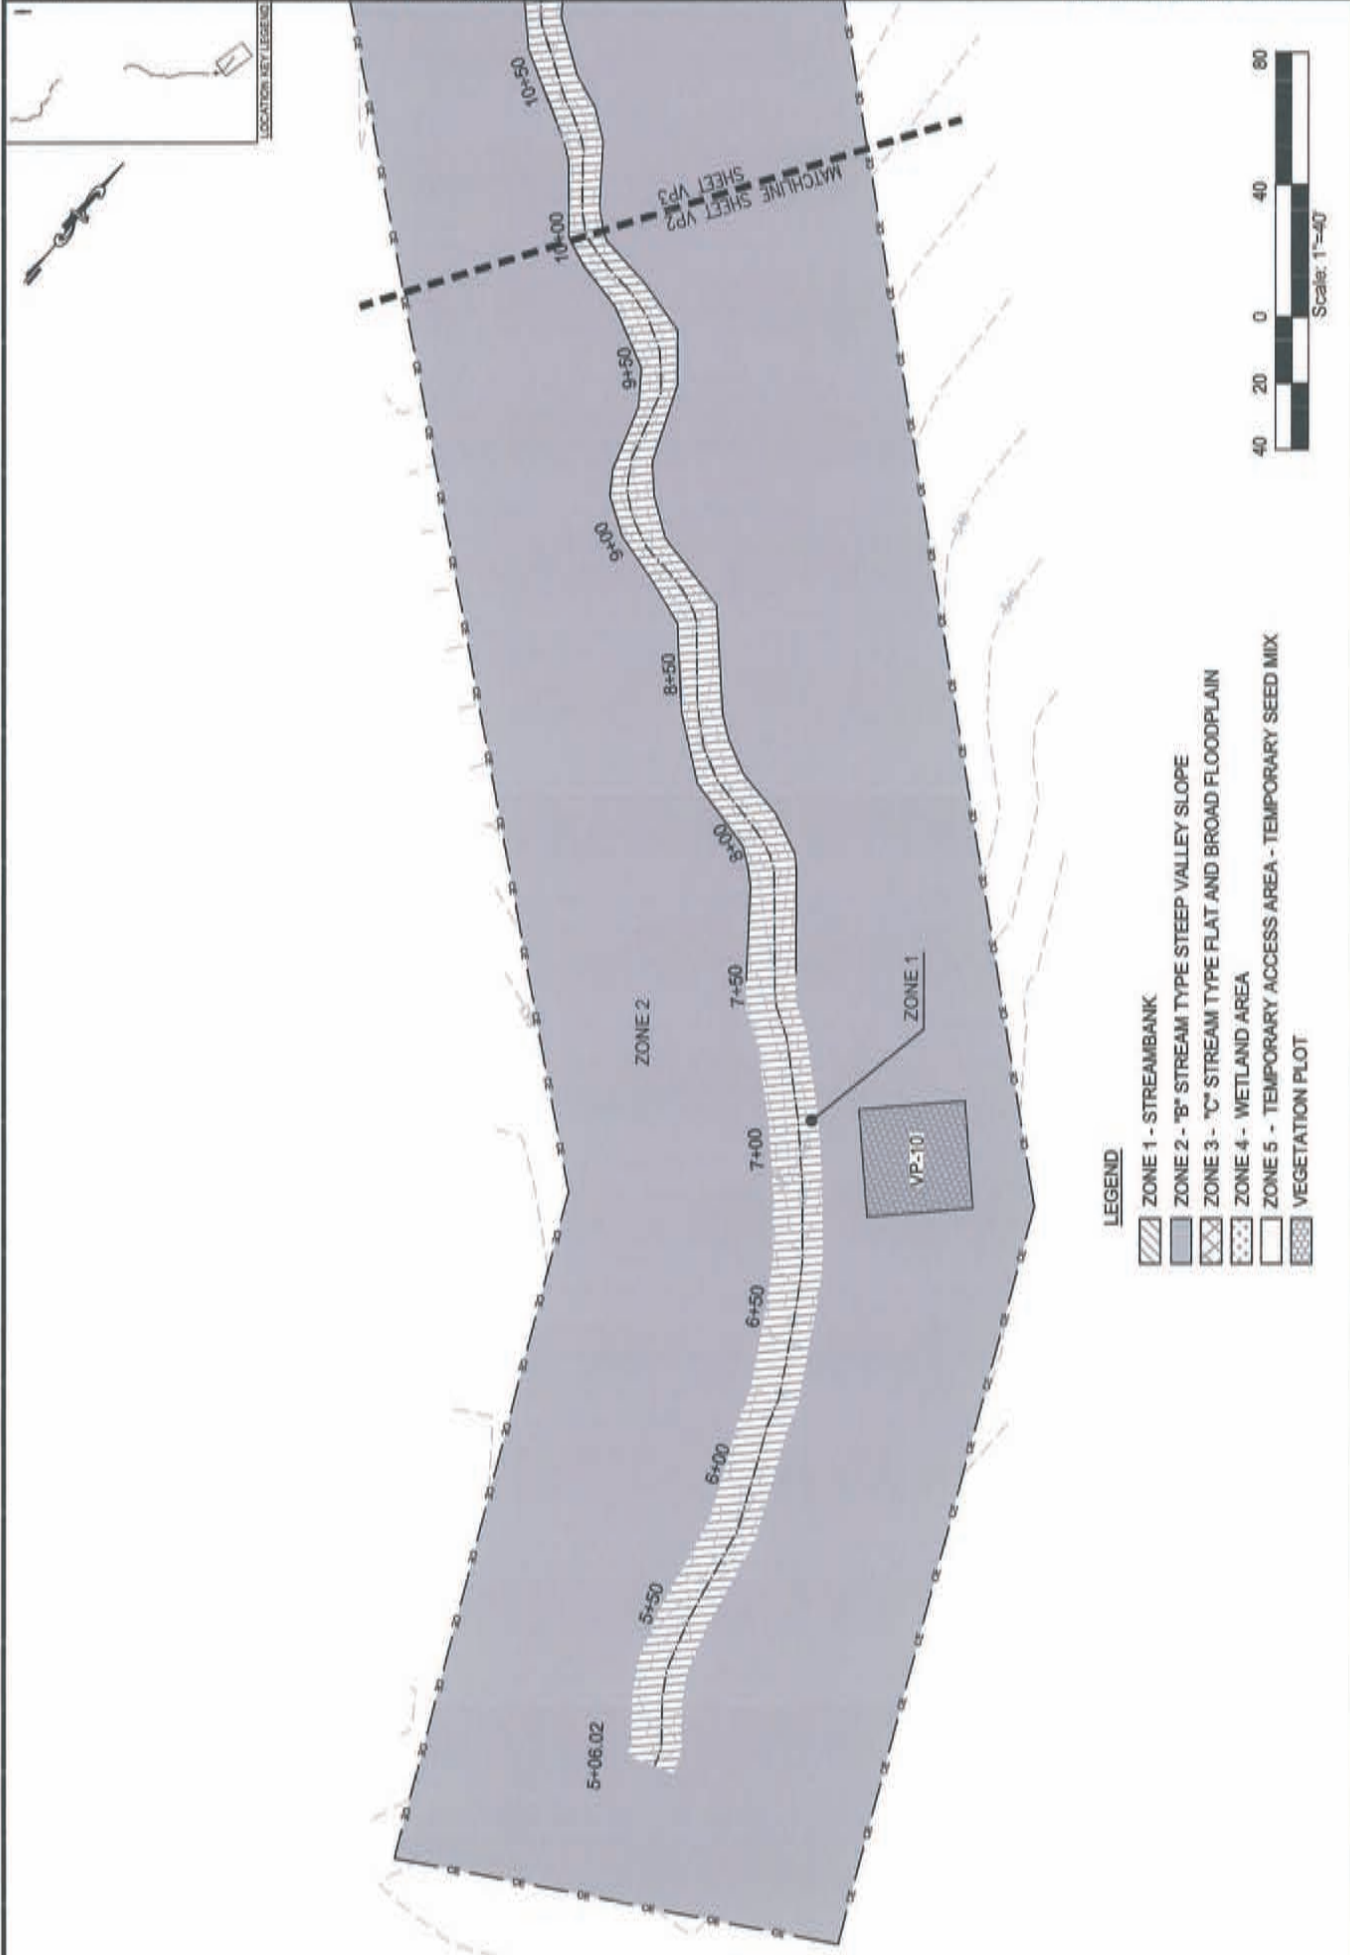


601 EAST
AS-BUILT PLANTING PLAN
STATION 10+00 TO 15+00
UNION COUNTY, NORTH CAROLINA

Ward Consulting Engineers, P.C.
 FIRM LICENSE NO. C-2819
 4805 Green Rd, Suite 100
 Raleigh, NC 27616-2848
 (919) 870-0326
 FAX (919) 870-0326

Environmental Services & Exchange
 309 Capital City Dr., Suite 3100
 Raleigh, NC 27606
 Phone: (919) 829-0000
 Fax: (919) 229-0913



DATE: 11/08/2013	PROJECT NAME:	RECORD DRAWINGS
DRAWN BY:	SHEET NO.:	
CHECKED BY:	DATE:	
APPROVED BY:		

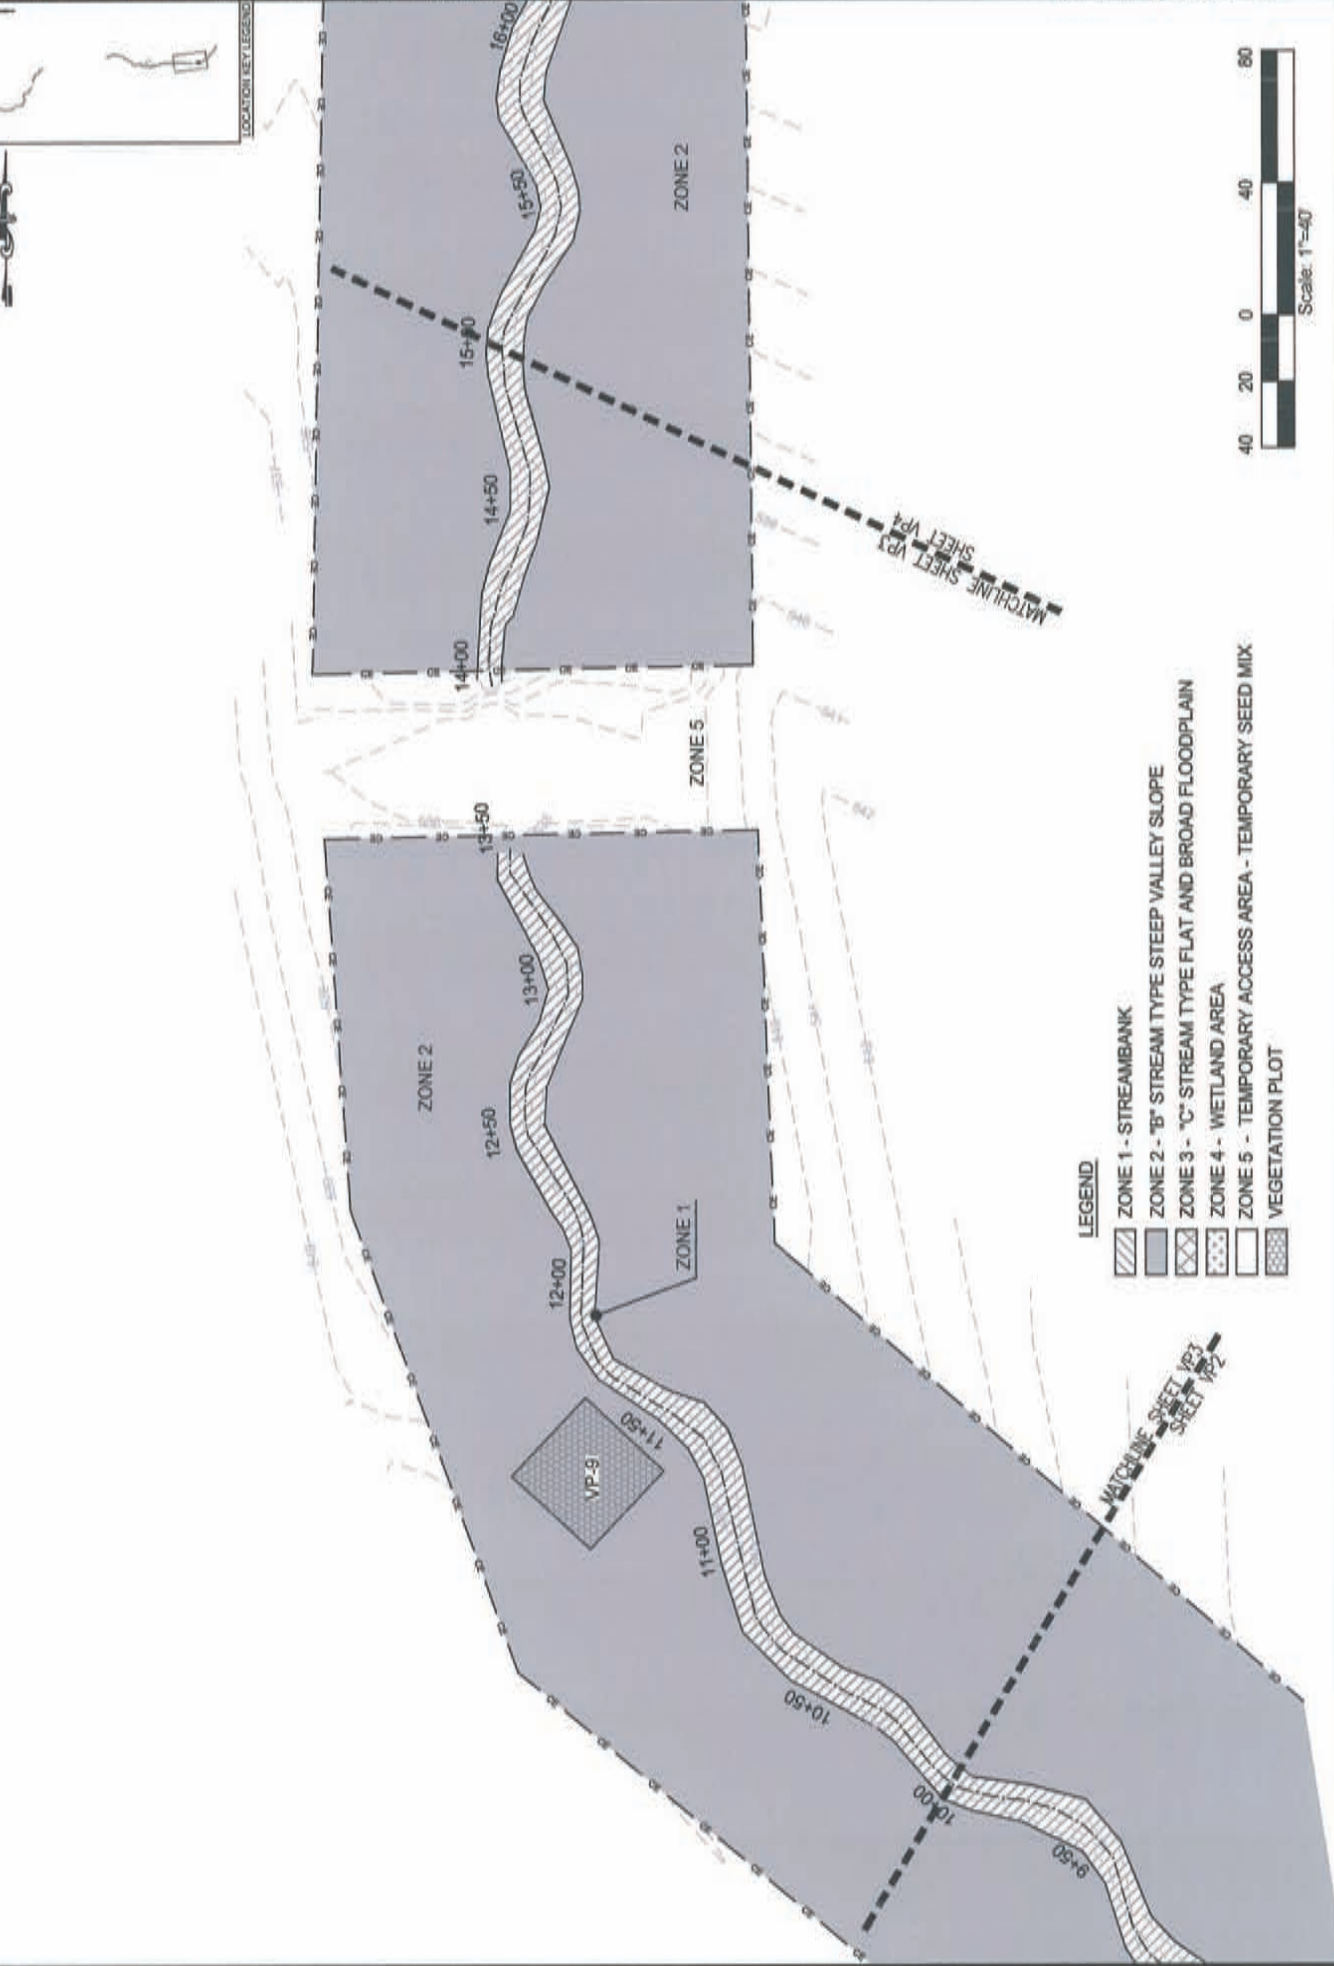

- LEGEND**
- ZONE 1 - STREAMBANK
 - ZONE 2 - "B" STREAM TYPE STEEP VALLEY SLOPE
 - ZONE 3 - "C" STREAM TYPE FLAT AND BROAD FLOODPLAIN
 - ZONE 4 - WETLAND AREA
 - ZONE 5 - TEMPORARY ACCESS AREA - TEMPORARY SEED MIX
 - VEGETATION PLOT

LOCATION KEY LEGEND



VP3


Ward Consulting Engineers, P.C.
 PIMA LICENSE NO. 0-2610
 4805 Green Rd, Suite 100
 Raleigh, NC 27616-2848
 (919) 870-0526
 FAX (919) 870-5359

Environmental Plans & Exchange
 600 Capability Drive, Suite 2100
 Raleigh, NC 27606
 Phone: (919) 829-0000
 Fax: (919) 229-0913



601 EAST
 AS-BUILT PLANTING PLAN
 STATION 15+00 TO 20+00
 UNION COUNTY, NORTH CAROLINA

DATE: 01/17/2014
REVISIONS:
PROJECT NAME:
DATE:
SCALE:
AS NOTED
RECORD DRAWINGS
DRAWING NO.
VP4

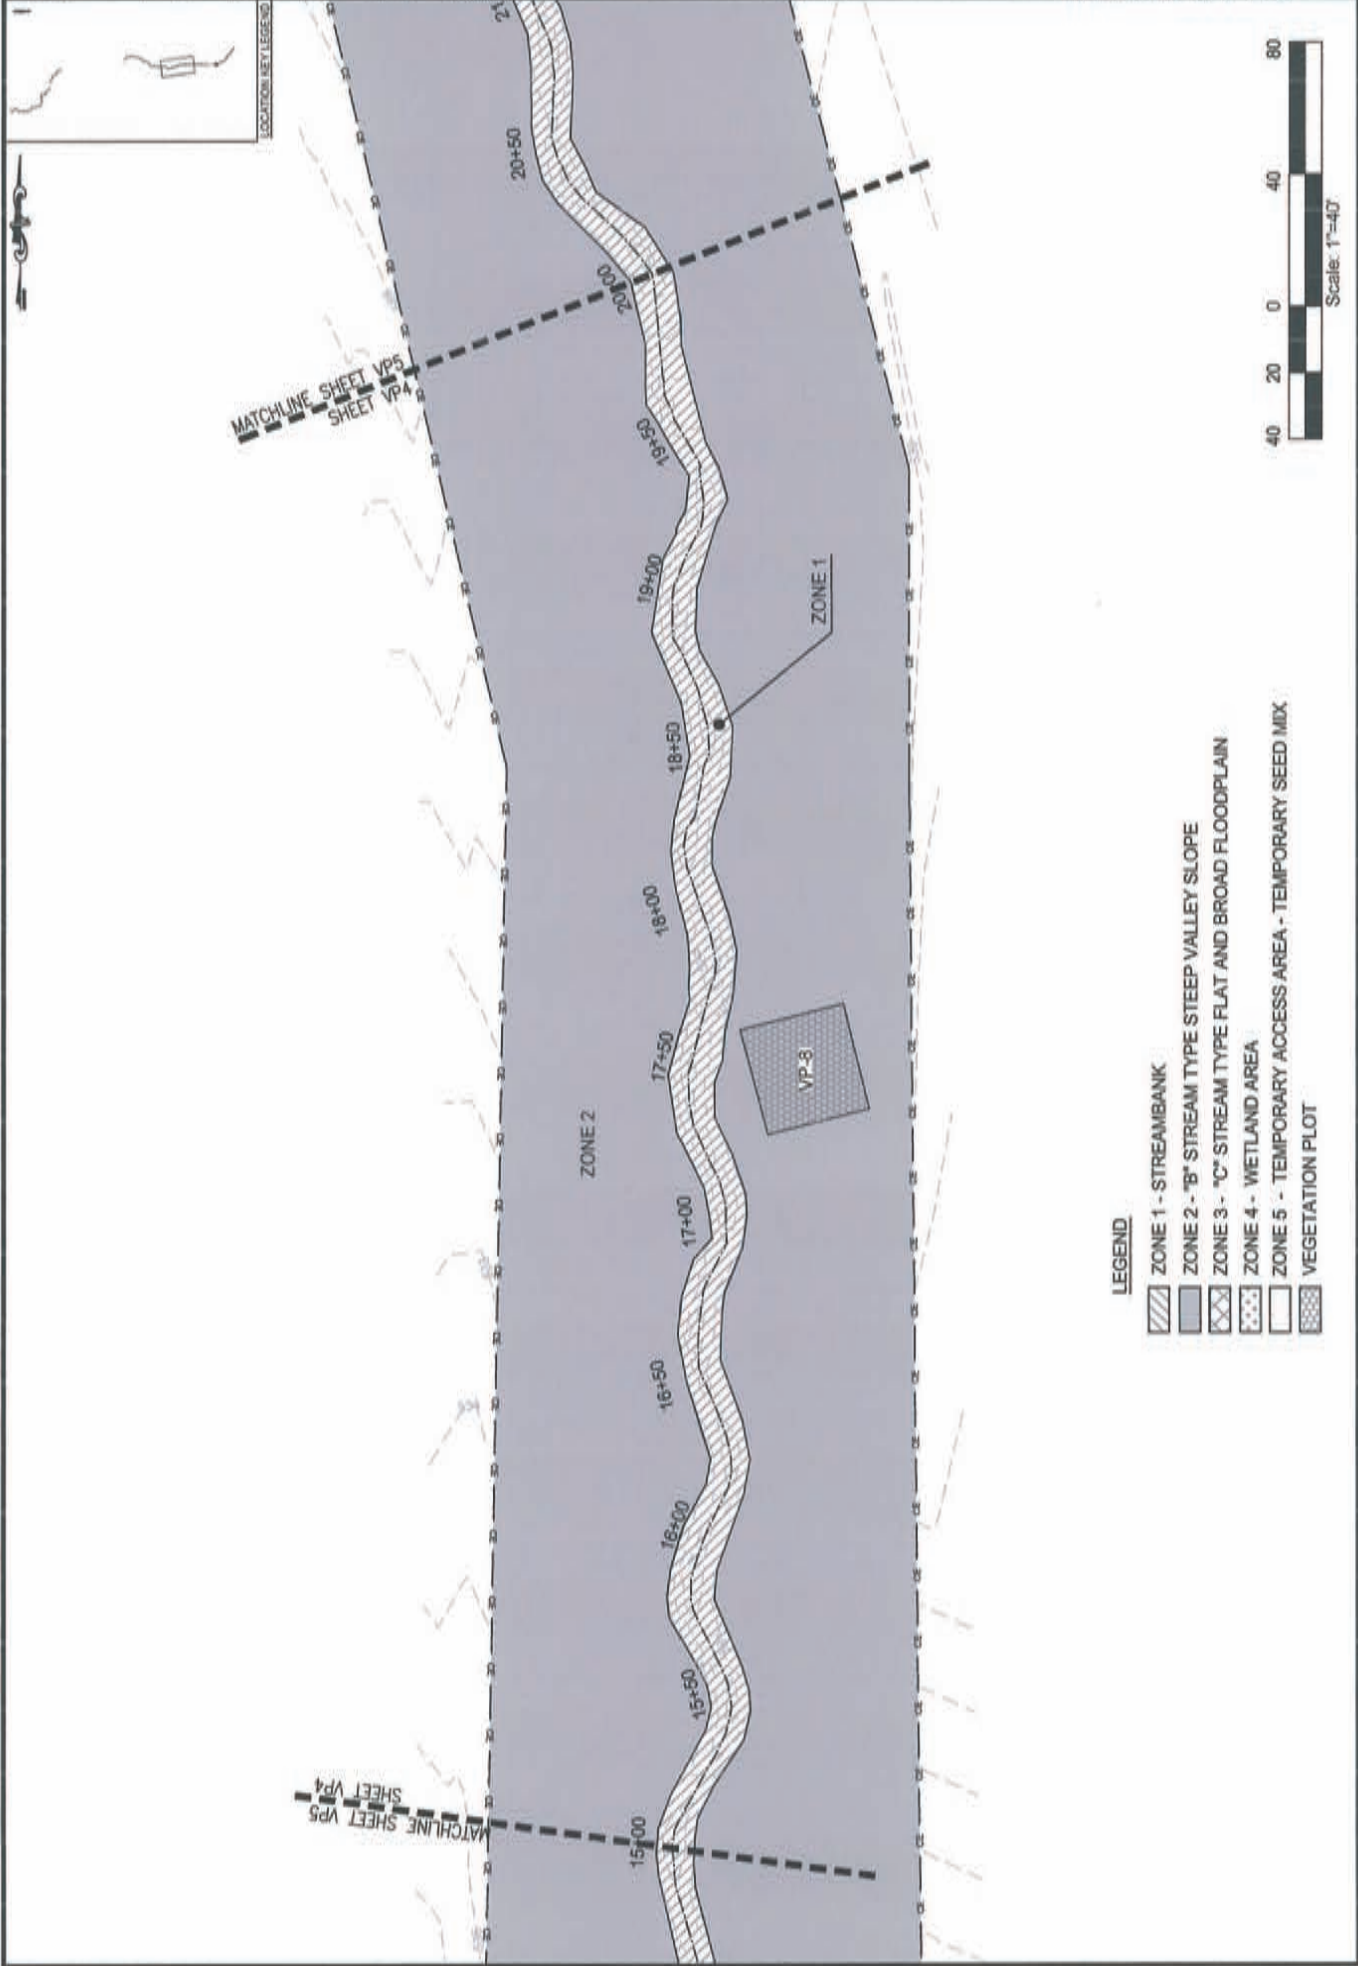

- LEGEND**
- ZONE 1 - STREAMBANK
 - ZONE 2 - "B" STREAM TYPE STEEP VALLEY SLOPE
 - ZONE 3 - "C" STREAM TYPE FLAT AND BROAD FLOODPLAIN
 - ZONE 4 - WETLAND AREA
 - ZONE 5 - TEMPORARY ACCESS AREA - TEMPORARY SEED MIX
 - VEGETATION PLOT




Ward Consulting Engineers, P.C.
 Environmental, Survey & Exchange
 800 Capability Drive, Suite 3100
 Raleigh, NC 27606 Phone: (919) 829-0000
 Fax: (919) 229-0013

4605 Green Hill, Suite 100
 Plasmid, NC 27182-2848
 Phone: (919) 870-0326
 Fax: (919) 870-0326
 FIRM LICENSE NO. C-2619



601 EAST
 AS-BUILT PLANTING PLAN
 STATION 20+00 TO 26+00
 UNION COUNTY, NORTH CAROLINA

DATE: 11 FEB 2014	PROJECT NAME:
DESIGNER:	DATE:
DRAWN BY:	SCALE:
CHECKED BY:	AS NOTED:
APPROVED BY:	RECORD DRAWINGS:
	SHEET NO.:

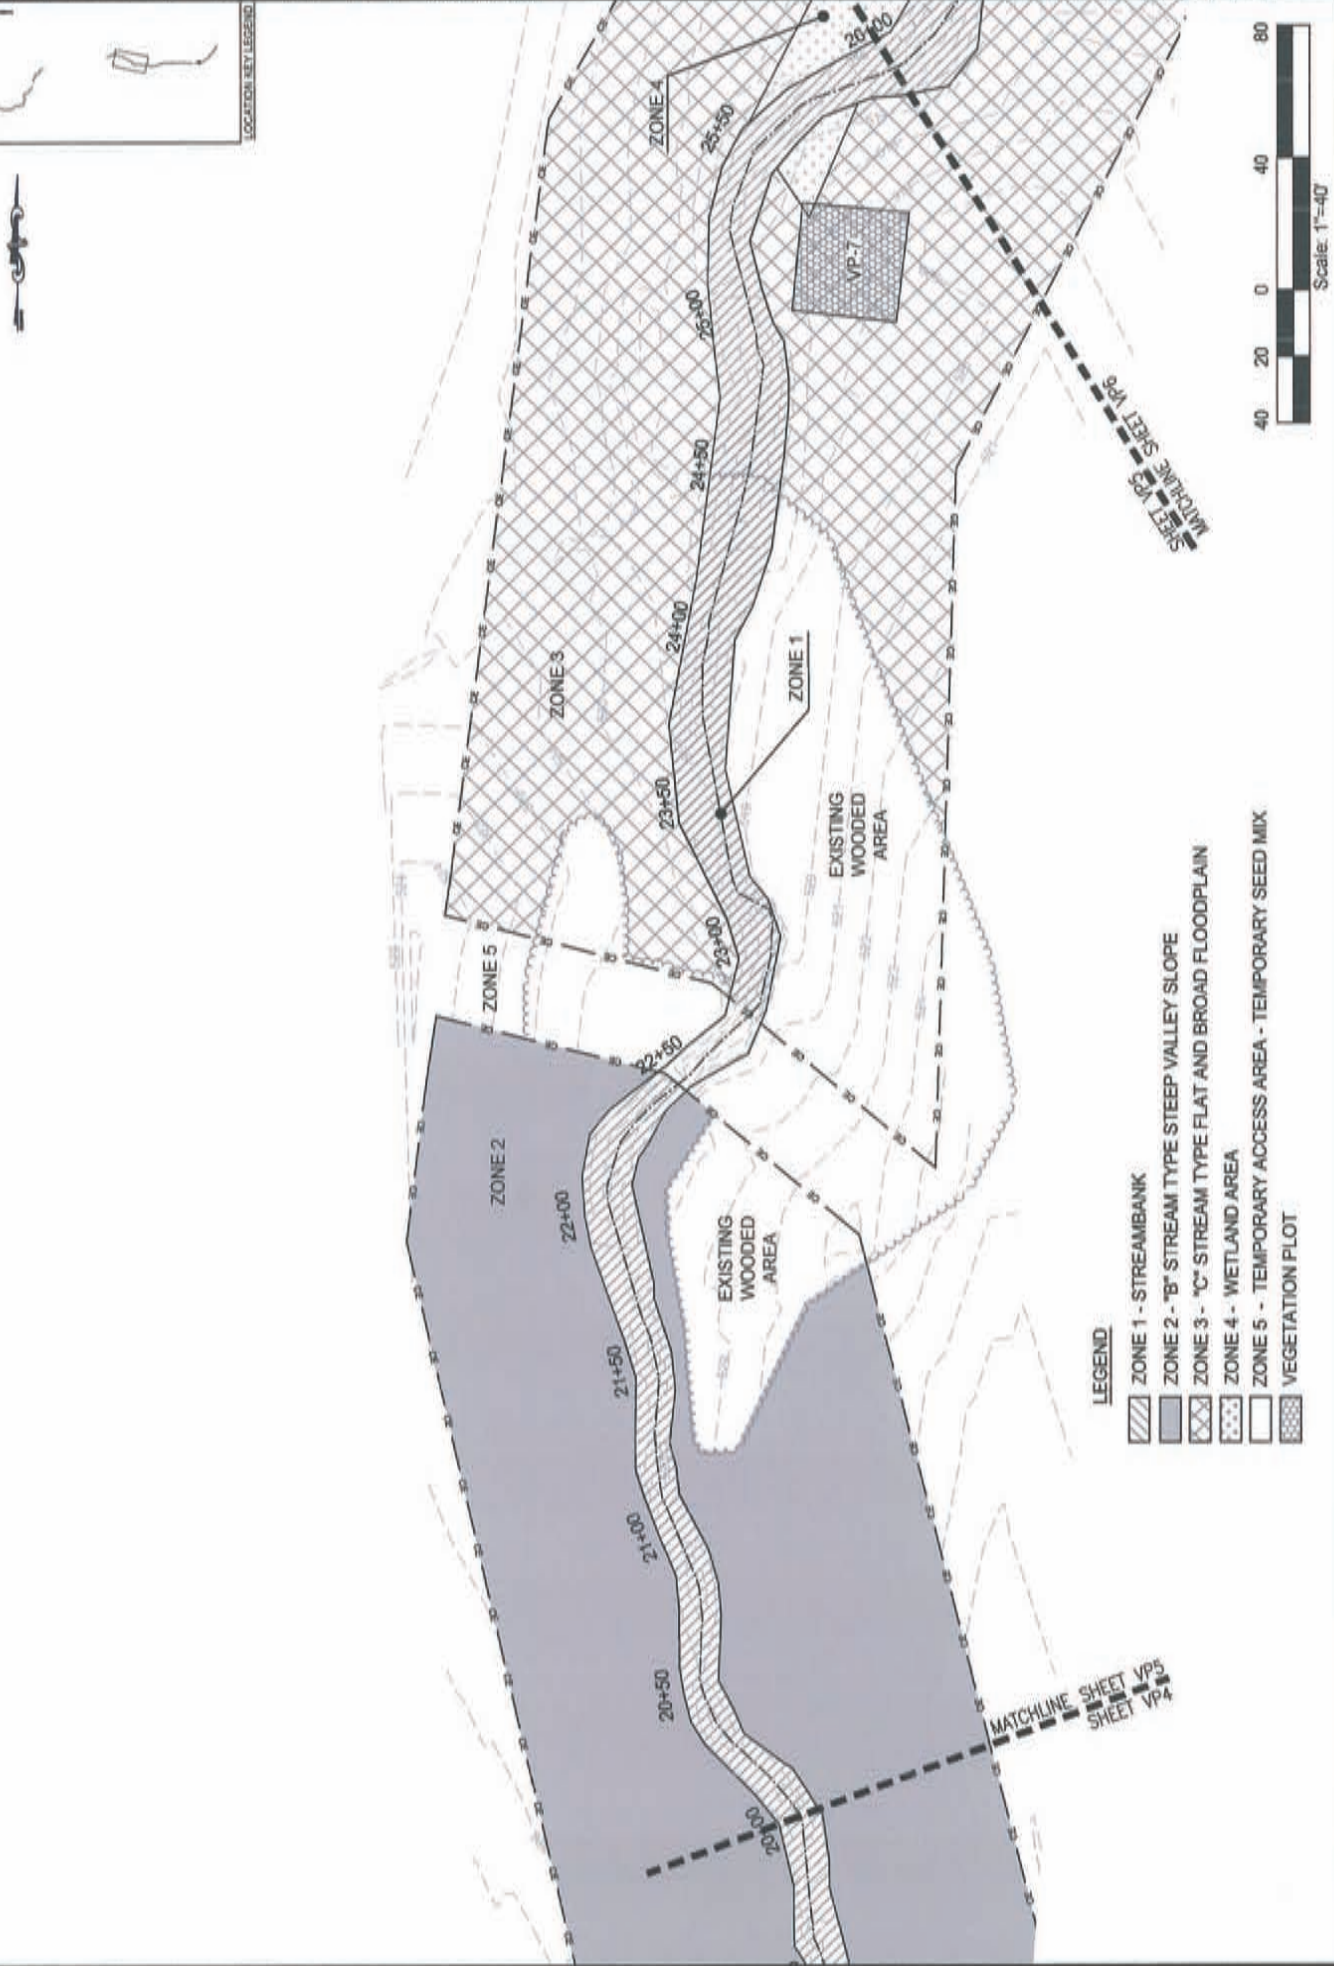

- LEGEND**
- ZONE 1 - STREAMBANK
 - ZONE 2 - "B" STREAM TYPE STEEP VALLEY SLOPE
 - ZONE 3 - "C" STREAM TYPE FLAT AND BROAD FLOODPLAIN
 - ZONE 4 - WETLAND AREA
 - ZONE 5 - TEMPORARY ACCESS AREA - TEMPORARY SEED MIX
 - VEGETATION PLOT




Ward Consulting Engineers, P.C.
 FIRM LICENSE NO. C-2819
 1405 Green Rd, Suite 100
 Raleigh, NC 27606
 (919) 870-0506
 FAX (919) 870-0359



601 EAST
 AS-BUILT PLANTING PLAN
 STATION 26+00 TO 31+45.18
 UNION COUNTY, NORTH CAROLINA

PROJECT NAME	601 EAST
DATE	07/23/2019
DESIGNER	
CHECKED	
DATE	
RECORD DRAWINGS	
DRAWING NO.	VP6

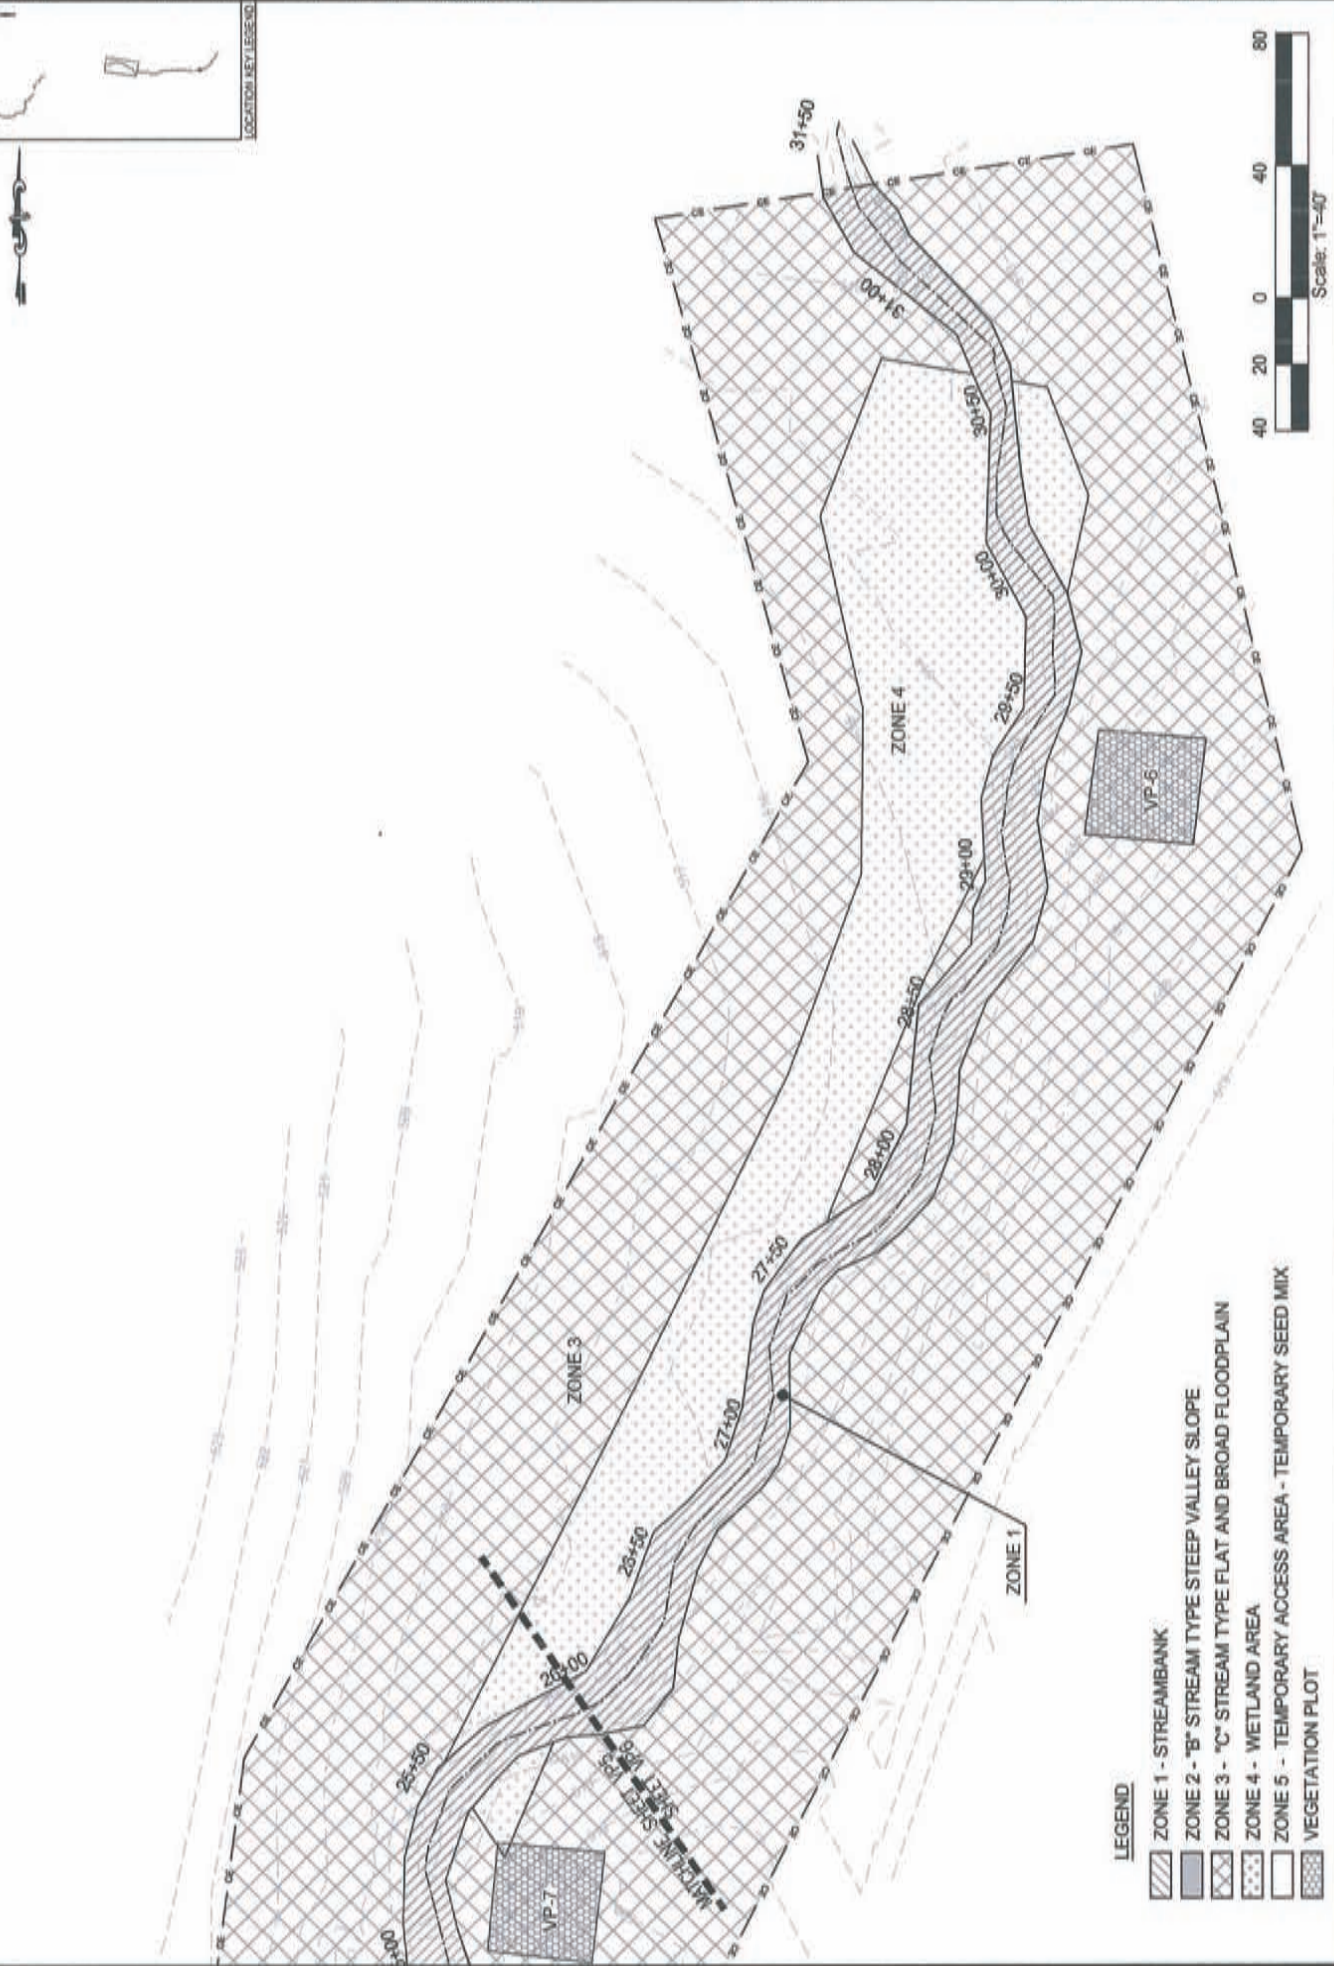

- LEGEND**
- ZONE 1 - STREAMBANK
 - ZONE 2 - "B" STREAM TYPE STEEP VALLEY SLOPE
 - ZONE 3 - "C" STREAM TYPE FLAT AND BROAD FLOODPLAIN
 - ZONE 4 - WETLAND AREA
 - ZONE 5 - TEMPORARY ACCESS AREA - TEMPORARY SEED MIX
 - VEGETATION PLOT




601 EAST
AS-BUILT PLANTING PLAN
STATION 42+92 TO 48+00
UNION COUNTY, NORTH CAROLINA

Ward Consulting Engineers, P.C.
Firm License No. C-2819
4605 Green Mt. Drive 100
Raleigh, NC 27616-2945
Phone: (919) 870-0528
Fax: (919) 870-8350



DATE	07/25/2018
BY	VP7
CHECKED	VP7
DATE	
BY	
CHECKED	
DATE	
BY	
CHECKED	
RECORD DRAWINGS
VP7

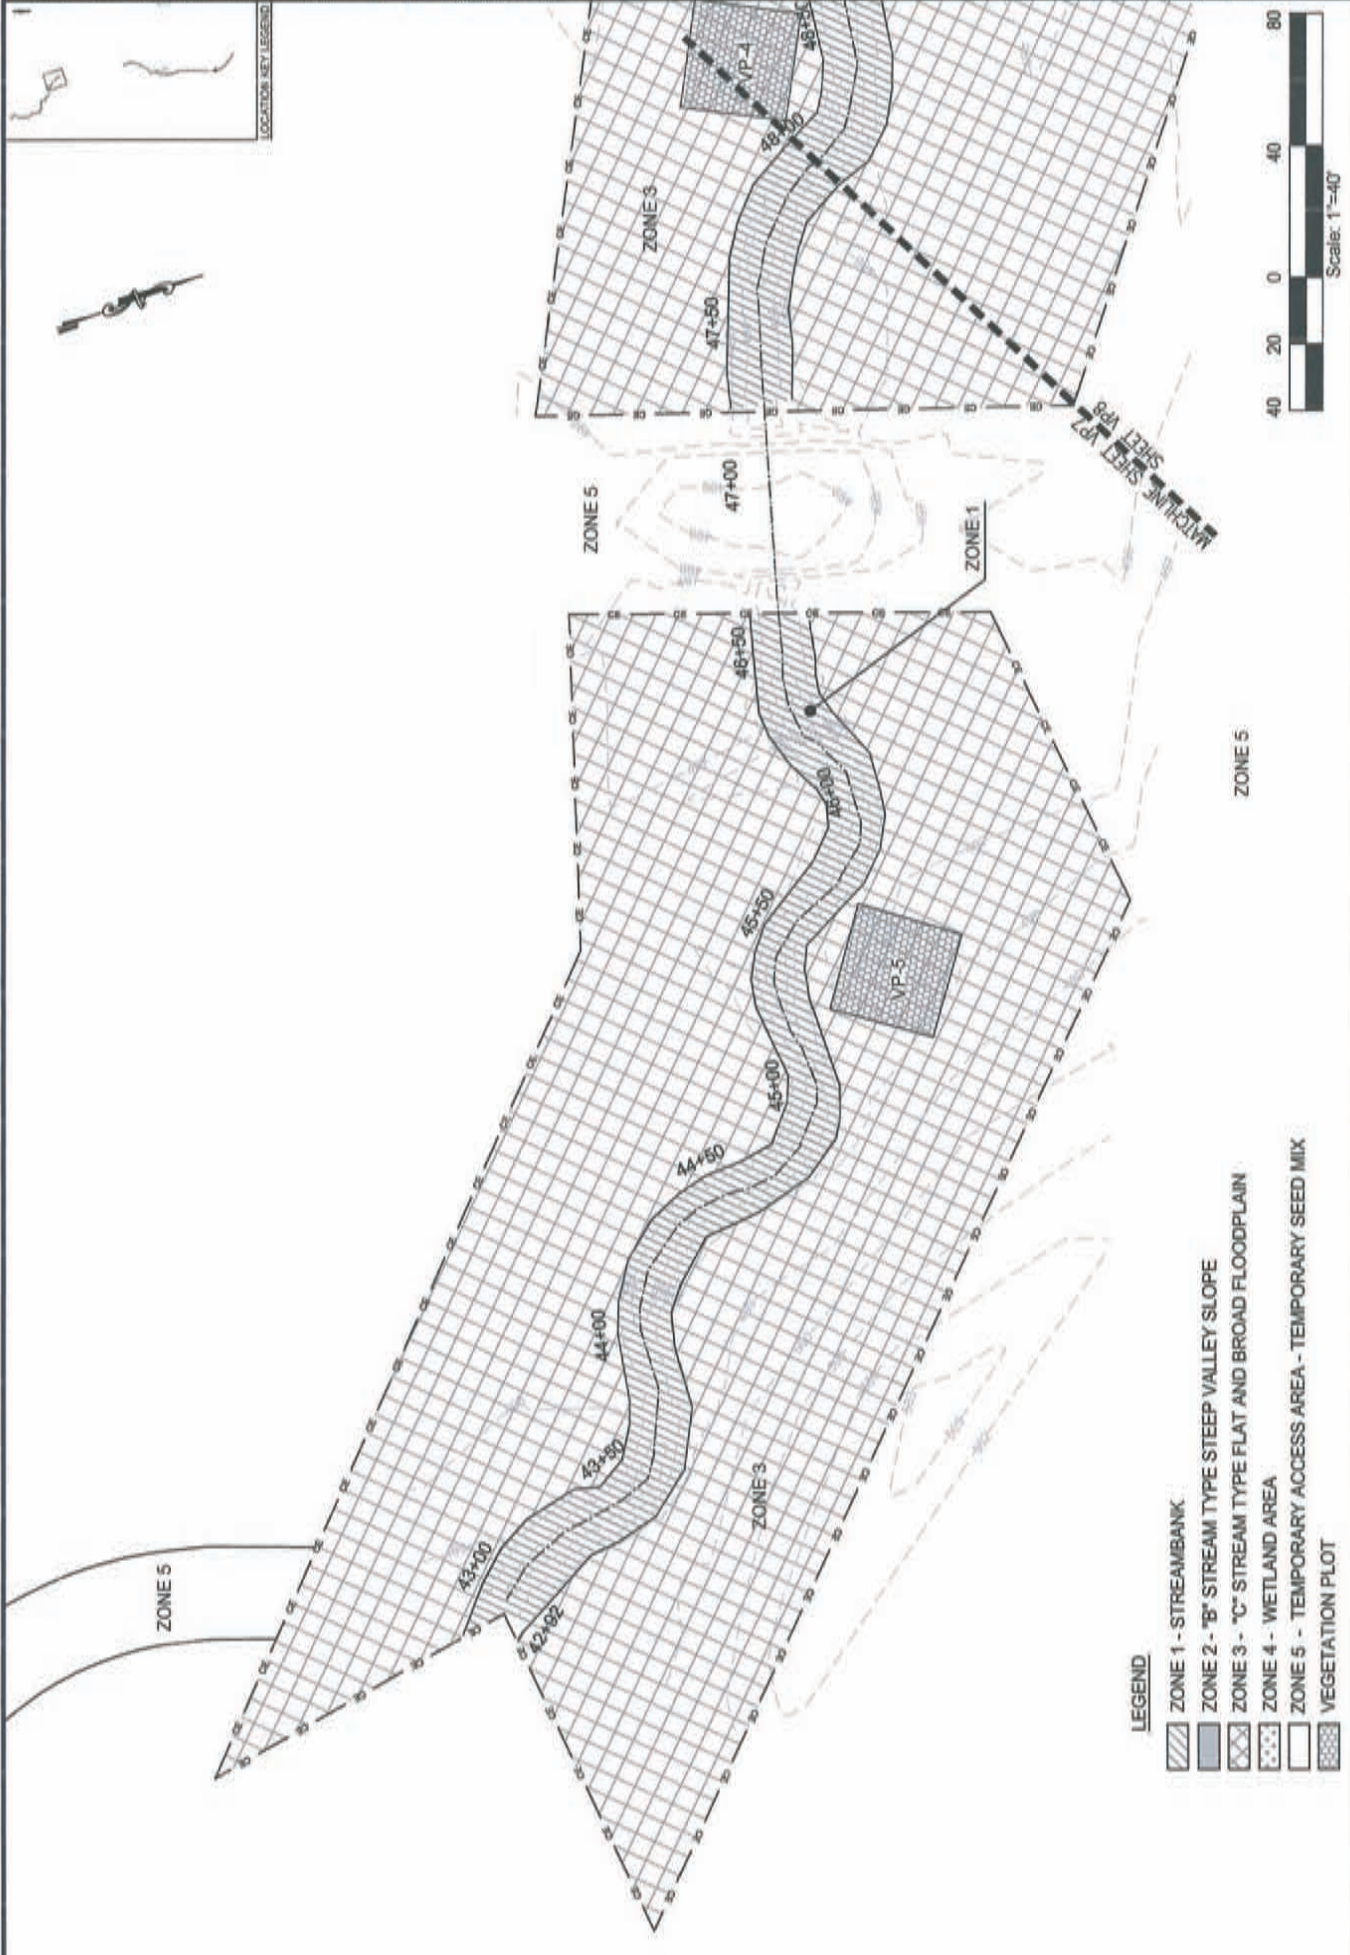

LEGEND

[Hatched pattern]	ZONE 1 - STREAMBANK
[Cross-hatched pattern]	ZONE 2 - "B" STREAM TYPE STEEP VALLEY SLOPE
[Diagonal lines]	ZONE 3 - "C" STREAM TYPE FLAT AND BROAD FLOODPLAIN
[Dotted pattern]	ZONE 4 - WETLAND AREA
[Horizontal lines]	ZONE 5 - TEMPORARY ACCESS AREA - TEMPORARY SEED MIX
[Checkered pattern]	VEGETATION PLOT

601 EAST
 AS-BUILT PLANTING PLAN
 (RELIC CHANNEL)
 STATION 48+00 TO 54+00
 UNION COUNTY, NORTH CAROLINA


Ward Consulting Engineers, P.C.
 Environmental Data & Exchange
 500 Capability Drive, Suite 3100
 Raleigh, NC 27606 Phone: (919) 829-0000
 Fax: (919) 229-9913

4005 Green Rd., Suite 100
 Raleigh, NC 27610-2848
 Phone: (919) 870-0326
 Fax: (919) 870-0320

FIRM LICENSE NO. C-2619



DATE: 08/12/2010	PROJECT NAME:
DRAWN BY:	DESIGNED BY:
CHECKED BY:	APPROVED BY:
SCALE:	NO. SHEETS:
TITLE:	SHEET NO.:
RECORD DRAWINGS:	VP8

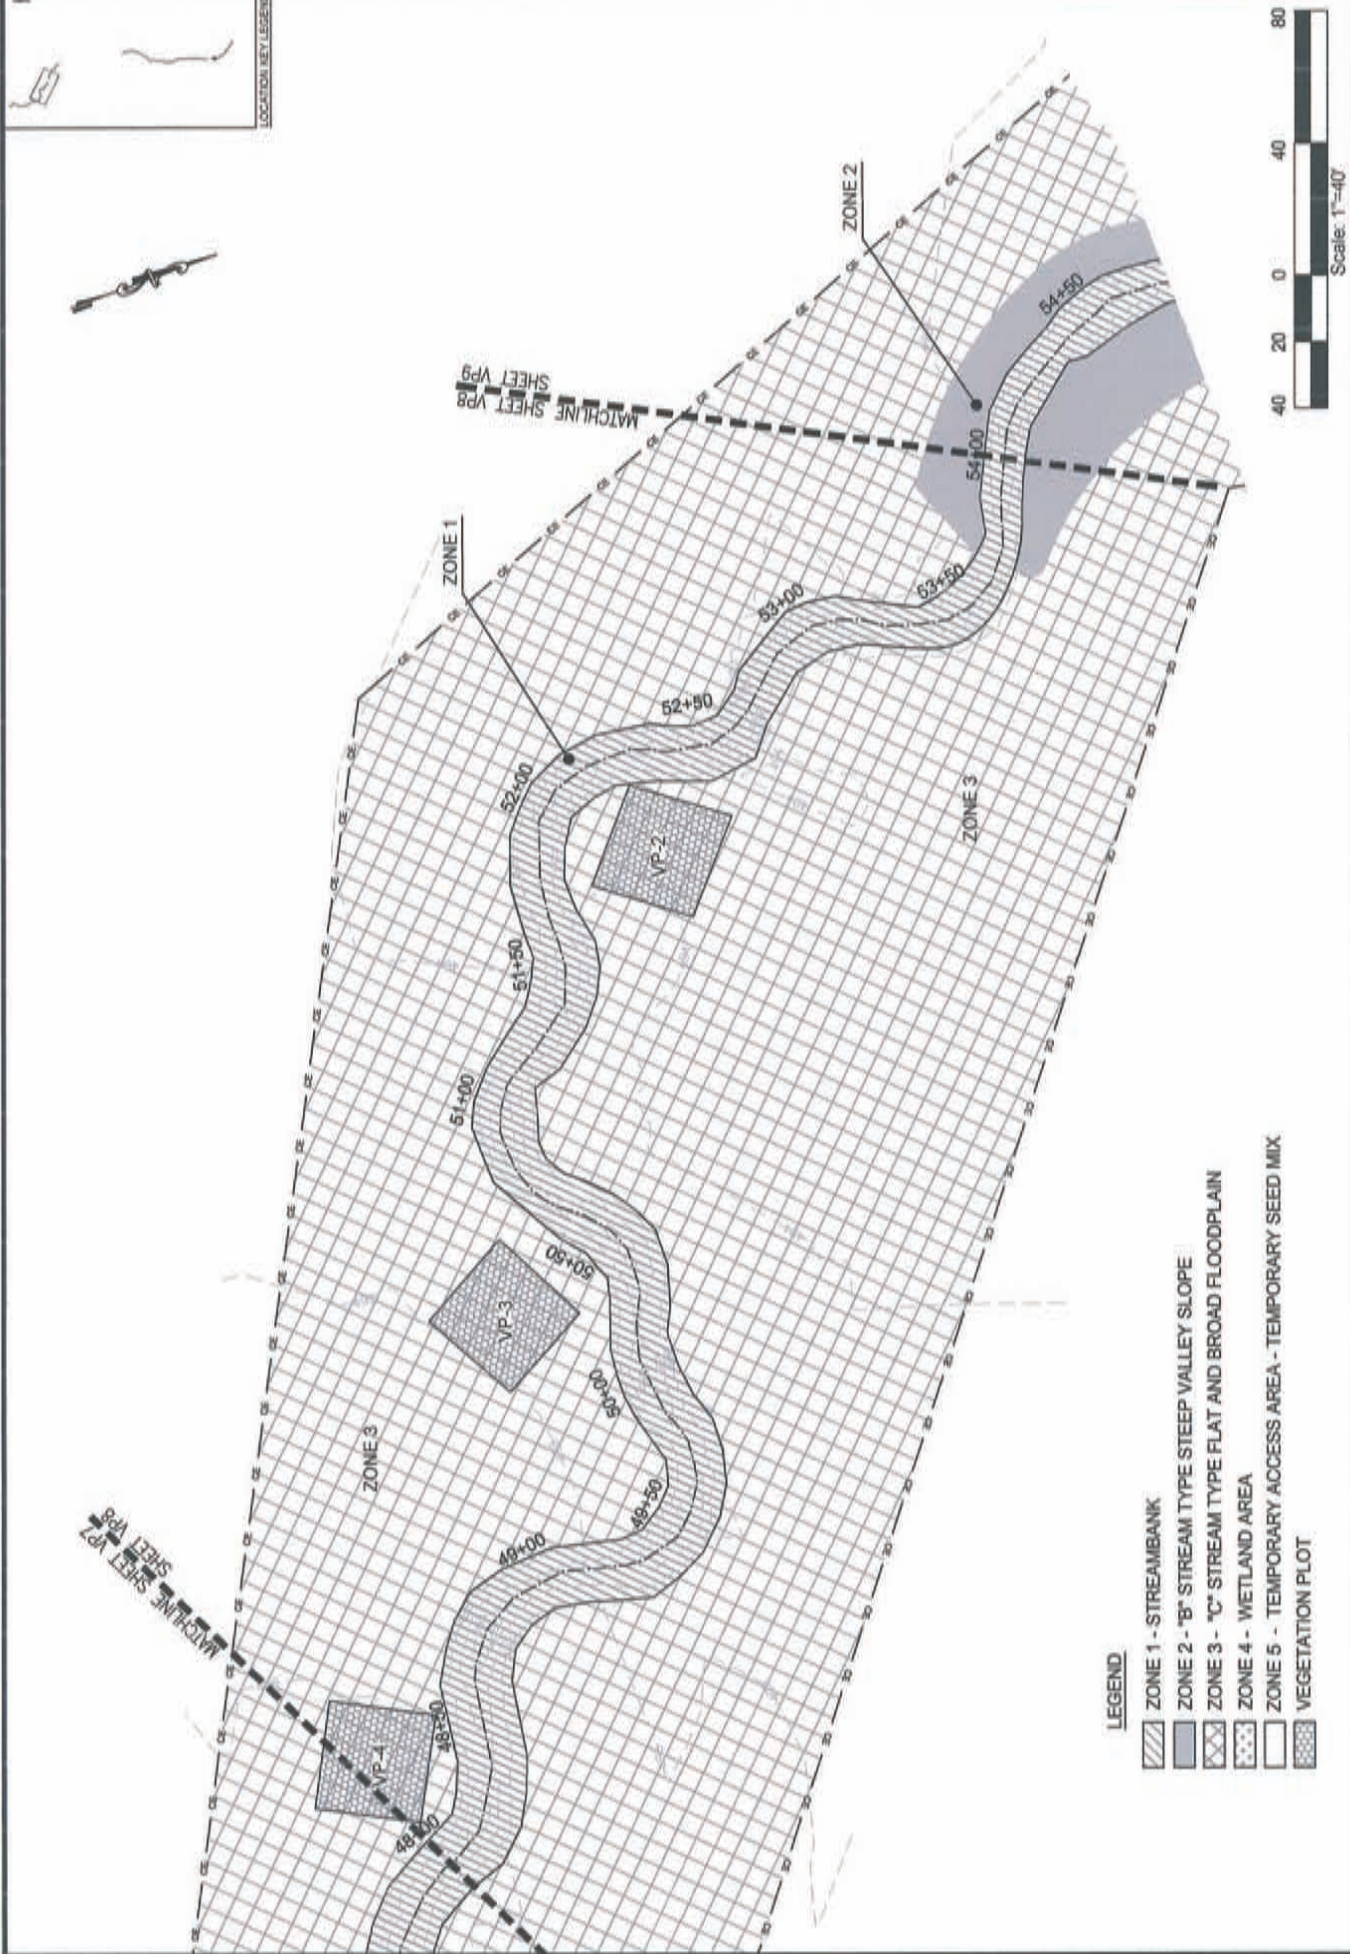

- LEGEND**
- ZONE 1 - STREAMBANK
 - ZONE 2 - "B" STREAM TYPE STEEP VALLEY SLOPE
 - ZONE 3 - "C" STREAM TYPE FLAT AND BROAD FLOODPLAIN
 - ZONE 4 - WETLAND AREA
 - ZONE 5 - TEMPORARY ACCESS AREA - TEMPORARY SEED MIX
 - VEGETATION PLOT

LOCATIONAL NET LEGEND




DATE	11/13/2013
PROJECT NAME	601 EAST AS-BUILT PLANTING PLAN (RELIC CHANNEL)
PROJECT NO.	1301-000
PROJECT LOCATION	STATION 54+00 TO 58+68.63 UNION COUNTY, NORTH CAROLINA
SCALE	AS SHOWN
AS SHOWN	
RECORD DRAWINGS	
DRAWN BY	
CHECKED BY	
DATE	

601 EAST
AS-BUILT PLANTING PLAN
(RELIC CHANNEL)
STATION 54+00 TO 58+68.63
UNION COUNTY, NORTH CAROLINA



Ward Consulting Engineers, P.C.
 PIMA LICENSE NO. C-2019
 4005 Green Rd, Suite 100
 Raleigh, NC 27616-2048
 (919) 870-0258
 FAX (919) 870-0258
 Environmental Data & Exchange
 800 Capital Blvd, Suite 3100
 Raleigh, NC 27608
 Phone: (919) 829-9006
 Fax: (919) 229-9013

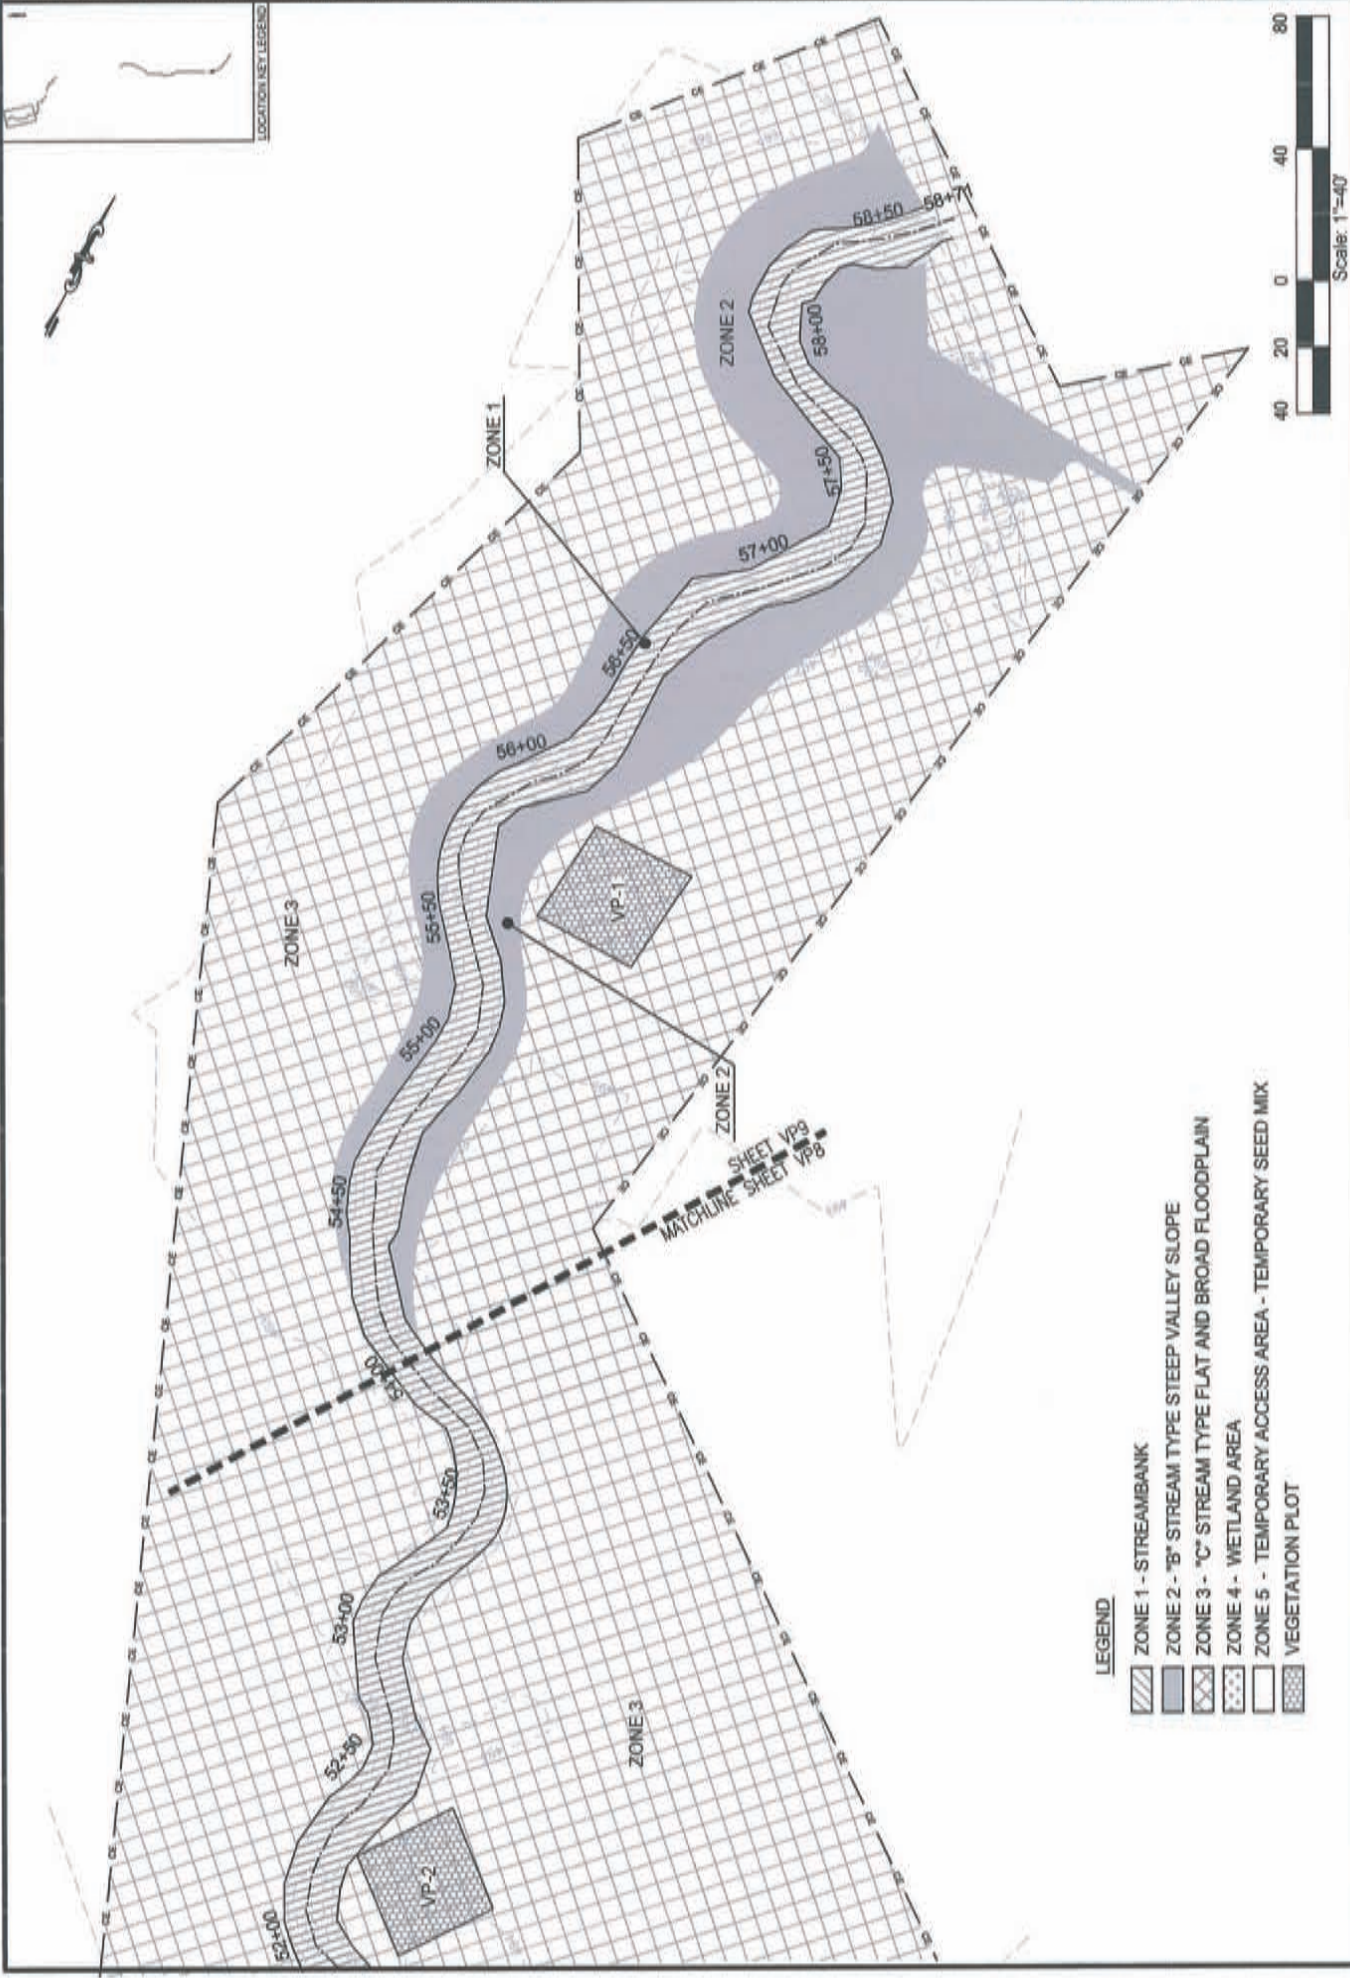

- LEGEND**
- ZONE 1 - STREAMBANK
 - ZONE 2 - "B" STREAM TYPE STEEP VALLEY SLOPE
 - ZONE 3 - "C" STREAM TYPE FLAT AND BROAD FLOODPLAIN
 - ZONE 4 - WETLAND AREA
 - ZONE 5 - TEMPORARY ACCESS AREA - TEMPORARY SEED MIX
 - VEGETATION PLOT