

***BASELINE MONITORING DOCUMENT &
AS-BUILT BASELINE REPORT***

**ADKIN BRANCH STREAM RESTORATION PROJECT
PHASE 1 – WASHINGTON AVE. TO LINCOLN ST.**

Lenoir County, North Carolina
Project ID No. 050656101



Prepared for:



NCDENR-Ecosystem Enhancement Program
2728 Capital Boulevard, Suite 1H 103
Raleigh, North Carolina 27604

Data Collected: February - March, 2011
Submitted: September 9, 2011

Prepared by:



Florence & Hutcheson

CONSULTING ENGINEERS

&

Axiom Environmental, Inc.
218 Snow Avenue
Raleigh, North Carolina 27603


Design Firm:

Florence & Hutcheson, Inc.
5121 Kingdom Way, Suite 100
Raleigh, North Carolina 27607
919.851.6066
919.851.6846 (fax)

I HEREBY CERTIFY THAT THE DOCUMENTS CONTAINED HEREIN, ADKIN BRANCH
BASELINE MONITORING DOCUMENT & AS-BUILT BASELINE REPORT, WERE PREPARED BY
ME OR UNDER MY DIRECT SUPERVISION.

SIGNED SEALED, AND DATED THIS 7TH DAY OF JULY 2011.

Chris L. Smith, PE

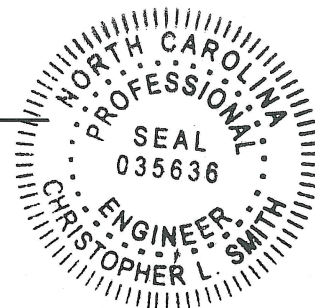

EXECUTIVE SUMMARY

The North Carolina Ecosystem Enhancement Program (NCEEP) has completed Phase I of the Adkin Branch Stream Restoration Project (hereafter referred to as the “Project”) in Kinston, Lenoir County, North Carolina to assist in fulfilling stream mitigation needs in the Project area.

The primary goals of the Project focused on restoring a stable dimension, pattern, and profile to Adkin Branch and UT to Adkin Branch, improving water quality, decreasing floodwater levels, restoring aquatic and riparian habitat, and implementing best management practices (BMPs) for stormwater quality and retention. These goals were accomplished by:

1. Reducing sediment input to Adkin Branch by restoring 7,579 linear feet of stream to a stable dimension, pattern, and profile, and establishing a vegetated stream bank, floodplain, and terrace forest. Forest vegetation species were selected by studying a Reference Forest Ecosystem located directly upstream of the Project and reviewing species listed in *Classification of the Natural Communities of North Carolina: Third Approximation* (Schafale and Weakley 1990) for a Coastal Plain Levee Forest. A total of 32.44 acres of the conservation easement were reforested.
2. Promoting floodwater attenuation and decreasing floodwater levels by excavating a gently sloping floodplain that begins at the bankfull discharge elevation and slopes up to the terrace elevation, in addition to increasing roughness in the floodplain by establishing a vegetated riparian buffer.
3. Improving aquatic habitat by enhancing stream bed variability (ripple-pool sequence), and introducing woody debris in the form of rootwads, log vanes, and log sills. A ripple-pool sequence and woody debris structures will provide places for forage, cover, and reproduction for fauna and flora.
4. Improving terrestrial habitat by restoring a forested riparian corridor through a highly urbanized environment, which has historically experienced vegetation maintenance and forest segmentation. This corridor will provide a diversity of habitats such as mature forest, early successional forest, riparian wetlands and uplands.
5. Reducing nonpoint source pollution associated with urban land uses (i.e. maintained ball fields, roadways, residential communities, etc.) by providing a vegetated riparian buffer adjacent to streams to treat surface runoff. Reforestation of the Project resulted in a total of 1,171,272 sq. ft. (26.89 acres) of Neuse River Riparian Buffers (area within 200’ of top of bank of channel that is at least 50’ wide).
6. Improving water quality by creating 0.69 acres of riparian stormwater wetland adjacent to the UT to Adkin Branch, implementing six (6) sand filter device BMPs along Adkin Branch for stormwater runoff to retain sediments and nutrients prior to entering Adkin Branch, and removing creosote timber retaining walls throughout the project.

Prior to construction, the Project contained a degraded stream channel with a disturbed riparian buffer. The Project watershed is characterized primarily by urban development associated with the City of Kinston, agriculture, disturbed forest, former neighborhoods, a former landfill, and a



former wastewater treatment plant. The removal of riparian vegetation, impervious surfaces, and straightening and rerouting of stream channels, had resulted in degraded water quality and unstable channel characteristics (stream entrenchment, erosion, and bank collapse). Many of the former neighborhoods, landfill, and wastewater treatment plant were purchased by the City of Kinston with Federal Emergency Management Agency (FEMA) funds following flooding from Hurricanes Fran and Floyd.

Project construction was completed between March 9, 2009 and April 1, 2011. The project restored 7,579 linear feet of stream using Priority II restoration by constructing a new meandering channel within the Adkin Branch and UT's floodplains, incorporating in-stream structures, installing grade control structures, and planting native vegetative species. The Project will be protected by a permanent conservation easement held by the State of North Carolina.

Project activities provide 7,787* Stream Mitigation Units and 3,990 lbs of Neuse River Nutrient Offset Pound Reduction Credits. Riparian Buffer areas may be used for stream & wetland mitigation, stream & riparian buffer mitigation, or nutrient offset buffer restoration credit (Estimating/Calculating Riparian Buffer Credits, EEP PPPM Section 8.3.1.2). Credit options for Riparian Buffer restoration areas are summarized below:

| Credit Options for Riparian Buffer Restoration Areas | | | | | |
|---|--------------------------------------|-------------------|--|--|-----------------|
| Neuse Riparian Buffer Restoration Credits | | | Nutrient Offset Buffer Restoration Credits | | |
| 50' Area (sf) | 50' - 200' Adjusted Area (sf)* | Credit Yield** | <= 50' Nitrogen Removal (lbs)*** | 50' - 200' Nitrogen Removal (lbs)*** | Credit Yield*** |
| 562,799 | 696,704 | 1,259,503 | 0 | 31,751 | 31,751 |
| * - Credits adjusted based on proposed DWQ guidelines (DRAFT Regulatory Guidance for the Calculation of Stream and Buffer Mitigation Credit for Buffer Widths Different from Standard Minimum Widths, Version 4.5, July 20, 2010) | | | | | |
| ** - Riparian Buffer Restoration Credit Yield is the sum of 50' area and 50' - 200' adjusted area | | | | | |
| *** - Nitrogen Credits were calculated based on a rate of 2,273 lbs per acre over 30 years per DWQ policy (Estimating/Calculating Riparian Buffer Credits, EEP PPPM Section 8.3.1.2) | | | | | |

It is to be noted that the Adkin Branch Stream Restoration project was instituted before October 11, 2007, and is grandfathered to allow mitigation credit for buffer restoration out to 200 feet as measured horizontally out from the water surface. Allowing this project to be grandfathered is in accordance with an email from Tom Reeder (DWQ) dated October 10, 2007 which states: "This decision was made so as to not penalize those projects that may have been completed in good faith under any misunderstanding caused by the distribution of the internal DWQ memo dated Oct 23, 2002".

The first year monitoring report will be submitted at the end of December. Monitoring will continue for five years or until agreed upon success criteria are achieved, with a report submitted by the end of December for each monitoring year. Monitoring will include a survey of representative stream profiles and cross-sections, representative surveys of vegetation, and an annual monitoring report verifying that the Site has remained relatively unchanged.

At this time, no issues or mitigating factors have arisen in the period immediately following the completion of grading and planting.



TABLE OF CONTENTS

| <u>SECTION</u> | <u>PAGE</u> |
|---|--------------------|
| EXECUTIVE SUMMARY | 1 |
| TABLE OF CONTENTS | 4 |
| 1.0 PROJECT GOALS, BACKGROUND AND ATTRIBUTES | 6 |
| 1.1 LOCATION AND SETTING | 6 |
| 1.2 PROJECT GOALS AND OBJECTIVES | 6 |
| 1.3 PROJECT STRUCTURE, RESTORATION TYPE AND APPROACH..... | 7 |
| 1.3.1 Project Structure..... | 7 |
| 1.3.2 Restoration Type and Approach | 8 |
| 1.4 PROJECT HISTORY, CONTACTS AND ATTRIBUTE DATA | 8 |
| 2.0 SUCCESS CRITERIA..... | 9 |
| 2.1 MORPHOLOGIC PARAMETERS AND CHANNEL STABILITY | 9 |
| 2.1.1 Dimension | 9 |
| 2.1.2 Pattern and Profile..... | 9 |
| 2.1.3 Substrate..... | 9 |
| 2.2 VEGETATION | 10 |
| 2.3 HYDROLOGY | 10 |
| 3.0 MONITORING PLAN GUIDELINES..... | 11 |
| 3.1 STREAM HYDROLOGY | 11 |
| 3.2 STREAM CHANNEL STABILITY AND GEOMORPHOLOGY | 11 |
| 3.2.1 Dimension..... | 11 |
| 3.2.2 Profile..... | 12 |
| 3.2.3 Pattern | 12 |
| 3.2.4 Visual Assessments..... | 12 |
| 3.2.5 Bank Stability Assessments | 12 |
| 3.3 VEGETATION..... | 12 |
| 3.4 STORMWATER WETLAND..... | 12 |
| 3.5 WATERSHED | 12 |
| 4.0 MAINTENANCE AND CONTINGENCY PLANS..... | 14 |
| 4.1 STREAM | 14 |
| 4.1.1 Structure Failure..... | 14 |
| 4.1.2 Headcut Migration through the Site..... | 14 |
| 4.1.3 Bank Erosion..... | 14 |
| 4.2 VEGETATION | 14 |
| 4.3 STORMWATER MANAGEMENT DEVICES..... | 15 |
| 4.3.1 Sand Filter Devices..... | 15 |

| | |
|---|-----------|
| 5.0 AS-BUILT STATE..... | 16 |
| 5.1 AS-BUILT/RECORD DRAWINGS | 16 |
| 5.2 MORPHOLOGIC STATE OF THE CHANNEL | 16 |
| 5.3 SEDIMENT TRANSPORT IN THE AS-BUILT STATE | 16 |
| 5.4 VERIFICATION OF PLANTINGS | 16 |
| 6.0 REFERENCES..... | 17 |
| 7.0 APPENDICES..... | 18 |
| APPENDIX A: GENERAL TABLES & FIGURES..... | 18 |
| APPENDIX B: MORPHOLOGICAL SUMMARY DATA, PLOTS, & PHOTOS..... | 36 |
| APPENDIX C: VEGETATION DATA & PHOTOS..... | 64 |
| APPENDIX D: CREDIT CALCULATION DOCUMENTATION AND FIGURES..... | 71 |
| APPENDIX E: AS-BUILT/RECORD DRAWING PLAN SHEETS..... | 83 |

1.0 PROJECT GOALS, BACKGROUND AND ATTRIBUTES

1.1 Location and Setting

The Project is located on the southeast side of the City of Kinston, in Lenoir County, North Carolina and includes Adkin Branch and an unnamed tributary (UT) to Adkin Branch (Figure 1, Appendix A). Phase I of the Project begins at Washington Ave. and ends at Lincoln Street. The surrounding watershed is highly urbanized. The Project is located in United States Geological Survey (USGS) Hydrologic Unit (HU) and Targeted Local Watershed 03020202060030 (North Carolina Division of Water Quality [NCDWQ] Subbasin 03-04-05) of the Neuse River Basin and will service USGS 8-digit Cataloging Unit (CU) 03020202. The Project site is located in the Coastal Plain physiographic province of North Carolina.

1.2 Project Goals and Objectives

The primary goals of this stream restoration project focused on:

1. Restoring a stable dimension, pattern, and profile to Adkin Branch and UT to Adkin Branch,
2. Improving water quality,
3. Decreasing floodwater levels,
4. Restoring aquatic and riparian habitat, and
5. Implementing best management practices (BMPs) for stormwater quality and retention.

These goals were accomplished by:

1. Reducing sediment input to Adkin Branch by restoring 7,579 linear feet of stream to a stable dimension, pattern, and profile, and establishing a vegetated stream bank, floodplain, and terrace forest. Forest vegetation species were selected by studying a Reference Forest Ecosystem located directly upstream of the Project and reviewing species listed in *Classification of the Natural Communities of North Carolina: Third Approximation* (Schafale and Weakley 1990) for a Coastal Plain Levee Forest. A total of 32.44 acres of the conservation easement were reforested.
2. Promoting floodwater attenuation and decreasing floodwater levels by excavating a gently sloping floodplain that begins at the bankfull discharge elevation and slopes up to the terrace elevation, in addition to increasing roughness in the floodplain by establishing a vegetated riparian buffer.
3. Improving aquatic habitat by enhancing stream bed variability (ripple-pool sequence), and introducing woody debris in the form of rootwads, log vanes, and log sills. A ripple-pool sequence and woody debris structures will provide places for forage, cover, and reproduction for fauna and flora.
4. Improving terrestrial habitat by restoring a forested riparian corridor through a highly urbanized environment, which has historically experienced vegetation maintenance and forest segmentation. This corridor will provide a diversity of habitats such as mature forest, early successional forest, riparian wetlands and uplands.

7. Reducing nonpoint source pollution associated with urban land uses (i.e. maintained ball fields, roadways, residential communities) by providing a vegetated riparian buffer adjacent to streams to treat surface runoff. Reforestation of the Project resulted in a total of 1,171,272 sq. ft. (26.89 acres) of Neuse River Riparian Buffers (area within 200' of top of bank of channel that is at least 50' wide).
5. Improving water quality by creating 0.69 acres of riparian stormwater wetland adjacent to the UT to Adkin Branch, implementing six (6) sand filter device BMPs along Adkin Branch for stormwater runoff to retain sediments and nutrients prior to entering Adkin Branch, and removing creosote timber retaining walls throughout the project.

1.3 Project Structure, Restoration Type and Approach

1.3.1 Project Structure

Phase I of the Project restored 7,579 linear feet of Adkin Branch and a UT between Washington Ave. and Lincoln St. in the City of Kinston, NC. Accounting for varying Riparian Buffer widths, utility easements, and stormwater conveyances throughout the site, Project activities provide 7,787* Stream Mitigation Units and 3,990 lbs of Neuse River Nutrient Offset Pound Reduction Credits. Riparian Buffer areas may be used for stream & wetland mitigation, stream & riparian buffer mitigation, or nutrient offset buffer restoration credit (Estimating/Calculating Riparian Buffer Credits, EEP PPPM Section 8.3.1.2). Credit options for Riparian Buffer restoration areas are summarized below:

| Credit Options for Riparian Buffer Restoration Areas | | | | | |
|---|--------------------------------|----------------|--|--------------------------------------|-----------------|
| Neuse Riparian Buffer Restoration Credits | | | Nutrient Offset Buffer Restoration Credits | | |
| 50' Area (sf) | 50' - 200' Adjusted Area (sf)* | Credit Yield** | <= 50' Nitrogen Removal (lbs)*** | 50' - 200' Nitrogen Removal (lbs)*** | Credit Yield*** |
| 562,799 | 696,704 | 1,259,503 | 0 | 31,751 | 31,751 |
| * - Credits adjusted based on proposed DWQ guidelines (DRAFT Regulatory Guidance for the Calculation of Stream and Buffer Mitigation Credit for Buffer Widths Different from Standard Minimum Widths, Version 4.5, July 20, 2010) | | | | | |
| ** - Riparian Buffer Restoration Credit Yield is the sum of 50' area and 50' - 200' adjusted area | | | | | |
| *** - Nitrogen Credits were calculated based on a rate of 2,273 lbs per acre over 30 years per DWQ policy (Estimating/Calculating Riparian Buffer Credits, EEP PPPM Section 8.3.1.2) | | | | | |

The structure and components of the Project are summarized in Figure 1 and Table 1, Appendix A. Additional credit calculation figures and documentation are attached in Appendix D.

The original project scope, Restoration Plan, and Construction Plans included an additional reach upstream of Phase I, from NC 11/55 to Washington Ave. Due to a delay in easement acquisition, this portion of the project will be constructed separately as Phase II.

1.3.2 Restoration Type and Approach

Prior to construction, the Project contained a degraded stream channel with a disturbed riparian buffer. The removal of riparian vegetation, impervious surfaces, and straightening and rerouting of stream channels, had resulted in degraded water quality and unstable channel characteristics (stream entrenchment, erosion, and bank collapse).

Adkin Branch and the UT were designed and constructed using Priority II restoration techniques. In-stream structures were installed to control grade, protect banks, and to increase bed form diversity for aquatic habitat. Other construction activities included excavating a floodplain bench, installing sod matting, backfilling of the abandoned channel, installing channel plugs, removing timber and concrete bag walls, removing three pedestrian bridges, constructing two new pedestrian bridges, installing a stormwater wetland and six BMP sand filter devices, and planting with native vegetative species. Planting occurred within 32.44 acres of the 35.97 acre conservation easement, including stream banks, floodplain, and stormwater BMPs. Target natural communities consist of Coastal Plain Levee Forest (Brownwater subtype), stream-side assemblage, and stormwater BMP wetland assemblage (Schafale and Weakley 1990).

1.4 Project History, Contacts and Attribute Data

The Project watershed is characterized primarily by urban development associated with the City of Kinston. Other land uses in the watershed include agriculture, disturbed forest, former neighborhoods, a former landfill, and a former wastewater treatment plant. Many of the former neighborhoods, the landfill, and the wastewater treatment plant were purchased by the City of Kinston with Federal Emergency Management Agency (FEMA) funds following flooding from Hurricanes Fran and Floyd. The City of Kinston donated permanent conservation easements on these properties and other City owned properties (parks, public housing) for areas associated with this Project. Easements on the privately owned properties were obtained in a joint effort between the City of Kinston and the EEP.

Florence and Hutcheson (F&H) provided engineering, design, and construction oversight services to the EEP for the Project. Construction began in March 2009, however Article 29 was declared on the Original Contractor in January 2010. The contractor's surety hired a new contractor (Surety Contractor) to complete the Original Contractor's work. Repairs to damages resulting from Tropical Storm Ida in November 2009 were completed under an Informal Contract by a third contractor (Repair Contractor). The Informal Contract also covered planting of bare root trees throughout the site and ball-and-burlap trees along the conservation easement line at Holloway Park. The repair work included the installation of in-stream structures, reshaping of the channel banks, regrading overbank scour areas, and installation of soil lifts in areas damaged by Tropical Storm Ida. All grading and planting was completed by April 1, 2011.

Completed project activities, reporting history, completion dates, project contacts, and background information are summarized in Tables 2-4 (Appendix A).

2.0 SUCCESS CRITERIA

In general, the restoration success criteria, and required remediation actions, are based on Appendix II of the *Stream Mitigation Guidelines* (USACE et al. 2003).

2.1 Morphologic Parameters and Channel Stability

Success criteria for stream restoration will include 1) successful classification of the reach as a functioning stream system (Rosgen 1996) and 2) channel variables indicative of a stable stream system.

The channel configuration will be measured on an annual basis in order to track changes in channel geometry and profile. These data will be utilized to determine the success in restoring stream channel stability. Specifically, the width-to-depth ratio should characterize a B-type channel for Adkin Branch and an E-type or borderline E-/C-type channel for the UT to Adkin Branch, bank-height ratios indicative of a stable or moderately unstable channel, and minimal changes in cross-sectional area, channel width, and/or bank erosion along the monitoring reach. The field indicator of bankfull will be described in each monitoring year and indicated on a representative channel cross-section figure. If the stream channel is down-cutting or the channel width is enlarging due to bank erosion, additional bank or slope stabilization methods will be employed.

2.1.1 Dimension

General maintenance of a stable cross-section and hydrologic access to the floodplain features over the course of the monitoring period will generally represent success in dimensional stability. Some changes in dimension (such as lowering of bankfull width) should be expected. Key parameters such as cross-sectional area and the channel's width to depth ratio should demonstrate modest overall change. Riffle sections should generally maintain a Bank Height ratio of 1.0 to 1.5, with some variation in this ratio naturally occurring. Pool sections naturally adjust based on recent flows and time between flows, therefore more variation on pool section geometry is expected.

2.1.2 Pattern and Profile

The profile should not demonstrate significant trends towards degradation or aggradation over a significant portion of a reach. Additionally, bed form variables should remain noticeably intact and consistent with original design parameters that were based off of reference conditions. Pattern features should show little adjustment over the standard 5 year monitoring period. In addition, channel abandonment and/or shoot cutoffs must not occur and sinuosity values must remain at approximately 1.03 – 1.04 (thalweg distance/straight-line distance) for Adkin Branch and approximately 1.3 for the UT to Adkin Branch.

2.1.3 Substrate

The stream substrate is predominately sand, and is not expected to coarsen over time; therefore, pebble counts are not proposed as part of the stream success criteria.

2.2 Vegetation

Success criteria have been established to verify that the vegetation component supports community elements necessary for forest development. Success criteria are dependent upon the density and growth of characteristic forest species. Additional success criteria are dependent upon density and growth of “Character Tree Species.” Character Tree Species include planted species along with species identified through visual inventory of an approved reference (relatively undisturbed) forest community used to orient the project design. All canopy tree species planted and identified in the reference forest will be utilized to define “Character Tree Species” as termed in the success criteria. This project seeks both stream and riparian buffer credit which have differing success criteria as described below.

Stream

Vegetation monitoring will be considered successful for stream mitigation credit if at least 260 stems/acre (trees and shrubs), both, volunteer and planted, are surviving at the end of five years. The interim measure of vegetative success for the site will be the survival of at least 320 3-year old stems per acre at the end of year three of the monitoring period and 280 4-year old stems per acre at the end of year four of the monitoring period.

Buffer

Vegetation monitoring will be considered successful for riparian buffer mitigation credit if at least 320 native planted hardwood stems/acre (trees only) are surviving at the end of year five. Planted vegetation must include a minimum of at least two planted native hardwood tree species. There is no interim measure of vegetative success for riparian buffers.

2.3 Hydrology

Success criteria include documentation of two bankfull channel events during the monitoring period. In the event that less than two bankfull events occur during the first five years, monitoring will continue until the second event is documented. In addition, bankfull events must occur during separate monitoring years.



3.0 MONITORING PLAN GUIDELINES

Monitoring of Project restoration efforts will be performed until success criteria are fulfilled. Monitoring is proposed for the stream channel, stormwater management devices, and vegetation. The establishment, collection, and summarization of monitoring data shall be conducted in accordance with the most current version of the EEP document entitled *Procedural Guidance and Content Requirements for EEP Monitoring Reports (version 1.3)*.

3.1 Stream Hydrology

Verification of bankfull events and changes in stream hydrology will be recorded by crest gauges installed in the stream as well as visual evidence of above bankfull flows. Two crest gages were installed along Adkin Branch and two were installed along the UT (Figures 2-13, Appendix A). Evidence of above bankfull flows may include trash/debris lines in or above the floodplain, vegetation pushed over towards the downstream direction in the floodplain, terrace slope scour, and staining of vegetation. Early monitoring of crest gauges will allow for additional verification of bankfull design targets.

All visits to the site for purposes of data collection will be documented by the monitoring performer and will describe in detail: weather conditions; physical appearance of the site; highest stage for that monitoring interval as recorded on the crest gauge; a reset of the crest gauge; photo documentation. Data collected for the purposes of bankfull verification will be compiled and summarized in each annual version of the monitoring report.

3.2 Stream Channel Stability and Geomorphology

Three reaches (Washington Ave. to Gordon St., Gordon St. to Lincoln St., and the UT) were established for monitoring stream dimension, pattern, and longitudinal profile (Figures 2-13, Appendix A). The Restoration Plan for the Project indicated two reaches between Gordon St. and Lincoln St., separated at Caswell St. Due to the similarity of the design parameters for the two reaches, they were combined into a single reach for monitoring. Annual monitoring surveys will include assessment of channel cross-sections on riffles and pools and a water surface profile of the channel. The stream will be classified according to stream geometry and substrate (Rosgen 1996). Significant changes in channel morphology will be tracked and reported by comparing data in each successive monitoring year. In addition, visual assessments of the stream will be conducted by walking the length of stream.

3.2.1 Dimension

Seventeen permanent cross-sections were established and will be used to evaluate stream dimension. Cross-sections are permanently monumented with 2-foot rebar posts at each end point. Cross-sections will be measured to provide a detailed evaluation of the stream and banks including points on the adjacent floodplain, top of bank, bankfull, breaks in slope, edge of water, and thalweg. Data will be used to calculate bankfull dimensions, width-depth ratios, entrenchment ratios, and bank height ratios for each cross-section. In addition, photographs will be taken at each permanent cross-section location annually.



3.2.2 Profile

The three reaches established for monitoring will be surveyed annually using a Total Station to collect data on channel thalweg, bankfull, and water surface elevations. The profile data will be used to calculate water surface slopes, riffle/pool lengths and depths, and pool-to-pool spacing.

3.2.3 Pattern

Stream parameters such as channel belt width, radius of curvature, and meander wavelength will be collected in monitoring year five if profile and dimensional data indicate that significant geomorphological adjustments have occurred.

3.2.4 Visual Assessments

Visual stream morphology stability assessments will be completed annually in each of the three monitoring reaches in accordance with the most current version of the EEP document entitled *Procedural Guidance and Content Requirements for EEP Monitoring Reports (version 1.3)*. The visual assessment data will be used to assess the channel bed, banks, and in-stream structures.

3.2.5 Bank Stability Assessments

Bank stability will be assessed as part of the annual visual assessment and will consist of cataloging the amount of bank footage demonstrating some level of instability. Near Bank Stress (NBS) and Bank Erosion Hazard Index (BEHI) assessments were not part of the pre-construction existing conditions surveys, therefore they will not be included in the monitoring phase.

3.3 Vegetation

Twenty-two sample vegetation plots (10-meter by 10-meter) were installed within the Site as per guidelines established in CVS-EEP Protocol for Recording Vegetation, Version 4.0 (Lee et al. 2006). Vegetation plots are permanently monumented with 4-foot metal garden posts at each corner. In each sample plot, vegetation parameters to be monitored will conform to Level 2 Standards and include species composition and species density. Visual observations of the percent cover of shrub and herbaceous species will also be documented by photograph.

3.4 Stormwater Wetland

Plant coverage within the stormwater wetland should be assessed and documented each growing season. If a minimum of 70 percent coverage is not achieved after the second growing season, supplemental planting should be completed. Plant coverage of 90 to 95 percent is desirable. Vegetation monitoring will be considered successful for riparian buffer mitigation credit if at least 320 native planted hardwood stems/acre (trees only), are surviving at the end of year five.

3.5 Watershed

Any changes to the project watershed will be monitored and recorded. In the event that a change to the watershed might introduce new sediment or changes in water flow to the site, such as a new development upstream, it will be closely monitored and analyzed. Any significant effects to site streams will be documented so that action can be taken, if necessary. Additionally, rare or



significant hydrologic and weather events will be recorded in detail so that changes to site streams can be accounted for.



4.0 MAINTENANCE AND CONTINGENCY PLANS

In the event that success criteria are not fulfilled, a mechanism for contingency will be implemented.

4.1 Stream

In the event that stream success criteria are not fulfilled, a mechanism for contingency will be implemented. Stream contingency may include, but may not be limited to 1) structure repair and/or installation; 2) repair of dimension, pattern, and/or profile variables; and 3) bank stabilization. The method of contingency is expected to be dependent upon stream variables that are not in compliance with success criteria. Primary concerns, which may jeopardize stream success, include 1) structure failure, 2) headcut migration through the Site, and/or 3) bank erosion.

4.1.1 Structure Failure

In the event that structures are compromised, the affected structure will be repaired, maintained, or replaced. Once the structure is repaired or replaced, it must function to stabilize adjacent stream banks and/or maintain grade control within the channel. Structures which remain intact, but exhibit flow around, beneath, or through the header/footer pilings will be repaired by excavating a trench on the upstream side of the structure and reinstalling filter fabric in front of the pilings. Structures which have been compromised, resulting in shifting or collapse of header/footer pilings, will be removed and replaced with a structure suitable for Project flows.

4.1.2 Headcut Migration through the Site

In the event that a headcut occurs within the Project (identified visually or through measurements [i.e. bank-height ratios exceeding 1.4]), provisions for impeding headcut migration and repairing damage caused by the headcut will be implemented. Headcut migration may be impeded through the installation of in-stream grade control structures (log sill and/or log cross-vane) and/or restoring stream geometry variables until channel stability is achieved. Channel repairs to stream geometry may include channel backfill with coarse material and stabilizing the material with erosion control matting, vegetative transplants, and/or willow stakes.

4.1.3 Bank Erosion

In the event that severe bank erosion occurs at the Project resulting in elevated width-to-depth ratios, contingency measures to reduce bank erosion and width-to-depth ratio will be implemented. Bank erosion contingency measures may include the installation of soil lifts and/or other bank stabilization measures. If the resultant bank erosion induces shoot cutoffs or channel abandonment, a channel may be excavated which will reduce shear stress to stable values.

4.2 Vegetation

If vegetation success criteria are not achieved based on average density calculations from combined plots over the entire restoration area, supplemental planting may be performed with



tree species approved by regulatory agencies. Supplemental planting will be performed as needed until achievement of vegetation success criteria.

4.3 Stormwater Management Devices

Stormwater BMP devices will be monitored and maintained periodically, as necessary, to ensure the life of the devices. The City of Kinston has agreed to provide maintenance for the sand filter BMP devices and the stormwater wetland for the life of the BMPs (30 years) per Attachment C of the Conservation Easement. A maintenance guideline manual will be provided to the City of Kinston by EEP.

4.3.1 Sand Filter Devices

The maintenance guidelines are summarized as follows (NCDWQ 2005):

- The sediment chamber outlet devices should be cleaned or repaired when drawdown times exceed 24 hours. In addition, trash and debris should be removed as necessary and sediment should be cleaned out when it accumulates to 6 inches or more.
- When the infiltration capacity of the filter diminishes or water ponds on the filter bed surface for greater than 24 hours, the topsoil and underlying 3 inches of filter material should be removed and replaced. The removed sediments should be tested and disposed of appropriately. Sediment/silt should be removed from the filter bed when accumulation exceeds 1 inch.
- Vegetation within the sediment chamber should be mowed to limit the height to 12 inches.
- Direct maintenance access should be provided to the pretreatment area and the filter bed.



5.0 AS-BUILT STATE

This section documents the as-built/baseline condition. Appendices B & C include Tables 5, 6 & 7 which detail specific geomorphic and vegetative data in relation to the as-built conditions.

5.1 As-built/Record Drawings

The As-built/Record Drawings are attached in Appendix E.

5.2 Morphologic State of the Channel

Upon completion of grading and structure installation, a baseline survey was performed for the three monitoring reaches and 17 cross-sections. Baseline morphologic data is summarized in Tables 5a-c and Table 6 in Appendix B. Plots of the profiles are shown in Figures 14-16 in Appendix B. Cross-section plots and photos can also be found in Appendix B. Cross-section photos were taken facing in the downstream direction.

5.3 Sediment Transport in the As-built State

As-built capacity (unit stream power) values are depicted in Table 5 and can be compared with design and existing values for each reach. For sand based systems such as Adkin Branch and the UT to Adkin Branch, capacity is the primary tool for assessing the channel's ability to transport sediment through the system.

5.4 Verification of Plantings

After planting was completed, an initial evaluation was performed per guidelines established in CVS-EEP Protocol for Recording Vegetation, Version 4.0 (Lee et al. 2006) to verify planting methods were successful and to determine initial species composition and density. Baseline vegetation plot data can be found in Table 7 in Appendix C. Plot photos are also located in Appendix C. Initial stem count measurements indicate an average of 881 planted stems per acre (excluding live stakes) across the Site. In addition, each individual plot met success criteria based on planted stems alone. Final planting tables (8a-b) can be found in Appendix C.



6.0 REFERENCES

Lee, M.T., R.K. Peet, S.D. Roberts, and T.R. Wentworth. 2006. CVS-EEP Protocol for Recording Vegetation. Version 4.0. North Carolina Department of Environment and Natural Resources, Ecosystem Enhancement Program. Raleigh, North Carolina.

North Carolina Division of Water Quality (NCDWQ). 2005. Updated Draft Manual of Stormwater Best Management Practices. North Carolina Department of Environment and Natural Resources, Raleigh, North Carolina.

Rosgen, D.L. 1996. Applied River Morphology. Wildland Hydrology Books, Pagosa Springs, CO.

Schafale, M.P. and A.S. Weakley. 1990. Classification of the Natural Communities of North Carolina: Third Approximation. North Carolina Natural Heritage Program, Division of Parks and Recreation, North Carolina Department of Environment, Health, and Natural Resources. Raleigh, North Carolina.

United States Army Corps of Engineers, United States Environmental Protection Agency, North Carolina Wildlife Resources Commission, North Carolina Division of Water Quality (USACE et al.). 2003. Stream Mitigation Guidelines.

United States Geological Survey (USGS). 1974. Hydrologic Unit Map - 1974. State of North Carolina.

Estimating/Calculating Riparian Buffer Credits, EEP PPPM Section 8.3.1.2.

DRAFT Regulatory Guidance for the Calculation of Stream and Buffer Mitigation Credit for Buffer Widths Different from Standard Minimum Widths, NC Interagency Review Team (IRT), Version 4.5, July 20, 2010.

DWQ Memo #2008-019, dated August 19, 2008.

DWQ Memo #2009-006, dated November 17, 2009.




7.0 APPENDICES

Appendix A: General Tables & Figures



Lenoir County North Carolina

PROJECT AREA

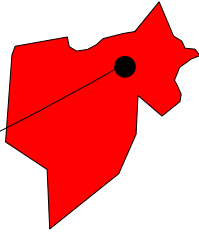

Date: 06/15/11

Figure: 1


Vicinity/Asset Map



Florence & Hutcheson
CONSULTING ENGINEERS
5121 KINGDOM WAY, SUITE 100
RALEIGH, N.C. 27607
(919) 851-6066
License No: F-0258



Adkin Branch Phase I
PROJECT NO. 050656101
Lenoir County, North Carolina

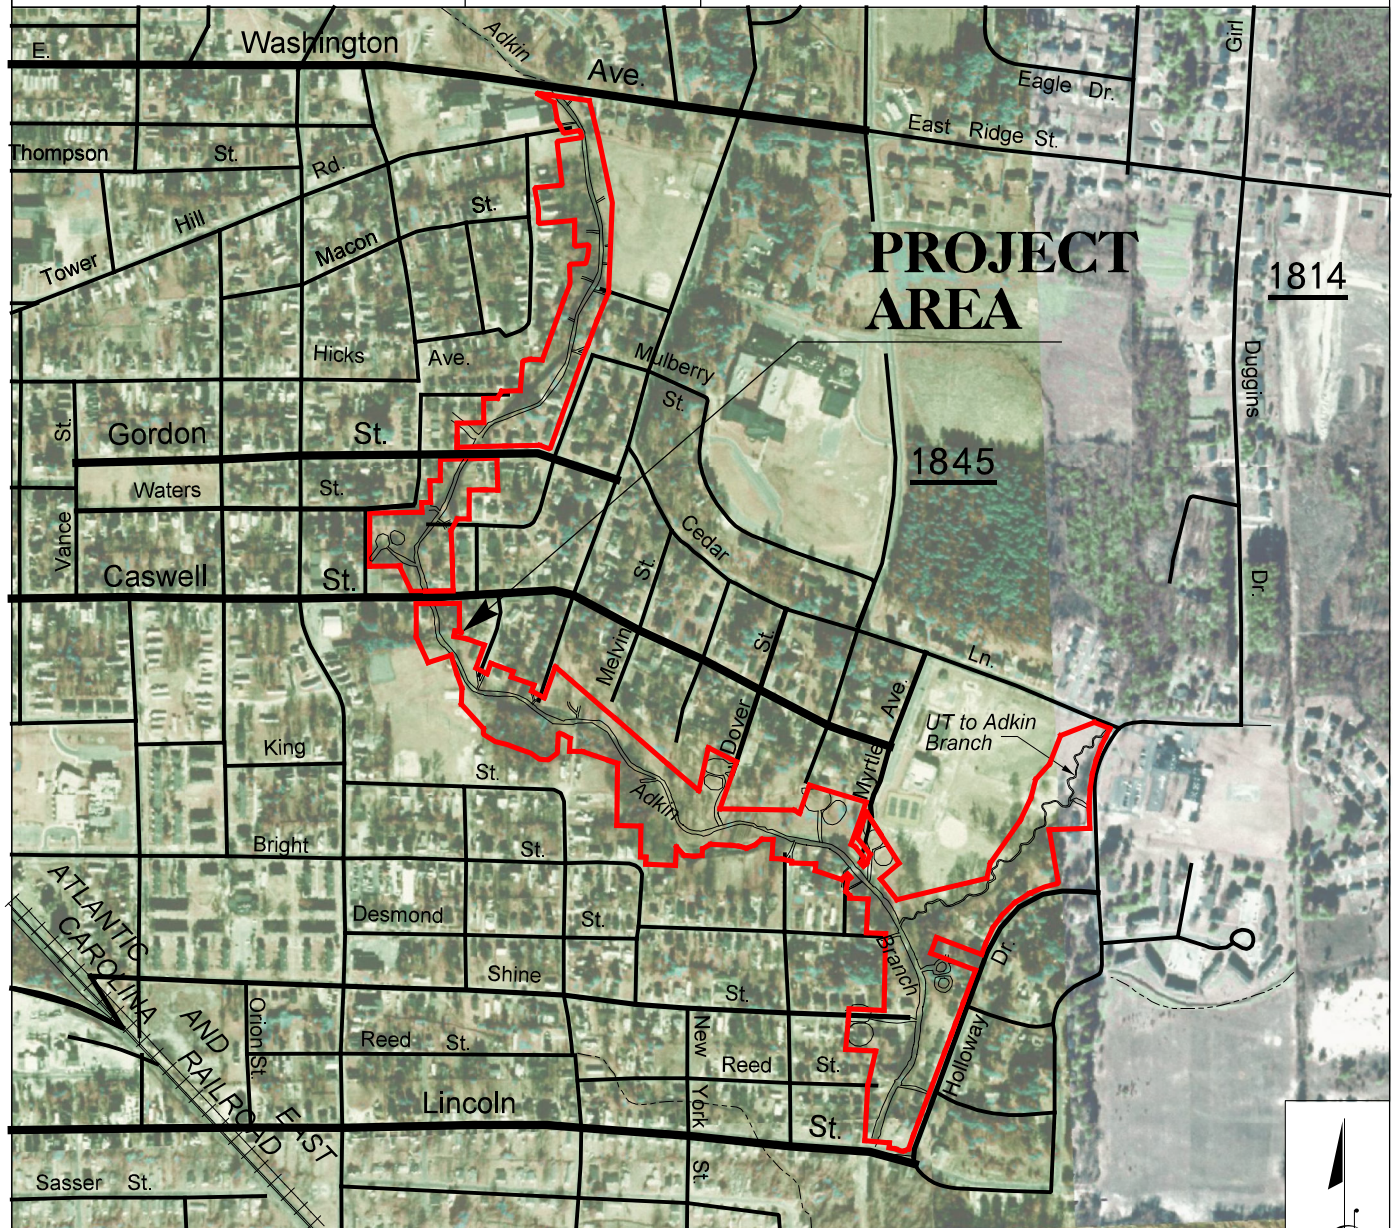

FROM RALEIGH:

- Take I-40 East for approximately 6.5 miles to US 70 East
- Take US Hwy 70 East for approximately 68.5 miles to NC 1155
- Turn left and travel Northeast on NC 1155 thru Kinston for 1.7 miles
- Turn left onto Martin Luther King Jr Blvd. and travel for 0.5 miles
- Turn right onto the East Washington Ave. and travel 0.4 miles to the intersection with Adkin Branch Project. Site is Southeast of Washington Ave.

"The subject project site is an environmental restoration site of the NCDENR Ecosystem Enhancement Program (EEP) and is encompassed by a recorded conservation easement, but is bordered by land under private ownership. Accessing the site may require traversing areas near or along the easement boundary and therefore access by the general public is not permitted. Access by authorized personnel of state and federal agencies or their designees/contractors involved in the development, oversight and stewardship of the restoration site is permitted within the terms and timeframes of their defined roles. Any intended site visitation or activity by any person outside of these previously sanctioned roles and activities requires prior coordination with EEP."

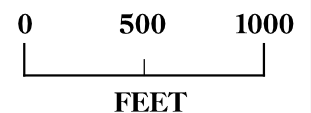


Table 1. Project Components and Mitigation Credits

| Mitigation Credits | | | | | | | | | | |
|--|-------------------------------|---------------------------------|--------------|------------------------------|---------------------------------------|--|--------------------------------|--------------------------|-----------------------|------------|
| | Stream | Riparian Wetland | | Non-riparian Wetland | | Riparian Buffer ** | | Nitrogen Nutrient Offset | | |
| | | | | | | | | Pound Reduction | Buffer Restoration ** | |
| Type | R | R | RE | R | RE | 50' | 50' - 200' | | <= 50' | 50' - 200' |
| Totals | 7,787 * | N/A | N/A | N/A | N/A | 562,799 | 696,704 * | 3,990 | 0 | 31,751 |
| Project Components | | | | | | | | | | |
| Project Component -or- Reach ID | Stationing/Location | | | Existing Footage/ Acreage | Approach (PI, PII etc.) | Restoration - or- Restoration Equivalent | Restoration Footage or Acreage | Mitigation Ratio | | |
| Reach 1 | Washington Ave. to Gordon St. | | | 1,680 | PII | R | 1,727 | Varies* | | |
| Reach 2 | Gordon St. to Lincoln St. | | | 4,224 | PII | R | 4,270 | Varies* | | |
| Reach 3 | UT to Adkin Branch. | | | 1,200 | PII | R | 1,582 | Varies* | | |
| Riparian Buffers | 50' | | | 7.58 | - | R | 12.92 | 1 to 1 | | |
| | 50' - 200' | | | | | R | 13.97 | Varies* | | |
| Component Summation | | | | | | | | | | |
| Restoration Level | Stream (linear feet) | Riparian Wetland (acres) | | Non-riparian Wetland (acres) | Buffer (square ft.) | Upland (acres) | | | | |
| | | Riverine | Non-Riverine | | | | | | | |
| Restoration | 7,579 | N/A | N/A | N/A | 1,171,272 | N/A | | | | |
| Enhancement | | N/A | N/A | N/A | N/A | N/A | | | | |
| Enhancement II | N/A | | | | | | | | | |
| Enhancement II | N/A | | | | | | | | | |
| Creation | | N/A | N/A | N/A | | | | | | |
| Preservation | N/A | N/A | N/A | N/A | | N/A | | | | |
| High Quality Preservation | N/A | N/A | N/A | N/A | | N/A | | | | |
| BMP Elements | | | | | | | | | | |
| Element | Location | Purpose/Function | | | 30 yr. Total Nitrogen Reduction (lbs) | | Notes | | | |
| Stormwater Wetland | UT Adkin | Water Quality / Nutrient Uptake | | | N/A | | - | | | |
| BMP #4 - Sand Filter | Miller St. | Water Quality / Infiltration | | | 300 | | - | | | |
| BMP #5 - Sand Filter | Dover St. | Water Quality / Infiltration | | | 750 | | - | | | |
| BMP #6 - Sand Filter | Seacrest St. | Water Quality / Infiltration | | | 1,170 | | - | | | |
| BMP #7 - Sand Filter | Myrtle Ave. | Water Quality / Infiltration | | | 600 | | - | | | |
| BMP #8 - Sand Filter | Holloway Dr. | Water Quality / Infiltration | | | 180 | | - | | | |
| BMP #9 - Sand Filter | Shine St. | Water Quality / Infiltration | | | 990 | | - | | | |
| * - Stream & Riparian Buffer Mitigation Credit numbers were adjusted based on proposed DWQ guidelines (DRAFT Regulatory Guidance for the Calculation of Stream and Buffer Mitigation Credit for Buffer Widths Different from Standard Minimum Widths, Version 4.5, July 20, 2010). See Appendix D for further explanation. | | | | | | | | | | |
| ** - Riparian Buffer areas may be used for stream & wetland mitigation, stream & riparian buffer mitigation, or nutrient offset credit (Estimating/Calculating Riparian Buffer Credits, EEP PPPM Section 8.3.1.2) . | | | | | | | | | | |



BASELINE MONITORING DOCUMENT & AS-BUILT BASELINE REPORT

Table 2. Project Activity and Reporting History

| Activity or Report | Data Collection Complete | Completion or Delivery |
|--|---------------------------------|-------------------------------|
| Restoration Plan | | March 2007 |
| Final Design – Construction Plans | | May 2007 |
| Bid Opening | | October 2008 |
| Begin Construction | | March 2009 |
| <i>Tropical Storm Ida</i> | | <i>November 2009</i> |
| Article 29 declared on original contractor | | January 2010 |
| Surety Contractor Begin Construction | | June 2010 |
| Tropical Storm Repairs Bid Opening | | September 2010 |
| Begin Tropical Storm Repairs Construction | | December 2010 |
| Construction Complete | | April 2011 |
| Baseline Monitoring Document | March 2011 | July 2011 |
| Year 1 Monitoring | | |
| Year 2 Monitoring | | |
| Year 3 Monitoring | | |
| Year 4 Monitoring | | |
| Year 5 Monitoring | | |

Table 3. Project Contact Table

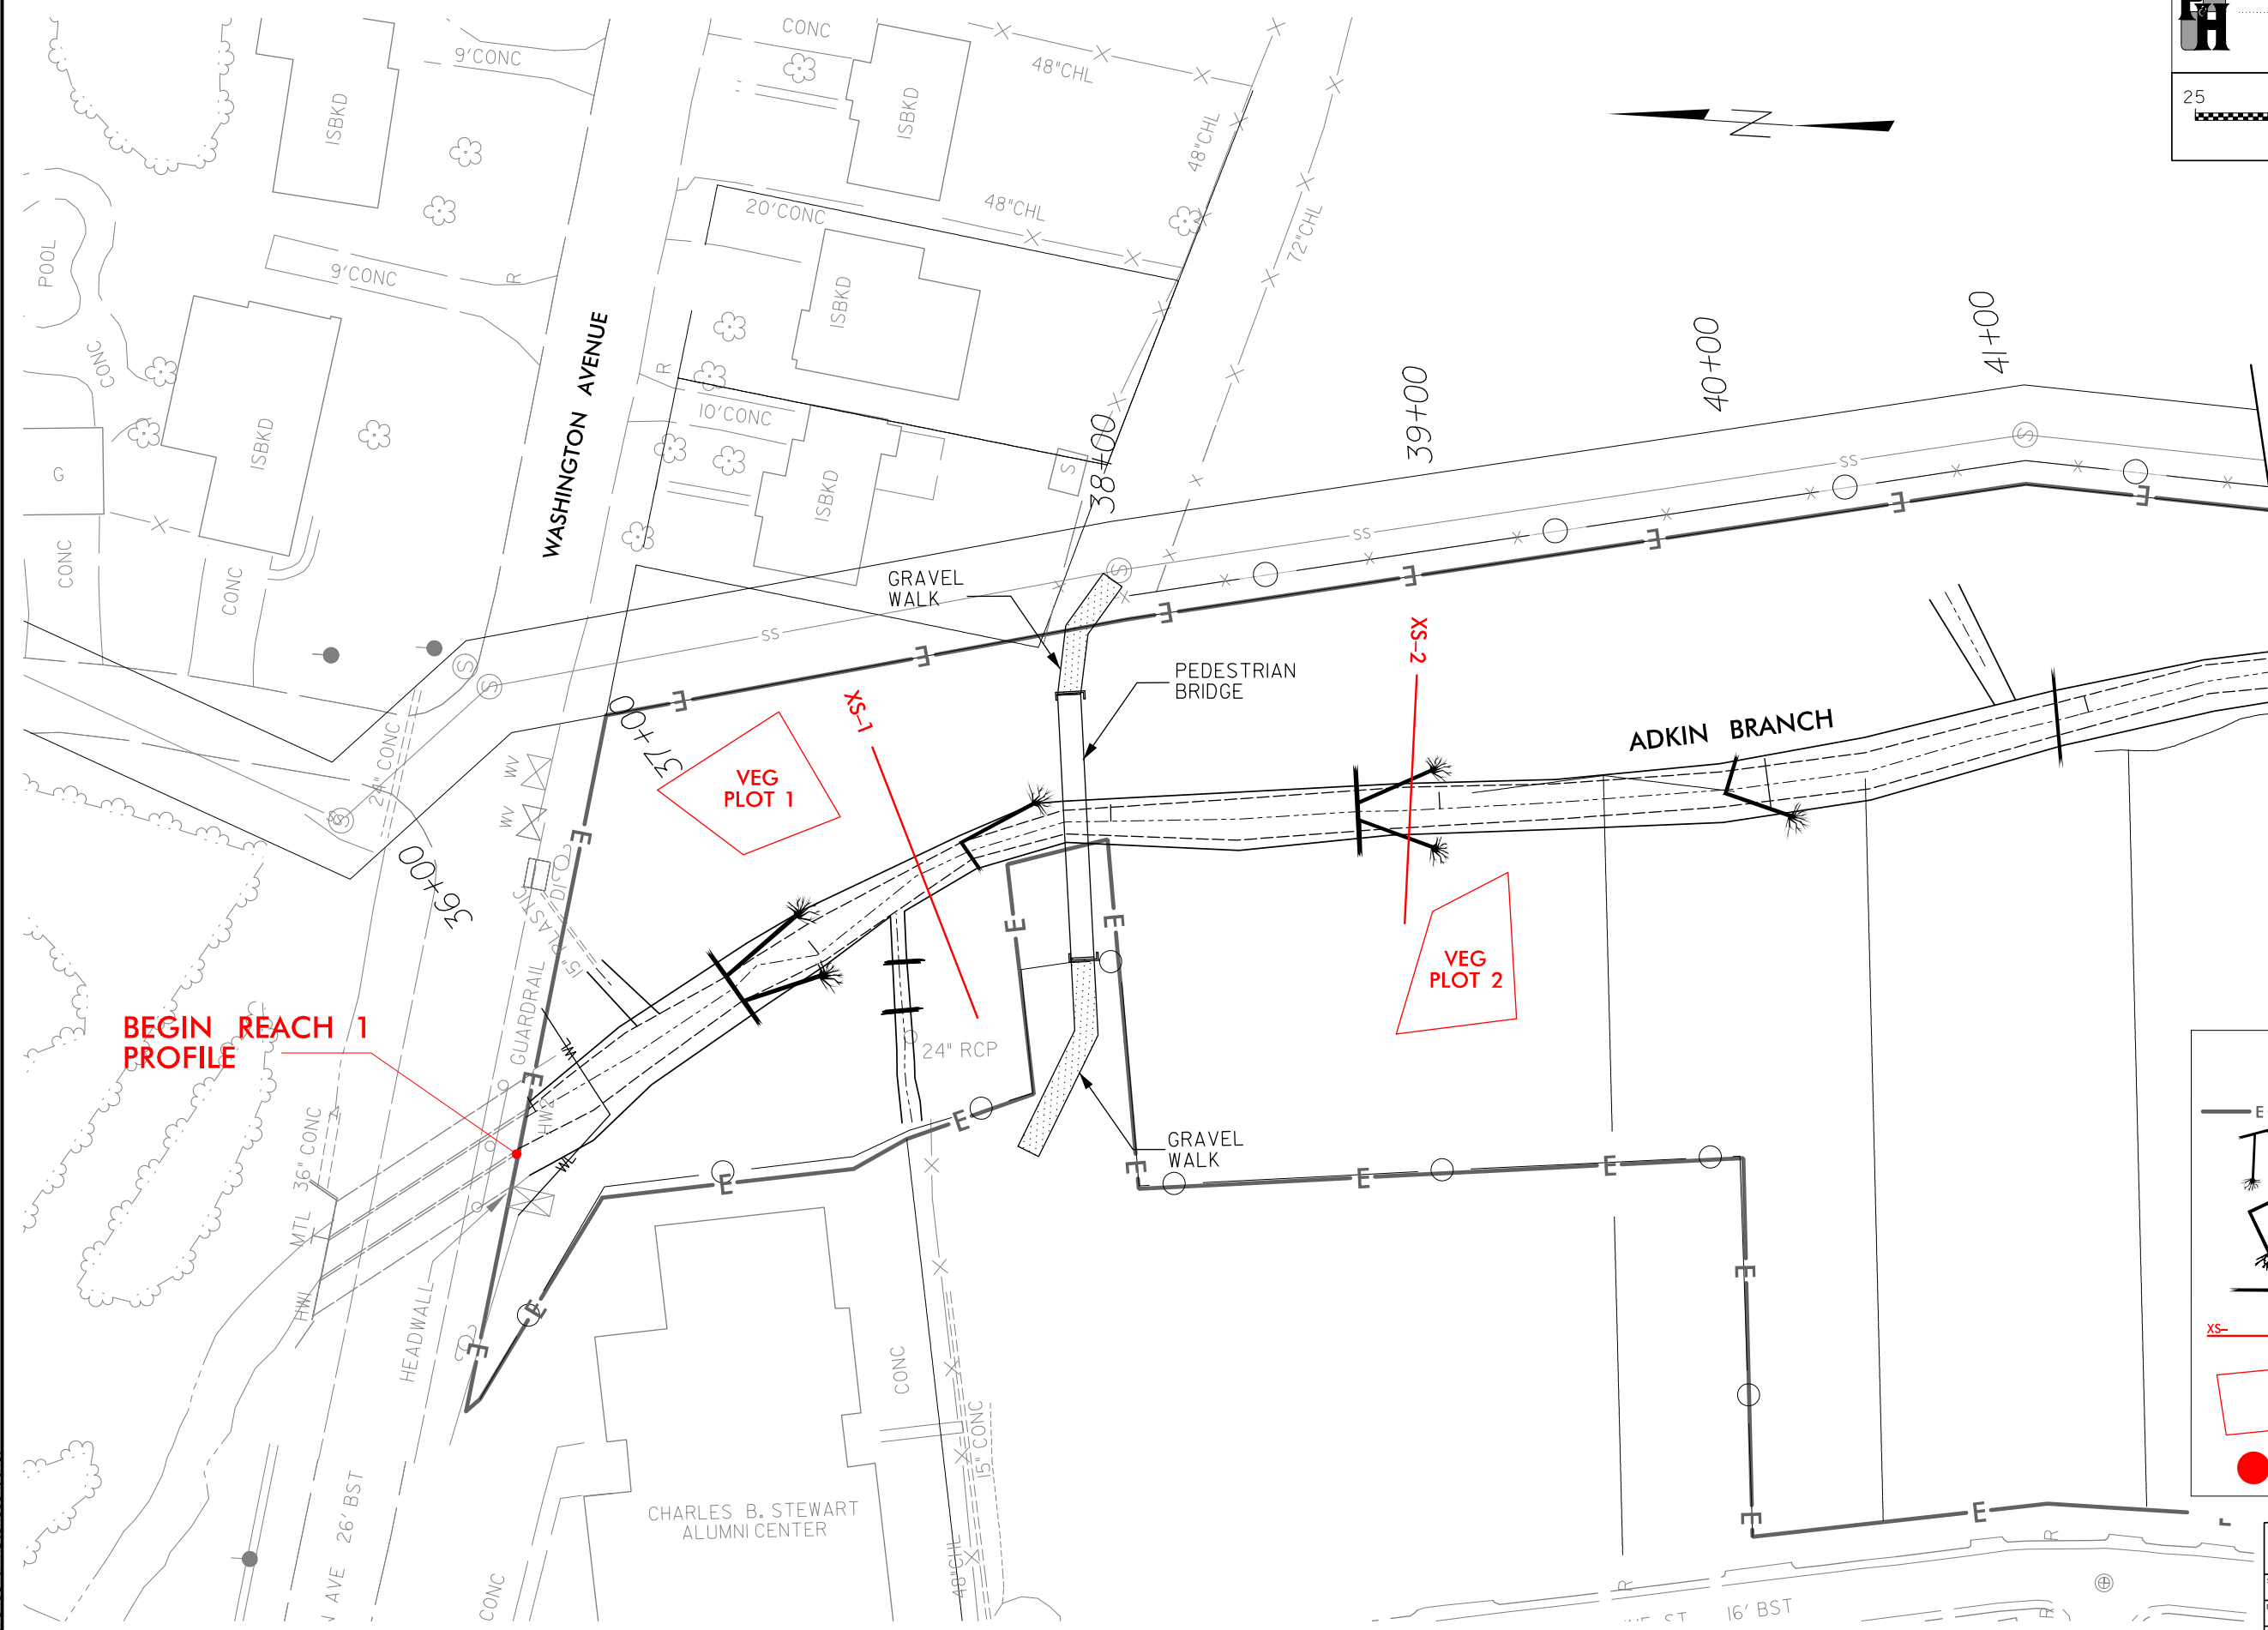
| | |
|------------------------------|--|
| Designer | Florence & Hutcheson, Inc. 5121 Kingdom Way, Suite 100 Raleigh, North Carolina 27607 Kevin Williams (919) 851-6066 |
| Original Contractor | Appalachian Environmental Services 1165 W. Main St. Sylva, NC 28779 Mickey B. Henson |
| Surety Contractor | Environmental Quality Resources, LLC 1405 Benson Court, Suite C Baltimore, MD 21227 John Talley (443) 304-3310 |
| Repair Contractor | Fluvial Solutions P.O. Box 28749 Raleigh, NC 27611 Peter Jelenevsky (919) 821-4300 |
| Planting Contractor | Bruton Natural Systems (Fluvial Solutions Sub-contractor) PO Box 1197 Fremont, NC 27830 Charlie Bruton (919) 242-6555 |
| Seeding Contractor | See Original Contractor, Surety Contractor, & Repair Contractor above. |
| Nursery Stock Suppliers | 1) ArborGen - South Carolina SuperTree Nursery 2) Evergreen Partners of Raleigh 3) NC Division of Forest Resources |
| Monitoring Performers | |
| Stream Monitoring | Florence & Hutcheson, Inc. 5121 Kingdom Way, Suite 100 Raleigh, North Carolina 27607 Ryan Smith (919) 851-6066 |
| Vegetation Monitoring | Axiom Environmental, Inc. 218 Snow Avenue Raleigh, North Carolina 27603 Corri Faquin (919) 414-2471 |










Table 4. Project Baseline Information and Attributes

| Project Information | | | |
|---|--|---|--------------------------|
| Project Name | | Adkin Branch Stream Restoration Project – Phase I | |
| County | | Lenoir | |
| Project Area (acres) | | 36 | |
| Project Coordinates | | 035° 15' 13" N, 77° 33' 36" W (@ Lincoln St.) | |
| Project Watershed Summary Information | | | |
| Physiographic Province | | Coastal Plain | |
| River Basin | | Neuse | |
| USGS 8-digit HUC | 3020202 | USGS 14-digit HUC | 3020202060030 |
| NCDWQ Subbasin | | 03-04-05 | |
| Project Drainage Area | | 5.46 sq. mi (at Lincoln St.) | |
| Watershed Land Use | Urban Land | 76% | Agricultural Land 13% |
| | Mixed Forest / Disturbed Forest | 7% | Evergreen Forest 4% |
| Reach Summary Information | | | |
| Parameters | Adkin Branch | | UT to Adkin |
| | Washington Ave. to Gordon St. | Gordon St. to Lincoln St. | |
| Length of reach (linear ft) | 1727 | 4270 | 1582 |
| Valley Classification | VIII | | VIII |
| Drainage Area (acres) | 3220 | 3495 | 78 |
| NCDWQ stream ID score | 39.5 | | 27 |
| NCDWQ Classification | C | | C |
| Pre-Existing Stream Type | G5 | B5c | E5 |
| As-built Stream Type | B5c | B5c | C/E5 |
| Underlying mapped soils | Bibb | | Kenansville |
| Drainage Class | Poorly Drained | | Well-drained |
| Soil Hydric Status | Hydric | | Non-Hydric |
| Slope | 0.0016 | 0.0014 | 0.0022 |
| FEMA Classification | AE | | |
| Native Vegetation Community | Coastal Plain Levee Forest / Streamside Assemblage | | |
| Percent composition of exotic invasive vegetation | 5% | 10% | 5% |
| Wetland Summary Information | | | |
| N/A | | | |
| Regulatory Considerations | | | |
| Regulation | Applicable | Resolved | Supporting Documentation |
| Waters of the U.S. –Sections 404 and 401 | Yes | Yes | Restoration Plan |
| Endangered Species Act | Yes | Yes | Restoration Plan |
| Historic Preservation Act | Yes | Yes | Restoration Plan |
| CZMA/CAMA | No | -- | -- |
| FEMA Floodplain Compliance | Yes | Yes | Restoration Plan |
| Essential Fisheries Habitat | No | -- | -- |

MONITORING PLANS




LEGEND

-  CONSERVATION EASEMENT LINE
-  LOG CROSS VANE
-  LOG VANE
-  LOG SILL
-  MONITORING CROSS SECTION (XS-)
-  VEGETATION PLOT
-  CREST GAUGE





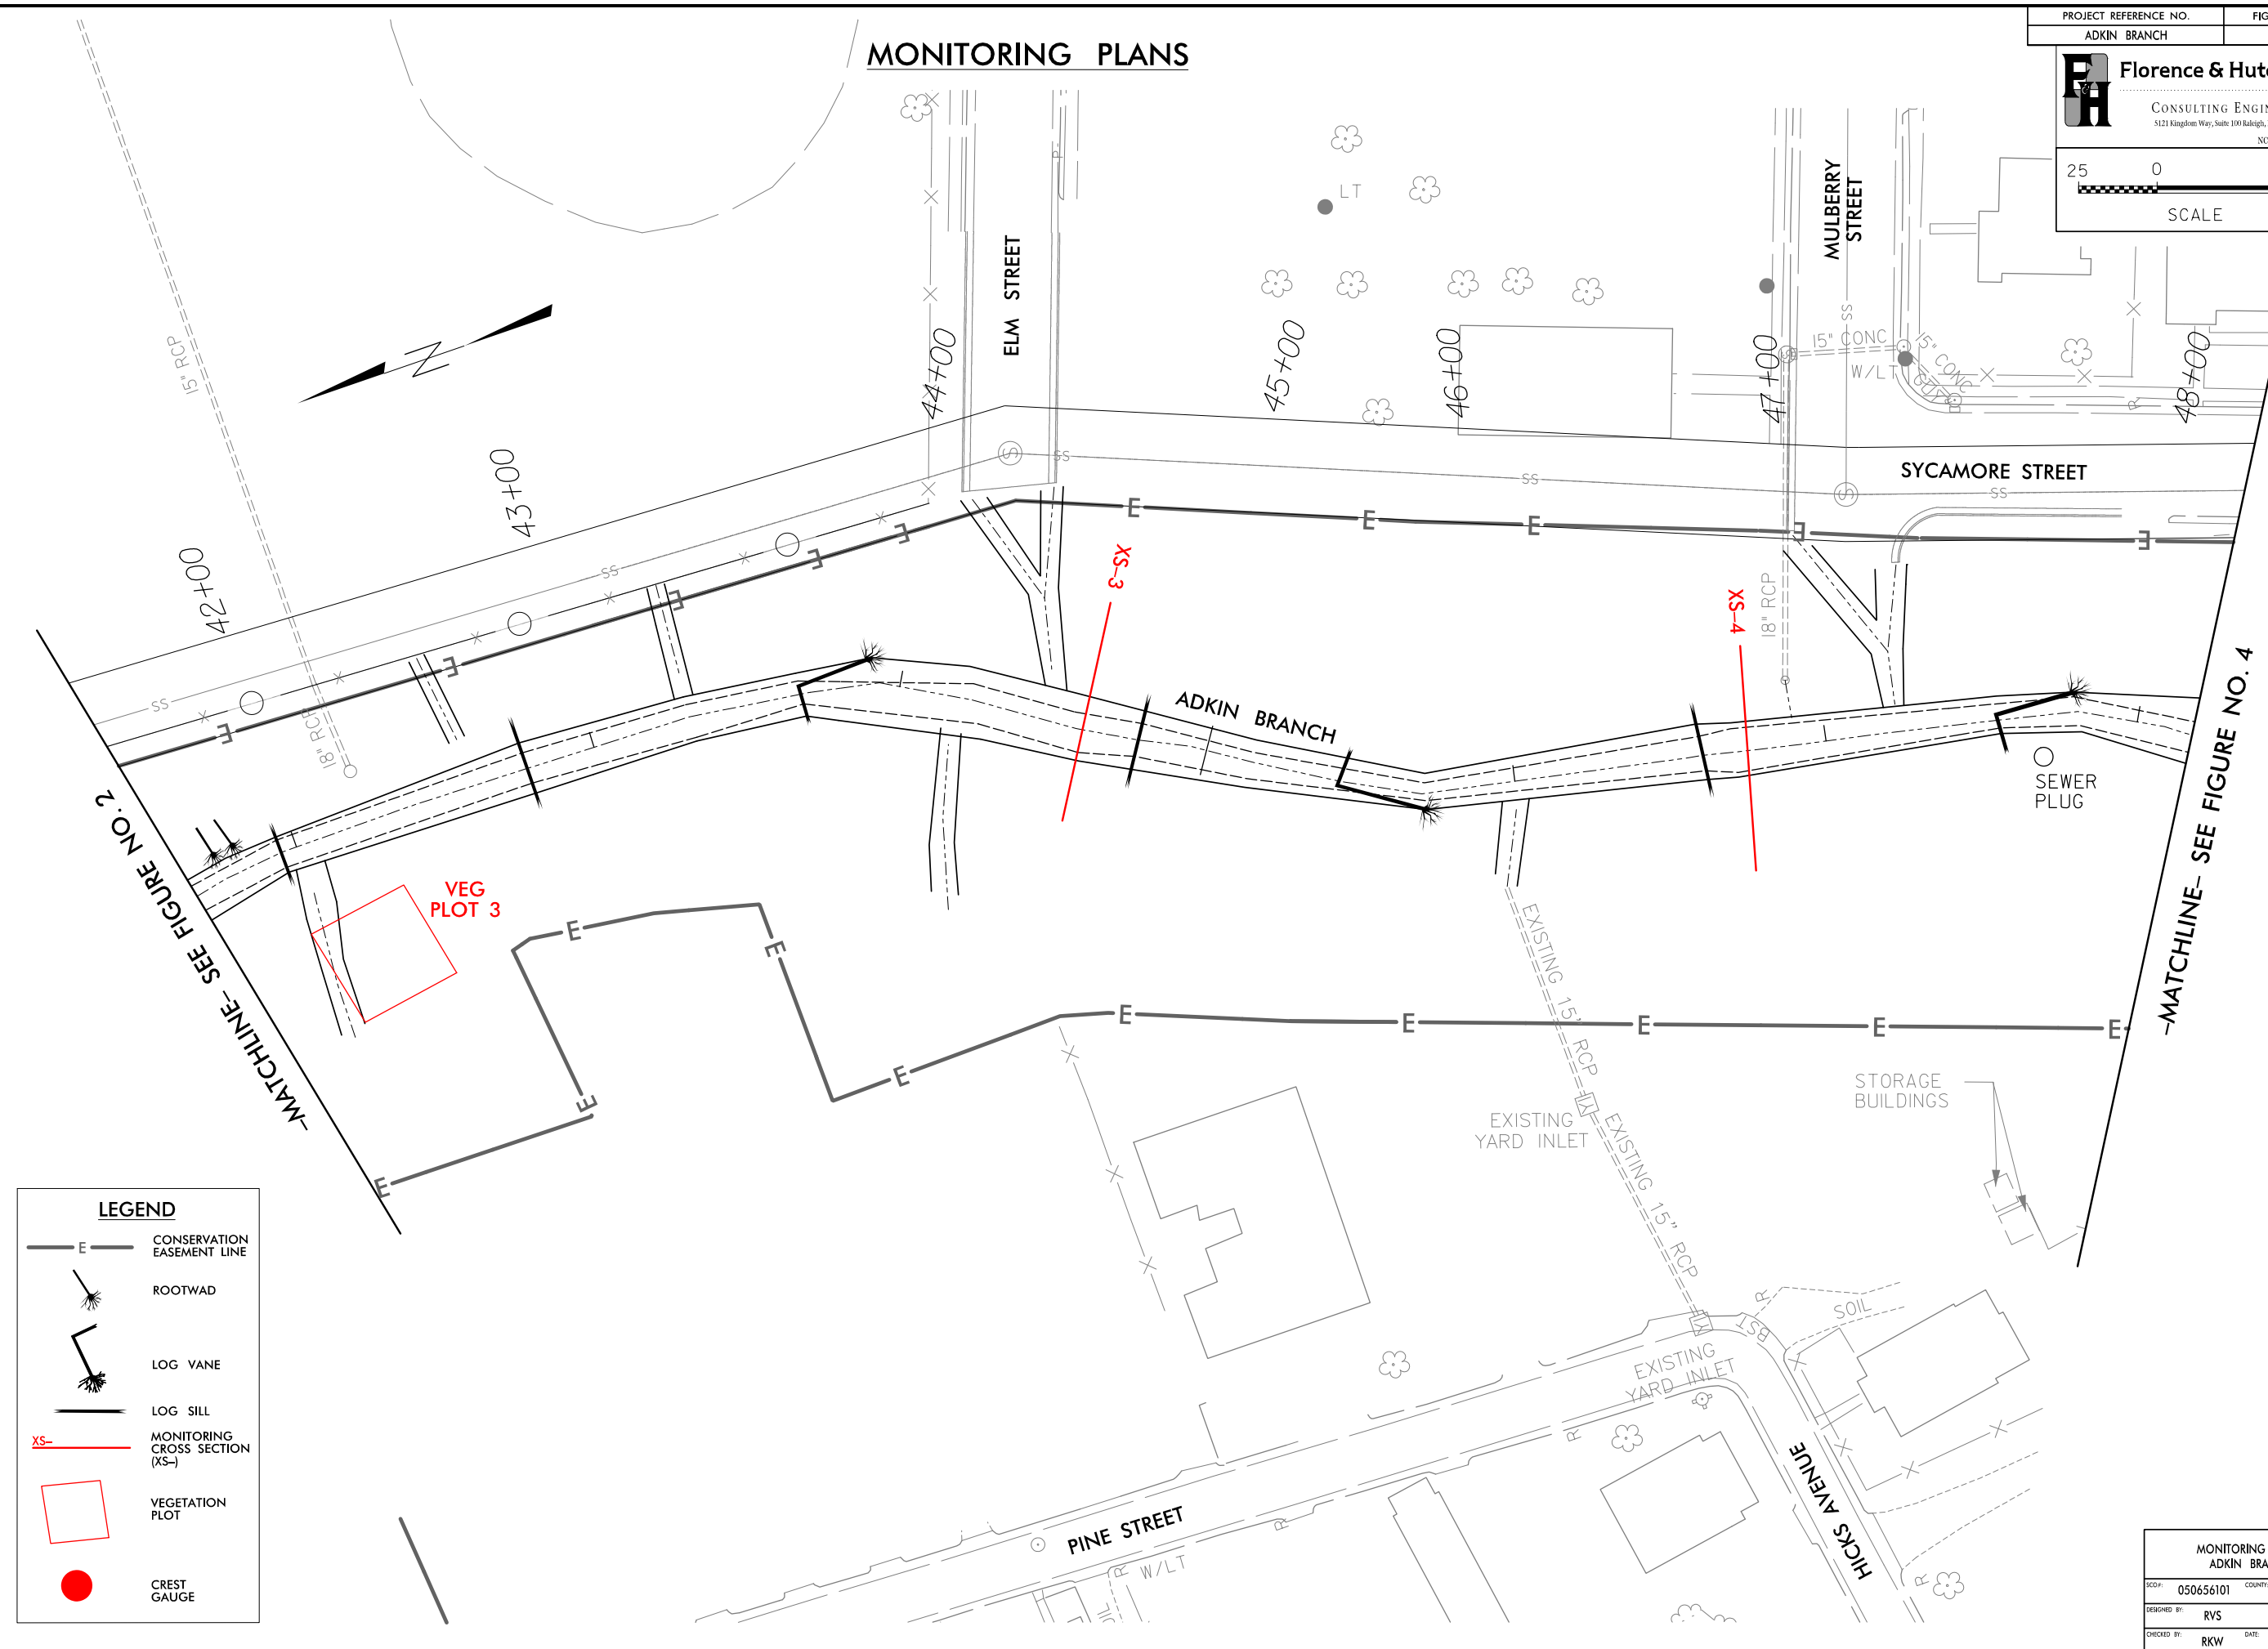


| | |
|----------------------------------|-----------------|
| MONITORING PLANS ADKIN BRANCH | |
| SCOPE: 050656101 | COUNTY: LENOIR |
| DESIGNED BY: RVS | CHECKED BY: RKW |
| DATE: | DATE: 5/11 |

6/30/2011 Proj: Monitoring\AdkinBranch_Monitoring.psh_2.dgn
 Florence & Hutcheson, Inc.

MONITORING PLANS




LEGEND

-  CONSERVATION EASEMENT LINE
-  ROOTWAD
-  LOG VANE
-  LOG SILL
-  MONITORING CROSS SECTION (XS-)
-  VEGETATION PLOT
-  CREST GAUGE

6/30/2011 Proj: Monitoring\AdkinBranch_Monitoring.psh_3.dgn
 Florence & Hutcheson, Inc.

-MATCHLINE- SEE FIGURE NO. 4



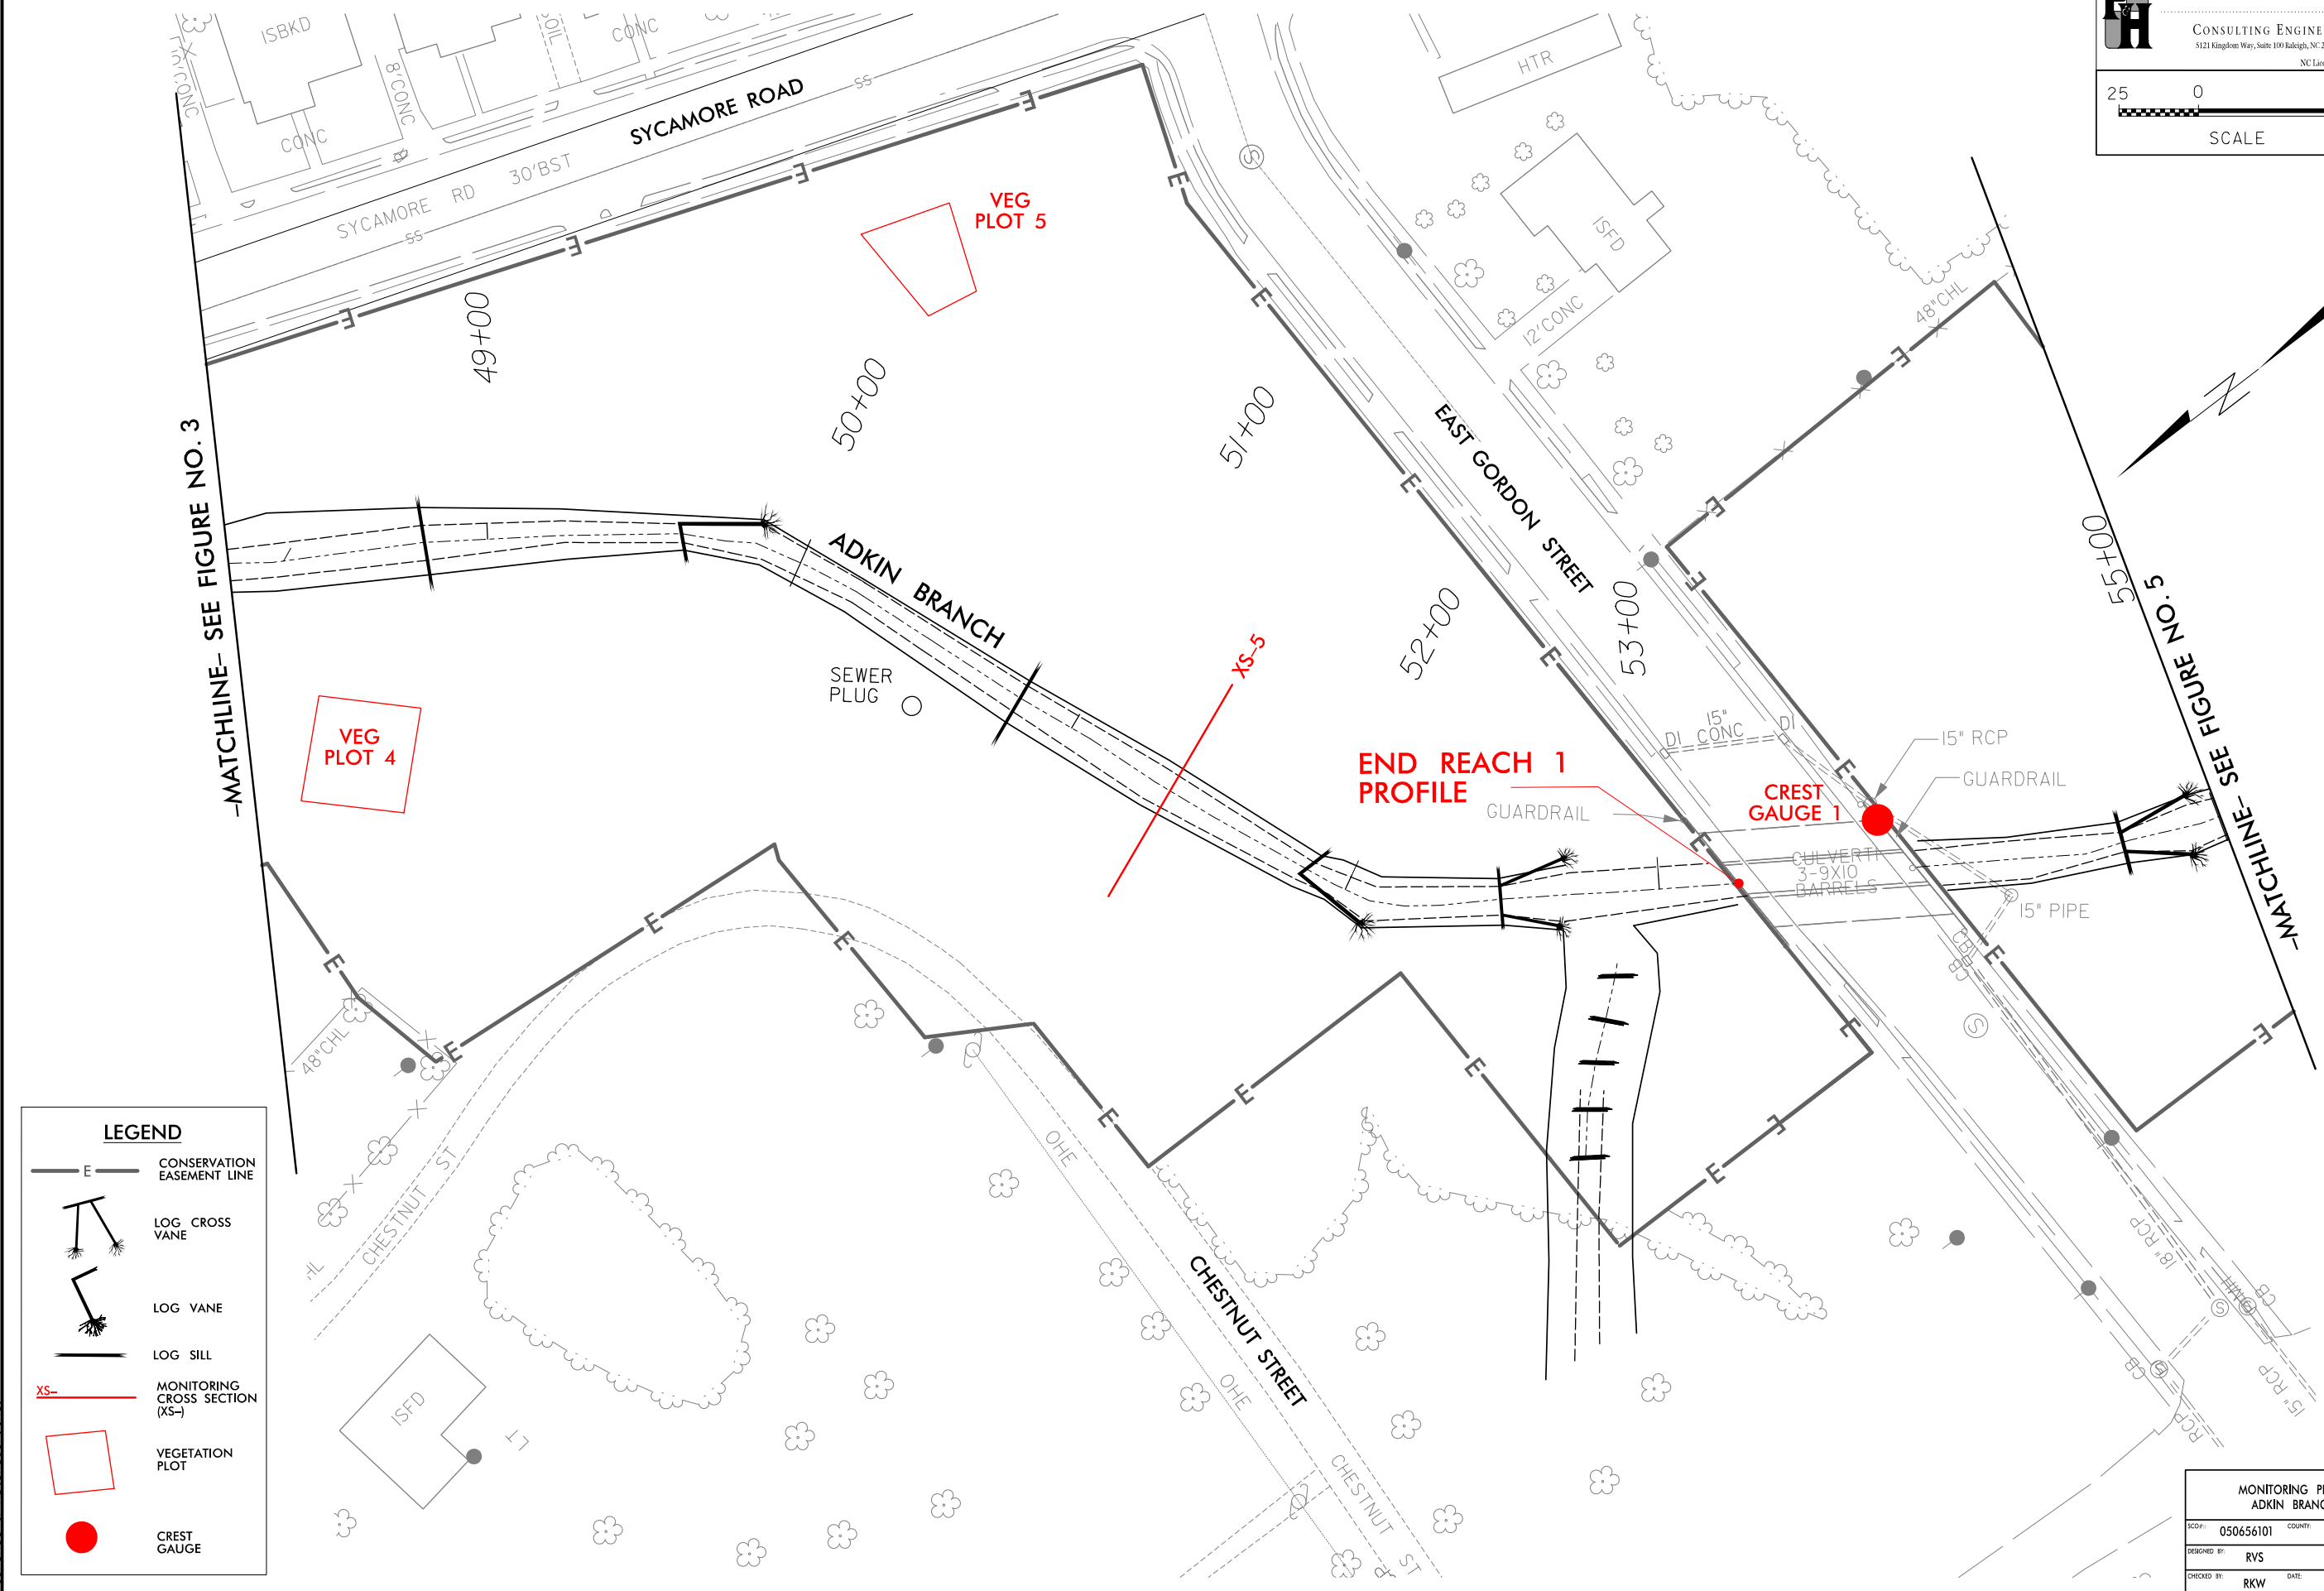




MONITORING PLANS



-MATCHLINE- SEE FIGURE NO. 3

-MATCHLINE- SEE FIGURE NO. 5


LEGEND

-  CONSERVATION EASEMENT LINE
-  LOG CROSS VANE
-  LOG VANE
-  LOG SILL
-  MONITORING CROSS SECTION (XS-)
-  VEGETATION PLOT
-  CREST GAUGE




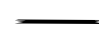



6/30/2011 Proj: Monitoring\AdkinBranch_Monitoring.psh_4.dgn
Florence & Hutcheson, Inc.
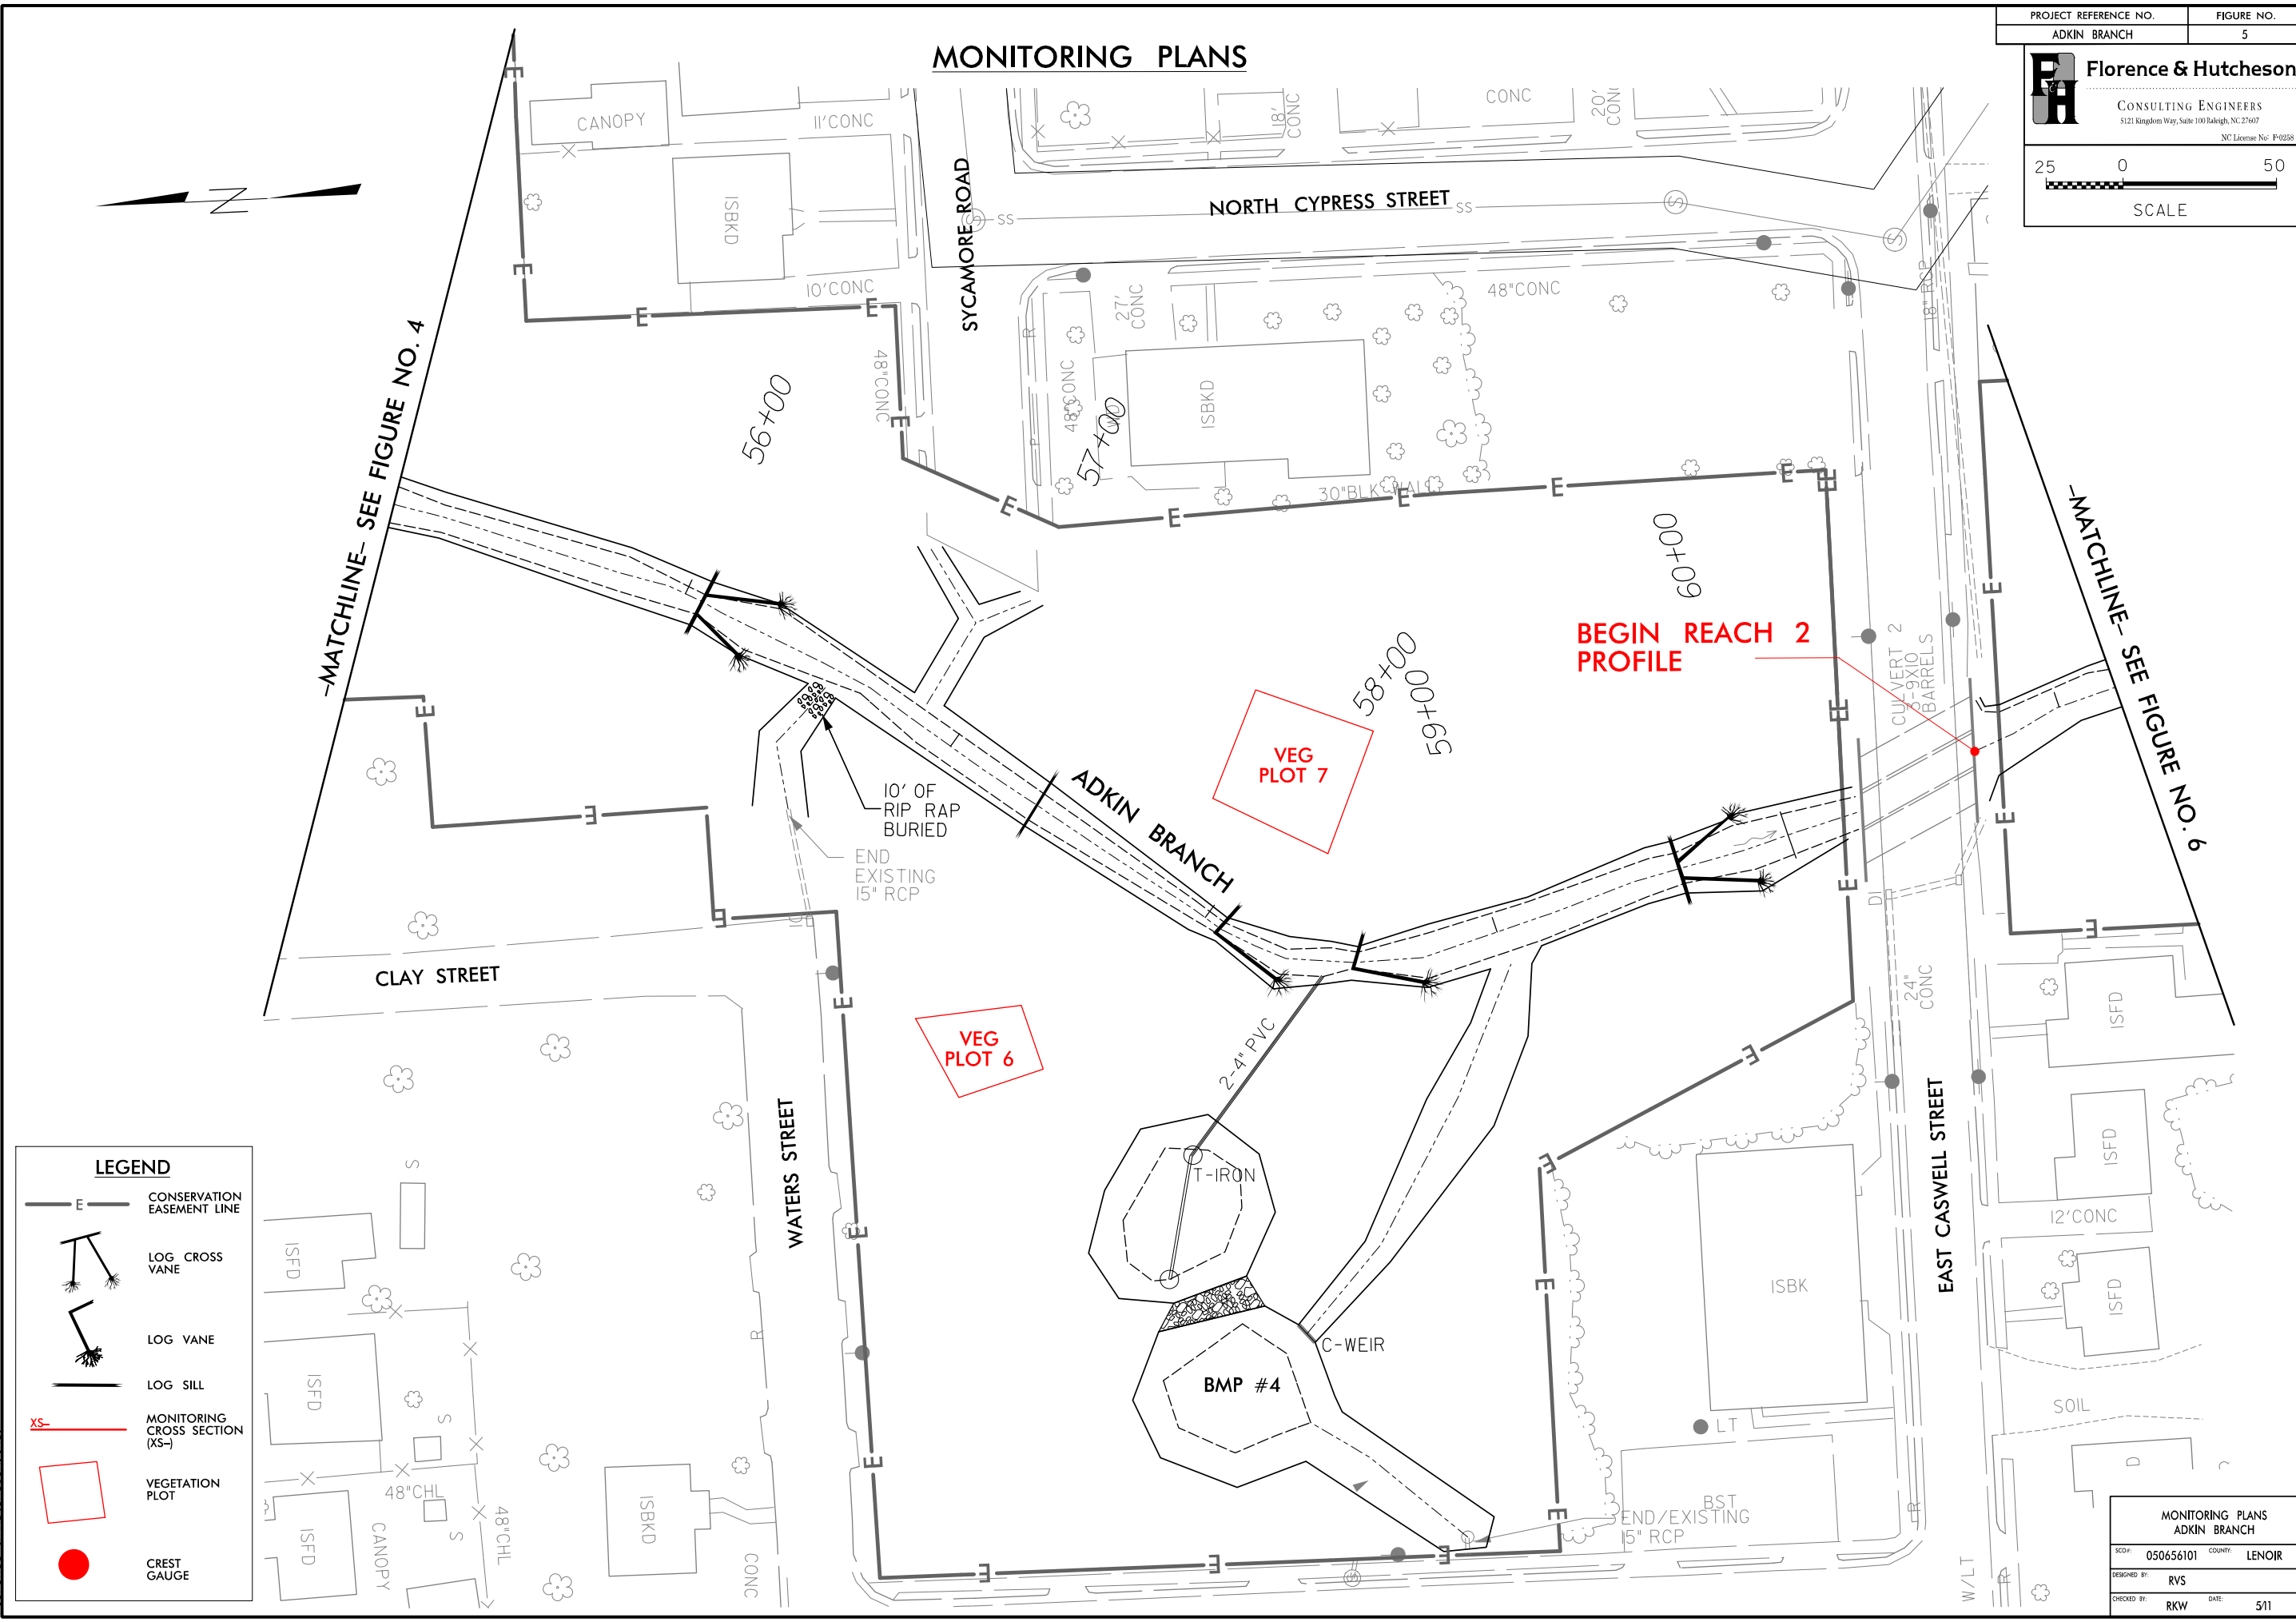
| | |
|----------------------------------|----------------|
| MONITORING PLANS ADKIN BRANCH | |
| SCD#: 050656101 | COUNTY: LENOIR |
| DESIGNED BY: RVS | |
| CHECKED BY: RKW | DATE: 5/11 |

MONITORING PLANS



LEGEND






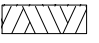



-  CONSERVATION EASEMENT LINE
-  LOG CROSS VANE
-  LOG VANE
-  LOG SILL
-  MONITORING CROSS SECTION (XS)
-  VEGETATION PLOT
-  CREST GAUGE


6/30/2011 Proj: Monitoring\AdkinBranch_Monitoring.psh_5.dgn
 Florence & Hutcheson, Inc.

| | |
|----------------------------------|-----------------|
| MONITORING PLANS ADKIN BRANCH | |
| SCD#: 050656101 | COUNTY: LENOIR |
| DESIGNED BY: RVS | CHECKED BY: RKW |
| DATE: 5/11 | |

MONITORING PLANS

LEGEND


-  CONSERVATION EASEMENT LINE
-  ROOTWAD
-  LOG CROSS VANE
-  LOG VANE
-  LOG SILL
-  SOIL LIFT
-  MONITORING CROSS SECTION (XS-)
-  VEGETATION PLOT
-  CREST GAUGE

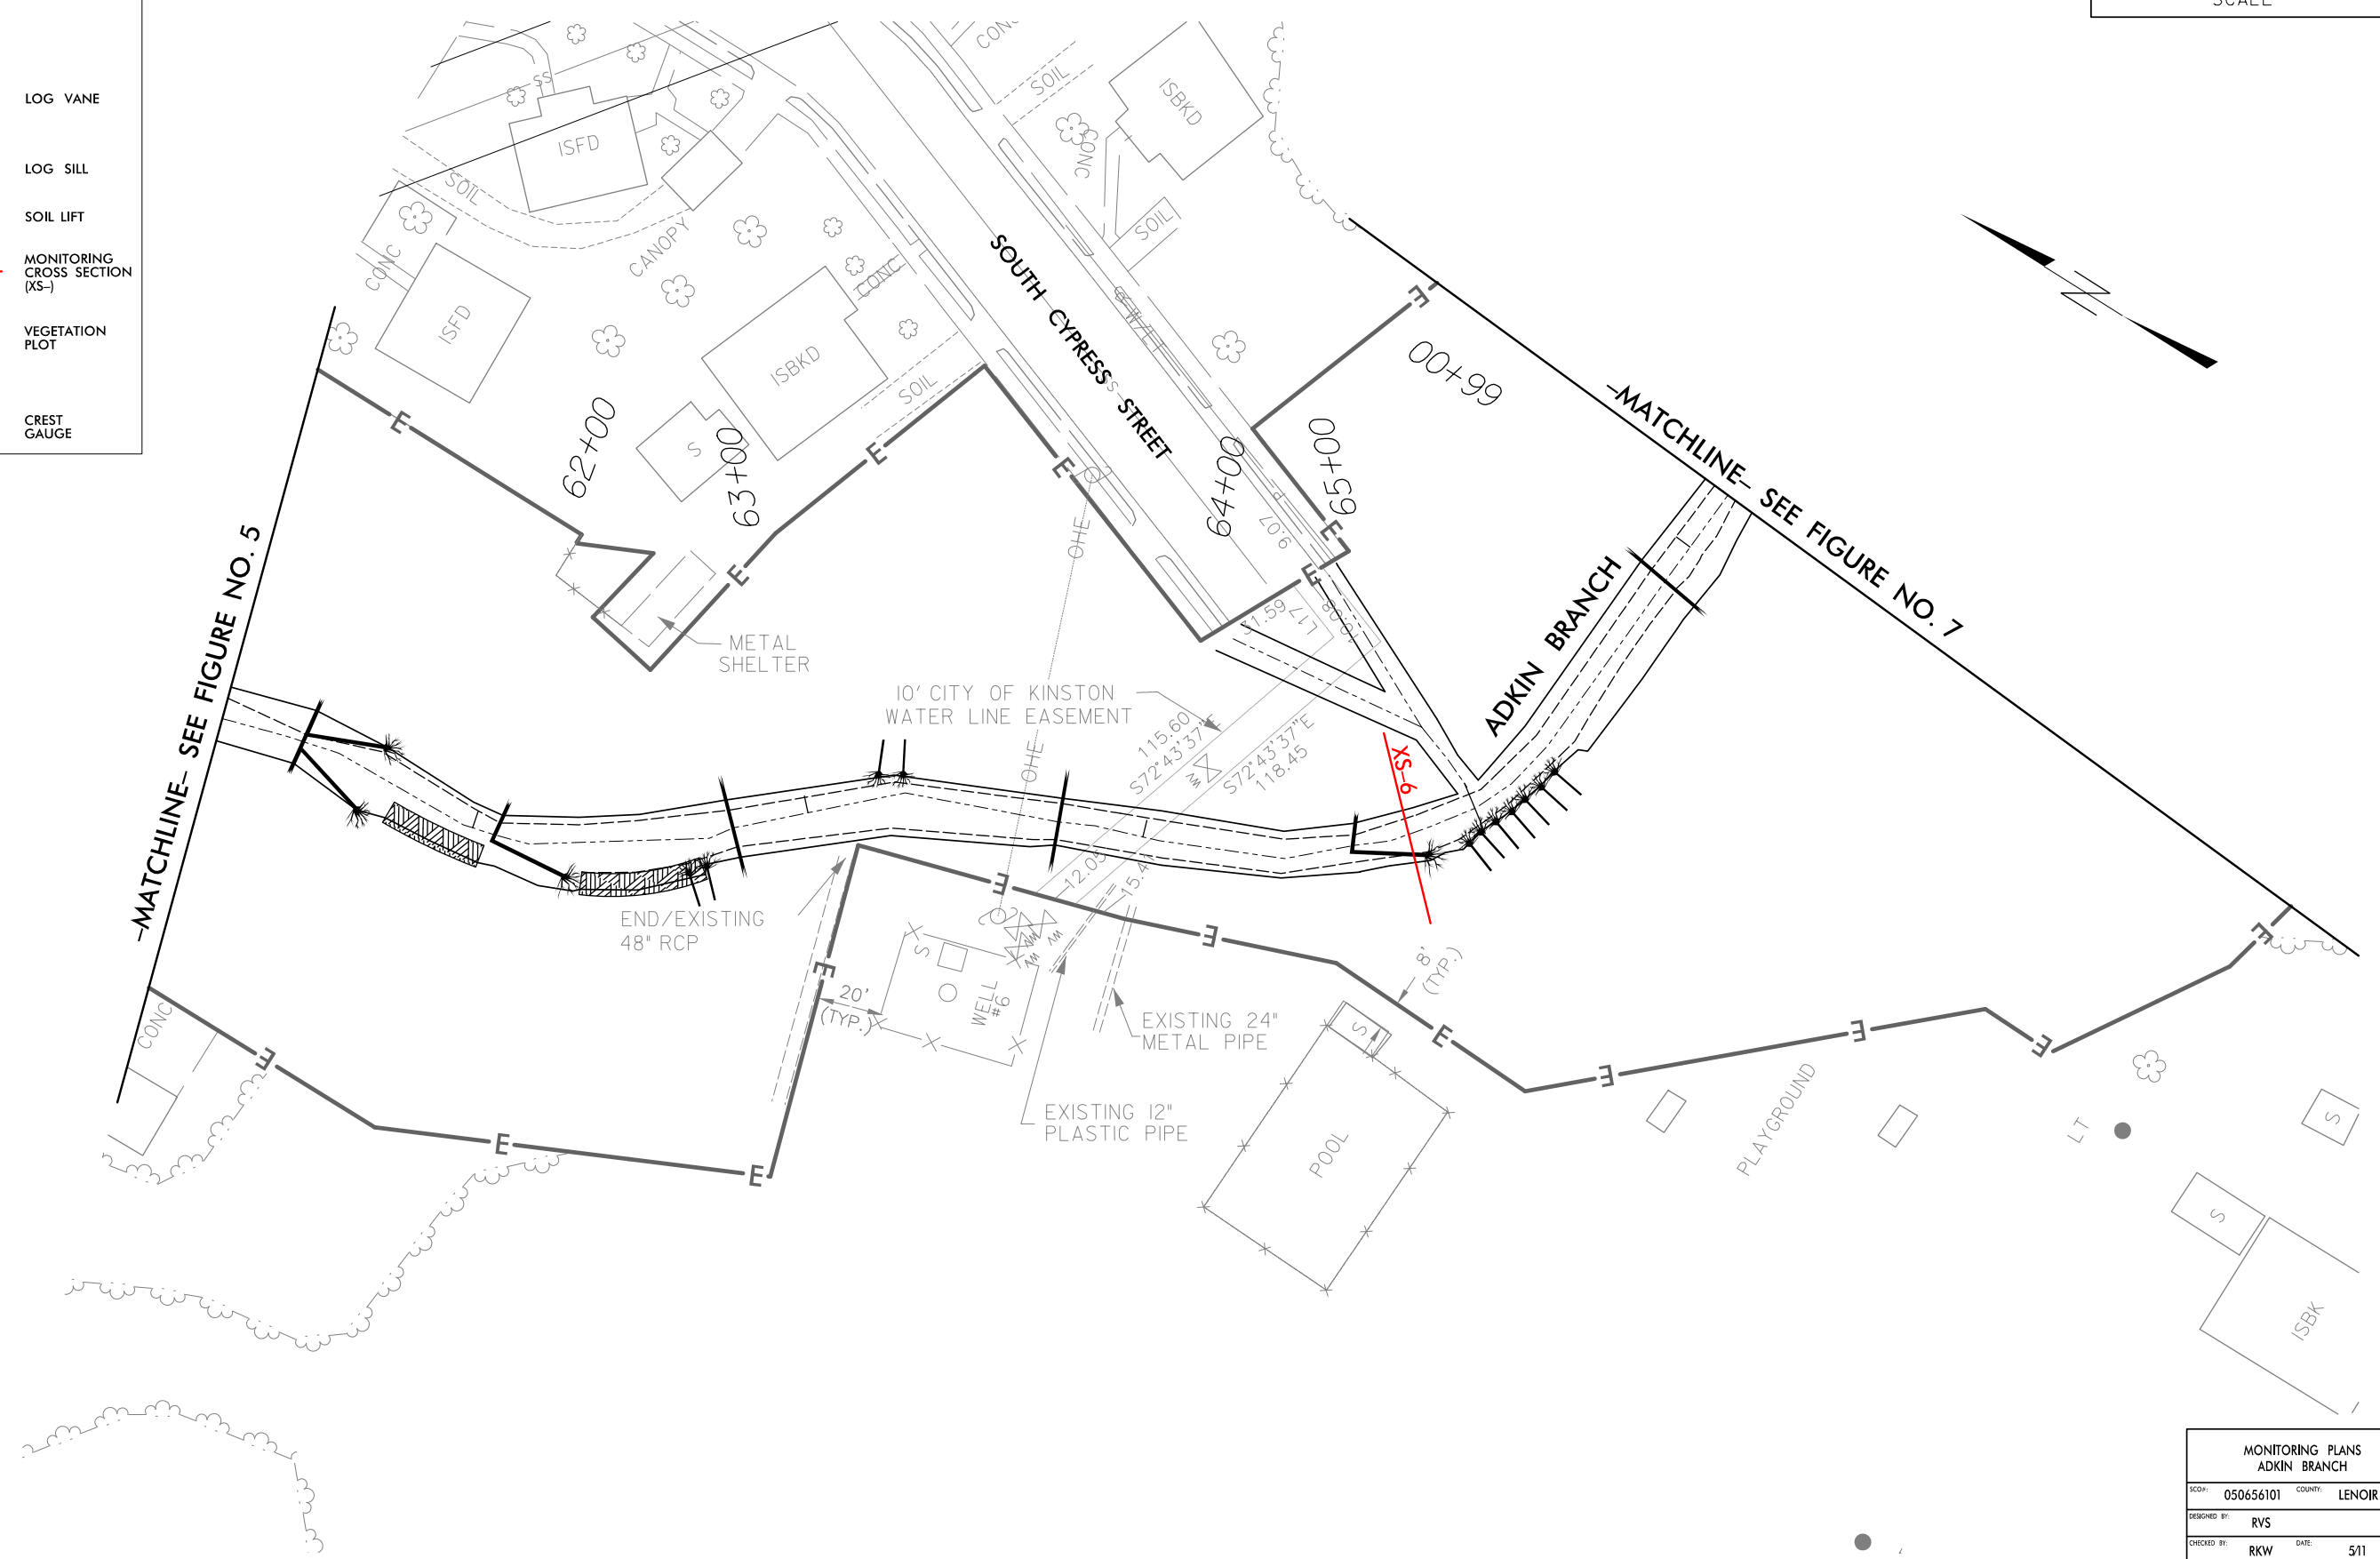







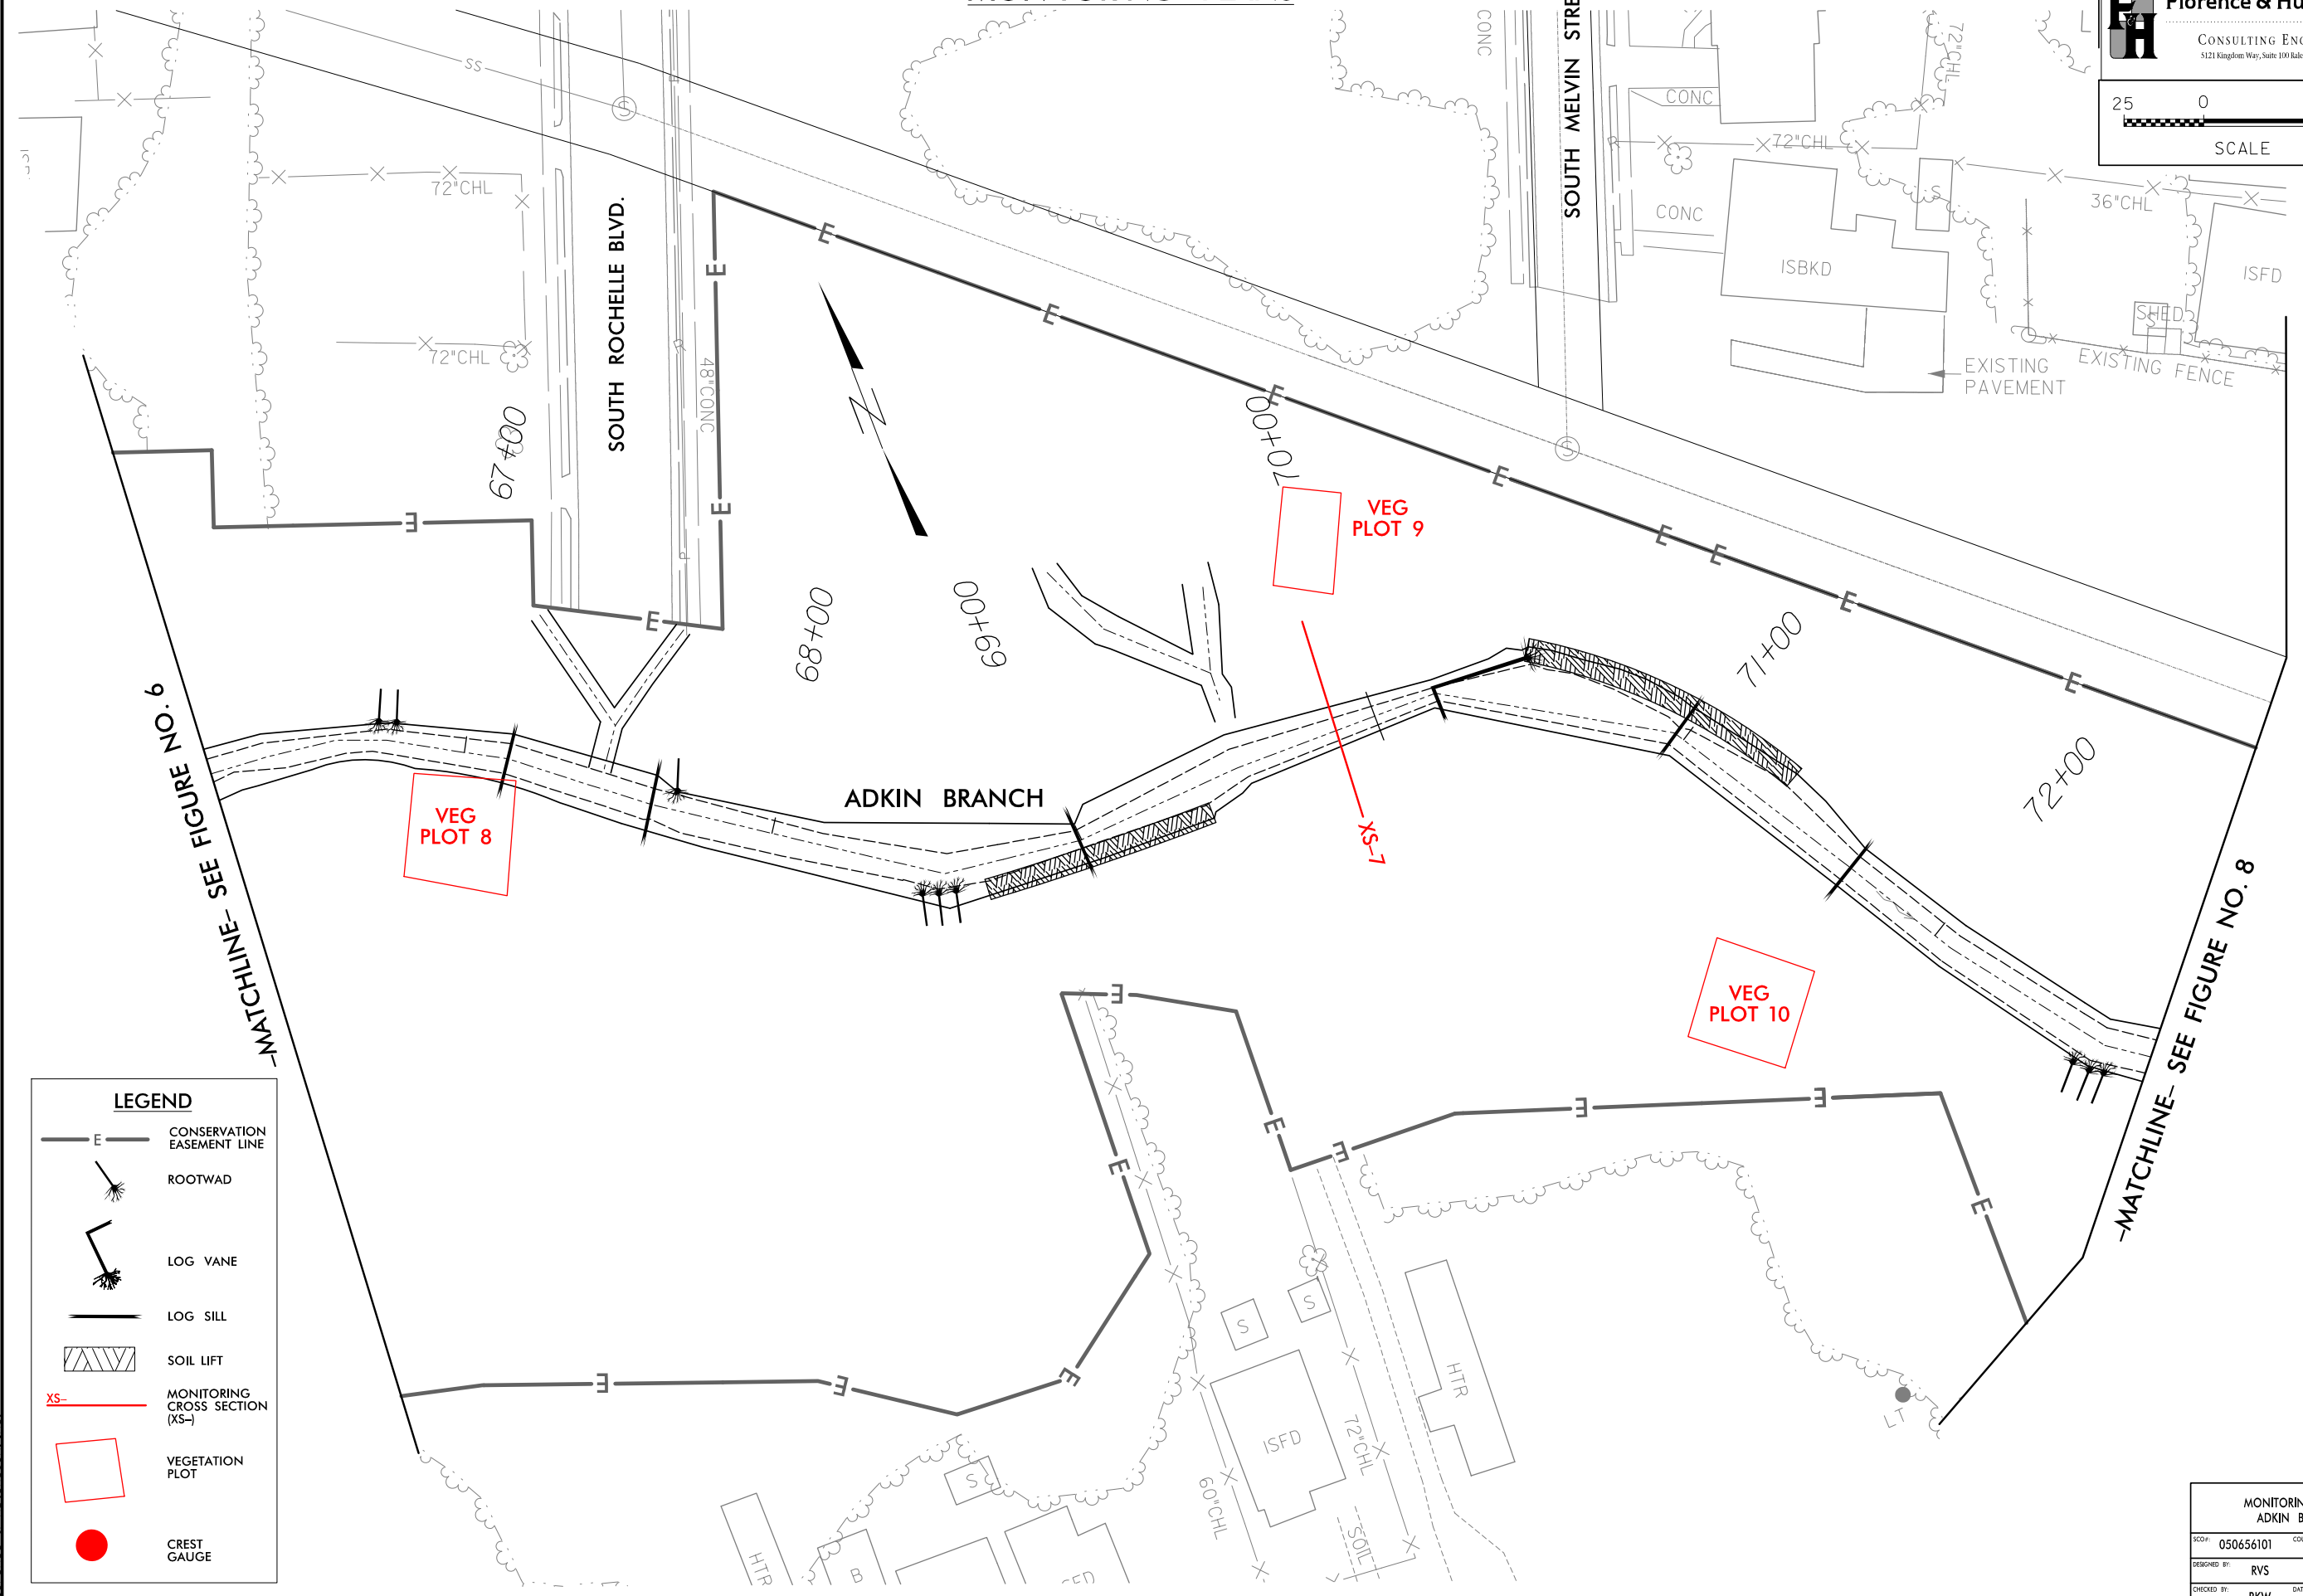

6/30/2011
 P:\Streams\Proj\Monitoring\AdkinBranch_Monitoring.psh_6.dgn
 Florence & Hutcheson, Inc.

| | |
|----------------------------------|----------------|
| MONITORING PLANS ADKIN BRANCH | |
| SCOP: 050656101 | COUNTY: LENOIR |
| DESIGNED BY: RVS | |
| CHECKED BY: RKW | DATE: 5/11 |

MONITORING PLANS



LEGEND

-  CONSERVATION EASEMENT LINE
-  ROOTWAD
-  LOG VANE
-  LOG SILL
-  SOIL LIFT
-  MONITORING CROSS SECTION (XS-1)
-  VEGETATION PLOT
-  CREST GAUGE

MATCHLINE - SEE FIGURE NO. 6









MATCHLINE - SEE FIGURE NO. 8


6/30/2011 Proj: Monitoring\AdkinBranch_Monitoring.psh_7.dgn Florence & Hutcheson, Inc.

| | |
|----------------------------------|----------------|
| MONITORING PLANS ADKIN BRANCH | |
| SCOP: 050656101 | COUNTY: LENOIR |
| DESIGNED BY: RVS | |
| CHECKED BY: RKW | DATE: 5/11 |

MONITORING PLANS

LEGEND


-  CONSERVATION EASEMENT LINE
-  ROOTWAD
-  LOG VANE
-  LOG SILL
-  SOIL LIFT
-  MONITORING CROSS SECTION (XS-)
-  VEGETATION PLOT
-  CREST GAUGE

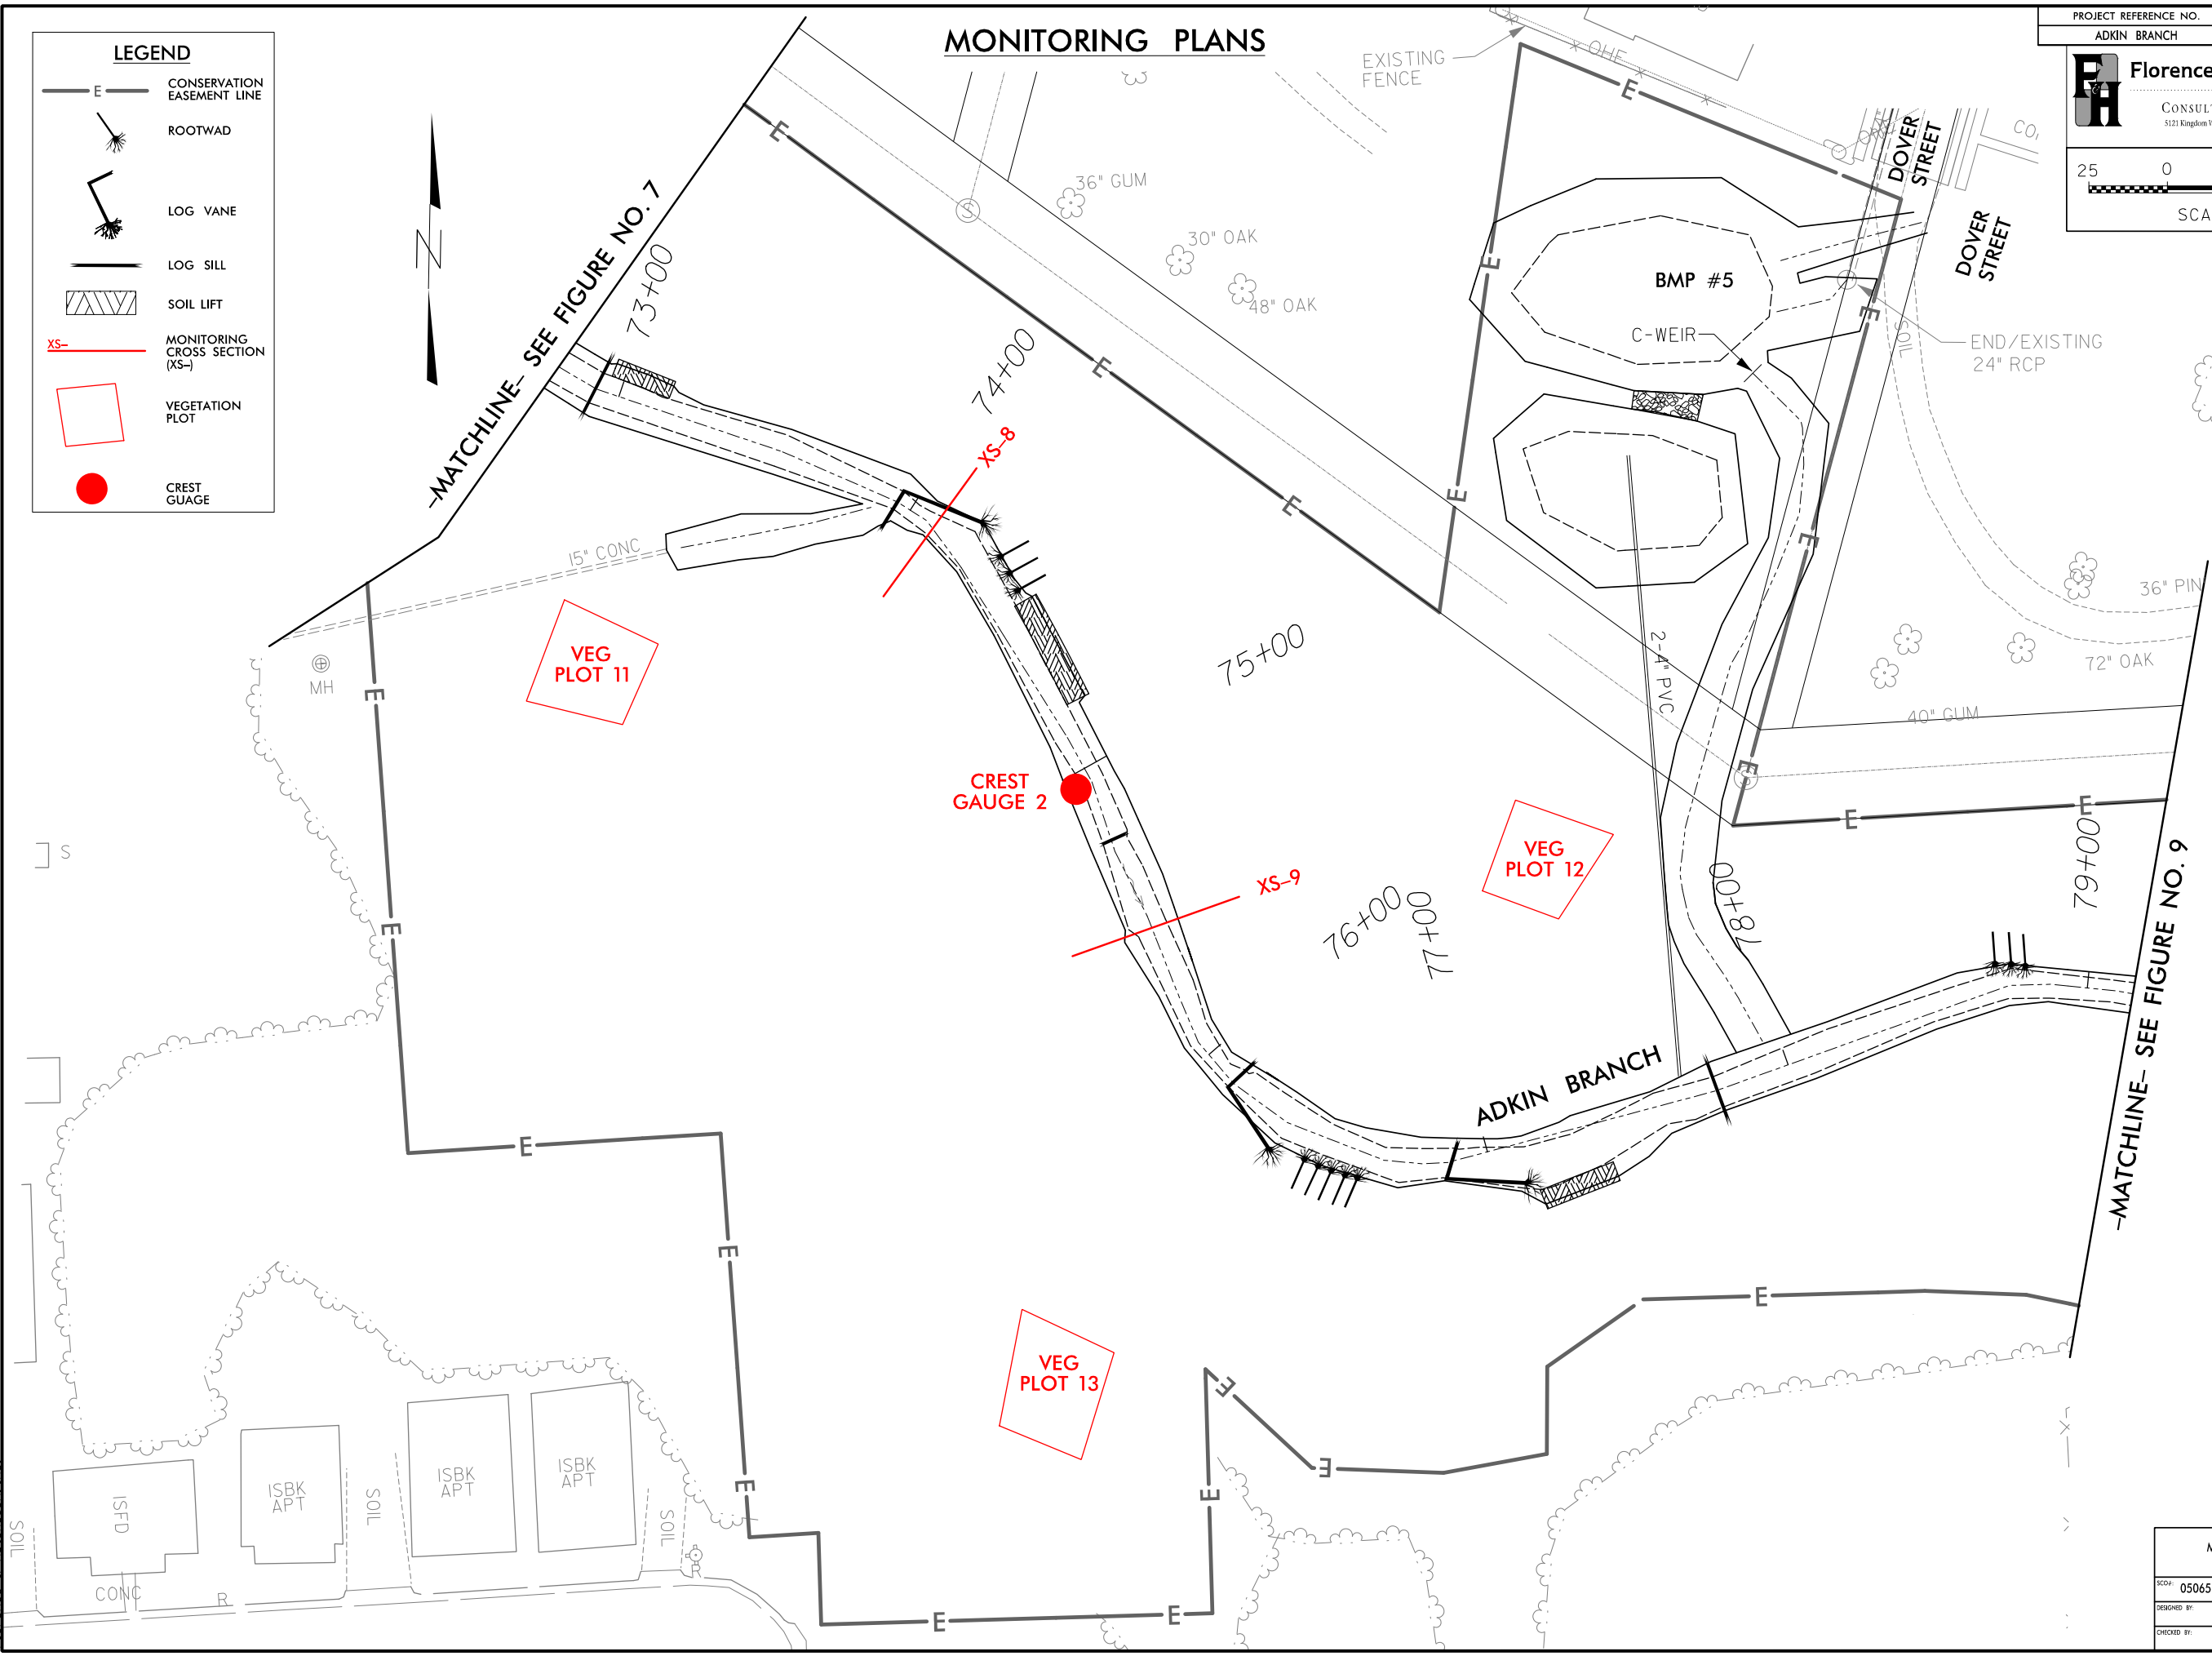

6/30/2011
 E:\Streams\Proj\Monitoring\AdkinBranch_Monitoring.psh_B.dgn
 Florence & Hutcheson, Inc.





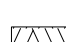


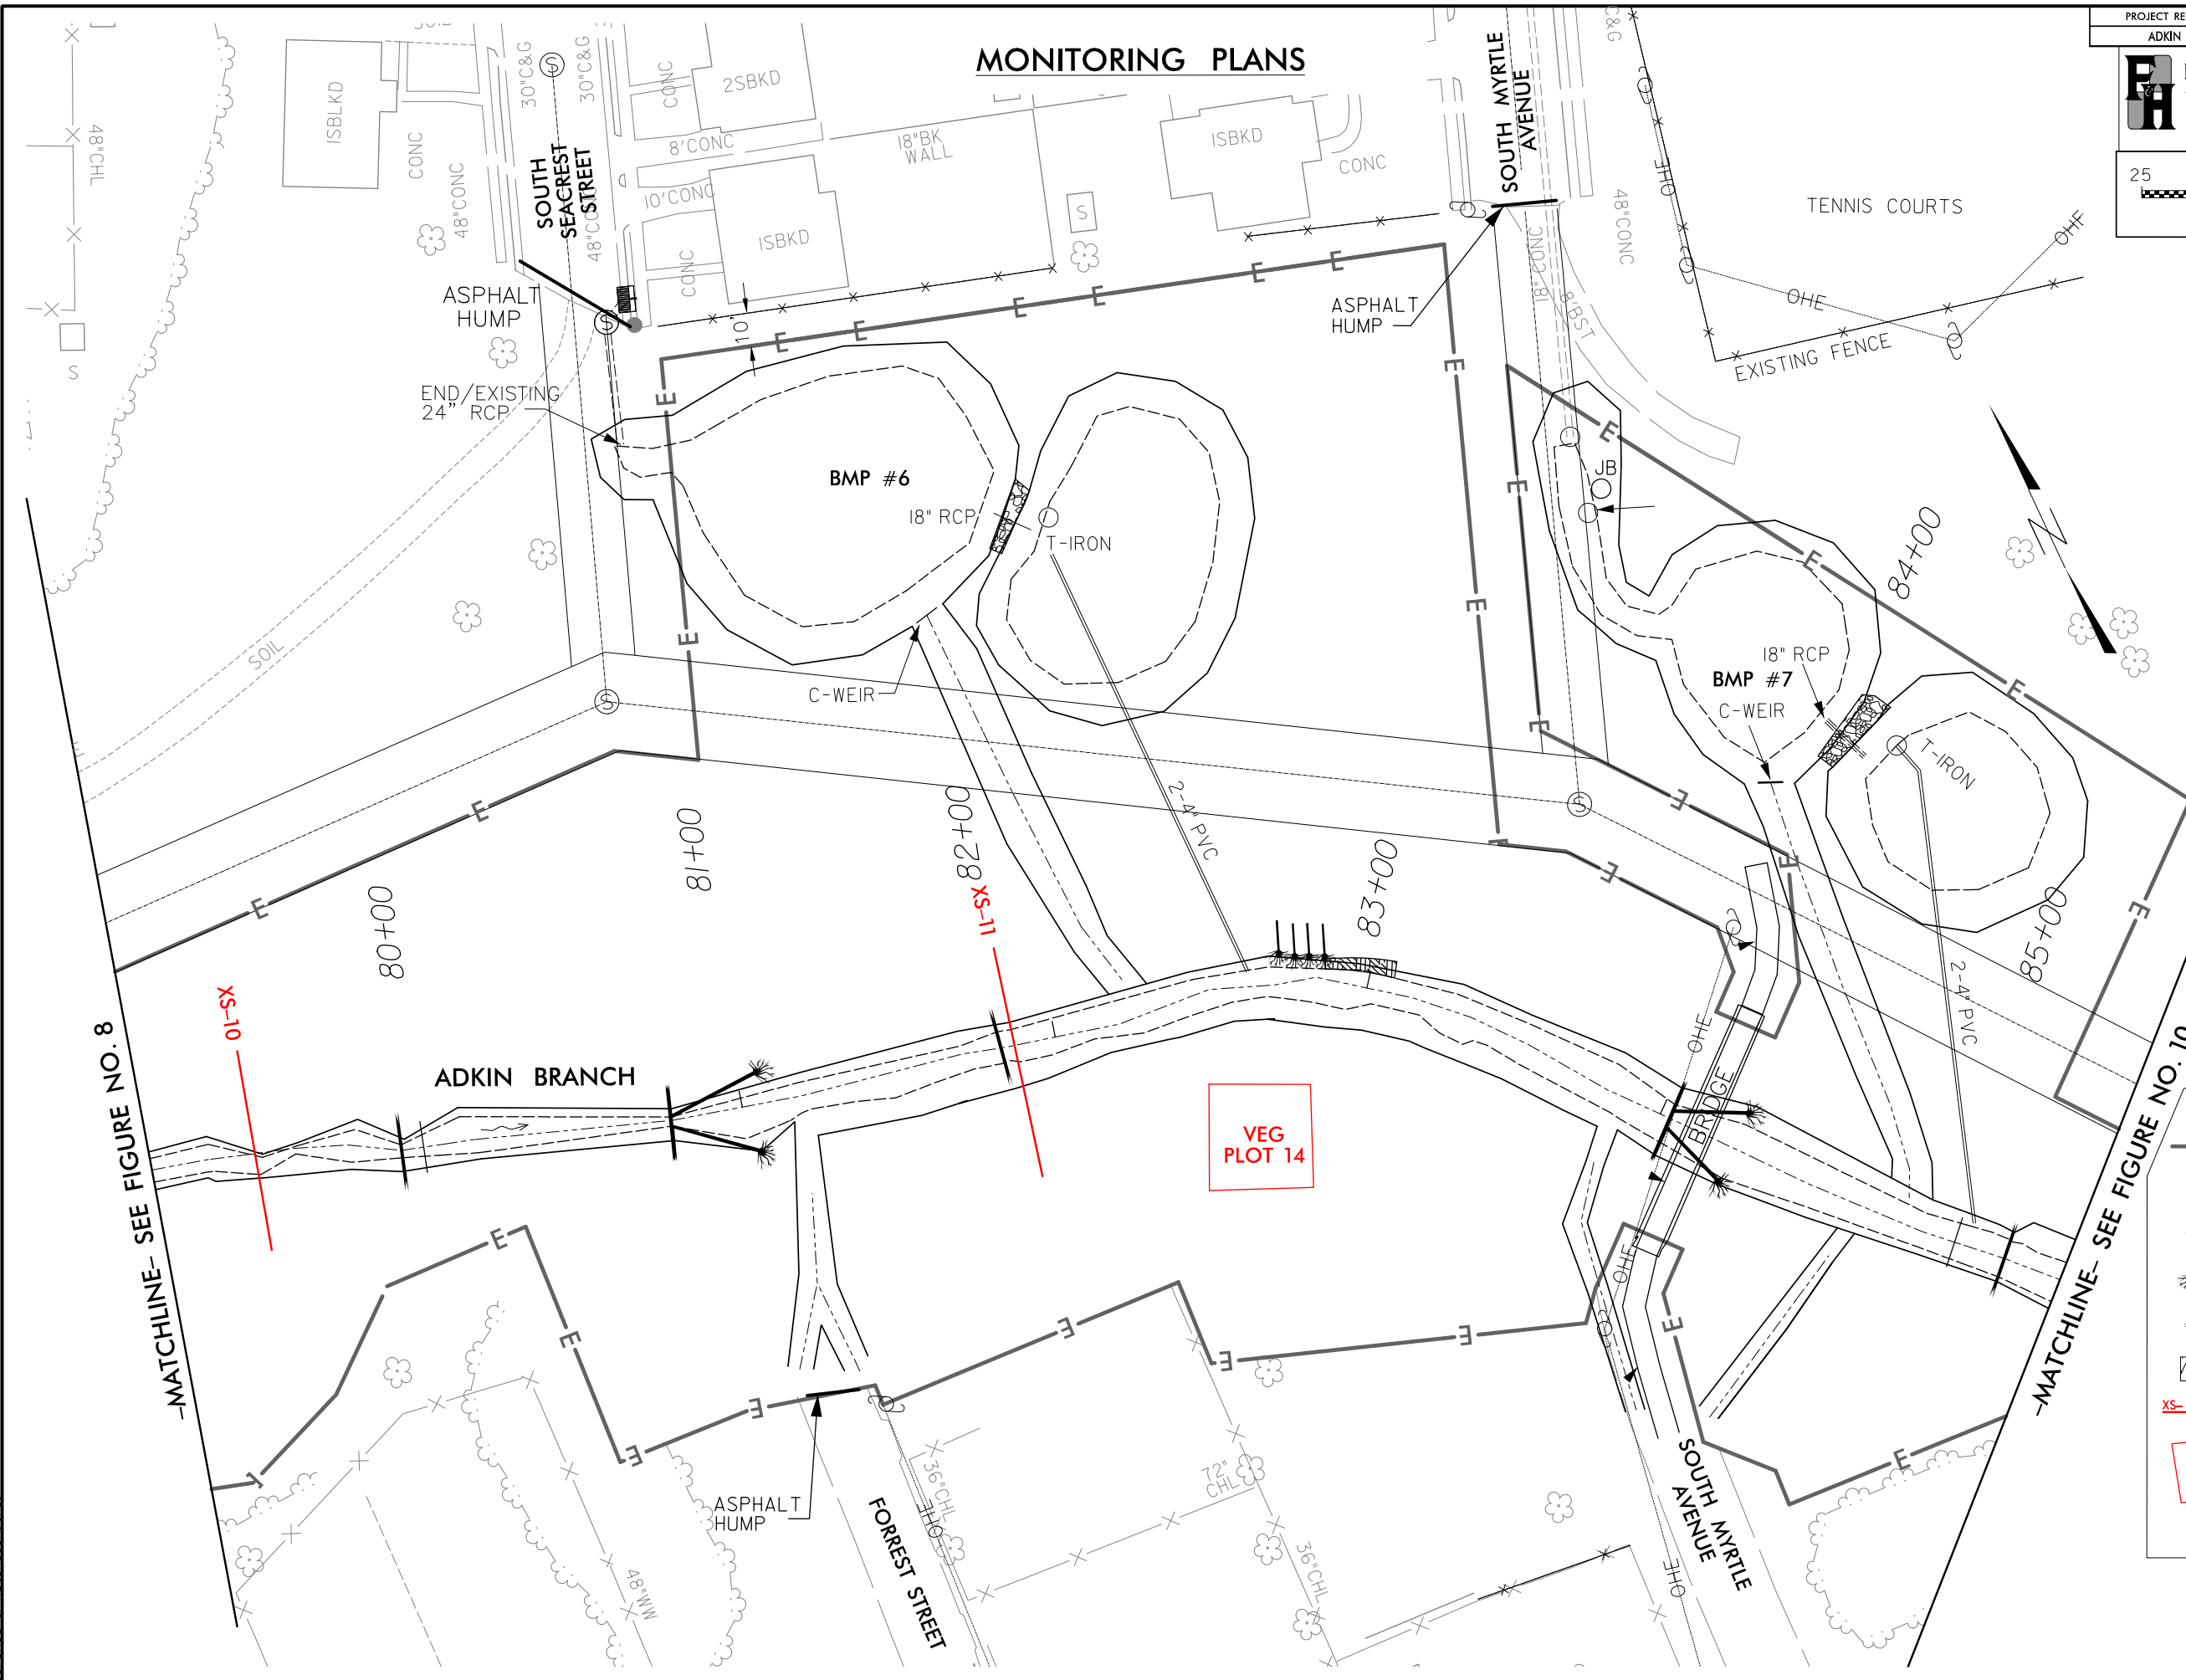
| | |
|----------------------------------|----------------|
| MONITORING PLANS ADKIN BRANCH | |
| SCOP: 050656101 | COUNTY: LENOIR |
| DESIGNED BY: RVS | |
| CHECKED BY: RKW | DATE: 5/11 |

MONITORING PLANS



-MATCHLINE- SEE FIGURE NO. 8

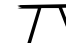

-MATCHLINE- SEE FIGURE NO. 10


| LEGEND | |
|---|--------------------------------|
|  | CONSERVATION EASEMENT LINE |
|  | ROOTWAD |
|  | LOG CROSS VANE |
|  | LOG SILL |
|  | SOIL LIFT |
|  | MONITORING CROSS SECTION (XS-) |
|  | VEGETATION PLOT |
|  | CREST GAUGE |

| | |
|----------------------------------|----------------|
| MONITORING PLANS ADKIN BRANCH | |
| SCD#: 050656101 | COUNTY: LENOIR |
| DESIGNED BY: RVS | |
| CHECKED BY: RKW | DATE: 5/11 |






 


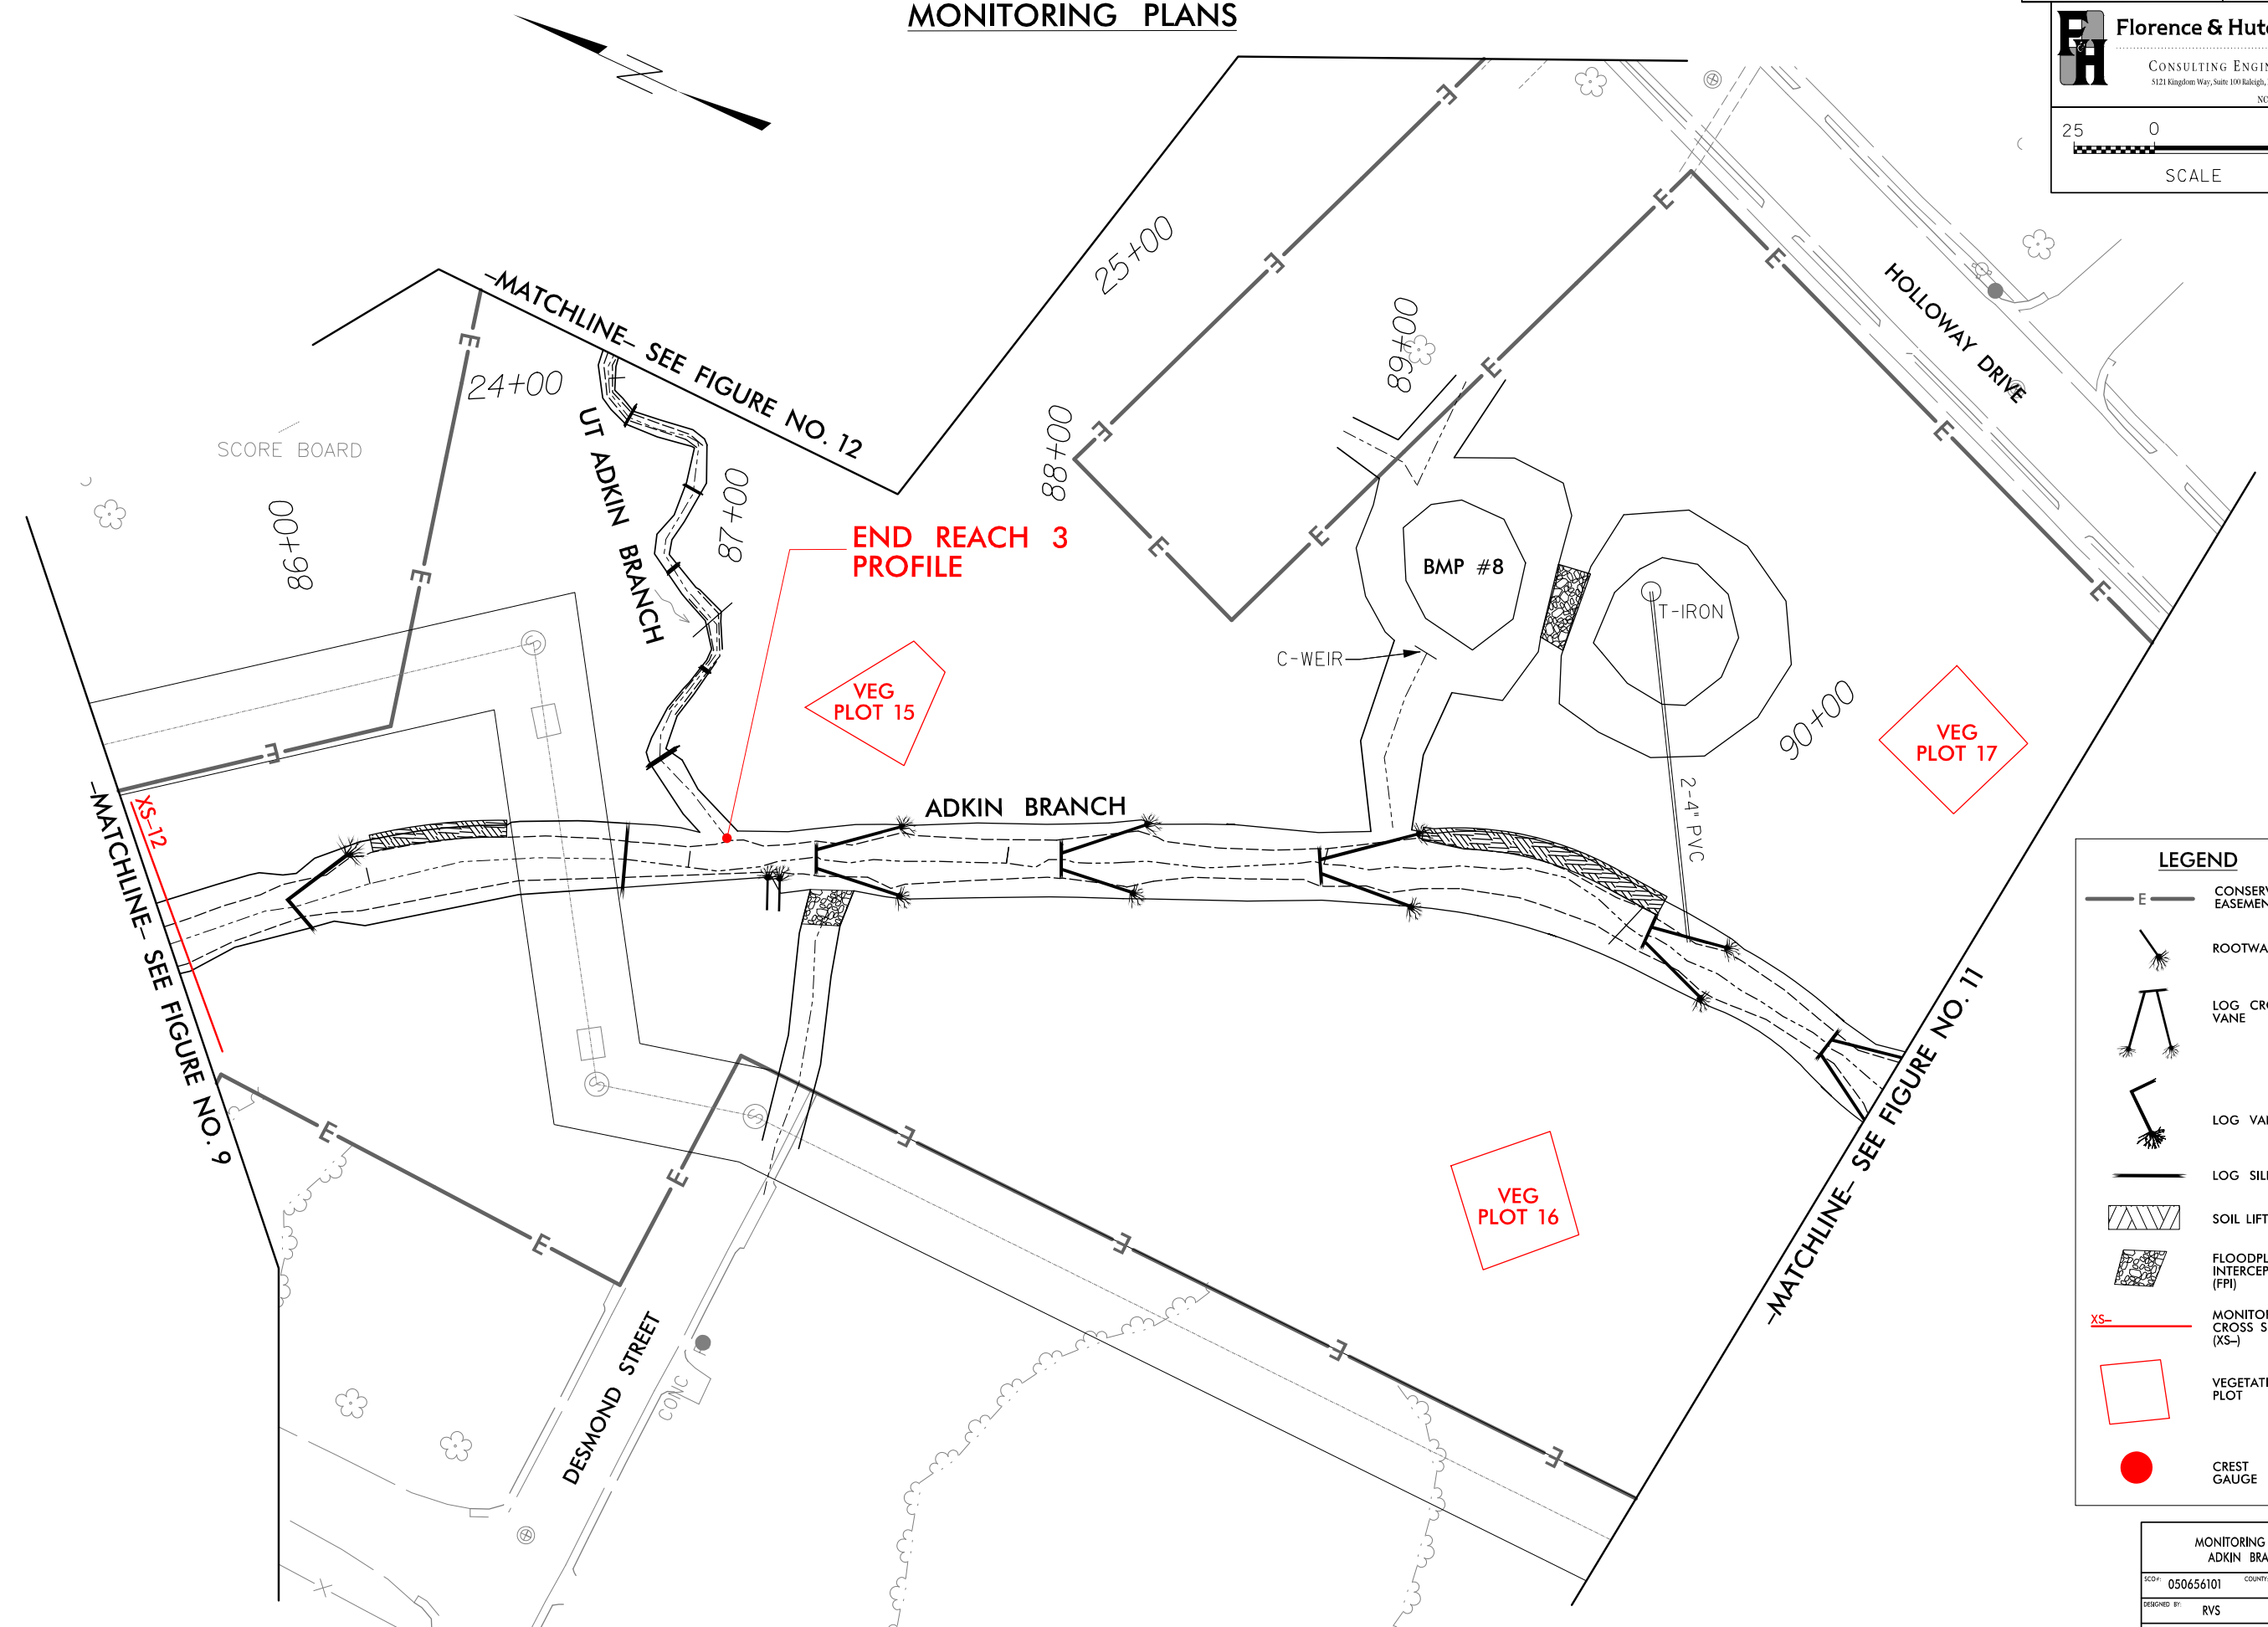

6/30/2011
 E:\Streams\Proj\Monitoring\AdkinBranch_Monitoring.psh_9.dgn
 Florence & Hutcheson, Inc.

MONITORING PLANS

| | |
|---|------------------|
| PROJECT REFERENCE NO. ADKIN BRANCH | FIGURE NO. 10 |
|  Florence & Hutcheson CONSULTING ENGINEERS 5121 Kingdom Way, Suite 100 Raleigh, NC 27607 NC License No. P-0258 | |
|  SCALE | |




LEGEND

-  CONSERVATION EASEMENT LINE
-  ROOTWAD
-  LOG CROSS VANE
-  LOG VANE
-  LOG SILL
-  SOIL LIFT
-  FLOODPLAIN INTERCEPTOR (FPI)
-  MONITORING CROSS SECTION (XS-)
-  VEGETATION PLOT
-  CREST GAUGE

| | |
|----------------------------------|---------------|
| MONITORING PLANS ADKIN BRANCH | |
| SCO#: 050656101 | COUNT: LENOIR |
| DESIGNED BY: RVS | |
| CHECKED BY: RKW | DATE: 5/11 |


6/30/2011
 P:\Streams\Proj\Monitoring\AdkinBranch_Monitoring.psh_10.dgn
 Florence & Hutcheson, Inc.

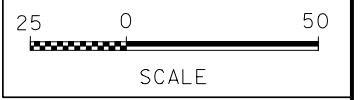

MONITORING PLANS



-MATCHLINE- SEE FIGURE NO. 10

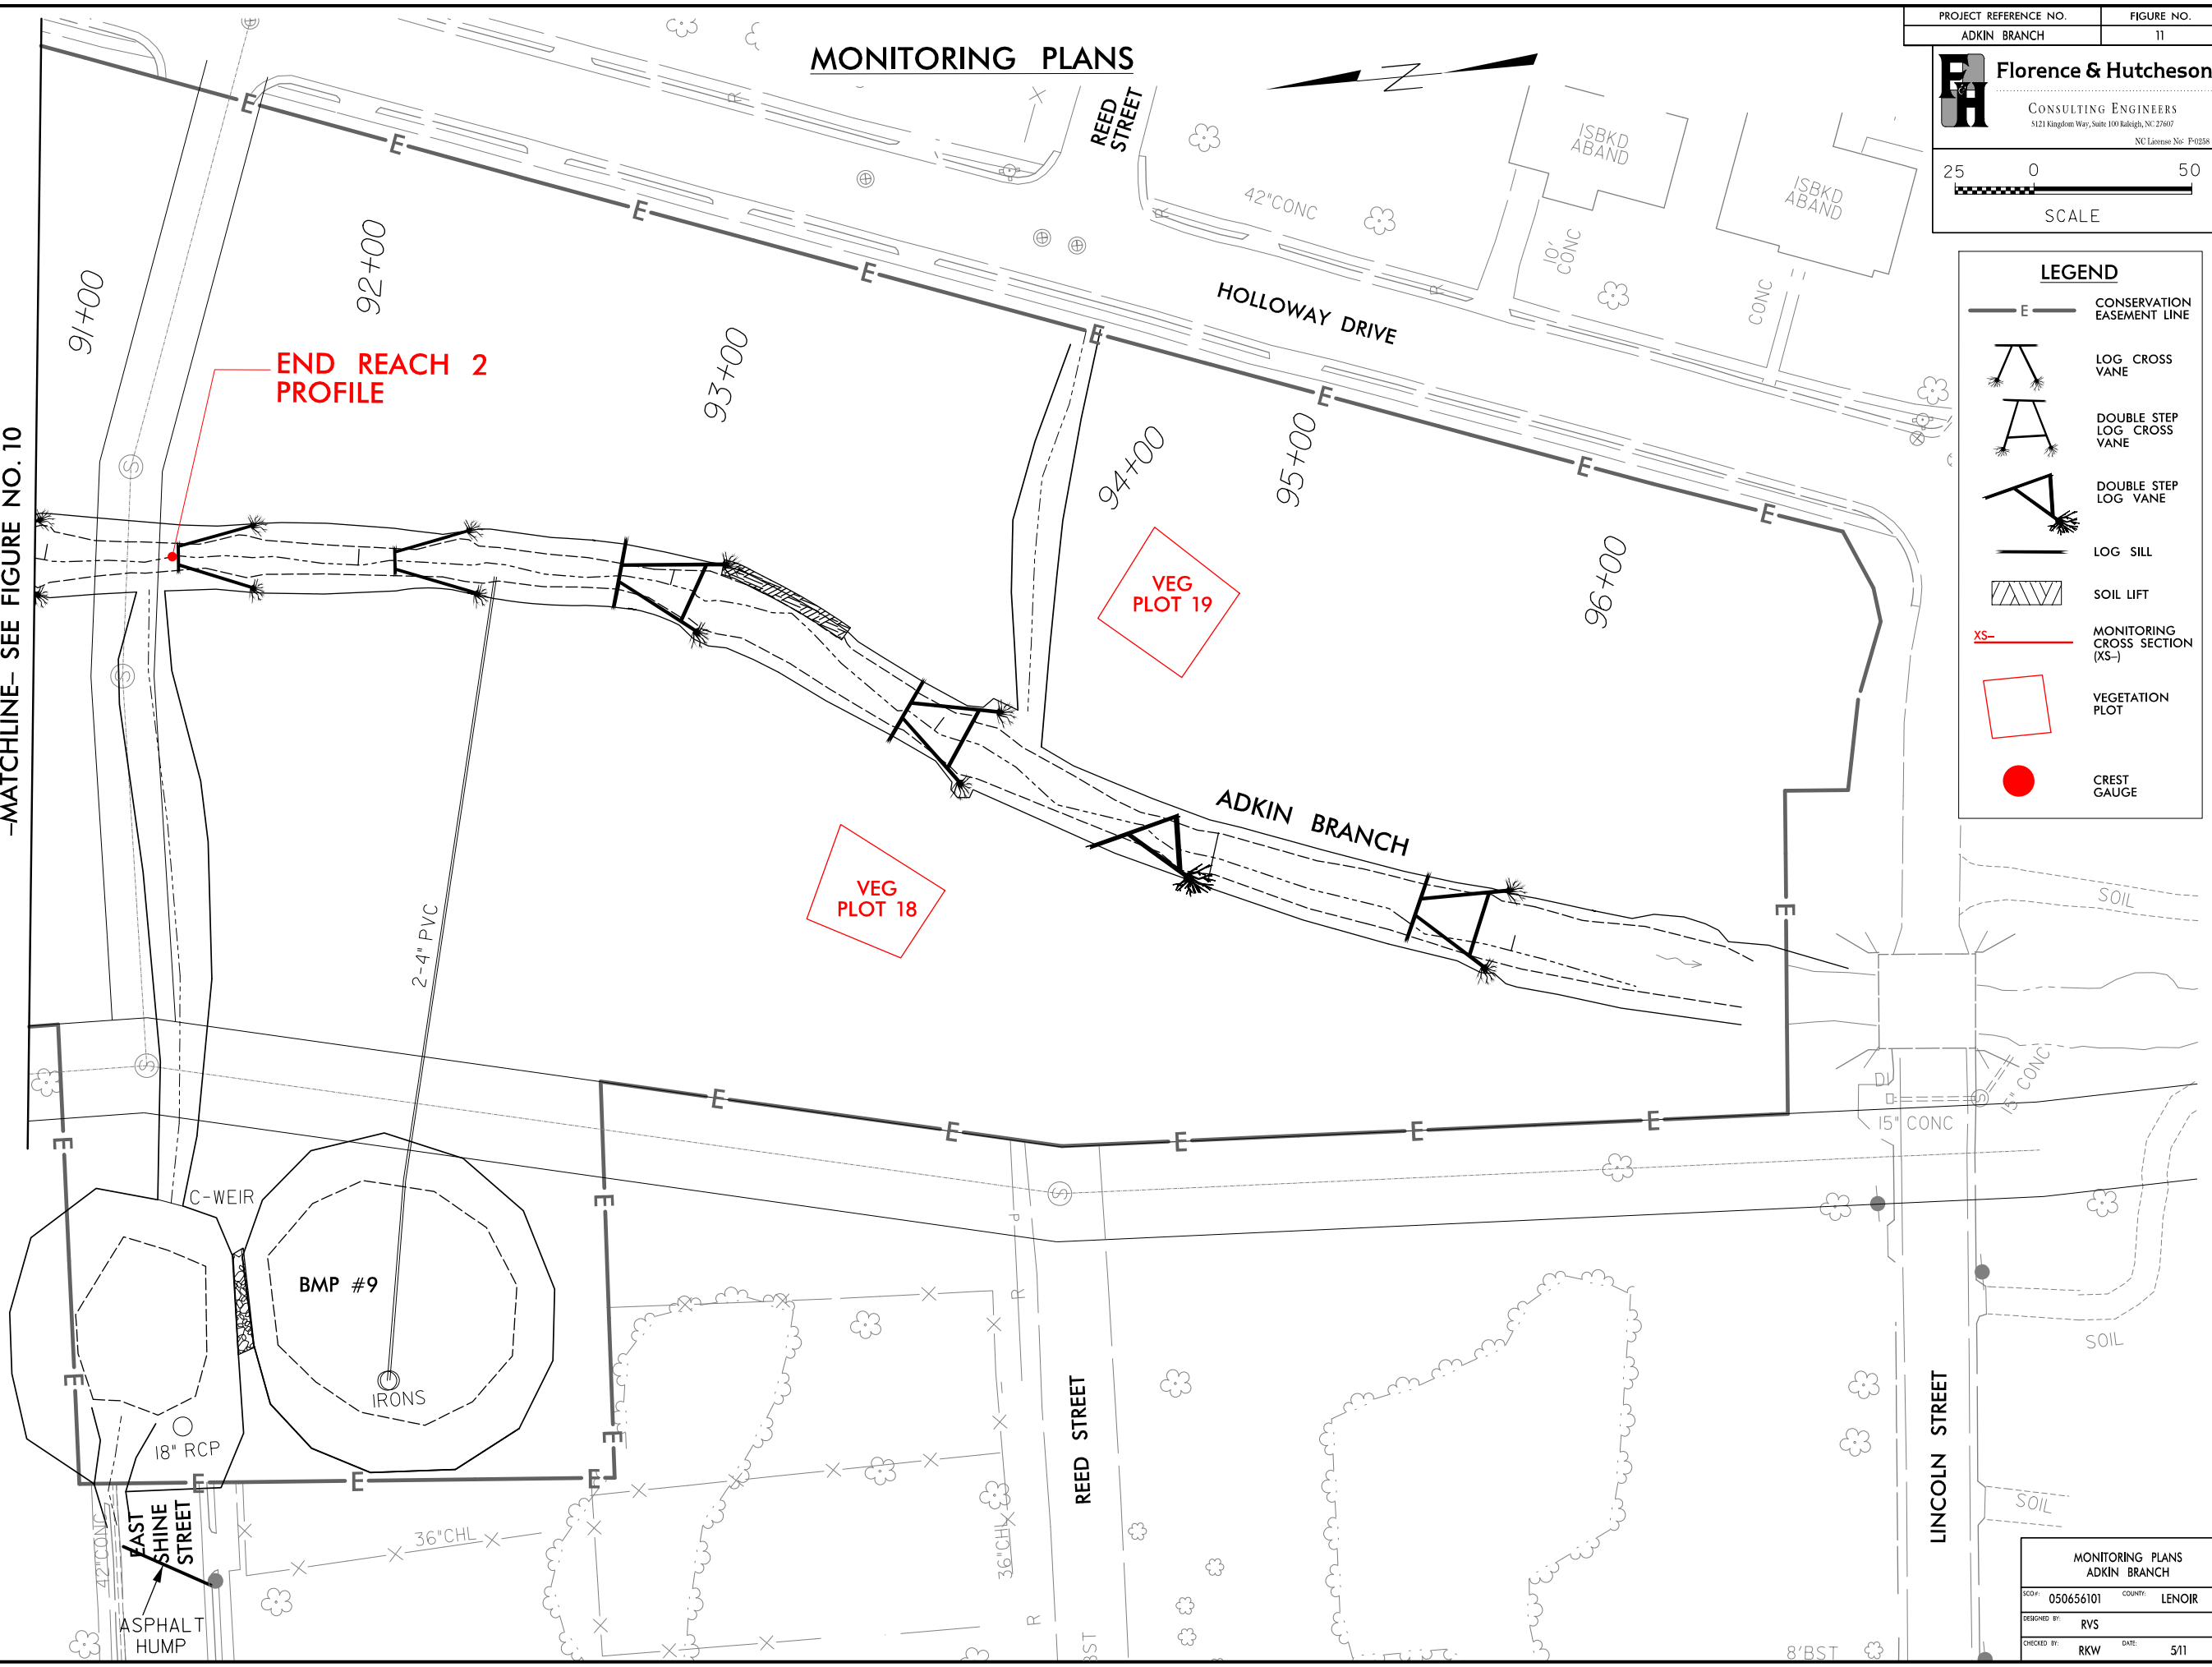

LEGEND



| | |
|--|--------------------------------|
| | CONSERVATION EASEMENT LINE |
| | LOG CROSS VANE |
| | DOUBLE STEP LOG CROSS VANE |
| | DOUBLE STEP LOG VANE |
| | LOG SILL |
| | SOIL LIFT |
| | MONITORING CROSS SECTION (XS-) |
| | VEGETATION PLOT |
| | CREST GAUGE |


6/30/2011
 P:\Streams\Proj\Monitoring\AdkinBranch_Monitoring.psh_11.dgn
 Florence & Hutcheson, Inc.

MONITORING PLANS
ADKIN BRANCH






| | |
|------------------|----------------|
| SCOPE: 050656101 | COUNTY: LENOIR |
| DESIGNED BY: RVS | |
| CHECKED BY: RKW | DATE: 5/11 |

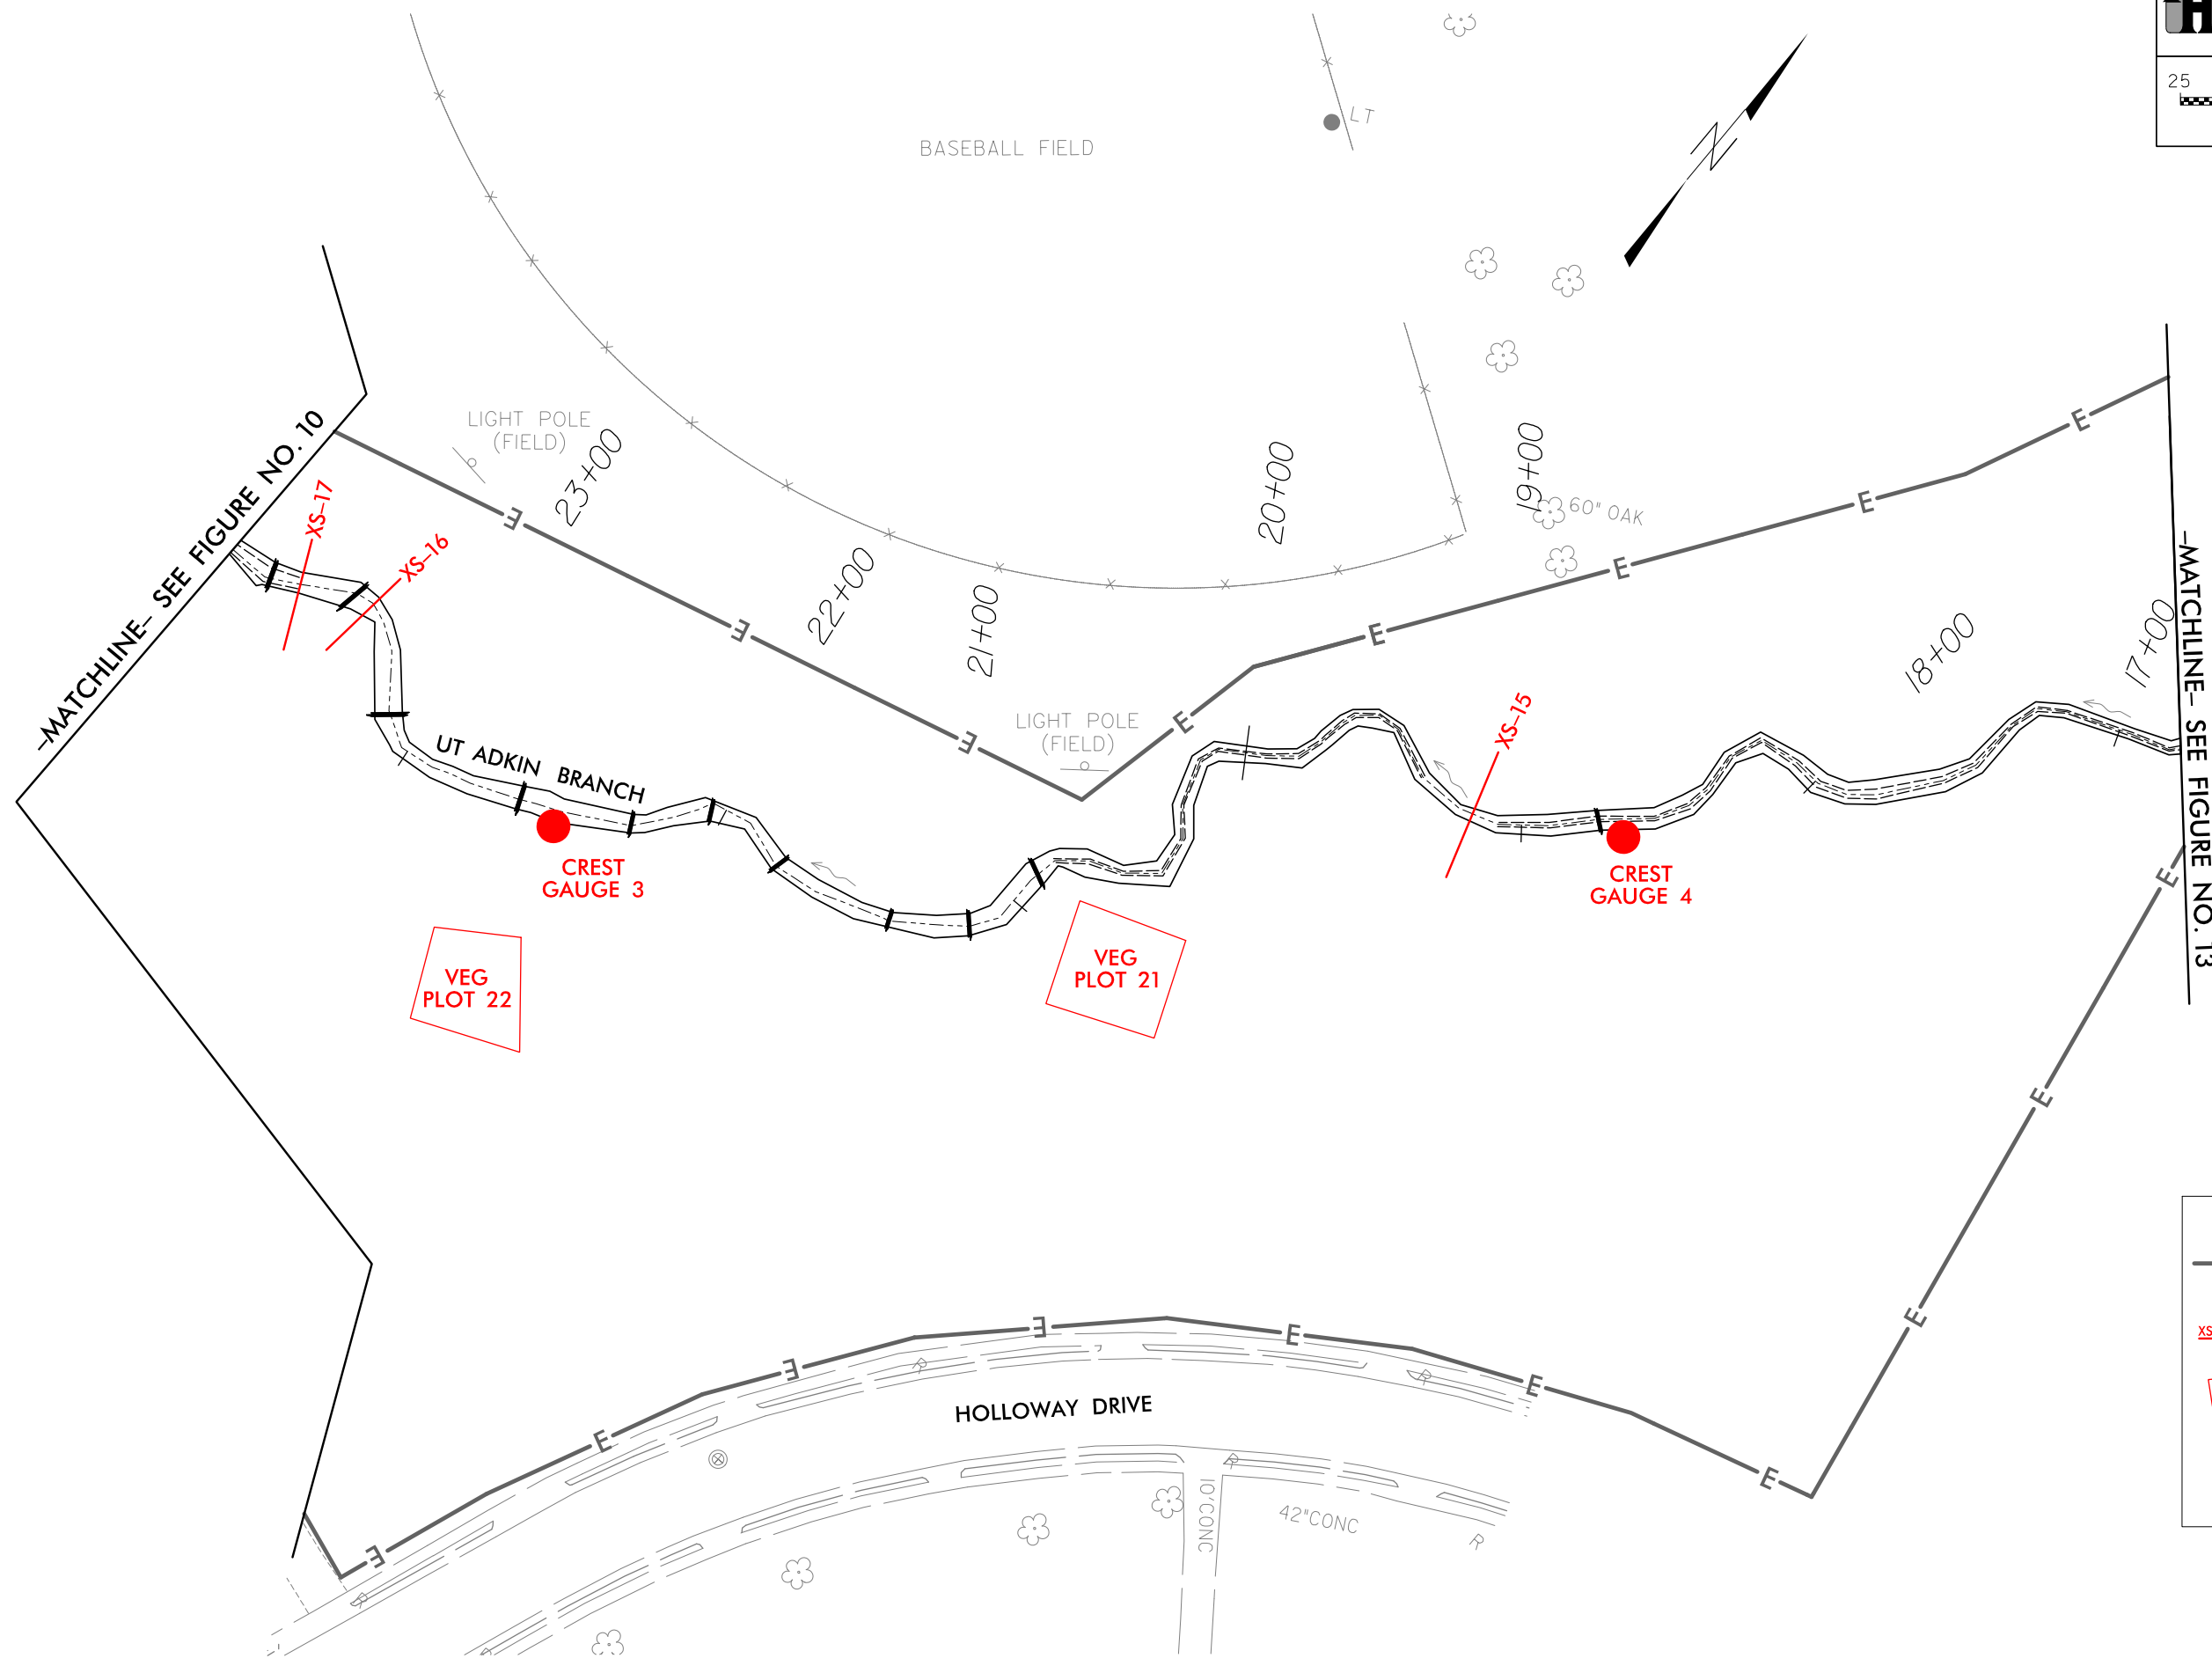MONITORING PLANS

| | |
|---|------------------|
| PROJECT REFERENCE NO. ADKIN BRANCH | FIGURE NO. 12 |
|  Florence & Hutcheson CONSULTING ENGINEERS 5121 Kingdom Way, Suite 100 Raleigh, NC 27607 NC License No. F-0058 | |
|  SCALE | |




LEGEND

-  CONSERVATION EASEMENT LINE
-  LOG SILL
-  MONITORING CROSS SECTION (XS-)
-  VEGETATION PLOT
-  CREST GAUGE






| | |
|----------------------------------|----------------|
| MONITORING PLANS ADKIN BRANCH | |
| SCOPE: 050656101 | COUNTY: LENOIR |
| DESIGNED BY: RVS | |
| CHECKED BY: RKW | DATE: 5/11 |

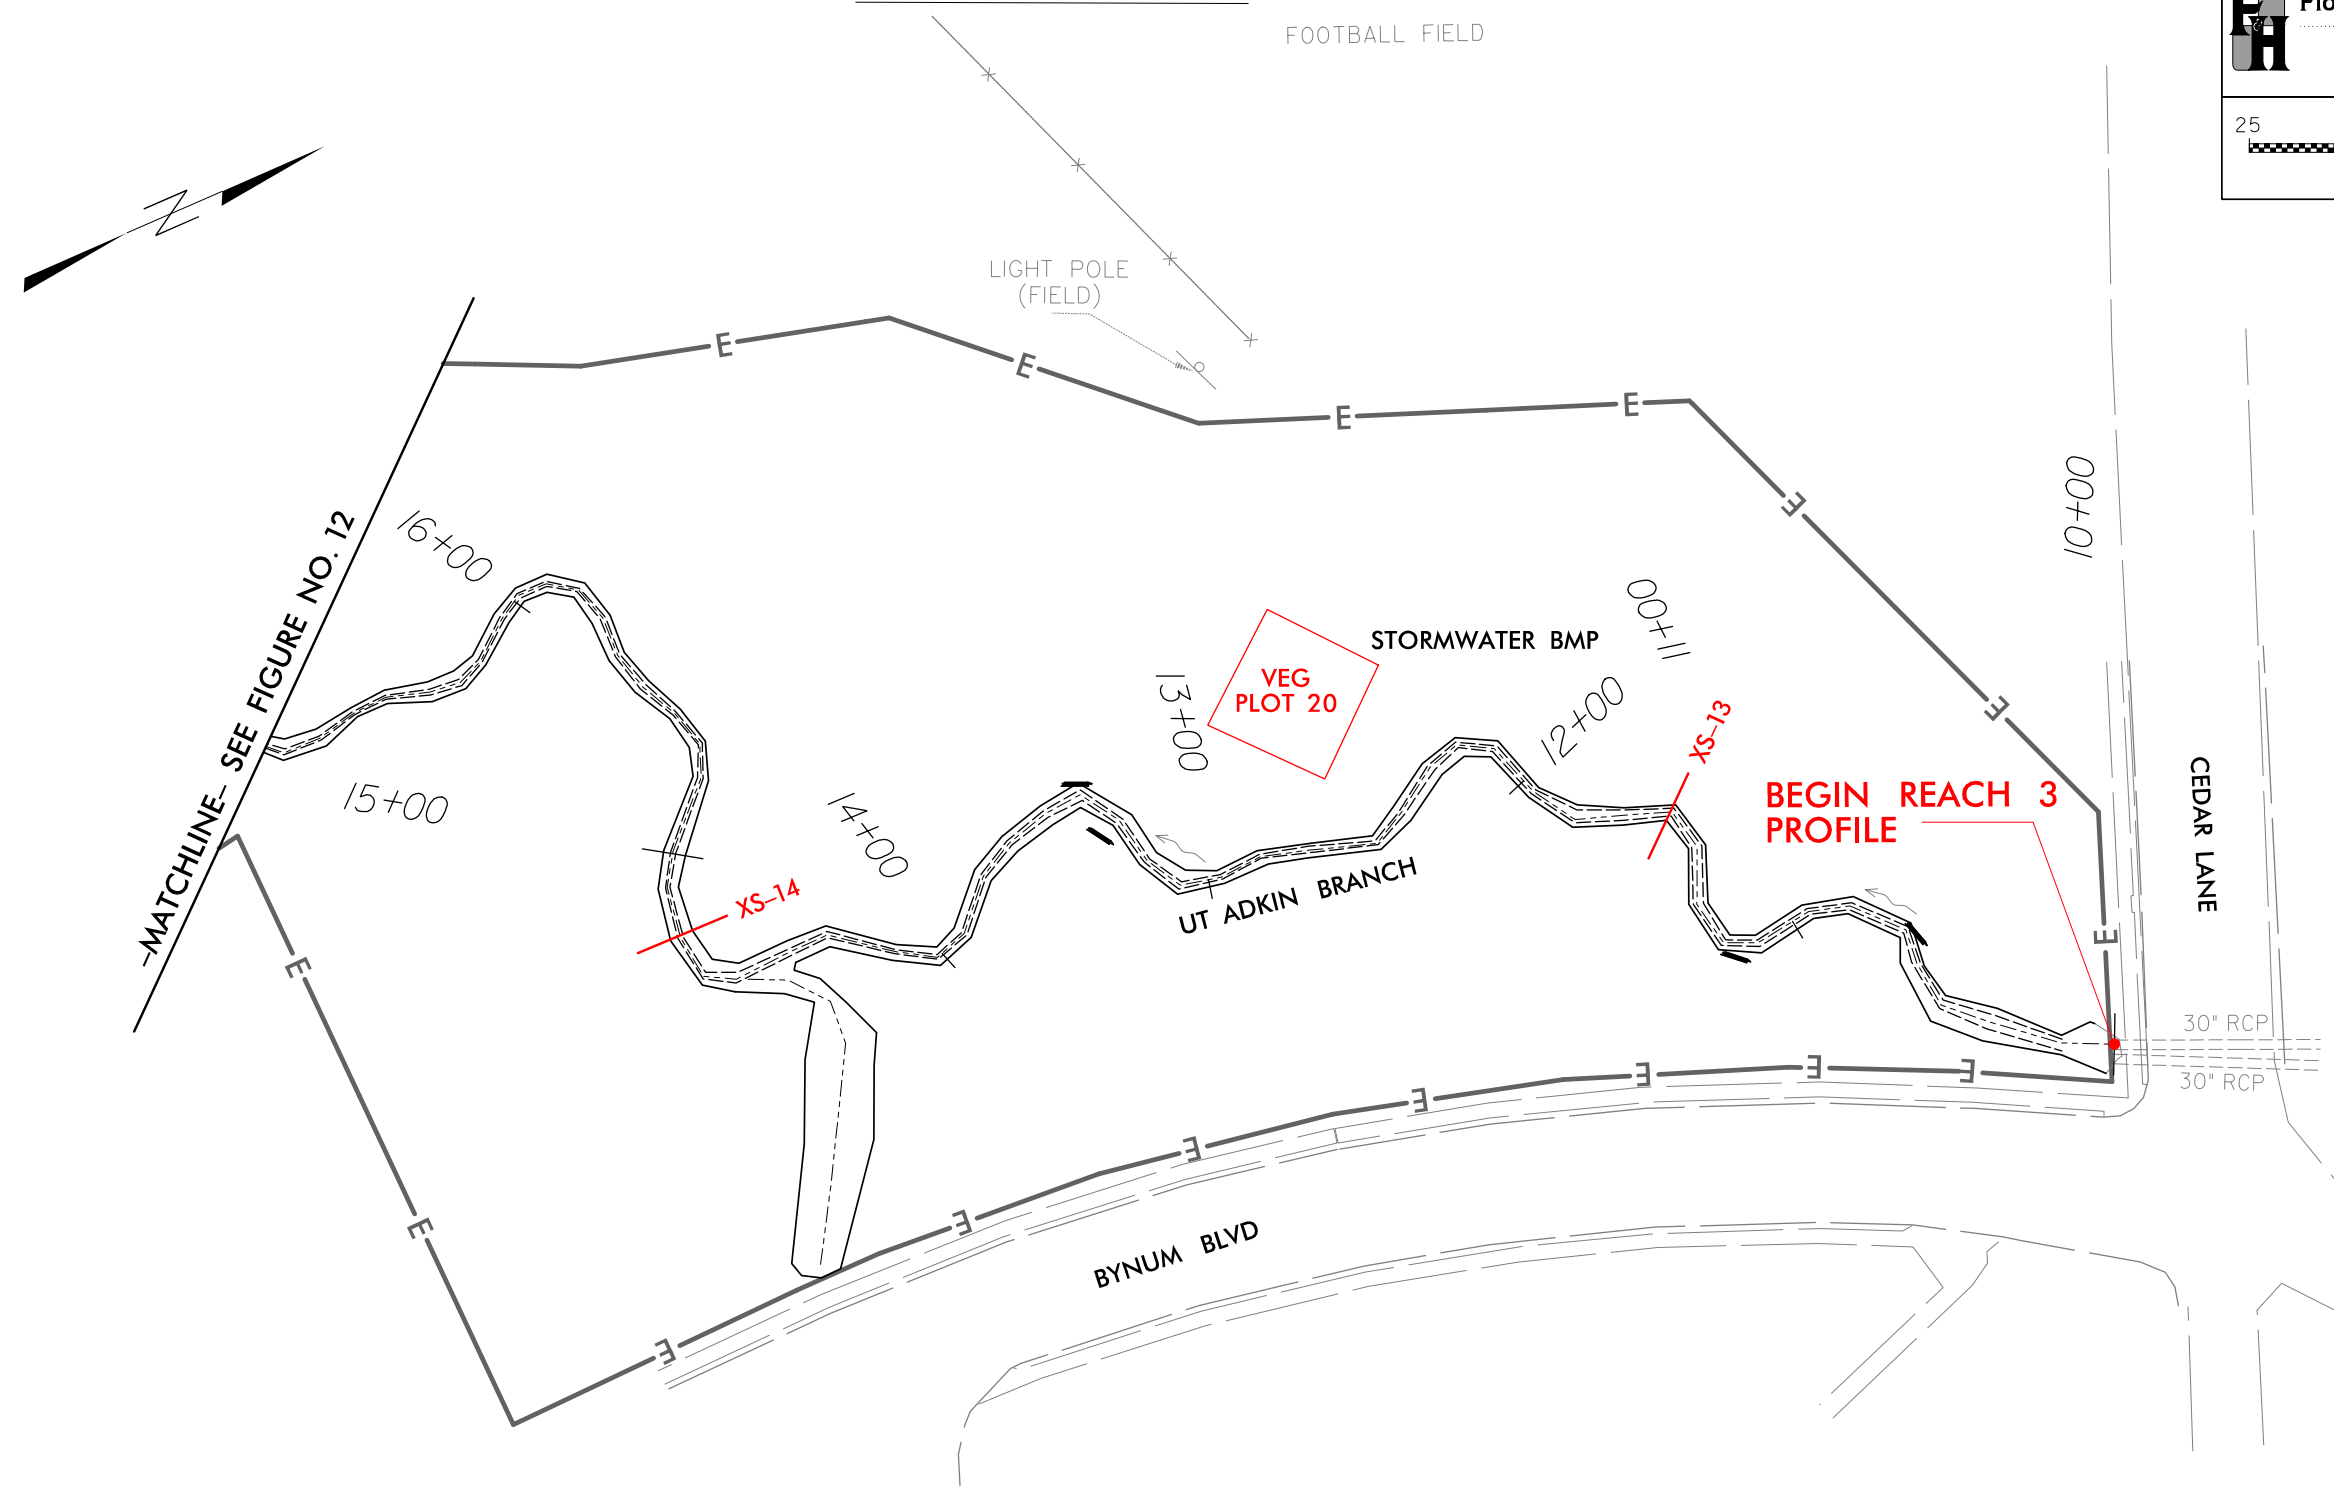6/30/2011
 E:\Streams\Proj\Monitoring\AdkinBranch_Monitoring.psh_12.dgn
 Florence & Hutcheson, Inc.

MONITORING PLANS



LEGEND

-  CONSERVATION EASEMENT LINE
-  LOG SILL
-  MONITORING CROSS SECTION (XS-)
-  VEGETATION PLOT
-  CREST GAUGE

| | |
|----------------------------------|----------------|
| MONITORING PLANS ADKIN BRANCH | |
| SCOPE: 050656101 | COUNTY: LENOIR |
| DESIGNED BY: RVS | |
| CHECKED BY: RKW | DATE: 5/11 |

6/30/2011
 P:\Streams\Proj\Monitoring\AdkinBranch_Monitoring.psh_13.dgn
 Florence & Hutcheson, Inc.

Appendix B: Morphological Summary Data, Plots, & Photos



Table 5a. Baseline Stream Data Summary – Reach 1

| Parameter | Existing Condition (Wash Ave. to Gordon) | Reference Reach (Johnson Mill) | Proposed (Wash Ave. to Gordon) | Reach 1 Baseline (Washington Ave. to Gordon St.) | | | | | |
|---|---|-----------------------------------|-----------------------------------|--|--------|--------|--------|--------|----|
| | | | | Min | Mean | Med | Max | SD | n |
| Dimension and Substrate - Riffle | | | | | | | | | |
| | Mean | Mean | Mean | | | | | | |
| Bankfull Width (ft) | 20.90 | 21.20 | 22.00 | 14.84 | 15.95 | 14.99 | 18.03 | 1.80 | 3 |
| Floodprone Width (ft) | 29.40 | 34.90 | 40.00 | 28.45 | 42.14 | 41.72 | 56.25 | 13.90 | 3 |
| Bankfull Mean Depth (ft) | 1.95 | 2.25 | 1.38 | 0.92 | 1.35 | 1.42 | 1.70 | 0.40 | 3 |
| Bankfull Max Depth (ft) | 2.26 | 2.42 | 1.65 | 1.50 | 2.11 | 2.07 | 2.77 | 0.64 | 3 |
| Bankfull Cross Sectional Area (ft ²) | 40.90 | 47.60 | 30.30 | 13.78 | 21.57 | 25.23 | 25.69 | 6.75 | 3 |
| Width/Depth Ratio | 10.70 | 9.40 | 16.00 | 8.73 | 12.57 | 12.70 | 16.29 | 3.78 | 3 |
| Entrenchment Ratio | 1.40 | 1.60 | 1.80 | 1.90 | 2.67 | 2.31 | 3.79 | 0.99 | 3 |
| Bank Height Ratio | - | - | - | 1.00 | 1.00 | 1.00 | 1.00 | 0.00 | 3 |
| d50 (mm) | - | - | - | | | | | | |
| Profile | | | | | | | | | |
| Riffle Length (ft) | - | - | - | 13.69 | 88.32 | 82.84 | 173.90 | 51.83 | 14 |
| Riffle Slope (ft/ft) | 0.0012 | 0.00001 | 0.0026 | 0.0002 | 0.0016 | 0.0013 | 0.0062 | 0.0016 | 14 |
| Pool Length (ft) | - | - | - | 11.36 | 24.52 | 24.15 | 46.88 | 8.60 | 19 |
| Pool Max depth (ft) | 3.18 | 3.56 | 3.44 | 2.11 | 2.99 | 2.86 | 4.33 | 0.72 | 19 |
| Pool Spacing (ft) | 183 - 231 | 91.1 - 130.0 | 88 - 132 | 22.73 | 95.81 | 94.46 | 180.40 | 41.64 | 18 |
| Pool Cross Sectional Area (ft ²) | 35.50 | 47.97 | 39.33 | 25.48 | 36.62 | 36.62 | 47.75 | 15.75 | 2 |
| Pattern | | | | | | | | | |
| Channel Beltwidth (ft) | 30 - 50 | 50 - 1500 | 44 - 176 | | | | | | |
| Radius of Curvature (ft) | 150 - 320 | 43 - 235 | 66 - 110 | | | | | | |
| Rc: Bankfull Width (ft/ft) | 7.2 - 15.3 | 2.0 - 11.1 | 3.0 - 5.0 | | | | | | |
| Meander Wavelength (ft) | 175 - 400 | 250 - 400 | 264 - 418 | | | | | | |
| Meander Width Ratio | 1.43 - 2.39 | 2.4 - 70.9 | 2.0 - 8.0 | | | | | | |
| Substrate, bed and transport parameters | | | | | | | | | |
| Ri% / P% | - | - | - | 73% / 27% | | | | | |
| SC% / Sa% / G% / C% / B% / Be% | - | - | - | | | | | | |
| d16 / d35 / d50 / d84 / d95 / di ^p / di ^{sp} (mm) | - | - | - | | | | | | |
| Reach Shear Stress (competency) lb/ft ² | N/A | | N/A | N/A | | | | | |
| Max part size (mm) mobilized at bankfull | - | | - | | | | | | |
| Unit Stream Power (transport capacity) lbs/ft.s | 0.075 | 0.197 | 0.220 | 0.325 | | | | | |
| Additional Reach Parameters | | | | | | | | | |
| Drainage Area (SM) | 4.60 | 13.50 | 5.03 | | | | | | |
| Impervious cover estimate (%) | - | - | - | | | | | | |
| Rosgen Classification | G5 | B5c | B5c | B5c | | | | | |
| Bankfull Velocity (fps) | 1.20 | 1.70 | 1.70 | 1.95 | | | | | |
| Bankfull Discharge (cfs) | 50.00 | 80.90 | 50.00 | | | | | | |
| Valley length (ft) | - | - | 1685 | 1685 | | | | | |
| Channel Thalweg length (ft) | - | - | 1750 | 1727 | | | | | |
| Sinuosity (ft) | 1.04 | 1.10 | 1.04 | 1.03 | | | | | |
| Water Surface Slope (Channel) (ft/ft) | 0.0005 | 0.0010 | 0.0016 | 0.00166 | | | | | |
| BF slope (ft/ft) | - | - | - | 0.00240 | | | | | |
| Bankfull Floodplain Area (acres) | - | - | - | | | | | | |
| Proportion over wide (%) | - | - | - | | | | | | |
| Entrenchment Class (ER Range) | - | - | - | | | | | | |
| Incision Class (BHR Range) | - | - | - | | | | | | |
| BEHI VL% / L% / M% / H% / VH% / E% | - | - | - | | | | | | |
| Channel Stability or Habitat Metric | - | - | - | | | | | | |
| Biological or Other | - | - | - | | | | | | |

It should be noted that As-built conditions were completed at the end of construction. Many storm events had occurred between beginning of construction and end of construction that naturally modified constructed parameters.



Table 5b. Baseline Stream Data Summary – Reach 2

| Parameter | Existing Condition (Gordon to Lincoln) | Reference Reach (Johnson Mill) | Proposed (Gordon to Lincoln) | Reach 2 Baseline (Gordon St. to Lincoln St.) | | | | | |
|---|---|-----------------------------------|---------------------------------|--|--------|--------|--------|--------|----|
| | | | | Min | Mean | Med | Max | SD | n |
| Dimension and Substrate - Riffle | | | | | | | | | |
| Bankfull Width (ft) | 23.60 | 21.20 | 22.00 | 16.23 | 16.98 | 16.81 | 17.91 | 0.85 | 3 |
| Floodprone Width (ft) | 45.00 | 34.90 | 40.00 | 48.33 | 52.40 | 51.29 | 57.58 | 4.72 | 3 |
| Bankfull Mean Depth (ft) | 1.83 | 2.25 | 1.47 | 1.46 | 1.66 | 1.64 | 1.88 | 0.21 | 3 |
| Bankfull Max Depth (ft) | 2.98 | 2.42 | 1.76 | 2.21 | 2.38 | 2.26 | 2.68 | 0.26 | 3 |
| Bankfull Cross Sectional Area (ft ²) | 43.30 | 47.60 | 32.30 | 23.68 | 28.32 | 27.58 | 33.70 | 5.05 | 3 |
| Width/Depth Ratio | 12.90 | 9.40 | 15.00 | 9.53 | 10.30 | 10.25 | 11.12 | 0.80 | 3 |
| Entrenchment Ratio | 1.90 | 1.60 | 1.80 | 2.99 | 3.09 | 3.05 | 3.22 | 0.12 | 3 |
| Bank Height Ratio | - | - | - | 1.00 | 1.00 | 1.00 | 1.00 | 0.00 | 3 |
| d50 (mm) | - | - | - | | | | | | |
| Profile | | | | | | | | | |
| Riffle Length (ft) | - | - | - | 27.43 | 62.71 | 62.38 | 93.27 | 19.56 | 10 |
| Riffle Slope (ft/ft) | 0.0024 | 0.00001 | 0.0031 | 0.0002 | 0.0013 | 0.0010 | 0.0039 | 0.0013 | 10 |
| Pool Length (ft) | - | - | - | 14.20 | 56.38 | 56.82 | 113.64 | 27.38 | 39 |
| Pool Max depth (ft) | 4.14 | 3.56 | 3.67 | 2.74 | 4.23 | 4.22 | 6.48 | 0.76 | 39 |
| Pool Spacing (ft) | 59.62 - 117.86 | 91.1 - 130.0 | 88.0 - 132.0 | 17.05 | 73.45 | 69.60 | 164.78 | 32.96 | 38 |
| Pool Cross Sectional Area (ft ²) | 58.41 | 47.97 | 45.17 | 31.92 | 48.19 | 48.21 | 64.42 | 13.63 | 4 |
| Pattern | | | | | | | | | |
| Channel Beltwidth (ft) | 75 - 120 | 50 - 1500 | 44.0 - 176.0 | | | | | | |
| Radius of Curvature (ft) | 40 - 146 | 43 - 235 | 66.0 - 110.0 | | | | | | |
| Rc: Bankfull Width (ft/ft) | 1.7 - 6.2 | 2.0 - 11.1 | 3.0 - 5.0 | | | | | | |
| Meander Wavelength (ft) | 224 - 260 | 250 - 400 | 264.0 - 418.0 | | | | | | |
| Meander Width Ratio | 3.18 - 5.08 | 2.4 - 70.9 | 2.0 - 8.0 | | | | | | |
| Substrate, bed and transport parameters | | | | | | | | | |
| Ri% / P% | - | - | - | 29% / 71% * | | | | | |
| SC% / Sa% / G% / C% / B% / Be% | - | - | - | | | | | | |
| d16 / d35 / d50 / d84 / d95 / di ^p / di ^{sp} (mm) | - | - | - | | | | | | |
| Reach Shear Stress (competency) lb/ft ² | N/A | | N/A | N/A | | | | | |
| Max part size (mm) mobilized at bankfull | - | | - | | | | | | |
| Unit Stream Power (transport capacity) lbs/ft.s | 0.106 | 0.197 | 0.230 | 0.321 | | | | | |
| Additional Reach Parameters | | | | | | | | | |
| Drainage Area (SM) | 5.30 | 13.50 | 5.50 | | | | | | |
| Impervious cover estimate (%) | - | - | - | | | | | | |
| Rosgen Classification | B5 | B5c | B5c | B5c | | | | | |
| Bankfull Velocity (fps) | 1.30 | 1.70 | 1.80 | 1.99 | | | | | |
| Bankfull Discharge (cfs) | 55.00 | 80.90 | 55.00 | | | | | | |
| Valley length (ft) | - | - | 4106 | 4106 | | | | | |
| Channel Thalweg length (ft) | - | - | 4246 | 4270 | | | | | |
| Sinuosity (ft) | 1.12 | 1.10 | 1.03 | 1.04 | | | | | |
| Water Surface Slope (Channel) (ft/ft) | 0.0007 | 0.0010 | 0.0014 | 0.0016 | | | | | |
| BF slope (ft/ft) | - | - | - | 0.0018 | | | | | |
| Bankfull Floodplain Area (acres) | - | - | - | | | | | | |
| Proportion over wide (%) | - | - | - | | | | | | |
| Entrenchment Class (ER Range) | - | - | - | | | | | | |
| Incision Class (BHR Range) | - | - | - | | | | | | |
| BEHI VL% / L% / M% / H% / VH% / E% | - | - | - | | | | | | |
| Channel Stability or Habitat Metric | - | - | - | | | | | | |
| Biological or Other | - | - | - | | | | | | |
| It should be noted that As-built conditions were completed at the end of construction. Many storm events had occurred between beginning of construction and end of construction that naturally modified constructed parameters. | | | | | | | | | |
| * Reach 2 is a predominately pool system due to need to drop grade at the lower end of the project. | | | | | | | | | |



Table 5c. Baseline Stream Data Summary – Reach 3

| Parameter | Existing Condition (UT to Adkin Branch) | Reference Reach (UT to Wildcat Branch) | Proposed (UT to Adkin Branch) | Reach 3 Baseline (UT to Adkin Branch) | | | | | |
|---|---|--|-------------------------------|---------------------------------------|--------|--------|--------|--------|----|
| | | | | Min | Mean | Med | Max | SD | n |
| Dimension and Substrate - Riffle | | | | | | | | | |
| | Mean | Mean | Mean | | | | | | |
| Bankfull Width (ft) | 3.60 | 7.70 | 6.00 | 6.06 | 7.27 | 7.69 | 8.06 | 1.06 | 3 |
| Floodprone Width (ft) | 8.30 | 130.00 | 15.00 | 23.07 | 27.62 | 25.11 | 34.69 | 6.20 | 3 |
| Bankfull Mean Depth (ft) | 0.47 | 1.03 | 0.55 | 0.35 | 0.42 | 0.40 | 0.50 | 0.08 | 3 |
| Bankfull Max Depth (ft) | 3.40 | 1.56 | 0.85 | 0.72 | 0.81 | 0.82 | 0.90 | 0.09 | 3 |
| Bankfull Cross Sectional Area (ft ²) | 1.70 | 7.90 | 3.30 | 2.43 | 3.04 | 2.68 | 4.00 | 0.84 | 3 |
| Width/Depth Ratio | 7.60 | 7.50 | 11.00 | 15.15 | 17.75 | 16.12 | 21.97 | 3.69 | 3 |
| Entrenchment Ratio | 2.30 | 16.90 | 2.50 | 2.86 | 3.95 | 3.26 | 5.72 | 1.55 | 3 |
| Bank Height Ratio | - | - | - | 1.00 | 1.00 | 1.00 | 1.00 | 0.00 | 3 |
| d50 (mm) | - | - | - | | | | | | |
| Profile | | | | | | | | | |
| Riffle Length (ft) | - | - | - | 9.59 | 34.33 | 26.34 | 165.84 | 30.38 | 28 |
| Riffle Slope (ft/ft) | 0.0002 | 0.0021 | 0.0032 | 0.0012 | 0.0051 | 0.0044 | 0.0121 | 0.0031 | 28 |
| Pool Length (ft) | - | - | - | 4.26 | 21.38 | 23.26 | 52.81 | 12.04 | 32 |
| Pool Max depth (ft) | 1.45 | 1.90 | 1.36 | 0.64 | 1.59 | 1.32 | 2.95 | 0.70 | 32 |
| Pool Spacing (ft) | 21.63 | 14.0 - 16.6 | 12.0 - 36.0 | 13.49 | 42.26 | 37.22 | 93.07 | 20.82 | 30 |
| Pool Cross Sectional Area (ft ²) | 4.40 | 10.80 | 4.91 | 1.81 | 3.58 | 3.58 | 5.34 | 2.50 | 2 |
| Pattern | | | | | | | | | |
| Channel Beltwidth (ft) | 50.00 | 13.8 - 19.4 | 12.0 - 36.0 | | | | | | |
| Radius of Curvature (ft) | 93 - 105 | 10.9 - 15.3 | 12.0 - 18.0 | | | | | | |
| Rc: Bankfull Width (ft/ft) | 26.0 - 29.3 | 1.4 - 2.0 | 2.0 - 3.0 | | | | | | |
| Meander Wavelength (ft) | 212 - 517 | 22.5 - 29.0 | 18.0 - 48.0 | | | | | | |
| Meander Width Ratio | 13.97 | 1.8 - 2.5 | 2.0 - 6.0 | | | | | | |
| Substrate, bed and transport parameters | | | | | | | | | |
| Ri% / P% | - | - | - | 58% / 42% | | | | | |
| SC% / Sa% / G% / C% / B% / Be% | - | - | - | | | | | | |
| d16 / d35 / d50 / d84 / d95 / di ^p / di ^{sp} (mm) | - | - | - | | | | | | |
| Reach Shear Stress (competency) lb/ft ² | N/A | | N/A | N/A | | | | | |
| Max part size (mm) mobilized at bankfull | - | | - | | | | | | |
| Unit Stream Power (transport capacity) lbs/ft.s | 0.007 | 0.140 | 0.080 | 0.083 | | | | | |
| Additional Reach Parameters | | | | | | | | | |
| Drainage Area (SM) | 0.12 | 0.44 | 0.12 | | | | | | |
| Impervious cover estimate (%) | - | - | - | | | | | | |
| Rosgen Classification | E5 | E5 | E5 | E5 | | | | | |
| Bankfull Velocity (fps) | 2.10 | 1.20 | 1.10 | 1.44 | | | | | |
| Bankfull Discharge (cfs) | 3.50 | 9.20 | 3.50 | | | | | | |
| Valley length (ft) | 1200 | - | 1200 | 1200 | | | | | |
| Channel Thalweg length (ft) | 1200 | - | 1615 | 1582 | | | | | |
| Sinuosity (ft) | 1.00 | 1.15 | 1.35 | 1.32 | | | | | |
| Water Surface Slope (Channel) (ft/ft) | 0.0001 | 0.0024 | 0.0022 | 0.0028 | | | | | |
| BF slope (ft/ft) | - | - | - | 0.0030 | | | | | |
| Bankfull Floodplain Area (acres) | - | - | - | | | | | | |
| Proportion over wide (%) | - | - | - | | | | | | |
| Entrenchment Class (ER Range) | - | - | - | | | | | | |
| Incision Class (BHR Range) | - | - | - | | | | | | |
| BEHI VL% / L% / M% / H% / VH% / E% | - | - | - | | | | | | |
| Channel Stability or Habitat Metric | - | - | - | | | | | | |
| Biological or Other | - | - | - | | | | | | |

It should be noted that As-built conditions were completed at the end of construction. Many storm events had occurred between beginning of construction and end of construction that naturally modified constructed parameters.



Table 6. Morphology and Hydraulic Monitoring Summary (Dimensional Parameters – Cross Section)

| | Cross Section 1 (Riffle) | | | | | | | Cross Section 2 (Pool) | | | | | | | Cross Section 3 (Riffle) | | | | | | | Cross Section 4 (Pool) | | | | | | | Cross Section 5 (Riffle) | | | | | | | | | | | | | |
|---|
| Dimension and substrate ¹ | Base | MY1 | MY2 | MY3 | MY4 | MY5 | MY+ | Base | MY1 | MY2 | MY3 | MY4 | MY5 | MY+ | Base | MY1 | MY2 | MY3 | MY4 | MY5 | MY+ | Base | MY1 | MY2 | MY3 | MY4 | MY5 | MY+ | Base | MY1 | MY2 | MY3 | MY4 | MY5 | MY+ | | | | | | | |
| Bankfull Width (ft) | 14.84 | | | | | | | 24.28 | | | | | | | 18.03 | | | | | | | 17.42 | | | | | | | 14.99 | | | | | | | | | | | | | |
| Floodprone Width (ft) | 56.25 | | | | | | | 72.2 | | | | | | | 41.72 | | | | | | | 39.81 | | | | | | | 28.45 | | | | | | | | | | | | | |
| Bankfull Mean Depth (ft) | 1.7 | | | | | | | 1.97 | | | | | | | 1.42 | | | | | | | 1.46 | | | | | | | 0.92 | | | | | | | | | | | | | |
| Bankfull Max Depth (ft) | 2.77 | | | | | | | 3.33 | | | | | | | 2.07 | | | | | | | 2.05 | | | | | | | 1.5 | | | | | | | | | | | | | |
| Bankfull Cross Sectional Area (ft ²) | 25.23 | | | | | | | 47.75 | | | | | | | 25.69 | | | | | | | 25.48 | | | | | | | 13.78 | | | | | | | | | | | | | |
| Bankfull Width/Depth Ratio | 8.73 | | | | | | | 12.32 | | | | | | | 12.7 | | | | | | | 11.93 | | | | | | | 16.29 | | | | | | | | | | | | | |
| Bankfull Entrenchment Ratio | 3.79 | | | | | | | 2.97 | | | | | | | 2.31 | | | | | | | 2.29 | | | | | | | 1.9 | | | | | | | | | | | | | |
| Bankfull Bank Height Ratio | 1 | | | | | | | 1 | | | | | | | 1 | | | | | | | 1 | | | | | | | 1 | | | | | | | | | | | | | |
| | Cross Section 6 (Pool) | | | | | | | Cross Section 7 (Riffle) | | | | | | | Cross Section 8 (Pool) | | | | | | | Cross Section 9 (Riffle) | | | | | | | Cross Section 10 (Riffle) | | | | | | | | | | | | | |
| Dimension and substrate ¹ | Base | MY1 | MY2 | MY3 | MY4 | MY5 | MY+ | Base | MY1 | MY2 | MY3 | MY4 | MY5 | MY+ | Base | MY1 | MY2 | MY3 | MY4 | MY5 | MY+ | Base | MY1 | MY2 | MY3 | MY4 | MY5 | MY+ | Base | MY1 | MY2 | MY3 | MY4 | MY5 | MY+ | | | | | | | |
| Bankfull Width (ft) | 15.1 | | | | | | | 17.91 | | | | | | | 16.57 | | | | | | | 16.81 | | | | | | | 16.23 | | | | | | | | | | | | | |
| Floodprone Width (ft) | 57.39 | | | | | | | 57.58 | | | | | | | 50.57 | | | | | | | 51.29 | | | | | | | 48.33 | | | | | | | | | | | | | |
| Bankfull Mean Depth (ft) | 2.94 | | | | | | | 1.88 | | | | | | | 1.93 | | | | | | | 1.64 | | | | | | | 1.46 | | | | | | | | | | | | | |
| Bankfull Max Depth (ft) | 4.39 | | | | | | | 2.68 | | | | | | | 3.51 | | | | | | | 2.21 | | | | | | | 2.26 | | | | | | | | | | | | | |
| Bankfull Cross Sectional Area (ft ²) | 44.41 | | | | | | | 33.7 | | | | | | | 31.92 | | | | | | | 27.58 | | | | | | | 23.68 | | | | | | | | | | | | | |
| Bankfull Width/Depth Ratio | 5.14 | | | | | | | 9.53 | | | | | | | 8.59 | | | | | | | 10.25 | | | | | | | 11.12 | | | | | | | | | | | | | |
| Bankfull Entrenchment Ratio | 3.8 | | | | | | | 3.22 | | | | | | | 3.05 | | | | | | | 3.05 | | | | | | | 2.99 | | | | | | | | | | | | | |
| Bankfull Bank Height Ratio | 1 | | | | | | | 1 | | | | | | | 1 | | | | | | | 1 | | | | | | | 1 | | | | | | | | | | | | | |
| | Cross Section 11 (Pool) | | | | | | | Cross Section 12 (Pool) | | | | | | | Cross Section 13 (Pool) | | | | | | | Cross Section 14 (Riffle) | | | | | | | Cross Section 15 (Riffle) | | | | | | | | | | | | | |
| Dimension and substrate ¹ | Base | MY1 | MY2 | MY3 | MY4 | MY5 | MY+ | Base | MY1 | MY2 | MY3 | MY4 | MY5 | MY+ | Base | MY1 | MY2 | MY3 | MY4 | MY5 | MY+ | Base | MY1 | MY2 | MY3 | MY4 | MY5 | MY+ | Base | MY1 | MY2 | MY3 | MY4 | MY5 | MY+ | | | | | | | |
| Bankfull Width (ft) | 16.31 | | | | | | | 23.66 | | | | | | | 5.89 | | | | | | | 7.69 | | | | | | | 6.06 | | | | | | | | | | | | | |
| Floodprone Width (ft) | 72.56 | | | | | | | 82.52 | | | | | | | 24.44 | | | | | | | 25.11 | | | | | | | 34.69 | | | | | | | | | | | | | |
| Bankfull Mean Depth (ft) | 3.19 | | | | | | | 2.72 | | | | | | | 0.31 | | | | | | | 0.35 | | | | | | | 0.4 | | | | | | | | | | | | | |
| Bankfull Max Depth (ft) | 4.71 | | | | | | | 4.68 | | | | | | | 0.71 | | | | | | | 0.72 | | | | | | | 0.9 | | | | | | | | | | | | | |
| Bankfull Cross Sectional Area (ft ²) | 52.00 | | | | | | | 64.42 | | | | | | | 1.81 | | | | | | | 2.68 | | | | | | | 2.43 | | | | | | | | | | | | | |
| Bankfull Width/Depth Ratio | 5.11 | | | | | | | 8.7 | | | | | | | 19 | | | | | | | 21.97 | | | | | | | 15.15 | | | | | | | | | | | | | |
| Bankfull Entrenchment Ratio | 4.45 | | | | | | | 3.49 | | | | | | | 4.15 | | | | | | | 3.26 | | | | | | | 5.72 | | | | | | | | | | | | | |
| Bankfull Bank Height Ratio | 1 | | | | | | | 1 | | | | | | | 1 | | | | | | | 1 | | | | | | | 1 | | | | | | | | | | | | | |
| | Cross Section 16 (Pool) | | | | | | | Cross Section 17 (Riffle) | | | | | | | NOTE: Reach 1 - Washington Ave. to Gordon St. - Cross-Sections 1 through 5 Reach 2 - Gordon St. to Lincoln St. - Cross-Sections 6 - 12 Reach 3 - UT to Adkin Branch - Cross-Sections 13-17 | | | Dimension and substrate ¹ | Base | MY1 | MY2 | MY3 | MY4 | MY5 | MY+ | Base | MY1 | MY2 | MY3 | MY4 | MY5 | MY+ | | | Bankfull Width (ft) | 11.59 | | | | | | | 8.06 | | | | | | | | | | | | | | | | | | | | | | | | | | | | | | | | | | |
| Floodprone Width (ft) | 30.42 | | | | | | | 23.07 | | | | | | | | | | | | | | | | | | | | | | | | | | | | | | | | | | |
| Bankfull Mean Depth (ft) | 0.46 | | | | | | | 0.5 | | | | | | | | | | | | | | | | | | | | | | | | | | | | | | | | | | |
| Bankfull Max Depth (ft) | 1.11 | | | | | | | 0.82 | | | | | | | | | | | | | | | | | | | | | | | | | | | | | | | | | | |
| Bankfull Cross Sectional Area (ft ²) | 5.34 | | | | | | | 4 | | | | | | | | | | | | | | | | | | | | | | | | | | | | | | | | | | |
| Bankfull Width/Depth Ratio | 25.2 | | | | | | | 16.12 | | | | | | | | | | | | | | | | | | | | | | | | | | | | | | | | | | |
| Bankfull Entrenchment Ratio | 2.62 | | | | | | | 2.86 | | | | | | | | | | | | | | | | | | | | | | | | | | | | | | | | | | |
| Bankfull Bank Height Ratio | 1 | | | | | | | 1 | | | | | | | | | | | | | | | | | | | | | | | | | | | | | | | | | | |

¹ = Based on fixed baseline bankfull elevation. Widths and depths for each resurvey will be based on the baseline bankfull datum regardless of dimensional/depositional development.

Figure 14. Reach 1 (Washington Ave. to Gordon St.) - Longitudinal Profile


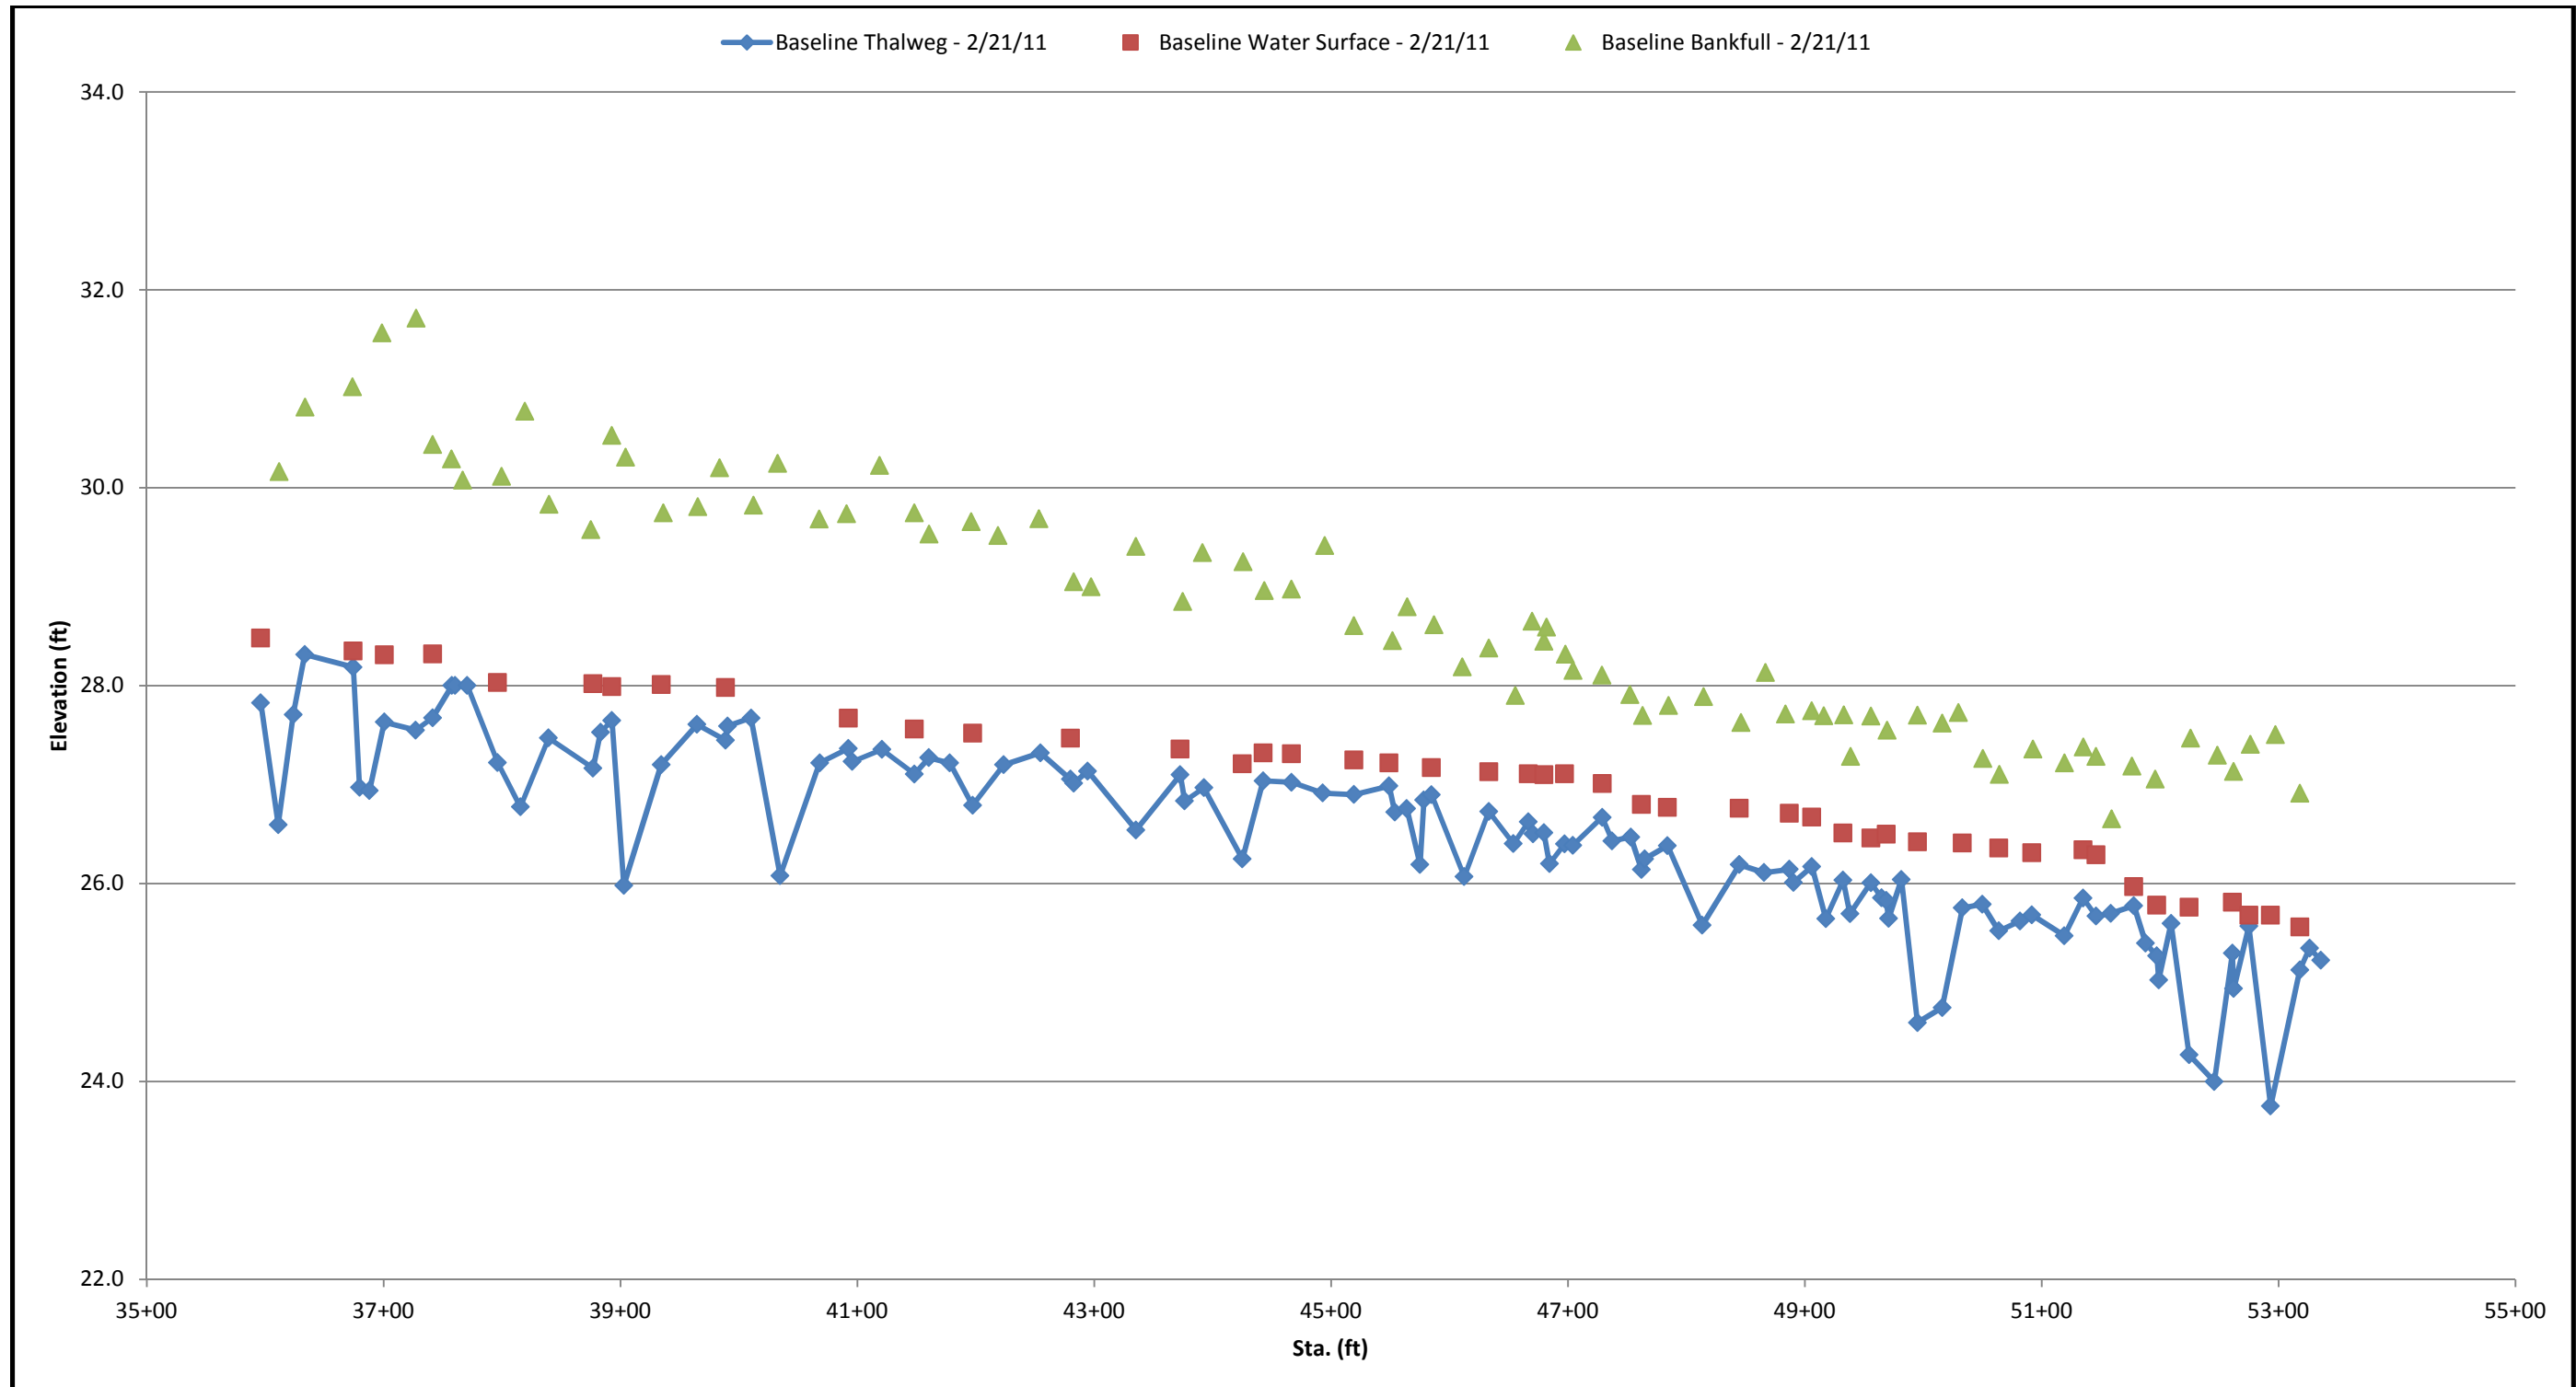


Figure 15. Reach 2 (Gordon St. to Lincoln St.) - Longitudinal Profile




Figure 16. Reach 3 (UT to Adkin Branch) - Longitudinal Profile

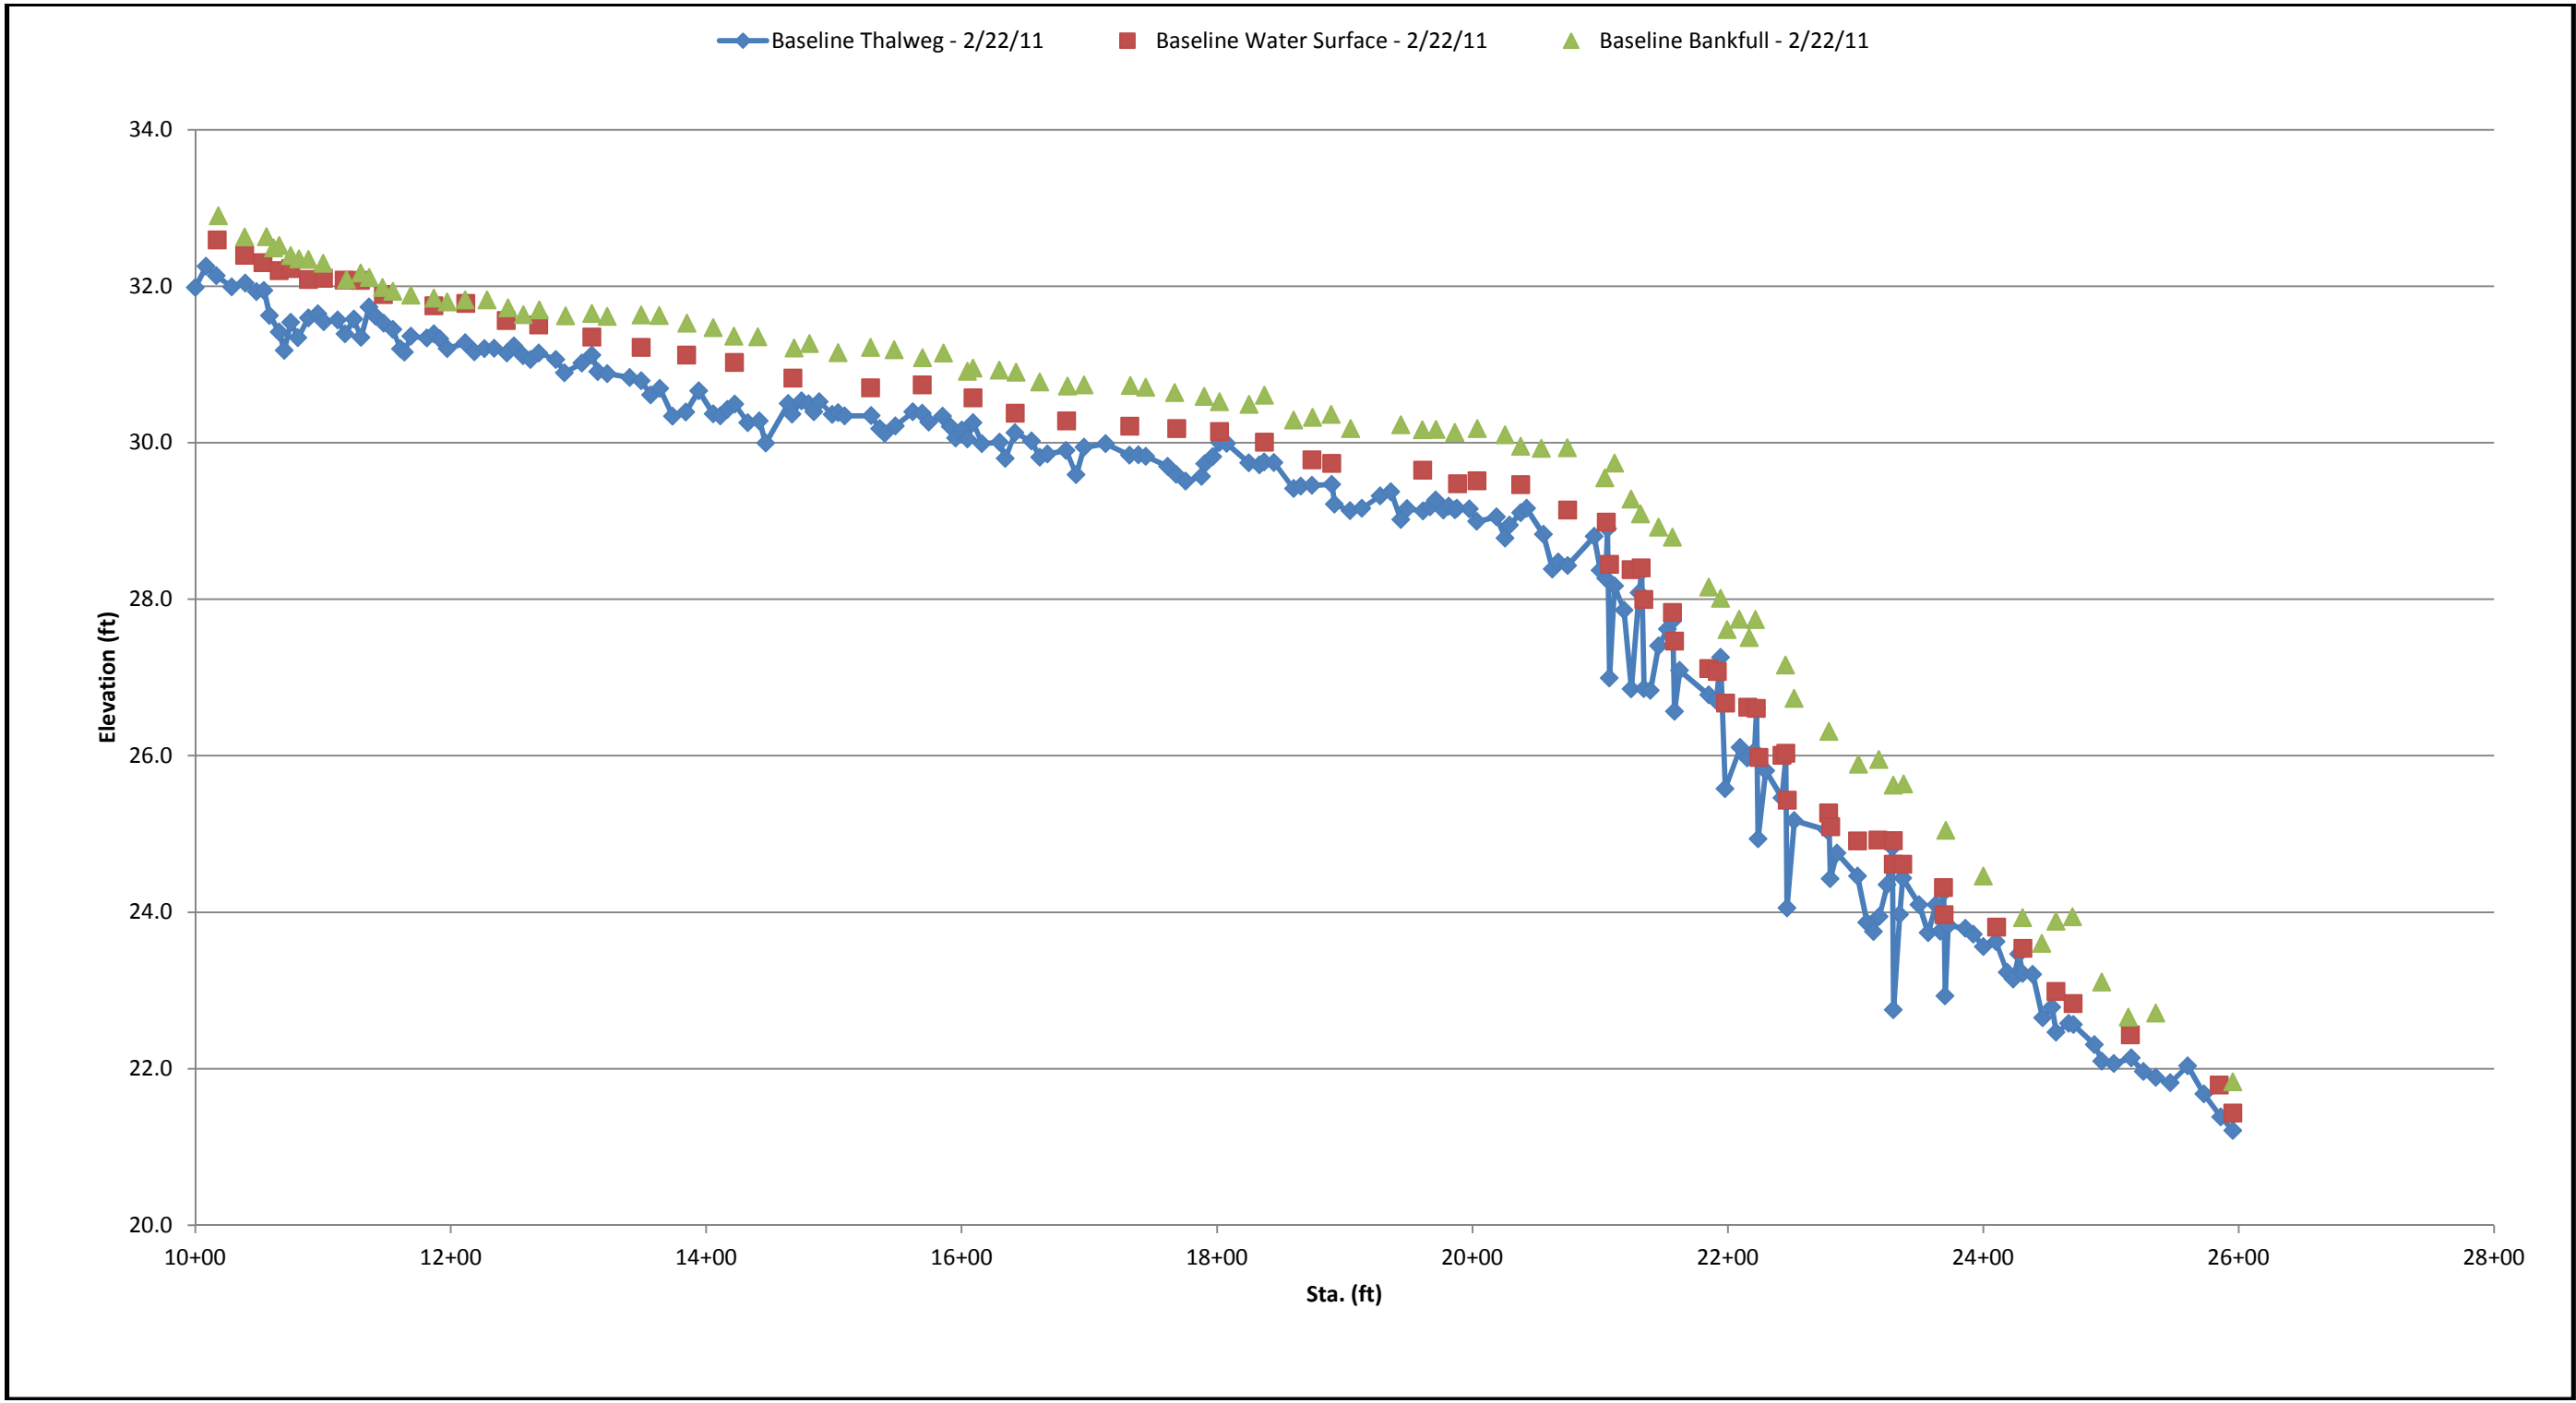

Cross Section Plots & Photos


Reach 1 Cross Sections – Washington Ave. to Gordon St.



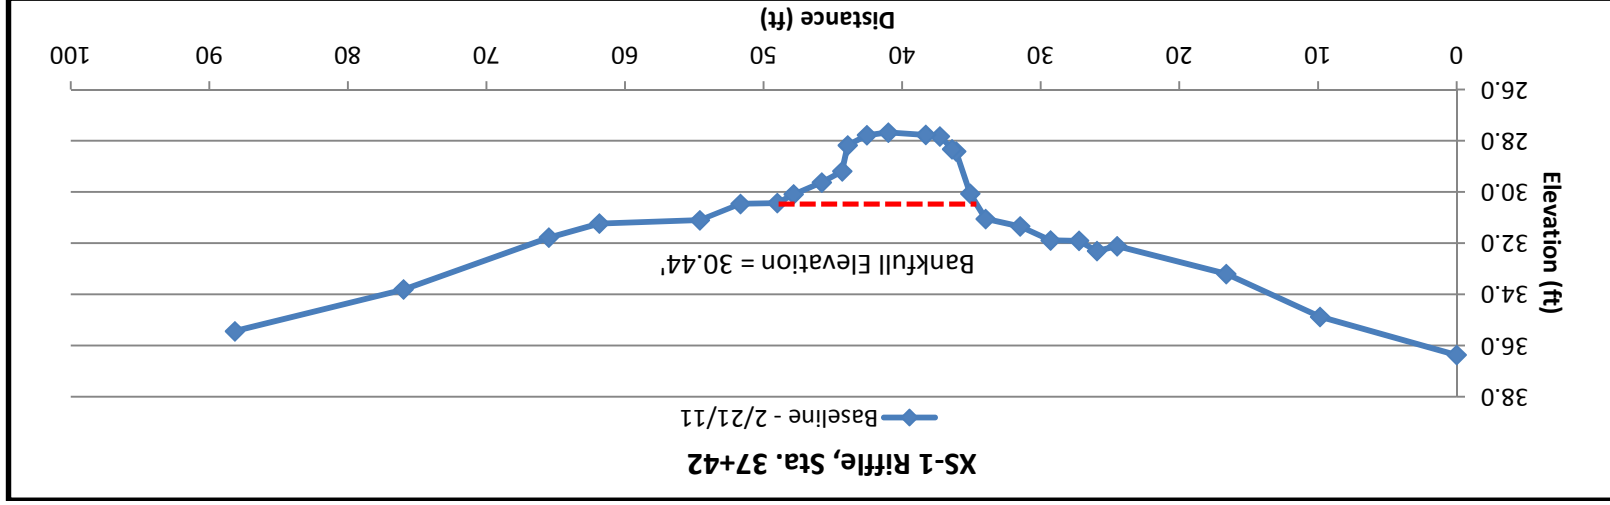


| | |
|-------|--|
| 14.84 | Bankfull Width (ft) |
| 56.25 | Floodprone Width (ft) |
| 1.7 | Bankfull Mean Depth (ft) |
| 2.77 | Bankfull Max Depth (ft) |
| 25.23 | Bankfull Cross Sectional Area (ft ²) |
| 8.73 | Bankfull Width/Depth Ratio |
| 3.79 | Bankfull Entrenchment Ratio |
| 1 | Bankfull Bank Height Ratio |



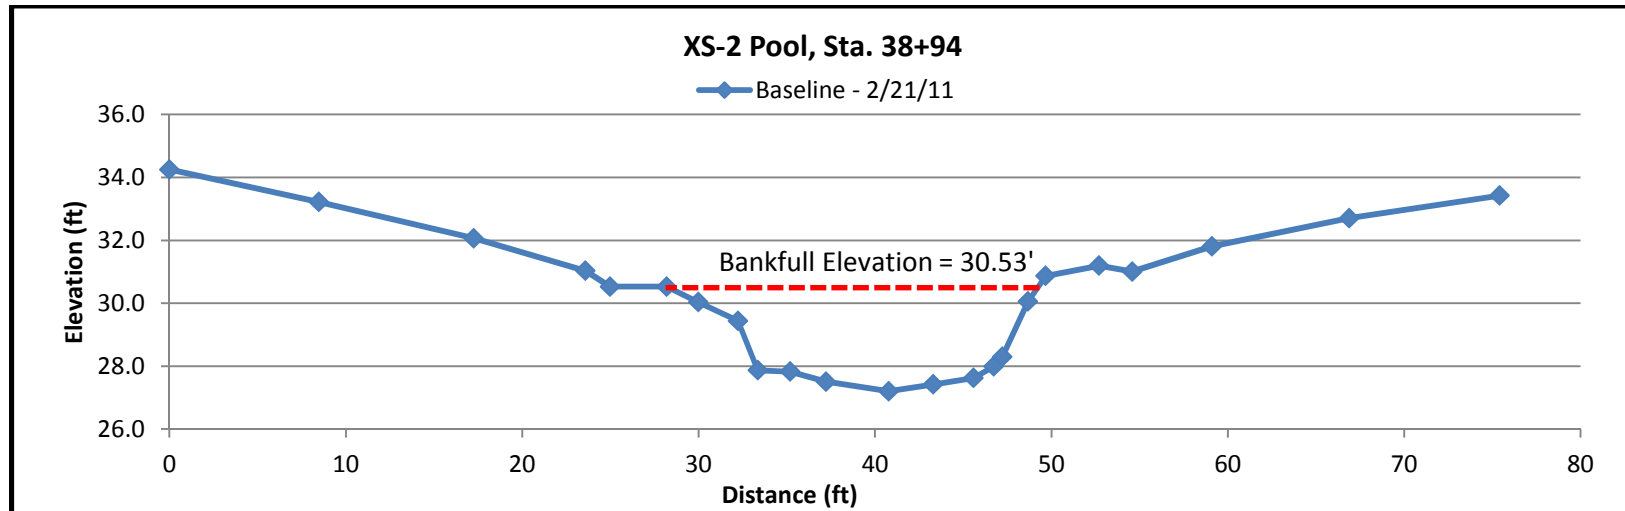


| | |
|--|-------|
| Bankfull Width (ft) | 24.28 |
| Floodprone Width (ft) | 72.2 |
| Bankfull Mean Depth (ft) | 1.97 |
| Bankfull Max Depth (ft) | 3.33 |
| Bankfull Cross Sectional Area (ft ²) | 47.75 |
| Bankfull Width/Depth Ratio | 12.32 |
| Bankfull Entrenchment Ratio | 2.97 |
| Bankfull Bank Height Ratio | 1 |

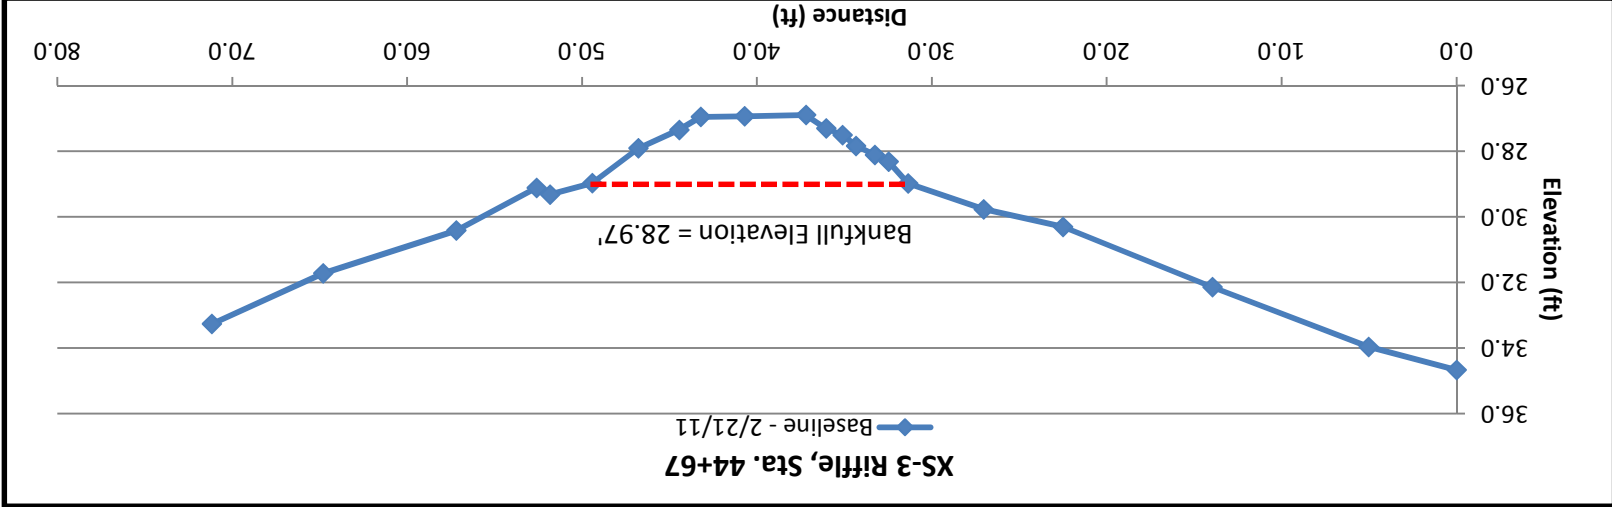

| | |
|--|-------|
| Bankfull Width (ft) | 18.03 |
| Floodprone Width (ft) | 41.72 |
| Bankfull Mean Depth (ft) | 1.42 |
| Bankfull Max Depth (ft) | 2.07 |
| Bankfull Cross Sectional Area (ft ²) | 25.69 |
| Bankfull Width/Depth Ratio | 12.7 |
| Bankfull Entrenchment Ratio | 2.31 |
| Bankfull Bank Height Ratio | 1 |




BASELINE MONITORING DOCUMENT & AS-BUILT BASELINE REPORT

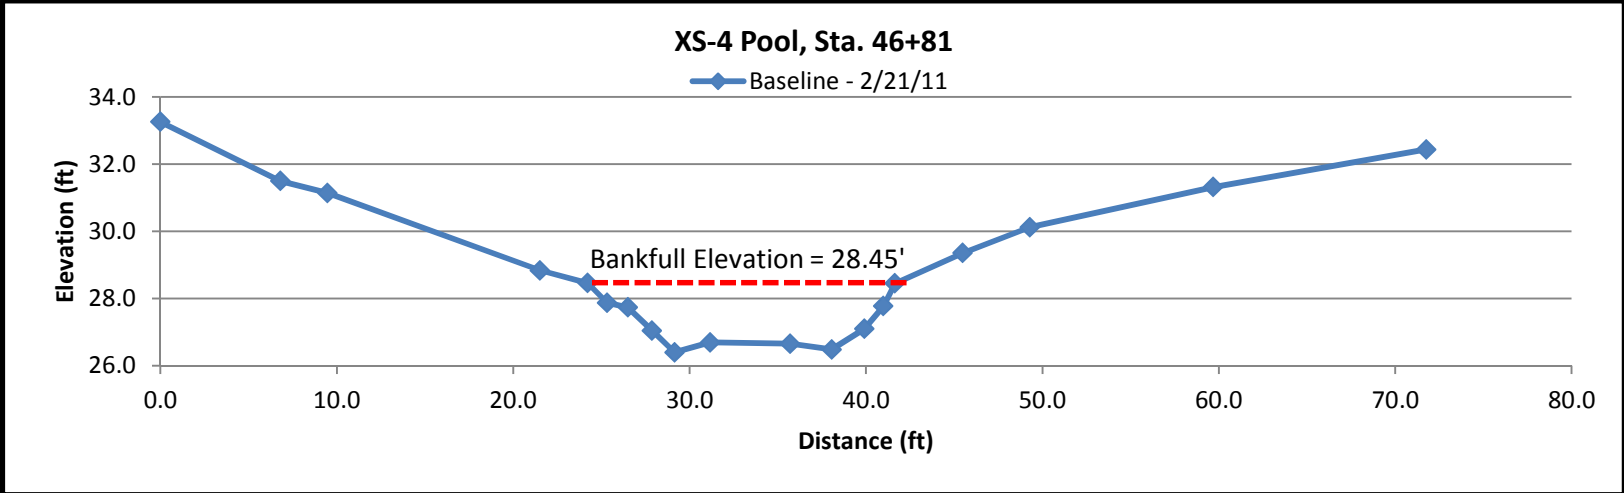

| | |
|--|-------|
| Bankfull Width (ft) | 17.42 |
| Floodprone Width (ft) | 39.81 |
| Bankfull Mean Depth (ft) | 1.46 |
| Bankfull Max Depth (ft) | 2.05 |
| Bankfull Cross Sectional Area (ft ²) | 25.48 |
| Bankfull Width/Depth Ratio | 11.93 |
| Bankfull Entrenchment Ratio | 2.29 |
| Bankfull Bank Height Ratio | 1 |




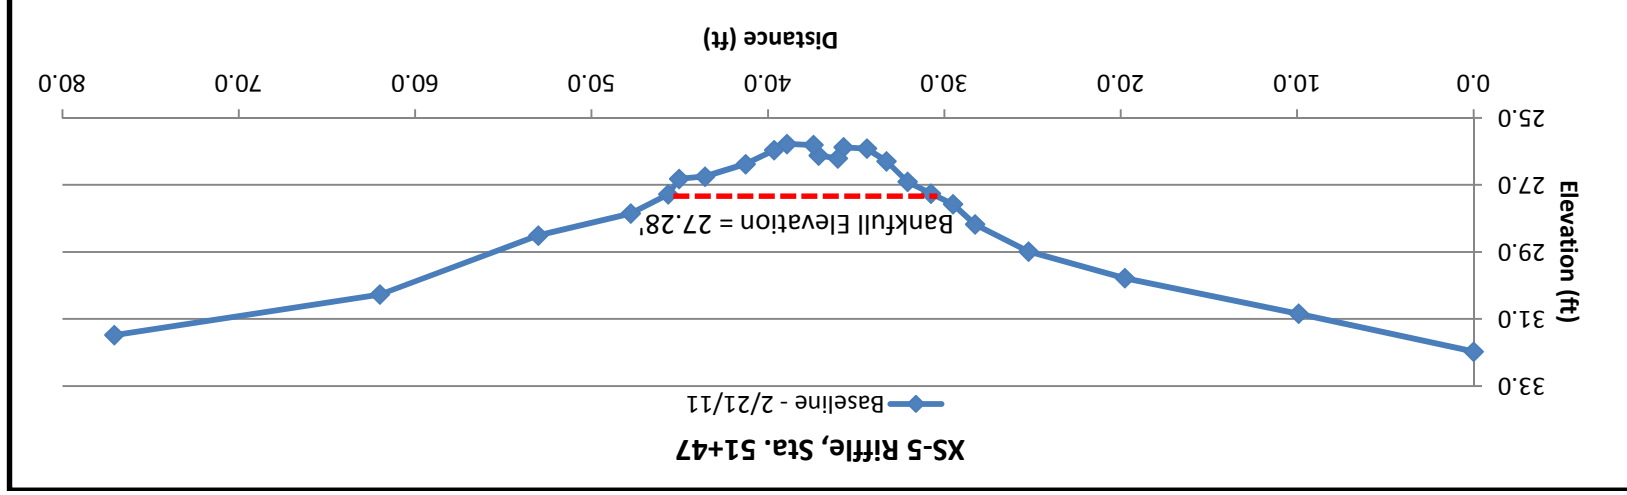

| | |
|--|-------|
| Bankfull Width (ft) | 14.99 |
| Floodprone Width (ft) | 28.45 |
| Bankfull Mean Depth (ft) | 0.92 |
| Bankfull Max Depth (ft) | 1.5 |
| Bankfull Cross Sectional Area (ft ²) | 13.78 |
| Bankfull Width/Depth Ratio | 16.29 |
| Bankfull Entrenchment Ratio | 1.9 |
| Bankfull Bank Height Ratio | 1 |


Reach 2 Cross Sections – Caswell St. to Lincoln St.



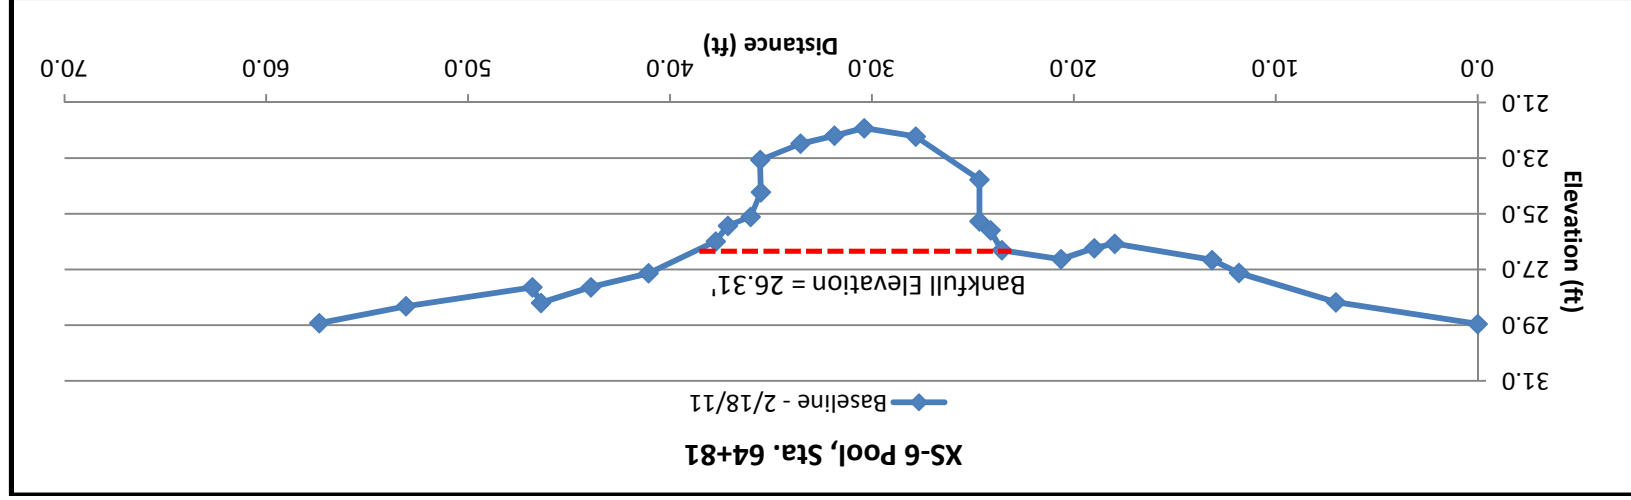


| | |
|--|-------|
| Bankfull Width (ft) | 15.1 |
| Floodprone Width (ft) | 57.39 |
| Bankfull Mean Depth (ft) | 2.94 |
| Bankfull Max Depth (ft) | 4.39 |
| Bankfull Cross Sectional Area (ft ²) | 44.41 |
| Bankfull Width/Depth Ratio | 5.14 |
| Bankfull Entrenchment Ratio | 3.8 |
| Bankfull Bank Height Ratio | 1 |



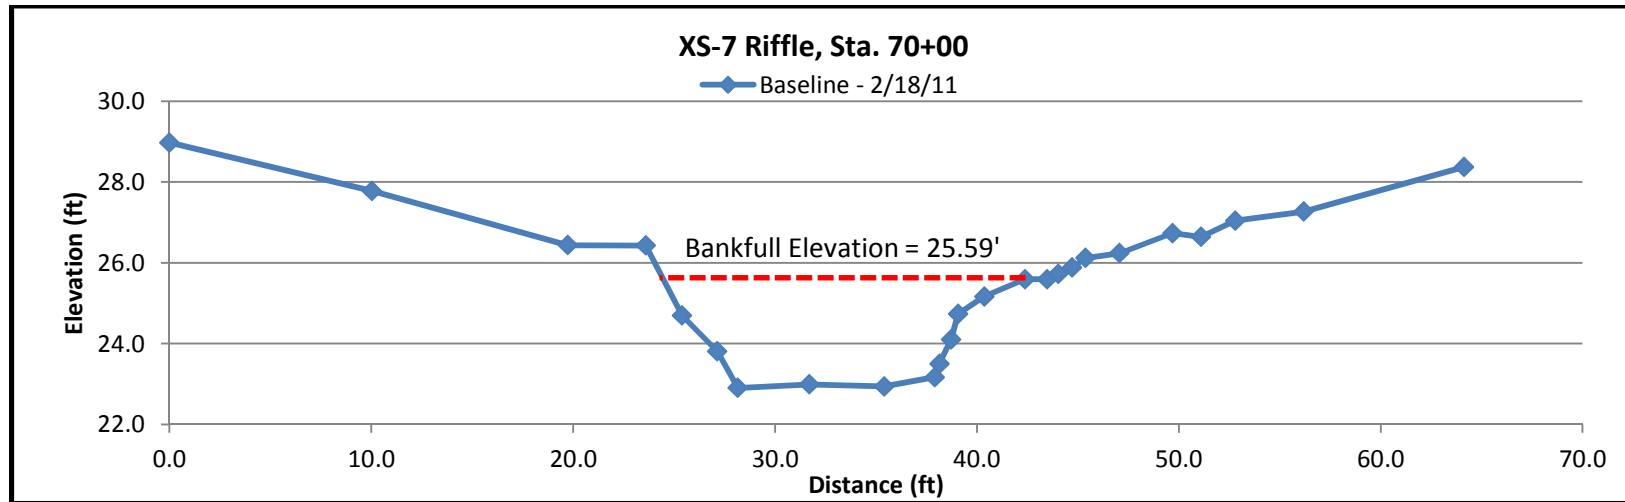


| | |
|--|-------|
| Bankfull Width (ft) | 17.91 |
| Floodprone Width (ft) | 57.58 |
| Bankfull Mean Depth (ft) | 1.88 |
| Bankfull Max Depth (ft) | 2.68 |
| Bankfull Cross Sectional Area (ft ²) | 33.7 |
| Bankfull Width/Depth Ratio | 9.53 |
| Bankfull Entrenchment Ratio | 3.22 |
| Bankfull Bank Height Ratio | 1 |

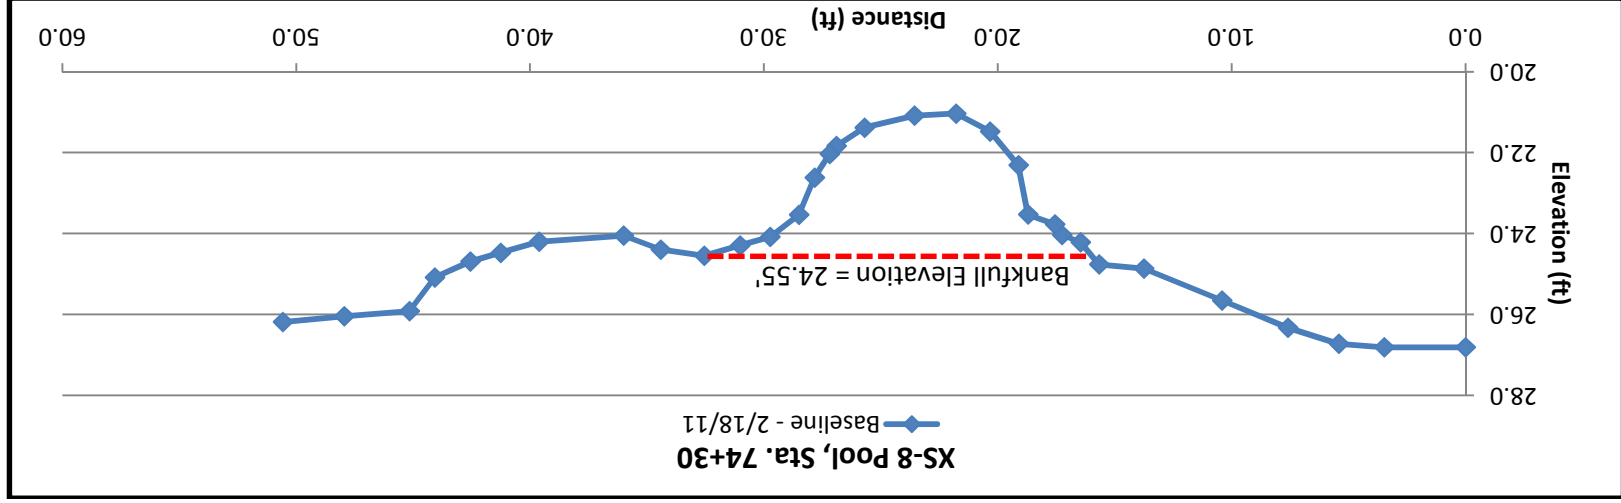


| | |
|-------|--|
| 16.57 | Bankfull Width (ft) |
| 50.57 | Floodprone Width (ft) |
| 1.93 | Bankfull Mean Depth (ft) |
| 3.51 | Bankfull Max Depth (ft) |
| 31.92 | Bankfull Cross Sectional Area (ft ²) |
| 8.59 | Bankfull Width/Depth Ratio |
| 3.05 | Bankfull Entrenchment Ratio |
| 1 | Bankfull Bank Height Ratio |

BASELINE MONITORING DOCUMENT & AS-BUILT BASELINE REPORT

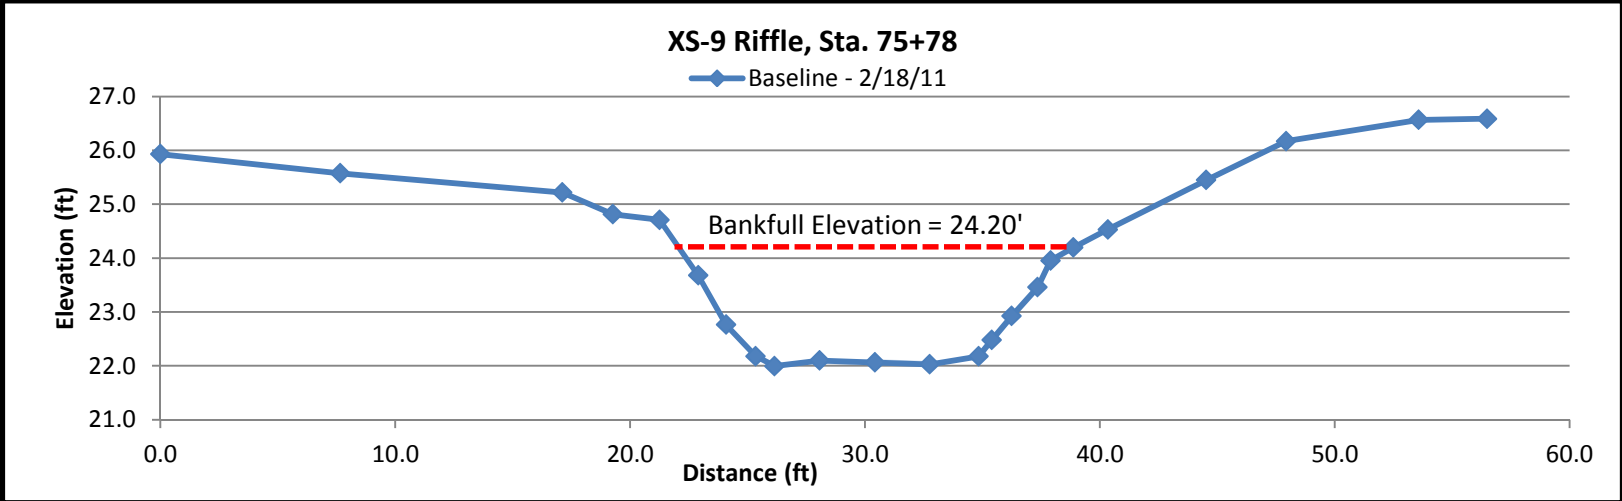


| | |
|--|-------|
| Bankfull Width (ft) | 16.81 |
| Floodprone Width (ft) | 51.29 |
| Bankfull Mean Depth (ft) | 1.64 |
| Bankfull Max Depth (ft) | 2.21 |
| Bankfull Cross Sectional Area (ft ²) | 27.58 |
| Bankfull Width/Depth Ratio | 10.25 |
| Bankfull Entrenchment Ratio | 3.05 |
| Bankfull Bank Height Ratio | 1 |

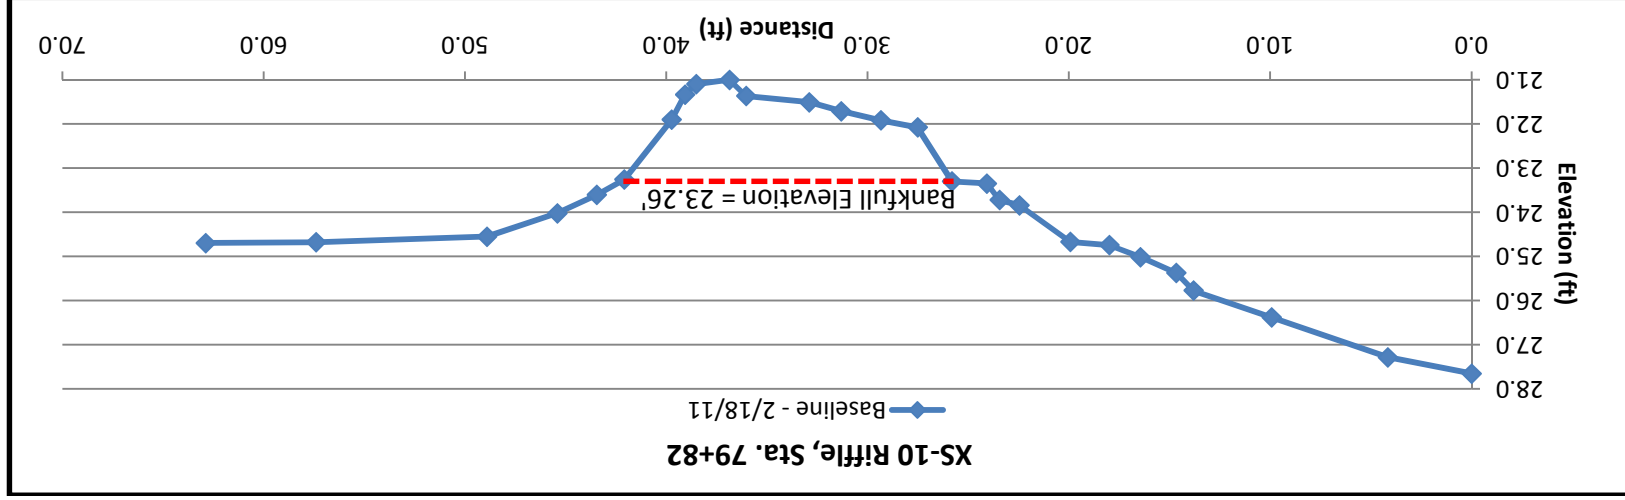


| | |
|--|-------|
| Bankfull Width (ft) | 16.23 |
| Floodprone Width (ft) | 48.33 |
| Bankfull Mean Depth (ft) | 1.46 |
| Bankfull Max Depth (ft) | 2.26 |
| Bankfull Cross Sectional Area (ft ²) | 23.68 |
| Bankfull Width/Depth Ratio | 11.12 |
| Bankfull Entrenchment Ratio | 2.99 |
| Bankfull Bank Height Ratio | 1 |

BASELINE MONITORING DOCUMENT & AS-BUILT BASELINE REPORT

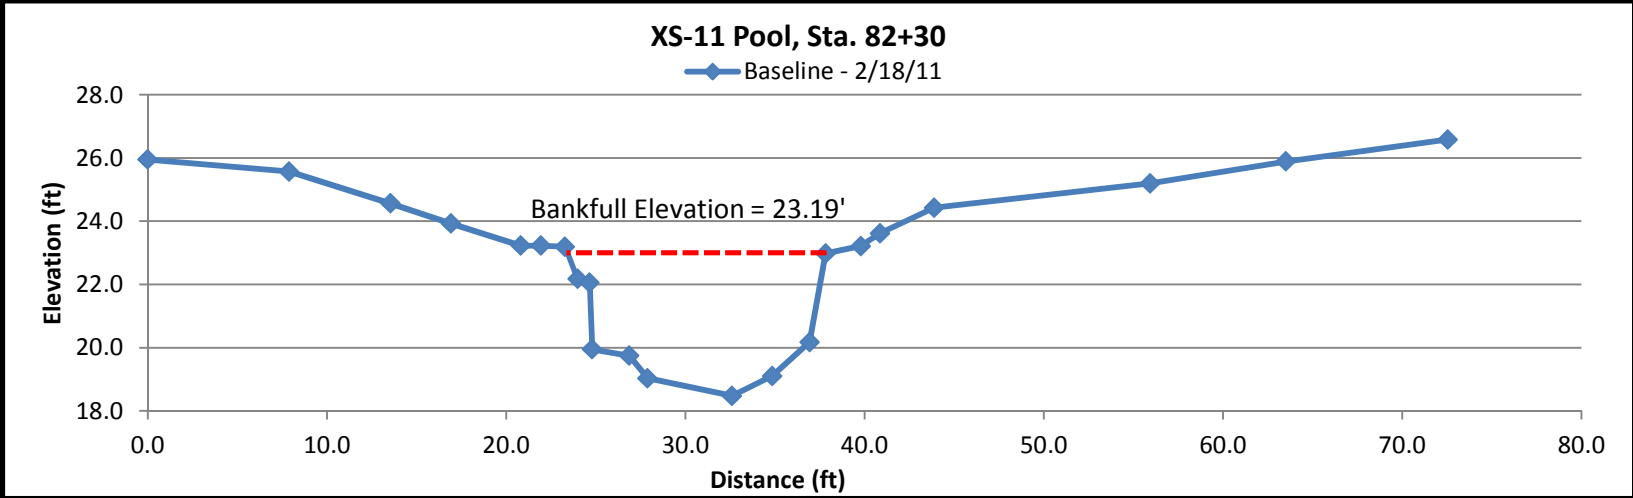

| | |
|--|-------|
| Bankfull Width (ft) | 16.31 |
| Floodprone Width (ft) | 72.56 |
| Bankfull Mean Depth (ft) | 3.19 |
| Bankfull Max Depth (ft) | 4.71 |
| Bankfull Cross Sectional Area (ft ²) | 52.00 |
| Bankfull Width/Depth Ratio | 5.11 |
| Bankfull Entrenchment Ratio | 4.45 |
| Bankfull Bank Height Ratio | 1 |



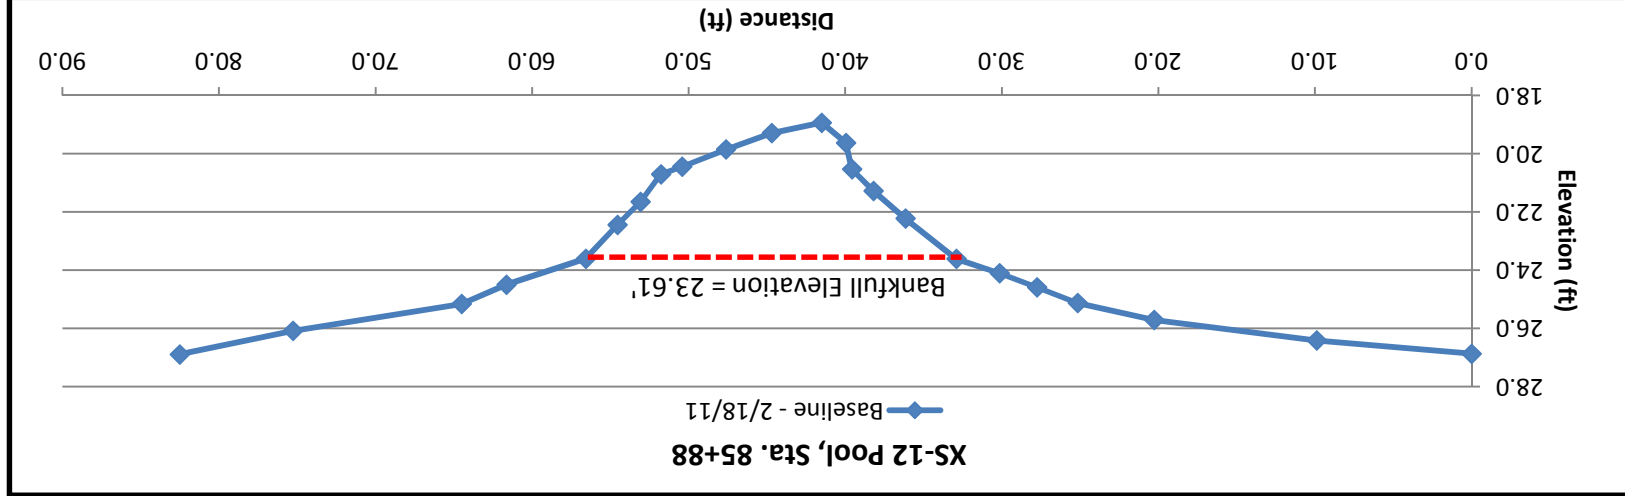


| | |
|--|-------|
| Bankfull Width (ft) | 23.66 |
| Floodprone Width (ft) | 82.52 |
| Bankfull Mean Depth (ft) | 2.72 |
| Bankfull Max Depth (ft) | 4.68 |
| Bankfull Cross Sectional Area (ft ²) | 64.42 |
| Bankfull Width/Depth Ratio | 8.7 |
| Bankfull Entrenchment Ratio | 3.49 |
| Bankfull Bank Height Ratio | 1 |



Reach 3 Cross Sections – UT to Adkin Branch




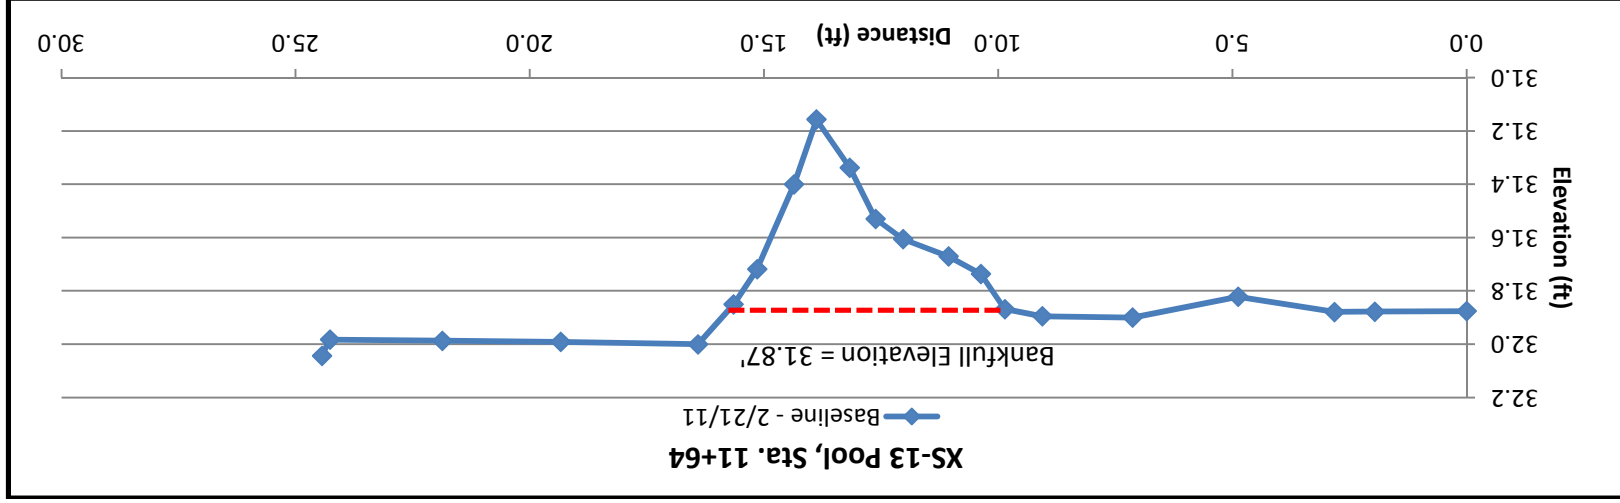


| | |
|--|-------|
| Bankfull Width (ft) | 5.89 |
| Floodprone Width (ft) | 24.44 |
| Bankfull Mean Depth (ft) | 0.31 |
| Bankfull Max Depth (ft) | 0.71 |
| Bankfull Cross Sectional Area (ft ²) | 1.81 |
| Bankfull Width/Depth Ratio | 19 |
| Bankfull Entrenchment Ratio | 4.15 |
| Bankfull Bank Height Ratio | 1 |




BASELINE MONITORING DOCUMENT & AS-BUILT BASELINE REPORT

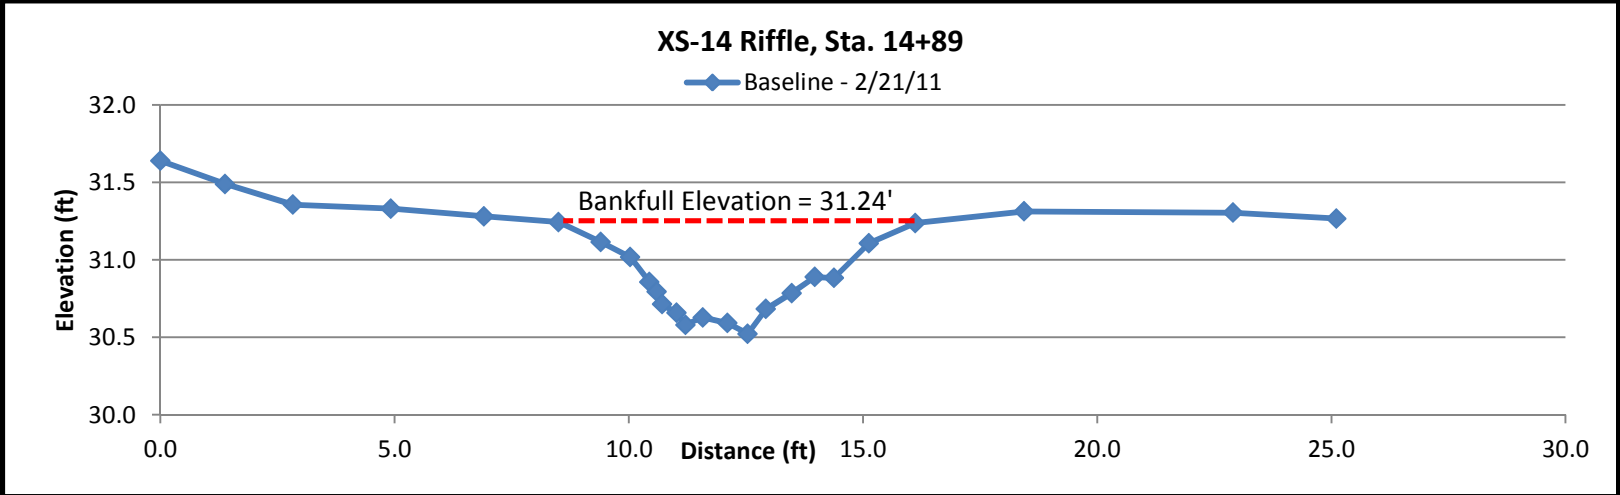


| | |
|--|-------|
| Bankfull Width (ft) | 7.69 |
| Floodprone Width (ft) | 25.11 |
| Bankfull Mean Depth (ft) | 0.35 |
| Bankfull Max Depth (ft) | 0.72 |
| Bankfull Cross Sectional Area (ft ²) | 2.68 |
| Bankfull Width/Depth Ratio | 21.97 |
| Bankfull Entrenchment Ratio | 3.26 |
| Bankfull Bank Height Ratio | 1 |

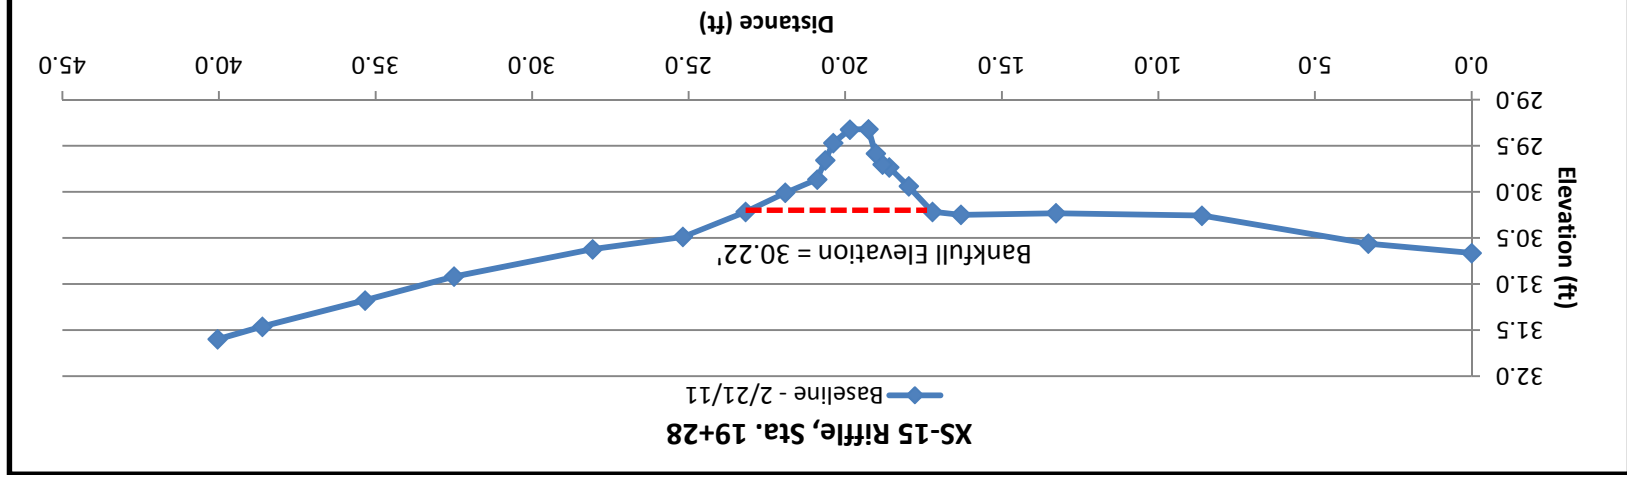

| | |
|--|-------|
| Bankfull Width (ft) | 6.06 |
| Floodprone Width (ft) | 34.69 |
| Bankfull Mean Depth (ft) | 0.4 |
| Bankfull Max Depth (ft) | 0.9 |
| Bankfull Cross Sectional Area (ft ²) | 2.43 |
| Bankfull Width/Depth Ratio | 15.15 |
| Bankfull Entrenchment Ratio | 5.72 |
| Bankfull Bank Height Ratio | 1 |

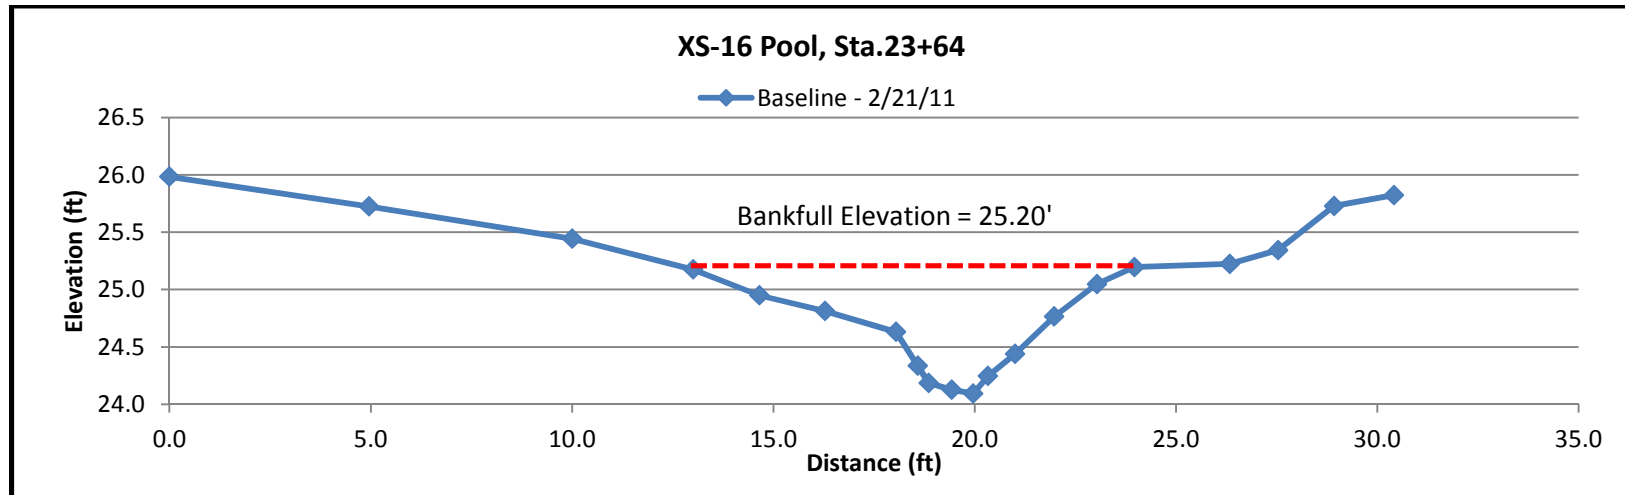

| | |
|--|-------|
| Bankfull Width (ft) | 11.59 |
| Floodprone Width (ft) | 30.42 |
| Bankfull Mean Depth (ft) | 0.46 |
| Bankfull Max Depth (ft) | 1.11 |
| Bankfull Cross Sectional Area (ft ²) | 5.34 |
| Bankfull Width/Depth Ratio | 25.2 |
| Bankfull Entrenchment Ratio | 2.62 |
| Bankfull Bank Height Ratio | 1 |

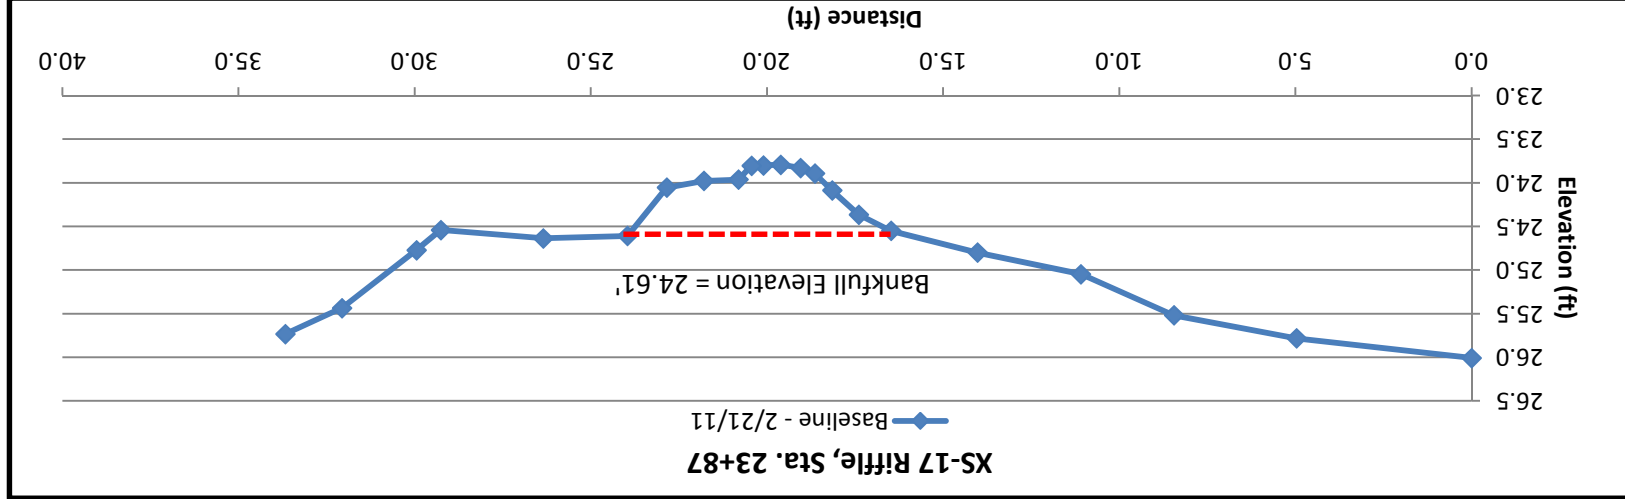

| | |
|--|-------|
| Bankfull Width (ft) | 8.06 |
| Floodprone Width (ft) | 23.07 |
| Bankfull Mean Depth (ft) | 0.5 |
| Bankfull Max Depth (ft) | 0.82 |
| Bankfull Cross Sectional Area (ft ²) | 4 |
| Bankfull Width/Depth Ratio | 16.12 |
| Bankfull Entrenchment Ratio | 2.86 |
| Bankfull Bank Height Ratio | 1 |

Appendix C: Vegetation Data & Photos



Table 8a. Final Planting Plan

| Vegetation Association | Requested Coastal Plain Levee Forest | Revised Coastal Plain Levee Forest | Stream-side Assemblage - Adkin Branch | Stream-side Assemblage - UT to Adkin Branch | Stormwater BMP Wetland Assemblage | TOTAL |
|--|---------------------------------------|---------------------------------------|---|---|---------------------------------------|----------------|
| Area (acres) | 30.65 Acres | 30.65 Acres | 1.40 Acres | 0.19 Acres | 0.69 Acres | 63.58 Acres |
| Species | Number Planted 680/AC (% of total) | Number Planted 680/AC (% of total) | Number Planted 12812/AC (% of total) | Number Planted 4271/AC (% of total) | Number Planted 680/AC (% of total) | Number planted |
| River birch (<i>Betula nigra</i>)* | 3,127 (15) | 4,169 (20) | | | | 3,127 |
| Slippery elm (<i>Ulmus rubra</i>)* | 2,085 (10) | 0 (0) | | | | 2,085 |
| Winged elm (<i>Ulmus alata</i>)* | 2,085 (10) | 0 (0) | | | | 2,085 |
| Pignut hickory (<i>Carya glabra</i>)* | 2,085 (10) | 0 (0) | | | | 2,085 |
| Black walnut (<i>Juglans nigra</i>)* | 0 (0) | 1,043 (5) | | | | 0 |
| Mockernut hickory (<i>Carya tomentosa</i>)* | 3,127 (15) | 4,169 (20) | | | | 3,127 |
| Southern red oak (<i>Quercus falcata</i> var. <i>falcata</i>)* | 2,085 (10) | 3,127 (15) | | | | 2,085 |
| Water oak (<i>Quercus nigra</i>)* | 2,085 (10) | 3,127 (15) | | | | 2,085 |
| Ironwood (<i>Carpinus caroliniana</i>)* | 2,085 (10) | 0 (0) | | | | 2,085 |
| Redbud (<i>Cercis canadensis</i>)* | 0 (0) | 3,127 (15) | | | | 0 |
| Sassafras (<i>Sassafras albidum</i>)* | 1,043 (5) | 1,043 (5) | | | | 1,043 |
| Black cherry (<i>Prunus serotina</i>)* | 1,043 (5) | 0 (0) | | | | 1,043 |
| Persimmon (<i>Diospyros virginiana</i>)* | 0 (0) | 1,043 (5) | | | | 0 |
| Black willow (<i>Salix nigra</i>)** | | | 3,585 (20) | 162 (20) | 71 (15) | 3,818 |
| Silky dogwood (<i>Cornus amomum</i>)** | | | 3,585 (20) | 162 (20) | 71 (15) | 3,818 |
| Buttonbush (<i>Cephalanthus occidentalis</i>)** | | | 2,689 (15) | 122 (15) | 71 (15) | 2,882 |
| Elderberry (<i>Sambucus canadensis</i>)** | | | 2,689 (15) | 122 (15) | | 2,811 |
| Tag alder (<i>Alnus serrulata</i>)** | | | 2,689 (15) | 122 (15) | 71 (15) | 2,882 |
| Bald cypress (<i>Taxodium distichum</i>)** | | | | | 71 (15) | 71 |
| Water tupelo (<i>Nyssa aquatica</i>)** | | | | | 71 (15) | 71 |
| Arrow arum (<i>Peltandra virginica</i>)** | | | | | 47 (10) | 47 |
| Common rush (<i>Juncus effusus</i>)** | | | 2,689 (15) | 122 (15) | | 2,811 |
| TOTAL | 20,850 (100) | 20,848 (100) | 17,926 (100) | 812 (100) | 473 (100) | 40,061 |


* Planted at a density of 680 stems/acre (~ 8-foot spacing).
 ** Planted at ~ 2-foot spacing along three rows on Adkin Branch and ~4-foot spacing along one row on UT to Adkin Branch if in Stream-side Assemblage or 680 stems/acre at 2' spacing if planted in Stormwater BMP.
 *** Emergent herbaceous seed mix spread at a rate of 50 pounds per acre.

BASELINE MONITORING DOCUMENT & AS-BUILT BASELINE REPORT

Table 8b. Holloway Park Ball & Burlap

| Table 8b. Holloway Park Ball & Burlap Planting | | |
|--|--|---|
| Vegetation Association | <i>Holloway Park Ball & Burlap Requested 12/9/10</i> | Holloway Park Ball & Burlap Revised 1/3/11 |
| | <i>86 Total Plants</i> | 86 Total Plants |
| Species | <i>(% of total)</i> | (% of total) |
| River birch (<i>Betula nigra</i>)* | 17 (20) | 20 (23.0) |
| Pignut hickory (<i>Carya glabra</i>)* | 13 (15) | 15 (17.5) |
| Mockernut hickory (<i>Carya tomentosa</i>)* | 13 (15) | |
| Southern red oak (<i>Quercus falcata</i> var. <i>falcata</i>)* | 17 (20) | 21 (24.5) |
| Water oak (<i>Quercus nigra</i>)* | 13 (15) | 15 (17.5) |
| Black cherry (<i>Prunus serotina</i>)* | 13 (15) | 15 (17.5) |
| TOTAL | 86 (100) | 86 (100) |


Vegetation Baseline Monitoring Photographs (taken March 2011)

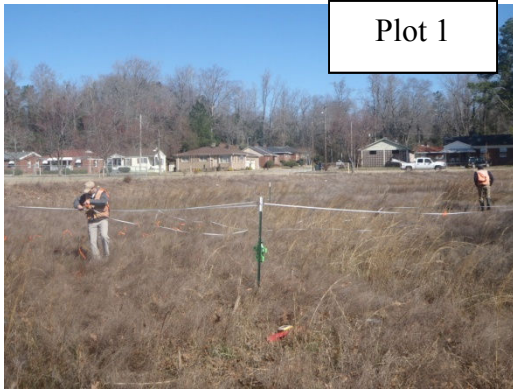

Plot 1



Plot 2

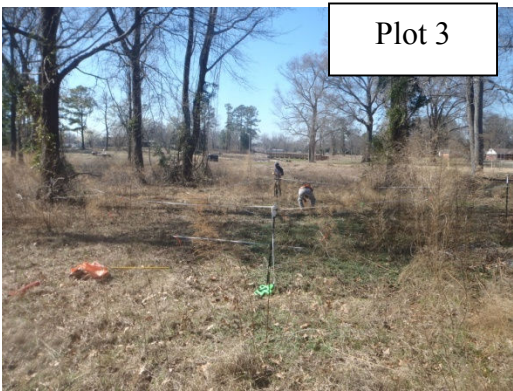

Plot 3



Plot 4



Plot 5



Plot 6





Plot 7



Plot 8



BASELINE MONITORING DOCUMENT & AS-BUILT BASELINE REPORT

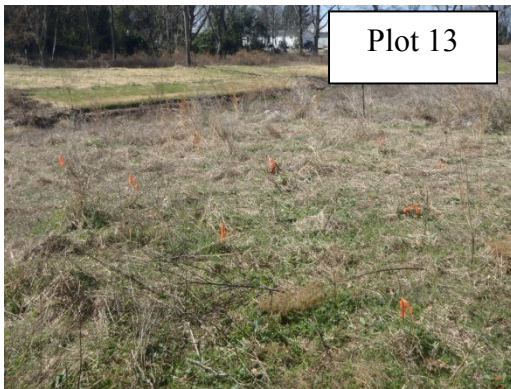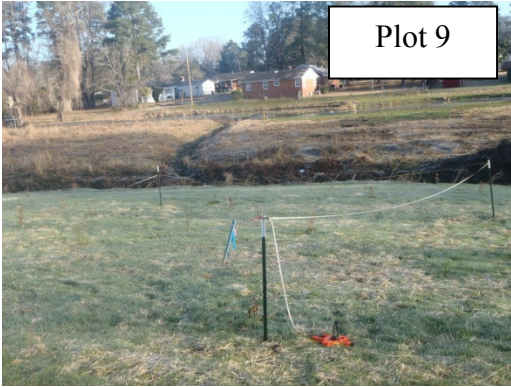

BASELINE MONITORING DOCUMENT & AS-BUILT BASELINE REPORT



Appendix D: Credit Calculation Documentation and Figures

The following tables and figures were prepared to document the methods used in determining stream restoration (SR), riparian buffer restoration (RBR), nutrient offset pound reduction (NO lb.), and nutrient offset buffer restoration (NOBR) credits for the Project. It is to be noted that the Adkin Branch Stream Restoration project was instituted before October 11, 2007, and is grandfathered to allow mitigation credit for buffer restoration out to 200 feet as measured horizontally out from the water surface. Allowing this project to be grandfathered is in accordance with an email from Tom Reeder (DWQ) dated October 10, 2007 which states: “This decision was made so as to not penalize those projects that may have been completed in good faith under any misunderstanding caused by the distribution of the internal DWQ memo dated Oct 23, 2002”.

Riparian buffer areas were measured for three different categories: areas with less than 50’ buffer, areas with a 50’ buffer, and areas with a buffer greater than 50’ and up to 200’. Stream and Riparian Buffer restoration credits were calculated based on Tables 1 and 3 in the *DRAFT Regulatory Guidance for the Calculation of Stream and Buffer Mitigation Credit for Buffer Widths Different from Standard Minimum Widths, Version 4.5, July 20, 2010*. Riparian Buffer restoration areas may be used for stream & wetland mitigation, stream & riparian buffer mitigation, or nutrient offset buffer restoration credit (Estimating/Calculating Riparian Buffer Credits, EEP PPPM Section 8.3.1.2).

Stream lengths and buffer areas were outlined and measured in MicroStation. For each buffered ditch entering the project area, 0.10 acres was deducted from the corresponding buffer area (DWQ Memo #2008-019, dated August 19, 2008). For areas with buffer widths between 50’ to 200’, the buffers were divided into areas with similar widths and assigned an average width to determine the appropriate buffer correction factor. A similar approach was used for SR credits. Each reach was divided into segments with similar buffer widths to determine the percent increase or decrease in stream restoration credit. Left and right banks were calculated separately and then averaged to determine total credits.

Sewer easement and stormwater BMP footprints within the conservation easement were not included in riparian buffer acreage calculations. In areas where the sewer easement lies within Zone 2 (30’-50’), buffer credit was allowed for the area between the easement and the stream top of bank at the full 1:1 ratio (DWQ Memo #2009-006, dated November 17, 2009). Segments of the stream in these areas were also calculated at a 1:1 ratio. No stream credit was given for segments of channel at perpendicular sewer easement crossings or at pedestrian bridge crossings.

Stream Restoration Credits (SR)

| Stream Restoration Credit Summary | | | | |
|--|-----------------|-----------------------------------|------------------------------------|-----------------------|
| | Gross LF | Left Bank Adjusted LF* | Right Bank Adjusted LF* | Credit Yield** |
| Washington to Gordon | 1,727 | 1,778 | 1,740 | 1,759 |
| Gordon to Caswell | 620 | 671 | 650 | 661 |
| Caswell to Lincoln | 3,650 | 3,815 | 3,725 | 3,770 |
| Adkin Branch Subtotal | 5,997 | 6,264 | 6,115 | 6,189 |
| UT Adkin | 1,582 | 1,631 | 1,565 | 1,598 |
| TOTAL LF | 7,579 | 7,894 | 7,681 | 7,787 |
| * - LF (Linear Feet) adjusted based on proposed DWQ guidelines (DRAFT Regulatory Guidance for the Calculation of Stream and Buffer Mitigation Credit for Buffer Widths Different from Standard Minimum Widths, Version 4.5, July 20, 2010) | | | | |
| ** - Credit Yield is the average of left and right bank adjusted LF | | | | |



Neuse Riparian Buffer Restoration Credits (RBR)

| Riparian Buffer Restoration Credit Summary | | | | |
|--|------------------|------------------------|----------------------------|-----------------------|
| | 50' | 50' - 200' | 50' - 200' | |
| | Area (sf) | Gross Area (sf) | Adjusted Area (sf)* | Credit Yield** |
| Washington to Gordon | 110,986 | 113,251 | 125,269 | 236,255 |
| Gordon to Caswell | 50,195 | 68,346 | 77,405 | 127,600 |
| Caswell to Lincoln | 286,008 | 329,882 | 381,370 | 667,378 |
| UT Adkin | 115,610 | 96,994 | 112,661 | 228,271 |
| TOTAL (sf) | 562,799 | 608,473 | 696,704 | 1,259,503 |
| TOTAL (ac) | 12.92 | 13.97 | 15.99 | 28.91 |
| <p>* - Areas adjusted based on proposed values in Table 1 of the “Draft Regulatory Guidance for the Calculation of Stream and Buffer Mitigation Credit for Buffer Widths Different From Standard Minimum Widths NC IRT Version 4.5 July 20, 2010”.</p> | | | | |
| <p>** - Credit Yield is the sum of 50' area and 50' - 200' adjusted area</p> | | | | |



BASELINE MONITORING DOCUMENT & AS-BUILT BASELINE REPORT

Neuse Nutrient Offset Pound Reduction Credits (NO lb.)

| Nutrient Offset Pound Reduction Credit Summary | | | | |
|---|---|---|--|--|
| BMP | Pre-Existing Annual Total Nitrogen Load (lbs/yr) | Annual Total Nitrogen Load w/ BMP (lbs/yr) | Annual Total Nitrogen Load Reduction (lbs/yr) | 30 yr. Total Nitrogen Reduction (lbs) |
| BMP 4 | 29 | 19 | 10 | 300 |
| BMP 5 | 72 | 47 | 25 | 750 |
| BMP 6 | 111 | 72 | 39 | 1,170 |
| BMP 7 | 56 | 36 | 20 | 600 |
| BMP 8 | 18 | 12 | 6 | 180 |
| BMP 9 | 94 | 61 | 33 | 990 |
| | | | Total | 3,990 |

Neuse Nutrient Offset Buffer Restoration Credits (NOBR)

| Nutrient Offset Buffer Restoration Credit Summary | | | | | | |
|--|------------------|--------------------------|-------------------|---------------------------|------------------|---------------------------|
| | <= 50' | | 50' - 200' | | Total | |
| | Area (ac) | Nitrogen Credits* | Area (sf) | Nitrogen Credits** | Area (ac) | Nitrogen Credits** |
| Washington to Gordon | 2.65 | 0 | 2.60 | 5,910 | 5.25 | 5,910 |
| Gordon to Caswell | 1.18 | 0 | 1.57 | 3,566 | 2.75 | 3,566 |
| Caswell to Lincoln | 6.88 | 0 | 7.57 | 17,214 | 14.45 | 17,214 |
| UT Adkin | 2.88 | 0 | 2.23 | 5,061 | 5.11 | 5,061 |
| TOTAL | 13.60 | 0 | 13.97 | 31,751 | 27.57 | 31,751 |
| * - In accordance with EEP PPPM Section 8.3.1.2, <i>Estimating/Calculating Riparian Buffer Credits</i> , no Nitrogen Credits were calculated for 0-50' buffer area. | | | | | | |
| ** - Nitrogen Credits were calculated based on a rate of 2,273 lbs per acre over 30 years per DWQ policy (<i>Estimating/Calculating Riparian Buffer Credits, EEP PPPM Section 8.3.1.2</i>) | | | | | | |



Project ID No. 050656101
Adkin Branch Stream Restoration Project – Phase 1
 Lenoir County, NC
BASELINE MONITORING DOCUMENT & AS-BUILT BASELINE REPORT

| Adkin Branch - Stream Restoration Credit Calculations | | | | | | | | | | | | |
|---|-----------|----------|------------|-------------------|---|------------|--------------|----------|------------|-------------------|---|------------|
| | Left Bank | | | | | | Right Bank | | | | | |
| | Beg Sta. | End Sta. | LF* | Buffer Width (ft) | % increase or decrease in stream credit** | Net LF*** | Beg Sta. | End Sta. | LF* | Buffer Width (ft) | % increase or decrease in stream credit** | Net LF*** |
| Washington to Gordon | 35+99 | 36+56 | 56.9 | 30 | 62.5% | 35.6 | 35+99 | 36+61 | 61.8 | 30 | 62.5% | 38.6 |
| | 36+56 | 37+83 | 127.2 | 65 | 103.5% | 131.6 | 36+61 | 37+68 | 107.3 | 60 | 103.5% | 111.0 |
| | 37+83 | 37+88 | 5.1 | 50 | 100.0% | 5.1 | 37+68 | 38+01 | 33.1 | 0 | 0.0% | 0.0 |
| | 37+88 | 37+95 | 7.0 | 0 | 0.0% | 0.0 | 38+01 | 39+90 | 188.4 | 100 | 106.0% | 199.7 |
| | 37+95 | 41+39 | 344.2 | 60 | 103.5% | 356.3 | 39+90 | 41+23 | 133.7 | 200 | 113.0% | 151.0 |
| | 41+39 | 44+23 | 284.0 | 50 | 100.0% | 284.0 | 41+23 | 42+58 | 134.9 | 100 | 106.0% | 143.0 |
| | 44+23 | 47+63 | 339.9 | 65 | 103.5% | 351.8 | 42+58 | 43+13 | 54.8 | 45 | 94.0% | 51.6 |
| | 47+63 | 48+26 | 62.5 | 50 | 100.0% | 62.5 | 43+13 | 44+71 | 158.1 | 90 | 106.0% | 167.6 |
| | 48+26 | 53+26 | 500.6 | 115 | 110.0% | 550.6 | 44+71 | 48+31 | 359.6 | 75 | 103.5% | 372.1 |
| | | | | | | | 48+31 | 50+45 | 214.0 | 90 | 106.0% | 226.8 |
| | | | | | | | 50+45 | 52+11 | 166.3 | 80 | 106.0% | 176.3 |
| | | | | | | | 52+11 | 52+47 | 36.5 | 27 | 62.5% | 22.8 |
| | | | | | | | 52+47 | 53+26 | 79.0 | 50 | 100.0% | 79.0 |
| | Sub-total | | | 1,727 | | | 1,778 | | | 1,727 | | |
| Gordon to Caswell | 54+07 | 55+25 | 117.8 | 115 | 110% | 129.6 | 54+07 | 57+02 | 294.6 | 65 | 103.5% | 304.9 |
| | 55+25 | 56+44 | 118.9 | 75 | 104% | 123.0 | 57+02 | 58+06 | 104.9 | 130 | 110.0% | 115.4 |
| | 56+44 | 56+90 | 46.4 | 65 | 104% | 48.1 | 58+06 | 58+31 | 24.3 | 200 | 113.0% | 27.4 |
| | 56+90 | 60+27 | 336.4 | 110 | 110% | 370.1 | 58+31 | 58+90 | 59.0 | 130 | 110.0% | 64.9 |
| | | | | | | | 58+90 | 59+87 | 97.5 | 60 | 103.5% | 100.9 |
| | | | | | | | 59+87 | 60+27 | 39.2 | 45 | 94.0% | 36.8 |
| Sub-total | | | 620 | | | 671 | | | 620 | | | 650 |
| | 60+78 | 62+63 | 184.6 | 80 | 106% | 195.6 | 60+78 | 63+16 | 237.5 | 75 | 103.5% | 245.8 |
| | 62+63 | 62+84 | 21.7 | 45 | 94% | 20.4 | 63+16 | 64+88 | 172.1 | 20 | 50.0% | 86.0 |
| | 62+84 | 64+18 | 133.8 | 85 | 106% | 141.9 | 64+88 | 68+89 | 401.3 | 150 | 110.0% | 441.5 |
| | 64+18 | 65+51 | 132.5 | 65 | 104% | 137.1 | 68+89 | 69+15 | 26.5 | 45 | 94.0% | 24.9 |
| | 65+51 | 66+48 | 97.1 | 100 | 106% | 102.9 | 69+15 | 72+18 | 303.0 | 105 | 110.0% | 333.3 |
| | 66+48 | 67+23 | 75.6 | 65 | 104% | 78.3 | 72+18 | 72+65 | 46.7 | 40 | 87.5% | 40.9 |
| | 67+23 | 67+81 | 57.8 | 45 | 94% | 54.3 | 72+65 | 76+50 | 384.5 | 160 | 113.0% | 434.5 |
| | 67+81 | 70+61 | 279.8 | 120 | 110% | 307.8 | 76+50 | 77+20 | 70.8 | 90 | 106.0% | 75.0 |
| | 70+61 | 71+08 | 46.8 | 50 | 100% | 46.8 | 77+20 | 77+72 | 51.1 | 45 | 94.0% | 48.1 |
| | 71+08 | 75+17 | 409.3 | 80 | 106% | 433.8 | 77+72 | 80+01 | 229.0 | 75 | 103.5% | 237.0 |
| | 75+17 | 78+21 | 304.2 | 125 | 110% | 334.7 | 80+01 | 80+50 | 49.6 | 30 | 62.5% | 31.0 |
| | 78+21 | 78+87 | 66.0 | 60 | 104% | 68.3 | 80+50 | 84+16 | 365.5 | 80 | 106.0% | 387.4 |
| | 78+87 | 78+95 | 7.7 | 50 | 100% | 7.7 | 84+16 | 84+22 | 6.5 | 23 | 50.0% | 3.3 |
| 78+95 | 82+46 | 350.9 | 70 | 104% | 363.1 | 84+22 | 84+29 | 7.0 | 0 | 0.0% | 0.0 | |



BASELINE MONITORING DOCUMENT & AS-BUILT BASELINE REPORT

| | | | | | | | | | | | | |
|---|-------|-------|--------------|-----|------|--------------|-------|-------|--------------|-----|--------|--------------|
| Caswell to Lincoln | 82+46 | 82+63 | 17.3 | 60 | 104% | 17.9 | 84+29 | 84+36 | 6.8 | 23 | 50.0% | 3.4 |
| | 82+63 | 82+93 | 30.4 | 50 | 100% | 30.4 | 84+36 | 85+26 | 90.4 | 70 | 103.5% | 93.6 |
| | 82+93 | 83+38 | 44.4 | 170 | 113% | 50.1 | 85+26 | 85+72 | 45.6 | 45 | 94.0% | 42.9 |
| | 83+38 | 84+16 | 78.3 | 50 | 100% | 78.3 | 85+72 | 86+59 | 87.0 | 95 | 106.0% | 92.2 |
| | 84+16 | 84+23 | 6.5 | 25 | 50% | 3.3 | 86+59 | 86+89 | 30.3 | 0 | 0.0% | 0.0 |
| | 84+23 | 84+30 | 7.0 | 0 | 0% | 0.0 | 86+89 | 87+24 | 34.3 | 50 | 100.0% | 34.3 |
| | 84+30 | 84+36 | 6.1 | 23 | 50% | 3.1 | 87+24 | 91+33 | 408.9 | 115 | 110.0% | 449.8 |
| | 84+36 | 85+07 | 70.8 | 50 | 100% | 70.8 | 91+33 | 91+53 | 20.1 | 0 | 0.0% | 0.0 |
| | 85+07 | 85+28 | 21.7 | 120 | 110% | 23.8 | 91+53 | 96+04 | 451.2 | 115 | 110.0% | 496.3 |
| | 85+28 | 86+59 | 130.5 | 50 | 100% | 130.5 | 96+04 | 97+28 | 124.2 | 50 | 100.0% | 124.2 |
| | 86+59 | 86+89 | 30.3 | 0 | 0% | 0.0 | | | | | | |
| | 86+89 | 87+73 | 83.5 | 50 | 100% | 83.5 | | | | | | |
| | 87+73 | 88+37 | 64.7 | 115 | 110% | 71.2 | | | | | | |
| | 88+37 | 88+89 | 52.0 | 90 | 106% | 55.1 | | | | | | |
| | 88+89 | 89+32 | 42.9 | 80 | 106% | 45.5 | | | | | | |
| | 89+32 | 91+32 | 200.1 | 175 | 113% | 226.1 | | | | | | |
| | 91+32 | 91+52 | 20.1 | 0 | 0% | | | | | | | |
| | 91+52 | 97+28 | 575.3 | 140 | 110% | 632.9 | | | | | | |
| | | | | | | | | | | | | |
| Sub-total | | | 3,650 | | | 3,815 | | | 3,650 | | | 3,725 |
| UT Adkin | 10+00 | 11+20 | 119.5 | 30 | 63% | 74.7 | 10+00 | 10+22 | 21.5 | 50 | 100.0% | 21.5 |
| | 11+20 | 16+76 | 556.3 | 75 | 104% | 575.7 | 10+22 | 19+49 | 927.8 | 80 | 106.0% | 983.5 |
| | 16+76 | 16+84 | 8.4 | 35 | 81% | 6.8 | 19+49 | 20+91 | 141.6 | 20 | 50.0% | 70.8 |
| | 16+84 | 24+39 | 754.6 | 150 | 110% | 830.0 | 20+91 | 21+92 | 101.0 | 50 | 100.0% | 101.0 |
| | 24+39 | 25+82 | 143.4 | 50 | 100% | 143.4 | 21+92 | 22+06 | 13.9 | 48 | 94.0% | 13.1 |
| | | | | | | | 22+06 | 23+40 | 134.5 | 60 | 103.5% | 139.2 |
| | | | | | | | 23+40 | 24+05 | 64.6 | 40 | 87.5% | 56.5 |
| | | | | | | | 24+05 | 24+75 | 69.7 | 65 | 103.5% | 72.2 |
| | | | | | | | 24+75 | 25+82 | 107.5 | 50 | 100.0% | 107.5 |
| Sub-total | | | 1,582 | | | 1,631 | | | 1,582 | | | 1,565 |
| TOTAL LF* | | | 7,579 | | | 7,894 | | | 7,579 | | | 7,681 |
| * - LF = Linear Feet | | | | | | | | | | | | |
| ** - As shown in Table 3 of the "Draft Regulatory Guidance for the Calculation of Stream and Buffer Mitigation Credit for Buffer Widths Different From Standard Minimum Widths NC IRT Version 4.5 July 20, 2010". | | | | | | | | | | | | |
| *** - Net LF is equal to LF times the percent increase or decrease in stream credit. | | | | | | | | | | | | |










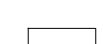
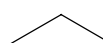
Florence & Hutcheson



CONSULTING ENGINEERS

5121 Kingdom Way, Suite 100 Raleigh, NC 27607

NC License No: F-0258

 


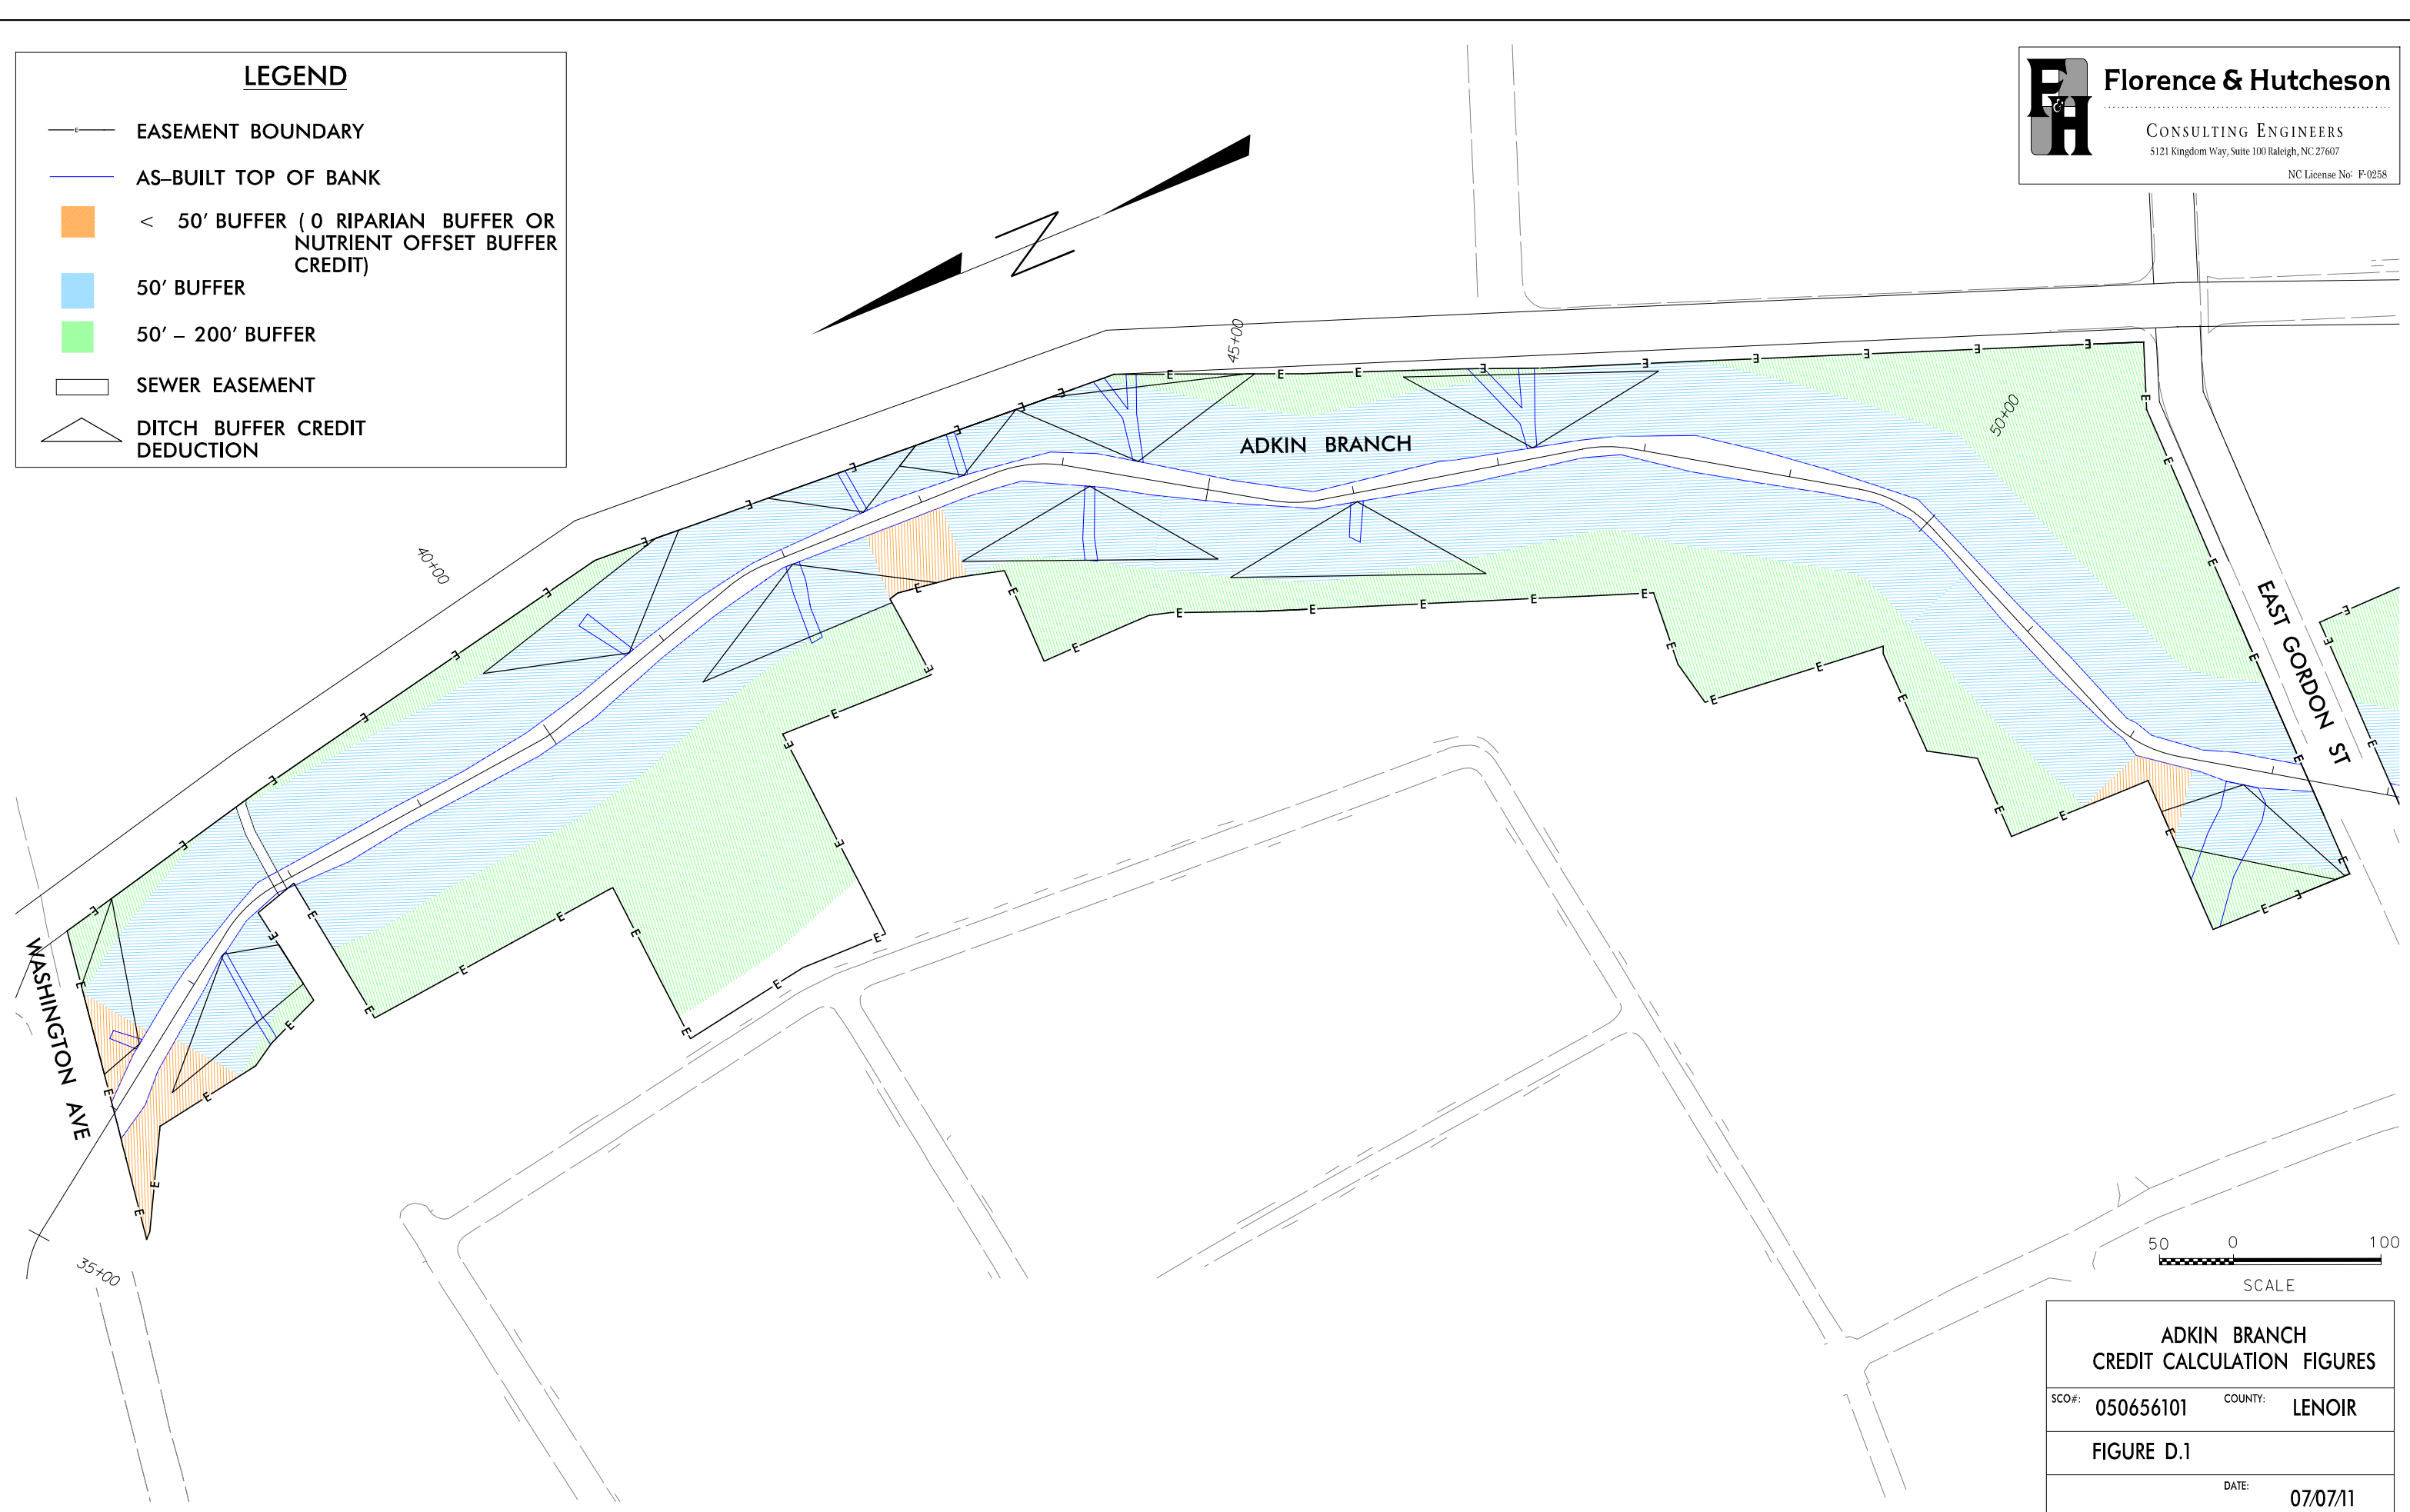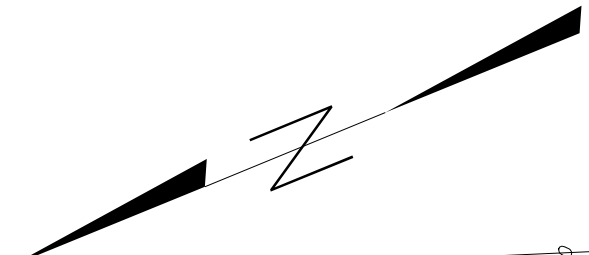


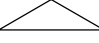
LEGEND



-  EASEMENT BOUNDARY
-  AS-BUILT TOP OF BANK
-  < 50' BUFFER (0 RIPARIAN BUFFER OR NUTRIENT OFFSET BUFFER CREDIT)
-  50' BUFFER
-  50' - 200' BUFFER
-  SEWER EASEMENT
-  DITCH BUFFER CREDIT DEDUCTION



| | |
|--|----------------|
| ADKIN BRANCH CREDIT CALCULATION FIGURES | |
| SCO#: 050656101 | COUNTY: LENOIR |
| FIGURE D.1 | |
| DATE: 07/07/11 | |





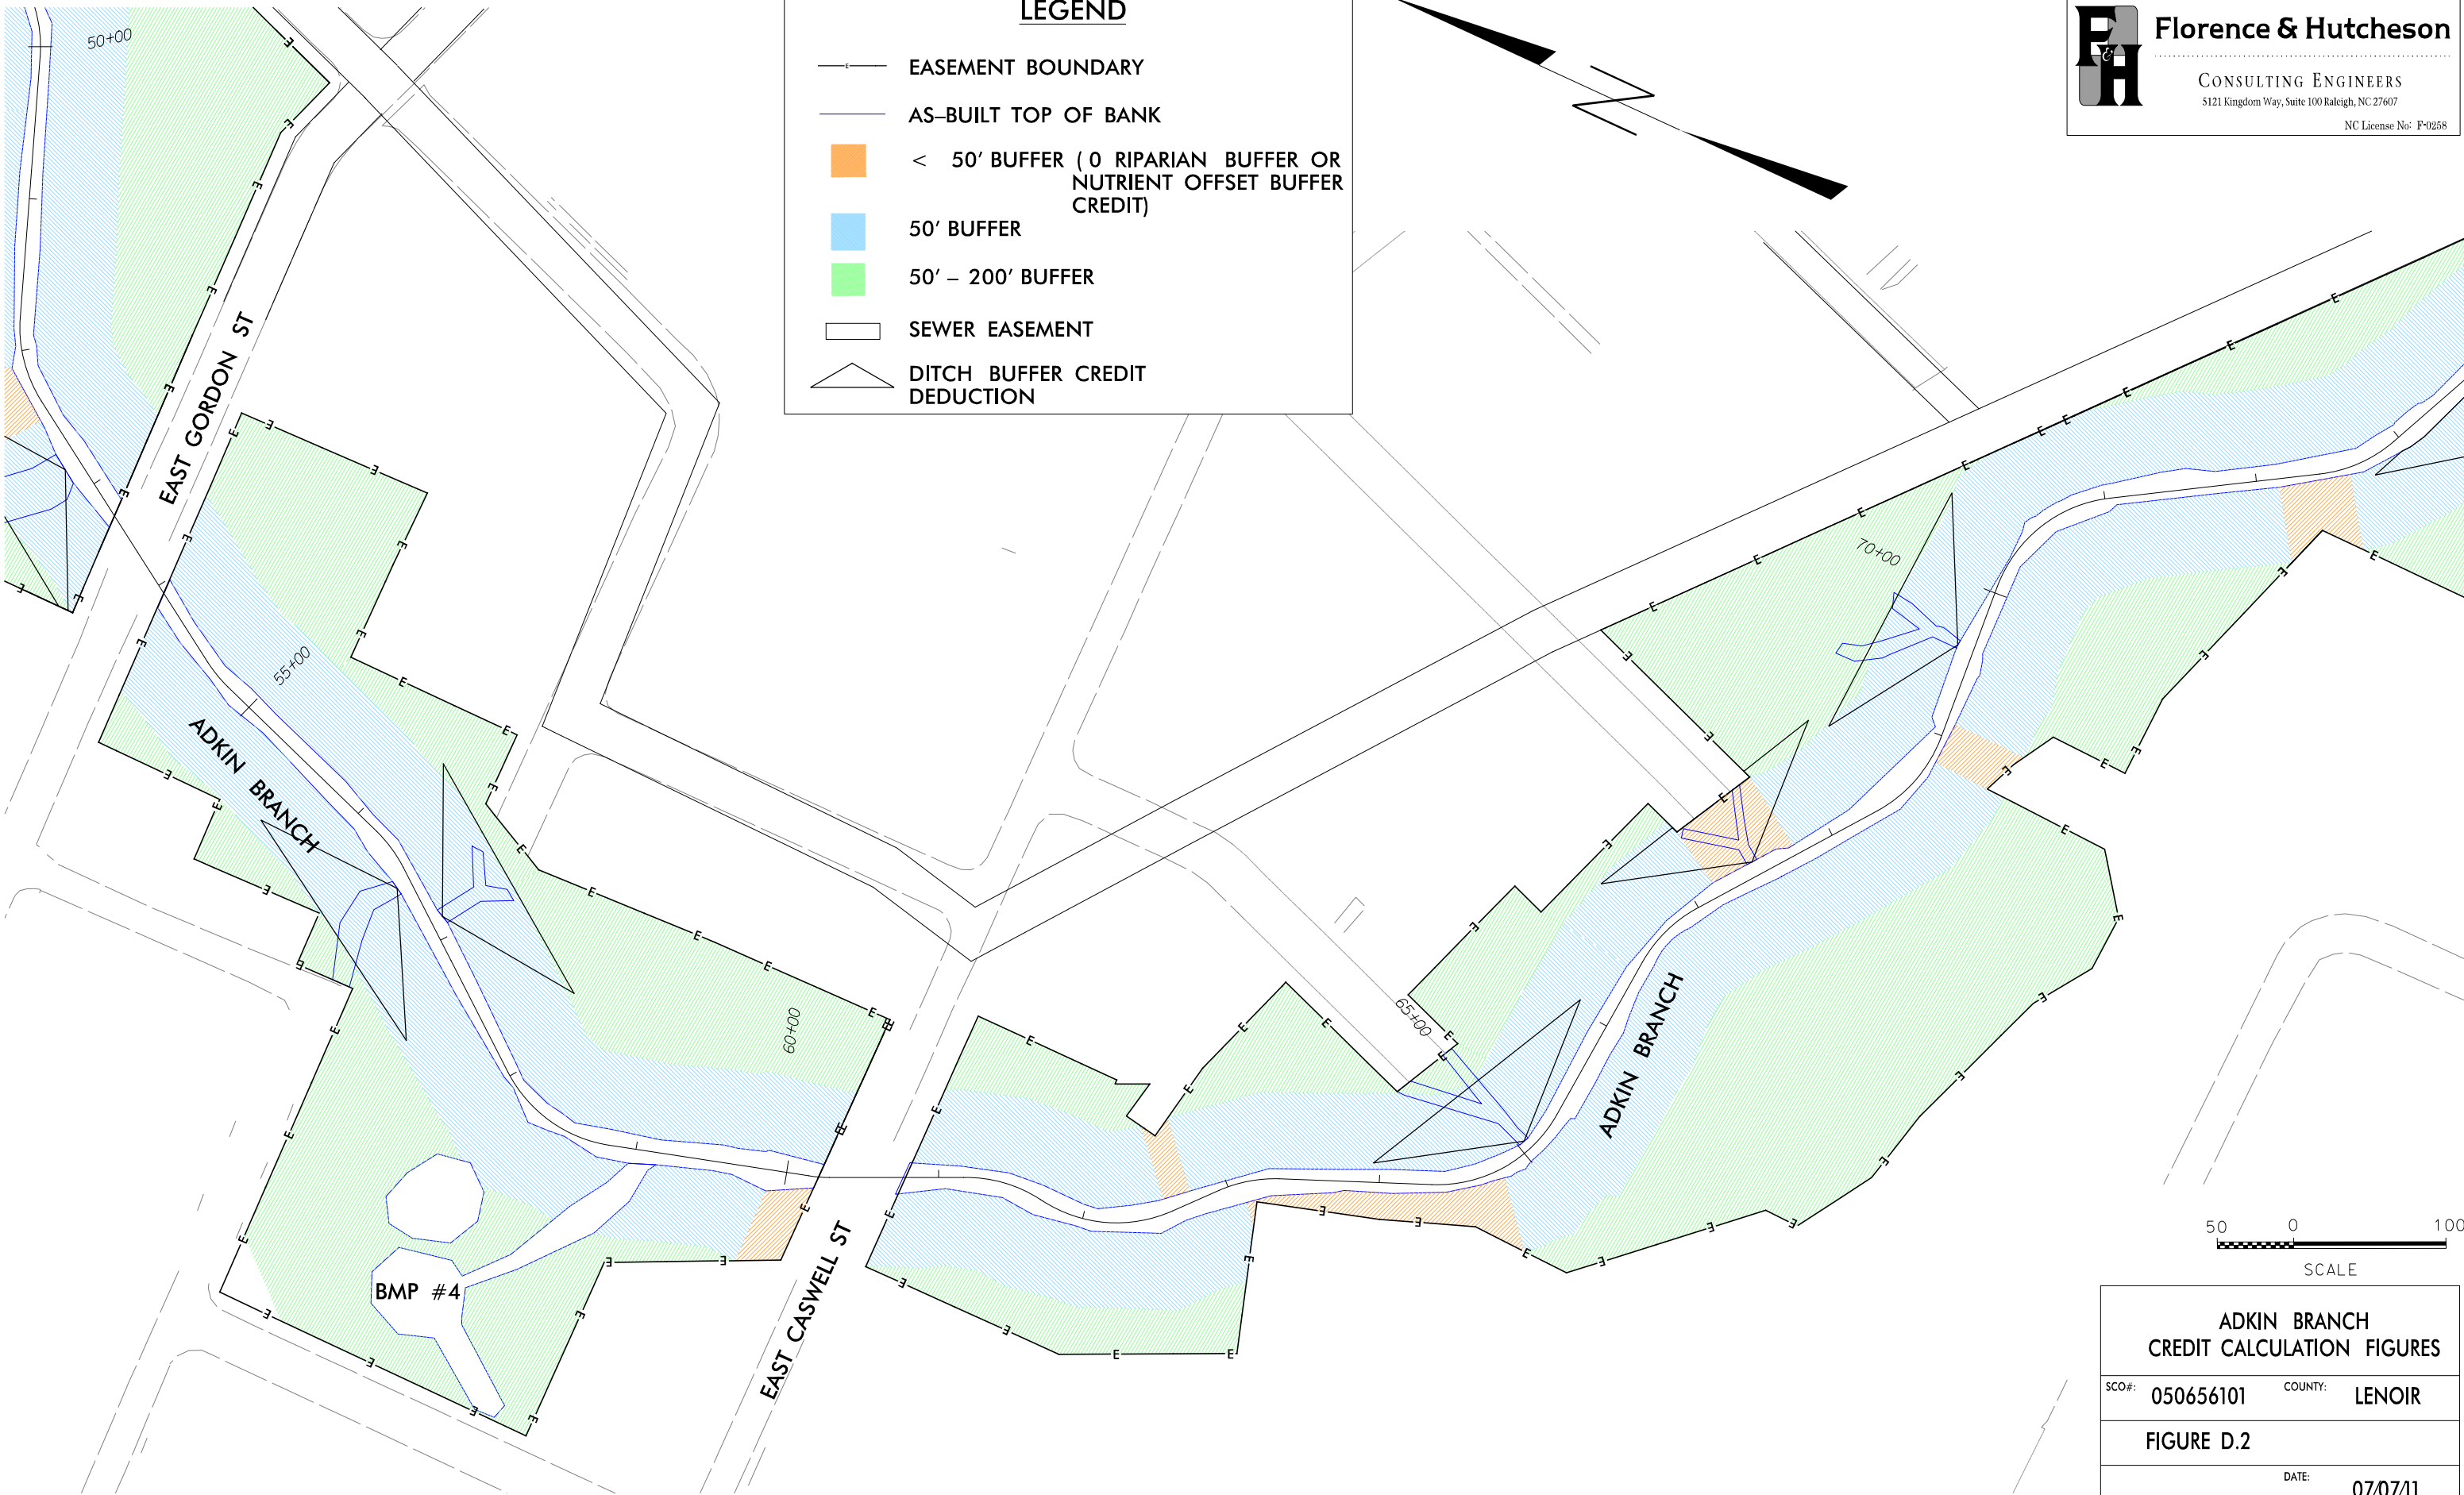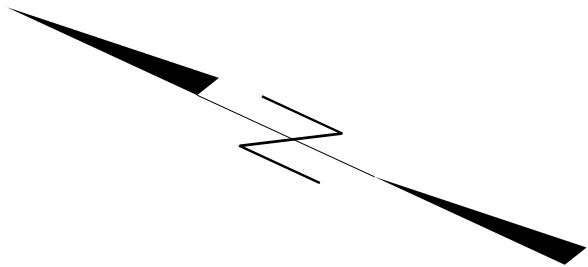


LEGEND

-  EASEMENT BOUNDARY
-  AS-BUILT TOP OF BANK
-  < 50' BUFFER (0 RIPARIAN BUFFER OR NUTRIENT OFFSET BUFFER CREDIT)
-  50' BUFFER
-  50' - 200' BUFFER
-  SEWER EASEMENT
-  DITCH BUFFER CREDIT DEDUCTION



| | |
|--|----------------|
| ADKIN BRANCH CREDIT CALCULATION FIGURES | |
| SCO#: 050656101 | COUNTY: LENOIR |
| FIGURE D.2 | |
| DATE: 07/07/11 | |

LEGEND


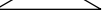
-  EASEMENT BOUNDARY
-  AS-BUILT TOP OF BANK
-  < 50' BUFFER (0 RIPARIAN BUFFER OR NUTRIENT OFFSET BUFFER CREDIT)
-  50' BUFFER
-  50' - 200' BUFFER
-  SEWER EASEMENT
-  DITCH BUFFER CREDIT DEDUCTION



Florence & Hutcheson
 CONSULTING ENGINEERS
 5121 Kingdom Way, Suite 100 Raleigh, NC 27607
 NC License No: F-0258




| ADKIN BRANCH CREDIT CALCULATION FIGURES | |
|--|----------------|
| SCO#: 050656101 | COUNTY: LENOIR |
| FIGURE D.3 | |
| DATE: 07/07/11 | |

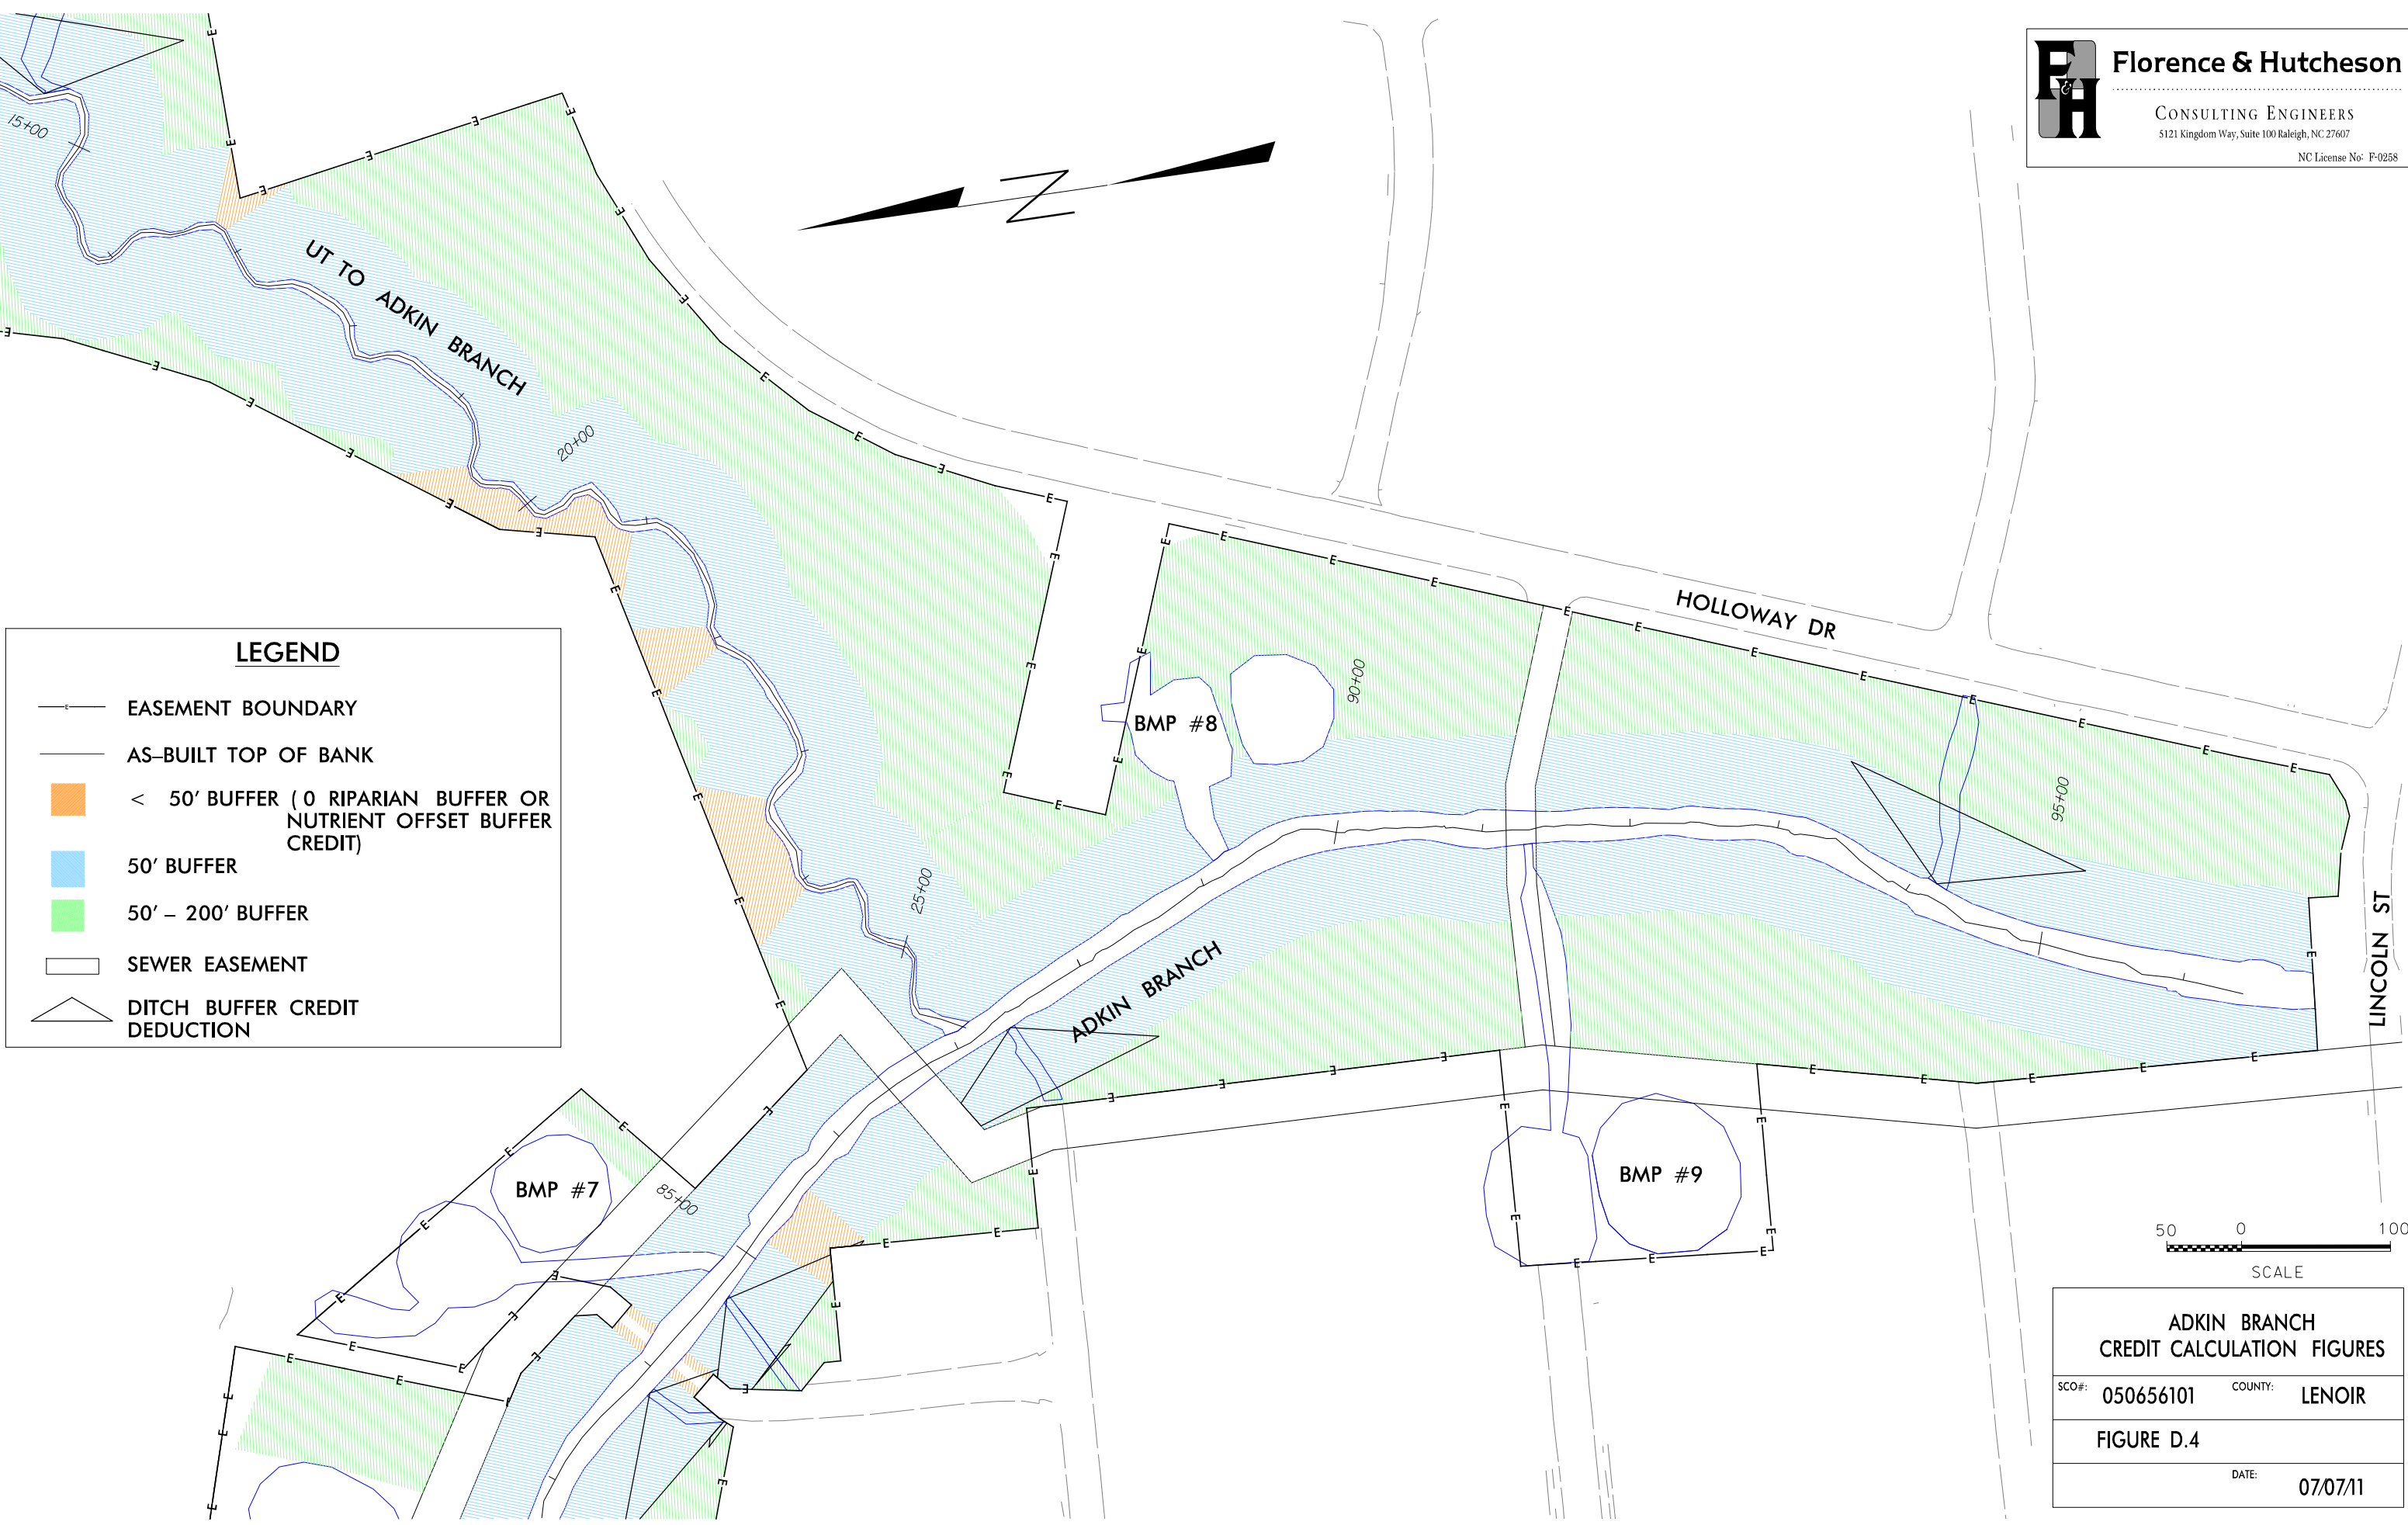
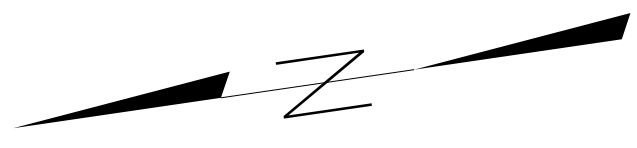


LEGEND

- EASEMENT BOUNDARY
- AS-BUILT TOP OF BANK
- < 50' BUFFER (0 RIPARIAN BUFFER OR NUTRIENT OFFSET BUFFER CREDIT)
- 50' BUFFER
- 50' - 200' BUFFER
- SEWER EASEMENT
- DITCH BUFFER CREDIT DEDUCTION

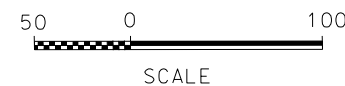

| | |
|--|----------------|
| ADKIN BRANCH CREDIT CALCULATION FIGURES | |
| SCO#: 050656101 | COUNTY: LENOIR |
| FIGURE D.4 | |
| DATE: 07/07/11 | |

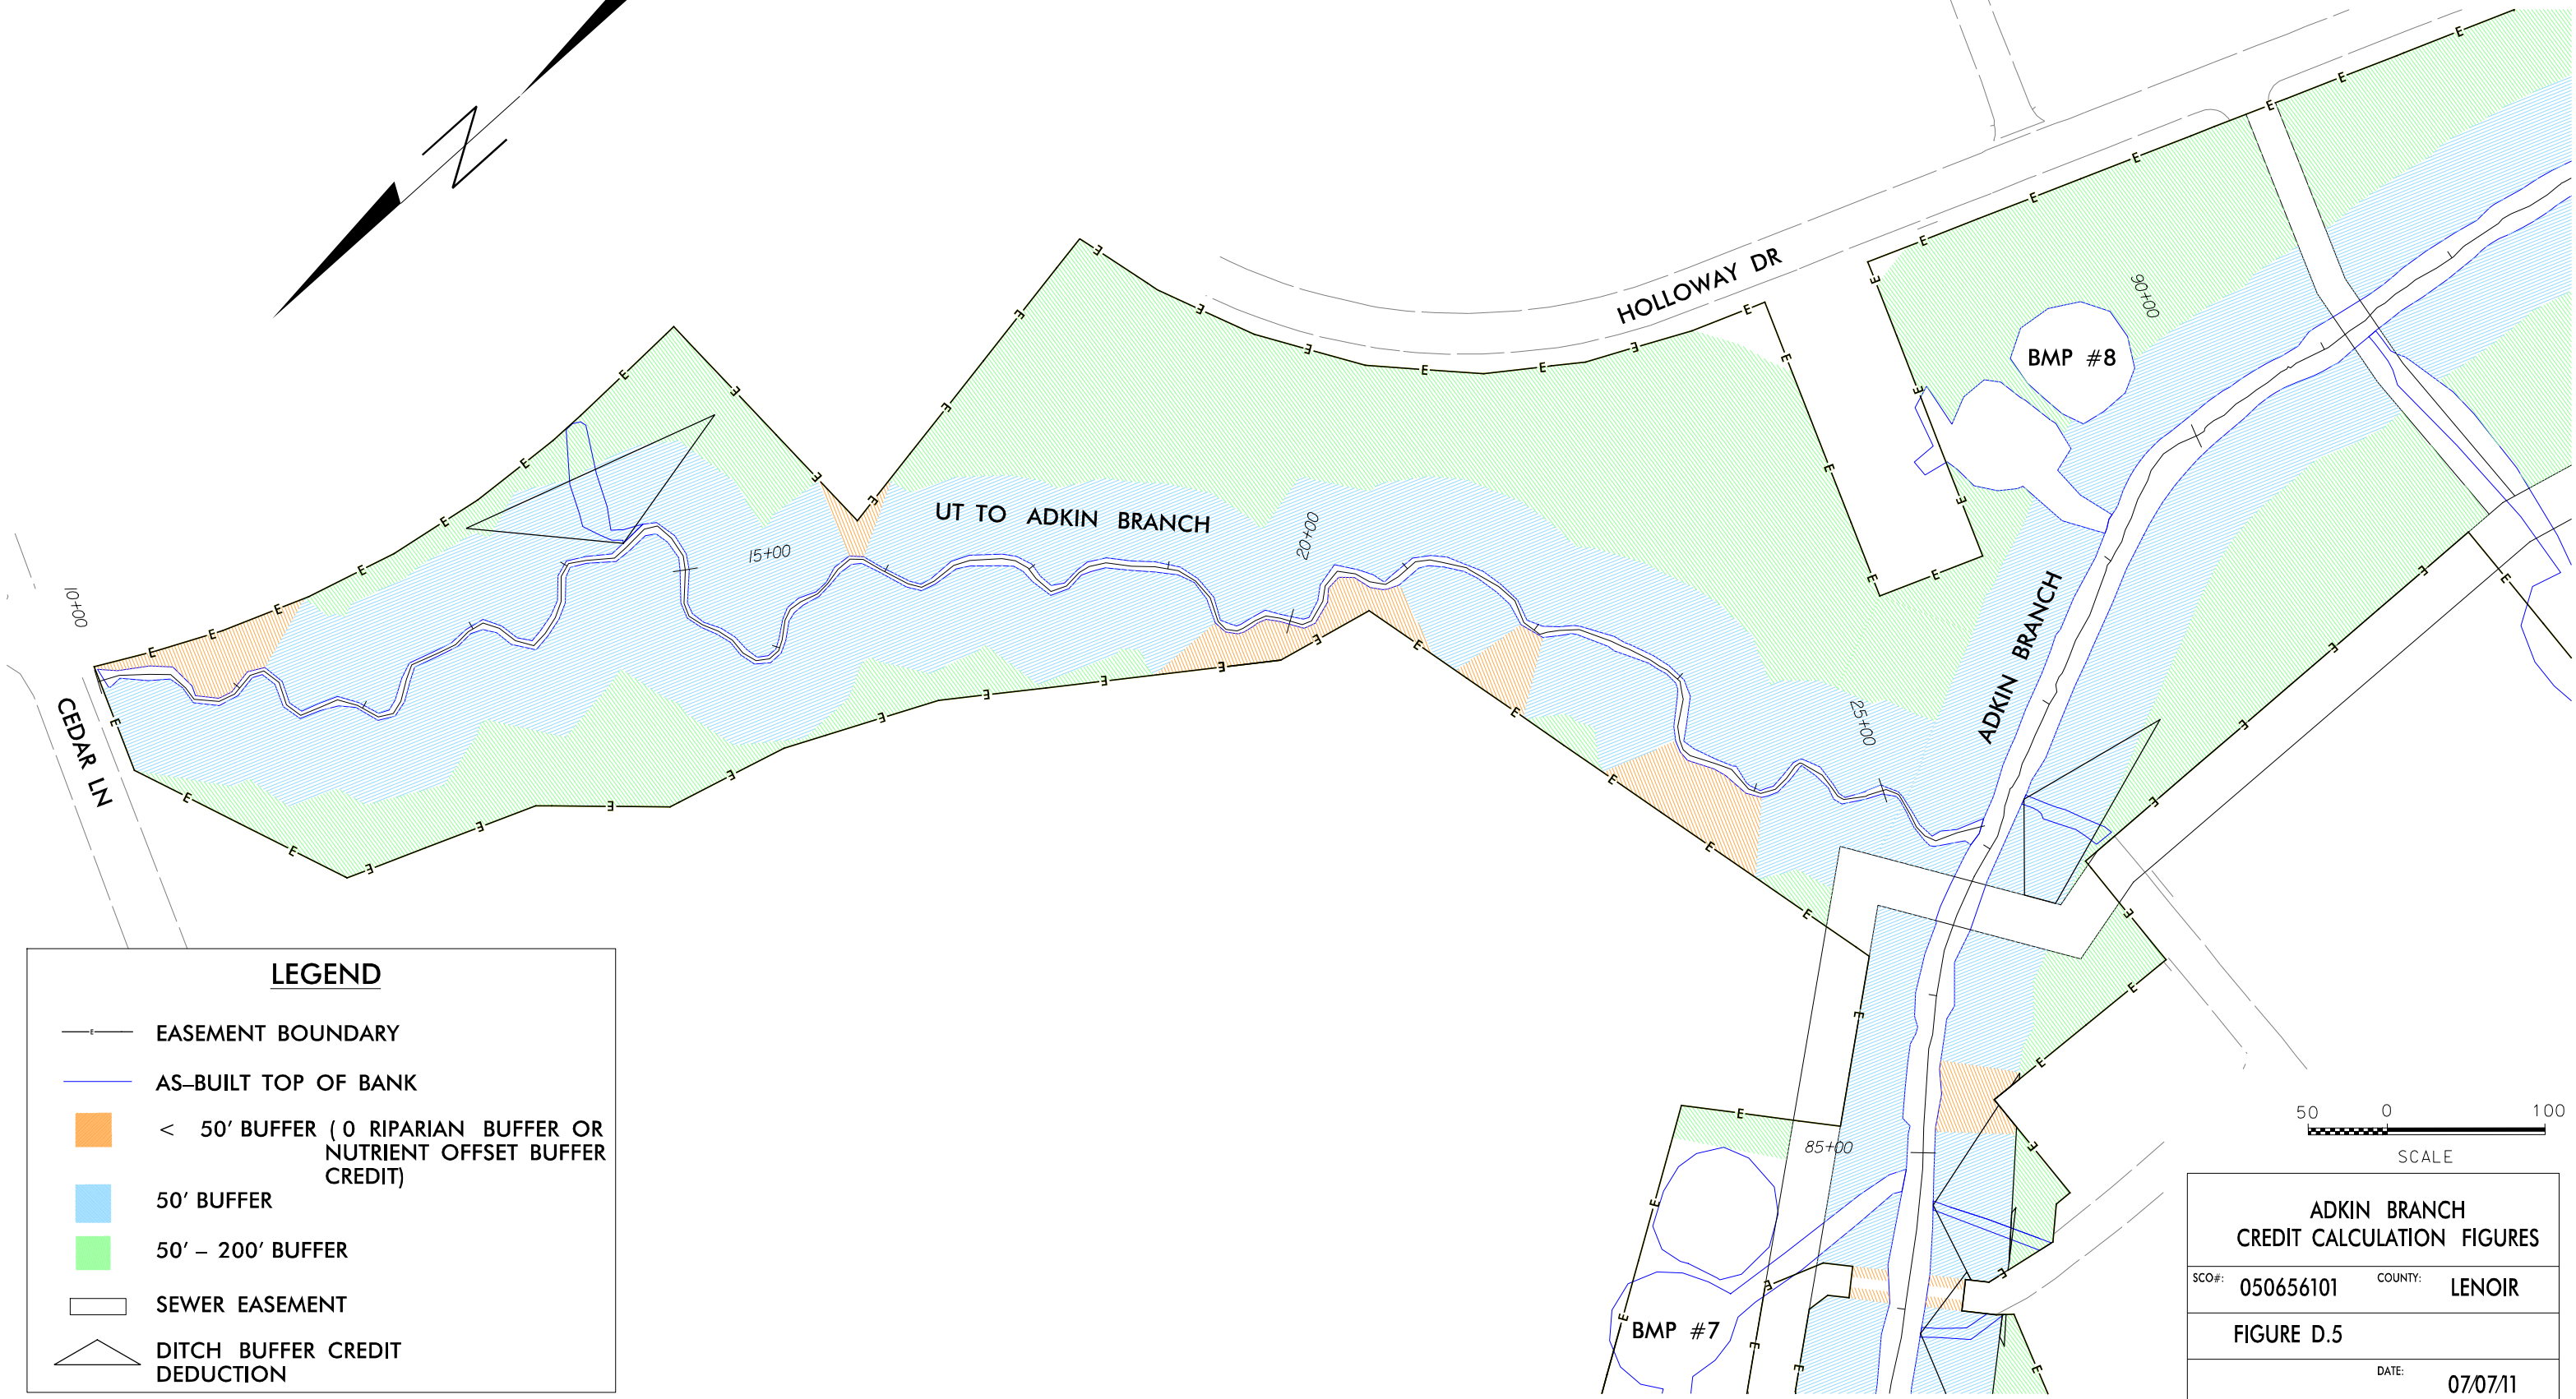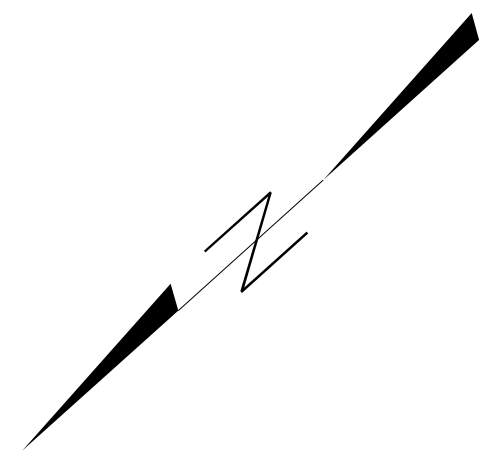

LEGEND

- EASEMENT BOUNDARY
- AS-BUILT TOP OF BANK
- < 50' BUFFER (0 RIPARIAN BUFFER OR NUTRIENT OFFSET BUFFER CREDIT)
- 50' BUFFER
- 50' - 200' BUFFER
- SEWER EASEMENT
- DITCH BUFFER CREDIT DEDUCTION



| | |
|--|----------------|
| ADKIN BRANCH CREDIT CALCULATION FIGURES | |
| SCO#: 050656101 | COUNTY: LENOIR |
| FIGURE D.5 | |
| DATE: 07/07/11 | |


Appendix E: As-Built/Record Drawing Plan Sheets
(Attached)



SCO: 050656101

ADKIN BRANCH

CONTRACT:

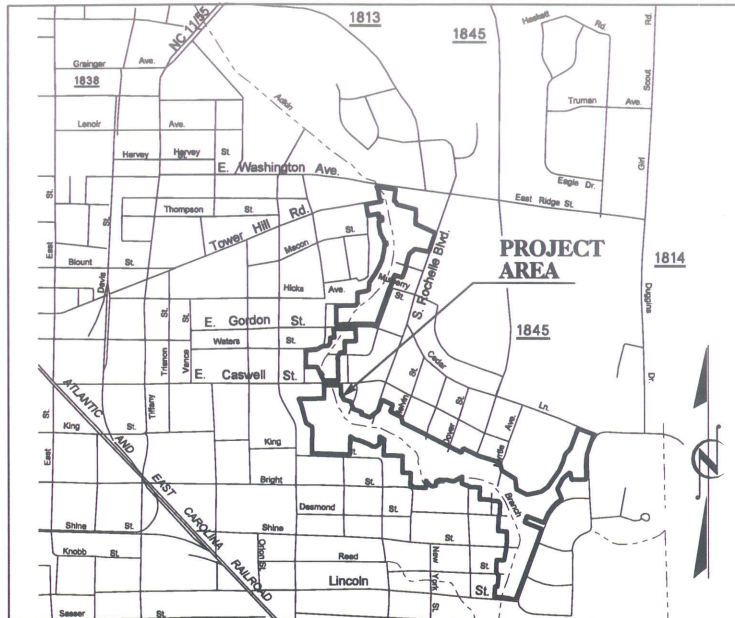

VICINITY MAP
KINSTON, NORTH CAROLINA


ADKIN BRANCH RECORD DRAWINGS STREAM RESTORATION

LOCATION: KINSTON (LENOIR COUNTY), NORTH CAROLINA
LAT: 35°15'42.5" N LONG: 77°33'55.6" W

| | | | |
|-------|--------------|-----------|--------------|
| STATE | ADKIN BRANCH | SHEET NO. | TOTAL SHEETS |
| N.C. | | 1 | 13 |

RECORD DRAWINGS

This record drawing has been prepared in part, based upon information furnished by others. While this information is believed to be reliable, the Engineer cannot assure its accuracy, and thus is not responsible for the accuracy of this record drawing or for any errors or omissions which may have been incorporated into it as a result. Those relying on this record document are advised to obtain independent verification of its accuracy before applying for any purpose.

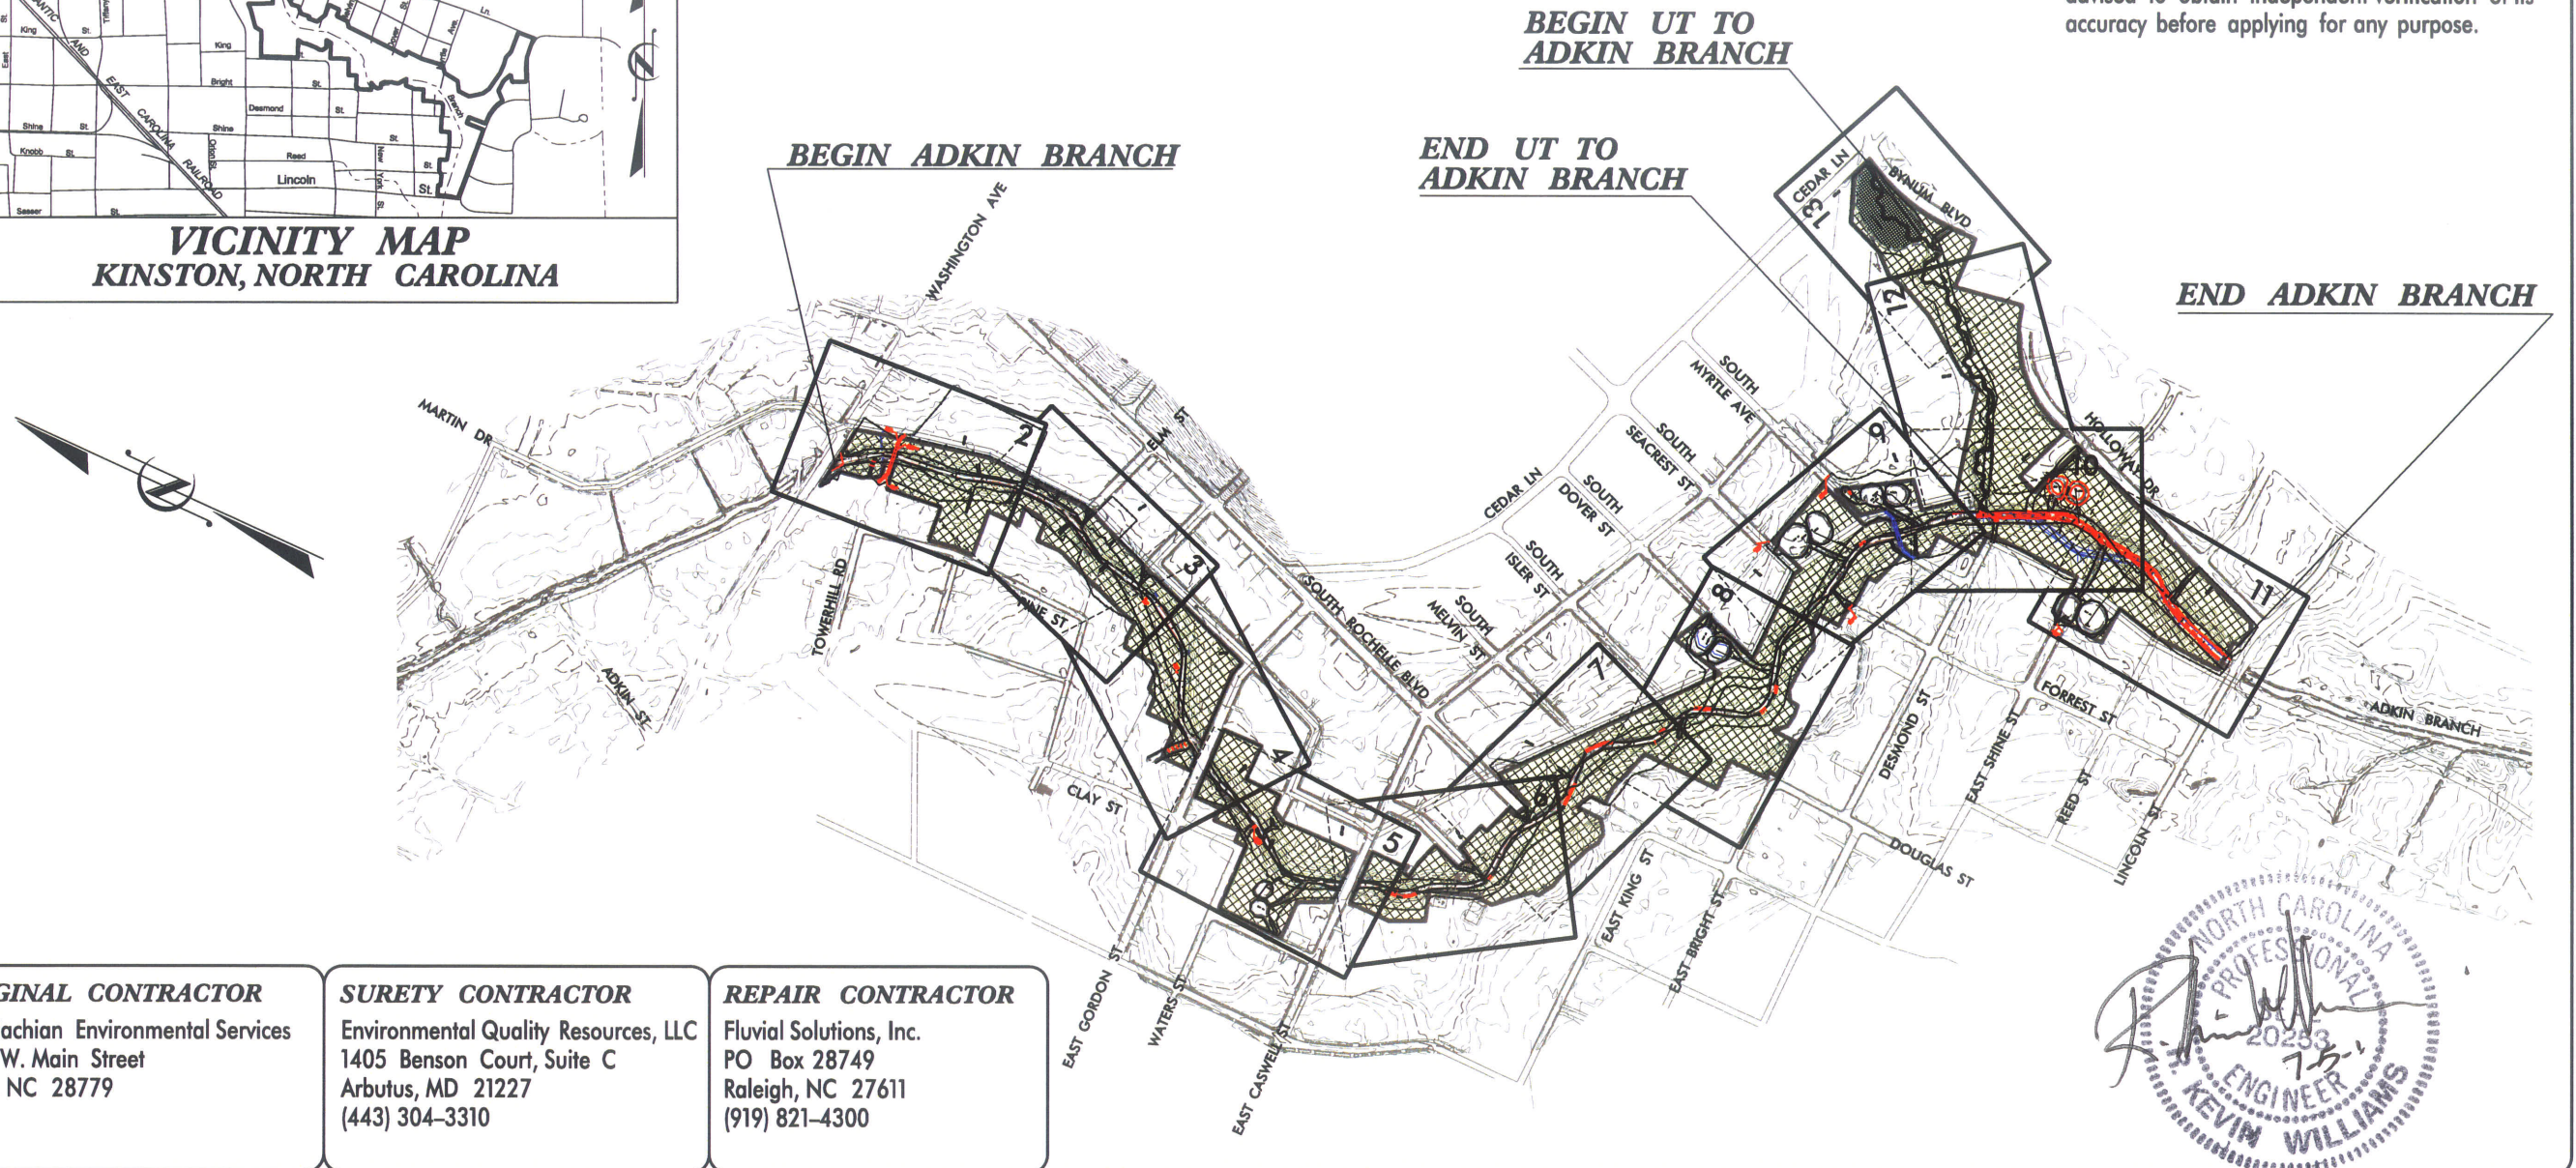

ORIGINAL CONTRACTOR
Appalachian Environmental Services
1165 W. Main Street
Slyva, NC 28779

SURETY CONTRACTOR
Environmental Quality Resources, LLC
1405 Benson Court, Suite C
Arbutus, MD 21227
(443) 304-3310

REPAIR CONTRACTOR
Fluvial Solutions, Inc.
PO Box 28749
Raleigh, NC 27611
(919) 821-4300

GRAPHIC SCALES



INDEX OF SHEETS

TITLE SHEET.....1
PLAN SHEETS.....2 - 13

DISTURBED AREA = 49.86 Ac.

PROJECT LENGTH

| | ADKIN BRANCH | UT TO ADKIN BRANCH |
|---------------------------|--------------|--------------------|
| EXISTING STREAM LENGTH | = 8,392 FT | 1,200 FT |
| CONSTRUCTED STREAM LENGTH | = 5,922 FT | 1,582 FT |



OWNER CONTACT:

KRISTIE CORSON
EEP PROJECT MANAGER

LIN XU
REVIEW COORDINATOR



Prepared In the Office of:

Florence & Hutcheson
CONSULTING ENGINEERS
5121 KINGDOM WAY, SUITE 100
RALEIGH, N.C. 27607
(919) 851-6066
License No. F-4214

R. KEVIN WILLIAMS
PROJECT ENGINEER


RYAN V. SMITH
PROJECT DESIGNER

ADKIN BRANCH RECORD DRAWINGS


Florence & Hutcheson
 CONSULTING ENGINEERS
 5121 Kingslow Way, Suite 100 Raleigh, NC 27607
 NC License No. P-0358

| | |
|-----------------------|-----------|
| PROJECT REFERENCE NO. | SHEET NO. |
| ADKIN BRANCH | 2 |

PROJECT ENGINEER
RECORD DRAWINGS
 This record drawing has been prepared in part, based upon information furnished by others. While this information is believed to be reliable, the Engineer cannot assure its accuracy, and thus is not responsible for the accuracy of this record drawing or for any errors or omissions which may have been incorporated into it as a result. Those relying on this record document are advised to obtain independent verification of its accuracy before applying for any purpose.

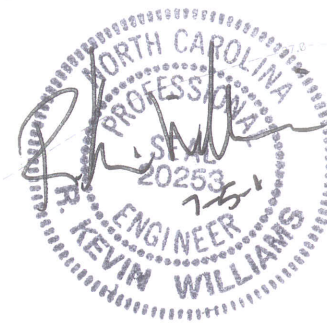

- LEGEND**
- X — LIMITS OF DISTURBANCE
 - E — CONSERVATION EASEMENT LINE
 - - - THALWEG
 - BANKFULL
 - - - TOE OF SLOPE
 - — FENCE LINE
 - ⊕ — LOG CROSS VANE
 - ⊕ — LOG VANE
 - LOG SILL
 - CONSTRUCTION REVISIONS
 - ORIGINAL CONSTRUCTION PLANS
 - IMPERVIOUS CHANNEL PLUG
 - STREAMSIDE ASSEMBLAGE PLANTING ZONE
 - ▨ COASTAL PLAIN LEVEE FOREST PLANTING ZONE

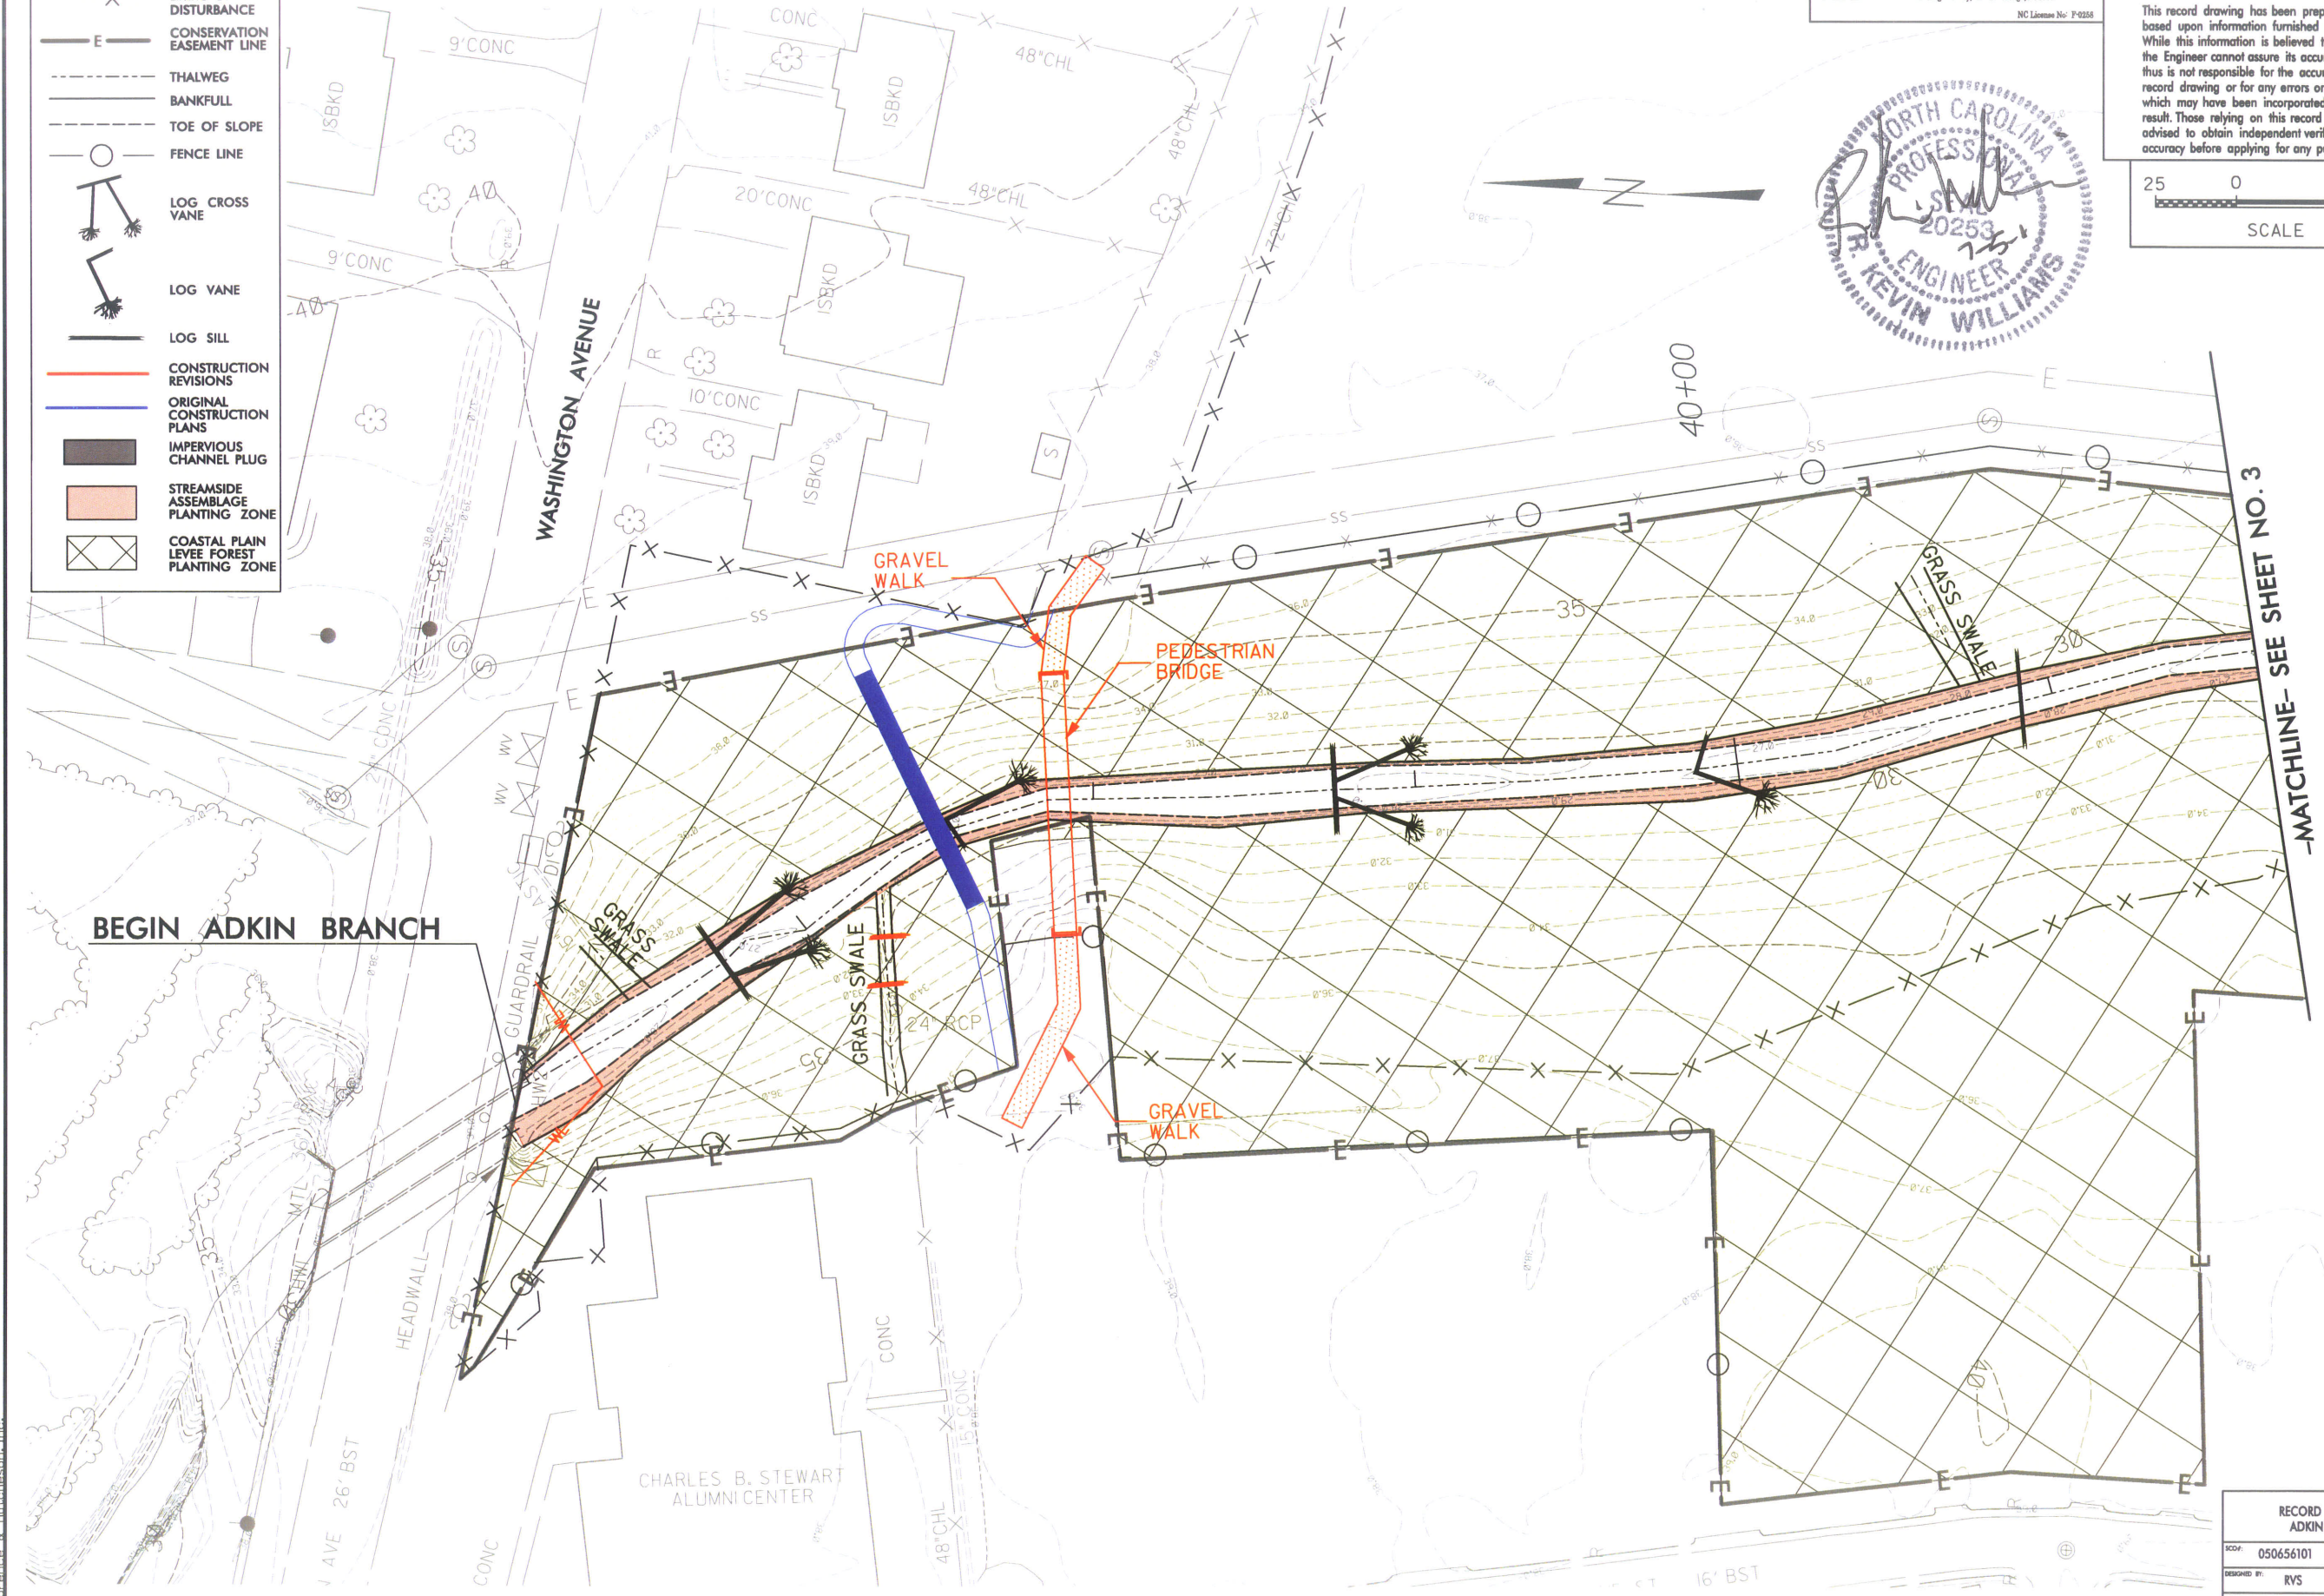

BEGIN ADKIN BRANCH

-MATCHLINE- SEE SHEET NO. 3


6/16/2011
 R:\Construction\As-Builts\AdkinBranch_AsBuilts_pah_2.dgn
 Florence & Hutcheson, Inc.

| | |
|---------------------------------|----------------|
| RECORD DRAWINGS ADKIN BRANCH | |
| SCD: 050656101 | COUNTY: LENOIR |
| DESIGNED BY: RVS | |
| CHECKED BY: RKW | DATE: 6/10/11 |


ADKIN BRANCH RECORD DRAWINGS

Florence & Hutcheson
 CONSULTING ENGINEERS
 5121 Kingston Way, Suite 100 Raleigh, NC 27607
 NC License No. P-0255

| | |
|---|-----------|
| PROJECT REFERENCE NO. | SHEET NO. |
| ADKIN BRANCH | 3 |
| PROJECT ENGINEER | |
| RECORD DRAWINGS | |
| This record drawing has been prepared in part, based upon information furnished by others. While this information is believed to be reliable, the Engineer cannot assure its accuracy, and thus is not responsible for the accuracy of this record drawing or for any errors or omissions which may have been incorporated into it as a result. Those relying on this record document are advised to obtain independent verification of its accuracy before applying for any purpose. | |
| 25 0 50 SCALE | |

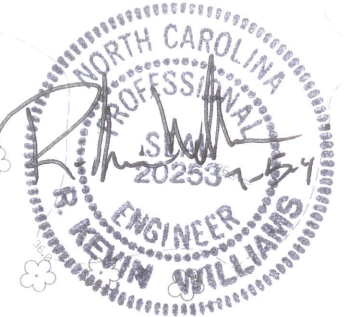

NOTE:
 PIPE INSTALLED BY THE CITY
 OF KINSTON WITHIN EASEMENT
 TO BE REMOVED BY THE CITY.

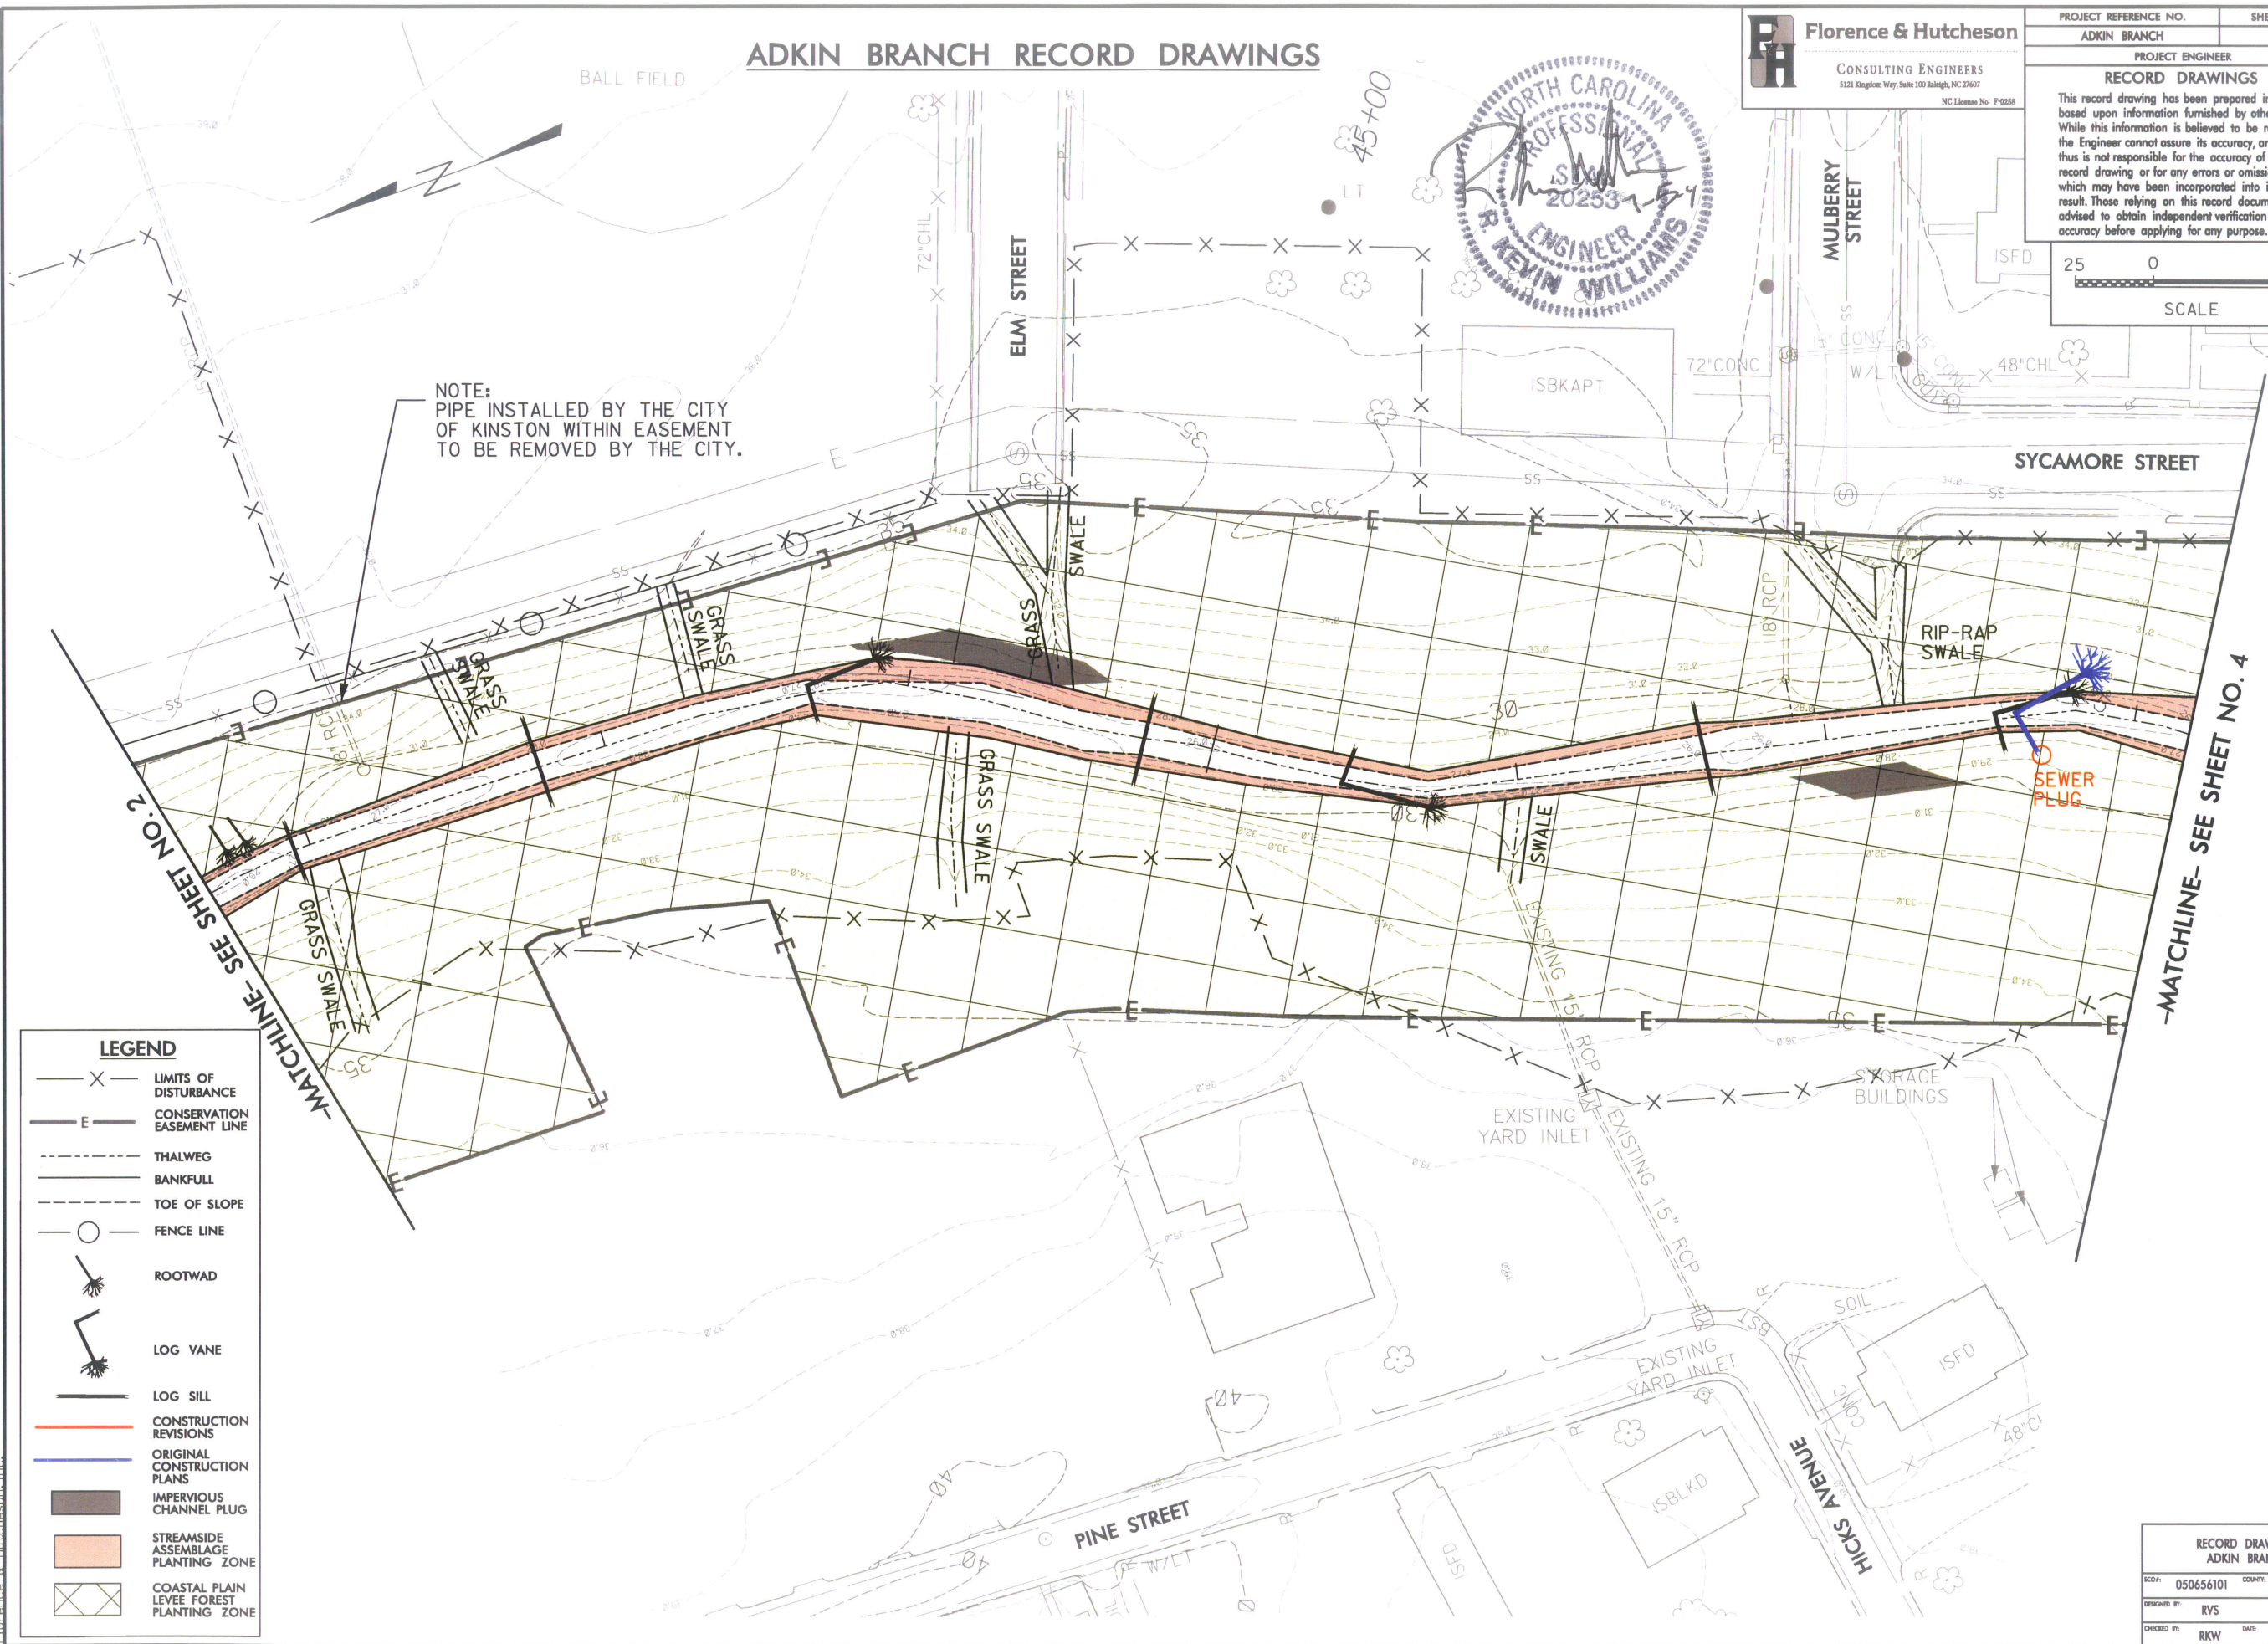

LEGEND

| | |
|--|--|
| | LIMITS OF DISTURBANCE |
| | CONSERVATION EASEMENT LINE |
| | THALWEG |
| | BANKFULL |
| | TOE OF SLOPE |
| | FENCE LINE |
| | ROOTWAD |
| | LOG VANE |
| | LOG SILL |
| | CONSTRUCTION REVISIONS |
| | ORIGINAL CONSTRUCTION PLANS |
| | IMPERVIOUS CHANNEL PLUG |
| | STREAMSIDE ASSEMBLAGE PLANTING ZONE |
| | COASTAL PLAIN LEVEE FOREST PLANTING ZONE |

6/16/2011
 R:\Construction\As-Builts\AdkinBranch_AsBuilts_psh_3.dgn
 Florence & Hutcheson, Inc.

-MATCHLINE- SEE SHEET NO. 4

-MATCHLINE- SEE SHEET NO. 2

| | |
|------------------|---------------|
| RECORD DRAWINGS | |
| ADKIN BRANCH | |
| SCD: 050656101 | COUNT: LENOIR |
| DESIGNED BY: RVS | |
| CHECKED BY: RKW | DATE: 6/10/11 |


ADKIN BRANCH RECORD DRAWINGS

Florence & Hutcheson
 CONSULTING ENGINEERS
 5121 Kingston Way, Suite 100 Raleigh, NC 27607
 NC License No. P-0285

| | |
|-----------------------|-----------|
| PROJECT REFERENCE NO. | SHEET NO. |
| ADKIN BRANCH | 4 |

PROJECT ENGINEER
RECORD DRAWINGS

This record drawing has been prepared in part, based upon information furnished by others. While this information is believed to be reliable, the Engineer cannot assure its accuracy, and thus is not responsible for the accuracy of this record drawing or for any errors or omissions which may have been incorporated into it as a result. Those relying on this record document are advised to obtain independent verification of its accuracy before applying for any purpose.

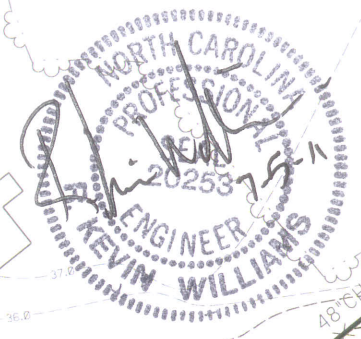

| LEGEND | |
|-----------|--|
| — X — | LIMITS OF DISTURBANCE |
| — E — | CONSERVATION EASEMENT LINE |
| - - - - - | THALWEG |
| — — — — — | BANKFULL |
| - - - - - | TOE OF SLOPE |
| | LOG CROSS VANE |
| | LOG VANE |
| | LOG SILL |
| | CONSTRUCTION REVISIONS |
| | ORIGINAL CONSTRUCTION PLANS |
| | IMPERVIOUS CHANNEL PLUG |
| | STREAMSIDE ASSEMBLAGE PLANTING ZONE |
| | COASTAL PLAIN LEVEE FOREST PLANTING ZONE |



6/16/2011
 R:\Construction\As-Built\AsAdkinBranch_AsBuilt.pah_4.dgn
 Florence & Hutcheson, Inc.



| | |
|---------------------------------|----------------|
| RECORD DRAWINGS ADKIN BRANCH | |
| SCOPE: 050656101 | COUNTY: LENOIR |
| DESIGNED BY: RVS | |
| CHECKED BY: RKW | DATE: 6/10/11 |

ADKIN BRANCH RECORD DRAWINGS

Florence & Hutcheson
 CONSULTING ENGINEERS
 5121 Kingston Way, Suite 100 Raleigh, NC 27607
 NC License No: P-0258


PROJECT REFERENCE NO. ADKIN BRANCH SHEET NO. 5

PROJECT ENGINEER
RECORD DRAWINGS
 This record drawing has been prepared in part, based upon information furnished by others. While this information is believed to be reliable, the Engineer cannot assure its accuracy, and thus is not responsible for the accuracy of this record drawing or for any errors or omissions which may have been incorporated into it as a result. Those relying on this record document are advised to obtain independent verification of its accuracy before applying for any purpose.

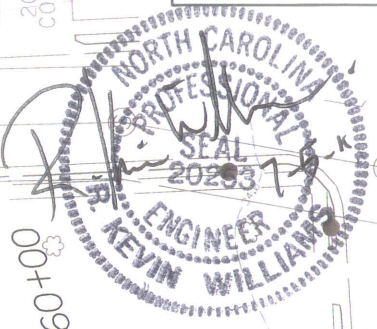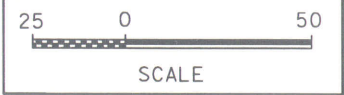

LEGEND

- X LIMITS OF DISTURBANCE
- E CONSERVATION EASEMENT LINE
- - - THALWEG
- BANKFULL
- - - TOE OF SLOPE
- LOG CROSS VANE
- LOG VANE
- LOG SILL
- CONSTRUCTION REVISIONS
- ORIGINAL CONSTRUCTION PLANS
- IMPERVIOUS CHANNEL PLUG
- STREAMSIDE ASSEMBLAGE PLANTING ZONE
- COASTAL PLAIN LEVEE FOREST PLANTING ZONE

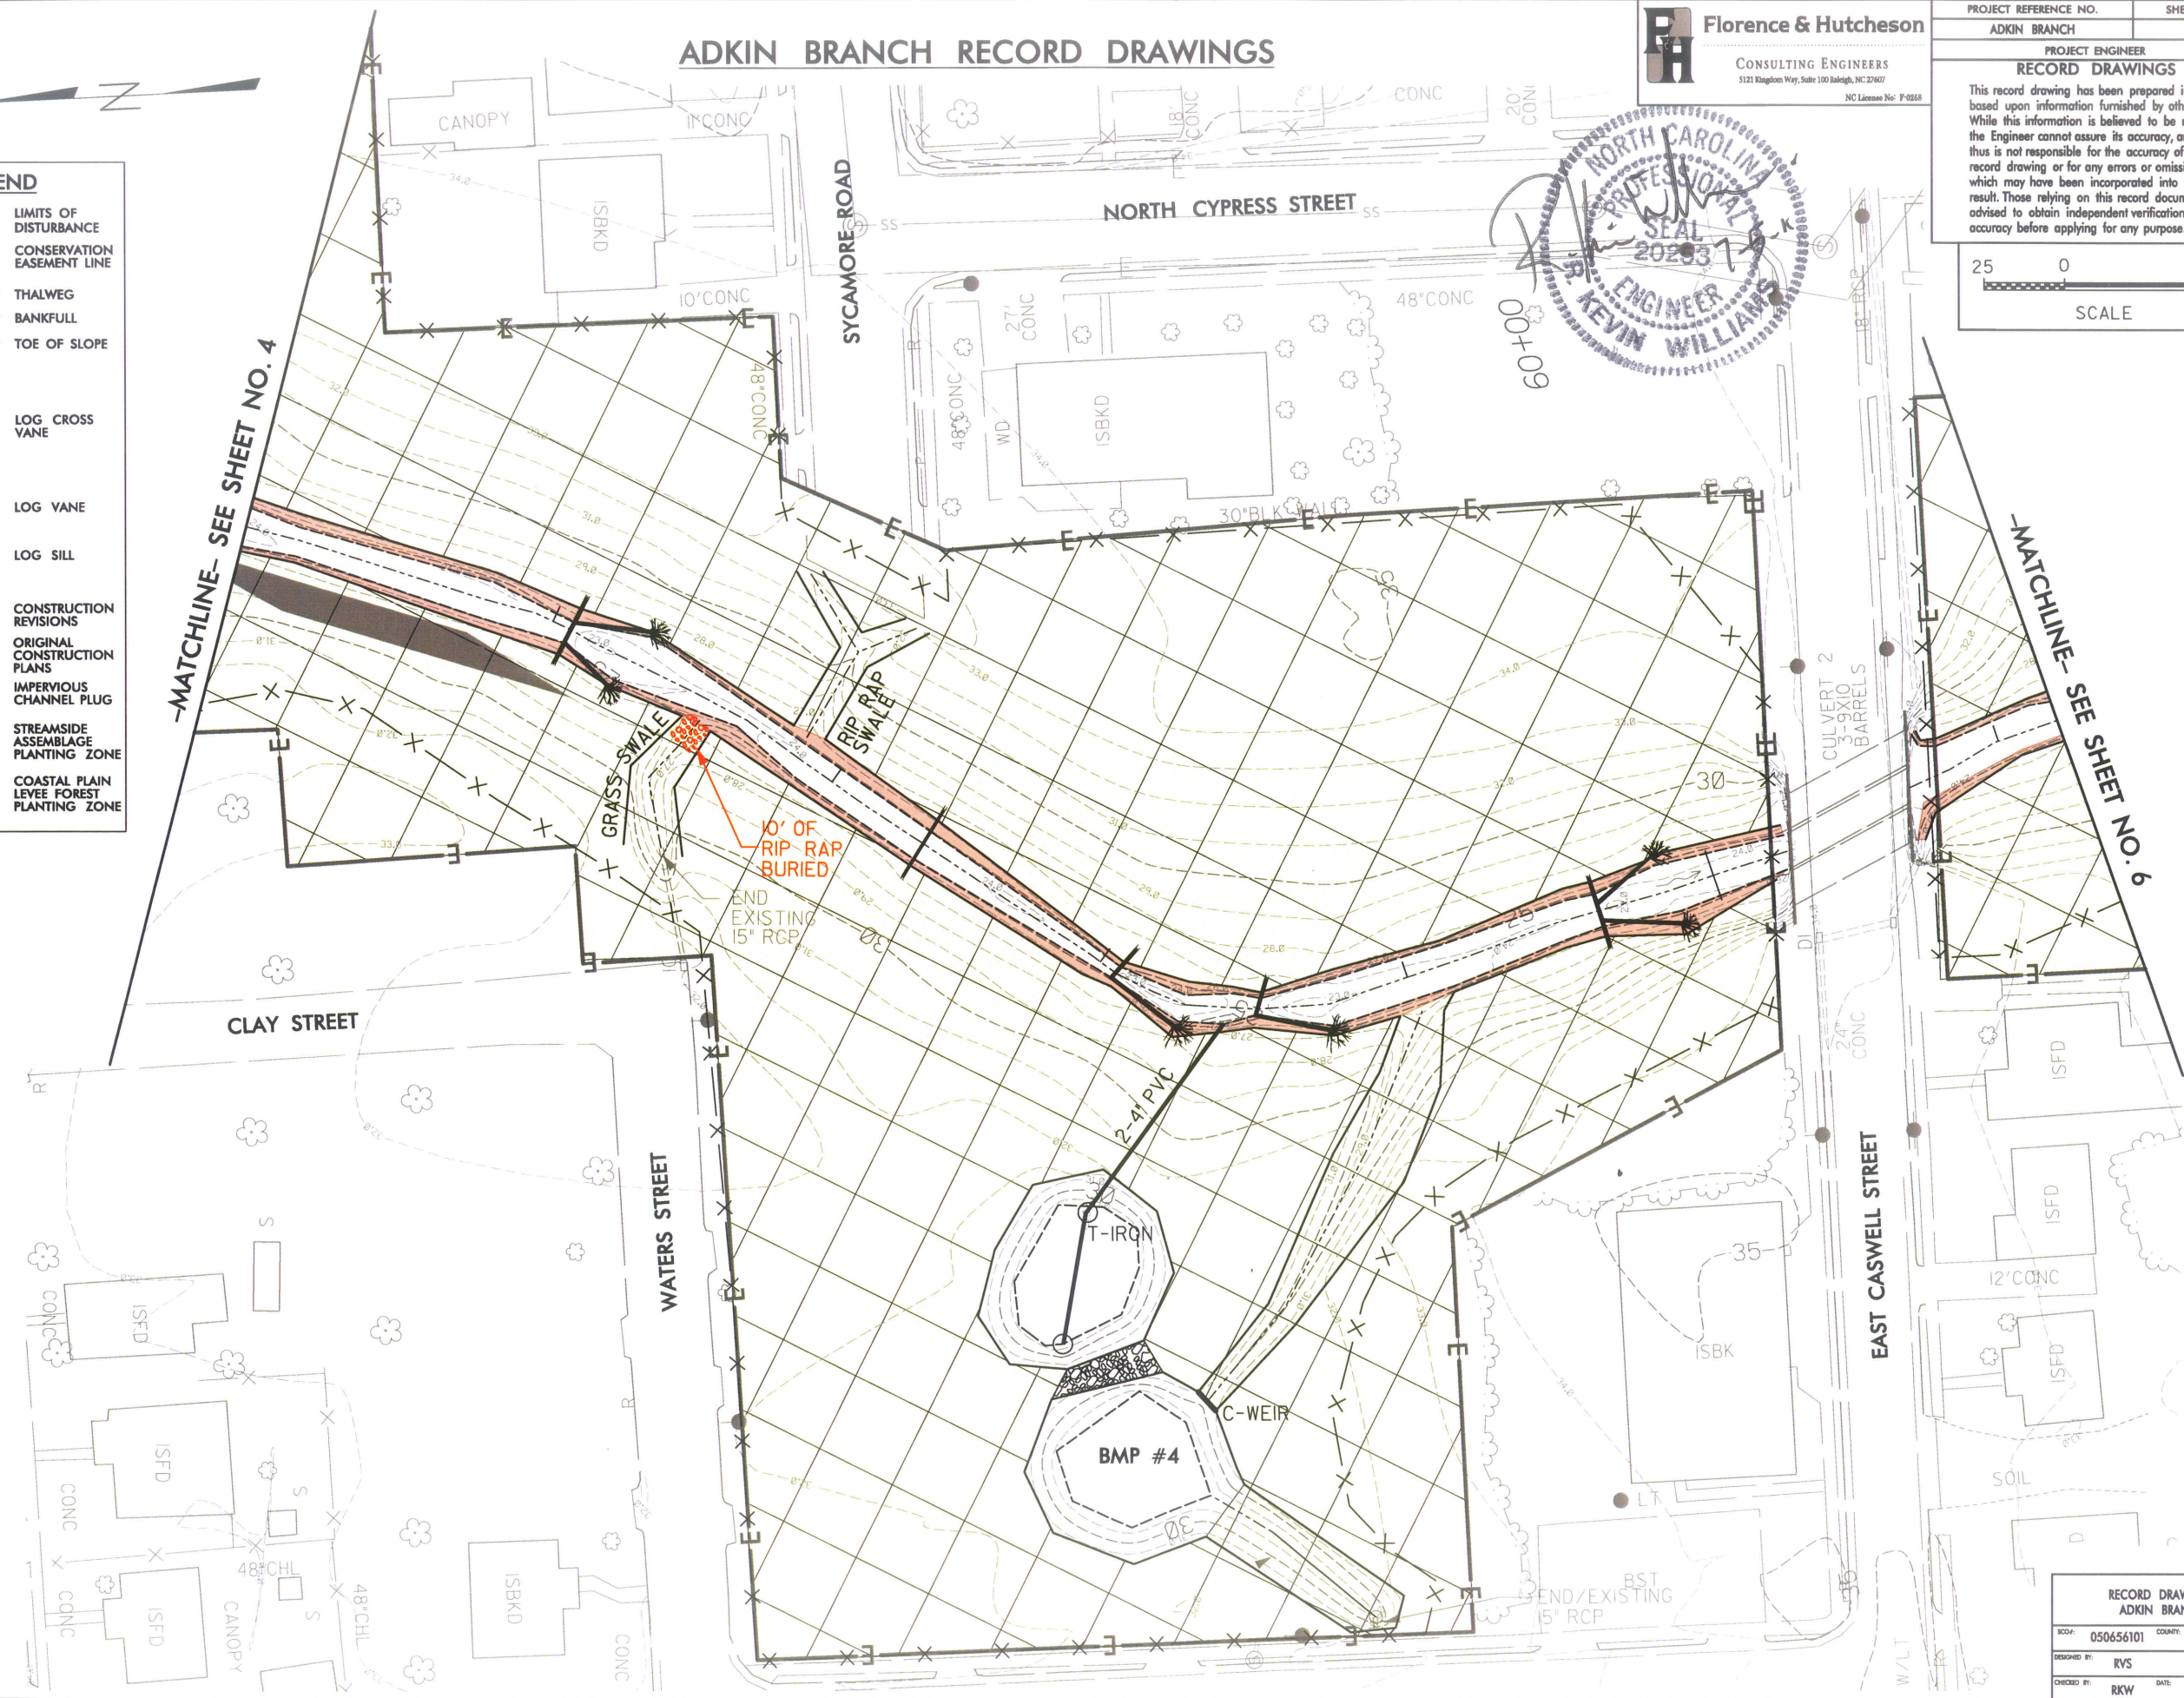

6/16/2011
 R:\Construction\As-Builts\AdkinBranch_AsBuilts_psh_5.dgn
 Florence & Hutcheson, Inc.



| | |
|---------------------------------|----------------|
| RECORD DRAWINGS ADKIN BRANCH | |
| NO: 050656101 | COUNTY: LENOIR |
| DESIGNED BY: RVS | |
| CHECKED BY: RKW | DATE: 6/10/11 |

ADKIN BRANCH RECORD DRAWINGS

Florence & Hutcheson
 CONSULTING ENGINEERS
 5121 Kingsdon Way, Suite 100 Raleigh, NC 27607
 NC License No. P-0268

| | |
|-----------------------|-----------|
| PROJECT REFERENCE NO. | SHEET NO. |
| ADKIN BRANCH | 6 |

PROJECT ENGINEER
RECORD DRAWINGS
 This record drawing has been prepared in part, based upon information furnished by others. While this information is believed to be reliable, the Engineer cannot assure its accuracy, and thus is not responsible for the accuracy of this record drawing or for any errors or omissions which may have been incorporated into it as a result. Those relying on this record document are advised to obtain independent verification of its accuracy before applying for any purpose.

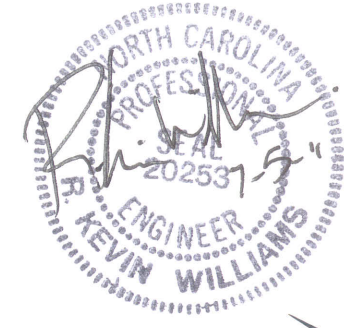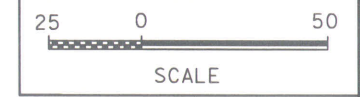

- LEGEND**
- X — LIMITS OF DISTURBANCE
 - E — CONSERVATION EASEMENT LINE
 - - - THALWEG
 - BANKFULL
 - - - TOE OF SLOPE
 - ROOTWAD
 - LOG CROSS VANE
 - LOG VANE
 - LOG SILL
 - SOIL LIFT
 - CONSTRUCTION REVISIONS
 - ORIGINAL CONSTRUCTION PLANS
 - IMPERVIOUS CHANNEL PLUG
 - STREAMSIDE ASSEMBLAGE PLANTING ZONE
 - COASTAL PLAIN LEVEE FOREST PLANTING ZONE



6/16/2011
 R:\Construction\As-Built\AdkinBranch_AsBuilt.psh_6.dgn
 Florence & Hutcheson, Inc.

| | |
|---------------------------------|----------------|
| RECORD DRAWINGS ADKIN BRANCH | |
| SCOPE: 050656101 | COUNTY: LENOIR |
| DESIGNED BY: RVS | |
| CHECKED BY: RKW | DATE: 6/10/11 |

ADKIN BRANCH RECORD DRAWINGS

Florence & Hutcheson
 CONSULTING ENGINEERS
 5121 Kingslow Way, Suite 100 Raleigh, NC 27607
 NC License No. P-02558

25 0 50
 SCALE



| | |
|---|-----------|
| PROJECT REFERENCE NO. | SHEET NO. |
| ADKIN BRANCH | 7 |
| PROJECT ENGINEER | |
| RECORD DRAWINGS | |
| This record drawing has been prepared in part, based upon information furnished by others. While this information is believed to be reliable, the Engineer cannot assure its accuracy, and thus is not responsible for the accuracy of this record drawing or for any errors or omissions which may have been incorporated into it as a result. Those relying on this record document are advised to obtain independent verification of its accuracy before applying for any purpose. | |

LEGEND

| | |
|--|--|
| | LIMITS OF DISTURBANCE |
| | CONSERVATION EASEMENT LINE |
| | THALWEG |
| | BANKFULL |
| | TOE OF SLOPE |
| | ROOTWAD |
| | LOG VANE |
| | LOG SILL |
| | SOIL LIFT |
| | CONSTRUCTION REVISIONS |
| | ORIGINAL CONSTRUCTION PLANS |
| | IMPERVIOUS CHANNEL PLUG |
| | STREAMSIDE ASSEMBLAGE PLANTING ZONE |
| | COASTAL PLAIN LEVEE FOREST PLANTING ZONE |



6/16/2011
 R:\Construction\As-Builts\AdkinBranch_AsBuilts_pah_7.dgn
 Florence & Hutcheson, Inc.

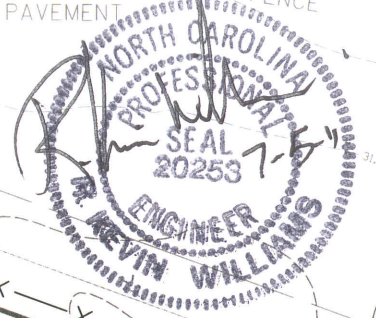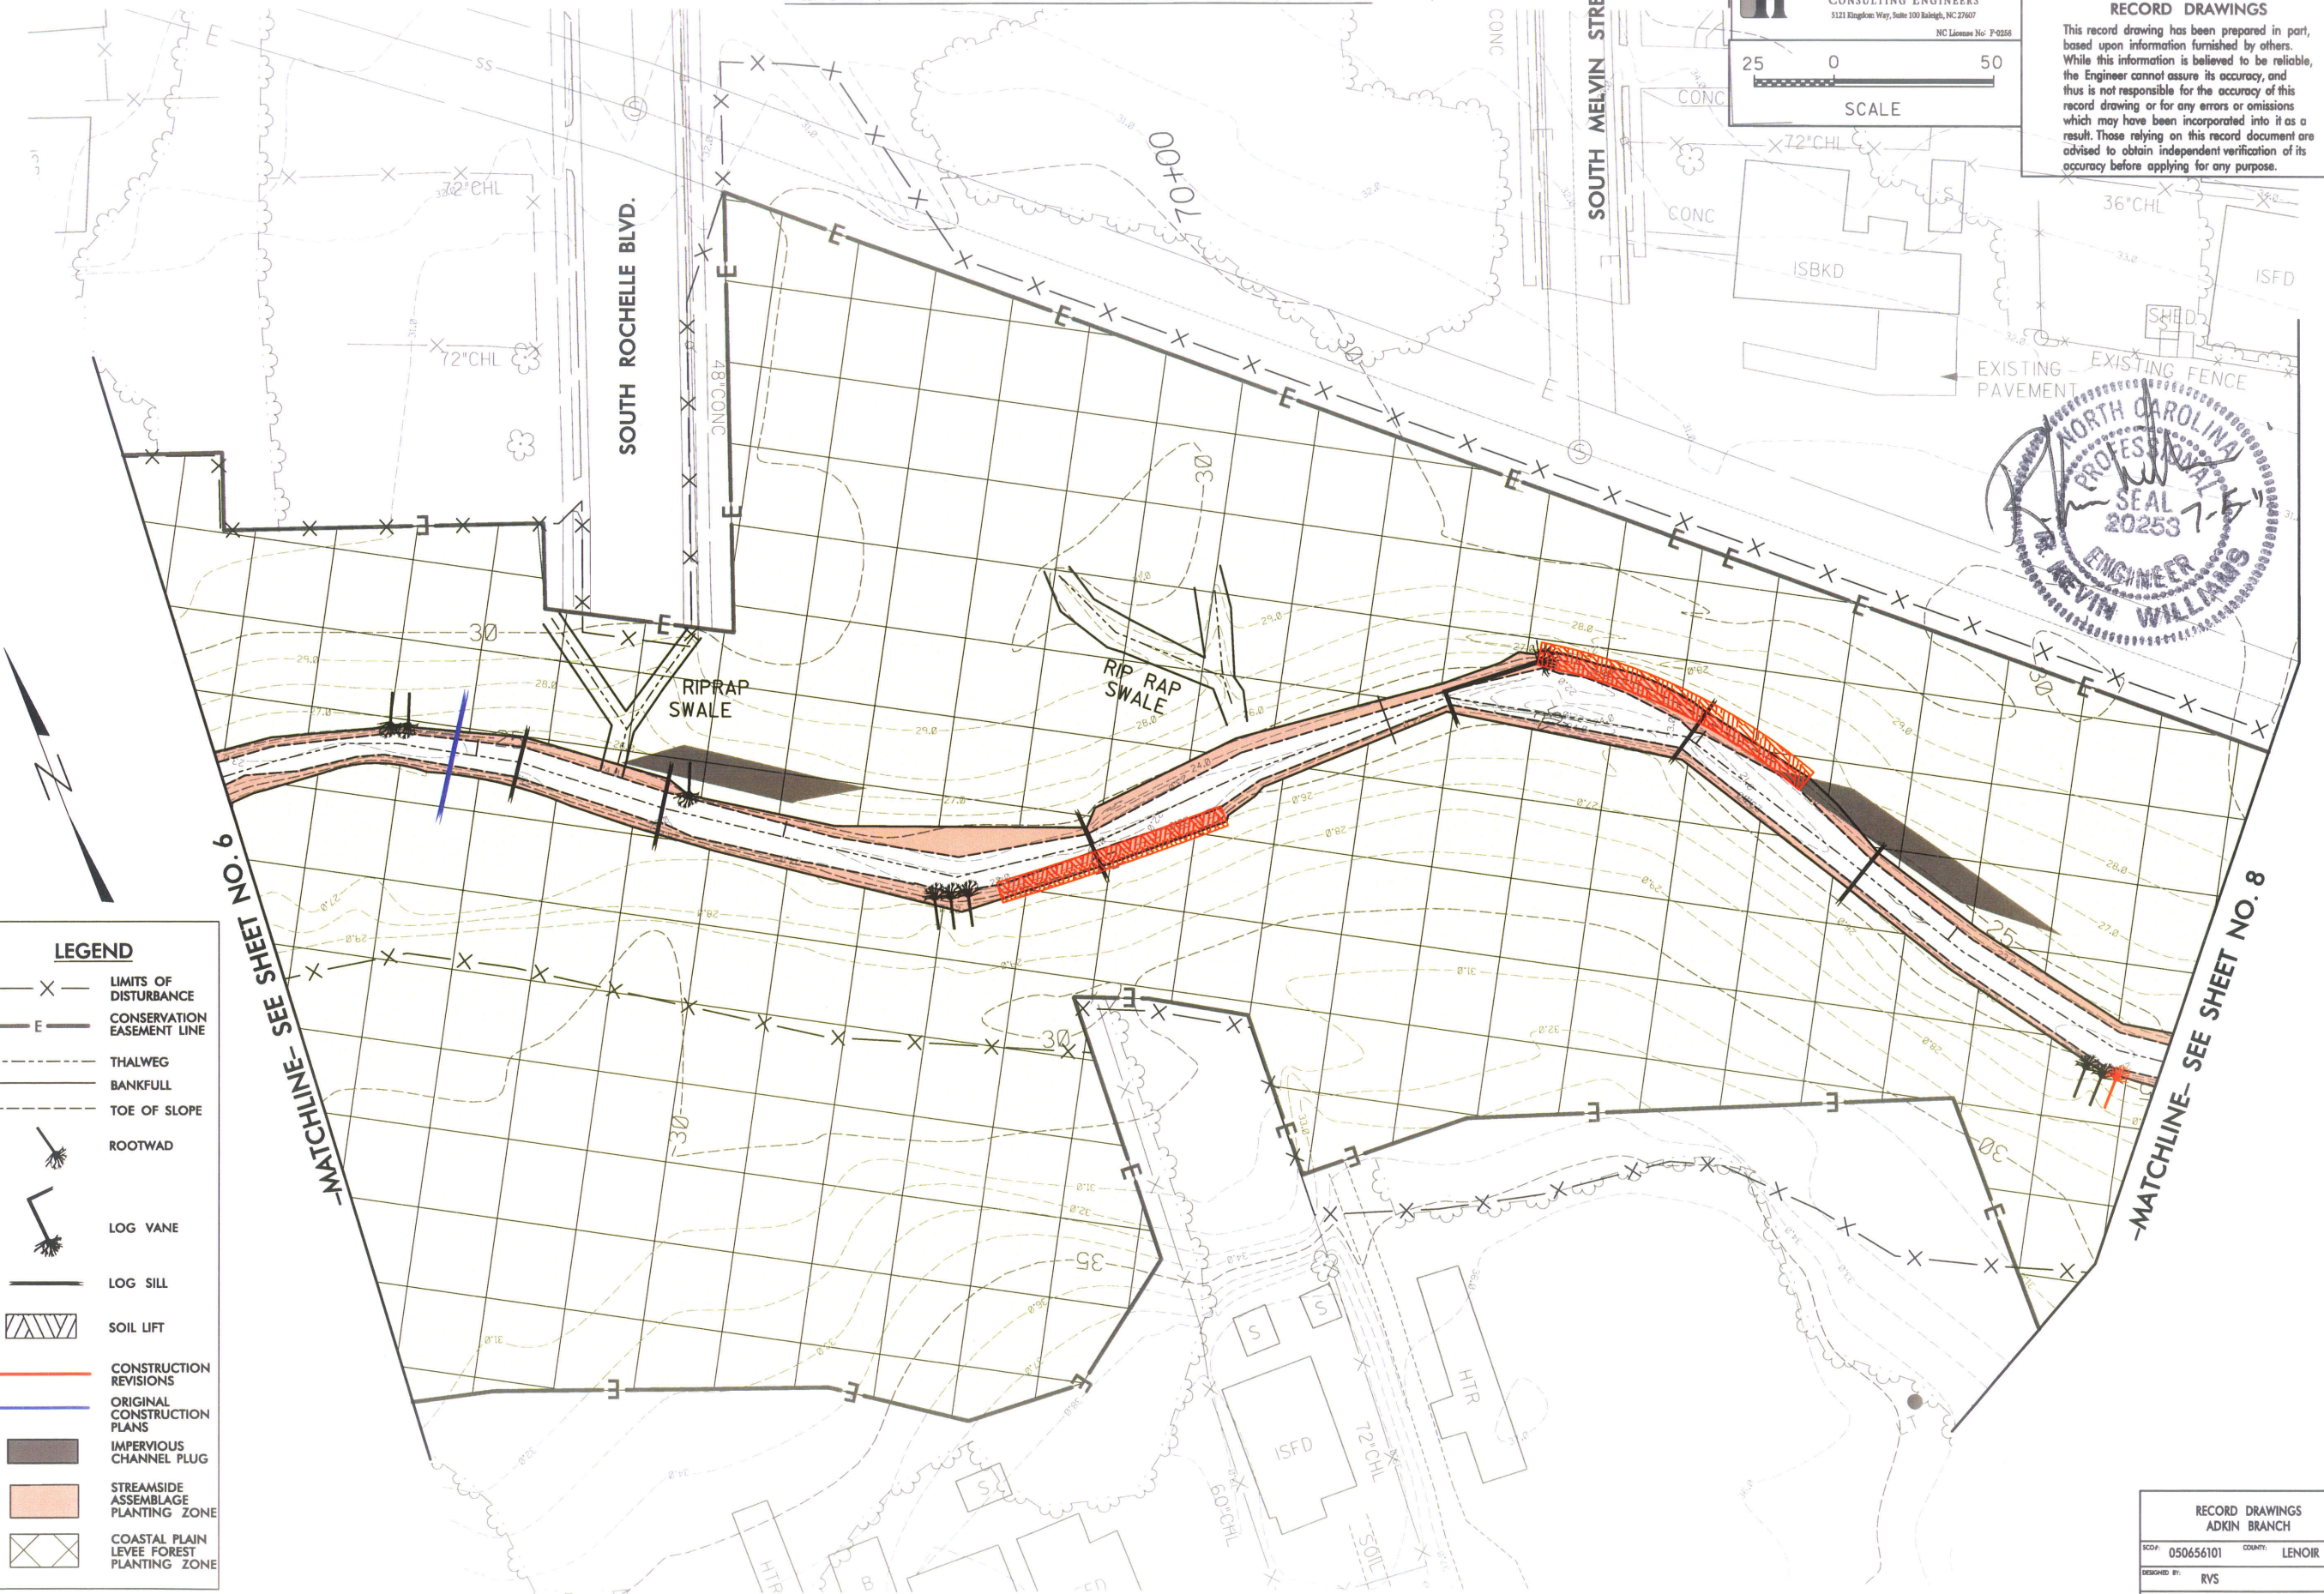


| | |
|------------------|----------------|
| RECORD DRAWINGS | |
| ADKIN BRANCH | |
| SCOP: 050656101 | COUNTY: LENOIR |
| DESIGNED BY: RVS | |
| CHECKED BY: RKW | DATE: 6/10/11 |

ADKIN BRANCH RECORD DRAWINGS

Florence & Hutcheson
 CONSULTING ENGINEERS
 5121 Kingston Way, Suite 100 Raleigh, NC 27607
 NC License No. P-0258


| | |
|-----------------------|-----------|
| PROJECT REFERENCE NO. | SHEET NO. |
| ADKIN BRANCH | 8 |

PROJECT ENGINEER
RECORD DRAWINGS
 This record drawing has been prepared in part, based upon information furnished by others. While this information is believed to be reliable, the Engineer cannot assure its accuracy, and thus is not responsible for the accuracy of this record drawing or for any errors or omissions which may have been incorporated into it as a result. Those relying on this record document are advised to obtain independent verification of its accuracy before applying for any purpose.

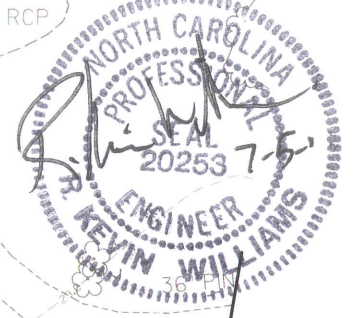

- LEGEND**
- X LIMITS OF DISTURBANCE
 - E CONSERVATION EASEMENT LINE
 - THALWEG
 - BANKFULL
 - TOE OF SLOPE
 - Rootwad symbol
 - Log Vane symbol
 - Log Sill symbol
 - SOIL LIFT symbol
 - CONSTRUCTION REVISIONS symbol
 - ORIGINAL CONSTRUCTION PLANS symbol
 - IMPERVIOUS CHANNEL PLUG symbol
 - STREAMSIDE ASSEMBLAGE PLANTING ZONE symbol
 - COASTAL PLAIN LEVEE FOREST PLANTING ZONE symbol

6/16/2011
 R:\Construction\As-Built\AdkinBranch.ASBuilt.psh_8.dgn
 Florence & Hutcheson, Inc.

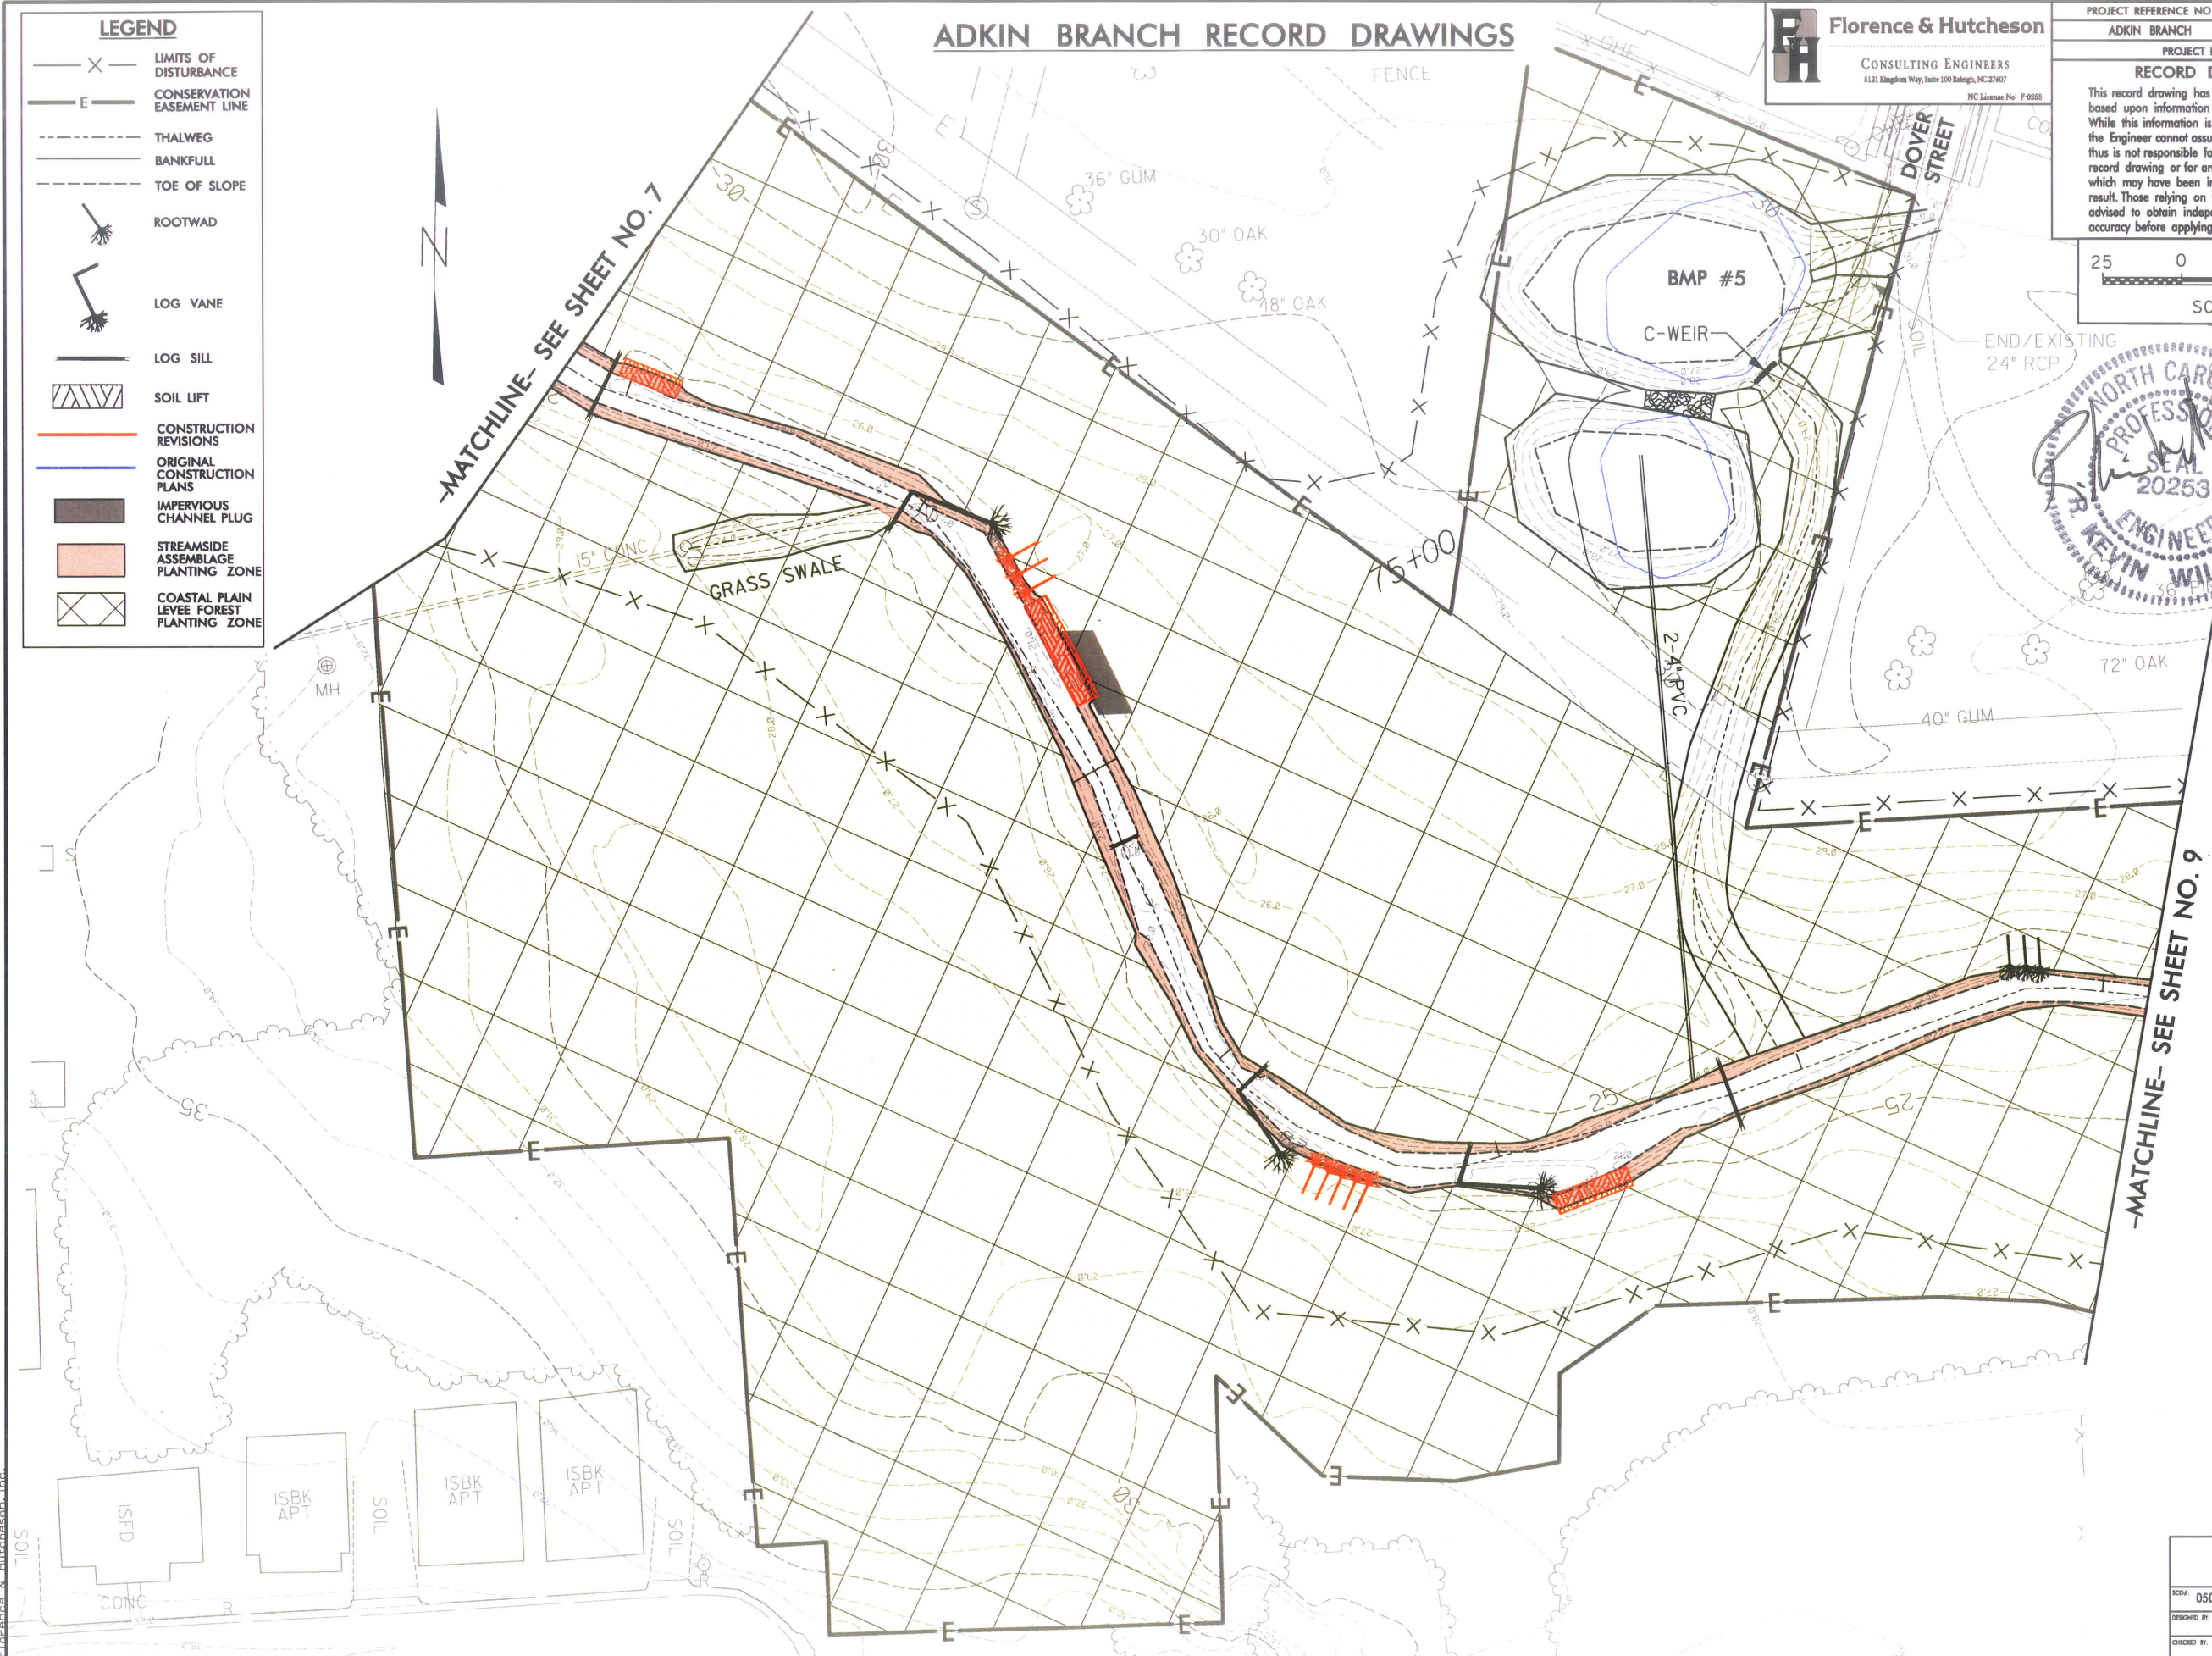

| | |
|---------------------------------|----------------|
| RECORD DRAWINGS ADKIN BRANCH | |
| SCOP: 050656101 | COUNTY: LENOIR |
| DESIGNED BY: RVS | |
| CHECKED BY: RKW | DATE: 6/10/11 |


ADKIN BRANCH RECORD DRAWINGS

Florence & Hutcheson
 CONSULTING ENGINEERS
 5121 Kingston Way, Suite 100 Raleigh, NC 27607
 NC License No. P-0288

| | |
|---|-----------|
| PROJECT REFERENCE NO. | SHEET NO. |
| ADKIN BRANCH | 9 |
| PROJECT ENGINEER | |
| RECORD DRAWINGS | |
| This record drawing has been prepared in part, based upon information furnished by others. While this information is believed to be reliable, the Engineer cannot assure its accuracy, and thus is not responsible for the accuracy of this record drawing or for any errors or omissions which may have been incorporated into it as a result. Those relying on this record document are advised to obtain independent verification of its accuracy before applying for any purpose. | |
| 25 0 50 SCALE | |

LEGEND

- X — LIMITS OF DISTURBANCE
- E — CONSERVATION EASEMENT LINE
- - - THALWEG
- BANKFULL
- - - TOE OF SLOPE
- ROOTWAD
- LOG CROSS VANE
- LOG SILL
- SOIL LIFT
- CONSTRUCTION REVISIONS
- ORIGINAL CONSTRUCTION PLANS
- IMPERVIOUS CHANNEL PLUG
- STREAMSIDE ASSEMBLAGE PLANTING ZONE
- COASTAL PLAIN LEVEE FOREST PLANTING ZONE

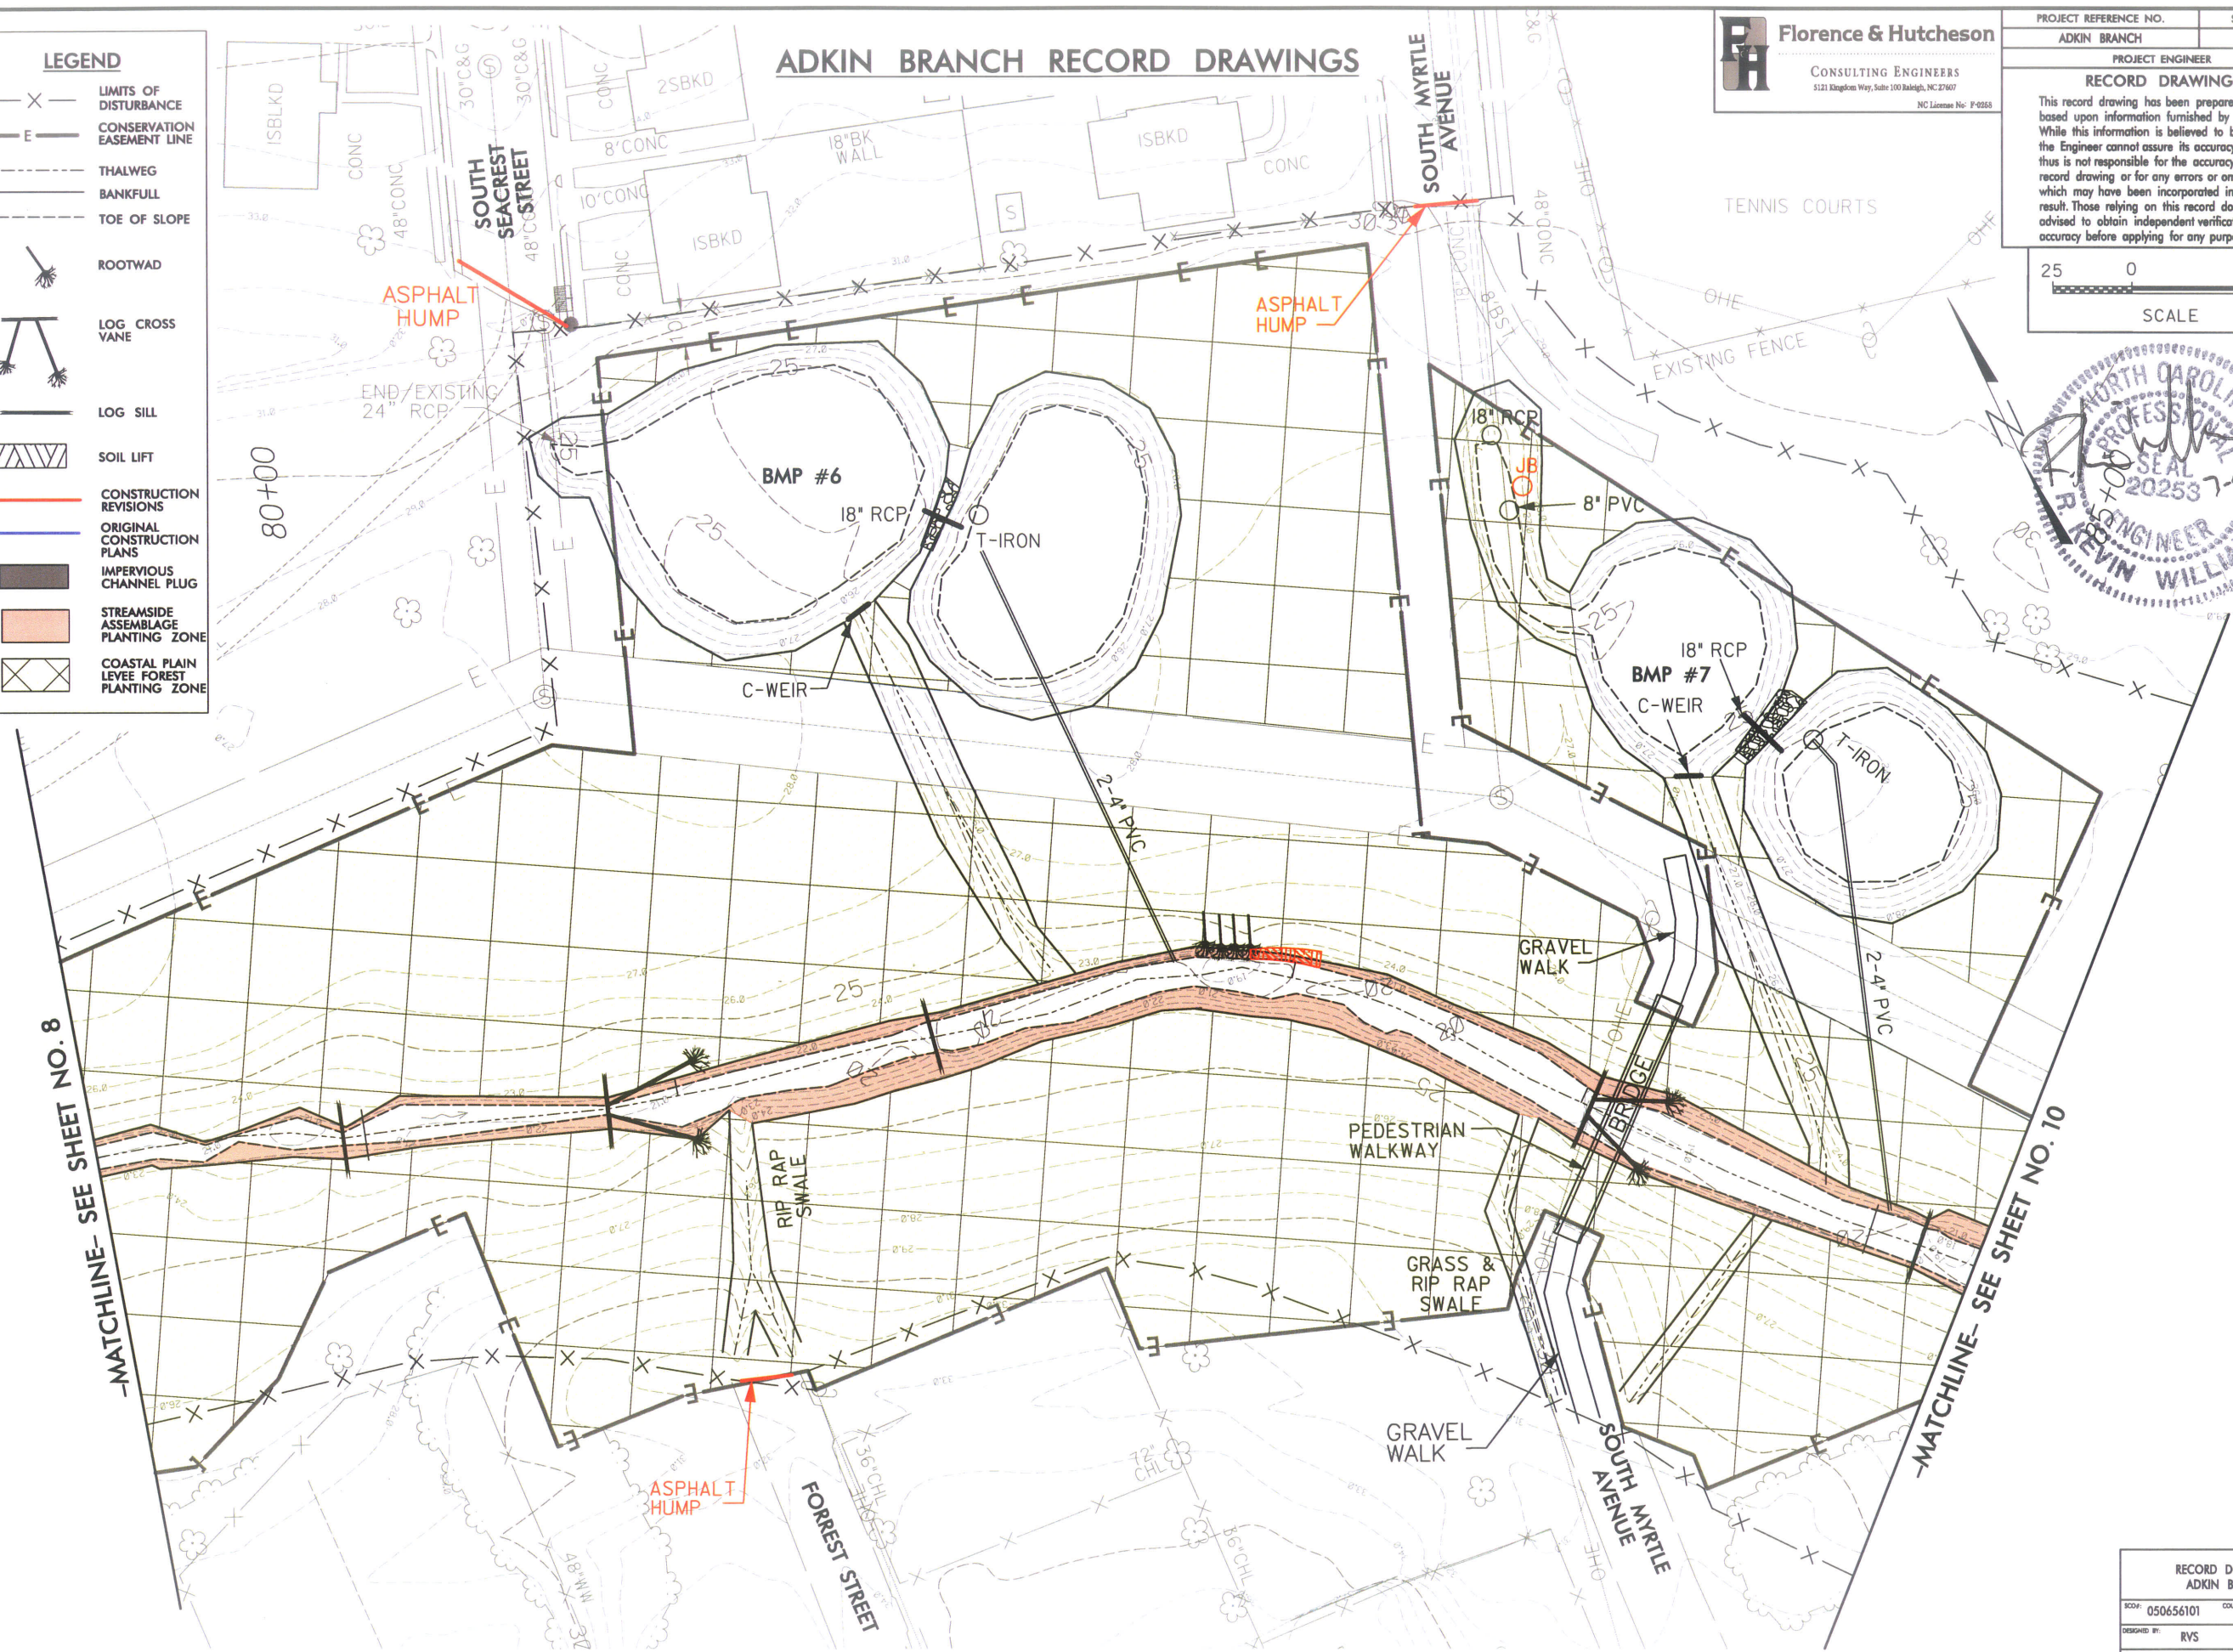

6/16/2011
 R:\Construction\As-Built\AdkinBranch_AsBuilt.psh_9.dgn
 Florence & Hutcheson, Inc.

| | |
|------------------|---------------|
| RECORD DRAWINGS | |
| ADKIN BRANCH | |
| SCOP: 050656101 | COUNT: LENOIR |
| DESIGNED BY: RVS | |
| CHECKED BY: RKW | DATE: 6/10/11 |

ADKIN BRANCH RECORD DRAWINGS

Florence & Hutcheson
 CONSULTING ENGINEERS
 5121 Kingsley Way, Suite 100 Raleigh, NC 27607
 NC License No. P-0258

| | |
|---|-----------|
| PROJECT REFERENCE NO. | SHEET NO. |
| ADKIN BRANCH | 10 |
| PROJECT ENGINEER | |
| RECORD DRAWINGS | |
| This record drawing has been prepared in part, based upon information furnished by others. While this information is believed to be reliable, the Engineer cannot assure its accuracy, and thus is not responsible for the accuracy of this record drawing or for any errors or omissions which may have been incorporated into it as a result. Those relying on this record document are advised to obtain independent verification of its accuracy before applying for any purpose. | |




| LEGEND | |
|--------|--|
| — X — | LIMITS OF DISTURBANCE |
| — E — | CONSERVATION EASEMENT LINE |
| --- | THALWEG |
| --- | BANKFULL |
| --- | TOE OF SLOPE |
| | ROOTWAD |
| | LOG CROSS VANE |
| | LOG VANE |
| | LOG SILL |
| | SOIL LIFT |
| | FLOODPLAIN INTERCEPTOR (FPI) |
| | CONSTRUCTION REVISIONS |
| | ORIGINAL CONSTRUCTION PLANS |
| | IMPERVIOUS CHANNEL PLUG |
| | STREAMSIDE ASSEMBLAGE PLANTING ZONE |
| | COASTAL PLAIN LEVEE FOREST PLANTING ZONE |

6/16/2011
 R:\Construction\As-Built\AdkinBranch.ASBuilt.ps_10.dgn
 Florence & Hutcheson, Inc.

| | |
|------------------|----------------|
| RECORD DRAWINGS | |
| ADKIN BRANCH | |
| SCOP: 050656101 | COUNTY: LENOIR |
| DESIGNED BY: RVS | |
| CHECKED BY: RKW | DATE: 6/10/11 |

ADKIN BRANCH RECORD DRAWINGS

Florence & Hutcheson
 CONSULTING ENGINEERS
 5121 Kingston Way, Suite 100 Raleigh, NC 27607
 NC License No: P-0258

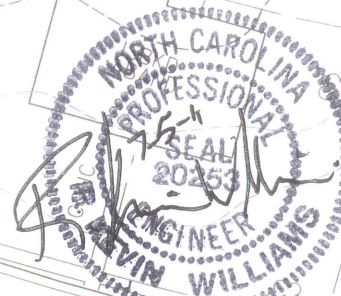


PROJECT REFERENCE NO. ADKIN BRANCH SHEET NO. 11

RECORD DRAWINGS
 This record drawing has been prepared in part, based upon information furnished by others. While this information is believed to be reliable, the Engineer cannot assure its accuracy, and thus is not responsible for the accuracy of this record drawing or for any errors or omissions which may have been incorporated into it as a result. Those relying on this record document are advised to obtain independent verification of its accuracy before applying for any purpose.



| LEGEND | |
|--------|--|
| — X — | LIMITS OF DISTURBANCE |
| — E — | CONSERVATION EASEMENT LINE |
| --- | THALWEG |
| --- | BANKFULL |
| --- | TOE OF SLOPE |
| | LOG CROSS VANE |
| | DOUBLE STEP LOG CROSS VANE |
| | DOUBLE STEP LOG VANE |
| — | LOG SILL |
| | SOIL LIFT |
| — | CONSTRUCTION REVISIONS |
| — | ORIGINAL CONSTRUCTION PLANS |
| | IMPERVIOUS CHANNEL PLUG |
| | STREAMSIDE ASSEMBLAGE PLANTING ZONE |
| | COASTAL PLAIN LEVEE FOREST PLANTING ZONE |

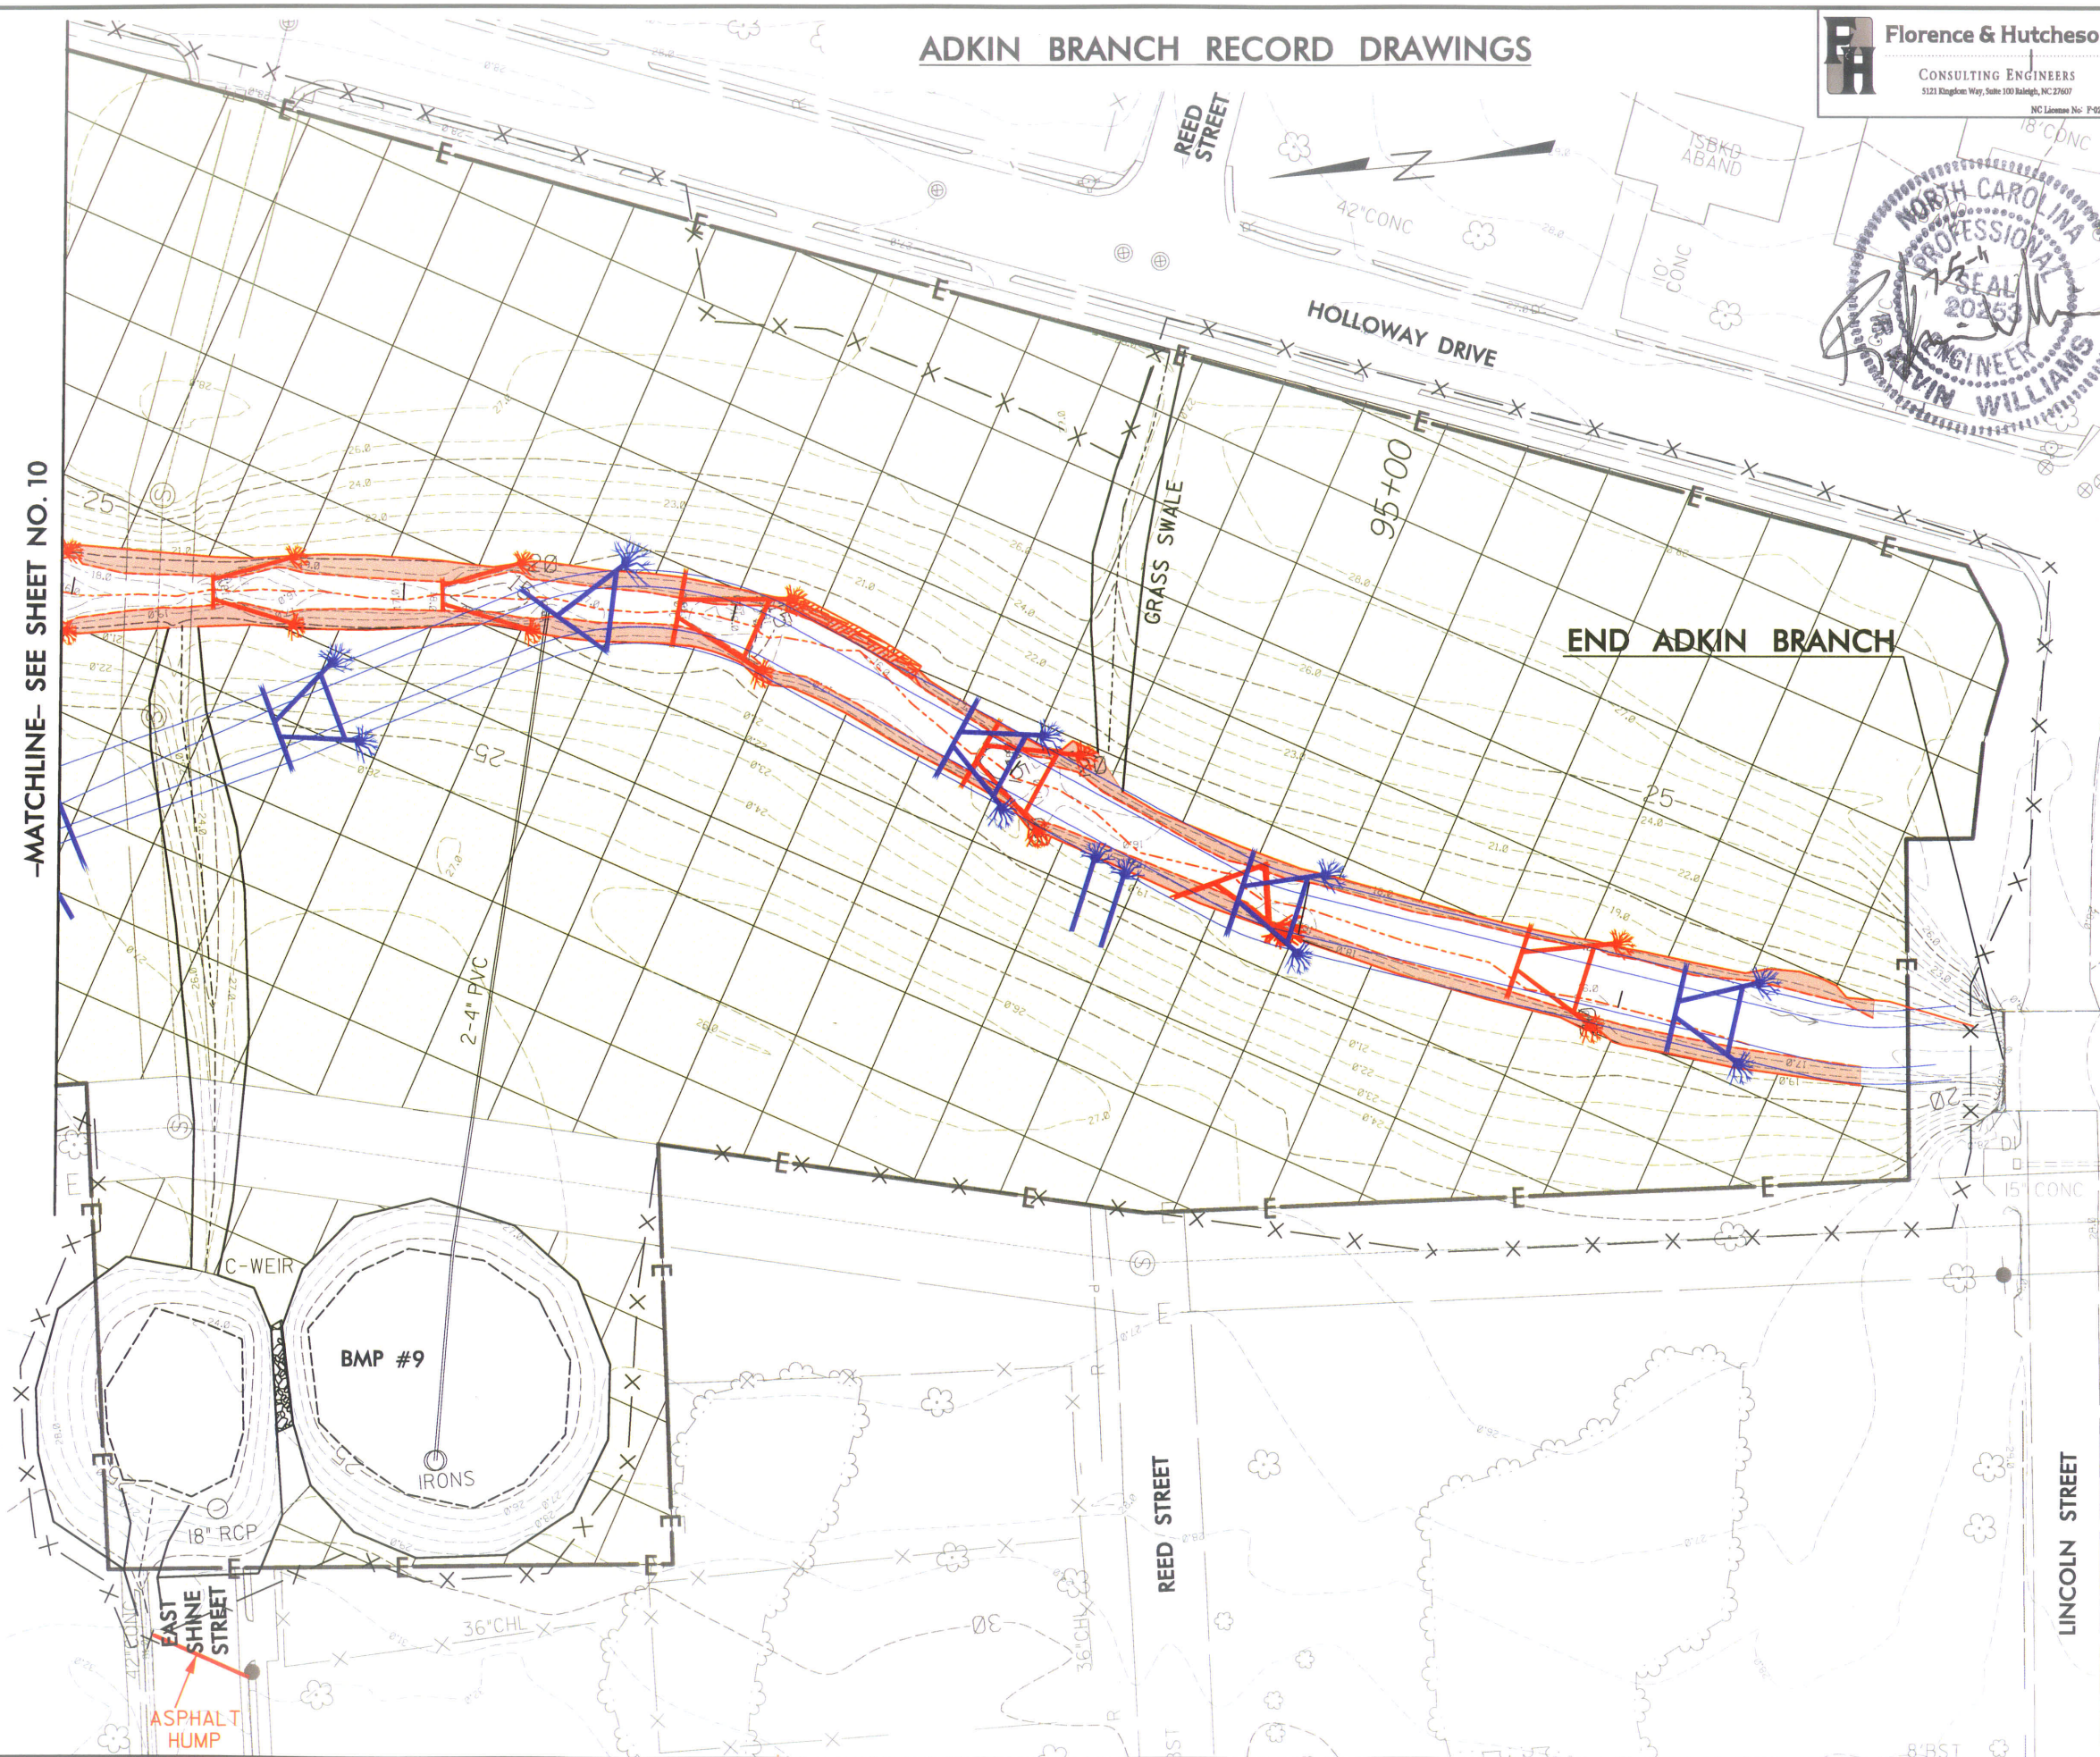

-MATCHLINE- SEE SHEET NO. 10

END ADKIN BRANCH

6/16/2011
 R:\Construction\As-Built\AdkinBranch_AsBuilt.psh_11.dgn
 Florence & Hutcheson, Inc.

| | |
|---------------------------------|---------------|
| RECORD DRAWINGS ADKIN BRANCH | |
| SCD: 050656101 | CONTR: LENOIR |
| DESIGNED BY: RVS | |
| CHECKED BY: RWK | DATE: 6/10/11 |



ADKIN BRANCH RECORD DRAWINGS

Florence & Hutcheson
 CONSULTING ENGINEERS
 5121 Edgemon Way, Suite 100 Raleigh, NC 27607
 NC License No. P-0258

| | |
|-----------------------|-----------|
| PROJECT REFERENCE NO. | SHEET NO. |
| ADKIN BRANCH | 12 |

RECORD DRAWINGS

This record drawing has been prepared in part, based upon information furnished by others. While this information is believed to be reliable, the Engineer cannot assure its accuracy, and thus is not responsible for the accuracy of this record drawing or for any errors or omissions which may have been incorporated into it as a result. Those relying on this record document are advised to obtain independent verification of its accuracy before applying for any purpose.

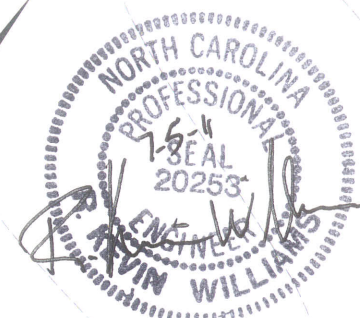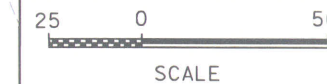

| LEGEND | |
|--------|--|
| X | LIMITS OF DISTURBANCE |
| E | CONSERVATION EASEMENT LINE |
| - - - | THALWEG |
| — | BANKFULL |
| - - - | TOE OF SLOPE |
| — | LOG SILL |
| — | CONSTRUCTION REVISIONS |
| — | ORIGINAL CONSTRUCTION PLANS |
| ■ | IMPERVIOUS CHANNEL PLUG |
| ■ | STREAMSIDE ASSEMBLAGE PLANTING ZONE |
| ■ | COASTAL PLAIN LEVEE FOREST PLANTING ZONE |

6/16/2011
 F:\Construction\As-Built\As-Built\AdkinBranch_AsBuilt.psh_12.dgn
 Florence & Hutcheson, Inc.

| | |
|---------------------------------|----------------|
| RECORD DRAWINGS ADKIN BRANCH | |
| SCOPE: 050656101 | COUNTY: LENOIR |
| DESIGNED BY: RVS | |
| CHECKED BY: RKW | DATE: 6/10/11 |


ADKIN BRANCH RECORD DRAWINGS

Florence & Hutcheson
 CONSULTING ENGINEERS
 5121 Kingdom Way, Suite 100 Raleigh, NC 27607
 NC License No. P-0258

| | |
|-----------------------|-----------|
| PROJECT REFERENCE NO. | SHEET NO. |
| ADKIN BRANCH | 13 |


RECORD DRAWINGS

This record drawing has been prepared in part, based upon information furnished by others. While this information is believed to be reliable, the Engineer cannot assure its accuracy, and thus is not responsible for the accuracy of this record drawing or for any errors or omissions which may have been incorporated into it as a result. Those relying on this record document are advised to obtain independent verification of its accuracy before applying for any purpose.

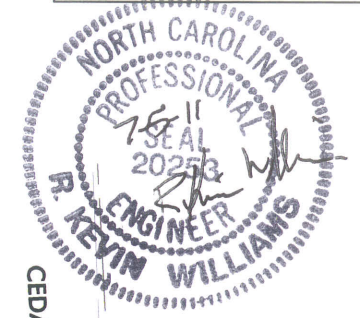


LEGEND

- X — LIMITS OF DISTURBANCE
- E — CONSERVATION EASEMENT LINE
- - - THALWEG
- BANKFULL
- - - TOE OF SLOPE
- LOG SILL
- CONSTRUCTION REVISIONS
- ORIGINAL CONSTRUCTION PLANS
- IMPERVIOUS CHANNEL PLUG
- STREAMSIDE ASSEMBLAGE PLANTING ZONE
- COASTAL PLAIN LEVEE FOREST PLANTING ZONE
- COASTAL PLAIN LEVEE FOREST PLANTING ZONE

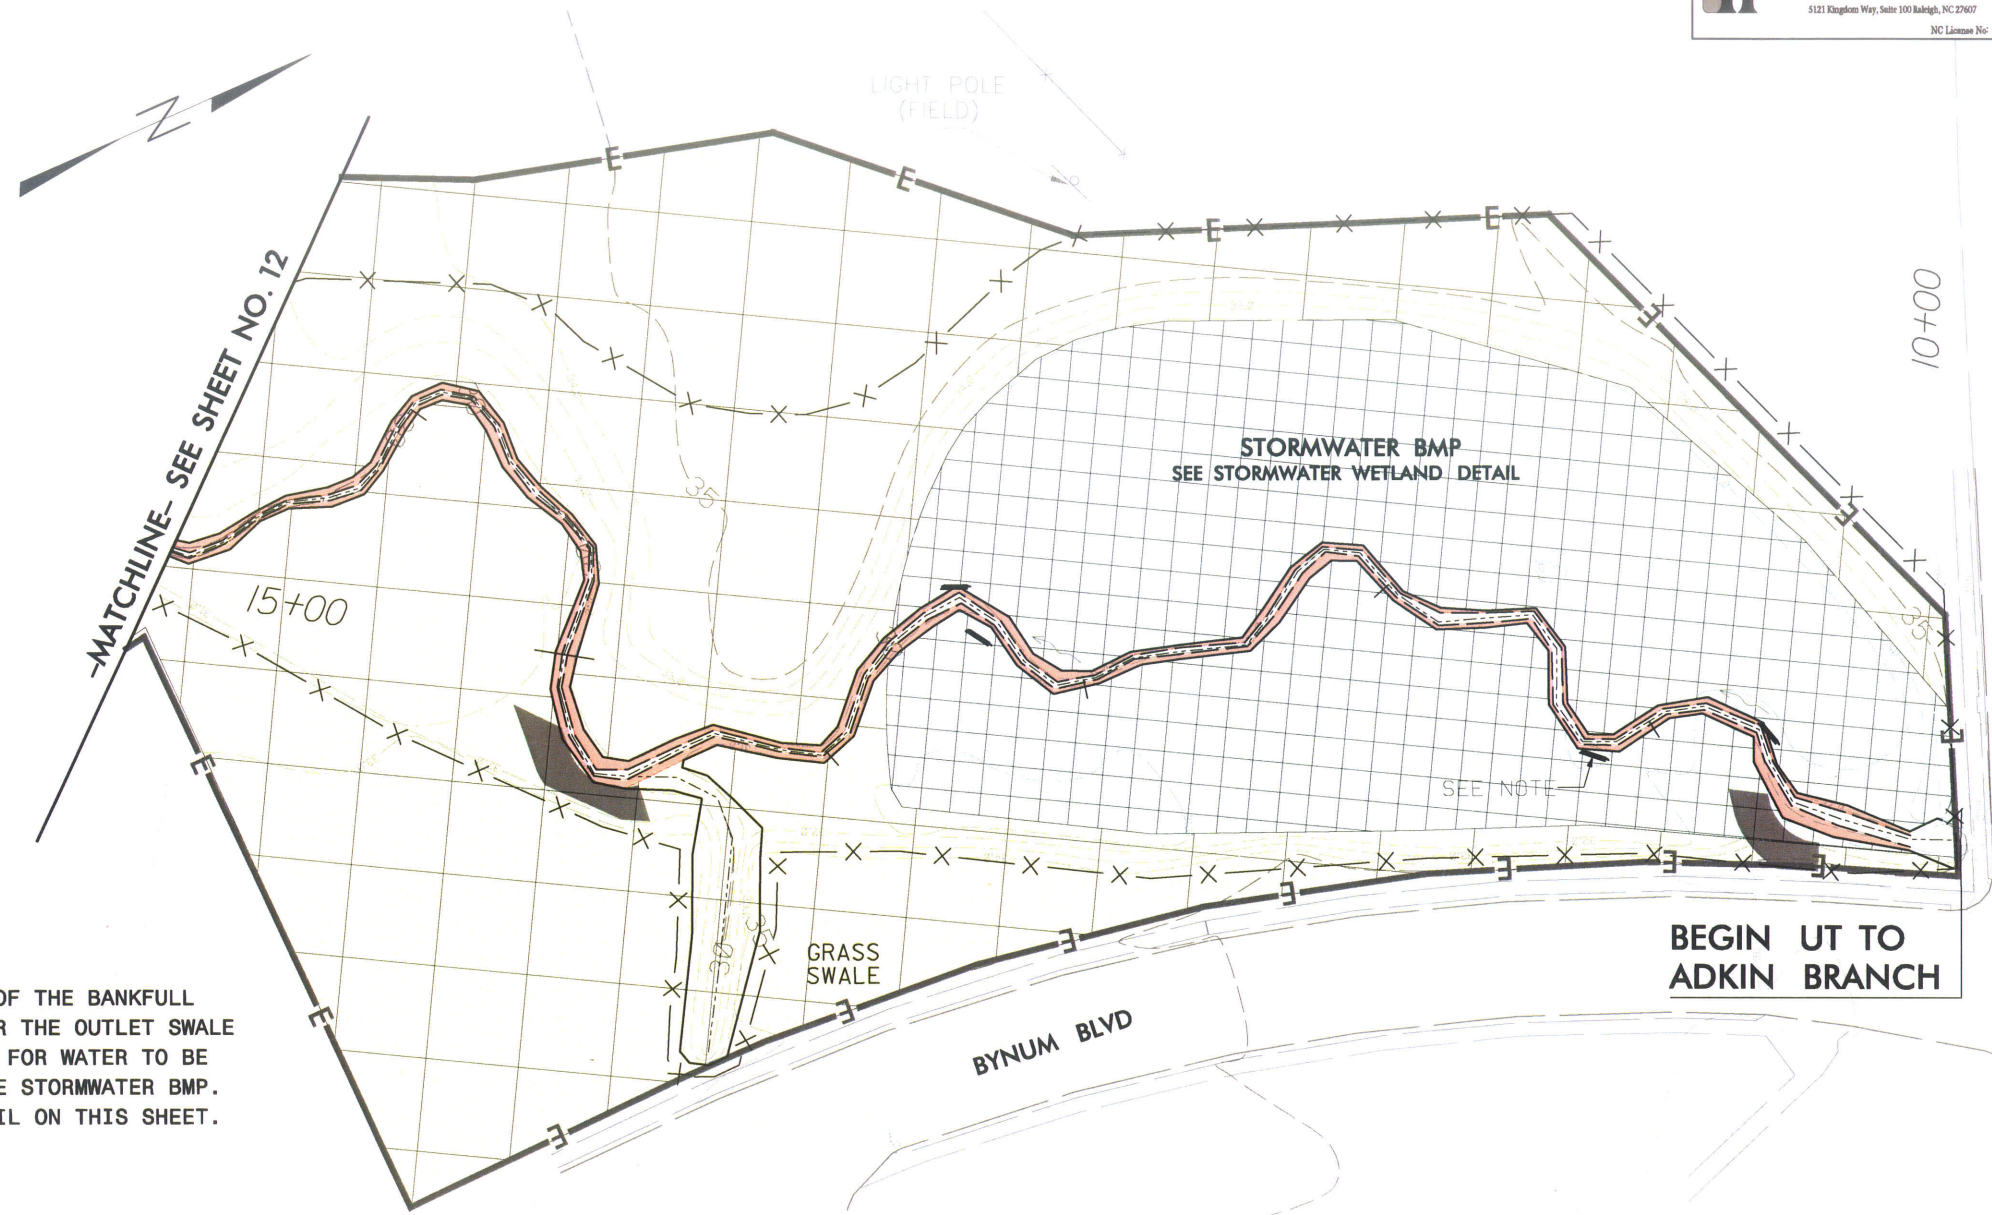


NOTE:
 LOG SILLS PLACED OUTSIDE OF THE BANKFULL CHANNEL MAINTAIN GRADE FOR THE OUTLET SWALE AT HALF BANKFULL TO ALLOW FOR WATER TO BE DISTRIBUTED THROUGHOUT THE STORMWATER BMP. SEE THE CONSTRUCTION DETAIL ON THIS SHEET.

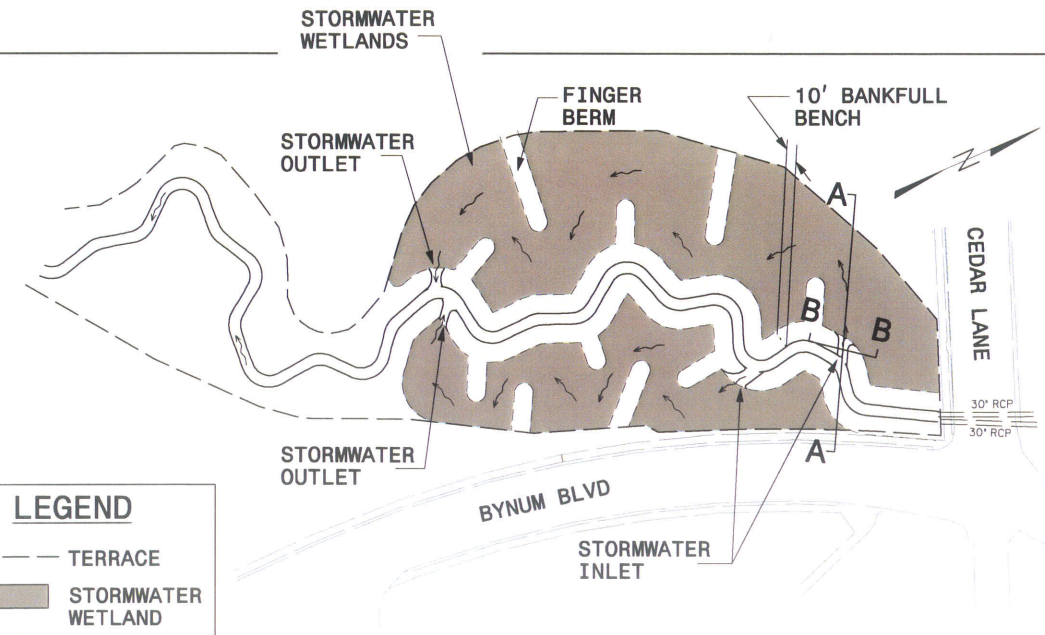

LEGEND


- - - TERRACE
- STORMWATER WETLAND

STORMWATER WETLAND

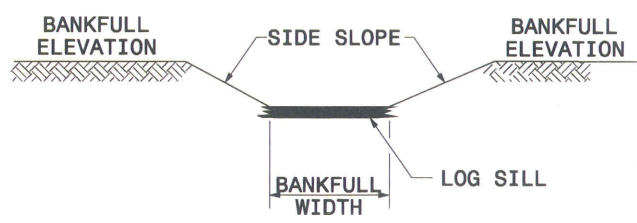

STORMWATER INLET/OUTLET CROSS-SECTION SECTION B-B

- NOTES:**
1. INVERT SET AT 1/2 BANKFULL DEPTH.
 2. LOG SILL SET AT INVERT TO PROTECT FROM SCOUR.
 3. BASE WIDTH SHALL BE 1/2 BANKFULL CHANNEL BASE WIDTH. SIDE SLOPES SHALL BE BUILT AT A 3:1 SLOPE.

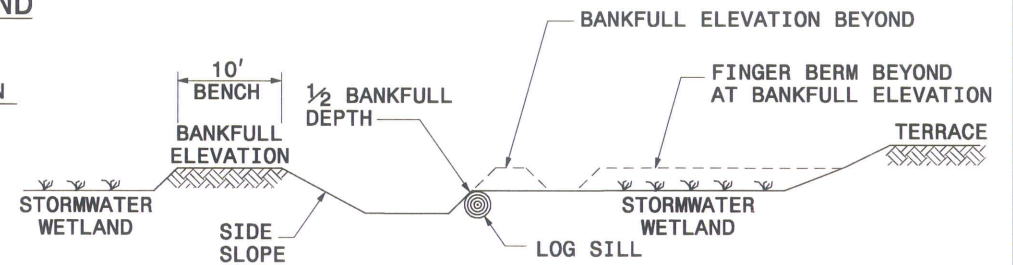

STORMWATER INLET/OUTLET PROFILE SECTION A-A

- NOTES:**
1. STORMWATER WETLAND'S ELEVATION SHALL BE SET AT 1/2 THE BANKFULL DEPTH UP FROM CHANNEL INVERT.

| | |
|---------------------------------|----------------|
| RECORD DRAWINGS ADKIN BRANCH | |
| SCD: 050656101 | COUNTY: LENOIR |
| DESIGNED BY: RVS | |
| CHECKED BY: RKW | DATE: 6/10/11 |

6/17/2011 \\fs\construction\As-Built\AdkinBranch\As-Built\As-Built\13.dgn