

**Badin Inn Stream Restoration
Stanly County, NC**

**Mitigation Plan and As-built Baseline Report
DRAFT**

**EEP Project Number 92666
SCO Project Number D06125-E
Data Collection Period: April-July, 2009
Submission Date: August, 2009**



Prepared for:



**NCDENR Ecosystem Enhancement Program
1652 Mail Service Center
Raleigh, NC 27699-1652**

August 2009

EXECUTIVE SUMMARY/PROJECT ABSTRACT

The Badin Inn Stream Restoration Project, located in Stanly County, North Carolina, involves the Priority I restoration of 4,174 feet of stream channel. This length consists of 3,994 feet of a perennial stream (UT to Little Mountain Creek) that was channelized and lined with concrete nearly a century ago, and the “daylighting” and restoration of 180 feet of an intermittent tributary that was routed through a culvert during the same period. The overall goals of the Badin Inn Stream Restoration Project are to restore the pre-disturbance ecology and hydrology of these stream systems and the riparian corridor thorough which they flow. Specifically, the restoration is intended to improve flood attenuation, remove some portion of the pollutant influx from the surrounding golf course, improve aquatic and riparian habitat, help create a contiguous wildlife corridor linking the upslope Uwharrie Mountain ridgeline with the Little Mountain Creek riparian corridor, and provide aesthetic value and educational opportunities.

To meet these goals, restored stream channels were designed and constructed in the relict floodplain with dimension, pattern and profile parameters derived from local reference reach data. Appropriately sized bedload was introduced into the channel to account for the lack of natural bedload, and the channels were raised where practical to meet the relict floodplain. In addition, a riparian area was established and protected through acquisition of a conservation easement. The riparian area was planted with native vegetation, and graded in many locations with low points (“wet swales”) that, although not intended to be credit-generating wetland areas, would provide floodplain storage, protect the stream channel during flood events and increase diversity of vegetation within the riparian corridor.

A description of the overall restoration approach to the three primary project elements (stream, vegetation, hydrology) and how these elements compare in the as-built state to the design is outlined below:

Stream

The restoration approach to the channel of UT to Little Mountain Creek was to construct a new channel within the relict floodplain that would match the dimension, pattern, and profile obtained from dimensionless reference reach criteria of nearby streams. The restored bankfull elevation of most of the channel was to be reconnected with the relict floodplain. In several short sections where bankfull could not be reconnected, a new floodplain was to be constructed. In addition, a short tributary that flows into UT to Little Mountain Creek near the upstream end of the project was to be “daylighted” and also restored with a Priority I approach.

All of these goals were accomplished in the construction phase of the project; and the intent of the design was fully carried out. At the beginning of construction, the cross-sectional area of the channel was reduced slightly from that proposed in the restoration plan due to concerns of over-excavation, but this was

accomplished by reducing side slopes, and keeping the bankfull width and depth intact. Otherwise, the designed plan and profile were constructed as intended.

Vegetation

Vegetation plans called for planting a mixture of live stakes, bare root seedlings, and permanent seed mix of native perennial trees, shrubs and herbaceous species. Fourteen species of trees and four species of shrubs were planted on-site. Additionally, four species of live stakes and one herbaceous rush species were planted along the streambank. Temporary seed mix was applied in conjunction with the permanent seed mix to reduce the erosive effect of floodplain flows while the permanent vegetation was becoming established on-site. At the time of sampling for this report, vegetation density for the overall site was good averaging 621 stems per acre. The rush species and live stakes are growing well with little evidence of difficulty. The permanent seed mix has germinated and some species have reached flowering at the time of this report.

Hydrology

Besides the construction of restored stream channels, the only plans for hydrologic modification on this project were the grading of “wet swales” within the restored floodplain of UT to Little Mountain Creek. The intent of these features, which are graded low points within the restored floodplain, are to provide flood storage and attenuation, and to help protect the stream channel. Several of these swales were planned to capture some of the runoff of the golf course by being located at outfalls from the golf course drainage system. These swales were graded as planned and are functioning as expected: they hold water immediately following rain and flood events, and become dry during extended periods without rain. Various species of amphibians were observed inhabiting them immediately following construction. Moreover, several of the swales located at outfalls are exhibiting the growth of algae, indicating that they are helping to capture some of the fertilizers contained in runoff from the golf course.

The monitoring of the Badin Inn Stream Restoration Project encompasses geomorphic surveys to track any changes in dimension, pattern and profile, vegetation monitoring in established vegetation plots, hydrological monitoring through installation of a stream gauge, and biological monitoring by collecting Qual 4 macroinvertebrate samples. Baseline data was collected in July of 2009 and will serve as a basis for comparison for future monitoring efforts. Monitoring methods will be repeated for five years following the as-built effort.

TABLE OF CONTENTS

1.0 PROJECT GOALS, BACKGROUND AND ATTRIBUTES	1
1.1 Location and Setting	1
1.2 Project Goals and Objectives	2
1.3 Project Structure, Restoration Type and Approach	3
1.3.1 <i>Project Structure</i>	3
1.3.2 <i>Restoration Type and Approach</i>	3
1.4 Project History, Contacts and Attribute Data	4
2.0 SUCCESS CRITERIA	4
2.1 Stream	4
2.2 Vegetation	5
2.3 Hydrology	5
3.0 MONITORING PLAN GUIDELINES	5
3.1 Stream Channel Stability and Geomorphology	6
3.2.1 <i>Dimension</i>	6
3.2.2 <i>Pattern</i>	6
3.2.3 <i>Profile</i>	6
3.2.3 <i>Stream Substrate</i>	7
3.2.4 <i>Visual Assessment</i>	7
3.2.5 <i>Bank Stability Assessments</i>	7
3.2 Vegetation	7
3.3 Hydrology	7
3.4 Digital Photos	8
3.5 Biological Measurements	8
4.0 MAINTENANCE AND CONTINGENCY PLANS	8
4.1 Stream	8
4.1 Vegetation	9
5.0 DOCUMENTING THE AS-BUILT CONDITION (BASELINE)	9
5.1 Verification of Plantings	9
5.2 As-Built Baseline Data Collection	10
6.0 REFERENCES	10

APPENDICES

- Appendix A. General Tables and Figures
- Appendix B. Morphological Summary Data and Plots
- Appendix C. Vegetation Data
- Appendix D. As-Built Plan Sheets

1.0 PROJECT GOALS, BACKGROUND AND ATTRIBUTES

1.1 Location and Setting

The Badin Inn Stream Restoration Project is located in the Town of Badin in Stanly County, North Carolina and is situated entirely within the golf course of the Badin Inn Resort and Country Club (Figure 1). The project site encompasses a perennial, unnamed tributary to Little Mountain Creek (UT to Little Mountain Creek) and a small, first-order intermittent tributary of UT to Little Mountain Creek (Tributary) and the associated floodplain through which these channels flow. Prior to restoration, the channel of UT to Little Mountain Creek consisted of approximately 3,700 feet of a concrete-lined and straightened perennial stream that had been in its altered state for nearly a century. The Tributary consisted of approximately 141 feet of an intermittent channel routed through a culvert from where it entered the golf course property until it's confluence with UT to Little Mountain Creek. The channels are located in the Yadkin River Basin 8-digit Catalogue Unit 03040104 and the 14-digit hydrological unit 03040104010010. This watershed was identified by the NC Ecosystem Enhancement Program (EEP) as a Targeted Local Watershed and is also classified by the NC Division of Water Quality (NCDWQ) as a Water Supply Watershed (WSIV). The receiving stream, Little Mountain Creek, is listed on the 303(d) list for biological impairment (NCDENR, 2008).

The project location is shown on the Badin 7.5 minute United States Geological Service (USGS) Topographic Quadrangle Map at approximately 580331 E and 3917513 N.

The project site is located in the Carolina Slate Belt ecoregion (Griffith *et. al*, 2002). The primary adjacent land use throughout the project watershed consists of managed herbaceous areas (which consists mainly of the Badin Inn golf course), developed areas, including much of the residential areas of the Town of Badin, and forested areas on the slopes above the town. **Table 4** summarizes the land use of the UT to Little Mountain Creek watershed.

UT to Little Mountain Creek is a 2nd order stream, as several small 1st order tributaries flow into it near the top of the watershed. As it passes through the town, the channel has uniform rectangular dimensions and is lined with concrete. As the primary drainage feature in the Town of Badin, it receives the discharge of numerous stormwater pipes flowing from houses and townhouse complexes. The channelization of this stream occurred during the development of Badin by ALCOA during the early 1920's, and has since served as the primary stormwater conveyance system for a portion of the town. Where the stream enters the Badin Inn and Country Club golf course, the stream is confined to a narrow, stone-lined channel for roughly 700 feet. It continues in this form until reaching the conservation easement and the upstream end of the project reach, after passing through a 48" culvert under Henderson Street (State Road 1720). At this point, prior to restoration, the stream entered a much larger, concrete-lined channel that traveled straight down the valley until joining with Little Mountain Creek. An intermittent tributary that was routed underground through a culvert entered the main channel approximately 500 feet downstream of the beginning of the project. The relict floodplain

of the pre-restoration channel was covered by fairways of the Badin Inn and Resort golf course, and some modification to the valley had been done to create bunkers, greens and tee boxes. In addition, a network of drains, pipes and irrigation systems had been installed within the valley, and numerous stormwater outfalls discharged into the stream.

1.2 Project Goals and Objectives

The overarching goals of the Badin Inn stream restoration project are:

- Restoring the pre-disturbance ecology and hydrology of a perennial, unnamed tributary to Little Mountain Creek, which was hardened with concrete and relocated to its present location nearly a century ago.
- Improvement of flood attenuation characteristics of a highly urbanized and industrialized watershed.
- Removal of some portion of the pollutant influx from the adjacent golf course management practices.
- Improve aquatic habitat of the main channel with the use of natural material stabilization structures such as root wads, log vanes, woody debris, and a riparian buffer.
- Provide aesthetic value, wildlife habitat, and bank stability through the creation of a riparian zone.
- Create a contiguous wildlife corridor, with connection of the adjacent natural habitats and state natural heritage areas including Morrow Mountain State Park, Little Mountain Creek riparian corridor and Badin basic forest.
- Provide shading and biomass input to the stream and mast for wildlife when vegetation is mature.
- Provide educational opportunities with information signs along the project and take advantage of the high exposure of the project.

The objectives, which specify how each of the goals will be obtained, are:

- 1) construct a new stream channel in the valley of the existing stream that:
 - a) Possesses dimension, profile and cross-section appropriate for streams in the Uwharrie Mountains region of the piedmont, as based on reference reaches.
 - b) Will contain changes in stream type that are appropriate for changes in the valley slope along the project.
 - c) Will have bedload introduced into channel to account for the lack of bedload produced by the watershed, and for any excess shear stress generated by the lack of bedload and to provide instream habitat. The bedload will be sized appropriately based on entrainment calculations, while also ensuring that the bedload will not be mobilized out of the stream completely following restoration.
 - d) Will be raised where practical so that bankfull elevation meets the existing floodplain.
 - e) Will have structural measures to protect outside meander bends before vegetation becomes established. The structures will contain woody

material for habitat, and stone material that is sized appropriately for a stream with a cross sectional area of only approximately 13 square feet.

- 2) establish a riparian corridor that:
 - a) Is planted with local propagules of native vegetation.
 - b) Meets the minimum vegetative criteria for survival(outlined below in Section 7.2).
 - c) Contains riparian wetland “swales”, to improve the quality of water passing through the buffer, to provide floodplain storage for reduction of overbank flood velocities and flooding, to increase the functional diversity of vegetation within the riparian corridor, and to protect the stream channel during flood events.
- 3) implement educational and aesthetic components:
 - a) Install several information kiosks along the edge of the conservation easement with information on stream ecology, hydrology and stream restoration.
 - b) Use blue bird boxes as conservation easement boundary markers, along with a barrier/low fence along the easement boundary that will prevent maintenance equipment from entering the easement.

1.3 Project Structure, Restoration Type and Approach

1.3.1 Project Structure

This project consists of 4,174 linear feet of stream restoration. This length consists of approximately 3,994 linear feet of Priority I restoration on UT Little Mountain Creek and approximately 180 linear feet of Priority I restoration on an intermittent tributary to UT to Little Mountain Creek. This information is summarized in **Table 1** and graphically depicted in **Figure 2**, both of which are found in Appendix A.

1.3.2 Restoration Type and Approach

The restoration of UT to Little Mountain Creek was planned as a Priority I restoration in that the bed elevation of the restored stream channel would be raised so that bankfull elevation is reconnected to the relict floodplain elevation. In some sections, the bankfull elevation would need to be lowered where certain constraints, such as pipe invert elevations, had to be met. In these areas, however a new floodplain was to be built a slightly lower elevation than the relict floodplain. The channel of UT to Little Mountain creek was designed as a C4 channel, and was intended to have a somewhat high width to depth ratio to account for a lack of natural channel roughness, a condition created by the lack of natural bed material in the pre-restoration channel, and the lack of a source of bedload from upstream. This lack of roughness was expected to have a tendency to increase mean velocity and shear stress in the design channel, thus the design called for a high width to depth ratio and the placement of bed material into the channel. Dimension, pattern and profile were designed in accordance with reference criteria obtained from two

reference reaches. The design approach to the small tributary was identical to that of the main channel.

Another element of the restoration approach was the incorporation of riparian wetland “swales”, which are small depressions built within the floodplain of the restored stream. Research has shown that overbank flooding dampens the peak of the hydrograph, and that flows stored within the riparian floodplain typically undergo biochemical processes that improve the quality of water prior to it being returned to the stream (Evans *et al.*, 2008). Riparian wetland “swales” were incorporated into the design to improve the quality of water passing through the buffer, to provide floodplain storage for reduction of overbank flood velocities and flooding, to increase the functional diversity of vegetation within the riparian corridor, and to protect the stream channel during flood events. These riparian wetland swales were not intended to generate riparian wetland credits.

1.4 Project History, Contacts and Attribute Data

The Badin Inn stream restoration project was identified as part of a North Carolina Ecosystem Enhancement Program full-delivery proposal submitted in October of 2006. Upon winning the project, Earth Tech|AECOM acquired for the State of North Carolina a conservation easement on the golf course property of Badin Inn Resort and Club to protect in perpetuity the riparian corridor of the restored stream. Construction of the stream was completed in April of 2009. As-built data was collected following completion of construction, with the last data collected in July, 2009. Year one monitoring will begin in December 2009 and will take place once every year for five years. A complete project history is contained in **Table 2** in Appendix A. **Table 3** in Appendix A lists all of the relevant contact information pertaining to the project. Finally, **Table 4** in Appendix A contains a summation of project attribute data, including information about the UT to Little Mountain Creek watershed, floodplain soils and water quality classification of the restored channels.

2.0 SUCCESS CRITERIA

The following section outlines the success criteria for the three restoration elements: stream, hydrology and vegetation.

2.1 Stream

Considering the 5 year timeframe of standard mitigation monitoring, restored streams should demonstrate morphologic stability in order to be considered successful. Stability does not equate to an absence of change, but rather to sustainable rates of change or stable patterns of variation. Restored streams often demonstrate some level of initial adjustment in the several months that follow construction and some change/variation subsequent to that is to also be expected. However, the observed change should not indicate a high rate or be unidirectional over time such that a robust trend is evident. If some trend is evident, it should be very modest or indicate migration to another stable form. Examples of the latter include depositional processes resulting in the development

of constructive features on the banks and floodplain, such as an inner berm, slight channel narrowing, modest natural levees, and general floodplain deposition. Annual variation is to be expected, but over time this should demonstrate maintenance around some acceptable central tendency while also demonstrating consistency or a reduction in the amplitude of variation. Lastly, all of this must be evaluated in the context of hydrologic events to which the system is exposed over the monitoring period.

For channel dimension, cross-sectional overlays and key parameters such as cross-sectional area and the channel's width to depth ratio should demonstrate modest overall change and patterns of variation that are in keeping with above. For the channels' profile, the reach under assessment should not demonstrate any consistent trends in thalweg aggradation or degradation over any significant continuous portion of its length. Over the monitoring period, the profile should also demonstrate the maintenance or development of bedform (facets) more in keeping with reference level diversity and distributions for the stream type in question. It should also provide a meaningful contrast in terms of bedform diversity against the pre-existing condition. Bedform distributions, riffle/pool lengths and slopes will vary, but should do so with maintenance around design/As-built distributions. This requires that the majority of pools are maintained at greater depths with lower water surface slopes and riffles are shallow with greater water surface slopes. Substrate measurements should indicate the progression towards, or the maintenance of, the known distributions from the design phase.

2.2 Vegetation

The final vegetative success criteria will be a minimum survival rate of 260 trees per acre in the conservation easement at the end of five years, in accordance with USACE Stream Mitigation guidelines. An interim measure of vegetation planting success will be a minimum survival rate of 320 trees per acre in the riparian buffer at the end of 3 years. At least six different representative tree and shrub species should be present on the entire site throughout the monitoring period and at the end of five years.

2.3 Hydrology

Hydrologic success will be measured based on the ability of the restored stream to regularly access its floodplain during above-bankfull flows, and of the proper functioning of the wet swales.

3.0 MONITORING PLAN GUIDELINES

Monitoring is essential in order to document whether the success criteria discussed above are being met. The following section outlines the approach to monitoring the Badin Inn restoration project in the 5 years following construction. The monitoring effort will encompass both quantitative measurements and visual observation of the restored stream channel, hydrology and vegetation. In addition, biological monitoring of benthic

macroinvertebrates will be conducted in order to document biological uplift of the restored stream channel.

3.1 Stream Channel Stability and Geomorphology

3.2.1 Dimension

Channel dimension will be surveyed once each year in the five years following As-built at permanently established cross sections located along UT to Little Mountain Creek and the Tributary. These will be surveyed using RTK Survey Grade GPS and/or total station. The data will be analyzed for all of the geomorphic variables housed in **Table 5**, Appendix B of this report. Graphs of profile and cross-sections will be plotted against previous year's data using Rivermorph software.

Ten permanent cross-sections were established following construction and their endpoints marked with rebar. One cross-section is located on the Tributary reach, and the other nine are located on UT to Little Mountain Creek. The cross-section locations are as follows:

Cross-Section #1. UT to Little Mountain Creek, Station 47+67, riffle
Cross-Section #2. UT to Little Mountain Creek, Station 43+05, pool
Cross-Section #3. UT to Little Mountain Creek, Station 38+26, riffle
Cross-Section #4. UT to Little Mountain Creek, Station 33+72, riffle
Cross-Section #5. UT to Little Mountain Creek, Station 29+78, pool
Cross-Section #6. UT to Little Mountain Creek, Station 25+39, riffle
Cross-Section #7. UT to Little Mountain Creek, Station 20+45, pool
Cross-Section #8. UT to Little Mountain Creek, Station 16+50, pool
Cross-Section #9. UT to Little Mountain Creek, Station 13+61, riffle
Tributary Cross-Section. Tributary, Station 10+85, riffle

3.2.2 Pattern

Pattern will not be measured until year 5 unless the other assessments/measurements (e.g. profile and visual assessment) indicate pattern may be changing. Pattern measurements to be obtained will include radius of curvature, meander wavelength, sinuosity, and belt width. For stream pattern data refer to **Table 5** in Appendix B.

3.2.3 Profile

Channel profile will be surveyed once each year using RTK survey-grade GPS and/or total station in order to detect thalweg, bankfull, and water surface elevations of the UT to Little Mountain Creek and Tributary. Only 3,000 feet of UT to Little Mountain Creek

will be monitored in this way, with endpoints beginning at the downstream end of the project and extending upstream to approximately station 20+22. The entire length of the Tributary will be surveyed. Data will be collected for the thalweg, water surface and left and right bankfull elevations at each change in facet slope of the stream, and at any other locations necessary to provide sufficient detail of the various features of the stream.

3.2.3 Stream Substrate

Surface particle size distributions will be monitored over time to indicate if the bed substrate is coarsening, fining or remaining constant. Monitoring of substrate will be done by conducting pebble counts at each of the ten cross-sections, following methods described by Bunte and Abt (2001).

3.2.4 Visual Assessment

A visual assessment of the stream to identify problem areas will be completed in accordance with the most recent version of the EEP Monitoring Report Template. Problem areas will be documented with photographs and will be depicted on a planview map showing their location and level of severity.

3.2.5 Bank Stability Assessments

Due to the channelized state of UT to Little Mountain Creek prior to restoration, no pre-construction bank stability data could be obtained. As such, bank stability assessments will not be included in the monitoring effort.

3.2 Vegetation

Monitoring of vegetation will follow the Level II protocols established in the 2006 version of the Carolina Vegetative Survey-EEP Protocol (Lee *et al*, 2006). Nine 10m X 10m (100m²) plots were established following planting of permanent vegetation in 2009. These nine plots will be sampled in the fall of every year to determine vegetation survival and also demonstrate if vegetation survival is successful.

3.3 Hydrology

All bankfull events will be cataloged over the monitoring period using an instream crest gauge and/or visual evidence such as fresh alluvium or wrack lines. An instream crest gauge will be installed in 2009. Without continuous recording, multiple bankfull events may occur between observation intervals and thus not every event may be cataloged. However, each crest gauge will be visited a minimum of three times annually as part of standard monitoring. This procedure will capture most bankfull events and provide ample opportunity to capture the two events as required by the 2008 EEP stream monitoring guidelines.

3.4 Digital Photos

Digital photos will be taken in each monitoring year to document the state of the channel and vegetation. Photos of the stream will be captured at each of the ten cross-section locations, and will be taken standing in the channel looking upstream and downstream from the cross-section. These photos will be taken when the vegetation is minimal and within the same 2-month window between monitoring years. Vegetation photos will also be taken at each of the nine vegetation plots from the same vantage point every year.

3.5 Biological Measurements

In order to document the increase in function from the restoration of UT Little Mountain Creek, Earth Tech|AECOM will monitor variables above the minimum requirements of stream restoration monitoring. Earth Tech|AECOM will survey for macroinvertebrates following the NCDENR Standard Operating Procedures for Benthic macroinvertebrates, developed by the Biological Assessment Unit. Because UT Little Mountain Creek is a small 2nd order stream with a 0.5 sq. mi. watershed, the Qual 4 sampling method will be used. Macroinvertebrates will be collected by an Earth Tech|AECOM biologist with the NC Certification required by the NCDWQ for performing this work. Use of the stream and riparian area by amphibians and other fauna will also be evaluated and documented.

4.0 MAINTENANCE AND CONTINGENCY PLANS

The following serves as a guideline for corrective actions that should be taken in the restored stream channel and floodplain in the event of a failure. In addition, several items of maintenance are listed that may be necessary through the monitoring period in order to help ensure the success of the project at the end of Year 5.

4.1 Stream

In general, corrective action will be taken in the channel whenever there is a failure in the intended plan, profile or dimension that is so great as to create the danger of the channel success criteria not being met. “Failure” may not have a precise threshold for each of the stream components. Some shifting in the pattern, profile and dimension of the channel is expected, and some localized area of scour, deposition or bank erosion might occur. It is only when a stream problem area poses a threat to the stability of the channel upstream or downstream that the problem area may rise to the level of a “failure”. Some examples of failures that might warrant corrective action are listed below:

- Significant bed scour or deposition creating the potential for instability upstream or downstream of the localized area of scour or deposition

- Avulsion of the stream channel
- Abandonment of the restored alignment/down-valley migration
- Significant bank failure

In the event that these or other types of failure occur, the stream channel should be evaluated for the source of the problem and appropriate action should be taken to correct the problem. If the failure is related to design criteria for profile, plan or dimension, re-grading of portions of the project within appropriate geomorphic parameters may be necessary. If the failure is related to structures, whether as to location or type of structure, then removal, replacement or reconfiguration of the structure may be necessary. In some cases the problem may be caused by outside sources, such as beaver influence. In these situations, appropriate corrective actions would include removal of the beavers and beaverdams.

4.1 Vegetation

The USACE Stream Mitigation Guidelines give an interim criterion for vegetative success of 320 woody stems/acre at the end of Year 3, and require that 260 stems/acre be present at the end of Year 5. In the event that the Year 3 criterion is not met, the site should be replanted with woody stems at an appropriate density to ensure the survival of at least 260 stems/acre to the end of Year 5.

Maintenance throughout the five-year monitoring period may include re-seeding of permanent or temporary seed mixes in areas where seed has washed away or is not growing properly.

5.0 DOCUMENTING THE AS-BUILT CONDITION (BASELINE)

5.1 Verification of Plantings

Vegetation was planted along the riparian easement of the restored tributary of Little Mountain Creek. Fourteen species of trees and four species of shrubs were planted on-site. Additionally, four species of live stakes and one herbaceous rush species were planted along the streambank. Temporary seed mix was applied in conjunction with the permanent seed mix to reduce the erosive effect of precipitation while the permanent vegetation was becoming established on-site.

Planted woody stems in each of the nine vegetation monitoring plots were flagged and counted to establish a baseline of planted vegetation for each plot. Based on this data collection, vegetation density for the overall site was good averaging 621 stems per acre. The range of stem densities encountered on the mitigation site varied from 324 to 850 stems per acre. Vegetation diversity was low in many individual plots. Species counts of 6 or fewer woody species occurred in 3 plots: plot 2, plot 7, and plot 9. Some dead stems were also noted in the vegetation plots with an average of 1.7 dead stems per plot.

Physical damage to stems was noted in most plots. The majority of the damage was minor and consisted of broken stems or branches on the bare root plantings. Fifty-nine percent of the stems had some damage of this nature. The majority of stems having this damage will continue to grow with ease despite having minor damage. Over time growth will bypass the damaged areas which will gradually disappear. Due to the easement's location along a golf course, it is unclear if this damage originated from the planting itself or from trampling by golfers searching for inaccurately hit balls. Other damage was noted but was fairly rare and did not occur on many stems. Of the less common damage categories stunted growth, due to the planting location being too wet, and insect damage were the most common but each of these damage categories occurred only on a few stems averaging less than one occurrence per plot.

The *Juncus* plugs and live stakes are growing well with little evidence of difficulty. The permanent seed mix has germinated and some species have reached flowering at the time of this report. Five of nine species planted in the permanent seed mix have been observed growing. It is unsure if the other four species have germinated and are in a small stage that would make observation difficult or did not germinate. The first year monitoring should provide additional information about the permanent seed mix survival.

5.2 As-Built Baseline Data Collection

Baseline cross-section and longitudinal surveys were completed in July of 2009. Ten cross-sections and the entire length of both UT to Little Mountain Creek and the Tributary were surveyed. A bed particle size distribution analysis (pebble count) was completed at each cross-section, and photos were captured looking upstream and downstream at each cross-section location. A summation of the geomorphic measurements obtained from the survey is contained in Tables 5 and 6 in Appendix B. Long profile, cross-section, and pebble count graphs are also included in Appendix B, along with photos taken at each of the cross-sections.

Topographic surveys were conducted of the restored channel following construction. The topography, thalweg and bankfull of the as-built channel are depicted in the As-Built Plansheets in Appendix D. Also included in Appendix D are overlays of the design channel alignment with the as-built channel alignment, and comparisons of the as-built profile with the design profile.

6.0 REFERENCES

Bunte, K. Abt, S.R. 2001. *Sampling surface and subsurface particle-size distributions in wadable gravel and cobble-bed streams for analyses in sediment transport, hydraulics, and streambed monitoring*. Gen. Tech. Rep. RMRS-GTR-74. Fort Collins, CO: US Department of Agriculture, Forest Service, Rocky Mountains Research Station.

Evans, R.O. ; Bass, K.L. ; Burchell, M.R. ; Hinson, R.D. ; Johnson, R. ; Doxey, M. 2007. *Management alternatives to enhance water quality and ecological function of channelized streams and drainage canals*. Journal of Soil and Water Conservation.

Griffith, Glenn; Omernik, James; Comstock, Jeffrey. *Ecoregions of North Carolina-Regional Descriptions*. US Department of Agriculture, Natural Resources Conservation Service, US Geological Survey. August 31, 2002

Lee, M.T., R.K. Peet, S.D. Roberts, T.R. Wentworth.. 2006. *CVS-EEP Protocol for RecordingVegetation Version 4.0*.

NCDENR. "North Carolina 303(d) List Draft for Public Review". *Water Quality Section*. http://h2o.enr.state.nc.us/tmdl/General_303d.htm. (January 10, 2008)

Schafale, M. P., and A. S. Weakley. 1990. *Classification of the Natural Communities of North Carolina, Third Approximation*. North Carolina Natural Heritage Program, Division of Parks and Recreation, Dept. of Environment, Health and Natural Resources, Raleigh, NC.




APPENDIX A

General Tables and Figures


Vicinity Maps and General Site Maps

Project Component/Asset Maps

Tables 1-4

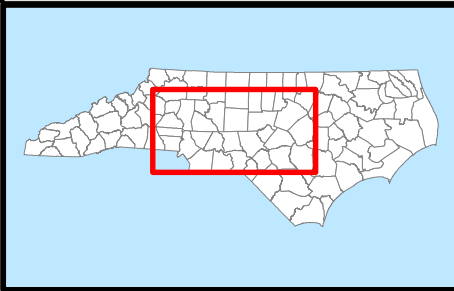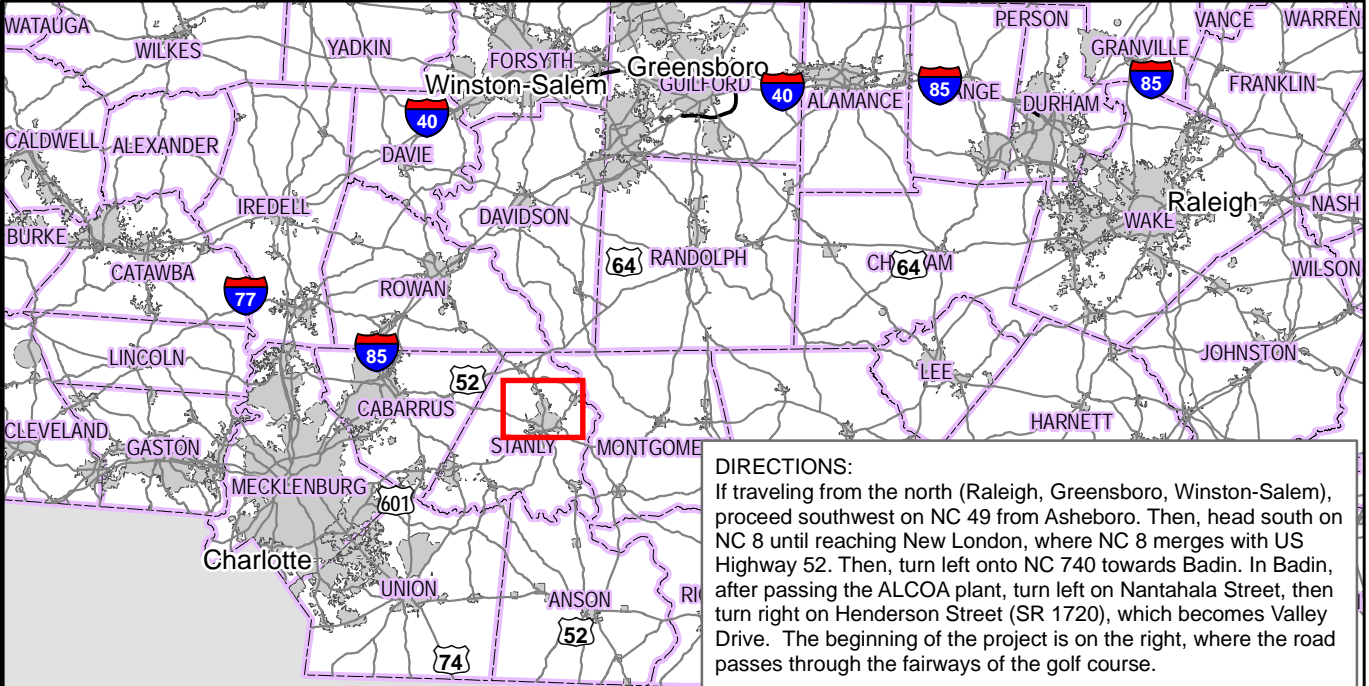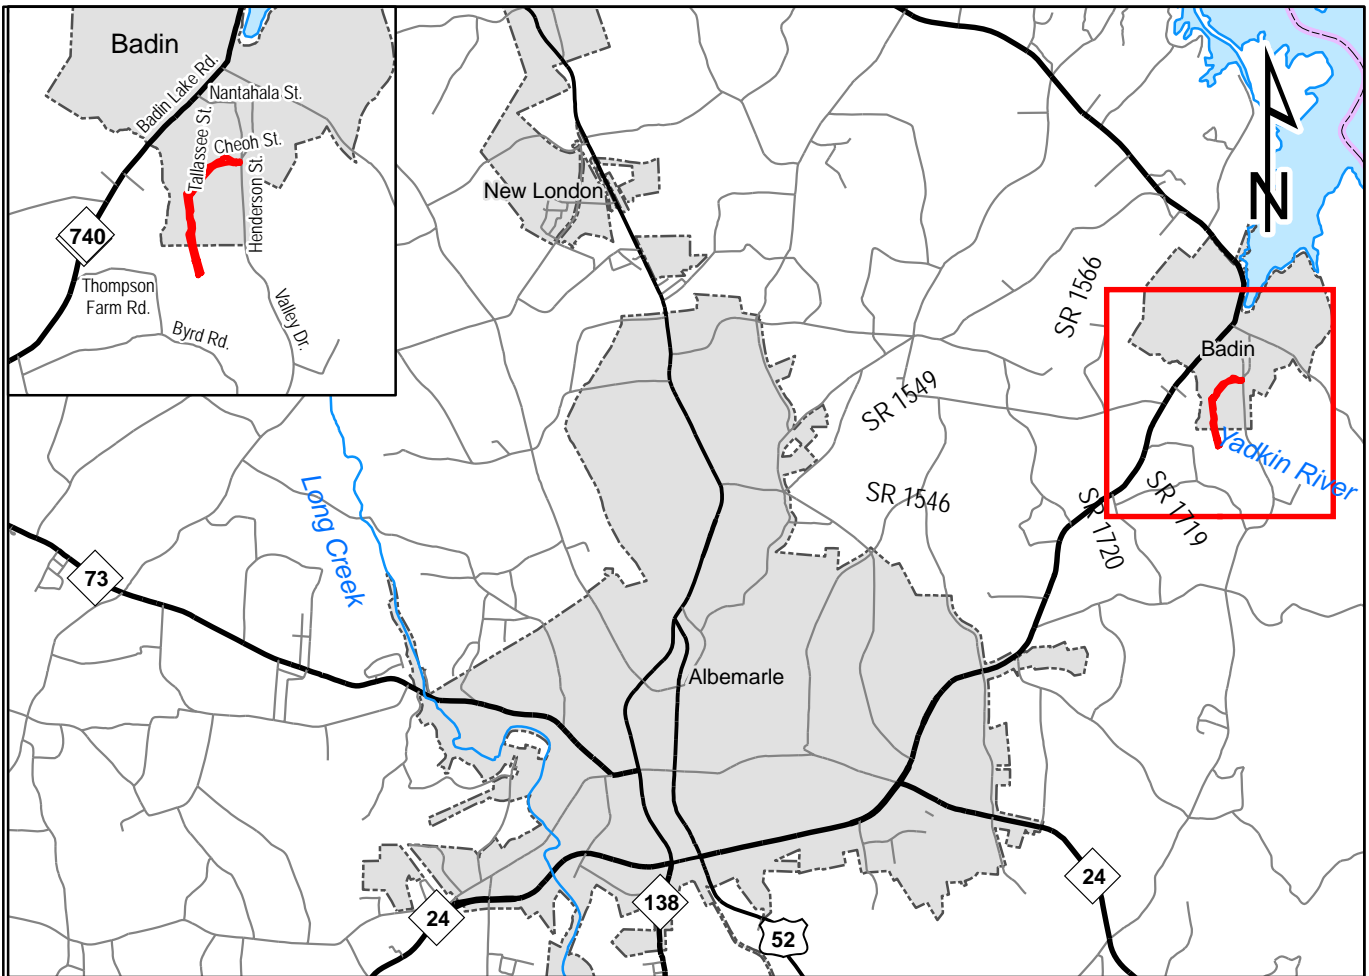

**FIGURE 1
VICINITY MAP**
 Badin Inn Mitigation Plan
 Stanly County, North Carolina
 EEP Project No. 92666
 August, 2009
 Not to Scale

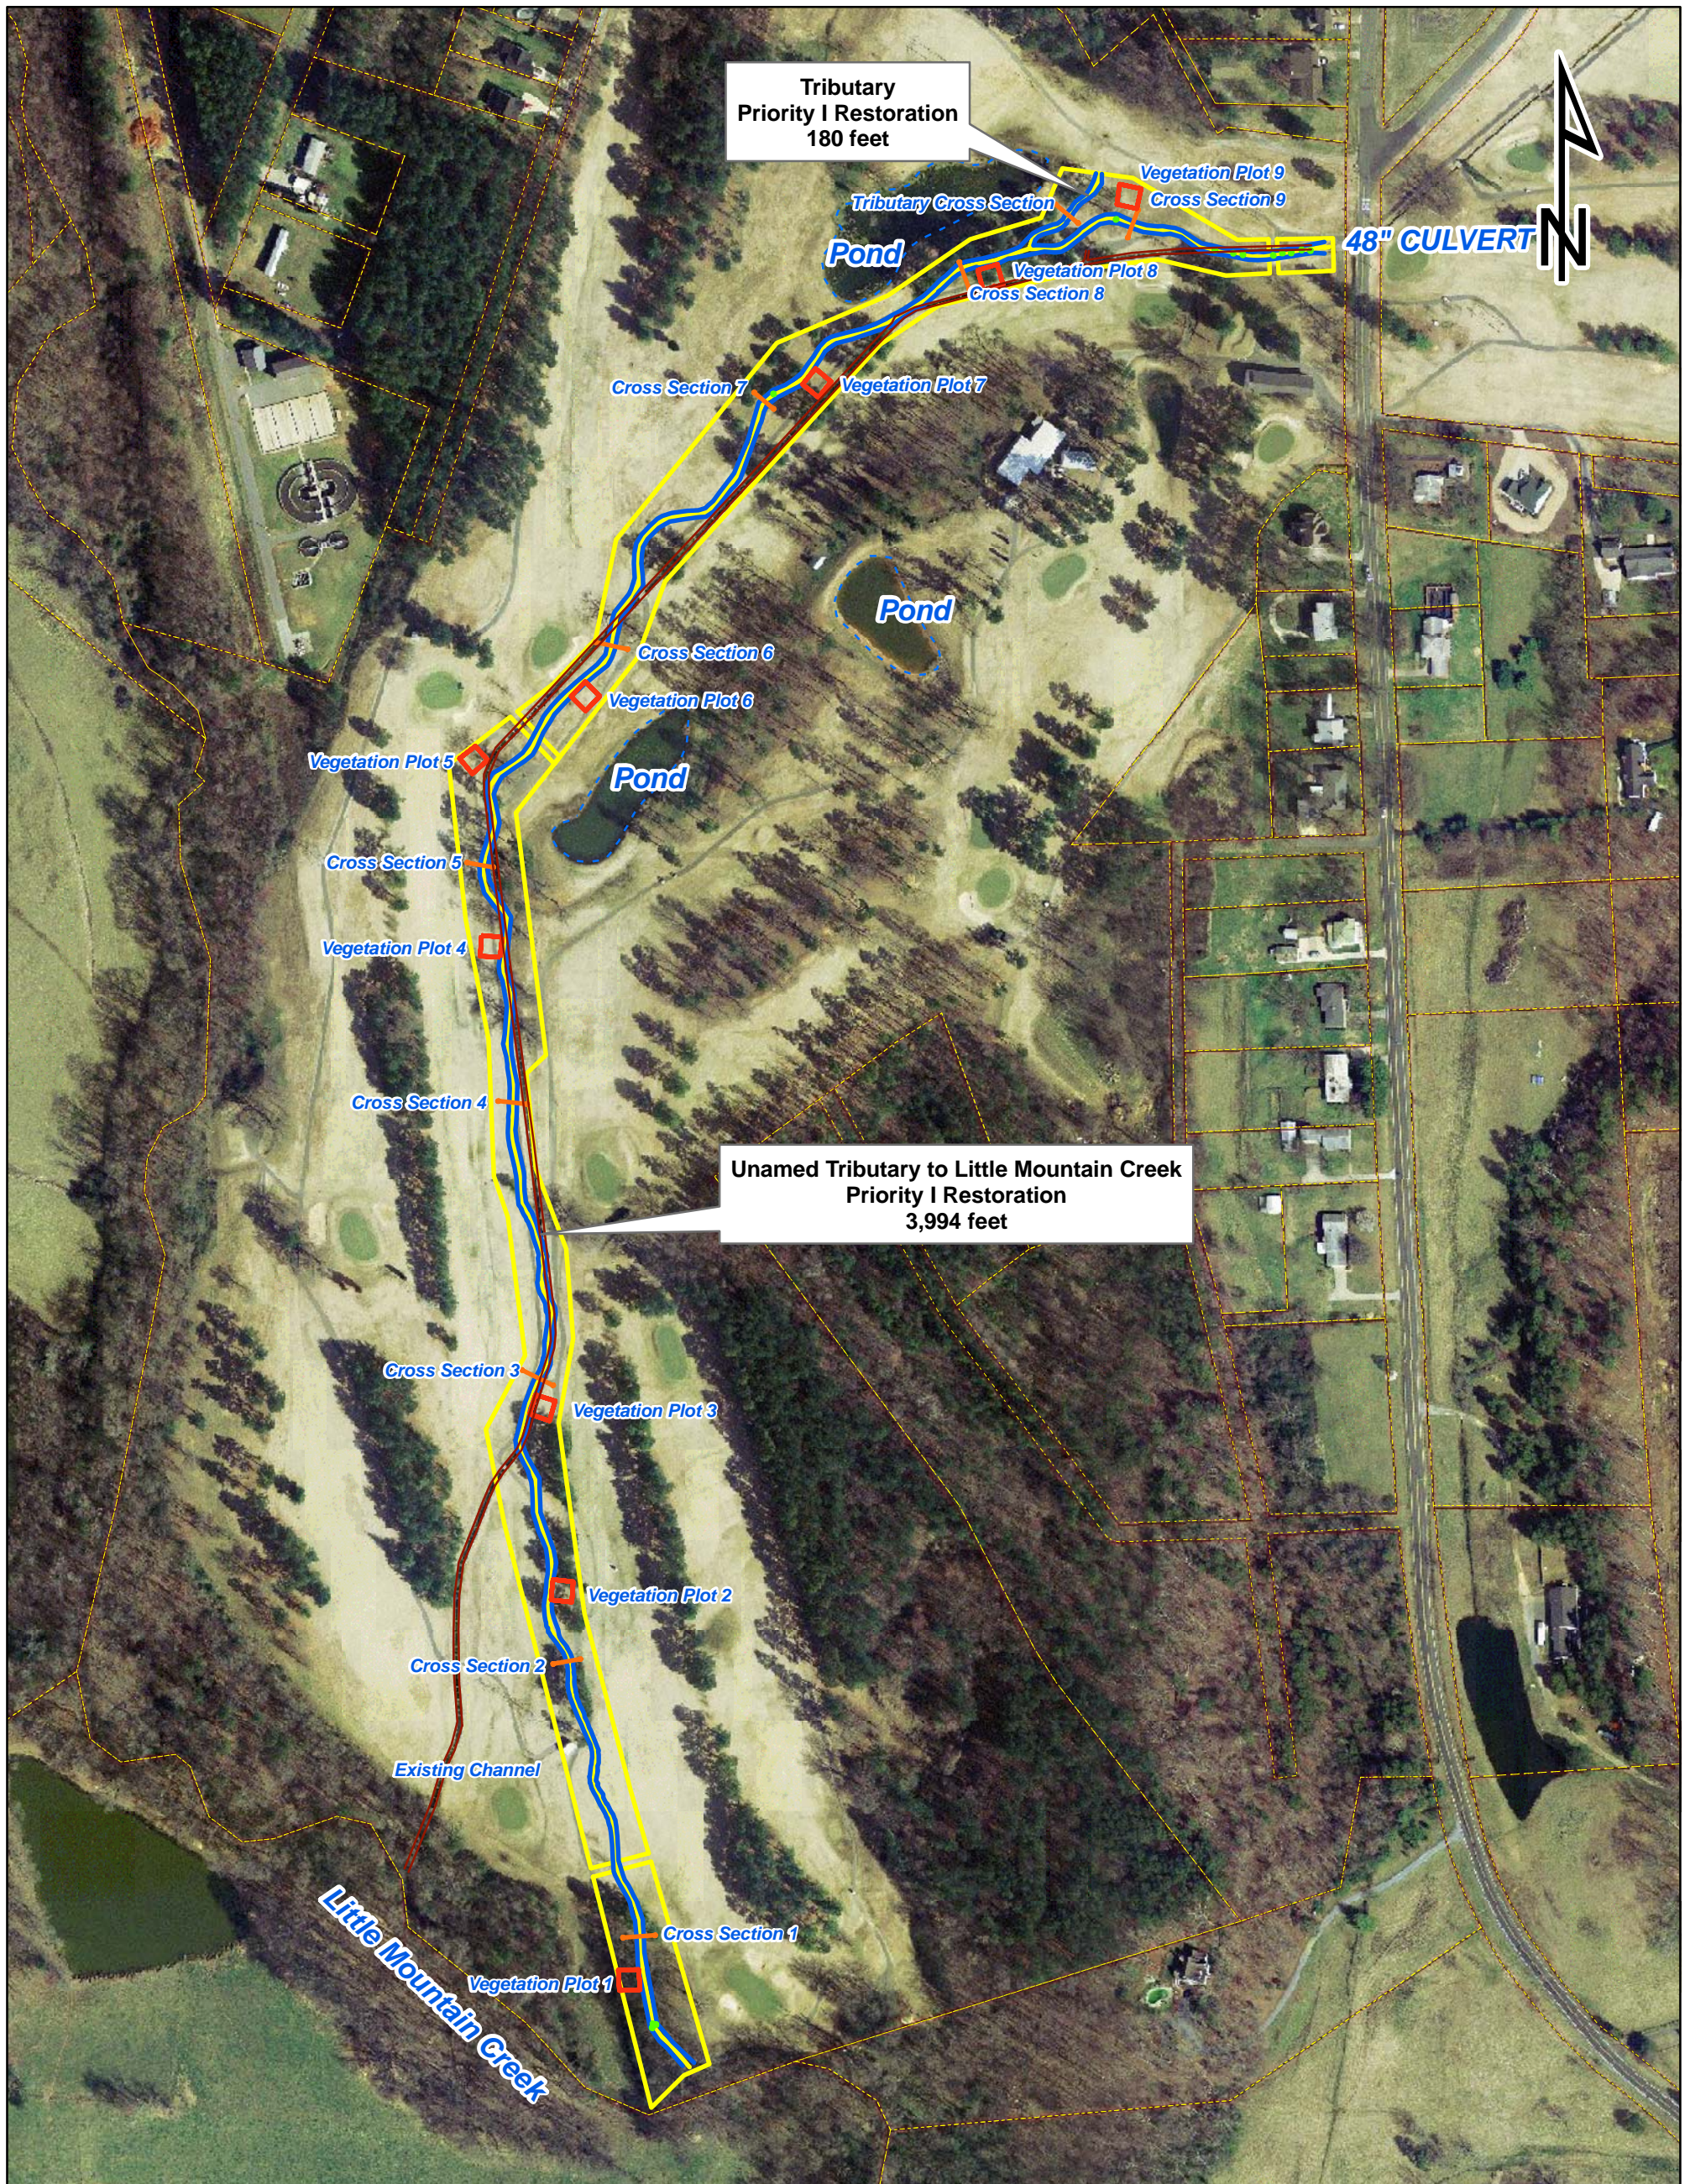

Legend

- Pre-Restoration Channel
- Vegetation Plots
- Structures
- Cross Sections
- Restored Bankfull
- Restored Thalweg
- - - Ponds
- Parcel Boundaries
- Conservation Easement



EARTH TECH | AECOM

**FIGURE 2
SITE MAP**

Badin Inn Mitigation Plan
Stanly County, North Carolina
EEP Project No. 92666
August, 2009

0 250 500 1,000 Feet

 


Table 1a. Project Components
Badin Inn Stream Restoration - EEP Project No. 92666

Project Component or Reach ID	Existing Feet/Acres	Restoration Level	Approach	Footage or Acreage	Stationing	Buffer Acres	BMP Elements	Comment
UT to Little Mountain Creek	3,540 feet	R	PI	3,994 feet	10+00 - 50+22			Construction started 28 feet from the start of stationing
Tributary	141 feet	R	PI	180 feet	10+00 - 11+80			

Notes: R = Restoration
 PI = Priority I

**Table 1b. Component Summations
Badin Inn Stream Restoration - EEP Project No. 92666**

Restoration Level	Stream (lf)	Riparian Wetland (Ac)		Non-Ripar (Ac)	Upland (Ac)	Buffer (Ac)	BMP
		Riverine	Non-Riverine				
Restoration	4,174						
Enhancement							
Enhancement I							
Enhancement II							
Creation							
Preservation							
HQ Preservation							
		0	0				
Totals	4174	0	0	0	0	0	Count

Non-Applicable

**Table 2. Project Activity and Reporting History
Badin Inn Stream Restoration - EEP Project No. 92666**

Activity or Deliverable	Data Collection Complete	Completion or Delivery
Restoration Plan	Sep-07	Jul-08
Final Design – Construction Plans	Jul-08	Dec-08
Construction	NA	Apr-09
Temporary S&E mix applied to entire project area	NA	Jul-09
Permanent seed mix applied to reach/segments 1& 2	NA	Aug-09
Containerized and B&B plantings for reach/segments 1&2	NA	Apr-09
Mitigation Plan / As-built (Year 0 Monitoring – baseline)	Jul-09	Aug-09
Year 1 Monitoring	Dec-09	-
Year 2 Monitoring	Dec-10	-
Year 3 Monitoring	Dec-11	-
Year 4 Monitoring	Dec-12	-
Year 5 Monitoring	Dec-13	-

Table 3. Project Contacts Table
Badin Inn Stream Restoration - EEP Project No. 92666

Designer	Earth Tech AECOM 701 Corporate Center Drive, Suite 475 Raleigh, NC 27607 Phone: (919) 854-6200	
Construction Contractor	River Works, Inc. 8000 Regency Parkway, Suite 200 Cary, NC 27511 Phone: (919) 459-9001	
Survey Contractor	Earth Tech AECOM 701 Corporate Center Drive, Suite 475 Raleigh, NC 27607 Phone: (919) 854-6200	
Planting Contractor	Efird Landscaping, Inc 42759 Greenview Dr. Albemarle, NC 28001 Phone: (704) 983-1970	
Seeding Contractor	Efird Landscaping, Inc 42759 Greenview Dr. Albemarle, NC 28001 Phone: (704) 983-1970	
Seed Mix Sources	Mellow Marsh Farm, Inc. 1312 Woody Store Rd. Siler City, NC 27344 Phone: (919) 742-1200	
Nursery Stock Suppliers	Arborgen LLC 5594 Highway 38 Blenheim, SC 29516 Phone: (843) 528-9669	Carolina Wetland Services 550 E. Westinghouse Blvd. Charlotte, NC 28273 Phone: (704) 527-1177
Monitoring Performers	Earth Tech AECOM 701 Corporate Center Drive, Suite 475 Raleigh, NC 27607	
Stream Monitoring	Earth Tech AECOM	Phone: (919) 854-6200
Vegetation Monitoring	Earth Tech AECOM	Phone: (919) 854-6200

**Table 4. Project Attribute Table
Badin Inn Stream Restoration - EEP Project No. 92666**

Project County	Stanly County	
Physiographic Region	Piedmont	
Ecoregion	Slate Belt	
Project River Basin	Yadkin-Pee Dee River Basin	
USGS HUC for Project (14 digit)	3040104010010	
NCDWQ Sub-basin for Project	Yadkin-Pee Dee River Sub-basin	
Within extent of EEP Watershed Plan?	Mountain, Little Mtn & Jacobs Creeks	
WRC Hab Class (Warm, Cool, Cold)	Warm	
% of project easement fenced or demarcated	100	
Beaver activity observed during design phase?	No	
Restoration Component Attribute Table		
	UT to Little Mountain Creek	Tributary
Drainage area	0.5 Sq. Miles	0.05 Sq. Miles
Stream order	2nd	1st
Restored length (feet)	3,994 feet	180 feet
Perennial or Intermittent	Perennial	Intermittent
Watershed type (Rural, Urban, Developing etc.)	Urban	Urban
Watershed LULC Distribution (e.g.)		
Urban	10.60%	100.00%
Ag-Pasture	30.70%	0.00%
Forested	58.70%	0.00%
Watershed impervious cover (%)	5%	15%
NCDWQ AU/Index number	13-5-1(2)	13-5-1(2)
NCDWQ classification	WS-IV	WS-IV
303d listed?	No	No
Upstream of a 303d listed segment?	Yes	Yes
Reasons for 303d listing or stressor	Biological Impairment	Biological Impairment
Total acreage of easement	8.235	
Total vegetated acreage within the easement	8.235	
Total planted acreage as part of the restoration	8.235	
Rosgen classification of pre-existing	NA	NA
Rosgen classification of As-built	C4	E4
Valley type	VIII	VIII
Valley slope	2.50%	2.50%
Valley side slope range (e.g. 2-3.%)	8-12%	7-8%
Valley toe slope range (e.g. 2-3.%)		
Cowardin classification	N/A	N/A
Trout waters designation	No	No
Species of concern, endangered etc.? (Y/N)	No	No
Dominant soil series and characteristics		
Series	Oakboro/Kirksey Silt Loams	Oakboro Silt Loam
Depth	<20 inches	<20 inches
Clay%	>35%	>35%
K		
T	59-64 degrees Farenheit	60 degrees Farenheit

APPENDIX B

Morphological Summary Data and Plots

Tables 5 - 6

Longitudinal Plots

XS-Plots

Pebble Count Plots

Photo Log

**Exhibit Table 5. Baseline Stream Data Summary
Badin Inn Stream Restoration - EEP Project No. 92666**

Parameter	Gauge ²	Regional Curve			Pre-Existing Condition			UT to Meadow Fork Creek			Reference Reach Spencer Creek			Design UT to Little Mountain Creek			Design Tributary			As-Built UT to Little Mountain Creek			As-Built Tributary		
		LL	UL	Eq.	Min	Max	Avg	Min	Max	Avg	Min	Max	Avg	Min	Max	Avg	Min	Max	Avg	Min	Max	Avg	Min	Max	Avg
Dimension and Substrate - Riffle																									
Bankfull Width (ft)	NA									11.81			12.3			10			5.6	9.37	11.63	10.914			6.29
Floodprone Width (ft)																				44.55	53.44	48.742			46.89
Bankfull Mean Depth (ft)	NA									1.3			0.88			0.7			0.57	0.65	0.8	0.734			0.42
¹ Bankfull Max Depth (ft)	NA				2.5					2.11			1.8			1			0.7	1.04	1.25	1.196			0.56
Bankfull Cross Sectional Area (ft ²)	NA									15.34			10.8			7			3.2	7.21	9	8.004			2.64
Width/Depth Ratio	NA									9.08			13.98			14.3			9.82	12.17	17.89	14.99			14.98
Entrenchment Ratio	NA									28.11			>2.2			>2.2			>2.2	3.97	5.37	4.498			7.45
¹ Bank Height Ratio	NA							1.03	1.05	1.04			1.1			1			1			1			1
Profile																									
Riffle Length (ft)														14.32	154.43	49.04	18.93	28.54	24.84	18.24	121.02	54.01	17.17	22.51	20.96
Riffle Slope (ft/ft)								0.011	0.021	0.017	0.02	0.036	0.026	0.012	0.037	0.019	0.022	0.04	0.03	0.0053	0.0205	0.0143	0.0162	0.0505	0.0275
Pool Length (ft)								12.98	20.86	18.02	9.29	23.92	17.78	18.3	31	24.65	10.25	17.36	13.8	14.79	41.85	22.14	10.89	25.78	16.34
Pool Max depth (ft)																2			1.1	1.29	3.54	2.06	1.34	1.7	1.55
Pool Spacing (ft)								79.48	96.97	88.23	13	46.5	24.2	68.4	83.1	75.75	5.92	21.17	13.54	36.33	148.07	66.65	36.63	39.7	38.17
Pattern																									
Channel Beltwidth (ft)								22	57.1	37.2	24	52	38	18.6	48.3	33.45	10.42	27.05	18.73	18.6	48.3	33.45	10.42	27.05	18.73
Radius of Curvature (ft)								18	42.8	25	5.4	22.1	12.9	22.1	42.3	32.2	12.38	23.69	18.03	22.1	42.3	32.2	12.38	23.69	18.03
Rc/Bankfull width (ft/ft)										2.1169			1.0488			3.22			3.2196	2.3586	3.6371	2.9503			2.8665
Meander Wavelength (ft)								78.5	149.9	107.1	54	196	125	43.9	159.35	101.63	24.59	89.24	56.91	43.9	159.35	101.63	24.59	89.24	56.91
Meander Width Ratio								1.86	4.83	3.15	1.95	4.23	3.09	1.86	4.83	3.35	1.86	4.83	3.35	1.86	4.83	3.35	1.86	4.83	3.35
Transport parameters																									
Reach Shear Stress (competency) lb/ft ²																							0.549		0.314
Max part size (mm) mobilized at bankfull																							97.88		64.9
Stream Power (transport capacity) W/m ²																									
Additional Reach Parameters																									
Rosgen Classification					NA			E4			C4			C4			E4			C4			E4		
Bankfull Velocity (fps)																									
Bankfull Discharge (cfs)																									
Valley length (ft)					3540			200			235			3820			157								
Channel Thalweg length (ft)					3540			288			266			3994			180			3994			180		
Sinuosity (ft)					1			1.4			1.1			1.33			1.03			1.33			1.03		
Water Surface Slope (Channel) (ft/ft)					0.0178			0.0122			0.0132			0.0134			0.0147			0.012			0.012		
BF slope (ft/ft)					0.0178			0.0122			0.0132			0.0134			0.0147			0.012			0.012		
³ Bankfull Floodplain Area (acres)					N/A			N/A			N/A									20.75			0.5		
⁴ Proportion over wide (%)					N/A			N/A			N/A														
Channel Stability or Habitat Metric					N/A			N/A			N/A														
Biological or Other					N/A			N/A			N/A														

NOT APPLICABLE - STREAM IS COMPLETELY MODIFIED

**Exhibit Table 5b. Baseline Stream Data Summary (Substrate, Bed, Bank, and Hydrologic Containment Parameter Distributions)
Badin Inn Stream Restoration - EEP Project No. 92666**


Parameter	Pre-Existing Condition						UT to Meadow Fork Creek						Spencer Creek					
¹ Ri% / Ru% / P% / G% / S%							40		60				45		55			
¹ SC% / Sa% / G% / C% / B% / Be%	NOT APPLICABLE						8	12	67	13	0	0	5	27	47	19	1	1
¹ d16 / d35 / d50 / d84 / d95 / di ^p / di ^{sp} (mm)	DUE TO CHANNELIZATION						0.7	13.83	21.4	58.82	84.8		0.35	16.42	18.53	70.84	85.89	
² Entrenchment Class <1.5 / 1.5-1.99 / 2.0-4.9 / 5.0-9.9 / >10	DUE TO CHANNELIZATION								2-4.9						2-4.9			
³ Incision Class <1.2 / 1.2-1.49 / 1.5-1.99 / >2.0							<1.2						<1.2					
BEHI VL% / L% / M% / H% / VH% / E%								100										
Design vs. As-built/Baseline Comparison																		
Parameter	Design						As-built/Baseline											
¹ Ri% / Ru% / P% / G% / S%	73.2		26.8				75		25									
¹ SC% / Sa% / G% / C% / B% / Be%							22.38	9.786	60.46	6.68	0.698							
¹ d16 / d35 / d50 / d84 / d95 / di ^p / di ^{sp} (mm)							2.356	6.654	12.64	37.41	84							
² Entrenchment Class <1.5 / 1.5-1.99 / 2.0-4.9 / 5.0-9.9 / >10											>10							
³ Incision Class <1.2 / 1.2-1.49 / 1.5-1.99 / >2.0							<1.2											
BEHI VL% / L% / M% / H% / VH% / E%	100						100											

Exhibit Table 6. Dimensional Morphology Summary (Dimensional Parameters – Cross Sections)


Project Name/Number (XYZ) Segment/Reach: XYZ (4500 feet)

	Cross Section 1 (Riffle)							Cross Section 2 (Pool)							Cross Section 3 (Riffle)							Cross Section 4 (Riffle)							Cross Section 5 (Pool)						
Based on fixed baseline bankfull elevation¹	Base	MY1	MY2	MY3	MY4	MY5	MY+	Base	MY1	MY2	MY3	MY4	MY5	MY+	Base	MY1	MY2	MY3	MY4	MY5	MY+	Base	MY1	MY2	MY3	MY4	MY5	MY+	Base	MY1	MY2	MY3	MY4	MY5	MY+
Bankfull Width (ft)	11.63							13.91							11.23							11.23							11.98						
Floodprone Width (ft)	48.11							41.31							53.44							44.55							42.02						
Bankfull Mean Depth (ft)	0.65							0.7							0.7							0.8							0.96						
Bankfull Max Depth (ft)	1.24							1.4							1.21							1.24							2.17						
Bankfull Cross Sectional Area (ft ²)	7.62							9.78							7.87							9							11.52						
Bankfull Width/Depth Ratio	17.89							19.87							16.04							14.04							12.48						
Bankfull Entrenchment Ratio	4.14							2.97							4.76							3.97							3.51						
Bankfull Bank Height Ratio	1							1							1							1							1						
Based on current/developing bankfull feature²																																			
Bankfull Width (ft)																																			
Floodprone Width (ft)																																			
Bankfull Mean Depth (ft)																																			
Bankfull Max Depth (ft)																																			
Bankfull Cross Sectional Area (ft ²)																																			
Bankfull Width/Depth Ratio																																			
Bankfull Entrenchment Ratio																																			
Bankfull Bank Height Ratio																																			
Cross Sectional Area between end pins (ft ²)																																			
d50 (mm)	21.4							11.3							5.46							17.8							0.83						
	Cross Section 6 (Riffle)							Cross Section 7 (Pool)							Cross Section 8 (Pool)							Cross Section 9 (Riffle)							Tributary (Riffle)						
Based on fixed baseline bankfull elevation¹	Base	MY1	MY2	MY3	MY4	MY5	MY+	Base	MY1	MY2	MY3	MY4	MY5	MY+	Base	MY1	MY2	MY3	MY4	MY5	MY+	Base	MY1	MY2	MY3	MY4	MY5	MY+	Base	MY1	MY2	MY3	MY4	MY5	MY+
Bankfull Width (ft)	9.37							16.05							10.64							11.11							6.29						
Floodprone Width (ft)	50.33							40.5							45.83							47.28							46.89						
Bankfull Mean Depth (ft)	0.77							0.88							1.19							0.75							0.42						
Bankfull Max Depth (ft)	1.04							2.3							2.47							1.25							0.56						
Bankfull Cross Sectional Area (ft ²)	7.21							14.18							12.69							8.32							2.64						
Bankfull Width/Depth Ratio	12.17							18.24							8.94							14.81							14.98						
Bankfull Entrenchment Ratio	5.37							2.52							4.31							4.25							7.45						
Bankfull Bank Height Ratio	1							1							1							1							1						
Based on current/developing bankfull feature²																																			
Bankfull Width (ft)																																			
Floodprone Width (ft)																																			
Bankfull Mean Depth (ft)																																			
Bankfull Max Depth (ft)																																			
Bankfull Cross Sectional Area (ft ²)																																			
Bankfull Width/Depth Ratio																																			
Bankfull Entrenchment Ratio																																			
Bankfull Bank Height Ratio																																			
Cross Sectional Area between end pins (ft ²)																																			
d50 (mm)	26.71							0.79							0.04							13.39							28.64						


UT to Little Mountain Creek Long Profile

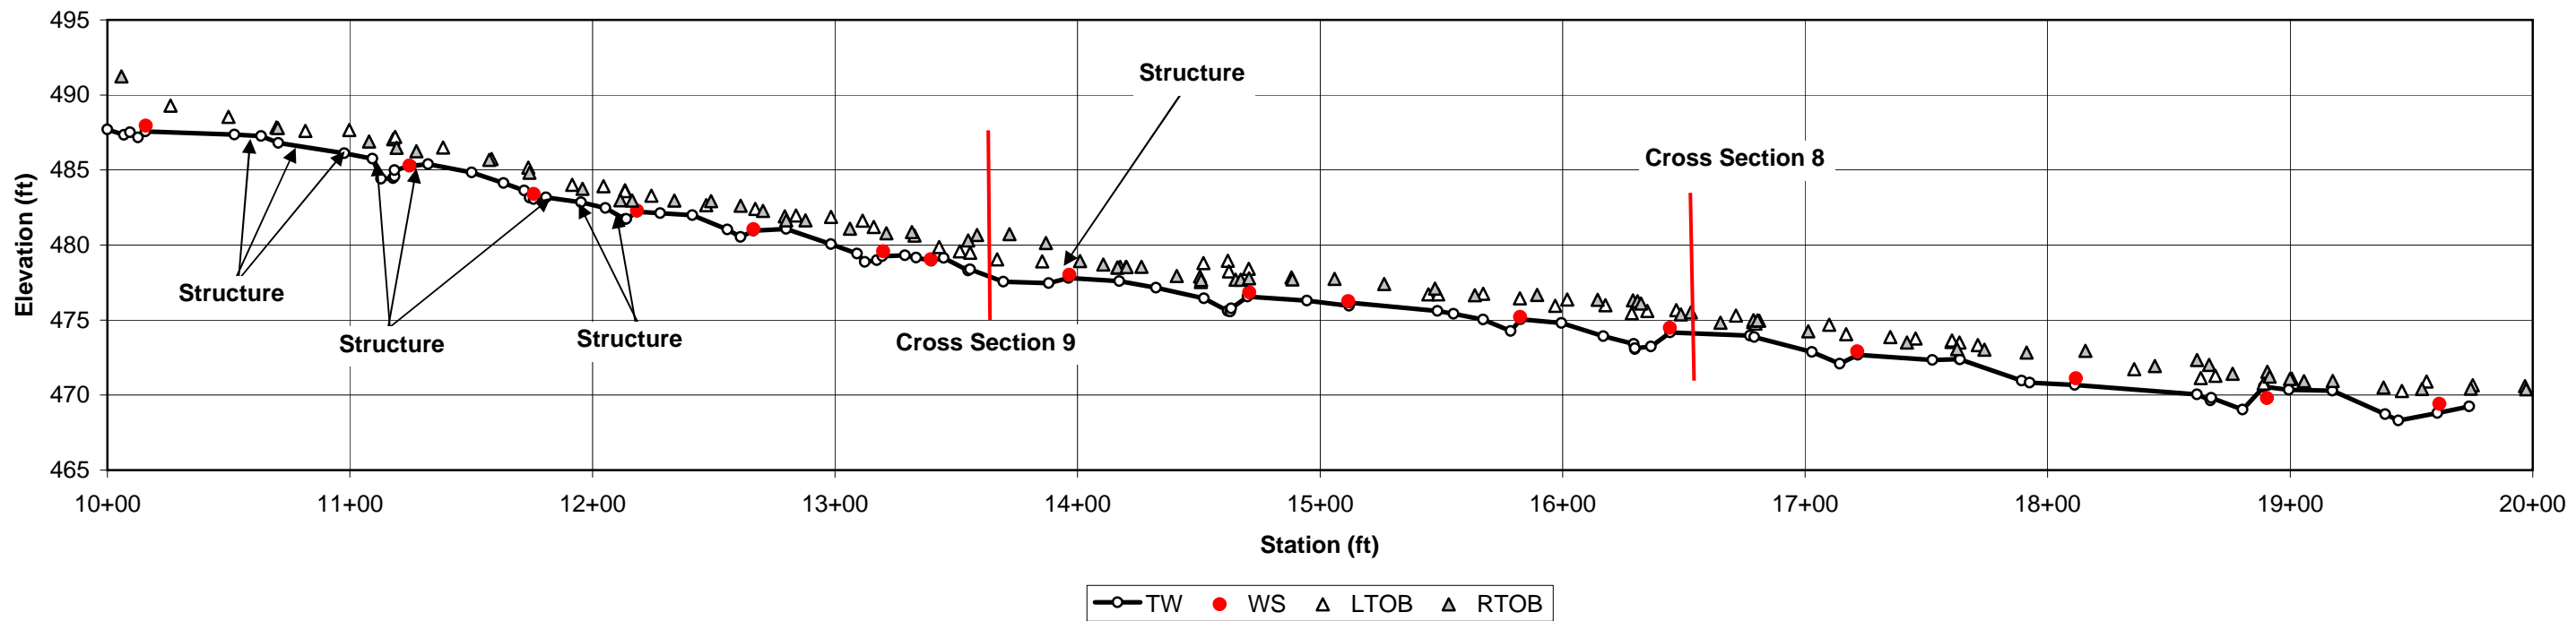


UT to Little Mountain Creek Long Profile

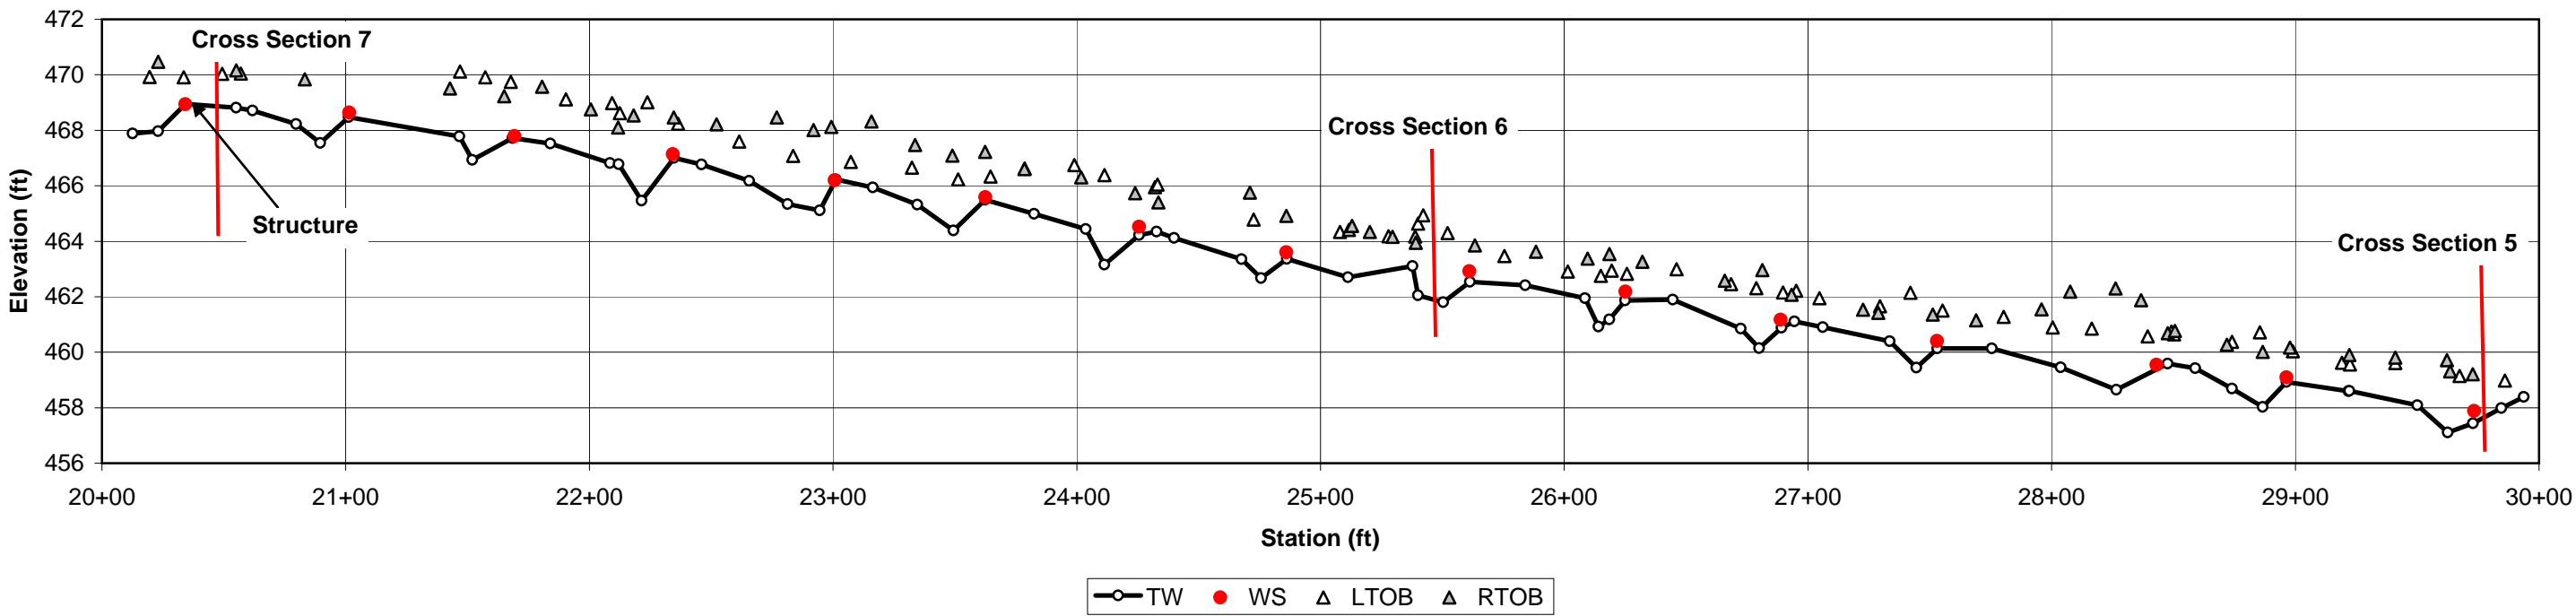


UT to Little Mountain Creek Long Profile

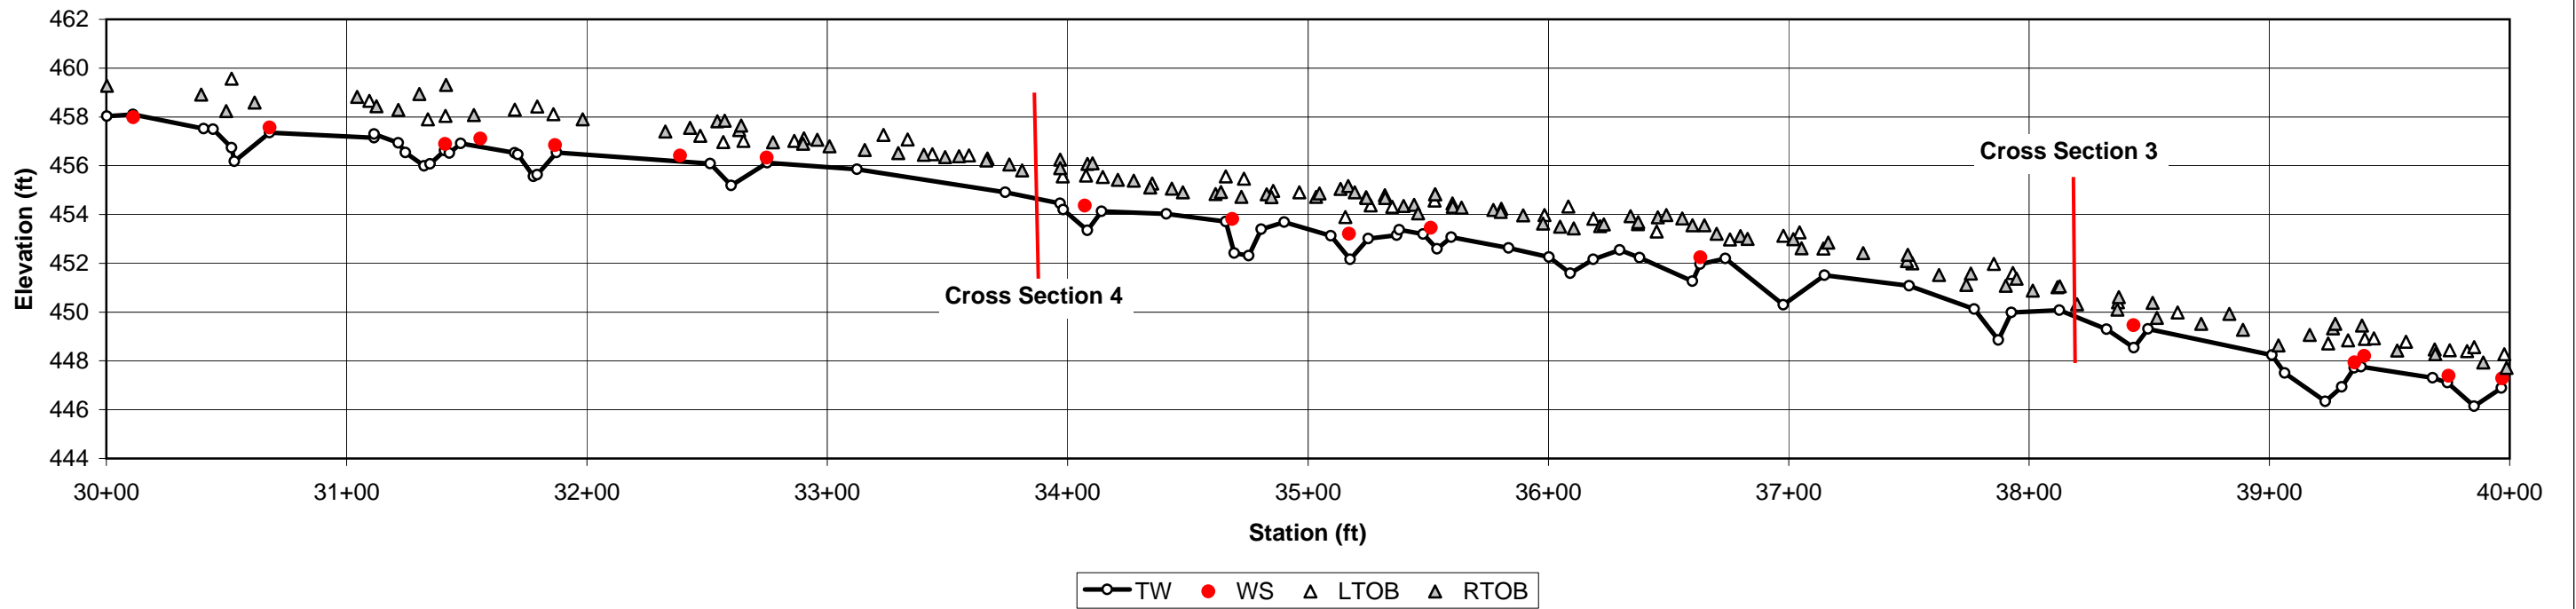

UT to Little Mountain Creek Long Profile

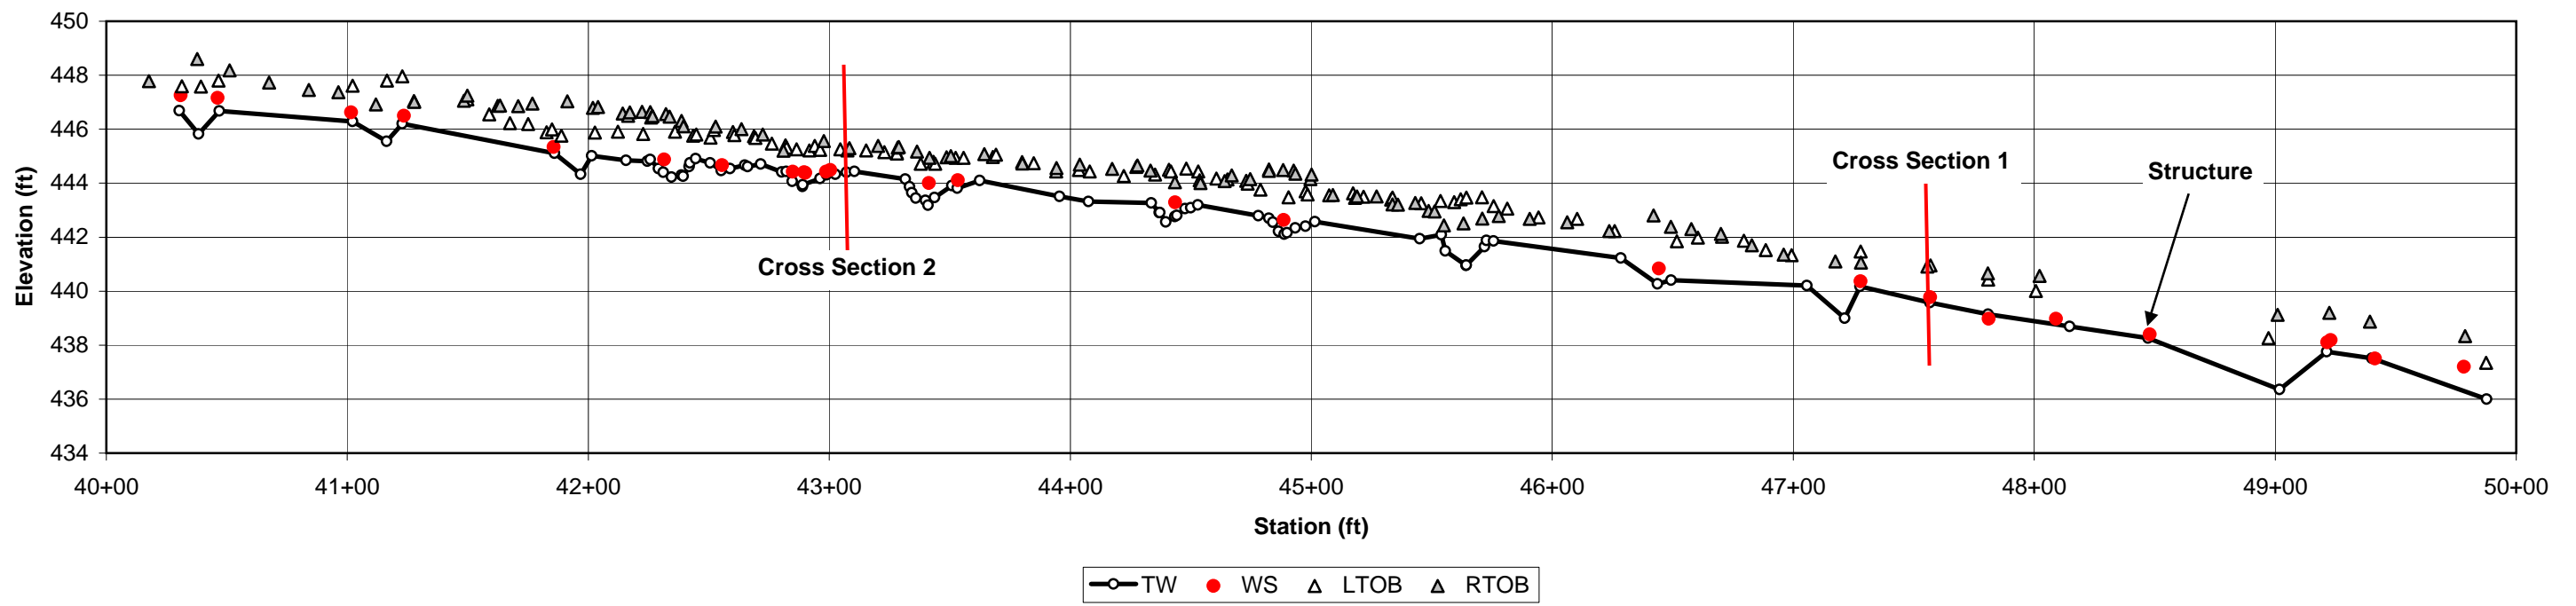


UT to Little Mountain Creek-Tributary Long Profile

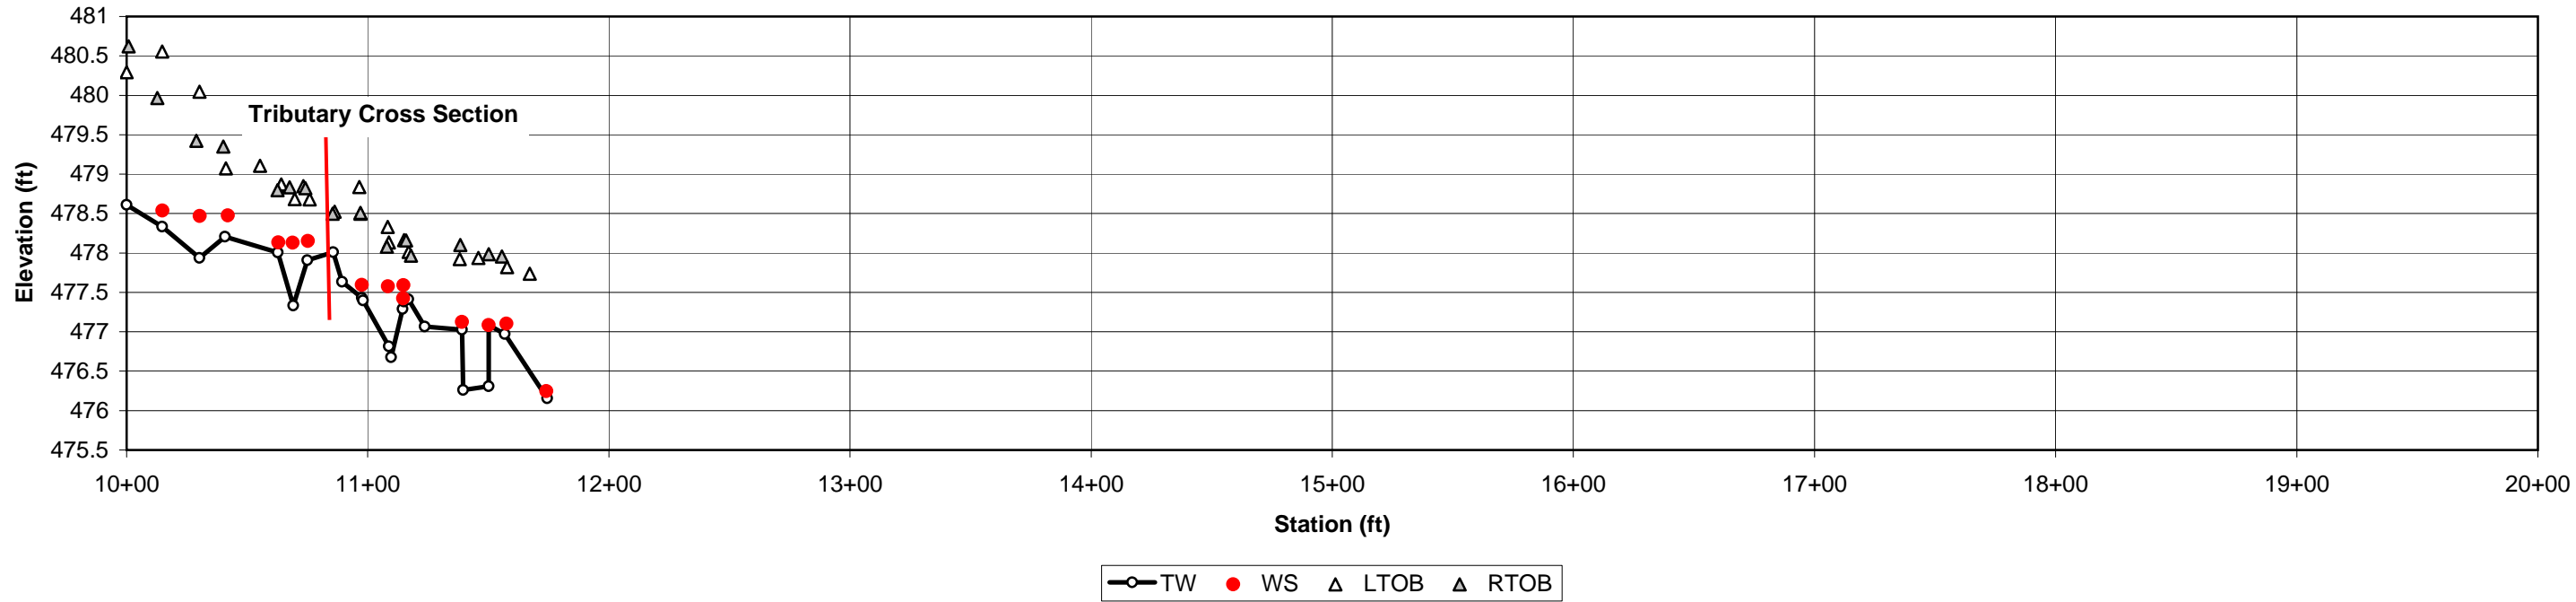

Cross Section 1 Riffle

○ Ground Points ◆ Bankfull Indicators ▼ Water Surface Points

Wbkf = 11.6 Dbkf = .65 Abkf = 7.62

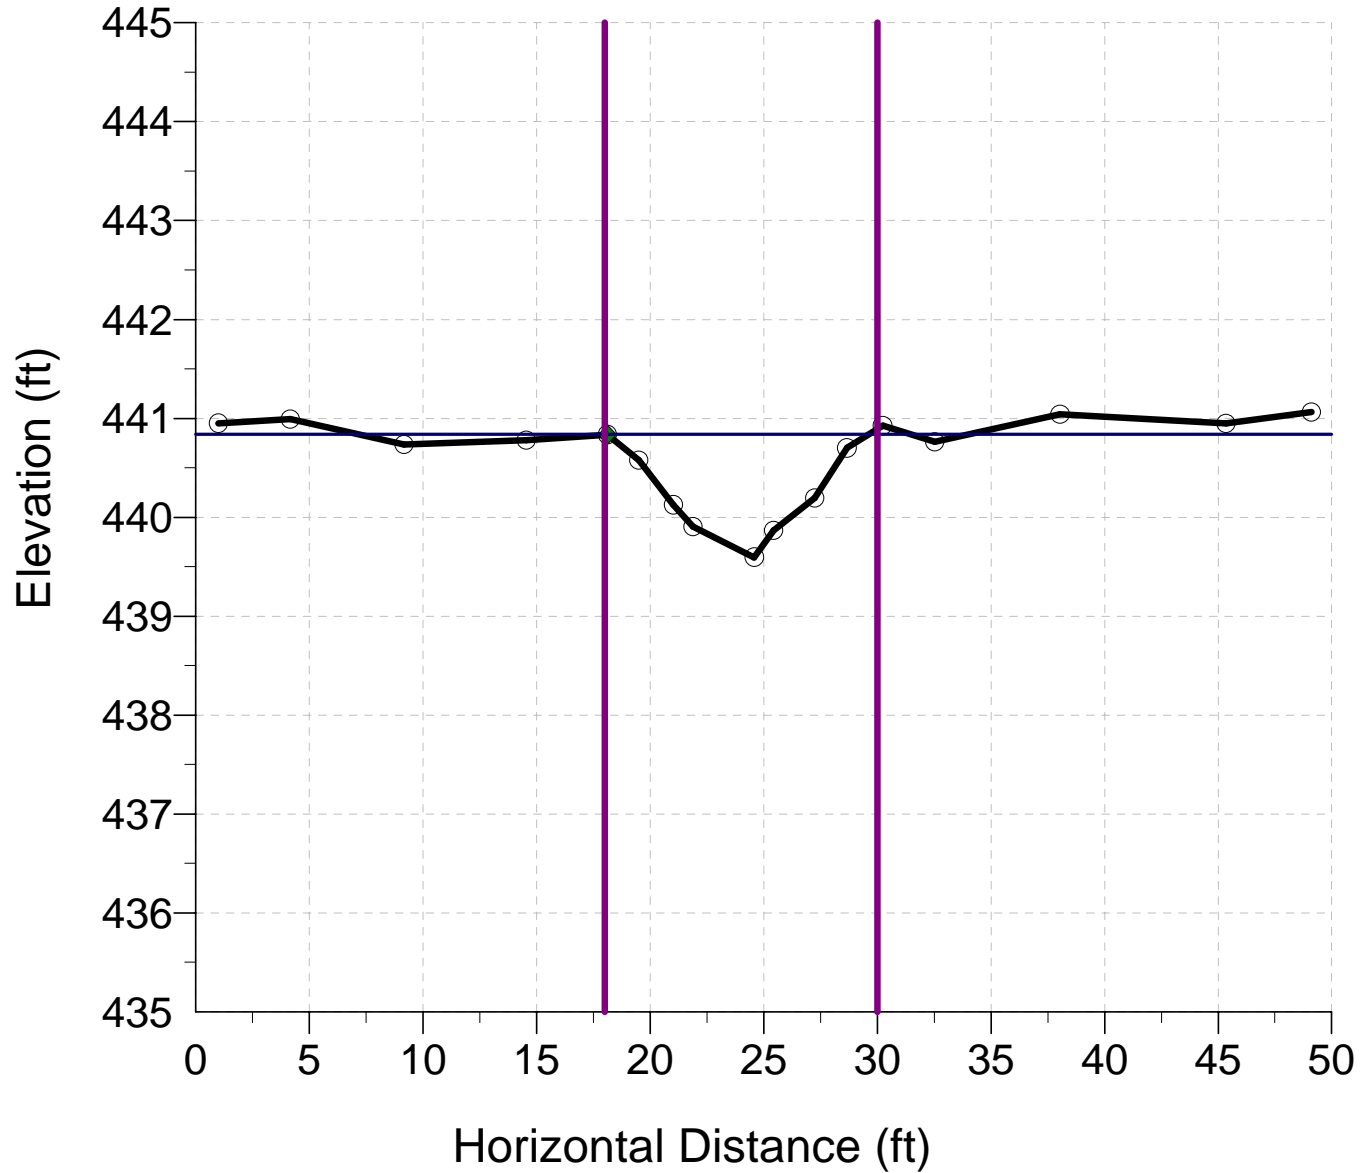


Cross Section 2 Pool

○ Ground Points ◆ Bankfull Indicators ▼ Water Surface Points

Wbkf = 13.9

Dbkf = .7

Abkf = 9.78

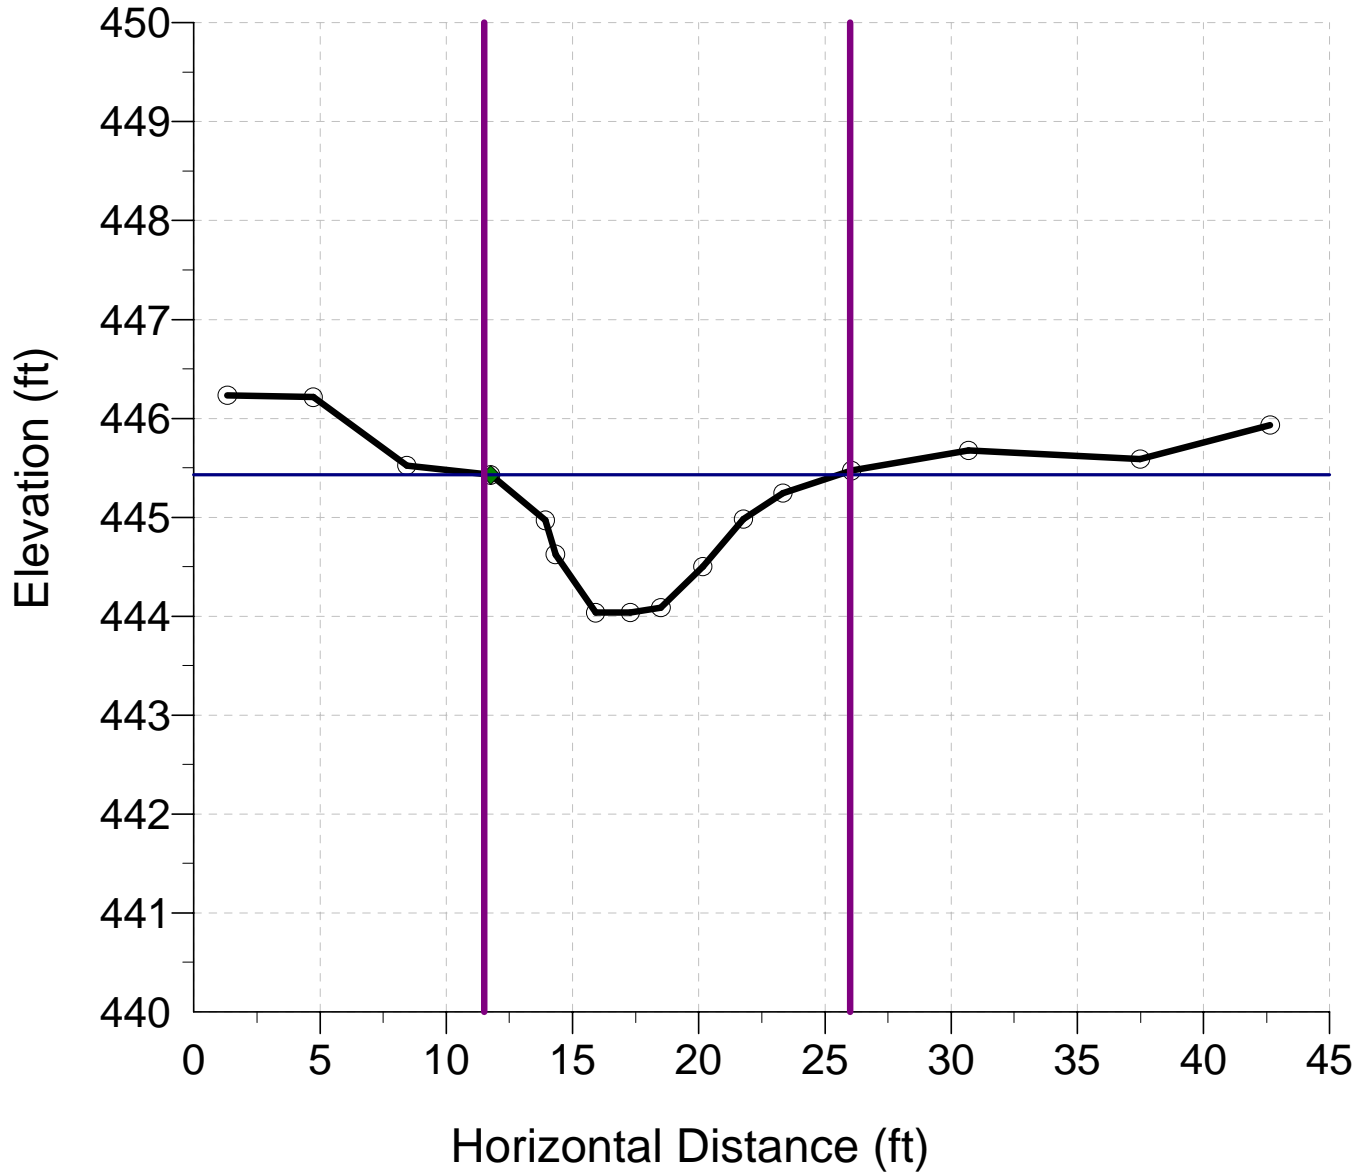


Cross Section 3 Riffle

○ Ground Points ◆ Bankfull Indicators ▼ Water Surface Points

Wbkf = 11.2

Dbkf = .7

Abkf = 7.87

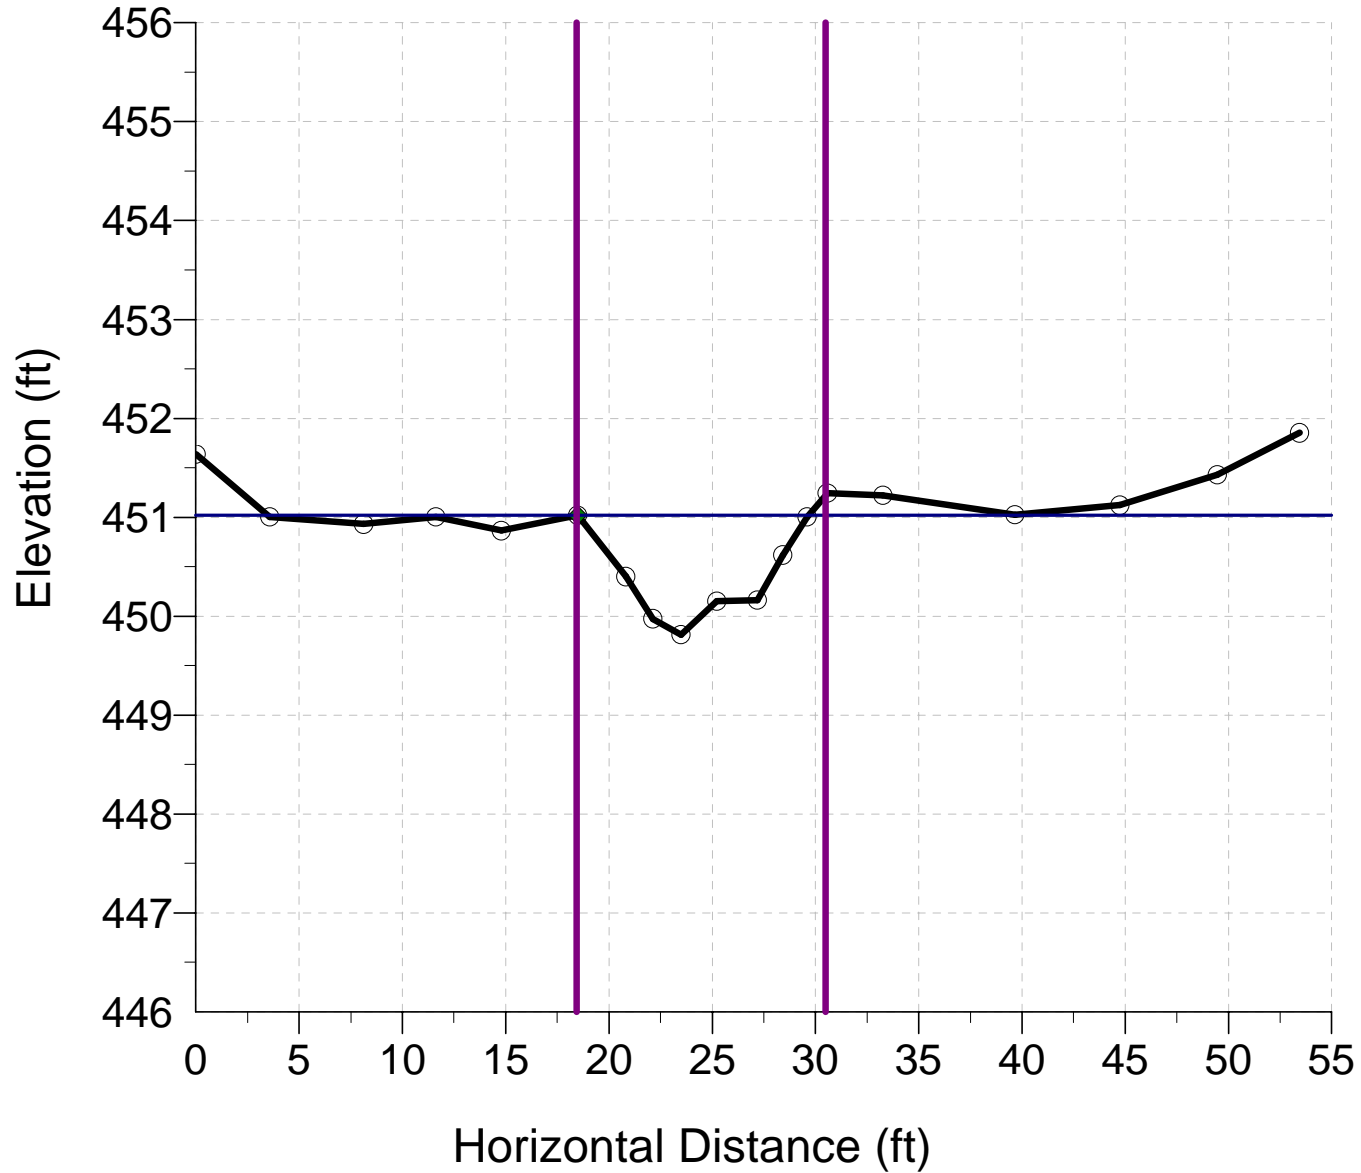


Cross Section 4 Riffle

○ Ground Points ◆ Bankfull Indicators ▼ Water Surface Points

Wbkf = 11.2

Dbkf = .8

Abkf = 9

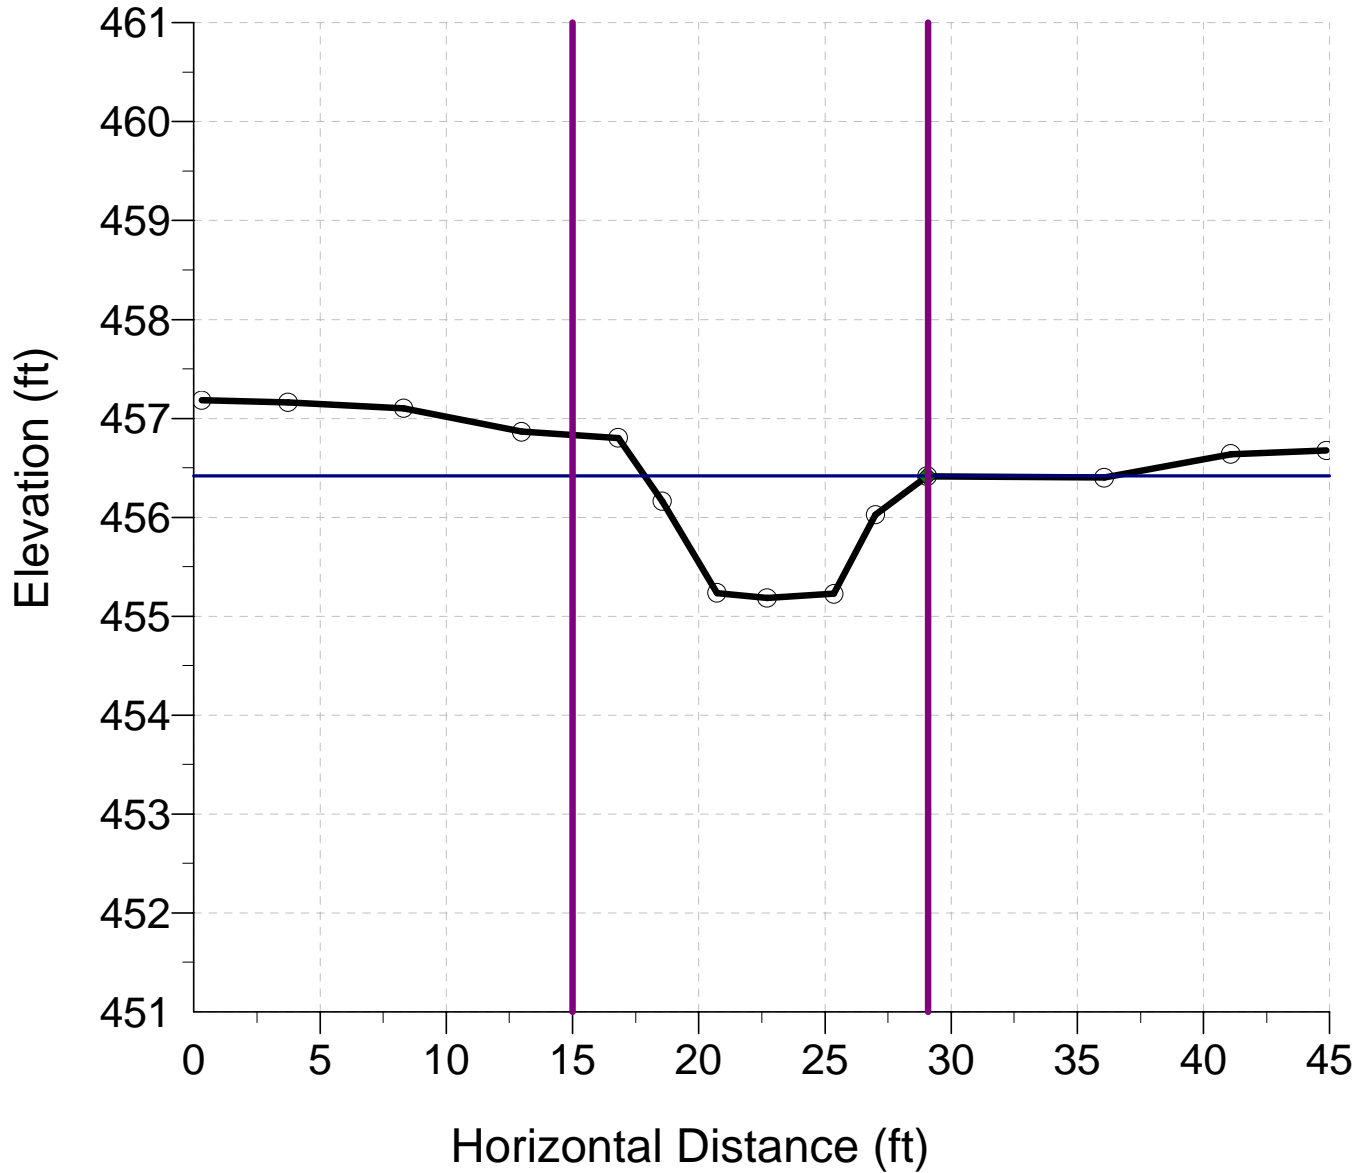


Cross Section 5 Pool

○ Ground Points ◆ Bankfull Indicators ▼ Water Surface Points

Wbkf = 12

Dbkf = .96

Abkf = 11.5

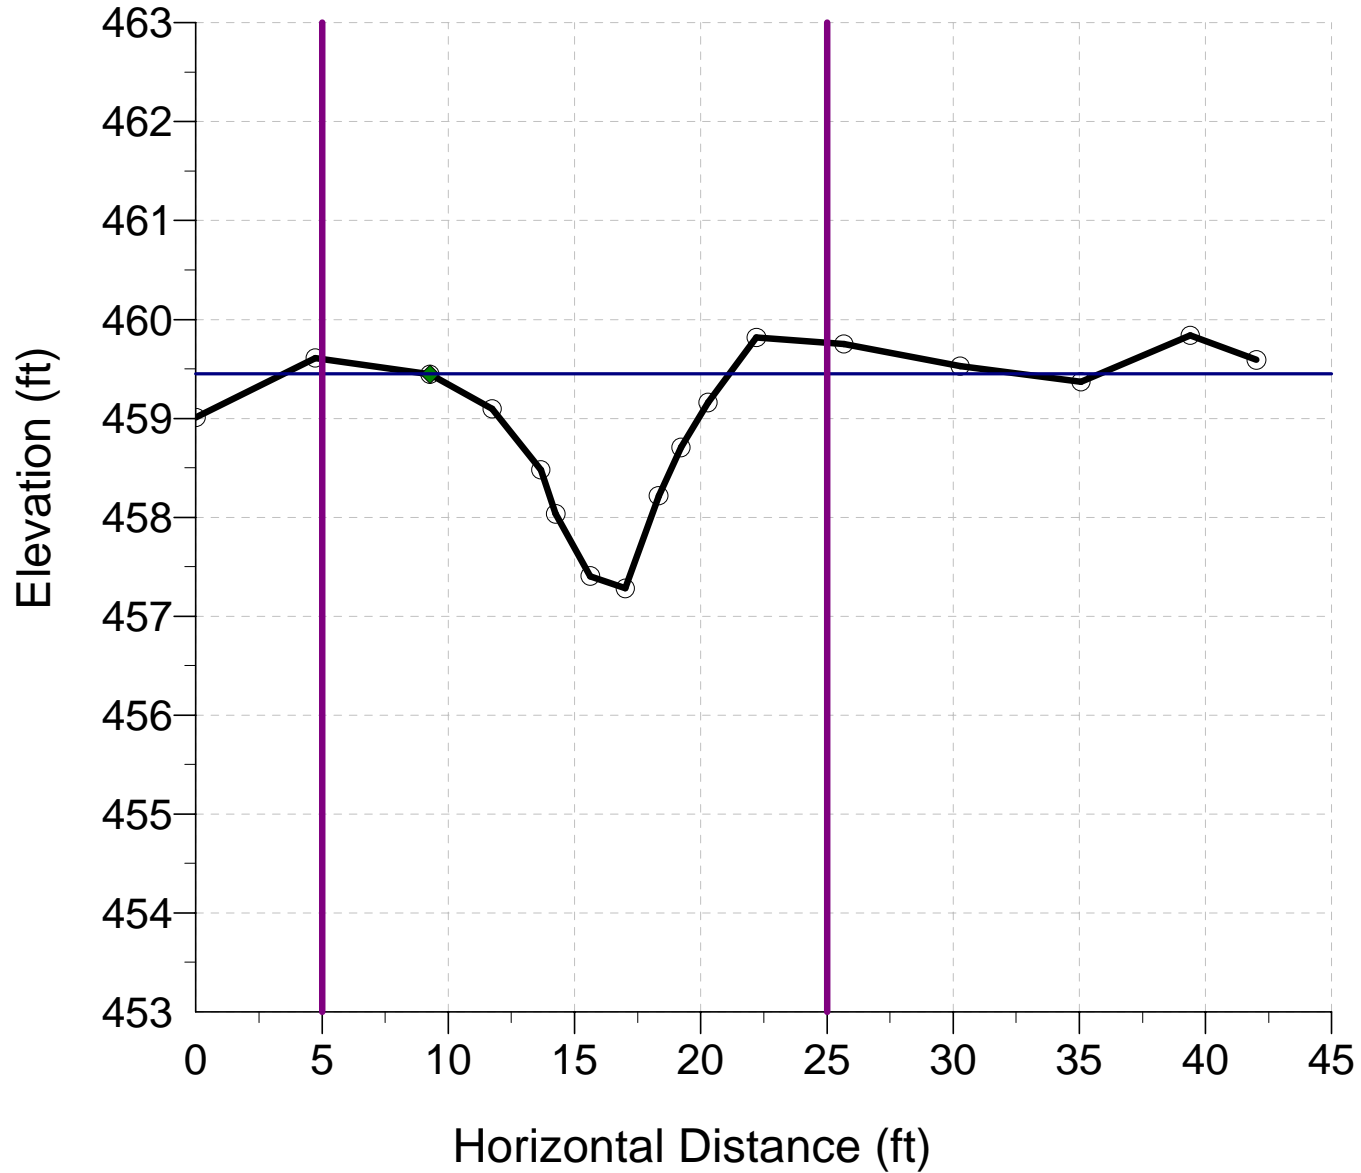


Cross Section 6 Riffle

○ Ground Points ◆ Bankfull Indicators ▼ Water Surface Points

Wbkf = 9.37

Dbkf = .77


Abkf = 7.21

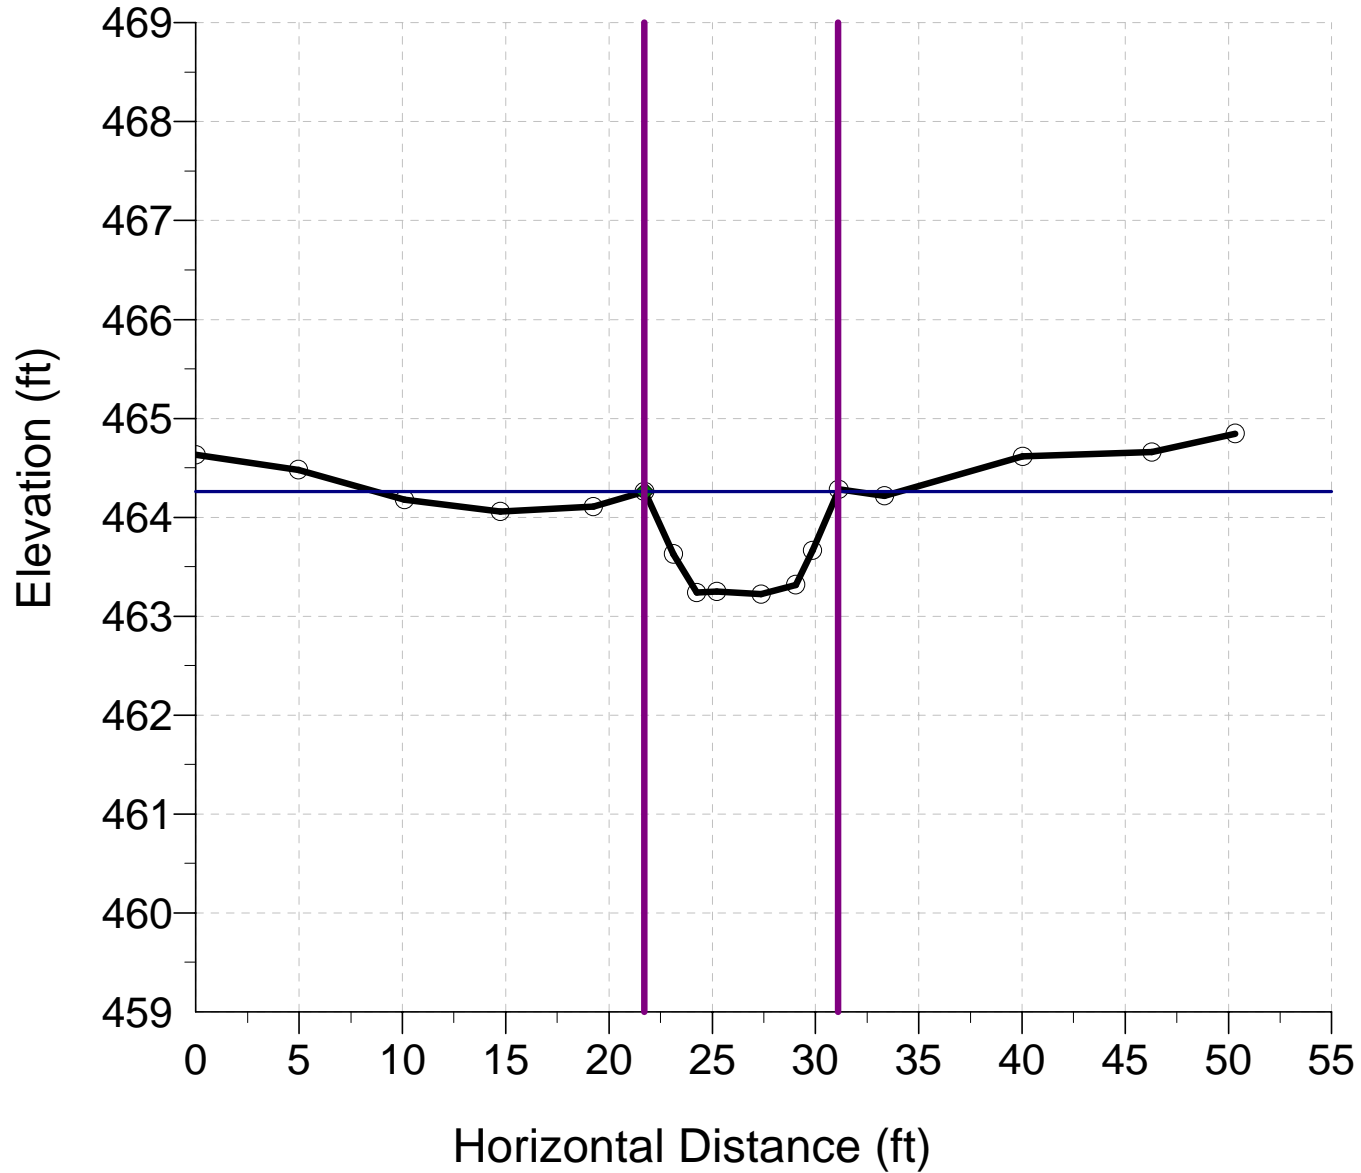

Cross Section 7 Pool

○ Ground Points ♦ Bankfull Indicators ▼ Water Surface Points


Wbkf = 16.1 Dbkf = .88 Abkf = 14.2

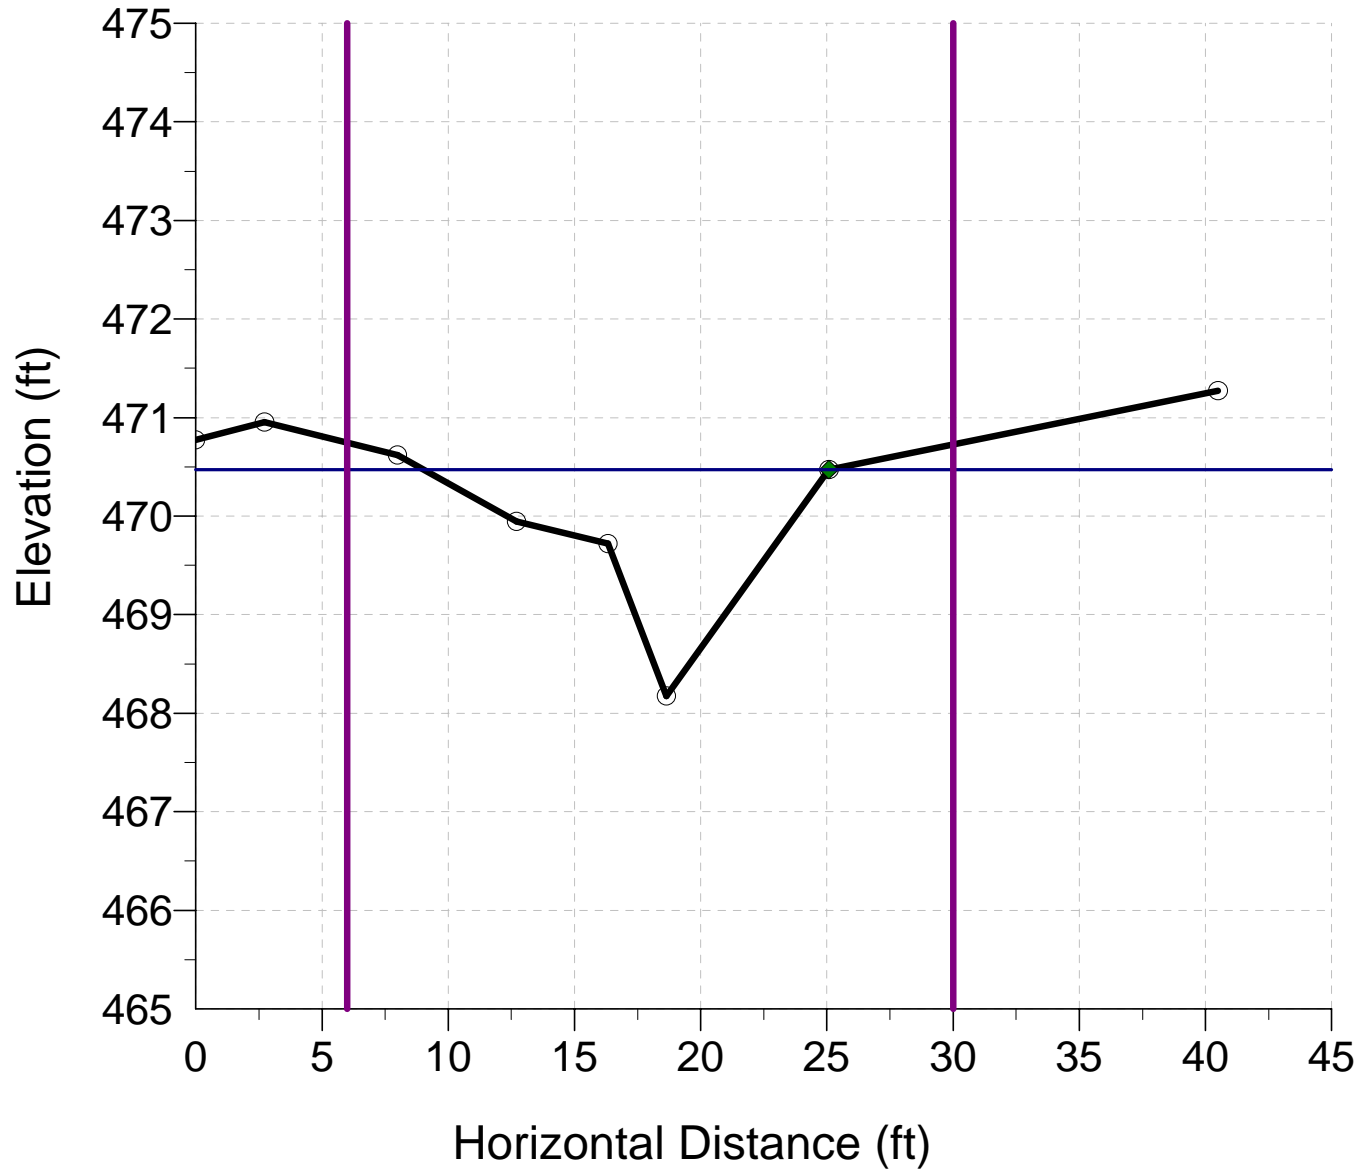

Cross Section 8 Pool

○ Ground Points ◆ Bankfull Indicators ▼ Water Surface Points


Wbkf = 10.6 Dbkf = 1.19 Abkf = 12.7

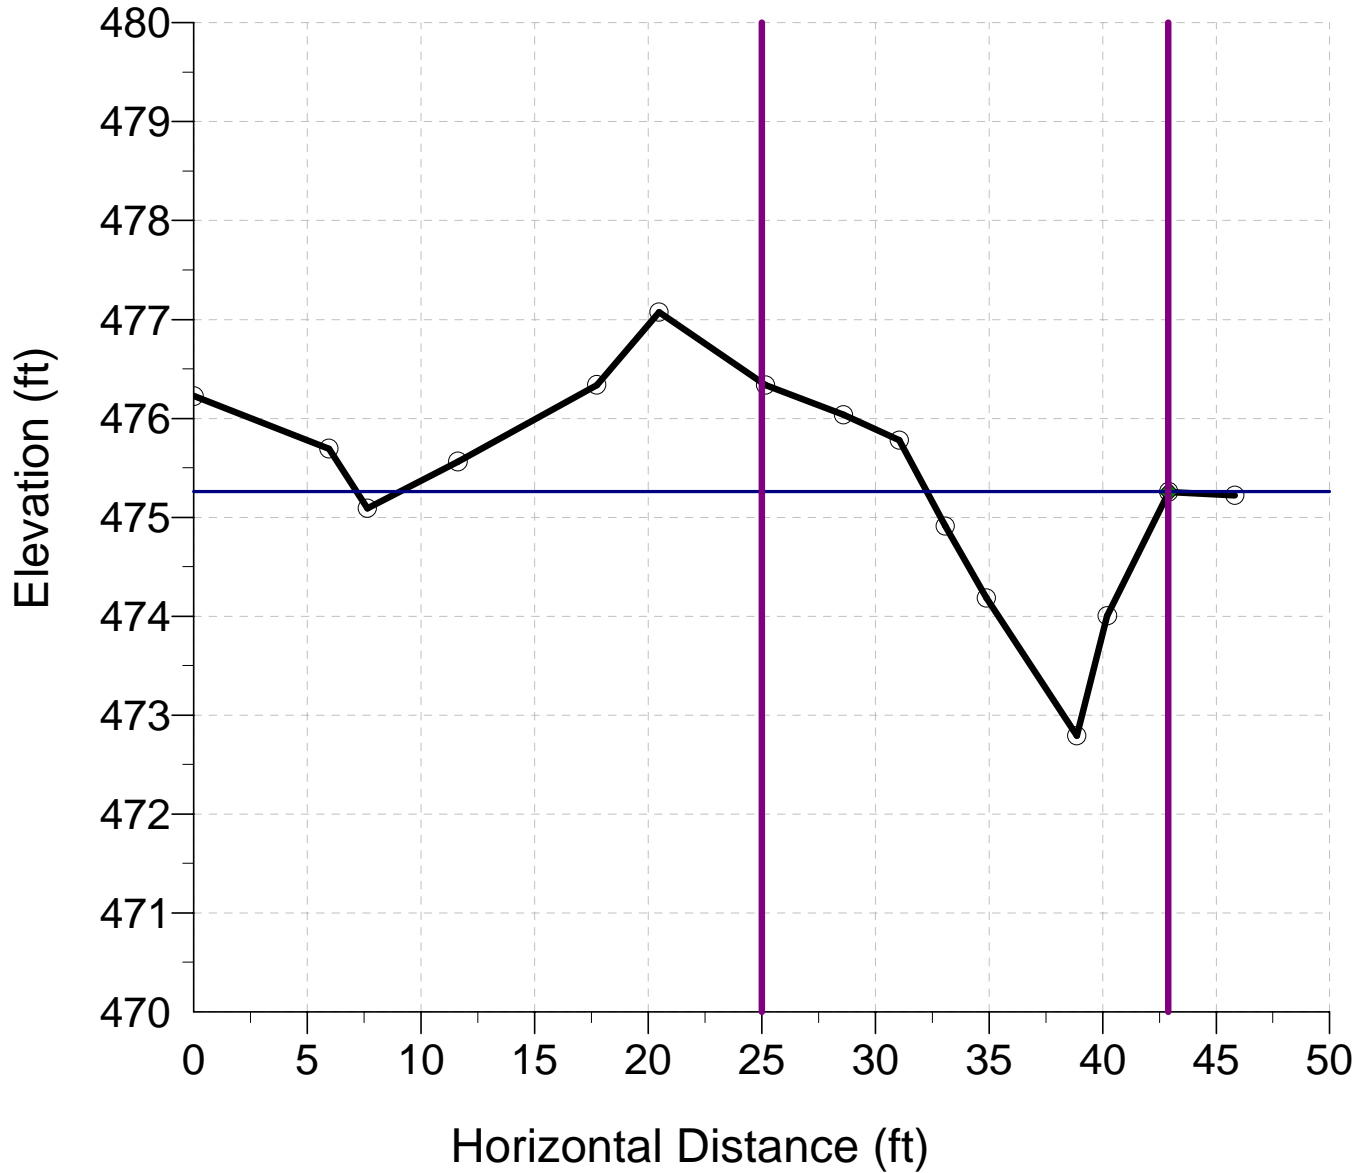

Cross Section 9 Riffle

○ Ground Points ◆ Bankfull Indicators ▼ Water Surface Points


Wbkf = 11.1 Dbkf = .75 Abkf = 8.32

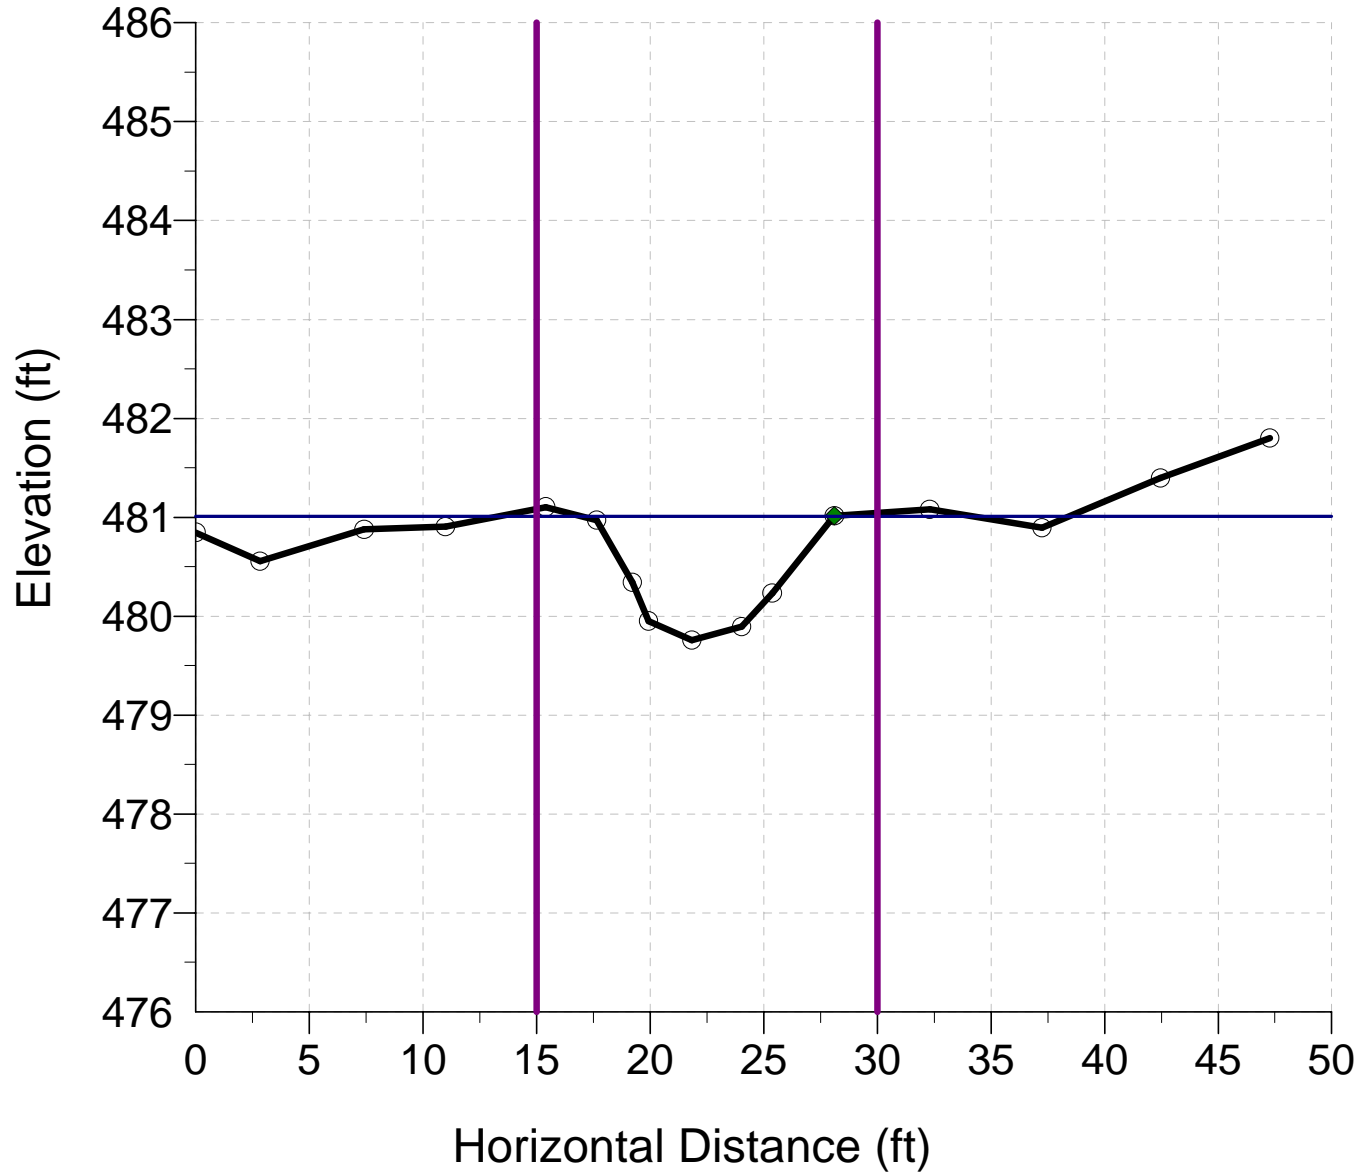


Tributary Cross Section Riffle

○ Ground Points ◆ Bankfull Indicators ▼ Water Surface Points


Wbkf = 6.29 Dbkf = .42 Abkf = 2.64

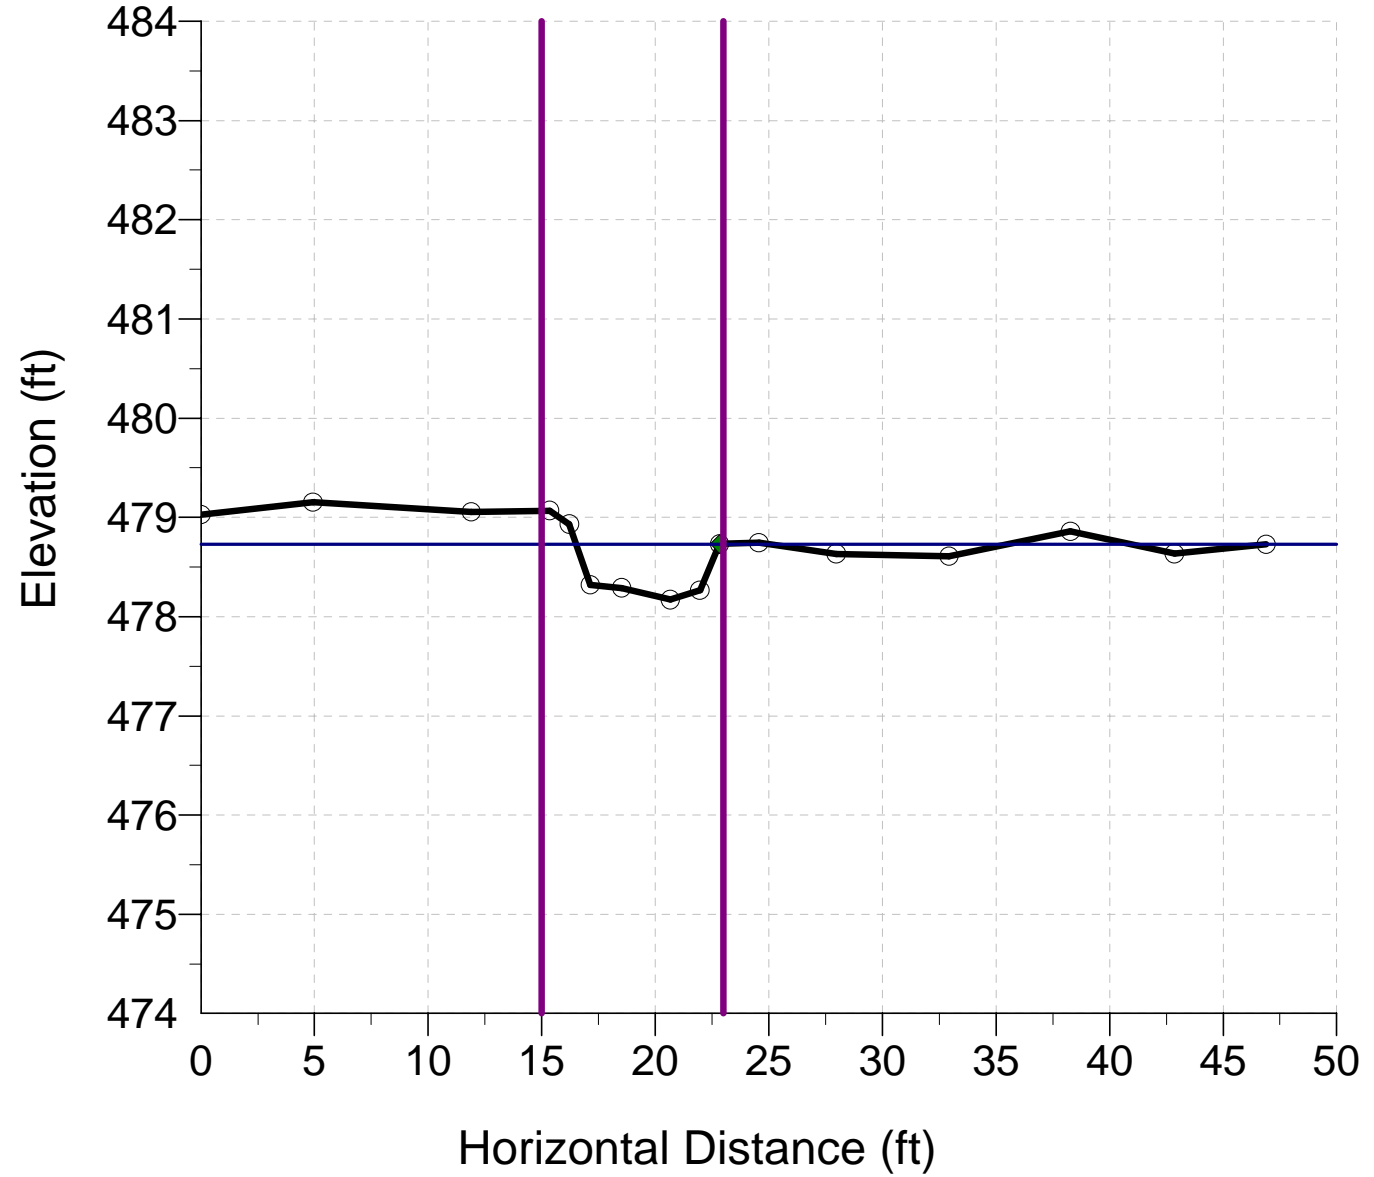


Pebble Count 1 Riffle

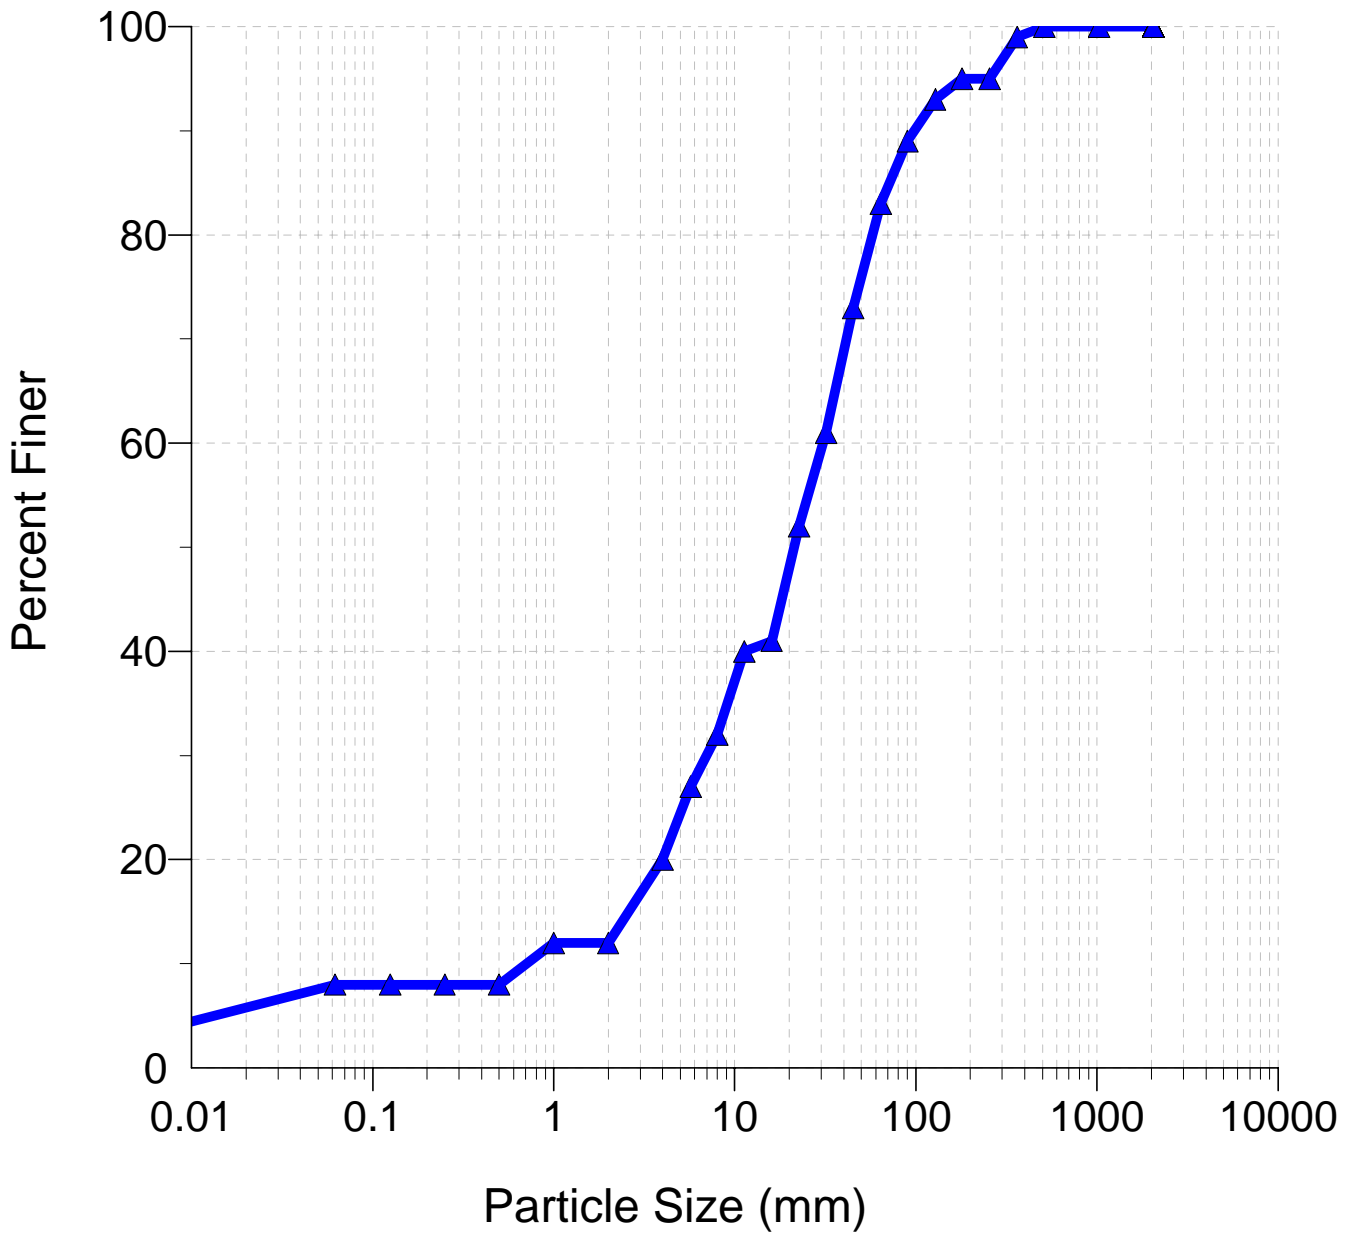


Pebble Count 2 Pool

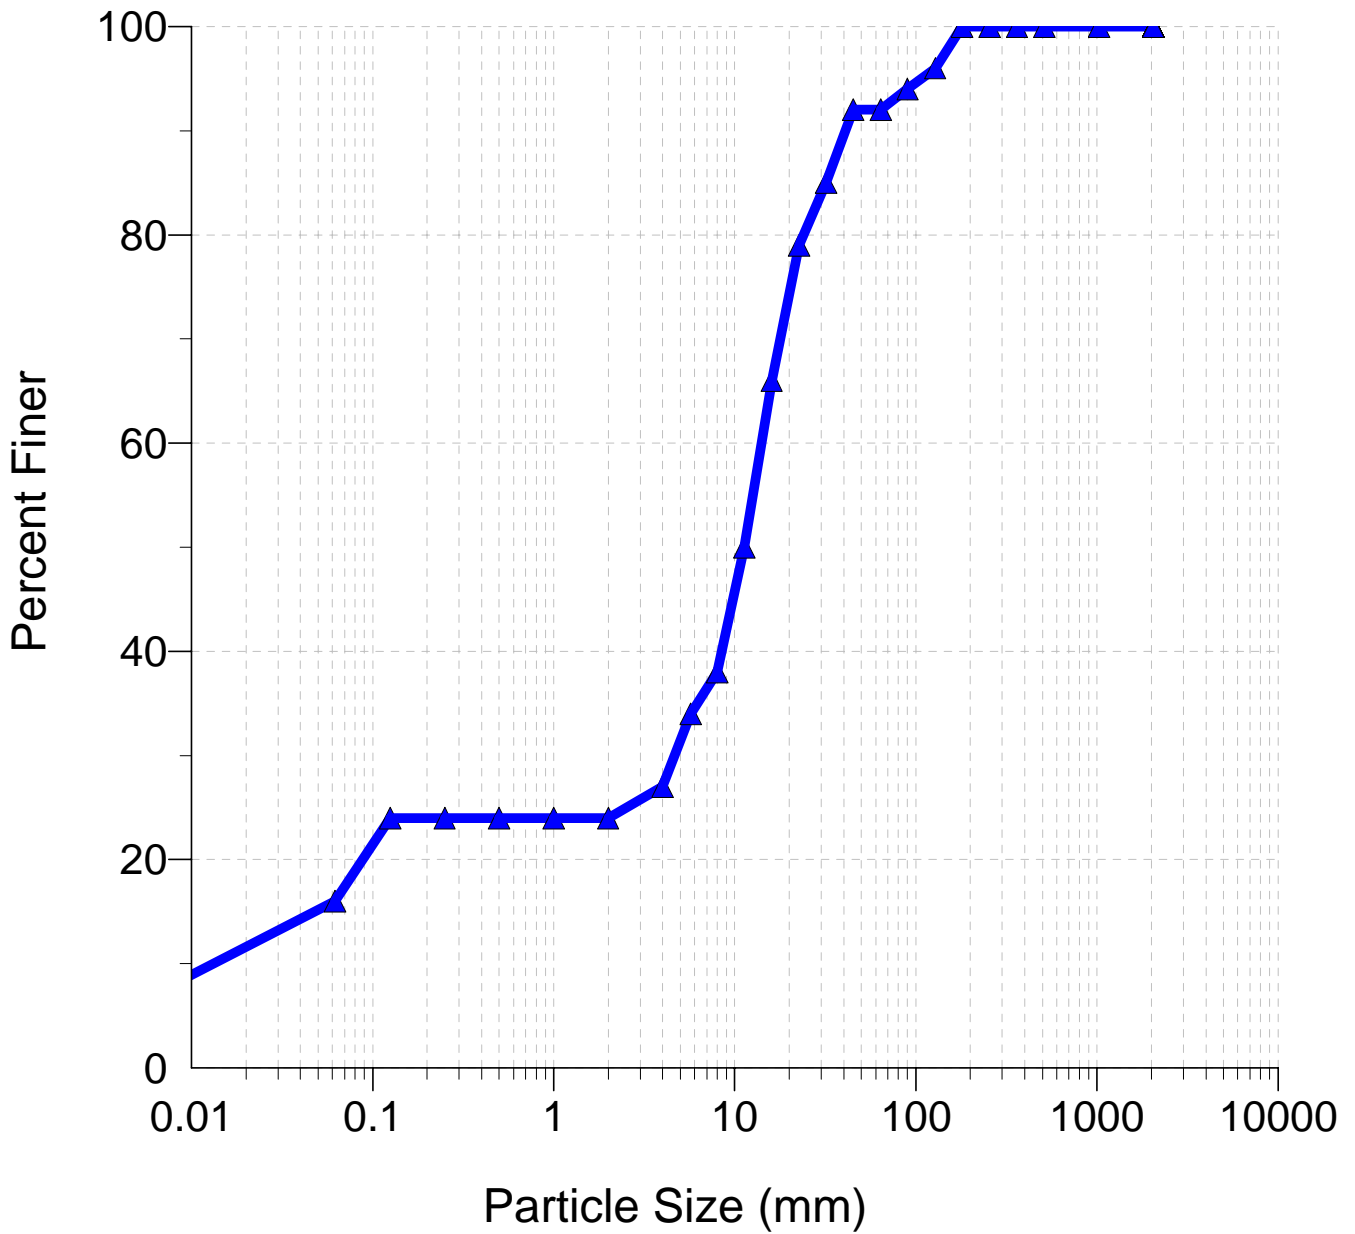


Pebble Count 3 Riffle

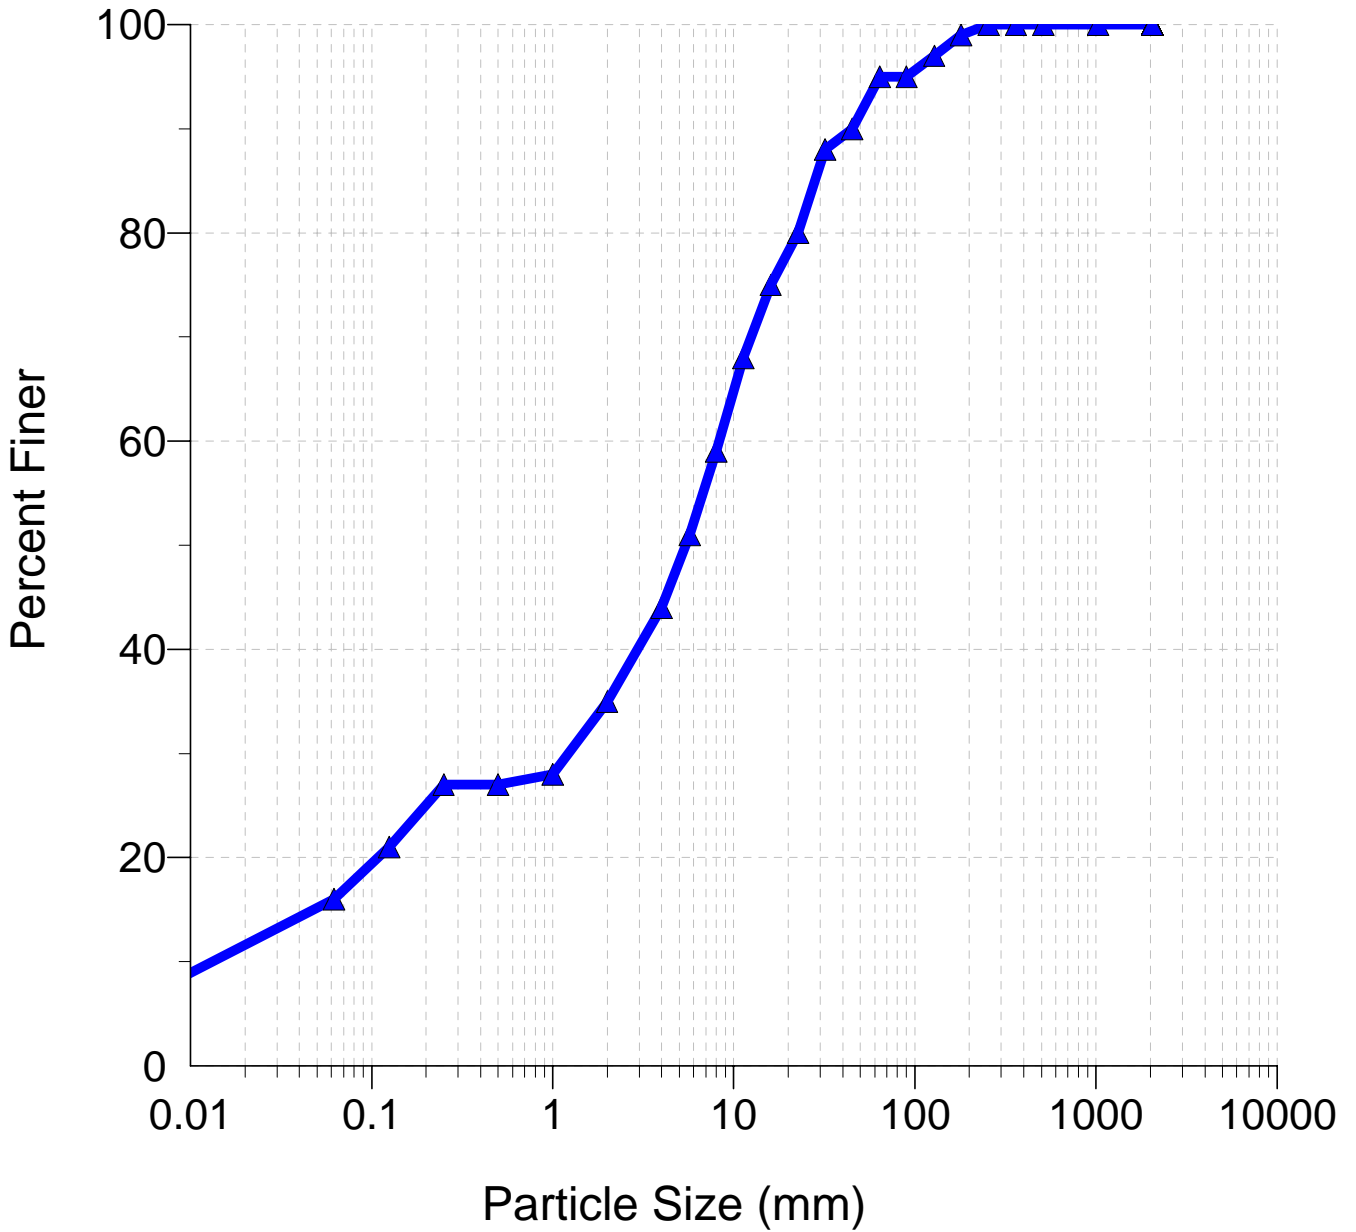


Pebble Count 4 Riffle

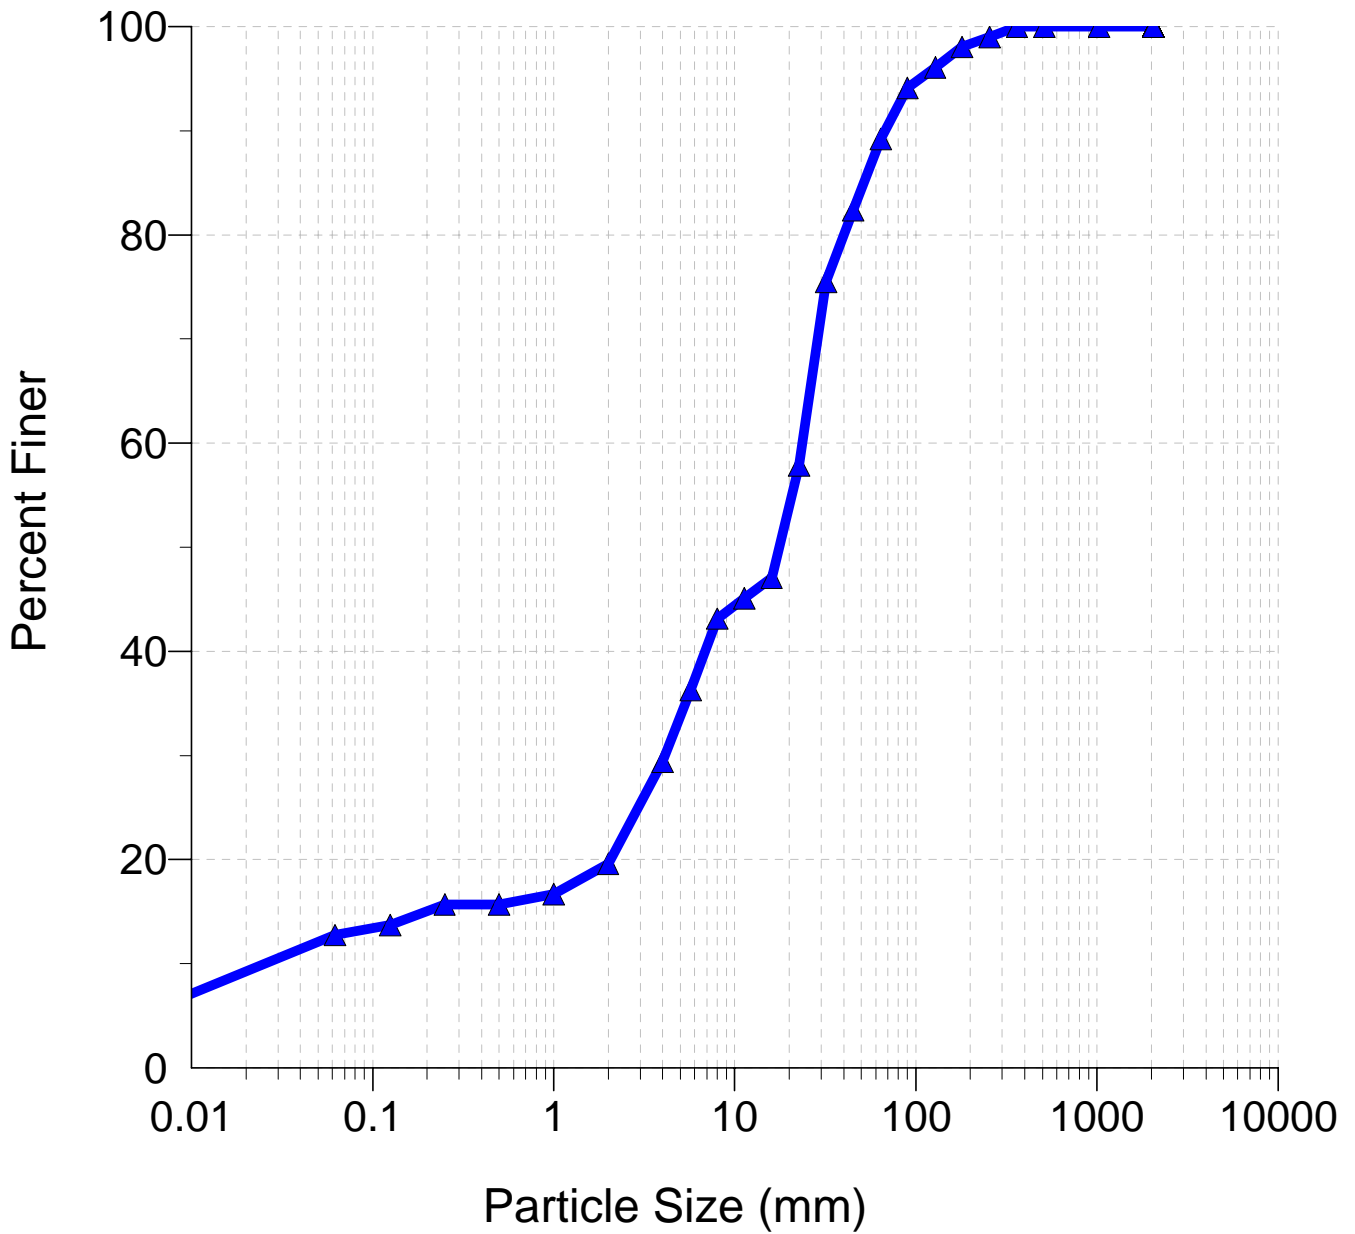


Pebble Count 5 Pool

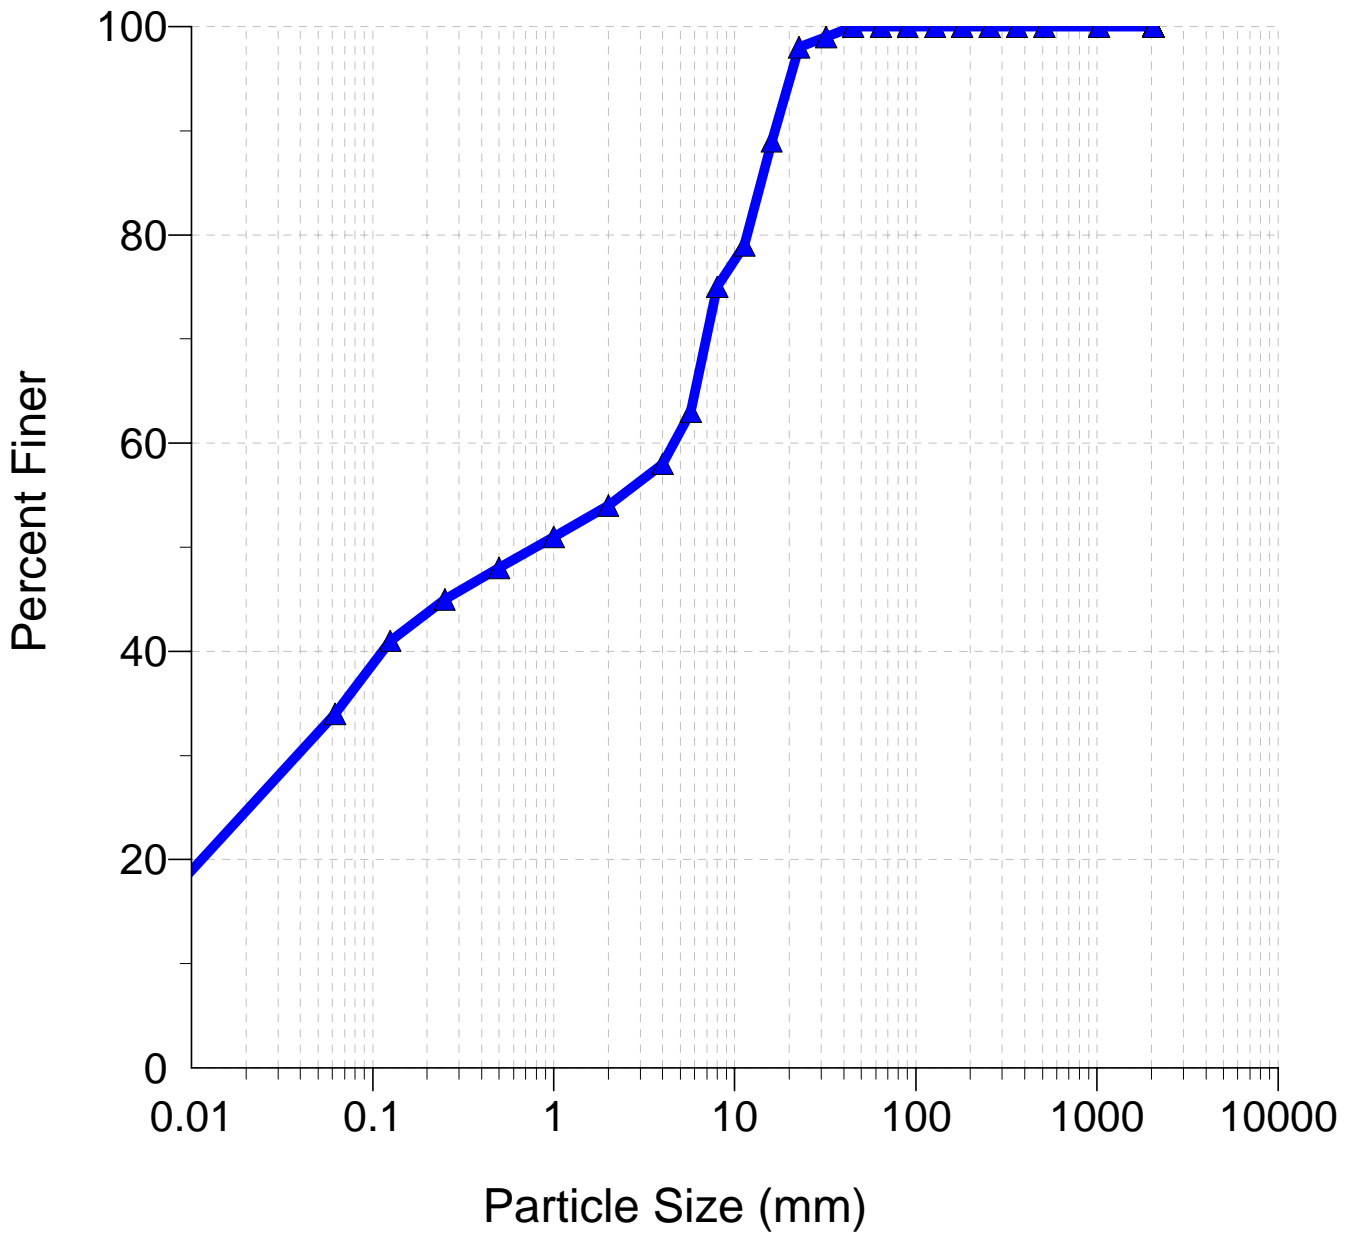


Pebble Count 6 Riffle

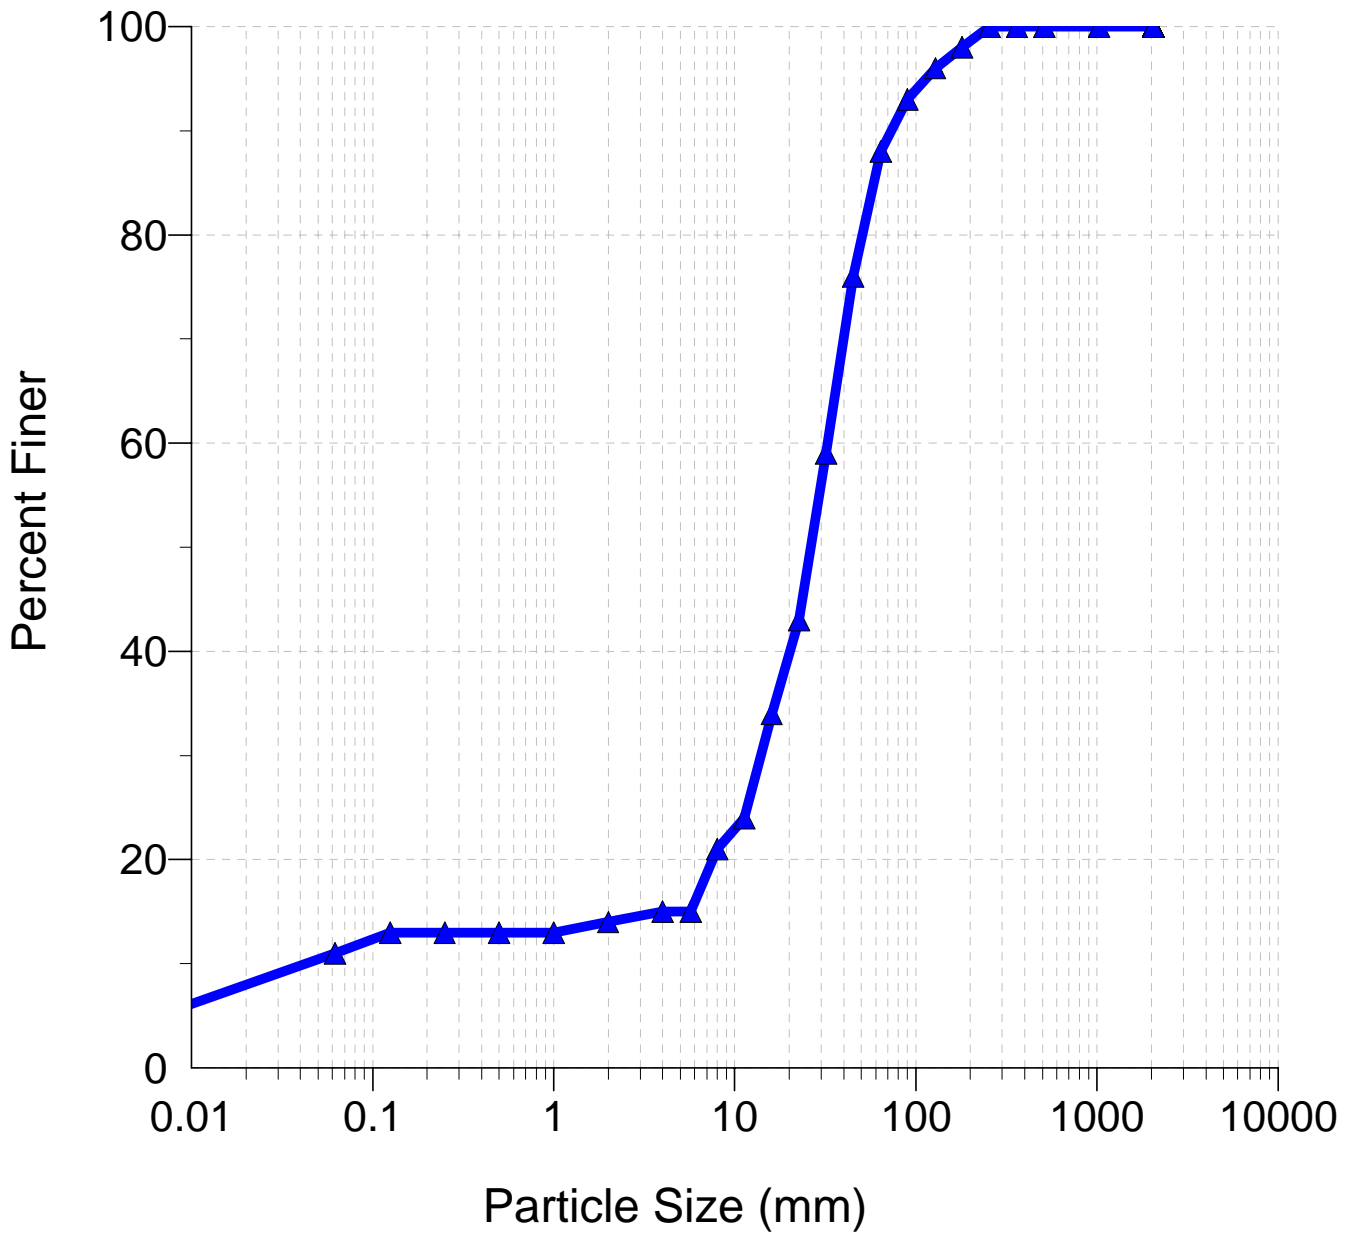


Pebble Count 7 Pool

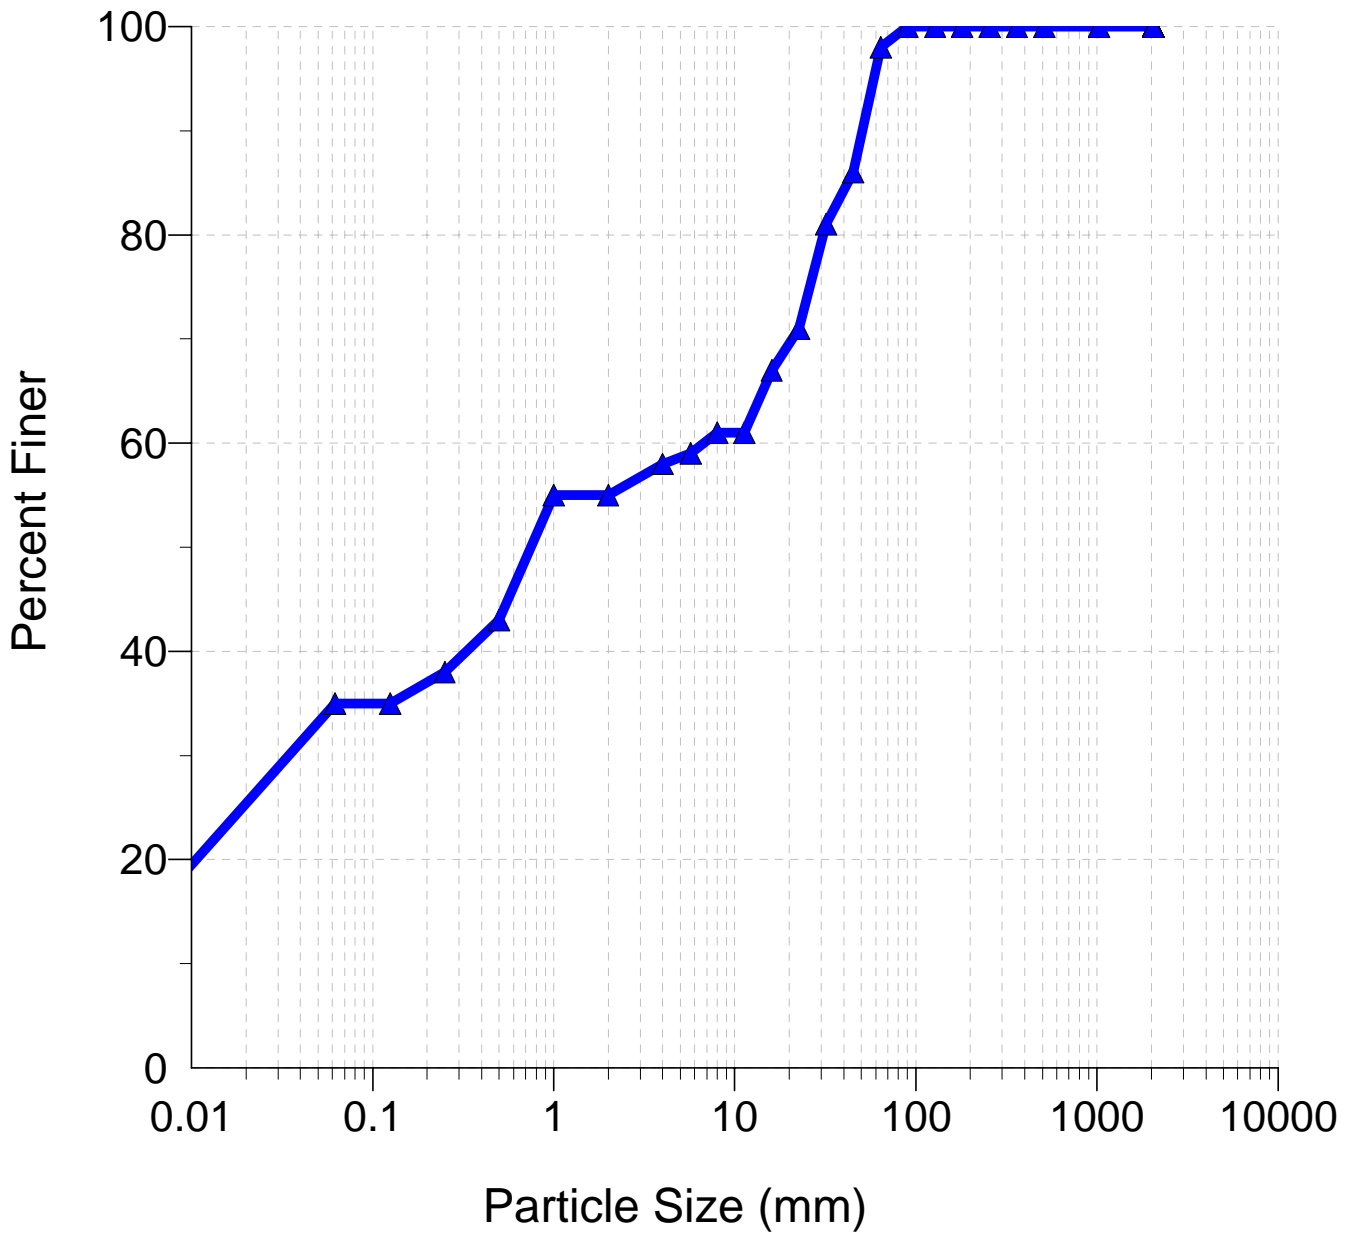

Pebble Count 8 Pool

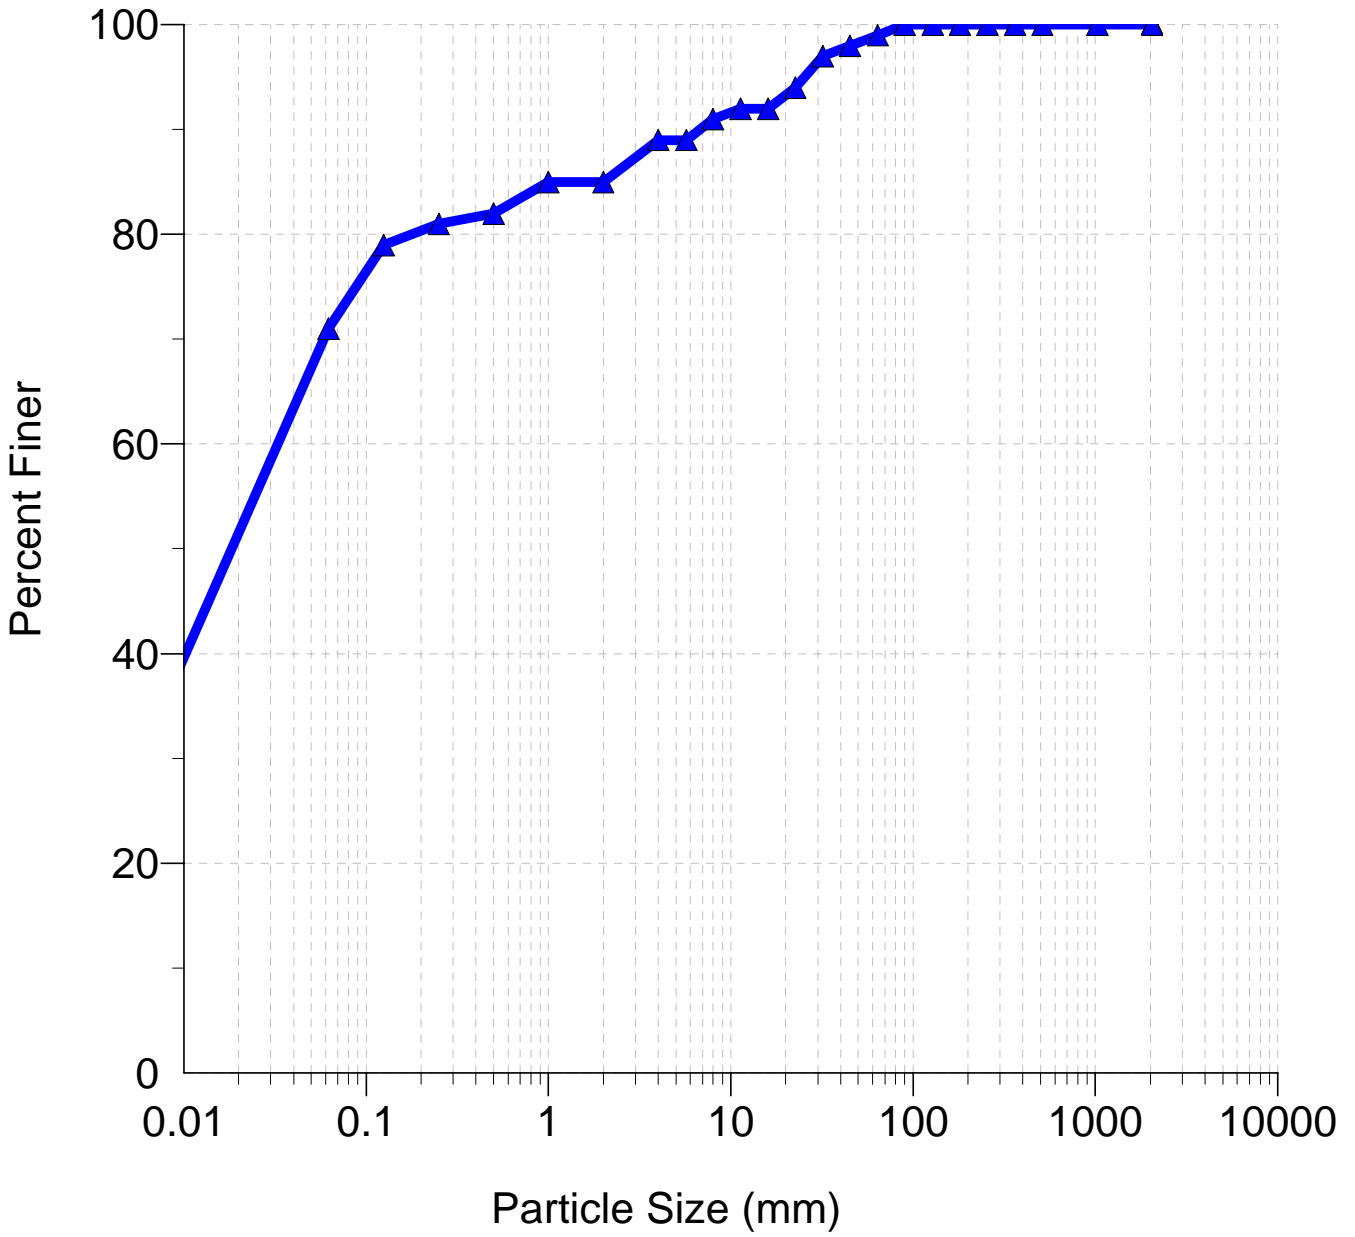

Pebble Count 9 Riffle

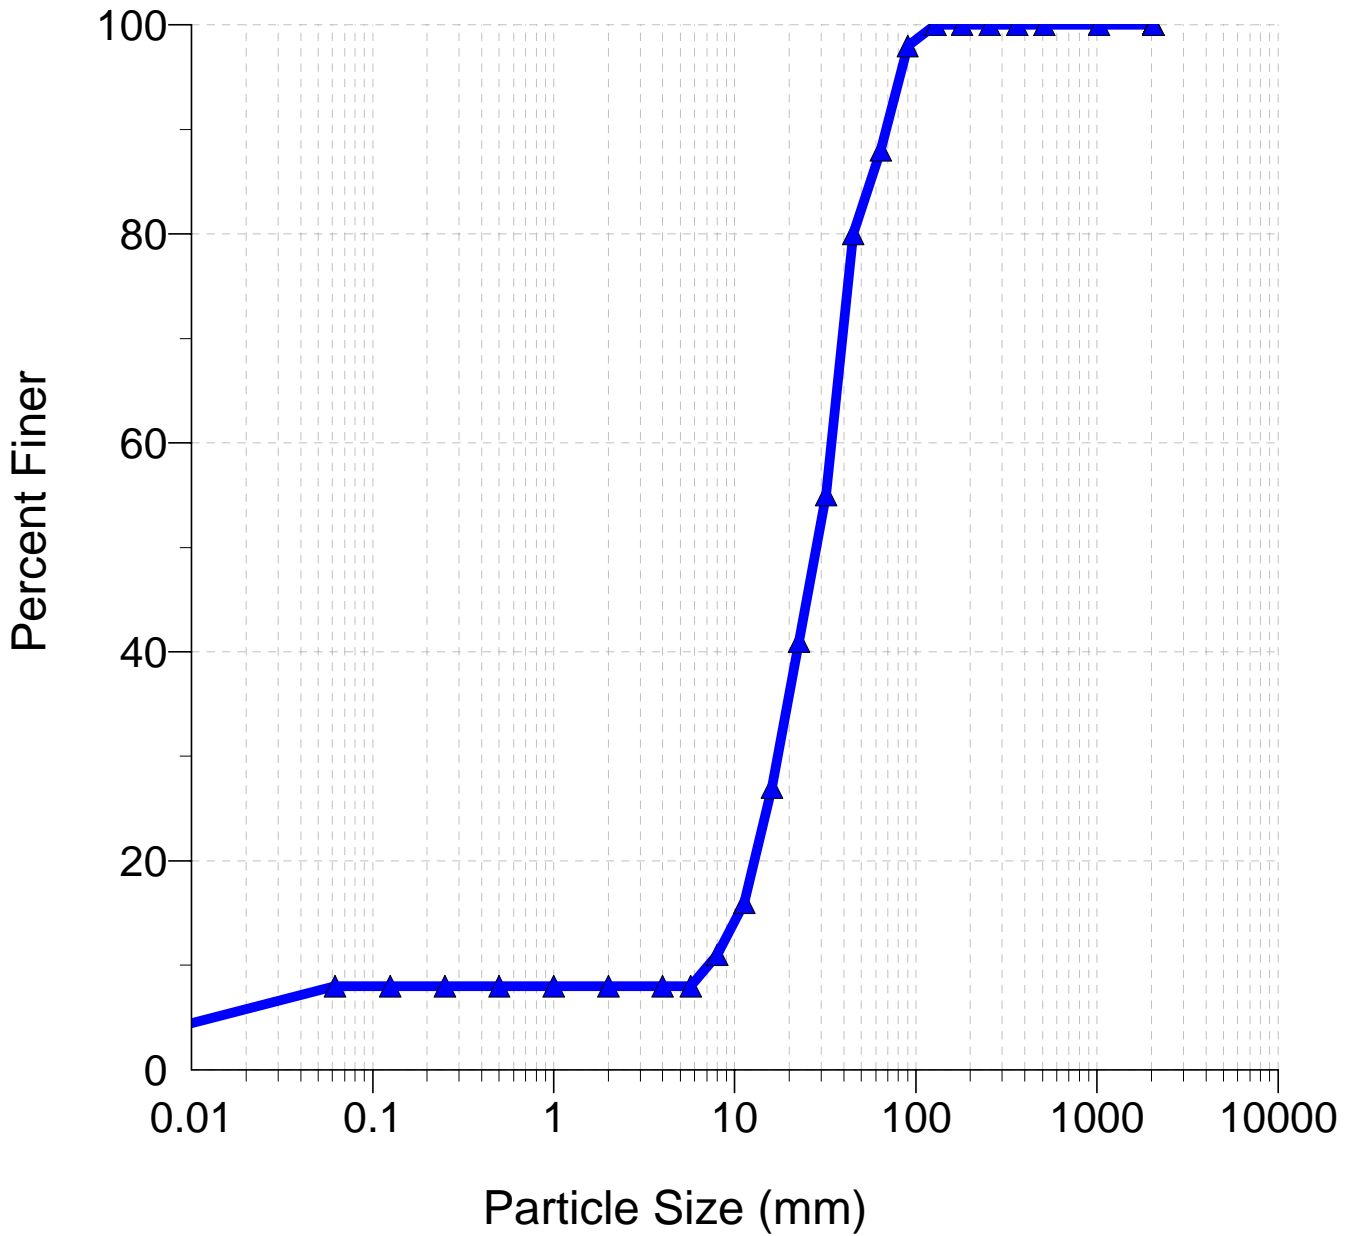

Tributary Pebble Count Riffle

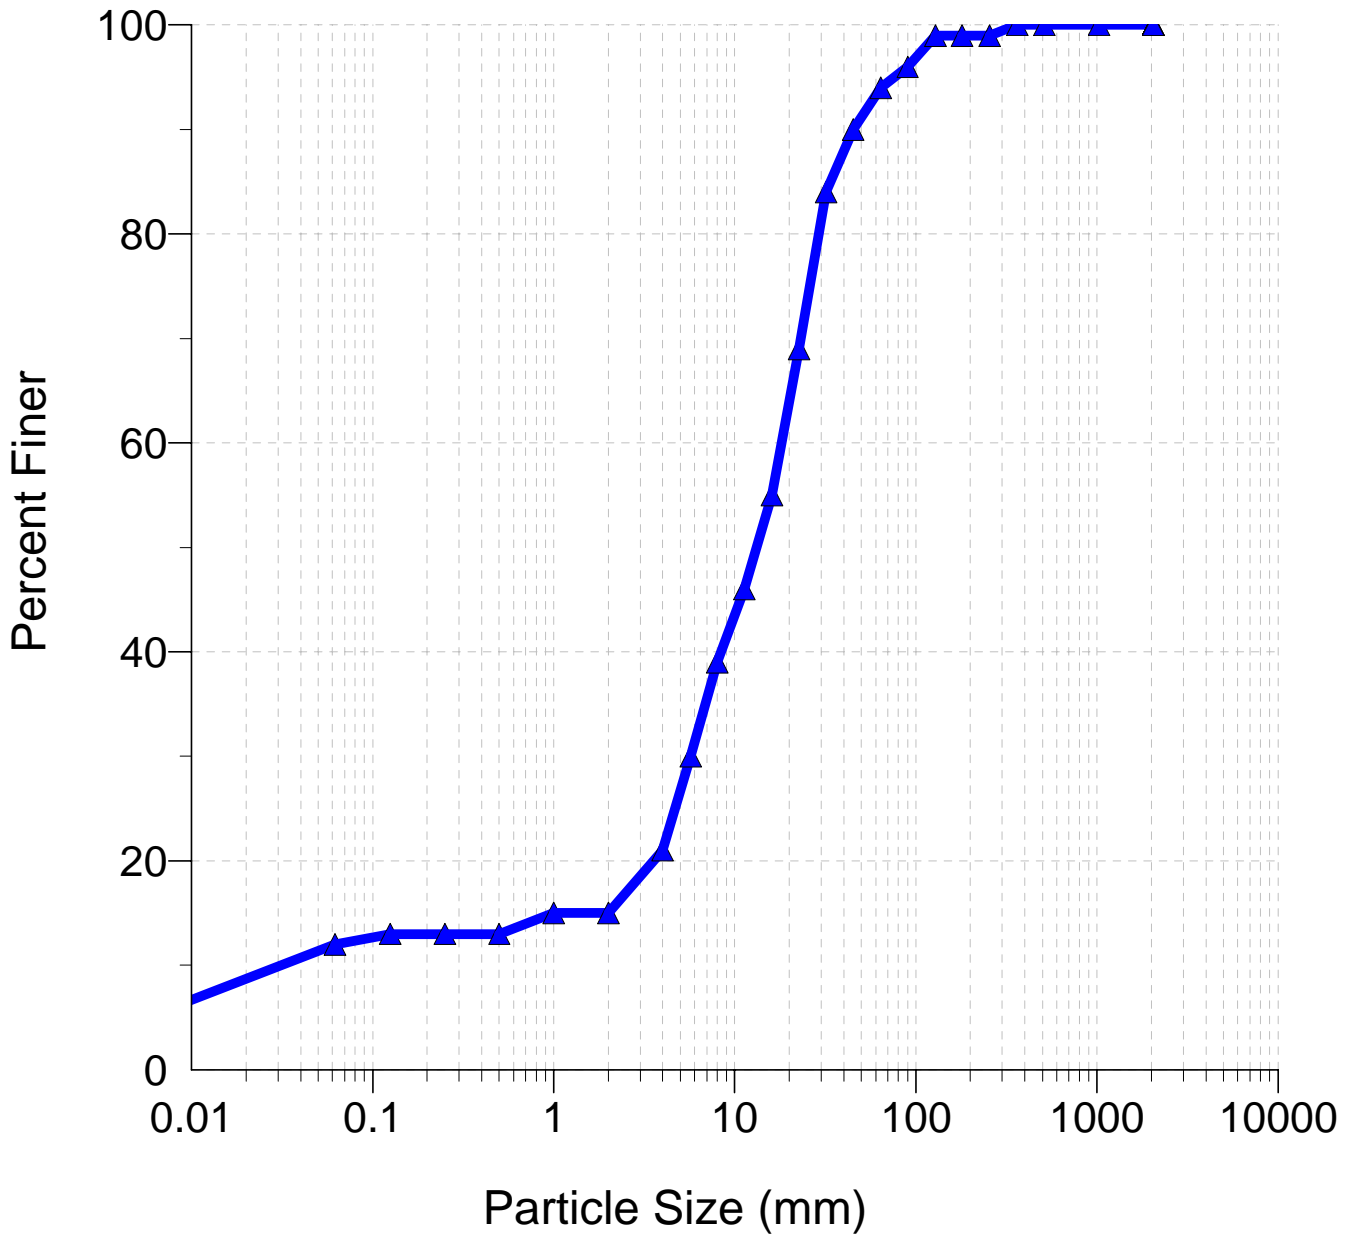


Photo Log

Badin Inn Restoration Plan, Stanly County, North Carolina



1. UT to Little Mountain Creek at Cross Section 1, facing downstream.

Date: 07/29/2009

Monitoring Year: 0



07.29.2009

2. UT to Little Mountain Creek at Cross Section 1, facing downstream
Date: 07/29/2009 Monitoring Year: 0



3. UT to Little Mountain Creek at Cross Section 2, facing downstream.
Date: 07/29/2009 Monitoring Year: 0



4. UT to Little Mountain Creek at Cross Section 2, facing upstream.
Date: 07/29/2009 Monitoring Year: 0



5. UT to Little Mountain Creek at Cross Section 3, facing upstream.

Date: 07/29/2009

Monitoring Year: 0



6. UT to Little Mountain Creek at Cross Section 3, facing downstream.
Date: 07/29/2009 Monitoring Year: 0



7. UT to Little Mountain Creek at Cross Section 4, facing upstream.
Date: 07/29/2009 Monitoring Year: 0



07.29.2009

8. UT to Little Mountain Creek at Cross Section 4, facing downstream.
Date: 07/29/2009 Monitoring Year: 0



07.29.2009

9. UT to Little Mountain Creek at Cross Section 5, facing upstream.
Date: 07/29/2009 Monitoring Year: 0



10. UT to Little Mountain Creek at Cross Section 5, facing downstream.
Date: 07/29/2009 Monitoring Year: 0



07.29.2009

11. UT to Little Mountain Creek at Cross Section 6, facing upstream.
Date: 07/29/2009 Monitoring Year: 0



12. UT to Little Mountain Creek at Cross Section 6, facing downstream.
Date: 07/29/2009 Monitoring Year: 0



14. UT to Little Mountain Creek at Cross Section 7, facing upstream.
Date: 07/29/2009 Monitoring Year: 0



07.29.2009

15. UT to Little Mountain Creek at Cross Section 7, facing downstream.
Date: 07/29/2009 Monitoring Year: 0



16. UT to Little Mountain Creek at Cross Section 8, facing upstream.
Date: 07/29/2009 Monitoring Year: 0



17. UT to Little Mountain Creek at Cross Section 8, facing downstream.
Date: 07/29/2009 Monitoring Year: 0



18. UT to Little Mountain Creek at Cross Section 9, facing upstream.
Date: 07/29/2009 Monitoring Year: 0




19. UT to Little Mountain Creek at Cross Section 9, facing downstream.
Date: 07/29/2009 Monitoring Year: 0




20. UT to Little Mountain Creek at Cross Section 10, facing upstream.
Date: 07/29/2009 Monitoring Year: 0



21. UT to Little Mountain Creek at Cross Section 10, facing downstream.
Date: 07/29/2009 Monitoring Year: 1

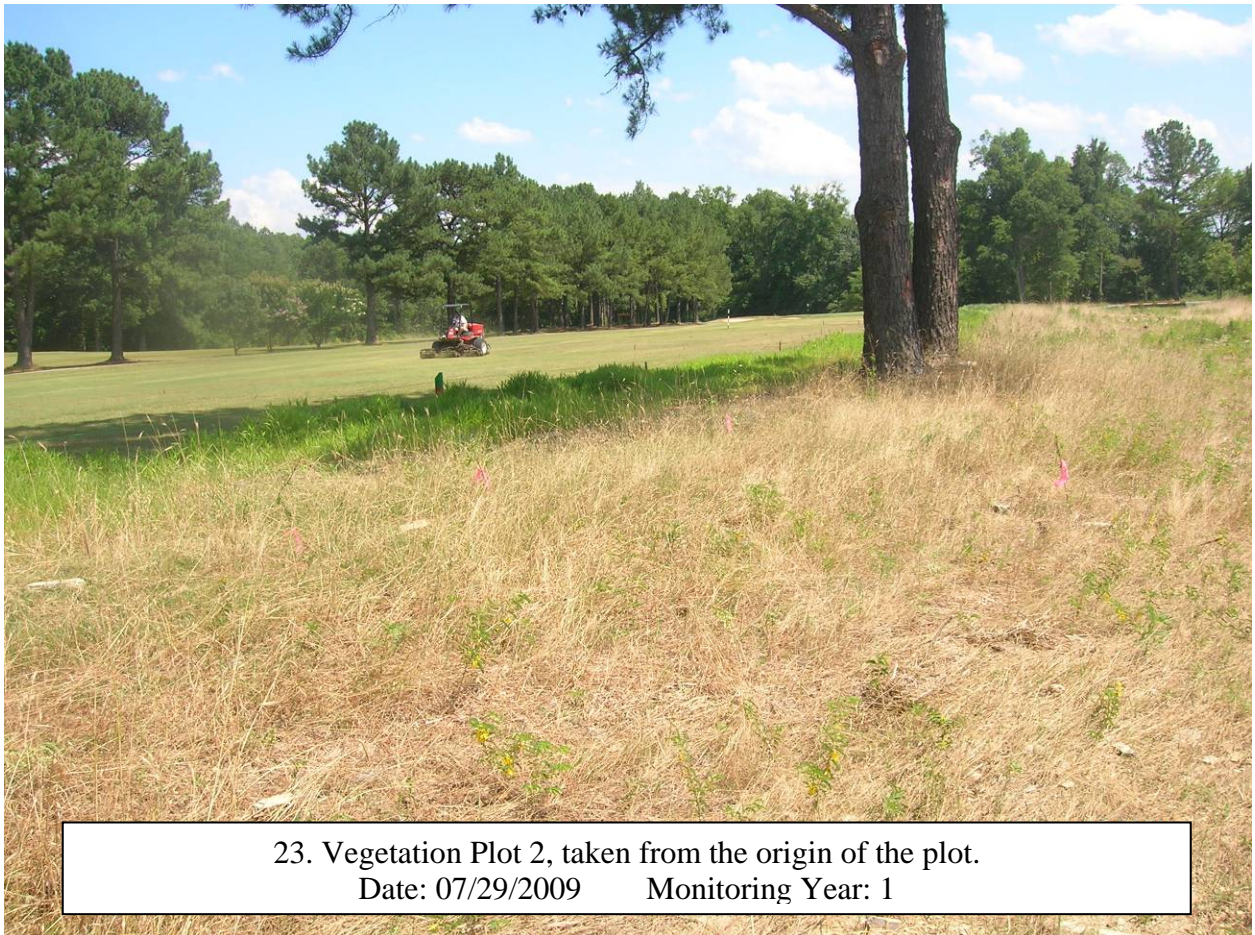

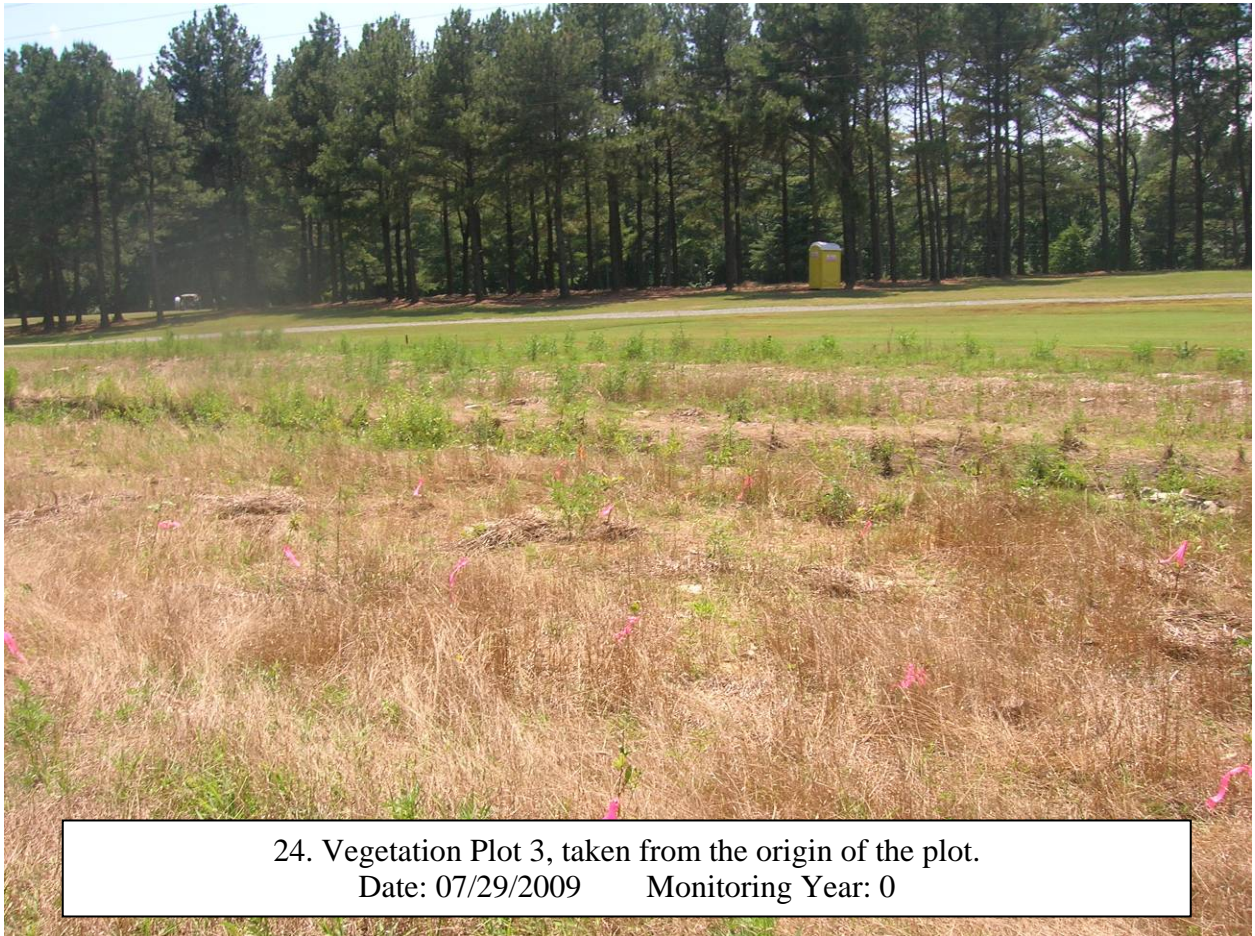




26. Vegetation Plot 5, taken from the origin of the plot.
Date: 07/29/2009 Monitoring Year: 1



27. Vegetation Plot 6, taken from the origin of the plot.
Date: 07/29/2009 Monitoring Year: 1

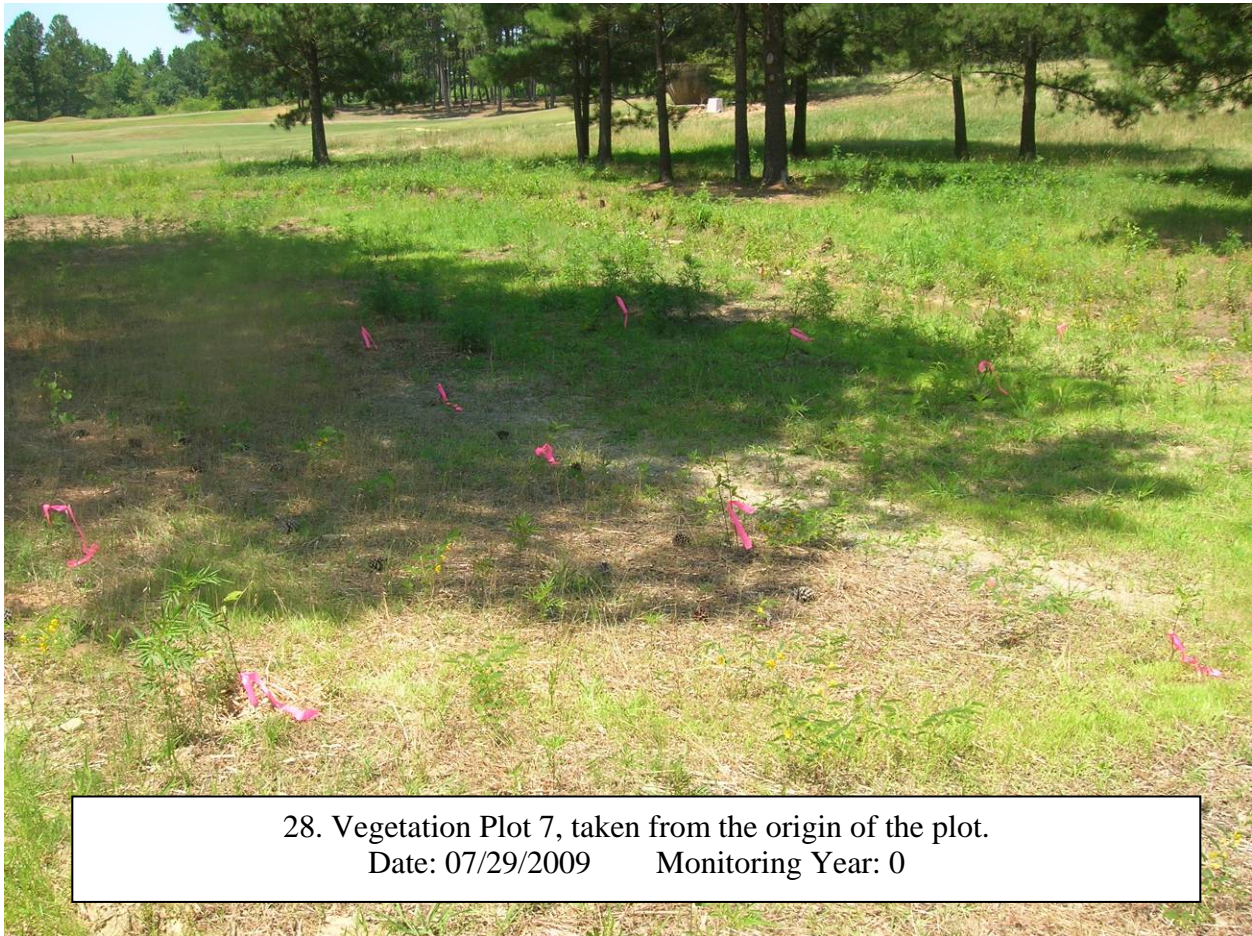



30. Vegetation Plot 9, taken from the origin of the plot.
Date: 07/29/2009 Monitoring Year: 0

APPENDIX C
Vegetation Data

Table 7
CVS Output Tables

**Table 7. Vegetation Plot Attribute Data
Badin Inn Stream Restoration - EEP Project No. 92666**

Plot ID	Community Type	Planting Zone ID	Reach ID	Associated Gauge(s)	Method¹	CVS Level
1	Mesic Mixed Hardwood Forest	Well Drained Riparian Floodplain	1	NA	CVS	2
2	Mesic Mixed Hardwood Forest	Well Drained Riparian Floodplain	1	NA	CVS	2
3	Mesic Mixed Hardwood Forest	Well Drained Riparian Floodplain	1	NA	CVS	2
4	Mesic Mixed Hardwood Forest	Well Drained Riparian Floodplain	1	NA	CVS	2
5	Mesic Mixed Hardwood Forest	Well Drained Riparian Floodplain	1	NA	CVS	2
6	Mesic Mixed Hardwood Forest	Well Drained Riparian Floodplain	1	NA	CVS	2
7	Mesic Mixed Hardwood Forest	Well Drained Riparian Floodplain	1	NA	CVS	2
8	Mesic Mixed Hardwood Forest	Well Drained Riparian Floodplain	1	NA	CVS	2
9	Mesic Mixed Hardwood Forest	Well Drained Riparian Floodplain	1	NA	CVS	2

Table 8. Stem Counts for Each Species by Plot Badin Inn/Project No. 92666

Species		Plots*									Initial Totals
Scientific Name	Common Name	01	02	03	04	05	06	07	08	09	
Shrubs											
<i>Sambucus canadensis</i>	Elderberry	3				2					5
<i>Callicarpa americana</i>	American Beautyberry	2	1			3	1	1	1	7	16
<i>Prunus americana</i>	American plum		1								1
	Total Shrubs	5	2	0	0	5	1	1	1	7	22
Trees											
<i>Cercis canadensis</i>	Redbud	1	3	2	1		7	5	3		22
<i>Carpinus caroliniana</i>	Ironwood	3			1						4
<i>Quercus alba</i>	White oak	3		1							4
<i>Quercus nigra</i>	Water oak	2									2
<i>Quercus velutina</i>	Black oak	1		4					1		6
<i>Nyssa sylvatica</i>	Black gum	1	1		3	1	1				7
<i>Asimina triloba</i>	Paw Paw	1				1				8	10
<i>Quercus phellos</i>	Willow oak		1	1				1			3
<i>Cornus florida</i>	Flowering dogwood		1	1	1	1		2			6
<i>Castanea pumila</i>	Chinquapin			7	4	3	1	12	5		32
<i>Diospyros virginiana</i>	American persimmon			3	3	2	1		2		11
<i>Morus rubra</i>	Red mulberry	3		1	1						5
<i>Quercus sp.</i>	Oak species								1		1
<i>Betula nigra</i>	River birch						1		2		3
	Total Trees	15	6	20	14	8	11	20	14	8	116
											10000
											1%
TABLE SUMMARY	<i>Total Stems of planted woody vegetation</i>	20	8	20	14	13	12	21	15	15	138
	% Shrubs	25%	25%	0%	0%	38%	8%	5%	7%	47%	16%
	% Trees	75%	75%	100%	100%	62%	92%	95%	93%	53%	84%
	Current Density										
	Shrubs per acre	202	81	0	0	202	40	40	40	283	99
	Shrubs per hectare	500	200	0	0	500	100	100	100	700	244
	Trees per acre	607	243	809	567	324	445	809	567	324	522
	Trees per hectare	1500	600	2000	1400	800	1100	2000	1400	800	1289
	Total stems per acre	809	324	809	567	526	486	850	607	607	621
	Total stems per hectare	2000	800	2000	1400	1300	1200	2100	1500	1500	1533

Report Prepared By
Date Prepared

Kevin Lapp

8/10/2009 8:09

database name
database location
computer name
file size

AECOM-2008-0.mdb
Q:\99255\Monitoring\Vegetation
USRAL3PC035

41586688

DESCRIPTION OF WORKSHEETS IN THIS DOCUMENT-----

Metadata Description of database file, the report worksheets, and a summary of project(s) and project data.

Proj, planted Each project is listed with its PLANTED stems per acre, for each year. This excludes live stakes.

Proj, total stems Each project is listed with its TOTAL stems per acre, for each year. This includes live stakes, all planted stems, and all natural/volunteer stems.

Plots List of plots surveyed with location and summary data (live stems, dead stems, missing, etc.).

Vigor Frequency distribution of vigor classes for stems for all plots.

Vigor by Spp Frequency distribution of vigor classes listed by species.

Damage List of most frequent damage classes with number of occurrences and percent of total stems impacted by each.

Damage by Spp Damage values tallied by type for each species.

Damage by Plot Damage values tallied by type for each plot.

ALL Stems by Plot and spp A matrix of the count of total living stems of each species (planted and natural volunteers combined) for each plot; dead and missing stems are excluded.

PROJECT SUMMARY-----

Project Code		92666
project Name	Badin Inn	
Description		
River Basin	Yadkin-Pee Dee	
length(ft)		4174
stream-to-edge width (ft)		42
area (sq m)		32570
Required Plots (calculated)		9
Sampled Plots		9

Living planted stems, excluding live stakes, per acre:

Negative (red) numbers indicate the project failed to reach requirements in a particular year.

Project Code	Project Name	River Basin	Year 0 (baseline)
92666	Badin Inn	Yadkin-Pee Dee	607.03

Total stems, including planted stems of all kinds (including live stakes) and natural/volunteer stems:

Project Code	Project Name	River Basin	Year 0 (baseline)
92666	Badin Inn	Yadkin-Pee Dee	607.0284645

plot	Plot Level	Year	Latitude/Northing	Longitude/Easting	Zone	Datum	Date Sampled	Planted Living Stems	Planted Living Stems EXCLUDING Live Stakes	Dead/Missing Stems
92666-01-0001	2	0	599291.44	1666637.61		NAD83/WGS84	7/1/2009	20	20	2
92666-01-0002	2	0	599948.92	1666498.25		NAD83/WGS84	7/1/2009	8	8	0
92666-01-0003	2	0	600244.88	1666470.66		NAD83/WGS84	7/1/2009	20	20	0
92666-01-0004	2	0	600945.80	1666413.75		NAD83/WGS84	7/1/2009	14	14	2
92666-01-0005	2	0	601239.80	1666369.81		NAD83/WGS84	7/1/2009	13	13	1
92666-01-0006	2	0	601387.46	1666549.82		NAD83/WGS84	7/1/2009	12	12	5
92666-01-0007	2	0	601868.31	1666943.00		NAD83/WGS84	7/1/2009	19	19	2
92666-01-0008	2	0	602056.52	1667209.19		NAD83/WGS84	7/1/2009	14	14	3
92666-01-0009	2	0	602152.13	1667400.27		NAD83/WGS84	7/1/2009	15	15	0

Natural (Volunteer) Stems	Total Living Stems	Total Living Stems EXCLUDING Live Stakes	Planted Living Stems per ACRE	Planted Living Stems EXCLUDING Live Stakes PER ACRE
	20	20	809.371286	809.371286
	8	8	323.7485144	323.7485144
	20	20	809.371286	809.371286
	14	14	566.5599002	566.5599002
	13	13	526.0913359	526.0913359
	12	12	485.6227716	485.6227716
	19	19	768.9027217	768.9027217
	14	14	566.5599002	566.5599002
	15	15	607.0284645	607.0284645

Natural (Volunteer) Stems PER ACRE	Total Living Stems PER ACRE	Total Living Stems EXCLUDING Live Stakes PER ACRE	# species
	809.371286	809.371286	10
	323.7485144	323.7485144	6
	809.371286	809.371286	8
	566.5599002	566.5599002	7
	526.0913359	526.0913359	7
	485.6227716	485.6227716	6
	768.9027217	768.9027217	5
	566.5599002	566.5599002	7
	607.0284645	607.0284645	2

vigor	Count	Percent
0	15	10
1	11	7.3
2	41	27.3
3	52	34.7
4	31	20.7

	Species	4	3	2	1	0	Missing	Unknown
	Asimina triloba	4	6					
	Betula nigra	1		1	1			
	Callicarpa americana	8	6	2				
	Castanea pumila	5	13	9	3	5		
	Cornus florida		2	4				
	Diospyros virginiana	4	4	3				
	Nyssa sylvatica	2	2	4				
	Prunus americana	1						
	Quercus alba	3		1				
	Quercus nigra				2			
	Quercus phellos	2	1					
	Quercus velutina		2	3				
	Sambucus canadensis		1	3	1			
	Morus rubra		2	3				
	Carpinus caroliniana		4					
	Cercis canadensis	1	9	8	3	4		
	Quercus				1	1		
	Unknown					5		
TOT:	18	31	52	41	11	15		

Damage	Count	Percent Of Stems
[Enter other damage]	88	58.7
(no damage)	43	28.7
Site Too Wet	7	4.7
Insects	5	3.3
Other/Unknown Animal	3	2
Site Too Dry	2	1.3
Unknown	1	0.7
Human Trampled	1	0.7

	Species	All Damage Categories (no damage)	Enter other damage	Human Trampled	Insects	Other/Unknown Animal	Site Too Dry	Site Too Wet	Unknown	
	Asimina triloba	10	6	4						
	Betula nigra	3	1	2						
	Callicarpa americana	16	5	11						
	Carpinus caroliniana	4	1	1		2				
	Castanea pumila	35	11	23					1	
	Cercis canadensis	25	5	14		1	1	4		
	Cornus florida	6	2	1	2		1			
	Diospyros virginiana	11	4	7						
	Morus rubra	5		5						
	Nyssa sylvatica	8	1	7						
	Prunus americana	1		1						
	Quercus	2	1	1						
	Quercus alba	4	2	2						
	Quercus nigra	2			1			1		
	Quercus phellos	3	2	1						
	Quercus velutina	5	1	2	2					
	Sambucus canadensis	5		5						
	Unknown	5	1	1	1			2		
TOT:	18	150	43	88	1	5	3	2	7	1

	<i>plot</i>	<i>All Damage Categories (no damage)</i>			<i>Enter other damage</i>	<i>Human Trampled</i>	<i>Insects</i>	<i>Other/Unknown Animal</i>	<i>Site Too Dry</i>	<i>Site Too Wet</i>	<i>Unknown</i>
	92666-01-0001	22	7	10		1	2	1	1		
	92666-01-0002	8		8							
	92666-01-0003	20	5	12		2				1	
	92666-01-0004	16	8	8							
	92666-01-0005	14	3	10				1			
	92666-01-0006	17	4	7					6		
	92666-01-0007	21	6	12		2	1				
	92666-01-0008	17	4	12	1						
	92666-01-0009	15	6	9							
TOT:	9	150	43	88	1	5	3	2	7	1	

	Species	Total Planted Stems	# plots	avg# stems	plot 92666-01-0001	plot 92666-01-0002	plot 92666-01-0003	plot 92666-01-0004	plot 92666-01-0005	plot 92666-01-0006	plot 92666-01-0007	plot 92666-01-0008	plot 92666-01-0009
	Asimina triloba	10	3	3.33	1			1					8
	Betula nigra	3	2	1.5					1				2
	Callicarpa americana	16	7	2.29	2	1		3	1	1	1		7
	Carpinus caroliniana	4	2	2	3		1						
	Castanea pumila	30	6	5		7	4	3	1	10	5		
	Cercis canadensis	21	7	3	1	3	2	1	7	5	2		
	Cornus florida	6	5	1.2		1	1	1		2			
	Diospyros virginiana	11	5	2.2			3	3	2	1		2	
	Morus rubra	5	3	1.67	3		1	1					
	Nyssa sylvatica	8	6	1.33	1	1		3	1	1		1	
	Prunus americana	1	1	1		1							
	Quercus	1	1	1								1	
	Quercus alba	4	2	2	3		1						
	Quercus nigra	2	1	2	2								
	Quercus phellos	3	3	1		1	1			1			
	Quercus velutina	5	2	2.5	1		4						
	Sambucus canadensis	5	2	2.5	3			2					
TOT:	17	135	17		20	8	20	14	13	12	19	14	15

	Species	Total Stems	# plots	avg# stems	92666-01-0001	92666-01-0002	92666-01-0003	92666-01-0004	92666-01-0005	92666-01-0006	92666-01-0007	92666-01-0008	92666-01-0009
	Asimina triloba	10	3	3.33	1			1					8
	Betula nigra	3	2	1.5					1				2
	Callicarpa americana	16	7	2.29	2	1		3	1	1	1		7
	Castanea pumila	35	7	5	1	7	6	3	1	12	5		
	Cornus florida	6	5	1.2		1	1	1		2			
	Diospyros virginiana	11	5	2.2			3	3	2	1		2	
	Nyssa sylvatica	8	6	1.33	1	1		3	1	1		1	
	Prunus americana	1	1	1		1							
	Quercus alba	4	2	2	3		1						
	Quercus nigra	2	1	2	2								
	Quercus phellos	3	3	1		1	1				1		
	Quercus velutina	5	2	2.5	1		4						
	Sambucus canadensis	5	2	2.5	3				2				
	Morus rubra	5	3	1.67	3		1	1					
	Carpinus caroliniana	4	2	2	3			1					
	Cercis canadensis	25	7	3.57	1	3	2	1		10	5	3	
	Quercus	2	2	1					1				1
	Unknown	5	3	1.67	1					2			2
TOT:	18	150	18		22	8	20	16	14	17	21	17	15


APPENDIX D

As-Built Plan Sheets


BADIN INN STREAM RESTORATION STANLY COUNTY, NC (CONSTRUCTION PLANS)

Clearing, grading, erosion control, stream restoration, drainage, debris removal, landscaping, and other improvements as noted on the plans. This work will include all items necessary to construct the stream, the wet swales, and associated structures with the associated landscaping, plantings, seeding and live staking.

RECEIVING STREAM: LITTLE MOUNTAIN CREEK
NCDWQ CLASSIFICATION: WS IV

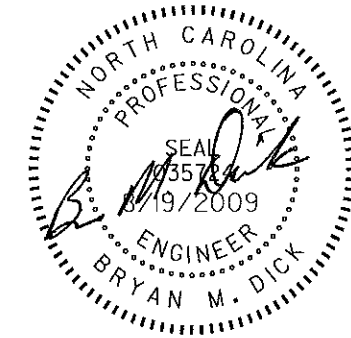


**AS-BUILT DRAWINGS
08/17/09**

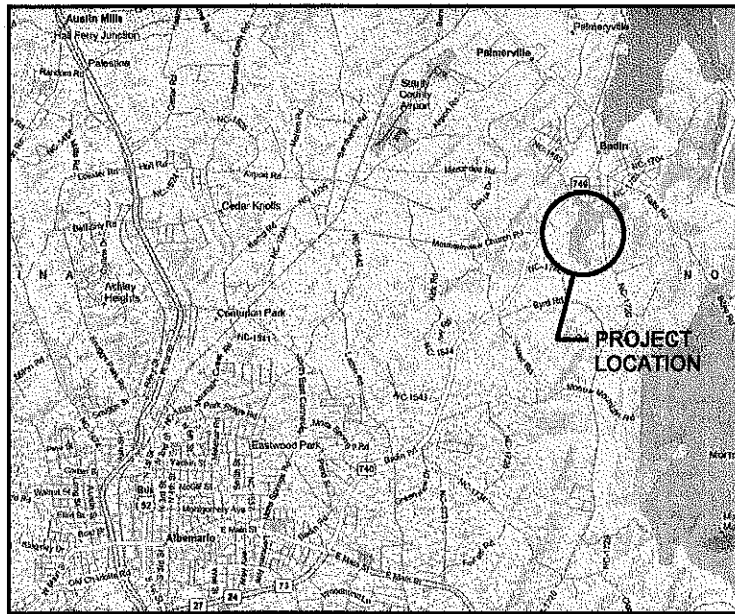

VICINITY MAP
(Not to Scale)

INDEX OF SHEETS

- | | |
|----------------------|---------------------------------|
| C-1 | TITLE SHEET |
| C-2 THRU C-6 | PLAN VIEW, GRADING AND DRAINAGE |
| C-7 THRU C-10 | PROPOSED CHANNEL PROFILE |
| C-11 | TYPICAL CROSS SECTIONS |
| C-12 THRU C-17 | GENERAL DETAILS |
| L-1 THRU L-6 | VEGETATION PLANS |

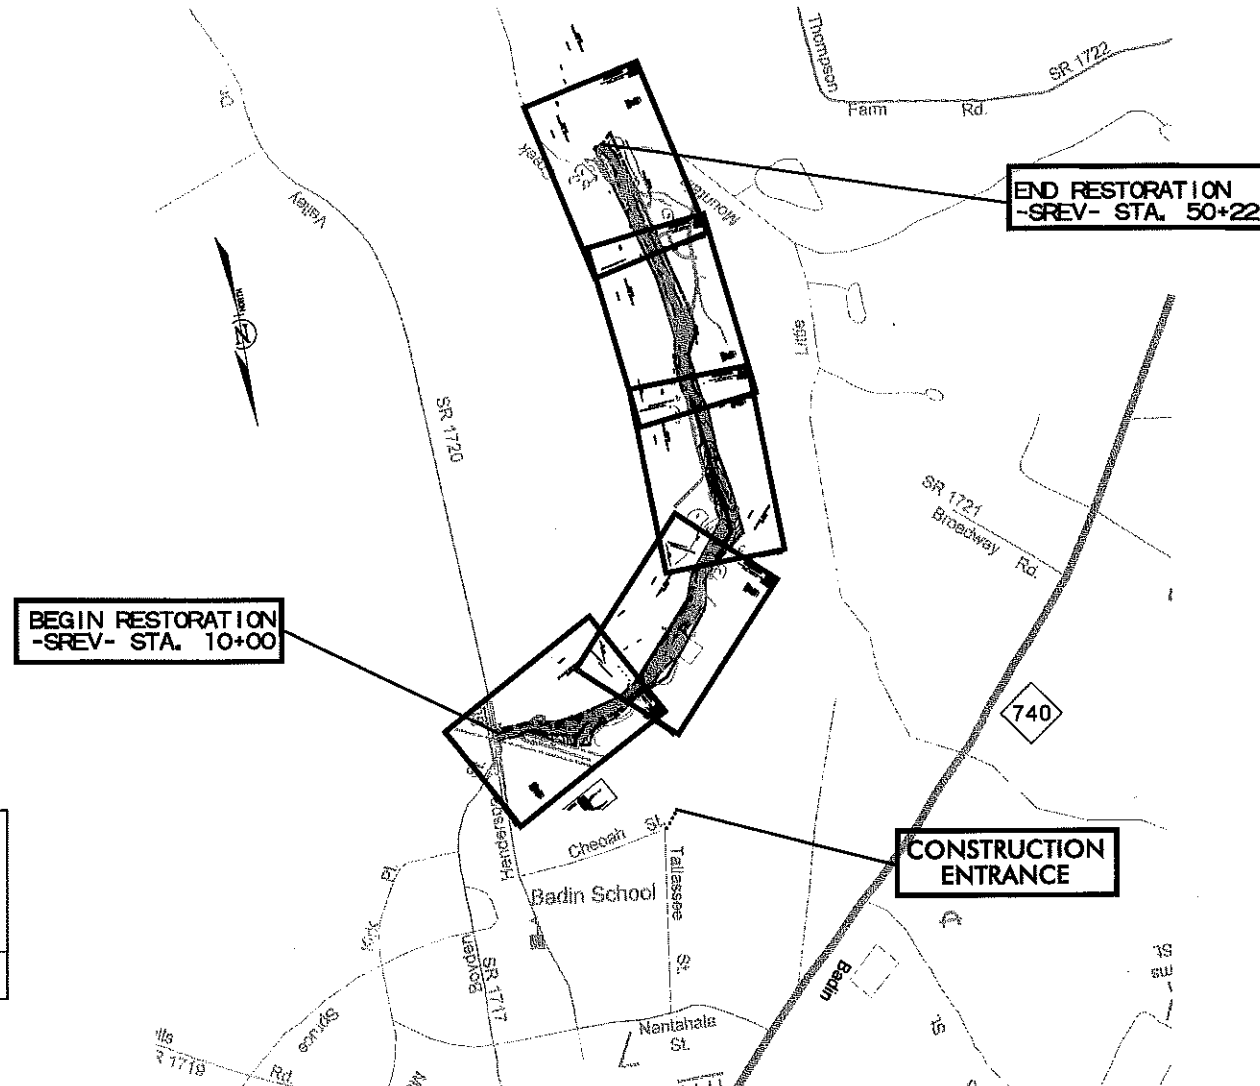

CONSULTANT: **EARTH TECH | AECOM**
701 Corporate Center Drive, Suite #475 Raleigh, NC 27607
Phone: (919) 854-6200 Fax: (919) 854-6259

SENIOR DESIGN CONTACT: **BRYAN DICK (919-854-6252)**

EARTHWORK

UNCLASSIFIED EXCAVATION (CY)	UNDERCUT (CY)	EMBANKMENT (CY)	BORROW (CY)	WASTE (CY)
5742		5103	0	639

STREAM DATA

STREAM REACH	PROPOSED CENTER LENGTH	MODIFICATION TYPE
SREV	3994 FT	RESTORATION
TRIB	180 FT	ENHANCEMENT

LONGITUDE AND LATITUDE:

STA. 10+00
LONGITUDE 80° 6' 54" W
LATITUDE 35° 23' 57" N

DISTURBED AREA:

9.5 ACRES

DATE: 8/19/2009
TIME: 5:44:55 PM


USER: WILSONVAB
DGN: C:\99255\acad\plans\title.dgn

NO	REVISIONS	DRN	CHK	DATE
1	REVISED DISTURBED AREA, ADDED CONST. ENTRANCE			08/17/09
2				
3				

BADIN INN STREAM RESTORATION
TITLE SHEET
EARTH TECH | AECOM
701 CORPORATE CENTER DRIVE, SUITE 475, RALEIGH, NC 27607
919-854-6200 919-854-6259

DATE	8/19/2009
PROJECT NO	99255
FILENAME	99255_title.dgn
SHEET NO	C-1
DRAWN BY	ICJ
CHKD BY	JWJ


USER: WILSONAB DATE: 8/19/2009
 DSN: q:\59255\Cadd\plan\sheet\99255_pch_30scale_grad\ng01.dgn TIME: 5:03:38 PM

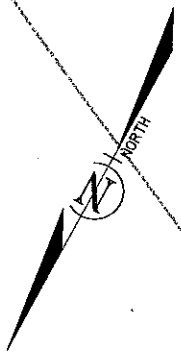

**AS-BUILT DRAWINGS
08/17/09**

MATCHLINE SHEET C60-2

NO	REVISIONS	DATE
1		
2		
3		

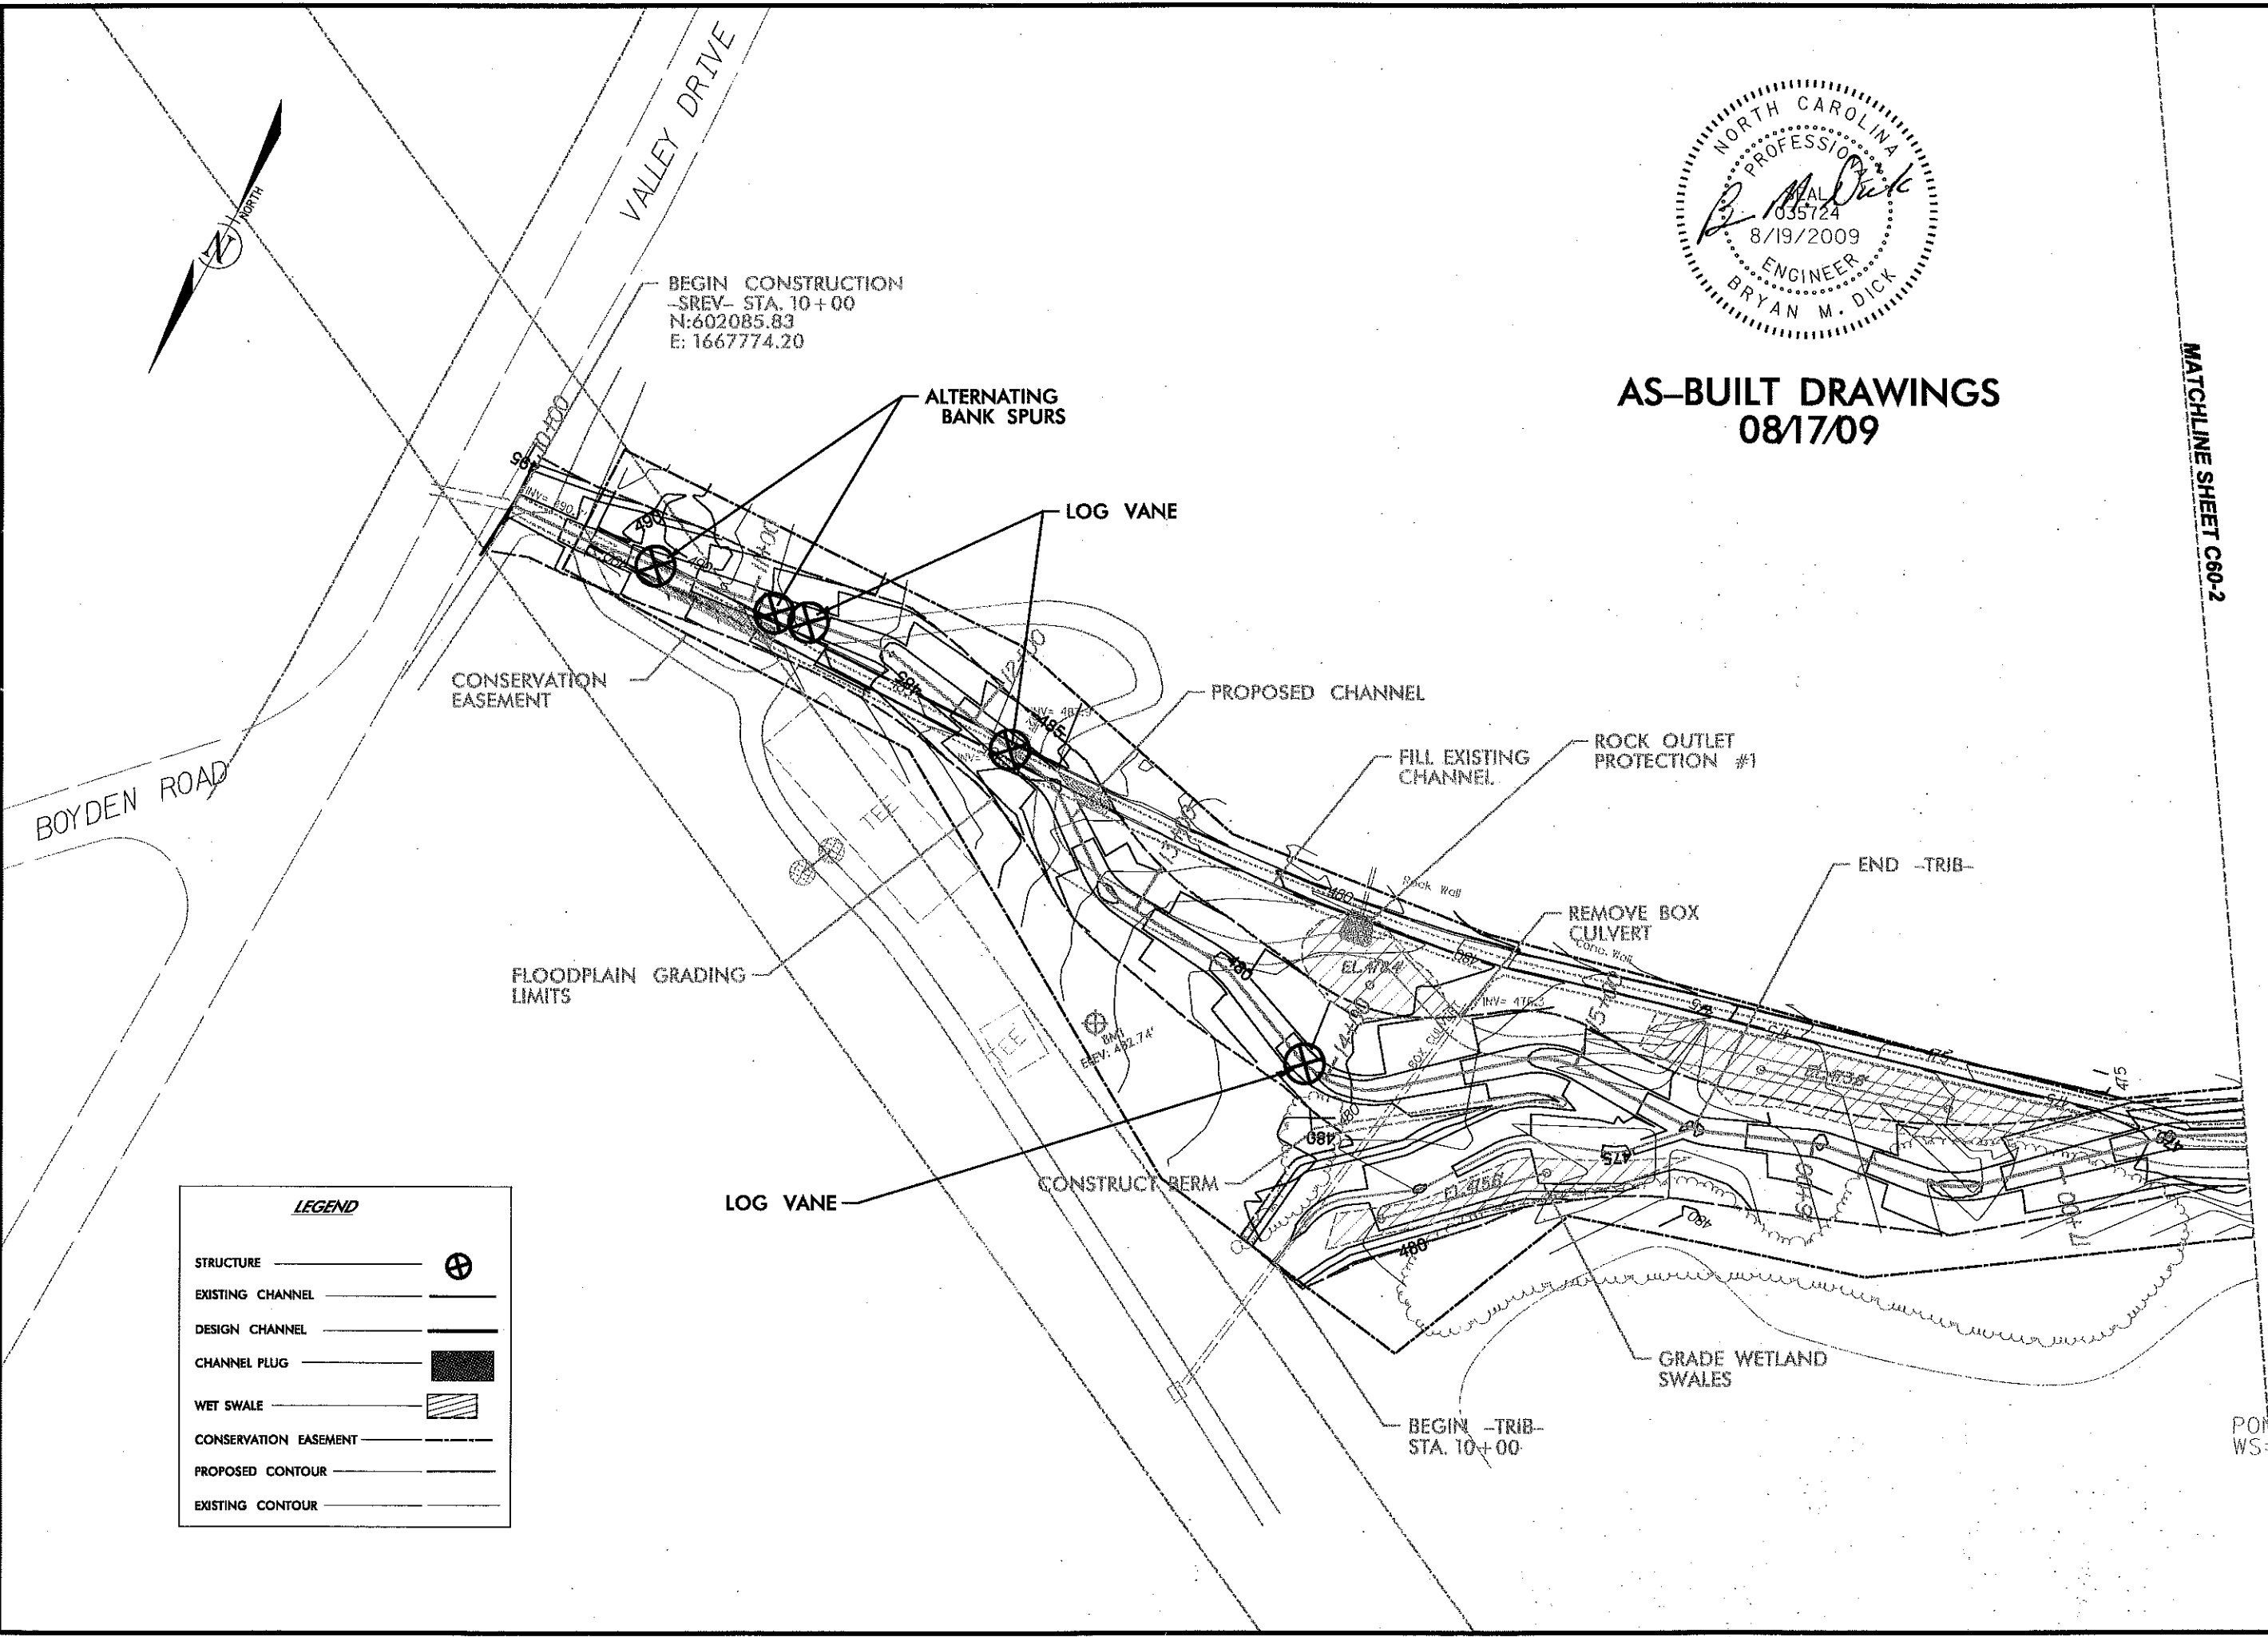

LEGEND

STRUCTURE	
EXISTING CHANNEL	
DESIGN CHANNEL	
CHANNEL PLUG	
WET SWALE	
CONSERVATION EASEMENT	
PROPOSED CONTOUR	
EXISTING CONTOUR	



BADIN INN STREAM RESTORATION
SITE PLAN, GRADING AND DRAINAGE
EARTHTECH | AECOM
701 CORPORATE CENTER DRIVE, SUITE 475, HALDIGH, NC 27607
 919-850-6600 919-850-6629 FAX



DATE	8/19/2009
PROJECT NO	99255
FILENAME	
SHEET NO	C-2
DRAWN BY	ABW
CHKD BY	BMD

MATCHLINE SHEET C60-1

MATCHLINE SHEET C60-3



AS-BUILT DRAWINGS 08/17/09

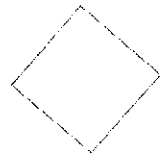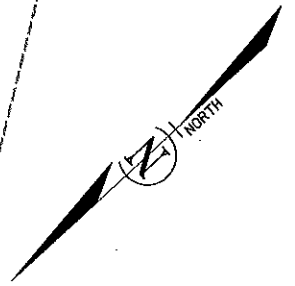

CONSERVATION EASEMENT

CHANNEL PLUG (TYP.)

CHANNEL PLUG (TYP.)
TEE

REMOVE EXISTING
CART PATH

PROPOSED CHANNEL

BUNKER
GREEN
FLOODPLAIN GRADING
LIMITS

ROCK OUTLET
PROTECTION #3

LOG VANE

FLOODPLAIN GRADING
LIMITS

B.M.2
ELEV: 471.14'

NO	REVISIONS	DN	CHK	DATE
1				
2				
3				




LEGEND	
STRUCTURE	
EXISTING CHANNEL	
DESIGN CHANNEL	
CHANNEL PLUG	
WET SWALE	
CONSERVATION EASEMENT	
PROPOSED CONTOUR	
EXISTING CONTOUR	

BADIN INN STREAM RESTORATION	
SITE PLAN, GRADING AND DRAINAGE	
EARTHTECH AECOM	
701 CORPORATE CENTER DRIVE, SUITE 415, RALEIGH, NC 27607 919-854-8200 919-854-8253 1100	
DATE	8/19/2009
PROJECT NO	99255
FILENAME	
SHEET NO	C-3
DRAWN BY	CHKD BY
ABW	BMD

USER: WILSONAB DATE: 8/19/2009 TIME: 5:03:36 PM
DGN: q:\99255\Cadd\plan\sheet\99255_psl_30scale_grading02.dgn




MATCHLINE SHEET C60-2

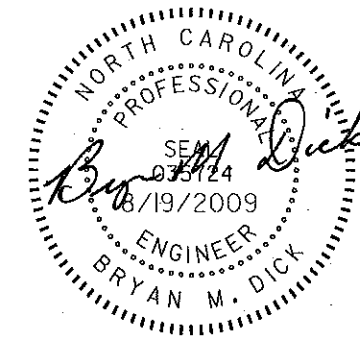

AS-BUILT DRAWINGS 08/17/09

MATCHLINE SHEET C60-4

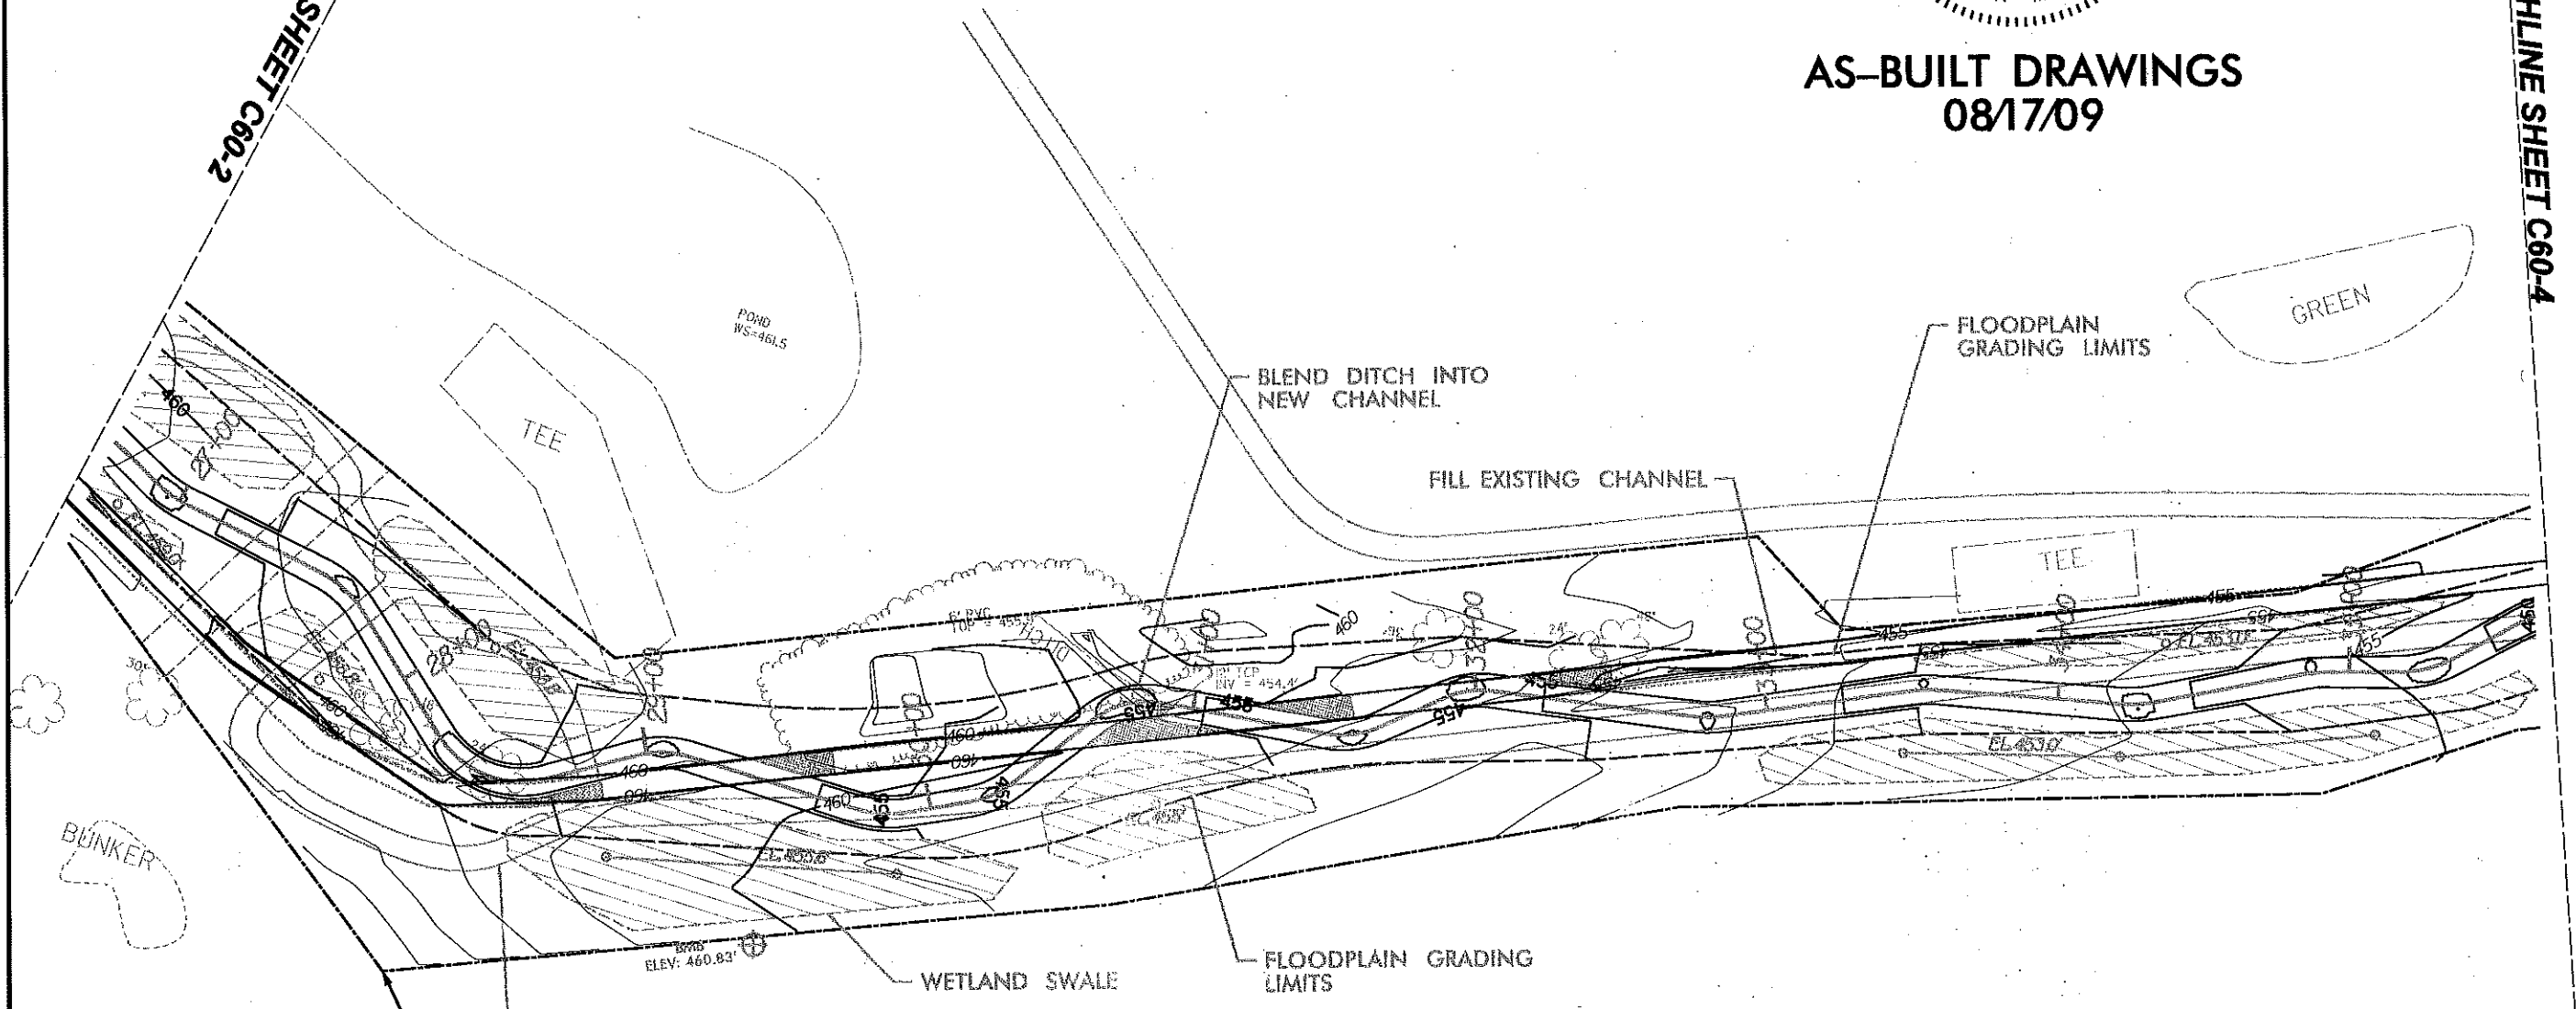

NO	REVISIONS	DRN	CHK	DATE
1				
2				
3				



BADIN INN STREAM RESTORATION
SITE PLAN, GRADING AND DRAINAGE
EARTH TECH | AECOM
701 CORPORATE CENTER DRIVE, SUITE 475, RALEIGH, NC 27607
 919-854-8200 919-854-8229 (fax)


LEGEND	
STRUCTURE	
EXISTING CHANNEL	
DESIGN CHANNEL	
CHANNEL PLUG	
WET SWALE	
CONSERVATION EASEMENT	
PROPOSED CONTOUR	
EXISTING CONTOUR	

DATE	8/19/2009
PROJECT NO	99255
FILENAME	
SHEET NO	C-4
DRAWN BY	ABW
CHKD BY	BMD

USER: WJL50MAB
 DATE: 8/19/2009
 TIME: 5:03:33 PM
 FILE: q:\99255\card\plansheet\99255_psf_30scale_grading03.dgn


MATCHLINE SHEET C60-3

MATCHLINE SHEET C60-5

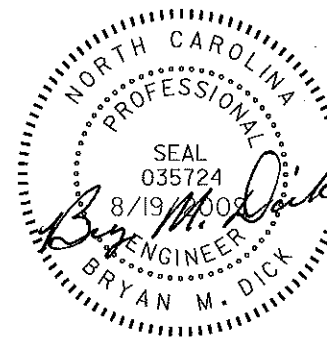

AS-BUILT DRAWINGS 08/17/09

REMOVE EXISTING
CART PATH
NEW CART PATH TO BE
INSTALLED OFF-SITE BY OTHERS

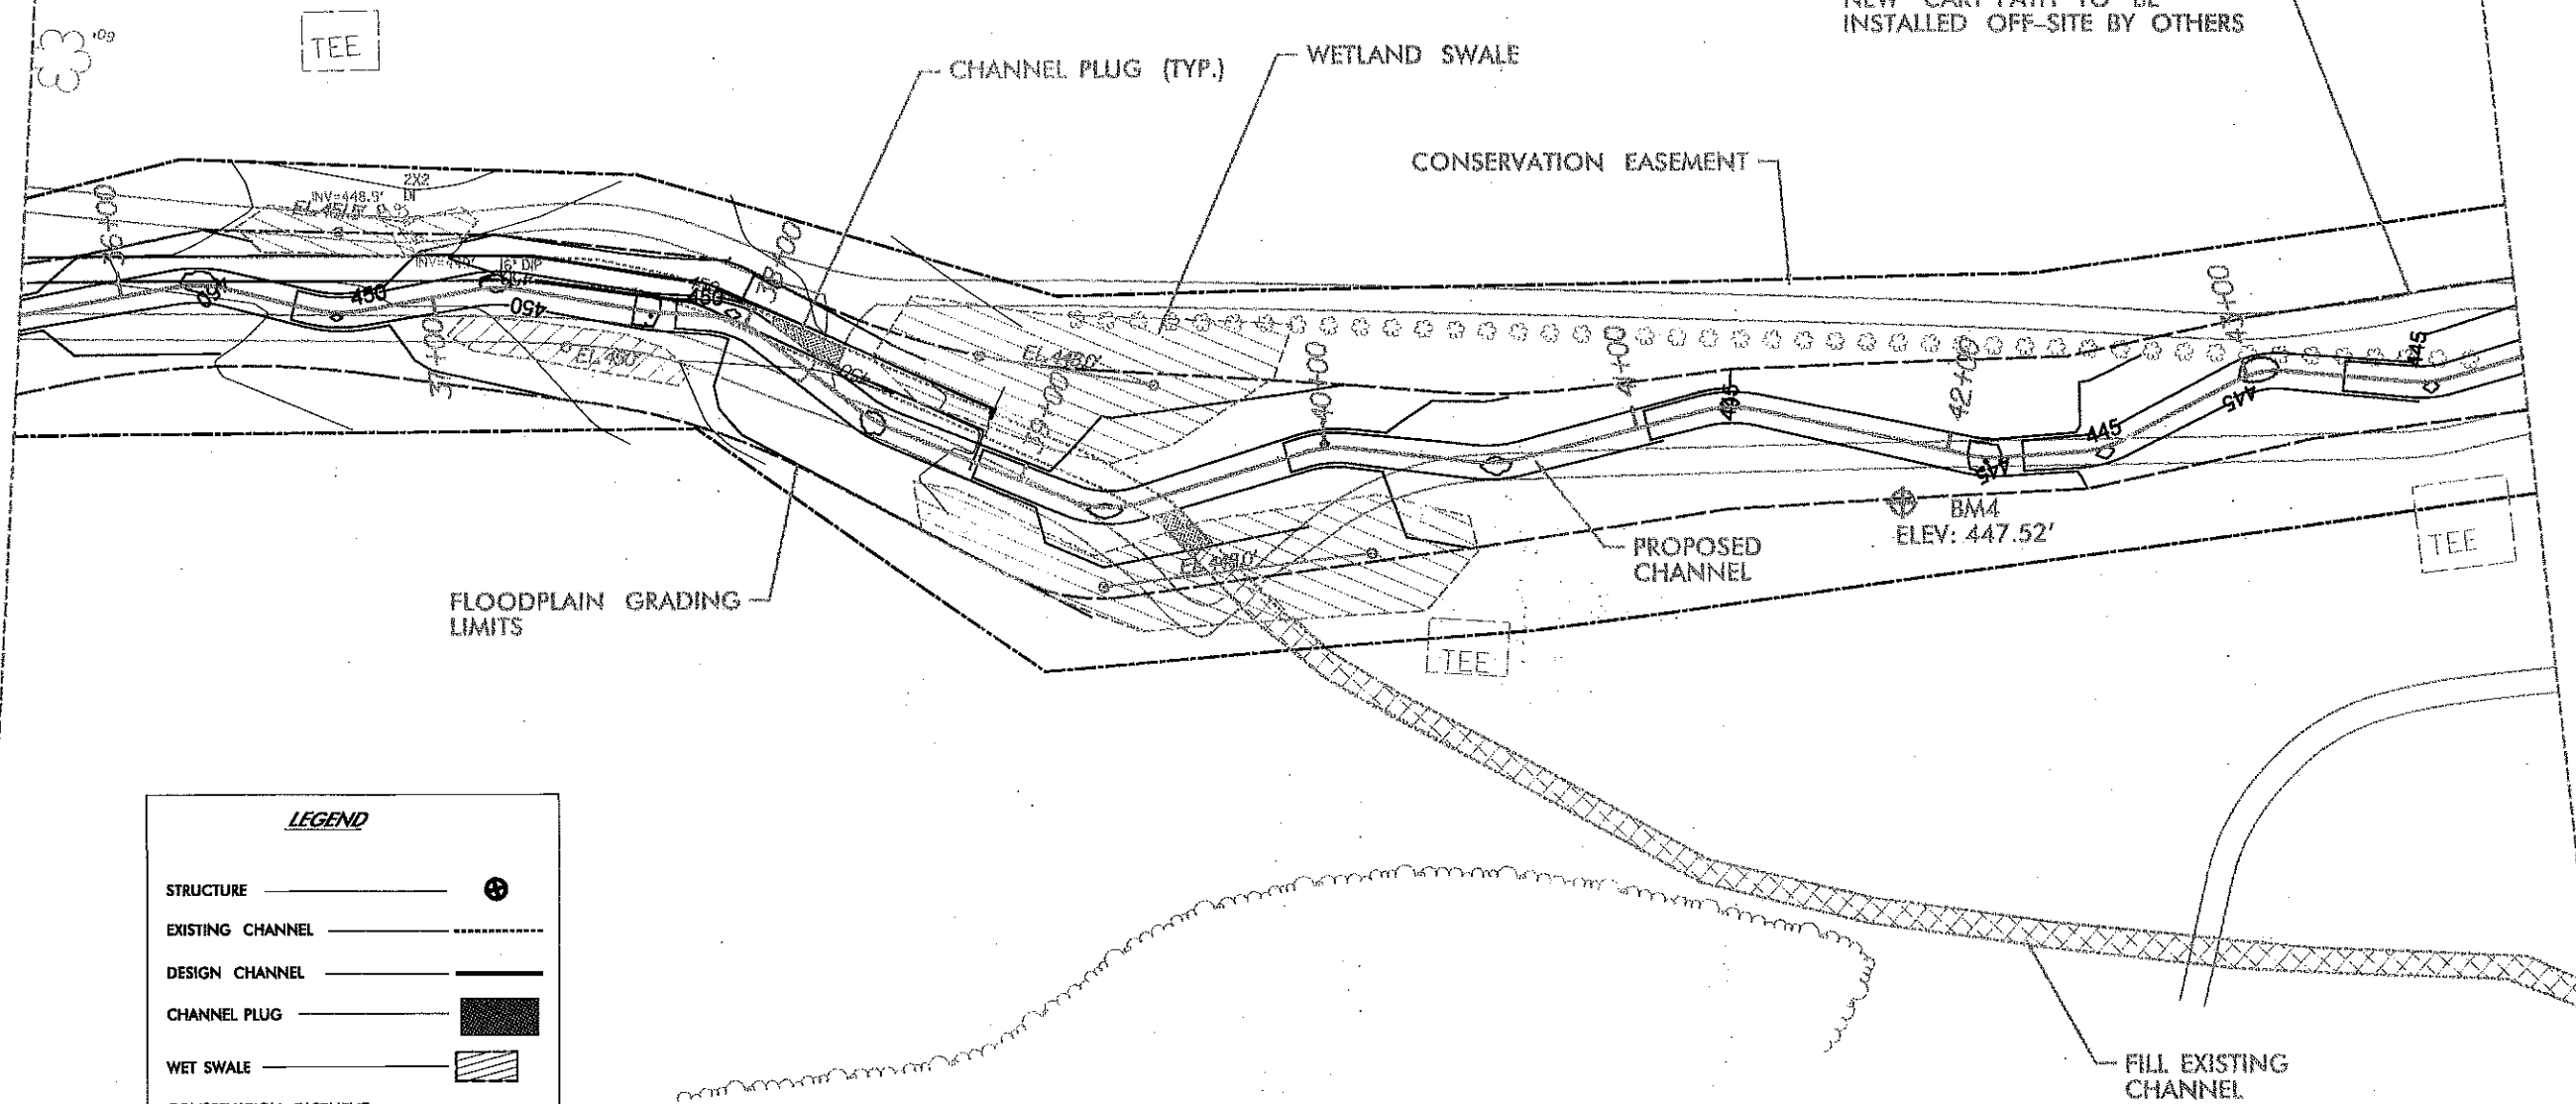

LEGEND

STRUCTURE	
EXISTING CHANNEL	
DESIGN CHANNEL	
CHANNEL PLUG	
WET SWALE	
CONSERVATION EASEMENT	
PROPOSED CONTOUR	
EXISTING CONTOUR	



BADIN INN STREAM RESTORATION
SITE PLAN, GRADING AND DRAINAGE

EARTHTECH | AECOM

701 CORPORATE CENTER DRIVE, SUITE 475, WALESH, NC 27607
315-854-8800 315-854-8259 Fax

DATE	8/19/2009
PROJECT NO	99255
FILENAME	
SHEET NO	C-5
DRAWN BY	ABW
CHKD BY	BMD

NO	REVISIONS	DRN	CHK	DATE
1				
2				
3				


USER: WILSONAB
DGN: c:\99255\cadd\plansheets\99255_pst_30scale_grading04.dgn
DATE: 8/19/2009
TIME: 5:03:30 PM

USER: WILSONAB
 Date: 8/19/2009 5:03:28 PM
 Path: q:\92255\cadd\plansheets\99255_psh_30scale_Grading05.dgn


MATCHLINE SHEET C60-4



END CONSTRUCTION
 -SREV- STA 50+22
 N: 599169.39
 E: 1666742.68

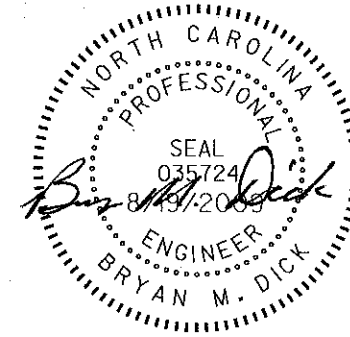


AS-BUILT DRAWINGS
 08/17/09

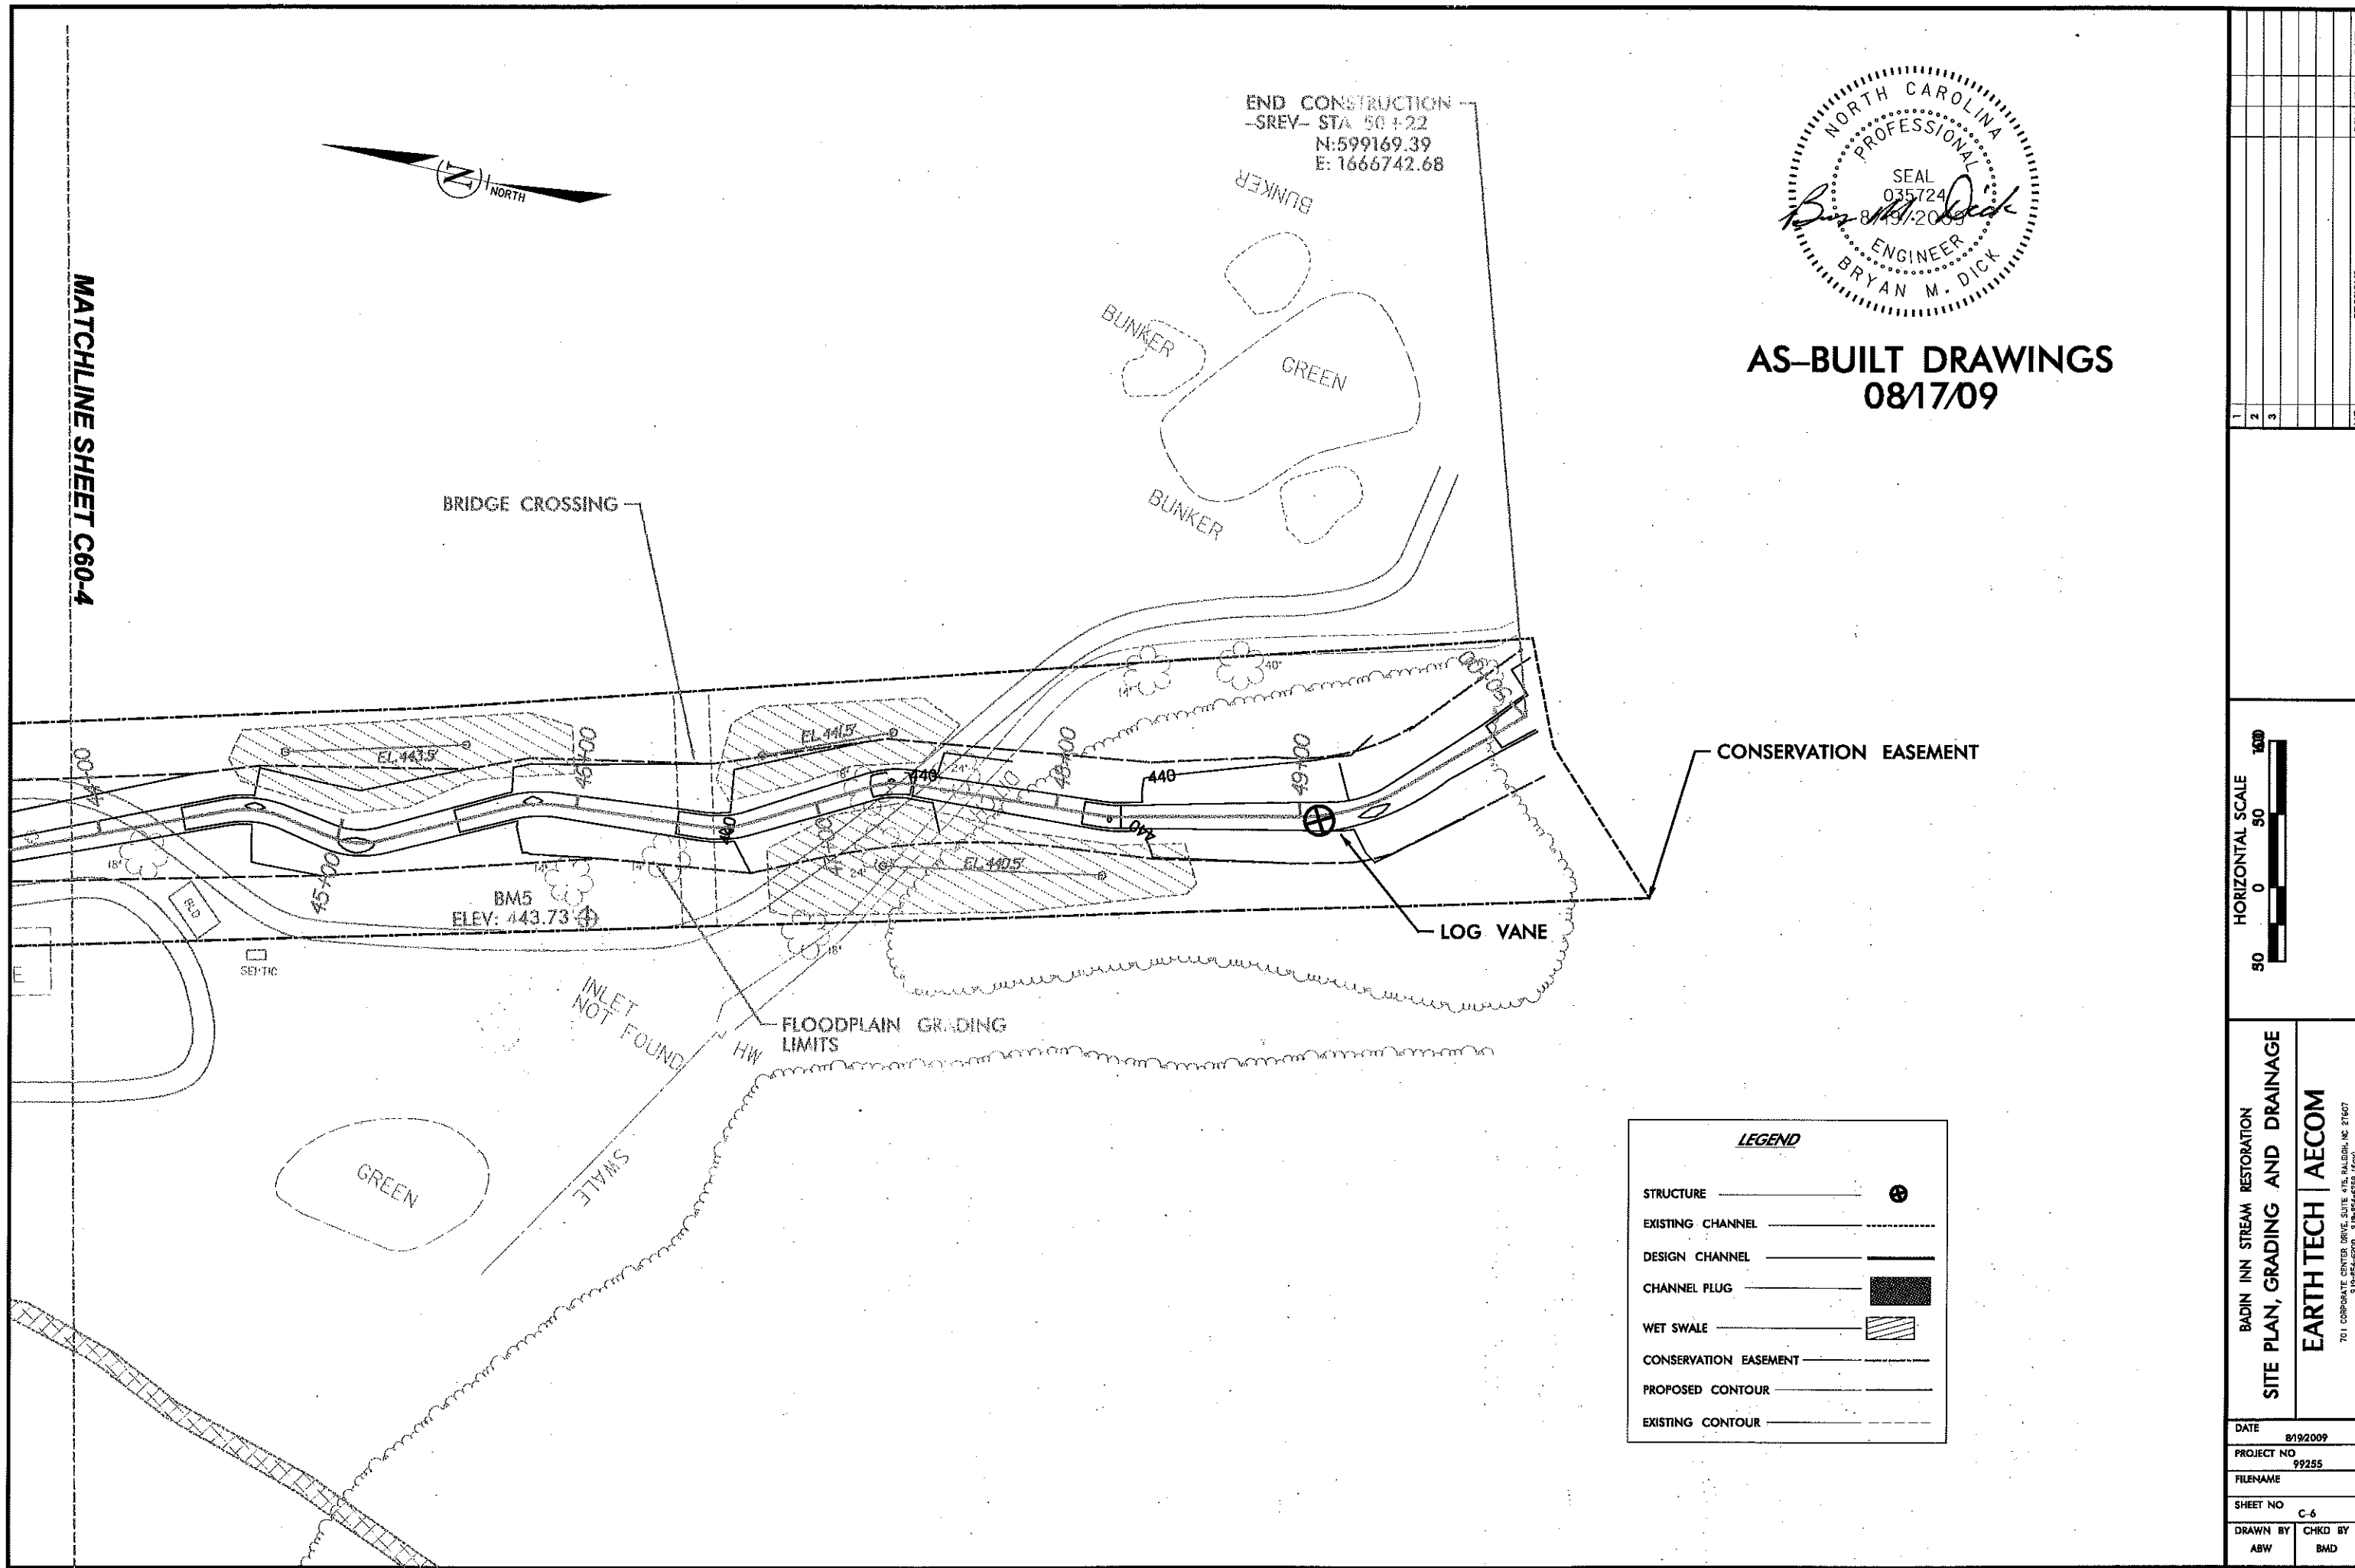

NO	REVISIONS	DRN	CHK	DATE
1				
2				
3				

--	--	--	--	--

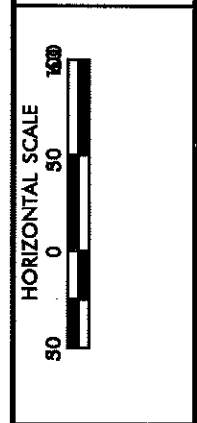




BADIN INN STREAM RESTORATION
 SITE PLAN, GRADING AND DRAINAGE
 EARTH TECH | AECOM
 701 CORPORATE CENTER DRIVE, SUITE 410, RALEIGH, NC 27607
 919-851-6600 ETP@ET-AECOM.COM

LEGEND

STRUCTURE	
EXISTING CHANNEL	
DESIGN CHANNEL	
CHANNEL PLUG	
WET SWALE	
CONSERVATION EASEMENT	
PROPOSED CONTOUR	
EXISTING CONTOUR	


DATE	8/19/2009
PROJECT NO	99255
FILENAME	
SHEET NO	C-6
DRAWN BY	ABW
CHKD BY	BMD

USER: WILSONAB
 DATE: 8/19/2009
 TIME: 5:03:26 PM

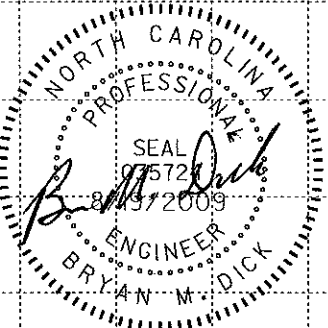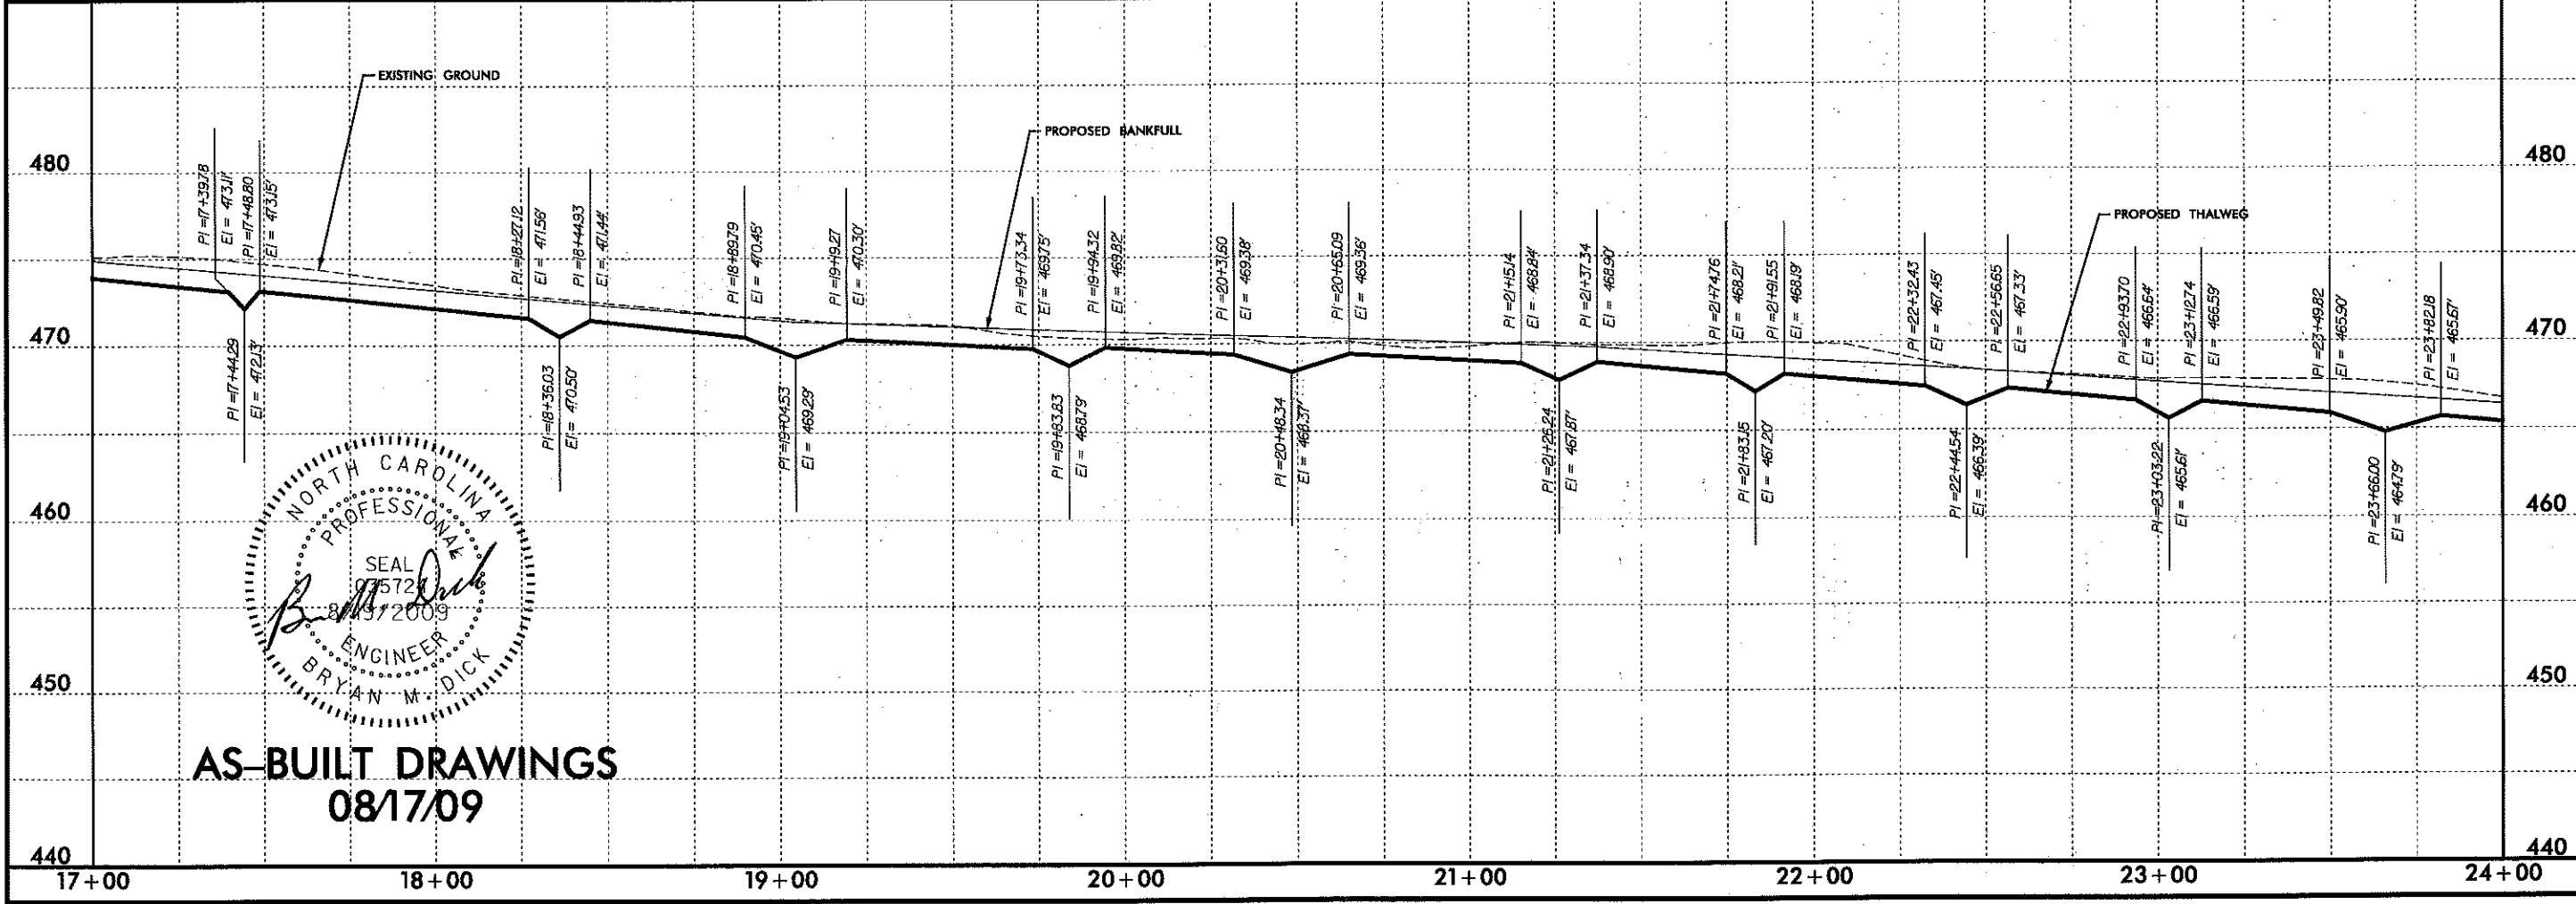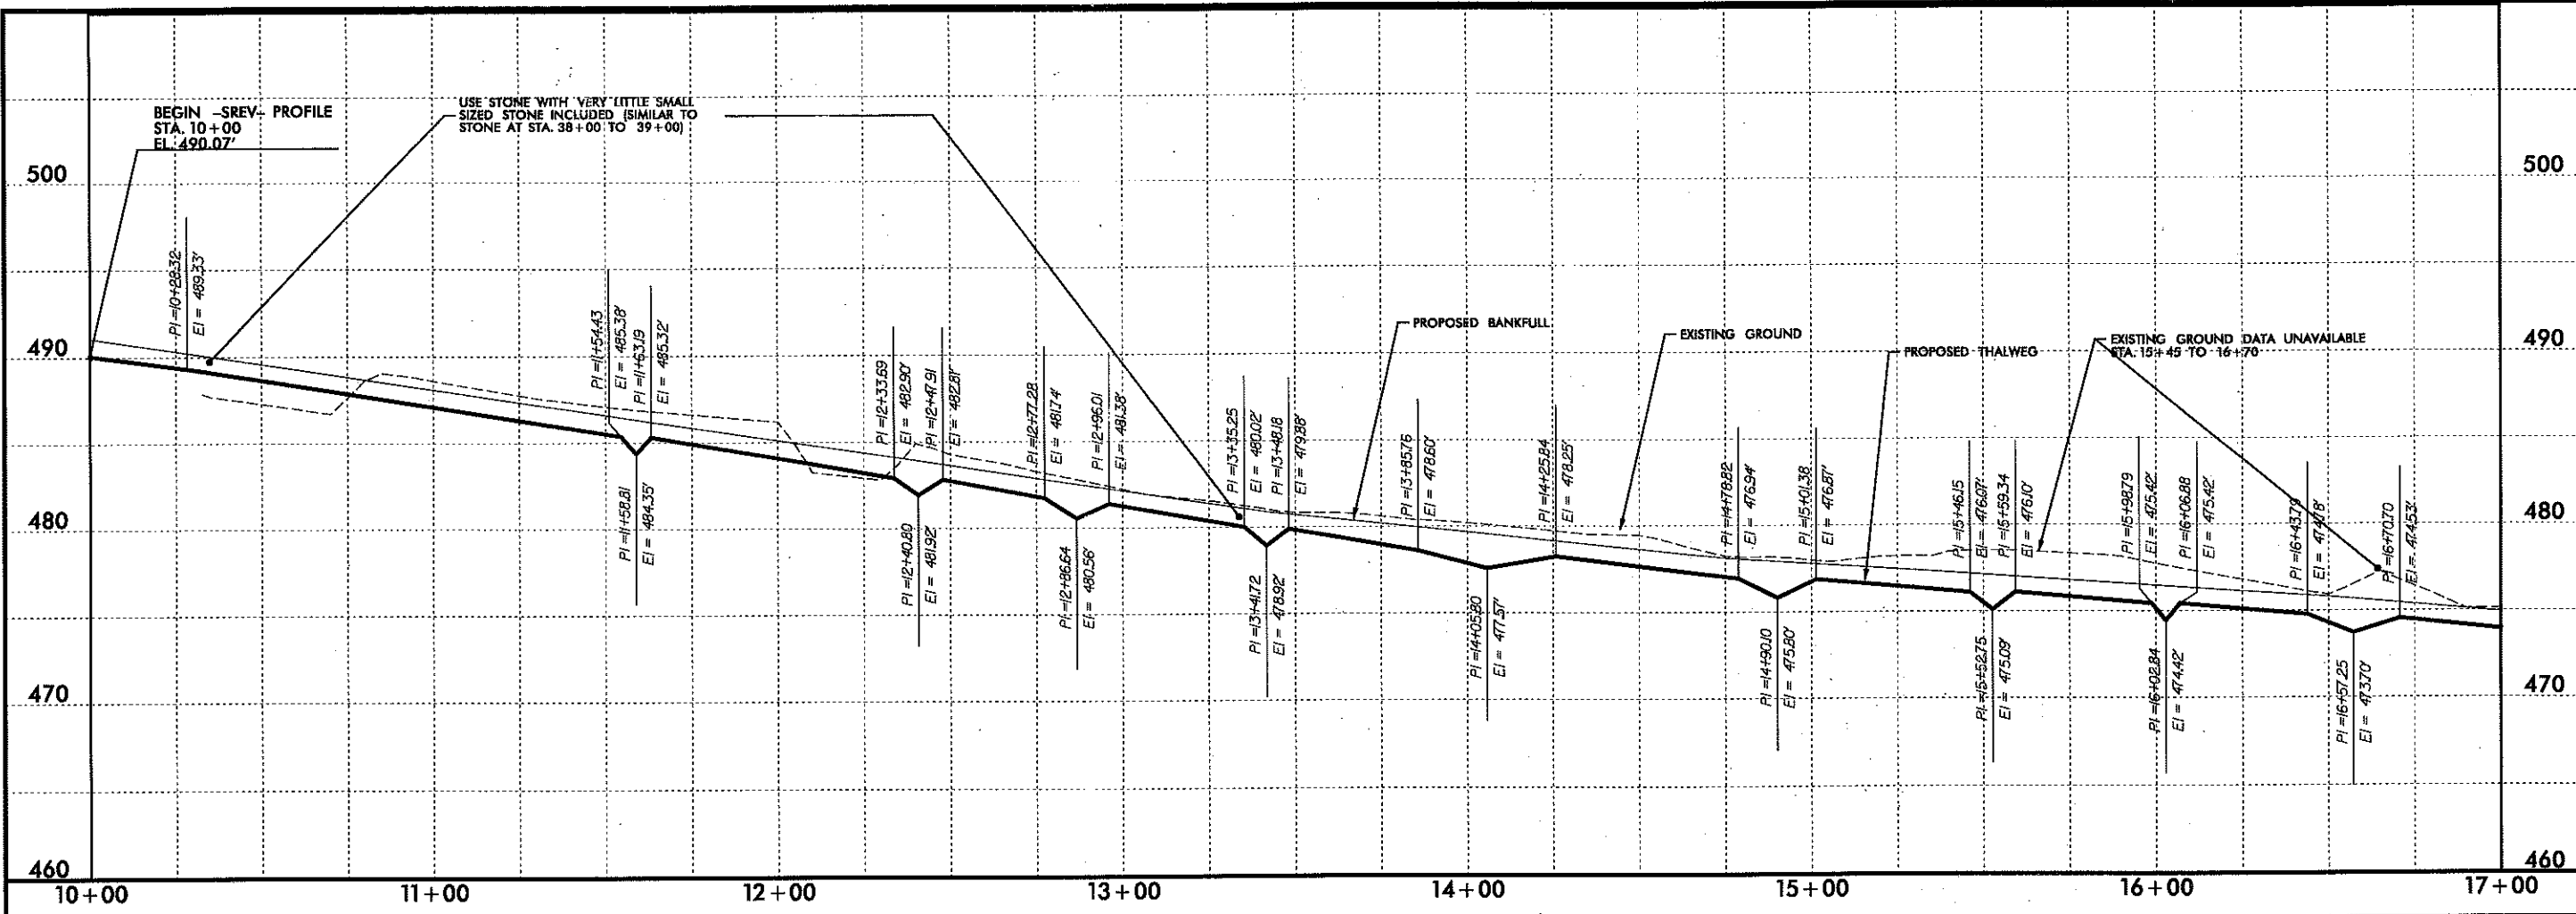

AS-BUILT DRAWINGS
08/17/09

NO	REVISIONS	CHK	DATE
1			
2			
3			

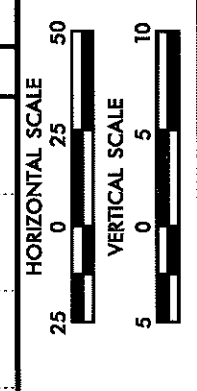



BADIN INN STREAM RESTORATION
PROPOSED CHANNEL PROFILE

EARTH TECH | AECOM


701 CORPORATE CENTER DRIVE, SUITE 415, RALEIGH, NC 27607
 919-851-6200 919-851-6259 (fax)

DATE	8/19/2009
PROJECT NO	99255
FILENAME	
SHEET NO	C-7
DRAWN BY	ICJ
CHKD BY	JWI


DATE: 8/19/2009
 TIME: 5:03:24 PM
 USER: WILSONAB
 DSN: q:\9255\cadd\plansheets\99255_psh_C-06_Profile.dgn

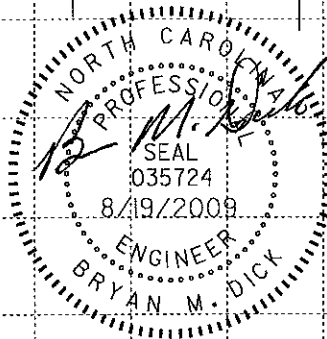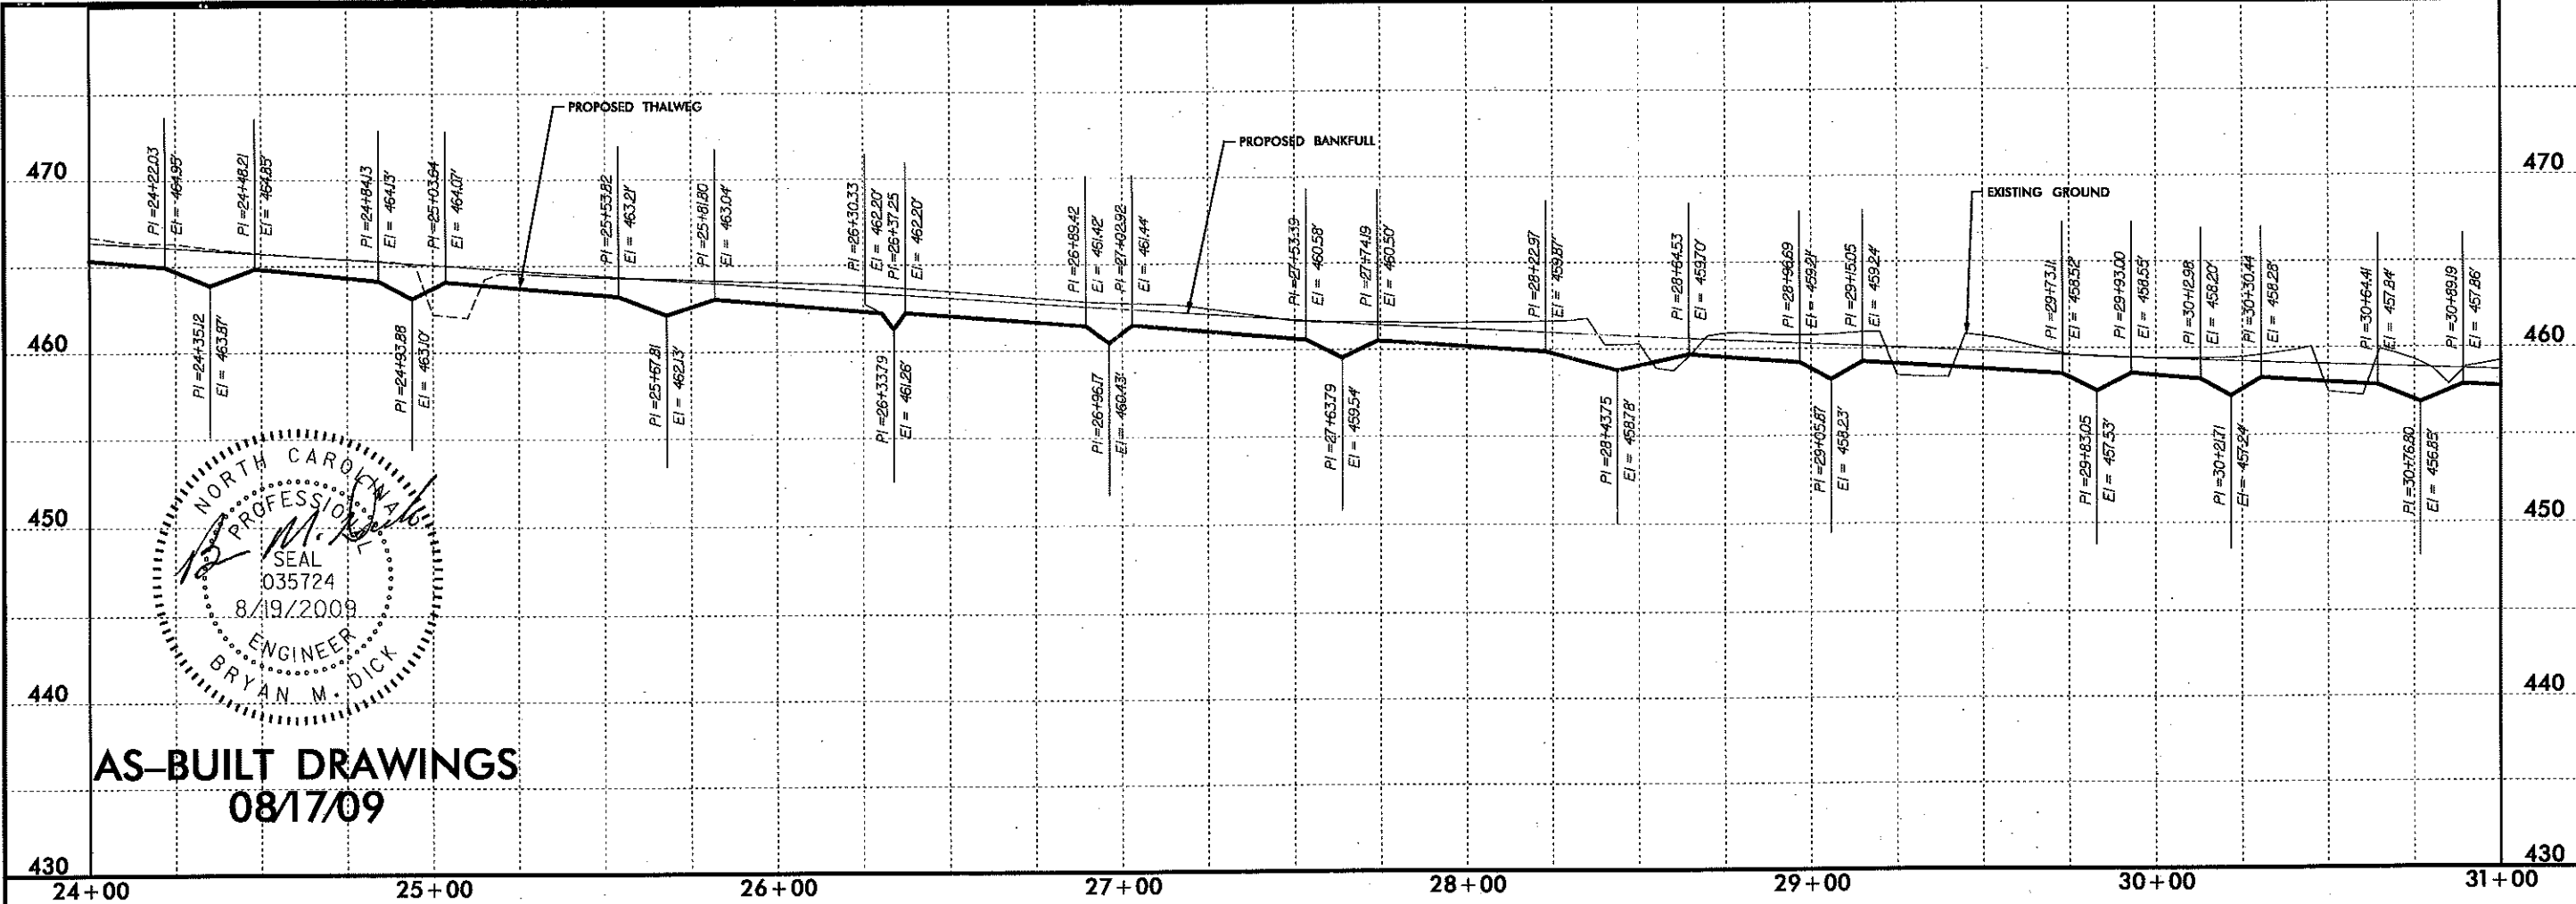

AS-BUILT DRAWINGS
08/17/09

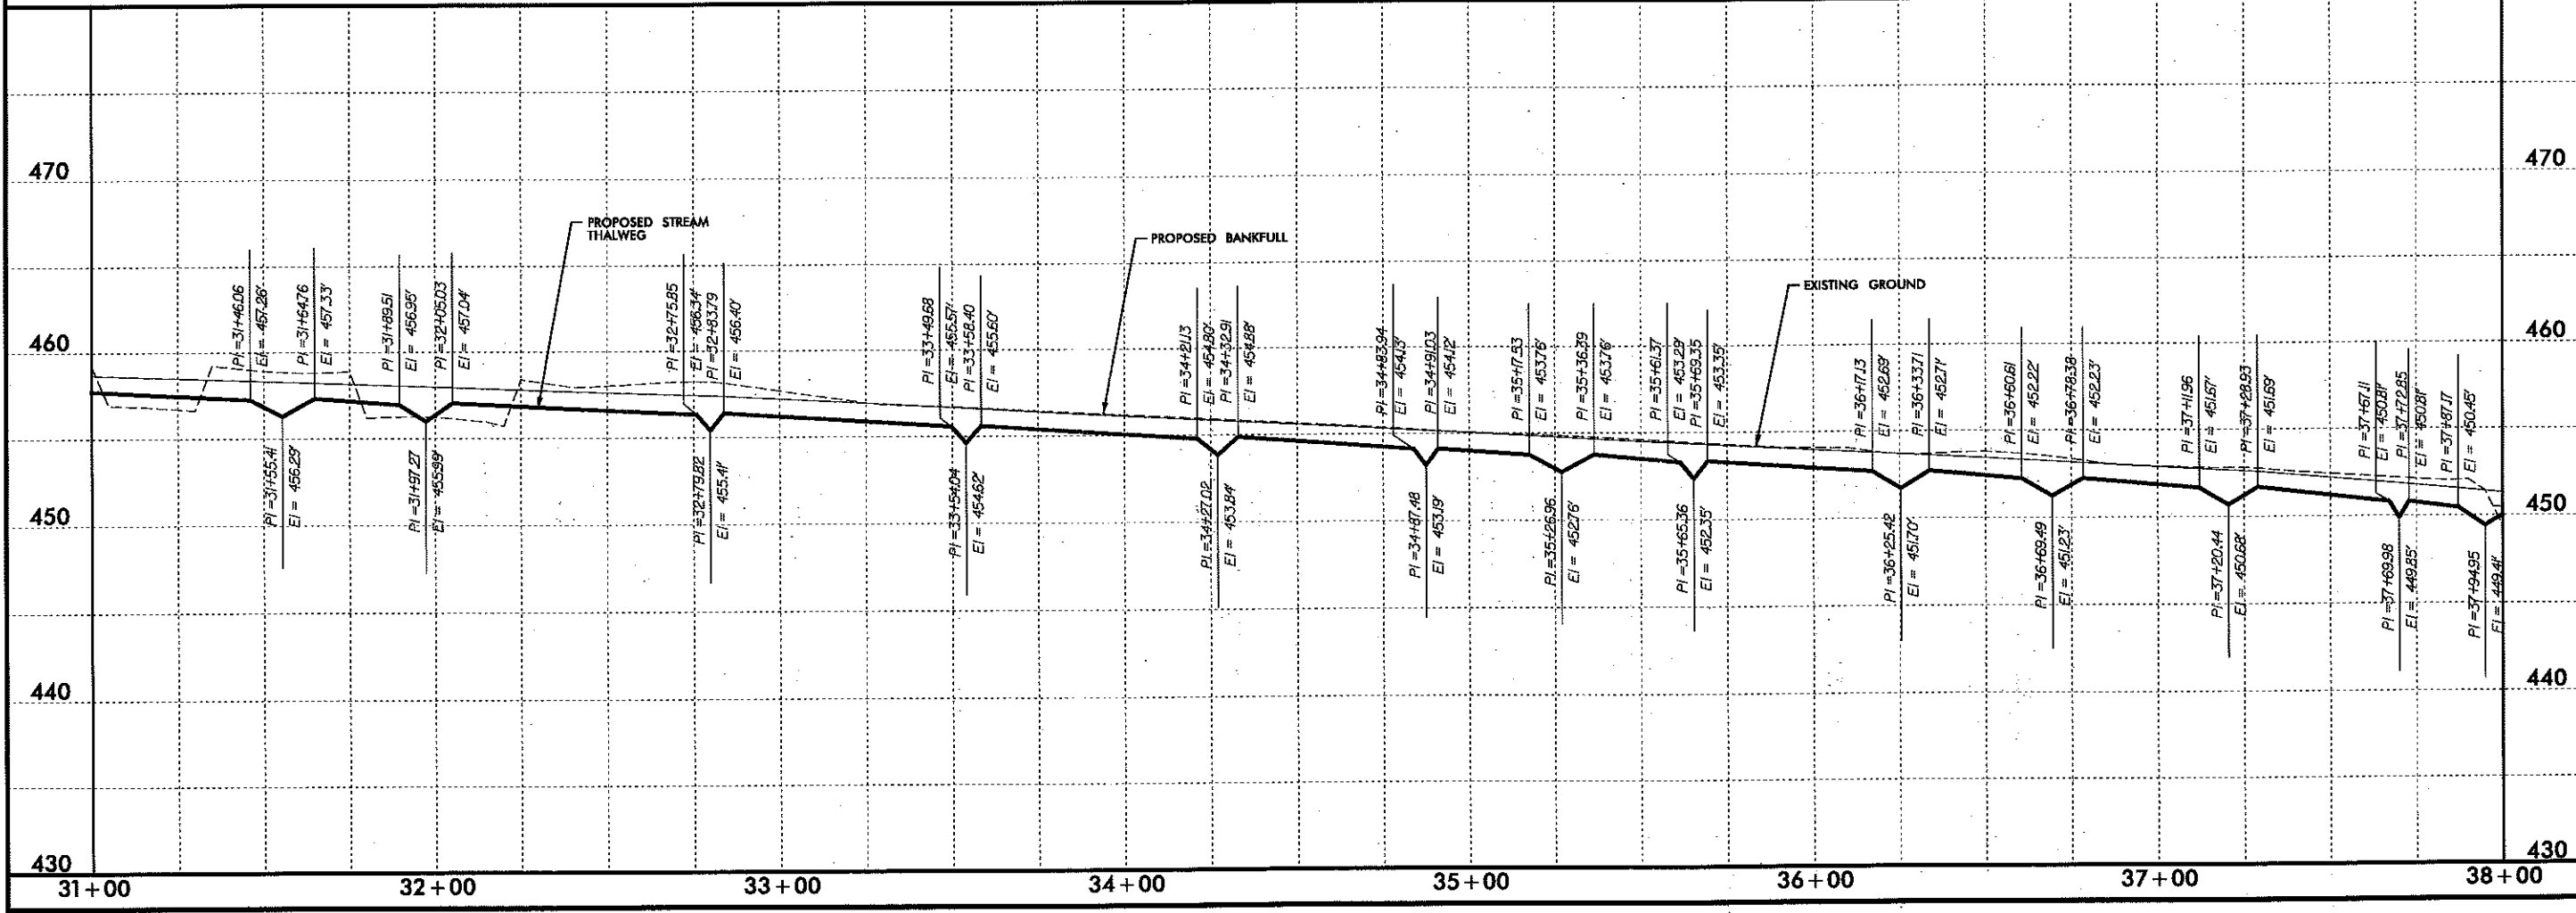

NO	REVISIONS	DRN	CHK	DATE
1				
2				
3				

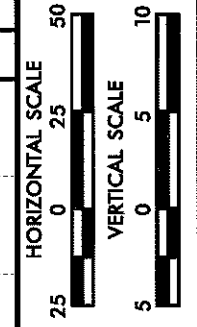



BADIN INN STREAM RESTORATION
PROPOSED CHANNEL PROFILE

EARTH TECH | AECOM



101 CORPORATE CENTER DRIVE, SUITE 415, RALEIGH, NC 27607
 919-851-6200 919-851-6289 (fax)

DATE	8/19/2009
PROJECT NO	99255
FILENAME	
SHEET NO	C-8
DRAWN BY	ICJ
CHKD BY	JWJ

USER: WILSONAB DATE: 8/19/2009
 DSN: 09255\acad\plansheets\99255_psh_C-07_Prf\file.dgn TIME: 5:03:18 PM

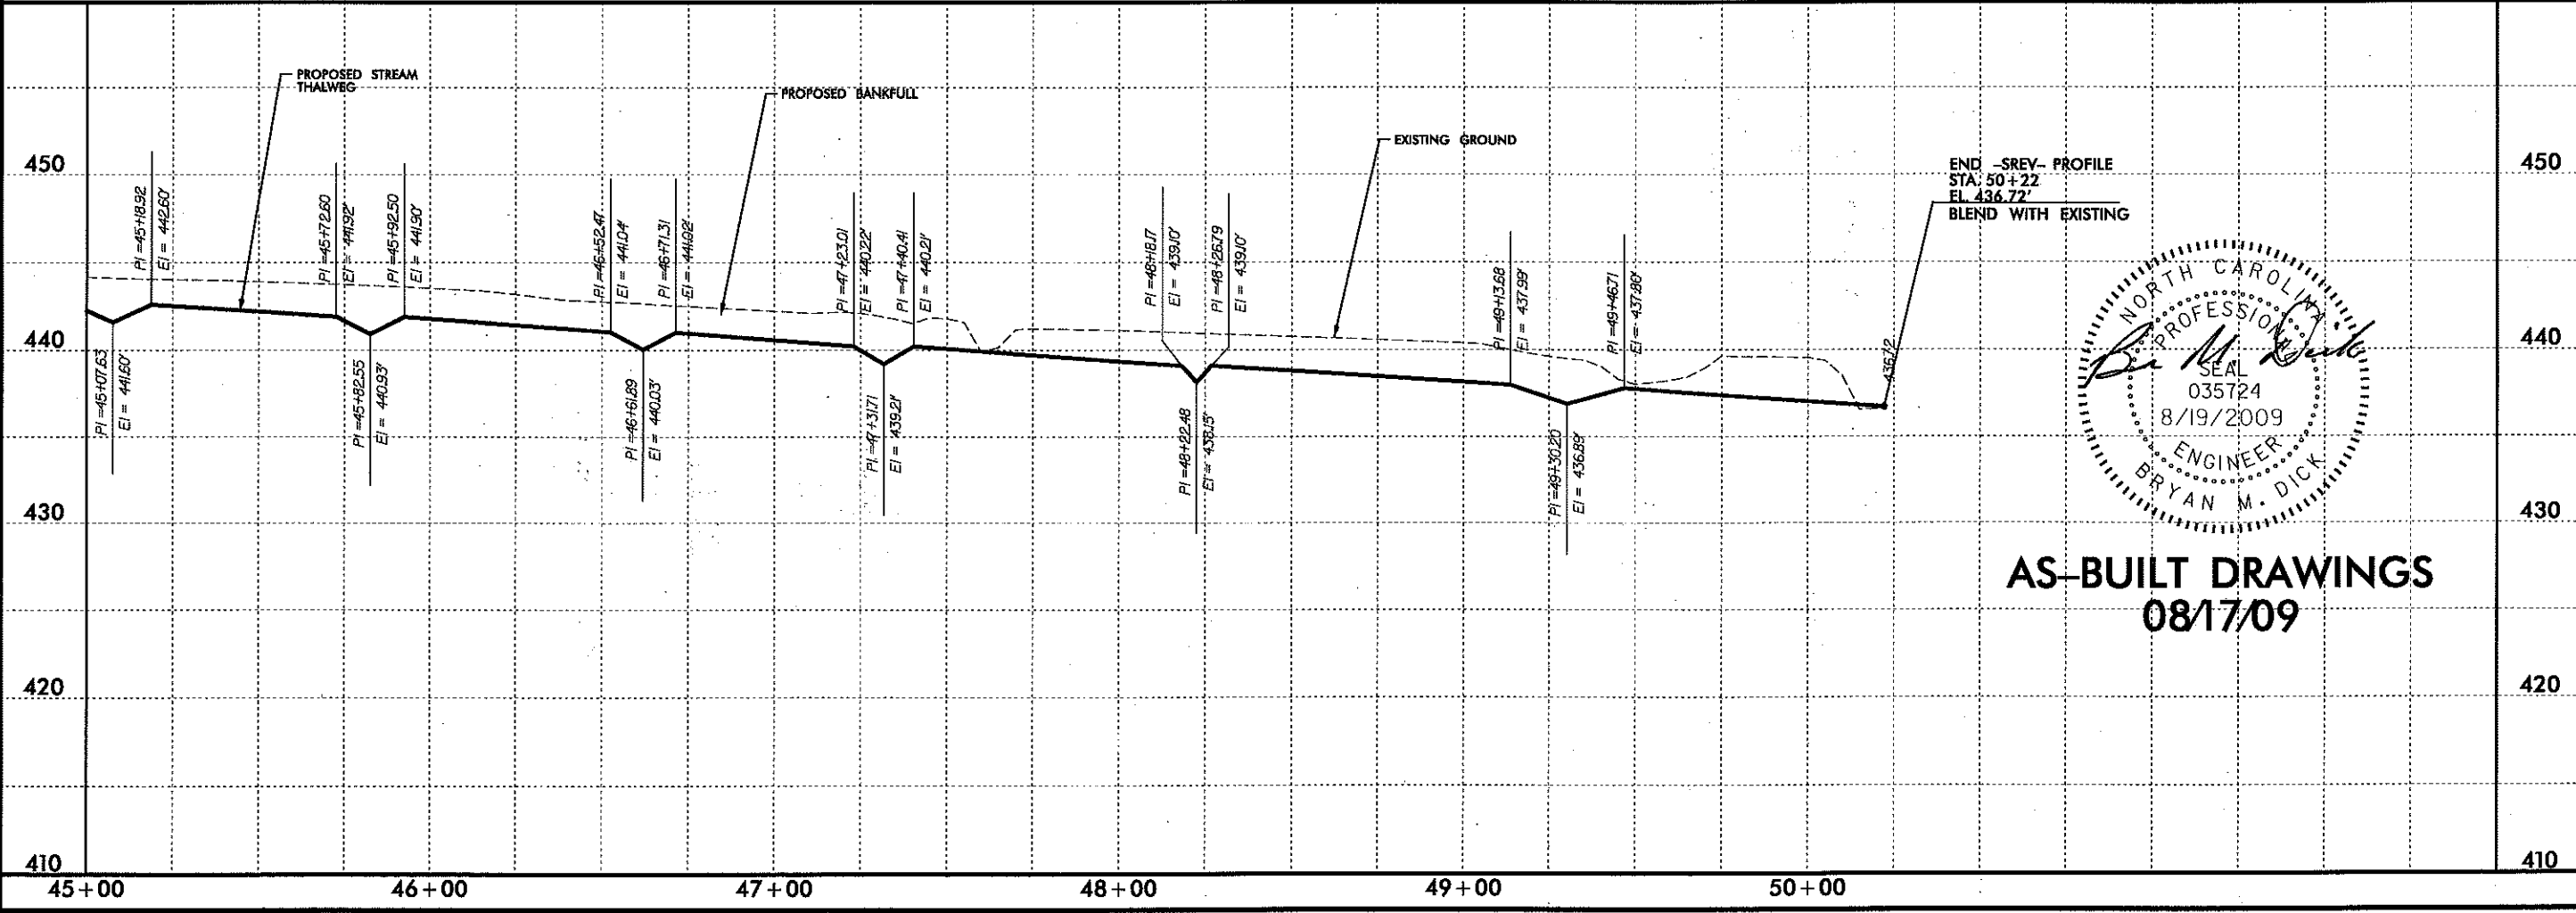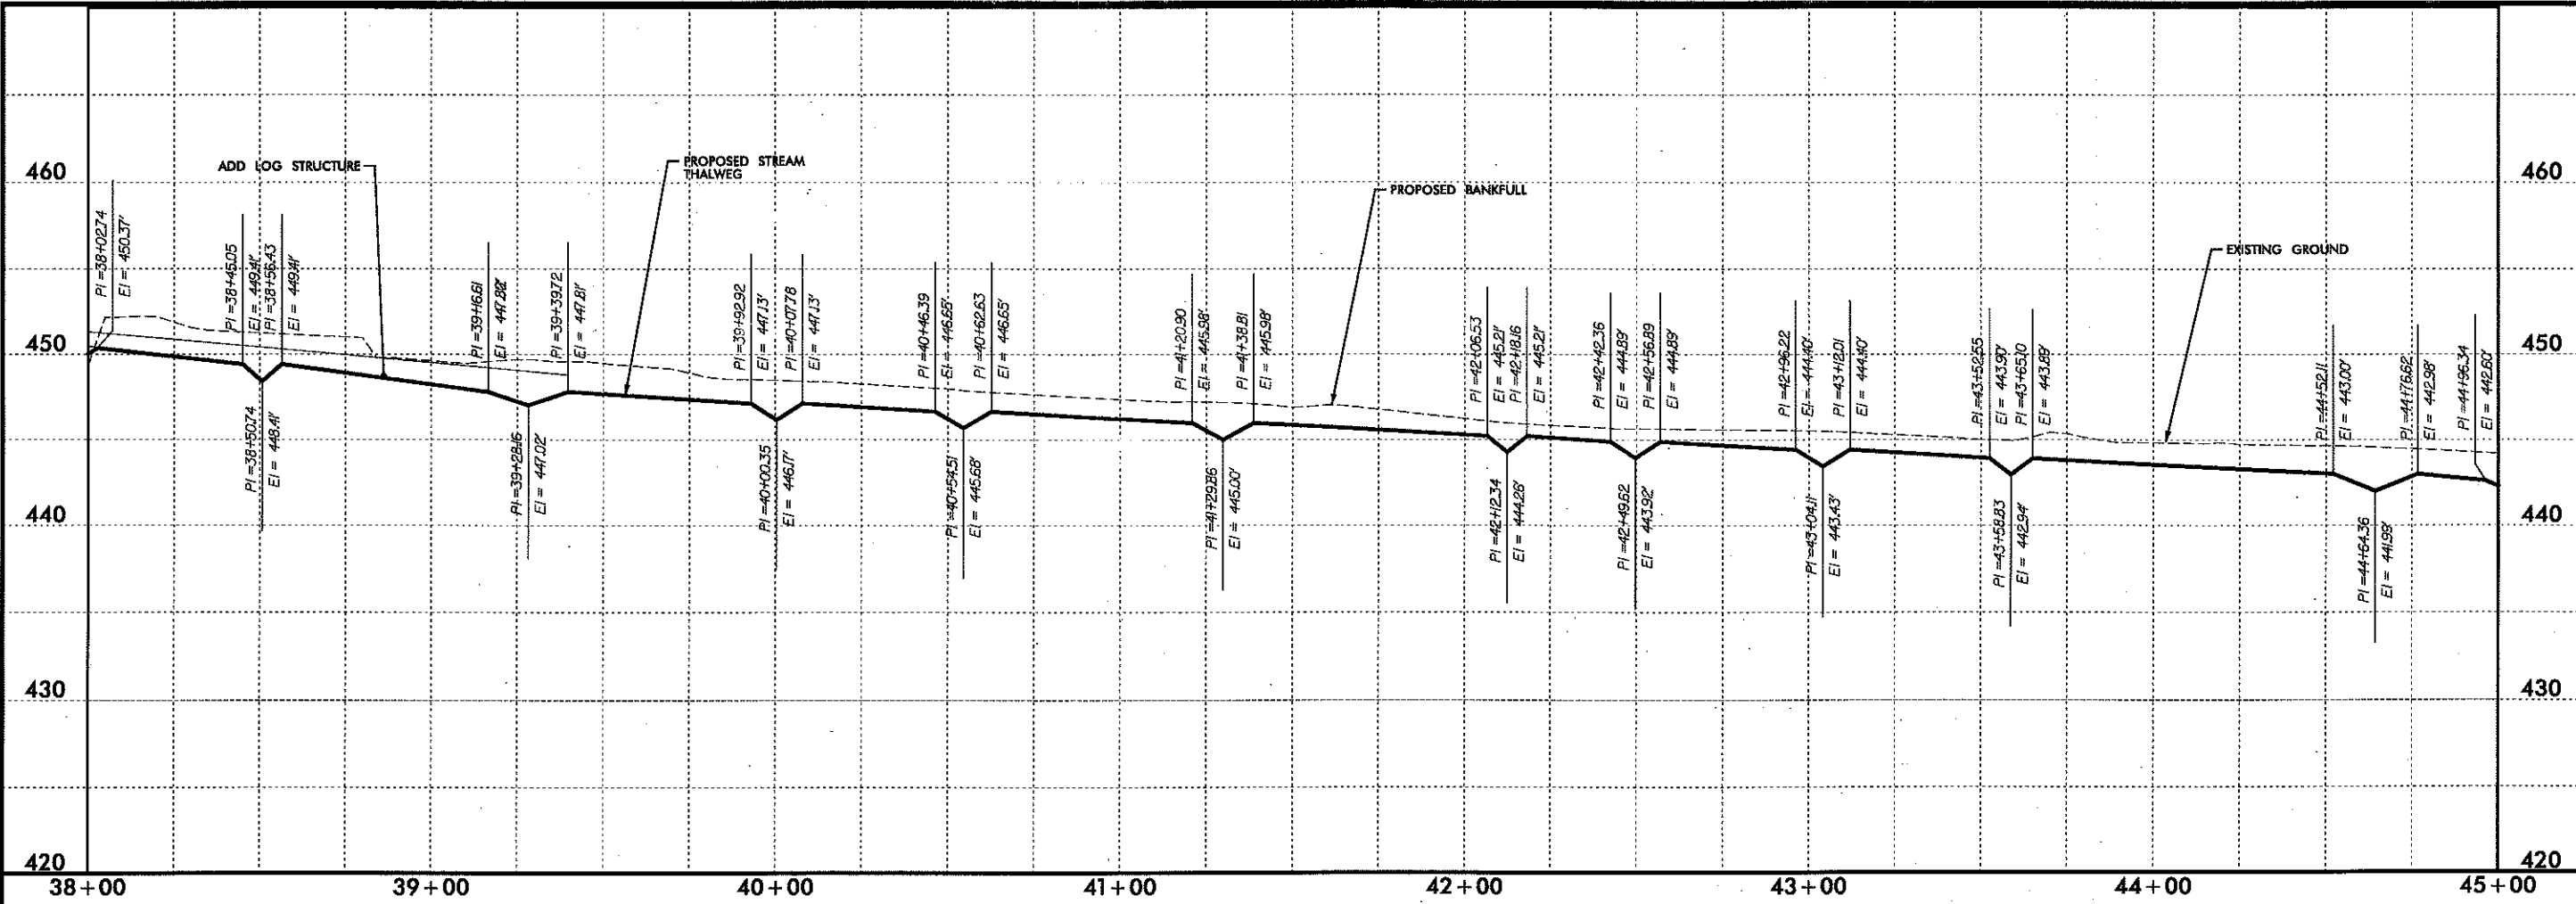



NO	REVISIONS	DWN	CHK	DATE
1				
2				
3				

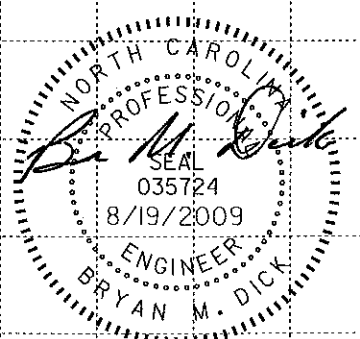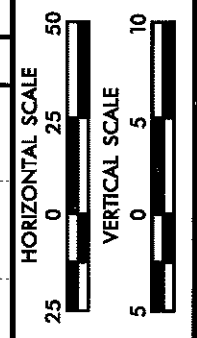

AS-BUILT DRAWINGS
08/17/09


BADIN INN STREAM RESTORATION	
PROPOSED CHANNEL PROFILE	
EARTH TECH AECOM	
DATE	8/19/2009
PROJECT NO	99255
FILENAME	
SHEET NO	C-9
DRAWN BY	ICJ
CHKD BY	JWJ

USER: WILSONAB DSN: q:\99255\cadd\plansheets\99255_psl_c-08_Profile.dgn DATE: 8/19/2009 TIME: 5:03:46 PM

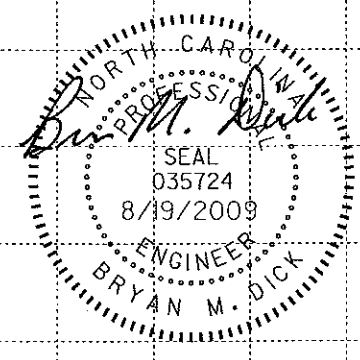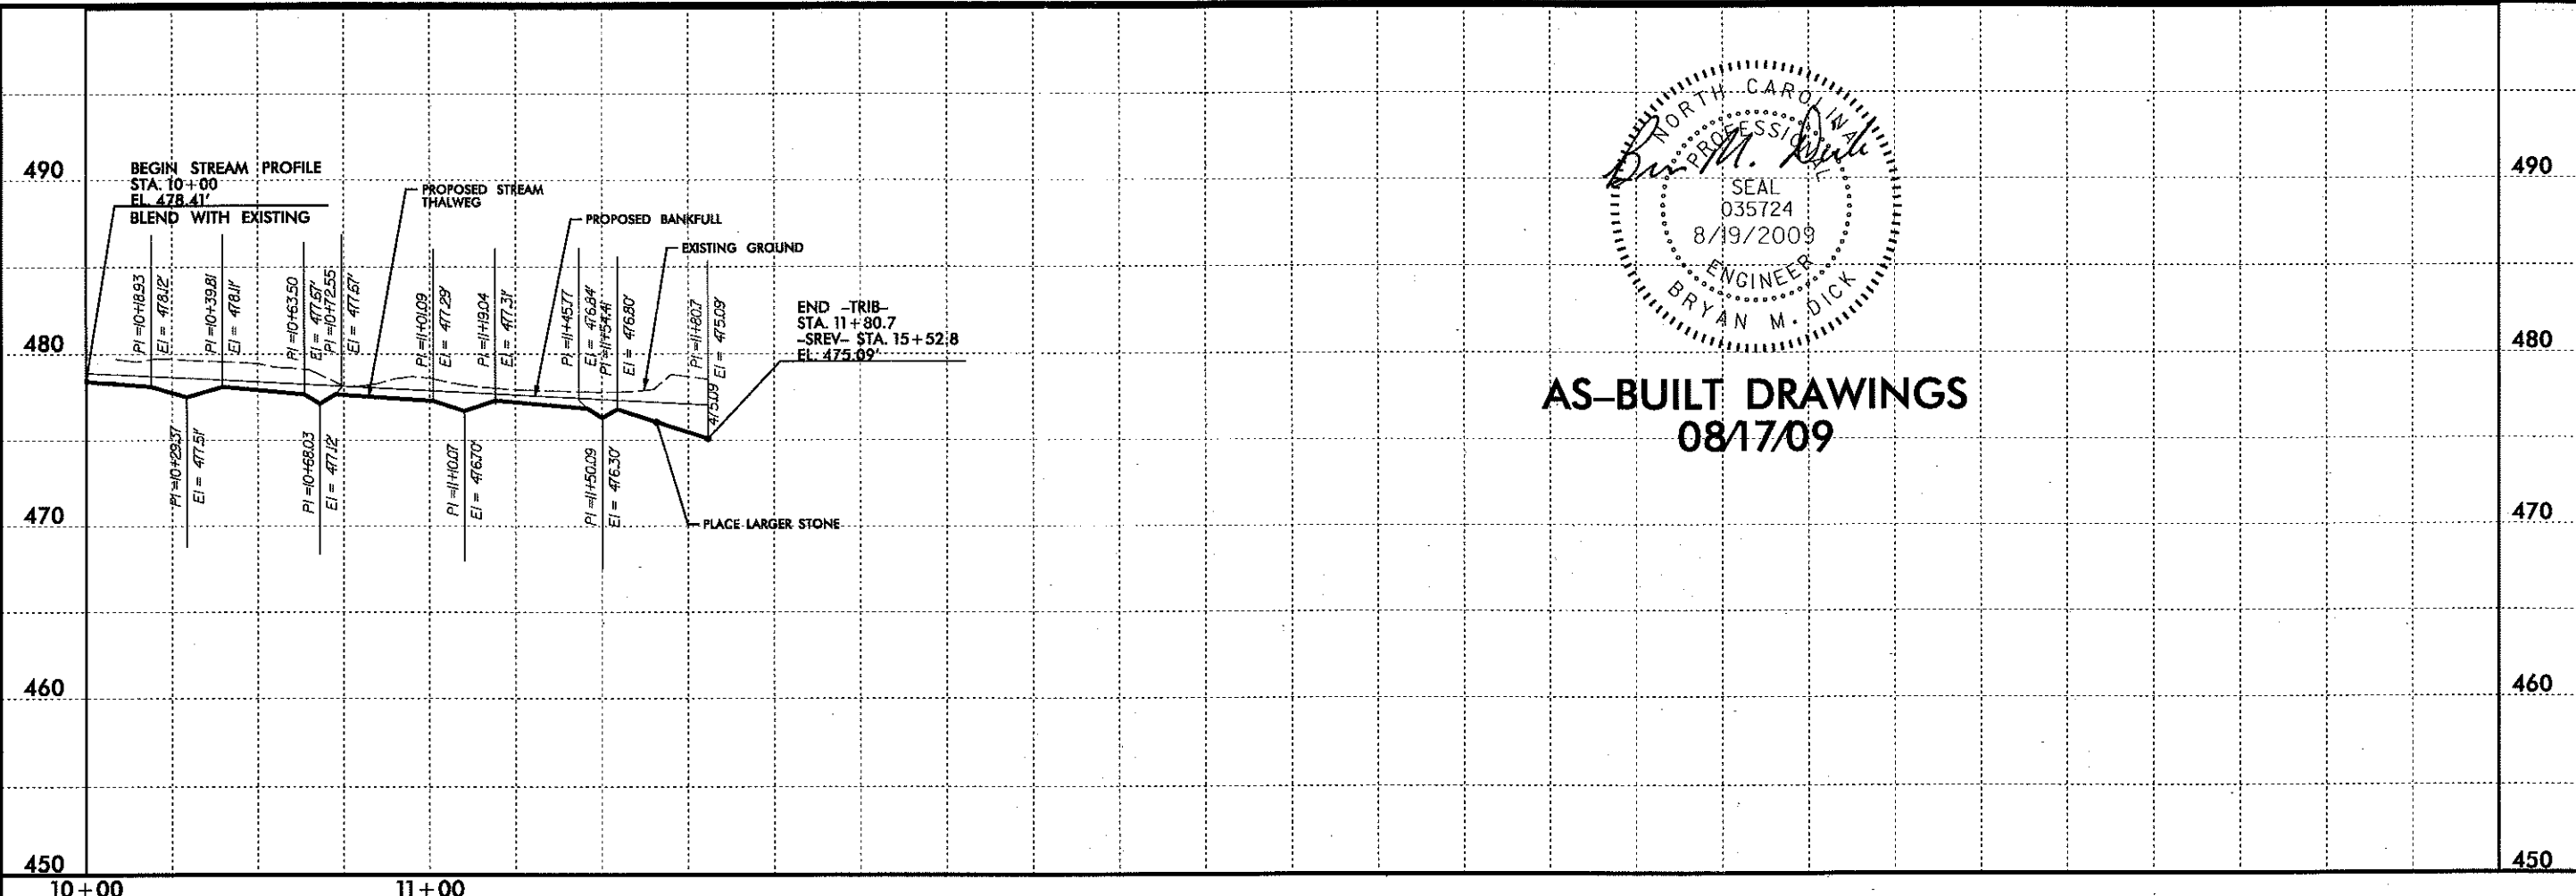

AS-BUILT DRAWINGS
08/17/09

NO	REVISIONS	DRN	CHK	DATE
1				
2				
3				

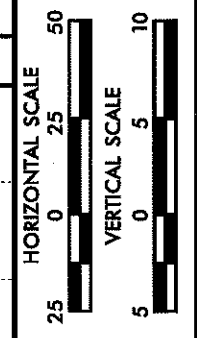


BADIN INN STREAM RESTORATION
PROPOSED CHANNEL PROFILE

EARTHTECH | AECOM
701 CORPORATE CENTER DRIVE, SUITE 415, RALEIGH, NC 27607
919-981-6200 919-981-6258 Fax

DATE	8/19/2009
PROJECT NO	99255
FILENAME	
SHEET NO	C-10
DRAWN BY	ICJ
CHKD BY	JWJ


DATE: 8/19/2009
 USER: WILSONAB
 DGN: q:\9255\cadd\plan\shelr\99255_psh_c-09_typical cross section.dgn 5:03:41 PM

☉ = THALWEG LOCATION

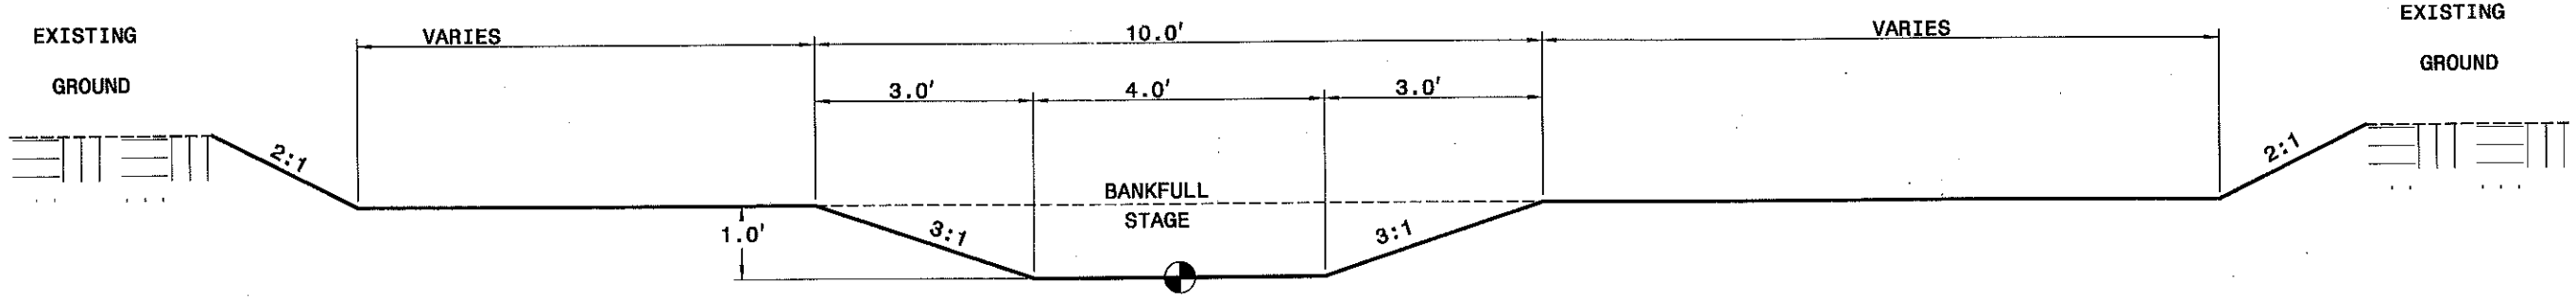

TYPICAL SECTION -SREV-


RIFFLE

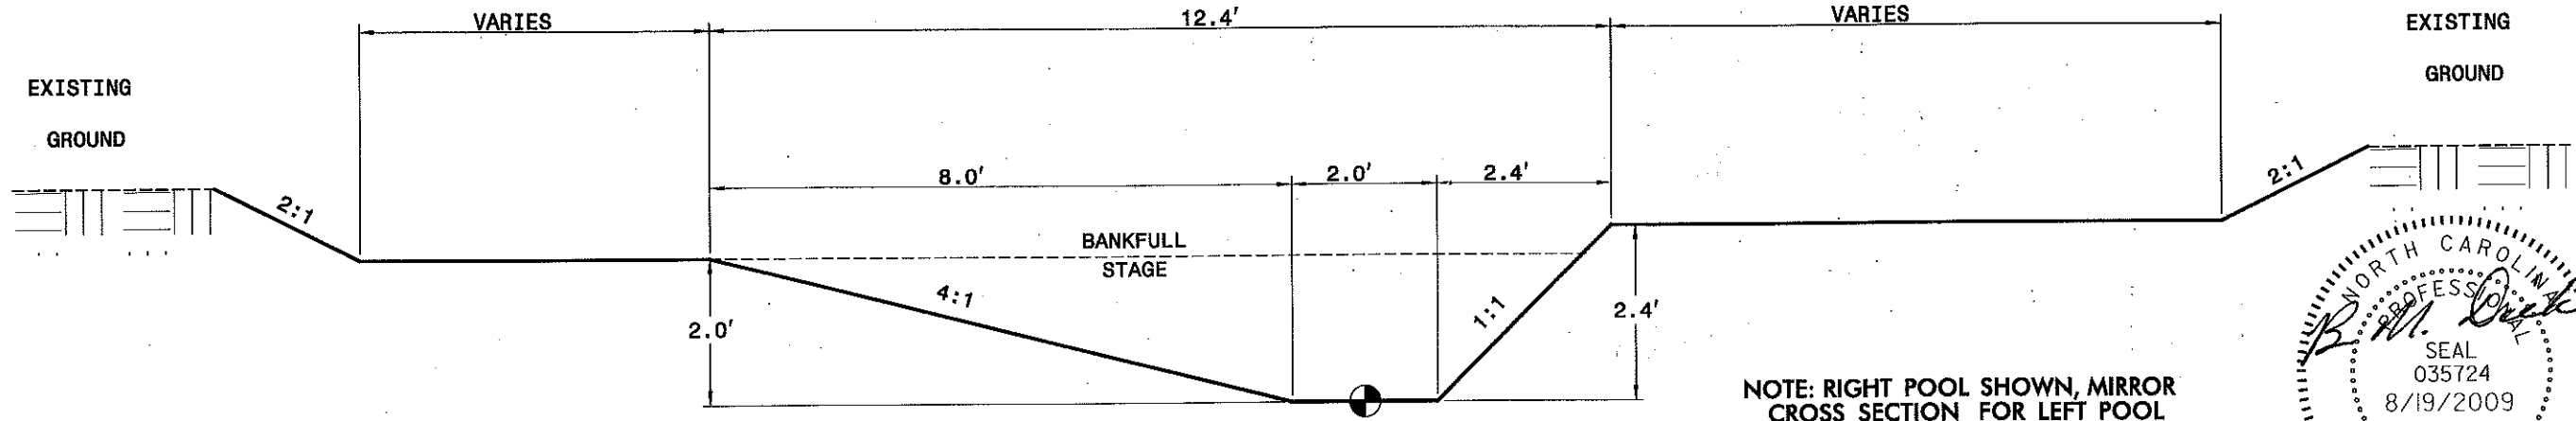


TYPICAL SECTION -SREV-

POOL

NOTE: RIGHT POOL SHOWN, MIRROR CROSS SECTION FOR LEFT POOL

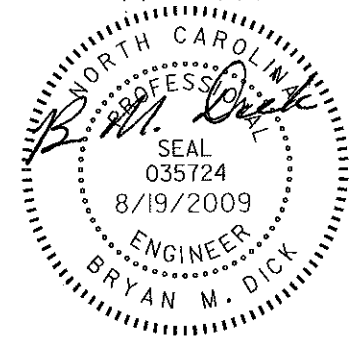


AS-BUILT DRAWINGS
 08/17/09

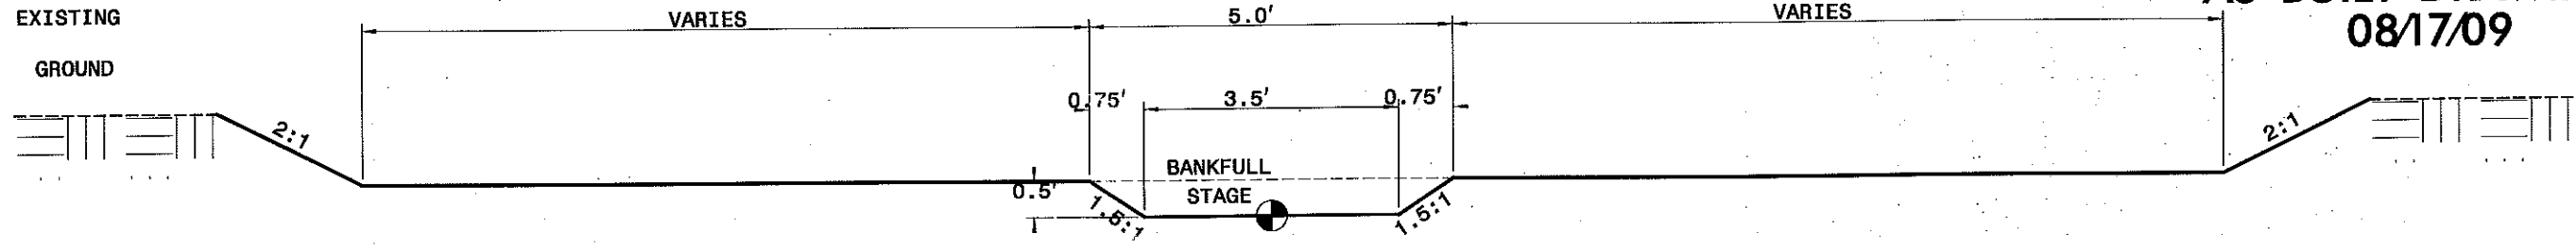

TYPICAL SECTION -TRIB-

RIFFLE

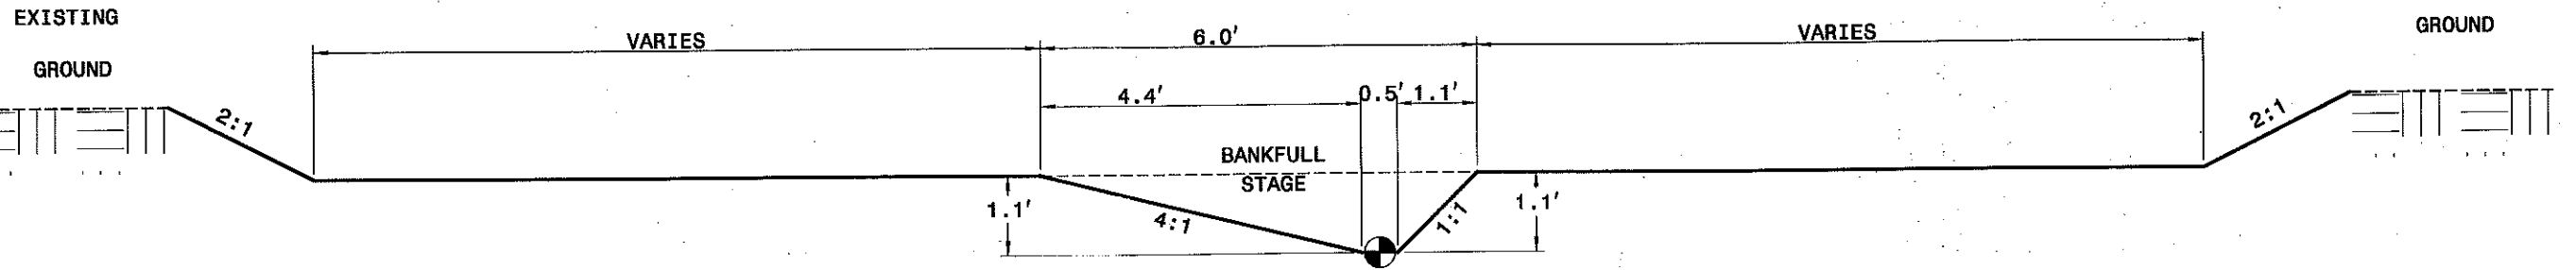

TYPICAL SECTION -TRIB-


POOL

NOTE: RIGHT POOL SHOWN, MIRROR CROSS SECTION FOR LEFT POOL

NO	REVISIONS	CHK	DATE
1			
2			
3			

BADIN INN STREAM RESTORATION
 TYPICAL CROSS SECTIONS
 EARTHTECH | AECOM
 701 CORPORATE CENTER DRIVE, SUITE 4705, RALEIGH, NC 27607
 919-854-6200 919-854-6255 (FAX)



DATE	8/19/2009
PROJECT NO	99255
FILENAME	
SHEET NO	C-11
DRAWN BY	ICJ
CHKD BY	BMD

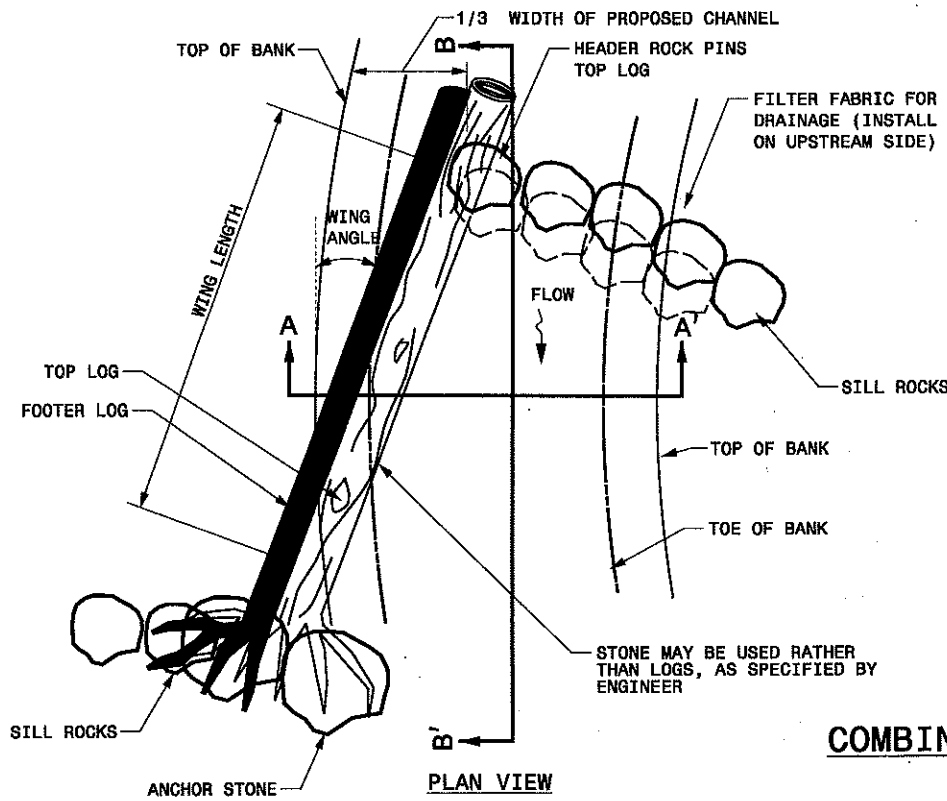

WING LENGTH	-SREV-
APPROXIMATE LENGTH ALONG CENTERLINE	
WING ANGLE	


NOTES:
 HEADER, FOOTER, AND SILL ROCKS TO BE STRUCTURE STONE, 18" - 30".
 AT THE DISCRETION OF THE ENGINEER, SURGE STONE MAY BE USED IN LIEU OF #57 STONE AND CLASS 'A' USED TO FILL VOIDS.

NOTE:
 VANE PARAMETERS WILL BE DETERMINED IN FINAL DESIGN

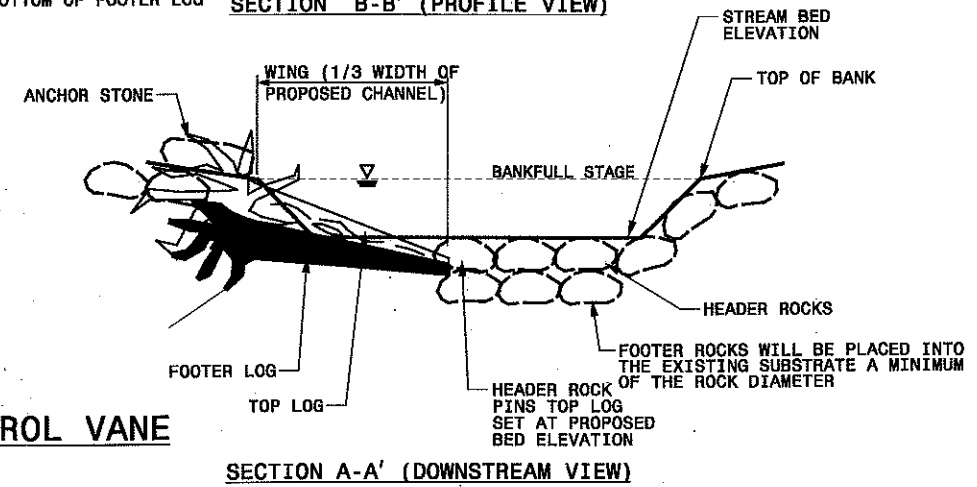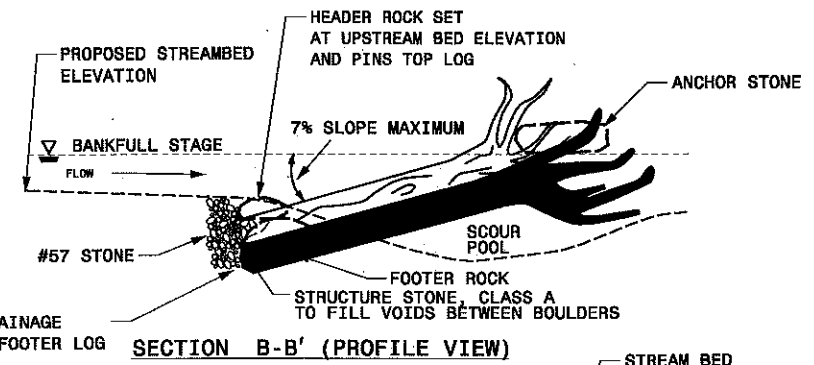


COMBINATION GRADE CONTROL VANE/ ROCK GRADE CONTROL VANE

SCALE: NTS


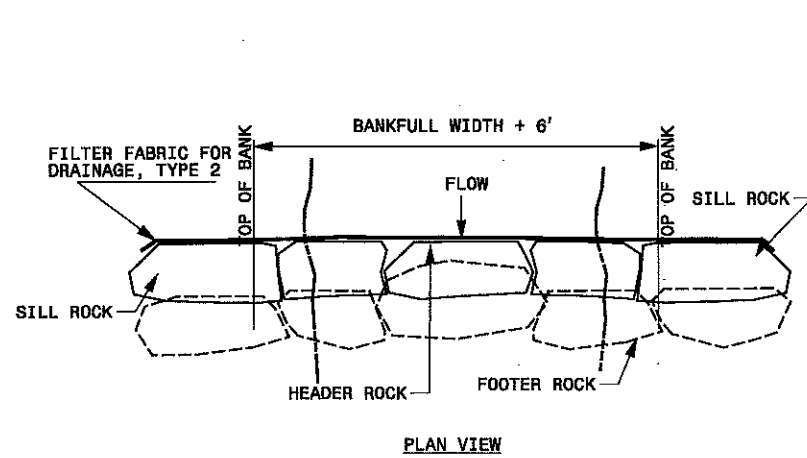


NOTES:
 HEADER, FOOTER, AND SILL ROCKS TO BE STRUCTURE STONE, CLASS BOULDER
 HEADER ROCK IS PLACED LOWER THAN TOE ROCKS

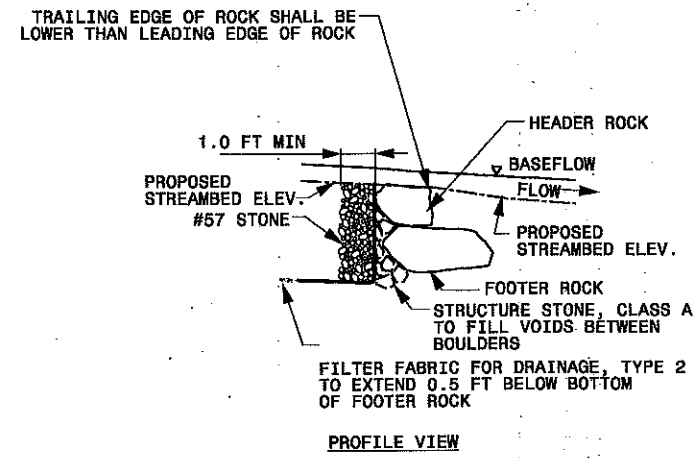

ROCK SILL

SCALE: NTS

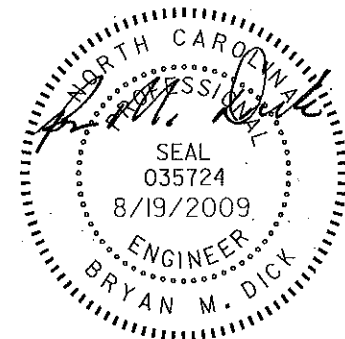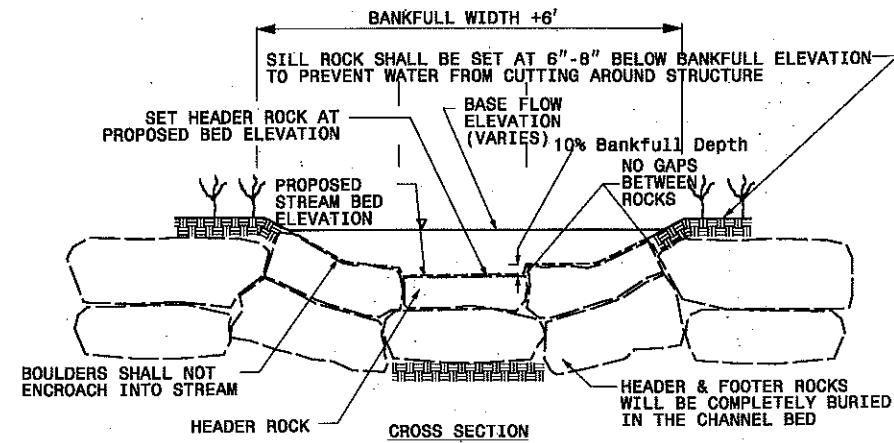

AS-BUILT DRAWINGS
08/17/09

DATE: 8/19/2009
 TIME: 5:03:09 PM

USER: WILSONAB
 DGN: Q:\99255\road\plansheets\99255_psh_C-10-15_Details.dgn


NO	REVISIONS	DRN	CHK	DATE

--	--	--	--	--



--	--	--	--	--

BADIN INN STREAM RESTORATION	
GENERAL DETAILS	
EARTH TECH AECOM	
701 CORPORATE CENTER DRIVE SUITE 415, RALEIGH, NC 27607 919-884-6200 919-884-6253 (fax)	


DATE	8/19/2009
PROJECT NO	99255
FILENAME	
SHEET NO	C-12
DRAWN BY	CHKD BY
ICJ	BMD

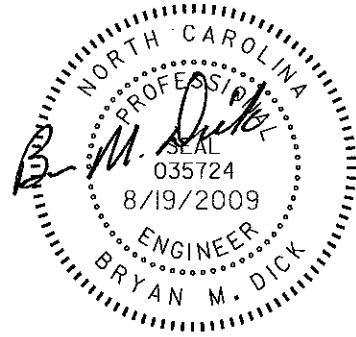


AS-BUILT DRAWINGS
08/17/09

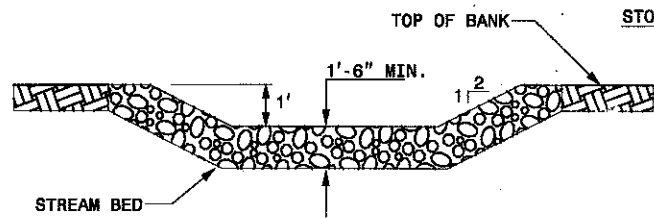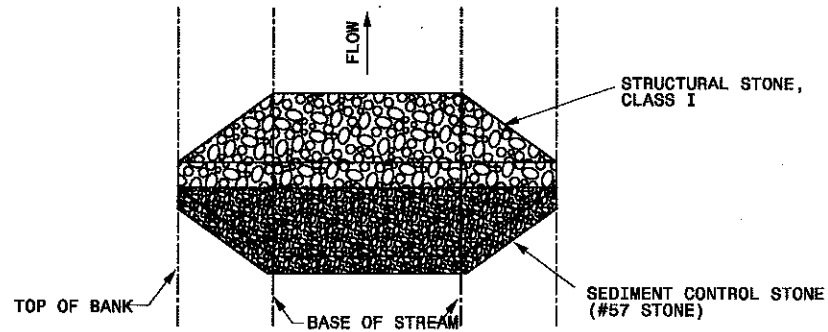


STONE IMPERVIOUS DIKE
CROSS SECTION

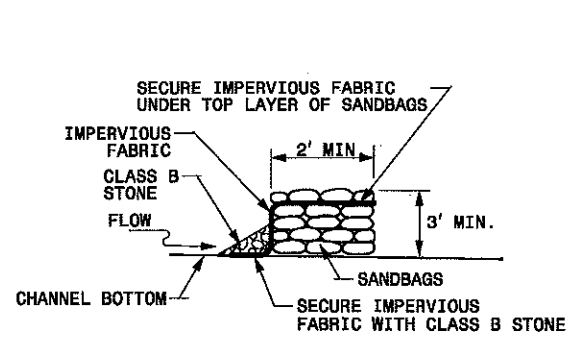

SANDBAG IMPERVIOUS
DIKE PROFILE

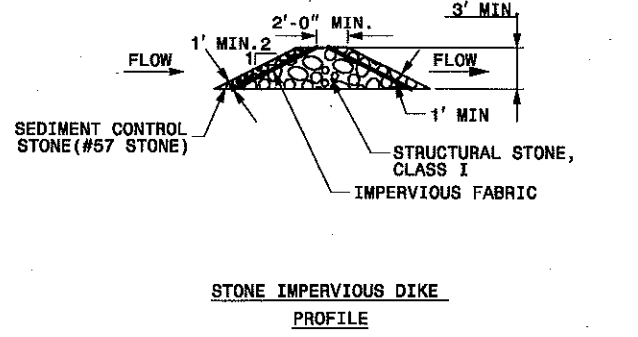

STONE IMPERVIOUS DIKE
PROFILE

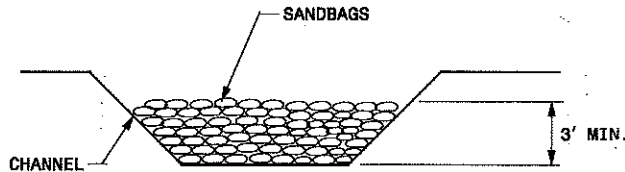


SANDBAG IMPERVIOUS DIKE
CROSS SECTION

IMPERVIOUS DIKE

SCALE: NTS

- NOTES:
1. THE STRUCTURE SHALL BE USED FOR DIVERTING AND PUMPING ONLY. THE STRUCTURE SHALL BE RELOCATED OR REMOVED ONCE PUMPING/DIVERTING IS COMPLETE.
 2. EITHER TYPE OF IMPERVIOUS DIKE (SANDBAG OR STONE) MAY BE USED.

STATE OF NORTH CAROLINA
DEPT. OF TRANSPORTATION
DIVISION OF HIGHWAYS
RALEIGH, N.C.
7-208
ENGLISH STANDARD DRAWING FOR
SPECIAL STILLING BASIN
SHEET 1 OF 1
1630.06

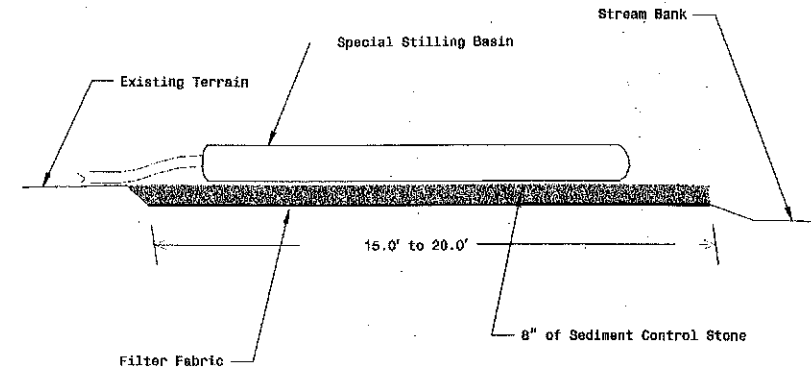


Note: Provide Stabilized Outlet to Streambank
Not To Scale

STATE OF NORTH CAROLINA
DEPT. OF TRANSPORTATION
DIVISION OF HIGHWAYS
RALEIGH, N.C.
7-208
ENGLISH STANDARD DRAWING FOR
SPECIAL STILLING BASIN
SHEET 1 OF 1
1630.06

SPECIAL STILLING BASIN


SCALE: NTS

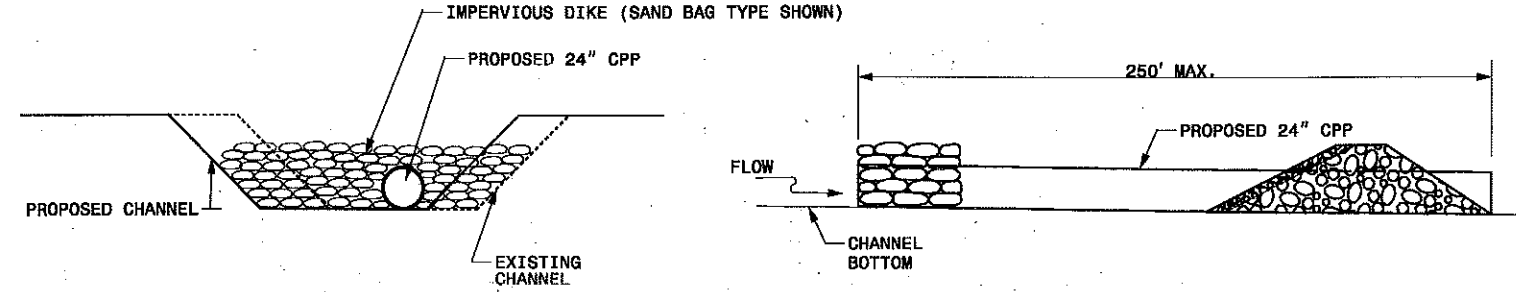

DIVERSION CROSS SECTION

DIVERSION PROFILE

NOTE:
PIPE MUST HAVE POSITIVE DRAINAGE WHEN USING DIVERSION (0.3% TO 2.0% PIPE SLOPE IS RECOMMENDED)

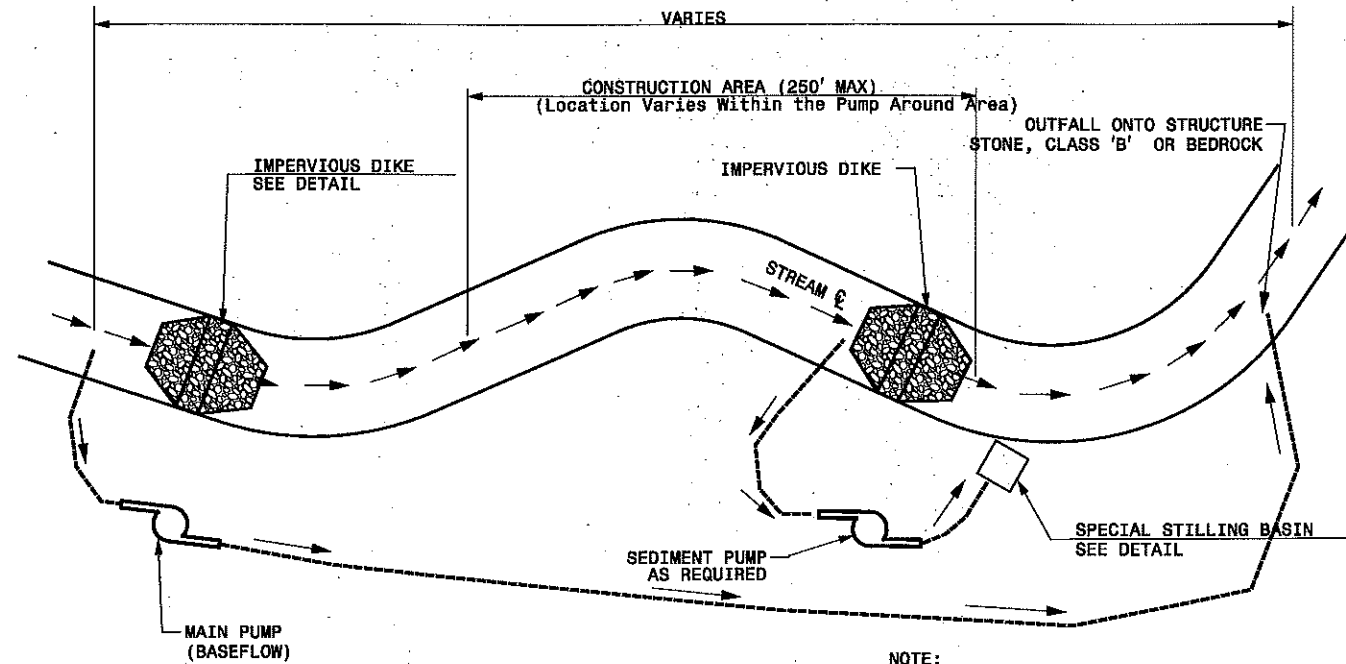

NOTE:
CHANNEL SHALL BE MATTED WITH COIR FIBER MATTING (SEE DETAIL) PRIOR TO THE CLOSE OF EACH WORK DAY.

PUMP-AROUND/PIPE DIVERSION


SCALE: NTS

USER: WILSONAB DATE: 8/19/2009
LGN: g:\99255\cadd\plansheets\99255_psh_c-10-15_Details.dgn TIME: 5:03:09 PM


NO	REVISIONS	DRN	CHK	DATE
1				
2				
3				

BADIN INN STREAM RESTORATION
GENERAL DETAILS
EARTH TECH | AECOM
701 CORPORATE CENTER DRIVE, SUITE 475, RALEIGH, NC 27607
919-853-6600 919-853-6625 (FAX)

DATE	8/19/2009
PROJECT NO	99255
FILENAME	
SHEET NO	C-13
DRAWN BY	CHKD BY
ICJ	BMD

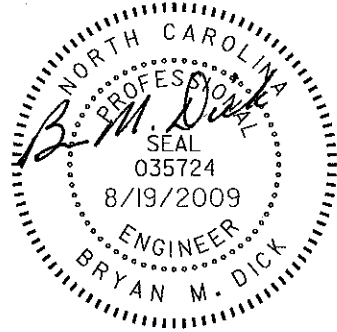

AS-BUILT DRAWINGS
08/17/09

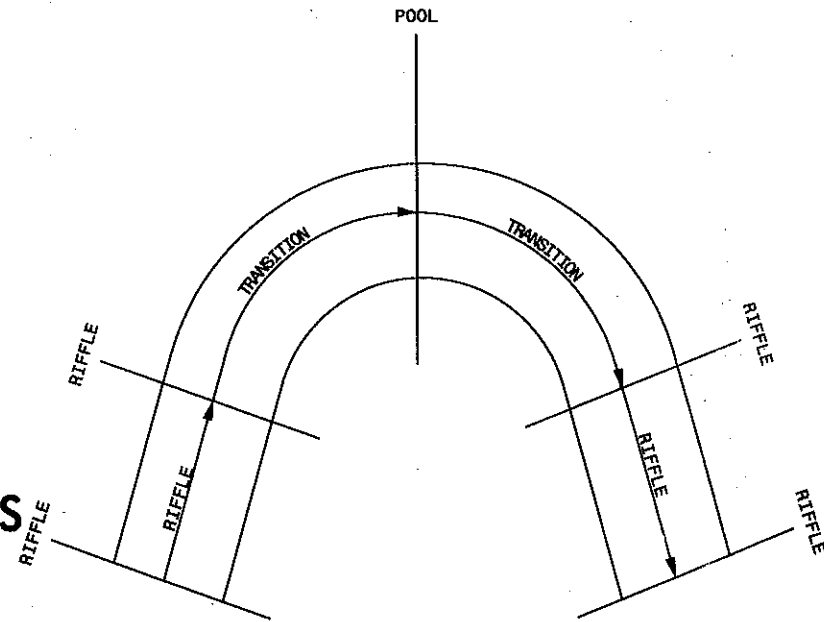


NOTES:

1. AREAS IN BETWEEN LABELED FEATURES ARE TRANSITION AREAS.
2. SEE TYPICALS AND STATIONING FOR MORE DETAIL.
3. THE AREA BETWEEN THE CONCURRENT RIFFLE CROSS-SECTIONS ARE CONSIDERED THE RIFFLE SECTION.
4. THE AREA BETWEEN THE DOWNSTREAM RIFFLE AND RUN CROSS-SECTION IS CONSIDERED THE RUN SECTION.
5. THE AREA BETWEEN THE RUN AND GLIDE CROSS-SECTION IS CONSIDERED THE POOL SECTION.
6. THE AREA BETWEEN THE GLIDE AND THE UPSTREAM RIFFLE CROSS-SECTION IS CONSIDERED THE GLIDE SECTION.


CROSS SECTION TRANSITION LOCATIONS

SCALE: NTS

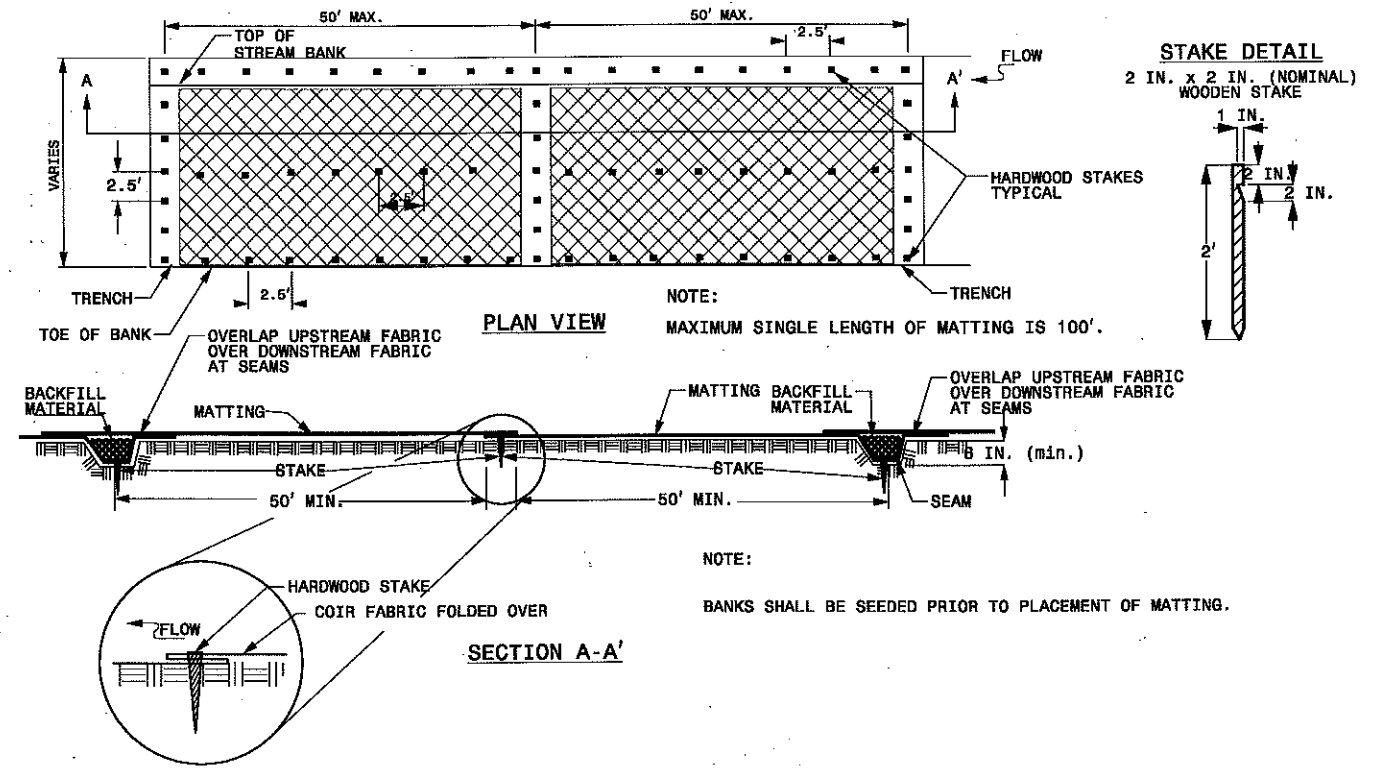

COIR FABRIC

SCALE: NTS

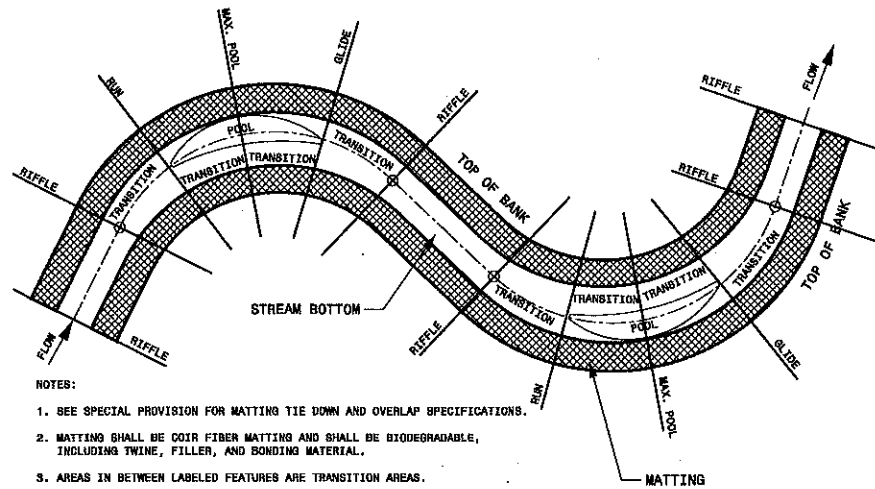

NOTES:


1. SEE SPECIAL PROVISION FOR MATTING TIE DOWN AND OVERLAP SPECIFICATIONS.
2. MATTING SHALL BE COIR FIBER MATTING AND SHALL BE BIODEGRADABLE, INCLUDING TWINE, FILLER, AND BONDING MATERIAL.
3. AREAS IN BETWEEN LABELED FEATURES ARE TRANSITION AREAS.
4. THE AREA BETWEEN THE CONCURRENT RIFFLE CROSS-SECTIONS ARE CONSIDERED THE RIFFLE SECTION.
5. THE AREA BETWEEN THE DOWNSTREAM RIFFLE AND RUN CROSS-SECTION IS CONSIDERED THE RUN SECTION.
6. THE AREA BETWEEN THE RUN AND GLIDE CROSS-SECTION IS CONSIDERED THE POOL SECTION.
7. THE AREA BETWEEN THE GLIDE AND THE UPSTREAM RIFFLE CROSS-SECTION IS CONSIDERED THE GLIDE SECTION.

TYPICAL MATTING LOCATION & STANDARD PLAN LAYOUT

SCALE: NTS

NOTES:

1. 90% COMPACTION RATE IS REQUIRED ON CHANNEL PLUG OR AS APPROVED BY THE ENGINEER.
2. SIDE SLOPE THAT IS ADJACENT TO PROPOSED STREAM NEEDS TO MATCH PROPOSED CROSS SECTION IN THAT REGION.
3. THIS STRUCTURE SHALL BE PLACED AS DIRECTED BY THE ENGINEER.

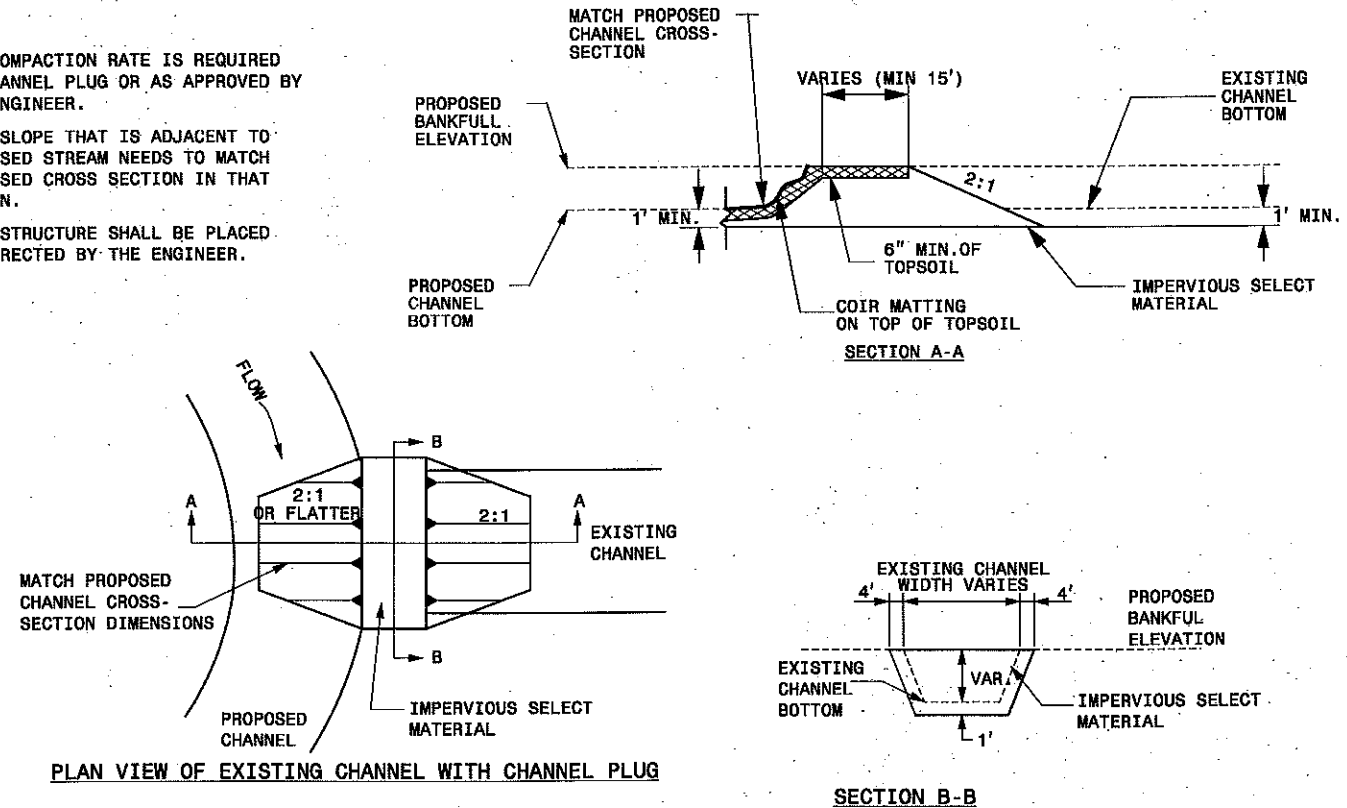

CHANNEL PLUG

SCALE: NTS


DATE: 8/19/2009
TIME: 5:03:07 PM

USER: WILSONAB
DGN: q:\99255\acad\plansheets\99255_psh_c-10-15_Details.dgn


NO	REVISIONS	DRN	CHK	DATE
1				
2				
3				

BADIN INN STREAM RESTORATION	
GENERAL DETAILS	
EARTH TECH AECOM	
701 CORPORATE CENTER DRIVE, SUITE 475, RALEIGH, NC 27607	
919-854-8000 919-854-8235 (fax)	

DATE	8/19/2009
PROJECT NO	99255
FILENAME	
SHEET NO	C-14
DRAWN BY	ICJ
CHKD BY	BMD

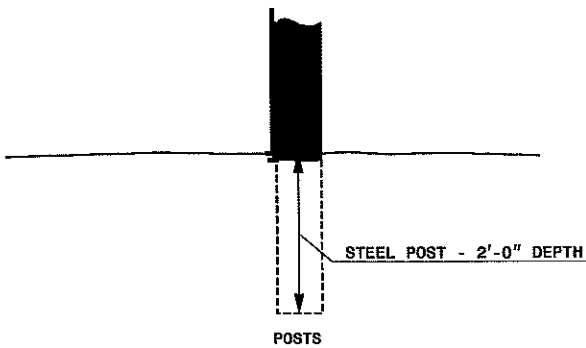


- NOTES:
1. STEEL POSTS SHALL BE 5'-0" IN HEIGHT AND BE OF THE SELF-FASTENER ANGLE STEEL TYPE.
 2. WOOD POST SHALL BE 6'-0" IN HEIGHT AND 3" MINIMUM IN DIAMETER.

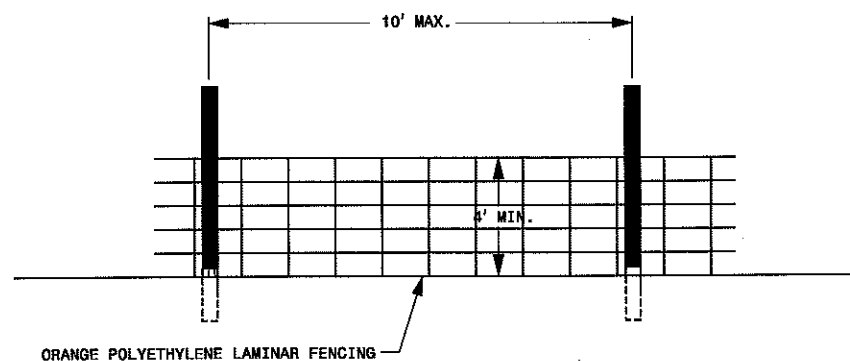

SAFETY FENCE/TREE PROTECTION FENCE


SCALE: NTS

- NOTES:
1. PUT SILT FENCE OR TREE PROTECTION FENCE UP TO ENSURE CONSTRUCTION ENTRANCE IS USED
 2. A 6" TO 12" MINIMUM STABILIZED PAD OF WASHED STONE SHALL BE LOCATED WHERE TRAFFIC WILL BE ENTERING OR LEAVING A CONSTRUCTION SITE TO OR FROM A PUBLIC STREET. THE STONE SHALL BE PLACED ON TOP OF FILTER FABRIC FOR A DISTANCE OF 50 FEET MINIMUM.
 3. THE ENTRANCE SHALL BE MAINTAINED IN A CONDITION WHICH WILL PREVENT TRACKING OR FLOWING OF SEDIMENT ONTO PUBLIC STREETS OR EXISTING PAVEMENT. THIS MAY REQUIRE PERIODIC TOP DRESSING WITH ADDITIONAL STONE AS CONDITIONS DEMAND AND REPAIR AND/OR CLEAR OUT OF ANY MEASURES USED TO TRAP SEDIMENT.
 4. ALL SEDIMENT SPILLED, DROPPED, WASHED, OR TRACKED ONTO PUBLIC STREETS MUST BE REMOVED IMMEDIATELY.
 5. IF CONSTRUCTION ON THE SITES ARE SUCH THAT THE MUD IS NOT REMOVED BY THE VEHICLE TRAVELING OVER THE STONE, THEN THE TIRES OF THE VEHICLES MUST BE WASHED BEFORE ENTERING THE PUBLIC ROAD. WHEN WASHING IS REQUIRED, IT SHALL BE DONE ON AN AREA STABILIZED WITH CRUSHED STONE WHICH DRAINS INTO AN APPROVED SEDIMENT BASIN.
 6. ADDITIONAL GRADING SHALL BE REQUIRED TO CONNECT THE STONE ENTRANCE TO THE EXISTING GROUND. UPON COMPLETION OF THE PROJECT, THE ROAD SHALL BE RETURNED TO A CONDITION THAT MEETS OR EXCEEDS THE PRE-EXISTING CONDITIONS.

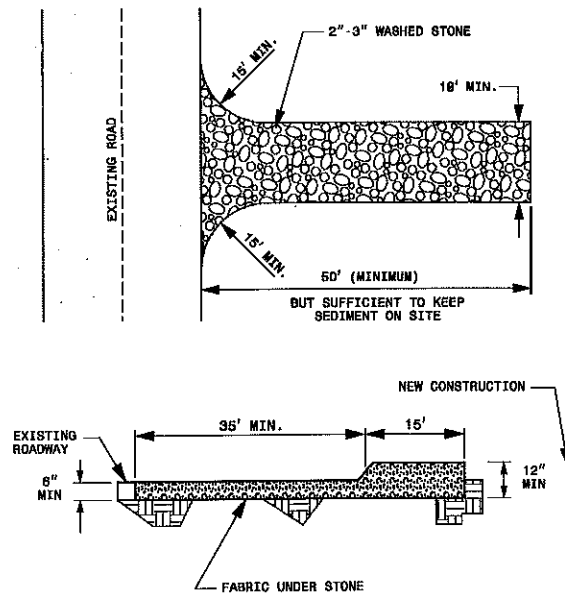


TEMPORARY CONSTRUCTION ENTRANCE

SCALE: NTS

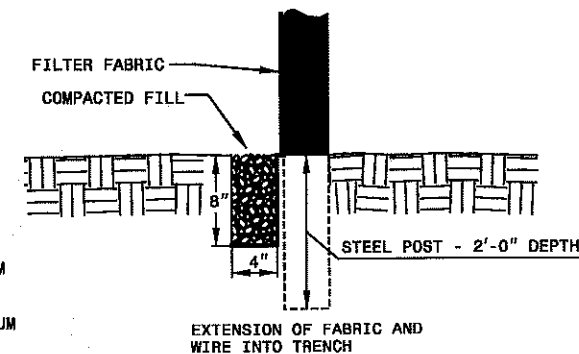


- NOTES
- WIRE SHALL BE A MINIMUM OF 32" IN WIDTH AND SHALL HAVE A MINIMUM OF 6 LINE WIRES WITH 12" STAY SPACING.
- FILTER FABRIC SHALL BE A MINIMUM OF 36" IN WIDTH AND SHALL BE FASTENED ADEQUATELY TO THE WIRE AS DIRECTED BY THE ENGINEER.
- STEEL POST SHALL BE 5'-0" IN HEIGHT AND BE OF THE SELF-FASTENER ANGLE STEEL TYPE.

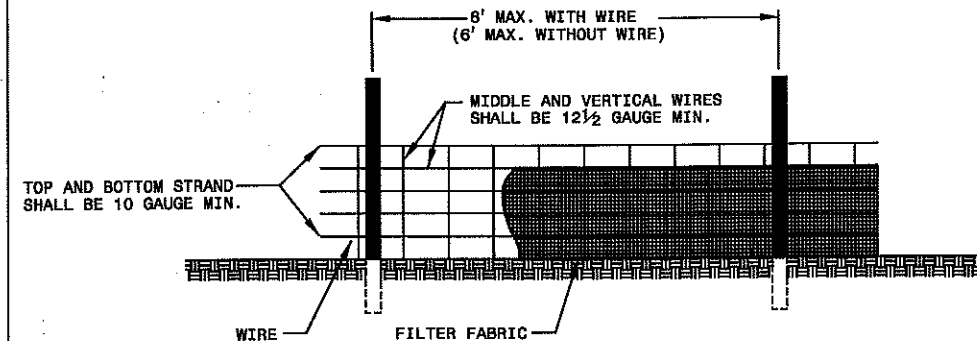

TEMPORARY SILT FENCE (HIGH VISIBILITY)

SCALE: NTS

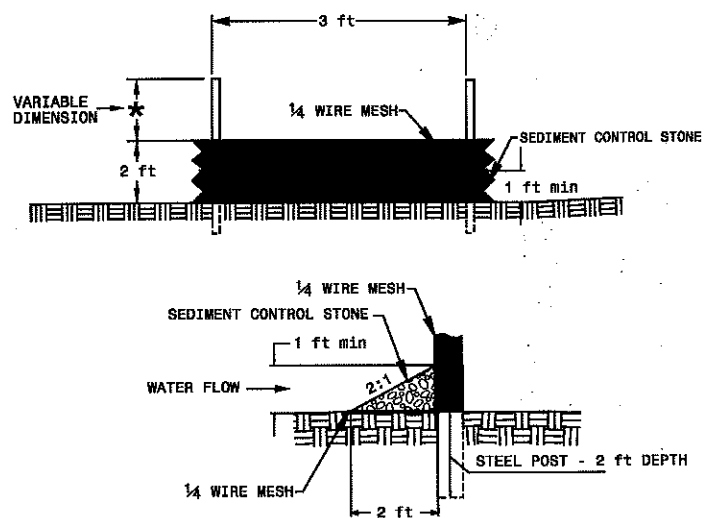

GENERAL NOTES:

SEDIMENT CONTROL STONE SHALL BE NO. 5 OR NO. 57 AND SHALL BE PAID FOR AT THE CONTRACT UNIT PRICE PER TON "SEDIMENT CONTROL STONE."


USE HARDWARE CLOTH 24 GAUGE WIRE MESH WITH 1/4 INCH MESH OPENINGS.

INSTALL 5 FT. SELF FASTENER ANGLE STEEL POST 2 FT. DEEP MINIMUM.


POST SPACING SHALL BE A MAXIMUM OF 3 FT.

SPECIAL SEDIMENT CONTROL FENCE

SCALE: NTS

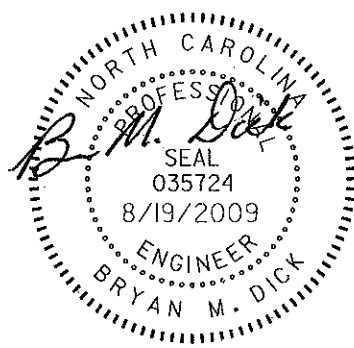


AS-BUILT DRAWINGS
08/17/09

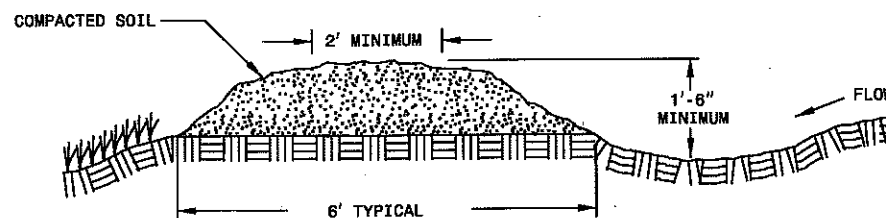

CROSS SECTIONAL VIEW

TEMPORARY DIVERSION

SCALE: NTS

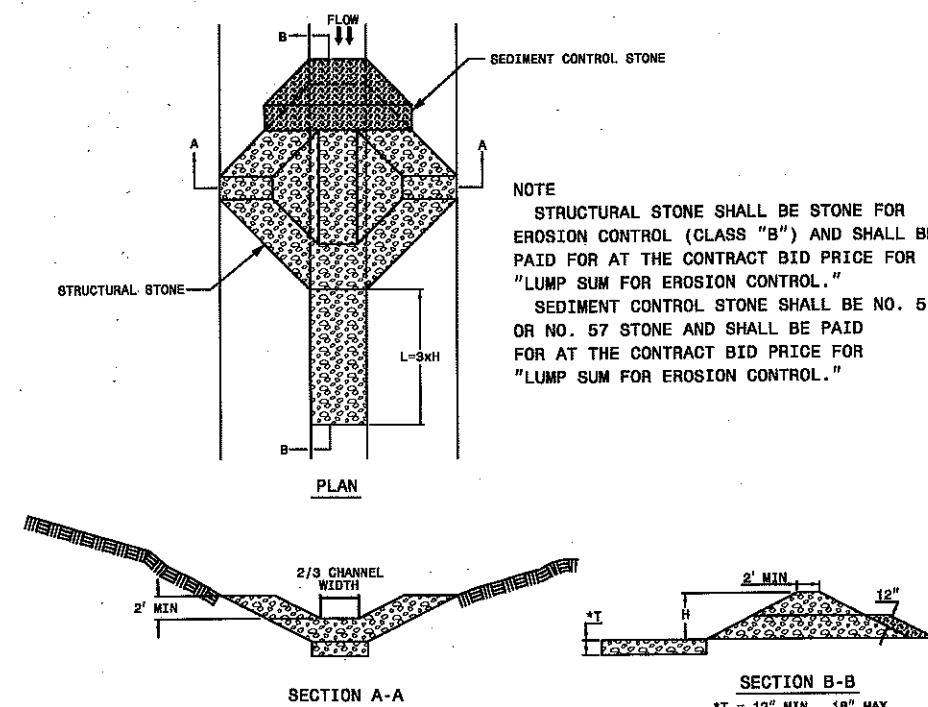

- NOTE
- STRUCTURAL STONE SHALL BE STONE FOR EROSION CONTROL (CLASS "B") AND SHALL BE PAID FOR AT THE CONTRACT BID PRICE FOR "LUMP SUM FOR EROSION CONTROL."
- SEDIMENT CONTROL STONE SHALL BE NO. 5 OR NO. 57 STONE AND SHALL BE PAID FOR AT THE CONTRACT BID PRICE FOR "LUMP SUM FOR EROSION CONTROL."


TEMPORARY ROCK SILT CHECK TYPE 'A'

SCALE: NTS

NO	REV	CHK	DATE
1			
2			
3			

BADIN INN STREAM RESTORATION	
GENERAL DETAILS	
EARTH TECH AECOM	
701 CORPORATE CENTER DRIVE, SUITE 415, RALEIGH, NC 27607 919-854-6200 919-854-6259 (fax)	
DATE	8/19/2009
PROJECT NO	99255
FILENAME	
SHEET NO	C-15
DRAWN BY	CHKD BY
ICJ	BMD


DATE: 8/19/2009
 TIME: 5:03:07 PM
 USER: WILSONAB
 DGN: 0199255_cadd\plans\rest\99255_psh_c-10-15_Details.dgn

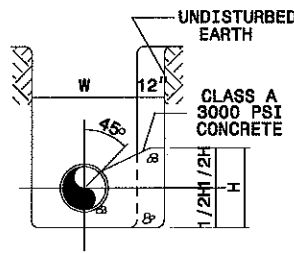


TYPICAL SECTION
TEE OR BEND

PIPE SIZE INCHES	TEE				BEND			
	90	45*	22**	11 1/2*	90	45*	22**	11 1/2*
2"	75	1.5	50	1.0	50	75	50	50
4"	1.5	3.0	1.0	2.5	1.0	1.5	1.0	1.0
6"	2.0	4.0	1.5	3.5	1.0	3.0	1.0	1.5
8"	2.5	5.0	2.0	4.0	1.5	3.5	1.0	2.5
10"	3.0	6.0	2.5	4.5	2.0	4.0	1.0	3.0
12"	3.5	7.0	3.0	5.0	2.5	5.0	1.5	3.5

CONCRETE THRUST BLOCK SCHEDULE
* FOR DESIGN PRESSURE=200 PSI
SIZE SCHEDULE

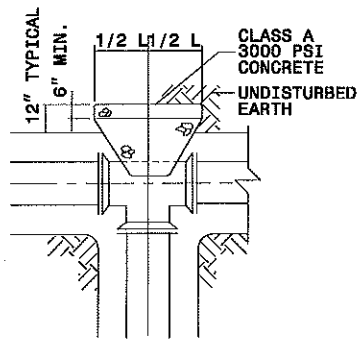


PLAN - TEE

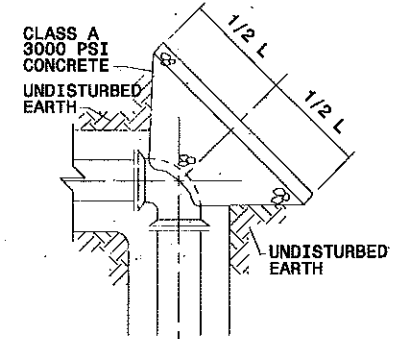


PLAN - BEND


THRUST BLOCKING
SCALE: NTS

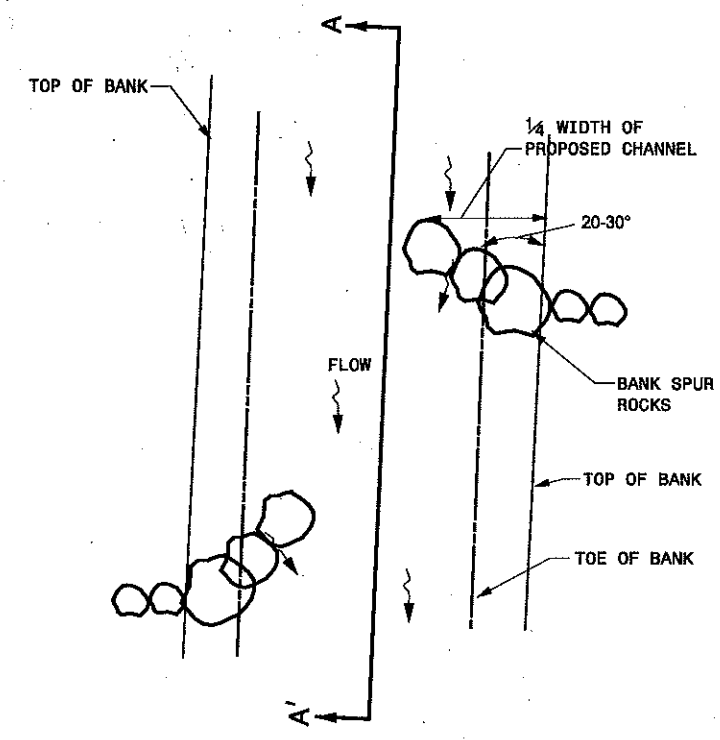

PLAN VIEW

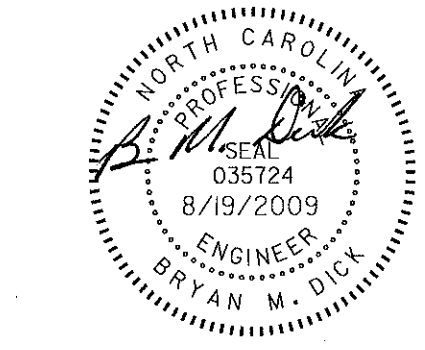


AS-BUILT DRAWINGS
08/17/09

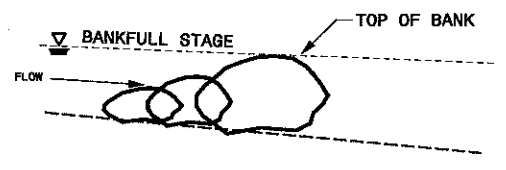


SECTION A-A' (PROFILE VIEW)

BANK SPUR
SCALE: NTS

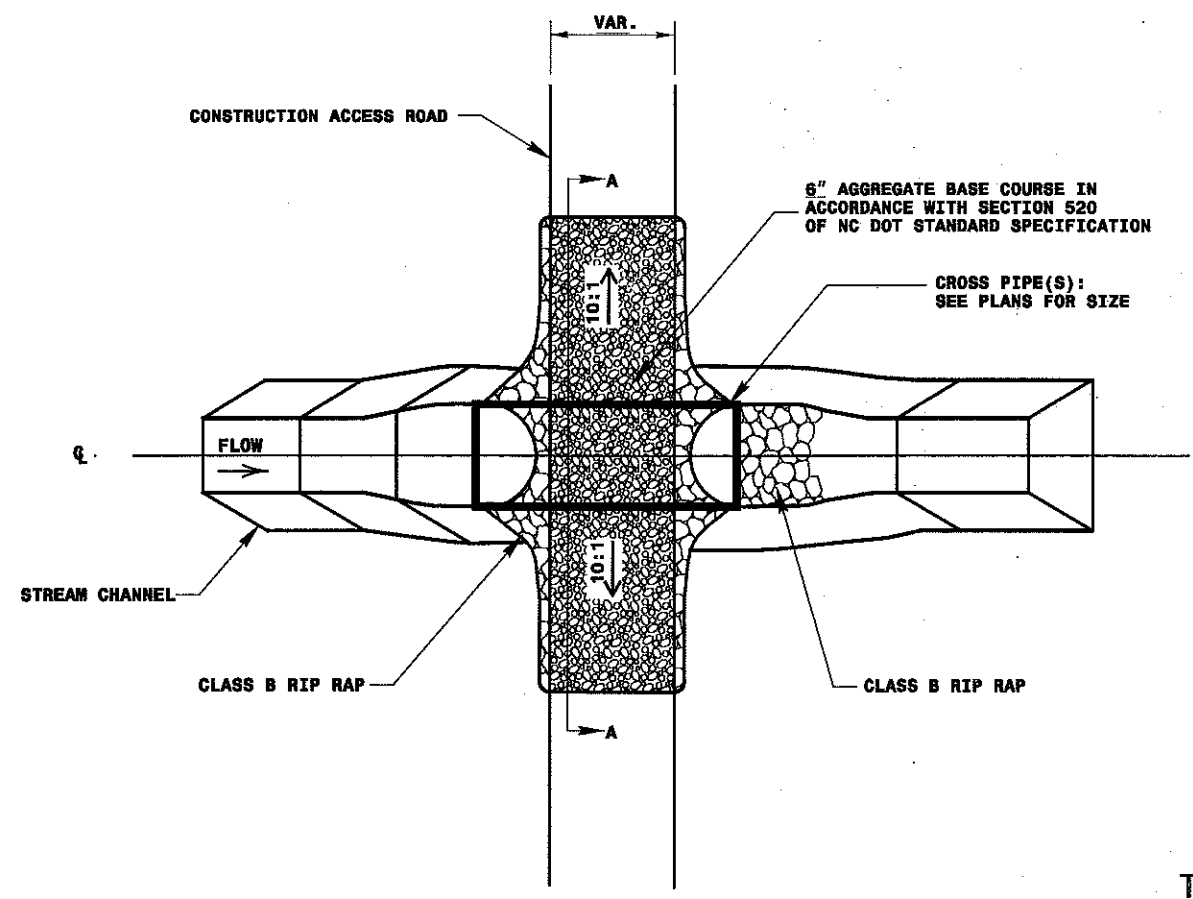

PLAN VIEW

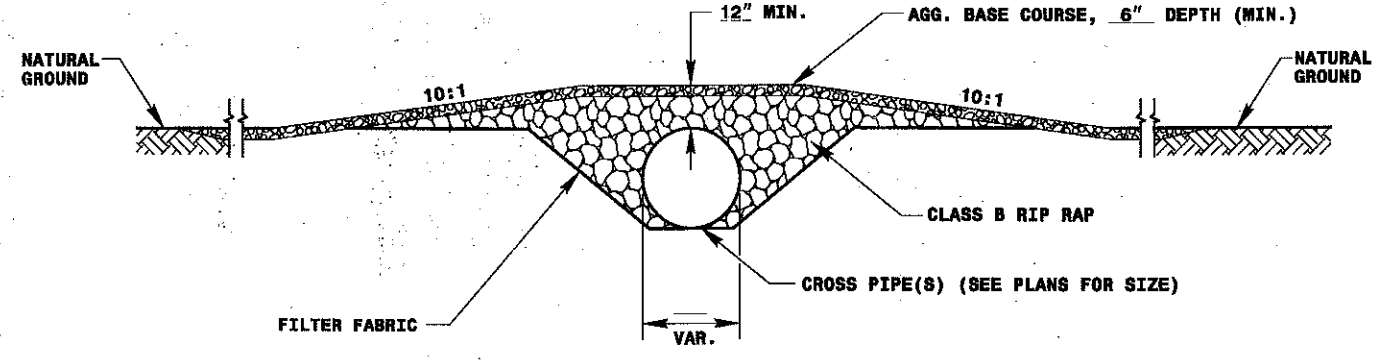

SECTION A-A
NOT TO SCALE

TEMPORARY STREAM CROSSING
SCALE: NTS

USER: WILSONAB DATE: 8/19/2009
 DGN: q:\99255\acad\plansheets\99255_psh_c-10-15_Details.dgn TIME: 5:03:06 PM

NO	REVISIONS	DRN	CHK	DATE
1				
2				
3				

BADIN INN STREAM RESTORATION
 GENERAL DETAILS
EARTH TECH | AECOM
701 CORPORATE CENTER DRIVE, SUITE 415, RALEIGH, NC 27607
 919-881-6600 919-881-6629 FAX


DATE	8/19/2009
PROJECT NO	99255
FILENAME	
SHEET NO	C-16
DRAWN BY	CHKD BY
ICJ	BMD

TEMPORARY SEEDING SCHEDULE



SEEDING DATES	SEEDING MIXTURE	SEEDING RATE (POUNDS/ACRE)	FERTILIZATION	FERTILIZER RATE (POUNDS/ACRE) ##	MULCH \$	MULCHING RATE (POUNDS/ACRE)	MAINTENANCE
OCT 1 - MAR 31 (WINTER)	WRENS ABRUZZI WINTER RYE	50	4-12-12	500	STRAW	4000	REFERTILIZE IF GROWTH IS NOT FULLY ADEQUATE. RESEED, REFERTILIZE, AND MULCH IMMEDIATELY FOLLOWING EROSION OR OTHER DAMAGE
APR 1- SEP 30 (SUMMER)	BROWN-TOP MILLET	50	4-12-12	2000	STRAW	4000	REFERTILIZE IF GROWTH IS NOT FULLY ADEQUATE. RESEED, REFERTILIZE, AND MULCH IMMEDIATELY FOLLOWING EROSION OR OTHER DAMAGE

IF SOIL TESTS ARE PERFORMED, APPLY LIME ACCORDING TO RECOMMENDATIONS. SOILS WITH A pH OF 6 OR HIGHER DO NOT NEED LIME.

\$ USE JUTE/EXCELSIOR MATTING TO COVER THE BOTTOM OF GRASS-LINED CHANNELS. GRAIN STRAW SHOULD BE USED ON CHANNEL SIDE SLOPES ABOVE THE HIGHEST CALCULATED DEPTH OF FLOW.

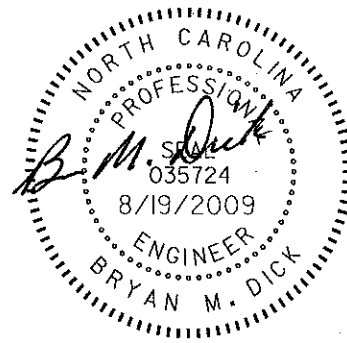


AS-BUILT DRAWINGS 08/17/09

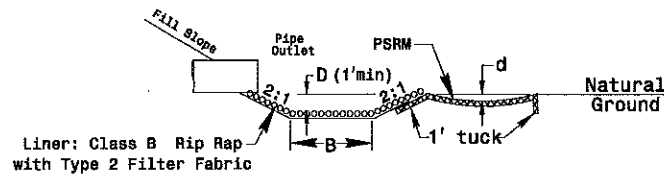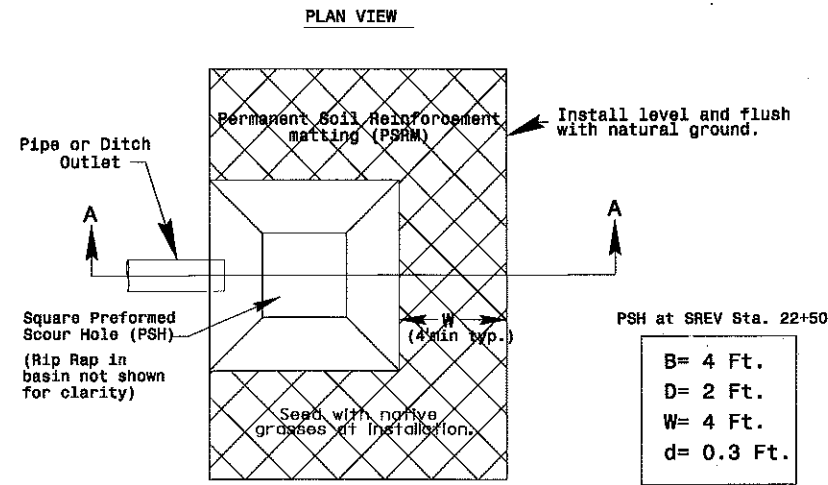


PREFORMED SCOUR HOLE

SCALE: NTS

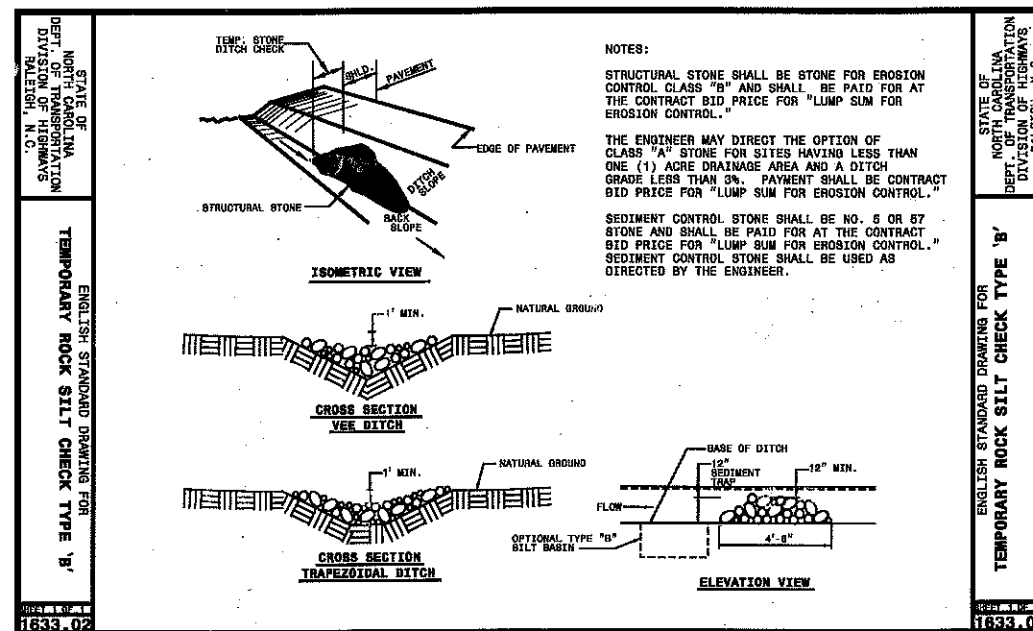

TEMPORARY ROCK SILT CHECK TYPE "B"

SCALE: NTS

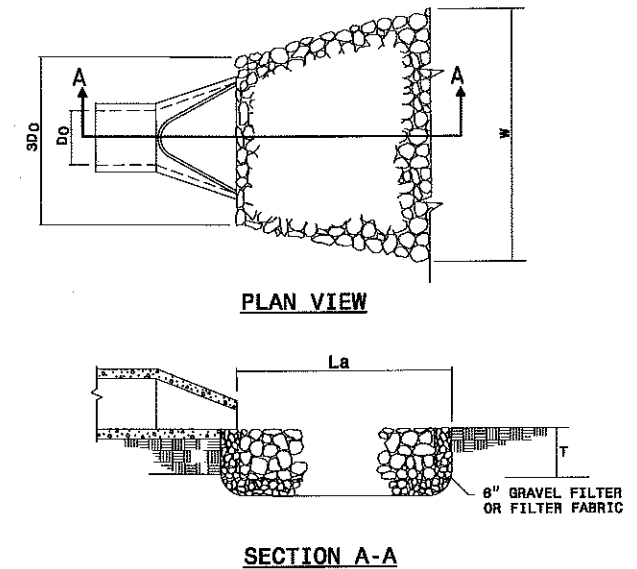

NOTES:

- La IS THE LENGTH OF THE RIPRAP APRON.
- THE DOWNSTREAM WIDTH OF THE APRON IS EQUAL TO $D_0 + 0.4L_a$
- A FILTER BLANKET OR FILTER FABRIC SHOULD BE INSTALLED BETWEEN THE RIPRAP AND SOIL FOUNDATION.
- IN A WELL DEFINED CHANNEL EXTEND THE APRON UP THE CHANNEL BANKS TO AN ELEVATION OF 6" ABOVE THE MAXIMUM TAILWATER DEPTH OR TO THE TOP OF THE BANK, WHICHEVER IS LESS.

REQUIRED OUTLET PROTECTION DIMENSIONS

RIP RAP OUTLET NUMBER	D ₀ (in.)	3D ₀ (ft.)	La (ft.)	W (ft.)	T (in.)	RIP-RAP CLASS
1	18	3.75	7	4	5.5	B
2	12	3.00	4	2.75	5.5	B
3	15	3.75	7	4	5.5	B

OUTLET STABILIZATION

SCALE: NTS


BADIN INN STREAM RESTORATION

GENERAL DETAILS
EARTH TECH | AECOM


101 CORPORATE CENTER DRIVE, SUITE 415, RALEIGH, NC 27607
919-854-6200 919-854-6268 (FAX)

DATE	8/19/2009
PROJECT NO	99255
FILENAME	
SHEET NO	C-17
DRAWN BY	RR
CHKD BY	BMD

USER: WILSONAB DATE: 8/19/2009 TIME: 5:03:05 PM
DGN: q:\99255\badin\plansheets\99255_psh_c-10-15_Detail.sdg

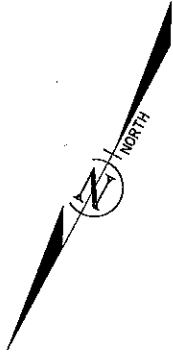

VEGETATION ZONES	
Description	Symbol
Limits of Disturbance	-----
Conservation Easement	-----
Zone 1 Well-Drained Floodplain	
Zone 2 Wetland Swale	
Zone 3 Stream Bank	

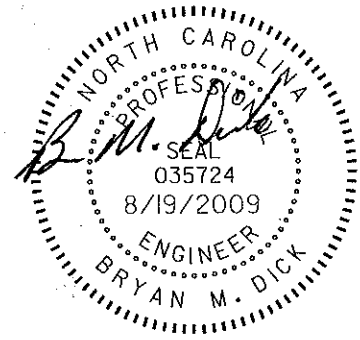

AS-BUILT DRAWINGS
08/17/09


TEMPORARY SEEDED FOR
STABILIZATION
PERMANENT GRASS PLANTED
BY OTHERS.

POND
WS=476.5

MATCHLINE SHEET L-2

EXISTING GRAVEL ROAD

NO	REVISIONS	DRN	CHK	DATE
1				
2				
3				

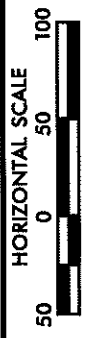

BADIN INN STREAM RESTORATION
VEGETATION PLANS

EARTH TECH | AECOM
701 CORPORATE CENTER DRIVE, SUITE 475, RALEIGH, NC 27607
919-851-6200 919-851-6255 (fax)


DATE	8/19/2009
PROJECT NO	99255
FILENAME	
SHEET NO	L-1
DRAWN BY	ICJ
CHKD BY	BMD

USER: WILSONAB DATE: 8/19/2009
JOB: 99255\card\plansheet\99255_psh_L-01_Vegetation.dgn TIME: 5:03:01 PM

USER: WILSONAB
 DGN: q:\99255\cadd\plansheets\99255_psl.L-02_Vegetation.dgn
 DATE: 8/19/2009
 TIME: 5:02:58 PM




VEGETATION ZONES	
Description	Symbol
EXISTING GRAVEL ROAD	---
Zone of Disturbance	---
Conservation Easement	---
Zone 1 Well-Drained Floodplain	[Cross-hatched symbol]
Zone 2 Wetland Swale	[Diagonal hatched symbol]
Zone 3 Stream Bank	[Solid shaded symbol]

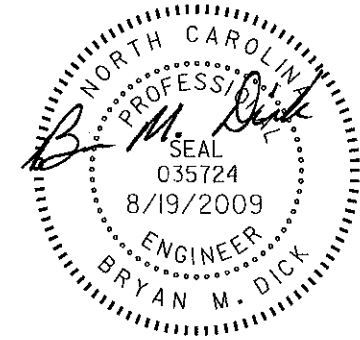

AS-BUILT DRAWINGS
08/17/09

MATCHLINE SHEET L-1

MATCHLINE SHEET L-3

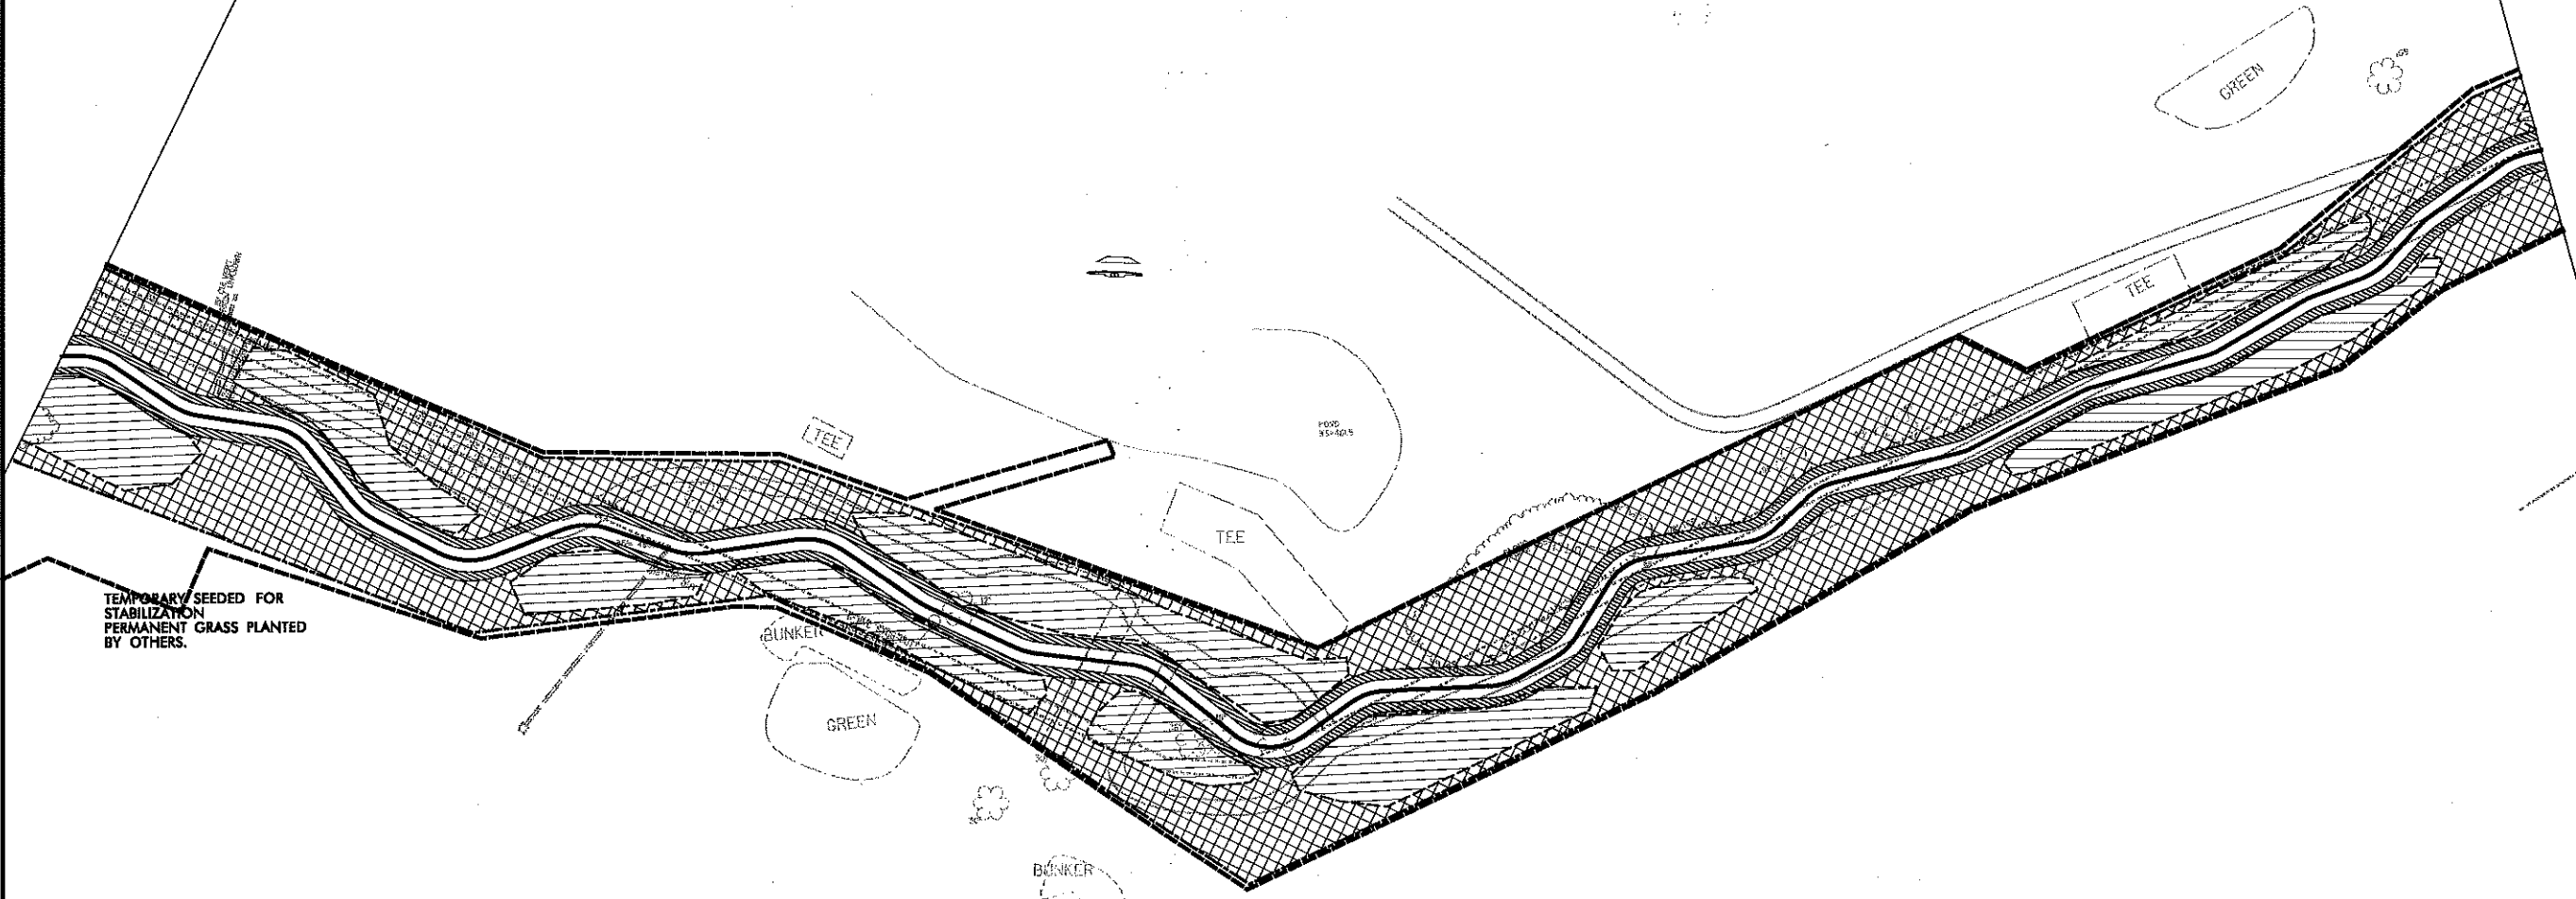

NO	REVISIONS	DRN	CHK	DATE
1				
2				
3				



BADIN INN STREAM RESTORATION
 VEGETATION PLAN
EARTHTECH | AECOM
701 CORPORATE CENTER DRIVE, SUITE 415, RALEIGH, NC 27607
 919-984-6200 919-984-6259 (fax)

DATE	8/19/2009
PROJECT NO	99255
FILENAME	
SHEET NO	L-2
DRAWN BY	CHKD BY
ICJ	BMD


USER: WILSONAB DATE: 8/19/2009
 LGW: q:\99255\cadd\plansheets\99255_pos1_L-03_Vegetation.dgn TIME: 5:02:55 PM




AS-BUILT DRAWINGS
08/17/09

VEGETATION ZONES	
Description	Symbol
Limits of Disturbance	-----
Conservation Easement	-----
Zone 1 Well-Drained Floodplain	
Zone 2 Wetland Swale	
Zone 3 Stream Bank	

MATCHLINE SHEET L-2

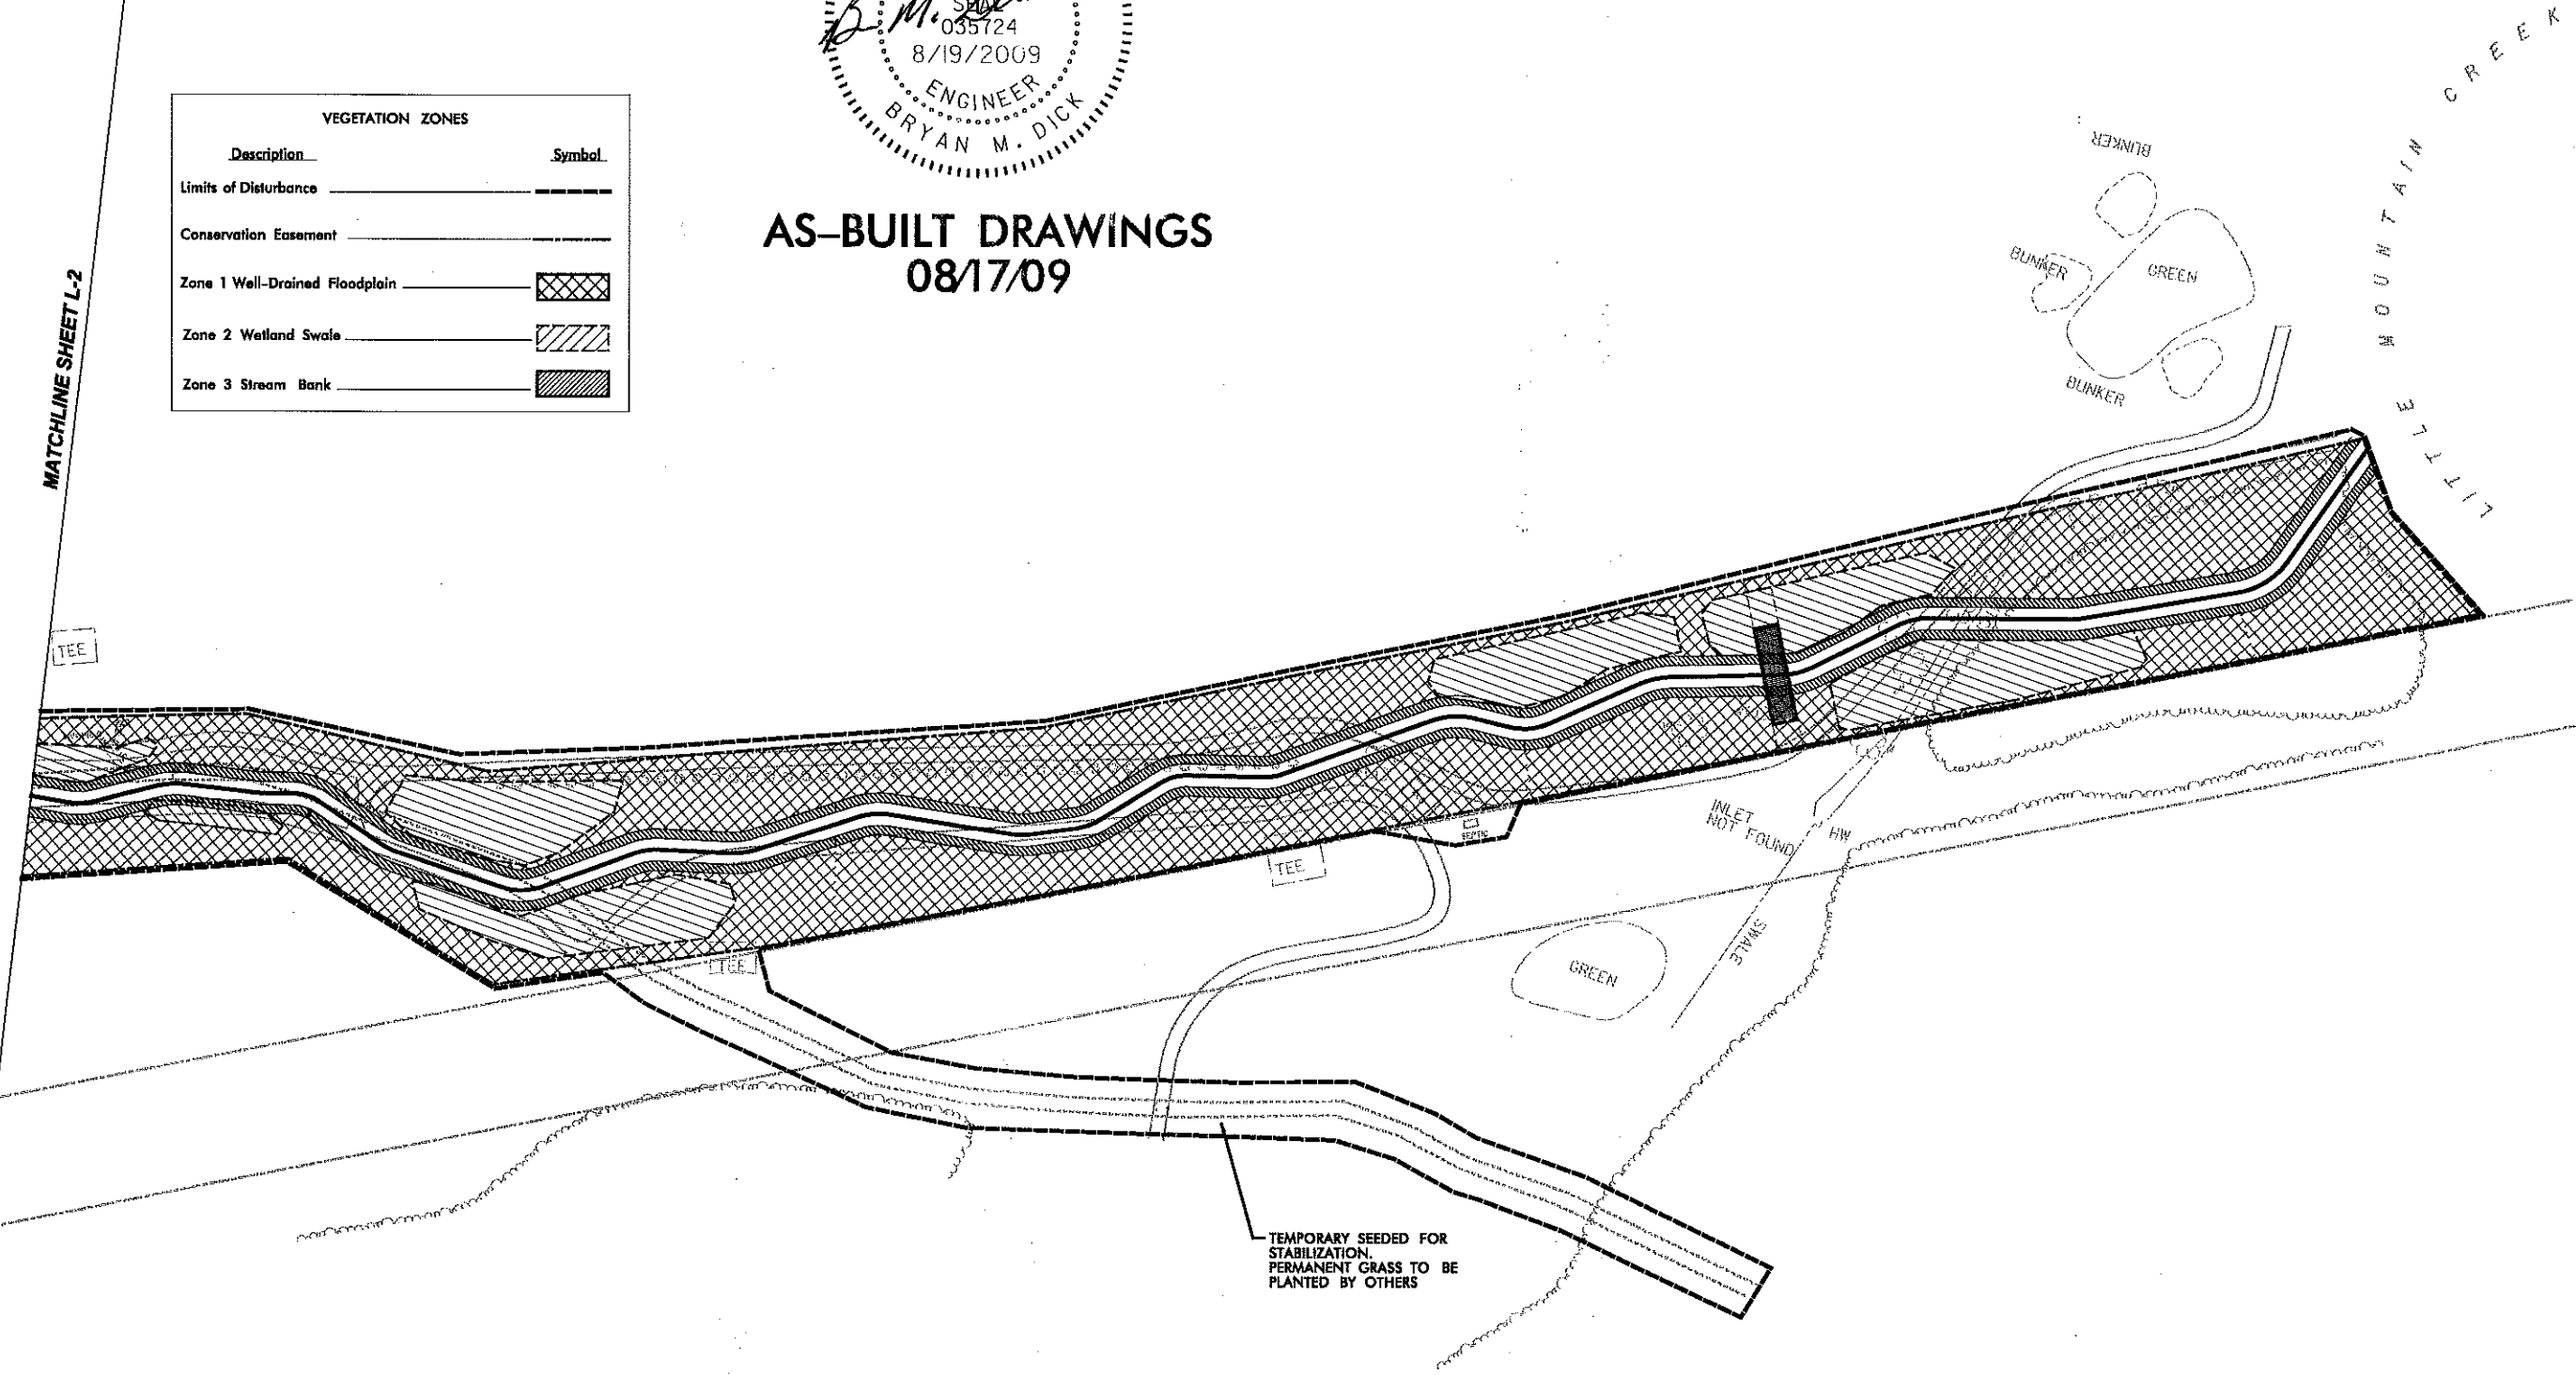

TEMPORARY SEEDED FOR STABILIZATION. PERMANENT GRASS TO BE PLANTED BY OTHERS

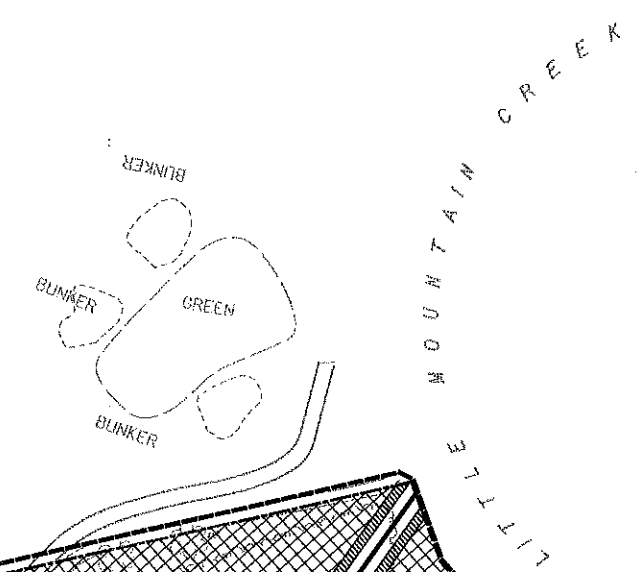


NO	REVISIONS	DRN	CHK	DATE
1				
2				
3				




BADIN INN STREAM RESTORATION
 VEGETATION PLAN
EARTH TECH | AECOM
701 CORPORATE CENTER DRIVE, SUITE 415, RALEIGH, NC 27607
 919-884-6200 919-884-6226 FAX

DATE	8/19/2009
PROJECT NO	99255
FILENAME	
SHEET NO	L-3
DRAWN BY	CHKD BY
ICJ	BMD

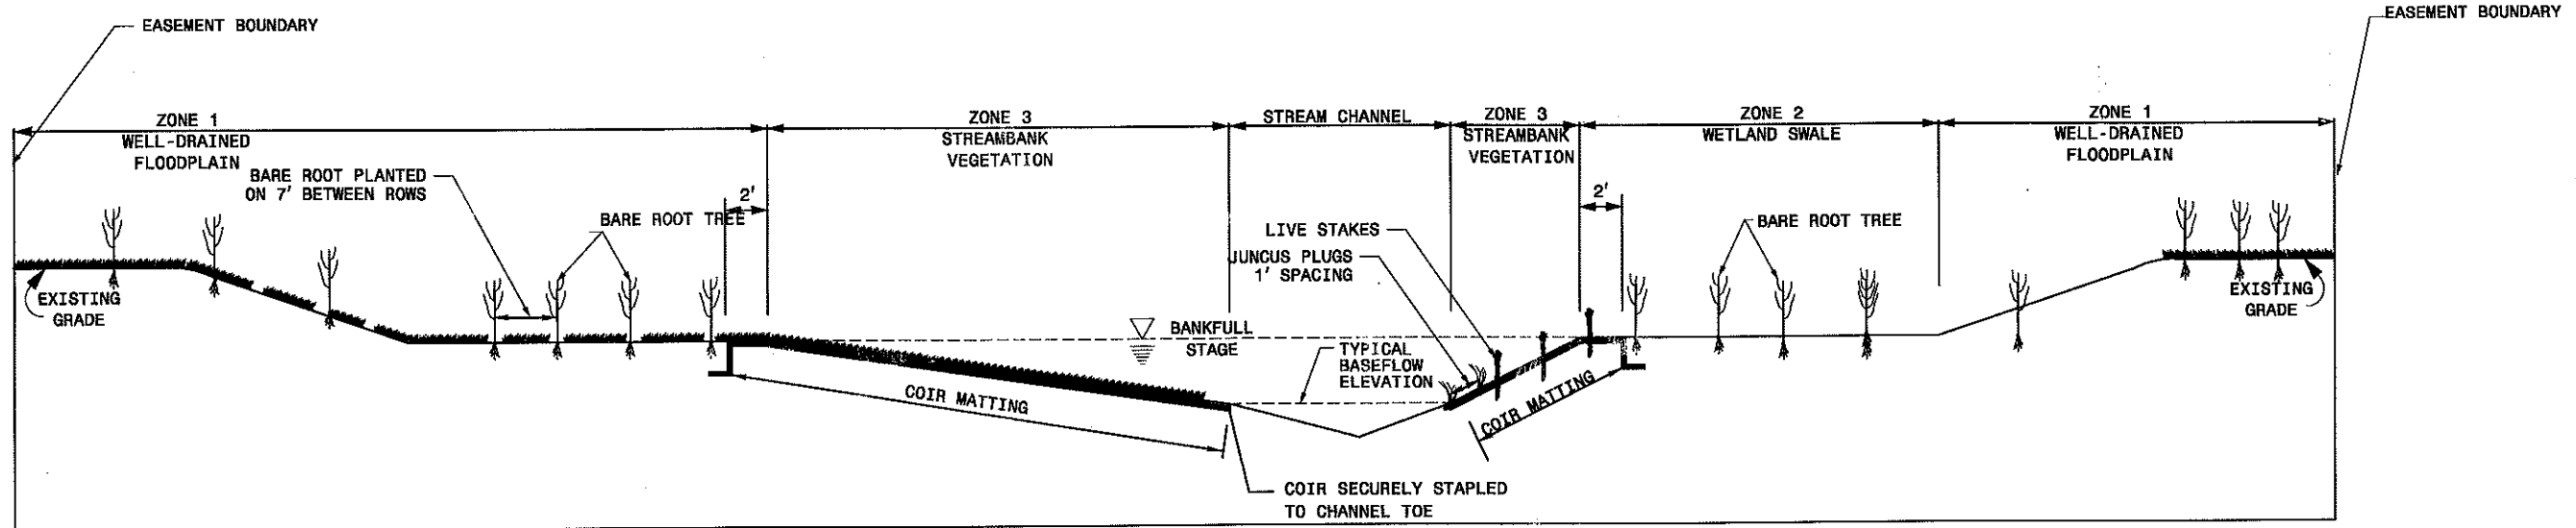

VEGETATION ZONE DETAIL-POOL


SCALE: NTS

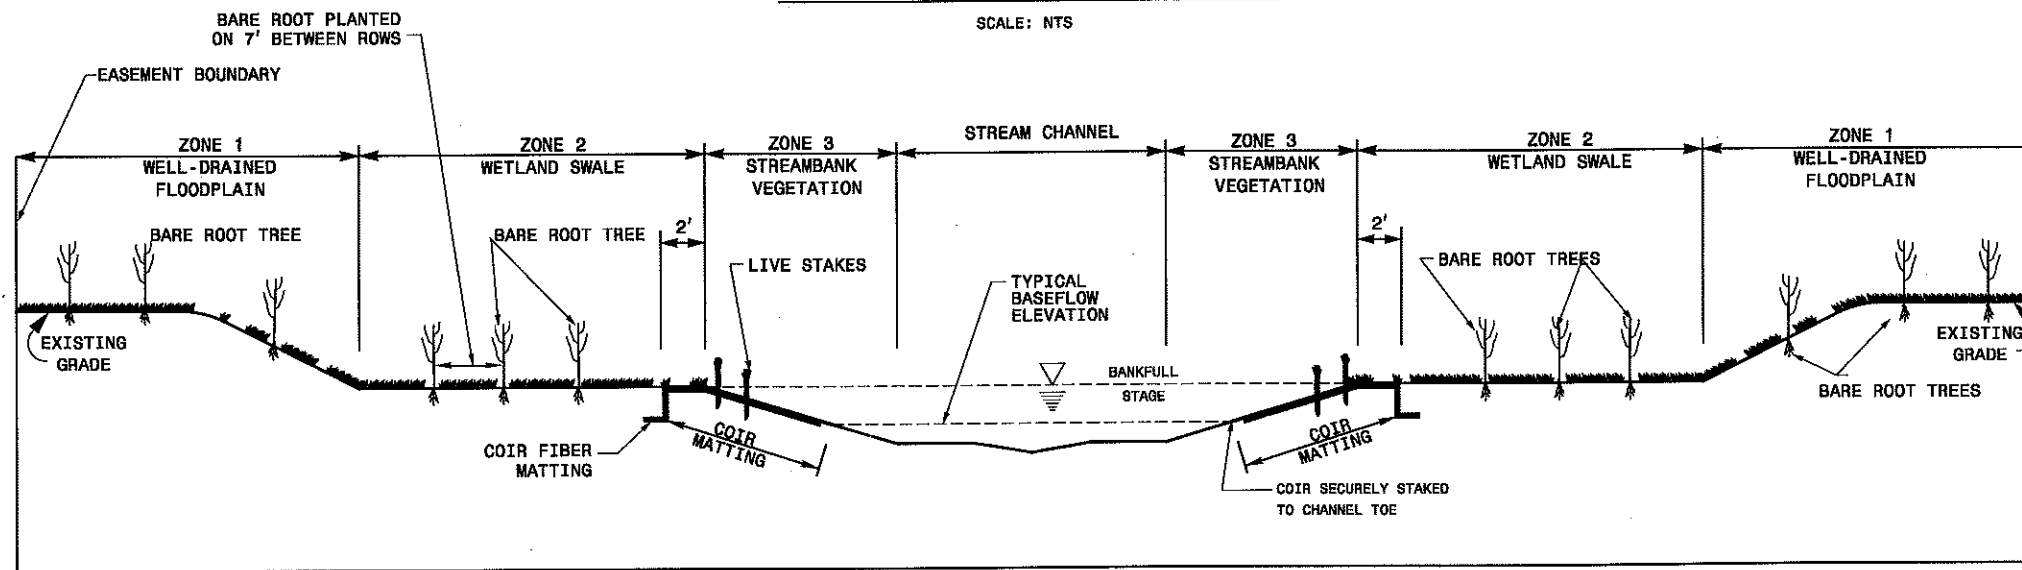

VEGETATION ZONE DETAIL- RIFFLE

SCALE: NTS

VEGETATION ZONE DETAIL

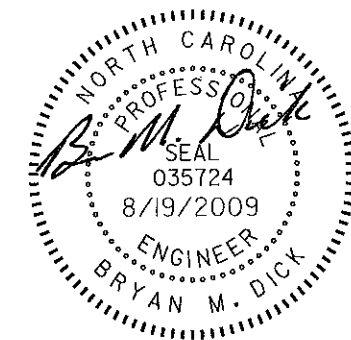

AS-BUILT DRAWINGS
08/17/09

USER: WILSONAB DATE: 8/19/2009
DGN: 499255\cadd\plansheets\99255_psl_L-04-7_Vegetation_Details.dgn 5:02:50 PM


NO	REVISIONS	CHK	DATE
1			
2			
3			

BADIN INN STREAM RESTORATION	
VEGETATION DETAILS	
EARTH TECH AECOM	
TO: CORPORATE CENTER DRIVE, SUITE 475, RALEIGH, NC 27607 919-854-6000 919-854-6005 (fax)	
DATE	8/19/2009
PROJECT NO	99255
FILENAME	
SHEET NO	L-4
DRAWN BY	ICI
CHKD BY	BMD

PLANTING SCHEDULE

SCALE: NTS

		Key	Scientific Name	Common Name	LS	BR	Plug	Zone %	Remarks
ZONE 1	WELL-DRAINED FLOODPLAIN COMMUNITY	TREES	<i>Cornus florida</i>	Flowering dogwood		620		20.00%	Bare root 1/0 seedlings randomly placed on 8-ft centers. Place 2 fertilizer packets per stem.
			<i>Cercis canadensis</i>	Redbud		620		20.00%	
			<i>Nyssa sylvatica</i>	Black gum		160		5.00%	
			<i>Robinia psuedoacacia</i>	Black locust		160		5.00%	
			<i>Magnolia grandiflora</i>	Bull bay magnolia		160		5.00%	
			<i>Quercus rubra</i>	Northern red oak		60		2.00%	
			<i>Quercus phellos</i>	Willow Oak		60		2.00%	
			<i>Quercus velutina</i>	Black Oak		60		2.00%	
			<i>Quercus alba</i>	White Oak		60		2.00%	
		<i>Crataegus spp.</i>	Hawthorne		160		5.00%		
		SHRUBS	<i>Amelanchier aborea</i>	Downy Serviceberry		220		7.00%	Begin first row of plantings 7' inside easement, outermost row shall consist only of shrubs.
			<i>Sambucus canadensis</i>	Elderberry		220		7.00%	
			<i>Calicarpa americana</i>	American Beautyberry		220		7.00%	
<i>Lindera benzoin</i>	Spicebush			190		6.00%			
ZONE 2	WETLAND SWALE COMMUNITY	TREES	<i>Carpinus caroliniana</i>	Ironwood		300		25.00%	Bare root 1/0 seedlings randomly placed on 8-ft centers.
			<i>Cercis canadensis</i>	Redbud		300		25.00%	
		SHRUBS	<i>Ilex verticallata</i>	Winterberry		300		25.00%	Bare root 1/0 seedlings randomly placed on 8-ft centers.
			<i>Alnus serrulata</i>	Tag alder		300		25.00%	
ZONE 3	STREAMBANK VEGETATION	TREES	<i>Salix nigra</i>	Black willow	1500			30.00%	Install upstream and downstream of rock structures where sill intersects bank.
		SHRUBS	<i>Alnus serrulata</i>	Tag alder	2000			40.00%	
			<i>Cornus amomum</i>	Silky dogwood	1500			30.00%	
		PLUGS	<i>Juncus effusus</i>	Soft rush			2200		Two rows of plugs on outer meander of pools only: one row at baseflow elevation, and one half way up slope, spacing is 1 foot between plugs.
ZONE 1-3	PERMANENT SEED MIX		Use Mellow Marsh Farm Piedmont Shade Mix						Apply at 15 lbs/acre, apply juncus seed to riffle sections
			Use Hancocks Wildflower mix near road						
ZONES 1-3	TEMPORARY SEED MIX - WINTER		<i>Secale cereale</i>	Wrens Abuzze Winter rye				50	Winter - Apply at 50 lbs/acre to all disturbed areas in Zones 1-5.
	TEMPORARY SEED MIX - SUMMER		<i>Panicum ramosum</i>	Brown-top millet				50	

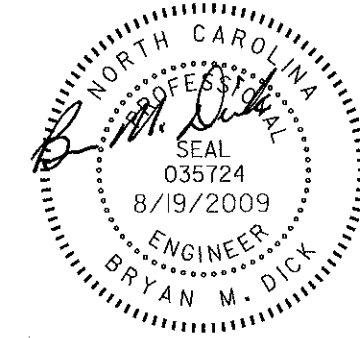


AS-BUILT DRAWINGS
08/17/09

NO	REVISIONS	CHK	DRN	DATE
1				
2				
3				

BADIN INN STREAM RESTORATION	VEGETATION DETAILS
EARTH TECH AECOM	
701 CORPORATE CENTER DRIVE, SUITE 416, RALEIGH, NC 27607 919-854-9300 919-854-6229 (fax)	


DATE	8/19/2009
PROJECT NO	99255
FILENAME	
SHEET NO	L-5
DRAWN BY	ICJ
CHKD BY	BMD

USER: WILSONBAR DATE: 8/19/2009
DGN: G:\99255\Acad\Wksheets\99255_posh_L-04-7_Vegetation_Details.dwg 5:02:50 PM

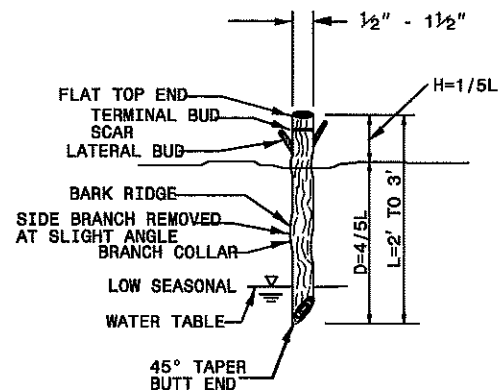


NOTES:

1. ALL LATERAL BRANCHES SHALL BE TRIMMED TO AVOID DAMAGE TO THE BARK RIDGE AND BRANCH COLLAR.
2. A MINIMUM OF TWO BUDS (ONE LATERAL PLUS ONE TERMINAL OR TWO TERMINAL) SHALL BE ABOVE THE PLANTING DEPTH.

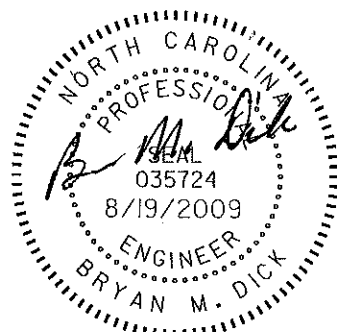


AS-BUILT DRAWINGS
08/17/09

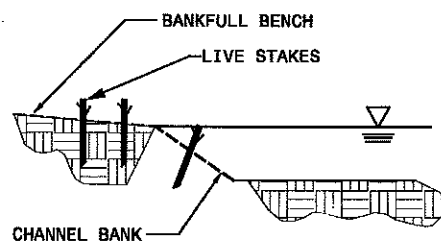

LIVE STAKE

SCALE: NTS

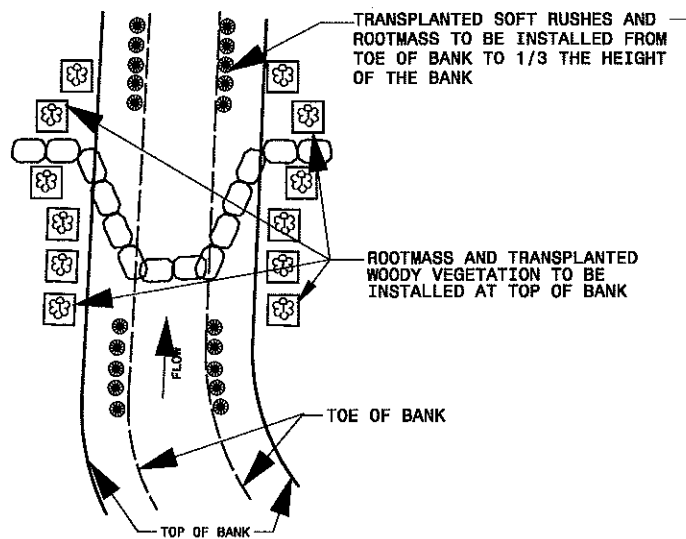

CROSS VANE/GRADE CONTROL VANE

TRANSPLANT PLACEMENT BY STRUCTURE TYPE


SCALE: NTS

BARE ROOT PLANTING DETAILS


SEEDLING/LINER BAREROOT PLANTING DETAIL

HEALING IN


1. LOCATE A HEALING-IN SITE IN A SHADY, WELL PROTECTED AREA.
2. EXCAVATE A FLAT BOTTOM TRENCH 300 MM DEEP AND PROVIDE DRAINAGE.

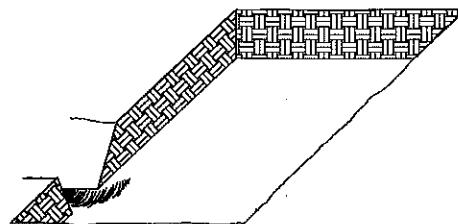


3. BACKFILL THE TRENCH WITH 50 MM OF WELL ROTTED SAWDUST. PLACE A 50 MM LAYER OF WELL ROTTED SAWDUST AT A SLOPING ANGLE AT ONE END OF THE TRENCH.

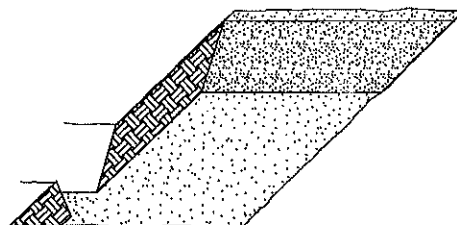

4. PLACE A SINGLE LAYER OF PLANTS AGAINST THE SLOPING END SO THAT THE ROOT COLLAR IS AT GROUND LEVEL.

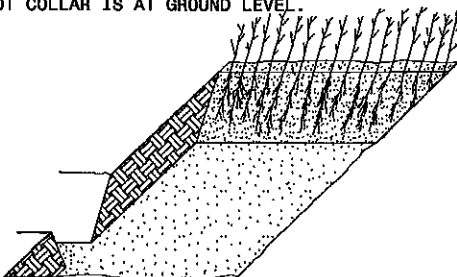


5. PLACE A 50 MM LAYER OF WELL ROTTED SAWDUST OVER THE ROOTS MAINTAINING A SLOPING ANGLE.

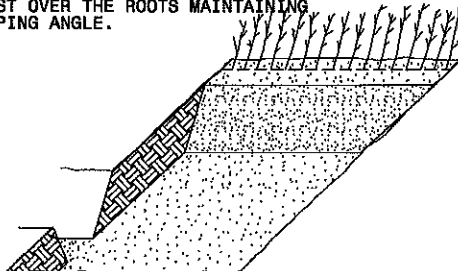


6. REPEAT LAYERS OF PLANTS AND SAWDUST AS NECESSARY AND WATER THOROUGHLY.

DIBBLE PLANTING METHOD USING THE KBC PLANTING BAR

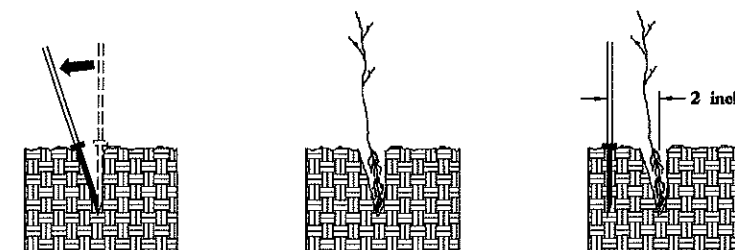

1. INSERT PLANTING BAR AS SHOWN AND PULL HANDLE TOWARD PLANTER.
2. REMOVE PLANTING BAR AND PLACE SEEDLING AT CORRECT DEPTH.
3. INSERT PLANTING BAR 50 MM TOWARD PLANTER FROM SEEDLING.

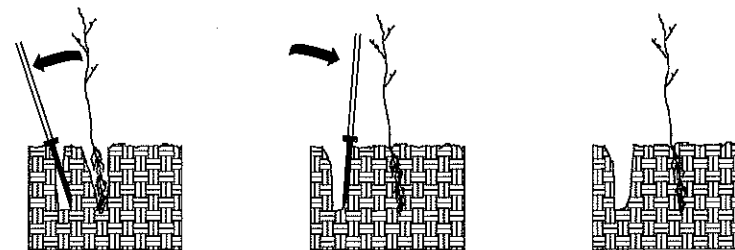

4. PULL HANDLE OF BAR TOWARD PLANTER, FIRING SOIL AT BOTTOM.
5. PUSH HANDLE FORWARD FIRING SOIL AT TOP.
6. LEAVE COMPACTION HOLE OPEN. WATER THOROUGHLY.

PLANTING NOTES:

PLANTING BAG DURING PLANTING, SEEDLINGS SHALL BE KEPT IN A MOIST CANVAS BAG OR SIMILAR CONTAINER TO PREVENT THE ROOT SYSTEMS FROM DRYING.



KBC PLANTING BAR PLANTING BAR SHALL HAVE A BLADE WITH A TRIANGULAR CROSS SECTION, AND SHALL BE 300 MM LONG, 100 MM WIDE AND 25 MM THICK AT CENTER.



ROOT PRUNING ALL SEEDLINGS SHALL BE ROOT PRUNED, IF NECESSARY, SO THAT NO ROOTS EXTEND MORE THAN 250 MM BELOW THE ROOT COLLAR.

USER: WILSONAB DATE: 8/19/2009
DGN: 4159255.vcd\plans\beets\99255_psh_L-04-7_Vegetation_Details.dwg 5:01:46 PM


NO	REVISIONS	CHK	DATE
1			
2			
3			
4			
5			
6			
7			
8			
9			
10			

BADIN INN STREAM RESTORATION		VEGETATION DETAILS		EARTHTECH AECOM	
TO: CORPORATE CENTER DRIVE, SUITE 415, WALESH, NC 27607 319-854-6600 319-854-6625 FAX					
DATE	8/19/2009	PROJECT NO	99255	FILENAME	
SHEET NO	L-6	DRAWN BY	ICJ	CHKD BY	BMD


BADIN INN STREAM RESTORATION STANLY COUNTY, NC (AS-BUILT PLANS)

Clearing, grading, erosion control, stream restoration, drainage, debris removal, landscaping, and other improvements as noted on the plans. This work will include all items necessary to construct the stream, the wet swales, and associated structures with the associated landscaping, plantings, seeding and live staking.

RECEIVING STREAM: LITTLE MOUNTAIN CREEK
NCDWQ CLASSIFICATION: WS IV

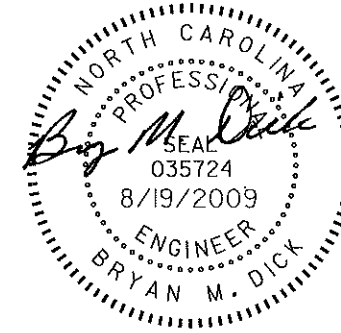


AS-BUILT DRAWINGS 08/17/09

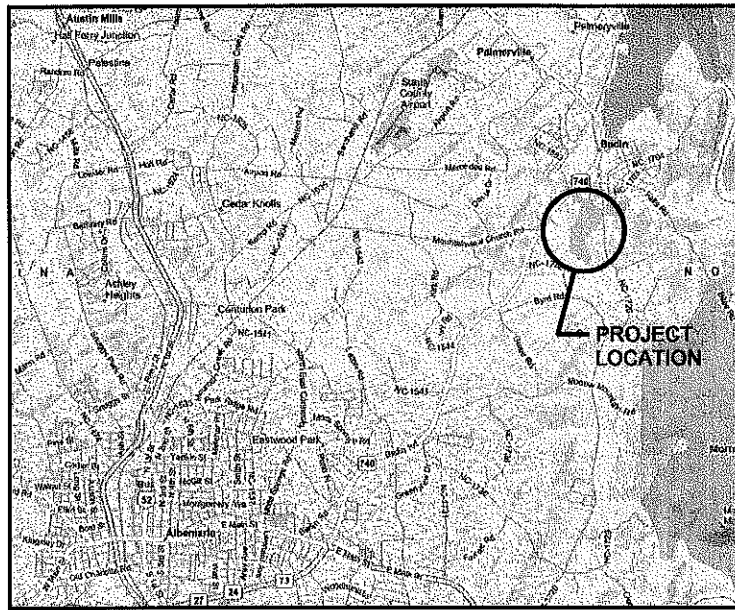

VICINITY MAP
(Not to Scale)

INDEX OF SHEETS

- C-18..... AS-BUILT TITLE SHEET
- C-19 THRU C-23..... AS-BUILT DRAWINGS OVER DESIGN DRAWINGS
- C-24 THRU C-27..... AS-BUILT PROFILE OVER DESIGN PROFILE
- C-28 THRU C-31..... AS-BUILT CROSS SECTIONS OVER TYPICAL CROSS SECTIONS
- C-32 THRU C-36..... AS-BUILT DRAWINGS
- C-37 THRU C-40..... AS-BUILT CROSS SECTIONS
- C-41 THRU C-44..... AS-BUILT PROFILES

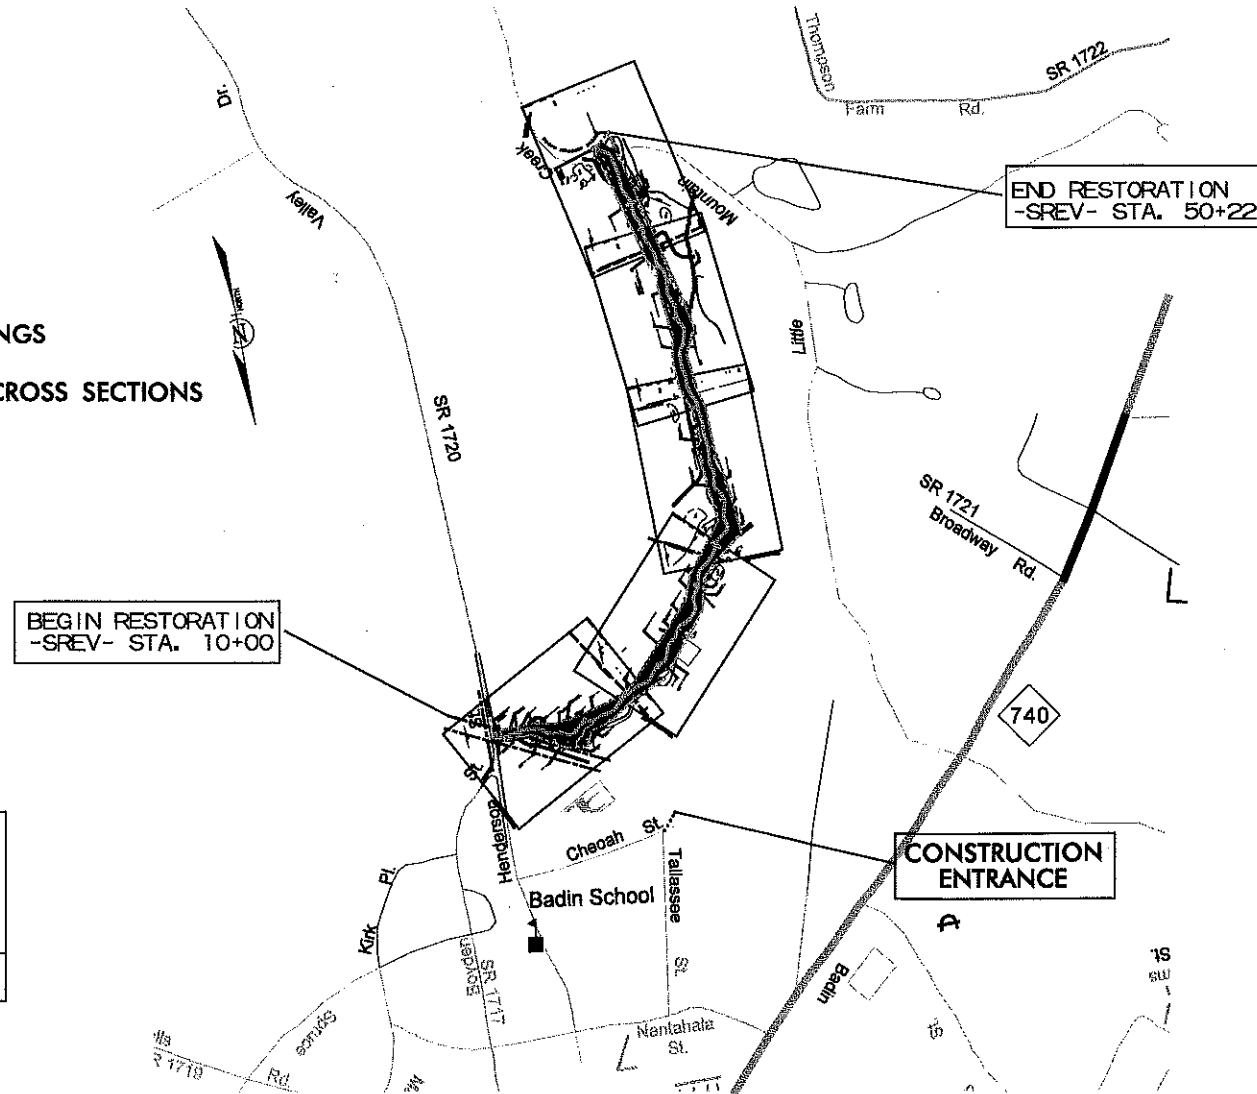

CONSULTANT: EARTH TECH | AECOM
701 Corporate Center Drive, Suite #475 Raleigh, NC 27607
Phone: (919) 854-6200 Fax: (919) 854-6259

SENIOR DESIGN CONTACT: BRYAN DICK (919-854-6252)

EARTHWORK

UNCLASSIFIED EXCAVATION (CY)	UNDERCUT (CY)	EMBANKMENT (CY)	BORROW (CY)	WASTE (CY)
5742		5103	0	639

STREAM REACH	PROPOSED CENTER LENGTH	MODIFICATION TYPE
SREV	3994 FT	RESTORATION
TRIB	180 FT	ENHANCEMENT

LONGITUDE AND LATITUDE:

STA. 10+00
LONGITUDE 80° 6' 54" W
LATITUDE 35° 23' 57" N


DISTURBED AREA:

9.5 ACRES

NO	REVISIONS	DRN	CHK	DATE
1	T1 REVISED DISTURBED AREA, ADDED CONST. ENTRANCE	RR	II	25/09

BADIN INN STREAM RESTORATION
TITLE SHEET
EARTH TECH | AECOM
701 CORPORATE CENTER DRIVE, SUITE 475, RALEIGH, NC 27607
919-854-6200 919-854-6259 (FAX)


DATE	8/19/2009
PROJECT NO	99255
FILENAME	99255_title.dgn
SHEET NO	C-18
DRAWN BY	ICJ
CHKD BY	JWJ

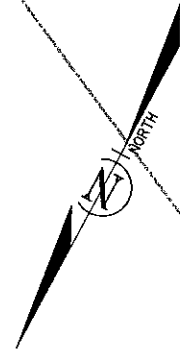

VALLEY DRIVE


BOYDEN ROAD

BEGIN CONSTRUCTION
-SREV- STA. 10+00
N: 602085.83
E: 1667774.20

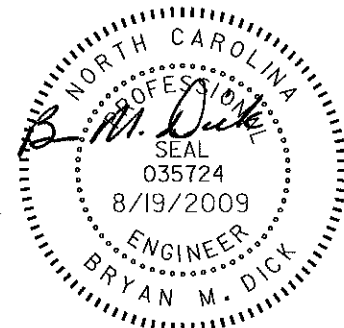

AS-BUILT DRAWINGS 08/17/09


MATCHLINE SHEET C80-2

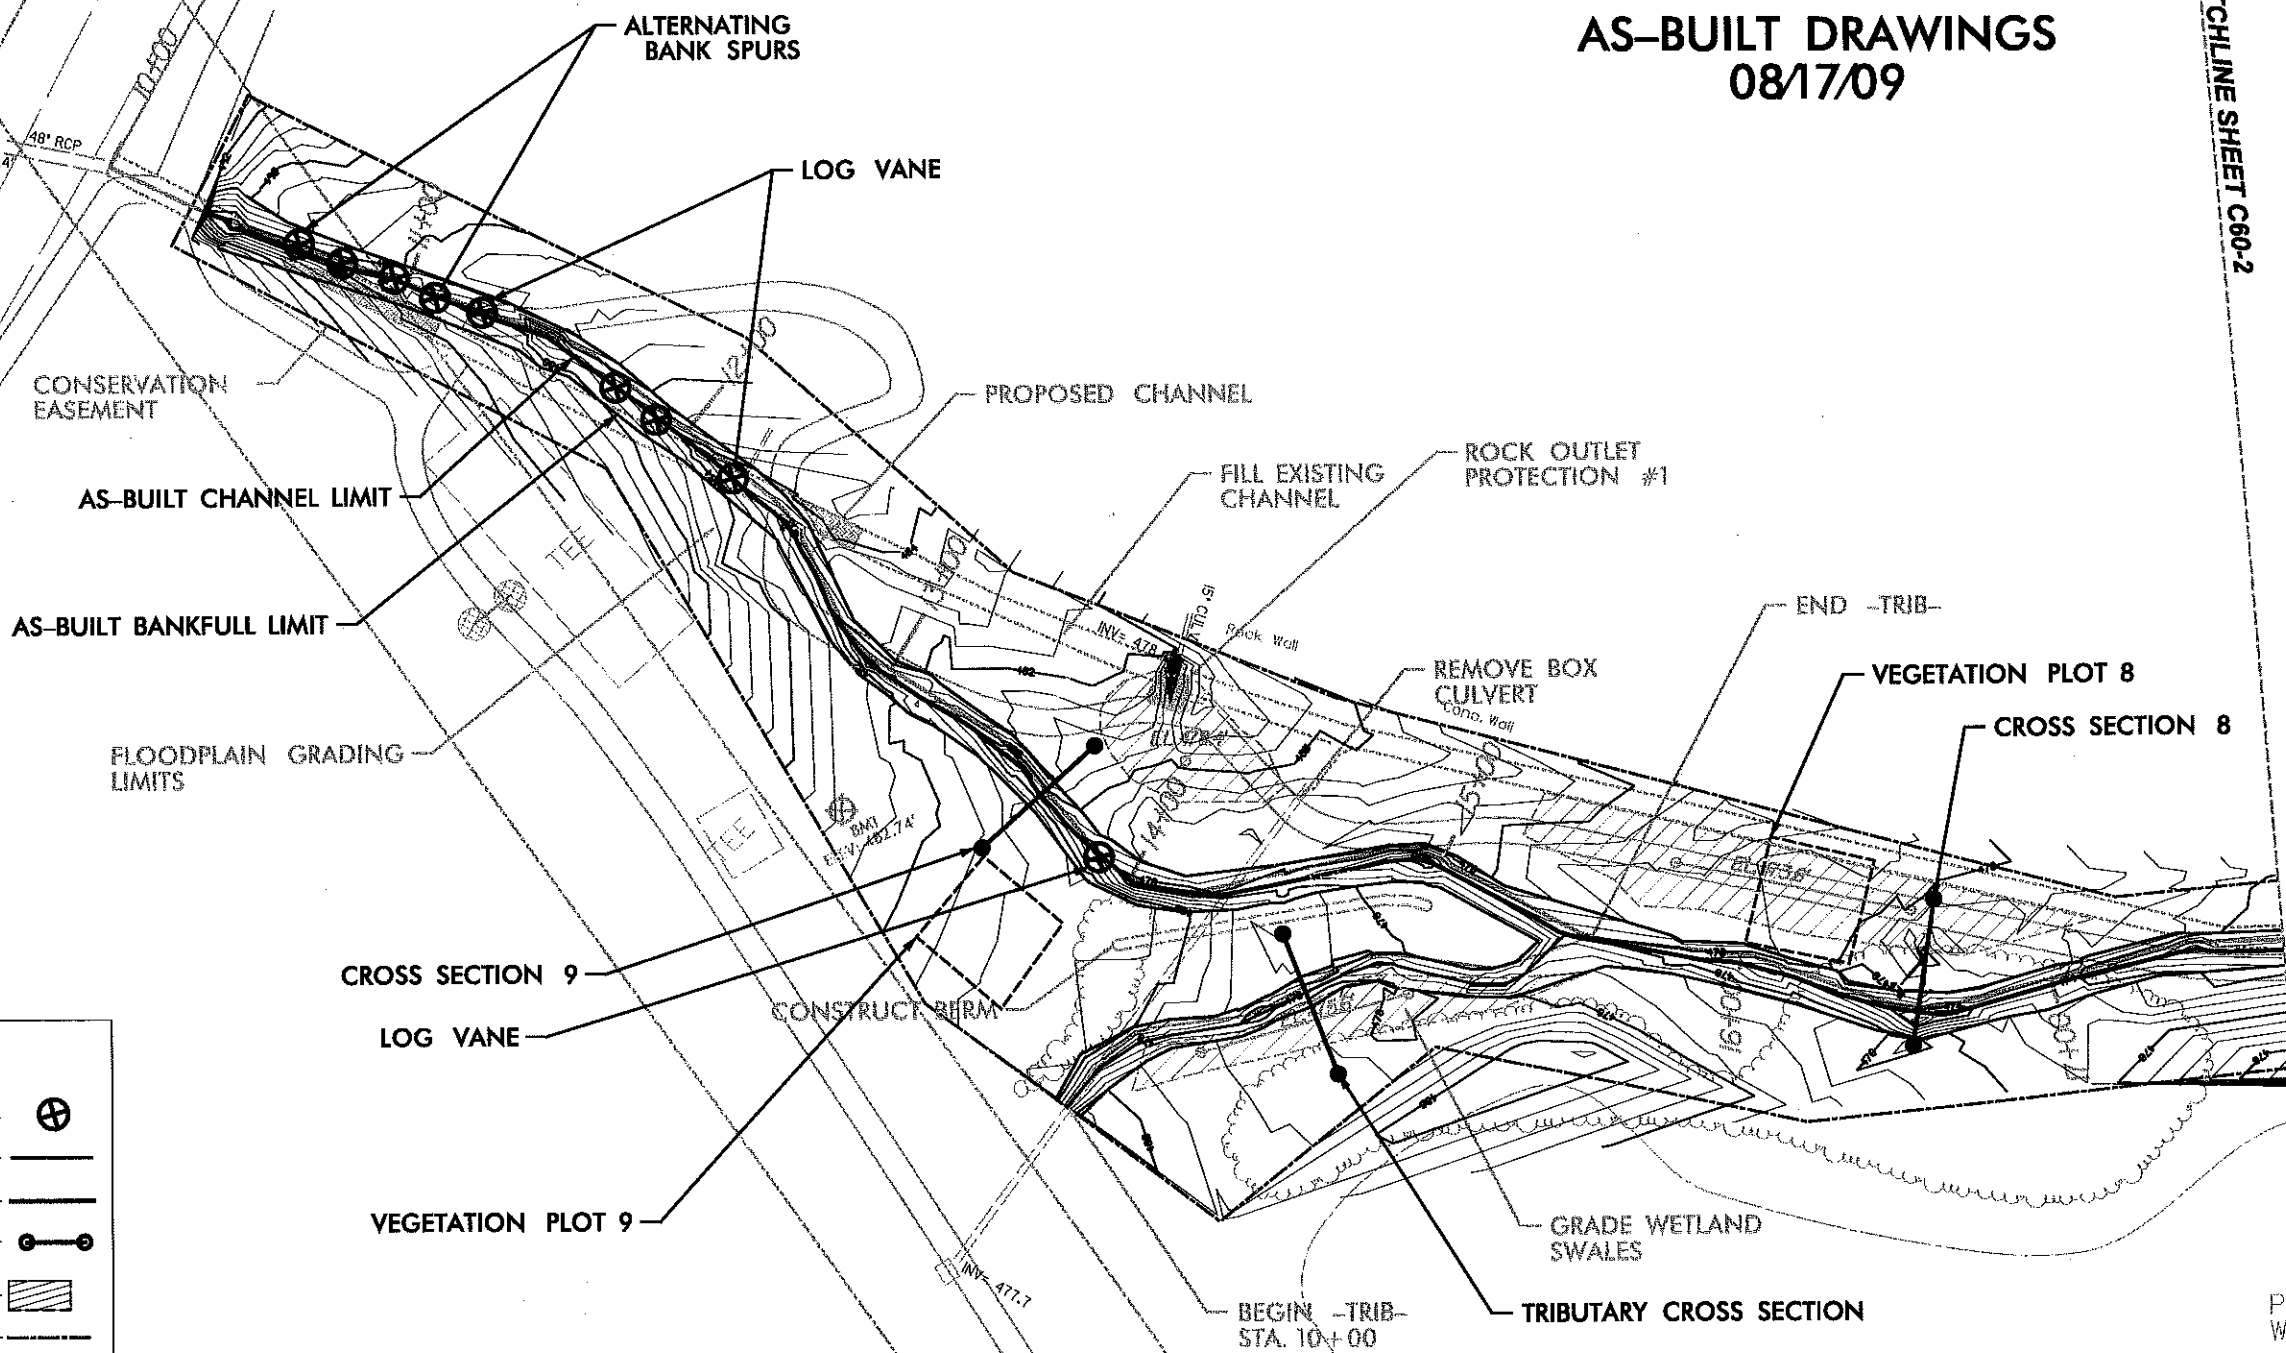

LEGEND

STRUCTURE	
AS-BUILT TOP OF BANK	
AS-BUILT CHANNEL	
CROSS SECTION	
WET SWALE	
CONSERVATION EASEMENT	
MAJOR CONTOUR	
MINOR CONTOUR	
DESIGN CHANNEL	
VEGETATION PLOT	

NO	REVISIONS	DRN	CHK	DATE
1				
2				
3				

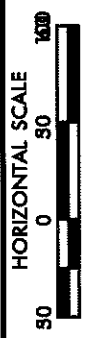


BADIN INN STREAM RESTORATION
AS-BUILT DRAWINGS
OVER DESIGN DRAWINGS
EARTH TECH | AECOM

701 CORPORATE CENTER DRIVE, SUITE 475, RALEIGH, NC 27607
919-854-6200 919-854-6255 (fax)

DATE	8/19/2009
PROJECT NO	99255
FILENAME	
SHEET NO	C-19
DRAWN BY	ABW
CHKD BY	BMD



USER: WILSONAR DATE: 8/19/2009
JOB: C:\99255\ccdr\as-built\Files\AS-Built\Files\AS-Built\AS-Built\AS-Built\AS-Built.dgn

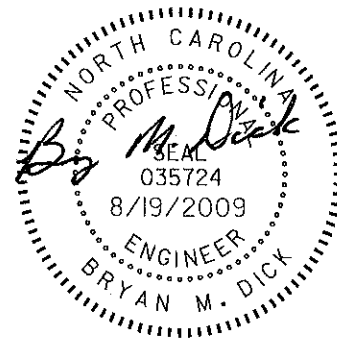

AS-BUILT DRAWINGS 08/17/09

MATCHLINE SHEET C60-1

MATCHLINE SHEET C60-3

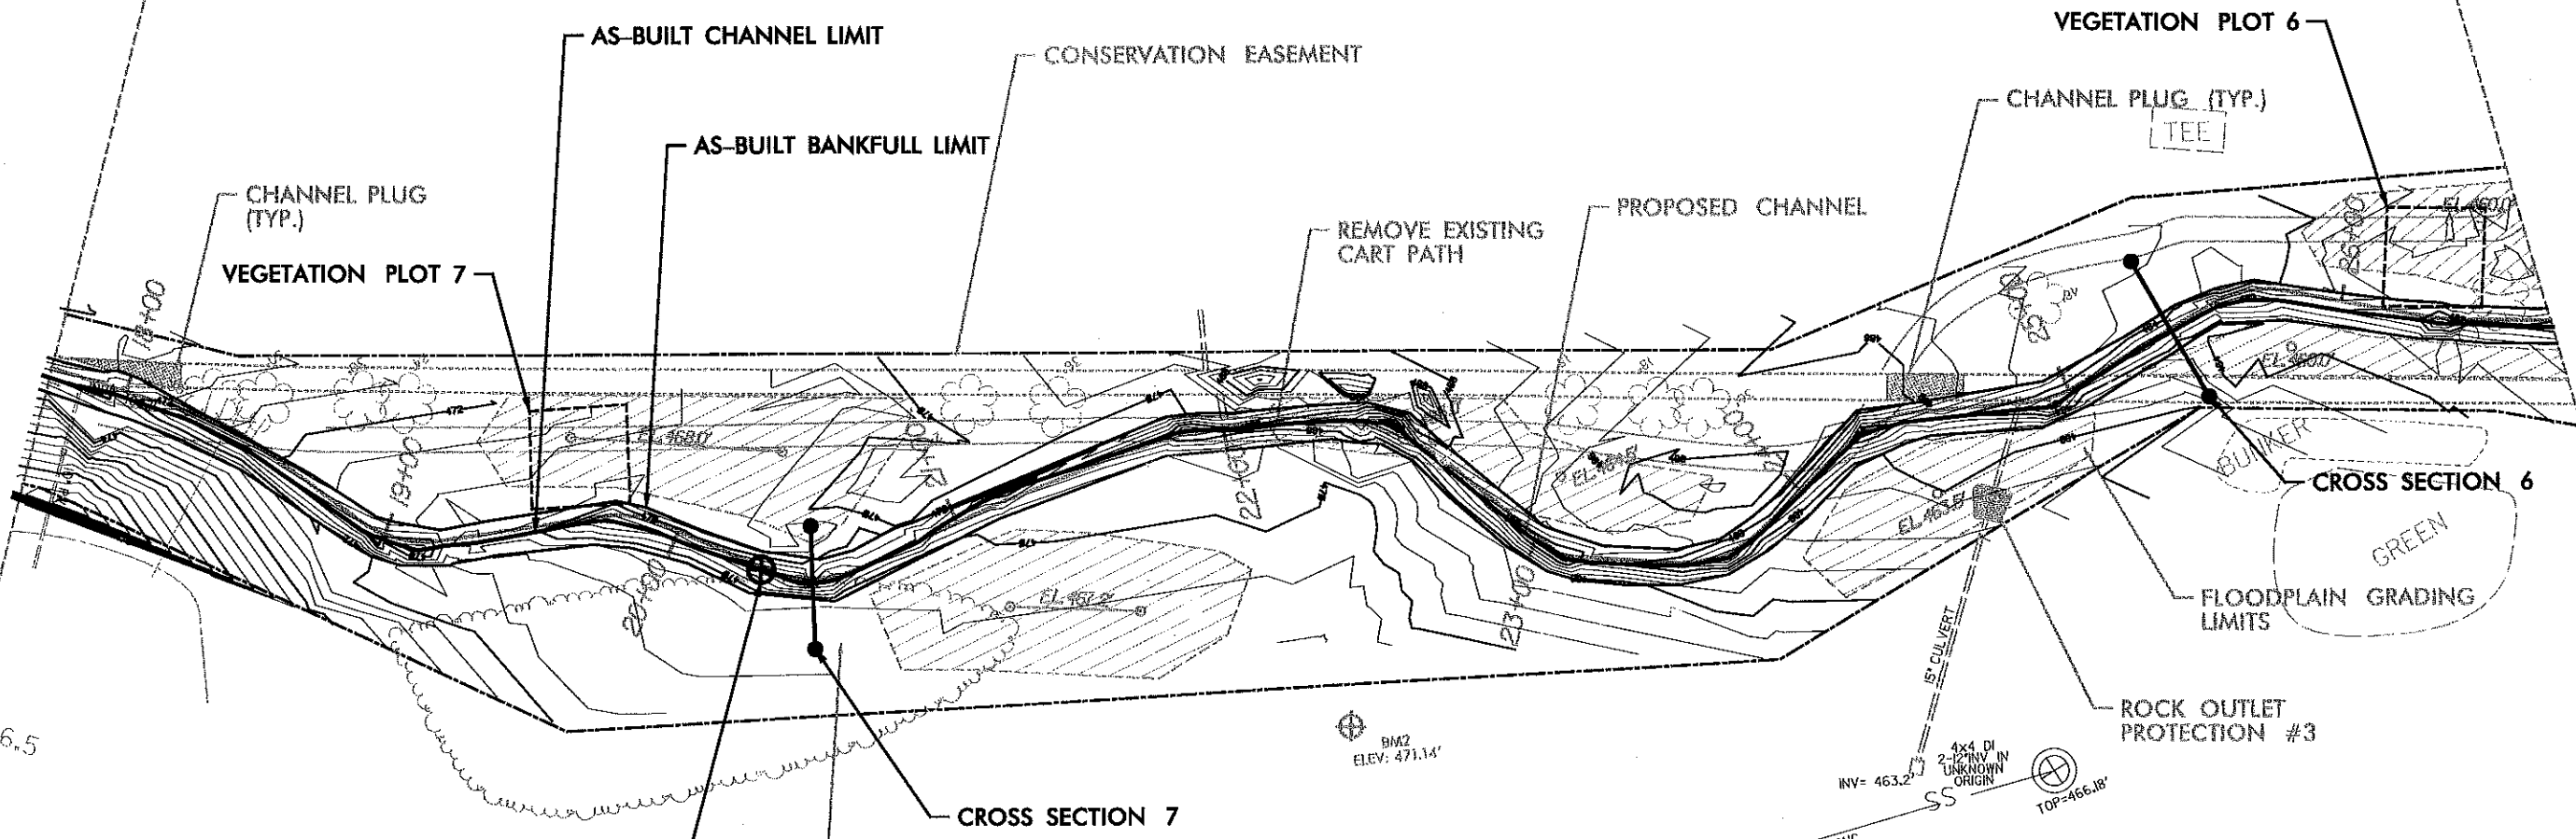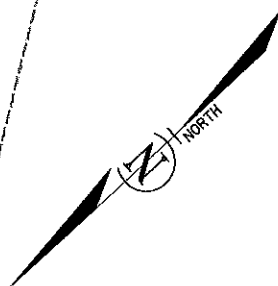

NO	REVISIONS	DATE
1		
2		
3		




LEGEND	
STRUCTURE	
AS-BUILT TOP OF BANK	
AS-BUILT CHANNEL	
CROSS SECTION	
WET SWALE	
CONSERVATION EASEMENT	
MAJOR CONTOUR	
MINOR CONTOUR	
DESIGN CHANNEL	
VEGETATION PLOT	

BADIN INN STREAM RESTORATION
AS-BUILT DRAWINGS
OVER DESIGN DRAWINGS
EARTH TECH | AECOM
701 CORPORATE CENTER DRIVE, SUITE 475, RALEIGH, NC 27607
919-884-6200 919-884-6258 Fax

DATE	8/19/2009
PROJECT NO	99255
FILENAME	
SHEET NO	C-20
DRAWN BY	CHKD BY
ARW	BMD


USER: WILSONAB
DATE: 8/19/2009
DGN: C:\99255\cadd\as-built\Filas\AS-BUILT_Plansheets\99255_plansheets\cadd\1102.dgn

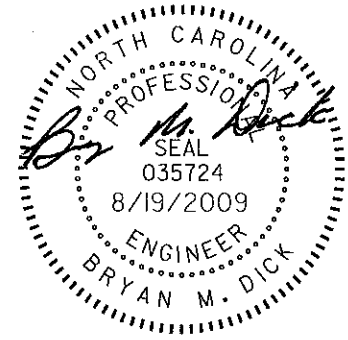

AS-BUILT DRAWINGS 08/17/09

MATCHLINE SHEET C60-2

MATCHLINE SHEET C60-4

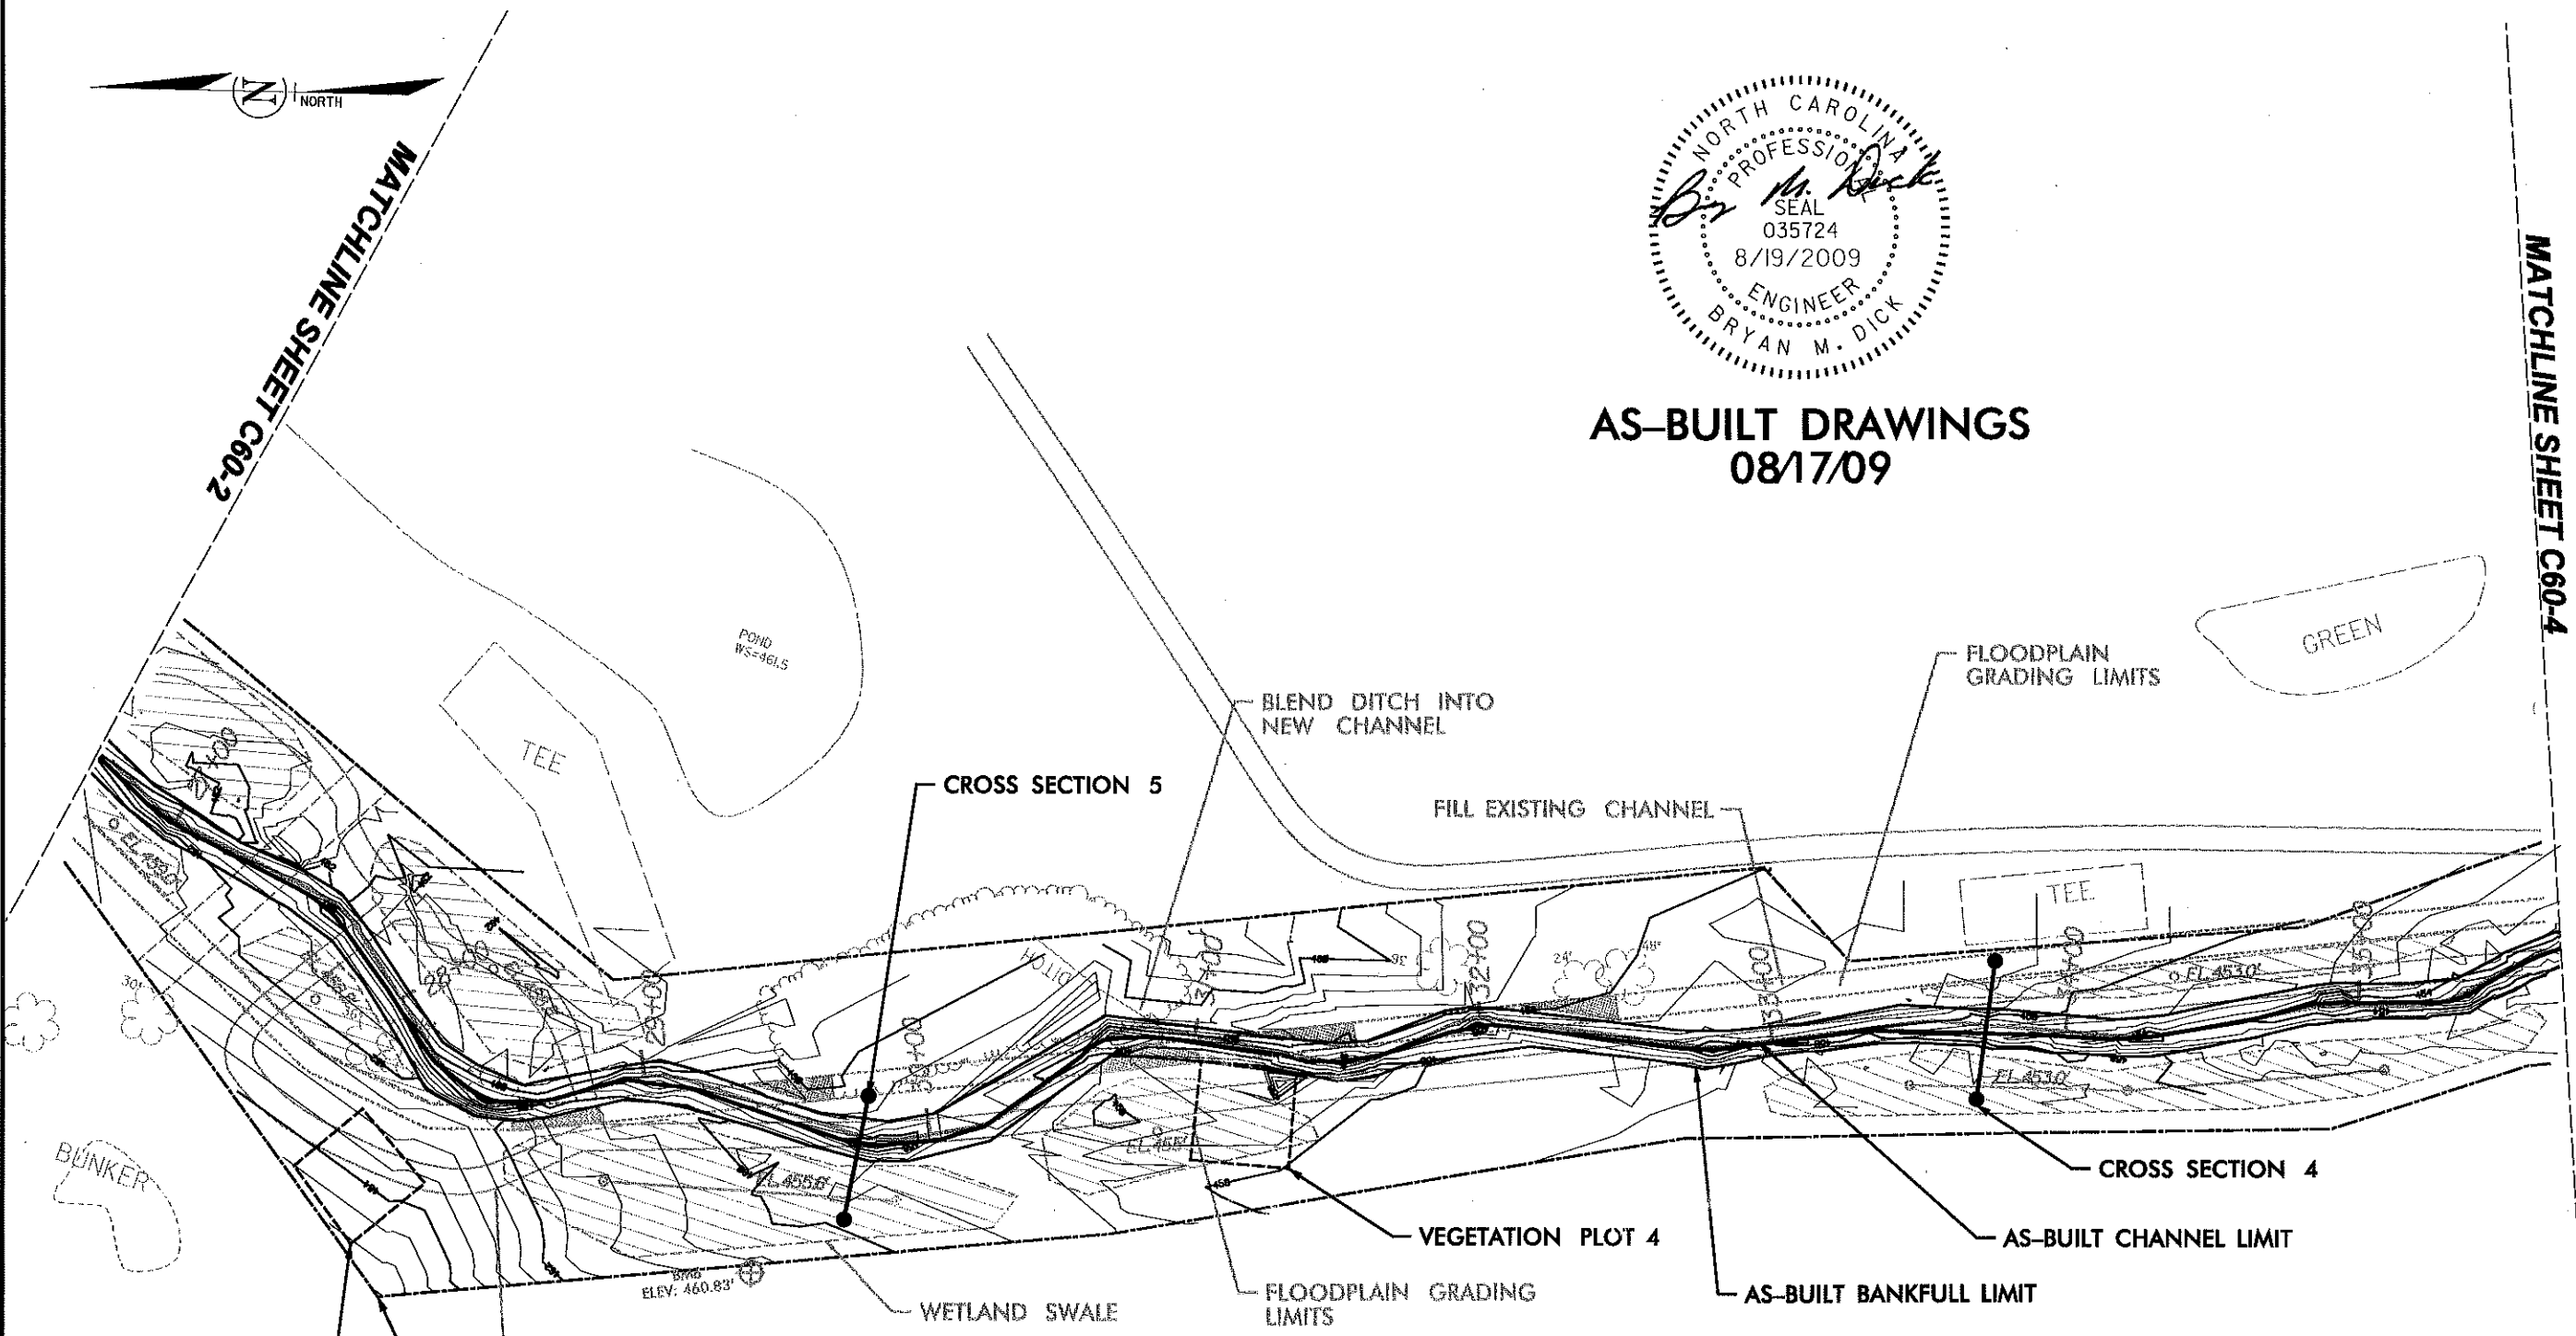

NO	REVISIONS	DRN	CHK	DATE
1				
2				
3				



LEGEND

STRUCTURE	—————	⊕
AS-BUILT TOP OF BANK	—————	—————
AS-BUILT CHANNEL	—————	—————
CROSS SECTION	—————	⊕
WET SWALE	—————	▨
CONSERVATION EASEMENT	—————	—————
MAJOR CONTOUR	—————	—————
MINOR CONTOUR	—————	—————
DESIGN CHANNEL	—————	—————
VEGETATION PLOT	—————	⊔

USER: WILSONAB DATE: 8/19/2009
DGN: G:\99255\acad\as-built\Files\AS-BUILT_Plansheets\99255_plansheets\c60-2.dgn

BADIN INN STREAM RESTORATION
AS-BUILT DRAWINGS
OVER DESIGN DRAWINGS
EARTH TECH | AECOM

701 CORPORATE CENTER DRIVE SUITE 415 RALEIGH, NC 27607
919-851-6200 919-851-6299 (FAX)


DATE	8/19/2009
PROJECT NO	99255
FILENAME	
SHEET NO	C-21
DRAWN BY	ARW
CHKD BY	BMD

MATCHLINE SHEET C60-3

MATCHLINE SHEET C60-5




AS-BUILT DRAWINGS 08/17/09

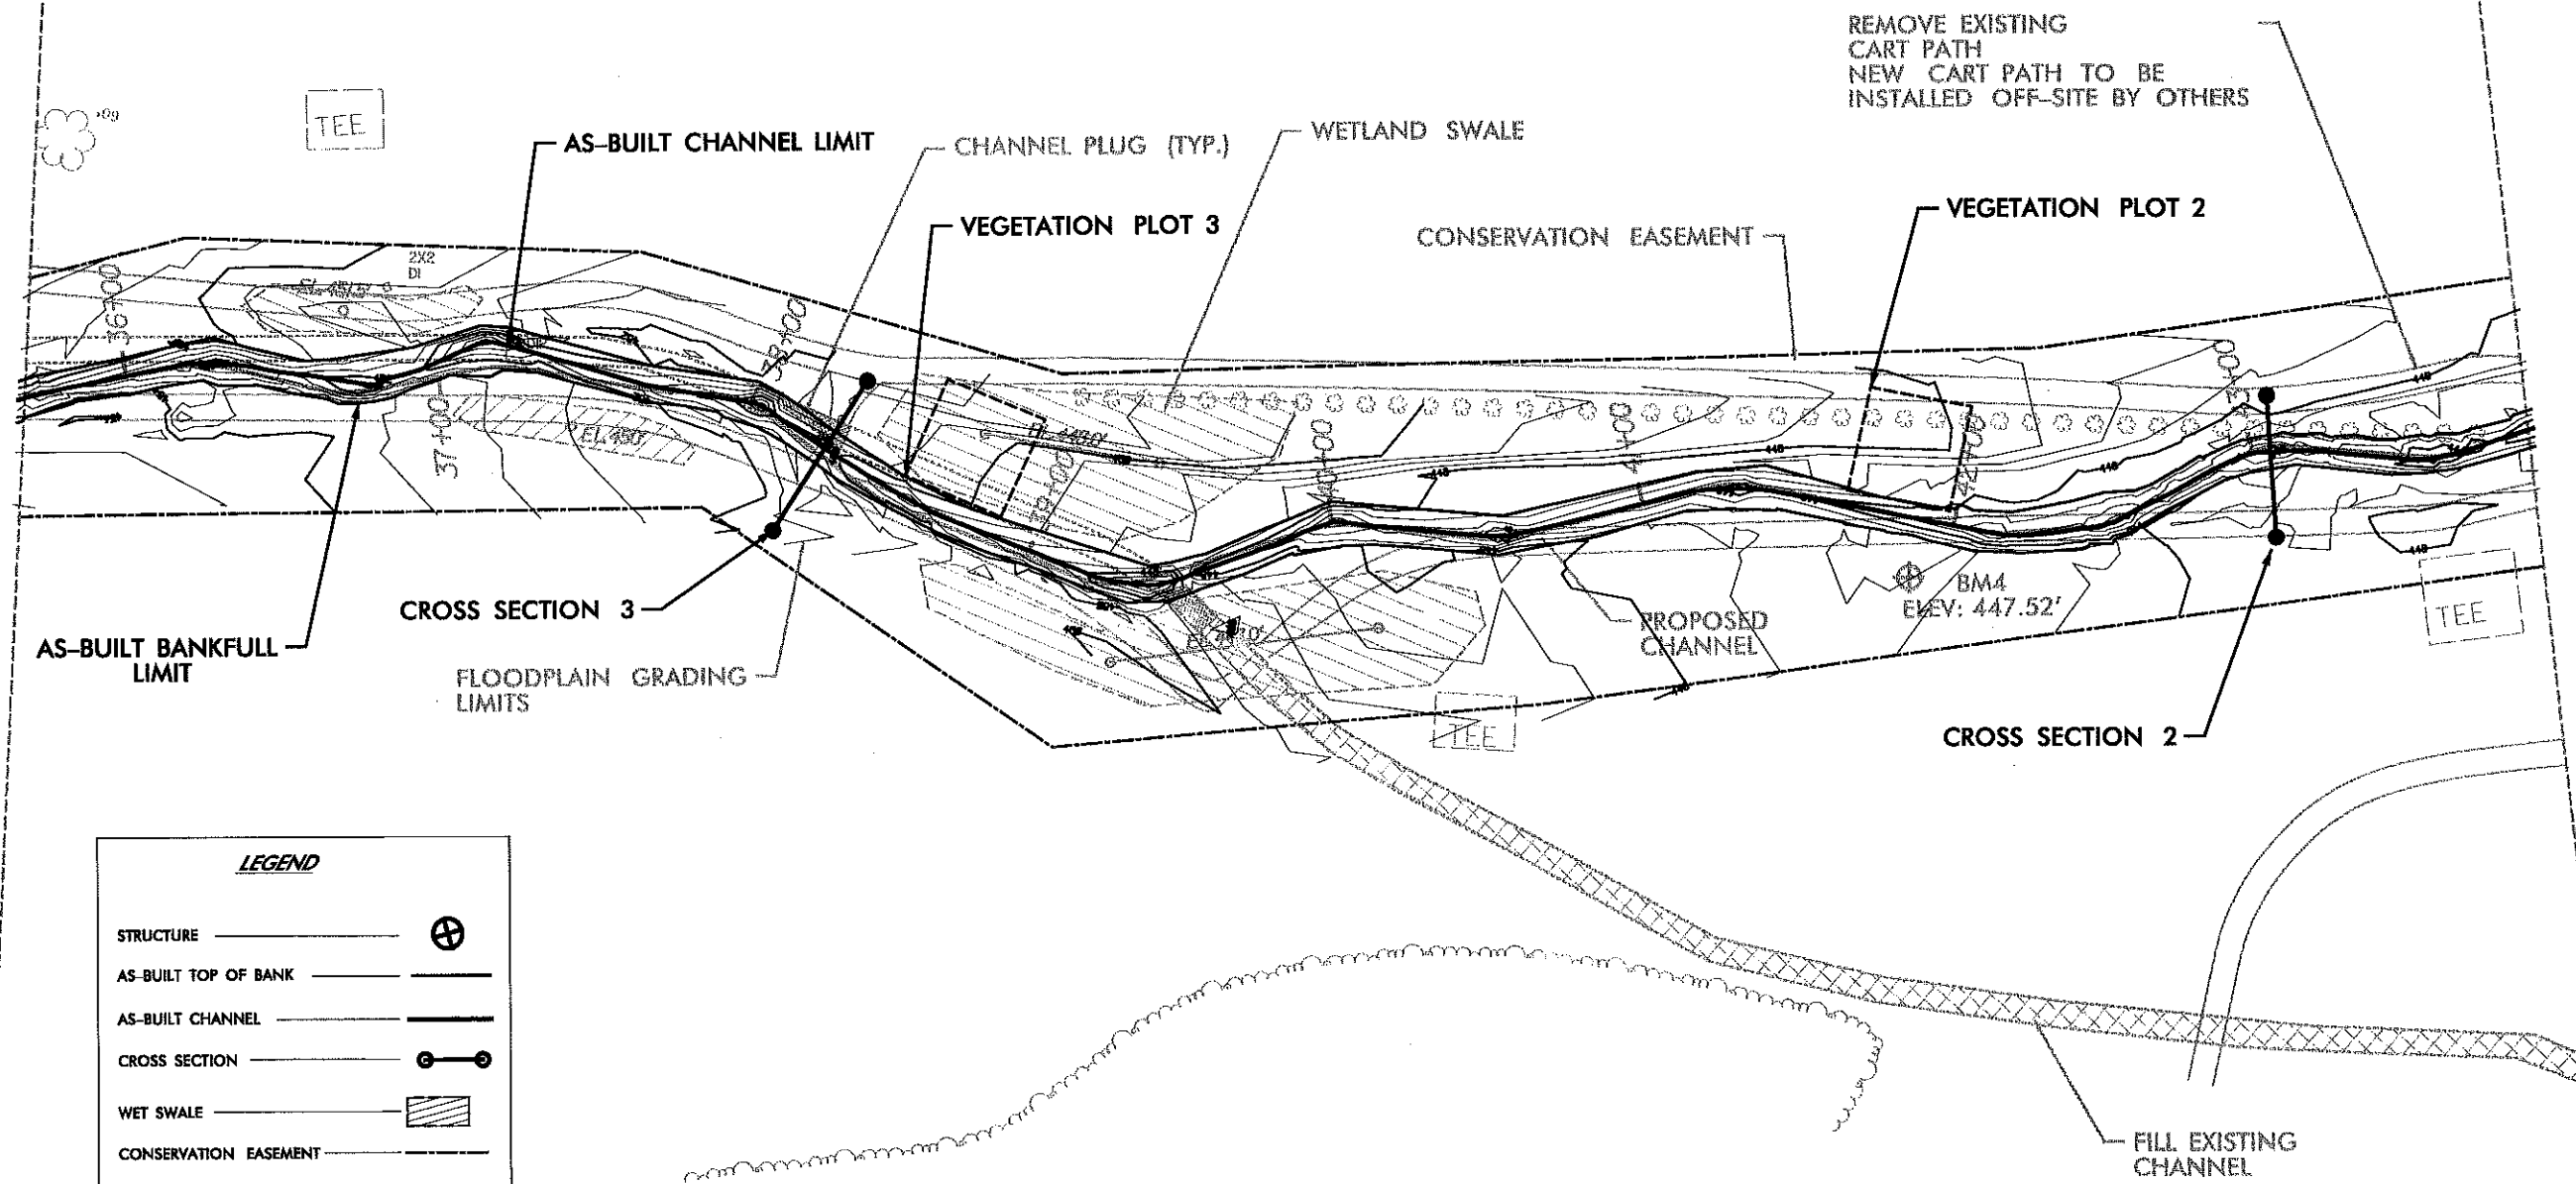

LEGEND	
STRUCTURE	
AS-BUILT TOP OF BANK	
AS-BUILT CHANNEL	
CROSS SECTION	
WET SWALE	
CONSERVATION EASEMENT	
MAJOR CONTOUR	
MINOR CONTOUR	
DESIGN CHANNEL	
VEGETATION PLOT	

NO	REVISIONS	DRN	CHK	DATE
1				
2				
3				

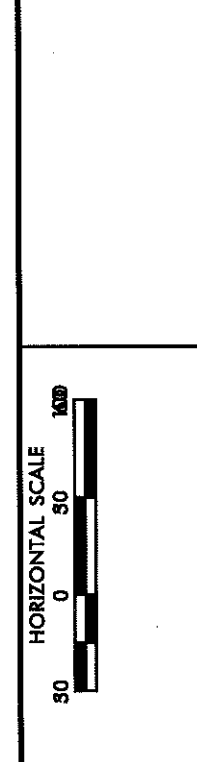

BADIN INN STREAM RESTORATION
AS-BUILT DRAWINGS
OVER DESIGN DRAWINGS
EARTH TECH | AECOM

TO: CORPORATE CENTER DRIVE, SUITE 415, RALEIGH, NC 27607
919-854-6200 919-854-6209 (fax)

DATE	8/19/2009
PROJECT NO	99255
FILENAME	
SHEET NO	C-22
DRAWN BY	ABW
CHKD BY	BMD

USER: WILSONAB
DATE: 8/19/2009
C:\US9255\cadd\as-Built\Files\AS-BUILT_Plansheets\99255_plansheets\AS-Built\AS-Built_Plansheets\99255.dgn




END CONSTRUCTION
 -SREV- STA. 50+22
 N: 599169.39
 E: 1666742.68



**AS-BUILT DRAWINGS
 08/17/09**

MATCHLINE SHEET C60-4

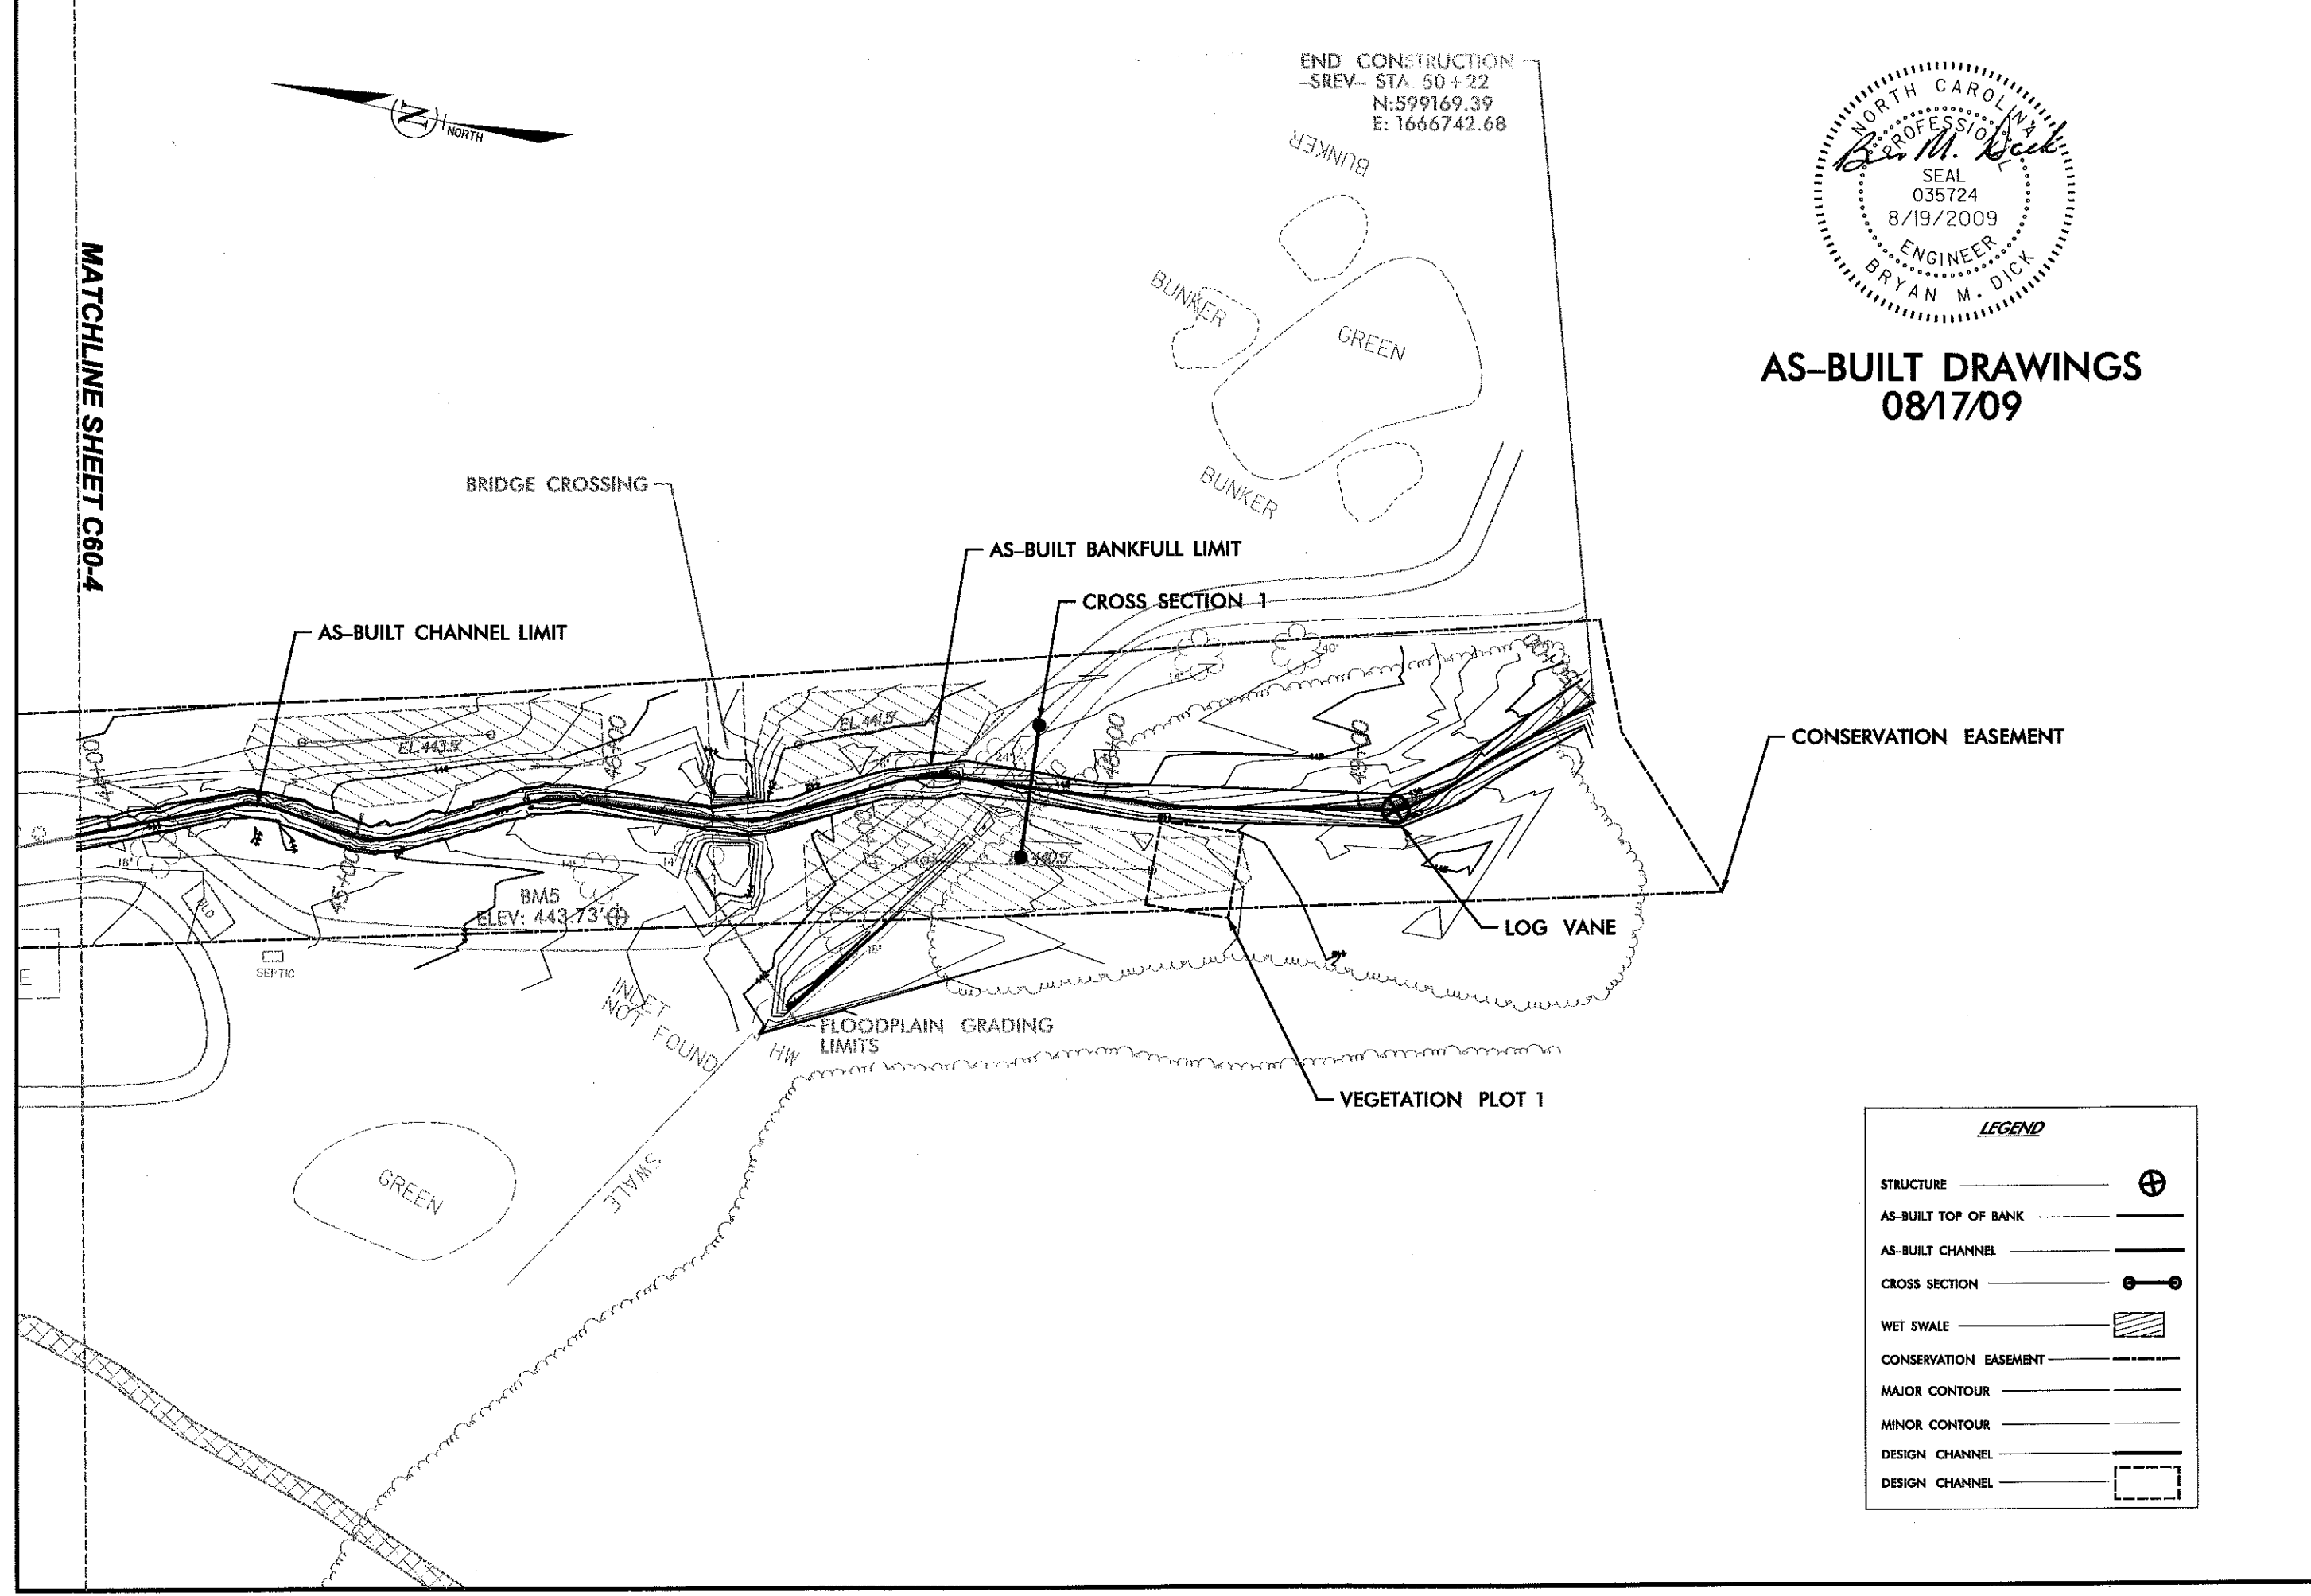

NO	REVISIONS	DRN	CHK	DATE
1				
2				
3				



LEGEND




STRUCTURE	
AS-BUILT TOP OF BANK	
AS-BUILT CHANNEL	
CROSS SECTION	
WET SWALE	
CONSERVATION EASEMENT	
MAJOR CONTOUR	
MINOR CONTOUR	
DESIGN CHANNEL	
DESIGN CHANNEL	

BADIN INN STREAM RESTORATION
 AS-BUILT DRAWINGS
 OVER DESIGN DRAWINGS
 EARTH TECH | AECOM
 701 CORPORATE CENTER DRIVE, SUITE 475, WALEGA, NC 27607
 919-854-6200 919-854-6289 FAX

DATE	8/19/2009
PROJECT NO	99255
FILENAME	
SHEET NO	C-23
DRAWN BY	ABW
CHKD BY	BMD


USER: WILSONAB
 DGN: 0299255\cada\as-built\Files\AS-Built_Plansheets\99255_per\1165\as-built\c60-4.dgn
 DATE: 8/19/2009

USER: WILSONAB
 DATE: 8/19/2009
 Path: C:\99255\cards\as-built\Files\AS-Built_Plan\as-built_Plan\Drawn.dwg

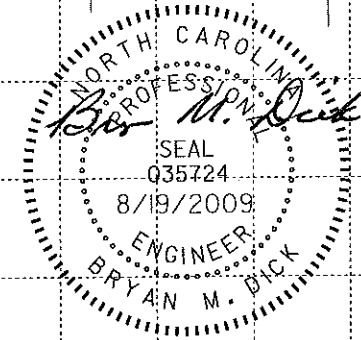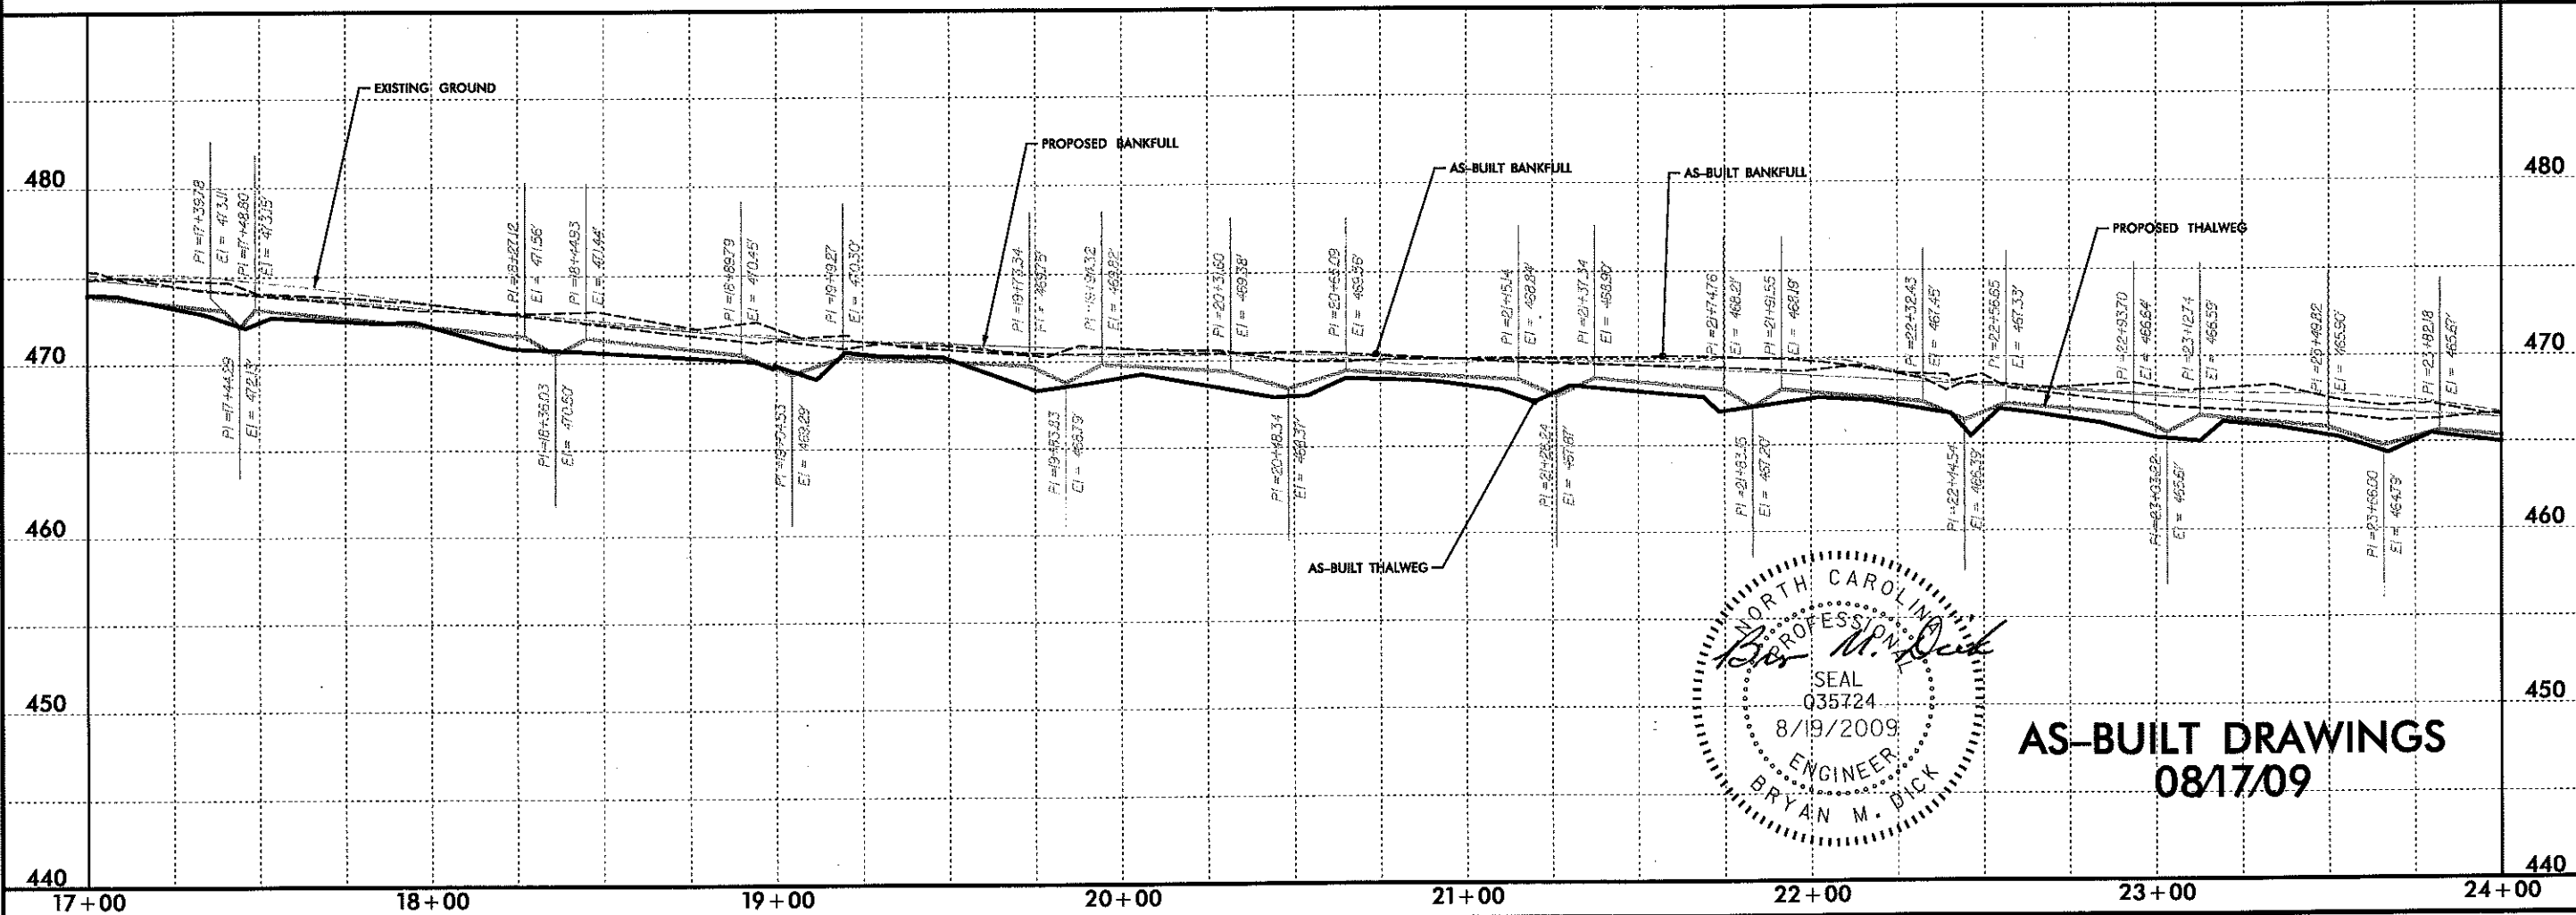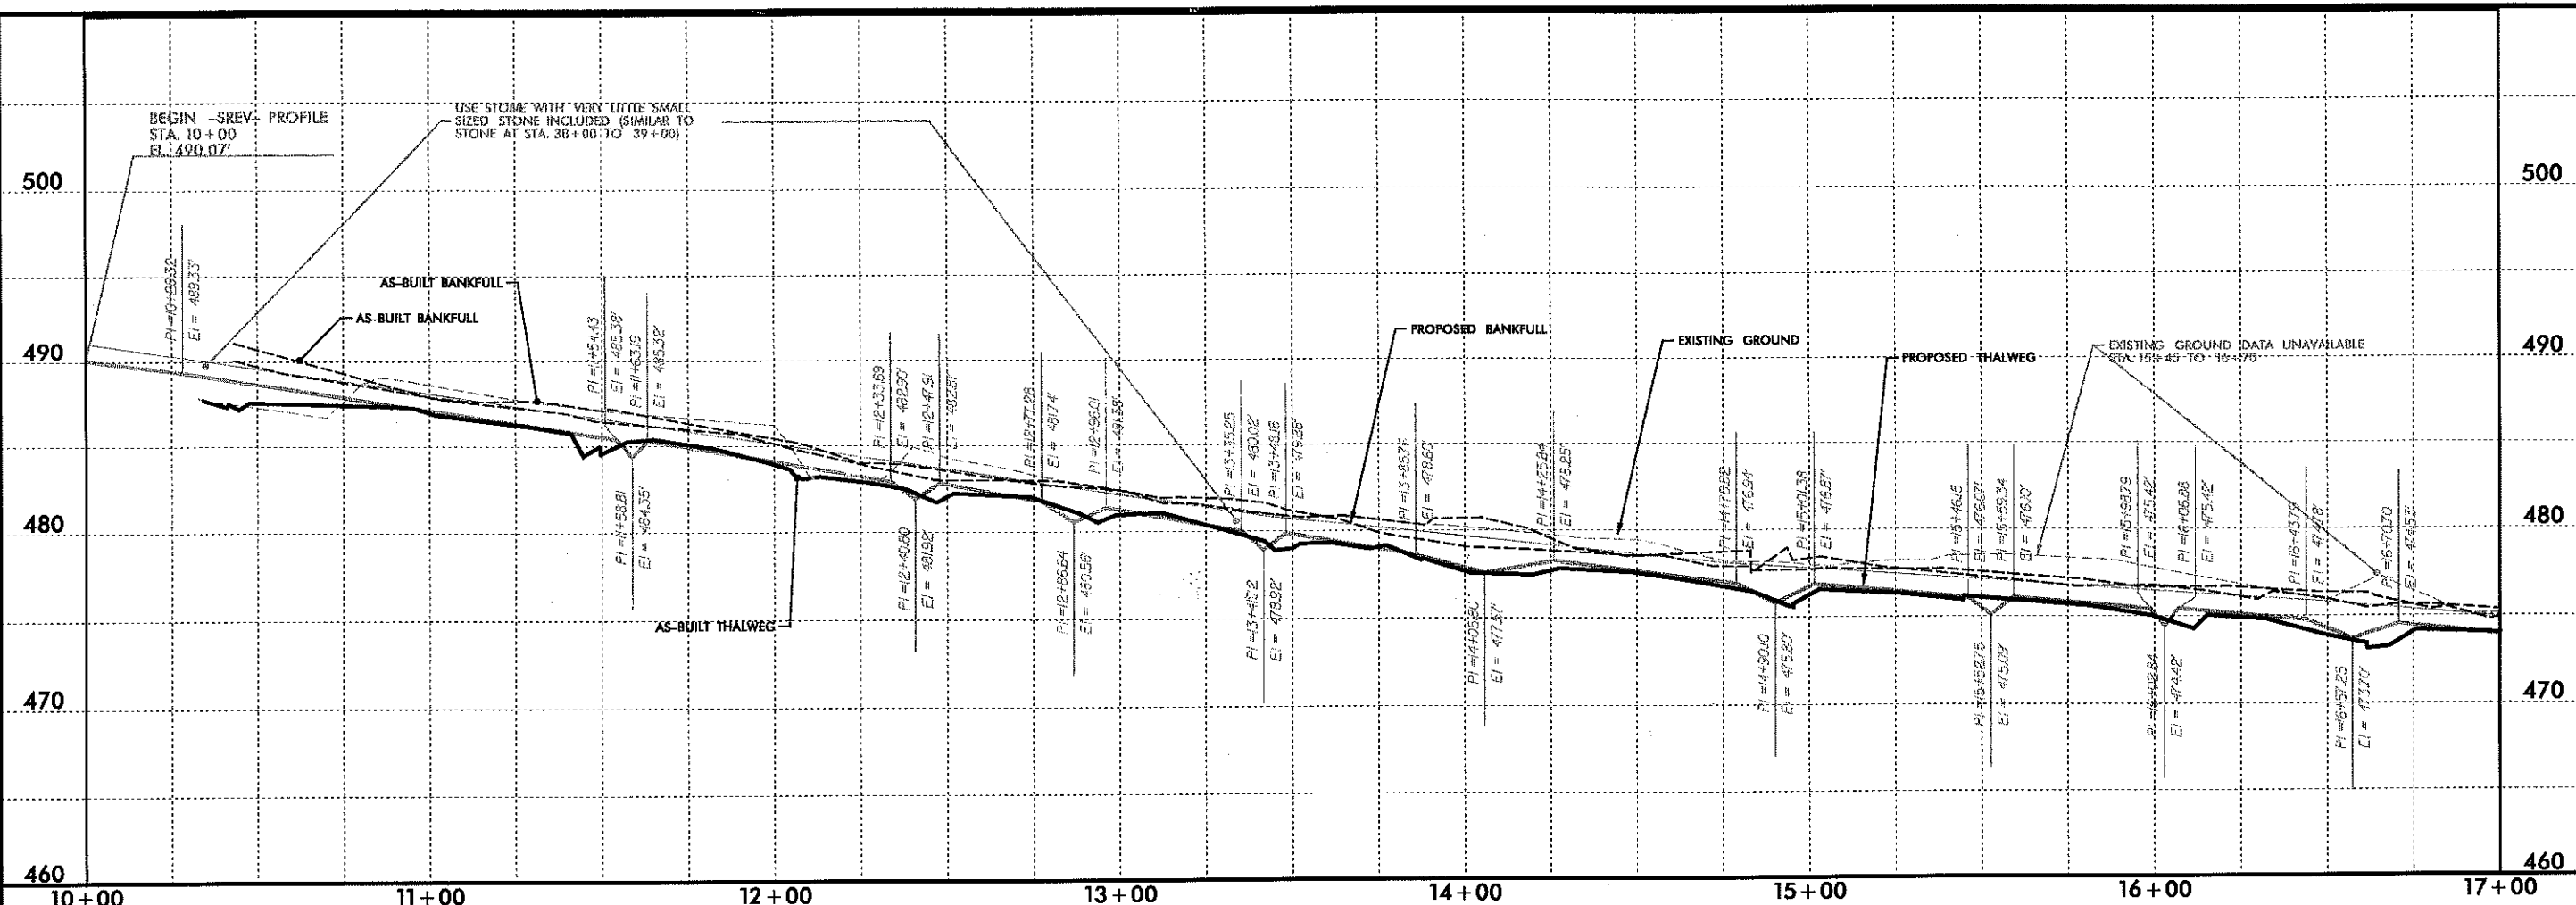



AS-BUILT DRAWINGS
08/17/09

NO	REVISIONS	CHK	DATE
1			
2			
3			

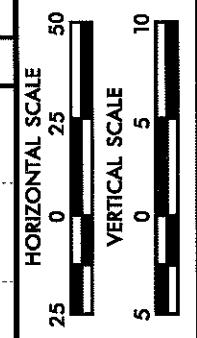

BADIN INN STREAM RESTORATION	
AS-BUILT CHANNEL PROFILE	
EARTH TECH AECOM	
701 CORPORATE CENTER DRIVE, SUITE 415, RALEIGH, NC 27603 919-854-6000 919-854-6029 (fax)	
DATE	8/19/2009
PROJECT NO	99255
FILENAME	
SHEET NO	C-24
DRAWN BY	ABW
CHKD BY	BMD




USER: WILSONAB DATE: 8/19/2009
 DGN: G:\9255\cadd\As-Built Files\AS-Built Plans\Sheet\9255.dwg

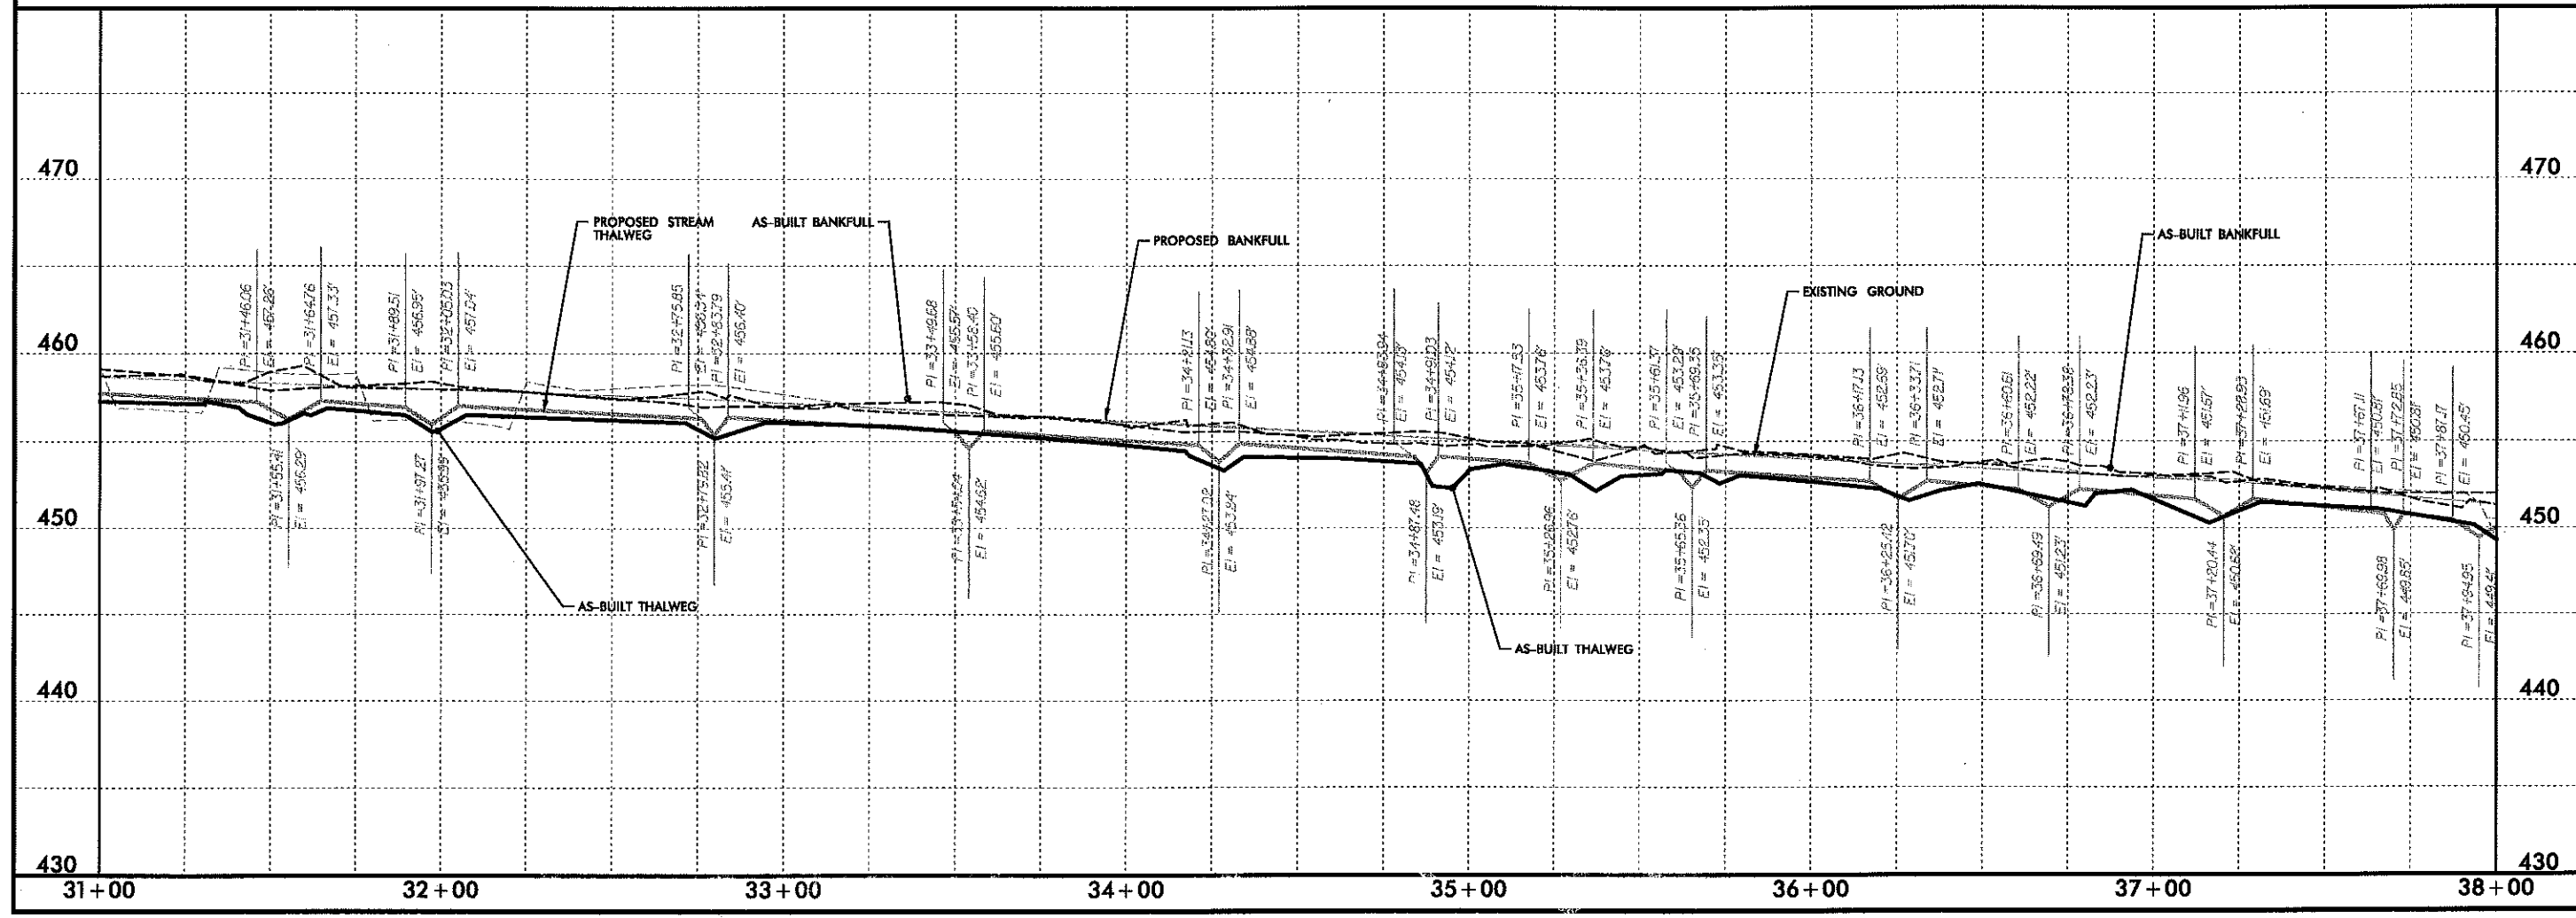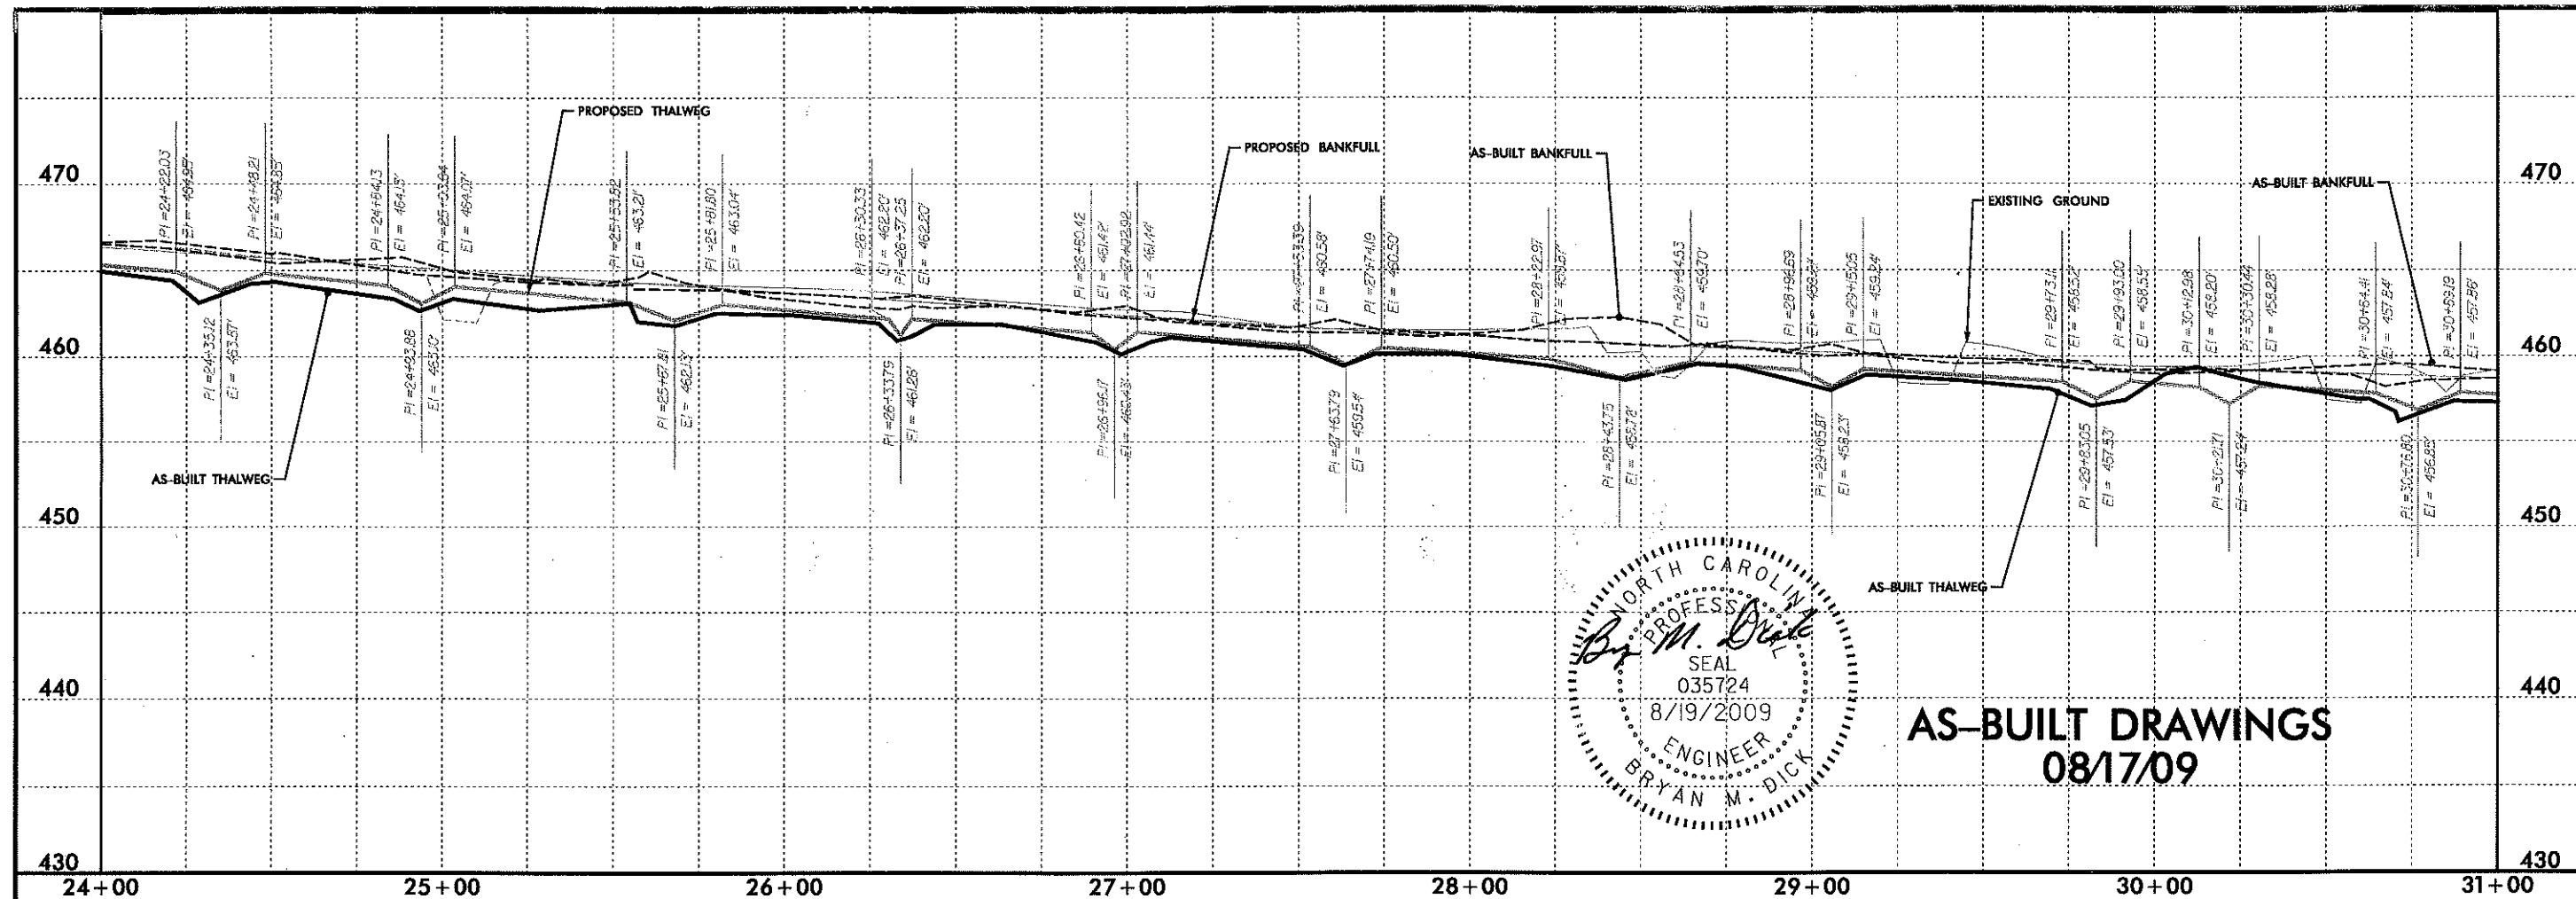

REVISIONS		DWN	CHK	DATE
1				
2				
3				

BADIN INN STREAM RESTORATION	
AS-BUILT CHANNEL PROFILE	
EARTH TECH AECOM	
TO: CORPORATE CENTER DRIVE, SUITE 475, HALLMARK, NC 27607 315-564-6622 315-564-6625 (FAX)	
DATE	8/19/2009
PROJECT NO	99255
FILENAME	
SHEET NO	C-25
DRAWN BY	ABW
CHKD BY	BMD

USER: WILSONAB DATE: 8/19/2009
 DGN: G:\99255\add\as-built\Files\AS-BUILT_Plansheets\99255_as-built\ps\B428_Pmf11e.dgn

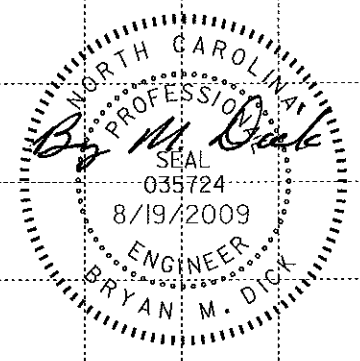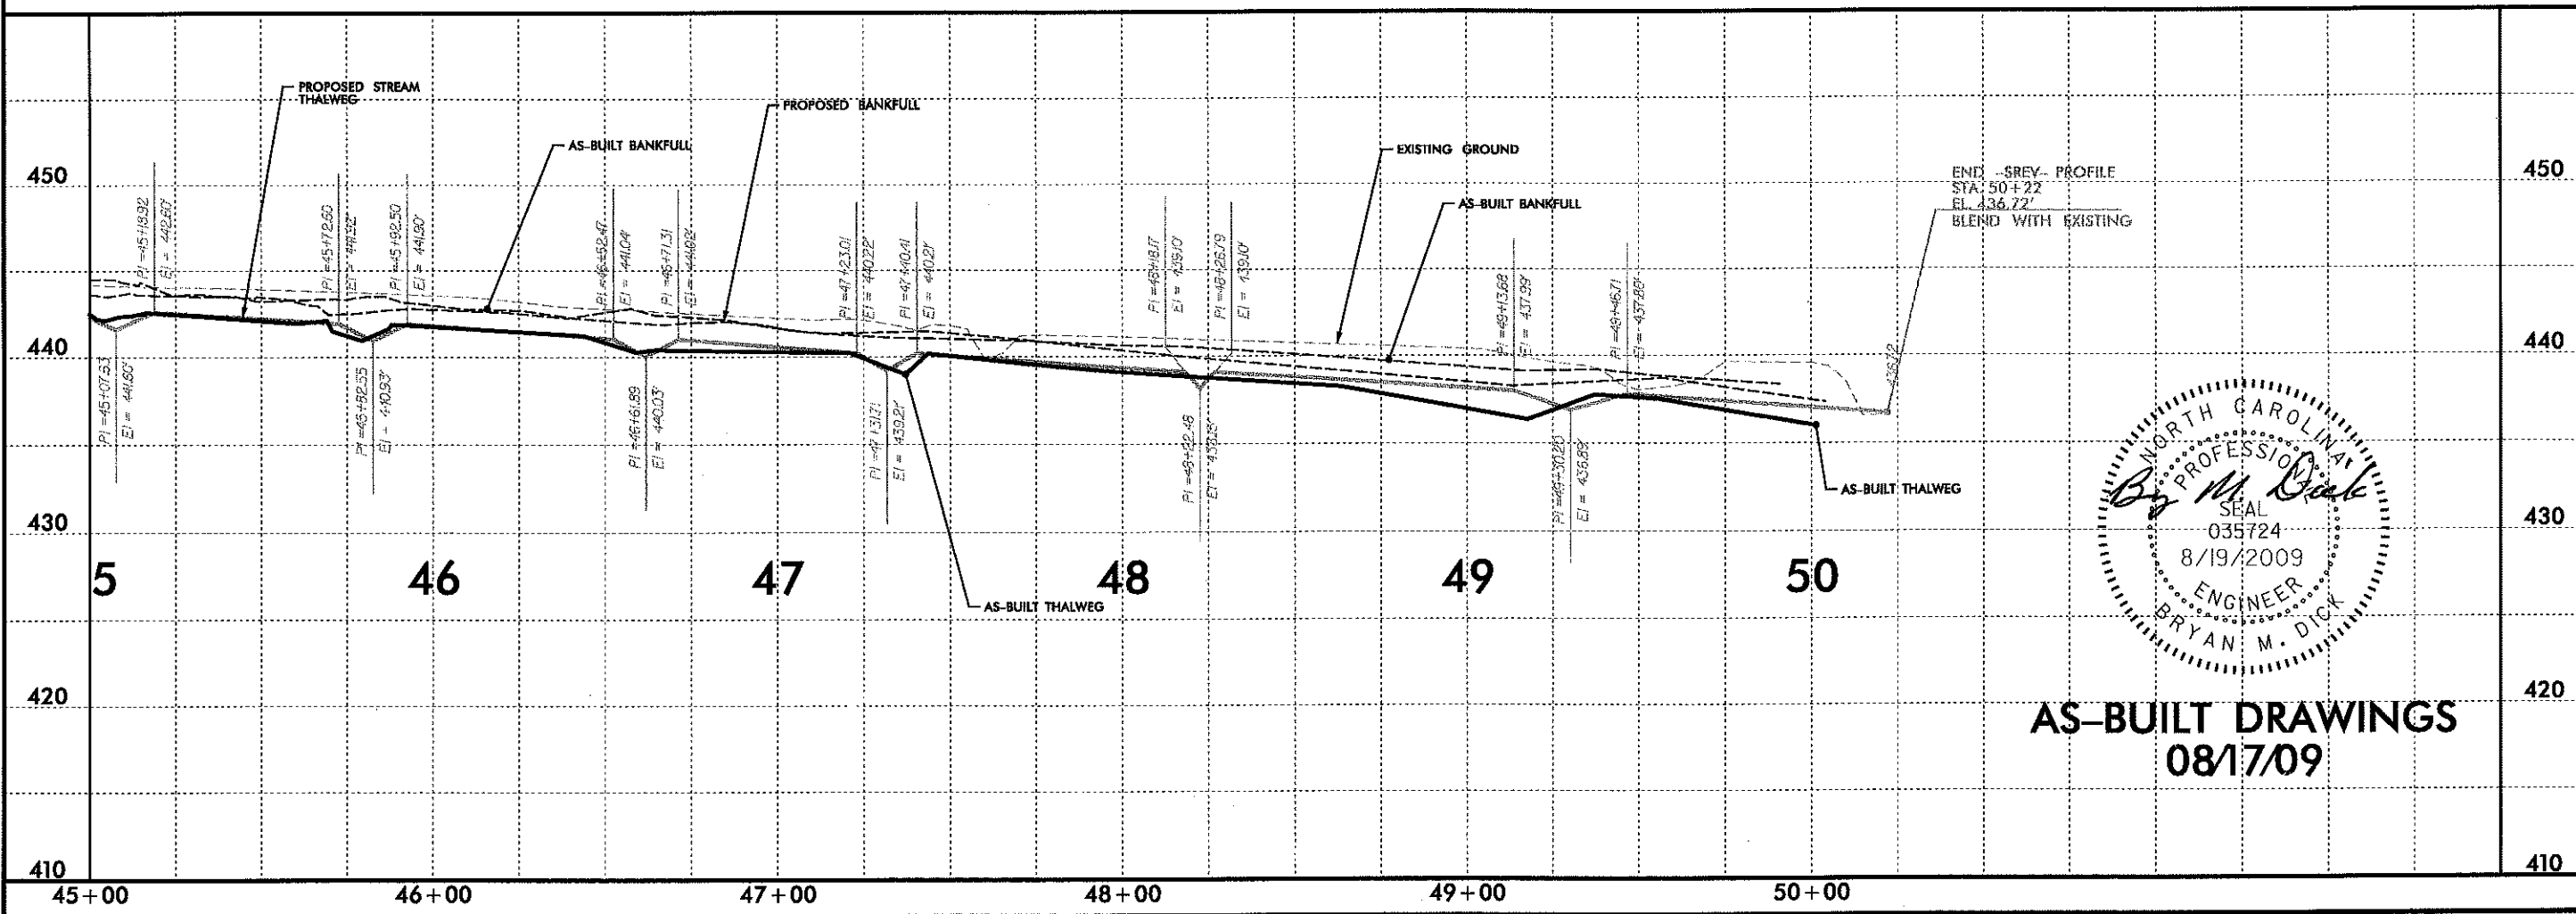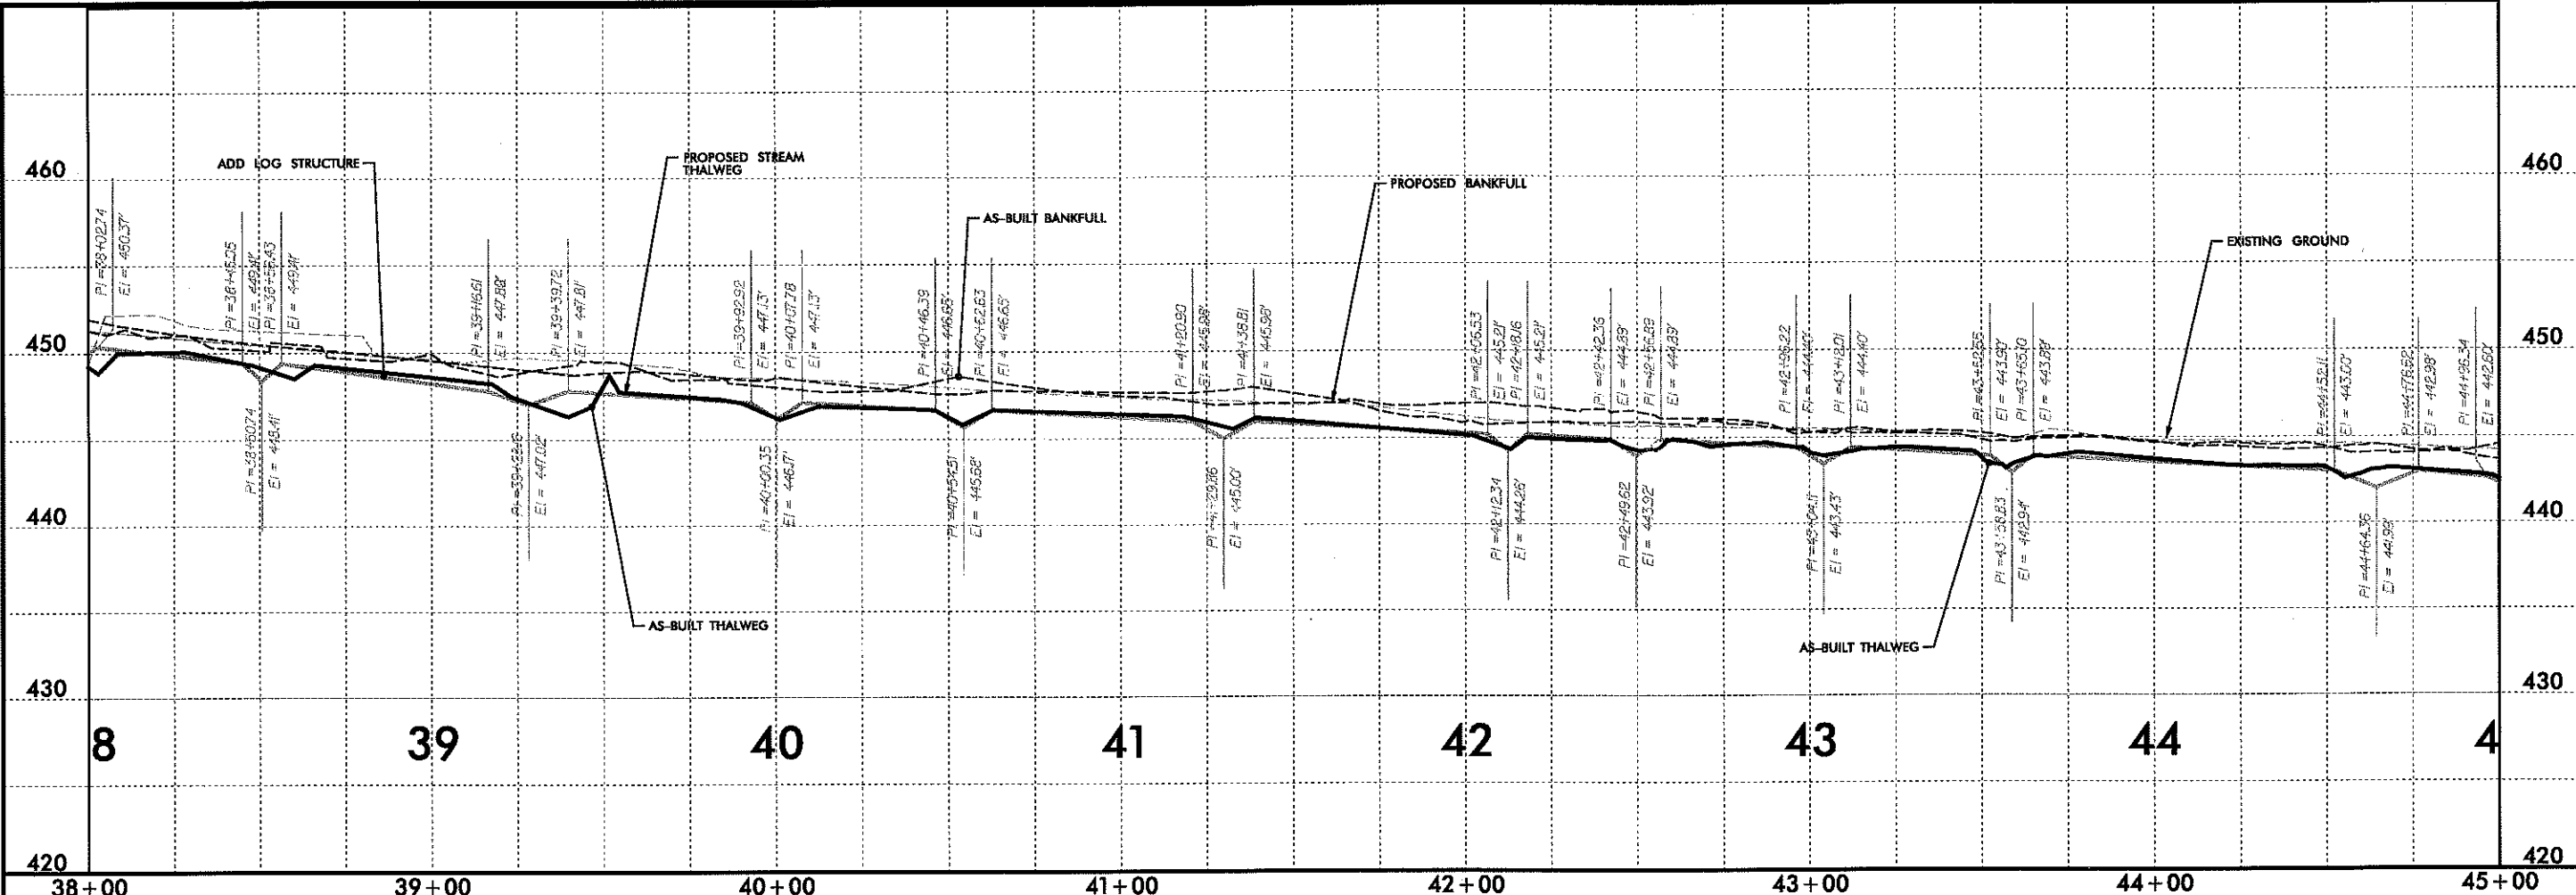

AS-BUILT DRAWINGS
08/17/09


REVISIONS		DRN	CHK	DATE
1				
2				
3				

HORIZONTAL SCALE	25	50
VERTICAL SCALE	5	10



BADIN INN STREAM RESTORATION	
AS-BUILT CHANNEL PROFILE	
EARTH TECH AECOM	
TO: 1 CORPORATE CENTER DRIVE, SUITE 475, BALDWIN, NC 27607	
919-854-6000 919-854-6009 (fax)	

DATE	8/19/2009
PROJECT NO	99255
FILENAME	
SHEET NO	C-26
DRAWN BY	ARW
CHKD BY	BMD

USER: WILSONAB DATE: 8/19/2009
 DGN: Q:\99255\road\4s-Built Files\4s-Built_PlanSheet\99255.dwg

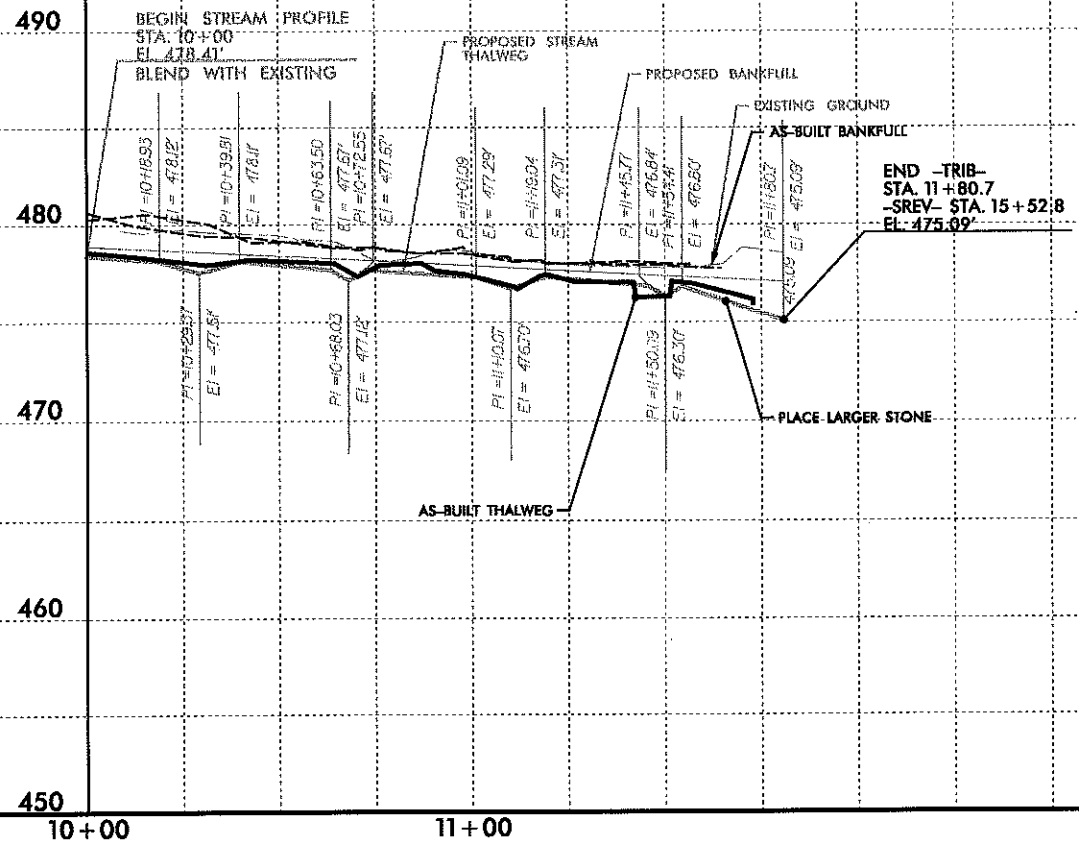


NO	REVISIONS	DRN	CHK	DATE
1				
2				
3				

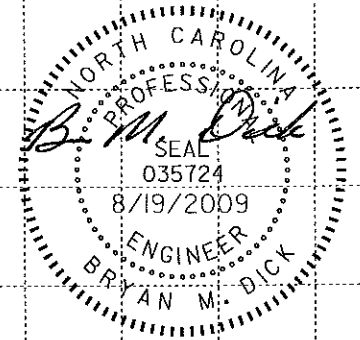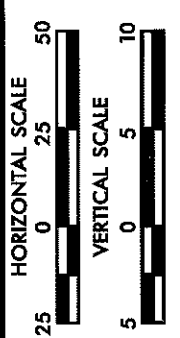


AS-BUILT DRAWINGS
08/17/09

BADIN INN STREAM RESTORATION	
AS-BUILT CHANNEL PROFILE	
EARTH TECH AECOM	
701 CORPORATE CENTER DRIVE, SUITE 475, HALESBURN, NC 27607 <small>919-854-6200 919-854-6259 (fax)</small>	
DATE	8/19/2009
PROJECT NO	99255
FILENAME	
SHEET NO	C-27
DRAWN BY	ABW
CHKD BY	BMD


USER: WILSONAB
 DATE: 8/19/2009
 D:\99255\cadd\as-Built Files\AS-BUILT_Plan sheets\99255_cri\0817\sections\as-built.dgn

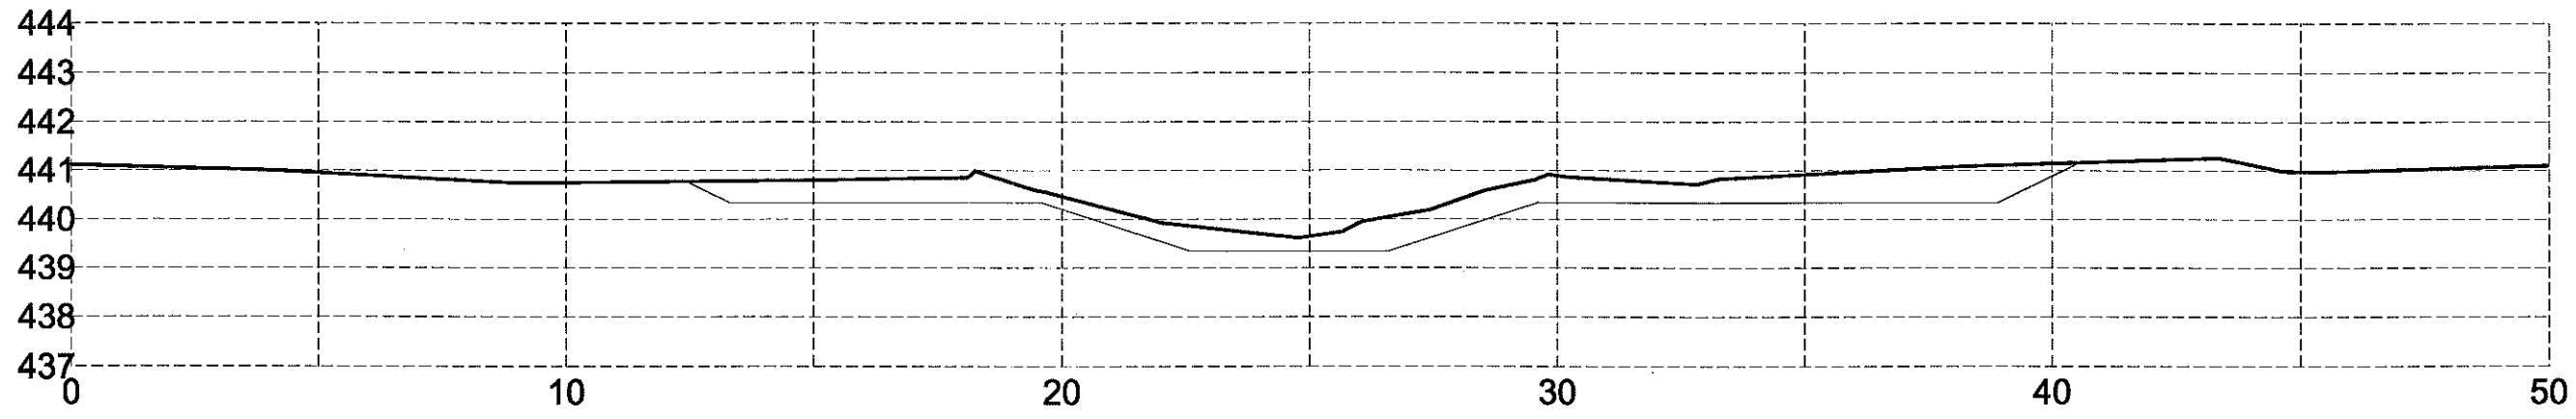


CROSS SECTION 1 - RIFFLE
 STA. 47+67

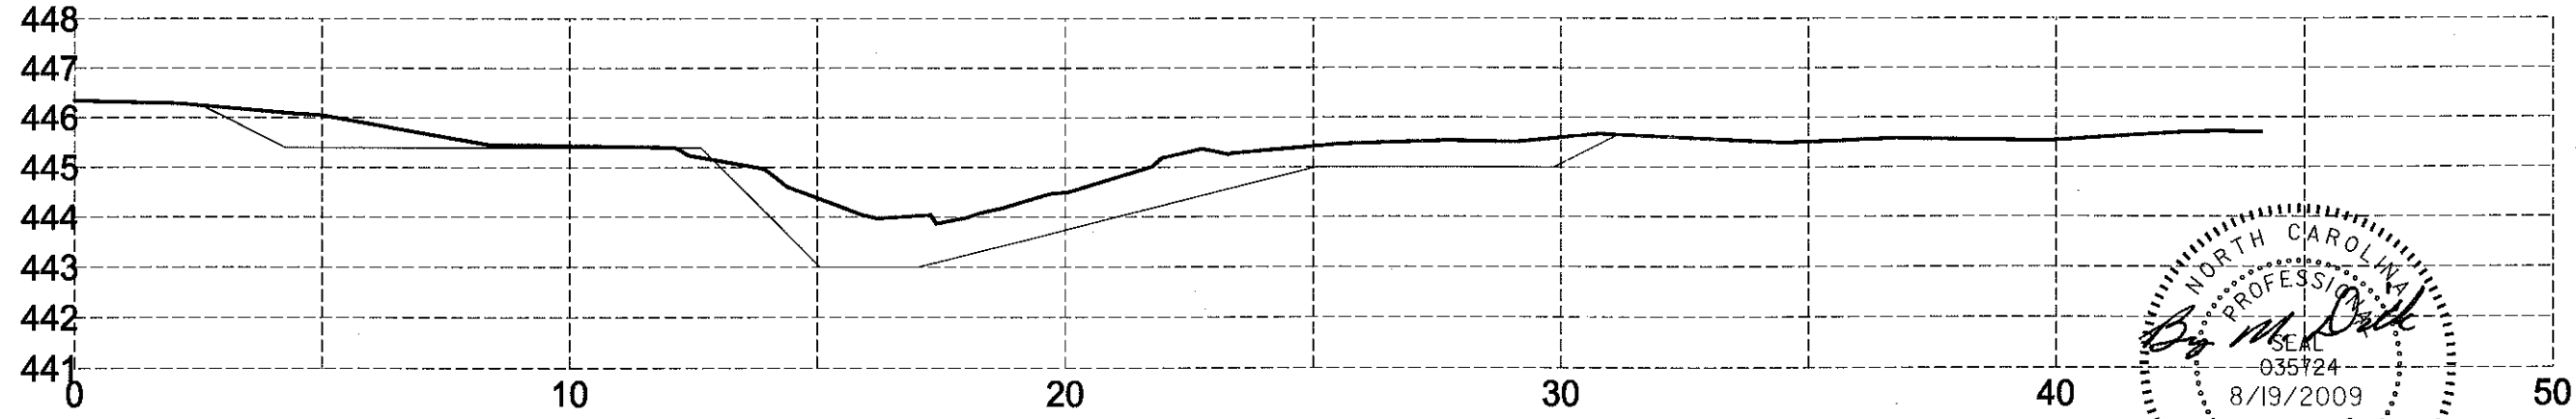

CROSS SECTION 2 - POOL
 STA. 43+05

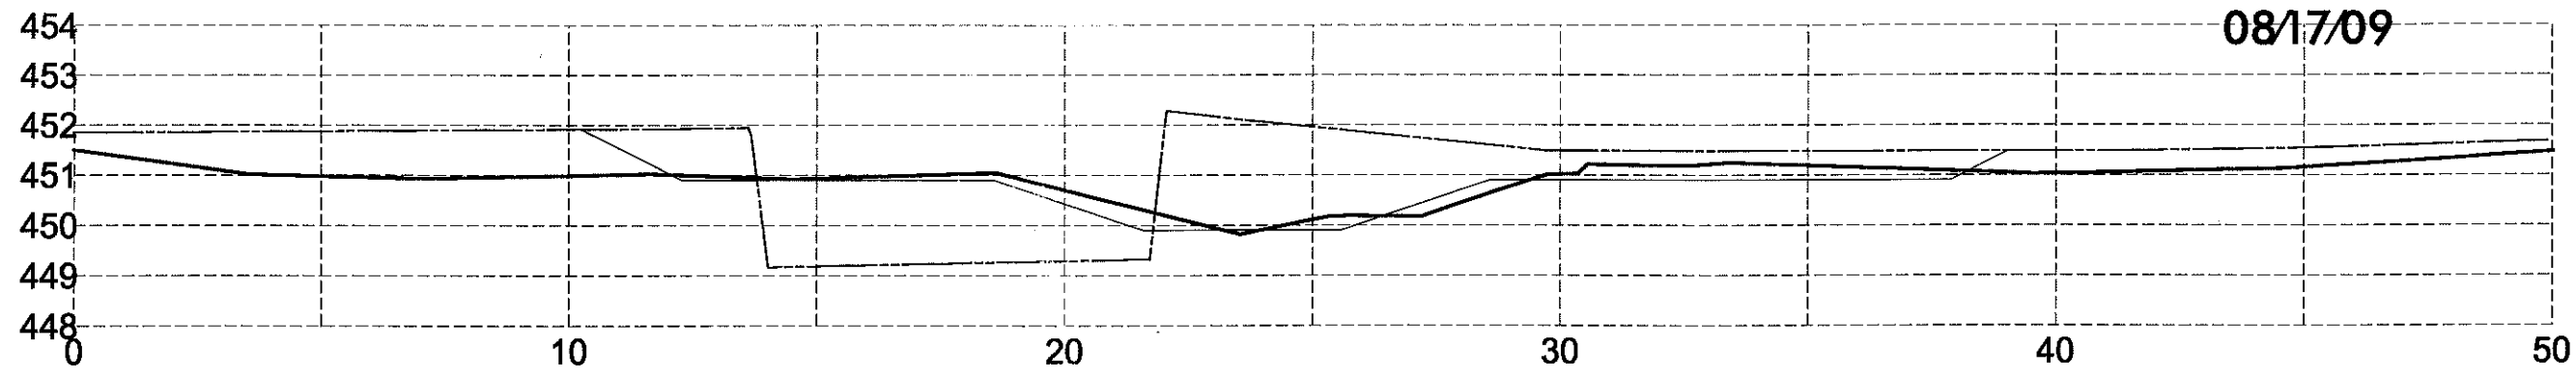

CROSS SECTION 3 - RIFFLE
 STA. 38+26

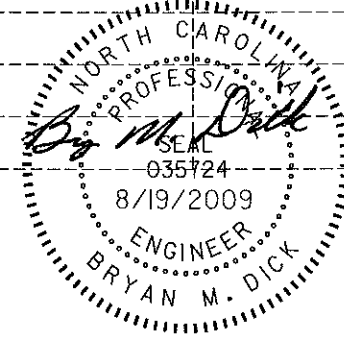


AS-BUILT DRAWINGS
08/17/09


NO	REVISIONS	DRN	CHK	DATE
1				
2				
3				

BADIN INN STREAM RESTORATION
 CROSS SECTIONS AND TYPICALS
EARTH TECH AECOM
 701 CORPORATE CENTER DRIVE, SUITE 415, RALEIGH, NC 27607
 919-881-0000 919-881-0228 FAX


DATE	8/19/2009
PROJECT NO	99255
FILENAME	
SHEET NO	C-28
DRAWN BY	ABW
CHKD BY	BMD

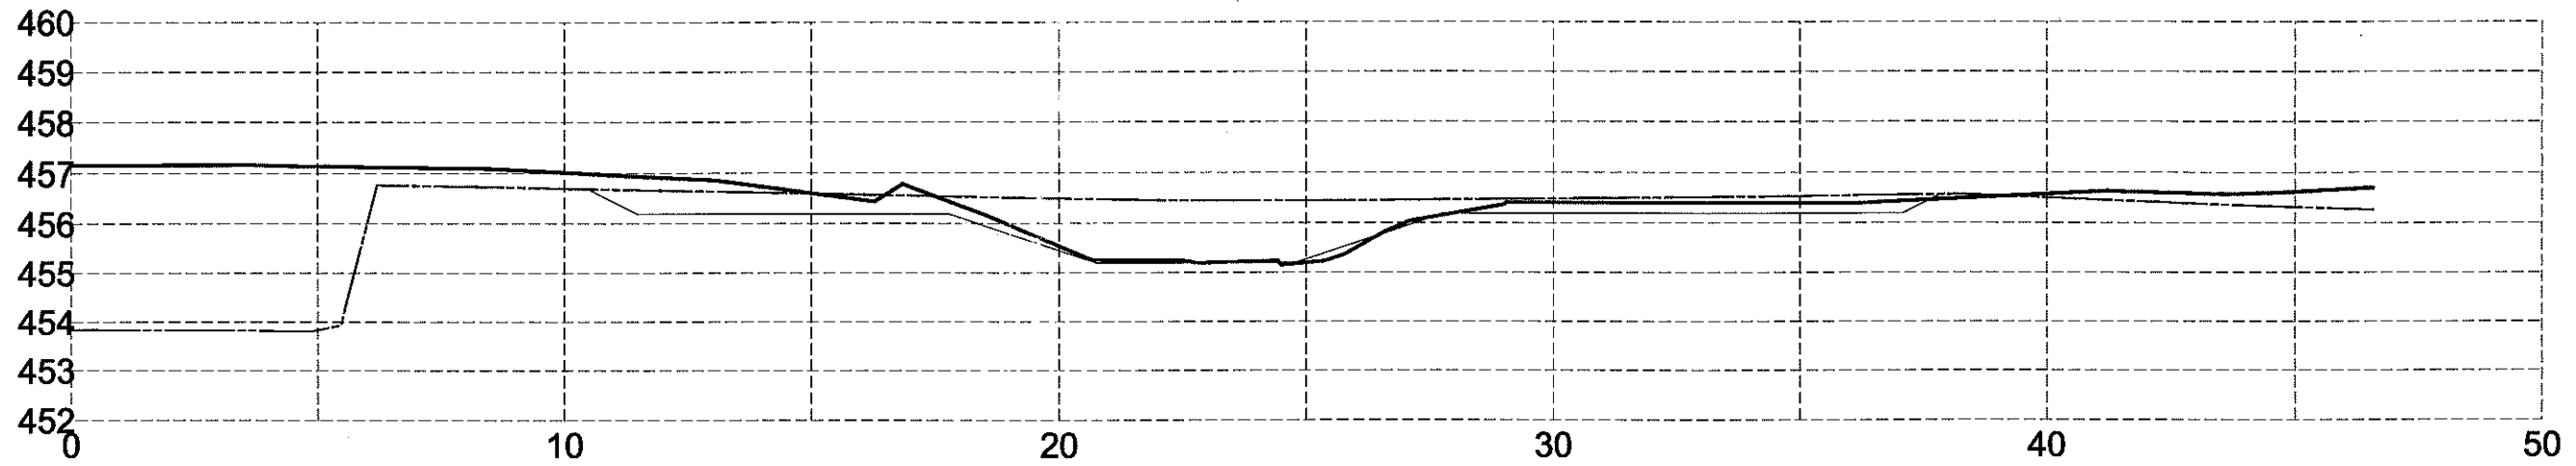


CROSS SECTION 4 - RIFFLE
STA. 33+72

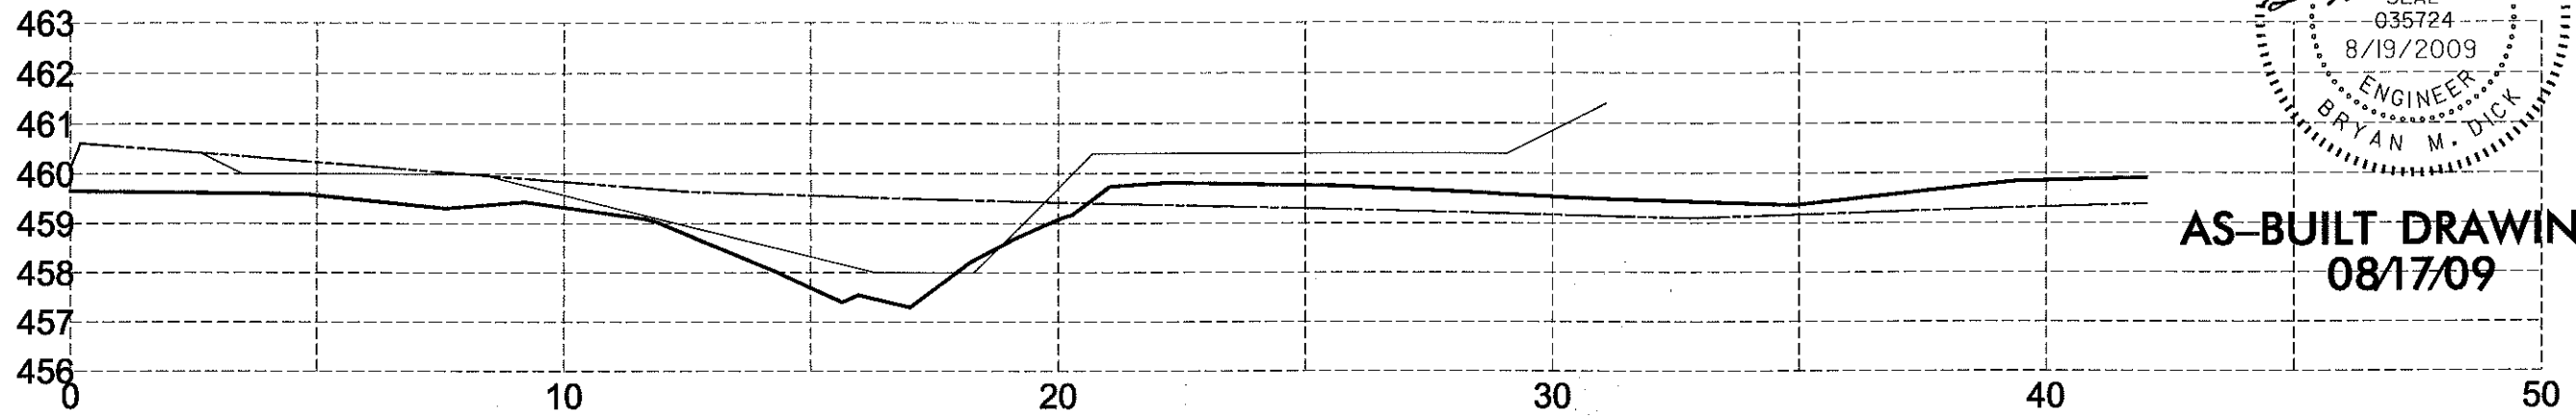

CROSS SECTION 5 - POOL
STA. 29+78

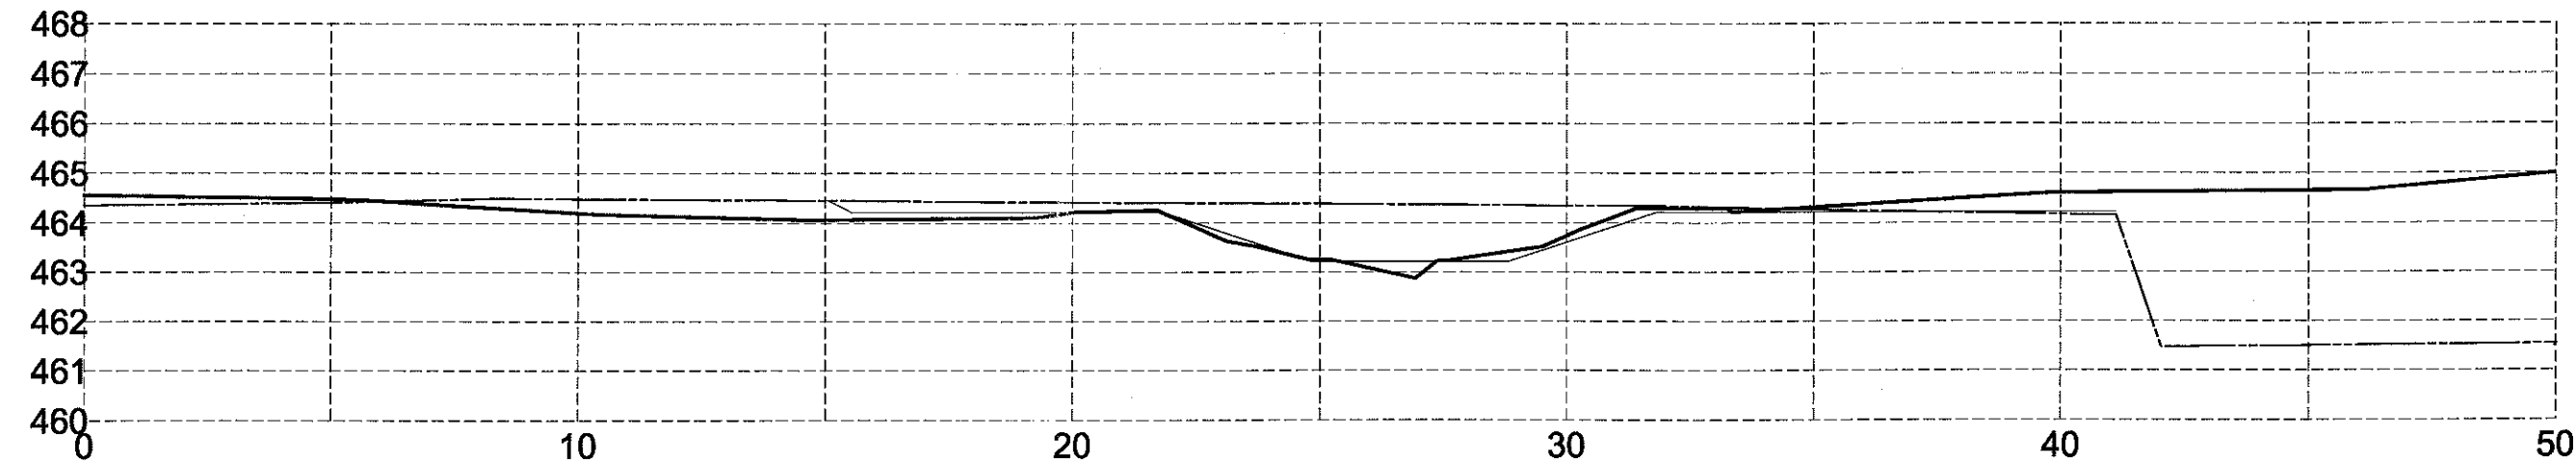

CROSS SECTION 6 - RIFFLE
STA. 25+39

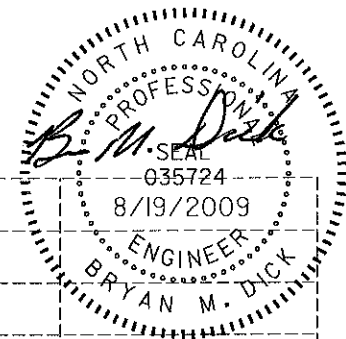


AS-BUILT DRAWINGS
08/17/09


USER: WILSONAB
DGN: C:\99255\work\as-built\Files\AS-BUILT_Plan\sheet\99255_CrossSections.dgn
DATE: 8/19/2009

NO	REVISIONS	DN	CHK	DATE
1				
2				
3				


BADIN INN STREAM RESTORATION CROSS SECTIONS AND TYPICALS	
EARTHTECH AECOM	
701 CORPORATE CENTER DRIVE, SUITE 415, RALEIGH, NC 27607 919-854-6200 919-854-6258 (fax)	
DATE	8/19/2009
PROJECT NO	99255
FILENAME	
SHEET NO	C-29
DRAWN BY	CHKD BY
ABW	BMD

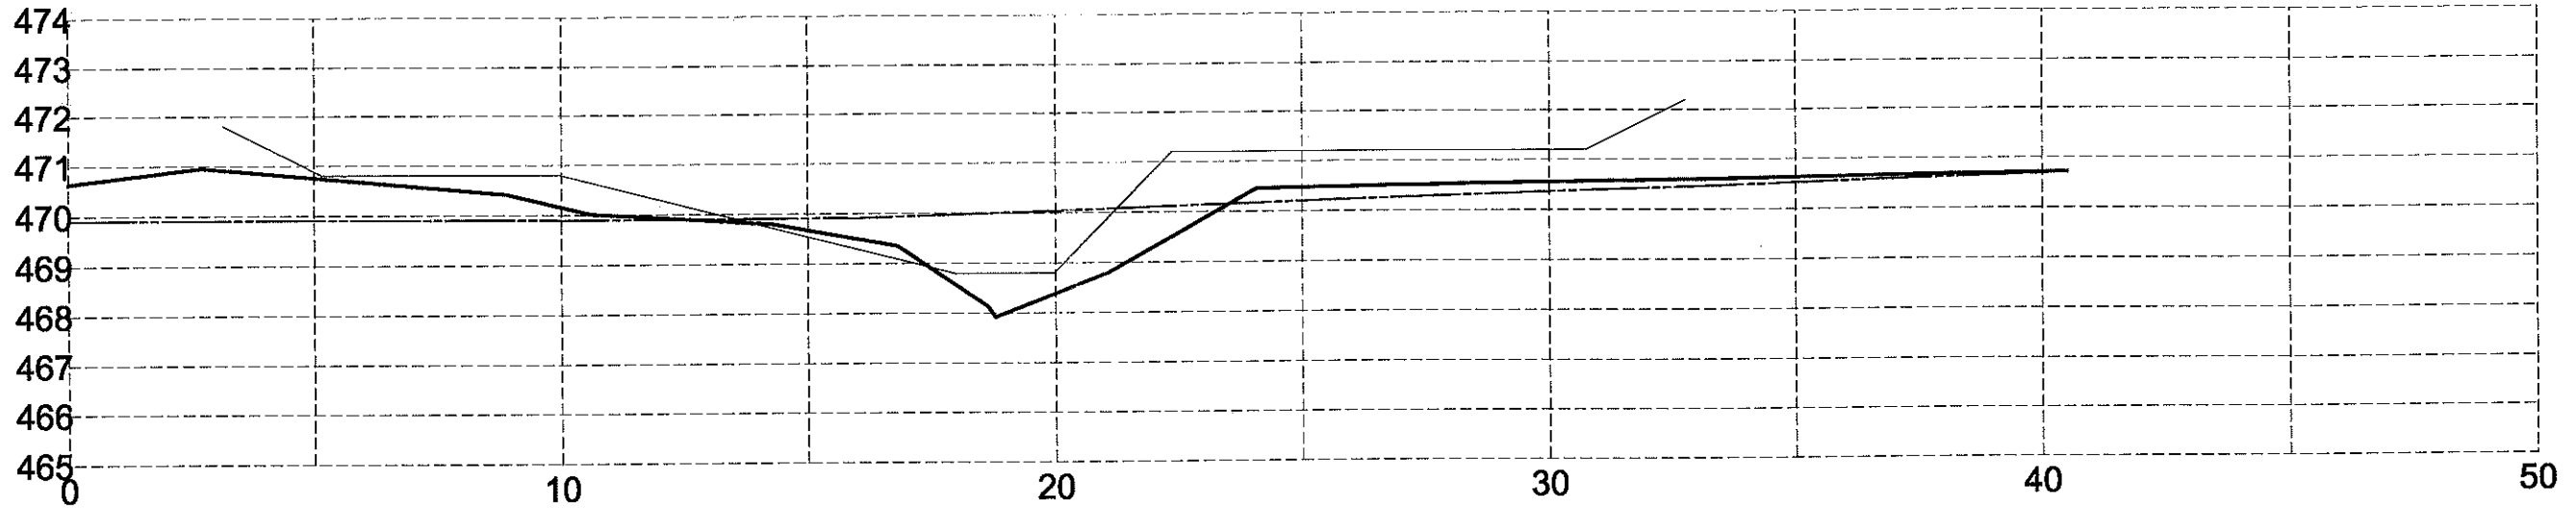

CROSS SECTION 7 - POOL
STA. 20+45

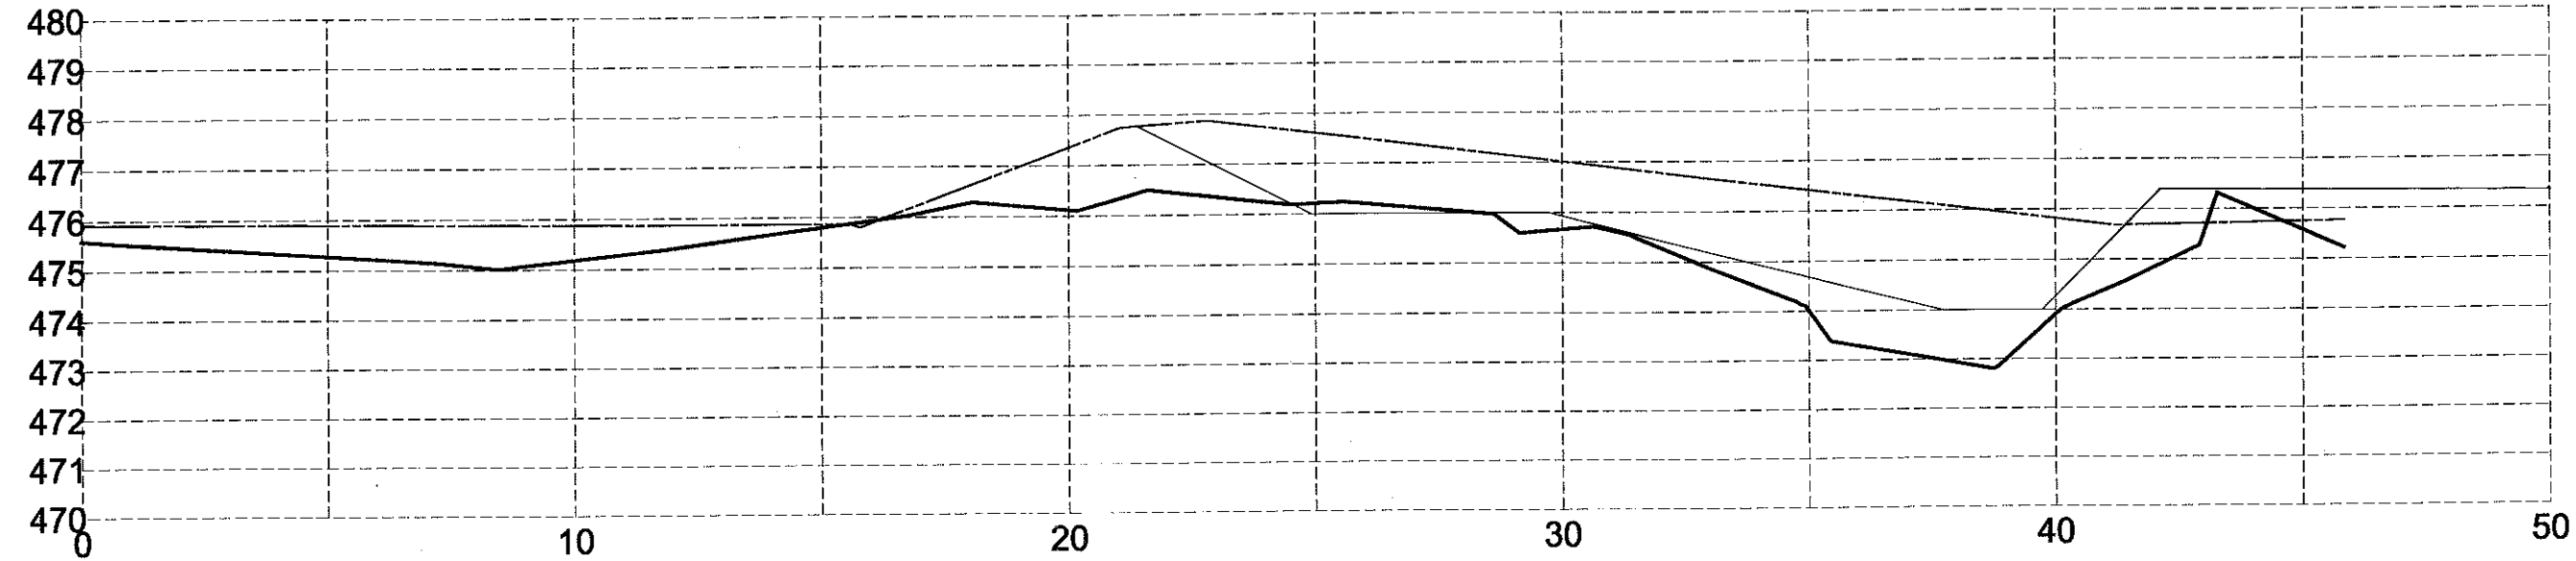

CROSS SECTION 8 - POOL
STA. 16+50

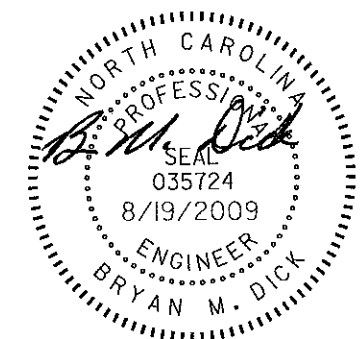


AS-BUILT DRAWINGS
08/17/09

USER: WILSONAB DATE: 8/19/2009
 DSN: C:\99255\cadd\as-built\Files\AS-BUILT_Plans\as-built\Files\cadd\AS-BUILT.dgn

REVISIONS		DATE
NO	CHK	DATE
1		
2		
3		


BADIN INN STREAM RESTORATION CROSS SECTIONS AND TYPICALS	EARTHTECH AECOM <small>T/O: CORPORATE CENTER DRIVE, SUITE 475, RALEIGH, NC 27607 919-854-6200, 919-854-6225 (fax)</small>
---	--

DATE	8/19/2009
PROJECT NO	99255
FILENAME	
SHEET NO	C-30
DRAWN BY	CHKD BY
ABW	BMD

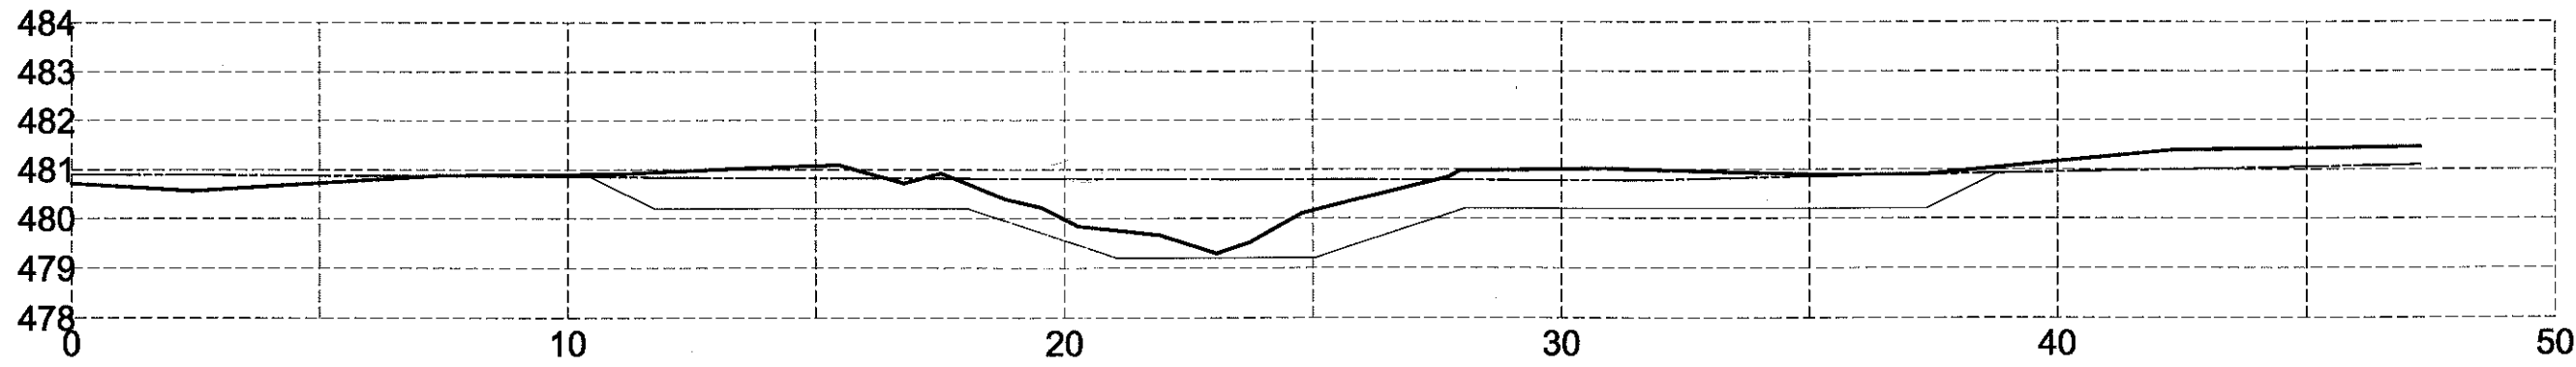


CROSS SECTION 9 - RIFFLE

STA. 13+61

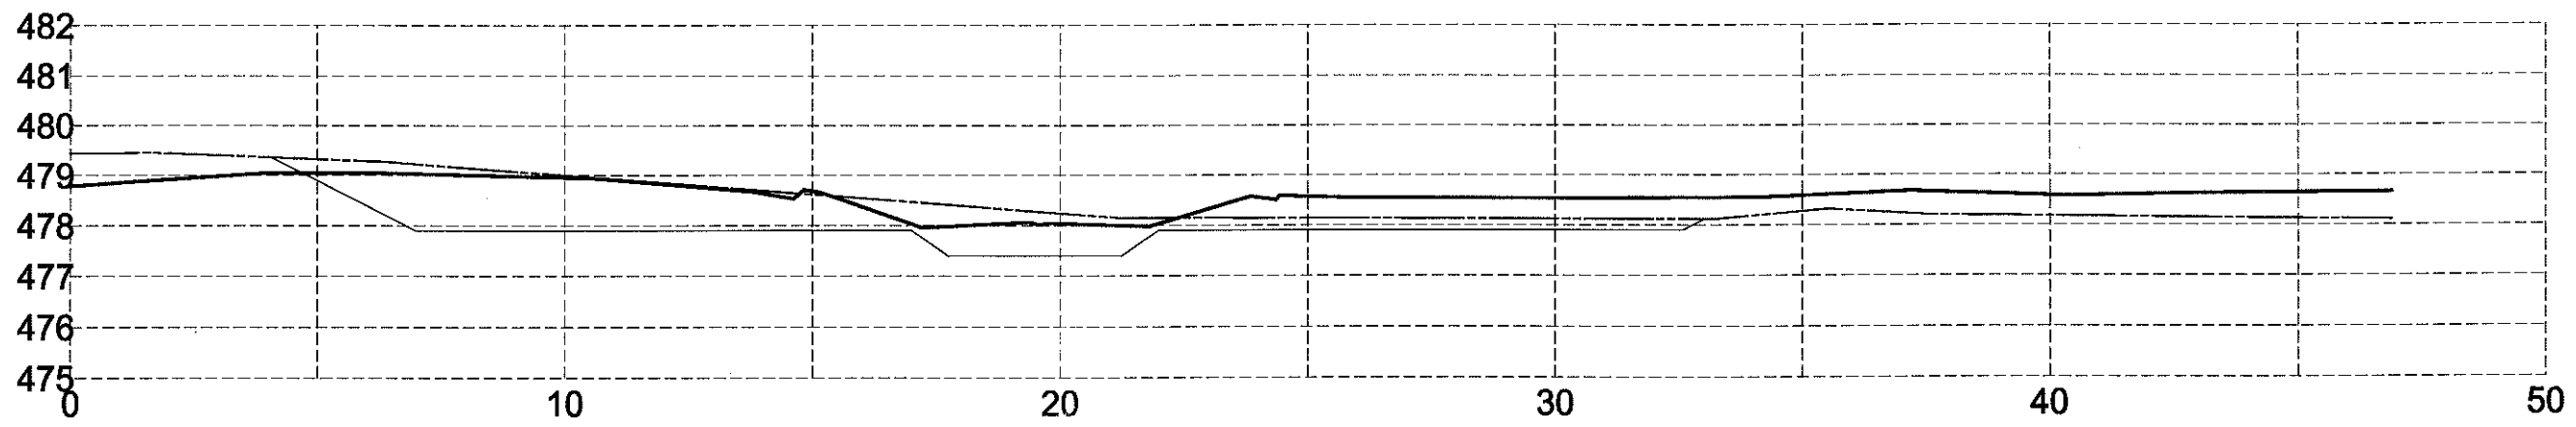

TRIBUTARY CROSS SECTION - RIFFLE

STA. 10+85

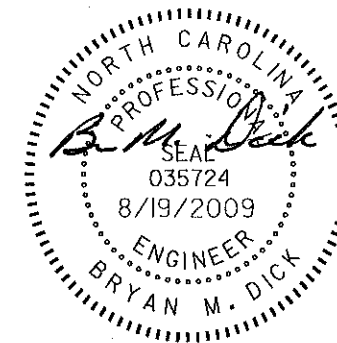

AS-BUILT DRAWINGS
08/17/09

NO	REVISIONS	CHK	DATE
1			
2			
3			

BADIN INN STREAM RESTORATION
CROSS SECTIONS AND TYPICALS
EARTHTECH | AECOM
701 CORPORATE CENTER DRIVE, SUITE 475, RALEIGH, NC 27607
919-854-8200 919-854-8258 Fax

DATE	8/19/2009
PROJECT NO	99255
FILENAME	
SHEET NO	C-31
DRAWN BY	ABW
CHKD BY	BMD


USER: WILSONAB
DATE: 8/19/2009
DGN: G:\99255\cadd\As-Built Files\AS-BUILT_Plansheets\99255_riffle\section09.rvt

NO	REVISIONS	DATE
1		
2		
3		

I, DONALD T. ISRAEL, PLS, CERTIFY THAT THIS STREAM RESTORATION PROJECT WAS CONSTRUCTED IN SUBSTANTIAL CONFORMANCE WITH THE PLANS AND SPECIFICATIONS; AND THAT THE STREAM LIES WHOLLY WITHIN THE CONSERVATION EASEMENT AS SHOWN ON THE PLAT ENTITLED "BADIN INN STREAM RESTORATION" DATED 4-23-07 AND FOUND IN THE STANLEY COUNTY REGISTRY IN PLAT BOOK 20 PAGE 54.

BY *Donald T. Israel* (SURVEYOR)
 PROFESSIONAL LAND SURVEYOR L-3756

EARTH TECH | AECOM

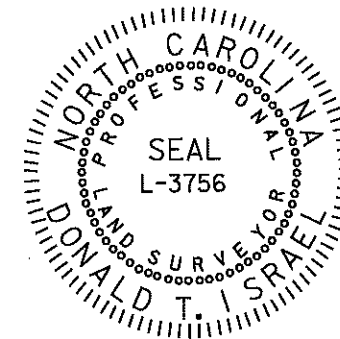


MATCHLINE SHEET C60-2




BADIN INN STREAM RESTORATION
 AS-BUILT FEATURES
 EARTH TECH | AECOM
701 CORPORATE CENTER DRIVE SUITE 415 RALEIGH, NC 27607
 919-854-4200 919-854-4258 (fax)

DATE	8/18/2009
PROJECT NO	99255
FILENAME	
SHEET NO	C-32
DRAWN BY	ABW
CHKD BY	BMD

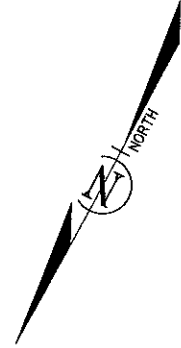

BEGIN CONSTRUCTION
 -SREV- STA. 10+00
 N: 602085.83
 E: 1667774.20

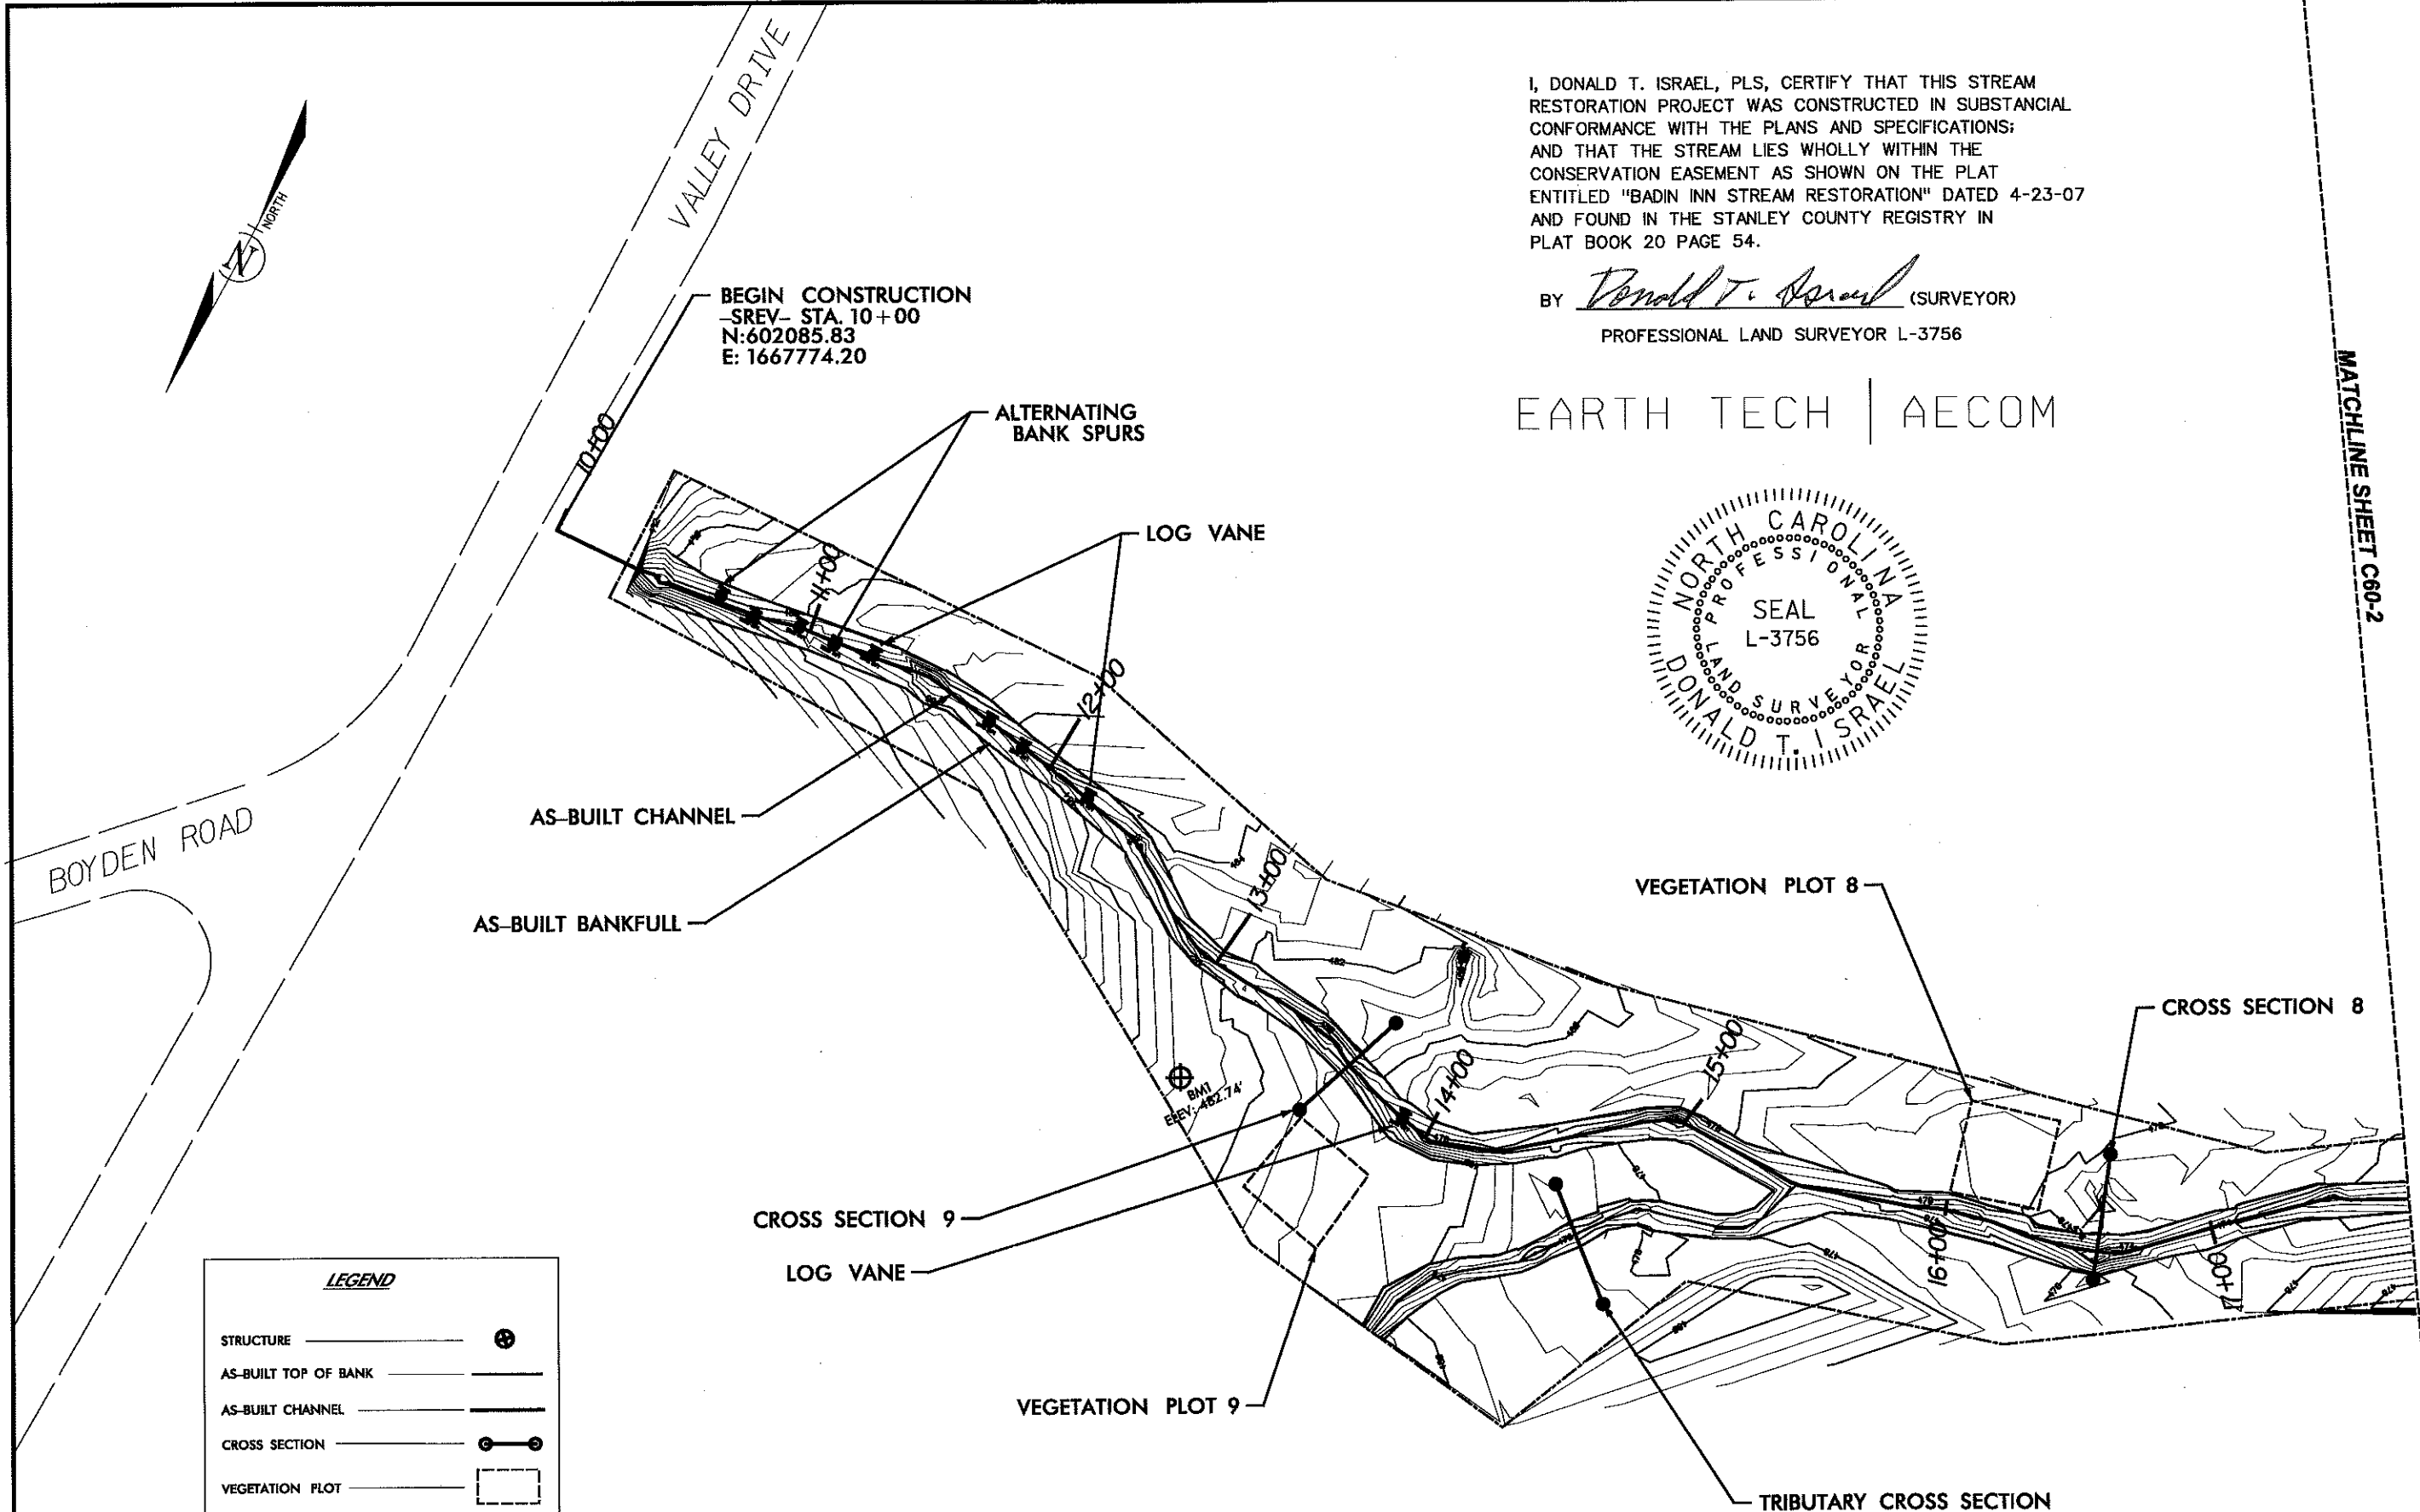


LEGEND	
STRUCTURE	
AS-BUILT TOP OF BANK	
AS-BUILT CHANNEL	
CROSS SECTION	
VEGETATION PLOT	
CONSERVATION EASEMENT	
MAJOR CONTOUR	
MINOR CONTOUR	
DESIGN CHANNEL	

USER: WILSONAB
 DATE: 8/18/2009
 DGN: Q:\99255\cadd\as-built\Files\AS-Built_Plan\sheet\99255.dgn

I, DONALD T. ISRAEL, PLS, CERTIFY THAT THIS STREAM RESTORATION PROJECT WAS CONSTRUCTED IN SUBSTANTIAL CONFORMANCE WITH THE PLANS AND SPECIFICATIONS; AND THAT THE STREAM LIES WHOLLY WITHIN THE CONSERVATION EASEMENT AS SHOWN ON THE PLAT ENTITLED "BADIN INN STREAM RESTORATION" DATED 4-23-07 AND FOUND IN THE STANLEY COUNTY REGISTRY IN PLAT BOOK 20 PAGE 54.



BY Donald T. Israel (SURVEYOR)
 PROFESSIONAL LAND SURVEYOR L-3756

EARTH TECH | AECOM

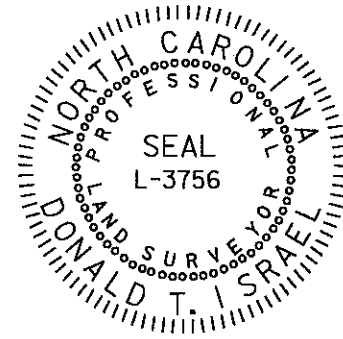

MATCHLINE SHEET C60-1

MATCHLINE SHEET C60-3

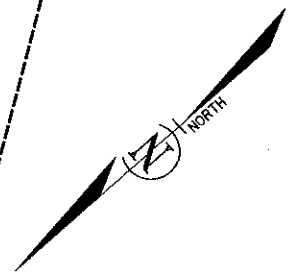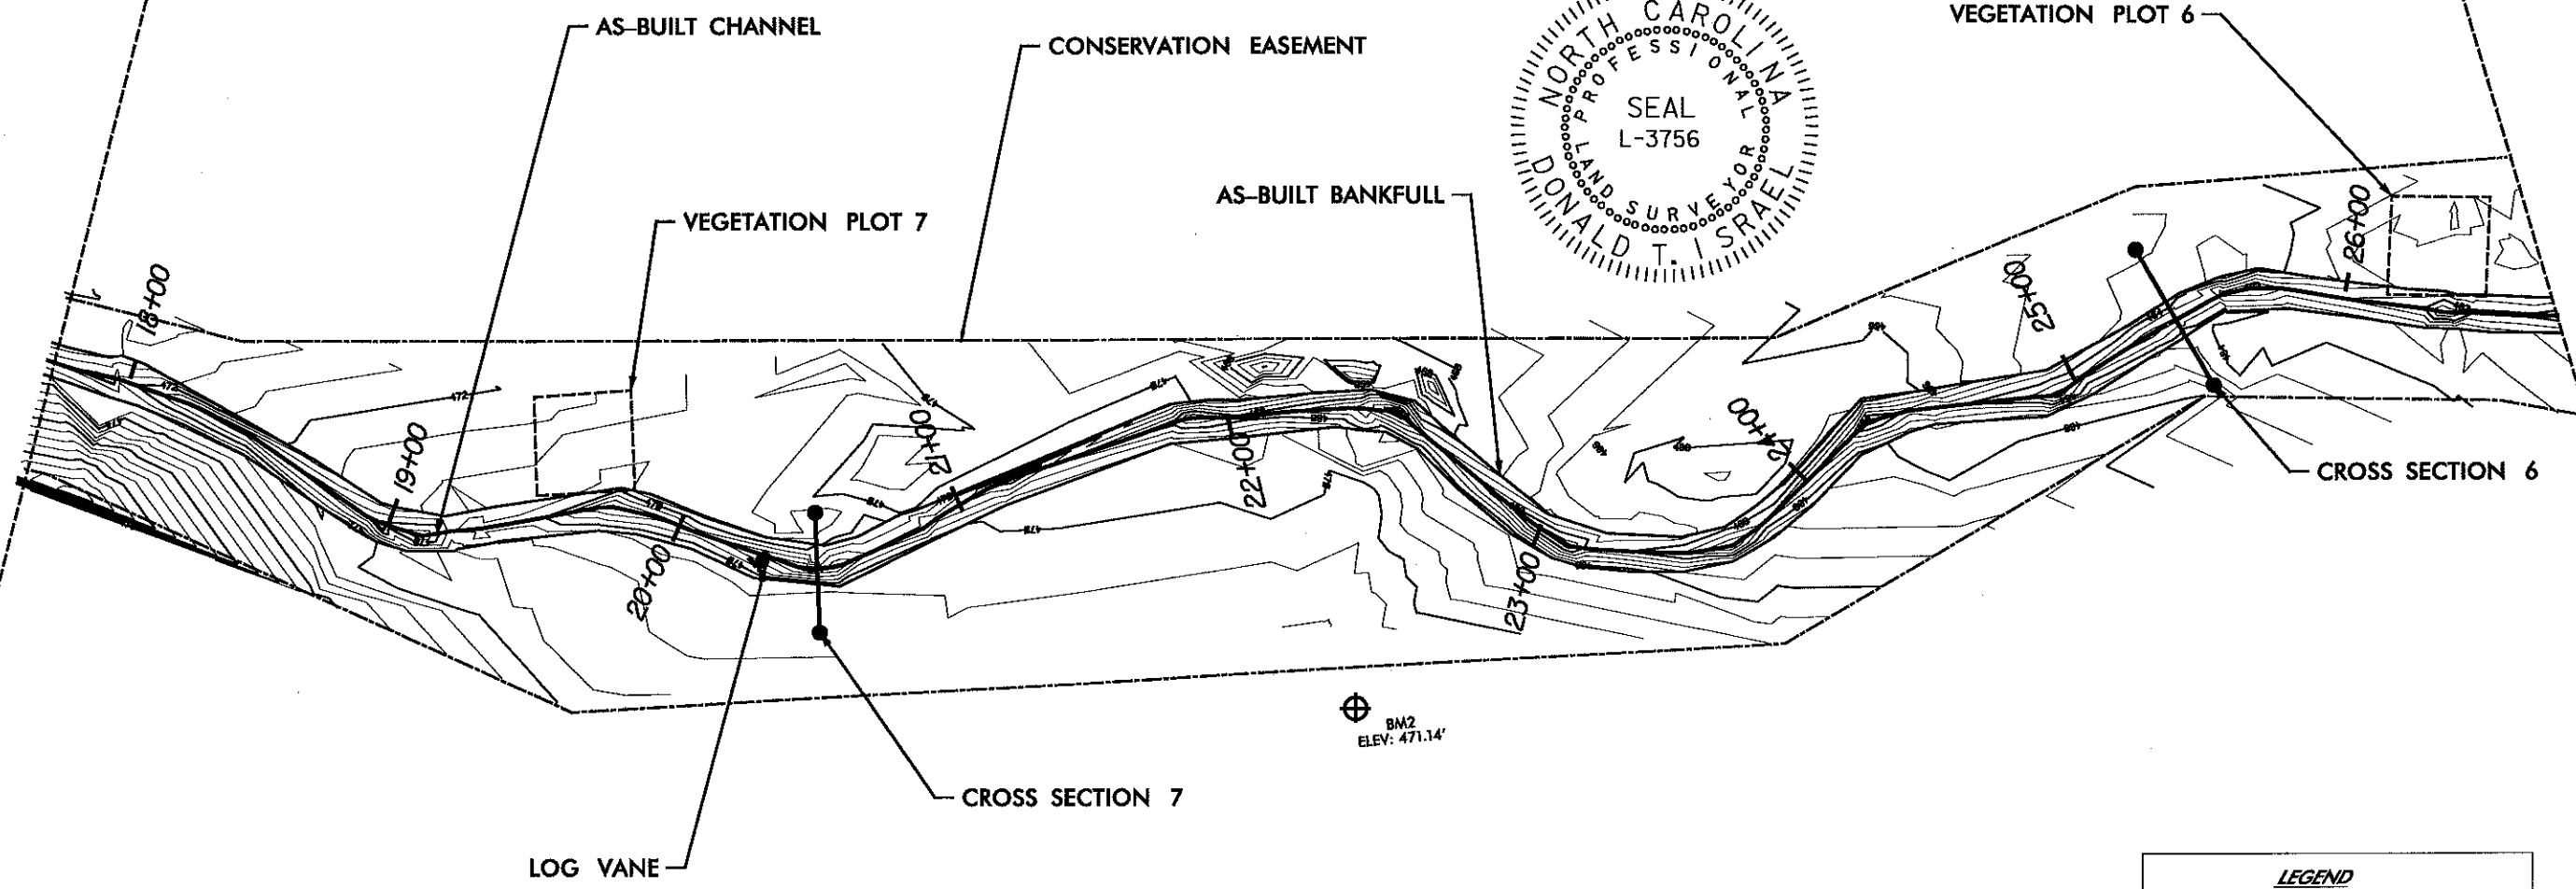

NO	REVISIONS	DN	CHK	DATE
1				
2				
3				



LEGEND	
STRUCTURE	
AS-BUILT TOP OF BANK	
AS-BUILT CHANNEL	
CROSS SECTION	
VEGETATION PLOT	
CONSERVATION EASEMENT	
MAJOR CONTOUR	
MINOR CONTOUR	
DESIGN CHANNEL	

BADIN INN STREAM RESTORATION
 AS-BUILT FEATURES
 EARTH TECH | AECOM
701 CORPORATE CENTER DRIVE, SUITE 415, RALEIGH, NC 27607
 919-854-6200 919-854-6259 (fax)

DATE	8/18/2009
PROJECT NO	99255
FILENAME	
SHEET NO	C-33
DRAWN BY	CHKD BY
ABW	BWD


USER: WILSONAB
 DATE: 8/18/2009
 C:\99255\Cadd\As-Built Files\AS-Built_Plansheets\99255_ASBuilt\AS-Built_Plansheets\AS-Built_Plansheets\AS-Built_Plansheets.dgn



I, DONALD T. ISRAEL, PLS, CERTIFY THAT THIS STREAM RESTORATION PROJECT WAS CONSTRUCTED IN SUBSTANCIAL CONFORMANCE WITH THE PLANS AND SPECIFICATIONS; AND THAT THE STREAM LIES WHOLLY WITHIN THE CONSERVATION EASEMENT AS SHOWN ON THE PLAT ENTITLED "BADIN INN STREAM RESTORATION" DATED 4-23-07 AND FOUND IN THE STANLEY COUNTY REGISTRY IN PLAT BOOK 20 PAGE 54.


BY Donald T. Israel (SURVEYOR)
PROFESSIONAL LAND SURVEYOR L-3756

EARTH TECH | AECOM

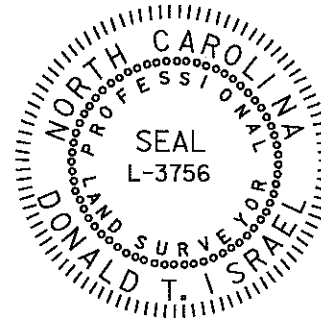

MATCHLINE SHEET C60-2

MATCHLINE SHEET C60-4

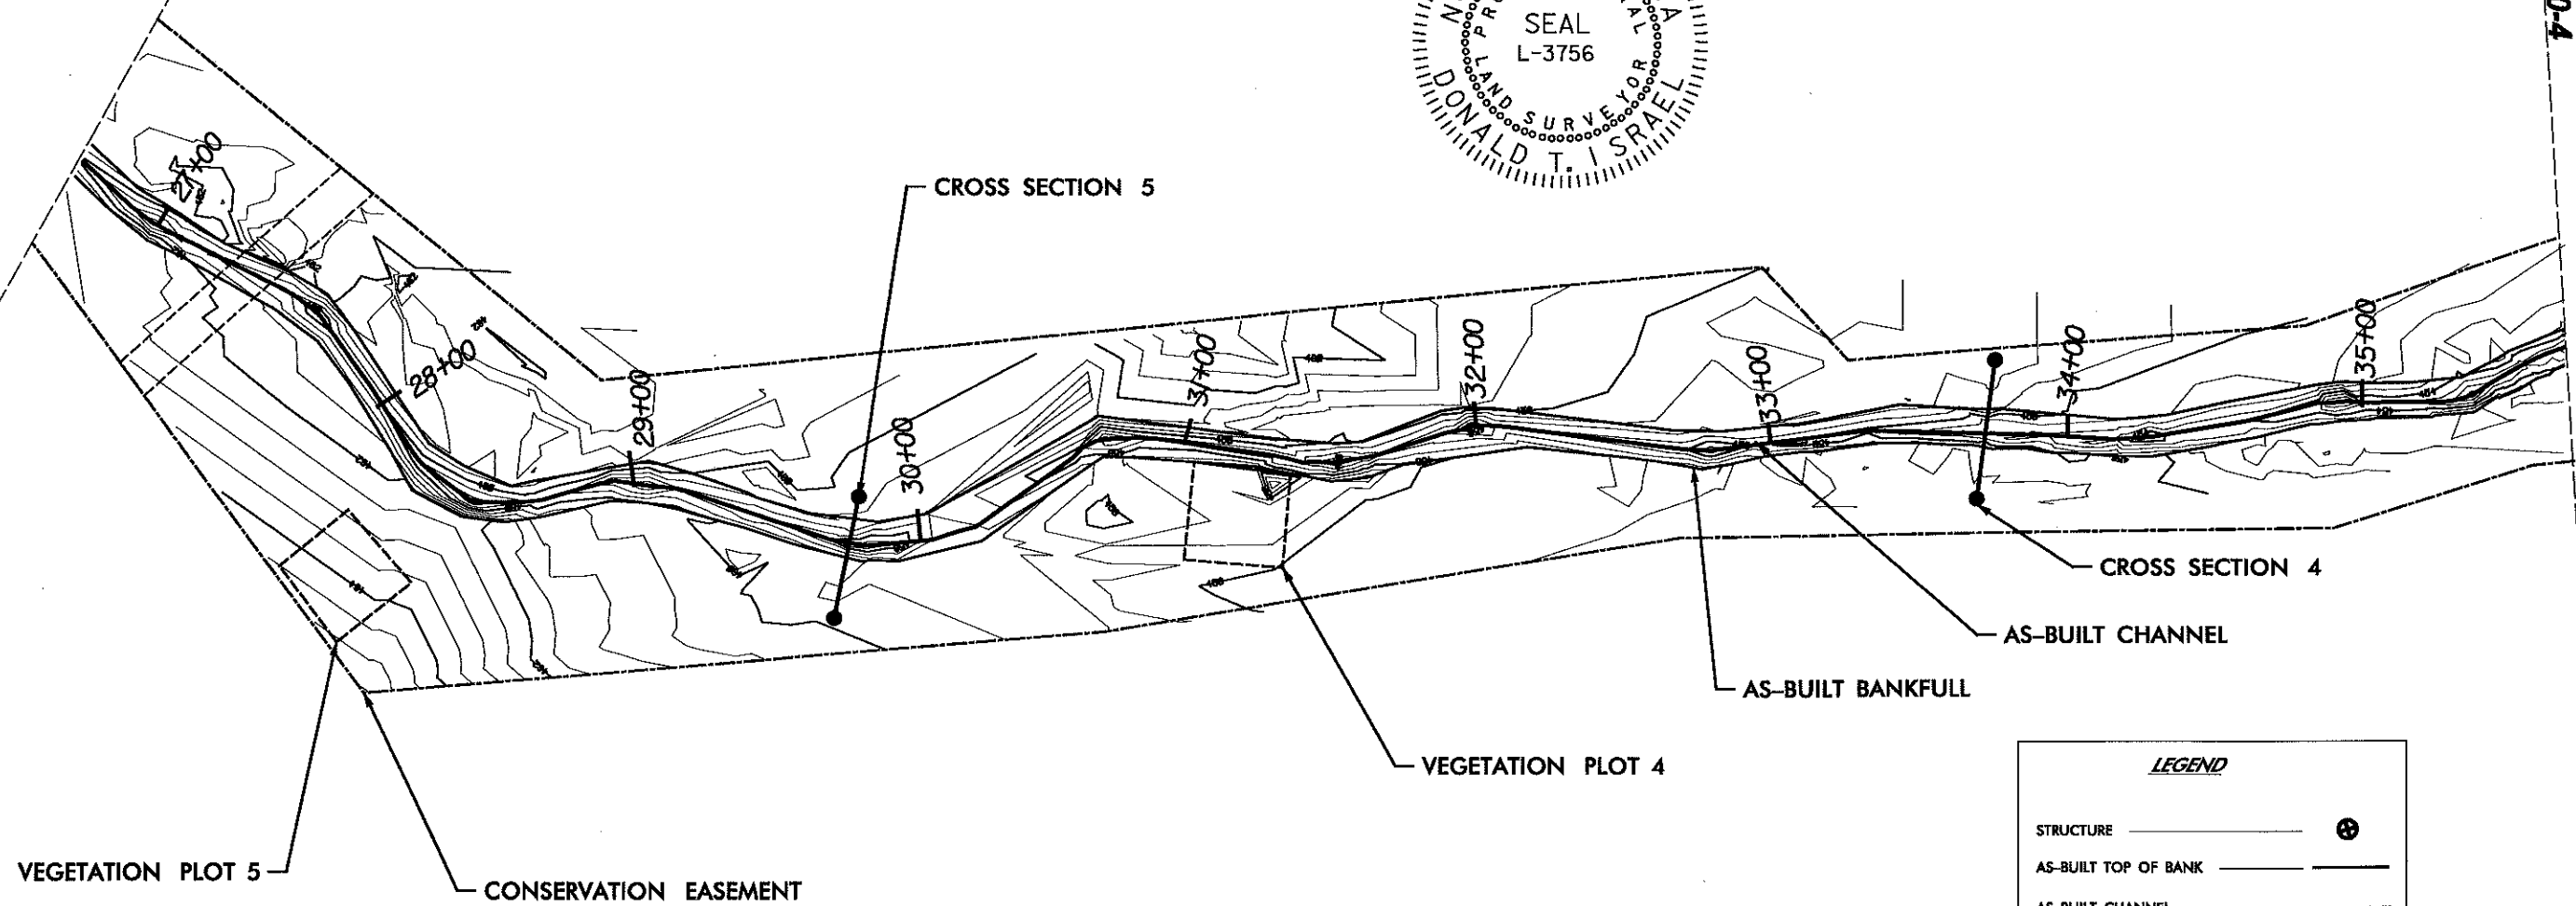

LEGEND

STRUCTURE	
AS-BUILT TOP OF BANK	
AS-BUILT CHANNEL	
CROSS SECTION	
VEGETATION PLOT	
CONSERVATION EASEMENT	
MAJOR CONTOUR	
MINOR CONTOUR	
DESIGN CHANNEL	

NO	REVISIONS	CHK	DATE
1			
2			
3			



BADIN INN STREAM RESTORATION
AS-BUILT FEATURES
EARTH TECH | AECOM
701 CORPORATE CENTER DRIVE, SUITE 475, RALEIGH, NC 27607
919-851-9200 919-851-9229

DATE	8/8/2009
PROJECT NO	99255
FILENAME	
SHEET NO	C-34
DRAWN BY	ABW
CHKD BY	BMD

USER: WILSONAB DATE: 8/18/2009
CON: C:\99255\cad\AS-Built\Files\AS-Built_Plan\as-built.dwg

MATCHLINE SHEET C60-3



MATCHLINE SHEET C60-5



I, DONALD T. ISRAEL, PLS, CERTIFY THAT THIS STREAM RESTORATION PROJECT WAS CONSTRUCTED IN SUBSTANCIAL CONFORMANCE WITH THE PLANS AND SPECIFICATIONS; AND THAT THE STREAM LIES WHOLLY WITHIN THE CONSERVATION EASEMENT AS SHOWN ON THE PLAT ENTITLED "BADIN INN STREAM RESTORATION" DATED 4-23-07 AND FOUND IN THE STANLEY COUNTY REGISTRY IN PLAT BOOK 20 PAGE 54.

BY Donald T. Israel (SURVEYOR)
PROFESSIONAL LAND SURVEYOR L-3756

EARTH TECH | AECOM

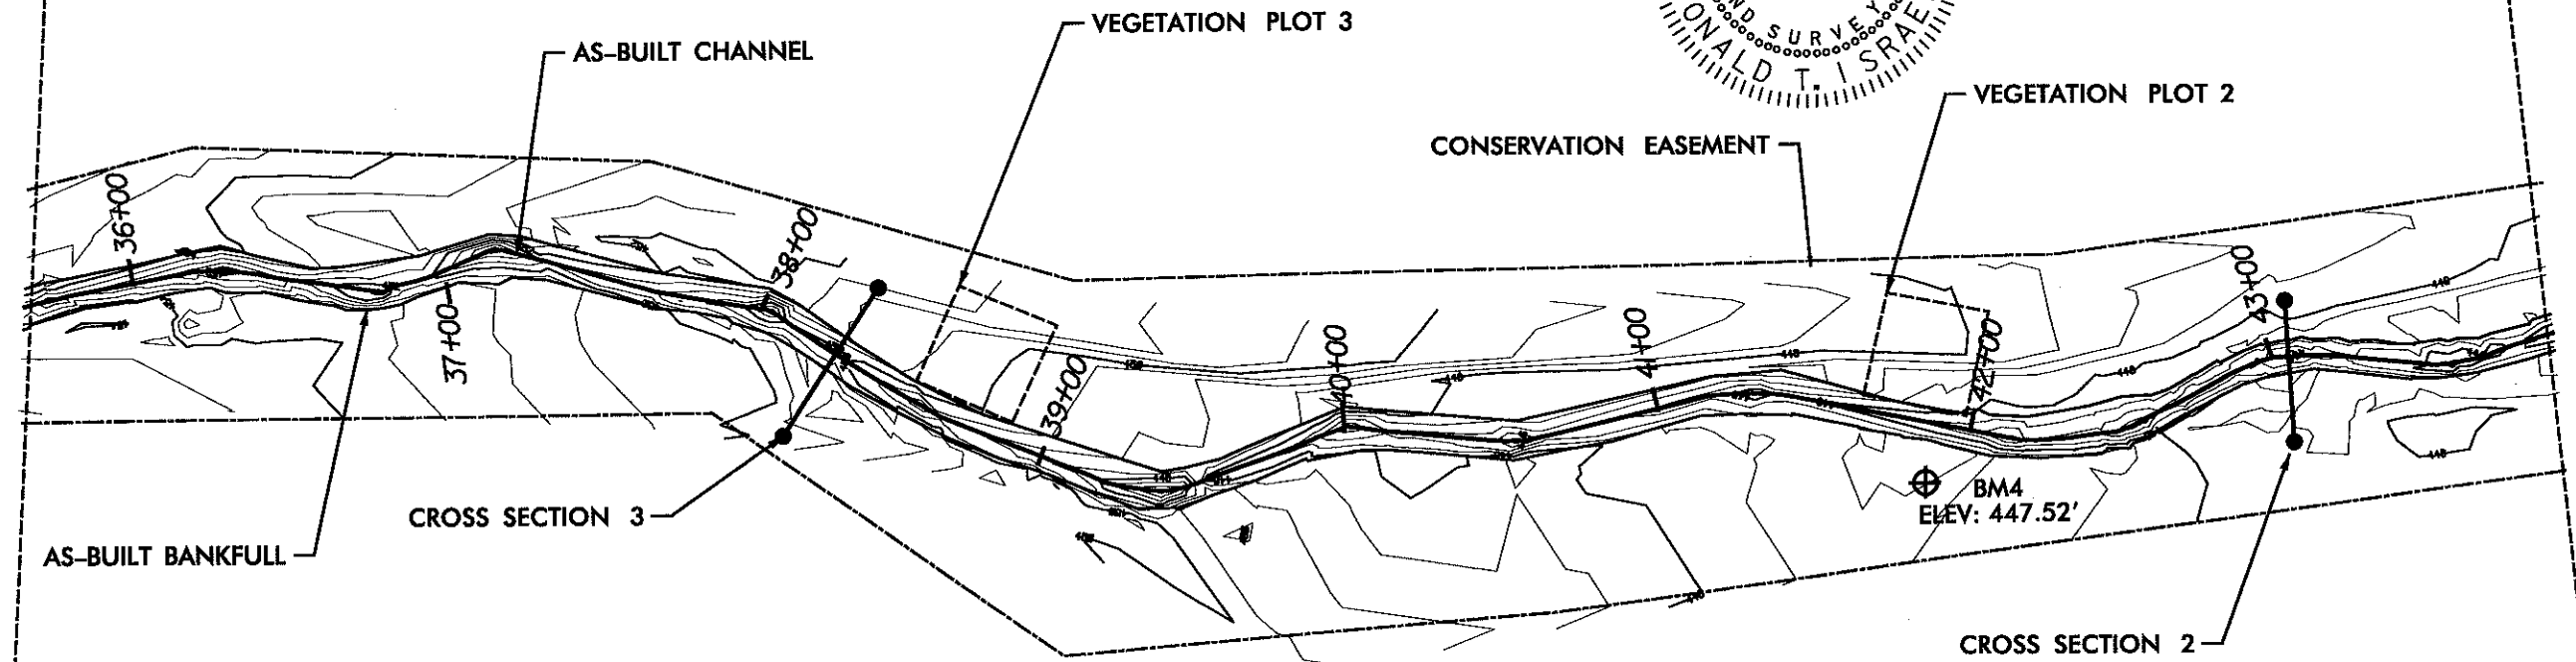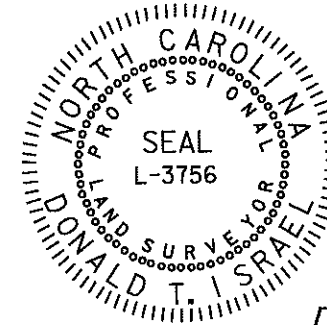

LEGEND

STRUCTURE	
AS-BUILT TOP OF BANK	
AS-BUILT CHANNEL	
CROSS SECTION	
VEGETATION PLOT	
CONSERVATION EASEMENT	
MAJOR CONTOUR	
MINOR CONTOUR	
DESIGN CHANNEL	

NO	REVISIONS	CHK	DATE
1			
2			
3			



BADIN INN STREAM RESTORATION
AS-BUILT FEATURES
EARTH TECH | AECOM
701 CORPORATE CENTER DRIVE, SUITE 400, WALTON, NC 27107
252-551-1000 252-551-1001


DATE	8/18/2009
PROJECT NO	99255
FILENAME	
SHEET NO	C-35
DRAWN BY	ABW
CHKD BY	BMD

USER: WILSONAB
DGN: Q:\99255\cadd\as-Built\Filas\AS-BUILT_Plansheets\99255_p\as-Built\AS-Built.dgn
DATE: 8/18/2009


I, DONALD T. ISRAEL, PLS, CERTIFY THAT THIS STREAM RESTORATION PROJECT WAS CONSTRUCTED IN SUBSTANTIAL CONFORMANCE WITH THE PLANS AND SPECIFICATIONS; AND THAT THE STREAM LIES WHOLLY WITHIN THE CONSERVATION EASEMENT AS SHOWN ON THE PLAT ENTITLED "BADIN INN STREAM RESTORATION" DATED 4-23-07 AND FOUND IN THE STANLEY COUNTY REGISTRY IN PLAT BOOK 20 PAGE 54.

BY Donald T. Israel (SURVEYOR)
PROFESSIONAL LAND SURVEYOR L-3756

EARTH TECH | AECOM

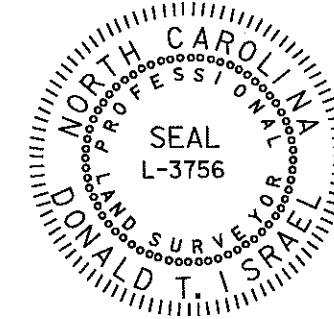

MATCHLINE SHEET C60-4

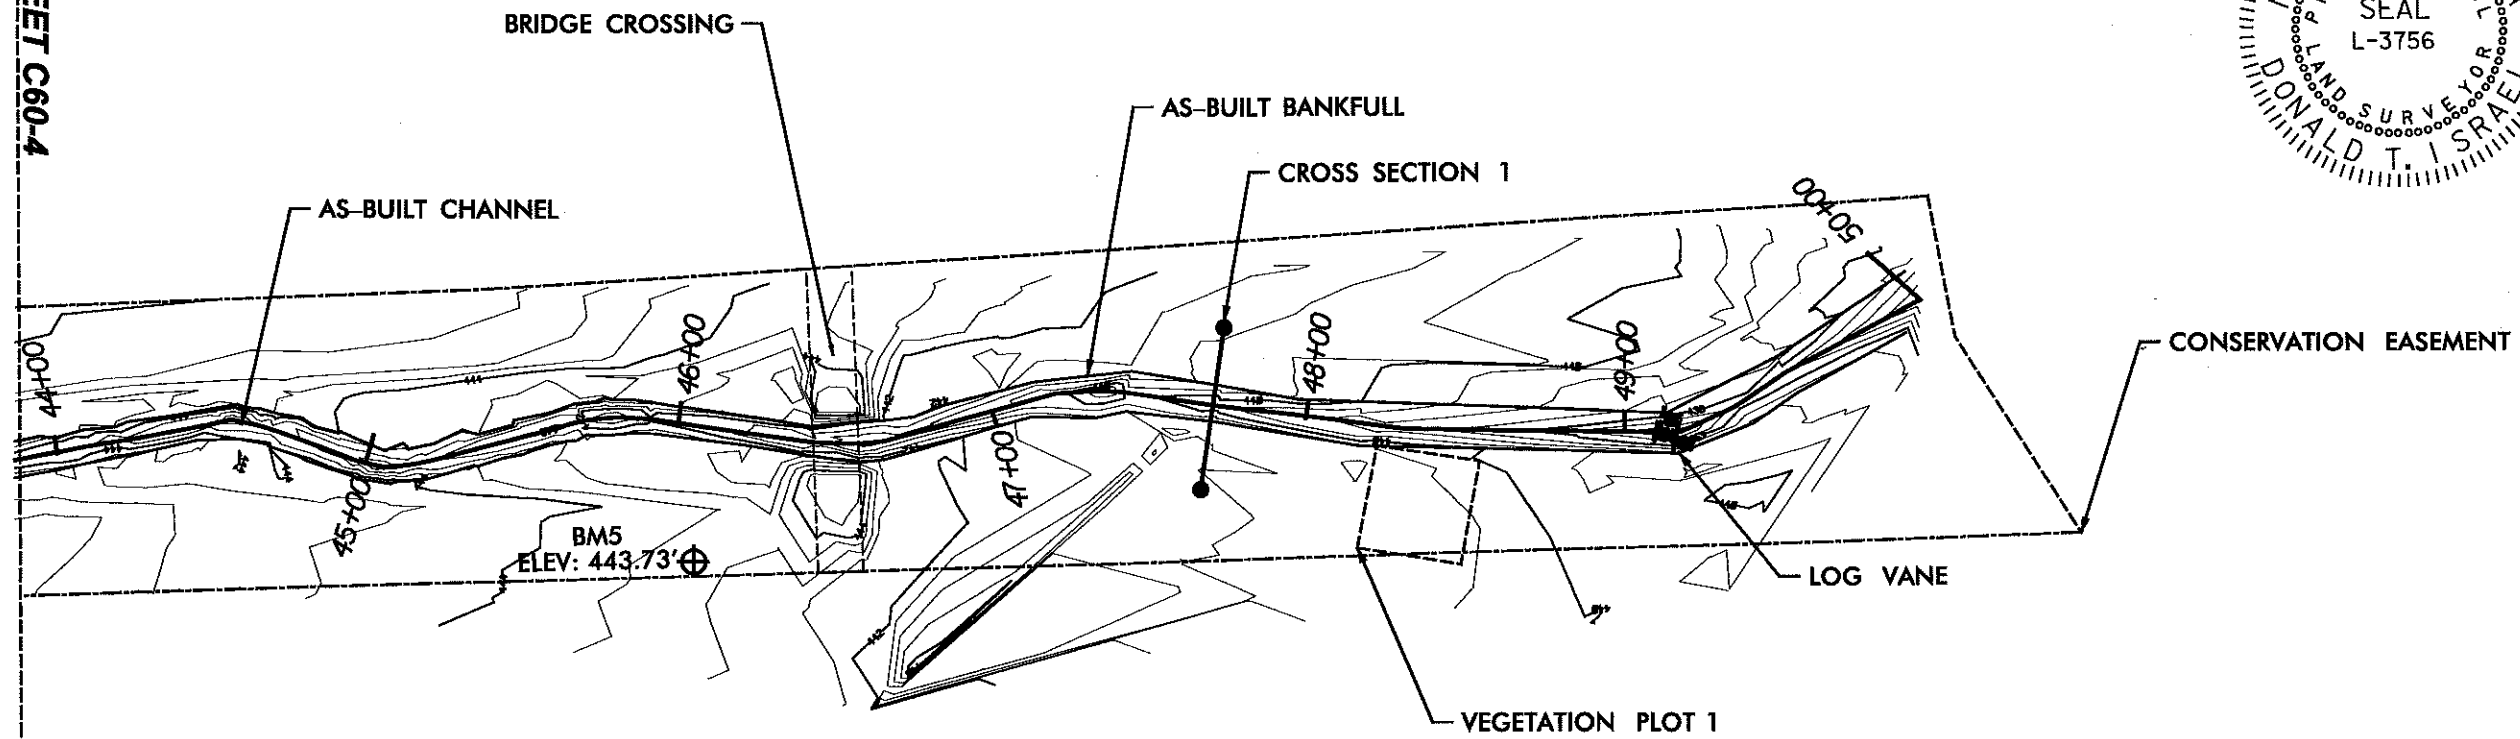

NO	REVISIONS	DRN	CHK	DATE
1				
2				
3				




LEGEND	
STRUCTURE	
AS-BUILT TOP OF BANK	
AS-BUILT CHANNEL	
CROSS SECTION	
VEGETATION PLOT	
CONSERVATION EASEMENT	
MAJOR CONTOUR	
MINOR CONTOUR	
DESIGN CHANNEL	


BADIN INN STREAM RESTORATION
AS-BUILT FEATURES
EARTH TECH | AECOM
701 CORPORATE CENTER DRIVE, SUITE 415, RALEIGH, NC 27607
919-854-6200 919-854-6299 (fax)

DATE	9/18/2009
PROJECT NO	99255
FILENAME	
SHEET NO	C-36
DRAWN BY	ABW
CHKD BY	BWD


USER: WILSONAB
DATE: 8/18/2009
DGN: C:\99255\card\As-Built\Files\AS-BUILT_Plansheets\99255_per\1115\as-built\AS-Built.dgn

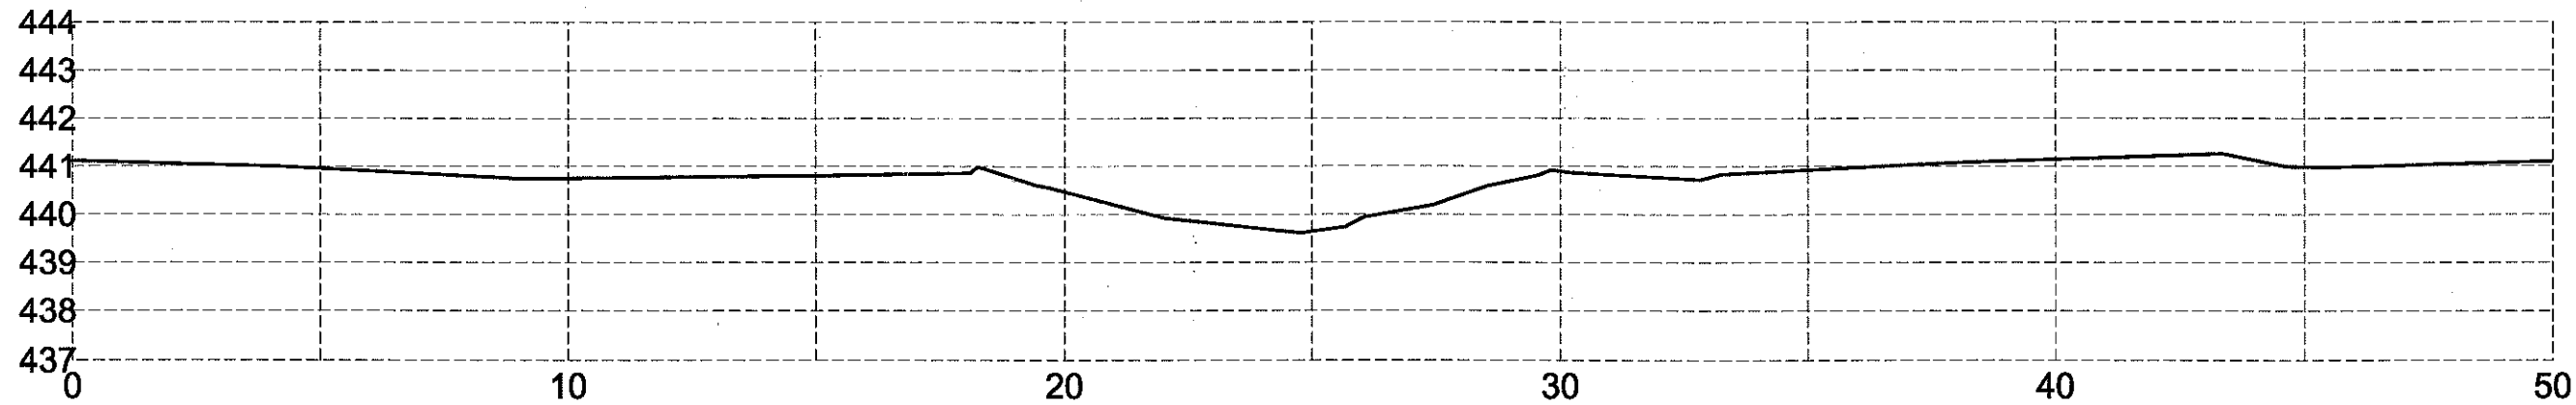


CROSS SECTION 1 - RIFFLE
STA. 47+67

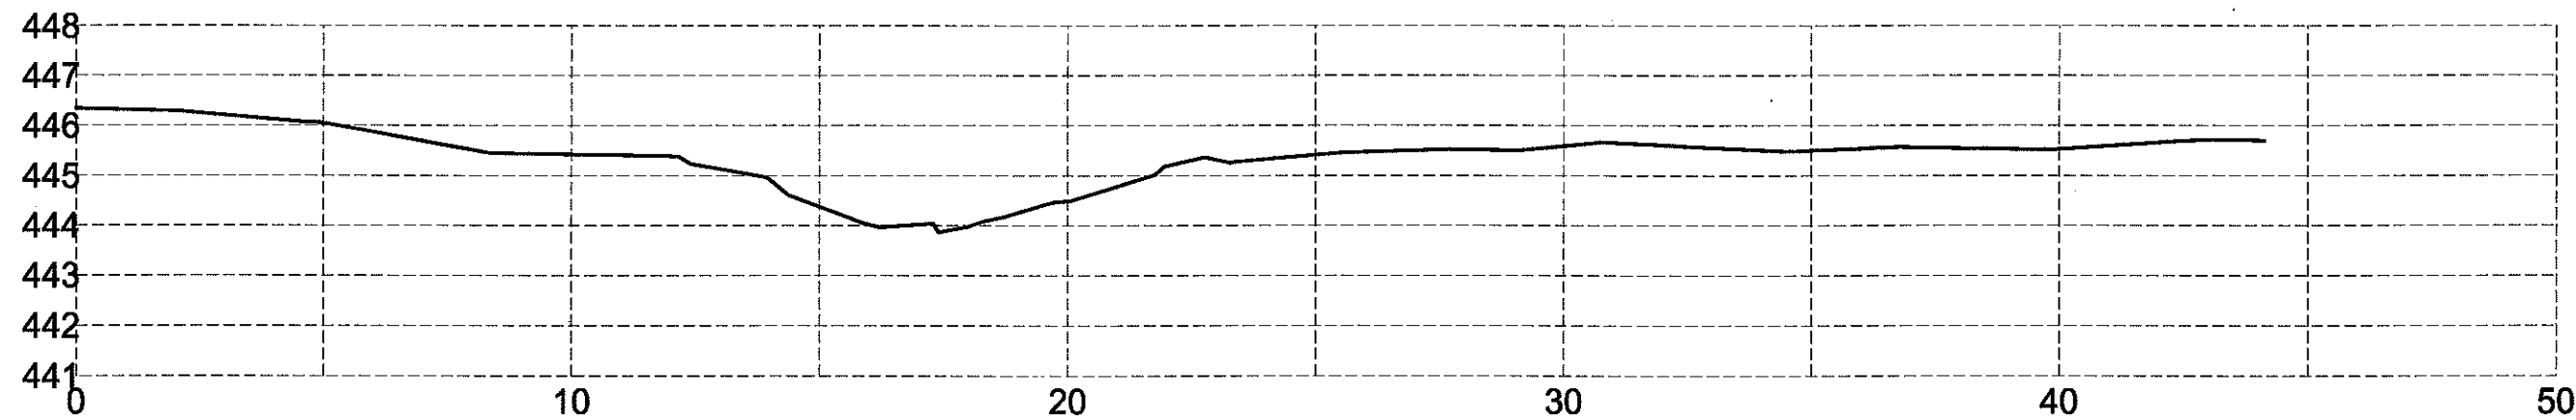

CROSS SECTION 2 - POOL
STA. 43+05

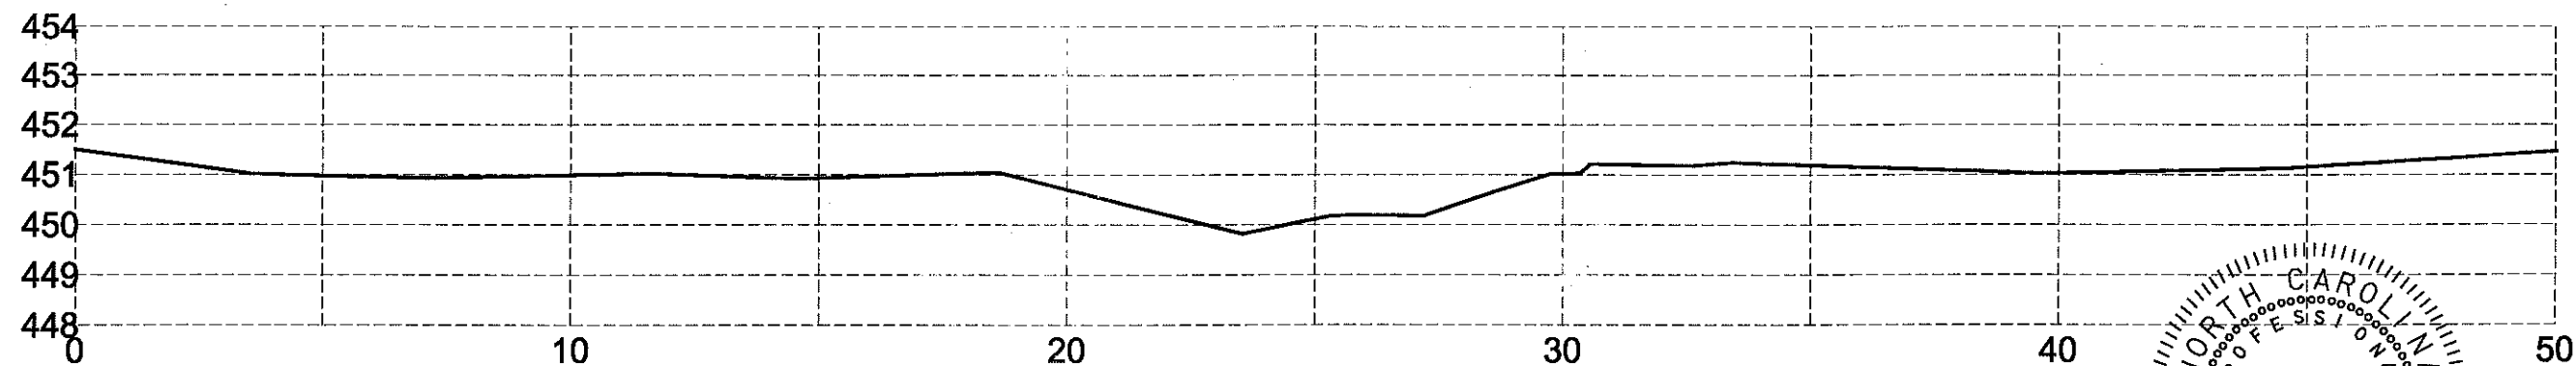

CROSS SECTION 3 - RIFFLE
STA. 38+26

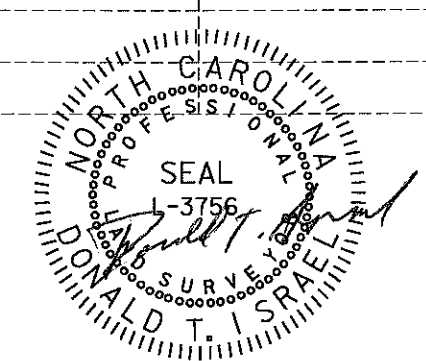


REVISIONS		DATE
NO		
1		
2		
3		
DRN	CHK	

BADIN INN STREAM RESTORATION AS-BUILT CROSS SECTIONS	
EARTH TECH AECOM	
701 CORPORATE CENTER DRIVE, SUITE 415, RALEIGH, NC 27607 919-854-8000 919-854-8225 (fax)	



DATE	8/18/2009
PROJECT NO	99255
FILENAME	
SHEET NO	C-37
DRAWN BY	CHKD BY
ARW	BMD

USER: WILSONAB
 DATE: 8/18/2009
 C:\99255\Cadd\As-Built Files\AS-Built_Plan\sections99255_AST\BUILT 2009\12\12\12\sections.dgn


USER: WILSONAB
 DGN: G:\99255\road\as-Built Files\AS-BUILT_Plansheets\99255_AST\BUILT 2007\sections ec07f0ns.dgn
 DATE: 8/18/2009

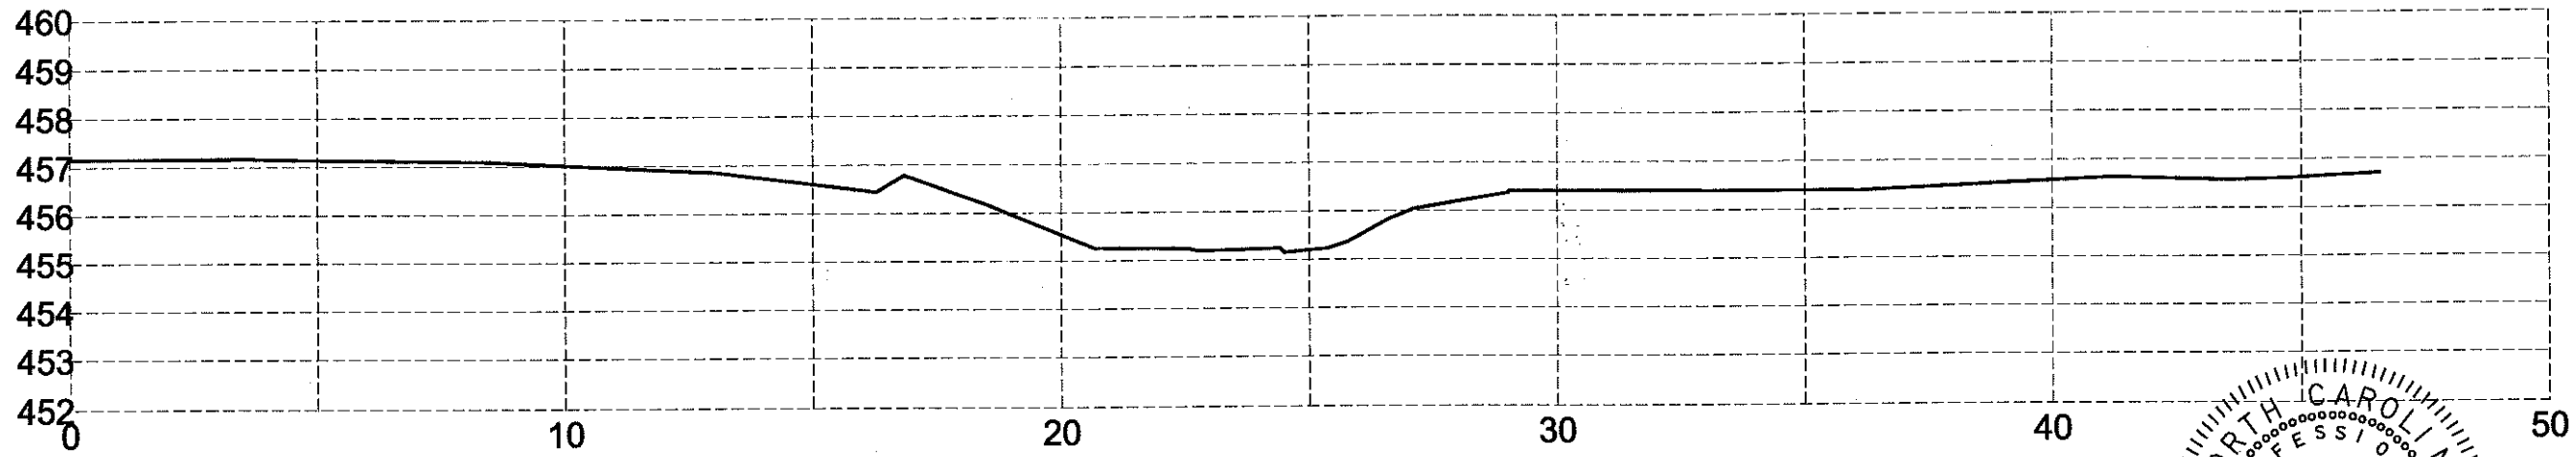

CROSS SECTION 4 - RIFFLE
 STA. 33+72

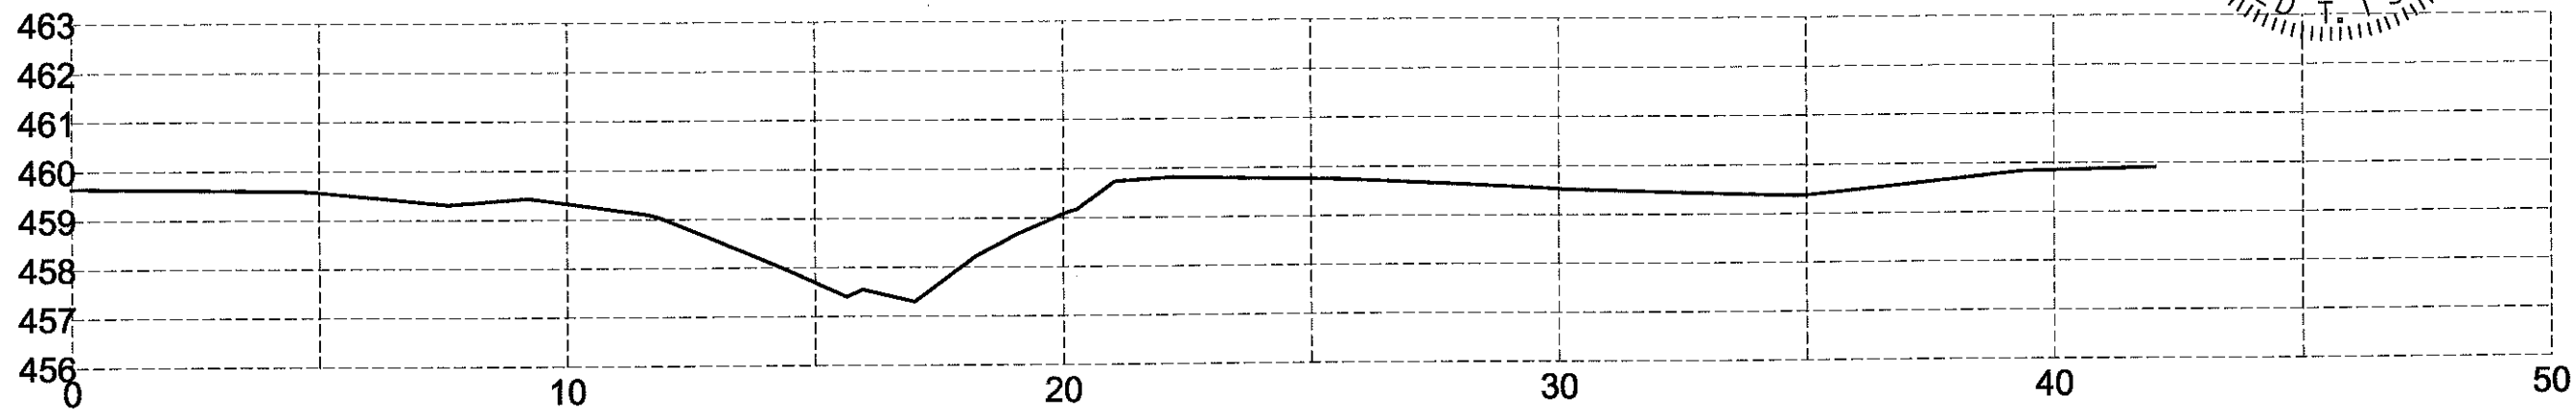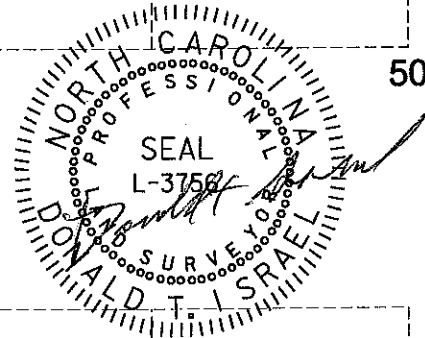


CROSS SECTION 5 - POOL
 STA. 29+78

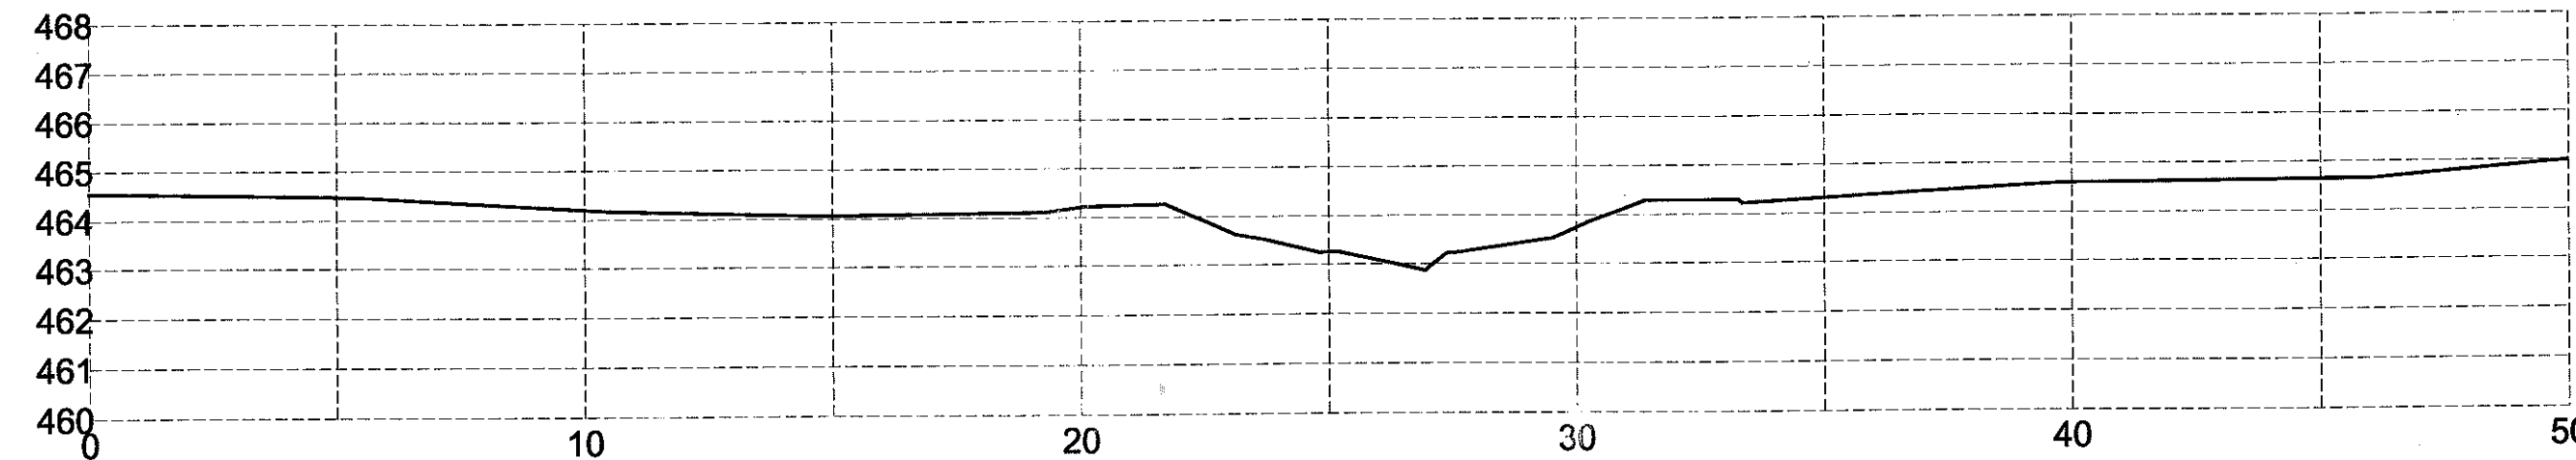


CROSS SECTION 6 - RIFFLE
 STA. 25+39

DATE		8/18/2009
PROJECT NO		99255
FILENAME		
SHEET NO		C-38
DRAWN BY	CHKD BY	
ABW	BMD	
BADIN INN STREAM RESTORATION AS-BUILT CROSS SECTIONS		
EARTHTECH AECOM		
701 CORPORATE CENTER DRIVE, SUITE 4125, RALEIGH, NC 27617 919-871-6200 FAX 919-871-6203		
REVISIONS		
NO		
1		
2		
3		
	DIRN	CHK
		DATE

USER: WILSONAB DATE: 8/18/2009
 C:\99255\card\46-Built-Files\AS-Built-Plans\sheet\99255_AS-Built-Plans\sections.dgn

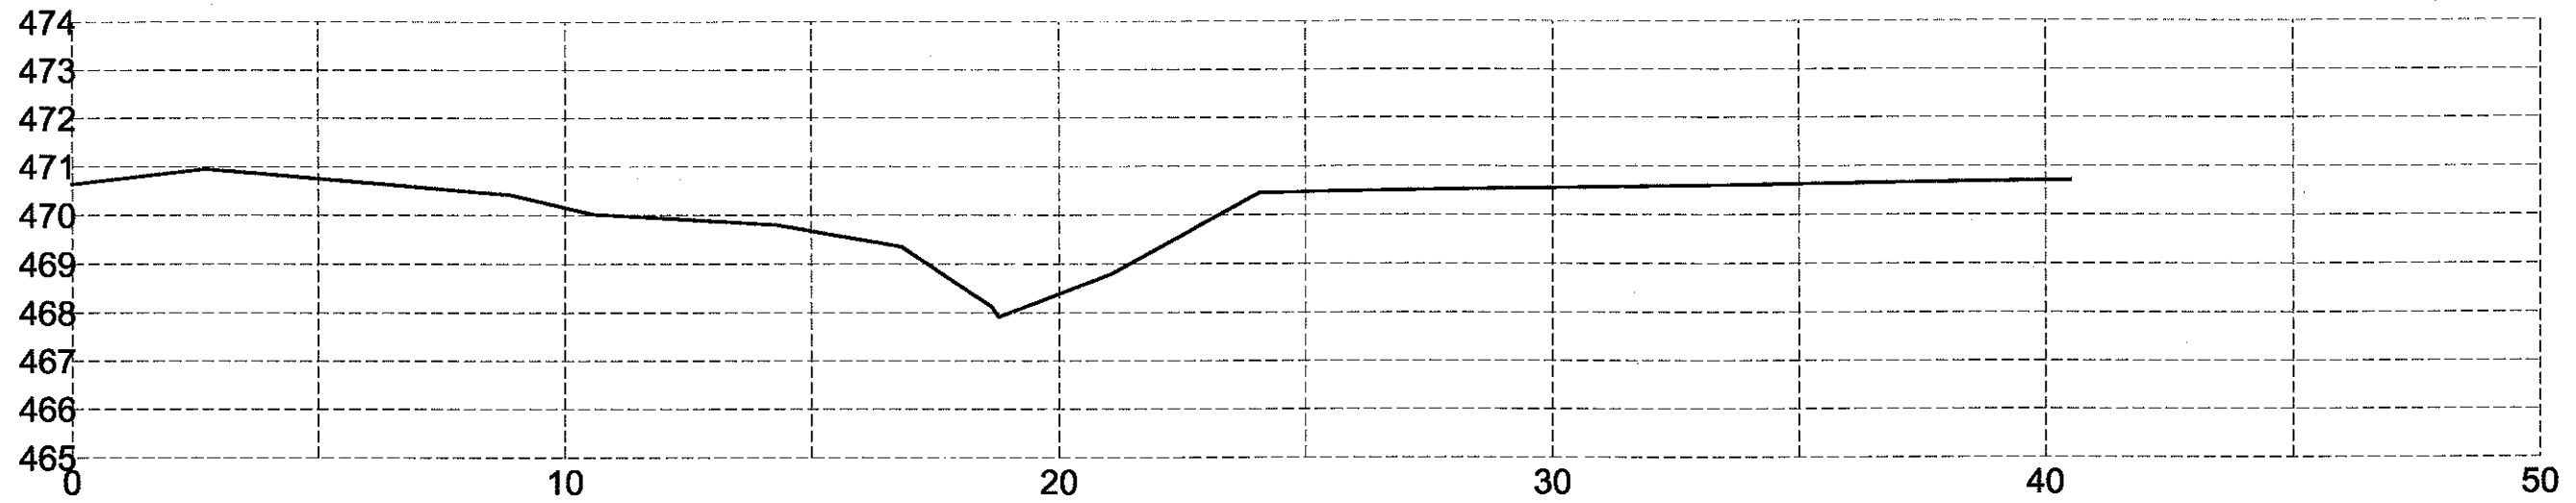


CROSS SECTION 7 - POOL
 STA. 20+45

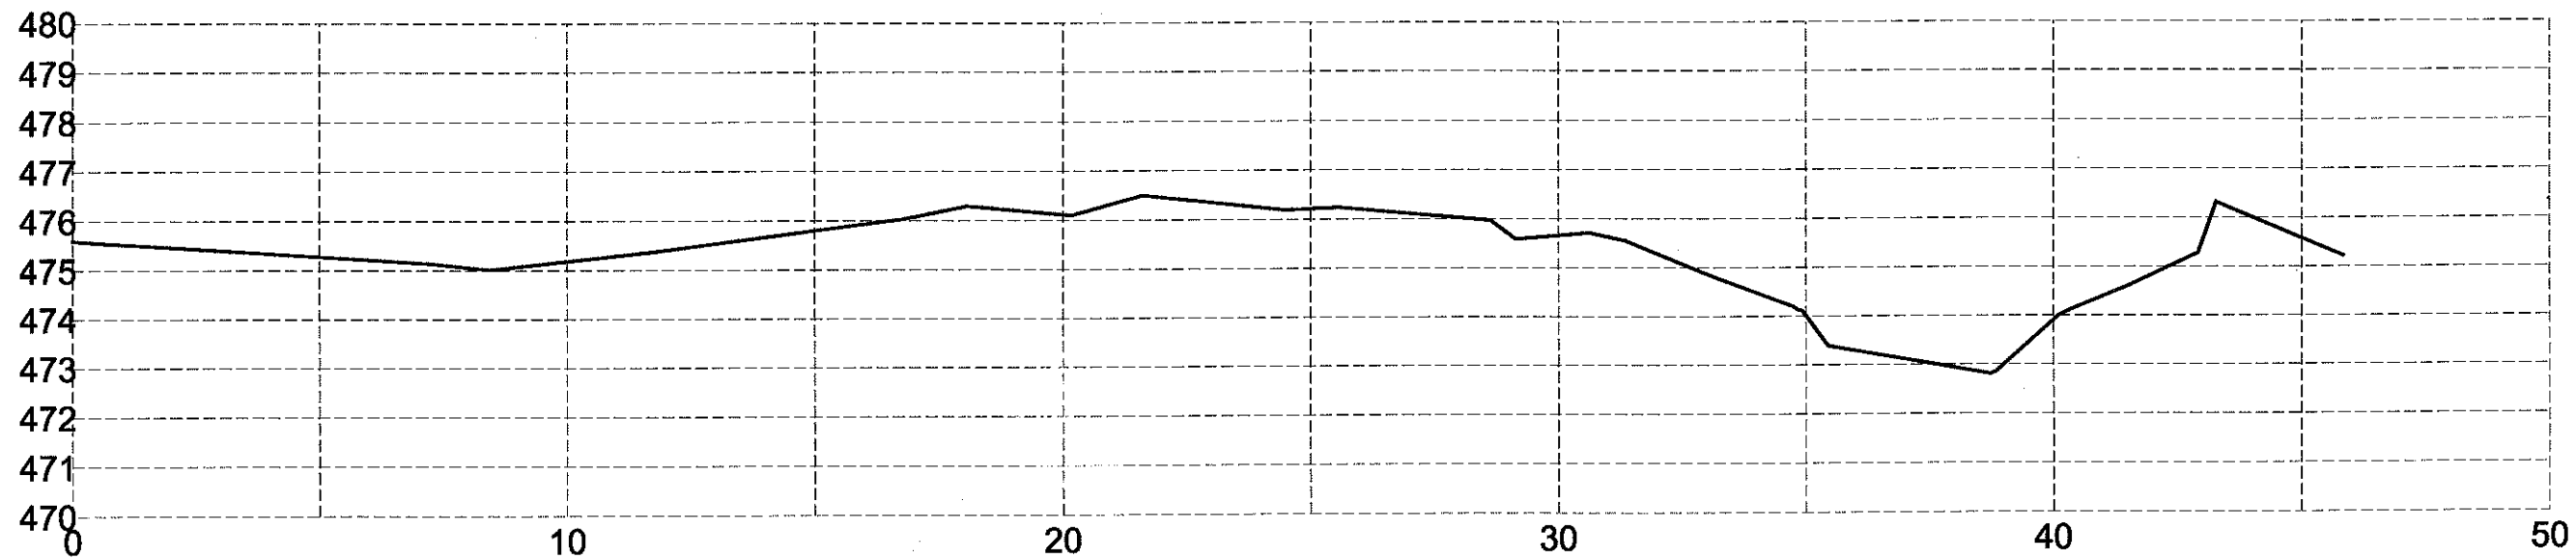

CROSS SECTION 8 - POOL
 STA. 16+50

I, DONALD T. ISRAEL, PLS, CERTIFY THAT THIS STREAM RESTORATION PROJECT WAS CONSTRUCTED IN SUBSTANTIAL CONFORMANCE WITH THE PLANS AND SPECIFICATIONS; AND THAT THE STREAM LIES WHOLLY WITHIN THE CONSERVATION EASEMENT AS SHOWN ON THE PLAT ENTITLED "BADIN INN STREAM RESTORATION" DATED 4-23-07 AND FOUND IN THE STANLEY COUNTY REGISTRY IN PLAT BOOK 20 PAGE 54.

BY Donald T. Israel (SURVEYOR)
 PROFESSIONAL LAND SURVEYOR L-3756

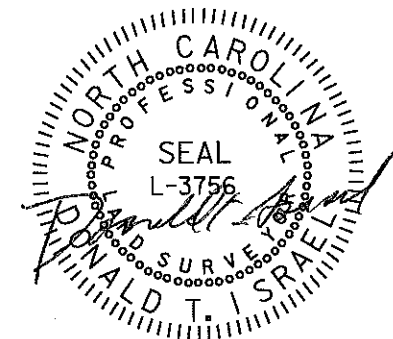


EARTH TECH AECOM

NO	REVISIONS	DRN	CHK	DATE
1				
2				
3				


BADIN INN STREAM RESTORATION	
AS-BUILT CROSS SECTIONS	
EARTH TECH AECOM	
701 CORPORATE CENTER DRIVE, SUITE 415, RALEIGH, NC 27607 919-854-8200 919-854-8225 (fax)	

DATE	8/18/2009
PROJECT NO	99255
FILENAME	
SHEET NO	C-39
DRAWN BY	ABW
CHKD BY	BMD

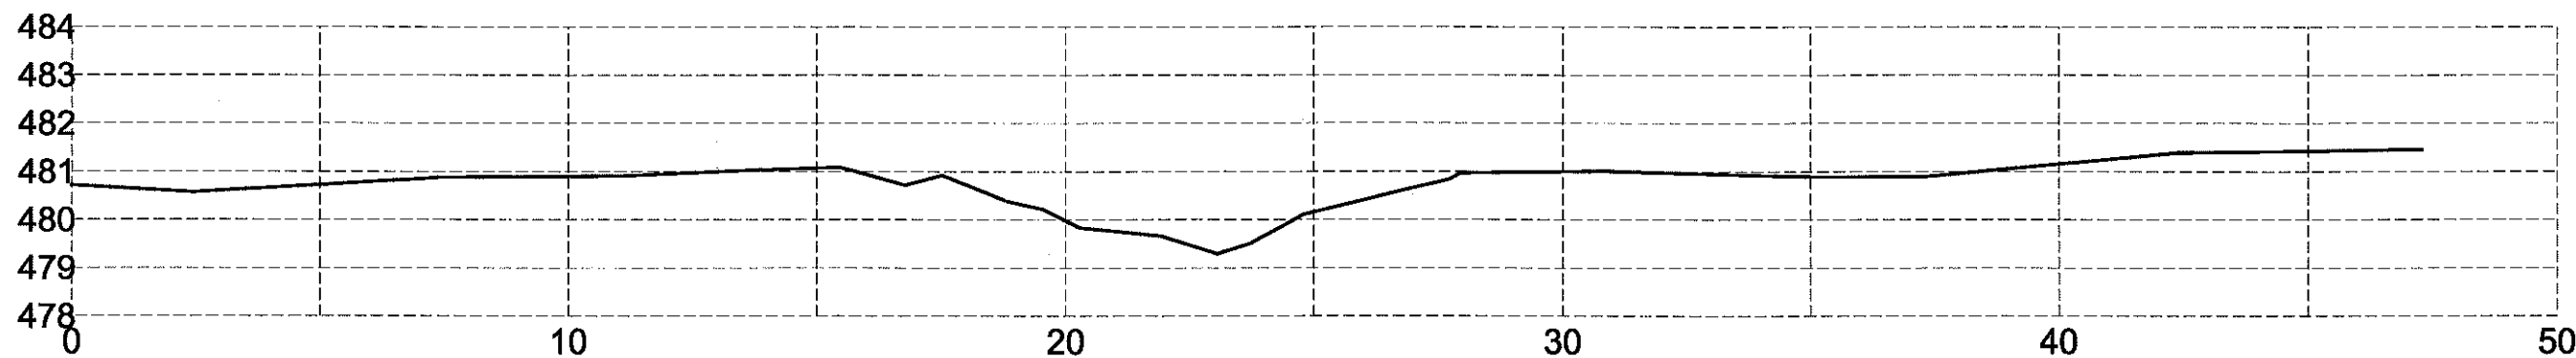

CROSS SECTION 9 - RIFFLE

STA. 13+61

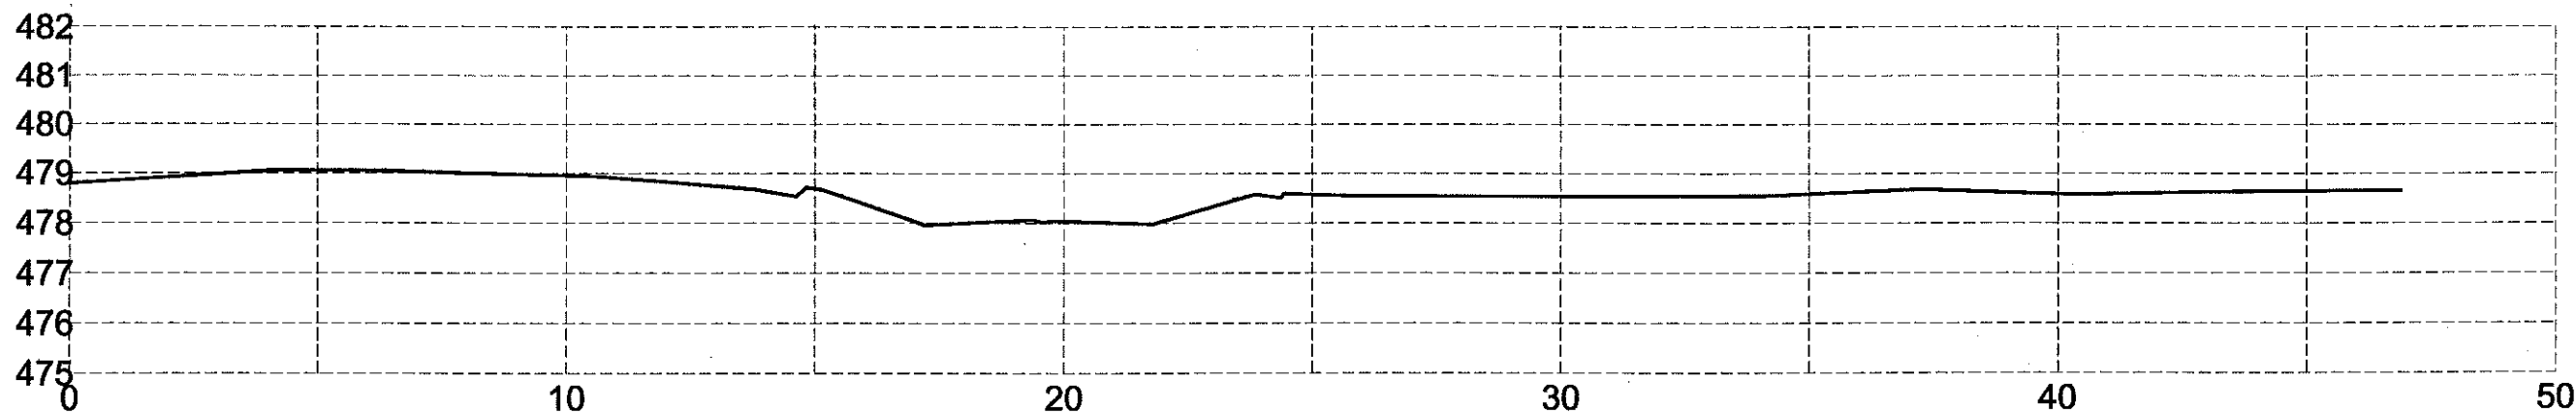


TRIBUTARY CROSS SECTION - RIFFLE

STA. 10+85

I, DONALD T. ISRAEL, PLS, CERTIFY THAT THIS STREAM RESTORATION PROJECT WAS CONSTRUCTED IN SUBSTANCIAL CONFORMANCE WITH THE PLANS AND SPECIFICATIONS; AND THAT THE STREAM LIES WHOLLY WITHIN THE CONSERVATION EASEMENT AS SHOWN ON THE PLAT ENTITLED "BADIN INN STREAM RESTORATION" DATED 4-23-07 AND FOUND IN THE STANLEY COUNTY REGISTRY IN PLAT BOOK 20 PAGE 54.

BY Donald T. Israel (SURVEYOR)
 PROFESSIONAL LAND SURVEYOR L-3756

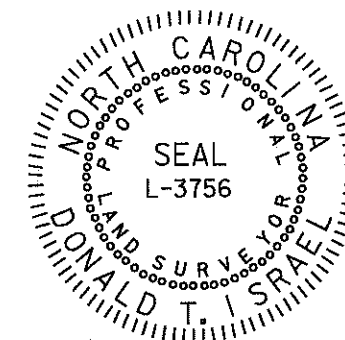



EARTH TECH | AECOM

USER: WILSONAB
 PCN: C:\99255\card\As-Built Files\AS-Built_Plans\99255_ASBuilt_CrossSections sections.dgn
 DATE: 8/18/2009

DATE		8/18/2009
PROJECT NO		99255
FILENAME		
SHEET NO		C-40
DRAWN BY	CHKD BY	
ABW	BMD	
REVISIONS		
NO	NO	
1		
2		
3		
DN	CHK	DATE

BADIN INN STREAM RESTORATION
 AS-BUILT CROSS SECTIONS
 EARTH TECH | AECOM
 TO: 1 CORPORATE CENTER DRIVE, SUITE 415, RALEIGH, NC 27607
 919-854-8200 919-854-8209 FAX

USER: WILSONAB
 DATE: 8/18/2009
 DGN: C:\99255\cadd\As-Built\Files\AS-Built_Plansheets\99255_ASBuilt\25113355.dwg -41 Profile.dgn

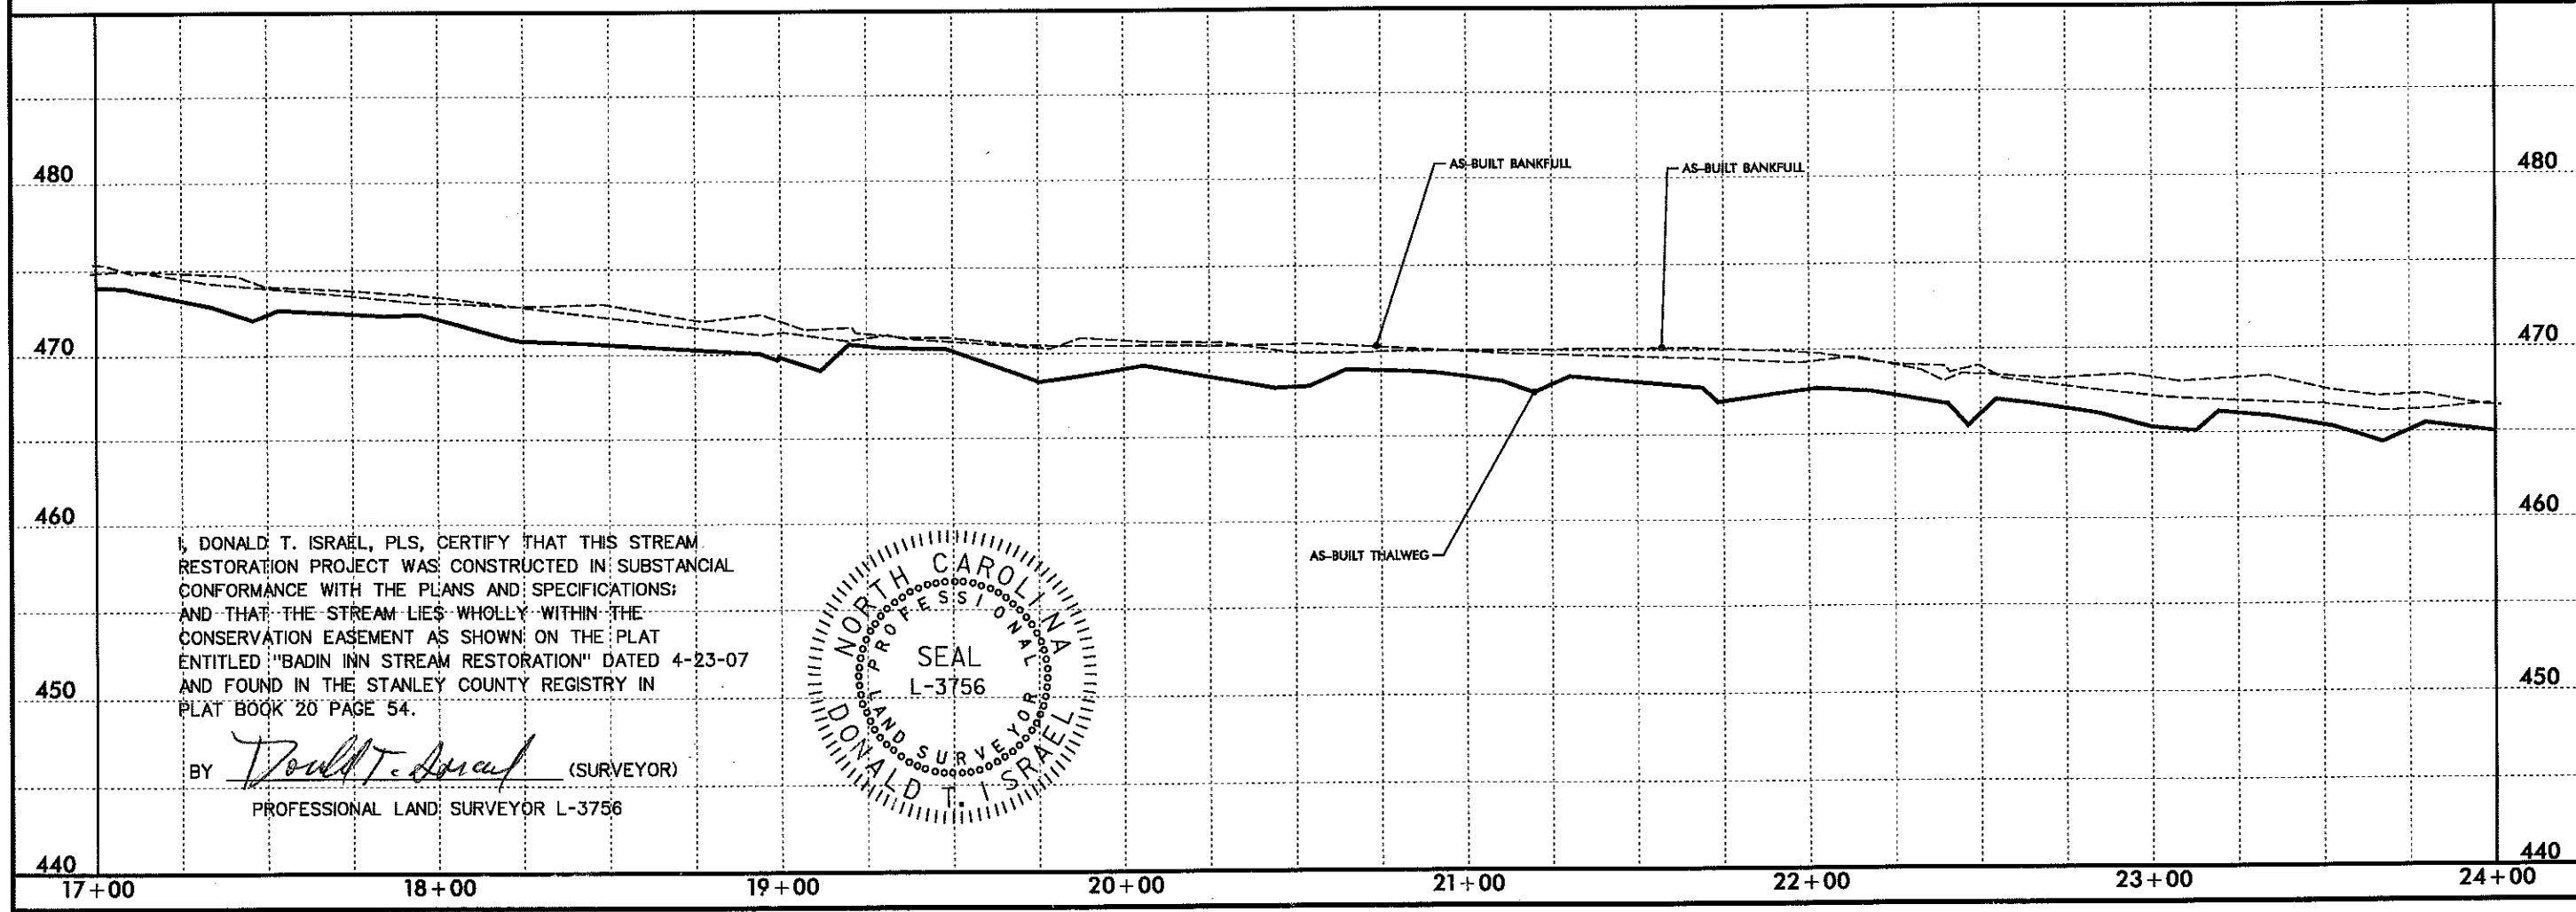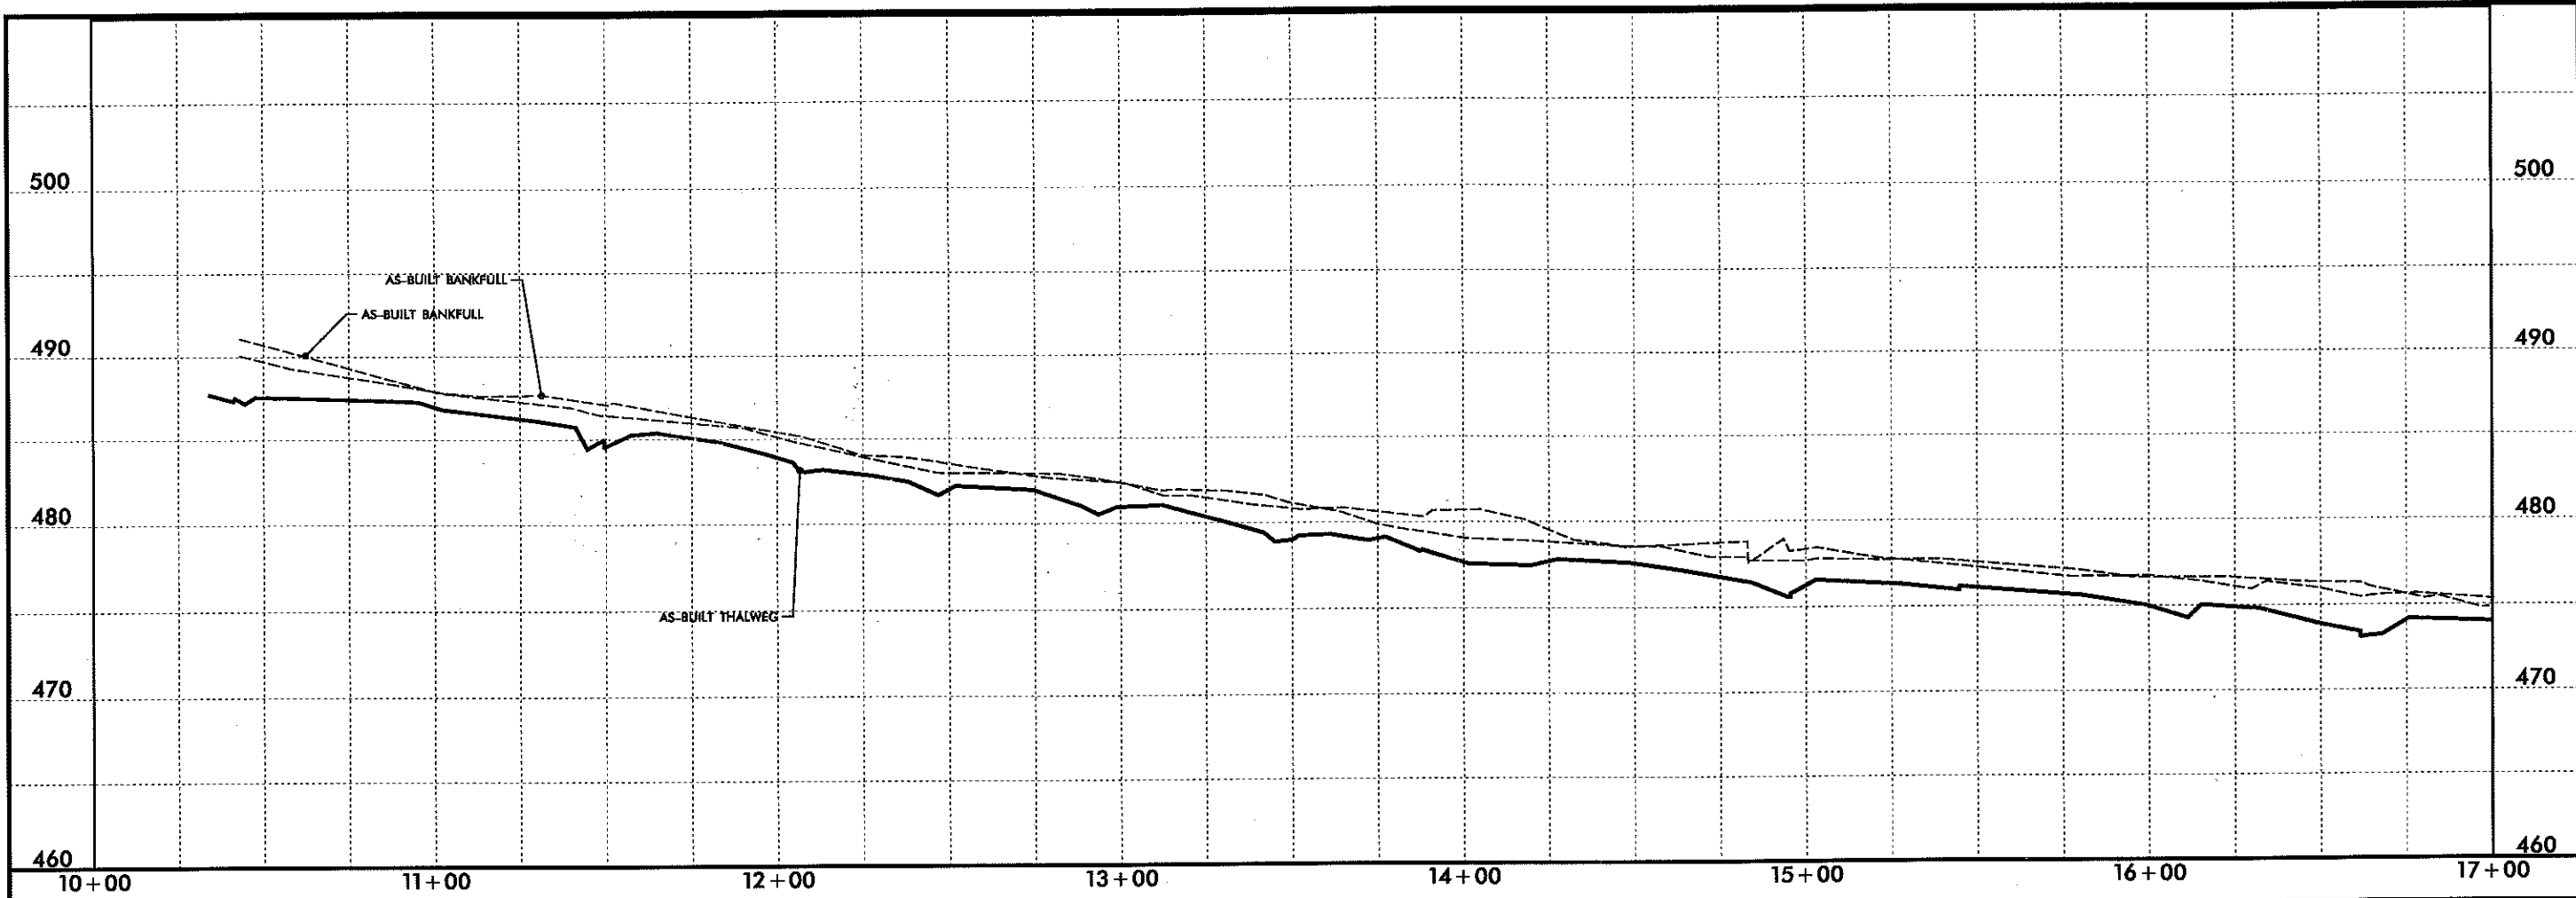

NO	REVISIONS	DSN	CHK	DATE
1				
2				
3				




BADIN INN STREAM RESTORATION
 AS-BUILT CHANNEL PROFILE
 EARTH TECH | AECOM
 701 CORPORATE CENTER DRIVE, SUITE 200, RALEIGH, NC 27607
 919-996-4600 | 919-996-4609 (FAX)



DATE	8/18/2009
PROJECT NO	99255
FILENAME	
SHEET NO	C-41
DRAWN BY	ABW
CHKD BY	BMD

I, DONALD T. ISRAEL, PLS, CERTIFY THAT THIS STREAM RESTORATION PROJECT WAS CONSTRUCTED IN SUBSTANTIAL CONFORMANCE WITH THE PLANS AND SPECIFICATIONS; AND THAT THE STREAM LIES WHOLLY WITHIN THE CONSERVATION EASEMENT AS SHOWN ON THE PLAT ENTITLED "BADIN INN STREAM RESTORATION" DATED 4-23-07 AND FOUND IN THE STANLEY COUNTY REGISTRY IN PLAT BOOK 20 PAGE 54.


BY Donald T. Israel (SURVEYOR)
 PROFESSIONAL LAND SURVEYOR L-3756

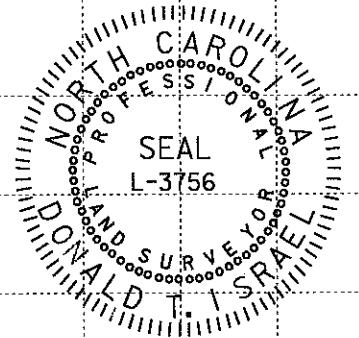

USER: WILSONAB DATE: 8/18/2009
 DWT C:\99255\coord\as-built\Files\AS-Built_Plansheet\99255_ASBuilt\2009\DWG\C-42_Profile.dgn

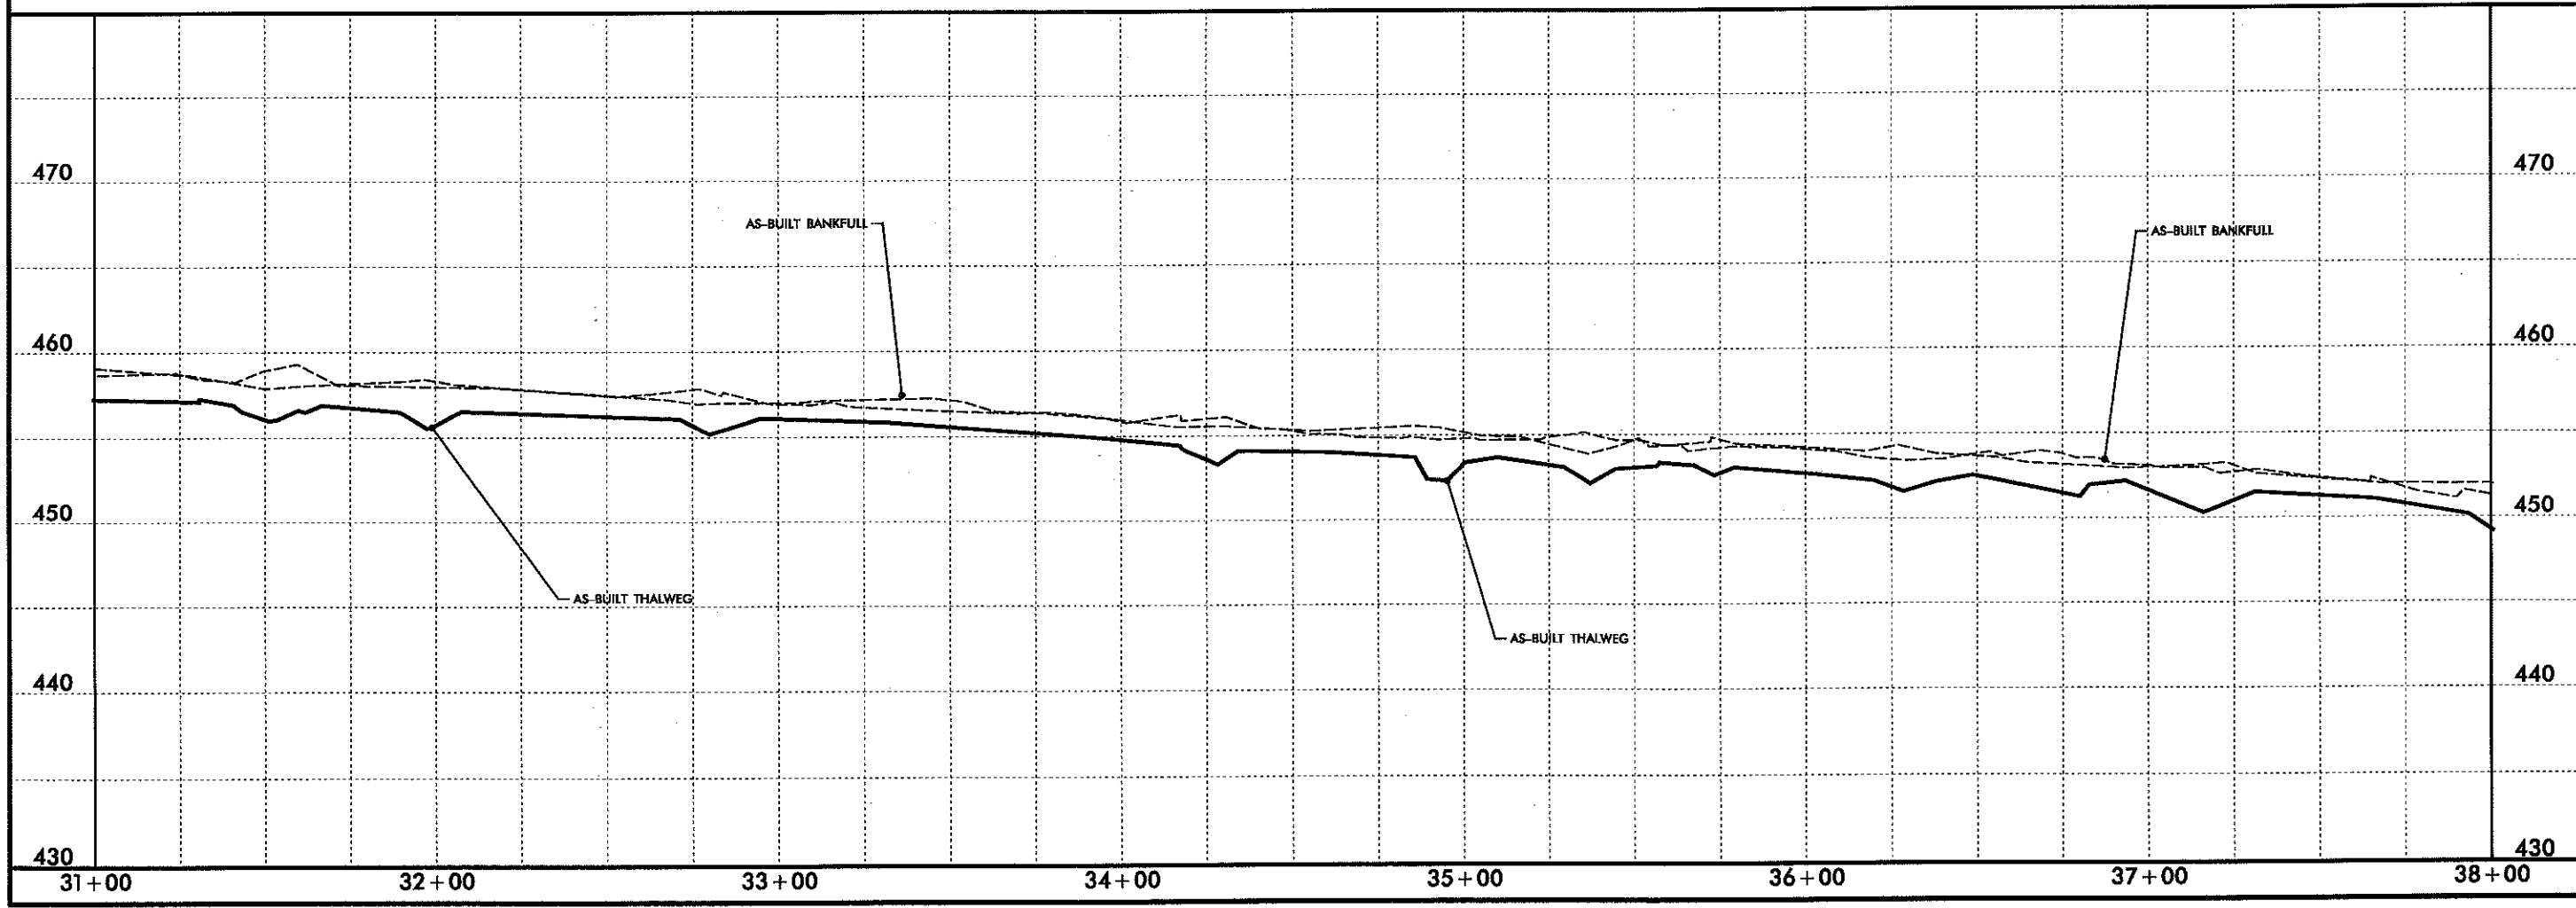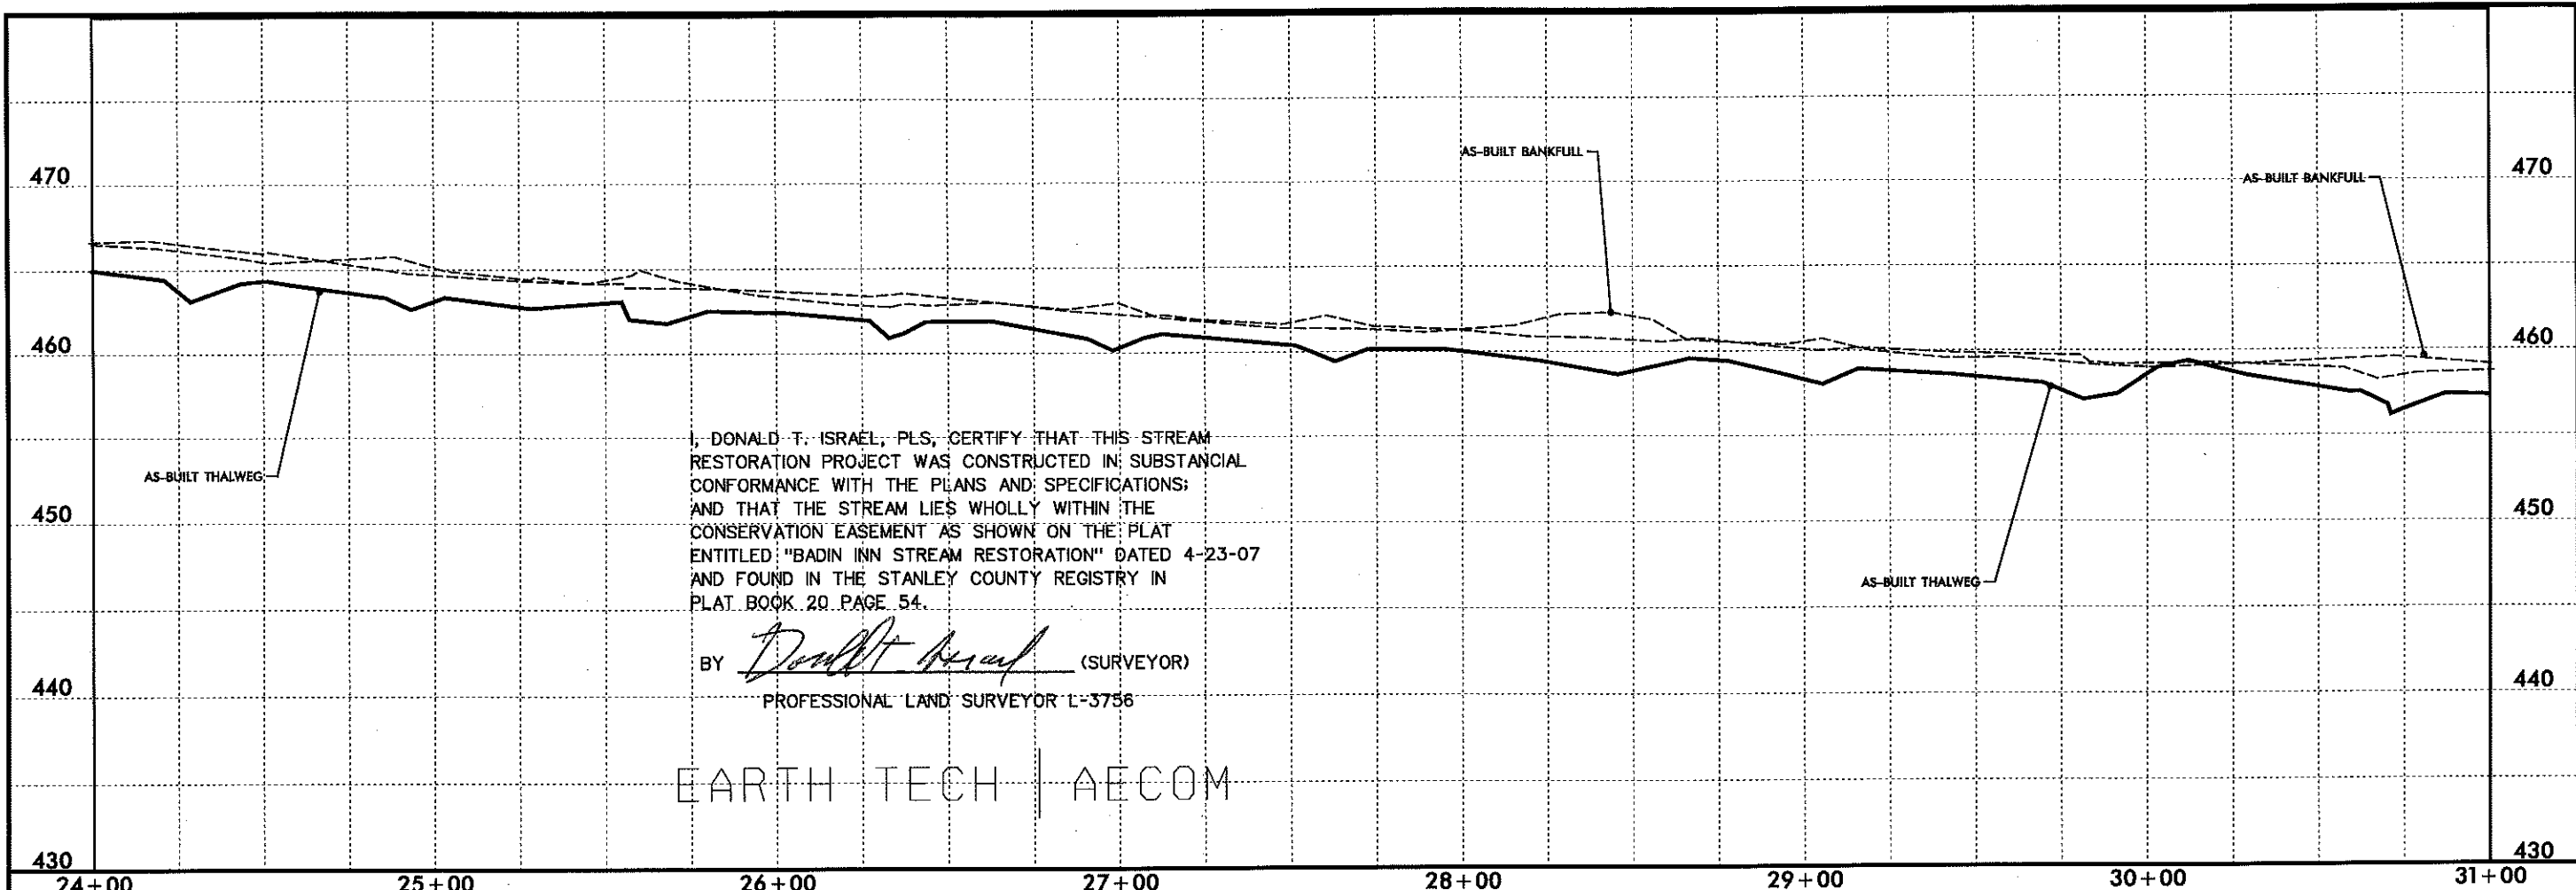



NO	REVISIONS	DRN	CHK	DATE
1				
2				
3				

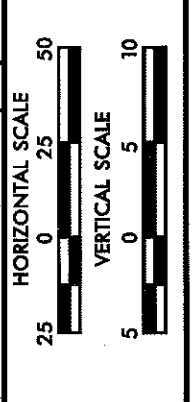

BADIN INN STREAM RESTORATION
 AS-BUILT CHANNEL PROFILE
 EARTH TECH | AECOM
 701 CORPORATE CENTER DRIVE, SUITE 415, RALEIGH, NC 27607
 919-954-8200 919-954-8255 (fax)

DATE	8/18/2009
PROJECT NO	99255
FILENAME	
SHEET NO	C-42
DRAWN BY	ABW
CHKD BY	BMD


USER: WILSONAB DATE: 8/18/2009
 DGN: C:\99255\cadd\as-built\Files\AS-BUILT_Plansheet\99255_ASBUILT_2002.dwg

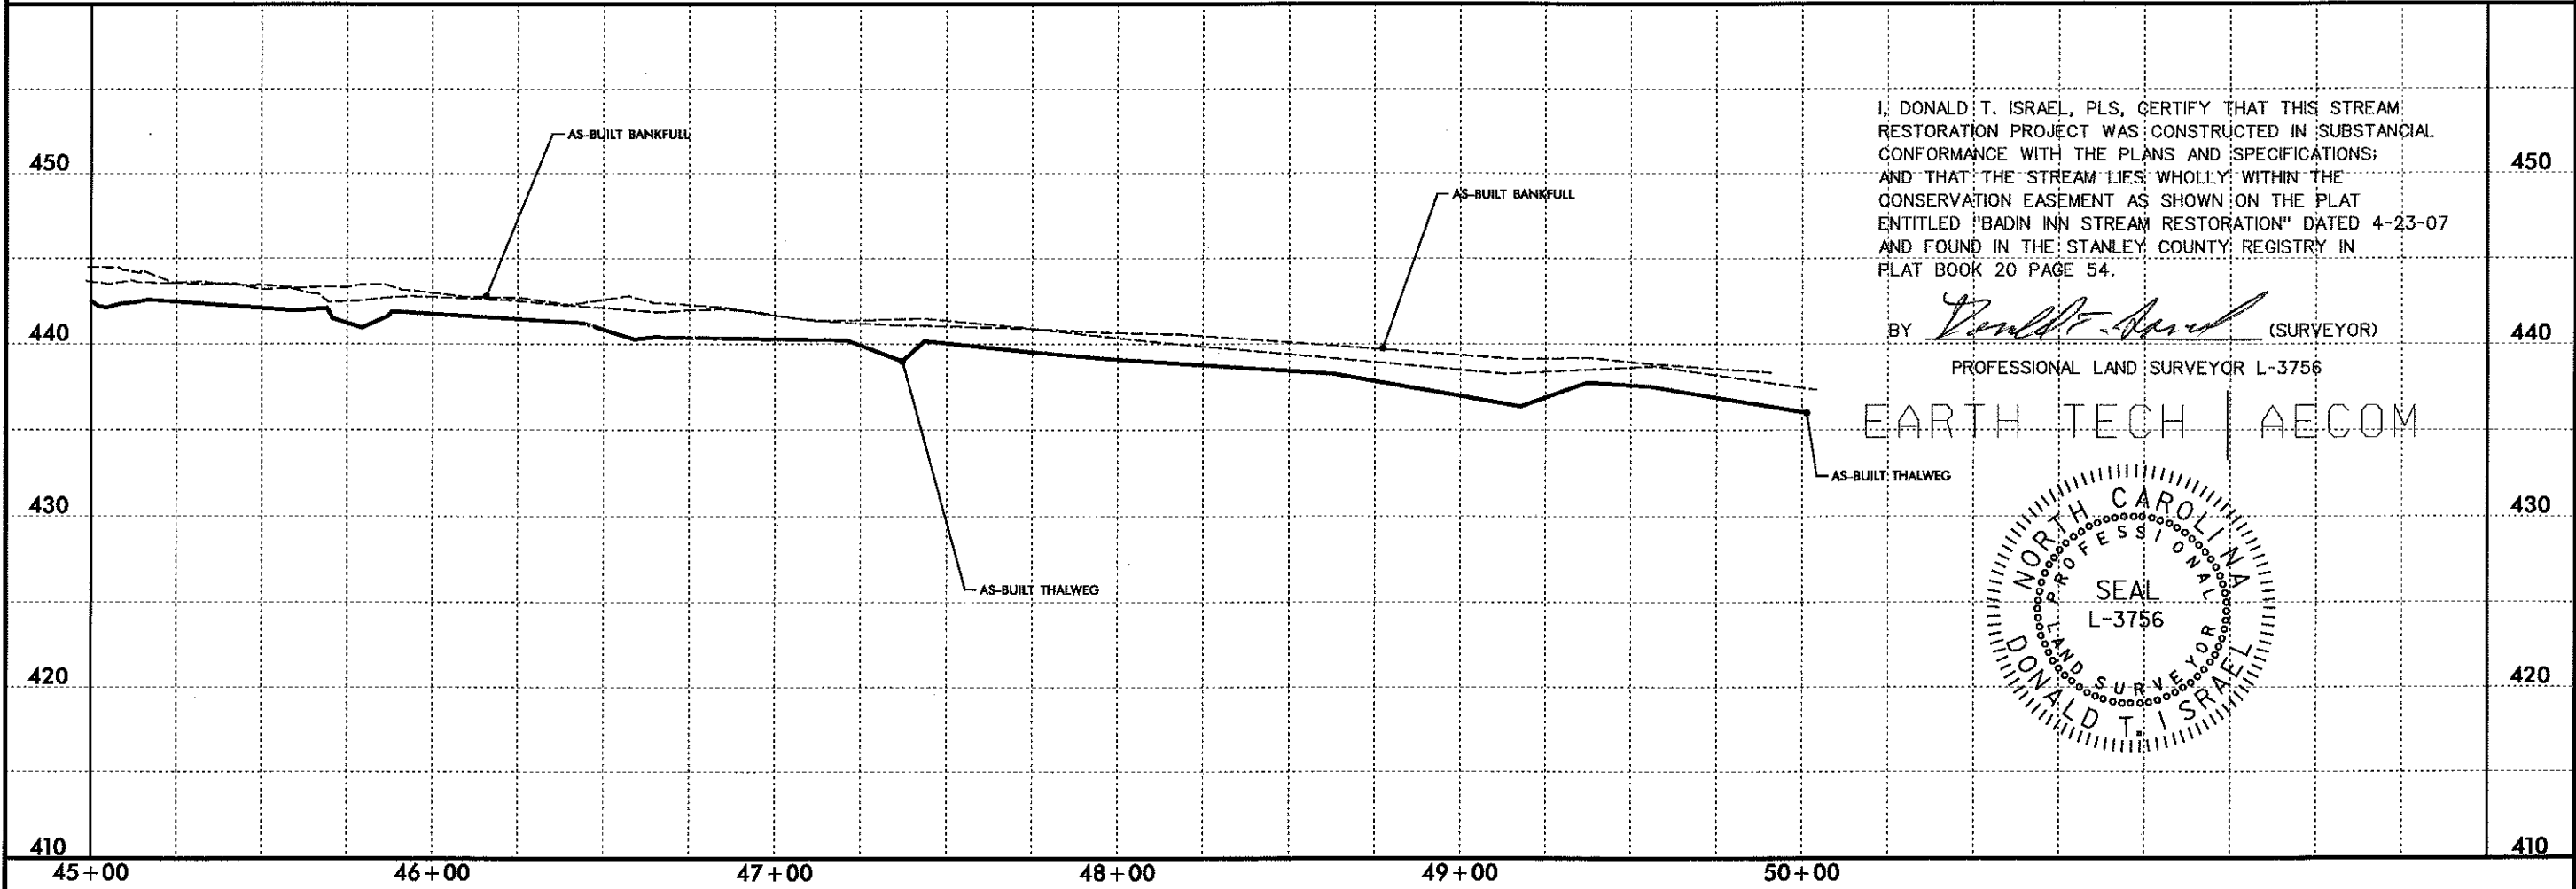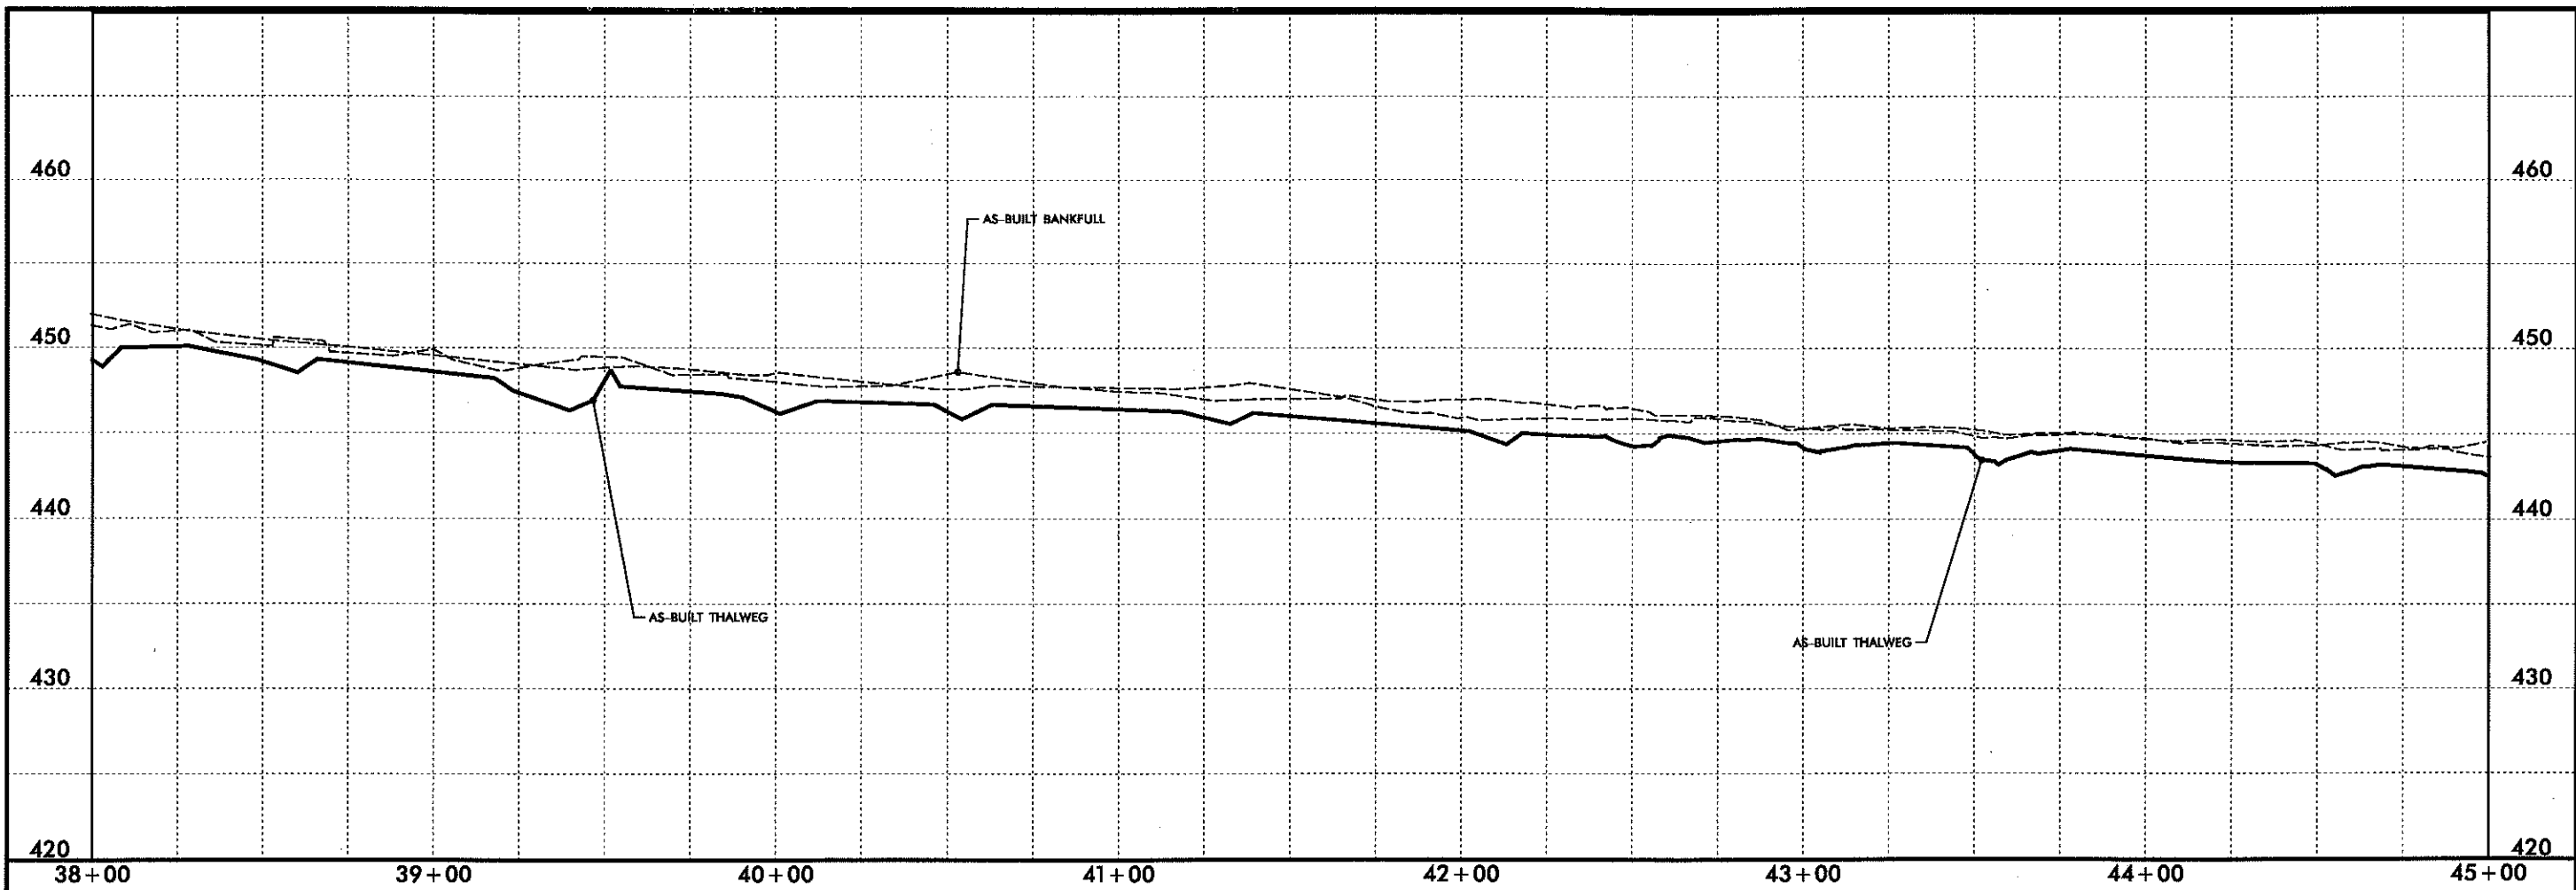

I, DONALD T. ISRAEL, PLS, CERTIFY THAT THIS STREAM RESTORATION PROJECT WAS CONSTRUCTED IN SUBSTANTIAL CONFORMANCE WITH THE PLANS AND SPECIFICATIONS; AND THAT THE STREAM LIES WHOLLY WITHIN THE CONSERVATION EASEMENT AS SHOWN ON THE PLAT ENTITLED "BADIN INN STREAM RESTORATION" DATED 4-23-07 AND FOUND IN THE STANLEY COUNTY REGISTRY IN PLAT BOOK 20 PAGE 54.

BY *Donald T. Israel* (SURVEYOR)
 PROFESSIONAL LAND SURVEYOR L-3756

EARTH TECH | AECOM

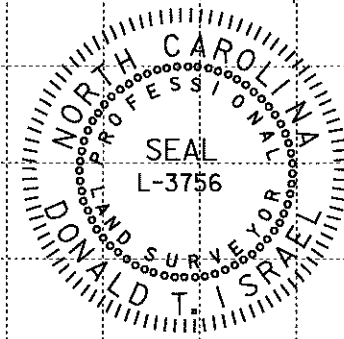


DATE		8/18/2009	
PROJECT NO		99255	
FILENAME			
SHEET NO		C-43	
DRAWN BY	CHKD BY		
ABW	BMD		

HORIZONTAL SCALE		VERTICAL SCALE	
25	50	5	10

BADIN INN STREAM RESTORATION		AS-BUILT CHANNEL PROFILE	
AS-BUILT CHANNEL PROFILE		EARTH TECH AECOM	
TO: CORPORATE CENTER DRIVE, SUITE 415, RALEIGH, NC 27607		919-854-6200 919-854-6225 (fax)	

NO	REVISIONS	DRN	CHK	DATE
1				
2				
3				


USER: WILSONAB DATE: 8/18/2009
 2011 G:\9255\card\as-Built Files\AS-Built Plans\9255_ASBuilt\20110818\9255-44_Prf\11.dgn

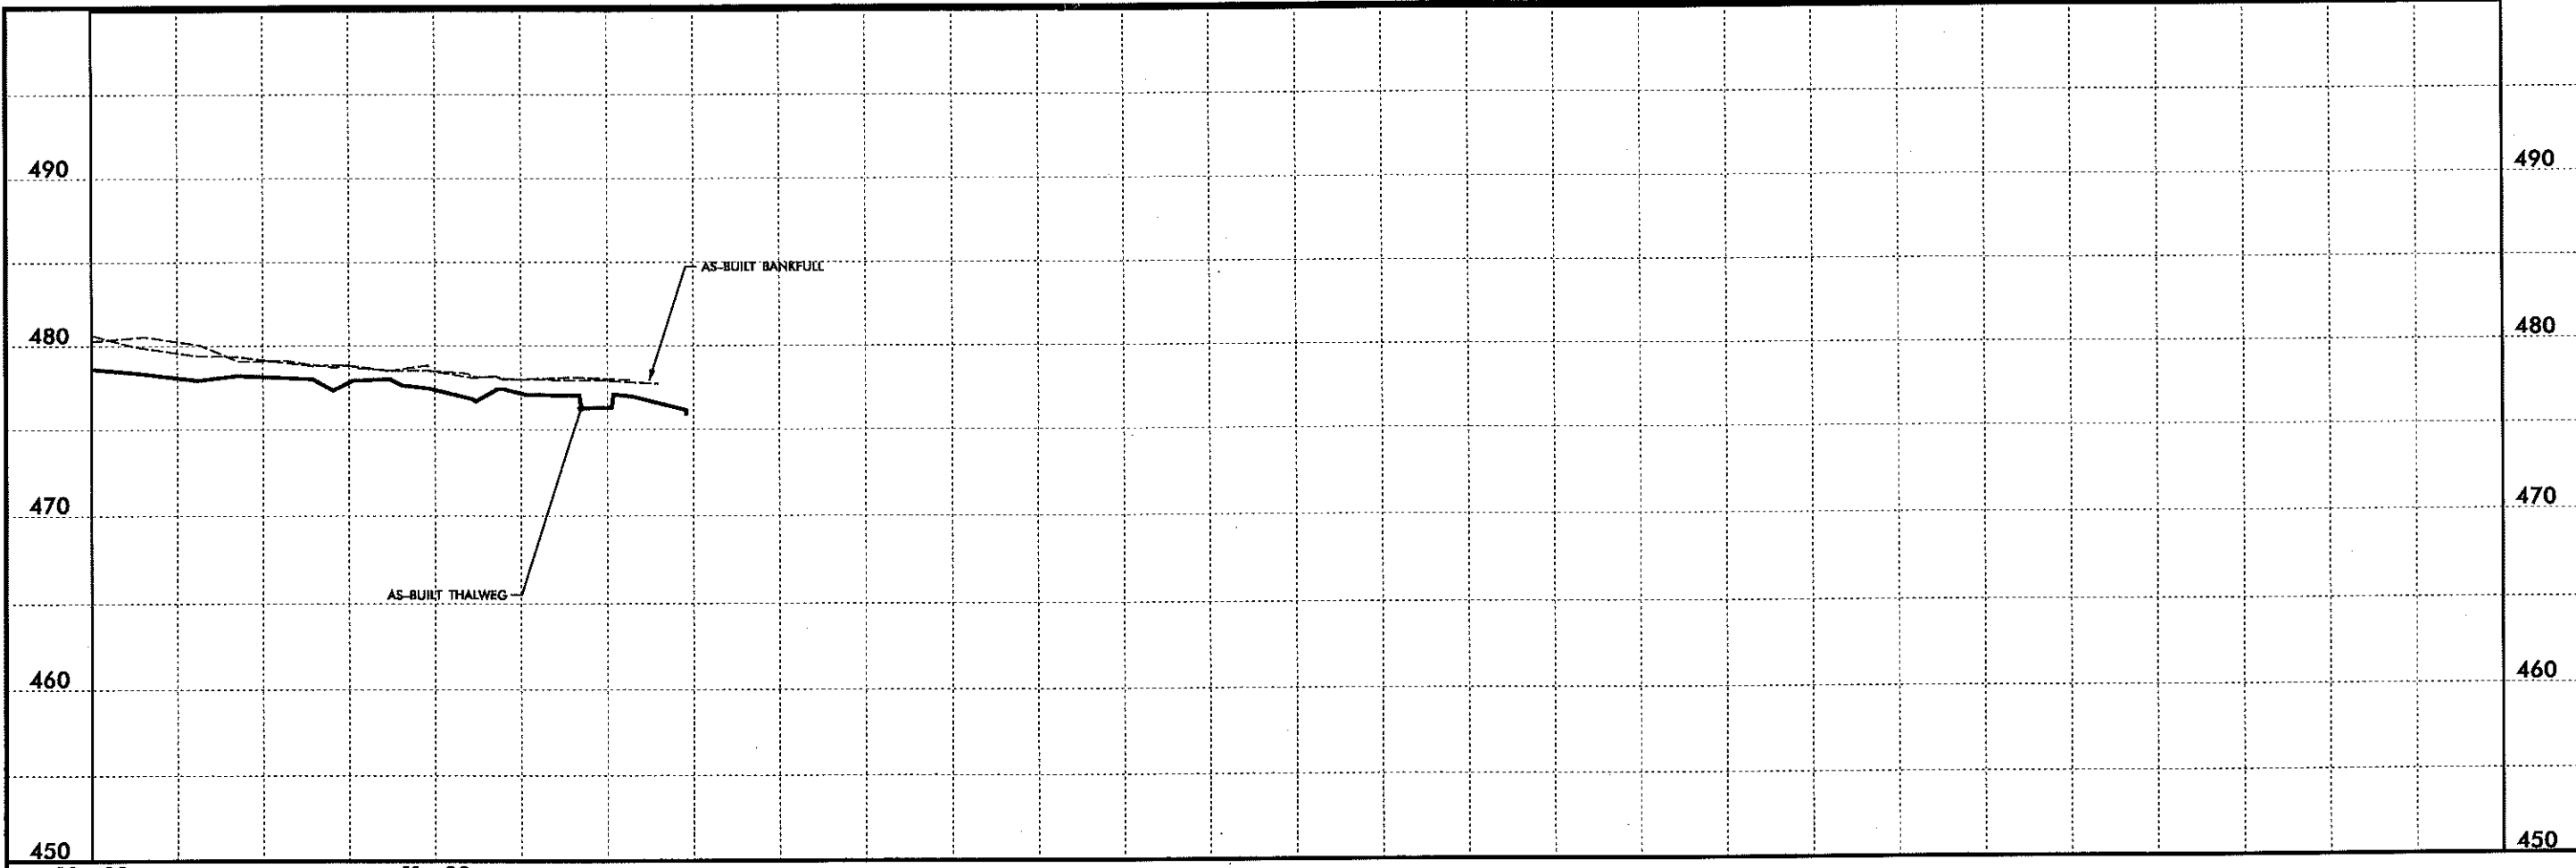


I, DONALD T. ISRAEL, PLS, CERTIFY THAT THIS STREAM RESTORATION PROJECT WAS CONSTRUCTED IN SUBSTANTIAL CONFORMANCE WITH THE PLANS AND SPECIFICATIONS; AND THAT THE STREAM LIES WHOLLY WITHIN THE CONSERVATION EASEMENT AS SHOWN ON THE PLAT ENTITLED "BADIN INN STREAM RESTORATION" DATED 4-23-07 AND FOUND IN THE STANLEY COUNTY REGISTRY IN PLAT BOOK 20 PAGE 54.

BY: *Donald T. Israel* (SURVEYOR)
 PROFESSIONAL LAND SURVEYOR L-3756

EARTH TECH | AECOM

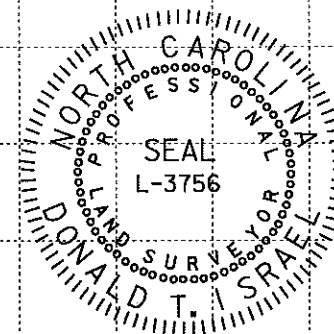

NO	REVISIONS	DRN	CHK	DATE
1				
2				
3				

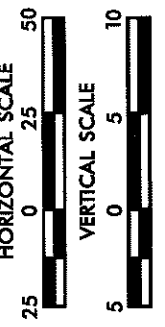

BADIN INN STREAM RESTORATION
 AS-BUILT CHANNEL PROFILE
 EARTH TECH | AECOM
TO: CORPORATE CENTER DRIVE, SUITE 475, RALEIGH, NC 27607
 919-854-6000 919-854-6258 (fax)

DATE	8/18/2009
PROJECT NO	99255
FILENAME	
SHEET NO	C-44
DRAWN BY	ABW
CHKD BY	BWD