

**BEAVERDAM CREEK  
STREAM RESTORATION PROJECT**  
ANNUAL MONITORING REPORT FOR 2006-2007 (YEAR 1)

**Project Number: D05016-1**

---



Submitted to:

NC Ecosystem Enhancement Program  
2728 Capital Blvd, Suite 1H 103  
Raleigh, NC 27604



December, 2007

Prepared for: River Works, Inc.



8000 Regency Parkway  
Suite 200  
Cary, NC 27511

Prepared by: Baker Engineering



1447 South Tryon St., Ste. 200  
Charlotte, NC 28203

# TABLE OF CONTENTS

## TITLE PAGE

<b>TABLE OF CONTENTS</b> .....	<b>i</b>
<b>EXECUTIVE SUMMARY</b> .....	<b>1</b>
<b>1.0 PROJECT BACKGROUND</b> .....	<b>2</b>
1.1 Project Location .....	2
1.2 Mitigation Goals and Objectives.....	2
1.3 Project Description and Restoration Approach.....	2
1.4 Project History and Background .....	4
1.5 Project Plan .....	8
<b>2.0 VEGETATION MONITORING</b> .....	<b>8</b>
2.1 Soil Data.....	8
2.2 Description of Species and Monitoring Protocol .....	9
2.3 Vegetation Success Criteria .....	9
2.4 Results of Vegetative Monitoring .....	10
2.5 Vegetation Observations .....	12
2.6 Vegetation Problem Areas .....	12
2.7 Vegetation Photos .....	12
<b>3.0 STREAM MONITORING</b> .....	<b>12</b>
3.1 Description of Stream Monitoring .....	12
3.2 Stream Restoration Success Criteria .....	13
3.3 Bankfull Discharge Monitoring Results.....	13
3.4 Stream Monitoring Data and Photos .....	14
3.5 Stream Stability Assessment .....	14
3.6 Cross-section, Longitudinal Profile, and Bed Material Analysis Monitoring Results...	15
3.7 Areas of Concern.....	15
<b>4.0 HYDROLOGY</b> .....	<b>16</b>
<b>5.0 CONCLUSIONS AND RECOMMENDATIONS</b> .....	<b>17</b>
<b>6.0 WILDLIFE OBSERVATIONS</b> .....	<b>17</b>
<b>7.0 REFERENCES</b> .....	<b>17</b>

## APPENDICES

APPENDIX A – Project Photo Log

APPENDIX B – Stream Monitoring Data

APPENDIX C – As-built Plan Sheets

APPENDIX D – Baseline Stream Summary for Restoration Reaches

APPENDIX E – Morphology and Hydraulic Monitoring Summary – Year 1 Monitoring

## LIST OF TABLES

<b>Table 1.</b>	Project Mitigation Approach
<b>Table 2.</b>	Project Activity and Reporting History
<b>Table 3.</b>	Project Contact Table
<b>Table 4.</b>	Project Background
<b>Table 5.</b>	Soil Data for Project
<b>Table 6.</b>	Tree Species Planted
<b>Table 7.</b>	Year 1 Stem Counts for Each Species Arranged by Plot
<b>Table 8.</b>	Verification of Bankfull Events
<b>Table 9.</b>	Categorical Stream Feature Visual Stability Assessment
<b>Table 10.</b>	Comparison of Historic Rainfall to Observed Rainfall
<b>Table 11.</b>	Hydrologic Monitoring Results for Year 1

## LIST OF FIGURES

<b>Figure 1.</b>	Site Vicinity Map
<b>Figure 2.</b>	Site Topographic Map
<b>Figure 3.</b>	Restoration Summary Map
<b>Figure 4.</b>	Stage Recorder Locations
<b>Figure 5.</b>	Historic Average vs. Observed Rainfall

## **EXECUTIVE SUMMARY**

This Annual Report details the monitoring activities during the 2007 growing season on the Beaverdam Creek Stream Restoration Site ("Site"). Construction of the Site, including planting of trees, was completed in March 2007. In order to document project success, twenty-four vegetation monitoring plots, eighteen permanent cross-sections, 9,576 linear feet (LF) of longitudinal profile survey, one rain gage, and two automated stage recorders were installed and assessed across the restoration Site. The 2007 data represents results from the first year of vegetation and hydrologic monitoring for streams.

Prior to restoration, stream and buffer functions on the Site were historically impaired as a result of heavy land timbering and subsequently farmed aggressively. Recently some areas have been reforested within the project site, but it has continued to be actively farmed and grazed or converted to medium density residential developments. After construction was finalized the project restored or enhanced 13,203 linear feet (LF) of channelized stream on two unnamed tributaries of Beaverdam Creek: UT1 and UT2, and preserved an additional 1,641 LF of Beaverdam Creek and 962 LF of UT2 to total 15,806 LF of restored, enhanced, or preserved stream.

Weather station data from the for NRCS National Climate and Water Center (Charlotte WSO AP WETS Station in Mecklenburg County – NC 1690) and the USGS Water Data for North Carolina (USGS 35090308100454 Withers Cove in Mecklenburg County, NC) were used to document precipitation amounts. For the 2007 growing season, March 2007 through October 2007 rainfall was recorded as below normal for greater than 87% of the time.

Twenty-four monitoring plots that are 10 meter by 10 meters or 0.025 of an acre in size were used to assess survivability of the woody vegetation planted on Site. They are randomly located to represent the different zones within the project. The vegetation monitoring indicated a survivability range of 440 stems per acre to 1000 stems per acre with an overall average of 572 stems per acre. Overall, the Site is on track for meeting the initial vegetation survival criteria of 320 stems per acre surviving after the third growing season and the final success criteria of 260 trees per acre by the end of year five.

In general, dimension, pattern, profile and in-stream structures remained stable during the first growing season. Minor bed scour was noted in a few isolated areas along UT1. These areas are the result of the large storm event that occurred shortly after construction was completed. One bankfull event was documented during the month of February.

## **1.0 PROJECT BACKGROUND**

The Beaverdam Creek site is located within the extraterritorial jurisdiction (ETJ) of the City of Charlotte, Mecklenburg County, and lies within the Catawba River Basin (Figure 1). The site lies within North Carolina Department of Water Quality (NCDWQ) sub-basin 03-08-34 and U.S. Geologic Survey (USGS) hydrologic unit 03050101170040. The recent land use of the site consists of agriculture and medium density residential development.

The project involved the restoration, enhancement, and preservation of 15,806 LF of stream along Beaverdam Creek (the mainstem) and two unnamed tributaries (UT 1 and UT2).

### **1.1 Project Location**

The Beaverdam Creek site is located approximately 3 miles southwest of the Charlotte-Douglas International Airport. The site extends from the newly constructed Interstate 485 corridor to Brown's Cove of Lake Wylie, an impounded reservoir on the Catawba River. The site can be accessed from Dixie River Road (UT1 to the north and UT2 to the south) 1.5 miles northeast of the intersection with Steele Creek Road. See Figures 1 and 2 for an overview of the project site.

### **1.2 Mitigation Goals and Objectives**

The specific goals for the Beaverdam Creek Restoration Project were as follows:

- Preserve/Restore/Enhance 15,806 LF of stream channel.
- Create geomorphically stable stream channel and floodplain conditions along UT1, UT2 and their associated tributaries within the Beaverdam Creek watershed.
- Improve the local hydrology through increased groundwater recharge, groundwater storage, and hydrologic connectivity between the channel and the adjacent floodplain.
- Improve water quality in the Beaverdam Creek watershed by increasing dissolved oxygen concentrations and reducing nutrient and sediment loads.
- Improve aquatic and riparian terrestrial habitat through improved hydraulic and biologic diversity.



### **1.3 Project Description and Restoration Approach**

For analysis and design purposes, Beaverdam Creek and the two unnamed tributaries (UT1 and UT2) were subdivided into 15 individual reaches based on their hydrologic and geomorphic characteristics. The mainstem of Beaverdam Creek consists of only 1 of the 15 design reaches, where only preservation and no restoration activities were proposed. The remaining 14 reaches exist within UT1 (8 reaches) and UT2 (6 reaches). Among these 14 reaches, 12 were scheduled for restoration, the upstream reach of UT1 was scheduled for enhancement and the downstream reach of UT2 was scheduled for preservation. All reach locations are shown in Figure 3. The following describes the site's preconstruction conditions.

The project constraints on UT1 began at I-485 flowing from the northeast direction. UT1 was divided into 5 reaches starting in the upstream with Reach 1 and continuing downstream to Reach 5 and changing designation at tributary confluences or at significant grade breaks. The three tributary confluences were included within the design parameters on UT1 and were identified as UT1B, UT1C, and UT1D from the upstream confluence and continuing downstream.

UT2 watershed abuts the UT1 watershed to the south, is bordered by Dixie River Road, and is generally flows in the southwest direction. The mainstem of UT2 was divided into four reaches starting upstream at Reach 1 and continuing downstream to Reach 4. One tributary confluence, UT2A, was included within the design parameters of UT2. Reach UT2A, upstream of station 10+00, consisted only of a non-

The site can be accessed from Dixie River Road (UT1 to the north and UT2 to the south) 1.5 miles northeast of the intersection with Steele Creek Road.

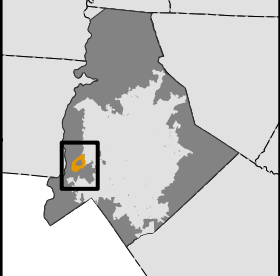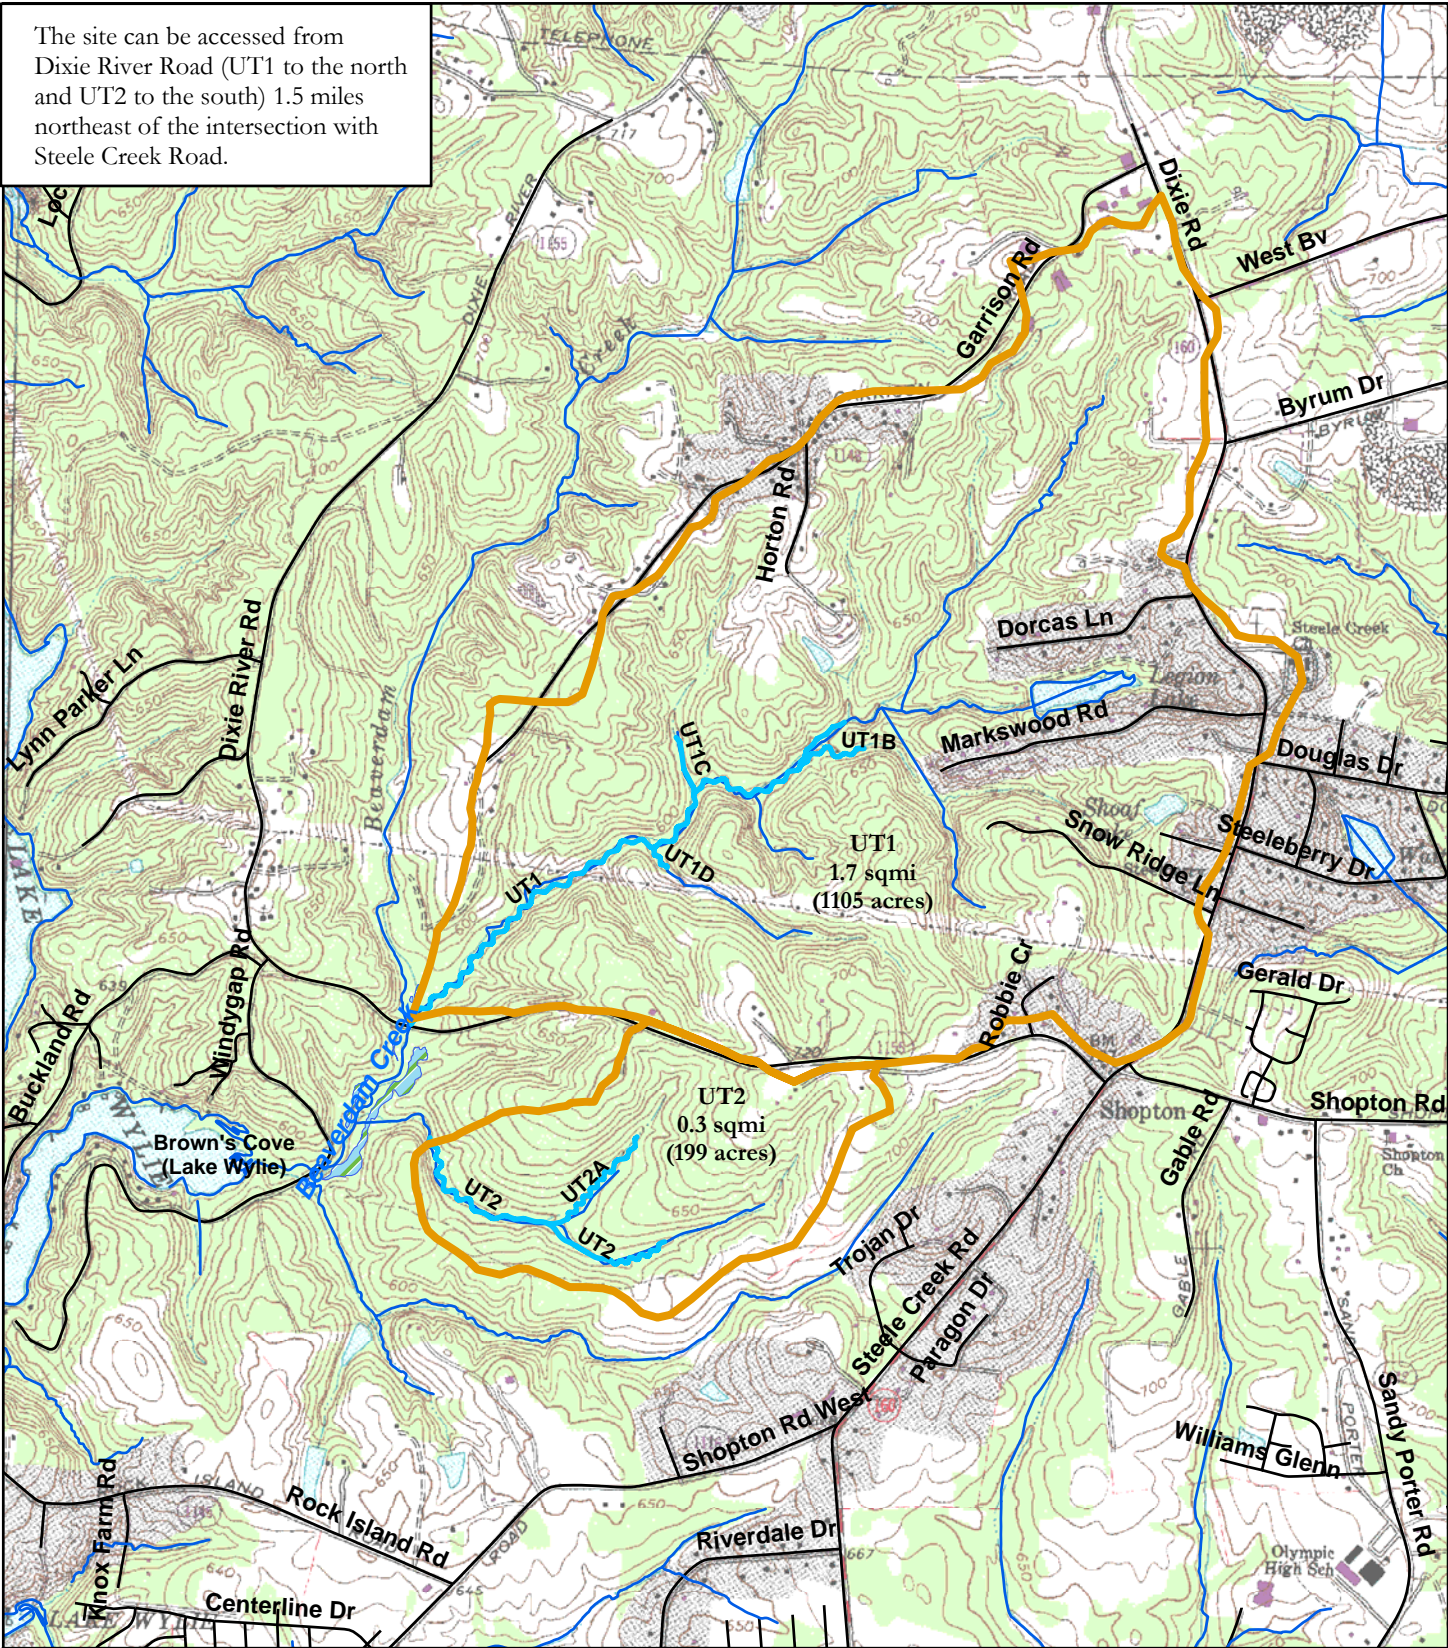

**LEGEND**

- Project Watershed Boundary
- Project Reaches
- Creeks
- Roads



December 2007


EEP Contract No.: D05016-1



**Figure 2: Site Topographic Map**

**Beaverdam Creek  
Year 1 Monitoring  
Mecklenburg County, NC**



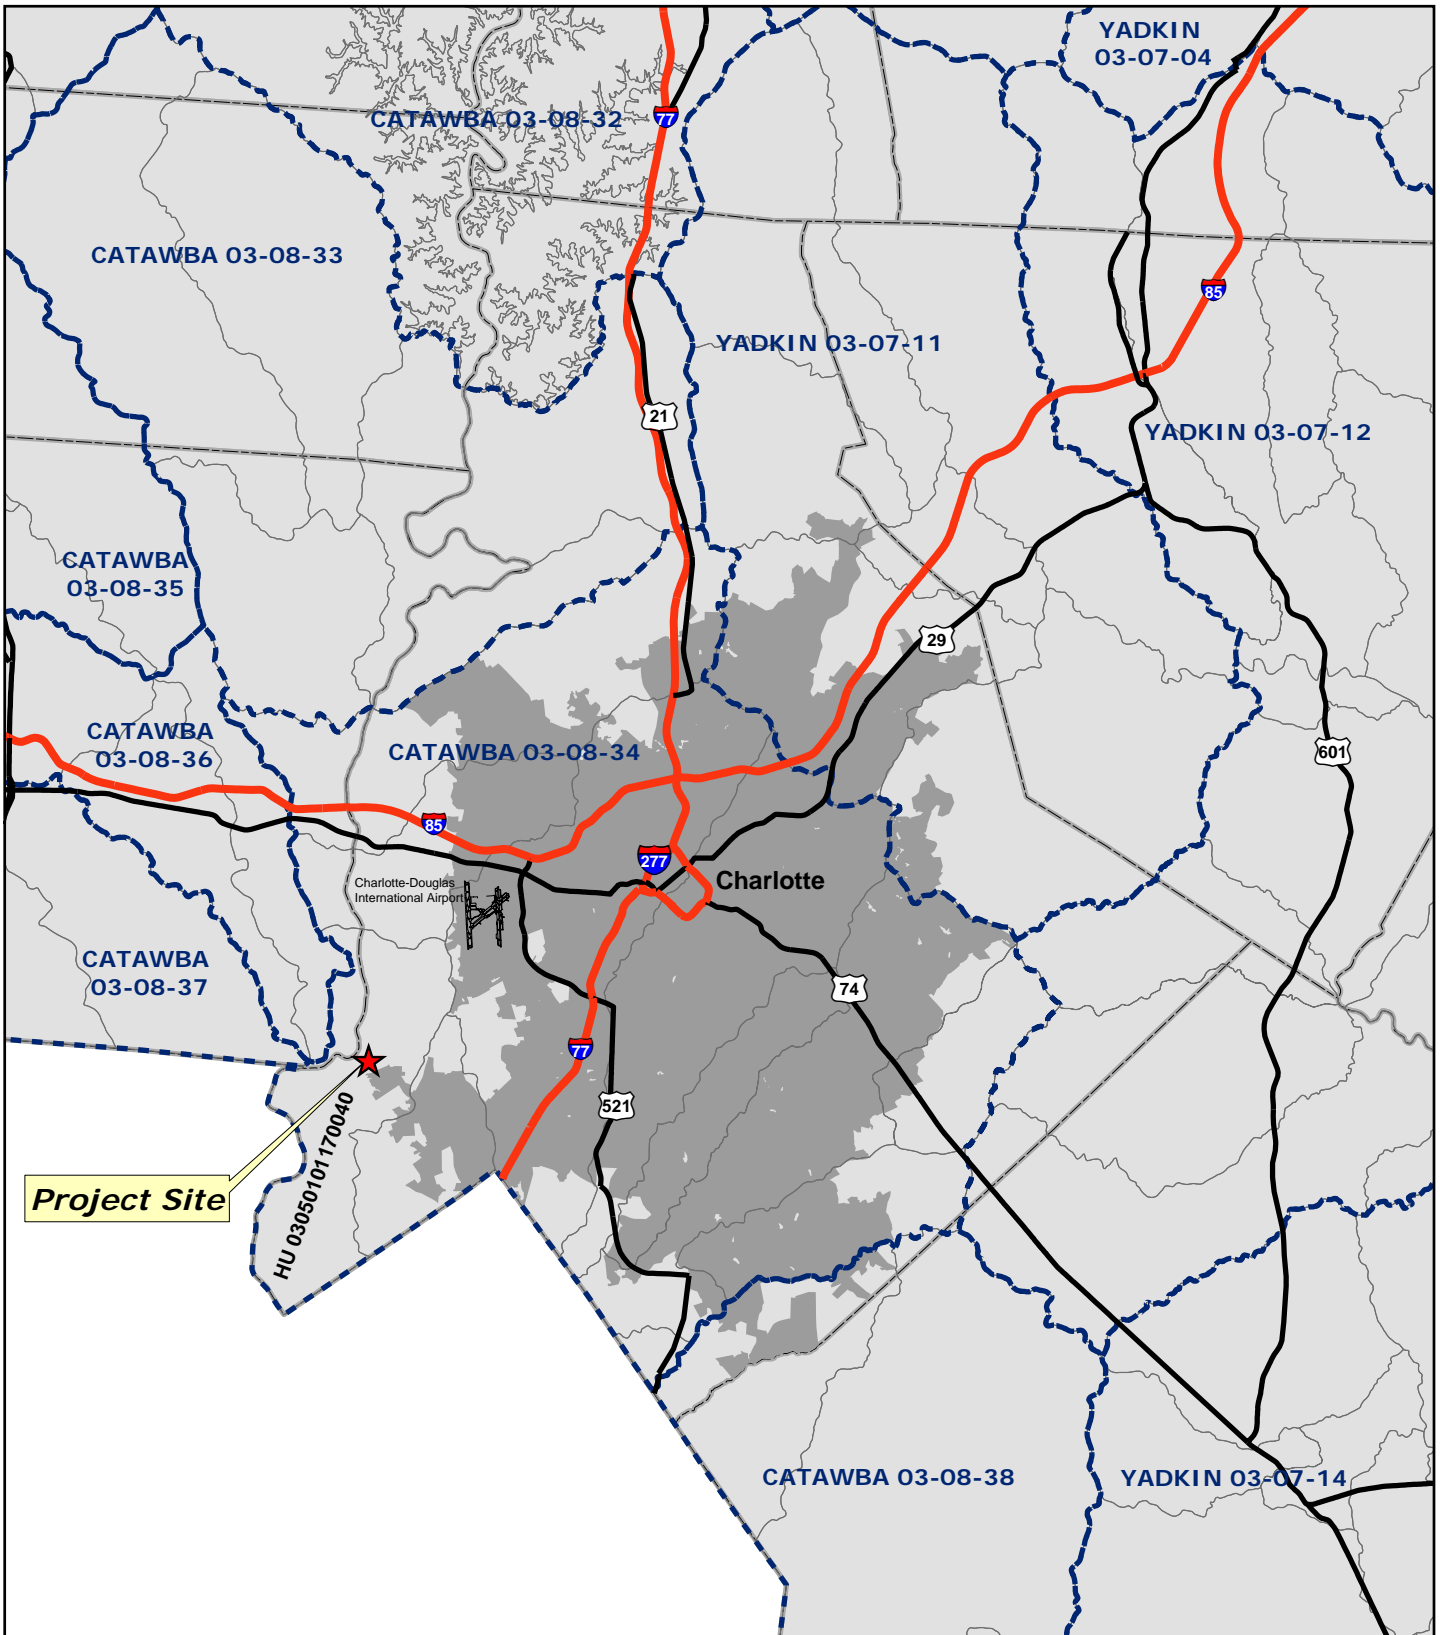

**Project Site**

HU 03050101170040

Charlotte-Douglas International Airport

Charlotte

Map Inset



Mecklenburg County, NC

**LEGEND**

- HUC
- DWQ Sub-basin
- Counties

4 2 0 4 Miles

December 2007



EEP Contract No.: D05016-1



**Figure 1: Project Vicinity Map**

**Beaverdam Creek  
Year 1 Monitoring  
Mecklenburg County, NC**



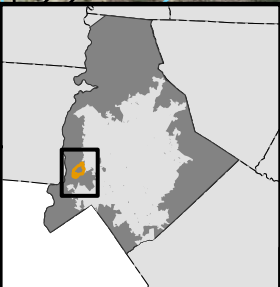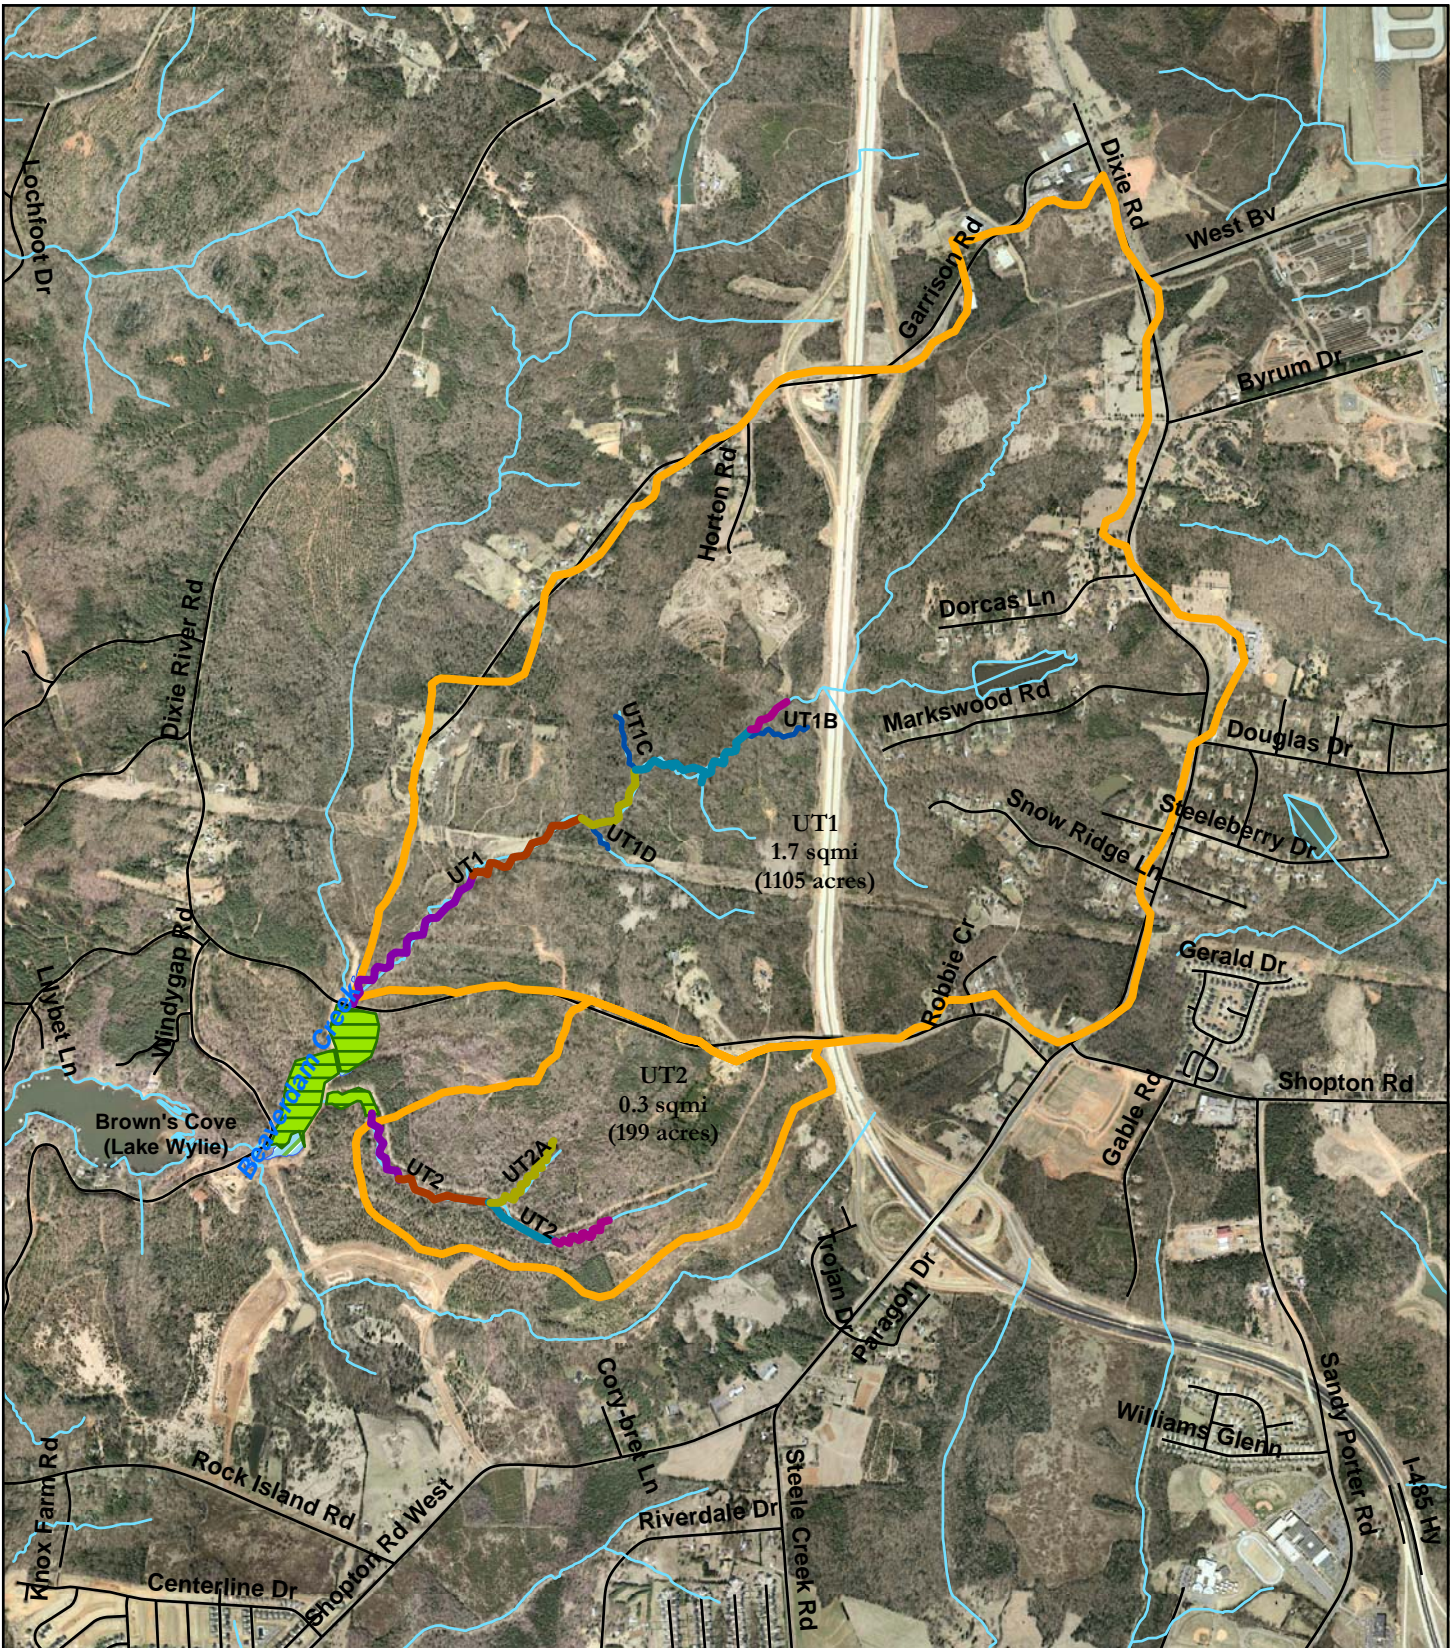

LEGEND

- Project Watershed Boundary
- Preservation Easement
- Creeks
- Roads

0 900 1,800 3,600 Feet

December 2007

EPP Contract No.: D05016-1

**Figure 3: Restoration Summary Map**

Beaverdam Creek  
Year 1 Monitoring  
Mecklenburg County, NC



disturbance area (not for credit). The downstream section of UT2A, from a headcut at station 10+00 to its confluence at the terminus of Reach 2, was 1138 LF with a channel slope of 1.4 percent.

Preservation was proposed for reaches within the project area that were currently in stable, functioning condition and did not warrant restoration. The two reaches proposed for preservation were along the mainstem of Beaverdam and the downstream section of UT2. The reach along the mainstem of Beaverdam Creek proposed for preservation had reach length of 1,641 LF. It began at the confluence with UT1 and extended downstream to the confluence of UT2. The reach along the mainstem of UT2 proposed for preservation had a length of 962 LF. It began immediately downstream of UT2 Reach 4 and ended at its confluence with the mainstem of Beaverdam Creek.

Throughout most of UT1, the restoration approach identified the existing evolutionary process and established a naturally successional stable C/E-type stream channel. Additionally, soil bioengineering, structural reinforcement, and revetments were applied to promote stability immediately following construction when the stream was most vulnerable. Given the wide floodplain, relatively flat slopes, generally stable nature of the soil, and favorable growing conditions at the site, this restoration approach was an achievable goal. Removal of the majority of invasive species and planting of native vegetative species throughout the existing riparian buffer complemented the channel restoration and promoted climax successional habitat.

Similar to UT1, the restoration approach throughout UT2 entailed establishing a successional C/E-type stream channel while maintaining the ability to accommodate subsequent natural channel evolution towards an E-type channel, as warranted by future influences to the discharge and sediment regime. This was accomplished through application of a Priority 1 design throughout with short segments of Priority 2 design to tie into the incised channels.

**Table 1. Project Mitigation Approach**

Beaverdam Creek Restoration Site: Project No. D05016-1								
Project Segment or Reach ID	Existing Footage/Acreage	Mitigation Type *	Approach**	Linear Footage or Acreage	Mitigation Ratio	Mitigation Units	Stationing	Comment
UT1 (Reach 1)	542	E	EI	567	1.5:1	378	10+00 - 15+67	Low slope, minimal meander and floodplain benching.
UT1 (Reach 2-5)	5796	R	P1	6,310	1:1	6,310	15+67 - 78+77	The beginning of channel utilizes the existing wide, flat floodplain then narrows through the valley and straightens through the Duke Power easement and connects into the mainstem of Beaverdam through a wide, flat floodplain.
UT1B	743	R	P2	778	1:1	778	10+00 - 17+78	The valley is pinched so floodplain grading will create adequate benching.
UT1C	744	R	P1	624	1:1	624	10+00 - 16+24	Step-pool design dominated by log drops. The valley is narrow resulting minimal meander.
UT1D	323	R	P1	338	1:1	338	10+00 - 13+38	The channel will have the appropriate belt width throughout the ample floodplain. A series of drop structures at the end of the reach will tie into UT1.
UT2	3130	R	P1	3,448	1:1	3,448	10+00 - 44+48	Increase sinuosity, pool development, and reestablish connection with the floodplain and construct in channel step-pools in areas where the valley is confined and steep.
UT2A	886	R	P1	1,138	1:1	1,138	10+00 - 21+38	A step-pool channel will be constructed in the areas where the valley is confined and steep. Transition connections constructed between the constructed channel and the existing channels.
Beaverdam Creek	1641	P	---	1,641	1:5	328	-	
UT2	962	P	---	962	1:5	192	-	
<b>Total linear ft of channel restored or</b>				15,806				
<b>Mitigation Unit Summation for Streams:</b>				13,534				

\* R = Restoration  
 E = Enhancement  
 P = Preservation

\*\* P1 = Priority I  
 P2 = Priority II  
 P3 = Priority III  
 EI = Enhancement I

## 1.4 Project History and Background

The chronology of the Beaverdam Creek Restoration Project is presented in Table 2. The contact information for all designers, contractors, and relevant suppliers is presented in Table 3. Relevant project background information is presented in Table 4.

**Table 2. Project Activity and Reporting History**

<b>Beaverdam Creek Restoration Site: Project No. D05016-1</b>			
<b>Activity or Report</b>	<b>Scheduled Completion</b>	<b>Data Collection Complete</b>	<b>Actual Completion or Delivery</b>
Restoration Plan Prepared	Nov-05	N/A	
Restoration Plan Amended	Dec-05	N/A	
Restoration Plan Approved	Dec-05	N/A	
Final Design – (at least 90% complete)	Dec-05	N/A	
Construction Begins	May-06	N/A	Jun-06
Temporary S&E mix applied to entire project area	N/A	N/A	Jan-07
Permanent seed mix applied to entire project area	Mar-06	N/A	Jan-07
Planting of live stakes	Nov-06	N/A	Jan-07
Planting of bare root trees	Nov-06	N/A	Jan-07
Survey of As-built conditions (Year 0 Monitoring-baseline)	Jan-07	Mar-07	Apr-07
Repair work			
Year 1 Monitoring	Dec-07	Nov-07	Dec-07
Year 2 Monitoring	Dec-08	Unknown	Unknown
Year 3 Monitoring	Dec-09	Unknown	Unknown
Year 4 Monitoring	Dec-10	Unknown	Unknown
Year 5 Monitoring	Dec-11	Unknown	Unknown

**Table 3. Project Contact**

<b>Beaverdam Creek Restoration Site: Project No. D05016-1</b>	
<b>Full Service Delivery Contractor</b>	
Riverworks	8000 Regency Parkway, Suite 200 Cary, NC 27518 <u>Contact:</u> Will Pedersen, Tel. 919-459-9001
<b>Designer</b>	
Baker Engineering	8000 Regency Parkway, Suite 200 Cary, NC 27518 <u>Contact:</u> Kevin Tweedy, Tel 919-463-5488

**Table 3. Project Contact**

<b>Beaverdam Creek Restoration Site: Project No. D05016-1</b>	
<b>Construction Contractor</b>	
Riverworks	8000 Regency Parkway, Suite 200 Cary, NC 27518 <u>Contact:</u> Will Pedersen, Tel. 919-459-9001
<b>Planting Contractor</b>	
Riverworks	8000 Regency Parkway, Suite 200 Cary, NC 27518 <u>Contact:</u> Will Pedersen, Tel. 919-459-9001
<b>Seeding Contractor</b>	
Riverworks	8000 Regency Parkway, Suite 200 Cary, NC 27518 <u>Contact:</u> Will Pedersen, Tel. 919-459-9001
Seed Mix Sources	Mellow Marsh Farm, 919-742-1200
Nursery Stock Suppliers	Mellow Marsh Farm, 919-742-1200 International Paper, 1-888-888-7159
<b>Monitoring Performers</b>	
Baker Engineering	1447 S. Tryon Street, Suite 200 Charlotte, NC 28203
Stream Monitoring Point of Contact:	Ian Eckardt, Tel.704-334-4454
Vegetation Monitoring Point of Contact:	Ian Eckardt, Tel. 704-334-4454

**Table 4. Project Background**

<b>Beaverdam Creek Restoration Site: Project No. D05016-1</b>	
Project County:	Mecklenburg County, NC
Drainage Area:	
UT1 (Reach 1)	0.70 mi <sup>2</sup>
UT1 (Reach 2-5)	1.73 mi <sup>2</sup>
UT1B	0.34 mi <sup>2</sup>
UT1C	0.15mi <sup>2</sup>
UT1D	0.16 mi <sup>2</sup>
UT2	0.3 mi <sup>2</sup>
UT2A	0.1 mi <sup>2</sup>
Estimated Drainage % Impervious Cover:	
UT1 (Reach 1)	15%
UT1 (Reach 2-5)	12%
UT1B	10%
UT1C	5%
UT1D	21%
UT2	4%
UT2A	2%

**Table 4. Project Background Table**

<b>Beaverdam Creek Restoration Site: Project No. D05016-1</b>	
Stream Order:	
UT1 (Reach 1)	1
UT1 (Reach 2-5)	2
UT1B	1
UT1C	1
UT1D	1
UT2	1
UT2A	1
Physiographic Region	Piedmont
Ecoregion	Southern Outer Piedmont
Rosgen Classification of As-Built	
UT1 (Reach 1)	C/E
UT1 (Reach 2-5)	C/E
UT1B	C/E
UT1C	C/E
UT1D	C/E
UT2	C/E
UT2A	C/E
Cowardin Classification	Riverine, Upper Perennial, Unconsolidated Bottom, Cobble-Gravel
Dominant Soil Types	
UT1 (Reach 1)	MO
UT1 (Reach 2-5)	MO, DaD, CeD2, PaE
UT1B	MO
UT1C	MO, PaE, CeD2
UT1D	MO, PaE, CeD2
UT2	MO, CeD2
UT2A	MO
Reference site ID	Spencer Creek, UT to Spencer Creek, McDowell Park, Latta Plantation, McClintock Creek (McNair & Stockwood), UT to Cleghorn, UT to Lake Jeanette, UT to Big Lost Cove
USGS HUC for Project and Reference sites	3050101170040
NCDWQ Sub-basin for Project and Reference	03-08-34
NCDWQ classification for Project and Reference	C
Any portion of any project segment 303d listed?	No
Any portion of any project segment upstream of a 303d listed segment?	No
Reasons for 303d listing or stressor?	N/A
% of project easement fenced	10%

## 1.5 Project Plan

Plans depicting the as-built conditions of the major project elements, location of permanent monitoring cross-sections, and locations of permanent vegetation monitoring plots are presented in Appendix C of this report.

## 2.0 VEGETATION MONITORING

### 2.1 Soil Data

The soil data for the Site is presented in Table 5.

**Table 5. Soil Data for Project**

Beaverdam Creek Restoration Site: Project No. D05016-1					
Series	Max Depth (in)	% Clay on Surface	K	T	OM %
Cecil Sandy Clay Loam (CeD2)	80	20-35	0.28	5	0.5-1
Monacan Loam (MO)	80	7-27	0.43	5	2-3
Davidson sandy clay loam (DaD)	75	20-35	0.28	5	0.5-2
Pacolet sandy loam (PaE)	62	8-20	0.2	5	0.5-2
Pacolet sandy loam (PaF)	62	8-20	0.2	5	0.5-2

NRCS, USDA. Official Soil Series Descriptions (<http://soils.usda.gov/soils/technical/classification/osd/index.html>)

#### General taxonomy of soils:

Cecil: The Cecil series consists of well-drained soils with moderate permeability on and near floodplains. They formed in residuum weathered felsic igneous and metamorphic rock, such as granite. Slopes range from 8 to 15 percent.

Monacan: Soils of the Monacan series are deep, moderately well and somewhat poorly drained with moderate permeability. They formed in recent alluvial sediments of the Piedmont and Coastal Plain. Slopes are commonly less than 2 percent.

Pacolet: The Pacolet series consists of very deep, well drained, moderately permeable soils that formed in material weathered mostly from acid crystalline rocks of the Piedmont uplands. Slopes commonly are 15 to 25 percent but range up to 2 to 60 percent.

Davidson: The Davidson series consists of very deep, well drained moderately permeable soils that formed in materials weathered from dark colored rocks high in ferromagnesian minerals. These soils are on gently sloping to moderately steep uplands in the Piedmont. Slopes are commonly 2 to 15 percent but range up to 25 percent.

## 2.2 Description of Species and Monitoring Protocol

The Site was planted in bottomland hardwood forest species in early – mid March of 2007. There were twenty-four vegetation-monitoring plots established throughout the planting areas. The following tree species were planted in the restoration area:

**Table 6. Tree Species Planted in the Beaverdam Restoration Area**  
**Beaverdam Creek Restoration Site: Project No. D05016-1**

<b>ID</b>	<b>Scientific Name</b>	<b>Common Name</b>	<b>FAC Status</b>
1	<i>Alnus serrulata</i>	Tag Alder	FACW+
2	<i>Asimina triloba</i>	Paw paw	FAC
3	<i>Cercis canadensis</i>	Redbud	FACU
4	<i>Celtis laevigata</i>	Sugarberry	FACW
5	<i>Cephalanthus occidentalis</i>	Buttonbush	OBL
6	<i>Cornus amomum</i>	Silky Dogwood	FACW+
7	<i>Cornus florida</i>	Flowering Dogwood	FACU
8	<i>Diospyros virginiana</i>	Persimmon	FAC
9	<i>Fraxinus pennsylvanica</i>	Green Ash	FACW
10	<i>Juglan nigra</i>	Black Walnut	FACU
11	<i>Liriodendron tulipifera</i>	Tulip poplar	FACW
12	<i>Platanus occidentalis</i>	Sycamore	FACW-
13	<i>Nyssa sylvatica</i>	Blackgum	FAC
14	<i>Quercus michauxii</i>	Swamp chestnut oak	FACW-
15	<i>Quercus phellos</i>	Willow oak	FACW-
16	<i>Quercus rubra</i>	Red oak	FACU
17	<i>Sambucus candensis</i>	Elderberry	FACW-
18	<i>Viburnum dentatum</i>	Arrow-wood viburnum	FAC

(Radford, et al., 1968 and Resource Management Group, Inc., 1999)

The following monitoring protocol was designed to predict vegetative survivability. Twenty-four plots were established throughout the Beaverdam Creek Site. The number of sites was based on the species/area curve method and their location was based on EEP monitoring guidance. The size of individual quadrants was 100 square meters for woody tree species, 25 square meters for shrubs, and 1 square meter for herbaceous vegetation. The locations of the vegetation plots are shown on the as-built plan sheets in Appendix C.

Individual quadrant data provided includes density and coverage quantities. Relative values were calculated, and importance values were determined. Individual seedlings were marked to ensure that they can be found in succeeding monitoring years. Mortality was determined from the difference between the previous year's living, planted seedlings and the current year's living, planted seedlings.

## 2.3 Vegetation Success Criteria

The interim measure of vegetative success for the Site will be the survival of at least 320 3-year old planted trees per acre at the end of year three of the monitoring period. The final vegetative success

criteria will be the survival of 260 5-year old planted trees per acre at the end of year five of the monitoring period.

## 2.4 Results of Vegetative Monitoring

The following tables present stem counts for each of the monitoring plots. Each planted tree species is identified down the left column, and each plot is identified across the top row. The numbers on the top row correlate to the ID column of the table. Trees are flagged in the field on an as-needed basis before the flags degrade. Flags are utilized, because they will not interfere with the growth of the tree. Volunteer species are also flagged during this process.

During the initial counts of species totals during the as-built monitoring report, some tree species were unidentifiable (no buds or leaves) and documented as *Unknown Quercus* in the stem plot counts or were labeled incorrectly. During Year 1 vegetative monitoring, three of the four *Unknown Quercus* have been identified as *Quercus michauxii* and updated in the Year 1 vegetative totals in Table 7. In addition, tree species that were labeled incorrectly have been updated and coded within Table 7 to represent the correction.

The average stem count per acre for Year 1 Monitoring was 572. The range of stem counts throughout the 24 vegetative monitoring plots was from 440 – 1000. The current survivability rate for Year 1 is 91.5%. The data reflects that the overall site is on trajectory for meeting the minimum success interim criteria of 320 trees per acre by the end of year three and the final success criteria of 260 trees per acre by the end of year five.

No volunteer species were noted in any of the Site's vegetation plots, or were too small to verify. If any woody volunteer species are observed in subsequent monitoring years they will be flagged and added to the overall stems per acre assessment of the Site.



**Table 7. Year 1 Stem Counts for Each Species Arranged by Plot**

Beaverdam Creek Restoration Site : Project No. D05016-1																													
Tree Species	Plots																										Initial Totals	Year 1 Totals	% Survival
	UT1																	UT2											
	1	2	3	4	5	6	7	8	9	10	11	12	13	14	15	16	17	1	2	3	4	5	6	7					
<i>Alnus serrulata</i>								2																		2	2	100.0	
<i>Asimina tulloba</i>							4	5		4	4	1														21	18	85.7	
<i>Cercis canadensis</i>								1						1		1										3	3	100.0	
<i>Celtis laevigata</i>	1												2													6	3	50.0	
<i>Cephalanthus occidentalis</i>								1																		1	1	100.0	
<i>Cornus amomum</i>																										1	0	0.0	
<i>Cornus florida</i>					1												2									2	3	150.0	
<i>Diospyros virginiana</i>		1													1								1			3	3	100.0	
<i>Fraxinus pennsylvanica</i>	4			4	7	1	6	1			1	3	3	3	6	5		3	13			2	8	5	1	77	76	98.7	
<i>Juglan nigra</i>	1	2	1	1		4	1	2		8	1	3	2			1						1				31	28	90.3	
<i>Liriodendron tulipiferra</i>	1		1	1	1	1	3			2		4		2	1	1	2	3			1	2	1		2	36	29	80.6	
<i>Platanus occidentalis</i>		2		2	4	5	2	7		3				1		1	1	2			7	7		1	1	54	46	85.2	
<i>Nyssa sylvatica</i>	4	1	2	4		1		1			1	7		3	3	5	3			3	2		8	2		55	50	90.9	
<i>Quercus michauxii</i>	1	4	7	2			2	7			1	2	3	3	2	1	4	5			3	7	2	1		55	57	103.6	
<i>Quercus phellos</i>	1	1	2	1	1		1	3		1	4		1			3		1								20	20	100.0	
<i>Quercus rubra</i>														1												1	1	100.0	
<i>Sambucus candensis</i>																										1	0	0.0	
<i>Viburnum dentatum</i>									2																	2	2	100.0	
<i>Unknown Quercus</i>													1													4	1	25.0	
<b>Stems/plot</b>	13	11	13	15	14	12	15	25	11	14	11	17	18	12	14	15	15	17	13	11	16	17	17	7	375	343	91.5		
<b>Stems/acre</b>	520	440	520	600	560	480	600	1000	440	560	440	680	720	480	560	600	600	680	520	440	640	680	680	280	<b>572</b>	<b>average</b>			

- Tree # 3-7 was mislabeled as *Platanus occidentalis* in As-built Initial Counts
- Tree # 3-16 was mislabeled as *Liriodendron tulipifera* in As-built Initial Counts
- Tree # 7-10 was mislabeled as *Asimina tulloba* in As-built Initial Counts
- Tree # 7-2, -3, -4 were mislabeled as *Fraxinus pennsylvanica* in As-built Initial Counts
- Tree # 14-5, -8, -10 were mislabeled as unknown in As-built Initial Counts
- Tree # 7-21 was labeled as *Liriodendron tulipifera* in the field but was not added in the As-built Initial Counts

## **2.5 Vegetation Observations**

Just following construction of the site, a 3.5-inch precipitation event occurred and caused minor bank destabilization and required various sections of UT1 to be reseeded. At this time, channel degradation that was caused by the storm event was repaired. During repair of the channel, large equipment accessed the site. Additional live stakes were replanted along the channel where needed for restabilization.

During the Year 1 Monitoring site visit the stream-side vegetation was noted as being successfully reestablished. In addition, the annual herbaceous plant *Bidens frondosa* (*tickseed sunflower*) intended as a nurse crop, to discourage aggressive weeds while the permanent seedlings become established, has been successful throughout the Site (USDA, 2007). See Project ID photos in Appendix A.

## **2.6 Vegetation Problem Areas**

At this time, there seem to be no invasive species problem areas throughout the project site. However, though none seem to be posing any problems, invasive species can very quickly affect the survivability of the planted stems the weedy species should be maintained aggressively to prevent any major mortality issue.

## **2.7 Vegetation Photos**

Photos of the project showing the on-site vegetation are included in Appendix A of this report.

## **3.0 STREAM MONITORING**



### **3.1 Description of Stream Monitoring**

To document the stated success criteria, the following monitoring program was instituted following construction completion on the Beaverdam Creek Restoration Project:

*Bankfull Events:* The occurrence of bankfull events within the monitoring period was documented by the use of two automated stage recorders. The University of North Carolina (UNCC) installed and monitored the readings from both stage recorders. Gauging station BD2 was installed on UT1 and gauging station BD3 was installed on UT2. Each data logger recorded the watermark at 15 minute intervals at each Site and was checked at each Site visit to determine if a bankfull event had occurred. Data from stage recorder BD1 was used when BD2 was out of order during the monitoring year. Documentation photos of the bankfull events were not available from UNCC. Figure 4 shows the locations of the stage recorders.

*Cross-Sections:* Two permanent cross-sections were installed per 1,000 linear feet of stream restoration work, with one located at a riffle cross-section and one located at a pool cross-section. Twenty-four total cross-sections were established. Each cross-section was marked on both banks with permanent pins to establish the exact transect used. A common benchmark was used for cross-sections and consistently referenced to facilitate comparison of year-to-year data. The annual cross-sectional survey included points measured at all breaks in slope, including top of bank, bankfull, inner berm, edge of water, and thalweg, if the features are present. Riffle cross-sections were classified using the Rosgen stream classification system (Rosgen, 1994). Permanent cross-sections for 2007 (Year 1) were surveyed in October 2007.

*Longitudinal Profiles:* A representative longitudinal profile was surveyed for 2007 (Year 1). The initial 3000 linear feet of profile was collected for the mainstem reaches of UT1 and UT2. The entire lengths of UT1B, UT1C, UT1D, and UT2A were also surveyed. Measurements included thalweg, water surface, bankfull, and top of low bank. Each of these measurements was taken at the head of each feature (e.g.,

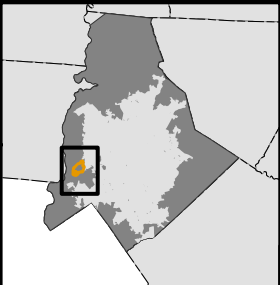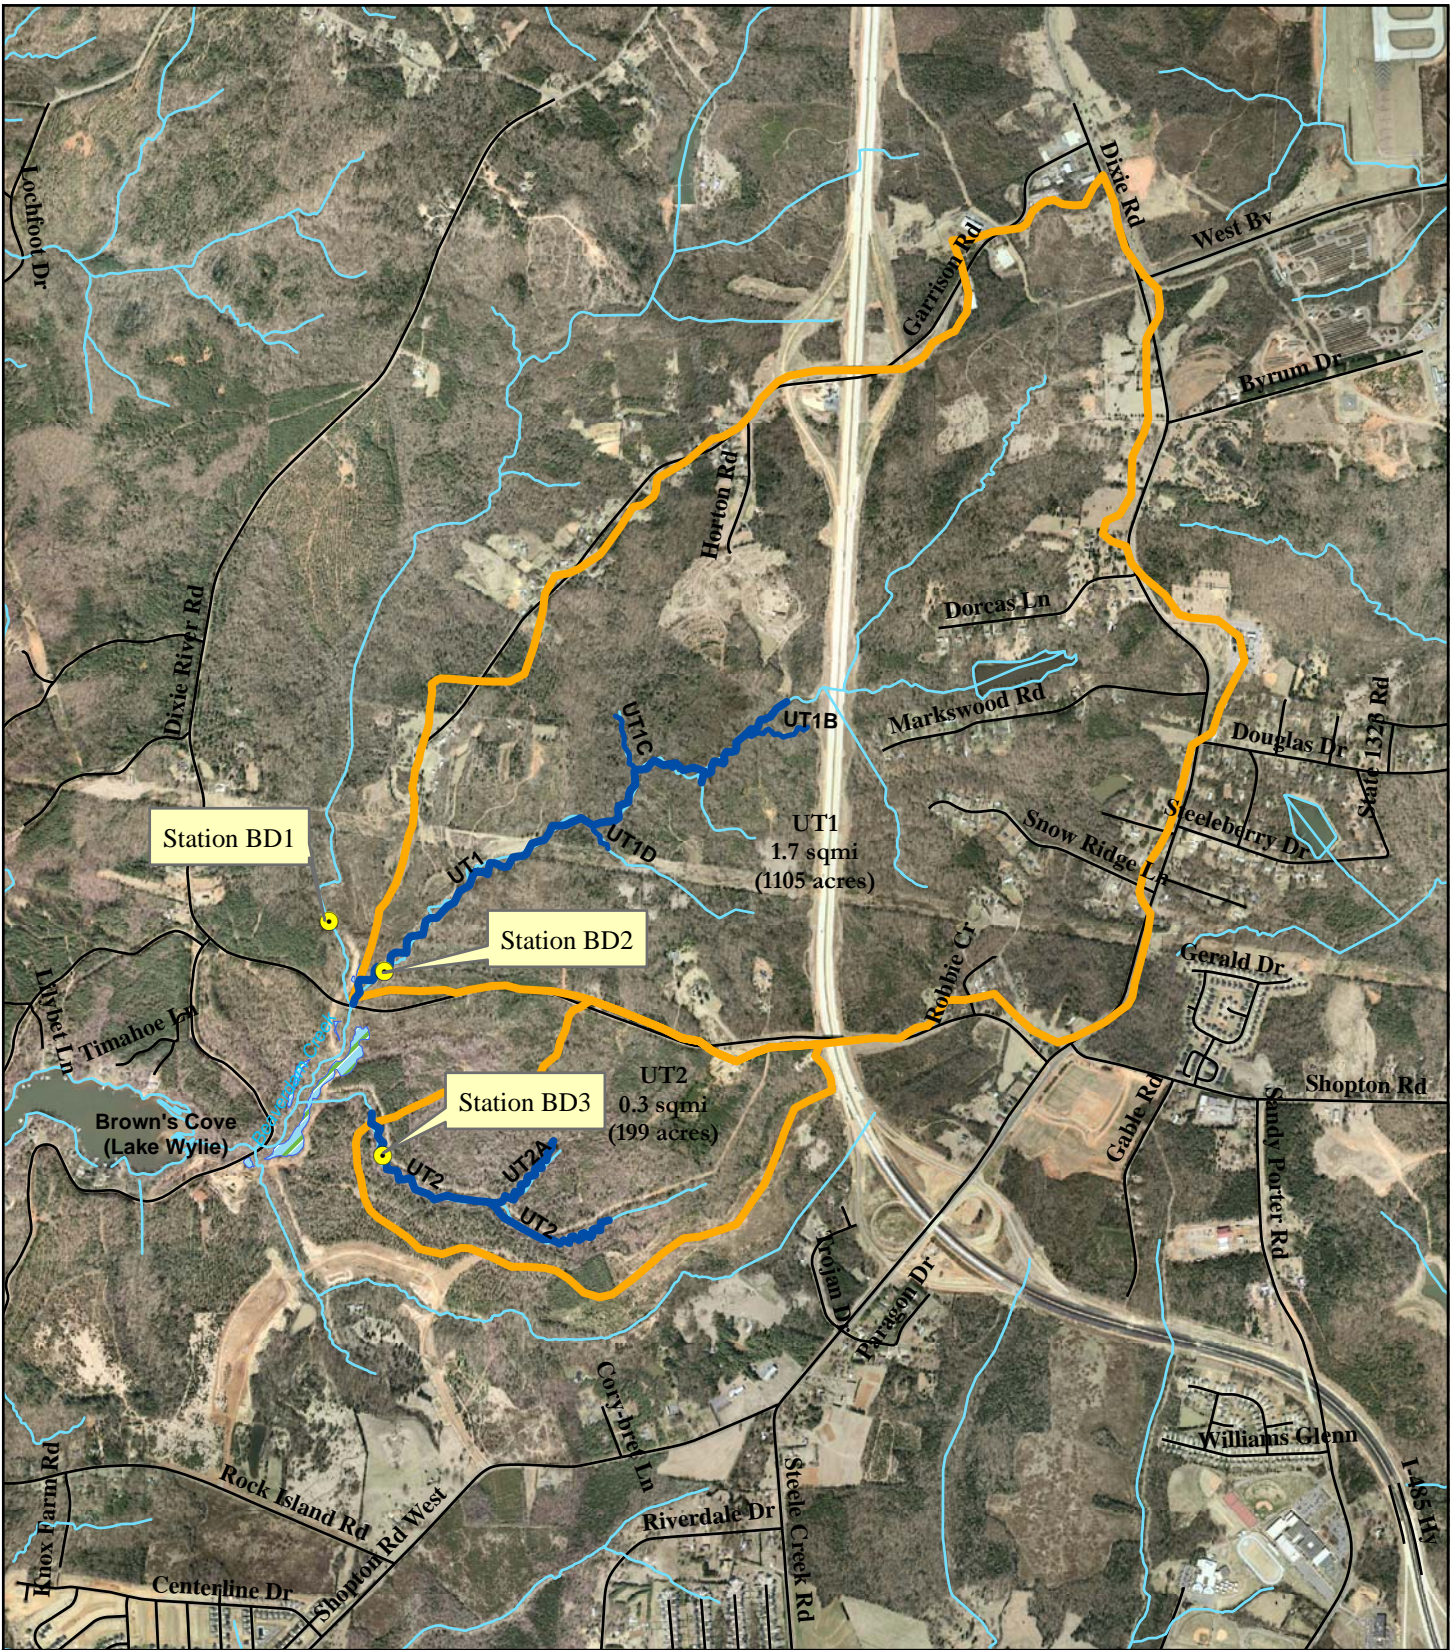

**LEGEND**

- Crest Gauges
- As-built Alignments
- Project Watershed Boundary
- Creeks
- Roads

0 950 1,900 3,800 Feet

December 2007



EEP Contract No.: D05016-1

**Figure 4: Stage Recorder Locations**

Beaverdam Creek  
Year 1 Monitoring  
Mecklenburg County, NC



riffle, pool, glide). In addition, maximum pool depth was recorded. All survey was tied to a single permanent benchmark.

*Bed Material Analysis:* Pebble counts were conducted for the permanent cross-sections (100 counts per cross-section) on the project reaches. Pebble count data were plotted on a semi-log graph and are included in Appendix B.

*Photo Reference Stations:* Photographs were used to visually document restoration success. Fifty-one (51) reference stations were established to document conditions at the constructed grade control structures across the Site. These photos are provided in Appendix A. The GPS coordinates of each photo station were noted as additional reference to ensure the same photo location was used throughout the monitoring period. These stations are included in the As-built Plan Sheets in Appendix C. Reference photos were taken once per year.

Each streambank was photographed at each permanent cross-section photo station. For each streambank photo, the photo view line followed a survey tape placed across the channel, perpendicular to flow (representing the cross-section line). The photograph was framed so that the survey tape is centered in the photo (appears as a vertical line at the center of the photograph), keeping the channel water surface line horizontal and near the lower edge of the frame. These photos are presented along with the cross-section monitoring data in Appendix B.

### **3.2 Stream Restoration Success Criteria**

The approved Mitigation Plan requires the following criteria be met to achieve stream restoration success:

- *Bankfull Events:* Two bankfull flow events must be documented within the five-year monitoring period. The two bankfull events must occur in separate years.
- *Cross-Sections:* There should be little change in as-built cross-sections. If changes to channel cross-section take place, they should be minor changes representing an increase in stability (e.g., settling, vegetative changes, deposition along the banks, or decrease in width/depth ratio).
- *Longitudinal Profiles:* The longitudinal profiles should show that the bedform features are remaining stable (not aggrading or degrading). The pools should remain deep with flat water surface slopes and the riffles should remain steeper and shallower than the pools.
- *Bed Material Analysis:* Pebble counts should indicate maintenance of bed material.
- *Photo Reference Stations:* Photographs will be used to subjectively evaluate channel aggradation or degradation, bank erosion, success of riparian vegetation and effectiveness of erosion control measures. Photos should indicate the absence of developing bars within the channel, no excessive bank erosion or increase in channel depth over time, and maturation of riparian vegetation.

### **3.3 Bankfull Discharge Monitoring Results**

On-site data loggers documented the occurrence of one bankfull flow event during the first year (2007) of the post-construction monitoring period (Table 8). During the bankfull occurrence data logger BD2 was inoperable, so BD1 on Beaverdam Creek, upstream of the confluence with UT1, was used to document the bankfull event. UNCC inspection of the Site revealed visual evidence of out-of-bank flow, confirming the data logger reading. The largest stream flow documented by the data loggers during Year 1 monitoring were a stage height of 2.75 feet for BD1 and 0.84 feet for BD3.

**Table 8. Verification of Bankfull Events**

<b>Beaverdam Creek Restoration Site: Project No. D05016-1</b>				
Station Number	Date of Data Collection	Date of Occurrence of Bankfull Event	Method of Data Collection	Gage Height (feet)
BD1	N/A	2/13/2007	Datalogger	2.75
BD3	N/A	2/14/2007	Datalogger	0.84

BD2 was out of order on the date of the bankfull event

### 3.4 Stream Monitoring Data and Photos

A photo log of the project showing each of the fifty-one (51) permanent photo locations is included in Appendix A of this report. Survey data and photos from each permanent cross-section are included in Appendix B of this report.

### 3.5 Stream Stability Assessment

Table 9 presents a summary of the results obtained from the visual inspection of in-stream structures performed during Year 1 of post-construction monitoring. The percentages noted are a general overall field evaluation of how the features were performing after the repair work had been completed at the time of the last photo point survey on November 21, 2007. These percentages are solely based on the field evaluator's visual assessment at the time of the site visit.

Visual observations of the various structures throughout Year 1 growing season indicated that structures were functioning as designed and holding their elevation grade. Root wads placed on the outside of meander bends provided bank stability and in-stream cover for fish and other aquatic organisms. Cover logs placed in meander pool areas allowed scour to keep pools deep and provide cover for fish.

The result of a large storm event that produced 3.5 inches of rain on the project site shortly after construction was completed resulted in a few minor scour areas along UT1. Scour was evident immediately underneath a few cover log and log vane structures resulting in a minor decrease in performance. This was observed at stations 41+50, 53+80, 56+00, 56+50, and 63+90. In addition, isolated pockets of bed scour, resulting in a performance score of 99%, were also observed at stations 50+15, 56+00, 56+50, and 63+90. All of the areas of scour are minor and should not result in any future problems with stream stability.

**Table 9. Categorical Stream Feature Visual Stability Assessment**

<b>Beaverdam Creek Restoration Site : Project No. D05016-1</b>						
<b>Feature</b>	<b>Performance Percentage</b>					
	<b>Initial</b>	<b>MY-01</b>	<b>MY-02</b>	<b>MY-03</b>	<b>MY-04</b>	<b>MY-05</b>
Riffles	100%	100%				
Pools	100%	100%				
Thalweg	100%	100%				
Meanders	100%	100%				
Bed General	100%	99%				
Vanes / J Hooks etc.	100%	97%				
Wads and Boulders	100%	100%				

### **3.6 Cross-section, Longitudinal Profile, and Bed Material Analysis Monitoring Results**

#### **Cross Sections**

Year 1 cross-section monitoring data for stream stability was collected during October 2007 and compared to as-built conditions (collected March 2007).

The twenty four permanent cross-sections along the restored channels (twelve located across riffles and twelve across pools) were re-surveyed to document stream dimension at the end of the first monitoring year (Year 1). Cross-sections are provided in Appendix B, and data from the cross-sections are summarized in Appendix E. The cross-sections show that there has been minor adjustment to stream dimension within the last year.

A few cross-sections show point bar formation along UT1 and include cross-sections 3, 10, 11, and 13, which are located across pools found at the apex of a meander bend. Flow through a meander bend possesses higher conveyance velocity along its boundary with the outer bank of the bend, and lower flow velocity along its boundary with the bend's inner bank. As flow reduces, its sediment transport capacity also reduces, causing flow to drop some of its transported sediment as it slows down. Point bar formation along the inside of a meander bend indicates flow velocity vectors occurring as designed, and is therefore expected. Cross-section 10 has slightly aggraded along the outside bank of a meander. This channel geometry reflects a plug of sediment deposited during the large storm event that occurred shortly after construction was completed. Drought conditions haven't allowed flow to correct channel geometry in this meander bend.

#### **Longitudinal Profiles**

The Year 1 longitudinal profile was conducted during November 2007. The initial 3,000 LF of channel was surveyed along the mainstem of UT1 and UT2. The entire lengths of UT1B, UT1C, UT1D, and UT2A were also collected. The longitudinal profile is included in Appendix B. A summary of parameters measured are provided in Appendix D. Please note that this summary represents only the portion of project that was surveyed.

The representative longitudinal profiles along the restored channels were resurveyed to document stream profile at the end of monitoring Year 1. Drought conditions resulted in little to no water within the restored channels and therefore profile data such as riffle slopes and pool-to-pool spacing could not be calculated. Sinuosity for all restored reaches has remained the same and there's been no measurable change in stream pattern. Though there was some minor areas of bed scour, as mentioned in Section 3.5 of this report, none of the areas need to be addressed, at this time, nor should result any future problems. Inspections of these areas will be performed in subsequent monitoring periods.

#### **Bed Material Analysis**

Year 1 bed material samples were collected at each permanent cross-section during October 2007. The pebble count data were plotted on a semi-log graph and will be compared with future monitoring data. Data should indicate a relative coarsening of the riffles (or maintenance of a coarse bed in constructed riffles) and a relative fining in the pools. All pebble count data are provided in Appendix B.

### **3.7 Areas of Concern**

Adjacent to the Site's property boundaries are new residential developments under construction. During Year 1 Monitoring, several Best Management Practices (BMPs) were noted as areas of concern within and immediately outside the conservation easement along UT2 and UT2A of the Restoration Project. The BMPs consist of both temporary and permanent detention ponds which are discharging stormwater into the Project Site, and a retaining wall. Locations of the BMPs are shown on the as-built plans included in Appendix C.

Currently, none of the BMPs are causing any significant degradation of the restored channels; however, discharge from the BMP adjacent to Station 20+00 along UT2 has caused some minor headcutting below the riffle at the log sill. See Appendix A for photo documentation of the BMP structure and the in-stream impact.

Monitoring of these areas of concern will continue throughout the Project’s monitoring period and will be discussed accordingly.

#### 4.0 HYDROLOGY

Rainfall data were collected to document the hydrologic conditions throughout the project area in the 2007 growing season. Since no rain gauges were installed within the project boundaries, monthly rainfall totals were calculated from data downloaded from the Withers Cove USGS gauge 35090308100454 in Mecklenburg County, NC. Historical rainfall data were collected from the Charlotte WSO AP WETS Station in Mecklenburg County (NC 1690) using NRCS National Water and Climate Data Center website. Hydrologic monitoring results are shown in Table 10 and Figure 5.

**Table 10. Comparison of Historic Rainfall to Observed Rainfall**


<b>Beaverdam Creek Restoration Site: EEP Contract No. D05016-1</b>				
<b>Month</b>	<b>Average (in.)</b>	<b>30% (in.)</b>	<b>70% (in.)</b>	<b>Observed 2007 Precipitation (in.)</b>
January	4.00	3.21	5.15	3.25
February	3.55	2.34	4.42	1.88
March	4.39	3.01	5.54	3.93
April	2.95	1.98	3.73	3.51
May	3.66	2.33	4.29	0.61
June	3.42	2.43	4.68	3.18
July	3.79	2.49	4.76	1.72
August	3.72	2.34	4.57	0.56
September	3.83	2.00	4.68	1.11
October	3.66	1.80	4.49	0.41 <sup>A</sup>
November	3.36	2.51	4.24	-
December	3.18	2.11	3.81	-
<b>Total Rainfall</b>	<b>43.51</b>	<b>28.55</b>	<b>54.36</b>	<b>20.16*</b>

(USDA, 2003 and USGS, 2007)

<sup>A</sup> Monthly rainfall data was calculated based on rainfall data from 10/1/07 – 10/23/07 using the nearest USGS rain gauge data (USGS 35090308100454 Withers Cove in Mecklenburg County) to the project site. (USGS, 2007)

\*Total Observed Rainfall does not include data from October 23 – 31, November, nor December of 2007.

**Figure 5. Historic Average vs. Observed Rainfall**

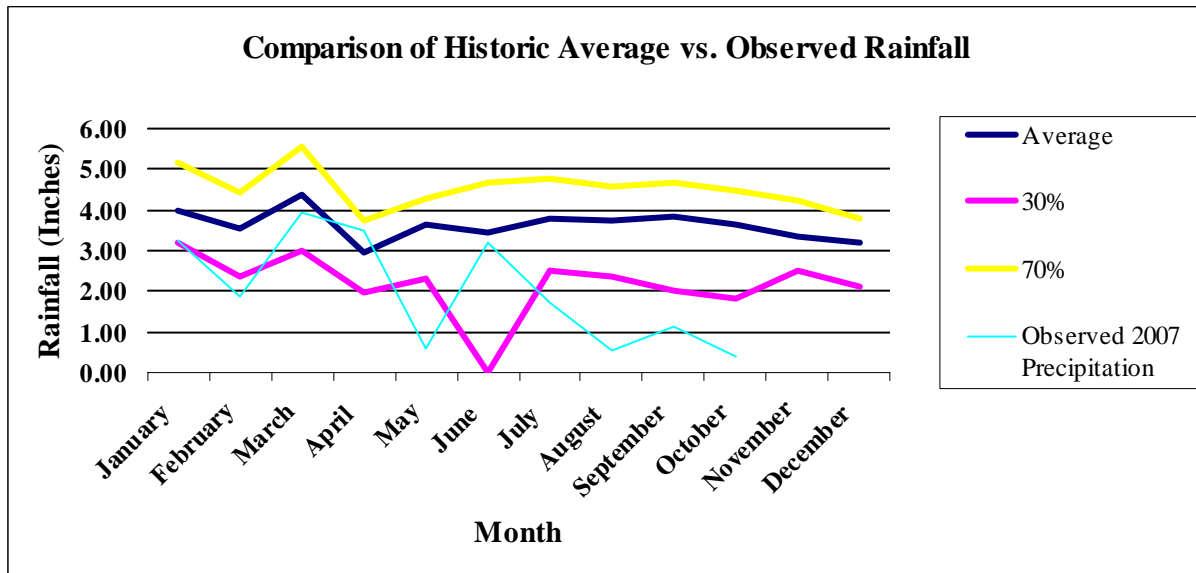

## 5.0 CONCLUSIONS AND RECOMMENDATIONS

*Vegetation Monitoring.* Vegetation monitoring efforts have calculated the range of stems per acre for each plot to be from 440 to 1000 stems per acre on the 24 vegetation plots. The average number of stems per acre is 572, which is a survival rate of greater than 91%, based on the initial planting count of 625 stems per acre. Assuming that preventative methods will be used to maintain the invasive exotics, vegetation survivability should remain excellent on the Site and vegetative success criteria will be met.

*Stream Monitoring.* The total length of stream channel restored and/or preserved on the Site was 15,806 linear feet. This entire length was inspected during Year 1 of the monitoring period (2007) to assess stream performance. Based on the data collected, all riffles, pools, and other constructed features along the restored channel are stable and functioning as designed. Minor bed scour was noted at isolated pockets along UT1. The lack of major problem areas along the length of the restored channels after the occurrence of a stream flow event larger than bankfull discharge further supports functionality of the design. It is expected that stability and in-stream habitat of the system will improve in the coming years as permanent vegetation becomes more established.

## 6.0 WILDLIFE OBSERVATIONS

Observations of deer and raccoon tracks are common on the Site. During certain times of the year, frogs, turtles, turkey, and fish have also been periodically observed.

## 7.0 REFERENCES

Radford, Albert E., Harry E. Ahles, and C. Ritchie Bell. 1968. Manual of the Vascular Flora of the Carolinas. The University of North Carolina Press, Chapel Hill, NC.



Resource Management Group, Inc. 1999. National List of Plant Species That Occur in Wetlands. Dickinson Press, Inc., Grand Rapids, MI..

Rosgen, D.L. 1994. A Classification of Natural Rivers. *Catena* 22:169-199.

Rosgen, D.L. 1996. Applied River Morphology. Pagosa Springs, CO: Wildland Hydrology Books.

United States Department of Agriculture (USDA), Natural Resources Conservation Service (NRCS). 2006. Soil Series Descriptions. <http://soils.usda.gov/soils/technical/classification/osd/index.html>

USDA, NRCS. 2003. Climate Information for Mecklenburg County in the State of North Carolina (1971-2000). TAPS Station : CHARLOTTE WSO AP, NC1690  
<ftp://ftp.wcc.nrcs.usda.gov/support/climate/taps/nc/37119.txt>

USDA, NRCS. 2007. The PLANTS Database (<http://plants.usda.gov>, 28 November 2007). National Plant Data Center, Baton Rouge, LA 70874-4490 USA.

U.S. Geological Service (USGS). 2007. Real-Time Data for North Carolina - Precipitation USGS Water-Data Site Information for North Carolina. USGS 35090308100454 Withers Cove in Mecklenburg County, NC. Retrieved on 2007-10-25 12:30:56 EDT  
[http://waterdata.usgs.gov/nc/nwis/current/?type=precip&group\\_key=county\\_cd](http://waterdata.usgs.gov/nc/nwis/current/?type=precip&group_key=county_cd)

# **APPENDIX A**

## **Photo Log**

## PHOTO LOG – UT1



**UT1 – PID 1**



**UT1 – PID 2**



**UT1 – PID 3**



**UT1 – PID 4**



**UT1 – PID 5**



**UT1 – PID 6**

## PHOTO LOG – UT1



**UT1 – PID 7**



**UT1 – PID 8**



**UT1 – PID 9**



**UT1 – PID 10**



**UT1 – PID 11**



**UT1 – PID 12**

## PHOTO LOG – UT1



**UT1 – PID 13**



**UT1 – PID 14**



**UT1 – PID 15**



**UT1 – PID 16**



**UT1 – PID 17**



**UT1 – PID 18**

## PHOTO LOG – UT1



**UT1 – PID 19**



**UT1 – PID 20**



**UT1 – PID 21**



**UT1 – PID 22**



**UT1 – PID 23**

# PHOTO LOG – UT1B, UT1C, & UT1D



**UT1B – PID 1**



**UT1B – PID 2**



**UT1B – PID 3**



**UT1B – PID 4**



**UT1B – PID 5**



**UT1C – PID 6**

## PHOTO LOG – UT1B, UT1C, & UT1D



**UT1C – PID 7**



**UT1C – PID 8**



**UT1C – PID 9**



**UT1D – PID 10**



**UT1D – PID 11**



**UT1D – PID 12**



## PHOTO LOG – UT2 & UT2A



**UT2 – PID 1**



**UT2 – PID 2**



**UT2 – PID 3**



**UT2 – PID 4**



**UT2 – PID 5**



**UT2 – PID 6**

## PHOTO LOG – UT2 & UT2A



**UT2 – PID 7**



**UT2 – PID 8**



**UT2 – PID 9**



**UT2 – PID 10**



**UT2 – PID 11**



**UT2 – PID 12**

**PHOTO LOG – UT2 & UT2A**



**UT2A – PID 1**



**UT2A – PID 2**



**UT2A – PID 3**



**UT2A – PID 4**

## VEG PLOT PHOTOS – UT1 & UT1B – UT1D



**UT1 – Veg Plot 1**



**UT1 – Veg Plot 2**



**UT1 – Veg Plot 3**



**UT1 – Veg Plot 4**



**UT1 – Veg Plot 5**



**UT1 – Veg Plot 6**

## VEG PLOT PHOTOS – UT1 & UT1B – UT1D



**UT1 – Veg Plot 7**



**UT1 – Veg Plot 8**



**UT1 – Veg Plot 9**



**UT1 – Veg Plot 10**



**UT1 – Veg Plot 11**



**UT1 – Veg Plot 12**

## VEG PLOT PHOTOS – UT1 & UT1B – UT1D



**UT1 – Veg Plot 13**



**UT1 – Veg Plot 14**



**UT1B – Veg Plot 15**



**UT1C – Veg Plot 16**



**UT1D – Veg Plot 17**

## VEG PLOT PHOTOS – UT2 & UT2A



**UT2A – Veg Plot 1**



**UT2A – Veg Plot 2**



**UT2 – Veg Plot 3**



**UT2 – Veg Plot 4**



**UT2 – Veg Plot 5**



**UT2 – Veg Plot 6**

## VEG PLOT PHOTOS – UT2 & UT2A



**UT2 – Veg Plot 7**



# **AREA OF CONCERN PHOTOS**

## **PHOTO LOG – UT2 at STATION 20+00**



**Detention Pond – Adjacent  
to UT2 at STA 20+00**




**Beginning headcut below  
riffle at STA 20+00 on UT2**


**APPENDIX B**

**STREAM MONITORING DATA**


### UT1 Mainstem Profile (2007 Monitoring)

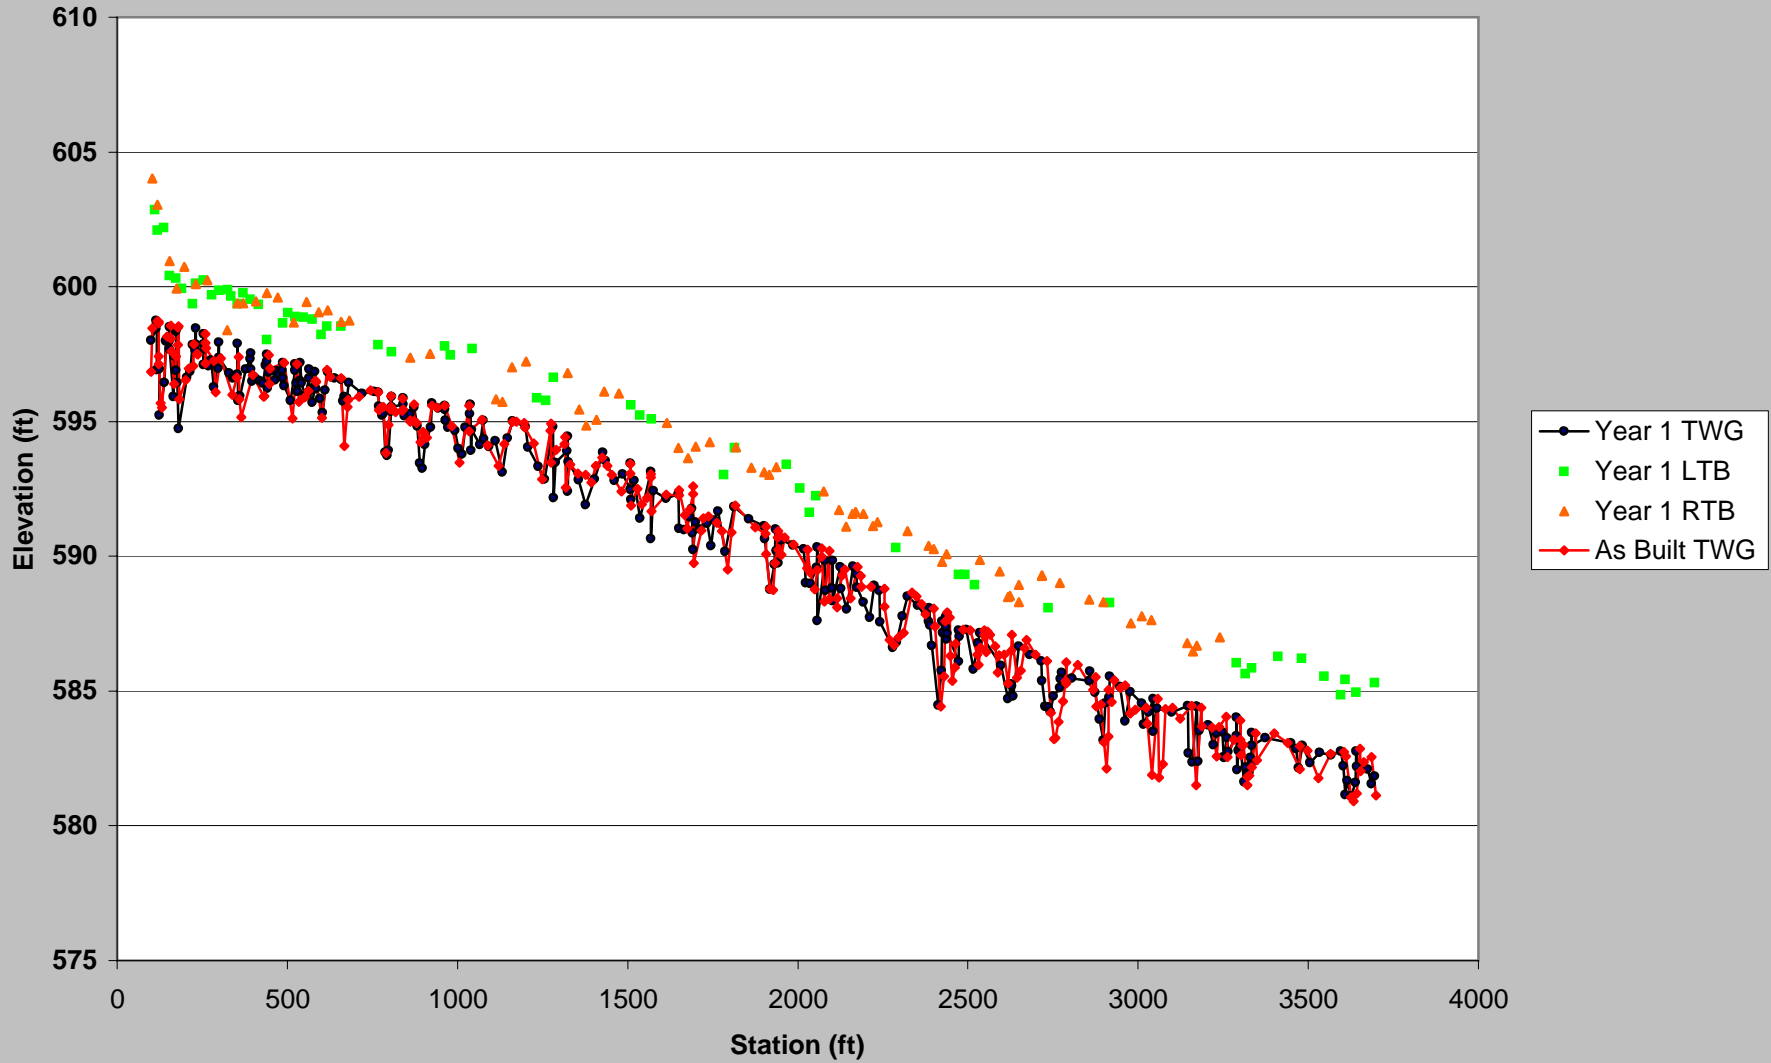


### UT1B Profile (2007 Monitoring)

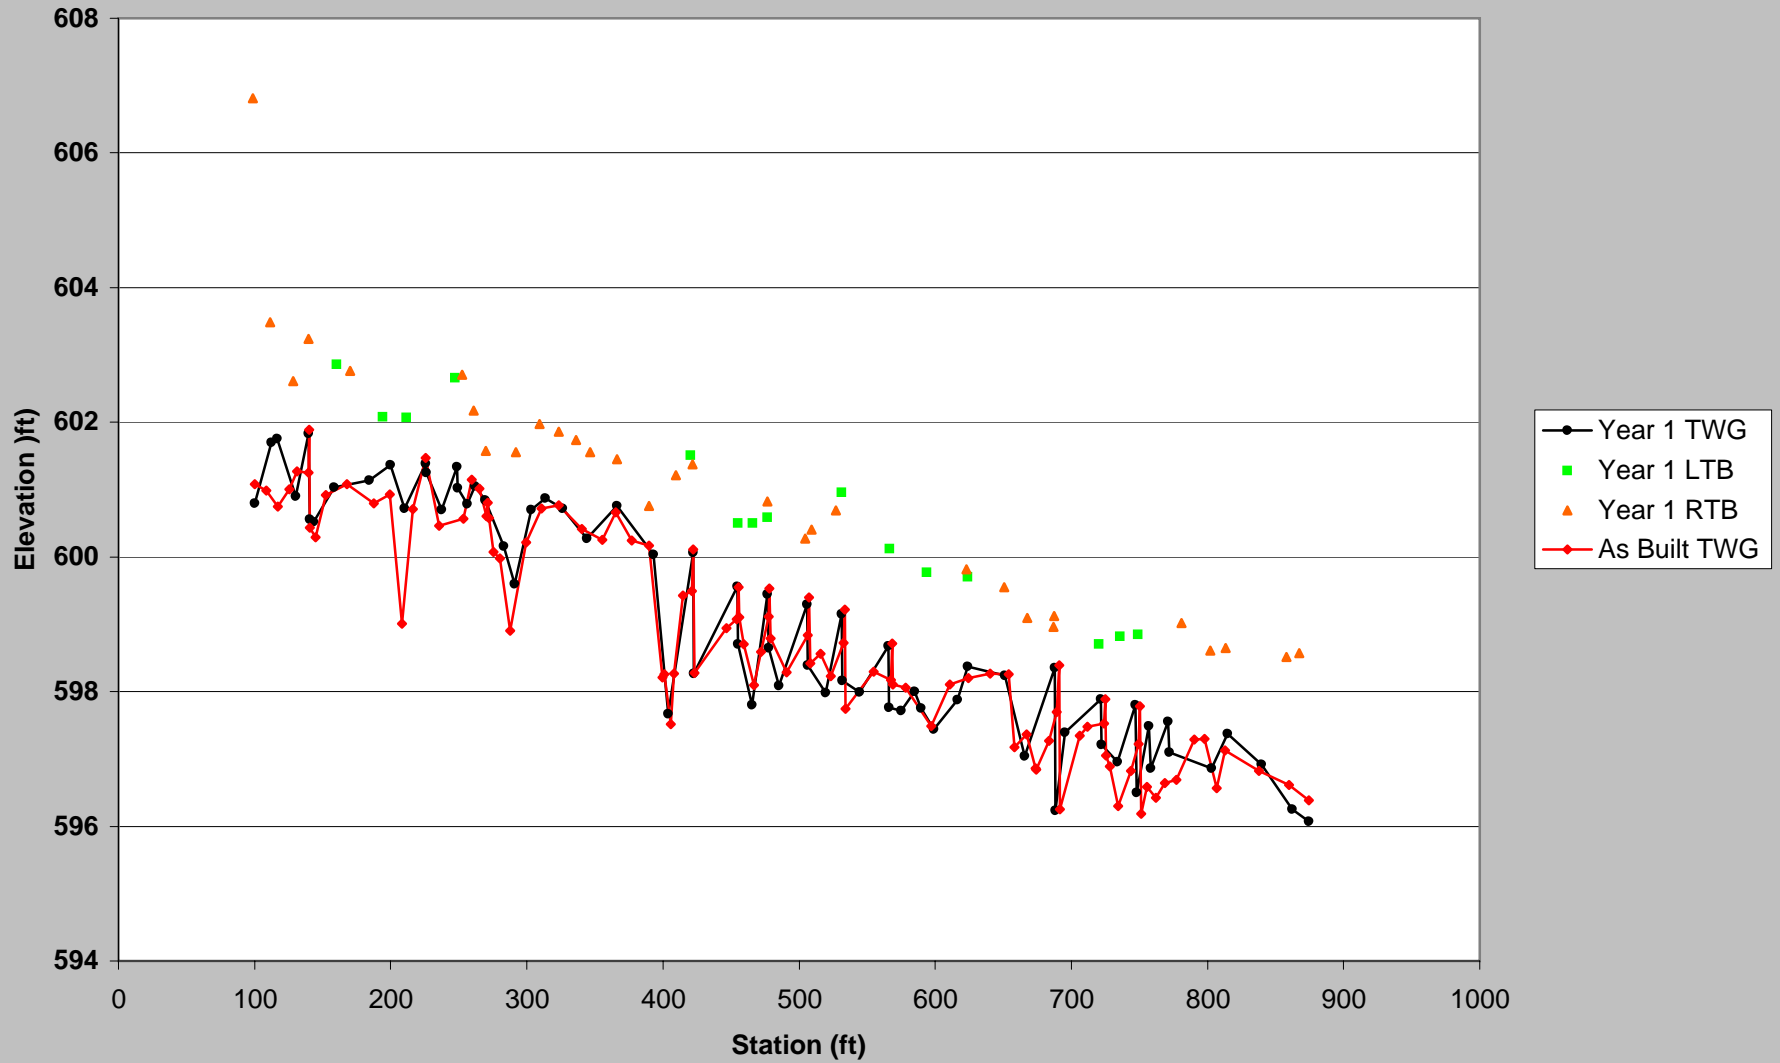

UT1C Profile (2007 Monitoring)

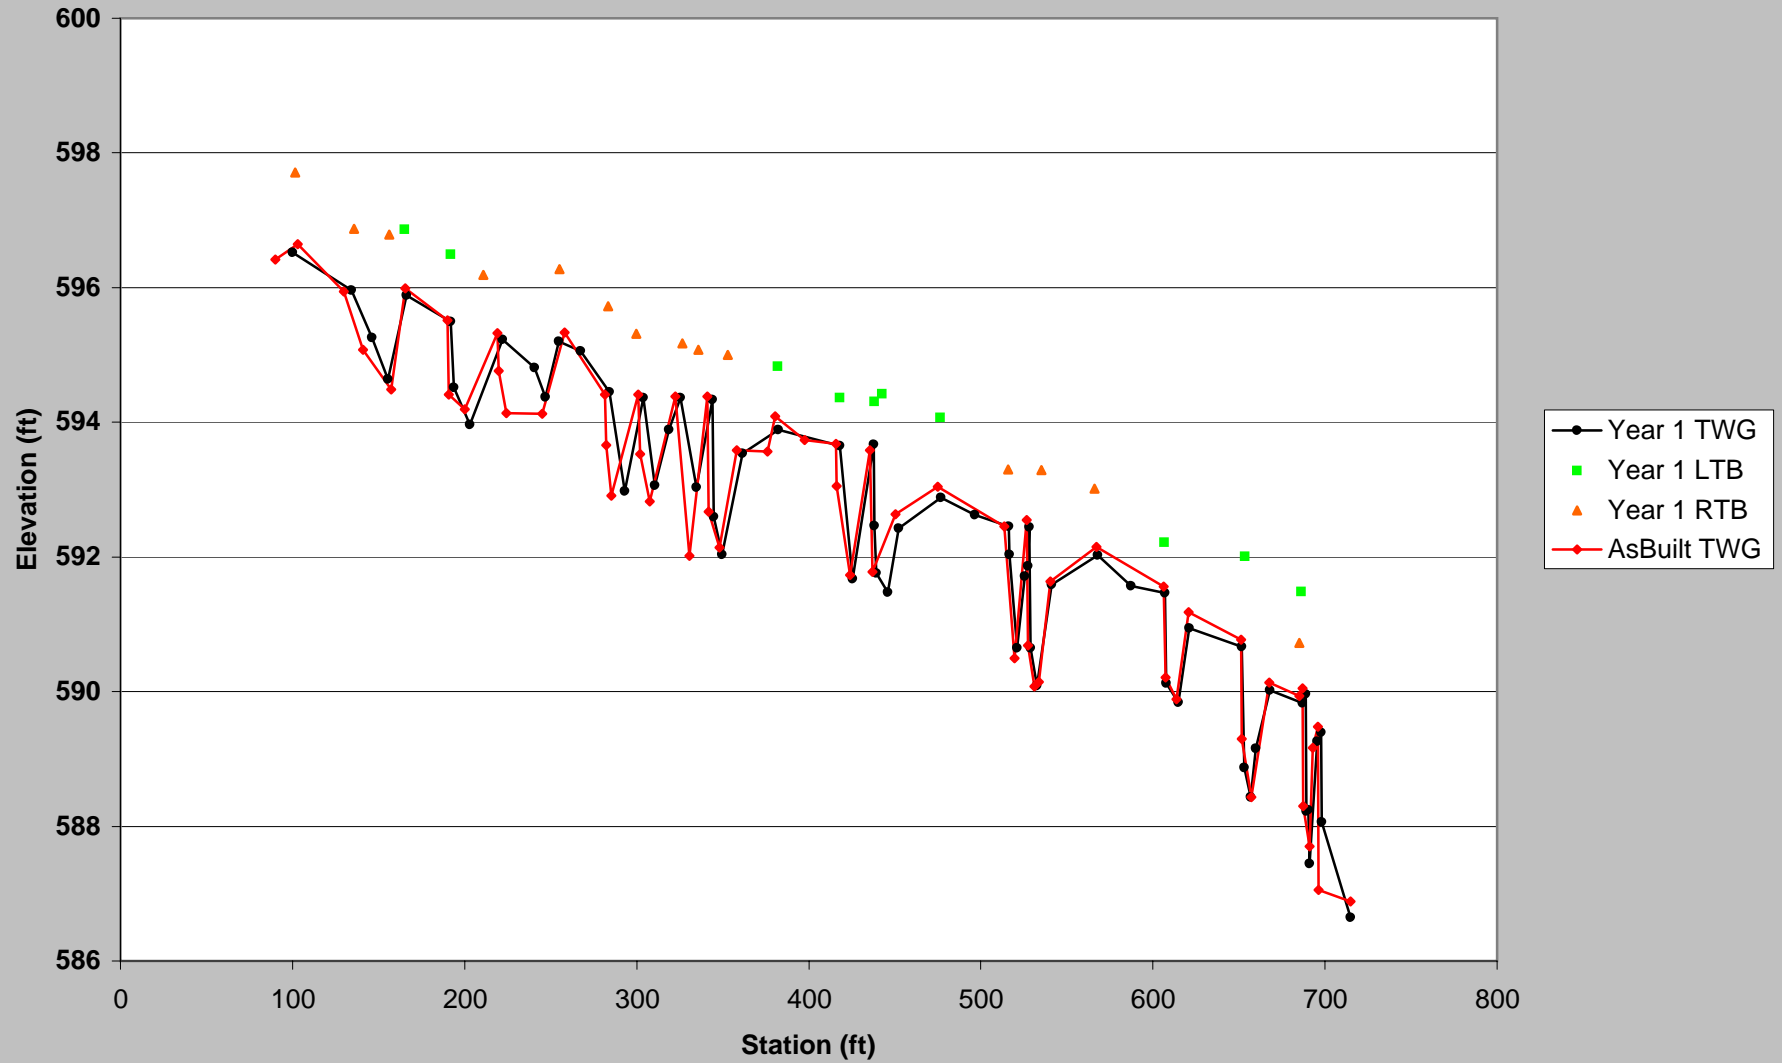

### UT1C Profile (2007 Monitoring)

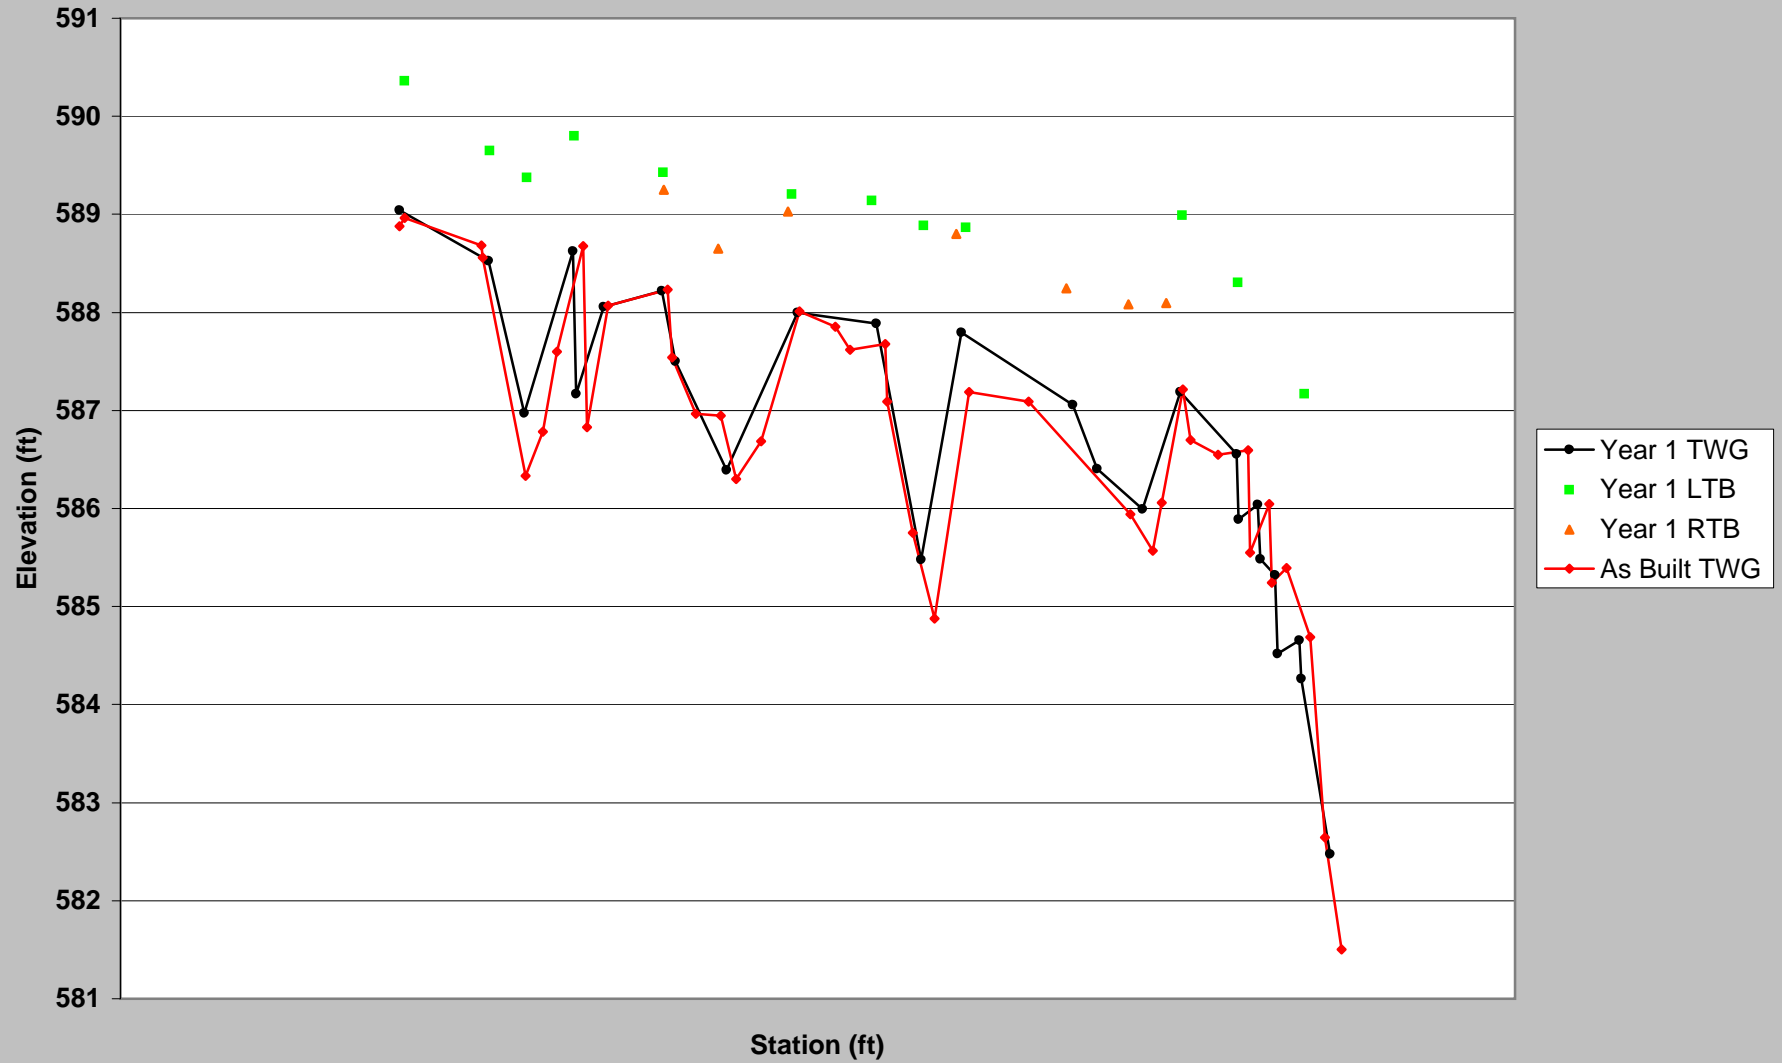

## PEBBLE COUNT DATA SHEET: POOL 100-COUNT


<b>BAKER PROJECT NO.</b>		108528
SITE OR PROJECT:	Beaverdam Creek 1st Year Monitoring	
REACH/LOCATION:	UT1 X1-Pool (Reach 1)	
DATE COLLECTED:	10/15/2007	
FIELD COLLECTION BY:	RR/IE	
DATA ENTRY BY:	IE	

MATERIAL	PARTICLE	SIZE (mm)	PARTICLE CLASS COUNT		Summary		Distribution Plot Size (mm)
			Pool		Class %	% Cum	
<b>SILT/CLAY</b>	Silt / Clay	< .063	100		100%	100%	0.063
<b>S A N D</b>	Very Fine	.063 - .125				100%	0.125
	Fine	.125 - .25				100%	0.25
	Medium	.25 - .50				100%	0.50
	Coarse	.50 - 1.0				100%	1.0
	Very Coarse	1.0 - 2.0				100%	2.0
<b>G R A V E L</b>	Very Fine	2.0 - 2.8				100%	2.8
	Very Fine	2.8 - 4.0				100%	4.0
	Fine	4.0 - 5.6				100%	5.6
	Fine	5.6 - 8.0				100%	8.0
	Medium	8.0 - 11.0				100%	11.3
	Medium	11.0 - 16.0				100%	16.0
	Coarse	16.0 - 22.6				100%	22.6
	Coarse	22.6 - 32				100%	32
	Very Coarse	32 - 45				100%	45
	Very Coarse	45 - 64				100%	64
<b>COBBLE</b>	Small	64 - 90				100%	90
	Small	90 - 128				100%	128
	Large	128 - 180				100%	180
	Large	180 - 256				100%	256
<b>BOULDER</b>	Small	256 - 362				100%	362
	Small	362 - 512				100%	512
	Medium	512 - 1024				100%	1024
	Large-Very Large	1024 - 2048				100%	2048
<b>BEDROCK</b>	Bedrock	> 2048				100%	5000
<b>Total</b>			<b>100</b>		<b>100%</b>		

**Largest particles:** \_\_\_\_\_  
(riffle)



Beaverdam Creek UT1 (Reach 1)  
X1 Pool  
Pebble Count Particle Size Distribution

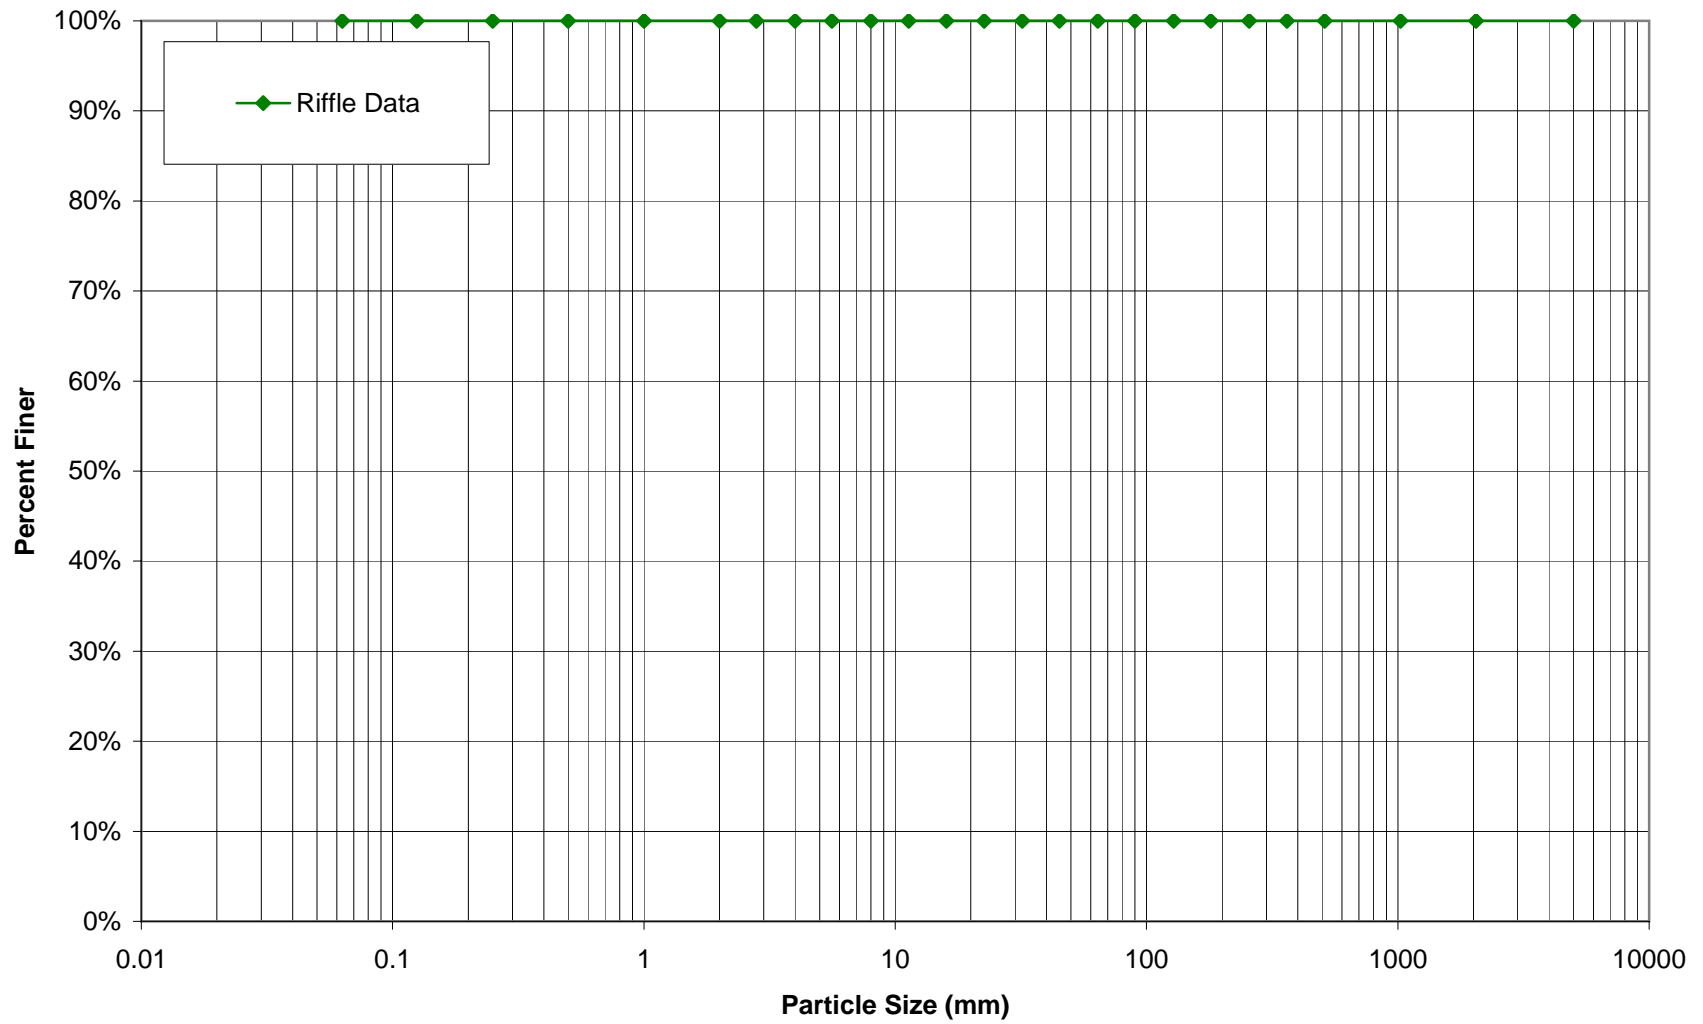

**PEBBLE COUNT DATA SHEET: RIFFLE 100-COUNT**


BAKER PROJECT NO. 108528

SITE OR PROJECT:	Beaverdam Creek 1st Year Monitoring
REACH/LOCATION:	UT1 X2-Riffle (Reach 1)
DATE COLLECTED:	10/15/2007
FIELD COLLECTION BY:	RR/IE
DATA ENTRY BY:	IE

MATERIAL	PARTICLE	SIZE (mm)	PARTICLE CLASS COUNT		Summary		Distribution Plot Size (mm)
			Riffle		Class %	% Cum	
<b>SILT/CLAY</b>	Silt / Clay	< .063	10		10%	10%	0.063
<b>SAND</b>	Very Fine	.063 - .125				10%	0.125
	Fine	.125 - .25				10%	0.25
	Medium	.25 - .50				10%	0.50
	Coarse	.50 - 1.0				10%	1.0
	Very Coarse	1.0 - 2.0				10%	2.0
<b>GRAVEL</b>	Very Fine	2.0 - 2.8				10%	2.8
	Very Fine	2.8 - 4.0				10%	4.0
	Fine	4.0 - 5.6	1		1%	11%	5.6
	Fine	5.6 - 8.0				11%	8.0
	Medium	8.0 - 11.0				11%	11.3
	Medium	11.0 - 16.0	1		1%	12%	16.0
	Coarse	16.0 - 22.6				12%	22.6
	Coarse	22.6 - 32	10		10%	22%	32
	Very Coarse	32 - 45	32		32%	54%	45
	Very Coarse	45 - 64	25		25%	79%	64
<b>COBBLE</b>	Small	64 - 90	12		12%	91%	90
	Small	90 - 128	9		9%	100%	128
	Large	128 - 180				100%	180
	Large	180 - 256				100%	256
<b>BOULDER</b>	Small	256 - 362				100%	362
	Small	362 - 512				100%	512
	Medium	512 - 1024				100%	1024
	Large-Very Large	1024 - 2048				100%	2048
<b>BEDROCK</b>	Bedrock	> 2048				100%	5000
<b>Total</b>			<b>100</b>		<b>100%</b>		

**Largest particles:** \_\_\_\_\_  
(riffle)

Beaverdam Creek UT1 (Reach 1)  
X2 Riffle  
Pebble Count Particle Size Distribution

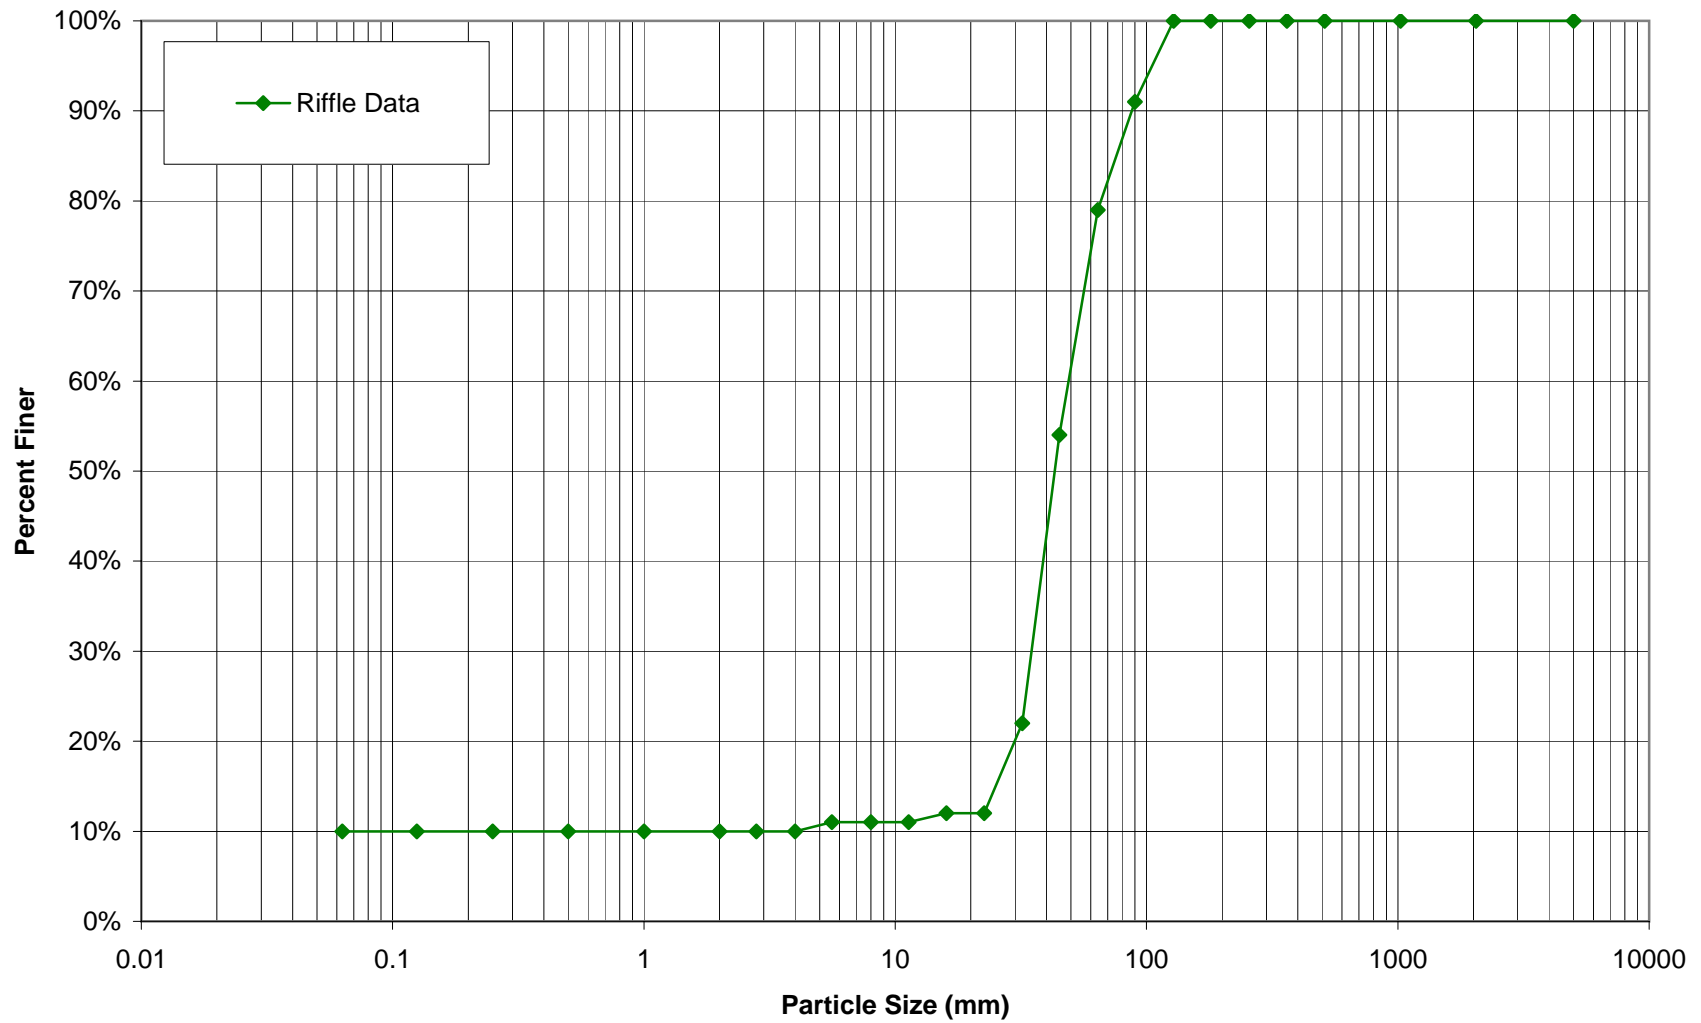

## PEBBLE COUNT DATA SHEET: POOL 100-COUNT


BAKER PROJECT NO. 108528

SITE OR PROJECT:	Beaverdam Creek 1st Year Monitoring
REACH/LOCATION:	UT1B X3-Pool
DATE COLLECTED:	10/15/2007
FIELD COLLECTION BY:	RR/IE
DATA ENTRY BY:	IE

MATERIAL	PARTICLE	SIZE (mm)	PARTICLE CLASS COUNT		Summary		Distribution Plot Size (mm)
			Pool	Class %	% Cum		
SILT/CLAY	Silt / Clay	< .063	37	37%	37%		0.063
S A N D	Very Fine	.063 - .125	3	3%	40%		0.125
	Fine	.125 - .25	29	29%	69%		0.25
	Medium	.25 - .50	20	20%	89%		0.50
	Coarse	.50 - 1.0	11	11%	100%		1.0
	Very Coarse	1.0 - 2.0			100%		2.0
G R A V E L	Very Fine	2.0 - 2.8			100%		2.8
	Very Fine	2.8 - 4.0			100%		4.0
	Fine	4.0 - 5.6			100%		5.6
	Fine	5.6 - 8.0			100%		8.0
	Medium	8.0 - 11.0			100%		11.3
	Medium	11.0 - 16.0			100%		16.0
	Coarse	16.0 - 22.6			100%		22.6
	Coarse	22.6 - 32			100%		32
	Very Coarse	32 - 45			100%		45
	Very Coarse	45 - 64			100%		64
C O B B L E	Small	64 - 90			100%		90
	Small	90 - 128			100%		128
	Large	128 - 180			100%		180
	Large	180 - 256			100%		256
B O U L D E R	Small	256 - 362			100%		362
	Small	362 - 512			100%		512
	Medium	512 - 1024			100%		1024
	Large-Very Large	1024 - 2048			100%		2048
BEDROCK	Bedrock	> 2048			100%		5000
<b>Total</b>			<b>100</b>	<b>100%</b>			

Largest particles: \_\_\_\_\_  
(pool)

Beaverdam Creek UT1B  
X3 Pool  
Pebble Count Particle Size Distribution

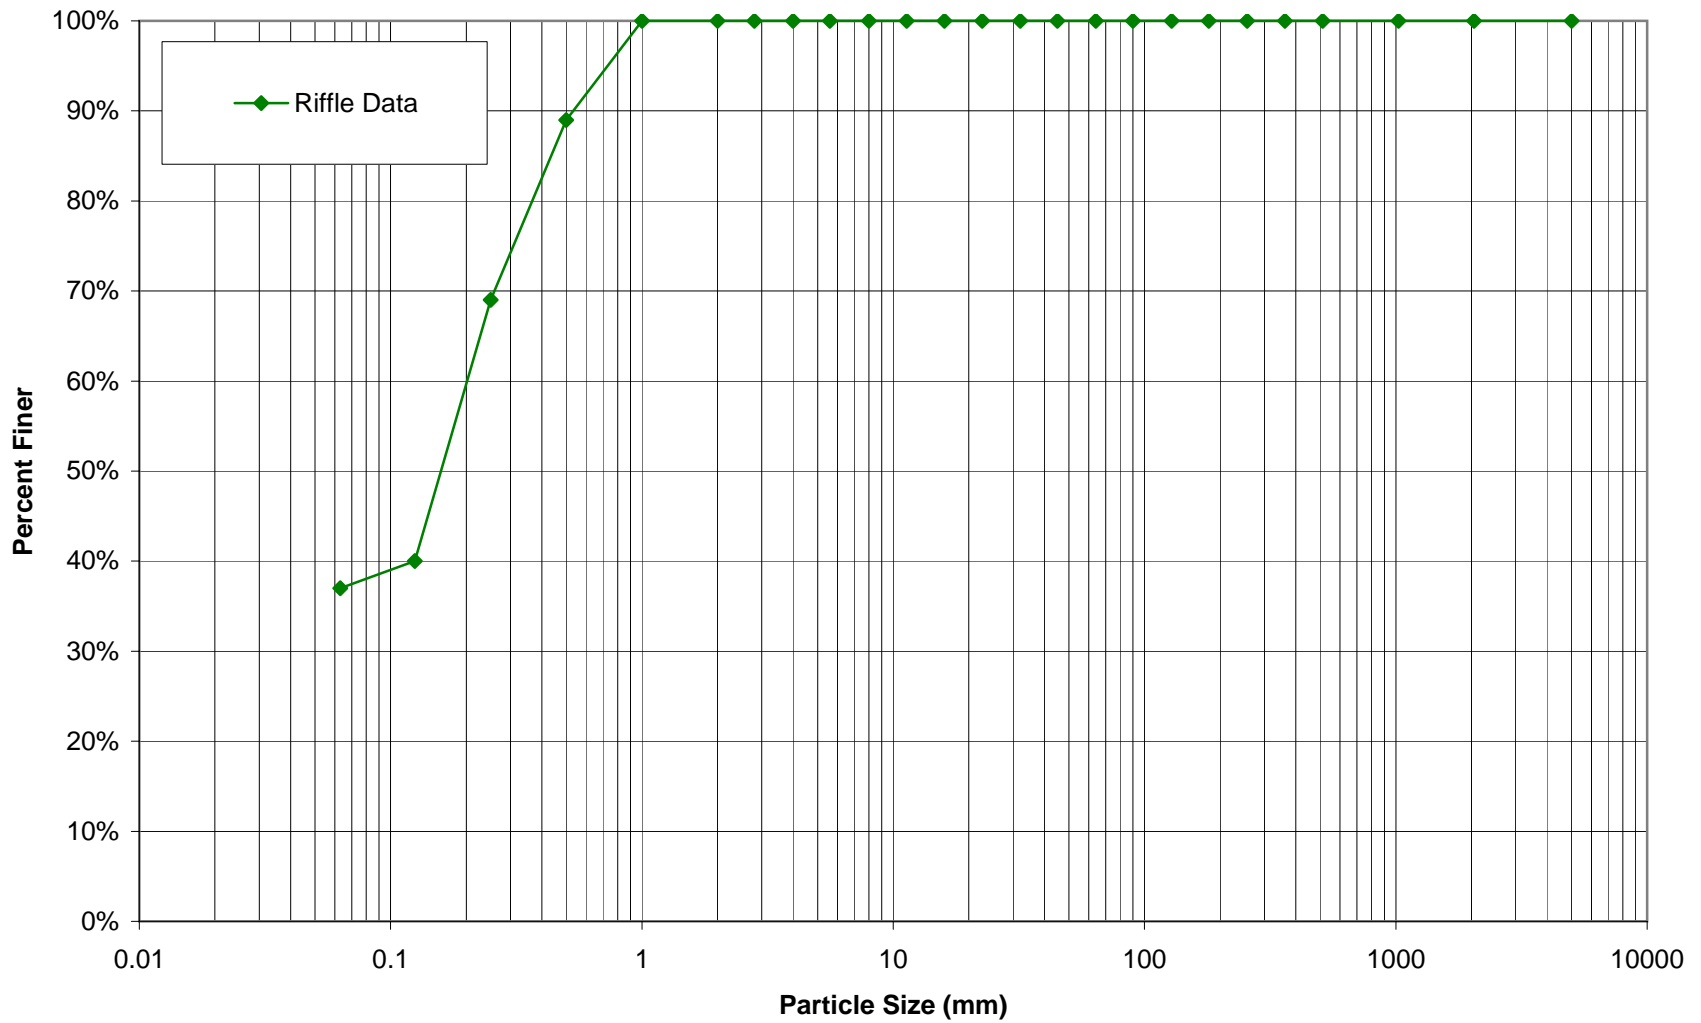

**PEBBLE COUNT DATA SHEET: RIFFLE 100-COUNT**


BAKER PROJECT NO. 108528

SITE OR PROJECT:	Beaverdam Creek 1st Year Monitoring
REACH/LOCATION:	UT1B X4-Riffle
DATE COLLECTED:	10/15/2007
FIELD COLLECTION BY:	RR/IE
DATA ENTRY BY:	IE

MATERIAL	PARTICLE	SIZE (mm)	PARTICLE CLASS COUNT		Summary		Distribution Plot Size (mm)
			Riffle		Class %	% Cum	
<b>SILT/CLAY</b>	Silt / Clay	< .063	77		77%	77%	0.063
<b>SAND</b>	Very Fine	.063 - .125				77%	0.125
	Fine	.125 - .25	11		11%	88%	0.25
	Medium	.25 - .50	11		11%	99%	0.50
	Coarse	.50 - 1.0	1		1%	100%	1.0
	Very Coarse	1.0 - 2.0				100%	2.0
<b>GRAVEL</b>	Very Fine	2.0 - 2.8				100%	2.8
	Very Fine	2.8 - 4.0				100%	4.0
	Fine	4.0 - 5.6				100%	5.6
	Fine	5.6 - 8.0				100%	8.0
	Medium	8.0 - 11.0				100%	11.3
	Medium	11.0 - 16.0				100%	16.0
	Coarse	16.0 - 22.6				100%	22.6
	Coarse	22.6 - 32				100%	32
	Very Coarse	32 - 45				100%	45
	Very Coarse	45 - 64				100%	64
<b>COBBLE</b>	Small	64 - 90				100%	90
	Small	90 - 128				100%	128
	Large	128 - 180				100%	180
	Large	180 - 256				100%	256
<b>BOULDER</b>	Small	256 - 362				100%	362
	Small	362 - 512				100%	512
	Medium	512 - 1024				100%	1024
	Large-Very Large	1024 - 2048				100%	2048
<b>BEDROCK</b>	Bedrock	> 2048				100%	5000
<b>Total</b>			<b>100</b>		<b>100%</b>		

**Largest particles:** \_\_\_\_\_  
(riffle)

Beaverdam Creek UT1B  
X4 Riffle  
Pebble Count Particle Size Distribution

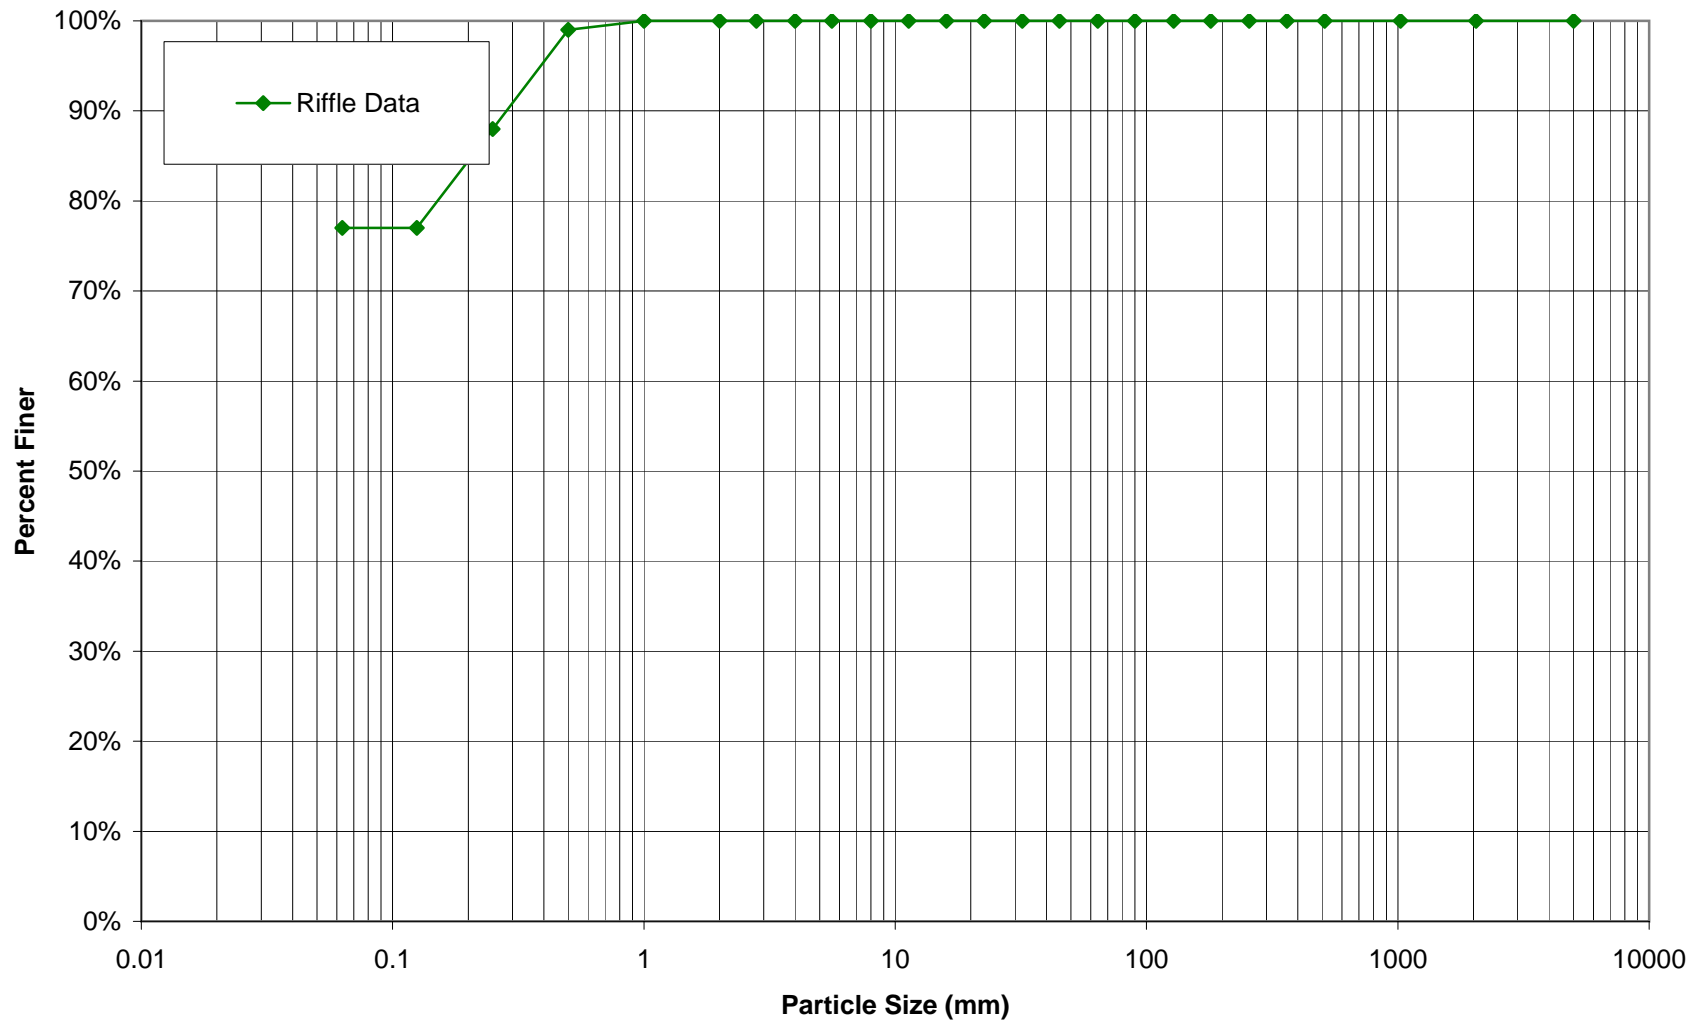

**PEBBLE COUNT DATA SHEET: RIFFLE 100-COUNT**

BAKER PROJECT NO. 108528


SITE OR PROJECT:	Beaverdam Creek 1st Year Monitoring
REACH/LOCATION:	UT1 X5-Riffle (Reach 2-5)
DATE COLLECTED:	10/15/2007
FIELD COLLECTION BY:	RR/IE
DATA ENTRY BY:	IE

MATERIAL	PARTICLE	SIZE (mm)	PARTICLE CLASS COUNT		Summary		Distribution Plot Size (mm)
			Riffle		Class %	% Cum	
<b>SILT/CLAY</b>	Silt / Clay	< .063	5		5%	5%	0.063
<b>SAND</b>	Very Fine	.063 - .125				5%	0.125
	Fine	.125 - .25				5%	0.25
	Medium	.25 - .50				5%	0.50
	Coarse	.50 - 1.0	2		2%	7%	1.0
	Very Coarse	1.0 - 2.0	1		1%	8%	2.0
<b>GRAVEL</b>	Very Fine	2.0 - 2.8	2		2%	10%	2.8
	Very Fine	2.8 - 4.0	1		1%	11%	4.0
	Fine	4.0 - 5.6	1		1%	12%	5.6
	Fine	5.6 - 8.0	1		1%	13%	8.0
	Medium	8.0 - 11.0	1		1%	14%	11.3
	Medium	11.0 - 16.0	1		1%	15%	16.0
	Coarse	16.0 - 22.6				15%	22.6
	Coarse	22.6 - 32	9		9%	24%	32
	Very Coarse	32 - 45	26		26%	50%	45
	Very Coarse	45 - 64	21		21%	71%	64
<b>COBBLE</b>	Small	64 - 90	15		15%	86%	90
	Small	90 - 128	10		10%	96%	128
	Large	128 - 180	4		4%	100%	180
	Large	180 - 256				100%	256
<b>BOULDER</b>	Small	256 - 362				100%	362
	Small	362 - 512				100%	512
	Medium	512 - 1024				100%	1024
	Large-Very Large	1024 - 2048				100%	2048
<b>BEDROCK</b>	Bedrock	> 2048				100%	5000
<b>Total</b>			<b>100</b>		<b>100%</b>		

**Largest particles:** \_\_\_\_\_  
(riffle)



**Beaverdam Creek UT1 (Reaches 2-5)  
X5 Riffle  
Pebble Count Particle Size Distribution**

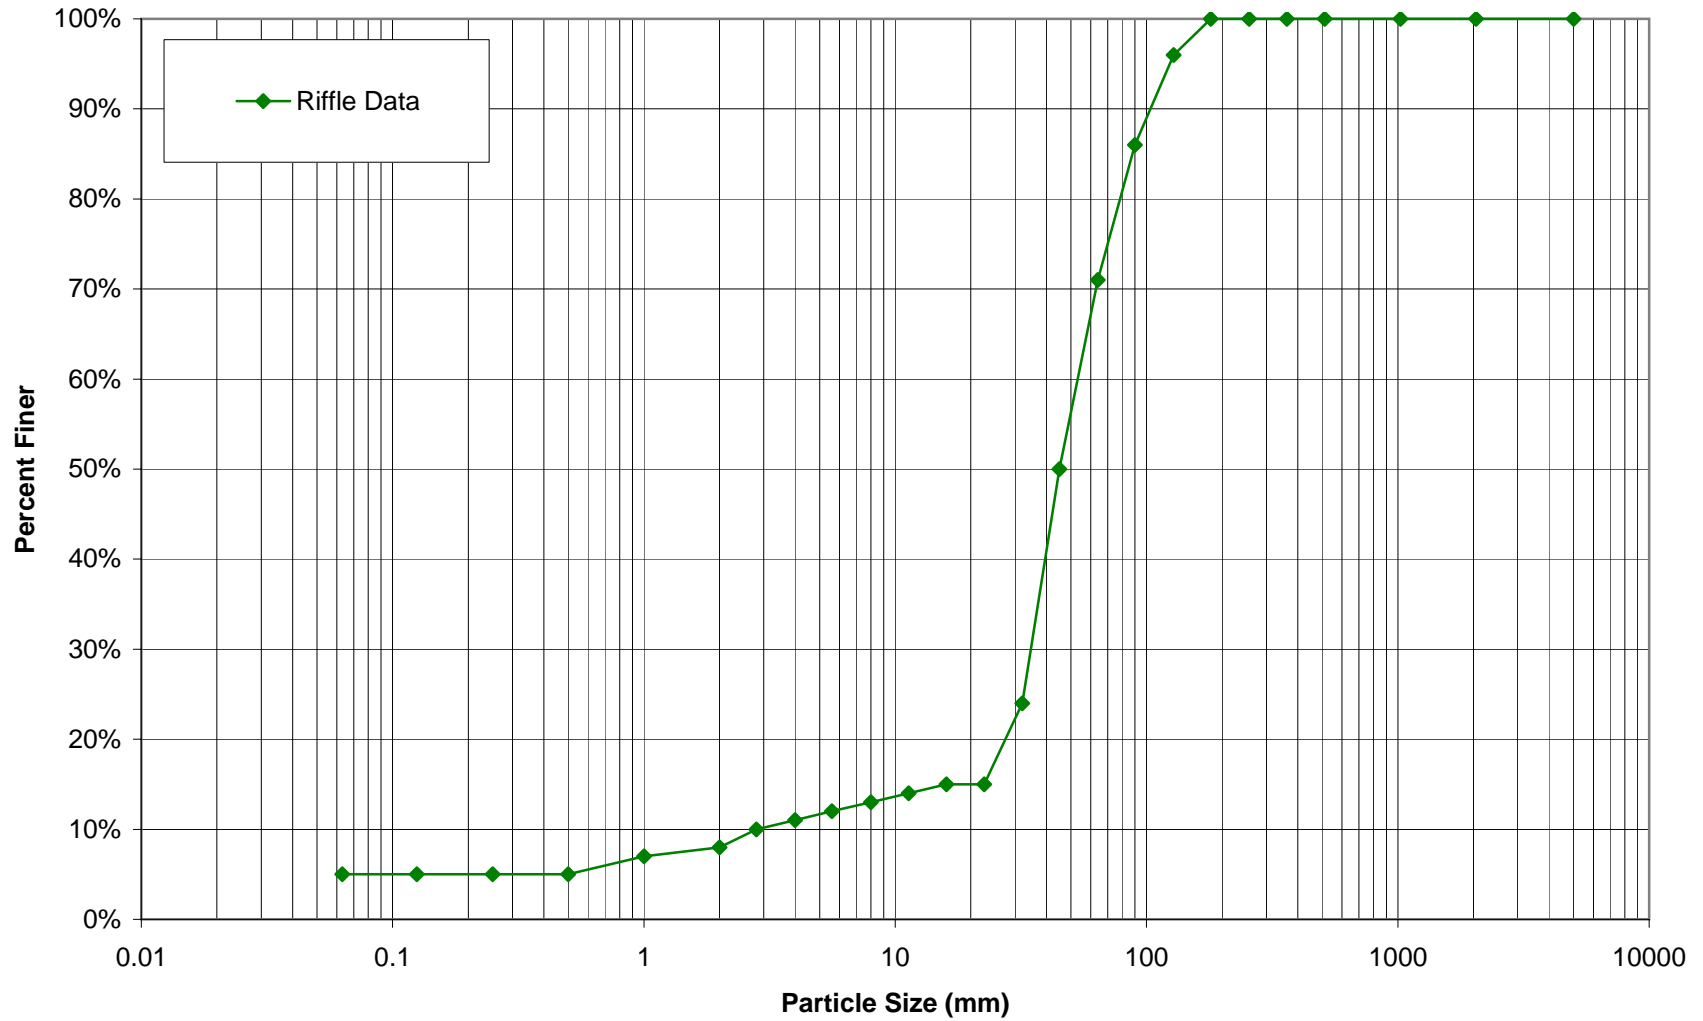

## PEBBLE COUNT DATA SHEET: POOL 100-COUNT


BAKER PROJECT NO. 108528

SITE OR PROJECT:	Beaverdam Creek 1st Year Monitoring
REACH/LOCATION:	UT1 X6-Pool (Reach 2-5)
DATE COLLECTED:	10/15/2007
FIELD COLLECTION BY:	RR/IE
DATA ENTRY BY:	IE

MATERIAL	PARTICLE	SIZE (mm)	PARTICLE CLASS COUNT		Summary		Distribution Plot Size (mm)
			Pool		Class %	% Cum	
SILT/CLAY	Silt / Clay	< .063	35		35%	35%	0.063
	S A N D	Very Fine	.063 - .125	4		4%	39%
Fine		.125 - .25	16		16%	55%	0.25
Medium		.25 - .50	34		34%	89%	0.50
Coarse		.50 - 1.0	10		10%	99%	1.0
Very Coarse		1.0 - 2.0				99%	2.0
G R A V E L	Very Fine	2.0 - 2.8				99%	2.8
	Very Fine	2.8 - 4.0				99%	4.0
	Fine	4.0 - 5.6				99%	5.6
	Fine	5.6 - 8.0				99%	8.0
	Medium	8.0 - 11.0				99%	11.3
	Medium	11.0 - 16.0				99%	16.0
	Coarse	16.0 - 22.6				99%	22.6
	Coarse	22.6 - 32	1		1%	100%	32
	Very Coarse	32 - 45				100%	45
	Very Coarse	45 - 64				100%	64
C O B B L E	Small	64 - 90				100%	90
	Small	90 - 128				100%	128
	Large	128 - 180				100%	180
	Large	180 - 256				100%	256
B O U L D E R	Small	256 - 362				100%	362
	Small	362 - 512				100%	512
	Medium	512 - 1024				100%	1024
	Large-Very Large	1024 - 2048				100%	2048
BEDROCK	Bedrock	> 2048				100%	5000
<b>Total</b>			<b>100</b>		<b>100%</b>		

Largest particles: \_\_\_\_\_  
(riffle)

Beaverdam Creek UT1 (Reaches 2-5)  
X6 Pool  
Pebble Count Particle Size Distribution

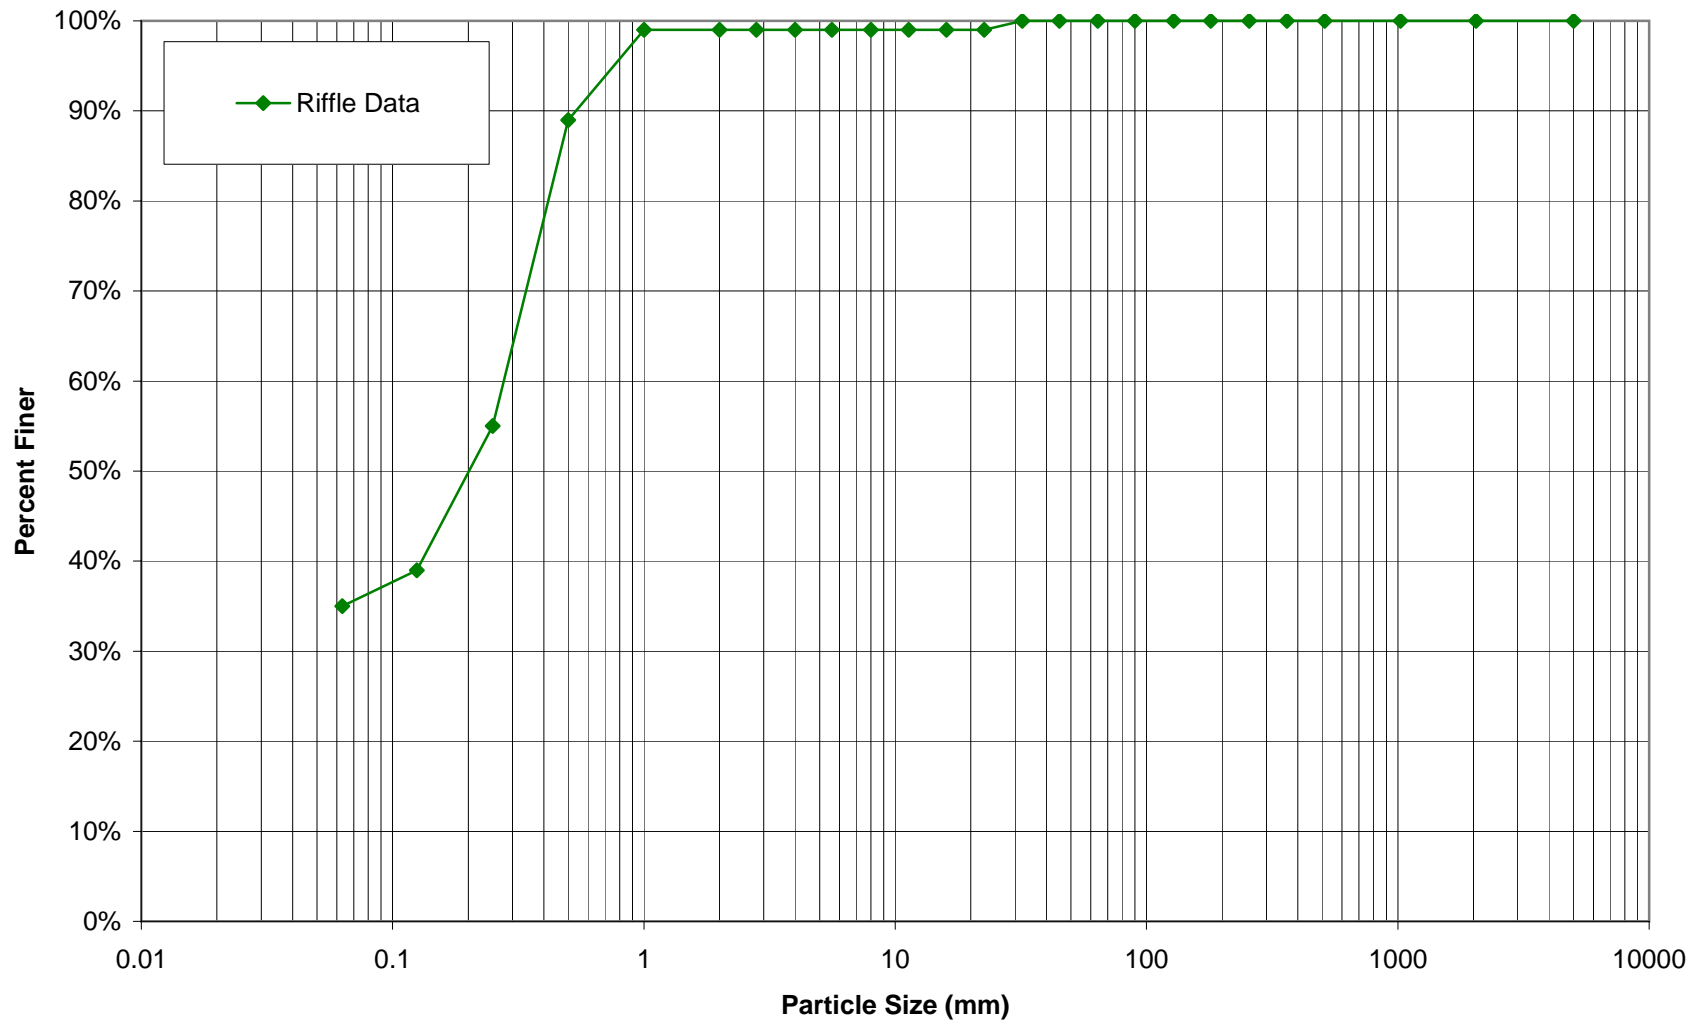

## PEBBLE COUNT DATA SHEET: RIFFLE 100-COUNT


BAKER PROJECT NO. 108528

SITE OR PROJECT:	Beaverdam Creek 1st Year Monitoring
REACH/LOCATION:	UT1C X7-Riffle
DATE COLLECTED:	10/15/2007
FIELD COLLECTION BY:	RR/IE
DATA ENTRY BY:	IE

MATERIAL	PARTICLE	SIZE (mm)	PARTICLE CLASS COUNT		Summary		Distribution Plot Size (mm)
			Riffle		Class %	% Cum	
SILT/CLAY	Silt / Clay	< .063	10		10%	10%	0.063
S A N D	Very Fine	.063 - .125				10%	0.125
	Fine	.125 - .25	1		1%	11%	0.25
	Medium	.25 - .50				11%	0.50
	Coarse	.50 - 1.0				11%	1.0
	Very Coarse	1.0 - 2.0				11%	2.0
G R A V E L	Very Fine	2.0 - 2.8				11%	2.8
	Very Fine	2.8 - 4.0				11%	4.0
	Fine	4.0 - 5.6				11%	5.6
	Fine	5.6 - 8.0				11%	8.0
	Medium	8.0 - 11.0				11%	11.3
	Medium	11.0 - 16.0				11%	16.0
	Coarse	16.0 - 22.6				11%	22.6
	Coarse	22.6 - 32	10		10%	21%	32
	Very Coarse	32 - 45	31		31%	52%	45
	Very Coarse	45 - 64	19		19%	71%	64
C O B B L E	Small	64 - 90	23		23%	94%	90
	Small	90 - 128	3		3%	97%	128
	Large	128 - 180	3		3%	100%	180
	Large	180 - 256				100%	256
B O U L D E R	Small	256 - 362				100%	362
	Small	362 - 512				100%	512
	Medium	512 - 1024				100%	1024
	Large-Very Large	1024 - 2048				100%	2048
BEDROCK	Bedrock	> 2048				100%	5000
<b>Total</b>			<b>100</b>		<b>100%</b>		

Largest particles: \_\_\_\_\_  
(riffle)

Beaverdam Creek UT1C  
X7 Riffle  
Pebble Count Particle Size Distribution

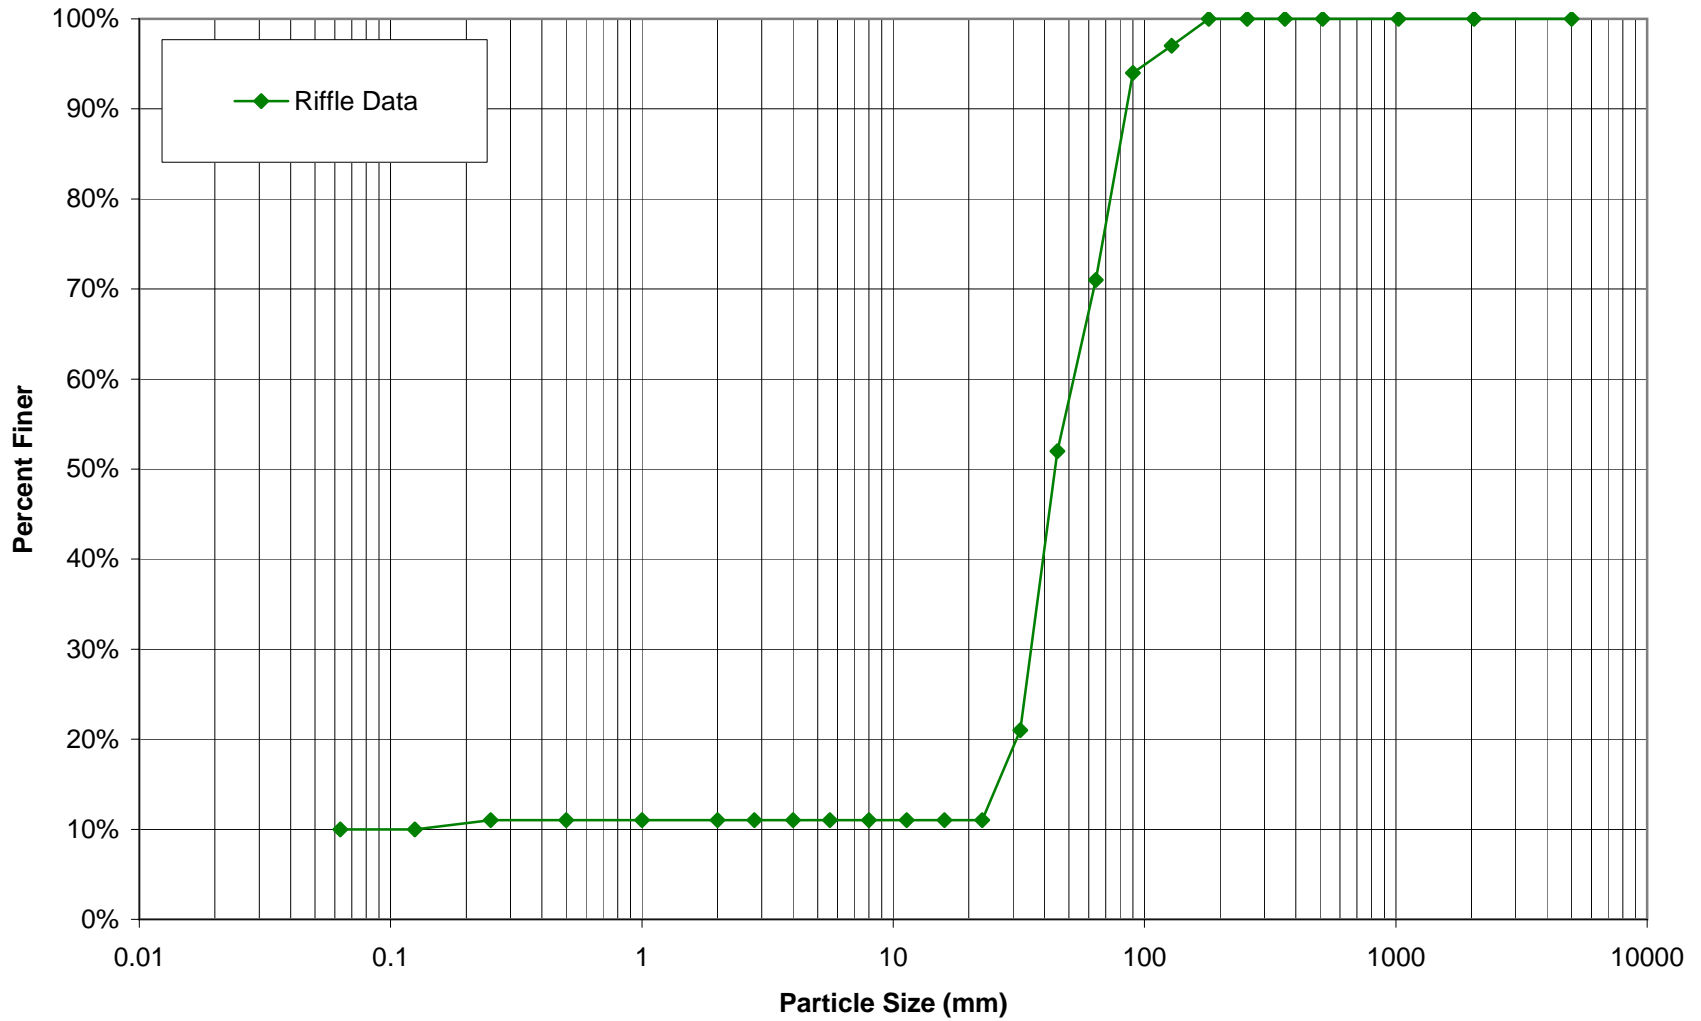

## PEBBLE COUNT DATA SHEET: POOL 100-COUNT


BAKER PROJECT NO. 108528

SITE OR PROJECT:	Beaverdam Creek 1st Year Monitoring
REACH/LOCATION:	UT1C X-8 Pool
DATE COLLECTED:	10/15/2007
FIELD COLLECTION BY:	RR/IE
DATA ENTRY BY:	IE

MATERIAL	PARTICLE	SIZE (mm)	PARTICLE CLASS COUNT		Summary		Distribution Plot Size (mm)
			Pool	Class %	% Cum		
<b>SAND</b>	Silt / Clay	< .063	72	72%	72%		0.063
	Very Fine	.063 - .125			72%		0.125
	Fine	.125 - .25	13	13%	85%		0.25
	Medium	.25 - .50	10	10%	95%		0.50
	Coarse	.50 - 1.0			95%		1.0
<b>GRAVEL</b>	Very Coarse	1.0 - 2.0			95%		2.0
	Very Fine	2.0 - 2.8			95%		2.8
	Very Fine	2.8 - 4.0			95%		4.0
	Fine	4.0 - 5.6			95%		5.6
	Fine	5.6 - 8.0			95%		8.0
	Medium	8.0 - 11.0			95%		11.3
	Medium	11.0 - 16.0			95%		16.0
	Coarse	16.0 - 22.6	2	2%	97%		22.6
	Coarse	22.6 - 32	1	1%	98%		32
	Very Coarse	32 - 45	1	1%	99%		45
<b>COBBLE</b>	Very Coarse	45 - 64			99%		64
	Small	64 - 90	1	1%	100%		90
	Small	90 - 128			100%		128
	Large	128 - 180			100%		180
<b>BOULDER</b>	Large	180 - 256			100%		256
	Small	256 - 362			100%		362
	Small	362 - 512			100%		512
	Medium	512 - 1024			100%		1024
<b>BEDROCK</b>	Large-Very Large	1024 - 2048			100%		2048
	Bedrock	> 2048			100%		5000
<b>Total</b>			<b>100</b>	<b>100%</b>			

Largest particles: \_\_\_\_\_  
(riffle)

Beaverdam Creek UT1C  
X8 Pool  
Pebble Count Particle Size Distribution

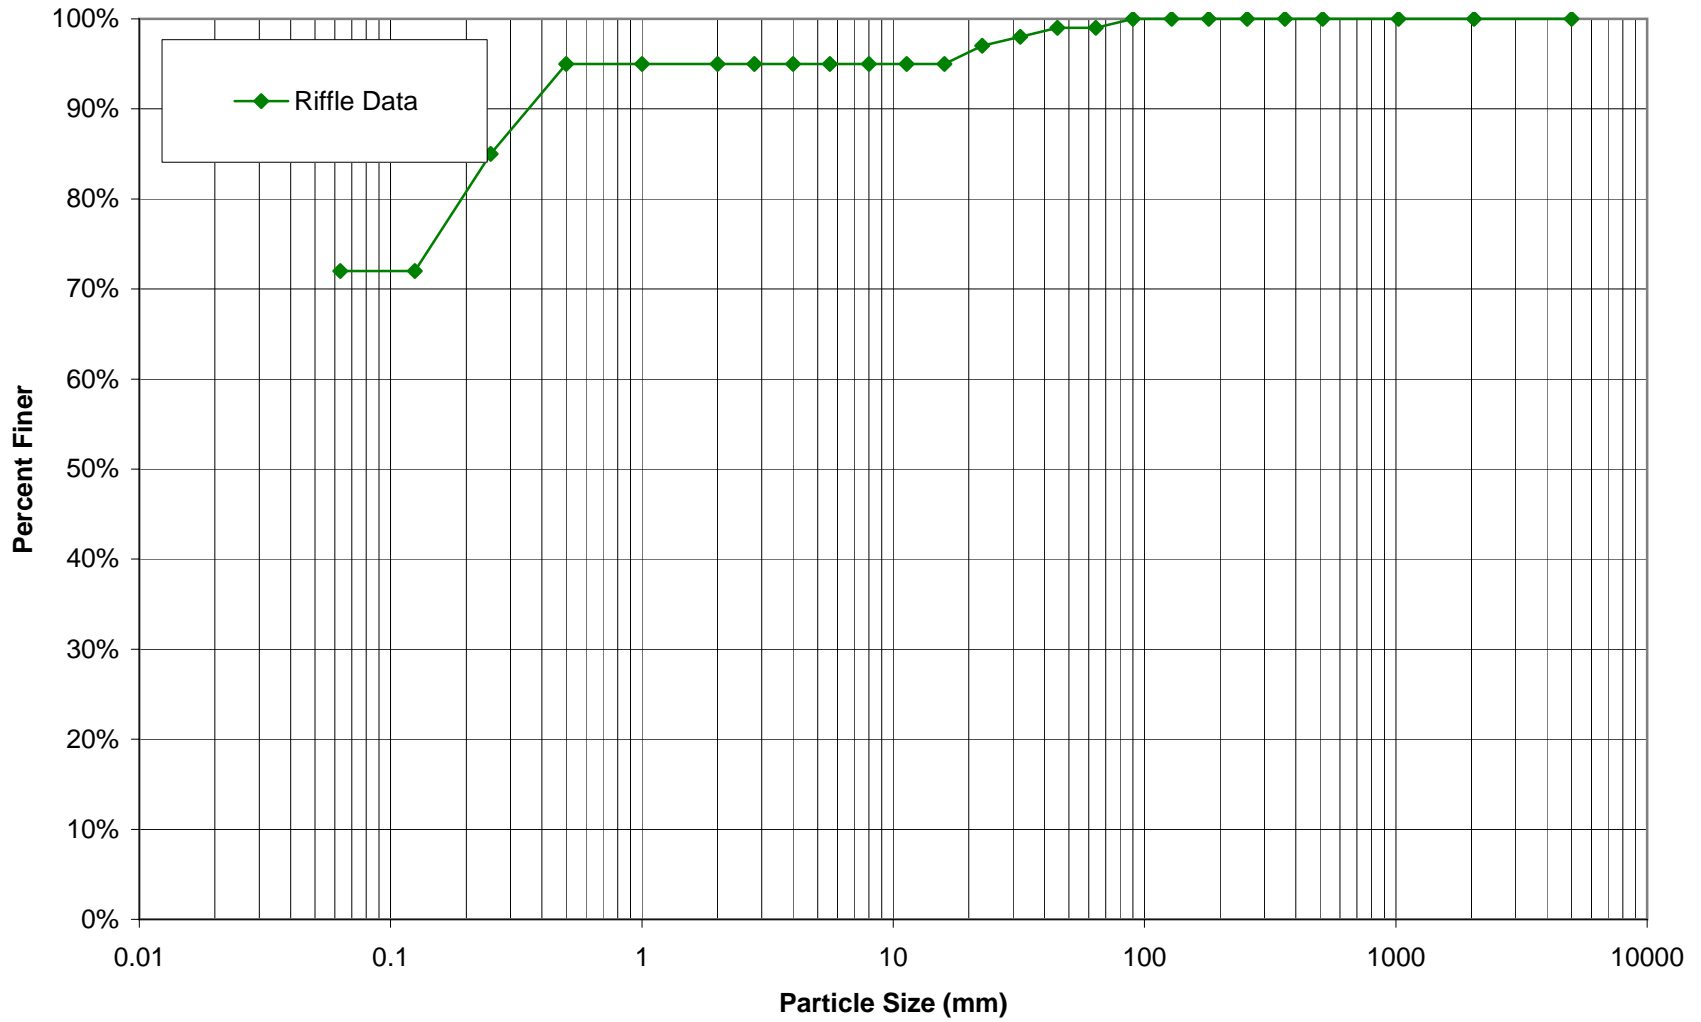

**PEBBLE COUNT DATA SHEET: RIFFLE 100-COUNT**

BAKER PROJECT NO. 108528


SITE OR PROJECT:	Beaverdam Creek 1st Year Monitoring
REACH/LOCATION:	UT1 X-9 Riffle (Reach 2-5)
DATE COLLECTED:	10/15/2007
FIELD COLLECTION BY:	RR/IE
DATA ENTRY BY:	IE

MATERIAL	PARTICLE	SIZE (mm)	PARTICLE CLASS COUNT		Summary		Distribution Plot Size (mm)
			Riffle		Class %	% Cum	
<b>SILT/CLAY</b>	Silt / Clay	< .063	10		10%	10%	0.063
<b>SAND</b>	Very Fine	.063 - .125				10%	0.125
	Fine	.125 - .25	2		2%	12%	0.25
	Medium	.25 - .50				12%	0.50
	Coarse	.50 - 1.0	5		5%	17%	1.0
	Very Coarse	1.0 - 2.0				17%	2.0
<b>GRAVEL</b>	Very Fine	2.0 - 2.8				17%	2.8
	Very Fine	2.8 - 4.0				17%	4.0
	Fine	4.0 - 5.6				17%	5.6
	Fine	5.6 - 8.0				17%	8.0
	Medium	8.0 - 11.0				17%	11.3
	Medium	11.0 - 16.0	2		2%	19%	16.0
	Coarse	16.0 - 22.6	3		3%	22%	22.6
	Coarse	22.6 - 32	15		15%	37%	32
	Very Coarse	32 - 45	31		31%	68%	45
	Very Coarse	45 - 64	13		13%	81%	64
<b>COBBLE</b>	Small	64 - 90	7		7%	88%	90
	Small	90 - 128	9		9%	97%	128
	Large	128 - 180	1		1%	98%	180
	Large	180 - 256	2		2%	100%	256
<b>BOULDER</b>	Small	256 - 362				100%	362
	Small	362 - 512				100%	512
	Medium	512 - 1024				100%	1024
	Large-Very Large	1024 - 2048				100%	2048
<b>BEDROCK</b>	Bedrock	> 2048				100%	5000
<b>Total</b>			<b>100</b>		<b>100%</b>		

**Largest particles:** \_\_\_\_\_  
(riffle)



**Beaverdam Creek UT1 (Reaches 2-5)  
X9 Riffle  
Pebble Count Particle Size Distribution**

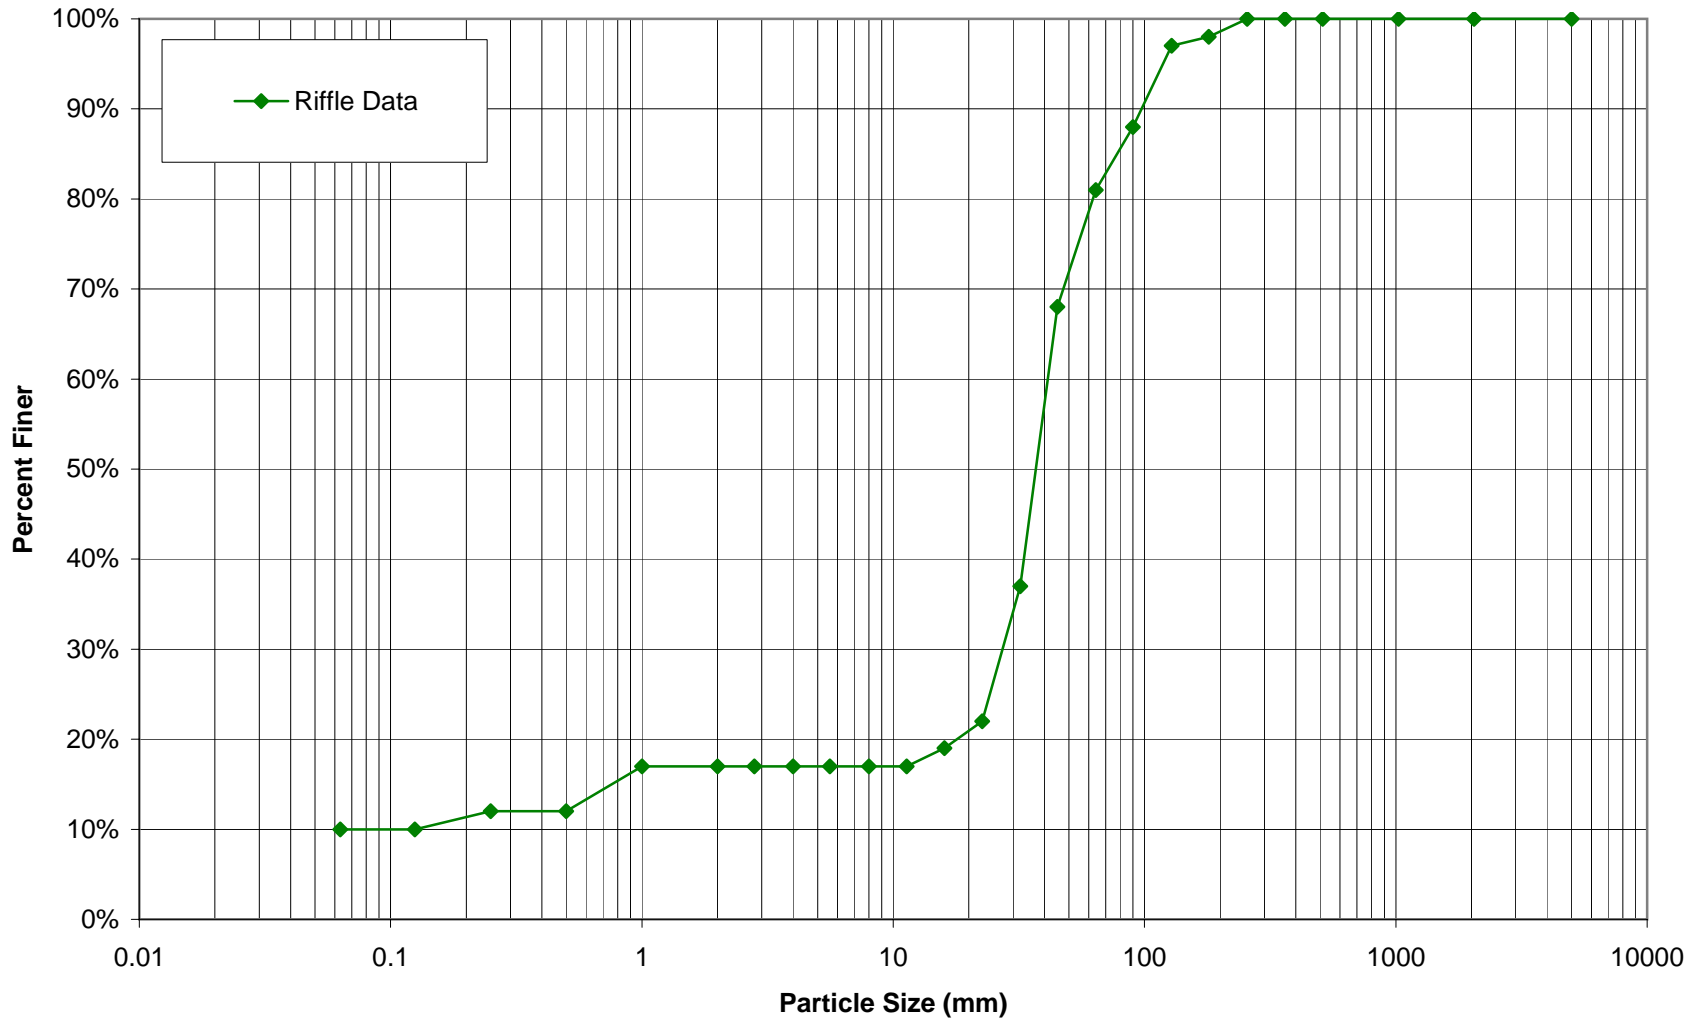


## PEBBLE COUNT DATA SHEET: POOL 100-COUNT

	<b>BUCK PROJECT NO.</b>	108528
SITE OR PROJECT:	Beaverdam Creek 1st Year Monitoring	
REACH/LOCATION:	UT1 X-10 Pool (Reach 2-5)	
DATE COLLECTED:	10/15/2007	
FIELD COLLECTION BY:	RR/IE	
DATA ENTRY BY:	IE	

MATERIAL	PARTICLE	SIZE (mm)	PARTICLE CLASS COUNT		Summary		Distribution Plot Size (mm)
			Pool	Class %	% Cum		
<b>SILT/CLAY</b>	Silt / Clay	< .063	64	64%	64%	0.063	
	<b>S A N D</b>	Very Fine	.063 - .125	5	5%	69%	0.125
Fine		.125 - .25	8	8%	77%	0.25	
Medium		.25 - .50	4	4%	81%	0.50	
Coarse		.50 - 1.0	7	7%	88%	1.0	
Very Coarse		1.0 - 2.0			88%	2.0	
<b>G R A V E L</b>	Very Fine	2.0 - 2.8			88%	2.8	
	Very Fine	2.8 - 4.0			88%	4.0	
	Fine	4.0 - 5.6			88%	5.6	
	Fine	5.6 - 8.0			88%	8.0	
	Medium	8.0 - 11.0	1	1%	89%	11.3	
	Medium	11.0 - 16.0	2	2%	91%	16.0	
	Coarse	16.0 - 22.6	1	1%	92%	22.6	
	Coarse	22.6 - 32	3	3%	95%	32	
	Very Coarse	32 - 45	4	4%	99%	45	
	Very Coarse	45 - 64	1	1%	100%	64	
<b>COBBLE</b>	Small	64 - 90			100%	90	
	Small	90 - 128			100%	128	
	Large	128 - 180			100%	180	
	Large	180 - 256			100%	256	
<b>BOULDER</b>	Small	256 - 362			100%	362	
	Small	362 - 512			100%	512	
	Medium	512 - 1024			100%	1024	
	Large-Very Large	1024 - 2048			100%	2048	
<b>BEDROCK</b>	Bedrock	> 2048			100%	5000	
<b>Total</b>			<b>100</b>	<b>100%</b>			

**Largest particles:** \_\_\_\_\_  
(riffle)

**Beaverdam Creek UT1 (Reaches 2-5)  
X10 Pool  
Pebble Count Particle Size Distribution**

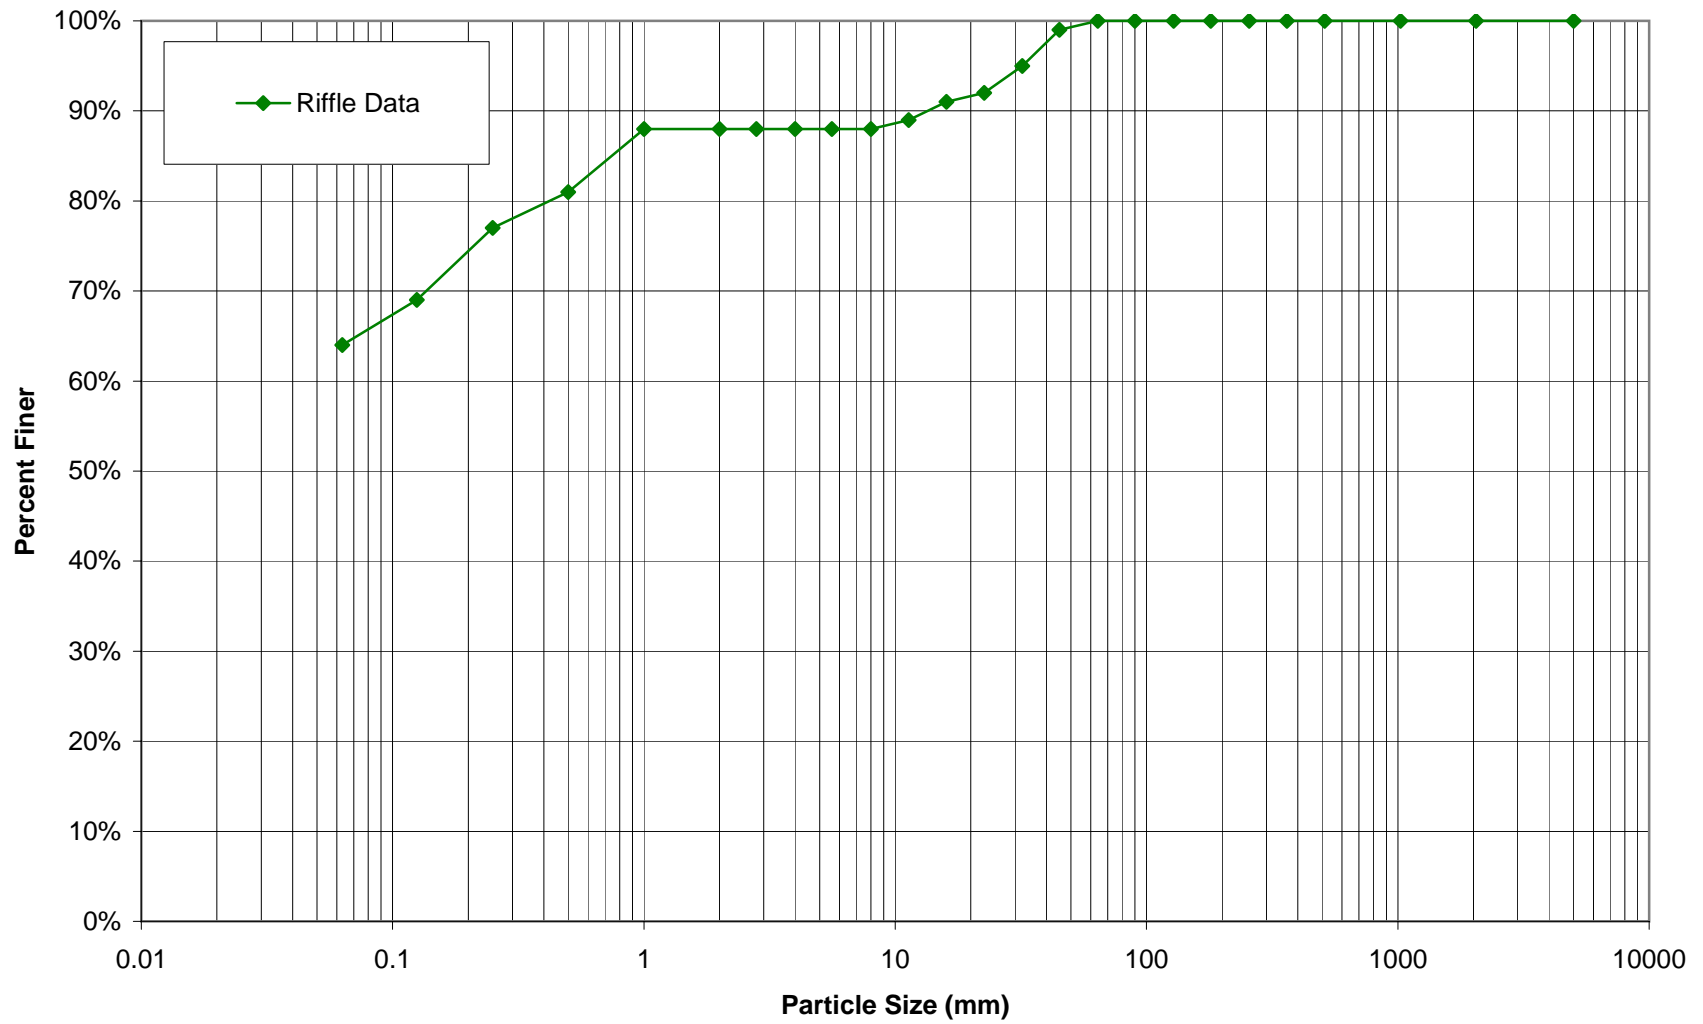

## PEBBLE COUNT DATA SHEET: POOL 100-COUNT


BAKER PROJECT NO. 108528

SITE OR PROJECT:	Beaverdam Creek 1st Year Monitoring
REACH/LOCATION:	UT1-D X-11 Pool
DATE COLLECTED:	10/15/2007
FIELD COLLECTION BY:	RR/IE
DATA ENTRY BY:	IE

MATERIAL	PARTICLE	SIZE (mm)	PARTICLE CLASS COUNT		Summary		Distribution Plot Size (mm)
			Pool	Class %	% Cum		
<b>SILT/CLAY</b>	Silt / Clay	< .063	61	61%	61%	0.063	
	<b>S A N D</b>	Very Fine	.063 - .125	6	6%	67%	0.125
Fine		.125 - .25	22	22%	89%	0.25	
Medium		.25 - .50			89%	0.50	
Coarse		.50 - 1.0			89%	1.0	
Very Coarse		1.0 - 2.0			89%	2.0	
<b>G R A V E L</b>	Very Fine	2.0 - 2.8			89%	2.8	
	Very Fine	2.8 - 4.0			89%	4.0	
	Fine	4.0 - 5.6			89%	5.6	
	Fine	5.6 - 8.0	1	1%	90%	8.0	
	Medium	8.0 - 11.0	3	3%	93%	11.3	
	Medium	11.0 - 16.0	1	1%	94%	16.0	
	Coarse	16.0 - 22.6	4	4%	98%	22.6	
	Coarse	22.6 - 32	1	1%	99%	32	
	Very Coarse	32 - 45	1	1%	100%	45	
	Very Coarse	45 - 64			100%	64	
<b>COBBLE</b>	Small	64 - 90			100%	90	
	Small	90 - 128			100%	128	
	Large	128 - 180			100%	180	
	Large	180 - 256			100%	256	
<b>BOULDER</b>	Small	256 - 362			100%	362	
	Small	362 - 512			100%	512	
	Medium	512 - 1024			100%	1024	
	Large-Very Large	1024 - 2048			100%	2048	
<b>BEDROCK</b>	Bedrock	> 2048			100%	5000	
<b>Total</b>			<b>100</b>	<b>100%</b>			

Largest particles: \_\_\_\_\_  
(riffle)

Beaverdam Creek UT1D  
X11 Pool  
Pebble Count Particle Size Distribution

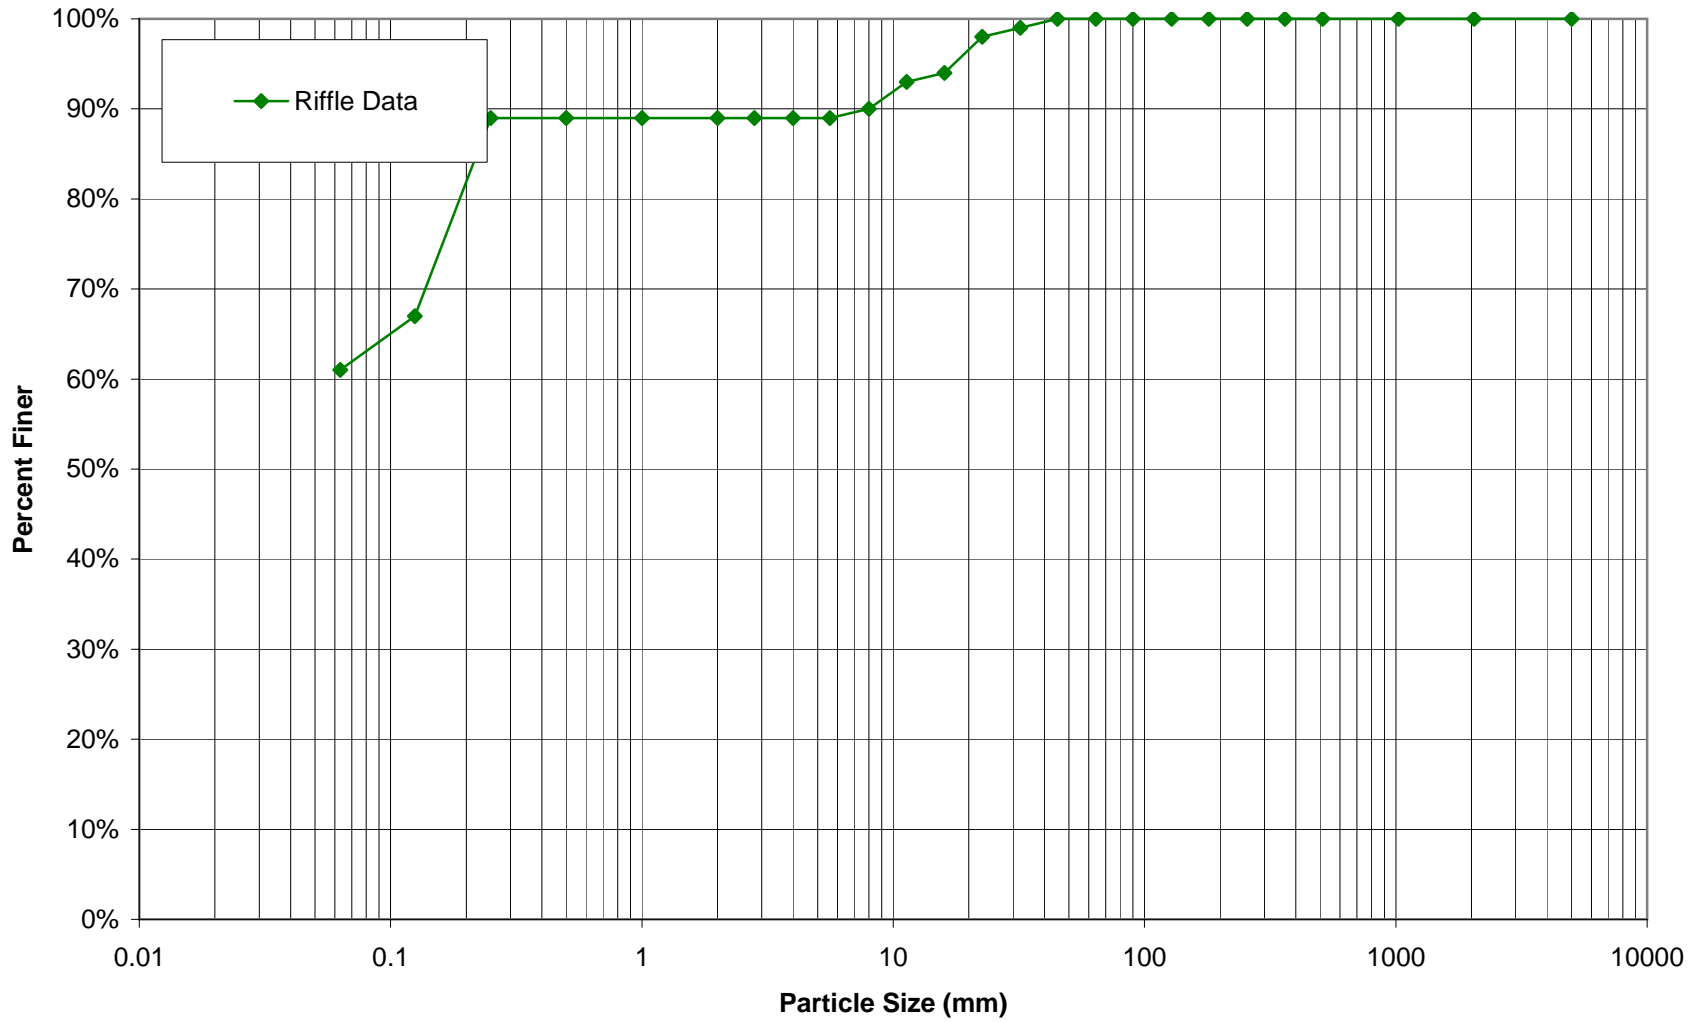

**PEBBLE COUNT DATA SHEET: RIFFLE 100-COUNT**


BAKER PROJECT NO. 108528

SITE OR PROJECT:	Beaverdam Creek 1st Year Monitoring
REACH/LOCATION:	UT1-D X-12 Riffle
DATE COLLECTED:	10/15/2007
FIELD COLLECTION BY:	RR/IE
DATA ENTRY BY:	IE

MATERIAL	PARTICLE	SIZE (mm)	PARTICLE CLASS COUNT		Summary		Distribution Plot Size (mm)
			Riffle		Class %	% Cum	
<b>SILT/CLAY</b>	Silt / Clay	< .063	2		2%	2%	0.063
<b>SAND</b>	Very Fine	.063 - .125				2%	0.125
	Fine	.125 - .25	3		3%	5%	0.25
	Medium	.25 - .50				5%	0.50
	Coarse	.50 - 1.0				5%	1.0
	Very Coarse	1.0 - 2.0				5%	2.0
<b>GRAVEL</b>	Very Fine	2.0 - 2.8				5%	2.8
	Very Fine	2.8 - 4.0	1		1%	6%	4.0
	Fine	4.0 - 5.6				6%	5.6
	Fine	5.6 - 8.0				6%	8.0
	Medium	8.0 - 11.0				6%	11.3
	Medium	11.0 - 16.0	1		1%	7%	16.0
	Coarse	16.0 - 22.6	1		1%	8%	22.6
	Coarse	22.6 - 32	8		8%	16%	32
	Very Coarse	32 - 45	37		37%	53%	45
	Very Coarse	45 - 64	22		22%	75%	64
<b>COBBLE</b>	Small	64 - 90	11		11%	86%	90
	Small	90 - 128	11		11%	97%	128
	Large	128 - 180	3		3%	100%	180
	Large	180 - 256				100%	256
<b>BOULDER</b>	Small	256 - 362				100%	362
	Small	362 - 512				100%	512
	Medium	512 - 1024				100%	1024
	Large-Very Large	1024 - 2048				100%	2048
<b>BEDROCK</b>	Bedrock	> 2048				100%	5000
<b>Total</b>			<b>100</b>		<b>100%</b>		

**Largest particles:** \_\_\_\_\_  
(riffle)

Beaverdam Creek UT1D  
X12 Riffle  
Pebble Count Particle Size Distribution

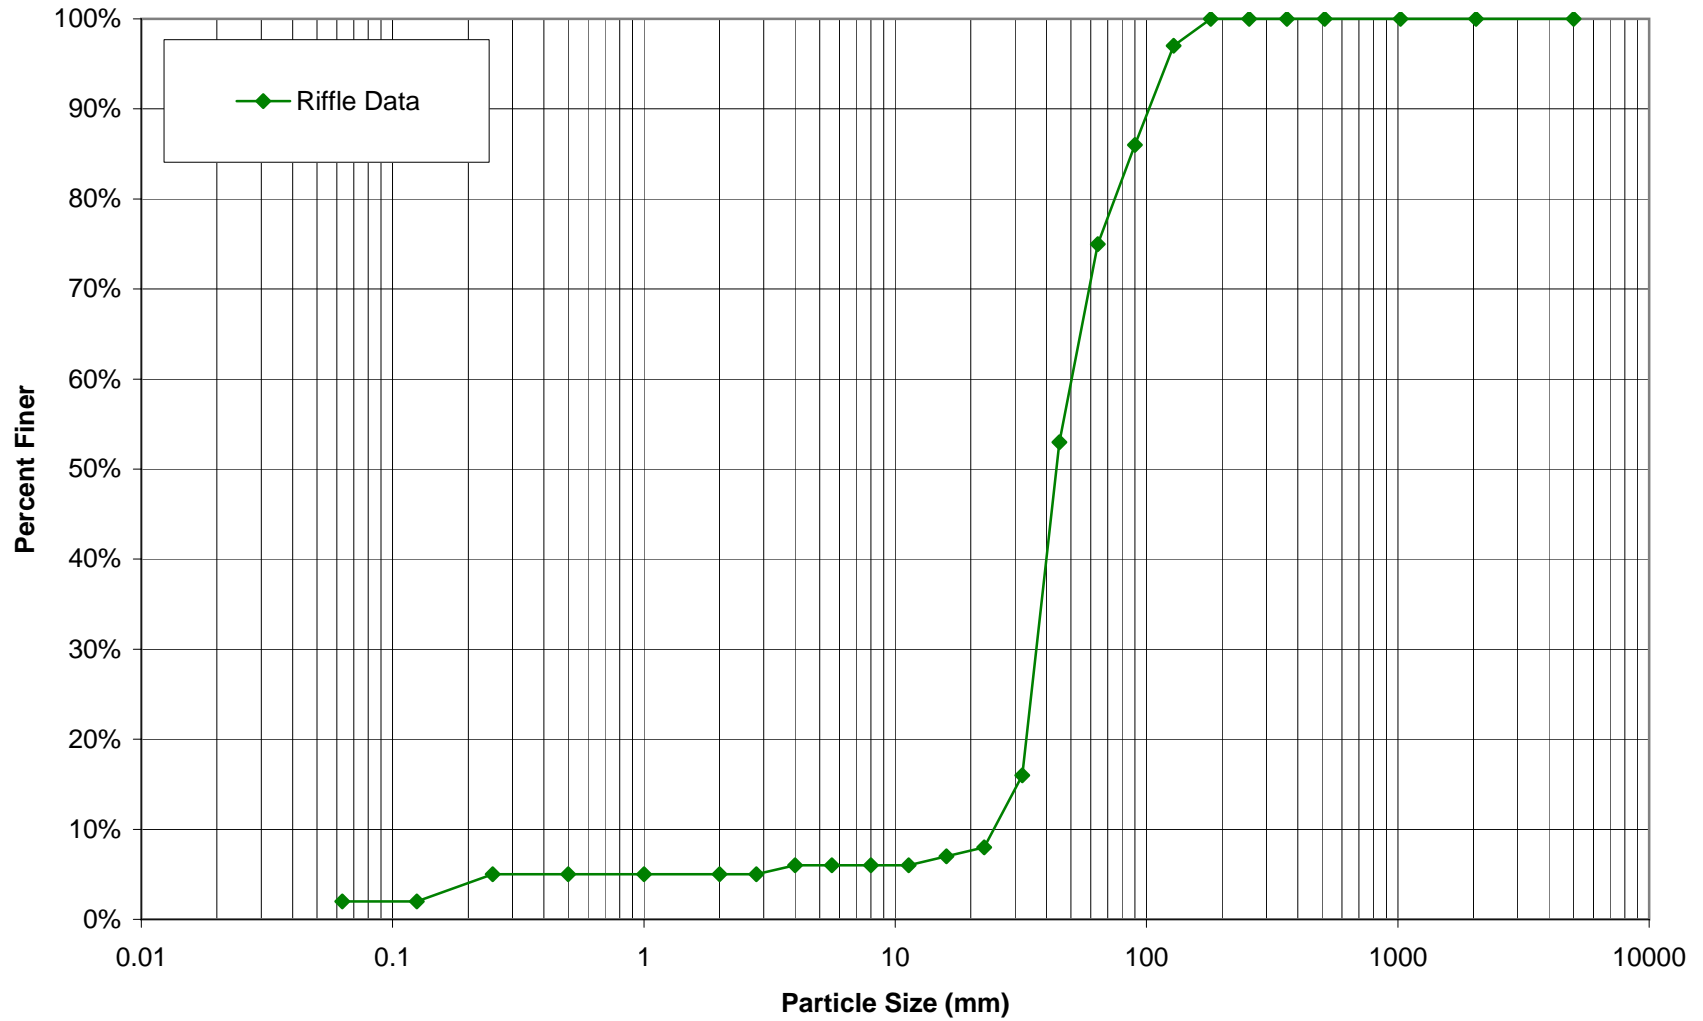

## PEBBLE COUNT DATA SHEET: POOL 100-COUNT

BAKER PROJECT NO. 108528


SITE OR PROJECT:	Beaverdam Creek 1st Year Monitoring
REACH/LOCATION:	UT1 X-13 Pool (Reach 2-5)
DATE COLLECTED:	10/15/2007
FIELD COLLECTION BY:	RR/IE
DATA ENTRY BY:	IE

MATERIAL	PARTICLE	SIZE (mm)	PARTICLE CLASS COUNT		Summary		Distribution Plot Size (mm)
			Pool	Class %	% Cum		
<b>SAND</b>	Silt / Clay	< .063	24	24%	24%	0.063	
	Very Fine	.063 - .125			24%	0.125	
	Fine	.125 - .25	17	17%	41%	0.25	
	Medium	.25 - .50	31	31%	72%	0.50	
	Coarse	.50 - 1.0	20	20%	92%	1.0	
<b>GRAVEL</b>	Very Coarse	1.0 - 2.0	1	1%	93%	2.0	
	Very Fine	2.0 - 2.8			93%	2.8	
	Very Fine	2.8 - 4.0			93%	4.0	
	Fine	4.0 - 5.6			93%	5.6	
	Fine	5.6 - 8.0			93%	8.0	
	Medium	8.0 - 11.0	1	1%	94%	11.3	
	Medium	11.0 - 16.0			94%	16.0	
	Coarse	16.0 - 22.6	1	1%	95%	22.6	
	Coarse	22.6 - 32	4	4%	99%	32	
	Very Coarse	32 - 45	1	1%	100%	45	
<b>COBBLE</b>	Very Coarse	45 - 64			100%	64	
	Small	64 - 90			100%	90	
	Small	90 - 128			100%	128	
	Large	128 - 180			100%	180	
<b>BOULDER</b>	Large	180 - 256			100%	256	
	Small	256 - 362			100%	362	
	Small	362 - 512			100%	512	
	Medium	512 - 1024			100%	1024	
<b>BEDROCK</b>	Large-Very Large	1024 - 2048			100%	2048	
	Bedrock	> 2048			100%	5000	
<b>Total</b>			<b>100</b>	<b>100%</b>			

Largest particles: \_\_\_\_\_  
(riffle)



**Beaverdam Creek UT1 (Reaches 2-5)  
X13 Pool  
Pebble Count Particle Size Distribution**

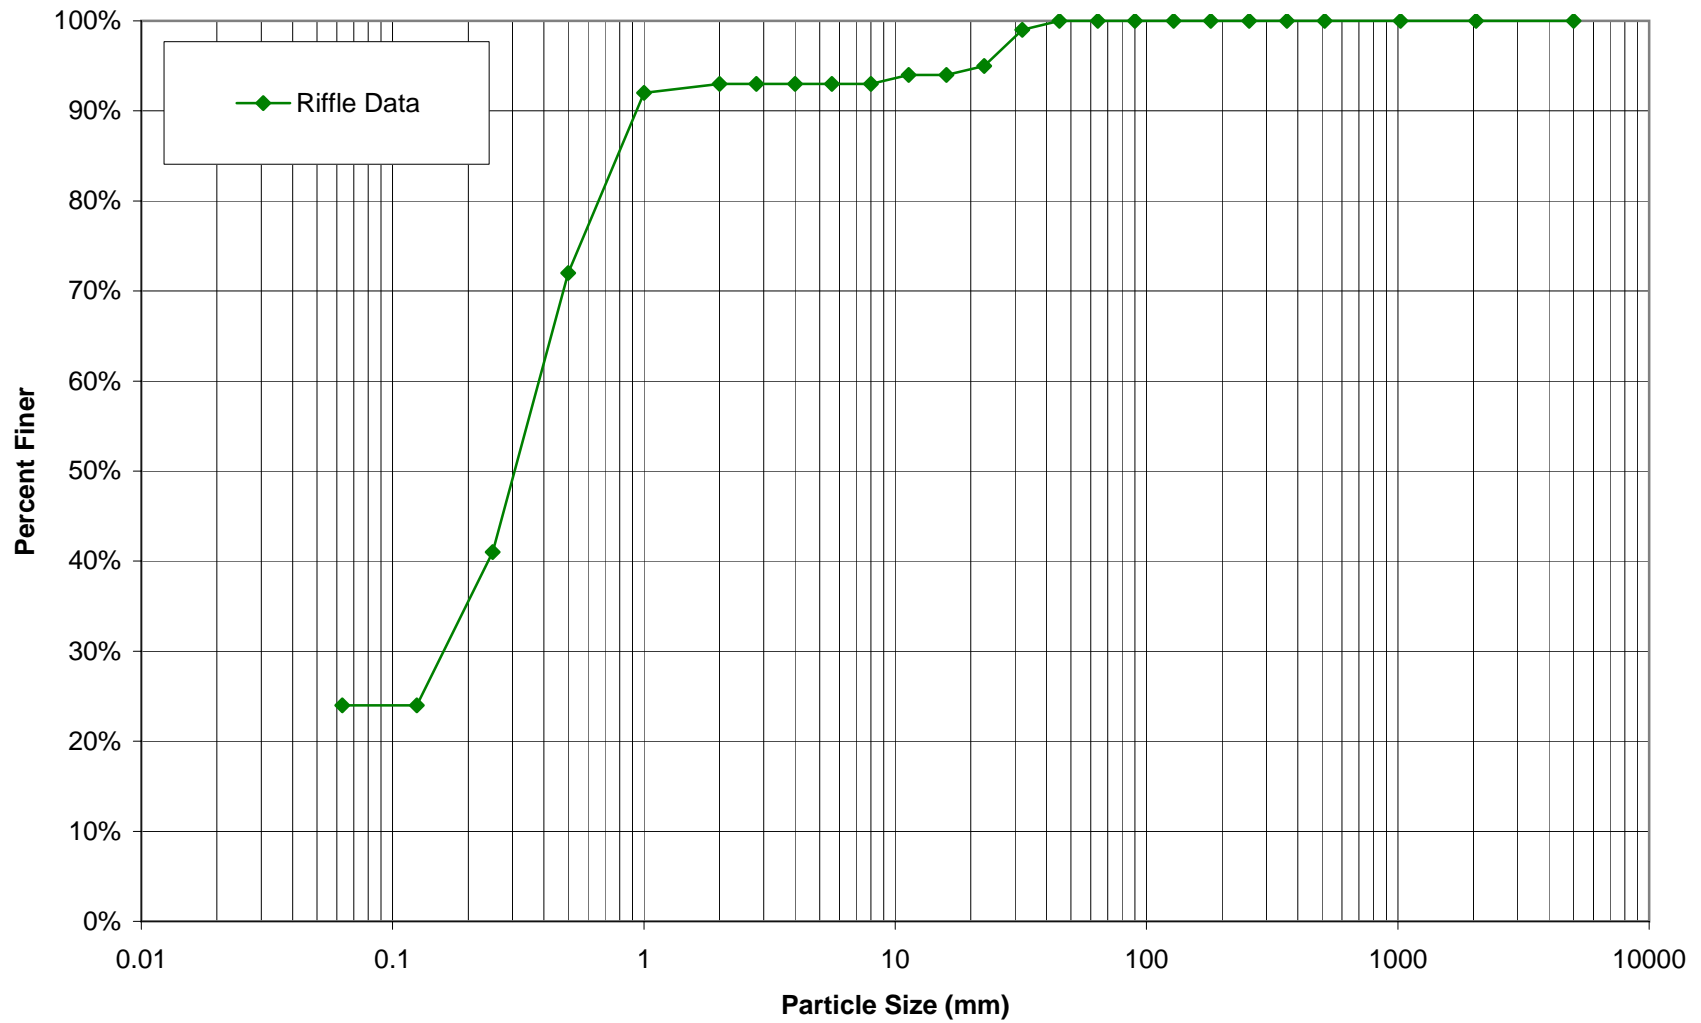

## PEBBLE COUNT DATA SHEET: RIFFLE 100-COUNT


BAKER PROJECT NO. 108528

SITE OR PROJECT:	Beaverdam Creek 1st Year Monitoring
REACH/LOCATION:	UT1 X-14 Riffle (Reach 2-5)
DATE COLLECTED:	10/15/2007
FIELD COLLECTION BY:	RR/IE
DATA ENTRY BY:	IE

MATERIAL	PARTICLE	SIZE (mm)	PARTICLE CLASS COUNT		Summary		Distribution Plot Size (mm)
			Riffle		Class %	% Cum	
SILT/CLAY	Silt / Clay	< .063	10		10%	10%	0.063
S A N D	Very Fine	.063 - .125				10%	0.125
	Fine	.125 - .25	12		12%	22%	0.25
	Medium	.25 - .50	12		12%	34%	0.50
	Coarse	.50 - 1.0	2		2%	36%	1.0
	Very Coarse	1.0 - 2.0				36%	2.0
G R A V E L	Very Fine	2.0 - 2.8				36%	2.8
	Very Fine	2.8 - 4.0				36%	4.0
	Fine	4.0 - 5.6				36%	5.6
	Fine	5.6 - 8.0	2		2%	38%	8.0
	Medium	8.0 - 11.0				38%	11.3
	Medium	11.0 - 16.0	2		2%	40%	16.0
	Coarse	16.0 - 22.6	4		4%	44%	22.6
	Coarse	22.6 - 32	8		8%	52%	32
	Very Coarse	32 - 45	14		14%	66%	45
	Very Coarse	45 - 64	16		16%	82%	64
C O B B L E	Small	64 - 90	8		8%	90%	90
	Small	90 - 128	10		10%	100%	128
	Large	128 - 180				100%	180
	Large	180 - 256				100%	256
B O U L D E R	Small	256 - 362				100%	362
	Small	362 - 512				100%	512
	Medium	512 - 1024				100%	1024
	Large-Very Large	1024 - 2048				100%	2048
BEDROCK	Bedrock	> 2048				100%	5000
<b>Total</b>			<b>100</b>		<b>100%</b>		

Largest particles: \_\_\_\_\_  
(riffle)

Beaverdam Creek UT1 (Reaches 2-5)  
X14 Riffle  
Pebble Count Particle Size Distribution

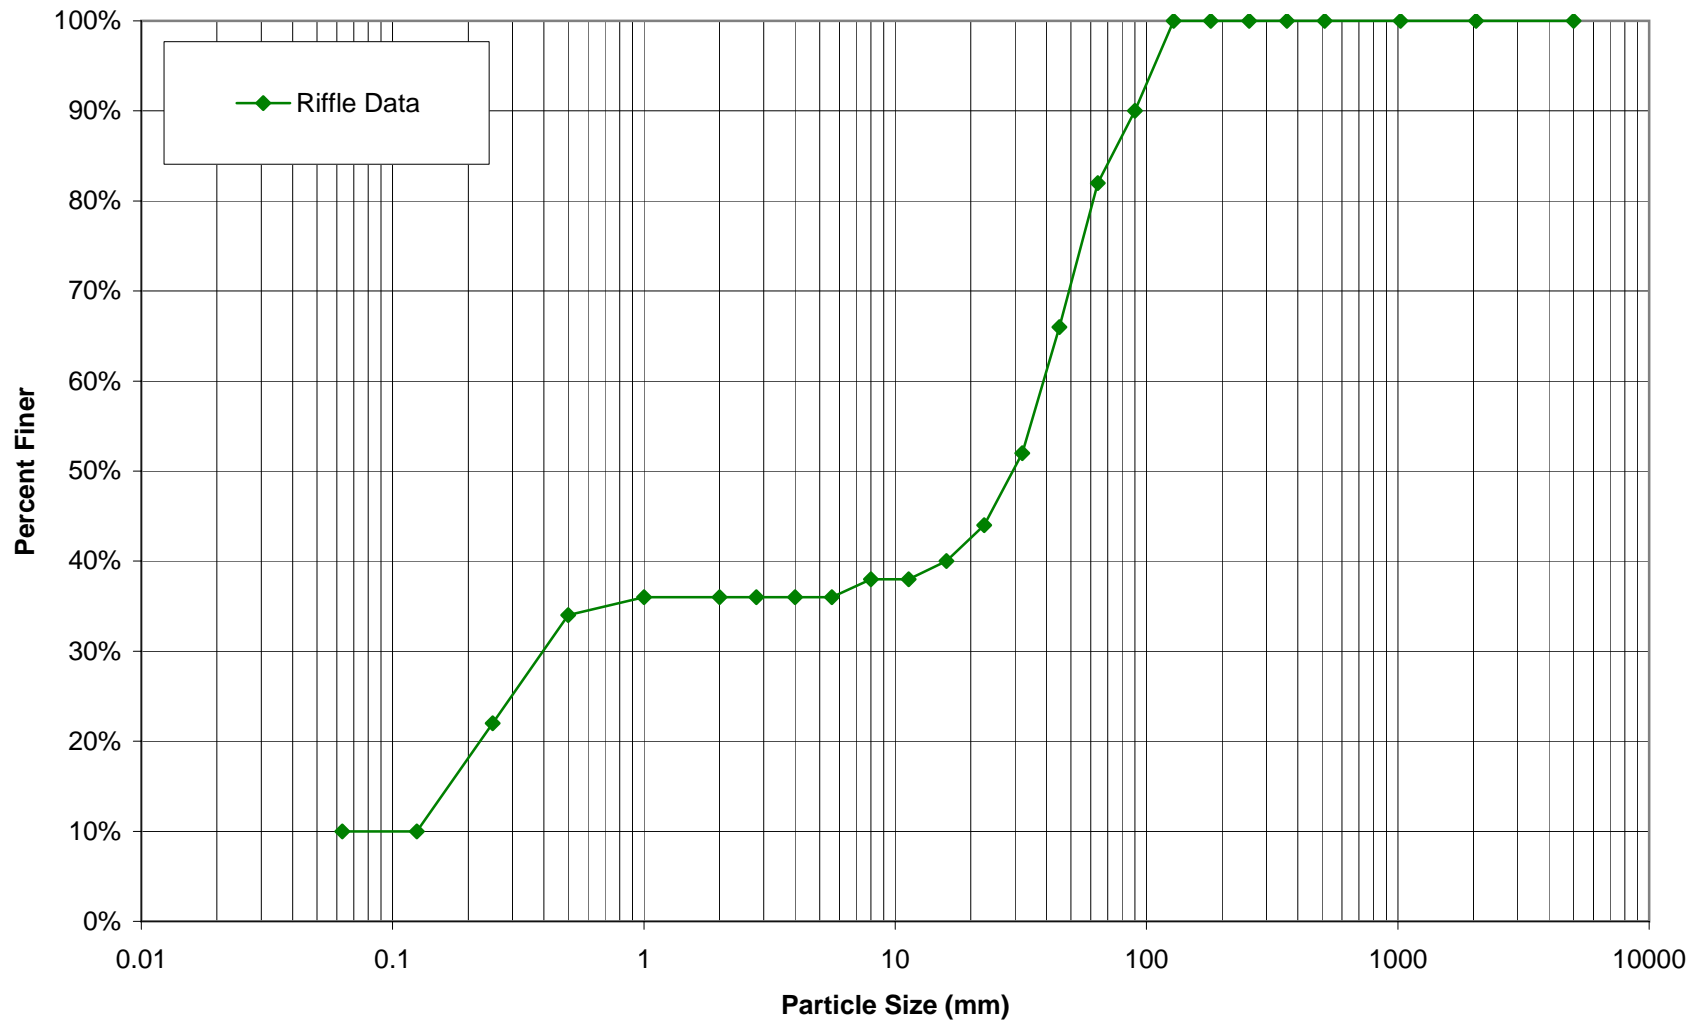

**UT1 Permanent Cross Section X1**  
 (Year 1 Monitoring Data - collected October 2007)




Looking at the Left Bank



Looking at the Right Bank

Feature	Stream Type	BKF Area	BKF Width	BKF Depth	Max BKF Depth	W/D	BH Ratio	ER	BKF Elev	TOB Elev
Pool		33.1	22.14	1.49	3.13	14.82	1	3.4	599.5	599.5

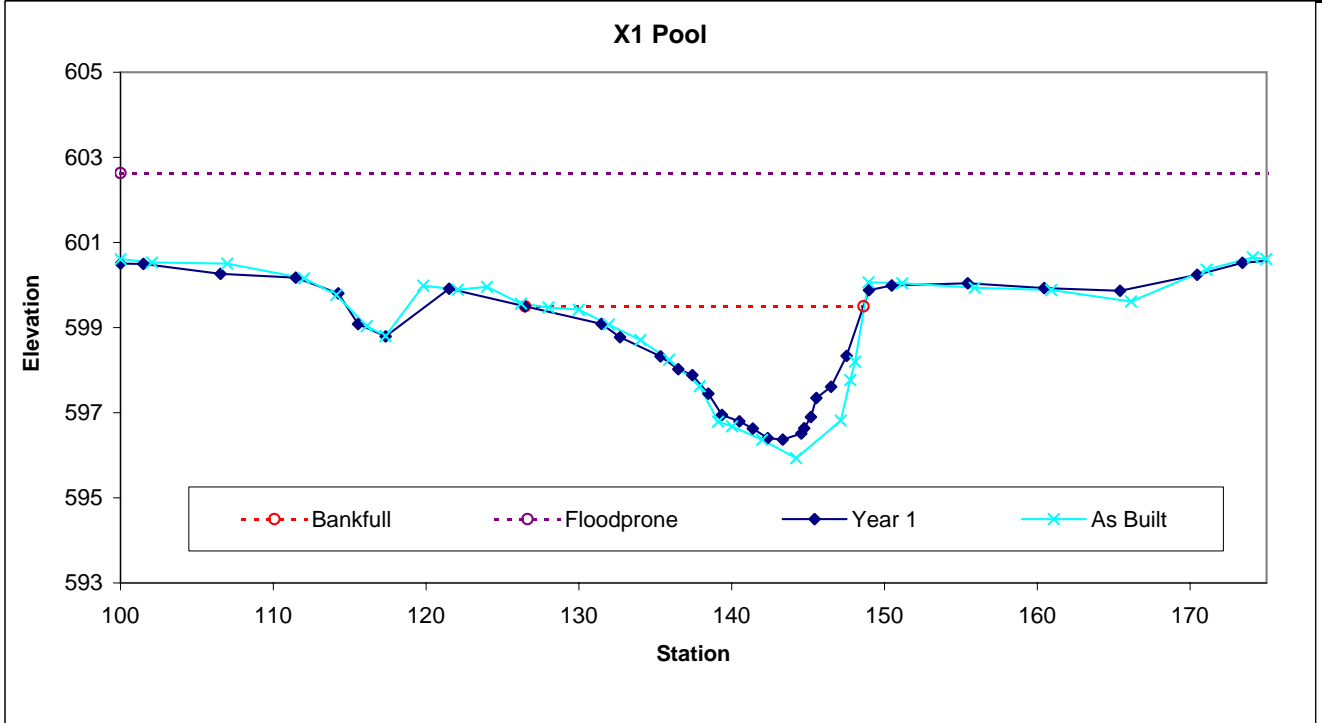

**UT1 Permanent Cross Section X2**  
 (Year 1 Monitoring Data - collected October 2007)




Looking at the Left Bank



Looking at the Right Bank

Feature	Stream Type	BKF Area	BKF Width	BKF Depth	Max BKF Depth	W/D	BH Ratio	ER	BKF Elev	TOB Elev
Riffle	C/E	18.8	13.12	1.43	2.06	9.17	1	5.7	598.82	598.82

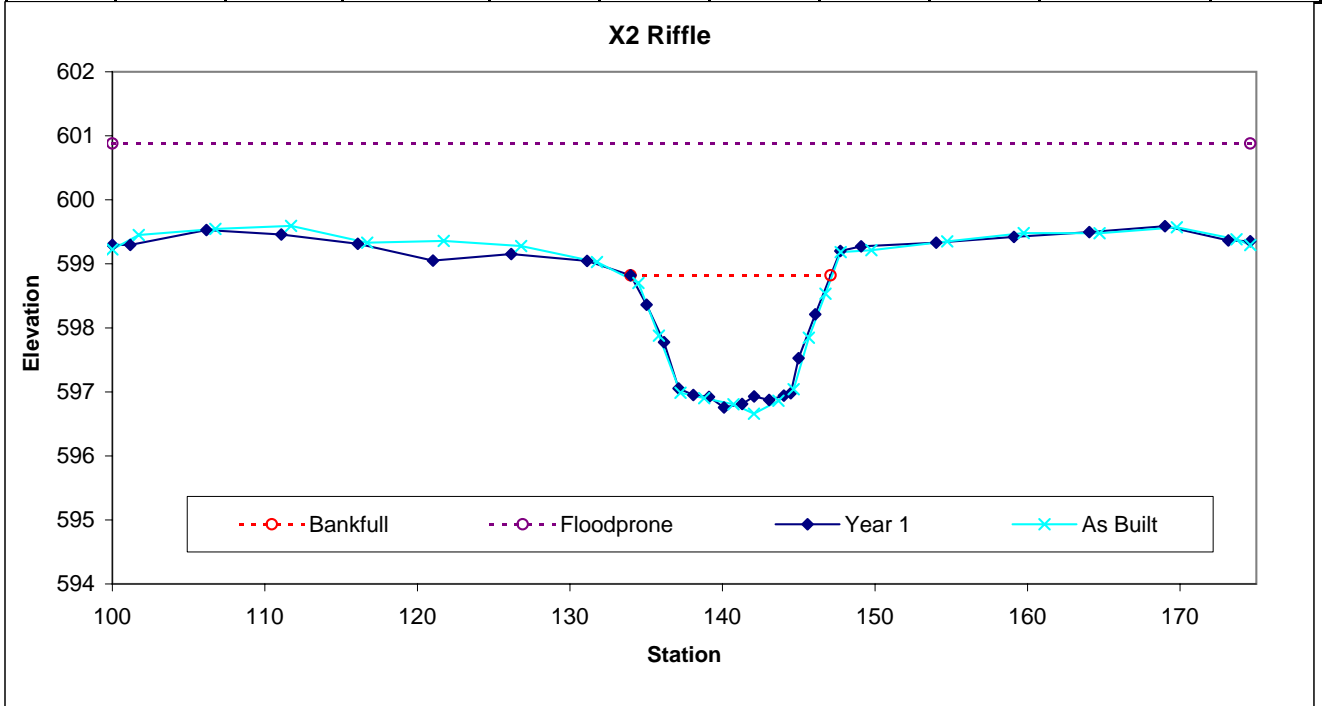

**UT1 Permanent Cross Section X3**  
 (Year 1 Monitoring Data - collected October 2007)




Looking at the Left Bank



Looking at the Right Bank

Feature	Stream Type	BKF Area	BKF Width	BKF Depth	Max BKF Depth	W/D	BH Ratio	ER	BKF Elev	TOB Elev
Pool		16.4	15.32	1.07	2.31	14.29	1	4.9	599.7	599.7

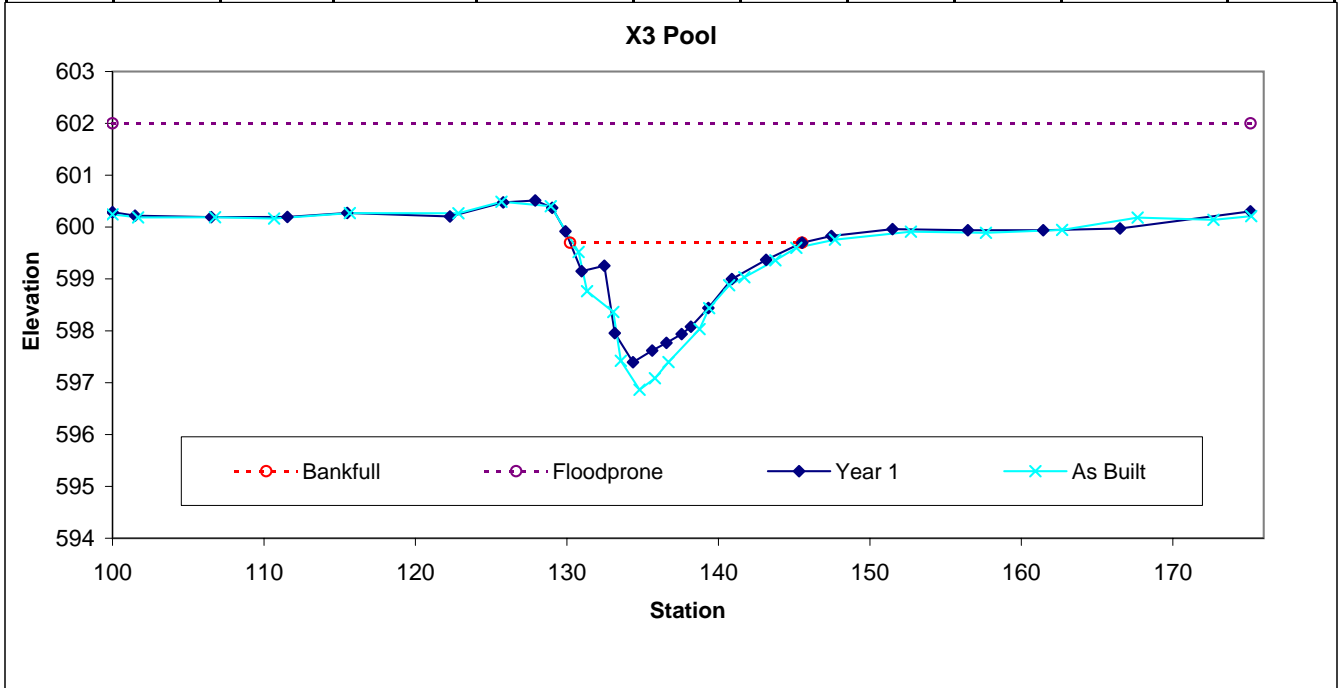

**UT1 Permanent Cross Section X4**  
 (Year 1 Monitoring Data - collected October 2007)




Looking at the Left Bank



Looking at the Right Bank

Feature	Stream Type	BKF Area	BKF Width	BKF Depth	Max BKF Depth	W/D	BH Ratio	ER	BKF Elev	TOB Elev
Riffle	C/E	16.5	11.83	1.39	2.33	8.5	1	6.3	599.79	599.79

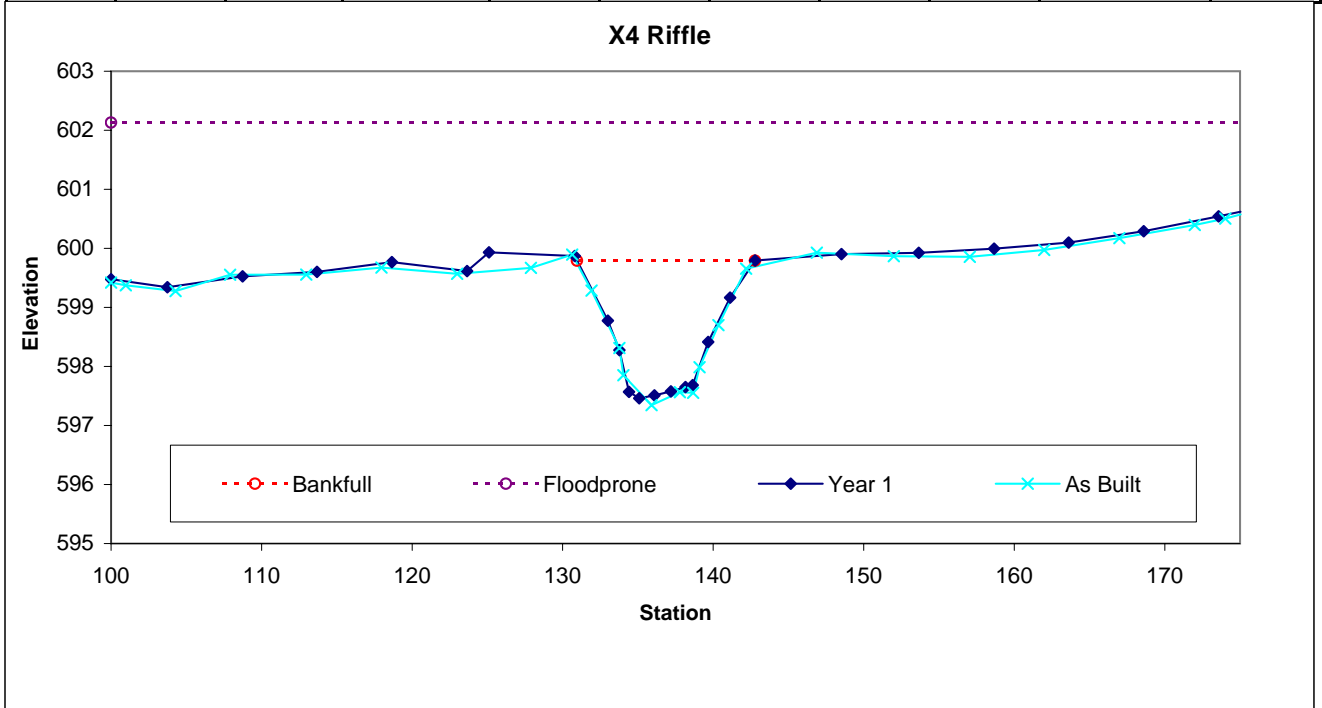

**UT1 Permanent Cross Section X5**  
 (Year 1 Monitoring Data - collected October 2007)




Looking at the Left Bank



Looking at the Right Bank

Feature	Stream Type	BKF Area	BKF Width	BKF Depth	Max BKF Depth	W/D	BH Ratio	ER	BKF Elev	TOB Elev
Riffle	C/E	23.7	15.19	1.56	2.26	9.72	1	4.9	597.88	597.88

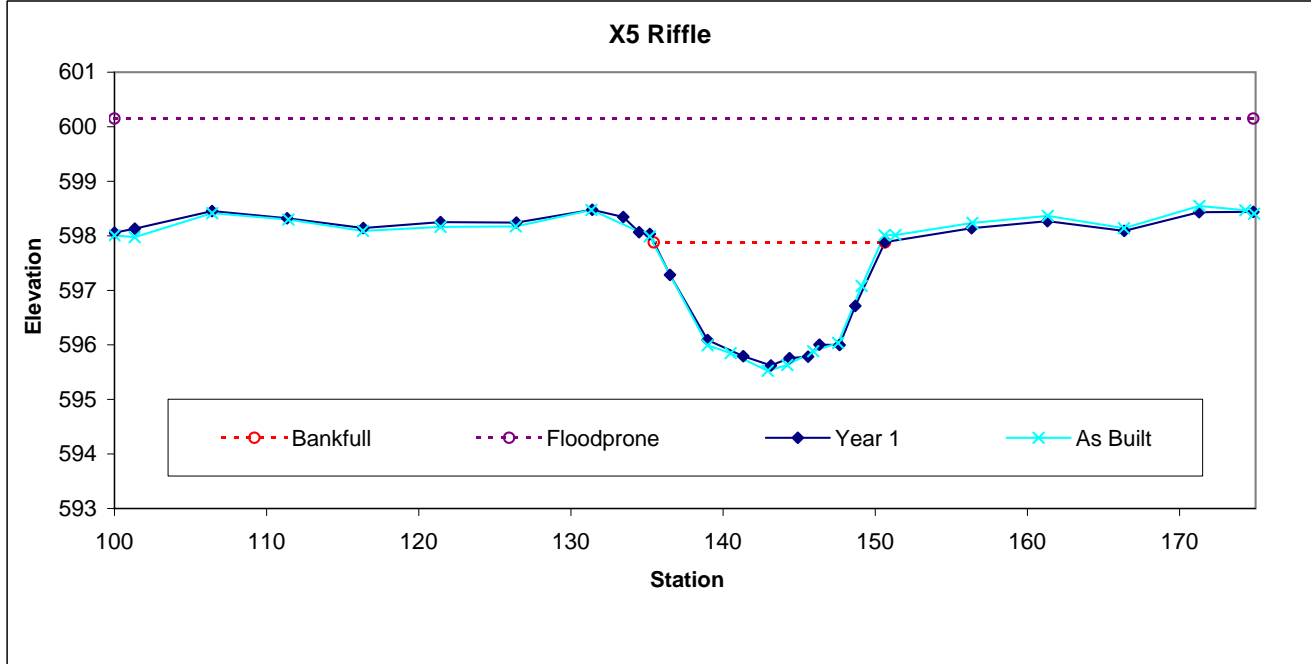



**UT1 Permanent Cross Section X6**  
 (Year 1 Monitoring Data - collected October 2007)




Looking at the Left Bank



Looking at the Right Bank

Feature	Stream Type	BKF Area	BKF Width	BKF Depth	Max BKF Depth	W/D	BH Ratio	ER	BKF Elev	TOB Elev
Pool		41.1	23.5	1.75	3.53	13.43	1	3.2	596.98	596.99

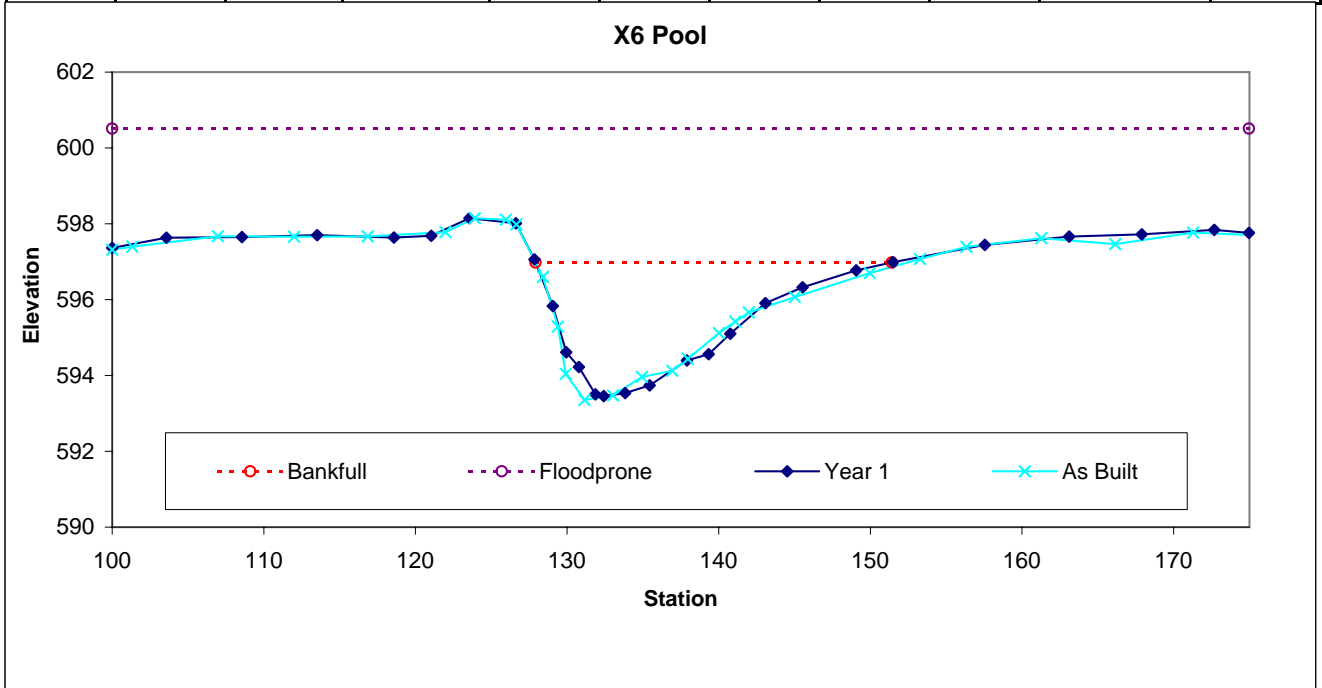

**UT1 Permanent Cross Section X7**  
 (Year 1 Monitoring Data - collected October 2007)




Looking at the Left Bank



Looking at the Right Bank

Feature	Stream Type	BKF Area	BKF Width	BKF Depth	Max BKF Depth	W/D	BH Ratio	ER	BKF Elev	TOB Elev
Riffle	B	8.8	12.04	0.73	1.09	16.49	1	5.9	594.83	594.83

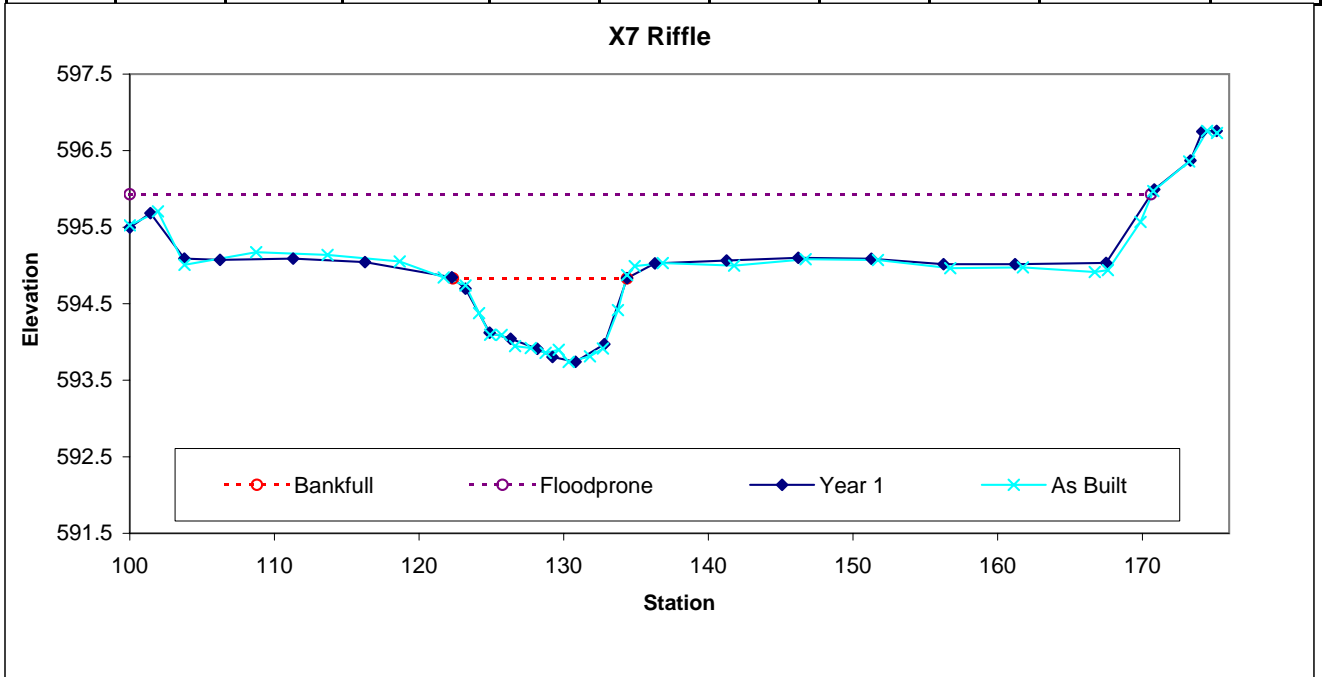

**UT1 Permanent Cross Section X8**  
 (Year 1 Monitoring Data - collected October 2007)




**Looking at the Left Bank**



**Looking at the Right Bank**

Feature	Stream Type	BKF Area	BKF Width	BKF Depth	Max BKF Depth	W/D	BH Ratio	ER	BKF Elev	TOB Elev
Pool		31.6	13.56	2.33	3.24	5.82	1	5.5	593.41	593.41

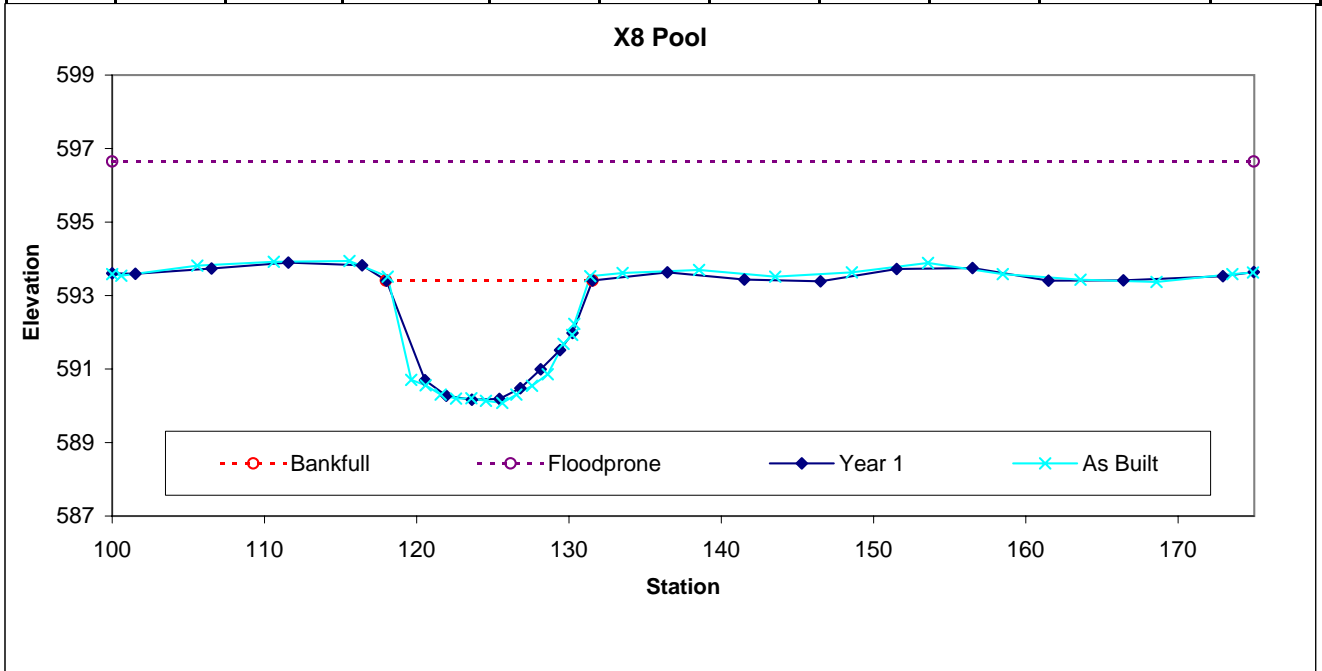

**UT1 Permanent Cross Section X9**  
 (Year 1 Monitoring Data - collected October 2007)




Looking at the Left Bank



Looking at the Right Bank

Feature	Stream Type	BKF Area	BKF Width	BKF Depth	Max BKF Depth	W/D	BH Ratio	ER	BKF Elev	TOB Elev
Riffle	C/E	29.3	17.8	1.64	2.65	10.83	1	4.2	590.77	590.77

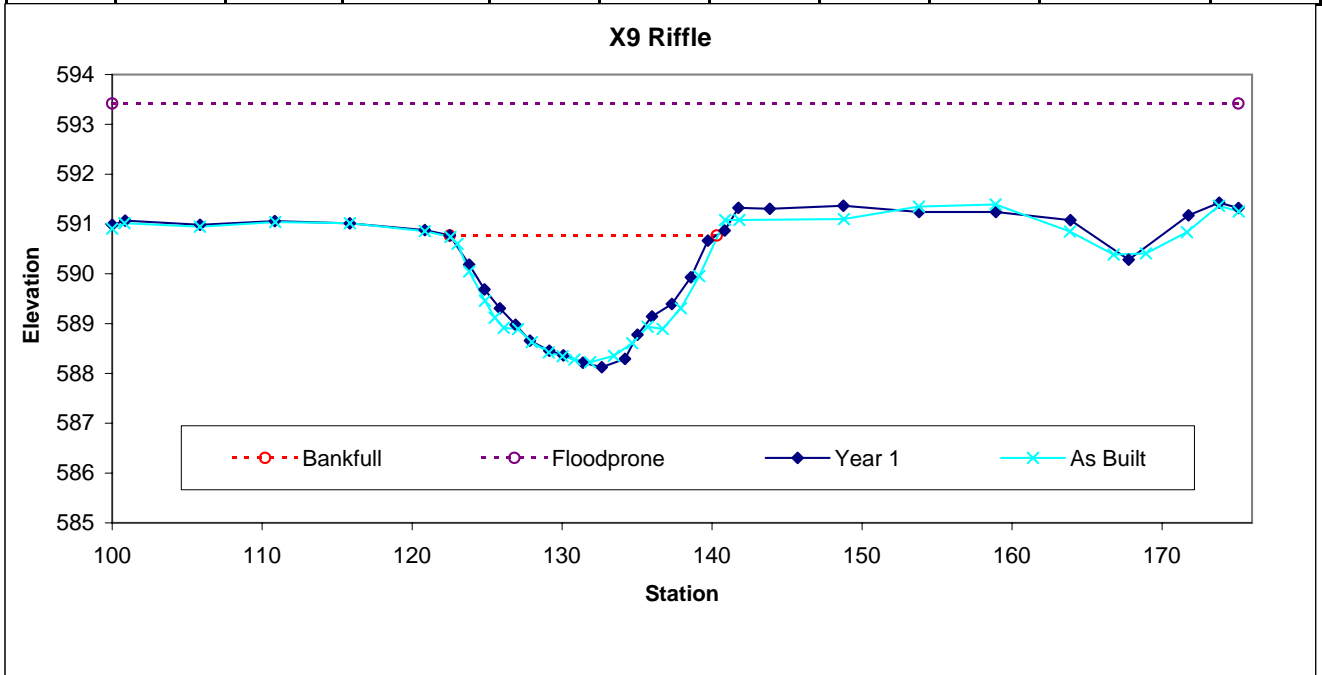

**UT1 Permanent Cross Section X10**  
 (Year 1 Monitoring Data - collected October 2007)




Looking at the Left Bank



Looking at the Right Bank

Feature	Stream Type	BKF Area	BKF Width	BKF Depth	Max BKF Depth	W/D	BH Ratio	ER	BKF Elev	TOB Elev
Pool		44.8	22.23	2.02	3.34	11.03	1	3.4	588.69	588.7

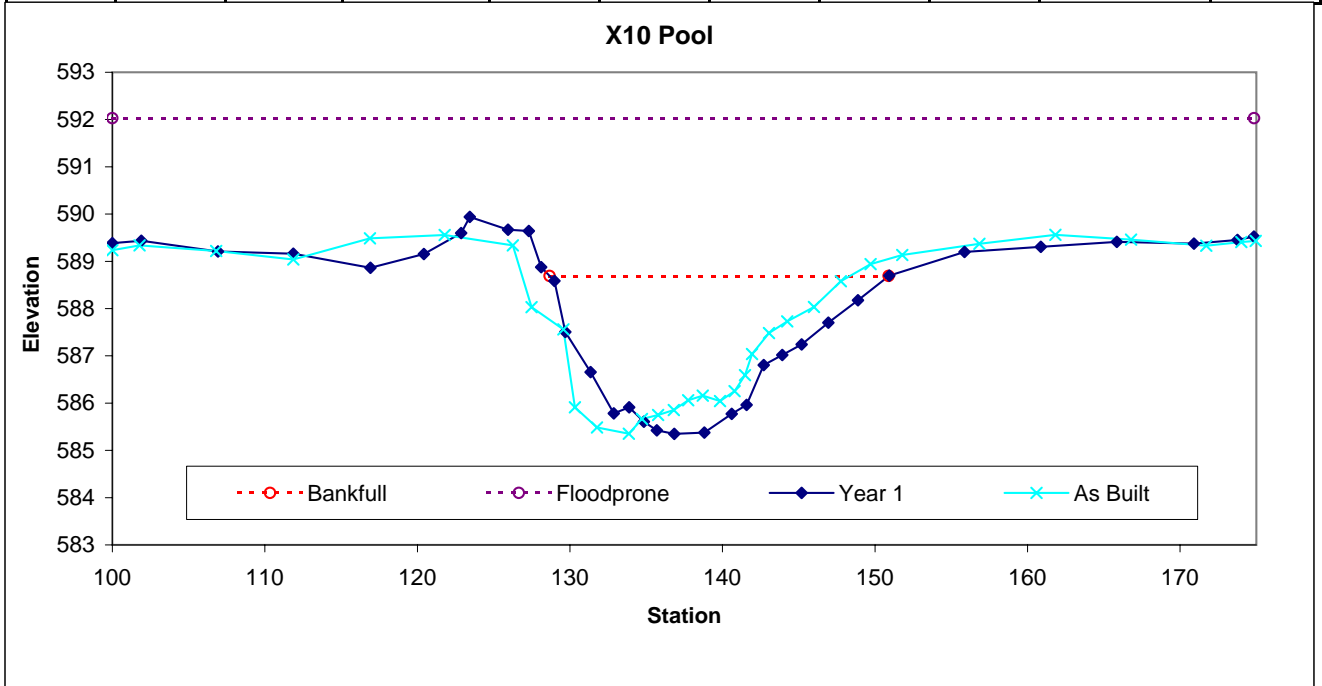

**UT1 Permanent Cross Section X11**  
 (Year 1 Monitoring Data - collected October 2007)




Looking at the Left Bank




Looking at the Right Bank

Feature	Stream Type	BKF Area	BKF Width	BKF Depth	Max BKF Depth	W/D	BH Ratio	ER	BKF Elev	TOB Elev
Pool		20.9	15.32	1.36	2.45	11.25	1	4.9	589.83	589.83

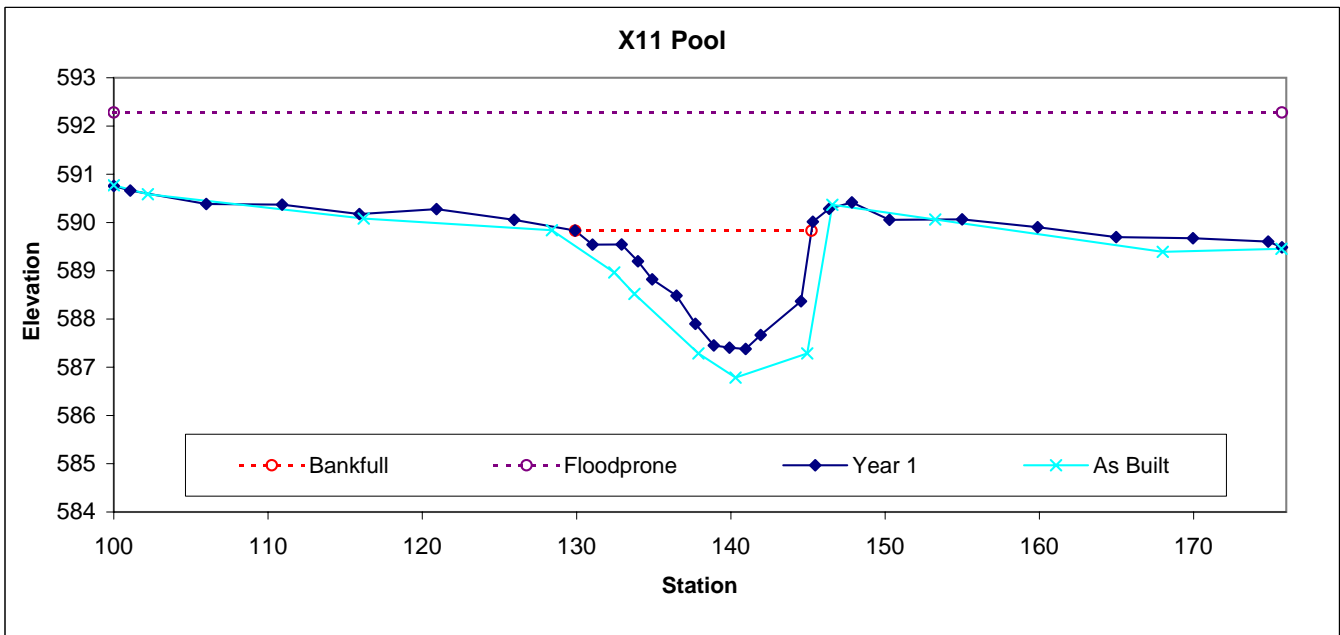

**UT1 Permanent Cross Section X12**  
 (Year 1 Monitoring Data - collected October 2007)

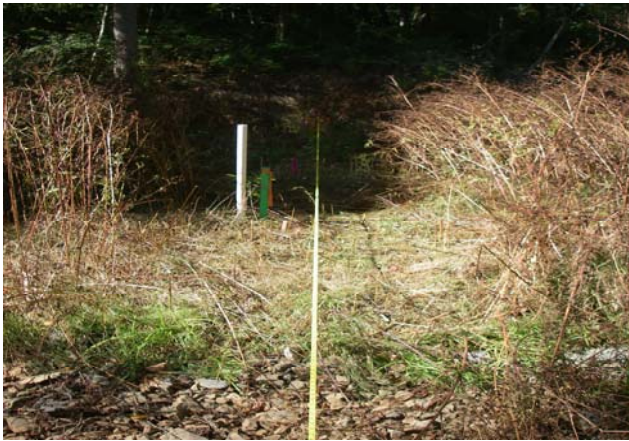


Looking at the Left Bank



Looking at the Right Bank

Feature	Stream Type	BKF Area	BKF Width	BKF Depth	Max BKF Depth	W/D	BH Ratio	ER	BKF Elev	TOB Elev
Riffle	C/E	9.2	12.67	0.73	1.07	17.46	1	6	589.02	589.03

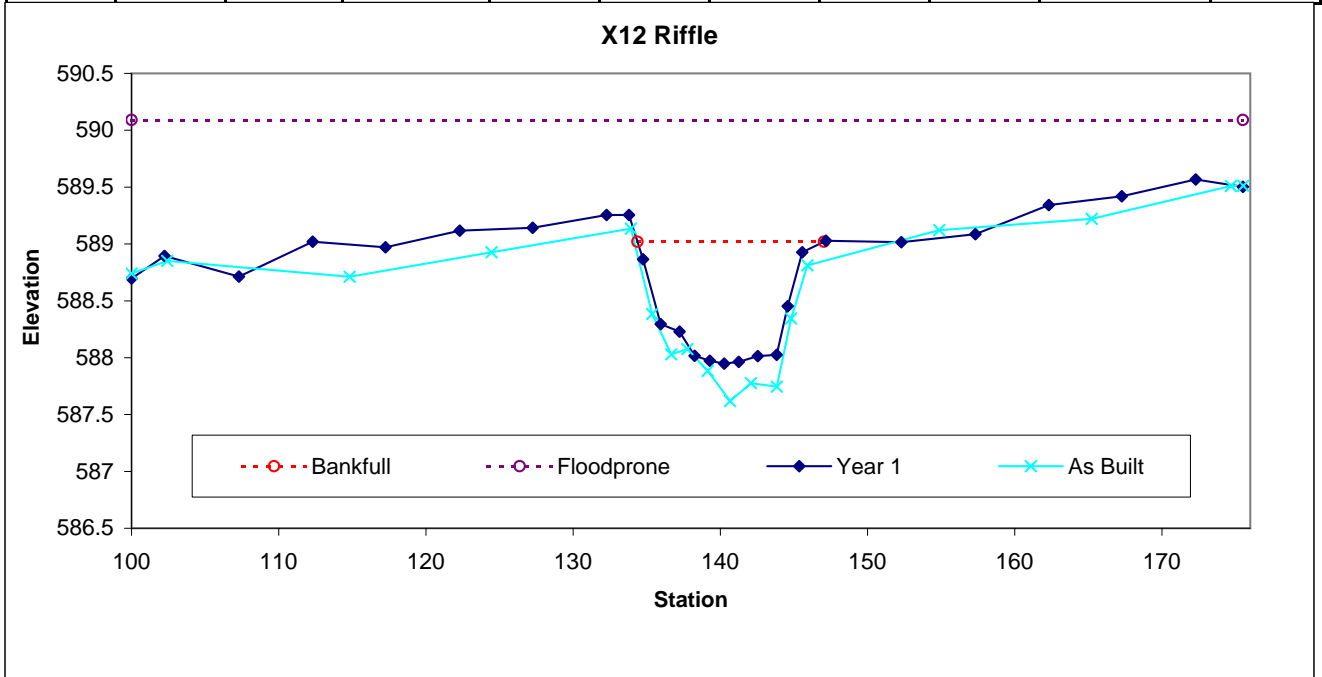

**UT1 Permanent Cross Section X13**  
 (Year 1 Monitoring Data - collected October 2007)




**Looking at the Left Bank**



**Looking at the Right Bank**

Feature	Stream Type	BKF Area	BKF Width	BKF Depth	Max BKF Depth	W/D	BH Ratio	ER	BKF Elev	TOB Elev
Pool		71.7	29.99	2.39	5.33	12.55	1	3	586.89	586.89

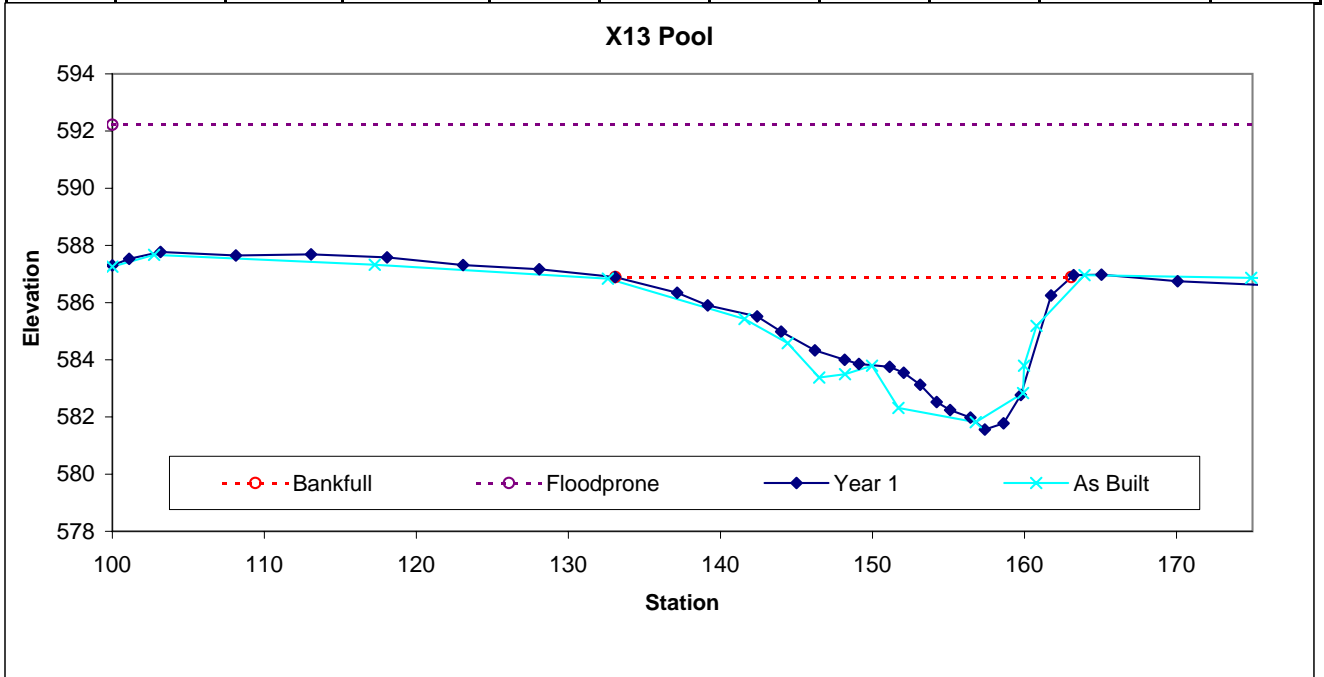



**UT1 Permanent Cross Section X14**  
 (Year 1 Monitoring Data - collected October 2007)




Looking at the Left Bank



Looking at the Right Bank

Feature	Stream Type	BKF Area	BKF Width	BKF Depth	Max BKF Depth	W/D	BH Ratio	ER	BKF Elev	TOB Elev
Riffle	C/E	37.9	19.09	1.99	3.07	9.61	1	3.9	584.86	584.87

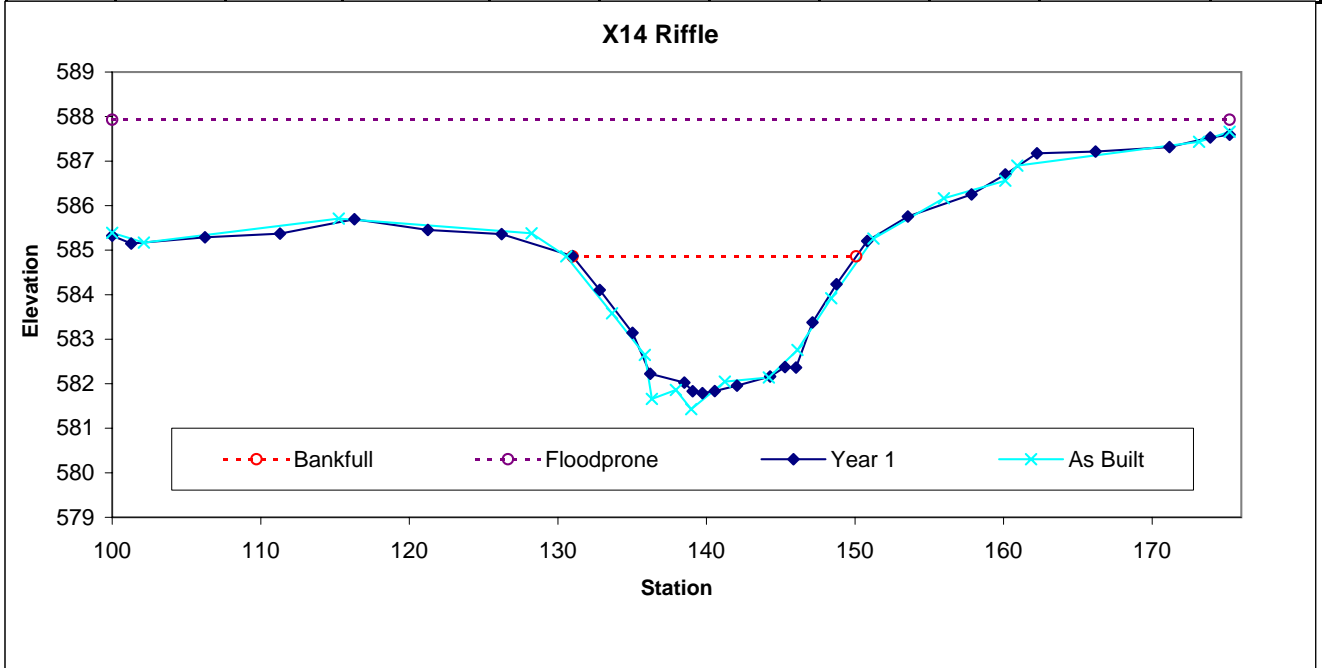

**UT1 Permanent Cross Section X15**  
 (Year 1 Monitoring Data - collected October 2007)




Looking at the Left Bank



Looking at the Right Bank

Feature	Stream Type	BKF Area	BKF Width	BKF Depth	Max BKF Depth	W/D	BH Ratio	ER	BKF Elev	TOB Elev
Riffle	C/E	59.7	26.86	2.22	4.05	12.1	1	2.9	579.57	579.57

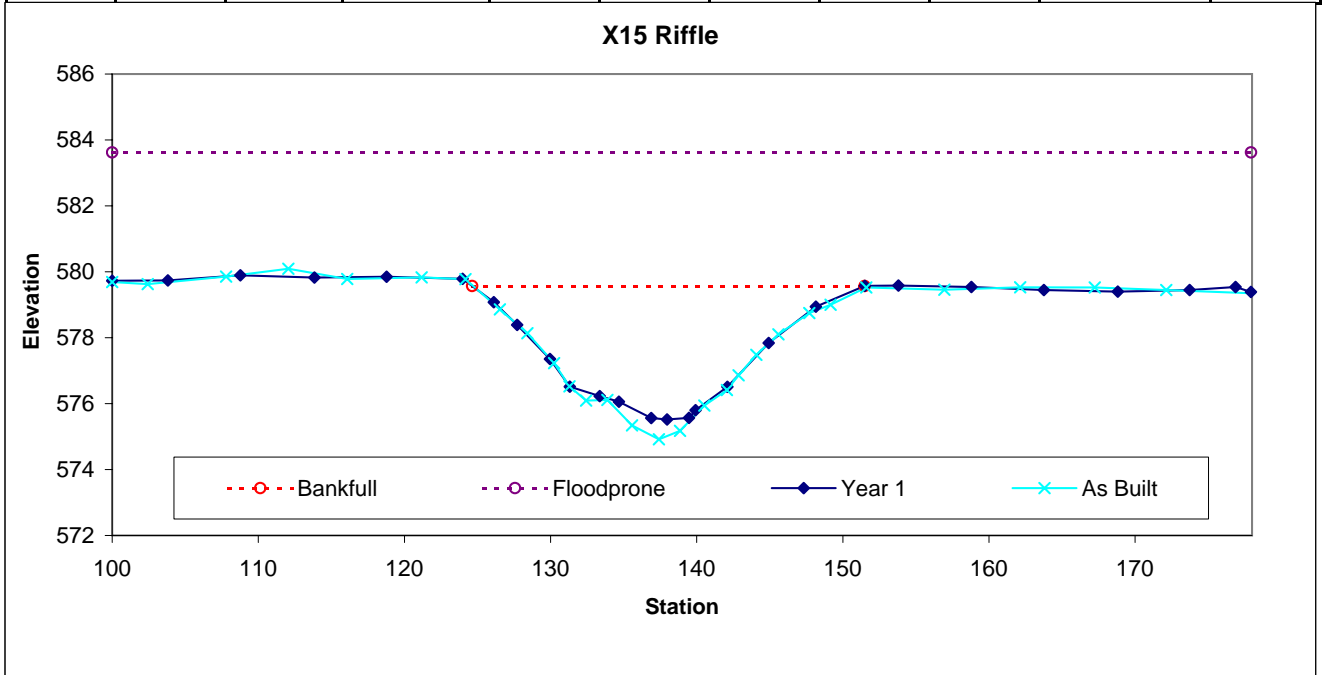

**UT1 Permanent Cross Section X16**  
 (Year 1 Monitoring Data - collected October 2007)




**Looking at the Left Bank**



**Looking at the Right Bank**

Feature	Stream Type	BKF Area	BKF Width	BKF Depth	Max BKF Depth	W/D	BH Ratio	ER	BKF Elev	TOB Elev
Pool		36.8	20.92	1.76	3.44	11.88	1	2.5	576.7	576.7

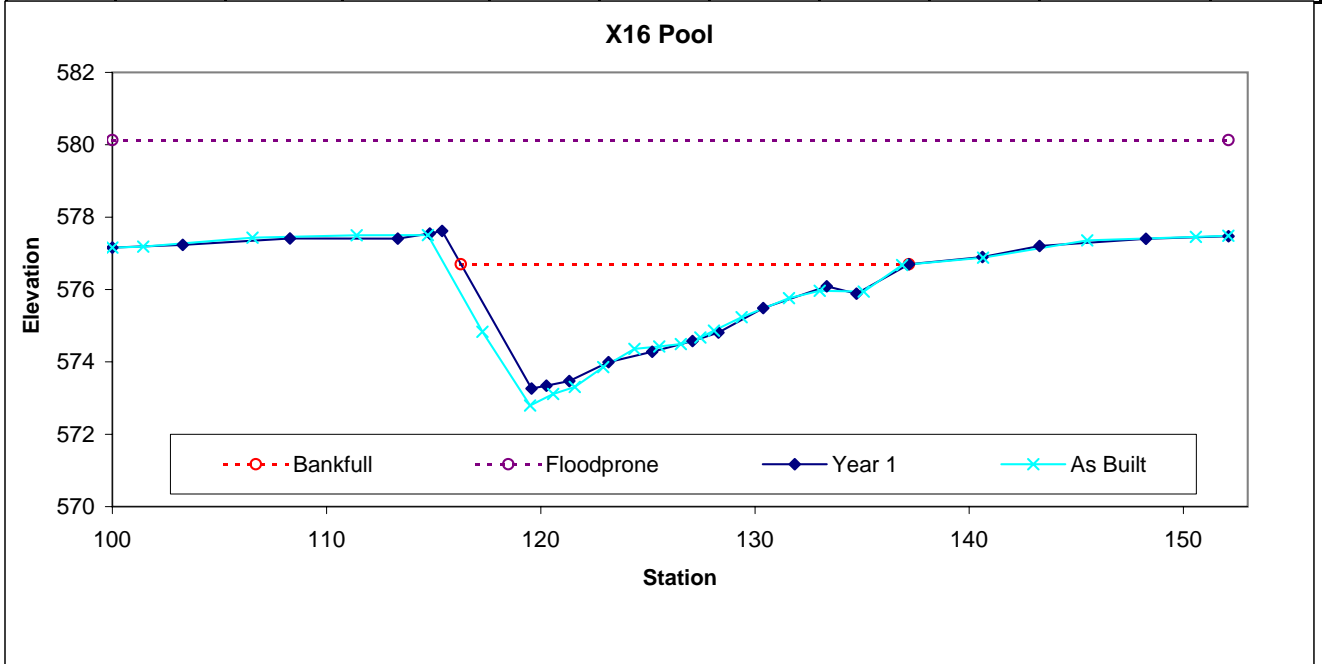

**UT1 Permanent Cross Section X17**  
 (Year 1 Monitoring Data - collected October 2007)




Looking at the Left Bank



Looking at the Right Bank

Feature	Stream Type	BKF Area	BKF Width	BKF Depth	Max BKF Depth	W/D	BH Ratio	ER	BKF Elev	TOB Elev
Pool		33.2	27	1.23	2.51	21.94	1	2.5	573.79	573.79

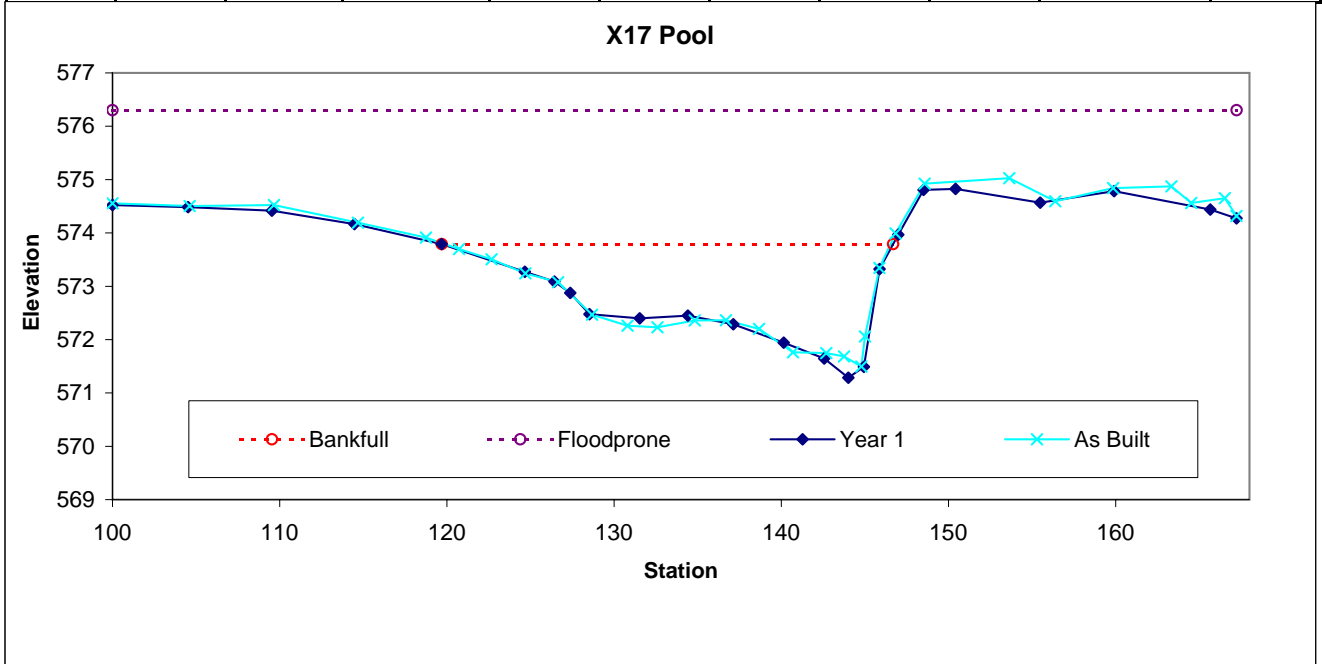

**UT1 Permanent Cross Section X18**  
 (Year 1 Monitoring Data - collected October 2007)




Looking at the Left Bank



Looking at the Right Bank


Feature	Stream Type	BKF Area	BKF Width	BKF Depth	Max BKF Depth	W/D	BH Ratio	ER	BKF Elev	TOB Elev
Riffle	C/E	34.7	22.49	1.54	2.66	14.59	1	3.6	574.12	574.11

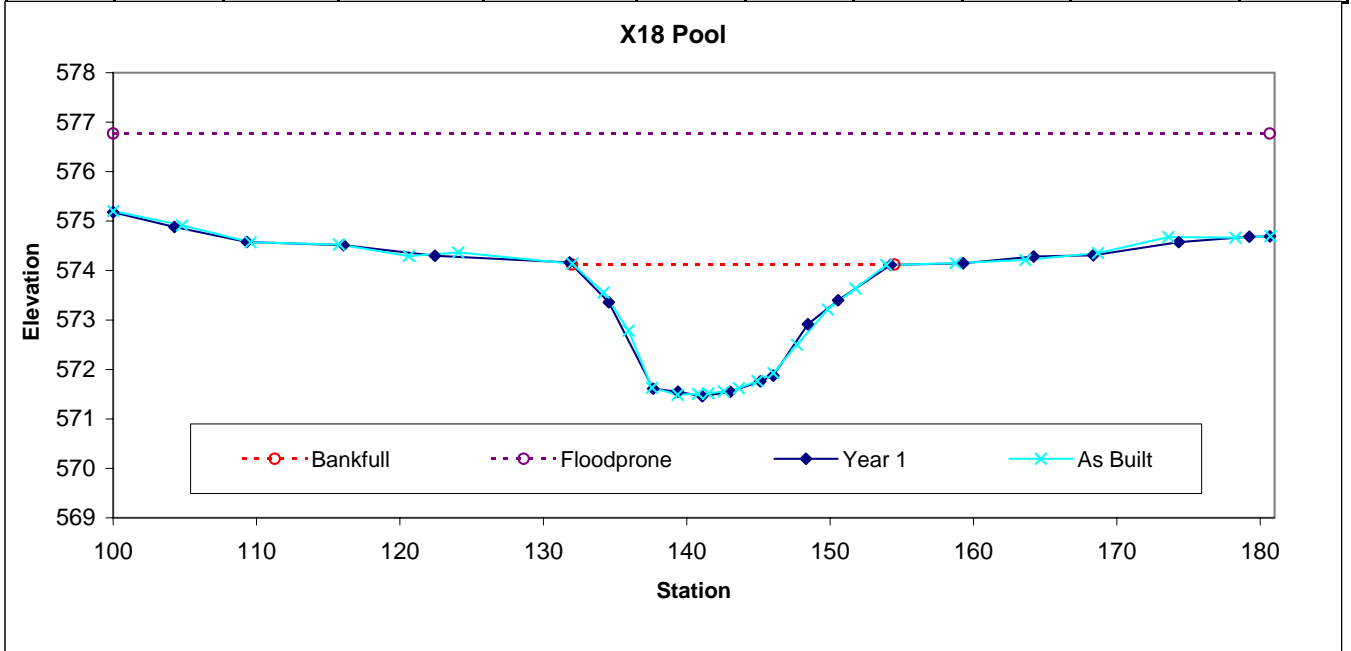

### UT2 Mainstem Profile (2007 Monitoring)



UT2A Profile (2007 Monitoring)

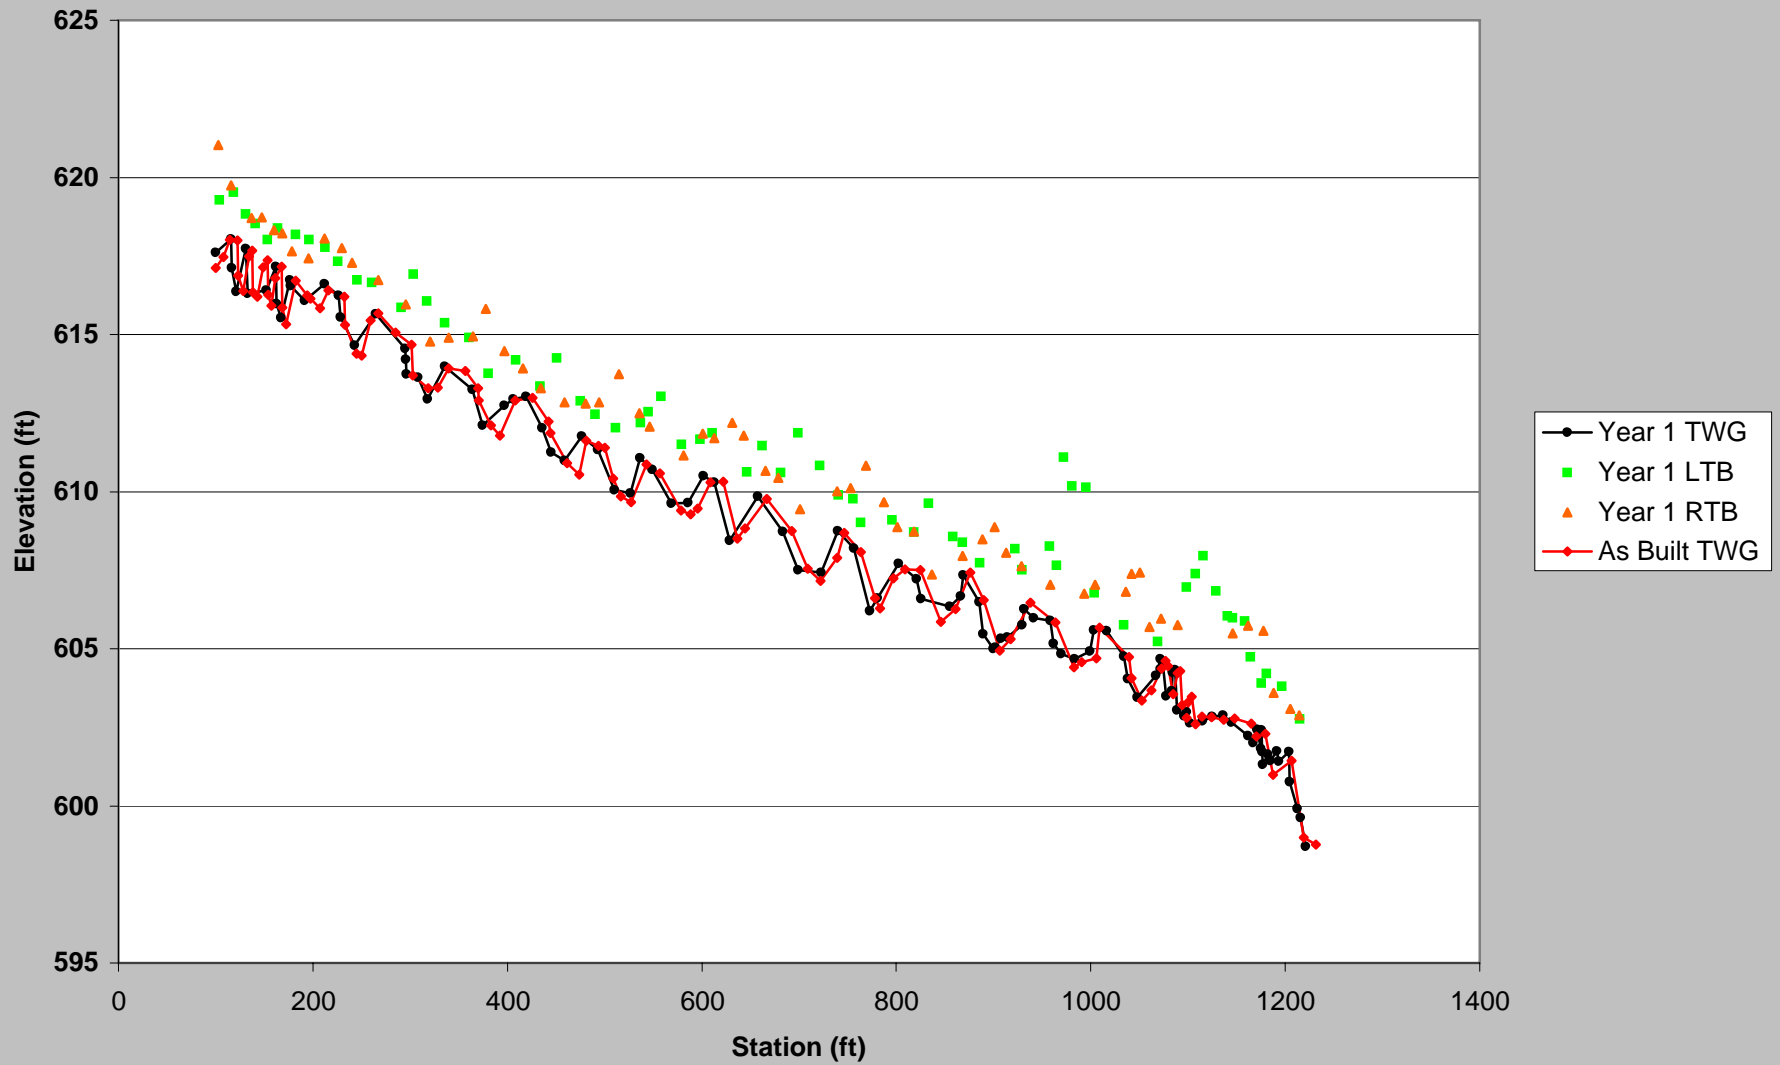

**PEBBLE COUNT DATA SHEET: RIFFLE 100-COUNT**

BAKER PROJECT NO. 108528


SITE OR PROJECT:	Beaverdam Creek 1st Year Monitoring
REACH/LOCATION:	UT2A X1-Riffle
DATE COLLECTED:	10/15/2007
FIELD COLLECTION BY:	RR/IE
DATA ENTRY BY:	IE

MATERIAL	PARTICLE	SIZE (mm)	PARTICLE CLASS COUNT		Summary		Distribution Plot Size (mm)
			Riffle		Class %	% Cum	
<b>SILT/CLAY</b>	Silt / Clay	< .063	3		3%	3%	0.063
<b>SAND</b>	Very Fine	.063 - .125				3%	0.125
	Fine	.125 - .25				3%	0.25
	Medium	.25 - .50				3%	0.50
	Coarse	.50 - 1.0				3%	1.0
	Very Coarse	1.0 - 2.0				3%	2.0
<b>GRAVEL</b>	Very Fine	2.0 - 2.8				3%	2.8
	Very Fine	2.8 - 4.0				3%	4.0
	Fine	4.0 - 5.6				3%	5.6
	Fine	5.6 - 8.0				3%	8.0
	Medium	8.0 - 11.0				3%	11.3
	Medium	11.0 - 16.0				3%	16.0
	Coarse	16.0 - 22.6				3%	22.6
	Coarse	22.6 - 32	39		39%	42%	32
	Very Coarse	32 - 45	36		36%	78%	45
	Very Coarse	45 - 64	12		12%	90%	64
<b>COBBLE</b>	Small	64 - 90	8		8%	98%	90
	Small	90 - 128	1		1%	99%	128
	Large	128 - 180	1		1%	100%	180
	Large	180 - 256				100%	256
<b>BOULDER</b>	Small	256 - 362				100%	362
	Small	362 - 512				100%	512
	Medium	512 - 1024				100%	1024
	Large-Very Large	1024 - 2048				100%	2048
<b>BEDROCK</b>	Bedrock	> 2048				100%	5000
<b>Total</b>			<b>100</b>		<b>100%</b>		

**Largest particles:** \_\_\_\_\_  
(riffle)



Beaverdam Creek UT2A  
X1 Riffle  
Pebble Count Particle Size Distribution

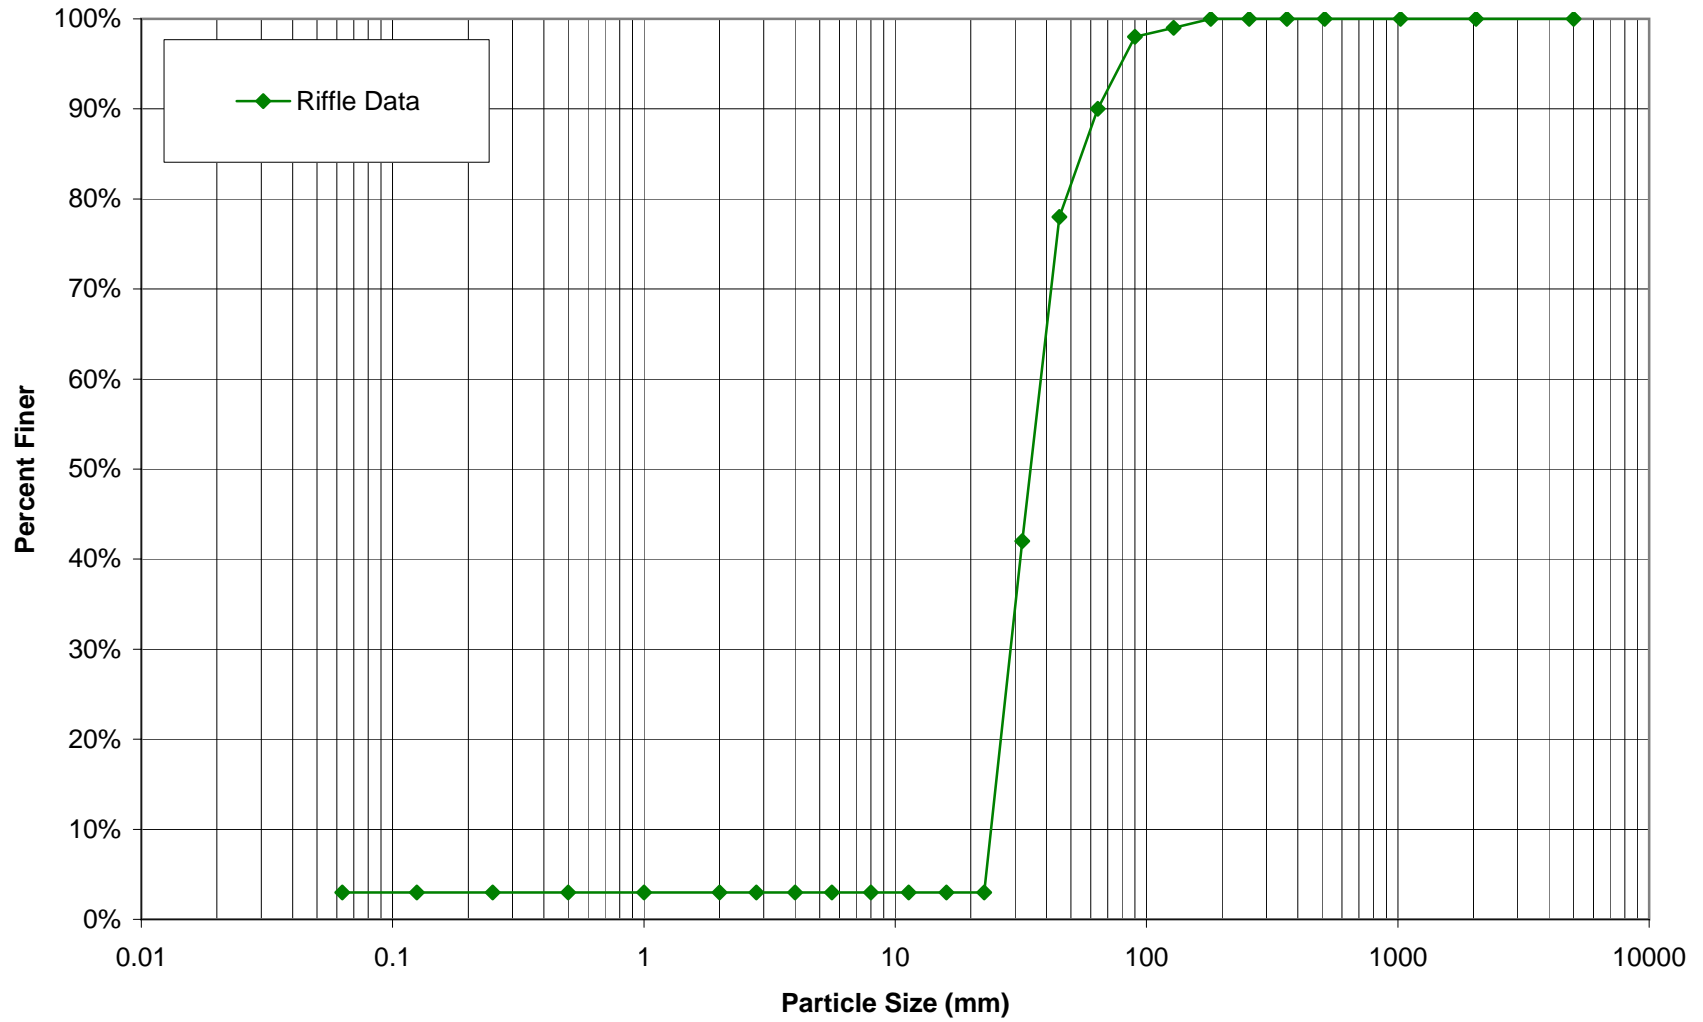

## PEBBLE COUNT DATA SHEET: POOL 100-COUNT


BAKER PROJECT NO. 108528

SITE OR PROJECT:	Beaverdam Creek 1st Year Monitoring
REACH/LOCATION:	UT2A X2-Pool
DATE COLLECTED:	10/15/2007
FIELD COLLECTION BY:	RR/IE
DATA ENTRY BY:	IE

MATERIAL	PARTICLE	SIZE (mm)	PARTICLE CLASS COUNT		Summary		Distribution Plot Size (mm)
			Pool		Class %	% Cum	
SILT/CLAY	Silt / Clay	< .063	100		100%	100%	0.063
S A N D	Very Fine	.063 - .125				100%	0.125
	Fine	.125 - .25				100%	0.25
	Medium	.25 - .50				100%	0.50
	Coarse	.50 - 1.0				100%	1.0
	Very Coarse	1.0 - 2.0				100%	2.0
G R A V E L	Very Fine	2.0 - 2.8				100%	2.8
	Very Fine	2.8 - 4.0				100%	4.0
	Fine	4.0 - 5.6				100%	5.6
	Fine	5.6 - 8.0				100%	8.0
	Medium	8.0 - 11.0				100%	11.3
	Medium	11.0 - 16.0				100%	16.0
	Coarse	16.0 - 22.6				100%	22.6
	Coarse	22.6 - 32				100%	32
	Very Coarse	32 - 45				100%	45
	Very Coarse	45 - 64				100%	64
C O B B L E	Small	64 - 90				100%	90
	Small	90 - 128				100%	128
	Large	128 - 180				100%	180
	Large	180 - 256				100%	256
B O U L D E R	Small	256 - 362				100%	362
	Small	362 - 512				100%	512
	Medium	512 - 1024				100%	1024
	Large-Very Large	1024 - 2048				100%	2048
BEDROCK	Bedrock	> 2048				100%	5000
<b>Total</b>			<b>100</b>		<b>100%</b>		

Largest particles: \_\_\_\_\_  
(riffle)

Beaverdam Creek UT2A  
X2 Pool  
Pebble Count Particle Size Distribution

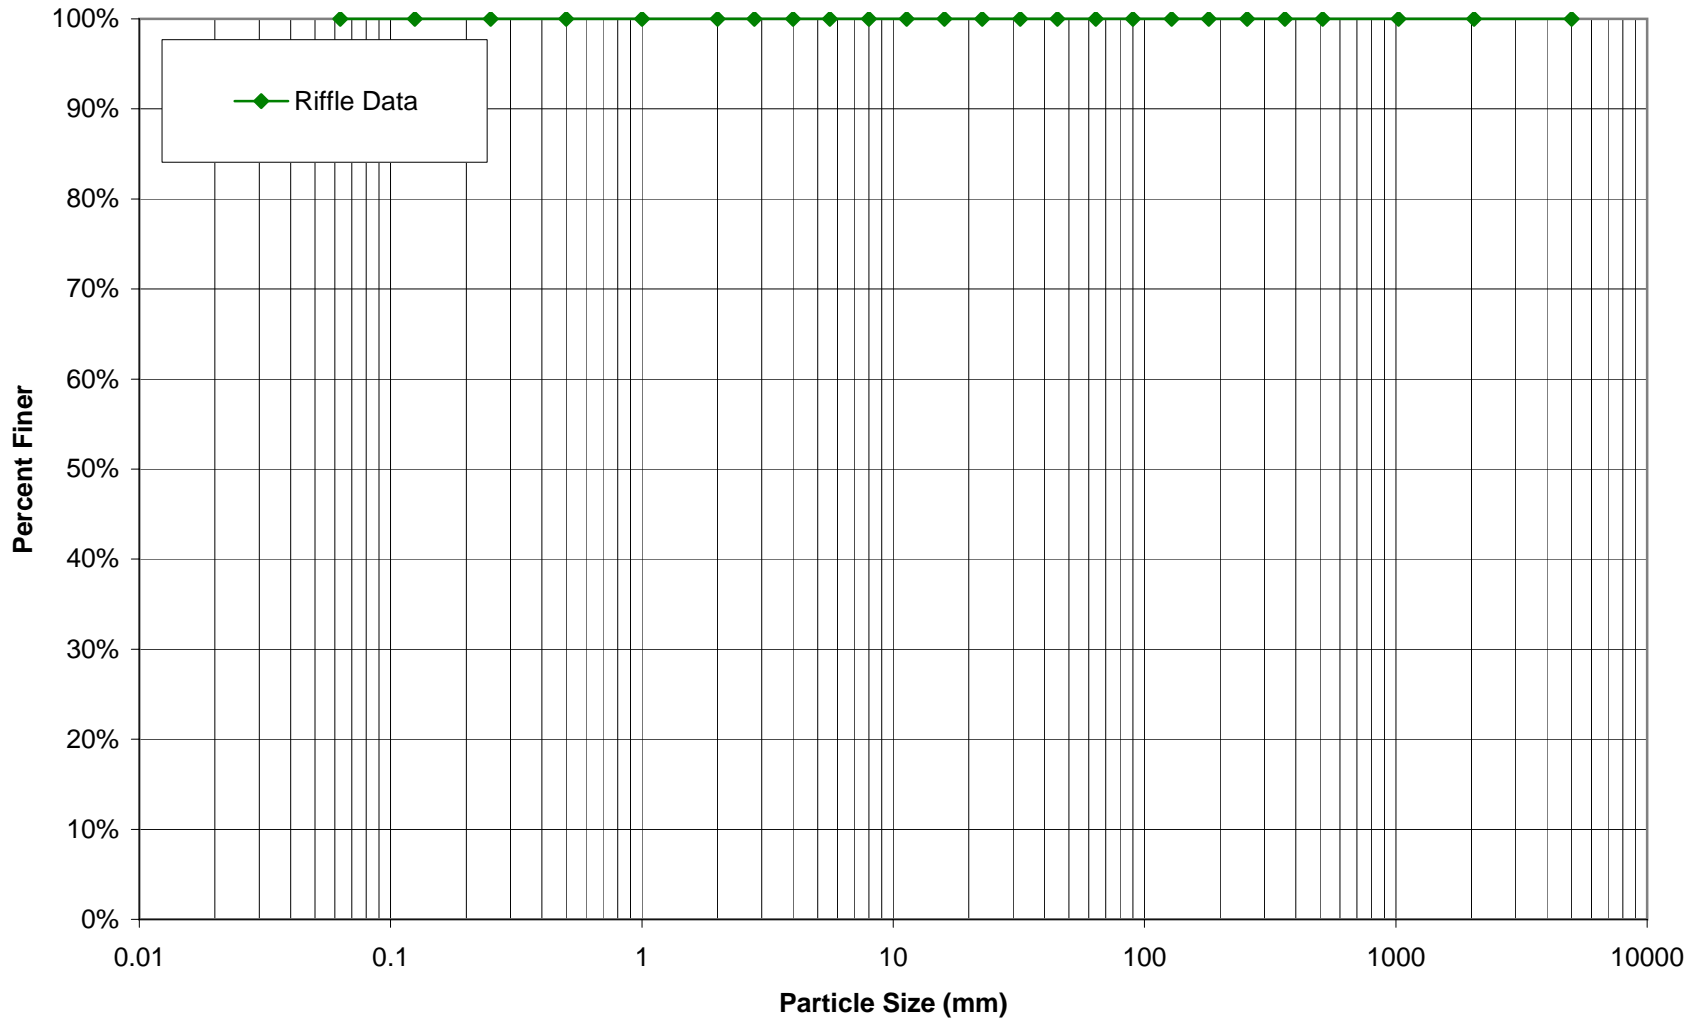

**PEBBLE COUNT DATA SHEET: RIFFLE 100-COUNT**


BAKER PROJECT NO. 108528

SITE OR PROJECT:	Beaverdam Creek 1st Year Monitoring
REACH/LOCATION:	UT2 X3-Riffle
DATE COLLECTED:	10/15/2007
FIELD COLLECTION BY:	RR/IE
DATA ENTRY BY:	IE

MATERIAL	PARTICLE	SIZE (mm)	PARTICLE CLASS COUNT		Summary		Distribution Plot Size (mm)
			Riffle		Class %	% Cum	
<b>SILT/CLAY</b>	Silt / Clay	< .063				0%	0.063
<b>SAND</b>	Very Fine	.063 - .125				0%	0.125
	Fine	.125 - .25	4		4%	4%	0.25
	Medium	.25 - .50	2		2%	6%	0.50
	Coarse	.50 - 1.0				6%	1.0
	Very Coarse	1.0 - 2.0				6%	2.0
<b>GRAVEL</b>	Very Fine	2.0 - 2.8				6%	2.8
	Very Fine	2.8 - 4.0				6%	4.0
	Fine	4.0 - 5.6				6%	5.6
	Fine	5.6 - 8.0				6%	8.0
	Medium	8.0 - 11.0				6%	11.3
	Medium	11.0 - 16.0	2		2%	8%	16.0
	Coarse	16.0 - 22.6	1		1%	9%	22.6
	Coarse	22.6 - 32	18		18%	27%	32
	Very Coarse	32 - 45	43		43%	70%	45
	Very Coarse	45 - 64	19		19%	89%	64
<b>COBBLE</b>	Small	64 - 90	5		5%	94%	90
	Small	90 - 128	5		5%	99%	128
	Large	128 - 180				99%	180
	Large	180 - 256				99%	256
<b>BOULDER</b>	Small	256 - 362				99%	362
	Small	362 - 512	1		1%	100%	512
	Medium	512 - 1024				100%	1024
	Large-Very Large	1024 - 2048				100%	2048
<b>BEDROCK</b>	Bedrock	> 2048				100%	5000
<b>Total</b>			<b>100</b>		<b>100%</b>		

**Largest particles:** \_\_\_\_\_  
(riffle)

Beaverdam Creek UT2  
X3 Riffle  
Pebble Count Particle Size Distribution

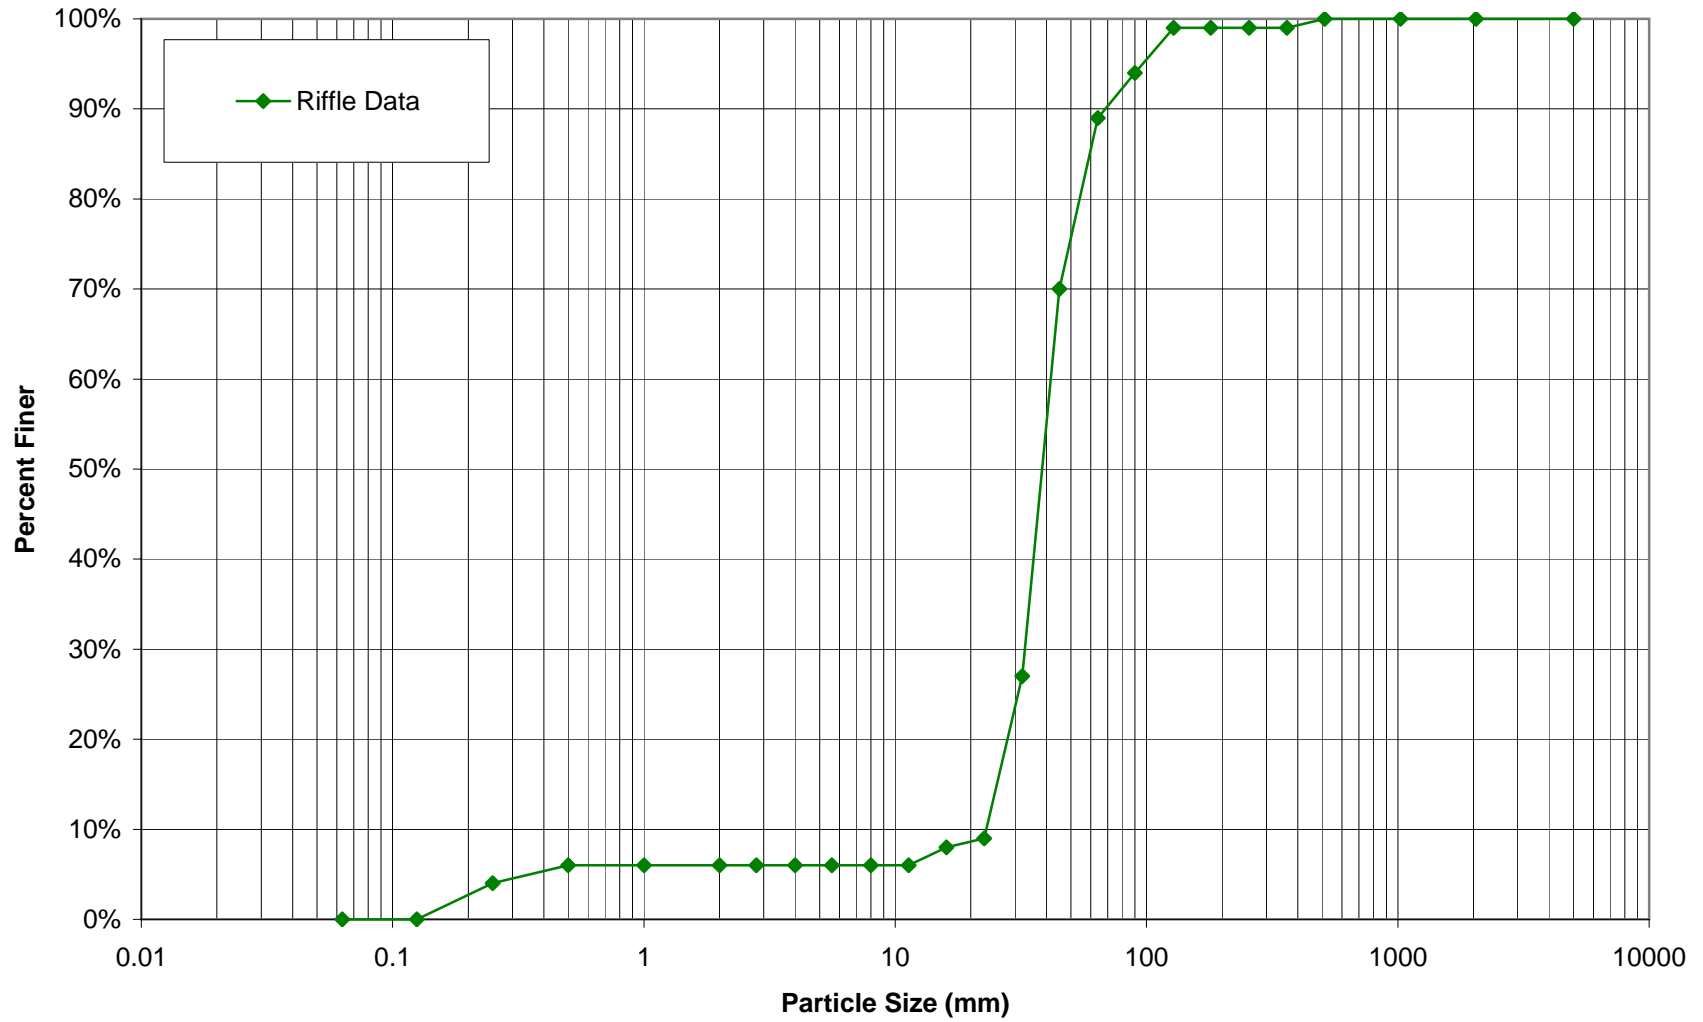

## PEBBLE COUNT DATA SHEET: POOL 100-COUNT


BAKER PROJECT NO. 108528

SITE OR PROJECT:	Beaverdam Creek 1st Year Monitoring
REACH/LOCATION:	UT2 X4-Pool
DATE COLLECTED:	10/15/2007
FIELD COLLECTION BY:	RR/IE
DATA ENTRY BY:	IE

MATERIAL	PARTICLE	SIZE (mm)	PARTICLE CLASS COUNT		Summary		Distribution Plot Size (mm)
			Pool	Class %	% Cum		
<b>SILT/CLAY</b>	Silt / Clay	< .063	94	94%	94%		0.063
	<b>S A N D</b>	Very Fine	.063 - .125			94%	
Fine		.125 - .25	5	5%	99%		0.25
Medium		.25 - .50			99%		0.50
Coarse		.50 - 1.0			99%		1.0
Very Coarse		1.0 - 2.0			99%		2.0
<b>G R A V E L</b>	Very Fine	2.0 - 2.8			99%		2.8
	Very Fine	2.8 - 4.0			99%		4.0
	Fine	4.0 - 5.6			99%		5.6
	Fine	5.6 - 8.0			99%		8.0
	Medium	8.0 - 11.0			99%		11.3
	Medium	11.0 - 16.0			99%		16.0
	Coarse	16.0 - 22.6			99%		22.6
	Coarse	22.6 - 32			99%		32
	Very Coarse	32 - 45			99%		45
	Very Coarse	45 - 64			99%		64
<b>COBBLE</b>	Small	64 - 90	1	1%	100%		90
	Small	90 - 128			100%		128
	Large	128 - 180			100%		180
	Large	180 - 256			100%		256
<b>BOULDER</b>	Small	256 - 362			100%		362
	Small	362 - 512			100%		512
	Medium	512 - 1024			100%		1024
	Large-Very Large	1024 - 2048			100%		2048
<b>BEDROCK</b>	Bedrock	> 2048			100%		5000
<b>Total</b>			<b>100</b>	<b>100%</b>			

Largest particles: \_\_\_\_\_  
(riffle)

Beaverdam Creek UT2  
X4 Pool  
Pebble Count Particle Size Distribution

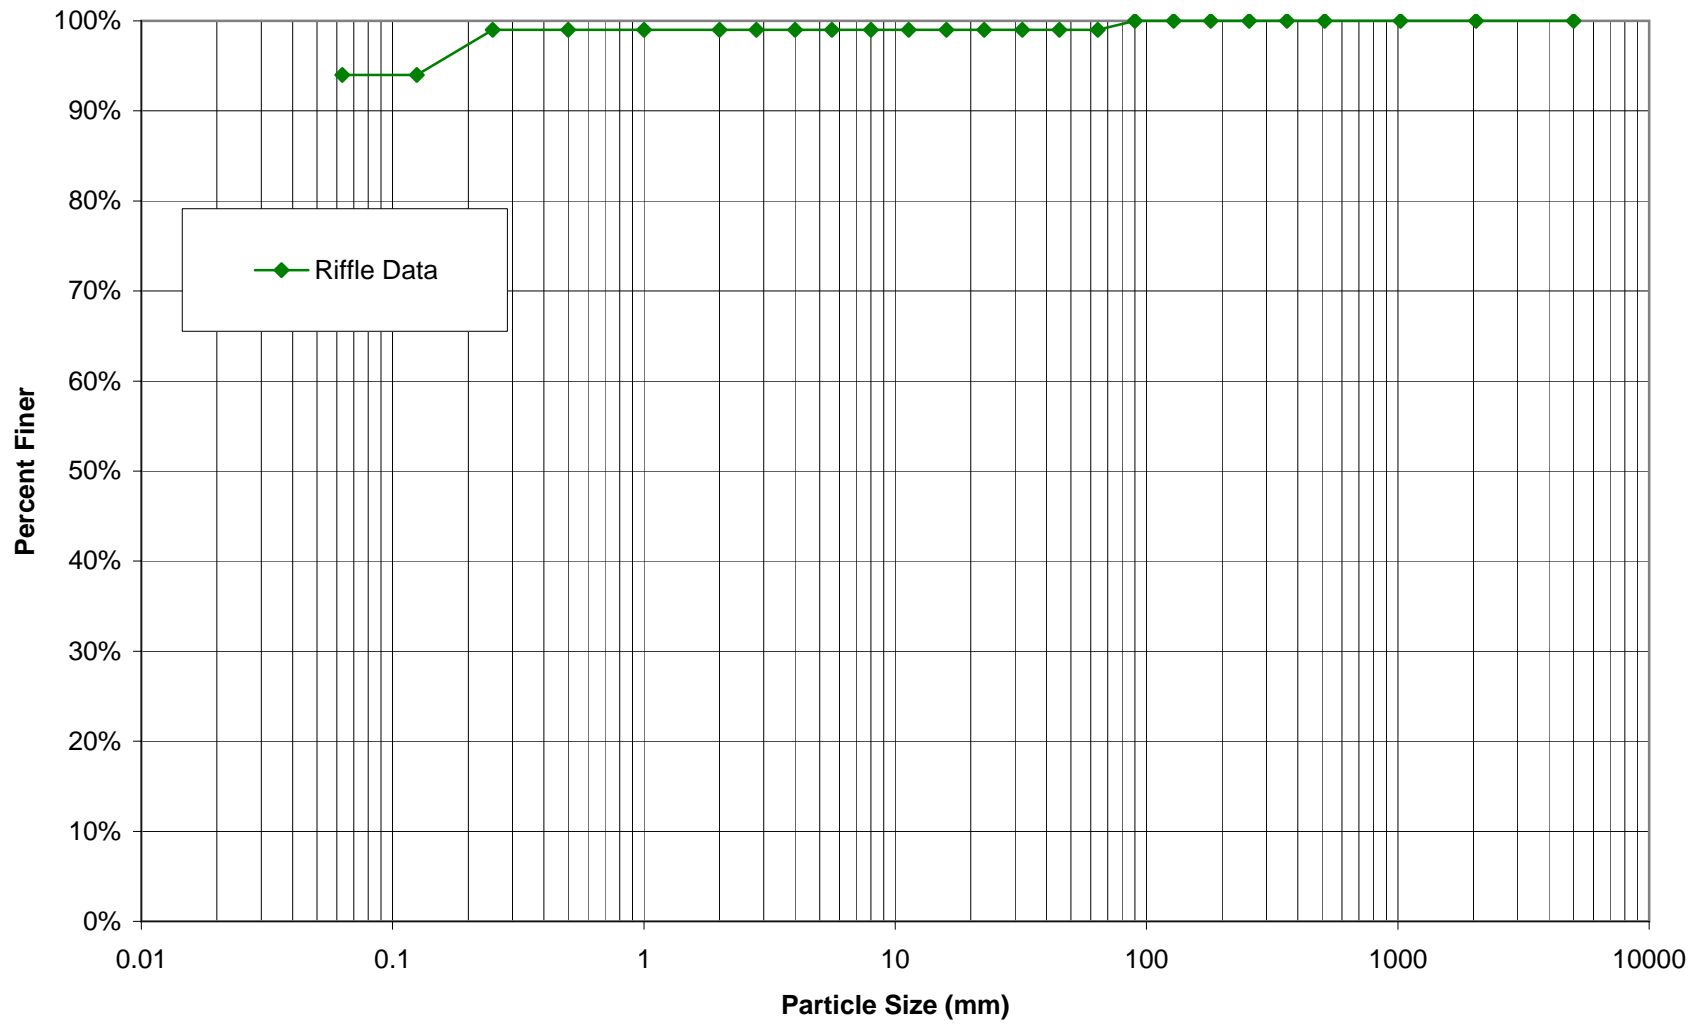

## PEBBLE COUNT DATA SHEET: RIFFLE 100-COUNT


<b>BAKER PROJECT NO.</b>		108528
SITE OR PROJECT:	Beaverdam Creek 1st Year Monitoring	
REACH/LOCATION:	UT2 X5-Riffle	
DATE COLLECTED:	10/15/2007	
FIELD COLLECTION BY:	RR/IE	
DATA ENTRY BY:	IE	

MATERIAL	PARTICLE	SIZE (mm)	PARTICLE CLASS COUNT		Summary		Distribution Plot Size (mm)
			Riffle		Class %	% Cum	
<b>SILT/CLAY</b>	Silt / Clay	< .063	2		2%	2%	0.063
<b>S A N D</b>	Very Fine	.063 - .125				2%	0.125
	Fine	.125 - .25				2%	0.25
	Medium	.25 - .50				2%	0.50
	Coarse	.50 - 1.0				2%	1.0
	Very Coarse	1.0 - 2.0				2%	2.0
<b>G R A V E L</b>	Very Fine	2.0 - 2.8				2%	2.8
	Very Fine	2.8 - 4.0				2%	4.0
	Fine	4.0 - 5.6				2%	5.6
	Fine	5.6 - 8.0				2%	8.0
	Medium	8.0 - 11.0				2%	11.3
	Medium	11.0 - 16.0				2%	16.0
	Coarse	16.0 - 22.6	4		4%	6%	22.6
	Coarse	22.6 - 32	17		17%	23%	32
	Very Coarse	32 - 45	57		57%	80%	45
	Very Coarse	45 - 64	9		9%	89%	64
<b>COBBLE</b>	Small	64 - 90	5		5%	94%	90
	Small	90 - 128	1		1%	95%	128
	Large	128 - 180	5		5%	100%	180
	Large	180 - 256				100%	256
<b>BOULDER</b>	Small	256 - 362				100%	362
	Small	362 - 512				100%	512
	Medium	512 - 1024				100%	1024
	Large-Very Large	1024 - 2048				100%	2048
<b>BEDROCK</b>	Bedrock	> 2048				100%	5000
<b>Total</b>			<b>100</b>		<b>100%</b>		

**Largest particles:** \_\_\_\_\_  
(riffle)



Beaverdam Creek UT2  
X5 Riffle  
Pebble Count Particle Size Distribution

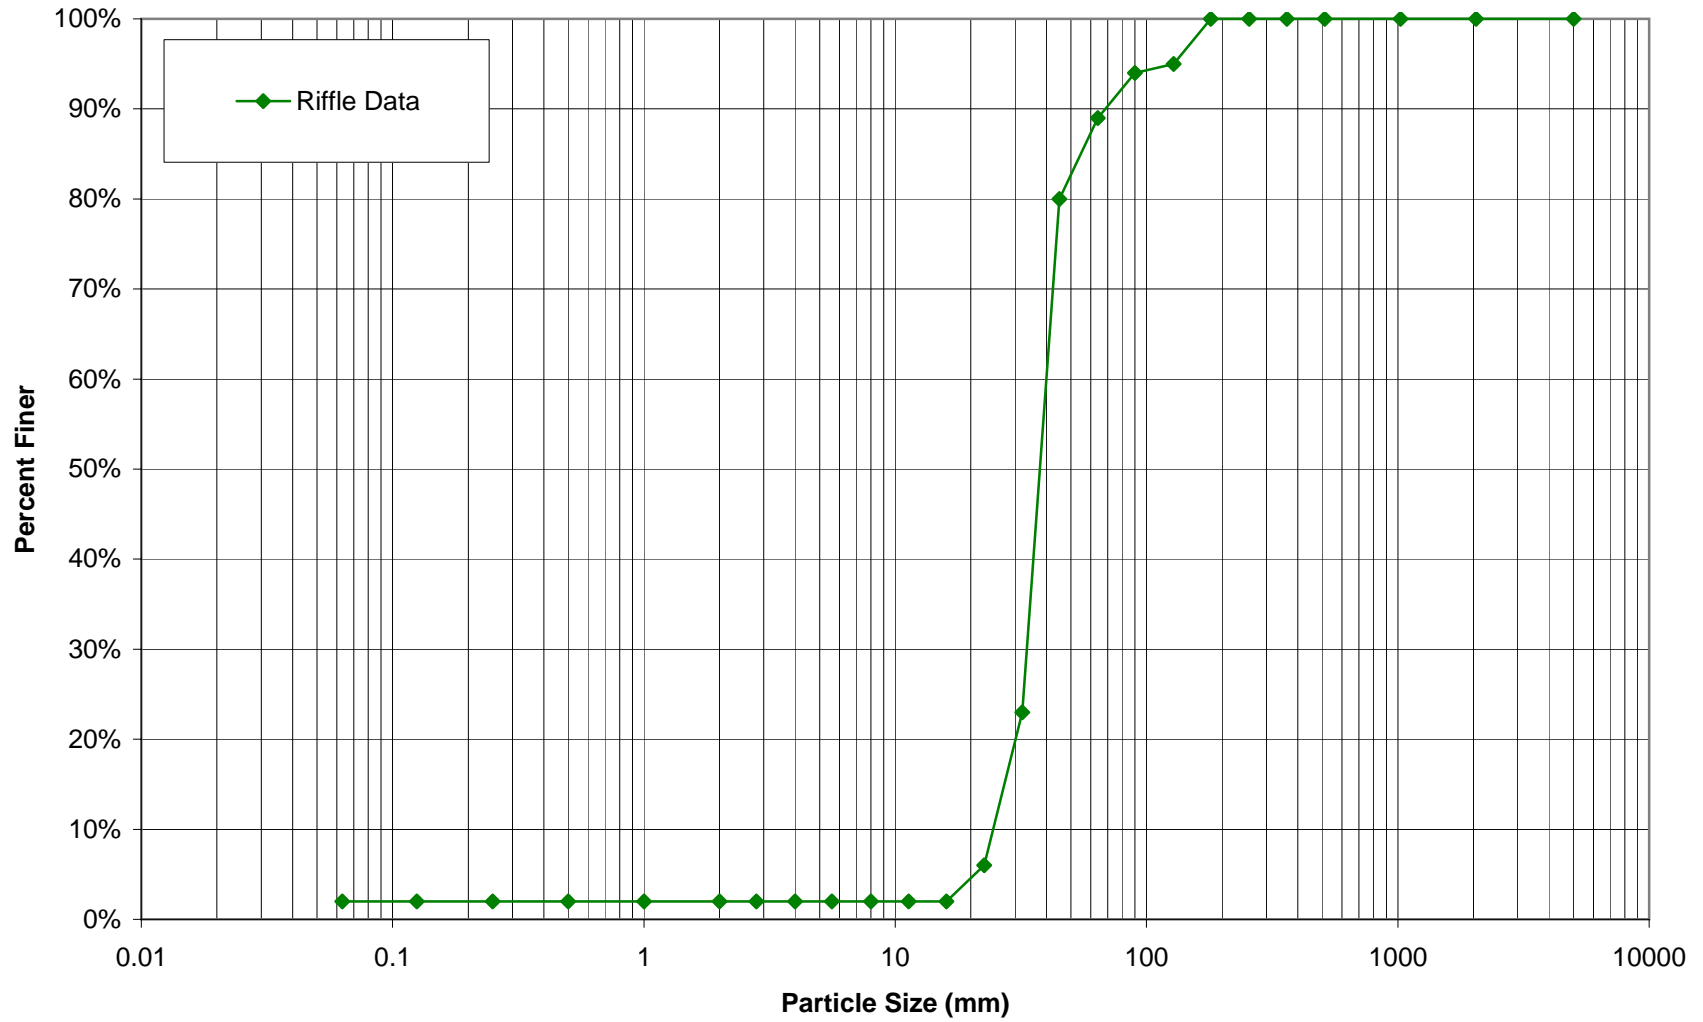

## PEBBLE COUNT DATA SHEET: POOL 100-COUNT


BAKER PROJECT NO. 108528

SITE OR PROJECT:	Beaverdam Creek 1st Year Monitoring
REACH/LOCATION:	UT2 X6-Pool
DATE COLLECTED:	10/15/2007
FIELD COLLECTION BY:	RR/IE
DATA ENTRY BY:	IE

MATERIAL	PARTICLE	SIZE (mm)	PARTICLE CLASS COUNT		Summary		Distribution Plot Size (mm)
			Pool		Class %	% Cum	
SILT/CLAY	Silt / Clay	< .063	88		88%	88%	0.063
S A N D	Very Fine	.063 - .125				88%	0.125
	Fine	.125 - .25	2		2%	90%	0.25
	Medium	.25 - .50				90%	0.50
	Coarse	.50 - 1.0				90%	1.0
	Very Coarse	1.0 - 2.0				90%	2.0
G R A V E L	Very Fine	2.0 - 2.8				90%	2.8
	Very Fine	2.8 - 4.0				90%	4.0
	Fine	4.0 - 5.6				90%	5.6
	Fine	5.6 - 8.0				90%	8.0
	Medium	8.0 - 11.0	2		2%	92%	11.3
	Medium	11.0 - 16.0				92%	16.0
	Coarse	16.0 - 22.6				92%	22.6
	Coarse	22.6 - 32	1		1%	93%	32
	Very Coarse	32 - 45	3		3%	96%	45
	Very Coarse	45 - 64	2		2%	98%	64
C O B B L E	Small	64 - 90				98%	90
	Small	90 - 128	1		1%	99%	128
	Large	128 - 180	1		1%	100%	180
	Large	180 - 256				100%	256
B O U L D E R	Small	256 - 362				100%	362
	Small	362 - 512				100%	512
	Medium	512 - 1024				100%	1024
	Large-Very Large	1024 - 2048				100%	2048
BEDROCK	Bedrock	> 2048				100%	5000
<b>Total</b>			<b>100</b>		<b>100%</b>		

Largest particles: \_\_\_\_\_  
(riffle)

Beaverdam Creek UT2  
X6 Pool  
Pebble Count Particle Size Distribution

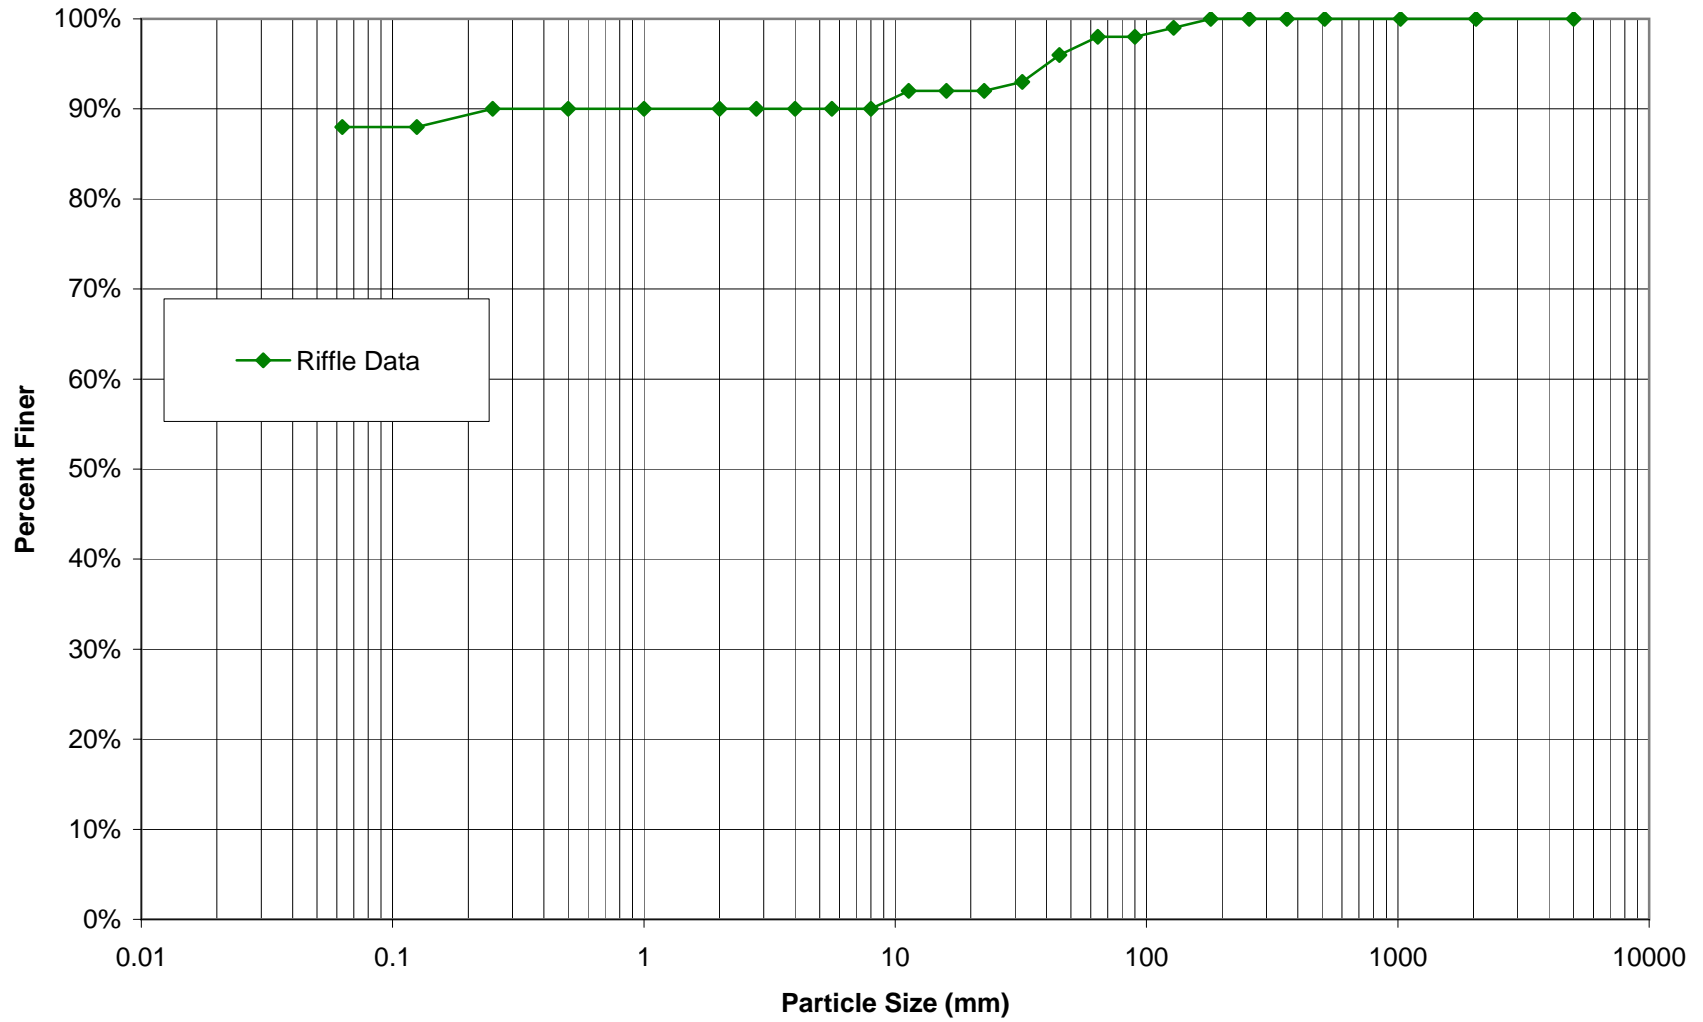

**UT2 Permanent Cross Section X1**  
 (Year 1 Monitoring Data - collected October 2007)




**Looking at the Left Bank**



**Looking at the Right Bank**

Feature	Stream Type	BKF Area	BKF Width	BKF Depth	Max BKF Depth	W/D	BH Ratio	ER	BKF Elev	TOB Elev
Riffle	C	9.6	12.15	0.79	1.12	15.45	1	3.3	612.58	612.58

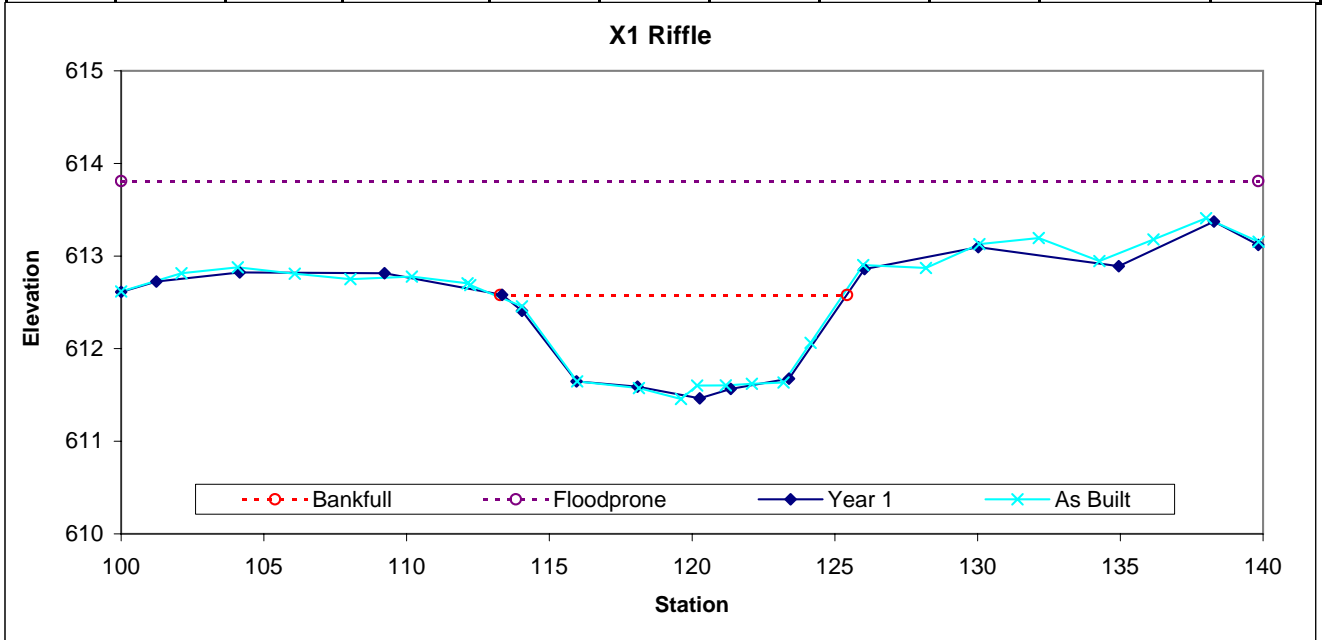

**UT2 Permanent Cross Section X2**  
 (Year 1 Monitoring Data - collected October 2007)




Looking at the Left Bank



Looking at the Right Bank

Feature	Stream Type	BKF Area	BKF Width	BKF Depth	Max BKF Depth	W/D	BH Ratio	ER	BKF Elev	TOB Elev
Pool		20.4	20.12	1.01	1.93	19.83	1	2	611.43	611.43

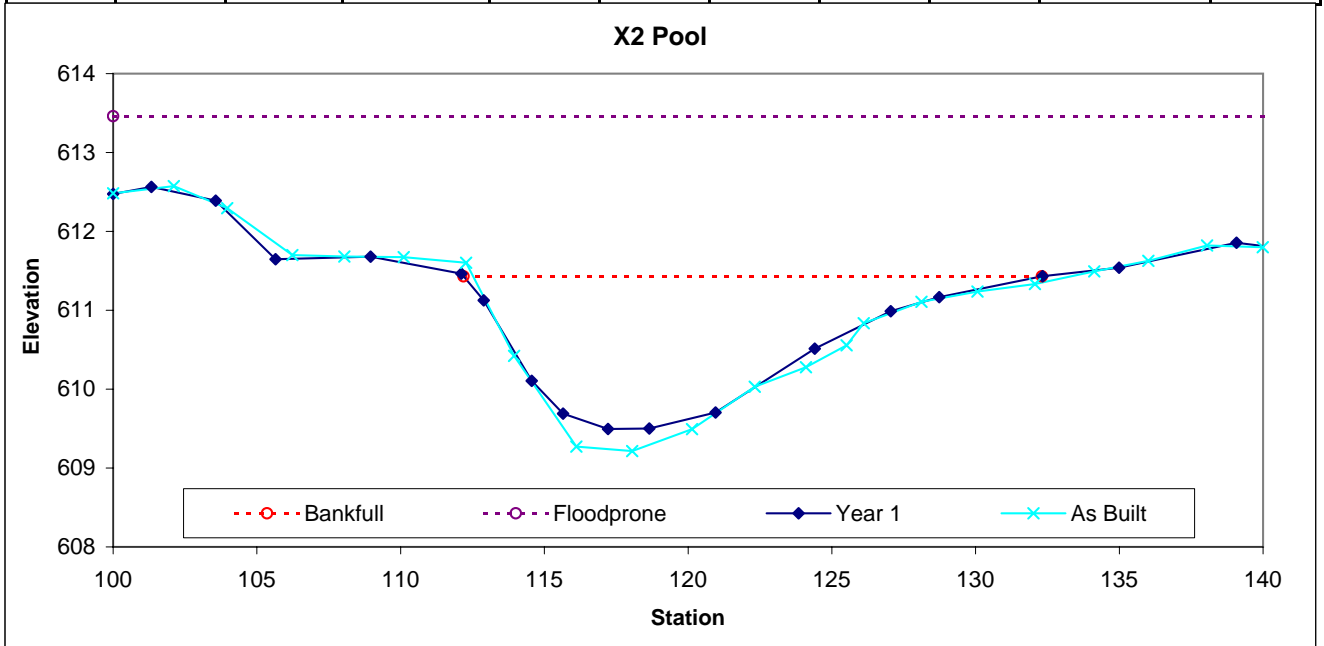

**UT2 Permanent Cross Section X3**  
 (Year 1 Monitoring Data - collected October 2007)




Looking at the Left Bank



Looking at the Right Bank

Feature	Stream Type	BKF Area	BKF Width	BKF Depth	Max BKF Depth	W/D	BH Ratio	ER	BKF Elev	TOB Elev
Riffle	C	10.9	16.14	0.67	1.06	23.92	1	2.5	623.07	623.07

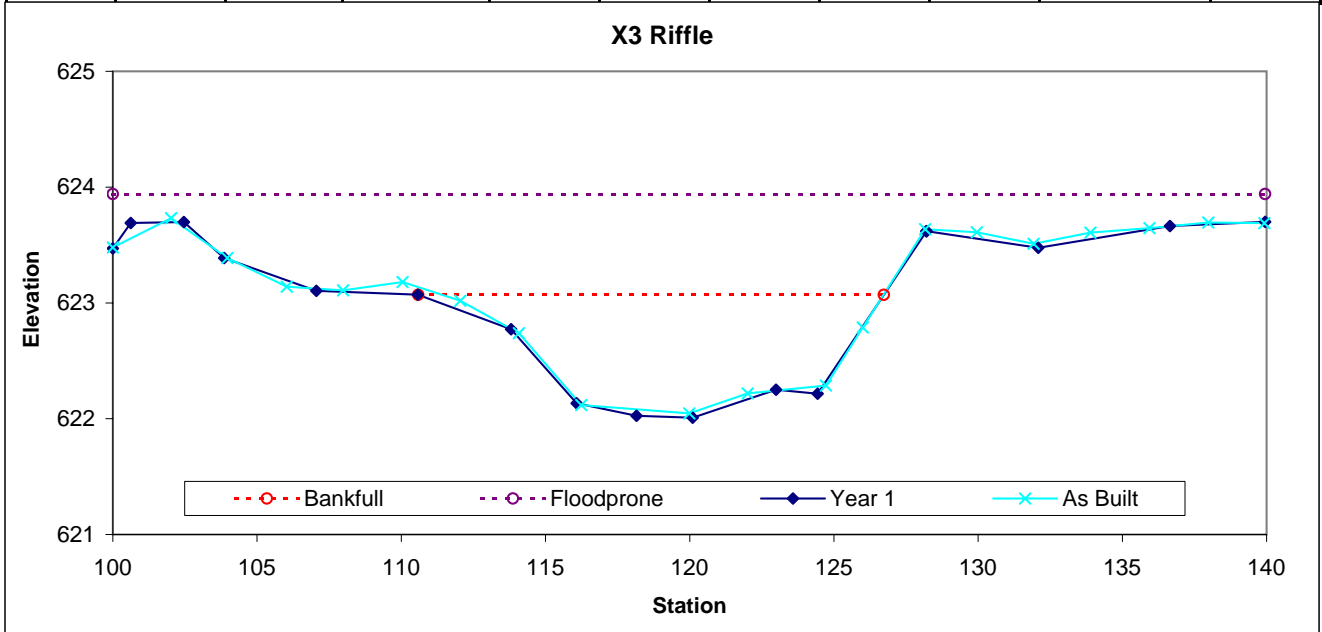

**UT2 Permanent Cross Section X4**  
 (Year 1 Monitoring Data - collected October 2007)




Looking at the Left Bank



Looking at the Right Bank

Feature	Stream Type	BKF Area	BKF Width	BKF Depth	Max BKF Depth	W/D	BH Ratio	ER	BKF Elev	TOB Elev
Pool		25.8	20.88	1.24	2.46	16.9	1	1.9	619.54	619.3

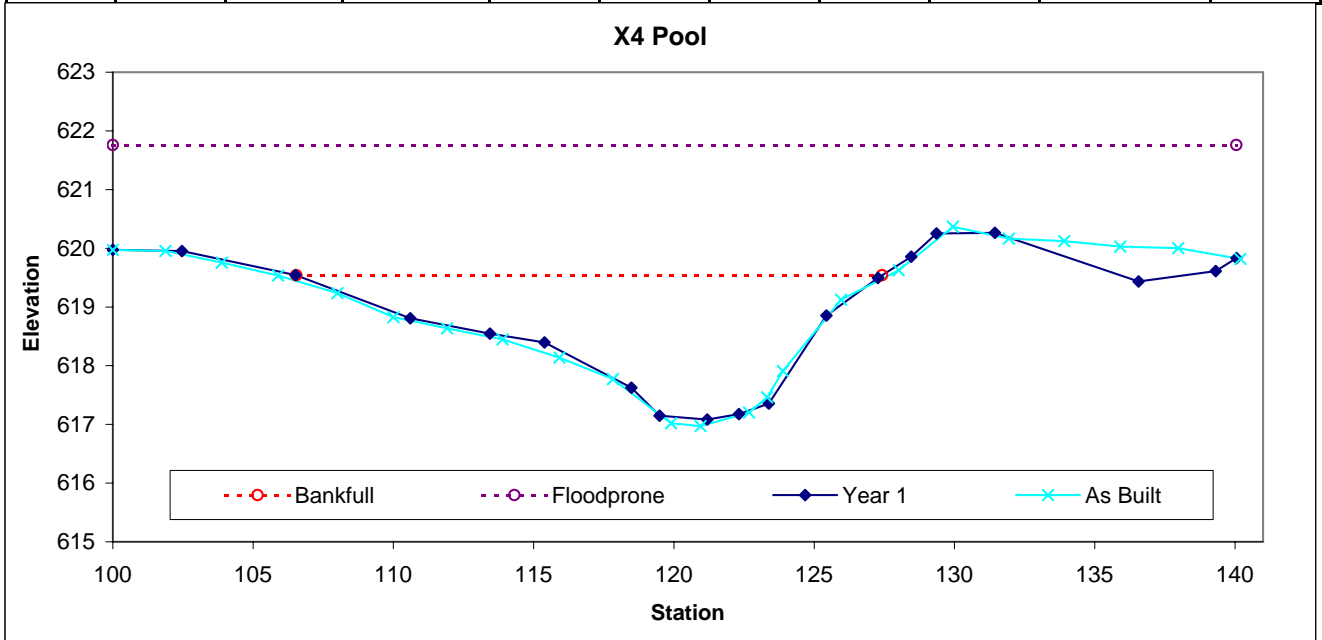

**UT2 Permanent Cross Section X5**  
 (Year 1 Monitoring Data - collected October 2007)




Looking at the Left Bank



Looking at the Right Bank

Feature	Stream Type	BKF Area	BKF Width	BKF Depth	Max BKF Depth	W/D	BH Ratio	ER	BKF Elev	TOB Elev
Riffle	C	22.6	16.63	1.36	1.92	12.23	1	2.4	585.91	585.92

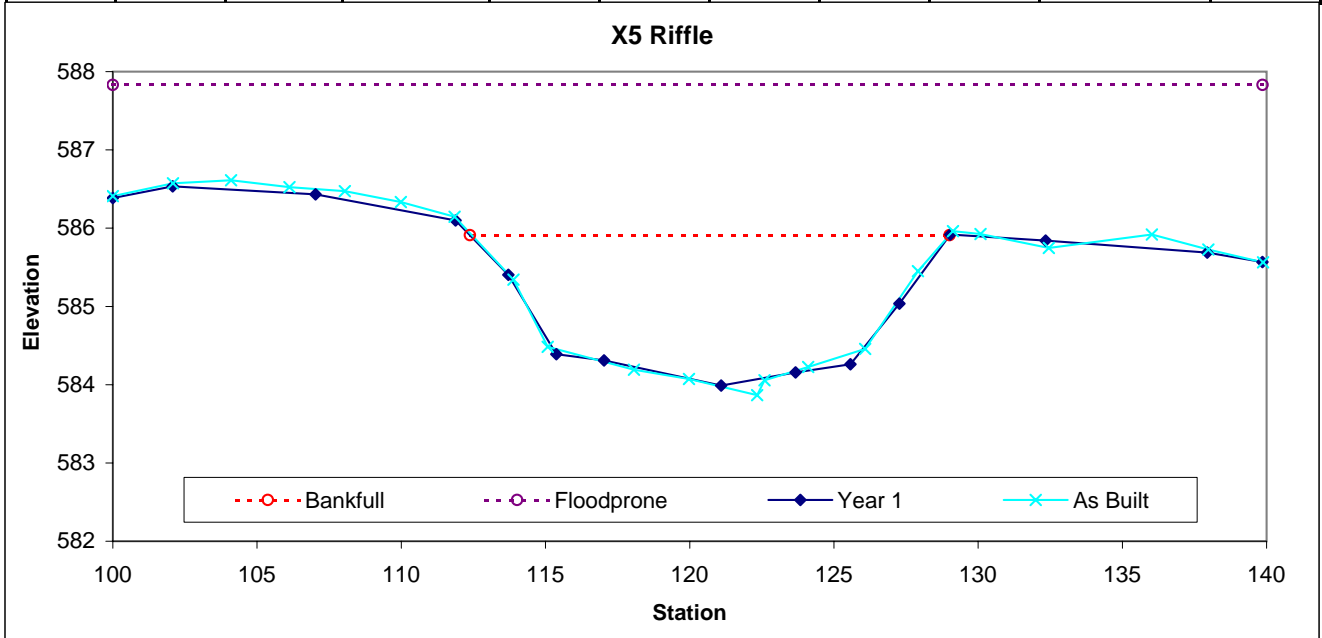



**UT2 Permanent Cross Section X6**  
 (Year 1 Monitoring Data - collected October 2007)




Looking at the Left Bank




Looking at the Right Bank

Feature	Stream Type	BKF Area	BKF Width	BKF Depth	Max BKF Depth	W/D	BH Ratio	ER	BKF Elev	TOB Elev
Pool		23.2	14.04	1.65	2.55	8.5	1	2	583.52	583.52

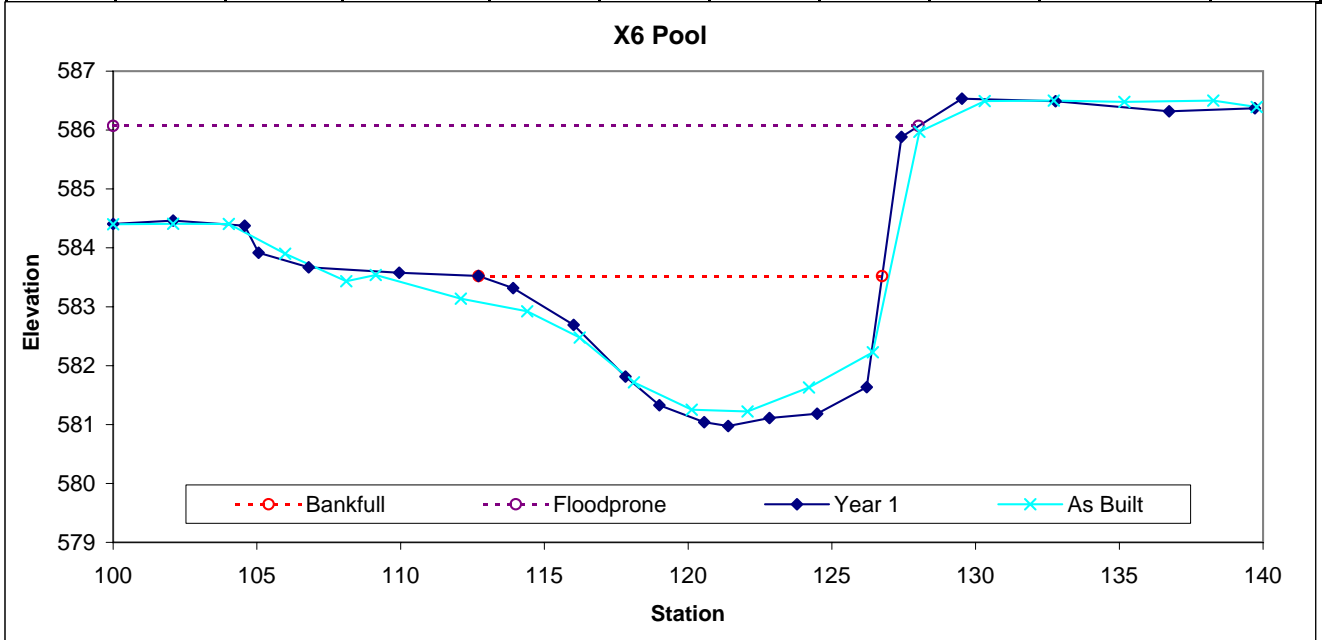


**APPENDIX C**

**AS-BUILT PLAN SHEETS**

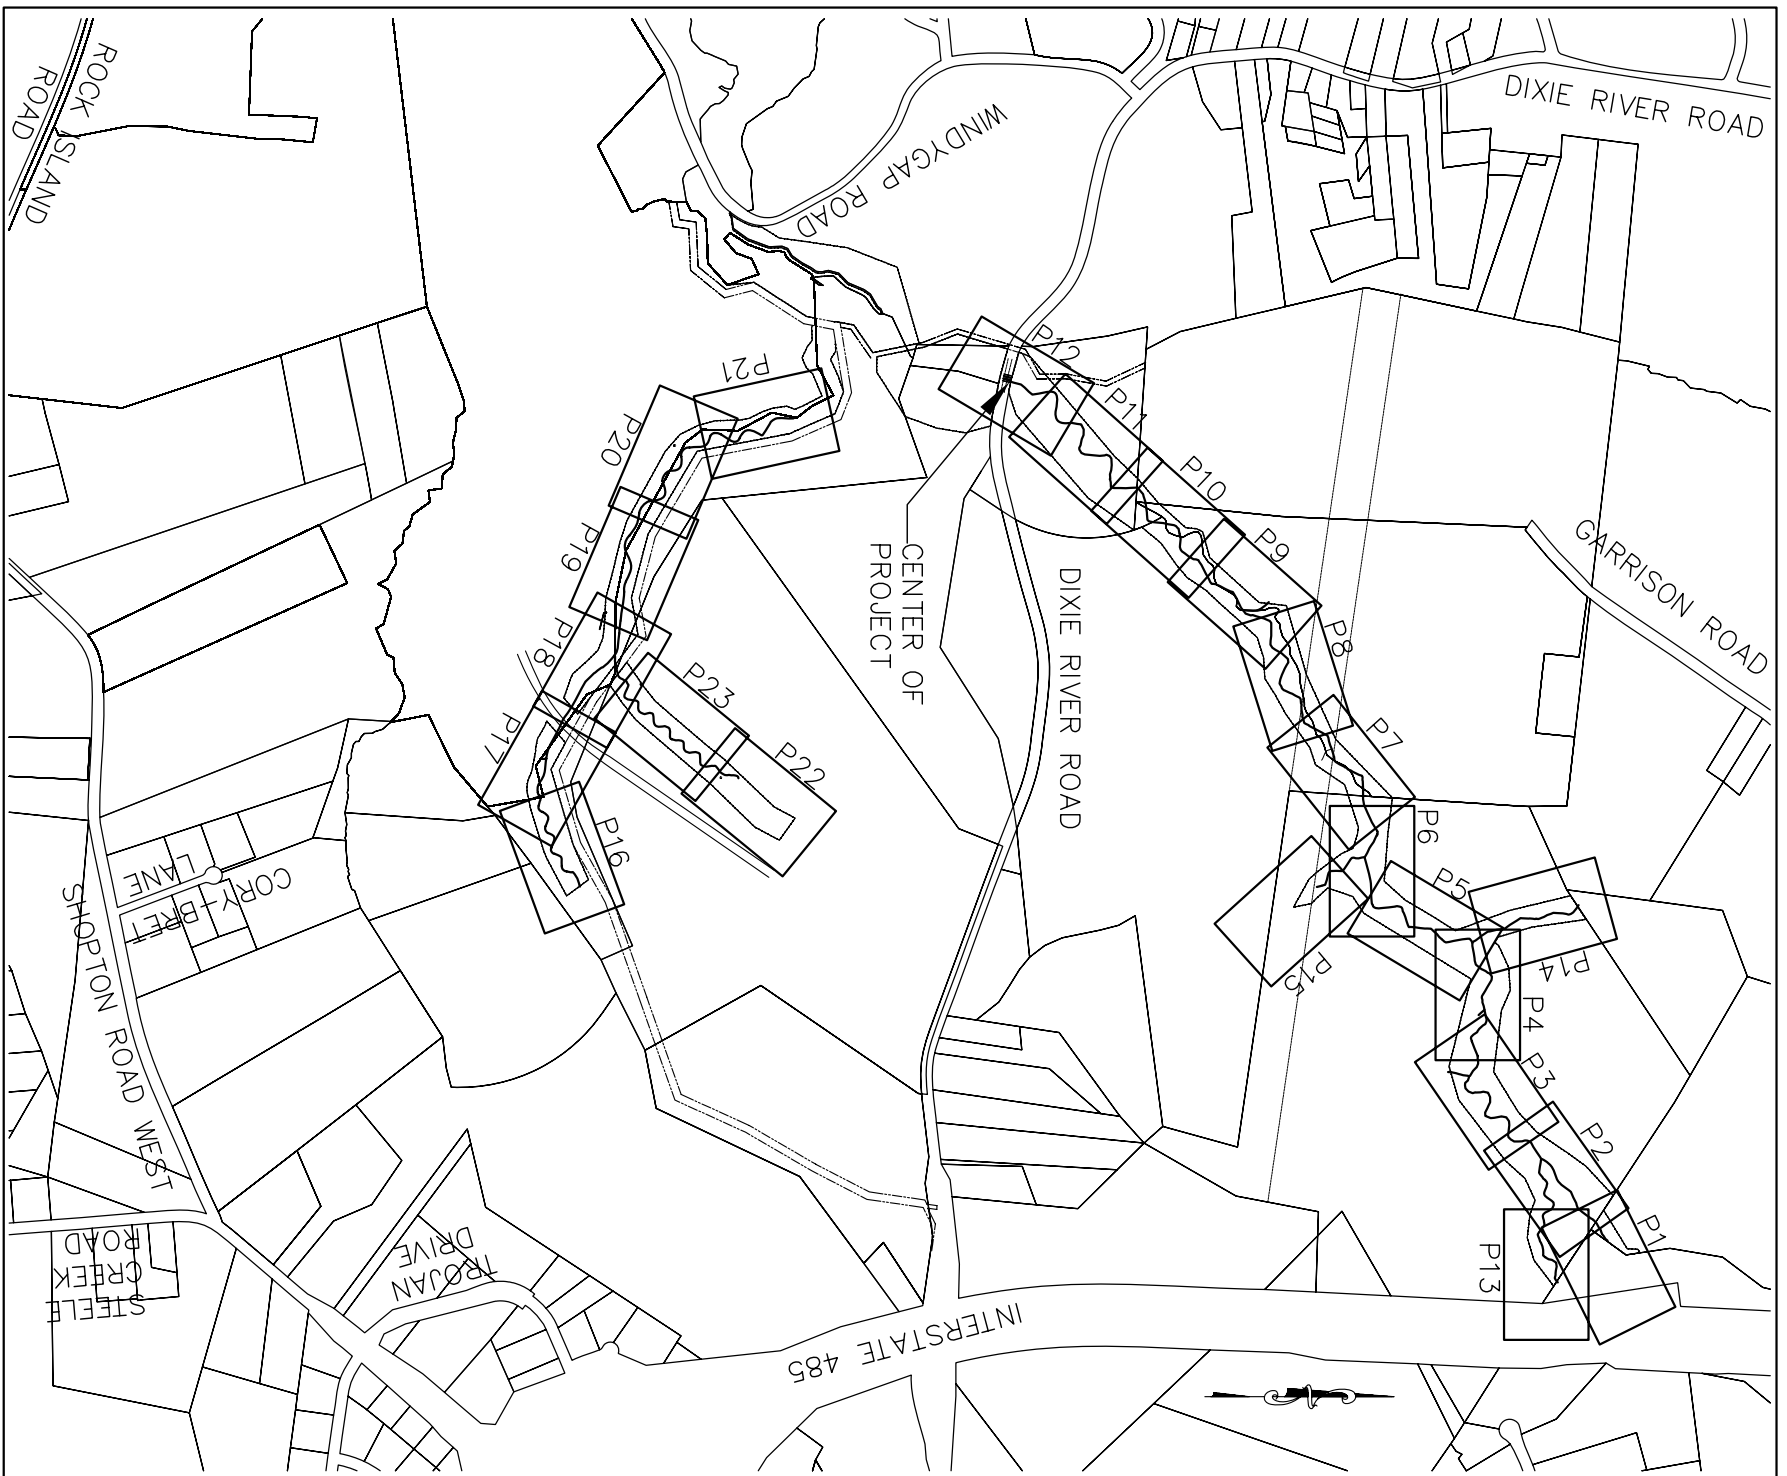

# BEAVERDAM CREEK STREAM RESTORATION AS-BUILT PLANS WITH BMP LOCATIONS

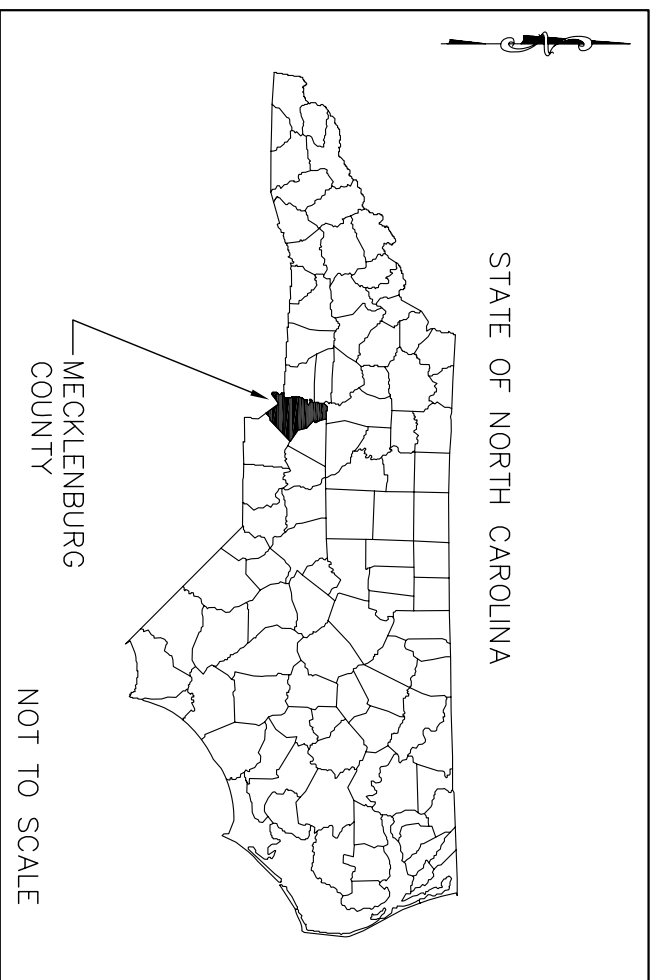

**INDEX OF SHEETS**

TITLE SHEET	T1
LEGEND	T2
REFERENCE SHEET	R1-R4
AS-BUILT PLANS	P1-P23







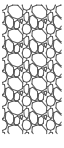







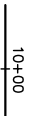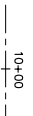





**CENTER OF PROJECT:**  
 LAT: 35-10-21.7  
 LONG: 80-59-08.5

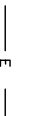UT1	PRE-PROJECT STREAM LENGTH	= 8,148 LF
UT1	AS-BUILT STREAM RESTORATION LENGTH	= 8,617 LF
UT2	PRE-PROJECT STREAM LENGTH	= 4,016 LF
UT2	AS-BUILT STREAM RESTORATION LENGTH	= 4,377 LF
	PRESERVATION LENGTH	= 962 LF
	BEAVERDAM CREEK PRESERVATION LENGTH	= 1,641 LF

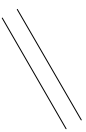PROJECT REFERENCE NO. 108528	SHEET NO. T1
DRAFT	
PROJECT ENGINEER KLT	
APPROVED BY WAH	
DATE 10/11/2007	

BEAVERDAM CREEK AS-BUILT WITH BMPS
TITLE SHEET

# CONVENTIONAL SYMBOLS

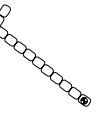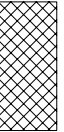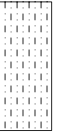-  AS-BUILT THALWEG
-  DESIGN THALWEG
-  EXISTING MAJOR CONTOUR
-  EXISTING MINOR CONTOUR
-  CONSERVATION EASEMENT
-  PROPERTY LINE
-  CONSTRUCTED RIFFLE
-  EXISTING TREE
-  LOG SILL
-  LOG VANE
-  FLOW DIRECTION
-  ROCK CROSS VANE
-  BOULDER CLUSTER
-  PHOTO ID POINT
-  SURVEY CONTROL POINT
-  ROOT WAD
-  ROCK VANE
-  OFFSITE BMPs BY OTHERS (FROM MAY 2007 MECKLENBURG COUNTY AERIAL)
-  DISTURBANCE BY OTHERS WITHIN CONSERVATION EASEMENT BOUNDARIES (FROM MAY 2007 MECKLENBURG COUNTY AERIAL)
-  OFFSITE BMP OUTFALLS BY OTHERS (FROM MAY 2007 MECKLENBURG COUNTY AERIAL)

PROJECT REFERENCE NO. 108528  
SHEET NO. T2

DRAFT

PROJECT ENGINEER  
KLT  
APPROVED BY  
WAH  
DATE  
10/11/2007

**Baker**  
Baker Engineering, PC Inc.  
 1412 South Tryon Street  
 Charlotte, NC 28203  
 Phone: 704.334.8404  
 Fax: 704.334.8405

BEAVERDAM CREEK  
AS-BUILT WITH BMPs

LEGEND

PROJECT REFERENCE NO. 108528 SHEET NO. RT

PROJECT ENGINEER

KLT



APPROVED BY

WAH


DATE

10/11/2007

DRAFT

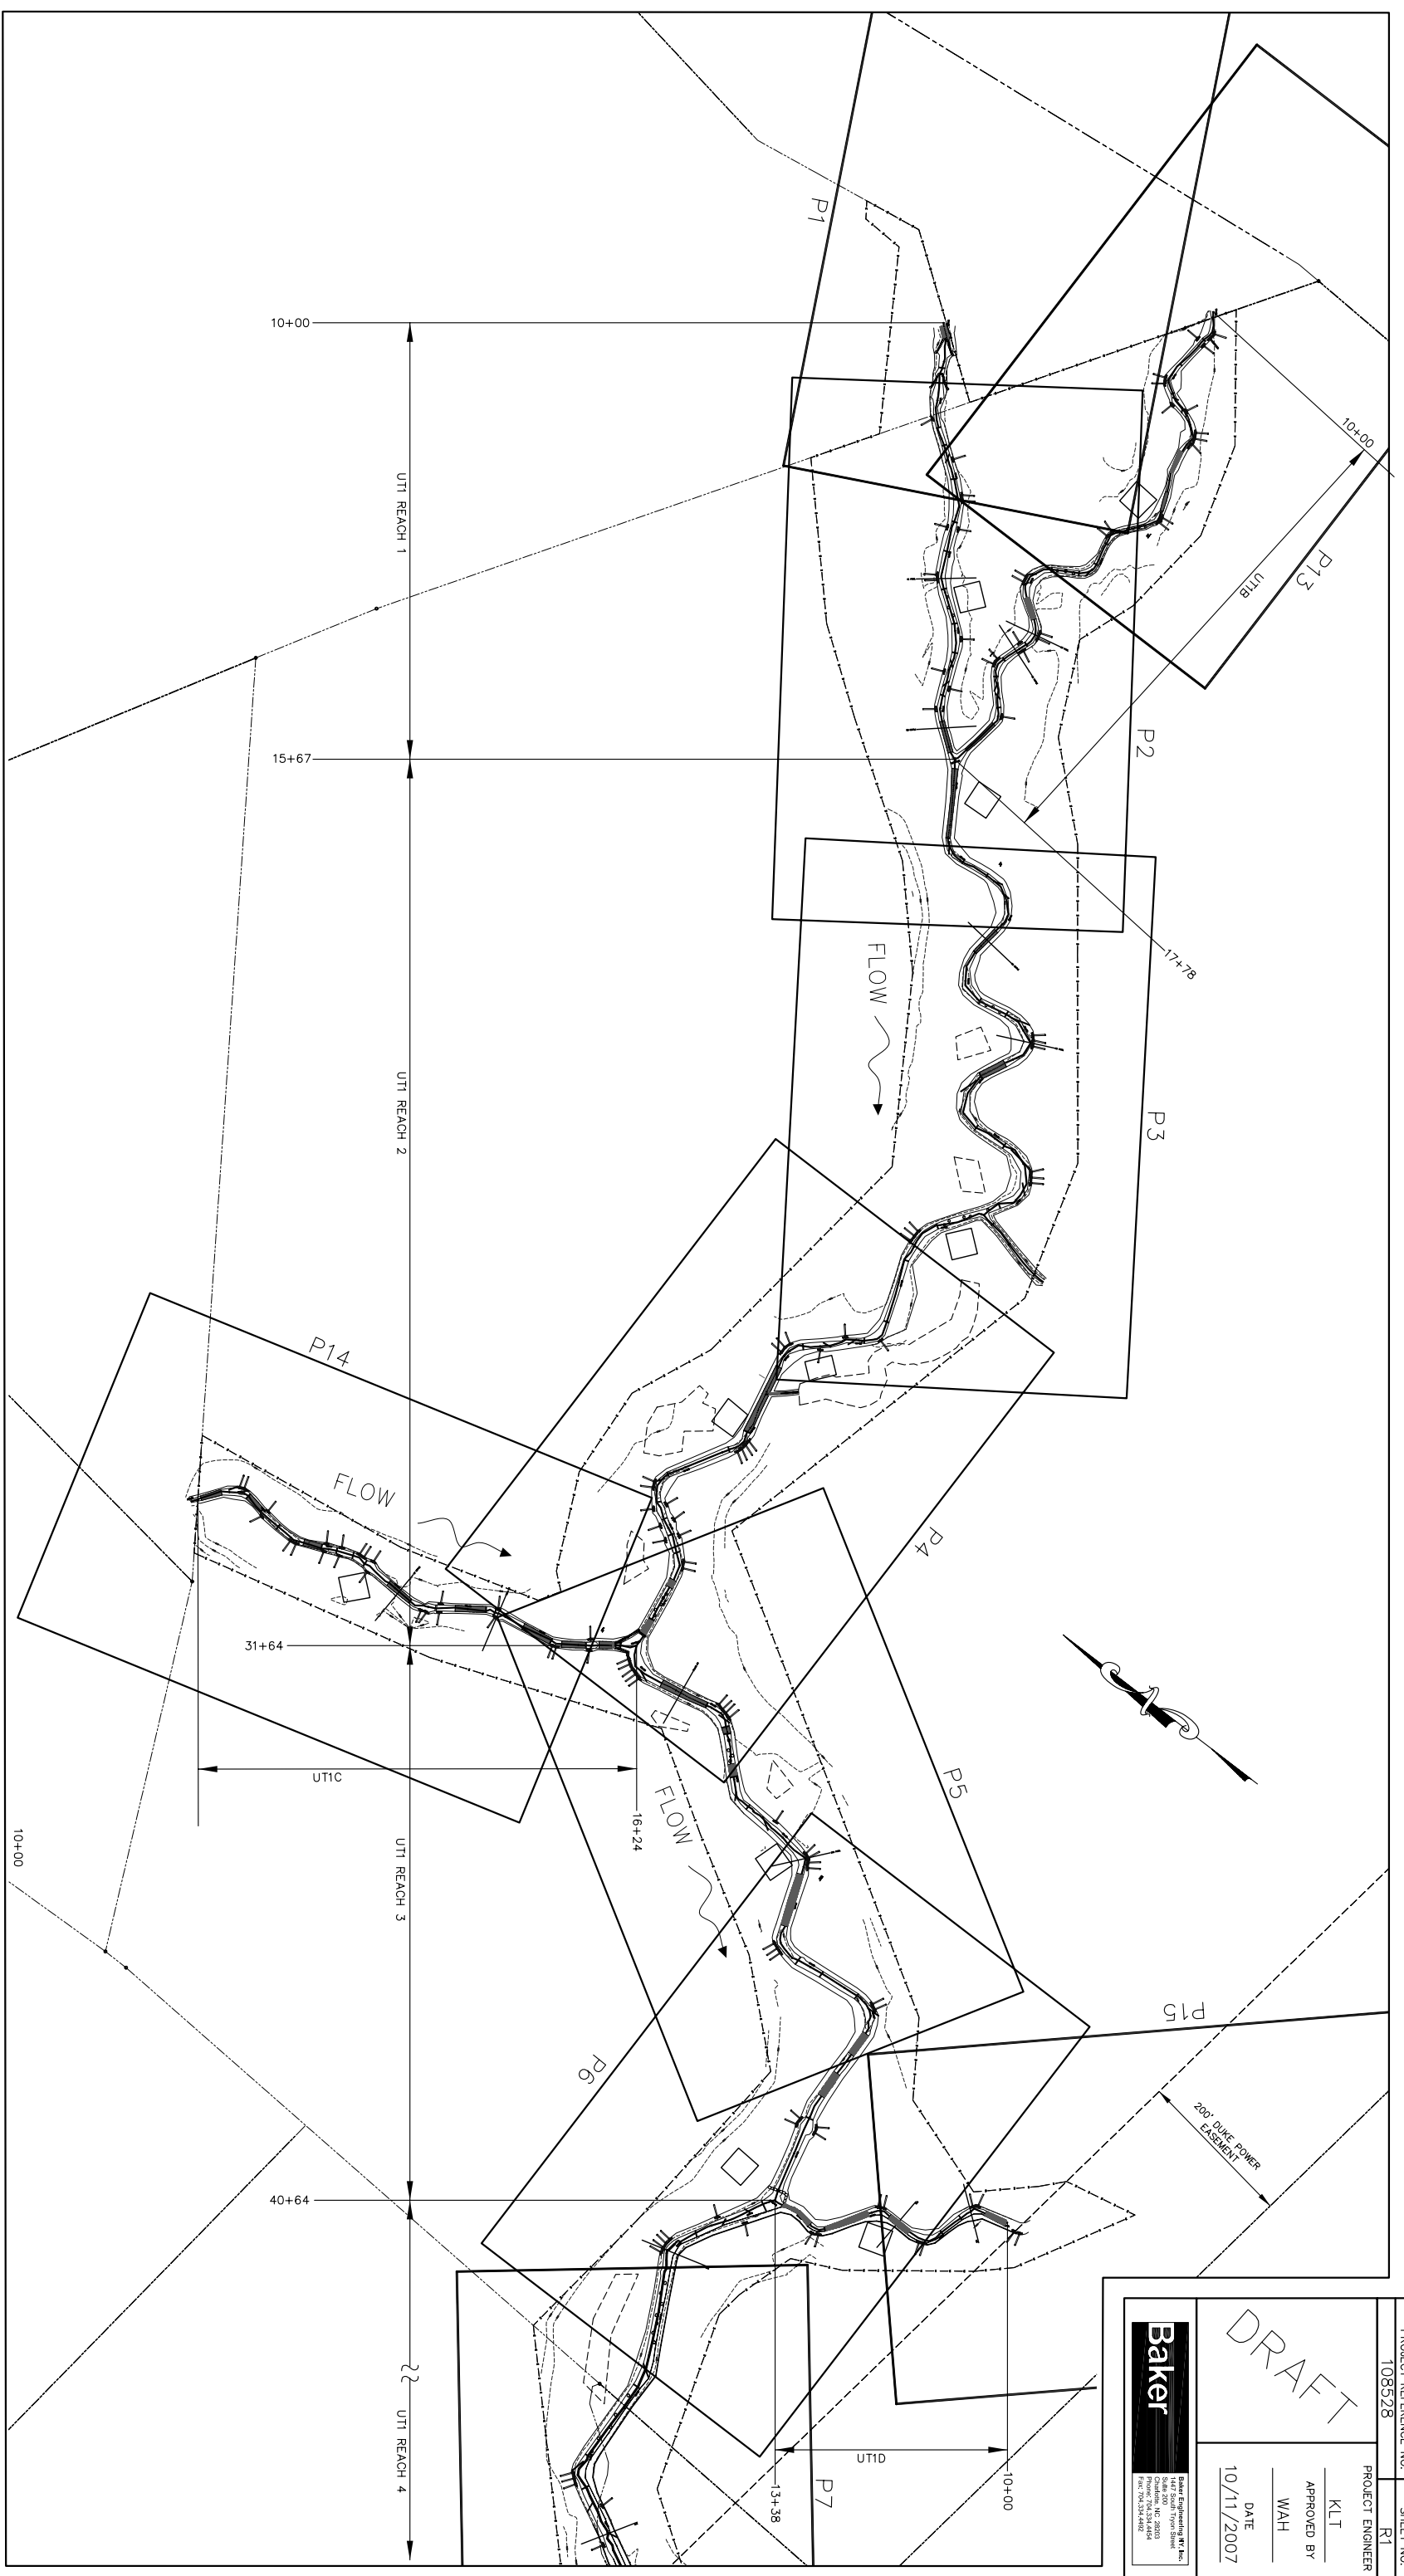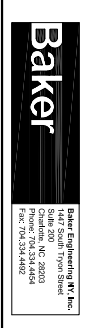

BEAVERDAM CREEK - UT1

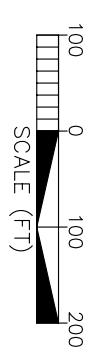

BEAVERDAM CREEK  
 AS-BUILT WITH BMPS  
 REFERENCE SHEET

PROJECT REFERENCE NO. 108528 SHEET NO. R2

PROJECT ENGINEER

KLT

APPROVED BY


WAH

DATE

10/11/2007

DRAFT

**Baker**  
Baker Engineering, PC  
442 South Third Street  
Chattanooga, TN 37403  
Phone: 423.249.8484  
Fax: 423.249.8485

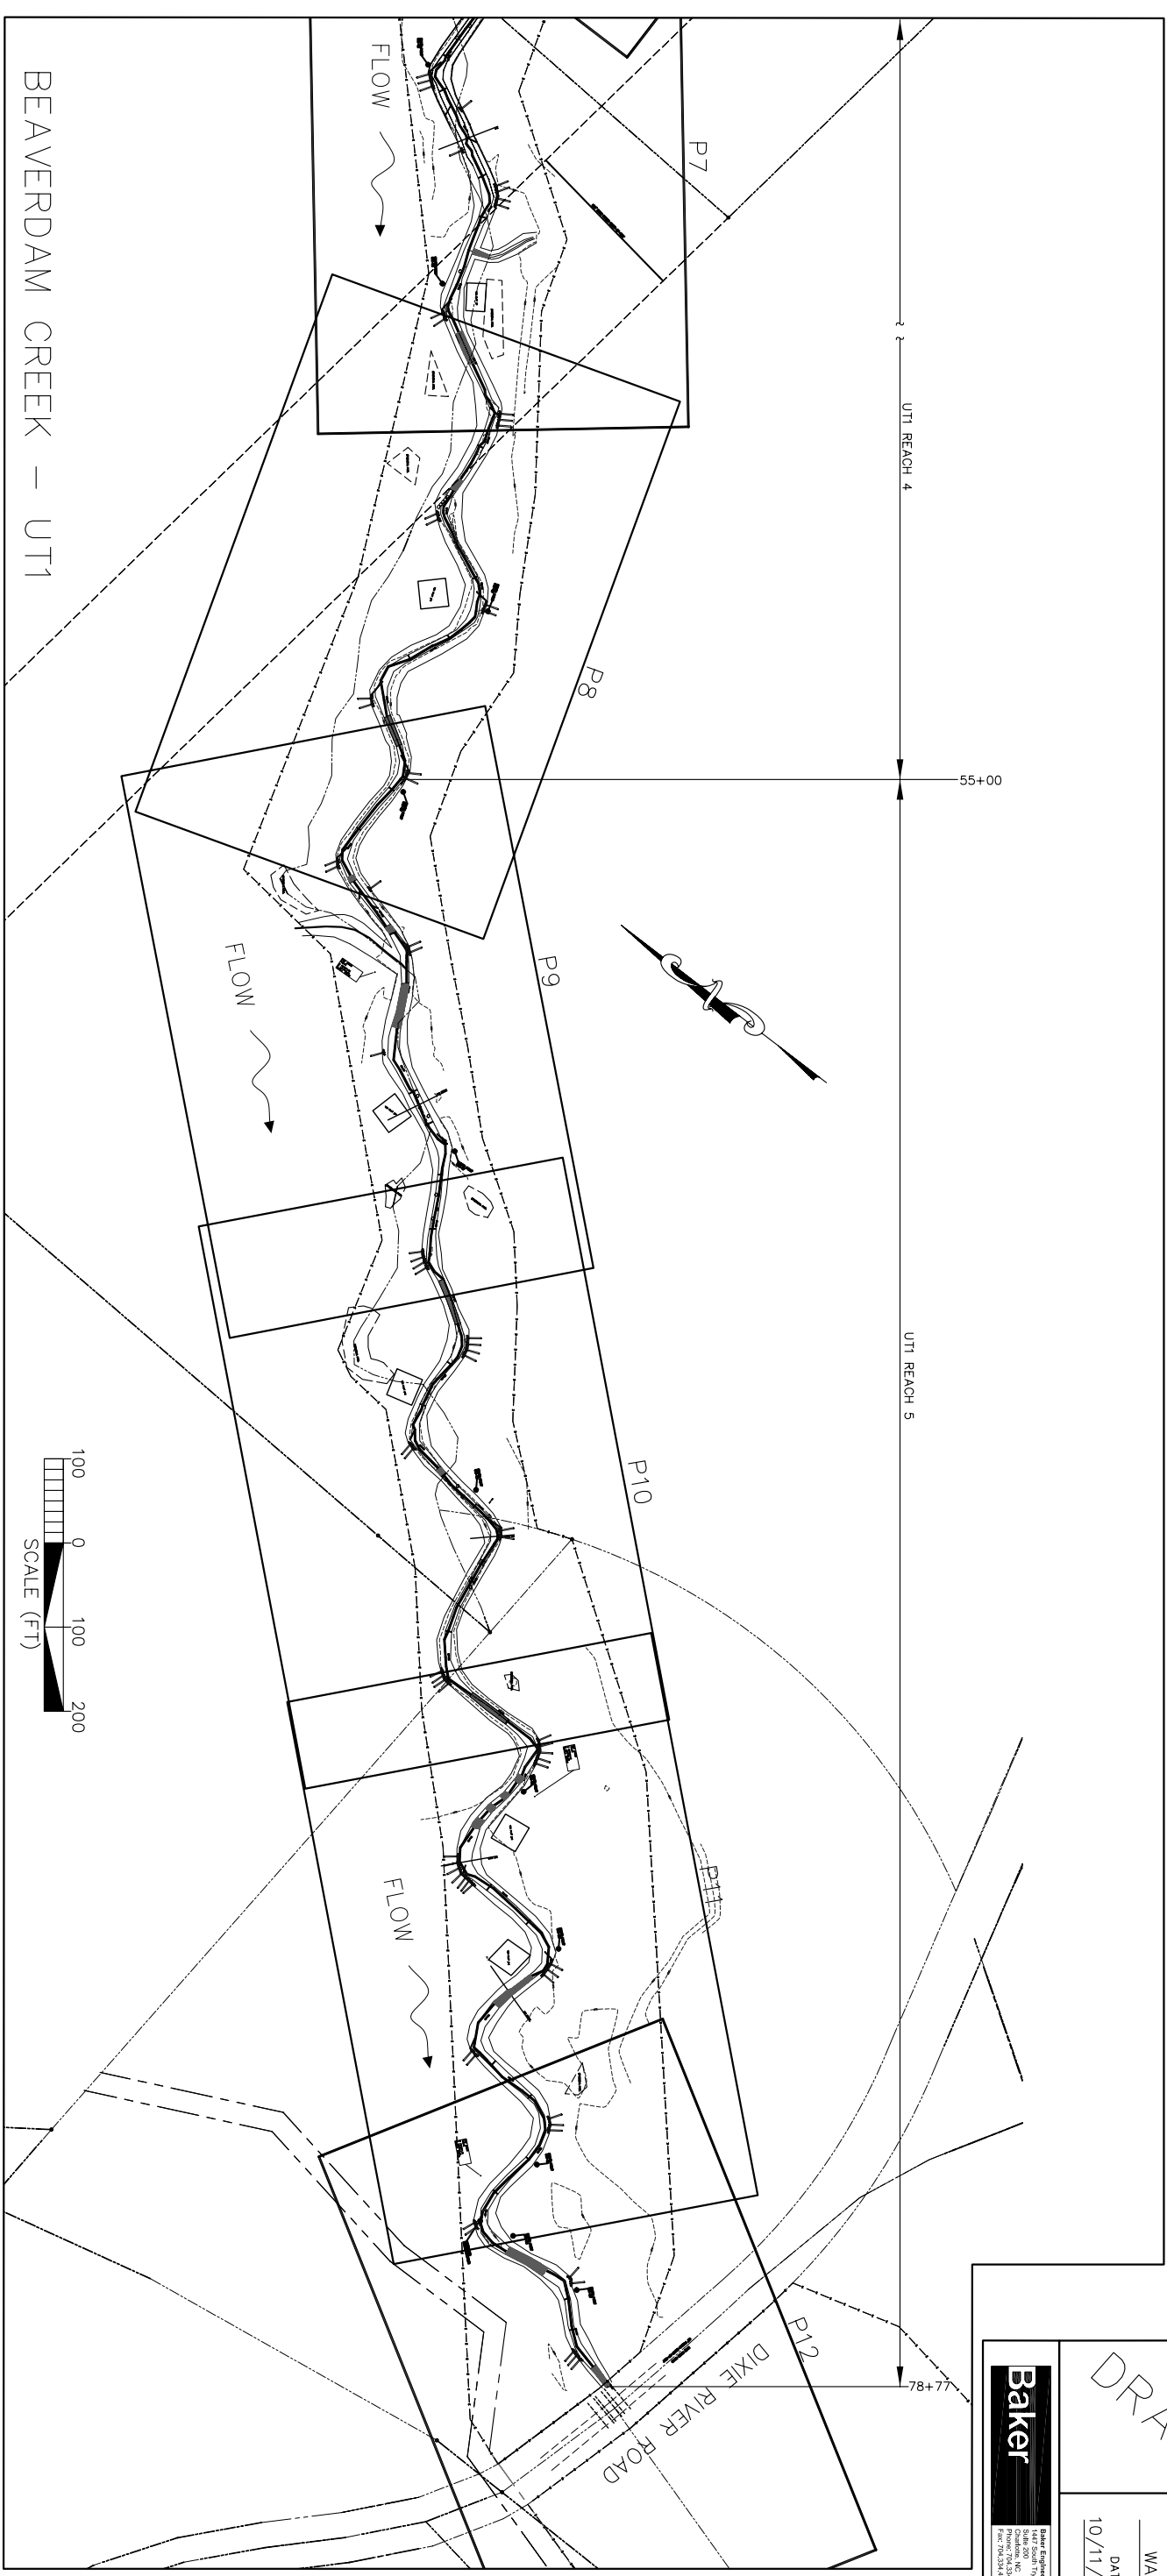

BEAVERDAM CREEK - UT1

BEAVERDAM CREEK  
AS-BUILT WITH BMPs  
REFERENCE SHEET

PROJECT REFERENCE NO.  
108528

SHEET NO.  
R3

PROJECT ENGINEER

KLT


APPROVED BY

WAH


DATE

10/11/2007



DRAFT

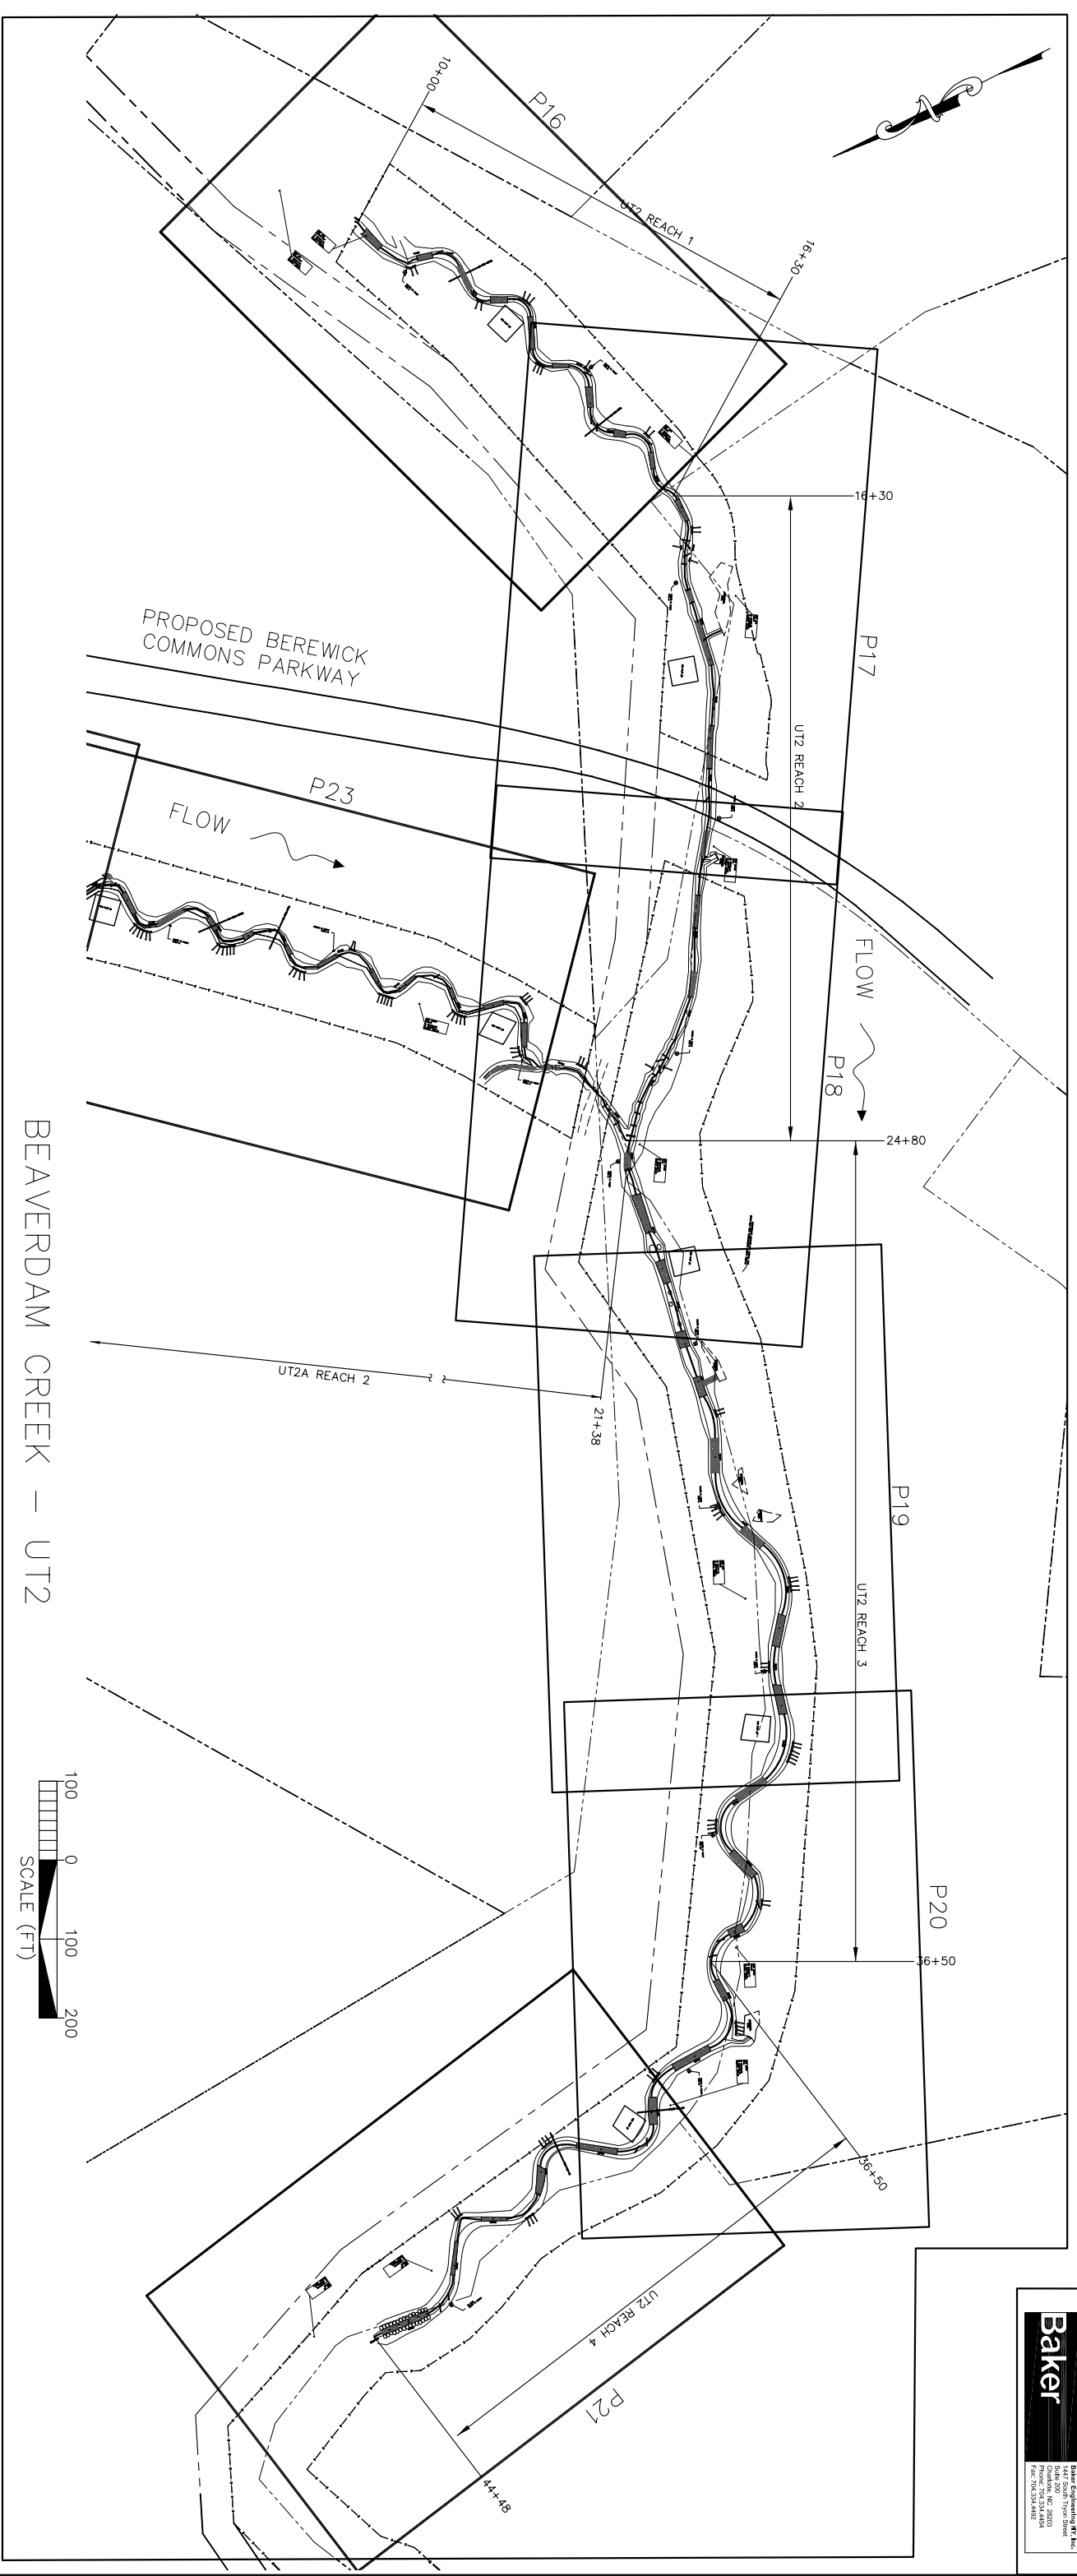

BEAVERDAM CREEK - UT2

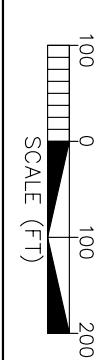

BEAVERDAM CREEK  
AS-BUILT WITH BMPS  
REFERENCE SHEET

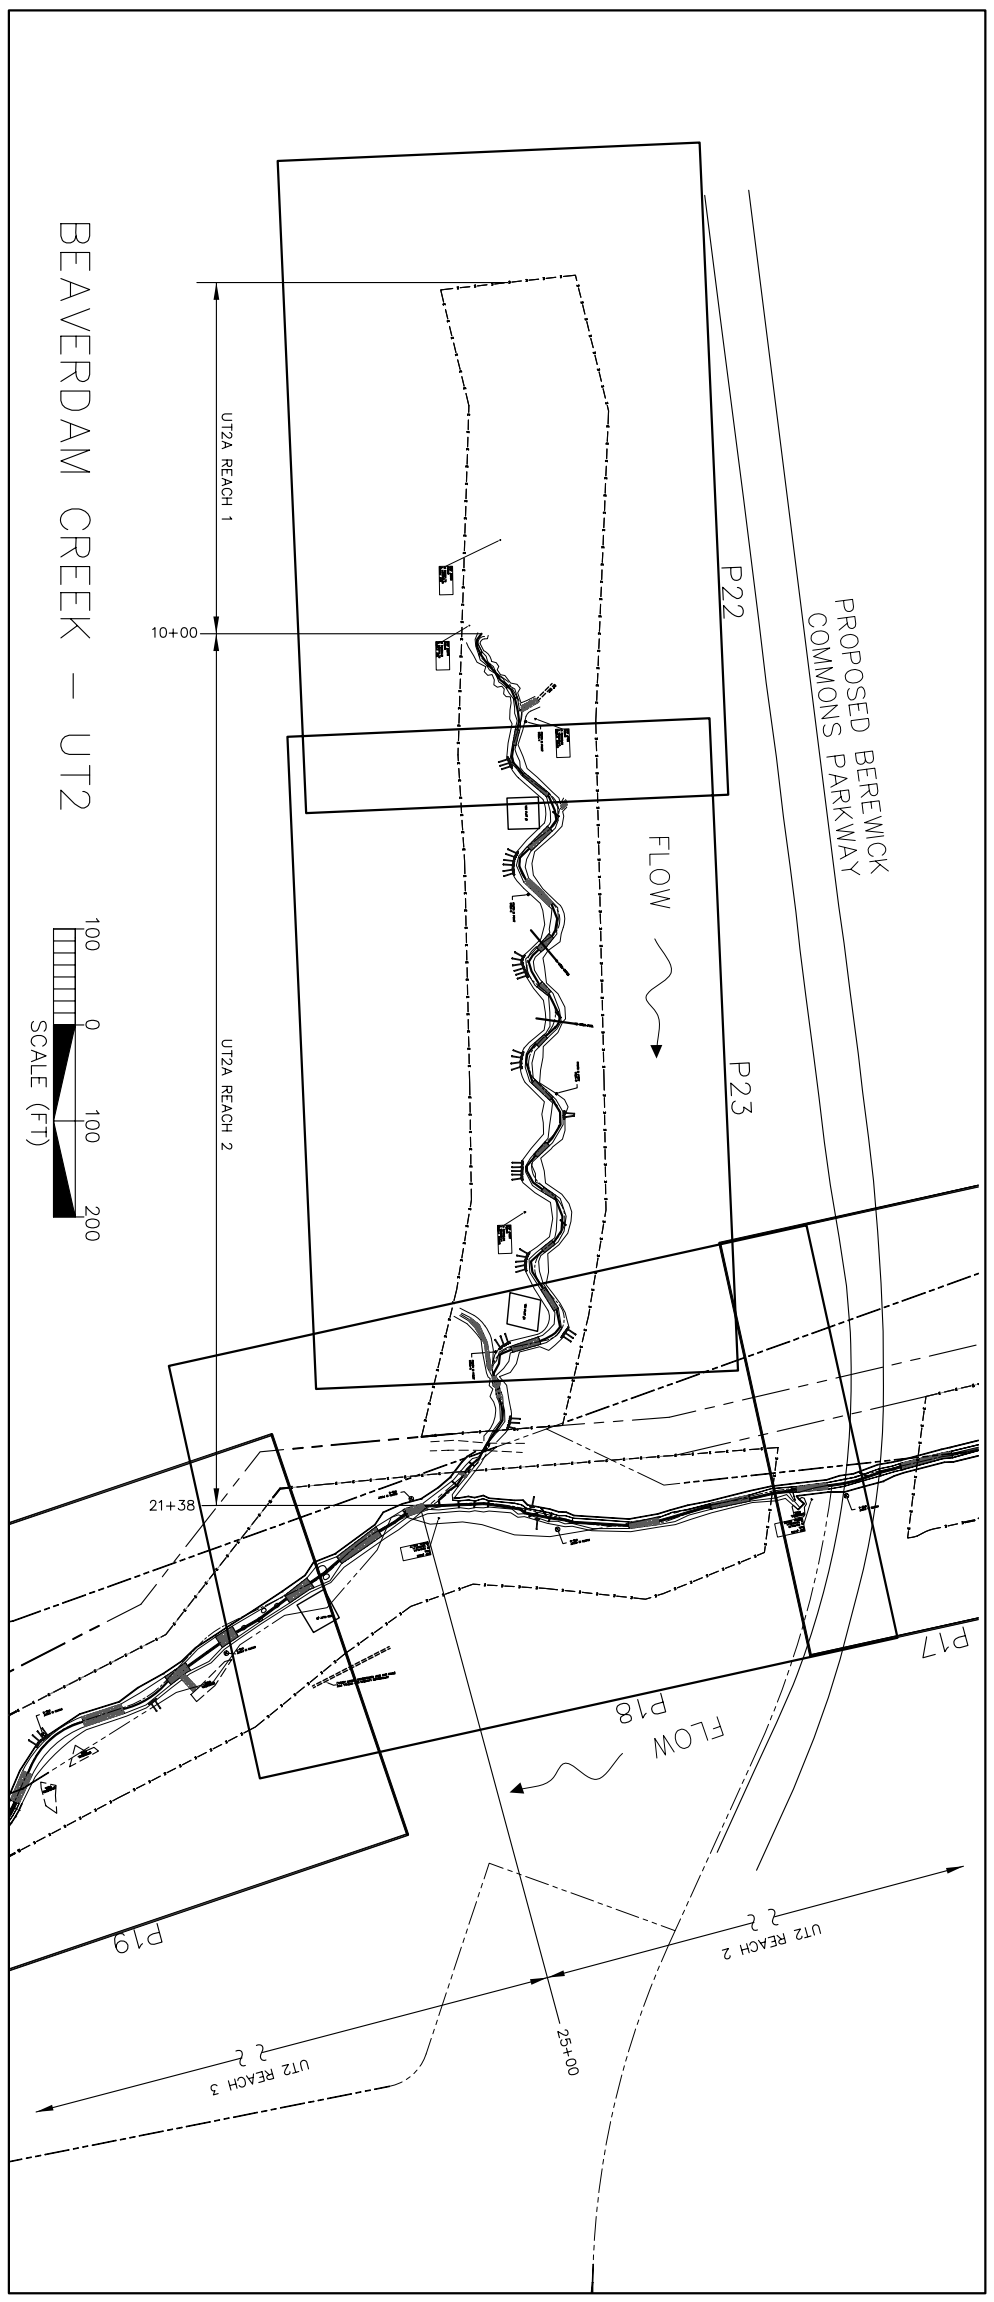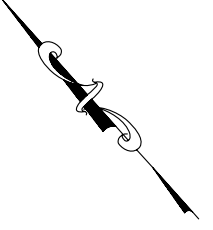

BEAVERDAM CREEK - UT2



PROJECT REFERENCE NO. 108528	SHEET NO. R4
<b>DRAFT</b>	
PROJECT ENGINEER KLT	APPROVED BY WAH
DATE 10/11/2007	

**Baker**  
 Baker Engineering, PC  
 1417 South Tryon Street  
 Charlotte, NC 28203  
 Phone: 704.334.8404  
 Fax: 704.334.8500

BEAVERDAM CREEK  
 AS-BUILT WITH BMPs  
 REFERENCE SHEET



PROJECT REFERENCE NO. 108528 SHEET NO. P1

PROJECT ENGINEER

KLT


APPROVED BY

WAH

DATE

10/11/2007

DRAFT

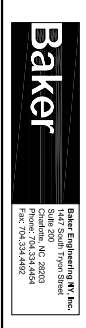

Baker Engineering, P.C.  
1412 South Third Street  
Chattanooga, TN 37403  
Phone: 423.249.4804  
Fax: 423.249.4805

MECKLENBURG COUNTY  
REAL ESTATE / FINANCE DEPT.  
TAX 1417712  
DB 14350 PG 408  
DIXIE RIVER ROAD

DEPARTMENT OF TRANSPORTATION  
AND JOHN L. SHOEMAKER  
TAX 1418164  
DB 10219 PG 764  
GARRISON ROAD

DEPARTMENT OF TRANSPORTATION  
AND JOHN L. SHOEMAKER  
TAX 1418164  
DB 10219 PG 764  
GARRISON ROAD

WILLIAM H. KELLEY, III.  
TAX 1418102  
DB 4869 PG 301  
10137 HORTON ROAD

PHOTO POINT  
UT1-1

MATCHLINE - SHEET P2 - STA 11+61



BEAVERDAM CREEK  
AS-BUILT WITH BMPs  
UT1 SITE PLAN

MATCHLINE - SHEET P3 - STA 14+58

MATCHLINE - SHEET P3 - STA 17+78

BSP # 3314  
 REBAR  
 N 12061223  
 E 12061223  
 ELEV. 501.58

MECKLENBURG COUNTY  
 REAL ESTATE / FINANCE DEPT.  
 TAX 14117112  
 DB 14350 PG 408  
 DIKE RIVER ROAD

DRAFT

PROJECT REFERENCE NO. 108528  
 SHEET NO. P2

PROJECT ENGINEER

KLT

APPROVED BY

WAH

DATE

10/11/2007

**Baker**  
 Baker Engineering, PC  
 442 South Tryon Street  
 Charlotte, NC 28203  
 Phone: 704.334.8484  
 Fax: 704.334.8500



BEAVERDAM CREEK  
 AS-BUILT WITH BMPs

UT1/UT1-B SITE PLAN

PROJECT REFERENCE NO. 108528  
SHEET NO. P3

PROJECT ENGINEER

KLT

APPROVED BY


WAH

DATE

10/11/2007

DRAFT

**Baker**  
Baker Engineering, Inc.  
1412 South Third Street  
Chandler, NC 28503  
Phone: 734.344.804  
Fax: 734.344.800

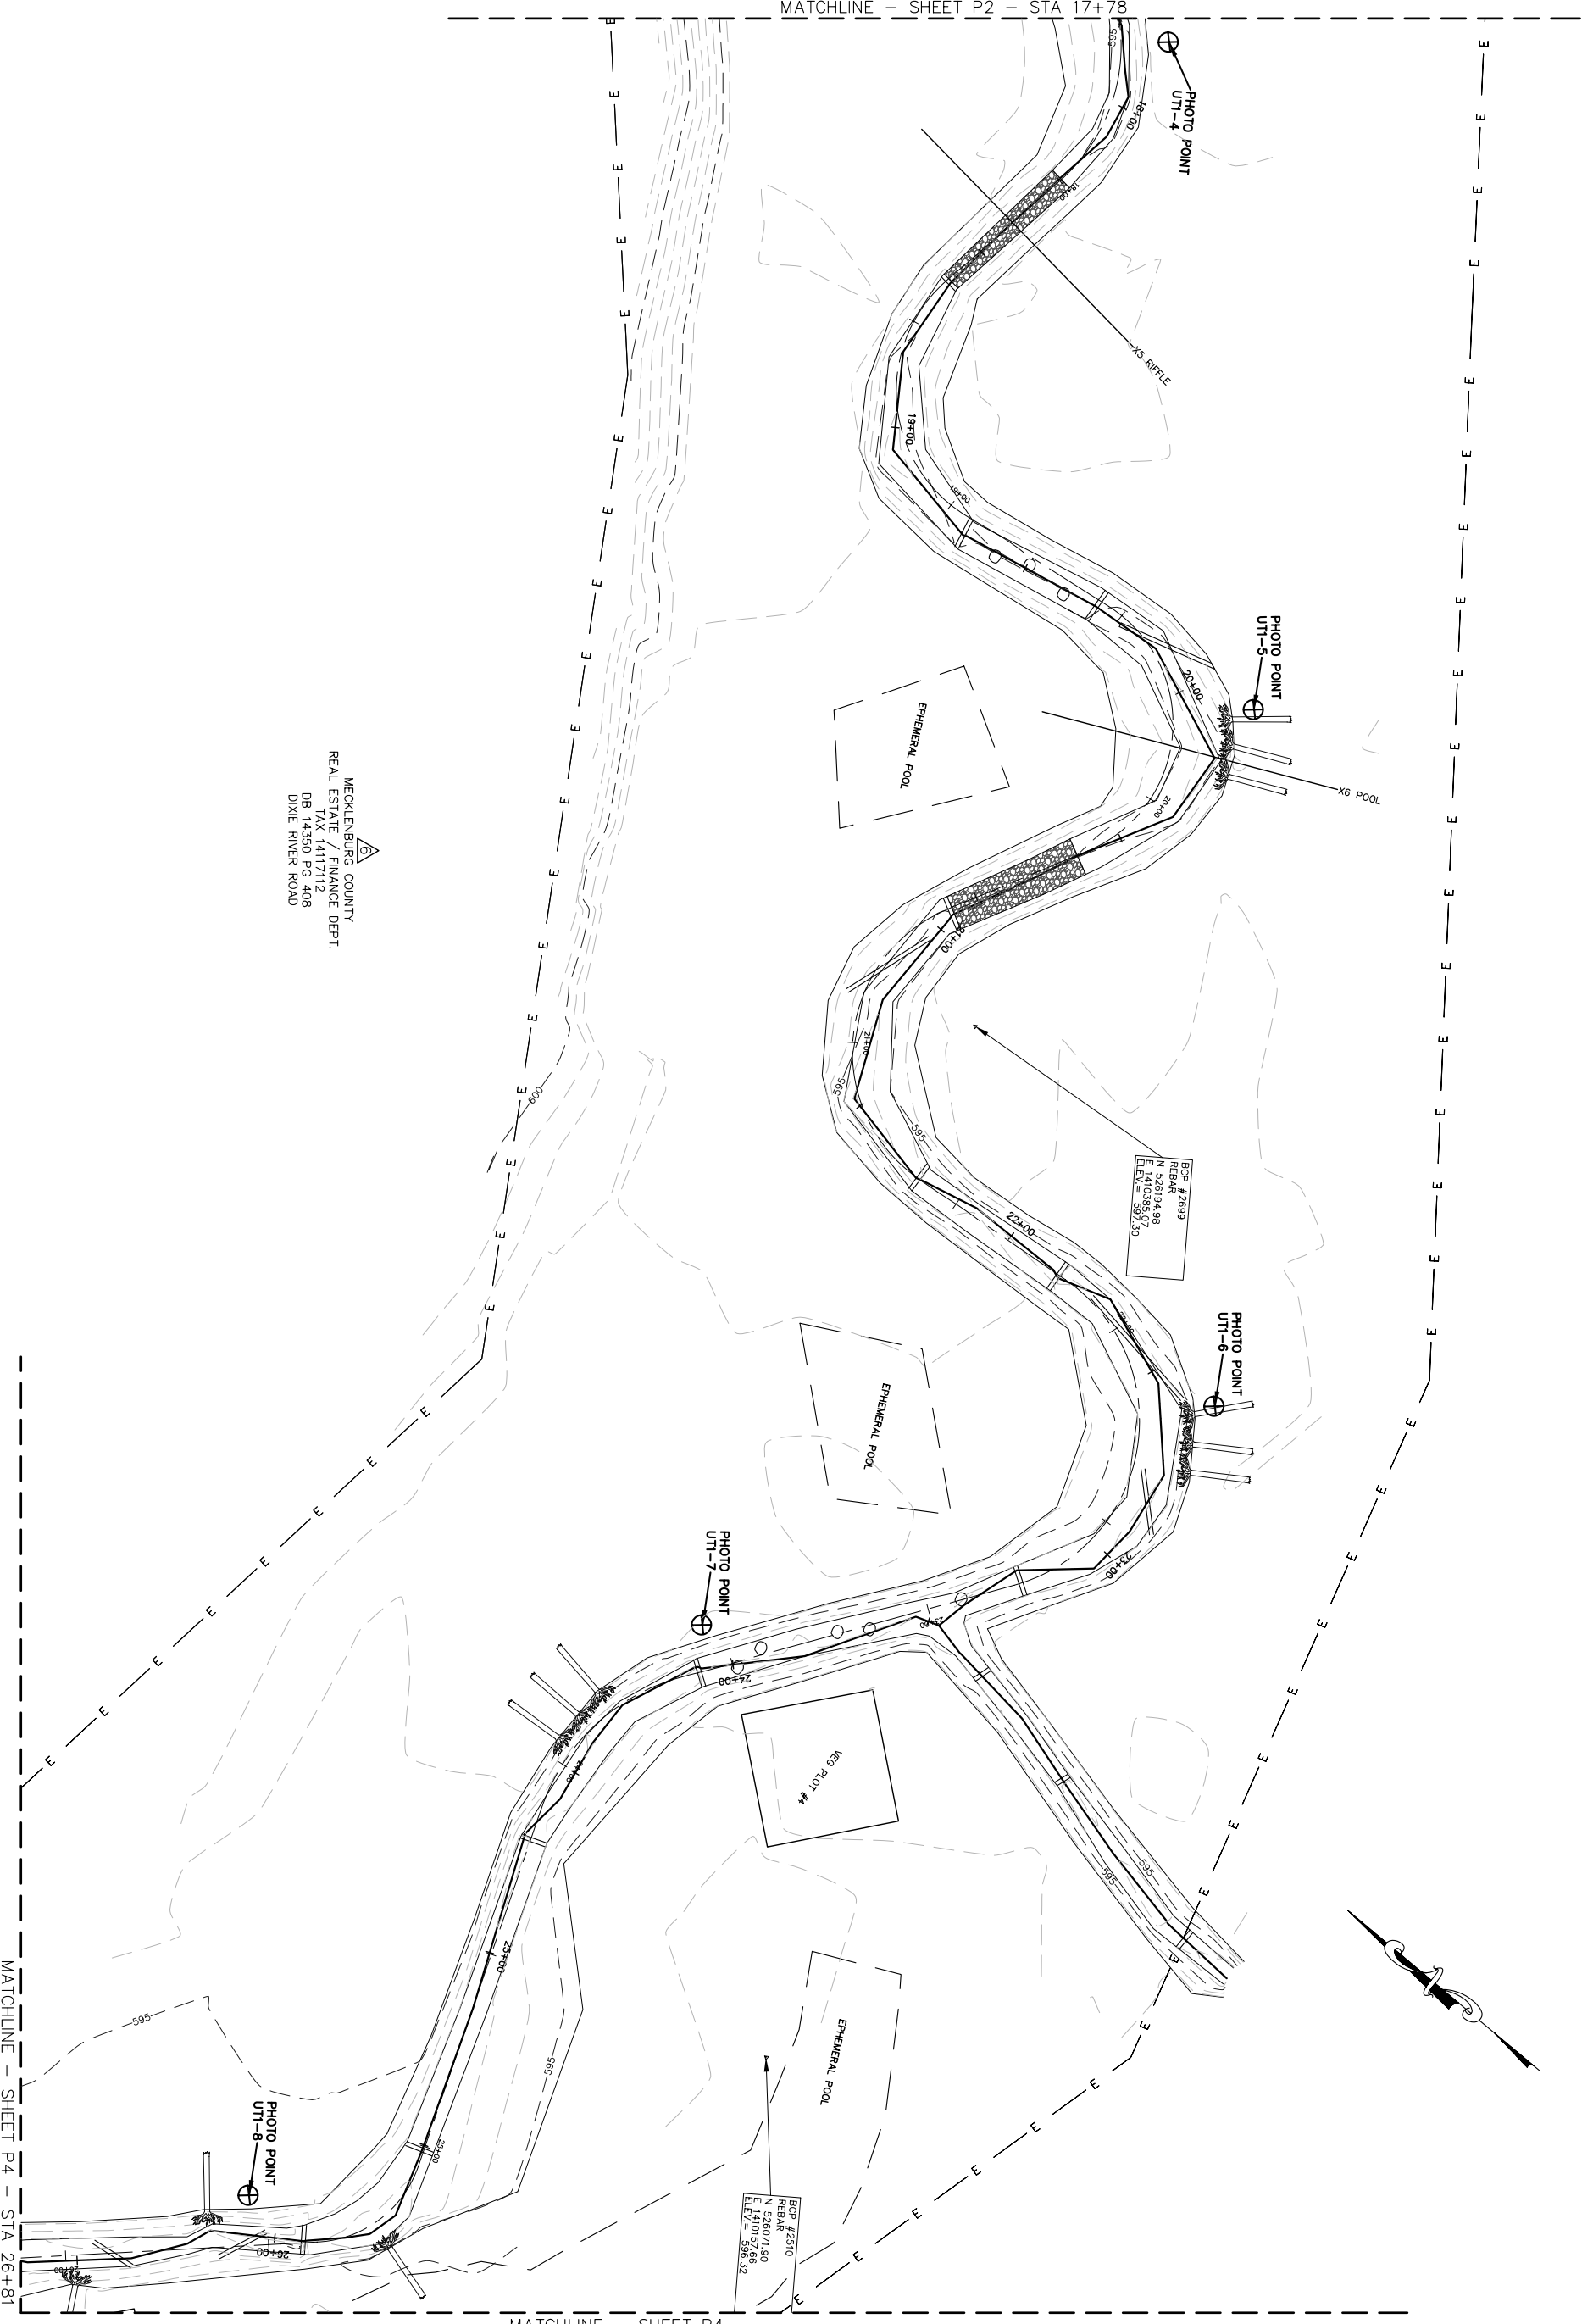

MECKLENBURG COUNTY  
REAL ESTATE / FINANCE DEPT.  
TAX 1417112  
DB 14350 PG. 408  
DIXIE RIVER ROAD

BCP #2699  
REBAR  
N 526194.98  
E 1410385.07  
ELEV. = 397.30

BCP #2310  
REBAR  
N 526071.90  
E 1410157.66  
ELEV. = 398.32



BEAVERDAM CREEK  
AS-BUILT WITH BMPS

UT1 SITE PLAN

PROJECT REFERENCE NO. 108528 SHEET NO. P4

PROJECT ENGINEER

KLT

APPROVED BY

WAH



DATE

10/11/2007

DRAFT

**Baker**  
 Baker Engineering, PC  
 1412 South Tryon Street  
 Charlotte, NC 28203  
 Phone: 704.334.8484  
 Fax: 704.334.8500

MECKLENBURG COUNTY  
 REAL ESTATE / FINANCE DEPT.  
 TAX 1417112  
 DB 14350 PG 408  
 DIXIE RIVER ROAD

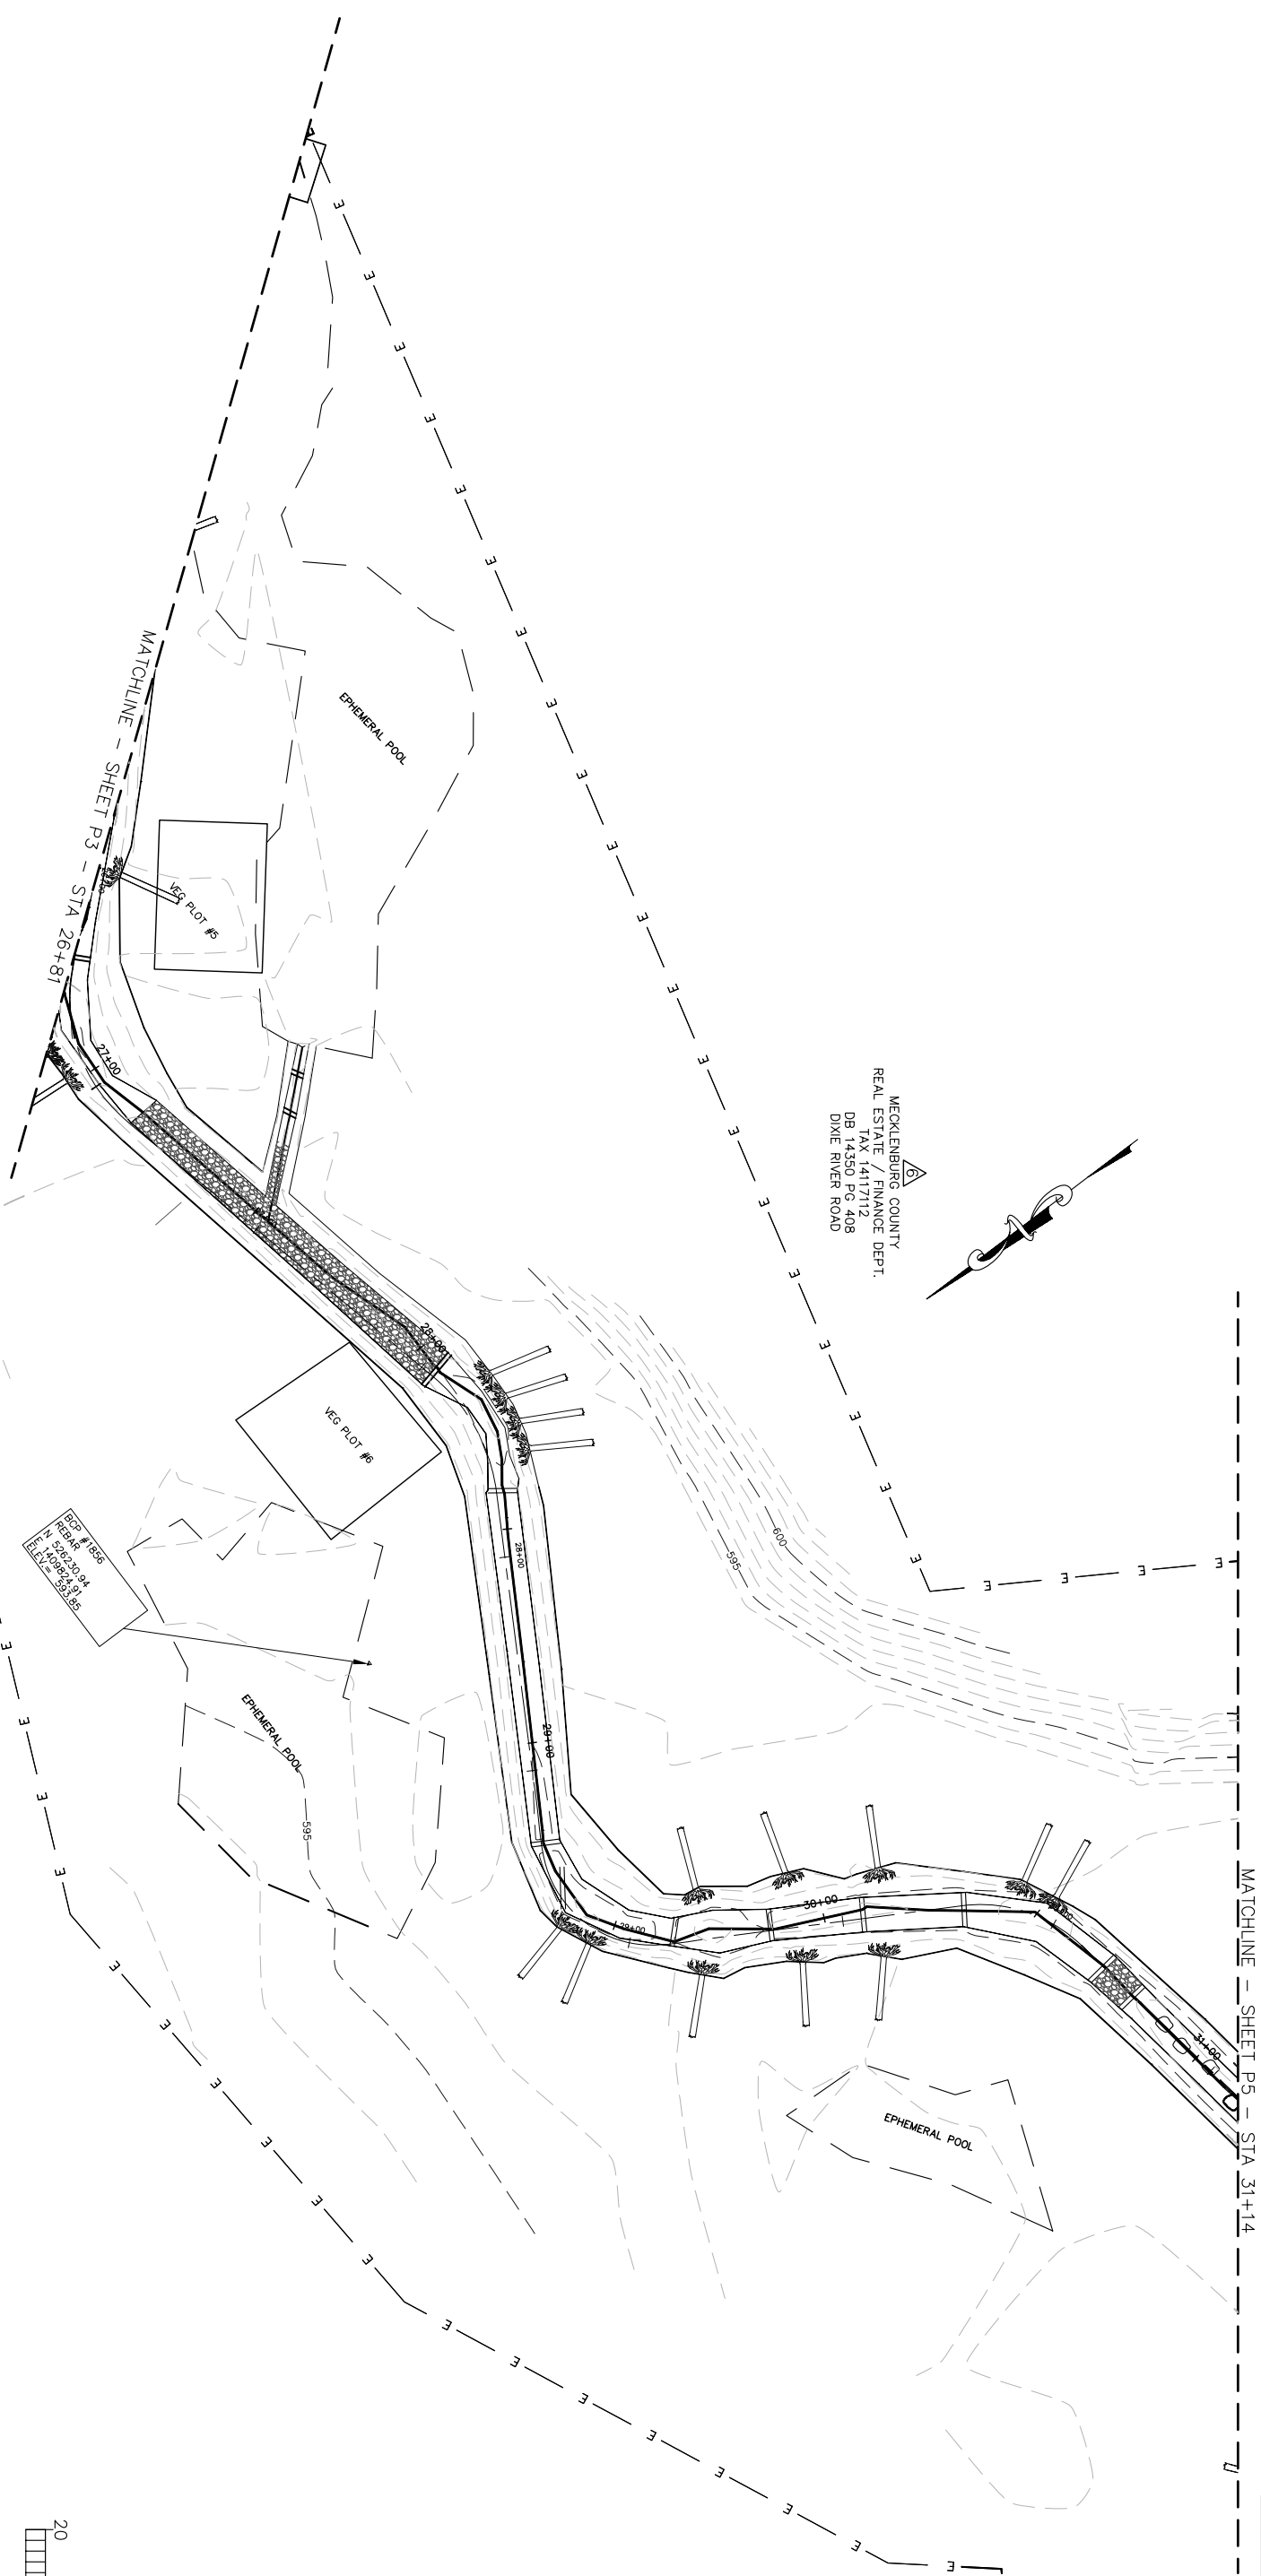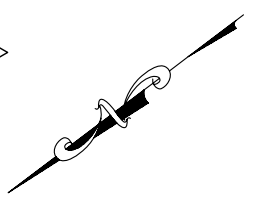

BEAVERDAM CREEK  
 AS-BUILT WITH BMPS  
 UT1 SITE PLAN

PROJECT REFERENCE NO. 108528  
SHEET NO. P5

PROJECT ENGINEER

KLT


APPROVED BY  
WAH

DATE  
10/11/2007

DRAFT

**Baker**  
Baker Engineering, Inc.  
1412 South Tyng Street  
Chatham, NC 28520  
Phone: 754.242.8084  
Fax: 754.242.8085

MECKLENBURG COUNTY  
REAL ESTATE / FINANCE DEPT.  
TAX 1417712  
DB 14350 PG 408  
DIXIE RIVER ROAD

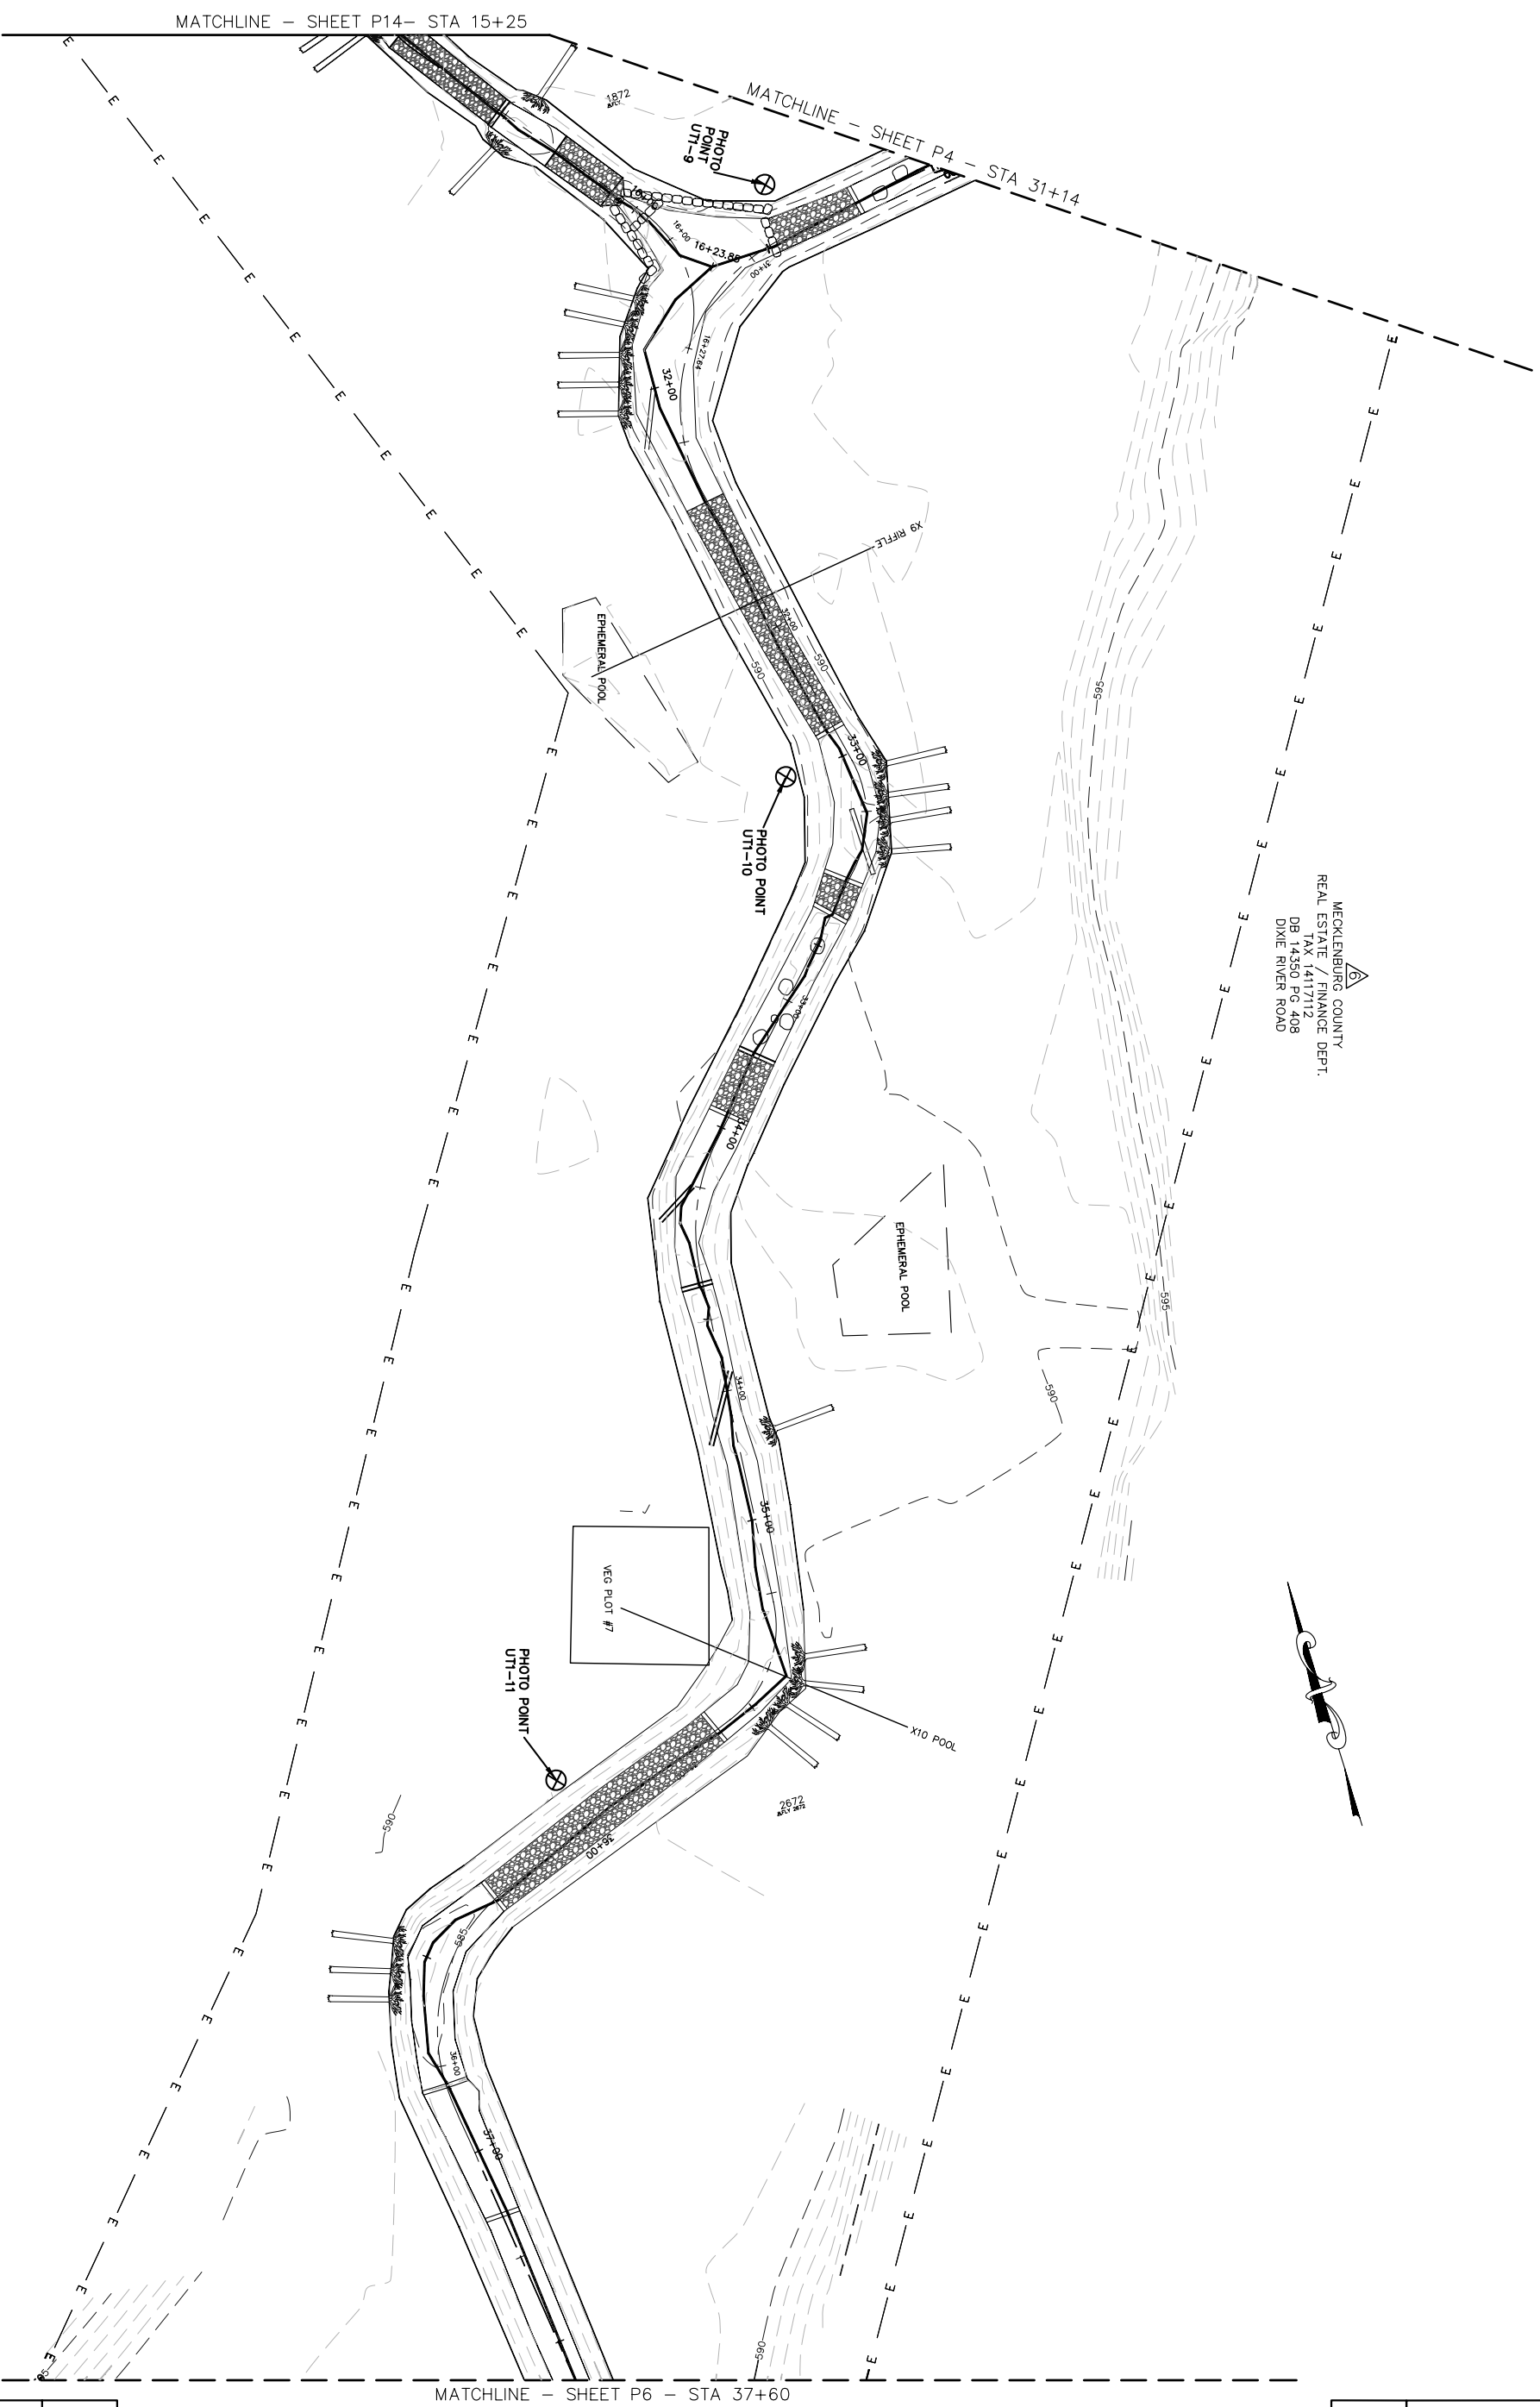

BEAVERDAM CREEK  
AS-BUILT WITH BMPS

UT1/UT1-C SITE PLAN

PROJECT REFERENCE NO. 108528 SHEET NO. P6

PROJECT ENGINEER

KLT

APPROVED BY

WAH


DATE

10/11/2007

DRAFT

**Baker**  
 Baker Engineering, PC  
 442 South Third Street  
 Columbia, SC 29203  
 Phone: 793.234.8484  
 Fax: 793.234.8485

MECKLENBURG COUNTY  
 REAL ESTATE / FINANCE DEPT.  
 TAX 141711  
 DB 14350 PG 408  
 DIKE RIVER ROAD

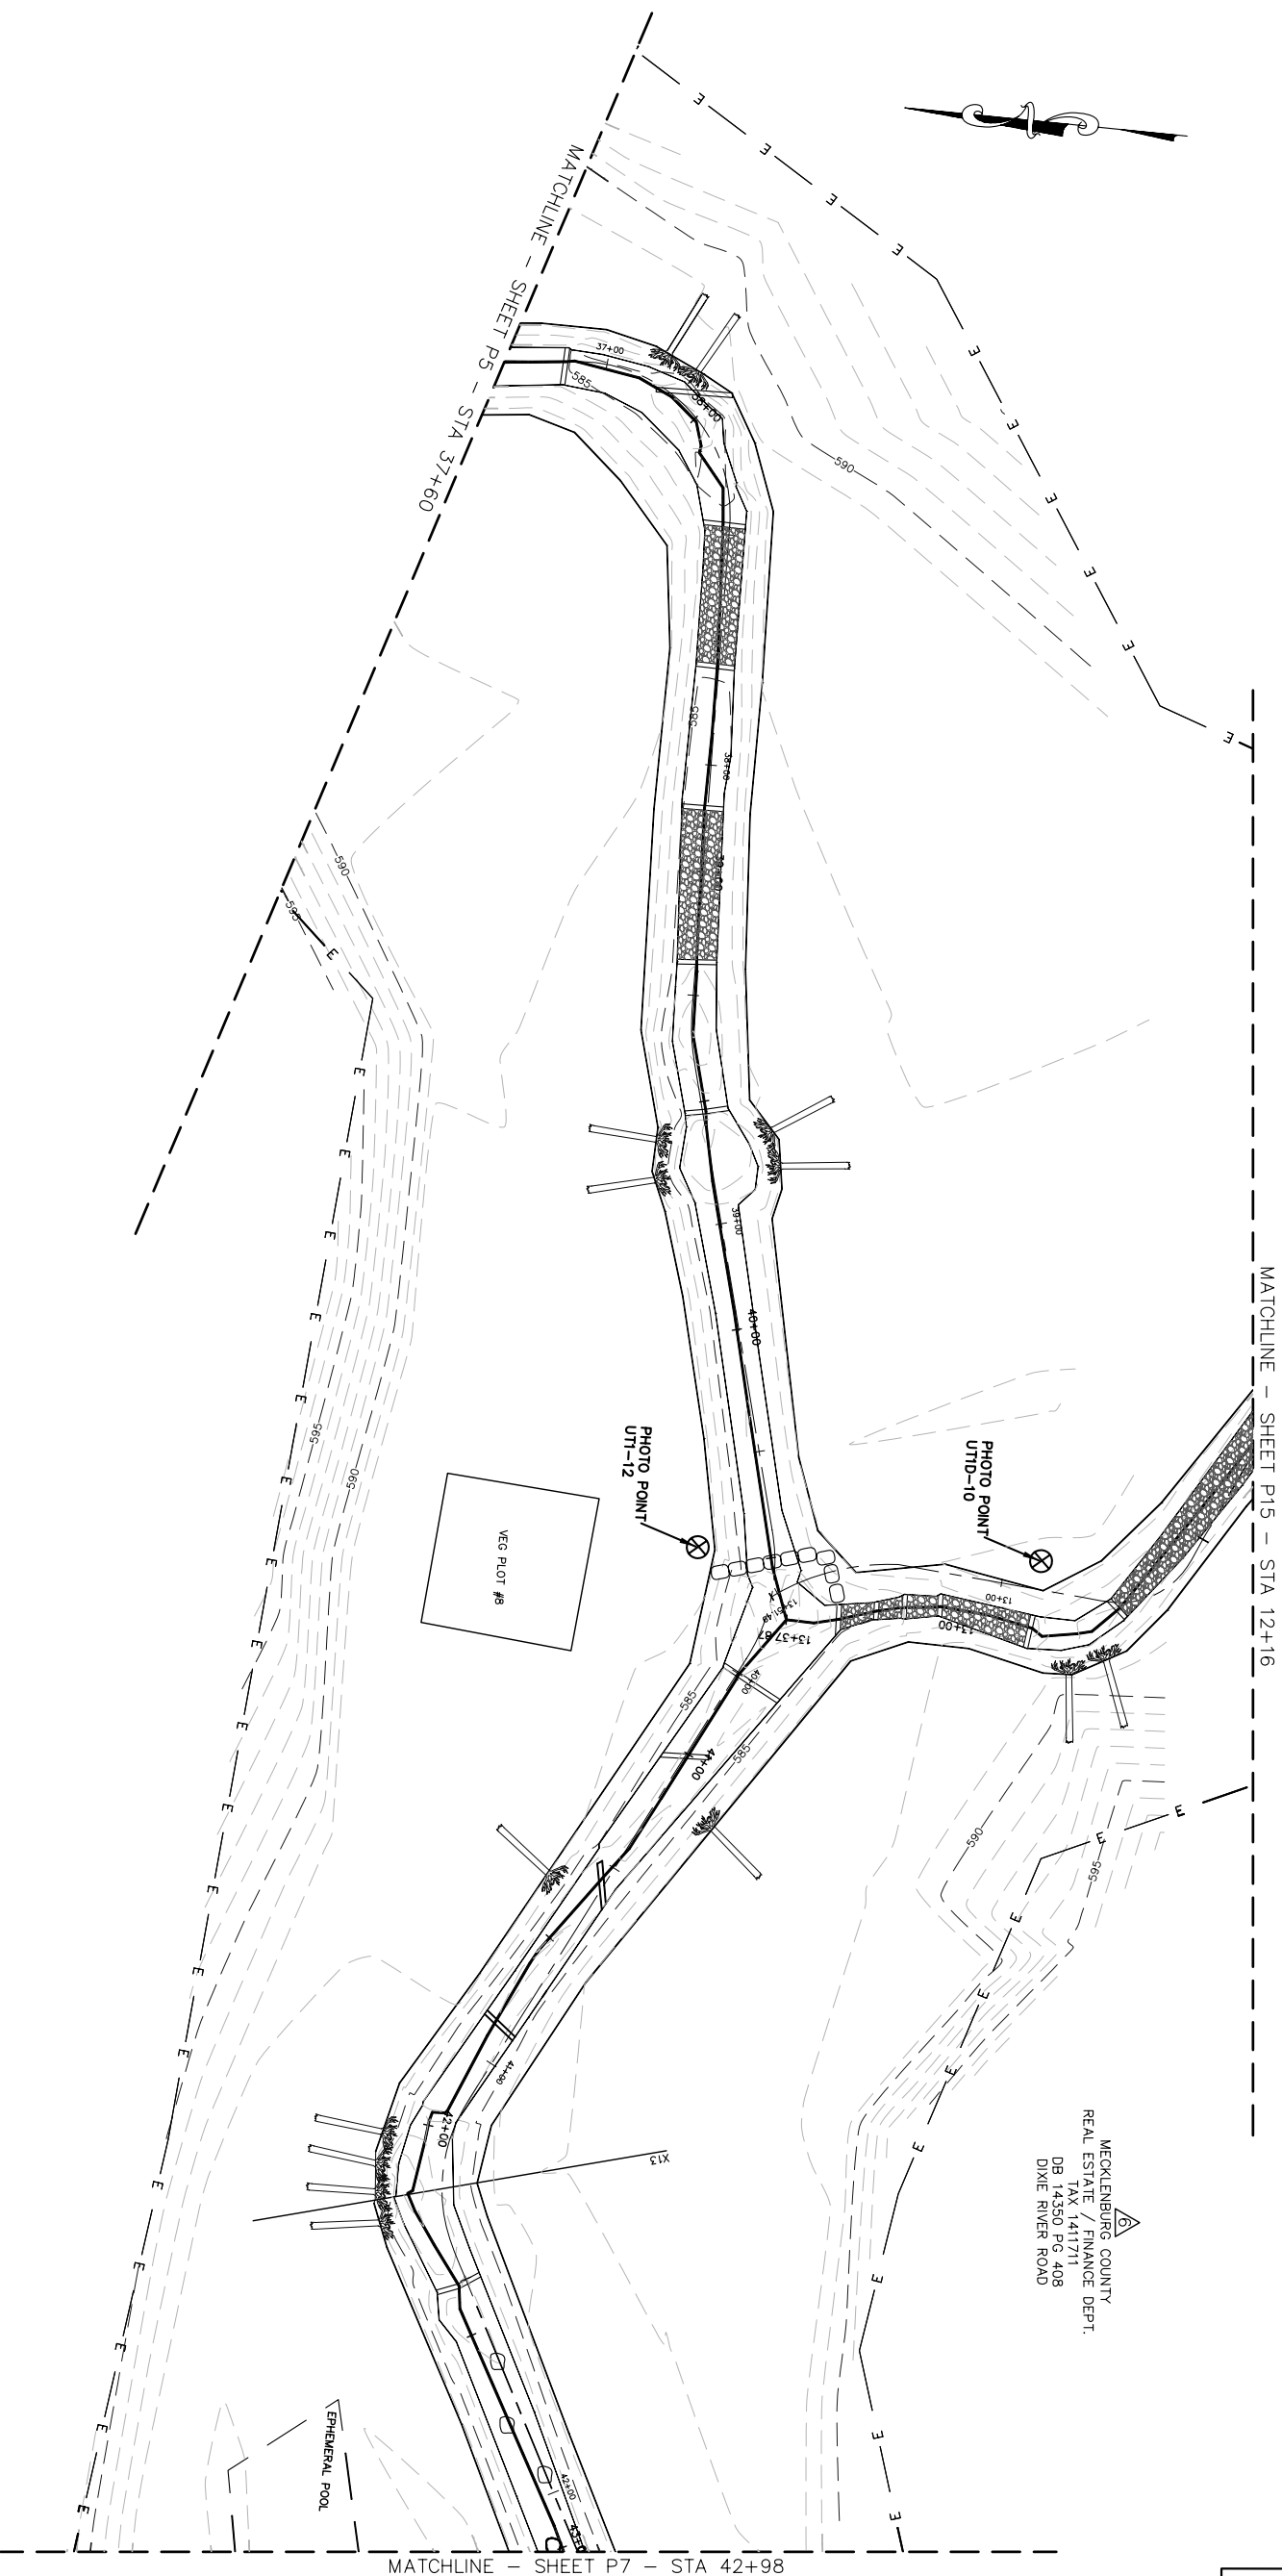

BEAVERDAM CREEK  
 AS-BUILT WITH BMPS

UT1/UT1-D SITE PLAN

PROJECT REFERENCE NO. 108528 SHEET NO. P7

PROJECT ENGINEER

KLT

APPROVED BY

WAH

DATE

10/11/2007


DRAFT

**Baker**  
 Baker Engineering, PC  
 442 South Tryon Street  
 Charlotte, NC 28203  
 Phone: 704.334.8484  
 Fax: 704.334.8500

MECKLENBURG COUNTY  
REAL ESTATE / FINANCE DEPT.  
TAX 14117112  
DB 14350 PG 408  
DIXIE RIVER ROAD

MECKLENBURG COUNTY  
REAL ESTATE / FINANCE DEPT.  
TAX 14117111  
DB 14350 PG 402  
DIXIE RIVER ROAD

WILLIAM A. SHAW, JR.  
TAX 14129103  
DB 1766 PG 196  
ADDRESS

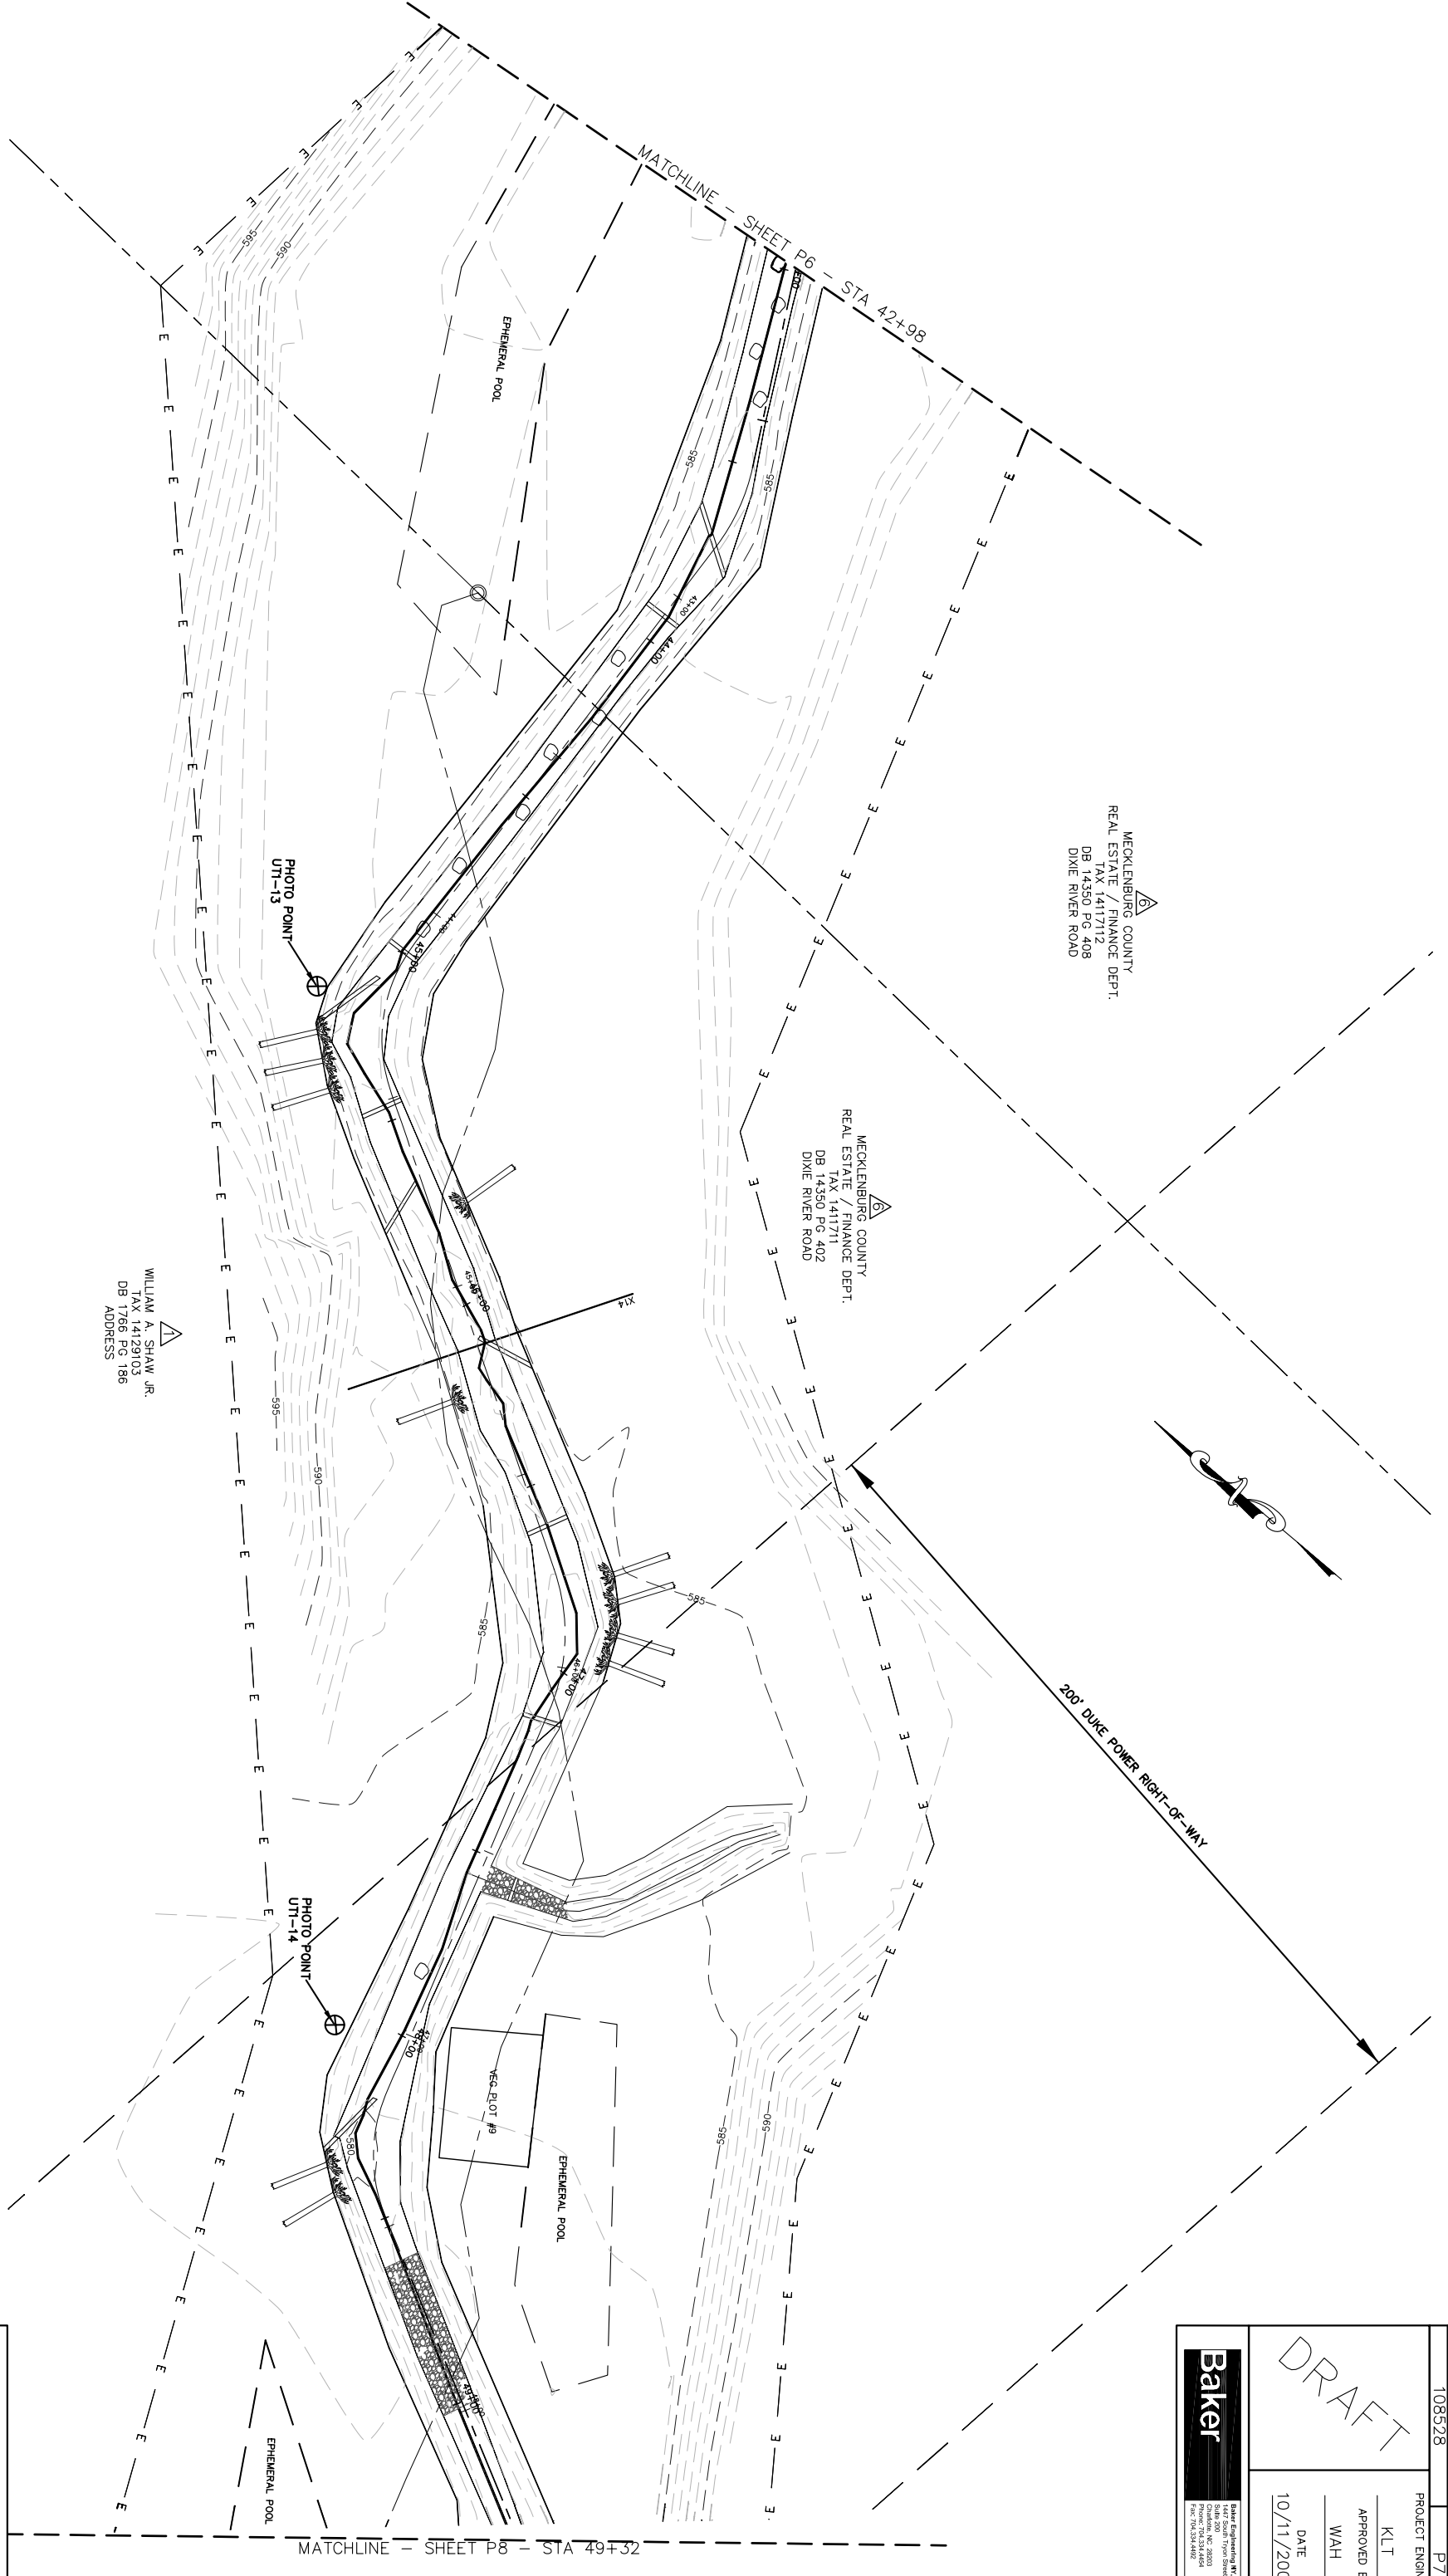

BEAVERDAM CREEK  
 AS-BUILT WITH BMPs  
 UT1 SITE PLAN

PROJECT REFERENCE NO. 108528 SHEET NO. P8

PROJECT ENGINEER

KLT

APPROVED BY

WAH


DATE

10/11/2007

DRAFT

**Baker**  
Baker Engineering, PC  
1412 South Tyng Street  
Chesapeake, VA 20830  
Phone: 757.534.8484  
Fax: 757.534.8500

MECKLENBURG COUNTY  
REAL ESTATE / FINANCE DEPT.  
TAX 1417711  
DB 14350 PG 402  
DIXIE RIVER ROAD

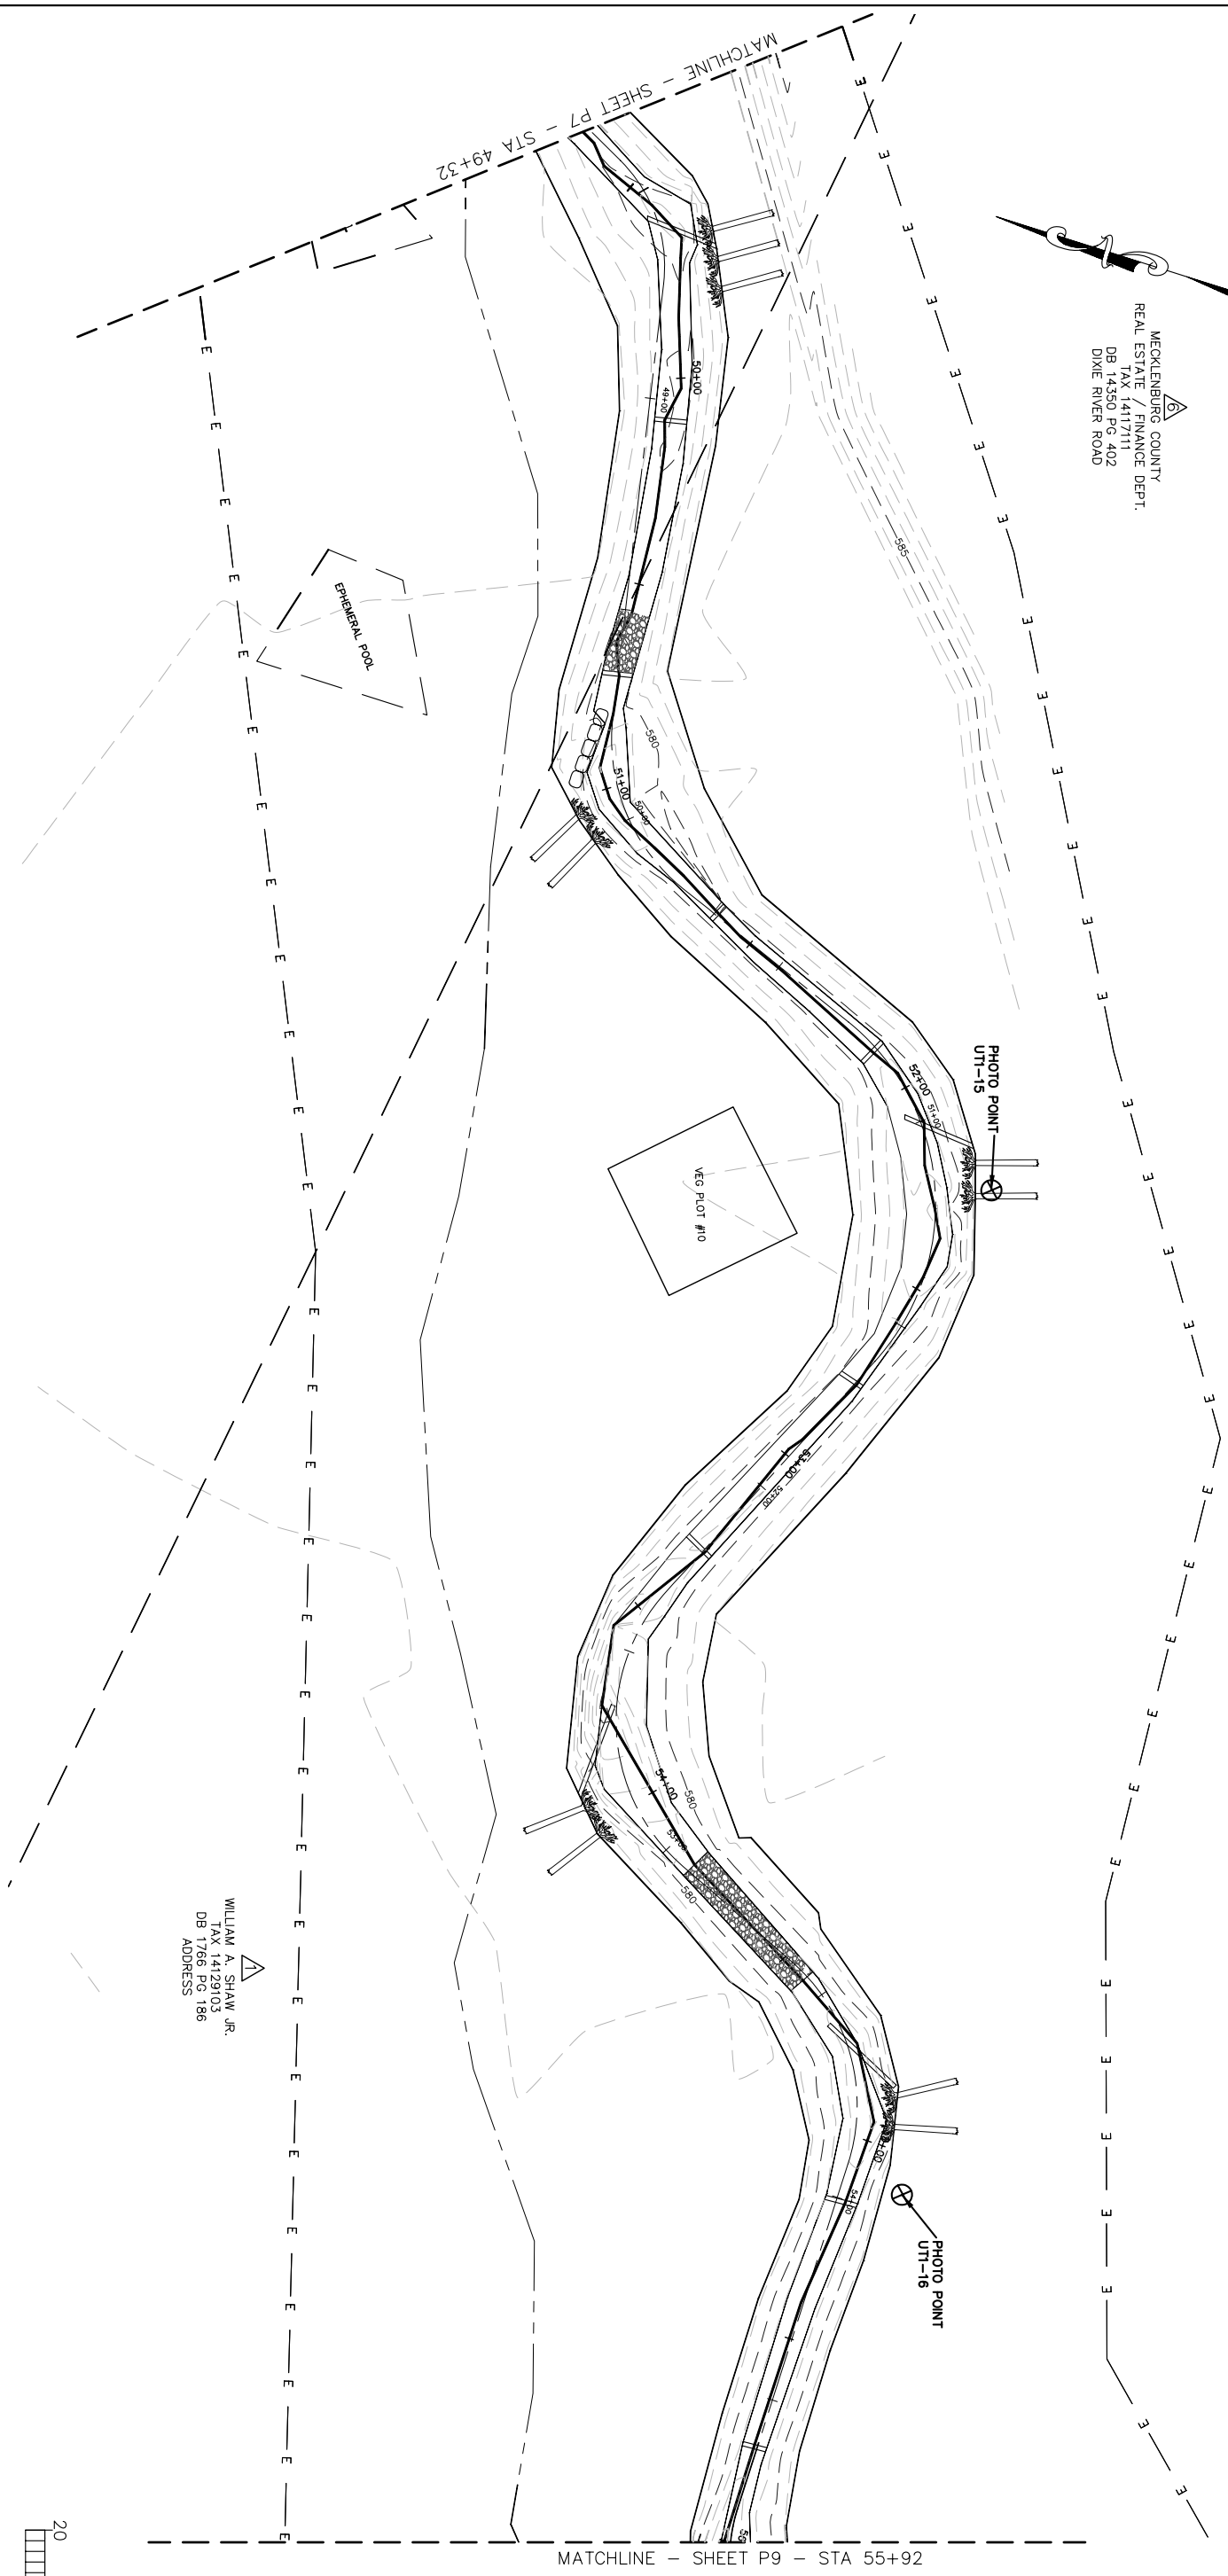

WILLIAM A. SHAW JR.  
TAX 14129103  
DB 1766 PG 186  
ADDRESS



BEAVERDAM CREEK  
AS-BUILT WITH BMPs

UT1 SITE PLAN



PROJECT REFERENCE NO. 108528 SHEET NO. P9

PROJECT ENGINEER

KLT

APPROVED BY WAH

DATE 10/11/2007

DRAFT


**Baker**  
Baker Engineering, PC  
4427 South Tryon Street  
Charlotte, NC 28203  
Phone: 704.234.8484  
Fax: 704.234.8485



MECKLENBURG COUNTY  
REAL ESTATE / FINANCE DEPT.  
TAX MAP #11  
DB 14350 G-402  
DIXIE RIVER ROAD

SCP # 3888  
N 524957.82  
E 1407814.29  
ELEV. = 580.47

WILLIAM A. SHAW, JR.  
TAX 14129103  
DB 1766 PG 186  
ADDRESS

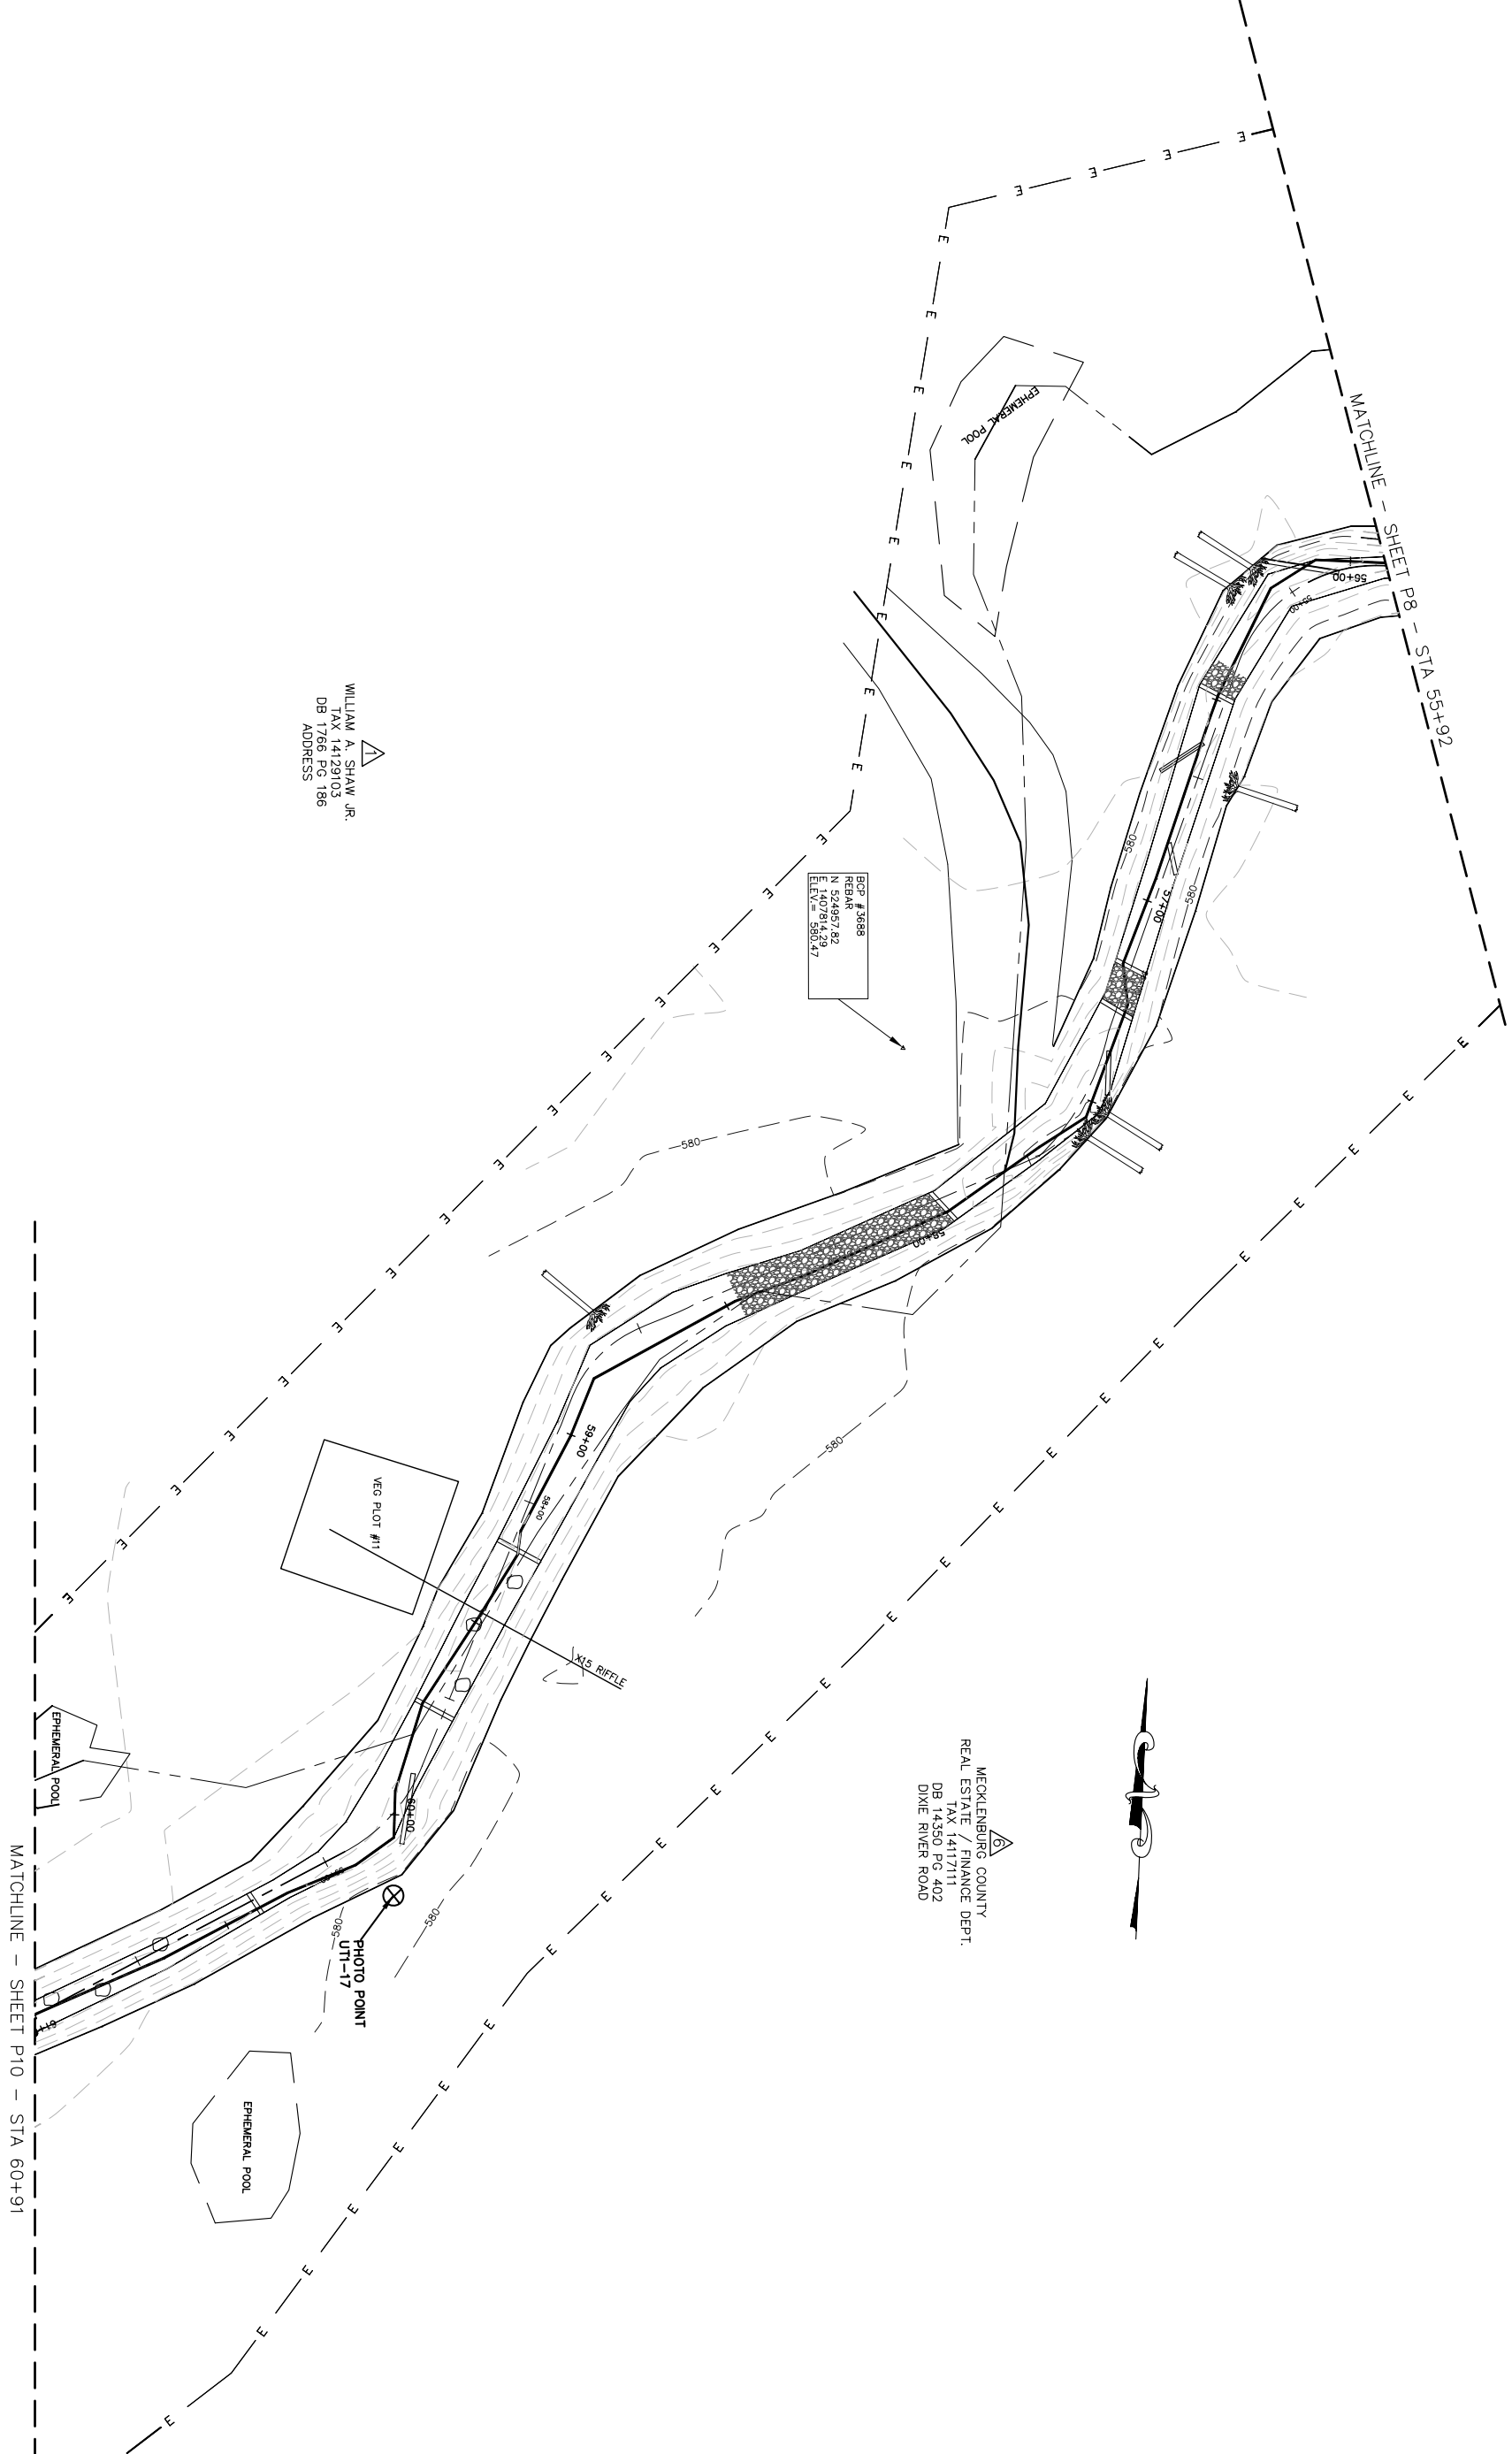

BEAVERDAM CREEK  
AS-BUILT WITH BMPs

UT1 SITE PLAN

PROJECT REFERENCE NO. 108528 SHEET NO. P10

PROJECT ENGINEER


KLT

APPROVED BY WAH

DATE 10/11/2007

DRAFT

**Baker**  
 Baker Engineering, PC  
 1412 South Tryon Street  
 Charlotte, NC 28203  
 Phone: 704.334.8404  
 Fax: 704.334.8405

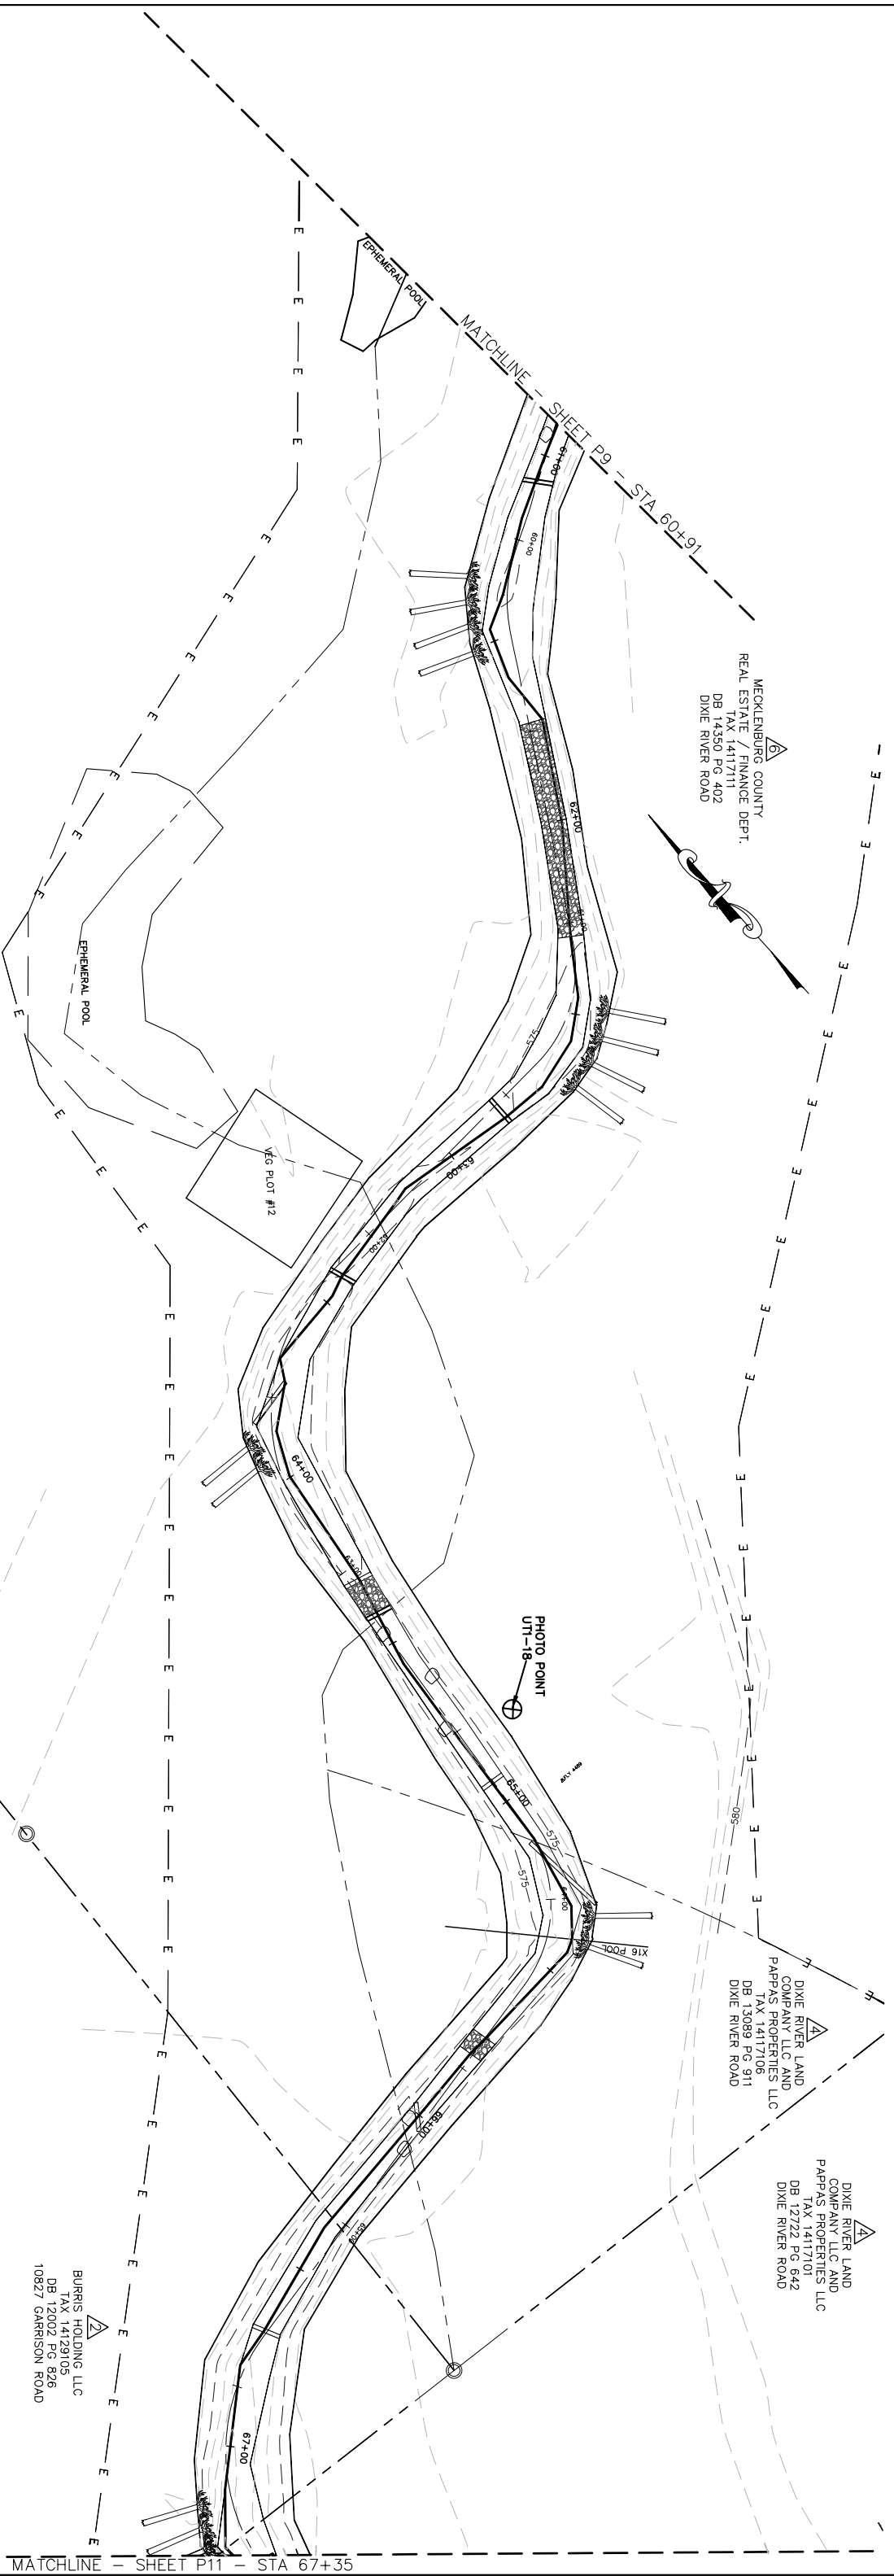

BEAVERDAM CREEK  
 AS-BUILT WITH BMPS  
 UT1 SITE PLAN

PROJECT REFERENCE NO. 108528  
SHEET NO. P11

PROJECT ENGINEER

KLT

APPROVED BY

WAH

DATE

10/11/2007


DRAFT

**Baker**  
Baker Engineering, PC  
442 South Tenth Street  
Chattanooga, TN 37403  
Phone: 734.244.8084  
Fax: 734.244.8085

▲ DIXIE RIVER LAND COMPANY LLC AND PAPPAS PROPERTIES LLC  
TAX 14117101  
DB 12722 PG 642  
DIXIE RIVER ROAD

BCP # 3989  
REBAR  
N 524210.95  
E 524210.95  
ELEV = 575.93

BCP # 4490  
REBAR  
N 5248755.99  
E 5248755.99  
ELEV = 573.79

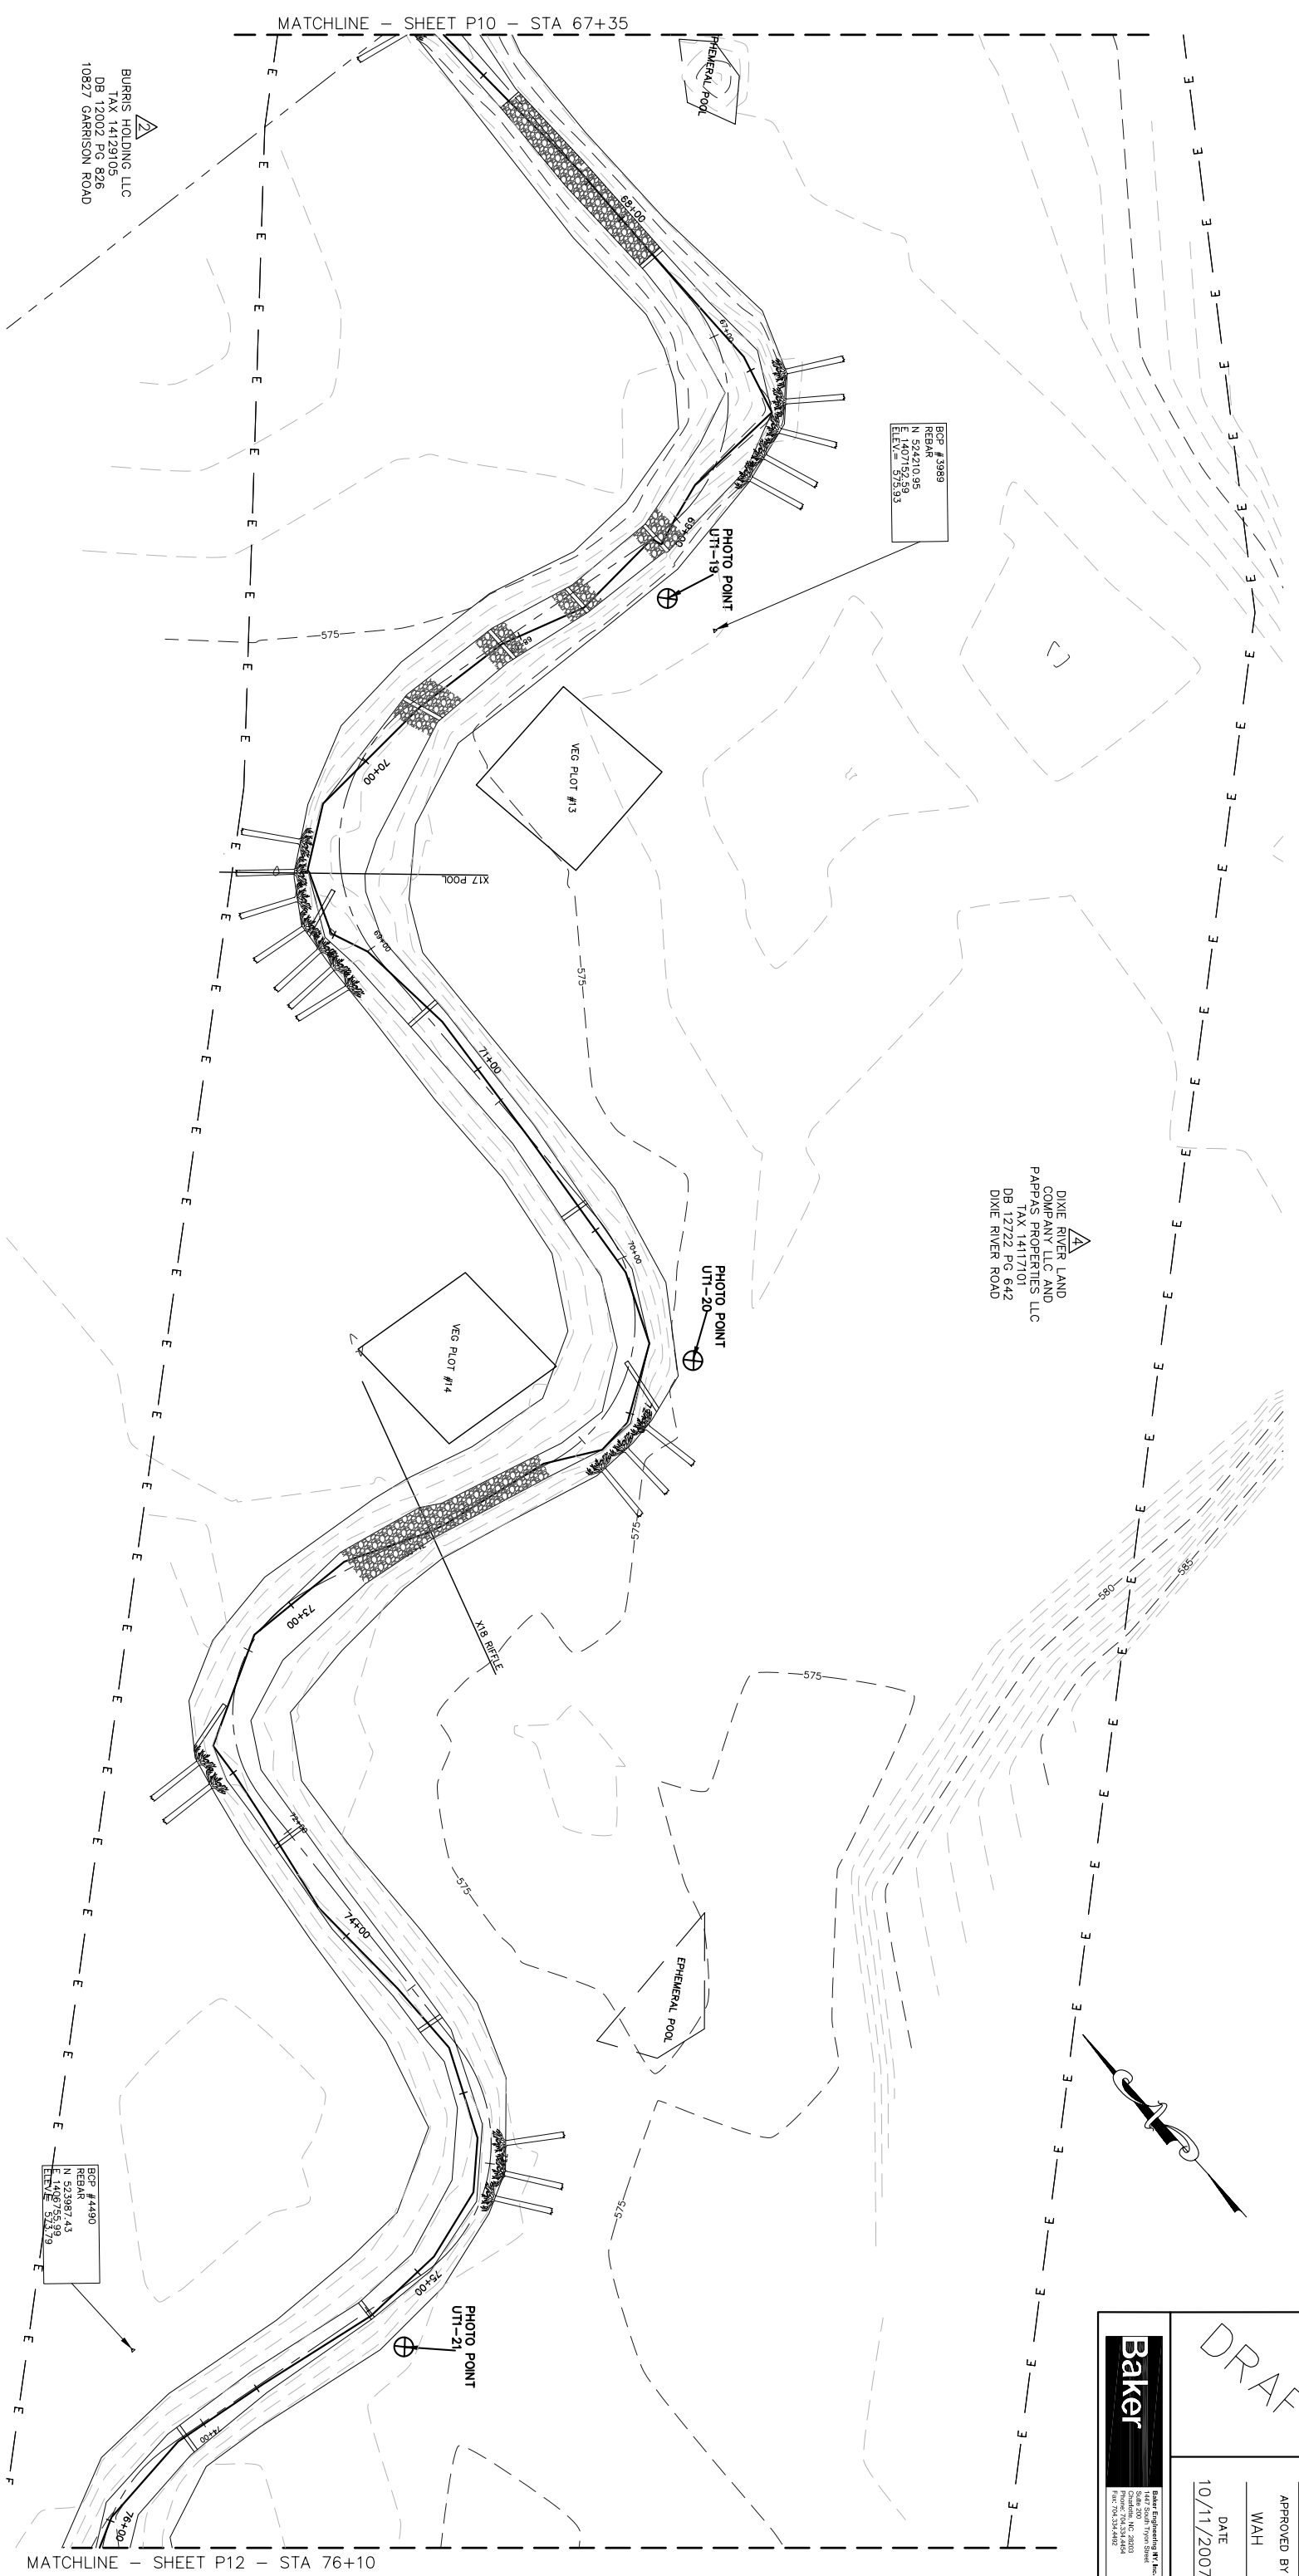

▲ BURRIS HOLDING LLC  
TAX 14129105  
DB 12002 PG 826  
10827 GARRISON ROAD



BEAVERDAM CREEK  
AS-BUILT WITH BMPs  
UTI1 SITE PLAN

PROJECT REFERENCE NO. 108528 SHEET NO. P12

PROJECT ENGINEER

KLT

APPROVED BY

WAH


DATE

10/11/2007


DRAFT

**Baker**  
Baker Engineering, PC  
1412 South Tryon Street  
Charlotte, NC 28203  
Phone: 704.334.8484  
Fax: 704.334.8500

DIXIE RIVER LAND  
COMPANY, LLC AND  
PAPPAS PROPERTIES, LLC  
TAX 1417701  
DB 12722 PG 642  
DIXIE RIVER ROAD

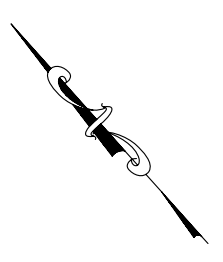

MATCHLINE - SHEET P11 - STA 76+10

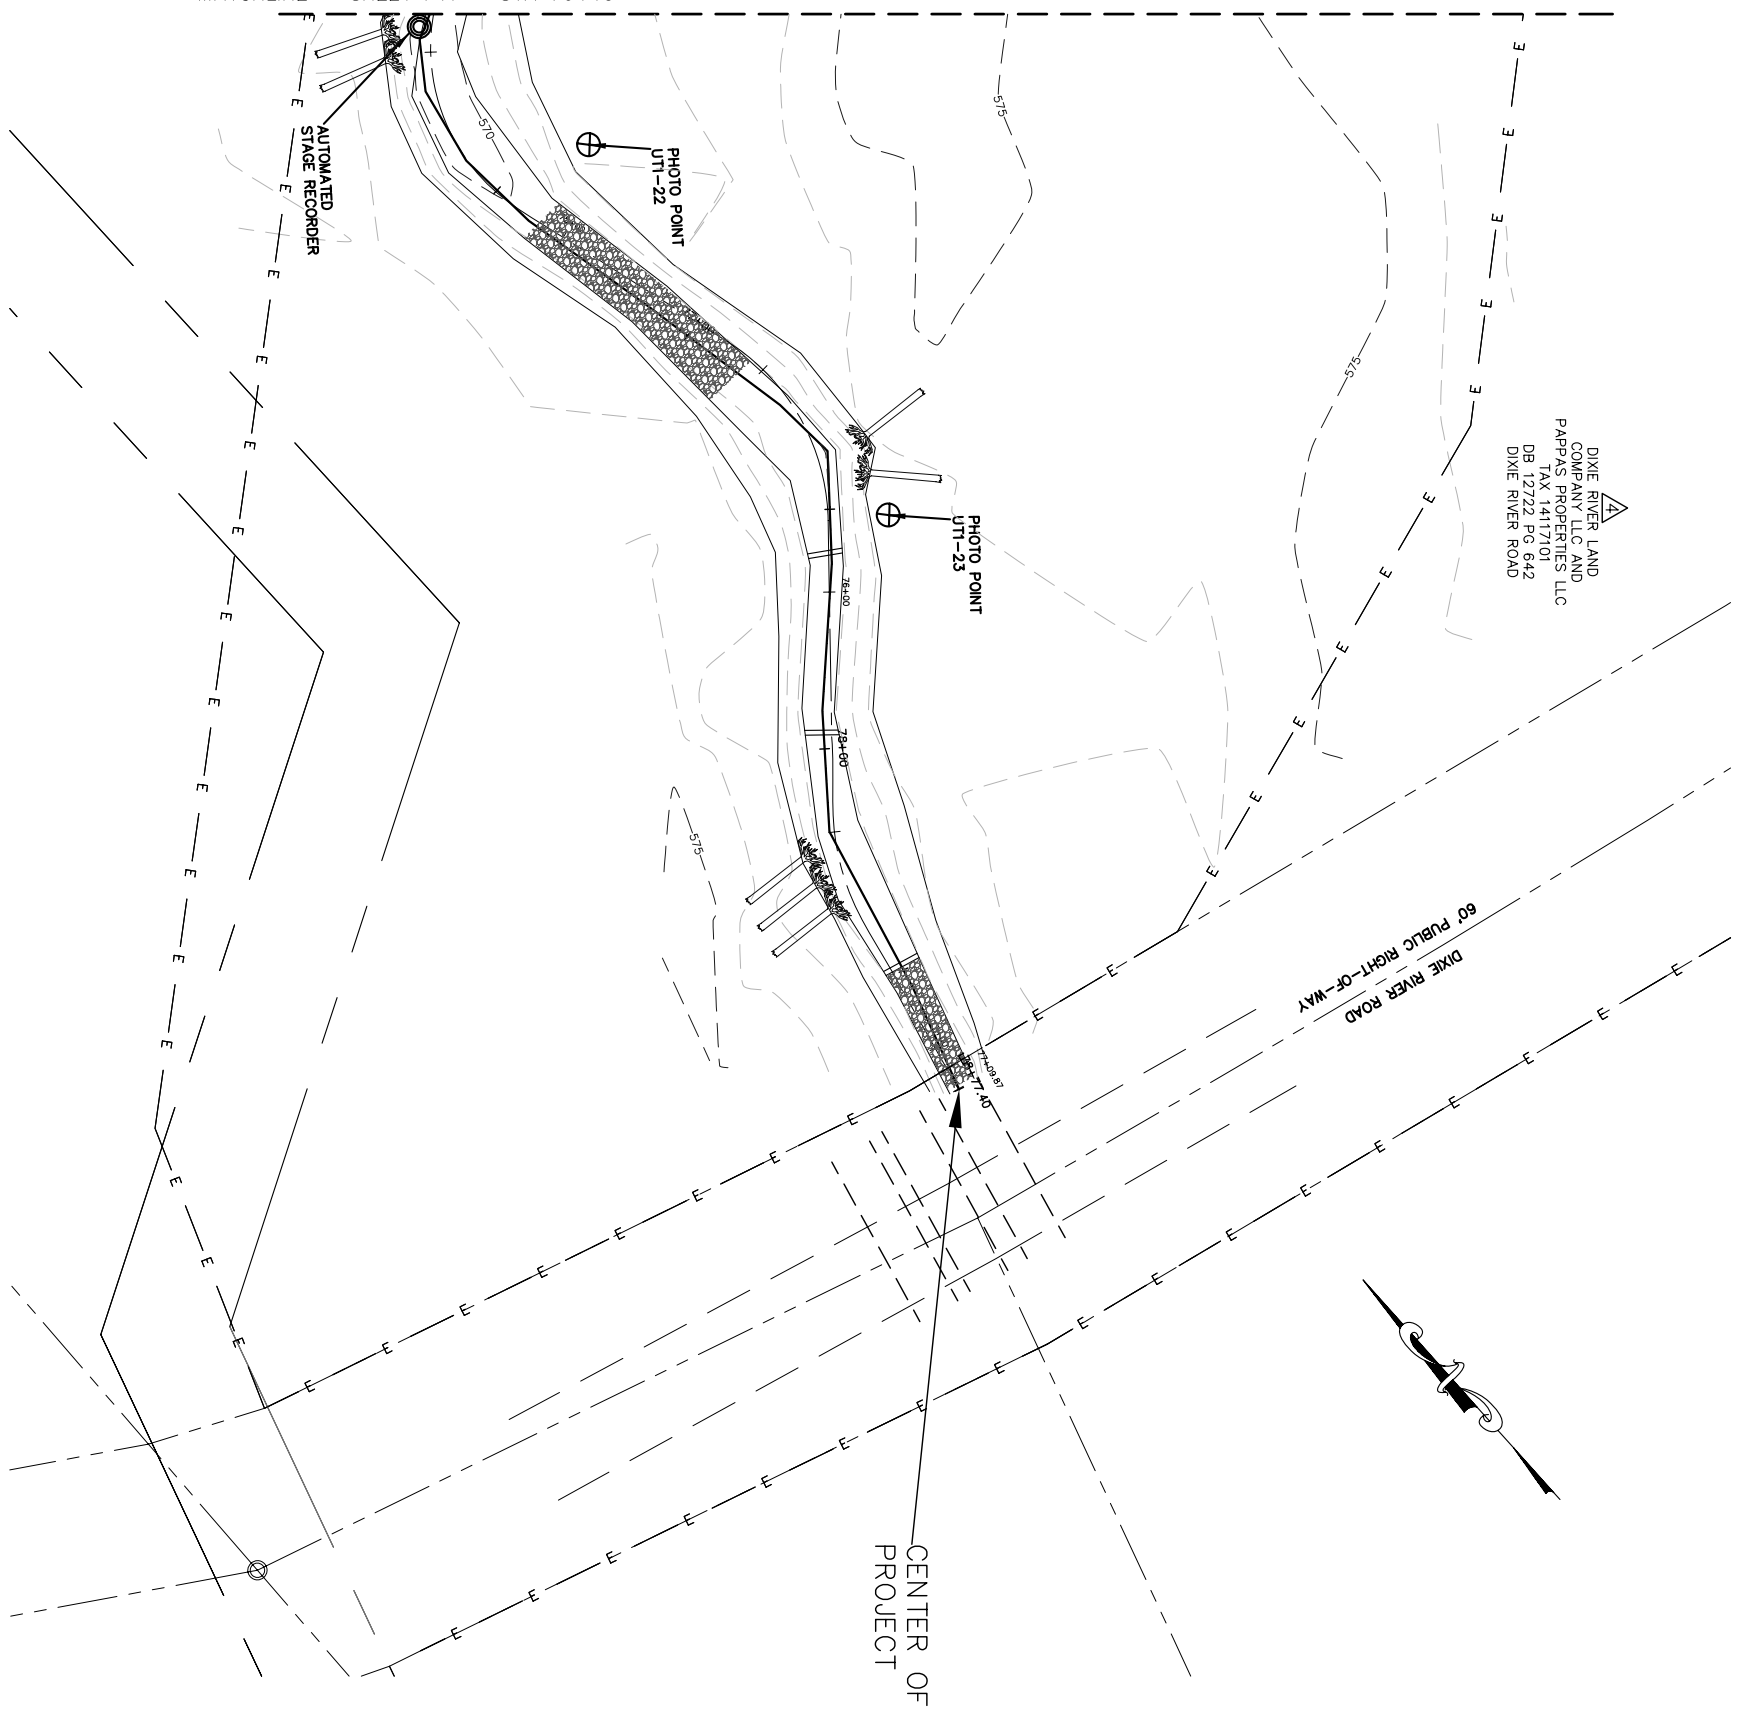

BEAVERDAM CREEK  
AS-BUILT WITH BMPS

UT1 SITE PLAN

PROJECT REFERENCE NO. 108528 SHEET NO. P13

PROJECT ENGINEER

KLT

APPROVED BY

WAH

DATE



10/11/2007

DRAFT

**Baker**  
 Baker Engineering, Inc.  
 1412 South Tryon Street  
 Charlotte, NC 28203  
 Phone: 704.334.8484  
 Fax: 704.334.8500

MECKLENBURG COUNTY  
 REAL ESTATE / FINANCE DEPT.  
 TAX 1417712  
 DB 14350 PG 408  
 DIXIE RIVER ROAD

DEPARTMENT OF TRANSPORTATION  
 AND JOHN L. SHOEMAKER  
 TAX 1418164  
 DB 10218 PG 764  
 GARRISON ROAD

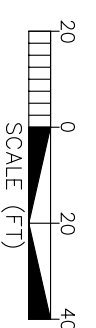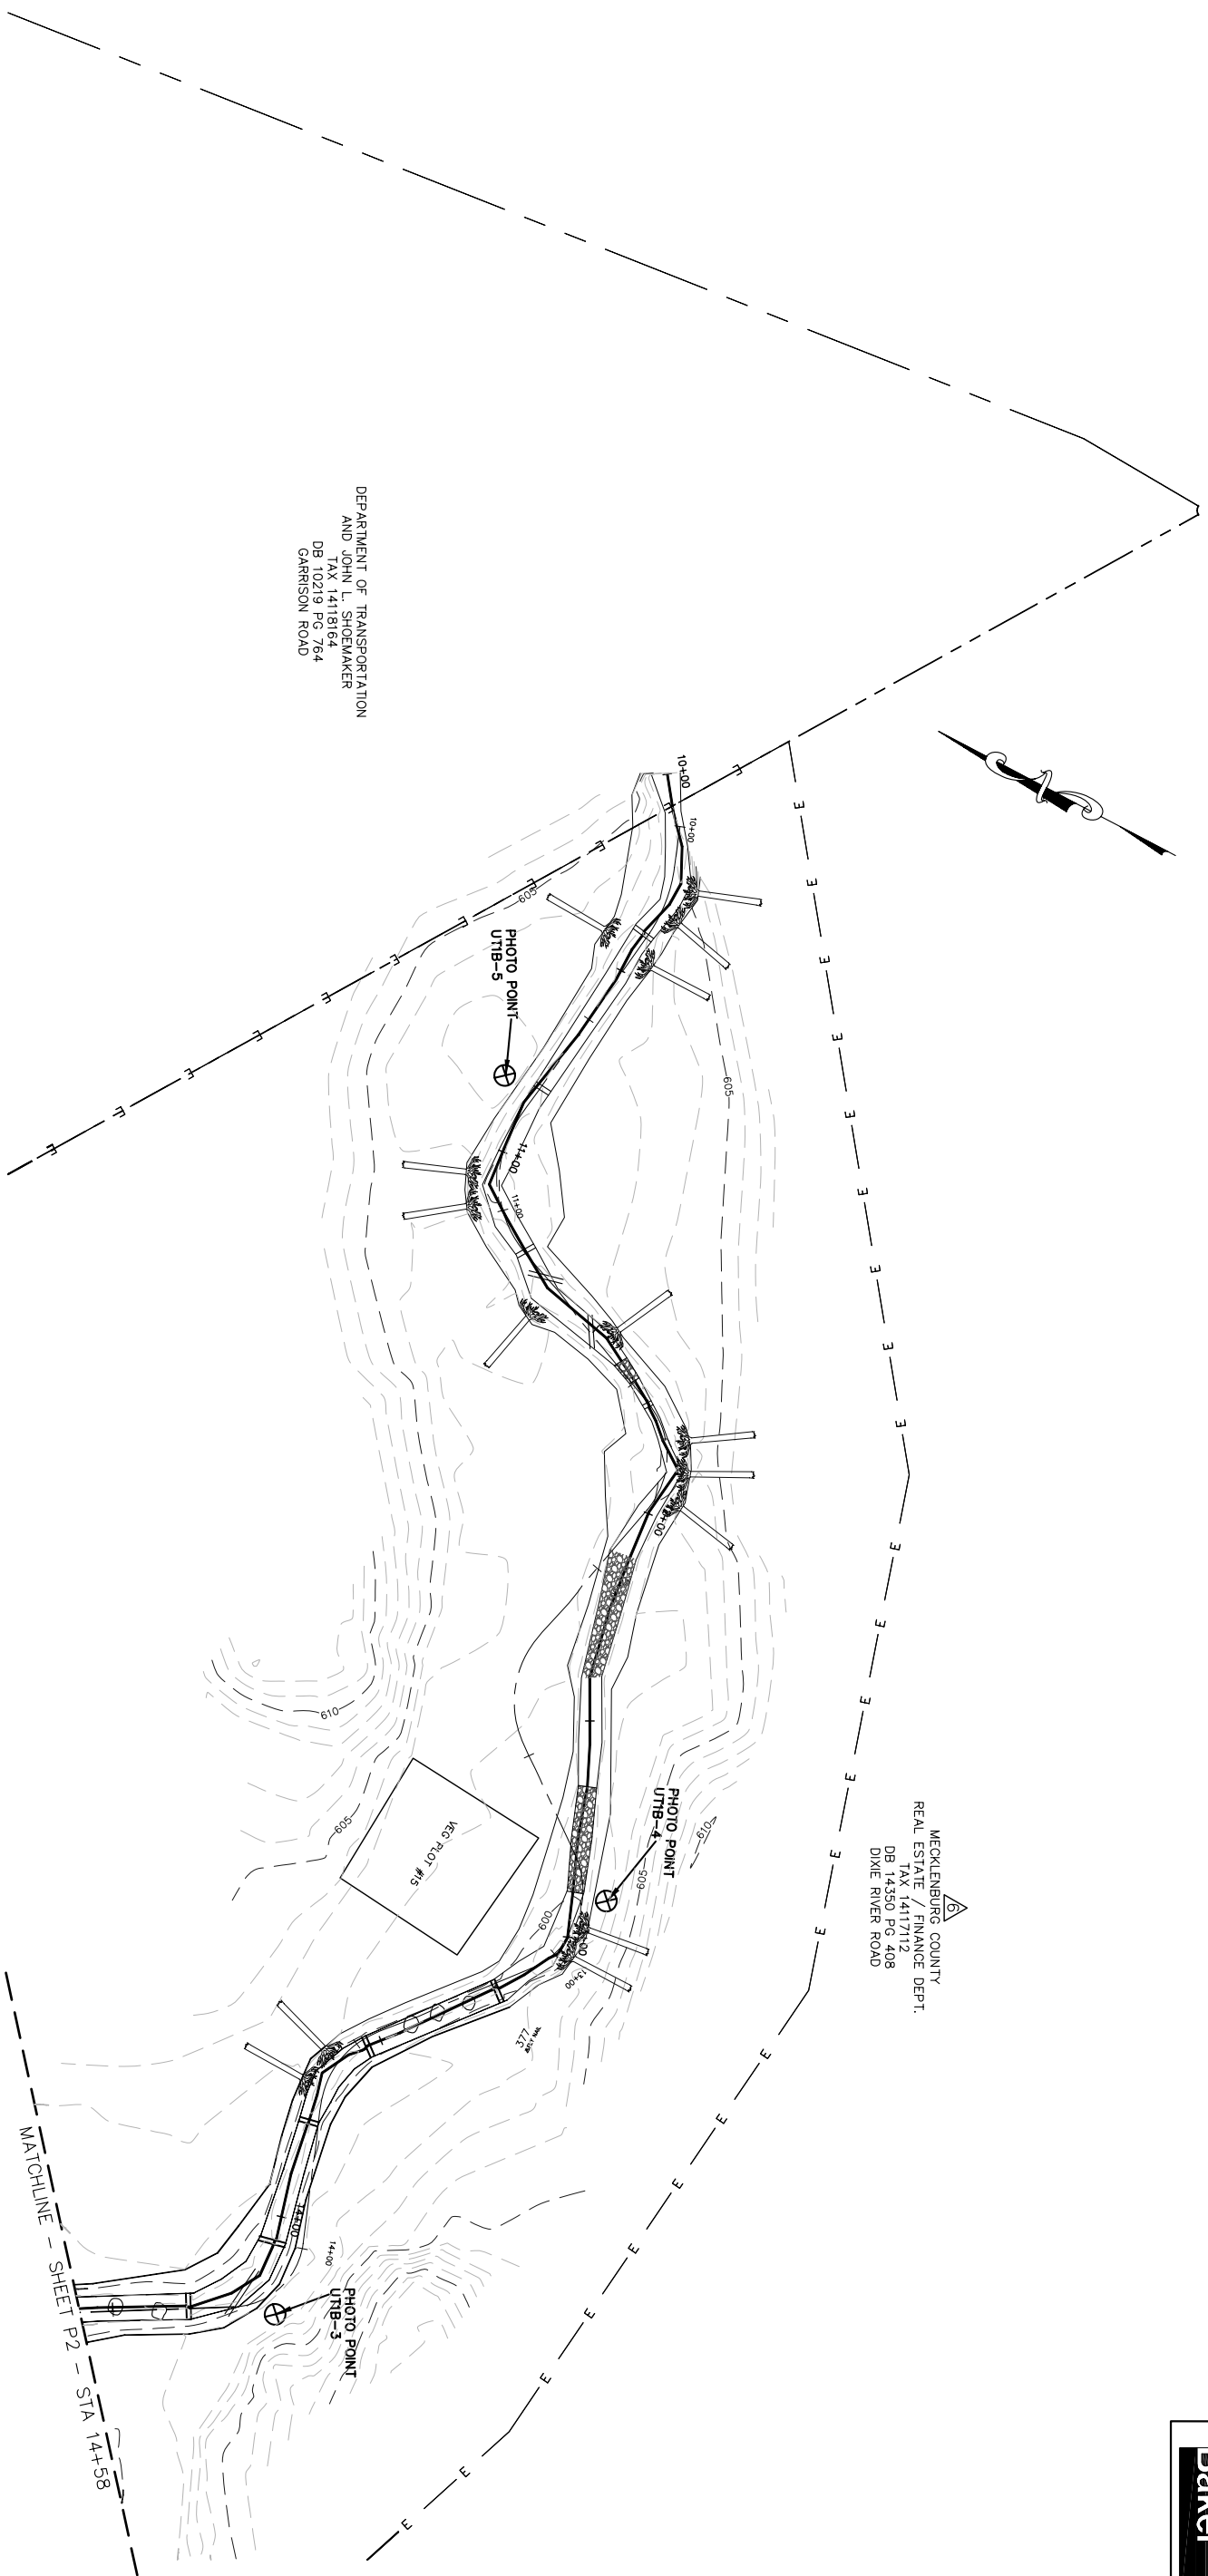

BEAVERDAM CREEK  
 AS-BUILT WITH BMPs


UT1-B SITE PLAN

PROJECT REFERENCE NO. 108528  
SHEET NO. P14

**DRAFT**

PROJECT ENGINEER  
KLT  
APPROVED BY  
WAH  
DATE  
10/11/2007

**Baker**  
Baker Engineering, Inc.  
1412 South Tryon Street  
Charlotte, NC 28203  
Phone: 704.334.8484  
Fax: 704.334.8500

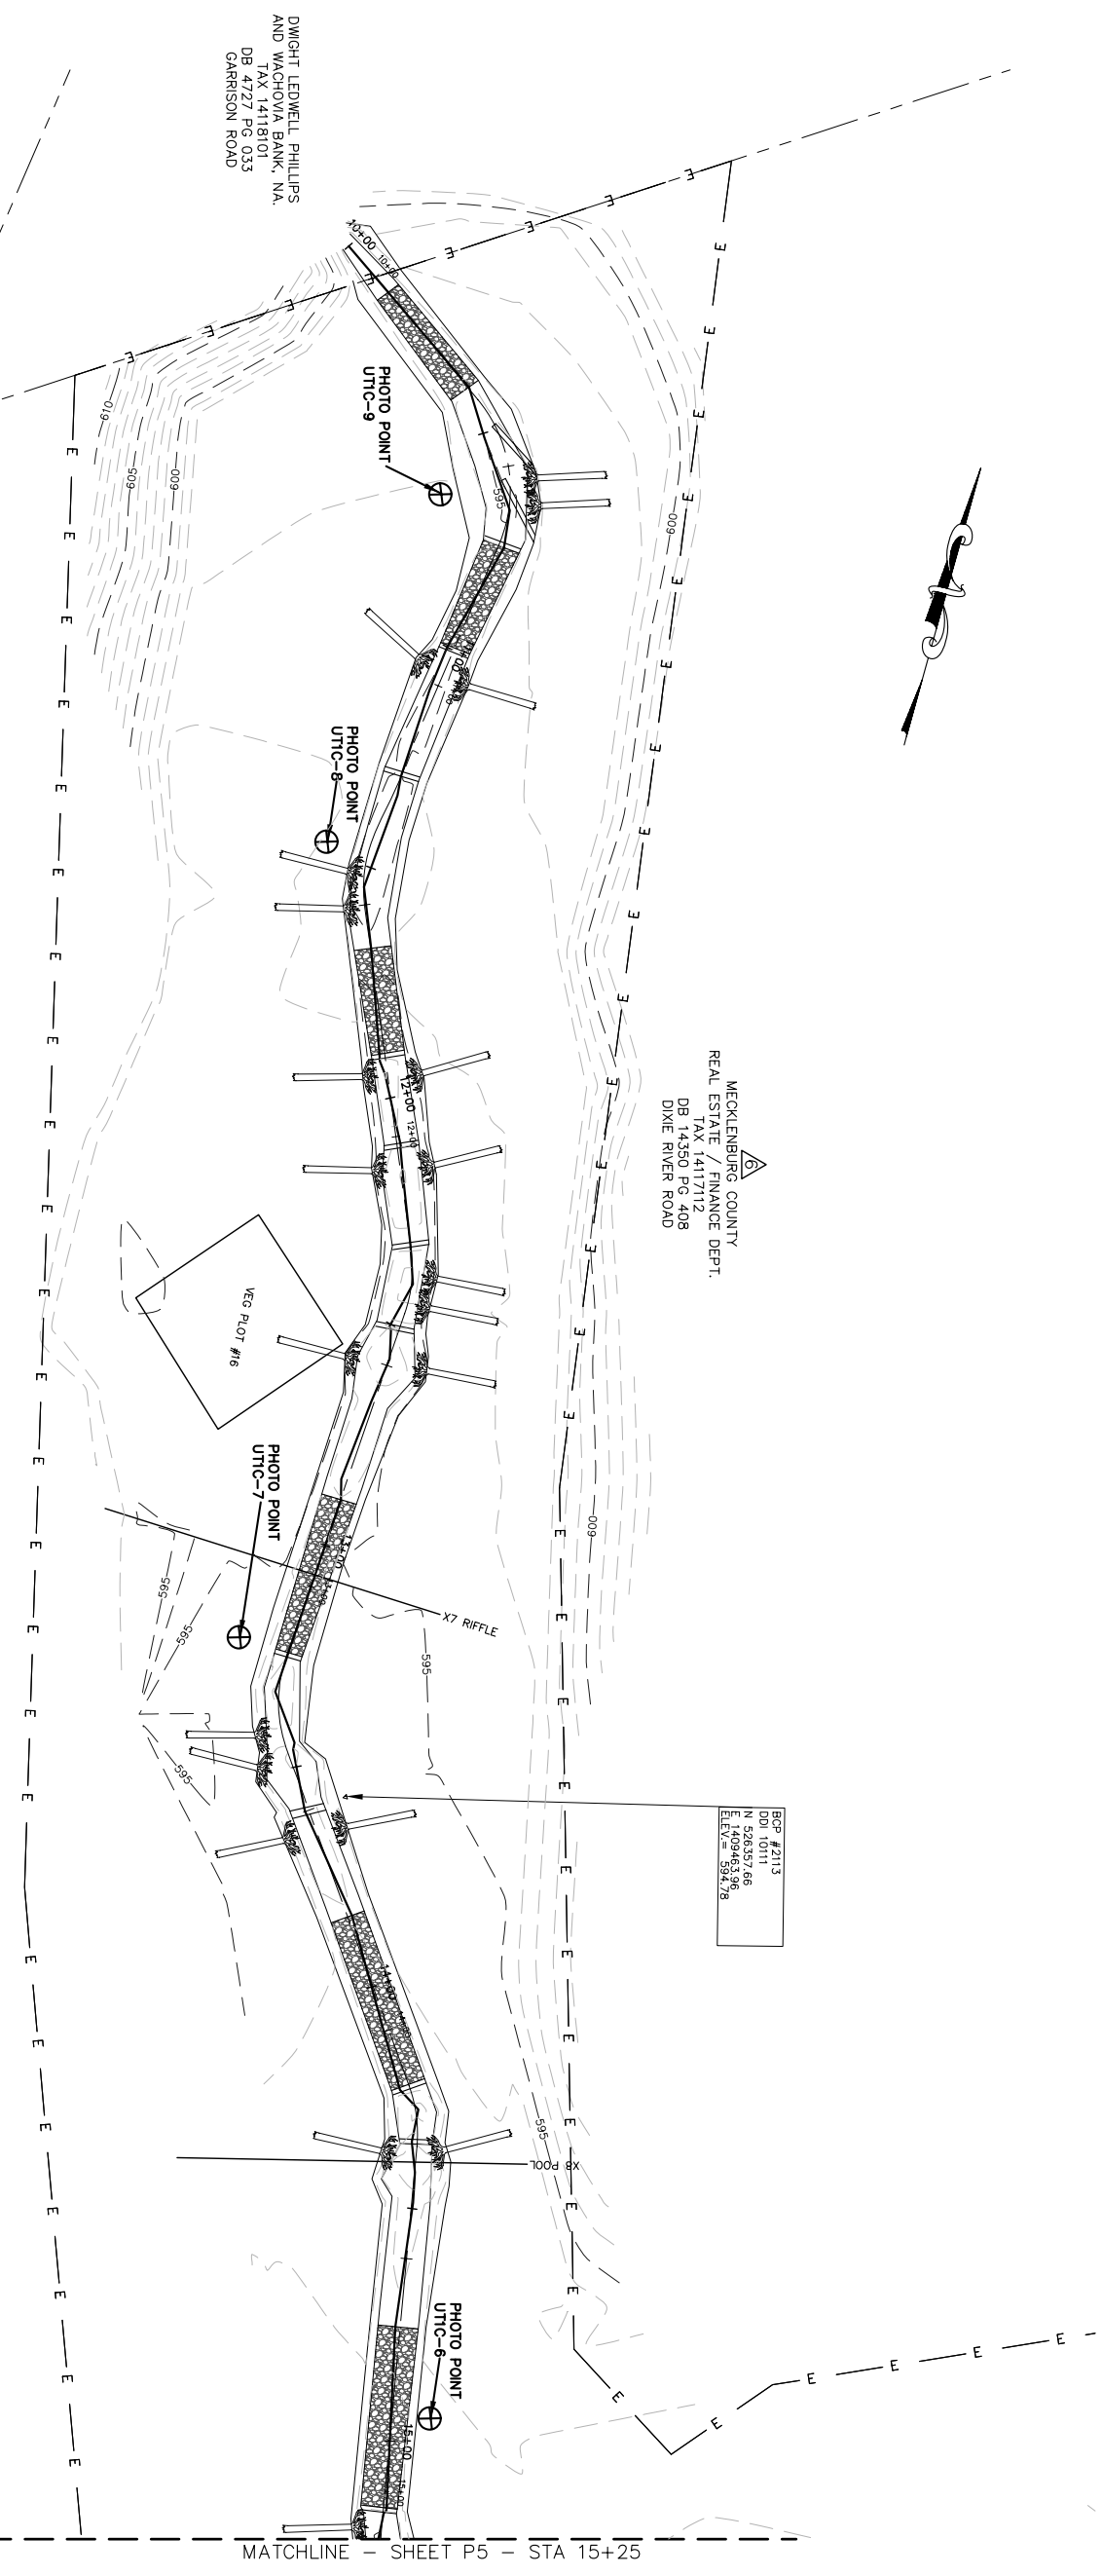

MECKLENBURG COUNTY  
REAL ESTATE / FINANCE DEPT.  
TAX 14117112  
DB 14350 PG 408  
DIXIE RIVER ROAD

BCP #2113  
DN 10111  
N 526357.66  
E 409453.96  
L 587.78

DWIGHT LEDWELL PHILLIPS  
AND WACHOVA BANK, NA.  
TAX 1418101  
DB 4727 PG 033  
GARRISON ROAD

MATCHLINE - SHEET P5 - STA 15+25



BEAVERDAM CREEK  
AS-BUILT WITH BMPS

UT1-C SITE PLAN

PROJECT REFERENCE NO. 108528 SHEET NO. P15

PROJECT ENGINEER

KLT


APPROVED BY

WAH

DATE


10/11/2007

DRAFT

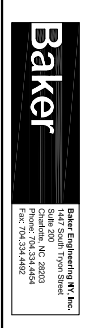

Baker Engineering, P.C.  
1412 South Tryon Street  
Charlotte, NC 28203  
Phone: 704.334.8404  
Fax: 704.334.8400

MECKLENBURG COUNTY  
REAL ESTATE / FINANCE DEPT.  
DB 14350 PG 408  
DIXIE RIVER ROAD

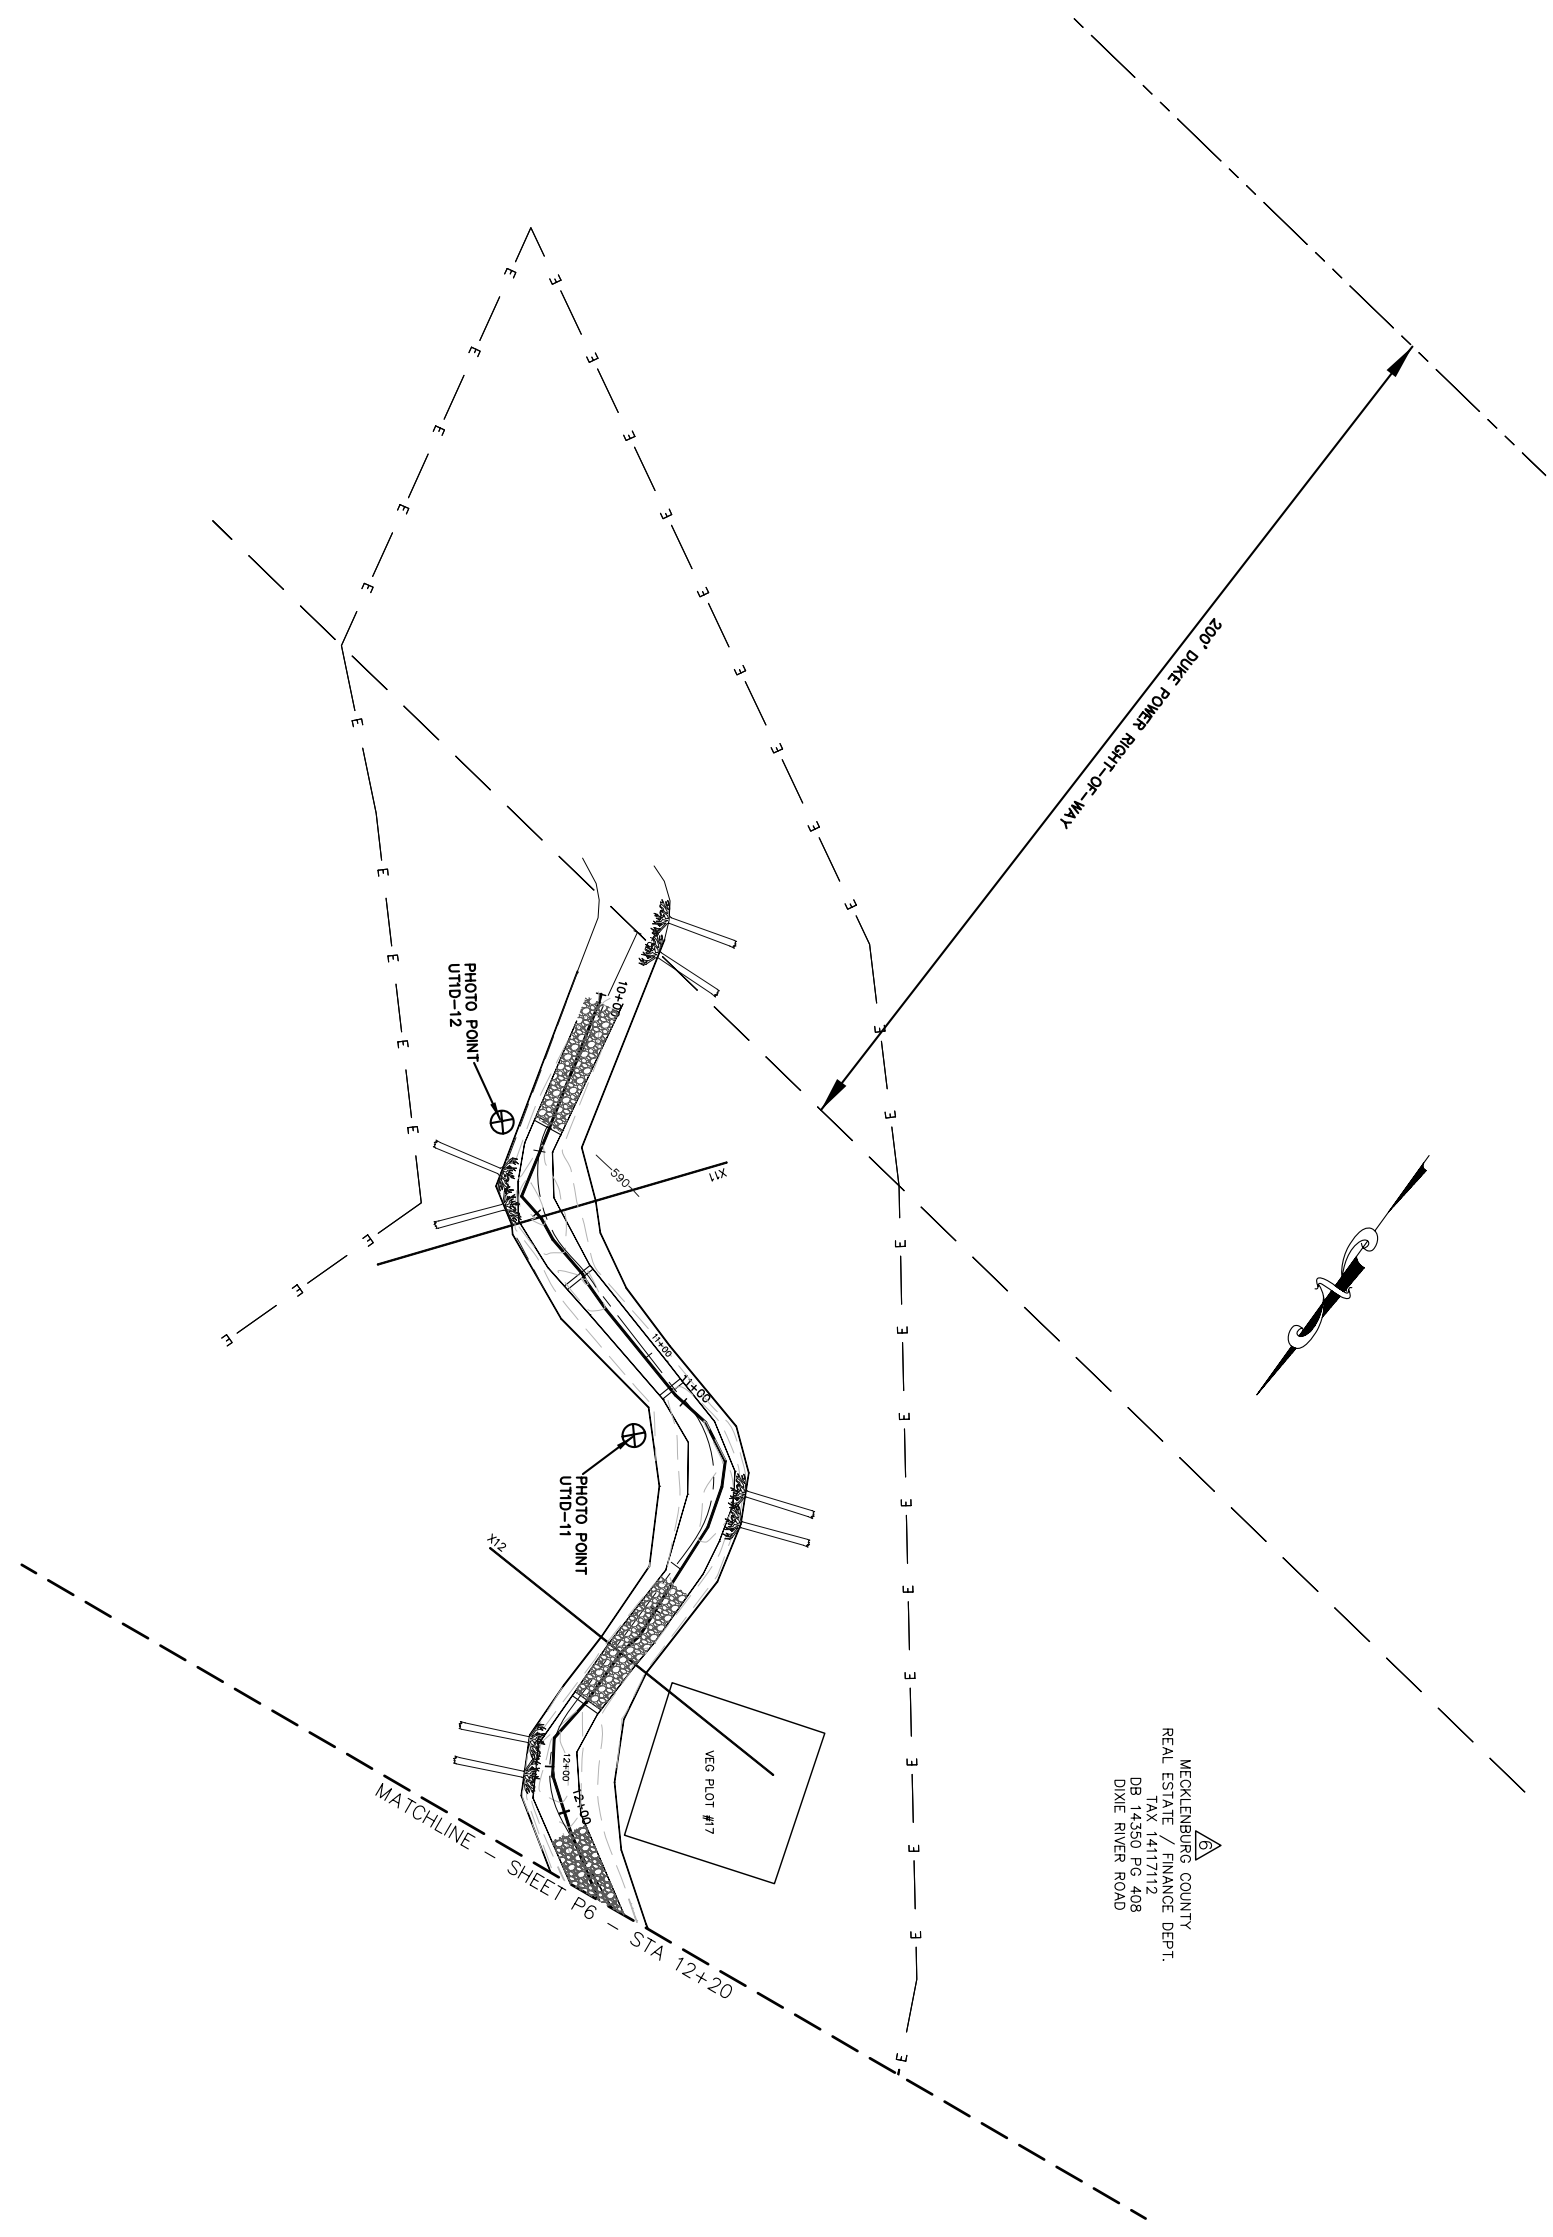

SCALE (FT)

BEAVERDAM CREEK  
AS-BUILT WITH BMPs

UT1-D SITE PLAN



WATERS CONSTRUCTION COMPANY, INC.  
 TAX 19924137  
 DB 12943 PG 842  
 DIXIE RIVER ROAD

WATERS CONSTRUCTION COMPANY, INC.  
 TAX 19925107  
 DB 12629 PG 886  
 WINDY GAP ROAD

PROJECT REFERENCE NO.  
108528

SHEET NO.  
P16

PROJECT ENGINEER

KLT


APPROVED BY

WAH

DATE

10/11/2007

DRAFT

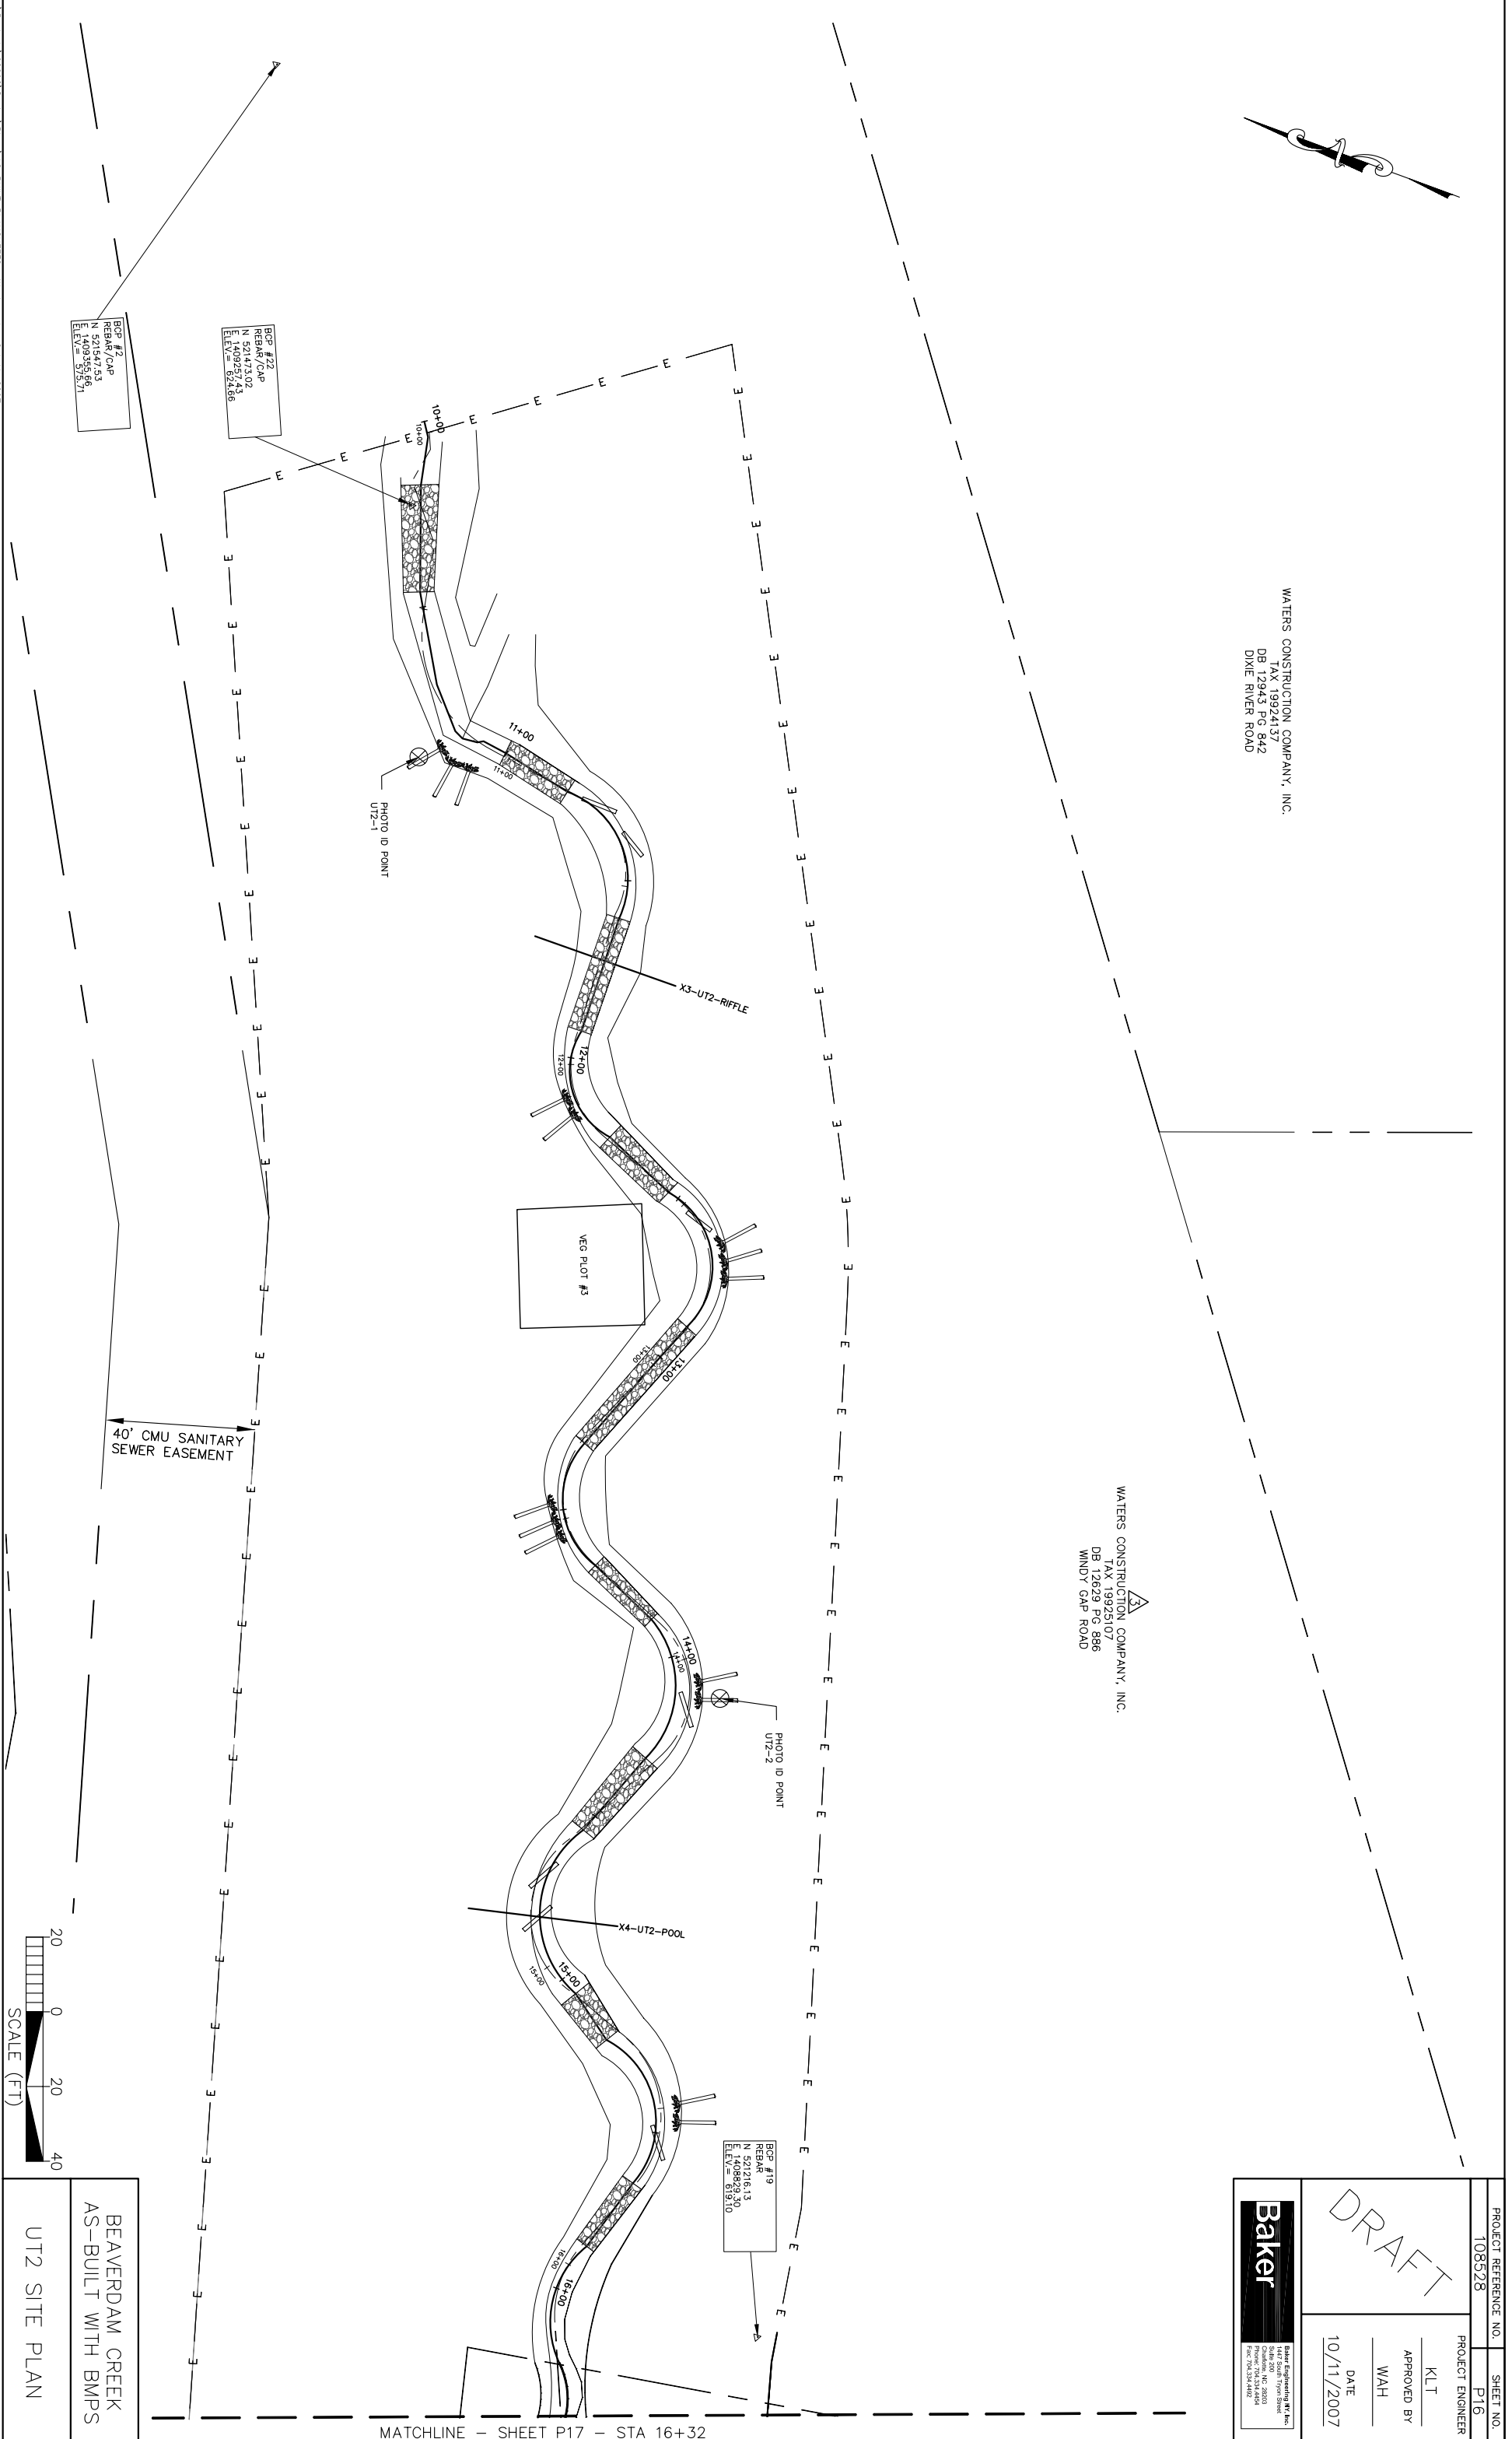

MATCHLINE - SHEET P17 - STA 16+32



BEAVERDAM CREEK  
 AS-BUILT WITH BMPS  
 UT2 SITE PLAN



PROJECT REFERENCE NO. 108528 SHEET NO. P17


PROJECT ENGINEER

KLT

APPROVED BY WAH

DATE 10/11/2007

DRAFT

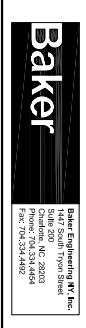

Baker Engineering, Inc.  
4427 South Tryon Street  
Charlotte, NC 28203  
Phone: 704.334.8404  
Fax: 704.334.8500  
www.bakerinc.com

DIXIE RIVER LAND COMPANY  
AND PAPPAS PROPERTIES, LLC.  
DB 13089 PG 911  
GLENBURN LANE

BCP #18  
REBAR  
N 521241.15  
E 120661.57  
ELEV 617.57

24" OUTLET PIPE WITH RIP RAP APRON  
RIP RAP SPILLWAY

MATCHLINE - SHEET P18 - STA 20+93

WATERS CONSTRUCTION COMPANY, INC.  
DB 12629 PG 886  
WINDY GAP ROAD

40' CMU SANITARY SEWER EASEMENT

VEG PLOT #4

EPHEMERAL POOL

MATCHLINE - SHEET P16 - STA 16+32

PHOTO ID POINT UT2-3

PHOTO ID POINT UT2-4



BEAVERDAM CREEK  
AS-BUILT WITH BMPS  
UT2 SITE PLAN

PROJECT REFERENCE NO. 108528  
SHEET NO. P18

PROJECT ENGINEER

KLT

APPROVED BY

WAH

DATE

10/11/2007

DRAFT

**Baker**  
Baker Engineering, Inc.  
1412 South Tyler Street  
Chandler, AZ 85226  
Phone: 480.948.8804  
Fax: 480.948.8805

BELLASERA BEREWICK, LLC  
c/o THOMAS A. SAIED JR.  
TAX 19925111  
DB 18271 PG 145  
WINDY GAP ROAD

DAVE RIVER LAND COMPANY  
AND PAPPA'S PROPERTIES, LLC  
TAX 18925114  
DB 13089 PG 911  
PHOTO ID POINT  
UT2-9  
WINDY GAP ROAD

WATKINS CONSTRUCTION COMPANY, INC.  
TAX 19925103  
DB 12829 PG 902  
DAVE RIVER ROAD

BCP #1322  
NAL N 521845.54  
ELEV = 802.77

BCP #1396  
NAL N 521401.00  
ELEV = 809.83  
EPHEMERAL POOL

WAFCRS CONSTRUCTION COMPANY, INC.  
TAX 19925107  
DB 12629 PG 886  
WINDY GAP ROAD

L:\Projects\02690\Design\Plans\AS-BUILT-FRASHSHEETS-with-Bmps.dwg Oct 11, 2007


BEAVERDAM CREEK  
AS-BUILT WITH BMPS  
UT2/UT2-A  
SITE PLAN



MATCHLINE - SHEET P23 - STA 19+72

MATCHLINE - SHEET P17 - STA 20+93

MATCHLINE - SHEET P19 - STA 27+45

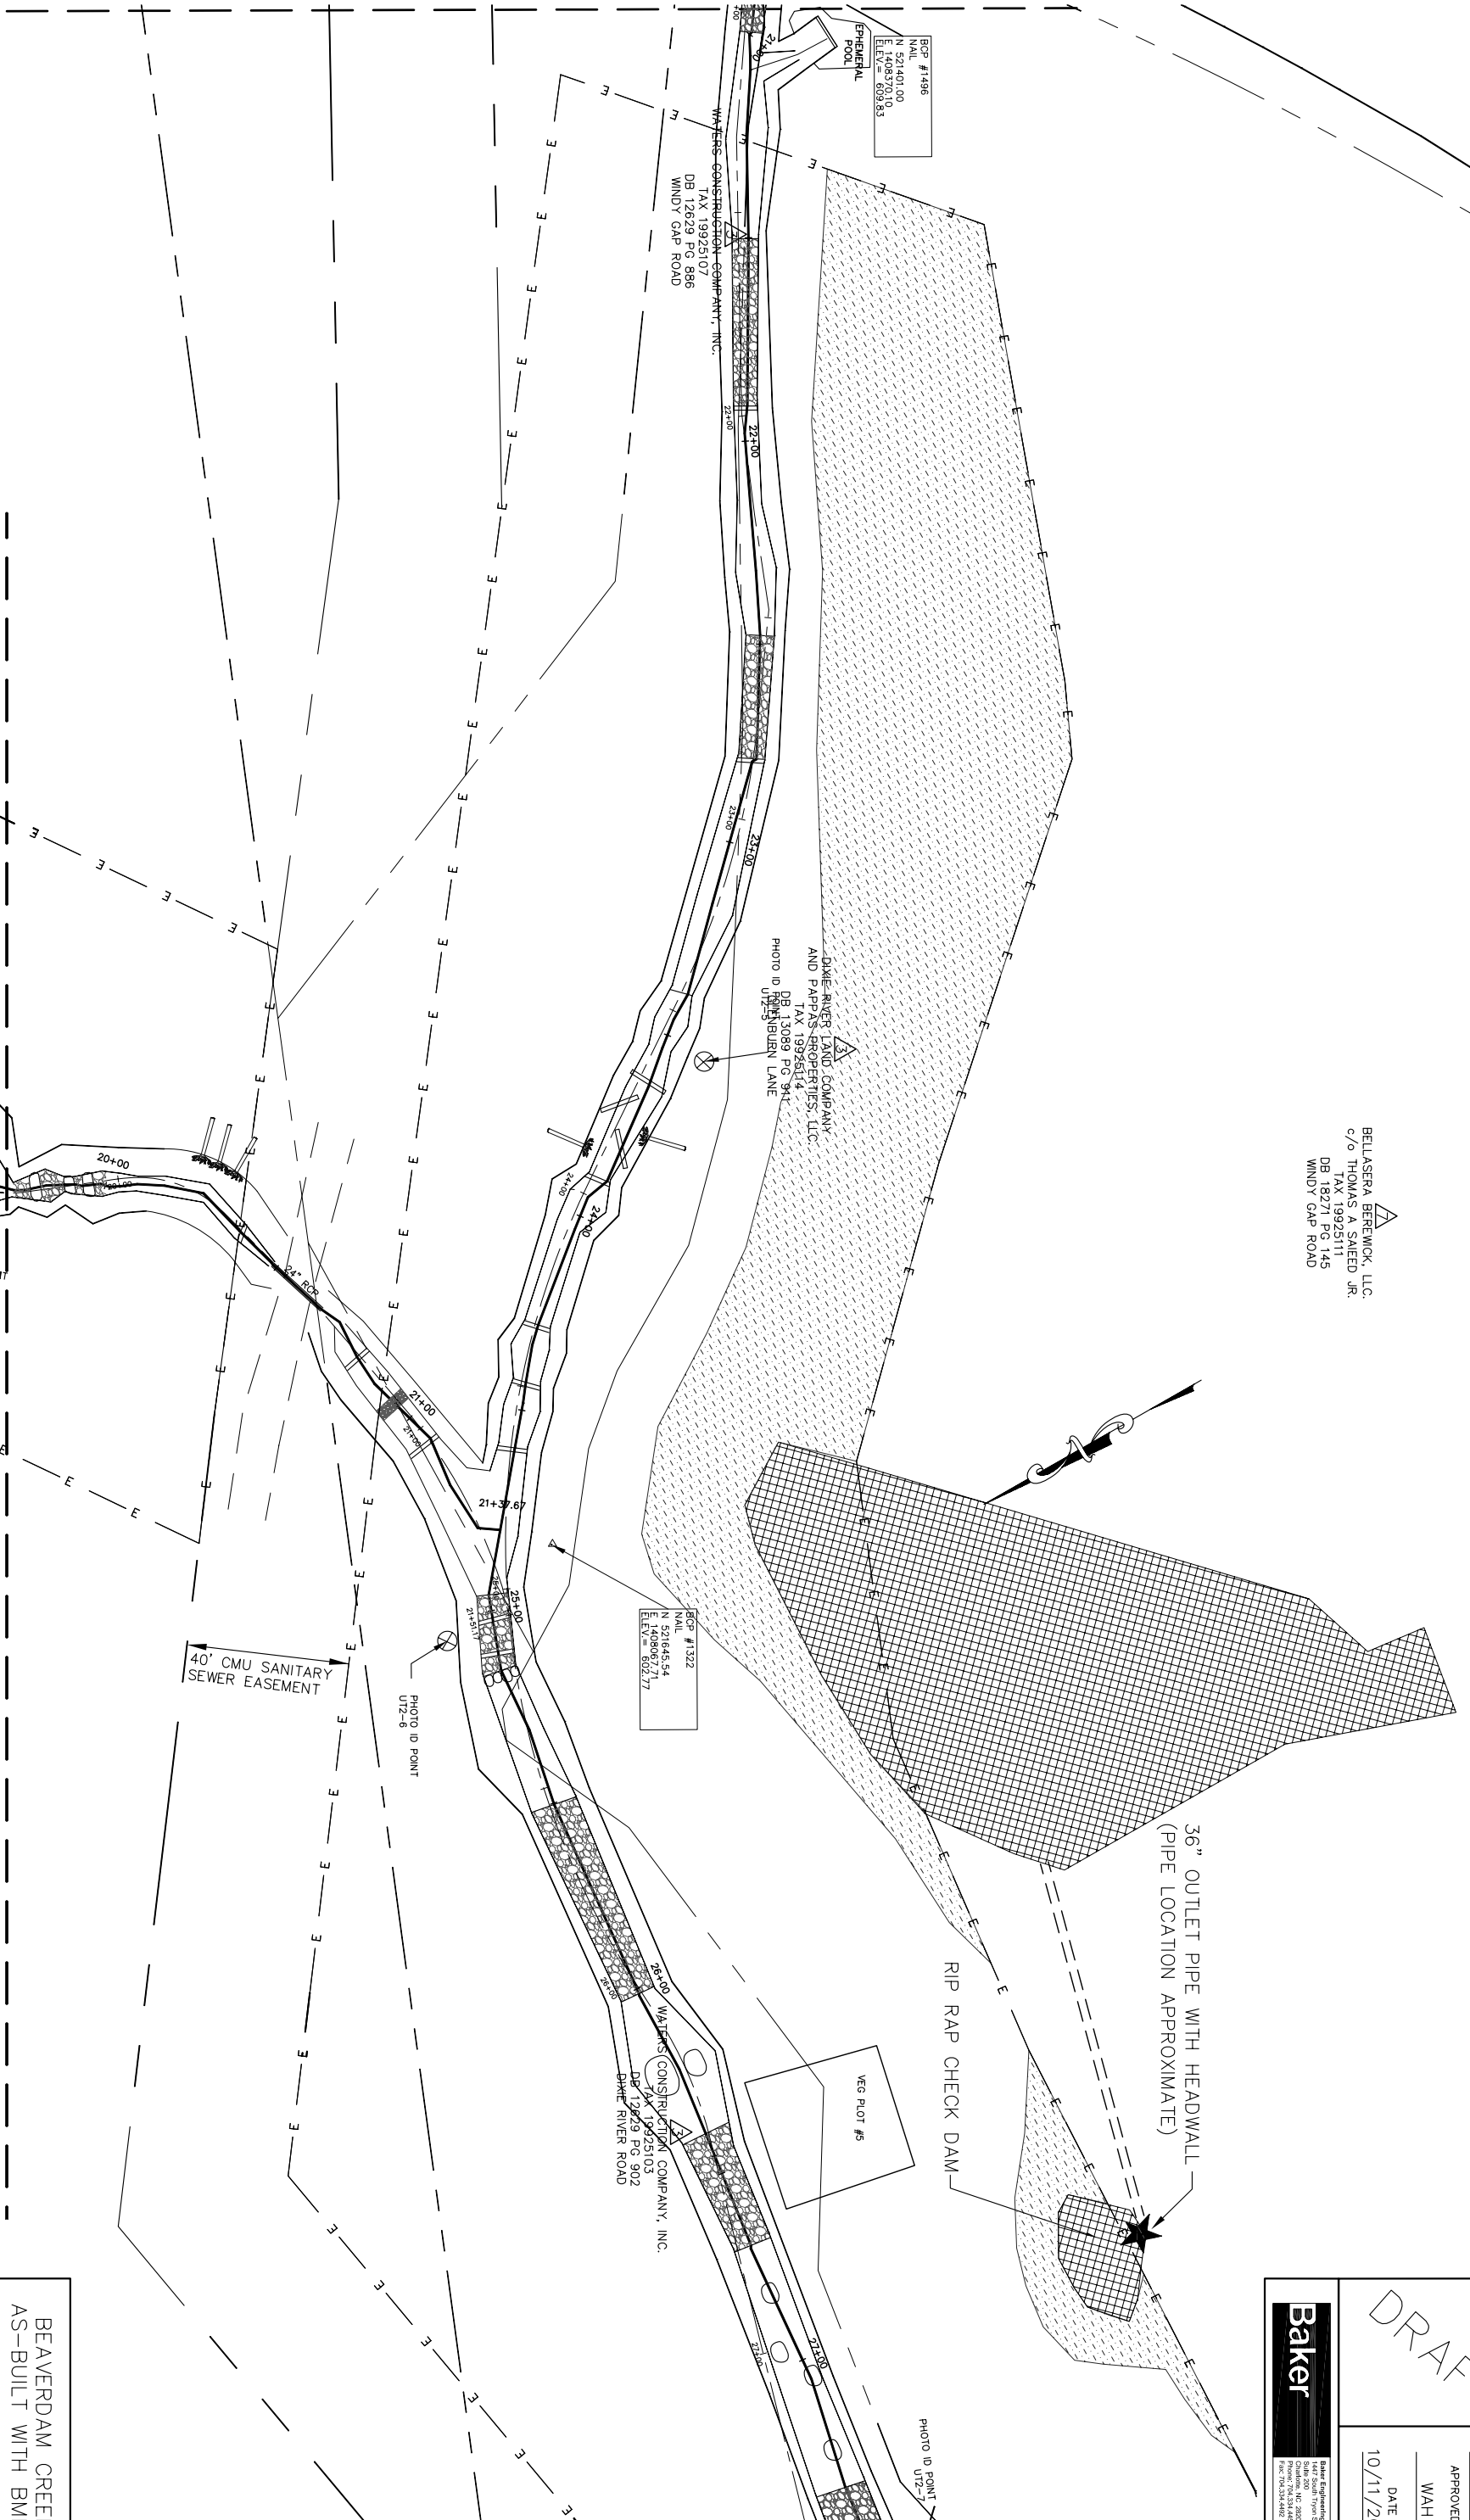

PROJECT REFERENCE NO. 108528  
SHEET NO. P19

PROJECT ENGINEER

KLT

APPROVED BY

WAH



DATE

10/11/2007

DRAFT

**Baker**  
Baker Engineering, PC, Inc.  
442 South Tryon Street  
Charlotte, NC 28203  
Phone: 704.334.8484  
Fax: 704.334.8500  
www.bakereng.com

BELLASERA BEREWICK, LLC.  
c/o THOMAS A SAIED JR.  
TAX 19925111  
DB 18271 PG 145  
WINDY GAP ROAD

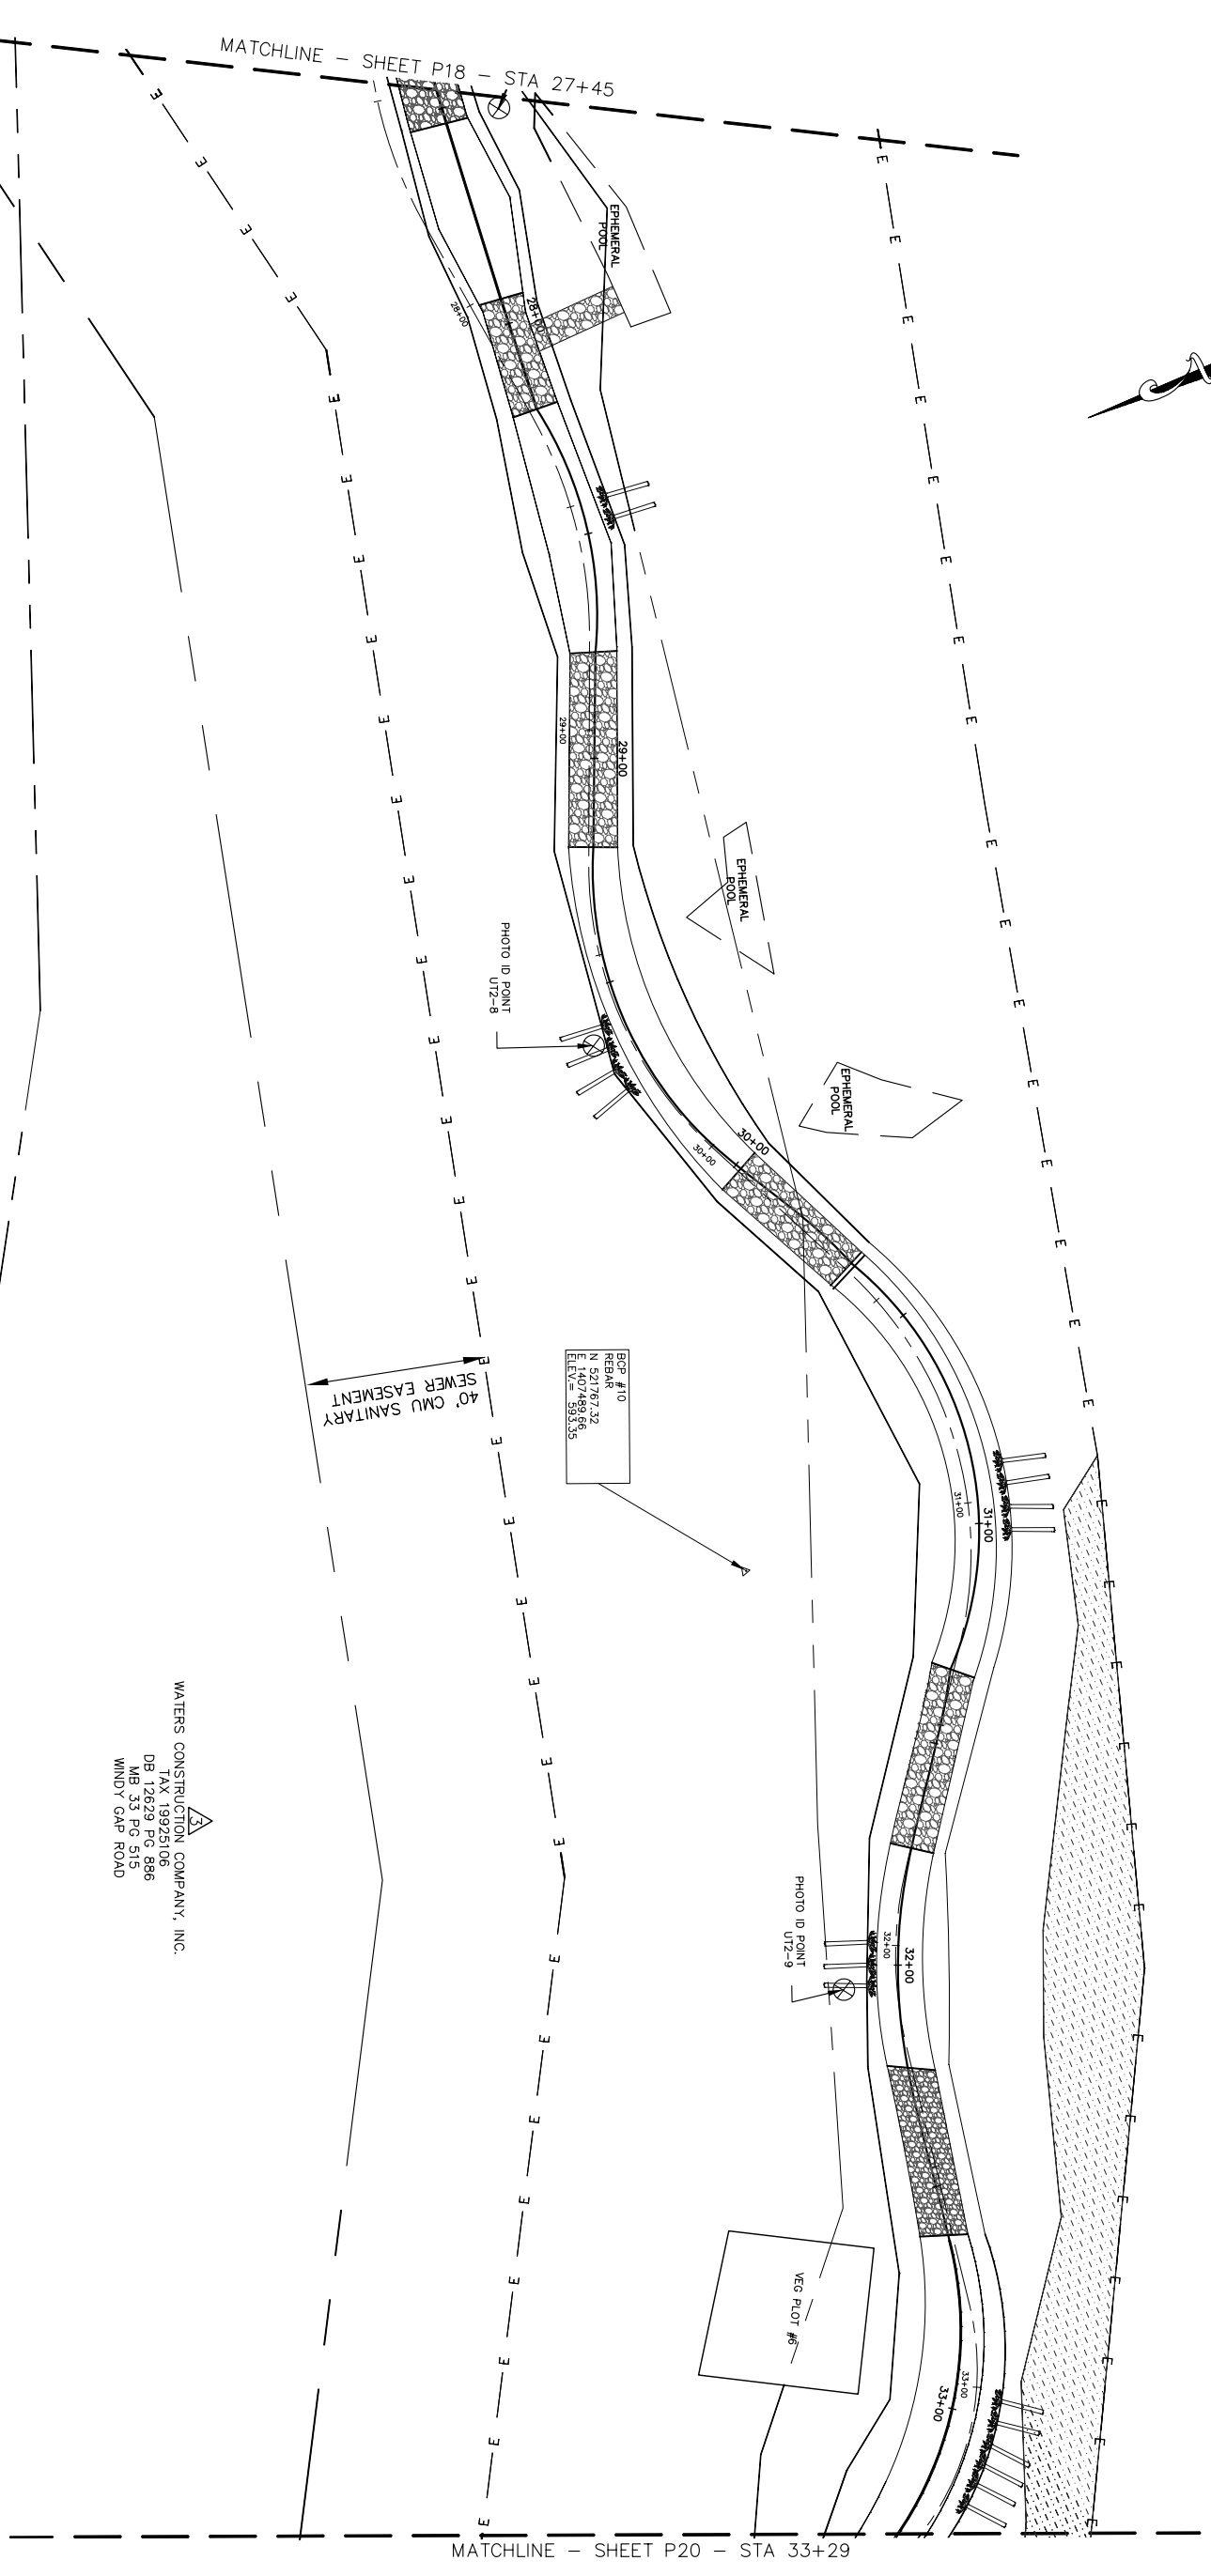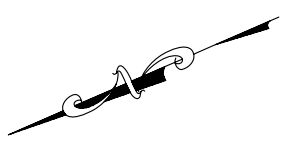

WATERS CONSTRUCTION COMPANY, INC.  
TX 10925106  
DB 12629 PG 886  
MB 33 PG 515  
WINDY GAP ROAD




BEAVERDAM CREEK  
AS-BUILT WITH BMPS  
UT2 SITE PLAN

PROJECT REFERENCE NO. 108528 SHEET NO. P20

**DRAFT**

PROJECT ENGINEER  
KLT  
APPROVED BY  
WAH  
DATE  
10/11/2007

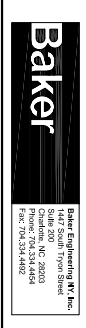


36" OUTLET PIPE WITH  
RIP RAP CHECK DAM

WATERS OF  
MERRA BERWICK, LLC.  
DOMAS A SAIED JR.  
TAX 19925111  
18271 PG 145  
WINDY GAP ROAD

M. HONES OF  
CHARTERED SURVEYORS, LLC  
TAX 10024111  
DB 19186 PG 179  
GLENBURN LANE

WATERS CONSTRUCTION COMPANY, INC.  
TAX 19925106  
DB 12629 PG 886  
MB 33 PG 515  
WINDY GAP ROAD

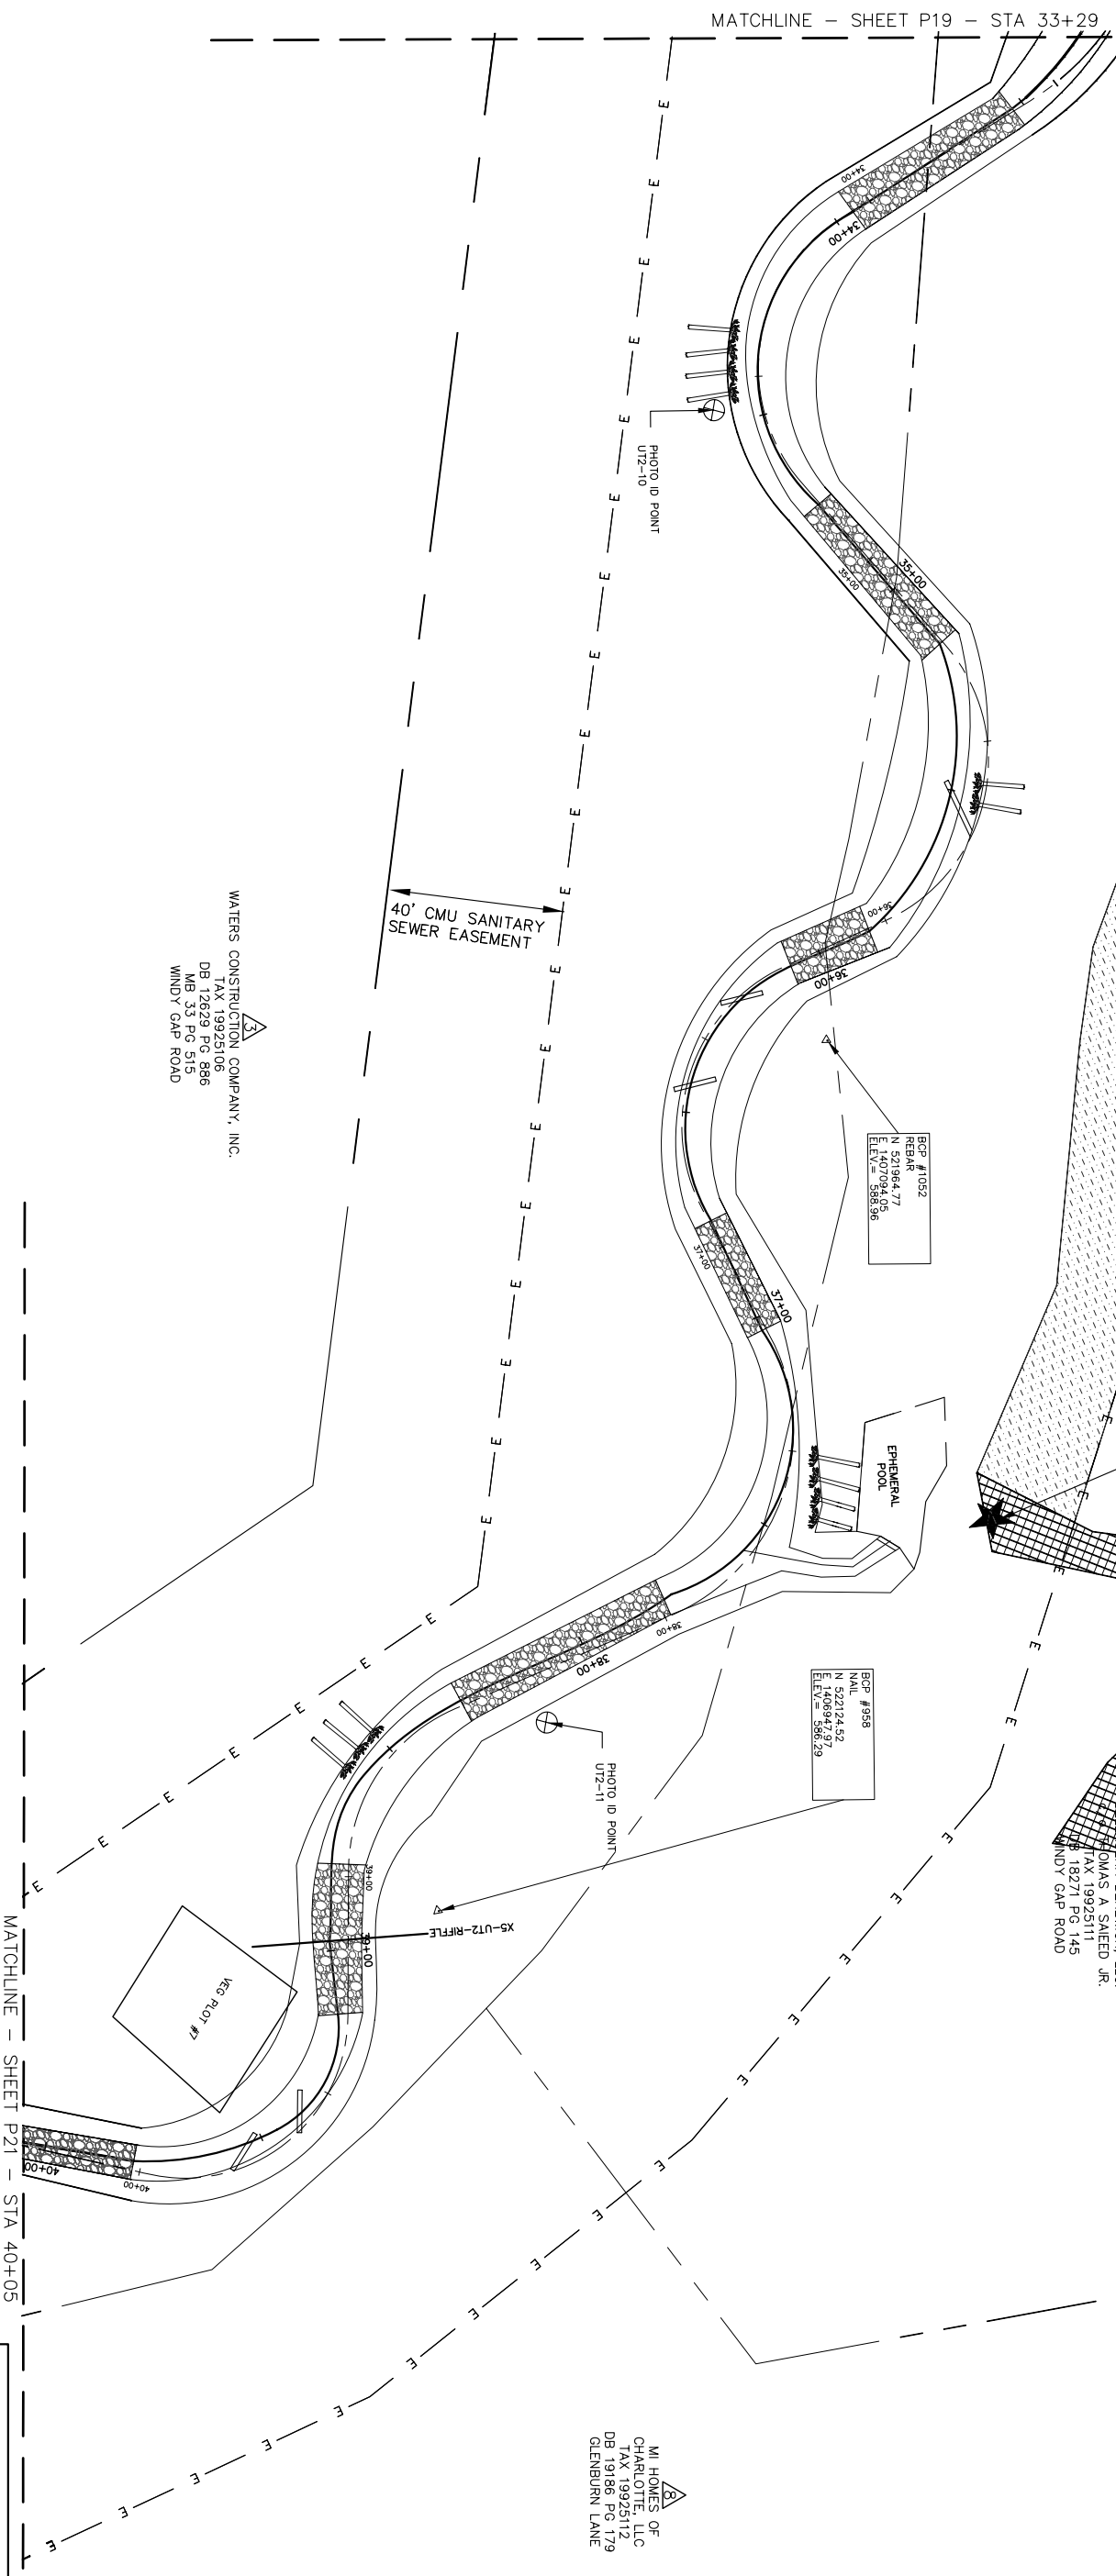

BEAVERDAM CREEK  
AS-BUILT WITH BMPs  
UT2 SITE PLAN


PROJECT REFERENCE NO. 108528 SHEET NO. P21

**DRAFT**

PROJECT ENGINEER  
KLT  
APPROVED BY  
WAH  
DATE  
10/11/2007

**Baker**  
Baker Engineering, PC  
1412 South Tryon Street  
Charlotte, NC 28203  
Phone: 704.334.8404  
Fax: 704.334.8500

MI HOMES OF  
CHARLOTTE, LLC  
TAX 18928106  
DB 33 PG 519  
GLENBURN LANE

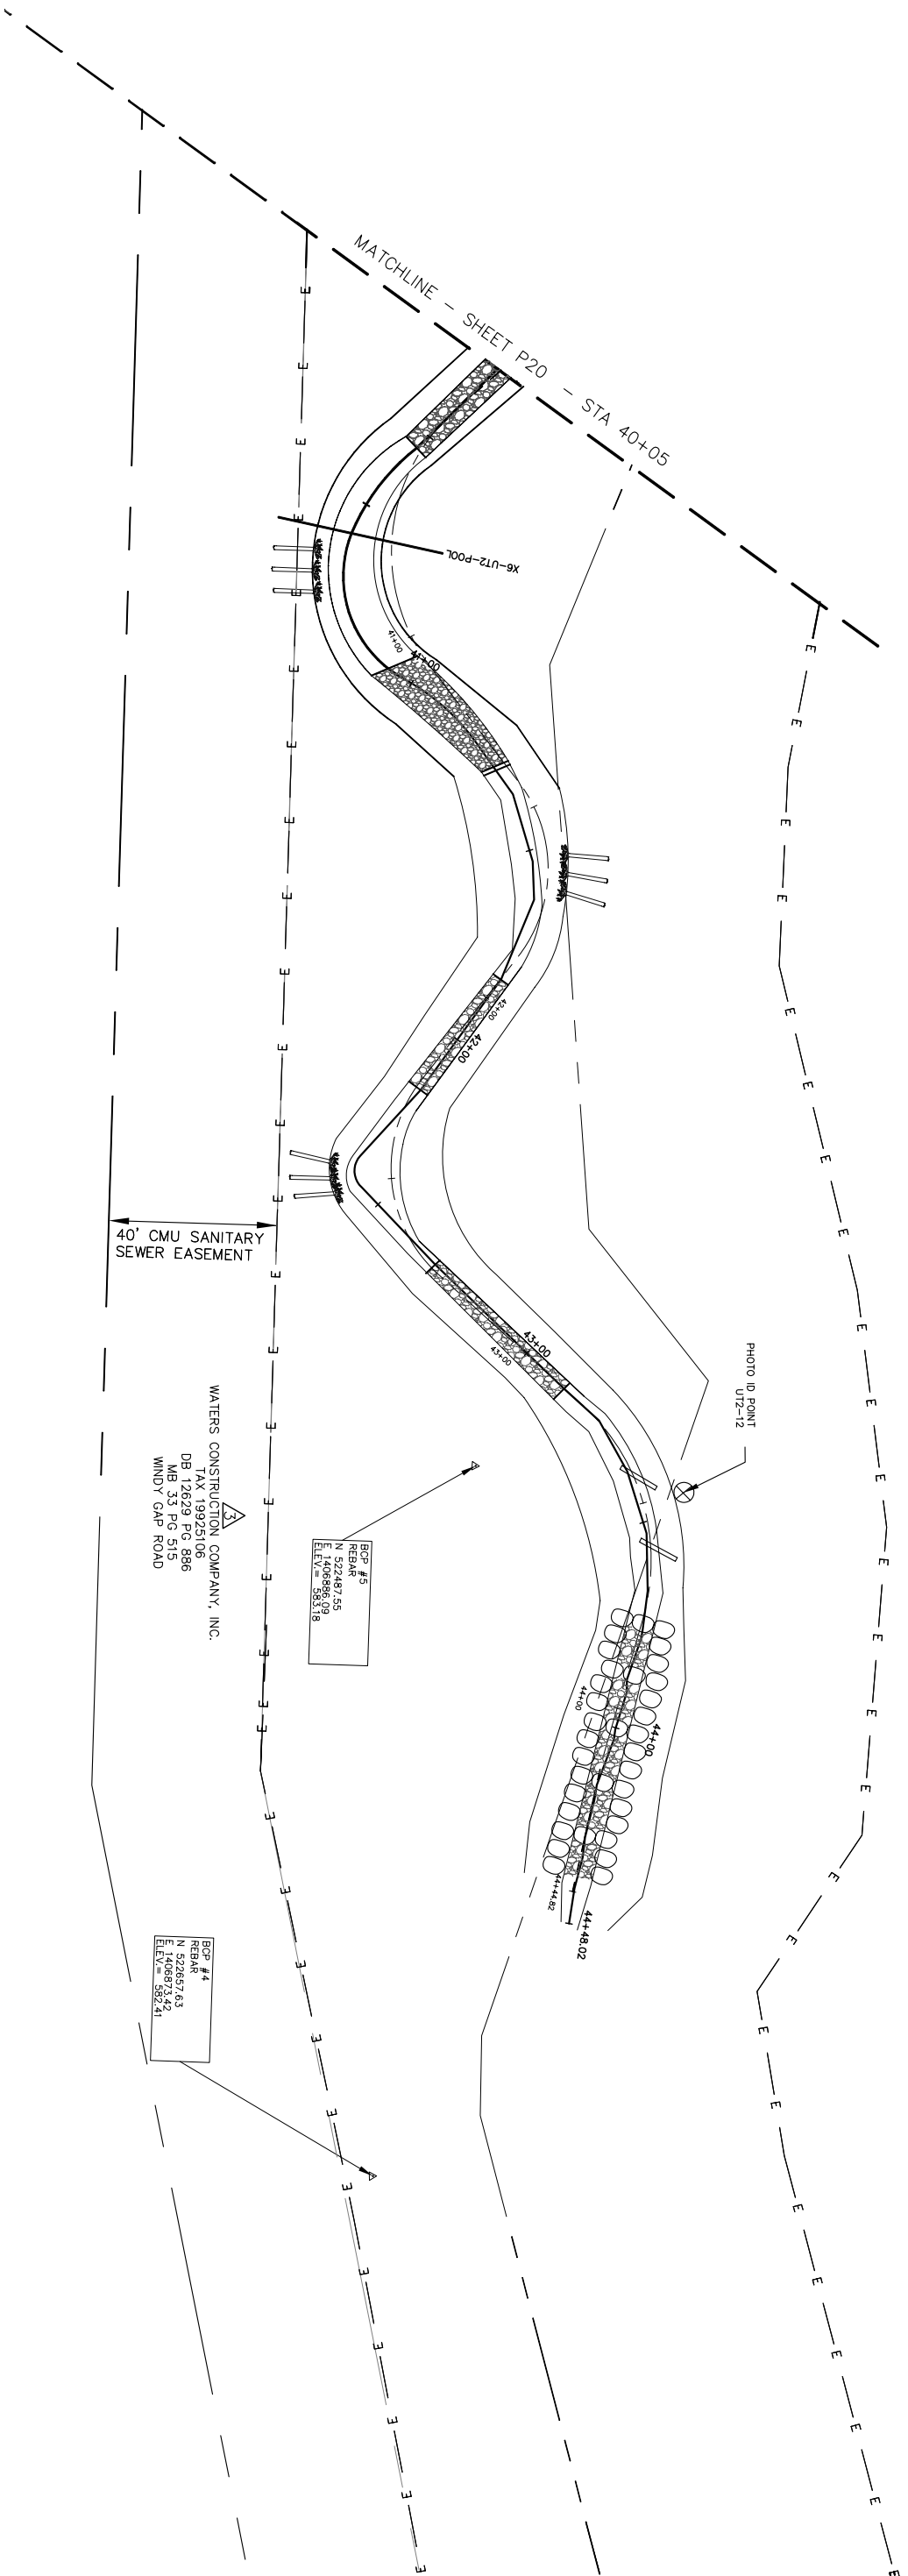

BEAVERDAM CREEK  
AS-BUILT WITH BMPs  
UT2 SITE PLAN

PROJECT REFERENCE NO. 108528 SHEET NO. P22

PROJECT ENGINEER

KLT


APPROVED BY WAH

DATE 10/11/2007

DRAFT

**Baker**  
 Baker Engineering, Inc.  
 442 South Third Street  
 Charlotte, NC 28203  
 Phone: 704.334.8484  
 Fax: 704.334.8500

WATERS CONSTRUCTION COMPANY, INC.  
 19925103  
 DB 12629 PG 902  
 DIXIE RIVER ROAD

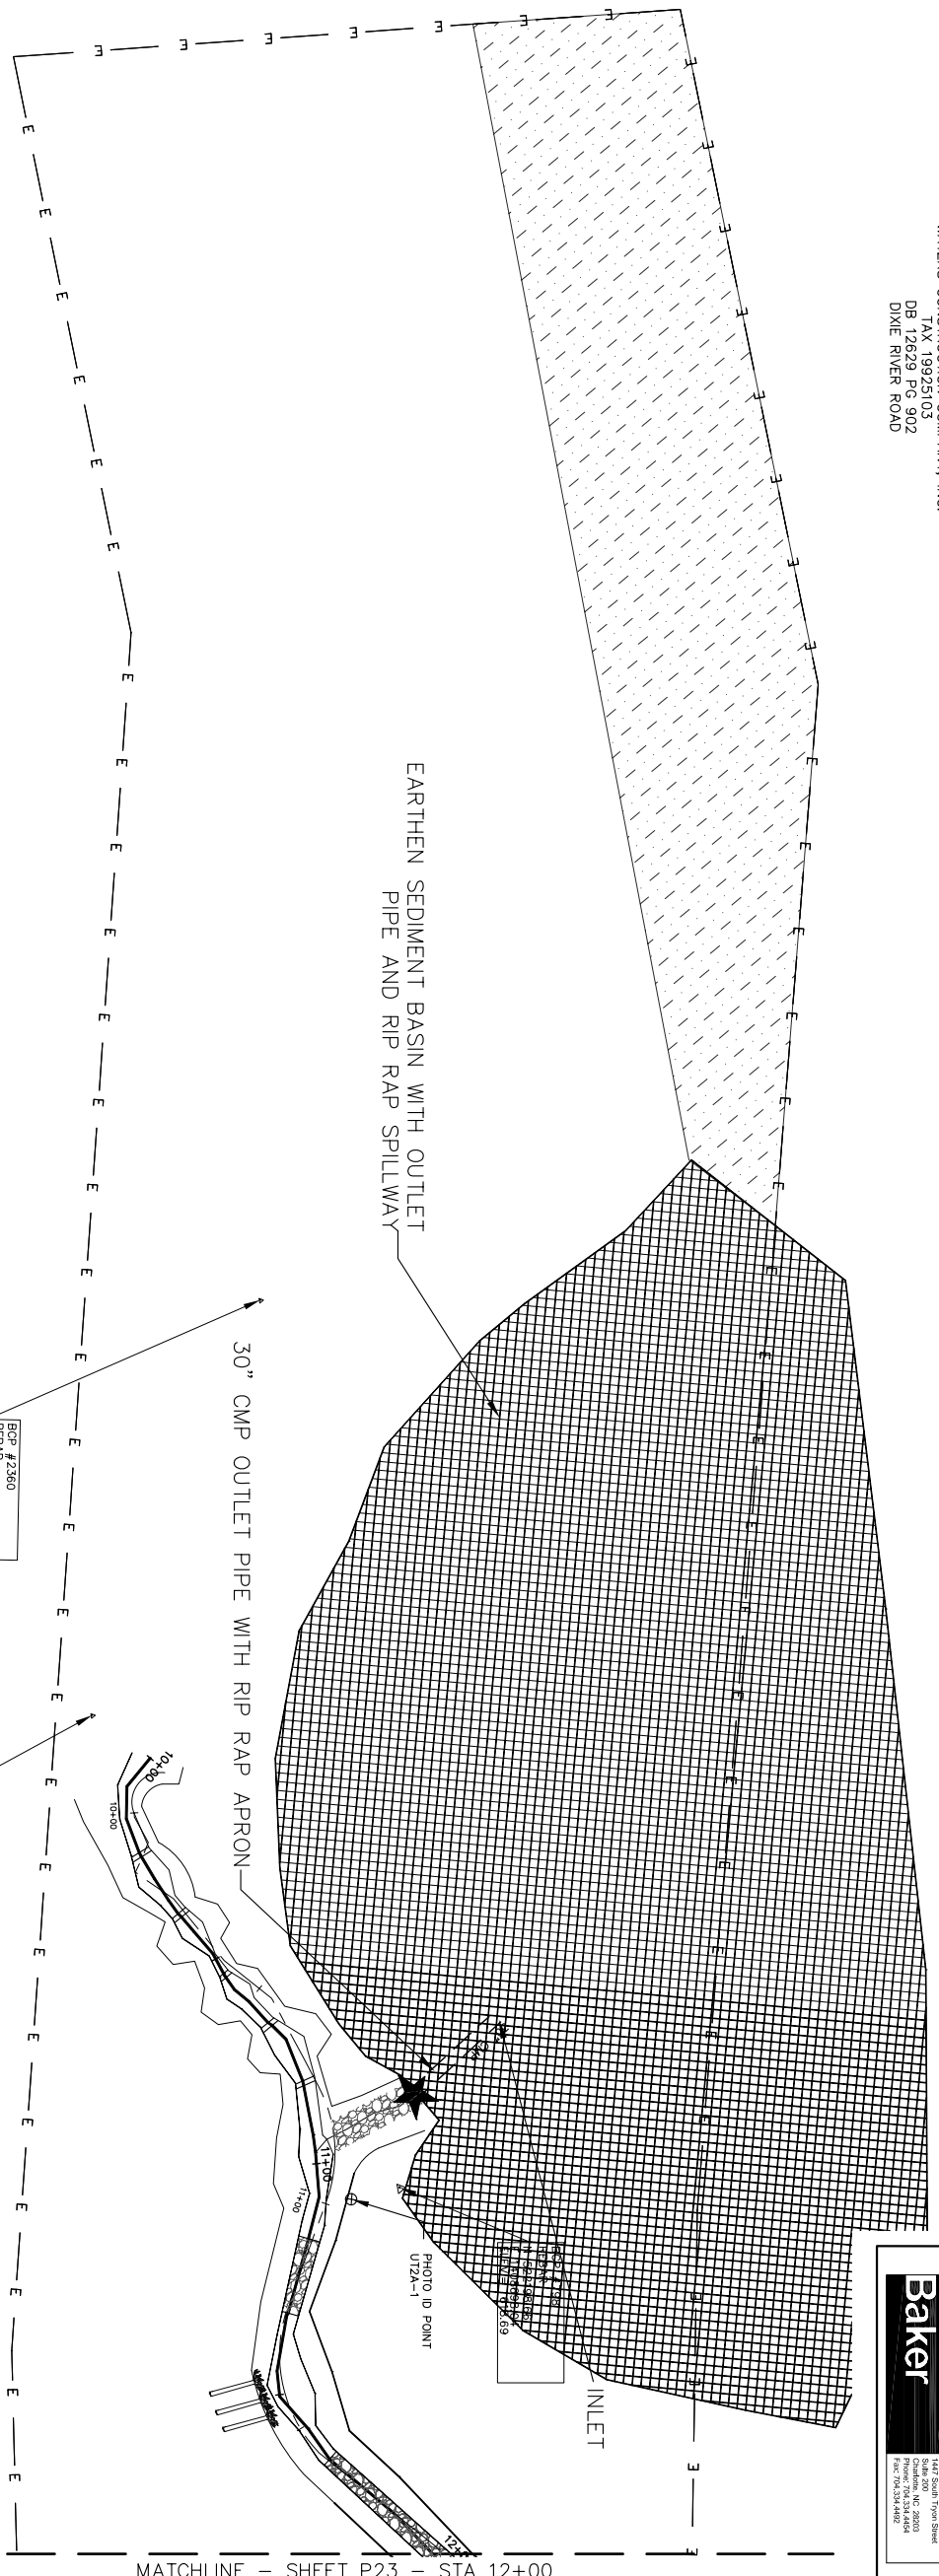

MATCHLINE - SHEET P23 - STA 12+00

WATERS CONSTRUCTION COMPANY, INC.  
 19925103  
 DB 12629 PG 902  
 DIXIE RIVER ROAD

BCP #22860  
 REBAR #  
 N 522561.78  
 E 1448715.89  
 ELEV. = XXX

BCP #22773  
 REBAR #  
 N 529316.91  
 E 1408711.70  
 ELEV. = XXX



BEAVERDAM CREEK  
 AS-BUILT WITH BMPs  
 UT2-A SITE PLAN

PROJECT REFERENCE NO. 108528 SHEET NO. P23

PROJECT ENGINEER

KLT



APPROVED BY WAH

DATE 10/11/2007

DRAFT

**Baker**  
 Baker Engineering, PC Inc.  
 1412 South Tryon Street  
 Charlotte, NC 28203  
 Phone: 704.334.8484  
 Fax: 704.334.8500

WATERS CONSTRUCTION COMPANY, INC.  
 1100 W. GORDON ST.  
 DP 13629 ENC 902  
 DIXIE RIVER ROAD

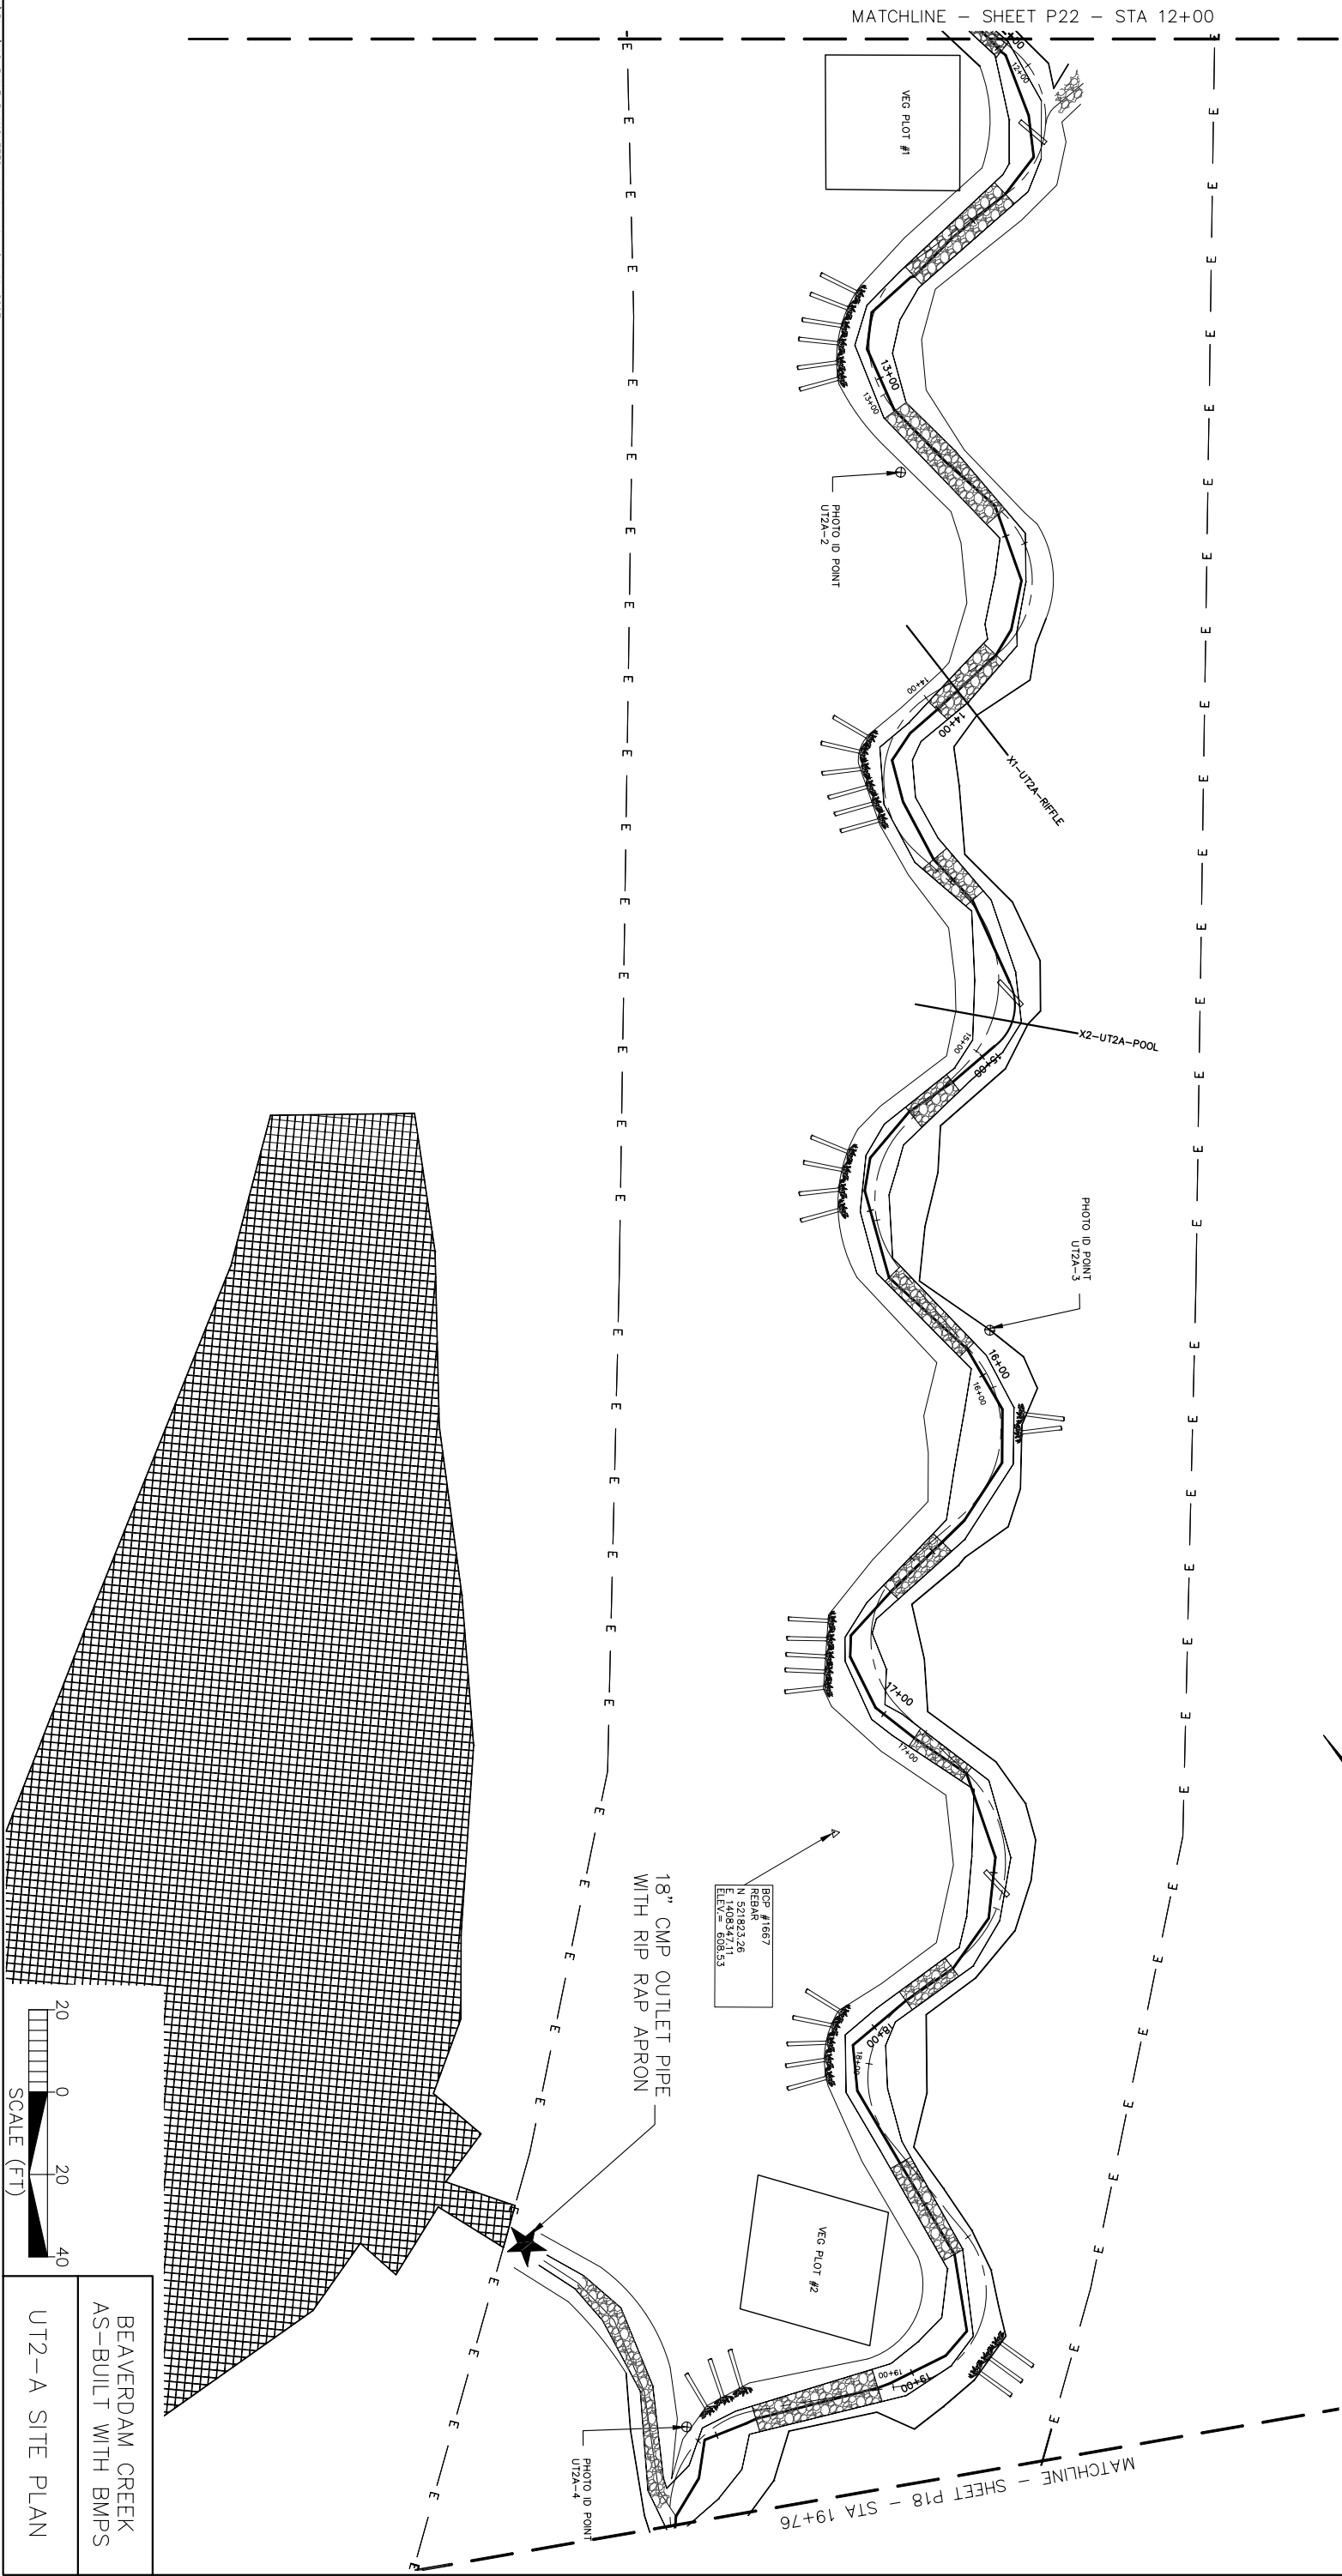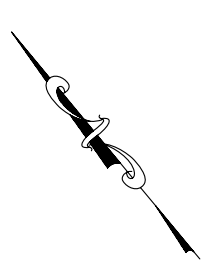

BEAVERDAM CREEK  
 AS-BUILT WITH BMPs  
 UT2-A SITE PLAN

## **APPENDIX D**

# **BASELINE STREAM SUMMARY FOR RESTORATION REACHES**



**Beaverdam Creek Restoration Site - UT1 (Reach 1)**

Parameter	Design			As-built			MY-1 (2007)		
	Min	Mean	Max	Min	Mean	Max	Min	Mean	Max
<b>Dimension - Riffle</b>									
Bankfull Width (ft)		14.6		----	12.5	----	----	13.1	----
Floodprone Width (ft)	----	45.0	----	----	74.6	----	----	74.6	----
Bankfull Mean Depth (ft)	----	1.5	----	----	1.4	----	----	1.4	----
Bankfull Max Depth (ft)	----	2.1	----	----	2.0	----	----	2.1	----
Bankfull Cross Sectional Area (ft2)	----	21.0	----	----	18.0	----	----	18.8	----
Width/Depth Ratio	----	10.0	----	----	8.7	----	----	9.2	----
Entrenchment Ratio	----	3.1	----	----	6.0	----	----	5.7	----
Bank Height Ratio	----	1.0	----	----	1.0	----	----	1.0	----
Bankfull Velocity (fps)	----	3.5	----	----	----	----	----	----	----
<b>Pattern</b>									
Channel Beltwidth (ft)	----	0	----	----	----	----	----	----	----
Radius of Curvature (ft)	0	----	15	----	----	----	----	----	----
Meander Wavelength (ft)	0	----	29	----	----	----	----	----	----
Meander Width Ratio	----	0	----	----	----	----	----	----	----
<b>Profile</b>									
Riffle Length (ft)	----	----	----	----	----	----	----	----	----
Riffle Slope (ft/ft)	0.0067	----	0.009	----	----	----	----	----	----
Pool Length (ft)	----	----	----	----	----	----	----	----	----
Pool Spacing (ft)	----	43.8	----	----	----	----	----	----	----
<b>Substrate and Transport Parameters</b>									
d16 / d35 / d50 / d84 / d95	----	----	----	----	----	----	25 / 36 / 42 / 75 / 105		
Reach Shear Stress (competency) lb/f2	----	----	----	----	----	----	----	----	----
Stream Power (transport capacity) W/m2	----	----	----	----	----	----	----	----	----
<b>Additional Reach Parameters</b>									
Channel length (ft)	----	----	555	----	----	567	----	----	568
Drainage Area (SM)	----	----	0.7	----	----	0.7	----	----	0.7
Rosgen Classification	----	Bc	----	----	----	----	----	C	----
Bankfull Discharge (cfs)	----	75	----	----	----	----	----	----	----
Sinuosity	----	1.02	----	----	----	----	----	1.05	----
BF slope (ft/ft)	----	----	----	----	----	----	----	----	----

Beaverdam Creek, EEP Contract No. D05016-1, River Works, Inc.

December 2007, Monitoring Year 1 - Draft

**Beaverdam Creek Restoration Site - UT1 (Reach 2-5)**

Parameter	Design			As-built			MY-1 (2007)		
	Min	Mean	Max	Min	Mean	Max	Min	Mean	Max
<b>Dimension - Riffle</b>									
Bankfull Width (ft)	16.8	----	20.0	15.4	----	23.0	15.2	----	26.9
Floodprone Width (ft)	----	100.0	----	74.9	----	80.7	74.9	----	80.7
Bankfull Mean Depth (ft)	1.7	----	2.0	1.7	----	2.1	1.5	----	2.2
Bankfull Max Depth (ft)	2.4	----	2.9	2.5	----	4.1	2.3	----	4.1
Bankfull Cross Sectional Area (ft <sup>2</sup> )	28.0	----	40.0	25.6	----	26.8	23.8	----	59.7
Width/Depth Ratio	9.8	----	10.1	9.2	----	13.9	9.6	----	14.6
Entrenchment Ratio	5.0	----	6.0	3.4	----	4.9	2.9	----	4.9
Bank Height Ratio	----	1.0	----	----	1.0	----	----	1.0	----
Bankfull Velocity (fps)	3.1	----	3.8	----	----	----	----	----	----
<b>Pattern</b>									
Channel Beltwidth (ft)	84	----	100	----	----	----	----	----	----
Radius of Curvature (ft)	34	----	60	----	----	----	----	----	----
Meander Wavelength (ft)	134	----	200	----	----	----	----	----	----
Meander Width Ratio	2	----	10	----	----	----	----	----	----
<b>Profile</b>									
Riffle Length (ft)	----	----	----	----	----	----	----	----	----
Riffle Slope (ft/ft)	0.0048	----	0.012	----	----	----	----	----	----
Pool Length (ft)	----	----	----	----	----	----	----	----	----
Pool Spacing (ft)	101	----	120	----	----	----	----	----	----
<b>Substrate and Transport Parameters</b>									
d16 / d35 / d50 / d84 / d95	----	----	----	----	----	----	0.17-25 / 0.75-37 / 30-45 / 70-85 / 110-120		
Reach Shear Stress (competency) lb/ft <sup>2</sup>	----	----	----	----	----	----	----	----	----
Stream Power (transport capacity) W/m <sup>2</sup>	----	----	----	----	----	----	----	----	----
<b>Additional Reach Parameters</b>									
Channel length (ft)	----	----	6155	----	----	5897	----	----	3021
Drainage Area (SM)	0.7	----	1.75	0.7	----	1.75	0.7	----	1.75
Rosgen Classification	----	C/E	----	----	----	----	----	C	----
Bankfull Discharge (cfs)	105	----	155	----	----	----	----	----	----
Sinuosity	1.1	----	1.2	----	----	----	----	1.3	----
BF slope (ft/ft)	0.002	----	0.006	----	----	----	----	----	----

Beaverdam Creek, EEP Contract No. D05016-1, River Works, Inc.

December 2007, Monitoring Year 1 - Draft

Beaverdam Creek Restoration Site - UT1B									
Parameter	Design			As-built			MY-1 (2007)		
Dimension - Riffle	Min	Mean	Max	Min	Mean	Max	Min	Mean	Max
Bankfull Width (ft)	----	10.4	----	----	11.1	----	----	11.8	----
Floodprone Width (ft)	----	100.0	----	----	75.0	----	----	75.0	----
Bankfull Mean Depth (ft)	----	1.1	----	----	1.4	----	----	1.4	----
Bankfull Max Depth (ft)	----	1.4	----	----	2.3	----	----	2.3	----
Bankfull Cross Sectional Area (ft2)	----	11.0	----	----	15.3	----	----	16.5	----
Width/Depth Ratio	----	9.7	----	----	8.0	----	----	8.5	----
Entrenchment Ratio	----	9.6	----	----	6.8	----	----	6.3	----
Bank Height Ratio	----	1.0	----	----	1.0	----	----	1.0	----
Bankfull Velocity (fps)	----	4.0	----	----	----	----	----	----	----
Pattern									
Channel Beltwidth (ft)	----	52	----	----	----	----	----	----	----
Radius of Curvature (ft)	21	----	31	----	----	----	----	----	----
Meander Wavelength (ft)	83	----	104	----	----	----	----	----	----
Meander Width Ratio	----	5	----	----	----	----	----	----	----
Profile									
Riffle Length (ft)	----	----	----	----	----	----	----	----	----
Riffle Slope (ft/ft)	0.0104	----	0.0138	----	----	----	----	----	----
Pool Length (ft)	----	----	----	----	----	----	----	----	----
Pool Spacing (ft)	----	52	----	----	----	----	----	----	----
Substrate and Transport Parameters									
d16 / d35 / d50 / d84 / d95	----	----	----	----	----	----	<0.063 / <0.063 / <0.063 / 0.2 / 0.4		
Reach Shear Stress (competency) lb/f2	----	----	----	----	----	----	----	----	----
Stream Power (transport capacity) W/m2	----	----	----	----	----	----	----	----	----
Additional Reach Parameters									
Channel length (ft)	----	----	790	----	----	778	----	----	775
Drainage Area (SM)	----	----	0.34	----	----	0.34	----	----	0.34
Rosgen Classification	----	C/E	----	----	C	----	----	C	----
Bankfull Discharge (cfs)	----	45	----	----	----	----	----	----	----
Sinuosity	----	1.15	----	----	1.1	----	----	1.1	----
BF slope (ft/ft)	----	0.003	----	----	0.013	----	----	----	----

Beaverdam Creek, EEP Contract No. D05016-1, River Works, Inc.

December 2007, Monitoring Year 1 - Draft

**Beaverdam Creek Restoration Site - UTIC**

Parameter	Design			As-built			MY-1 (2007)		
	Min	Mean	Max	Min	Mean	Max	Min	Mean	Max
<b>Dimension - Riffle</b>									
Bankfull Width (ft)	----	11.2	----	----	11.0	----	----	12.0	----
Floodprone Width (ft)	----	100.0	----	----	70.2	----	----	70.6	----
Bankfull Mean Depth (ft)	----	0.8	----	----	0.7	----	----	0.7	----
Bankfull Max Depth (ft)	----	0.9	----	----	1.0	----	----	1.1	----
Bankfull Cross Sectional Area (ft2)	----	8.0	----	----	7.8	----	----	8.8	----
Width/Depth Ratio	----	14.8	----	----	15.6	----	----	16.5	----
Entrenchment Ratio	----	8.9	----	----	6.4	----	----	5.9	----
Bank Height Ratio	----	1.0	----	----	1.0	----	----	1.0	----
Bankfull Velocity (fps)	----	3.2	----	----	----	----	----	----	----
<b>Pattern</b>									
Channel Beltwidth (ft)	----	----	----	----	----	----	----	----	----
Radius of Curvature (ft)	----	----	----	----	----	----	----	----	----
Meander Wavelength (ft)	----	----	----	----	----	----	----	----	----
Meander Width Ratio	----	----	----	----	----	----	----	----	----
<b>Profile</b>									
Riffle Length (ft)	----	----	----	----	----	----	----	----	----
Riffle Slope (ft/ft)	0.0191	----	0.0265	----	----	----	----	----	----
Pool Length (ft)	----	----	----	----	----	----	----	----	----
Pool Spacing (ft)	----	44.8	----	----	----	----	----	----	----
<b>Substrate and Transport Parameters</b>									
d16 / d35 / d50 / d84 / d95	----	----	----	----	----	----	26 / 37 / 42 / 75 / 100		
Reach Shear Stress (competency) lb/f2	----	----	----	----	----	----	----	----	----
Stream Power (transport capacity) W/m2	----	----	----	----	----	----	----	----	----
<b>Additional Reach Parameters</b>									
Channel length (ft)	----	----	628	----	----	616	----	----	615
Drainage Area (SM)	----	----	0.15	----	----	0.15	----	----	0.15
Rosgen Classification	----	B	----	----	C	----	----	C	----
Bankfull Discharge (cfs)	----	27	----	----	----	----	----	----	----
Sinuosity	----	1.05	----	----	1.1	----	----	1.1	----
BF slope (ft/ft)	----	0.017	----	----	0.013	----	----	----	----

Beaverdam Creek, EEP Contract No. D05016-1, River Works, Inc.

December 2007, Monitoring Year 1 - Draft

**Beaverdam Creek Restoration Site - UT1D**

Parameter	Design			As-built			MY-1 (2007)		
	Min	Mean	Max	Min	Mean	Max	Min	Mean	Max
<b>Dimension - Riffle</b>									
Bankfull Width (ft)	----	10.4	----	----	11.4	----	----	12.7	----
Floodprone Width (ft)	----	100.0	----	----	75.5	----	----	75.5	----
Bankfull Mean Depth (ft)	----	0.9	----	----	0.8	----	----	0.7	----
Bankfull Max Depth (ft)	----	1.2	----	----	1.2	----	----	1.1	----
Bankfull Cross Sectional Area (ft2)	----	10.0	----	----	9.0	----	----	9.2	----
Width/Depth Ratio	----	11.2	----	----	14.4	----	----	17.5	----
Entrenchment Ratio	----	9.6	----	----	6.6	----	----	6.0	----
Bank Height Ratio	----	1.0	----	----	1.0	----	----	1.0	----
Bankfull Velocity (fps)	----	2.9	----	----	----	----	----	----	----
<b>Pattern</b>									
Channel Beltwidth (ft)	----	52	----	----	----	----	----	----	----
Radius of Curvature (ft)	21	----	31	----	----	----	----	----	----
Meander Wavelength (ft)	83	----	104	----	----	----	----	----	----
Meander Width Ratio	8	----	10	----	----	----	----	----	----
<b>Profile</b>									
Riffle Length (ft)	----	----	----	----	----	----	----	----	----
Riffle Slope (ft/ft)	----	----	----	----	----	----	----	----	----
Pool Length (ft)	----	----	----	----	----	----	----	----	----
Pool Spacing (ft)	----	52	----	----	----	----	----	----	----
<b>Substrate and Transport Parameters</b>									
d16 / d35 / d50 / d84 / d95	----	----	----	----	----	----	32 / 38 / 43 / 85 / 120		
Reach Shear Stress (competency) lb/f2	----	----	----	----	----	----	----	----	----
Stream Power (transport capacity) W/m2	----	----	----	----	----	----	----	----	----
<b>Additional Reach Parameters</b>									
Channel length (ft)	----	----	352	----	----	338	----	----	334
Drainage Area (SM)	----	----	0.16	----	----	0.16	----	----	0.16
Rosgen Classification	----	C/E	----	----	C	----	----	C	----
Bankfull Discharge (cfs)	----	28	----	----	----	----	----	----	----
Sinuosity	----	1.15	----	----	1.2	----	----	1.2	----
BF slope (ft/ft)	----	0.007	----	----	0.014	----	----	----	----

Beaverdam Creek, EEP Contract No. D05016-1, River Works, Inc.  
 December 2007, Monitoring Year 1 - Draft

**Beaverdam Creek Restoration Site - UT2**

Parameter	Design			As-built			MY-1 (2007)		
	Min	Mean	Max	Min	Mean	Max	Min	Mean	Max
<b>Dimension - Riffle</b>									
Bankfull Width (ft)	10.2	----	15.6	16.8	----	16.9	16.1	----	16.6
Floodprone Width (ft)	30.0	----	80	39.9	----	39.9	39.9	----	39.9
Bankfull Mean Depth (ft)	0.92	----	1.5	0.7	----	1.4	0.7	----	1.4
Bankfull Max Depth (ft)	1.3	----	2.3	1.1	----	2.1	1.1	----	1.9
Bankfull Cross Sectional Area (ft <sup>2</sup> )	9.9	----	23.9	12.2	----	23.4	10.9	----	22.6
Width/Depth Ratio	10.2	----	12.6	12.1	----	23.4	12.2	----	23.9
Entrenchment Ratio	2.8	----	5.9	2.4	----	2.4	2.4	----	2.5
Bank Height Ratio	----	1.0	----	----	1.0	----	1	----	1.0
Bankfull Velocity (fps)	4.7	----	5.4	----	----	----	----	----	----
<b>Pattern</b>									
Channel Beltwidth (ft)	20	----	75	----	----	----	----	----	----
Radius of Curvature (ft)	23	----	100	----	----	----	----	----	----
Meander Wavelength (ft)	100	----	300	----	----	----	----	----	----
Meander Width Ratio	9.6	----	27.8	----	----	----	----	----	----
<b>Profile</b>									
Riffle Length (ft)	----	----	----	----	----	----	----	----	----
Riffle Slope (ft/ft)	0.0122	----	0.0279	----	----	----	----	----	----
Pool Length (ft)	----	----	----	----	----	----	----	----	----
Pool Spacing (ft)	40	----	105	----	----	----	----	----	----
<b>Substrate and Transport Parameters</b>									
d16 / d35 / d50 / d84 / d95	----	----	----	----	----	----	26-27 / 35 / 39-39 / 53-59 / 95		
Reach Shear Stress (competency) lb/ft <sup>2</sup>	----	----	----	----	----	----	----	----	----
Stream Power (transport capacity) W/m <sup>2</sup>	----	----	----	----	----	----	----	----	----
<b>Additional Reach Parameters</b>									
Channel length (ft)	----	----	3290	----	----	3293	----	----	3142
Drainage Area (SM)	0.1	----	0.3	0.1	----	0.3	0.1	----	0.3
Rosgen Classification	----	C	----	----	C	----	----	C	----
Bankfull Discharge (cfs)	48	----	120	----	----	----	----	----	----
Sinuosity	1.03	----	1.21	----	1.3	----	----	1.3	----
BF slope (ft/ft)	0.008	----	0.019	----	0.0138	----	----	----	----

Beaverdam Creek, EEP Contract No. D05016-1, River Works, Inc.

December 2007, Monitoring Year 1 - Draft

**Beaverdam Creek Restoration Site - UT2A**

Parameter	Design			As-built			MY-1 (2007)		
	Min	Mean	Max	Min	Mean	Max	Min	Mean	Max
<b>Dimension - Riffle</b>									
Bankfull Width (ft)	----	15.6	----	----	13.3	----	----	12.2	----
Floodprone Width (ft)	----	80.0	----	----	39.8	----	----	39.8	----
Bankfull Mean Depth (ft)	----	1.0	----	----	0.8	----	----	0.8	----
Bankfull Max Depth (ft)	----	1.4	----	----	1.2	----	----	1.1	----
Bankfull Cross Sectional Area (ft2)	----	10.2	----	----	10.6	----	----	9.6	----
Width/Depth Ratio	----	10.2	----	----	16.6	----	----	15.5	----
Entrenchment Ratio	----	5.9	----	----	3.0	----	----	3.3	----
Bank Height Ratio	----	1.0	----	----	1.0	----	----	1	----
Bankfull Velocity (fps)	----	5.1	----	----	----	----	----	----	----
<b>Pattern</b>									
Channel Beltwidth (ft)	40	----	55	----	----	----	----	----	----
Radius of Curvature (ft)	24	----	30	----	----	----	----	----	----
Meander Wavelength (ft)	100	----	120	----	----	----	----	----	----
Meander Width Ratio	9.8	----	11.8	----	----	----	----	----	----
<b>Profile</b>									
Riffle Length (ft)	----	----	----	----	----	----	----	----	----
Riffle Slope (ft/ft)	0.02	----	0.0273	----	----	----	----	----	----
Pool Length (ft)	----	----	----	----	----	----	----	----	----
Pool Spacing (ft)	----	57	----	----	----	----	----	----	----
<b>Substrate and Transport Parameters</b>									
d16 / d35 / d50 / d84 / d95	----	----	----	----	----	----	26 / 30 / 35 / 53 / 78		
Reach Shear Stress (competency) lb/f2	----	----	----	----	----	----	----	----	----
Stream Power (transport capacity) W/m2	----	----	----	----	----	----	----	----	----
<b>Additional Reach Parameters</b>									
Channel length (ft)	----	----	1099	----	----	1131	----	----	1121
Drainage Area (SM)	----	----	0.1	----	----	0.1	----	----	0.1
Rosgen Classification	----	C/E	----	----	C	----	----	C	----
Bankfull Discharge (cfs)	----	51	----	----	----	----	----	----	----
Sinuosity	----	1.21	----	----	1.25	----	----	1.22	----
BF slope (ft/ft)	----	0.012	----	----	0.015	----	----	----	----

Beaverdam Creek, EEP Contract No. D05016-1, River Works, Inc.

December 2007, Monitoring Year 1 - Draft

## **APPENDIX E**

# **MORHOLOGY AND HYDRAULIC MONITORING SUMMARY – YEAR 1**



Beaverdam Creek Restoration Site : Project No. D05016-1															
Reach: Beaverdam Creek UT1 (Reach 1)															
I. Cross-Section Parameters	Cross Section 1					Cross Section 2									
	Pool					Riffle									
	MY1	MY2	MY3	MY4	MY5	MY1	MY2	MY3	MY4	MY5					
<b>Dimension</b>															
BF Width (ft)	22.1					13.1									
Floodprone Width (ft)	75.1					74.6									
BF Cross Sectional Area (ft <sup>2</sup> )	33.1					18.8									
BF Mean Depth (ft)	1.5					1.4									
BF Max Depth (ft)	3.1					2.1									
Width/Depth Ratio	14.8					9.2									
Entrenchment Ratio	3.4					5.7									
Wetted Perimeter (ft)	25.1					16.0									
Hydraulic Radius (ft)	1.3					1.2									
<b>Substrate</b>															
d50 (mm)	<0.063					42									
d84 (mm)	<0.063					75									
II. Reachwide Parameters	MY-1 (2006)			MY-2 (2007)			MY-3 (2008)			MY-4 (2009)			MY-5 (2010)		
	Min	Max	Med	Min	Max	Med	Min	Max	Med	Min	Max	Med	Min	Max	Med
<b>Pattern</b>															
Channel Beltwidth (ft)	-	-	-												
Radius of Curvature (ft)	-	-	-												
Meander Wavelength (ft)	-	-	-												
Meander Width Ratio	-	-	-												
<b>Profile</b>															
Riffle length (ft)	-	-	-												
Riffle Slope (ft/ft)	-	-	-												
Pool Length (ft)	-	-	-												
Pool Spacing (ft)	-	-	-												
<b>Additional Reach Parameters</b>															
Valley Length (ft)	540	-	-												
Channel Length (ft)	568	-	-												
Sinuosity	1.1	-	-												
Water Surface Slope (ft/ft)	-	-	-												
BF Slope (ft/ft)	-	-	-												
Rosgen Classification	C	-	-												

Beaverdam Creek Restoration Site : Project No. D05016-1																			
Reach: Beaverdam Creek UT1 (Reaches 2-5)																			
I. Cross-Section Parameters	Cross Section 5 Riffle					Cross Section 6 Pool					Cross Section 9 Riffle					Cross Section 10 Pool			
	MY1	MY2	MY3	MY4	MY5	MY1	MY2	MY3	MY4	MY5	MY1	MY2	MY3	MY4	MY5	MY1	MY2	MY3	MY4
<b>Dimension</b>																			
BF Width (ft)	15.2					23.5					17.8					22.2			
Floodprone Width (ft)	74.9					75.0					75.09					74.9			
BF Cross Sectional Area (ft <sup>2</sup> )	23.8					41.1					29.26					44.8			
BF Mean Depth (ft)	1.6					1.8					1.64					2.0			
BF Max Depth (ft)	2.3					3.5					2.65					3.3			
Width/Depth Ratio	9.7					13.4					10.83					11.0			
Entrenchment Ratio	4.9					3.2					4.22					3.4			
Wetted Perimeter (ft)	18.3					27.0					21.1					26.3			
Hydraulic Radius (ft)	1.3					1.5					1.4					1.7			
<b>Substrate</b>																			
d50 (mm)	45					0.2					36					<0.063			
d84 (mm)	85					0.45					72					0.7			
<b>II. Reachwide Parameters</b>																			
	MY-1 (2006)			MY-2 (2007)			MY-3 (2008)			MY-4 (2009)			MY-5 (2010)						
	Min	Max	Med	Min	Max	Med	Min	Max	Med	Min	Max	Med	Min	Max	Med				
<b>Pattern</b>																			
Channel Beltwidth (ft)	-	-	-																
Radius of Curvature (ft)	-	-	-																
Meander Wavelength (ft)	-	-	-																
Meander Width Ratio	-	-	-																
<b>Profile</b>																			
Riffle length (ft)	-	-	-																
Riffle Slope (ft/ft)	-	-	-																
Pool Length (ft)	-	-	-																
Pool Spacing (ft)	-	-	-																
<b>Additional Reach Parameters</b>																			
Valley Length (ft)	2370	-	-																
Channel Length (ft)	3021	-	-																
Sinuosity	1.3	-	-																
Water Surface Slope (ft/ft)	-	-	-																
BF Slope (ft/ft)	-	-	-																
Rosgen Classification	C	-	-																

Beaverdam Creek, EEP Contract No. D05016-1, River Works, Inc.  
November 2007, Monitoring Year 1 - Draft

Beaverdam Creek Restoration Site : Project No. D05016-1																				
Reach: Beaverdam Creek UT1 (Reaches 2-5) cont'd																				
I. Cross-Section Parameters	Cross Section 13 Pool					Cross Section 14 Riffle					Cross Section 15 Riffle					Cross Section 16 Pool				
	MY1	MY2	MY3	MY4	MY5	MY1	MY2	MY3	MY4	MY5	MY1	MY2	MY3	MY4	MY5	MY1	MY2	MY3	MY4	MY5
<b>Dimension</b>																				
BF Width (ft)	30.0					19.1					26.9					20.9				
Floodprone Width (ft)	90.9					75.2					77.9					52.1				
BF Cross Sectional Area (ft <sup>2</sup> )	71.7					37.9					59.7					36.8				
BF Mean Depth (ft)	2.4					2.0					2.2					1.8				
BF Max Depth (ft)	5.3					3.1					4.1					3.4				
Width/Depth Ratio	12.6					9.6					12.1					11.8				
Entrenchment Ratio	3.0					3.9					2.9					2.5				
Wetted Perimeter (ft)	34.8					23.1					31.3					24.4				
Hydraulic Radius (ft)	101.6					81.4					86.0					59.0				
<b>Substrate</b>																				
d50 (mm)	0.3					30					-					-				
d84 (mm)	0.8					70					-					-				
Reach: Beaverdam Creek UT1 (Reaches 2-5) cont'd																				
I. Cross-Section Parameters	Cross Section 17 Pool					Cross Section 18 Riffle														
	MY1	MY2	MY3	MY4	MY5	MY1	MY2	MY3	MY4	MY5										
<b>Dimension</b>																				
BF Width (ft)	27.0					22.5														
Floodprone Width (ft)	67.2					80.7														
BF Cross Sectional Area (ft <sup>2</sup> )	33.2					34.7														
BF Mean Depth (ft)	1.2					1.5														
BF Max Depth (ft)	2.5					2.7														
Width/Depth Ratio	21.9					14.6														
Entrenchment Ratio	2.5					3.6														
Wetted Perimeter (ft)	29.5					25.6														
Hydraulic Radius (ft)	72.3					86.0														
<b>Substrate</b>																				
d50 (mm)	-					-														
d84 (mm)	-					-														

**Beaverdam Creek Restoration Site : Project No. D05016-1**

**Reach: Beaverdam Creek UT1B**

I. Cross-Section Parameters	Cross Section 3 Pool					Cross Section 4 Riffle									
	MY1	MY2	MY3	MY4	MY5	MY1	MY2	MY3	MY4	MY5					
<b>Dimension</b>															
BF Width (ft)	15.3					11.8									
Floodprone Width (ft)	75.1					75.0									
BF Cross Sectional Area (ft <sup>2</sup> )	16.4					16.5									
BF Mean Depth (ft)	1.1					1.4									
BF Max Depth (ft)	2.3					2.3									
Width/Depth Ratio	14.3					8.5									
Entrenchment Ratio	4.9					6.3									
Wetted Perimeter (ft)	17.5					14.6									
Hydraulic Radius (ft)	0.9					1.1									
<b>Substrate</b>															
d50 (mm)	0.16					<0.063									
d84 (mm)	0.42					0.2									
II. Reachwide Parameters	MY-1 (2006)			MY-2 (2007)			MY-3 (2008)			MY-4 (2009)			MY-5 (2010)		
	Min	Max	Med	Min	Max	Med	Min	Max	Med	Min	Max	Med	Min	Max	Med
<b>Pattern</b>															
Channel Beltwidth (ft)	-	-	-												
Radius of Curvature (ft)	-	-	-												
Meander Wavelength (ft)	-	-	-												
Meander Width Ratio	-	-	-												
<b>Profile</b>															
Riffle length (ft)	-	-	-												
Riffle Slope (ft/ft)	-	-	-												
Pool Length (ft)	-	-	-												
Pool Spacing (ft)	-	-	-												
<b>Additional Reach Parameters</b>															
Valley Length (ft)	680	-	-												
Channel Length (ft)	775	-	-												
Sinuosity	1.1	-	-												
Water Surface Slope (ft/ft)	-	-	-												
BF Slope (ft/ft)	-	-	-												
Rosgen Classification	C	-	-												

Beaverdam Creek Restoration Site : Project No. D05016-1															
Reach: Beaverdam Creek UT1C															
I. Cross-Section Parameters	Cross Section 7 Riffle					Cross Section 8 Pool									
	MY1	MY2	MY3	MY4	MY5	MY1	MY2	MY3	MY4	MY5					
<b>Dimension</b>															
BF Width (ft)	12.0					13.6									
Floodprone Width (ft)	70.6					75.0									
BF Cross Sectional Area (ft <sup>2</sup> )	8.8					31.6									
BF Mean Depth (ft)	0.7					2.3									
BF Max Depth (ft)	1.1					3.2									
Width/Depth Ratio	16.5					5.9									
Entrenchment Ratio	5.9					5.5									
Wetted Perimeter (ft)	13.5					18.2									
Hydraulic Radius (ft)	0.7					1.7									
<b>Substrate</b>															
d50 (mm)	42					<0.063									
d84 (mm)	75					0.23									
II. Reachwide Parameters	MY-1 (2006)			MY-2 (2007)			MY-3 (2008)			MY-4 (2009)			MY-5 (2010)		
	Min	Max	Med	Min	Max	Med	Min	Max	Med	Min	Max	Med	Min	Max	Med
<b>Pattern</b>															
Channel Beltwidth (ft)	-	-	-												
Radius of Curvature (ft)	-	-	-												
Meander Wavelength (ft)	-	-	-												
Meander Width Ratio	-	-	-												
<b>Profile</b>															
Riffle length (ft)	-	-	-												
Riffle Slope (ft/ft)	-	-	-												
Pool Length (ft)	-	-	-												
Pool Spacing (ft)	-	-	-												
<b>Additional Reach Parameters</b>															
Valley Length (ft)	544	-	-												
Channel Length (ft)	615	-	-												
Sinuosity	1.1	-	-												
Water Surface Slope (ft/ft)	-	-	-												
BF Slope (ft/ft)	-	-	-												
Rosgen Classification	C	-	-												

Beaverdam Creek Restoration Site : Project No. D05016-1															
Reach: Beaverdam Creek UT1D															
I. Cross-Section Parameters	Cross Section 11 Pool					Cross Section 12 Riffle									
	MY1	MY2	MY3	MY4	MY5	MY1	MY2	MY3	MY4	MY5					
<b>Dimension</b>															
BF Width (ft)	15.3					12.7									
Floodprone Width (ft)	75.7					75.5									
BF Cross Sectional Area (ft <sup>2</sup> )	20.9					9.2									
BF Mean Depth (ft)	1.4					0.7									
BF Max Depth (ft)	2.5					1.1									
Width/Depth Ratio	11.3					17.5									
Entrenchment Ratio	3.4					6.0									
Wetted Perimeter (ft)	18.0					14.1									
Hydraulic Radius (ft)	1.2					0.7									
<b>Substrate</b>															
d50 (mm)	<0.063					43									
d84 (mm)	0.22					85									
II. Reachwide Parameters	MY-1 (2006)			MY-2 (2007)			MY-3 (2008)			MY-4 (2009)			MY-5 (2010)		
	Min	Max	Med	Min	Max	Med	Min	Max	Med	Min	Max	Med	Min	Max	Med
<b>Pattern</b>															
Channel Beltwidth (ft)	-	-	-												
Radius of Curvature (ft)	-	-	-												
Meander Wavelength (ft)	-	-	-												
Meander Width Ratio	-	-	-												
<b>Profile</b>															
Riffle length (ft)	-	-	-												
Riffle Slope (ft/ft)	-	-	-												
Pool Length (ft)	-	-	-												
Pool Spacing (ft)	-	-	-												
<b>Additional Reach Parameters</b>															
Valley Length (ft)	300	-	-												
Channel Length (ft)	334	-	-												
Sinuosity	1.1	-	-												
Water Surface Slope (ft/ft)	-	-	-												
BF Slope (ft/ft)	-	-	-												
Rosgen Classification	C	-	-												

Beaverdam Creek Restoration Site : Project No. D05016-1															
Reach: Beaverdam Creek UT2A															
I. Cross-Section Parameters	Cross Section 1 Riffle					Cross Section 2 Pool									
	MY1	MY2	MY3	MY4	MY5	MY1	MY2	MY3	MY4	MY5					
<b>Dimension</b>															
BF Width (ft)	12.2					20.1									
Floodprone Width (ft)	39.8					40.0									
BF Cross Sectional Area (ft <sup>2</sup> )	9.6					20.4									
BF Mean Depth (ft)	0.8					1.0									
BF Max Depth (ft)	1.1					1.9									
Width/Depth Ratio	15.5					19.8									
Entrenchment Ratio	3.3					2.0									
Wetted Perimeter (ft)	13.7					22.1									
Hydraulic Radius (ft)	0.7					0.9									
<b>Substrate</b>															
d50 (mm)	35					<0.063									
d84 (mm)	53					<0.063									
II. Reachwide Parameters	MY-1 (2006)			MY-2 (2007)			MY-3 (2008)			MY-4 (2009)			MY-5 (2010)		
	Min	Max	Med	Min	Max	Med	Min	Max	Med	Min	Max	Med	Min	Max	Med
<b>Pattern</b>															
Channel Beltwidth (ft)	-	-	-												
Radius of Curvature (ft)	-	-	-												
Meander Wavelength (ft)	-	-	-												
Meander Width Ratio	-	-	-												
<b>Profile</b>															
Riffle length (ft)	-	-	-												
Riffle Slope (ft/ft)	-	-	-												
Pool Length (ft)	-	-	-												
Pool Spacing (ft)	-	-	-												
<b>Additional Reach Parameters</b>															
Valley Length (ft)	920	-	-												
Channel Length (ft)	1121	-	-												
Sinuosity	1.2	-	-												
Water Surface Slope (ft/ft)	-	-	-												
BF Slope (ft/ft)	-	-	-												
Rosgen Classification	C	-	-												

Beaverdam Creek Restoration Site : Project No. D05016-1																				
Reach: Beaverdam Creek UT2																				
I. Cross-Section Parameters	Cross Section 3 Riffle					Cross Section 4 Pool					Cross Section 5 Riffle					Cross Section 6 Pool				
	MY1	MY2	MY3	MY4	MY5	MY1	MY2	MY3	MY4	MY5	MY1	MY2	MY3	MY4	MY5	MY1	MY2	MY3	MY4	MY5
<b>Dimension</b>																				
BF Width (ft)	16.1					20.9					16.6					14.0				
Floodprone Width (ft)	40.0					40.1					39.9					28.0				
BF Cross Sectional Area (ft <sup>2</sup> )	10.9					25.8					22.6					23.2				
BF Mean Depth (ft)	0.7					1.2					1.4					1.7				
BF Max Depth (ft)	1.1					2.5					1.9					2.6				
Width/Depth Ratio	23.9					16.9					12.2					8.5				
Entrenchment Ratio	2.5					1.9					2.4					2.0				
Wetted Perimeter (ft)	17.5					23.4					19.4					17.3				
Hydraulic Radius (ft)	0.6					1.1					1.2					1.3				
<b>Substrate</b>																				
d50 (mm)	39					<0.063					38					<0.063				
d84 (mm)	59					<0.063					59					<0.063				
II. Reachwide Parameters	MY-1 (2006)			MY-2 (2007)			MY-3 (2008)			MY-4 (2009)			MY-5 (2010)							
	Min	Max	Med	Min	Max	Med	Min	Max	Med	Min	Max	Med	Min	Max	Med					
<b>Pattern</b>																				
Channel Beltwidth (ft)	-	-	-																	
Radius of Curvature (ft)	-	-	-																	
Meander Wavelength (ft)	-	-	-																	
Meander Width Ratio	-	-	-																	
<b>Profile</b>																				
Riffle length (ft)	-	-	-																	
Riffle Slope (ft/ft)	-	-	-																	
Pool Length (ft)	-	-	-																	
Pool Spacing (ft)	-	-	-																	
<b>Additional Reach Parameters</b>																				
Valley Length (ft)	2470	-	-																	
Channel Length (ft)	3142	-	-																	
Sinuosity	1.3	-	-																	
Water Surface Slope (ft/ft)	-	-	-																	
BF Slope (ft/ft)	-	-	-																	
Rosgen Classification	C	-	-																	