

# Unnamed Tributary to Billy's Creek Stream Restoration

Franklin County, North Carolina  
Cataloging Unit 03020101  
State Construction Office Number 010559801  
North Carolina Ecosystem Enhancement Program Number 36

## **FINAL** **Mitigation As-Built Report (Baseline Monitoring)**



Prepared For:  
North Carolina Department of Environment and Natural Resources  
North Carolina Ecosystem Enhancement Program  
1652 Mail Service Center  
Raleigh, NC 27699-1652



April 2006

# Unnamed Tributary to Billy's Creek Stream Restoration

Franklin County, North Carolina

## **FINAL** **Mitigation As-Built Report (Baseline Monitoring)**

Prepared by:



URS Corporation – North Carolina  
1600 Perimeter Park Drive  
Suite 400  
Morrisville, North Carolina 27560  
(919) 461-1100  
Fax (919) 461-1415

Project Manager:  
Kathleen M McKeithan, PE, CPESC, CPSWQ  
(919) 461-1597  
Kathleen\_Mckeithan@urscorp.com

April 28, 2006

---

## EXECUTIVE SUMMARY

The unnamed tributary to Billy's Creek project reach drains approximately 143 acres within the Tar River Basin. The project reach is constrained on the north and south by culverts for unpaved farm road crossings and is approximately 300 feet upstream of the confluence with Billy's Creek.

The pre-construction conditions consist of a 1,878 linear foot section of degraded, perennial channel and several ditch-like tributaries entering. The upstream portions of the restoration reach retained an active floodplain area, whereas the downstream portions were severely incised (4 to 6 feet). Prior to restoration, the restoration reach was a G5c stream with a small section of E5 according to the Rosgen stream classification system. Another unnamed tributary to Billy's Creek upstream of the Project Study Area was used as the reference reach for this project. The reference reach is a first-order, perennial type E5 stream. The proposed stream classification for the project reach was a meandering E5 channel. Priority 1 restoration (returning the channel to an elevation such that the historic floodplain is utilized for above bankfull flows) and Priority 2 restoration (constructing a floodplain at the channel's existing elevation) was proposed for this project; however, the final design was able to complete the entire project as a Priority 1 system. The restored channel measures 2,101 linear feet.

Approximately 2.6 acres of buffer was planted along the restored stream channel. A 6.2-acre Conservation Easement has been established on the site.

Environmental components monitored in this report are those that allow an evaluation of channel stability and riparian vegetation survivability. Specifically, the success of channel modification, erosion control, seeding, and woody vegetation plantings will be evaluated. This will be accomplished through the following activities for five years after construction.

- Permanent Cross Section Establishment: Four cross sections (2 riffle, 2 pool) will be monitored for five years.
- Longitudinal Profile: A longitudinal profile will be performed after construction, after the first year, and then every two years until the monitoring period has ended.
- Bed Material Analysis: Pebble counts will be performed each year at the location of the permanent cross sections.
- Permanent Photo Reference Points: Permanent reference photo points have been established for each cross section and each vegetation plot.
- Vegetation Plots: Five vegetation plots have been established within the planted area along the stream.

URS will assess the condition of the stream, structures, vegetation, and bank stability during the first year of monitoring. Remedial actions will be performed, if necessary. NCEEP will oversee monitoring for subsequent years to provide five years of monitoring.

# TABLE OF CONTENTS

---

**TABLE OF CONTENTS**

**EXECUTIVE SUMMARY ..... i**

**TABLE OF CONTENTS ..... ii**

**1.0 INTRODUCTION..... 1**

    1.1 Project Goals and Objectives ..... 1

    1.2 Project Location..... 1

**2.0 SUMMARY..... 2**

    2.1 Project Description and Watershed ..... 2

    2.2 Methodology ..... 3

    2.3 Plan View ..... 3

    2.4 Points of Contact..... 4

**3.0 SUCCESS CRITERIA ..... 6**

    3.1 Dimension ..... 6

    3.2 Pattern and Profile..... 6

    3.3 Bed Material Analysis..... 6

    3.4 Photo Reference Sites ..... 7

    3.5 Vegetation Plots ..... 7

**4.0 MONITORING SCHEDULE AND METHODS ..... 8**

**5.0 MITIGATION ..... 9**

    5.1 Mitigation Proposal..... 9

    5.2 Design Summary..... 9

    5.3 Mitigation Credit ..... 9

**6.0 MAINTENANCE AND CONTINGENCY PLANS ..... 10**

**7.0 REFERENCE ..... 11**

**FIGURES**

- Figure 1. Vicinity Map
- Figure 2. Location Map
- Figure 3. Watershed Area
- Figure 4. Land Use
- Figure 5. Cross Section and Vegetation Plot Locations

**APPENDICES**

- Appendix A. As-Built Plan View
- Appendix B. GPS Coordinates
- Appendix C. As-Built Longitudinal Profile and Cross Sections
- Appendix D. Pebble Count Data
- Appendix E. Reference Photos
- Appendix F. Vegetation Data

---

## 1.0 INTRODUCTION

### 1.1 Project Goals and Objectives

The goals and objectives for the Unnamed Tributary to Billy's Creek Stream Restoration Project are to:

1. Restore the project reach to a more natural dimension, pattern and profile so that the stream will be able to efficiently transport water and sediment loads provided by the watershed;
2. Reconnect the project reach's channel to its historic floodplain where feasible;
3. Eliminate the excessive sediment contribution to the system by the mass wasting and erosion of the stream banks along the reach; and
4. Repair and restore the riparian corridor along the project reach in order to improve habitat and protect the stream from further erosion.

### 1.2 Project Location

The section of stream channel included in this restoration project is located south of Montgomery Road (SR 1210), approximately three miles east of US 1 to the northeast of Franklinton in Franklin County (Figure 1 Vicinity Map). The restoration reach lies on property privately held by the Grove family. The restoration reach flows from the north to the south through pastured fields and is defined by unpaved farm roads at each end (Figure 2 Location Map). The restoration reach flows approximately 1,900 feet from the northern property line to the fence line near the southern border of the property.

---

## 2.0 SUMMARY

### 2.1 Project Description and Watershed

The project reach lies within the Tar River Basin, in Cataloging Unit 03020101. The drainage area for the tributary to Billy's Creek is approximately 143 acres (0.22 square miles) (Figure 3 Watershed Area). A ridge approximately 800 feet north of Montgomery Road forms the northern boundary of the project watershed. Montgomery Road runs east-west through the northern third of the watershed. The watershed can be roughly divided in half by the unpaved farm road that crosses east-west at the northern end of the restoration reach. Ridges from the northernmost point form the watershed's western and eastern edges as they slope down towards Billy's Creek. The southern end of project watershed is at the point where an unpaved farm road crosses the restoration reach approximately 300 feet upstream of the confluence with Billy's Creek.

Land use within the watershed is dominated by agriculture, open space/forest, and low density residential areas. The majority of the agricultural lands are used for cattle pasture. Transportation corridors and high density residential areas are also present (Figure 4 Land Use). The entire Project Study Area is zoned as an Agricultural-Residential District. This zoning designation permits a mixture of agricultural, forestry, conservation, and very low-density residential uses with few public services.

Pre-construction conditions of the unnamed tributary to Billy's Creek project reach included a 1,878 linear foot section of degraded, perennial channel and several ditch-like tributaries. The upstream portions of the restoration reach retained an active floodplain area, whereas the downstream portions were severely incised (4 to 6 feet). Prior to restoration, the restoration reach was a G5c stream with a small section of E5 according to the Rosgen stream classification system (Rosgen 1996). The width-to-depth ratio of the stream ranged from 5.2 to 10.4. The entrenchment ratio ranged from 1.3 to 2.9 with a 1.5 percent slope in the G5c section, and a 0.6 percent slope in the E section. Sinuosity was 1.1 in the G5c section and 1.3 in the E section. A Priority 1 restoration was proposed for this project. The proposed stream classification was an E5 channel. The Restoration Plan called for raising the new channel to meet the existing floodplain where feasible and removing the drainage ditches within the pasture, thus allowing the floodplain to function as it has historically. In areas where returning the restoration reach to its original floodplain was not sure to be possible, a Priority 2 restoration was proposed; however, the final design was able to utilize a Priority 1 restoration (Rosgen 1996). The constraints associated with this stream restoration project included two culvert crossings under unpaved agricultural roads at construction limits.

Another unnamed tributary to Billy's Creek upstream of the Project Study Area was used as the reference reach for this project. The reference reach is a first order, perennial type E5 stream.

Approximately 2.6 acres of buffer was planted along the restored stream channel. A 6.2-acre Conservation Easement has been established on the site.

Construction began on March 16, 2005 and ended on June 8, 2005. Planting began December 6, 2005 and ended December 19, 2005. Upon completion, the restoration reach measured approximately 2,101 linear feet.

---

For a complete description of the existing conditions prior to construction, see the Billy's Creek Stream Restoration Plan designed by URS – North Carolina (URS) in August 2003.

## 2.2 Methodology

Natural channel design methodology was used while considering watershed and site conditions for the restoration reach to provide the highest level of stability post-construction. Information was collected on existing conditions, reference conditions, and proposed conditions for the stream restoration. The design was intended to transform the G5c/E5 stream to an E5 channel at its completion. Pattern, dimension, and profile were designed to provide the highest level of restoration considering site constraints. The design was developed based upon reference data for the stream type, watershed, and location. The restoration parameters were developed using reference data and hydraulic geometry relationships.

As a guide for taking existing conditions surveys, *The Stream Channel Reference Sites: An Illustrated Guide to Field Technique*, US Forest Service General Technical Report RM-245 (Harrelson et al 1994) and *Applied River Morphology* (Rosgen 1996) were used as references to classify the stream and reference reaches. The existing conditions of the surrounding area were first observed and recorded in order to understand what was occurring within the system and why. The field data collected were used to determine width-to-depth ratio, entrenchment ratio, slope, sinuosity, sediment transport analysis, and dominant type of channel material for the existing conditions and reference reaches. This enabled the development of a plan, which focuses on the restoration of the entire system. The plan included the restored channel morphology design, structure design and placement, streambank stabilization measures, and erosion and sediment control plan.

URS provided bid administration assistance to the North Carolina Ecosystem Enhancement Program (NCEEP) and conducted construction management and oversight for the duration of the restoration. McQueen Construction, Inc. completed the construction of the stream. Chas H. Sells Inc. & Surveying, PA, under contract with URS provided the As-Built survey for the project.

## 2.3 Plan View

As-Built plan sheets are included in Appendix A.



---

## 2.4 Points of Contact

### Owner:

NCEEP  
Point of Contact – Jeff Schaffer  
1652 Mail Service Center  
Raleigh, NC 27604  
(919) 715-1952  
Fax (919) 715-2001  
[Jeff.Schaffer@ncmail.net](mailto:Jeff.Schaffer@ncmail.net)

### Design Firm:

URS  
Point of Contact – Kathleen McKeithan  
1600 Perimeter Park Drive  
Suite 400  
Morrisville, NC 27560  
(919) 461-1597  
Fax (919) 461-1415  
[kathleen\\_mckeithan@urscorp.com](mailto:kathleen_mckeithan@urscorp.com)

Chas H. Sells Inc. & Surveying, PA  
Point of Contact – David Brubaker, PLS  
15300 Weston Parkway, Suite 106  
Cary, NC 27513  
(919) 678-0035  
Mobile (919) 524-9485

### Construction Firm:

McQueen Construction Inc.  
Point of Contact – Harvey McQueen  
619 Patrick Road  
Bahama, NC 27503  
(919) 479-4766  
Fax (919) 479-0213

### Subcontractors and Material Suppliers as supplied by Construction Firm:

Niall Gillespie, RLS  
1801 White Oak Church Road  
Apex, NC 27523

Louisburg Lawn  
289 Stone-Southerland Road  
Louisburg, NC 27549

Guins Excavating Services  
2321 Eagle Rock Road  
Wendell, NC 27591

Erosion Control Solutions  
5508 Peakton Road  
Raleigh, NC 27604

CFP, Inc.  
PO Box 38327  
Charlotte, NC 28278

Martin Marietta  
PO Box 75328  
Charlotte, NC 28275

Carolina Sunrock  
PO Box 30727  
Charlotte, NC 28230-0727

Fluvial Solutions  
3719 Benson Drive  
Raleigh, NC 27609

Hanson Aggregates  
PO Box 777-W2390  
Philadelphia, PA 19175-2390

Hertz Corporation  
PO Box 26390  
Oklahoma, OK 73126-6390

---

Wheat Swamp Landscape  
4675 Ben Call Road  
LaGrange, NC 28551

Carolina Environmental  
Point of Contact – Joanne Chetham  
PO Box 1905  
Mt. Airy, NC 27030  
(336) 320-3849

---

## 3.0 SUCCESS CRITERIA

Environmental components monitored in this report are those that allow an evaluation of channel stability and riparian vegetation survivability. Specifically, the success of channel modification, erosion control, seeding, and woody vegetation plantings will be evaluated. The following elements will be monitored for five years after construction: dimension, pattern and profile, bed material, photo reference sites, and vegetation plots.

### 3.1 Dimension

Per the October 16, 2003 Scope of Services for Tributary to Billy's Creek between URS and the Wetland Restoration Program (now represented by NCEEP), four permanent cross sections were established at intervals no greater than 500 feet. Two cross sections were established in pools and two in riffles. Each cross section was marked with rebar at the edge of the flood-prone zone on both sides of the channel. A 10-foot length of polyvinyl chloride (PVC) pipe was placed over the rebar on the left bank at each cross section. The pipes are flagged with orange tape. Global Positioning System (GPS) coordinates were collected for each cross section on the left bank. GPS coordinates are located in Appendix B. Permanent cross section locations are shown on the As-Built survey. A common benchmark was used for cross sections to facilitate easy comparison of year-to-year data. The annual cross section survey includes points measured at all breaks in slope, including top of bank, bankfull, and thalweg. Riffle cross sections will be classified using the Rosgen stream classification system.

Success Criteria: It is anticipated that there should be little or no change in cross sections from year-to-year. Changes in dimension should be evaluated to determine if there is potential for the stream to move toward an unstable condition. In some cases such variability may represent an increase in stream stability.

### 3.2 Pattern and Profile

At the completion of construction, a longitudinal profile was completed as part of the As-Built survey. A longitudinal profile will be completed during each subsequent year of monitoring. Measurements were taken beginning at the head of stream features such as riffle, run, glide, and the maximum pool depth. A permanent benchmark was used for the survey. The As-Built longitudinal profile and cross sections are located in Appendix C.

Success Criteria: The longitudinal profiles should show that the bedform features are remaining stable (e.g. they are not aggrading or degrading over the five-year period). Short term aggradation/degradation may occur depending on the peak annual discharge. The gravel bed pools should remain deep with flat-water surface slopes and the riffles should remain steeper and shallower than the pools. Bedform features observed should be consistent with those observed in E type channels. The pattern, sinuosity, and riffle/pool sequence should remain consistent.

### 3.3 Bed Material Analysis

Modified Wolman pebble counts were completed at each permanent cross section. Data are presented in Appendix D.

---

Success Criteria: The pebble counts should show the pools contain a finer material than the riffles, which should show coarsening over the five-year monitoring period. The D50 and D84 will be compared to determine changes in the surface material of the cross section.

### 3.4 Photo Reference Sites

Photographs were taken at the time of the As-Built survey and will be used to evaluate the restoration of the project reach over time. Stations for photographs were located at the permanent cross sections (Figure 5 Cross Section and Vegetation Plot Location). Photographs will be taken at the photograph stations with a digital camera each year during monitoring of the site. All reference photos are located in Appendix E.

Longitudinal Reference Photos: Photographs will be taken looking upstream and downstream at each cross section location (permanent photo station).

Lateral Reference Photos: Reference photos were also taken at each permanent cross section in a lateral direction. Photographs were taken in a manner to show both banks of each cross section. Subsequent photos should be taken in the same location to consistently provide the same view of these sections over time.

Success Criteria: The photograph documentation will be used to provide a visual evaluation of the channel to identify aggradation and degradation, issues with erosion control, and riparian vegetation success. Photos taken over time will provide an indication of the stages of maturation of the riparian vegetation, the formation of bars within the channel, aggradation along the floodplain, or erosion control issues.

### 3.5 Vegetation Plots

Survival of vegetation will be evaluated using survival plots and counts. Per the NCEEP monitoring guidance (NCEEP 2005), five 100-square meter plots were randomly established within the planted area (2.6 acres) along the channel. Rebar was used to mark all four corners of the vegetation plots and the southwest corner of each plot was marked with a 10-foot length of PVC pipe flagged with orange tape. GPS coordinates were obtained for each corner and the approximate bearing of each corner from the southwest corner was determined (Appendix B). A reference photograph was taken from the southwest corner, facing the northeast corner, of each plot.

All quadrats were permanently established in the field and records of sampling locations will be maintained. All planted and transplanted woody vegetation was inventoried. This initial inventory will be used as baseline data for future inventories. As-Built vegetation data are located in Appendix F.

Success Criteria: Evaluation of planted vegetation survival will be measured based upon the survival of 320 stems per acre at the end of three years of monitoring. A tolerance of 10 percent mortality rate will be acceptable for years four and five. The final vegetated success criteria will be survival of 260 trees per acre through year five (USACE *et al.* 2003). In addition, survival percentages will also be monitored on a species by species basis.

---

#### 4.0 MONITORING SCHEDULE AND METHODS

Chas H. Sells Inc. & Surveying, PA conducted the As-Built survey and URS will conduct the first year survey. URS will monitor the site as per the monitoring schedule submitted in this Mitigation Plan. At the end of the first year following construction, URS will conduct a technical assessment of the site (i.e. detailed surveys, stem counts, photographs, pebble counts) and compile the data.

The stability of the stream channel will be monitored approximately six months after restoration is complete or as appropriate following greater than bankfull events. Assessments and measurements taken of the stream channel will focus on lateral (streambank changes), vertical (streambed changes), and overall stability of the stream.

The cross sections will be surveyed each year using a tape and level between the permanent cross section pins. This will include reference photographs taken as outlined in Section 3.4. Pebble counts will also be taken at each cross section.

The longitudinal survey will be completed using a Total Station or laser level for the first year and then every two years for a total of four (As-Built completed in January 2006, monitoring surveys should occur in October of 2006, 2008, and 2010).

The restoration site was inspected during and following completion of the planting to ensure that proper planting methods for spacing, density, and species composition were followed. Vegetation monitoring plots were established and distributed randomly throughout the site. Photo points were established at the southwest corner of each plot and visual observations were recorded (Appendix E).

A quantitative sampling of established vegetation plots will be performed in late summer/early fall (August – November) at the end of the first year of completion and after each growing season for five years of monitoring. These samplings are intended to identify any problem areas early in order to allow for quick remedial measures. Success will be determined based on the survival of planted woody species at the end of a three and five-year period. There should be at least 320 stems per acre through year three and 260 stems per acre through year five (USACE *et al.* 2003). The three-year period is through November 2008 and the five-year period is through November 2010.

Photographs of the site will be taken each year during monitoring. These photos will include those taken at the permanent photo points as identified on the plan view (Appendix A). Photos will be taken at the identified locations each year to provide a visual documentation of the restoration throughout the monitoring period.

URS will use the compiled data to prepare a monitoring report summarizing the results of the first year of restoration. The monitoring report will assess the performance of the project using the success criteria identified in this Mitigation Plan. NCEEP will handle all monitoring activities following the first year's monitoring report in order to fulfill the project's monitoring requirements.

---

## 5.0 MITIGATION

### 5.1 Mitigation Proposal

The proposed mitigation after the completion of the project is 2,101 linear feet of perennial stream restoration credit.

### 5.2 Design Summary

The stream restoration design for the unnamed tributary to Billy's Creek was based on natural channel design methodologies (Rosgen 1996). The design took into account drainage area, adjacent land use, upstream impoundments, and future development potential.

The design creates an improved profile/bedform of the channel by providing defined riffles and pools. The design includes the following parameters: width-to-depth ratio of 10.1, sinuosity of 1.22, radius of curvature ranging from 12.5 to 34.5 (ratio of 1.4 to 3.8), and average slope of 1.19%. Rock vanes and root wads were used to protect the meander bends. Rock step pools were utilized to diffuse energy through riffle sections.

During construction, some aspects of the site grading and drainage plan were modified with the engineer's approval. The typical design of the rock cross vane was modified to include placement of a large flat rock on the downstream side of the headrock to prevent headcutting and potential undermining of the structure. This rock was placed in such position that would not impede the formation and natural fluctuation of the dimension of the scour hole below the vane structure. Also, a drainage swale located between stations 27+00 and 28+00 was originally to have been filled; however, the plans were modified to accommodate the inflow from this drainage feature. The swale at completion of grading enters the project stream at the upstream side of the step-pool structure located at station 27+70.

The streambanks were matted to five feet beyond bankfull. Temporary and permanent seeding was completed once grading ended. Seedlings and live stakes were installed during dormancy in December, 2005.

### 5.3 Mitigation Credit

The mitigation credit proposal will be completed by NCEEP.

---

## 6.0 MAINTENANCE AND CONTINGENCY PLANS

The project site experienced several significant rain events during the construction period resulting in overbank flows. No areas of concern for stream stability were identified following these events or at other points during the construction period.

Prior to construction, the project site was heavily infested with Chinese privet (*Ligustrum sinense*). Eradication methods employed to remove this species from the project site did not include areas adjacent to the project and a seed-bank remains on most of the surrounding land. This species should be expected to recolonize the project site and further control methods may be required.

URS will assess the condition of the stream, structures, vegetation, and bank stability during the first year of monitoring. NCEEP will oversee monitoring for subsequent years to provide five years of monitoring.

---

## 7.0 REFERENCES

Harrelson, C., Rawlins, C.L., and J. Potypondy. 1994. Stream Channel Reference Sites: An Illustrated Guide to Field Technique. US Department of Agriculture, Forest Service. General Technical Report RM-245.

NCEEP. 2005. Content, Format, and Data Requirements for EEP Monitoring Reports. Version 1.1 (9/16/05). NCDENR, NCEEP. 17pp.

Rosgen, D.L. 1996. Applied River Morphology. Wildland Hydrology, Pagosa Springs, CO.

URS Corporation – North Carolina. 2003. Billy's Creek Stream Restoration Plan. August 2003.

USACE, Wilmington District, US Environmental Protection Agency, NC Wildlife Resources Commission, and NC Division of Water Quality. 2003. Stream Mitigation Guidelines. April 2003. 26 pp.



## FIGURES



Figure 1. Vicinity Map



Figure 2. Location Map

Figure 3. Watershed Area

Figure 4. Land Use

Figure 5. Cross Section and Vegetation Plot  
Locations

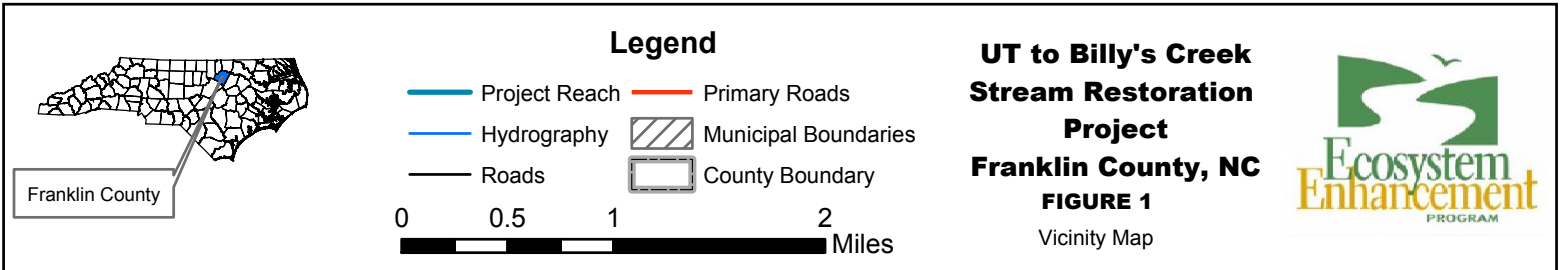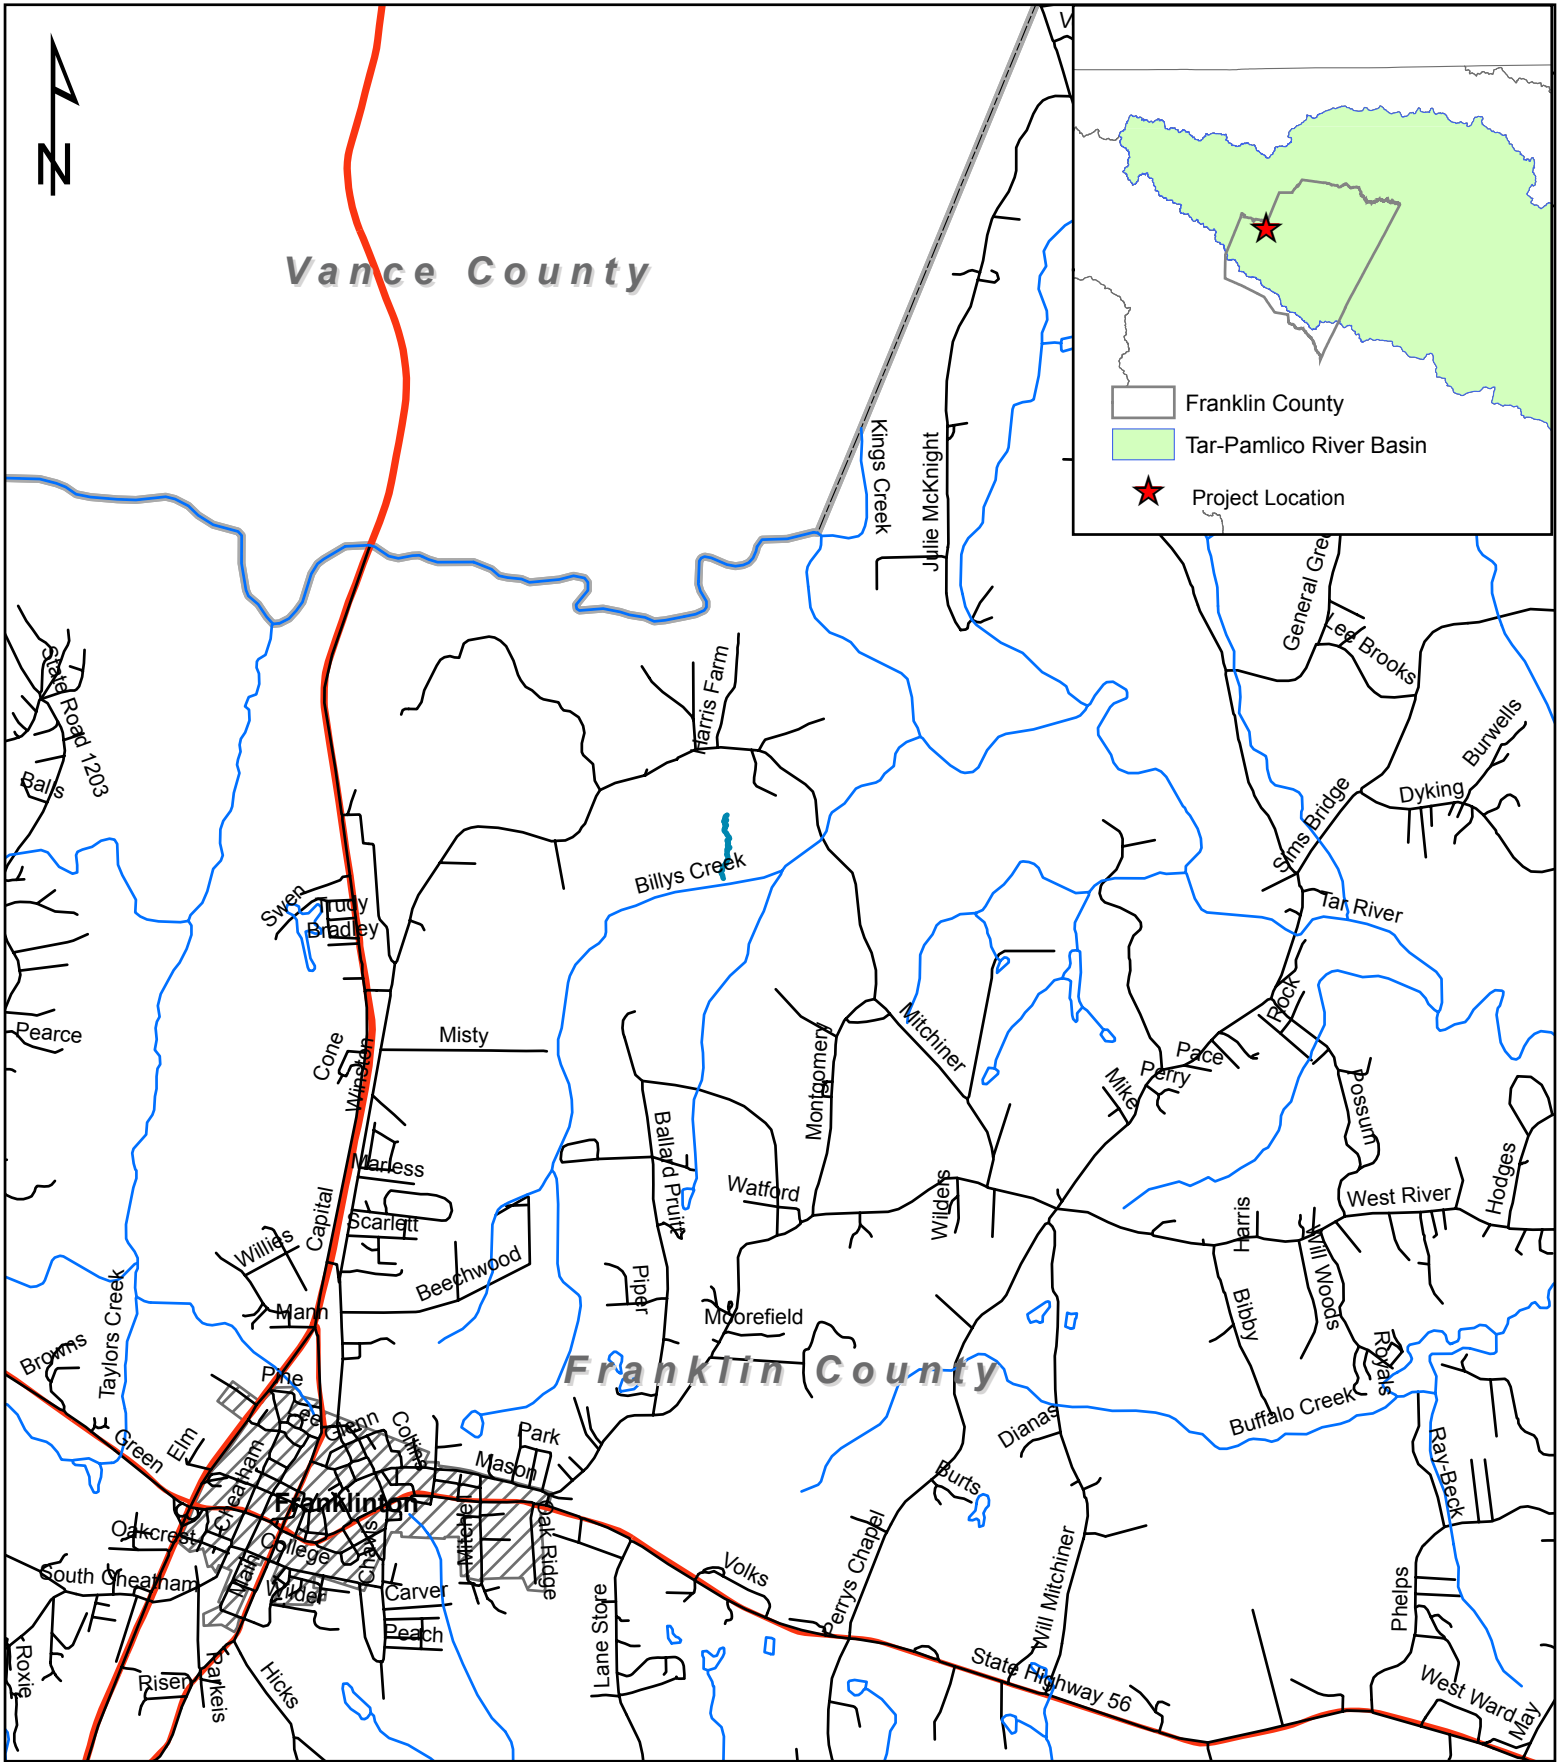

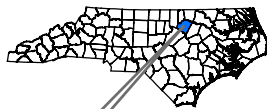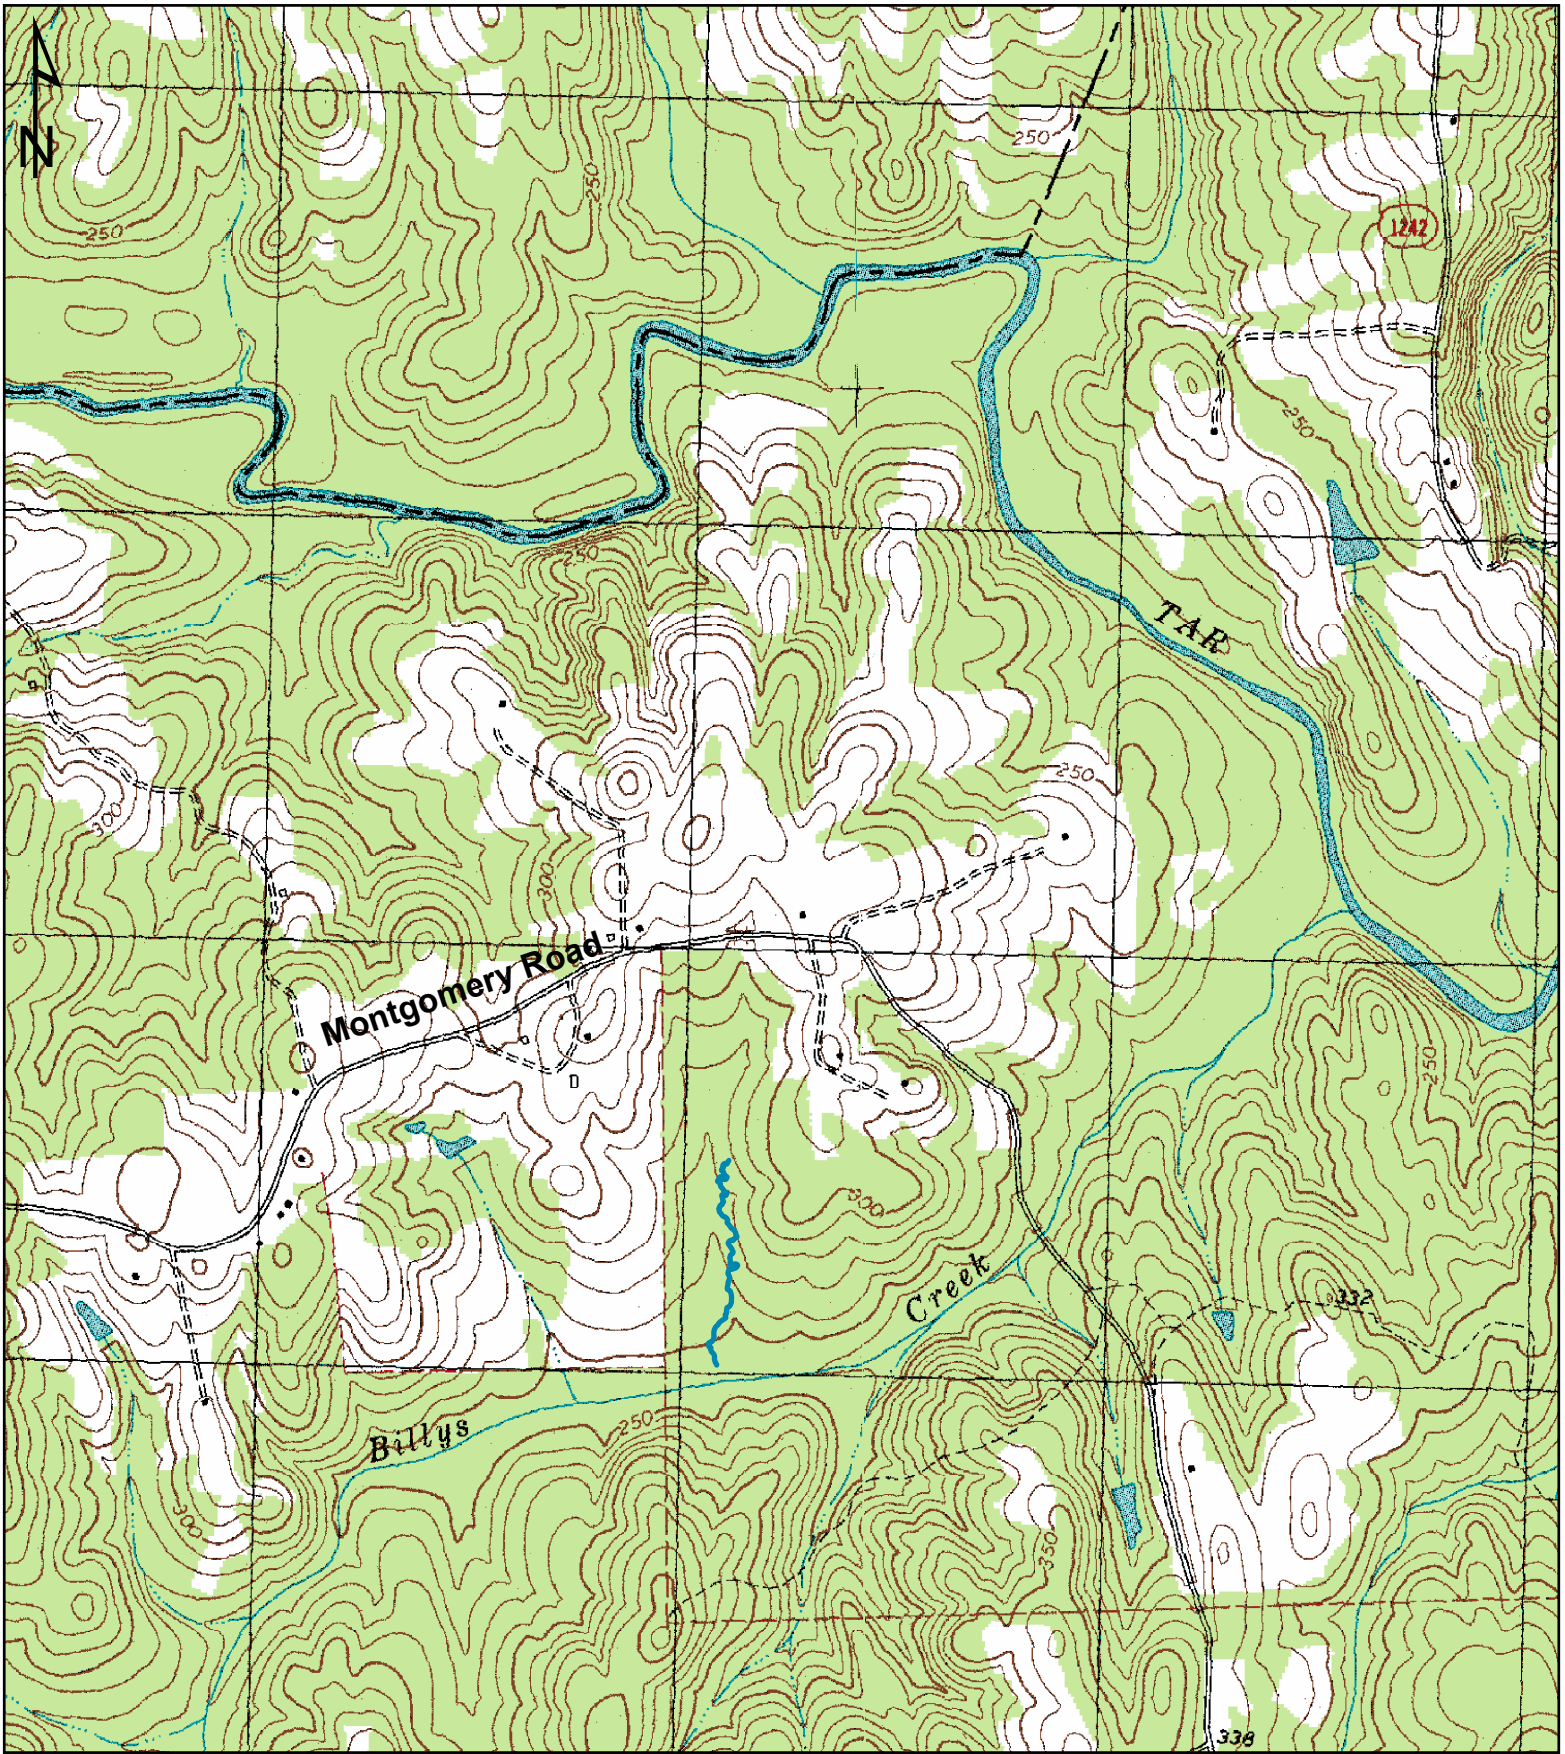


Franklin County

### Legend

 Project Reach

0 750 1,500 3,000 Feet






 

**UT to Billy's Creek  
Stream Restoration  
Project  
Franklin County, NC**

**FIGURE 2**  
Location Map






**Legend**

-  Project Reach
-  Watershed Area
-  Hydrography
-  Roads
-  County Boundary


0 250 500 1,000 1,500 2,000 2,500 Feet

**UT to Billy's Creek  
Stream Restoration  
Project  
Franklin County, NC**



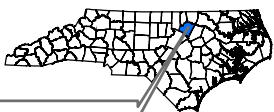



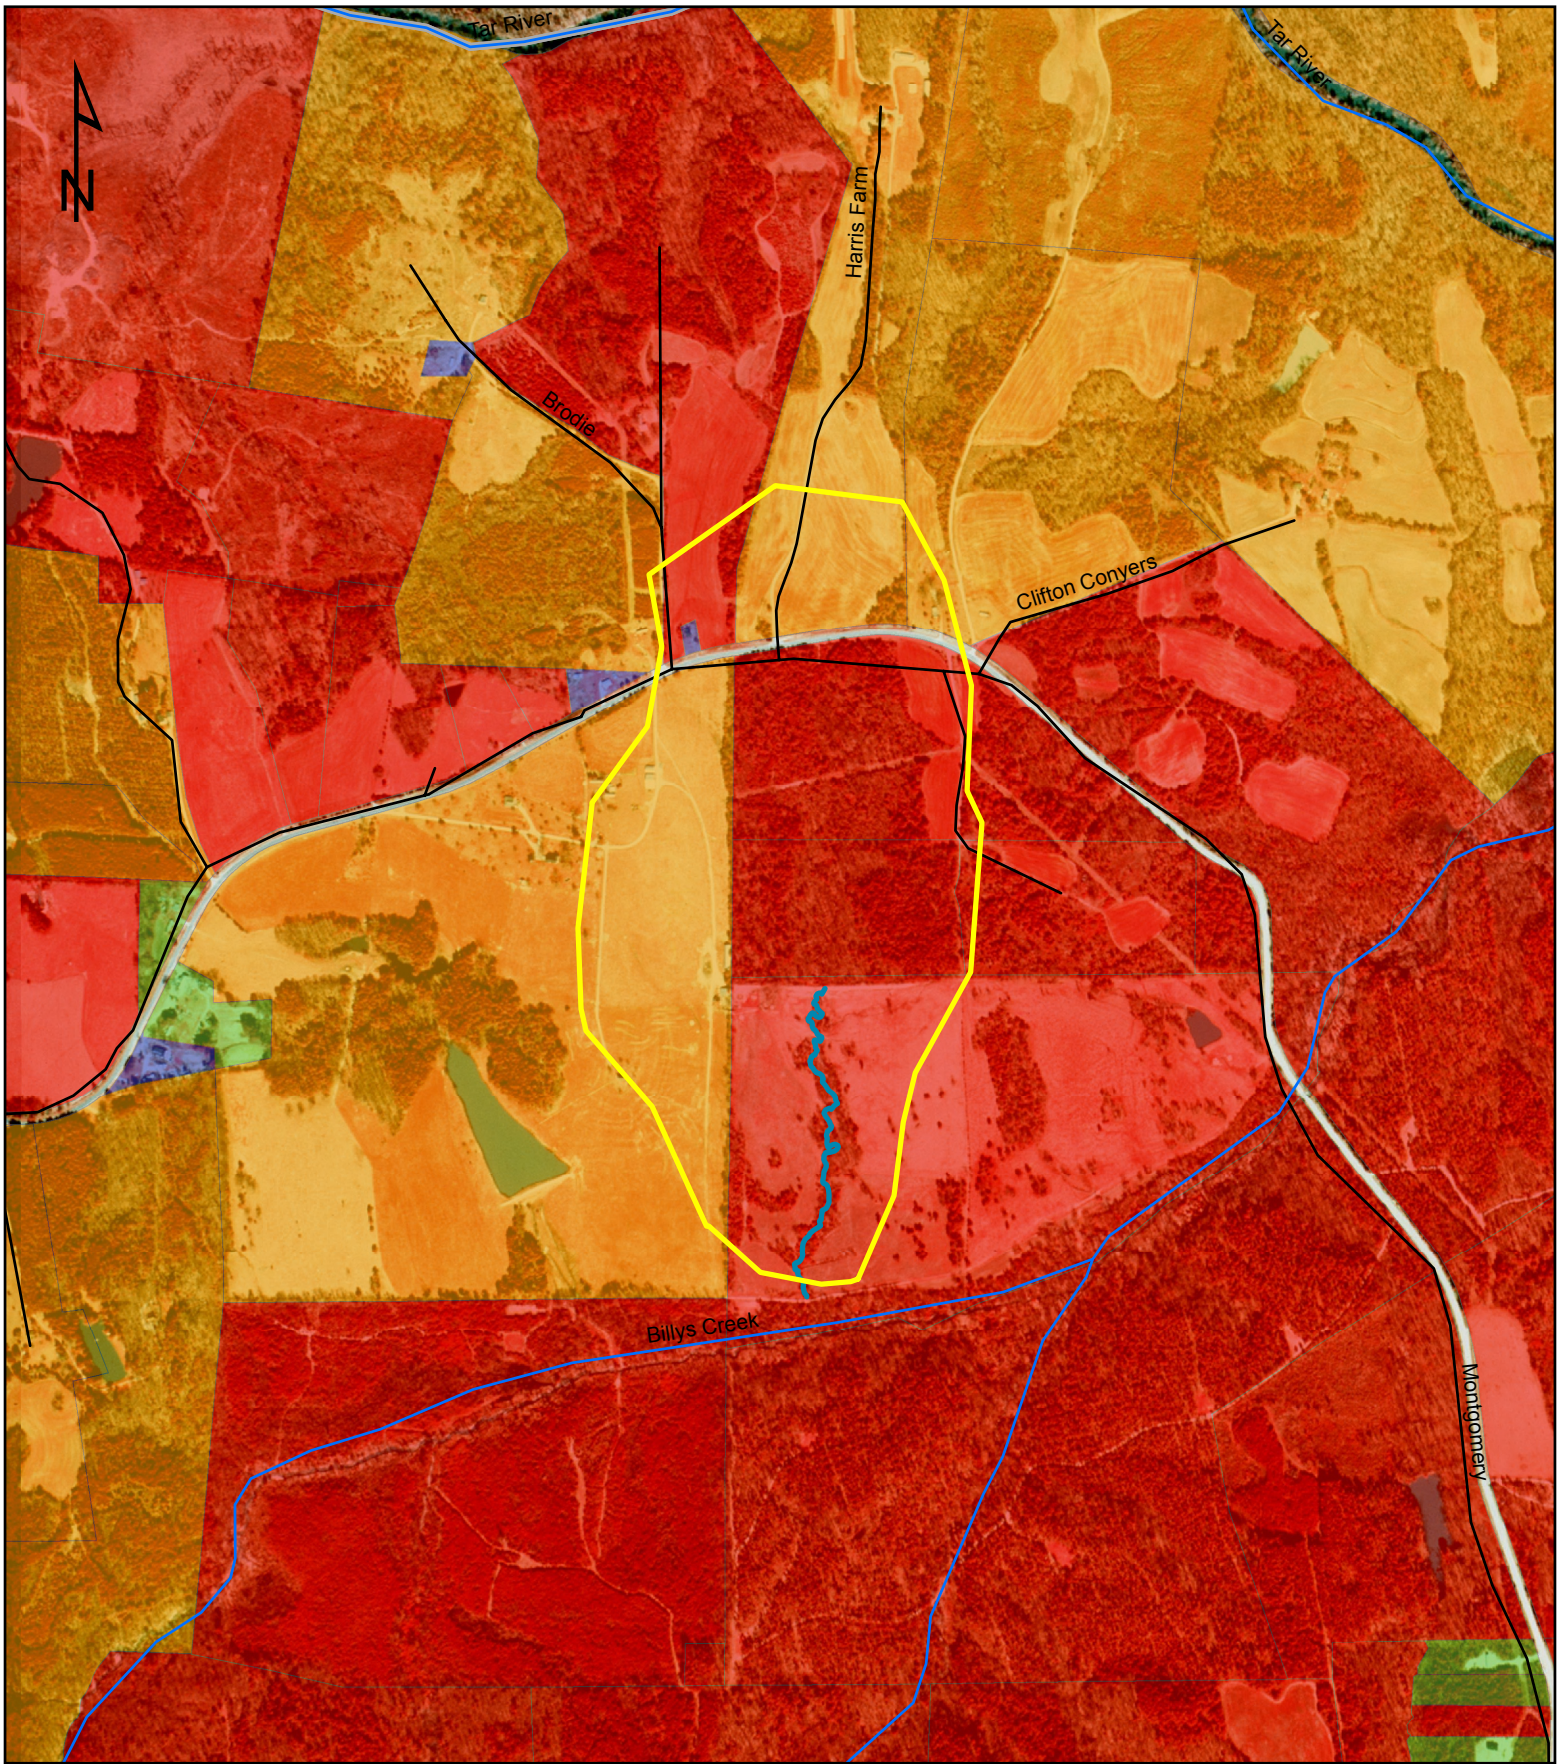


**FIGURE 3**  
Watershed Area



Franklin County





**Legend**



- |   |                 |   |                            |
|---|-----------------|---|----------------------------|
|  | Project Reach   |  | <b>LANDUSE</b>             |
|  | Watershed Area  |  | Agriculture & Open Space   |
|  | Hydrography     |  | High Density Residential   |
|  | Roads           |  | Medium Density Residential |
|  | County Boundary |   | Residential & Agricultural |

**UT to Billy's Creek  
Stream Restoration  
Project  
Franklin County, NC**




**FIGURE 4**  
Land Use

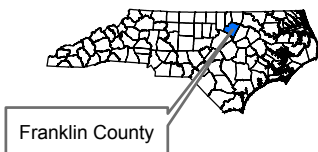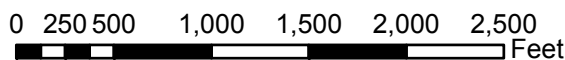

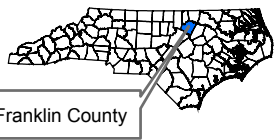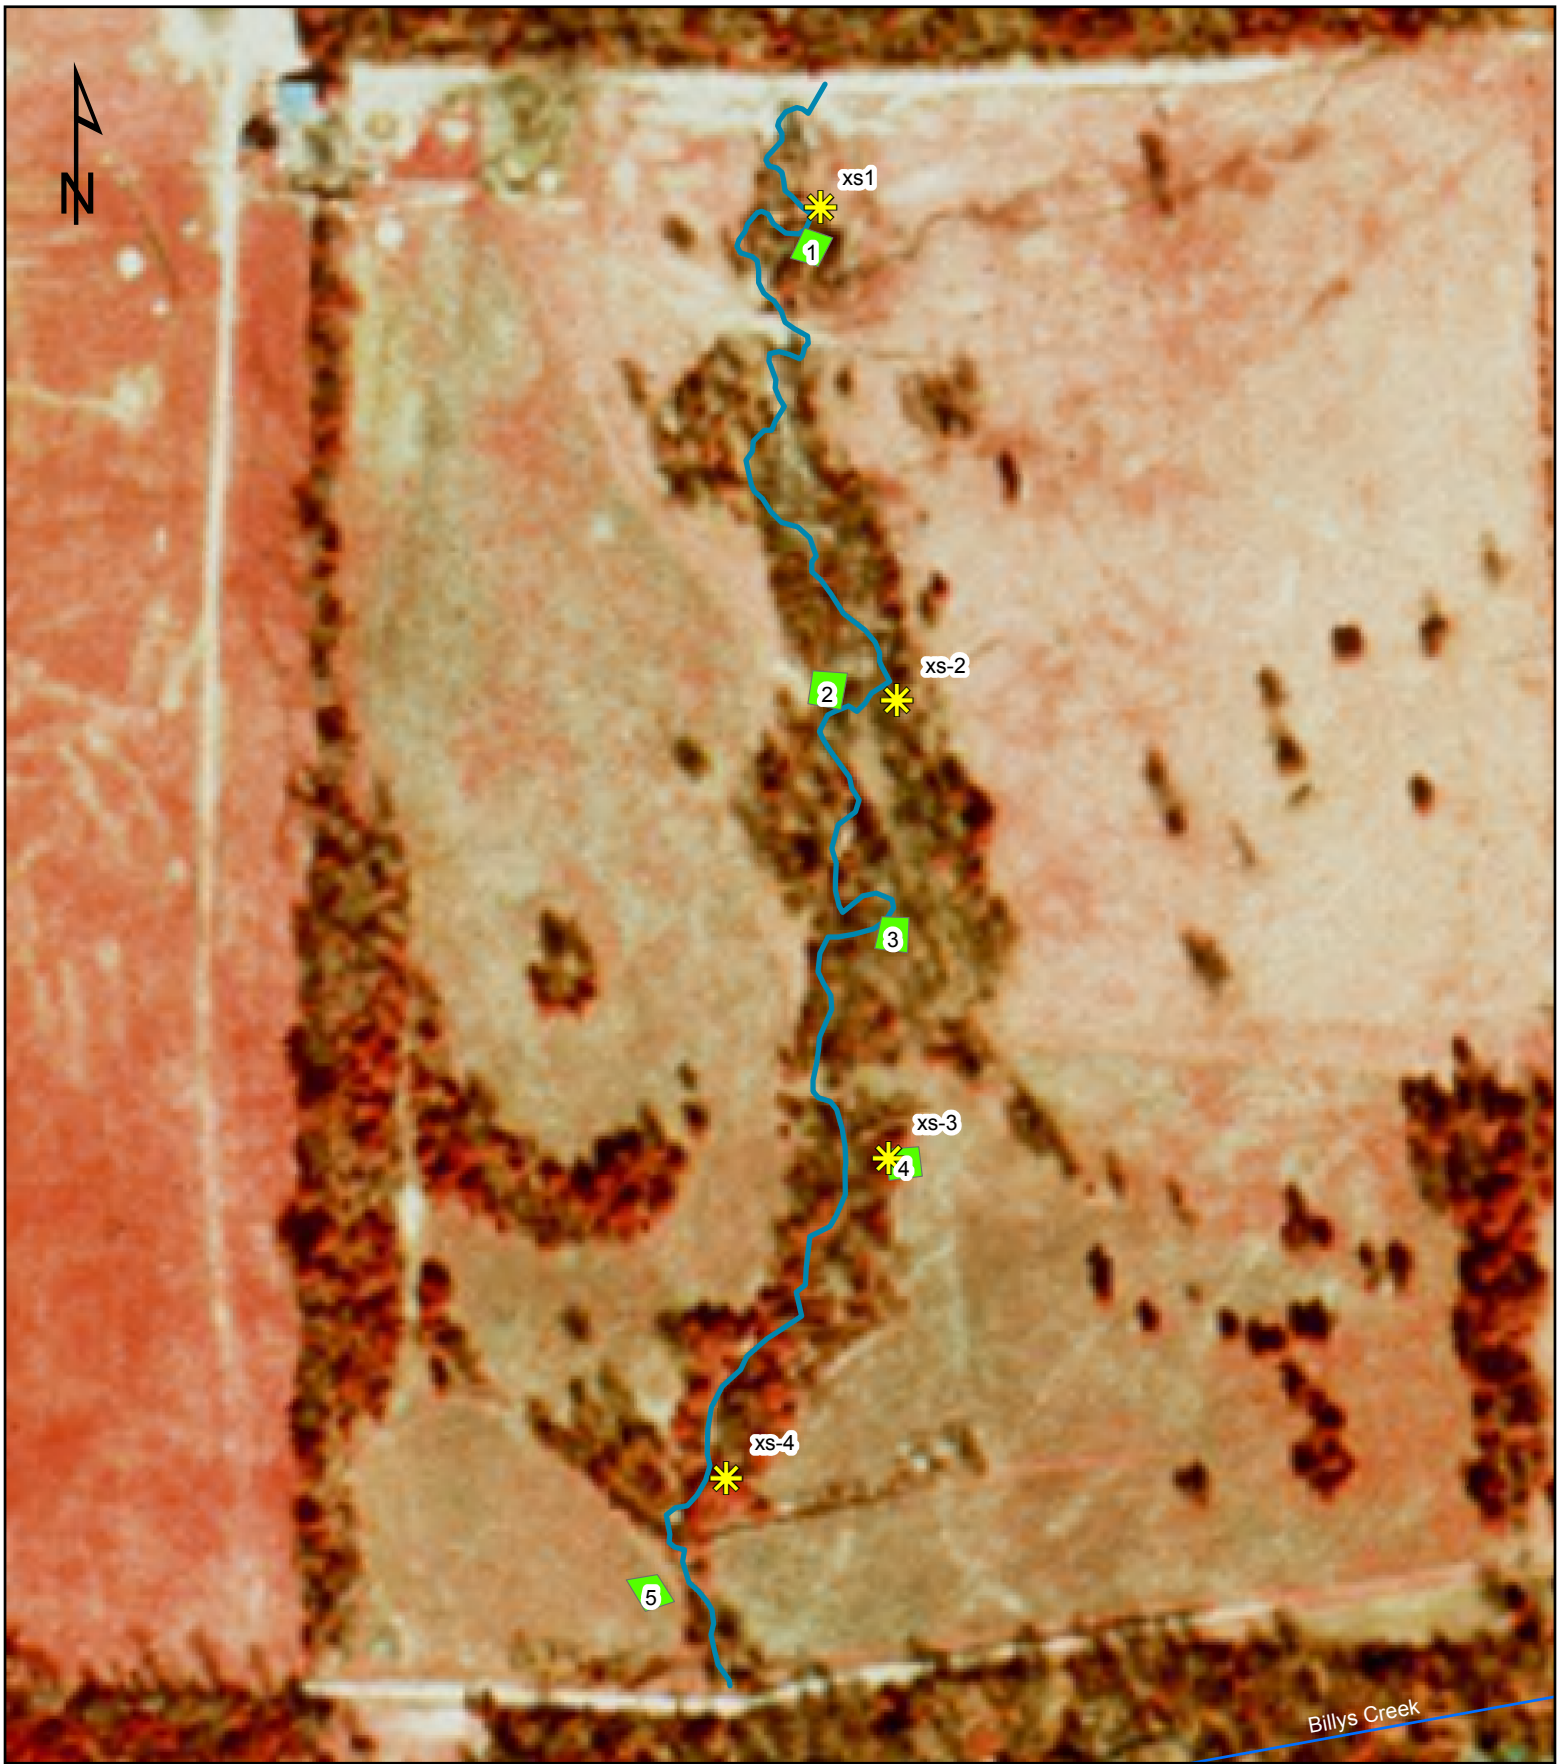

**Legend**

-  Cross Section
-  Vegetation Plots
-  Hydrography
-  Project Reach

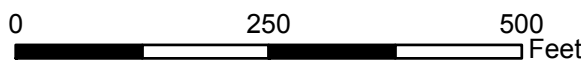

**UT to Billy's Creek  
Stream Restoration  
Project  
Franklin County, NC**

**FIGURE 5**

Cross Section and  
Vegetation Plot Location




# APPENDICES

- APPENDIX A. As-Built Plan View
- APPENDIX B. GPS Coordinates
- APPENDIX C. As-Built Longitudinal Profile and  
Cross Sections
- APPENDIX D. Pebble Count Data
- APPENDIX E. Reference Photos
- APPENDIX F. Vegetation Data

APPENDIX A  
AS-BUILT PLAN VIEW



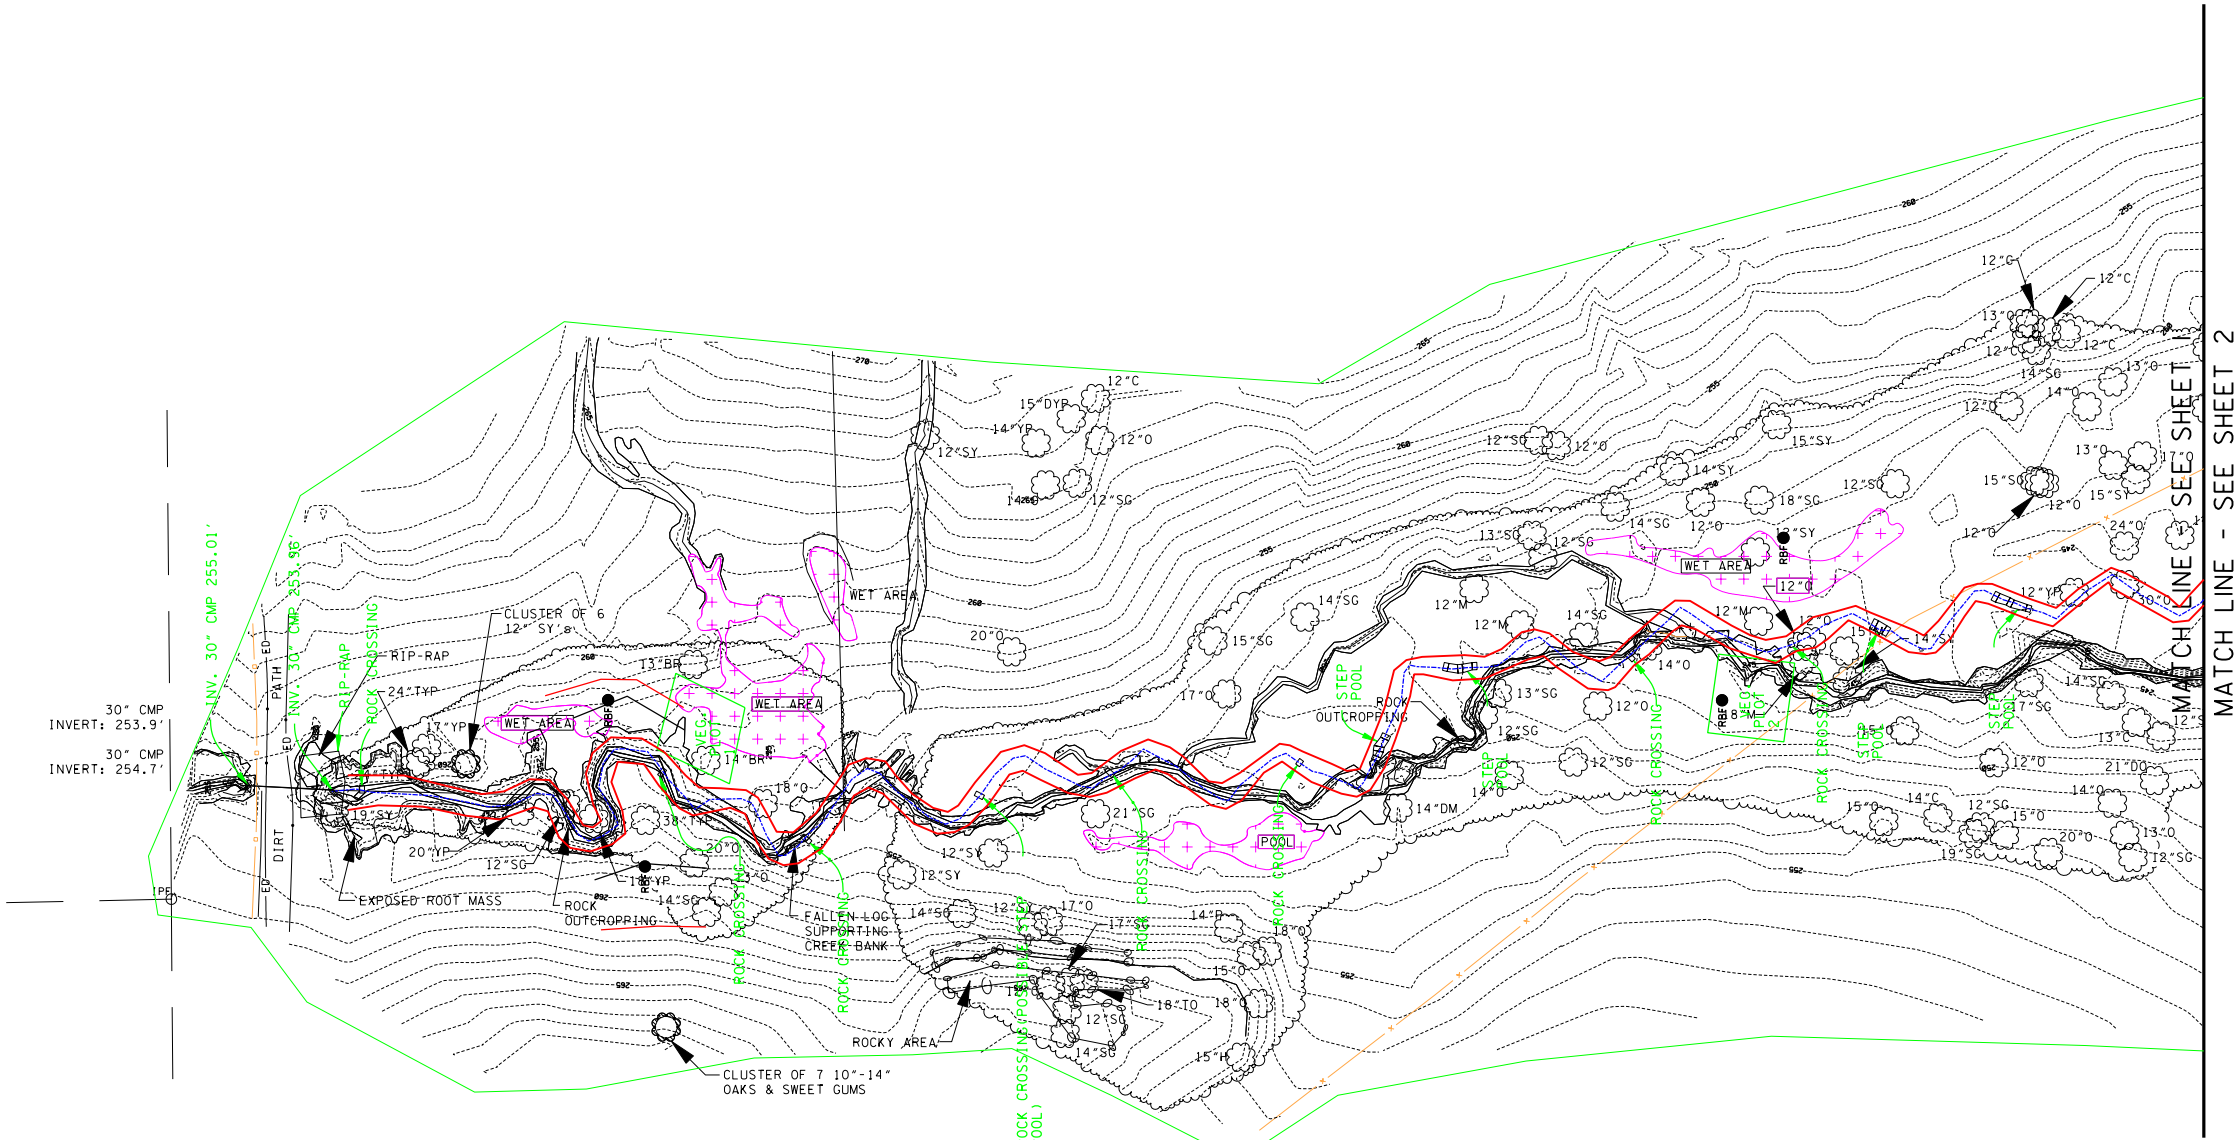


**LEGEND**

- ROCK CROSSING (POSSIBLE STEP POOL)
- STEP POOL
- REBAR PIN FOUND
- VEG. PLOT
- CHANNEL BOUNDARY/BANKFULL
- THALWEG
- EASEMENT BOUNDARY
- FENCING
- TREE LINE
- WET AREA

**TREE CODE TABLE**

BR	BIRCH
C	CEDAR
DM	DOUBLE MAPLE
DO	DOUBLE OAK
DSC	DOUBLE SWEET GUM
H	HICKORY
HW	HAWTHORNE
O	OAK
P	PINE
QO	QUADRUPLE OAK
SG	SWEET GUM
SY	SYCAMORE
TO	TRIPLE OAK
TYP	TRIPLE YELLOW
P	POPLAR
YP	YELLOW POPLAR

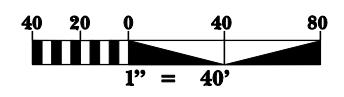

**REVISIONS**

NO.	DATE

Prepared by  
**URS**  
 URS Corporation - North Carolina  
 1600 Perimeter Park Drive  
 Morrisville, North Carolina 27560  
 TELEPHONE (919) 465-1100 FAX (919) 465-1415


PROJECT: UT TO BILLY'S CREEK  
 STREAM RESTORATION  
 FRANKLIN COUNTY  
 TITLE:

CLIENT: NORTH CAROLINA DEPARTMENT  
 OF ENVIRONMENT AND  
 NATURAL RESOURCES



DATE: JAN 2006  
 TECHNICIAN: EHJ  
 CHECKED BY: KM  
 MONITORING  
 YEAR 0  
 SCO I.D.#  
 O10559801  
 SHEET NO.  
 I

MATCH LINE - SEE SHEET 1

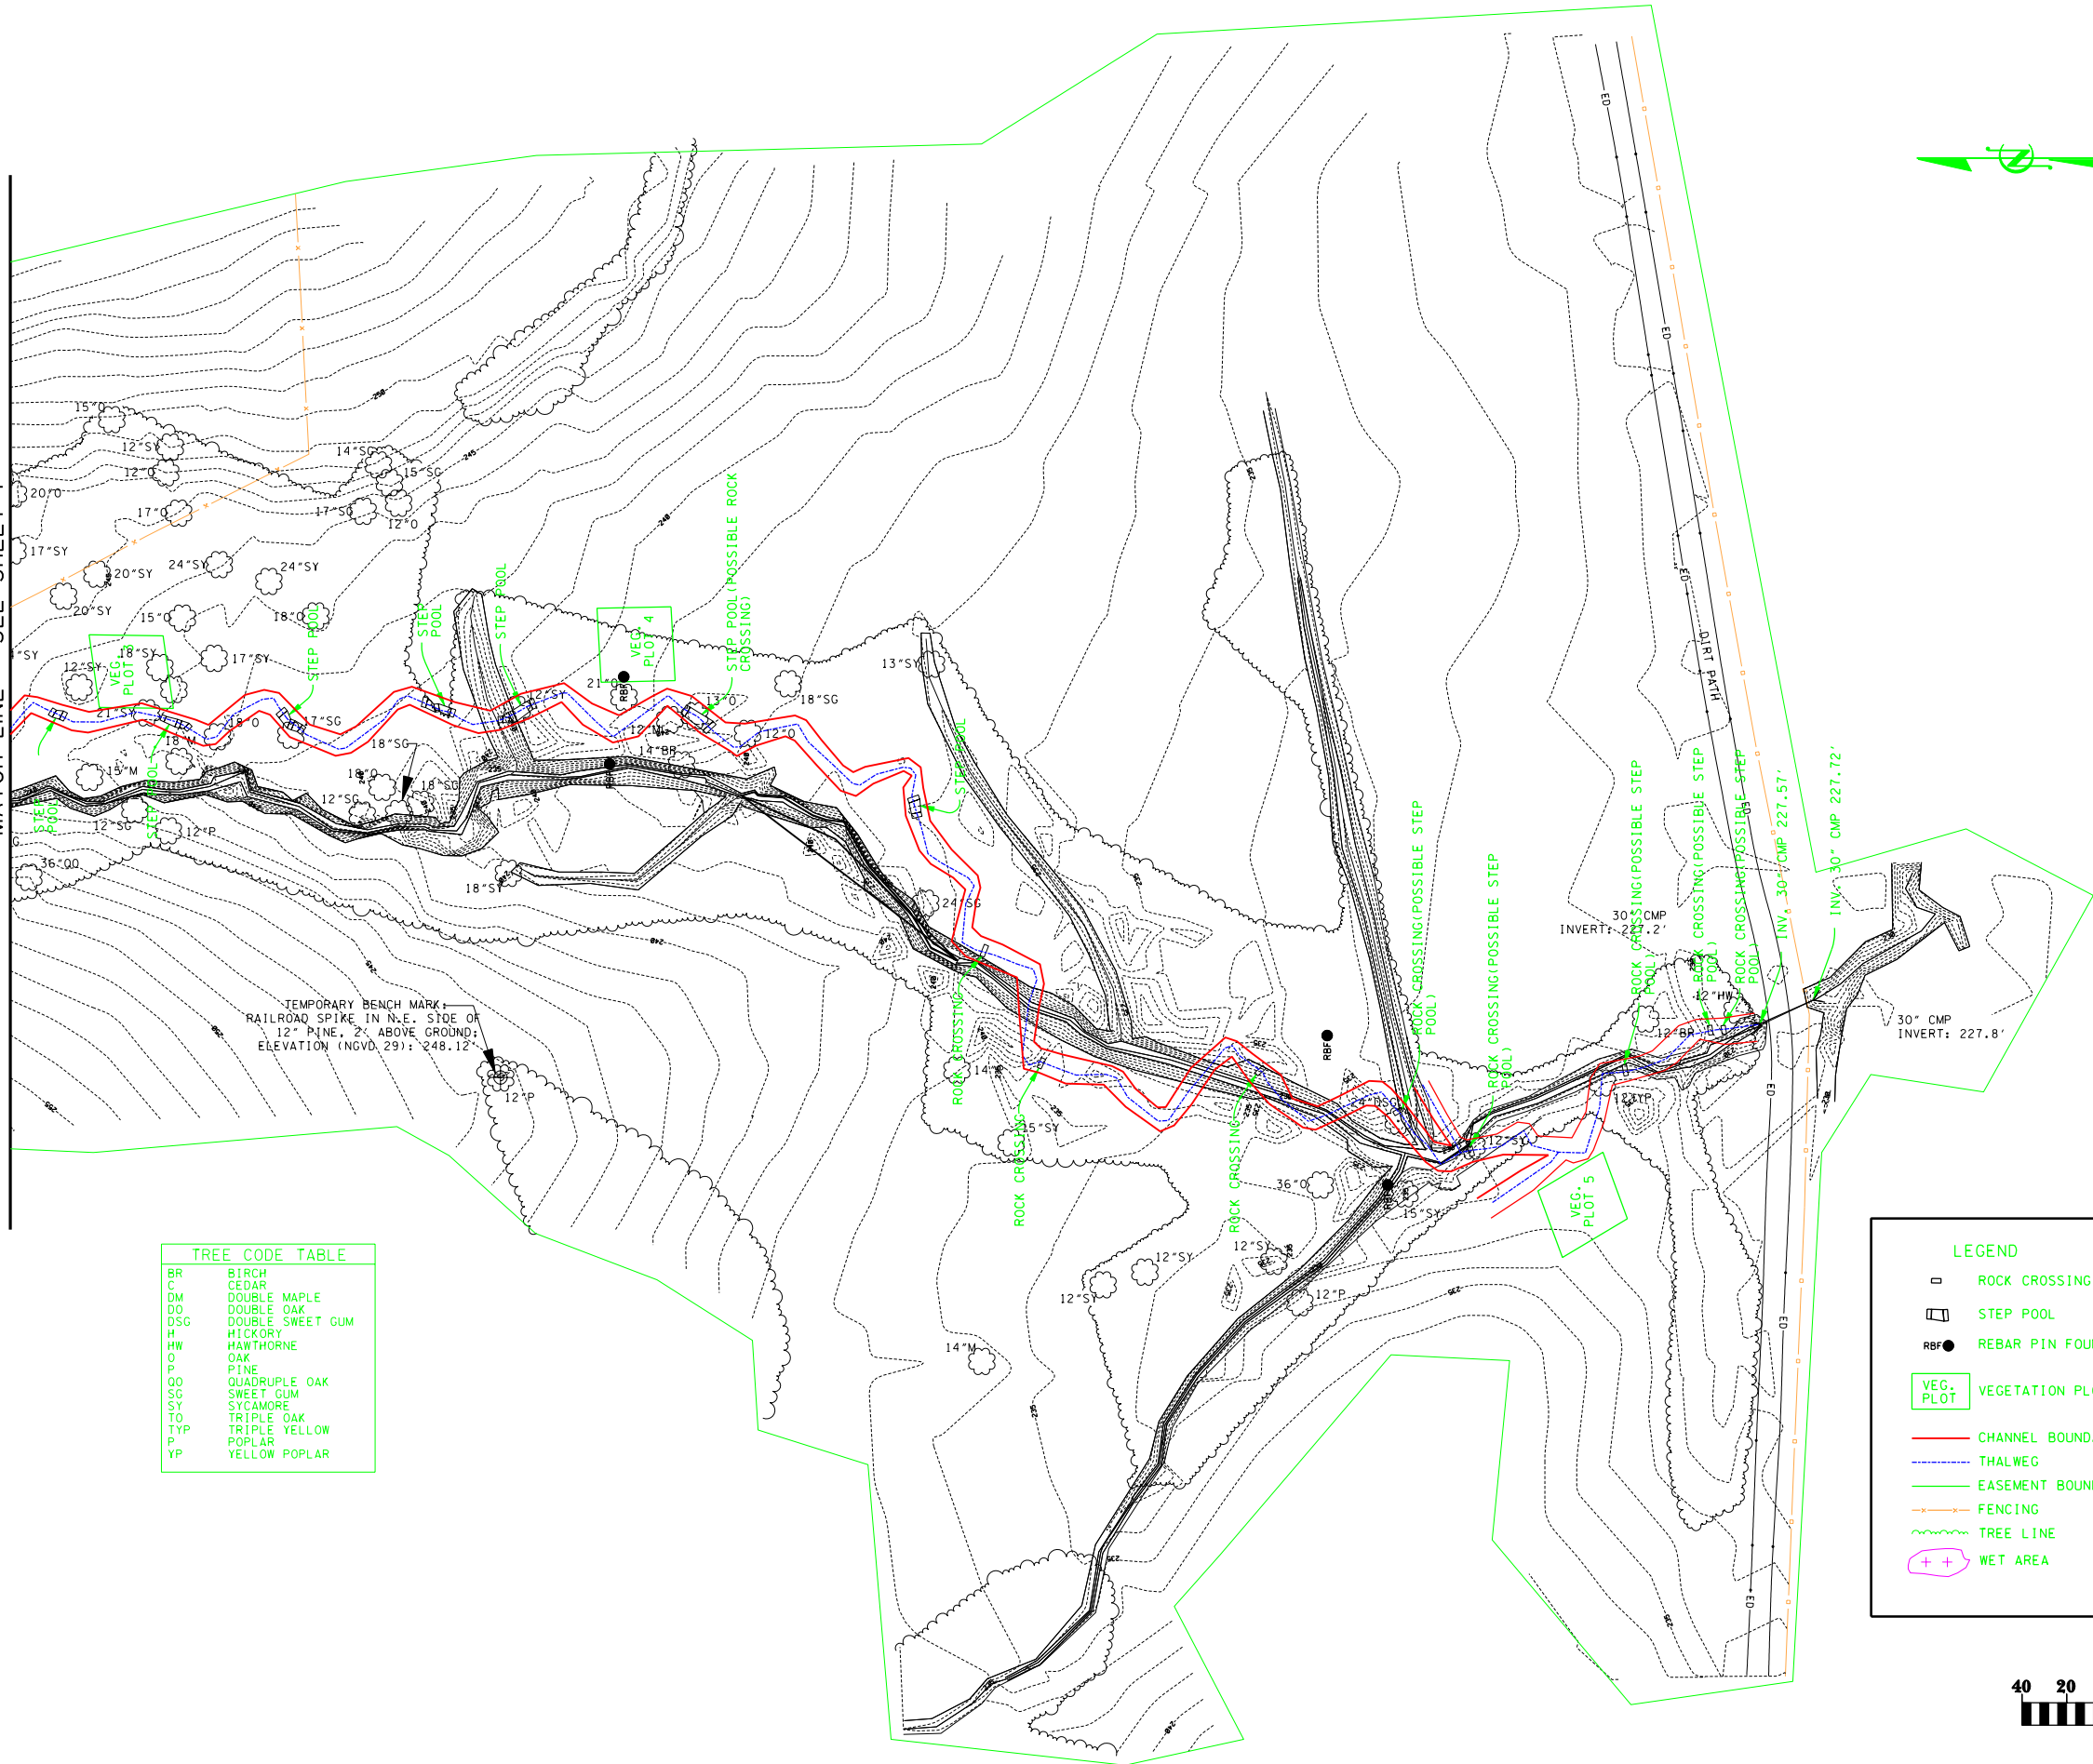


**TREE CODE TABLE**

BR	BIRCH
C	CEDAR
DM	DOUBLE MAPLE
DO	DOUBLE OAK
DSG	DOUBLE SWEET GUM
H	HICKORY
HW	HAWTHORNE
O	OAK
P	PINE
OO	QUADRUPLE OAK
SG	SWEET GUM
SY	SYCAMORE
TO	TRIPLE OAK
TYP	TRIPLE YELLOW
P	POPLAR
YP	YELLOW POPLAR

**LEGEND**

- ROCK CROSSING (POSSIBLE STEP POOL)
- STEP POOL
- REBAR PIN FOUND
- VEGETATION PLOTS
- CHANNEL BOUNDARY/BANKFULL
- THALWEG
- EASEMENT BOUNDARY
- FENCING
- TREE LINE
- WET AREA

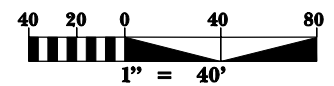

**REVISIONS**

NO.	DATE

Prepared by  
**URS**  
 URS Corporation - North Carolina  
 1600 Perimeter Park Drive  
 Morrisville, North Carolina 27560  
 TELEPHONE (919) 461-1100 FAX (919) 461-1415

PROJECT: UT TO BILLY'S CREEK  
 STREAM RESTORATION  
 FRANKLIN COUNTY

CLIENT: NORTH CAROLINA DEPARTMENT  
 OF ENVIRONMENT AND  
 NATURAL RESOURCES



DATE: JAN 2006  
 TECHNICIAN: EHJ  
 CHECKED BY: KM

MONITORING  
 YEAR 0  
 SCO I.D.#  
 010559801  
 SHEET NO.  
 2

**APPENDIX B**

**GPS COORDINATES**

### Permanent Cross Section Locations







Cross Section	X	Y
1	-78.41984	36.15008
2	-78.41960	36.14874
3	-78.41964	36.14750
4	-78.42019	36.14664

### Vegetation Plot Location and Bearings

Plot Number	Corner	X	Y	Bearing from SW Corner (degrees)
1	SW	-78.41996	36.14994	--
1	SE	-78.41986	36.14992	110
1	NW	-78.41990	36.15002	40
1	NE	-78.41981	36.14999	80
2	SW	-78.41990	36.14873	--
2	SE	-78.41979	36.14872	115
2	NW	-78.41989	36.14882	18
2	NE	-78.41977	36.14882	58
3	SW	-78.41969	36.14807	--
3	SE	-78.41958	36.14806	90
3	NW	-78.41966	36.14816	10
3	NE	-78.41957	36.14815	50
4	SW	-78.41964	36.14744	--
4	SE	-78.41953	36.14745	90
4	NW	-78.41965	36.14753	0
4	NE	-78.41954	36.14753	50
5	SW	-78.42047	36.14628	--
5	SE	-78.42037	36.14630	70
5	NW	-78.42053	36.14636	340
5	NE	-78.42043	36.14638	20

## APPENDIX C

# AS-BUILT LONGITUDINAL PROFILE AND CROSS SECTIONS

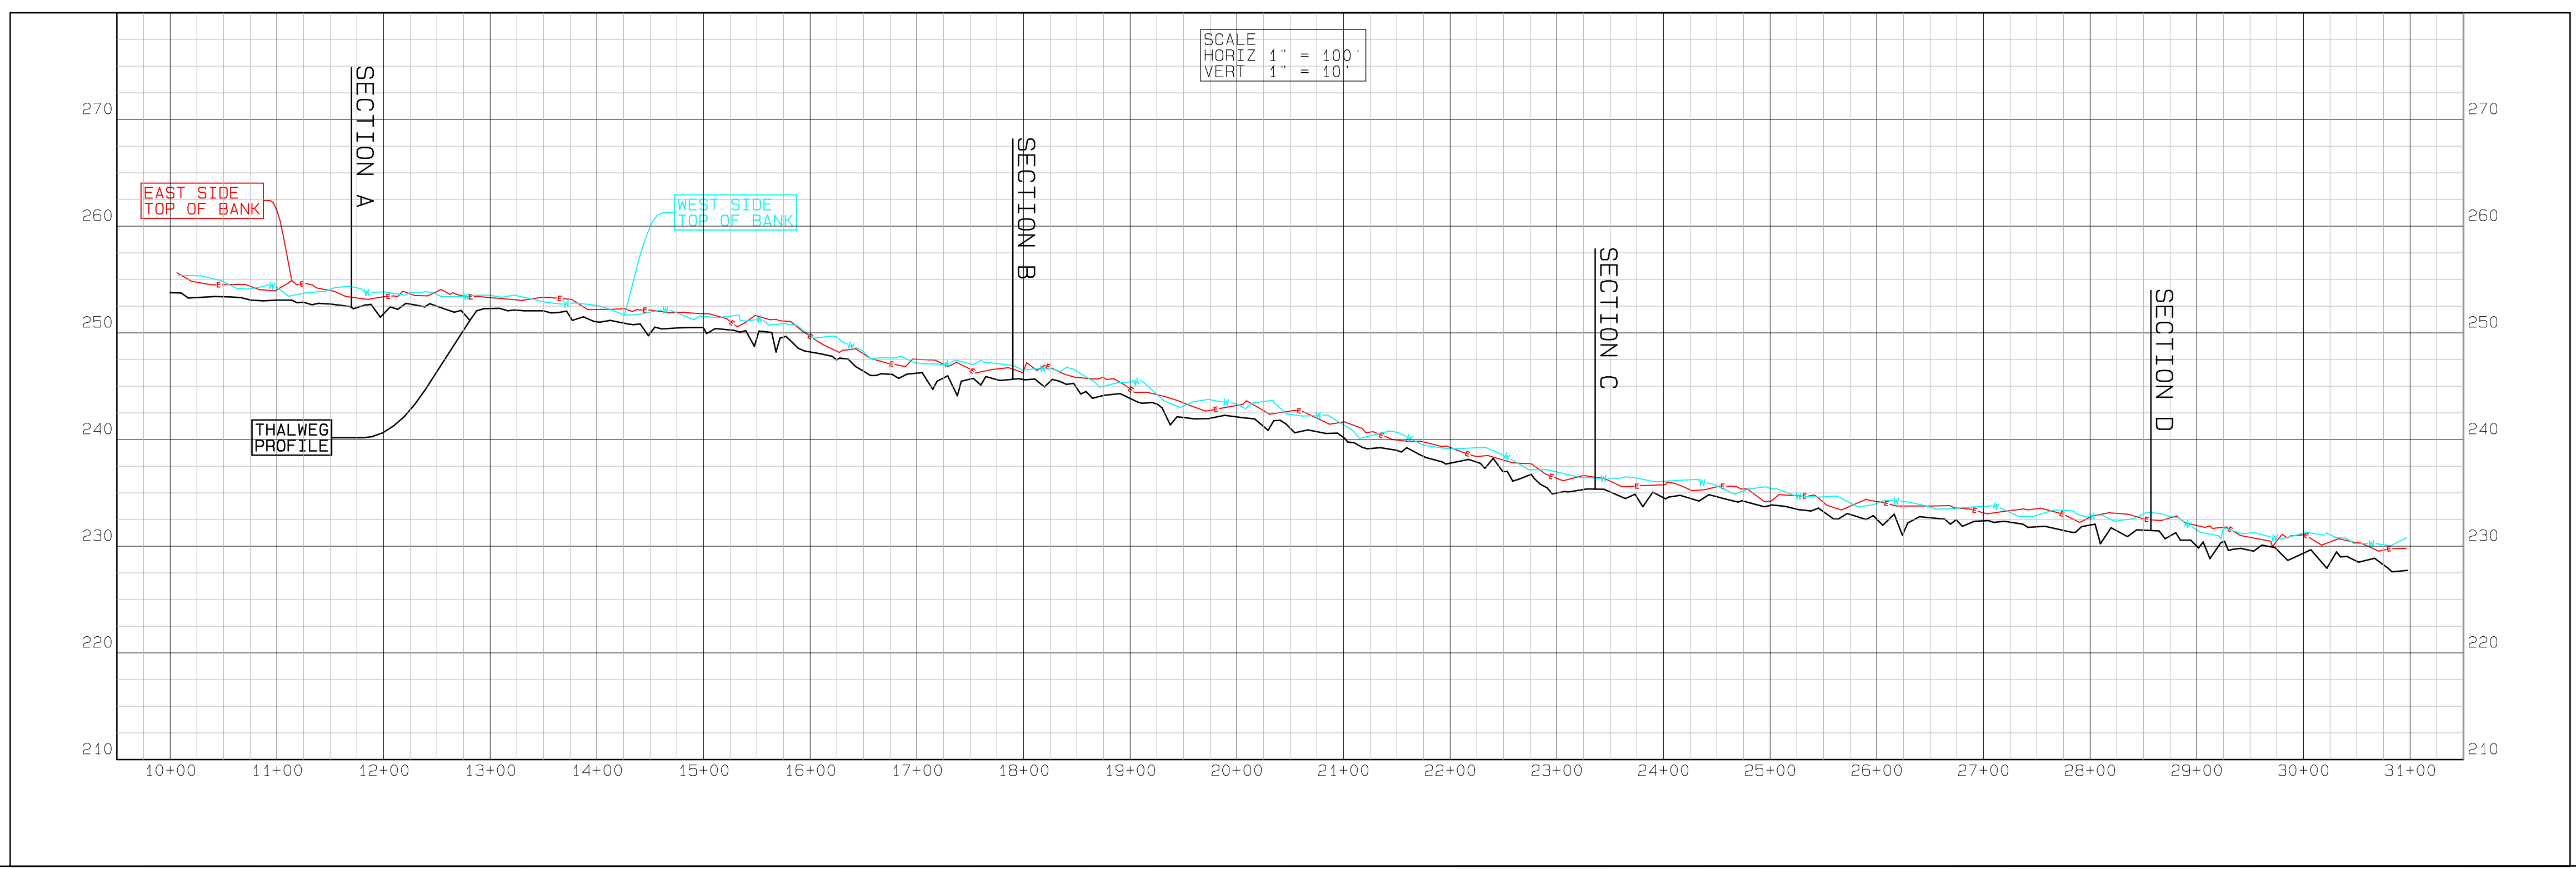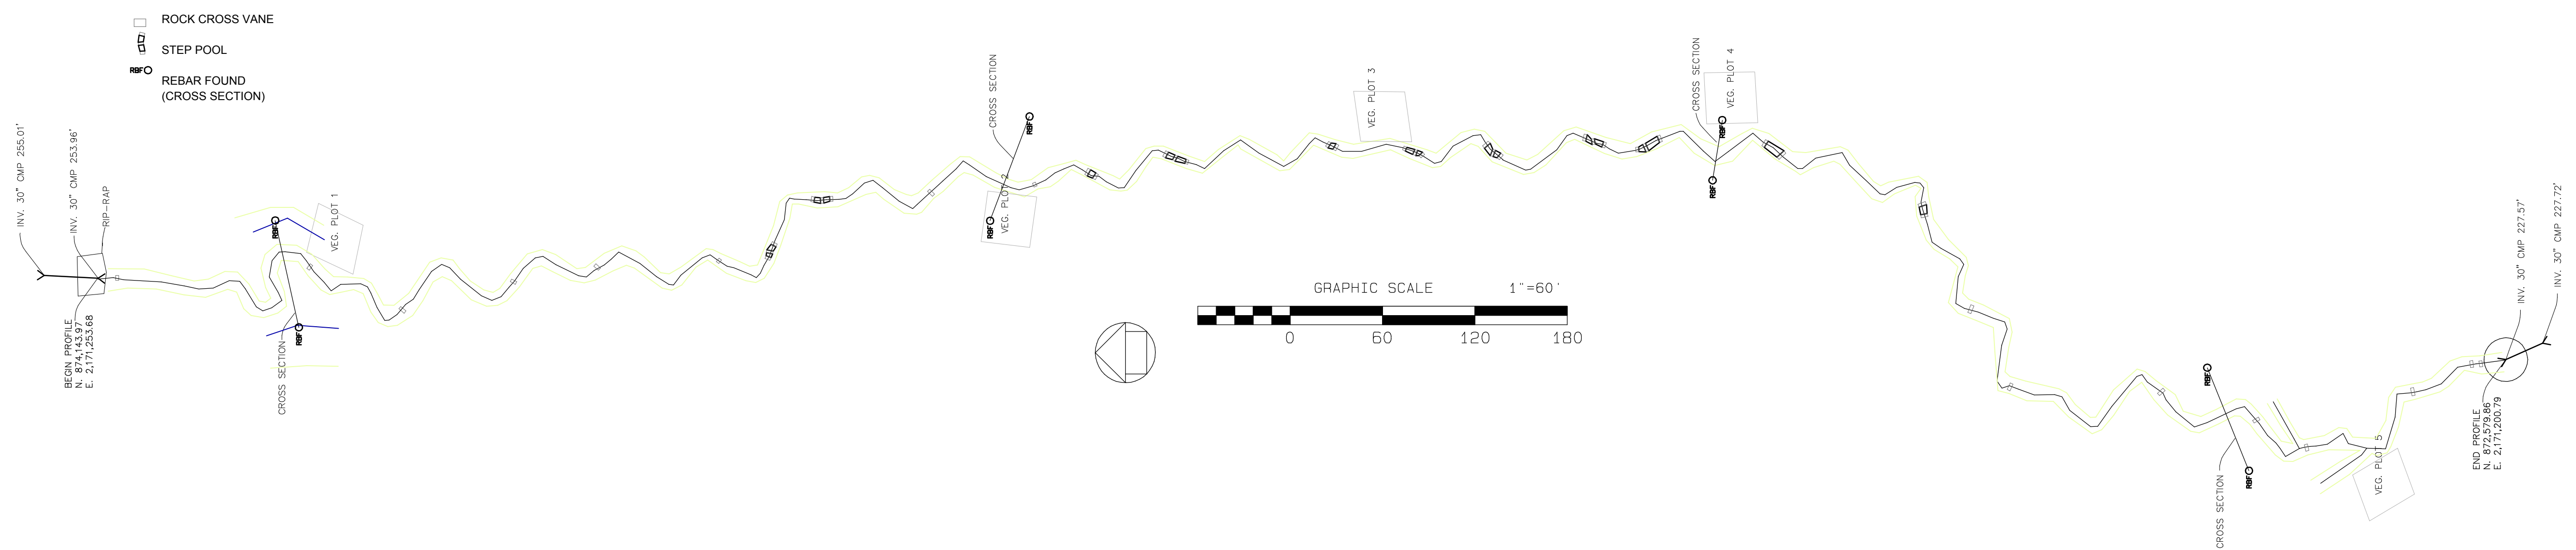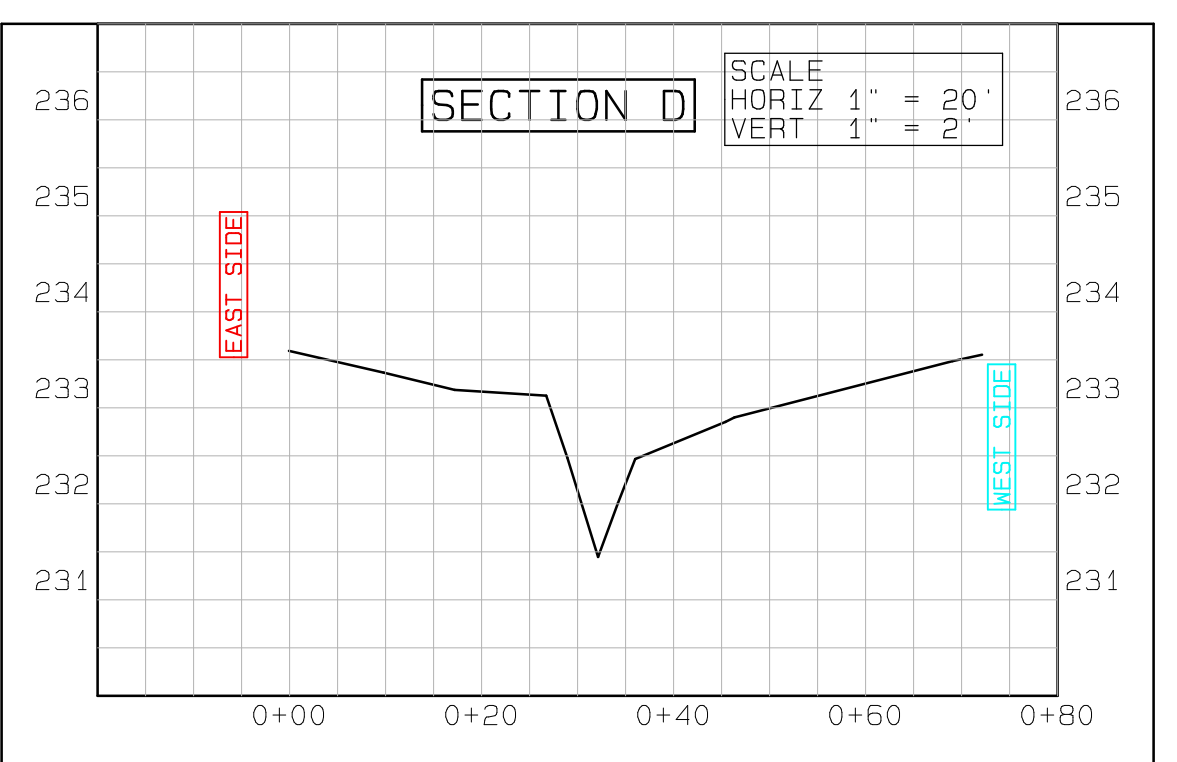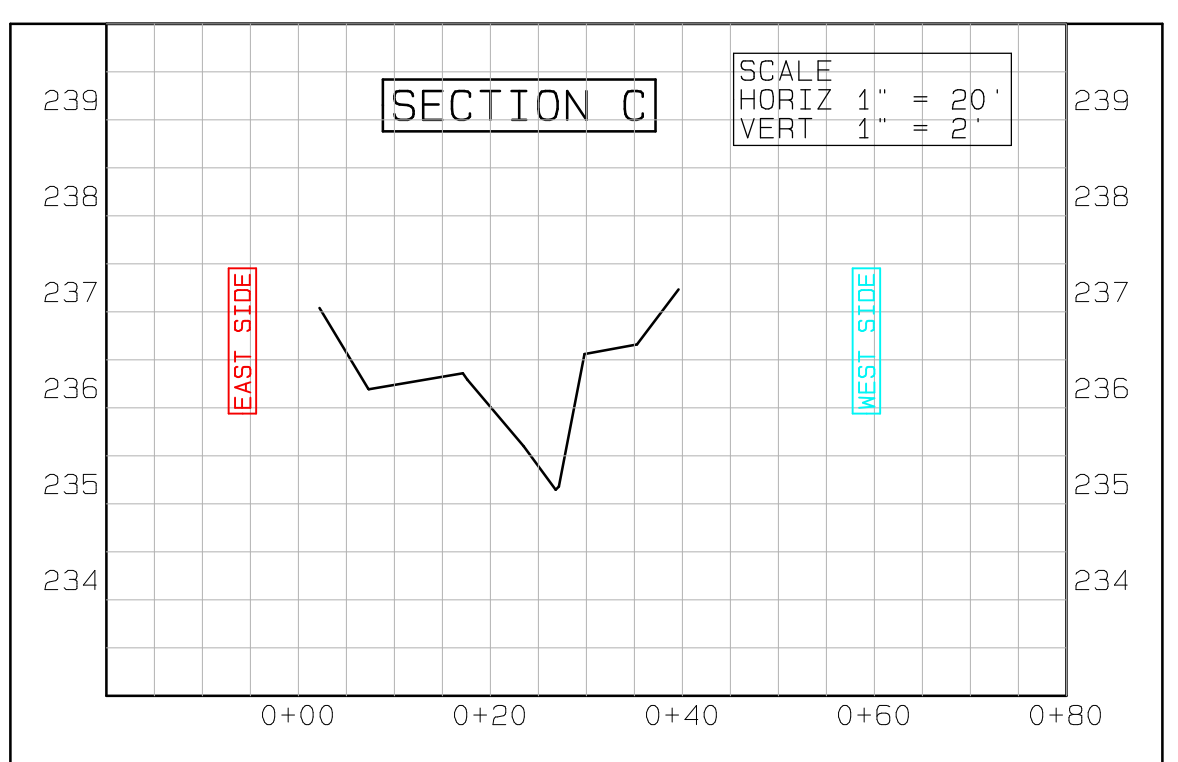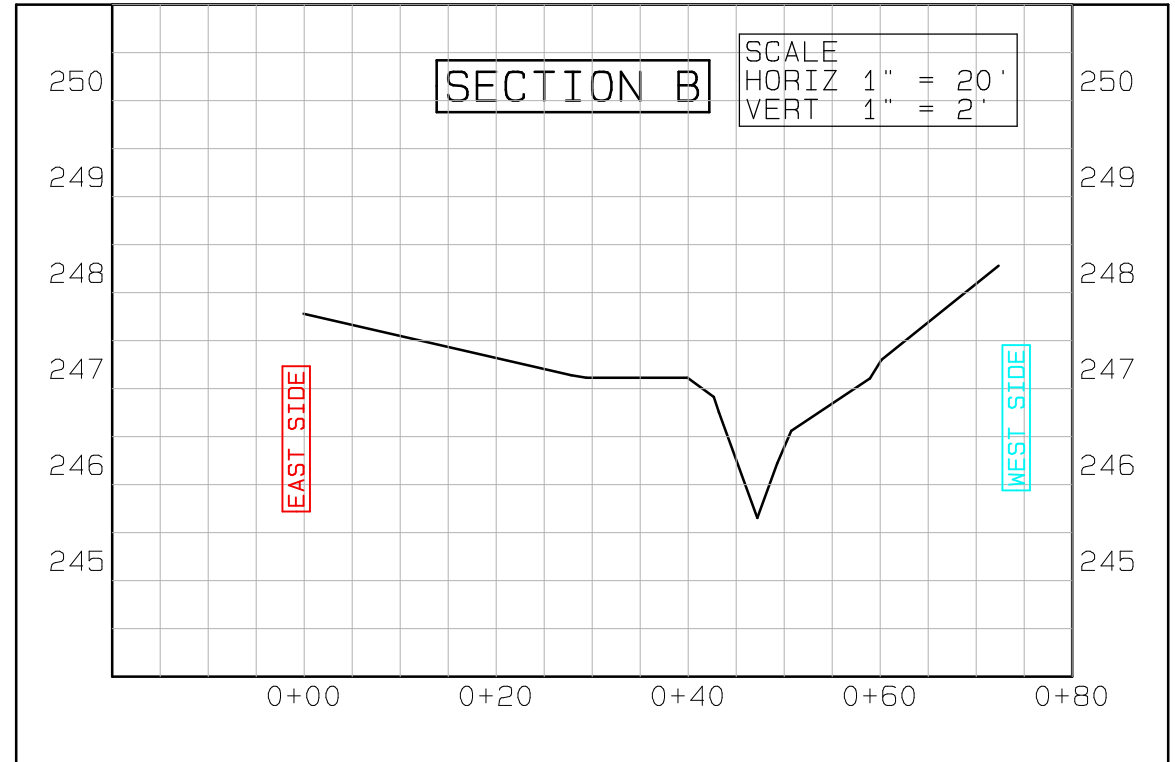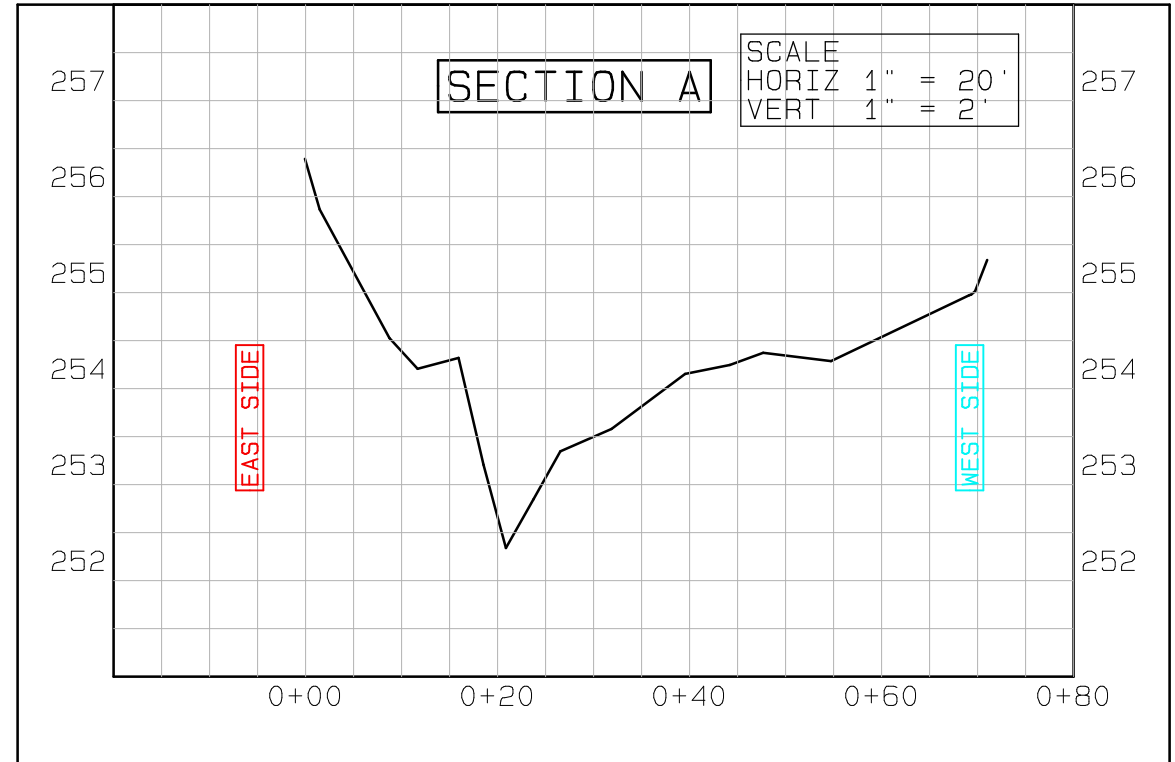

REVISIONS	

Project #: 03707.001	Date: Apr 26, 2006
Drawn by: TS	Checked by: CB/DB
TITLE	
SHEET	

© CHAS.H.SELLS,INC. ALL RIGHTS ARE RESERVED. ANY POSSESSION, REPRODUCTION OR OTHER USE OF THIS DOCUMENT WITHOUT PRIOR PERMISSION FROM CHAS.H.SELLS,INC., IS EXPRESSLY PROHIBITED.

URS — GROVE

URS Corporation  
1600 Perimeter Park Dr.  
Morrisville, North Carolina 27560





PRELIMINARY  
NOT FOR  
CONSTRUCTION

CHAS. H. SELLS, INC.  
CONSULTING ENGINEERS, SURVEYORS & PROFESSIONAL ARCHITECTS

15401 Weston Parkway  
Suite 100  
Cary, NC 27513  
Tel: 919-678-0035  
Fax: 919-678-0206  
www.chasells.com

# APPENDIX D

## PEBBLE COUNT DATA

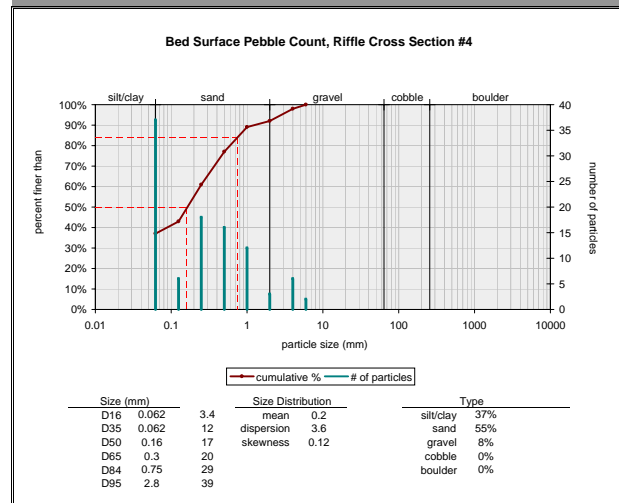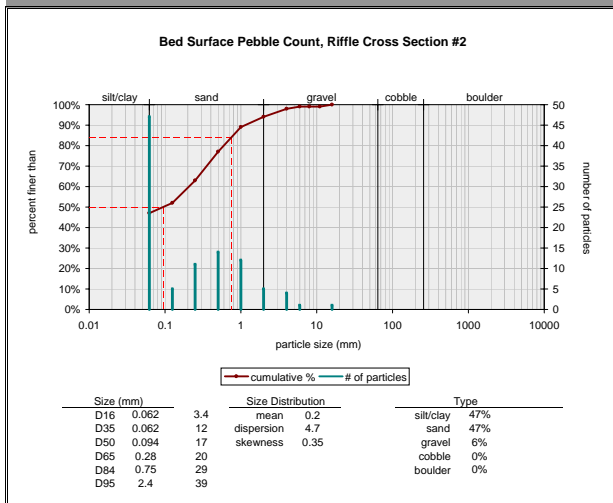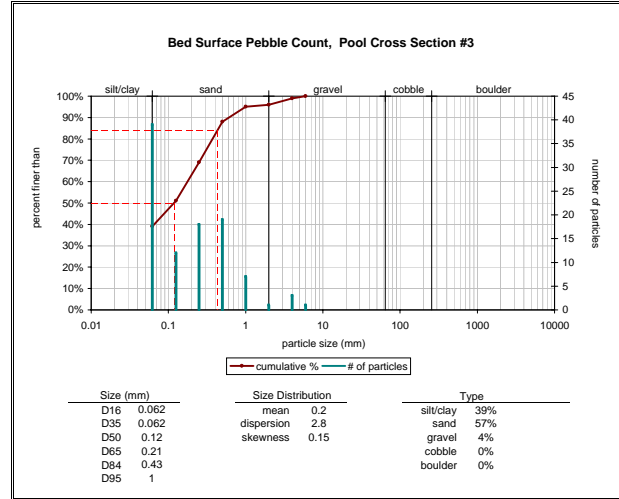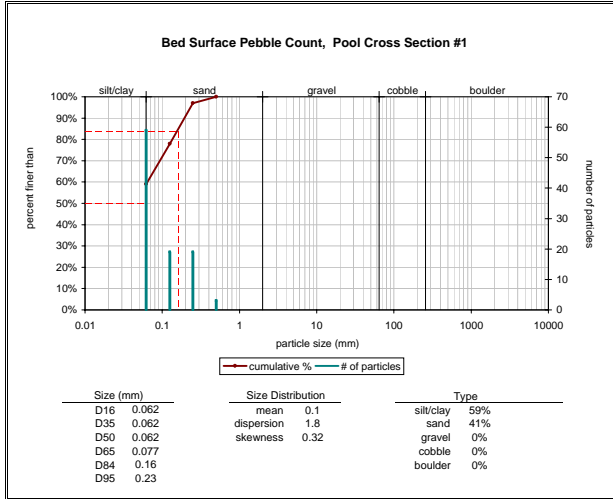



APPENDIX E  
REFERENCE PHOTOS

Billy's Creek Stream Restoration  
Permanent Cross Section Photos



Cross Section 1: Right Bank



Cross Section 1: Left Bank

Billy's Creek Stream Restoration  
Permanent Cross Section Photos



Cross Section 1: Upstream



Cross Section 1: Downstream

Billy's Creek Stream Restoration  
Permanent Cross Section Photos



Cross Section 2: Right Bank



Cross Section 2: Left Bank

Billy's Creek Stream Restoration  
Permanent Cross Section Photos



Cross Section 2: Upstream



Cross Section 2: Downstream

Billy's Creek Stream Restoration  
Permanent Cross Section Photos



Cross Section 3: Right Bank



Cross Section 3: Left Bank

Billy's Creek Stream Restoration  
Permanent Cross Section Photos



Cross Section 3: Upstream



Cross Section 3: Downstream

Billy's Creek Stream Restoration  
Permanent Cross Section Photos



Cross Section 4: Right Bank



Cross Section 4: Left Bank



Billy's Creek Stream Restoration  
Permanent Cross Section Photos



Cross Section 4: Upstream



Cross Section 4: Downstream

Billy's Creek Stream Restoration  
Vegetation Plot Photos



Vegetation Plot 1



Vegetation Plot 2

Billy's Creek Stream Restoration  
Vegetation Plot Photos



Vegetation Plot 3



Vegetation Plot 4

Billy's Creek Stream Restoration  
Vegetation Plot Photos



Vegetation Plot 5

APPENDIX F  
VEGETATION DATA

## As-Built Vegetation Data

<b>VEGETATION PLOT NUMBER 1</b>		
<b>Common Name</b>	<b>Scientific Name</b>	<b>Count</b>
Elderberry	<i>Sambucus canadensis</i>	1
Swamp laurel oak	<i>Quercus laurifolia</i>	4
Tulip poplar	<i>Liriodendron tulipifera</i>	1
Southern red oak	<i>Quercus falcata</i>	3
Willow oak	<i>Quercus phellos</i>	2
Silky dogwood	<i>Cornus amomum</i>	1
Red chokeberry	<i>Aronia arbutifolia</i>	1
<b>LIVE STAKES</b>		
Silky dogwood	<i>Cornus amomum</i>	3
Elderberry	<i>Sambucus canadensis</i>	2
<b>VEGETATION PLOT NUMBER 2</b>		
<b>Common Name</b>	<b>Scientific Name</b>	<b>Count</b>
Tag alder	<i>Alnus serrulata</i>	7
Winged sumac	<i>Rhus copallina</i>	2
Elderberry	<i>Sambucus canadensis</i>	3
Hackberry or Sugarberry	<i>Celtis sp.</i>	2
Buttonbush	<i>Cephananthus occidentalis</i>	1
Flowering dogwood	<i>Cornus florida</i>	1
<b>LIVE STAKES</b>		
Silky dogwood	<i>Cornus amomum</i>	1
Silky willow	<i>Salix sericea</i>	1
<b>VEGETATION PLOT NUMBER 3</b>		
<b>Common Name</b>	<b>Scientific Name</b>	<b>Count</b>
Elderberry	<i>Sambucus canadensis</i>	3
Possumhaw viburnum	<i>Viburnum nudum</i>	1
Buttonbush	<i>Cephananthus occidentalis</i>	1
Willow oak	<i>Quercus phellos</i>	2
Black gum	<i>Nyssa sylvatica</i>	3
Hackberry or Sugarberry	<i>Celtis sp.</i>	3
Southern red oak	<i>Quercus falcata</i>	1
Flowering dogwood	<i>Cornus florida</i>	1
<b>LIVE STAKES</b>		
Silky dogwood	<i>Cornus amomum</i>	7
Elderberry	<i>Sambucus canadensis</i>	5
Black willow	<i>Salix nigra</i>	2
Silky willow	<i>Salix sericea</i>	1
<b>VEGETATION PLOT NUMBER 4</b>		
<b>Common Name</b>	<b>Scientific Name</b>	<b>Count</b>
Silky dogwood	<i>Cornus amomum</i>	2
Possumhaw viburnum	<i>Viburnum nudum</i>	2
Hackberry or Sugarberry	<i>Celtis sp.</i>	4
Willow oak	<i>Quercus phellos</i>	2
Black gum	<i>Nyssa sylvatica</i>	1
Swamp laurel oak	<i>Quercus laurifolia</i>	1
Tag alder	<i>Alnus serrulata</i>	2
Winged sumac	<i>Rhus copallina</i>	2
Buttonbush	<i>Cephananthus occidentalis</i>	1
Elderberry	<i>Sambucus canadensis</i>	1
Beautyberry	<i>Callicarpa americana</i>	2
Red chokeberry	<i>Aronia arbutifolia</i>	1
<b>LIVE STAKES</b>		
Silky willow	<i>Salix sericea</i>	1
<b>VEGETATION PLOT NUMBER 5</b>		
<b>Common Name</b>	<b>Scientific Name</b>	<b>Count</b>
Willow oak	<i>Quercus phellos</i>	8
Hackberry or Sugarberry	<i>Celtis sp.</i>	2
Swamp laurel oak	<i>Quercus laurifolia</i>	4
Tag alder	<i>Alnus serrulata</i>	2
Elderberry	<i>Sambucus canadensis</i>	1
Possumhaw viburnum	<i>Viburnum nudum</i>	2
River birch	<i>Betula nigra</i>	2
Southern red oak	<i>Quercus falcata</i>	1
Silky dogwood	<i>Cornus amomum</i>	1
<b>LIVE STAKES</b>		
Silky willow	<i>Salix sericea</i>	2