
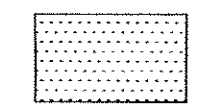
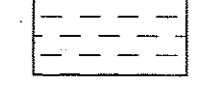
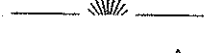





BISHOP ROAD WETLAND RESTORATION PROJECT
 HYDE COUNTY, NORTH CAROLINA
 SCO # 050653801 NCDERN PROJECT # D08017S
 SHEET 1 OF 12 SHEETS MAY 4, 2009

AS BUILT OVERLAY LAYER
 PROJECT COVER SHEET


LEGEND

-  TREE LINE
-  NON-RIVERINE RESTORATION AREA
-  COASTAL MARSH RESTORATION AREA
-  MARSH LINE
- MW or  MONITORING WELL
- EIP OR EIR EXISTING IRON PIPE OR ROD
- WS WOOD STAKE
-  or NPS NO POINT SET
- PLOTTED OR COMPUTED LINES


DISTANCES HORIZONTAL
 COORDINATES ARE NCDOT LOCAL SYSTEM
 BASED ON USGS MONU N-244

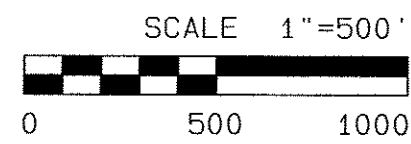

NC GRID

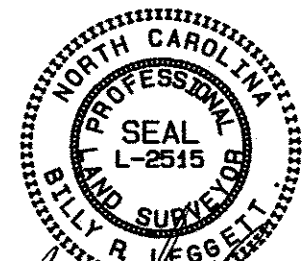


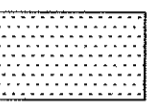


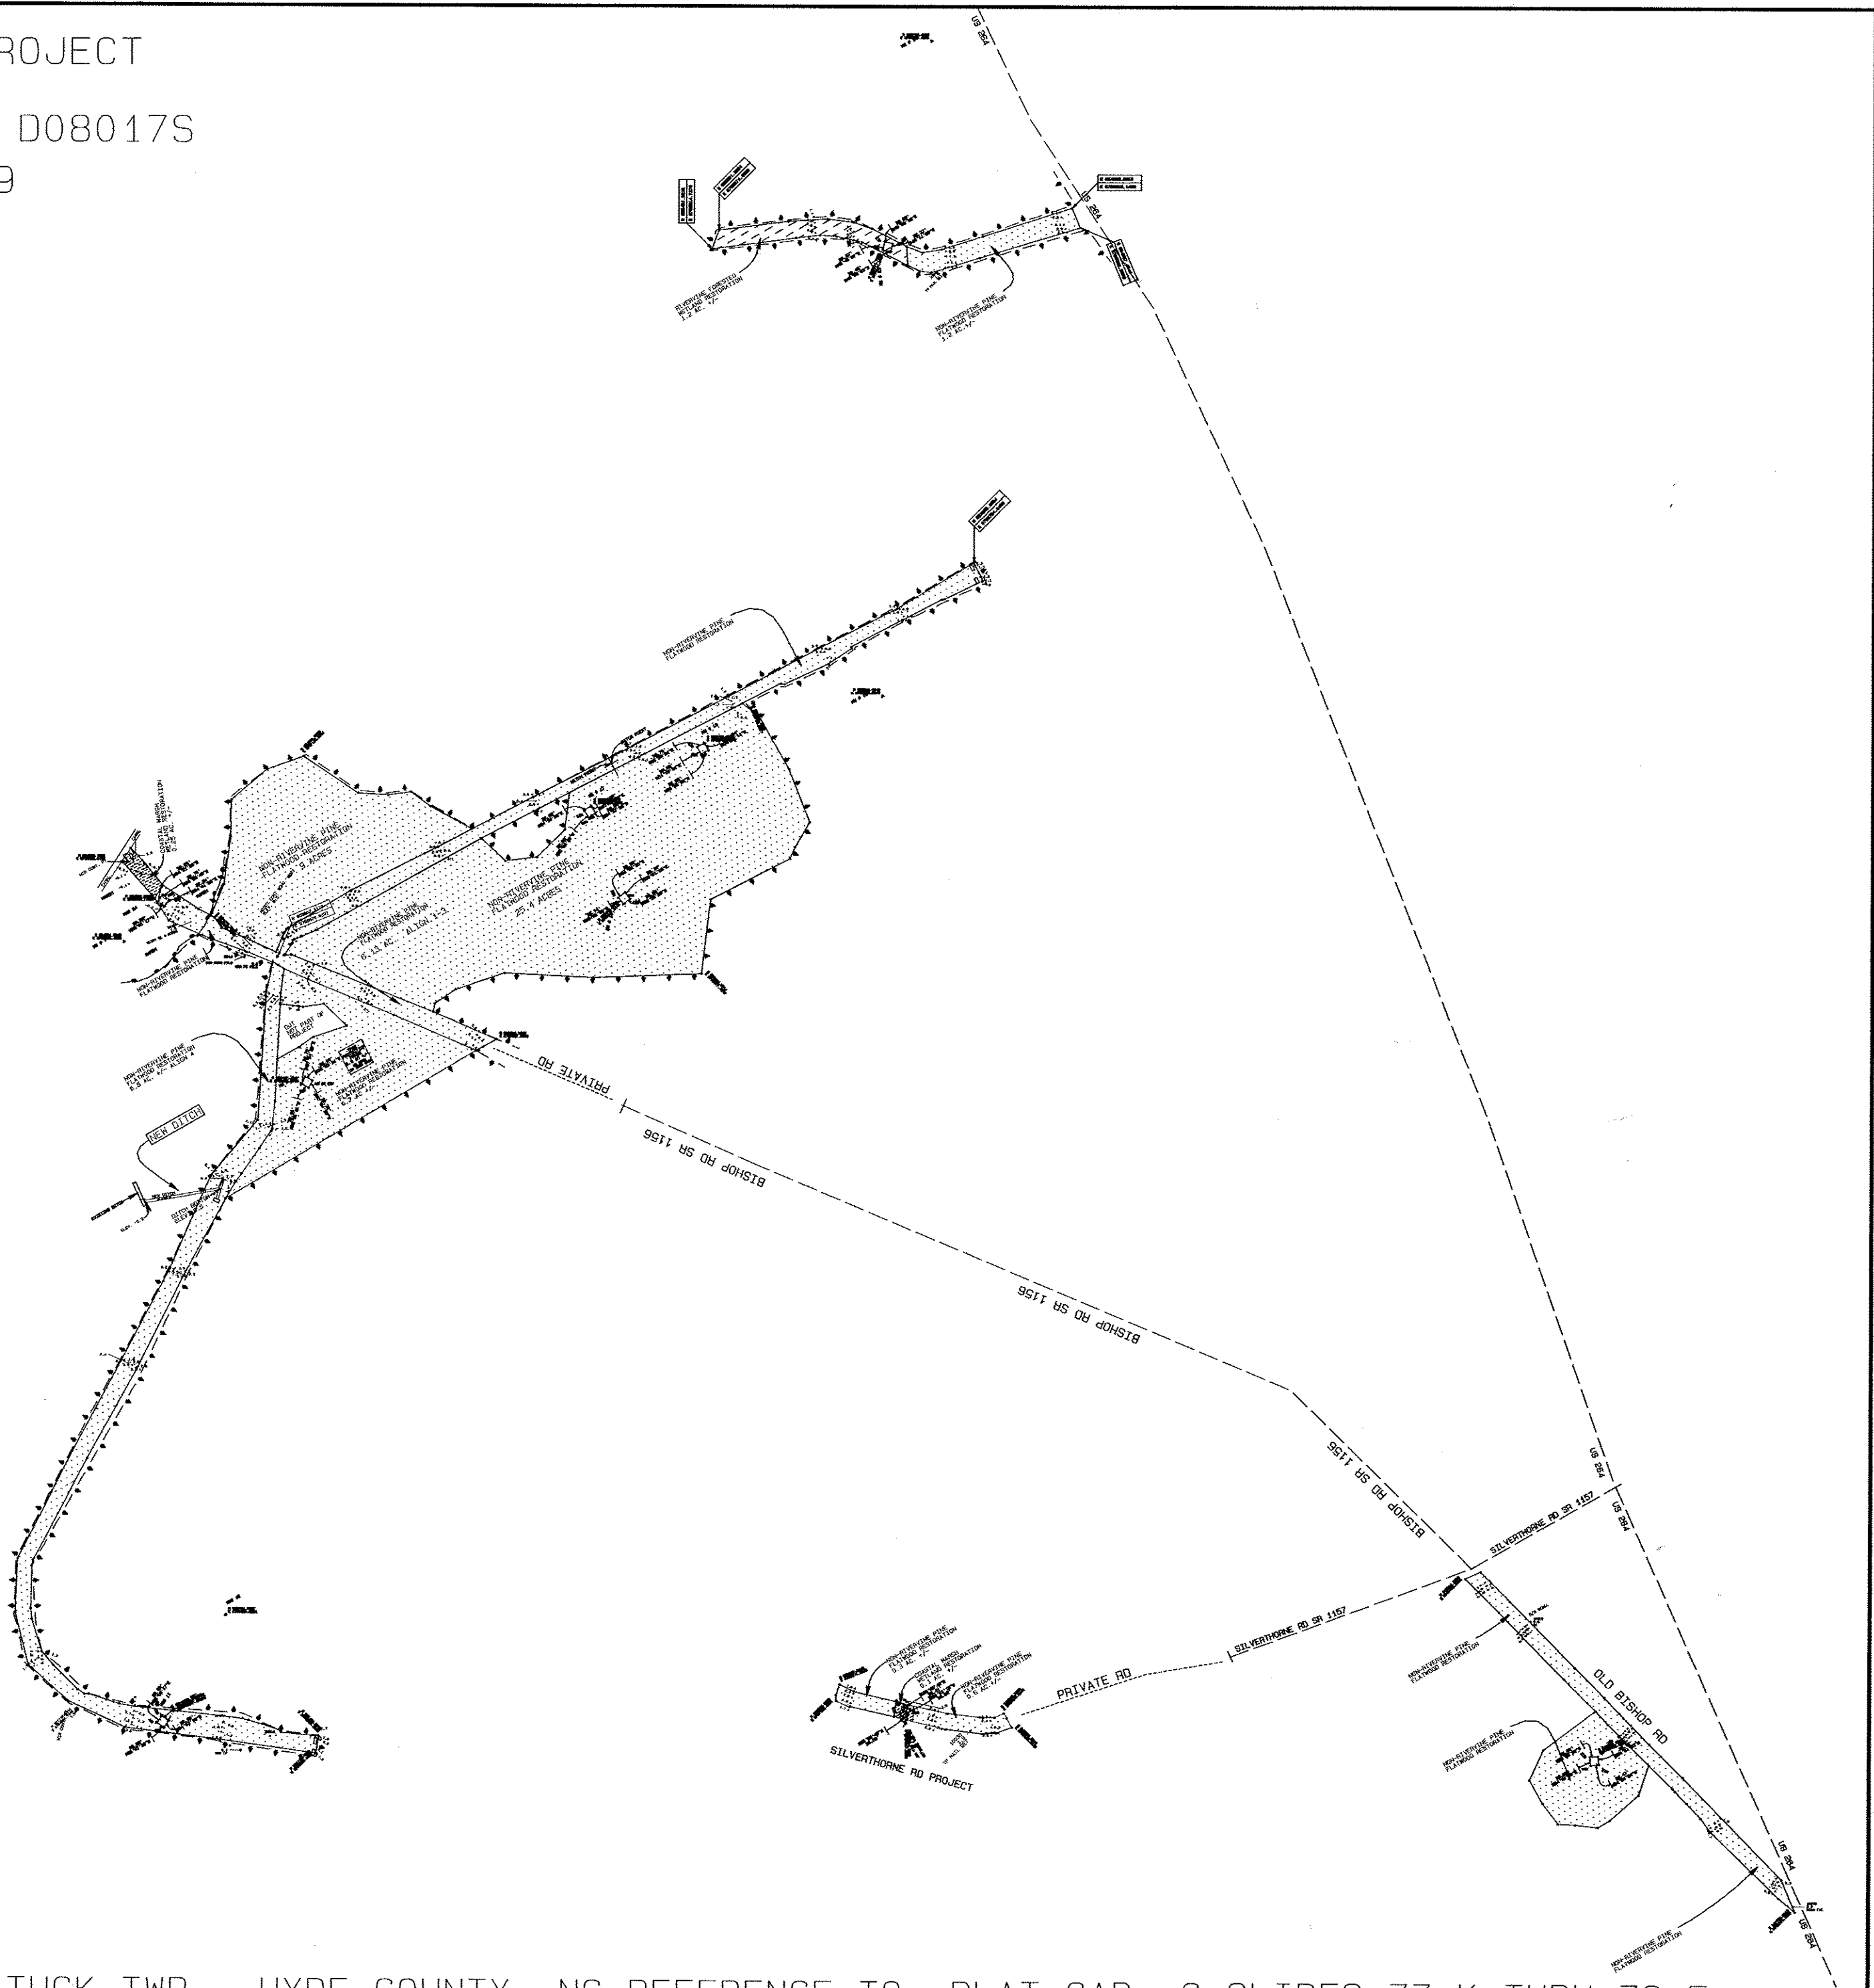
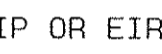

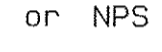

B.R. Veggel 5-4-09



BISHOP ROAD WETLAND RESTORATION, CURRITUCK TWP., HYDE COUNTY, NC REFERENCE TO PLAT CAB. C SLIDES 77-K THRU 78-F AND PLANS PREPARED BY ARCADIS G & M OF NORTH CAROLINA, 801 CORPORATE CENTER DRIVE, SUITE 300, RALEIGH, NC 27607

BISHOP ROAD WETLAND RESTORATION PROJECT
 HYDE COUNTY, NORTH CAROLINA
 SCO # 050653801 NCDERN PROJECT # D08017S
 SHEET 2 OF 12 SHEETS MAY 4, 2009


LEGEND

-  TREE LINE
-  NON-RIVERINE RESTORATION AREA
-  COASTAL MARSH RESTORATION AREA
-  MARSH LINE
- MW or  MONITORING WELL
- EIP OR EIR  EXISTING IRON PIPE OR ROD
- WS  WOOD STAKE
-  or NPS NO POINT SET
-  PLOTTED OR COMPUTED LINES


DISTANCES HORIZONTAL
 COORDINATES ARE NCDOT LOCAL SYSTEM
 BASED ON USGS MONU N-244

NC GRID


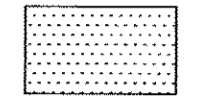


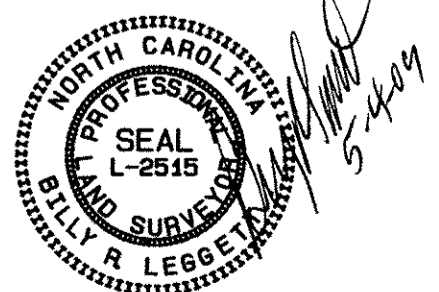




SCALE 1"=200'

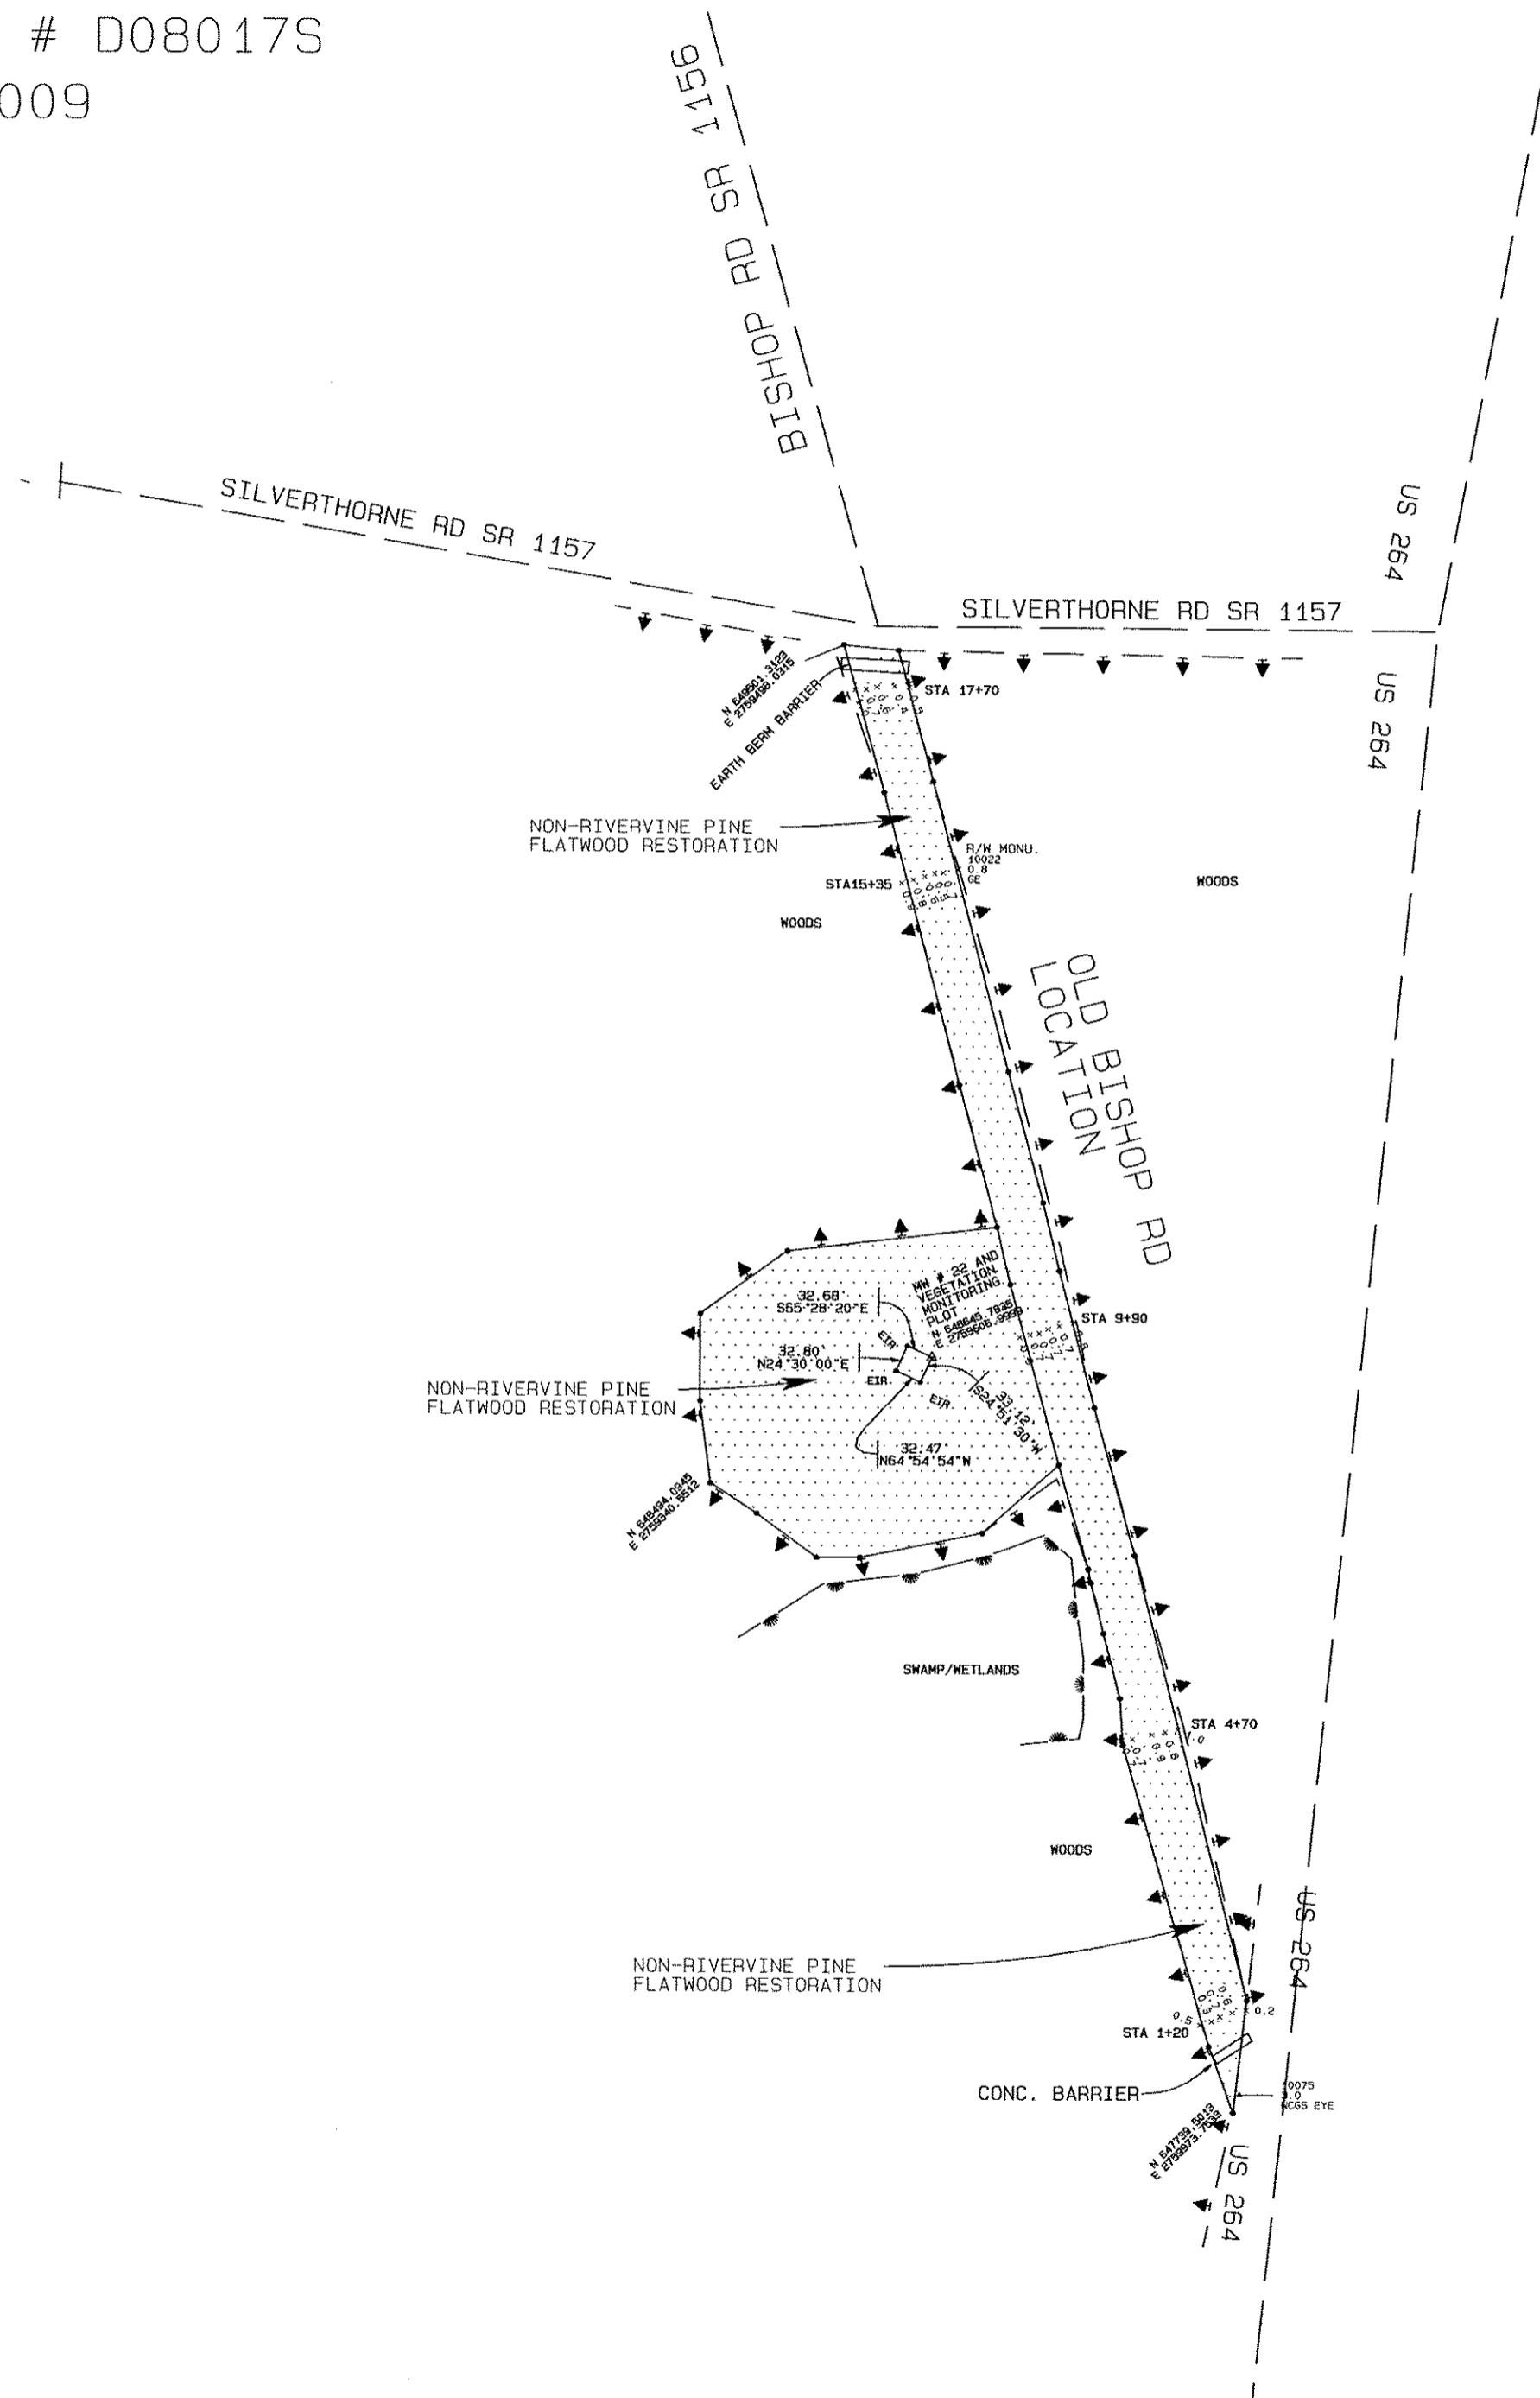



AS BUILT OVERLAY LAYER
 BISHOP ROAD

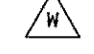


BISHOP ROAD WETLAND RESTORATION PROJECT
 HYDE COUNTY, NORTH CAROLINA
 SCO # 050653801 NCDERN PROJECT # D08017S
 SHEET 3 OF 12 SHEETS MAY 4, 2009
 REVISED 5-13-2009 REMOVED CONC. BARRIER

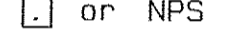- LEGEND**
-  TREE LINE
 -  NON-RIVERINE RESTORATION AREA
 -  COASTAL MARSH RESTORATION AREA
 -  MARSH LINE
 - MW or  MONITORING WELL
 - EIP OR EIR  EXISTING IRON PIPE OR ROD
 - WS  WOOD STAKE
 -  or NPS NO POINT SET
 -  PLOTTED OR COMPUTED LINES

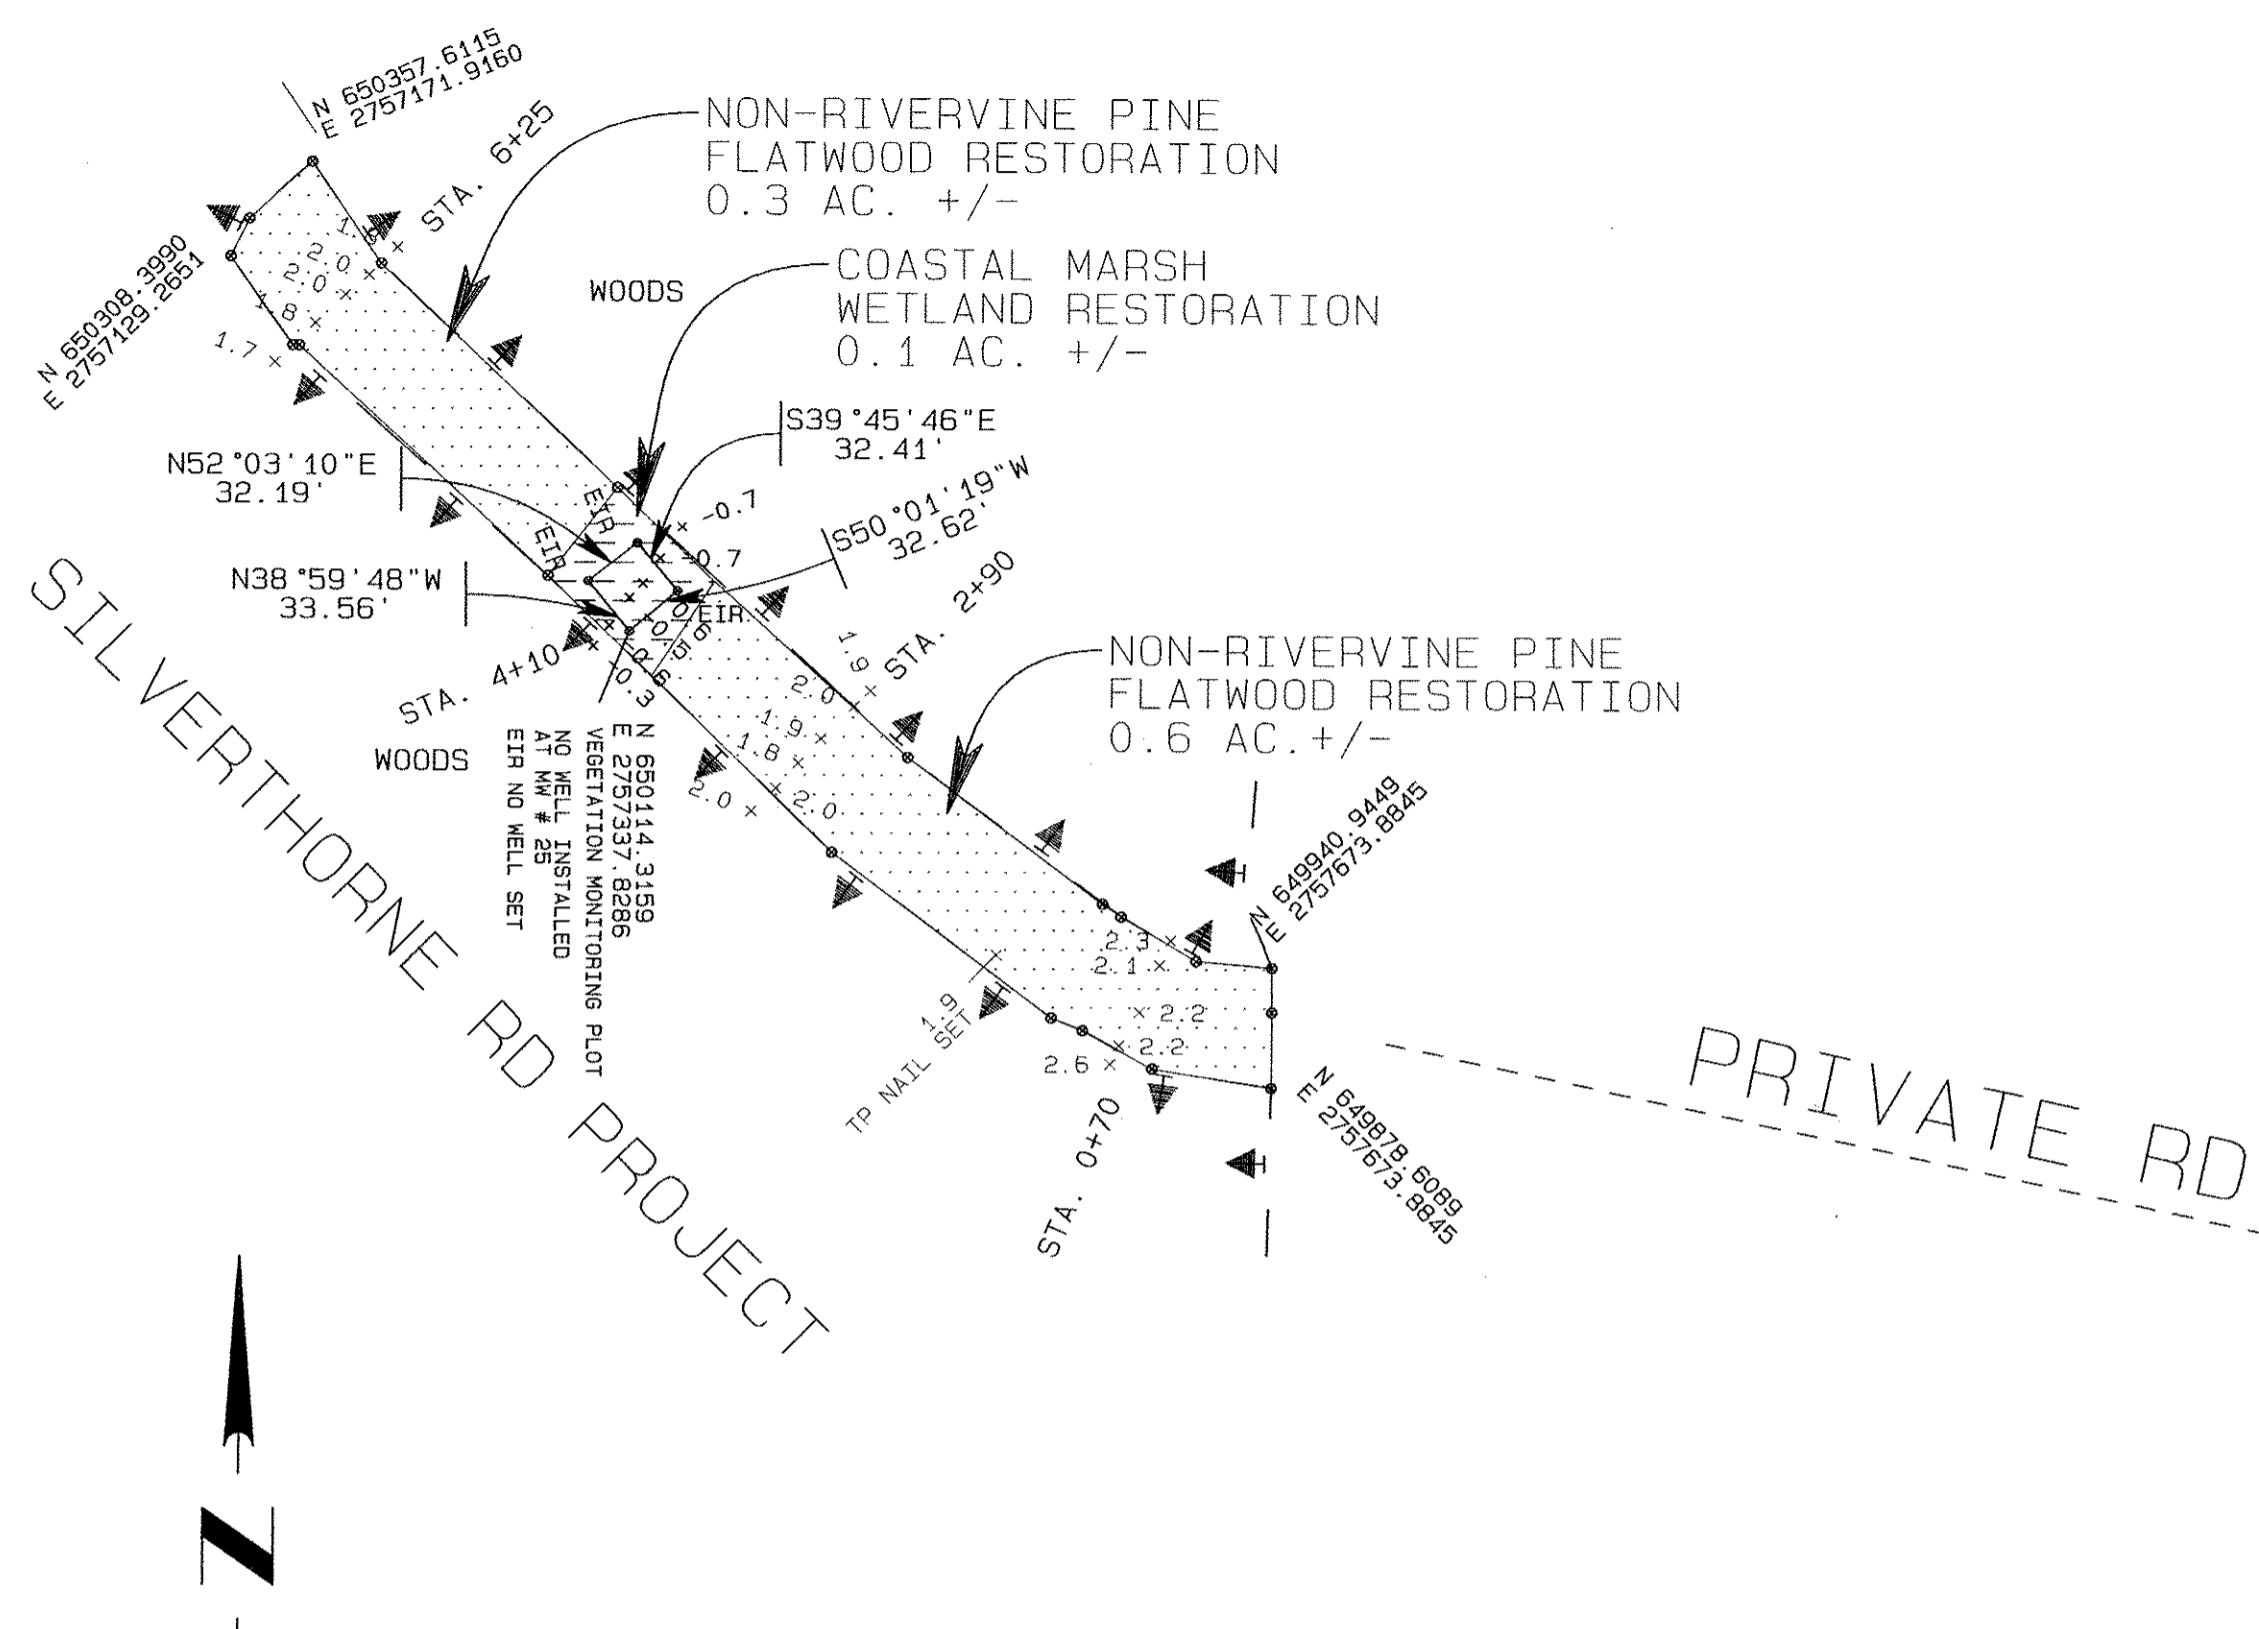

DISTANCES HORIZONTAL
 COORDINATES ARE NCDOT LOCAL SYSTEM
 BASED ON USGS MONU N-244

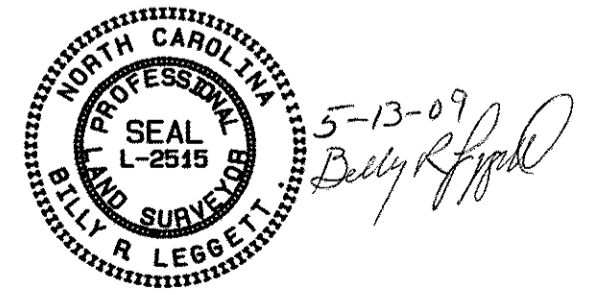

AS BUILT OVERLAY LAYER
 BISHOP ROAD

BISHOP ROAD WETLAND RESTORATION, CURRITUCK TWP., HYDE COUNTY, NC REFERENCE TO PLAT CAB. C SLIDES 77-K THRU 78-F AND PLANS PREPARED BY ARCADIS G & M OF NORTH CAROLINA, 801 CORPORATE CENTER DRIVE, SUITE 300, RALEIGH, NC 27607


MW # 14
 N 655725.4235
 E 2760660.1394

LEGEND


- TREE LINE
- NON-RIVERINE RESTORATION AREA
- COASTAL MARSH OR RIVERINE RESTORATION AREA
- MARSH LINE
- MW or MONITORING WELL
- EIP OR EIR EXISTING IRON PIPE OR ROD
- WS WOOD STAKE
- or NPS NO POINT SET
- PLOTTED OR COMPUTED LINES

RIVERVINE FORESTED WETLAND RESTORATION
 1.2 AC. +/-

NON-RIVERVINE PINE FLATWOOD RESTORATION
 1.2 AC. +/-

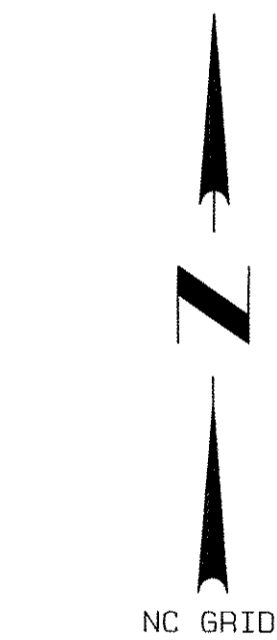

DISTANCES HORIZONTAL
 COORIDINATES ARE NCDOT LOCAL SYSTEM
 BASED ON USGS MONU N-244

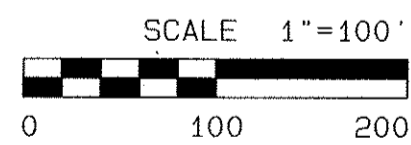

BISHOP ROAD WETLAND RESTORATION PROJECT
 HYDE COUNTY, NORTH CAROLINA
 SCO # 050653801 NCDERN PROJECT # D08017S
 SHEET 4 OF 12 SHEETS MAY 4, 2009

AS BUILT OVERLAY LAYER
 WEYERHAUSER SERVICE ROAD

BISHOP ROAD WETLAND RESTORATION, CURRITUCK TWP., HYDE COUNTY, NC REFERENCE TO PLAT CAB. C SLIDES 77-K THRU 78-F AND PLANS PREPARED BY ARCADIS G & M OF NORTH CAROLINA, 801 CORPORATE CENTER DRIVE, SUITE 300, RALEIGH, NC 27607

N 655451.2210
 E 2759514.7270

N 655501.5094
 E 2759574.4929

N 655265.6291
 E 2760045.7080

N 655094.7736
 E 2760114.2287
 MW # 23 AND VEGETATION MONITORING PLOT

N 654889.6310
 E 2760812.1492

N 654807.4844
 E 2760802.3699

US 264

US 264

WOODS

WOODS

WOODS

WOODS

32.87' N42°49'57"E

32.65' S46°06'25"E

32.45' N46°59'03"W

32.37' S43°11'00"W

N 654045.9714
 E 2760210.3819

STA. 5+90

STA. 11+20

STA. 9+90

STA. 1+15

CONC. BARRIER

0.7 x

0.8 x

0.9 x

1.0 x

1.0 x

1.1 x

1.3 x

0.9 x

0.8 x

0.7 x

0.6 x

0.5 x

0.4 x

0.3 x

0.2 x

0.1 x

0.0 x

0.0 x


0.0 x

0.0 x



0.0 x

BISHOP ROAD WETLAND RESTORATION PROJECT
 HYDE COUNTY, NORTH CAROLINA
 SCO # 050653801 NCDERN PROJECT # D08017S
 SHEET 5 OF 12 SHEETS MAY 4, 2009

- LEGEND
- TREE LINE
 - NON-RIVERINE RESTORATION AREA
 - COASTAL MARSH RESTORATION AREA
 - MARSH LINE
 - MW or MONITORING WELL
 - EIP OR EIR EXISTING IRON PIPE OR ROD
 - WS WOOD STAKE
 - or NPS NO POINT SET
 - PLOTTED OR COMPUTED LINES

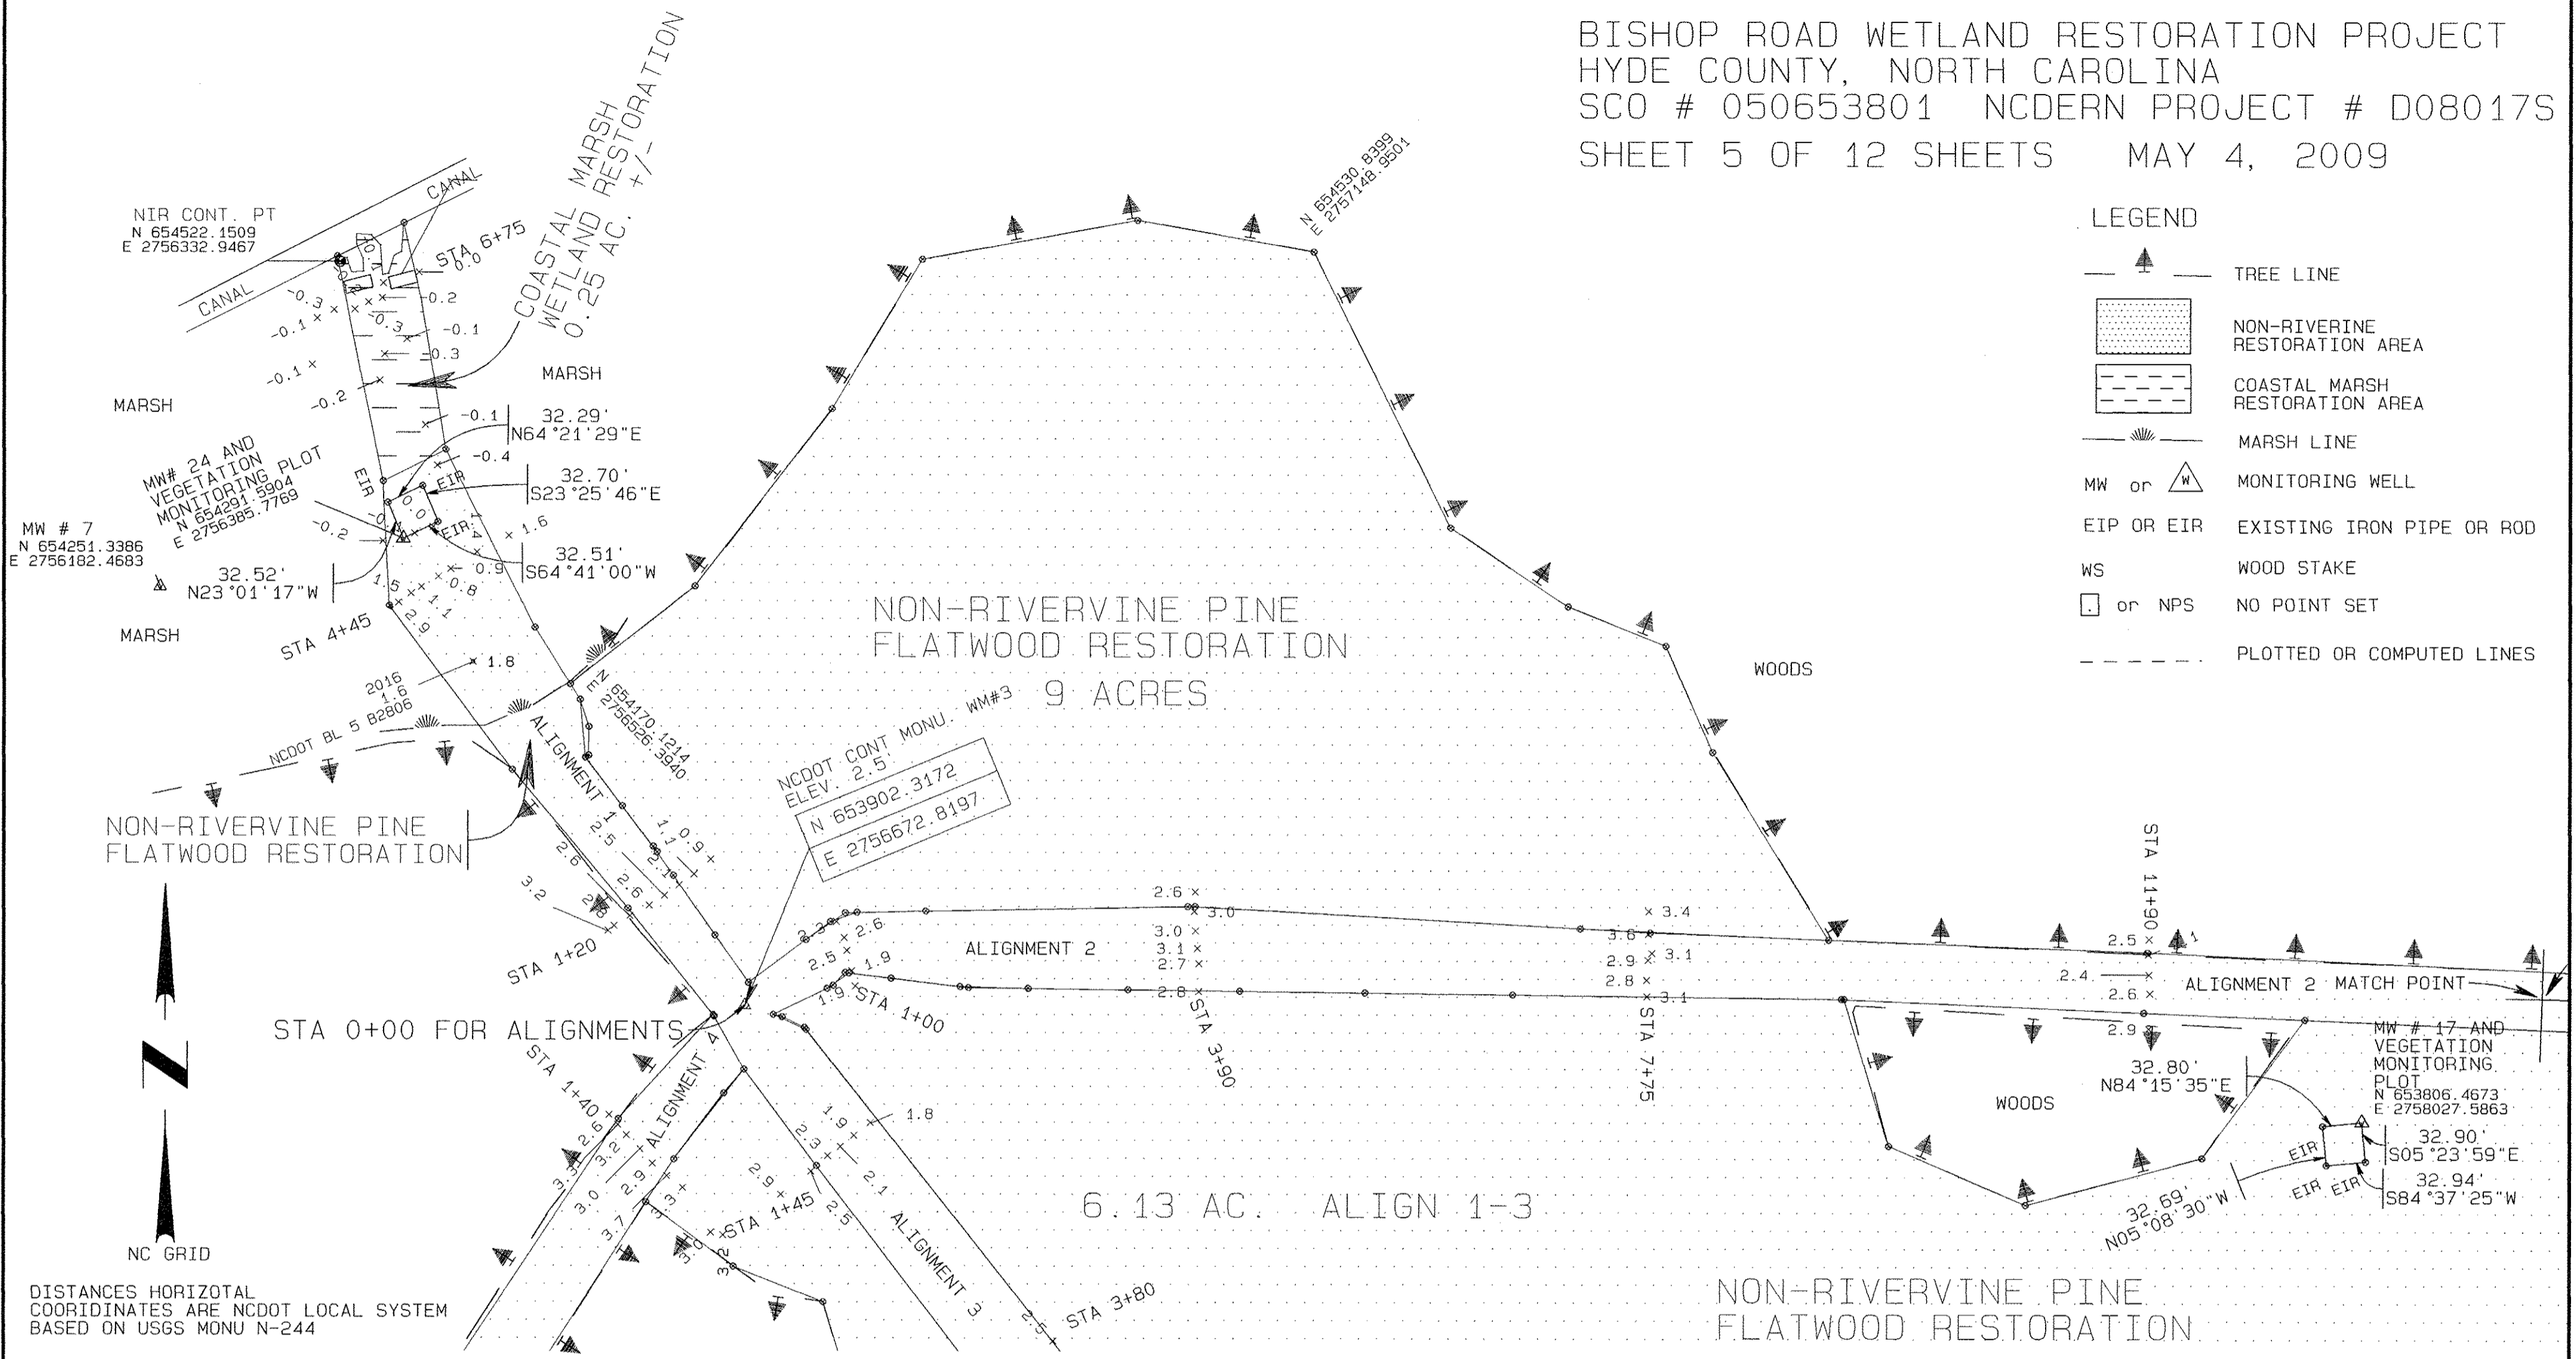


DISTANCES HORIZONTAL
 COORDINATES ARE NCDOT LOCAL SYSTEM
 BASED ON USGS MONU N-244

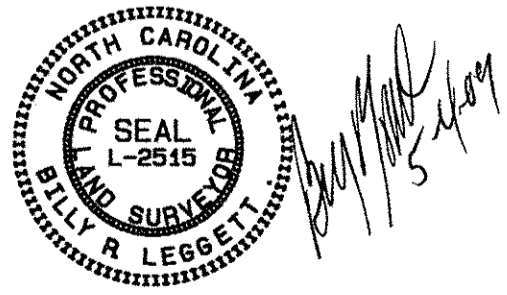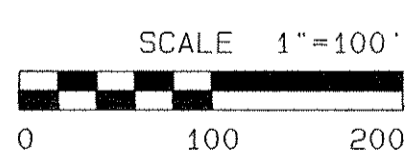

AS BUILT OVERLAY LAYER
 ALIGN 1
 PART OF ALIGN 2



BISHOP ROAD WETLAND RESTORATION, CURRITUCK TWP., HYDE COUNTY, NC REFERENCE TO PLAT CAB. C SLIDES 77-K THRU 78-F
 AND PLANS PREPARED BY ARCADIS G & M OF NORTH CAROLINA, 801 CORPORATE CENTER DRIVE, SUITE 300, RALEIGH, NC 27607

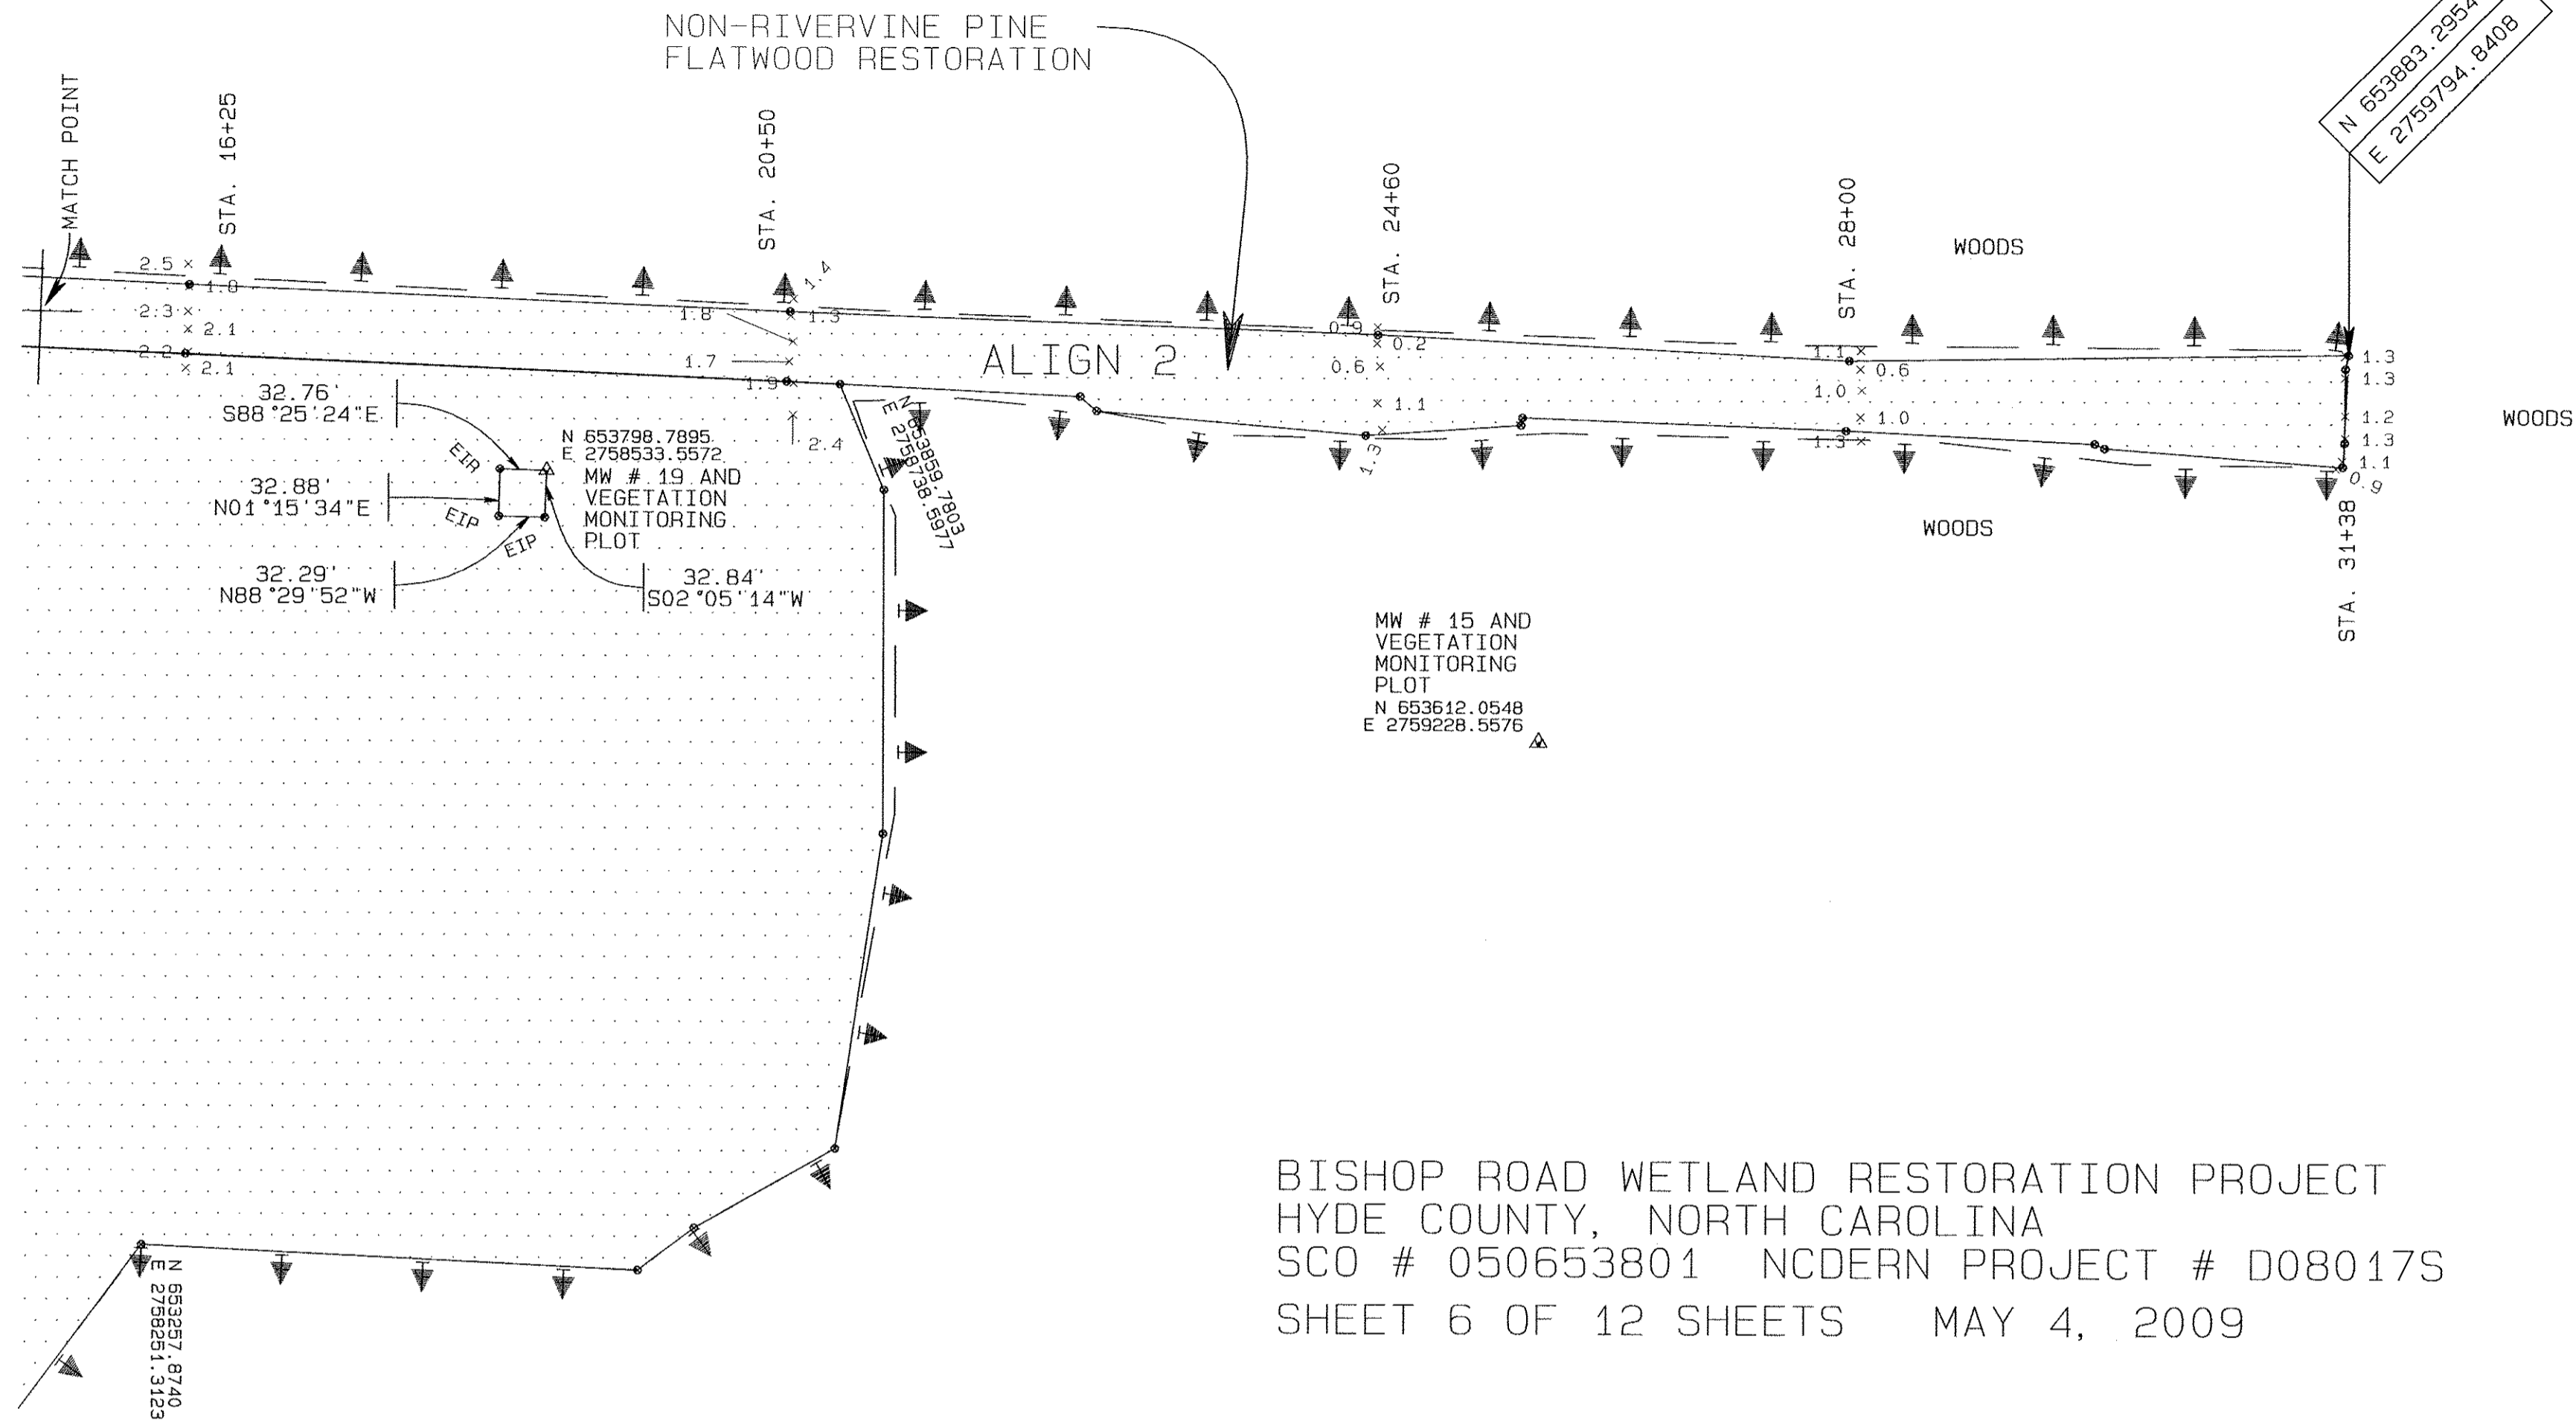

N 653883.2954
E 2759794.8408




DISTANCES HORIZONTAL
COORDINATES ARE NCDOT LOCAL SYSTEM
BASED ON USGS MONU N-244

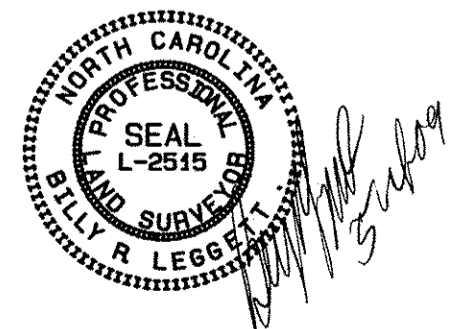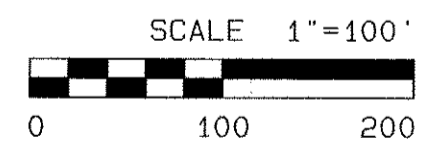

BISHOP ROAD WETLAND RESTORATION PROJECT
HYDE COUNTY, NORTH CAROLINA
SCO # 050653801 NCDERN PROJECT # D08017S
SHEET 6 OF 12 SHEETS MAY 4, 2009


AS BUILT OVERLAY LAYER
PART OF ALIGN 2

BISHOP ROAD WETLAND RESTORATION, CURRITUCK TWP., HYDE COUNTY, NC REFERENCE TO PLAT CAB. C SLIDES 77-K THRU 78-F
AND PLANS PREPARED BY ARCADIS G & M OF NORTH CAROLINA, 801 CORPORATE CENTER DRIVE, SUITE 300, RALEIGH, NC 27607

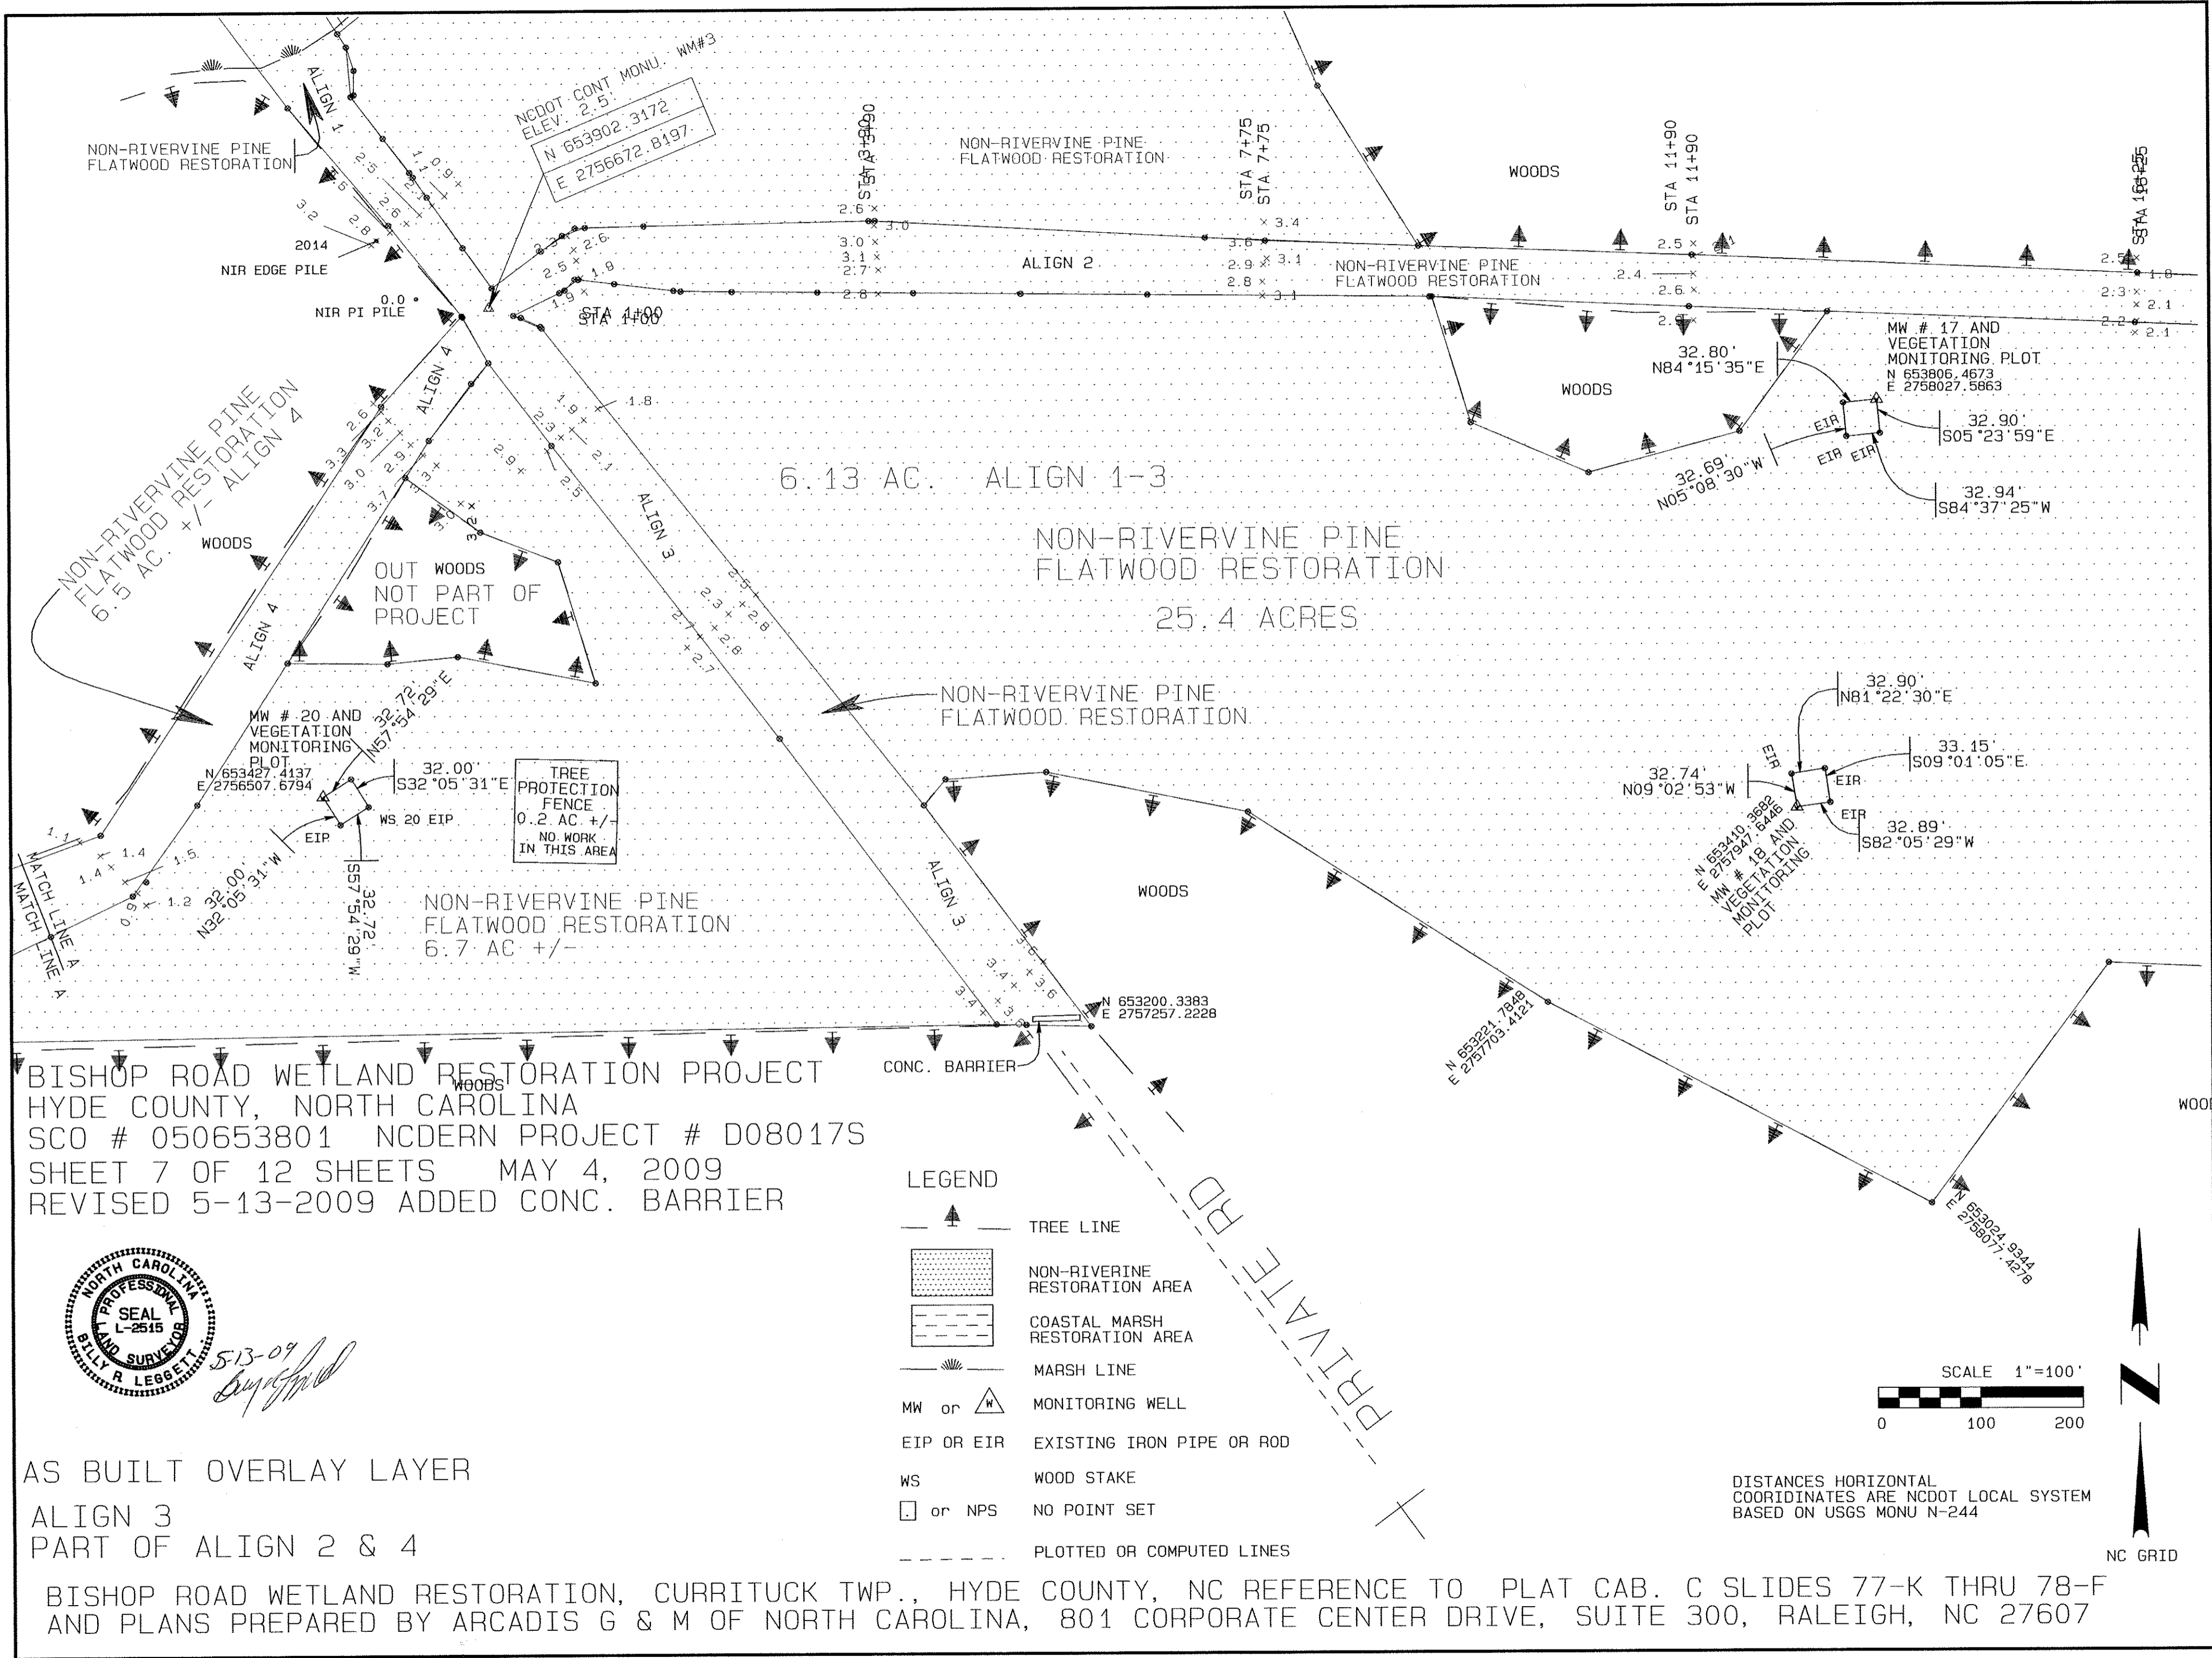


BISHOP ROAD WETLAND RESTORATION PROJECT
 HYDE COUNTY, NORTH CAROLINA
 SCO # 050653801 NCDERN PROJECT # D08017S
 SHEET 7 OF 12 SHEETS MAY 4, 2009
 REVISED 5-13-2009 ADDED CONC. BARRIER

- LEGEND**
- TREE LINE
 - NON-RIVERINE RESTORATION AREA
 - COASTAL MARSH RESTORATION AREA
 - MARSH LINE
 - MW or MONITORING WELL
 - EIP or EIR EXISTING IRON PIPE OR ROD
 - WS WOOD STAKE
 - or NPS NO POINT SET
 - PLOTTED OR COMPUTED LINES

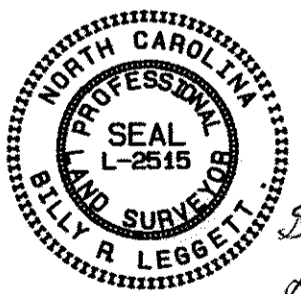


5-13-09
[Signature]

AS BUILT OVERLAY LAYER
 ALIGN 3
 PART OF ALIGN 2 & 4

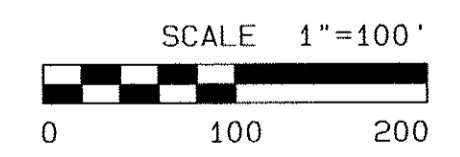


DISTANCES HORIZONTAL
 COORDINATES ARE NCDOT LOCAL SYSTEM
 BASED ON USGS MONU N-244

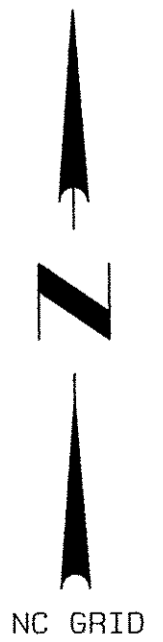

BISHOP ROAD WETLAND RESTORATION, CURRITUCK TWP., HYDE COUNTY, NC REFERENCE TO PLAT CAB. C SLIDES 77-K THRU 78-F
 AND PLANS PREPARED BY ARCADIS G & M OF NORTH CAROLINA, 801 CORPORATE CENTER DRIVE, SUITE 300, RALEIGH, NC 27607



BISHOP ROAD WETLAND RESTORATION PROJECT
 HYDE COUNTY, NORTH CAROLINA
 SCO # 050653801 NCDERN PROJECT # D08017S
 SHEET 8 OF 12 SHEETS MAY 4, 2009

AS BUILT OVERLAY LAYER
 MID PART OF ALIGN 4

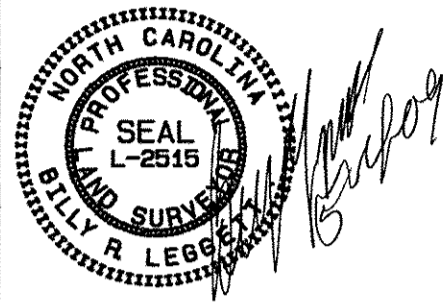

LEGEND

- TREE LINE
- NON-RIVERINE RESTORATION AREA
- COASTAL MARSH RESTORATION AREA
- MARSH LINE
- MW or MONITORING WELL
- EIP OR EIR EXISTING IRON PIPE OR ROD
- WS WOOD STAKE
- or NPS NO POINT SET
- PLOTTED OR COMPUTED LINES

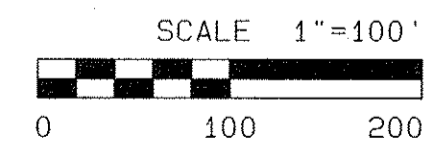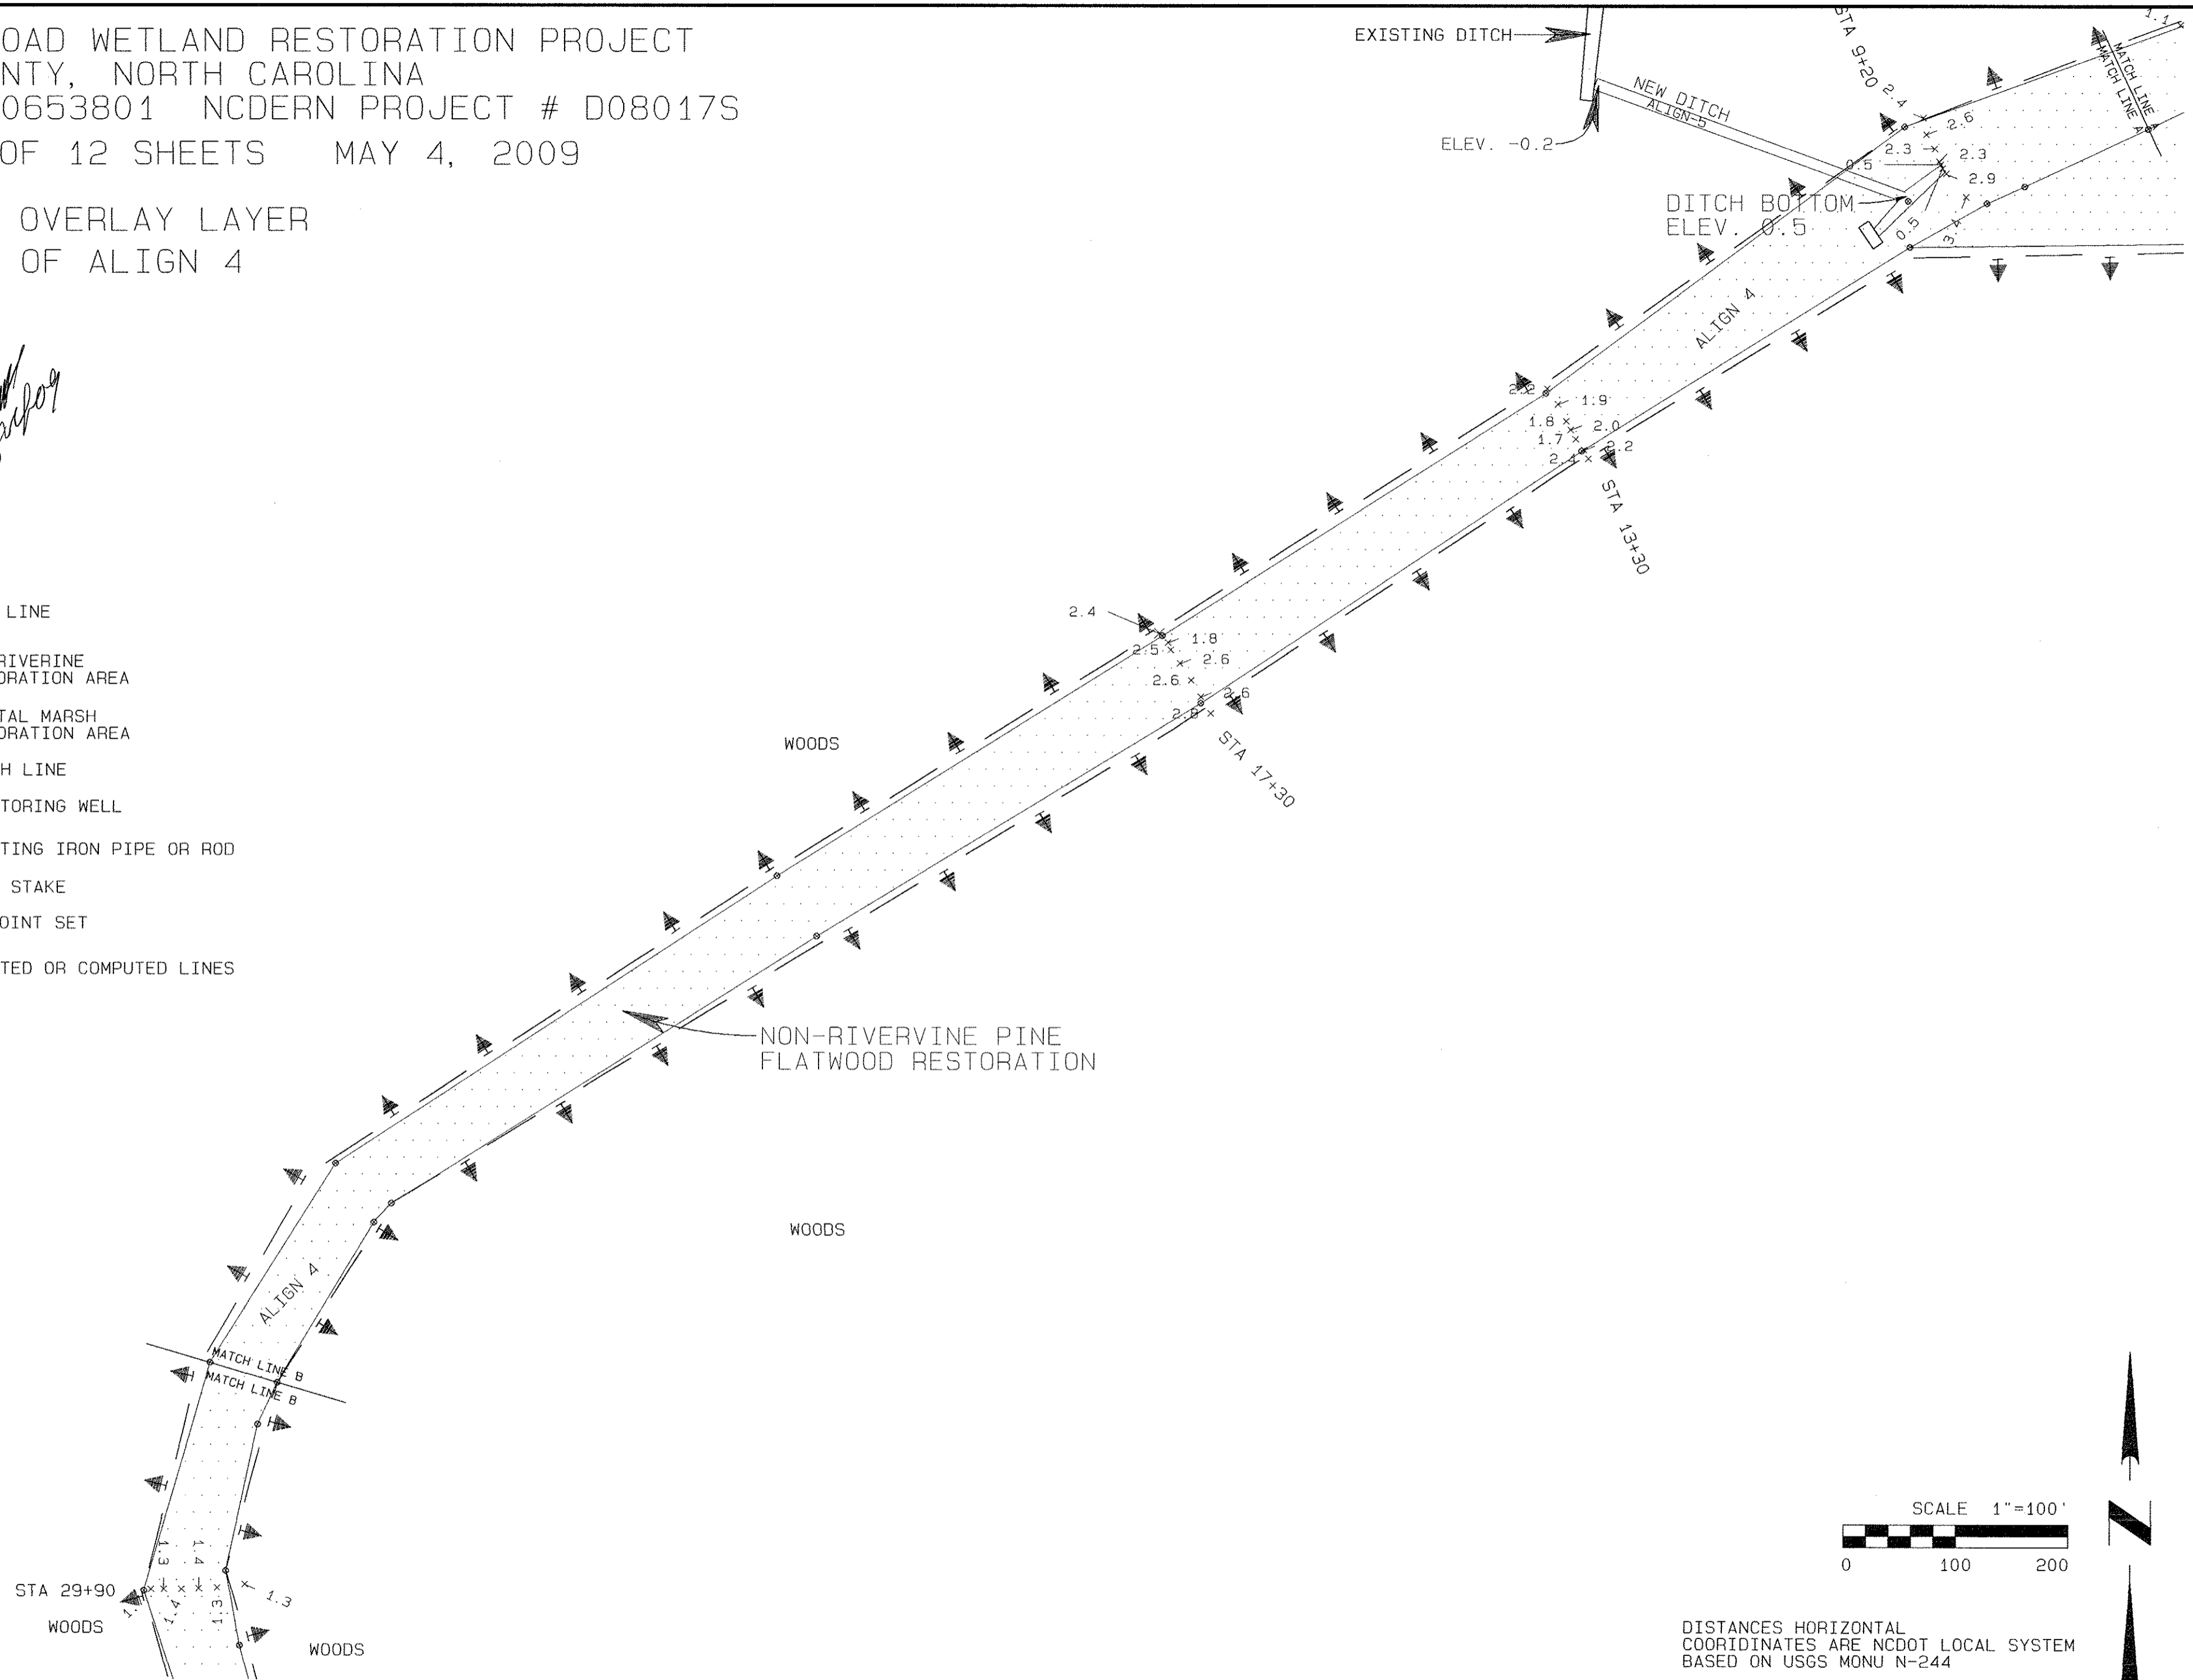


DISTANCES HORIZONTAL
 COORDINATES ARE NCDOT LOCAL SYSTEM
 BASED ON USGS MONU N-244



BISHOP ROAD WETLAND RESTORATION, CURRITUCK TWP., HYDE COUNTY, NC REFERENCE TO PLAT CAB. C SLIDES 77-K THRU 78-F
 AND PLANS PREPARED BY ARCADIS G & M OF NORTH CAROLINA, 801 CORPORATE CENTER DRIVE, SUITE 300, RALEIGH, NC 27607


BISHOP ROAD WETLAND RESTORATION PROJECT
 HYDE COUNTY, NORTH CAROLINA
 SCO # 050653801 NCDERN PROJECT # D08017S
 SHEET 9 OF 12 SHEETS MAY 4, 2009

AS BUILT OVERLAY LAYER
 LOWER (SOUTHERN) PART OF ALIGN 4

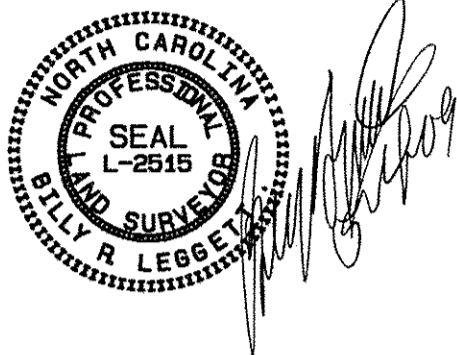


LEGEND


- TREE LINE
- NON-RIVERINE RESTORATION AREA
- COASTAL MARSH RESTORATION AREA
- MARSH LINE
- MW or MONITORING WELL
- EIP OR EIR EXISTING IRON PIPE OR ROD
- WS WOOD STAKE
- or NPS NO POINT SET
- PLOTTED OR COMPUTED LINES

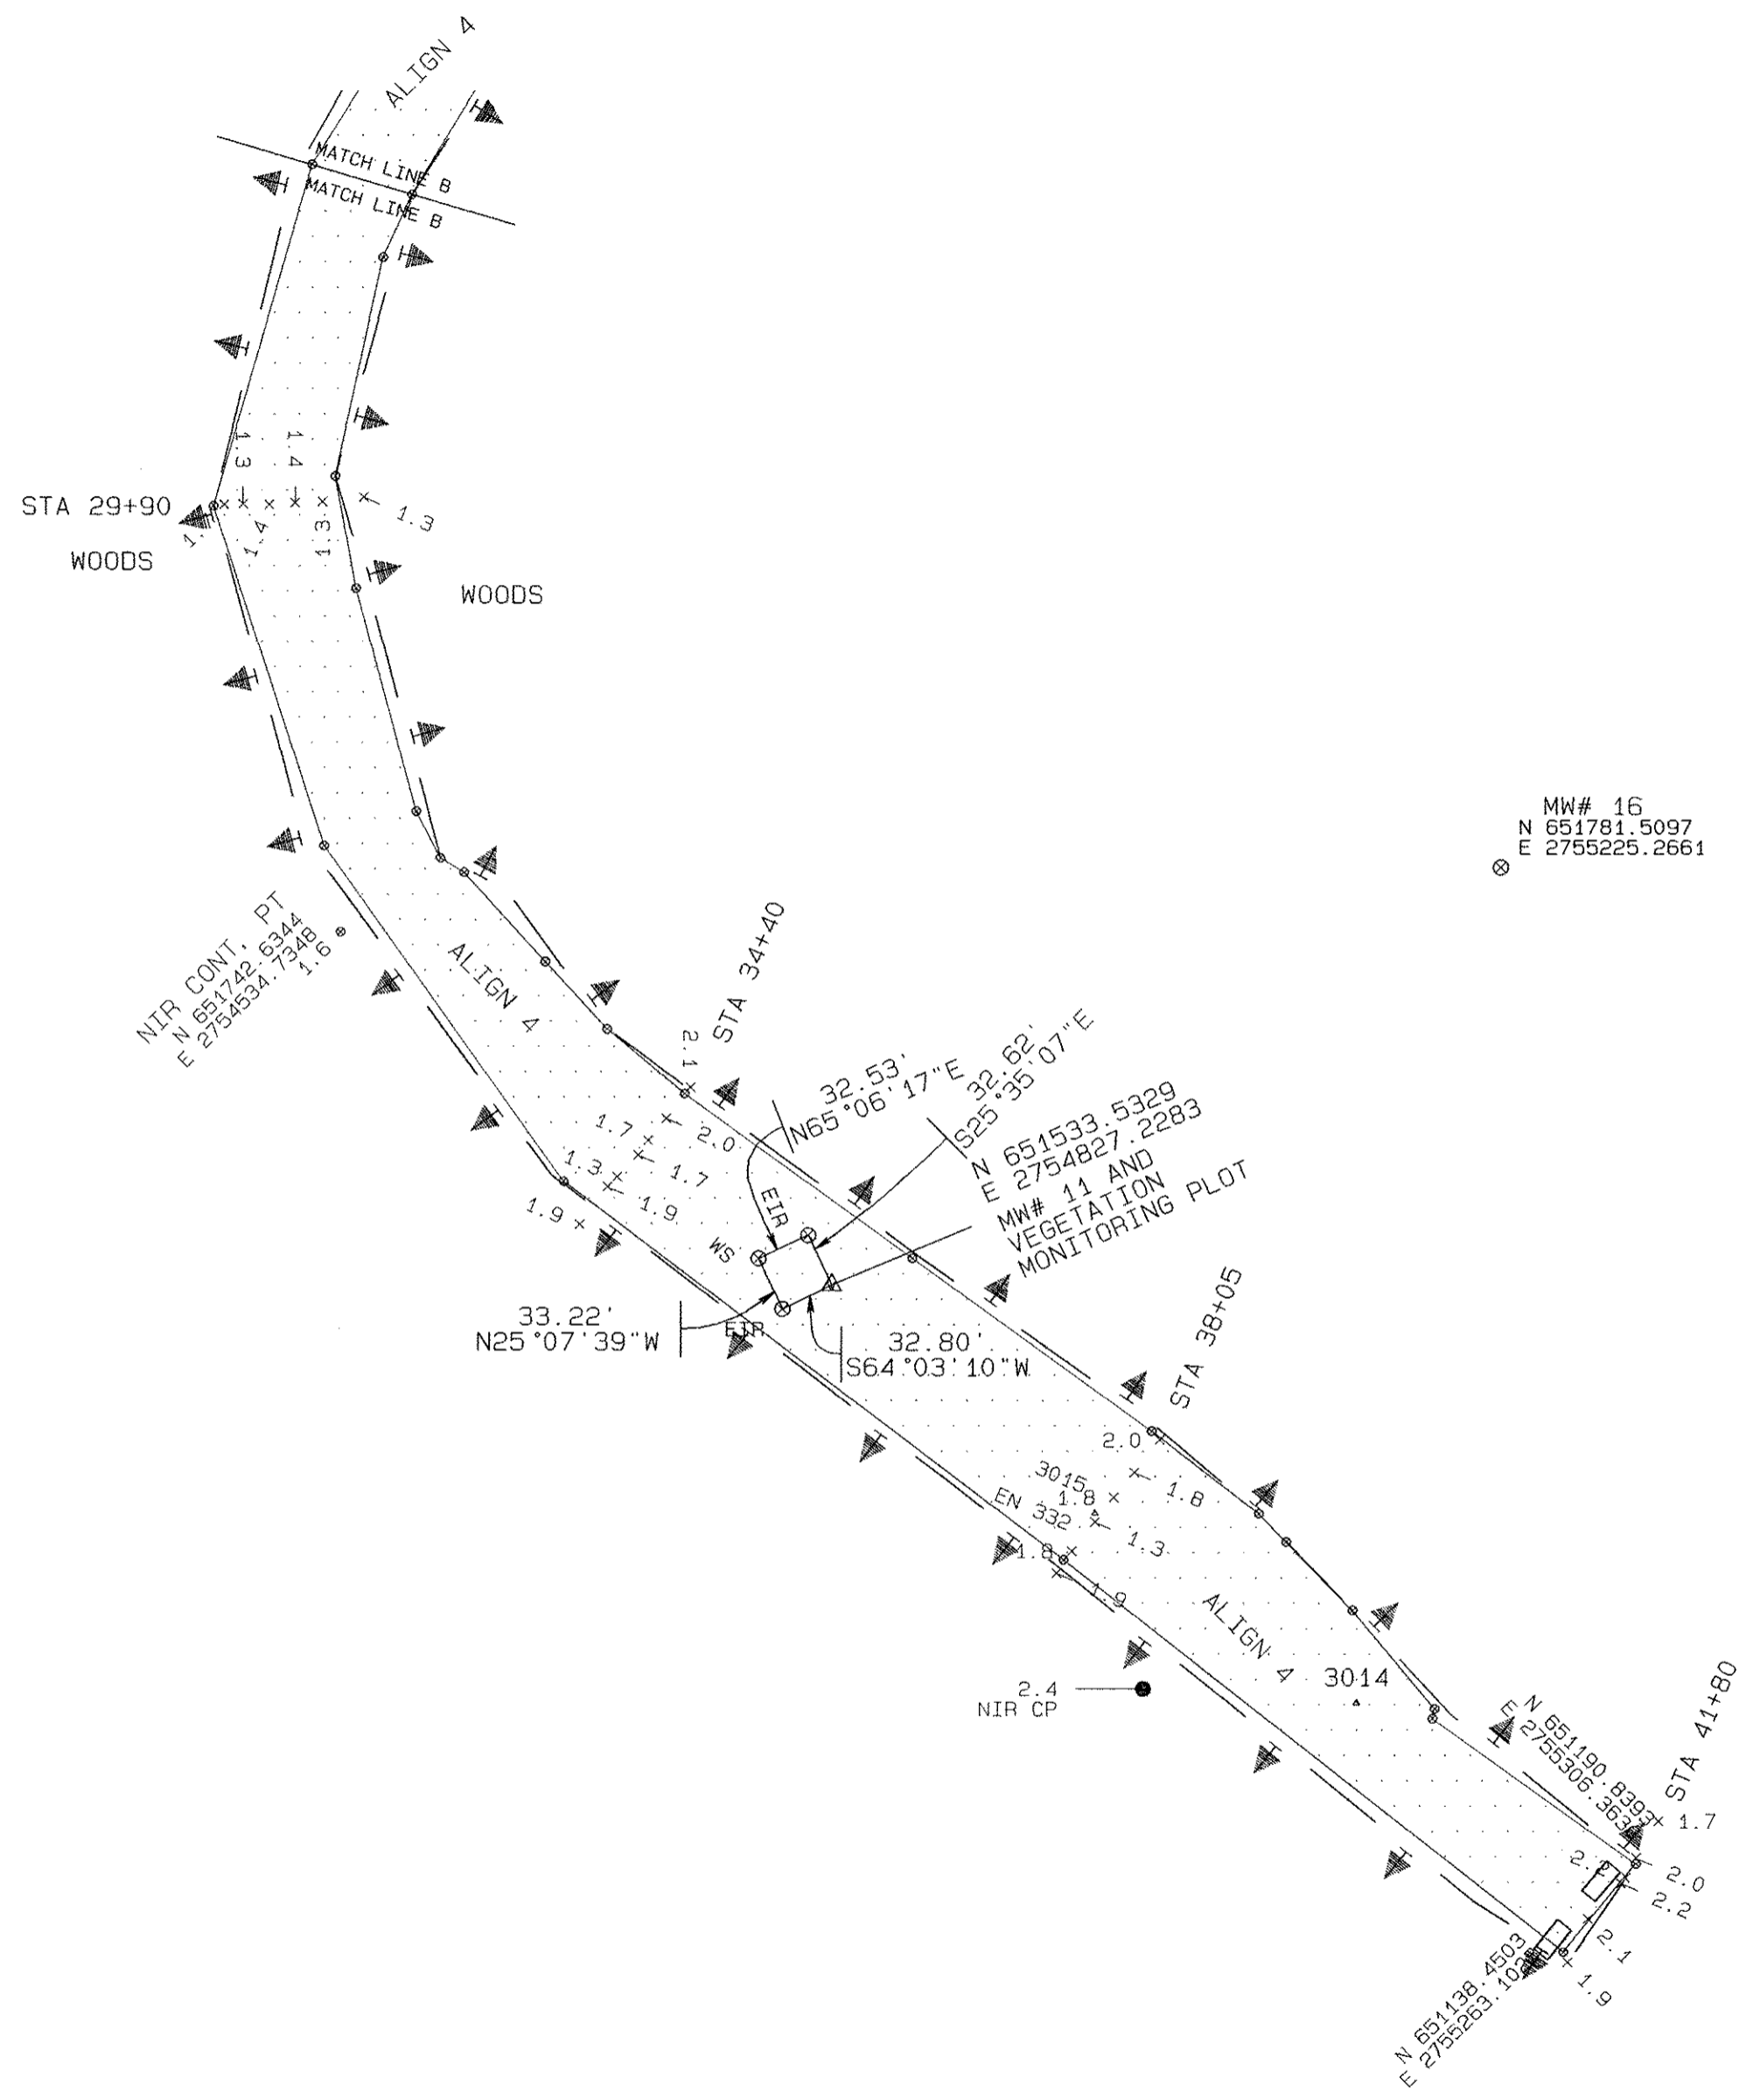






MW# 16
 N 651781.5097
 E 2755225.2661

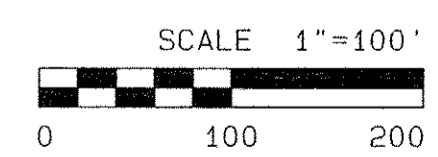





DISTANCES HORIZONTAL
 COORDINATES ARE NCDOT LOCAL SYSTEM
 BASED ON USGS MONU N-244

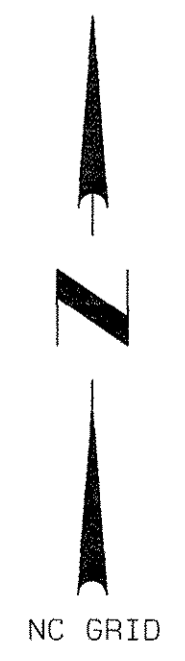

BISHOP ROAD WETLAND RESTORATION PROJECT
 HYDE COUNTY, NORTH CAROLINA
 SCO # 050653801 NCDERN PROJECT # D08017S
 SHEET 10 OF 12 SHEETS MAY 4, 2009

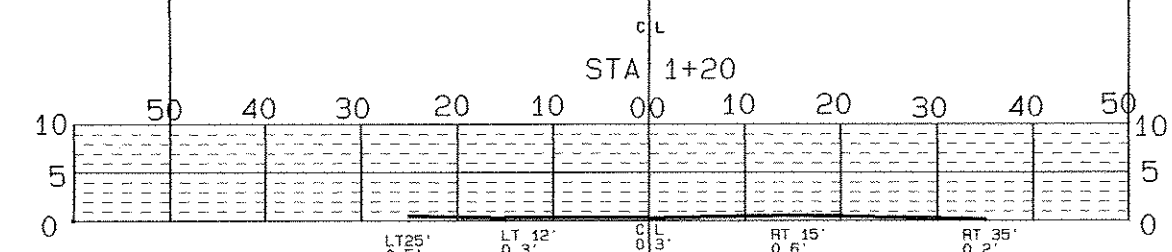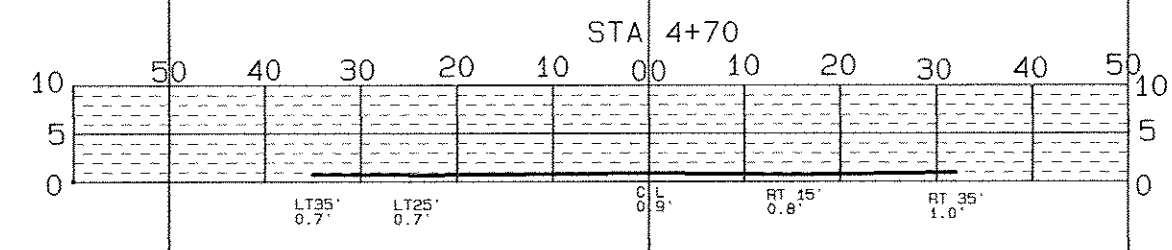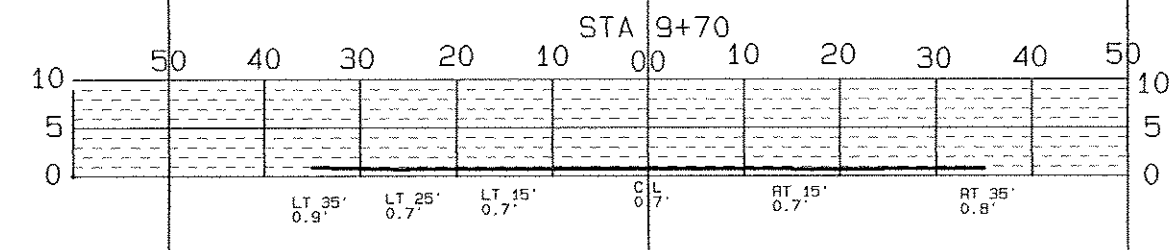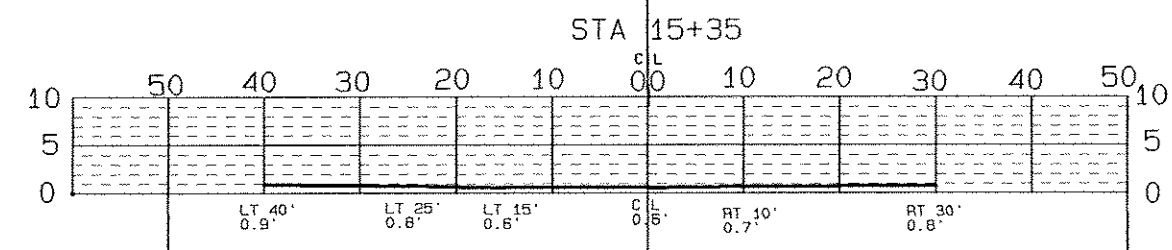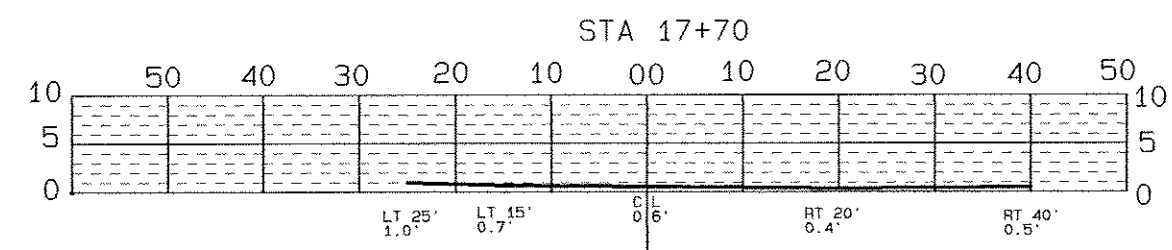

BISHOP ROAD FROM US 264 NORTHWARD

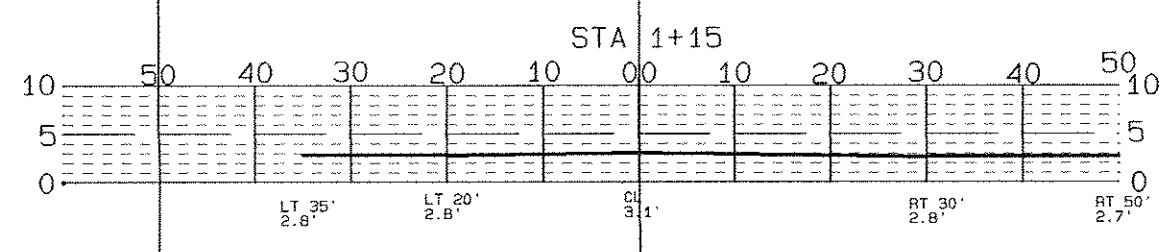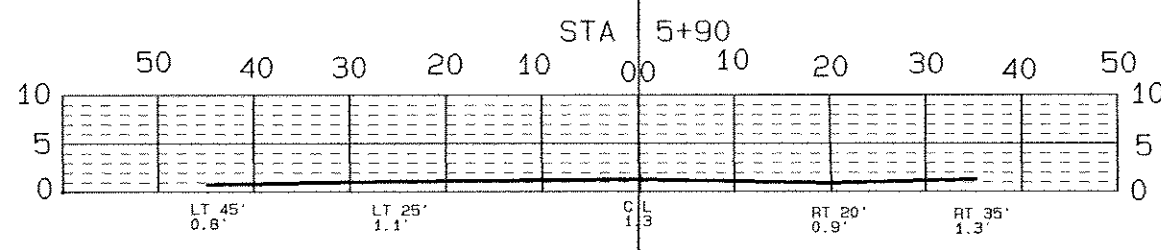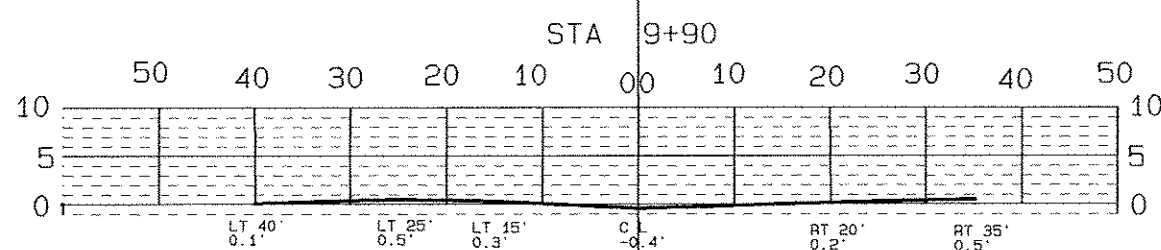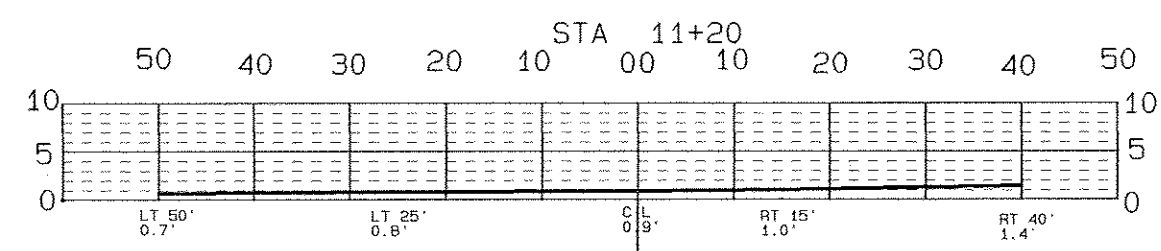

WEYERHAUSER SERVICE ROAD
 FROM WEST TO EAST

BISHOP ROAD WETLAND RESTORATION PROJECT
 HYDE COUNTY, NORTH CAROLINA
 SCO # 050653801 NCDERN PROJECT # D08017S
 SHEET 11 OF 12 SHEETS MAY 4, 2009

