

FINAL
AS-BUILT BASELINE
MONITORING REPORT

BOBS CREEK
STREAM MITIGATION SITE

NCDMS Project No. 92879
Contract No. D09023S
USACE Action ID No. SAW-2009-917 & NCDWR Project No. 10-0122
SCO No. 08-07308-01
McDowell County, North Carolina

Data Collection: April 2016
Submission: July 2016



PREPARED FOR:

N.C. DEPARTMENT OF ENVIRONMENTAL QUALITY
DIVISION OF MITIGATION SERVICES
1601 MAIL SERVICE CENTER
RALEIGH, NORTH CAROLINA 27699-1601

FINAL
AS-BUILT BASELINE
MONITORING REPORT

BOBS CREEK
STREAM MITIGATION SITE


NCDMS Project No. 92879
Contract No. D09023S
USACE Action ID No. SAW-2009-917 & NCDWR Project No. 10-0122
SCO No. 08-07308-01
McDowell County, North Carolina

Data Collection: April 2016
Submission: July 2016



PREPARED BY:

AXIOM ENVIRONMENTAL, INC.
218 SNOW AVENUE
RALEIGH, NORTH CAROLINA 27603

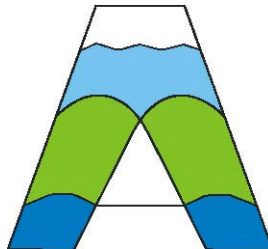

JULY 2016

PROJECT SUMMARY

The North Carolina Division of Mitigation Services (NCDMS) has established the Bobs Creek Stream Mitigation Site (Site). The primary goals of the project focused on improving water quality by reducing nutrient loading from the on-site buffalo and horse operation, reducing excess sedimentation input from site channel banks and hill slopes, increasing the attenuation of floodwater flows, and restoring and enhancing aquatic and riparian habitat. These goals were accomplished through the following objectives.

- Reduce point (i.e. buffalo directly accessing the channel) and non-point source (i.e. stormwater runoff through pastures) pollution associated with an on-site buffalo and horse operation by exclusionary fencing from the stream and riparian buffer, and by providing a vegetative buffer on stream banks and adjacent floodplains to treat nutrient enriched surface runoff from adjacent pastureland.
- Stabilize degraded portions of on-site streams, to reduce sediment inputs. Stabilization methods will include the following.
 1. Restoring a stable dimension, pattern, and profile to selected sections of channels to ensure the channel will transport and attenuate watershed flows and sediment loads without aggrading or degrading.
 2. Stabilize selected channel banks by excavating bankfull benches, placing stream structures to reduce shearing forces on outside meander bends, and planting native vegetative species to provide soil stability.
 3. Stabilize selected channel banks by matting and planting native vegetative species to establish root masses along channel and valley side slopes.
- Improve aquatic habitat by enhancing stream bed variability, providing shading/cover areas within the stream channel, and introducing woody debris in the form of rootwads, log vanes, and log sills.
- Diversify aquatic habitat by creating floodplain oxbows that will be breeding grounds for amphibians and also store overbank flows from adjacent stream channels.
- Enhance fish passage within Bobs Creek and UT 8 Bobs Creek. This is accomplished by removing livestock fencing that has become clogged with debris on Bobs Creek, and restoring UT 8 Bobs Creek and replacing an existing perched culvert to allow fish passage upstream.
- Enhance riparian wildlife habitat by fencing livestock out of existing and restored riparian buffers as well as installing alternative watering devices that will ensure livestock have sufficient watering areas. This is detailed further in the Farm Management Plans completed for the site by NCDMS.
- Enhance wildlife habitat by vegetating existing denuded riparian buffers with native trees, shrubs, herbs, and grasses. Forest vegetation species were selected by studying a Reference Forest Ecosystem located on-site and reviewing Montane Alluvial Forest species listed in *Classification of the Natural Communities of North Carolina: Third Approximation* (Schafale and Weakley 1990).
- Create wildlife corridors through agricultural lands which have significantly dissected the landscape. The corridors will provide connectivity to a diversity of habitats including mature forest, early successional forest, stream-side forest, riparian wetlands, and uplands.

Stream Success Criteria: Success criteria for stream restoration will include 1) successful classification of the reach as a functioning stream system (Rosgen 1996) and 2) channel variables indicative of a stable stream system.

Collected data will be utilized to determine the success in restoring stream channel stability. Specifically, the width-to-depth ratio and bank-height ratios should be indicative of a stable or moderately unstable channel with minimal changes in cross-sectional area, channel width, and/or bank erosion along the monitoring reach. In addition, channel abandonment and/or shoot cutoffs must not occur and sinuosity values must remain relatively constant. Visual assessment of instream structures will be conducted to determine if failure has occurred. Failure of a structure may be indicated by collapse of the structure,

undermining of the structure, abandonment of the channel around the structure, and/or stream flow beneath the structure.

Stream Dimension: General maintenance of a stable cross-section and hydrologic access to the floodplain features over the course of the monitoring period will generally represent success in dimensional stability. Some changes in dimension (such as lowering of bankfull width) should be expected. Riffle cross-sections should generally maintain a bank-height ratio approaching 1.0, with some variation in this ratio naturally occurring. Pool cross-sections naturally adjust based on recent flows and time between flows, therefore more leeway on pool cross-section geometry is expected.

Stream Pattern and Profile: The profile should not demonstrate significant trends towards degradation or aggradation over a significant portion of a reach. Additionally, bed form variables should remain noticeably intact and consistent with original design parameters that were based off of reference conditions. Pattern features should show little adjustment over the standard 5-year monitoring period and will be monitored to ensure adjustment is minor prior to close out.

Substrate: Substrate measurements should indicate the progression towards or the maintenance of the known distributions from the design phase.

Sediment Transport: There should be an absence of any significant trend in the aggradational or depositional potential of the channel.

Hydraulics: A minimum of two bankfull events must be documented within the standard 5-year monitoring period. The two bankfull events shall occur within separate years.

Vegetation Success Criteria: Success criteria have been established to verify that the vegetation component supports community elements necessary for forest development. Success criteria are dependent upon the density and growth of characteristic forest species. An average density of 320 stems per acre of planted stems must be surviving in the first three monitoring years. Subsequently, 290 planted stems per acre must be surviving in year 4 and 260 planted stems per acre in year 5.

The Bobs Site is located approximately five miles southeast of the town of Marion (Figure 1, Appendix B). The Site is situated due southwest of the intersection of Marlowe Road and Fat Wall Road in McDowell County, North Carolina and is located within the United States Geological Survey (USGS) Hydrologic Unit and Targeted Local Watershed 03050101040010 (North Carolina Division of Water Quality Subbasin 03-08-30) of the Catawba River Basin and will service USGS 8-digit Cataloging Unit 03050101.

The contributing watersheds are characterized primarily by forest land (approximately 87 percent of the total area) with pasture at the lower elevations (approximately 10 percent of the total area) and low-density residential development scattered along the outer fringes of the pasture/agricultural land. Impervious surfaces appear to account for approximately one percent of the watershed land surface. Prior to Site construction, riparian vegetation had been removed, stream channels were manipulated, and hoof shear from livestock on stream banks and floodplain soils was responsible for degraded water quality and unstable channel characteristics (stream entrenchment, erosion, and bank collapse) within Site streams.

Project mitigation efforts resulted in the following.

- Restore 929 linear feet of stream
- Enhance (Level I) 238 linear feet of stream
- Enhance (Level II) 402 linear feet of stream
- Preserve 6794 linear feet of stream
- Preserve 0.35 acres of riparian wetland

The Muddy Creek Restoration Partnership (Partnership) was formed in 1998 to address impacts to the Muddy Creek Watershed. The Partnership completed the *Muddy Creek Watershed Restoration Initiative Feasibility Report and Restoration Plan* (Watershed Plan) for the Muddy Creek Watershed in December of 2003 (MCRP 2003). Since 2004 NCDMS has informally participated in the Partnership by implementing priority projects named by the partnership and adopted the 2003 report as part of its Local Watershed Plan (LWP). The NCDMS's *Upper Catawba River Basin Restoration Priorities* (2009) identifies North Muddy Creek as a Targeted Local Watershed (TLW). The Site is located within the North Muddy Creek Watershed. In 2008 NCDMS contracted with a consulting firm to conduct outreach programs with landowners and identify additional project sites in the Muddy Creek Watershed.

The primary goals identified by the Partnership's Watershed Plan include the following.

1. Restore the Watershed to its Full Intended Use
2. Restore Riparian Buffers
3. Enhance Open Space Preservation
4. Improve Water Quality
5. Restore Physical Habitat
6. Establish a Trout Fishery

The Watershed Plan listed the following components of watershed restoration to be expected.

1. Natural Channel Design Stream Restoration
2. Riparian Reforestation
3. Livestock Exclusion
4. Riparian Forest Preservation

These four components were included within the *Bobs Creek Site's Mitigation Plan* (NCEEP 2009). The project restored the watershed to its full intended use by restoring a stream, floodplain, and riparian wetland ecosystem through stream and wetland restoration, enhancement and preservation. The project restored riparian buffers through revegetation of buffer zones with native riparian and wetland species along all Site streams. The project enhanced open space preservation by placing Site streams, wetlands, and their buffers into a permanent conservation easement. The overall Site helps improve water quality by reducing sedimentation in on-Site streams and planted a vegetated riparian buffer that filters nutrients from adjacent pasturelands. Additionally, exclusionary fencing and alternate watering devices removed livestock from accessing on-site channels and riparian buffers. The project restored and enhanced physical habitat for both aquatic and terrestrial species by planting native vegetation along stream banks and riparian buffers, creating wildlife corridors through a dissected landscape, and restoring bedform variability to Site streams. The stabilization of streams and buffers in the project area enhanced water quality in downstream receiving waters, which should help in the re-establishment of the watershed's ability to host trout and enhance their ability to propagate.

Site design was completed in April 2014. Site construction was completed in December 2015 and Site planting was completed in December 2015. Completed project activities, reporting history, completion dates, project contacts, and project attributes are summarized in Tables 1-4 (Appendix A).

TABLE OF CONTENTS

| | |
|-----------------------|---|
| PROJECT SUMMARY | i |
| 1.0 METHODS | 1 |
| 2.0 REFERENCES | 2 |

APPENDICES

Appendix A. Background Tables

Table 1. Project Components and Mitigation Units

Table 2. Project Activity and Reporting History

Table 3. Project Contacts Table

Table 4. Project Attributes Table

Appendix B. Visual Assessment Data

Figure 1. Site Location

Figures 2, 2A-2B. Current Conditions Plan View

Figures 3, 3A-3B. Project Assets

Stream Fixed Station Photo Points

Vegetation Plot Photographs

Appendix C. Vegetation Data

Table 5. Planted Bare Root Woody Vegetation

Table 6. Total Planted Stems by Plot and Species

Appendix D. Stream Measurement and Geomorphology Data

Cross-section Plots

Longitudinal Profile Plots

Substrate Plots

Tables 7A-7B. Baseline Morphology and Hydraulic Summary

Tables 8A-8B. Morphology and Hydraulic Monitoring Summary

Appendix E. As-built Plan Sheets

1.0 METHODS

Monitoring of restoration efforts will be performed for five years or until success criteria are fulfilled. Monitoring is proposed for the stream channel and vegetation. In general, the restoration success criteria, and required remediation actions, are based on the *Stream Mitigation Guidelines* (USACE et al. 2003). Monitoring features are described below and are depicted on Figure 2 (Appendix B).

Streams

The restored stream reaches are proposed to be monitored for geometric activity as follows.

- 850 linear feet of stream profile
- 4 riffle cross-sections
- 1 pool cross-section

The data will be presented in graphic and tabular format. Data to be presented will include 1) cross-sectional area, 2) bankfull width, 3) average depth, 4) maximum depth, 5) width-to-depth ratio, 6) meander wavelength, 7) belt-width, 8) water surface slope, and 9) sinuosity. The stream will subsequently be classified according to stream geometry and substrate (Rosgen 1996). Significant changes in channel morphology will be tracked and reported by comparing data in each successive monitoring year. Pebble counts will be completed at the 4 riffle cross-sections to be used for substrate analysis (Appendix D). Annual photographs will include 27 fixed station photographs (Appendix B). In addition, the Site contains two stream crest gauges to assist with documentation of bankfull events.

Vegetation

Restoration monitoring procedures for vegetation will monitor plant survival and species diversity. The Site planting area consists of 1.8 acres. After planting was completed, three vegetation plots were installed and monitored at the Site; baseline results can be found in Appendix C. Annual measurements of vegetation will consist of the following.

- 2 plant warranty inspection plots (only monitoring years 1-3)
- 3 CVS vegetation plots

A photographic record of plant growth should be included in each annual monitoring report; baseline photographs are included in Appendix B. During the first year, vegetation will receive a cursory, visual evaluation on a periodic basis to ascertain the degree of overtopping of planted elements by nuisance species. Subsequently, quantitative sampling of vegetation will be performed as outlined in the *CVS-EEP Protocol for Recording Vegetation, Version 4.2* (Lee et al. 2008) in September of the first monitoring year and annually between June 1 and September 30 for the remainder of the monitoring period until vegetation success criteria are achieved.

2.0 REFERENCES

- Lee, M.T., R.K. Peet, S.D. Roberts, and T.R. Wentworth. 2008. CVS-EEP Protocol for Recording Vegetation. Version 4.2. North Carolina Department of Environment and Natural Resources, Ecosystem Enhancement Program. Raleigh, North Carolina.
- Muddy Creek Restoration Partners (MCRP), 2003. Feasibility Report and Restoration Plan for the Muddy Creek Watershed.
- North Carolina Ecosystem Enhancement Program (NCEEP). 2009. Bobs Creek Stream and Wetland Mitigation Site Mitigation Plan. North Carolina Department of Environment and Natural Resources, Ecosystem Enhancement Program. Raleigh, North Carolina.
- North Carolina Ecosystem Enhancement Program (NCEEP). 2009. Upper Catawba River Basin Restoration Priorities 2009 (online). Available: http://www.nceep.net/services/restplans/Upper_Catawba_RBRP_2009.pdf [March 12, 2009]. North Carolina Department of Environment and Natural Resources, Raleigh, North Carolina.
- Rosgen D. 1996. Applied River Morphology. Wildland Hydrology. Pagosa Springs, Colorado.
- Schafale, M.P. and A.S. Weakley. 1990. Classification of the Natural Communities of North Carolina: Third Approximation. North Carolina Natural Heritage Program, Division of Parks and Recreation, North Carolina Department of Environment, Health, and Natural Resources. Raleigh, North Carolina.
- United States Army Corps of Engineers (USACE), United States Environmental Protection Agency (USEPA), North Carolina Wildlife Resources Commission (NCWRC), Natural Resources Conservation Service (NRCS), and North Carolina Division of Water Quality (NCDWQ). 2003. Stream Mitigation Guidelines. State of North Carolina.

Appendix A.
Background Tables

- Table 1. Project Mitigation Components
Table 2. Project Activity and Reporting History
Table 3. Project Contacts Table
Table 4. Project Attributes Table

Table 1. Project Components and Mitigation Credits
Bobs Creek Mitigation Site/ DMS Number 92879

| Mitigation Credit Summations | | | | | | | |
|---|--|-----------------------------|--------------------------------|------------------------------|------------------|--------------------|---|
| Stream | Riparian Wetland | Nonriparian Wetland | Buffer | | Nitrogen Offset | Phosphorous Offset | |
| 2607 | 0.07 | --- | --- | | --- | --- | |
| Projects Components | | | | | | | |
| Project Component –or–Reach ID | Stationing | Existing Footage or Acreage | Restoration Footage or Acreage | Restoration Level/Equivalent | Mitigation Ratio | Mitigation Credits | Comment |
| Bobs Creek <i>Bob Creek As-built Plan Stationing</i> | 39+86 – 43+21 <i>(09+90 – 13+25)</i> | 3315 | 335 <i>335</i> | Restoration (PI) | 1:1 | 335 | Channel moved away from terrace and around existing mature vegetation. |
| Bobs Creek | 36+74 – 37+21 37+89 – 38+67 39+14 – 39+50 | | 161 | Enhance I | 1.5:1 | 107 | Bankfull bench excavation, channel structures, and vegetative plantings on degraded banks. |
| Bobs Creek | 37+21 – 37+89 38+67 – 39+14 39+50 – 39+86 | | 151 | Enhance II | 2.5:1 | 60 | Exclusionary fencing and permanent conservation easement. The easement break at 39+86 has been removed from credit summation. |
| Bobs Creek | 10+00 – 36+74 | | 2674 | Preservation | 5:1 | 535 | Two easement breaks have been removed from credit summation. |
| UT 1 Bobs Creek | 10+00 – 20+60 | 1060 | 1060 | Preservation | 5:1 | 212 | --- |
| UT 2 Bobs Creek | 10+00 – 15+90 | 590 | 590 | Preservation | 5:1 | 118 | --- |
| UT 3 Bobs Creek | 10+00 – 15+30 | 530 | 530 | Preservation | 5:1 | 106 | The easement break has been removed from credit summation. |
| UT 4 Bobs Creek | 10+00 – 16+51 10+00 – 10+75 | 726 | 726 | Preservation | 5:1 | 145 | |
| UT 5 Bobs Creek | 10+00 – 12+24 | 224 | 224 | Preservation | 5:1 | 45 | --- |
| UT 6 Bobs Creek | 10+17 – 10+37 10+73 – 10+78 12+50 – 12+76 | 369 | 51 | Enhance II | 2.5:1 | 20 | Vegetative plantings on degraded meanders and matting. |
| UT 6 Bobs Creek | 10+00 – 10+17 10+37 – 10+73 10+78 – 12+50 12+76 – 13+37 | | 286 | Preservation | 5:1 | 57 | --- |
| UT 7 Bobs Creek | 15+23 – 15+48 | 682 | 25 | Enhance I | 1.5:1 | 17 | Bankfull bench excavation, channel structures, and vegetative plantings on degraded banks. |
| UT 7 Bobs Creek | 10+00 – 15+23 15+48 – 16+36 | | 611 | Preservation | 5:1 | 122 | The easement break at the crossing has been removed from credit summation. |

| | | | | | | | |
|---|--|------|------|-------------------|-------|------|---|
| UT 8 Bobs Creek Bob Creek As-built Plan Stationing | 11+58 – 13+35 (10+00 – 11+77) 15+22 – 16+95 (10+00 – 11+73) 17+85 – 19+39 (13+16 – 14+70) | 985 | 504 | Restoration (PI) | 1:1 | 504 | Channel moved away from valley side slope, and around mature vegetation in Upstream Reach. New channel location in new valley in Downstream Reach. The easement break at the crossing in the downstream reach has been removed from credit summation. |
| UT 8 Bobs Creek Bob Creek As-built Plan Stationing | 16+95 – 17+85 (12+26 – 13+16) | | 90 | Restoration (PII) | 1:1 | 90 | Channel moved approximately 100 feet to the west of existing location to historic valley. |
| UT 8 Bobs Creek | 10+93 – 11+25 14+45 – 14+65 | | 52 | Enhance I | 1.5:1 | 35 | Bankfull bench excavation, channel structure, and vegetative plantings on degraded banks. |
| UT 8 Bobs Creek | 11+25 – 11+58 13+35 – 14+45 14+65 – 15+22 | | 200 | Enhance II | 2.5:1 | 80 | Vegetative plantings on degraded meanders and matting. |
| UT 8 Bobs Creek | 10+00 – 10+93 | | 93 | Preservation | 5:1 | 19 | --- |
| Wetlands | --- | 0.35 | 0.35 | Preservation | 5:1 | 0.07 | --- |

Length and Area Summations

| Restoration Level | Stream (linear footage) | Riparian Wetland (acreage) | | Nonriparian Wetland (acreage) | Buffer (square feet) | Upland (acres) |
|-------------------------|-------------------------|----------------------------|--------------|-------------------------------|----------------------|----------------|
| | | Riverine | Non-Riverine | | | |
| Restoration | 929 | -- | | -- | | |
| Enhancement (Level I) | 238 | -- | | -- | | |
| Enhancement (Level II) | 402 | -- | | -- | | |
| Preservation | 6,794 | 0.35 | | -- | | |
| Totals | 8,363 | 0.35 | | -- | | |
| Mitigation Units | 2,607 SMUs | 0.07 Riparian WMUs | | 0.00 Nonriparian WMUs | | |

BMP Elements

| Element | Location | Purpose/Function | Notes |
|---------|----------|------------------|-------|
| | | | |
| | | | |
| | | | |

**Table 2. Project Activity and Reporting History
Bobs Creek Mitigation Site/ DMS Number 92879**

| Activity or Deliverable | Data Collection Complete | Completion or Delivery |
|---|---------------------------------|-------------------------------|
| Project Institution | | |
| Mitigation Plan | April 2009 | December 2009 |
| Permits Issued | | |
| Final Design – Construction Plans | | April 2014 |
| Construction | -- | December 2015 |
| Temporary S&E Mix applied to Entire Project Site | -- | December 2015 |
| Permanent Seed Mix applied to the Entire Project Site | -- | December 2015 |
| Bare Root; Containerized; and B&B Plantings for the Entire Project Site | -- | December 2015 |
| Baseline Monitoring Document (Year 0 Monitoring Baseline) | April 2016 | July 2016 |
| Year 1 Monitoring | | |
| Year 2 Monitoring | | |
| Year 3 Monitoring | | |
| Year 4 Monitoring | | |
| Year 5 Monitoring | | |

**Table 3. Project Contact Table
Bobs Creek Mitigation Site/ DMS Number 92879**

| | |
|--|--|
| Designer | Florence & Hutcheson Engineering (Now HDR) 5121 Kingdom Way, Suite 100 Raleigh, NC 27607 Kevin Williams (919) 851-6066 |
| Construction Plans and Sediment and Erosion Control Plans | Florence & Hutcheson Engineering (Now HDR) 5121 Kingdom Way, Suite 100 Raleigh, NC 27607 Kevin Williams (919) 851-6066 |
| Construction Contractor | Carolina Environmental Contracting, Inc. Mount Airy, NC (336) 320-3849 |
| Planting Contractor | Keller Environmental 7291 Haymarket Lane Raleigh, NC 27615 Jay Keller (919) 749-8259 |
| As-built Surveyor | Turner Land Surveying, PLLC 3719 Benson Drive Raleigh, NC 27609 Elisabeth Turner (919) 827-0745 |
| Baseline Data Collection | Axiom Environmental, Inc. 218 Snow Avenue Raleigh, NC 27603 Grant Lewis (919) 215-1693 |


**Table 4. Project Baseline Information and Attributes
Bobs Creek Mitigation Site/ DMS Number 92879**

| Project Information | | | | | | |
|---|---------------------------------|--------------------|--------------------|-----------------|--------------|---------------------|
| Project name | Bobs Creek Mitigation Site | | | | | |
| Project county | McDowell County, North Carolina | | | | | |
| Project area (Acres) | 31.8 | | | | | |
| Project coordinates (lat/long) | 35.6567°N, 81.9355°W | | | | | |
| Project Watershed Summary Information | | | | | | |
| Physiographic region | Blue Ridge | | | | | |
| Project river basin | Catawba River Basin | | | | | |
| USGS hydrologic unit (8 digit) | 03050101 | | | | | |
| NCDWQ Sub-basin | 03-08-30 | | | | | |
| Project drainage area (acres) | 930 | | | | | |
| % Drainage area impervious | 1 | | | | | |
| CGIA land use classification | ---- | | | | | |
| Reach Summary Information | | | | | | |
| Parameters | Bobs Creek | UT's to Bobs Creek | | | | |
| | | UT 1 | UT 2/3 | UT 4/5 | UT 6/7 | UT 8 |
| Length of reach (linear feet) | 3321 | 1060 | 590/530 | 726/224 | 337/636 | 939 |
| Valley classification | VIII | II | II | II | II & VII | II |
| Drainage area (acres) | 930 | 1 | 20/120 | 20/40 | 440/45 | 60 |
| NCDWQ stream identification score | 46.5 | 24 | 39/24 | 27/34 | 27/41.5 | 33.5 |
| NCDWQ water quality classification | C | C | C | C | C | C |
| Morphological description (stream type) | B & C & F4 | B4 | B4 | E & C4 / A & B4 | B4 / C4 & E4 | B&C&G4 |
| Design Rosgen stream type | C4 | B4 | B4 | E & C4 / B4 | B4 / C4 & E4 | E & C4 |
| Evolutionary trend | | | | | | |
| Design approach (P1, P2, P3, E, etc.) | PI, EI, EII, & P | P | P | P | EI, EII, P | PI, PII, EI, EII, P |
| Underlying mapped soils | Tate/Chestnut/ Ashe | Tate | Tate/ Evard/ Cowee | Tate/ Evard | Iotla | Iotla |
| Drainage class | Well | Well | Well | Well | SW Poor | SW Poor |
| Soil hydric status | Nonhydric | Nonhydric | Nonhydric | Nonhydric | Nonhydric | Nonhydric |
| Slope | 0.0173 | 0.191 | 0.258/ 0.286 | 0.086/ 0.255 | 0.039/ 0.047 | 0.0342 |
| FEMA classification | Zone AE | Zone X | Zone X | Zone X | Zone X | Zone X |
| Native vegetation community | Forest/Pasture | Forest | Forest | Forest | Forest | Pasture |
| % Composition of exotic invasive spp. | <5 | <5 | <5 | <5 | <5 | <5 |
| Wetland Summary Information | | | | | | |
| Parameters | Wetland 1 | | | Wetland 2 | | |
| Size of wetland (acres) | 0.35 | | | | | |
| Wetland type | Riparian Riverine | | | | | |
| Mapped soil series | Tate Loam (Wehadkee) | | | | | |
| Drainage class | Well (poorly) | | | | | |
| Soil hydric status | Nonhydric (hydric) | | | | | |


| Source of hydrology | Overbank and groundwater | | |
|---|--------------------------|------------------|---------------------------------|
| Hydrologic impairment | None | | |
| Native vegetation community | Forested | | |
| % Composition of exotic invasive spp. | <5 | | |
| Regulatory Considerations | | | |
| Regulation | Applicable? | Resolved? | Supporting Documentation |
| Waters of the US – Section 404 | Yes | Yes | SAW-2009-917 |
| Waters of the US – Section 401 | Yes | Yes | SAW-2009-917 |
| Endangered Species Act | Yes | Yes | No Effect – CE Document |
| Historic Preservation Act | Yes | Yes | CE Document |
| Coastal Zone Management Act (CZMA/CAMA) | No | NA | NA |
| FEMA Floodplain Compliance | Yes | Yes | No Rise |
| Essential Fisheries Habitat | No | NA | NA |

Appendix B
Visual Assessment Data


Figure 1. Site Location
Figures 2, 2A-2B. Current Conditions Plan View
Figures 3, 3A-3B. Project Assets
Stream Fixed Station Photo Points
Vegetation Plot Photos

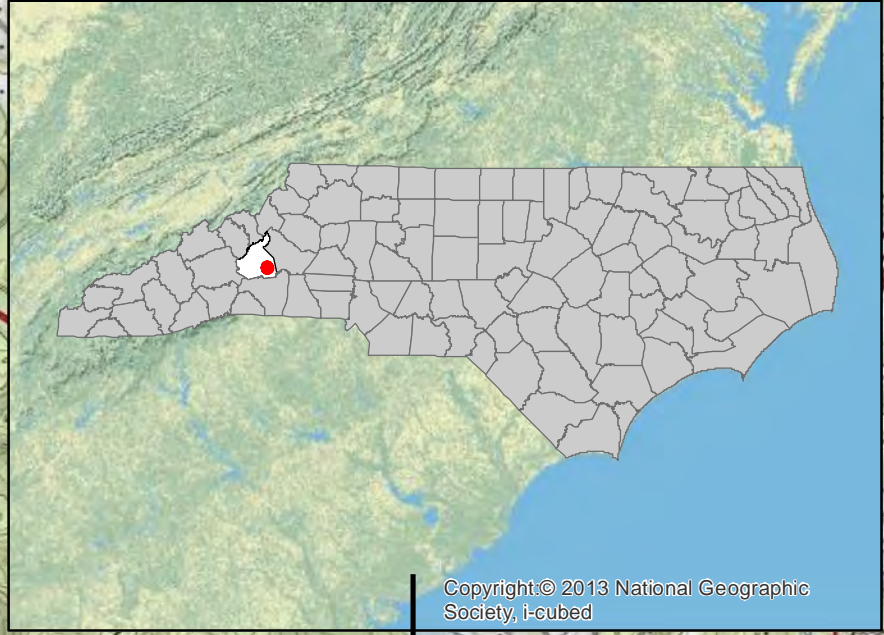

Copyright © 2013 National Geographic Society, i-cubed

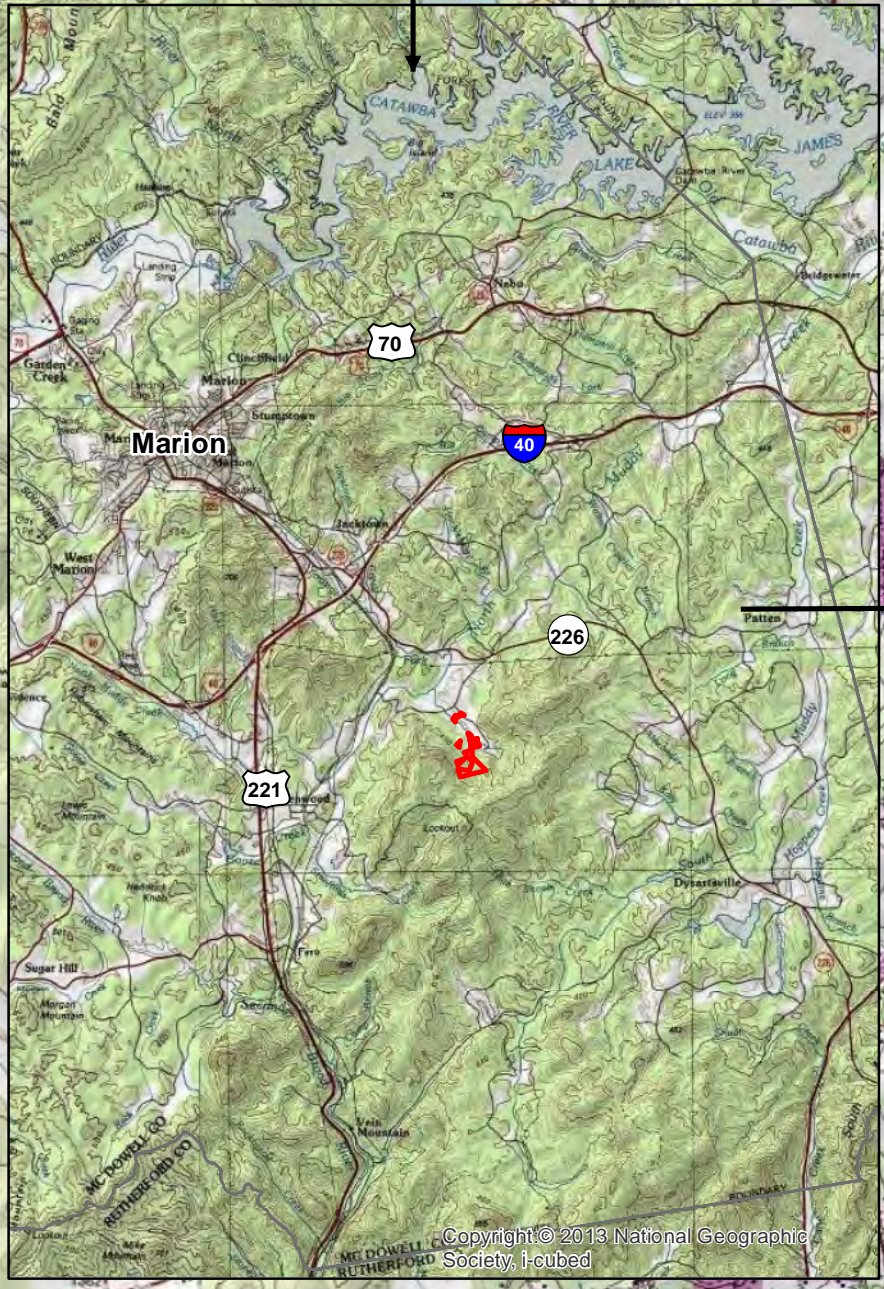

Copyright © 2013 National Geographic Society, i-cubed

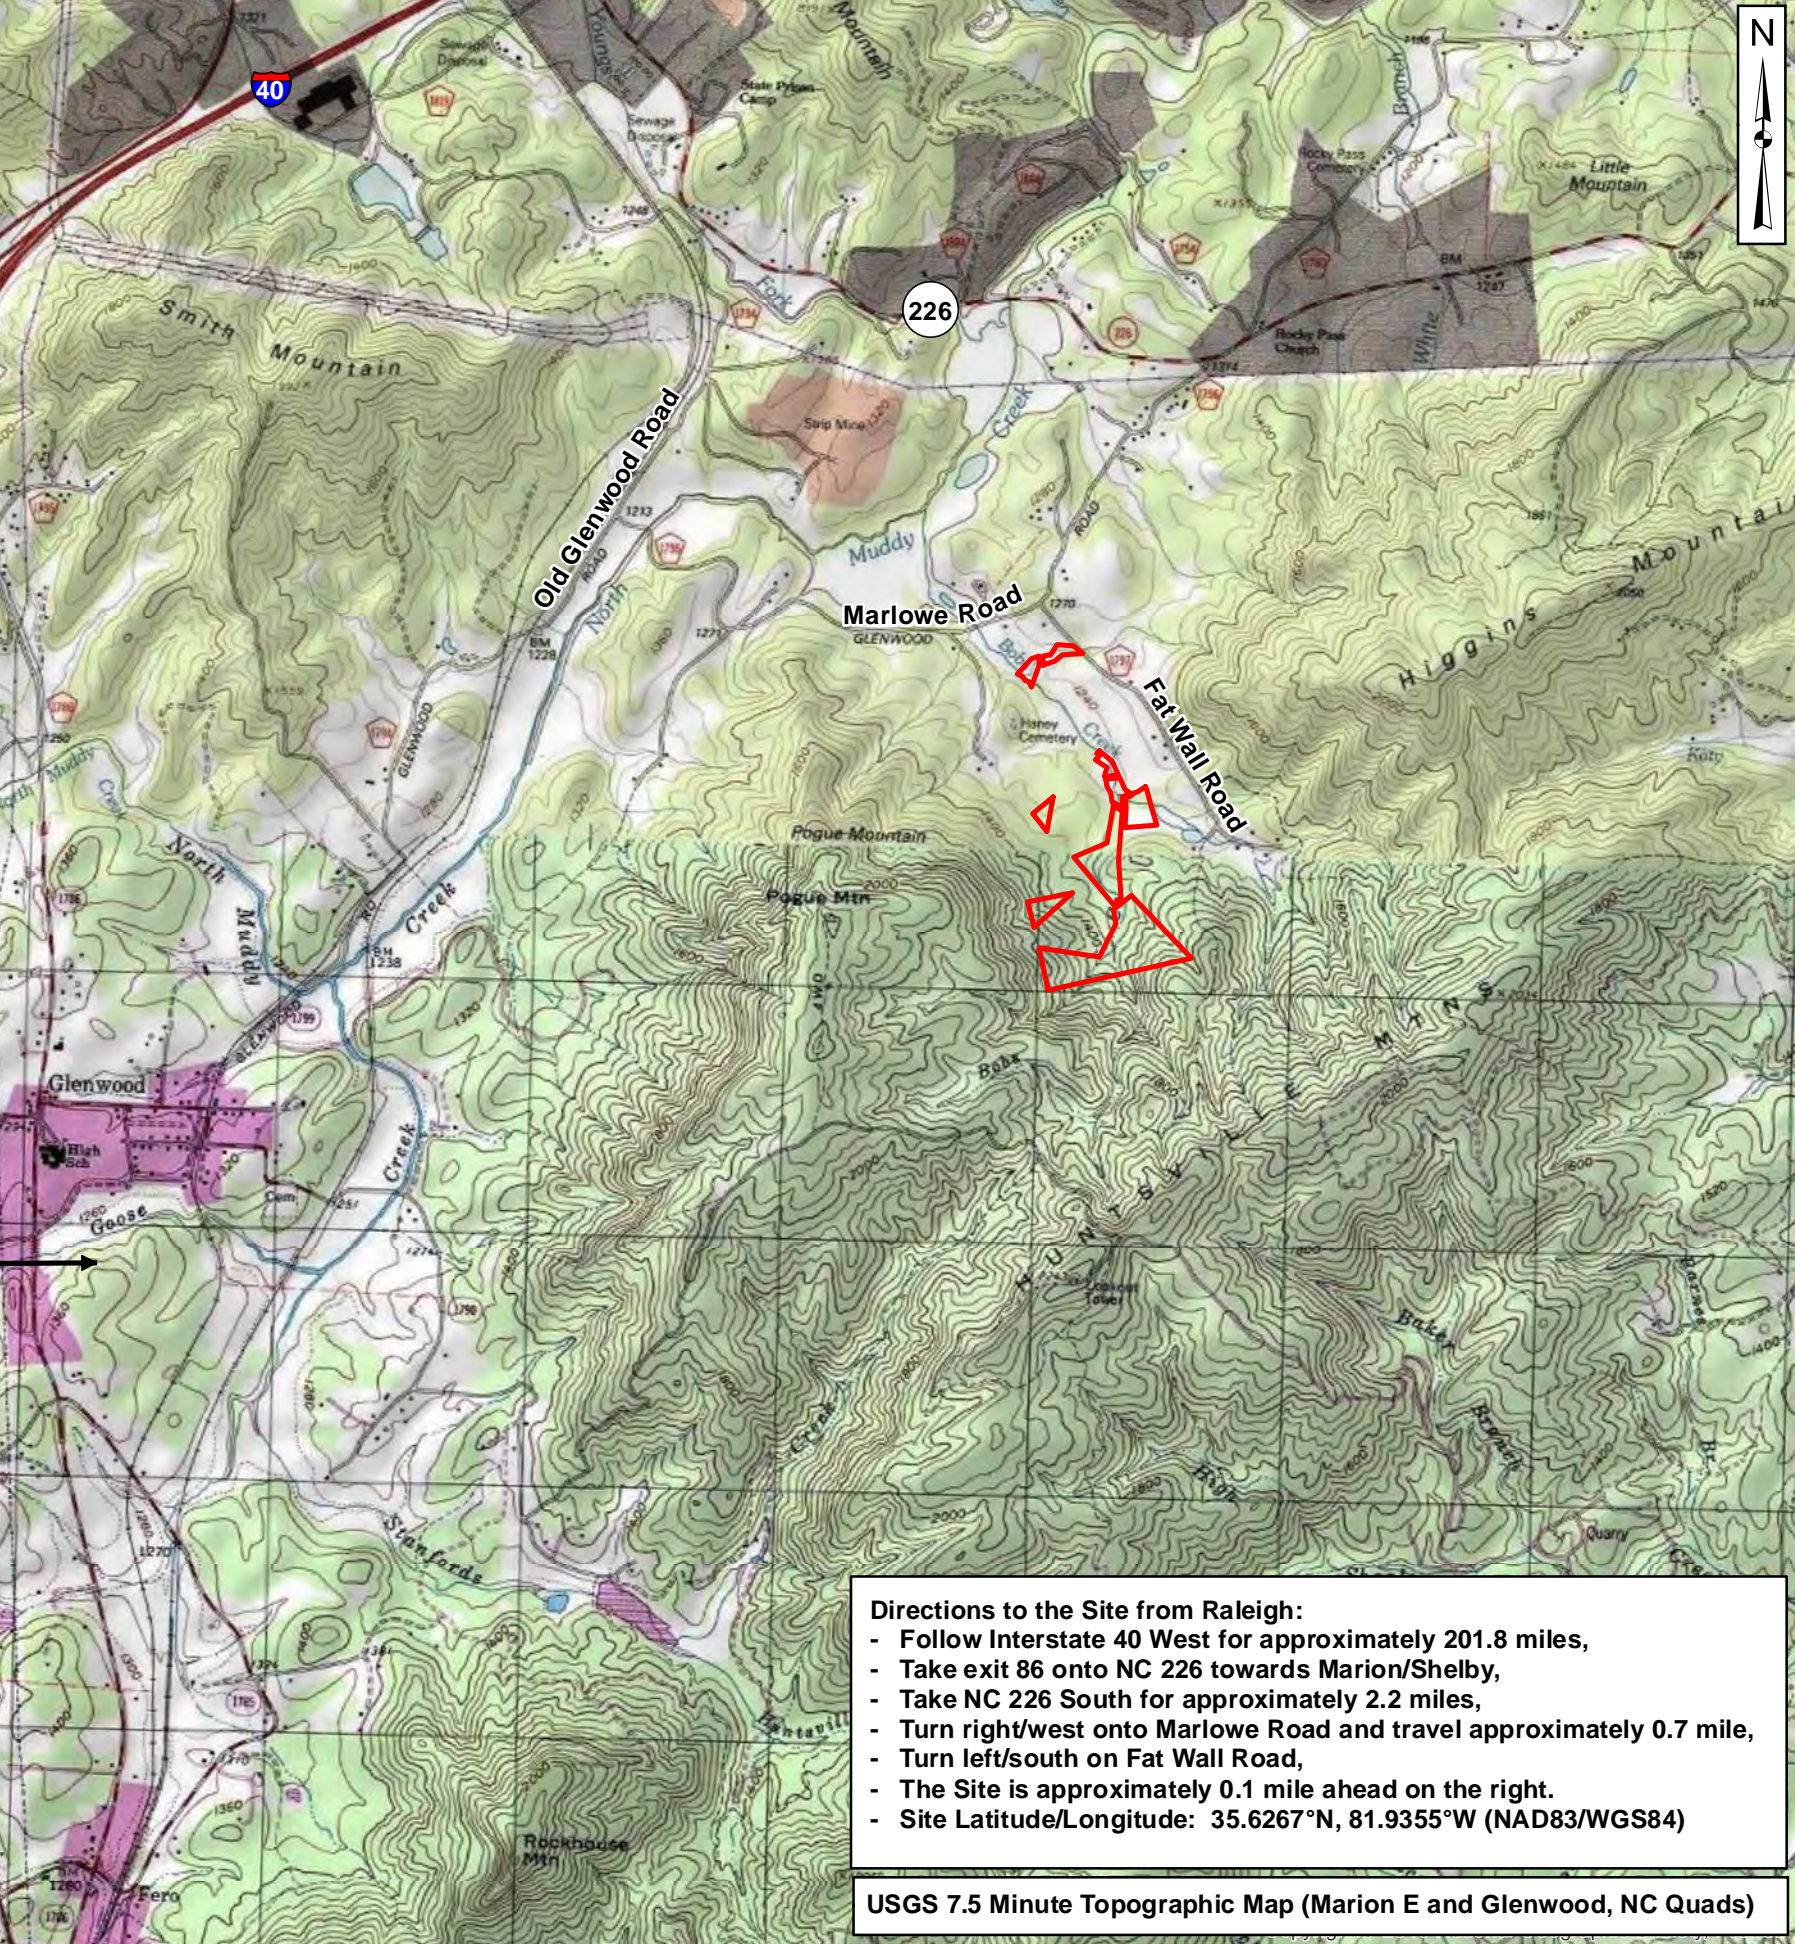

Prepared for:
NC Department of Environmental Quality
Division of Mitigation Services

Project:
BOBS CREEK
 McDowell County, NC

Title:
SITE LOCATION

Drawn by: **KRJ**

Date: **APR 2016**

Scale: **1:30000**


Project No.: **12-004.21**

Directions to the Site from Raleigh:

- Follow Interstate 40 West for approximately 201.8 miles,
- Take exit 86 onto NC 226 towards Marion/Shelby,
- Take NC 226 South for approximately 2.2 miles,
- Turn right/west onto Marlowe Road and travel approximately 0.7 mile,
- Turn left/south on Fat Wall Road,
- The Site is approximately 0.1 mile ahead on the right.
- Site Latitude/Longitude: 35.6267°N, 81.9355°W (NAD83/WGS84)

USGS 7.5 Minute Topographic Map (Marion E and Glenwood, NC Quads)

FIGURE
1

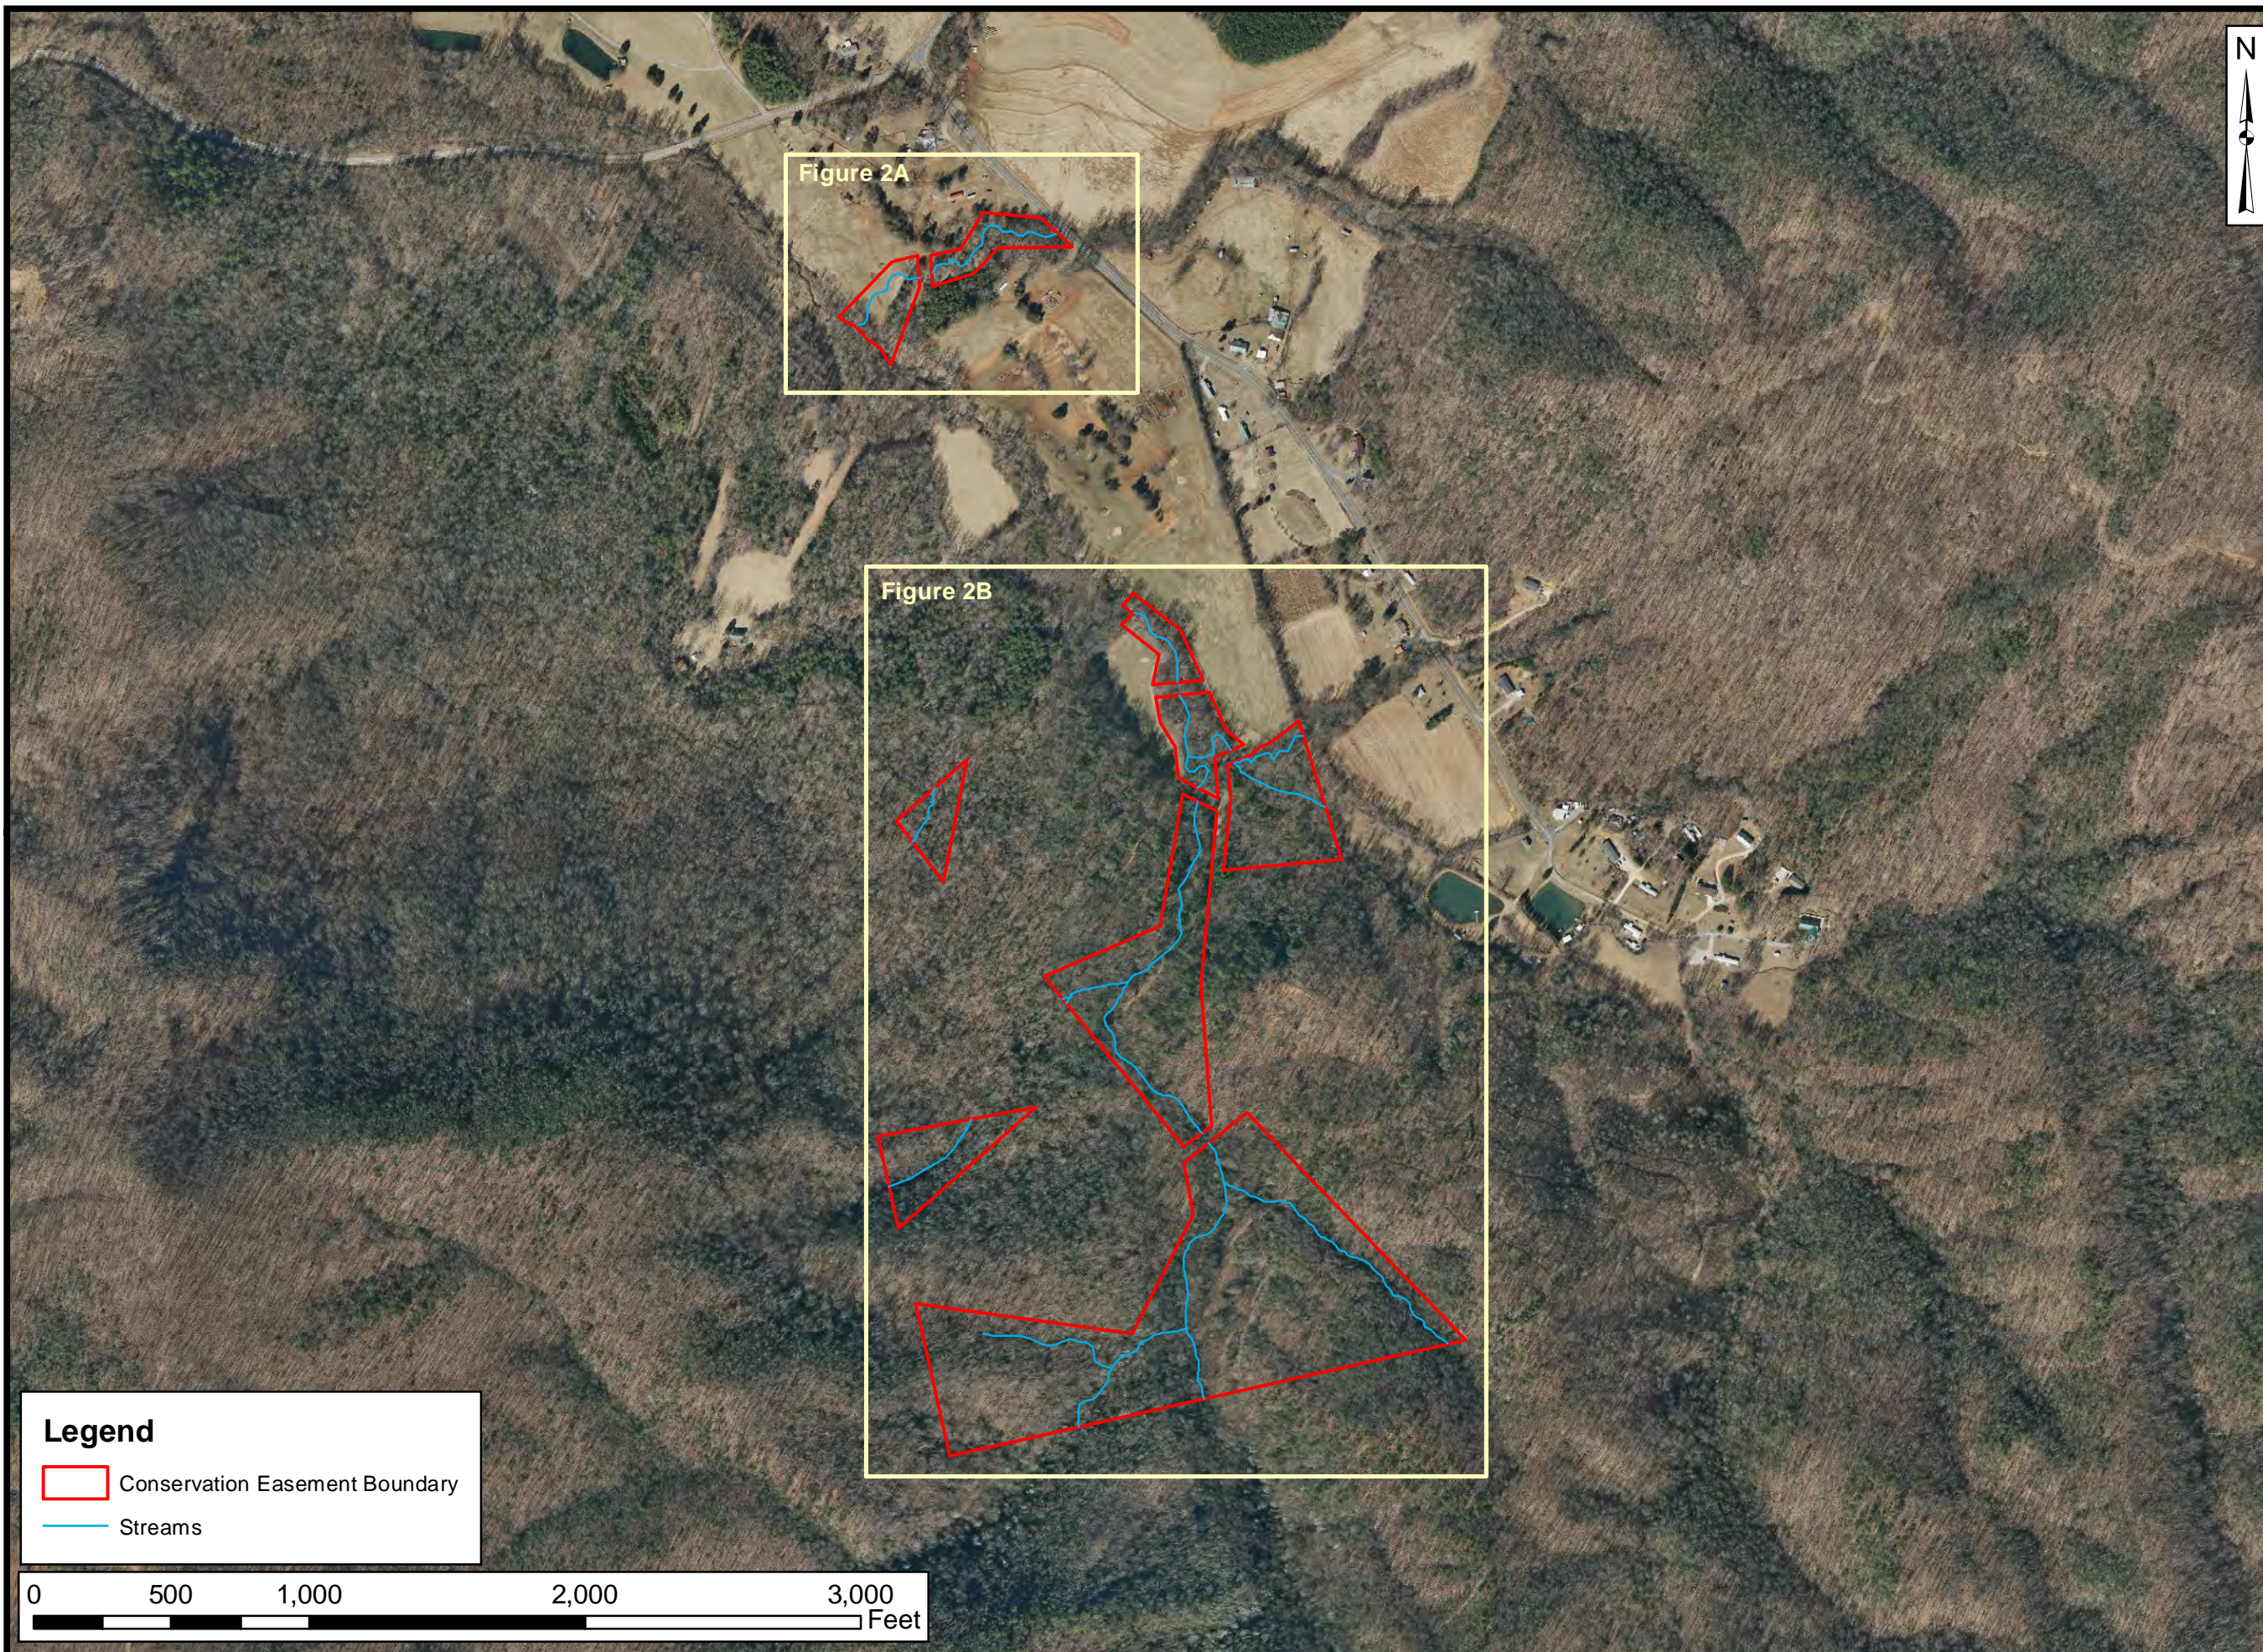

Prepared for:
**NC Department of
 Environmental
 Quality**
**Division of
 Mitigation
 Services**

Project:
**Bob's Creek
 Stream Restoration
 Project**
**DMS Project
 # 92879**
 McDowell County, NC

Title:
**Current Conditions
 Plan View**



Drawn by: KRJ


Date: MAY 2016


Scale: 1:7000

Project No.: 12-004.21

FIGURE
2

Legend
 Conservation Easement Boundary
 Streams

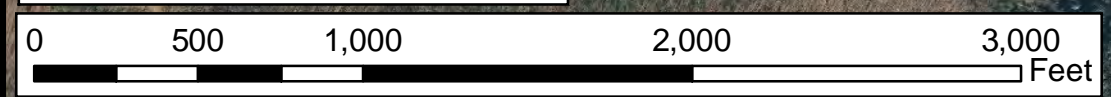

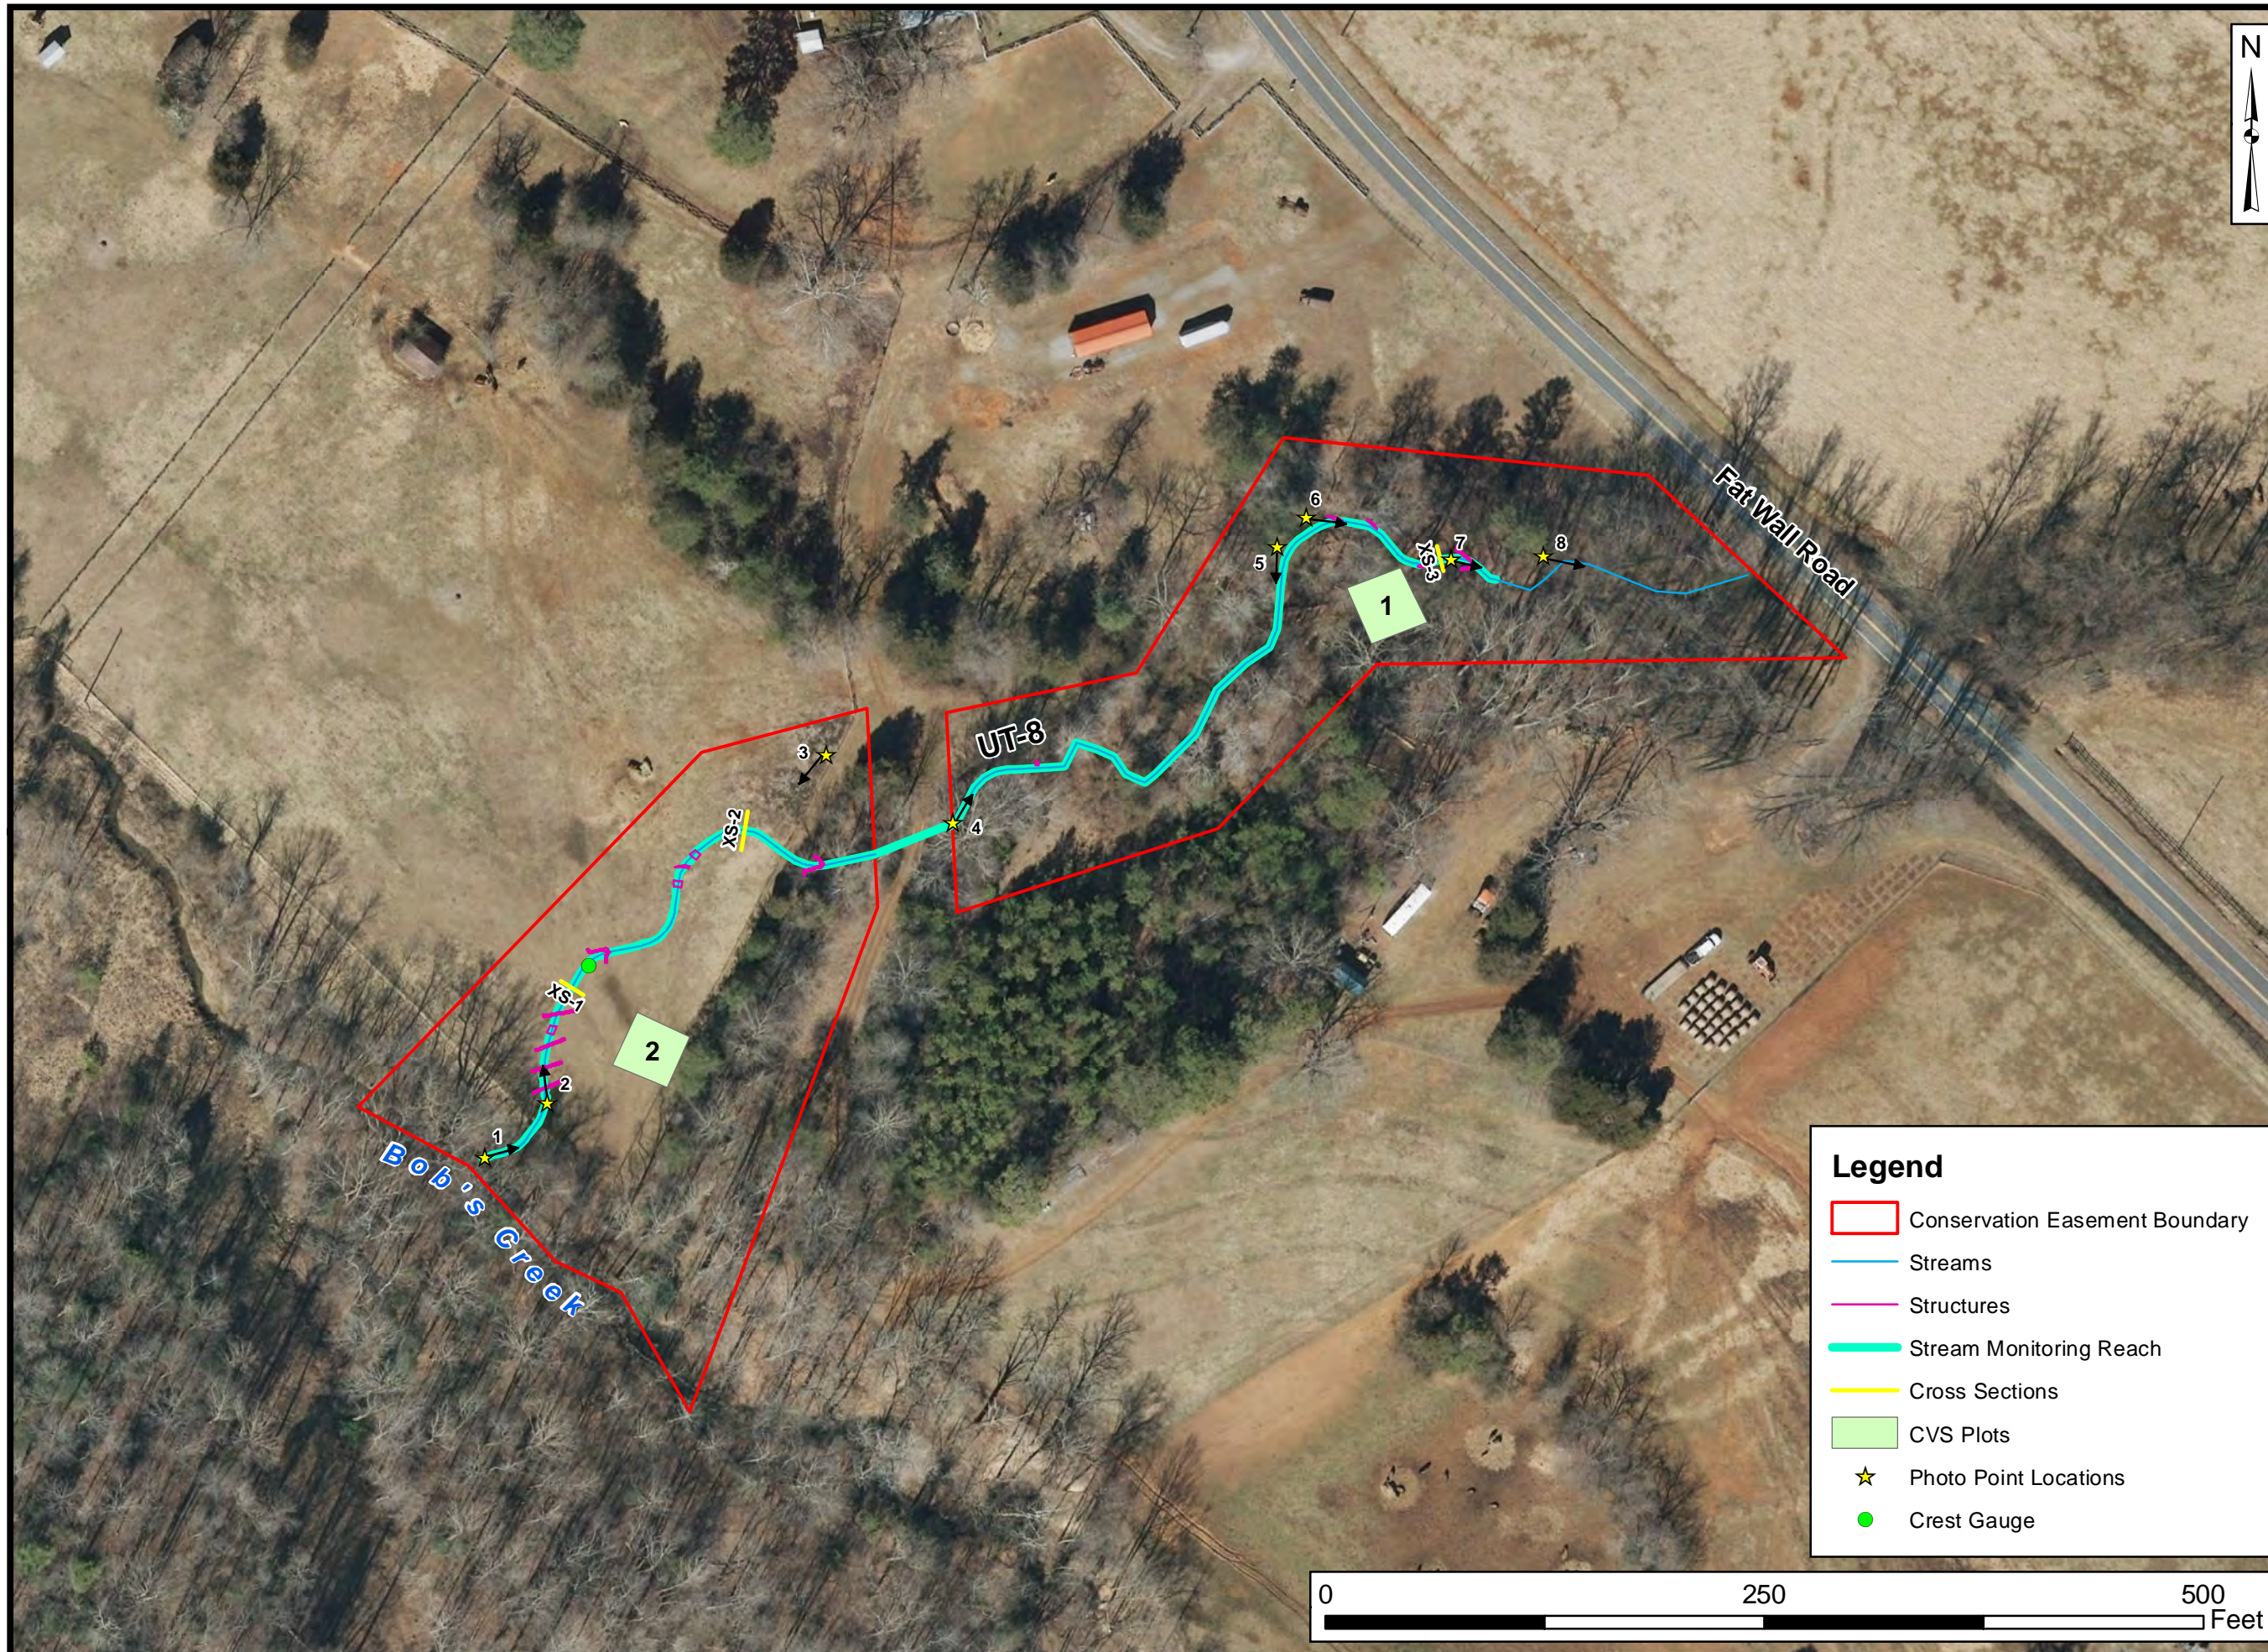

Prepared for:
NC Department of Environmental Quality
 Division of Mitigation Services

Project:
Bob's Creek Stream Restoration Project
DMS Project # 92879
 McDowell County, NC

Title:
Current Conditions Plan View

Drawn by: KRJ

Date: MAY 2016

Scale: 1:1100

Project No.: 12-004.21

Legend

- Conservation Easement Boundary
- Streams
- Structures
- Stream Monitoring Reach
- Cross Sections
- CVS Plots
- ★ Photo Point Locations
- Crest Gauge


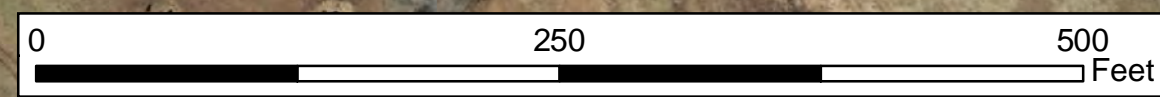


FIGURE
2A

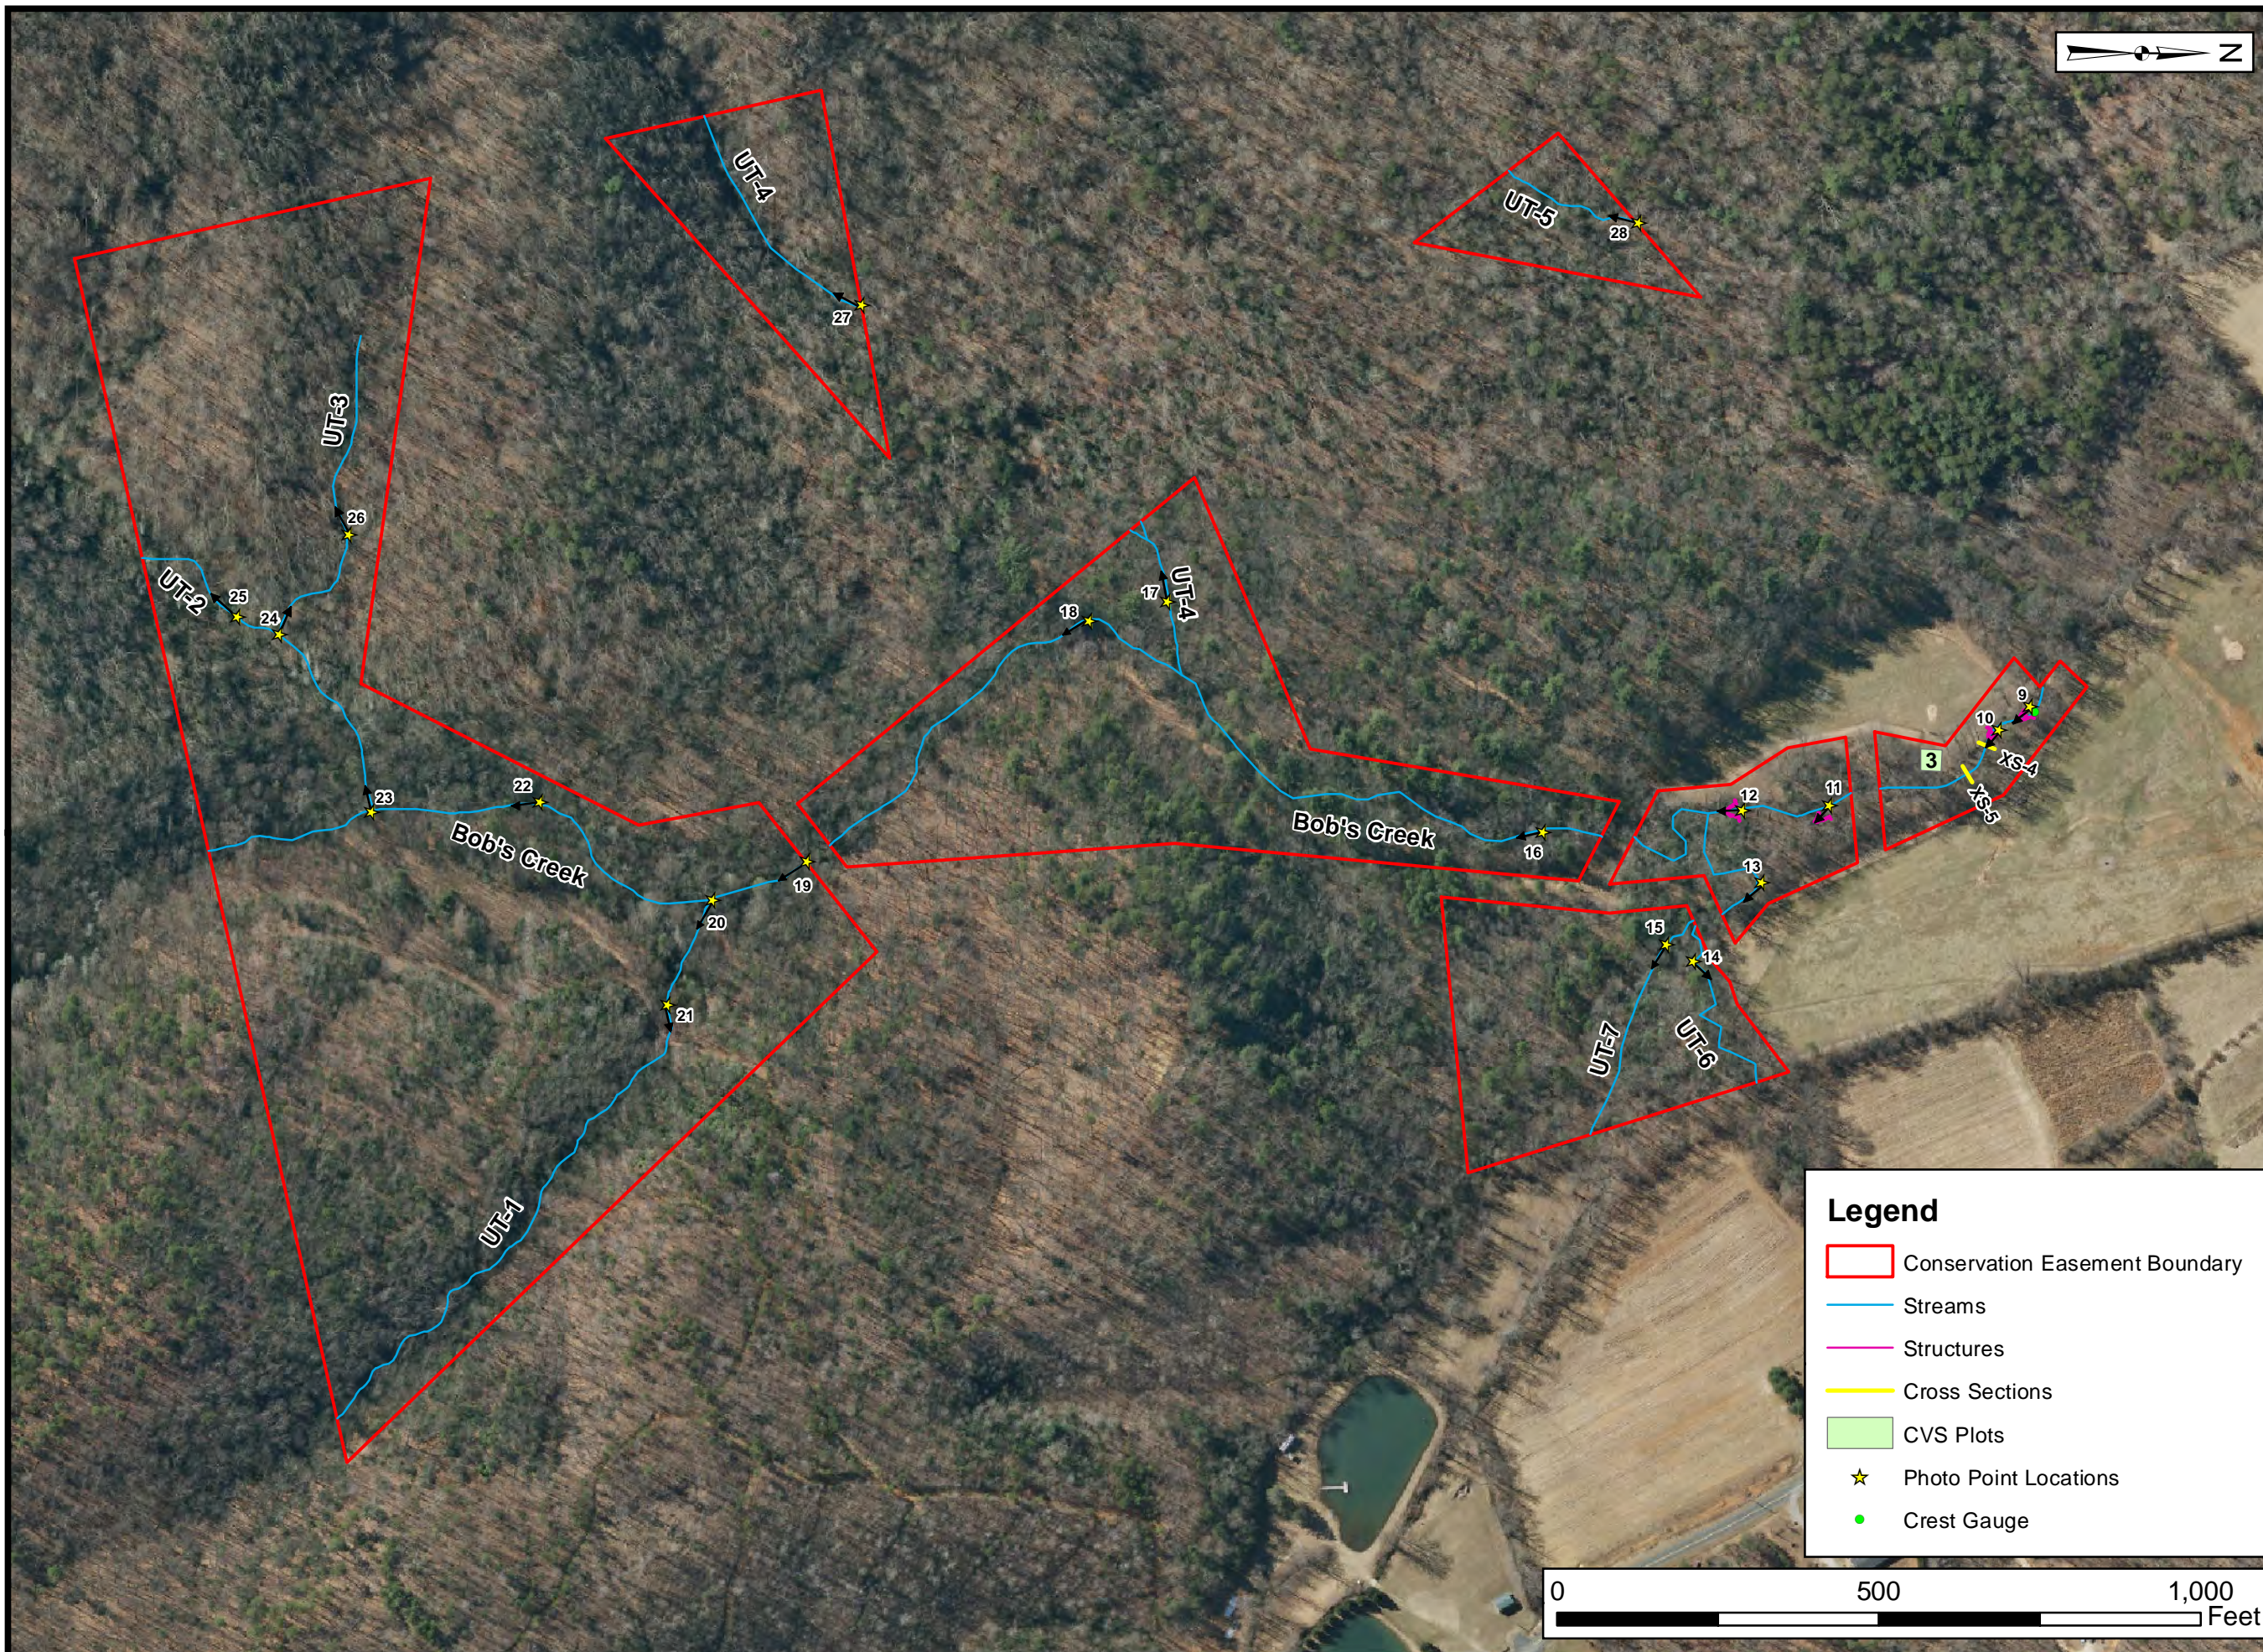

Prepared for:
NC Department of Environmental Quality
Division of Mitigation Services

Project:
Bob's Creek Stream Restoration Project
DMS Project # 92879

McDowell County, NC

Title:
Current Conditions Plan View

Drawn by: KRJ

Date: MAY 2016

Scale: 1:3000

Project No.: 12-004.21

FIGURE
2B



Prepared for:
**NC Department of
 Environmental
 Quality**
**Division of
 Mitigation
 Services**

Project:
**Bob's Creek
 Stream Restoration
 Project**
**DMS Project
 # 92879**

McDowell County, NC

Title:
Project Assets

Drawn by: KRJ

Date: JUN 2016


Scale: 1:7000

Project No.: 12-004.21

**FIGURE
 3**

- Legend**
- Conservation Easement Boundary
 - Stream Restoration
 - Stream Enhancement (level I)
 - Stream Enhancement (level II)
 - Stream Preservation
 - Wetland Preservation



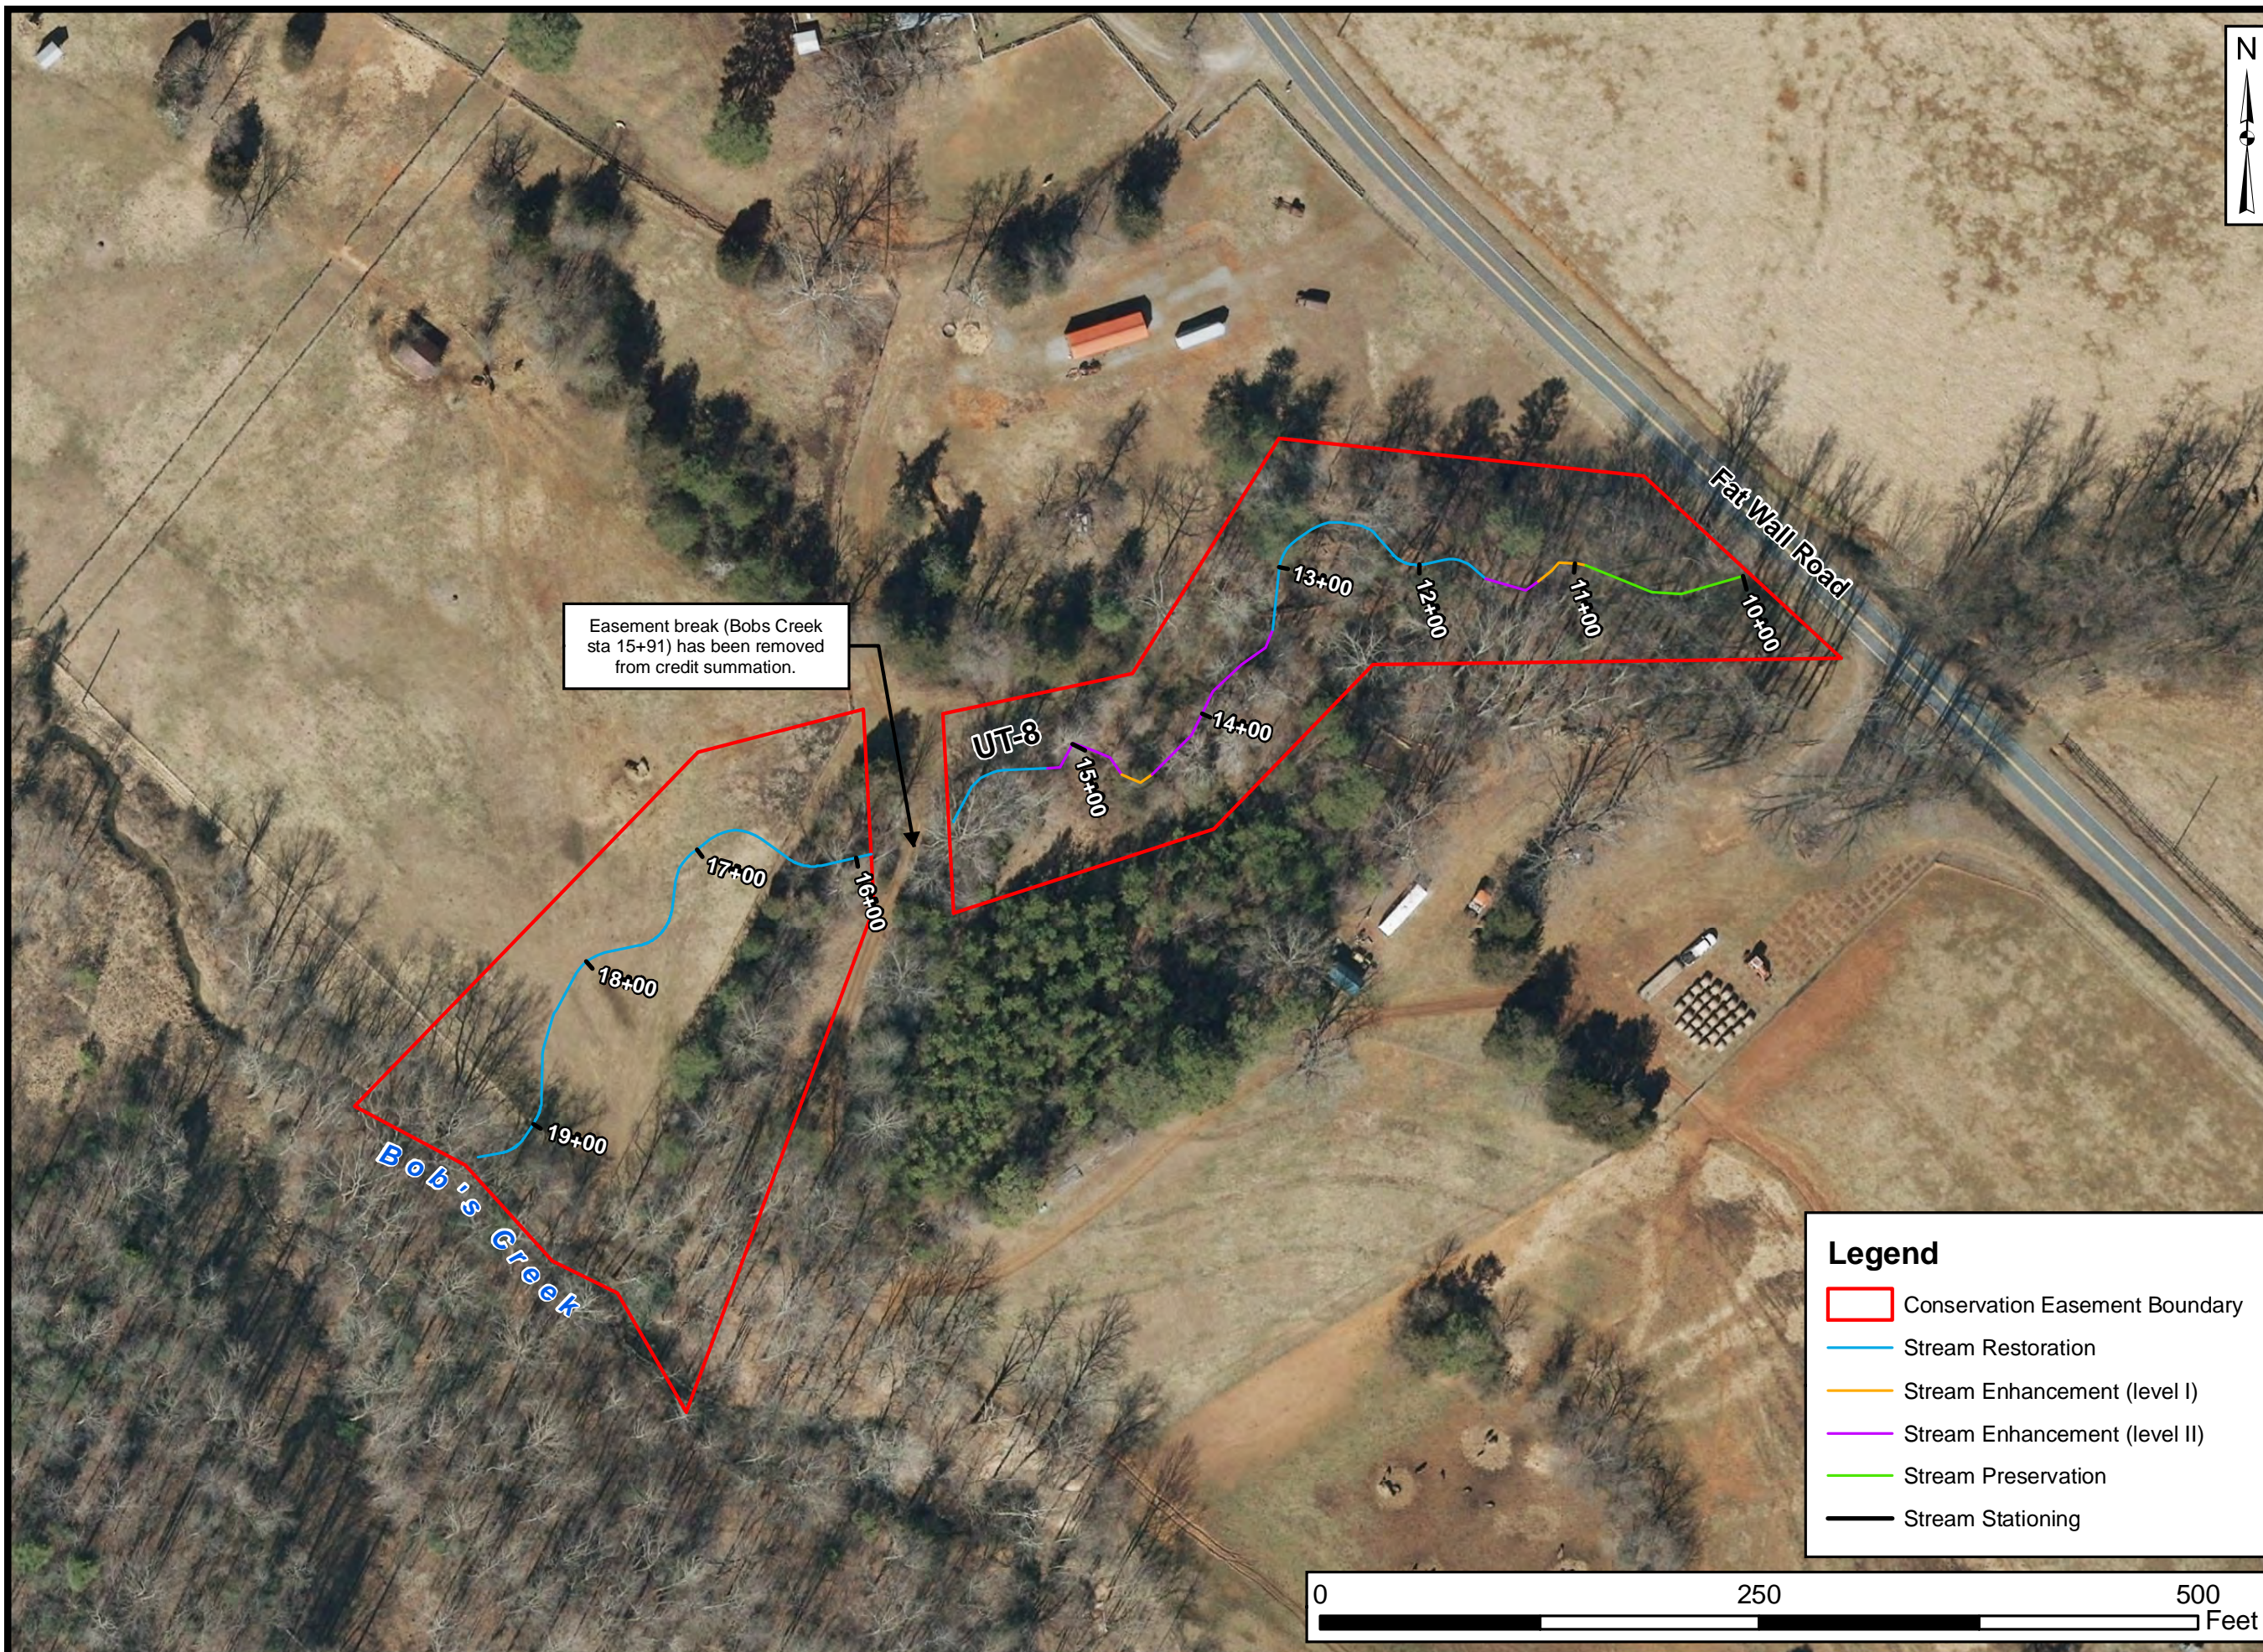

Easement break (Bobs Creek sta 15+91) has been removed from credit summation.

Legend

- Conservation Easement Boundary
- Stream Restoration
- Stream Enhancement (level I)
- Stream Enhancement (level II)
- Stream Preservation
- Stream Stationing




Prepared for:
NC Department of Environmental Quality
 Division of Mitigation Services


Project:
Bob's Creek Stream Restoration Project
DMS Project # 92879
 McDowell County, NC

Title:
Project Assets

Drawn by: KRJ
 Date: JUN 2016
 Scale: 1:1100
 Project No.: 12-004.21

FIGURE
3A

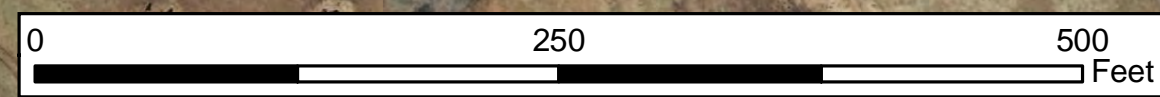

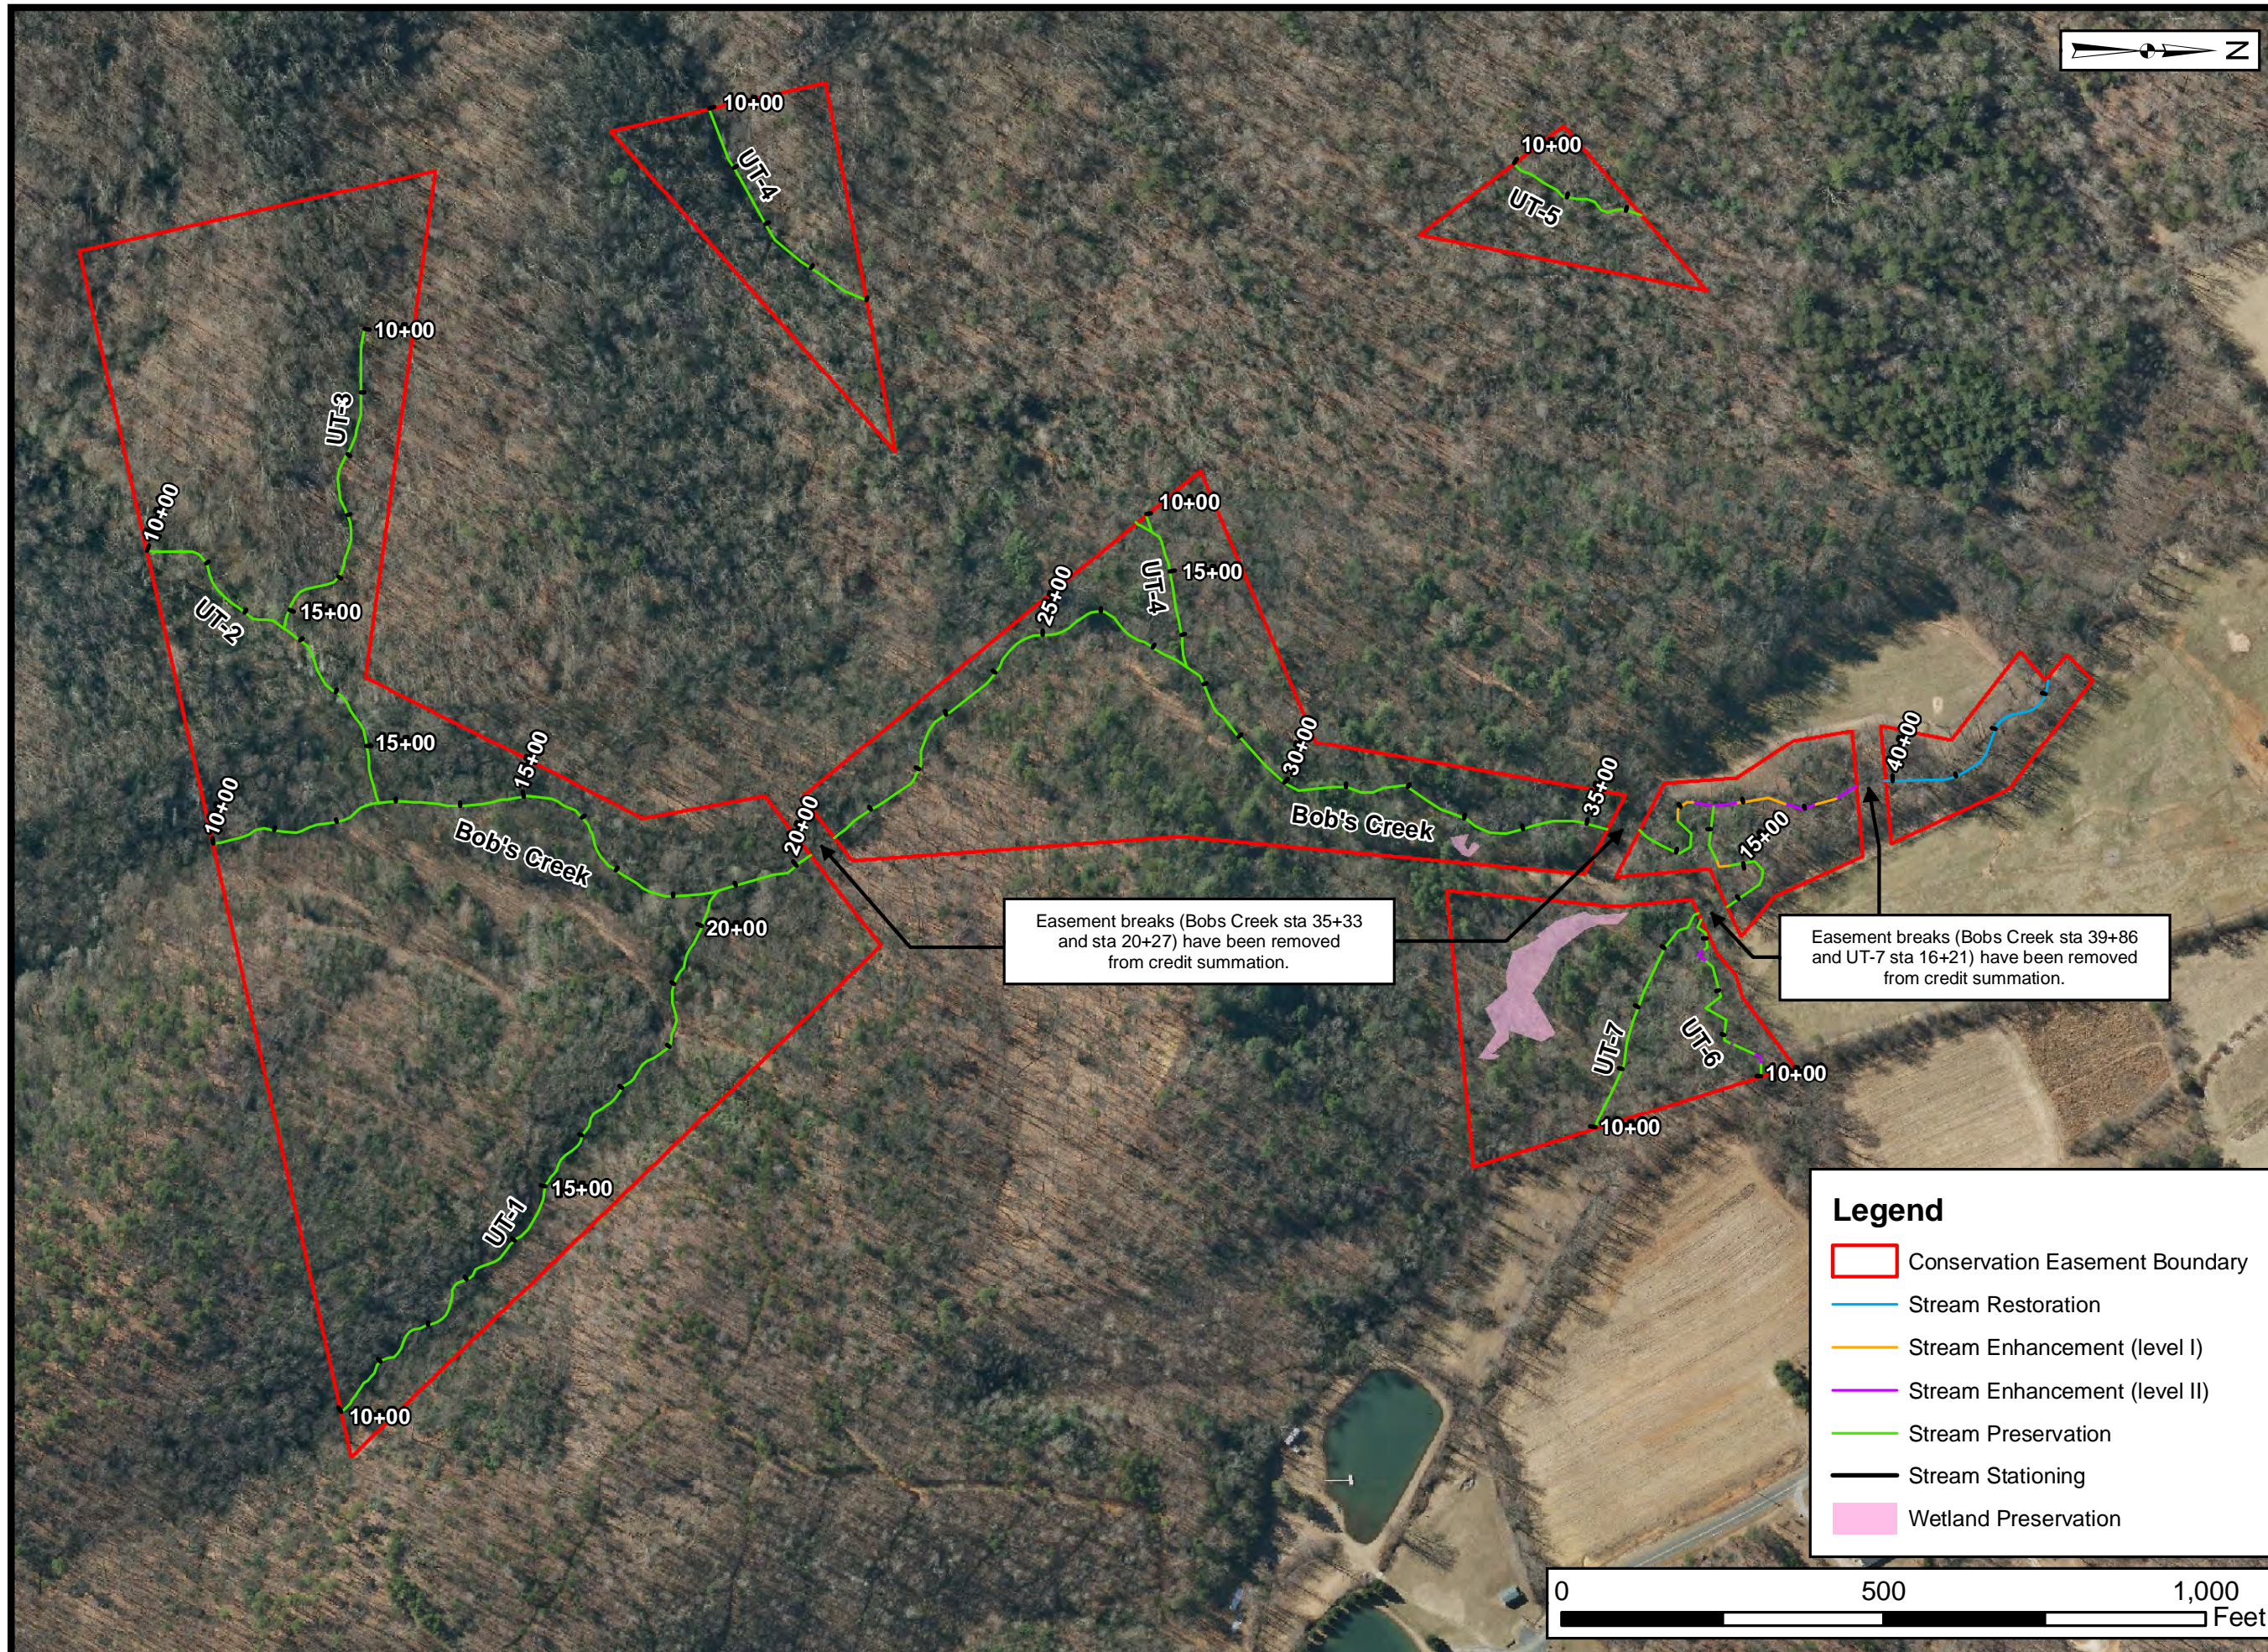

Prepared for:
NC Department of Environmental Quality
Division of Mitigation Services

Project:
Bob's Creek Stream Restoration Project
DMS Project # 92879
 McDowell County, NC

Title:
Project Assets

Drawn by: KRJ
 Date: JUN 2016
 Scale: 1:3000
 Project No.: 12-004.21

FIGURE 3B

**Bobs Creek
Baseline Fixed Station Photographs
Taken April 11, 2016**

Photo Point 1 – UT-8



Photo Point 2 – UT-8

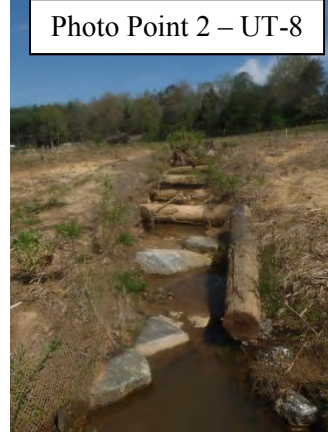


Photo Point 3 – UT-8

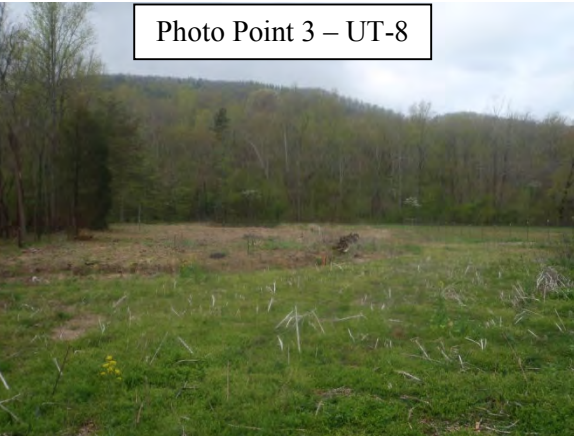


Photo Point 4 – UT-8






Photo Point 5 – UT-8







Photo Point 6 – UT-8



Bobs Creek
Baseline Fixed Station Photographs (continued)
Taken April 11, 2016

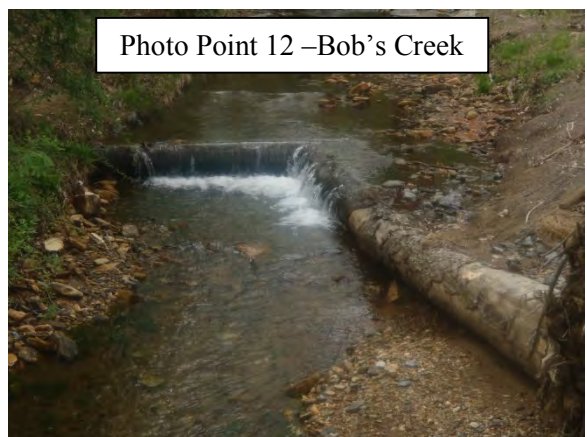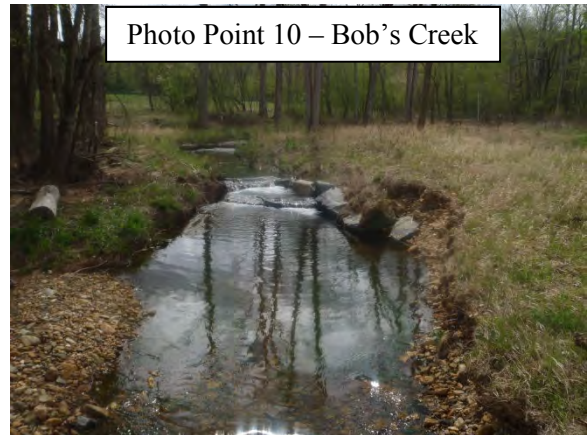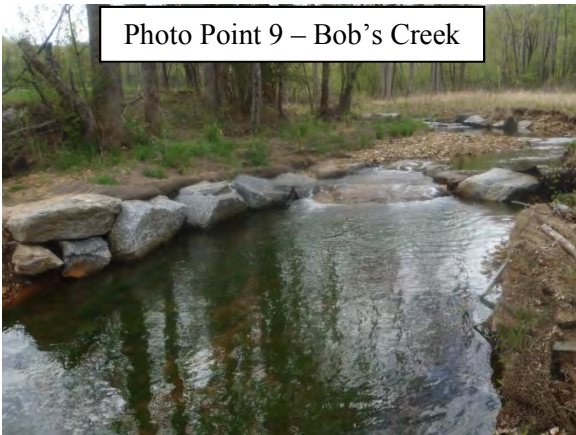

Bobs Creek
Baseline Fixed Station Photographs (continued)
Taken April 11, 2016

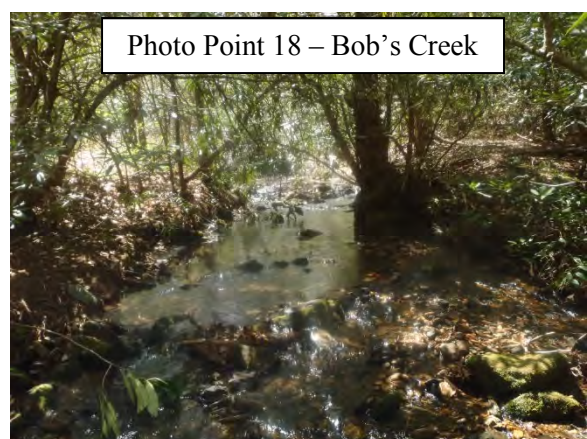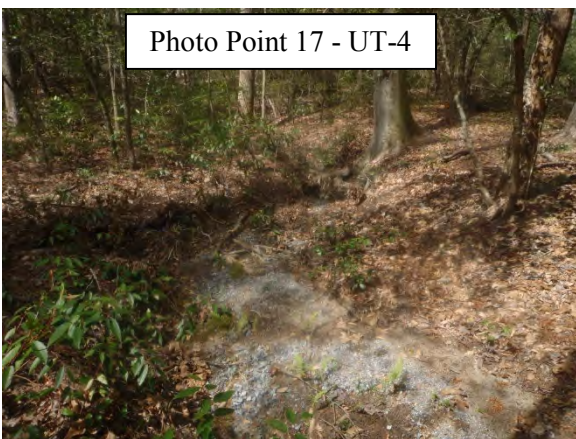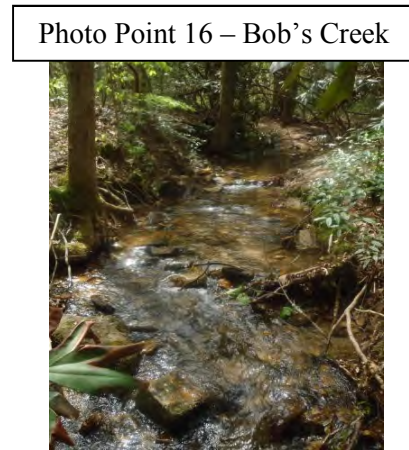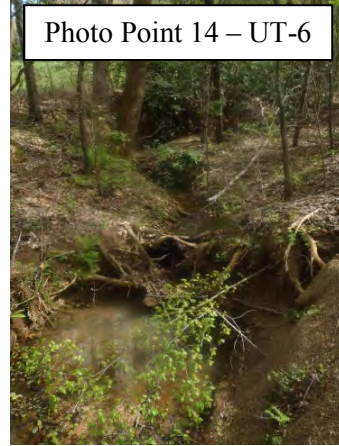

Bobs Creek
Baseline Fixed Station Photographs (continued)
Taken April 11, 2016

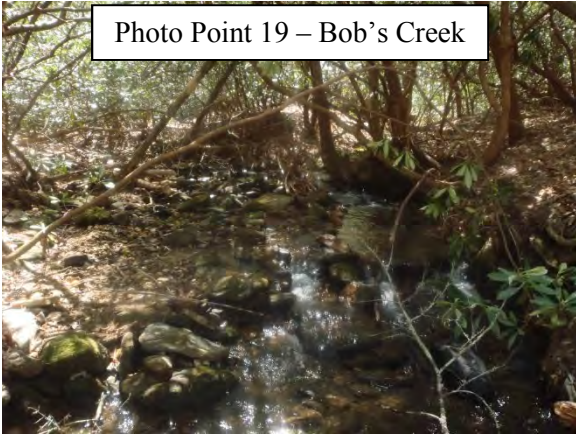


Photo Point 19 – Bob's Creek

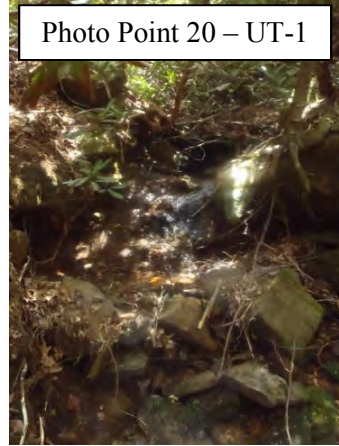


Photo Point 20 – UT-1



Photo Point 21 – UT-1



Photo Point 22 – Bob's Creek



Photo Point 23 – UT-2



Photo Point 24 – UT-3



Bobs Creek
Baseline Fixed Station Photographs (continued)
Taken April 11, 2016



Photo Point 28

Photo not taken during MY0 (2016)

**Bobs Creek
Baseline Vegetation Monitoring Photographs
Taken April 11, 2016**

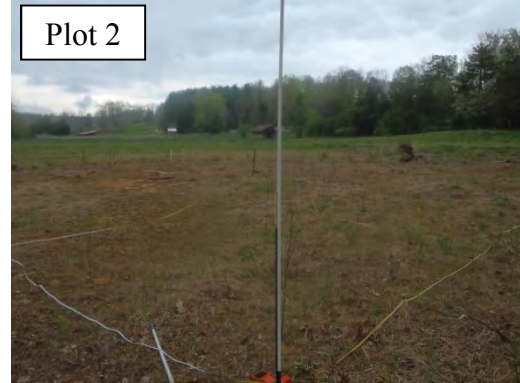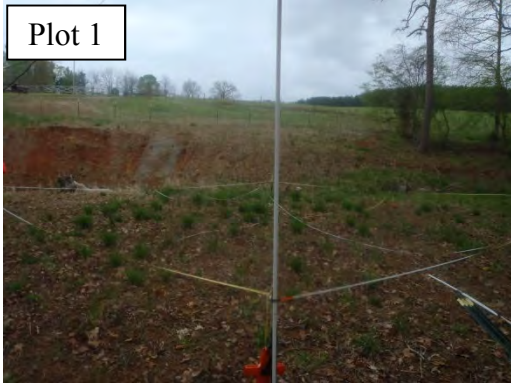

Appendix C.
Vegetation Plot Data

Table 5. Planted Woody Vegetation

Table 6. Total Planted Stems by Plot and Species

Table 5. Planted Bare Root Woody Vegetation

| Species | Quantity |
|---|-----------------|
| Black gum (<i>Nyssa sylvatica</i>) | 200 |
| Red maple (<i>Acer Rubrum</i>) | 100 |
| Persimmon (<i>Diospyros virginiana</i>) | 100 |
| Water oak (<i>Quercus nigra</i>) | 100 |
| Willow oak (<i>Quercus phellos</i>) | 200 |
| Green ash (<i>Fraxinus pennsylvanica</i>) | 50 |
| Sycamore (<i>Platanus occidentalis</i>) | 100 |
| TOTAL | 850 |

Table 6. Total Planted Stems by Plot and Species

Project Name: Bobs Creek

| Scientific Name | Common Name | Species Type | Current Plot Data (MY0 2016) | | | | | | | | | Annual Means | | |
|------------------------|-------------------|--------------|------------------------------|-------|-------|---------------|-------|-------|---------------|-------|------|--------------|-------|-------|
| | | | 92879-01-0001 | | | 92879-01-0002 | | | 92879-01-0003 | | | MY0 (2016) | | |
| | | | PnoLS | P-all | T | PnoLS | P-all | T | PnoLS | P-all | T | PnoLS | P-all | T |
| Acer rubrum | red maple | Tree | 1 | 1 | 1 | 1 | 1 | 1 | | | 23 | 2 | 2 | 25 |
| Diospyros virginiana | common persimmon | Tree | 2 | 2 | 2 | 2 | 2 | 2 | | | | 4 | 4 | 4 |
| Fraxinus pennsylvanica | green ash | Tree | 1 | 1 | 1 | | | | | | | 1 | 1 | 1 |
| Nyssa sylvatica | blackgum | Tree | 6 | 6 | 6 | 5 | 5 | 5 | | | | 11 | 11 | 11 |
| Platanus occidentalis | American sycamore | Tree | 3 | 3 | 3 | 1 | 1 | 1 | 6 | 6 | 6 | 10 | 10 | 10 |
| Quercus nigra | water oak | Tree | 2 | 2 | 2 | 1 | 1 | 1 | 2 | 2 | 2 | 5 | 5 | 5 |
| Quercus phellos | willow oak | Tree | 1 | 1 | 1 | 2 | 2 | 2 | 2 | 2 | 2 | 5 | 5 | 5 |
| Stem count | | | 16 | 16 | 16 | 12 | 12 | 12 | 10 | 10 | 33 | 38 | 38 | 61 |
| size (ares) | | | 1 | | | 1 | | | 1 | | | 3 | | |
| size (ACRES) | | | 0.02 | | | 0.02 | | | 0.02 | | | 0.07 | | |
| Species count | | | 7 | 7 | 7 | 6 | 6 | 6 | 3 | 3 | 4 | 7 | 7 | 7 |
| Stems per ACRE | | | 647.5 | 647.5 | 647.5 | 485.6 | 485.6 | 485.6 | 404.7 | 404.7 | 1335 | 512.6 | 512.6 | 822.9 |

Appendix D.
Stream Measurements and Geomorphology Data

Cross Section Plots
Longitudinal Profile Plots
Substrate Plots

Tables 7A-6D. Baseline Stream Data Summary
Tables 8A-8B. Monitoring Data-Dimensional Data Summary


| | |
|------------------------|---------------------|
| Site | Bobs Creek - UT 8 |
| Project Number: | 92879 |
| XS ID | XS - 1, Riffle |
| Reach | UT 8 |
| Date: | 4/11/2016 |
| Field Crew: | Perkinson, Jernigan |



| | |
|--------------------|---|
| Stream Type | E |
|--------------------|---|

| SUMMARY DATA | |
|---------------------------------------|--------|
| Bankfull Elevation: | 1218.8 |
| Bankfull Cross-Sectional Area: | 6.6 |
| Bankfull Width: | 8.3 |
| Flood Prone Area Elevation: | 1220.0 |
| Flood Prone Width: | 100.0 |
| Max Depth at Bankfull: | 1.2 |
| Mean Depth at Bankfull: | 0.8 |
| W / D Ratio: | 10.4 |
| Entrenchment Ratio: | 12.0 |
| Bank Height Ratio: | 1.0 |

| Station | Elevation |
|---------|-----------|
| 0.00 | 1218.95 |
| 1.43 | 1219.09 |
| 2.76 | 1219.07 |
| 3.80 | 1218.95 |
| 4.84 | 1218.50 |
| 5.47 | 1218.06 |
| 6.02 | 1217.87 |
| 7.27 | 1217.74 |
| 7.77 | 1217.73 |
| 8.72 | 1217.71 |
| 9.00 | 1217.92 |
| 9.35 | 1217.70 |
| 10.05 | 1217.60 |
| 10.64 | 1217.97 |
| 11.55 | 1218.42 |
| 12.4 | 1218.82 |
| 13.6 | 1218.88 |
| 14.9 | 1218.79 |
| | |
| | |
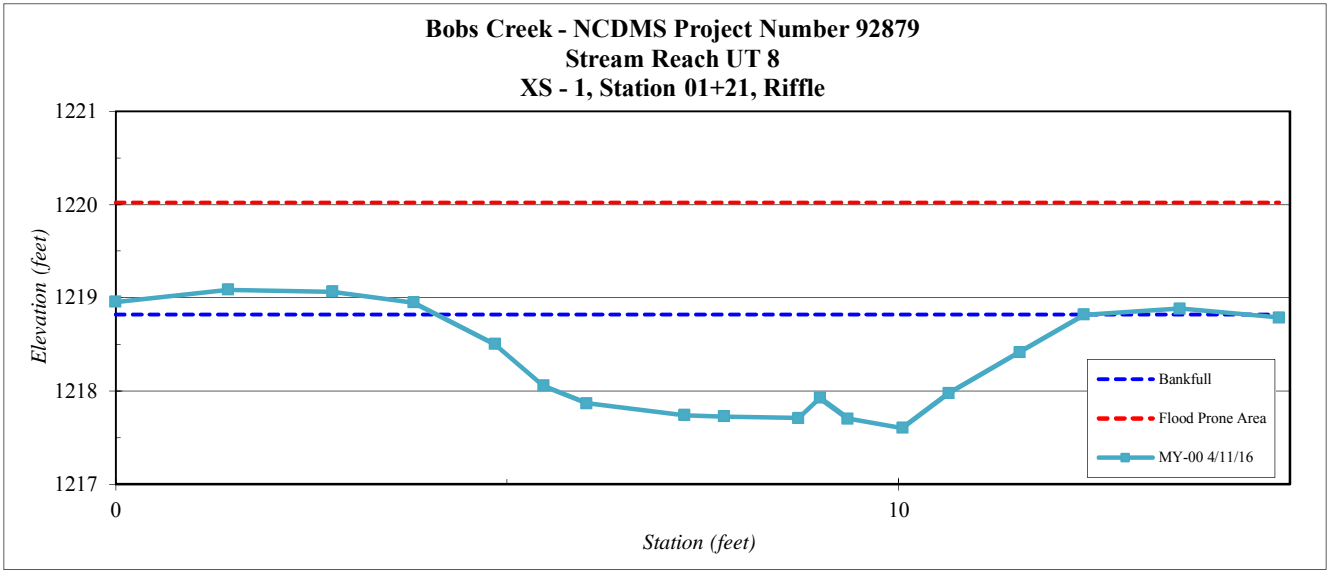


| | |
|------------------------|---------------------|
| Site | Bobs Creek - UT 8 |
| Project Number: | 92879 |
| XS ID | XS - 2, Pool |
| Reach | UT 8 |
| Date: | 4/11/2016 |
| Field Crew: | Perkinson, Jernigan |

| Station | Elevation |
|---------|-----------|
| 0.0 | 1222.7 |
| 4.1 | 1222.4 |
| 6.9 | 1222.1 |
| 8.0 | 1221.9 |
| 9.0 | 1221.8 |
| 10.4 | 1221.2 |
| 11.3 | 1220.8 |
| 12.5 | 1220.7 |
| 13.3 | 1220.5 |
| 13.9 | 1220.7 |
| 14.5 | 1221.1 |
| 15.1 | 1221.9 |
| 16.3 | 1222.4 |
| 18.3 | 1222.6 |
| 20.0 | 1222.6 |
| 22.9 | 1222.6 |
| | |
| | |
| SUMMARY DATA | |
|---------------------------------------|--------|
| Bankfull Elevation: | 1222.4 |
| Bankfull Cross-Sectional Area: | 10.4 |
| Bankfull Width: | 11.9 |
| Flood Prone Area Elevation: | NA |
| Flood Prone Width: | NA |
| Max Depth at Bankfull: | 1.9 |
| Mean Depth at Bankfull: | 0.9 |
| W / D Ratio: | NA |
| Entrenchment Ratio: | NA |
| Bank Height Ratio: | 1.0 |



| | |
|--------------------|---|
| Stream Type | E |
|--------------------|---|

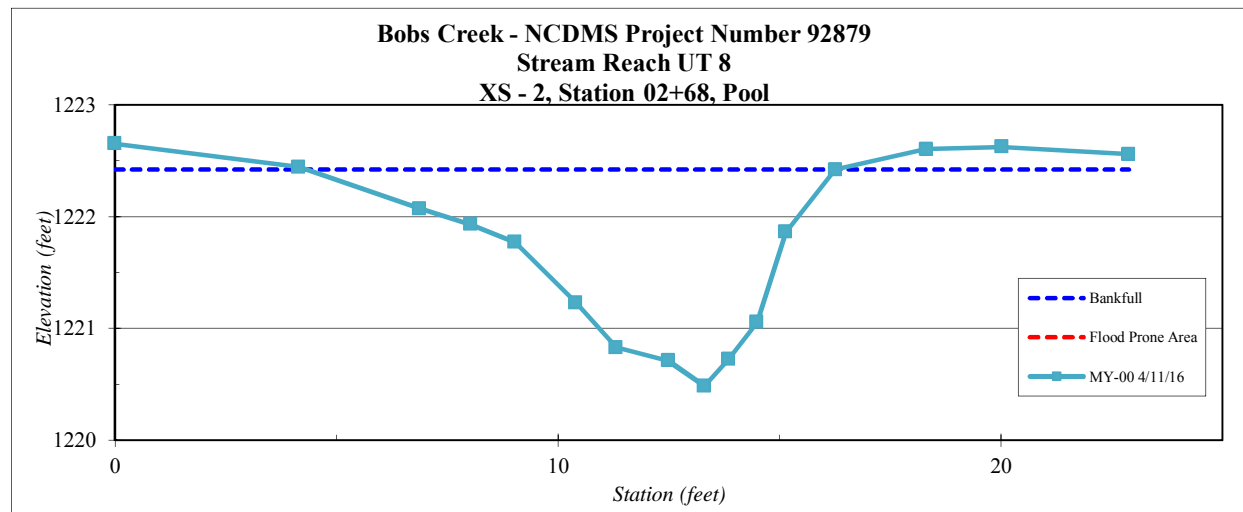


| | |
|------------------------|---------------------|
| Site | Bobs Creek - UT 8 |
| Project Number: | 92879 |
| XS ID | XS - 3, Riffle |
| Reach | UT 8 |
| Date: | 4/11/2016 |
| Field Crew: | Perkinson, Jernigan |



| | |
|--------------------|---|
| Stream Type | E |
|--------------------|---|

| SUMMARY DATA | |
|---------------------------------------|--------|
| Bankfull Elevation: | 1230.5 |
| Bankfull Cross-Sectional Area: | 8.3 |
| Bankfull Width: | 9.0 |
| Flood Prone Area Elevation: | 1232.2 |
| Flood Prone Width: | 100.0 |
| Max Depth at Bankfull: | 1.7 |
| Mean Depth at Bankfull: | 0.9 |
| W / D Ratio: | 9.8 |
| Entrenchment Ratio: | 11.1 |
| Bank Height Ratio: | 1.0 |

| Station | Elevation |
|---------|-----------|
| 0.00 | 1230.53 |
| 1.99 | 1230.57 |
| 2.66 | 1230.48 |
| 4.09 | 1229.97 |
| 4.92 | 1229.53 |
| 5.78 | 1228.95 |
| 6.16 | 1228.84 |
| 7.15 | 1228.78 |
| 7.51 | 1228.92 |
| 8.36 | 1229.07 |
| 8.60 | 1229.42 |
| 9.19 | 1229.39 |
| 10.15 | 1229.84 |
| 10.93 | 1230.23 |
| 12.13 | 1230.67 |
| 12.6 | 1230.67 |
| 13.6 | 1230.58 |
| 13.9 | 1230.33 |
| 14.9 | 1230.36 |
| | |
| | |
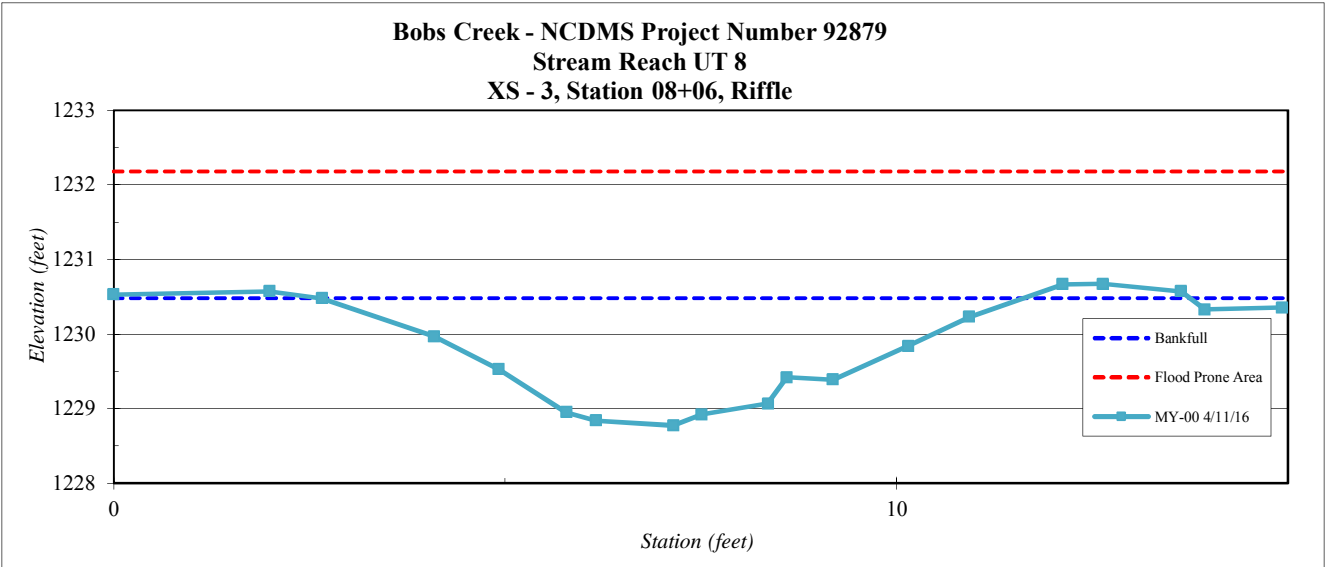


| | |
|------------------------|---------------------|
| Site | Bobs Creek |
| Project Number: | 92879 |
| XS ID | XS - 4, Riffle |
| Reach | Bobs Creek |
| Date: | 4/11/2016 |
| Field Crew: | Perkinson, Jernigan |



| | |
|--------------------|---|
| Stream Type | E |
|--------------------|---|

| SUMMARY DATA | |
|---------------------------------------|--------|
| Bankfull Elevation: | 1232.0 |
| Bankfull Cross-Sectional Area: | 19.9 |
| Bankfull Width: | 15.2 |
| Flood Prone Area Elevation: | 1234.2 |
| Flood Prone Width: | 150.0 |
| Max Depth at Bankfull: | 2.2 |
| Mean Depth at Bankfull: | 1.3 |
| W / D Ratio: | 11.6 |
| Entrenchment Ratio: | 9.9 |
| Bank Height Ratio: | 1.0 |

| Station | Elevation |
|---------|-----------|
| 0.00 | 1233.02 |
| 2.70 | 1233.08 |
| 4.52 | 1232.78 |
| 6.95 | 1231.78 |
| 8.33 | 1231.23 |
| 9.93 | 1230.56 |
| 11.63 | 1230.97 |
| 12.49 | 1230.19 |
| 13.60 | 1230.39 |
| 14.39 | 1229.87 |
| 15.10 | 1229.93 |
| 15.85 | 1229.95 |
| 16.98 | 1230.08 |
| 18.13 | 1230.26 |
| 18.86 | 1230.54 |
| 19.5 | 1230.97 |
| 20.5 | 1231.48 |
| 21.8 | 1232.15 |
| 22.5 | 1232.32 |
| 23.4 | 1232.30 |
| 23.9 | 1232.14 |
| 25.4 | 1232.31 |
| 27.0 | 1232.02 |
| | |
| | |

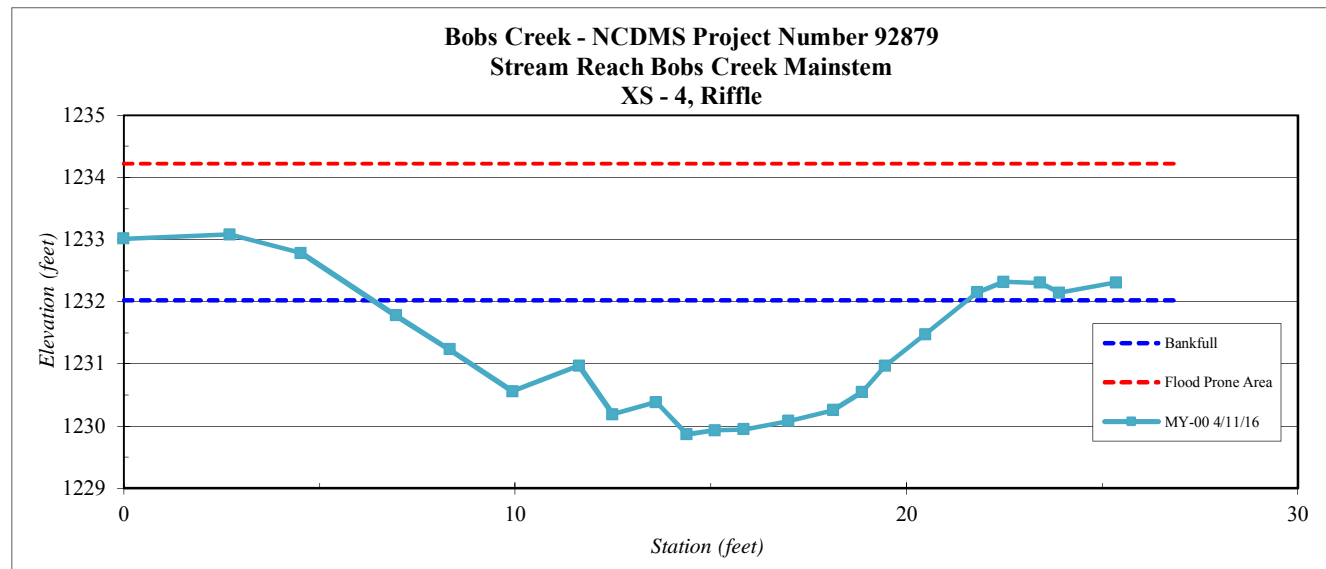

| | |
|------------------------|---------------------|
| Site | Bobs Creek |
| Project Number: | 92879 |
| XS ID | XS - 5, Riffle |
| Reach | Bobs Creek |
| Date: | 4/11/2016 |
| Field Crew: | Perkinson, Jernigan |




XS 5 Looking Upstream

| | |
|--------------------|---|
| Stream Type | E |
|--------------------|---|

| Station | Elevation |
|---------|-----------|
| 0.00 | 1233.17 |
| 2.89 | 1233.10 |
| 4.56 | 1233.21 |
| 6.10 | 1232.94 |
| 7.90 | 1232.37 |
| 8.55 | 1232.04 |
| 9.57 | 1231.46 |
| 10.34 | 1231.47 |
| 12.00 | 1231.36 |
| 13.38 | 1231.03 |
| 14.64 | 1231.15 |
| 15.87 | 1230.90 |
| 17.16 | 1230.92 |
| 18.47 | 1230.79 |
| 19.73 | 1230.93 |
| 21.1 | 1232.58 |
| 22.2 | 1233.13 |
| 25.2 | 1233.14 |
| 27.5 | 1233.17 |
| 29.1 | 1233.39 |
| | |
| | |
| SUMMARY DATA | |
|---------------------------------------|--------|
| Bankfull Elevation: | 1233.1 |
| Bankfull Cross-Sectional Area: | 25.2 |
| Bankfull Width: | 17.0 |
| Flood Prone Area Elevation: | 1235.4 |
| Flood Prone Width: | 150.0 |
| Max Depth at Bankfull: | 2.3 |
| Mean Depth at Bankfull: | 1.5 |
| W / D Ratio: | 11.5 |
| Entrenchment Ratio: | 8.8 |
| Bank Height Ratio: | 1.0 |

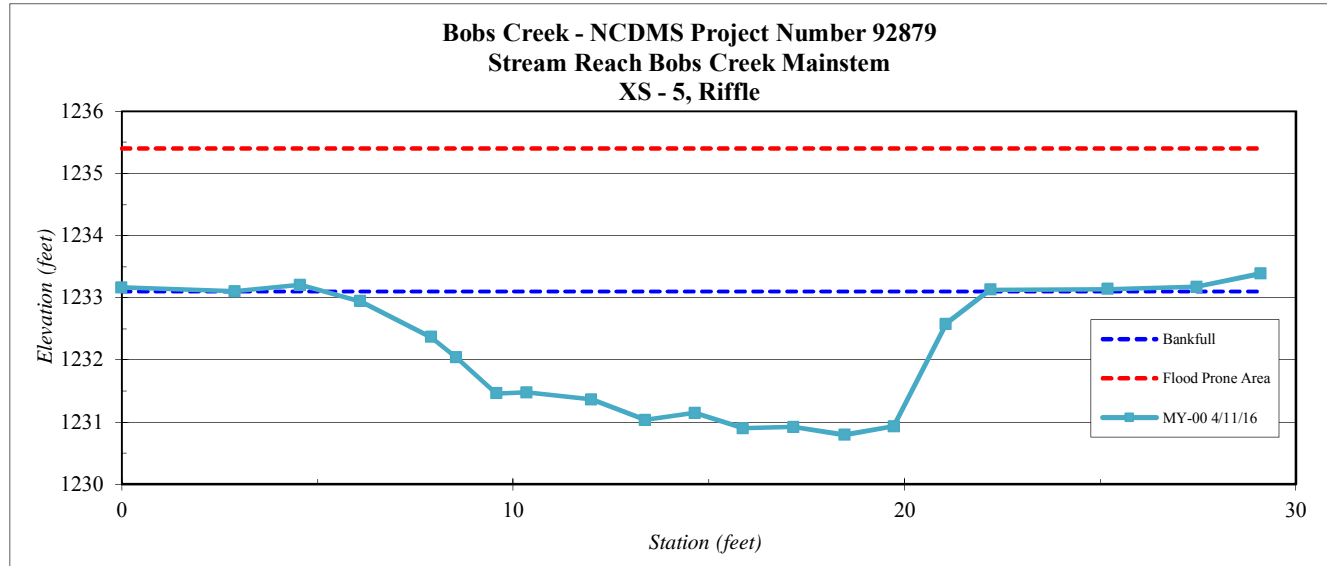


Project Name Bobs Creek - Profile
Reach UT 8 Station 00+00 - 09+00
Feature Profile
Date 4/11/16
Crew Perkinson, Jernigan

| 2016 Year 0 Monitoring \Survey | | | 2016 Year 1 Monitoring \Survey | | | 2017 Year 2 Monitoring \Survey | | | 2018 Year 3 Monitoring \Survey | | | 2019 Year 4 Monitoring \Survey | | |
|-----------------------------------|---------------|-----------------|-----------------------------------|---------------|-----------------|-----------------------------------|---------------|-----------------|-----------------------------------|---------------|-----------------|-----------------------------------|---------------|-----------------|
| Station | Bed Elevation | Water Elevation | Station | Bed Elevation | Water Elevation | Station | Bed Elevation | Water Elevation | Station | Bed Elevation | Water Elevation | Station | Bed Elevation | Water Elevation |
| 824.0 | 1212.1 | 1212.4 | | | | | | | | | | | | |
| 813.9 | 1212.2 | 1212.5 | | | | | | | | | | | | |
| 811.2 | 1211.7 | 1212.5 | | | | | | | | | | | | |
| 808.0 | 1211.5 | 1212.5 | | | | | | | | | | | | |
| 802.8 | 1211.7 | 1212.5 | | | | | | | | | | | | |
| 801.7 | 1212.8 | 1212.9 | | | | | | | | | | | | |
| 789.2 | 1213.2 | 1213.3 | | | | | | | | | | | | |
| 782.8 | 1212.9 | 1213.3 | | | | | | | | | | | | |
| 779.3 | 1212.4 | 1213.3 | | | | | | | | | | | | |
| 775.3 | 1212.4 | 1213.3 | | | | | | | | | | | | |
| 772.9 | 1213.3 | 1213.5 | | | | | | | | | | | | |
| 771.3 | 1213.0 | 1213.5 | | | | | | | | | | | | |
| 769.2 | 1213.0 | 1213.5 | | | | | | | | | | | | |
| 768.5 | 1213.7 | | | | | | | | | | | | | |
| 765.0 | 1213.3 | 1213.6 | | | | | | | | | | | | |
| 763.8 | 1212.9 | 1213.6 | | | | | | | | | | | | |
| 762.0 | 1212.9 | 1213.6 | | | | | | | | | | | | |
| 760.6 | 1214.6 | | | | | | | | | | | | | |
| 755.7 | 1214.2 | 1214.7 | | | | | | | | | | | | |
| 753.8 | 1214.1 | 1214.7 | | | | | | | | | | | | |
| 750.6 | 1213.9 | 1214.7 | | | | | | | | | | | | |
| 749.0 | 1215.7 | | | | | | | | | | | | | |
| 746.8 | 1214.5 | 1215.6 | | | | | | | | | | | | |
| 743.5 | 1214.4 | 1215.6 | | | | | | | | | | | | |
| 742.0 | | 1216.2 | | | | | | | | | | | | |
| 739.5 | 1214.3 | 1215.7 | | | | | | | | | | | | |
| 736.0 | 1213.6 | 1215.7 | | | | | | | | | | | | |
| 734.9 | 1216.6 | 1216.7 | | | | | | | | | | | | |



| | 2016 | 2016 | 2017 | 2018 | 2019 |
|--------------------------|--------|------|------|------|------|
| Avg. Water Surface Slope | 0.0212 | | | | |
| Riffle Length | 17 | | | | |
| Avg. Riffle Slope | 0.0019 | | | | |
| Pool Length | 15 | | | | |
| Pool to Pool Spacing | 26.0 | | | | |

Bobs Creek Year 0 (2016) Profile - Tributary 8 Station 00+00 to 09+00


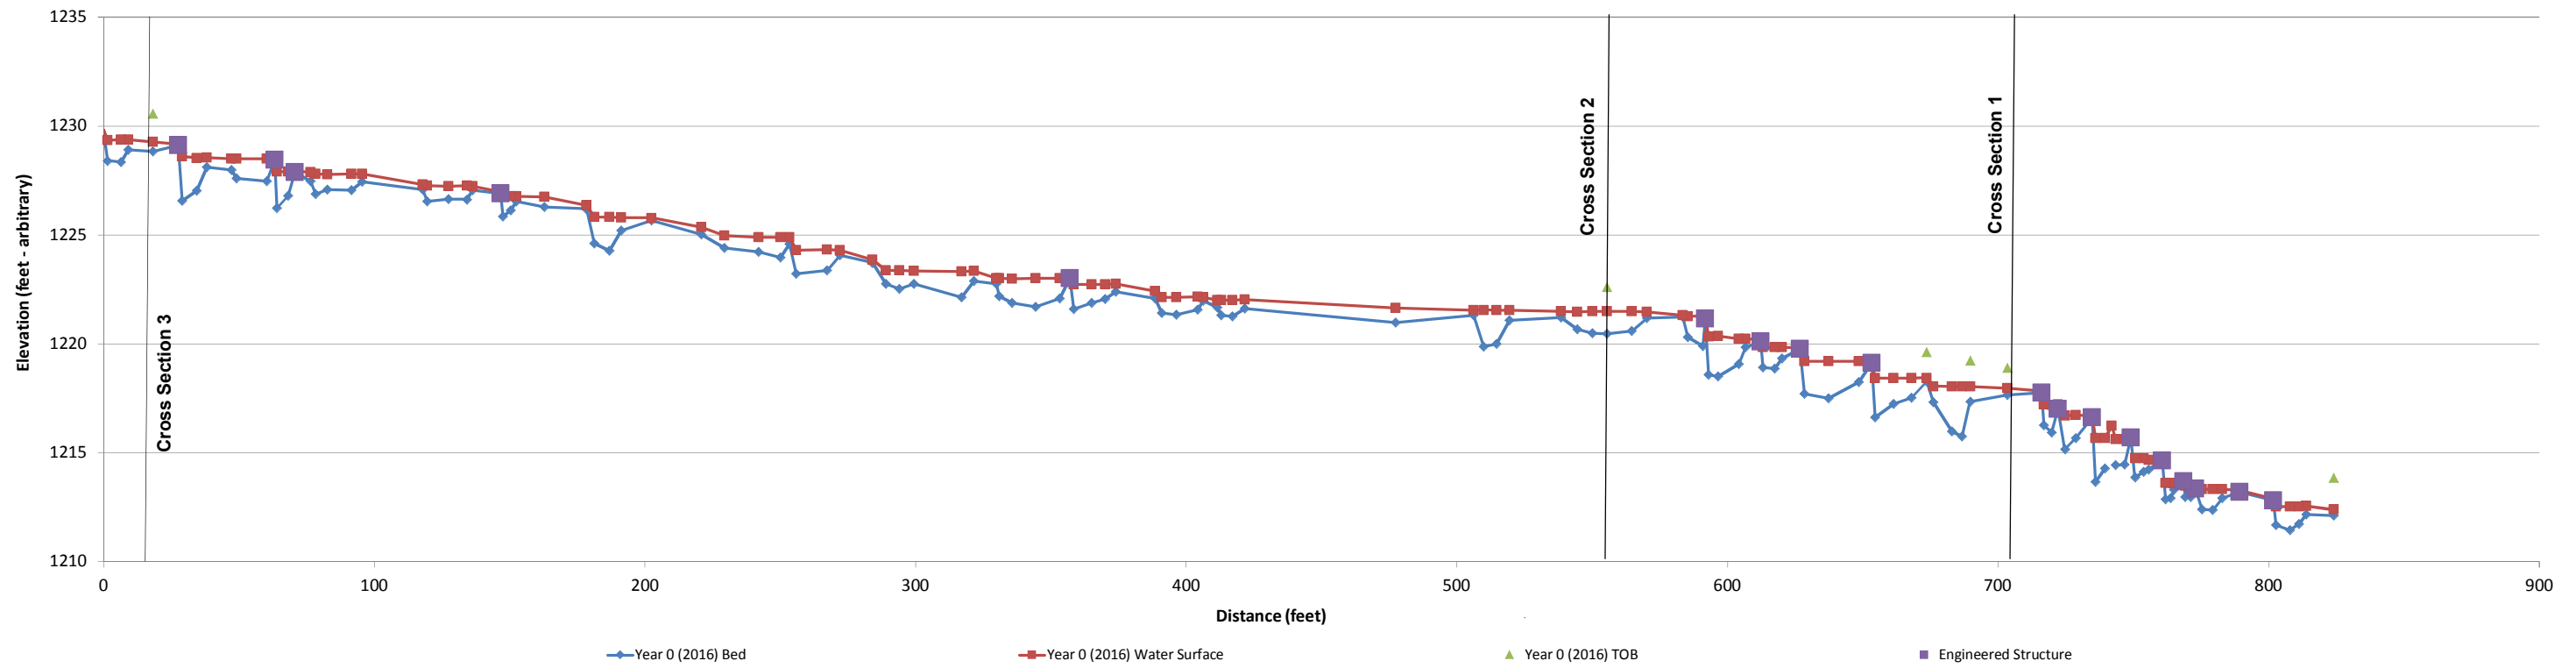


| Project Name: Bobs Creek - UT 8 | | | | | |
|---------------------------------|--------------------|-----------|---------|--------|-------|
| Cross-Section: 1 | | | | | |
| Feature: Rifle | | | | | |
| | | | 2014 | | |
| Description | Material | Size (mm) | Total # | Item % | Cum % |
| Silt/Clay | silt/clay | 0.062 | 36 | 36% | 36% |
| Sand | very fine sand | 0.125 | 8 | 8% | 44% |
| | fine sand | 0.250 | 4 | 4% | 48% |
| | medium sand | 0.50 | 0 | 0% | 48% |
| | coarse sand | 1.00 | 8 | 8% | 56% |
| | very coarse sand | 2.0 | 4 | 4% | 60% |
| Gravel | very fine gravel | 4.0 | 8 | 8% | 68% |
| | fine gravel | 5.7 | 4 | 4% | 72% |
| | fine gravel | 8.0 | 12 | 12% | 84% |
| | medium gravel | 11.3 | 8 | 8% | 92% |
| | medium gravel | 16.0 | 0 | 0% | 92% |
| | course gravel | 22.3 | 4 | 4% | 96% |
| | course gravel | 32.0 | 0 | 0% | 96% |
| | very coarse gravel | 45 | 0 | 0% | 96% |
| Cobble | very coarse gravel | 64 | 4 | 4% | 100% |
| | small cobble | 90 | 0 | 0% | 100% |
| | medium cobble | 128 | 0 | 0% | 100% |
| | large cobble | 180 | 0 | 0% | 100% |
| Boulder | very large cobble | 256 | 0 | 0% | 100% |
| | small boulder | 362 | 0 | 0% | 100% |
| | small boulder | 512 | 0 | 0% | 100% |
| | medium boulder | 1024 | 0 | 0% | 100% |
| Bedrock | large boulder | 2048 | 0 | 0% | 100% |
| | bedrock | 40096 | 0 | 0% | 100% |
| TOTAL % of whole count | | | 100 | 100% | 100% |



| Summary Data | |
|--------------|-----|
| D50 | 8.7 |
| D84 | 29 |
| D95 | 42 |

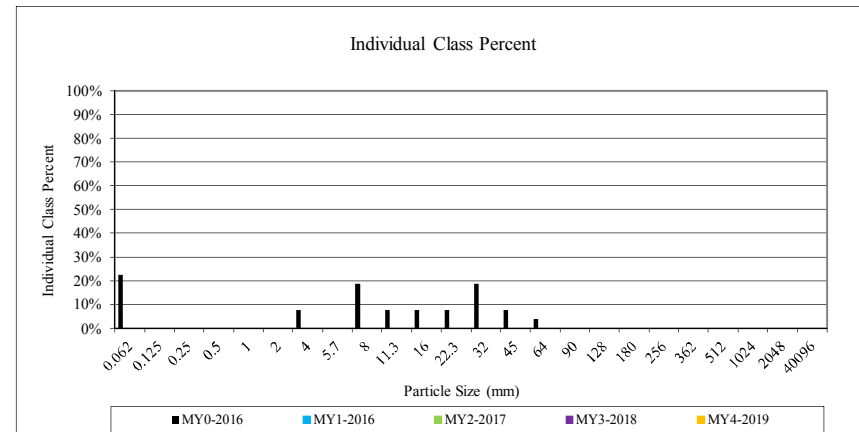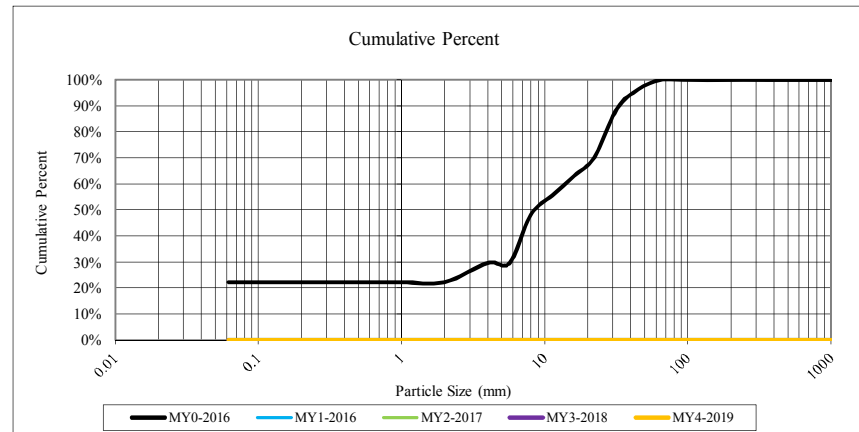

| Project Name: Bobs Creek - UT 8 | | | | | |
|---------------------------------|--------------------|--------------|---------|--------|-------|
| Cross-Section: 3 | | | | | |
| Feature: Riffle | | | | | |
| | | | 2014 | | |
| Description | Material | Size (mm) | Total # | Item % | Cum % |
| Silt/Clay | silt/clay | 0.062 | 28 | 33% | 33% |
| Sand | very fine sand | 0.125 | 8 | 10% | 43% |
| | fine sand | 0.250 | 4 | 5% | 48% |
| | medium sand | 0.50 | 4 | 5% | 52% |
| | coarse sand | 1.00 | 8 | 10% | 62% |
| | very coarse sand | 2.0 | 4 | 5% | 67% |
| Gravel | very fine gravel | 4.0 | 0 | 0% | 67% |
| | fine gravel | 5.7 | 0 | 0% | 67% |
| | fine gravel | 8.0 | 4 | 5% | 71% |
| | medium gravel | 11.3 | 4 | 5% | 76% |
| | medium gravel | 16.0 | 8 | 10% | 86% |
| | course gravel | 22.3 | 4 | 5% | 90% |
| | course gravel | 32.0 | 4 | 5% | 95% |
| | very coarse gravel | 45 | 0 | 0% | 95% |
| | very coarse gravel | 64 | 0 | 0% | 95% |
| | Cobble | small cobble | 90 | 4 | 5% |
| medium cobble | | 128 | 0 | 0% | 100% |
| large cobble | | 180 | 0 | 0% | 100% |
| very large cobble | | 256 | 0 | 0% | 100% |
| Boulder | small boulder | 362 | 0 | 0% | 100% |
| | small boulder | 512 | 0 | 0% | 100% |
| | medium boulder | 1024 | 0 | 0% | 100% |
| | large boulder | 2048 | 0 | 0% | 100% |
| Bedrock | bedrock | 40096 | 0 | 0% | 100% |
| TOTAL % of whole count | | | 84 | 100% | 100% |
| Summary Data | | | | | |
| D50 | 6.5 | | | | |
| D84 | 13 | | | | |
| D95 | 24 | | | | |

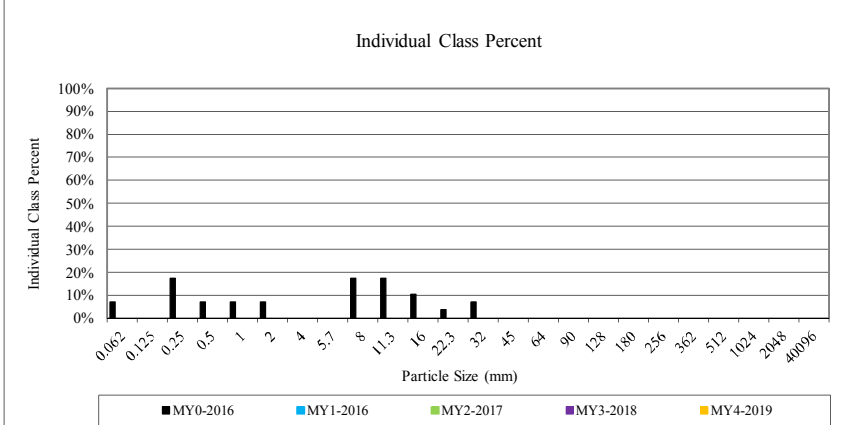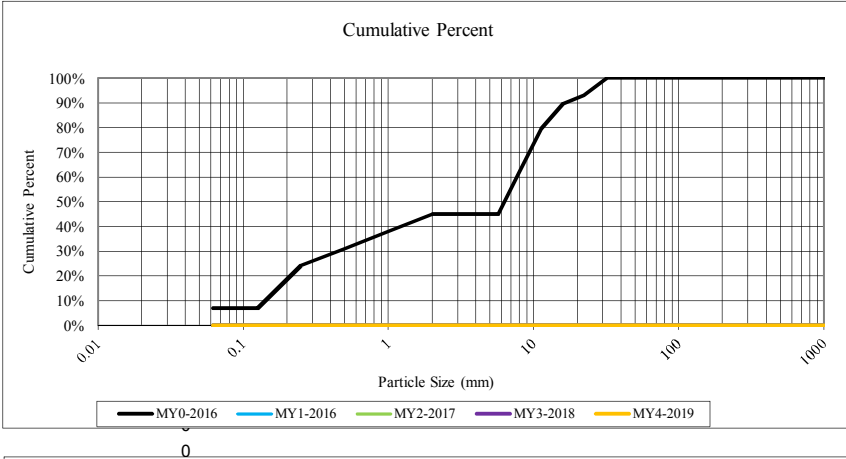

| Project Name: Bobs Creek | | | | | |
|-------------------------------|--------------------|--------------|---------|--------|-------|
| Cross-Section: 4 | | | | | |
| Feature: Riffle | | | | | |
| | | | 2014 | | |
| Description | Material | Size (mm) | Total # | Item % | Cum % |
| Silt/Clay | silt/clay | 0.062 | 24 | 24% | 24% |
| Sand | very fine sand | 0.125 | 8 | 8% | 32% |
| | fine sand | 0.250 | 12 | 12% | 44% |
| | medium sand | 0.50 | 4 | 4% | 48% |
| | coarse sand | 1.00 | 8 | 8% | 56% |
| | very coarse sand | 2.0 | 4 | 4% | 60% |
| Gravel | very fine gravel | 4.0 | 8 | 8% | 68% |
| | fine gravel | 5.7 | 4 | 4% | 72% |
| | fine gravel | 8.0 | 8 | 8% | 80% |
| | medium gravel | 11.3 | 0 | 0% | 80% |
| | medium gravel | 16.0 | 4 | 4% | 84% |
| | course gravel | 22.3 | 12 | 12% | 96% |
| | course gravel | 32.0 | 0 | 0% | 96% |
| | very coarse gravel | 45 | 0 | 0% | 96% |
| | very coarse gravel | 64 | 4 | 4% | 100% |
| | Cobble | small cobble | 90 | 0 | 0% |
| medium cobble | | 128 | 0 | 0% | 100% |
| large cobble | | 180 | 0 | 0% | 100% |
| very large cobble | | 256 | 0 | 0% | 100% |
| Boulder | small boulder | 362 | 0 | 0% | 100% |
| | small boulder | 512 | 0 | 0% | 100% |
| | medium boulder | 1024 | 0 | 0% | 100% |
| | large boulder | 2048 | 0 | 0% | 100% |
| Bedrock | bedrock | 40096 | 0 | 0% | 100% |
| TOTAL % of whole count | | | 100 | 100% | 100% |
| Summary Data | | | | | |
| D50 | 22 | | | | |
| D84 | 141 | | | | |
| D95 | 212 | | | | |

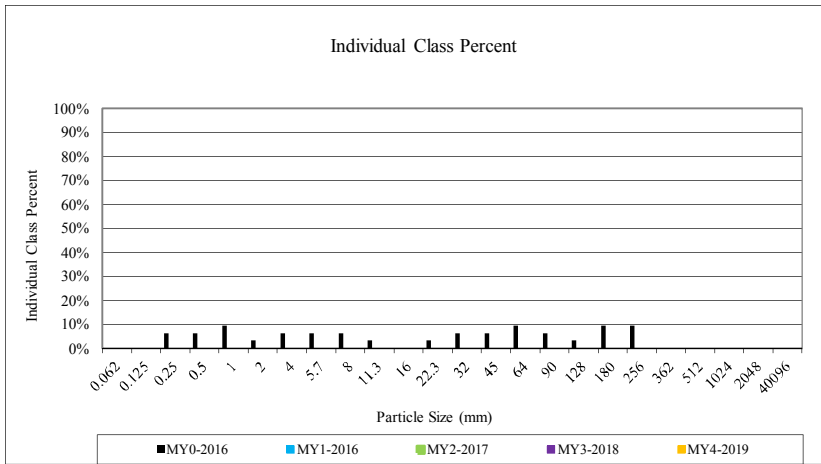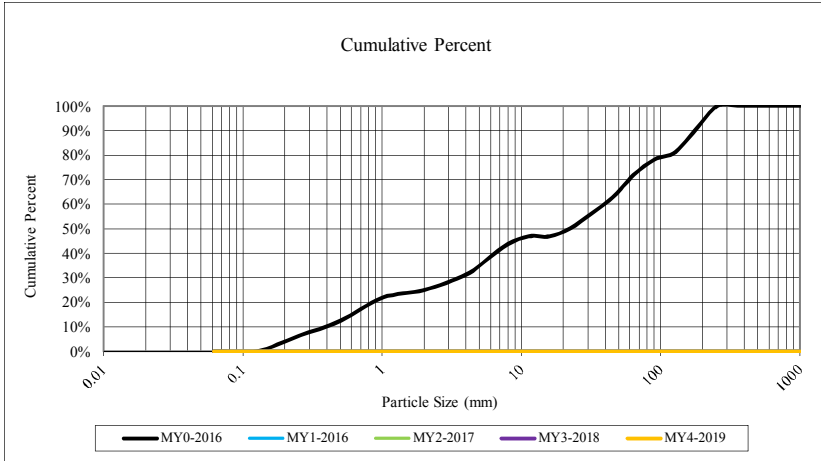

| Project Name: Bobs Creek | | | | | |
|-------------------------------|--------------------|--------------|---------|--------|-------|
| Cross-Section: 5 | | | | | |
| Feature: Riffle | | | | | |
| | | | 2014 | | |
| Description | Material | Size (mm) | Total # | Item % | Cum % |
| Silt/Clay | silt/clay | 0.062 | 68 | 68% | 68% |
| Sand | very fine sand | 0.125 | 4 | 4% | 72% |
| | fine sand | 0.250 | 12 | 12% | 84% |
| | medium sand | 0.50 | 0 | 0% | 84% |
| | coarse sand | 1.00 | 4 | 4% | 88% |
| | very coarse sand | 2.0 | 4 | 4% | 92% |
| Gravel | very fine gravel | 4.0 | 8 | 8% | 100% |
| | fine gravel | 5.7 | 0 | 0% | 100% |
| | fine gravel | 8.0 | 0 | 0% | 100% |
| | medium gravel | 11.3 | 0 | 0% | 100% |
| | medium gravel | 16.0 | 0 | 0% | 100% |
| | course gravel | 22.3 | 0 | 0% | 100% |
| | course gravel | 32.0 | 0 | 0% | 100% |
| | very coarse gravel | 45 | 0 | 0% | 100% |
| | very coarse gravel | 64 | 0 | 0% | 100% |
| | Cobble | small cobble | 90 | 0 | 0% |
| medium cobble | | 128 | 0 | 0% | 100% |
| large cobble | | 180 | 0 | 0% | 100% |
| very large cobble | | 256 | 0 | 0% | 100% |
| Boulder | small boulder | 362 | 0 | 0% | 100% |
| | small boulder | 512 | 0 | 0% | 100% |
| | medium boulder | 1024 | 0 | 0% | 100% |
| | large boulder | 2048 | 0 | 0% | 100% |
| Bedrock | bedrock | 40096 | 0 | 0% | 100% |
| TOTAL % of whole count | | | 100 | 100% | 100% |

| Summary Data | |
|--------------|------|
| D50 | 24.9 |
| D84 | 75 |
| D95 | 106 |

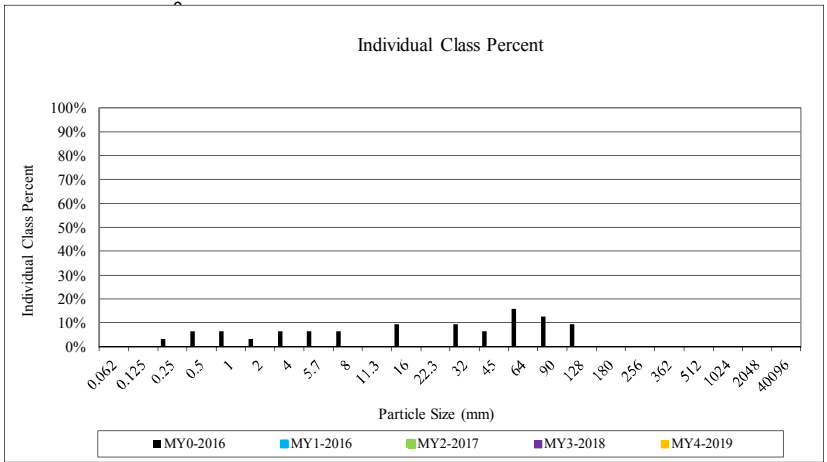
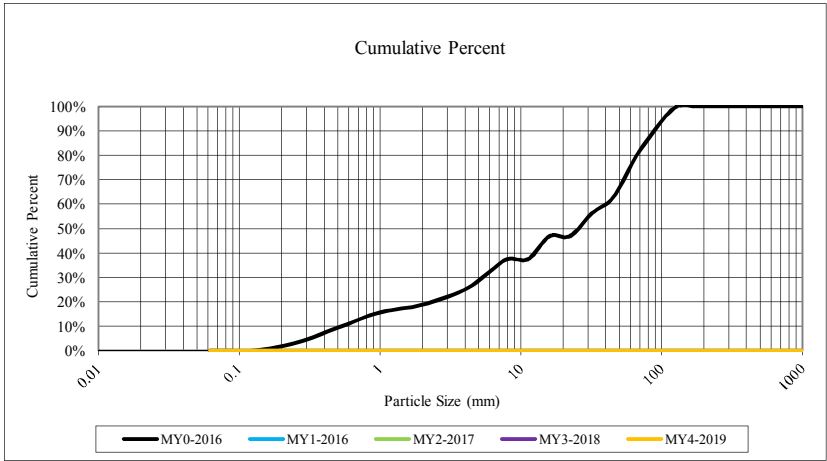



Table 7a. Baseline Stream Data Summary (Bob's Creek - UT 8)
Bob's Creek Mitigation Project - NCDMS Project Number 92633

| Parameter | Gauge | Regional Curve | | | Pre-Existing Condition (UT 8) | | | | | Reference Reach(es) Data | | | | | Design (UT 8) | | | Monitoring Baseline (UT 8) | | | | | | |
|---|-------|----------------|----|-----|-------------------------------|------|-----|-------|----|--------------------------|--------|-----|------|----|---------------|------|--------|----------------------------|--------|--------|--------|--------|------|----|
| | | LL | UL | Eq. | Min | Mean | Med | Max | SD | Min | Mean | Med | Max | SD | Min | Max | Med | Min | Mean | Med | Max | SD | n | |
| Dimension and Substrate - Riffle Only | | | | | | | | | | | | | | | | | | | | | | | | |
| BF Width (ft) | | | | | 5.0 | | | 7.8 | | | 5.6 | | | | | | 8.0 | 8.3 | | 8.7 | 9 | 3 | | |
| Floodprone Width (ft) | | | | | 7.8 | | | 20.0 | | | 13 | | | | 20 | 25 | | | | 100 | | 3 | | |
| BF Mean Depth (ft) | | | | | 0.6 | | | 0.9 | | | 0.5 | | | | | | 0.8 | 0.8 | | 0.9 | 0.9 | 3 | | |
| BF Max Depth (ft) | | | | | 0.9 | | | 1.2 | | | 0.7 | | | | | | 1.0 | 1.2 | | 1.5 | 1.7 | 3 | | |
| BF Cross Sectional Area (ft ²) | | | | | 3.7 | | | 4.7 | | | 3.0 | | | | | | 5.9 | 6.6 | | 7.5 | 8.3 | 3 | | |
| Width/Depth Ratio | | | | | 5.3 | | | 13.6 | | | 10.5 | | | | | | 10.5 | 10.0 | | 10.2 | 10.4 | 3 | | |
| Entrenchment Ratio | | | | | 1.6 | | | 2.6 | | | 2.3 | | | | 2.5 | 3.1 | | | 11.1 | | 11.6 | 12.0 | 3 | |
| Bank Height Ratio | | | | | 1.1 | | | 7.3 | | | 1.0 | | | | | | 1.0 | | | 1.0 | | 3 | | |
| Profile | | | | | | | | | | | | | | | | | | | | | | | | |
| Riffle length (ft) | | | | | | | | | | | | | | | | | | | 3.5 | 16.9 | 12 | 84.6 | 17.4 | 21 |
| Riffle slope (ft/ft) | | | | | 0.035 | | | 0.045 | | | 0.0480 | | | | | | 0.0060 | 0.0119 | 0.0172 | 0.0155 | 0.0418 | 0.0117 | 19 | |
| Pool length (ft) | | | | | | | | | | | | | | | | | | | 4.4 | 14.7 | 12.8 | 37.5 | 8.6 | 32 |
| Pool Max depth (ft) | | | | | 1.5 | | | 2.6 | | | 0.9 | | | | | | 1.9 | | | 1.9 | | | 1 | |
| Pool spacing (ft) | | | | | 15.3 | | | 45.2 | | 14.0 | | | 33.9 | | 8.0 | 37.1 | | | 4.4 | 25.8 | 24.8 | 94.8 | 17.6 | 32 |
| Pattern | | | | | | | | | | | | | | | | | | | | | | | | |
| Channel Beltwidth (ft) | | | | | 23 | | | 33 | | 17 | | | 25 | | 24 | 48 | | | 24 | | | 48 | | 2 |
| Radius of Curvature (ft) | | | | | 4 | | | 12 | | 10 | | | 13 | | 16 | 32 | | | 16 | | | 32 | | 2 |
| Rc:Bankfull width (ft/ft) | | | | | 0.6 | | | 2.3 | | 1.8 | | | 2.3 | | 2 | 4 | | | 2 | | | 4 | | 2 |
| Meander Wavelength (ft) | | | | | 32 | | | 65 | | 31 | | | 38 | | 40 | 80 | | | 40 | | | 80 | | 2 |
| Meander Width ratio | | | | | 3 | | | 6.6 | | 5.6 | | | 6.8 | | 50 | 10 | | | 50 | | | 10 | | 2 |
| Transport parameters | | | | | | | | | | | | | | | | | | | | | | | | |
| Reach Shear Stress (competency) lbs/ft ² | | | | | | | | | | | | | | | | | | | | | | | | |
| Max part size (mm) mobilized at bankfull | | | | | | | | | | | | | | | | | | | | | | | | |
| Stream Power (transport capacity) W/m ² | | | | | | | | | | | | | | | | | | | | | | | | |
| Additional Reach Parameters | | | | | | | | | | | | | | | | | | | | | | | | |
| Rosgen Classification | | | | | B/C/G | | | | | E/C | | | | | E/C | | | E/C | | | | | | |
| Bankfull Velocity (fps) | | | | | 3.2-4.0 | | | | | | | | | | | | | | | | | | | |
| Bankfull Discharge (cfs) | | | | | 15 | | | | | | | | | | | | | | | | | | | |
| Valley Length (ft) | | | | | ---- | | | | | ---- | | | | | | | | | | | | | | |
| Channel Thalweg Length (ft) | | | | | ---- | | | | | ---- | | | | | | | | 824 | | | | | | |
| Sinuosity | | | | | 1.11 - 1.18 | | | | | 1.28 | | | | | 1.11 - 1.17 | | | 1.11 - 1.17 | | | | | | |
| Water Surface Slope (ft/ft) | | | | | 0.0148 - 0.0172 | | | | | 0.048 | | | | | 0.004 | | | 0.0212 | | | | | | |
| BF slope (ft/ft) | | | | | ---- | | | | | ---- | | | | | ---- | | | ---- | | | | | | |
| Bankfull Floodplain Area (acres) | | | | | ---- | | | | | ---- | | | | | ---- | | | ---- | | | | | | |
| % of Reach with Eroding Banks | | | | | ---- | | | | | ---- | | | | | ---- | | | ---- | | | | | | |
| Channel Stability or Habitat Metric | | | | | ---- | | | | | ---- | | | | | ---- | | | ---- | | | | | | |
| Biological or Other | | | | | ---- | | | | | ---- | | | | | ---- | | | ---- | | | | | | |

Table 7b. Baseline Stream Data Summary (Bob's Creek)
Bob's Creek Mitigation Project - NCDMS Project Number 92633

| Parameter | Gauge | Regional Curve | | | Pre-Existing Condition (Bobs Cr) | | | | | Reference Reach(es) Data | | | | | Design (Bobs Cr) | | | Monitoring Baseline (Bobs Cr) | | | | | |
|---|-------|----------------|----|-----|----------------------------------|------|--------|-------|----|--------------------------|--------|-----|------|----|------------------|------|------|-------------------------------|--------|------|-----|-----|---|
| | | LL | UL | Eq. | Min | Mean | Med | Max | SD | Min | Mean | Med | Max | SD | Min | Max | Med | Min | Mean | Med | Max | SD | n |
| Dimension and Substrate - Riffle Only | | | | | | | | | | | | | | | | | | | | | | | |
| BF Width (ft) | | | | | 14.5 | | | 25.5 | | | 12.7 | | | | | 17.5 | 15.2 | | | 17 | | 2 | |
| Floodprone Width (ft) | | | | | 29.8 | | | 45.2 | | | 150 | | | | | 100 | | | 150 | | | 2 | |
| BF Mean Depth (ft) | | | | | 1.1 | | | 1.2 | | | 0.9 | | | | | 1.3 | 1.3 | | | 1.5 | | 2 | |
| BF Max Depth (ft) | | | | | 1.4 | | | 2.0 | | | 1.2 | | | | | 1.7 | 2.2 | | | 2.3 | | 2 | |
| BF Cross Sectional Area (ft ²) | | | | | 17.4 | | | 29.0 | | | 11.4 | | | | | 22.3 | 19.9 | | | 25.2 | | 2 | |
| Width/Depth Ratio | | | | | 12.1 | | | 22.3 | | | 14.1 | | | | | 14.0 | 11.3 | | | 11.7 | | 2 | |
| Entrenchment Ratio | | | | | 1.2 | | | 3.1 | | | 11.8 | | | | | 5.7 | 8.8 | | | 9.9 | | 2 | |
| Bank Height Ratio | | | | | 1.2 | | | 1.8 | | | 1.0 | | | | | 1.0 | | | 1.0 | | | 2 | |
| Profile | | | | | | | | | | | | | | | | | | | | | | | |
| Riffle length (ft) | | | | | | | | | | | | | | | | | | | | | | | |
| Riffle slope (ft/ft) | | | | | | | 0.0239 | | | | 0.0344 | | | | | | | | 0.0105 | | | | |
| Pool length (ft) | | | | | | | | | | | | | | | | | | | | | | | |
| Pool Max depth (ft) | | | | | | | 3.3 | | | | 2.2 | | | | | | | | 3.3 | | | | |
| Pool spacing (ft) | | | | | 43.8 | | | 171.6 | | 38.8 | | | 64.7 | | 53.7 | 89.4 | | | | | | | |
| Pattern | | | | | | | | | | | | | | | | | | | | | | | |
| Channel Beltwidth (ft) | | | | | 36 | | | 55 | | 30.5 | | | 32 | | 43.8 | 105 | | | 43.8 | | | 105 | 2 |
| Radius of Curvature (ft) | | | | | 7 | | | 30 | | 14.5 | | | 20 | | 40.3 | 70 | | | 40.3 | | | 70 | 2 |
| Rc:Bankfull width (ft/ft) | | | | | 0.3 | | | 2.1 | | 1.1 | | | 1.6 | | 2.3 | 4 | | | 2.3 | | | 4 | 2 |
| Meander Wavelength (ft) | | | | | 100 | | | 145 | | 95 | | | 98 | | 87.5 | 175 | | | 87.5 | | | 175 | 2 |
| Meander Width ratio | | | | | 1.41 | | | 3.8 | | 7.5 | | | 7.7 | | 5 | 10 | | | 5 | | | 10 | 2 |
| Transport parameters | | | | | | | | | | | | | | | | | | | | | | | |
| Reach Shear Stress (competency) lbs/ft ² | | | | | | | | | | | | | | | | | | | | | | | |
| Max part size (mm) mobilized at bankfull | | | | | | | | | | | | | | | | | | | | | | | |
| Stream Power (transport capacity) W/m ² | | | | | | | | | | | | | | | | | | | | | | | |
| Additional Reach Parameters | | | | | | | | | | | | | | | | | | | | | | | |
| Rosgen Classification | | | | | B/C/F | | | | | C | | | | | C | | | E/C | | | | | |
| Bankfull Velocity (fps) | | | | | 3.79-6.32 | | | | | | | | | | | | | | | | | | |
| Bankfull Discharge (cfs) | | | | | 110 | | | | | | | | | | | | | | | | | | |
| Valley Length (ft) | | | | | ---- | | | | | ---- | | | | | | | | | | | | | |
| Channel Thalweg Length (ft) | | | | | ---- | | | | | ---- | | | | | ---- | | | 371 | | | | | |
| Sinuosity | | | | | 1.17 | | | | | 1.22 | | | | | 1.13 | | | 1.13 | | | | | |
| Water Surface Slope (ft/ft) | | | | | 0.0149 | | | | | 0.0205 | | | | | 0.007 | | | | | | | | |
| BF slope (ft/ft) | | | | | ---- | | | | | ---- | | | | | ---- | | | ---- | | | | | |
| Bankfull Floodplain Area (acres) | | | | | ---- | | | | | ---- | | | | | ---- | | | ---- | | | | | |
| % of Reach with Eroding Banks | | | | | ---- | | | | | ---- | | | | | ---- | | | ---- | | | | | |
| Channel Stability or Habitat Metric | | | | | ---- | | | | | ---- | | | | | ---- | | | ---- | | | | | |
| Biological or Other | | | | | ---- | | | | | ---- | | | | | ---- | | | ---- | | | | | |

Appendix E.
As-built Plan Sheets

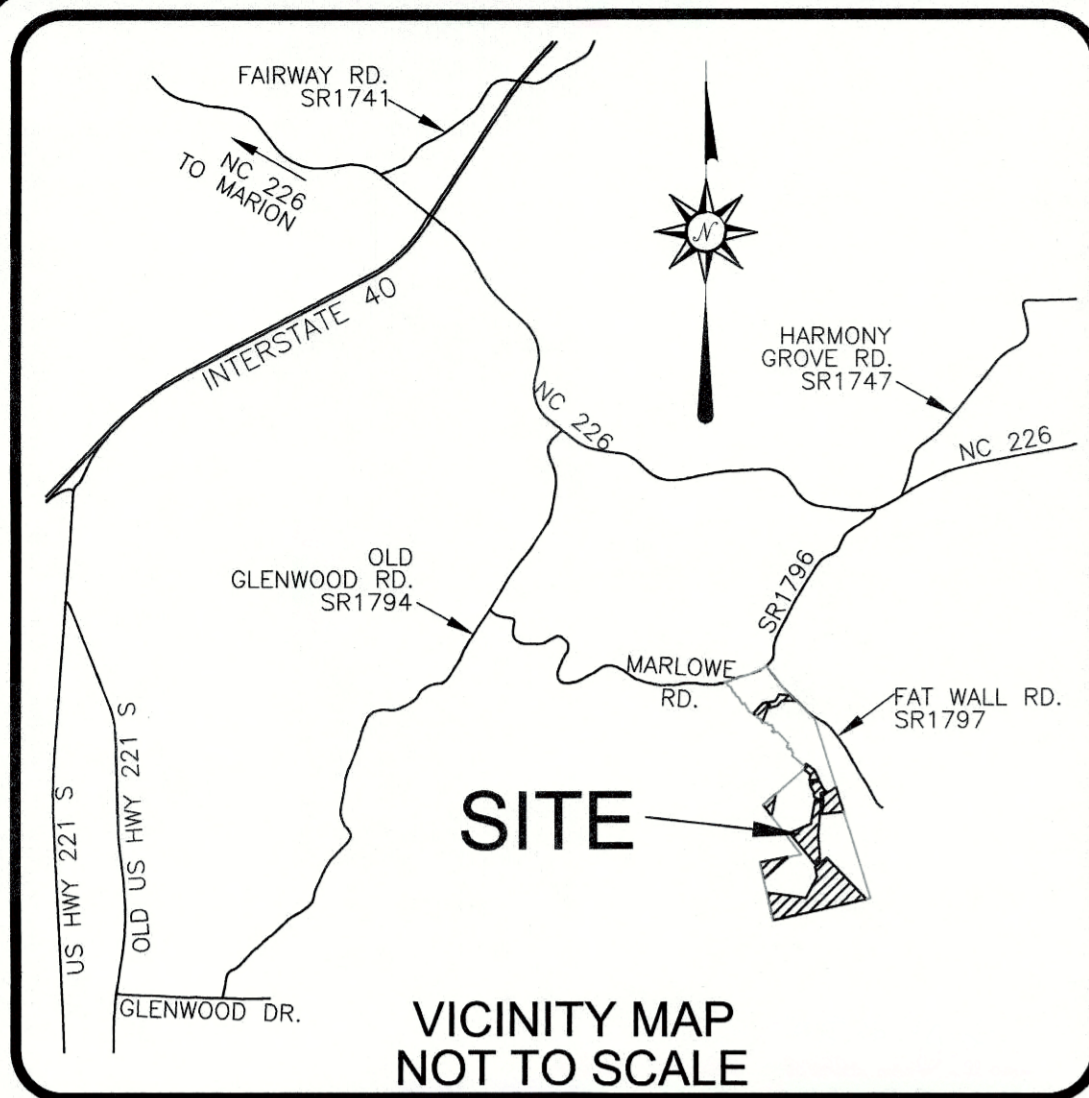


I, ELISABETH G. TURNER, AS A DULY REGISTERED PROFESSIONAL LAND SURVEYOR IN THE STATE OF NORTH CAROLINA, HEREBY CERTIFY THAT THE DATA SHOWN ON THIS DRAWING, WAS OBTAINED UNDER MY SUPERVISION, IS AN ACCURATE AND COMPLETE REPRESENTATION OF WHAT WAS CONSTRUCTED IN THE FIELD, AND THAT THE PHYSICAL DIMENSIONS OR ELEVATIONS SHOWN THUS ARE AS-BUILT CONDITIONS EXCEPT WHERE OTHERWISE NOTED HEREON. WITNESS MY ORIGINAL SIGNATURE, REGISTRATION NUMBER, AND SEAL THIS 23rd DAY OF SEPTEMBER, 2015.

Elisabeth G. Turner
 ELISABETH G. TURNER, P.L.S. #L-4440
 NORTH CAROLINA PROFESSIONAL LAND SURVEYOR
 SEAL L-4440
 ELISABETH G. TURNER

AS-BUILT SURVEY OF BOBS CREEK STREAM RESTORATION PROJECT

McDOWELL COUNTY, NC
 SCO# 080730801
 NCEEP PROJECT# 92879

REFERENCES:
 OWNER:
 NORTH CAROLINA DEPARTMENT
 OF MITIGATION SERVICES
 217 WEST JONES ST., SUITE 3000A
 RALEIGH, NC 27603
 (919)707-8976
 DSM PROJ. MANAGER: MATTHEW RIED
 DESIGNER:
 FLORENCE & HUTCHESON ENGINEERING
 (NOW HDR/ICA)
 5121 KINGDOM WAY, SUITE 100
 RALEIGH, NC 27607
 (919)851-6066
 CONTRACTOR:
 CAROLINA ENVIRONMENTAL
 CONTRACTING, INC.
 MOUNT AIRY, NC
 (336)320-3849

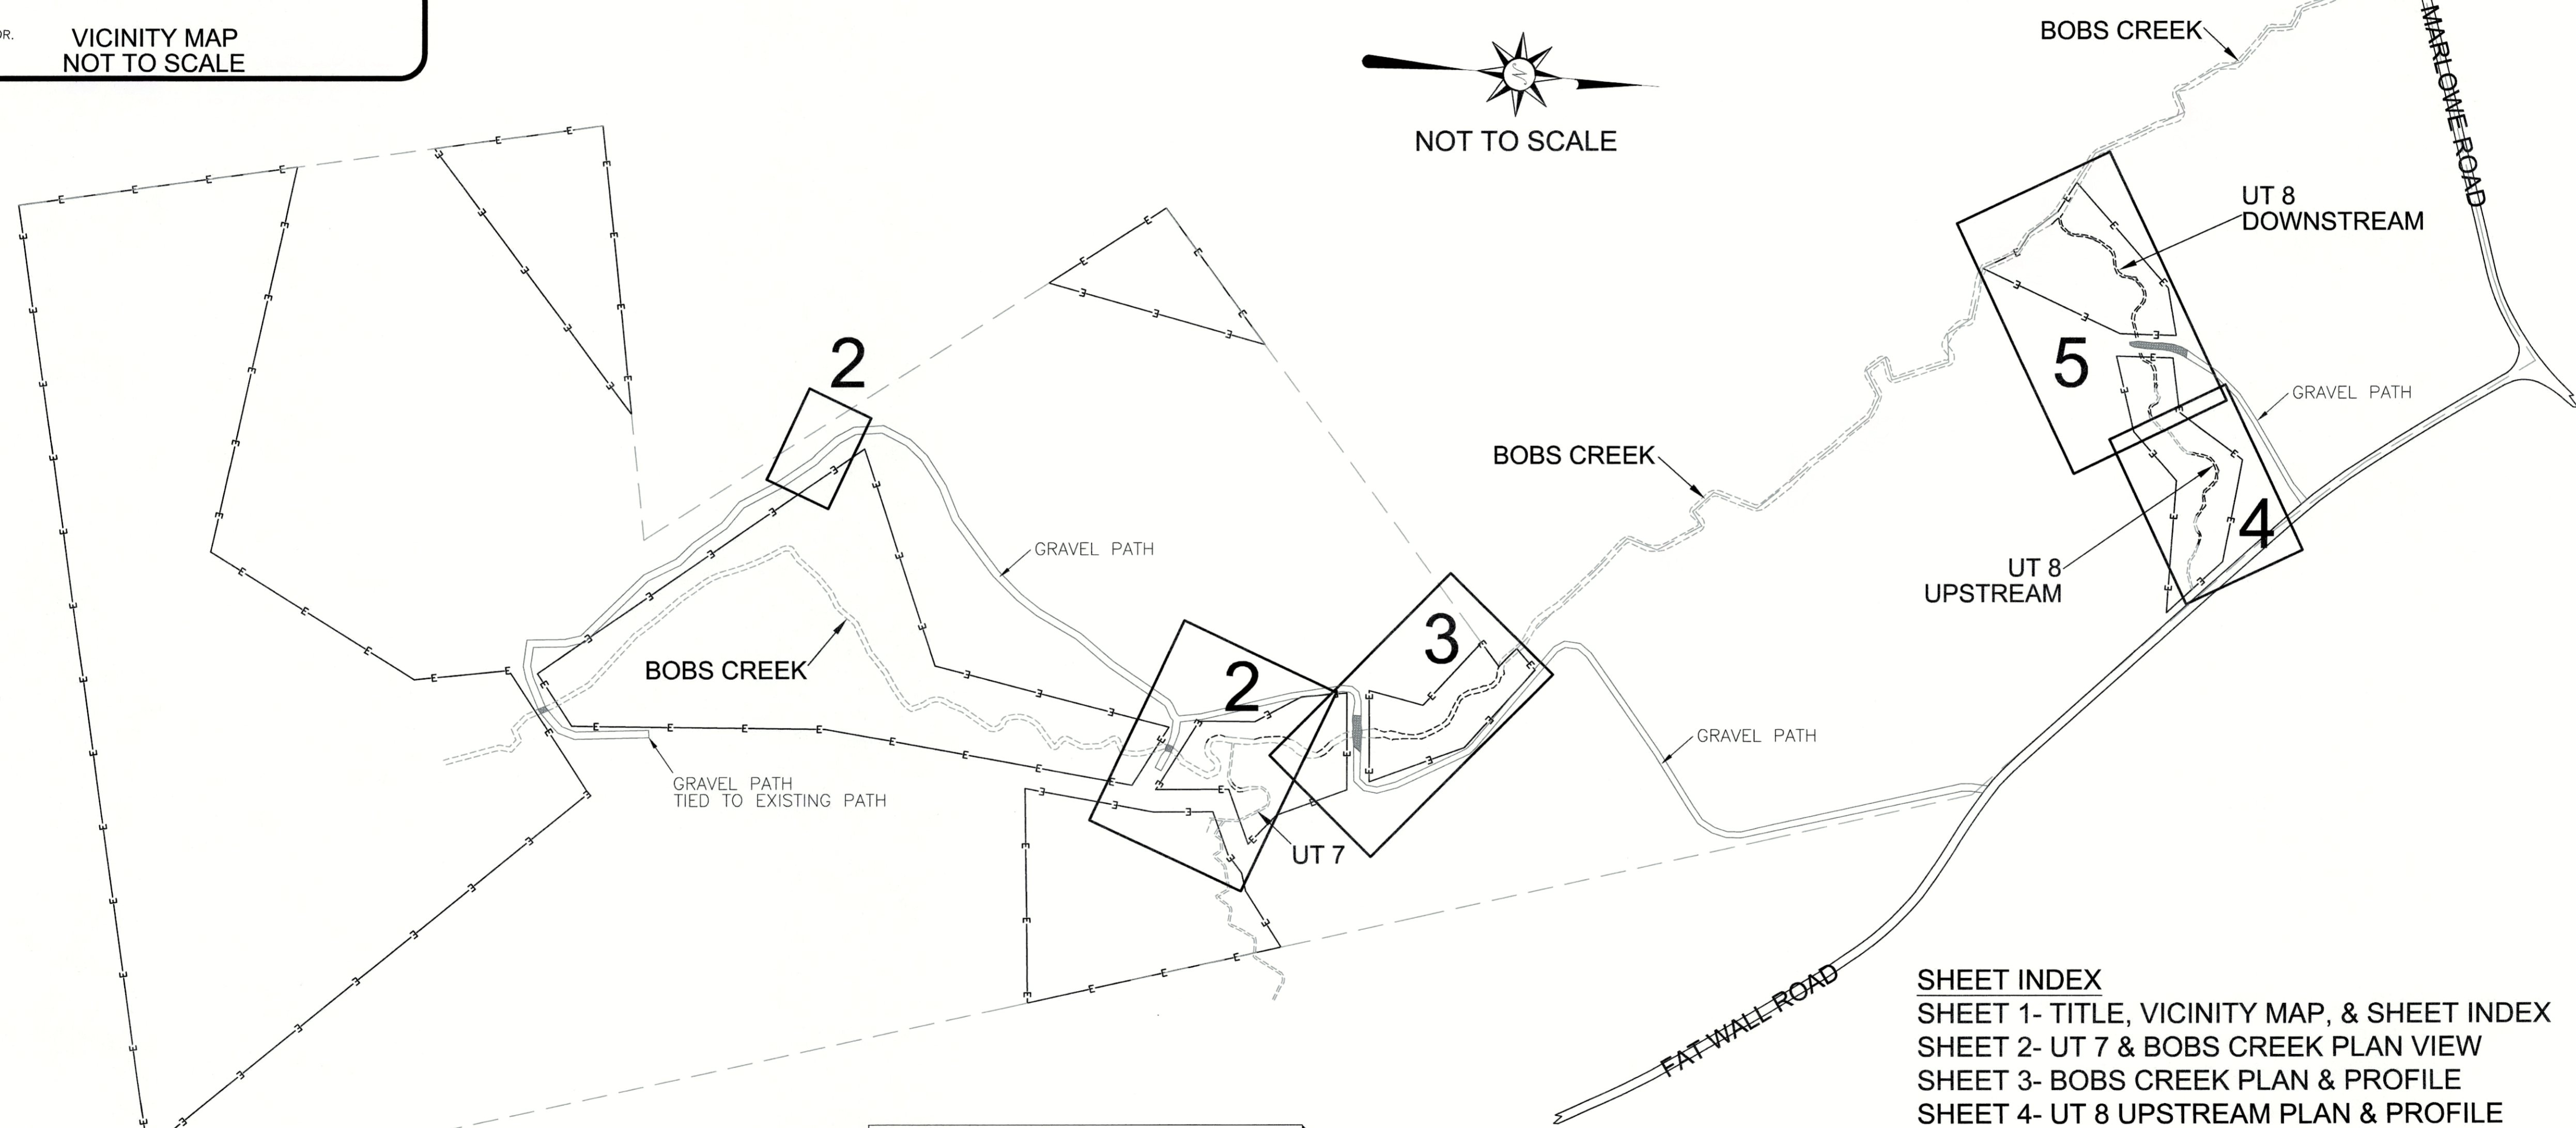

SHEET INDEX
 SHEET 1- TITLE, VICINITY MAP, & SHEET INDEX
 SHEET 2- UT 7 & BOBS CREEK PLAN VIEW
 SHEET 3- BOBS CREEK PLAN & PROFILE
 SHEET 4- UT 8 UPSTREAM PLAN & PROFILE
 SHEET 5- UT 8 DOWNSTREAM PLAN & PROFILE

GENERAL NOTES:
 1. ALL DISTANCES ARE HORIZONTAL UNLESS OTHERWISE NOTED.
 2. HORIZONTAL DATUM IS NAD83(2011) & VERTICAL DATUM IS NAVD88.
 3. CONTROL IS BASED ON EXISTING CONTROL DATA AS SHOWN ON SHEET 3 IN THE DESIGN PLANS AND RECOVERED DURING THE CONSTRUCTION & AS-BUILT SURVEYS. ADDITIONAL CONTROL WAS ESTABLISHED DURING TOTAL STATION & GPS/RTK METHODS AND CONFIRMED DURING AS-BUILT SURVEY. AS-BUILT CONTROL POINTS ARE LISTED ON SHEET 1.
 4. THIS MAP IS NOT FOR RECORDATION, SALES, OR CONVEYANCES AND DOES NOT COMPLY WITH G.S. 47-30 MAPPING REQUIREMENTS.
 5. THE PURPOSE OF THIS SURVEY IS TO SHOW THE POST CONSTRUCTION CONDITIONS OF THE STREAM AND GRADING RELATED TO THE BOBS CREEK STREAM RESTORATION PROJECT AND MAY NOT SHOW ALL UTILITIES, STRUCTURES, & BOUNDARIES.
 6. INFORMATION SHOWN OUTSIDE THE LIMITS OF AS-BUILT SURVEY WAS PROVIDED BY THE DESIGNER AND WAS NOT VERIFIED BY TURNER LAND SURVEYING, PLLC.
 7. NO PROPERTY RESEARCH WAS PERFORMED. FOR CONSERVATION EASEMENT SEE PLAT RECORDED IN McDOWELL COUNTY REGISTER OF DEEDS OFFICE PLAT BOOK 18, PAGE 89.

AS-BUILT SURVEY CONTROL POINTS:

| PT# | Northing(Y) | Easting(X) | Elev(Z) | Description |
|-----|-------------|------------|---------|-------------|
| 3 | 698045.26 | 1127075.56 | 1241.95 | ECTL#3 |
| 25 | 696701.38 | 1127656.05 | 1234.88 | TLS#25 NAIL |
| 26 | 696495.38 | 1127656.26 | 1236.87 | TLS#26 NAIL |
| 27 | 696125.89 | 1127760.57 | 1245.93 | TLS#27 NAIL |
| 28 | 695902.90 | 1127979.54 | 1250.41 | TLS#28 NAIL |
| 29 | 697664.01 | 1126743.23 | 1219.52 | TLS#29 NAIL |
| 30 | 697893.05 | 1126889.15 | 1229.24 | TLS#30 NAIL |
| 40 | 696570.17 | 1127691.91 | 1235.44 | TLS#40 NAIL |
| 41 | 696133.86 | 1127967.92 | 1244.03 | TLS#41 NAIL |
| 42 | 696245.39 | 1127849.32 | 1241.05 | TLS#42 NAIL |
| 44 | 697918.98 | 1127041.32 | 1229.90 | TLS#44 NAIL |
| 45 | 697897.98 | 1126929.53 | 1228.71 | TLS#45 NAIL |
| 46 | 698020.20 | 1127087.60 | 1238.88 | TLS#46 NAIL |
| 48 | 698017.20 | 1127288.59 | 1242.16 | TLS#48 NAIL |

REVISIONS, DATE AND INITIAL:

TURNER
LAND SURVEYING
Certified DBE/WBE

3719 BENSON DRIVE
 RALEIGH, NC 27609
 P-0702 (919) 827-0745
 www.turnerlandsurveying.com

TITLE, VICINITY MAP, & SHEET INDEX
**BOBS CREEK STREAM
 RESTORATION PROJECT**
 NCEEP PROJECT # 92879


NORTH CAROLINA
 McDowell County
 MARION

DATE: 06/09/2015
 SURVEYED BY: DST/JAP/DTH
 DRAWN BY: ROB/DST
 REVIEWED BY: DST/EGT
 PROJECT: TLS-15-007
 FILE: BOBS_CREEK_92879_AB_TLS_F
 SCALE: AS SHOWN

SHEET
1 of 5

I, ELISABETH G. TURNER, AS A DULY REGISTERED PROFESSIONAL LAND SURVEYOR IN THE STATE OF NORTH CAROLINA, HEREBY CERTIFY THAT THE DATA SHOWN ON THIS DRAWING, WAS OBTAINED UNDER MY SUPERVISION, IS AN ACCURATE AND COMPLETE REPRESENTATION OF WHAT WAS CONSTRUCTED IN THE FIELD, AND THAT THE PHYSICAL DIMENSIONS OR ELEVATIONS SHOWN THUS ARE AS-BUILT CONDITIONS EXCEPT WHERE OTHERWISE NOTED HEREON. WITNESS MY ORIGINAL SIGNATURE, REGISTRATION NUMBER, AND SEAL THIS 23rd DAY OF SEPTEMBER, 2015.

Elisabeth G. Turner
 ELISABETH G. TURNER, P.L.S. #L-4440
 NORTH CAROLINA PROFESSIONAL LAND SURVEYOR
 SEAL L-4440
 ELISABETH G. TURNER

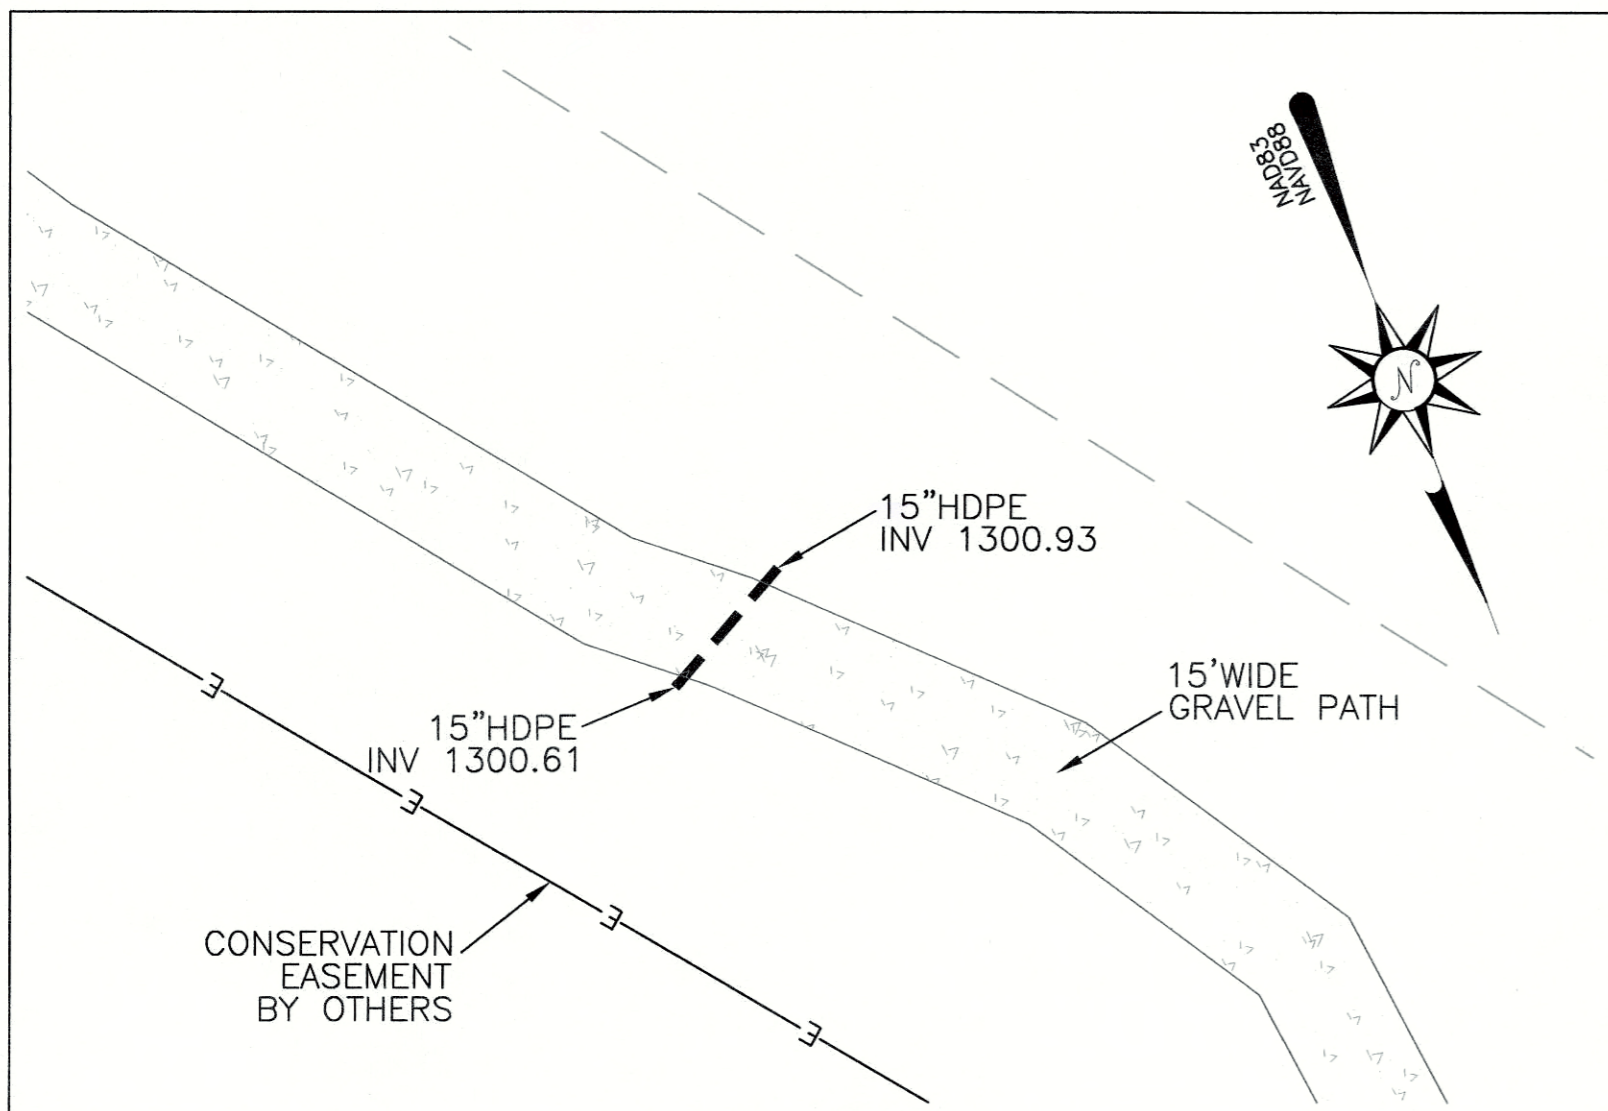

LEGEND:



| | |
|-----------|----------------------------------|
| --- | THALWEG |
| - - - - - | TOP OF BANK/TERRACE |
| - - - - - | BANK/TERRACE TOE |
| E | CONSERVATION EASEMENT |
| x - x | FENCE |
| - - - - - | AS-BUILT SURVEY LIMITS |
| - - - - - | EX. PROPERTY LINE (NOT SURVEYED) |
| x - x | EXISTING FENCE |
| △ | CONTROL POINT |

AS-BUILT SURVEY BY:
 TURNER LAND SURVEYING, PLLC
 SURVEYED JUNE-JULY 2015

25' 0' 25' 50'

SCALE: 1"=25' (22x34)
 1"=50' (11x17)
 CONTOUR INTERVAL = 1'

- GENERAL NOTES:**
1. ALL DISTANCES ARE HORIZONTAL UNLESS OTHERWISE NOTED.
 2. HORIZONTAL DATUM IS NAD83(2011) & VERTICAL DATUM IS NAVD88.
 3. CONTROL IS BASED ON EXISTING CONTROL DATA AS SHOWN ON SHEET 3 IN THE DESIGN PLANS AND RECOVERED DURING THE CONSTRUCTION & AS-BUILT SURVEYS. ADDITIONAL CONTROL WAS ESTABLISHED USING TOTAL STATION & GPS/RTK METHODS AND CONFIRMED DURING AS-BUILT SURVEY. AS-BUILT CONTROL POINTS ARE LISTED ON SHEET 1.
 4. THIS MAP IS NOT FOR RECORDATION, SALES, OR CONVEYANCES AND DOES NOT COMPLY WITH G.S. 47-30 MAPPING REQUIREMENTS.
 5. THE PURPOSE OF THIS SURVEY IS TO SHOW THE POST CONSTRUCTION CONDITIONS OF THE STREAM AND GRADING RELATED TO THE BOBS CREEK STREAM RESTORATION PROJECT AND MAY NOT SHOW ALL UTILITIES, STRUCTURES, & BOUNDARIES.
 6. INFORMATION SHOWN OUTSIDE THE LIMITS OF AS-BUILT SURVEY WAS PROVIDED BY THE DESIGNER AND WAS NOT VERIFIED BY TURNER LAND SURVEYING, PLLC.
 7. NO PROPERTY RESEARCH WAS PERFORMED. FOR CONSERVATION EASEMENT SEE PLAT RECORDED IN McDOWELL COUNTY REGISTER OF DEEDS OFFICE PLAT BOOK 18, PAGE 89.

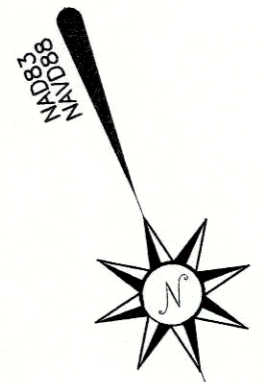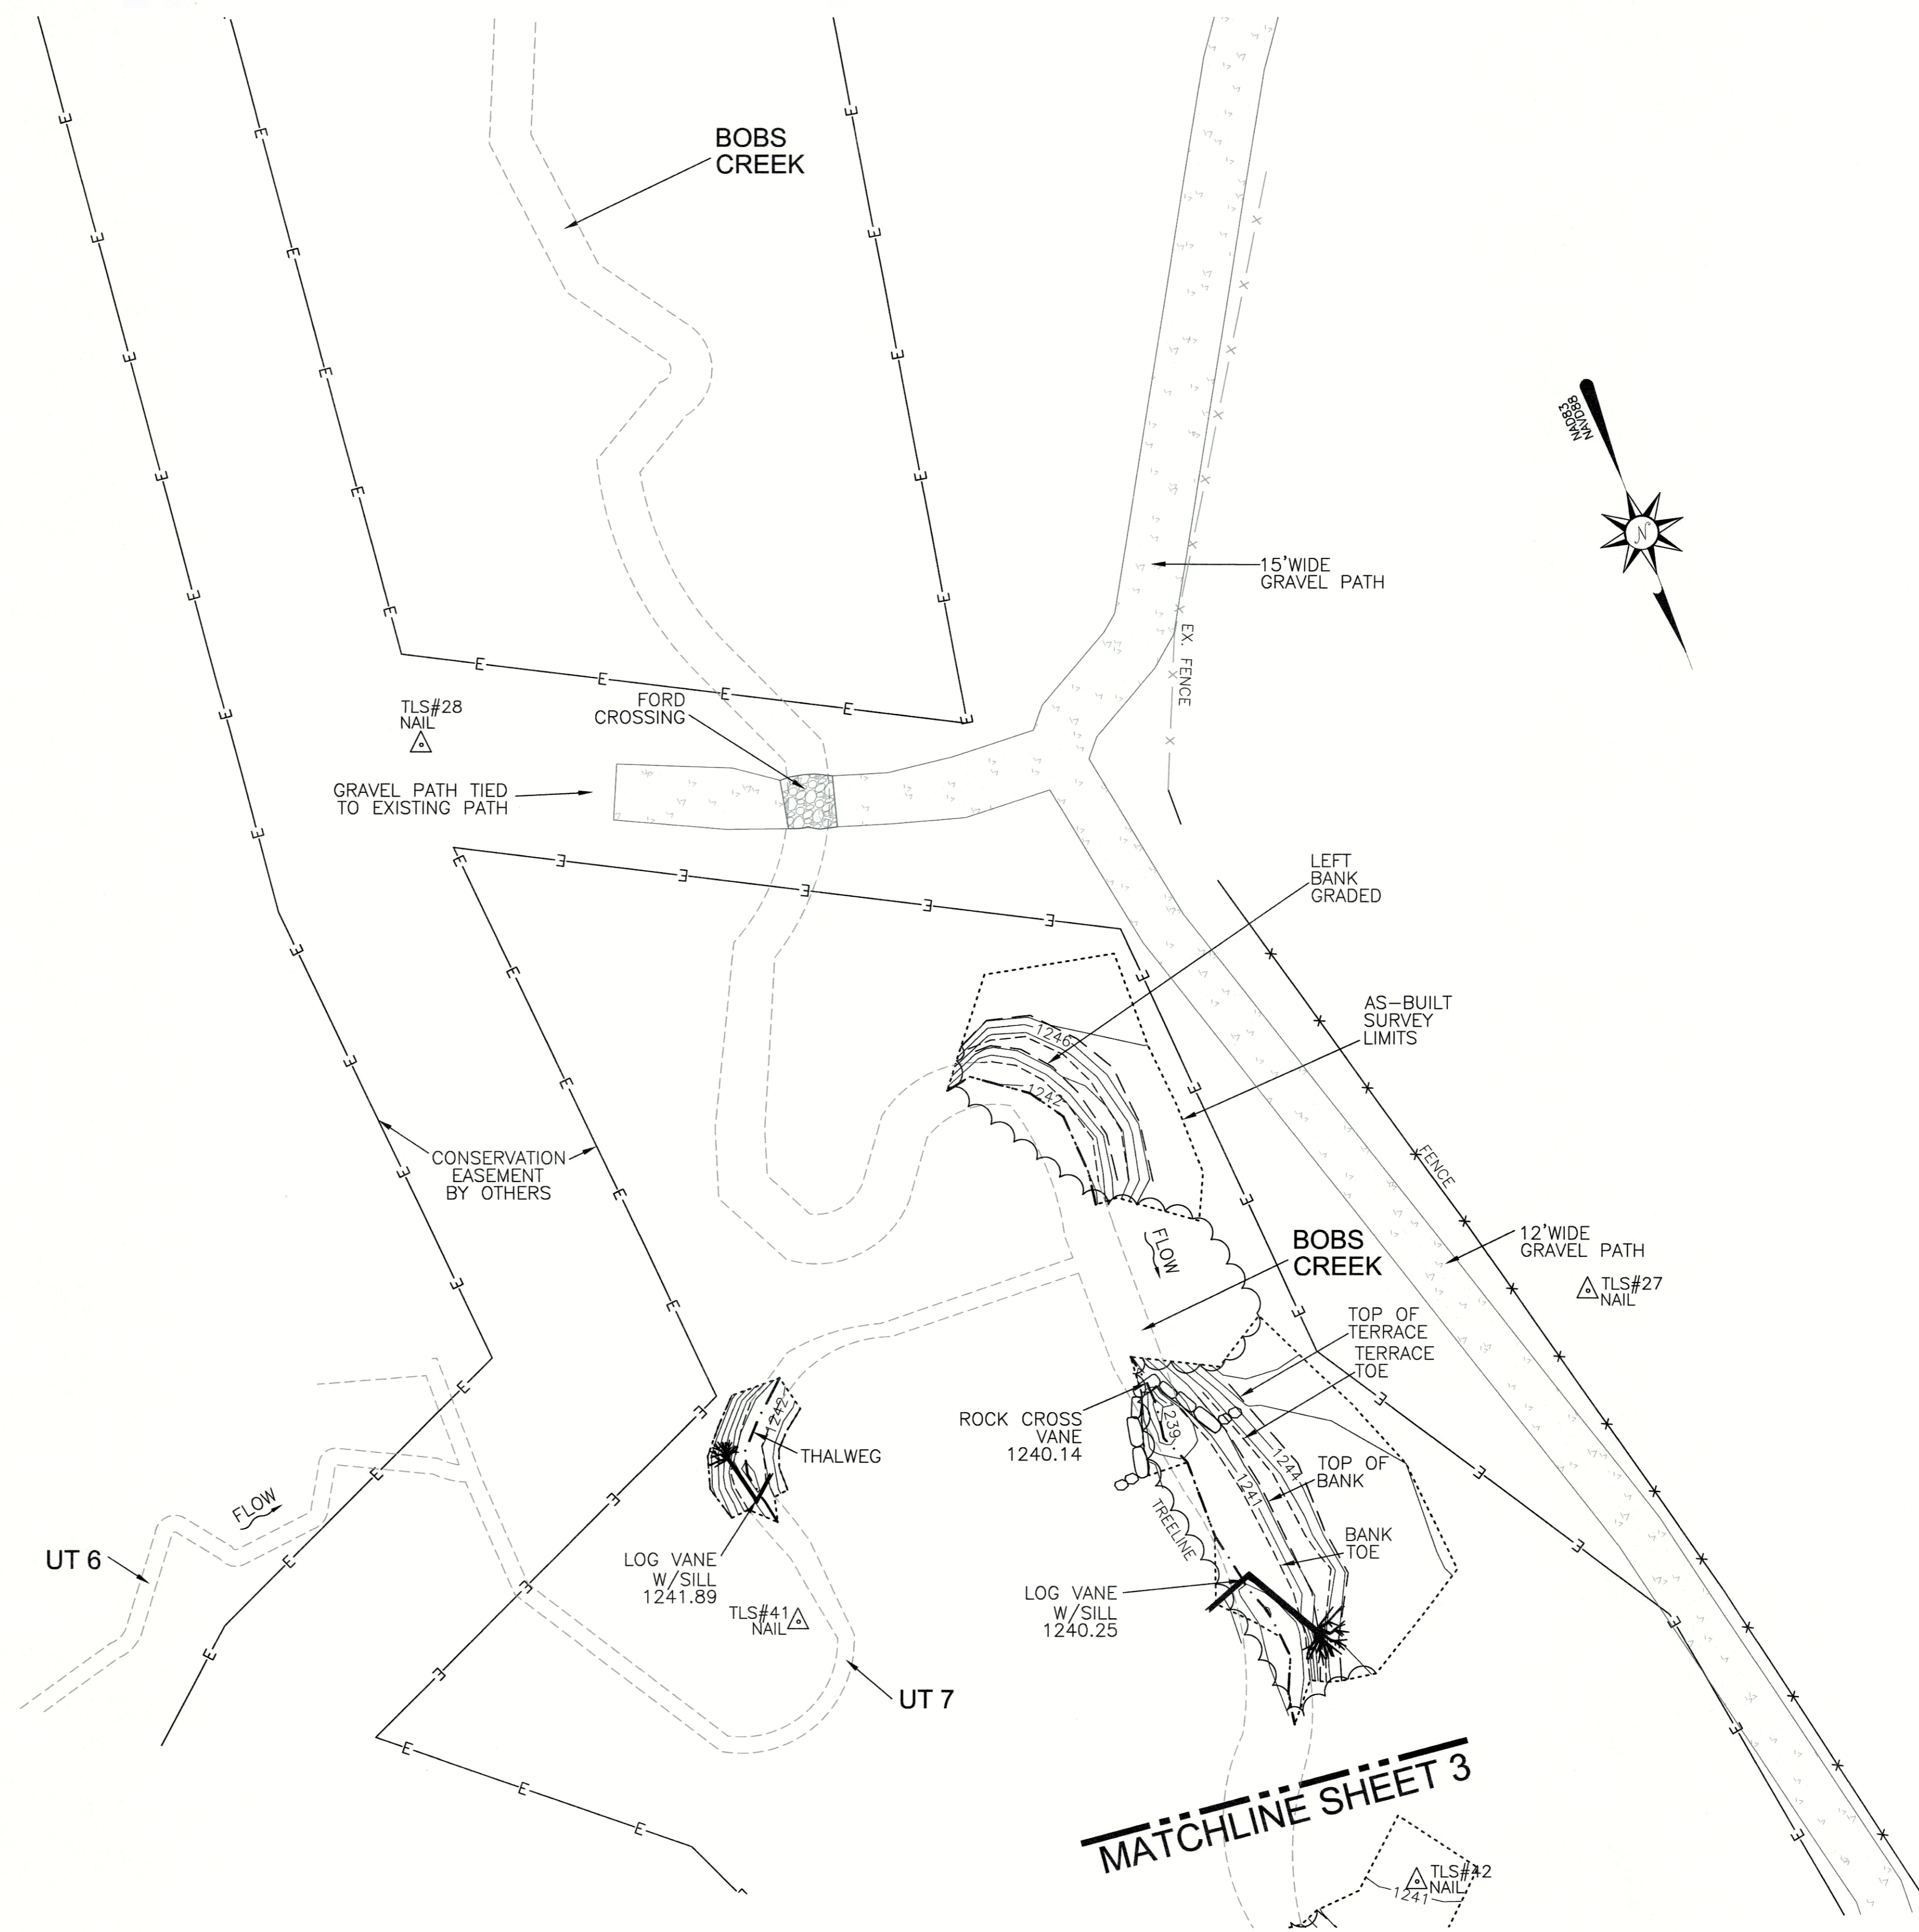

MATCHLINE SHEET 3

REVISIONS, DATE AND INITIAL:

3719 BENSON DRIVE
 RALEIGH, NC 27609
 P-0702 (919) 827-0745
 www.turnerlandsurveying.com
 Certified DBE/WBE



UT7 & BOBS CREEK PLAN VIEW

BOBS CREEK STREAM RESTORATION PROJECT
 NCEEP PROJECT # 92879

NORTH CAROLINA

McDOWELL COUNTY

MARION

| | |
|--------------|---------------------------|
| DATE: | 06/09/2015 |
| SURVEYED BY: | DST/JAP/DTH |
| DRAWN BY: | ROB/DST |
| REVIEWED BY: | DST/EGT |
| PROJECT: | TLS-15-007 |
| FILE: | BOBS CREEK_92879_AB_TLS_F |
| SCALE: | AS SHOWN |

SHEET
2 of 5

I, ELISABETH G. TURNER, AS A DULY REGISTERED PROFESSIONAL LAND SURVEYOR IN THE STATE OF NORTH CAROLINA, HEREBY CERTIFY THAT THE DATA SHOWN ON THIS DRAWING, WAS OBTAINED UNDER MY SUPERVISION, IS AN ACCURATE AND COMPLETE REPRESENTATION OF WHAT WAS CONSTRUCTED IN THE FIELD, AND THAT THE PHYSICAL DIMENSIONS OR ELEVATIONS SHOWN THUS ARE AS-BUILT CONDITIONS EXCEPT WHERE OTHERWISE NOTED HEREON. WITNESS MY ORIGINAL SIGNATURE, REGISTRATION NUMBER, AND SEAL THIS 23rd DAY OF SEPTEMBER, 2015.

Elisabeth G. Turner
 ELISABETH G. TURNER, P.L.S. #L-4440



MATCHLINE SHEET 2

| LEGEND: | |
|---------|----------------------------------|
| --- | THALWEG |
| ---- | TOP OF BANK/TERRACE |
| ---- | BANK/TERRACE TOE |
| E | CONSERVATION EASEMENT |
| x-x | FENCE |
| ---- | AS-BUILT SURVEY LIMITS |
| ---- | EX. PROPERTY LINE (NOT SURVEYED) |
| x-x | EXISTING FENCE |
| △ | CONTROL POINT |


AS-BUILT SURVEY BY:
 TURNER LAND SURVEYING, PLLC
 SURVEYED JUNE-JULY 2015

25' 0' 25' 50'

SCALE: 1"=25' (22x34)
 1"=50' (11x17)
 CONTOUR INTERVAL = 1'


GENERAL NOTES:

- ALL DISTANCES ARE HORIZONTAL UNLESS OTHERWISE NOTED.
- HORIZONTAL DATUM IS NAD83(2011) & VERTICAL DATUM IS NAVD88.
- CONTROL IS BASED ON EXISTING CONTROL DATA AS SHOWN ON SHEET 3 IN THE DESIGN PLANS AND RECOVERED DURING THE CONSTRUCTION & AS-BUILT SURVEYS. ADDITIONAL CONTROL WAS ESTABLISHED USING TOTAL STATION & GPS/RTK METHODS AND CONFIRMED DURING AS-BUILT SURVEY. AS-BUILT CONTROL POINTS ARE LISTED ON SHEET 1.
- THIS MAP IS NOT FOR RECORDATION, SALES, OR CONVEYANCES AND DOES NOT COMPLY WITH G.S. 47-30 MAPPING REQUIREMENTS.
- THE PURPOSE OF THIS SURVEY IS TO SHOW THE POST CONSTRUCTION CONDITIONS OF THE STREAM AND GRADING RELATED TO THE BOBS CREEK STREAM RESTORATION PROJECT AND MAY NOT SHOW ALL UTILITIES, STRUCTURES, & BOUNDARIES.
- INFORMATION SHOWN OUTSIDE THE LIMITS OF AS-BUILT SURVEY WAS PROVIDED BY THE DESIGNER AND WAS NOT VERIFIED BY TURNER LAND SURVEYING, PLLC.
- NO PROPERTY RESEARCH WAS PERFORMED. FOR CONSERVATION EASEMENT SEE PLAT RECORDED IN McDOWELL COUNTY REGISTER OF DEEDS OFFICE PLAT BOOK 18, PAGE 89.

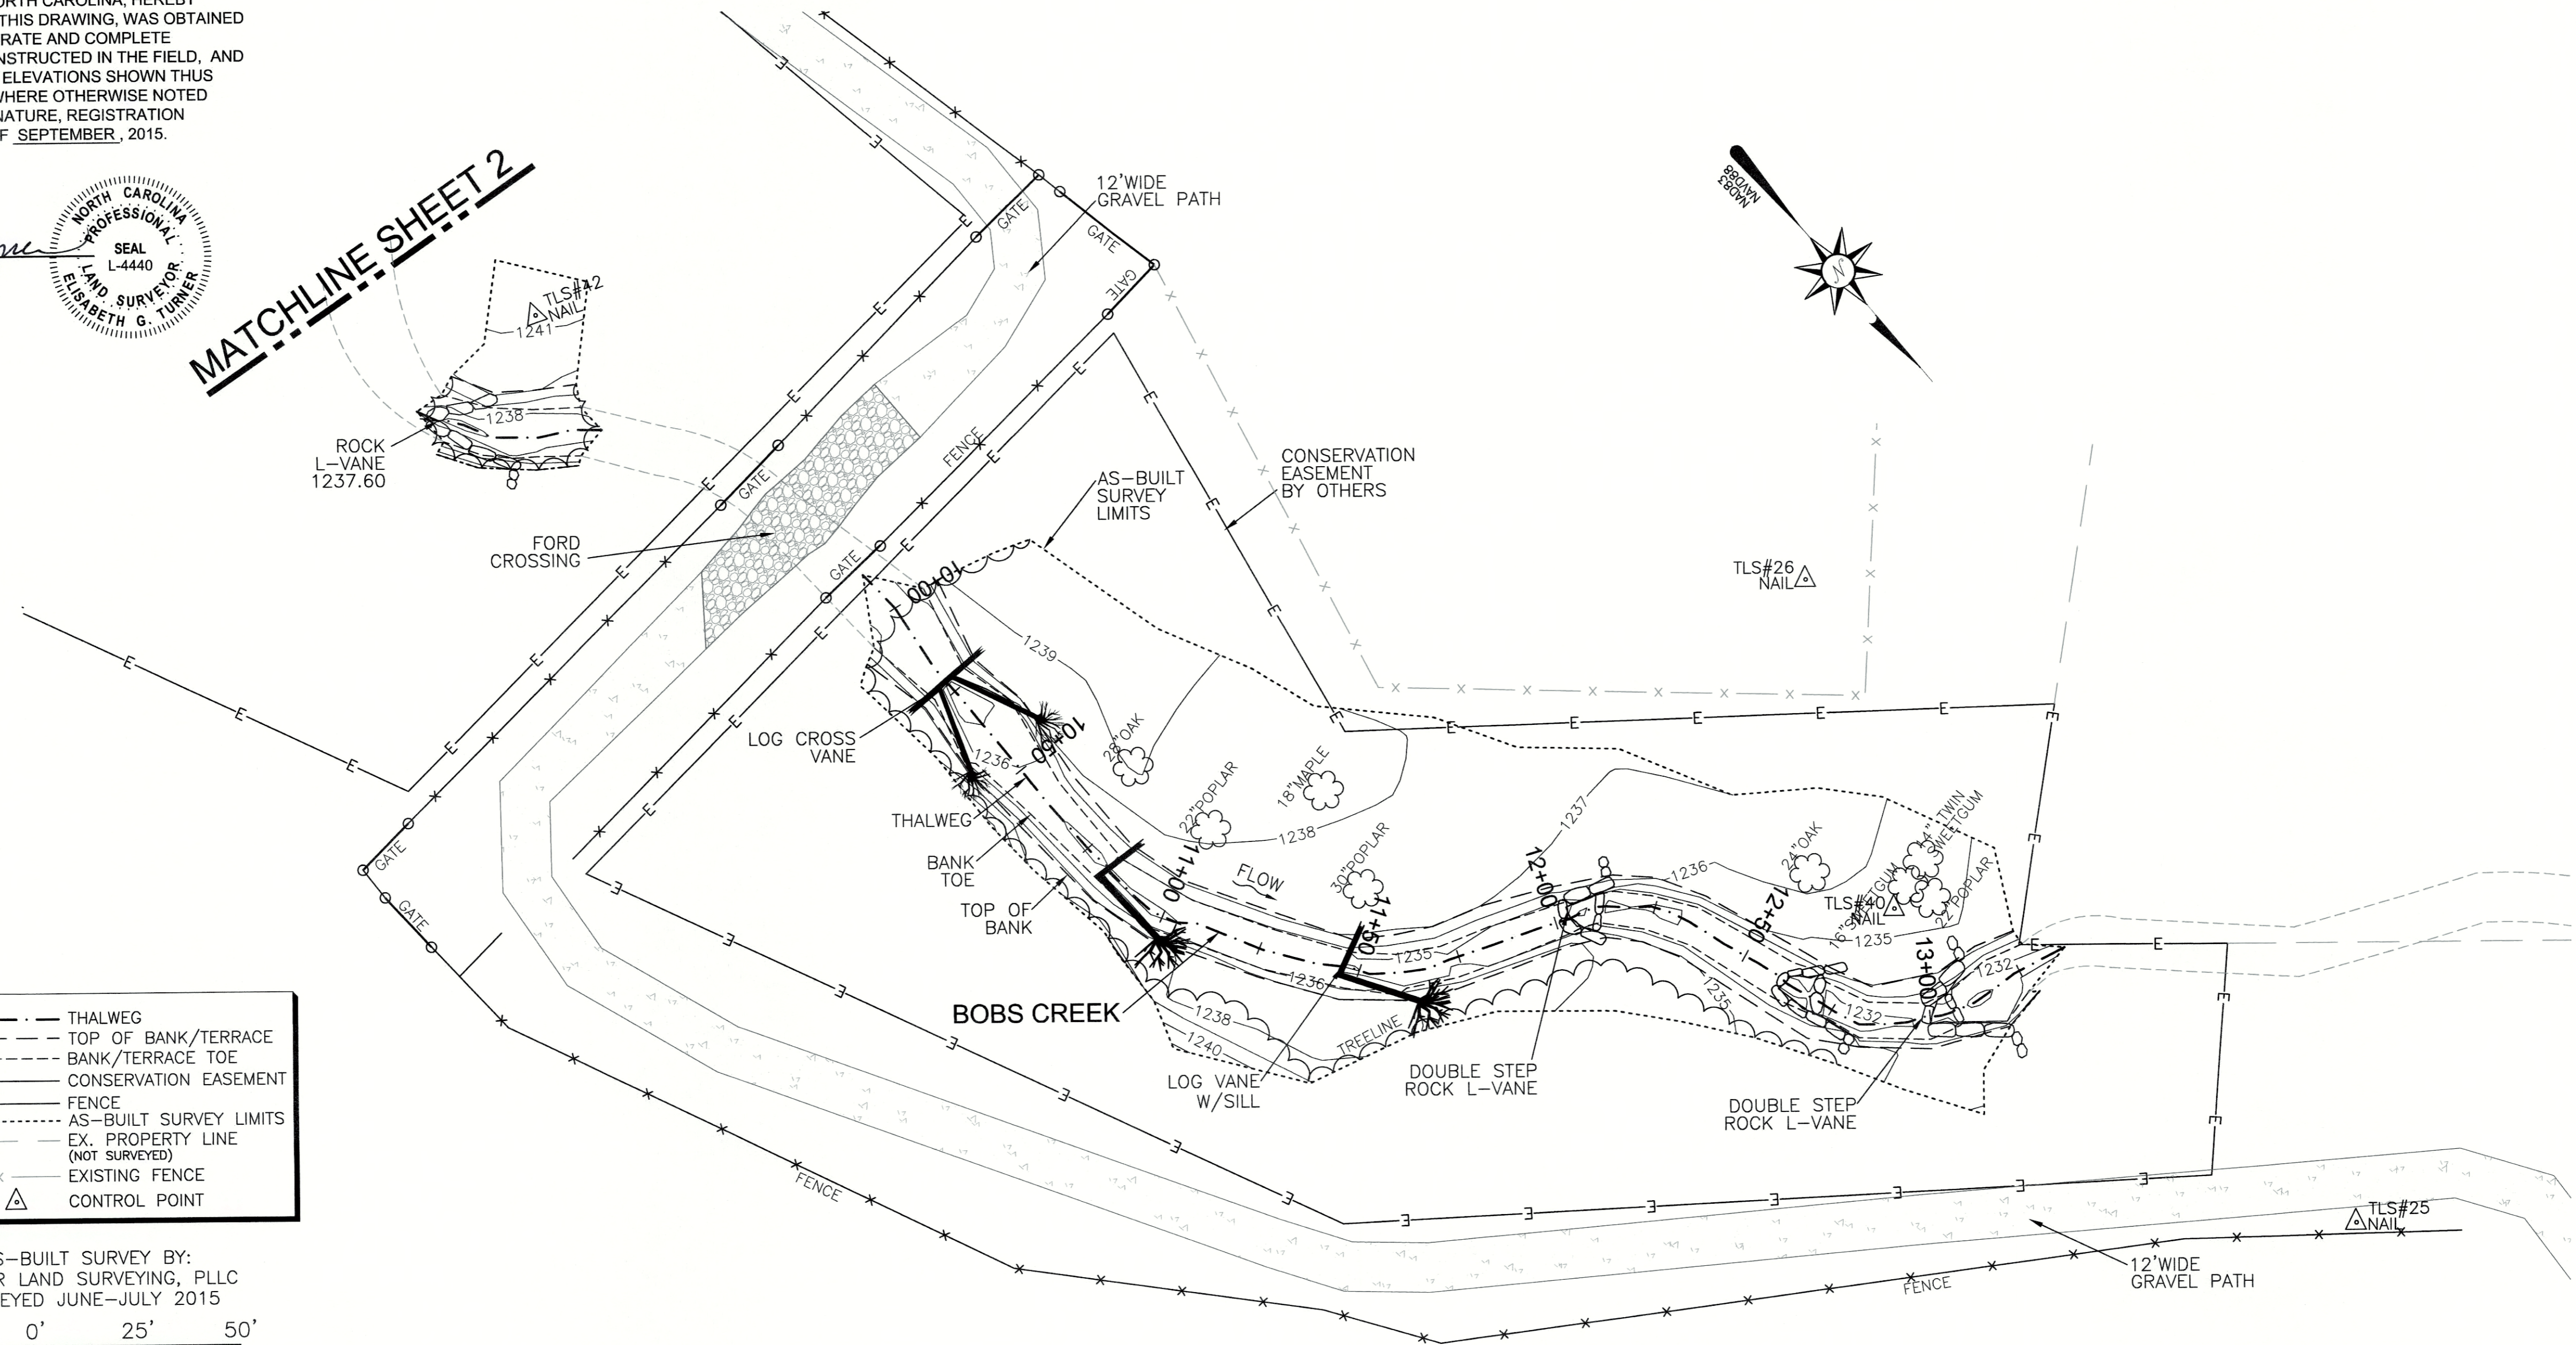

**AS-BUILT PROFILE
 BOBS CREEK
 STA 10+00 TO 13+25**

PROFILE SCALE
 HORIZONTAL: 1"=25'(22x34)
 1"=50'(11x17)
 VERTICAL: 1"=5'(22x34)
 1"=10'(11x17)

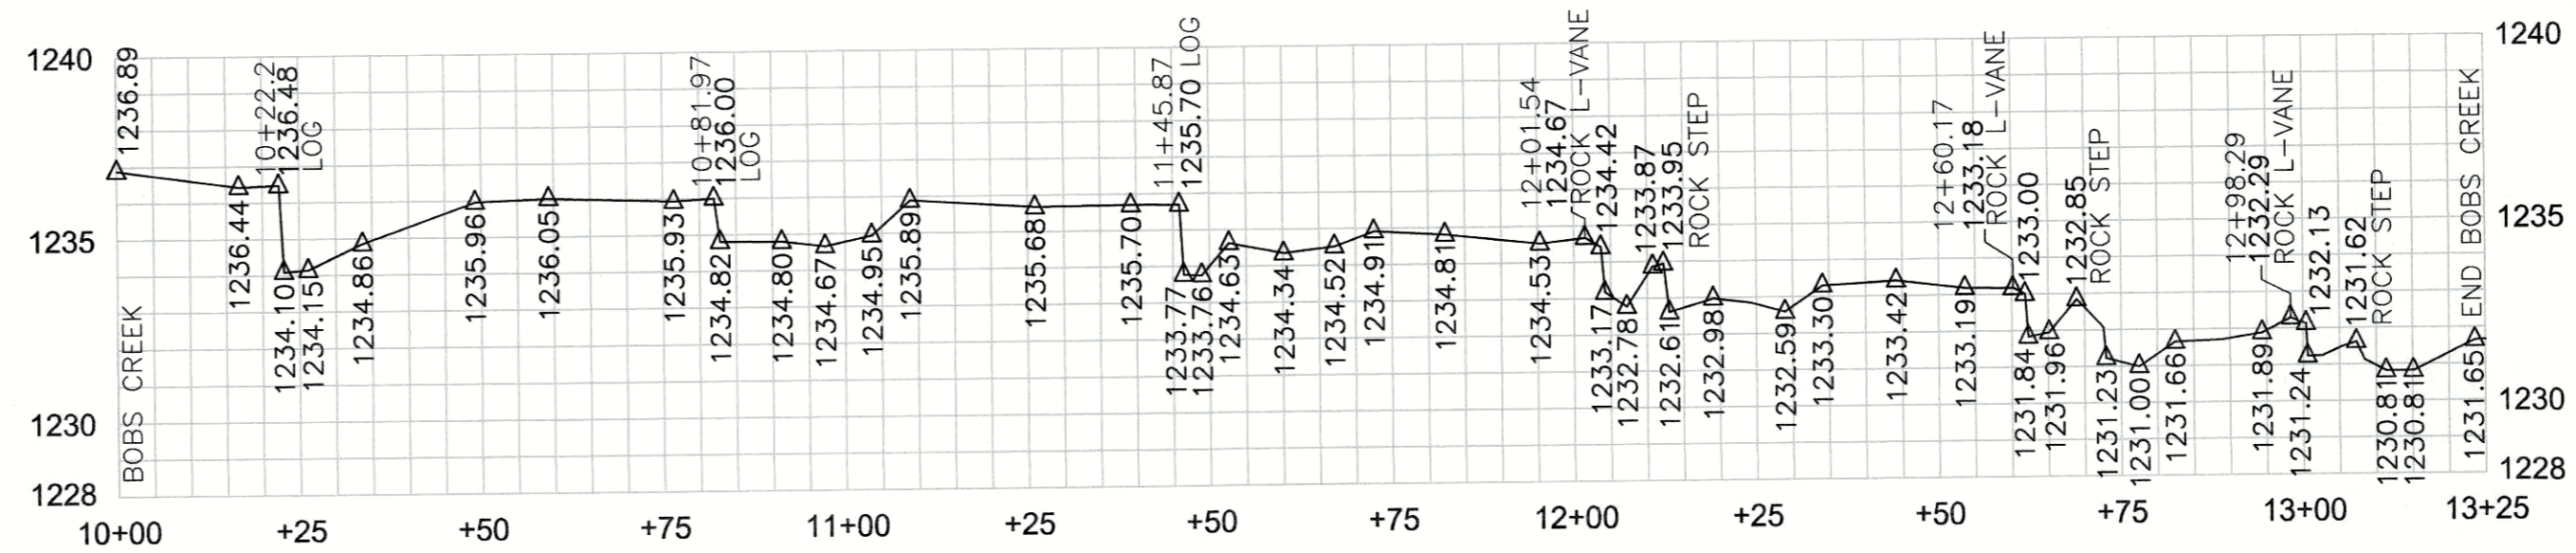

REVISIONS, DATE AND INITIAL:

BOBS CREEK PLAN & PROFILE
BOBS CREEK STREAM RESTORATION PROJECT
 NCEEP PROJECT # 92879

3719 BENSON DRIVE
 RALEIGH, NC 27609
 P-0702 (919) 827-0745
 www.turnerlandsurveying.com
 Certified DBE/WBE



NORTH CAROLINA
 McDOWELL COUNTY
 MARION

| | |
|--------------|---------------------------|
| DATE: | 06/09/2015 |
| SURVEYED BY: | DST/JAP/DTH |
| DRAWN BY: | ROB/DST |
| REVIEWED BY: | DST/EGT |
| PROJECT: | TLS-15-007 |
| FILE: | BOBS CREEK_92879_AB_TLS_F |
| SCALE: | AS SHOWN |


I, ELISABETH G. TURNER, AS A DULY REGISTERED PROFESSIONAL LAND SURVEYOR IN THE STATE OF NORTH CAROLINA, HEREBY CERTIFY THAT THE DATA SHOWN ON THIS DRAWING, WAS OBTAINED UNDER MY SUPERVISION, IS AN ACCURATE AND COMPLETE REPRESENTATION OF WHAT WAS CONSTRUCTED IN THE FIELD, AND THAT THE PHYSICAL DIMENSIONS OR ELEVATIONS SHOWN THUS ARE AS-BUILT CONDITIONS EXCEPT WHERE OTHERWISE NOTED HEREON. WITNESS MY ORIGINAL SIGNATURE, REGISTRATION NUMBER, AND SEAL THIS 23rd DAY OF SEPTEMBER, 2015.

Elisabeth G. Turner
 ELISABETH G. TURNER, P.L.S. #L-4440





| LEGEND: | |
|---------|----------------------------------|
| --- | THALWEG |
| --- | TOP OF BANK/TERRACE |
| --- | BANK/TERRACE TOE |
| E | CONSERVATION EASEMENT |
| x-x | FENCE |
| --- | AS-BUILT SURVEY LIMITS |
| --- | EX. PROPERTY LINE (NOT SURVEYED) |
| x-x | EXISTING FENCE |
| △ | CONTROL POINT |

AS-BUILT SURVEY BY:
 TURNER LAND SURVEYING, PLLC
 SURVEYED JUNE-JULY 2015

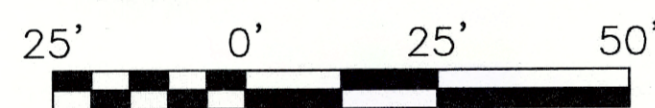


SCALE: 1"=25' (22x34)
 1"=50' (11x17)
 CONTOUR INTERVAL = 1'

UT 8 UPSTREAM

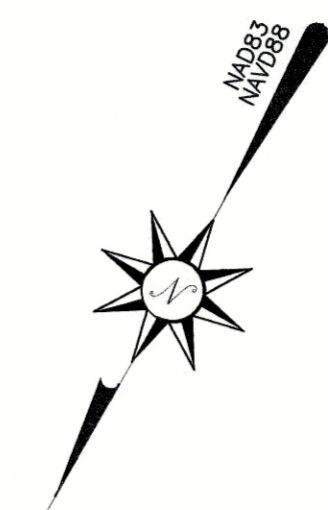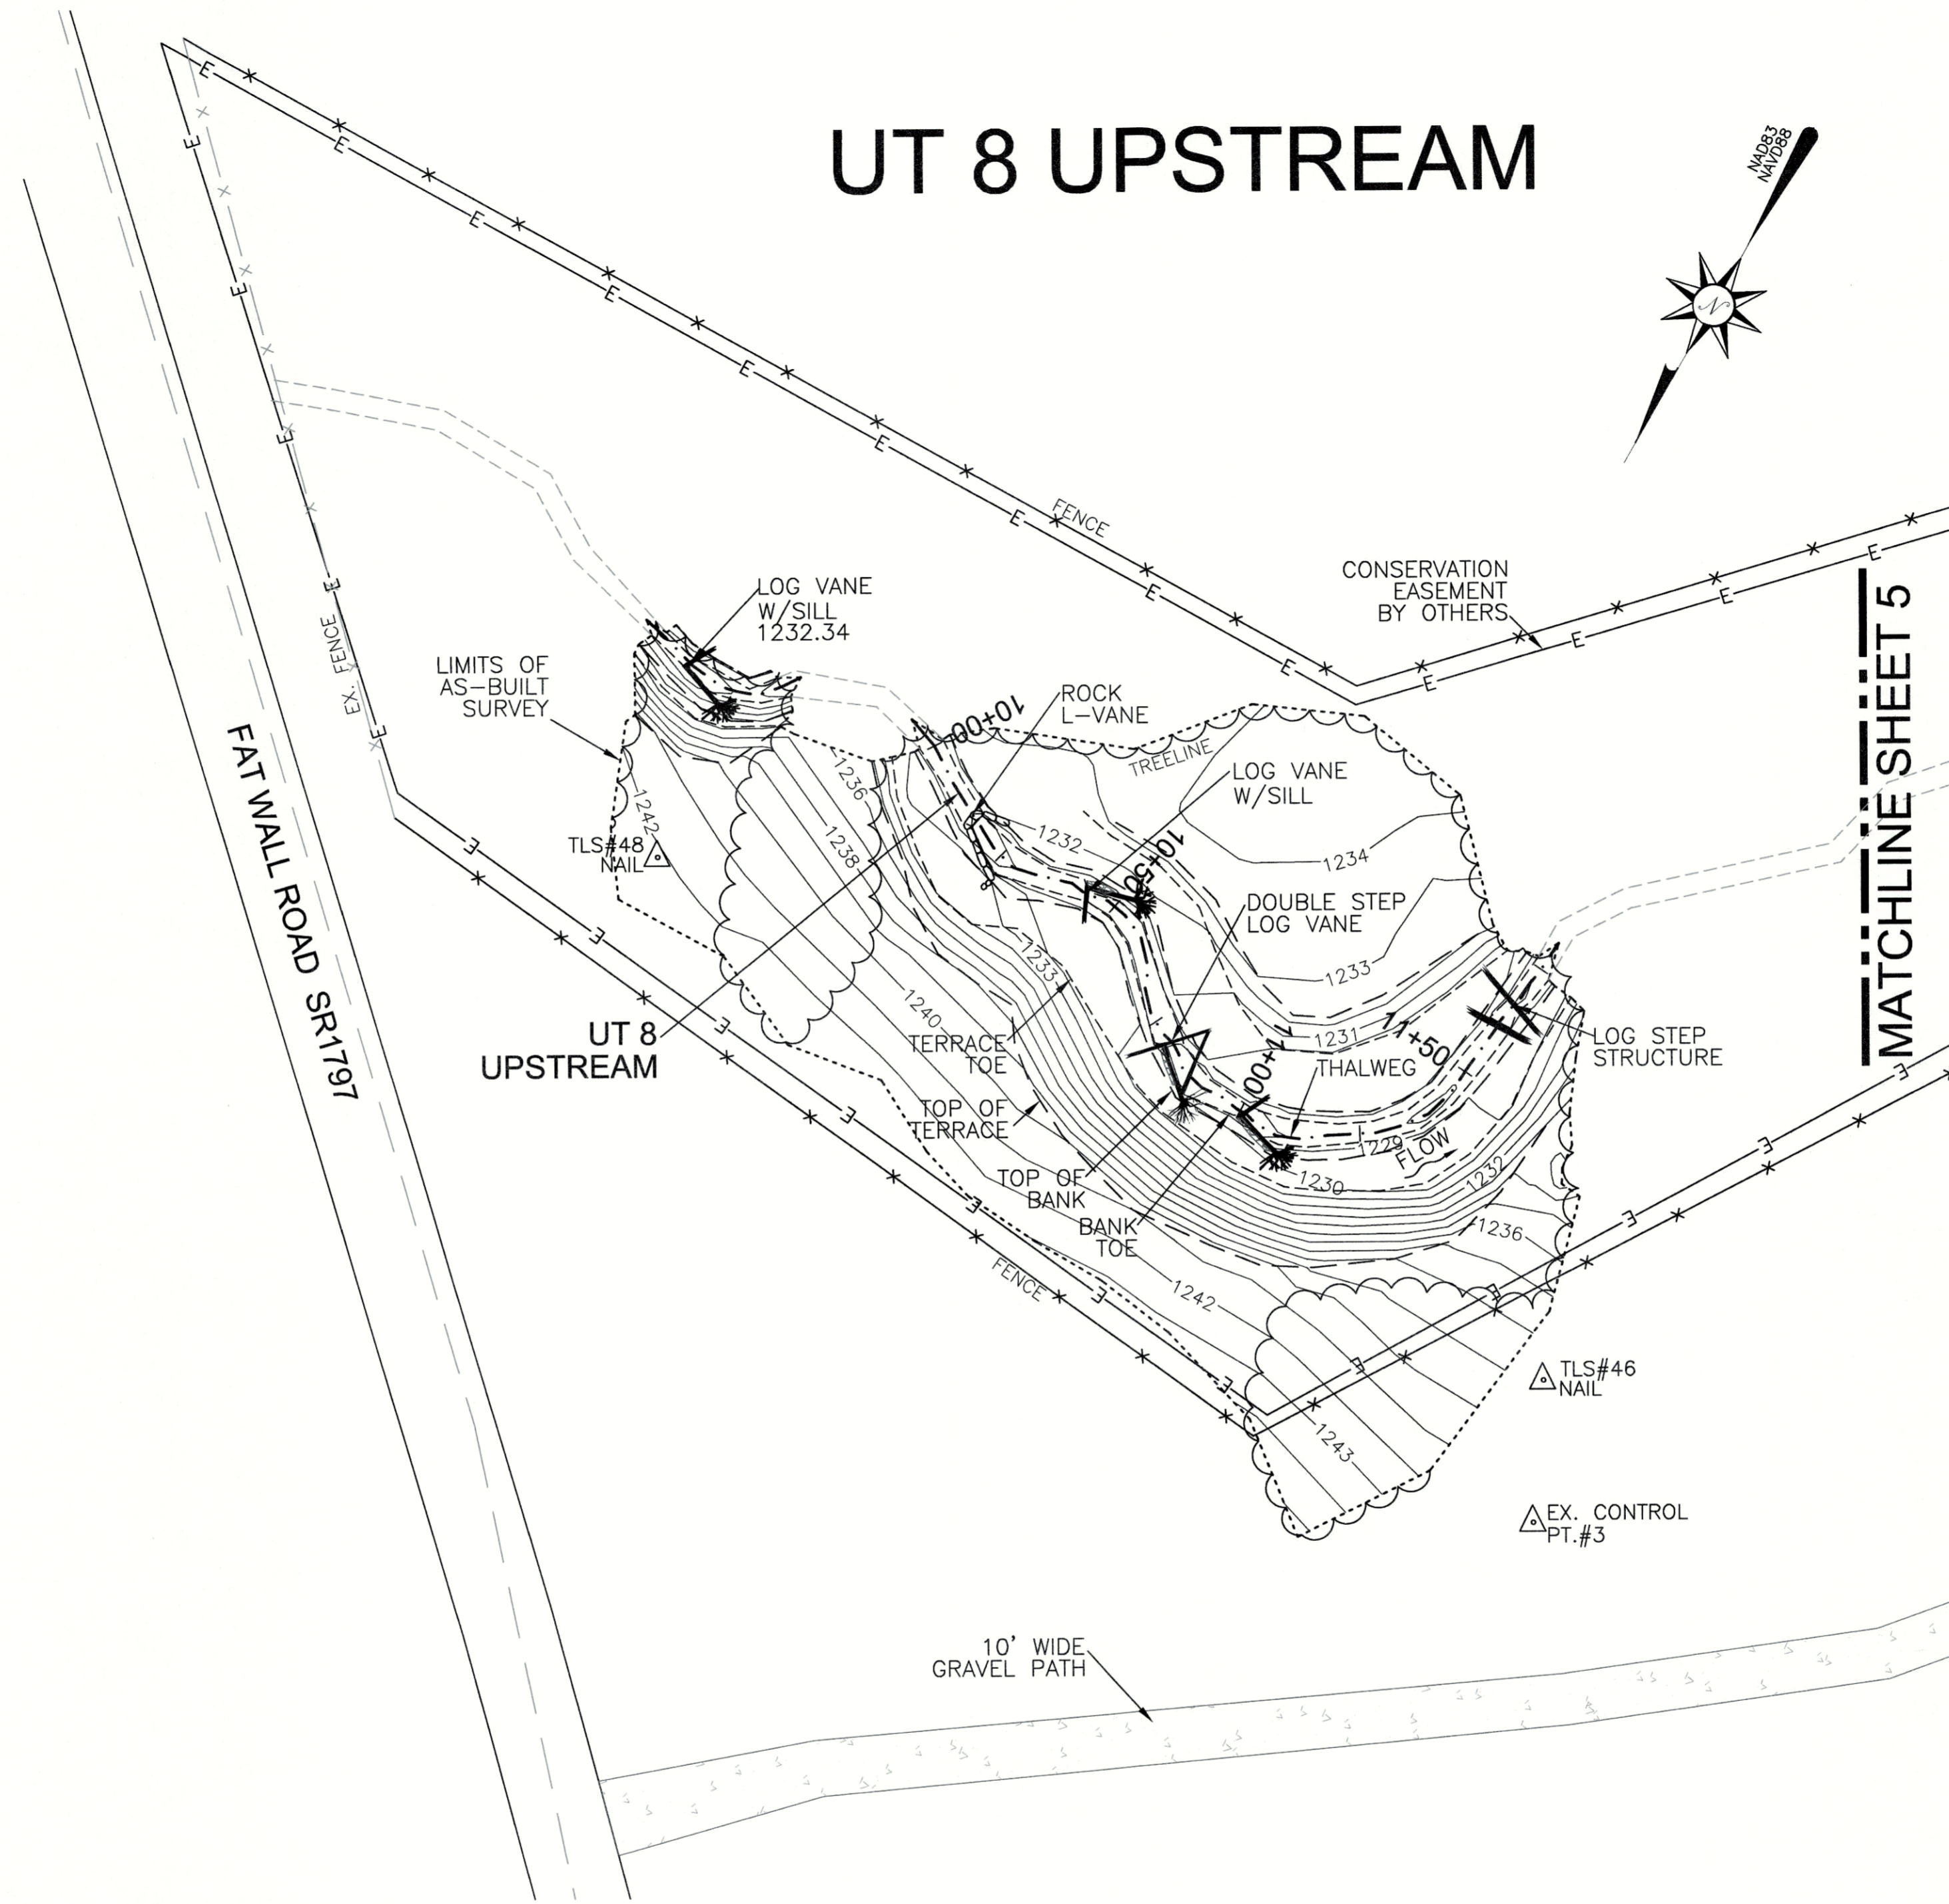

GENERAL NOTES:

- ALL DISTANCES ARE HORIZONTAL UNLESS OTHERWISE NOTED.
- HORIZONTAL DATUM IS NAD83(2011) & VERTICAL DATUM IS NAVD88.
- CONTROL IS BASED ON EXISTING CONTROL DATA AS SHOWN ON SHEET 3 IN THE DESIGN PLANS AND RECOVERED DURING THE CONSTRUCTION & AS-BUILT SURVEYS. ADDITIONAL CONTROL WAS ESTABLISHED USING TOTAL STATION & GPS/RTK METHODS AND CONFIRMED DURING AS-BUILT SURVEY. AS-BUILT CONTROL POINTS ARE LISTED ON SHEET 1.
- THIS MAP IS NOT FOR RECORDATION, SALES, OR CONVEYANCES AND DOES NOT COMPLY WITH G.S. 47-30 MAPPING REQUIREMENTS.
- THE PURPOSE OF THIS SURVEY IS TO SHOW THE POST CONSTRUCTION CONDITIONS OF THE STREAM AND GRADING RELATED TO THE BOBS CREEK STREAM RESTORATION PROJECT AND MAY NOT SHOW ALL UTILITIES, STRUCTURES, & BOUNDARIES.
- INFORMATION SHOWN OUTSIDE THE LIMITS OF AS-BUILT SURVEY WAS PROVIDED BY THE DESIGNER AND WAS NOT VERIFIED BY TURNER LAND SURVEYING, PLLC.
- NO PROPERTY RESEARCH WAS PERFORMED. FOR CONSERVATION EASEMENT SEE PLAT RECORDED IN McDOWELL COUNTY REGISTER OF DEEDS OFFICE PLAT BOOK 18, PAGE 89.

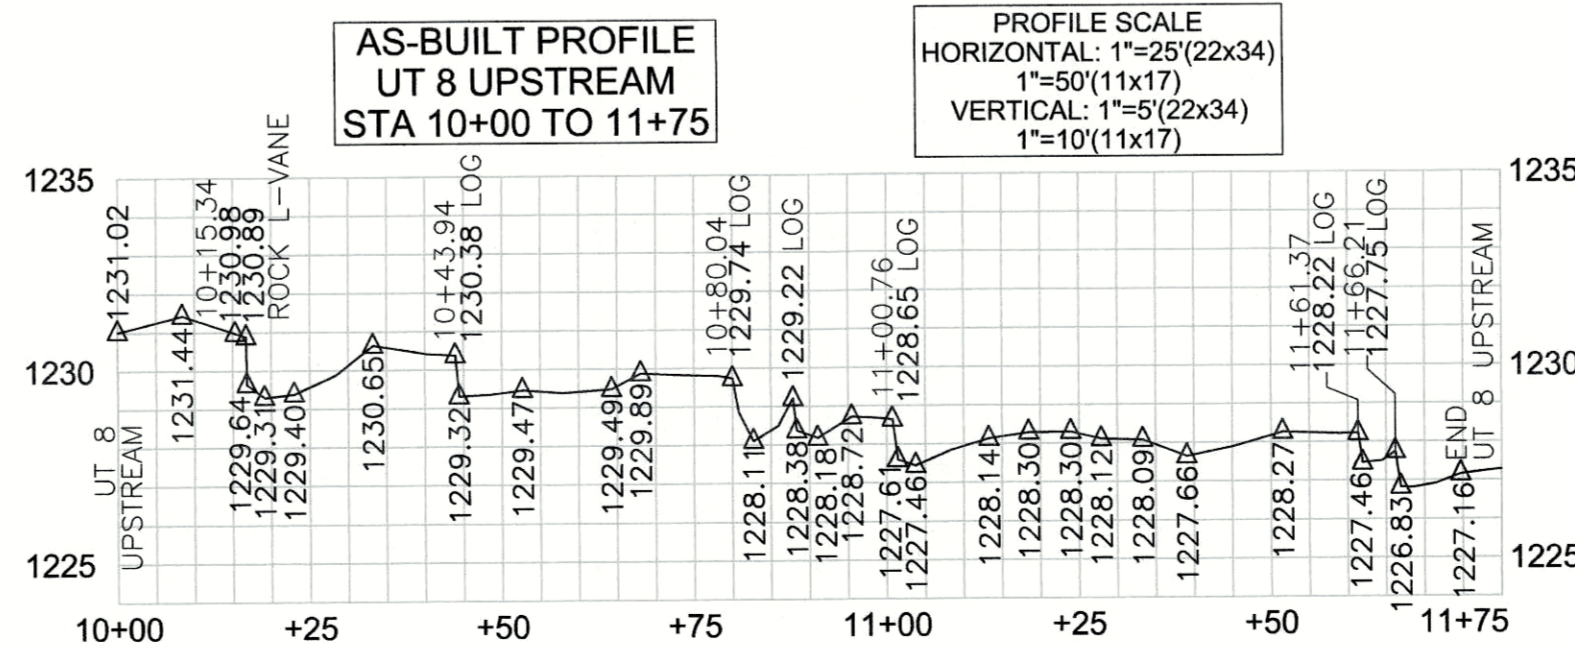

REVISIONS, DATE AND INITIAL:

3719 BENSON DRIVE
 RALEIGH, NC 27609
 P-0702 (919) 827-0745
 www.turnerlandsurveying.com
 Certified DBE/WBE



UT 8 UPSTREAM PLAN & PROFILE

BOBS CREEK STREAM RESTORATION PROJECT

NCEEP PROJECT # 92879
 McDowell County


MARION NORTH CAROLINA

| | |
|--------------|---------------------------|
| DATE: | 06/09/2015 |
| SURVEYED BY: | DST/JAP/DTH |
| DRAWN BY: | ROB/DST |
| REVIEWED BY: | DST/EGT |
| PROJECT: | TLS-15-007 |
| FILE: | BOBS CREEK_92879_AB_TLS.F |
| SCALE: | AS SHOWN |
| SHEET | 4 of 5 |

I, ELISABETH G. TURNER, AS A DULY REGISTERED PROFESSIONAL LAND SURVEYOR IN THE STATE OF NORTH CAROLINA, HEREBY CERTIFY THAT THE DATA SHOWN ON THIS DRAWING, WAS OBTAINED UNDER MY SUPERVISION, IS AN ACCURATE AND COMPLETE REPRESENTATION OF WHAT WAS CONSTRUCTED IN THE FIELD, AND THAT THE PHYSICAL DIMENSIONS OR ELEVATIONS SHOWN THUS ARE AS-BUILT CONDITIONS EXCEPT WHERE OTHERWISE NOTED HEREON. WITNESS MY ORIGINAL SIGNATURE, REGISTRATION NUMBER, AND SEAL THIS 23rd DAY OF SEPTEMBER, 2015.

Elisabeth G. Turner
 ELISABETH G. TURNER, P.L.S. #L-4440
 NORTH CAROLINA PROFESSIONAL LAND SURVEYOR SEAL L-4440 ELISABETH G. TURNER

UT 8 DOWNSTREAM

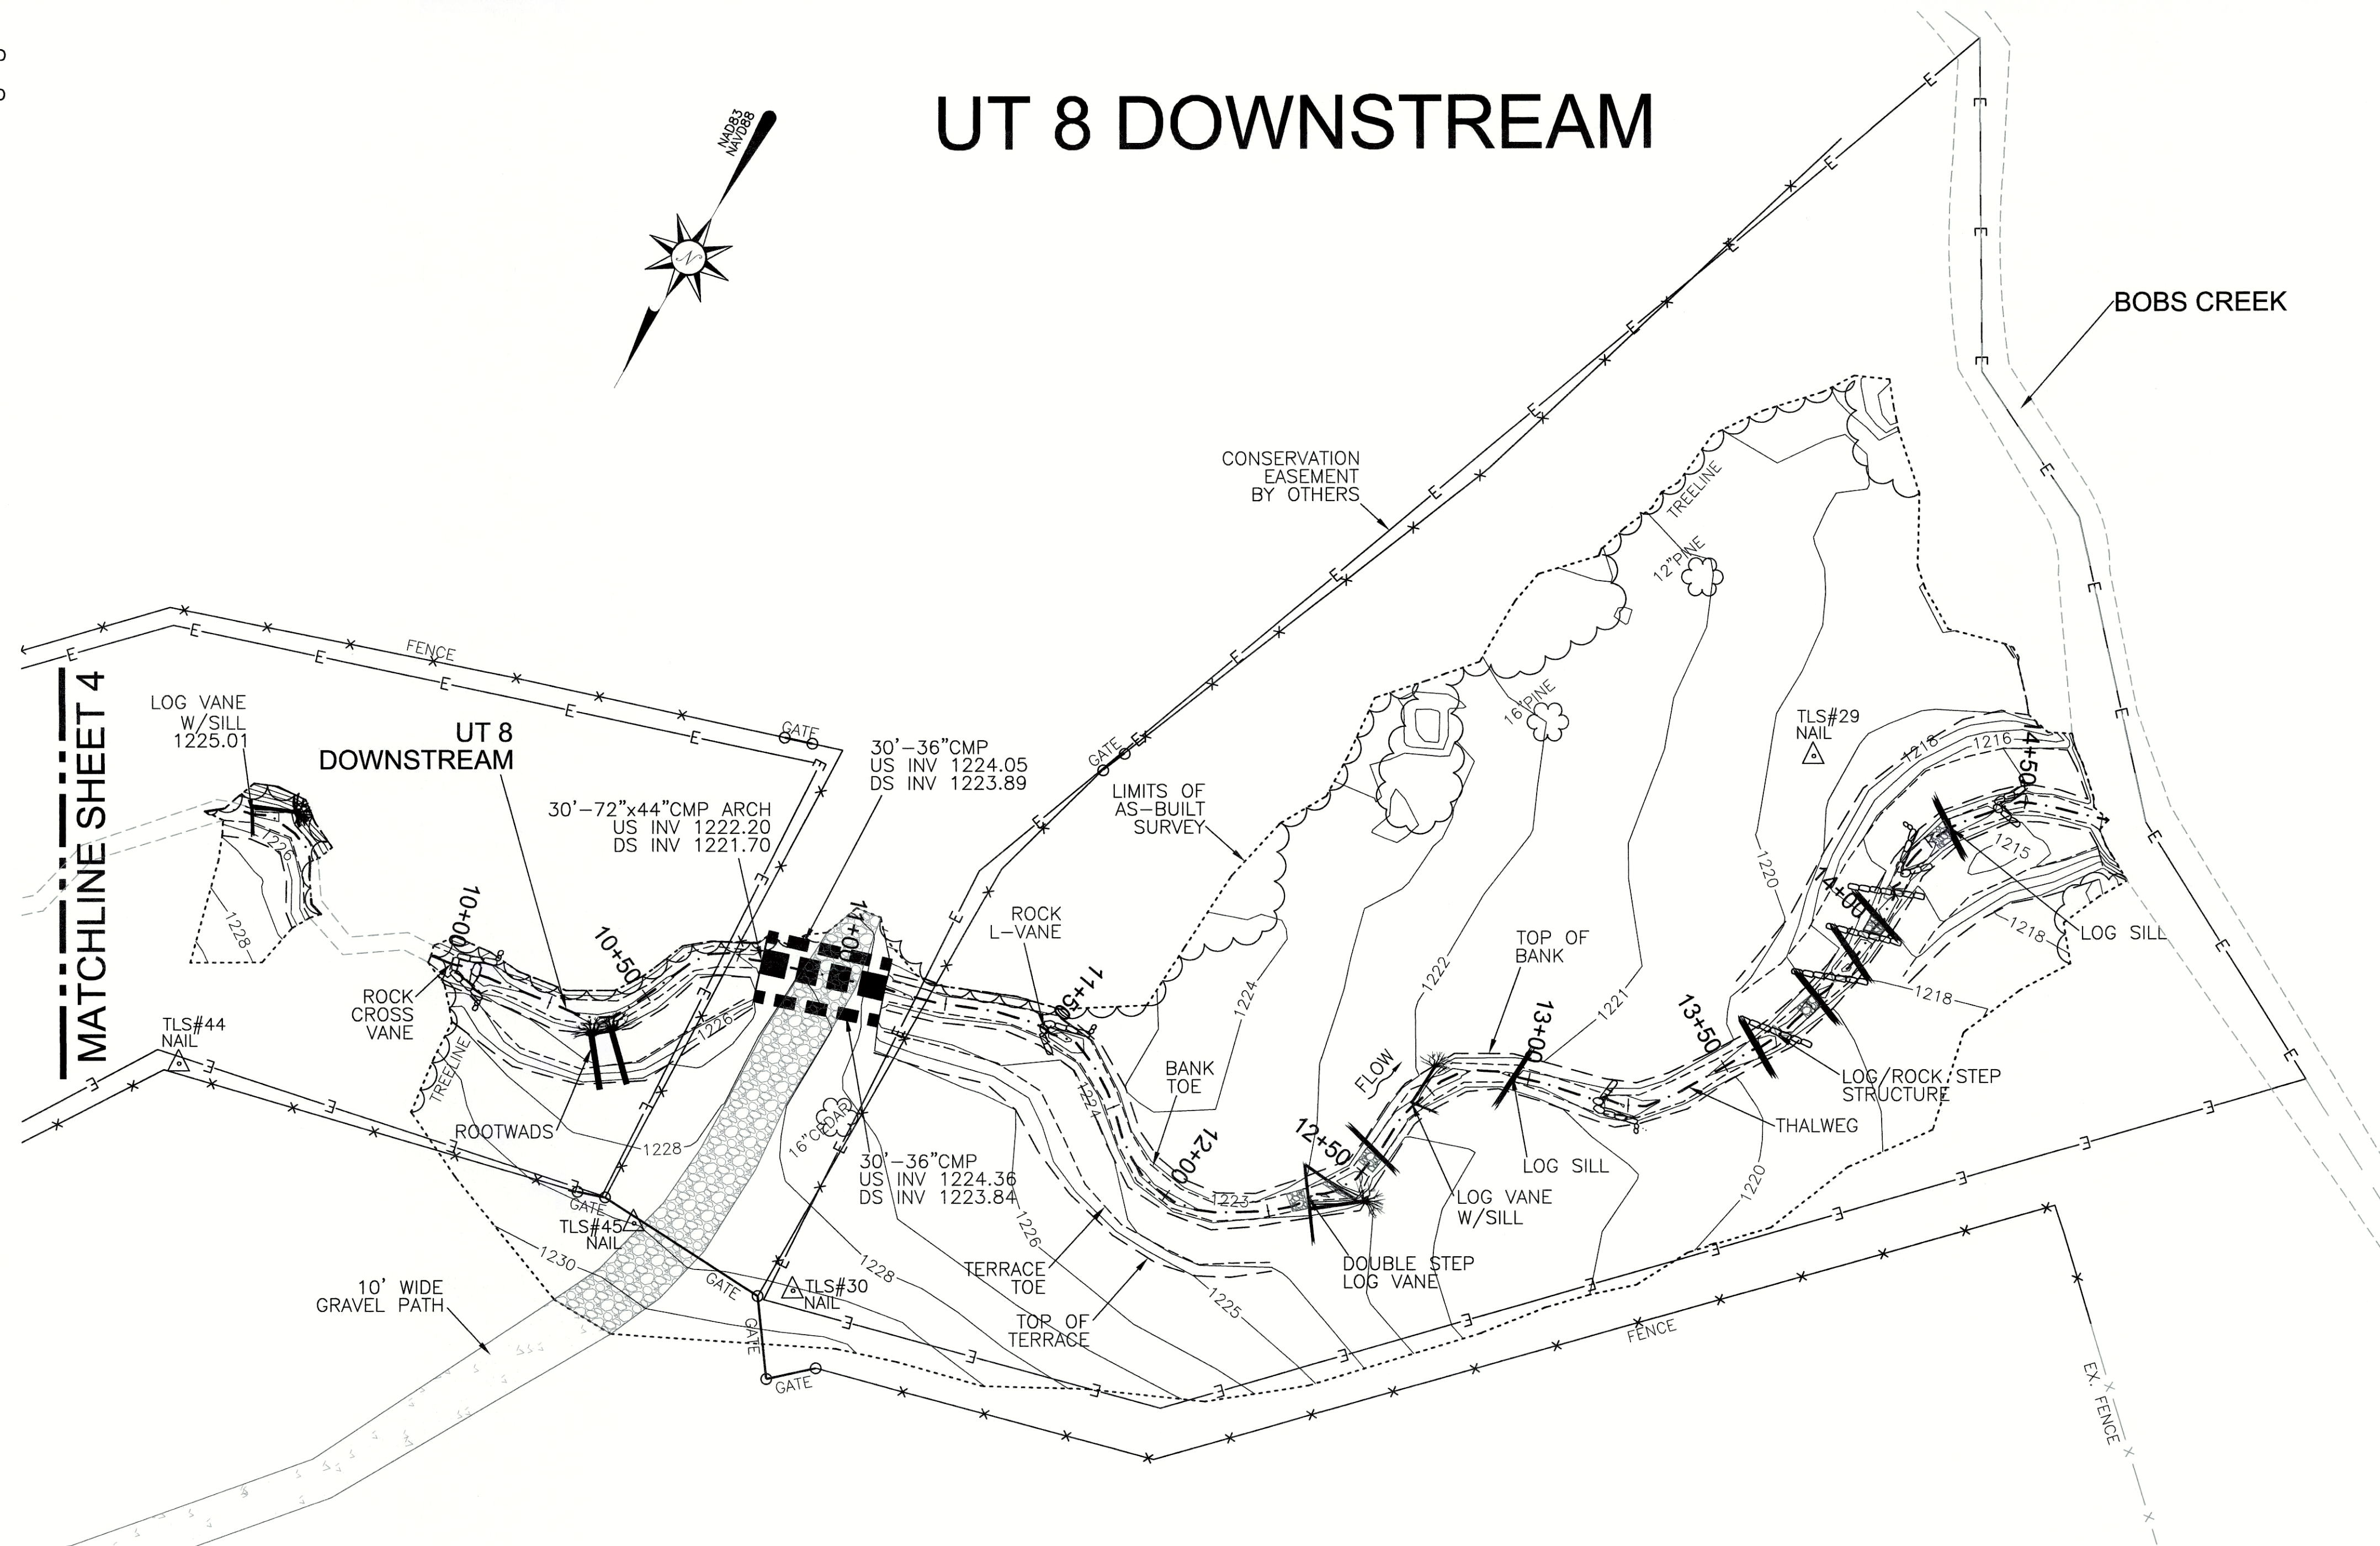

LEGEND:

| | |
|-----------|----------------------------------|
| --- | THALWEG |
| - - - - | TOP OF BANK/TERRACE |
| - · - · - | BANK/TERRACE TOE |
| E | CONSERVATION EASEMENT |
| x x x | FENCE |
| - · - · - | AS-BUILT SURVEY LIMITS |
| - · - · - | EX. PROPERTY LINE (NOT SURVEYED) |
| x x x | EXISTING FENCE |
| △ | CONTROL POINT |


AS-BUILT SURVEY BY:
 TURNER LAND SURVEYING, PLLC
 SURVEYED JUNE-JULY 2015

25' 0' 25' 50'

SCALE: 1"=25' (22x34)
 1"=50' (11x17)
 CONTOUR INTERVAL = 1'

GENERAL NOTES:

1. ALL DISTANCES ARE HORIZONTAL UNLESS OTHERWISE NOTED.
2. HORIZONTAL DATUM IS NAD83(2011) & VERTICAL DATUM IS NAVD88.
3. CONTROL IS BASED ON EXISTING CONTROL DATA AS SHOWN ON SHEET 3 IN THE DESIGN PLANS AND RECOVERED DURING THE CONSTRUCTION & AS-BUILT SURVEYS. ADDITIONAL CONTROL WAS ESTABLISHED USING TOTAL STATION & GPS/RTK METHODS AND CONFIRMED DURING AS-BUILT SURVEY. AS-BUILT CONTROL POINTS ARE LISTED ON SHEET 1.
4. THIS MAP IS NOT FOR RECORDATION, SALES, OR CONVEYANCES AND DOES NOT COMPLY WITH G.S. 47-30 MAPPING REQUIREMENTS.
5. THE PURPOSE OF THIS SURVEY IS TO SHOW THE POST CONSTRUCTION CONDITIONS OF THE STREAM AND GRADING RELATED TO THE BOBS CREEK STREAM RESTORATION PROJECT AND MAY NOT SHOW ALL UTILITIES, STRUCTURES, & BOUNDARIES.
6. INFORMATION SHOWN OUTSIDE THE LIMITS OF AS-BUILT SURVEY WAS PROVIDED BY THE DESIGNER AND WAS NOT VERIFIED BY TURNER LAND SURVEYING, PLLC.
7. NO PROPERTY RESEARCH WAS PERFORMED. FOR CONSERVATION EASEMENT SEE PLAT RECORDED IN McDOWELL COUNTY REGISTER OF DEEDS OFFICE PLAT BOOK 18, PAGE 89.

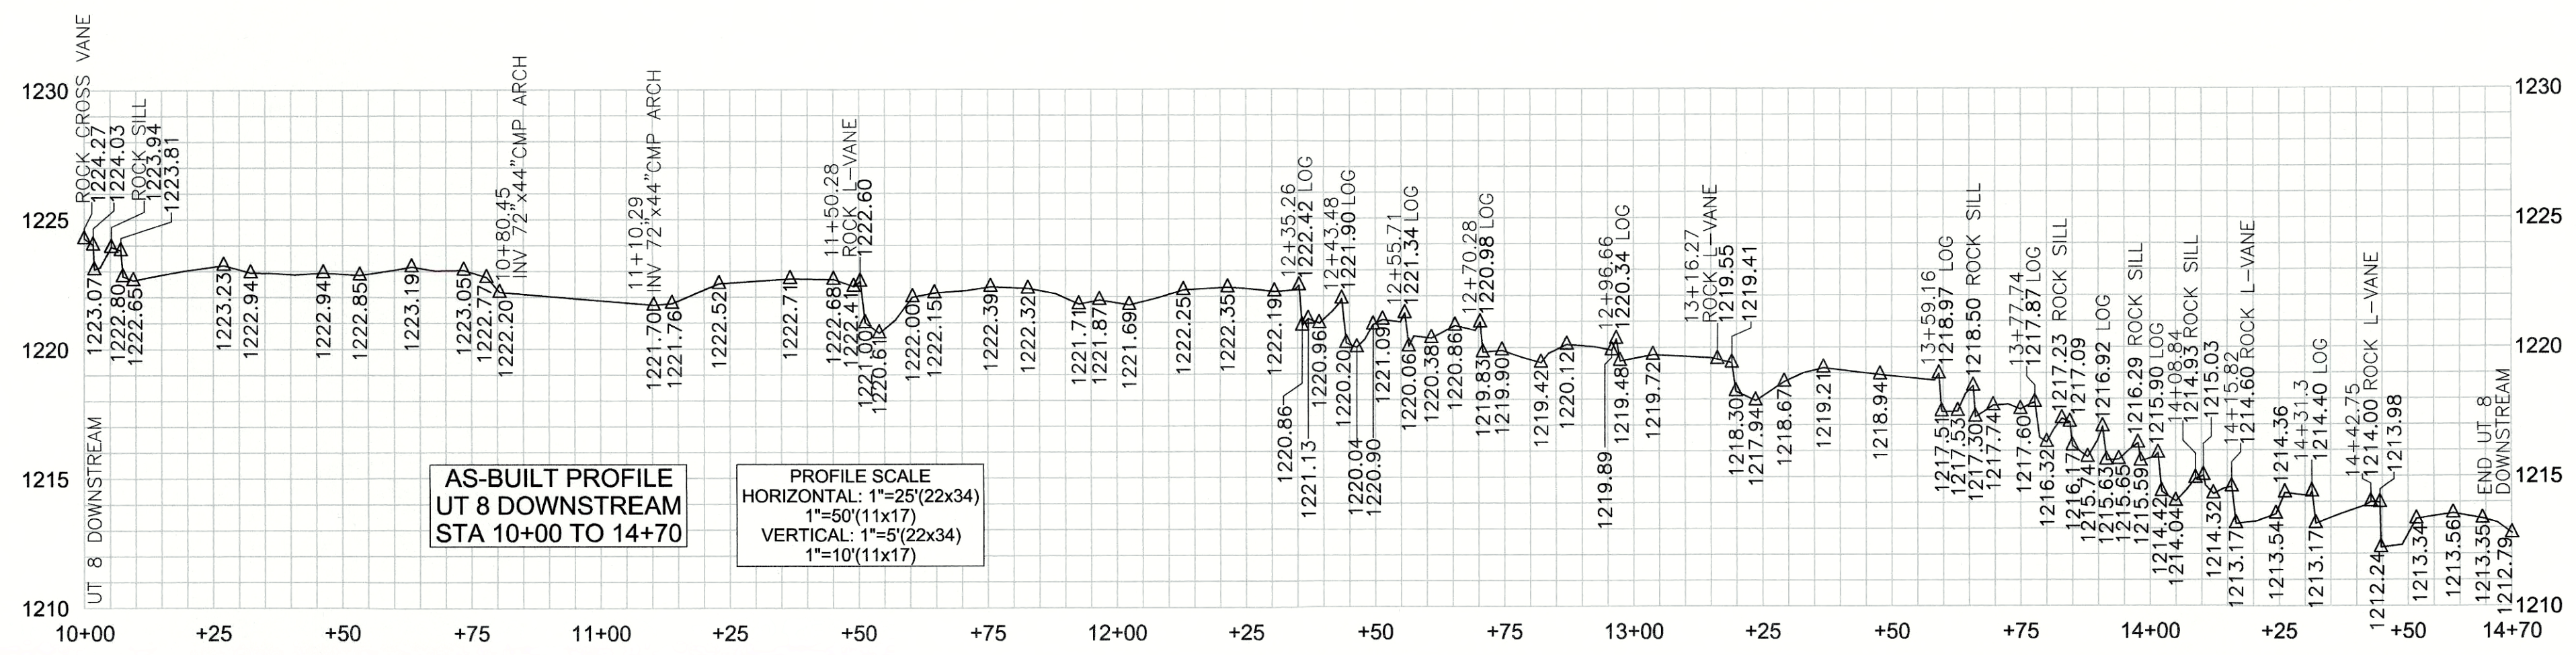

REVISIONS, DATE AND INITIAL:

TURNER
 LAND SURVEYING
 www.turnerlandsurveying.com
 Certified DBE/WBE

3719 BENSON DRIVE
 RALEIGH, NC 27609
 P-0702 (919) 827-0745

UT 8 DOWNSTREAM PLAN & PROFILE
BOBS CREEK STREAM RESTORATION PROJECT
 NCEEP PROJECT # 92879

NORTH CAROLINA
 McDOWELL COUNTY
 MARION

DATE: 06/09/2015
 SURVEYED BY: DST/JAP/DTH
 DRAWN BY: ROB/DST
 REVIEWED BY: DST/EGT
 PROJECT: TLS-15-007
 FILE: BOBS_CREEK_92879_AB_TLS_F
 SCALE: AS SHOWN

SHEET
5 of 5