


VICINITY MAP
(NOT TO SCALE)

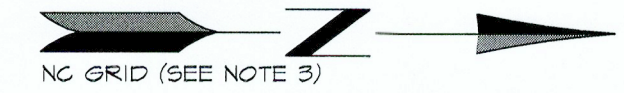

NC GRID (SEE NOTE 5)



north

CONTROL POINT
N 744520.75
E 1811197.86
EL. 541.10'

CONTROL POINT
N 744509.68
E 1811397.59
EL. 541.53'

CONSERVATION EASEMENT


LIMITS OF DISTURBANCE


CONSERVATION EASEMENT

NOTE: STONE WAS EXTENDED
AT THE ENDS OF THE FORD
CROSSING (BOTH SIDES)

REVISED 3/09/17: CHANGE NOTE TO SHOW UP AS RED ON FINAL MAP.

CERTIFICATE OF ACCURACY OF MAPPING
I, DUD E. BAUGHMAN, CERTIFY THAT THIS PLAN WAS DRAWN UNDER MY SUPERVISION FROM AN ACTUAL SURVEY MADE UNDER MY SUPERVISION (DEED DESCRIPTION RECORDED IN DEED BOOK 2012, PAGE 127), THAT THE BOUNDARIES NOT SURVEYED ARE SHOWN AS BROKEN LINES PLOTTED FROM INFORMATION FOUND IN DEEDS AS LISTED THAT THE RATIO OF PRECISION AS CALCULATED IS 1:10,000+ AND THAT THIS MAP MEETS THE REQUIREMENTS OF THE STANDARDS OF PRACTICE FOR LAND SURVEYING IN NORTH CAROLINA (2) NCAC 56-1600.

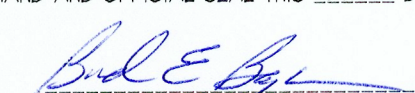WITNESS MY HAND AND OFFICIAL SEAL THIS 9TH DAY OF MARCH 2017.
L-3993
LICENSE NO.  PROFESSIONAL LAND SURVEYOR

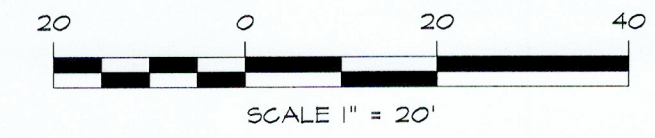

SCALE 1" = 20'

MLA GROUP
CIVIL ENGINEERS • SURVEYORS • LANDSCAPE ARCHITECTS
120 Club Oaks Ct, Suite 100
Winston-Salem, NC 27104
336.765.1923
WWW.MILLERLA.COM
TURNING LAND INTO LANDMARKS
NC CORPORATE LICENSE #C-3089

- NOTES:**
- THIS IS NOT A BOUNDARY SURVEY. THE PURPOSE OF THIS MAP IS TO SHOW TOPOGRAPHY AND AS-BUILT STRUCTURES FOR A STREAM RESTORATION PROJECT. ANY BOUNDARY AND EASEMENT LINES SHOWN HEREON HAVE BEEN TAKEN FROM REFERENCE #1 BELOW.
 - DISTANCES SHOWN ARE HORIZONTAL GROUND DISTANCES UNLESS NOTED OTHERWISE. DISTANCES, COORDINATES AND ELEVATIONS LISTED ARE IN U.S. SURVEY FEET UNLESS NOTED OTHERWISE.
 - REFERENCE #1 INDICATES THAT THIS PROJECT IS ON NORTH CAROLINA GRID (NAD83) AND VERTICAL DATUM NAVD83. CONTROL INFORMATION HAS BEEN PROVIDED BY THE PROJECT ENGINEER. SURVEYOR MAKES NO CERTIFICATION AS TO THE ACCURACY OR PRECISION OF HORIZONTAL OR VERTICAL LOCATIONS OF CONTROL POINTS USED FOR THIS SURVEY.
 - SURVEY FIELD WORK COMPLETED ON FEBRUARY 21, 2017.
 - THIS SURVEY IS SUBJECT TO ANY AND ALL FACTS THAT MAY BE DISCLOSED BY A FULL TITLE SEARCH, WHICH HAS NOT BEEN FURNISHED TO SURVEYOR AS OF THIS DATE.
 - CHANGES FROM CONSTRUCTION PLANS ARE SHOWN IN RED.
- REFERENCES:**
- DESIGN/CONSTRUCTION PLANS PREPARED BY KGI ASSOCIATES OF NC FOR MT. PLEASANT CREEK PROJECT (BOYMAN PROPERTY), DMS #44 DATED 4/24/2016, SIGNED/SEALED BY GARY MICHAEL NRYNCA.
 - PLAN ENTITLED 'BOUNDARY SURVEY AND CONSERVATION EASEMENT DEDICATION MAP OF THE MARTHA LEE BOYMAN PROPERTY' RECORDED SEPTEMBER 25, 2014 IN PLAT BOOK 141, PAGE 04, RANDOLPH COUNTY REGISTRY.

CURRENT OWNER:
MICKEY C. BOYMAN
5213 WHITE CHAPEL ROAD
STALEY, NC 27555
TOWNSHIP: COLUMBIA
COUNTY: RANDOLPH
STATE: NC
Date: MARCH 1, 2017
SURVEYED BY: BB
MAPPED BY: BB
PROJECT #: LS-17002

AS-BUILT TOPOGRAPHIC SURVEY
MT. PLEASANT CREEK
RESTORATION PROJECT
DMS #44
RANDOLPH COUNTY
NORTH CAROLINA