


PROJECT: 128975 BROWN CREEK TRIBS

STATE	BAKER PROJECT REFERENCE NO.	SHEET NO.	TOTAL SHEETS
NC	128975	1	34

NORTH CAROLINA
DIVISION OF MITIGATION SERVICES

ANSON COUNTY

LOCATION: APPROX. 4 MILES SOUTHEAST OF THE TOWN OF ANSONVILLE.
TYPE OF WORK: AS-BUILT SURVEY / RECORD DRAWINGS


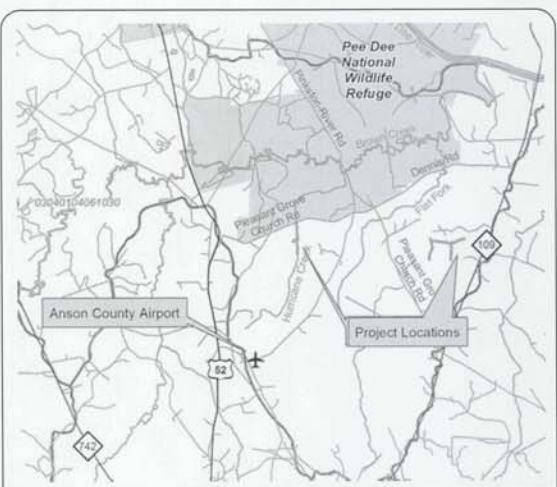


VICINITY MAP

INDEX OF SHEETS

1	TITLE SHEET
1-A	STREAM CONVENTIONAL SYMBOLS GENERAL NOTES STANDARD SPECIFICATIONS VEGETATION SELECTION
1-B	NCDOT CONVENTIONAL SYMBOLS
2 - 2-E	DETAILS
3 - 3I	AS-BUILT SURVEY PLAN
4 - 4I	RECORD DRAWING PLAN
5 - 9	AS-BUILT/RECORD DRAWING PROFILE

USACE ID: SAW-2012-01108
NCDWR # 14-0345
PCN APPROVED ON: 08/22/14

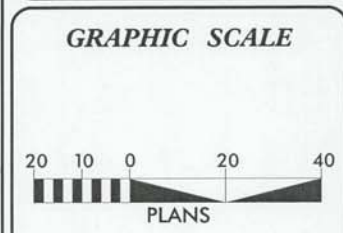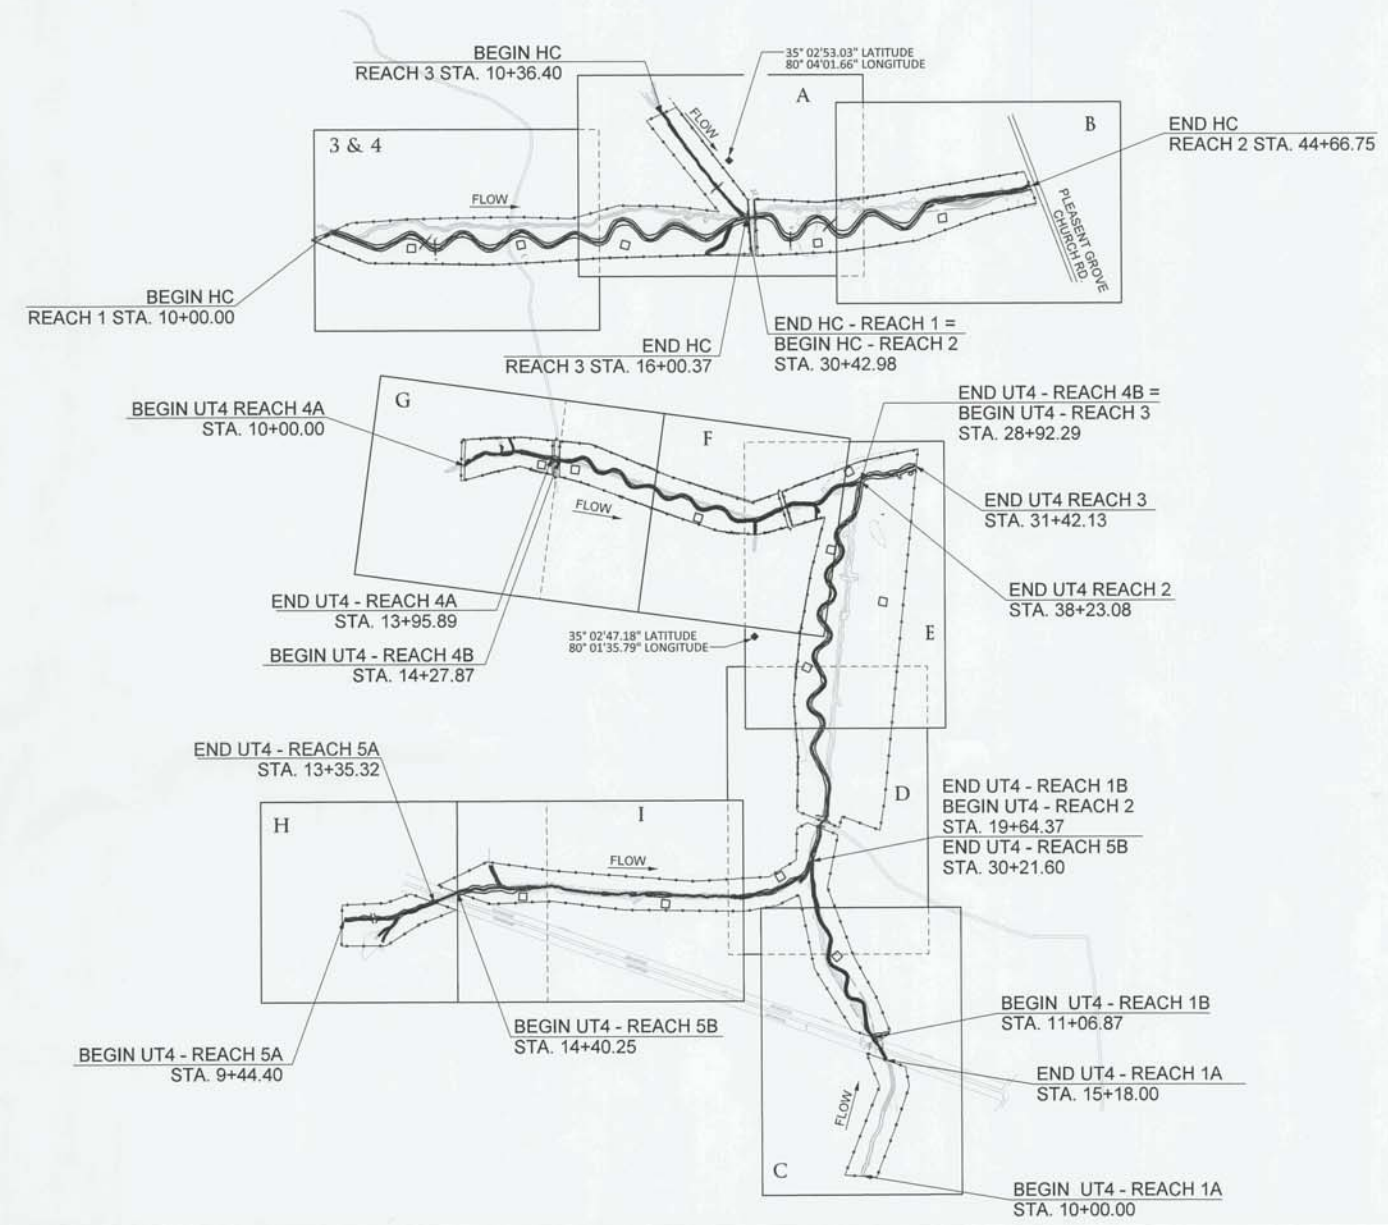

DESIGN SUMMARY

AS-BUILT HC REACH 1	LENGTH = 2043 FEET
AS-BUILT HC REACH 2	LENGTH = 1394 FEET
AS-BUILT HC REACH 3	LENGTH = 564 FEET
AS-BUILT UT4 - REACH 1A	LENGTH = 518 FEET
AS-BUILT UT4 - REACH 1B	LENGTH = 858 FEET
AS-BUILT UT4 - REACH 2	LENGTH = 1828 FEET
AS-BUILT UT4 - REACH 3	LENGTH = 250 FEET
AS-BUILT UT4 - REACH 4A	LENGTH = 396 FEET
AS-BUILT UT4 - REACH 4B	LENGTH = 1444 FEET
AS-BUILT UT4 - REACH 5A	LENGTH = 391 FEET
AS-BUILT UT4 - REACH 5B	LENGTH = 1582 FEET

PREPARED FOR THE OFFICE OF:

NCDEQ
DIVISION OF MITIGATION SERVICES
1652 MAIL SERVICE CENTER
RALEIGH, NC 27699-1652

CONTACT: HARRY TSOMIDES
PROJECT MANAGER

PREPARED IN THE OFFICE OF:

Michael Baker International
8000 Regency Parkway, Suite 500
Cary, NORTH CAROLINA 27518
Phone: 919.493.5458
Fax: 919.493.5490
License # F-1084

SEPTEMBER 2014
LETTING DATE:

JACOB M. BYERS, PE
PROJECT ENGINEER

SCOTT KING, LSS, PWS
PROJECT MANAGER

NORTH CAROLINA PROFESSIONAL SEAL L-4175 LAND SURVEYOR DAVID LEE II

J. Lee II 12-7-16

NCDMS ID NO. 95351

NORTH CAROLINA PROFESSIONAL SEAL 039201 ENGINEER JACOB M. BYERS

11/23/16 P.E.

BrownCreekTribes_95351_AB_12/15/2015_Final

STREAM CONVENTIONAL SYMBOLS
SUPERCEDES SHEET 1-B

	ROCK J-HOOK		SAFETY FENCE
	ROCK VANE		TAPE FENCE
	OUTLET PROTECTION		100 YEAR FLOOD PLAIN
	ROCK CROSS VANE		CONSERVATION EASEMENT
	DOUBLE DROP ROCK CROSS VANE		EXISTING MAJOR CONTOUR
	TEMPORARY SILT CHECK		EXISTING MINOR CONTOUR
	ROOT WAD		LIMITS OF DISTURBANCE
	LOG J-HOOK		FOOT BRIDGE
	LOG VANE		TEMPORARY STREAM CROSSING
	LOG WEIR		PERMANENT STREAM CROSSING
	LOG CROSS VANE		TRANSPLANTED VEGETATION
	CONSTRUCTED RIFFLE		TREE REMOVAL
	BOULDER CLUSTER		TREE PROTECTION
	LOG ROLLER		DITCH PLUG
	GRADE CONTROL LOG JAM		CHANNEL FILL
	LOG STEP POOL		BRUSH MATTRESS
			GEOLIFT

**NOTE: ALL ITEMS ABOVE MAY NOT BE USED ON THIS PROJECT

GENERAL NOTES

1. THE CONTRACTOR IS REQUIRED TO INSTALL INSTREAM STRUCTURES USING A TRACK HOE WITH A HYDRAULIC THUMB OF SUFFICIENT SIZE TO PLACE BOULDERS (3' x 2' x 2'), LOGS AND ROOTWADS.
2. WORK IS BEING PERFORMED AS AN ENVIRONMENTAL RESTORATION PLAN. THE CONTRACTOR SHOULD MAKE ALL REASONABLE EFFORTS TO REDUCE SEDIMENT LOSS AND MINIMIZE DISTURBANCE OF THE SITE WHILE PERFORMING THE CONSTRUCTION WORK.
3. CONSTRUCTION IS SCHEDULED TO BEGIN SUMMER 2014.
4. CONTRACTOR SHOULD CALL NORTH CAROLINA "ONE-CALL" BEFORE EXCAVATION STARTS. (1-800-632-4949)
5. ENGINEER WILL FLAG SIGNIFICANT TREES TO BE SAVED PRIOR TO CONSTRUCTION.
6. ALL GRADING ACTIVITIES SHALL TAKE PLACE WITHIN THE CONSERVATION EASEMENT OR LIMITS OF DISTURBANCE UNLESS SHOWN OTHERWISE.

PROJECT REFERENCE NO. 128975	SHEET NO. 1-A
PROJECT ENGINEER	
APPROVED BY:	
DATE: 11/10/16	
Michael Baker International	
Michael Baker Engineering Inc. 8000 Regency Parkway, Suite 600 Cary, NORTH CAROLINA 27518 Phone: 919.483.5488 Fax: 919.483.5490 License # F-1084	
NCDMS ID NO. 95351	

STANDARD SPECIFICATIONS

NORTH CAROLINA
EROSION AND SEDIMENT CONTROL PLANNING AND DESIGN MANUAL
MARCH 2009 (REV 2013)

- 6.05 TREE PRESERVATION AND PROTECTION
- 6.06 TEMPORARY GRAVEL CONSTRUCTION ENTRANCE
- 6.24 RIPARIAN AREA SEEDING
- 6.60 TEMPORARY SEDIMENT TRAP
- 6.62 TEMPORARY SILT FENCE
- 6.63 TEMPORARY ROCK DAM
- 6.70 TEMPORARY STREAM CROSSING

VEGETATION SELECTION

The following table lists the bare root vegetation selection for the project site. Total planting area is approximately 29 acres and will vary based on areas denuded during construction. Species shall be planted at density of 680 stems per acre and a minimum of 50 feet from the stream banks to the revegetation limits. Exact placement of species will be determined prior to site planting and based on apparent wetness of planting locations and per the vegetation specialist. Refer to the Revegetation Plan Sheets & Construction Specifications for vegetation planting locations and riparian buffer requirements.

Riparian Buffer - Trees (8'x8' spacing - 680 stems/acre)				
Scientific Name	Common Name	% Planted By Species	Wetland Tolerance	Approx. Number of Stems
<i>Fraxinus pennsylvanica</i>	Green Ash	9%	FACW	1,775
<i>Betula nigra</i>	River Birch	9%	FACW	1,775
<i>Liriodendron tulipifera</i>	Tulip Poplar	6%	FAC	1,183
<i>Quercus phellos</i>	Willow Oak	6%	FACW-	1,183
<i>Quercus michauxii</i>	Swamp Chestnut Oak	9%	FACW-	1,775
<i>Nyssa sylvatica</i>	Black Gum	6%	FAC	1,183
<i>Platanus occidentalis</i>	American Sycamore	9%	FACW-	1,775
<i>Quercus alba</i>	White Oak	6%	FACU	1,183
Sub-total		60%		11,832
Riparian Buffer - Understory (8'x8' spacing - 680 stems/acre)				
Scientific Name	Common Name	% Planted By Species	Wetland Tolerance	Approx. Number of Stems
<i>Diospyros virginiana</i>	Persimmon	5%	FAC	986
<i>Alnus serrulata</i>	Tag alder	5%	FACW	986
<i>Lindera benzoin</i>	Spicebush	5%	FACW	986
<i>Hamamelis virginiana</i>	Witch hazel	5%	FAC-	986
<i>Viburnum dentatum</i>	Arrowwood Viburnum	5%	FAC	986
<i>Ita virginica</i>	Virginia sweetspire	5%	FACW+	986
<i>Carpinus caroliniana</i>	American Hornbeam	5%	FAC	986
<i>Asimina triloba</i>	Paw paw	5%	FAC	986
Sub-total		40%		7,888
Total Bare-roots				19,720

Permanent herbaceous seed mixtures for the project site shall be planted throughout the floodplain and riparian buffer areas. Permanent seed mixtures shall be applied with temporary seed, as defined in the construction specifications.

Scientific Name	Common Name	% Planted By Species	Total lbs per Acre	Wetland Tolerance
<i>Andropogon gerardii</i>	Big blue stem	10%	1.50	FAC
<i>Dichanthelium clandestinum</i>	Deer Tongue	15%	1.50	FACW
<i>Carex crinata</i>	Fringed sedge	10%	2.25	FACW+
<i>Chasmanthium latifolium</i>	River oats	5%	1.50	FACU
<i>Elymus virginicus</i>	Virginia wild rye	15%	1.50	FAC
<i>Juncus effusus</i>	Soft rush	5%	2.25	FACW+
<i>Panicum virgatum</i>	Switchgrass	10%	1.50	FAC+
<i>Polygonum pensylvanicum</i>	Pennsylvania Smartweed	5%	0.75	FACW
<i>Schizachyrium scoparium</i>	Little blue stem	10%	0.75	FACU
<i>Tripsacum dactyloides</i>	Eastern gamagrass	5%	0.75	FAC+
<i>Sorghastrum nutans</i>	Indiangrass	10%	0.75	FACU
Total		100%	15.0	

Live staking will be applied to all restored streambanks following the details in this plan set and according to the construction specifications.

Scientific Name	Common Name	% Planted By Species	Wetland Tolerance
<i>Cornus amomum</i>	Silky Dogwood	10%	FACW+
<i>Salix nigra</i>	Black Willow	10%	OBL
<i>Salix sericea</i>	Silky Willow	40%	OBL
<i>Sambucus canadensis</i>	Elderberry	40%	FACW-

The following table lists temporary seed mix for the project site. All disturbed areas will be stabilized using mulch and temporary seed as defined in the construction specifications.

Planting Dates	Species Name	Rate (lbs/acre)
September to March	Annual Rye Grain (Cool Season)	130
April to August	Browntop Millet (Warm Season)	40

2/26/03
 I:\9\2016\128975\Design\Plans\AS-BUILD\PLANS\128975_ASB-HC_PSH_1A.dgn
 mcorley
 B:\cnc\creek\tr\bs_95351_AB_12/15/2015_F.mxd

STATE OF NORTH CAROLINA
DIVISION OF HIGHWAYS

CONVENTIONAL SYMBOLS

*S.U.E = SUBSURFACE UTILITY ENGINEER

BOUNDARIES AND PROPERTY:

State Line	-----
County Line	-----
Township Line	-----
City Line	-----
Reservation Line	-----
Property Line	-----
Existing Iron Pin	○
Property Corner	✕
Property Monument	□
Parcel/Sequence Number	⑫③
Existing Fence Line	× × ×
Proposed Woven Wire Fence	○
Proposed Chain Link Fence	□
Proposed Barbed Wire Fence	◇
Existing Wetland Boundary	-----
Proposed Wetland Boundary	-----
Existing Endangered Animal Boundary	-----
Existing Endangered Plant Boundary	-----

BUILDINGS AND OTHER CULTURE:

Gas Pump Vent or U/G Tank Cap	○
Sign	○
Well	○
Small Mine	✕
Foundation	□
Area Outline	□
Cemetery	↑
Building	□
School	□
Church	□
Dam	□

HYDROLOGY:

Stream or Body of Water	-----
Hydro, Pool or Reservoir	-----
Jurisdictional Stream	-----
Buffer Zone 1	-----
Buffer Zone 2	-----
Flow Arrow	←
Disappearing Stream	-----
Spring	○
Wetland	-----
Proposed Lateral, Tail, Head Ditch	-----
False Sump	-----

RAILROADS:

Standard Gauge	-----
RR Signal Milepost	○
Switch	□
RR Abandoned	-----
RR Dismantled	-----

RIGHT OF WAY:

Baseline Control Point	◆
Existing Right of Way Marker	△
Existing Right of Way Line	-----
Proposed Right of Way Line	-----
Proposed Right of Way Line with Iron Pin and Cap Marker	○
Proposed Right of Way Line with Concrete or Granite Marker	○
Existing Control of Access	○
Proposed Control of Access	○
Existing Easement Line	-----
Proposed Temporary Construction Easement	-----
Proposed Temporary Drainage Easement	-----
Proposed Permanent Drainage Easement	-----
Proposed Permanent Utility Easement	-----
Proposed Temporary Utility Easement	-----
Proposed Permanent Easement with Iron Pin and Cap Marker	◆

ROADS AND RELATED FEATURES:

Existing Edge of Pavement	-----
Existing Curb	-----
Proposed Slope Stakes Cut	-----
Proposed Slope Stakes Fill	-----
Proposed Wheel Chair Ramp	-----
Existing Metal Guardrail	-----
Proposed Guardrail	-----
Existing Cable Guiderail	-----
Proposed Cable Guiderail	-----
Equality Symbol	○
Pavement Removal	-----

VEGETATION:

Single Tree	○
Single Shrub	○
Hedge	-----
Woods Line	-----
Orchard	-----
Vineyard	-----

EXISTING STRUCTURES:

MAJOR:	
Bridge, Tunnel or Box Culvert	-----
Bridge Wing Wall, Head Wall and End Wall	-----
MINOR:	
Head and End Wall	-----
Pipe Culvert	-----
Footbridge	-----
Drainage Box: Catch Basin, DI or JB	-----
Paved Ditch Gutter	-----
Storm Sewer Manhole	-----
Storm Sewer	-----

UTILITIES:

POWER:	
Existing Power Pole	●
Proposed Power Pole	○
Existing Joint Use Pole	○
Proposed Joint Use Pole	○
Power Manhole	○
Power Line Tower	□
Power Transformer	□
U/G Power Cable Hand Hole	□
H-Frame Pole	●
Recorded U/G Power Line	-----
Designated U/G Power Line (S.U.E.*)	-----

TELEPHONE:

Existing Telephone Pole	●
Proposed Telephone Pole	○
Telephone Manhole	○
Telephone Booth	□
Telephone Pedestal	□
Telephone Cell Tower	□
U/G Telephone Cable Hand Hole	□
Recorded U/G Telephone Cable	-----
Designated U/G Telephone Cable (S.U.E.*)	-----
Recorded U/G Telephone Conduit	-----
Designated U/G Telephone Conduit (S.U.E.*)	-----
Recorded U/G Fiber Optics Cable	-----
Designated U/G Fiber Optics Cable (S.U.E.*)	-----

WATER:

Water Manhole	○
Water Meter	○
Water Valve	○
Water Hydrant	○
Recorded U/G Water Line	-----
Designated U/G Water Line (S.U.E.*)	-----
Above Ground Water Line	-----

TV:

TV Satellite Dish	○
TV Pedestal	□
TV Tower	○
U/G TV Cable Hand Hole	□
Recorded U/G TV Cable	-----
Designated U/G TV Cable (S.U.E.*)	-----
Recorded U/G Fiber Optic Cable	-----
Designated U/G Fiber Optic Cable (S.U.E.*)	-----

GAS:

Gas Valve	○
Gas Meter	○
Recorded U/G Gas Line	-----
Designated U/G Gas Line (S.U.E.*)	-----
Above Ground Gas Line	-----

SANITARY SEWER:




Sanitary Sewer Manhole	○
Sanitary Sewer Cleanout	○
U/G Sanitary Sewer Line	-----
Above Ground Sanitary Sewer	-----
Recorded SS Forced Main Line	-----
Designated SS Forced Main Line (S.U.E.*)	-----

MISCELLANEOUS:

Utility Pole	●
Utility Pole with Base	□
Utility Located Object	○
Utility Traffic Signal Box	□
Utility Unknown U/G Line	-----
U/G Tank; Water, Gas, Oil	□
A/G Tank; Water, Gas, Oil	□
U/G Test Hole (S.U.E.*)	○
Abandoned According to Utility Records	AATUR
End of Information	E.O.I.


2/26/83
 11/9/2015
 R:\128975\Design\Plans\AS-BUILD\PLANS\128975-ASB-HC-PSH-1B.dgn
 mcarney
 BrownCreek.Trib. 95351 AB 12/15/2015 F.tbl
 Revised 02/02/00

ROOT WADS

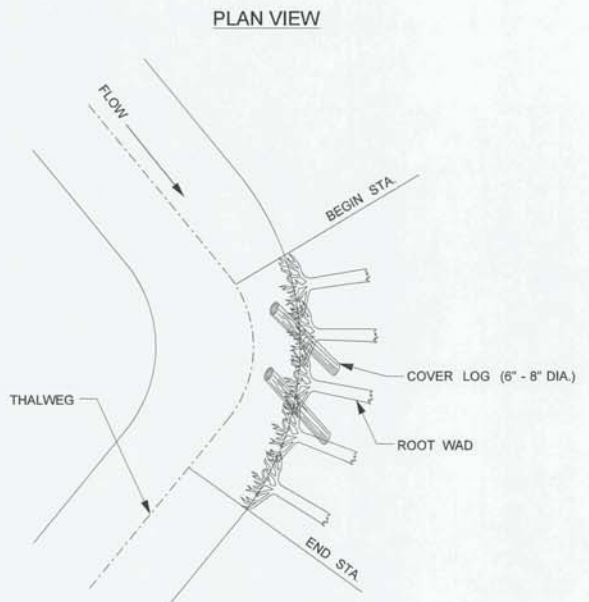
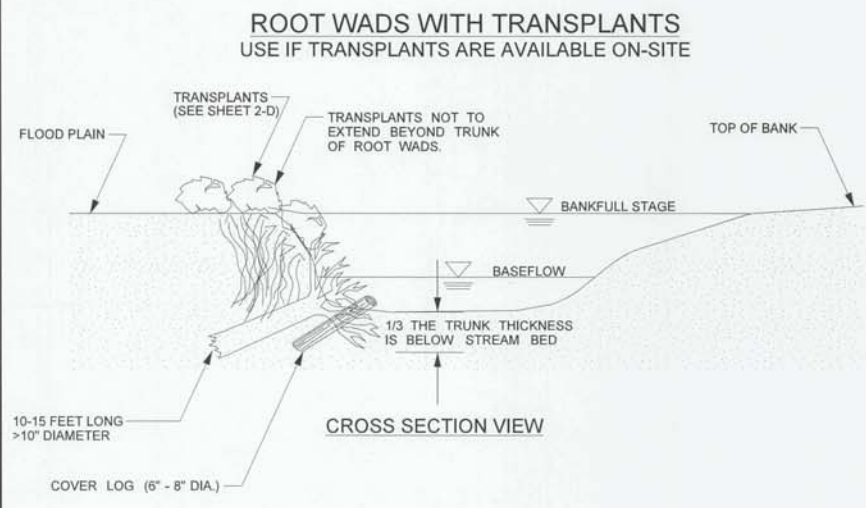
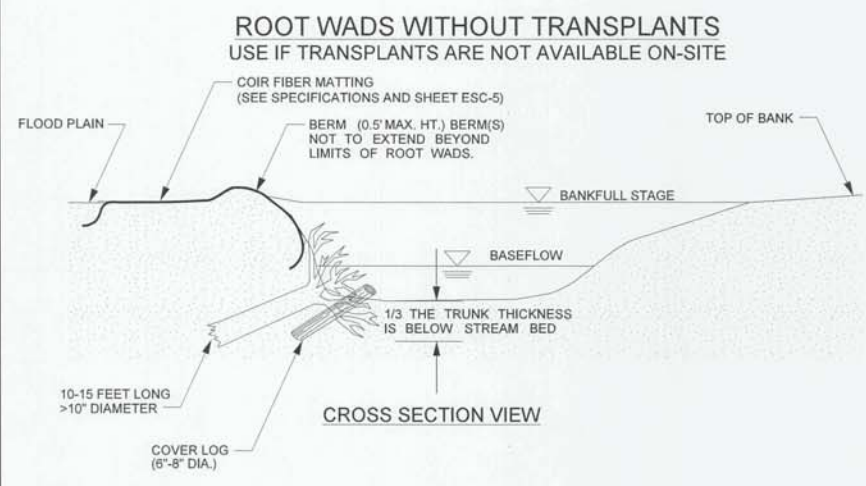


- NOTES:**
1. INSTALLATION USING THE TRENCHING METHOD REQUIRES THAT A TRENCH BE EXCAVATED FOR THE LOG PORTION OF THE ROOT WAD. ONE-THIRD OF THE ROOT WAD SHOULD REMAIN BELOW NORMAL BASE FLOW CONDITIONS OR CHANNEL BOTTOM.
 2. THE NUMBER OF ROOTWADS ESTIMATED MAY VARY DEPENDING ON THE ROOTMASS SIZE. IN GENERAL, ROOTWADS SHOULD PROTECT THE OUTER MEANDER BEND AS SHOWN. SEE PLANS FOR APPROXIMATE STATION AND LOCATION.
 3. INSTALL COVER LOGS BETWEEN ROOTWADS TO PROVIDE HABITAT ONLY WHEN AVAILABLE FROM ON-SITE HARVESTING.

TYPICAL STRUCTURE PLACEMENT

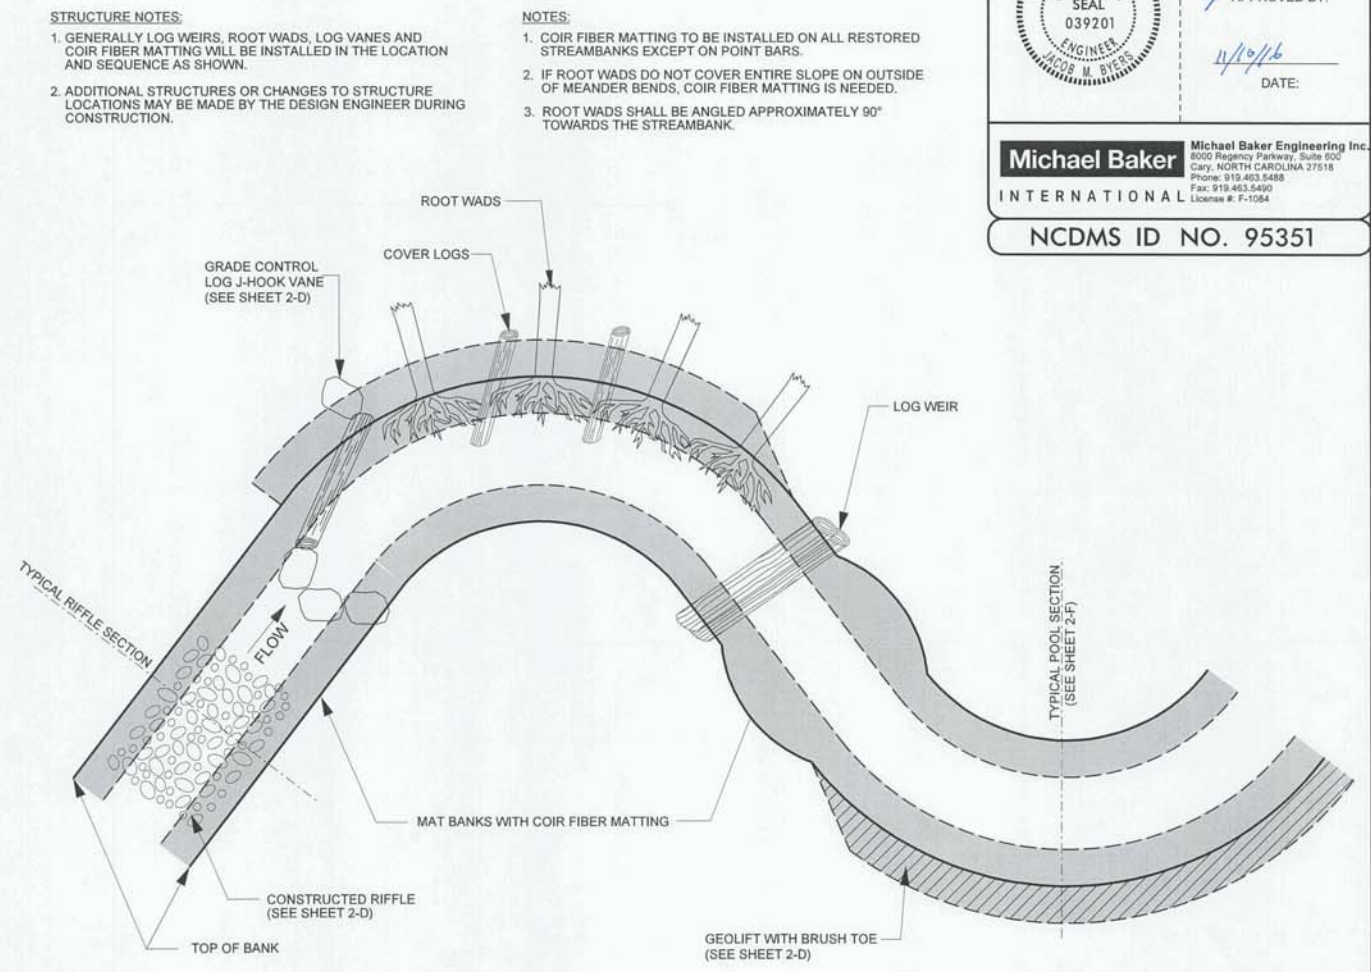

TYPICAL RIFFLE, POOL CROSS SECTIONS

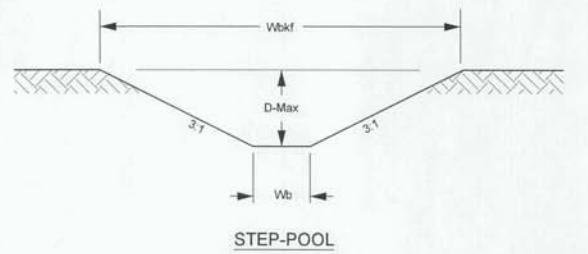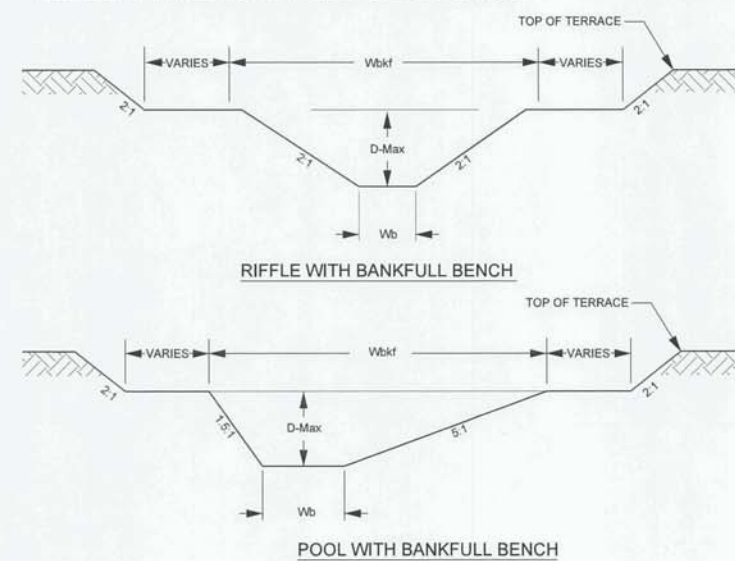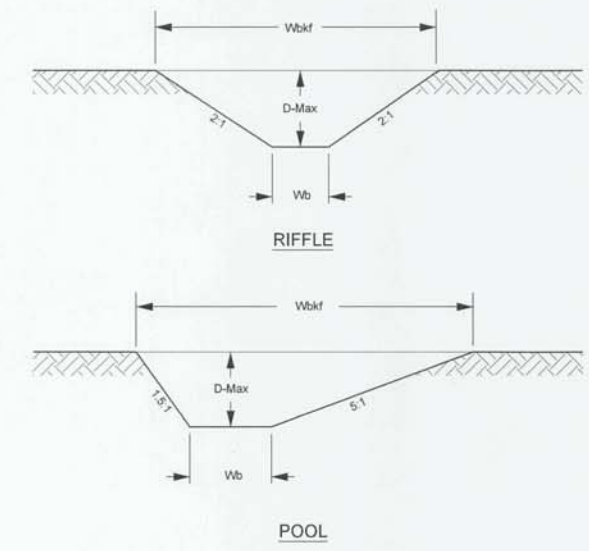



HURRICANE CREEK						UT4					
REACH 1	REACH 2	REACH 3	REACH 4	REACH 5	REACH 6	REACH 1	REACH 2	REACH 3	REACH 4	REACH 5	REACH 6
19.1	26.0	20.1	27.0	9.1	13.0	11.4	15.0	16.5	24.0	19.8	26.0
1.8	3.0	1.9	3.2	1.0	2.0	1.1	2.4	1.6	3.0	1.7	3.7
13.0	13.9	13.0	13.7	12.0	12.1	13.0	13.5	14.0	13.3	13.0	13.1
28.0	48.8	31.0	53.1	6.9	14.0	10.0	20.2	21.0	42.8	28.0	59.1
11.8	6.5	12.4	6.2	5.3	1.0	7.1	1.8	10.2	4.5	13.0	4.0

WIDTH OF BANKFULL (Wb)
 MAXIMUM DEPTH (D-Max)
 WIDTH TO DEPTH RATIO (Wb/D)
 BANKFULL AREA (Abkf)
 BOTTOM WIDTH (Wb)

- NOTES:**
1. DURING CONSTRUCTION CORNERS OF DESIGN CHANNEL WILL BE ROUNDED AND A THALWEG WILL BE SHAPED PER DIRECTION OF ENGINEER.
 2. POOLS SHOWN ABOVE ARE LEFT POOLS ONLY.


2/26/03

LIVE STAKING

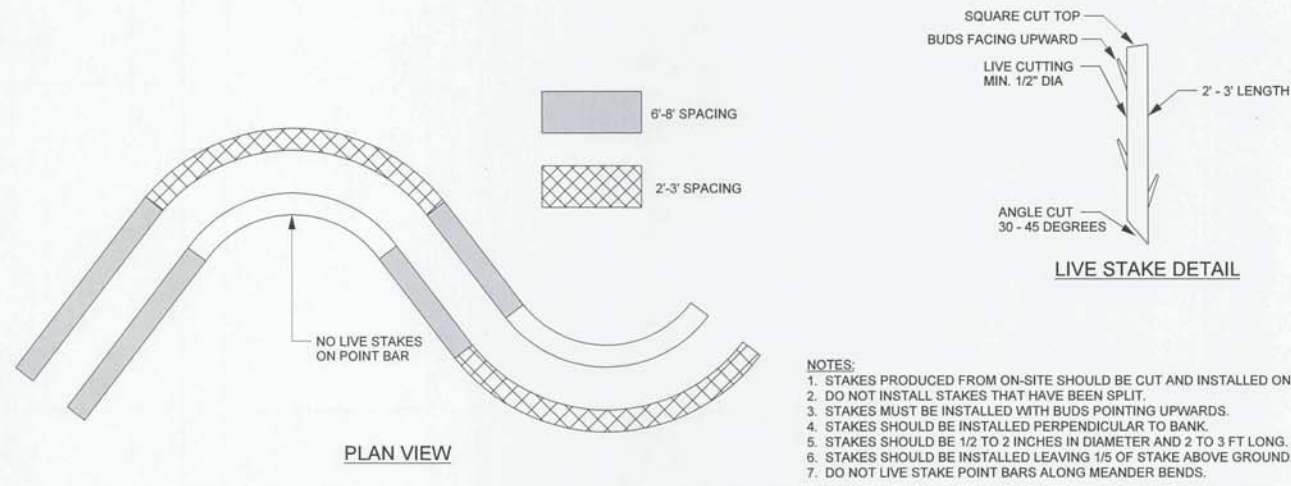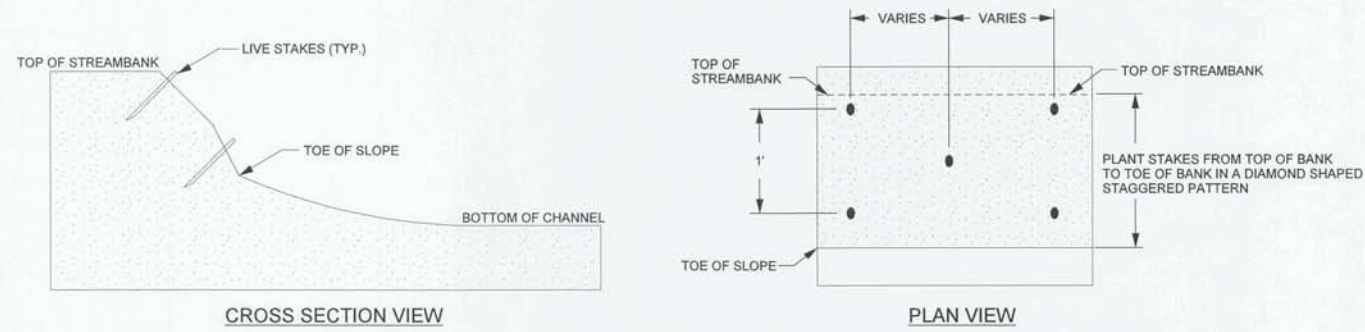

- NOTES:**
1. STAKES PRODUCED FROM ON-SITE SHOULD BE CUT AND INSTALLED ON THE SAME DAY.
 2. DO NOT INSTALL STAKES THAT HAVE BEEN SPLIT.
 3. STAKES MUST BE INSTALLED WITH BUDS POINTING UPWARDS.
 4. STAKES SHOULD BE INSTALLED PERPENDICULAR TO BANK.
 5. STAKES SHOULD BE 1/2 TO 2 INCHES IN DIAMETER AND 2 TO 3 FT LONG.
 6. STAKES SHOULD BE INSTALLED LEAVING 1/5 OF STAKE ABOVE GROUND.
 7. DO NOT LIVE STAKE POINT BARS ALONG MEANDER BENDS.

PLANTING SPECIFICATIONS

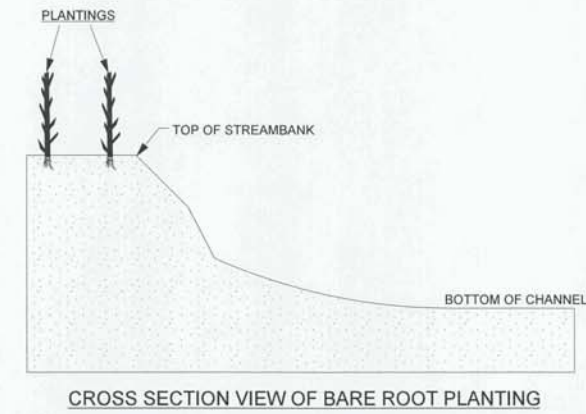



- NOTES:**
1. PLANT BARE ROOT SHRUBS AND TREES TO THE WIDTH OF THE BUFFER/PLANTING ZONE AS SHOWN ON THE PLANS.
 2. ALLOW FOR 6-10 FEET BETWEEN PLANTINGS, DEPENDING ON SIZE.
 3. LOOSEN COMPACTED SOIL.
 4. PLANT IN HOLES MADE BY A MATTOCK, DIBBLE, PLANTING BAR, OR OTHER APPROVED MEANS.
 5. PLANT IN HOLES DEEP AND WIDE ENOUGH TO ALLOW THE ROOTS TO SPREAD OUT AND DOWN WITHOUT J-ROOTING.
 6. KEEP ROOTS MOIST WHILE DISTRIBUTING OR WAITING TO PLANT BY MEANS OF WET CANVAS, BURLAP, OR STRAW.
 7. HEEL-IN PLANTS IN MOIST SOIL OR SAWDUST IF NOT PROMPTLY PLANTED UPON ARRIVAL TO PROJECT SITE.

BAKER PROJECT REFERENCE NO. 128975	SHEET NO. 2-A
PROJECT ENGINEER	
APPROVED BY: 	
DATE: 11/10/16	
Michael Baker International	
Michael Baker Engineering Inc. 8500 Regency Parkway, Suite 600 Cary, NORTH CAROLINA 27518 Phone: 919.463.5488 Fax: 919.463.5490 License #: F-1084	
NCDMS ID NO. 95351	



TRANSPLANTED VEGETATION

NOTES:

1. EXCAVATE A HOLE IN THE BANK TO BE STABILIZED THAT WILL ACCOMMODATE THE SIZE OF TRANSPLANT TO BE PLACED. BEGIN EXCAVATION AT THE TOE OF THE BANK.
2. EXCAVATE TRANSPLANT USING A FRONT END LOADER. EXCAVATE THE ENTIRE ROOT MASS AND AS MUCH ADDITIONAL SOIL MATERIAL AS POSSIBLE. IF ENTIRE ROOT MASS CAN NOT BE EXCAVATED IN ONE BUCKET LOAD, THE TRANSPLANT IS TOO LARGE AND ANOTHER SHOULD BE SELECTED.
3. PLACE TRANSPLANT IN THE BANK TO BE STABILIZED SO THAT VEGETATION IS ORIENTATED VERTICALLY.
4. FILL IN ANY HOLES AROUND THE TRANSPLANT AND COMPACT.
5. ANY LOOSE SOIL LEFT IN THE STREAM SHOULD BE REMOVED.
6. PLACE MULTIPLE TRANSPLANTS CLOSE TOGETHER SUCH THAT THEY TOUCH.

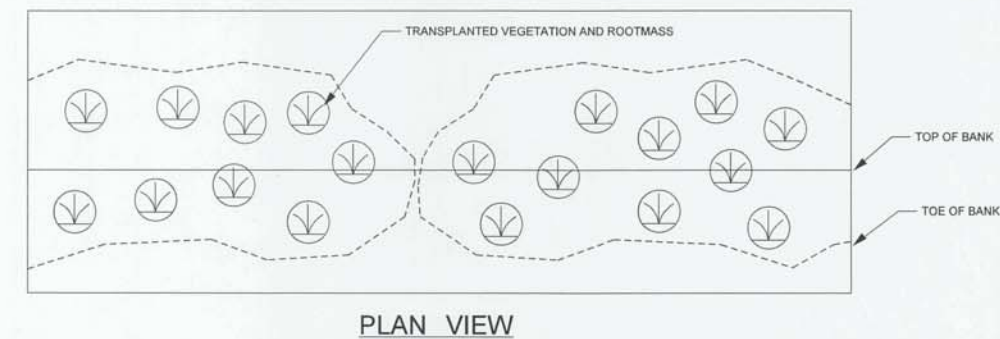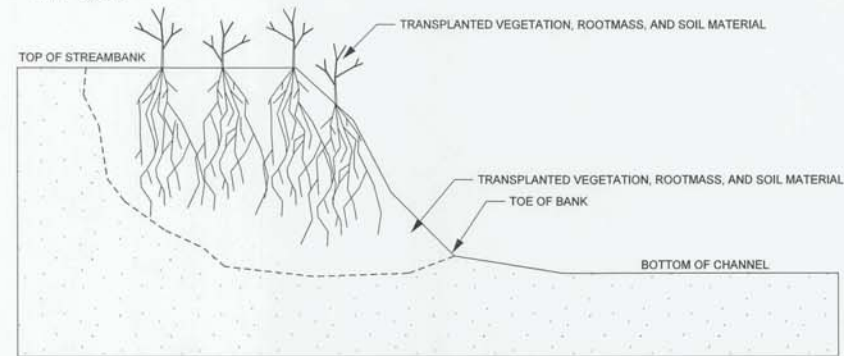


TYPICAL PLAN VIEW AND PROFILE

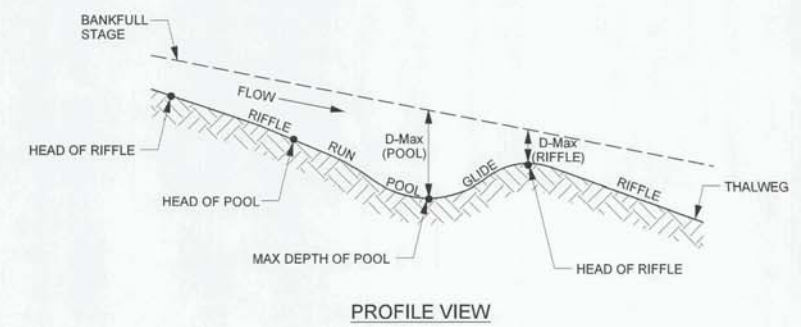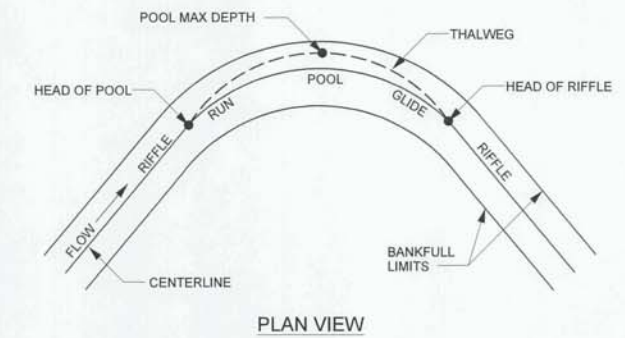

- NOTES:**
1. THE POINTS SHOWN, e.g. HEAD OF RIFFLE, HEAD OF POOL AND MAX DEPTH OF POOL ARE THE CONTROL POINTS USED TO CUT THE PROFILE. HOWEVER, THE CONTRACTOR SHOULD CREATE SMOOTH TRANSITIONS BETWEEN CONTROL POINTS AS SHOWN ABOVE.
 2. THE DOWNSTREAM HEAD OF RIFFLE ELEVATION SHOULD NOT EXCEED THE HEAD OF POOL ELEVATION.
 3. THE CHANGE IN WIDTH BETWEEN THE RIFFLES AND POOLS SHOULD OCCUR GRADUALLY OVER THE ENTIRE LENGTH OF THE BEND.


K:\9\28975\Design\Plans\ASB-BUILD\PLANS\128975-ASB-HC-FSH_2.dgn
 11/10/16
 incorey
 BrownCrackTribs_95351.dwg 12/15/2015, F.rral

LOG WEIR

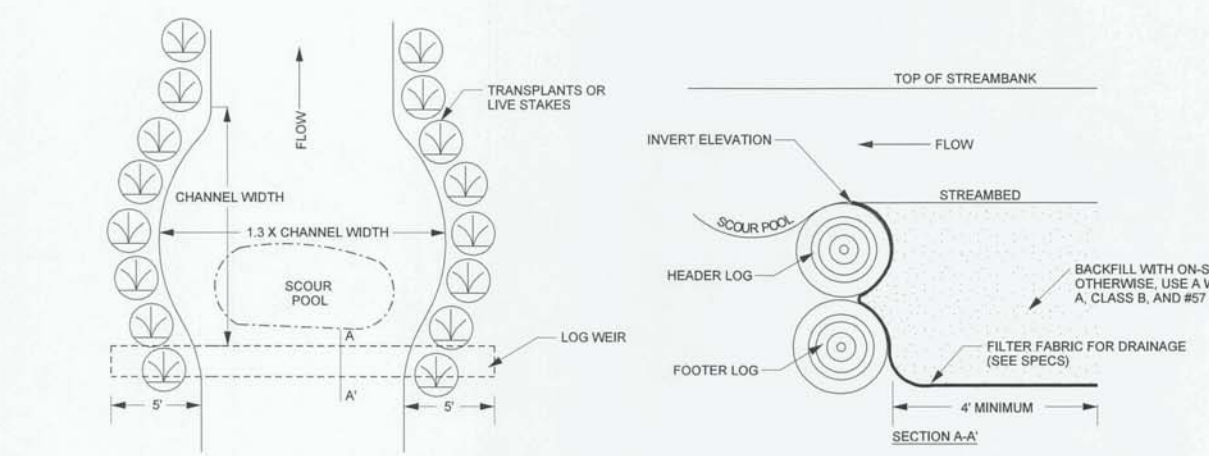


- NOTES:**
- LOGS SHOULD BE AT LEAST 12 INCHES IN DIAMETER, RELATIVELY STRAIGHT, HARDWOOD, AND RECENTLY HARVESTED.
 - LOGS >24 INCHES IN DIAMETER MAY BE USED ALONE WITHOUT AN ADDITIONAL LOG. FILTER FABRIC SHOULD STILL BE USED TO SEAL AROUND LOG.
 - PLACE FOOTER LOGS FIRST AND THEN HEADER (TOP) LOG. SET HEADER LOG AT A MAXIMUM OF 3 INCHES ABOVE THE INVERT ELEVATION.
 - CUT A NOTCH IN THE HEADER LOG APPROXIMATELY 30% OF THE CHANNEL BOTTOM WIDTH AND EXTENDING DOWN TO THE INVERT ELEVATION. NOTCH SHALL NOT EXCEED 3 INCHES IN DEPTH.
 - USE FILTER FABRIC FOR DRAINAGE TO SEAL GAPS BETWEEN LOGS.
 - PLACE TRANSPLANTS FROM TOE OF STREAMBANK TO TOP OF STREAMBANK.

LOG VANE

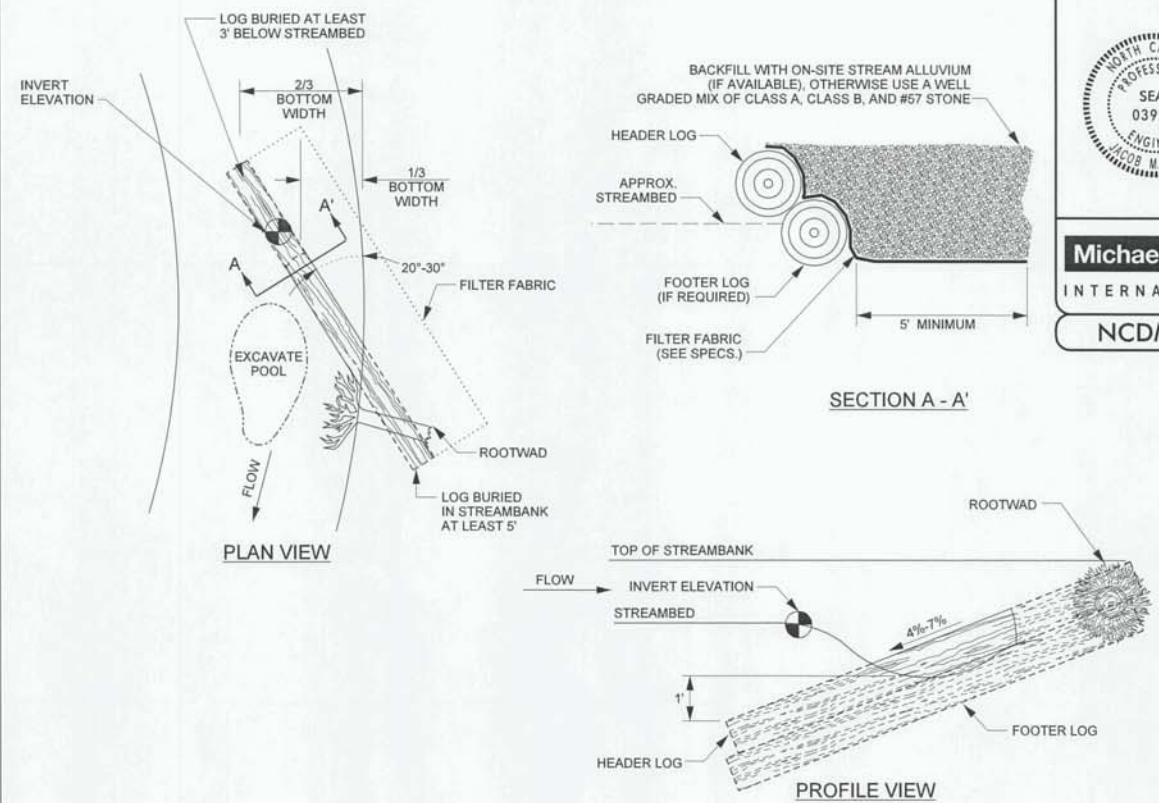


- NOTES:**
- LOGS SHOULD BE AT LEAST 10" IN DIAMETER, RELATIVELY STRAIGHT, HARDWOOD, AND RECENTLY HARVESTED.
 - SOIL SHOULD BE COMPACTED WELL AROUND BURIED PORTIONS OF LOG.
 - ROOTWADS SHOULD BE PLACED BENEATH THE HEADER LOG AND PLACED SO THAT IT LOCKS THE HEADER LOG INTO THE BANK. SEE ROOTWAD DETAIL.
 - FILTER FABRIC SHOULD BE NAILED TO THE LOG BELOW THE BACKFILL.

PERMANENT ROAD CULVERT CROSSING

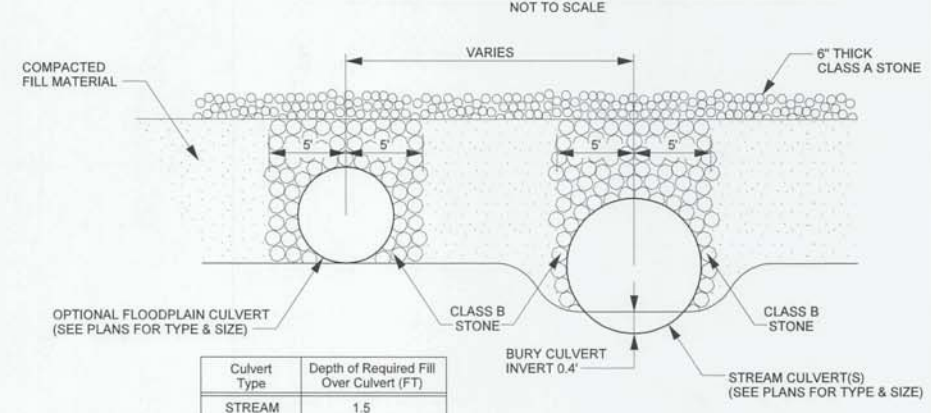


Culvert Type	Depth of Required Fill Over Culvert (FT)
STREAM	1.5
FLOOD PLAIN	1.5

- NOTES:**
- INSTALL PIPE CULVERT IN ACCORDANCE WITH DETAIL SPECIFICATIONS.
 - INSTALL COIR FIBER MATTING FOR EROSION CONTROL ALONG FILL SLOPES

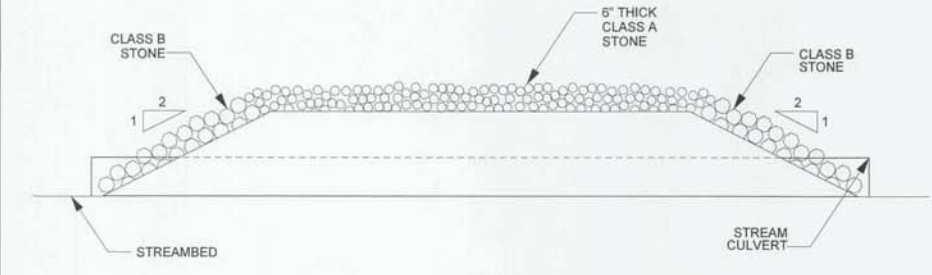


- NOTES:**
- TYPICAL SECTION APPLIES TO UT4 REACH 1B AT APPROXIMATE STATION 16+30 AND HC REACH 3, STATION 10+00.
 - CULVERTS ARE TO BE EVENLY SPACED MINIMUM OF 24" APART.
 - MINIMUM OF 18" COVER FOR ALL PIPES.

PERMANENT FORD STREAM CROSSING

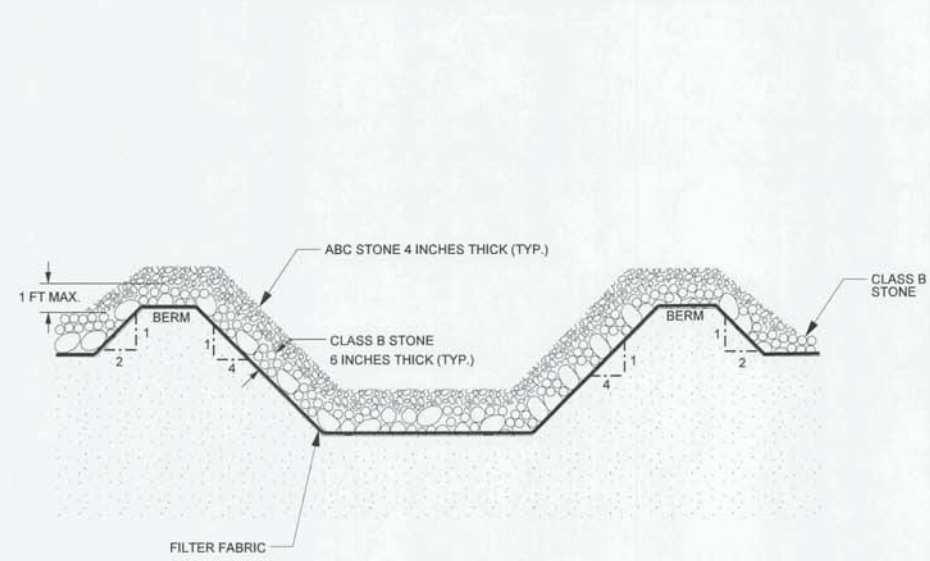

- NOTES:**
- CONSTRUCT STREAM CROSSING WHEN FLOW IS LOW.
 - HAVE ALL NECESSARY MATERIALS AND EQUIPMENT ON-SITE BEFORE WORK BEGINS.
 - MINIMIZE CLEARING AND EXCAVATION OF STREAMBANKS. DO NOT EXCAVATE CHANNEL BOTTOM. COMPLETE ONE SIDE BEFORE STARTING ON THE OTHER SIDE.
 - INSTALL STREAM CROSSING AT RIGHT ANGLE TO THE FLOW.
 - GRADE SLOPES TO A 4:1 SLOPE. TRANSPLANT SOD FROM ORIGINAL STREAMBANK ONTO SIDE SLOPES.
 - MAINTAIN CROSSING SO THAT RUNOFF IN THE CONSTRUCTION ROAD DOES NOT ENTER EXISTING CHANNEL.
 - A STABILIZED PAD OF CLASS B STONE, 1 FOOT THICK, LINED WITH FILTER FABRIC FOR DRAINAGE SHALL BE USED OVER THE BERM AND ACCESS SLOPES. ABC STONE APPROXIMATELY 4 INCHES THICK ADDED TO TOP LAYER.
 - WIDTH OF THE CROSSING SHALL BE SUFFICIENT TO ACCOMMODATE THE LARGEST VEHICLE CROSSING THE CHANNEL.
 - CONTRACTOR SHALL DETERMINE AN APPROPRIATE RAMP ANGLE ACCORDING TO EQUIPMENT UTILIZED.




STEEL GATES

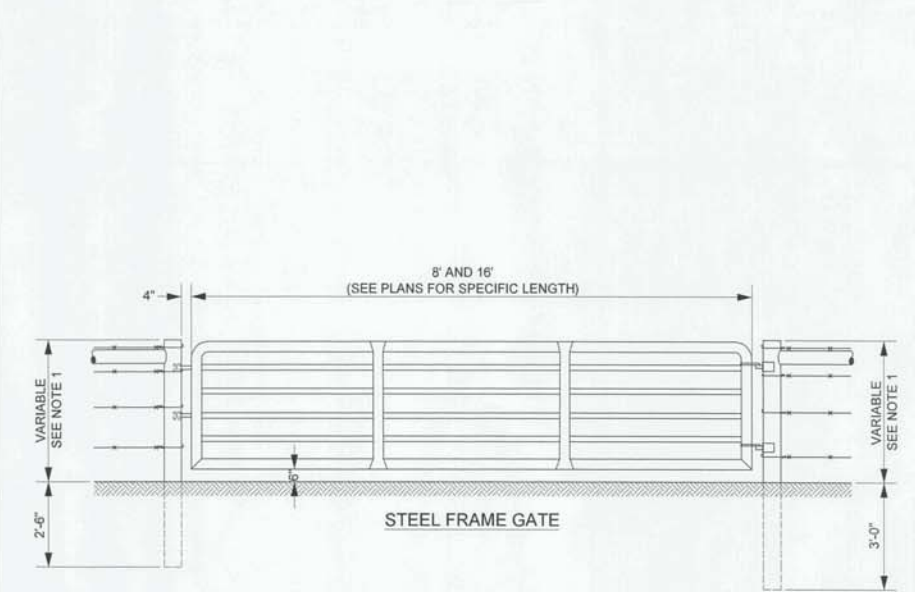

- NOTES:**
- POST HEIGHT DIMENSION SHALL BE THE SAME AS REQUIRED FOR THE ADJACENT FENCE.
 - CONSTRUCT AN END OR STRESS PANEL, AS REQUIRED IN THE SPECIFICATION, ON EACH SIDE OF GATE.
 - HINGES AND LOCKS SHALL BE INSTALLED AS SPECIFIED BY GATE MANUFACTURER.


27/26/83
 11/3/2016
 R:\128975\Design\Plans\AS-BUILD\PLANS\128975_ASB-HC_PSH_2b.dgn
 mcbrey
 BrownCreekTrlbs_95351_AB.12/15/2015_F.inel

GRADE CONTROL LOG JAM

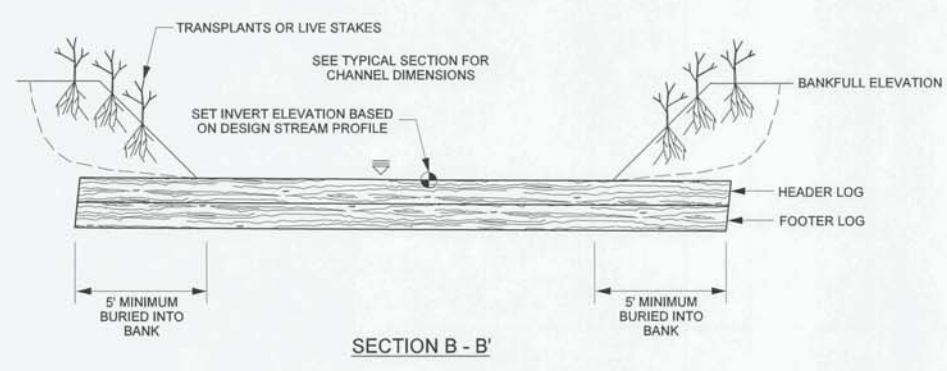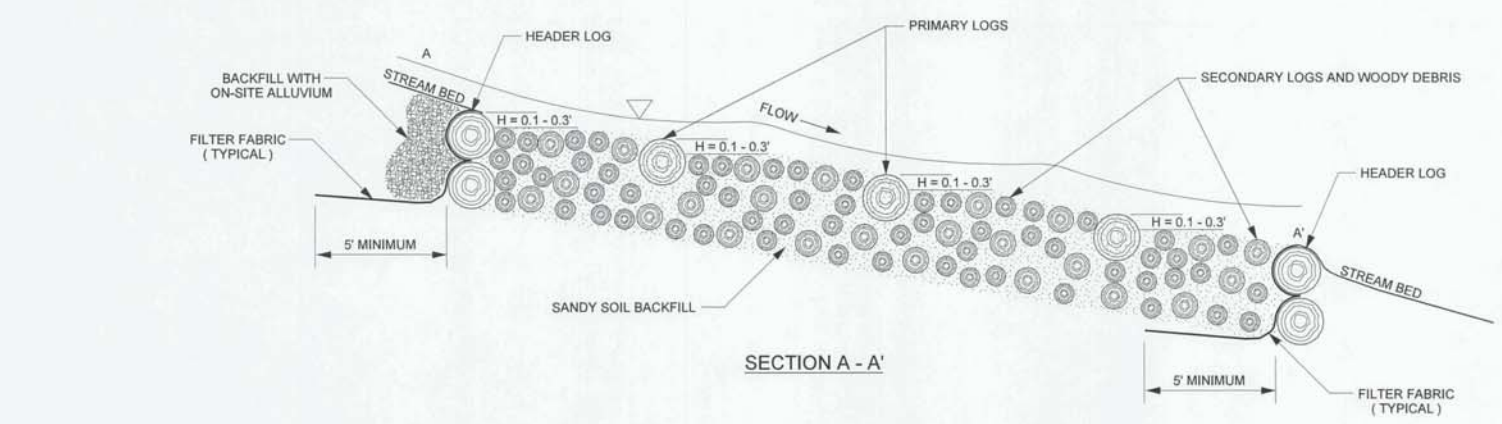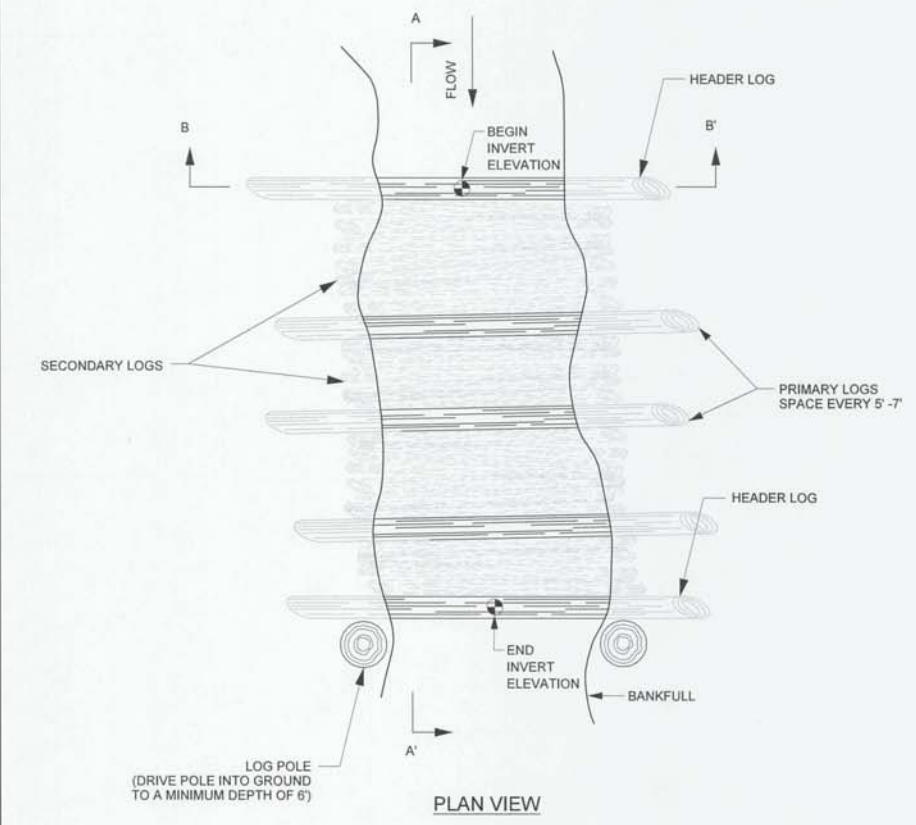


- NOTES:**
1. PRIMARY LOGS SHOULD BE AT LEAST 10" OR MORE IN DIAMETER, RELATIVELY STRAIGHT, HARDWOOD PREFERRED, AND RECENTLY HARVESTED AND EXTENDING INTO THE BANK 5' ON EACH SIDE.
 2. SECONDARY LOGS SHOULD BE AT LEAST 1" IN DIAMETER AND NO LARGER THAN 10", AND EXTEND INTO THE BANK 2 FEET ON EACH SIDE. WOOD MATERIAL SHALL BE VARYING DIAMETER TO ALLOW MATERIAL TO BE COMPACTED.
 3. VERTICAL POSTS SHOULD BE AT LEAST 10" IN DIAMETER AND SHOULD BE DRIVEN INTO THE GROUND A MINIMUM OF 6'.
 4. FILTER FABRIC SHOULD BE NAILED TO THE HEADER LOG BELOW THE BACKFILL.
 5. ROOTWADS AND COIR FIBER MATTING CAN BE USED INSTEAD OF TRANSPLANTS OR LIVE STAKES, PER DIRECTION OF ENGINEER.
 6. AFTER TRENCH HAS BEEN EXCAVATED A LAYER OF SECONDARY LOGS AND WOODY DEBRIS SHOULD BE PLACED WITH MINIMAL GAPS. A LAYER OF ON-SITE ALLUVIUM SHOULD BE APPLIED TO FILL VOIDS BETWEEN SECONDARY LOGS BEFORE ADDITIONAL LAYERS ARE PLACED.

DITCH PLUG

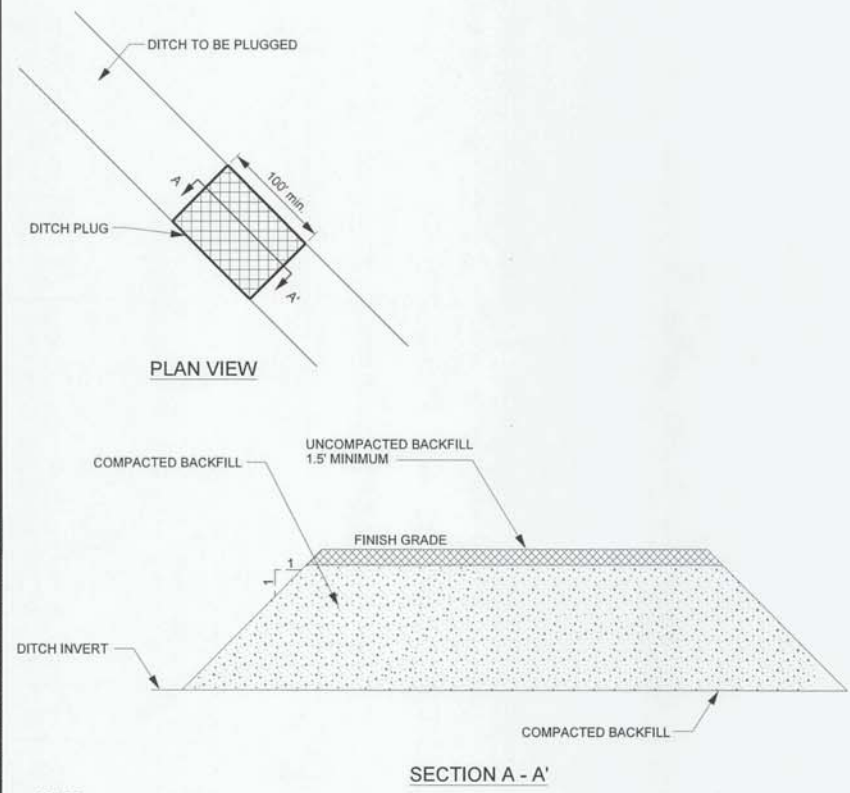


- NOTES:**
1. COMPACT BACKFILL USING ON-SITE HEAVY EQUIPMENT IN 10 INCH LIFTS.
 2. FILL DITCH TO TOP OF BANKS OR AS DIRECTED BY ENGINEER.

CHANNEL BLOCK

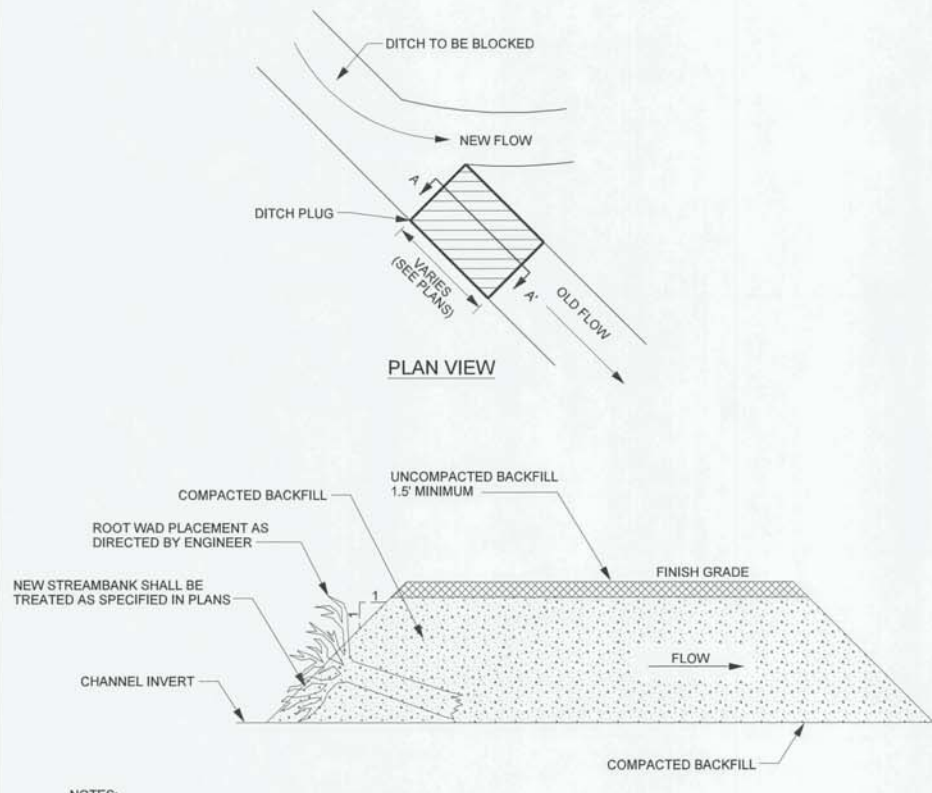

- NOTES:**
1. COMPACT BACKFILL USING ON-SITE HEAVY EQUIPMENT IN 10 INCH LIFTS.
 2. FILL DITCH TO TOP OF BANKS OR AS DIRECTED BY ENGINEER.


WOVEN FIELD FENCE

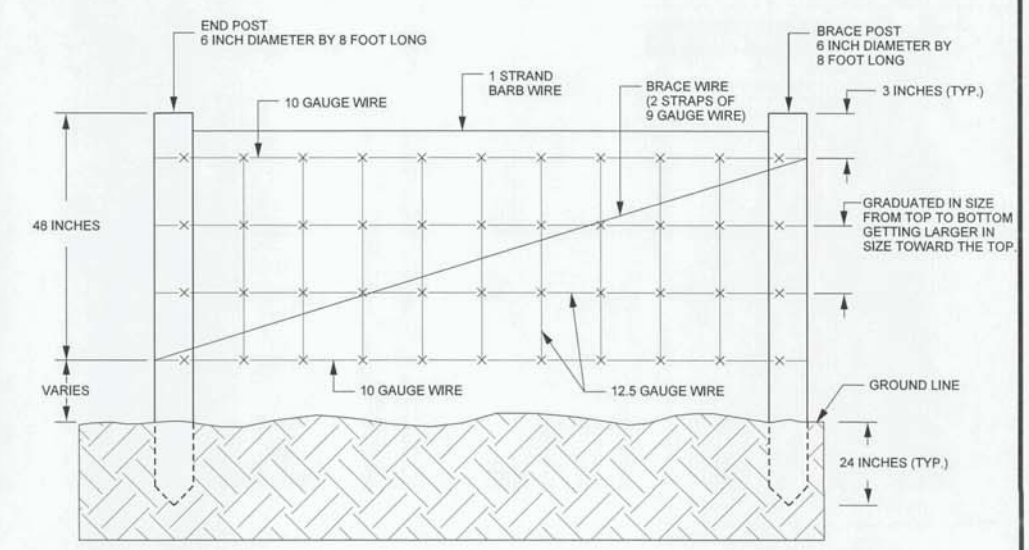

- NOTE:**
1. END POSTS SHALL BE INSTALLED AT A SPACING OF 10-15 FEET.

2/26/03
 11/9/2016
 R:\128975\Design\Plans\AS-BUILT\PLANS\128975_ASB-HC_PSH_2.c.dgn
 mcorley
 BrownCreek.Trib.95351.AB.12/15/2015.F.mnl


CONSTRUCTED RIFFLE

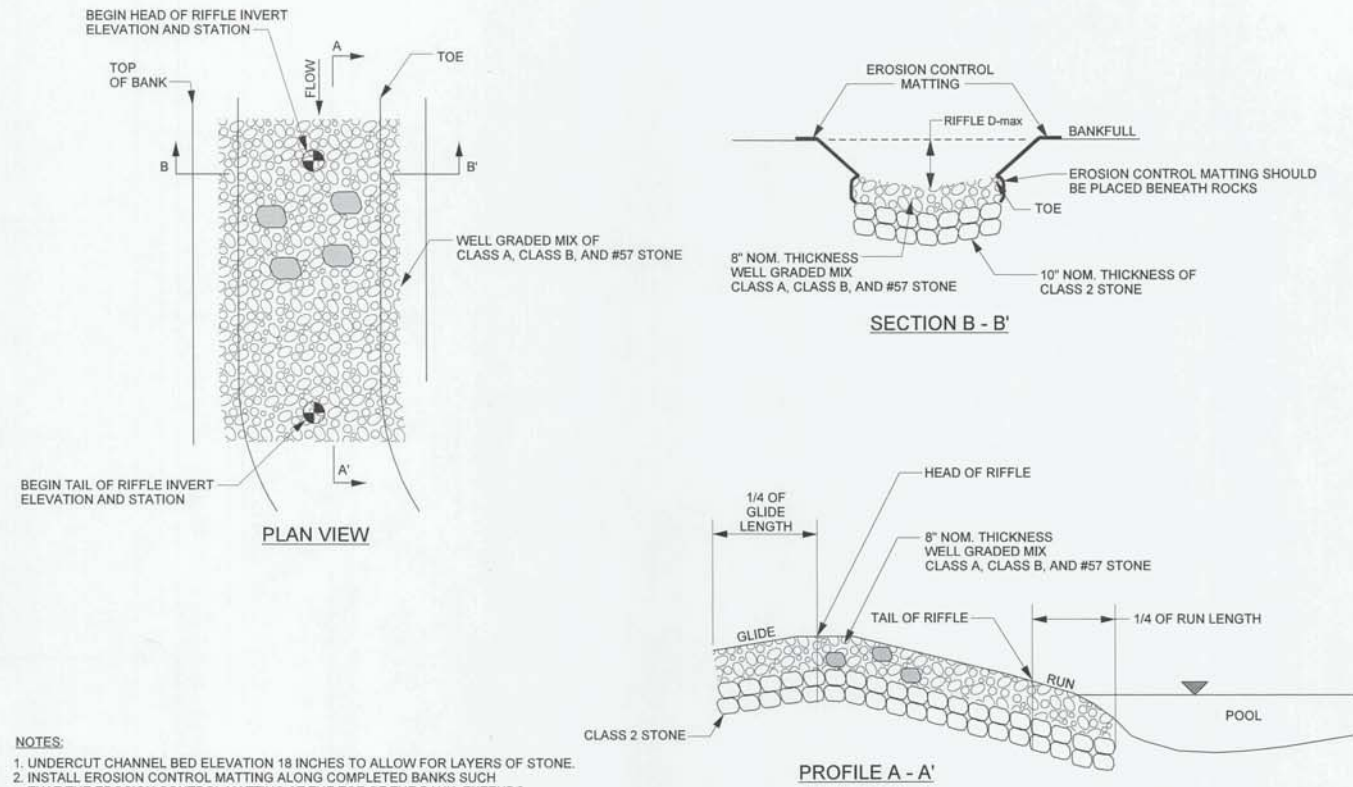

- NOTES:**
1. UNDERCUT CHANNEL BED ELEVATION 18 INCHES TO ALLOW FOR LAYERS OF STONE.
 2. INSTALL EROSION CONTROL MATTING ALONG COMPLETED BANKS SUCH THAT THE EROSION CONTROL MATTING AT THE TOE OF THE BANK EXTENDS DOWN TO THE UNDERCUT ELEVATION.
 3. INSTALL SUB LAYER OF CLASS 2 STONE.
 4. INSTALL A WELL GRADED MIX OF SPECIFIED STONE, COMPACTED TO GRADE.
 5. FINAL CHANNEL BED SHAPE SHOULD BE ROUNDED, SMOOTH, AND CONCAVE, WITH THE ELEVATION OF THE BED 0.2 FT DEEPER IN THE CENTER THAN AT THE EDGES.
 6. RIFFLE LENGTHS WILL VARY. SEE LONGITUDINAL PROFILE AND STRUCTURE TABLE FOR BEGINNING AND ENDING STATIONS AND ELEVATIONS.

GEOLIFT WITH BRUSH TOE


- NOTES:**
1. LIVE BRANCH CUTTINGS SHALL BE THE SAME SPECIES AS THE LIVE STAKES AND SHALL BE INSTALLED DURING VEGETATION DORMANCY.
 2. LIVE BRANCH CUTTINGS SHALL BE INSTALLED AT A DENSITY OF 20-30 CUTTINGS PER LINEAR FOOT AND A MAXIMUM DIAMETER OF 2.5 INCHES.
 3. NUMBER OF SOIL LIFTS MAY VARY. IN GENERAL LIFTS SHALL EXTEND TO THE TOP OF BANK OR BANKFULL STAGE.
 4. GEOLIFTS TO BE INSTALLED IN CHANNEL SECTIONS ALONG SIDE SLOPES STEEPER THAN 2:1 AND/OR ADJACENT TO HILL SLOPES.

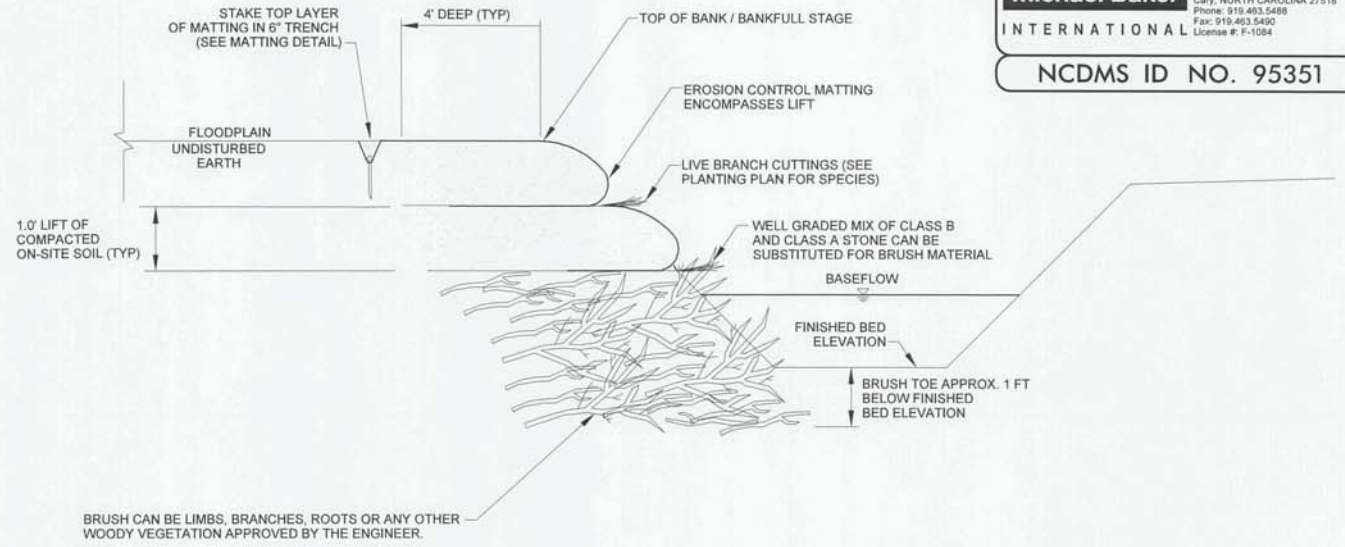

- NOTES:**
1. WHEN GEOLIFTS ARE BUILT ABOVE ROOTWAD CLUSTER, USE LARGE STONE BACKFILL BEHIND ROOT MASS TO BUILT FOUNDATION.


BAKER PROJECT REFERENCE NO. 128975	SHEET NO. 2-D
PROJECT ENGINEER	
APPROVED BY: 	
DATE: 11/10/16	
Michael Baker International Michael Baker Engineering Inc. 8000 Regency Parkway, Suite 600 Cary, NORTH CAROLINA 27518 Phone: 919.463.5488 Fax: 919.463.5490 License #: F-1084	
NCDMS ID NO. 95351	

ROCK CROSS VANE

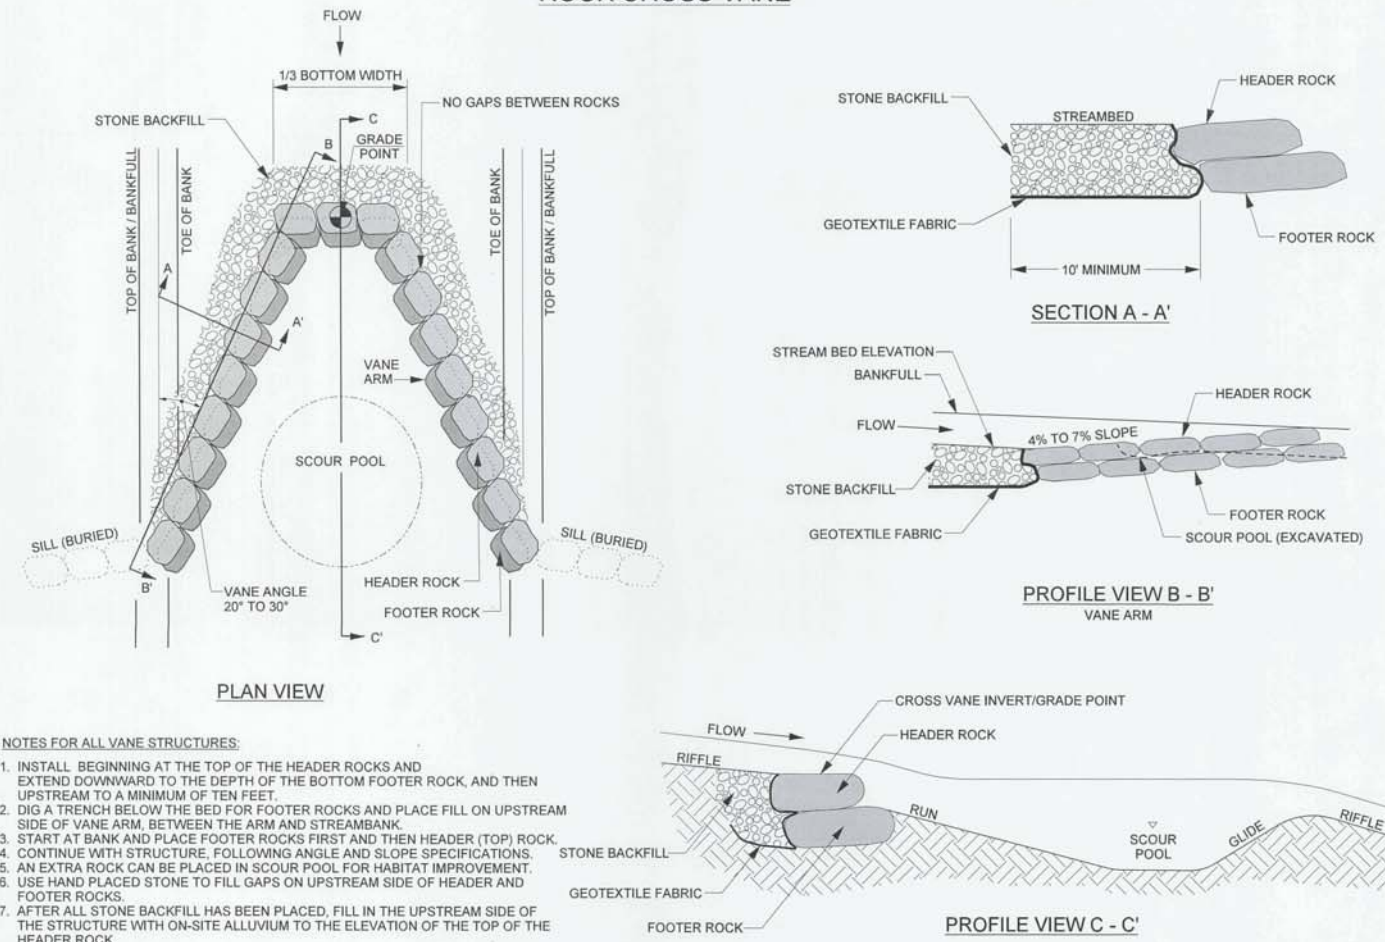

- NOTES FOR ALL VANE STRUCTURES:**
1. INSTALL BEGINNING AT THE TOP OF THE HEADER ROCKS AND EXTEND DOWNWARD TO THE DEPTH OF THE BOTTOM FOOTER ROCK, AND THEN UPSTREAM TO A MINIMUM OF TEN FEET.
 2. DIG A TRENCH BELOW THE BED FOR FOOTER ROCKS AND PLACE FILL ON UPSTREAM SIDE OF VANE ARM, BETWEEN THE ARM AND STREAMBANK.
 3. START AT BANK AND PLACE FOOTER ROCKS FIRST AND THEN HEADER (TOP) ROCK.
 4. CONTINUE WITH STRUCTURE, FOLLOWING ANGLE AND SLOPE SPECIFICATIONS.
 5. AN EXTRA ROCK CAN BE PLACED IN SCOUR POOL FOR HABITAT IMPROVEMENT.
 6. USE HAND PLACED STONE TO FILL GAPS ON UPSTREAM SIDE OF HEADER AND FOOTER ROCKS.
 7. AFTER ALL STONE BACKFILL HAS BEEN PLACED, FILL IN THE UPSTREAM SIDE OF THE STRUCTURE WITH ON-SITE ALLUVIUM TO THE ELEVATION OF THE TOP OF THE HEADER ROCK.


GRADE CONTROL LOG J-HOOK VANE

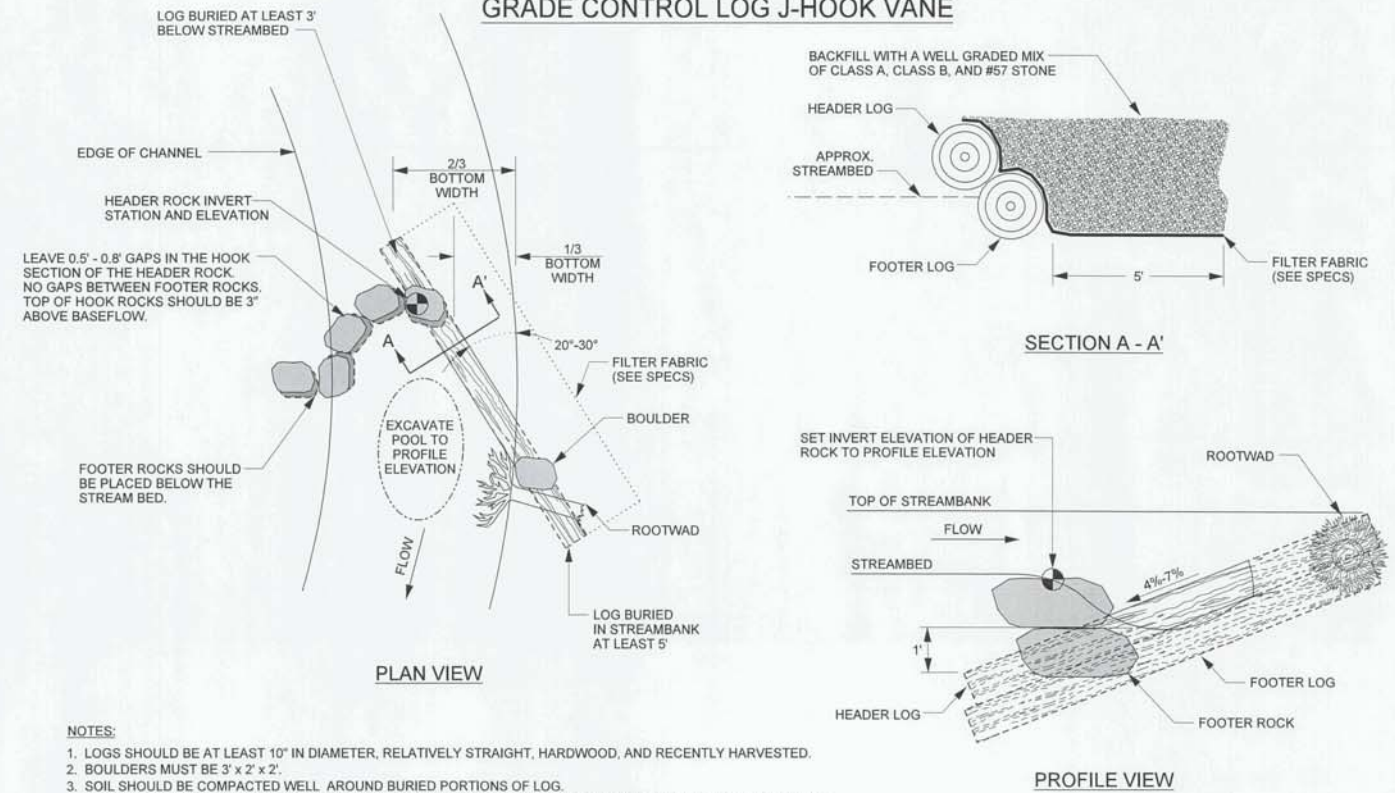


- NOTES:**
1. LOGS SHOULD BE AT LEAST 10" IN DIAMETER, RELATIVELY STRAIGHT, HARDWOOD, AND RECENTLY HARVESTED.
 2. BOULDERS MUST BE 3' x 2' x 2'.
 3. SOIL SHOULD BE COMPACTED WELL AROUND BURIED PORTIONS OF LOG.
 4. ROOTWADS SHOULD BE PLACED BENEATH THE HEADER LOG AND PLACED SO THAT IT SECURES THE HEADER LOG INTO THE BANK. SEE ROOTWAD DETAIL.
 5. BOULDERS SHOULD BE PLACED ON TOP OF HEADER LOG FOR ANCHORING.
 6. HEADER BOULDERS TO BE PLACED 0.5 TO 0.8 FEET APART.
 7. NON-WOVEN FILTER FABRIC SHOULD BE NAILED TO THE LOG BELOW THE BACKFILL.
 8. FOOTERS SHALL BE INSTALLED SUCH THAT 1/4 TO 1/3 OF THE LENGTH IS DOWNSTREAM OF THE HEADER.

2/26/03
 11/9/2016
 R:\128975\Design\Plans\AS-BUILD\PLANS\128975_ASB-HC_PSH_2d.dgn
 mcarey
 BrownCreekTrl.bs_95351_AB_12/15/2015_F.rvt


LOG VANE

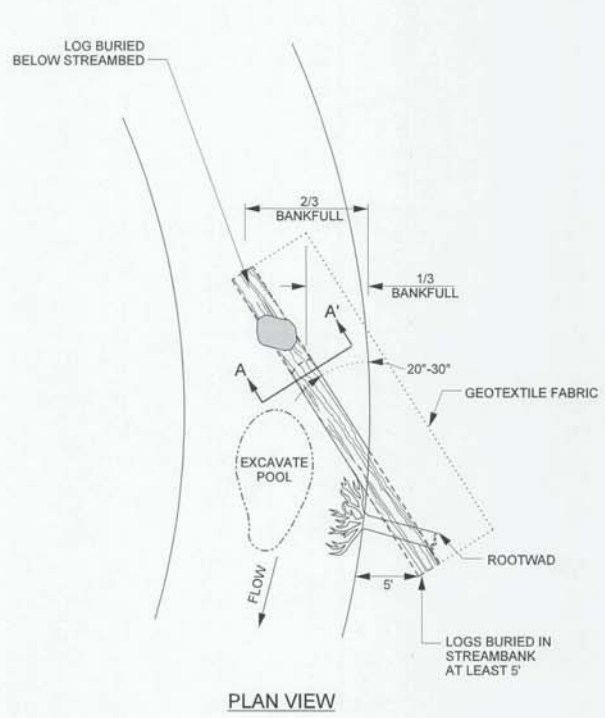

PLAN VIEW

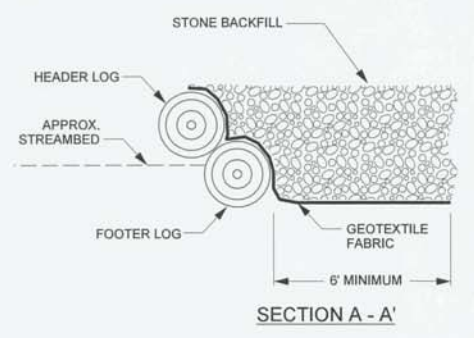



SECTION A - A'

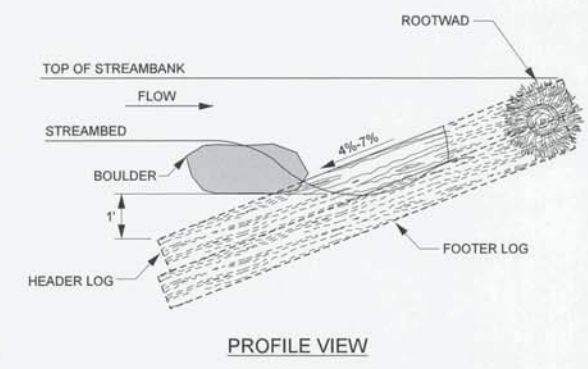


PROFILE VIEW

- NOTES:**
- LOGS SHOULD BE AT LEAST 10" IN DIAMETER, RELATIVELY STRAIGHT, HARDWOOD, AND RECENTLY HARVESTED.
 - BOULDERS MUST BE OF SUFFICIENT SIZE TO ANCHOR LOGS.
 - SOIL SHOULD BE COMPACTED WELL AROUND BURIED PORTIONS OF LOGS.
 - ROOTWADS SHOULD BE PLACED BENEATH THE HEADER LOG AND PLACED SO THAT IT LOCKS THE HEADER LOG INTO THE BANK. SEE ROOTWAD DETAIL.
 - BOULDER SHOULD BE PLACED ON TOP OF HEADER LOG FOR ANCHORING.
 - GEOTEXTILE FABRIC SHOULD BE NAILED TO THE LOG BELOW THE BACKFILL.
 - TRANSPLANTS CAN BE USED INSTEAD OF ROOTWADS, PER DIRECTION OF ENGINEER.

TIE-IN SWALE

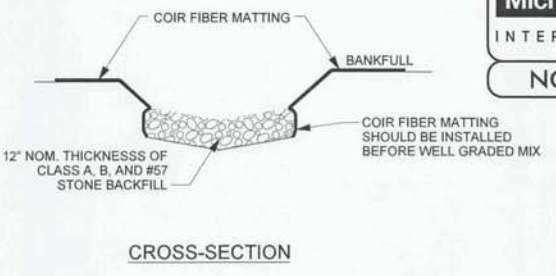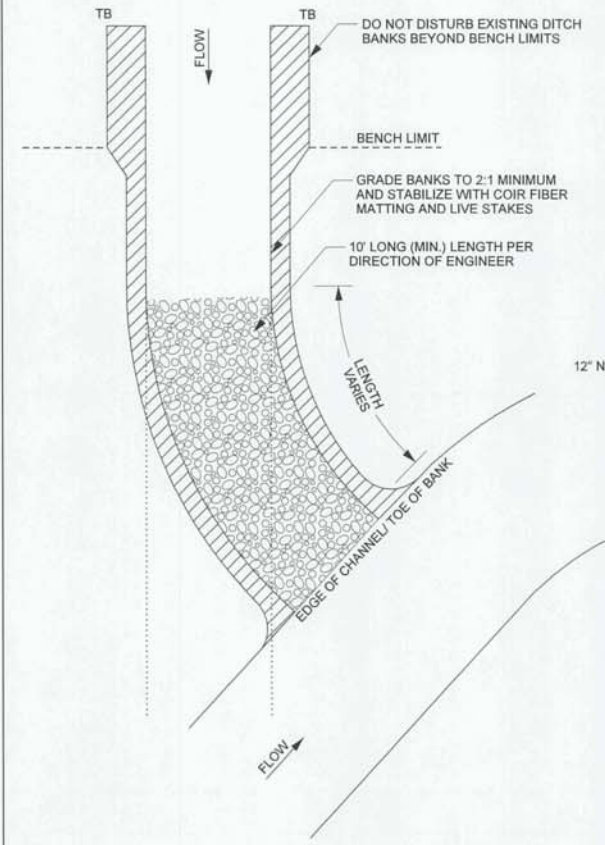


CROSS-SECTION

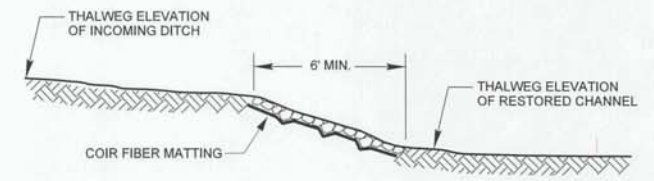


TYPICAL PROFILE FOR SWALE

BAKER PROJECT REFERENCE NO. 128975	SHEET NO. 2-E
PROJECT ENGINEER	
APPROVED BY:	
DATE: 1/24/16	
Michael Baker International	
Michael Baker Engineering Inc. 8000 Regency Parkway, Suite 100 Cary, NORTH CAROLINA 27518 Phone: 919.483.5488 Fax: 919.483.5490 License #: F-1084	
NCDMS ID NO. 95351	


LOG AND ROCK STEP-POOL

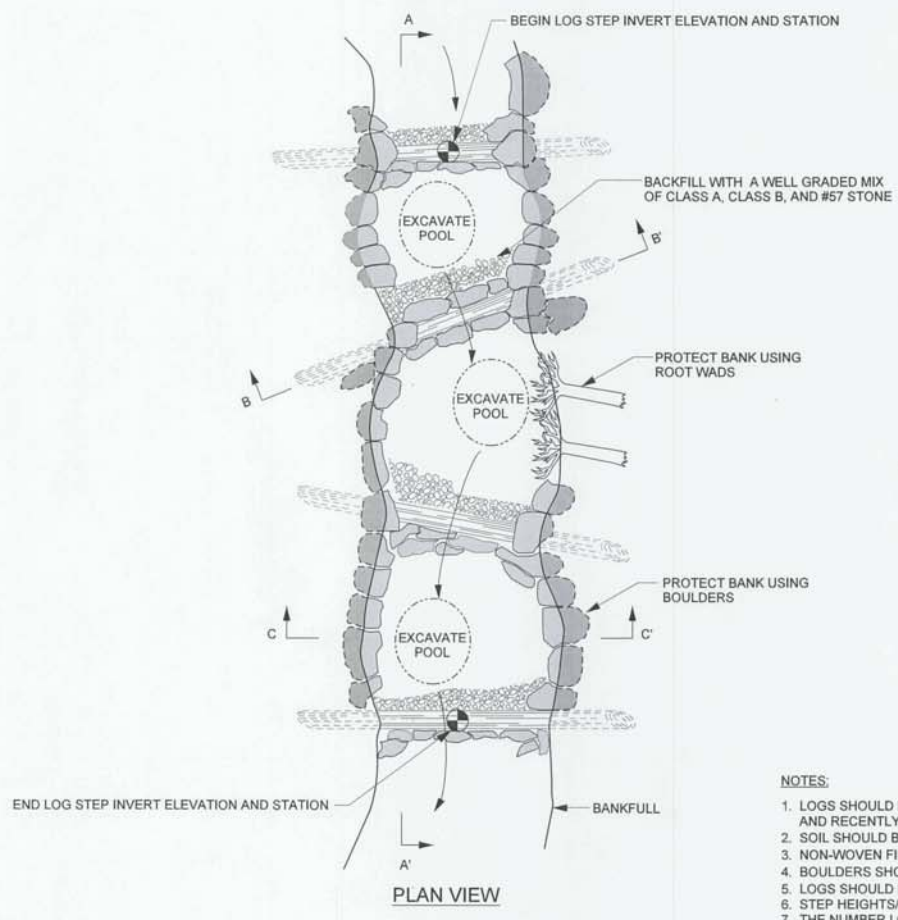


PLAN VIEW

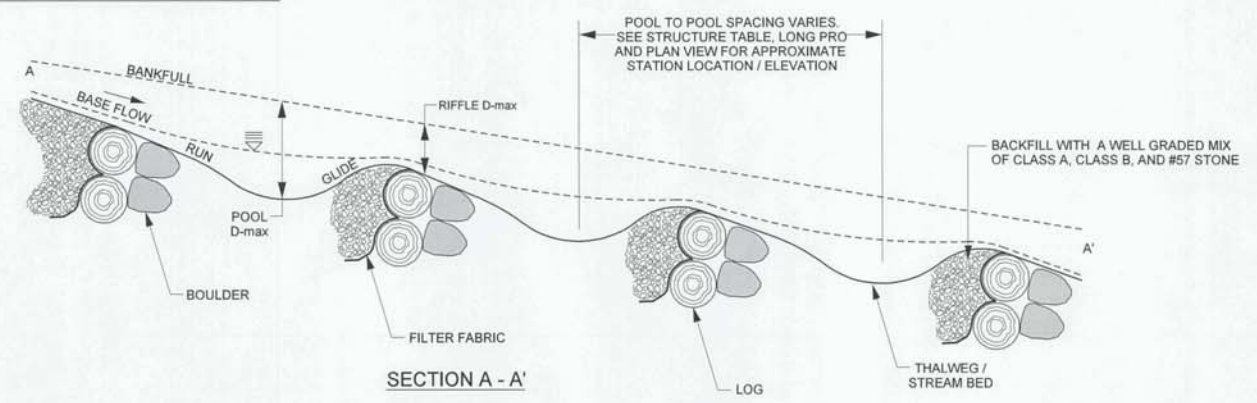

SECTION A - A'

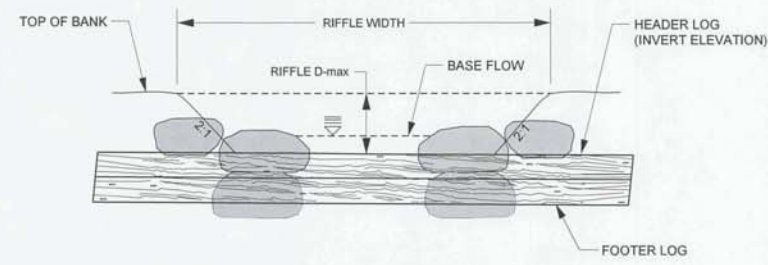

SECTION B - B'

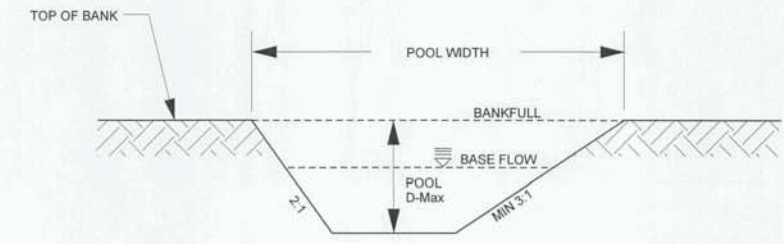

SECTION C - C'

- NOTES:**
- LOGS SHOULD BE AT LEAST 10" IN DIAMETER, RELATIVELY STRAIGHT, HARDWOOD, AND RECENTLY HARVESTED AND EXTENDING INTO THE BANK 5" ON EACH SIDE.
 - SOIL SHOULD BE COMPACTED WELL AROUND BURIED PORTIONS OF LOG.
 - NON-WOVEN FILTER FABRIC SHOULD BE NAILED/STAPLED TO THE LOG BELOW THE BACKFILL.
 - BOULDERS SHOULD BE 3' X 2' X 2' AND PLACED ON TOP OF HEADER LOG FOR ANCHORING.
 - LOGS SHOULD BE ANGLED 60° - 70° FROM THE STREAM BANK AND CROSS SLOPES SHOULD NOT EXCEED 2%.
 - STEP HEIGHTS/DROPS SHALL NOT EXCEED 0.4 FT AND POOL DEPTHS NOT TO EXCEED 1.8 FT.
 - THE NUMBER LOG STEPS MAY VARY BETWEEN BEGIN AND END STATIONING DEPENDING ON LOG DIAMETER SIZE. SEE LONGITUDINAL PROFILE AND STRUCTURE TABLE FOR STATION AND ELEVATION.




2/26/03
 1/9/2016
 H:\2015\Design\Plans\AS-BUILD\PLANS\128975_ASB-HC_PSH_Ze.dgn
 mcarey
 BrownCreekTrl.bs_95351_AB.12/15/2015_Final



J. David Lee
12-7-16


Michael Baker International
Michael Baker Engineering Inc.
8000 Regency Parkway, Suite 600
Cary, NORTH CAROLINA 27518
Phone: 919.463.5488
Fax: 919.463.5490
License #: F-1084

NC DMS ID NO. 95351

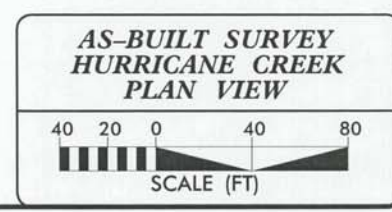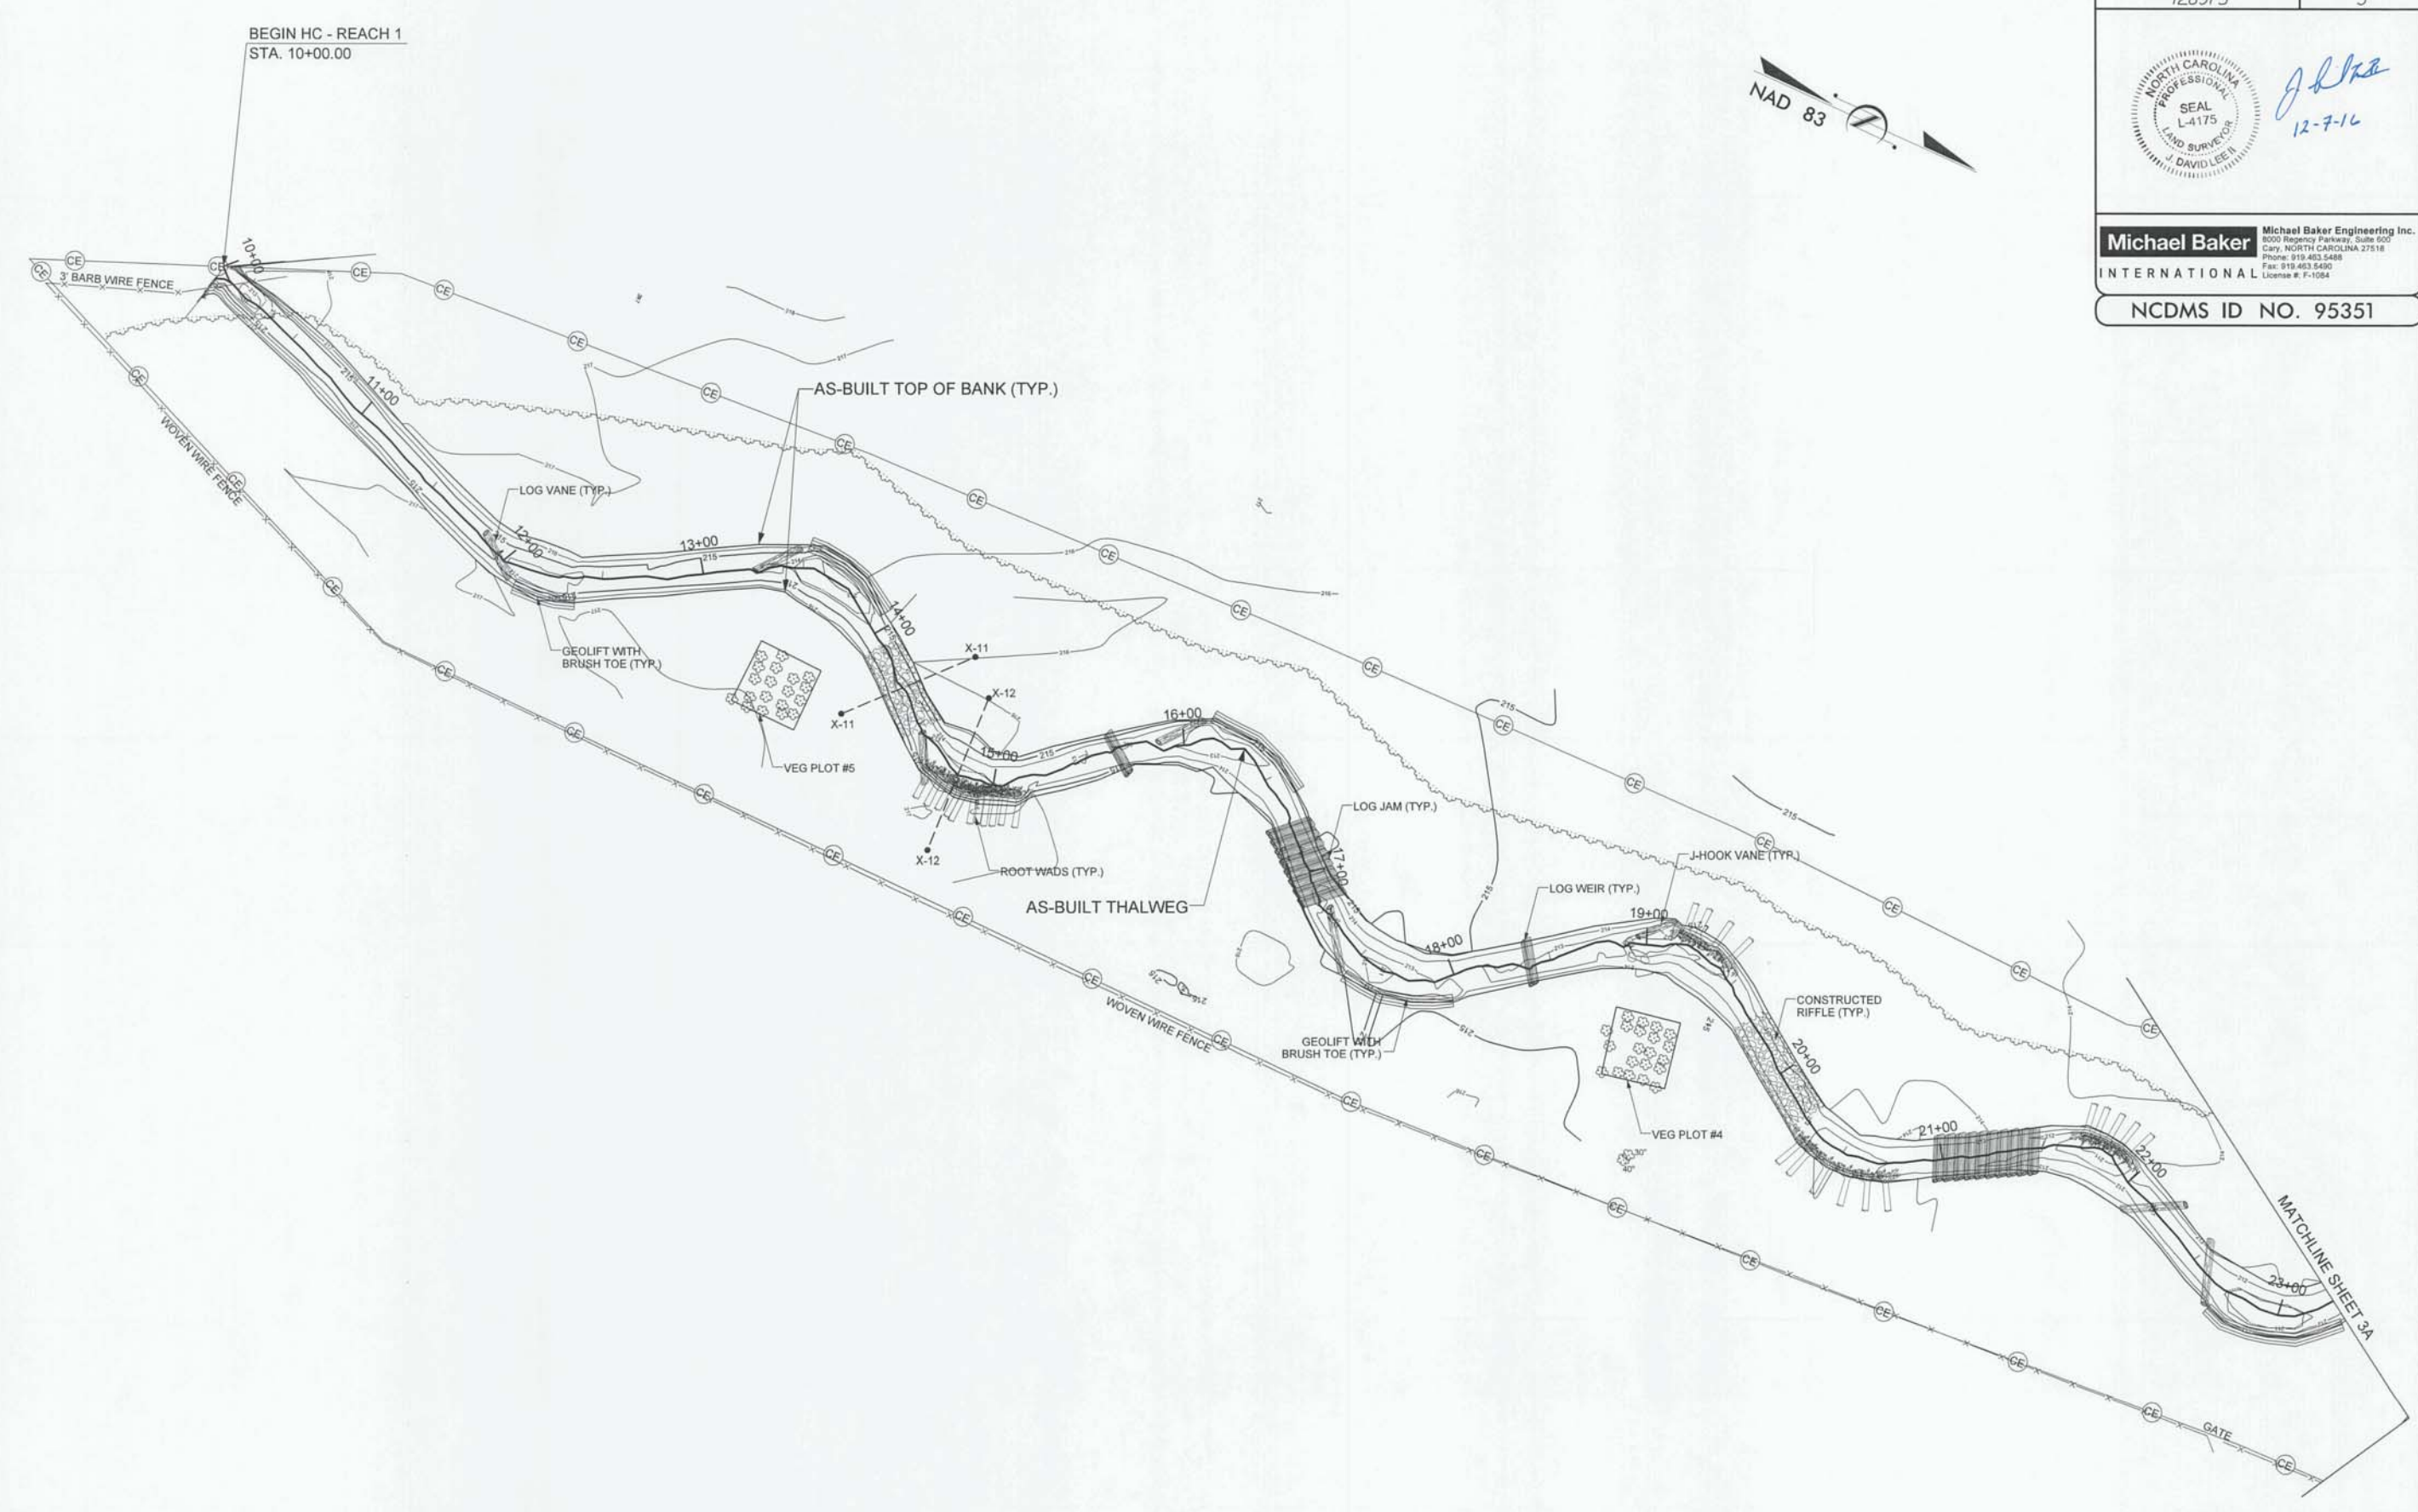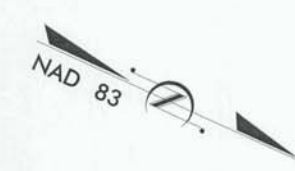




I:\2015\Design\1\ans\AS-BUILD\PLANS\128975_AS-BUILD_HC_PSH_03.dgn
 mcarney
 BrownCreekTrib_95351_AB_12.15.2015_Final

2/26/03

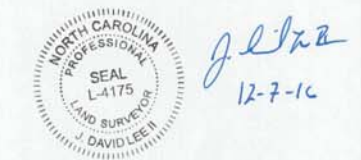

Michael Baker International
 Michael Baker Engineering Inc.
 8200 Regency Parkway, Suite 600
 Cary, NORTH CAROLINA 27518
 Phone: 919.463.5488
 Fax: 919.463.5490
 License #: F-1084

NCDMS ID NO. 95351

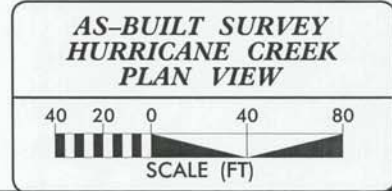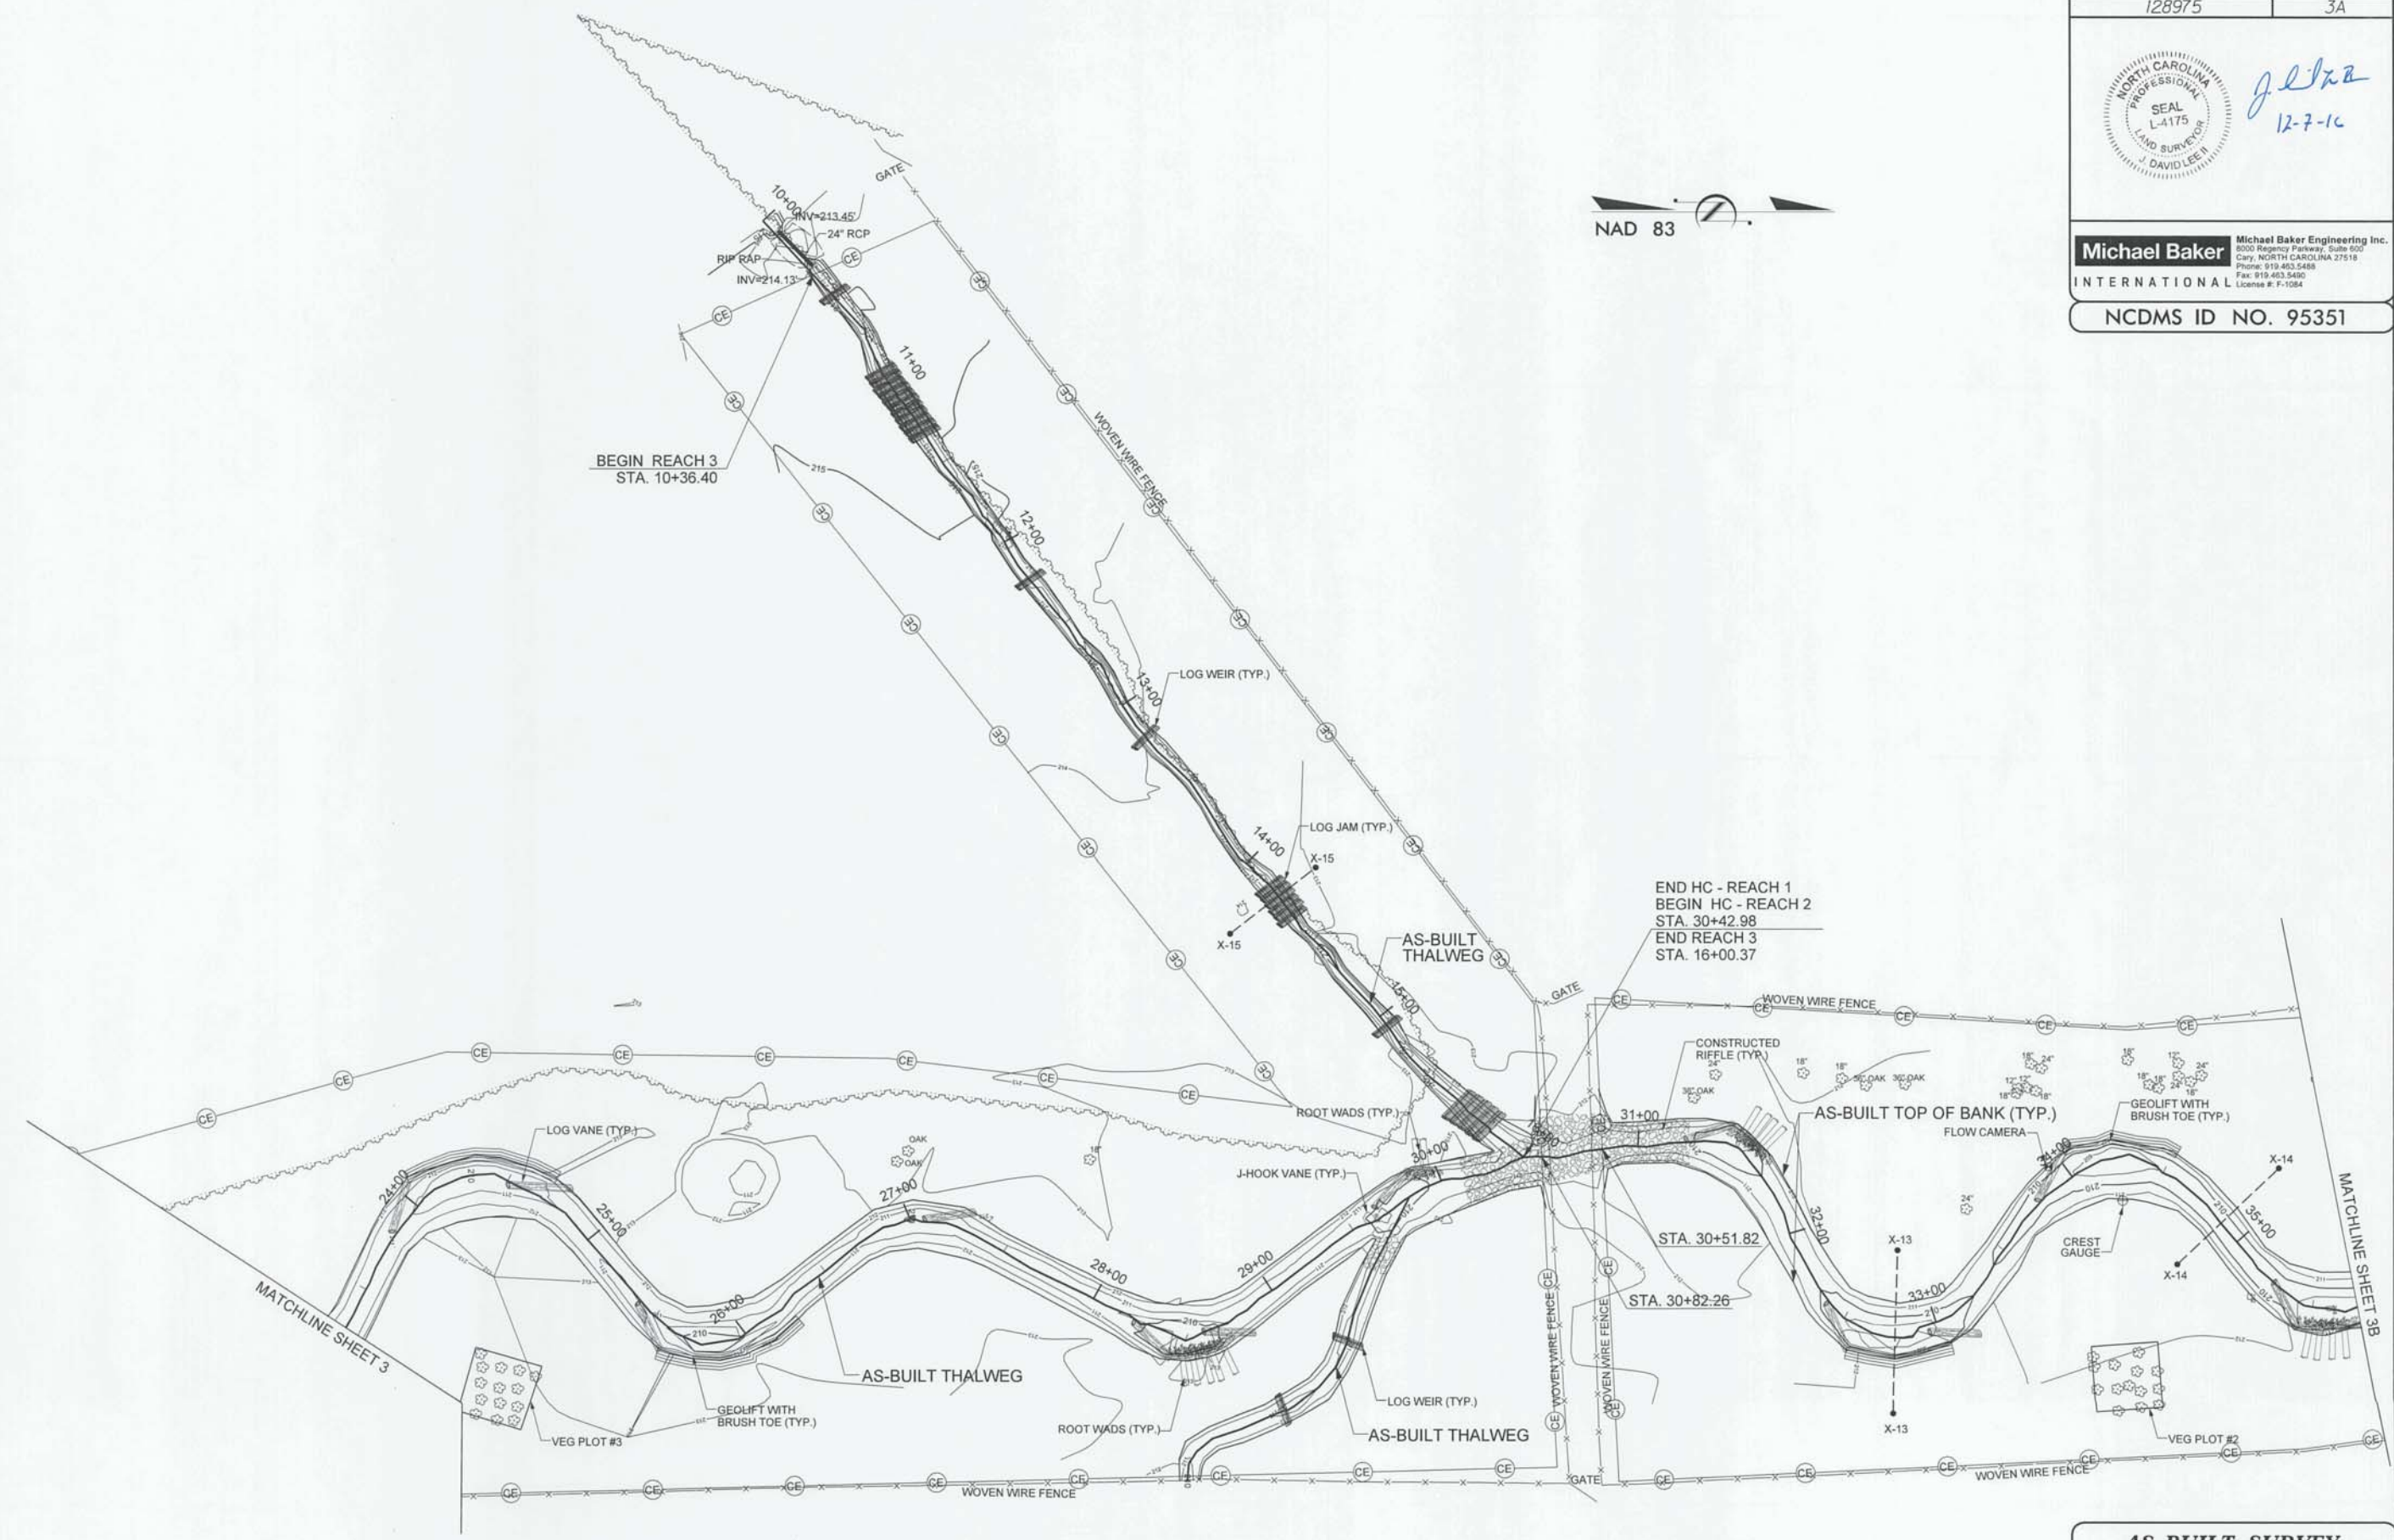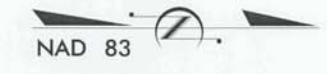



2/26/83
 I:\9\2015\128975\Design\Plans\AS-BUILT\PLANS\128975_ASB-HC_PSH_03A.dgn
 mcarey
 BrownCreekTribs_95351_08_12/15/2015_Final




J. Lee
12-7-16

Michael Baker INTERNATIONAL
Michael Baker Engineering Inc.
6500 Regency Parkway, Suite 600
Cary, North Carolina 27518
Phone: 919.463.5488
Fax: 919.463.5490
License #: F-1084

NCDMS ID NO. 95351

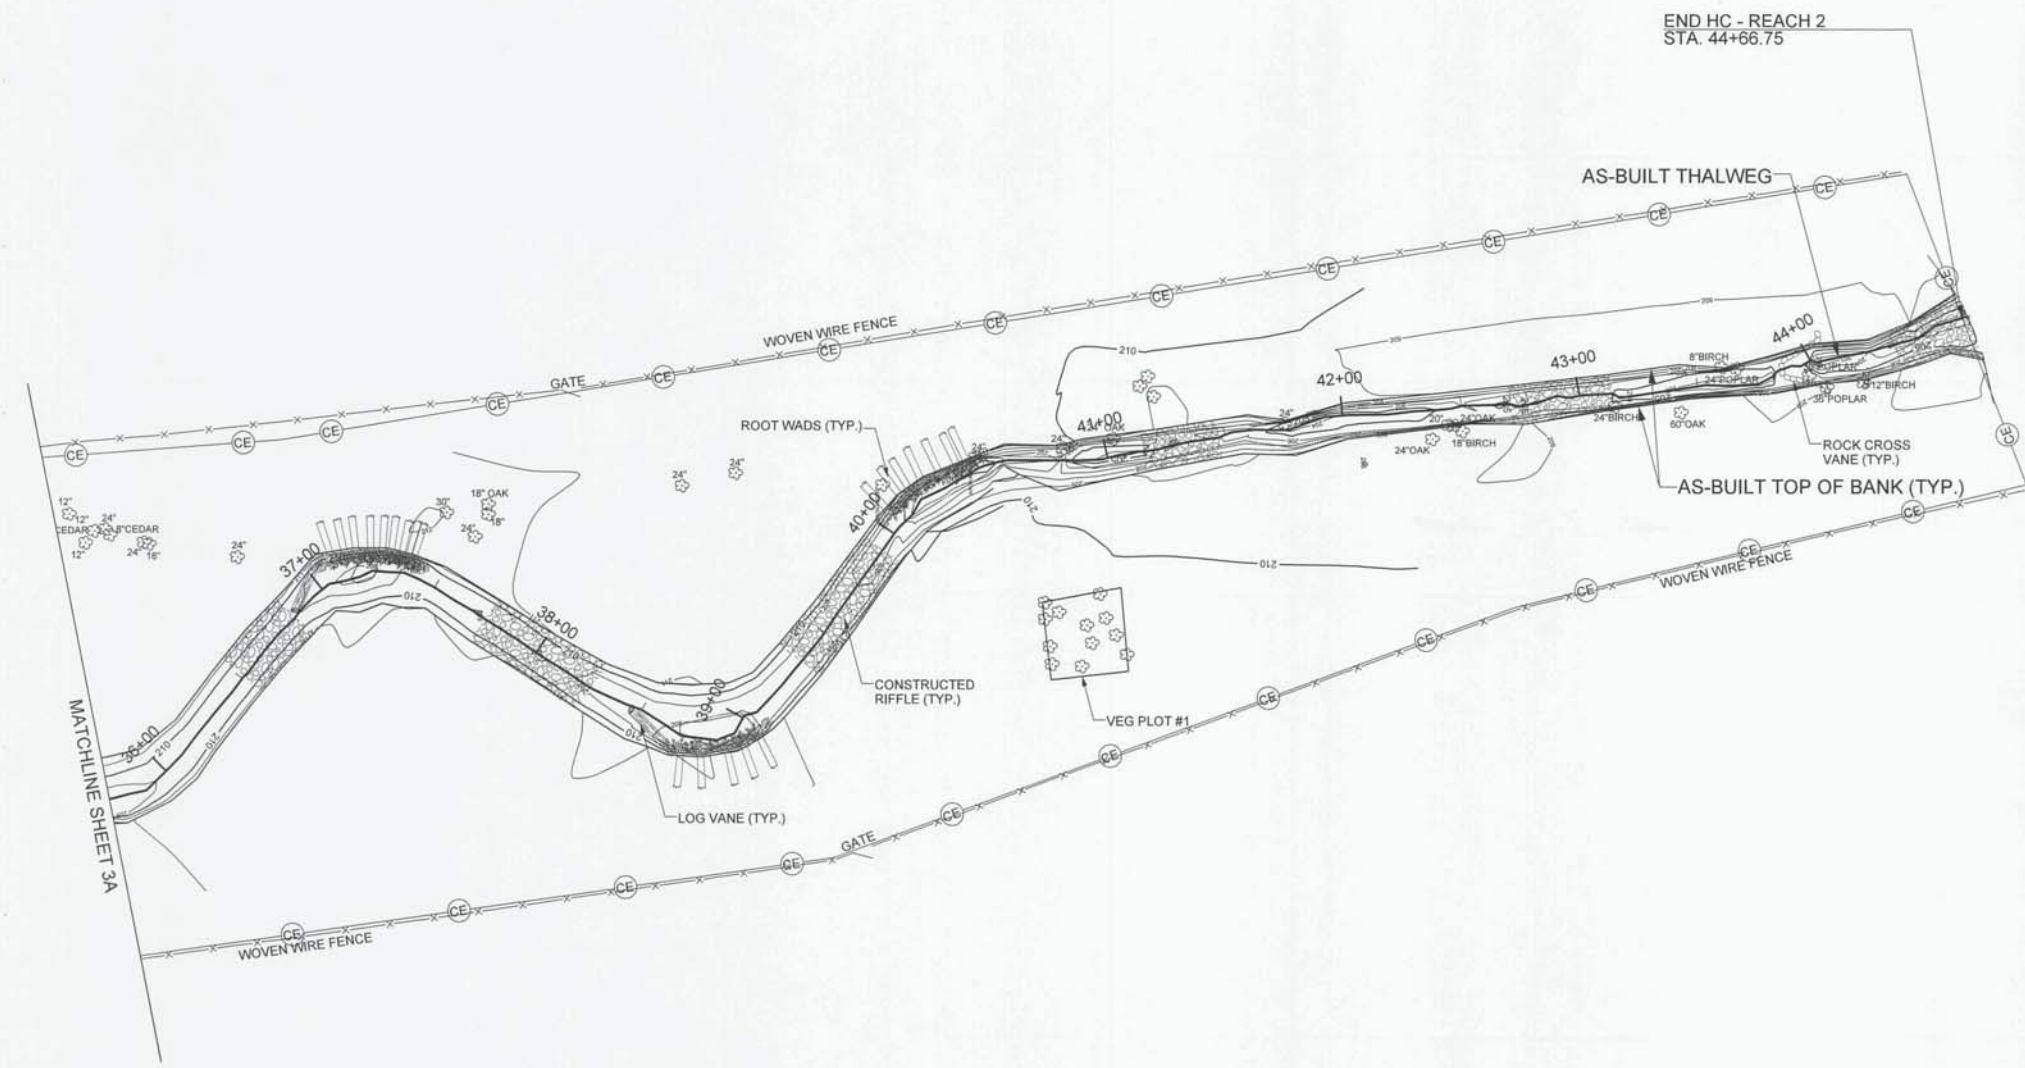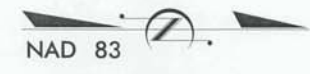

**AS-BUILT SURVEY
HURRICANE CREEK
PLAN VIEW**

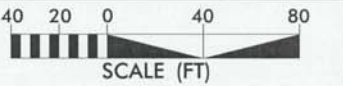

I:\3\2016\128975\Design\Plans\AS-BUILT\PLANS\128975-ASB-HC-PSH_03B.dgn
 mcbarey
 BrownCreek\Tr\bs-95351_AB_12\15\2015_Final



2/26/03



J. R. Lee
12-7-14


Michael Baker International
Michael Baker Engineering Inc.
8000 Regency Parkway, Suite 600
Cary, NORTH CAROLINA 27518
Phone: 919.463.5488
Fax: 919.463.5490
License #: F-1084

NCDMS ID NO. 95351

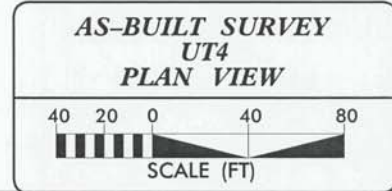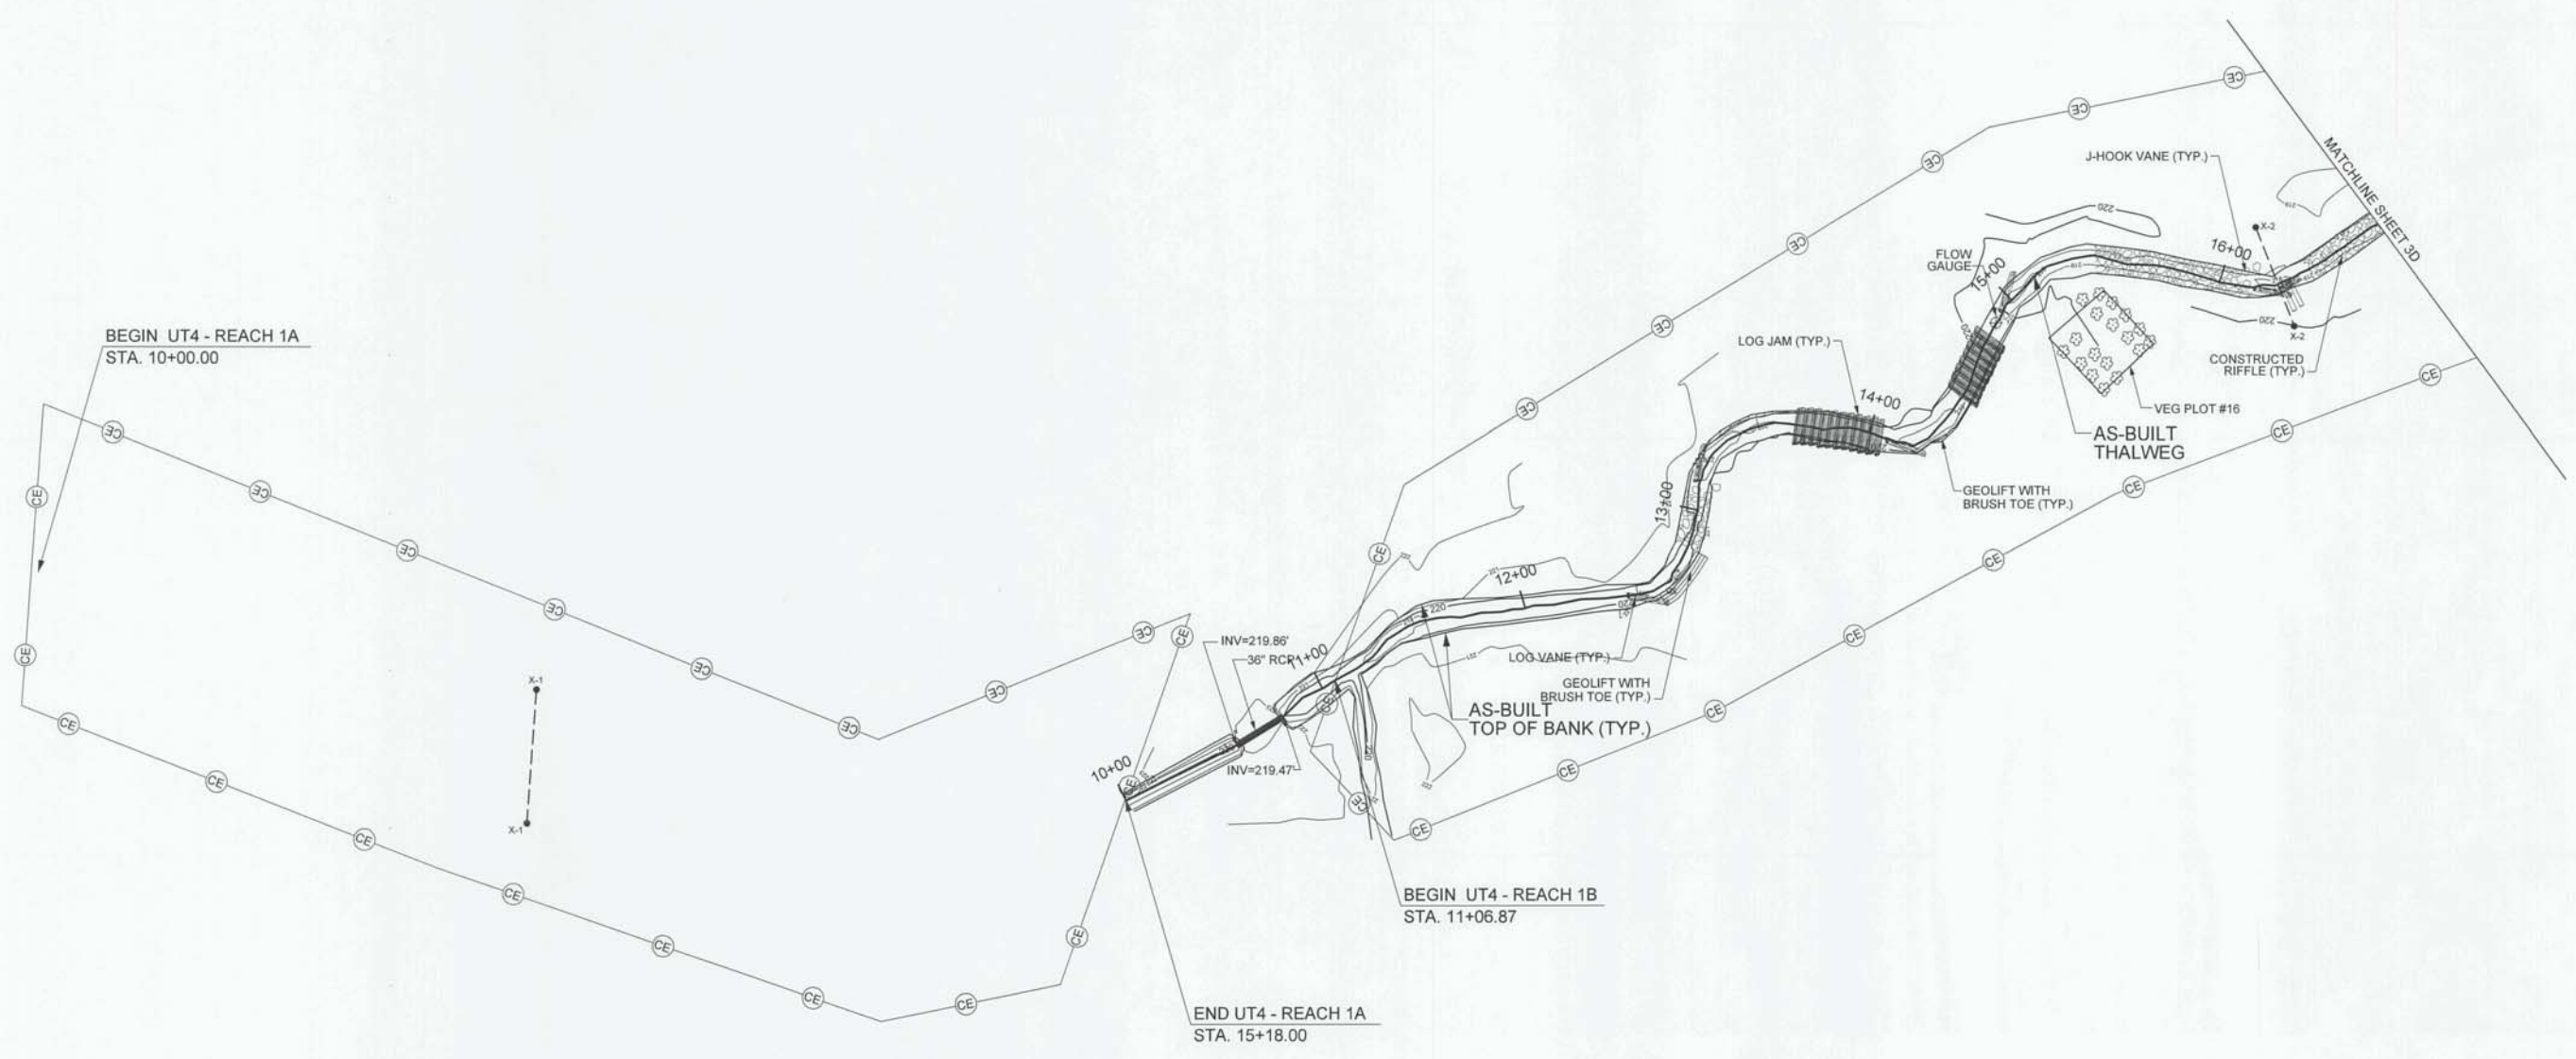


11/15/2015
 R:\128975\Design\Plans\NAS-BUILD\PLANS\128975_ASB-UT4_PSH_03C.dgn
 micarej
 BrownCreekTribs_95351_ABL12/15/2015_Final

2/26/03

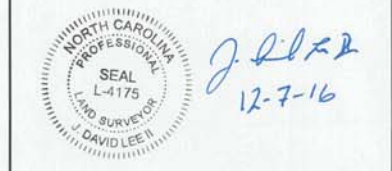

Michael Baker International
 Michael Baker Engineering Inc.
 8000 Regency Parkway, Suite 600
 Cary, NORTH CAROLINA 27518
 Phone: 919.453.5488 Fax: 919.453.5490 License #: F-1084
NCDMS ID NO. 95351

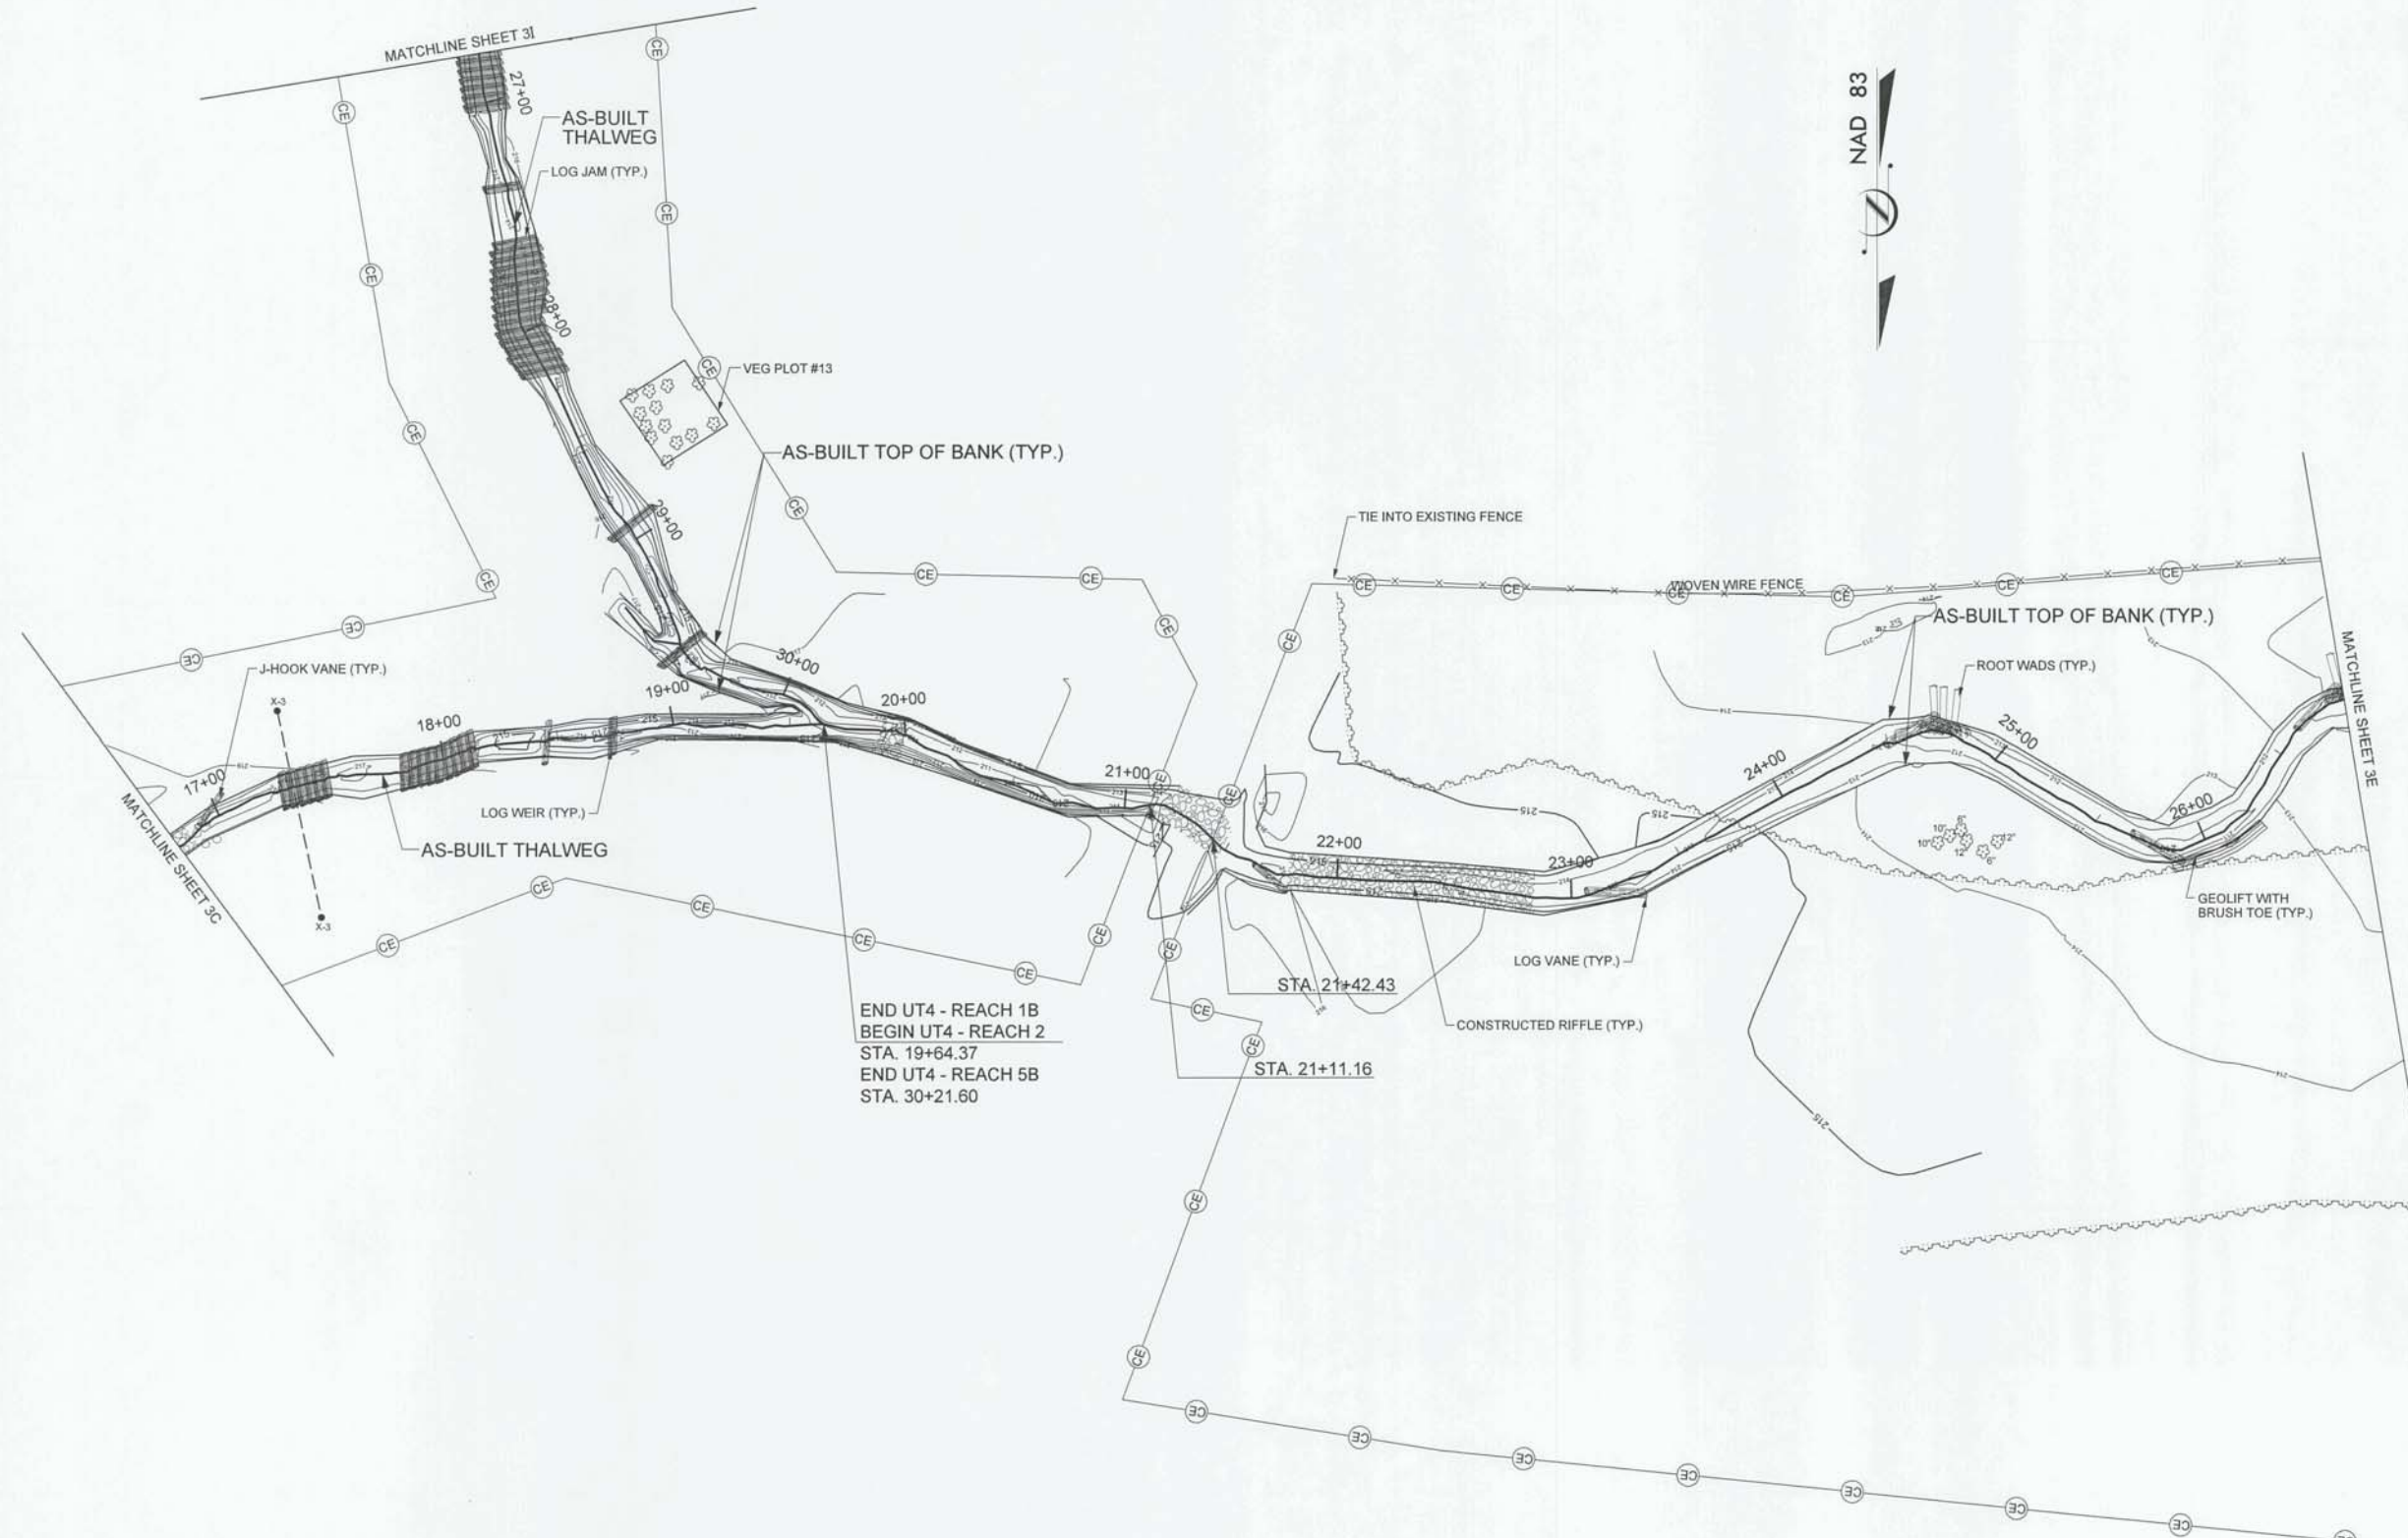

END UT4 - REACH 1B
 BEGIN UT4 - REACH 2
 STA. 19+64.37
 END UT4 - REACH 5B
 STA. 30+21.60

**AS-BUILT SURVEY
 UT4
 PLAN VIEW**

SCALE (FT)

11/9/2015
 R:\128975\Design\Plans\AS-BUILT\PLANS\128975_ASB-UT4_PSH_03D.dgn
 incorey
 BrownCreekTribs_95351_AB_12/15/2015_F.ino


2726703



Michael Baker International
 Michael Baker Engineering Inc.
 8000 Regency Parkway, Suite 600
 Cary, NORTH CAROLINA 27518
 Phone: 919.463.5488 Fax: 919.463.5490
 License #: F-1084


NCDMS ID NO. 95351

2/26/03

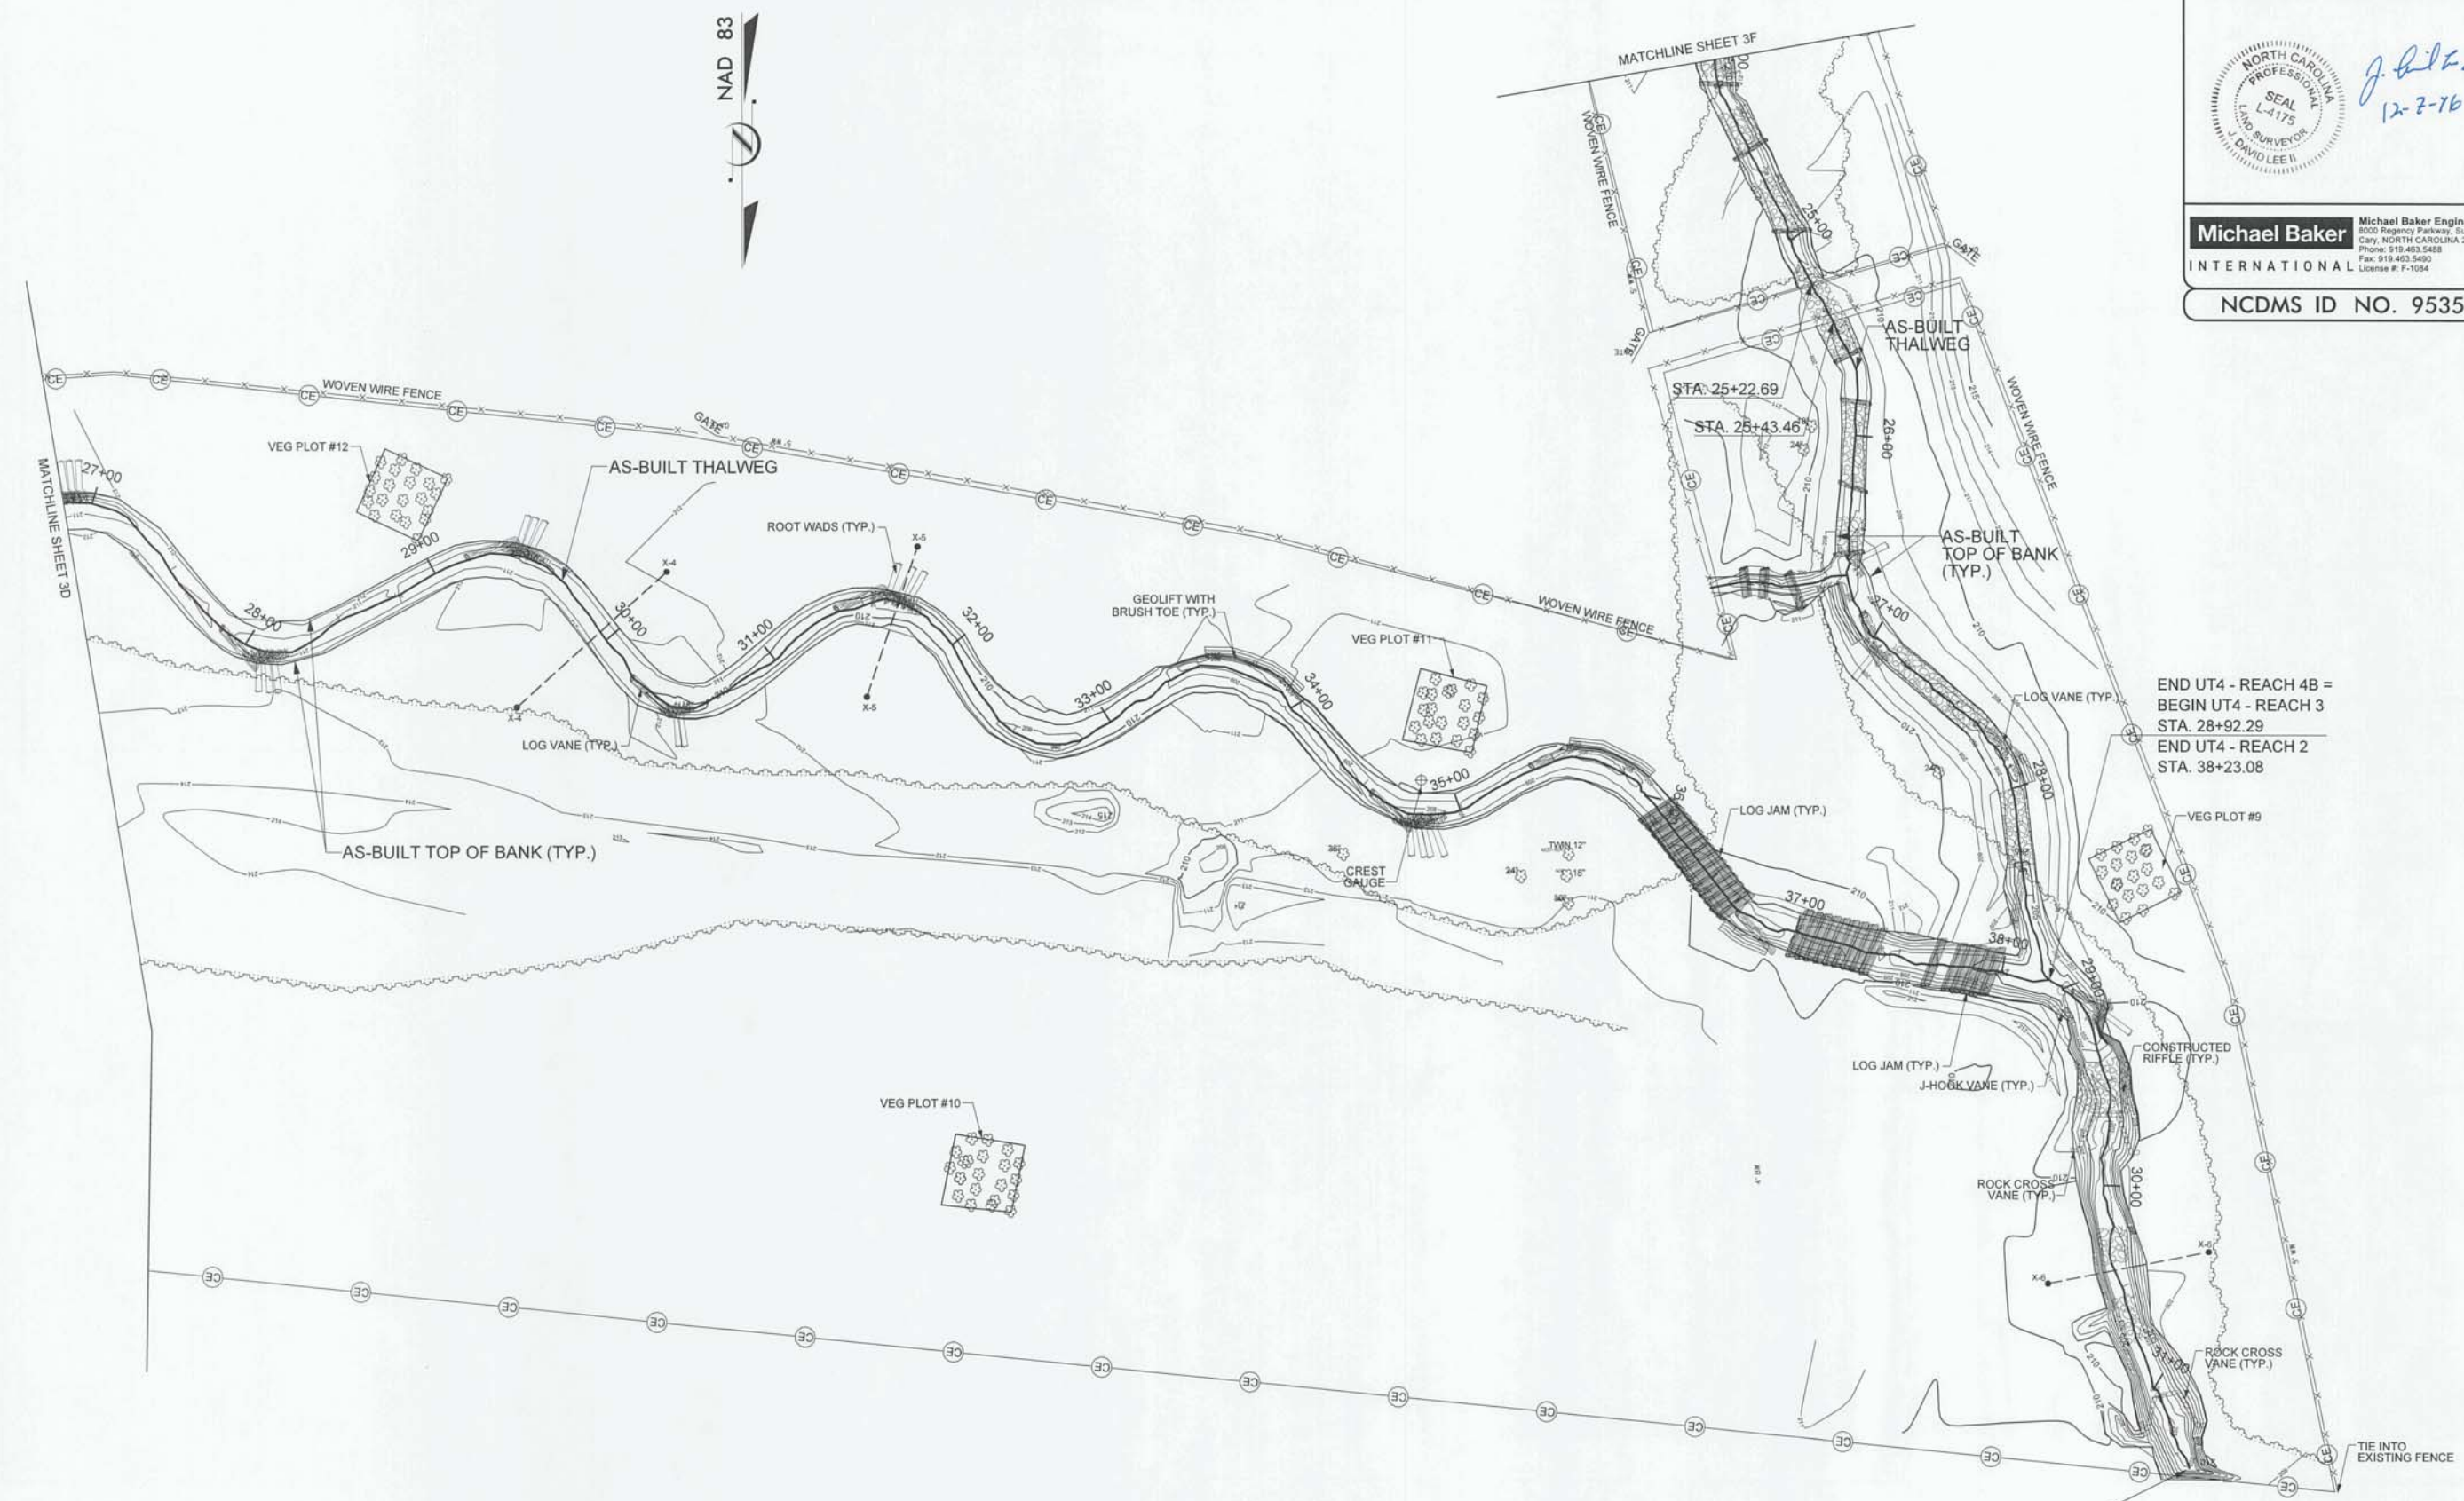


END UT4 - REACH 4B =
 BEGIN UT4 - REACH 3
 STA. 28+92.29
 END UT4 - REACH 2
 STA. 38+23.08

END UT4 - REACH 3
 STA. 31+42.13


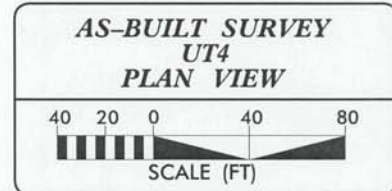


I:\9\2015\Design\Plans\AS-BUILT\PLANS\128975_ASB-UT4_PSH_03E.dgn
 mcarey
 BrownCreekTribs_95351_AB_12/15/2015_Final

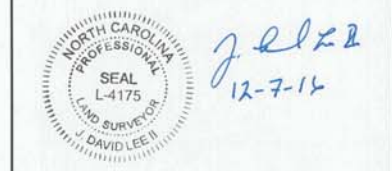


Michael Baker International
 Michael Baker Engineering Inc.
 8000 Regency Parkway, Suite 600
 Cary, NORTH CAROLINA 27518
 Phone: 919.463.5488
 Fax: 919.463.5490
 License #: F-1084

NCDMS ID NO. 95351

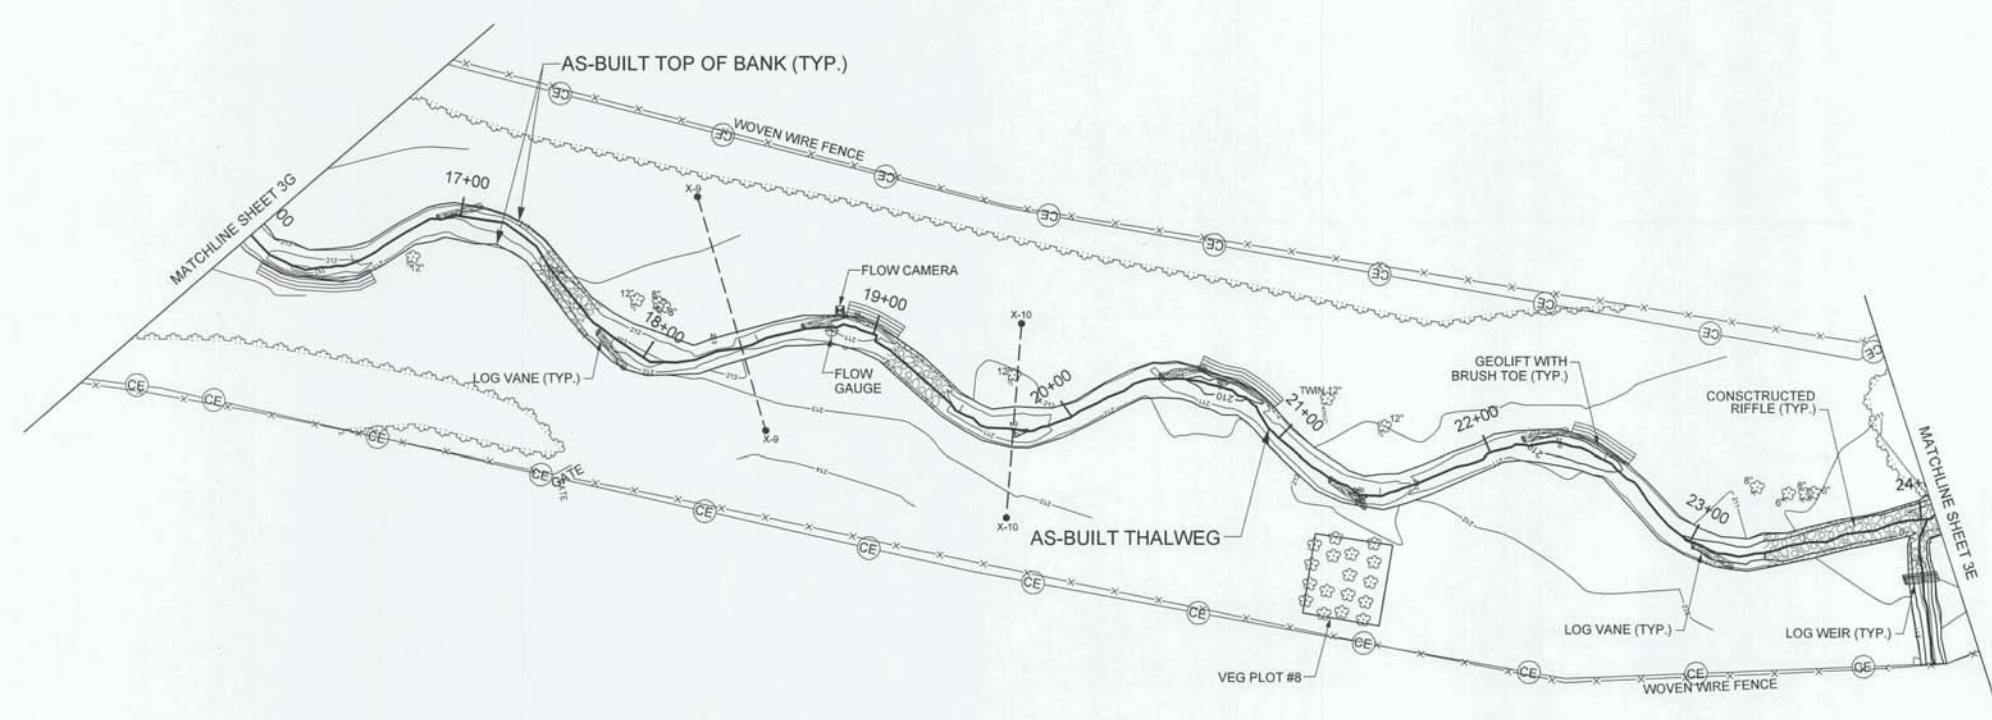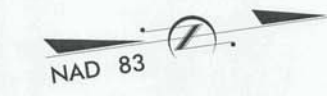




11/15/2015
 R:\128975\Design\Plans\AS-BUILT\PLANS\128975_ASB-UT4_PSH-03F.dgn
 mcarey
 BrownCreek\Trbs_95351_AB_12/15/2015_F.ino

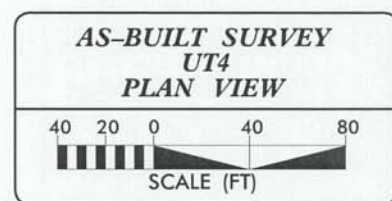



Michael Baker International
 Michael Baker Engineering Inc.
 5000 Regency Parkway, Suite 600
 Cary, NORTH CAROLINA 27516
 Phone: 919.463.5488
 Fax: 919.463.5490
 License #: F-1084

NCDMS ID NO. 95351

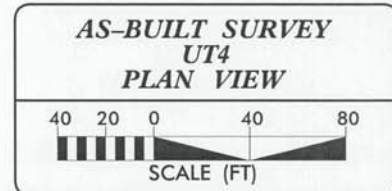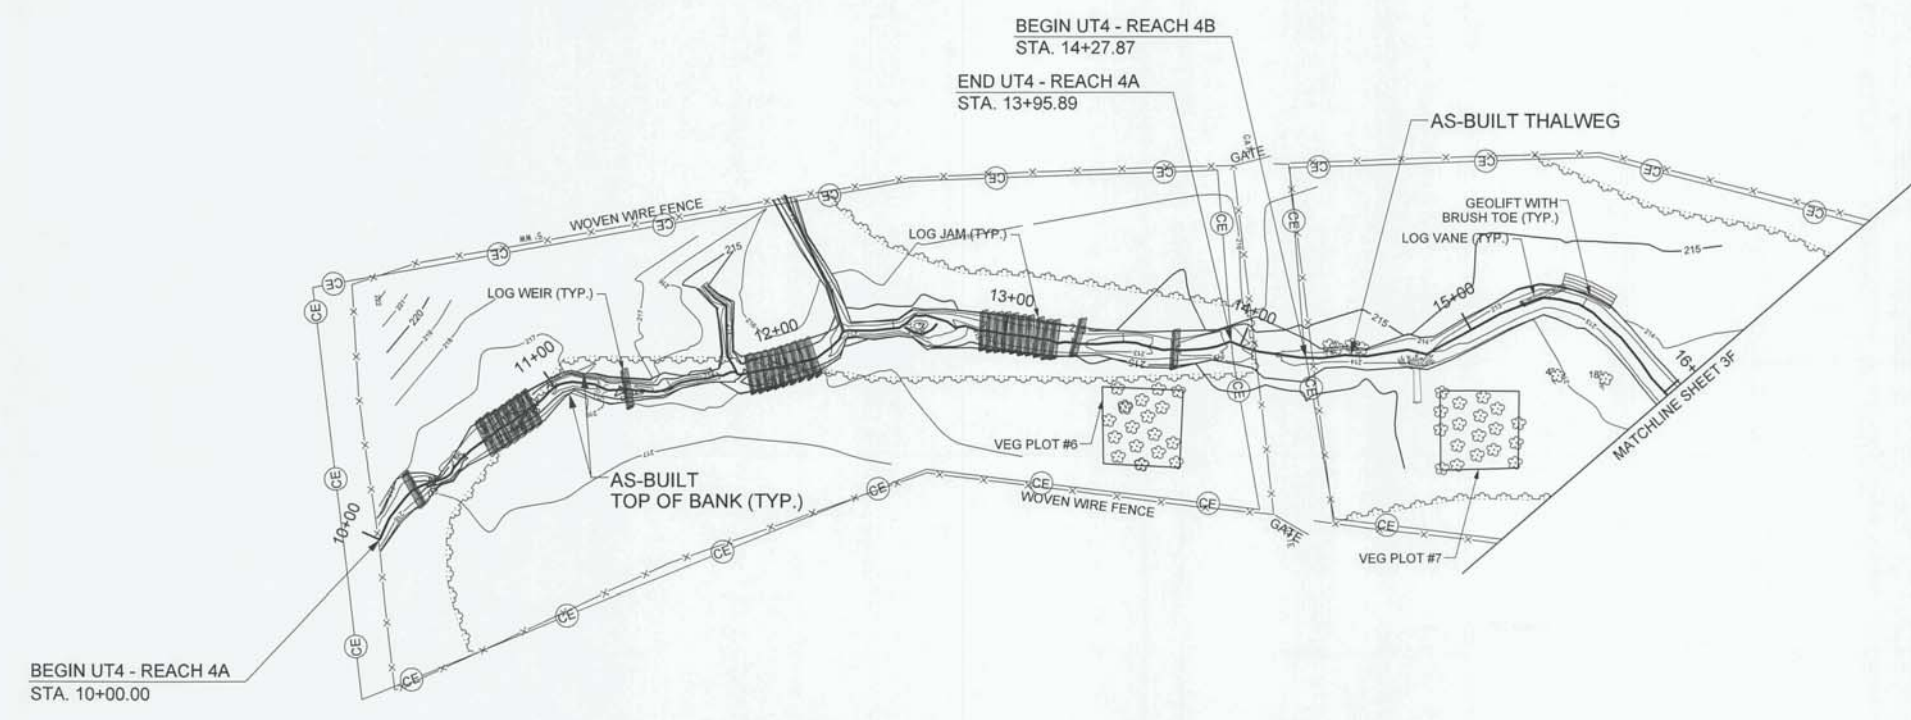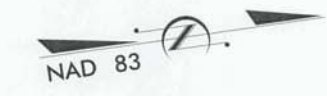



I:\2016\128975\Design\Plans\AS-BUILT\PLANS\128975-ASB-UT4_PSH_03C.dgn
 mcarey
 BrownCreekTrbs-95351-AB-12/15/2015_Final

2/26/03



Michael Baker International
 Michael Baker Engineering Inc.
 8000 Regency Parkway, Suite 600
 Cary, NORTH CAROLINA 27518
 Phone: 919.463.5488
 Fax: 919.463.5490
 License #: P-1084

NCDMS ID NO. 95351

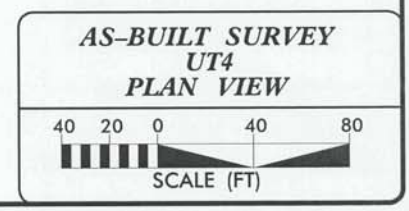
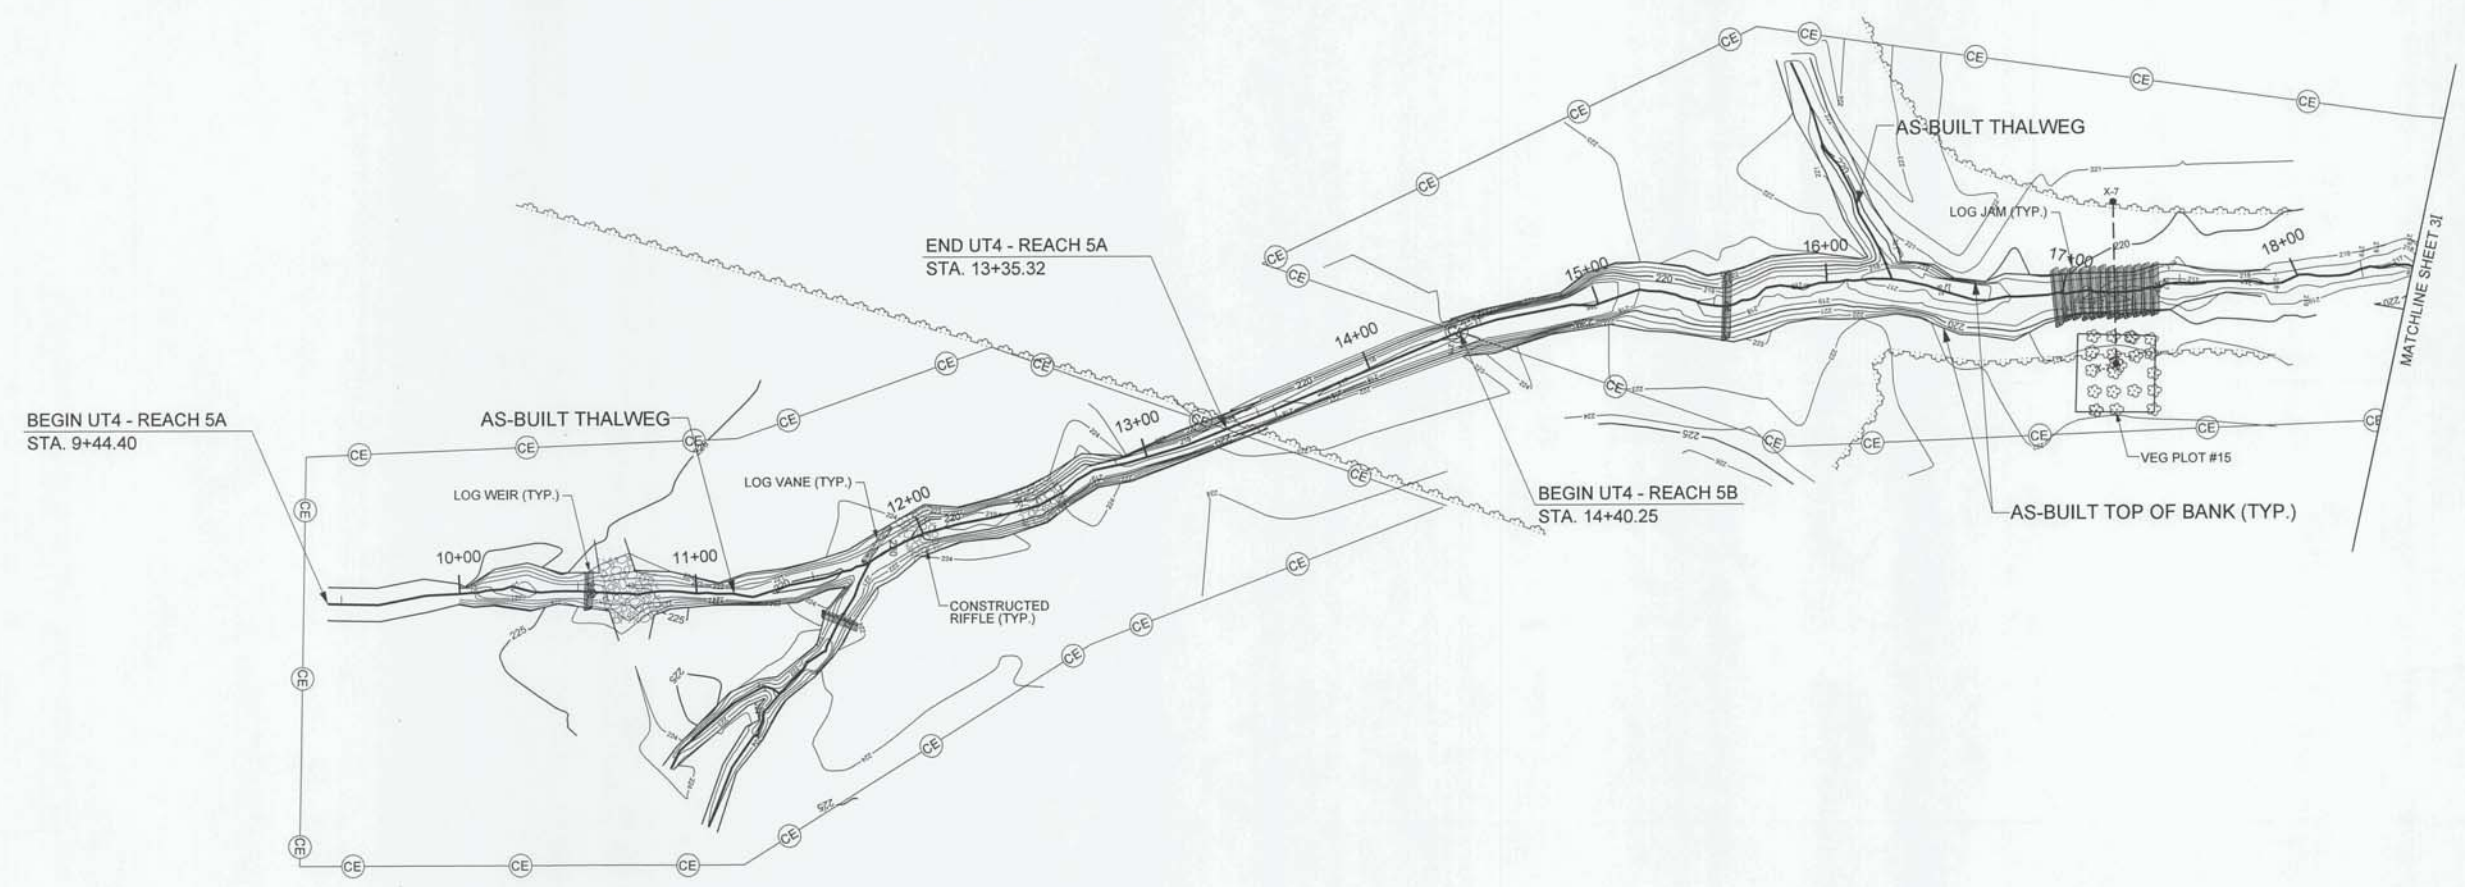


I:\15\2015\Design\Plans\AS-BUILT\PLANS\128975.ASB-UT4_PSH_03H.dgn
 mcorrey
 BrownCreek\T-bis_95351_AB_12/15/2015_F.mxd

2/26/03


2/26/03

BAKER PROJECT REFERENCE NO. 128975 SHEET NO. 31

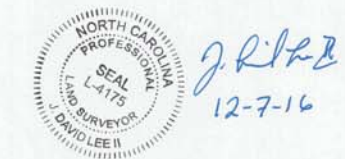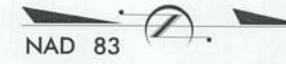


Michael Baker International
Michael Baker Engineering Inc.
8000 Regency Parkway, Suite 600
Cary, NORTH CAROLINA 27518
Phone: 919.453.5488
Fax: 919.453.5490
License #: F-1094



NCDMS ID NO. 95351

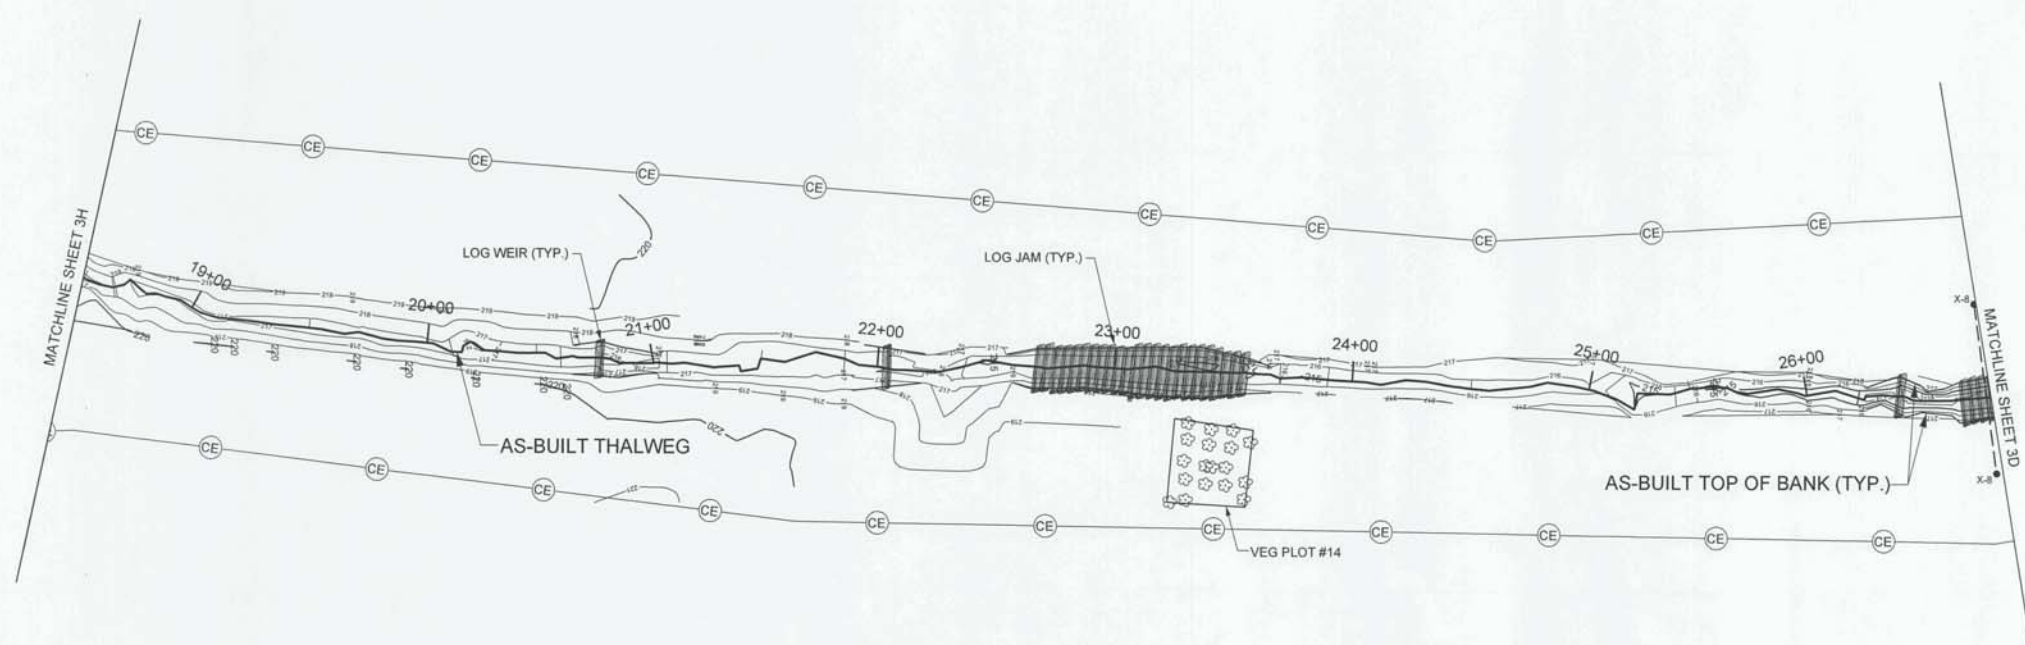

I:\9\2015\128975\Design\Plans\AS-BUILT\PLANS\128975_AS-B-UT4_PSH_031.dgn
micbey
BrownCreekTrlbs_95351_AB_12/15/2015_Final

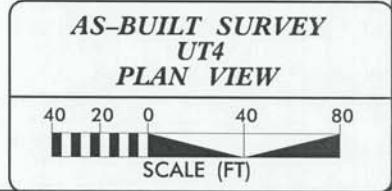

BAKER PROJECT REFERENCE NO. 128975	SHEET NO. 4
PROJECT ENGINEER	
	
APPROVED BY: 	
DATE: 11/16/16	
Michael Baker International <small>Michael Baker Engineering Inc. 8000 Regency Parkway, Suite 600 Cary, NORTH CAROLINA 27518 Phone: 919.403.5488 Fax: 919.403.5490 License #: F-1084</small>	
NCDMS ID NO. 95351	

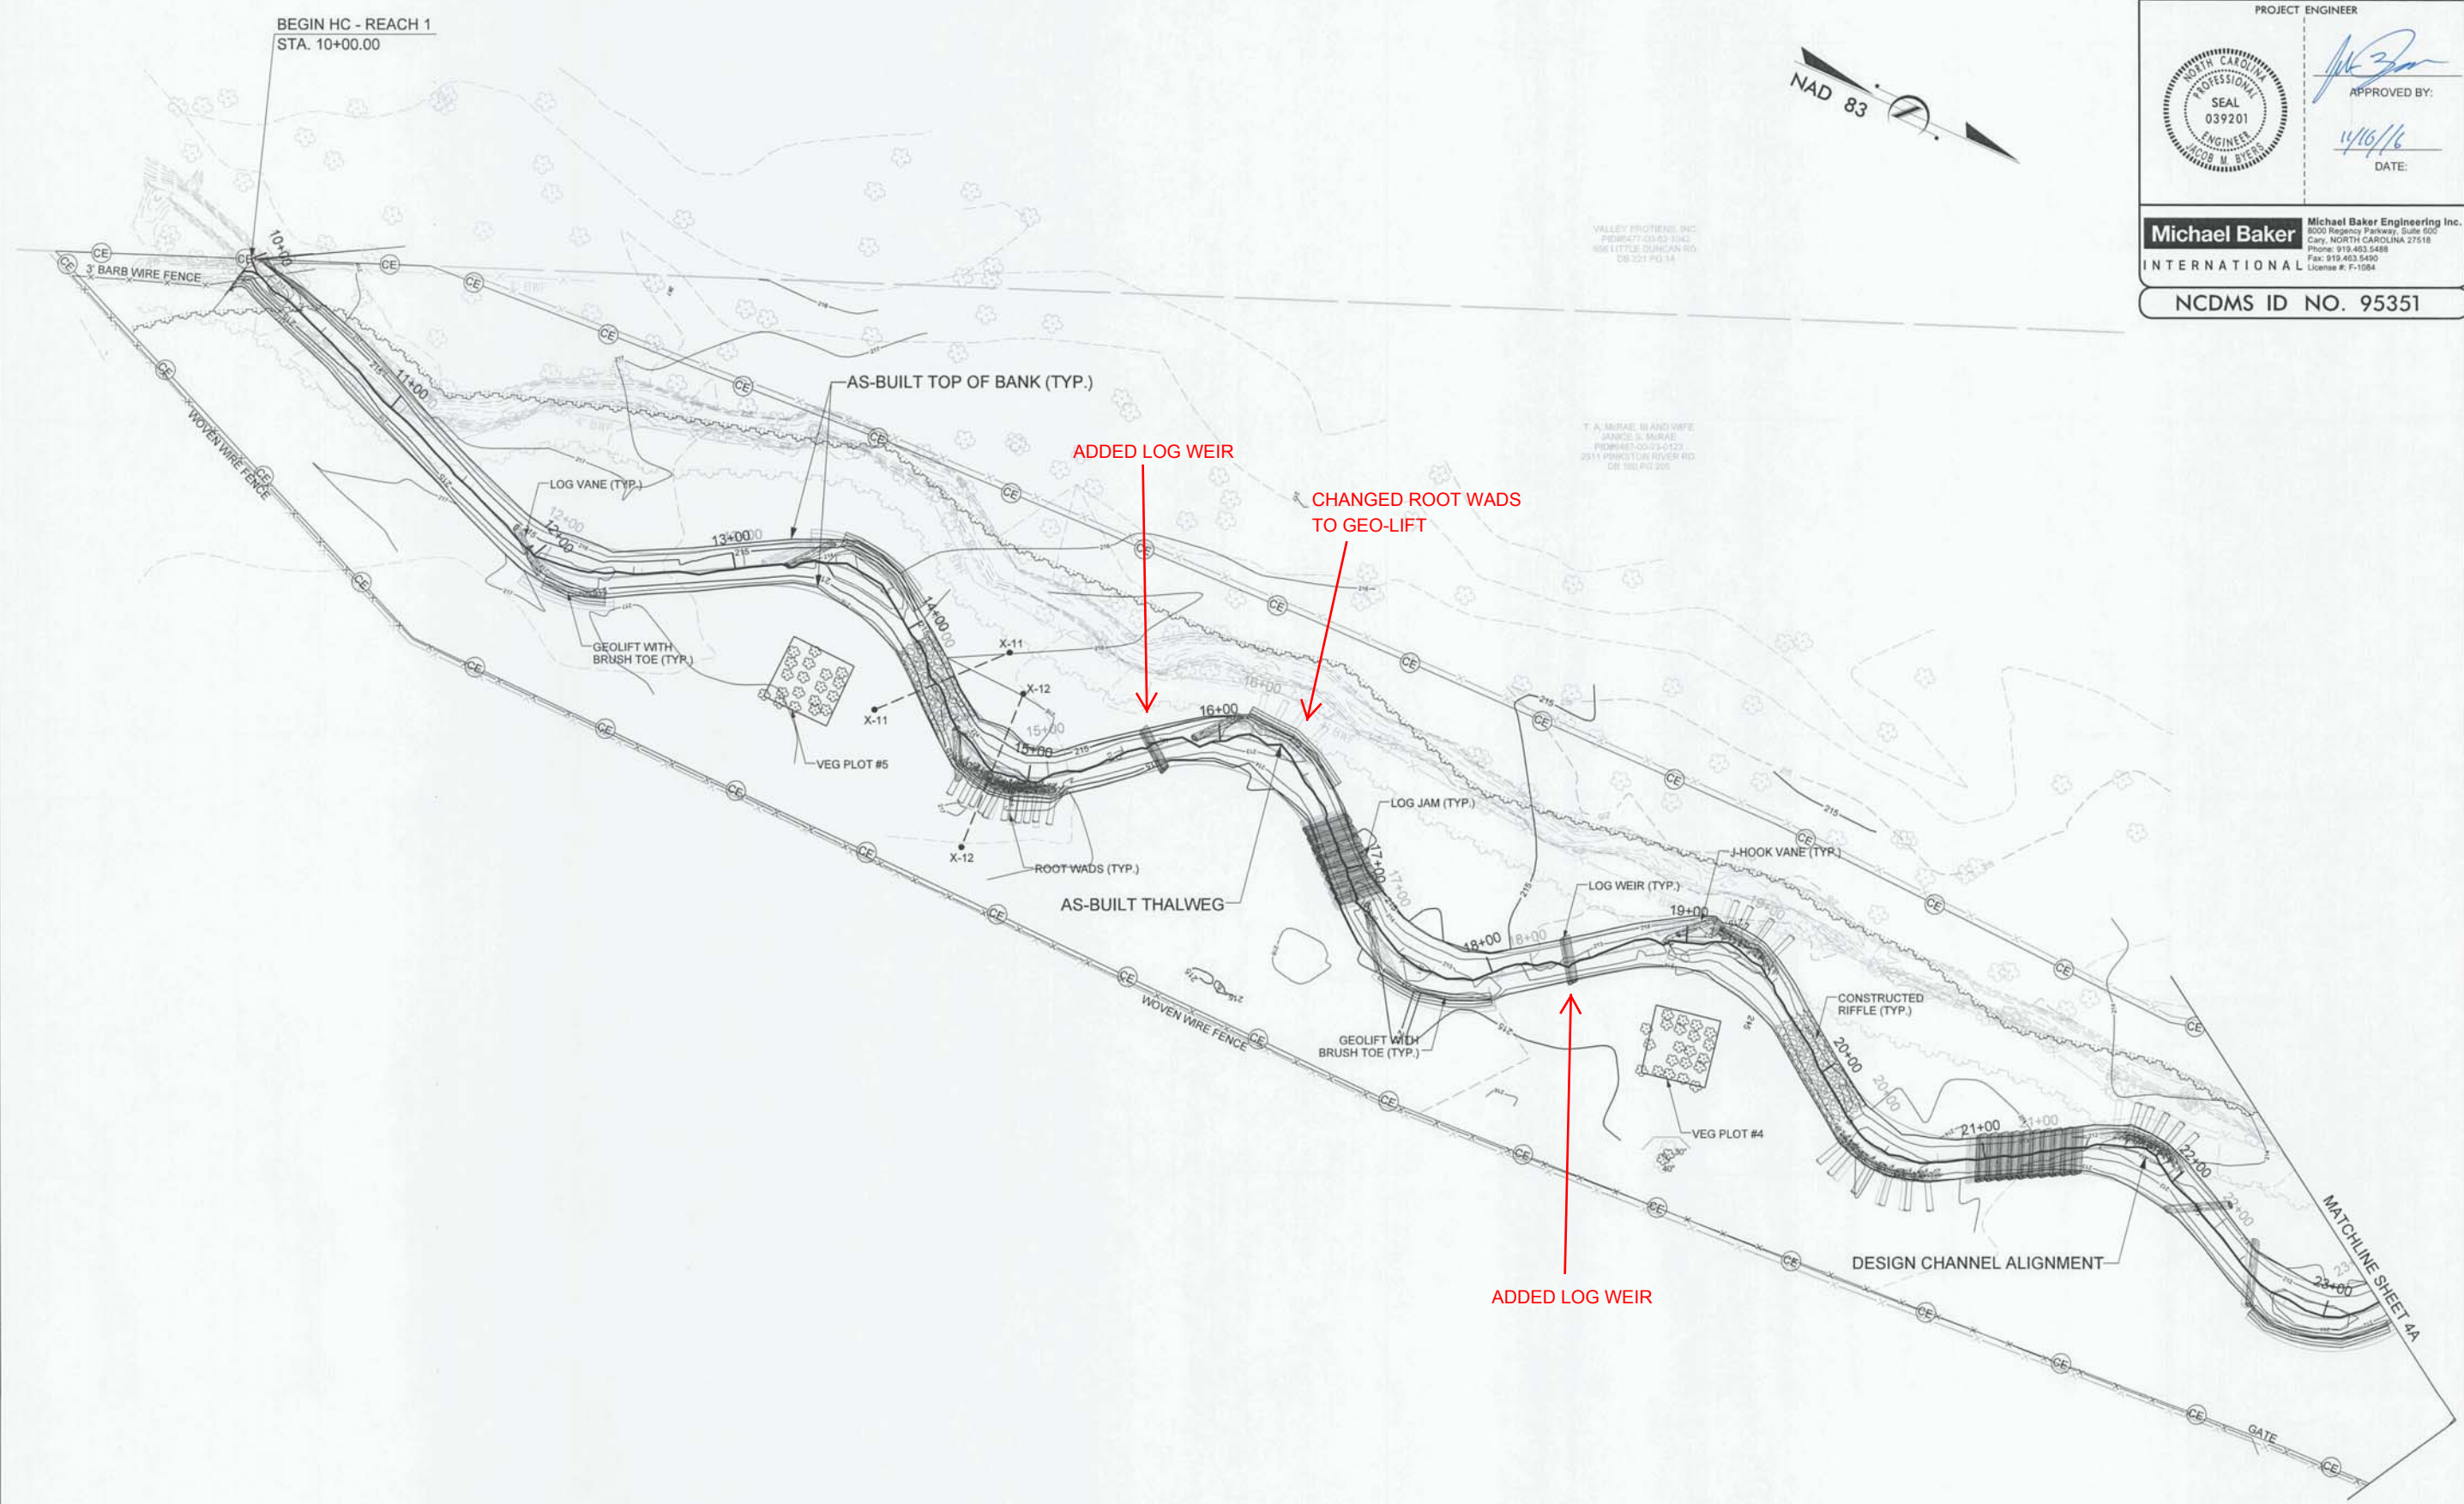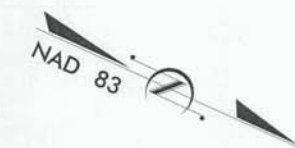




RECORD DRAWING
HURRICANE CREEK
PLAN VIEW

SCALE (FT)

I:\S\2015\Design\Plans\AS-BUILD\TVPLANS\128975_ASB-HC_PSH_04.dgn
 mc:ar:ej
 BrownCreek\Tr\ba_95351_AB_12/15/2015_F.rns

2/26/03

BAKER PROJECT REFERENCE NO. 128975	SHEET NO. 4A
PROJECT ENGINEER	
	
APPROVED BY: 	
DATE: 11/19/16	
Michael Baker International <small>Michael Baker Engineering Inc. 8500 Regency Parkway, Suite 602 Cary, North Carolina 27518 Phone: 919.463.5488 Fax: 919.463.5490 License #: F-1084</small>	
NCDMS ID NO. 95351	

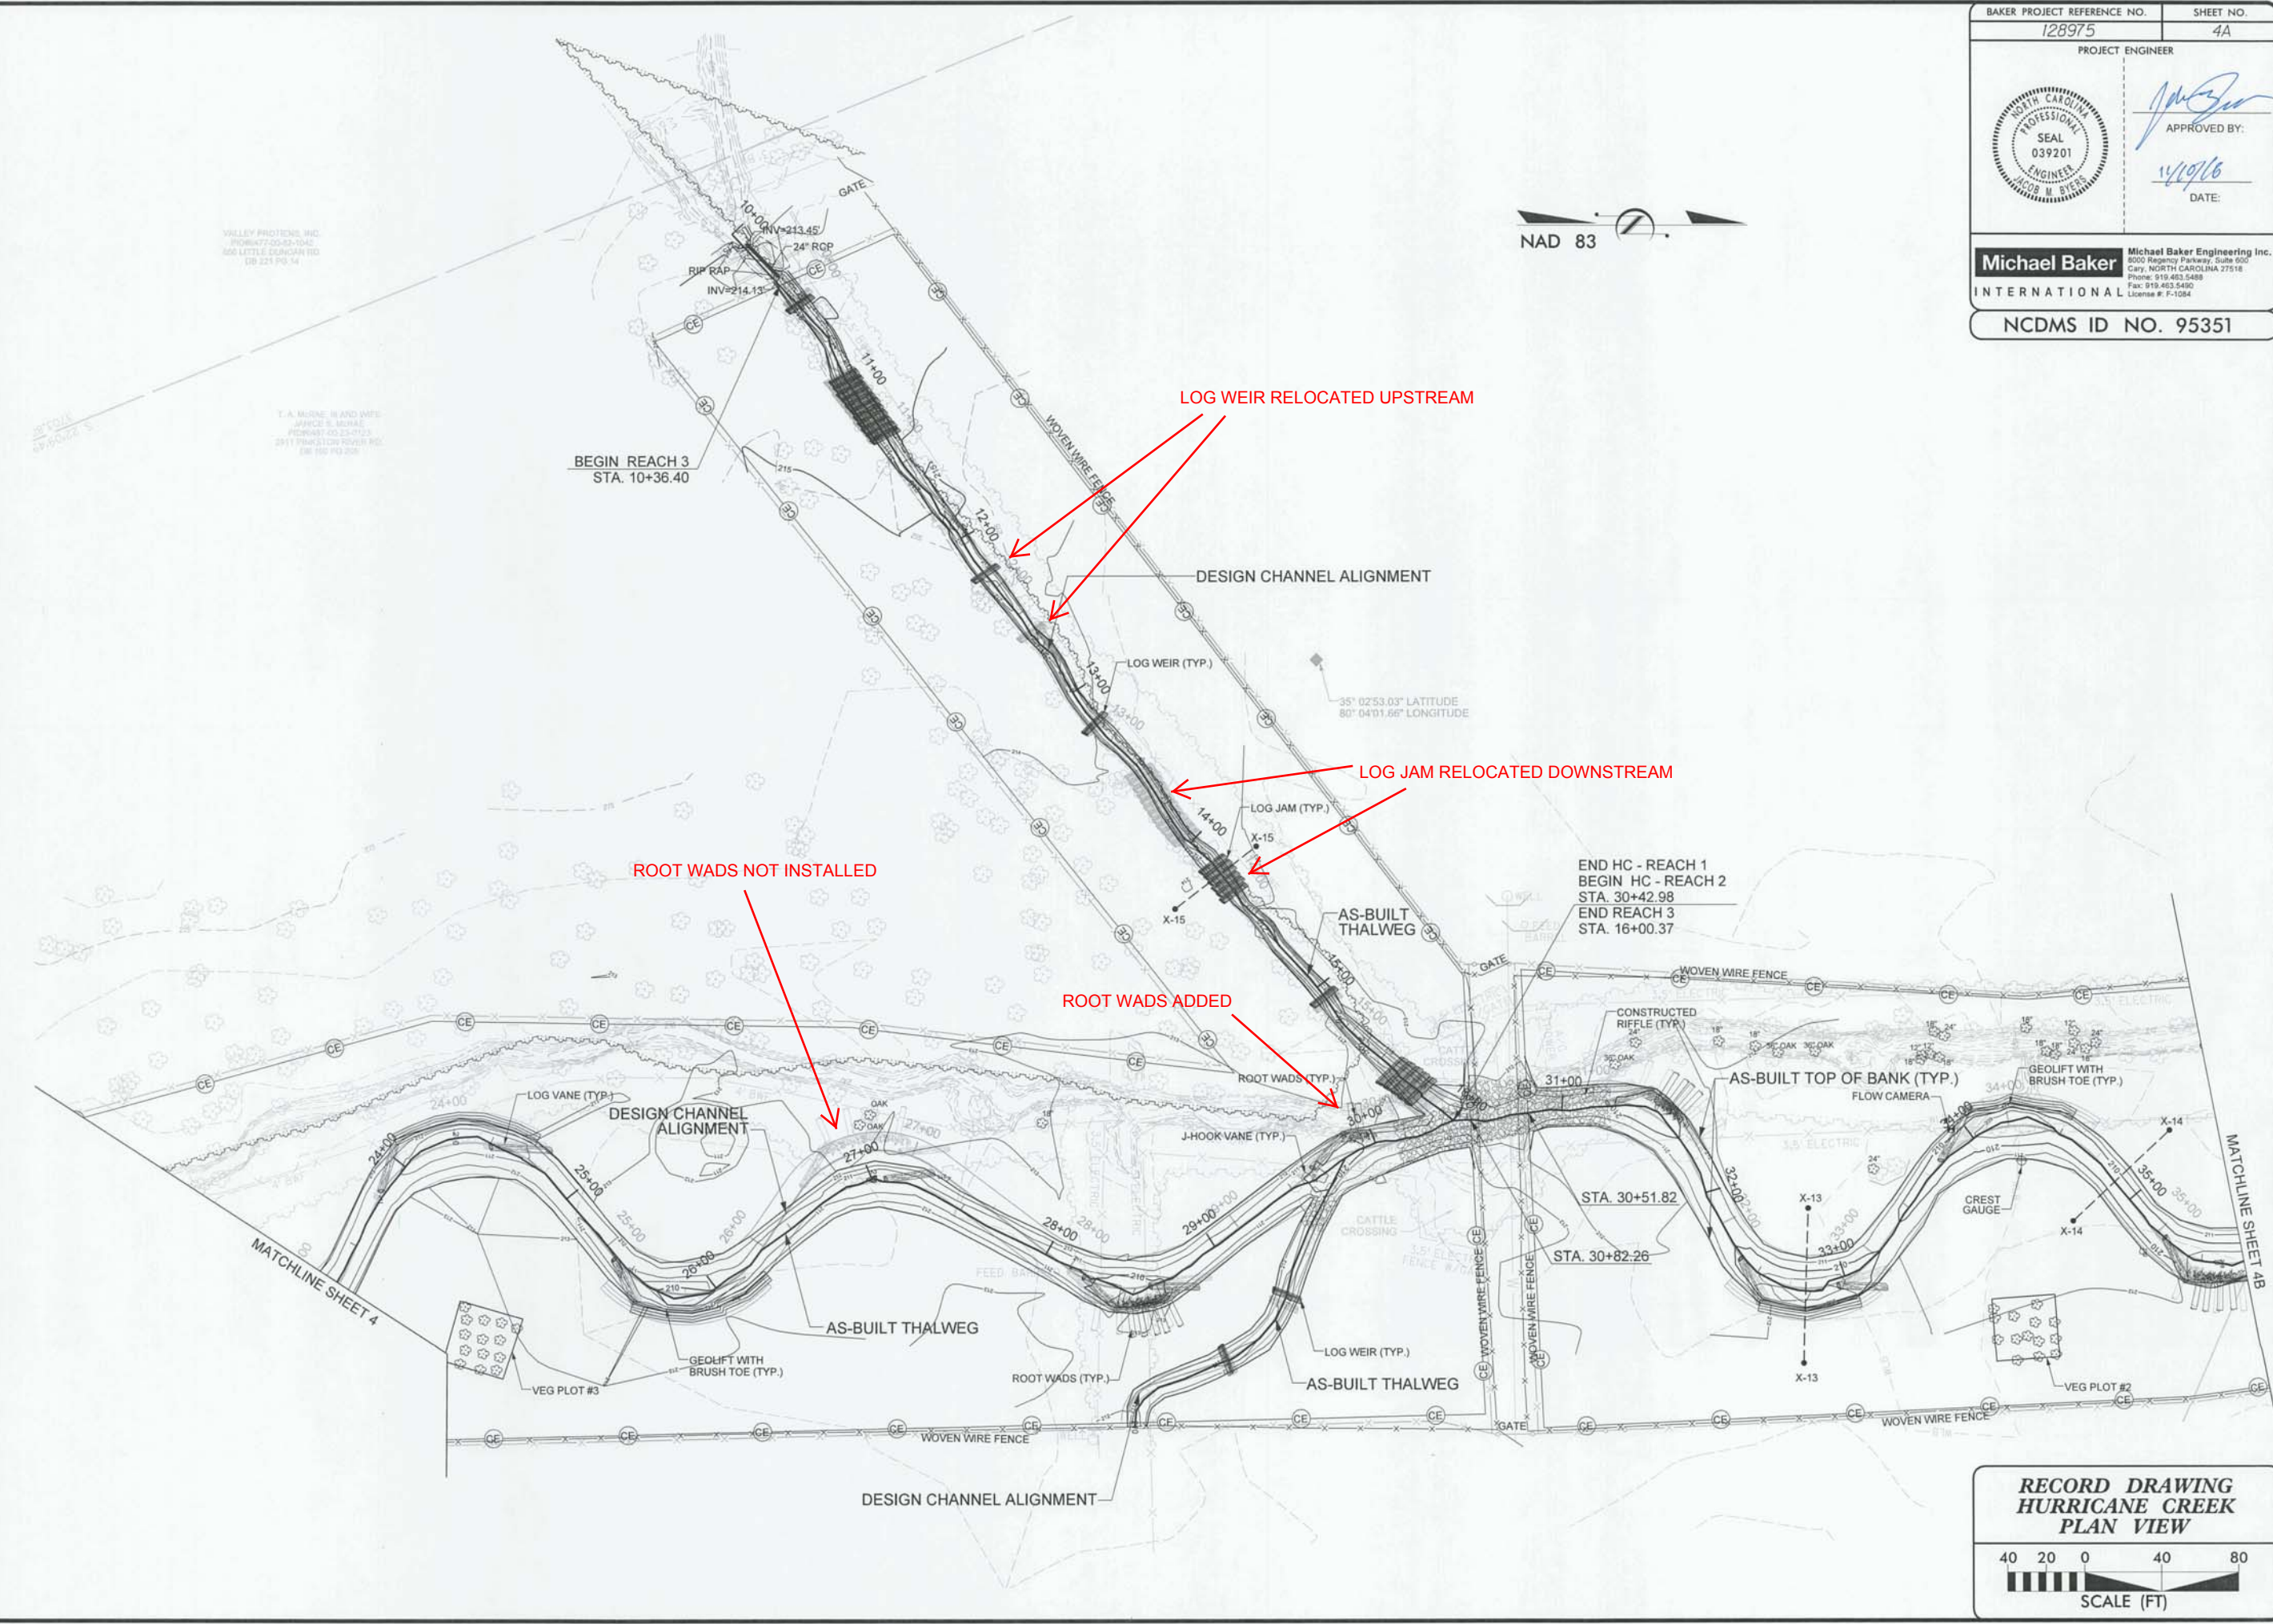



**RECORD DRAWING
HURRICANE CREEK
PLAN VIEW**

SCALE (FT)

2/26/03
 I:\9\2016\128975\Design\PI\ans\AS-BUILT\PLANS\128975-ASB-HC_PSH_04A.dgn
 mcarney
 BrownCreek.Trlbs.95351_AB.12/15/2015.F.mnl

2/26/03

BAKER PROJECT REFERENCE NO. 128975	SHEET NO. 4B
PROJECT ENGINEER	
	
APPROVED BY: 	
DATE: 4/10/16	
Michael Baker International	
<small>Michael Baker Engineering Inc. 8200 Regency Parkway, Suite 600 Cary, NORTH CAROLINA 27518 Phone: 919.483.5488 Fax: 919.483.5490 License #: F-1084</small>	
NCDMS ID NO. 95351	

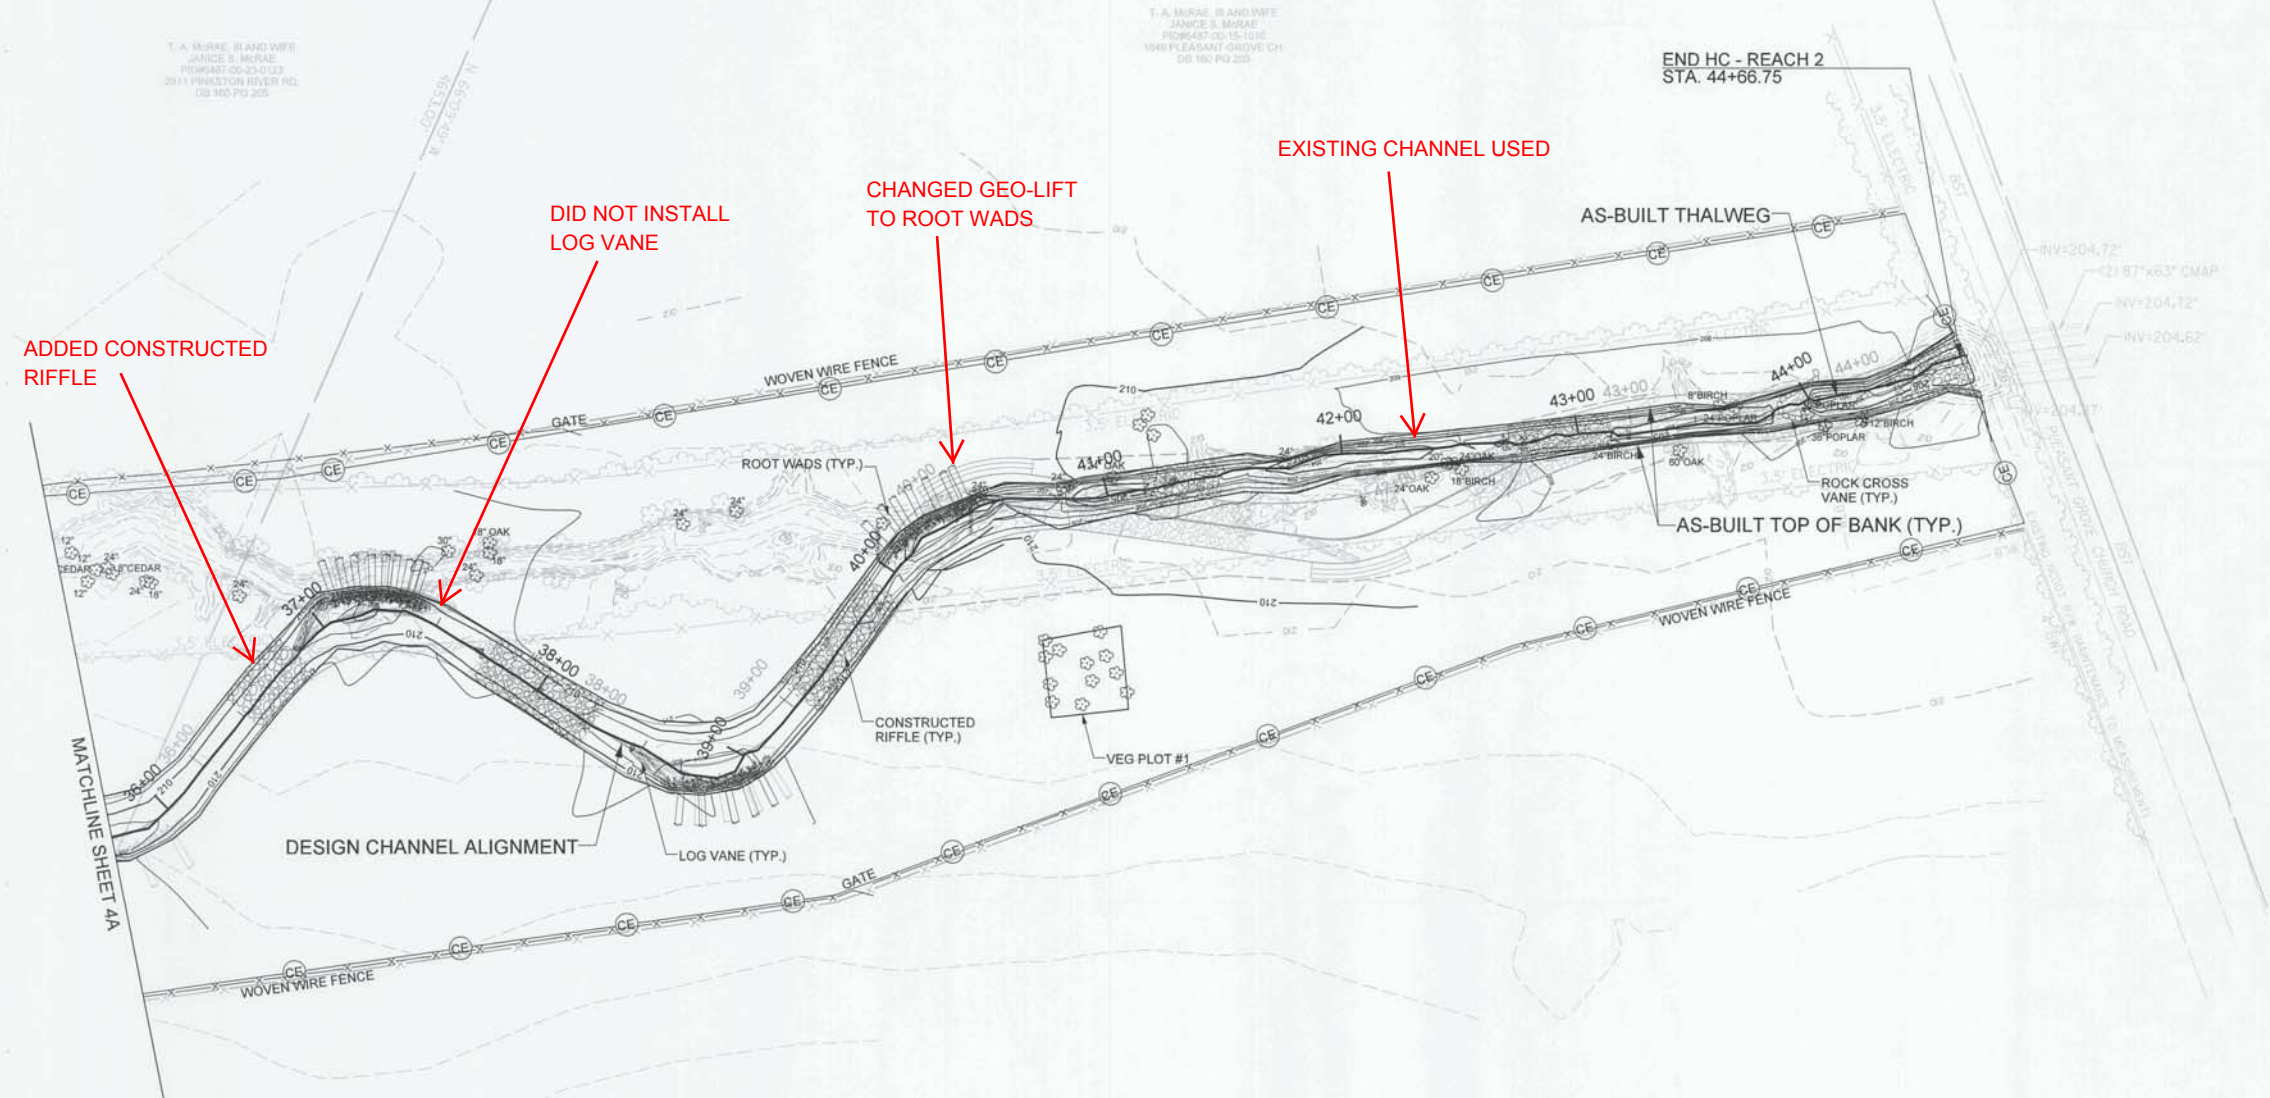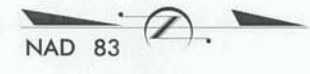


11/9/2016
 R:\128975\Design\Plans\AS-BUILT\PLANS\128975_ASB-HC_PSHL_04B.dgn
 micarej
 BrownCreekTribs_95351_AB_12/15/2015_Final

RECORD DRAWING
HURRICANE CREEK
PLAN VIEW

SCALE (FT)

BAKER PROJECT REFERENCE NO. 128975	SHEET NO. 4C
PROJECT ENGINEER	
	APPROVED BY:
	11/23/16
	DATE:
Michael Baker International	
<small>Michael Baker Engineering Inc. 3000 Regency Parkway, Suite 600 Cary, NORTH CAROLINA 27518 Phone: 919.463.5488 Fax: 919.463.5490 License #: P-1084</small>	
NCDMS ID NO. 95351	

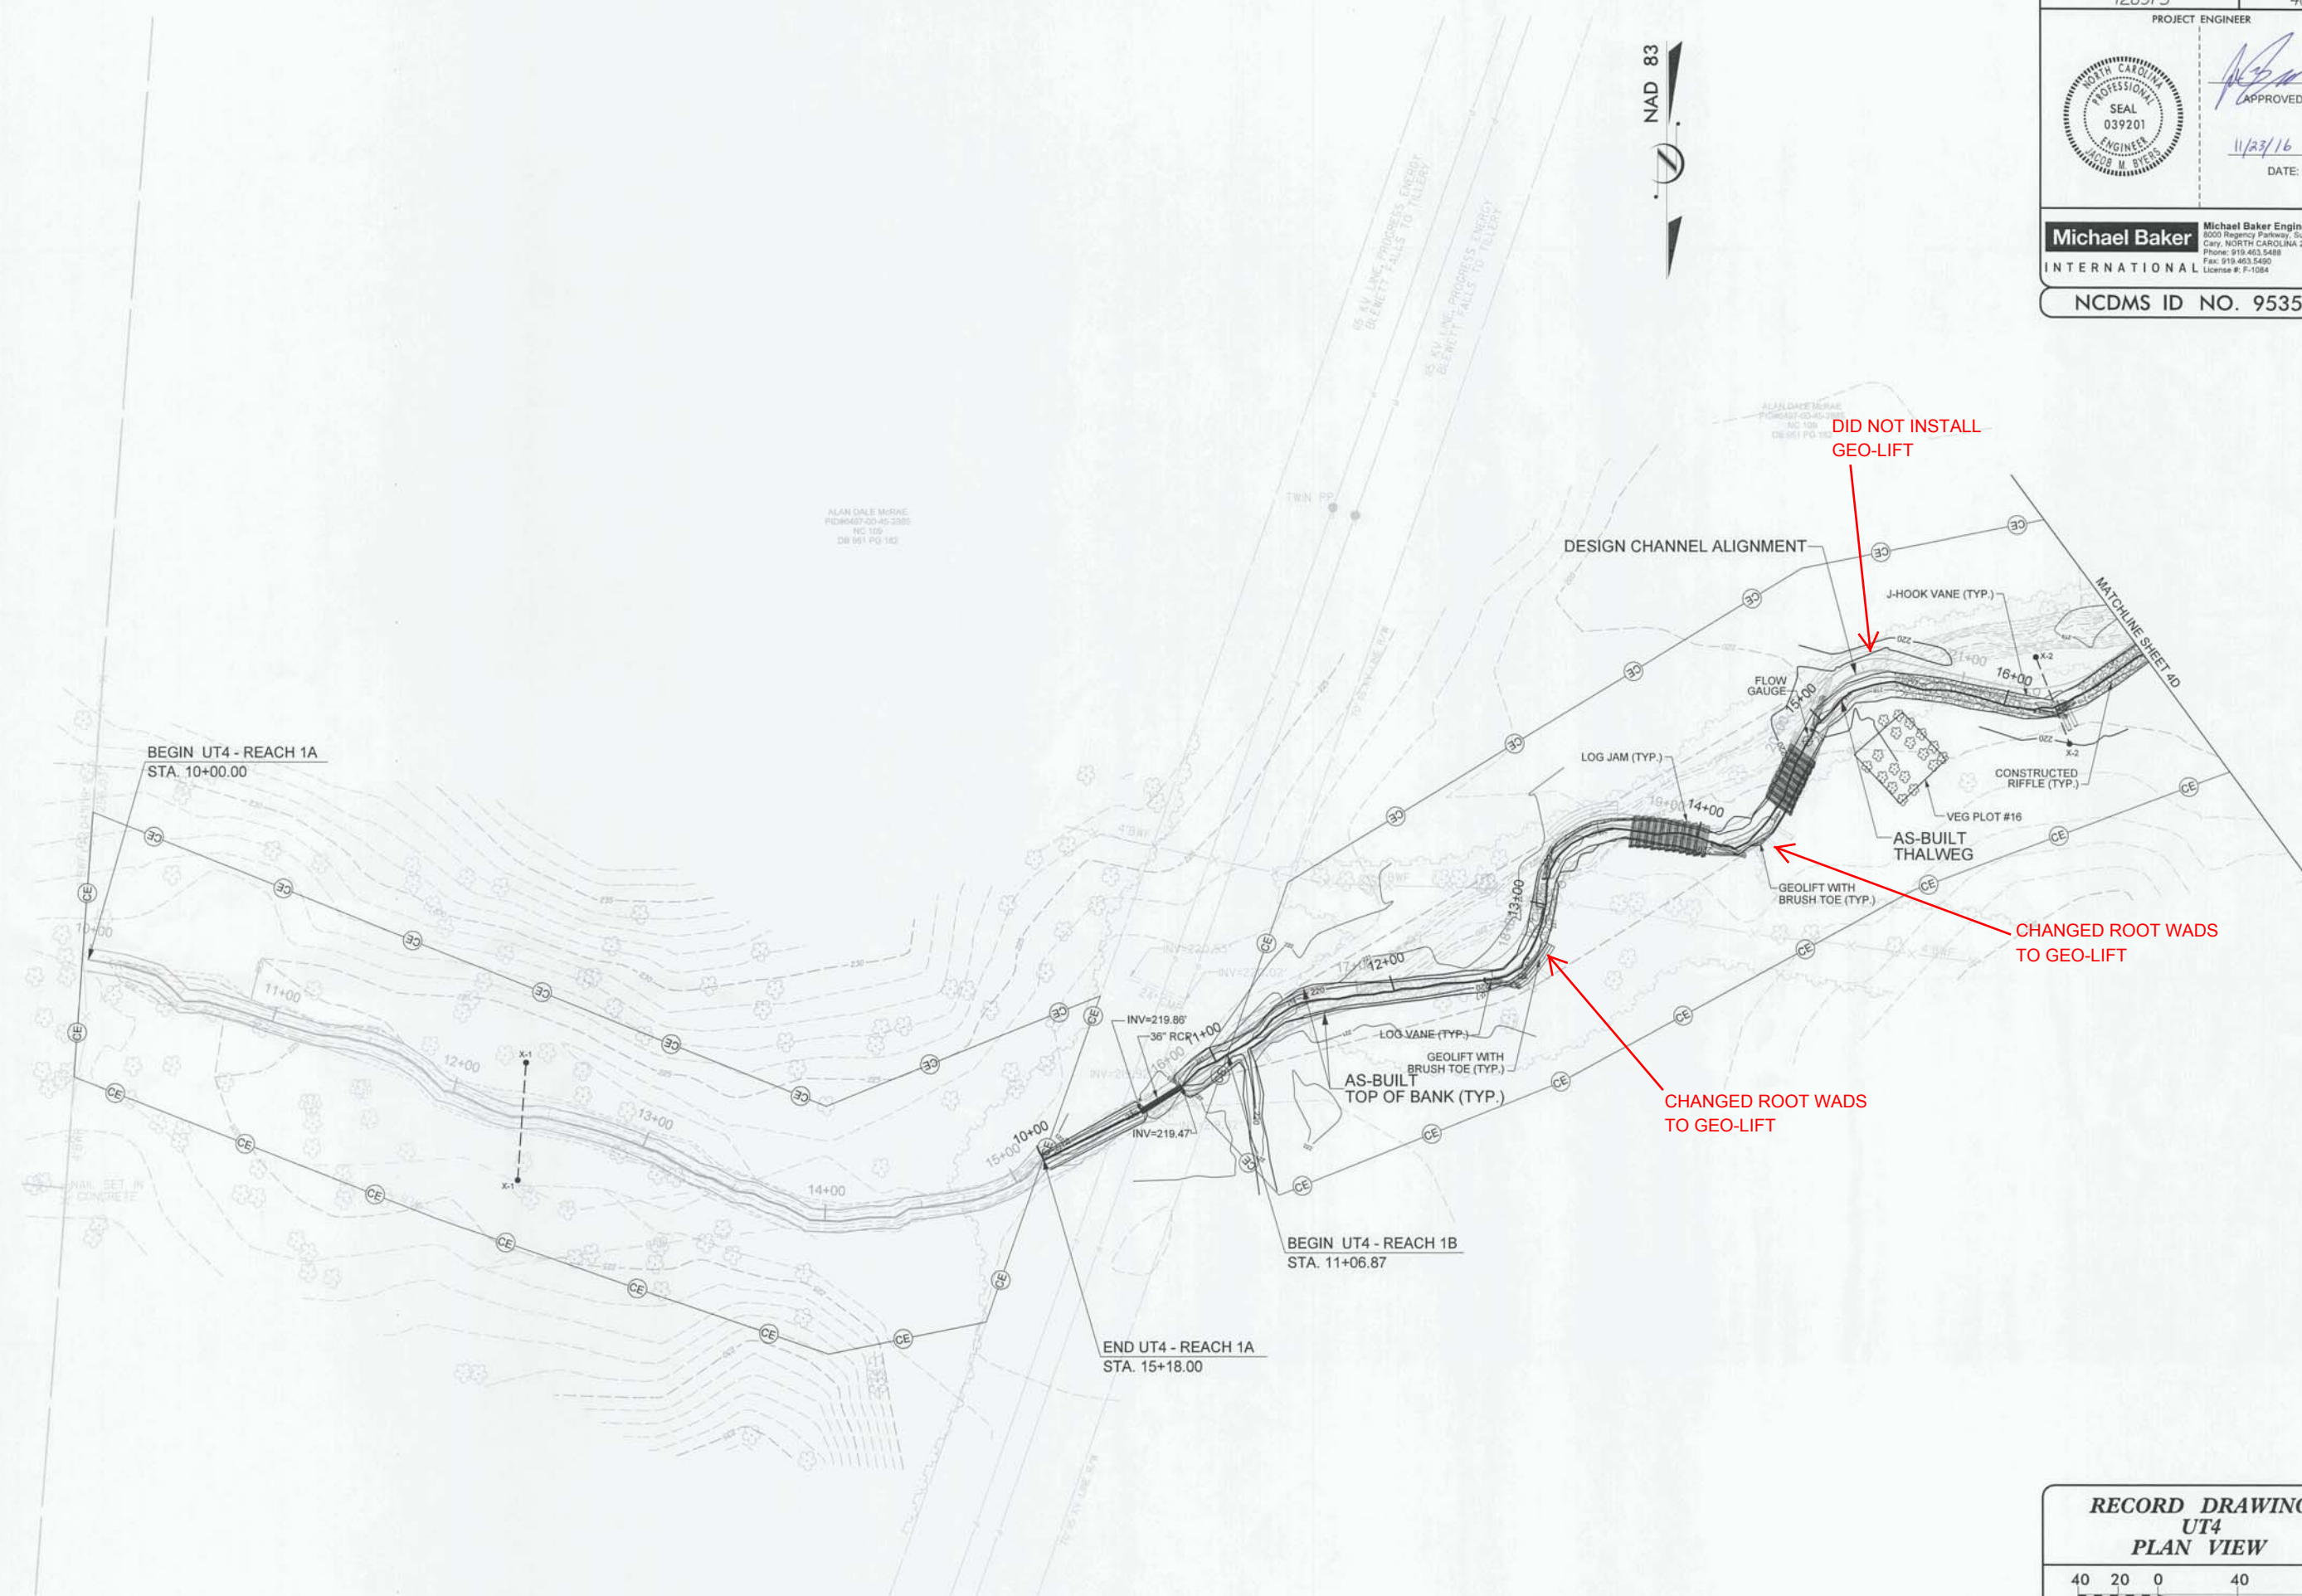


RECORD DRAWING
UT4
PLAN VIEW

SCALE (FT)

2/26/03
 11/15/2016
 H:\128975\Design\Plans\AS-BUILT\PLANS\128975-ASB-UT4_PSH_04C.dgn
 mcabrey
 BrownCreekTribs_95351_AB.12/15/2015_F.ino

BAKER PROJECT REFERENCE NO. 128975	SHEET NO. 4D
PROJECT ENGINEER	
	
APPROVED BY:	DATE:
	11/20/16
Michael Baker International Michael Baker Engineering Inc. 8500 Regency Parkway, Suite 600 Cary, North Carolina 27518 Phone: 919.463.5488 Fax: 919.463.5490 License # F-1594	
NCDMS ID NO. 95351	

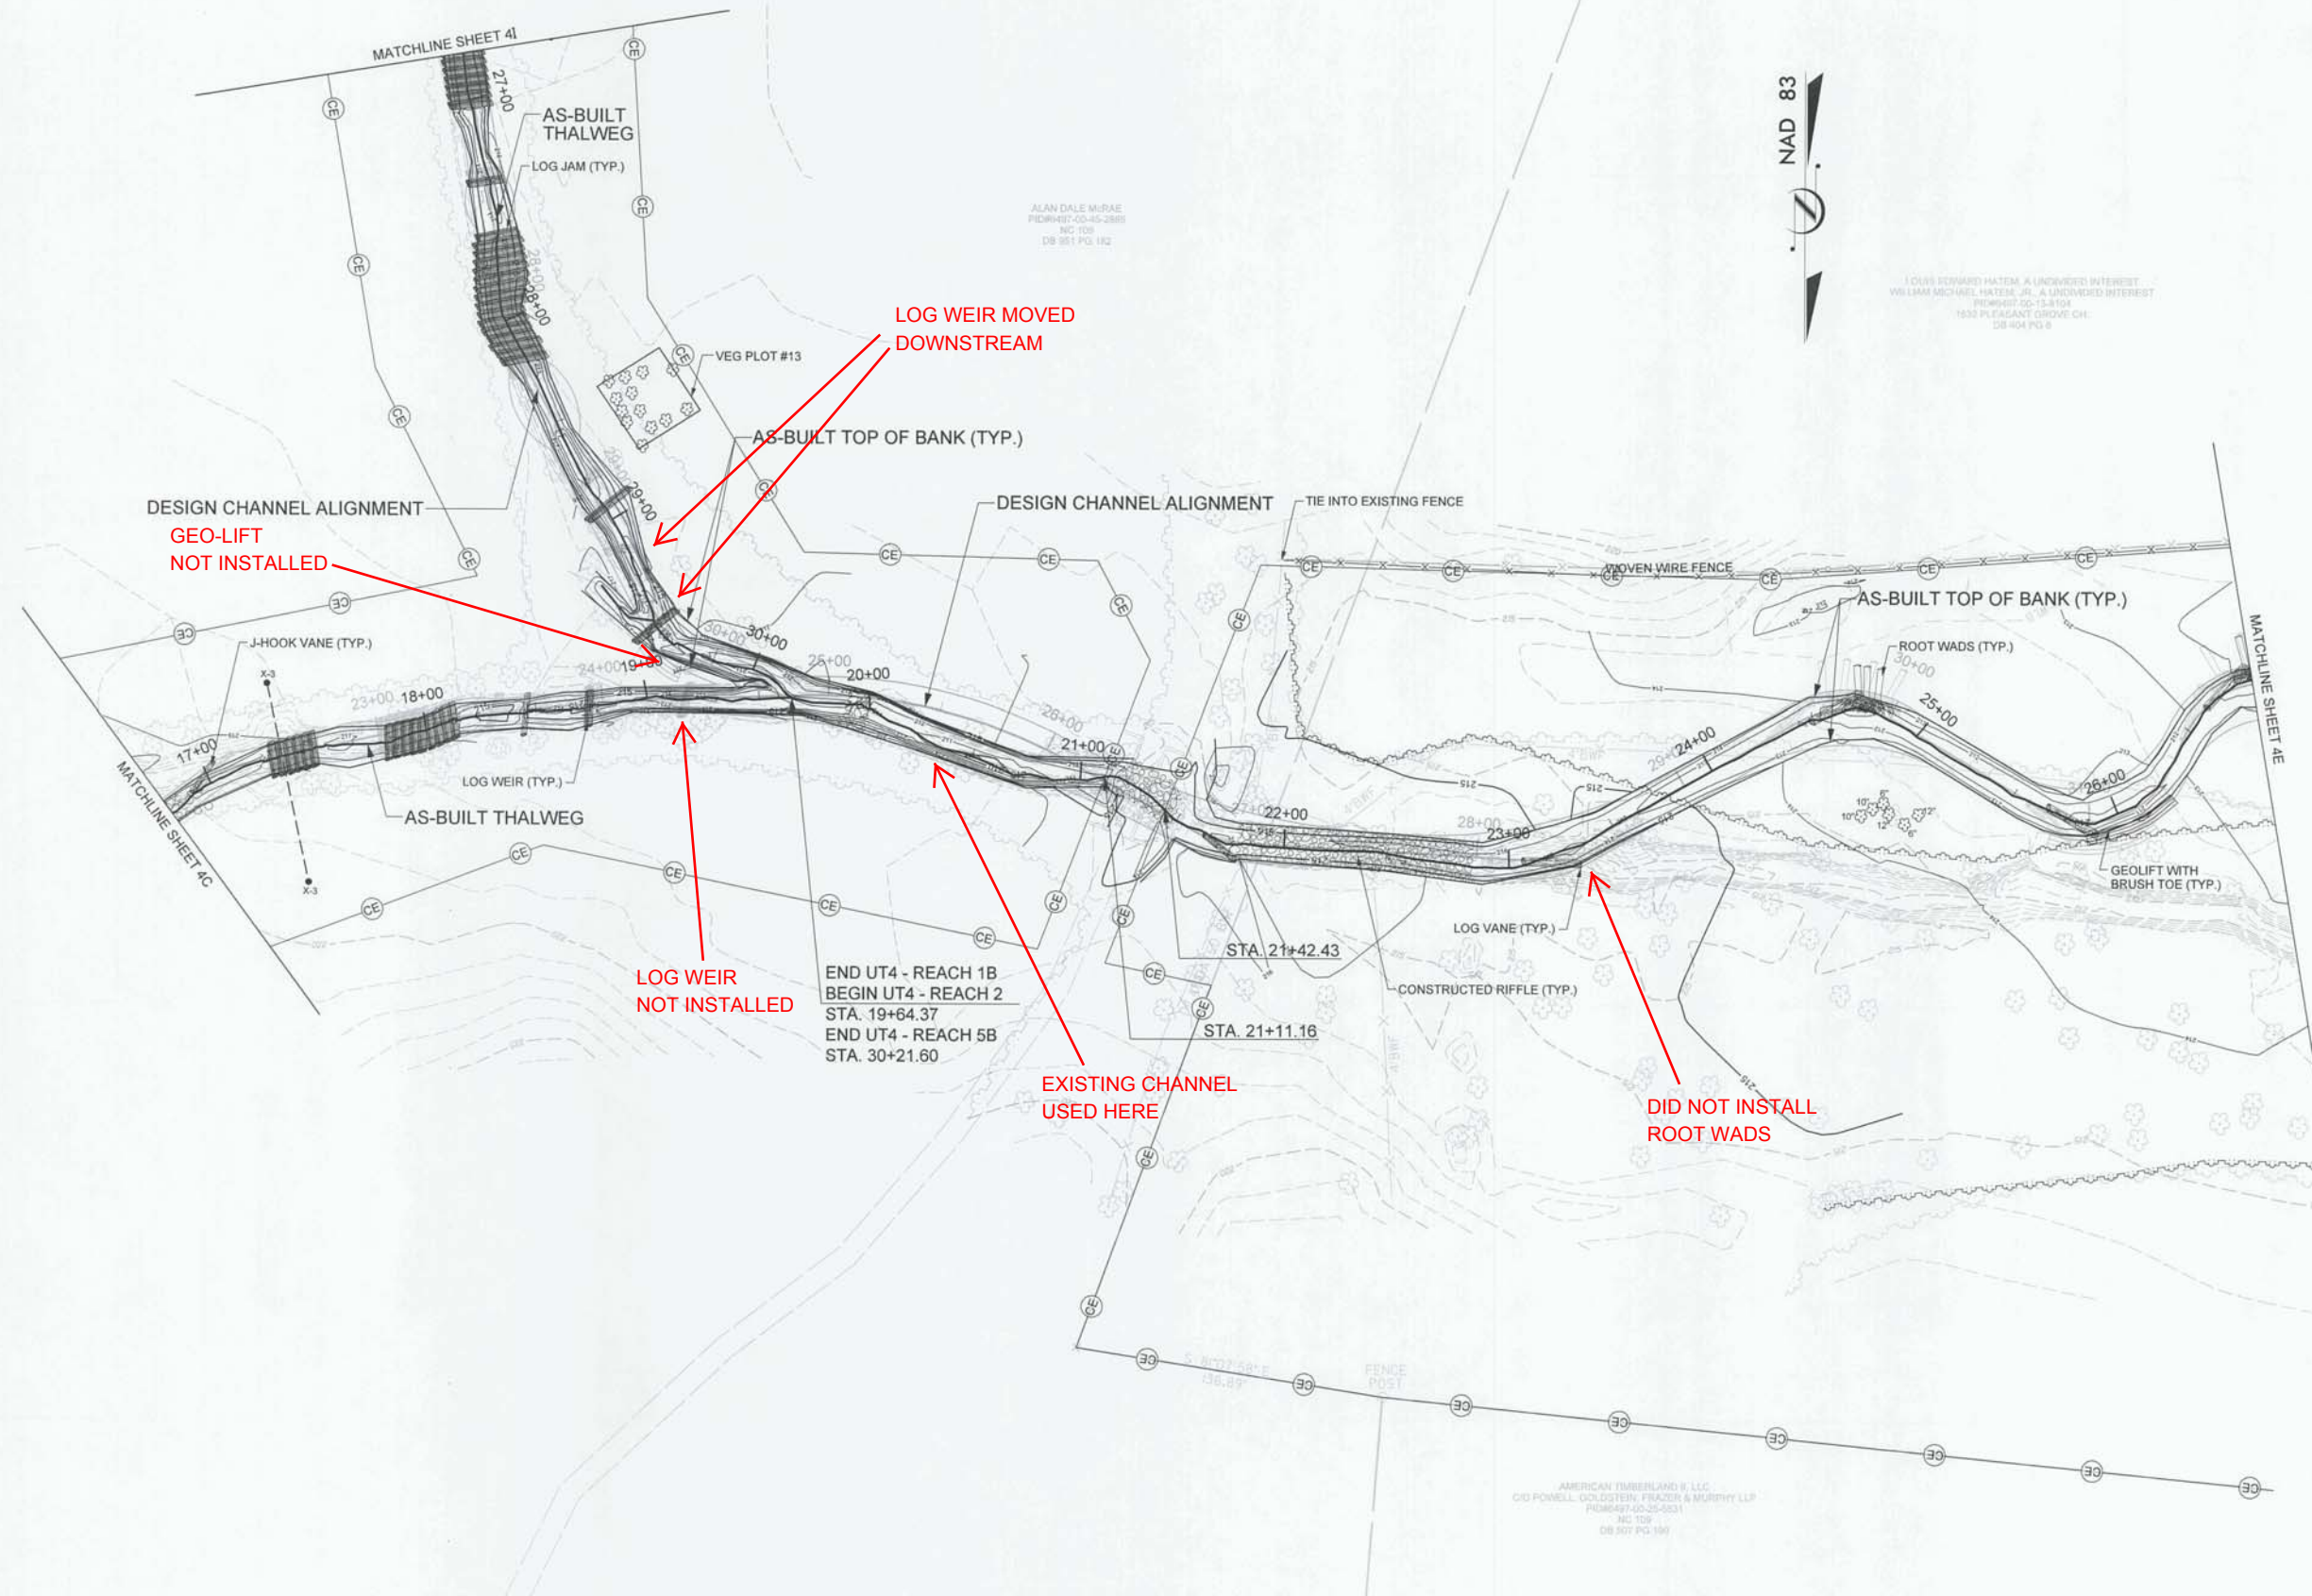


NAD 83



CLAUDE EDWARD HATEM, A UNDIVIDED INTEREST
 WILLIAM MICHAEL HATEM, JR., A UNDIVIDED INTEREST
 PROMISEE 00-13-8104
 1833 PLANTAGENET DRIVE, CH.
 27614 PG 8

END UT4 - REACH 1B
 BEGIN UT4 - REACH 2
 STA. 19+64.37
 END UT4 - REACH 5B
 STA. 30+21.60

RECORD DRAWING
UT4
PLAN VIEW





SCALE (FT)


I:\3\2015\Design\Plans\AS-BUILT\PLANS\128975_ASB-UT4_PSH_04D.dgn
 mcbrey
 BrownCreek-Tr-iba-95351_AB_12/15/2015_Final

2/26/03

ALAN DALE MURAE
 PE00047-00-40-2888
 NC 108
 DB 951 PG. 142

AMERICAN TIMBERLAND & L.L.C.
 C/O POMELL, GOLDSTEIN, FRAZER & MURPHY LLP
 PROMISEE 00-25-5031
 NC 108
 DB 907 PG. 197

BAKER PROJECT REFERENCE NO. 128975	SHEET NO. 4E
PROJECT ENGINEER	
	
APPROVED BY: 	
DATE: 4/10/16	
Michael Baker International Michael Baker Engineering Inc. 8000 Regency Parkway, Suite 600 Cary, NORTH CAROLINA 27516 Phone: 919.463.5488 Fax: 919.463.5490 License #: F-1084	
NCDMS ID NO. 95351	

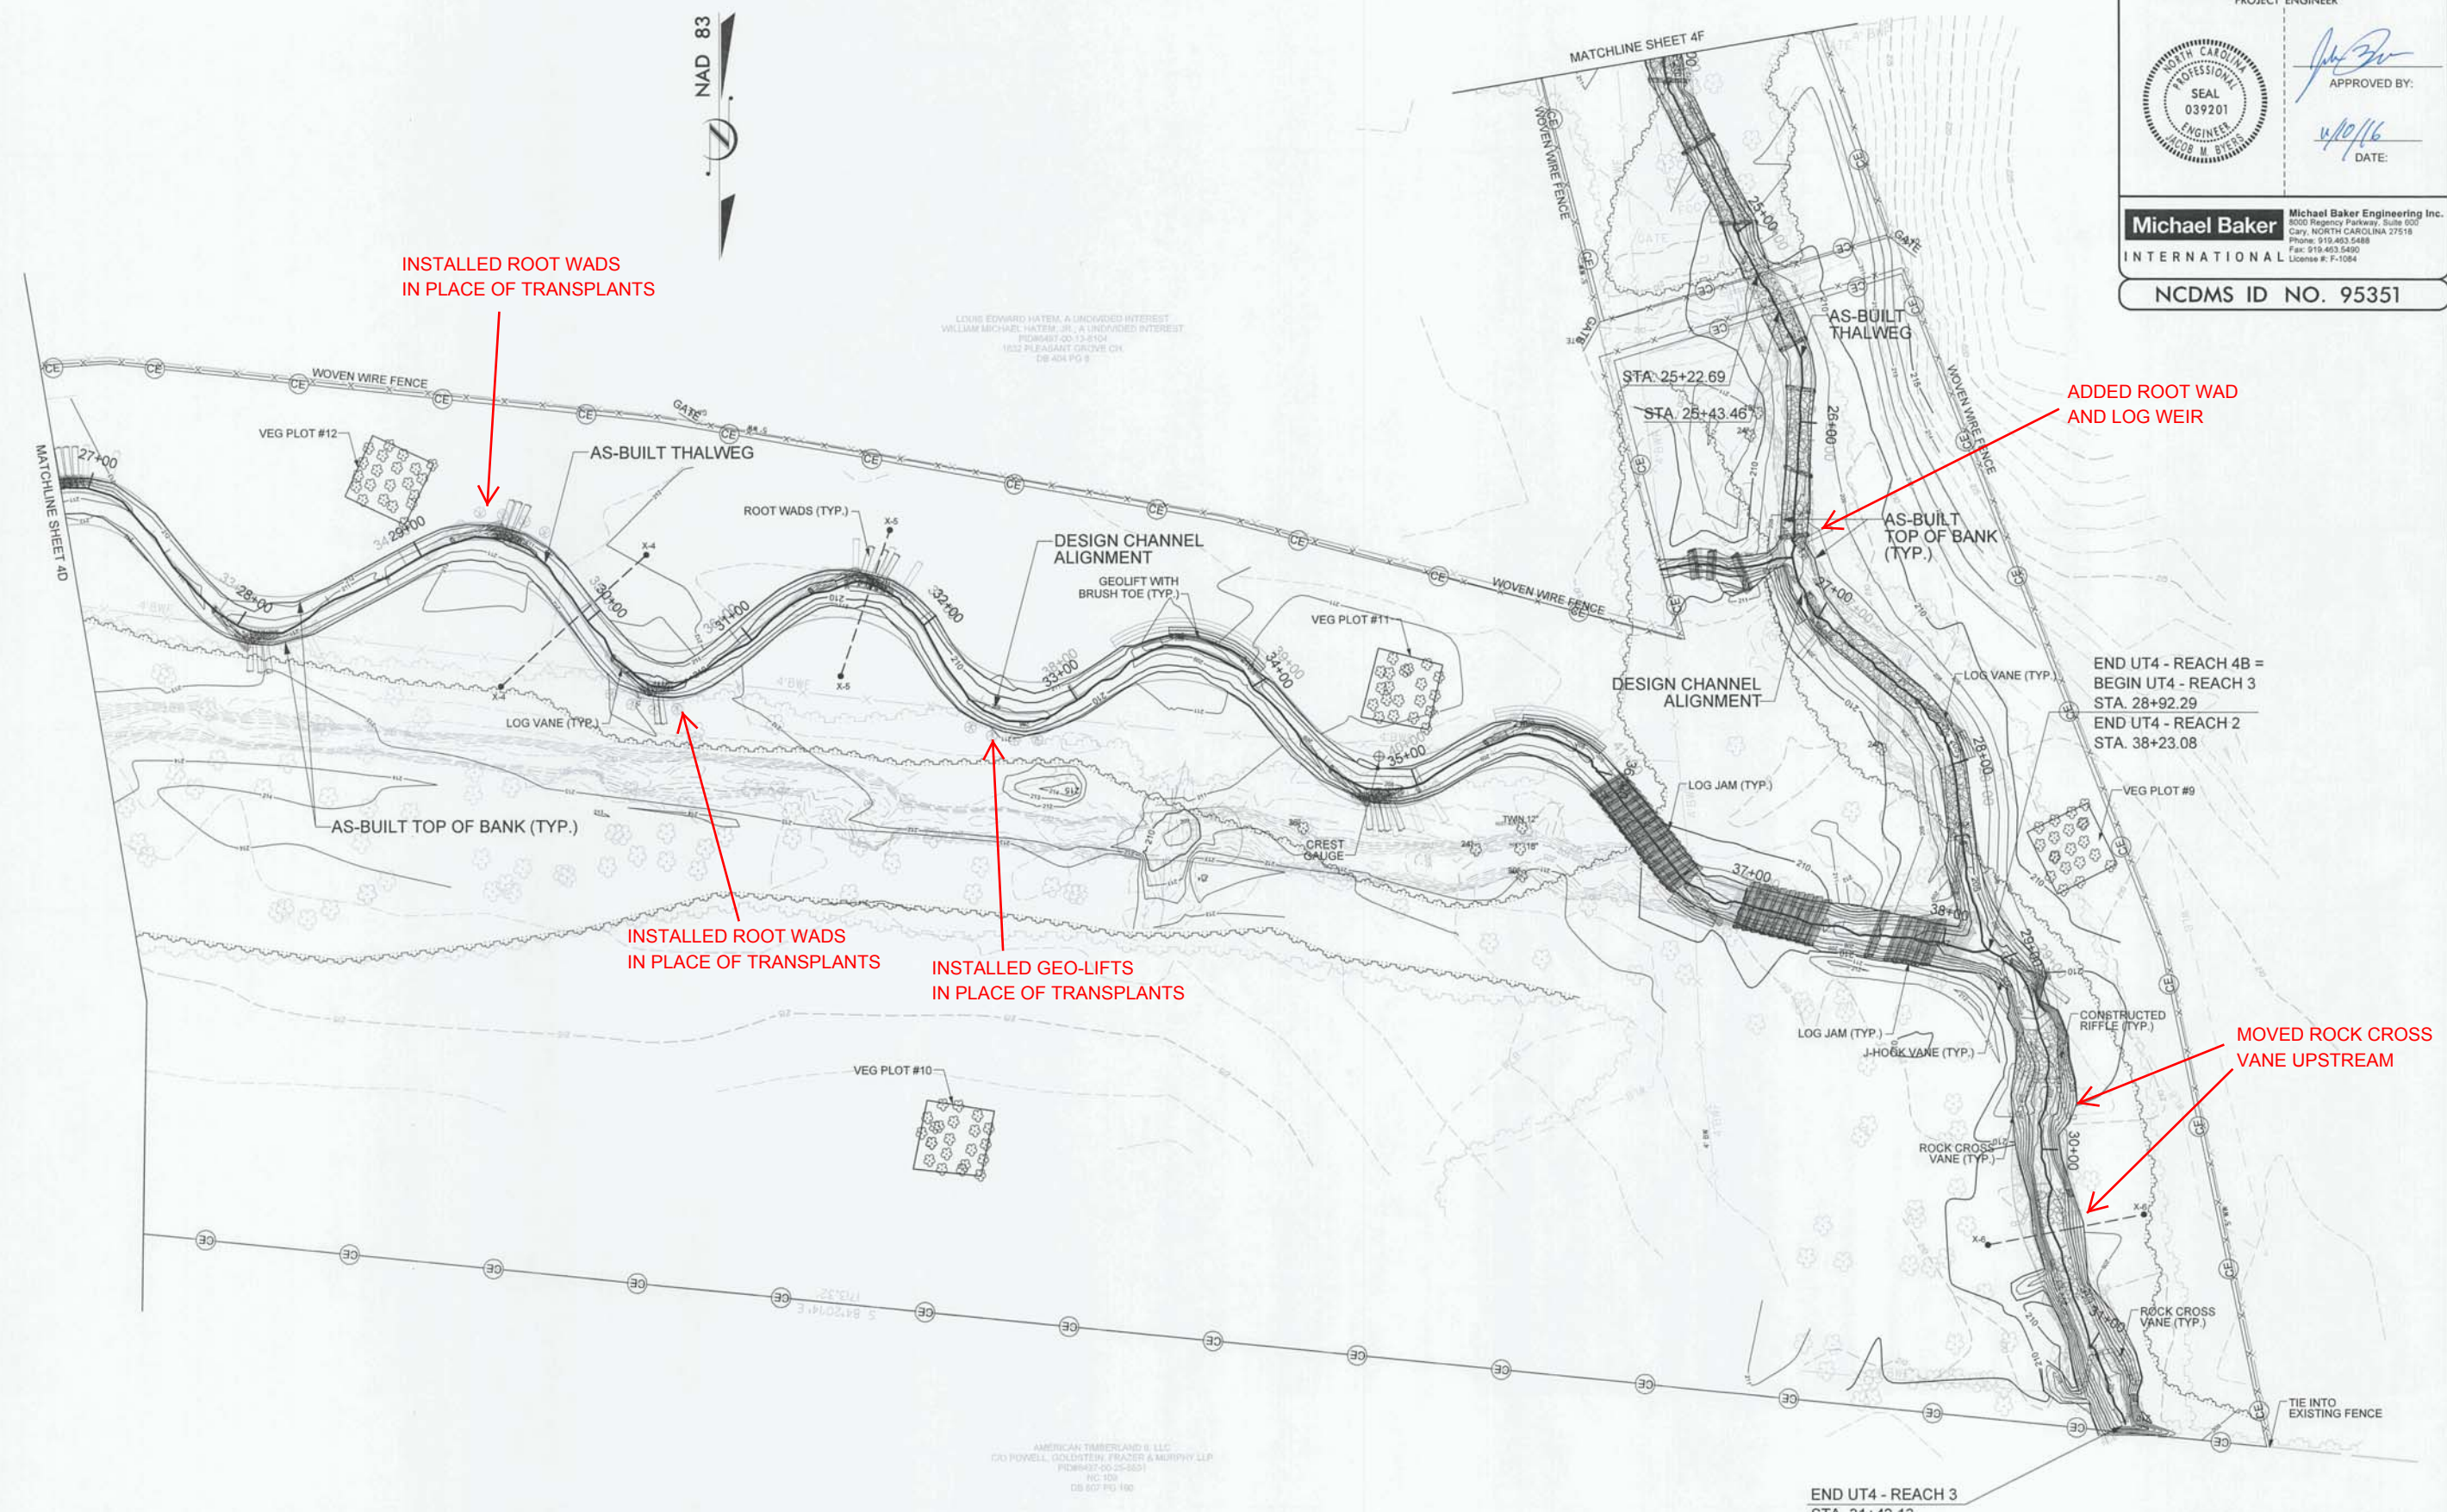

INSTALLED ROOT WADS
IN PLACE OF TRANSPLANTS

ADDED ROOT WAD
AND LOG WEIR


AS-BUILT TOP OF BANK (TYP.)

INSTALLED ROOT WADS
IN PLACE OF TRANSPLANTS

INSTALLED GEO-LIFTS
IN PLACE OF TRANSPLANTS

MOVED ROCK CROSS
VANE UPSTREAM

RECORD DRAWING
UT4
PLAN VIEW



SCALE (FT)

2/26/03
 11/9/2015
 H:\128975\Design\Plans\AS-BUILT\PLANS\128975_AS-B-UT4_PSH_04E.dgn
 mcarey
 BrownCreekTribs_95351_AB_12/15/2015_Final



AMERICAN TIMBERLAND & LLC
 C/O POWELL, GOLDSTEIN, FRACER & MURPHY LLP
 PERMIT NO. 25-5621
 NC-109
 DS 007 PG 140

LYNN EDWARD HAYEN, A UNDIVIDED INTEREST
 WILLIAM MICHAEL HAYEN, JR., A UNDIVIDED INTEREST
 PERMIT NO. 13-8104
 1832 PLEASANT CREEK CH
 DS 404 PG 9



2/26/03

BAKER PROJECT REFERENCE NO. 128975	SHEET NO. 4F
PROJECT ENGINEER	
	APPROVED BY: 
	DATE: 11/23/16
Michael Baker International <small>Michael Baker Engineering Inc. 2000 Regency Parkway, Suite 600 Cary, NORTH CAROLINA 27518 Phone: 919.463.5488 Fax: 919.463.5480 License #: F-1084</small>	
NCDMS ID NO. 95351	

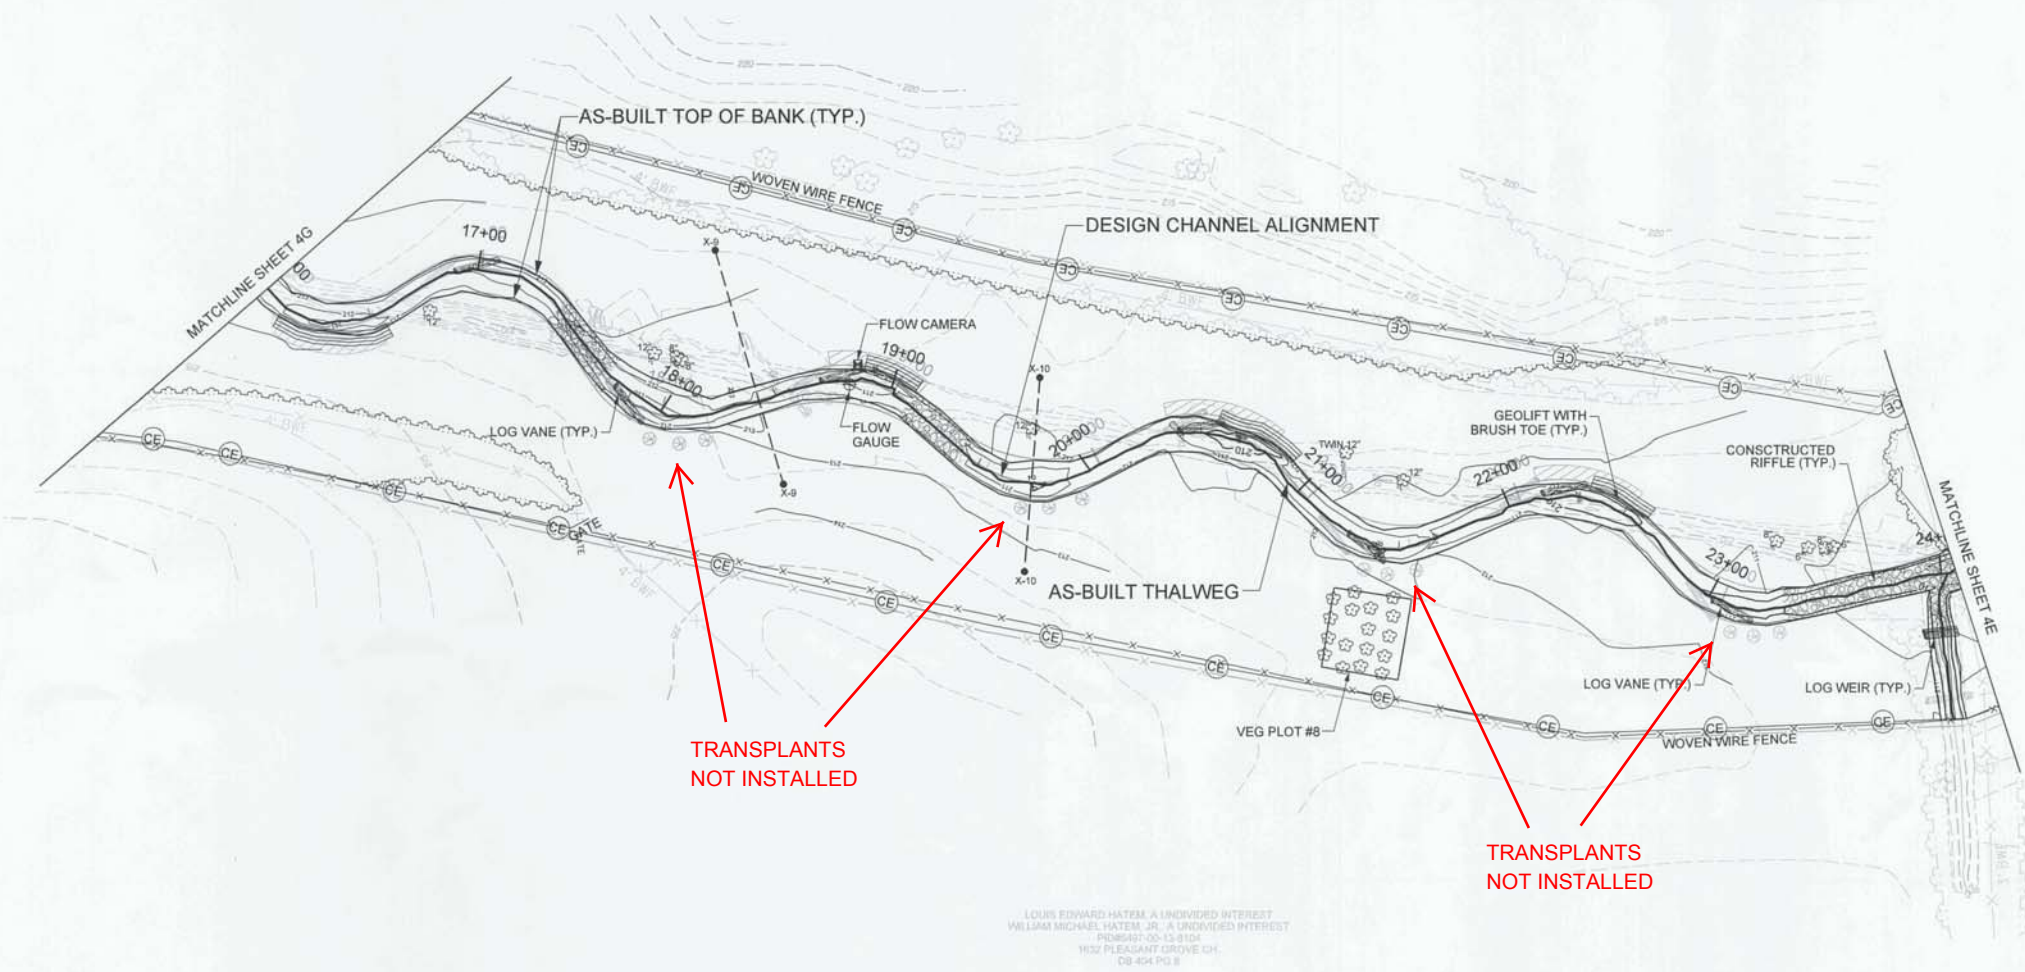
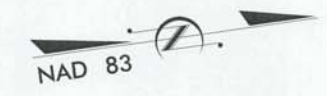


I:\16\2016\Design\Projects\AS-BUILD\PLANS\128975_ASB-UT4_PSH_04F.dgn
 mcarey
 BrownCreekTrbs_95351_AB_12/15/2015_Final

RECORD DRAWING
UT4
PLAN VIEW

SCALE (FT)

BAKER PROJECT REFERENCE NO. 128975	SHEET NO. 4G
PROJECT ENGINEER	
	
APPROVED BY: 	
DATE: 4/10/16	
Michael Baker International <small>Michael Baker Engineering Inc. 3030 Regency Parkway, Suite 602 Cary, NORTH CAROLINA 27518 Phone: 919.463.5488 Fax: 919.463.5495 License #: F-1084</small>	
NCDMS ID NO. 95351	

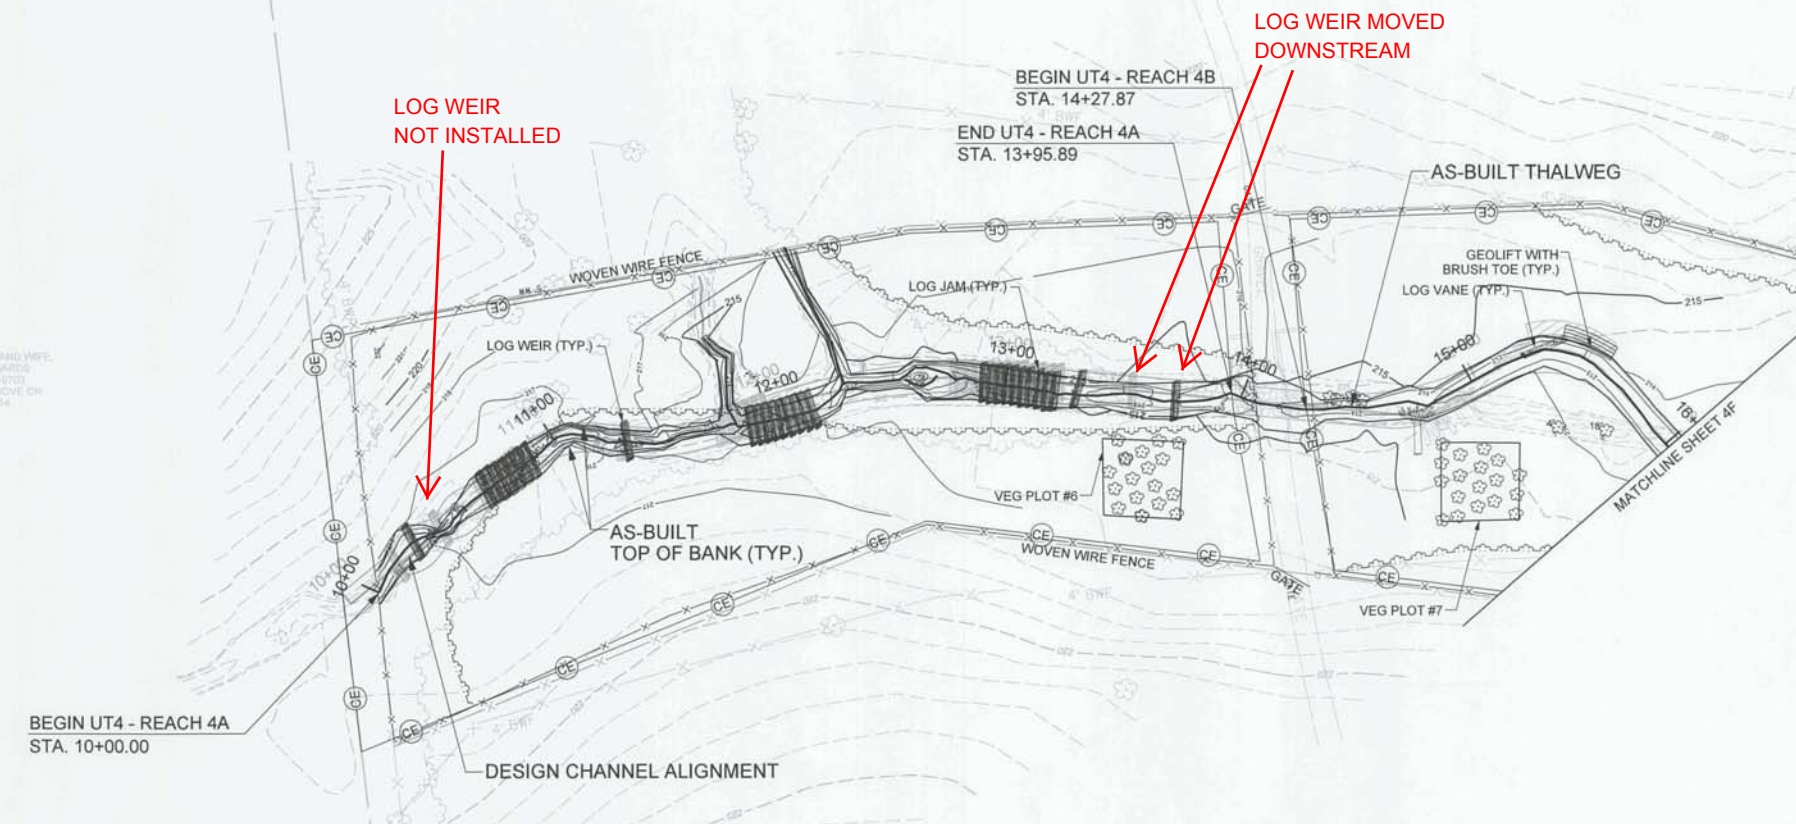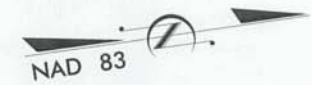

DAVID M. EDWARDS AND YAREL
 SHARON B. EDWARDS
 PERMIT NO. 13-8104
 1632 PLEASANT GROVE CH.
 DS 404 PG 214

LOUIS EDWARD HATTEM - A UNDIVIDED INTEREST
 WILLIAM MICHAEL HATTEM, JR. - A UNDIVIDED INTEREST
 PERMIT NO. 13-8104
 1632 PLEASANT GROVE CH.
 DS 404 PG 8

T. LYNN CLODFELTER
 AND YAREL J. ELKINS CLODFELTER
 PERMIT NO. 13-8104
 1632 PLEASANT GROVE CH.
 DS 404 PG 34



RECORD DRAWING
UT4
PLAN VIEW


SCALE (FT)

I:\3\2016\128975\Design\PI\ans\AS-BUILD\PLANS\128975-ASB-UT4_PSH_04G.dgn
 nicarey
 BrownCreekTrl.bs - 95351_AB.12/15/2015_F.rvt

2/26/03

2/26/03

BAKER PROJECT REFERENCE NO. 128975	SHEET NO. 4H
PROJECT ENGINEER	
	
APPROVED BY: 	
DATE: 1/23/16	
Michael Baker International <small>Michael Baker Engineering Inc. 8000 Regency Parkway, Suite 600 Cary, NORTH CAROLINA 27516 Phone: 919.463.5488 Fax: 919.463.5490 License #: P-1084</small>	
NCDMS ID NO. 95351	

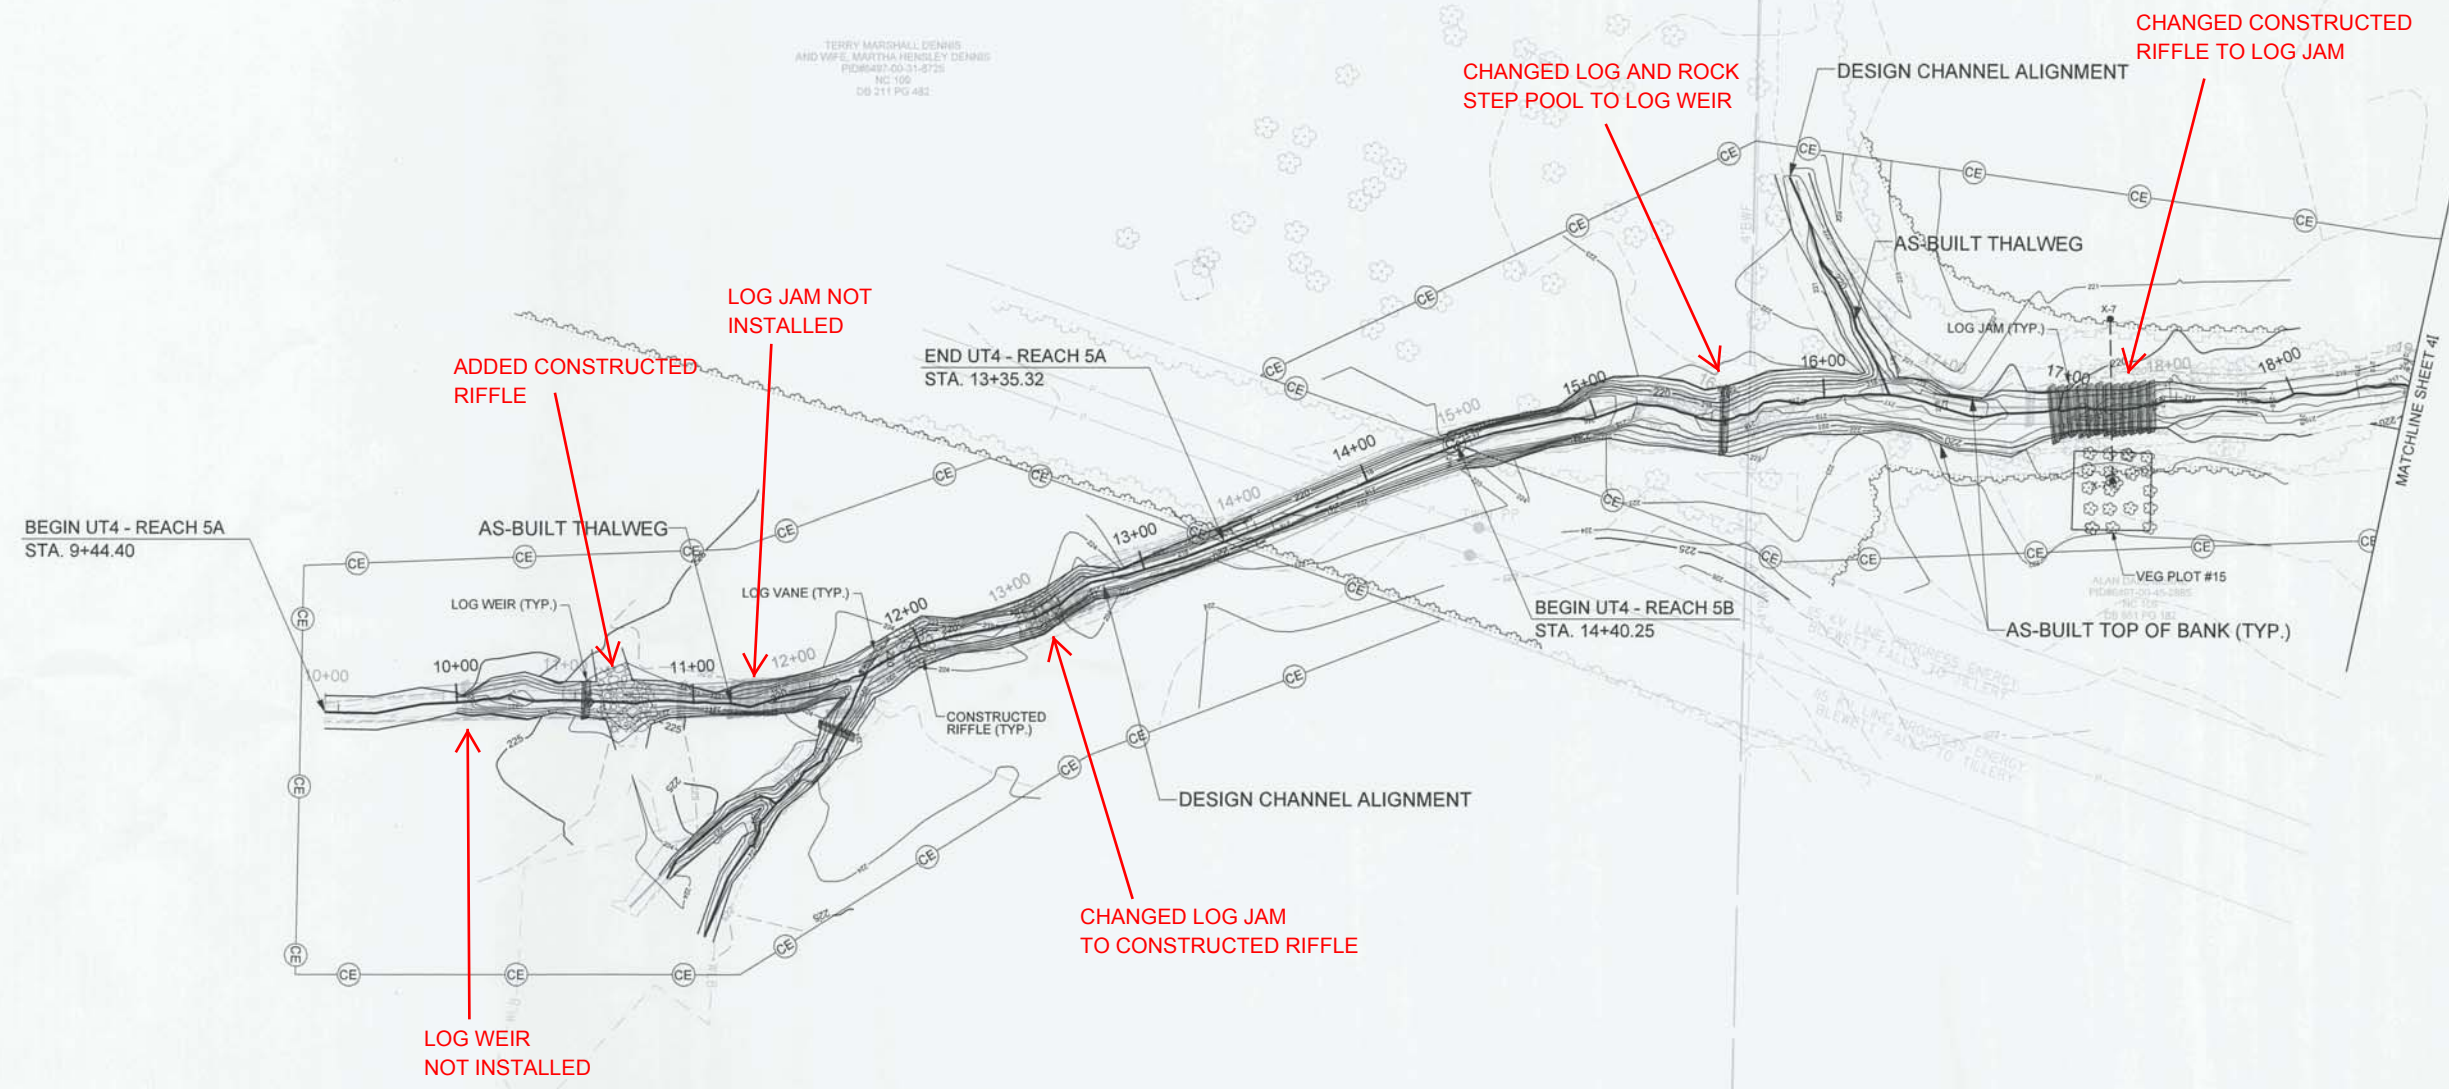

11/16/2016
 H:\128975\Design\Plans\AS-BUILT\PLANS\128975_ASB-UT4_PSH_04H.dgn
 mcarey
 BrownCreekTrbs_95351_AB.12/15/2015_Final

RECORD DRAWING
UT4
PLAN VIEW

SCALE (FT)

PROJECT ENGINEER




APPROVED BY: *Jacob M. Byers*

DATE: 4/10/16

Michael Baker International
 Michael Baker Engineering Inc.
 8500 Regency Parkway, Suite 600
 Cary, NORTH CAROLINA 27518
 Phone: 919.463.5488
 Fax: 919.463.5450
 License #: F-1084

NCDMS ID NO. 95351

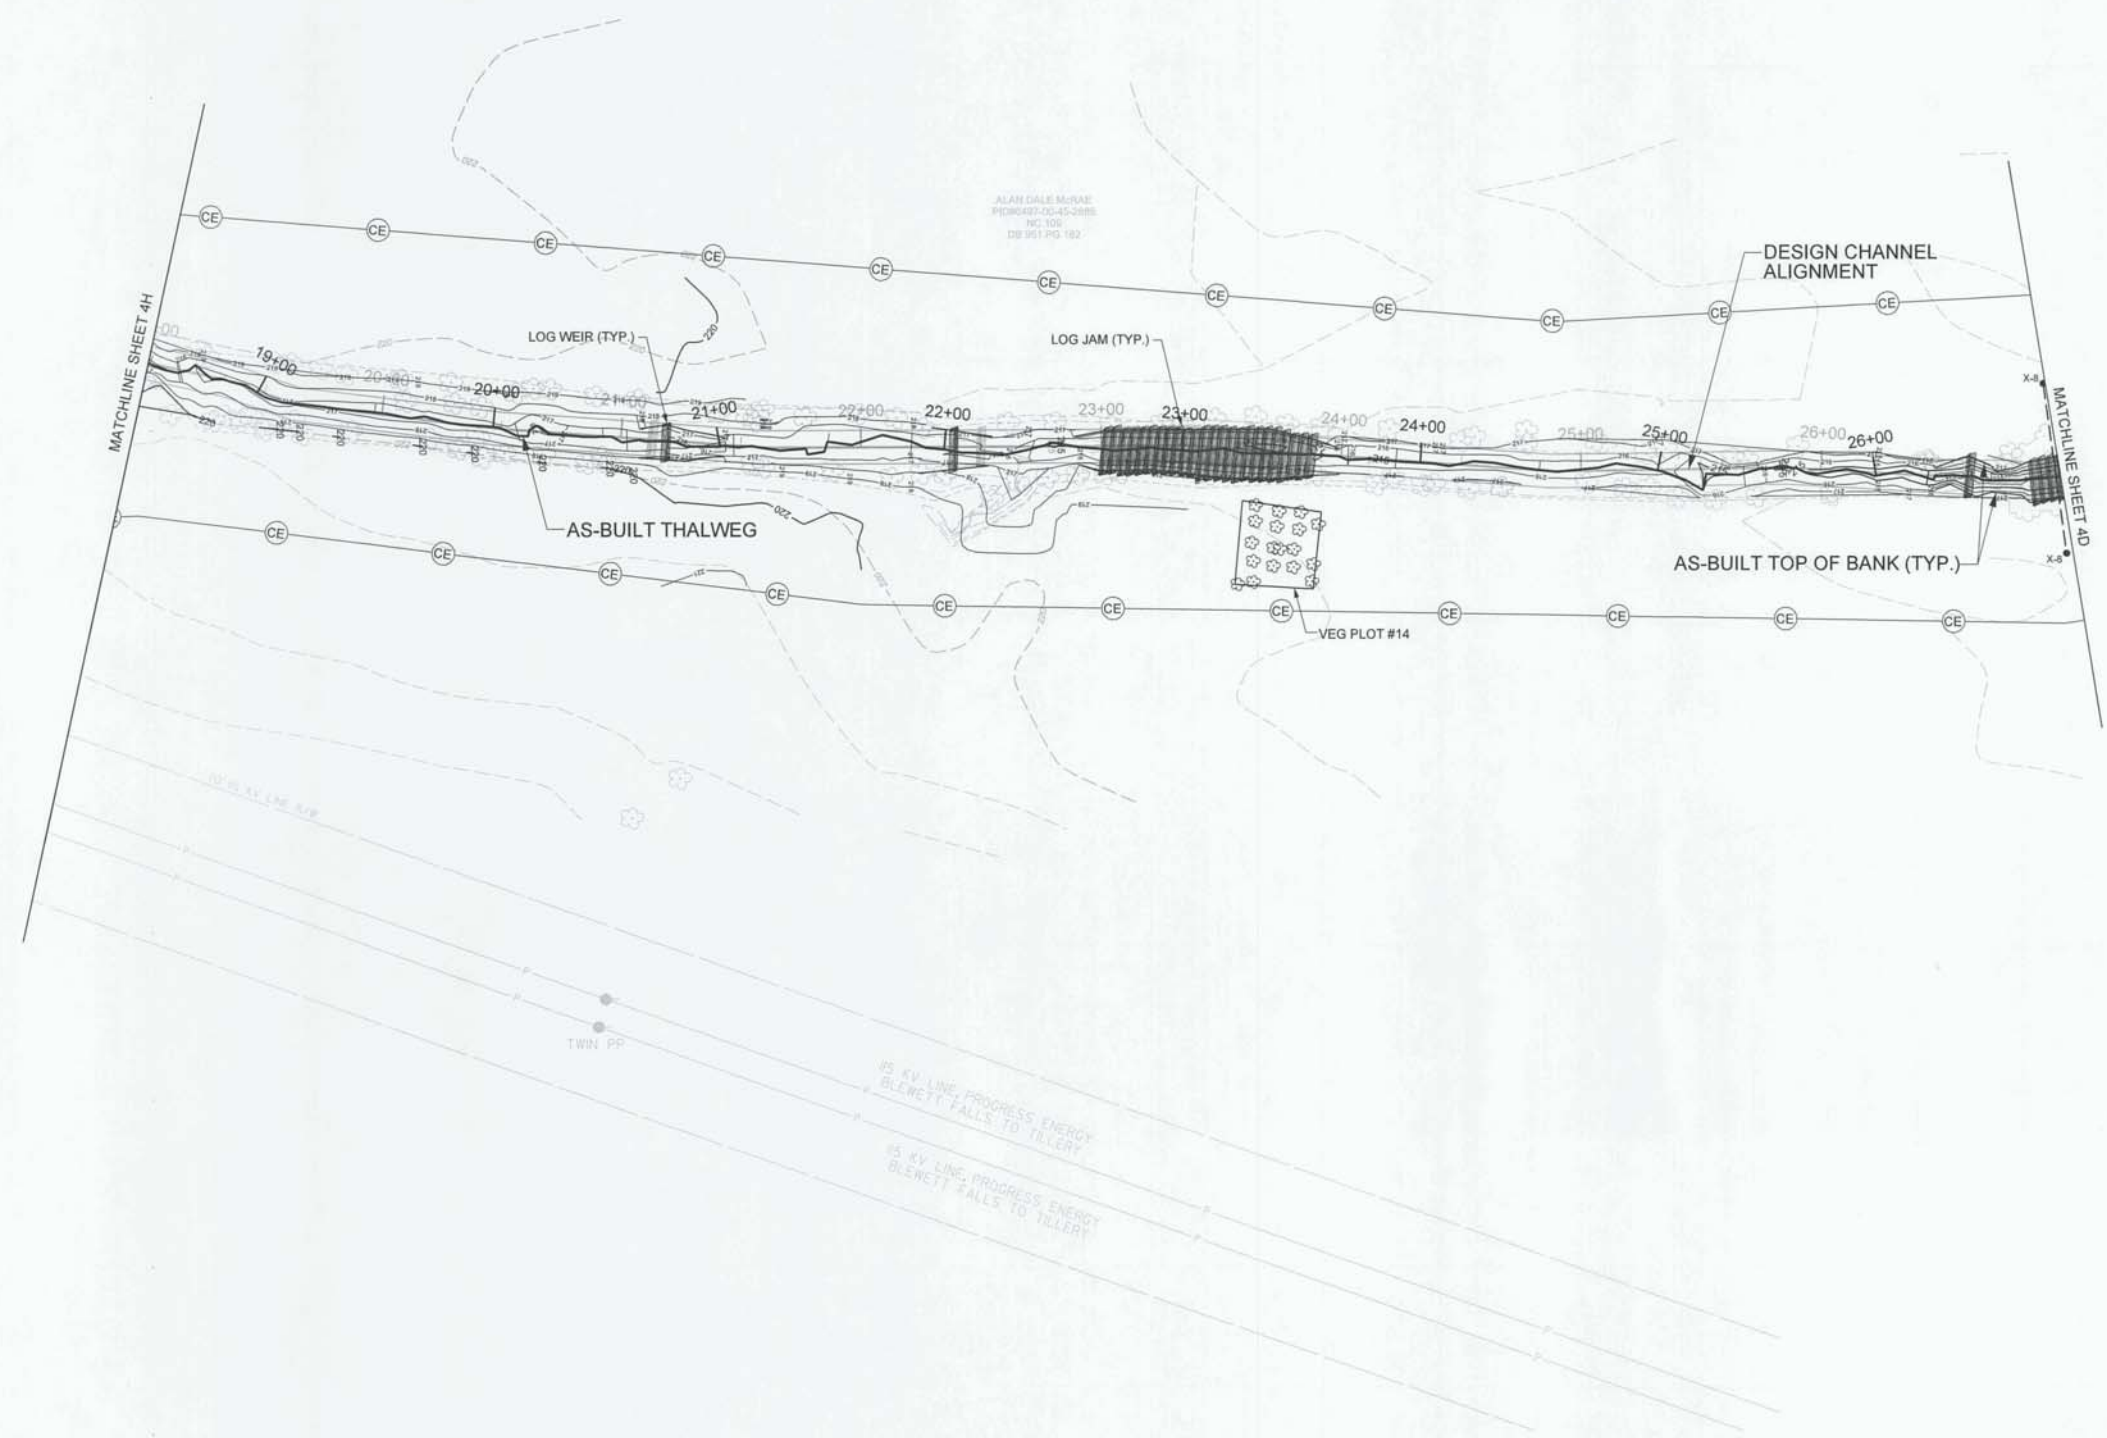


RECORD DRAWING
UT4
PLAN VIEW

SCALE (FT)

I:\9\2015\Design\Plans\AS-BUILT\PLANS\128975-ASB-UT4_PSH_041.dgn
 mcb:ej
 BrownCreek\Tribal_95351.dwg 12/15/2015 F.msl
 2/26/03

2/26/03


HURRICANE CREEK - REACH 1

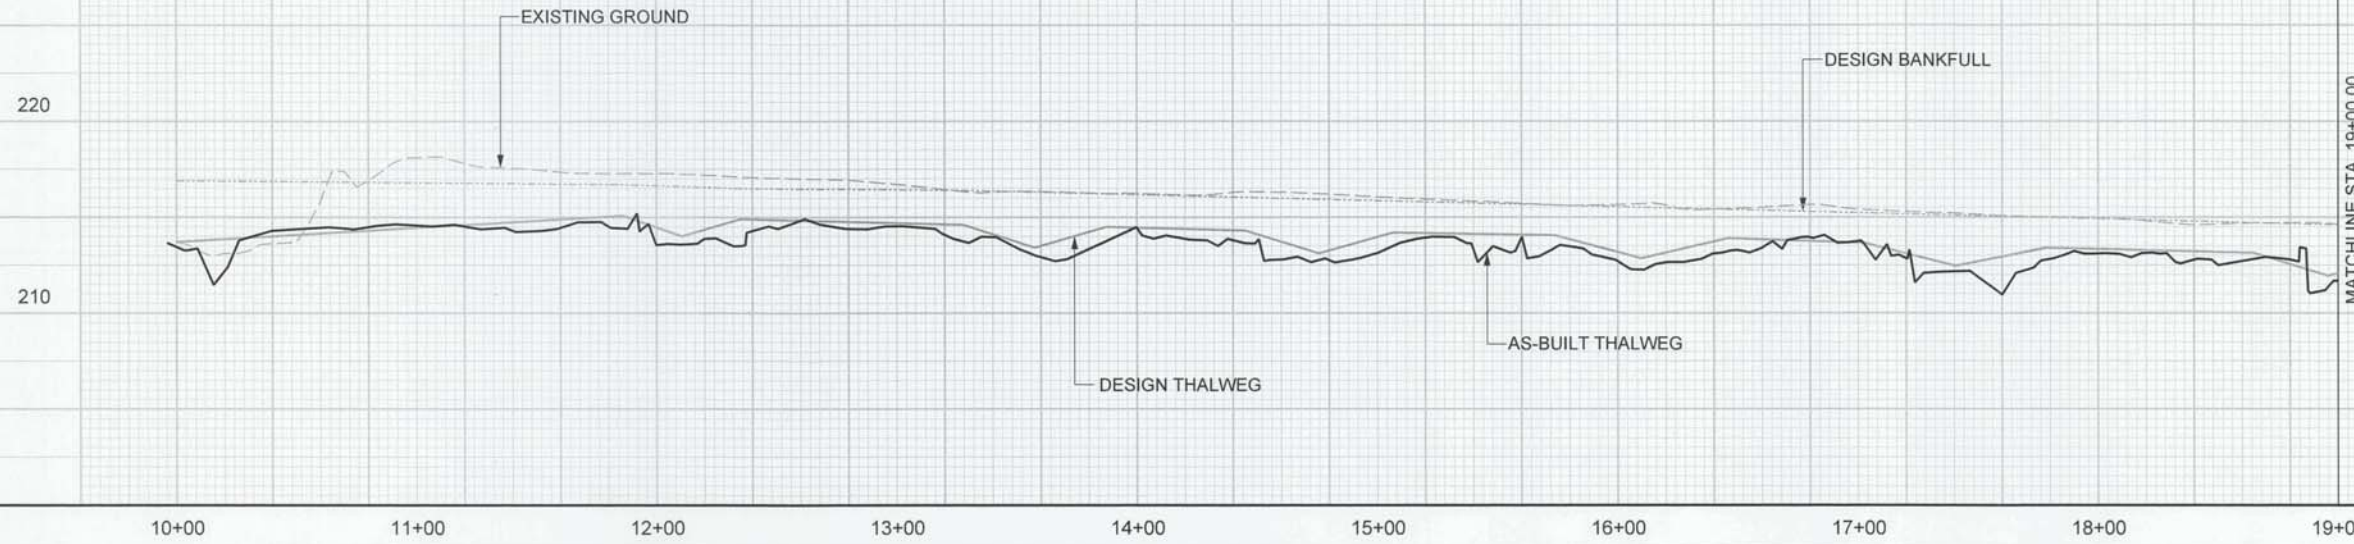


BAKER PROJECT REFERENCE NO. 128975	SHEET NO. 5
PROJECT ENGINEER	
APPROVED BY:	
DATE: 11/16/16	
Michael Baker International <small>Michael Baker Engineering Inc. 8000 Regency Parkway, Suite 600 Cary, NORTH CAROLINA 27518 Phone: 919.483.5488 Fax: 919.483.5490 License #: F-1084</small>	
NCDMS ID NO. 95351	

J. D. Lee
 12-7-16

HURRICANE CREEK - REACH 1

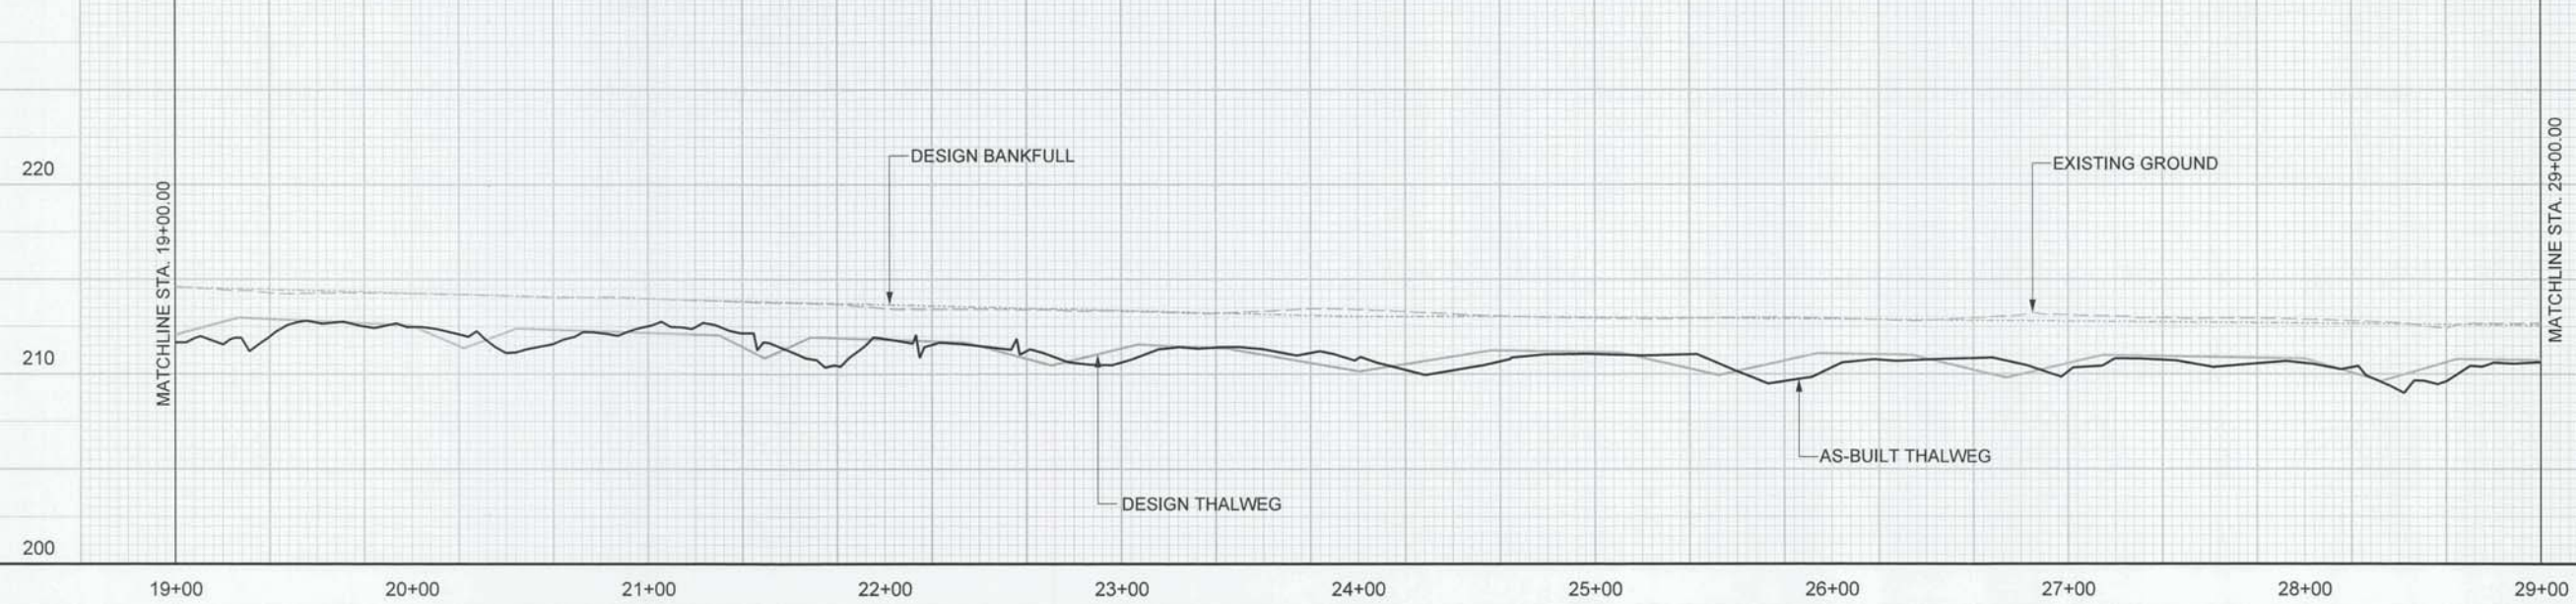

HURRICANE CREEK - REACH 1 & 2

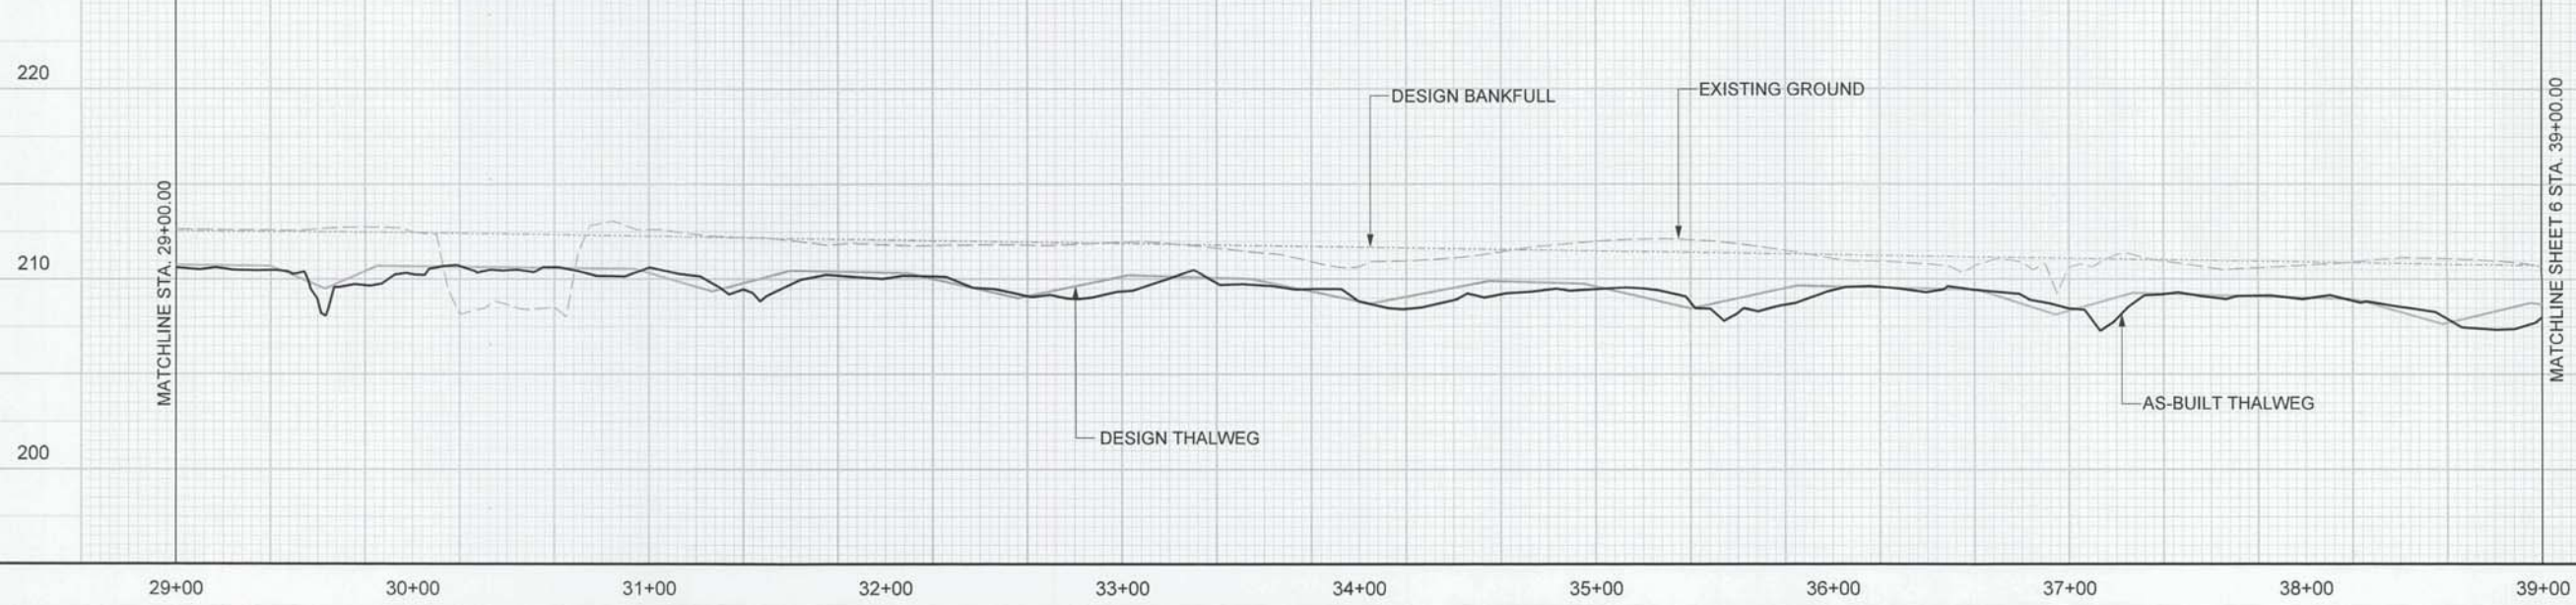

11/9/2016 12:28:58 PM
 I:\Projects\128975\Drawings\ASB\ASB-PFL_05.dgn
 BrownCreekTribs_95351_AB_12/15/2015_F.plt






APPROVED BY: *[Signature]*
DATE: 11/16/16

Michael Baker International
Michael Baker Engineering Inc.
8000 Regency Parkway, Suite 600
Cary, NORTH CAROLINA 27518
Phone: 919.483.5480
Fax: 919.483.5490
License #: F-1084

NCDMS ID NO. 95351




[Signature]
12-7-16

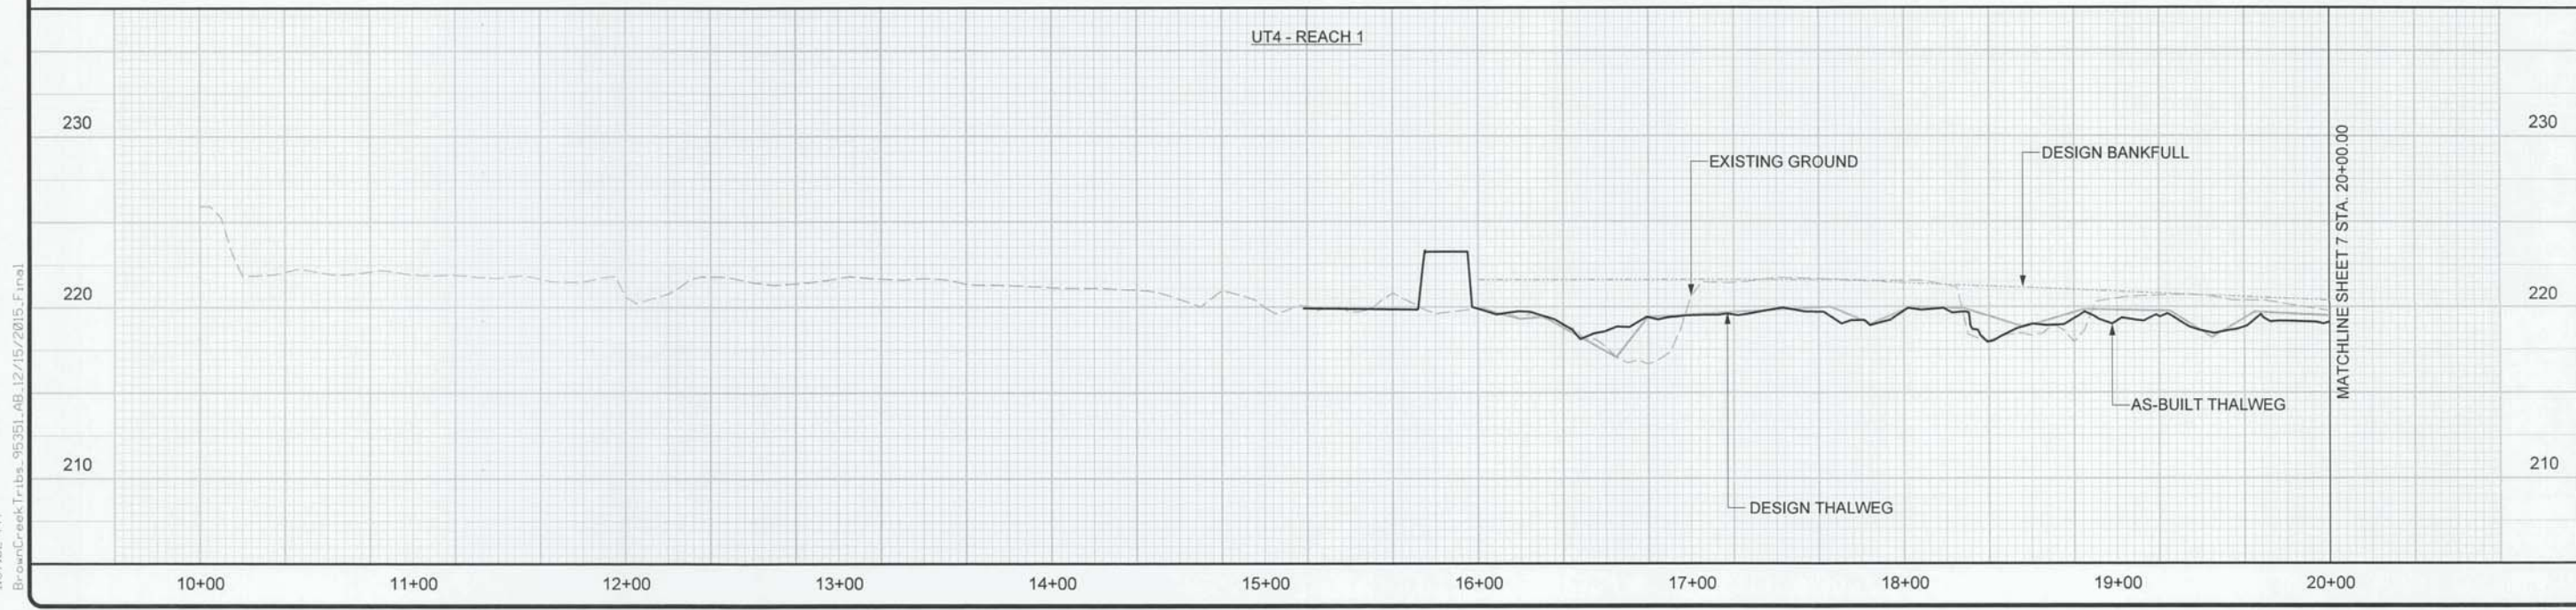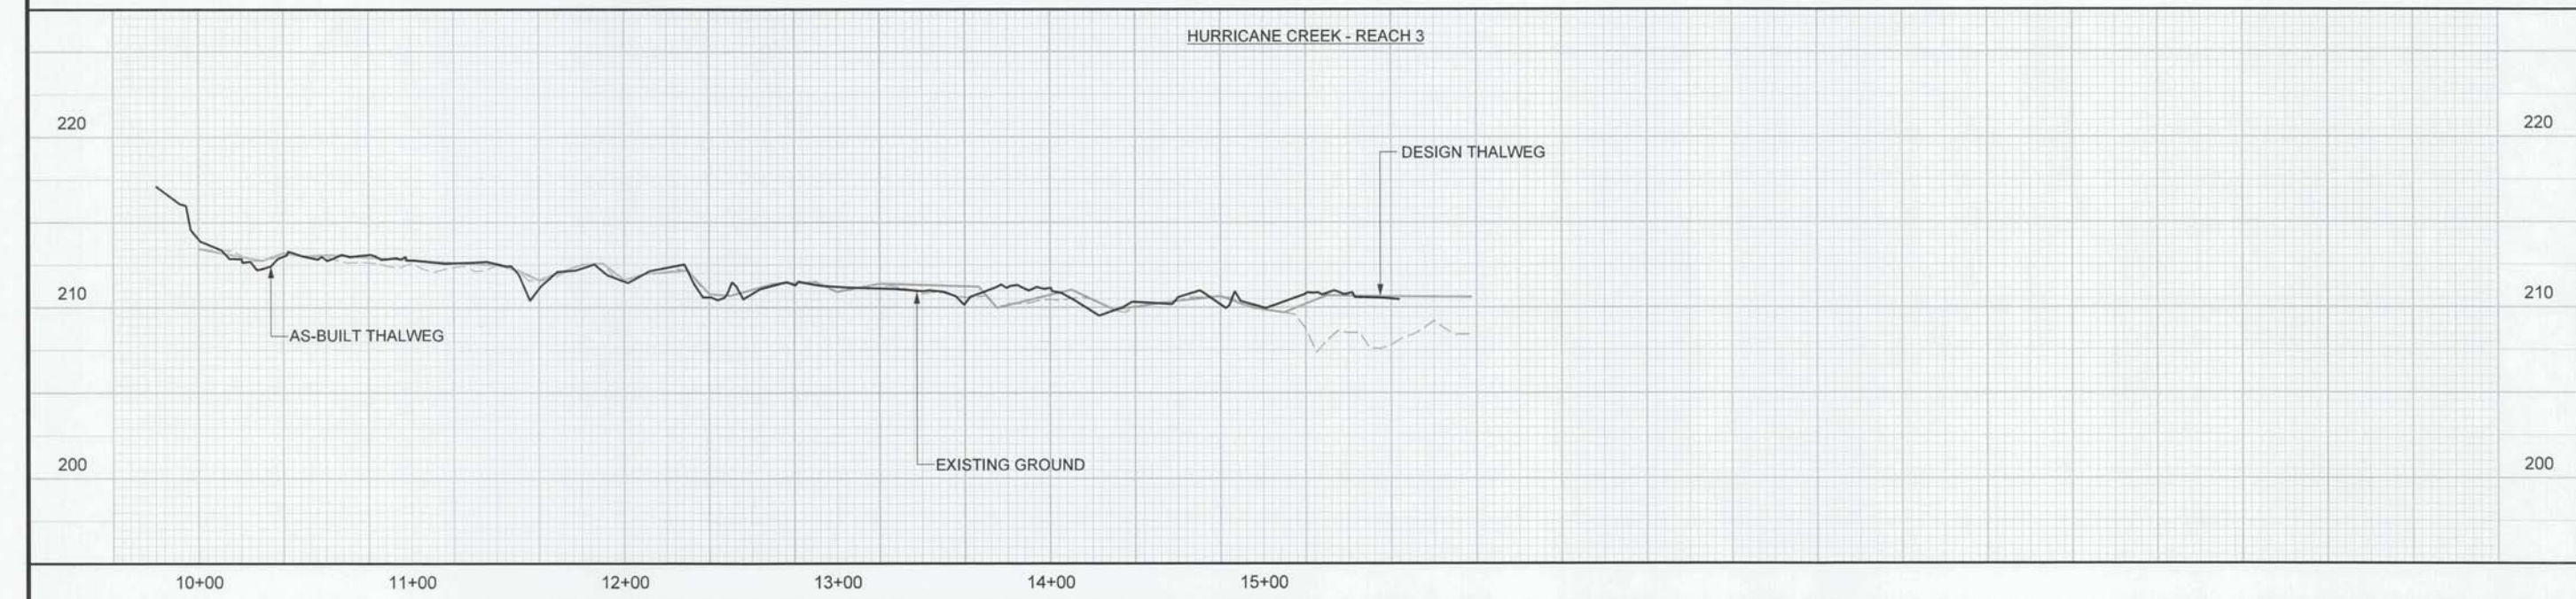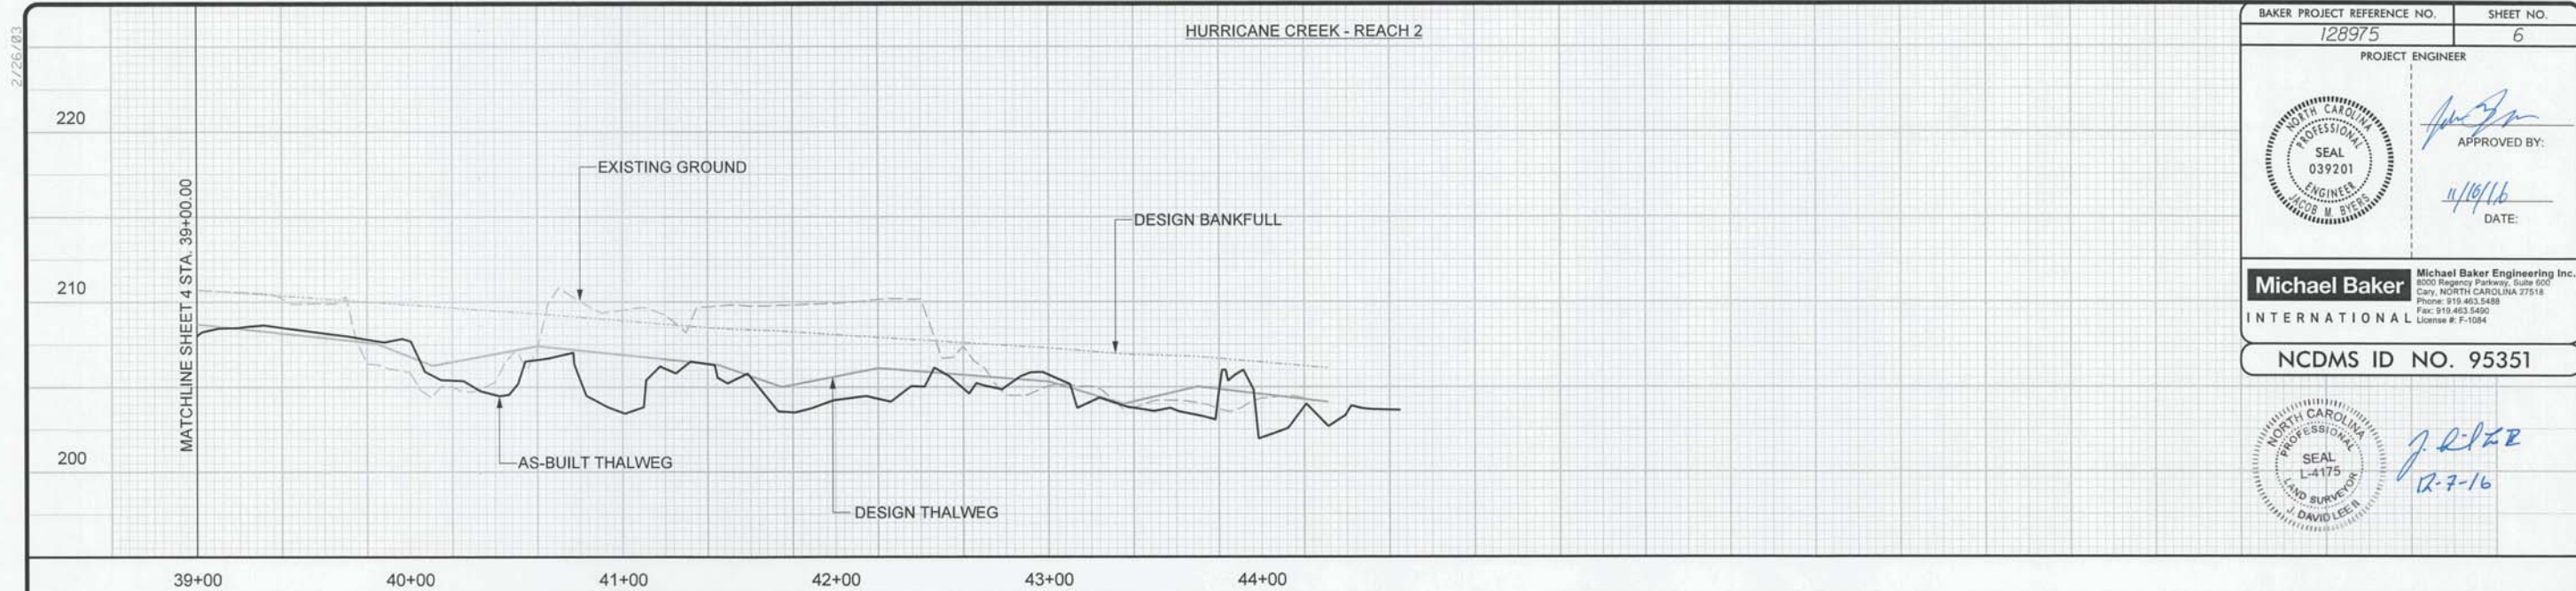

11/9/2016 1:57:58 PM
 I:\Projects\128975\Design\Plans\AS-BUILT\T\Final\To-DMS_10Nov2016\PI\ana\BrownC-Trib_95351_ASB-PPF_L_06.dgn
 BrownCreekTrib_95351_AB_12/15/2015_Final

2/26/03


UT4 - REACH 1 / REACH 2

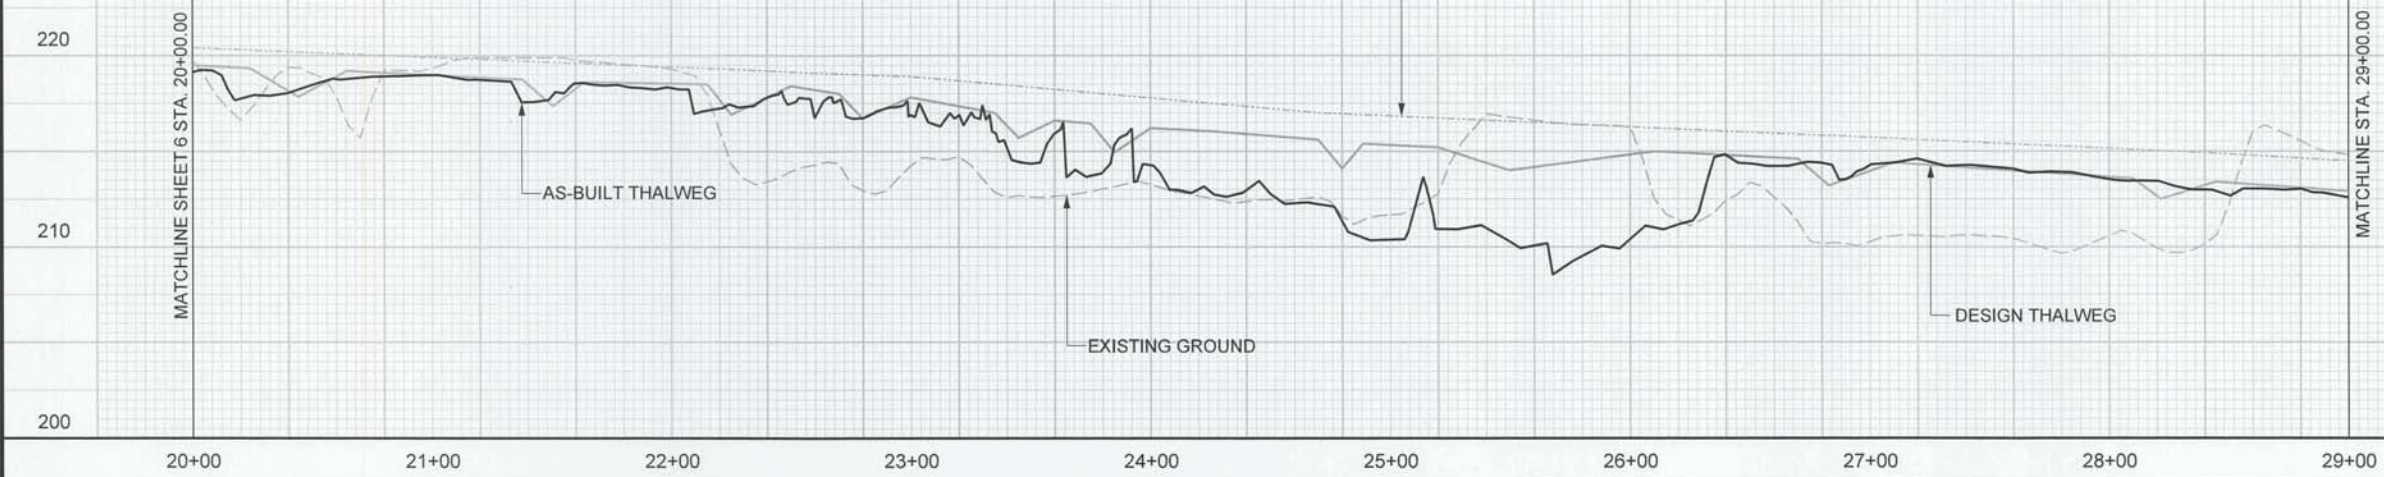


BAKER PROJECT REFERENCE NO. 128975	SHEET NO. 7
PROJECT ENGINEER	
APPROVED BY:	DATE:
<i>J. Baker</i>	1/10/11
Michael Baker International <small>Michael Baker Engineering Inc. 8000 Regency Parkway, Suite 600 Cary, NORTH CAROLINA 27518 Phone: 919.463.5458 Fax: 919.463.5490 License #: F-1084</small>	
NCDMS ID NO. 95351	

	<i>J. David Lee</i> 12-7-14
--	--------------------------------


UT4 - REACH 2

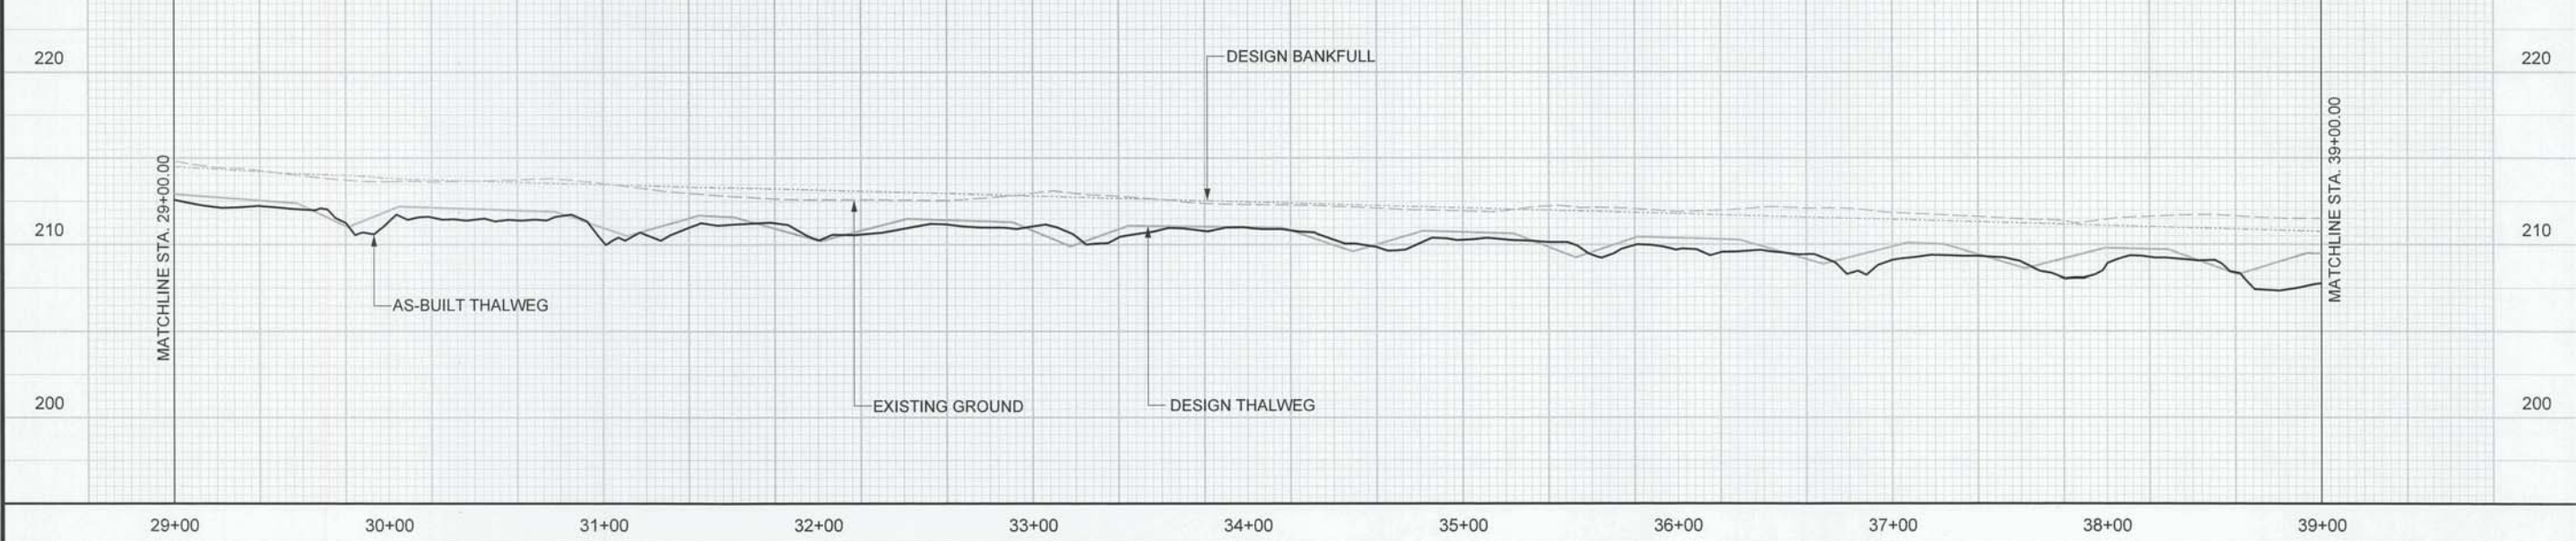




UT4 - REACH 2

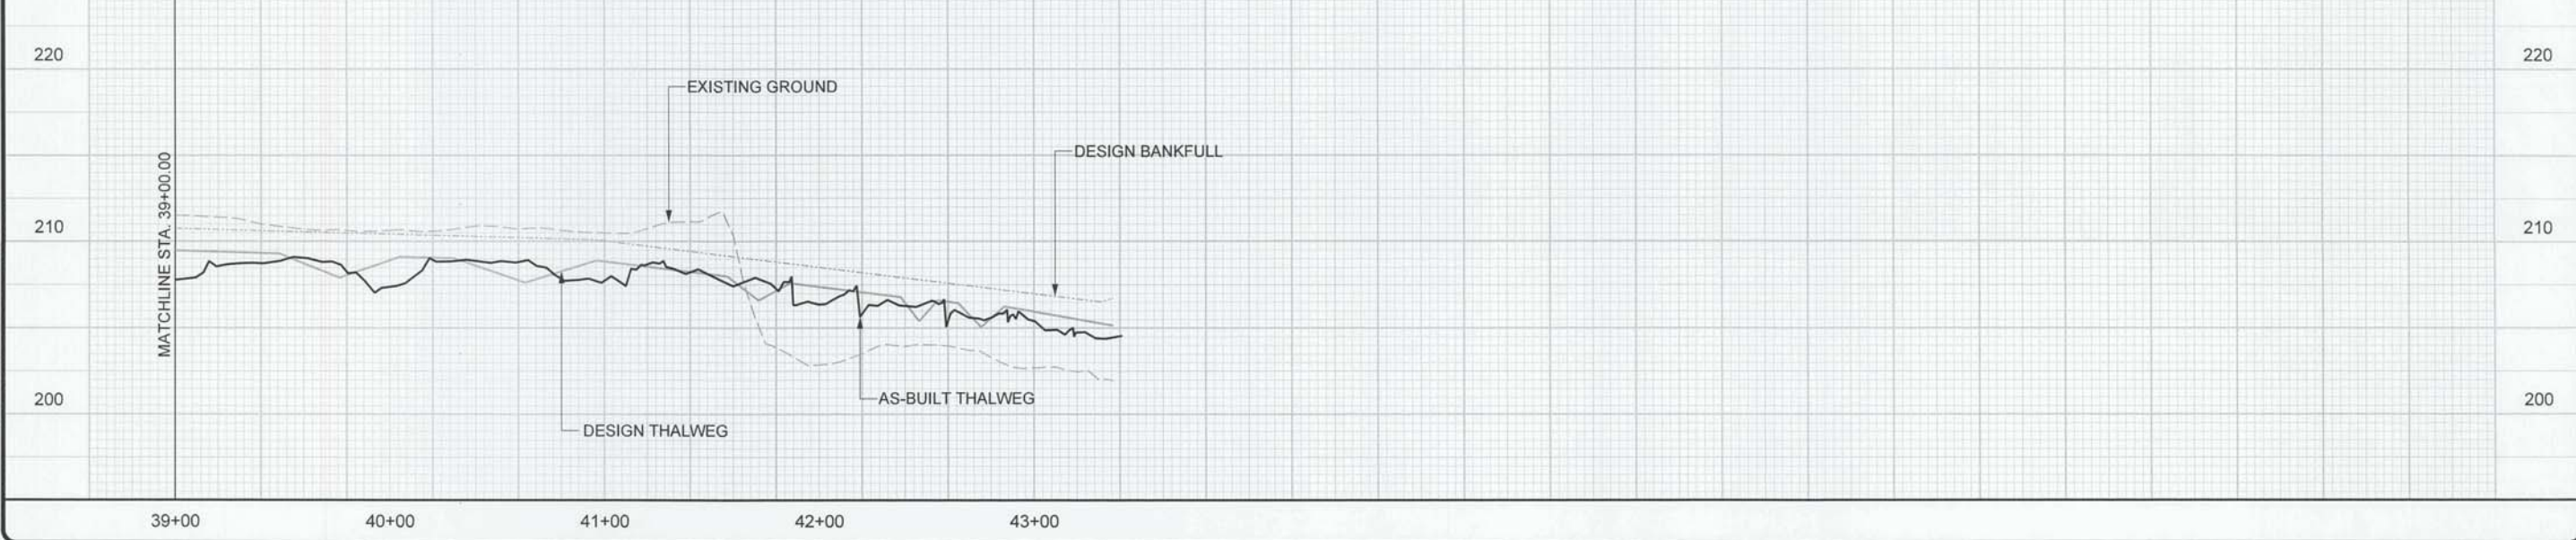

I:\9\2015\5\Design\Plans\AS-BUILT\PLANS\128975_ASB-PFL_07.dgn
 12/28/15 12:04:55 PM
 BrownCreekTribs_95351_AB_12/15/2015_Final

BAKER PROJECT REFERENCE NO. 128975	SHEET NO. 8
PROJECT ENGINEER	
APPROVED BY: <i>J. R. Lee</i>	
DATE: 11/10/16	
	
Michael Baker International <small>Michael Baker Engineering Inc. 8000 Regency Parkway, Suite 600 Cary, NORTH CAROLINA 27518 Phone: 919.463.5488 Fax: 919.463.5490 License #: F-1084</small>	
NCDMS ID NO. 95351	

	<i>J. R. Lee</i> 12-7-14
---	-----------------------------

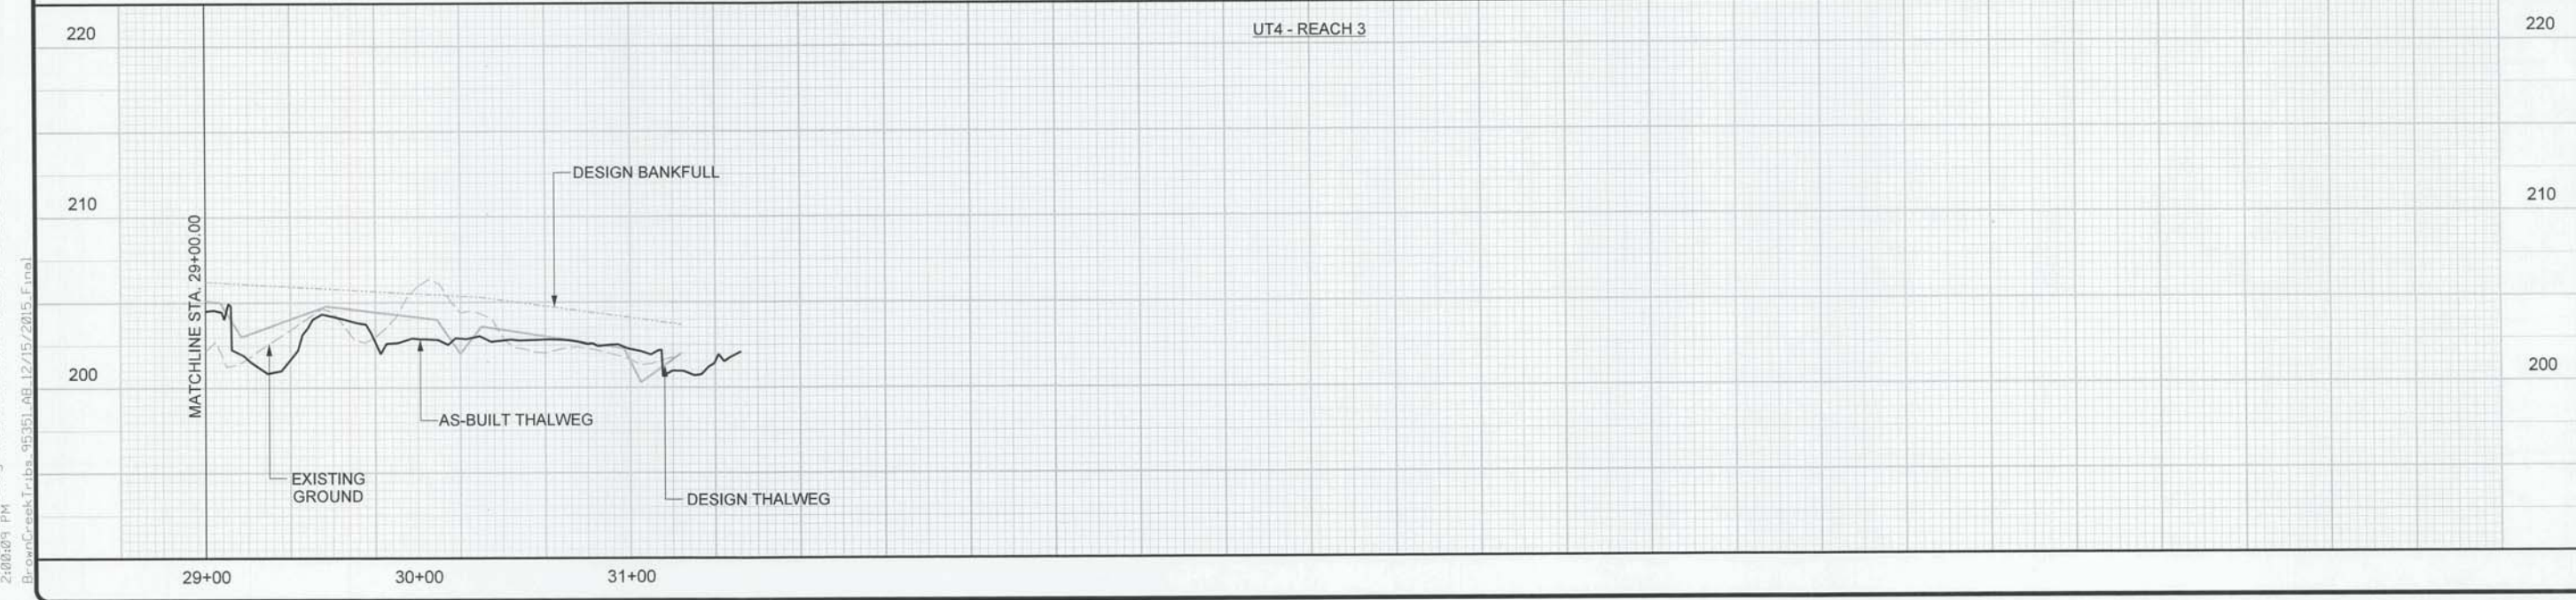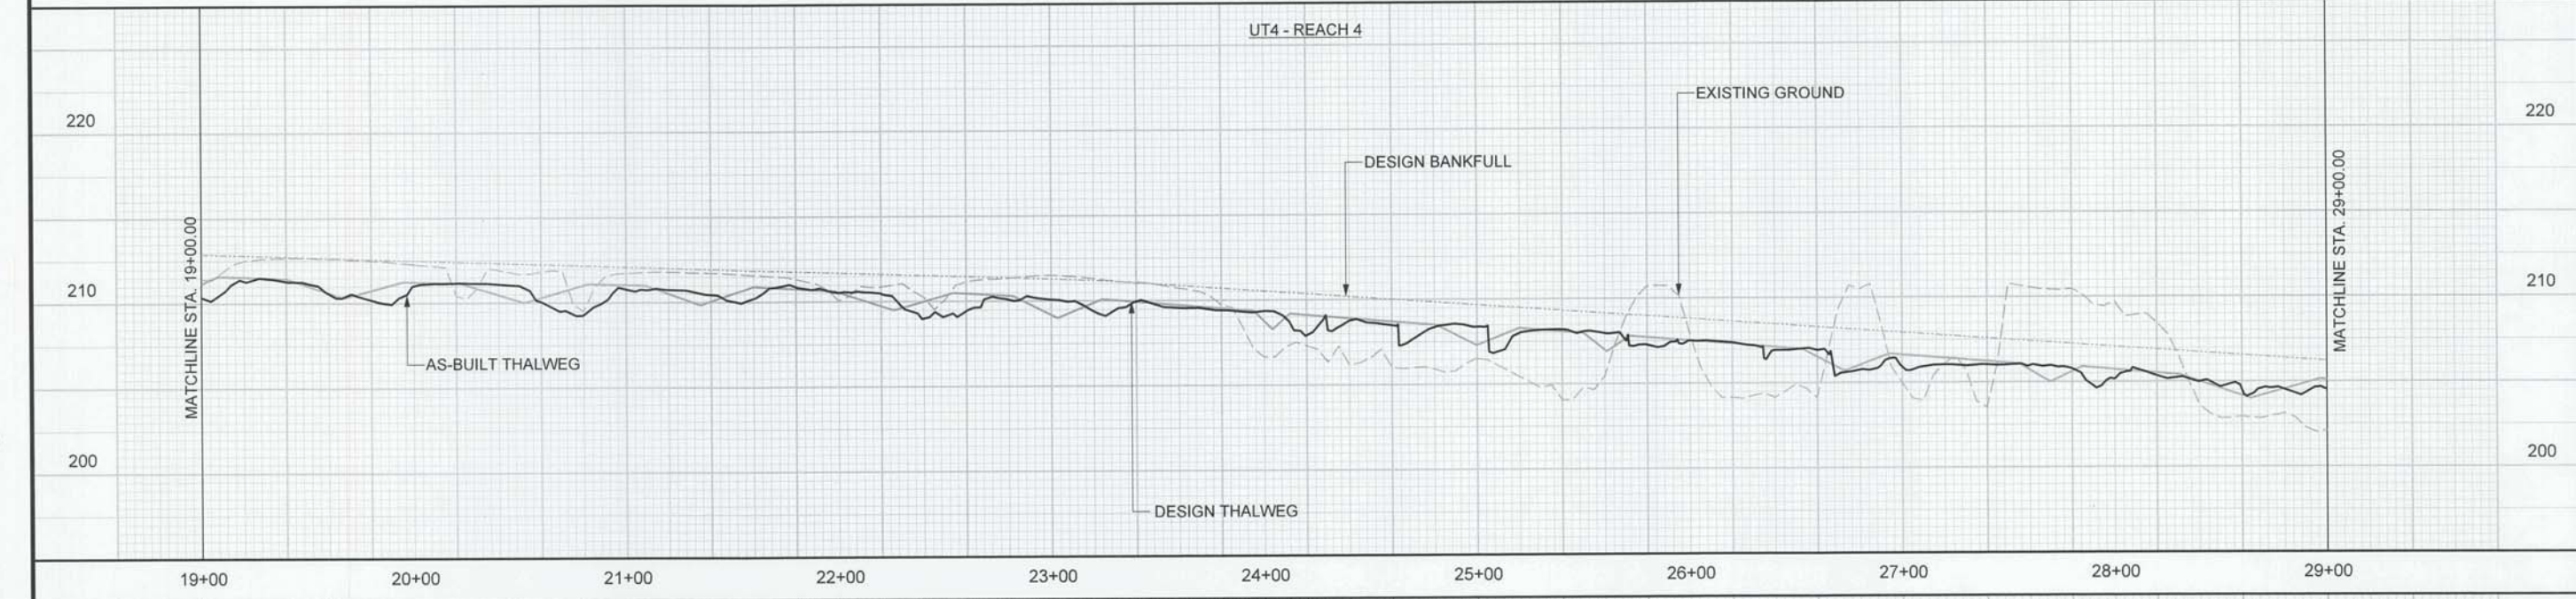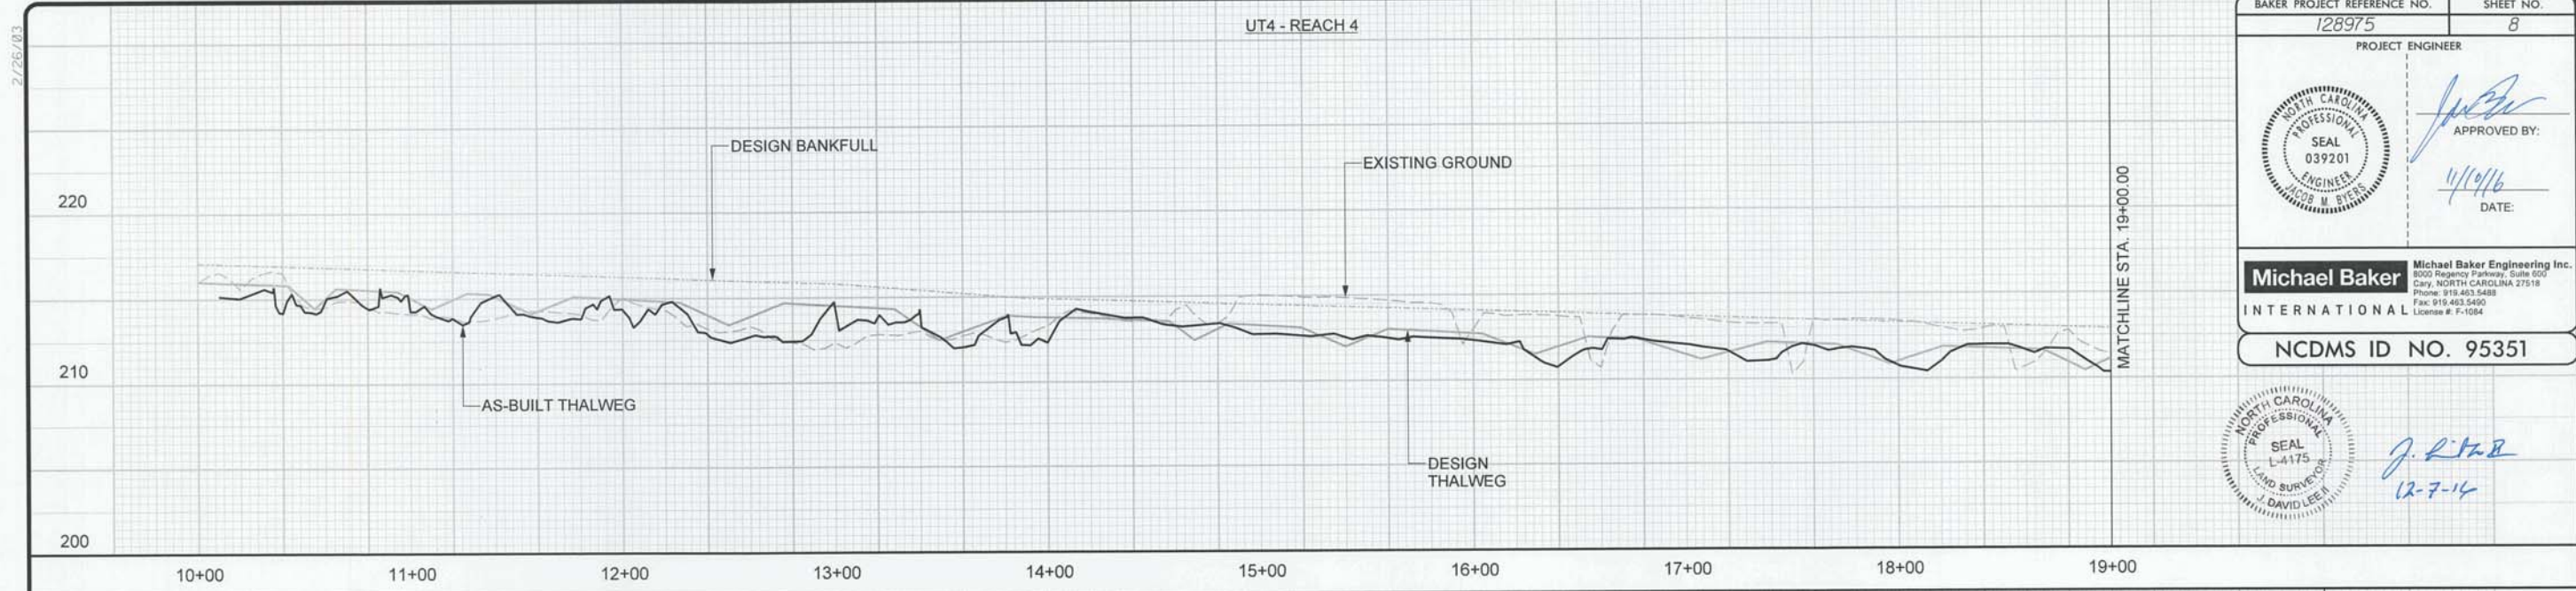




I:\Projects\2016\Design\Plans\AS-BUILT\Files-To-DMS\10Nov2016\Plans\BrownCrTrib\95351_ASB-PFL_08.dgn
 2:00:00 PM
 BrownCrTrib_95351.dwg 12/15/2015 1:51:51 PM

APPROVED BY: *[Signature]*
DATE: 4/27/16

Michael Baker International
Michael Baker Engineering Inc.
8000 Regency Parkway, Suite 600
Cary, NORTH CAROLINA 27518
Phone: 919.463.5488
Fax: 919.463.5490
License #: F-1084

NCDMS ID NO. 95351

[Seal]
NORTH CAROLINA PROFESSIONAL SEAL L-4175 LAND SURVEYOR DAVID LEE II
[Signature]
12-7-16

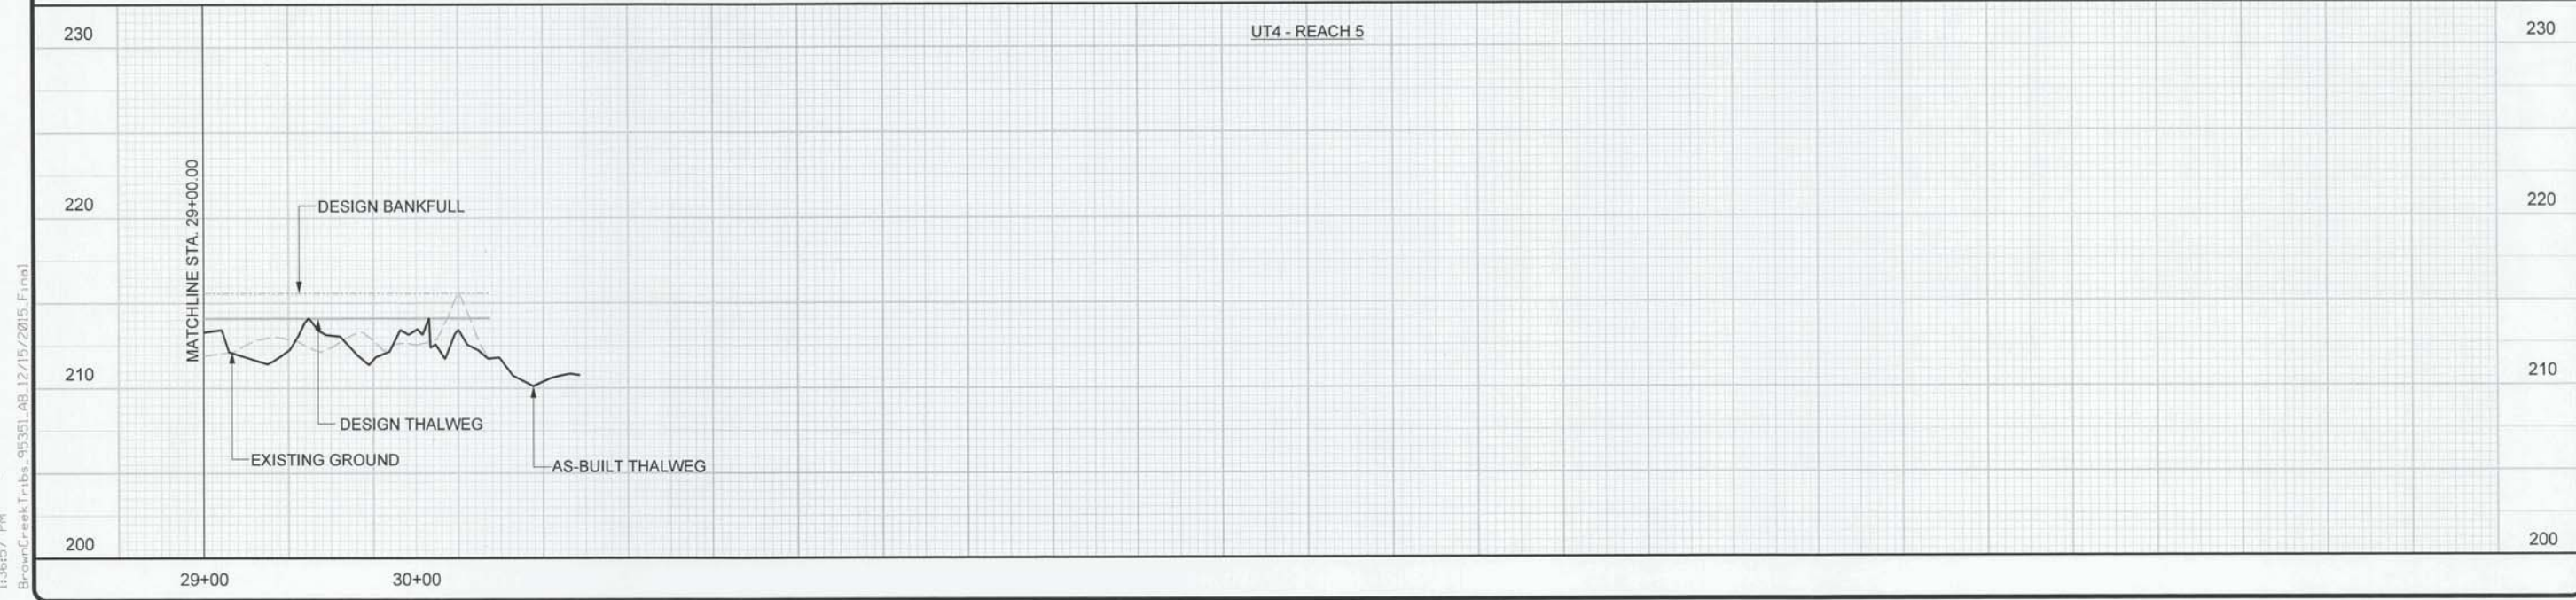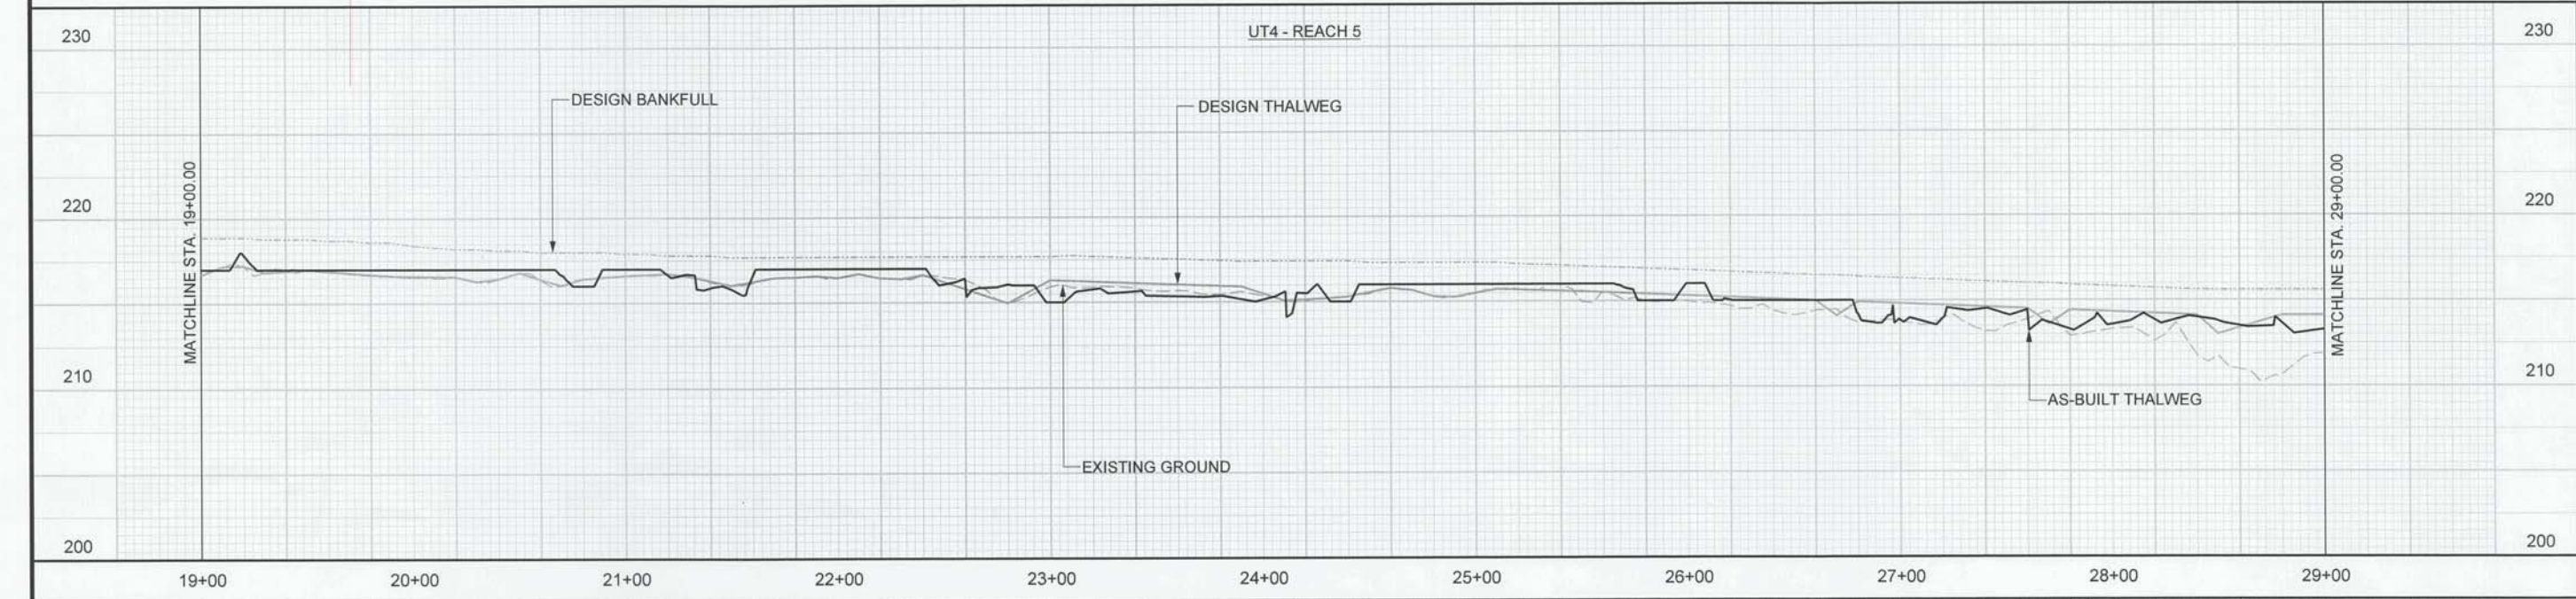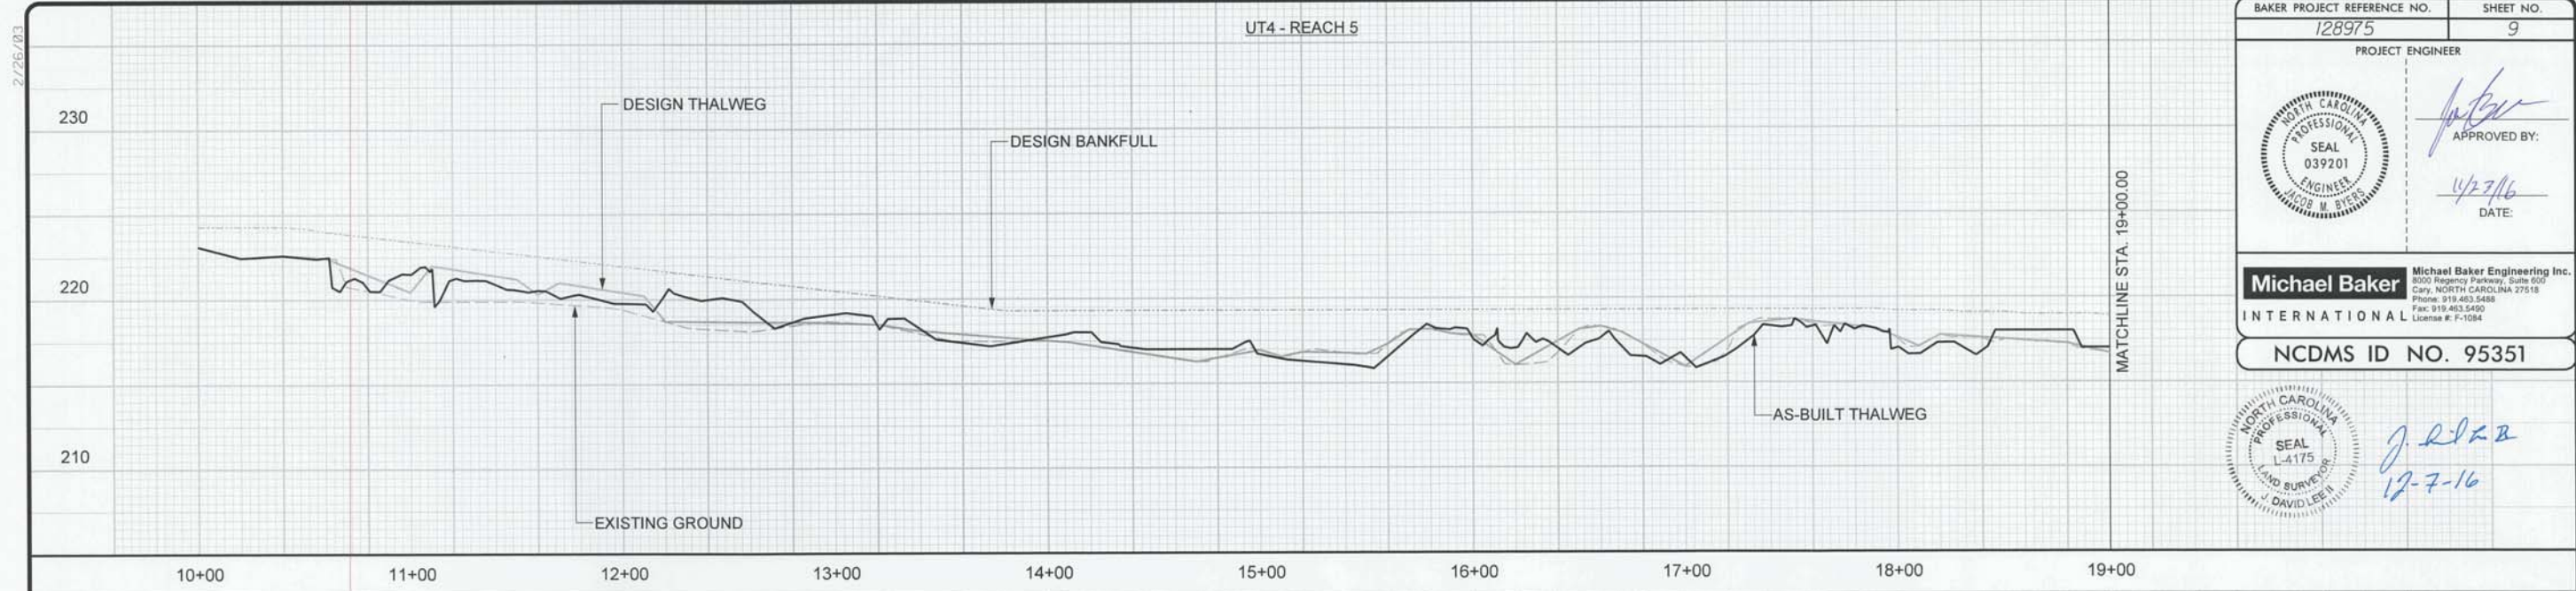

I:\15\2015\Design\Plans\AS-BUILT\PLANS\128975_45B-PFL_09.dgn
 1:36:57 PM
 BrownCreekTribs_95351_AB_12/15/2015_Final

2/26/03