

AS-BUILT MITIGATION PLAN
CANE CREEK RESTORATION SITE
RUTHERFORD COUNTY, NORTH CAROLINA

(CONTRACT #16-D06027-E)
FULL DELIVERY PROJECT
BROAD RIVER BASIN
CATALOGING UNIT 03050105



Prepared for:

NORTH CAROLINA DEPARTMENT OF ENVIRONMENT AND NATURAL RESOURCES
RALEIGH, NORTH CAROLINA

Prepared by:



Restoration Systems, LLC
1101 Haynes Street, Suite 211
Raleigh, North Carolina 27604

And



Axiom Environmental, Inc.
2126 Rowland Pond Drive
Willow Springs, North Carolina 27592

July 2008

**CANE CREEK STREAM AND WETLAND RESTORATION SITE
AS-BUILT MITIGATION PLAN
RUTHERFORD COUNTY**

EXECUTIVE SUMMARY

Restoration Systems, L.L.C. (Restoration Systems) has completed restoration of streams and wetlands at the Cane Creek Stream and Wetland Restoration Site (hereafter referred to as the “Site”) to assist the North Carolina Ecosystem Enhancement Program (EEP) in fulfilling stream and wetland mitigation goals. The Site, located in north Rutherford County less than 0.2 mile south of the Rutherford/McDowell County line along the eastern edge of Highway 64, will provide 6748 stream mitigation units, 4.4 riverine wetland mitigation units, and 5.0 riverine wetland mitigation units. The Site is located in United States Geological Survey (USGS) Hydrologic Unit (HU) 03050105060020 (North Carolina Division of Water Quality [NCDWQ] Subbasin 03-08-02) of the Broad River Basin and will service the USGS 8-digit Cataloging Unit (CU) 03050105. The Site is not located in a Targeted Local Watershed.

A Detailed Stream and Wetland Restoration Plan was completed for the Site in May 2007. The plan outlined methods to complete stream and wetland restoration activities at the Site. An approximately 43.5-acre conservation easement was placed on the Site to incorporate all restoration activities. The Site contains 9.4 acres of hydric soil, Cane Creek, three unnamed tributaries to Cane Creek, and adjacent floodplains. An undisturbed preservation reach located on the upper extents of Tributary 1 within the Site was utilized as the reference reach. Prior to implementation, the Site was characterized by agricultural land utilized primarily for row crop and hay production. Riparian vegetation adjacent to Site streams was sparse and disturbed due to plowing and regular maintenance, and row crop areas were subject to broadcast application of various agricultural chemicals.

Restoration, enhancement, and preservation of Site streams and wetlands will result in positive benefits for water quality and biological diversity in the Cane Creek watershed. Targeted mitigation efforts focused on improving water quality, enhancing flood attenuation, and restoring aquatic and riparian habitat and were accomplished by:

1. Removing nonpoint and point sources of pollution associated with agricultural practices including a) cessation of broadcasting fertilizer, pesticides, and other agricultural chemicals into and adjacent to the Site and b) provide a forested riparian buffer to treat surface runoff.
2. Reducing sedimentation within onsite and downstream receiving waters by a) reducing bank erosion associated with vegetation maintenance and agricultural plowing up to Site streams, and b) planting a forested riparian buffer adjacent to Site streams.
3. Reestablishing stream stability and the capacity to transport watershed flows and sediment loads by restoring a stable dimension, pattern, and profile supported by natural in-stream habitat and grade/bank stabilization structures.
4. Promoting floodwater attenuation by a) reconnecting bankfull stream flows to the abandoned floodplain terrace; b) restoring secondary, dredged, straightened, and entrenched tributaries, thereby reducing floodwater velocities within smaller catchment basins; and c) revegetating Site floodplains to increase frictional resistance on floodwaters.
5. Restoring onsite wetlands, thereby promoting flood storage, nutrient cycling, and aquatic wildlife habitat.
6. Improving aquatic habitat with bed variability and the use of in-stream structures.

7. Providing a terrestrial wildlife corridor and refuge in an area that is developed for agricultural and timber production.
8. Providing connectivity to a State Nature Preserve northeast of the Site.
9. Providing approximately 4.4 riverine WMUs.
10. Providing approximately 5.0 nonriverine WMUs.
11. Providing approximately 6748 SMUs.

As constructed, the Site restored historic stream and wetland functions, which existed onsite prior to channel straightening and dredging, agricultural impacts, and vegetation removal. Stream construction of meandering, E-type stream channel resulted in 4600 linear feet of stream restoration, 5078 linear feet of stream enhancement (level II), 1506 linear feet of stream preservation, 4.4 acres of riverine wetland restoration, and 5.0 acres of nonriverine wetland restoration.

TABLE OF CONTENTS

EXECUTIVE SUMMARY	i
1.0 INTRODUCTION	1
2.0 SUMMARY	2
2.2 Project History	3
3.0 RESTORATION ACTIVITIES.....	4
3.1 Stream Restoration.....	4
3.1.1 Belt-width Preparation and Grading.....	4
3.1.2 Floodplain Bench Excavation	4
3.1.3 Channel Excavation.....	5
3.1.4 Channel Plugs	5
3.1.5 Channel Backfilling.....	5
3.1.6 In-Stream Structures	5
3.1.7 Forded Channel Crossing.....	6
3.2 Stream Enhancement (Level II).....	7
3.3 Stream Preservation	7
3.4 Wetland Restoration.....	7
3.2.1 Reestablishment of Historic Groundwater Elevations.....	7
3.2.2 Redirecting Roadside Drainage.....	7
3.2.3 Excavation and Grading of Elevated Spoil and Sediment Embankments	7
3.2.4 Hydrophytic Vegetation.....	7
3.2.4 Reconstruction of Stream Corridors	8
4.0 PLANT COMMUNITY RESTORATION	8
5.0 MONITORING PLAN.....	9
5.1 Stream	9
5.2 Hydrology.....	10
5.3 Vegetation.....	10
6.0 SUCCESS CRITERIA	10
6.1 Stream Success Criteria.....	10
6.2 Hydrologic Success Criteria	11
6.2 Vegetation Success Criteria	11
7.0 MONITORING REPORT SUBMITTAL.....	12
8.0 CONTINGENCY	12
9.0 REFERENCES	14

TABLES

Table 1. Planted Tree Species	8
Table 2. Characteristic Tree Species	11

APPENDICES

- Appendix A. Figures and As-built Construction Sheets
- Appendix B. Preconstruction and Construction Photographs
- Appendix C. Baseline Stream Photographs and Stream Measurements

FIGURES and SHEETS

Figure 1. Site Location	Appendix A
Figure 2. USGS Hydrologic Unit Map	Appendix A
Figure 3. Preconstruction Conditions	Appendix A
Figures 4A-4B. Details	Appendix A
Figure 5. Planting Plan	Appendix A
Sheet 1. As-built Survey	Appendix A
Sheet 2. As-built for Trib. 1 & Trib. 2	Appendix A
Sheet 3. As-built for Trib. 3	Appendix A
Sheet 4. Stream Alignment for Trib. 1	Appendix A
Sheet 5. Stream Alignment for Trib. 2	Appendix A
Sheet 6. Stream Alignment for 3	Appendix A
Sheet 7. Cross-sections for Trib. 1	Appendix A
Sheets 8-9. Cross-sections for Trib. 2	Appendix A
Sheets 10-11. Cross-sections for Trib. 3	Appendix A

**CANE CREEK STREAM AND WETLAND RESTORATION SITE
AS-BUILT MITIGATION PLAN
RUTHERFORD COUNTY**

1.0 INTRODUCTION

Restoration Systems, L.L.C. (Restoration Systems) has completed restoration of streams and wetlands at the Cane Creek Stream and Wetland Restoration Site (hereafter referred to as the “Site”) to assist the North Carolina Ecosystem Enhancement Program (EEP) in fulfilling stream and wetland mitigation goals. The Site, located in north Rutherford County less than 0.2 mile south of the Rutherford/McDowell County line along the eastern edge of Highway 64, will provide 6748 stream mitigation units, 4.4 riverine wetland mitigation units, and 5.0 riverine wetland mitigation units (Figure 1, Appendix A). The Site is located in United States Geological Survey (USGS) Hydrologic Unit (HU) 03050105060020 (North Carolina Division of Water Quality [NCDWQ] Subbasin 03-08-02) of the Broad River Basin and will service the USGS 8-digit Cataloging Unit (CU) 03050105 (Figure 2, Appendix A). The Site is not located in a Targeted Local Watershed (NCWRP 2003).

A Detailed Stream and Wetland Restoration Plan was completed for the Site in May 2007. The plan outlined methods to complete stream and wetland restoration activities at the Site. An approximately 43.5-acre conservation easement was placed on the Site to incorporate all restoration activities. The Site contains 9.4 acres of hydric soil, Cane Creek, three unnamed tributaries to Cane Creek, and adjacent floodplains, which represent the primary hydrologic features of the Site. The drainage basin size is approximately 8.7 square miles at the Site outfall. The Site watershed is characterized by forest, agricultural land, and sparse industrial/residential development; less than five percent of the upstream watershed is composed of impervious surface. An undisturbed preservation reach located on the upper extents of Tributary 1 within the Site was utilized as the reference reach.

Prior to implementation the Site was characterized by agricultural land utilized primarily for row crop and hay production (Figure 3, Appendix A). Riparian vegetation adjacent to Site streams was sparse and disturbed due to plowing and regular maintenance, and row crop areas were subject to broadcast application of various agricultural chemicals. In addition, stream channels had been straightened and dredged. These factors resulted in degraded water quality, unstable channel characteristics (stream entrenchment, erosion, and bank collapse), and decreased wetland function.

The following objectives were proposed to provide mitigation credit requested under the EEP Request For Proposal (RFP) #16-D06027 dated October 26, 2005.

- Provide 6748 stream mitigation units (SMUs)
- Provide 4.4 riverine wetland mitigation units (Riverine WMUs)
- Provide 5.0 nonriverine wetland mitigation units (Nonriverin WMUs)
- Reforest approximately 30.0 acres of the Site with native forest species.

Restoration, enhancement, and preservation of Site streams and wetlands will result in positive benefits for water quality and biological diversity in the Cane Creek watershed. Targeted mitigation efforts focused on improving water quality, enhancing flood attenuation, and restoring aquatic and riparian habitat and were accomplished by:

1. Removing nonpoint and point sources of pollution associated with agricultural practices including a) cessation of broadcasting fertilizer, pesticides, and other agricultural chemicals into and adjacent to the Site and b) provide a forested riparian buffer to treat surface runoff.
2. Reducing sedimentation within onsite and downstream receiving waters by a) reducing bank erosion associated with vegetation maintenance and agricultural plowing up to Site streams, and b) planting a forested riparian buffer adjacent to Site streams.
3. Reestablishing stream stability and the capacity to transport watershed flows and sediment loads by restoring a stable dimension, pattern, and profile supported by natural in-stream habitat and grade/bank stabilization structures.
4. Promoting floodwater attenuation by a) reconnecting bankfull stream flows to the abandoned floodplain terrace; b) restoring secondary, dredged, straightened, and entrenched tributaries, thereby reducing floodwater velocities within smaller catchment basins; and c) revegetating Site floodplains to increase frictional resistance on floodwaters.
5. Restoring onsite wetlands, thereby promoting flood storage, nutrient cycling, and aquatic wildlife habitat.
6. Improving aquatic habitat with bed variability and the use of in-stream structures.
7. Providing a terrestrial wildlife corridor and refuge in an area that is developed for agricultural and timber production.
8. Providing connectivity to a State Nature Preserve northeast of the Site.
9. Providing approximately 4.4 riverine WMUs.
10. Providing approximately 5.0 nonriverine WMUs.
11. Providing approximately 6748 SMUs.

As constructed, the Site restored historic stream and wetland functions, which existed onsite prior to channel straightening and dredging, agricultural impacts, and vegetation removal. Stream construction of meandering, E-type stream channel resulted in 4600 linear feet of stream restoration, 5078 linear feet of stream enhancement (level II), 1506 linear feet of stream preservation, 4.4 acres of riverine wetland restoration, and 5.0 acres of nonriverine wetland restoration.

2.0 SUMMARY

2.1 Preconstruction Conditions

Prior to construction, the majority of the Site was utilized for row crop and hay production (Figure 3, Appendix A). In order to maximize useable field acreage streams were channelized and riparian vegetation was removed. Site streams were subject to contamination from the broadcast application of agricultural chemicals. The agricultural practices of the Site were contributory factors to degraded water quality, unstable channel characteristics (stream entrenchment, erosion, and bank collapse), and decreased wetland function.

Streams

The Site encompasses Cane Creek and three unnamed tributary to Cane Creek (Tributaries 1-3) as well as the adjacent floodplain and hydric soils. The tributaries converge with Cane Creek onsite and drain an approximately 8.7-square mile watershed at the Site outfall. Cane Creek is a fourth-order, bank-to-bank stream system characterized by eroding banks, excessive sediment transport, and a disturbed riparian buffer. Three unnamed tributaries to Cane Creek (Tributaries 1-3) are first- and second-order streams that had been dredged, straightened, and rerouted within the Site.

Hydric Soils

Hydric soil limits were mapped in the field during January 2007 by a Licensed Soil Scientist and encompassed 9.4 acres of the Site. Wetland restoration areas of the Site are underlain by hydric Wehadkee soils (inclusions within areas mapped as the Chewacla soil series). Based on field surveys and groundwater models, jurisdictional wetlands had been significantly disturbed by compaction due to agricultural practices; relocation, dredging, straightening, and rerouting of Site streams; ditching of fields; and removal of vegetation and were effectively drained below jurisdictional wetland hydrology thresholds.

Areas of the Site targeted for riverine wetland restoration will receive hydrological inputs from periodic overbank flooding of the restored tributaries, groundwater migration into the wetlands, upland/stormwater runoff, and, to a lesser extent, direct precipitation.

Hydrology of areas targeted for nonriverine wetland restoration occur outside of the restored tributary floodplains and will primarily be driven by precipitation with additional inputs from upland/stormwater runoff and slope seepage. Cane Creek is a controlled flow stream; the existing Cane Creek floodplain is acting as a terrace; therefore, Cane Creek will not provide hydrological input to these areas.

Plant Communities

Distribution and composition of plant communities reflected landscape-level variations in topography, soils, hydrology, and past or present land use practices. The Site was characterized primarily by agricultural land that was regularly maintained and plowed for row crops and hay, leaving soils disturbed and exposed to the edges of Site stream banks. Riparian vegetation adjacent to Site streams was predominantly disturbed.

Drainage Area

This hydrophysiographic region is considered characteristic of the Eastern Blue Ridge Foothills ecoregion of North Carolina. The region is characterized by low mountains and rolling foothills, gently rounded to steep slopes, and moderate gradient streams with bedrock, boulder, cobble, and gravel substrates (Griffith 2002). The Site occurs within USGS 14-digit HU 03050105060020 (NCDWQ Subbasin 03-08-02) of the Broad River

The Site drainage area encompasses approximately 8.7 square miles of land at the downstream Site outfall. The upstream watershed is dominated by forest, agricultural land, and sparse industrial/residential development. Cane Creek and its tributaries have been assigned Stream Index Number 9-41-12-(0.3), a Best Usage Classification of **WS-V**, and is fully supporting its intended uses (NCDWQ 2005).

2.2 Project History

On June 16, 2006, the EEP entered into a contract with Restoration Systems to restore the Site. A Detailed Stream and Wetland Restoration Plan was completed for the project in May 2007. Upon completion of the detailed plan, construction schematics were developed and construction was initiated in January 2008. Backwater Environmental completed earthwork and grading at the Site in April 2008. Carolina Silvics planted the Site during March and April 2008.

Information on project managers, owners, and contractors follows:

Owner Information

Restoration Systems, LLC
George Howard and John Preyer
1101 Haynes Street, Suite 211
Raleigh, North Carolina 27604
(919) 755-9490

Planting Contractor Information

Carolina Silvics
Dwight McKinney
908 Indian Trail Road
Edenton, North Carolina 27932
(919) 523-4375

Designer Information

Axiom Environmental, Inc.
W. Grant Lewis
2126 Rowland Pond Drive
Willow Spring, North Carolina 27592
(919) 215-1693

Earthwork Contractor Information

Backwater Environmental
Wes Newell
PO Box 1654
Pittsboro, North Carolina 27312
(919) 523-4375

3.0 RESTORATION ACTIVITIES

Primary activities at the Site included 1) stream restoration, 2) stream enhancement, 3) stream preservation, 4) wetland restoration, 5) soil scarification, and 6) plant community restoration. Restoration plans constructed 4600 linear feet of stream, enhanced (level II) 5078 linear feet of stream, preserved 1506 linear feet of stream, restored 4.4 acres of riverine wetland, and restored 5.0 acres of nonriverine wetland. In total the Site provides 6748 SMUs, 4.4 riverine WMUs, and 5.0 nonriverine WMUs (Sheets 1-8, Appendix A).

3.1 Stream Restoration

Tributaries 1-3 are located within a floodplain suitable for design channel excavation on new location. The streams were constructed on new location and the old dredged, straightened, and rerouted channels were abandoned and backfilled. Primary activities designed to restore the channels on new location included 1) belt-width preparation and grading, 2) floodplain bench excavation, 3) channel excavation, 4) installation of channel plugs, 5) backfilling of the abandoned channel, and 6) installation of in-stream structures.

3.1.1 Belt-width Preparation and Grading

The belt-width was prepared and graded; material excavated during grading was stockpiled immediately adjacent to channel segments to be abandoned and backfilled. These segments were backfilled after stream diversion was completed. After preparation of the corridor, the design channel and updated profile survey was developed and the location of each meander wavelength plotted and staked along the profile.

3.1.2 Floodplain Bench Excavation

A bankfull, floodplain bench was created to 1) remove eroding material and collapsing banks, 2) promote overbank flooding during bankfull flood events, 3) reduce the erosive potential of flood waters, and 4) increase the width of the active floodplain. Bankfull benches were created by excavating the adjacent floodplain to bankfull elevations or filling eroded/abandoned channel areas with suitable material. After excavation, or filling of the bench, a relatively level floodplain surface was stabilized with suitable erosion control measures. Planting of the bench with native floodplain vegetation occurred to reduce erosion of bench sediments, reduce flow velocities in flood waters, filter pollutants, and provide wildlife habitat.

3.1.3 Channel Excavation

The channel was constructed within the range of values depicted in the May 2007 Detailed Restoration Plan for the Site.

The stream banks and local belt-width area of constructed channels were planted with shrub and herbaceous vegetation. Deposition of shrub and woody debris into and/or overhanging the constructed channel was encouraged.

Particular attention was directed toward providing vegetative cover and root growth along the outer bends of each stream meander. Live willow stake revetments, available root mats, and/or biodegradable, erosion-control matting were embedded into the break-in-slope to promote more rapid development of an overhanging bank.

3.1.4 Channel Plugs

Impermeable plugs were installed along abandoned channel segments. The plugs consist of low-permeability materials designed to be of sufficient strength to withstand the erosive energy of surface flow events across the Site. Dense clays imported from off-site and existing material, compacted within the channel, were used for plug construction. The plugs were of sufficient width and depth to form an imbedded overlap in the existing banks and channel bed.

The design channel passed through several coarse alluvial lenses which piped flow away from the channel into the surrounding floodplain. Particularly vulnerable areas included footers for structures which were installed deep within the floodplain substrate. Loosing reaches of channel were overexcavated, backfilled with impermeable material, and graded to proposed channel dimensions.

3.1.5 Channel Backfilling

After impermeable plugs were installed, the abandoned channels were backfilled. Backfilling was performed primarily by pushing stockpiled materials into the channel. The channels were filled to the extent that onsite material was available and compacted to maximize microtopographic variability, including ruts, ephemeral pools, and hummocks in the vicinity of the backfilled channel.

Borrow material was generated through excavation of groundwater storage depressions throughout the Site landscape. The primary purpose of these depressions was to provide suitable, low permeability material for ditch plugs and backfilling, to increase water storage potential within the wetland restoration area, and to increase potential for biological diversity within the complex.

3.1.6 In-Stream Structures

In-stream structures were used within the Site for bank stabilization, grade control, and habitat improvement. This included the installation of two J-hook vanes, six log vanes, two rock cross-vanes, three step-pool structures, and ten A-vanes (Figures 4A-4B, Appendix A).

J-hook Vanes/Log Vanes

J-hook vanes and log vanes were used to direct high velocity flows during bankfull events towards the center of the channel. J-hook vanes were constructed of boulders approximately 24 inches in minimum width. J-hook vane construction was initiated by imbedding footer rocks into the stream bed for stability to prevent undercutting of the structure. Header rocks were then placed atop the footer rocks at the design elevation. Footer and header rocks create an arm that slopes from the center of the channel upward at approximately 7 to 10 degrees, tying in at the bankfull floodplain elevation. Once the header and footer

stones were in place, filter fabric was buried into a trench excavated around the upstream side of the J-hook vane arm. The filter fabric was then draped over the header rocks to force water over the vane. The upstream side of the structure was backfilled with suitable material to the elevation of the header stones.

Log vanes were constructed utilizing large tree trunks harvested from the Site. The tree stems harvested for log cross-vane arms were long enough to be imbedded into the stream channel and extend several feet into the floodplain. Logs create an arm that slopes from the center of the channel upward at approximately 5 to 7 degrees, tying in at the bankfull floodplain elevation. Logs extend from each stream bank at an angle of 20 to 30 degrees. A trench was dug into the stream channel that was deep enough for the head of the log to be at or below the channel invert. The trench was then extended into the floodplain and the log was set into the trench such that the log arm was below the floodplain elevation. Once the vane was in place, filter fabric was toed into a trench on the upstream side of the vane and draped over the structure to force water over the vane. The upstream side of the structure was then backfilled with suitable material.

Rock Cross-vanes

Rock cross-vanes were installed in the channel to 1) sustain bank stability, 2) direct high velocity flows during bankfull events toward the center of the channel, 3) maintain average pool depths throughout the reach, 4) preserve water surface elevations and reconnect bankfull stream flows with the adjacent floodplains, and 5) modify energy distributions through increases in channel roughness and local energy slopes during peak flows.

Rock cross-vanes were constructed of boulders approximately 24 inches in minimum width. Rock cross-vane construction was initiated by imbedding footer rocks into the stream bed for stability to prevent undercutting of the structure. Header rocks were then placed atop the footer rocks at the design elevation. Footer and header rocks create an arm that slopes from the center of the channel upward at approximately 7 to 10 degrees, tying in at the bankfull floodplain elevation. The cross-vane arms at both banks were tied into the bank with a sill to eliminate the possibility of water diverting around the structure. Once the header and footer stones were in place, filter fabric was buried into a trench excavated around the upstream side of the vane arms. The filter fabric was then draped over the header rocks to force water over the vane. The upstream side of the structure was backfilled with suitable material to the elevation of the header stones.

Step-Pool Structures/A-vanes

Step-pool structures and A-vanes were constructed to 1) sustain bank stability, 2) direct high velocity flows during bankfull events toward the center of the channel, 3) preserve water surface elevations and reconnect bankfull stream flows with the adjacent floodplains, and 4) modify energy distributions in steeper stream reaches through increases in channel roughness and local energy slopes during peak flows. Step-pool structures were installed at Tributaries 1-3 outfalls to Cane Creek to lower hydrology to the elevation of Cane Creek. Step-pool structures and A-vanes were constructed of boulders approximately 24 inches in minimum width. These structures were constructed similar to a series of rock cross-vanes as described above.

3.1.7 Forded Channel Crossing

Landowner constraints necessitated the installation of three channel fords to allow access to portions of the property isolated by the conservation easement and stream restoration activities. The location of the channel fords are depicted on Figure 4A (Appendix A). The fords were constructed of hydraulically stable rip-rap or suitable rock and are large enough to handle the weight of anticipated vehicular traffic.

Approach grades to the fords were at an approximate 15:1 slope and constructed of hard, scour-resistant crushed rock or other permeable material, which is free of fines. The bed elevations of the fords are equal the floodplain elevation above and below the ford to reduce the risk of headcutting.

3.2 Stream Enhancement (Level II)

Stream enhancement (Level II) on Cane Creek entailed planting riparian buffers with native forest vegetation, removal of invasive species, and bank stabilization through the installation of coir matting and/or willow stakes, where necessary. Particular attention was directed toward providing vegetative cover and root growth along the outer bends of each stream meander. Riparian buffers will facilitate stream recovery and prevent further degradation of Site streams. In addition, water quality functions and aquatic and wildlife habitat associated with stable riparian corridors/streams will be improved.

3.3 Stream Preservation

The forested/upstream reach of Tributary 1 was preserved as part of this project. Based on preliminary analysis and field investigations, this reach is stable due to a lack of human-induced impacts and a well-developed riparian buffer. This reach was protected in perpetuity through the establishment of a conservation easement including a minimum 30-foot forested buffer adjacent to each bank of the stream. The easement provides a natural riparian corridor between the Site and a State Nature Preserve.

3.4 Wetland Restoration

Wetland restoration activities focused on 1) the reestablishment of historic water table elevations, 2) redirecting roadside drainage, 3) excavation and grading of elevated spoil and sediment embankments, 4) reestablishment of hydrophytic vegetation, and 5) reconstruction of stream corridors.

3.2.1 Reestablishment of Historic Groundwater Elevations

Preconstruction Tributaries 1-3 depths averaged 3-5 feet, while the constructed Tributaries 1-3 average approximately 0.6-1 foot. Hydric soils adjacent to the incised channels were drained due to 1) redirecting tributaries from flowing across hydric soil depressions to flow directly into Cane Creek, 2) lowering of the groundwater tables, and 3) a lateral drainage effect from preconstruction stream reaches. Historic flow patterns were restored across the floodplain and channel inverts were reestablished to rehydrate soils adjacent to Site streams, resulting in the restoration of jurisdictional hydrology to riverine wetlands.

In addition, preconstruction drainage ditches within the Site effectively removed wetland hydrology within the interstream flat. These ditches were filled to rehydrate hydric soils within the Site, resulting in the restoration of jurisdictional hydrology to nonriverine wetlands.

3.2.2 Redirecting Roadside Drainage

Roadside drainage from the adjacent US 64, which was captured and directed through a drainage network across the Site prior to construction, was redistributed through the Site to rehydrate nonriverine hydric soils, as well as treat potentially harmful, nonpoint pollutants prior to discharging into the water supply watershed.

3.2.3 Excavation and Grading of Elevated Spoil and Sediment Embankments

Spoil/sediment deposition adjacent to the preconstruction channel and area ditches were removed. Spoil materials were used to fill of onsite ditches, which represented a critical element of onsite wetland restoration.

3.2.4 Hydrophytic Vegetation

Onsite wetland areas endured significant disturbance from land use activities prior to construction such as land clearing and other anthropogenic maintenance. Wetland areas were revegetated with native vegetation

typical of wetland communities in the region. Emphasis focused on developing a diverse plant assemblage. Plant Community Restoration is discussed in more detail in Section 4.0.

3.2.4 Reconstruction of Stream Corridors

The stream restoration plan involved the reconstruction of Tributaries 2-3 and the downstream reach of Tributary 1. Prior to construction, the tributaries were rerouted through the fields into Cane Creek; the tributary lengths were shortened by excavating a linear channel through the most direct path to Cane Creek. The tributaries were restored within the historic floodplain. Preconstruction channels were backfilled to restore the water table to historic conditions. However, some portions of the existing channels remain open for the creation of wetland “oxbow lake-like” features. These features were plugged on each side of the open channel and will function as open water systems. They are expected to provide habitat for a variety of wildlife as well as create open water/freshwater marsh within the Site.

4.0 PLANT COMMUNITY RESTORATION

The Site was planted with native tree species in March and April 2008. Onsite observations, reference forest, and pertinent community descriptions from *Classification of the Natural Communities of North Carolina* (Schafale and Weakley 1990) were used to develop the primary plant community association promoted during restoration efforts. Before plant community restoration was implemented, the entire Site was scarified. Scarification was performed as linear bands directed perpendicular to the land slope. Subsequently, community restoration was initiated on scarified surfaces. The Site was planted with species characteristic of Bottomland Forest and Nonriverine Wet Hardwoods communities within wetland areas, and a Piedmont/Low Mountain Alluvial Forest within the remainder of the Site. Fifteen tree species were planted at the Site; they are as shown in Table 1 (also in Figure 5, Appendix A).

Bare-root seedlings of canopy and understory tree species were planted within the Site at a density of approximately 2750 stems per acre within the stream-side assemblage and a density of approximately 610 stems per acre within the Bottomland Forest/Nonriverine Wet Hardwoods and Piedmont/Low Mountain Alluvial Forest communities. Bare-root seedlings were hand planted to minimize wetland soil disturbance. A total of 30,300 diagnostic tree and shrub seedlings were planted in support of Site restoration.

Table 1. Planted Tree Species

Vegetation Association	Bottomland Forest/Nonriverine Wet Hardwoods		Piedmont/Low Mountain Alluvial Forest		Stream-side Assemblage		TOTAL
Area (acres)	6.7		17.7		5.6		30.0
Species	Number planted	% of total	Number planted	% of total	Number planted	% of total	Number planted
Swamp chestnut oak (<i>Quercus michauxii</i>)	700	14.9	--	--	--	--	700
Cherrybark oak (<i>Quercus pagoda</i>)	700	14.9	--	--	--	--	700
Sycamore (<i>Platanus occidentalis</i>)	700	14.9	1200	11.8	--	--	1900
Hackberry (<i>Celtis laevigata</i>)	700	14.9	--	--	--	--	700
American elm (<i>Ulmus americana</i>)	700	14.9	--	--	--	--	700
Green ash (<i>Fraxinus pennsylvanica</i>)	500	10.6	--	--	--	--	500
Pawpaw (<i>Asimina triloba</i>)	400	8.5	1200	11.8	--	--	1600
Mockernut hickory (<i>Carya alba/tomentosa</i>)	--	--	1800	17.6	--	--	1800
Northern red oak (<i>Quercus rubra</i>)	--	--	1800	17.6	--	--	1800
White oak (<i>Quercus alba</i>)	--	--	1800	17.6	--	--	1800
Black cherry (<i>Prunus serotina</i>)	--	--	1200	11.8	--	--	1200
Persimmon (<i>Diospyros virginiana</i>)	--	--	1200	11.8	--	--	1200
Silky dogwood (<i>Cornus amomum</i>)	300	6.4	--	--	4600	29.8	4900
Buttonbush (<i>Cephalanthus occidentalis</i>)	--	--	--	--	5400	35.1	5400
Elderberry (<i>Sambucus canadensis</i>)	--	--	--	--	5400	35.1	5400
TOTAL	4700	100	10,200	100	15,400	100	30,300

5.0 MONITORING PLAN

The Cane Creek Stream and Wetland Restoration Site monitoring plan will entail analysis of the stream channel, hydrology, and vegetation. Monitoring of restoration efforts will be performed for a minimum of 5 years or until success criteria are fulfilled. The detailed monitoring plan is depicted in Sheets 1-3 (Appendix A).

5.1 Stream

Five stream reaches were monitored for geomorphic activity on restoration reaches of Tributaries 1-3 (Sheets 1-3, Appendix A). Each stream reach extends for approximately 600 linear feet for a total monitoring length of 3000 linear feet along the restored channel. After completion of Site construction 20 stream cross-sections were established; two riffle cross-sections and two pool cross-sections were established on each stream monitoring reach.

Annual monitoring will include development of channel cross-sections on riffles and pools, and a water surface profile of the channel. The data will be presented in graphic and tabular format. Data to be presented will include 1) cross-sectional area, 2) bankfull width, 3) average depth, 4) maximum depth, 5) width-to-depth ratio, 6) water surface slope, and 9) facet slope. The stream will subsequently be classified according to stream geometry and substrate (Rosgen 1996). Significant changes in channel morphology will be tracked and reported by comparing data in each successive monitoring year. A photographic record that will include preconstruction and post-construction pictures has been initiated (Appendix B).

Photographs of the enhancement (level II) reach will be taken for each year of the monitoring period and on the preservation reach in the first year.

Baseline/as-built measurements were performed in April 2008. As-built channels emulated the proposed channel morphology; cross-section and longitudinal profile plots can be found in Appendix C.

5.2 Hydrology

After hydrological modifications were completed at the Site, continuously recording, surficial monitoring gauges were installed in accordance with specifications in *Installing Monitoring Wells/Piezometers in Wetlands* (NCWRP 1993). Monitoring gauges were set to a depth of approximately 24 inches below the soil surface. Screened portions of each gauge were surrounded by filter fabric, buried in screened well sand, and sealed with a bentonite cap to prevent siltation and surface flow infiltration during floods.

Five monitoring gauges were installed in wetland restoration areas to provide representative coverage of the Site (Sheets 1-3, Appendix A). One additional gauge was placed in a reference wetland area adjacent to the stream preservation area north of Tributary 1 for comparison with onsite conditions. Hydrological sampling will be performed in restoration and reference areas during the growing season at daily intervals necessary to satisfy the hydrology success criteria within each physiographic landscape area (USEPA 1990).

5.3 Vegetation

Following Site planting, fifteen (10-meter by 10-meter or 20-meter by 5-meter) vegetation monitoring plots were established within the Site (Sheets 1-3, Appendix A). During the first year, vegetation will receive a cursory, visual evaluation on a periodic basis to ascertain the degree of overtopping of planted elements by nuisance species. Subsequently, quantitative sampling of vegetation will be performed each year using the CVS-EEP Protocol for Recording Vegetation Level 1-2 Plot Sampling Only (Version 4.0) (Lee et al. 2006) between June 1 and September 30 until the vegetation success criteria are achieved.

A photographic record of plant growth will be included in each annual monitoring report.

6.0 SUCCESS CRITERIA

6.1 Stream Success Criteria

Success criteria for stream restoration will include 1) successful classification of the reach as a functioning stream system (Rosgen 1996) and 2) channel variables indicative of a stable stream system. Annual monitoring will continue until success criteria are met and no less than two bankfull events have occurred, as determined by in situ crest gauge, otherwise monitoring will continue until the second bankfull event has occurred.

Visual assessment of in-stream structures will be conducted to determine if failure has occurred. Failure of a structure may be indicated by collapse of the structure, undermining of the structure, abandonment of the channel around the structure, and/or stream flow beneath the structure.

6.2 Hydrologic Success Criteria

Target hydrological characteristics include saturation or inundation for 5 to 12.5 percent of the growing season, during average climatic conditions. During growing seasons with atypical climatic conditions, groundwater gauges in reference wetlands may dictate threshold hydrology success criteria (75 percent of reference). These areas are expected to support hydrophytic vegetation. If wetland parameters are marginal as indicated by vegetation and/or hydrology monitoring, a jurisdictional determination will be performed.

6.2 Vegetation Success Criteria

Success criteria have been established to verify that the vegetation component supports community elements necessary for forest development. Success criteria are dependent upon the density and growth of characteristic forest species. Additional success criteria are dependent upon density and growth of "Characteristic Tree Species." Characteristic Tree Species include planted species, species identified through inventory of a reference (relatively undisturbed) forest community used to orient the planting plan, and appropriate Schafale and Weakley (1990) community descriptions. All canopy tree species planted and identified in the reference forest will be utilized to define "Characteristic Tree Species" as termed in the success criteria.

Table 2. Characteristic Tree Species

PLANTED SPECIES	REFERENCE SPECIES
Pawpaw (<i>Asimina triloba</i>)	Red maple (<i>Acer rubrum</i>)
Mockernut hickory (<i>Carya alba/tomentosa</i>)	Ironwood (<i>Carpinus caroliniana</i>)
Hackberry (<i>Celtis laevigata</i>)	Mockernut hickory (<i>Carya alba</i>)
Buttonbush(<i>Cephalanthus occidentalis</i>)	Hickory (<i>Carya</i> sp.)
Silky dogwood(<i>Cornus amomum</i>)	Dogwood (<i>Cornus florida</i>)
Persimmon (<i>Diospyros virginiana</i>)	Persimmon (<i>Diospyros virginiana</i>)
Green ash (<i>Fraxinus pennsylvanica</i>)	American beech (<i>Fagus grandifolia</i>)
Sycamore (<i>Platanus occidentalis</i>)	Eastern red cedar (<i>Juniperus virginiana</i>)
Black cherry (<i>Prunus serotina</i>)	Mountain laurel (<i>Kalmia latifolia</i>)
White oak (<i>Quercus alba</i>)	Doghobble (<i>Leucothoe fontanesiana</i>)
Swamp chestnut oak (<i>Quercus michauxii</i>)	Sycamore (<i>Platanus occidentalis</i>)
Cherrybark oak (<i>Quercus pagoda</i>)	Black cherry (<i>Prunus serotina</i>)
Northern red oak (<i>Quercus rubra</i>)	White oak (<i>Quercus alba</i>)
Elderberry(<i>Sambucus canadensis</i>)	Northern red oak (<i>Quercus rubra</i>)
American elm (<i>Ulmus americana</i>)	

An average density of 320 stems per acre of Characteristic Tree Species must be surviving at the end of the third monitoring year. Subsequently, 290 Characteristic Tree Species per acre must be surviving at the end

of year 4 and 260 Characteristic Tree Species per acre at the end of year 5.

If vegetation success criteria are not achieved, based on average density calculations from combined plots over the entire restoration area, supplemental planting may be performed with tree species approved by regulatory agencies. Supplemental planting will be performed as needed until achievement of vegetation success criteria.

7.0 MONITORING REPORT SUBMITTAL

An Annual Stream and Wetland Monitoring Report will be prepared at the end of each monitoring year (growing season). The monitoring report will depict the sample plot and quadrant locations and include photographs which illustrate Site conditions. Data compilation and analyses will be presented including graphic and tabular format, where practicable.

8.0 CONTINGENCY

In the event that success criteria are not fulfilled, a mechanism for contingency will be implemented.

Stream

In the event that stream success criteria are not fulfilled, a mechanism for contingency will be implemented. Stream contingency may include, but may not be limited to 1) structure installation; 2) repair of dimension, pattern, and/or profile variables; and 3) bank stabilization. The method of contingency is expected to be dependent upon stream variables that are not in compliance with success criteria. Primary concerns, which may jeopardize stream success include 1) headcut migration through the Site, and/or 2) bank erosion.

Headcut Migration Through the Site

In the event that a headcut occurs within the Site (identified visually or through onsite measurements [i.e. bank-height ratios exceeding 1.4]), provisions for impeding headcut migration and repairing damage caused by the headcut will be implemented. Headcut migration may be impeded through the installation of in-stream grade control structures (rip-rap sill and/or log cross-vane weir) and/or restoring stream geometry variables until channel stability is achieved. Channel repairs to stream geometry may include channel backfill with coarse material and stabilizing the material with erosion control matting, vegetative transplants, and/or willow stakes.

Bank Erosion

In the event that severe bank erosion occurs at the Site resulting in elevated width-to-depth ratios, contingency measures to reduce bank erosion and width-to-depth ratio will be implemented. Bank erosion contingency measures may include the installation of cross-vane weirs and/or other bank stabilization measures. If the resultant bank erosion induces shoot cutoffs or channel abandonment, a channel may be excavated which will reduce shear stress to stable values.

Hydrology

Hydrological contingency will require consultation with hydrologists and regulatory agencies if wetland hydrology enhancement is not achieved. Floodplain surface modifications, including construction of ephemeral pools, represent a likely mechanism to increase the floodplain area in support of jurisdictional wetlands. Recommendations for contingency to establish wetland hydrology will be implemented and monitored until Hydrology Success Criteria are achieved.


Vegetation

If vegetation success criteria are not achieved based on average density calculations from combined plots over the entire restoration area, supplemental planting may be performed with tree species approved by regulatory agencies. Supplemental planting will be performed as needed until achievement of vegetation success criteria.

9.0 REFERENCES



- Griffith, G.E. 2002. Ecoregions of North and South Carolina. Reston Virginia. U.S. Geological Society (map scale 1:1,500,000).
- Lee, M.T., R.K. Peet, S.D. Roberts, and T.R. Wentworth. 2006. CVS-EEP Protocol for Recording Vegetation. Version 4.0. North Carolina Department of Environment and Natural Resources, Ecosystem Enhancement Program. Raleigh, North Carolina.
- North Carolina Division of Water Quality (NCDWQ). 2005. North Carolina Water Bodies Report (online). Available: <http://dem.ehnr.state.nc.us/bims/reports/reportsWB.html> [March 6, 2006]. North Carolina Department of Environment and Natural Resources, Raleigh.
- North Carolina Wetlands Restoration Program (NCWRP). 1993. Installing Monitoring Wells/Piezometers in Wetlands (WRP Technical Note HY-IA-3.1). North Carolina Department of Environment, Health, and Natural Resources, Raleigh, North Carolina
- Rosgen D. 1996. Applied River Morphology. Wildland Hydrology. Pagosa Springs, Colorado.
- Schafale, M.P. and A.S. Weakley. 1990. Classification of the Natural Communities of North Carolina: Third Approximation. North Carolina Natural Heritage Program, Division of Parks and Recreation, North Carolina Department of Environment, Health, and Natural Resources. Raleigh, North Carolina.
- United States Environmental Protection Agency (USEPA). 1990. Mitigation Site Type Classification (MiST). USEPA Workshop, August 13-15, 1989. USEPA Region IV and Hardwood Research Cooperative, NCSU, Raleigh, North Carolina.
- United States Geological Survey (USGS). 1974. Hydrologic Unit Map - 1974. State of North Carolina.

Appendix A.
Figures and As-built Construction Sheets

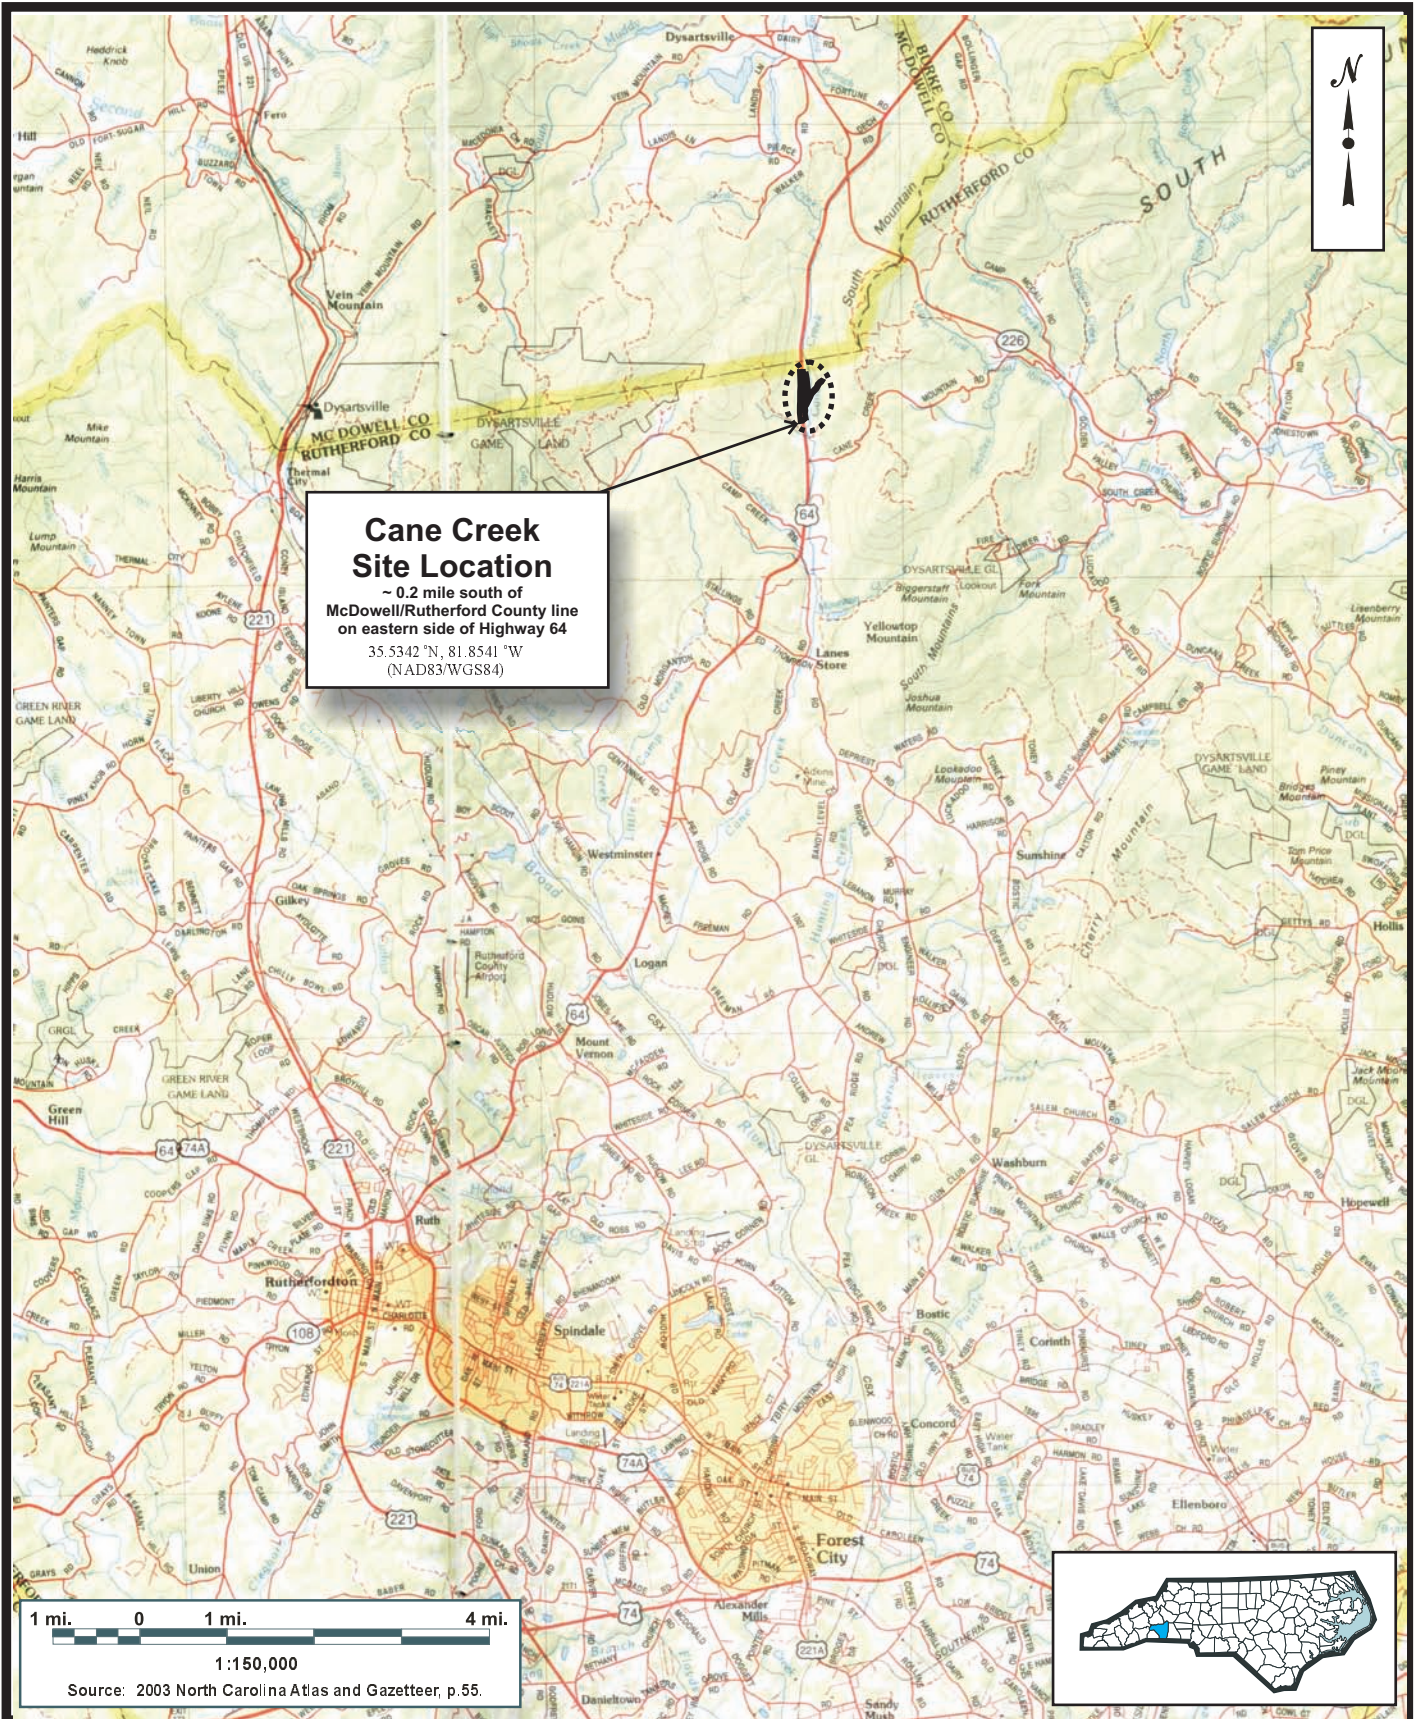


**Cane Creek
Site Location**
 ~ 0.2 mile south of
 McDowell/Rutherford County line
 on eastern side of Highway 64
 35.5342°N, 81.8541°W
 (NAD83/WGS84)

1 mi. 0 1 mi. 4 mi.
 1:150,000
 Source: 2003 North Carolina Atlas and Gazetteer, p. 55.

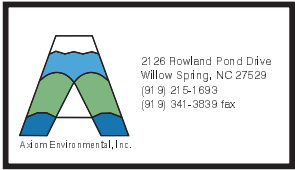
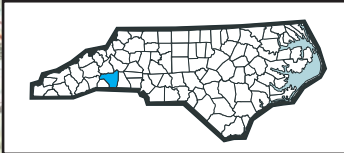


SITE LOCATION		FIGURE 1
CANE CREEK RESTORATION SITE		
Rutherford County, North Carolina		
Dwn. by:	CLF	
Date:	April 2007	
Project:	06-022	

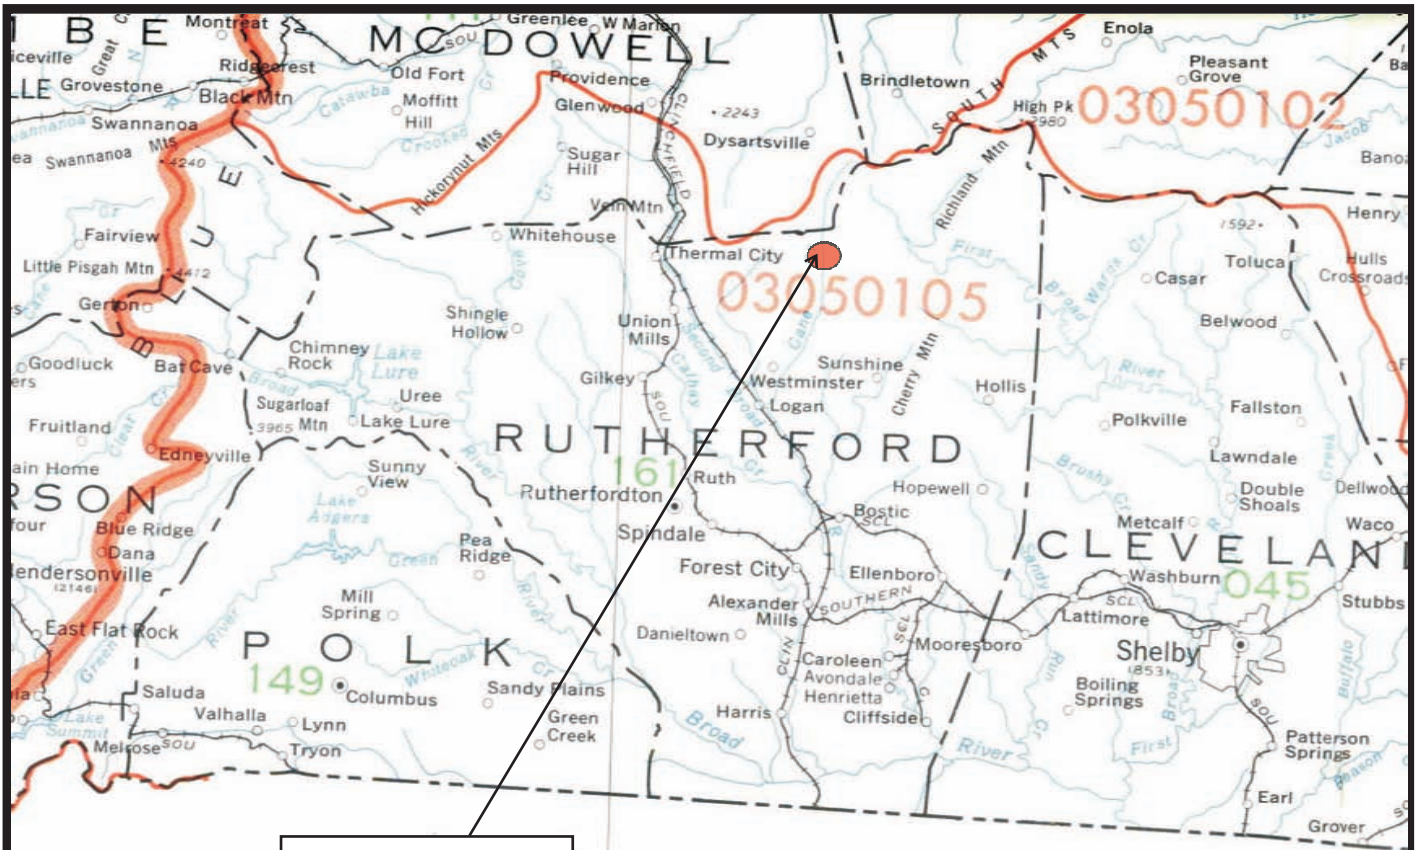

**Cane Creek
Site Location**
14-digit USGS Unit
03050105060020


SOUTH CAROLINA

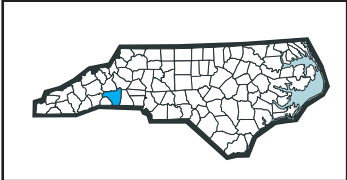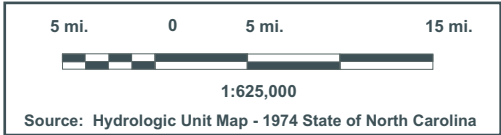

**USGS HYDROLOGIC UNIT MAP
CANE CREEK RESTORATION SITE
Rutherford County, North Carolina**

Dwn. by: CLF
Date: April 2007
Project: 06-002

FIGURE
2

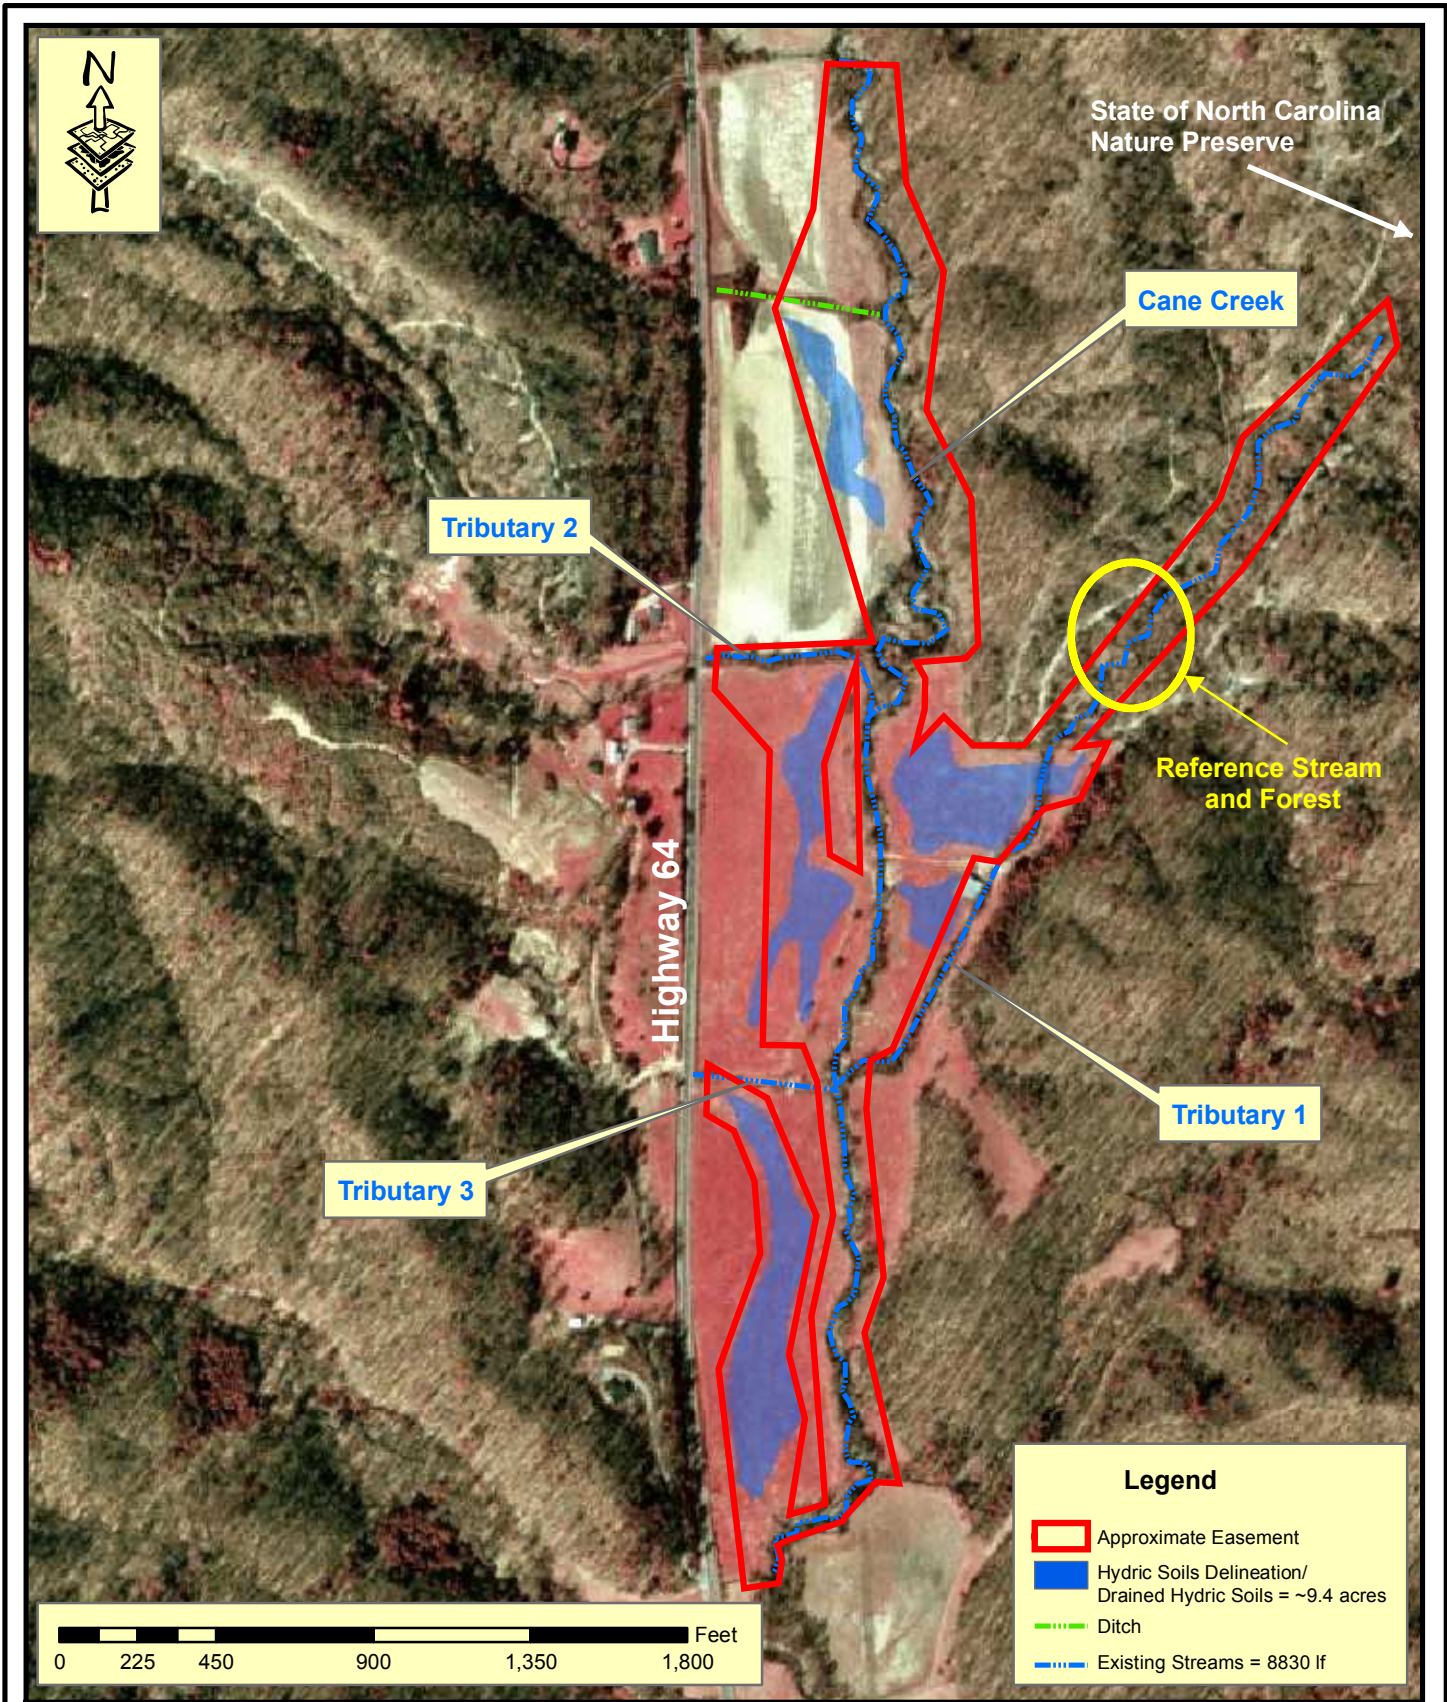



Axiom Environmental, Inc.
2126 Rowland Pond Drive
Willow Spring, NC 27592
(919) 215-1693
(919) 341-3839 fax

**PRECONSTRUCTION CONDITIONS
CANE CREEK RESTORATION SITE
Rutherford County, North Carolina**

Dwn. by:	CLF
Date:	May 2008
Project:	06-022

FIGURE
3

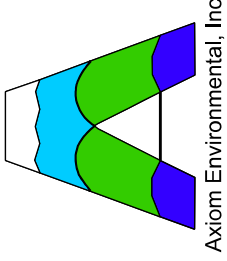

Axiom Environmental, Inc.

NOTES/REVISIONS



Project:
**Cane Creek
 Restoration
 Site**
 Rutherford County
 North Carolina

Title:
**TYPICAL
 STRUCTURE
 DETAILS**


Scale: NO SCALE
 Date: July 2008
 Project No.: 06-022

FIGURE NO.
4A

- NOTES:
1. EXPOSED VANE OCCUPIES 1/3 OF THE BANKFULL WIDTH OF THE CHANNEL.
 2. SUPPORT PILINGS SHALL BE PENCIL SHARPENED, UNTREATED, PEELED, A MINIMUM OF 4 INCHES IN TOP DIAMETER, AND 8 FEET LONG.
 3. LOGS SHALL CONSIST OF NATIVE HARDWOOD SPECIES, RELATIVELY STRAIGHT WITH A MINIMUM DIAMETER OF 15 INCHES AND APPROXIMATELY 35 FEET IN LENGTH.
 4. USE FILTER FABRIC TO SEAL GAPS BETWEEN LOGS.

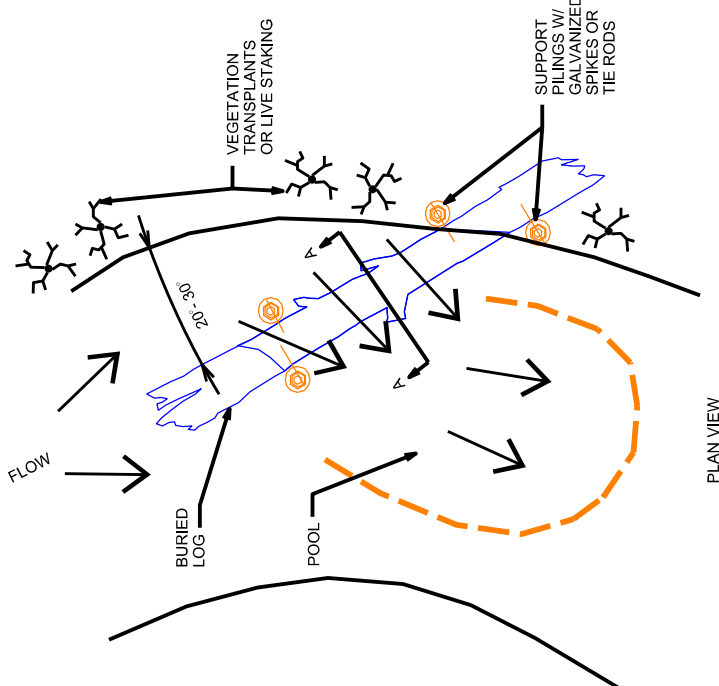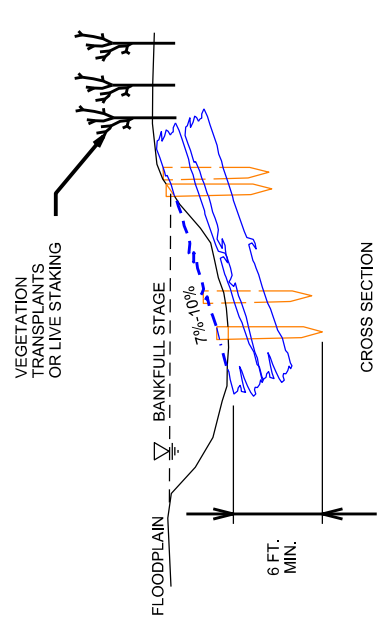


TYPICAL LOG VANE

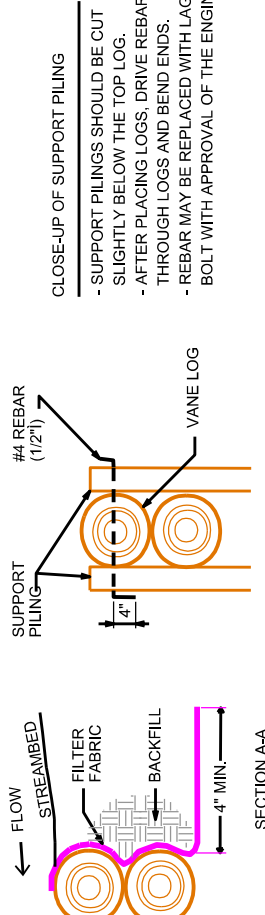

- CLOSE-UP OF SUPPORT PILING
- SUPPORT PILING SHOULD BE CUT SLIGHTLY BELOW THE TOP LOG.
 - AFTER PLACING LOGS, DRIVE REBAR THROUGH LOGS AND BEND ENDS.
 - REBAR MAY BE REPLACED WITH LAG BOLT WITH APPROVAL OF THE ENGINEER.


NOTE:
 HEADER AND FOOTER STONES ARE LARGE, ANGULAR BOULDERS MEASURING A MINIMUM OF 24" ALONG THE SHORTEST DIMENSION.

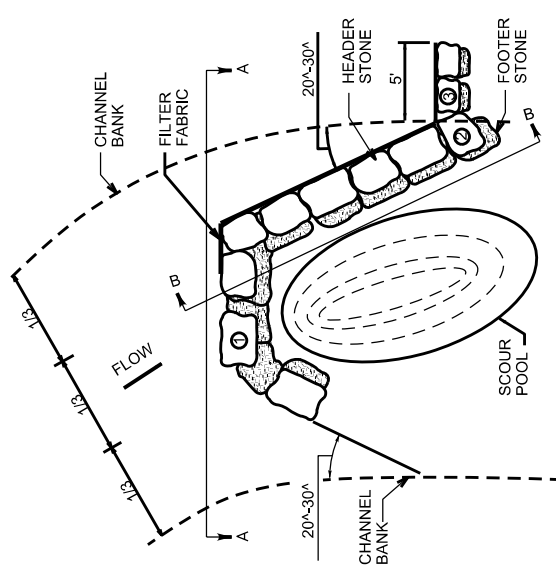



TYPICAL J-HOOK VANE


REACH	ARM LENGTH (FT.)	CHANNEL DEPTH (FT.)
TRIBUTARY 1	10.0	1.5
TRIBUTARIES 2 AND 3	7.0	0.8

NOTE:
 HEADER AND FOOTER STONES ARE LARGE, ANGULAR BOULDERS MEASURING A MINIMUM OF 24" ALONG THE SHORTEST DIMENSION.

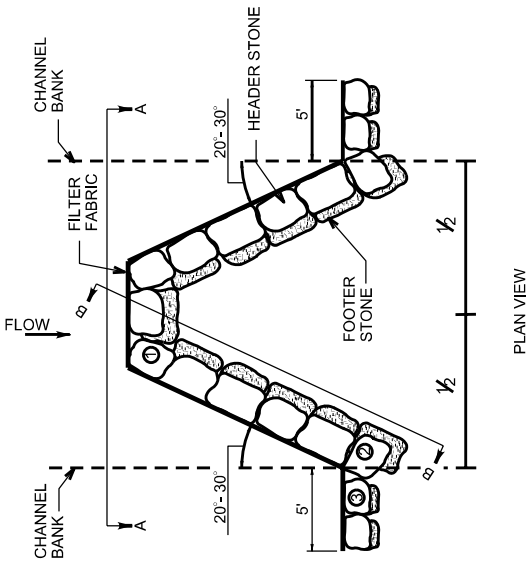

TYPICAL CROSS-VANE

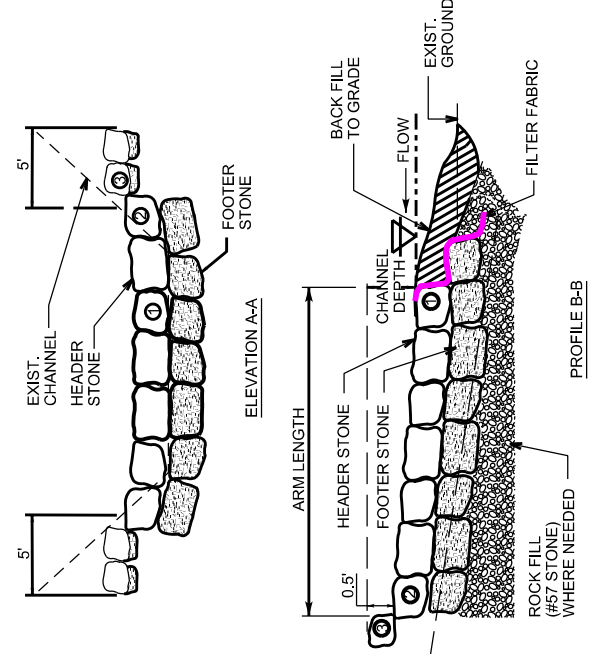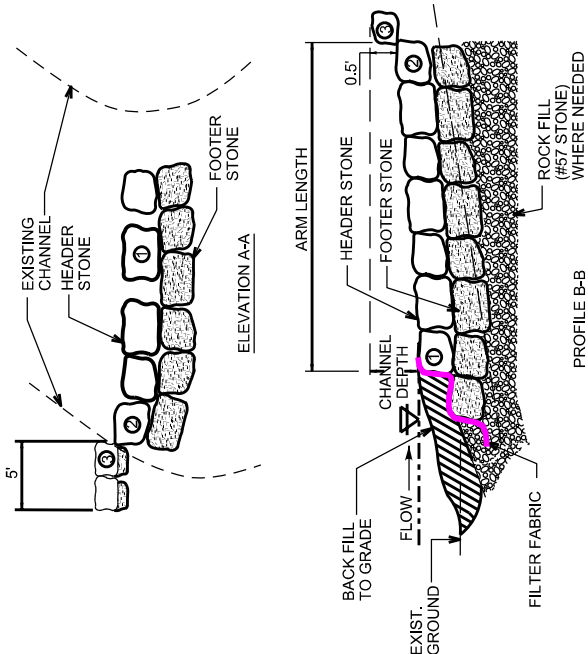

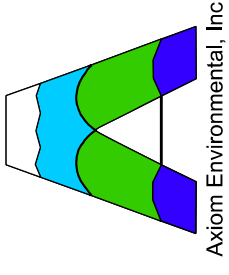

Axiom Environmental, Inc.

NOTES/REVISIONS

Project:

Cane Creek
Restoration
Site

Rutherford County
North Carolina

Title:

TYPICAL
STRUCTURE
DETAILS

Scale: NO SCALE


Date: July 2008

Project No.: 06-022


FIGURE NO.

4B



FILL SQUIL HOLE TO MINIMUM DEPTH
6 INCHES CLASS 1 STONE
ON TOP OF FILTER FABRIC

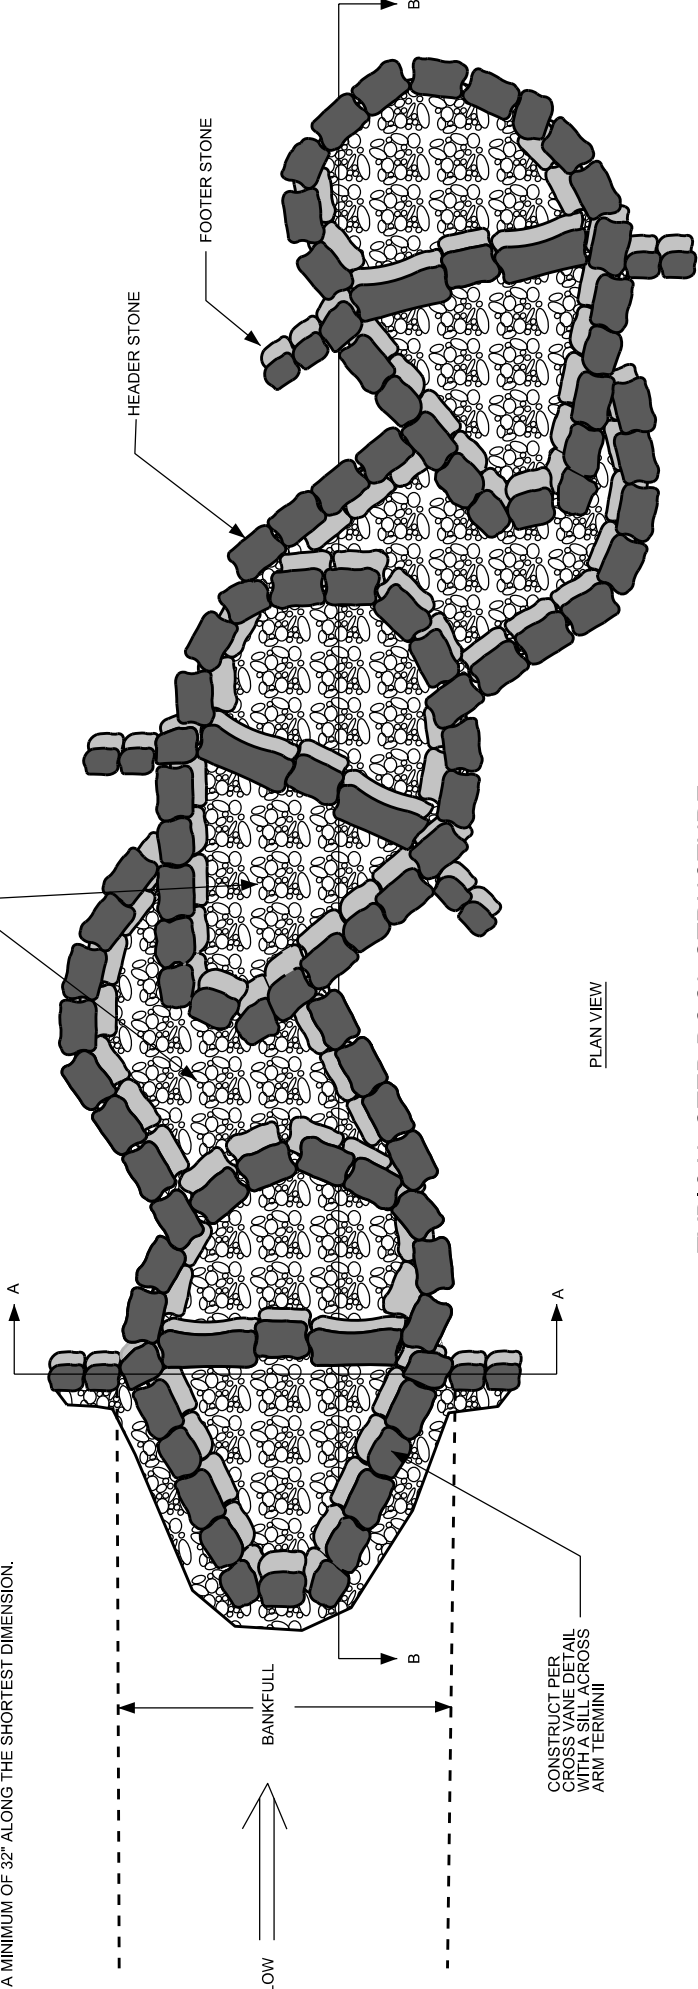

CONSTRUCT PER
CROSS VANE DETAIL
WITH A HILL ACROSS
ARM TERMINI

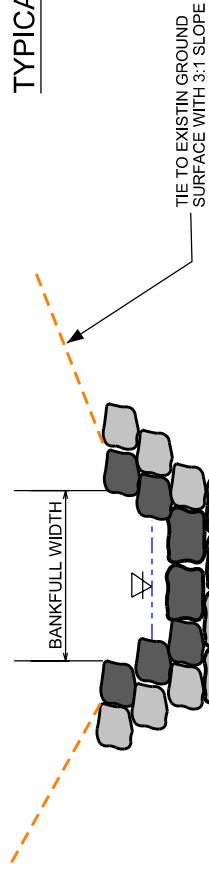


TYPICAL STEP POOL STRUCTURE

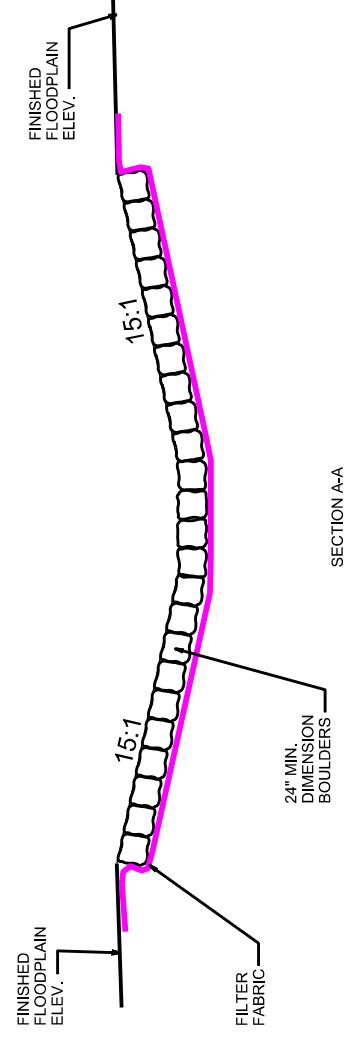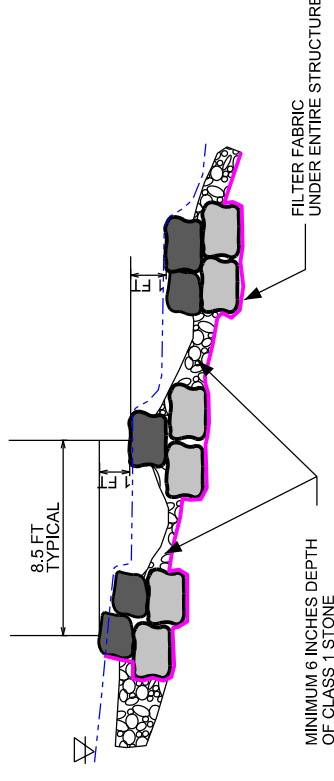


NOTES:

1. KEEP FORD CROSS FALL WITHIN 1-2% OF STREAM GRADIENT.
2. FILL VOIDS BETWEEN 24" MINIMUM DIMENSION BOULDERS W/ AGGREGATE BASE COURSE CLASS A TO CREATE DRIVEABLE SURFACE.

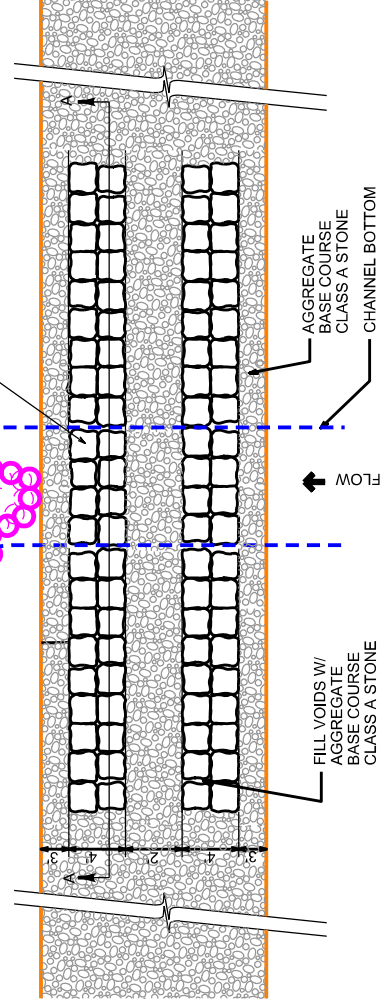

PERMANENT CHANNEL FORD DETAIL

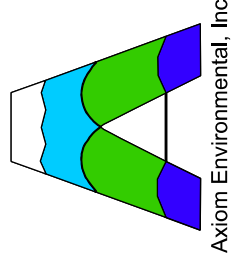

Axiom Environmental, Inc.

NOTES/REVISIONS



Project:
**Cane Creek
 Restoration
 Site**
 Rutherford County
 North Carolina

Title:
**Planting
 Plan**

Scale: 1 in. = 345 ft.
 Date: July 2008
 Project No.: 06-022
 FIGURE NO. **5**

Vegetation Association Area (acres)	Bottomland Forest/Nonriverine Wet Hardwoods 6.7		Piedmont/Low Mountain Alluvial Forest 17.7		Stream-side Assemblage 5.6		TOTAL 30.0
	Number planted	% of total	Number planted	% of total	Number planted	% of total	
Swamp chestnut oak (<i>Quercus michauxii</i>)	700	14.9	--	--	--	--	700
Cherrybark oak (<i>Quercus pagoda</i>)	700	14.9	--	--	--	--	700
Sycamore (<i>Platanus occidentalis</i>)	700	14.9	1200	11.8	--	--	1900
Hackberry (<i>Celtis laevigata</i>)	700	14.9	--	--	--	--	700
American elm (<i>Ulmus americana</i>)	700	14.9	--	--	--	--	700
Green ash (<i>Fraxinus pennsylvanica</i>)	500	10.6	--	--	--	--	500
Pawpaw (<i>Asimina triloba</i>)	400	8.5	1200	11.8	--	--	1600
Mockernut hickory (<i>Carya alba/tomentosa</i>)	--	--	1800	17.6	--	--	1800
Northern red oak (<i>Quercus rubra</i>)	--	--	1800	17.6	--	--	1800
White oak (<i>Quercus alba</i>)	--	--	1800	17.6	--	--	1800
Black cherry (<i>Prunus serotina</i>)	--	--	1200	11.8	--	--	1200
Persimmon (<i>Diospyros virginiana</i>)	--	--	1200	11.8	--	--	1200
Silky dogwood (<i>Cornus amomum</i>)	300	6.4	--	--	4600	29.8	4900
Buttonbush (<i>Cephalanthus occidentalis</i>)	--	--	--	--	5400	35.1	5400
Elderberry (<i>Sambucus canadensis</i>)	--	--	--	--	5400	35.1	5400
TOTAL	4700	100	10,200	100	15,400	100	30,300


Planting Plan Legend	
	Easement Boundary
	On-Site Streams
	Streamside Assemblage
	Piedmont / Mountain Bottomland Hardwood Forest
	Piedmont / Low Mountain Alluvial Forest
	48.3 ac
	5.6 ac
	6.7 ac
	17.7 ac

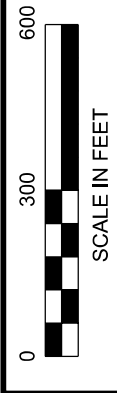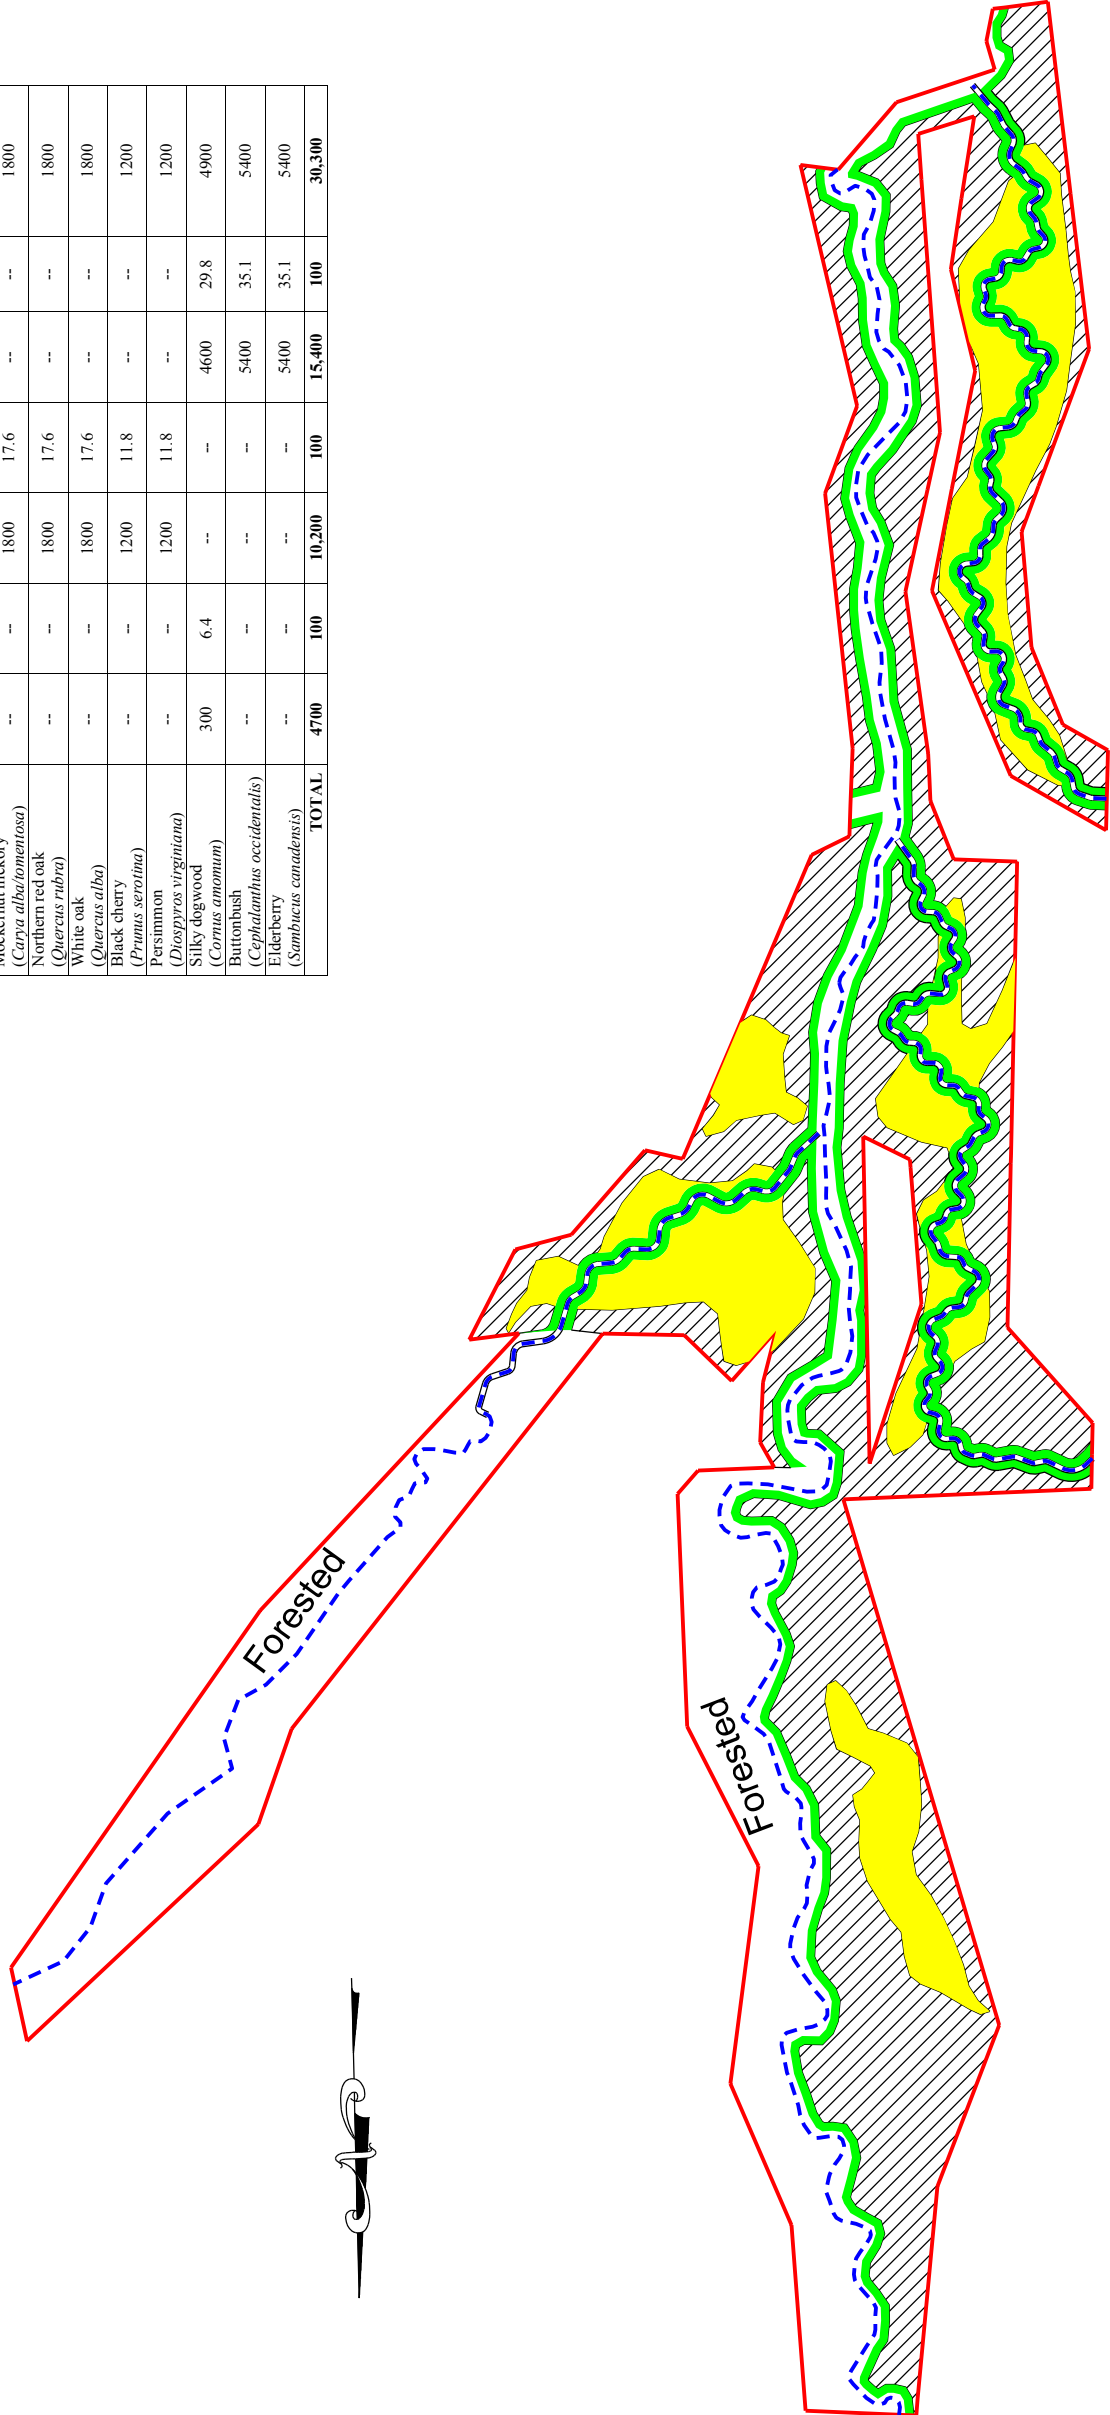


AGREEMENT: THE AREA OF THE CONSERVATION EASEMENT EXCLUDING ALL NEW ACCESS EASEMENTS EXCLUDING ALL NEW ACCESS EASEMENTS RIGHT-OF-WAY IS ALSO ACCESS BY COMPUTER

LINE DATA ALONG CONSERVATION EASEMENT table with columns: LINE, LENGTH, BEARING. Lines L1 through L190 are listed with their respective measurements.


THE AREA OF THE CONSERVATION EASEMENT EXCLUDING ALL NEW ACCESS EASEMENTS EXCLUDING ALL NEW ACCESS EASEMENTS RIGHT-OF-WAY IS ALSO ACCESS BY COMPUTER

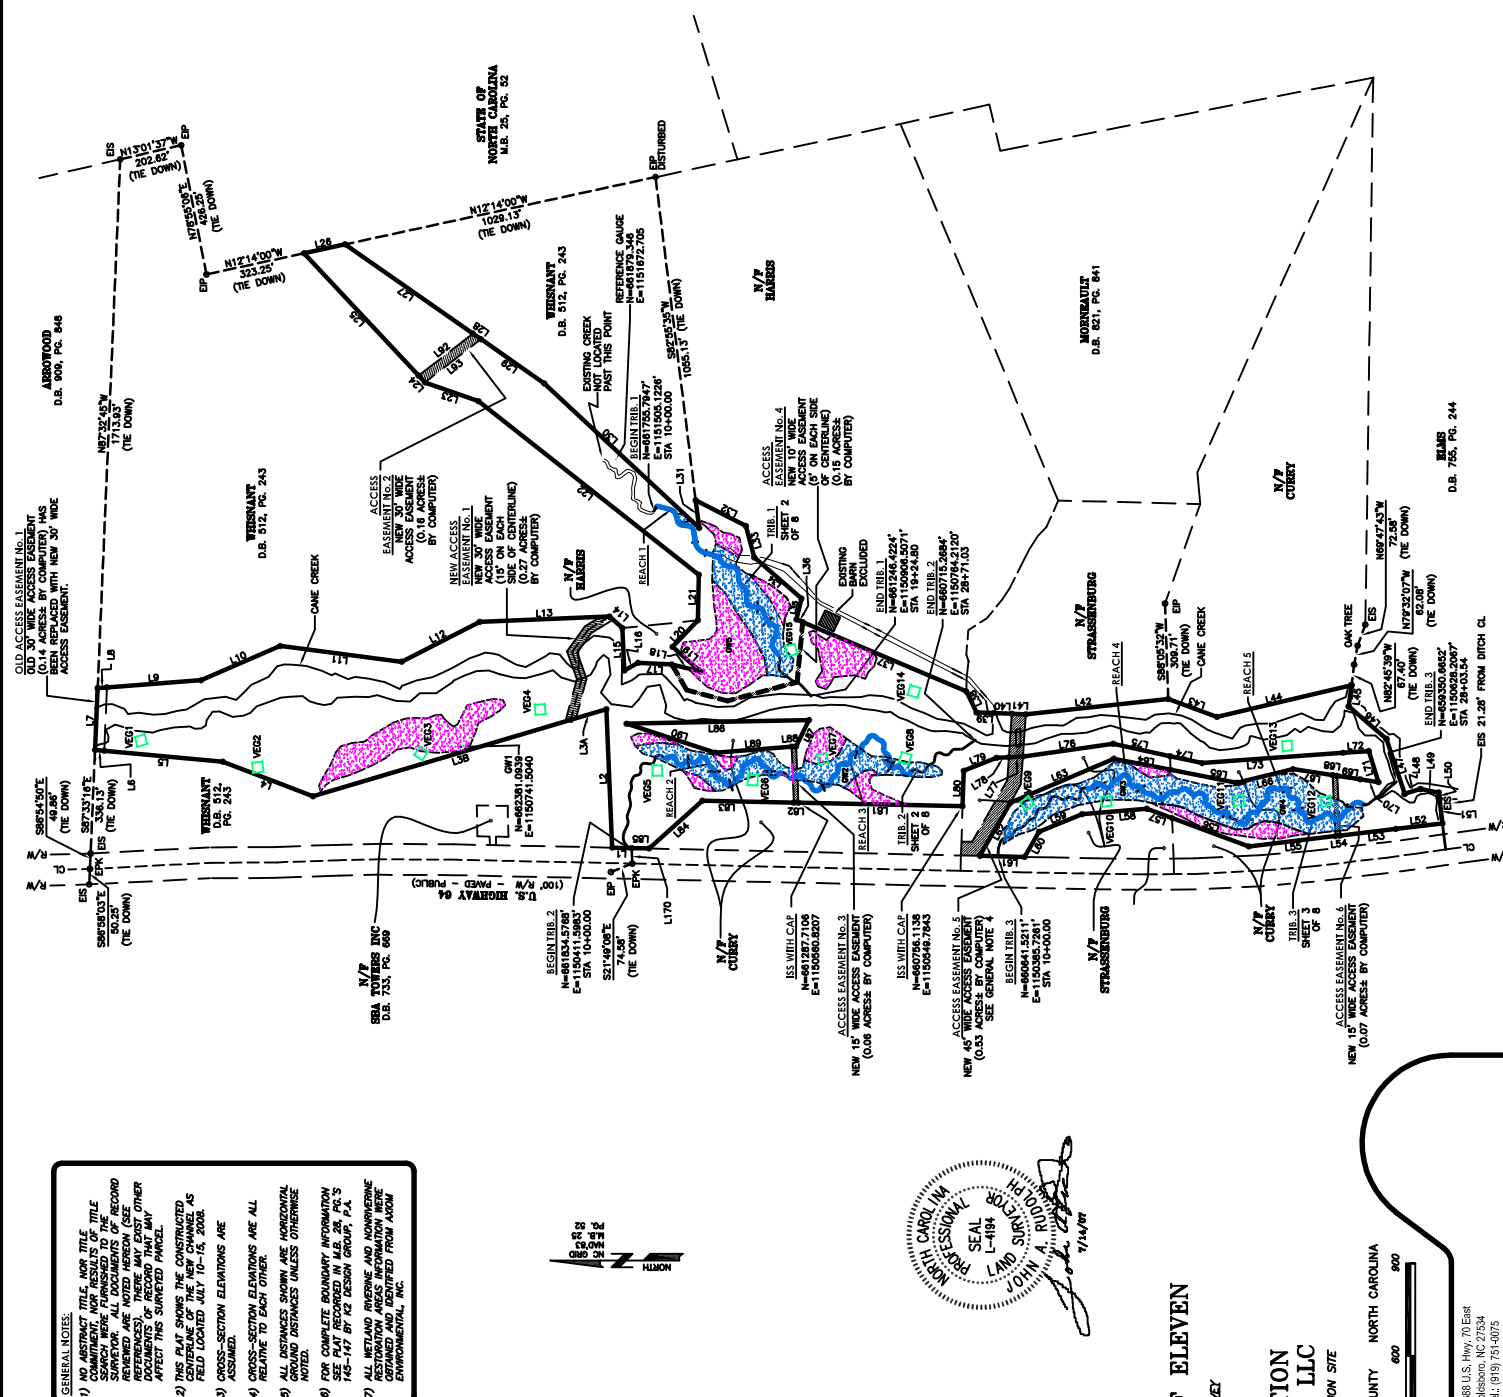

- GENERAL NOTES: 1) COPY THIS FILE AND THE TITLE... 2) THIS DRAWING SHOWS THE UNDISTURBED FIELD LOCATED JULY 10-15, 2008... 3) CROSS-SECTION ELEVATIONS ARE ASSUMED... 4) CROSS-SECTION ELEVATIONS ARE ALL RELATIVE TO EACH OTHER...

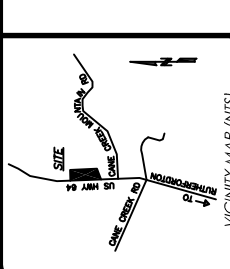



- LEGEND: EP - Existing Iron Stake, EP - Existing Iron Pipe, MAC - Non-Monumented Corner, S/W - Surveyed to Monument, R/W - Right-Of-Way, B/C - Back-Sight-Curb, MBL - Minimum Building Line, EOP - Edge of Pavement, EAP - Existing Concrete S/W Monument, E/W - Existing Well, E/W - Existing Well, E/W - Existing Well, E/W - Existing Well, E/W - Existing Well...

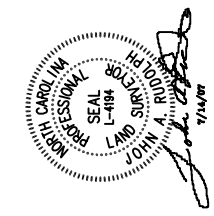

SHEET ONE OF ELEVEN AS-BUILT SURVEY FOR RESTORATION SYSTEMS, LLC CANE CREEK RESTORATION SITE

NORTH CAROLINA PROJECT SEAL L-104 JOSEPH R. KISER 1/14/19

DRAWN BY: FCR DATE: 07/14/2019 DWG. NO: 85592229E.DWG SURVEYED BY: J.A.R. 5688 U.S. Hwy. 70, East Collesboro, NC 27534 Tel: (919) 751-0075 Fax: (919) 779-9367 kziel@ksidetail.com

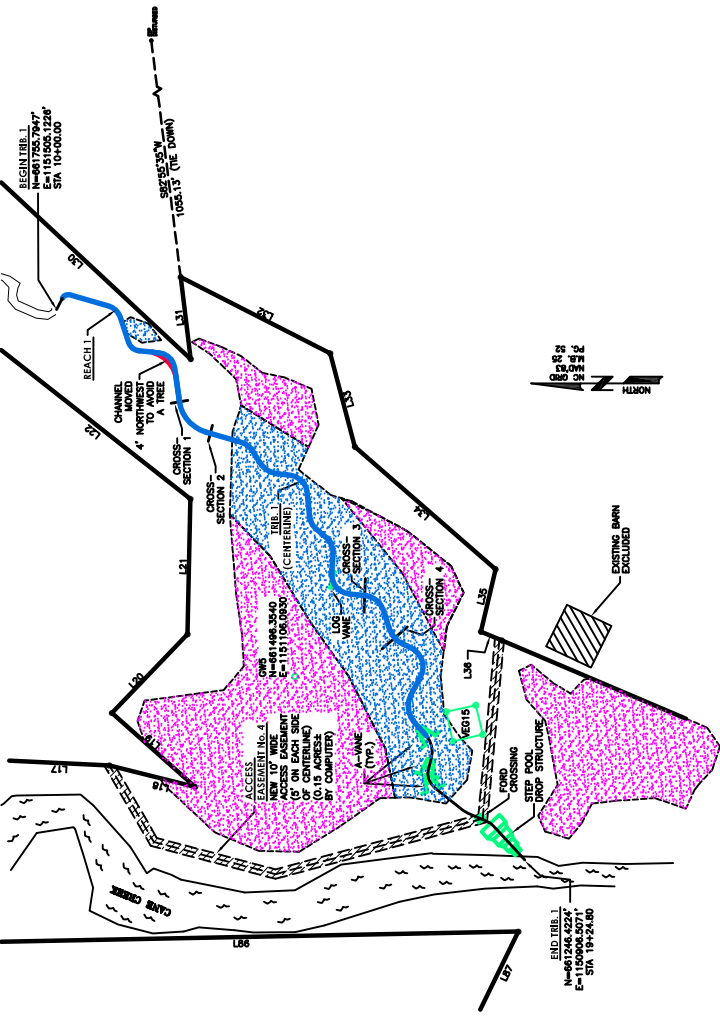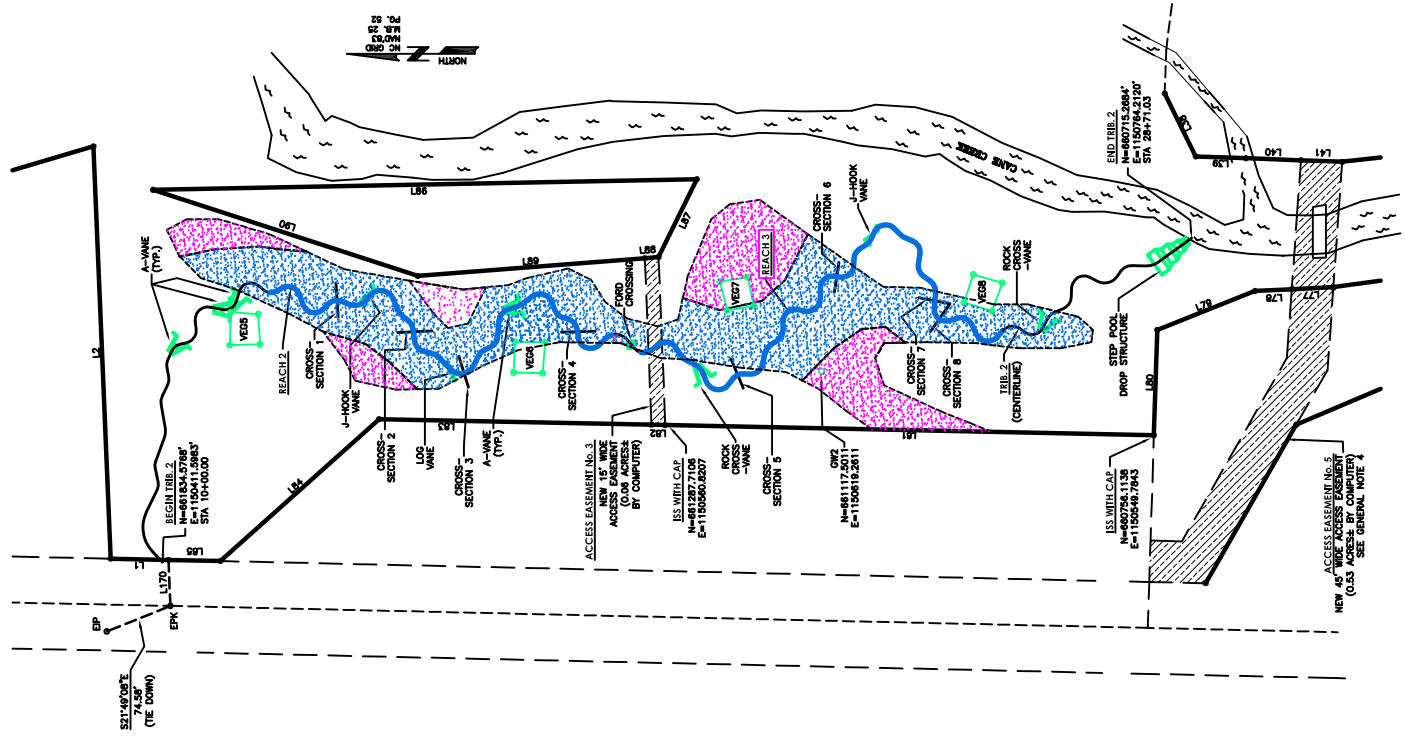

- LEGEND**
- STEP POOL DROP STRUCTURE
 - CROSS-SECTION
 - A-WAVE
 - LOG WAVE
 - FORD CROSSING
 - ROCK CROSS-WAVE
 - GROUNDWATER GAUGES
 - NOT CONSTRUCTED
 - MODIFIED CHANNEL
 - ADDED LOG WAVE
 - VEG PLOT AREA
 - RIVERINE WETLAND RESTORATION
 - NONRIVERINE WETLAND RESTORATION
 - MONITORING REACH
 - ACCESS EASEMENT



SHEET TWO OF ELEVEN

AS-BUILT FOR TRB. 1 & TRB. 2


FOR
RESTORATION SYSTEMS, LLC

CANE CREEK RESTORATION SITE




Restoration & Conservation
Natural Resources

LOGAN STORE TOWNSHIP RUTHERFORD COUNTY NORTH CAROLINA

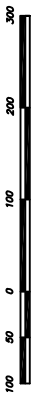


GRAPHIC SCALE 1" = 100'

TRB. 1 & TRB. 2

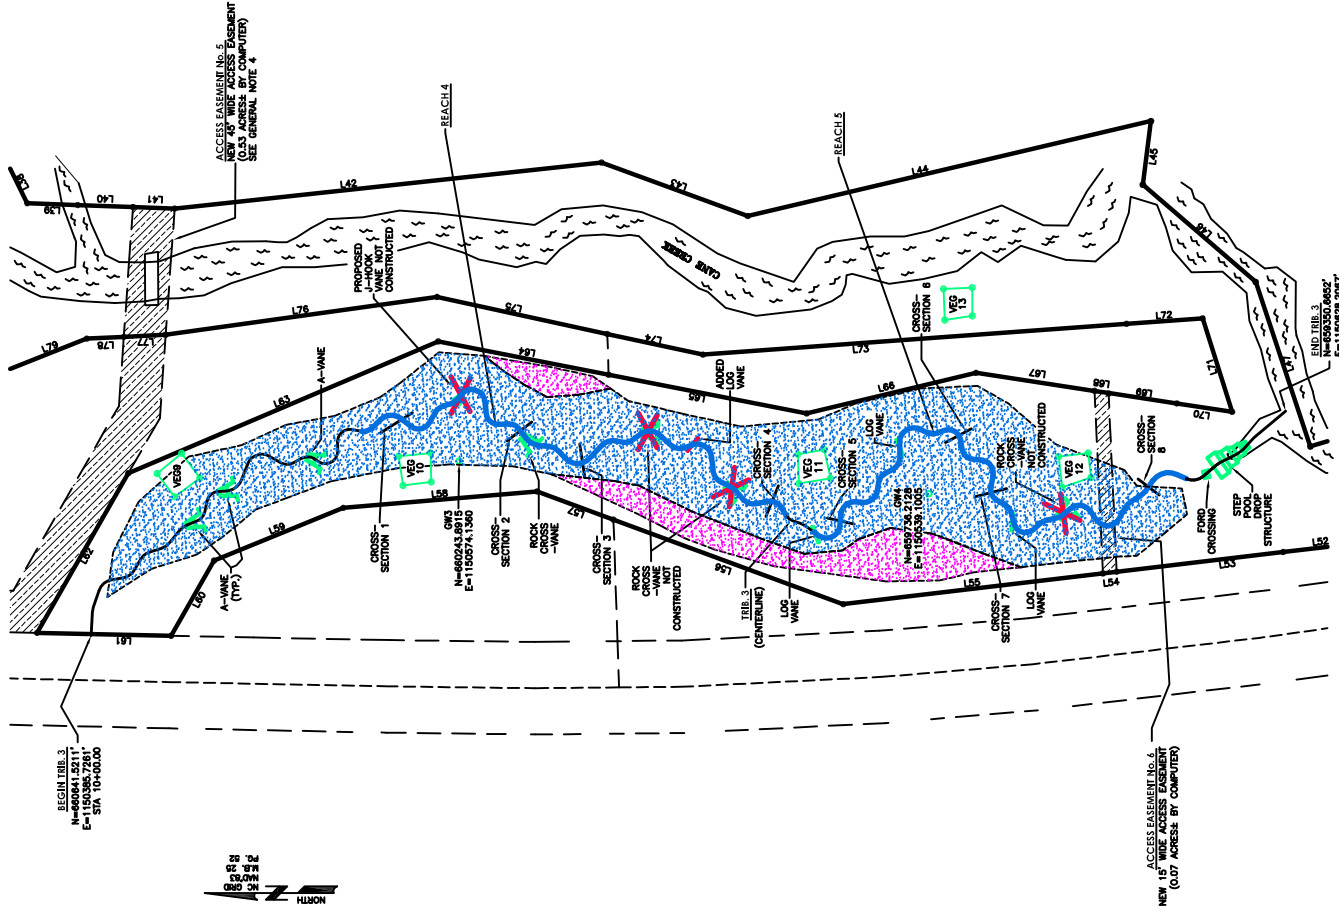

- LEGEND**
- VEG PLOT AREA
 - RIVERINE WETLAND RESTORATION
 - NONRIVERINE WETLAND RESTORATION
 - MONITORING REACH
 - ACCESS EASEMENT
 - STEP AND DROP STRUCTURE
 - CROSS-SECTION
 - A-WAVE
 - LOG WANE
 - FORD CROSSING
 - ROCK CROSS-WAVE
 - GROUNDWATER GAUGES
 - NOT CONSTRUCTED
 - MODIFIED CHANNEL
 - ADDED LOG WANE
 - ROCK CROSS-WAVE NOT CONSTRUCTED
 - ADDED LOG WANE NOT CONSTRUCTED
 - ROCK CROSS-WAVE NOT CONSTRUCTED
 - TRIBE 3 (CENTERLINE)
 - LOG WANE
 - A-WAVE (TYPE 1)
 - REACH 4
 - REACH 5
 - REACH 6

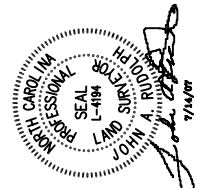

SHEET THREE OF ELEVEN
AS-BUILT FOR TRIBE 3

FOR
RESTORATION SYSTEMS, LLC
CANE CREEK RESTORATION SITE

Restoration & Conservation
Natural Resources
LOGAN STORE TOWNSHIP RUTHERFORD COUNTY NORTH CAROLINA

GRAPHIC SCALE 1" = 100'


TRIMETARY 3
1"=100'

BEGIN TRIBE 3
N=460844.152117
E=11500365.728117
STA 10+00.00




ACCESS EASEMENT NO. 4
NEW 15' WIDE ACCESS EASEMENT
(0.07 ADDRESS BY COMPUTER)


END TRIBE 3
N=460844.152117
E=11500365.728117
STA 28+03.54

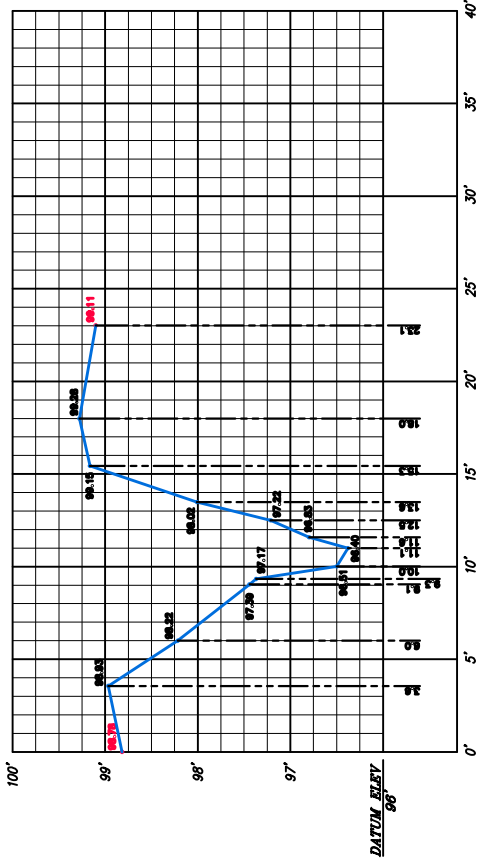


TRIB. 1 - CROSS-SECTION 1
(EAST BANK TO WEST BANK)
SCALE: 1"=5' HORZ./1"=1' VERT.

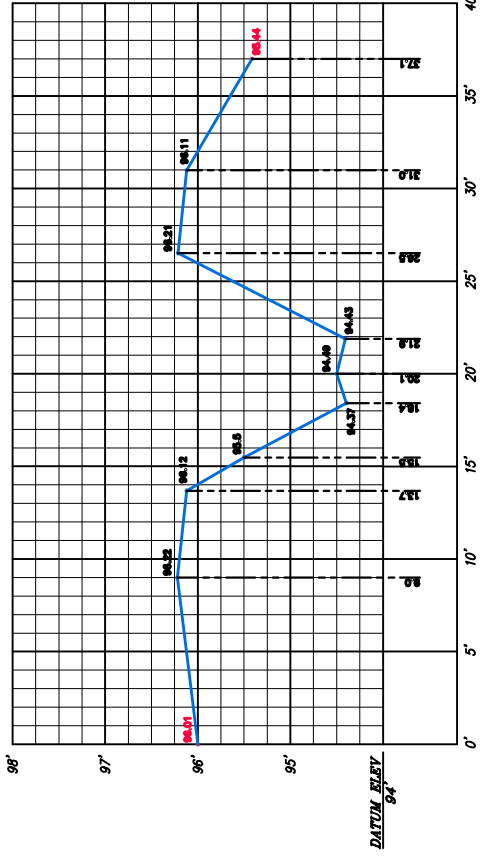

TRIB. 1 - CROSS-SECTION 3
(EAST BANK TO WEST BANK)
SCALE: 1"=5' HORZ./1"=1' VERT.

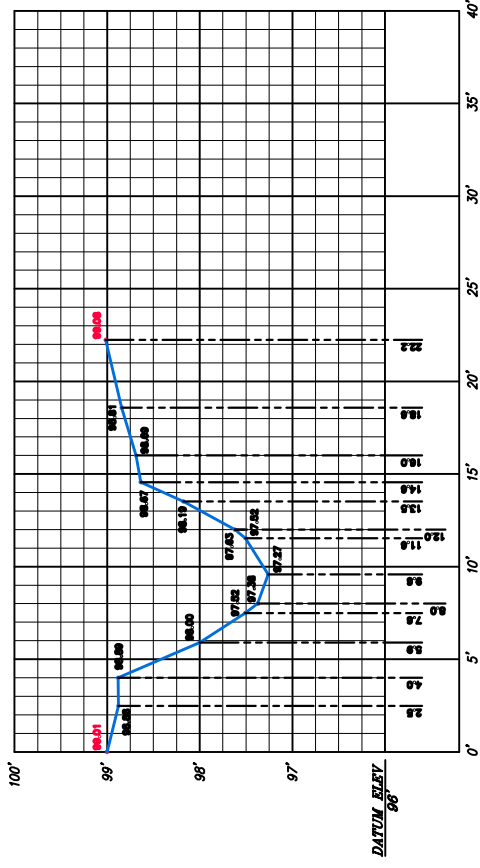

TRIB. 1 - CROSS-SECTION 2
(EAST BANK TO WEST BANK)
SCALE: 1"=5' HORZ./1"=1' VERT.

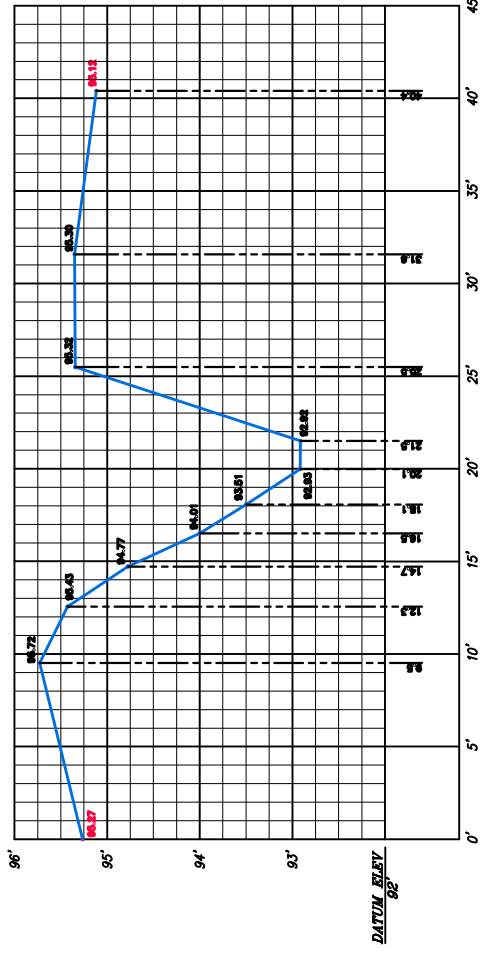

TRIB. 1 - CROSS-SECTION 4
(EAST BANK TO WEST BANK)
SCALE: 1"=5' HORZ./1"=1' VERT.

SHEET SEVEN OF ELEVEN

CROSS-SECTIONS FOR TRIB. 1




Restoration & Conservation
Systems, LLC
LOGAN STORE TOWNSHIP

FOR
RESTORATION
SYSTEMS, LLC
CANE CREEK RESTORATION SITE


RUTHERFORD COUNTY

NORTH CAROLINA


LEGEND
███ TYPICAL NATURAL GROUND
AT BOTTOM OF METAL STATE
(AS SHOWN ELEVATION)

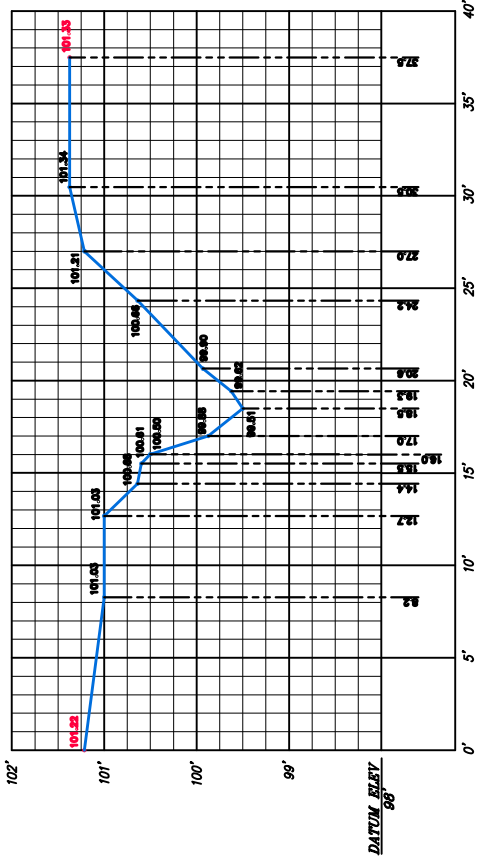


TRIB. 2 - CROSS-SECTION 1
 (EAST BANK TO WEST BANK)
 SCALE: 1"=5' HORIZ./1"=1' VERT.

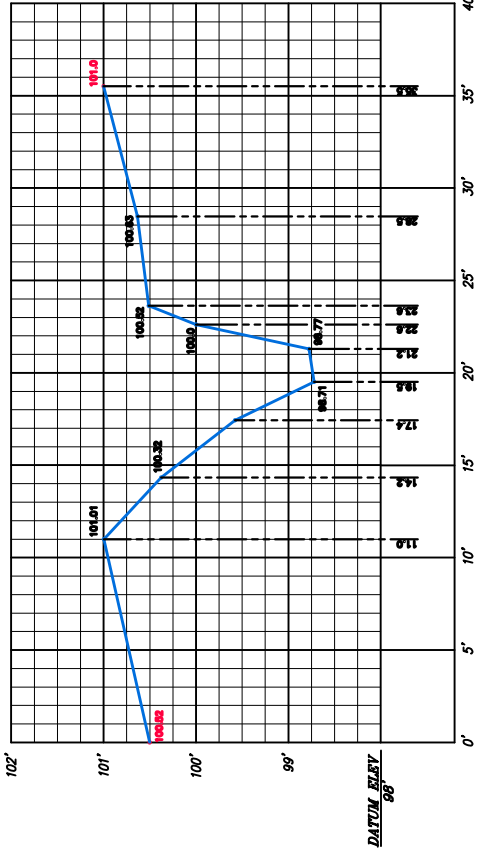

TRIB. 2 - CROSS-SECTION 3
 (EAST BANK TO WEST BANK)
 SCALE: 1"=5' HORIZ./1"=1' VERT.

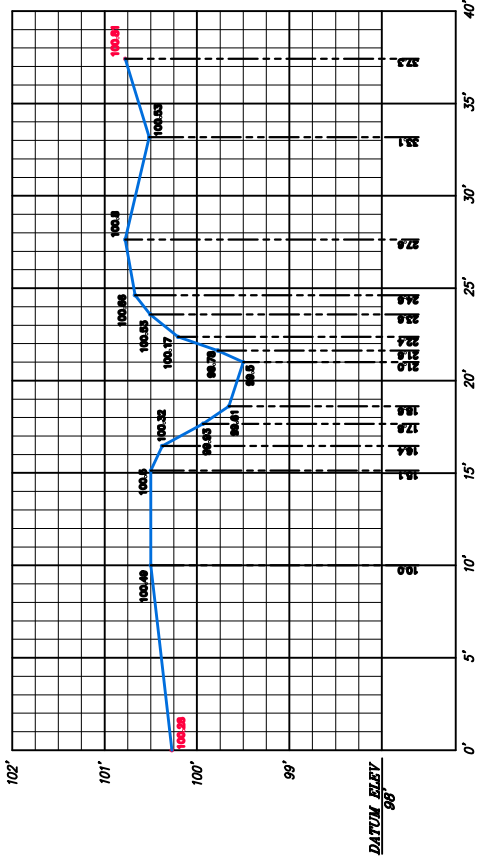

TRIB. 2 - CROSS-SECTION 2
 (EAST BANK TO WEST BANK)
 SCALE: 1"=5' HORIZ./1"=1' VERT.

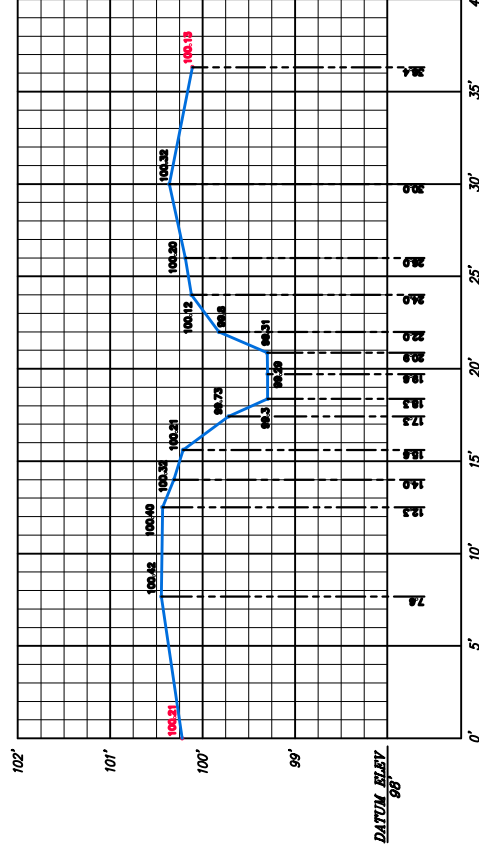

TRIB. 2 - CROSS-SECTION 4
 (EAST BANK TO WEST BANK)
 SCALE: 1"=5' HORIZ./1"=1' VERT.


SHEET EIGHT OF ELEVEN

CROSS-SECTIONS FOR TRIB. 2




FOR
**RESTORATION
 SYSTEMS, LLC**
 CANE CREEK RESTORATION SITE
 LOGAN STORE TOWNSHIP RUTHERFORD COUNTY NORTH CAROLINA


LEGEND
 100' ASSUMED ELEVATION
 100' ASSUMED ELEVATION

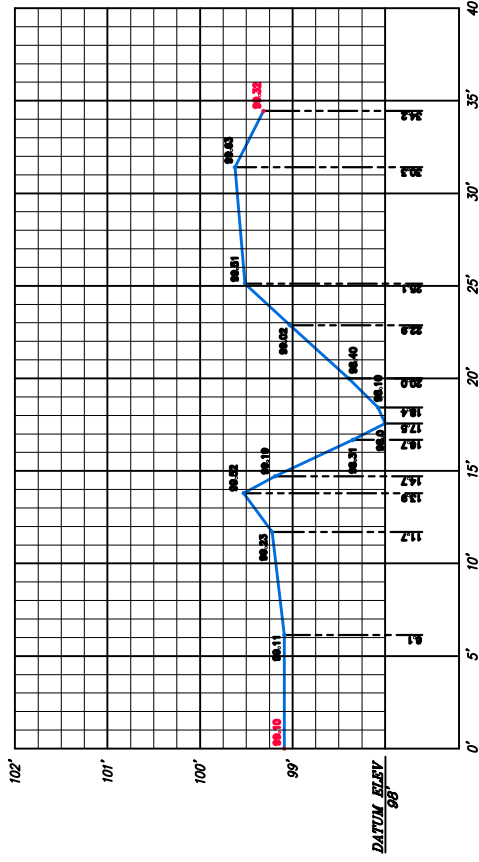


TRIB. 2 - CROSS-SECTION 5
(EAST BANK TO WEST BANK)
SCALE: 1"=5' HORIZ./1"=1' VERT.

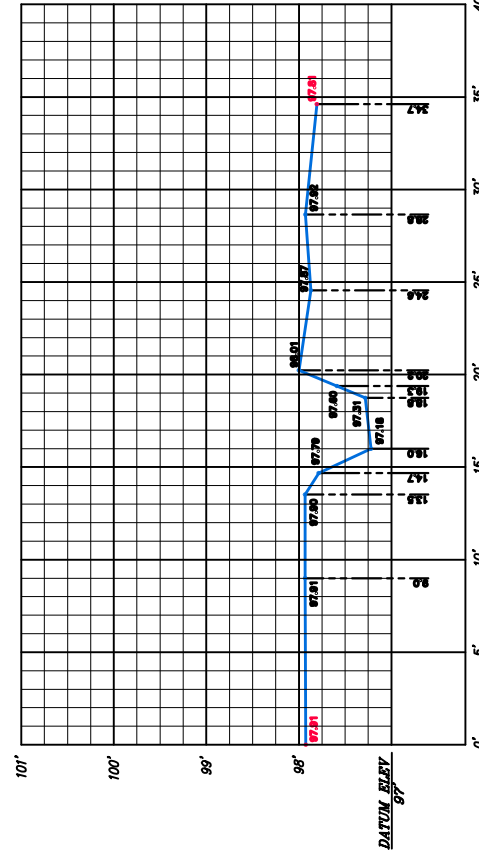

TRIB. 2 - CROSS-SECTION 7
(EAST BANK TO WEST BANK)
SCALE: 1"=5' HORIZ./1"=1' VERT.

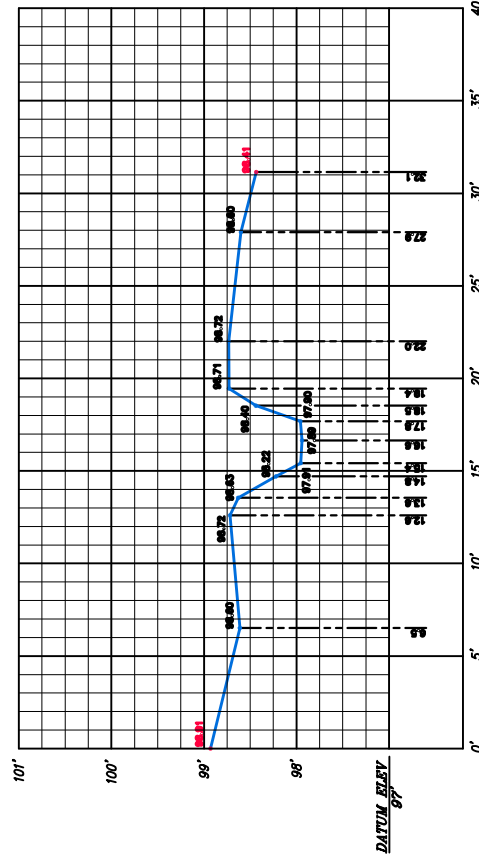

TRIB. 2 - CROSS-SECTION 6
(EAST BANK TO WEST BANK)
SCALE: 1"=5' HORIZ./1"=1' VERT.

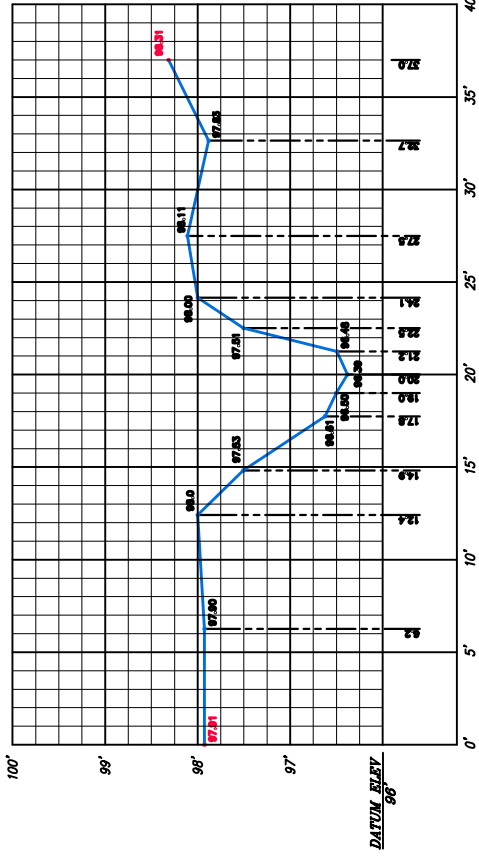

TRIB. 2 - CROSS-SECTION 8
(EAST BANK TO WEST BANK)
SCALE: 1"=5' HORIZ./1"=1' VERT.

SHEET NINE OF ELEVEN


CROSS-SECTIONS FOR TRIB. 2




Restoration & Conservation
Natural Resources
LOGAN STORE TOWNSHIP RUTHERFORD COUNTY NORTH CAROLINA

FOR
RESTORATION
SYSTEMS, LLC
CANE CREEK RESTORATION SITE


LEGEND
30' TBA IS NATURAL GROUND
AT BOTTOM OF METAL STAKE
(CHANGED ELEVATION)

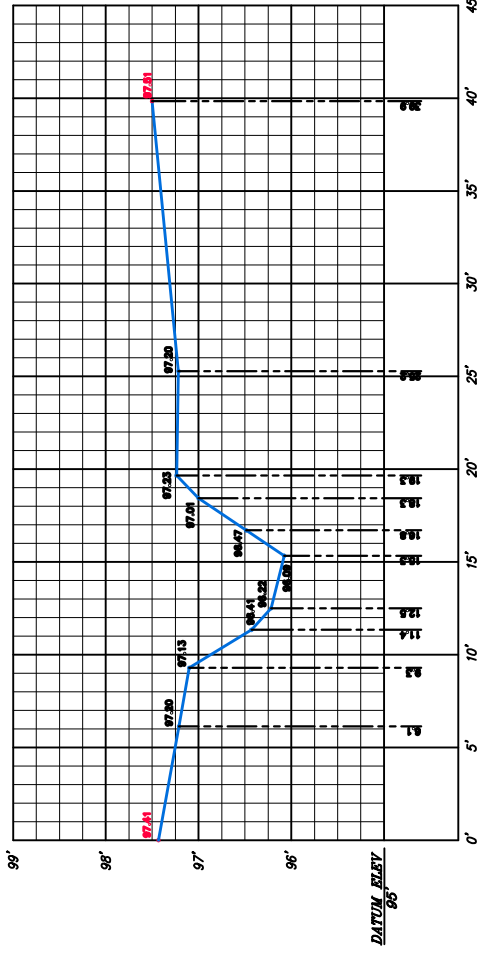


TRIB. 3 - CROSS-SECTION 5
(EAST BANK TO WEST BANK)
SCALE: 1"=5' HORZ./1"=1' VERT.

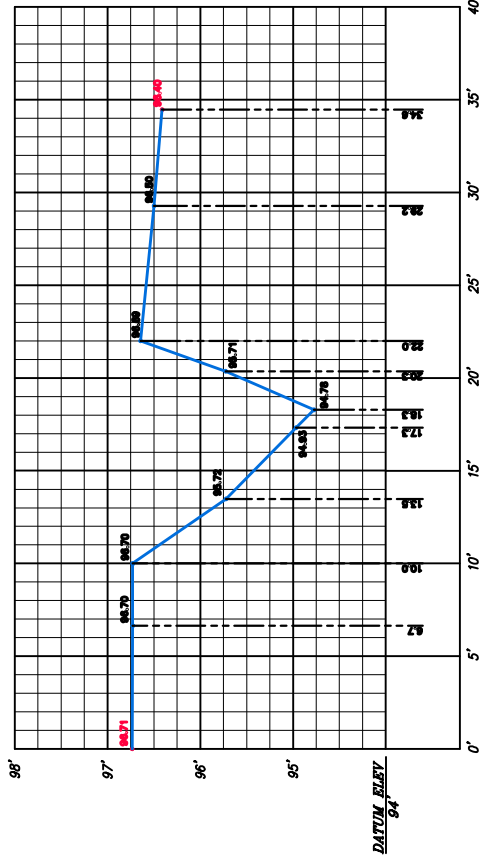

TRIB. 3 - CROSS-SECTION 7
(EAST BANK TO WEST BANK)
SCALE: 1"=5' HORZ./1"=1' VERT.

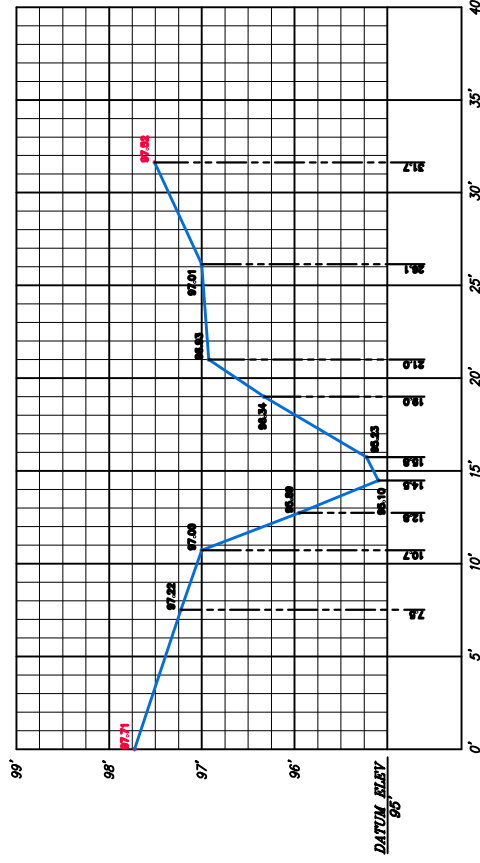

TRIB. 3 - CROSS-SECTION 6
(EAST BANK TO WEST BANK)
SCALE: 1"=5' HORZ./1"=1' VERT.

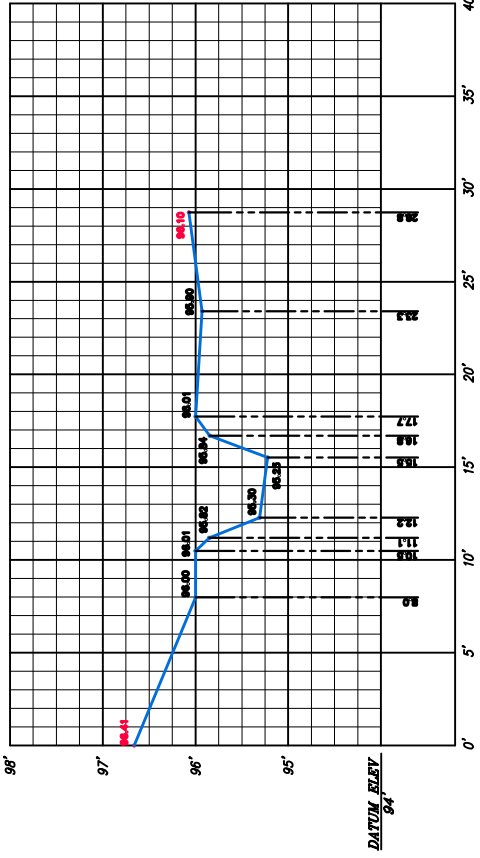

TRIB. 3 - CROSS-SECTION 8
(EAST BANK TO WEST BANK)
SCALE: 1"=5' HORZ./1"=1' VERT.

SHEET ELEVEN OF ELEVEN

CROSS-SECTIONS FOR TRIB. 3

FOR

RESTORATION
SYSTEMS, LLC

CAME CREEK RESTORATION SITE



Restoration & Conservation
Systems, LLC

National Resources

LOGAN STORE TOWNSHIP RUTHERFORD COUNTY NORTH CAROLINA

LEGEND
 1"=5' STANDARD GRID (ASSUMED ELEVATION)

**Appendix B.
Preconstruction and
Construction Photographs**

**Cane Creek Preconstruction Conditions
Taken March 2007**




**Cane Creek During Construction
Taken April 2008**



Appendix C.
Baseline Stream Photographs and Stream Measurements


Cane Creek
Baseline Stream Structure Photographs taken July 2008

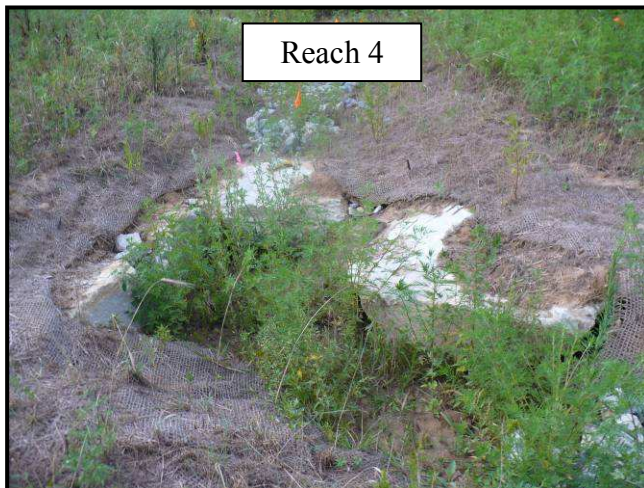

Project Name: Cane Creek AsBuilt												
Reach: 1												
Feature: Profile												
Date: 5/6/08												
Crew: Adams, Jeffers												
Station	As-built			2008 Survey			2009 Survey			2010 Survey		
	Bed Elevation	Water Elevation	Station	Bed Elevation	Water Elevation	Station	Bed Elevation	Water Elevation	Station	Bed Elevation	Water Elevation	
0.0	98.5	99.2										
4.9	99.1	99.2										
36.9	98.6	98.8										
44.7	97.6	98.7										
53.1	97.9	98.7										
67.2	98.3	98.7										
82.2	98.1	98.4										
92.5	97.2	98.4										
97.2	97.4	98.4										
103.9	98.1	98.4										
122.1	98.2	98.2										
132.4	97.3	98.2										
142.7	97.4	98.2										
150.6	97.8	98.1										
187.3	97.2	97.7										
193.7	96.4	97.6										
196.9	96.3	97.6										
204.3	97.1	97.7										
215.4	96.3	97.6										
223.8	96.4	97.6										
235.1	97.1	97.6										
269.3	96.9	97.2										
275.4	95.7	97.2										
282.8	96.0	97.2										
290.0	96.8	97.2										
304.4	96.1	96.7										
310.2	95.4	96.7										


AsBuilt	2008	2009	2010
Avg. Water Surface Slope			
Avg. Effile Slope			
Avg. Pool Slope			
Avg. Run Slope			
Avg. Cflie Slope			

Cane Creek AsBuilt Profile - Reach 1

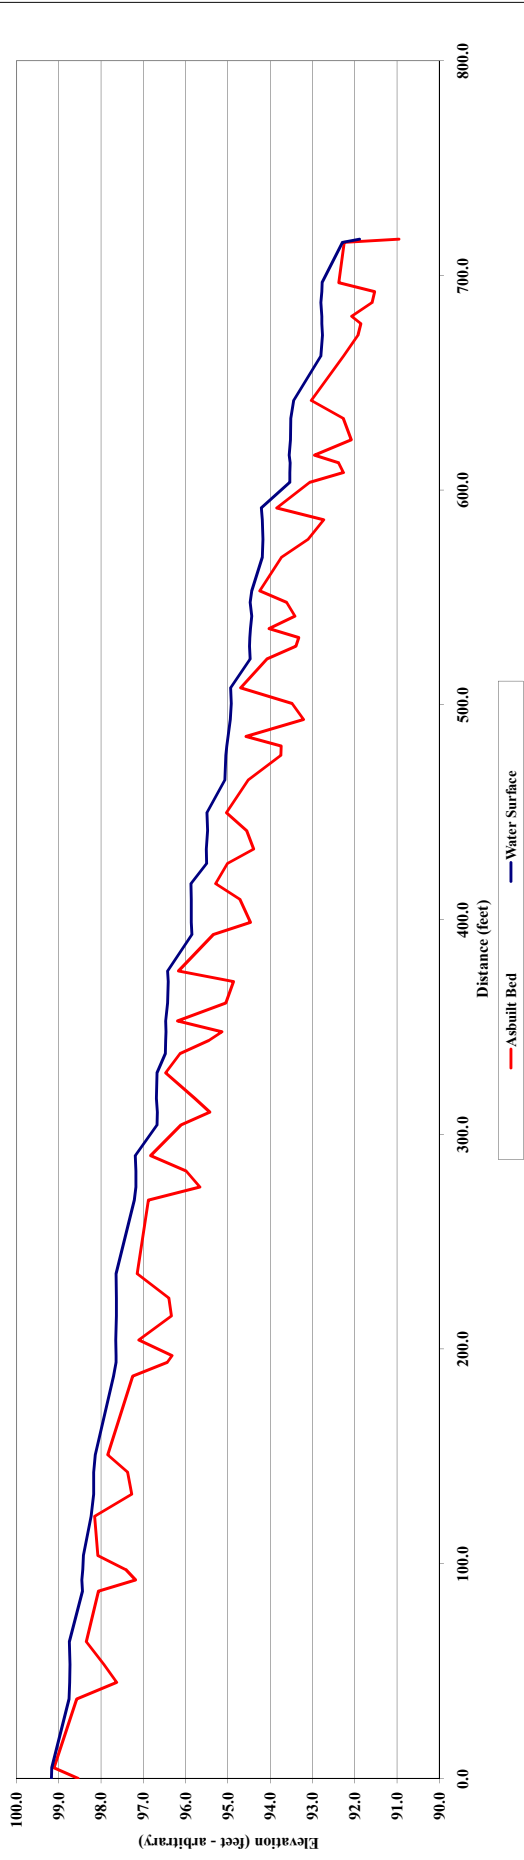


Project Name Cane Creek
 Cross Section R1-XS1
 Feature Pool
 Date 5/6/08
 Crew Adams, Jeffers

As-built		2008 Survey		2009 Survey		2010 Survey	
Station	Elevation	Station	Elevation	Station	Elevation	Station	Elevation
0.0	98.8						
3.8	98.9						
5.9	98.2						
8.9	97.3						
9.1	97.2						
10.0	96.5						
10.9	96.4						
11.6	96.7						
12.6	97.4						
13.5	98.0						
15.1	99.1						
17.9	99.2						
23.1	99.1						

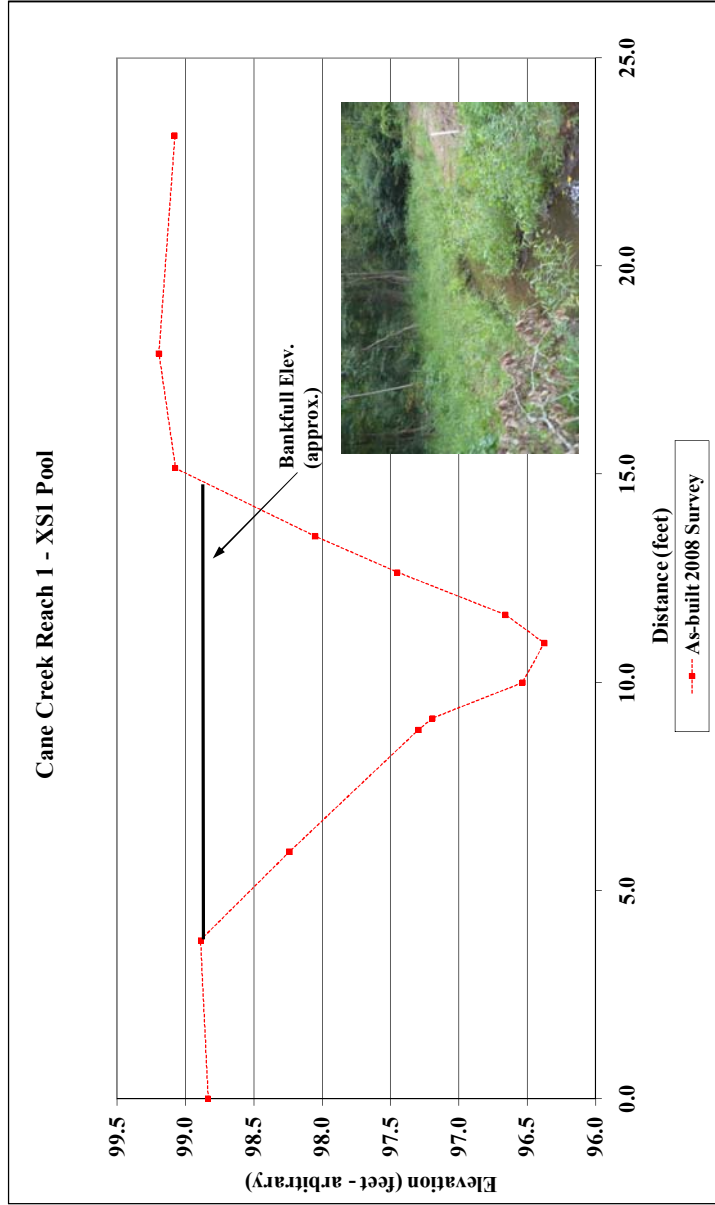


	As-built	2008	2009	2010
Area	13.5			
Width	11.0			
Mean Depth	1.2			
Max Depth	2.5			
W/D Ratio	NA			

Project Name Cane Creek			
Cross Section R1-XS2			
Feature Riffle			
Date 5/6/08			
Crew Adams, Jeffers			
As-built	2008	2009	2010
2008 Survey	2008 Survey	2009 Survey	2010 Survey
Station	Station	Station	Station
Elevation	Elevation	Elevation	Elevation
0.0 99.1			
2.5 98.9			
4.1 98.9			
5.9 98.1			
7.5 97.5			
7.9 97.4			
9.7 97.3			
11.6 97.5			
11.9 97.6			
13.5 98.2			
14.7 98.7			
16.0 98.7			
18.5 98.8			
22.1 99.0			

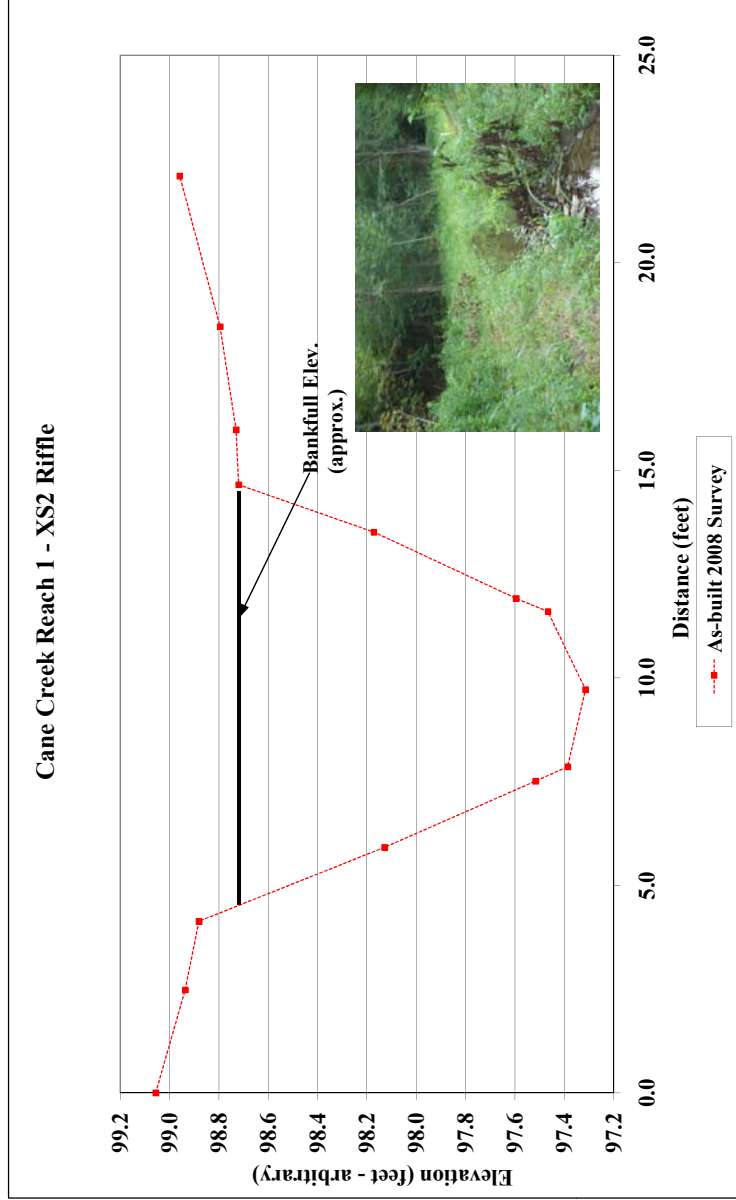


Area	As-built	2008	2009	2010
Width	9.4			
Mean Depth	10.1			
Max Depth	0.9			
W/D Ratio	1.4			
	11.0			

Project Name Cane Creek				
Cross Section R1-XS3				
Feature Riffle				
Date 5/6/08				
Crew Adams, Jeffers				
As-built	2008	2009	2010	
Station	2008 Survey	2009 Survey	2010 Survey	
0.0	Elevation	Station	Elevation	Station
9.1	96.2			
13.6	96.1			
15.4	95.5			
18.2	94.4			
20.2	94.5			
21.8	94.4			
26.6	96.2			
31.1	96.1			
36.9	95.4			

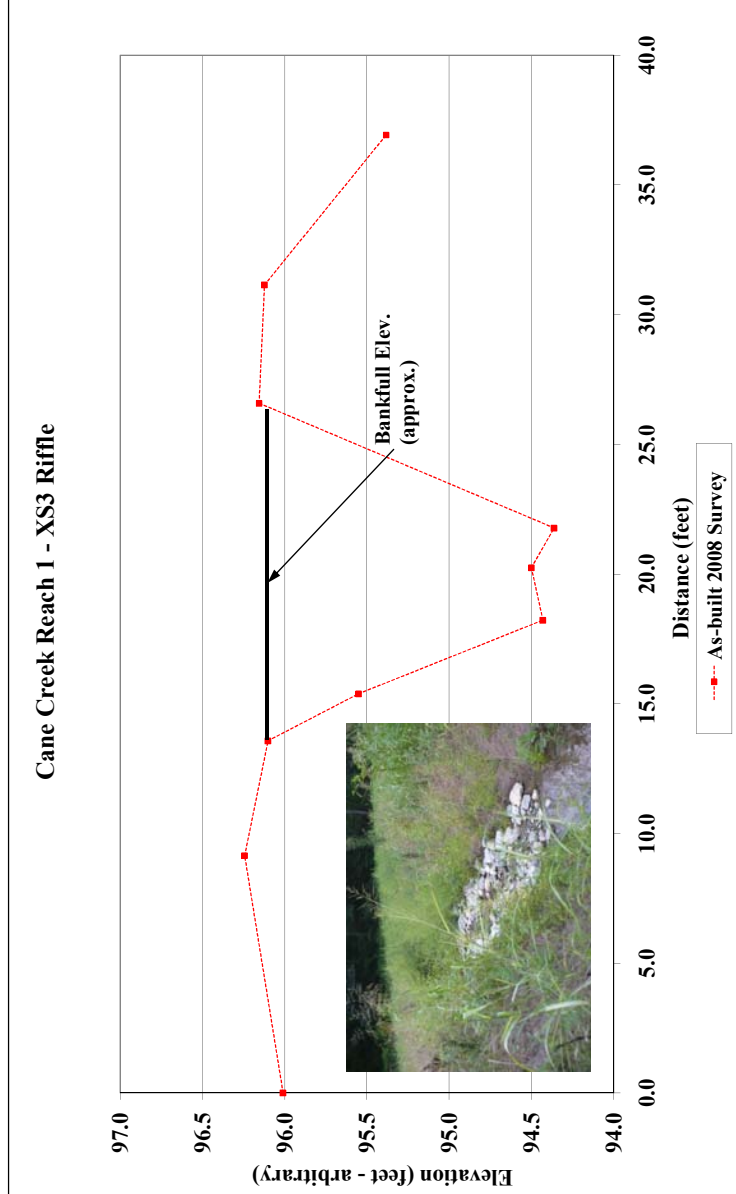

Area	As-built	2008	2009	2010
Width	13.6			
Mean Depth	12.9			
Max Depth	1.1			
W/D Ratio	1.7			
	12.2			

Project Name Cane Creek Cross Section R1-XS4 Feature Pool Date 5/6/08 Crew Adams, Jeffers				
	2008	2009	2010	
As-built	2008 Survey	2009 Survey	2010 Survey	
Station	Station	Station	Station	
0.0	95.3		Elevation	
9.6	95.7		Elevation	
12.3	95.4		Elevation	
14.6	94.8		Elevation	
16.5	94.0		Elevation	
18.2	93.5		Elevation	
20.0	92.9		Elevation	
21.5	92.9		Elevation	
25.4	95.3		Elevation	
31.5	95.3		Elevation	
40.4	95.1		Elevation	

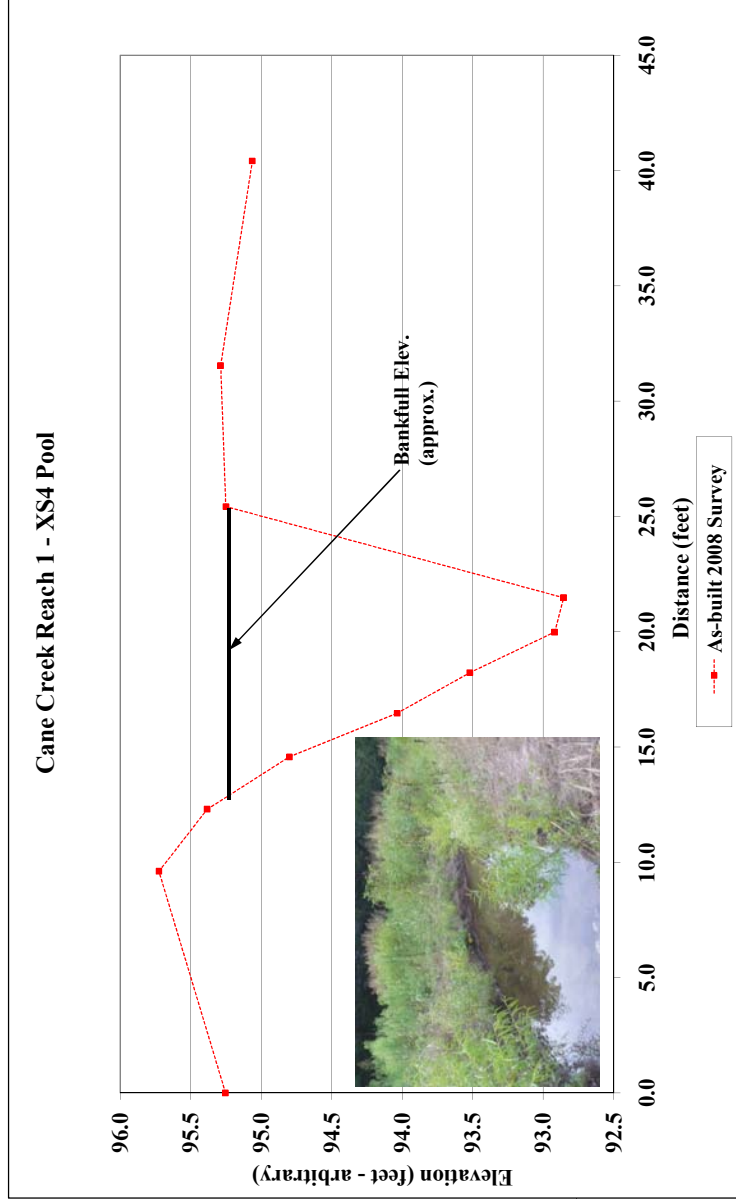


Area	As-built	2008	2009	2010
Width	16.4			
Mean Depth	12.6			
Max Depth	1.3			
W/D Ratio	2.4			
	NA			

Project Name Cane Creek AsBuilt									
Reach 2 Profile									
Feature 50608									
Date Adams, Jeffers									
Crew									
As-built		2008 Survey		2009 Survey		2010 Survey		2010	
Station	Bed Elevation	Water Elevation	Station	Bed Elevation	Water Elevation	Station	Bed Elevation	Water Elevation	Water Elevation
0.0	100.4								
5.1	101.1								
14.2	100.7								
22.3	100.0								
27.3	100.0								
33.9	100.7								
50.9	100.4								
58.9	100.0								
66.5	100.1								
74.6	100.5								
85.0	100.2								
89.0	99.5								
92.4	99.6								
95.4	100.1								
107.3	100.1								
114.9	99.4								
119.5	99.4								
123.9	100.1								
134.1	99.5								
135.3	98.2								
142.6	99.5								
150.6	99.1								


Avg. Water Surface Slope	2008	2009	2010
Avg. Riffle Slope			
Avg. Pool Slope			
Avg. Run Slope			
Avg. Gidle Slope			
As-built	0.0056		

Cane Creek Profile - Reach 2

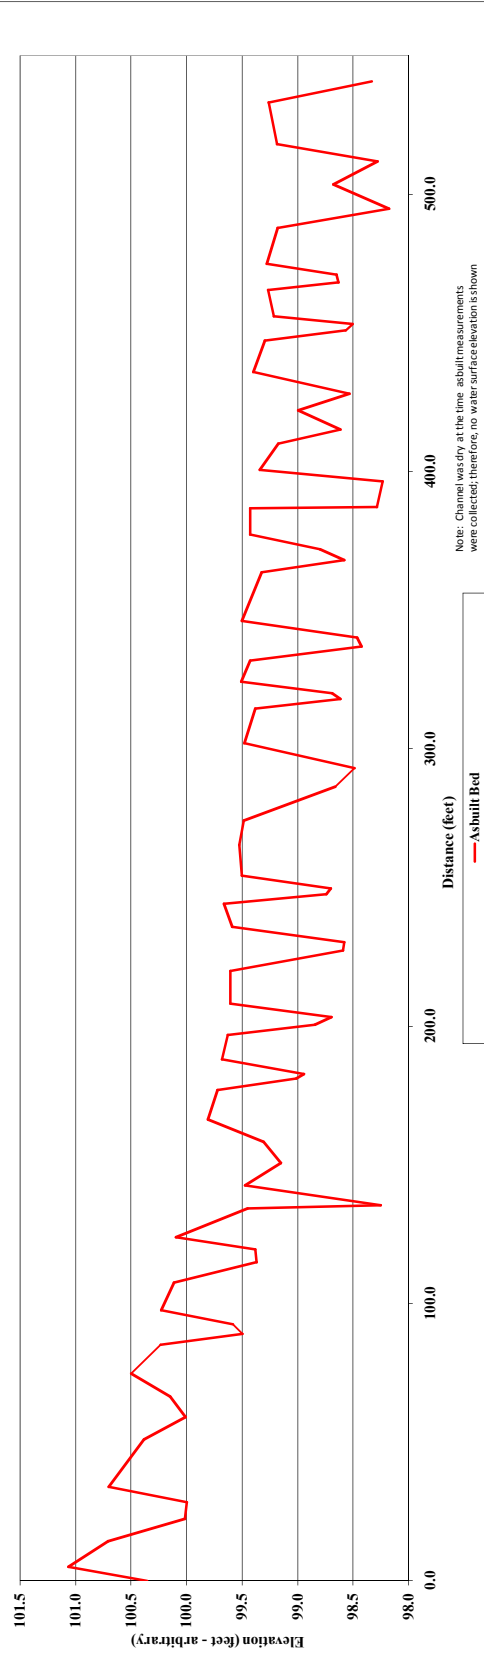


400.64	99.34
410.10	99.17
414.99	98.61
421.94	98.99
428.00	98.53
433.96	99.40
439.92	98.56
450.99	98.56
453.17	98.50
456.03	99.21
465.45	99.26
468.15	98.63
470.85	98.64
474.84	99.27
479.74	98.74
484.71	98.19
491.71	98.67
503.48	98.67
511.72	98.28
518.13	99.18
533.02	99.26
540.58	98.33

Project Name Cane Creek				
Cross Section R2-XS1				
Feature Pool				
Date 5/6/08				
Crew Adams, Jeffers				
As-built	2008	2009	2010	
Station	2008 Survey	2009 Survey	2010 Survey	
0.0	Elevation	Elevation	Elevation	
8.1	101.2			
12.7	101.0			
14.3	100.7			
15.6	100.6			
16.1	100.5			
16.9	99.9			
18.5	99.5			
19.4	99.6			
20.7	99.9			
24.3	100.7			
27.0	101.2			
30.6	101.3			
37.6	101.3			

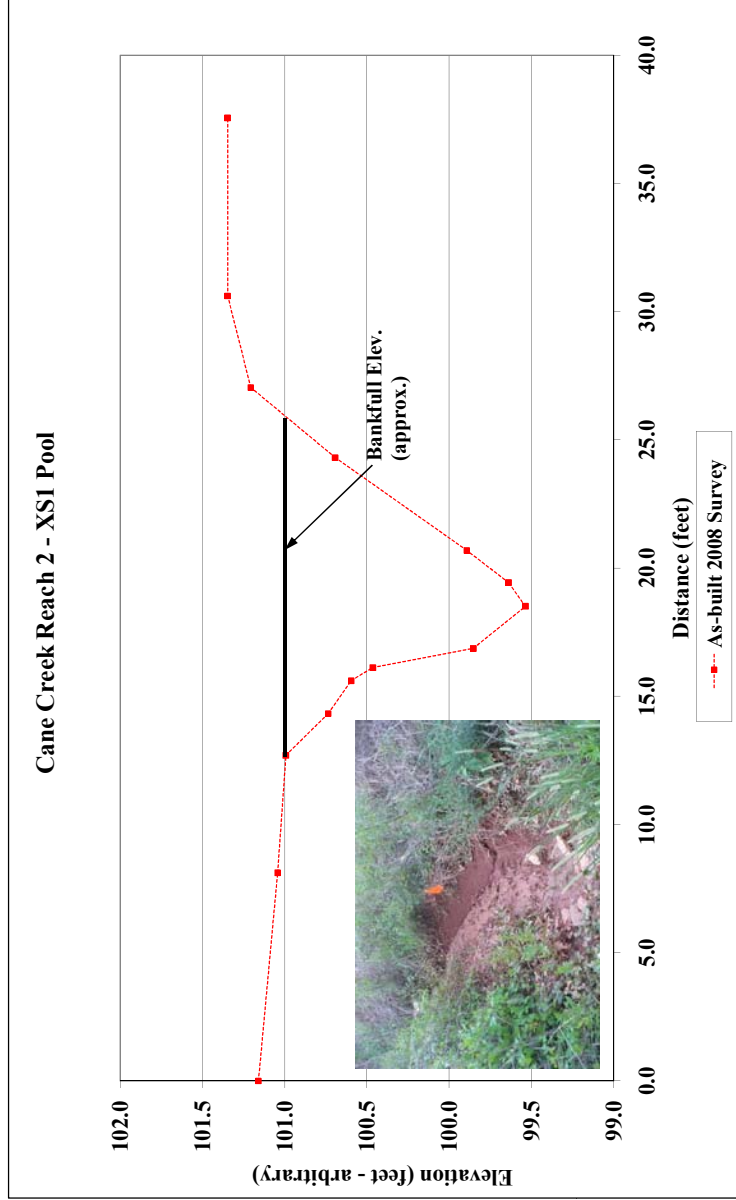


Area	As-built	2008	2009	2010
Width	9.3			
Mean Depth	13.4			
Max Depth	0.7			
W/D Ratio	1.5			
	N/A			

Project Name Cane Creek			
Cross Section R2-XS2			
Feature Riffle			
Date 5/6/08			
Crew Adams, Jeffers			
As-built	2008	2009	2010
Station	2008 Survey Station	2009 Survey Station	2010 Survey Station
0.0	100.3		
10.0	100.5		
15.2	100.5		
16.4	100.3		
17.9	99.9		
18.6	99.6		
20.9	99.5		
21.7	99.8		
22.4	100.2		
23.6	100.5		
24.5	100.7		
27.6	100.8		
33.0	100.5		
37.4	100.8		

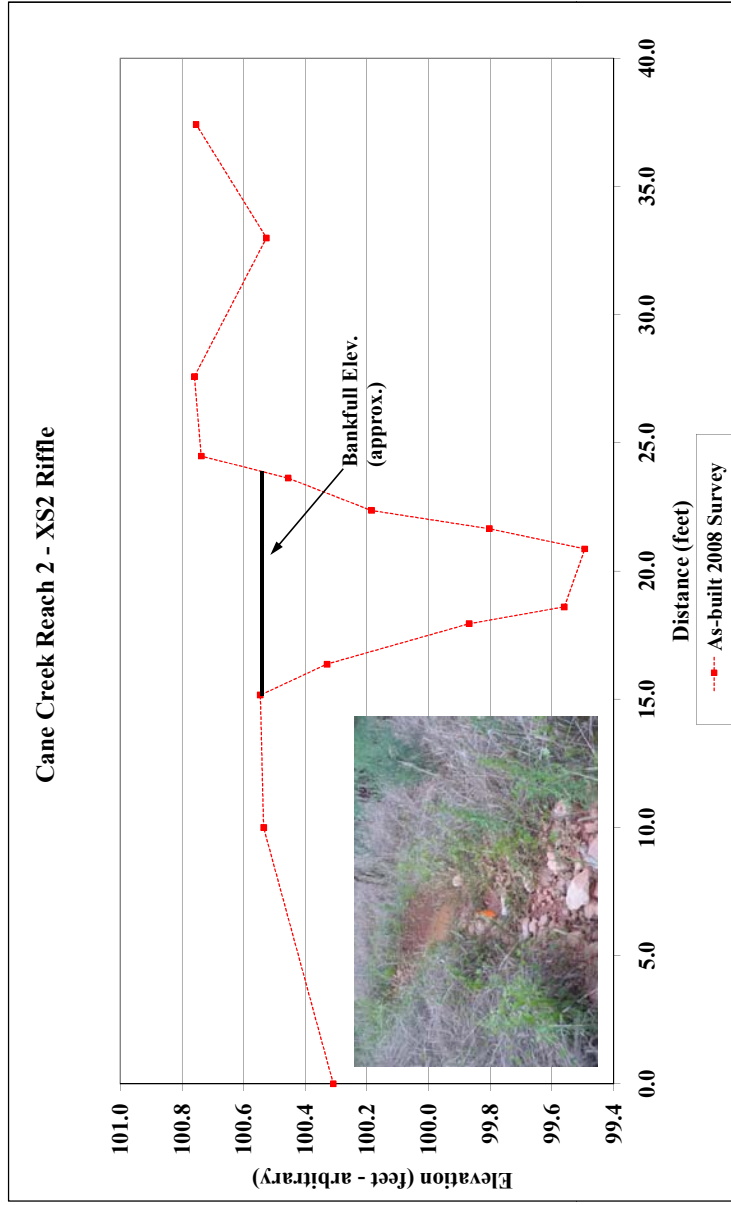


Area	As-built	2008	2009	2010
Width	5.1			
Mean Depth	9.2			
Max Depth	0.6			
W/D Ratio	1.1			
	16.5			

Project Name Cane Creek			
Cross Section R2-XS3			
Feature Pool			
Date 5/6/08			
Crew Adams, Jeffers			
As-built	2008	2009	2010
Survey Station	2008 Survey Station	2009 Survey Station	2010 Survey Station
Elevation	Elevation	Elevation	Elevation
0.0 100.5			
10.9 101.0			
14.2 100.3			
17.3 99.6			
19.4 98.7			
21.1 98.8			
22.6 100.0			
23.5 100.5			
28.5 100.6			
35.3 101.0			

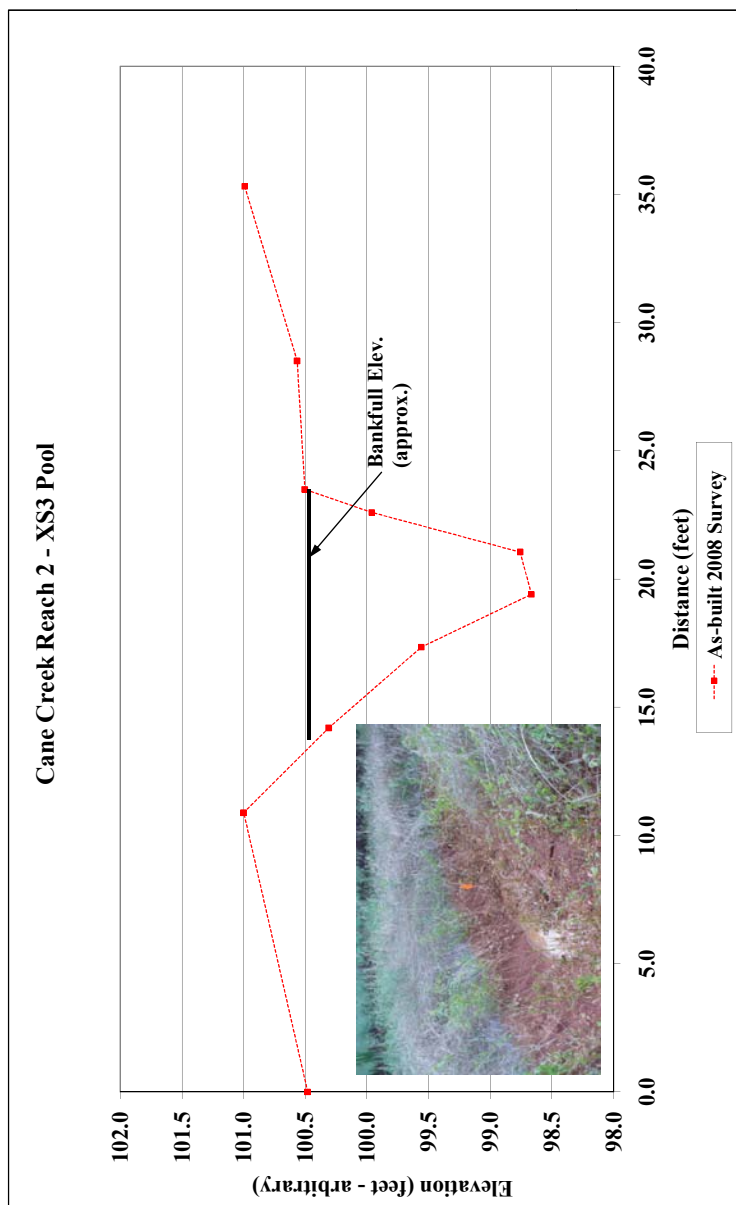

Area	As-built	2008	2009	2010
Width	9.7			
Mean Depth	10.2			
Max Depth	1.0			
W/D Ratio	1.8			
	N/A			

Project Name Cane Creek			
Cross Section R2-XS4			
Feature Riffle			
Date 5/6/08			
Crew Adams, Jeffers			
As-built	2008	2009	2010
Survey Station	2008 Survey Station	2009 Survey Station	2010 Survey Station
0.0	100.2		
7.6	100.4		
12.3	100.4		
14.0	100.3		
15.6	100.2		
17.3	99.7		
18.3	99.3		
19.6	99.3		
20.9	99.3		
22.0	99.8		
24.0	100.1		
26.0	100.2		
30.0	100.3		
36.5	100.1		

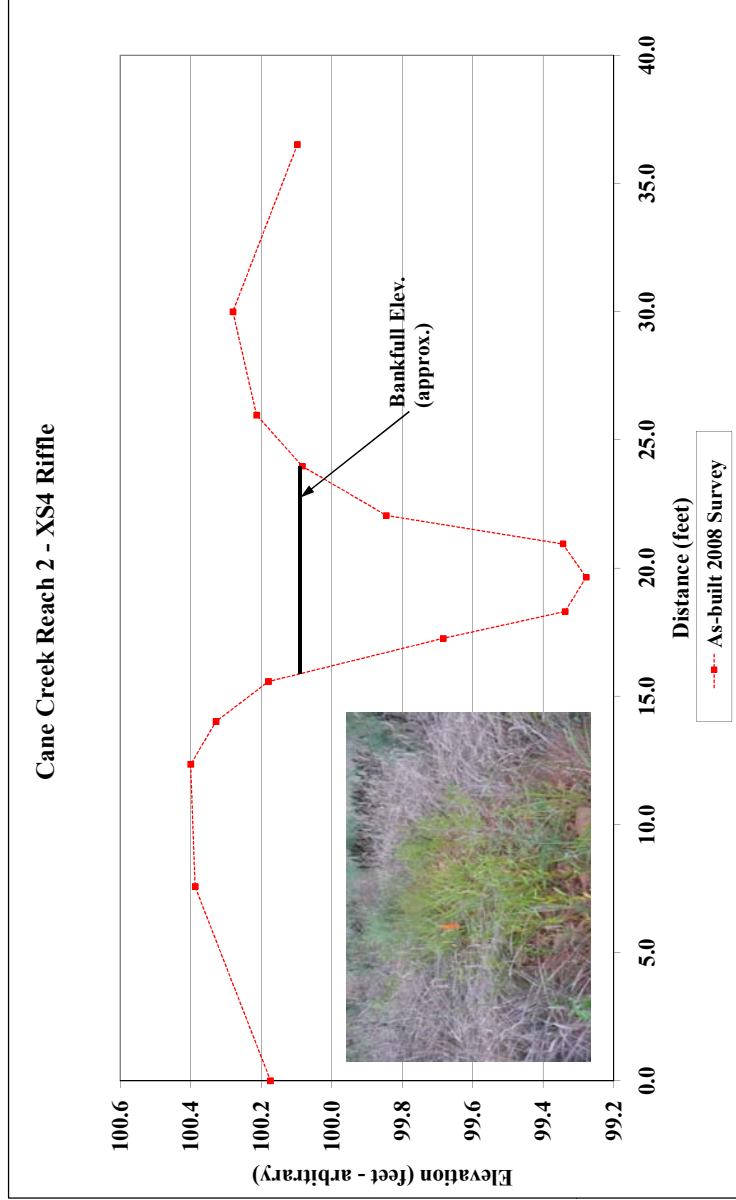


Area	As-built	2008	2009	2010
Width	3.7			
Mean Depth	8.1			
Max Depth	0.5			
W/D Ratio	0.8			
	17.8			

Project Name		Cane Creek Asphalt				
Reach		3				
Profile						
Feature		50608				
Date		Adams, Jeffers				
Crew						
Station	2008 Survey Bed Elevation	2008 Survey Water Elevation	2009 Survey Bed Elevation	2009 Survey Water Elevation	2010 Survey Bed Elevation	2010 Survey Water Elevation
0.0	98.2					
6.9	99.0					
17.5	99.1					
24.7	97.9					
27.6	97.9					
37.4	99.2					
45.9	99.1					
50.5	98.1					
52.9	98.1					
58.4	98.9					
69.0	98.3					
72.2	98.2					
78.2	98.2					
79.3	97.9					
85.1	98.0					
89.6	98.8					
94.6	98.8					
98.7	97.8					

Avg. Water Surface Slope	0.0035
Avg. Riffle Slope	
Avg. Pool Slope	
Avg. Run Slope	
Avg. Glide Slope	


Cane Creek Profile - Reach 3

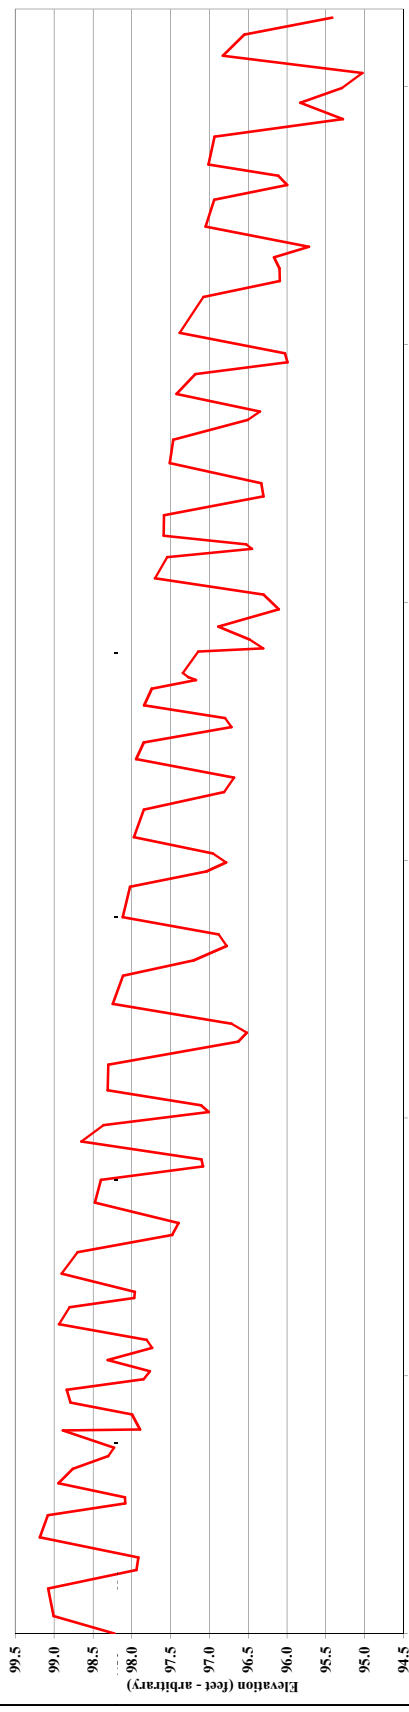

Note: Channel was dry at the time asphalt measurements were collected; therefore, no water surface elevation is shown


Station	2008 Survey Bed Elevation	2008 Survey Water Elevation	2009 Survey Bed Elevation	2009 Survey Water Elevation	2010 Survey Bed Elevation	2010 Survey Water Elevation
332.0	96.7					
339.2	97.9					
345.6	97.8					
351.6	96.7					
355.1	96.8					
360.0	97.8					
366.5	97.7					
369.9	97.2					
370.9	97.3					
374.6	97.1					
380.9	97.1					
382.1	96.3					
385.5	96.5					
390.6	96.9					
397.3	96.1					
403.0	96.3					
409.3	97.7					
414.2	96.4					
420.2	96.4					
422.5	96.5					

Project Name Cane Creek			
Cross Section R3-XS1			
Feature Pool			
Date 5/6/08			
Crew Adams, Jeffers			
As-built	2008	2009	2010
Station	2008 Survey	2009 Survey	2010 Survey
	Elevation	Elevation	Elevation
0.0	99.1		
6.2	99.1		
11.7	99.2		
13.9	99.5		
14.8	99.2		
16.7	98.3		
17.4	97.9		
18.4	98.0		
19.9	98.4		
22.9	99.0		
25.2	99.5		
30.3	99.6		
34.3	99.3		

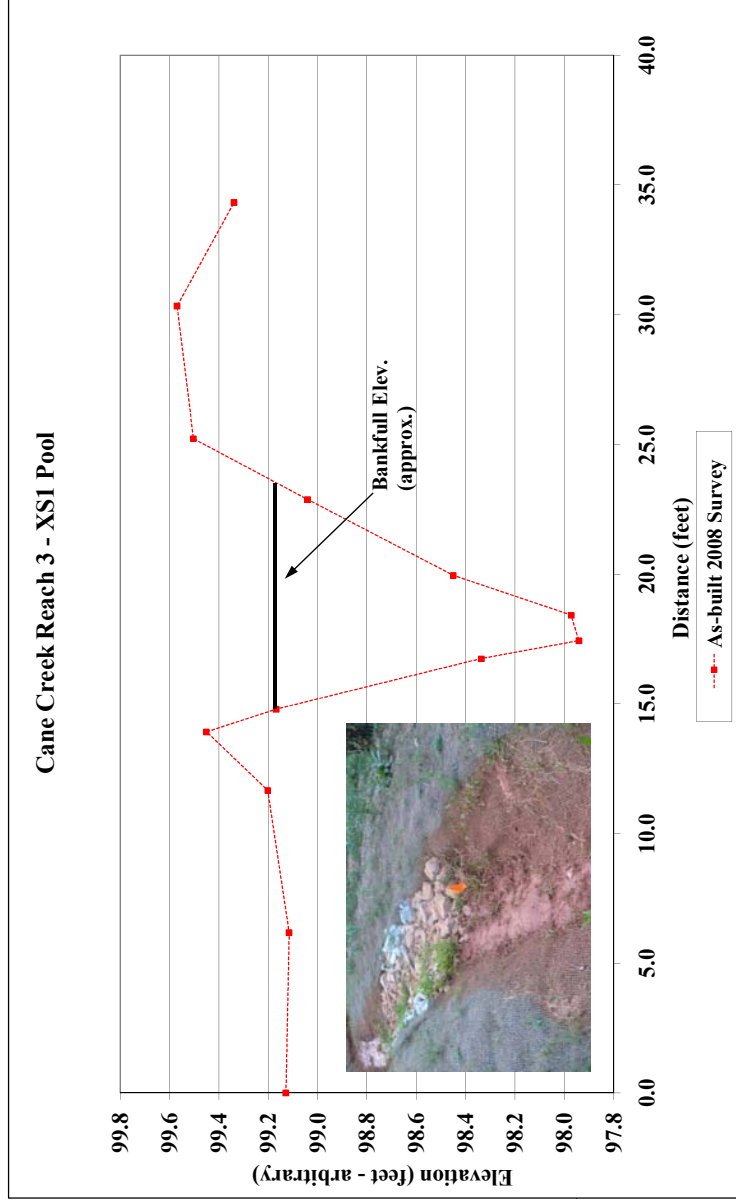


Area	As-built	2008	2009	2010
Width	5.4			
Mean Depth	8.7			
Max Depth	0.6			
W/D Ratio	1.2			
	N/A			

Project Name Cane Creek				
Cross Section R3-XS2				
Feature Riffle				
Date 5/6/08				
Crew Adams, Jeffers				
As-built	2008	2009	2010	
Station	2008 Survey Station	2009 Survey Station	2010 Survey Station	
Elevation	Elevation	Elevation	Elevation	
0.0	98.9			
6.4	98.6			
12.6	98.7			
13.7	98.6			
14.7	98.2			
15.4	97.9			
16.6	97.9			
17.7	97.9			
18.4	98.4			
19.4	98.7			
21.9	98.7			
27.9	98.6			
32.3	98.4			

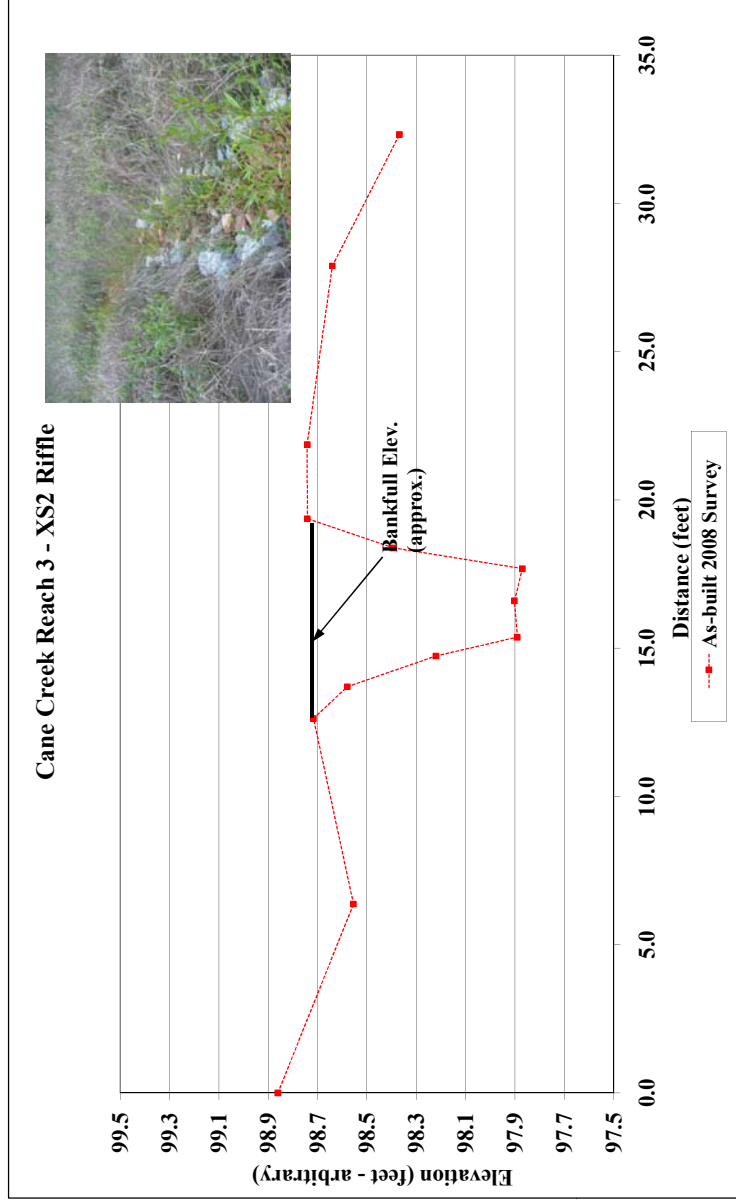


As-built	2008	2009	2010
Area	3.3		
Width	6.6		
Mean Depth	0.5		
Max Depth	0.8		
W/D Ratio	13.5		

Project Name Cane Creek			
Cross Section R3-XS3			
Feature Riffle			
Date 5/6/08			
Crew Adams, Jeffers			
As-built	2008	2009	2010
Station	2008 Survey Station	2009 Survey Station	2010 Survey Station
Elevation	Elevation	Elevation	Elevation
0.0	97.9		
9.0	97.9		
13.4	97.9		
14.7	97.8		
16.0	97.2		
18.7	97.3		
19.2	97.6		
20.3	98.0		
24.6	97.9		
28.7	97.9		
34.6	97.8		

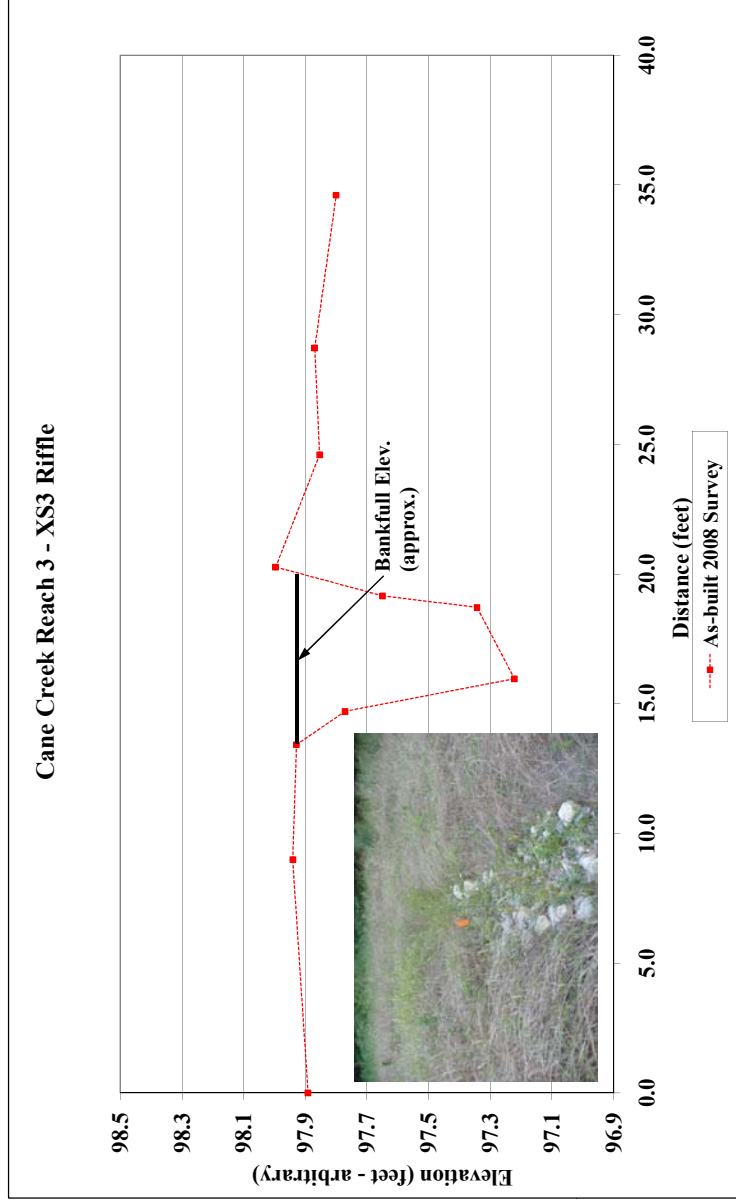

Area	As-built	2008	2009	2010
Width	2.7			
Mean Depth	6.6			
Max Depth	0.4			
W/D Ratio	0.7			
	16.0			

Project Name Cane Creek				
Cross Section R3-XS4				
Feature Pool				
Date 5/6/08				
Crew Adams, Jeffers				
As-built	2008	2009	2010	
2008 Survey	2008 Survey	2009 Survey	2010 Survey	
Station	Station	Station	Station	Elevation
0.0	97.9			
6.3	97.9			
12.4	98.0			
14.8	97.5			
17.7	96.6			
19.0	96.5			
20.0	96.4			
21.1	96.5			
22.6	97.5			
24.1	98.0			
27.6	98.1			
32.7	97.8			
37.0	98.3			

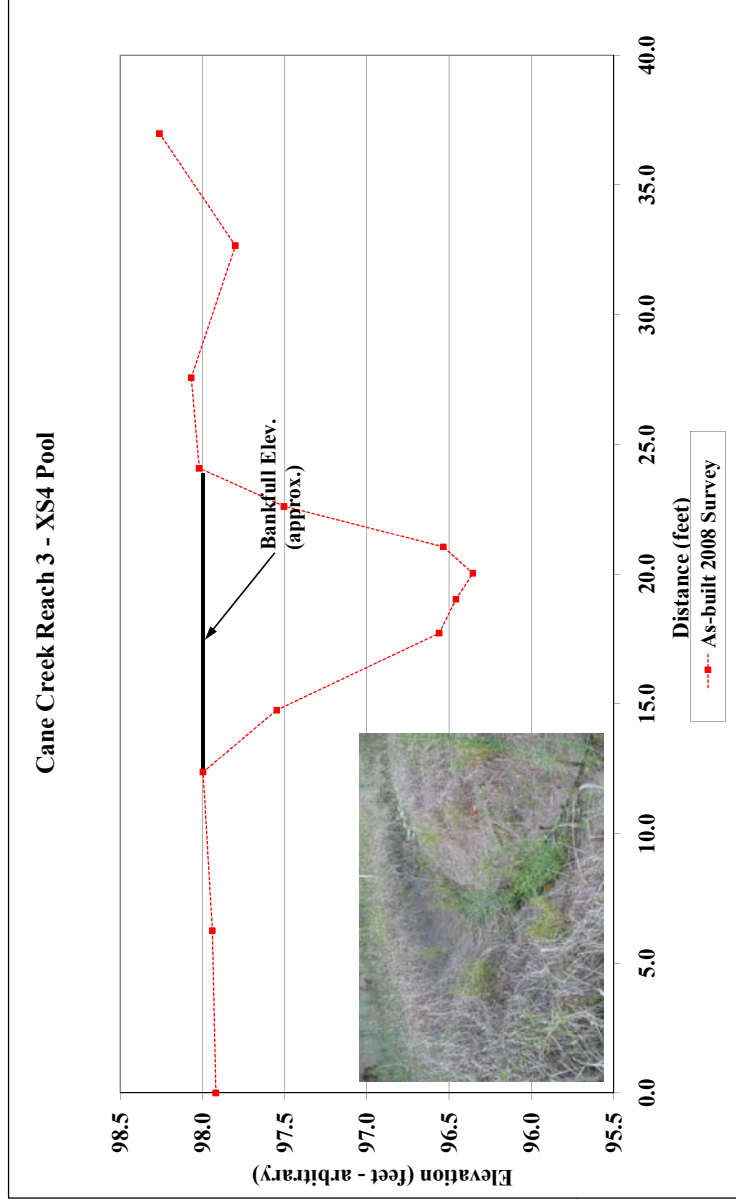


Area	As-built	2008	2009	2010
Width	10.3			
Mean Depth	11.6			
Max Depth	0.9			
W/D Ratio	1.6			
	N/A			

Project Name				Cane Creek As-built				
Reach				4				
Feature				Profile				
Date				06/08				
Drawn				Adrienne Jeffers				
Station	2008 Survey Bed Elevation	2008 Survey Water Elevation	Station	2009 Survey Bed Elevation	2009 Survey Water Elevation	Station	2010 Survey Bed Elevation	2010 Survey Water Elevation
0.0	96.3							
1.5	97.5							
3.0	97.4							
4.5	97.2							
6.0	96.1							
7.5	96.0							
9.0	97.0							
10.5	96.3							
12.0	96.3							
13.5	97.4							
15.0	97.1							
16.5	97.2							
18.0	96.3							
19.5	96.1							
21.0	97.4							
22.5	97.4							
24.0	96.4							
25.5	96.6							
27.0	100.4							
28.5	100.4							
30.0	97.3							
31.5	114.0							
33.0	96.3							
34.5	96.2							
36.0	118.9							
37.5	97.3							

A-s-built	2008	2009	2010
Avg. Water Surface Slope			
Avg. Right Slope			
Avg. Left Slope			
Avg. Grade Slope			
A-s-built	0.0020		


Cane Creek Profile - Reach 4

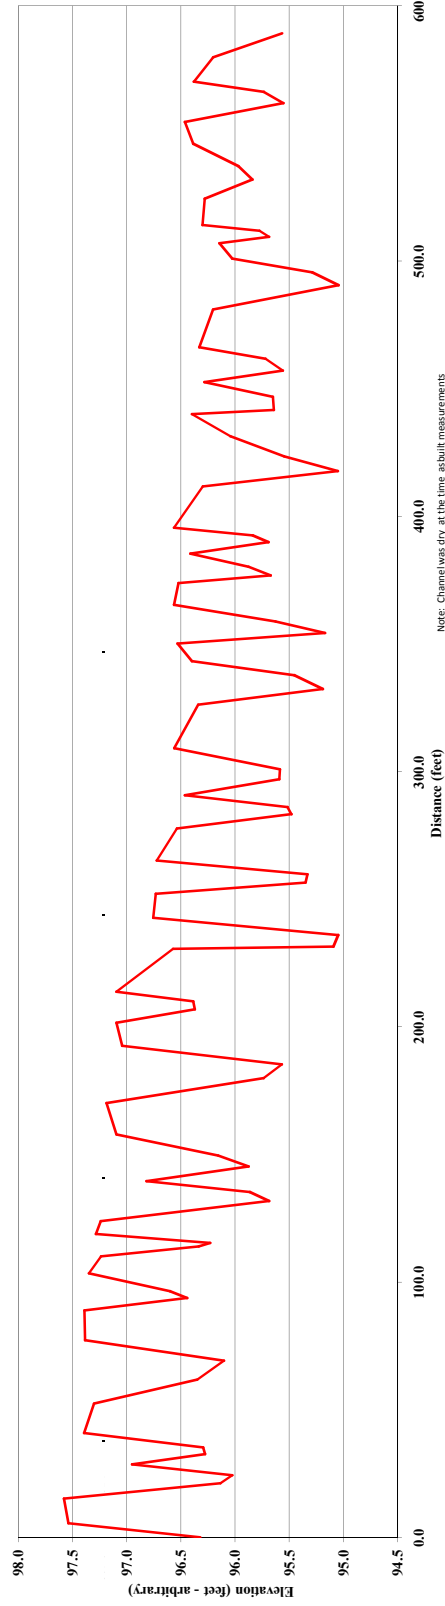

Station	2008 Survey Bed Elevation	2008 Survey Water Elevation	Station	2009 Survey Bed Elevation	2009 Survey Water Elevation	Station	2010 Survey Bed Elevation	2010 Survey Water Elevation
373.8	96.5							
375.3	96.5							
376.8	95.9							
378.3	96.4							
379.8	95.7							
381.3	95.8							
382.8	95.8							
384.3	95.7							
385.8	95.7							
387.3	95.8							
388.8	95.8							
Project Name Cane Creek			
Cross Section R4-XS1			
Feature Riffle			
Date 5/6/08			
Crew Adams, Jeffers			
As-built	2008	2009	2010
2008 Survey	2008 Survey	2009 Survey	2010 Survey
Station	Station	Station	Station
Elevation	Elevation	Elevation	Elevation
0.0 98.5			
9.5 98.4			
12.7 98.4			
15.1 97.9			
16.0 97.6			
16.6 97.3			
19.0 97.3			
20.6 97.8			
21.7 98.3			
26.2 98.3			
32.8 98.2			
40.7 98.0			

Cane Creek Reach 4 - XS1 Riffle

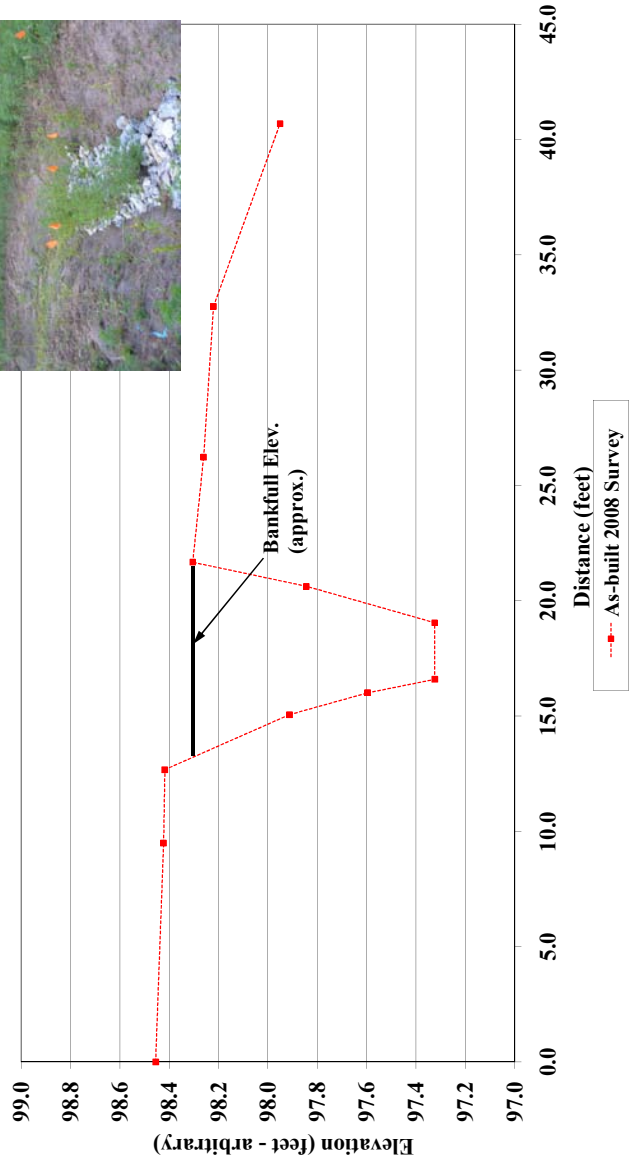


Area	As-built	2008	2009	2010
Width	5.2			
Mean Depth	8.5			
Max Depth	0.6			
W/D Ratio	1.0			
	13.8			

Project Name Cane Creek			
Cross Section R4-XS2			
Feature Riffle			
Date 5/6/08			
Crew Adams, Jeffers			
As-built	2008	2009	2010
Station	2008 Survey	2009 Survey	2010 Survey
	Station	Station	Station
	Elevation	Elevation	Elevation
0.0	98.1		
9.1	97.6		
11.7	97.7		
13.4	97.3		
14.0	96.9		
15.9	97.1		
17.0	97.1		
18.7	97.5		
20.1	97.8		
23.1	97.8		
33.4	97.6		

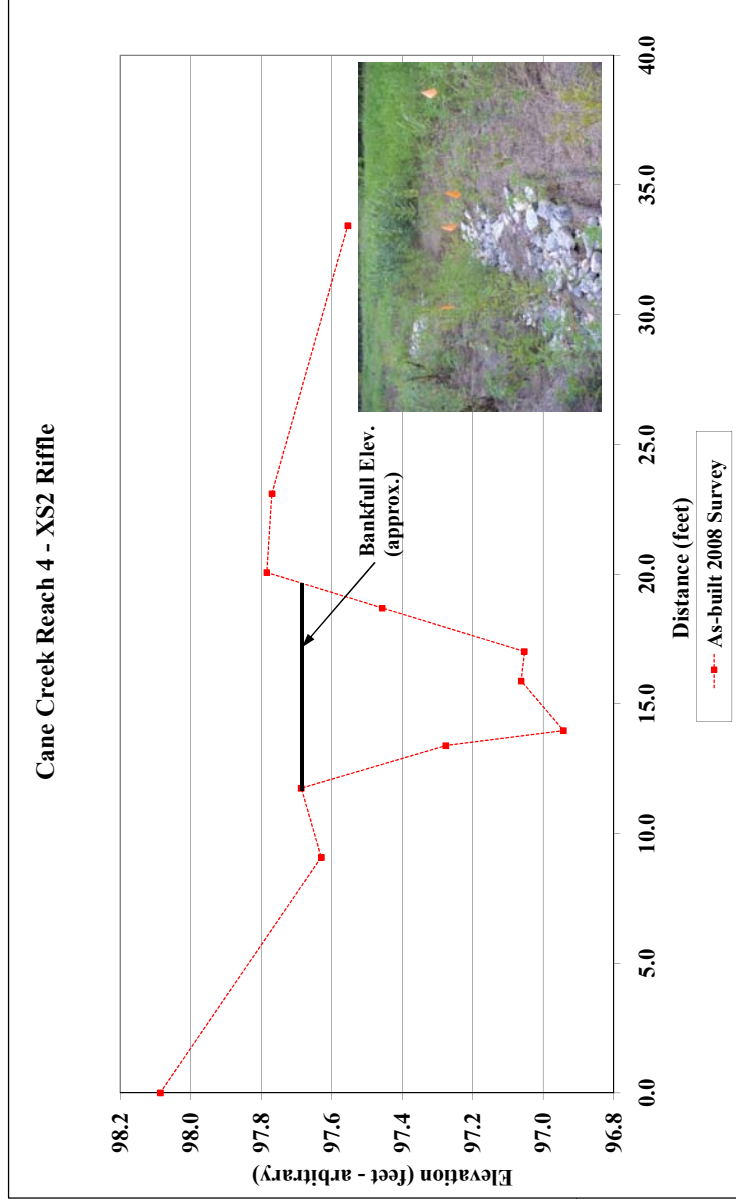


Area	As-built	2008	2009	2010
Width	3.5			
Mean Depth	7.9			
Max Depth	0.4			
W/D Ratio	0.7			
	17.7			

Project Name Cane Creek				
Cross Section R4-XS3				
Feature Pool				
Date 5/6/08				
Crew Adams, Jeffers				
As-built	2008	2009	2010	
Survey Station	2008 Survey Station	2009 Survey Station	2010 Survey Station	
0.0	97.2			
10.2	97.3			
13.0	97.1			
17.0	96.3			
19.7	95.7			
21.0	95.4			
22.8	96.5			
24.2	97.3			
30.5	97.8			
36.6	98.1			

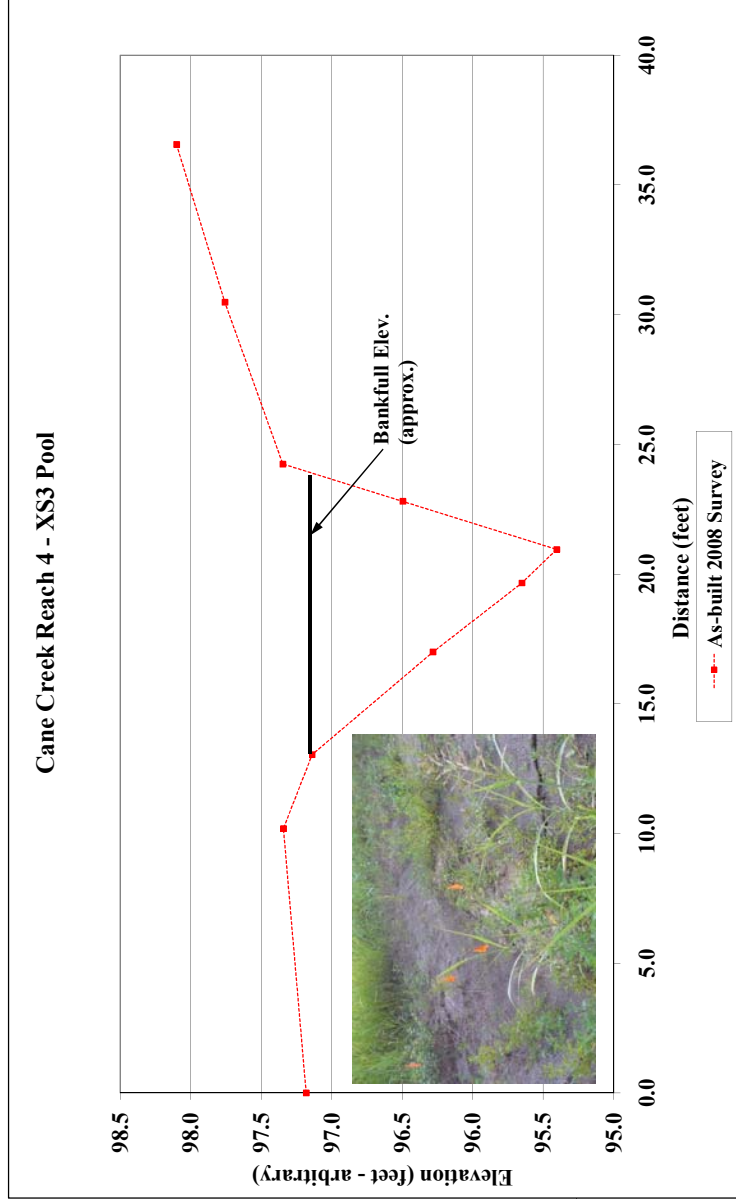

Area	As-built	2008	2009	2010
9.5				
Width	10.9			
Mean Depth	0.9			
Max Depth	1.7			
W/D Ratio	N/A			

Project Name Cane Creek			
Cross Section R4-XS4			
Feature Pool			
Date 5/6/08			
Crew Adams, Jeffers			
As-built	2008	2009	2010
2008 Survey	2008 Survey	2009 Survey	2010 Survey
Station	Station	Station	Station
Elevation	Elevation	Elevation	Elevation
0.0 96.9			
11.4 97.4			
13.5 97.3			
15.5 96.5			
16.8 95.6			
18.0 95.7			
20.5 96.5			
23.9 97.4			
25.7 97.4			
35.7 97.7			

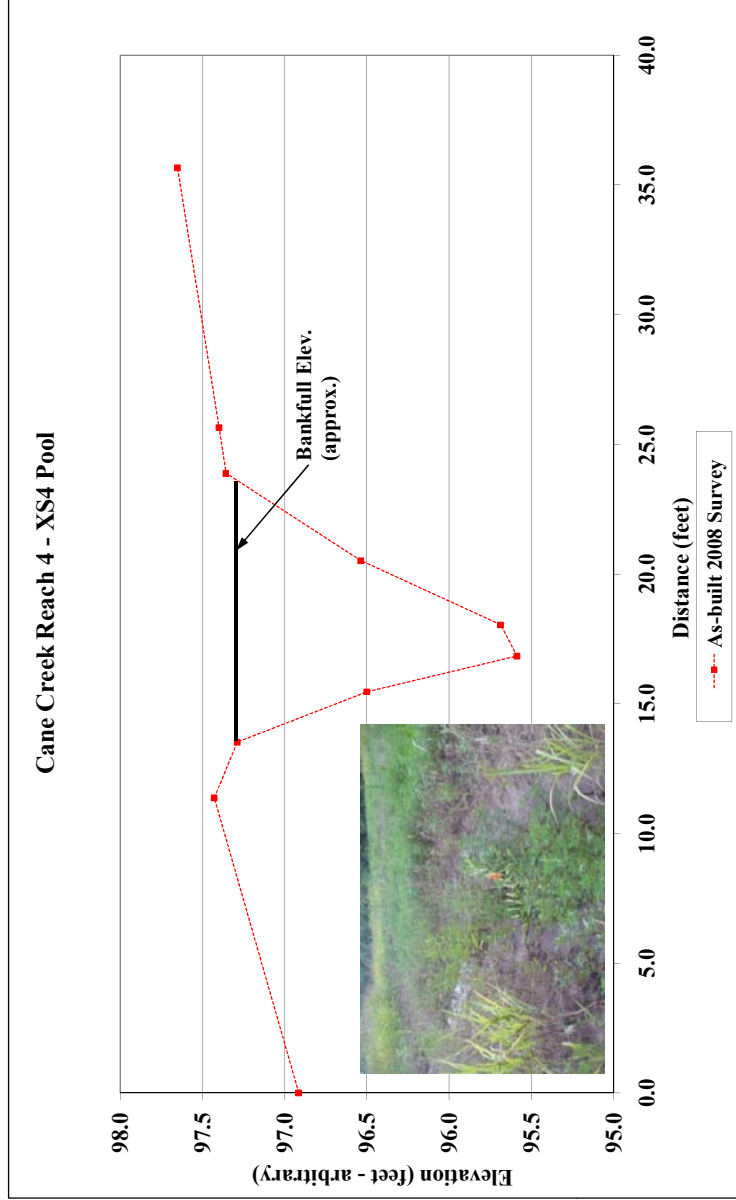


Area	As-built	2008	2009	2010
Width	8.5			
Mean Depth	10.1			
Max Depth	0.8			
W/D Ratio	1.7			
	NA			


Project Name		Cane Creek									
Reach		5									
Profile											
Feature											
Crew		Adams, Jeffers									
Station	As-built 2008 Survey Bed Elevation	2008 Survey Bed Elevation	Water Elevation	Station	2009 Survey Bed Elevation	2009 Survey Bed Elevation	Water Elevation	Station	2010 Survey Bed Elevation	2010 Survey Bed Elevation	Water Elevation
89.0	96.0	96.0									
89.5	95.5	95.5									
19.0	95.5	95.5									
23.7	96.2	96.2									
35.8	96.0	96.0									
41.1	95.2	95.2									
47.9	95.8	95.8									
52.0	94.9	94.9									
54.4	95.0	95.0									
58.8	96.1	96.1									
58.7	96.1	96.1									
67.1	95.2	95.2									
75.1	95.2	95.2									
79.2	96.2	96.2									
84.7	95.0	95.0									
88.3	95.1	95.1									
94.1	96.0	96.0									
97.1	95.1	95.1									
103.9	95.1	95.1									
107.7	95.3	95.3									
113.7	96.0	96.0									

Avg. Water Surface Slope	Asphalt	2008	2009	2010
Avg. Riffle Slope	0.0014			
Avg. Pool Slope				
Avg. Run Slope				
Avg. Gully Slope				

Cane Creek Profile--Reach 5

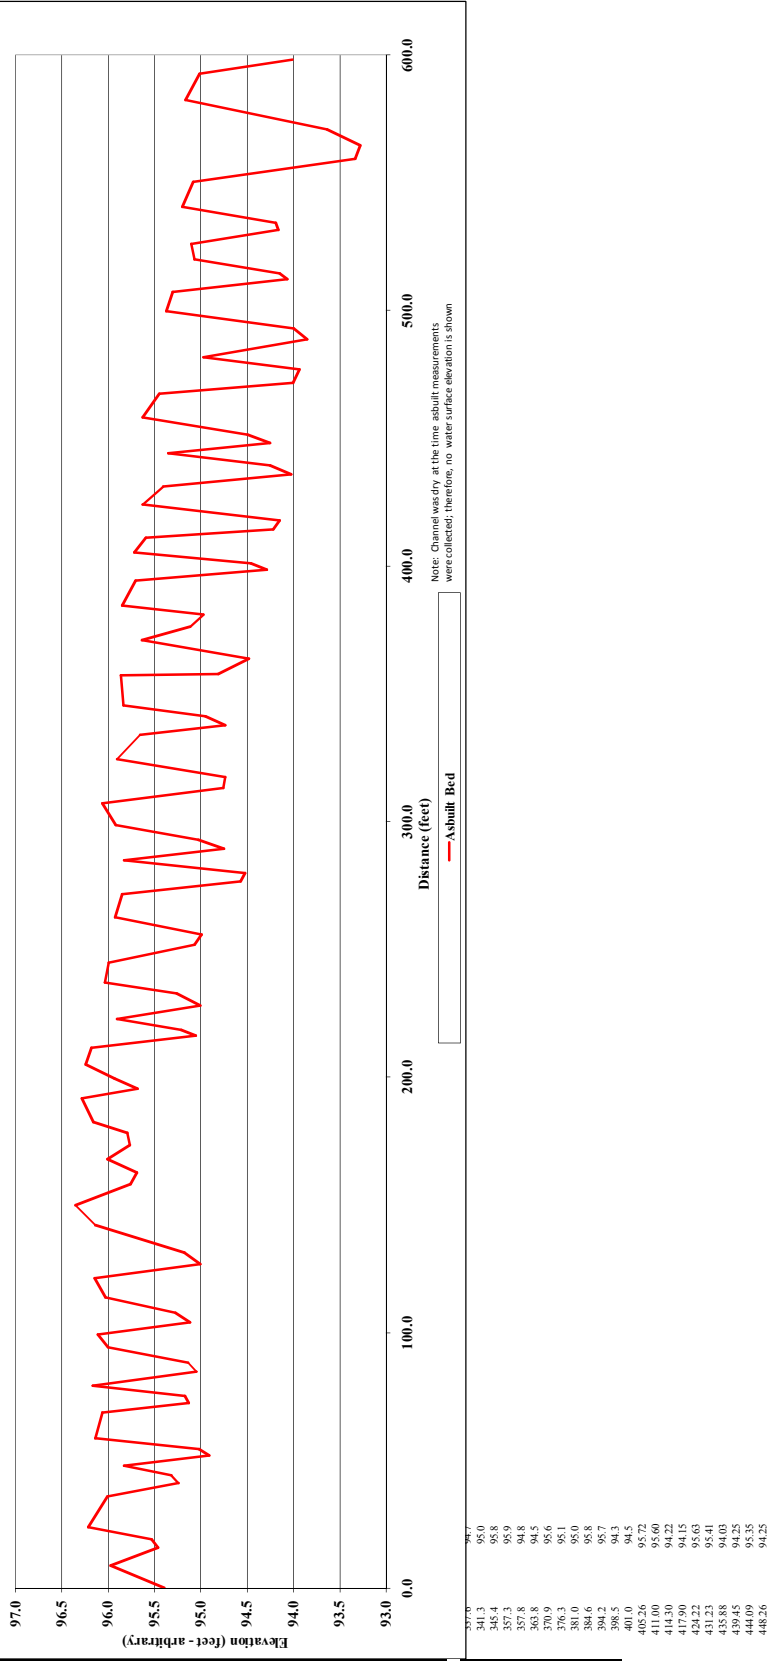


Project Name Cane Creek			
Cross Section R5-XS1			
Feature Riffle			
Date 5/6/08			
Crew Adams, Jeffers			
As-built	2008	2009	2010
2008 Survey	2008 Survey	2009 Survey	2010 Survey
Station	Station	Station	Station
Elevation	Elevation	Elevation	Elevation
0.0 97.4			
6.1 97.2			
9.3 97.1			
11.3 96.4			
12.5 96.2			
15.3 96.1			
16.7 96.5			
18.2 97.0			
19.5 97.2			
25.0 97.2			
29.6 97.5			

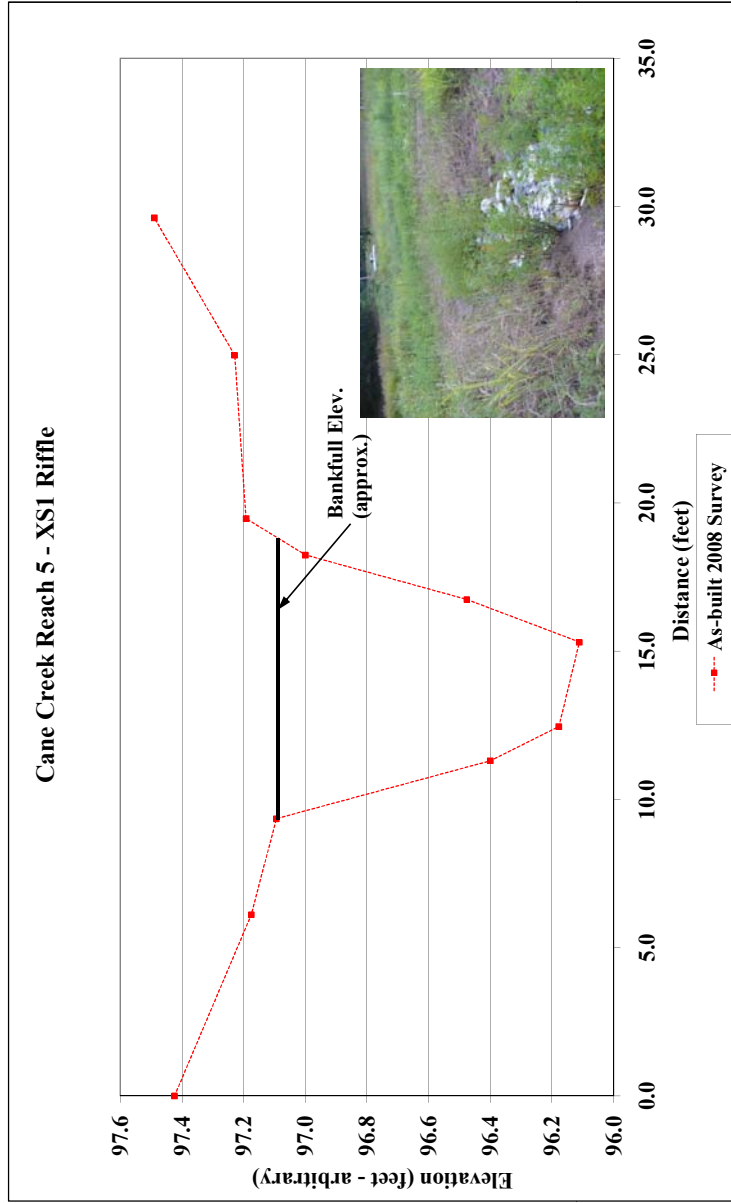


Area	As-built	2008	2009	2010
Width	6.0			
Mean Depth	9.4			
Max Depth	0.6			
W/D Ratio	1.0			
	14.9			

Project Name Cane Creek			
Cross Section R5-XS2			
Feature Pool			
Date 5/6/08			
Crew Adams, Jeffers			
As-built	2008	2009	2010
2008 Survey	2008 Survey	2009 Survey	2010 Survey
Station	Station	Station	Station
Elevation	Elevation	Elevation	Elevation
0.0 97.7			
7.6 97.2			
10.7 97.0			
12.8 95.9			
14.6 95.1			
15.7 95.2			
19.0 96.3			
21.1 96.9			
26.1 97.0			
31.9 97.5			

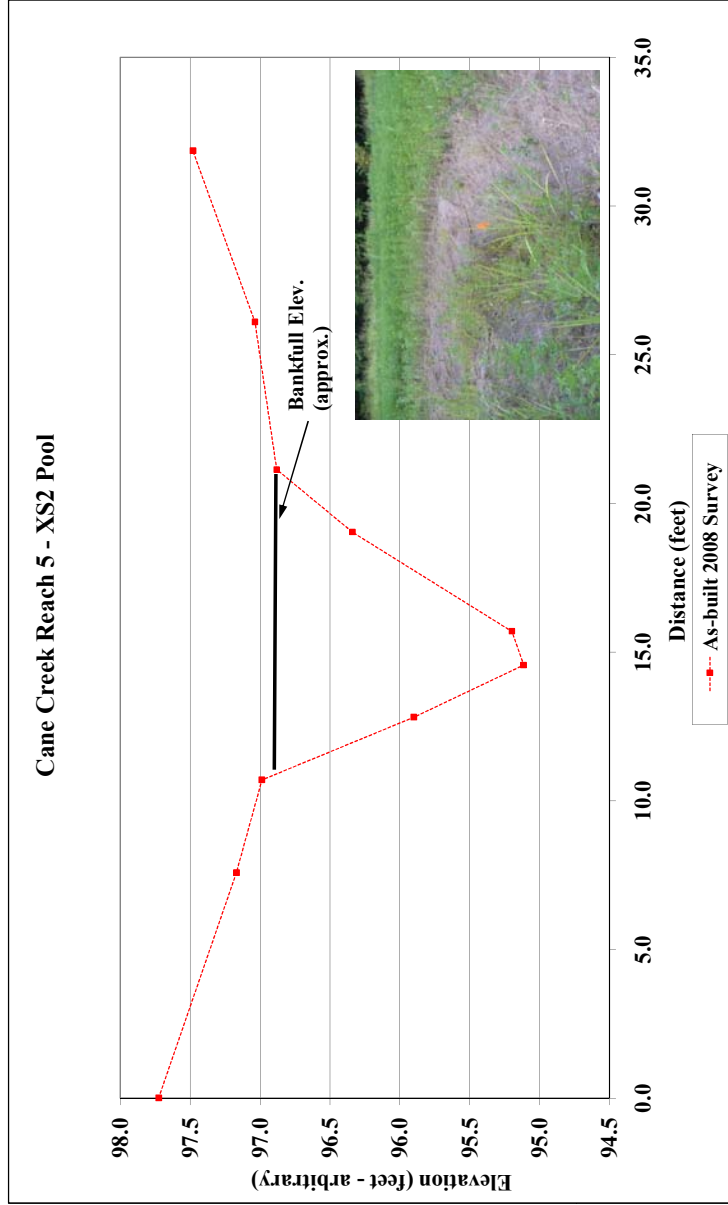


Area	As-built	2008	2009	2010
Width	8.5			
Mean Depth	9.6			
Max Depth	0.9			
W/D Ratio	1.7			
	NA			

Project Name Cane Creek			
Cross Section R5-XS3			
Feature Pool			
Date 5/6/08			
Crew Adams, Jeffers			
As-built	2008	2009	2010
2008 Survey	2008 Survey	2009 Survey	2010 Survey
Station	Station	Station	Station
Elevation	Elevation	Elevation	Elevation
0.0 96.7			
6.8 96.7			
10.0 96.7			
13.5 95.7			
17.2 94.9			
18.3 94.8			
20.2 95.7			
22.1 96.7			
29.1 96.5			
34.5 96.4			

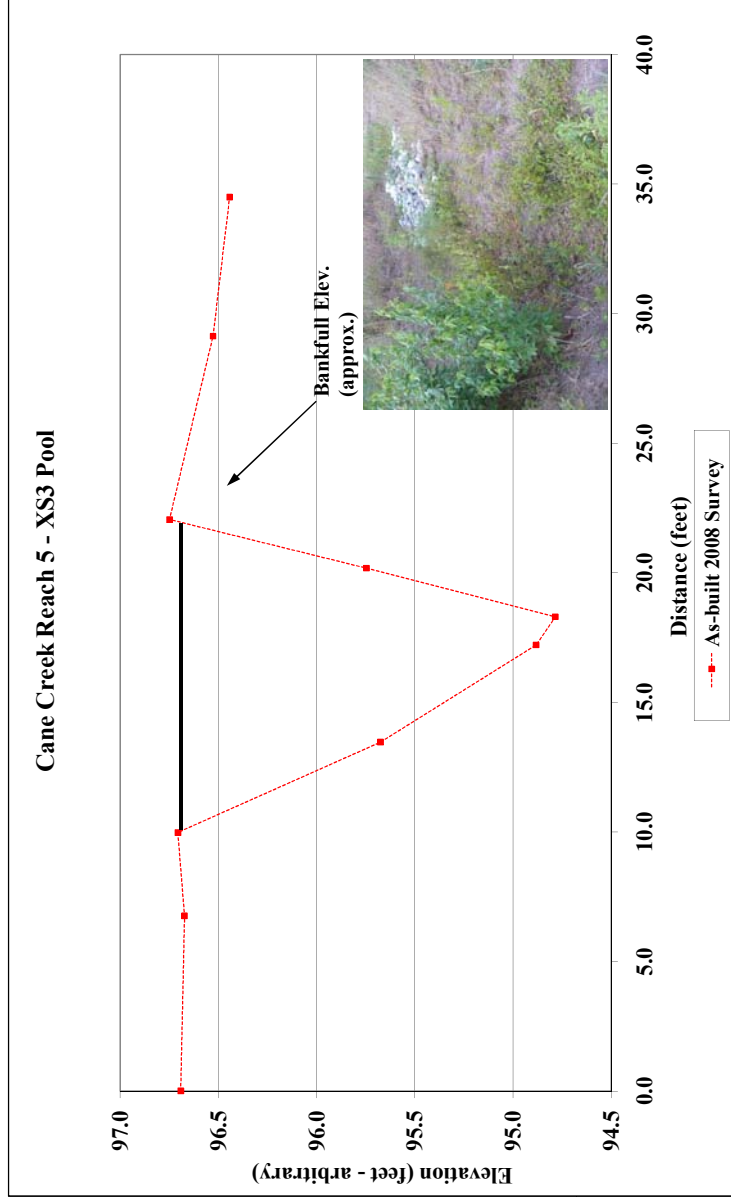

Area	As-built	2008	2009	2010
Width	12.3			
Mean Depth	11.8			
Max Depth	1.0			
W/D Ratio	1.9			
	N/A			

Project Name Cane Creek			
Cross Section R5-XS4			
Feature Riffle			
Date 5/6/08			
Crew Adams, Jeffers			
As-built	2008	2009	2010
2008 Survey	2008 Survey	2009 Survey	2010 Survey
Station	Station	Station	Station
Elevation	Elevation	Elevation	Elevation
0.0 96.4			
7.9 96.0			
10.6 96.0			
11.0 95.8			
12.2 95.3			
15.6 95.2			
16.8 95.8			
17.7 96.0			
23.4 95.9			
28.8 96.1			

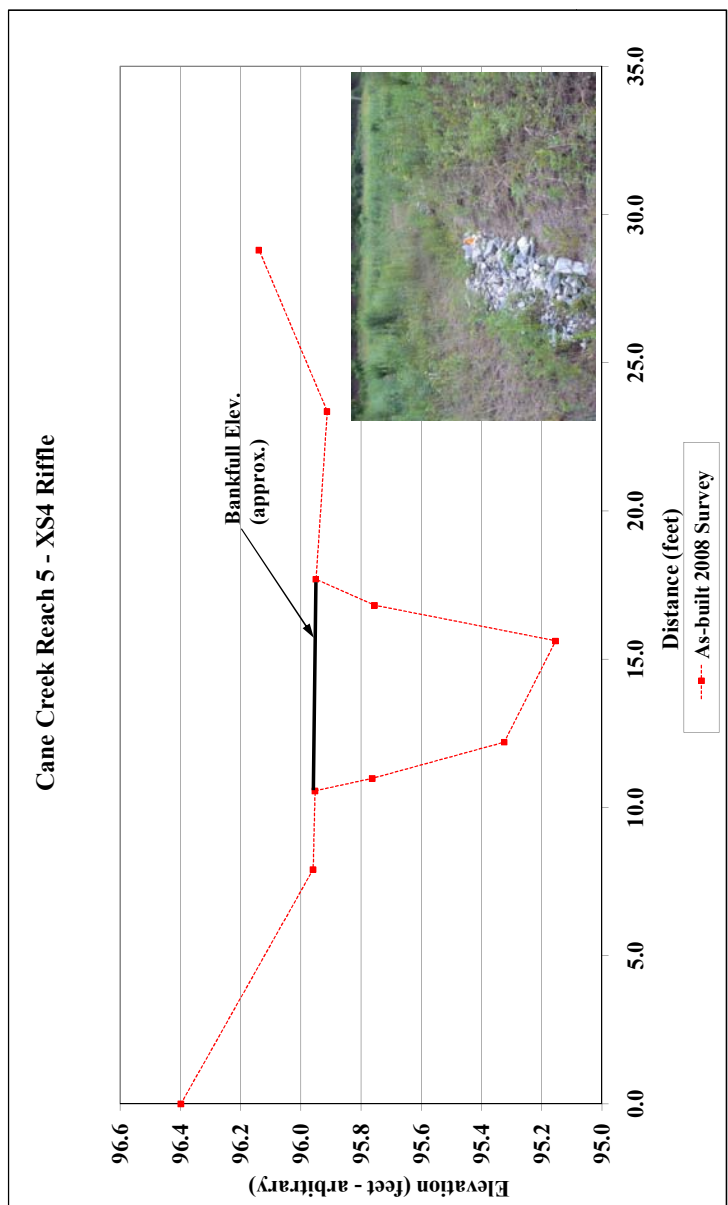

Area	As-built	2008	2009	2010
Width	3.6			
Mean Depth	7.1			
Max Depth	0.5			
W/D Ratio	0.8			
	13.9			