

**As-Built Baseline Monitoring Report**

**FINAL**

**CATBIRD SITE**

NCDMS Project #100022 (Contract #7186)

USACE Action ID: SAW-2017-01506

DWR Project #20171039

Davie County, North Carolina

Yadkin River Basin

HUC 03040101



**Provided by:**



Resource Environmental Solutions, LLC  
For Environmental Banc & Exchange, LLC

**Provided for:**

NC Department of Environmental Quality  
Division of Mitigation Services

**July 2020**



3600 Glenwood Avenue, Suite 100  
Raleigh, NC 27612

**Corporate Headquarters**  
6575 W Loop S #300  
Bellaire, TX 77401  
Main: 713.520.5400

July 10, 2020

Harry Tsomides  
NC DEQ Division of Mitigation Services  
5 Ravenscroft Drive, Suite 102  
Asheville, NC 28801

RE: Catbird Site: Baseline Report and As-Built Drawings (NCDMS ID 100022)

Listed below are comments provided by DMS on July 9, 2020 regarding the Catbird Site: Baseline Report and As-Built Drawings and RES' responses.

#### **Appendix F Detailed Easement/Asset Figure**

Uncredited reach is shown as white against a white background in the legend. Please use a color/pattern that is visible.

[Done.](#)

Please modify figure and report tables as discussed, to reflect accurate crediting and discussion of easement adjustment vs. mitigation plan, at upper limit of DS2-A. Please provide the resulting final digital support files for review.

[Done.](#)

#### **Vegetation Tables**

Table 9a needs to reflect the random plots; Please incorporate table 9b (random) into 9a (fixed) and calculate/report site wide average accordingly. DMS can provide examples.

[Table 9a and Table 9b have been combined into Table 9. Table 8 has also been updated to include Random Plot data for consistency.](#)

As built planted numbers for green ash exceed the mitigation plan target of 10%, including representing 40% of the planted species in Plot 1. It is now standard practice to minimize the green ash percentage planted from zero, to 5% maximum, due to the emerald ash borer (*Agilus planipennis*) threatening the longer-term viability of the riparian plantings. Please make note for future plans and as-built planting efforts that green ash should be minimal (5% or less) or absent from the project.

[Noted.](#)

#### **Record Drawings**

Record Drawings need to include the planting plan from the mitigation plan (sheet P1), to make clear the actual planting zones with stem counts and species and if/how any changes were made from the mitigation plan (shown in red).

[Done.](#)

#### **Other**

Table 9a Please provide all the updated final digitals and digital support files for review.

[Done.](#)

## **Table of Contents**

|  |   |
|--|---|
| 1.0 Project Summary.....                       | 1 |
| 1.1 Project Location and Description .....     | 1 |
| 1.2 Project Goals and Objectives .....         | 1 |
| 1.3 Project Success Criteria.....              | 2 |
| Stream Restoration Success Criteria .....      | 2 |
| Vegetation Success Criteria .....              | 3 |
| 1.4 Project Components .....                   | 4 |
| 1.5 Stream Design/Approach .....               | 5 |
| 1.6 Construction and As-Built Conditions ..... | 5 |
| 1.7 Baseline Monitoring Performance (MY0)..... | 6 |
| Vegetation .....                               | 6 |
| Stream Geomorphology .....                     | 6 |
| Stream Hydrology .....                         | 6 |
| 2.0 Methods .....                              | 7 |
| 3.0 References.....                            | 7 |

### **Appendix A: Background Tables**

|   |
|---|
| Table 1: Project Mitigation Components          |
| Table 2: Project Activity and Reporting History |
| Table 3: Project Contacts Table                 |
| Table 4: Project Background Information Table   |
| Figure 1: Site Location Map                     |

### **Appendix B: Visual Assessment Data**

|  |
|--|
| Figure 2: Current Conditions Plan View                 |
| Table 5. Visual Stream Morphology Stability Assessment |
| Table 6. Vegetation Condition Assessment               |
| Vegetation Plot Photos                                 |
| Monitoring Device Photos                               |

### **Appendix C: Vegetation Plot Data**

|   |
|---|
| Table 7: Planted Species Summary                      |
| Table 8: Vegetation Plot Mitigation Success Summary   |
| Table 9. Stem Count Total and Planted by Plot Species |

### **Appendix D: Stream Measurement and Geomorphology Data**

|   |
|---|
| Table 10. Baseline Stream Data Summary        |
| Table 11. Cross Section Morphology Data Table |
| Cross Section Overlay Plots                   |

### **Appendix E: Record Drawings**

### **Appendix F: Easement Comparison Map**

## **1.0 Project Summary**

### ***1.1 Project Location and Description***

The Catbird Site (the “Project”) is located in Davie County, North Carolina, approximately eight miles west of Clemmons and five miles northwest of Bermuda Run. Water quality stressors affecting the Project included livestock production, agricultural production, and lack of riparian buffer. The Project presents stream restoration and enhancement generating 2,080.8 Warm Stream Mitigation Units (SMU).

The Project’s total easement area is 6.33 acres within the overall drainage area of 53 acres. Grazing livestock historically had access to all the stream reaches within the Project. The lack of riparian buffer vegetation, deep-rooted vegetation, and unstable channel characteristics contributed to the degradation of stream banks throughout the Project area.

The stream design approach for the Project was to combine the analog method of natural channel design with analytical methods to evaluate stream flows and hydraulic performance of the channel and floodplain. The analog method involved the use of a reference reach, or “template” stream, adjacent to, nearby, or previously in the same location as the design reach. The template parameters of the analog reach were replicated to create the features of the design reach. The analog approach is useful when watershed and boundary conditions are similar between the design and analog reaches. Hydraulic geometry was developed using analytical methods to identify the design discharge.

The Project has been constructed and planted and will be monitored on a regular basis throughout the seven-year post-construction monitoring period, or until performance standards are met. The Project will be transferred to the NCDEQ Stewardship Program. This party shall serve as conservation easement holder and long-term steward for the property and will conduct periodic inspection of the site to ensure that restrictions required in the conservation easement are upheld. Funding will be supplied by the responsible party on a yearly basis until such time an endowment is established.

### ***1.2 Project Goals and Objectives***

Through the comprehensive analysis of the Project’s maximum functional uplift using the Stream Functions Pyramid Framework, specific, attainable goals and objectives were realized by the Project. These goals clearly address the degraded water quality and nutrient input from farming that were identified as major watershed stressors in the 2009 Upper Yadkin Pee-Dee River RBRP. These goals also reflect the goals and objectives as stated in the Catbird Site Final Mitigation Plan.

The Project goals are:

- Improve water transport from watershed to the channel in a non-erosive manner in a stable channel;
- Improve flood flow attenuation on site and downstream by allowing for overbank flows and connection to the floodplain;
- Improve instream habitat;
- Reduce sediment, nutrient and fecal coliform inputs into stream system;
- Restore and enhance native floodplain vegetation;
- Indirectly support the goals of the 2009 Upper Yadkin Pee-Dee RBRP to improve water quality and to reduce sediment and nutrient loads; and
- Protect Water Supply Watersheds (WSW).

The Project objectives to address the goals are:

- Design and reconstruct stream channels sized to convey bankfull flows that will maintain a stable dimension, profile, and planform;
- Add in-stream structures and bank stabilization measures to protect restored streams;
- Install habitat features such as brush toes, constructed riffles, woody materials, and pools of varying depths to restored streams;
- Increase forested riparian buffers to at least 50 feet on both sides of the channel along the Project reaches with a hardwood riparian plant community;
- Install approximately 4,200 linear feet of livestock exclusion fencing along the easement boundary to ensure livestock will no longer have stream access;
- Implement one agricultural BMP structure in order to limit inputs of sediment, nutrients, and fecal coliform to streams from surrounding farming operations;
- Treat exotic invasive species; and
- Establish a permanent conservation easement on the Project that will exclude future livestock from stream channels and their associated buffers.

Functional uplift, benefits, and improvements within the Project area, as based on the Function Based Framework, are outlined in the Mitigation Plan.

### ***1.3 Project Success Criteria***

The success criteria for the Project follows the 2016 USACE Wilmington District Stream and Wetland Compensatory Mitigation Update, the Catbird Site Final Mitigation Plan, and subsequent agency guidance. Cross section and vegetation plot monitoring takes place in Years 0, 1, 2, 3, 5, and 7. Stream hydrology and visual monitoring takes place annually. Specific success criteria components are presented below.

#### Stream Restoration Success Criteria

Four bankfull flow events must be documented within the seven-year monitoring period. The bankfull events must occur in separate years. Otherwise, the stream monitoring will continue until four bankfull events have been documented in separate years. Stage recorders were installed on DS1 and DS2-B to document bankfull events.

There should be little change in as-built cross sections. If changes do take place, they should be evaluated to determine if they represent a movement toward a less stable condition (for example down-cutting or erosion) or are minor changes that represent an increase in stability (for example settling, vegetative changes, deposition along the banks, or decrease in width/depth ratio). Cross sections shall be classified using the Rosgen stream classification method, and all monitored cross sections should fall within the quantitative parameters defined for channels of the design stream type. Bank height ratio shall not exceed 1.2, and the entrenchment ratio shall be above 2.2 within restored riffle cross sections (for C and E streams). Channel stability should be demonstrated through a minimum of four bankfull events documented in the seven-year monitoring period.

Digital images are used to subjectively evaluate channel aggradation or degradation, bank erosion, success of riparian vegetation, and effectiveness of erosion control measures. Longitudinal images should not indicate the absence of developing bars within the channel or an excessive increase in channel depth. Lateral images should not indicate excessive erosion or continuing degradation of the banks over time. A series of images over time should indicate successional maturation of riparian vegetation.

Stream restoration reaches will be monitored to document intermittent or seasonal surface flow. This will be accomplished through direct observation and the use of hydraulic pressure transducers with data loggers.

Intermittent reaches must demonstrate a minimum of 30 consecutive days of flow. A flow gauge was installed in the upper portion of DS1.

### Vegetation Success Criteria

Specific and measurable success criteria for plant density within the riparian buffers on the Project follow IRT Guidance. The interim measures of vegetative success for the Project is the survival of at least 320 planted three-year old trees per acre at the end of Year 3, 260 trees per acre with an average height of seven feet at the end of Year 5, and the final vegetative success criteria is 210 trees per acre with an average height of ten feet at the end of Year 7. Volunteer trees are counted, identified to species, and included in the yearly monitoring reports, but are not be counted towards the success criteria of total planted stems. Moreover, any single species can only account for up to 50 percent of the required number of stems within any vegetation plot. Any stems in excess of 50 percent will be shown in the monitoring table but will not be used to demonstrate success.

| Level                                  | Treatment   | Objective   | Monitoring Metric   | Performance Standard   |
|--|---|---|---|--|
| 1<br><i>Hydrology</i>                  | Converted land-use of Project reaches from pasture to riparian forest   | Improve the transport of water from the watershed to the Project reaches in a non-erosive way   | NA  | NA   |
|  | Installed one agricultural sediment load attenuation structure to limit inputs of sediment from surrounding farming operations coming into the reach (DS1)                                      |   | Visually monitor integrity of runoff attenuation structure:<br>Performed semiannually<br>( <i>indirect measurement</i> )              | Identify and document instability and/or flaws to the structure                                      |
| 2<br><i>Hydraulic</i>                  | Reduced bank height ratios and increased entrenchment ratios by reconstructing channels to mimic reference reach conditions   | Improve flood bank connectivity by reducing bank height ratios and increase entrenchment ratios   | Stage recorders and flow gauges:<br>Inspected semiannually  | Four bankfull events occurring in separate years   |
|  |   |   | Cross sections:<br>Surveyed in Years 1, 2, 3, 5 and 7   | At least 30 days of continuous flow each year  |
|  |   |   |   | Entrenchment ratio shall be above 2.2 within restored reaches (C and E)                              |
| Bank height ratio shall not exceed 1.2 |   |   |   |  |
| 3<br><i>Geomorphology</i>              | Established a riparian buffer to reduce erosion and sediment transport into project streams. Established stable banks with livestakes, erosion control matting, and other in stream structures. | Reduce erosion rates and channel stability to reference reach conditions<br><br>Improve bedform diversity (pool spacing, percent riffles, etc.)<br><br>Increase buffer width to 50 feet | As-built stream profile   | NA   |
|  |   |   | Cross sections:<br>Surveyed in Years 1, 2, 3, 5 and 7   | Entrenchment ratio shall be no less than 2.2 within restored reaches                                 |
|  |   |   | Visual monitoring   | Bank height ratio shall not exceed 1.2   |
|  |   |   | Visual monitoring:<br>Performed at least semiannually   | Identify and document significant stream problem areas; i.e. erosion, degradation, aggradation, etc. |
|  |   |   | Vegetation plots:<br>Surveyed in Years 1, 2, 3, 5 and 7   | MY 1-3: 320 trees/acre<br>MY 5: 260 trees/acre (7 ft. tall)<br>MY 7: 210 trees/acre (10 ft. tall)    |
| 4<br><i>Physicochemical</i>            | Excluded livestock from riparian areas with exclusion fence and conservation easement, and planted a riparian buffer  | <u>Unmeasurable Objective/Expected Benefit</u><br>Establish native hardwood riparian buffer and exclude livestock.  | Vegetation plots:<br>Surveyed in Years 1, 2, 3, 5 and 7<br>( <i>indirect measurement</i> )  | MY 1-3: 320 trees/acre<br>MY 5: 260 trees/acre (7 ft. tall)<br>MY 7: 210 trees/acre (10 ft. tall)    |
|  |   |   | Visual assessment of established fencing and conservation signage: Performed at least semiannually<br>( <i>indirect measurement</i> ) | Inspect fencing and signage. Identify and document any damaged or missing fencing and/or signs       |

### 1.4 Project Components

The restoration reaches were significantly impacted by livestock production, agricultural practices, and a lack of riparian buffer. Improvements to the Project help meet the river basin needs expressed in the 2009 Upper Yadkin Pee-Dee River Basin Restoration Priorities (RBRP) as well as ecological improvements to the riparian corridor within the easement.

Through stream restoration and enhancement, the Project presents 2,223 LF of stream, generating 2,080.8 Warm Stream Mitigation Units (SMU) (**Table 1**). This 14.2 SMU below the contract amount (2,095 SMU).

| Mitigation Approach | Linear Feet  | Ratio | Warm SMU       |
|---------------------|--------------|-------|----------------|
| Restoration         | 1,986        | 1     | 1,986          |
| Enhancement II      | 237          | 2.5   | 94.8           |
| <b>Total</b>        | <b>2,223</b> |       | <b>2,080.8</b> |

### ***1.5 Stream Design/Approach***

The Project includes Priority I and II Restoration and Enhancement Level II. Stream restoration incorporates the design of a single-thread meandering channel, with parameters based on data taken from reference sites, published empirical relationships, regional curves developed from existing project streams, and NC Regional Curves. Analytical design techniques were also a crucial element of the project and were used to determine the design discharge and to verify the design as a whole.

The Project is broken into the following reaches:

**Reach DS1**– Priority I and II Restoration was used for Reach DS1. The upstream portion of this reach required Priority II floodplain excavation as the profile transitions from the existing entrenched channel to the Priority I channel at the downstream end. To prevent any hydrology loss, the transition from Priority II to Priority I takes place over several hundred feet and includes multiple channel plugs. Both in-line and offline restoration was used, and locations were driven by valley constraints. In-stream structures such as rock sills, log sills and cross vanes were installed for vertical stability and to improve bedform diversity. The restoration of the riparian areas included planting wider riparian buffers and excluding cattle. A self-maintaining sediment pack was installed at the upper end of the reach to provide sediment load attenuation from the adjacent pasture.

**Reach DS2-A** – Enhancement Level II was used for Reach DS2-A. Enhancement activities included livestock exclusion and riparian buffer plantings. Livestock fencing follows current NRCS specifications.

**Reach DS2-B** – A combination of Priority I Restoration and Enhancement Level II was used for Reach DS2-B. Restoration activities realigned the existing channel to improve stability and floodplain connection. Rock and log structures were used to provide vertical stability and improve bedform diversity. Log toe structures were installed on the outside of certain meander bends to provide bank stability. The restoration of the riparian areas included planting wider riparian buffers and excluding cattle. The Enhancement Level II portion of the reach contains a diverse channel bed profile, and this portion of the reach does contain localized areas of bank erosion caused by hoof shear. The Enhancement of this reach involved livestock exclusion and buffer planting.

### ***1.6 Construction and As-Built Conditions***

Stream construction and planting was completed in March 2020. The Catbird Site was built to design plans and guidelines. Two structures were identified as needing repair during the initial post-construction site visit with DMS. The first was located at the top of DS-B (Lower) and included resetting a rock sill. The second was on the bottom of DS2-B (Lower) (below the confluence with DS-1) where a rock drop structure was repaired, and the left bank was graded to alleviate shear stress. The first area was repaired in April 2020 and the second was repaired in June 2020. The as-built survey (including a redlined version) is included in **Appendix E**.



Following Mitigation Plan approval, RES adjusted the easement to allow for an existing farm path (per landowner request). This 0.19-acre reduction only affected ephemeral stream channel therefore there was no change in credits (**Appendix F**).

Planting plan changes included removing black gum (*Nyssa sylvatica*) and adding crab apple (*Malus angustifolia*), silky dogwood (*Cornus amomum*), sugarberry (*Celtis laevigata*), black walnut (*Juglans nigra*), elderberry (*Sambucus canadensis*), and eastern redbud (*Cercis canadensis*). Planting plan changes were based on bare root availability. Minor monitoring device location changes were made during as-built installation, however, the quantities remained as proposed in the Mitigation Plan.

### ***1.7 Baseline Monitoring Performance (MY0)***

The Catbird Baseline Monitoring activities were performed in March 2020. All Baseline Monitoring data is present below and in the appendices. The Site is on track to meeting vegetation and stream interim success criteria.

#### Vegetation

Setup and monitoring of the four permanent vegetation plots and one random vegetation plot was completed after planting and stream construction on March 4, 2020. Vegetation data are in **Appendix C**, associated photos are in **Appendix B**, and plot locations are in **Appendix B**. MY0 monitoring data indicates that all plots are exceeding the interim success criteria of 320 planted stems per acre. Planted stem densities ranged from 1,133 to 1,740 planted stems per acre with a mean of 1,356 planted stems per acre across the permanent plots. A total of 13 species were documented within the plots. Volunteer species were not noted at baseline monitoring but are expected to establish in upcoming years. The average stem height in the permanent vegetation plots was 1.6 feet. The stem density in the random plot was 1,174 with an average height of 1.5 feet.

Visual assessment of vegetation outside of the monitoring plots indicates that the herbaceous vegetation is becoming well established throughout the project.

#### Stream Geomorphology

Cross section setup and geomorphology data collection for MY0 was collected on March 4, 2020. Summary tables and cross section plots are in **Appendix D**. Overall the baseline cross sections and profile relatively match the proposed design. The as-built conditions show that shear stress and velocities have been reduced for all restoration/enhancement reaches. All reaches were designed as gravel bed channels and remain classified as gravel bed channels post-construction.

Visual assessment of the stream channel was performed to document signs of instability, such as eroding banks, structural instability, or excessive sedimentation. The channel is transporting sediment as designed and will continue to be monitored for aggradation and degradation.

#### Stream Hydrology

Two stage recorders and one flow gauge were installed on March 4, 2020: one stage recorder on DS1 (Lower), one stage recorder on DS2-B (Lower) and one flow gauge on DS1 (Upper). The stage recorders are in place to document bankfull events and the flow gauge to document at least intermittent flow. Stream hydrology data will be included in the Monitoring Year 1 Report in this section and in the appendices. Gauge locations can be found on Figure 2 and photos are in **Appendix B**.

## **2.0 Methods**

Stream monitoring was conducted using a Topcon GTS-312 Total Station. Three-dimensional coordinates associated with cross-section data were collected in the field (NAD83 State Plane feet FIPS 3200). Morphological data were collected at 12 cross-sections. Survey data were imported into CAD, ArcGIS®, and Microsoft Excel® for data processing and analysis. The stage recorders include an automatic pressure transducer placed in PVC casing in a pool. The elevation of the bed and top of bank at each stage recorder are used to detect bankfull events. The flow gauge was also installed in a pool and records flow conditions at an hourly interval. Water level data from the flow gauge is corrected using the height of the downstream riffle to detect stream flow events.

Vegetation success is being monitored at four permanent monitoring plots and one random monitoring plot. Vegetation plot monitoring follows the CVS-EEP Level 2 Protocol for Recording Vegetation, version 4.2 (Lee et al. 2008) and includes analysis of species composition and density of planted species. Data are processed using the CVS data entry tool. In the field, the four corners of each plot were permanently marked with PVC at the origin and metal conduit at the other corners. Photos of each plot are to be taken from the origin each monitoring year. The random plots are to be collected in locations where there are no permanent vegetation plots. Random plots will most likely be collected in the form of 100 square meter belt transects with variable dimensions. Tree species and height will be recorded for each planted stem and the transects will be mapped and new locations will be monitored in subsequent years.

## **3.0 References**

- Griffith, G.E., J.M.Omernik, J.A. Comstock, M.P. Schafale, W.H.McNab, D.R.Lenat, T.F.MacPherson, J.B. Glover, and V.B. Shelburne. (2002). Ecoregions of North Carolina and South Carolina, (color Poster with map, descriptive text, summary tables, and photographs): Reston, Virginia, U.S. Geological Survey (map scale 1:1,500,000).
- Lee Michael T., Peet Robert K., Roberts Steven D., and Wentworth Thomas R., 2008. *CVS-EEP Protocol for Recording Vegetation Level*. Version 4.2
- Peet, R.K., Wentworth, T.S., and White, P.S. (1998), *A flexible, multipurpose method for recording vegetation composition and structure*. *Castanea* 63:262-274
- Resource Environmental Solutions (2019). Catbird Site Final Mitigation Plan.
- Schafale, M.P. 2012. Classification of the Natural Communities of North Carolina, Third Approximation. North Carolina Natural Heritage Program, Division of Parks and Recreation, NCDENR, Raleigh, NC.
- USACE. (2016). Wilmington District Stream and Wetland Compensatory Mitigation Update. NC: Interagency Review Team (IRT).

# **Appendix A**

## Background Tables

**Table 1. Catbird (100022) - Mitigation Assets and Components**

| Project Segment | Existing Footage or Acreage | Mitigation Plan Footage or Acreage | Mitigation Category | Restoration Level | Priority Level | Mitigation Ratio (X:1) | Mitigation Plan Credits |  | As-Built Footage or Acreage | Comments   |
|-----------------|-----------------------------|------------------------------------|---------------------|-------------------|----------------|------------------------|-------------------------|--|-----------------------------|--|
| DS1 (Upper)     | 300                         | 288                                | Warm                | R                 | 2              | 1.00000                | 288.00000               |  | 288                         | Channel restoration, planting, livestock exclusion |
| DS1 (Lower)     | 668                         | 661                                | Warm                | R                 | 1 & 2          | 1.00000                | 661.00000               |  | 661                         | Channel restoration, planting, livestock exclusion |
| DS2-A           | 78                          | 78                                 | Warm                | EII               | N/A            | 2.50000                | 31.20000                |  | 78                          | Planting, livestock exclusion                      |
| DS2-B (Upper)   | 515                         | 526                                | Warm                | R                 | 1 & 2          | 1.00000                | 526.00000               |  | 526                         | Channel restoration, planting, livestock exclusion |
| DS2-B (Middle)  | 181                         | 159                                | Warm                | EII               | N/A            | 2.50000                | 63.60000                |  | 159                         | Planting, livestock exclusion                      |
| DS2-B (Lower)   | 522                         | 511                                | Warm                | R                 | 1              | 1.00000                | 511.00000               |  | 511                         | Channel restoration, planting, livestock exclusion |

**Project Credits**

| Restoration Level | Stream          |      |      | Riparian Wetland |         | Non-Rip Wetland | Coastal Marsh |
|-------------------|-----------------|------|------|------------------|---------|-----------------|---------------|
|                   | Warm            | Cool | Cold | Riverine         | Non-Riv |                 |               |
| Restoration       | <b>1986.000</b> |      |      |                  |         |                 |               |
| Re-establishment  |                 |      |      |                  |         |                 |               |
| Rehabilitation    |                 |      |      |                  |         |                 |               |
| Enhancement       |                 |      |      |                  |         |                 |               |
| Enhancement I     |                 |      |      |                  |         |                 |               |
| Enhancement II    | <b>94.800</b>   |      |      |                  |         |                 |               |
| Creation          |                 |      |      |                  |         |                 |               |
| Preservation      |                 |      |      |                  |         |                 |               |
| <b>Total</b>      | <b>2080.800</b> |      |      |                  |         |                 |               |

**Table 2. Project Activity and Reporting History  
Catbird Mitigation Site**

**Elapsed Time Since grading complete: 6 months**  
**Elapsed Time Since planting complete: 4 months**  
**Number of reporting Years<sup>1</sup>: 0**


| <b>Activity or Deliverable</b>          | <b>Data Collection Complete</b> | <b>Completion or Delivery</b> |
|---|---------------------------------|-------------------------------|
| Restoration Plan                        | NA                              | Jan-19                        |
| Final Design – Construction Plans       | NA                              | Oct-19                        |
| Stream Construction                     | NA                              | Jan-20                        |
| Site Planting                           | NA                              | Feb-20                        |
| DS2-B Structure Repair 1                | NA                              | Apr-20                        |
| DS2-B Structure Repair 2                | NA                              | Jun-20                        |
| As-built (Year 0 Monitoring – baseline) | Mar-20                          | Jul-20                        |
| Year 1 Monitoring                       |                                 |                               |
| Year 2 Monitoring                       |                                 |                               |
| Year 3 Monitoring                       |                                 |                               |
| Year 4 Monitoring                       |                                 |                               |
| Year 5 Monitoring                       |                                 |                               |
| Year 6 Monitoring                       |                                 |                               |
| Year 7 Monitoring                       |                                 |                               |

<sup>1</sup> = The number of reports or data points produced excluding the baseline

**Table 3. Project Contacts Table  
Catbird Mitigation Site**



|                                |  |
|--------------------------------|--|
| <b>Designer</b>                | RES / 3600 Glenwood Ave., Suite 100, Raleigh, NC 27612           |
| Primary project design POC     | Ben Carroll  |
| <b>Construction Contractor</b> | KBS Earthwork Inc. / 5616 Coble Church Rd., Julian, NC 27283     |
| Construction contractor POC    | Kory Strader   |
| <b>Survey Contractor</b>       | Matrix East, PLLC / 906 N. Queen St., Suite A, Kinston, NC 28501 |
| Survey contractor POC          | Chris Paderick, PLS  |
| <b>Planting Contractor</b>     | H&J Forestry   |
| Planting contractor POC        | Matt Hitch   |
| <b>Monitoring Performers</b>   | RES / 3600 Glenwood Ave, Suite 100, Raleigh, NC 27612            |
| Stream Monitoring POC          | Ryan Medric (919) 741-6268                                       |
| Vegetation Monitoring POC      | Ryan Medric (919) 741-6268                                       |

| Table 4. Project Background Information                        |   |                               |                  |
|--|---|-------------------------------|------------------|
| Project Name   | Catbird   |                               |                  |
| County   | Davie   |                               |                  |
| Project Area (acres)   | 6.33  |                               |                  |
| Project Coordinates (latitude and longitude)                   | Latitude: 36.030644 Longitude: -80.500865           |                               |                  |
| Planted Acreage (Acres of Woody Stems Planted)                 | 5.26  |                               |                  |
| Project Watershed Summary Information                          |   |                               |                  |
| Physiographic Province   | Southern Outer Piedmont                             |                               |                  |
| River Basin  | Yadkin Pee-Dee                                      |                               |                  |
| USGS Hydrologic Unit 8-digit                                   | 03040101  | USGS Hydrologic Unit 14-digit | 03040101160010   |
| DWR Sub-basin  | 3/7/2002  |                               |                  |
| Project Drainage Area (Acres and Square Miles)                 | 53 ac (0.083 sqmi)                                  |                               |                  |
| Project Drainage Area Percentage of Impervious Area            | 4%  |                               |                  |
| CGIA Land Use Classification                                   | Managed Herbaceous Cover and Mixed Upland Hardwoods |                               |                  |
| Reach Summary Information                                      |   |                               |                  |
| Parameters   | DS1   | DS2-A                         | DS2-B            |
| Length of reach (linear feet)                                  | 968   | 78                            | 1218             |
| Valley confinement (Confined, moderately confined, unconfined) | mod. confined                                       | mod. unconfined               | confined         |
| Drainage area (Acres and Square Miles)                         | 26 (0.041)  | 12 (0.019)                    | 27 (0.042)       |
| Perennial, Intermittent, Ephemeral                             | Intermittent  | Intermittent                  | Perennial        |
| NCDWR Water Quality Classification                             | C, WS-IV  | C, WS-IV                      | C, WS-IV         |
| Stream Classification (existing)                               | G4  | F5b                           | G5               |
| Stream Classification (proposed)                               | E4  | F5b                           | E4               |
| Evolutionary trend (Simon)                                     | III/IV  | III/IV                        | III/IV           |
| FEMA classification  | N/A   | N/A                           | N/A              |
| Regulatory Considerations                                      |   |                               |                  |
| Parameters   | Applicable?   | Resolved?                     | Supporting Docs? |
| Water of the United States - Section 404                       | Yes   | Yes                           | SAW-2017-01506   |
| Water of the United States - Section 401                       | Yes   | Yes                           | DWR # 17-1039    |
| Endangered Species Act   | Yes   | Yes                           | Mit Plan         |
| Historic Preservation Act                                      | Yes   | Yes                           | Mit Plan         |
| Coastal Zone Management Act (CZMA or CAMA)                     | No  | N/A                           | N/A              |
| FEMA Floodplain Compliance                                     | Yes   | Yes                           | N/A              |
| Essential Fisheries Habitat                                    | No  | N/A                           | N/A              |

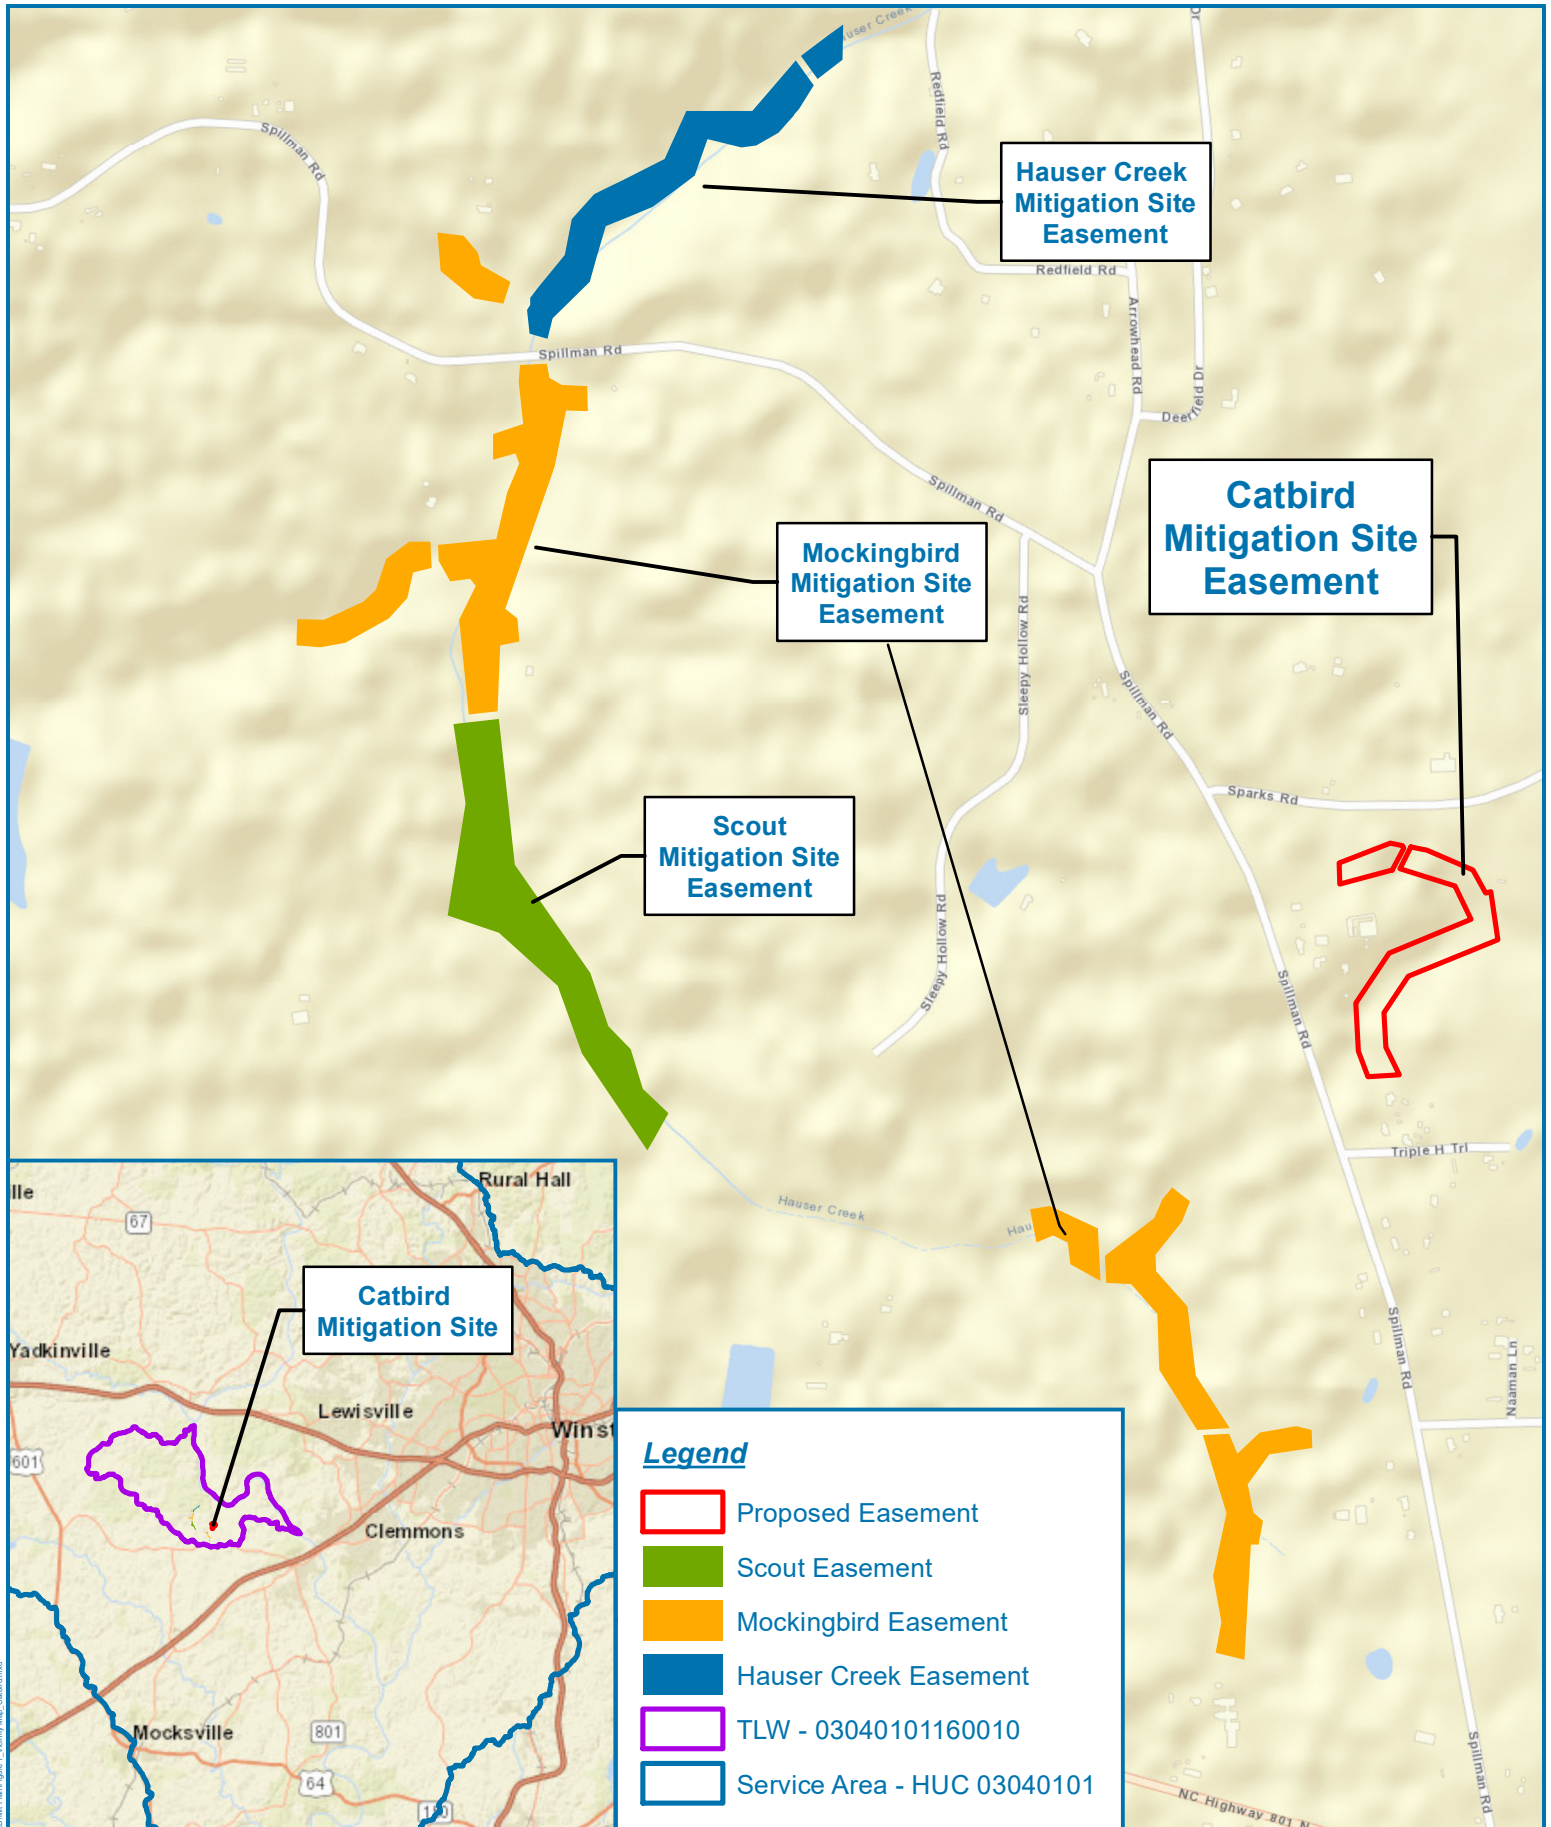

**Figure 1 - Site Location Map**  
**Catbird Mitigation Site**  
 Davie County, North Carolina

Date: 12/14/2018  
 Drawn by: SCF  
 Checked by: MDE  
 1 inch = 1,000 feet

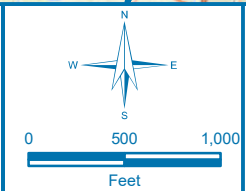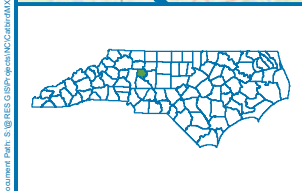


Document Path: S:\RES GIS\Projects\NC\Catbird\Map\_Footer\Map\_Catbird.mxd



# **Appendix B**

## Visual Assessment Data

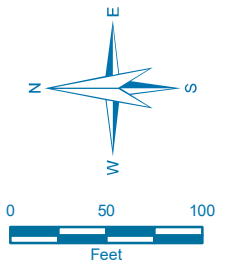

**Figure 2**

Current Conditions  
Plan View

MY0 2020

Catbird  
Mitigation Site

Davie County, NC

Date: 7/8/2020

Drawn by: RTM

Lat: 35.381042


Long: -78.420862

**LEGEND**

- ▭ Conservation Easement
- ▭ Veg Plots Catbird
- ▭ Random VP MY0 Catbird
- ▭ Existing Wetland
- Top of Bank
- + Flow Gauge
- x Stage Recorder
- o Rain Gauge/Ambient
- Mitigation Approach**
- Restoration
- Enhancement II
- No Credit
- Structure
- Cross Section

**Vegetation Condition Assessment**

|                  |         | Target Community |             |             |
|------------------|---------|------------------|-------------|-------------|
|                  |         | Present          | Marginal    | Absent      |
| Invasive Species | Absent  | No Fill          | No Fill     | No Fill     |
|                  | Present | Cross-hatch      | Cross-hatch | Cross-hatch |

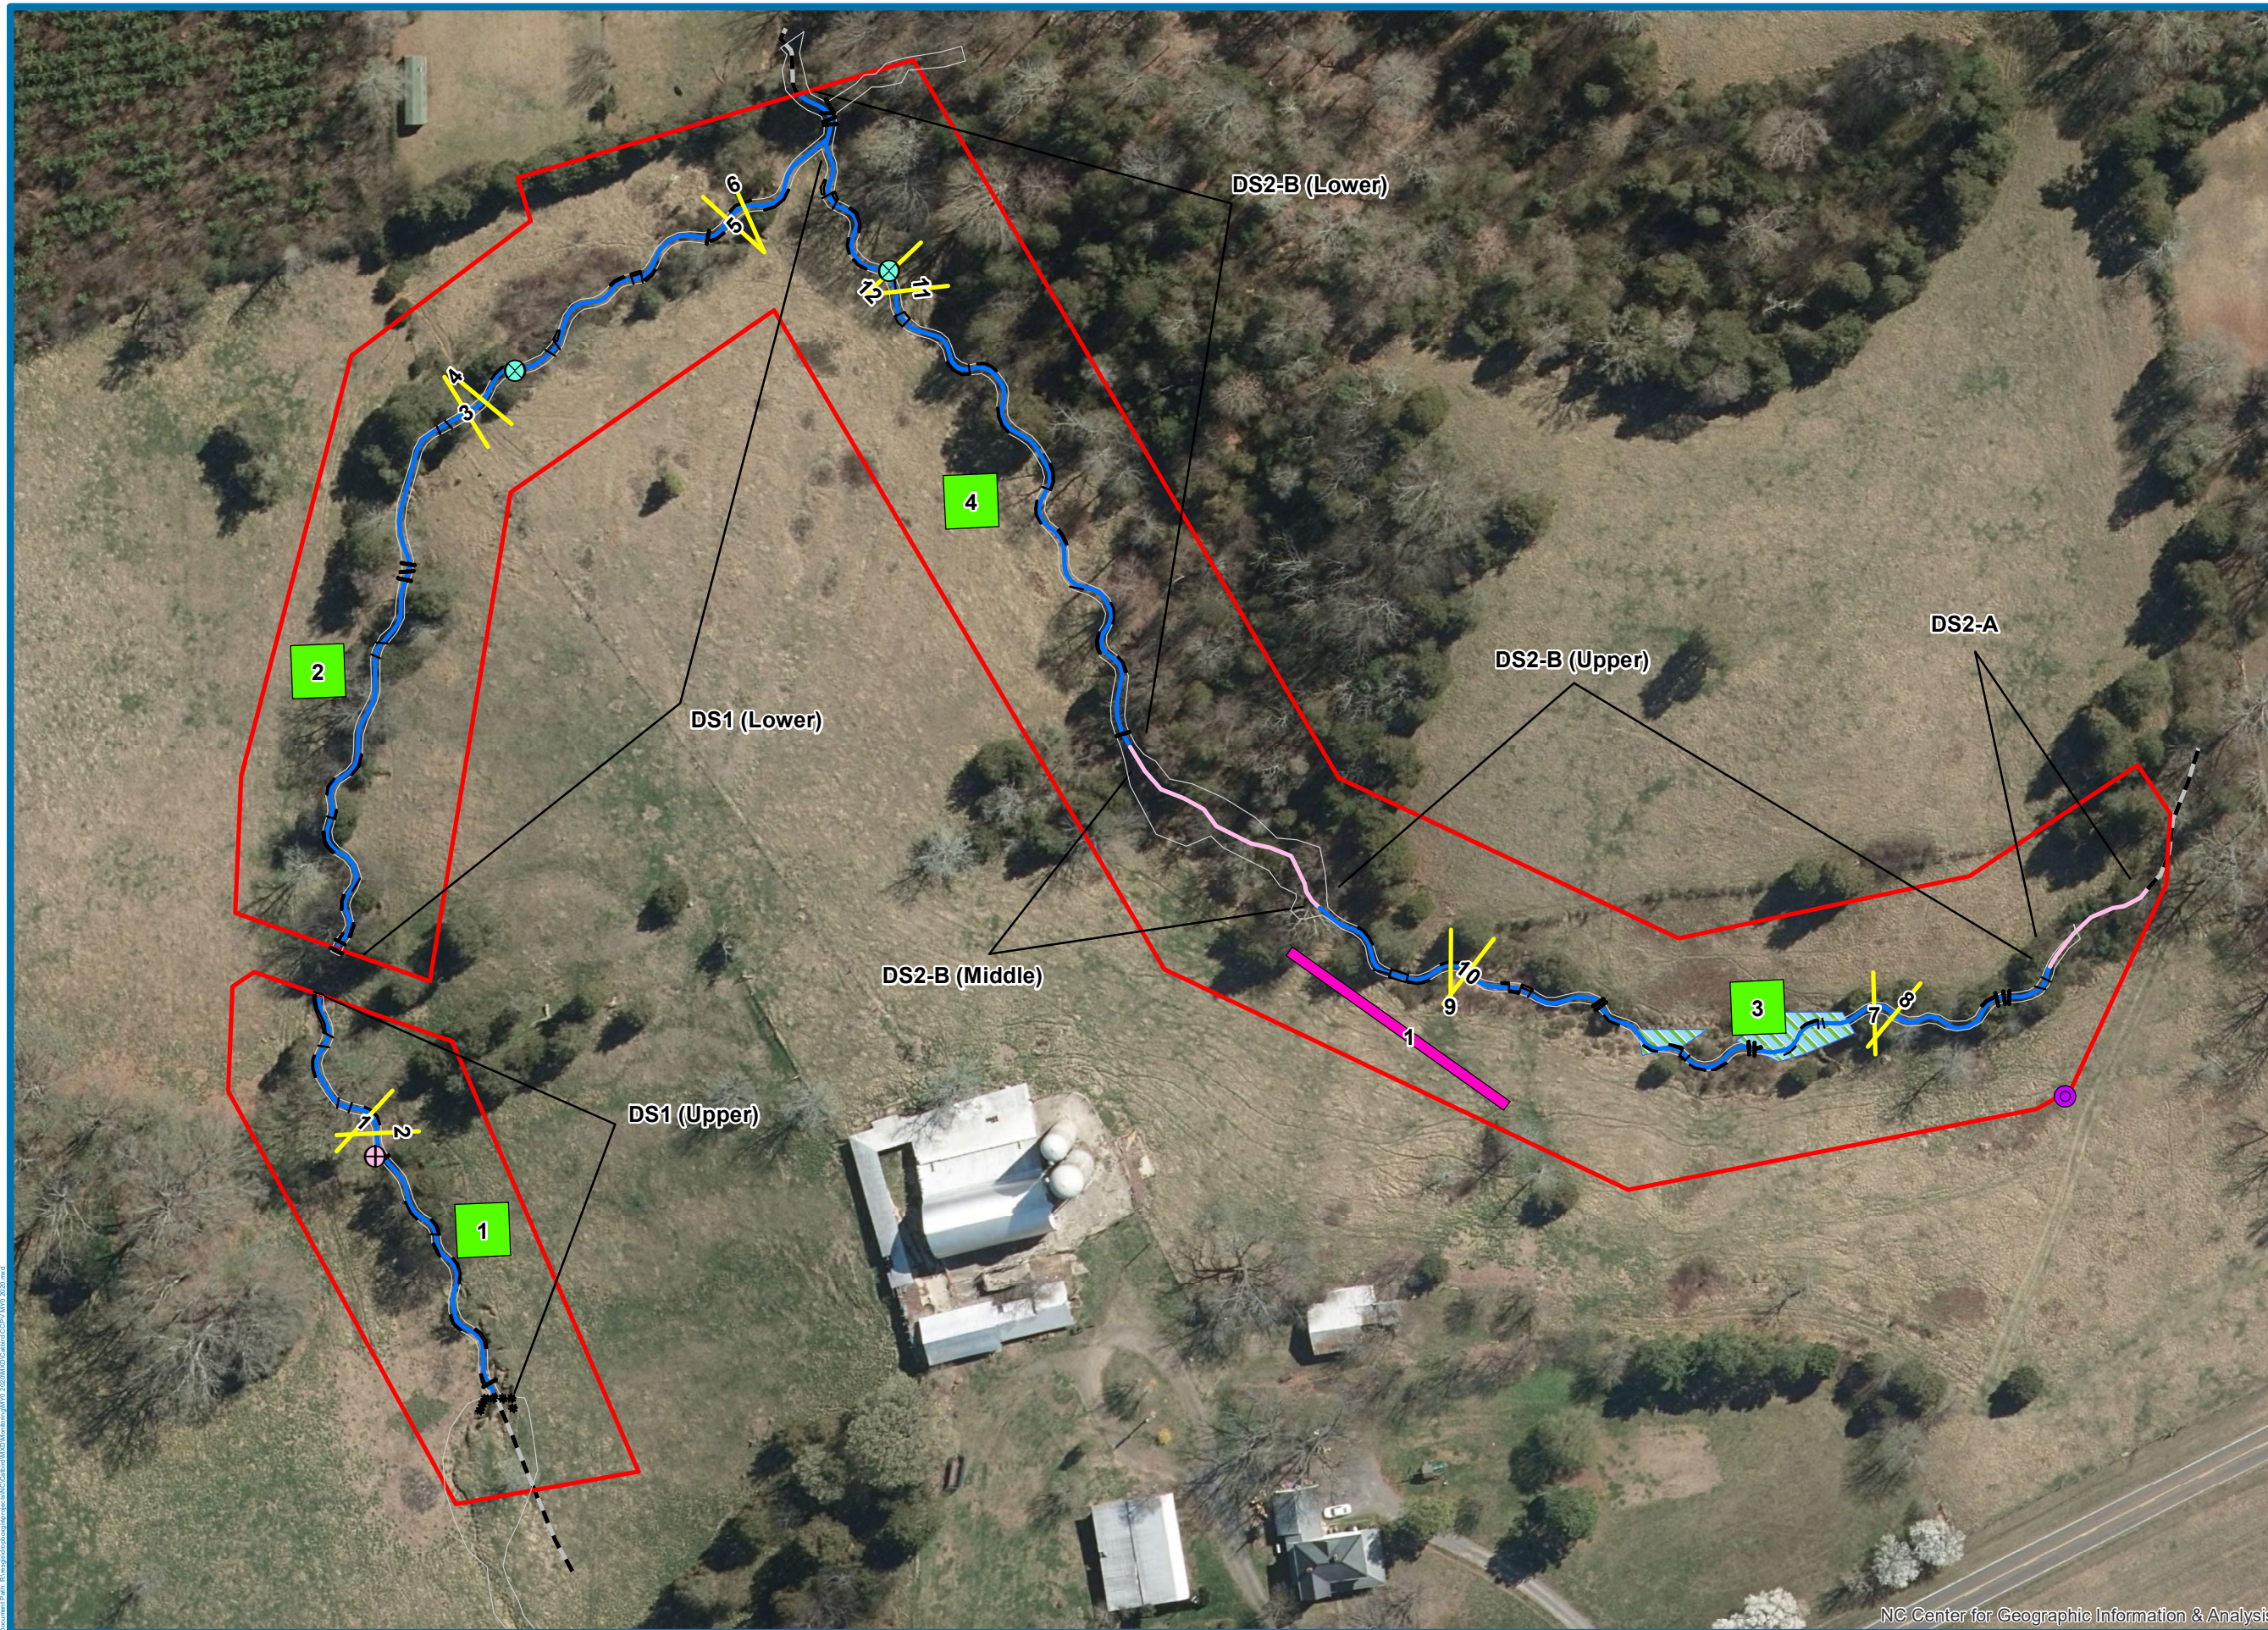

**Table 5. Visual Stream Morphology Stability Assessment  
Catbird Site - DS1  
Assessed Length 949 feet**

| Major Channel Category   | Channel Sub-Category  | Metric  | Number Stable, Performing as Intended                                    | Total Number in As-built | Number of Unstable Segments | Amount of Unstable Footage | % Stable, Performing as Intended | Number with Stabilizing Woody Vegetation | Footage with Stabilizing Woody Vegetation | Adjusted % for Stabilizing Woody Vegetation |
|--------------------------|---|---|--|--------------------------|-----------------------------|----------------------------|----------------------------------|--|---|---|
| 1. Bed                   | 1. Vertical Stability (Riffle and Run Units)  | 1. <u>Aggradation</u> - Bar formation/growth sufficient to significantly deflect flow laterally (not to include point bars).  |  |                          | 0                           | 0                          | 100%                             |  |   |   |
|                          |   | 2. <u>Degradation</u> - Evidence of downcutting.  |  |                          | 0                           | 0                          | 100%                             |  |   |   |
|                          | 2. Riffle Condition   | 1. <u>Texture/Substrate</u> - Riffle maintains coarser substrate.   | 35   | 35                       |                             |                            | 100%                             |  |   |   |
|                          |   | 3. Meander Pool Condition   | 1. <u>Depth</u> Sufficient (Max Pool Depth : Mean Bankfull Depth ≥ 1.6). | 38                       | 38                          |                            |                                  |  |   |   |
|                          | 2. <u>Length</u> appropriate (>30% of centerline distance between tail of upstream riffle and head of downstream riffle). |   | 38   | 38                       |                             |                            | 100%                             |  |   |   |
| 2. Bank                  | 1. Scoured / Eroding  | Bank lacking vegetative cover resulting simply from poor growth and/or scour and erosion.   |  |                          | 0                           | 0                          | 100%                             | 0  | 0   | 100%  |
|                          | 2. Undercut   | Banks undercut/overhanging to the extent that mass wasting appears likely. Does <b>NOT</b> include undercuts that are modest, appear sustainable and are providing habitat. |  |                          | 0                           | 0                          | 100%                             | 0  | 0   | 100%  |
|                          | 3. Mass Wasting   | Bank slumping, calving, or collapse.  |  |                          | 0                           | 0                          | 100%                             | 0  | 0   | 100%  |
| <b>Totals</b>            |   |   |  |                          | 0                           | 0                          | 100%                             | 0  | 0   | 100%  |
| 3. Engineered Structures | 1. Overall Integrity  | Structures physically intact with no dislodged boulders or logs.  | 21   | 21                       |                             |                            | 100%                             |  |   |   |
|                          | 2. Grade Control  | Grade control structures exhibiting maintenance of grade across the sill.   | 21   | 21                       |                             |                            | 100%                             |  |   |   |
|                          | 2a. Piping  | Structures lacking any substantial flow underneath sills or arms.   | 21   | 21                       |                             |                            | 100%                             |  |   |   |
|                          | 3. Bank Protection  | Bank erosion within the structures extent of influence does <b>NOT</b> exceed 15%.  | 21   | 21                       |                             |                            | 100%                             |  |   |   |
|                          | 4. Habitat  | Pool forming structures maintaining ~ Max Pool Depth : Mean Bankfull Depth Ratio ≥ 1.6. Rootwads/logs providing some cover at base-flow.                                    | 21   | 21                       |                             |                            | 100%                             |  |   |   |

**Table 5 Cont'd. Visual Stream Morphology Stability Assessment**  
**Catbird Site - DS2**  
**Assessed Length 1,037 feet**

| Major Channel Category          | Channel Sub-Category                                   | Metric   | Number Stable, Performing as Intended                                    | Total Number in As-built | Number of Unstable Segments | Amount of Unstable Footage | % Stable, Performing as Intended | Number with Stabilizing Woody Vegetation | Footage with Stabilizing Woody Vegetation | Adjusted % for Stabilizing Woody Vegetation |
|---------------------------------|--|--|--|--------------------------|-----------------------------|----------------------------|----------------------------------|--|---|---|
| <b>1. Bed</b>                   | <b>1. Vertical Stability</b><br>(Riffle and Run Units) | 1. <u>Aggradation</u> - Bar formation/growth sufficient to significantly deflect flow laterally (not to include point bars).   |  |                          | 0                           | 0                          | 100%                             |  |   |   |
|                                 |  | 2. <u>Degradation</u> - Evidence of downcutting.   |  |                          | 0                           | 0                          | 100%                             |  |   |   |
|                                 | <b>2. Riffle Condition</b>                             | 1. <u>Texture/Substrate</u> - Riffle maintains coarser substrate.  | 44   | 44                       |                             | 100%                       |                                  |  |   |   |
|                                 |  | <b>3. Meander Pool Condition</b>   | 1. <u>Depth</u> Sufficient (Max Pool Depth : Mean Bankfull Depth ≥ 1.6). | 50                       |                             | 50                         | 100%                             |  |   |   |
|                                 |  | 2. <u>Length</u> appropriate (>30% of centerline distance between tail of upstream riffle and head of downstream riffle).  | 50   | 50                       |                             | 100%                       |                                  |  |   |   |
| <b>Totals</b>                   |  |  |  |                          |                             |                            |                                  |  |   |   |
| <b>2. Bank</b>                  | <b>1. Scoured / Eroding</b>                            | Bank lacking vegetative cover resulting simply from poor growth and/or scour and erosion.  |  |                          | 0                           | 0                          | 100%                             | 0  | 0   | 100%  |
|                                 | <b>2. Undercut</b>                                     | Banks undercut/overhanging to the extent that mass wasting appears likely. Does NOT include undercuts that are modest, appear sustainable and are providing habitat. |  |                          | 0                           | 0                          | 100%                             | 0  | 0   | 100%  |
|                                 | <b>3. Mass Wasting</b>                                 | Bank slumping, calving, or collapse.   |  |                          | 0                           | 0                          | 100%                             | 0  | 0   | 100%  |
| <b>Totals</b>                   |  |  |  |                          |                             |                            |                                  |  |   |   |
| <b>3. Engineered Structures</b> | <b>1. Overall Integrity</b>                            | Structures physically intact with no dislodged boulders or logs.   | 25   | 25                       |                             |                            | 100%                             |  |   |   |
|                                 | <b>2. Grade Control</b>                                | Grade control structures exhibiting maintenance of grade across the sill.  | 25   | 25                       |                             |                            | 100%                             |  |   |   |
|                                 | <b>2a. Piping</b>                                      | Structures lacking any substantial flow underneath sills or arms.  | 25   | 25                       |                             |                            | 100%                             |  |   |   |
|                                 | <b>3. Bank Protection</b>                              | Bank erosion within the structures extent of influence does NOT exceed 15%.  | 25   | 25                       |                             |                            | 100%                             |  |   |   |
|                                 | <b>4. Habitat</b>                                      | Pool forming structures maintaining ~ Max Pool Depth : Mean Bankfull Depth Ratio ≥ 1.6. Rootwads/logs providing some cover at base-flow.                             | 25   | 25                       |                             |                            | 100%                             |  |   |   |

**Table 6**

**Vegetation Condition Assessment**

**Planted Acreage<sup>1</sup>**

**5.76**

| Vegetation Category                           | Definitions   | Mapping Threshold | CCPV Depiction      | Number of Polygons | Combined Acreage | % of Planted Acreage |
|---|---|-------------------|---------------------|--------------------|------------------|----------------------|
| <b>1. Bare Areas</b>                          | Very limited cover of both woody and herbaceous material.                                   | 0.1 acres         | Red Simple Hatch    | 0                  | 0.00             | 0.0%                 |
| <b>2. Low Stem Density Areas</b>              | Woody stem densities clearly below target levels based on MY3, 4, or 5 stem count criteria. | 0.1 acres         | Orange Simple Hatch | 0                  | 0.00             | 0.0%                 |
| <b>Total</b>                                  |   |                   |                     |                    |                  | 0.0%                 |
| <b>3. Areas of Poor Growth Rates or Vigor</b> | Areas with woody stems of a size class that are obviously small given the monitoring year.  | 0.25 acres        | Orange Simple Hatch | 0                  | 0.00             | 0.0%                 |
| <b>Cumulative Total</b>                       |   |                   |                     |                    |                  | 0.0%                 |

**Easement Acreage<sup>2</sup>**

**6.33**

| Vegetation Category                               | Definitions  | Mapping Threshold | CCPV Depiction    | Number of Polygons | Combined Acreage | % of Easement Acreage |
|---|--|-------------------|-------------------|--------------------|------------------|-----------------------|
| <b>4. Invasive Areas of Concern<sup>4</sup></b>   | Areas or points (if too small to render as polygons at map scale). | 1000 SF           | Yellow Crosshatch | 0                  | 0.00             | 0.0%                  |
| <b>5. Easement Encroachment Areas<sup>3</sup></b> | Areas or points (if too small to render as polygons at map scale). | none              | Red Simple Hatch  | 0                  | 0.00             | 0.0%                  |

**1** = Enter the planted acreage within the easement. This number is calculated as the easement acreage minus any existing mature tree stands that were not subject to supplemental planting of the understory, the channel acreage, crossings or any other elements not directly planted as part of the project effort.

**2** = The acreage within the easement boundaries.

**3** = Encroachment may occur within or outside of planted areas and will therefore be calculated against the overall easement acreage. In the event a polygon is cataloged into items 1, 2 or 3 in the table and is the result of encroachment, the associated acreage should be tallied in the relevant item (i.e., item 1,2 or 3) as well as a parallel tally in item 5.

**4** = Invasives may occur in or out of planted areas, but still within the easement and will therefore be calculated against the overall easement acreage. Invasives of concern/interest are listed below. The list of high concern species are those with the potential to directly outcompete native, young, woody stems in the short-term (e.g. monitoring period or shortly thereafter) or affect the community structure for existing, more established tree/shrub stands over timeframes that are slightly longer (e.g. 1-2 decades). The low/moderate concern group are those species that generally do not have this capacity over the timeframes discussed and therefore are not expected to be mapped with regularity, but can be mapped, if in the judgement of the observer their coverage, density or distribution is suppressing the viability, density, or growth of planted woody stems. Decisions as to whether remediation will be needed are based on the integration of risk factors by EEP such as species present, their coverage, distribution relative to native biomass, and the practicality of treatment. For example, even modest amounts of Kudzu or Japanese Knotweed early in the projects history will warrant control, but potentially large coverages of Microstegium in the herb layer will not likely trigger control because of the limited capacities to impact tree/shrub layers within the timeframes discussed and the potential impacts of treating extensive amounts of ground cover. Those species with the "watch list" designator in gray shade are of interest as well, but have yet to be observed across the state with any frequency. Those in *red italics* are of particular interest given their extreme risk/threat level for mapping as points where isolated specimens are found, particularly early in a projects monitoring history. However, areas of discreet, dense patches will of course be mapped as polygons. The symbology scheme below was one that was found to be helpful for symbolizing invasives polygons, particularly for situations where the condition for an area is somewhere between isolated specimens and dense, discreet patches. In any case, the point or polygon/area feature can be symbolized to describe things like high or low concern and species can be listed as a map inset, in legend items if the number of species are limited or in the narrative section of the executive summary.

## Catbird MY0 Vegetation Monitoring Plot Photos



Vegetation Plot 1 (3/4/2020)



Vegetation Plot 2 (3/4/2020)



Vegetation Plot 3 (3/4/2020)



Vegetation Plot 4 (3/4/2020)

**Catbird MY0 Random Vegetation Monitoring Plot Photo**



Random Vegetation Plot 1 (3/4/2020)

**Catbird Monitoring Device Photos**



Stage Recorder DS1



Flow Gauge DS1



Stage Recorder DS2



# **Appendix C**

## **Vegetation Plot Data**

**Table 7. Planted Species Summary**

| Common Name                 | Scientific Name                | Total Stems Planted |
|-----------------------------|--------------------------------|---------------------|
| Persimmon                   | <i>Diospyros virginiana</i>    | 1,100               |
| Water Oak                   | <i>Quercus nigra</i>           | 800                 |
| Willow Oak                  | <i>Quercus phellos</i>         | 800                 |
| River Birch                 | <i>Betula nigra</i>            | 800                 |
| Sycamore                    | <i>Platanus occidentalis</i>   | 800                 |
| Crab Apple                  | <i>Malus angustifolia</i>      | 800                 |
| Green Ash                   | <i>Fraxinus pennsylvanica</i>  | 600                 |
| Northern Red Oak            | <i>Quercus rubra</i>           | 600                 |
| Yellow Poplar               | <i>Liriodendron tulipifera</i> | 600                 |
| Silky Dogwood               | <i>Cornus amomum</i>           | 400                 |
| Sugarberry                  | <i>Celtis laevigata</i>        | 350                 |
| Black Walnut                | <i>Juglans nigra</i>           | 300                 |
| Elderberry                  | <i>Sambucus canadensis</i>     | 300                 |
| Eastern Redbud              | <i>Cercis canadensis</i>       | 300                 |
| <b>Total</b>                |                                | 8,550               |
| Planted Area                |                                | 5.26                |
| As-built Planted Stems/Acre |                                | 1,625               |

**Table 8. Vegetation Plot Mitigation Success Summary**

| Plot #             | Planted Stems/Acre | Volunteer Stems/Acre | Total Stems/Acre | Success Criteria Met? | Averaged Planted Stem Height (ft) |
|--------------------|--------------------|----------------------|------------------|-----------------------|-----------------------------------|
| 1                  | 1133               | 0                    | 1133             | Yes                   | 1.5                               |
| 2                  | 1295               | 0                    | 1295             | Yes                   | 1.6                               |
| 3                  | 1740               | 0                    | 1740             | Yes                   | 1.8                               |
| 4                  | 1255               | 0                    | 1255             | Yes                   | 1.6                               |
| R1                 | 1174               | 0                    | 1174             | Yes                   | 1.5                               |
| <b>Project Avg</b> | <b>1649</b>        | <b>0</b>             | <b>1649</b>      | <b>Yes</b>            | <b>1.6</b>                        |

**Table 9. Stem Count Total and Planted by Plot Species**

| Catbird                 |                    |              | Current Plot Data (MYO 2020) |       |      |                |       |      |                |       |      |                |       |      |              |       |      | Annual Means |       |      |
|-------------------------|--------------------|--------------|------------------------------|-------|------|----------------|-------|------|----------------|-------|------|----------------|-------|------|--------------|-------|------|--------------|-------|------|
| Scientific Name         | Common Name        | Species Type | 100022-01-0001               |       |      | 100022-01-0002 |       |      | 100022-01-0003 |       |      | 100022-01-0004 |       |      | 100022-01-R1 |       |      | MYO (2020)   |       |      |
|                         |                    |              | PnoLS                        | P-all | T    | PnoLS          | P-all | T    | PnoLS          | P-all | T    | PnoLS          | P-all | T    | PnoLS        | P-all | T    | PnoLS        | P-all | T    |
| Betula nigra            | river birch        | Tree         |                              |       |      | 6              | 6     | 6    | 6              | 6     | 6    | 5              | 5     | 5    |              |       |      | 17           | 17    | 17   |
| Celtis laevigata        | sugarberry         | Tree         |                              |       |      | 1              | 1     | 1    |                |       |      |                |       |      | 1            | 1     | 1    | 2            | 2     | 2    |
| Cercis canadensis       | eastern redbud     | Tree         |                              |       |      | 1              | 1     | 1    |                |       |      | 3              | 3     | 3    |              |       |      | 4            | 4     | 4    |
| Cornus amomum           | silky dogwood      | Shrub        | 3                            | 3     | 3    | 1              | 1     | 1    |                |       |      |                |       |      | 4            | 4     | 4    | 8            | 8     | 8    |
| Diospyros virginiana    | common persimmon   | Tree         | 3                            | 3     | 3    | 10             | 10    | 10   |                |       |      | 2              | 2     | 2    | 15           | 15    | 15   | 30           | 30    | 30   |
| Fraxinus pennsylvanica  | green ash          | Tree         | 11                           | 11    | 11   | 2              | 2     | 2    | 5              | 5     | 5    |                |       |      |              |       |      | 18           | 18    | 18   |
| Juglans nigra           | black walnut       | Tree         |                              |       |      | 3              | 3     | 3    |                |       |      | 1              | 1     | 1    |              |       |      | 4            | 4     | 4    |
| Liriodendron tulipifera | tuliptree          | Tree         |                              |       |      |                |       |      | 6              | 6     | 6    | 2              | 2     | 2    | 4            | 4     | 4    | 12           | 12    | 12   |
| Malus angustifolia      | southern crabapple | Tree         |                              |       |      |                |       |      |                |       |      | 3              | 3     | 3    |              |       |      | 3            | 3     | 3    |
| Platanus occidentalis   | American sycamore  | Tree         |                              |       |      | 1              | 1     | 1    | 6              | 6     | 6    | 1              | 1     | 1    |              |       |      | 8            | 8     | 8    |
| Quercus                 | oak                | Tree         | 7                            | 7     | 7    | 6              | 6     | 6    | 13             | 13    | 13   | 5              | 5     | 5    | 1            | 1     | 1    | 32           | 32    | 32   |
| Quercus nigra           | water oak          | Tree         | 3                            | 3     | 3    |                |       |      |                |       |      | 2              | 2     | 2    |              |       |      | 5            | 5     | 5    |
| Quercus phellos         | willow oak         | Tree         | 1                            | 1     | 1    | 1              | 1     | 1    | 4              | 4     | 4    | 3              | 3     | 3    | 4            | 4     | 4    | 13           | 13    | 13   |
| Quercus rubra           | northern red oak   | Tree         |                              |       |      |                |       |      | 3              | 3     | 3    | 4              | 4     | 4    |              |       |      | 7            | 7     | 7    |
| <b>Stem count</b>       |                    |              | 28                           | 28    | 28   | 32             | 32    | 32   | 43             | 43    | 43   | 31             | 31    | 31   | 29           | 29    | 29   | 163          | 163   | 163  |
| <b>size (ares)</b>      |                    |              | 1                            |       |      | 1              |       |      | 1              |       |      | 1              |       |      | 1            |       |      | 4            |       |      |
| <b>size (ACRES)</b>     |                    |              | 0.02                         |       |      | 0.02           |       |      | 0.02           |       |      | 0.02           |       |      | 0.02         |       |      | 0.10         |       |      |
| <b>Species count</b>    |                    |              | 6                            | 6     | 6    | 10             | 10    | 10   | 7              | 7     | 7    | 11             | 11    | 11   | 6            | 6     | 6    | 14           | 14    | 14   |
| <b>Stems per ACRE</b>   |                    |              | 1133                         | 1133  | 1133 | 1295           | 1295  | 1295 | 1740           | 1740  | 1740 | 1255           | 1255  | 1255 | 1174         | 1174  | 1174 | 1649         | 1649  | 1649 |

# **Appendix D**

## Stream Measurement and Geomorphology Data

**Table 10. Baseline Stream Data Summary  
Catbird Mitigation Site - Reach DS1**

| Parameter  | Gauge <sup>2</sup> | Regional Curve |     |     | Pre-Existing Condition |      |     |      |                 |     | Reference Reach(es) Data |      |     |      |                 |     | Design |      |     | Monitoring Baseline |      |      |      |                 |     |
|--|--------------------|----------------|-----|-----|------------------------|------|-----|------|-----------------|-----|--------------------------|------|-----|------|-----------------|-----|--------|------|-----|---------------------|------|------|------|-----------------|-----|
|  |                    | LL             | UL  | Eq. | Min                    | Mean | Med | Max  | SD <sup>b</sup> | n   | Min                      | Mean | Med | Max  | SD <sup>b</sup> | n   | Min    | Med  | Max | Min                 | Mean | Med  | Max  | SD <sup>b</sup> | n   |
| <b>Dimension and Substrate - Riffle Only</b>       |                    |                | Bankfull Width (ft)                                |                    | ---            | --- | --- | 3.0                    | ---  | 5.4 | 7.4  | ---             | 3   | 4.4                      | ---  | --- | 6.6  | ---             | 2   | ---    | 4.5  | --- | 5.1                 | 6.0  | 5.6  | 7.3  | 1.2             | 3   |
| Floodprone Width (ft)                              |                    |                |     |     | 5.4                    | ---  | 6.8 | 10.0 | ---             | 3   | 10.0                     | ---  | --- | 15.0 | ---             | 2   | ---    | 30.0 | --- | 50.0                | 50.0 | 50.0 | 50.0 | 0.1             | 3   |
| Bankfull Mean Depth (ft)                           |                    | ---            | --- | --- | 0.5                    | ---  | 0.7 | 0.8  | ---             | 3   | 0.6                      | ---  | --- | 0.6  | ---             | 2   | ---    | 0.5  | --- | ---                 | ---  | ---  | ---  | ---             | --- |
| <sup>1</sup> Bankfull Max Depth (ft)               |                    |                |     |     | 0.8                    | ---  | 1.1 | 1.1  | ---             | 3   | 0.9                      | ---  | --- | 1.2  | ---             | 2   | ---    | 0.7  | --- | 0.7                 | 1.0  | 0.9  | 1.3  | 0.3             | 3   |
| Bankfull Cross Sectional Area (ft <sup>2</sup> )   |                    | ---            | --- | --- | 2.3                    | ---  | 3.4 | 3.7  | ---             | 3   | 2.8                      | ---  | --- | 3.9  | ---             | 2   | ---    | 2.1  | --- | 1.9                 | 2.8  | 3.1  | 3.5  | 0.8             | 3   |
| Width/Depth Ratio                                  |                    |                |     |     | 3.9                    | ---  | 7.8 | 16.1 | ---             | 3   | 6.9                      | ---  | --- | 10.9 | ---             | 2   | ---    | 9.7  | --- | ---                 | ---  | ---  | ---  | ---             | --- |
| Entrenchment Ratio                                 |                    |                |     |     | 1.3                    | ---  | 1.4 | 1.8  | ---             | 3   | 2.2                      | ---  | --- | 2.2  | ---             | 2   | ---    | 6.7  | --- | 6.9                 | 8.6  | 9.0  | 9.9  | 1.5             | 3   |
| <sup>1</sup> Bank Height Ratio                     |                    |                |     |     | 1.0                    | ---  | 1.8 | 2.5  | ---             | 3   | 1.0                      | ---  | --- | 1.2  | ---             | 2   | ---    | 1.0  | --- | 1.0                 | 1.0  | 1.0  | 1.0  | 0.0             | 3   |
| <b>Profile</b>                                     |                    |                | Riffle Length (ft)                                 |                    |                |     |     | ---                    | ---  | --- | ---  | ---             | --- | 4                        | ---  | --- | 18   | ---             | --- | 3      | ---  | 15  | 2.2                 | 8.7  | 7.2  | 17.9 | 4.3             | 35  |
| Riffle Slope (ft/ft)                               |                    |                |     |     | ---                    | ---  | --- | ---  | ---             | --- | ---                      | ---  | --- | ---  | ---             | --- | ---    | ---  | --- | 0.4                 | 2.5  | 1.7  | 8.0  | 1.8             | 35  |
| Pool Length (ft)                                   |                    |                |     |     | ---                    | ---  | --- | ---  | ---             | --- | 3                        | ---  | --- | 10   | ---             | --- | 3      | ---  | 7   | 2.1                 | 6.4  | 6.0  | 17.1 | 2.5             | 38  |
| Pool Max depth (ft)                                |                    |                |     |     | ---                    | ---  |
| Pool Spacing (ft)                                  |                    |                |     |     | ---                    | ---  | --- | ---  | ---             | --- | 12                       | ---  | --- | 35   | ---             | --- | 10     | ---  | 30  | 5.9                 | 25.6 | 20.9 | 75.2 | 16.4            | 37  |
| <b>Pattern</b>                                     |                    |                | Channel Beltwidth (ft)                             |                    |                |     |     | ---                    | ---  | --- | ---  | ---             | --- | 18                       | ---  | --- | 35   | ---             | --- | 13     | ---  | 30  | ---                 | ---  | ---  | ---  | ---             | --- |
| Radius of Curvature (ft)                           |                    |                |     |     | ---                    | ---  | --- | ---  | ---             | --- | 7                        | ---  | --- | 19   | ---             | --- | 5      | ---  | 15  | ---                 | ---  | ---  | ---  | ---             | --- |
| Rc:Bankfull width (ft/ft)                          |                    |                |     |     | ---                    | ---  | --- | ---  | ---             | --- | 1.6                      | ---  | --- | 4.3  | ---             | --- | 1.1    | ---  | 3.3 | ---                 | ---  | ---  | ---  | ---             | --- |
| Meander Wavelength (ft)                            |                    |                |     |     | ---                    | ---  | --- | ---  | ---             | --- | 30                       | ---  | --- | 44   | ---             | --- | 20     | ---  | 37  | ---                 | ---  | ---  | ---  | ---             | --- |
| Meander Width Ratio                                |                    |                |     |     | ---                    | ---  | --- | ---  | ---             | --- | 4.1                      | ---  | --- | 8    | ---             | --- | 2.9    | ---  | 6.7 | ---                 | ---  | ---  | ---  | ---             | --- |
| <b>Transport parameters</b>                        |                    |                | Reach Shear Stress (competency) lb/ft <sup>2</sup> |                    |                | Max part size (mm) mobilized at bankfull           |                    |                | Stream Power (transport capacity) W/m <sup>2</sup> |                    |                | <b>Additional Reach Parameters</b>                 |                    |                | Rosgen Classification                              |                    |                | Bankfull Velocity (fps)                            |                    | ---            | --- | --- |                        |      | Bankfull Discharge (cfs)                           |                    | ---            | --- | --- |                        |      | Valley length (ft)                                 |                    |                | Channel Thalweg length (ft)                        |                    |                | Sinuosity (ft)                                     |                    |                | Water Surface Slope (Channel) (ft/ft)              |                    |                | Channel slope (ft/ft)                              |                    |                | <sup>3</sup> Bankfull Floodplain Area (acres)      |                    |                | <sup>4</sup> % of Reach with Eroding Banks         |                    |                | Channel Stability or Habitat Metric                |                    |                | Biological or Other                                |                    |                
Shaded cells indicate that these will typically not be filled in.

1 = The distributions for these parameters can include information from both the cross-section measurements and the longitudinal profile. 2 = For projects with a proximal USGS gauge in-line with the project reach (added bankfull verification - rare).

3. Utilizing XS measurement data produce an estimate of the bankfull floodplain area in acres, which should be the area from the top of bank to the toe of the terrace riser/slope.

4 = Proportion of reach exhibiting banks that are eroding based on the visual survey for comparison to monitoring data; 5. Of value/needed only if the n exceeds 3

**Table 10. Baseline Stream Data Summary (continued)  
Catbird Mitigation Site - Reach DS2-B (Upper)**

| Parameter  | Gauge <sup>2</sup> | Regional Curve |     |     | Pre-Existing Condition |      |     |        |                 |     | Reference Reach(es) Data |      |     |       |                 |     | Design |      |     | Monitoring Baseline |      |      |      |                 |     |
|--|--------------------|----------------|-----|-----|------------------------|------|-----|--------|-----------------|-----|--------------------------|------|-----|-------|-----------------|-----|--------|------|-----|---------------------|------|------|------|-----------------|-----|
|  |                    | LL             | UL  | Eq. | Min                    | Mean | Med | Max    | SD <sup>5</sup> | n   | Min                      | Mean | Med | Max   | SD <sup>5</sup> | n   | Min    | Med  | Max | Min                 | Mean | Med  | Max  | SD <sup>5</sup> | n   |
| <b>Dimension and Substrate - Riffle Only</b>       |                    |                | Bankfull Width (ft)                                |                    | ---            | --- | --- | 4.3                    | ---  | --- | 4.8    | ---             | 2   | 4.4                      | ---  | --- | 6.6   | ---             | 2   | ---    | 4.5  | --- | 4.2                 | 4.9  | 4.9  | 5.6  | 1.0             | 2   |
| Floodprone Width (ft)                              |                    |                |     |     | 5.6                    | ---  | --- | 7.6    | ---             | 2   | 10.0                     | ---  | --- | 15.0  | ---             | 2   | ---    | 30.0 | --- | 50.0                | 50.0 | 50.0 | 50.0 | 0.1             | 2   |
| Bankfull Mean Depth (ft)                           |                    | ---            | --- | --- | 0.5                    | ---  | --- | 0.7    | ---             | 2   | 0.6                      | ---  | --- | 0.6   | ---             | 2   | ---    | 0.5  | --- | ---                 | ---  | ---  | ---  | ---             | --- |
| <sup>1</sup> Bankfull Max Depth (ft)               |                    |                |     |     | 0.7                    | ---  | --- | 1.2    | ---             | 2   | 0.9                      | ---  | --- | 1.2   | ---             | 2   | ---    | 0.7  | --- | 0.8                 | 0.8  | 0.8  | 0.8  | 0.0             | 2   |
| Bankfull Cross Sectional Area (ft <sup>2</sup> )   |                    | ---            | --- | --- | 2.1                    | ---  | --- | 3.1    | ---             | 2   | 2.8                      | ---  | --- | 3.9   | ---             | 2   | ---    | 2.2  | --- | 2.2                 | 2.4  | 2.4  | 2.6  | 0.3             | 2   |
| Width/Depth Ratio                                  |                    |                |     |     | 7.3                    | ---  | --- | 9.0    | ---             | 2   | 6.9                      | ---  | --- | 10.9  | ---             | 2   | ---    | 9.3  | --- | ---                 | ---  | ---  | ---  | ---             | --- |
| Entrenchment Ratio                                 |                    |                |     |     | 1.3                    | ---  | --- | 1.6    | ---             | 2   | 2.2                      | ---  | --- | 2.2   | ---             | 2   | ---    | 6.7  | --- | 8.8                 | 10.3 | 10.3 | 11.8 | 2.1             | 2   |
| <sup>1</sup> Bank Height Ratio                     |                    |                |     |     | 0.8                    | ---  | --- | 8.4    | ---             | 2   | 1.0                      | ---  | --- | 1.2   | ---             | 2   | ---    | 1.0  | --- | 1.0                 | 1.0  | 1.0  | 1.0  | 0.0             | 2   |
| <b>Profile</b>                                     |                    |                | Riffle Length (ft)                                 |                    |                |     |     | ---                    | ---  | --- | ---    | ---             | --- |                          | ---  | --- |       | ---             | --- |        | ---  |     | 2.4                 | 6.6  | 5.8  | 18.2 | 3.2             | 44  |
| Riffle Slope (ft/ft)                               |                    |                |     |     | ---                    | ---  | --- | ---    | ---             | --- |                          | ---  | --- |       | ---             | --- |        | ---  |     | 0.3                 | 4.1  | 3.7  | 14.8 | 3.1             | 45  |
| Pool Length (ft)                                   |                    |                |     |     | ---                    | ---  | --- | ---    | ---             | --- |                          | ---  | --- |       | ---             | --- |        | ---  |     | 1.1                 | 5.1  | 5.0  | 13.7 | 2.4             | 50  |
| Pool Max depth (ft)                                |                    |                |     |     | ---                    | ---  | --- | ---    | ---             | --- |                          | ---  | --- |       | ---             | --- |        | ---  |     | ---                 | ---  | ---  | ---  | ---             | --- |
| Pool Spacing (ft)                                  |                    |                |     |     | ---                    | ---  | --- | ---    | ---             | --- |                          | ---  | --- |       | ---             | --- |        | ---  |     | 3.1                 | 19.2 | 19.1 | 40.5 | 7.5             | 48  |
| <b>Pattern</b>                                     |                    |                | Channel Beltwidth (ft)                             |                    |                |     |     | ---                    | ---  | --- | ---    | ---             | --- | 18                       | ---  | --- | 35    | ---             | --- | 13     | ---  | 30  |                     | ---  |      | ---  | ---             | --- |
| Radius of Curvature (ft)                           |                    |                |     |     | ---                    | ---  | --- | ---    | ---             | --- | 7                        | ---  | --- | 19    | ---             | --- | 5      | ---  | 15  |                     | ---  |      | ---  | ---             | --- |
| Rc:Bankfull width (ft/ft)                          |                    |                |     |     | ---                    | ---  | --- | ---    | ---             | --- | 1.6                      | ---  | --- | 4.3   | ---             | --- | 1.1    | ---  | 3.3 |                     | ---  |      | ---  | ---             | --- |
| Meander Wavelength (ft)                            |                    |                |     |     | ---                    | ---  | --- | ---    | ---             | --- | 30                       | ---  | --- | 44    | ---             | --- | 20     | ---  | 37  |                     | ---  |      | ---  | ---             | --- |
| Meander Width Ratio                                |                    |                |     |     | ---                    | ---  | --- | ---    | ---             | --- | 4.1                      | ---  | --- | 8     | ---             | --- | 2.9    | ---  | 6.7 |                     | ---  |      | ---  | ---             | --- |
| <b>Transport parameters</b>                        |                    |                | Reach Shear Stress (competency) lb/ft <sup>2</sup> |                    |                | Max part size (mm) mobilized at bankfull           |                    |                | Stream Power (transport capacity) W/m <sup>2</sup> |                    |                | <b>Additional Reach Parameters</b>                 |                    |                | Rosgen Classification                              |                    |                |     |     |                        |      |     | G5     |                 |     |                          |      |     | E4    |                 |     |        | E4   |     |                     |      |      |      | E4              |     |
| Bankfull Velocity (fps)                            |                    | ---            | --- | --- |                        |      |     | ---    |                 |     |                          |      |     | ---   |                 |     |        | ---  |     |                     |      |      |      | ---             |     |
| Bankfull Discharge (cfs)                           |                    | ---            | --- | --- |                        |      |     | ---    |                 |     |                          |      |     | ---   |                 |     |        | ---  |     |                     |      |      |      | ---             |     |
| Valley length (ft)                                 |                    |                |     |     |                        |      |     | 990    |                 |     |                          |      |     | 146   |                 |     |        | 482  |     |                     |      |      |      | ---             |     |
| Channel Thalweg length (ft)                        |                    |                |     |     |                        |      |     | 1051   |                 |     |                          |      |     | 185   |                 |     |        | 526  |     |                     |      |      |      | 526             |     |
| Sinuosity (ft)                                     |                    |                |     |     |                        |      |     | 1.06   |                 |     |                          |      |     | 1.27  |                 |     |        | 1.09 |     |                     |      |      |      | ---             |     |
| Water Surface Slope (Channel) (ft/ft)              |                    |                |     |     |                        |      |     | ---    |                 |     |                          |      |     | ---   |                 |     |        | ---  |     |                     |      |      |      | ---             |     |
| Channel slope (ft/ft)                              |                    |                |     |     |                        |      |     | 0.0383 |                 |     |                          |      |     | 0.013 |                 |     |        | 0.02 |     |                     |      |      |      | ---             |     |
| <sup>3</sup> Bankfull Floodplain Area (acres)      |                    |                |     |     |                        |      |     | ---    |                 |     |                          |      |     | ---   |                 |     |        | ---  |     |                     |      |      |      | ---             |     |
| <sup>4</sup> % of Reach with Eroding Banks         |                    |                |     |     |                        |      |     | ---    |                 |     |                          |      |     | ---   |                 |     |        | ---  |     |                     |      |      |      | ---             |     |
| Channel Stability or Habitat Metric                |                    |                |     |     |                        |      |     | ---    |                 |     |                          |      |     | ---   |                 |     |        | ---  |     |                     |      |      |      | ---             |     |
| Biological or Other                                |                    |                |     |     |                        |      |     | ---    |                 |     |                          |      |     | ---   |                 |     |        | ---  |     |                     |      |      |      | ---             |     |

Shaded cells indicate that these will typically not be filled in.

1 = The distributions for these parameters can include information from both the cross-section measurements and the longitudinal profile. 2 = For projects with a proximal USGS gauge in-line with the project reach (added bankfull verification - rare).

3. Utilizing XS measurement data produce an estimate of the bankfull floodplain area in acres, which should be the area from the top of bank to the toe of the terrace riser/slope.

4 = Proportion of reach exhibiting banks that are eroding based on the visual survey for comparison to monitoring data; 5. Of value/needed only if the n exceeds 3

**Table 10. Baseline Stream Data Summary (continued)  
Catbird Mitigation Site - Reach DS2-B (Lower)**

| Parameter  | Gauge <sup>2</sup> | Regional Curve |     |     | Pre-Existing Condition |      |     |        |                 |     | Reference Reach(es) Data |      |     |       |                 |     | Design |      |        | Monitoring Baseline |      |      |      |                 |     |
|--|--------------------|----------------|-----|-----|------------------------|------|-----|--------|-----------------|-----|--------------------------|------|-----|-------|-----------------|-----|--------|------|--------|---------------------|------|------|------|-----------------|-----|
|  |                    | LL             | UL  | Eq. | Min                    | Mean | Med | Max    | SD <sup>5</sup> | n   | Min                      | Mean | Med | Max   | SD <sup>5</sup> | n   | Min    | Med  | Max    | Min                 | Mean | Med  | Max  | SD <sup>5</sup> | n   |
| <b>Dimension and Substrate - Riffle Only</b>       |                    |                | Bankfull Width (ft)                                |                    | ---            | --- | --- | 4.3                    | ---  | --- | 4.8    | ---             | 2   | 4.4                      | ---  | --- | 6.6   | ---             | 2   | ---    | 5.2  | ---    | ---                 | ---  | 5.7  | ---  | ---             | --- |
| Floodprone Width (ft)                              |                    |                |     |     | 5.6                    | ---  | --- | 7.6    | ---             | 2   | 10.0                     | ---  | --- | 15.0  | ---             | 2   | ---    | 30.0 | ---    | ---                 | ---  | 50.0 | ---  | ---             | --- |
| Bankfull Mean Depth (ft)                           |                    | ---            | --- | --- | 0.5                    | ---  | --- | 0.7    | ---             | 2   | 0.6                      | ---  | --- | 0.6   | ---             | 2   | ---    | 0.5  | ---    | ---                 | ---  | ---  | ---  | ---             | --- |
| <sup>1</sup> Bankfull Max Depth (ft)               |                    |                |     |     | 0.7                    | ---  | --- | 1.2    | ---             | 2   | 0.9                      | ---  | --- | 1.2   | ---             | 2   | ---    | 0.8  | ---    | ---                 | ---  | 0.8  | ---  | ---             | --- |
| Bankfull Cross Sectional Area (ft <sup>2</sup> )   |                    | ---            | --- | --- | 2.1                    | ---  | --- | 3.1    | ---             | 2   | 2.8                      | ---  | --- | 3.9   | ---             | 2   | ---    | 2.8  | ---    | ---                 | ---  | 2.9  | ---  | ---             | --- |
| Width/Depth Ratio                                  |                    |                |     |     | 7.3                    | ---  | --- | 9.0    | ---             | 2   | 6.9                      | ---  | --- | 10.9  | ---             | 2   | ---    | 9.7  | ---    | ---                 | ---  | ---  | ---  | ---             | --- |
| Entrenchment Ratio                                 |                    |                |     |     | 1.3                    | ---  | --- | 1.6    | ---             | 2   | 2.2                      | ---  | --- | 2.2   | ---             | 2   | ---    | 5.8  | ---    | ---                 | ---  | 8.7  | ---  | ---             | --- |
| <sup>1</sup> Bank Height Ratio                     |                    |                |     |     | 0.8                    | ---  | --- | 8.4    | ---             | 2   | 1.0                      | ---  | --- | 1.2   | ---             | 2   | ---    | 1.0  | ---    | ---                 | ---  | 1.0  | ---  | ---             | --- |
| <b>Profile</b>                                     |                    |                | Riffle Length (ft)                                 |                    |                |     |     | ---                    | ---  | --- | ---    | ---             | --- | ---                      | ---  | --- | ---   | ---             | --- | ---    | ---  | ---    | 2.4                 | 6.6  | 5.8  | 18.2 | 3.2             | 44  |
| Riffle Slope (ft/ft)                               |                    |                |     |     | ---                    | ---  | --- | ---    | ---             | --- | ---                      | ---  | --- | ---   | ---             | --- | ---    | ---  | ---    | 0.3                 | 4.1  | 3.7  | 14.8 | 3.1             | 45  |
| Pool Length (ft)                                   |                    |                |     |     | ---                    | ---  | --- | ---    | ---             | --- | ---                      | ---  | --- | ---   | ---             | --- | ---    | ---  | ---    | 1.1                 | 5.1  | 5.0  | 13.7 | 2.4             | 50  |
| Pool Max depth (ft)                                |                    |                |     |     | ---                    | ---  |
| Pool Spacing (ft)                                  |                    |                |     |     | ---                    | ---  | --- | ---    | ---             | --- | ---                      | ---  | --- | ---   | ---             | --- | ---    | ---  | ---    | 3.1                 | 19.2 | 19.1 | 40.5 | 7.5             | 48  |
| <b>Pattern</b>                                     |                    |                | Channel Beltwidth (ft)                             |                    |                |     |     | ---                    | ---  | --- | ---    | ---             | --- | 18                       | ---  | --- | 35    | ---             | --- | 13     | ---  | 30     | ---                 | ---  | ---  | ---  | ---             | --- |
| Radius of Curvature (ft)                           |                    |                |     |     | ---                    | ---  | --- | ---    | ---             | --- | 7                        | ---  | --- | 19    | ---             | --- | 5      | ---  | 15     | ---                 | ---  | ---  | ---  | ---             | --- |
| Rc:Bankfull width (ft/ft)                          |                    |                |     |     | ---                    | ---  | --- | ---    | ---             | --- | 1.6                      | ---  | --- | 4.3   | ---             | --- | 1.1    | ---  | 3.3    | ---                 | ---  | ---  | ---  | ---             | --- |
| Meander Wavelength (ft)                            |                    |                |     |     | ---                    | ---  | --- | ---    | ---             | --- | 30                       | ---  | --- | 44    | ---             | --- | 20     | ---  | 37     | ---                 | ---  | ---  | ---  | ---             | --- |
| Meander Width Ratio                                |                    |                |     |     | ---                    | ---  | --- | ---    | ---             | --- | 4.1                      | ---  | --- | 8     | ---             | --- | 2.9    | ---  | 6.7    | ---                 | ---  | ---  | ---  | ---             | --- |
| <b>Transport parameters</b>                        |                    |                | Reach Shear Stress (competency) lb/ft <sup>2</sup> |                    |                | Max part size (mm) mobilized at bankfull           |                    |                | Stream Power (transport capacity) W/m <sup>2</sup> |                    |                | <b>Additional Reach Parameters</b>                 |                    |                | Rosgen Classification                              |                    |                |     |     |                        |      |     | G5     |                 |     |                          |      |     | E4    |                 |     |        |      | E4     |                     |      |      |      |                 | E4  |
| Bankfull Velocity (fps)                            |                    | ---            | --- | --- |                        |      |     | ---    |                 |     |                          |      |     | ---   |                 |     |        |      | ---    |                     |      |      |      |                 | --- |
| Bankfull Discharge (cfs)                           |                    | ---            | --- | --- |                        |      |     | ---    |                 |     |                          |      |     | ---   |                 |     |        |      | ---    |                     |      |      |      |                 | --- |
| Valley length (ft)                                 |                    |                |     |     |                        |      |     | 990    |                 |     |                          |      |     | 146   |                 |     |        |      | 450    |                     |      |      |      |                 | --- |
| Channel Thalweg length (ft)                        |                    |                |     |     |                        |      |     | 1051   |                 |     |                          |      |     | 185   |                 |     |        |      | 512    |                     |      |      |      |                 | 512 |
| Sinuosity (ft)                                     |                    |                |     |     |                        |      |     | 1.06   |                 |     |                          |      |     | 1.27  |                 |     |        |      | 1.14   |                     |      |      |      |                 | --- |
| Water Surface Slope (Channel) (ft/ft)              |                    |                |     |     |                        |      |     | ---    |                 |     |                          |      |     | ---   |                 |     |        |      | ---    |                     |      |      |      |                 | --- |
| Channel slope (ft/ft)                              |                    |                |     |     |                        |      |     | 0.0383 |                 |     |                          |      |     | 0.013 |                 |     |        |      | 0.0175 |                     |      |      |      |                 | --- |
| <sup>3</sup> Bankfull Floodplain Area (acres)      |                    |                |     |     |                        |      |     | ---    |                 |     |                          |      |     | ---   |                 |     |        |      | ---    |                     |      |      |      |                 | --- |
| <sup>4</sup> % of Reach with Eroding Banks         |                    |                |     |     |                        |      |     | ---    |                 |     |                          |      |     | ---   |                 |     |        |      | ---    |                     |      |      |      |                 | --- |
| Channel Stability or Habitat Metric                |                    |                |     |     |                        |      |     | ---    |                 |     |                          |      |     | ---   |                 |     |        |      | ---    |                     |      |      |      |                 | --- |
| Biological or Other                                |                    |                |     |     |                        |      |     | ---    |                 |     |                          |      |     | ---   |                 |     |        |      | ---    |                     |      |      |      |                 | --- |

Shaded cells indicate that these will typically not be filled in.

1 = The distributions for these parameters can include information from both the cross-section measurements and the longitudinal profile. 2 = For projects with a proximal USGS gauge in-line with the project reach (added bankfull verification - rare).

3. Utilizing XS measurement data produce an estimate of the bankfull floodplain area in acres, which should be the area from the top of bank to the toe of the terrace riser/slope.

4 = Proportion of reach exhibiting banks that are eroding based on the visual survey for comparison to monitoring data; 5. Of value/needed only if the n exceeds 3

**Appendix D. Table 11 - Monitoring Data - Dimensional Morphology Summary (Dimensional Parameters – Cross Sections)**

**Project Name/Number: Catbird #100022**

|   | Cross Section 1 (Pool)    |     |     |     |     |     |     | Cross Section 2 (Riffle) |     |     |     |     |     |     | Cross Section 3 (Riffle) |     |     |     |     |     |     | Cross Section 4 (Pool) |     |     |     |     |     |     | Cross Section 5 (Riffle)  |     |     |     |     |     |     |
|---|---------------------------|-----|-----|-----|-----|-----|-----|--------------------------|-----|-----|-----|-----|-----|-----|--------------------------|-----|-----|-----|-----|-----|-----|------------------------|-----|-----|-----|-----|-----|-----|---------------------------|-----|-----|-----|-----|-----|-----|
|   | Base                      | MY1 | MY2 | MY3 | MY5 | MY7 | MY+ | Base                     | MY1 | MY2 | MY3 | MY5 | MY7 | MY+ | Base                     | MY1 | MY2 | MY3 | MY5 | MY7 | MY+ | Base                   | MY1 | MY2 | MY3 | MY5 | MY7 | MY+ | Base                      | MY1 | MY2 | MY3 | MY5 | MY7 | MY+ |
| <b>Bankfull Elevation (ft) - Based on AB-XSA<sup>1</sup></b>  | 756.5                     |     |     |     |     |     |     | 756.6                    |     |     |     |     |     |     | 741.6                    |     |     |     |     |     |     | 741.0                  |     |     |     |     |     |     | 735.7                     |     |     |     |     |     |     |
| Bankfull Width (ft) <sup>1</sup>                              | -                         |     |     |     |     |     |     | 7.3                      |     |     |     |     |     |     | 5.1                      |     |     |     |     |     |     | -                      |     |     |     |     |     |     | 5.6                       |     |     |     |     |     |     |
| Floodprone Width (ft) <sup>1</sup>                            | -                         |     |     |     |     |     |     | >50                      |     |     |     |     |     |     | 50                       |     |     |     |     |     |     | -                      |     |     |     |     |     |     | 50                        |     |     |     |     |     |     |
| Bankfull Max Depth (ft) <sup>2</sup>                          | 1.6                       |     |     |     |     |     |     | 0.7                      |     |     |     |     |     |     | 1.3                      |     |     |     |     |     |     | 1.5                    |     |     |     |     |     |     | 0.9                       |     |     |     |     |     |     |
| Low Bank Elevation (ft)                                       | -                         |     |     |     |     |     |     | 756.6                    |     |     |     |     |     |     | 741.6                    |     |     |     |     |     |     | -                      |     |     |     |     |     |     | 735.7                     |     |     |     |     |     |     |
| Bankfull Cross Sectional Area (ft <sup>2</sup> ) <sup>2</sup> | 3.9                       |     |     |     |     |     |     | 1.9                      |     |     |     |     |     |     | 3.5                      |     |     |     |     |     |     | 4.6                    |     |     |     |     |     |     | 3.1                       |     |     |     |     |     |     |
| Bankfull Entrenchment Ratio <sup>1</sup>                      | -                         |     |     |     |     |     |     | >6.9                     |     |     |     |     |     |     | 9.9                      |     |     |     |     |     |     | -                      |     |     |     |     |     |     | 9.0                       |     |     |     |     |     |     |
| Bankfull Bank Height Ratio <sup>1</sup>                       | -                         |     |     |     |     |     |     | 1.0                      |     |     |     |     |     |     | 1.0                      |     |     |     |     |     |     | -                      |     |     |     |     |     |     | 1.0                       |     |     |     |     |     |     |
|   | Cross Section 6 (Pool)    |     |     |     |     |     |     | Cross Section 7 (Pool)   |     |     |     |     |     |     | Cross Section 8 (Riffle) |     |     |     |     |     |     | Cross Section 9 (Pool) |     |     |     |     |     |     | Cross Section 10 (Riffle) |     |     |     |     |     |     |
|   | Base                      | MY1 | MY2 | MY3 | MY5 | MY7 | MY+ | Base                     | MY1 | MY2 | MY3 | MY5 | MY7 | MY+ | Base                     | MY1 | MY2 | MY3 | MY5 | MY7 | MY+ | Base                   | MY1 | MY2 | MY3 | MY5 | MY7 | MY+ | Base                      | MY1 | MY2 | MY3 | MY5 | MY7 | MY+ |
| <b>Bankfull Elevation (ft) - Based on AB-XSA<sup>1</sup></b>  | 735.5                     |     |     |     |     |     |     | 774.5                    |     |     |     |     |     |     | 774.8                    |     |     |     |     |     |     | 763.4                  |     |     |     |     |     |     | 763.7                     |     |     |     |     |     |     |
| Bankfull Width (ft) <sup>1</sup>                              | -                         |     |     |     |     |     |     | -                        |     |     |     |     |     |     | 5.6                      |     |     |     |     |     |     | -                      |     |     |     |     |     |     | 4.2                       |     |     |     |     |     |     |
| Floodprone Width (ft) <sup>1</sup>                            | -                         |     |     |     |     |     |     | -                        |     |     |     |     |     |     | 50                       |     |     |     |     |     |     | -                      |     |     |     |     |     |     | 50                        |     |     |     |     |     |     |
| Bankfull Max Depth (ft) <sup>2</sup>                          | 1.7                       |     |     |     |     |     |     | 1.3                      |     |     |     |     |     |     | 0.8                      |     |     |     |     |     |     | 1.1                    |     |     |     |     |     |     | 0.8                       |     |     |     |     |     |     |
| Low Bank Elevation (ft)                                       | -                         |     |     |     |     |     |     | -                        |     |     |     |     |     |     | 774.8                    |     |     |     |     |     |     | -                      |     |     |     |     |     |     | 763.73                    |     |     |     |     |     |     |
| Bankfull Cross Sectional Area (ft <sup>2</sup> ) <sup>2</sup> | 5.1                       |     |     |     |     |     |     | 3.1                      |     |     |     |     |     |     | 2.6                      |     |     |     |     |     |     | 2.7                    |     |     |     |     |     |     | 2.2                       |     |     |     |     |     |     |
| Bankfull Entrenchment Ratio <sup>1</sup>                      | -                         |     |     |     |     |     |     | -                        |     |     |     |     |     |     | 8.8                      |     |     |     |     |     |     | -                      |     |     |     |     |     |     | 11.8                      |     |     |     |     |     |     |
| Bankfull Bank Height Ratio <sup>1</sup>                       | -                         |     |     |     |     |     |     | -                        |     |     |     |     |     |     | 1.0                      |     |     |     |     |     |     | -                      |     |     |     |     |     |     | 1.0                       |     |     |     |     |     |     |
|   | Cross Section 11 (Riffle) |     |     |     |     |     |     | Cross Section 12 (Pool)  |     |     |   | Base                      | MY1 | MY2 | MY3 | MY5 | MY7 | MY+ | Base                     | MY1 | MY2 | MY3 | MY5 | MY7 | MY+ |                          |     | <b>Bankfull Elevation (ft) - Based on AB-XSA<sup>1</sup></b>  | 737.5                     |     |     |     |     |     |     | 737.3                    |     |     | Bankfull Width (ft) <sup>1</sup>                              | 5.7                       |     |     |     |     |     |     | -                        |     |     | Floodprone Width (ft) <sup>1</sup>                            | >50                       |     |     |     |     |     |     | -                        |     |     | Bankfull Max Depth (ft) <sup>2</sup>                          | 0.8                       |     |     |     |     |     |     | 1.2                      |     |     | Low Bank Elevation (ft)                                       | 737.51                    |     |     |     |     |     |     | -                        |     |     | Bankfull Cross Sectional Area (ft <sup>2</sup> ) <sup>2</sup> | 2.9                       |     |     |     |     |     |     | 3.1                      |     |     | Bankfull Entrenchment Ratio <sup>1</sup>                      | >8.7                      |     |     |     |     |     |     | -                        |     |     | Bankfull Bank Height Ratio <sup>1</sup>                       | 1.0                       |     |     |     |     |     |     | -                        |     |     
1 - Uses the as-built cross sectional area as the basis for adjusting each subsequent years bankfull elevation

2 - Uses the current years low top of bank as the basis for adjusting each subsequent years bankfull elevation






Upstream



Downstream

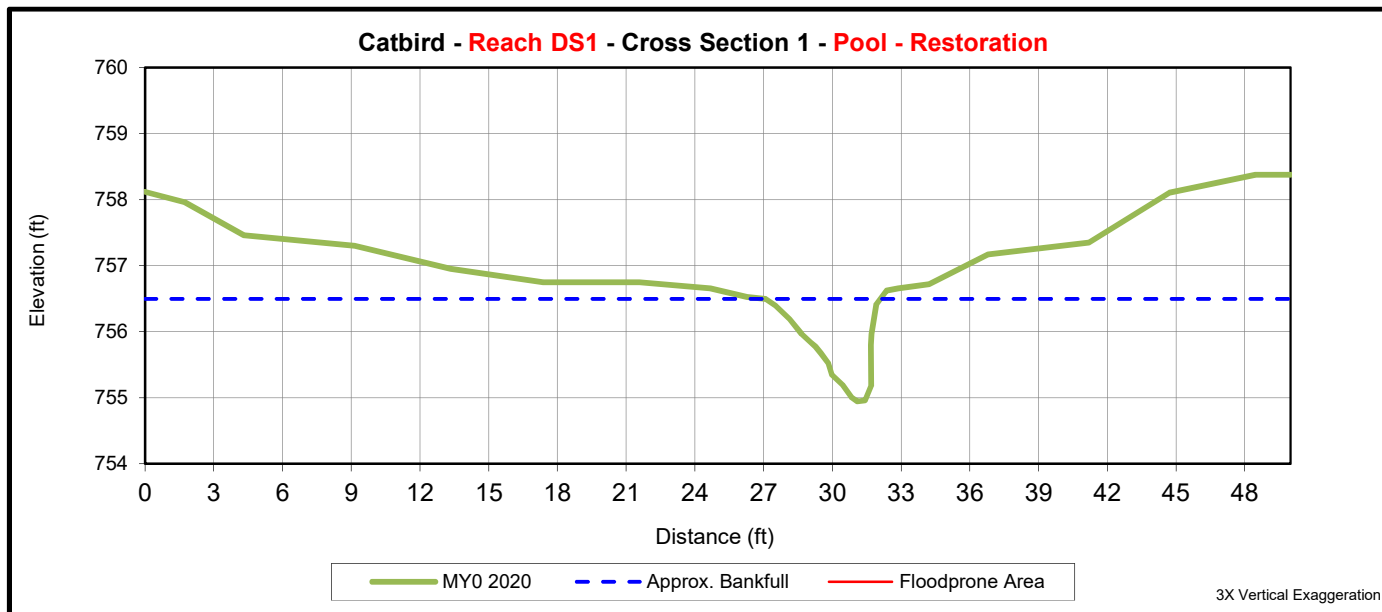

|   | <b>Cross Section 1 (Pool)</b> |     |     |     |     |     |     |
|---|-------------------------------|-----|-----|-----|-----|-----|-----|
|   | MY0                           | MY1 | MY2 | MY3 | MY5 | MY7 | MY+ |
| <b>Bankfull Elevation (ft) - Based on AB-XSA<sup>1</sup></b>  | 756.50                        |     |     |     |     |     |     |
| Bankfull Width (ft) <sup>1</sup>                              | -                             |     |     |     |     |     |     |
| Floodprone Width (ft) <sup>1</sup>                            | -                             |     |     |     |     |     |     |
| Bankfull Max Depth (ft) <sup>2</sup>                          | 1.6                           |     |     |     |     |     |     |
| Low Bank Elevation (ft)                                       | -                             |     |     |     |     |     |     |
| Bankfull Cross Sectional Area (ft <sup>2</sup> ) <sup>2</sup> | 3.9                           |     |     |     |     |     |     |
| Bankfull Entrenchment Ratio <sup>1</sup>                      | -                             |     |     |     |     |     |     |
| Bankfull Bank Height Ratio <sup>1</sup>                       | -                             |     |     |     |     |     |     |

1 - Uses the as-built cross sectional area as the basis for adjusting each subsequent years bankfull elevation


2 - Uses the current years low top of bank as the basis for adjusting each subsequent years bankfull elevation



Upstream



Downstream

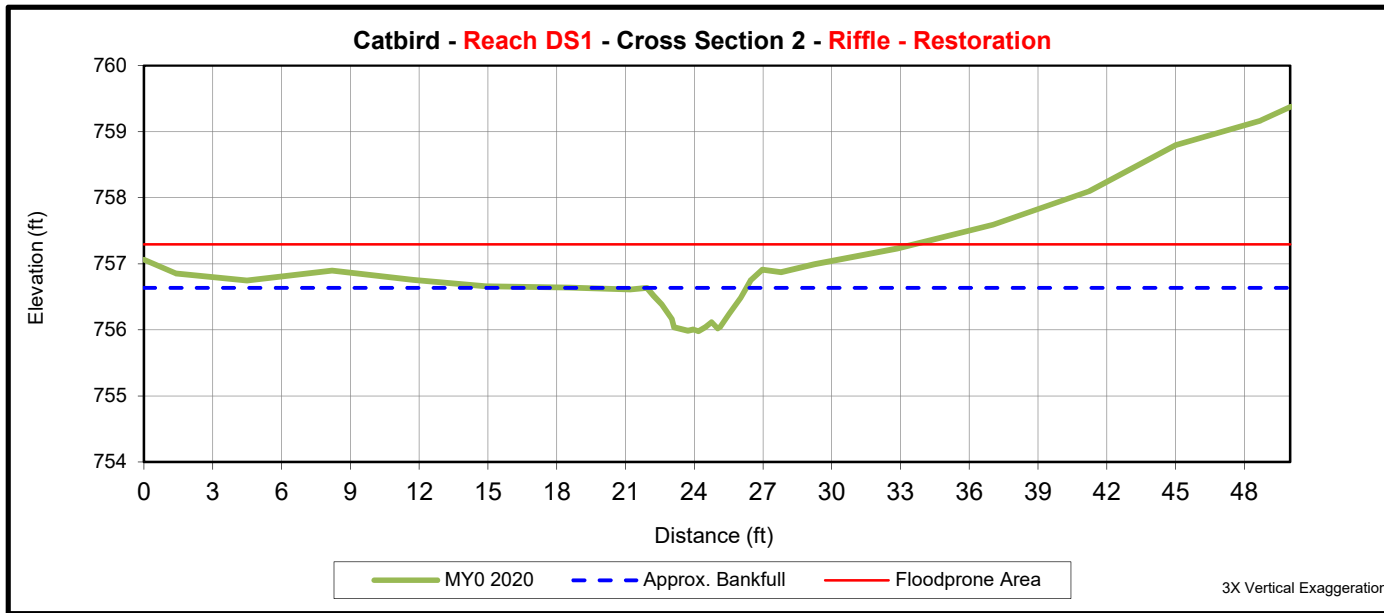

|   | Cross Section 2 (Rifle) |     |     |     |     |     |     |
|---|-------------------------|-----|-----|-----|-----|-----|-----|
|   | MY0                     | MY1 | MY2 | MY3 | MY5 | MY7 | MY+ |
| <b>Bankfull Elevation (ft) - Based on AB-XSA<sup>1</sup></b>  | 756.64                  |     |     |     |     |     |     |
| Bankfull Width (ft) <sup>1</sup>                              | 7.3                     |     |     |     |     |     |     |
| Floodprone Width (ft) <sup>1</sup>                            | >50                     |     |     |     |     |     |     |
| Bankfull Max Depth (ft) <sup>2</sup>                          | 0.7                     |     |     |     |     |     |     |
| Low Bank Elevation (ft)                                       | 756.64                  |     |     |     |     |     |     |
| Bankfull Cross Sectional Area (ft <sup>2</sup> ) <sup>2</sup> | 1.9                     |     |     |     |     |     |     |
| Bankfull Entrenchment Ratio <sup>1</sup>                      | >6.9                    |     |     |     |     |     |     |
| Bankfull Bank Height Ratio <sup>1</sup>                       | 1.0                     |     |     |     |     |     |     |

1 - Uses the as-built cross sectional area as the basis for adjusting each subsequent years bankfull elevation


2 - Uses the current years low top of bank as the basis for adjusting each subsequent years bankfull elevation



Upstream



Downstream

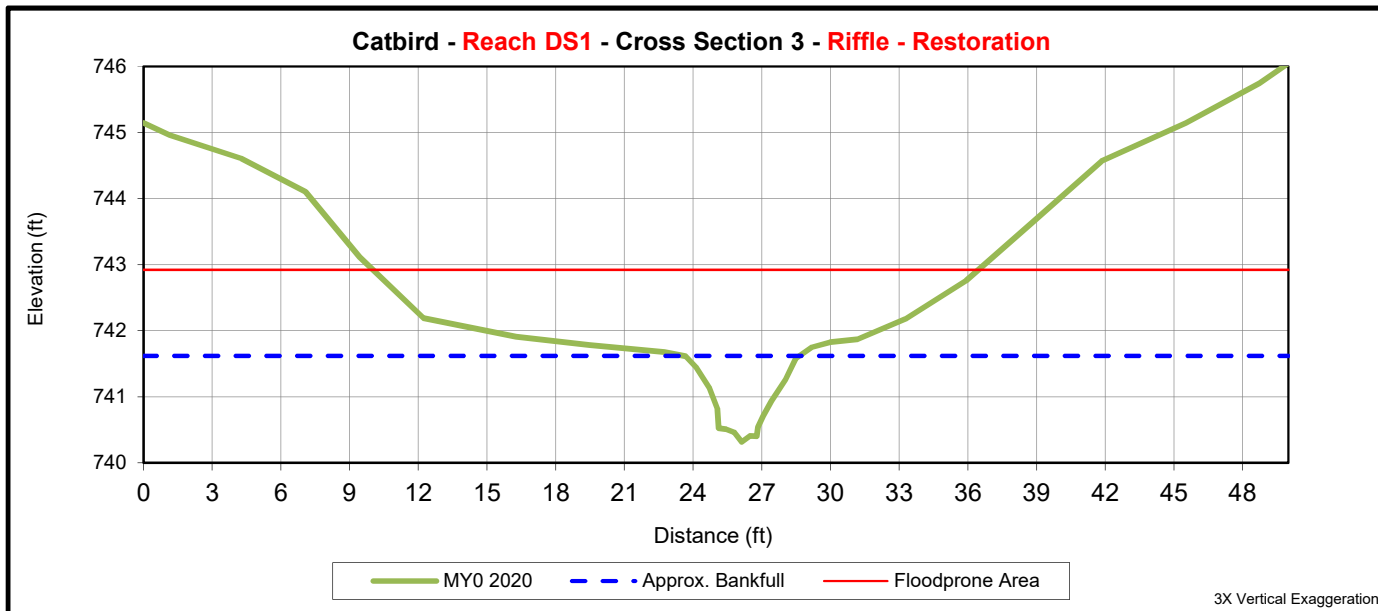

|   | <b>Cross Section 3 (Riffle)</b> |     |     |     |     |     |     |
|---|---------------------------------|-----|-----|-----|-----|-----|-----|
|   | MY0                             | MY1 | MY2 | MY3 | MY5 | MY7 | MY+ |
| <b>Bankfull Elevation (ft) - Based on AB-XSA<sup>1</sup></b>  | 741.62                          |     |     |     |     |     |     |
| Bankfull Width (ft) <sup>1</sup>                              | 5.1                             |     |     |     |     |     |     |
| Floodprone Width (ft) <sup>1</sup>                            | 50                              |     |     |     |     |     |     |
| Bankfull Max Depth (ft) <sup>2</sup>                          | 1.3                             |     |     |     |     |     |     |
| Low Bank Elevation (ft)                                       | 741.62                          |     |     |     |     |     |     |
| Bankfull Cross Sectional Area (ft <sup>2</sup> ) <sup>2</sup> | 3.5                             |     |     |     |     |     |     |
| Bankfull Entrenchment Ratio <sup>1</sup>                      | 9.9                             |     |     |     |     |     |     |
| Bankfull Bank Height Ratio <sup>1</sup>                       | 1.0                             |     |     |     |     |     |     |

1 - Uses the as-built cross sectional area as the basis for adjusting each subsequent years bankfull elevation


2 - Uses the current years low top of bank as the basis for adjusting each subsequent years bankfull elevation



Upstream



Downstream

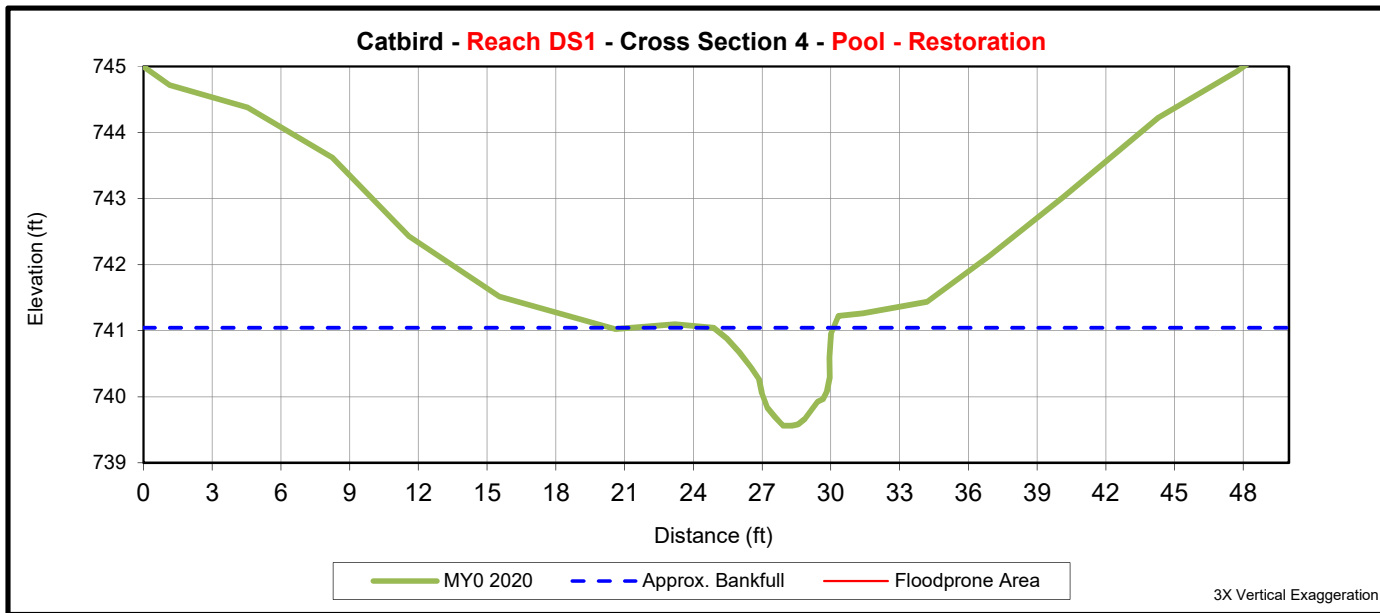

|   | <b>Cross Section 4 (Pool)</b> |     |     |     |     |     |     |
|---|-------------------------------|-----|-----|-----|-----|-----|-----|
|   | MY0                           | MY1 | MY2 | MY3 | MY5 | MY7 | MY+ |
| <b>Bankfull Elevation (ft) - Based on AB-XSA<sup>1</sup></b>  | 741.04                        |     |     |     |     |     |     |
| Bankfull Width (ft) <sup>1</sup>                              | -                             |     |     |     |     |     |     |
| Floodprone Width (ft) <sup>1</sup>                            | -                             |     |     |     |     |     |     |
| Bankfull Max Depth (ft) <sup>2</sup>                          | 1.5                           |     |     |     |     |     |     |
| Low Bank Elevation (ft)                                       | -                             |     |     |     |     |     |     |
| Bankfull Cross Sectional Area (ft <sup>2</sup> ) <sup>2</sup> | 4.6                           |     |     |     |     |     |     |
| Bankfull Entrenchment Ratio <sup>1</sup>                      | -                             |     |     |     |     |     |     |
| Bankfull Bank Height Ratio <sup>1</sup>                       | -                             |     |     |     |     |     |     |

1 - Uses the as-built cross sectional area as the basis for adjusting each subsequent years bankfull elevation


2 - Uses the current years low top of bank as the basis for adjusting each subsequent years bankfull elevation



Upstream



Downstream

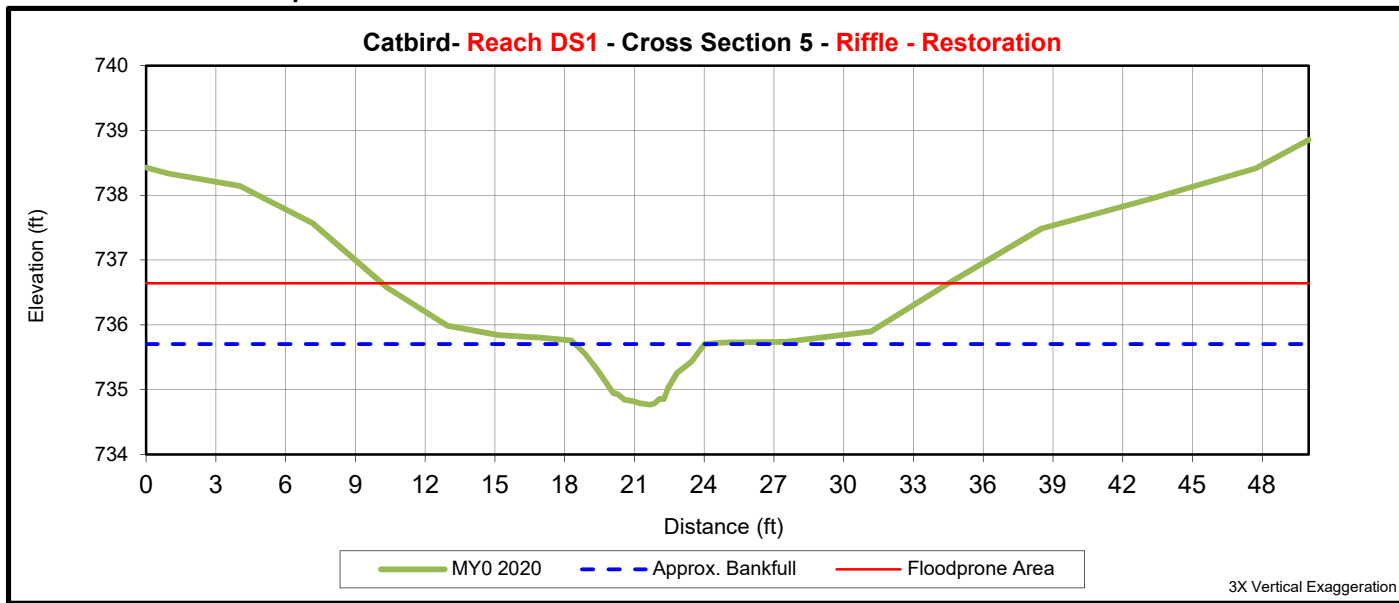

|   | <b>Cross Section 5 (Riffle)</b> |     |     |     |     |     |     |
|---|---------------------------------|-----|-----|-----|-----|-----|-----|
|   | MY0                             | MY1 | MY2 | MY3 | MY5 | MY7 | MY+ |
| <b>Bankfull Elevation (ft) - Based on AB-XSA<sup>1</sup></b>  | 735.70                          |     |     |     |     |     |     |
| Bankfull Width (ft) <sup>1</sup>                              | 5.6                             |     |     |     |     |     |     |
| Floodprone Width (ft) <sup>1</sup>                            | 50                              |     |     |     |     |     |     |
| Bankfull Max Depth (ft) <sup>2</sup>                          | 0.9                             |     |     |     |     |     |     |
| Low Bank Elevation (ft)                                       | 735.70                          |     |     |     |     |     |     |
| Bankfull Cross Sectional Area (ft <sup>2</sup> ) <sup>2</sup> | 3.1                             |     |     |     |     |     |     |
| Bankfull Entrenchment Ratio <sup>1</sup>                      | 9.0                             |     |     |     |     |     |     |
| Bankfull Bank Height Ratio <sup>1</sup>                       | 1.0                             |     |     |     |     |     |     |

1 - Uses the as-built cross sectional area as the basis for adjusting each subsequent years bankfull elevation


2 - Uses the current years low top of bank as the basis for adjusting each subsequent years bankfull elevation



Upstream



Downstream

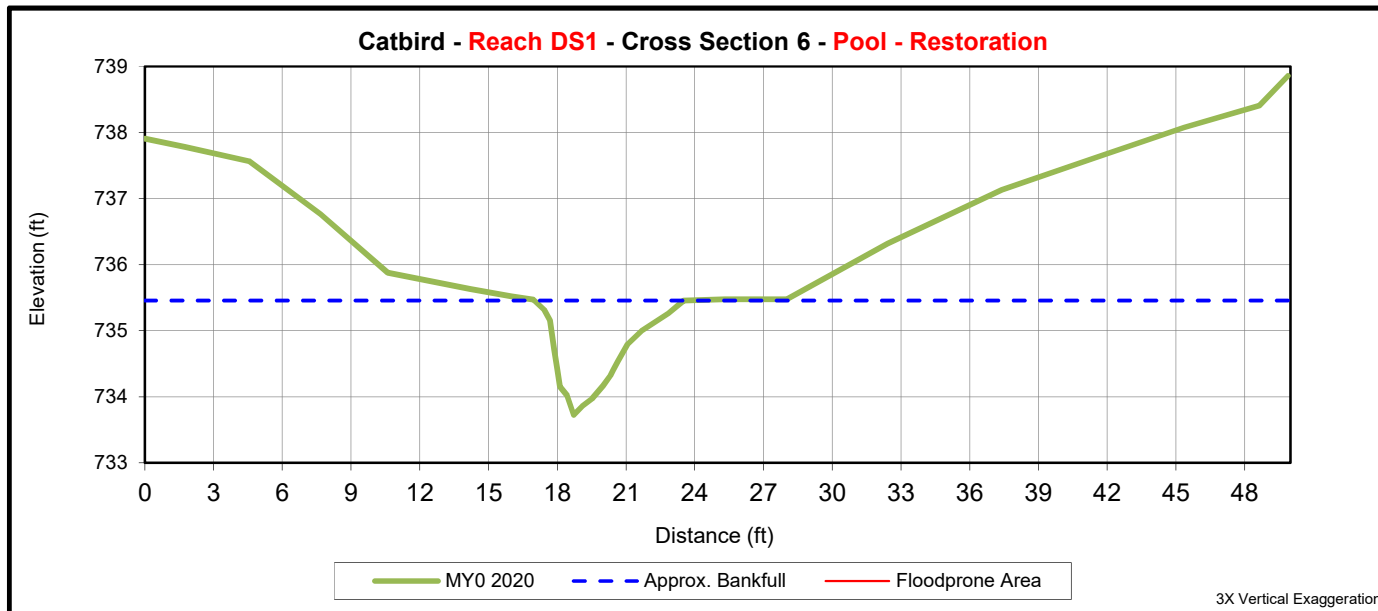

|   | <b>Cross Section 6 (Pool)</b> |     |     |     |     |     |     |
|---|-------------------------------|-----|-----|-----|-----|-----|-----|
|   | MY0                           | MY1 | MY2 | MY3 | MY5 | MY7 | MY+ |
| <b>Bankfull Elevation (ft) - Based on AB-XSA<sup>1</sup></b>  | 735.46                        |     |     |     |     |     |     |
| Bankfull Width (ft) <sup>1</sup>                              | -                             |     |     |     |     |     |     |
| Floodprone Width (ft) <sup>1</sup>                            | -                             |     |     |     |     |     |     |
| Bankfull Max Depth (ft) <sup>2</sup>                          | 1.7                           |     |     |     |     |     |     |
| Low Bank Elevation (ft)                                       | -                             |     |     |     |     |     |     |
| Bankfull Cross Sectional Area (ft <sup>2</sup> ) <sup>2</sup> | 5.1                           |     |     |     |     |     |     |
| Bankfull Entrenchment Ratio <sup>1</sup>                      | -                             |     |     |     |     |     |     |
| Bankfull Bank Height Ratio <sup>1</sup>                       | -                             |     |     |     |     |     |     |

1 - Uses the as-built cross sectional area as the basis for adjusting each subsequent years bankfull elevation


2 - Uses the current years low top of bank as the basis for adjusting each subsequent years bankfull elevation



Upstream



Downstream

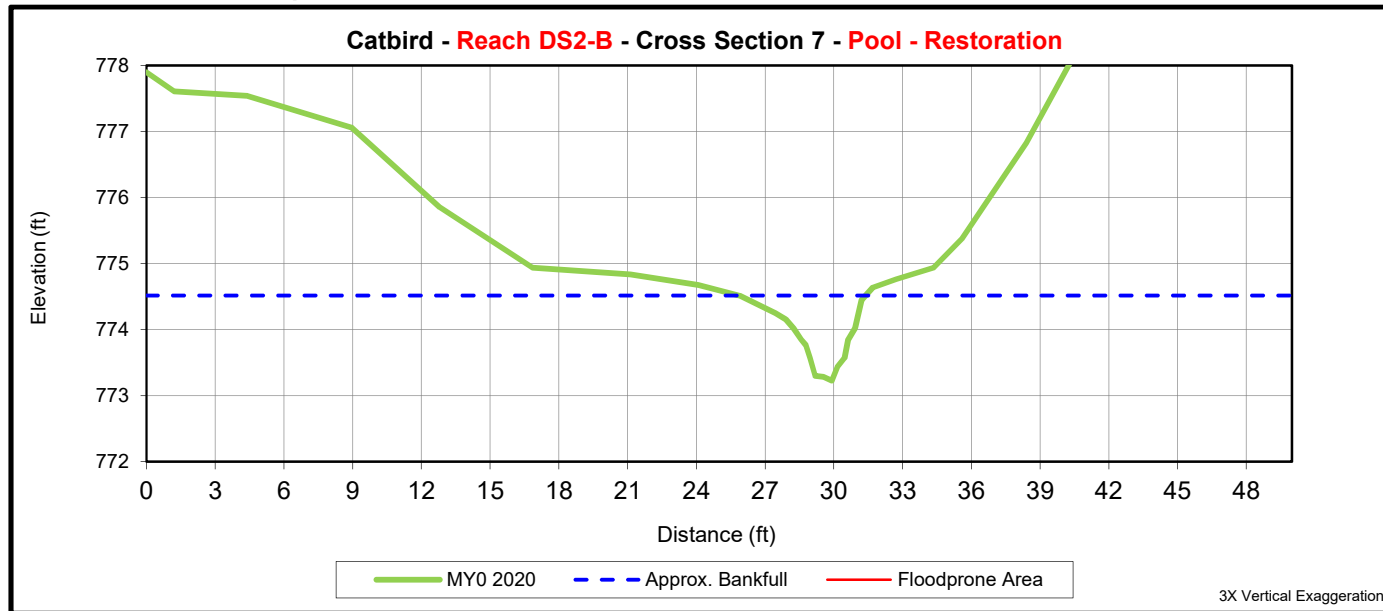

|   | <b>Cross Section 7 (Pool)</b> |     |     |     |     |     |     |
|---|-------------------------------|-----|-----|-----|-----|-----|-----|
|   | MY0                           | MY1 | MY2 | MY3 | MY5 | MY7 | MY+ |
| <b>Bank full Elevation (ft) - Based on AB-XSA<sup>1</sup></b> | 774.52                        |     |     |     |     |     |     |
| Bankfull Width (ft) <sup>1</sup>                              | -                             |     |     |     |     |     |     |
| Floodprone Width (ft) <sup>1</sup>                            | -                             |     |     |     |     |     |     |
| Bankfull Max Depth (ft) <sup>2</sup>                          | 1.3                           |     |     |     |     |     |     |
| Low Bank Elevation (ft)                                       | -                             |     |     |     |     |     |     |
| Bankfull Cross Sectional Area (ft <sup>2</sup> ) <sup>2</sup> | 3.1                           |     |     |     |     |     |     |
| Bankfull Entrenchment Ratio <sup>1</sup>                      | -                             |     |     |     |     |     |     |
| Bankfull Bank Height Ratio <sup>1</sup>                       | -                             |     |     |     |     |     |     |

1 - Uses the as-built cross sectional area as the basis for adjusting each subsequent years bankfull elevation


2 - Uses the current years low top of bank as the basis for adjusting each subsequent years bankfull elevation



Upstream



Downstream

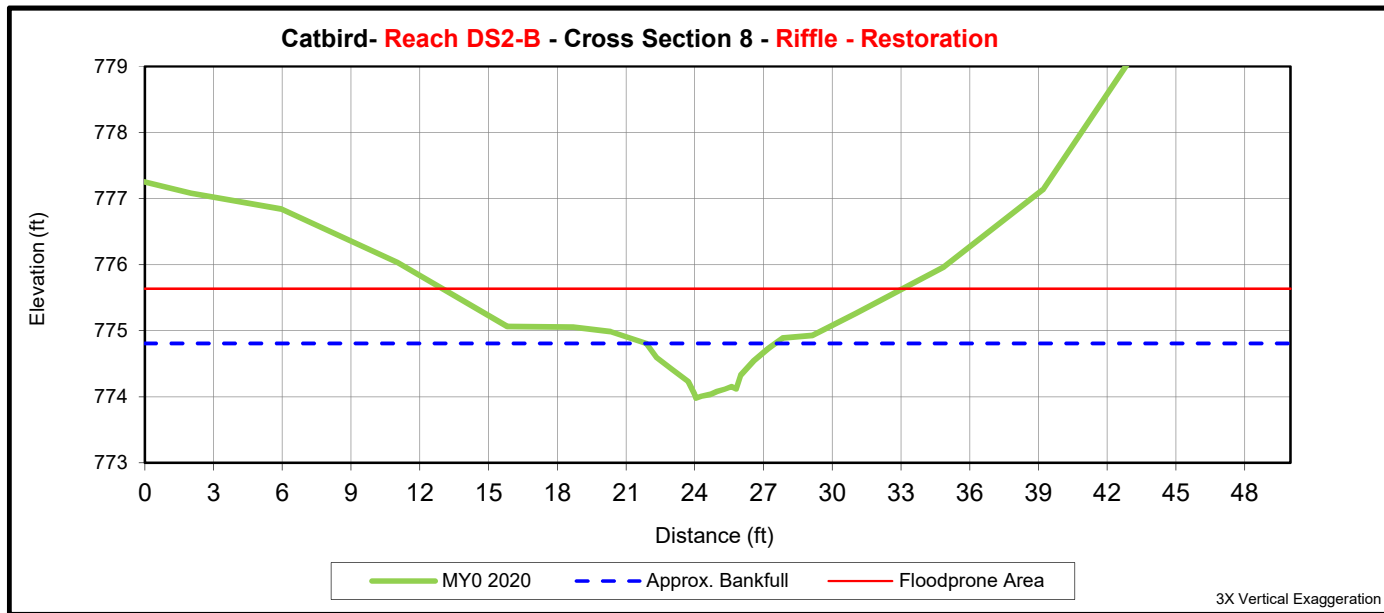

|   | <b>Cross Section 8 (Riffle)</b> |     |     |     |     |     |     |
|---|---------------------------------|-----|-----|-----|-----|-----|-----|
|   | MY0                             | MY1 | MY2 | MY3 | MY5 | MY7 | MY+ |
| <b>Bankfull Elevation (ft) - Based on AB-XSA<sup>1</sup></b>  | 774.81                          |     |     |     |     |     |     |
| Bankfull Width (ft) <sup>1</sup>                              | 5.6                             |     |     |     |     |     |     |
| Floodprone Width (ft) <sup>1</sup>                            | 50                              |     |     |     |     |     |     |
| Bankfull Max Depth (ft) <sup>2</sup>                          | 0.8                             |     |     |     |     |     |     |
| Low Bank Elevation (ft)                                       | 774.81                          |     |     |     |     |     |     |
| Bankfull Cross Sectional Area (ft <sup>2</sup> ) <sup>2</sup> | 2.6                             |     |     |     |     |     |     |
| Bankfull Entrenchment Ratio <sup>1</sup>                      | 8.8                             |     |     |     |     |     |     |
| Bankfull Bank Height Ratio <sup>1</sup>                       | 1.0                             |     |     |     |     |     |     |

1 - Uses the as-built cross sectional area as the basis for adjusting each subsequent years bankfull elevation

2 - Uses the current years low top of bank as the basis for adjusting each subsequent years bankfull elevation






Upstream



Downstream

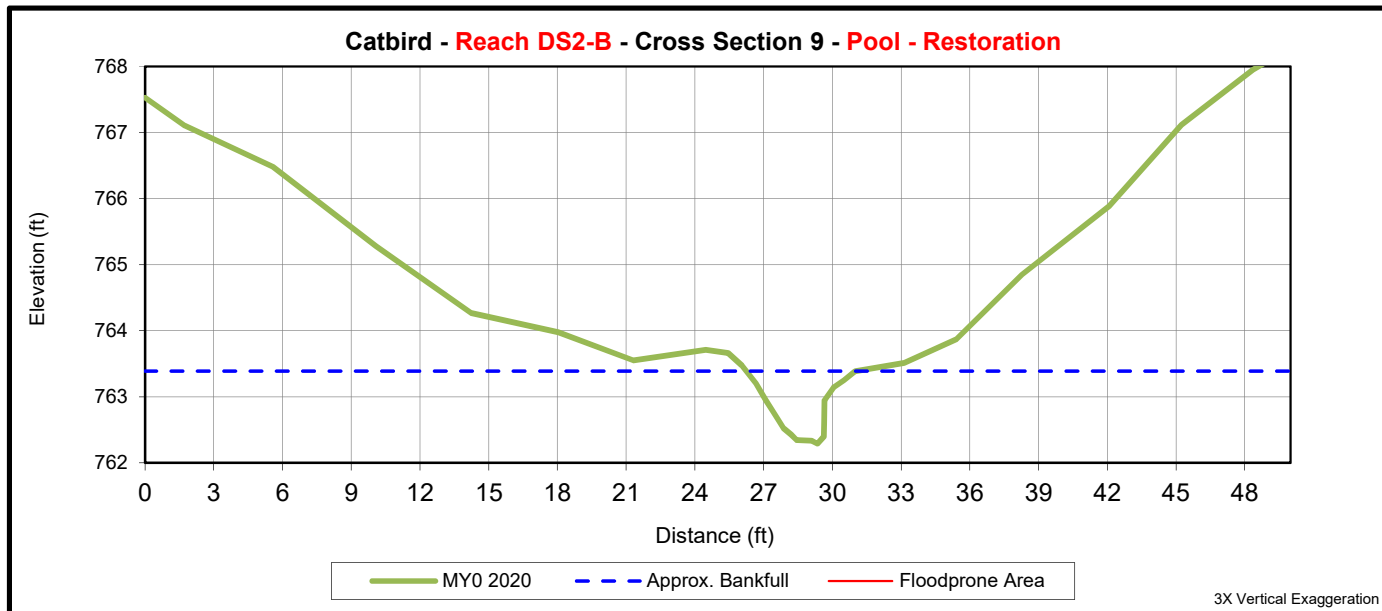

|   | <b>Cross Section 9 (Pool)</b> |     |     |     |     |     |     |
|---|-------------------------------|-----|-----|-----|-----|-----|-----|
|   | MY0                           | MY1 | MY2 | MY3 | MY5 | MY7 | MY+ |
| <b>Bankfull Elevation (ft) - Based on AB-XSA<sup>1</sup></b>  | 763.39                        |     |     |     |     |     |     |
| Bankfull Width (ft) <sup>1</sup>                              | -                             |     |     |     |     |     |     |
| Floodprone Width (ft) <sup>1</sup>                            | -                             |     |     |     |     |     |     |
| Bankfull Max Depth (ft) <sup>2</sup>                          | 1.1                           |     |     |     |     |     |     |
| Low Bank Elevation (ft)                                       | -                             |     |     |     |     |     |     |
| Bankfull Cross Sectional Area (ft <sup>2</sup> ) <sup>2</sup> | 2.7                           |     |     |     |     |     |     |
| Bankfull Entrenchment Ratio <sup>1</sup>                      | -                             |     |     |     |     |     |     |
| Bankfull Bank Height Ratio <sup>1</sup>                       | -                             |     |     |     |     |     |     |

1 - Uses the as-built cross sectional area as the basis for adjusting each subsequent years bankfull elevation


2 - Uses the current years low top of bank as the basis for adjusting each subsequent years bankfull elevation



Upstream



Downstream

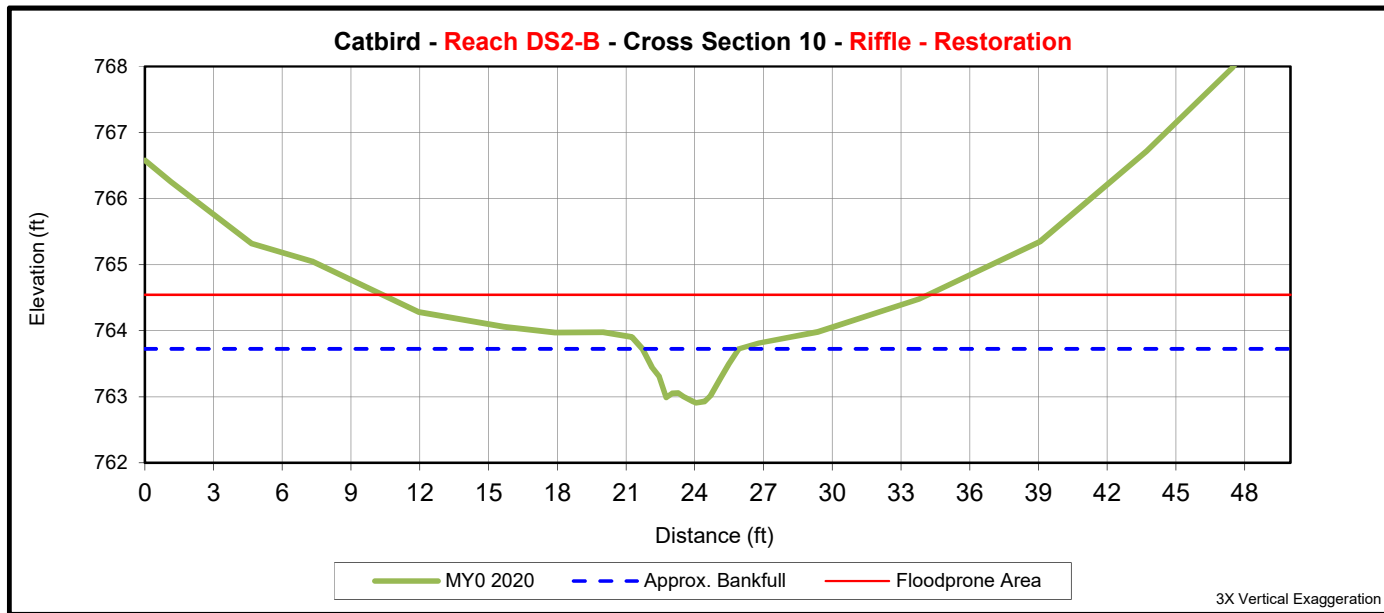

|   | <b>Cross Section 10 (Riffle)</b> |     |     |     |     |     |     |
|---|----------------------------------|-----|-----|-----|-----|-----|-----|
|   | MY0                              | MY1 | MY2 | MY3 | MY5 | MY7 | MY+ |
| <b>Bankfull Elevation (ft) - Based on AB-XSA<sup>1</sup></b>  | 763.73                           |     |     |     |     |     |     |
| Bankfull Width (ft) <sup>1</sup>                              | 4.2                              |     |     |     |     |     |     |
| Floodprone Width (ft) <sup>1</sup>                            | 50                               |     |     |     |     |     |     |
| Bankfull Max Depth (ft) <sup>2</sup>                          | 0.8                              |     |     |     |     |     |     |
| Low Bank Elevation (ft)                                       | 763.73                           |     |     |     |     |     |     |
| Bankfull Cross Sectional Area (ft <sup>2</sup> ) <sup>2</sup> | 2.2                              |     |     |     |     |     |     |
| Bankfull Entrenchment Ratio <sup>1</sup>                      | 11.8                             |     |     |     |     |     |     |
| Bankfull Bank Height Ratio <sup>1</sup>                       | 1.0                              |     |     |     |     |     |     |

1 - Uses the as-built cross sectional area as the basis for adjusting each subsequent years bankfull elevation


2 - Uses the current years low top of bank as the basis for adjusting each subsequent years bankfull elevation



Upstream



Downstream

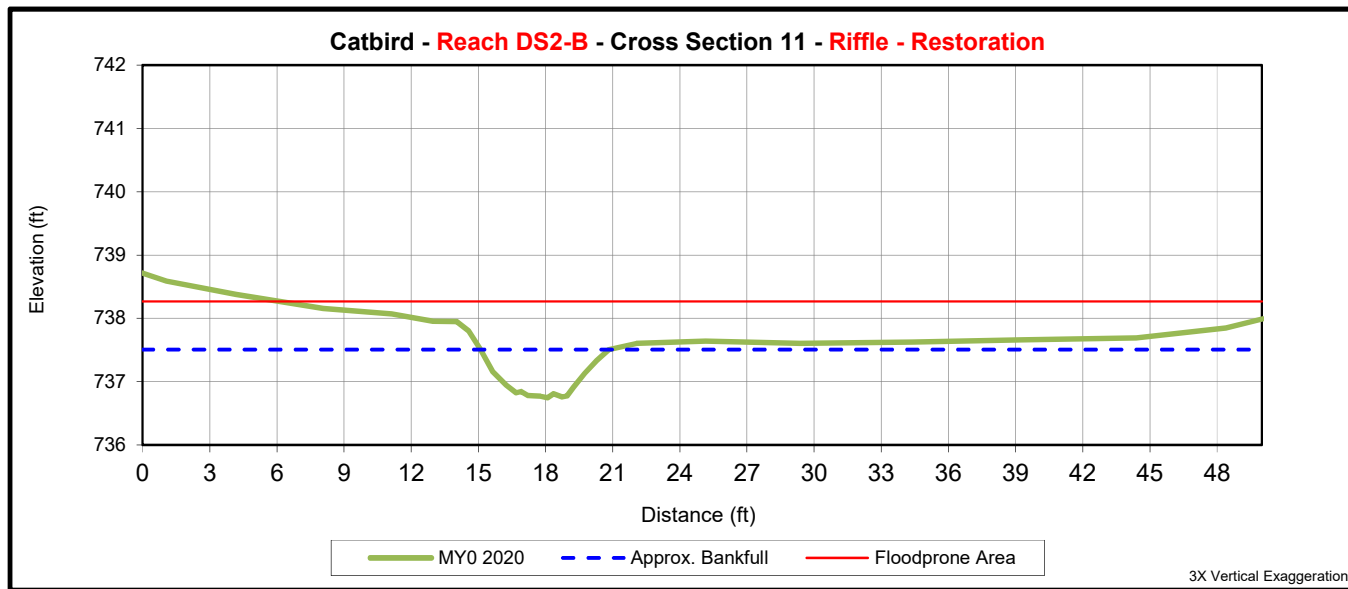

|   | <b>Cross Section 11 (Riffle)</b> |     |     |     |     |     |     |
|---|----------------------------------|-----|-----|-----|-----|-----|-----|
|   | MY0                              | MY1 | MY2 | MY3 | MY5 | MY7 | MY+ |
| <b>Bankfull Elevation (ft) - Based on AB-XSA<sup>1</sup></b>  | 737.51                           |     |     |     |     |     |     |
| Bankfull Width (ft) <sup>1</sup>                              | 5.7                              |     |     |     |     |     |     |
| Floodprone Width (ft) <sup>1</sup>                            | >50                              |     |     |     |     |     |     |
| Bankfull Max Depth (ft) <sup>2</sup>                          | 0.8                              |     |     |     |     |     |     |
| Low Bank Elevation (ft)                                       | 737.51                           |     |     |     |     |     |     |
| Bankfull Cross Sectional Area (ft <sup>2</sup> ) <sup>2</sup> | 2.9                              |     |     |     |     |     |     |
| Bankfull Entrenchment Ratio <sup>1</sup>                      | >8.7                             |     |     |     |     |     |     |
| Bankfull Bank Height Ratio <sup>1</sup>                       | 1.0                              |     |     |     |     |     |     |


1 - Uses the as-built cross sectional area as the basis for adjusting each subsequent years bankfull elevation  
 2 - Uses the current years low top of bank as the basis for adjusting each subsequent years bankfull elevation



Upstream



Downstream

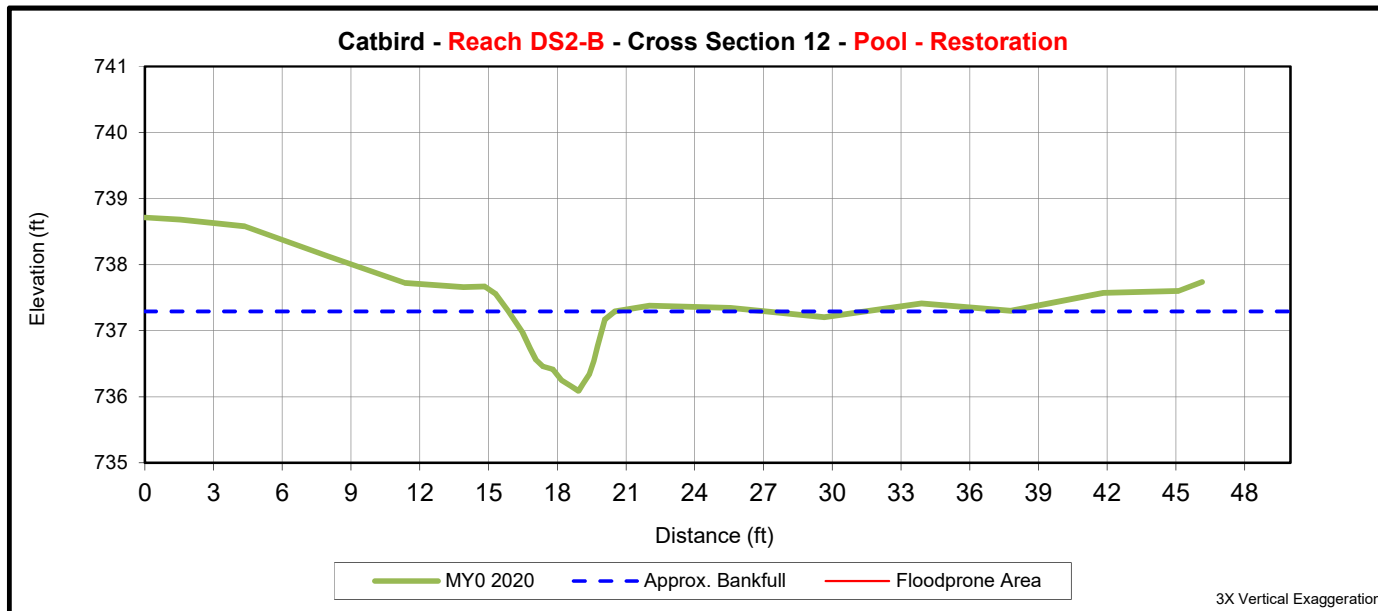


|   | <b>Cross Section 12 (Pool)</b> |     |     |     |     |     |     |
|---|--------------------------------|-----|-----|-----|-----|-----|-----|
|   | MY0                            | MY1 | MY2 | MY3 | MY5 | MY7 | MY+ |
| <b>Bankfull Elevation (ft) - Based on AB-XSA<sup>1</sup></b>  | 737.29                         |     |     |     |     |     |     |
| Bankfull Width (ft) <sup>1</sup>                              | -                              |     |     |     |     |     |     |
| Floodprone Width (ft) <sup>1</sup>                            | -                              |     |     |     |     |     |     |
| Bankfull Max Depth (ft) <sup>2</sup>                          | 1.2                            |     |     |     |     |     |     |
| Low Bank Elevation (ft)                                       | -                              |     |     |     |     |     |     |
| Bankfull Cross Sectional Area (ft <sup>2</sup> ) <sup>2</sup> | 3.1                            |     |     |     |     |     |     |
| Bankfull Entrenchment Ratio <sup>1</sup>                      | -                              |     |     |     |     |     |     |
| Bankfull Bank Height Ratio <sup>1</sup>                       | -                              |     |     |     |     |     |     |

1 - Uses the as-built cross sectional area as the basis for adjusting each subsequent years bankfull elevation

2 - Uses the current years low top of bank as the basis for adjusting each subsequent years bankfull elevation

# **Appendix E**

## Record Drawings

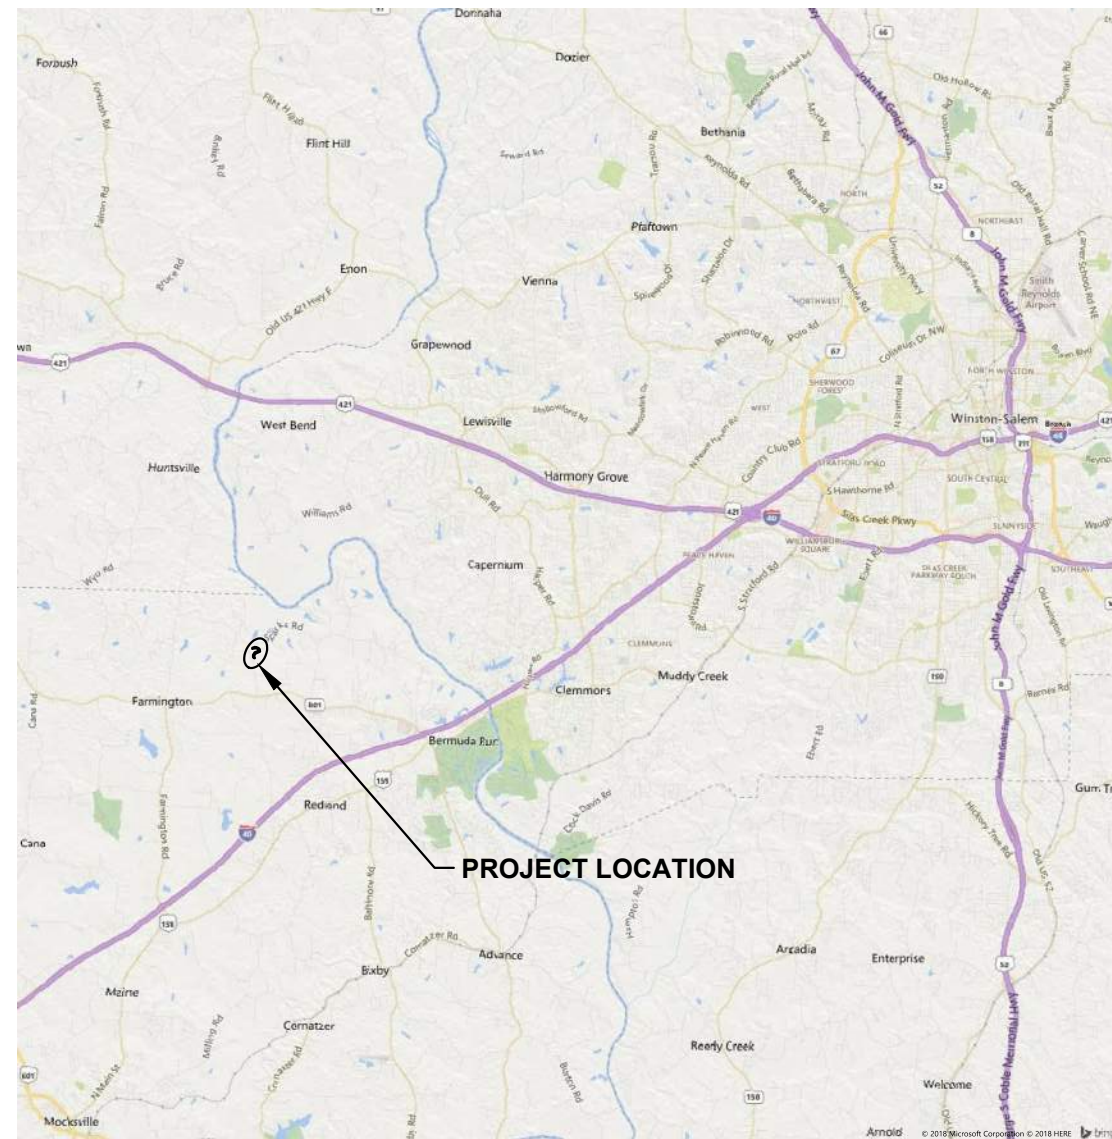

VICINITY MAP  
NTS

# CATBIRD RECORD DRAWINGS

DAVIE COUNTY, NORTH CAROLINA


YADKIN 01 RIVER BASIN: HUC 03040101

JULY 2020

RESOURCE ENVIRONMENTAL SOLUTIONS, LLC

3600 GLENWOOD AVE, SUITE 100

RALEIGH, NC 27612

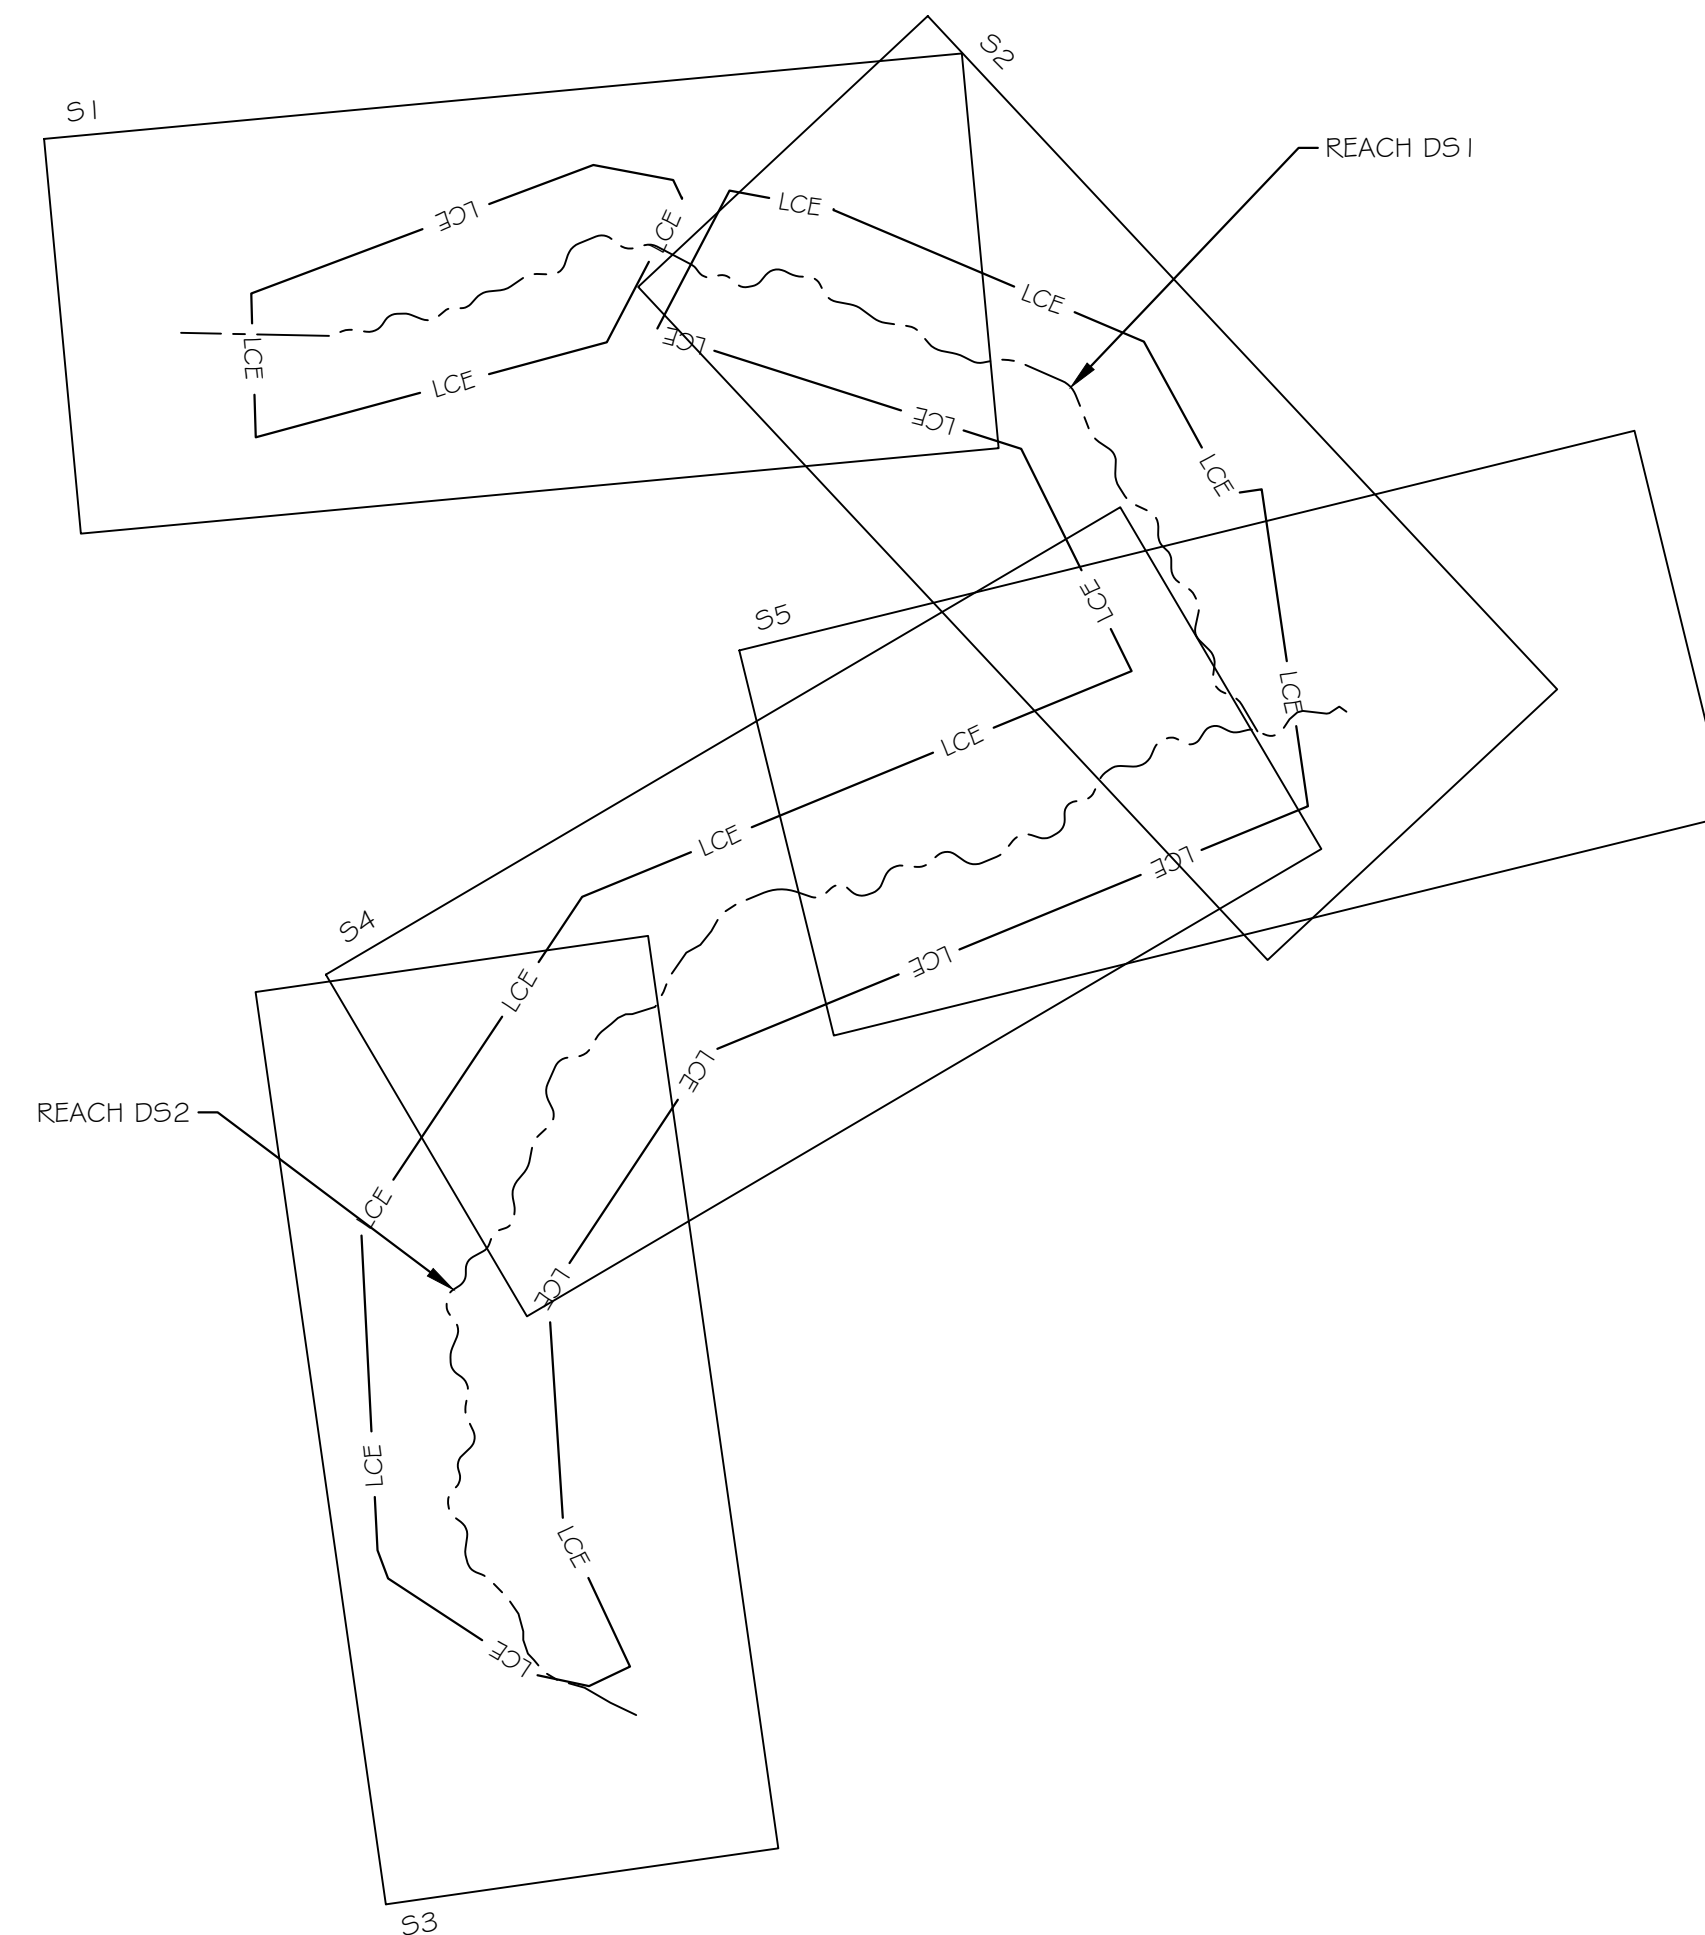

SITE MAP  
NTS

## PROJECT DIRECTORY

DESIGNED BY:  
RESOURCE ENVIRONMENTAL SOLUTIONS, LLC  
3600 GLENWOOD AVE, SUITE 100  
RALEIGH, NC 27612

DESIGNED FOR:  
HARRY TSOMIDES  
NC DEPARTMENT OF ENVIRONMENTAL QUALITY  
DIVISION OF MITIGATION SERVICES  
217 W. JONES ST. #3000A  
RALEIGH, NC 27603

SURVEYED BY:  
MATRIX EAST, PLLC.  
906 N. QUEEN ST., SUITE A  
KINSTON, NC 28501

DMS PROJECT #: 100022  
CONTRACT #: 7186  
USACE ACTION ID #: SAW-2017-01506  
RFP #: 16-006993

PROJECT TOPOGRAPHY AND AS-BUILT PLANIMETRICS SURVEY WAS PROVIDED BY MATRIX EAST, PLLC. (NC FIRM LICENSE NUMBER P-0221, JAMES R. WATSON, NC PLS L-4712), DATED APRIL 29, 2020



| Sheet List Table |               |
|------------------|---------------|
| Sheet Number     | Sheet Title   |
| -                | COVER         |
| S1               | REACH DS1     |
| S2               | REACH DS1     |
| S3               | REACH DS2     |
| S4               | REACH DS2     |
| S5               | REACH DS2     |
| P1               | PLANTING PLAN |



3600 Glenwood Ave, Suite 100  
Raleigh, NC 27612  
Main: 919.829.9909  
www.res.us

Engineering Services Provided By:  
Angler Environmental LLC  
License: F-1428

SEAL

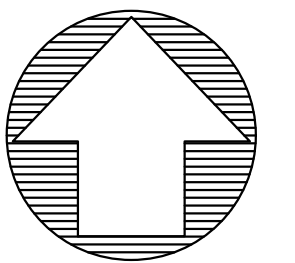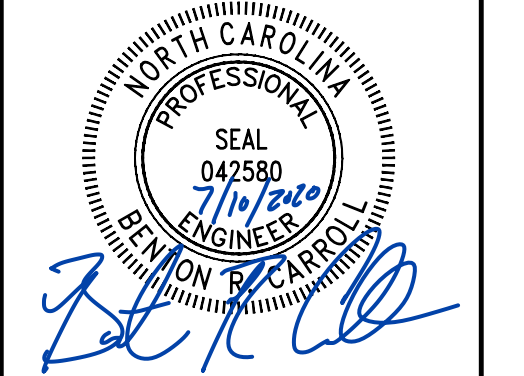

PLOT DATE:  
4/30/2020

REVISIONS:


RELEASED FOR:  
RECORD DRAWINGS

PROJECT NUMBER: 0386  
PROJECT MANAGER: BPB  
DESIGNED: BRC  
DRAWN: TRS  
CHECKED: AFM

SHEET NUMBER:

-

FILE NAME: F:\resgis\dropbox\projects\NC\Catbird\CAD\ABRL\0386\_ABRL\_DS1.dwg SAVED BY: Stesking

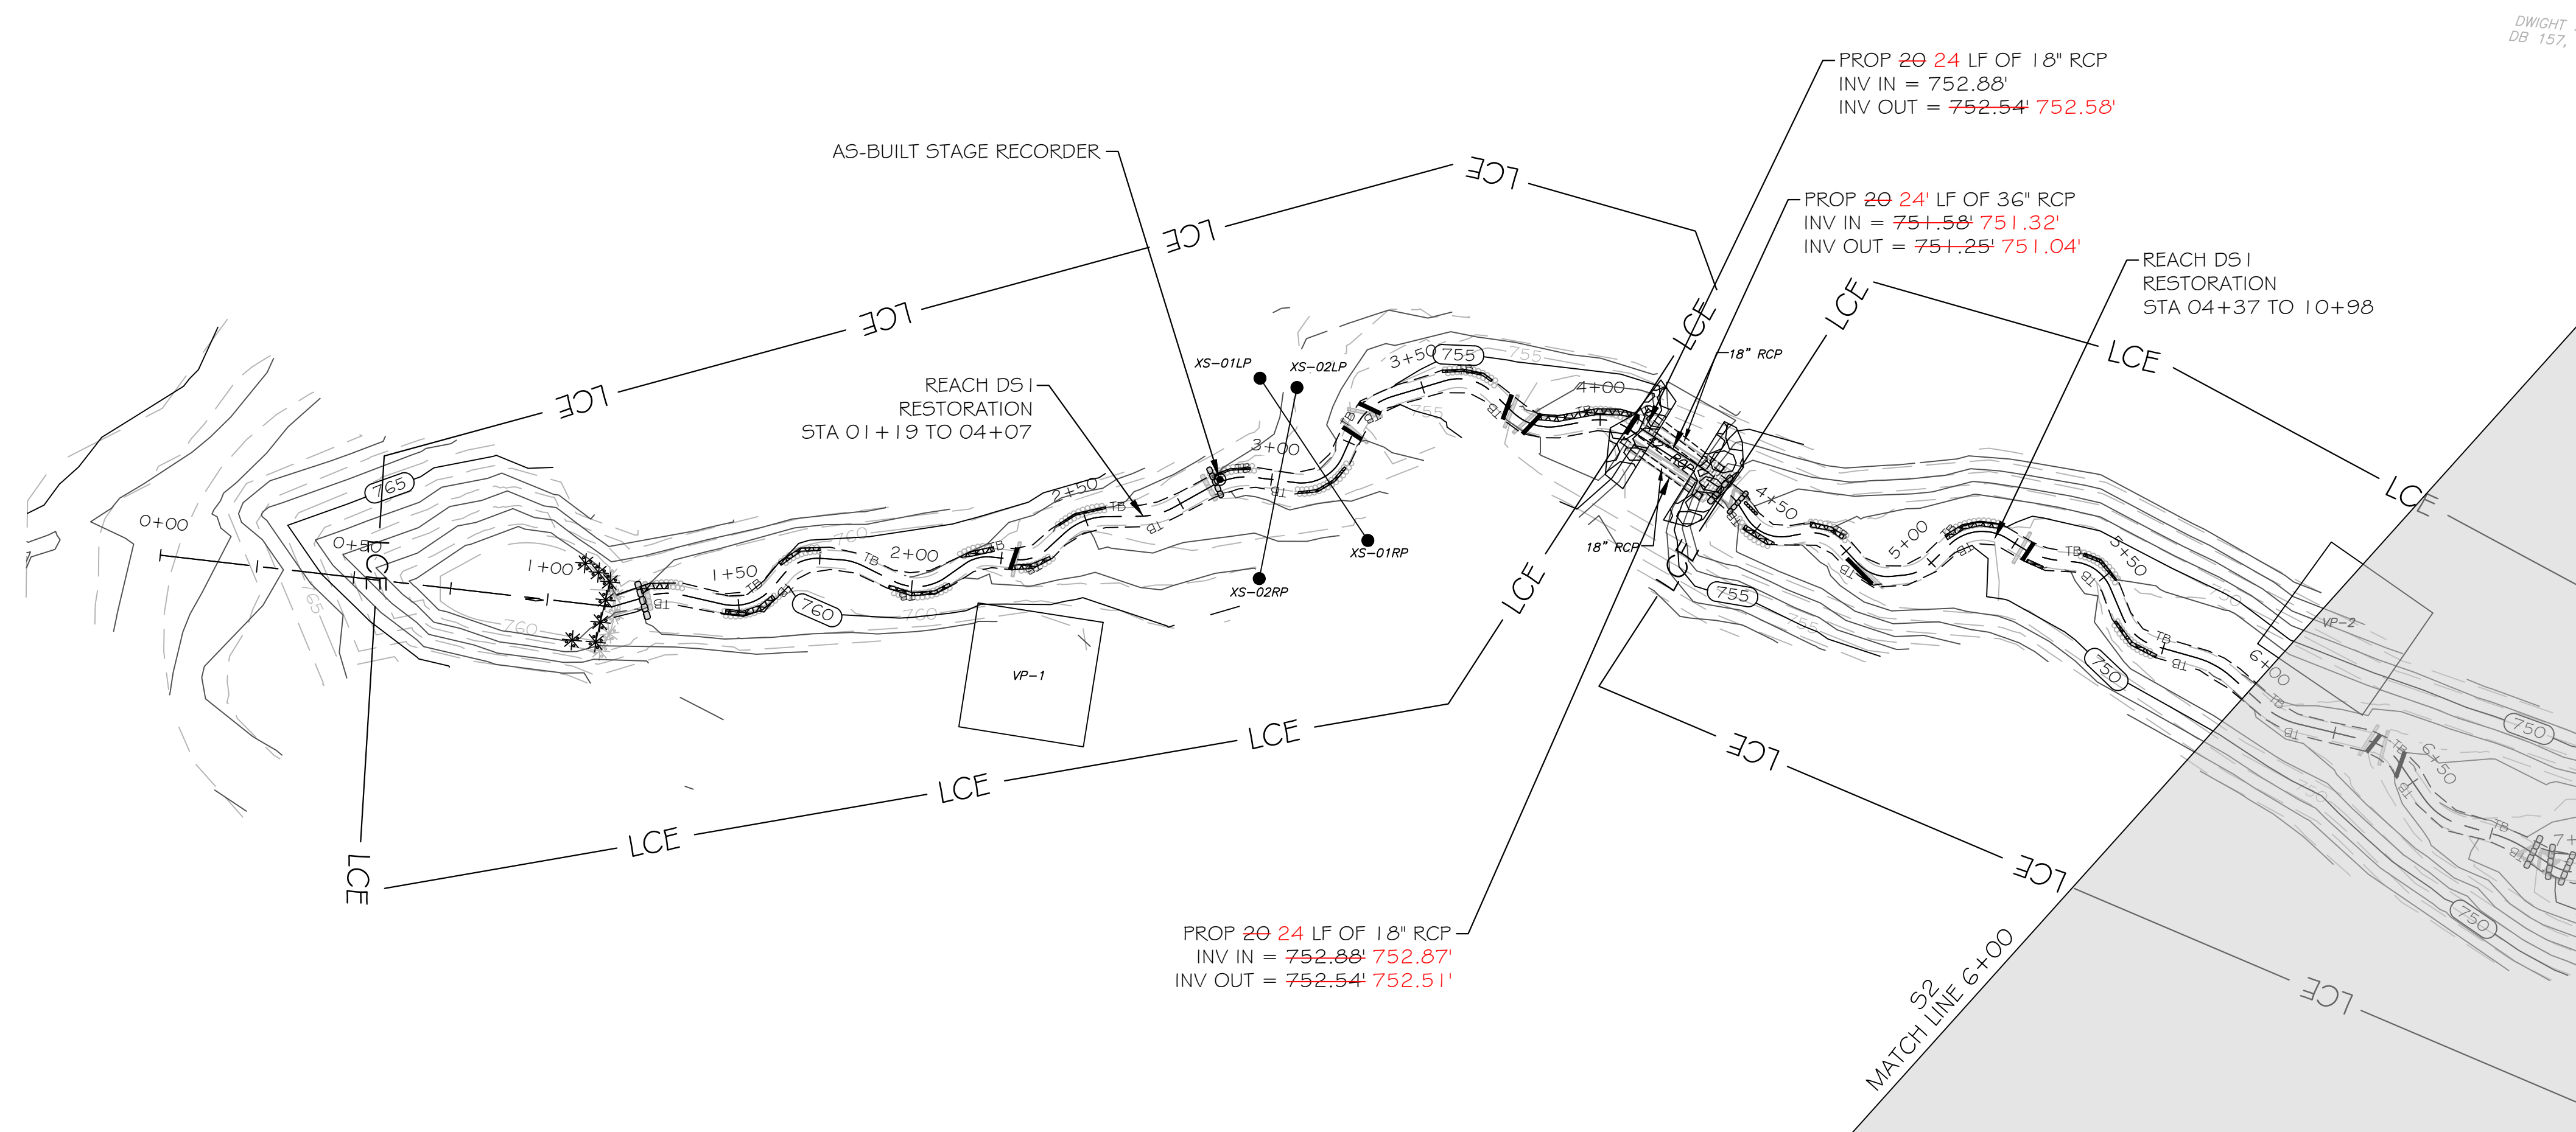


DWIGHT SPA  
DB 157, PG

### LEGEND



- EXISTING WETLAND
- EXISTING OVERHEAD ELECTRIC UTILITY LINE
- PROPERTY LINE
- PROPOSED CONTOUR MAJOR
- PROPOSED CONTOUR MINOR
- PROPOSED TOP OF BANK
- PROPOSED CHANNEL CENTERLINE
- AS-BUILT CONTOUR MAJOR
- AS-BUILT CONTOUR MINOR
- AS-BUILT TOP OF BANK
- AS-BUILT CHANNEL CENTERLINE
- BRUSH TOE PROTECTION
- LOG SILL
- LOG VANE
- ROCK SILL
- STEP POOL
- RIFFLE GRADE CONTROL
- SEDIMENT TRAP
- AS-BUILT BRUSH TOE
- AS-BUILT LOG STRUCTURE
- AS-BUILT ROCK STRUCTURE
- AS-BUILT RIFFLE GRADE CONTROL
- AS-BUILT SEDIMENT TRAP
- AS-BUILT CROSS-SECTION
- AS-BUILT STAGE RECORDER
- AS-BUILT FLOW GAUGE
- AS-BUILT VEGETATION MONITORING PLOT
- LIMITS OF PROPOSED CONSERVATION EASEMENT

NOTE: ALL SIGNIFICANT CHANGES FROM THE DESIGN ARE SHOWN IN RED

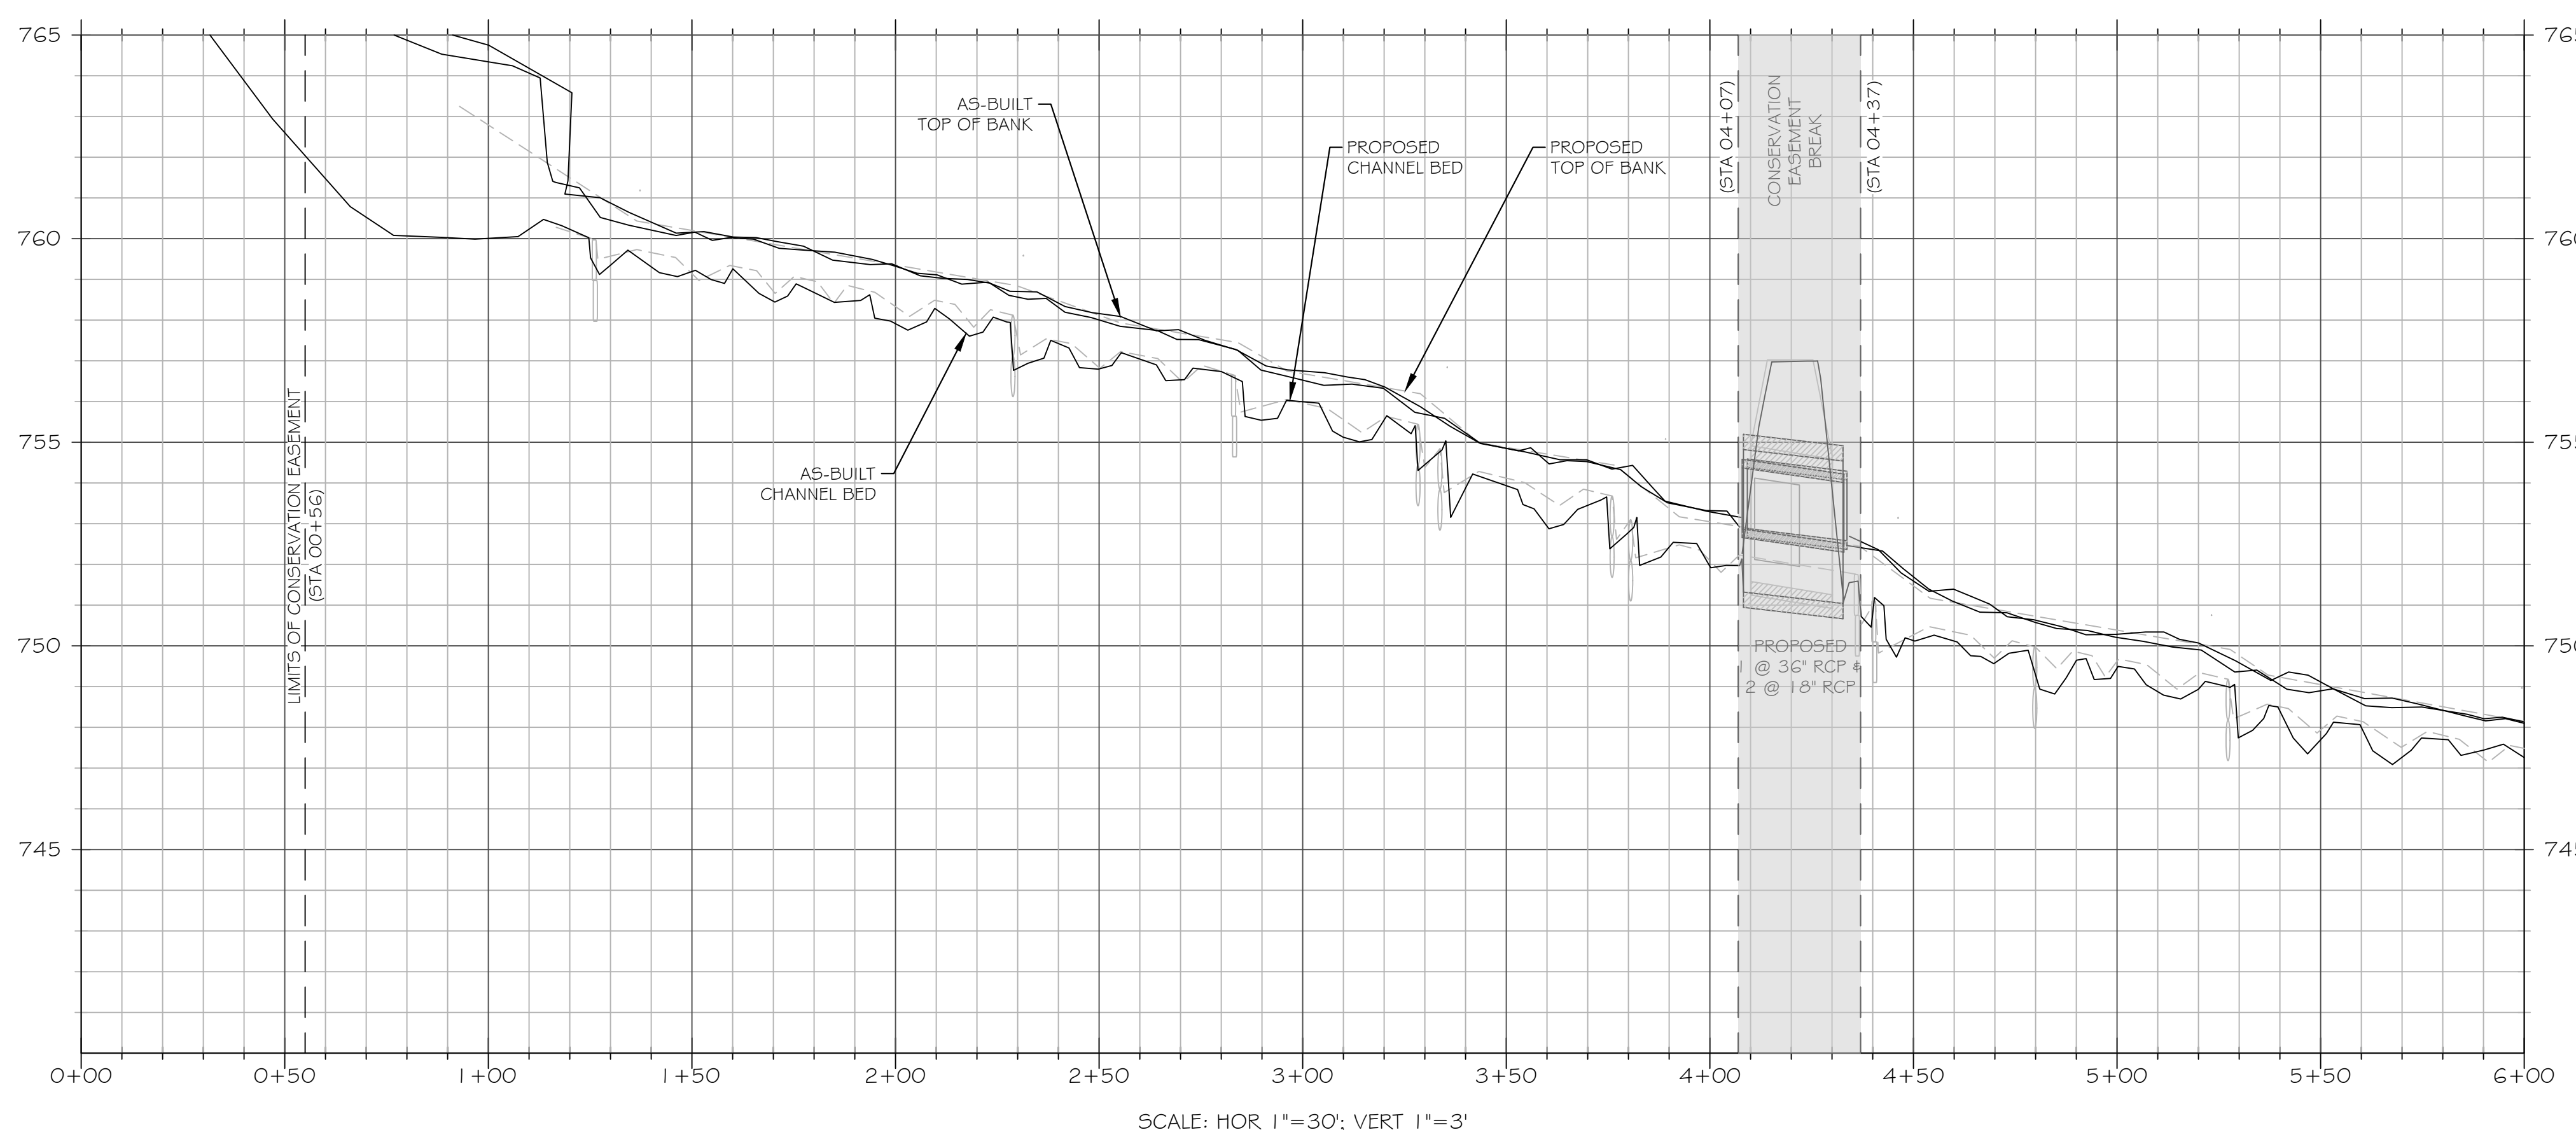

3600 Glenwood Ave, Suite 100  
Raleigh, NC 27612  
Main: 919.829.9909  
www.res.us

Engineering Services Provided By:  
Angler Environmental, LLC  
License: F-1428

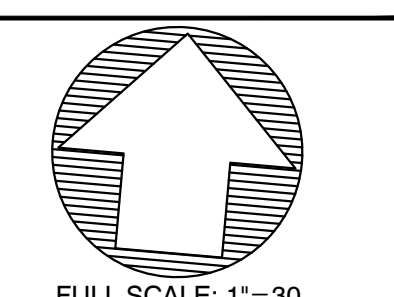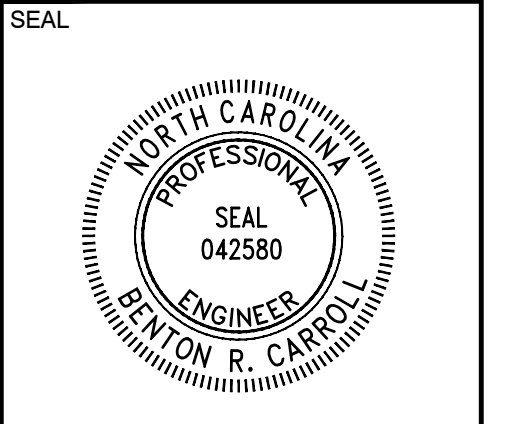

FULL SCALE: 1"=30  
0 30 60  
2" = FULL SCALE  
1" = HALF SCALE

PLOT DATE:  
7/11/2020


REVISIONS:  
  
RELEASED FOR:  
RECORD DRAWINGS

PROJECT NAME:  
**CATBIRD RECORD DRAWINGS  
DAVIE COUNTY, NORTH CAROLINA**

DRAWING TITLE:  
**REACH DS1**

PROJECT NUMBER: 0386  
PROJECT MANAGER: BPB  
DESIGNED: BRC  
DRAWN: TRS  
CHECKED: AFM

SHEET NUMBER:  
**S1**

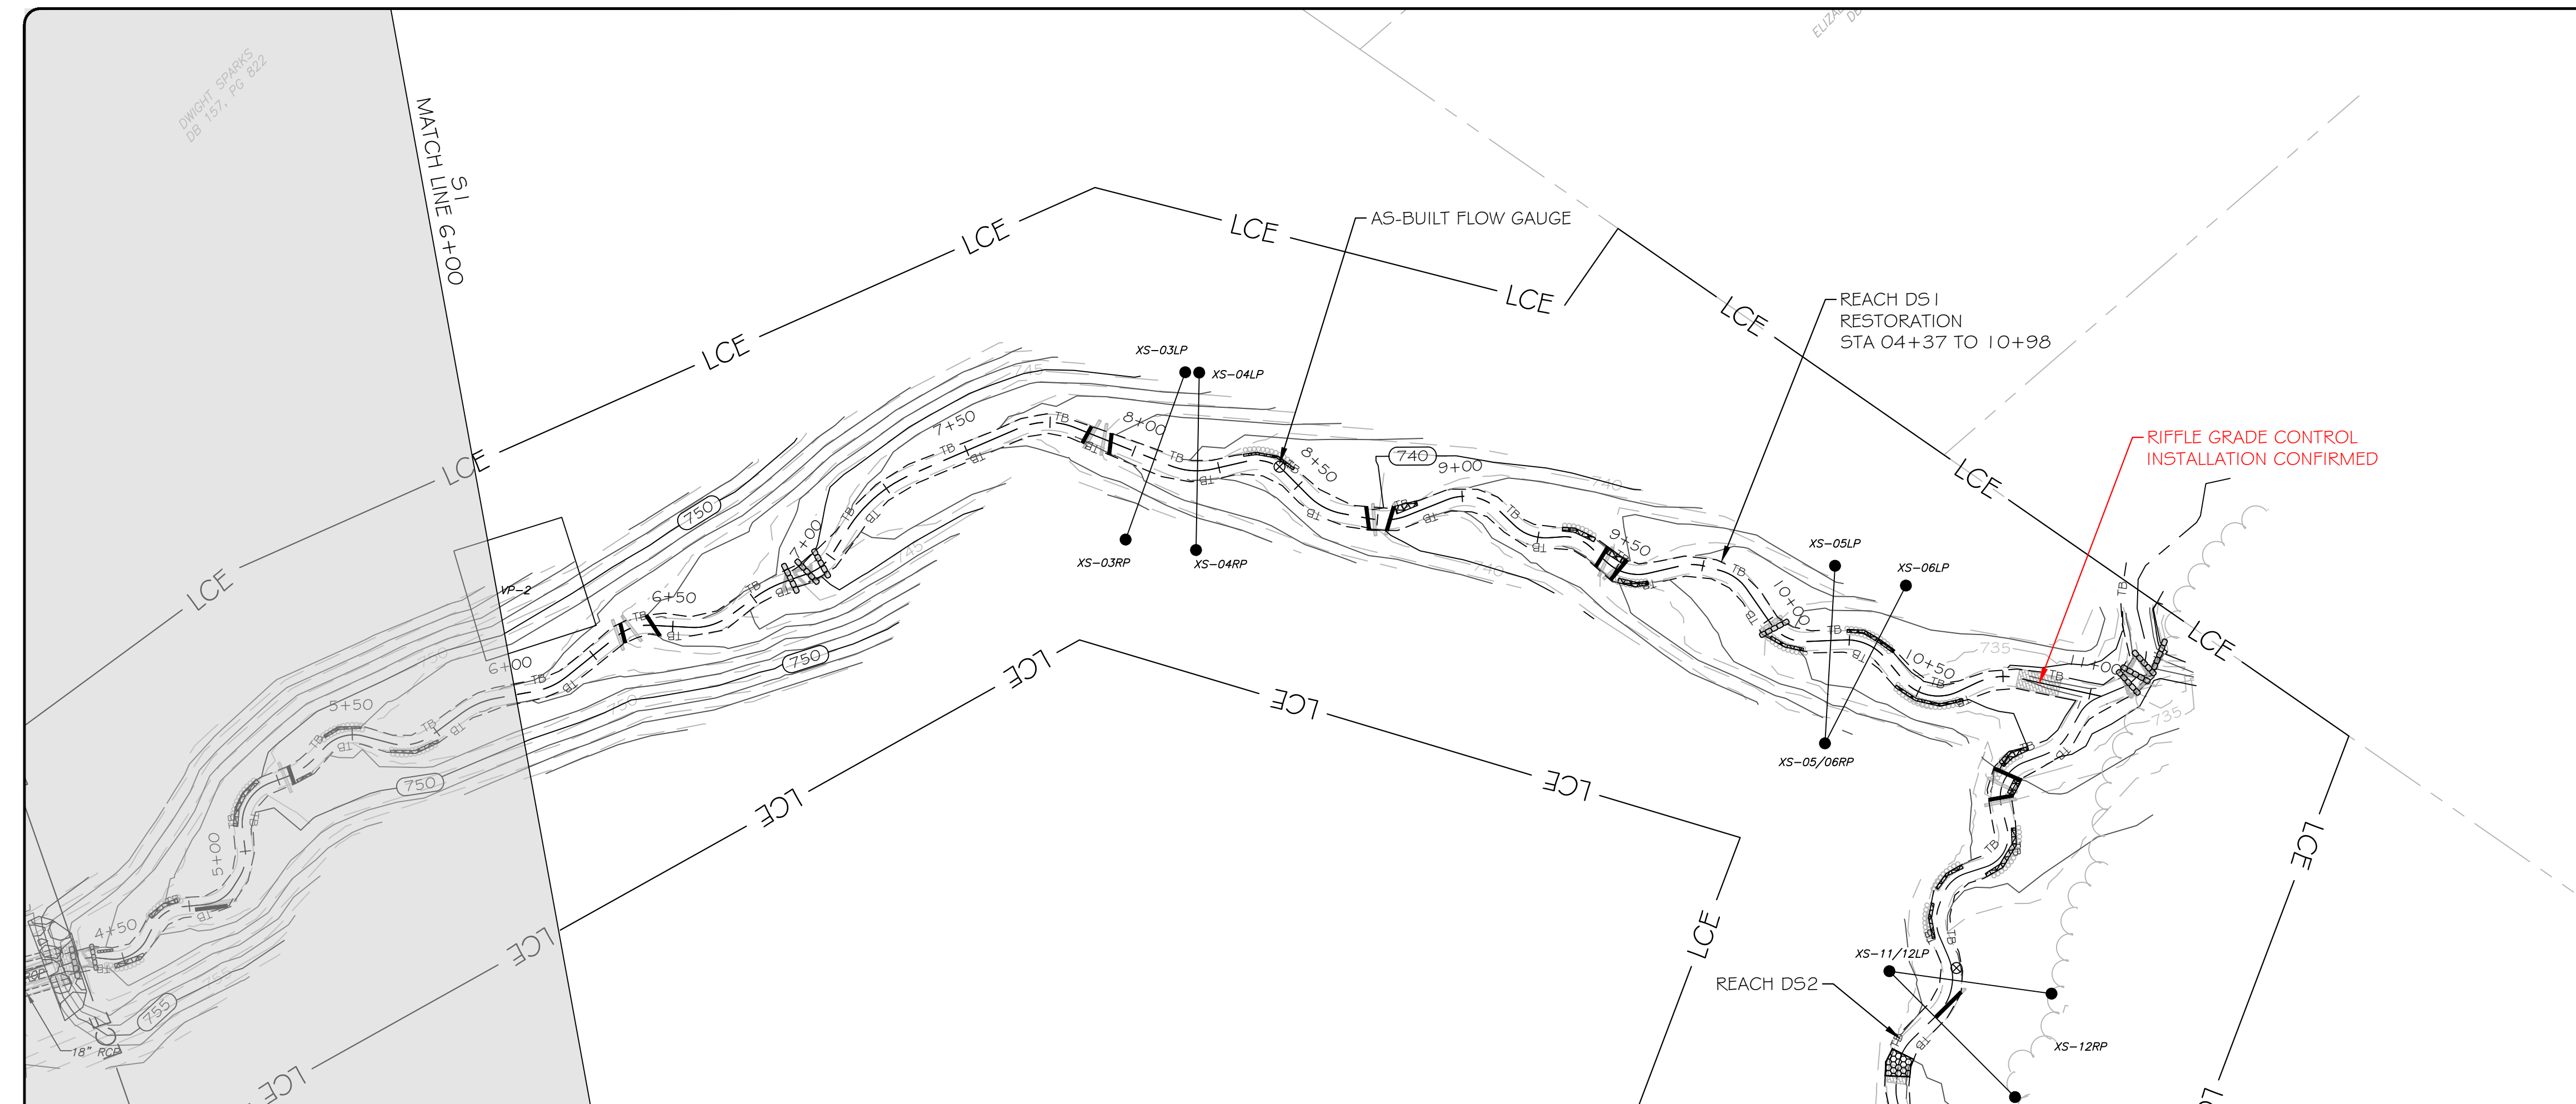



**LEGEND**

|  |  |
|--|--|
| EXISTING WETLAND                         |  |
| EXISTING OVERHEAD ELECTRIC UTILITY LINE  |  |
| PROPERTY LINE                            |  |
| PROPOSED CONTOUR MAJOR                   |  |
| PROPOSED CONTOUR MINOR                   |  |
| PROPOSED TOP OF BANK                     |  |
| PROPOSED CHANNEL CENTERLINE              |  |
| AS-BUILT CONTOUR MAJOR                   |  |
| AS-BUILT CONTOUR MINOR                   |  |
| AS-BUILT TOP OF BANK                     |  |
| AS-BUILT CHANNEL CENTERLINE              |  |
| BRUSH TOE PROTECTION                     |  |
| LOG SILL                                 |  |
| LOG VANE                                 |  |
| ROCK SILL                                |  |
| STEP POOL                                |  |
| RIFFLE GRADE CONTROL                     |  |
| SEDIMENT TRAP                            |  |
| AS-BUILT BRUSH TOE                       |  |
| AS-BUILT LOG STRUCTURE                   |  |
| AS-BUILT ROCK STRUCTURE                  |  |
| AS-BUILT RIFFLE GRADE CONTROL            |  |
| AS-BUILT SEDIMENT TRAP                   |  |
| AS-BUILT CROSS-SECTION                   |  |
| AS-BUILT STAGE RECORDER                  |  |
| AS-BUILT FLOW GAUGE                      |  |
| AS-BUILT VEGETATION MONITORING PLOT      |  |
| LIMITS OF PROPOSED CONSERVATION EASEMENT |  |



3600 Glenwood Ave, Suite 100  
Raleigh, NC 27612  
Main: 919.829.9909  
www.res.us

Engineering Services Provided By:  
Angler Environmental, LLC  
License: F-1428

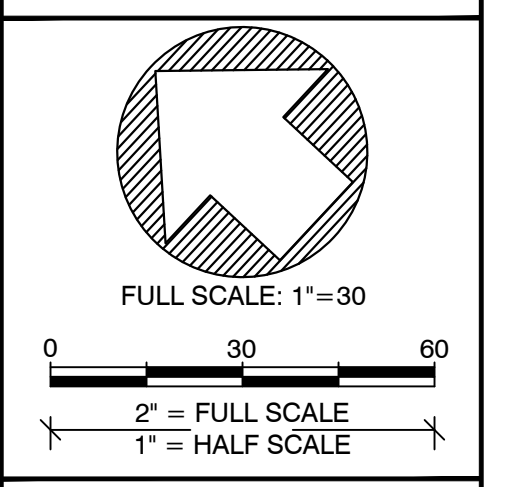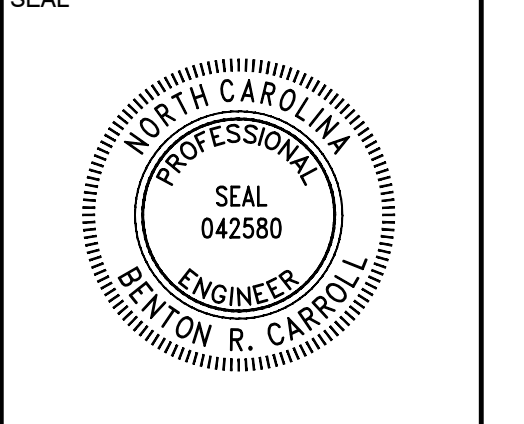


|               |                 |
|---------------|-----------------|
| PLOT DATE:    | 7/11/2020       |
| REVISIONS:    |                 |
| RELEASED FOR: | RECORD DRAWINGS |

PROJECT NAME:  
**CATBIRD RECORD DRAWINGS  
DAVIE COUNTY, NORTH CAROLINA**

DRAWING TITLE:  
**REACH DS1**

|                  |      |
|------------------|------|
| PROJECT NUMBER:  | 0386 |
| PROJECT MANAGER: | BPB  |
| DESIGNED:        | BRC  |
| DRAWN:           | TRS  |
| CHECKED:         | AFM  |


SHEET NUMBER:  
**S2**

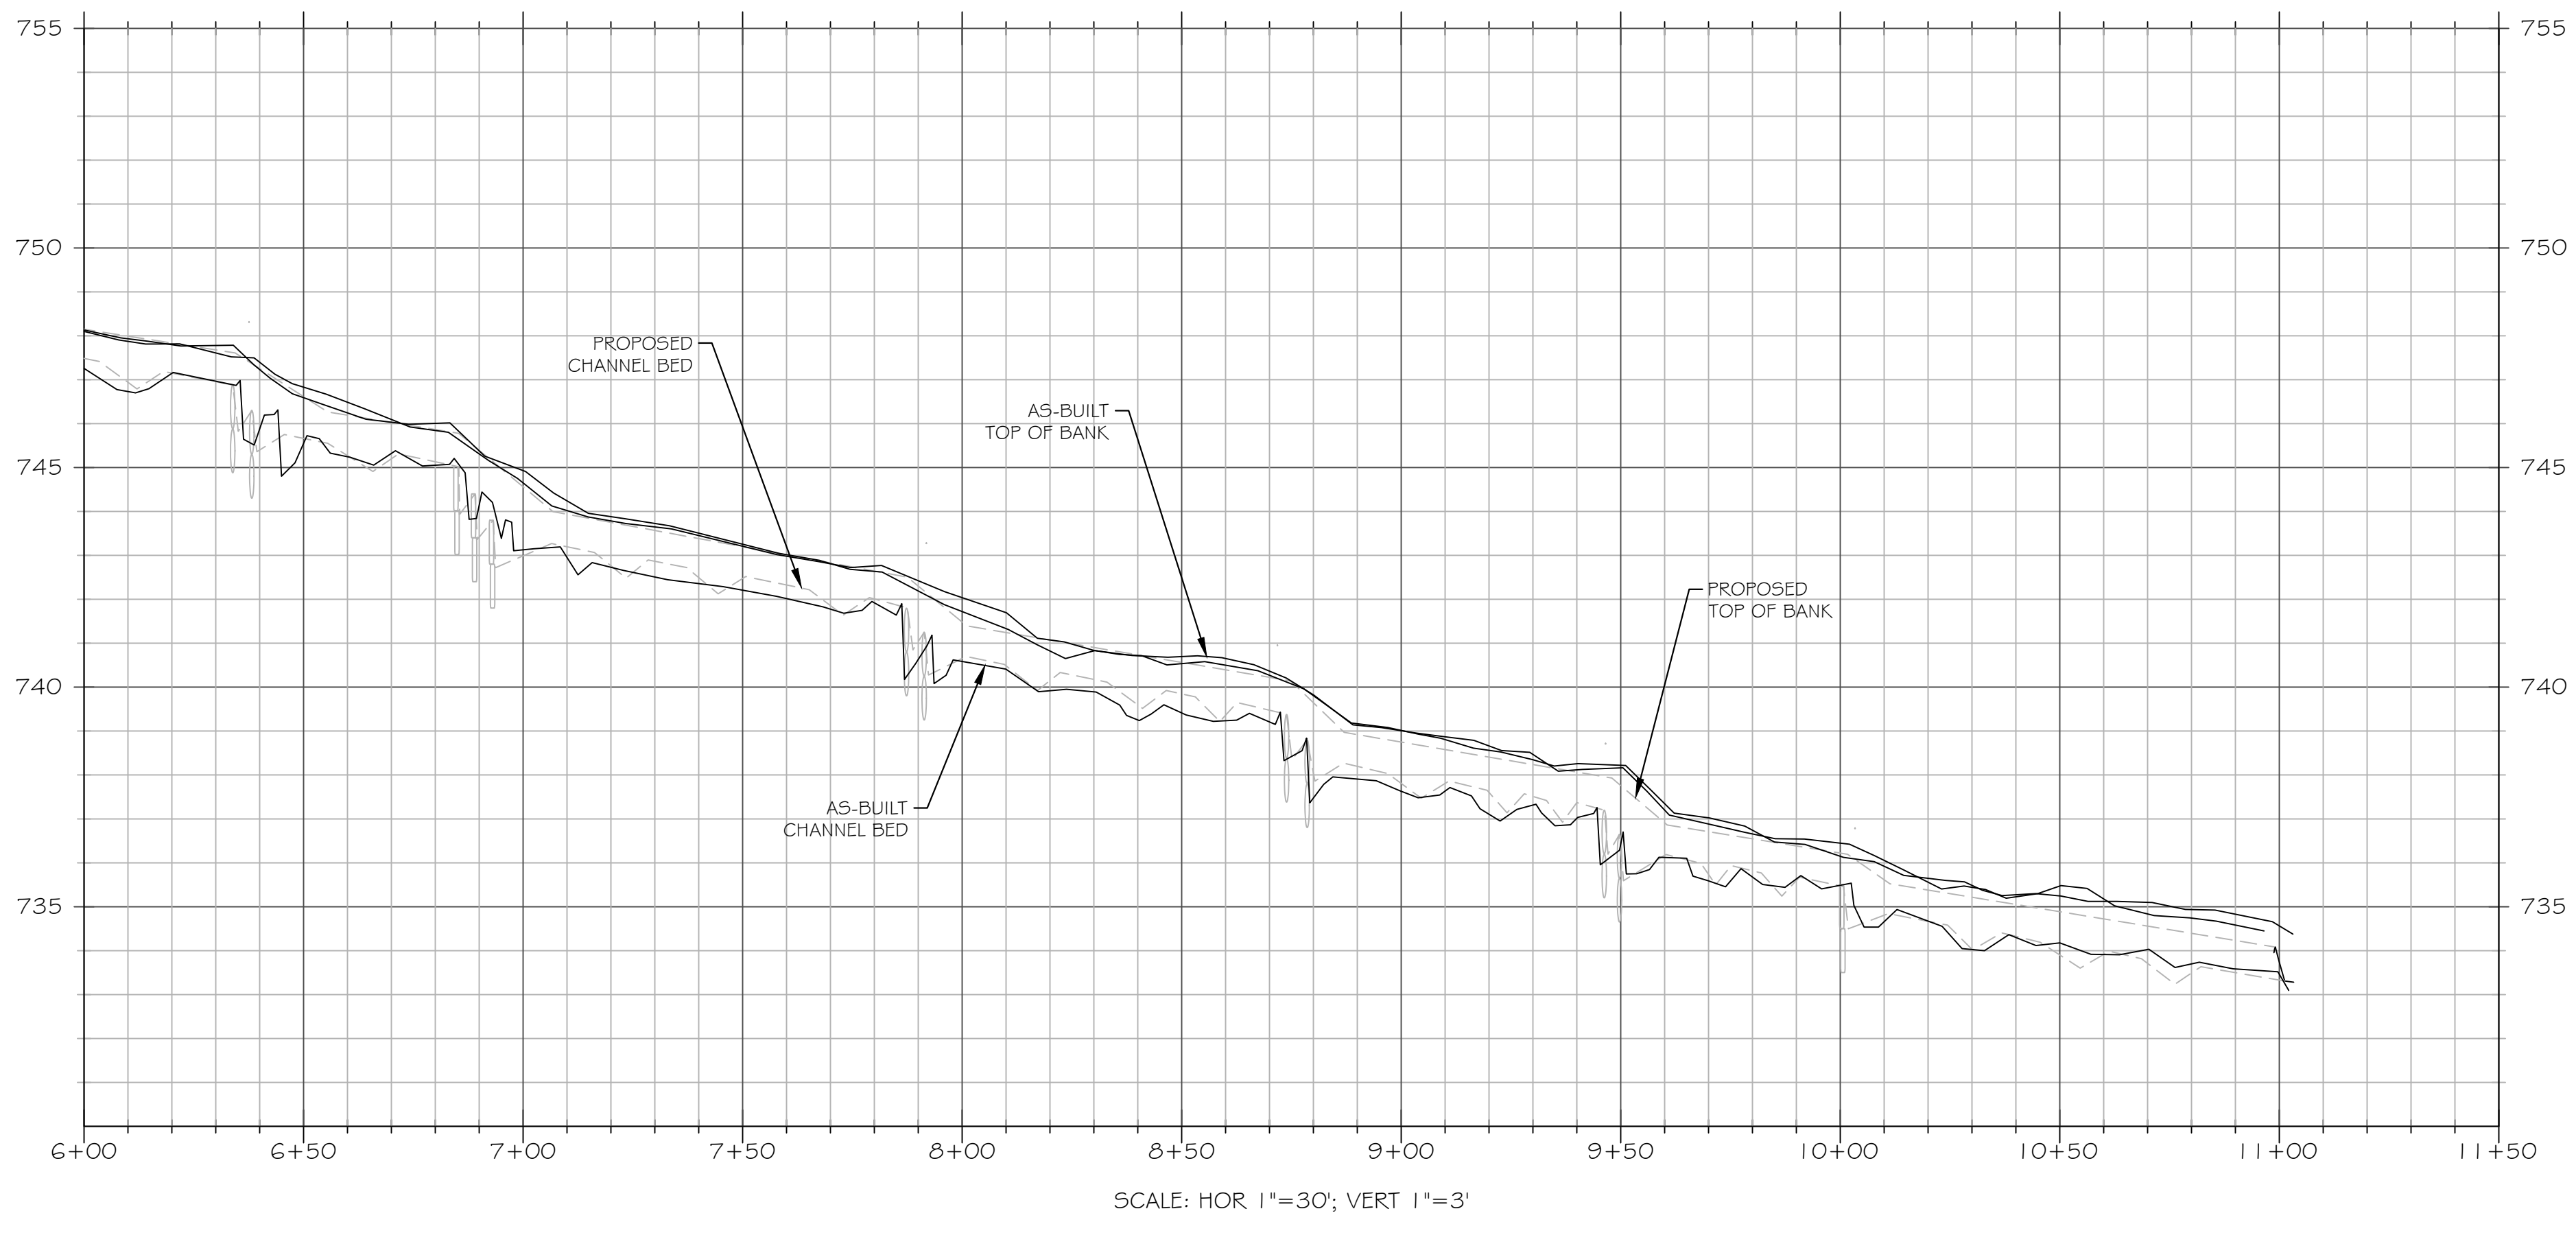

FILE NAME: F:\resgis\dropbox\projects\NC\Catbird\CAD\ABRL\0386\_ABRL\_DS1.dwg SAVED BY: Skeating




FILE NAME: F:\resgis\dropbox\projects\NC Catbird\CAD\ABR1\_0386\_ABR1\_DS2.dwg SAVED BY: Stasking

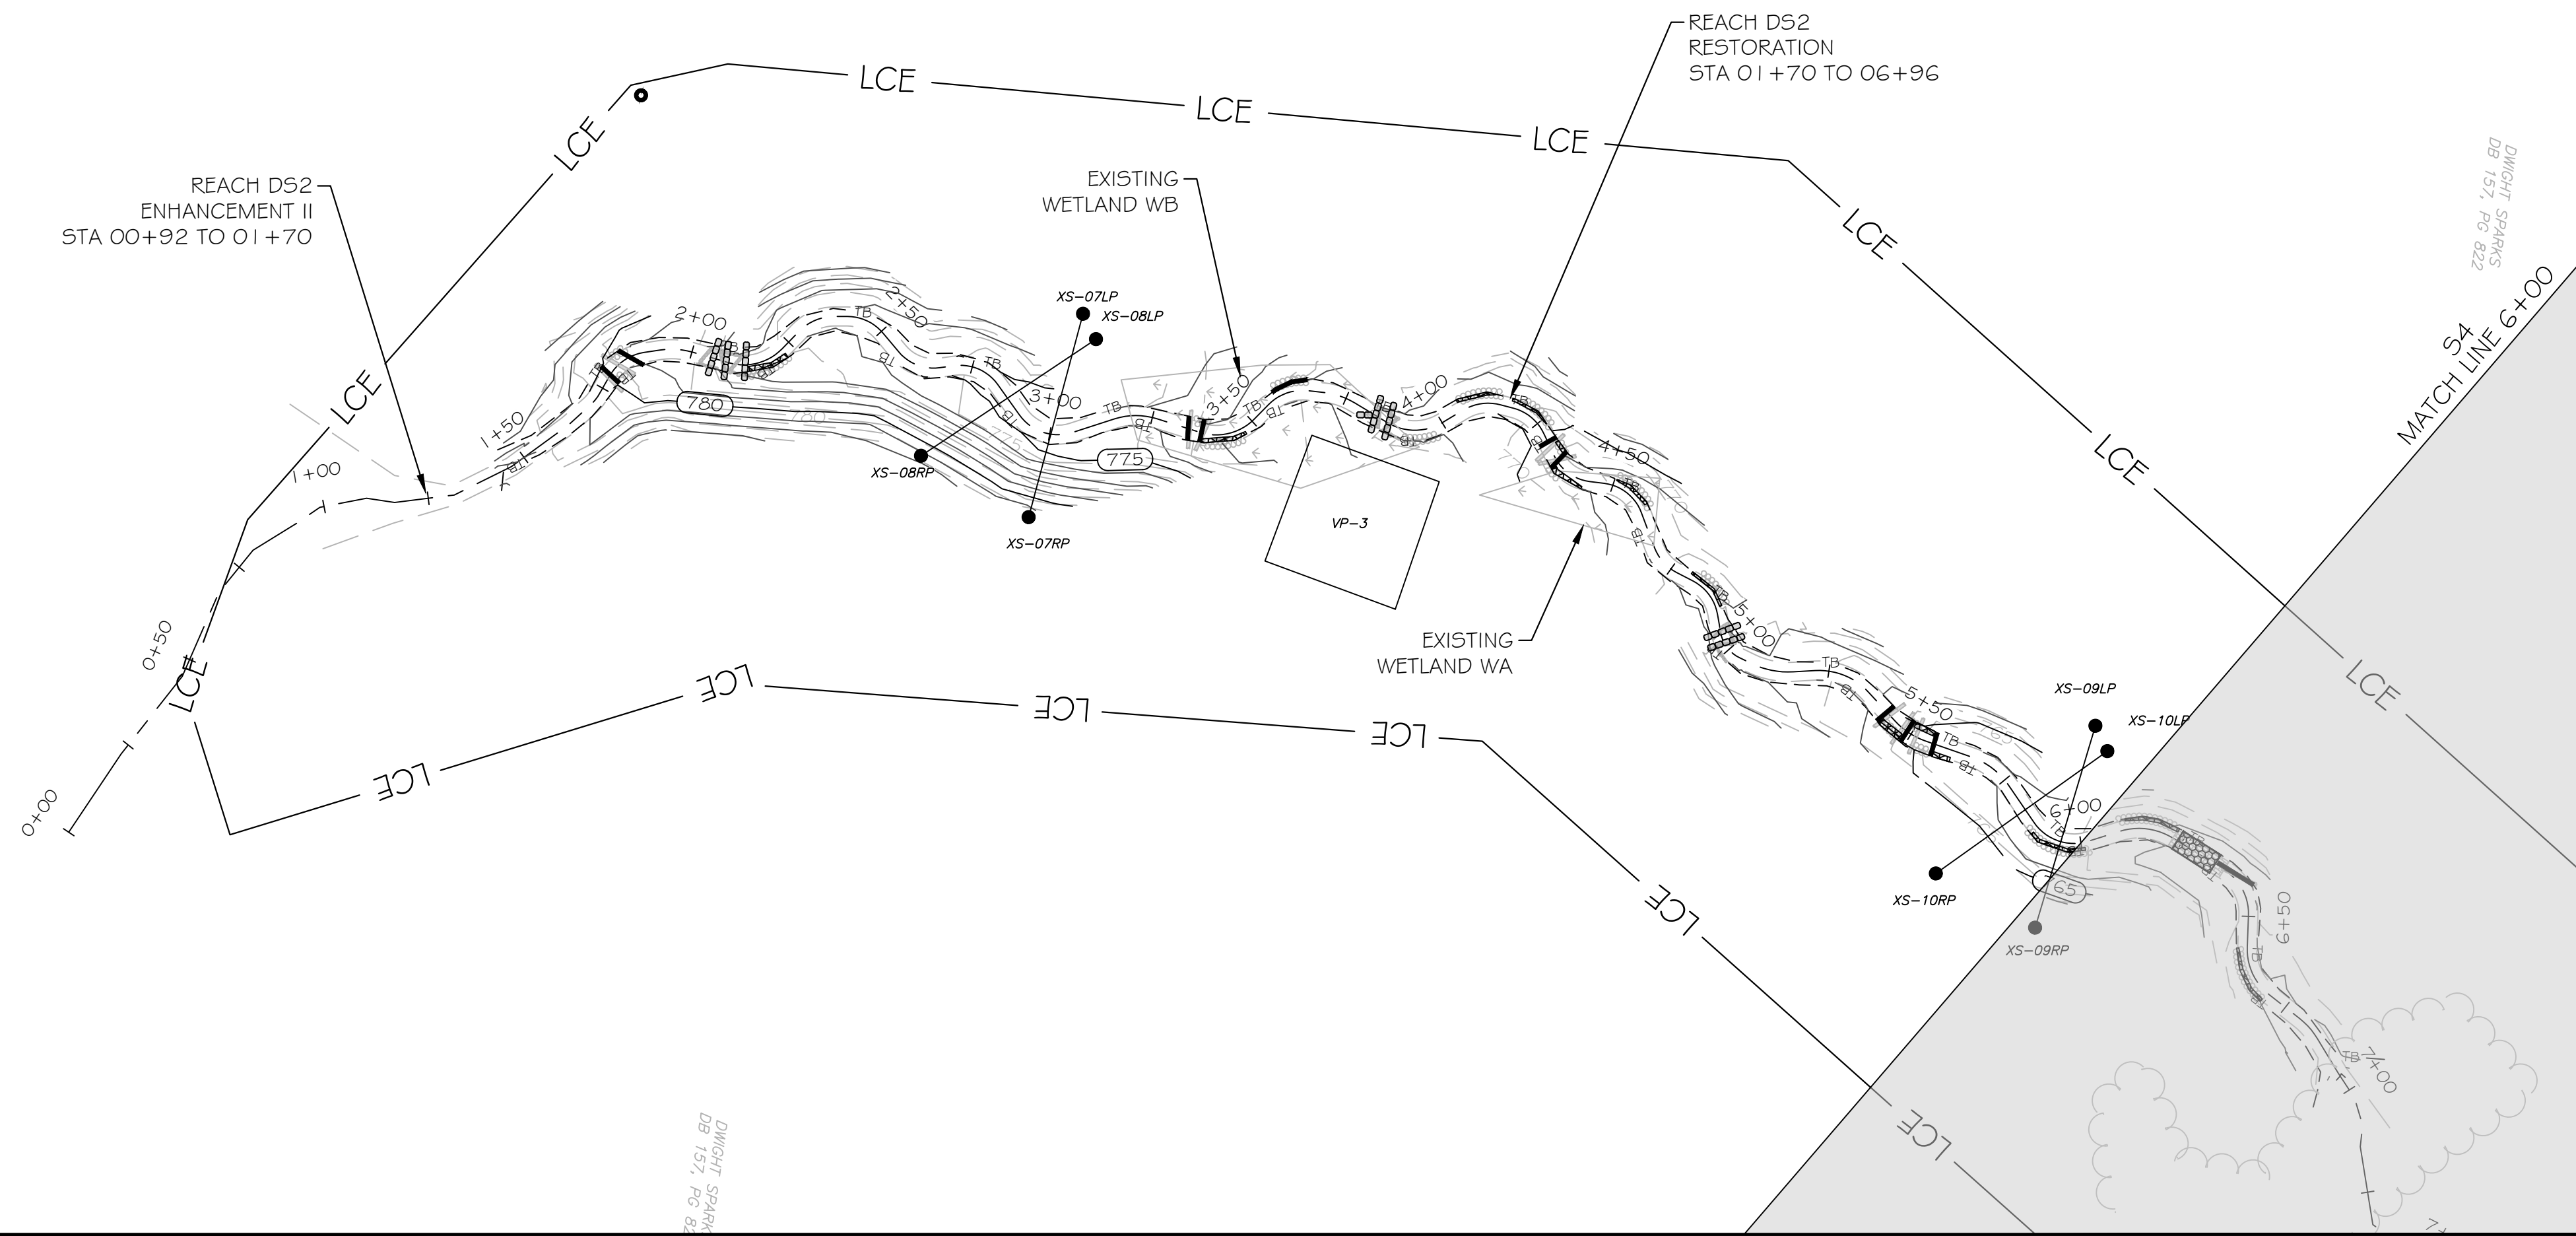

**LEGEND**

|  |  |
|--|--|
| EXISTING WETLAND                         |  |
| EXISTING OVERHEAD ELECTRIC UTILITY LINE  |  |
| PROPERTY LINE                            |  |
| PROPOSED CONTOUR MAJOR                   |  |
| PROPOSED CONTOUR MINOR                   |  |
| PROPOSED TOP OF BANK                     |  |
| PROPOSED CHANNEL CENTERLINE              |  |
| AS-BUILT CONTOUR MAJOR                   |  |
| AS-BUILT CONTOUR MINOR                   |  |
| AS-BUILT TOP OF BANK                     |  |
| AS-BUILT CHANNEL CENTERLINE              |  |
| BRUSH TOE PROTECTION                     |  |
| LOG SILL                                 |  |
| LOG VANE                                 |  |
| ROCK SILL                                |  |
| STEP POOL                                |  |
| RIFFLE GRADE CONTROL                     |  |
| SEDIMENT TRAP                            |  |
| AS-BUILT BRUSH TOE                       |  |
| AS-BUILT LOG STRUCTURE                   |  |
| AS-BUILT ROCK STRUCTURE                  |  |
| AS-BUILT RIFFLE GRADE CONTROL            |  |
| AS-BUILT SEDIMENT TRAP                   |  |
| AS-BUILT CROSS-SECTION                   |  |
| AS-BUILT STAGE RECORDER                  |  |
| AS-BUILT FLOW GAUGE                      |  |
| AS-BUILT VEGETATION MONITORING PLOT      |  |
| LIMITS OF PROPOSED CONSERVATION EASEMENT |  |


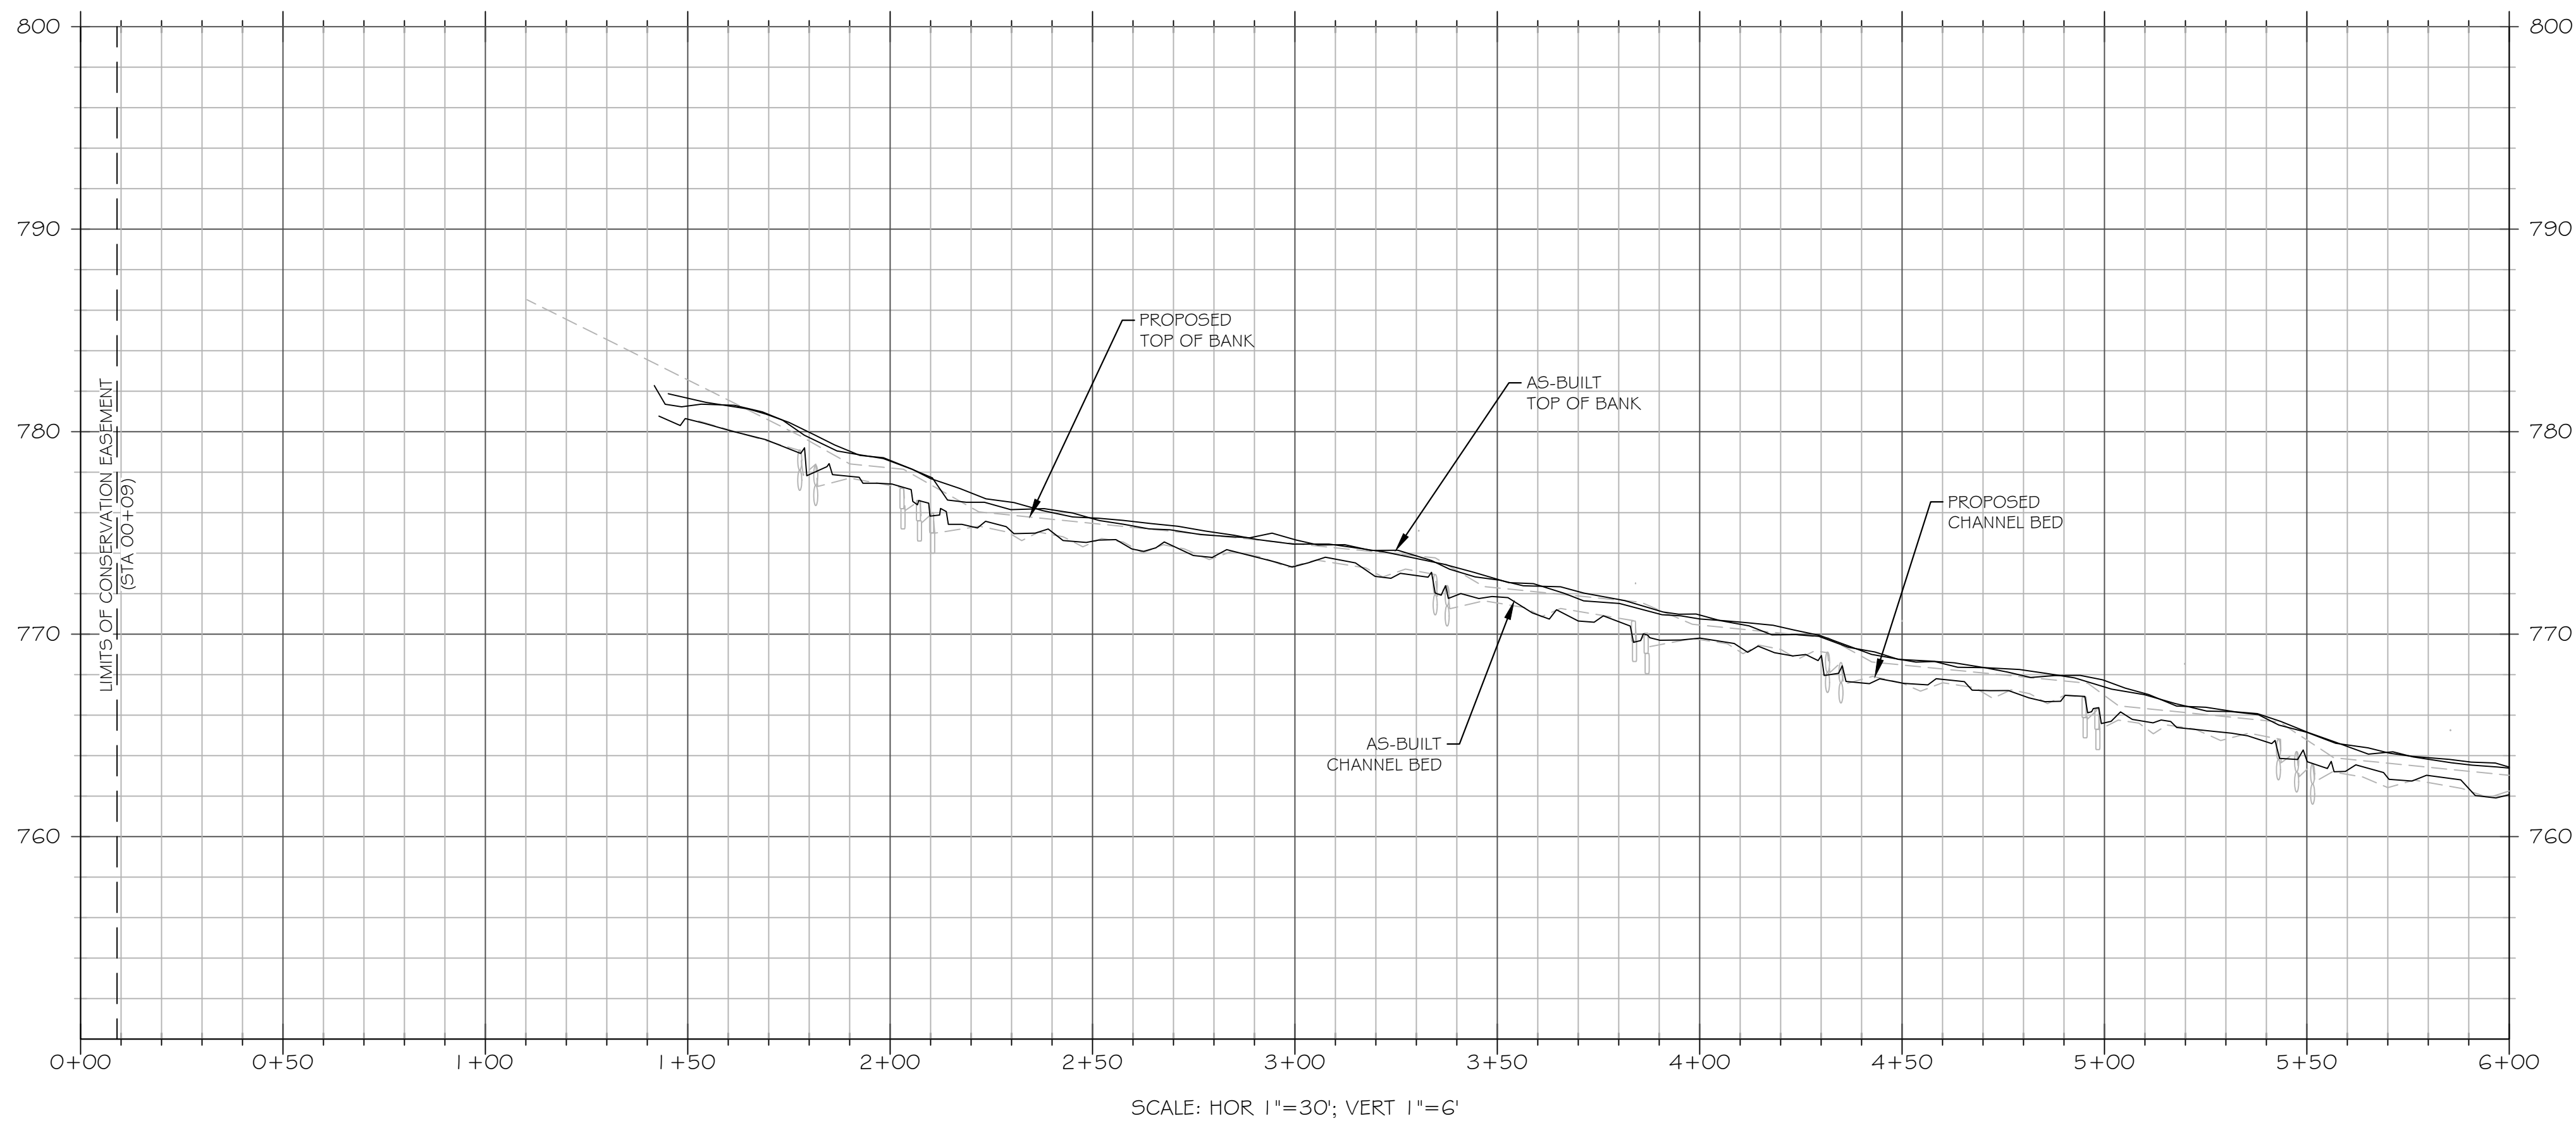


NOTE: ALL SIGNIFICANT CHANGES FROM THE DESIGN ARE SHOWN IN RED



3600 Glenwood Ave, Suite 100  
Raleigh, NC 27612  
Main: 919.829.9909  
www.res.us

Engineering Services Provided By:  
Angler Environmental, LLC  
License: F-1428

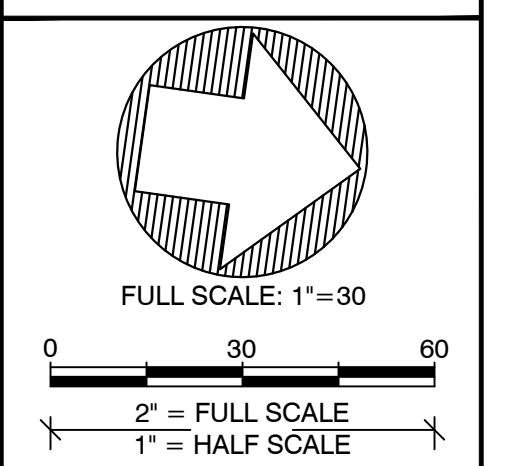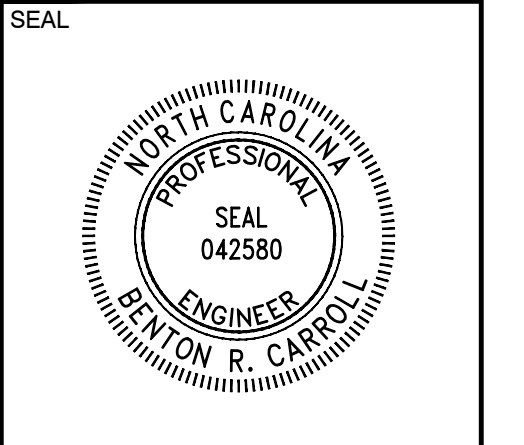

PLOT DATE:  
7/1/2020

REVISIONS:


RELEASED FOR:  
RECORD DRAWINGS

PROJECT NAME:  
**CATBIRD RECORD DRAWINGS**  
DAVIE COUNTY, NORTH CAROLINA

DRAWING TITLE:  
**REACH DS2**

PROJECT NUMBER: 0386  
PROJECT MANAGER: BPB  
DESIGNED: BRC  
DRAWN: TRS  
CHECKED: AFM

SHEET NUMBER:  
**S3**

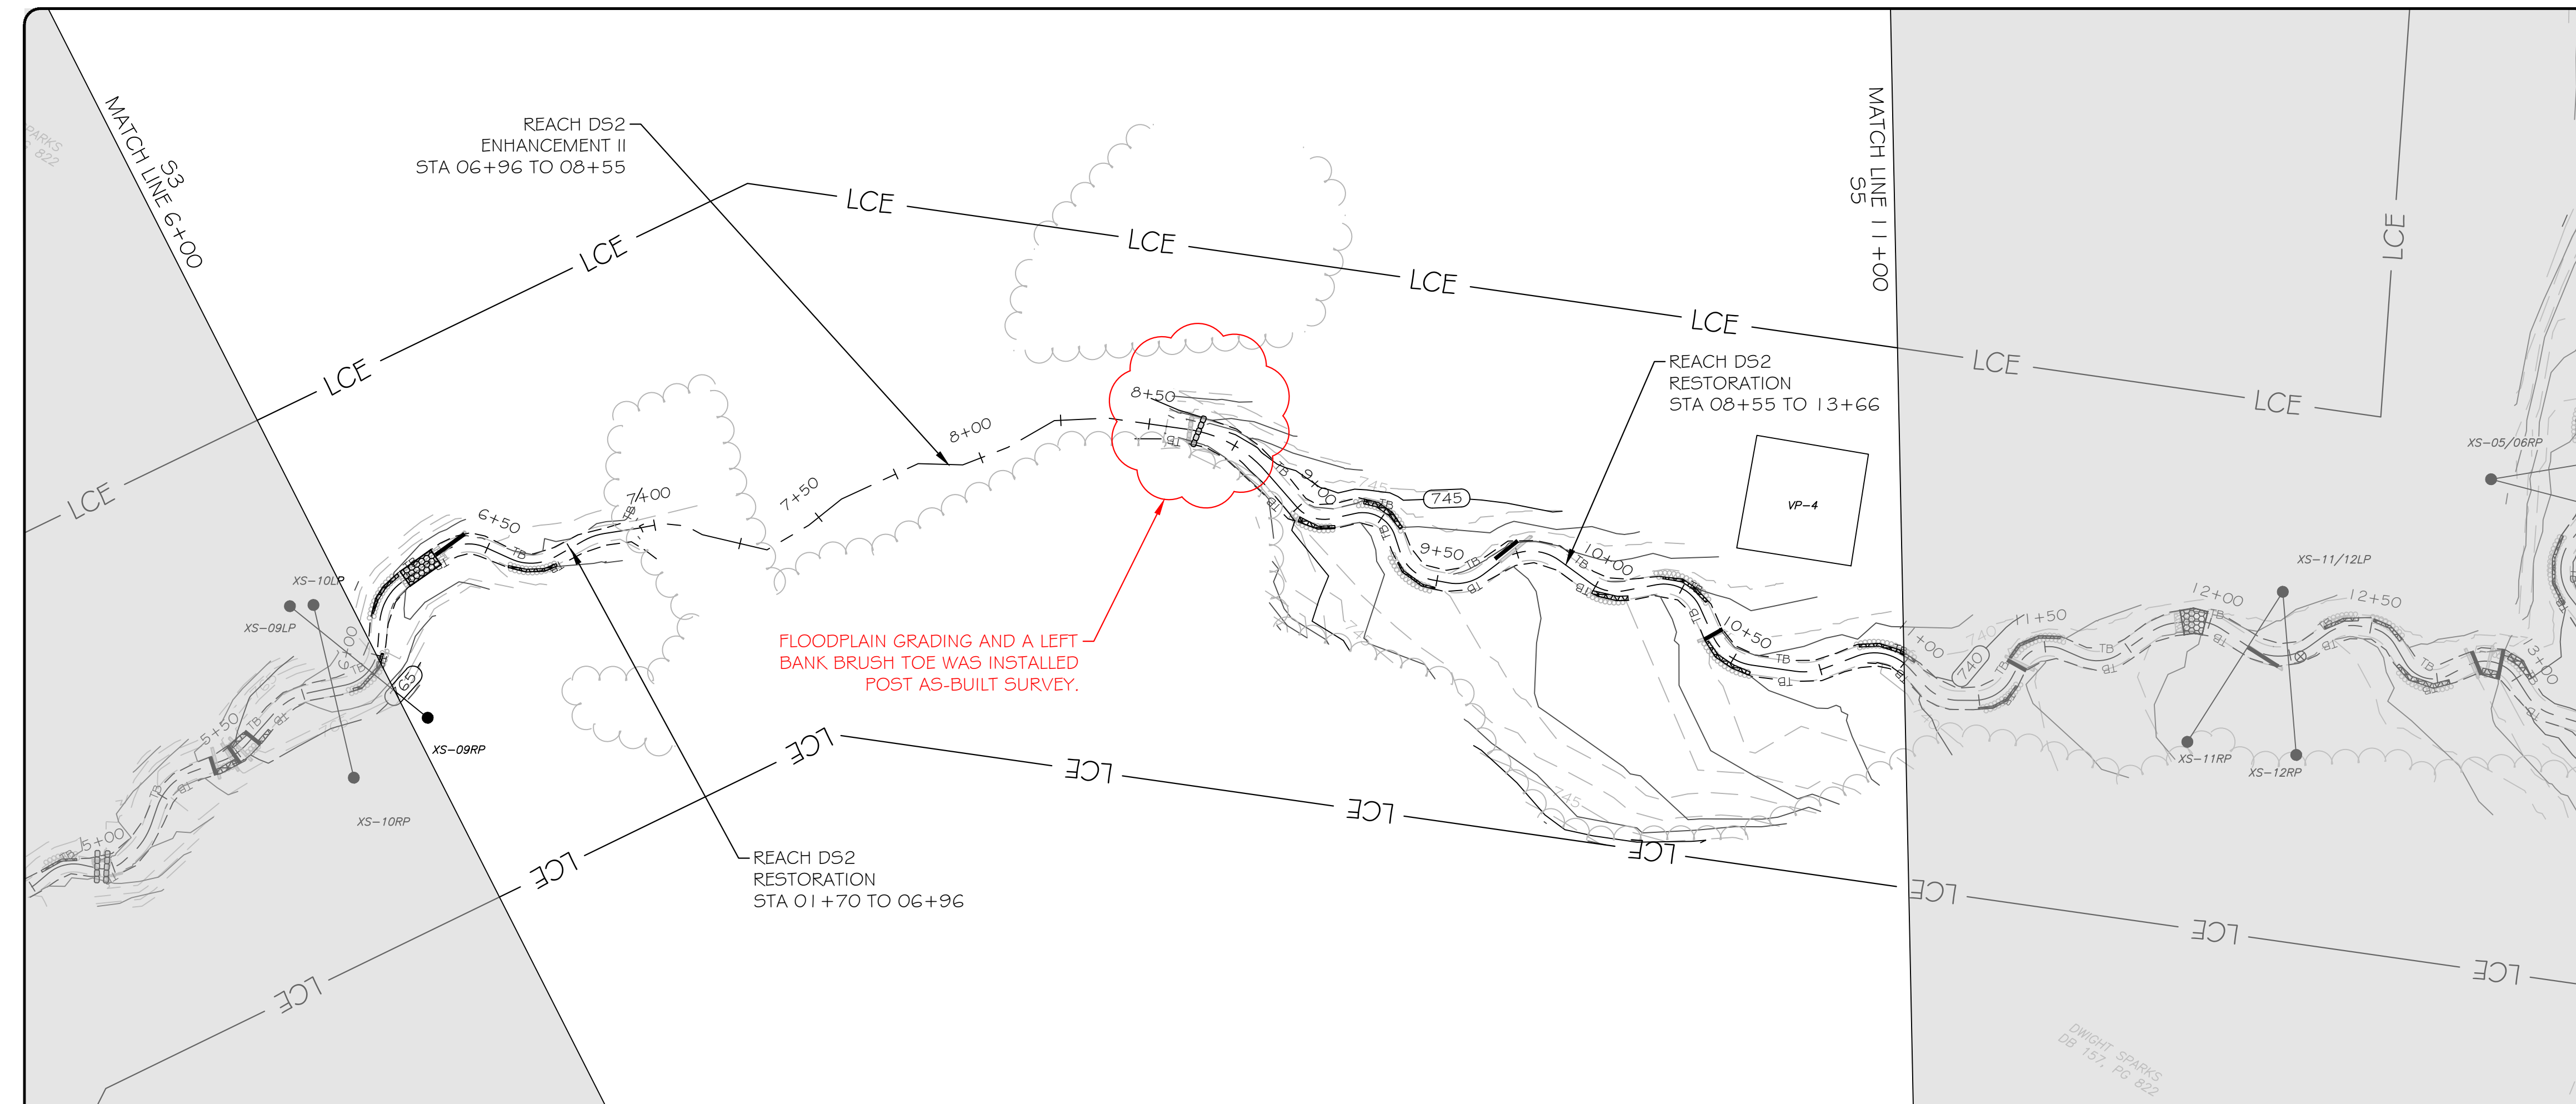



**LEGEND**

|  |  |
|--|--|
| EXISTING WETLAND                         |  |
| EXISTING OVERHEAD ELECTRIC UTILITY LINE  |  |
| PROPERTY LINE                            |  |
| PROPOSED CONTOUR MAJOR                   |  |
| PROPOSED CONTOUR MINOR                   |  |
| PROPOSED TOP OF BANK                     |  |
| PROPOSED CHANNEL CENTERLINE              |  |
| A5-BUILT CONTOUR MAJOR                   |  |
| A5-BUILT CONTOUR MINOR                   |  |
| A5-BUILT TOP OF BANK                     |  |
| A5-BUILT CHANNEL CENTERLINE              |  |
| BRUSH TOE PROTECTION                     |  |
| LOG SILL                                 |  |
| LOG VANE                                 |  |
| ROCK SILL                                |  |
| STEP POOL                                |  |
| RIFFLE GRADE CONTROL                     |  |
| SEDIMENT TRAP                            |  |
| A5-BUILT BRUSH TOE                       |  |
| A5-BUILT LOG STRUCTURE                   |  |
| A5-BUILT ROCK STRUCTURE                  |  |
| A5-BUILT RIFFLE GRADE CONTROL            |  |
| A5-BUILT SEDIMENT TRAP                   |  |
| A5-BUILT CROSS-SECTION                   |  |
| A5-BUILT STAGE RECORDER                  |  |
| A5-BUILT FLOW GAUGE                      |  |
| A5-BUILT VEGETATION MONITORING PLOT      |  |
| LIMITS OF PROPOSED CONSERVATION EASEMENT |  |

**res**

3600 Glenwood Ave, Suite 100  
Raleigh, NC 27612  
Main: 919.829.9909  
www.res.us

Engineering Services Provided By:  
Angler Environmental, LLC  
License: F-1428

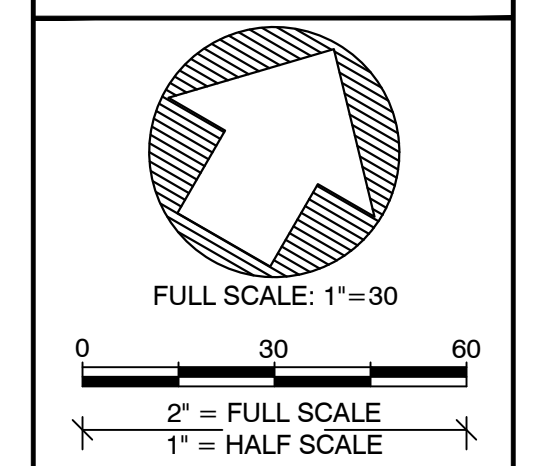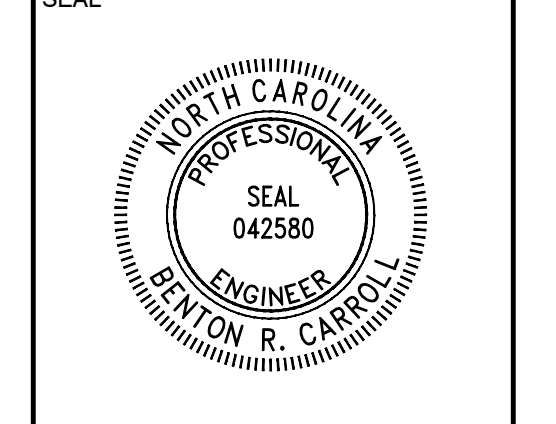

PLOT DATE:  
7/11/2020

REVISIONS:


RELEASED FOR:  
RECORD DRAWINGS

PROJECT NAME:  
CATBIRD RECORD DRAWINGS  
DAVIE COUNTY, NORTH CAROLINA

DRAWING TITLE:  
REACH DS2



PROJECT NUMBER: 0386  
PROJECT MANAGER: BPB  
DESIGNED: BRC  
DRAWN: TRS  
CHECKED: AFM

SHEET NUMBER:  
**S4**

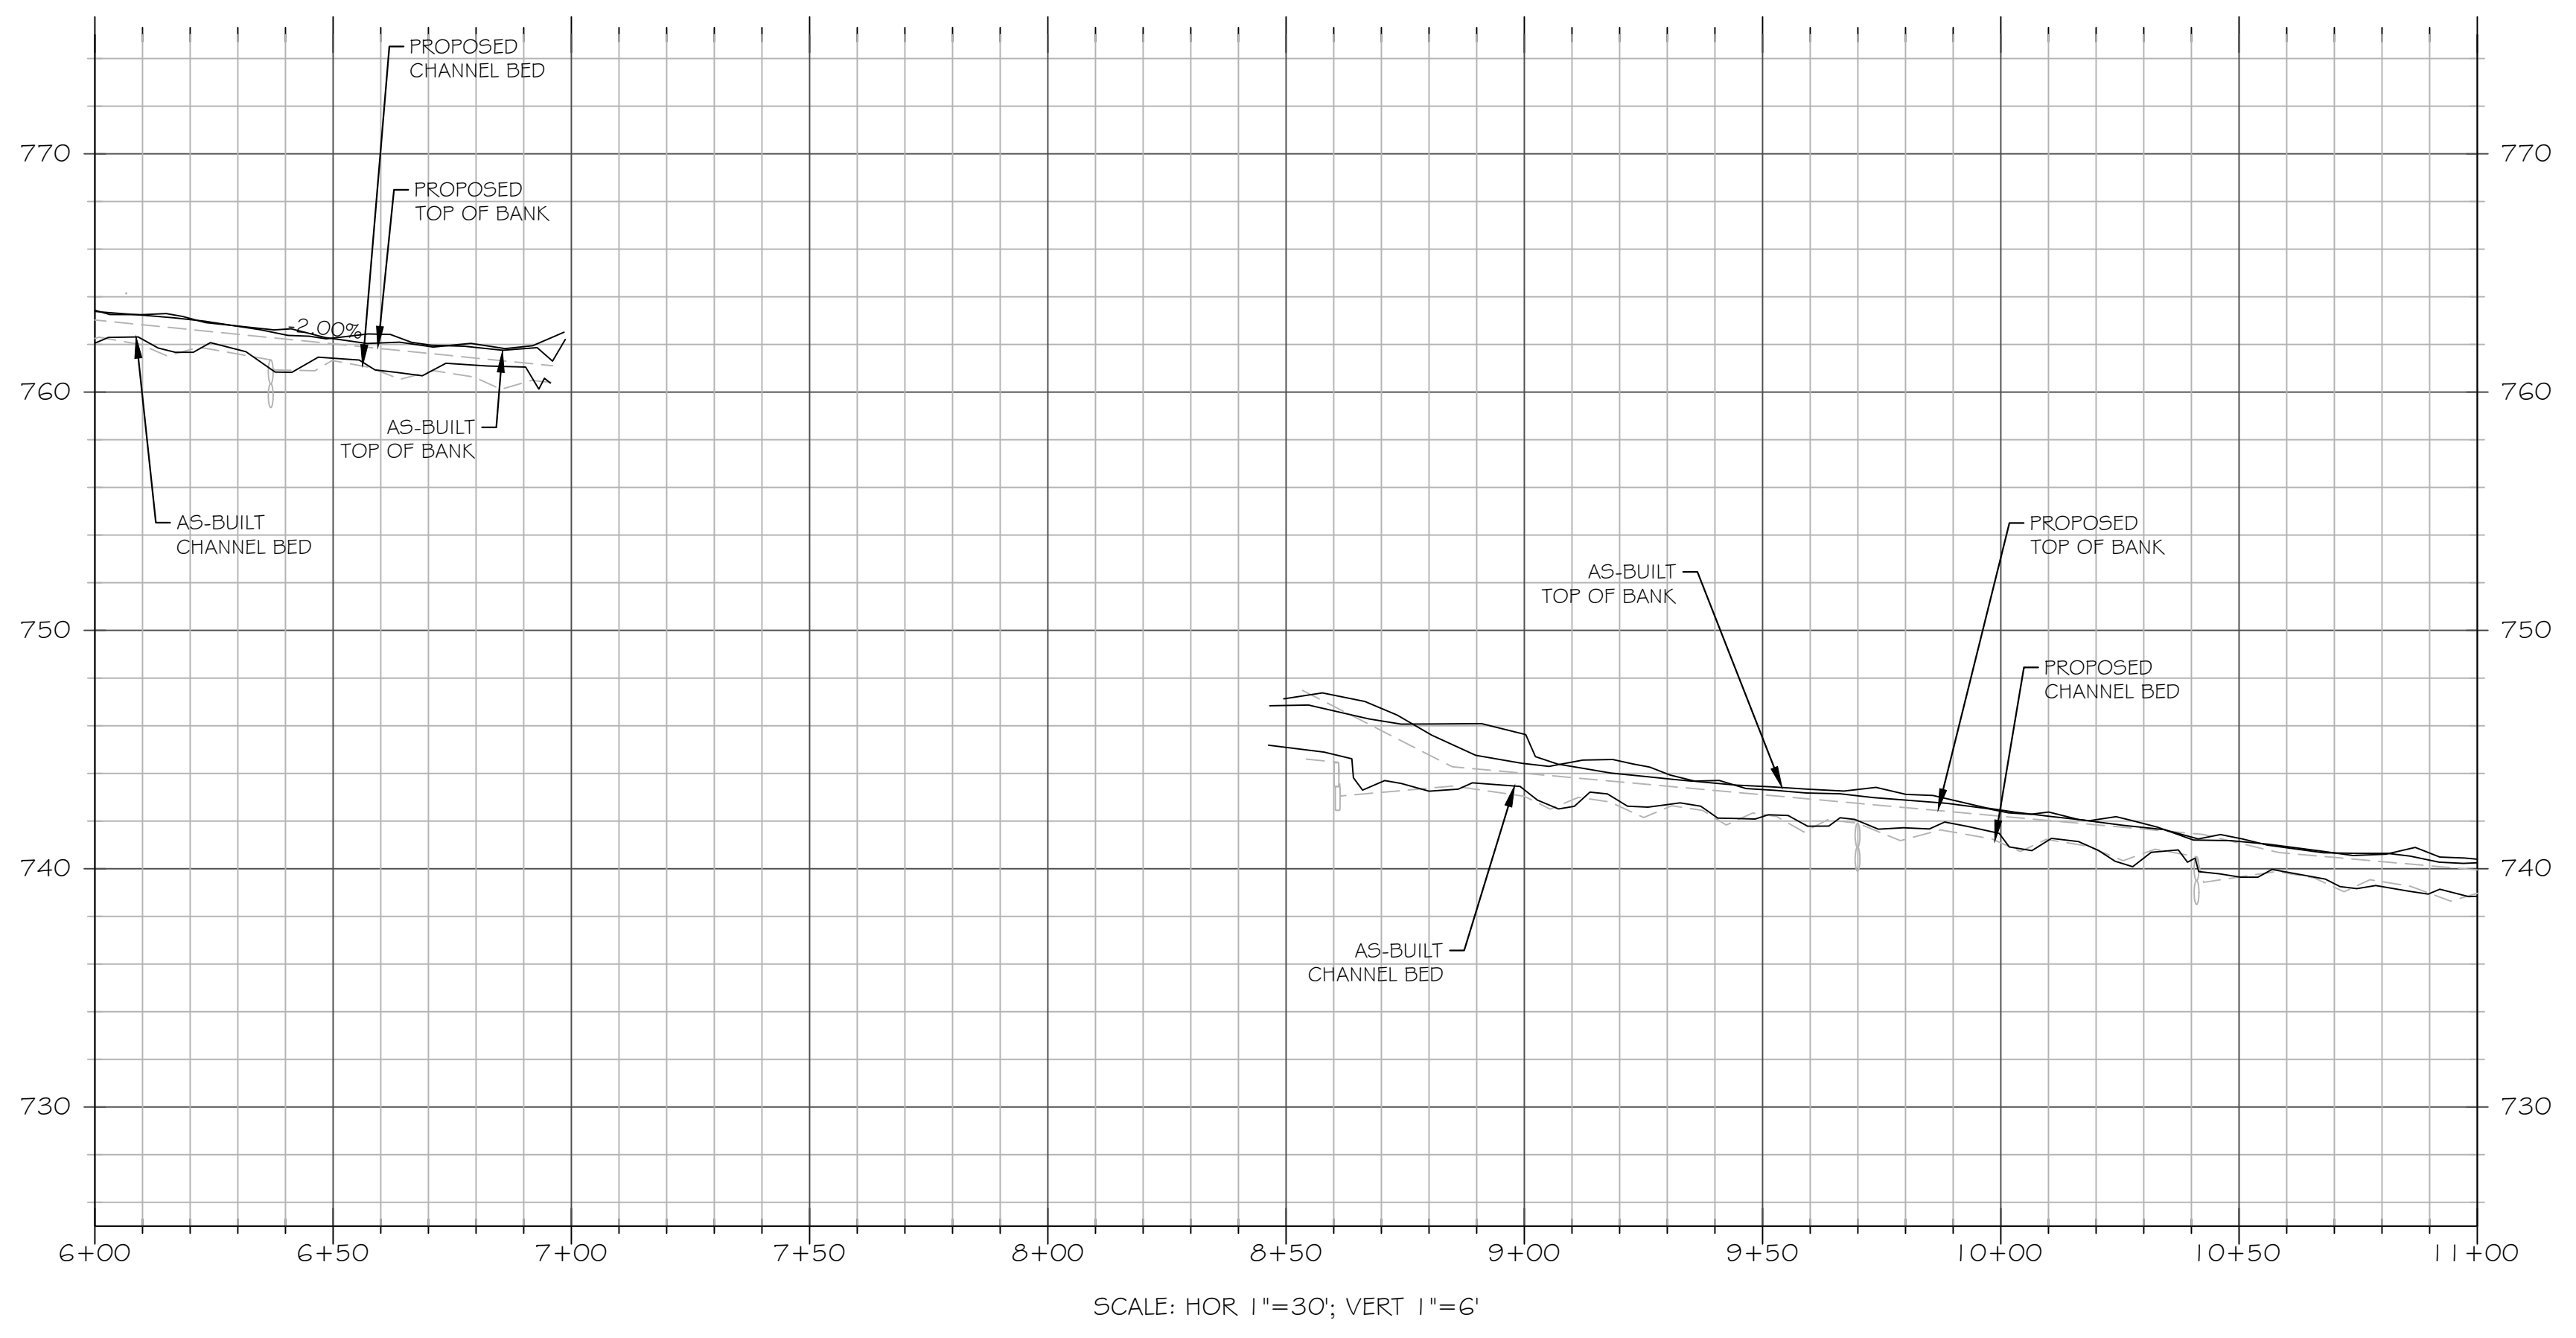

FILE NAME: F:\resgis\dropbox\projects\NC\Catbird\CAD\ABRL\_0386\_ABRL\_DS2.dwg SAVED BY: Stasking

FILE NAME: F:\resgis\dropbox\projects\NC Catbird\CAD\ABRL\_0386\_ABRL\_DS2.dwg SAVED BY: Sleeking

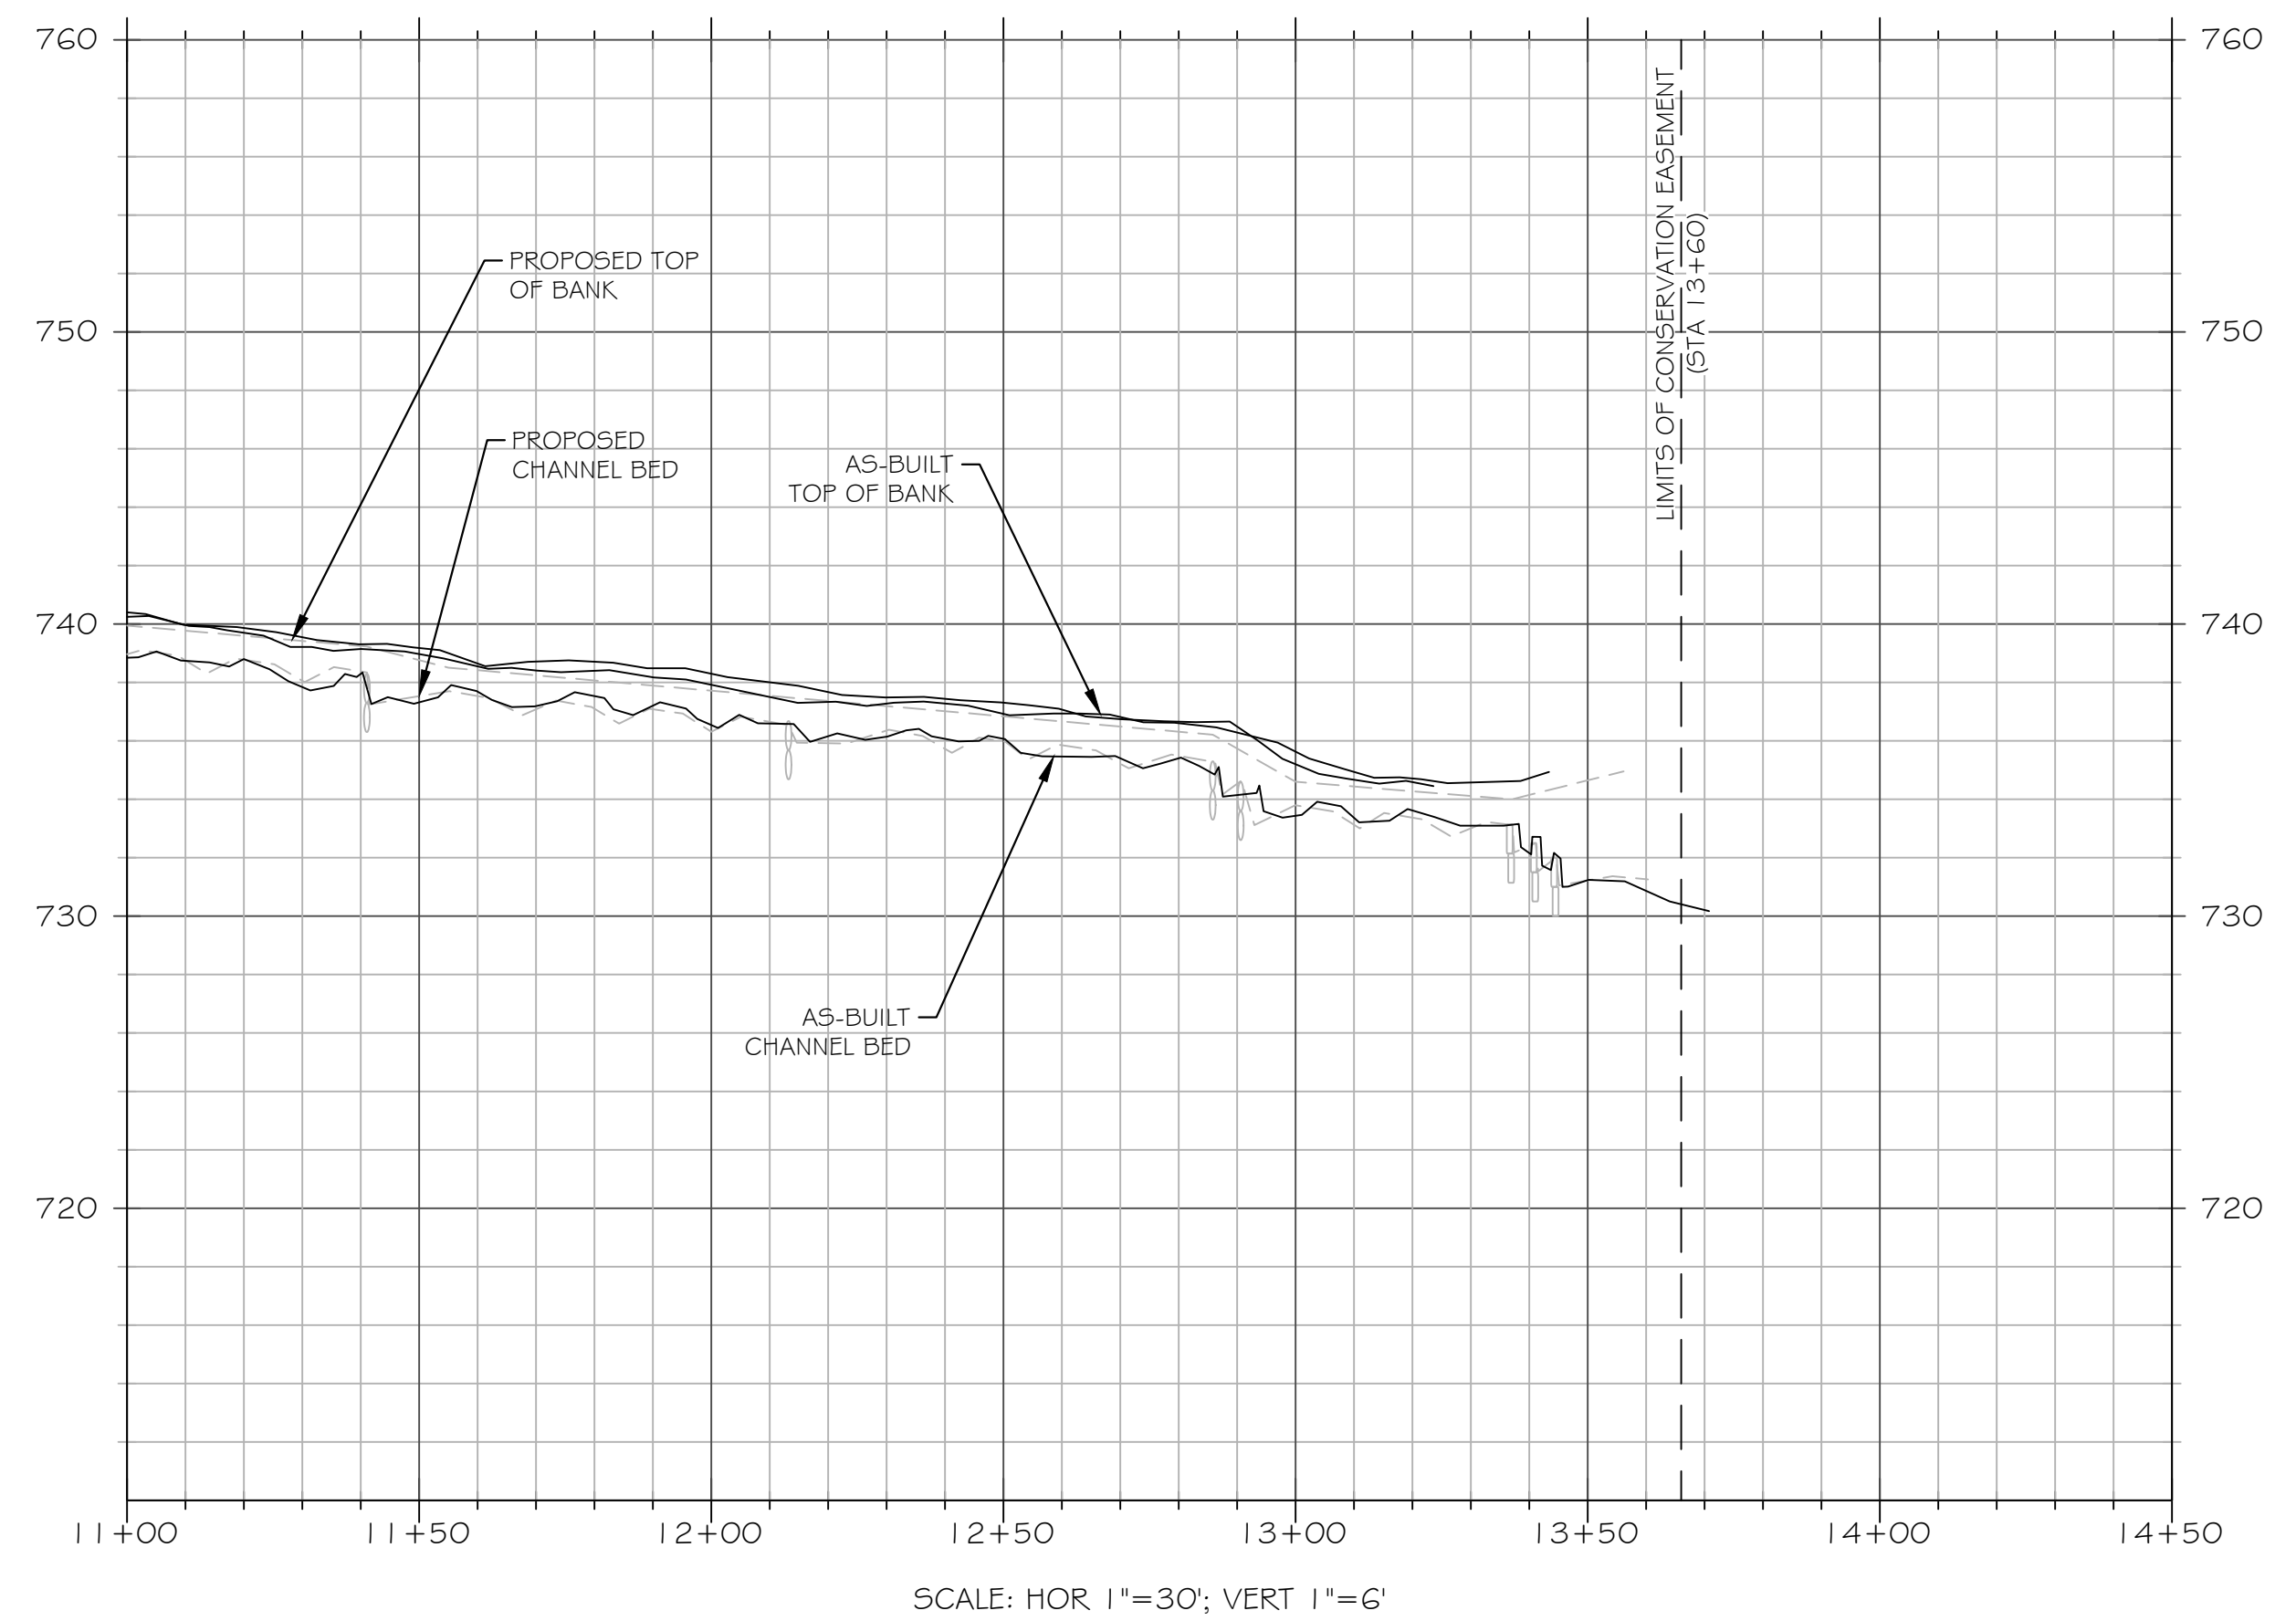
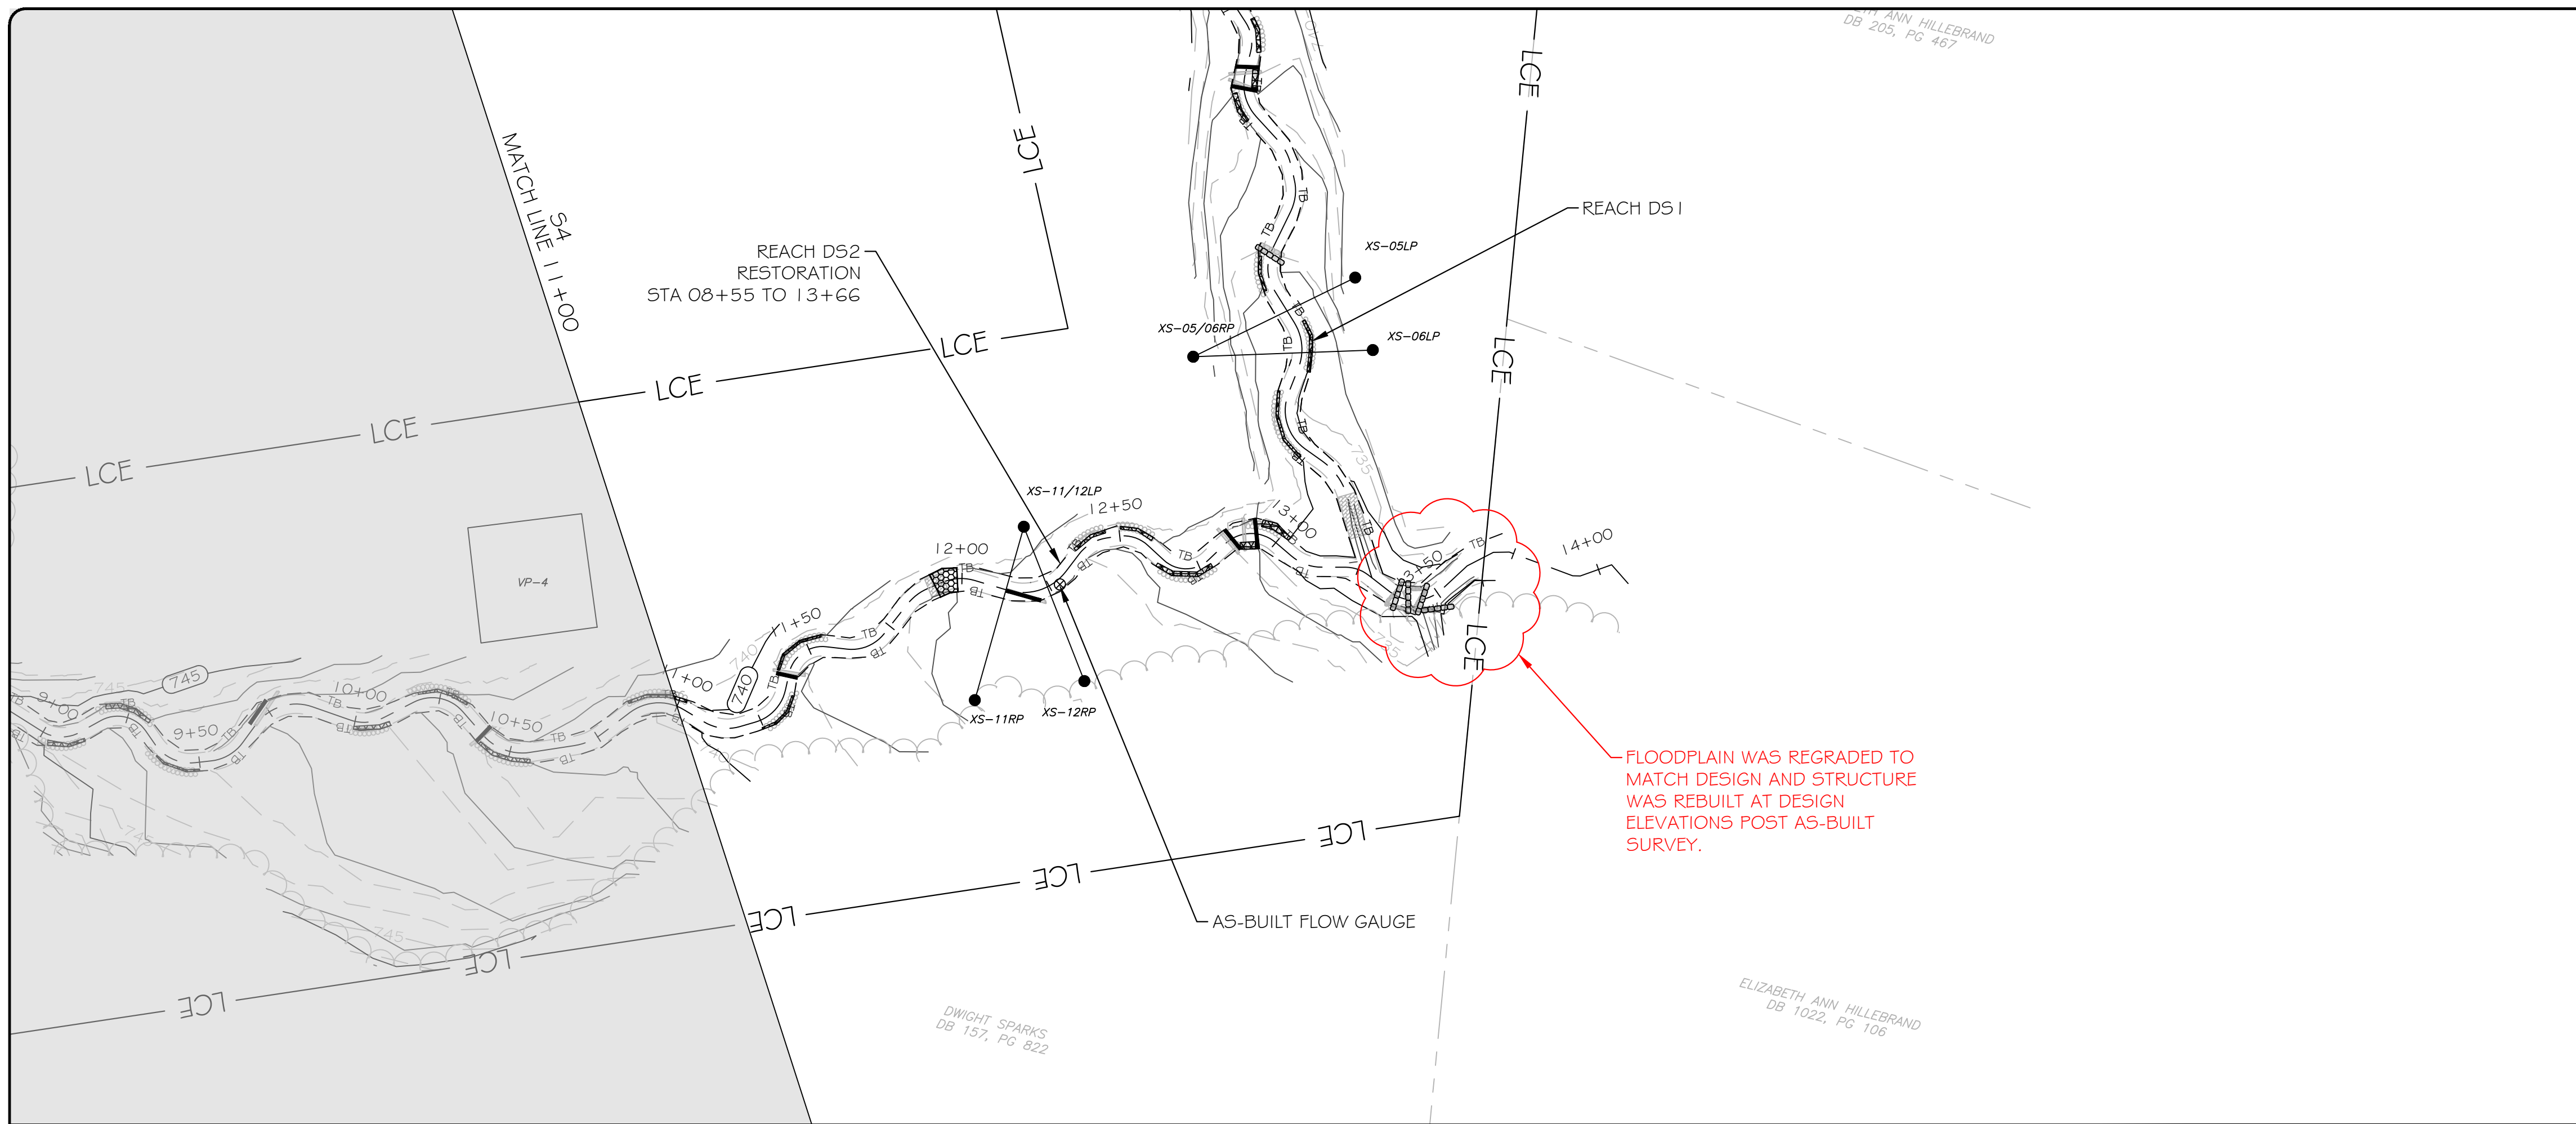


| LEGEND                                   |  |
|--|--|
| EXISTING WETLAND                         |  |
| EXISTING OVERHEAD ELECTRIC UTILITY LINE  |  |
| PROPERTY LINE                            |  |
| PROPOSED CONTOUR MAJOR                   |  |
| PROPOSED CONTOUR MINOR                   |  |
| PROPOSED TOP OF BANK                     |  |
| PROPOSED CHANNEL CENTERLINE              |  |
| AS-BUILT CONTOUR MAJOR                   |  |
| AS-BUILT CONTOUR MINOR                   |  |
| AS-BUILT TOP OF BANK                     |  |
| AS-BUILT CHANNEL CENTERLINE              |  |
| BRUSH TOE PROTECTION                     |  |
| LOG SILL                                 |  |
| LOG VANE                                 |  |
| ROCK SILL                                |  |
| STEP POOL                                |  |
| RIFFLE GRADE CONTROL                     |  |
| SEDIMENT TRAP                            |  |
| AS-BUILT BRUSH TOE                       |  |
| AS-BUILT LOG STRUCTURE                   |  |
| AS-BUILT ROCK STRUCTURE                  |  |
| AS-BUILT RIFFLE GRADE CONTROL            |  |
| AS-BUILT SEDIMENT TRAP                   |  |
| AS-BUILT CROSS-SECTION                   |  |
| AS-BUILT STAGE RECORDER                  |  |
| AS-BUILT FLOW GAUGE                      |  |
| AS-BUILT VEGETATION MONITORING PLOT      |  |
| LIMITS OF PROPOSED CONSERVATION EASEMENT |  |

NOTE: ALL SIGNIFICANT CHANGES FROM THE DESIGN ARE SHOWN IN RED

3600 Glenwood Ave, Suite 100  
Raleigh, NC 27612  
Main: 919.829.9909  
www.res.us

Engineering Services Provided By:  
Angler Environmental, LLC  
License: F-1428

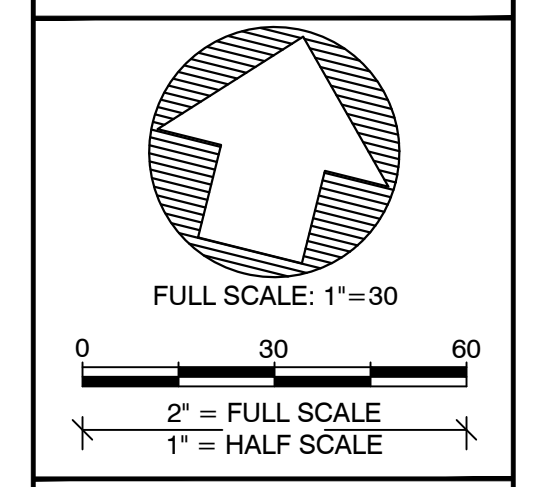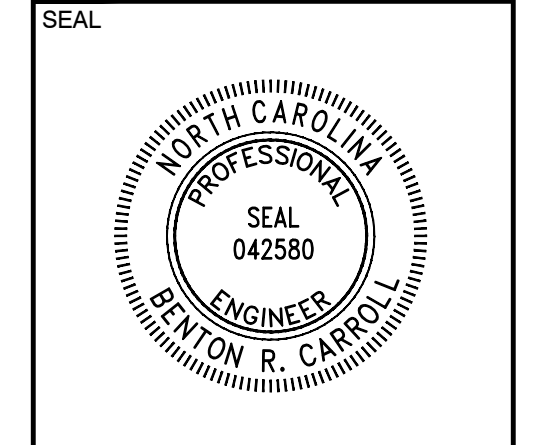

PLOT DATE:  
7/1/2020

REVISIONS:

RELEASED FOR:  
RECORD DRAWINGS


PROJECT NAME:  
CATBIRD RECORD DRAWINGS  
DAVIE COUNTY, NORTH CAROLINA

DRAWING TITLE:  
REACH DS2

PROJECT NUMBER: 0386  
PROJECT MANAGER: BPB  
DESIGNED: BRC  
DRAWN: TRS  
CHECKED: AFM

SHEET NUMBER:  
**S5**

FILE NAME: R:\Resgis\dropbox\projects\NC\Catbird\CAD\ABRL\0386\_ABRL\_PLANTING.dwg SAVED BY: Bearroll

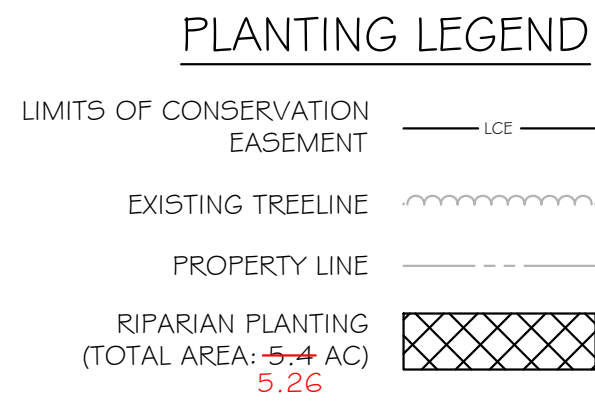

### PLANTING TABLE

| Permanent Riparian Seed Mix |                                   |                     |
|-----------------------------|-----------------------------------|---------------------|
| Common Name                 | Scientific Name                   | Percent Composition |
| Virginia Wildrye            | <i>Elymus virginicus</i>          | 25%                 |
| Indian Grass                | <i>Sorghastrum nutans</i>         | 25%                 |
| Little Blue Stem            | <i>Schizachyrium scapanum</i>     | 10%                 |
| Soft Rush                   | <i>Juncus effusus</i>             | 10%                 |
| Blackeyed susan             | <i>Rudbeckia hirta</i>            | 10%                 |
| Desertongue                 | <i>Dichanthelium clandestinum</i> | 10%                 |
| Common Milkweed             | <i>Asclepias syriaca</i>          | 5%                  |
| Showy Goldenrod             | <i>Solidago erecta</i>            | 5%                  |


| Live Staking and Live Cuttings Bundle Tree Species |                      |                     |
|--|----------------------|---------------------|
| Common Name  | Scientific Name      | Percent Composition |
| Silky dogwood                                      | <i>Cornus amomum</i> | 40%                 |
| Black willow                                       | <i>Salix nigra</i>   | 60%                 |

| Bare Root Planting Tree Species |                               |                     |
|---------------------------------|-------------------------------|---------------------|
| Common Name                     | Scientific Name               | Percent Composition |
| Water Oak                       | <i>Quercus nigra</i>          | <del>+5%</del> 9%   |
| Willow Oak                      | <i>Quercus phellos</i>        | <del>+5%</del> 9%   |
| River Birch                     | <i>Betula nigra</i>           | <del>+5%</del> 9%   |
| American Sycamore               | <i>Platanus occidentalis</i>  | <del>+5%</del> 9%   |
| Northern Red Oak                | <i>Quercus rubra</i>          | <del>+0%</del> 7%   |
| Green Ash                       | <i>Fraxinus pennsylvanica</i> | <del>+0%</del> 7%   |
| Yellow Poplar                   | <i>Liquidambar tulipifera</i> | <del>+0%</del> 7%   |
| Persimmon                       | <i>Diospyros virginiana</i>   | <del>-5%</del> 13%  |
| <del>Black Gum</del>            | <del>Nyssa biflora</del>      | <del>-5%</del>      |
| Crab Apple                      | <i>Malus angustifolia</i>     | 9%                  |
| Silky Dogwood                   | <i>Cornus amomum</i>          | 5%                  |
| Sugar Berry                     | <i>Celtis laevigata</i>       | 4%                  |
| Black Walnut                    | <i>Juglans nigra</i>          | 4%                  |
| Elderberry                      | <i>Sambucus canadensis</i>    | 4%                  |
| Eastern Redbud                  | <i>Cercis canadensis</i>      | 4%                  |

### PLANTING NOTES



#### ALL PLANTING AREAS

1. EROSION CONTROL MEASURES SHALL BE PROPERLY MAINTAINED UNTIL PERMANENT VEGETATION IS ESTABLISHED AND FINAL APPROVAL HAS BEEN ISSUED. THE CONTRACTOR SHALL INSPECT EROSION CONTROL MEASURES AT THE END OF EACH WORKING DAY TO ENSURE MEASURES ARE FUNCTIONING PROPERLY.
2. DISTURBED AREAS NOT AT FINAL GRADE SHALL BE TEMPORARILY VEGETATED WITHIN 10 WORKING DAYS. UPON COMPLETION OF FINAL GRADING, PERMANENT VEGETATION SHALL BE ESTABLISHED FOR ALL DISTURBED AREAS WITHIN 10 WORKING DAYS. SEEDING SHALL BE IN ACCORDANCE WITH EROSION CONTROL PLAN.
3. ALL DISTURBED AREAS SHALL BE PREPARED PRIOR TO PLANTING BY DISC OR SPRING-TOOTH CHISEL FLOW TO MINIMUM DEPTH OF 12 INCHES. MULTIPLE PASSES SHALL BE MADE ACROSS PLANTING AREAS WITH THE IMPLEMENT AND THE FINAL PASS SHALL FOLLOW TOPOGRAPHIC CONTOURS.
4. BARE ROOT PLANTINGS SHALL BE PLANTED ACCORDING TO DETAIL SHOWN ON SHEET D2. LIVE STAKES SHALL BE PLANTED ACCORDING TO DETAIL SHOWN ON SHEET D2.
5. TREATMENT/REMOVAL OF INVASIVE SPECIES, PINES AND SWEET GUMS LESS THAN 6" DBH SHALL BE PERFORMED THROUGHOUT THE PLANTED AREA.
6. SPECIES SHALL BE DISTRIBUTED SUCH THAT 3 TO 6 PLANTS OF THE SAME SPECIES ARE GROUPED TOGETHER.
7. BARE ROOT PLANTING DENSITY IS APPROXIMATELY 800 STEMS PER ACRE.
8. LIVE STAKES ARE PROPOSED ALONG THE OUTSIDE OF MEANDER BENDS AND ALONG BOTH BANKS OF STRAIGHT REACHES ADJACENT TO POOLS.
9. TEMPORARY SEED MIX SHALL BE APPLIED AT A RATE OF 150 LBS/ACRE TO ALL DISTURBED AREAS WITH SLOPES EQUAL TO OR STEEPER THAN 3:1.
10. PERMANENT RIPARIAN SEED MIX SHALL BE APPLIED TO ALL DISTURBED AREAS WITHIN THE CONSERVATION EASEMENT AT A RATE OF 15 LBS/ACRE.
11. PERMANENT HERB SEED MIX SHALL BE APPLIED TO ALL DISTURBED AREAS WITHIN THE CONSERVATION EASEMENT BREAKS AT A RATE OF 15 LBS/ACRE.
12. BARE ROOT SPECIES AND PERCENT COMPOSITION MAY BE ADJUSTED DUE TO COMMERCIAL AVAILABILITY PER APPROVAL FROM THE ENGINEER. REPLACEMENT SPECIES MUST NOT INCLUDE HACKBERRY (*Celtis occidentalis*) OR SUGARBERRY (*Celtis laevigata*).

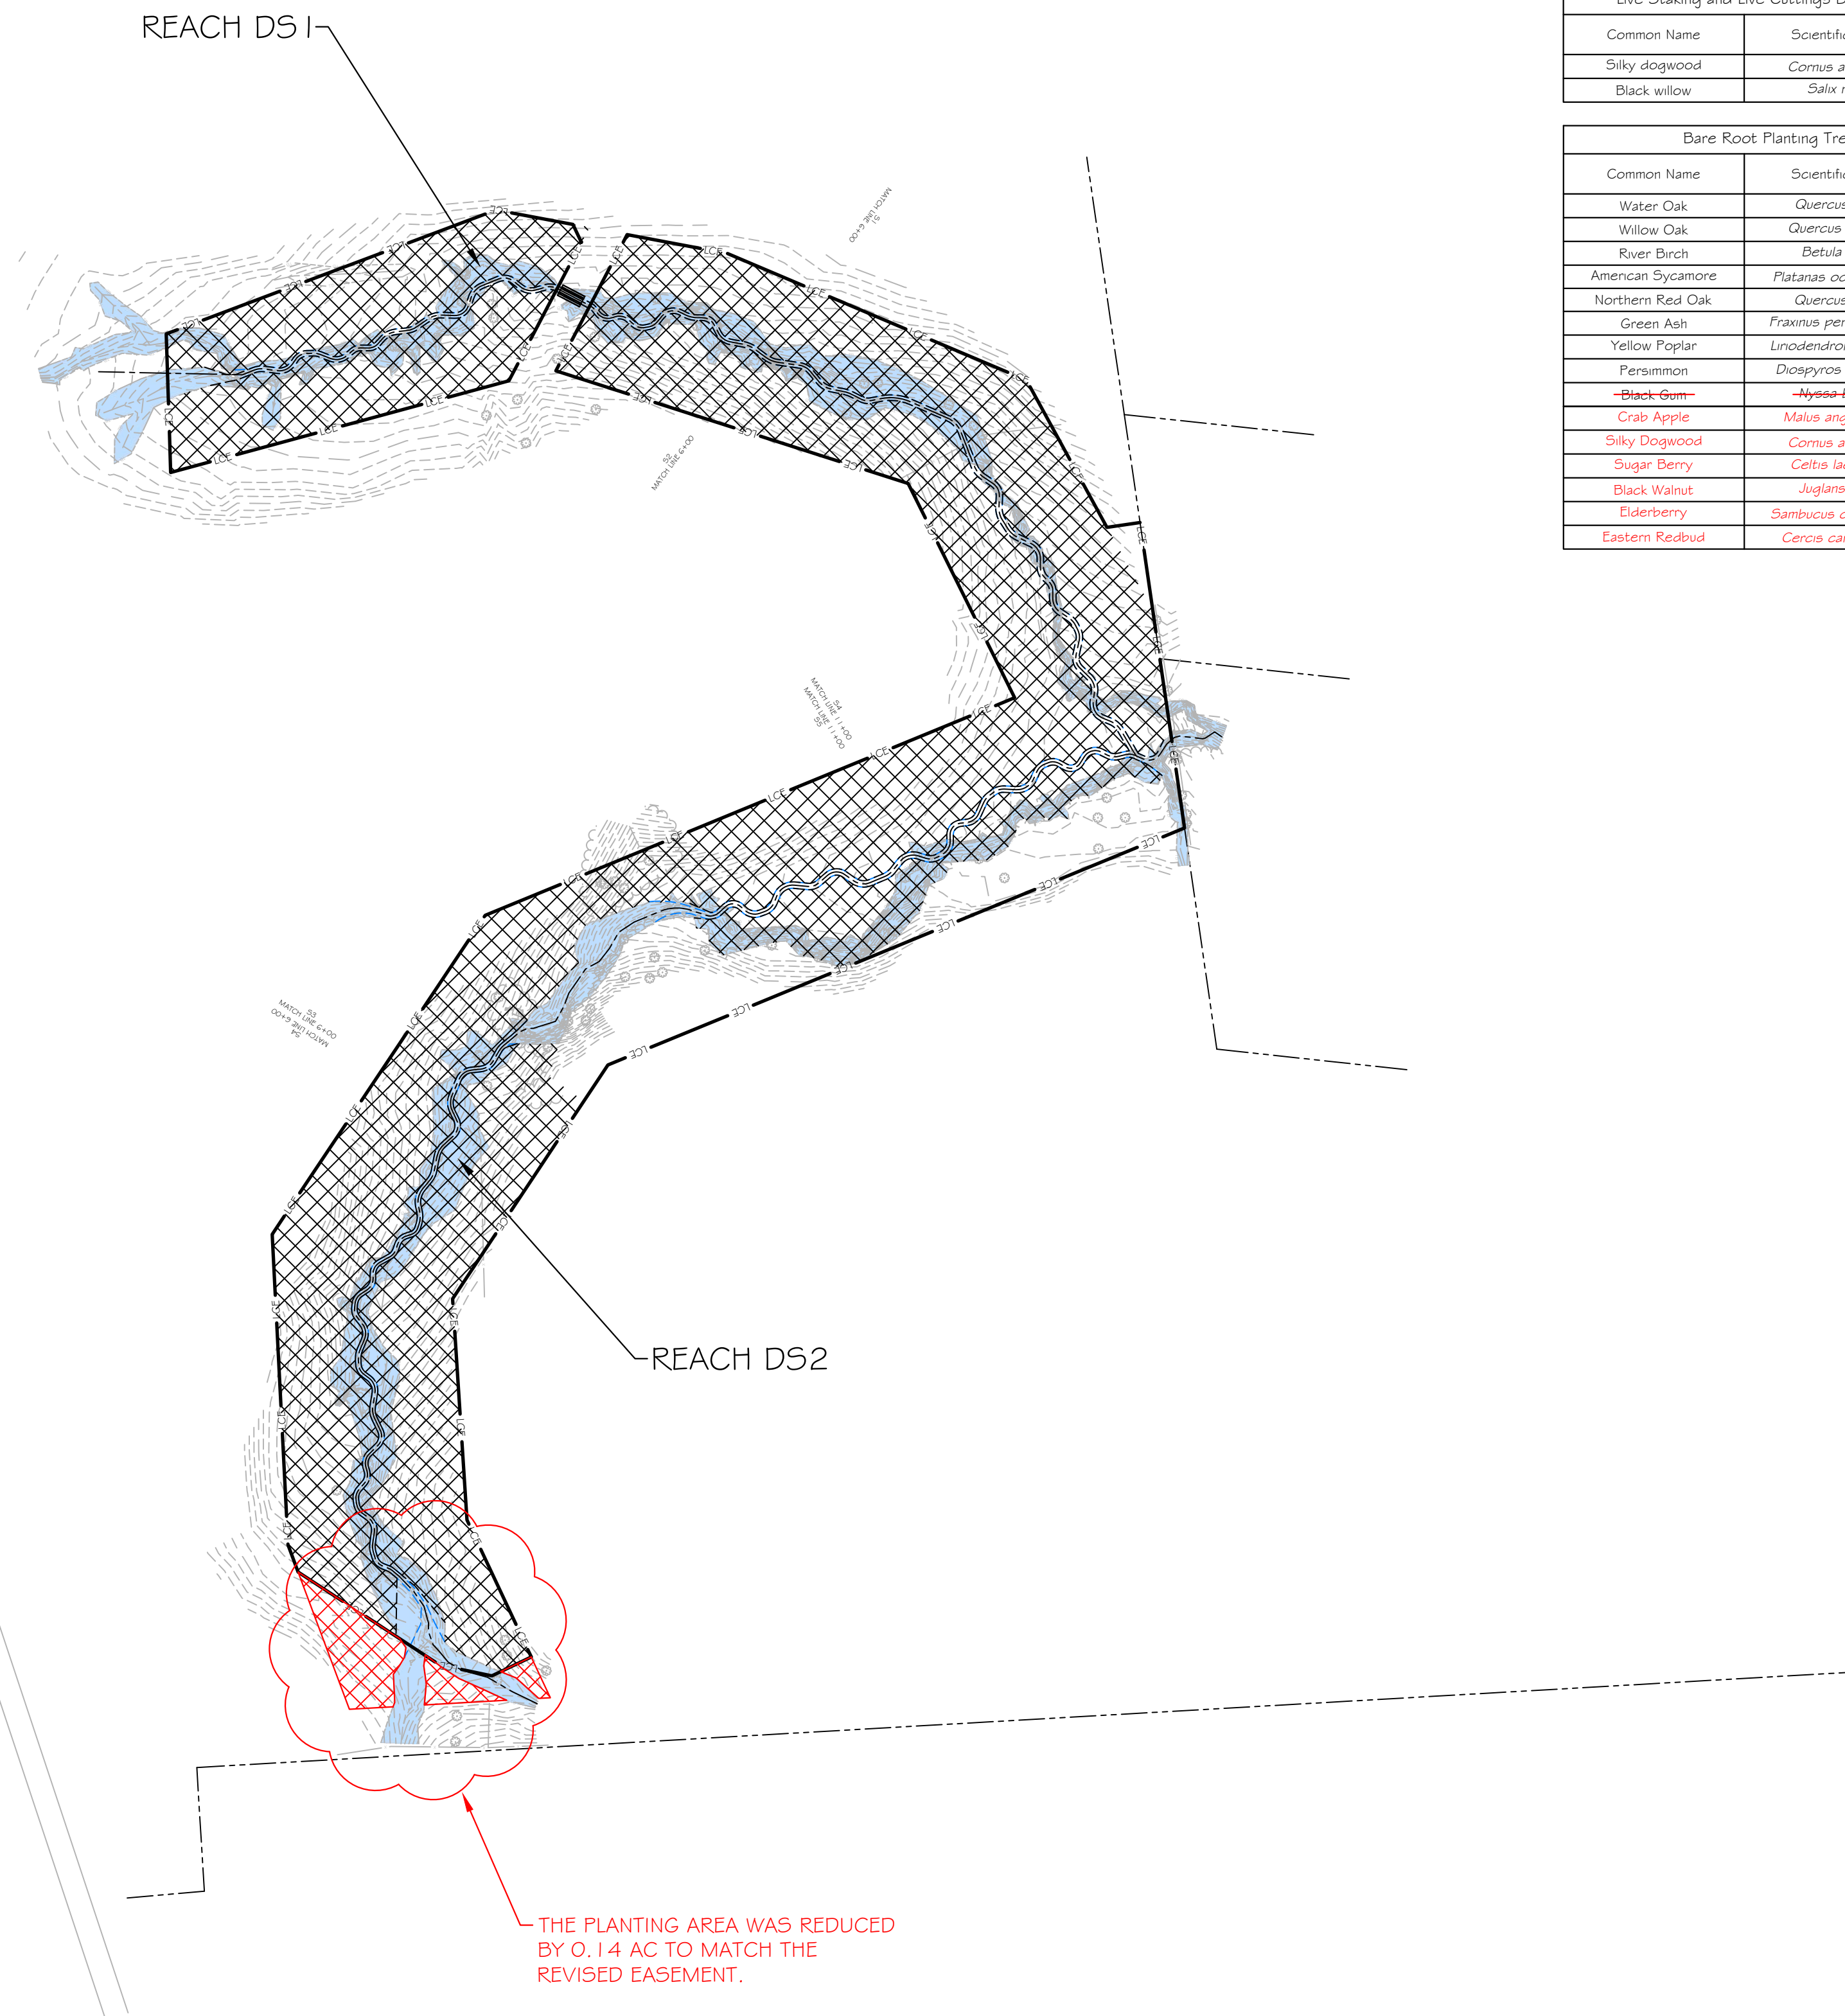


302 Jefferson Street, Suite 110  
Raleigh, NC 27605  
Main: 919.829.9909  
Fax: 919.829.9913  
www.res.us

SEAL

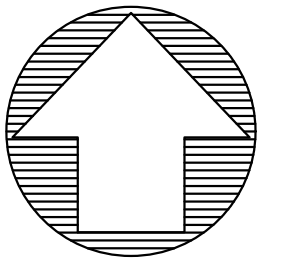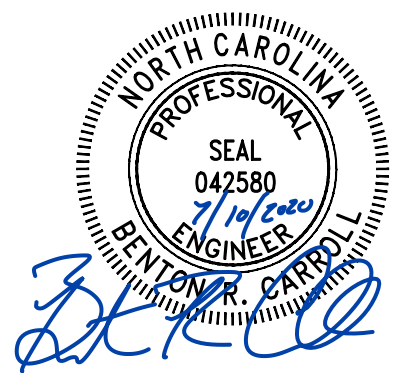

FULL SCALE: 1" = 100'

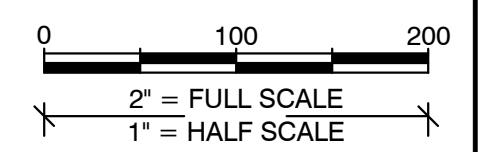

| MARK | DATE | DESCRIPTION | RELEASED FOR: | RECORD DRAWINGS | PLOT DATE: |
|------|------|-------------|---------------|-----------------|------------|
|      |      |             |               |                 | 07/10/2020 |

PROJECT NAME:  
CATBIRD RECORD DRAWINGS  
DAVIE COUNTY, NORTH CAROLINA

DRAWING TITLE:  
PLANTING PLAN


PROJECT NUMBER: 0386  
PROJECT MANAGER: BPB  
DESIGNED: BRC  
DRAWN: TRS  
CHECKED: AFM

SHEET NUMBER:

P1


# **Appendix F**

## Easement Comparison Map

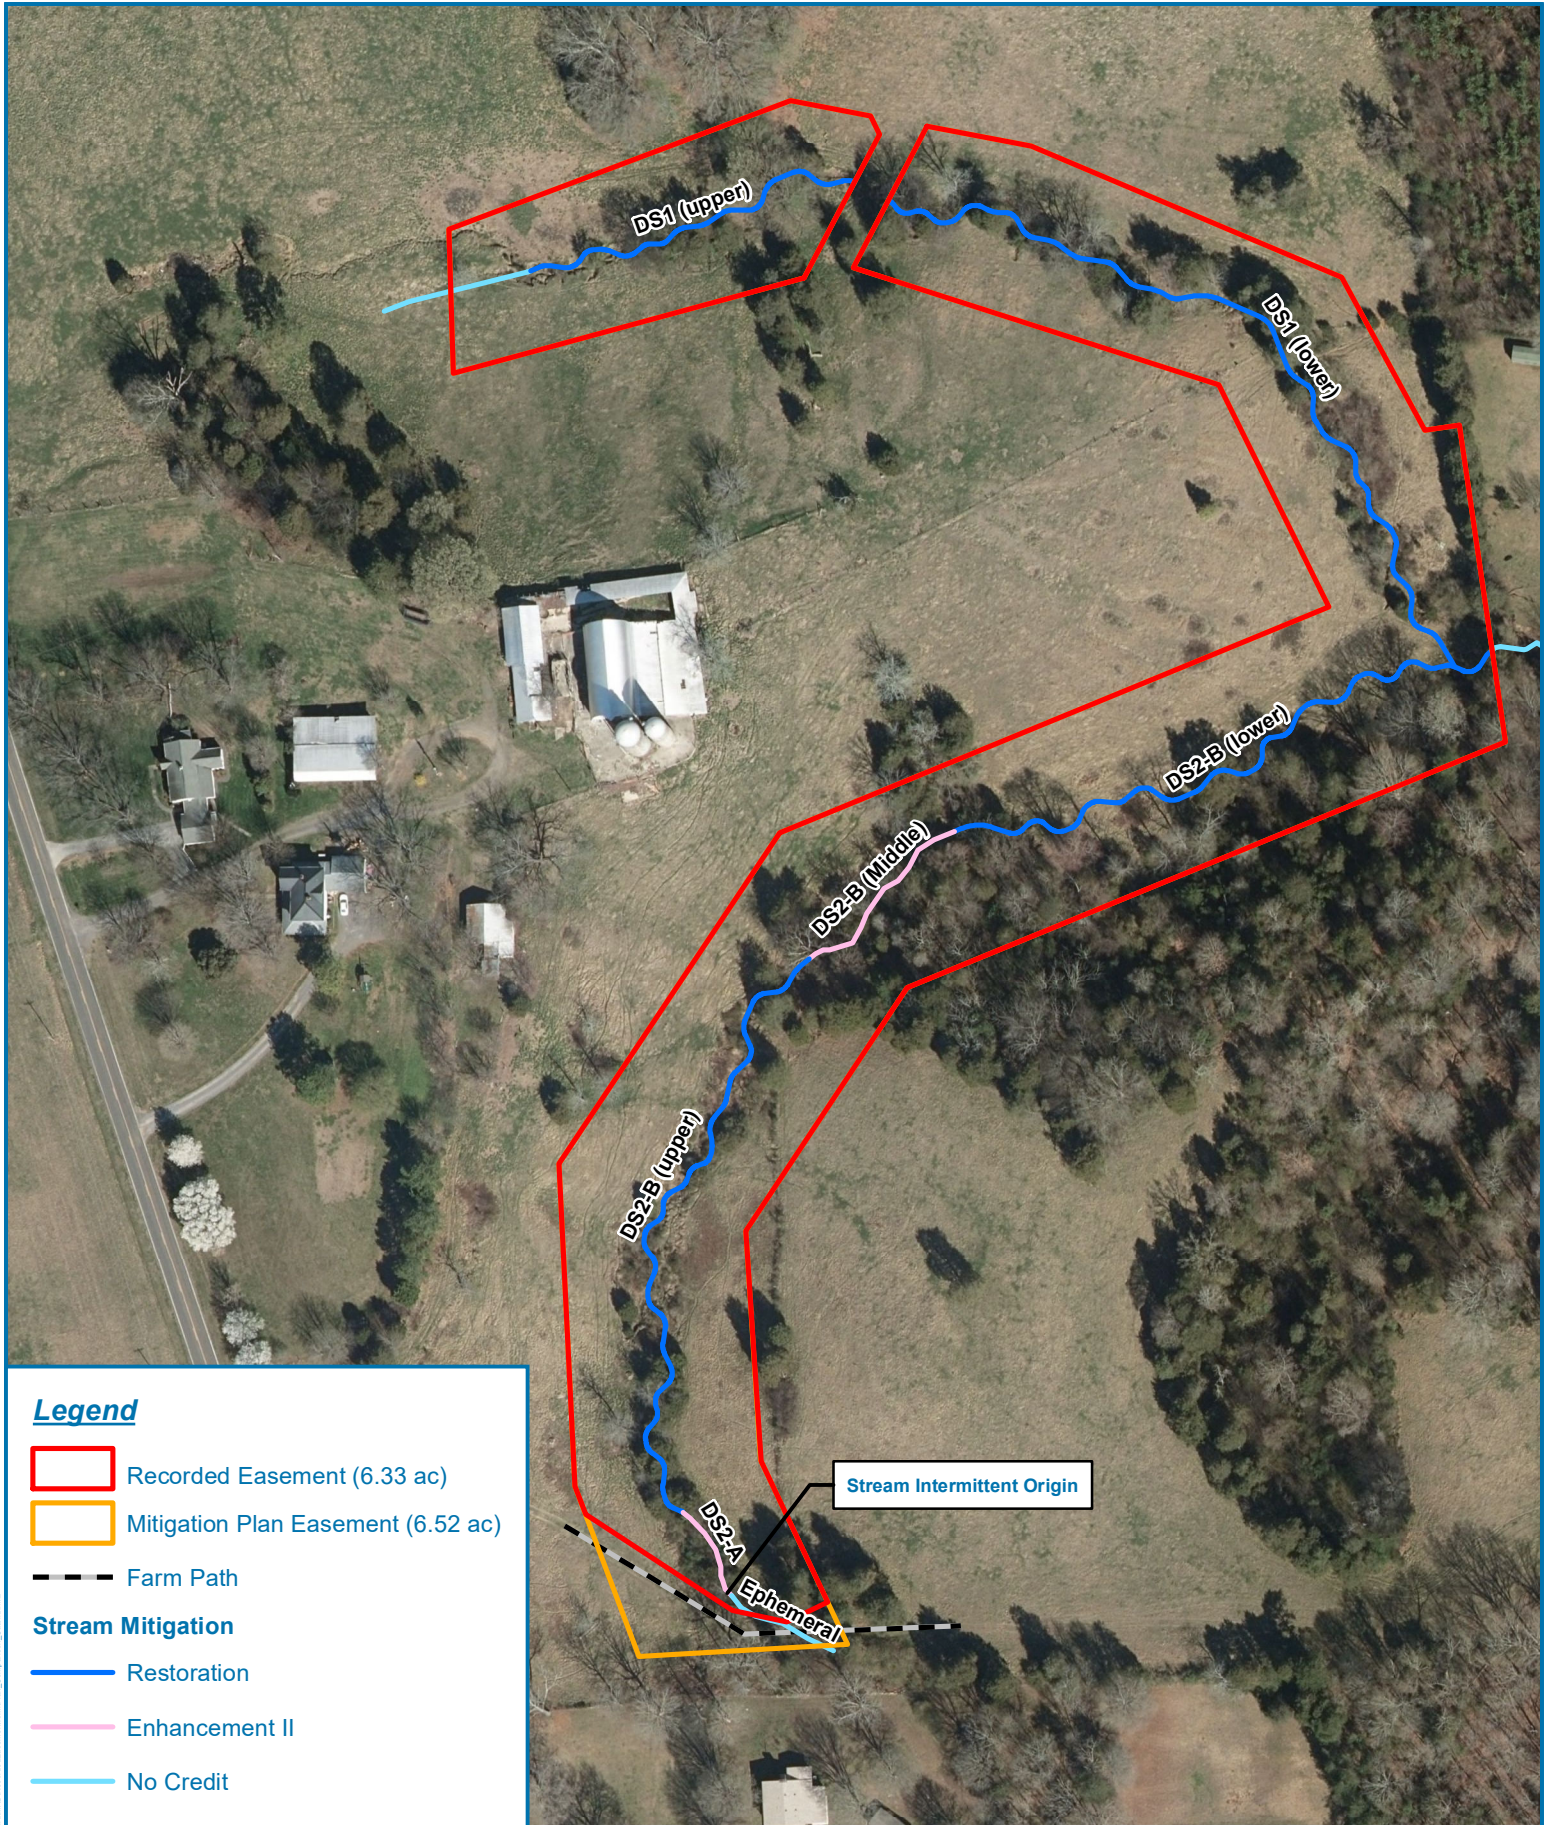

**Legend**

- Recorded Easement (6.33 ac)
- Mitigation Plan Easement (6.52 ac)
- Farm Path
- Stream Mitigation**
- Restoration
- Enhancement II
- No Credit

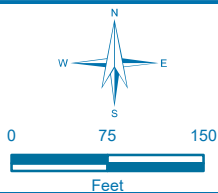

**Easement Comparison Map**  
**Catbird Mitigation Site**  
 Davie County, North Carolina

Date: 7/10/2020

Drawn by: RTM

Checked by: BPB

1 inch = 150 feet

