
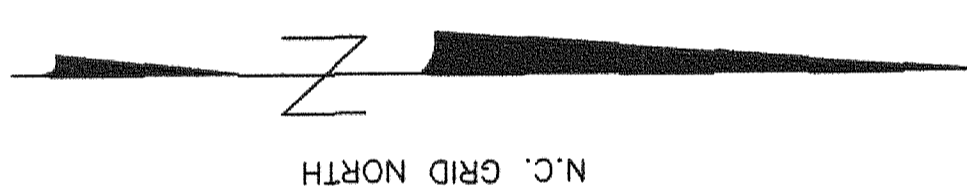


- REFERENCES**
1. PLAT BOOK 45, PAGE 93.
 2. PLAT BOOK 48, PAGE 91.
 3. BOUNDARY SURVEY OF BOULDER CREEK, HERRBERT H. PROCTOR, JR. AND AUTUMN RIDGE HOMEOWNERS ASSOCIATION, BY CONCORD ENGINEERING & SURVEYING, INC. FOR N.C.D.O.G.
 4. FEDERAL BUREAU OF SURVEYING, U.S. DEPARTMENT OF THE INTERIOR.
 5. DEEDS WITH ADDENDUMS.


- NOTES**
1. AREA BY COORDINATE CALCULATION.
 2. PROPERTY IS SUBJECT TO EASEMENTS AND RIGHTS OF WAY.
 3. THIS SURVEY IS SUBJECT TO THE RECORDS OF THIS SURVEY.
 4. ALL DISTANCES SHOWN ARE HORIZONTAL GROUND DISTANCES UNLESS OTHERWISE NOTED.
 5. SURVEY WAS PERFORMED WITHOUT THE BENEFIT OF A TITLE SEARCH. PROPERTY IS SUBJECT TO ALL FACTS NOTED HEREIN.
 6. THIS PLAT IS A CORRECT REPRESENTATION OF THE SURVEY AND HAS BEEN PREPARED IN CONFORMANCE WITH NORTH CAROLINA STANDARDS, GS-17-30, AND REQUIREMENTS SHOULD BE CONSULTED DEPARTMENT OF REVENUE, DIVISION OF RECORDS AND MAPPING, FOR A COMPLETE LIST OF REQUIREMENTS.
 7. QUESTIONS REVEALED BY A TITLE EXAMINATION.
 8. DASHED LINES REPRESENT LINES NOT SURVEYED.
 9. VERTICAL DATUM BASE PROVIDED BY OTHERS.

- LEGEND**
- LOG SILL
 - LOG VANE W/ ROOTWAD
 - LOG VANE W/ ROOTWAD AND SILL
 - LOG CROSS VANE
 - ROCK
 - CROSS VANE
 - LOG VANE
 - ROOTWAD
 - EROSION CONTROL DITCH
 - LIMITS OF DISTURBANCE
 - APPROXIMATE SIGN LOCATION
 - INTERCEPTOR

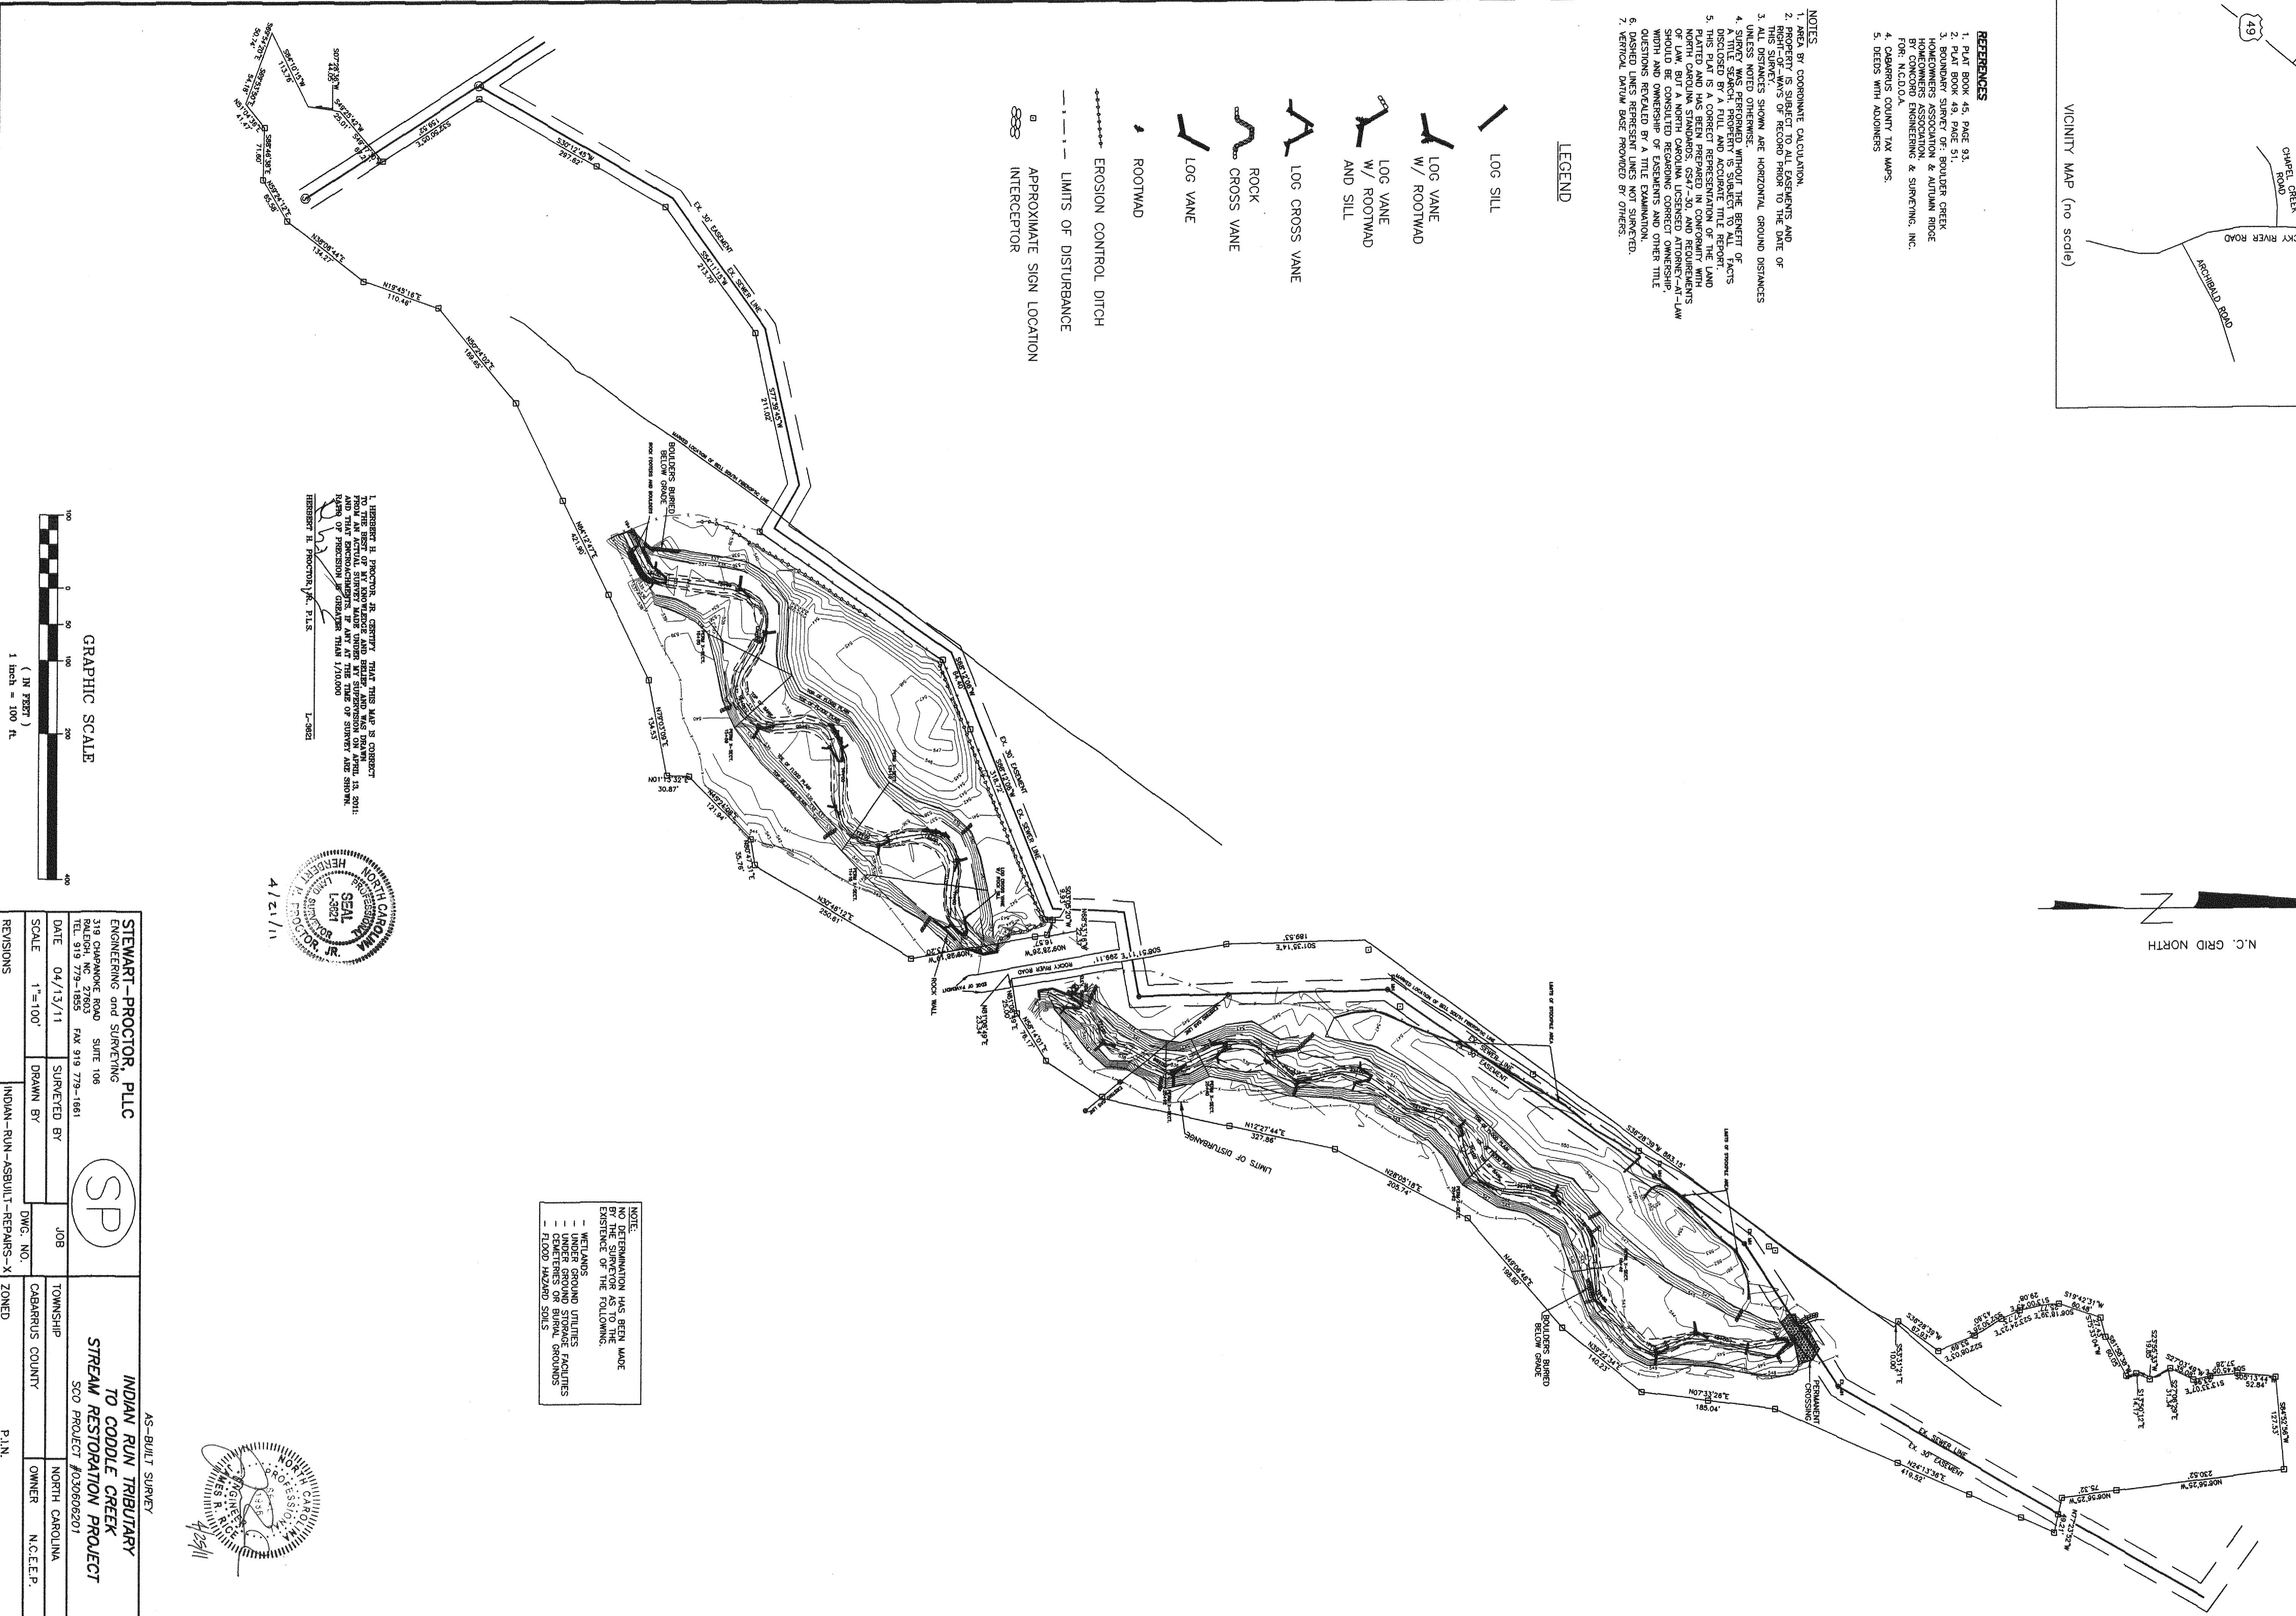



NOTE:
NO DETERMINATION HAS BEEN MADE BY THE SURVEYOR AS TO THE EXISTENCE OF THE FOLLOWING:
— WETLANDS
— UNDERGROUND UTILITIES
— UNDERGROUND STRUCTURES
— CEMETERIES OR BURIAL GROUNDS
— FLOOD HAZARD SOILS

I, HERRBERT H. PROCTOR, JR. CERTIFY THAT THIS MAP IS CORRECT TO THE BEST OF MY KNOWLEDGE AND BELIEF AND WAS DRAWN AND PLATED IN ACCORDANCE WITH THE REQUIREMENTS OF THE BOARD OF PROFESSIONAL ENGINEERS AND SURVEYORS OF THE STATE OF NORTH CAROLINA.
HERRBERT H. PROCTOR, JR. P.L.S.
L-3823

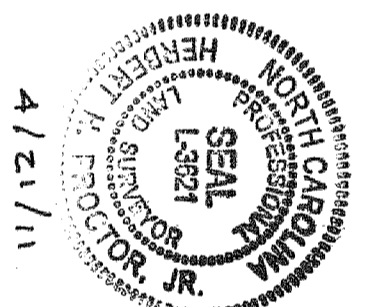

4/21/11

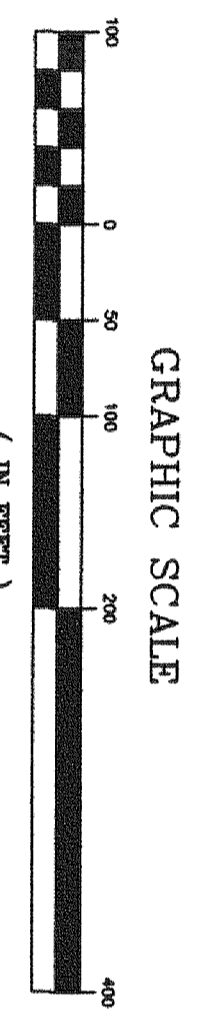

STEWART-PROCTOR, PLLC ENGINEERING and SURVEYING 319 CHAMPAGNE ROAD SUITE 106 WELLSVILLE, NC 27655 TEL. 319 729-1555 FAX 319 729-1861			
DATE	04/13/11	SURVEYED BY	
SCALE	1"=100'	DRAWN BY	
REVISIONS		DWG. NO.	INDIAN-RUN-ASBUILT-REPAIRS-X
AS-BUILT SURVEY INDIAN RUN TRIBUTARY TO CIDDLE CREEK STREAM RESTORATION PROJECT SCO PROJECT #03080201		TOWNSHIP	CABARRUS COUNTY
		OWNER	N.C.E.E.P.
		P.L.M.	

