

# **MYO FINAL MONITORING REPORT**

## **CRANE STREAM AND WETLAND MITIGATION SITE**

Lee County, North Carolina

Cape Fear River Basin

Cataloging Unit 03030004

DMS Project No. 100165

Full Delivery Contract No. 0302-01

DMS RFP No. 16-20190302 (issued 12/20/2019)

USACE Action ID No. SAW-2020-01401

DWR Project No. 20201292

Data Collection: December 2022-February 2023

Submission: April 2023



**Prepared for:**

NORTH CAROLINA DEPARTMENT OF ENVIRONMENTAL QUALITY

DIVISION OF MITIGATION SERVICES

1652 MAIL SERVICE CENTER

RALEIGH, NORTH CAROLINA 27699-1652





**Response to DMS Comments**

DMS Project ID No. 100165  
Full Delivery Contract No. 0302-01  
RFP No. 16-20190302  
USACE Action ID No. SAW-2020-01401  
DWR Project No. 20201292

**DMS Comments Received (Black Text) & Responses (Blue Text)**

1. Title Page(s) – The RFP date of issue is incorrect. Please correct to 12/20/2019 or omit the issue date completely.  
The RFP issue date was corrected.
  
2. Section 1.1 – 2nd paragraph states site design was completed in February 2023. This should presumably be 2022.  
The site design completion date was corrected.
  
3. Table 1 – All original mit plan stream lengths and as-built stream lengths are identical. Please report the actual surveyed lengths in the as-built column.  
Table was revised to include the surveyed as-built stream lengths.
  
4. Table 2 – The report is generally using the latest DMS monitoring report template tables. For consistency, please update Table 2 with the latest version of the table. Updating Table 2 would make Section 1.2 and Table C redundant, and those sections could be removed.  
Table 2 was updated to the latest DMS template, and Section 1.2 (Table A) and Table C were removed.
  
5. Section 4.0 – For the MY0 report, it would be useful to discuss or list construction deviations (red lines) here, i.e, the vane arm not constructed and the change to seed mix.  
Construction deviation discussions were added to this section- stream deviation (omitted vane arm) in Section 4.1 and seed mix changes in section 4.3.
  
6. Were 1m x 1m herbaceous plots proposed in the mit plan completed, or will those begin with MY1?  
As-built monitoring was performed in February, just after the Site was planted, before significant herbaceous vegetation had established. Herbaceous plots will be surveyed beginning in MY1.
  
7. Figure 1 – Please differentiate purpose of stream gauges, i.e., crest gauge vs. flow gauge.  
Figure 1 was updated to differentiate crest gauges from flow gauges.
  
8. Appendix C – Recommend removing BHR calculation from pool cross sections.  
BHR calculation was removed from all pool cross-sections.

**As-Built/Record Drawings:**

9. Sheet C5.00 – Please verify whether the riffle at UT1 Sta. 6+94 was surveyed. If not, please survey constructed riffles in the future.  
Constructed riffles will be surveyed moving forward- we apologize for missing this one.

10. Please add in-stream crest and flow gauges to the drawings if they were surveyed (one is shown on Sheet C5.12, but not on any others).  
Stream gauges are shown in the revised 5/2/23 as-built drawings.

11. Sheet C5.04 & Sheet L2.01 – Gravel access path and bridge are called out in red text. Was this a construction deviation, and if so, what was the deviation? If not, recommend calling out in black.  
Callouts have been modified to appear black on paper.

**Site Visit:**

12. A small area along the fence line on the left side of the UT1 EII area may not have been planted. Please verify.  
This area was checked and has been planted.

13. Ditch above start of UT3 is still very deep, and there is concern about its effect on the adjacent re-establishment wetlands.  
The short section of ditch that remains open is expected to fill with organic material as the site matures and serve as a headwater feature for the surrounding wetlands to the restored stream. This wetland headwater stream transition is observed in the sandhills ecoregion where surrounding wetlands discharge along the toe of slope to headwater forest wetlands found at stream origins. As observed in reference conditions this type of complex maintains wetland hydrology as hydrology discharges at the soil surface along the edges of the depressional feature.

We understand the concern for potential effects to adjacent wetland re-establishment assets. Given this type of complex in this ecoregion we propose to visually monitor the area for three years (MY1-3) to evaluate any potential effects to adjacent wetland assets. Annual visual monitoring of this area will include 4 fixed photo points of the ditch and surrounding area to document developments. During MY3 a delineation of the area including a minimum of three wetland delineation forms will be performed to identify any potential areas not meeting wetland re-establishment requirements.

# MYO FINAL MONITORING REPORT

## CRANE STREAM AND WETLAND MITIGATION SITE

Lee County, North Carolina  
Cape Fear River Basin  
Cataloging Unit 03030004

DMS Project No. 100165  
Full Delivery Contract No. 0302-01  
DMS RFP No. 16-20190302 (issued 12/20/2019)  
USACE Action ID No. SAW-2020-01401  
DWR Project No. 20201292

Data Collection: December 2022-February 2023  
Submission: April 2023

### Prepared for:

NORTH CAROLINA DEPARTMENT OF ENVIRONMENTAL QUALITY  
DIVISION OF MITIGATION SERVICES  
1652 MAIL SERVICE CENTER  
RALEIGH, NORTH CAROLINA 27699-1652




### Prepared by:



**Restoration Systems, LLC**  
1101 Haynes Street, Suite 211  
Raleigh, North Carolina 27604  
Contact: Raymond Holz  
919-755-9490 (phone)  
919-755-9492 (fax)

And

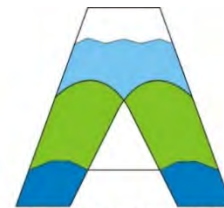

Axiom Environmental, Inc.

**Axiom Environmental, Inc.**  
218 Snow Avenue  
Raleigh, North Carolina 27603  
Contact: Grant Lewis  
919-215-1693 (phone)

## TABLE OF CONTENTS

1	PROJECT SUMMARY.....	1
1.1	PROJECT BACKGROUND, COMPONENTS, AND STRUCTURE .....	1
2	AS-BUILT CONDITION (BASELINE) .....	5
3	PROJECT MONITORING – METHODS .....	5
3.1	MONITORING .....	5
4	MONITORING YEAR 0 – DATA ASSESSMENT.....	6
4.1	STREAM ASSESSMENT .....	6
4.2	HYDROLOGY ASSESSMENT .....	6
4.3	VEGETATIVE ASSESSMENT.....	6
4.4	MONITORING YEAR 0 SUMMARY .....	6
5	REFERENCES.....	7

## LIST OF REPORT TABLES

Table 1. Project Mitigation Quantities and Credits .....	2
Table 2. Summary: Goals, Performance, and Results.....	3
Table 3. Project Attribute Table.....	4
Table A. Monitoring Schedule .....	5

## APPENDICES

Appendix A. Visual Assessment Data	Appendix D. Hydrologic Data
- Figure 1. Current Conditions Plan View	- Groundwater Gauge Soil Profiles
- Table 4A-E. Visual Stream Morphology Stability Assessment Table	Appendix E: Project Timeline and Contact Info
- Table 5. Vegetation Condition Assessment Table	- Table 11. Project Timeline
- Vegetation Plot Photographs	- Table 12. Project Contacts
- Photo Log	Appendix F. Record Drawings (As-built Survey)
Appendix B. Vegetation Plot Data	- As-built Drawings
- Table 6A. Planted Bare-Root Woody Vegetation	- As-built Survey
- Table 6B. Permanent Seed Mix	
- Table 7. Vegetation Plot Counts and Densities	
- Table 8. Vegetation Plot Data Table from Vegetation Data Entry Tool	
Appendix C. Stream Geomorphology Data	
- Cross-Sections with Annual Overlays	
- Longitudinal Profile	
- Table 9A-D. Baseline Stream Data Summary Tables	
- Table 10A-B. Cross-Section Morphology Monitoring Summary	

## 1 PROJECT SUMMARY

Restoration Systems, LLC has established the North Carolina Division of Mitigation Services (NCDMS) Crane Stream and Wetland Mitigation Site (Site). The Site is on three land parcels along unnamed tributaries to Little Crane Creek in the Sandhills Ecoregion of North Carolina. Located in the Cape Fear River Basin, cataloging unit 03030004, the Site is in the Targeted Local Watershed (TLW) 03030004070010 and North Carolina Division of Water Resources (NCDWR) subbasin number 03-06-14. The Site is located within a Local Watershed Plan (LWP), Hydrology Targeted Resource Area (TRA), and Water Quality TRA due to modifications/stressors in the watershed. Site hydrology drains to unnamed tributaries and into Little Crane Creek (Stream Index Number 18-23-16-4), assigned a Best Usage Classification of WS-III (NCDWR 2021). Little Crane Creek is not listed on the NCDENR draft 2018 or final 2016 303(d) lists (NCDEQ 2018a, NCDEQ 2018b). Site watershed sizes range from approximately 0.02 square miles (12.2 acres) on UT3 to 0.15 square miles (97.5 acres) on UT 1 at the outfall.

### 1.1 Project Background, Components, and Structure

Located approximately 2 miles southwest of Lemon Springs, 8 miles southwest of Sanford, NC, and west of Rocky Fork Church Road (SR 1179) in Lee County, the Site encompasses 27.7 acres. Mitigation work within the Site included 1) stream restoration, 2) stream enhancement (Level II), 3) wetland reestablishment, 4) wetland rehabilitation, 5) wetland enhancement, and 6) vegetation planting. The Site is expected to provide 3,533 Stream Mitigation Units (SMUs) and 14.593 Riparian Wetland Mitigation Units (WMUs) by closeout (Table 1, Page 2). A conservation easement was granted to the State of North Carolina and recorded at the Lee County Register of Deeds on June 22, 2021.

Before construction, land use at the Site was characterized by livestock pasture and disturbed forest. Site design was completed in February 2022. Construction started on June 6, 2022 and ended within a final walkthrough on July 15, 2022. The Site was planted on February 3, 2023. Completed project activities, reporting history, completion dates, and project contacts are summarized in Tables 11-12 (Appendix E).

*Space Purposefully Left Blank*

**Table 1. Crane Mitigation Site (ID-100165) Project Mitigation Quantities and Credits**

Project Segment	Original Mitigation Plan Ft/Ac	As-Built Ft/Ac	Original Mitigation Category	Original Restoration Level	Original Mitigation Ratio (X:1)	Credits	Comments
<b>Stream</b>							
UT 1, Reach 1	694	694	Warm	EII	2.5	237.600	Straight-line valley length used for credit calculation at request of IRT 60 foot easement break for crossing
UT 1, Reach 2 (above crossing)	1335	1330	Warm	R	1.0	1335.000	
UT 1, Reach 2 (below crossing)	267	265	Warm	R	1.0	267.000	
UT 1, Reach 3	232	233	Warm	EII	2.5	93.200	
UT 2, Reach 1	437	425	Warm	R	1.0	437.000	
UT 2, Reach 2	88	88	Warm	EII	2.5	35.200	
UT 3	463	451	Warm	R	1.0	463.000	
UT 4	422	414	Warm	R	1.0	422.000	
UT 5	243	241	Warm	R	1.0	243.000	
					<b>Total:</b>	<b>3533.000</b>	
<b>Wetland</b>							
Wetland Reestablishment	8.815	8.815	R	REE	1.00000	8.815	
Wetland Rehabilitation	0.683	0.683	R	RH	1.50000	0.455	
Wetland Enhancement	10.646	10.646	R	E	2.00000	5.323	
					<b>Total:</b>	<b>14.593</b>	

**Project Credits**

Restoration Level	Stream			Riparian	Non-Rip	Coastal
	Warm	Cool	Cold	Wetland	Wetland	Marsh
Restoration	3167.000	0.000	0.000	0.000	0.000	0.000
Re-establishment				8.815	0.000	0.000
Rehabilitation				0.455	0.000	0.000
Enhancement				5.323	0.000	0.000
Enhancement I	0.000	0.000	0.000			
Enhancement II	366.000	0.000	0.000			
Creation				0.000	0.000	0.000
Preservation	0.000	0.000	0.000	0.000	0.000	
<b>Totals</b>	<b>3,533.000</b>	<b>0.000</b>	<b>0.000</b>	<b>14.593</b>	<b>0.000</b>	<b>0.000</b>

**Total Stream Credit 3,533.000**

**Total Wetland Credit 14.593**

**Wetland Mitigation Category**

CM Coastal Marsh  
R Riparian  
NR Non-Riparian

**Restoration Level**

P Preservation  
E Wetland Enhancement  
EII Stream Enhancement II  
EI Stream Enhancement I  
C Wetland Creation  
RH Wetland Rehabilitation  
REE Wetland Re-establishment  
R Restoration

**Table 2: Summary: Goals, Performance and Results**

Goal	Objective/Treatment	Likely Functional Uplift	Performance Criteria	Measurement	Cumulative Monitoring Results
Reconnect channels with floodplains and riparian wetlands to allow a natural flooding regime.	Reconstruct stream channels with appropriate bankfull dimensions and depth relative to the existing floodplain. Remove overburden to reconnect with adjacent wetlands.	Dispersion of high flows on the floodplain, an increase in biogeochemical cycling within the system, and recharging of riparian wetlands.	<ul style="list-style-type: none"> <li>The stream shall remain stable, and all other performance standards shall be met through four separate bankfull events, occurring in separate years, during the monitoring years 1-7.</li> </ul>	2 crest gauges (pressure transducers) on UT1 and UT2, and documentation of visual/physical evidence of bankfull events	To be determined
Improve stability of stream channels.	Construct stream channels that will maintain stable cross-sections, patterns, and profiles over time.	Reduction in sediment inputs from bank erosion, reduction of shear stress, and improved overall hydraulic function.	<ul style="list-style-type: none"> <li>All streams must maintain an Ordinary High-Water Mark (OHWM), per RGL 05-05.</li> <li>Bank height ratio (BHR) cannot exceed 1.2 at any measured cross-section.</li> <li>BHR at any measure riffle cross-section should not change by more than 10% from baseline condition during any given monitoring period.</li> <li>Intermittent streams will demonstrate at least 30-days consecutive flow annually.</li> </ul>	Total of 16 cross-sections on restored channels and surface flow gauges on UT2, UT3, UT4, and UT5.	Site streams are stable, functioning as designed, and stream measurements are within design parameters.
Restore and enhance native floodplain and streambank vegetation.	Plant native tree and understory species in riparian zones and plant appropriate species on streambanks.	Reduction in floodplain sediment inputs from runoff, increased bank stability, increased LWD and organic material in streams, increased	<ul style="list-style-type: none"> <li>Within planted portions of the Site, a minimum of 320 stems per acre must be present at year 3; a minimum of 260 stems per acre must be present at year 5; and a minimum of 210 stems per acre must be present at year 7.</li> <li>Trees must average 7 feet in height at year 5 and 10 feet in height at year 7 in each plot.</li> <li>Planted and volunteer stems are counted, provided they are included in the approved planting list for the Site; natural recruits not on the planting list may be considered by the IRT on a case-by-case basis. Natural recruits can only be counted toward success after they have been in the ground for 2 years.</li> <li>Areas of herbaceous vegetation establishment will have a minimum of four species present.</li> </ul>	17 permanent vegetation plots, 6 random vegetation plots, and 3 random herbaceous plots spread across the Site	All plots meeting performance criteria during MY0. Herbaceous plots will be surveyed beginning MY1 to allow time for herbaceous vegetation to establish.
Restore and enhance groundwater hydrology to drained or impacted hydric soil areas.	Reduce channel depth in incised stream reaches, fill drainage ditches, and alleviate soil compaction from agriculture activities.	Particulate and pollution conversion, groundwater storage and reduced downstream flooding, habitat diversification, and vegetative composition conversion.	<ul style="list-style-type: none"> <li>Annual saturation or inundation within the upper 12 inches of the soil surface for, at a minimum, 12 percent of the growing season during average climatic conditions.</li> </ul>	15 groundwater gauges spread throughout restored wetlands	To be determined

Note: Onsite rain data will be collected throughout each monitoring period.



Table 3. Project Attribute Table					
Project Name	Crane Mitigation Site				
County	Lee County, North Carolina				
Project Area (acres)	27.66				
Project Coordinates (latitude and longitude decimal degrees)	35.367351°N, 79.222369°W				
Project Watershed Summary Information					
Physiographic Province	Sand Hills				
River Basin	Cape Fear				
USGS Hydrologic Unit 14-digit	3030004070010				
NCDWR Sub-basin	03-06-14				
Project Drainage Area (acres)	120.1				
Project Drainage Area Percentage of Impervious Area	<2%				
Land Use Classification	Managed Herbaceous Cover & Hardwood Swamps				
Reach Summary Information					
Parameters	UT 1	UT 2	UT 3	UT4	UT5
Pre-project length of reach (linear feet)	2170	489	345	373	319
Post-project length of reach (linear feet)	2429	525	463	421	243
Valley Classification & Confinement	Rosgen Type VIII and III	Rosgen Type VIII and III	Rosgen Type VIII	Rosgen Type VIII	Rosgen Type VIII
Drainage Area (acres)	97.5	22.6	12.2	13.2	47.4
Perennial, Intermittent, Ephemeral	Perennial	Intermittent	Intermittent	Intermittent	Intermittent/Perennial
NCDWR Water Quality Classification	WS III				
Existing Morphological Description (Rosgen 1996)	Eg 5	G 5	Eg 5	Eg 5	Ge 5
Proposed Morphological Description (Rosgen 1996)	Ce 5	Ce 5	Ce 5	Ce 5	Ce 5
Existing Evolutionary Stage (Simon and Hupp 1986)	III/IV	IV	IV	II/III	IV
Wetland Summary Information					
Parameters	Wetlands				
Pre-project (acres)	11.330				
Post-project (acres)	20.146				
Wetland Type (non-riparian, riparian)	Riparian riverine				
Mapped Soil Series	Wehadkee				
Hydric Soil Status	Hydric				
Regulatory Considerations					
Parameters	Applicable?	Resolved?		Supporting Docs?	
Water of the United States - Section 401	Yes	Yes		Section 401 Certification	
Water of the United States - Section 404	Yes	Yes		Section 404 Permit	
Endangered Species Act	Yes	Yes		CE Document	
Historic Preservation Act	Yes	Yes		CE Document	
Coastal Zone Management Act (CZMA or CAMA)	No	--		NA	
FEMA Floodplain Compliance	Yes	Yes		FEMA Mapping	
Essential Fisheries Habitat	No	--		NA	

## 2 AS-BUILT CONDITION (BASELINE)

Construction started on June 6, 2022 and ended within a final walkthrough on July 15, 2022. The Site was planted on February 3, 2023. As-built and MY0 data collection occurred between January 2023 and February 2023.

In general, no significant issues arose during the construction of the Site. A sealed half-size set of record drawings are provided in Appendix F, which includes the post-construction survey, alignments, structures, and monitoring features. These include redlines for any significant field adjustments made during construction that differ from the design plans.

Additional activities that occurred at the Site included the following.

- Planting 26.2 acres of the Site with 23,550 stems on February 3, 2023 – planted species are included in Table 6A (Appendix B).
- Applying seed mix across the Site. A species list is included in Table 6B (Appendix B).

## 3 PROJECT MONITORING – METHODS

Monitoring will be conducted by Axiom Environmental, Inc. Annual monitoring reports of the data collected will be submitted to the NCDMS by Restoration Systems no later than December 31st of each monitoring year data is collected. The monitoring schedule is summarized in the following table.

**Table A. Monitoring Schedule**

Resource	Year 1	Year 2	Year 3	Year 4	Year 5	Year 6	Year 7
Streams	X	X	X		X		X
Wetlands	X	X	X	X	X	X	X
Vegetation	X	X	X		X		X
Visual Assessment	X	X	X	X	X	X	X
Report Submittal	X	X	X	X	X	X	X

### 3.1 Monitoring

The monitoring parameters are summarized in Table 2.

*Space Purposefully Left Blank*

## 4 MONITORING YEAR 0 – DATA ASSESSMENT

Annual monitoring and site visits were conducted between October 2022 and February 2023 to assess the condition of the project. Stream, wetland, and vegetation criteria for the Site follow the approved success criteria presented in the Mitigation Plan and summarized in Section 1.2; monitoring methods are detailed in Section 3.0.

### 4.1 Stream Assessment

Morphological surveys for MY0 were conducted on January 26, 2023. All streams within the Site are stable and functioning as designed. Refer to Appendix A for the Visual Stream Morphology Stability Assessment Table and Stream Photographs. Refer to Appendix C for Stream Geomorphology Data. No stream areas of concern were identified during MY0.

One field adjustment was made during construction that differs from the design plans. A vane arm was not constructed on a cross vane on UT 1 at the confluence with UT 5. The vane arm would have extended into the UT 5 streambed, and it was determined in the field to be unnecessary (Sheet C5.02, Appendix F).

### 4.2 Hydrology Assessment

15 groundwater monitoring gauges were installed throughout the Site's wetlands. Hydrologic data will be collected and reported during MY1 (2023).

### 4.3 Vegetative Assessment

The MY0 vegetative survey was completed on February 8, 2023. Vegetation monitoring resulted in a sitewide stem density average of 600 planted stems per acre, above the interim requirement of 320 stems per acre required at MY3. All 23 vegetation plots, including 17 fixed vegetation plots and 6 temporary vegetation plots, met the interim success criteria. Please refer to Appendix A for Vegetation Plot Photographs and the Vegetation Condition Assessment Table, and Appendix B for Vegetation Plot Data. No vegetation areas of concern were identified during MY0.

All twenty planted species were included in the approved Mitigation Plan planting list. Species approved in the Mitigation Plan were selected based on Reference Forest Ecosystem (RFE) data, on-site observations, and community descriptions from Classification of the Natural Communities of North Carolina (Schafale and Weakley 2012) – Coastal Plain Bottomland Hardwood Forest. Table 6A (Appendix B) summarizes planted species and their individual quantities in total.

Several changes were made to the Site seed mixes based on seed availability at the time of construction. Grain Rye (*Secale cereale*) was omitted from the temporary seed mix, and Brown Top Millet (*Urochloa ramosa*) was applied site-wide instead. In the permanent seed mix, *Agrostis perennans*, *Carex vulpinoidea*, *Eupatorium coelestinum*, *Eupatorium perfoliatum*, *Juncus effusus*, *Juncus tenuis*, and *Lespedeza capitata* were omitted and replaced with equivalent quantities of *Eupatorium fistulosum*, *Panicum dichotomiflorum*, *Panicum rigidulum*, and *Pycnanthemum tenuifolium*. See sheet L5.01 (Appendix F) for details regarding as-built seed mixes.

### 4.4 Monitoring Year 0 Summary

Overall, the Site looks good, is performing as intended, and is on track to meet success criteria. All vegetation plots are on track to exceed the MY3 interim requirement of 320 planted stems per acre, and all streams within the Site are stable and are meeting project goals.

## 5 REFERENCES

- Lee, M.T., R.K. Peet, S.D. Roberts, and T.R. Wentworth. 2008. CVS-EEP Protocol for Recording Vegetation. Version 4.2. North Carolina Department of Environment and Natural Resources, Ecosystem Enhancement Program. Raleigh, North Carolina.
- North Carolina Department of Environmental Quality (NCDEQ). 2018a. Final 2016 Category 5 Assessments -303(d) List (online). Available: [https://files.nc.gov/ncdeq/Water%20Quality/Planning/TMDL/303d/2016/2016\\_NC\\_Category\\_5\\_303d\\_list.pdf](https://files.nc.gov/ncdeq/Water%20Quality/Planning/TMDL/303d/2016/2016_NC_Category_5_303d_list.pdf) (February 4, 2019).
- North Carolina Department of Environmental Quality (NCDEQ). 2018b. Draft 2018 North Carolina 303(d) List (online). Available: <https://files.nc.gov/ncdeq/Water%20Quality/Planning/TMDL/303d/2018/2018-DRAFT-NC-303-d--ListwCover.pdf> (February 4, 2019).
- North Carolina Division of Mitigation Services (NCDMS). 2014. Stream and Wetland Mitigation Monitoring Guidelines. North Carolina Department of Environmental Quality, Raleigh, North Carolina.
- North Carolina Interagency Review Team (NCIRT). 2016. Wilmington District Stream and Wetland Compensatory Mitigation Update. October 24, 2016.
- North Carolina Stream Functional Assessment Team. (NC SFAT 2015). N.C. Stream Assessment Method (NC SAM) User Manual. Version 2.1.
- North Carolina Wetland Functional Assessment Team. (NC WFAT 2010). N.C. Wetland Assessment Method (NC WAM) User Manual. Version 4.1.
- Schafale, M.P. and A.S. Weakley. 2012. Classification of the Natural Communities of North Carolina: Fourth Approximation. North Carolina Natural Heritage Program, Division of Parks and Recreation, North Carolina Department of Environment, Health, and Natural Resources. Raleigh, North Carolina.

## Appendix A: Visual Assessment Data

Figure 1. Current Conditions Plan View

Table 4A-E. Visual Stream Morphology Stability Assessment Table

Table 5. Visual Vegetation Condition Assessment Table

Vegetation Plot Photographs

Photo Log



Prepared for:



Project:

### CRANE MITIGATION SITE

Lee County, NC

Title:

### CURRENT CONDITIONS PLAN VIEW

Drawn by:

BEF

Date:

APR 2023

Scale:


1:2700

Project No.:

20-032

## FIGURE

# 1

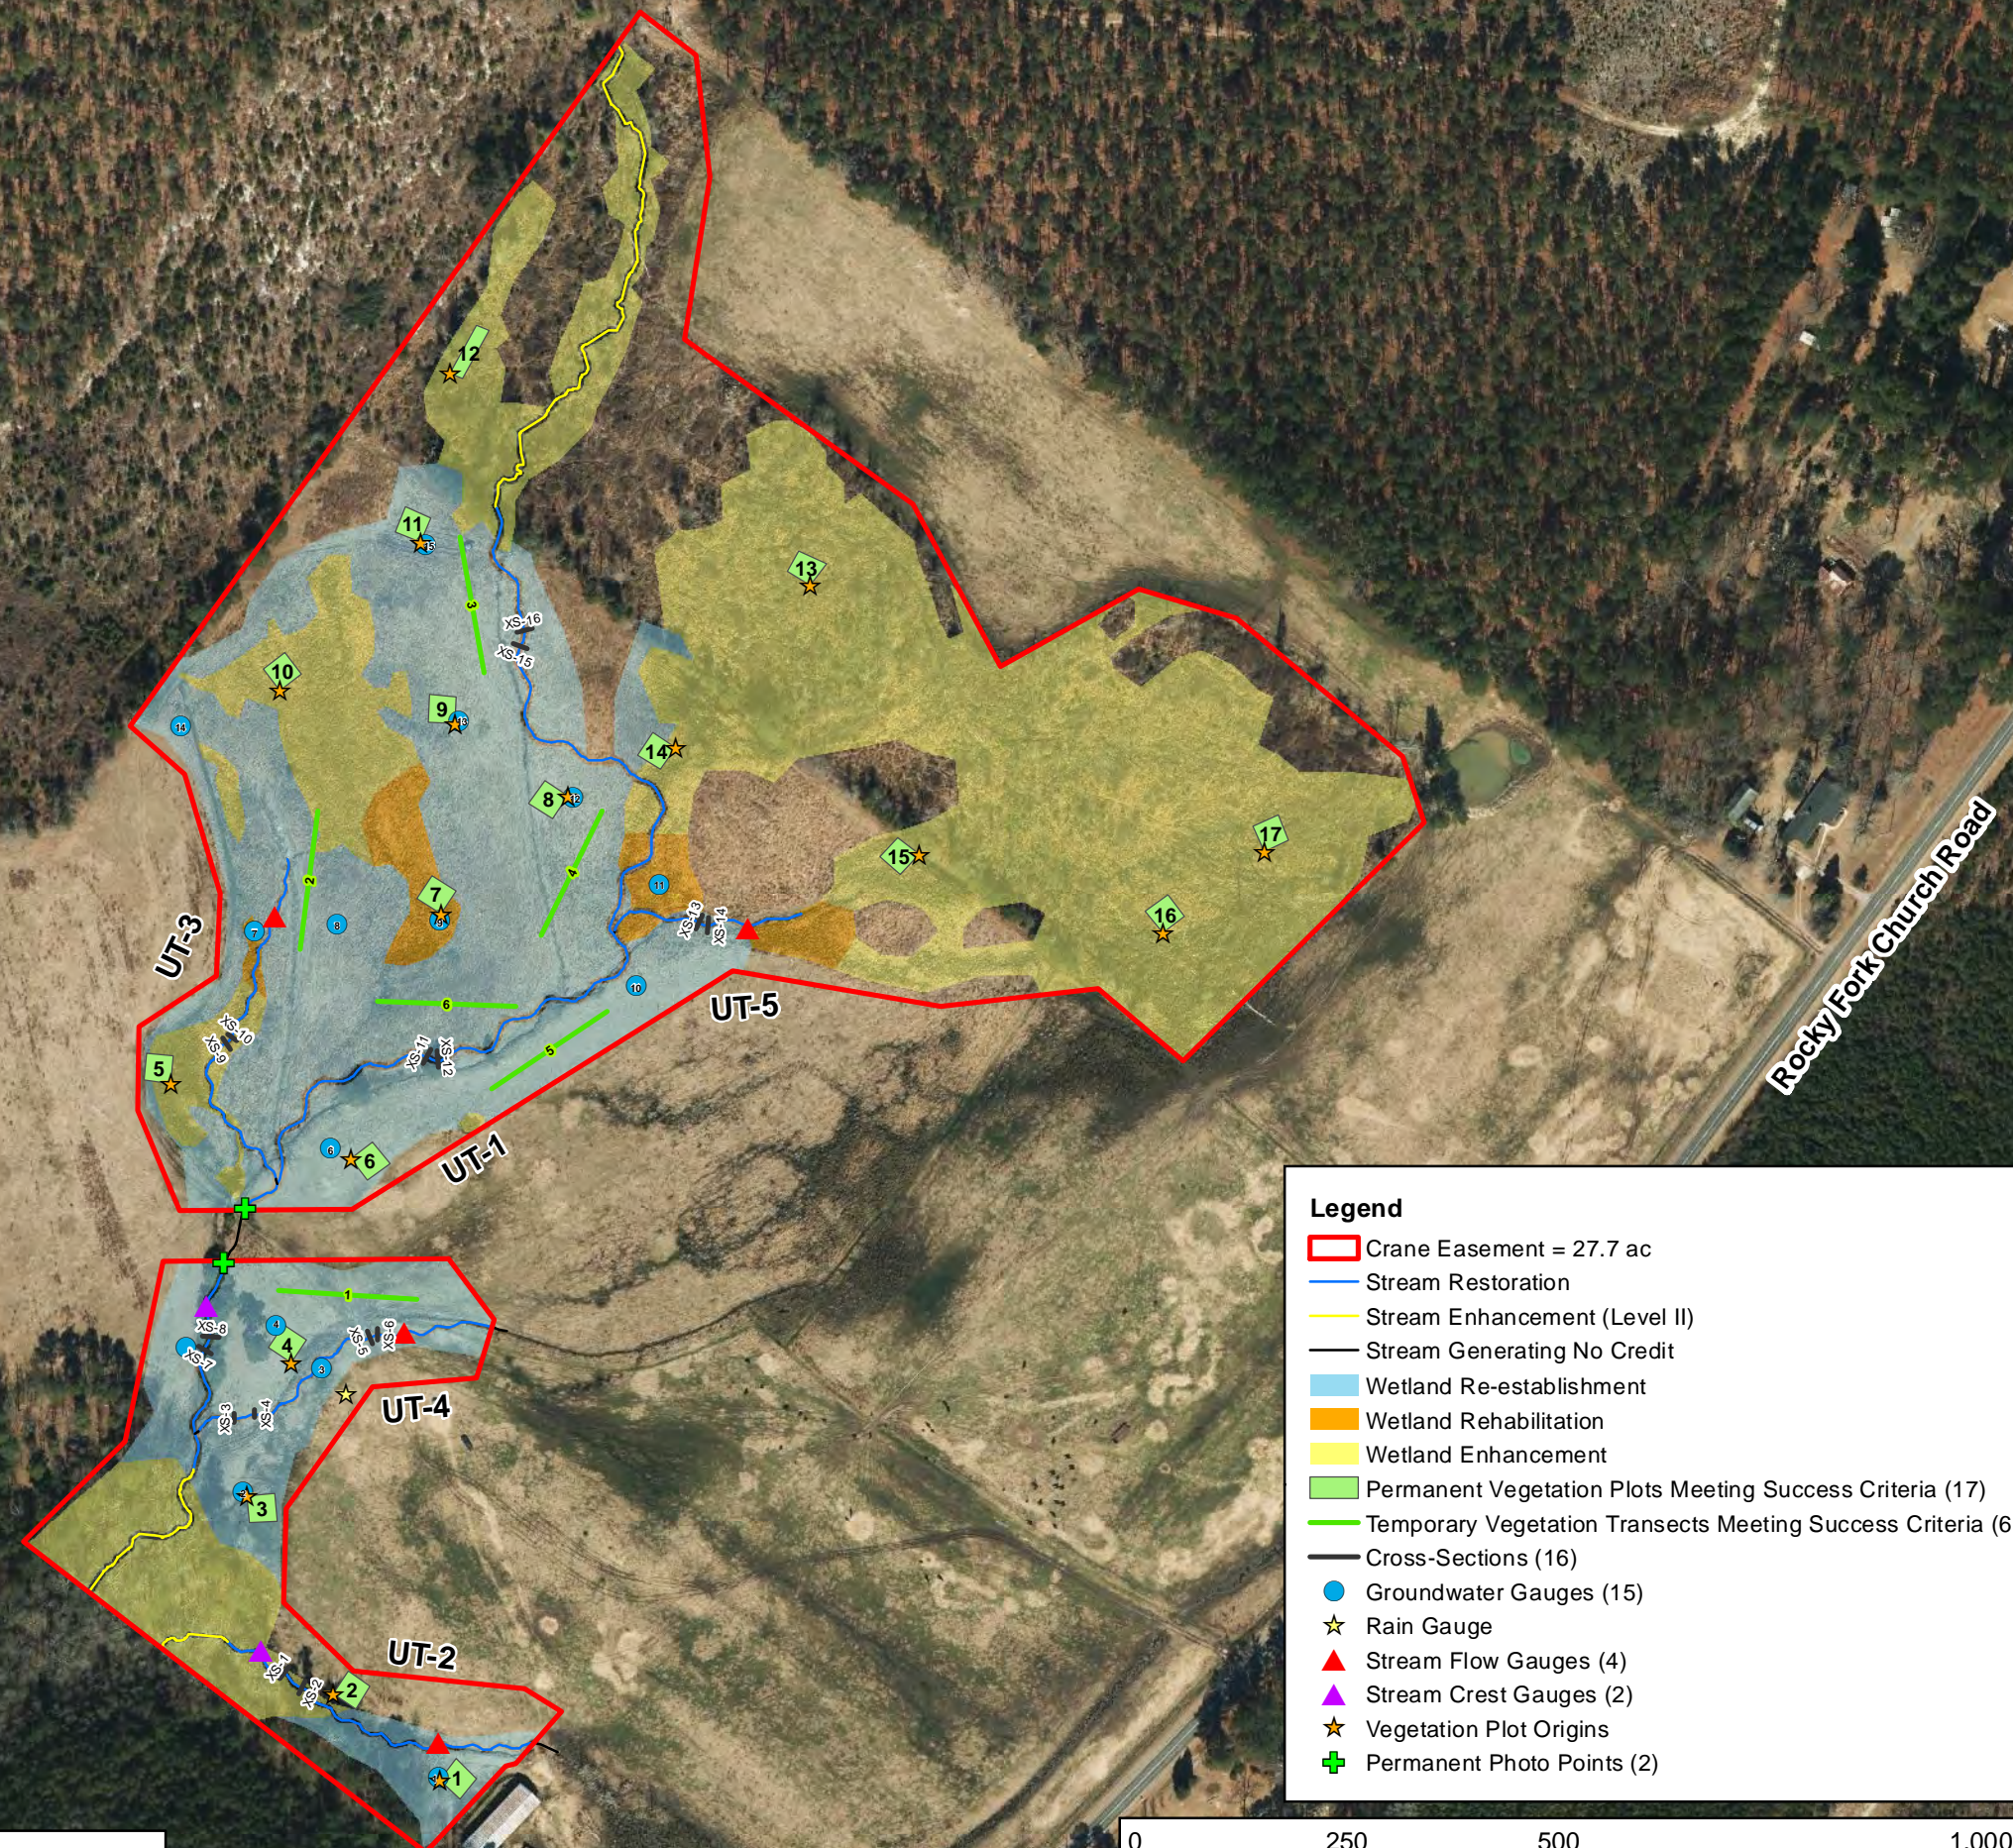

#### Legend

- Crane Easement = 27.7 ac
- Stream Restoration
- Stream Enhancement (Level II)
- Stream Generating No Credit
- Wetland Re-establishment
- Wetland Rehabilitation
- Wetland Enhancement
- Permanent Vegetation Plots Meeting Success Criteria (17)
- Temporary Vegetation Transects Meeting Success Criteria (6)
- Cross-Sections (16)
- Groundwater Gauges (15)
- ★ Rain Gauge
- ▲ Stream Flow Gauges (4)
- ▲ Stream Crest Gauges (2)
- ★ Vegetation Plot Origins
- + Permanent Photo Points (2)

Note: Basemap is aerial orthoimagery from 2021 NC OneMap.

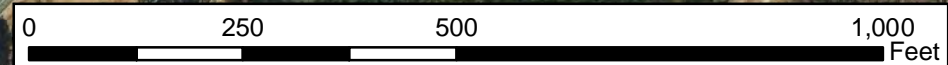


Table 4A. Visual Stream Stability Assessment

Reach UT 1, Reach 2  
 Assessed Stream Length 1602  
 Assessed Bank Length 3204

Major Channel Category		Metric	Number Stable, Performing as Intended	Total Number in As-built	Amount of Unstable Footage	% Stable, Performing as Intended
Bank	Surface Scour/Bare Bank	Bank lacking vegetative cover resulting simply from poor growth and/or surface scour			0	100%
	Toe Erosion	Bank toe eroding to the extent that bank failure appears likely. Does <u>NOT</u> include undercuts that are modest, appear sustainable and are providing habitat.			0	100%
	Bank Failure	Fluvial and geotechnical - rotational, slumping, calving, or collapse			0	100%
<b>Totals</b>					0	100%
Structure	Grade Control	Grade control structures exhibiting maintenance of grade across the sill.	35	35		100%
	Bank Protection	Bank erosion within the structures extent of influence does <u>not</u> exceed 15%. (See guidance for this table in DMS monitoring guidance document)	35	35		100%

Table 4B. Visual Stream Stability Assessment

Reach UT 2, Reach 1  
 Assessed Stream Length 437  
 Assessed Bank Length 874

Major Channel Category		Metric	Number Stable, Performing as Intended	Total Number in As-built	Amount of Unstable Footage	% Stable, Performing as Intended
Bank	Surface Scour/Bare Bank	Bank lacking vegetative cover resulting simply from poor growth and/or surface scour			0	100%
	Toe Erosion	Bank toe eroding to the extent that bank failure appears likely. Does <u>NOT</u> include undercuts that are modest, appear sustainable and are providing habitat.			0	100%
	Bank Failure	Fluvial and geotechnical - rotational, slumping, calving, or collapse			0	100%
<b>Totals</b>					0	100%
Structure	Grade Control	Grade control structures exhibiting maintenance of grade across the sill.	19	19		100%
	Bank Protection	Bank erosion within the structures extent of influence does <u>not</u> exceed 15%. (See guidance for this table in DMS monitoring guidance document)	19	19		100%



Table 4C. Visual Stream Stability Assessment

Reach UT 3  
 Assessed Stream Length 480  
 Assessed Bank Length 960

Major Channel Category		Metric	Number Stable, Performing as Intended	Total Number in As-built	Amount of Unstable Footage	% Stable, Performing as Intended
Bank	Surface Scour/Bare Bank	Bank lacking vegetative cover resulting simply from poor growth and/or surface scour			0	100%
	Toe Erosion	Bank toe eroding to the extent that bank failure appears likely. Does <u>NOT</u> include undercuts that are modest, appear sustainable and are providing habitat.			0	100%
	Bank Failure	Fluvial and geotechnical - rotational, slumping, calving, or collapse			0	100%
<b>Totals</b>					0	100%
Structure	Grade Control	Grade control structures exhibiting maintenance of grade across the sill.	22	22		100%
	Bank Protection	Bank erosion within the structures extent of influence does <u>not</u> exceed 15%. (See guidance for this table in DMS monitoring guidance document)	22	22		100%

Table 4D. Visual Stream Stability Assessment

Reach UT 4  
 Assessed Stream Length 427  
 Assessed Bank Length 854

Major Channel Category		Metric	Number Stable, Performing as Intended	Total Number in As-built	Amount of Unstable Footage	% Stable, Performing as Intended
Bank	Surface Scour/Bare Bank	Bank lacking vegetative cover resulting simply from poor growth and/or surface scour			0	100%
	Toe Erosion	Bank toe eroding to the extent that bank failure appears likely. Does <u>NOT</u> include undercuts that are modest, appear sustainable and are providing habitat.			0	100%
	Bank Failure	Fluvial and geotechnical - rotational, slumping, calving, or collapse			0	100%
<b>Totals</b>					0	100%
Structure	Grade Control	Grade control structures exhibiting maintenance of grade across the sill.	14	14		100%
	Bank Protection	Bank erosion within the structures extent of influence does <u>not</u> exceed 15%. (See guidance for this table in DMS monitoring guidance document)	14	14		100%

Table 4E. Visual Stream Stability Assessment

Reach UT 5  
 Assessed Stream Length 248  
 Assessed Bank Length 496

Major Channel Category		Metric	Number Stable, Performing as Intended	Total Number in As-built	Amount of Unstable Footage	% Stable, Performing as Intended
Bank	Surface Scour/Bare Bank	Bank lacking vegetative cover resulting simply from poor growth and/or surface scour			0	100%
	Toe Erosion	Bank toe eroding to the extent that bank failure appears likely. Does <u>NOT</u> include undercuts that are modest, appear sustainable and are providing habitat.			0	100%
	Bank Failure	Fluvial and geotechnical - rotational, slumping, calving, or collapse			0	100%
<b>Totals</b>					0	100%
Structure	Grade Control	Grade control structures exhibiting maintenance of grade across the sill.	8	8		100%
	Bank Protection	Bank erosion within the structures extent of influence does <u>not</u> exceed 15%. (See guidance for this table in DMS monitoring guidance document)	8	8		100%

**Table 5. Visual Vegetation Assessment**

Planted acreage

26.2







Vegetation Category	Definitions	Mapping Threshold	Combined Acreage	% of Planted Acreage
Bare Areas	Very limited cover of both woody and herbaceous material.	0.10 acres	0.00	0.0%
Low Stem Density Areas	Woody stem densities clearly below target levels based on current MY stem count criteria.	0.10acres	0.00	0.0%
<b>Total</b>			0.00	0.0%
Areas of Poor Growth Rates	Planted areas where average height is not meeting current MY Performance Standard.	0.10 acres	0.00	0.0%
<b>Cumulative Total</b>			0.00	0.0%

Easement Acreage





27.66

Vegetation Category	Definitions	Mapping Threshold	Combined Acreage	% of Easement Acreage
Invasive Areas of Concern	Invasives may occur outside of planted areas and within the easement and will therefore be calculated against the total easement acreage- Include species with the potential to directly outcompete native, young, woody stems in the short-term or community structure for existing communities. Species included in summation above should be identified in report summary.	0.10 acres	0.00	0.0%
Easement Encroachment Areas	Encroachment may be point, line, or polygon. Encroachment to be mapped consists of any violation of restrictions specified in the conservation easement. Common encroachments are mowing, cattle access, vehicular access. Encroachment has no threshold value as will need to be addressed regardless of impact area.	none	0 Encroachments noted	

Crane Mitigation Site  
MYO (2023) Vegetation Monitoring Photographs (taken February 8, 2023)

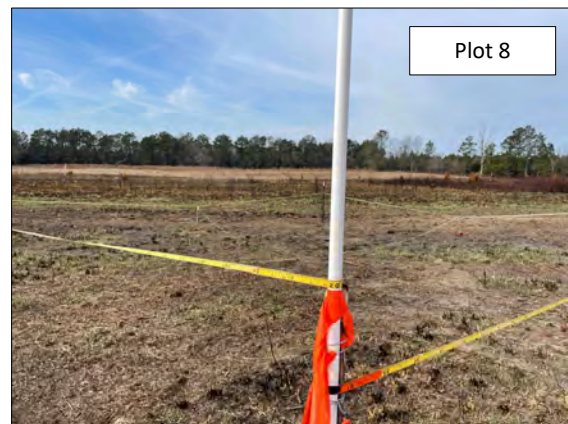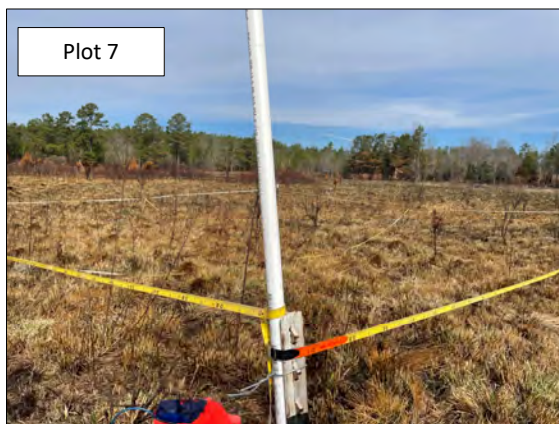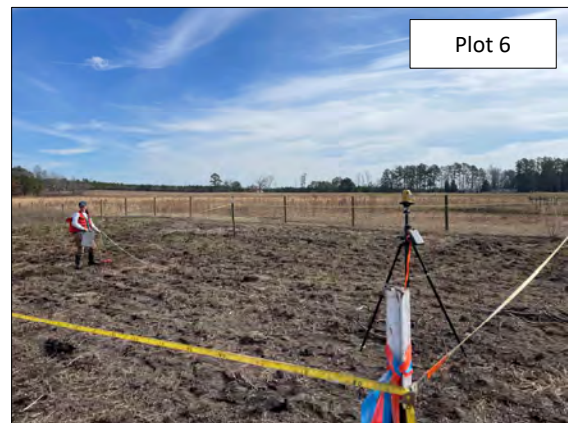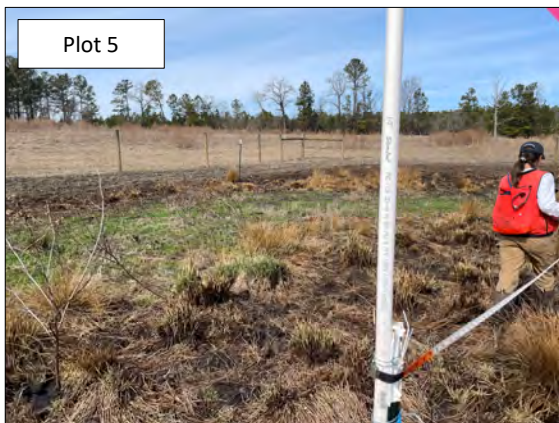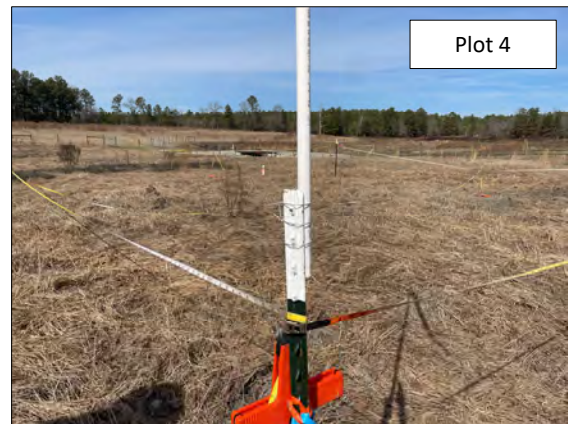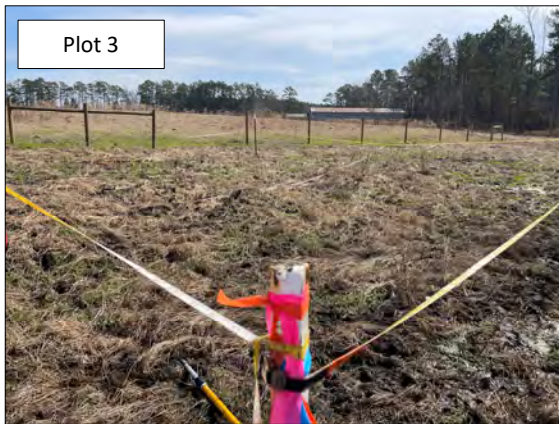

Crane Mitigation Site  
MYO (2023) Vegetation Monitoring Photographs (taken February 8, 2023)

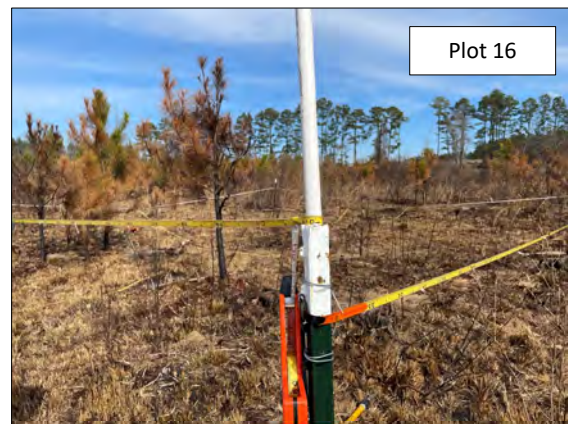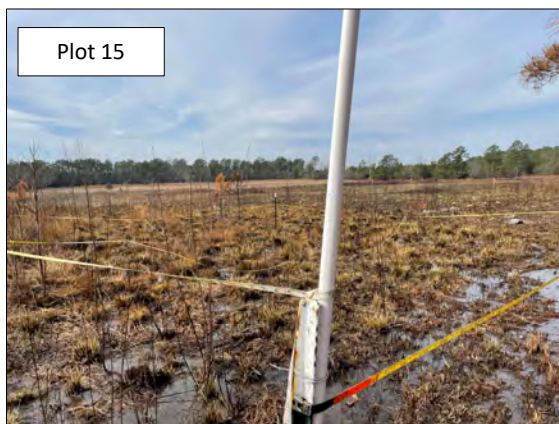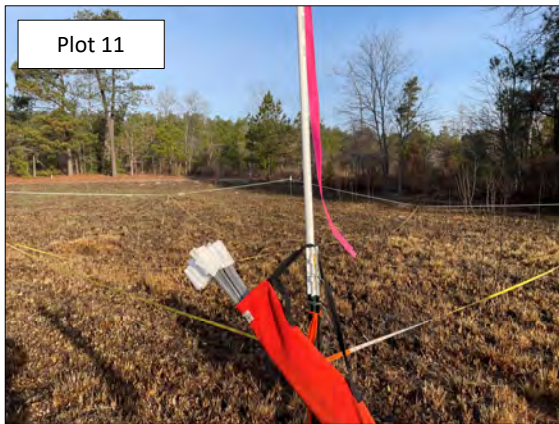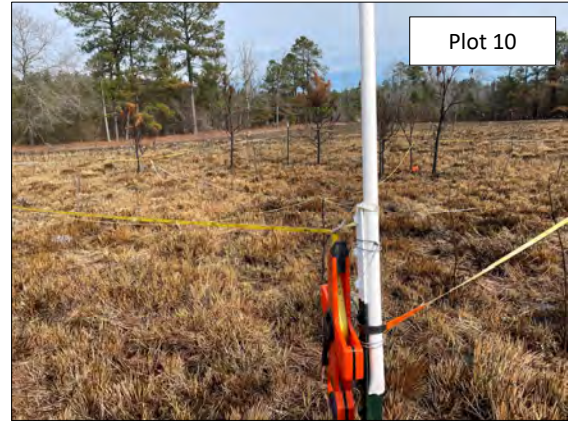

**Crane Mitigation Site  
MY0 (2023) Vegetation Monitoring Photographs (taken February 8, 2023)**



**Crane Mitigation Site  
As-Built (2023) Photo Log**

Photo 1: CCPV Permanent Photo Point 1  
UT 1 Crossing, facing upstream



Photo 2: CCPV Permanent Photo Point 2  
UT 1 Crossing, facing downstream





**Crane Mitigation Site  
As-Built (2023) Photo Log**

Photo 3: Easement Fencing



Photo 4: West of GW-10 facing East within the easement



**Crane Mitigation Site  
As-Built (2023) Photo Log**

Photo 5: UT-1 facing North



Photo 6: UT-2 facing West



**Crane Mitigation Site  
As-Built (2023) Photo Log**

Photo 7: UT-2 facing Southeast



Photo 8: Wetland GA near UT-2 and UT-4  
confluence



**Crane Mitigation Site  
As-Built (2023) Photo Log**

Photo 9: UT-4 facing South



Photo 10: UT-3 facing South



**Crane Mitigation Site  
As-Built (2023) Photo Log**

Photo 11: GW-8

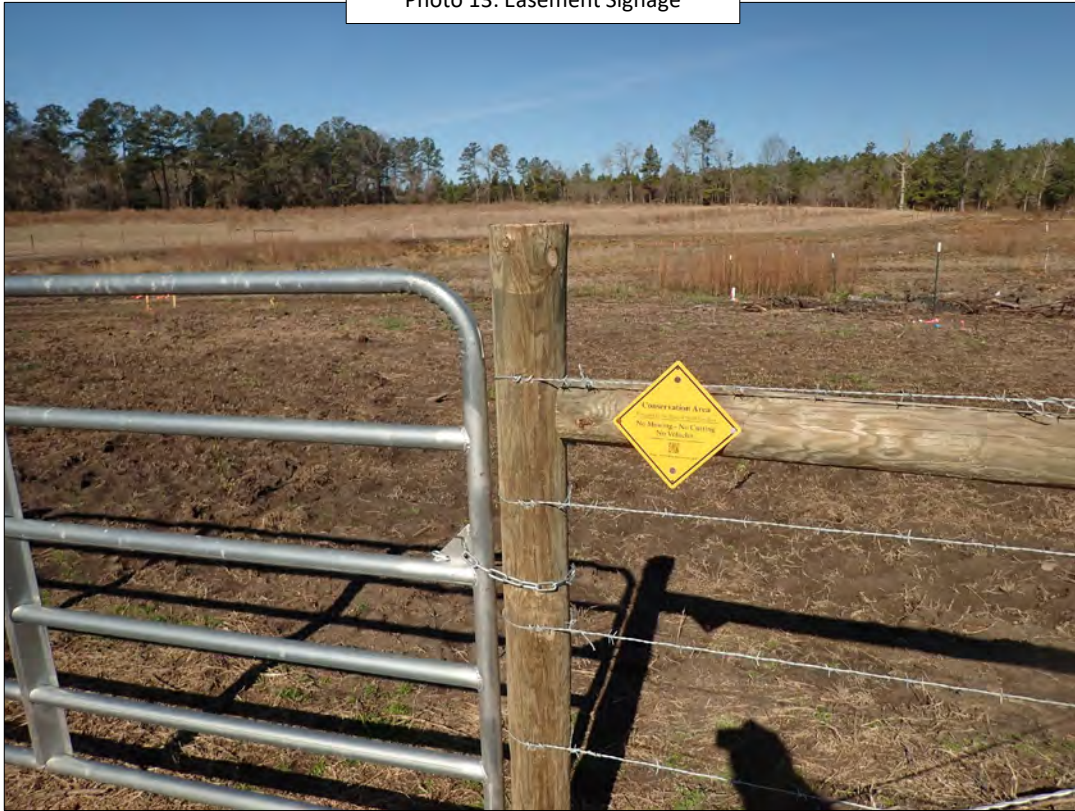


Photo 12: UT-1 Log Vanes



**Crane Mitigation Site  
As-Built (2023) Photo Log**

Photo 13: Easement Signage



## **Appendix B: Vegetation Data**

Table 6A. Planted Bare-Root Woody Vegetation

Table 6B. Permanent Seed Mix

Table 7. Vegetation Plot Counts and Densities

Table 8. Vegetation Plot Data Table from Vegetation Data Entry Tool

**Table 6A. Planted Bare Root Woody Vegetation  
Crane Stream and Wetland Mitigation Site**

Vegetation Association		Coastal Plain Bottomland Hardwood Forest*		Coastal Plain Small Stream Swamp*		Stream-side Assemblage**		TOTAL
Area (acres)		8		15.4		2.8		26.2
Species	Indicator Status	# planted*	% of total	# planted*	% of total	# planted**	% of total	# planted
Swamp black gum ( <i>Nyssa biflora</i> )	OBL	0	0.0%	1000	9.5%	0	0.0%	1000
Bald cypress ( <i>Taxodium distichum</i> )	OBL	500	9.2%	1000	9.5%	0	0.0%	1500
Tupelo gum ( <i>Nyssa aquatica</i> )	OBL	0	0.0%	1000	9.5%	0	0.0%	1000
Black gum ( <i>Nyssa sylvatica</i> )	FAC	500	9.2%	1000	9.5%	700	9.2%	2200
Silky dogwood ( <i>Cornus amomum</i> )	FACW	0	0.0%	0	0.0%	1500	19.7%	1500
Sweetbay ( <i>Magnolia virginiana</i> )	FACW	0	0.0%	1000	9.5%	0	0.0%	1000
Red bay ( <i>Persea borbonia</i> )	FAC	250	4.6%	500	4.8%	0	0.0%	750
River birch ( <i>Betula nigra</i> )	FACW	500	9.2%	500	4.8%	1500	19.7%	2500
Hackberry ( <i>Celtis occidentalis</i> )	FACW	300	5.5%	500	4.8%	400	5.3%	1200
American elm ( <i>Ulmus americana</i> )	FACW	300	5.5%	500	4.8%	800	10.5%	1600
Tulip poplar ( <i>Liriodendron tulipifera</i> )	FAC	300	5.5%	500	4.8%	800	10.5%	1600
Sycamore ( <i>Platanus occidentalis</i> )	FACW	300	5.5%	500	4.8%	800	10.5%	1600
Swamp chestnut oak ( <i>Quercus michauxii</i> )	FACW	300	5.5%	500	4.8%	0	0.0%	800
Water oak ( <i>Quercus nigra</i> )	FAC	500	9.2%	300	2.9%	400	5.3%	1200
Laurel oak ( <i>Quercus larifolia</i> )	FACW	300	5.5%	500	4.8%	0	0.0%	800
Cherrybark oak ( <i>Quercus pagoda</i> )	FAC	200	3.7%	0	0.0%	400	5.3%	600
Willow oak ( <i>Quercus phellos</i> )	FACW	300	5.5%	500	4.8%	0	0.0%	800
Shumard oak ( <i>Quercus shumardii</i> )	FACW	300	5.5%	500	4.8%	0	0.0%	800
Shagbark hickory ( <i>Carya ovata</i> )	FACU	300	5.5%	0	0.0%	0	0.0%	300
Bitternut hickory ( <i>Carya cordiformis</i> )	FAC	300	5.5%	200	1.9%	300	3.9%	800
<b>TOTAL</b>		<b>5450</b>		<b>10500</b>		<b>7600</b>		<b>23550</b>

\* Planted at a density of 680 stems/acre.

\*\* Planted at a density of 2720 stems/acre.



**Table 6B. Permanent Seed Mix  
Crane Stream and Wetland Mitigation Site**

Temporary Seed (Erosion and Sediment Control)			
Species	Application Rate	Application Date	Notes
<i>Urochloa ramosa</i> (Brown Top Millet)	40 lbs. per acre	May - September	All disturbed soil

Permanent Seed- Sitewide @ 2lbs /acre			
Latin Species	Common Name	Indicator	%
<i>Agrostis hyemalis</i>	Winter bentgrass	FAC	3
<i>Bidens aristosa</i>	Bur-marigold	FACW	0.6
<i>Carex albolutescens</i>	Greenwhite Sedge	FACW	2
<i>Carex lupulina</i>	Hop Sedge	OBL	2
<i>Chamaecrista fasciculata</i>	Partridge Pea	FACU	6
<i>Chamaecrista nictitans</i>	Sensitive Pea	FACU	3
<i>Coreopsis lanceolata</i>	Lance-leaved Coreopsis	NI	5
<i>Coreopsis tinctoria</i>	Plains Coreopsis	FAC	5
<i>Desmodium canadense</i>	Showy ticktrefoil	FAC	5
<i>Echinacea purpurea</i>	Coneflower	NI	5
<i>Elymus virginicus</i>	Virginia Wildrye	FACW	7
<i>Eupatorium fistulosum</i>	Joe Pye Weed	FACW	0.1
<i>Helianthus angustifolius</i>	Narrowleaved Sunflower	FACW	2
<i>Heliopsis helianthoides</i>	Oxeye sunflower	UPL	5
<i>Hibiscus moscheutos</i>	Crimsoneyed rosemallow	OBL	0.1
<i>Liatris spicata</i>	Marsh Blazing Star	FAC	0.1
<i>Monarda fistulosa</i>	Wild Bergamot	FACU	1
<i>Panicum anceps</i>	Beaked panicgrass	FAC	5
<i>Panicum clandestinum</i>	Deertongue	FAC	10
<i>Panicum dichotomiflorum</i>	Smooth panicgrass	FACW	8
<i>Panicum rigidulum</i>	Redtop Panicgrass	FACW	2
<i>Pycnanthemum tenuifolium</i>	Narrowleaf mountainmint	FACW	0.1
<i>Rudbeckia hirta</i>	Black eyed Susan	FACU	5
<i>Senna hebecarpa</i>	Wild Senna	FAC	2
<i>Tridens flavus</i>	Purpletop	FACU	10
<i>Verbena hastata</i>	Blue vervain	FACW	6

**Table 7. Planted Vegetation Totals  
Laurel Springs Stream and Wetland Mitigation Site**

<b>Plot #</b>	<b>Planted Stems/Acre</b>	<b>Success Criteria Met?</b>
1	405	Yes
2	526	Yes
3	648	Yes
4	607	Yes
5	607	Yes
6	607	Yes
7	486	Yes
8	607	Yes
9	324	Yes
10	526	Yes
11	688	Yes
12	607	Yes
13	445	Yes
14	526	Yes
15	607	Yes
16	607	Yes
17	729	Yes
R-1	607	Yes
R-2	729	Yes
R-3	607	Yes
R-4	364	Yes
R-5	891	Yes
R-6	1053	Yes
<b>Average Planted Stems/Acre</b>	<b>600</b>	<b>Yes</b>

**Table 8. Vegetation Plot Data Table from Vegetation Data Entry Tool**

Planted Acreage	26.2
Date of Initial Plant	2023-02-04
Date(s) of Supplemental Plant(s)	NA
Date(s) Mowing	2023-03-15
Date of Current Survey	2023-03-15
Plot size (ACRES)	0.0247

	Scientific Name	Common Name	Tree/S hrub	Indicator Status	Veg Plot 1 F		Veg Plot 2 F		Veg Plot 3 F		Veg Plot 4 F		Veg Plot 5 F		Veg Plot 6 F		Veg Plot 7 F		Veg Plot 8 F		Veg Plot 9 F		Veg Plot 10 F		
					Planted	Total	Planted	Total	Planted	Total	Planted	Total	Planted	Total	Planted	Total	Planted	Total	Planted	Total	Planted	Total	Planted	Total	Planted
Species Included in Approved Mitigation Plan	<i>Betula nigra</i>	river birch	Tree	FACW			1	1									1	1	2	2					
	<i>Carya cordiformis</i>	bitternut hickory	Tree	FAC			1	1																	
	<i>Carya ovata</i>	shagbark hickory	Tree	FACU										1	1										
	<i>Celtis occidentalis</i>	common hackberry	Tree	FACU																					
	<i>Cornus amomum</i>	silky dogwood	Shrub	FACW																					
	<i>Liriodendron tulipifera</i>	tuliptree	Tree	FACU					1	1	3	3						3	3						
	<i>Magnolia virginiana</i>	sweetbay	Tree	FACW					1	1	1	1						3	3				1	1	
	<i>Nyssa aquatica</i>	water tupelo	Tree	OBL		1	1	5	5		1	1		1	1	1	1	3	3	1	1	1	1	2	2
	<i>Nyssa sylvatica</i>	blackgum	Tree	FAC		1	1	1	1	2	2	2	2			1	1			2	2	1	1	4	4
	<i>Persea borbonia</i>	redbay	Tree	FACW					7	7												1	1		
	<i>Platanus occidentalis</i>	American sycamore	Tree	FACW			2	2	1	1	3	3	3	3	3	3	3	4	4						
	<i>Quercus alba</i>	white oak	Tree	FACU																					
	<i>Quercus laurifolia</i>	laurel oak	Tree	FACW	2	2							3	3	4	4	1	1	2	2					
	<i>Quercus michauxii</i>	swamp chestnut oak	Tree	FACW	1	1	1	1	1	1			1	1	2	2	1	1	1	1				1	1
	<i>Quercus nigra</i>	water oak	Tree	FAC	2	2									1	1								1	1
	<i>Quercus pagoda</i>	cherrybark oak	Tree	FACW	3	3	1	1					5	5	1	1	1	1				1	1		
	<i>Quercus phellos</i>	willow oak	Tree	FACW							1	1													
	<i>Quercus rubra</i>	northern red oak	Tree	FACU							2	2							1	1					
	<i>Quercus shumardii</i>	Shumard's oak	Tree	FAC																					
	<i>Taxodium distichum</i>	baldd cypress	Tree	OBL			1	1	3	3	2	2	2	2	1	1	1	1				5	5	2	2
<i>Ulmus americana</i>	American elm	Tree	FAC																						
Sum	Performance Standard				10	10	13	13	16	16	15	15	15	15	15	15	12	12	15	15	8	8	13	13	
Mitigation Plan Performance Standard	Current Year Stem Count				10		13		16		15		15		15		12		15		8		13		
	Stems/Acre				405		526		648		607		607		607		486		607		324		526		
	Species Count				6		8		7		8		6		9		7		8		4		7		
	Dominant Species Composition (%)				30		38		44		20		33		27		33		20		62		31		
	Average Plot Height (ft.)				1		0		0		0		1		1		1		0		1		1		
% Invasives				0		0		0		0		0		0		0		0		0		0			
Post Mitigation Plan Performance Standard	Current Year Stem Count				10		13		16		15		15		15		12		15		8		13		
	Stems/Acre				405		526		648		607		607		607		486		607		324		526		
	Species Count				6		8		7		8		6		9		7		8		4		7		
	Dominant Species Composition (%)				30		38		44		20		33		27		33		20		62		31		
	Average Plot Height (ft.)				1		0		0		0		1		1		1		0		1		1		
% Invasives				0		0		0		0		0		0		0		0		0		0			

1). Bolded species are proposed for the current monitoring year, italicized species are not approved, and a regular font indicates that the species has been approved.

2). The "Species Included in Approved Mitigation Plan" section contains only those species that were included in the original approved mitigation plan. The "Post Mitigation Plan Species" section includes species that are being proposed through a mitigation plan addendum for the current monitoring year (bolded), species that have been approved in prior monitoring years through a mitigation plan addendum (regular font), and species that are not approved (italicized).

3). The "Mitigation Plan Performance Standard" section is derived only from stems included in the original mitigation plan, whereas the "Post Mitigation Plan Performance Standard" includes data from mitigation plan approved, post mitigation plan approved, and proposed stems.

**Table 8. Vegetation Plot Data Table from Vegetation Data Entry Tool (cont.)**

Planted Acreage	26.2
Date of Initial Plant	2023-02-04
Date(s) of Supplemental Plant(s)	NA
Date(s) Mowing	2023-03-15
Date of Current Survey	2023-03-15
Plot size (ACRES)	0.0247

	Scientific Name	Common Name	Tree/S hrub	Indicator Status	Veg Plot 11 F		Veg Plot 12 F		Veg Plot 13 F		Veg Plot 14 F		Veg Plot 15 F		Veg Plot 16 F		Veg Plot 17 F		Veg Plot 1 R	Veg Plot 2 R	Veg Plot 3 R	Veg Plot 4 R	Veg Plot 5 R	Veg Plot 6 R	
					Planted	Total	Planted	Total	Planted	Total	Planted	Total	Planted	Total	Planted	Total	Planted	Total	Total	Total	Total	Total	Total	Total	Total
Species Included in Approved Mitigation Plan	<i>Betula nigra</i>	river birch	Tree	FACW			2	2					1	1					2				2	2	
	<i>Carya cordiformis</i>	bitternut hickory	Tree	FAC															1				1	1	
	<i>Carya ovata</i>	shagbark hickory	Tree	FACU															1				1	1	
	<i>Celtis occidentalis</i>	common hackberry	Tree	FACU	2	2																			
	<i>Cornus amomum</i>	silky dogwood	Shrub	FACU				1																3	3
	<i>Liriodendron tulipifera</i>	tuliptree	Tree	FACU				3		2			1	1					1	1	1	1	1	7	2
	<i>Magnolia virginiana</i>	sweetbay	Tree	FACW	3	3	2	2			2	2	1	1			1	1	1	1					3
	<i>Nyssa aquatica</i>	water tupelo	Tree	DBL	1	1	1	1	1	1										2	2	4	1	2	4
	<i>Nyssa sylvatica</i>	blackgum	Tree	FAC	2	2	1	1	1	1	2	2	1	1						1	2	3			3
	<i>Nersea borbonia</i>	redbay	Tree	FACW																1	2	3			
	<i>Platanus occidentalis</i>	American sycamore	Tree	FACW			1	1	3	3	1	1	2	2			1	1	1	1	1	1			
	<i>Quercus alba</i>	white oak	Tree	FACU	2	2							2	2											
	<i>Quercus laurifolia</i>	laurel oak	Tree	FACW							4	4			4	4	9	9	1			2	2		
	<i>Quercus michauxii</i>	swamp chestnut oak	Tree	FACW					4	4			1	1	1	1	2	2	1	1			3		
	<i>Quercus nigra</i>	water oak	Tree	FAC	1	1							2	2	6	6	3	3	4	1				2	1
	<i>Quercus pagoda</i>	cherrybark oak	Tree	FACW			2	3											2	1	1	1	1		3
	<i>Quercus phellos</i>	willow oak	Tree	FACW	2	2					1	1	1	1					2	3					1
	<i>Quercus rubra</i>	northern red oak	Tree	FACU	3	3					2	2			2	2	2	2							
<i>Quercus shumardii</i>	Shumard's oak	Tree	FAC			1	1					2	2	2	2						2			1	
<i>Taxodium distichum</i>	bald cypress	Tree	DBL	1	1	1	1			1	1	1	1											8	
<i>Ulmus americana</i>	American elm	Tree	FAC																					3	
Sum	Performance Standard				17	17	10	15	9	11	13	13	15	15	15	15	18	18	15	18	15	9	22	26	
Mitigation Plan Performance Standard	Current Year Stem Count				17		15		11		13		15		15		18	15	18	15	9	22	26		
	Stems/Acre				688		607		445		526		607		607		729	607	729	607	364	891	1053		
	Species Count				9		9		5		7		11		5		6	9	11	8	6	9	8		
	Dominant Species Composition (%)				18		20		36		31		13		40		50	27	17	27	33	32	31		
	Average Plot Height (ft.)				0		0		1		0		1		1		0	0	0	0	0	0	0		
% Invasives				0		0		0		0		0		0		0	0	0	0	0	0	0			
Post Mitigation Plan Performance Standard	Current Year Stem Count				17		15		11		13		15		15		18	15	18	15	9	22	26		
	Stems/Acre				688		607		445		526		607		607		729	607	729	607	364	891	1053		
	Species Count				9		9		5		7		11		5		6	9	11	8	6	9	8		
	Dominant Species Composition (%)				18		20		36		31		13		40		50	27	17	27	33	32	31		
	Average Plot Height (ft.)				0		0		1		0		1		1		0	0	0	0	0	0	0		
% Invasives				0		0		0		0		0		0		0	0	0	0	0	0	0			

1). Bolded species are proposed for the current monitoring year, italicized species are not approved, and a regular font indicates that the species has been approved.  
 2). The "Species Included in Approved Mitigation Plan" section contains only those species that were included in the original approved mitigation plan. The "Post Mitigation Plan Species" section includes species that are being proposed through a mitigation plan addendum for the current monitoring year (bolded), species that have been approved in prior monitoring years through a mitigation plan addendum (regular font), and species that are not approved (italicized).  
 3). The "Mitigation Plan Performance Standard" section is derived only from stems included in the original mitigation plan, whereas the "Post Mitigation Plan Performance Standard" includes data from mitigation plan approved, post mitigation plan approved, and proposed stems.

## **Appendix C: Stream Geomorphology Data**

Cross-Sections with Annual Overlays

Longitudinal Profile

Table 9A-E. Baseline Stream Data Summary Tables

Table 10A-B. Cross-Section Morphology Monitoring Summary


<b>Site</b>	Crane Site
<b>Watershed:</b>	Cape Fear River Basin, 03030004
<b>XS ID</b>	UT2, XS -1
<b>Feature</b>	Pool
<b>Date:</b>	2/7/2023
<b>Field Crew:</b>	Adams, Fleming, Smith

Station	Elevation
0.0	388.7
2.8	388.6
5.0	388.5
6.5	388.1
7.1	387.8
7.7	387.6
8.4	387.4
9.4	387.4
10.5	387.4
11.3	387.9
13.2	388.7
14.8	388.9
17.3	389.0

SUMMARY DATA	
<b>Bankfull Elevation:</b>	388.48
<b>Bank Hieght Ratio:</b>	NA
<b>Thalweg Elevation:</b>	387.36
<b>LTOB Elevation:</b>	388.48
<b>LTOB Max Depth:</b>	1.12
<b>LTOB Cross Sectional Area:</b>	5.1



<b>Stream Type</b>	
--------------------	--

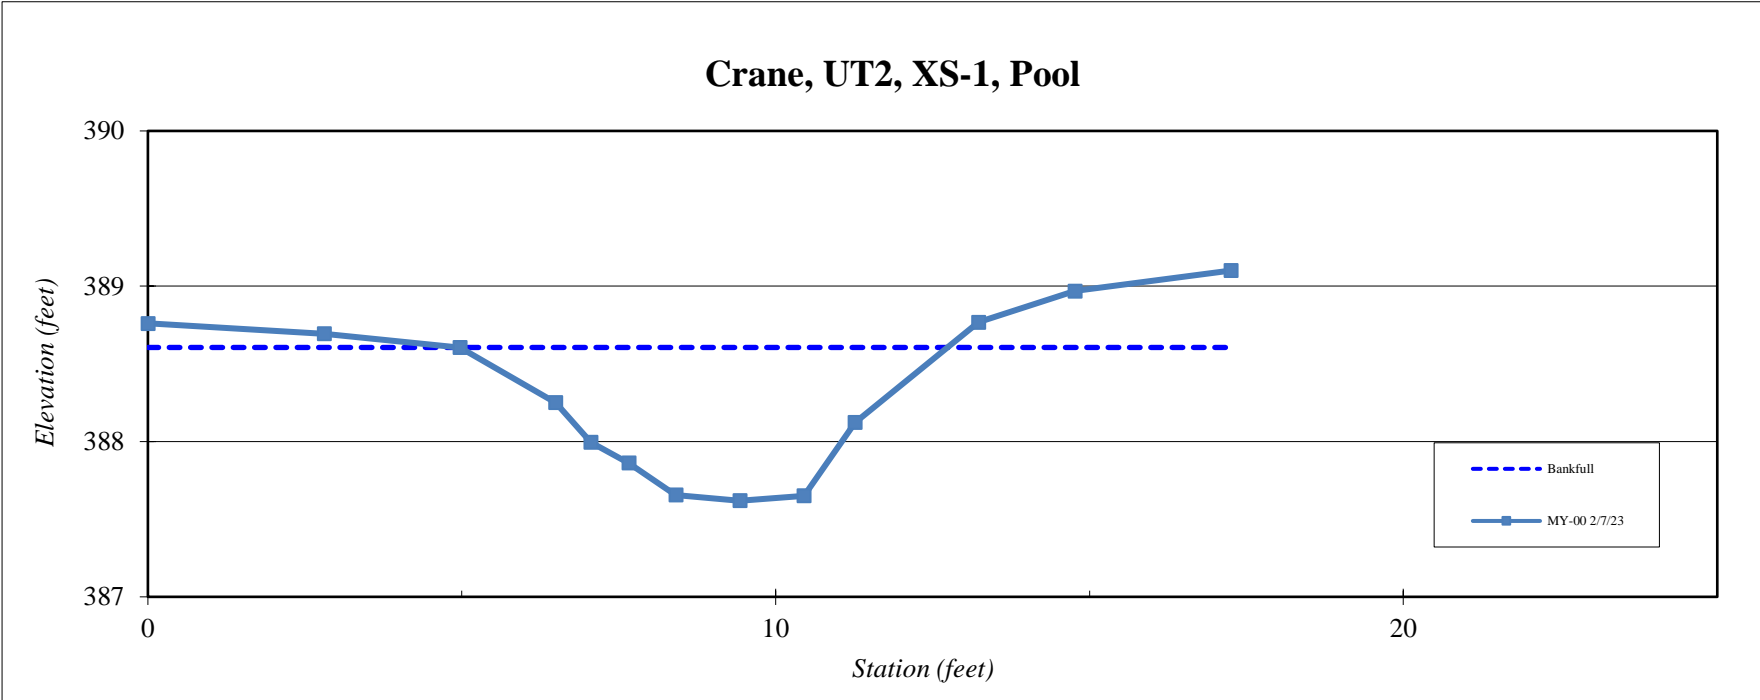


Site	Crane Site
Watershed:	Cape Fear River Basin, 03030004
XS ID	UT2, XS-2
Feature	Riffle
Date:	2/7/2023
Field Crew:	Adams, Fleming, Smith

Station	Elevation
0.0	389.0
1.4	388.9
4.1	388.9
5.7	388.5
6.8	388.1
7.2	387.9
7.5	388.0
8.0	388.1
8.5	388.1
9.1	388.1
9.9	388.4
11.6	389.0
13.9	389.3
16.8	389.7

SUMMARY DATA	
Bankfull Elevation:	388.92
Bank Height Ratio:	1.00
Thalweg Elevation:	387.92
LTOB Elevation:	388.92
LTOB Max Depth:	1.00
LTOB Cross Sectional Area:	3.8



Stream Type

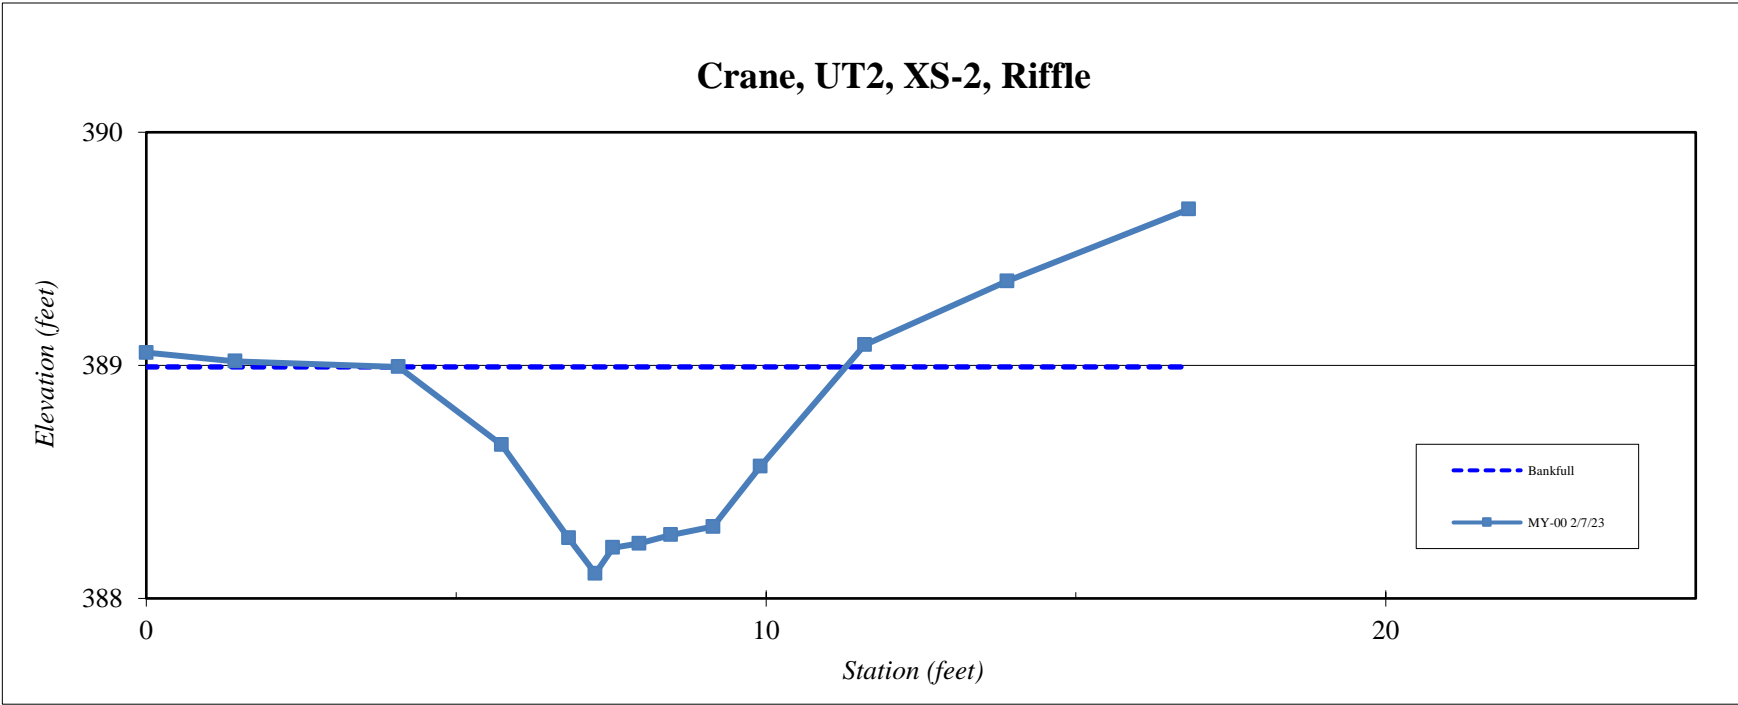


<b>Site</b>	Crane Site
<b>Watershed:</b>	Cape Fear River Basin, 03030004
<b>XS ID</b>	UT4, XS-3
<b>Feature</b>	Riffle
<b>Date:</b>	2/7/2023
<b>Field Crew:</b>	Adams, Fleming, Smith

Station	Elevation
0.0	388.9
1.9	388.9
3.6	388.8
4.4	388.6
4.8	388.3
5.5	388.3
6.0	388.3
6.7	388.3
7.6	388.2
8.1	388.4
9.8	388.7
12.0	389.0

SUMMARY DATA	
<b>Bankfull Elevation:</b>	388.85
<b>Bank Height Ratio:</b>	1.00
<b>Thalweg Elevation:</b>	388.24
<b>LTOB Elevation:</b>	388.85
<b>LTOB Max Depth:</b>	0.61
<b>LTOB Cross Sectional Area:</b>	2.7



Stream Type

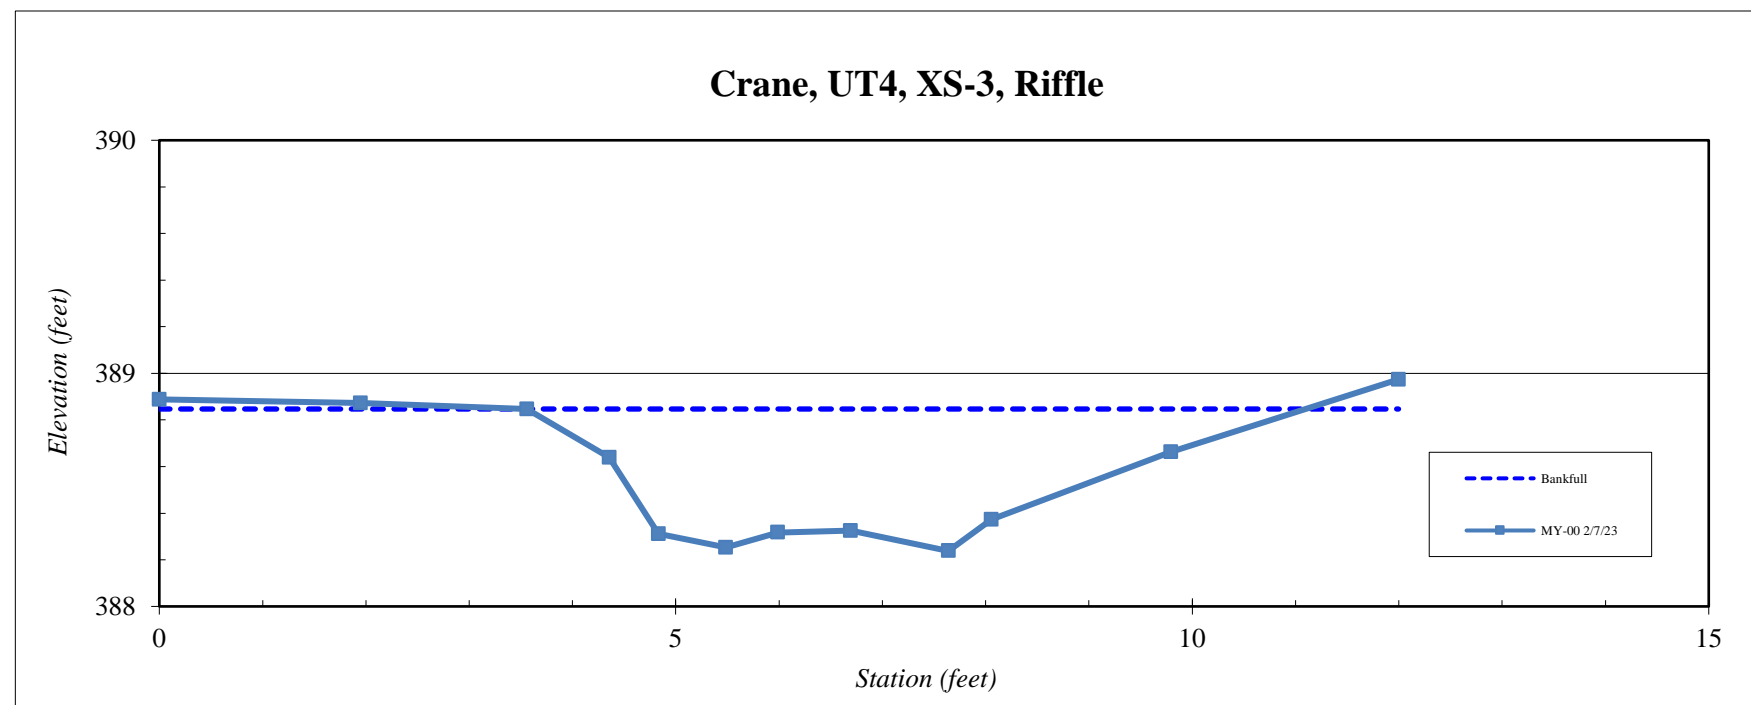




<b>Site</b>	Crane Site
<b>Watershed:</b>	Cape Fear River Basin, 03030004
<b>XS ID</b>	UT4, XS-4
<b>Feature</b>	Pool
<b>Date:</b>	2/7/2023
<b>Field Crew:</b>	Adams, Fleming, Smith

Station	Elevation
0.0	389.2
1.5	388.9
2.6	388.6
3.5	388.2
4.5	388.1
5.3	388.1
6.1	388.5
6.8	388.7
7.8	389.0
9.7	389.3

SUMMARY DATA	
<b>Bankfull Elevation:</b>	388.94
<b>Bank Height Ratio:</b>	NA
<b>Thalweg Elevation:</b>	388.06
<b>LTOB Elevation:</b>	388.94
<b>LTOB Max Depth:</b>	0.88
<b>LTOB Cross Sectional Area:</b>	3.0



**Stream Type**

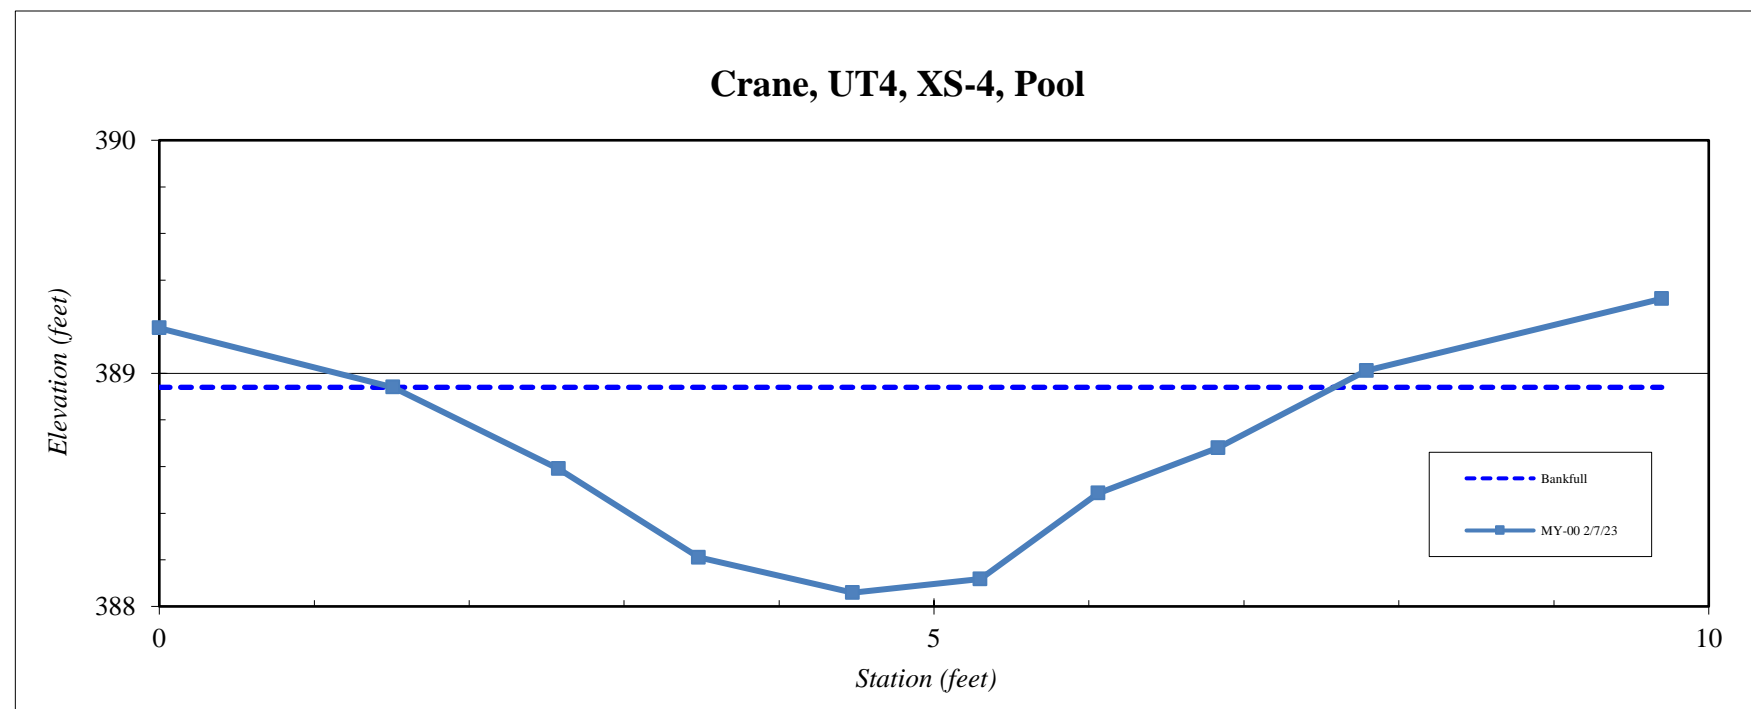


<b>Site</b>	Crane Site
<b>Watershed:</b>	Cape Fear River Basin, 03030004
<b>XS ID</b>	UT4, XS-5
<b>Feature</b>	Riffle
<b>Date:</b>	2/7/2023
<b>Field Crew:</b>	Adams, Fleming, Smith



Station	Elevation
0.0	392.6
2.7	392.2
5.6	392.1
6.8	391.6
7.5	391.5
8.0	391.6
8.9	391.4
9.3	391.7
10.6	392.0
12.2	392.0
16.2	392.1

SUMMARY DATA	
<b>Bankfull Elevation:</b>	391.96
<b>Bank Hieght Ratio:</b>	1.00
<b>Thalweg Elevation:</b>	391.43
<b>LTOB Elevation:</b>	391.96
<b>LTOB Max Depth:</b>	0.53
<b>LTOB Cross Sectional Area:</b>	1.4

Stream Type

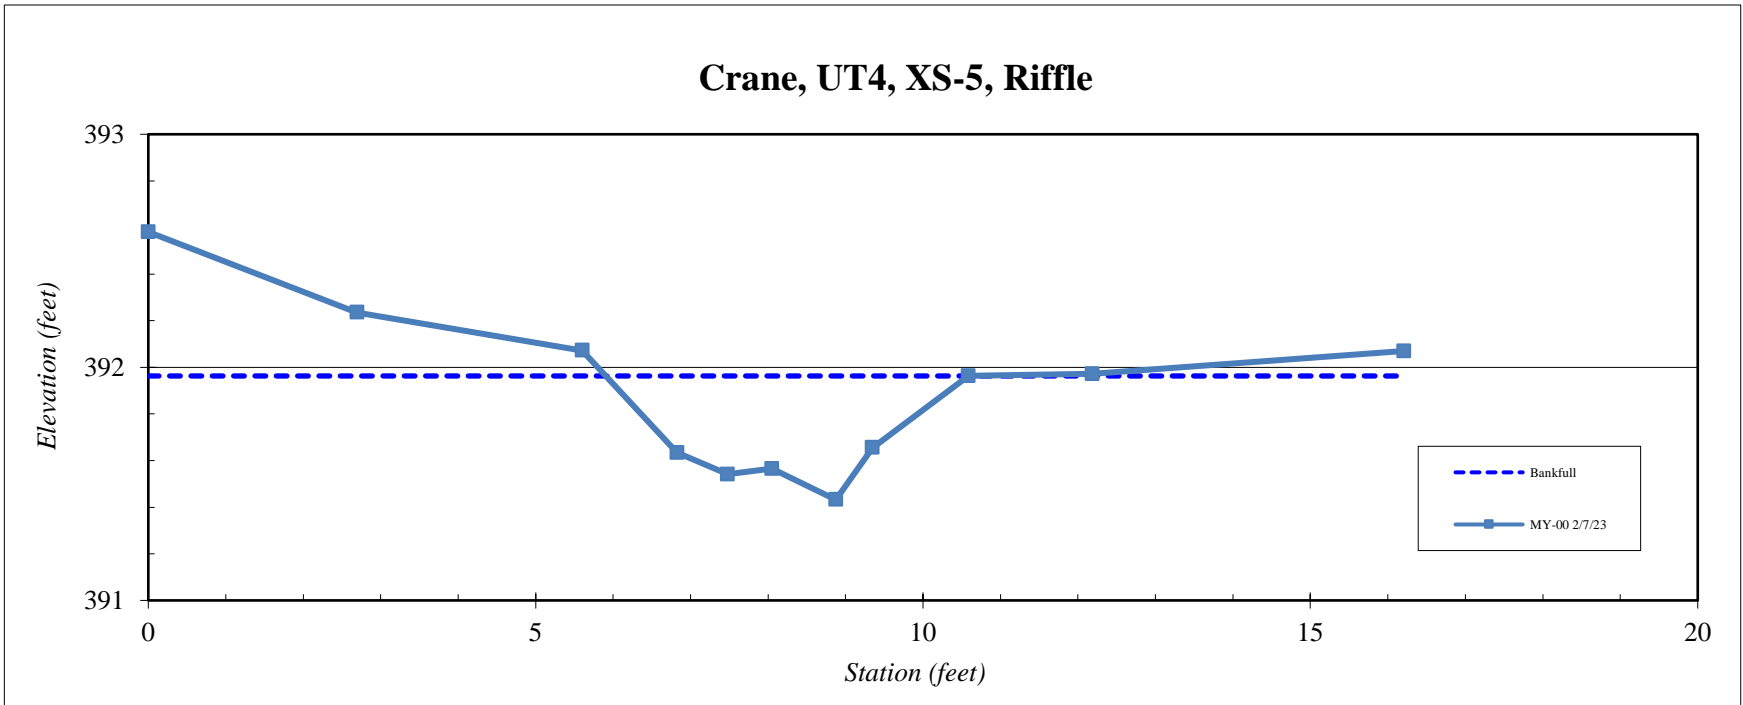


<b>Site</b>	Crane Site
<b>Watershed:</b>	Cape Fear River Basin, 03030004
<b>XS ID</b>	UT4, XS-6
<b>Feature</b>	Pool
<b>Date:</b>	2/7/2023
<b>Field Crew:</b>	Adams, Fleming, Smith

Station	Elevation
0.0	392.6
2.7	392.2
5.2	392.2
5.8	391.9
6.6	391.6
7.3	391.5
7.8	391.3
8.4	391.1
8.8	391.1
9.2	391.3
10.2	391.6
11.1	392.0
12.6	392.0
15.1	392.3

SUMMARY DATA	
<b>Bankfull Elevation:</b>	392.04
<b>Bank Height Ratio:</b>	NA
<b>Thalweg Elevation:</b>	391.06
<b>LTOB Elevation:</b>	392.04
<b>LTOB Max Depth:</b>	0.99
<b>LTOB Cross Sectional Area:</b>	3.0



<b>Stream Type</b>	
--------------------	--

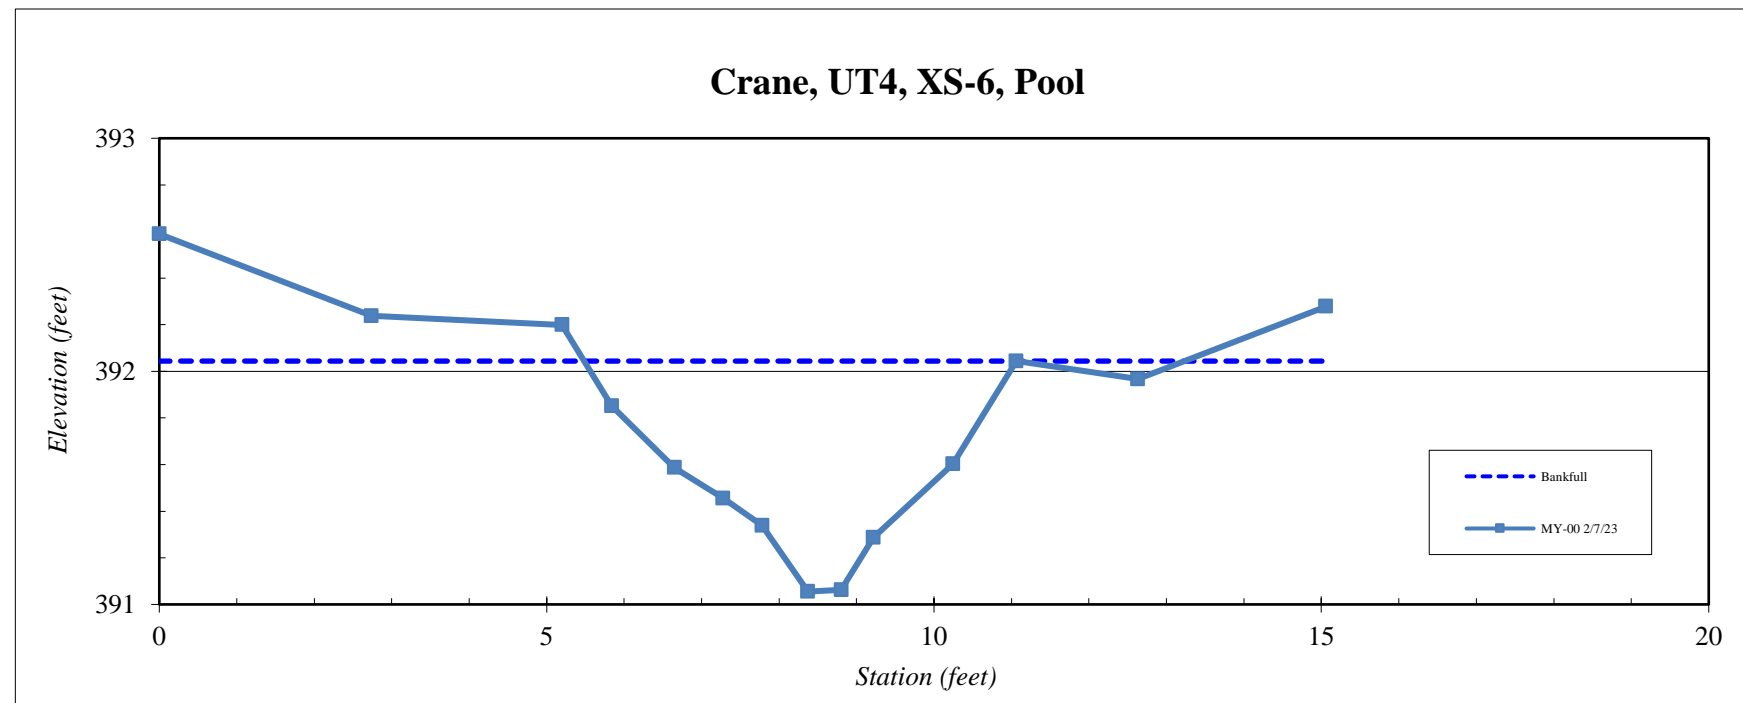


Site	Crane Site
Watershed:	Cape Fear River Basin, 03030004
XS ID	UT1, XS-7
Feature	Riffle
Date:	2/7/2023
Field Crew:	Adams, Fleming, Smith

Station	Elevation
0.0	390.0
2.9	389.9
5.0	389.7
6.2	389.4
7.7	389.1
8.5	388.8
9.3	388.8
10.4	388.9
11.0	388.9
11.8	388.9
12.4	389.0
13.3	389.3
14.4	389.8
16.4	389.9
18.9	390.0

SUMMARY DATA	
Bankfull Elevation:	389.84
Bank Height Ratio:	1.00
Thalweg Elevation:	388.83
LTOB Elevation:	389.84
LTOB Max Depth:	1.01
LTOB Cross Sectional Area:	6.7



Stream Type	
-------------	--

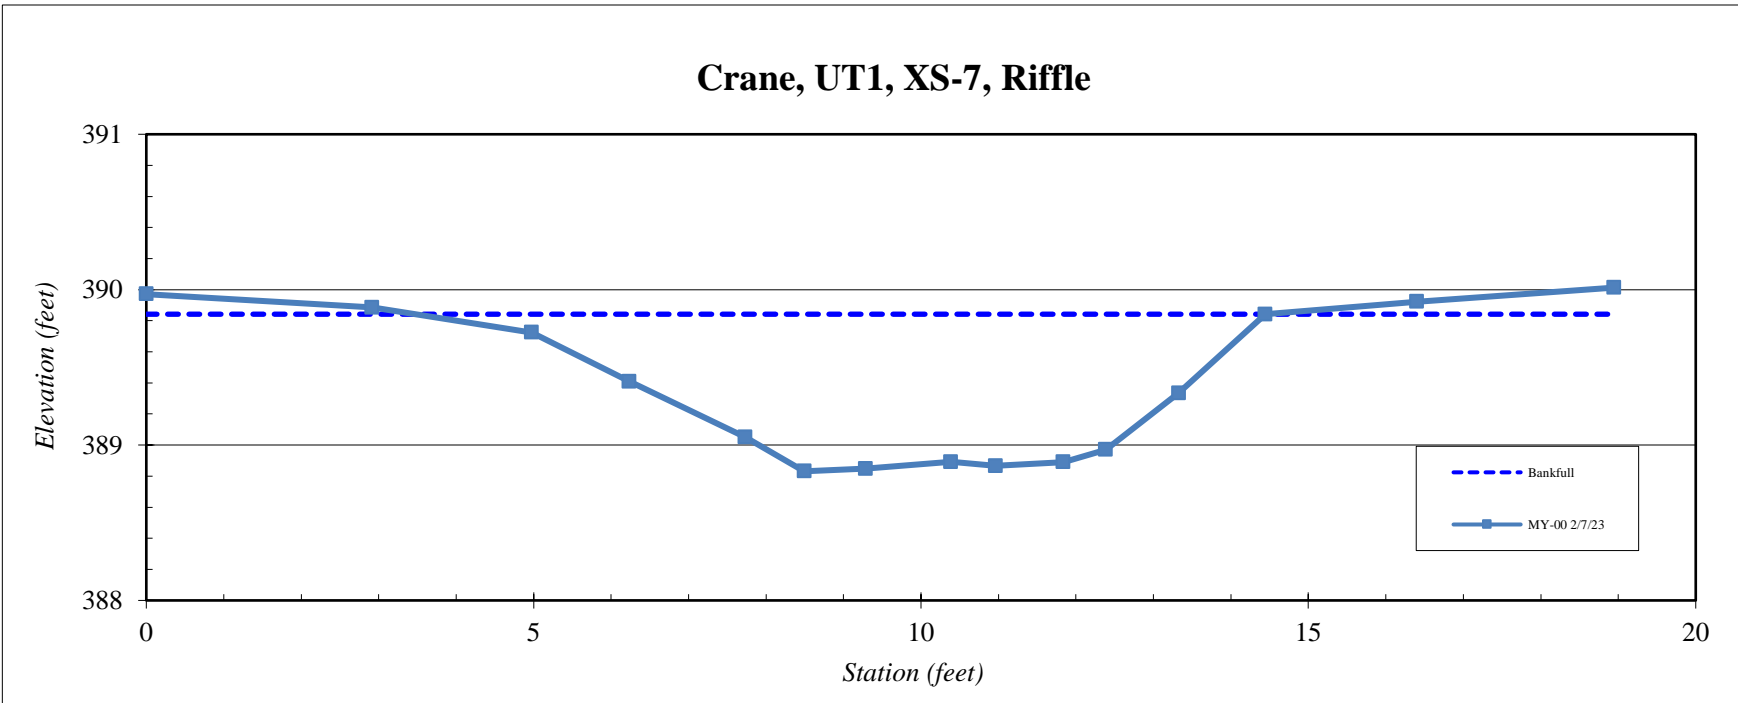


<b>Site</b>	Crane Site
<b>Watershed:</b>	Cape Fear River Basin, 03030004
<b>XS ID</b>	UT1, XS-8
<b>Feature</b>	Riffle
<b>Date:</b>	2/7/2023
<b>Field Crew:</b>	Adams, Fleming, Smith

Station	Elevation
0.0	390.1
3.2	389.9
4.8	389.7
5.8	389.4
6.8	389.3
7.6	388.3
8.7	388.2
9.6	388.3
10.5	388.3
11.4	388.3
12.0	388.4
12.4	388.6
13.1	388.9
14.1	389.3
15.6	389.8
18.3	390.0
20.2	390.1

<b>SUMMARY DATA</b>	
<b>Bankfull Elevation:</b>	389.72
<b>Bank Height Ratio:</b>	NA
<b>Thalweg Elevation:</b>	388.24
<b>LTOB Elevation:</b>	389.72
<b>LTOB Max Depth:</b>	1.48
<b>LTOB Cross Sectional Area:</b>	9.7



**Stream Type**

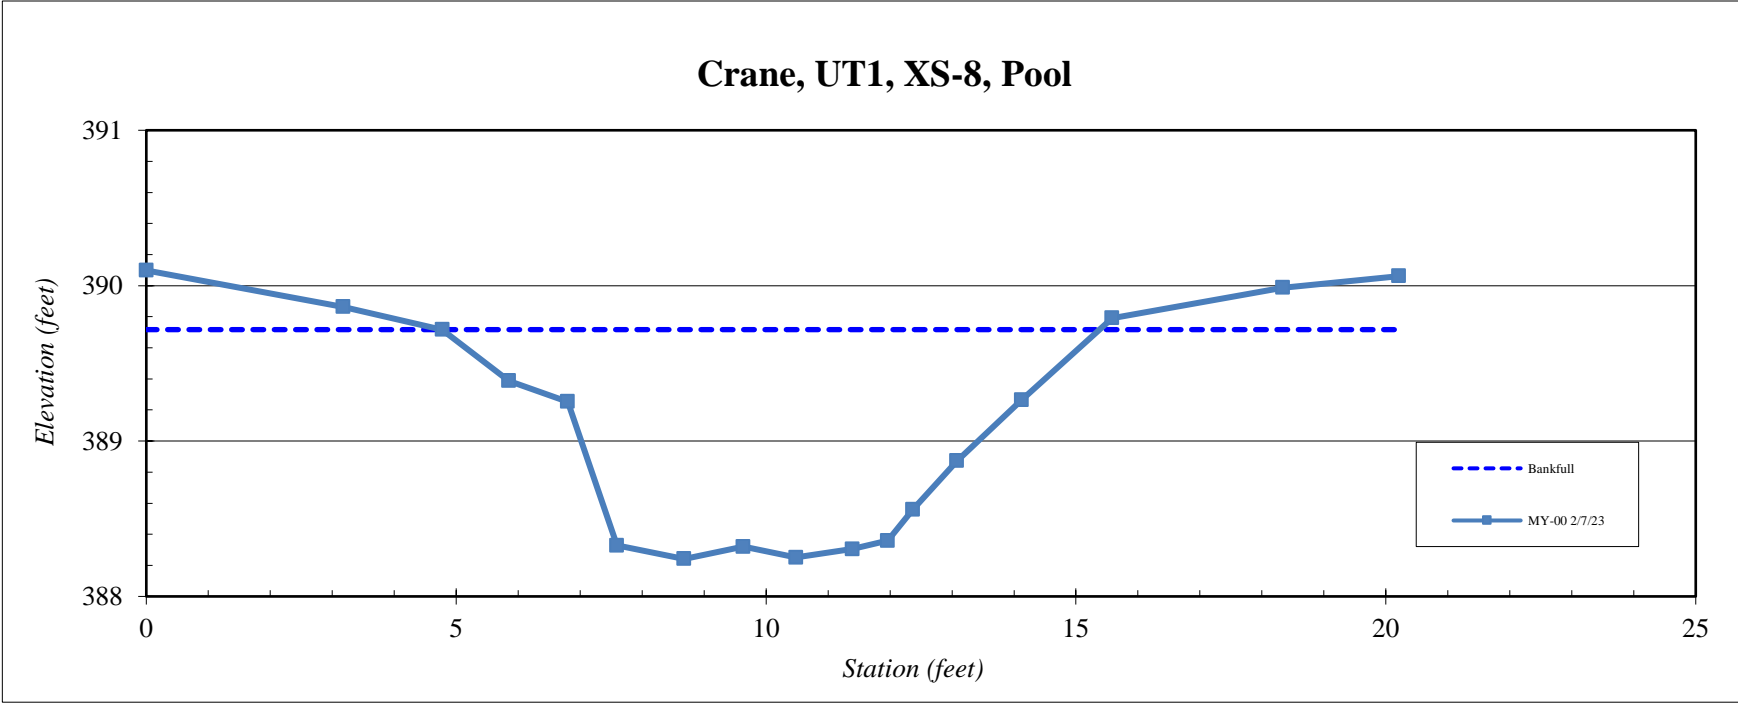


<b>Site</b>	Crane Site
<b>Watershed:</b>	Cape Fear River Basin, 03030004
<b>XS ID</b>	UT3, XS-9
<b>Feature</b>	Riffle
<b>Date:</b>	2/7/2023
<b>Field Crew:</b>	Adams, Fleming, Smith

Station	Elevation
0.0	394.6
2.8	394.7
4.4	394.4
5.5	394.1
6.6	393.9
7.6	393.9
8.5	394.1
9.3	394.1
10.3	394.7
11.1	394.8
12.9	394.8
15.0	395.1

SUMMARY DATA	
<b>Bankfull Elevation:</b>	394.72
<b>Bank Height Ratio:</b>	1.00
<b>Thalweg Elevation:</b>	393.90
<b>LTOB Elevation:</b>	394.72
<b>LTOB Max Depth:</b>	0.82
<b>LTOB Cross Sectional Area:</b>	3.9



<b>Stream Type</b>	
--------------------	--

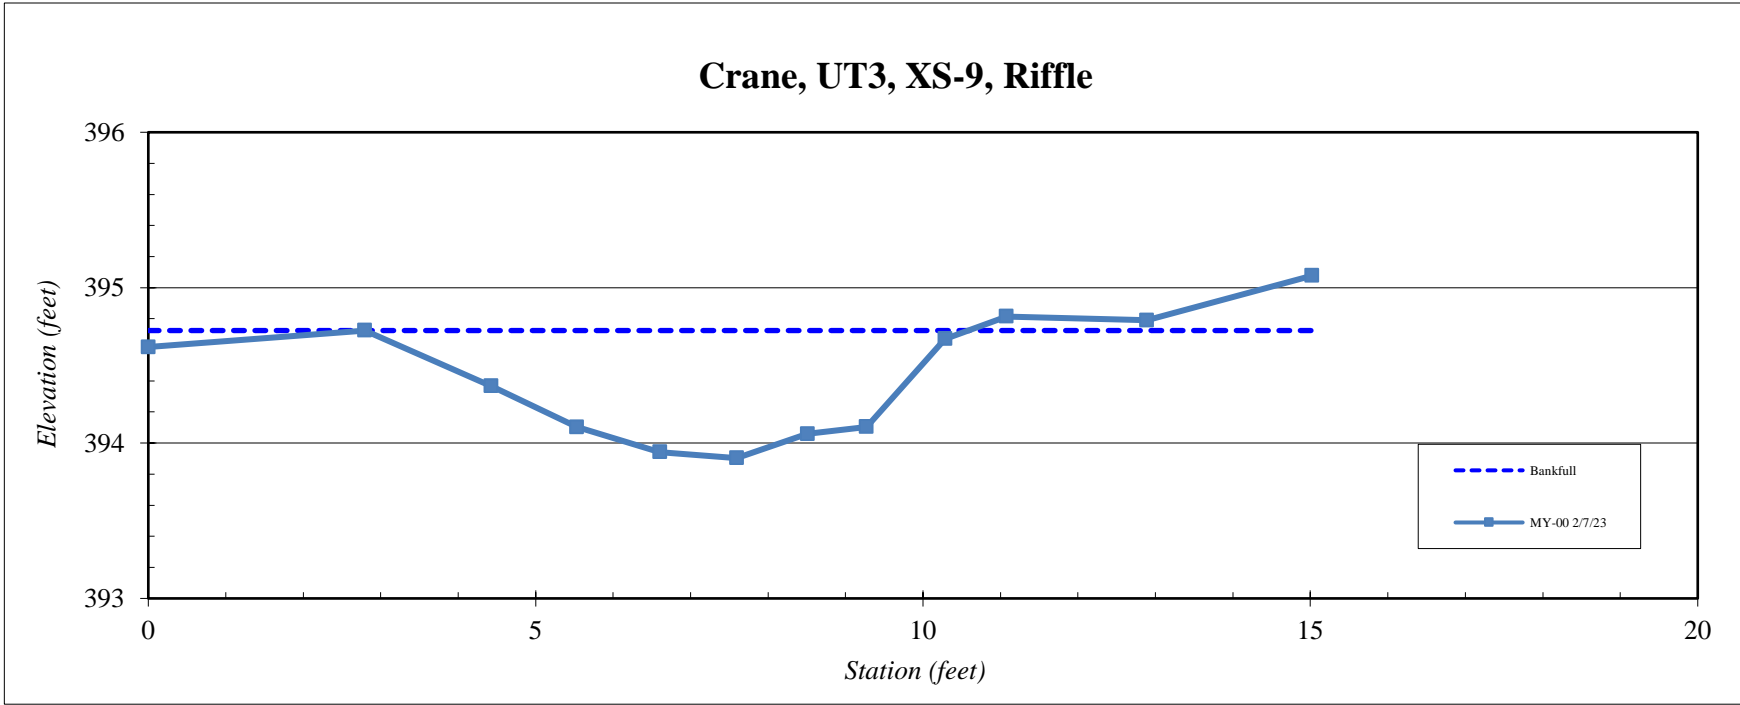


<b>Site</b>	Crane Site
<b>Watershed:</b>	Cape Fear River Basin, 03030004
<b>XS ID</b>	UT3, XS-10
<b>Feature</b>	Pool
<b>Date:</b>	2/7/2023
<b>Field Crew:</b>	Adams, Fleming, Smith



Station	Elevation
0.0	394.9
2.4	394.6
3.8	394.5
4.8	394.2
5.8	394.4
6.3	391.9
6.8	392.2
7.6	392.3
8.2	392.3
8.7	394.5
9.7	394.6
11.3	395.1
13.9	395.3

SUMMARY DATA	
<b>Bankfull Elevation:</b>	394.40
<b>Bank Hieght Ratio:</b>	NA
<b>Thalweg Elevation:</b>	391.94
<b>LTOB Elevation:</b>	394.40
<b>LTOB Max Depth:</b>	2.46
<b>LTOB Cross Sectional Area:</b>	5.3

Stream Type

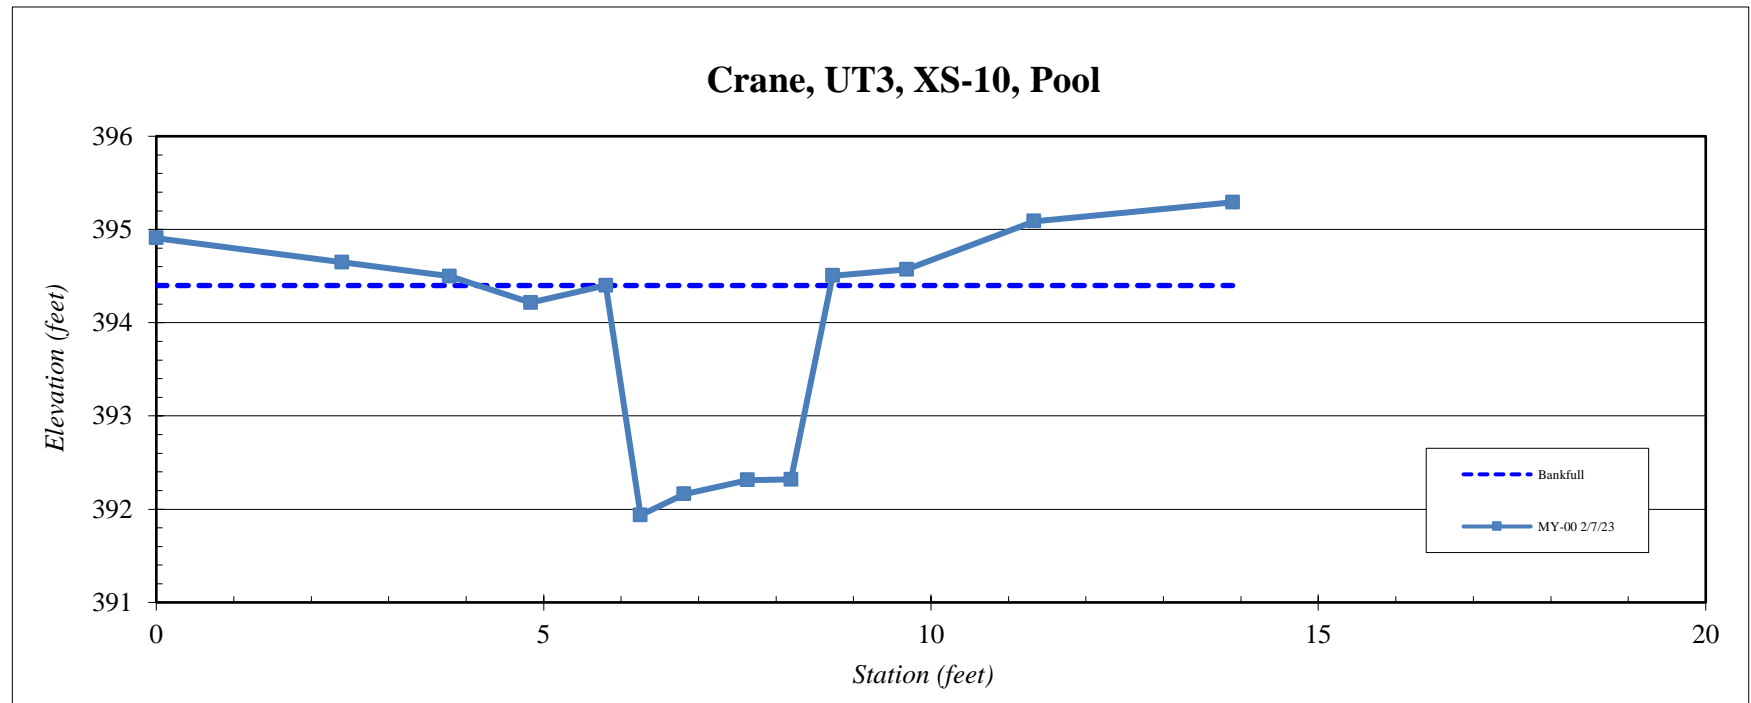


<b>Site</b>	Crane Site
<b>Watershed:</b>	Cape Fear River Basin, 03030004
<b>XS ID</b>	UT1, XS-11
<b>Feature</b>	Riffle
<b>Date:</b>	2/7/2023
<b>Field Crew:</b>	Adams, Fleming, Smith



Station	Elevation
0.0	395.3
3.8	395.3
4.9	395.1
6.0	394.6
6.8	394.4
7.6	394.4
8.7	394.2
9.0	394.2
9.4	394.2
10.3	394.2
10.9	394.2
11.7	394.5
12.8	394.7
13.5	395.1
15.7	395.2
19.3	395.3

SUMMARY DATA	
<b>Bankfull Elevation:</b>	395.05
<b>Bank Height Ratio:</b>	1.00
<b>Thalweg Elevation:</b>	394.18
<b>LTOB Elevation:</b>	395.05
<b>LTOB Max Depth:</b>	0.87
<b>LTOB Cross Sectional Area:</b>	5.1

Stream Type

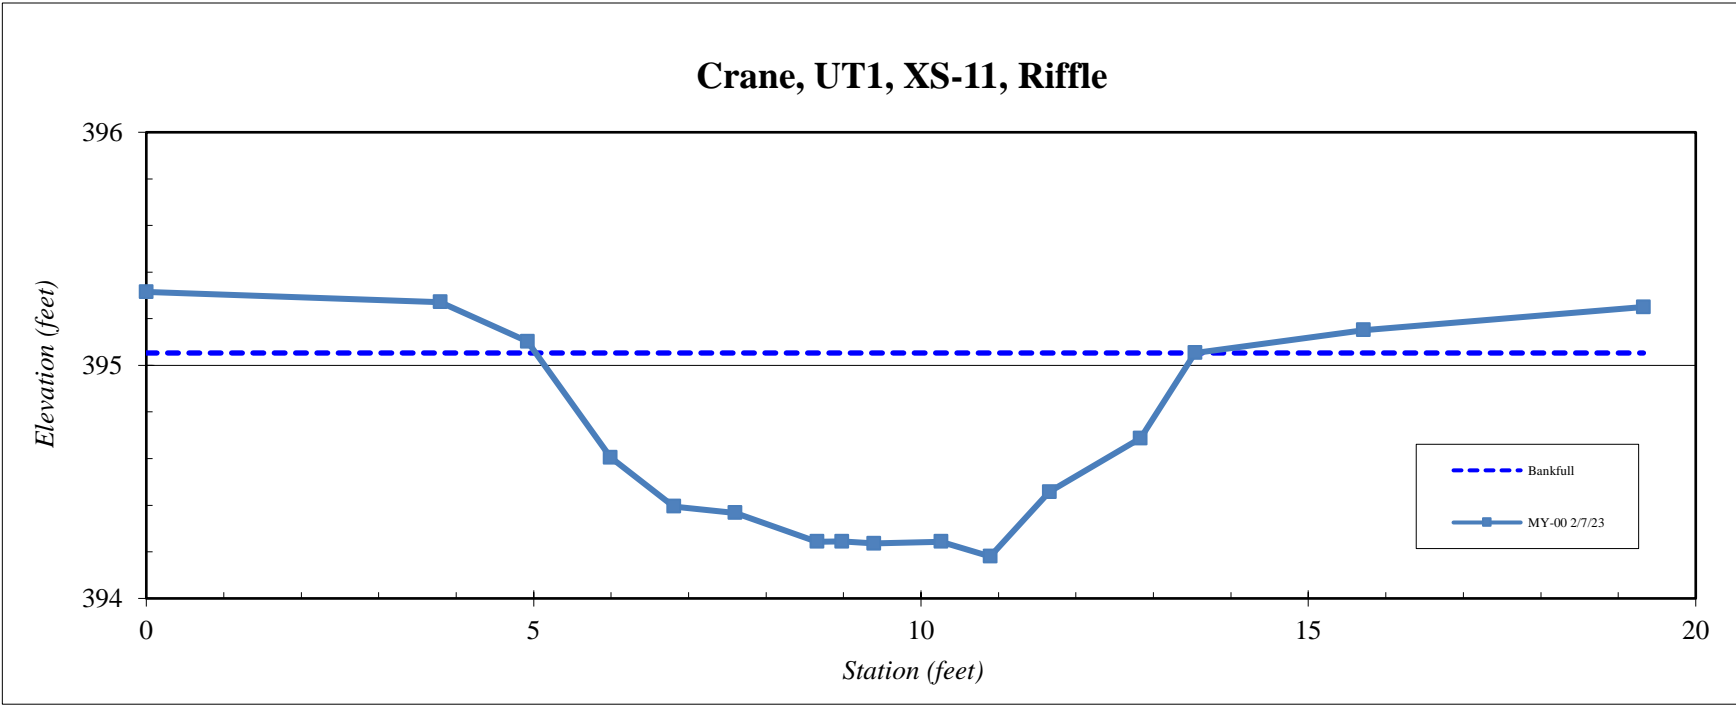




<b>Site</b>	Crane Site
<b>Watershed:</b>	Cape Fear River Basin, 03030004
<b>XS ID</b>	UT1, XS-12
<b>Feature</b>	Pool
<b>Date:</b>	2/7/2023
<b>Field Crew:</b>	Adams, Fleming, Smith

Station	Elevation
0.0	395.4
3.8	395.0
5.5	394.4
6.5	394.0
7.6	393.8
8.5	393.8
9.4	393.7
10.2	393.8
11.3	394.2
12.1	394.5
13.7	394.9
15.4	395.2
21.2	395.2

SUMMARY DATA	
<b>Bankfull Elevation:</b>	395.00
<b>Bank Height Ratio:</b>	NA
<b>Thalweg Elevation:</b>	393.69
<b>LTOB Elevation:</b>	395.00
<b>LTOB Max Depth:</b>	1.31
<b>LTOB Cross Sectional Area:</b>	8.0



Stream Type

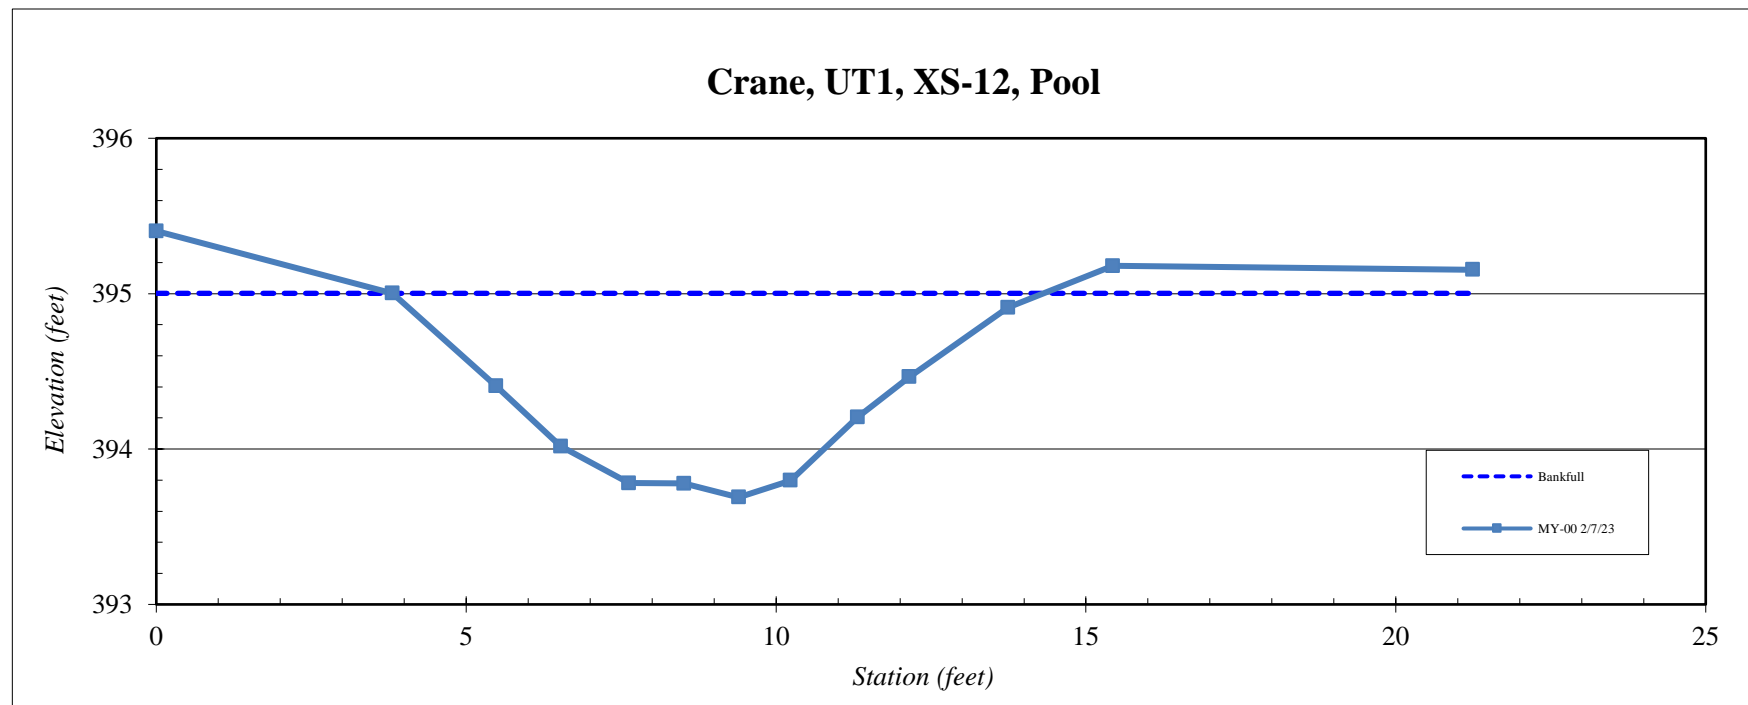


Site	Crane Site
Watershed:	Cape Fear River Basin, 03030004
XS ID	UT5, XS-13
Feature	Riffle
Date:	2/7/2023
Field Crew:	Adams, Fleming, Smith

Station	Elevation
0.0	399.4
3.2	399.3
4.6	399.4
5.6	399.2
6.5	398.7
7.8	398.4
8.9	398.3
9.9	398.2
10.6	398.3
11.1	398.4
11.7	398.7
12.5	398.9
13.0	399.1
15.9	399.1
18.2	399.6

SUMMARY DATA	
Bankfull Elevation:	399.13
Bank Height Ratio:	1.00
Thalweg Elevation:	398.21
LTOB Elevation:	399.13
LTOB Max Depth:	0.92
LTOB Cross Sectional Area:	4.4



Stream Type

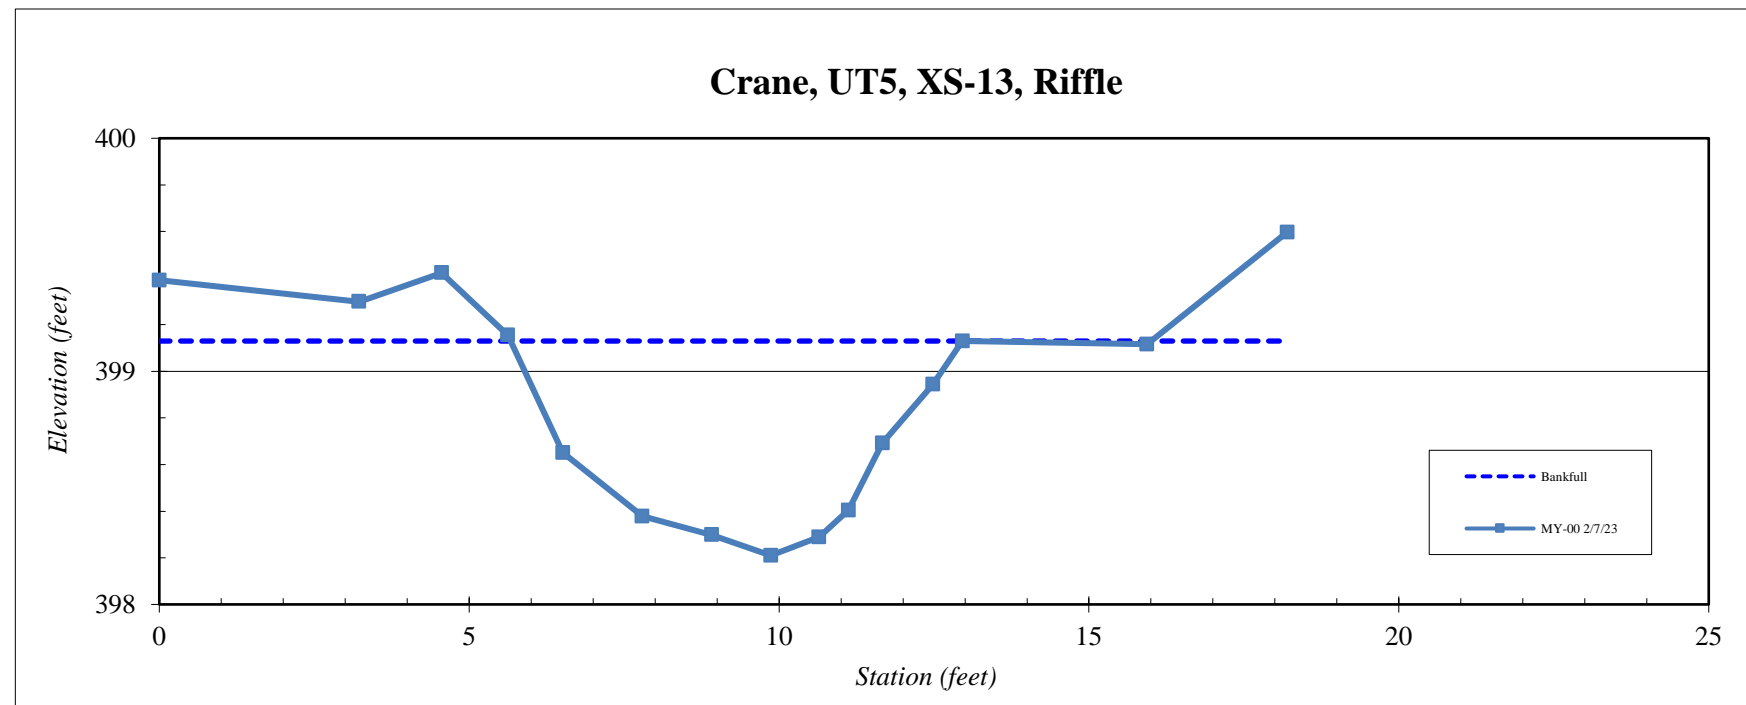




<b>Site</b>	Crane Site
<b>Watershed:</b>	Cape Fear River Basin, 03030004
<b>XS ID</b>	UT1, XS-15
<b>Feature</b>	Riffle
<b>Date:</b>	2/7/2023
<b>Field Crew:</b>	Adams, Fleming, Smith



Station	Elevation
0.0	408.7
3.8	408.4
4.8	408.2
6.3	407.6
7.4	407.5
8.3	407.4
9.1	407.5
10.5	407.5
11.2	407.7
11.9	408.1
13.2	408.6
15.4	408.7
18.2	409.0

SUMMARY DATA	
<b>Bankfull Elevation:</b>	408.40
<b>Bank Height Ratio:</b>	1.00
<b>Thalweg Elevation:</b>	407.44
<b>LTOB Elevation:</b>	408.40
<b>LTOB Max Depth:</b>	0.96
<b>LTOB Cross Sectional Area:</b>	5.8

Stream Type

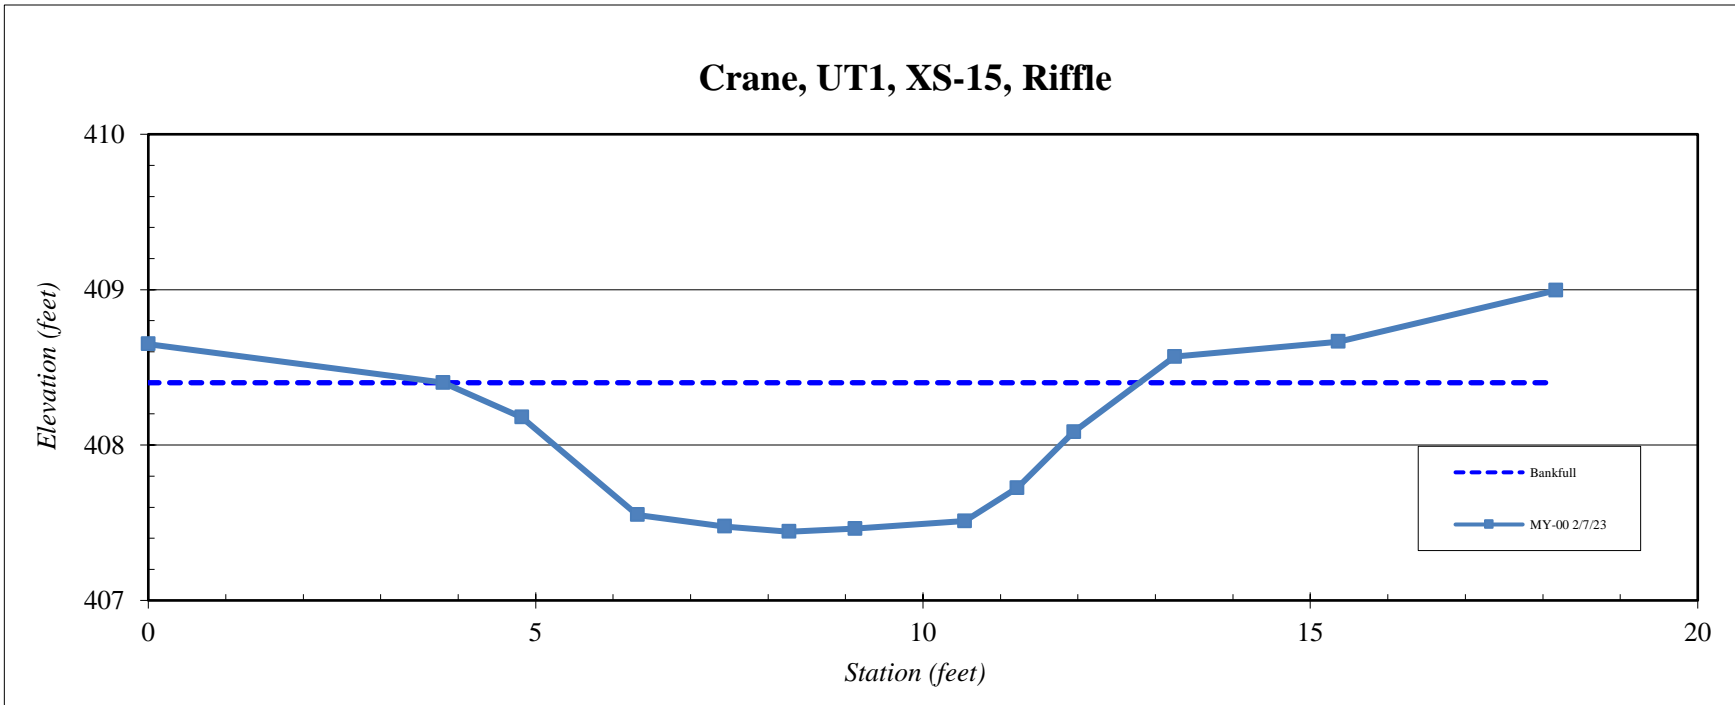
Site	Crane Site
Watershed:	Cape Fear River Basin, 03030004
XS ID	UT1, XS-16
Feature	Pool
Date:	2/7/2023
Field Crew:	Adams, Fleming, Smith

Station	Elevation
0.0	409.2
3.3	409.0
4.7	408.8
6.2	408.2
7.1	406.9
7.9	406.8
8.9	406.7
9.5	406.8
10.2	406.9
11.4	406.8
12.1	406.9
12.7	408.3
13.5	408.3
14.5	408.8
15.4	409.2
19.1	409.2

SUMMARY DATA	
Bankfull Elevation:	408.81
Bank Hieght Ratio:	NA
Thalweg Elevation:	406.67
LTOB Elevation:	408.81
LTOB Max Depth:	2.14
LTOB Cross Sectional Area:	12.9




Stream Type

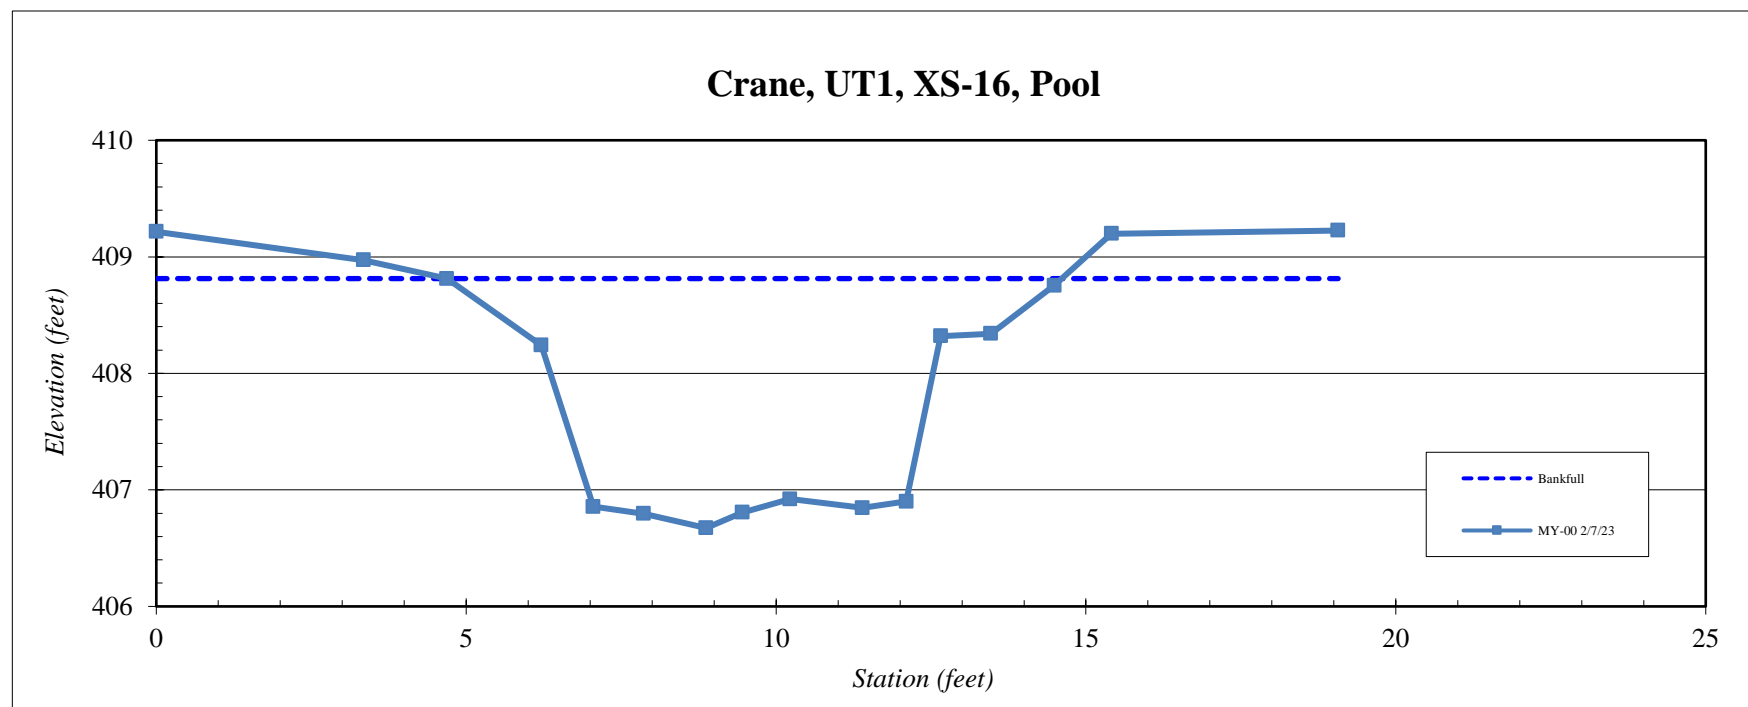

<b>Project Name</b>	Crane Mitigation Site - Baseline (2023) Profile		
<b>Reach</b>	UT 1 (Sta 00+00 to 17+50)		
<b>Feature</b>	Profile		
<b>Date</b>	1/26/23		
<b>Crew</b>	Perkinson, Smith		


2023 Baseline Survey				As needed				As needed				As needed			
Station	Bed Elevation	Water Elevation	TOB	Station	Bed Elevation	Water Elevation	TOB	Station	Bed Elevation	Water Elevation	TOB	Station	Bed Elevation	Water Elevation	TOB
0	393.86														
20.36	394.29														
35.11	393.98		395.59												
37.09	393.73														
44.70	393.11														
45.43	394.88														
60.77	394.77														
71.34	394.74		395.82												
75.40	394.54														
81.23	393.80														
82.25	395.43														
102.63	395.37		396.41												
108.19	396.19														
113.54	396.46														
127.16	394.95														
132.30	395.25														
142.25	395.72														
157.83	395.44		396.70												
162.47	395.07														
167.71	394.49														
169.04	396.30														
188.66	396.36		397.17												
192.31	396.09														
197.36	395.57														
202.56	395.11														
203.90	396.59														
231.05	396.51		397.61												
235.50	396.21														

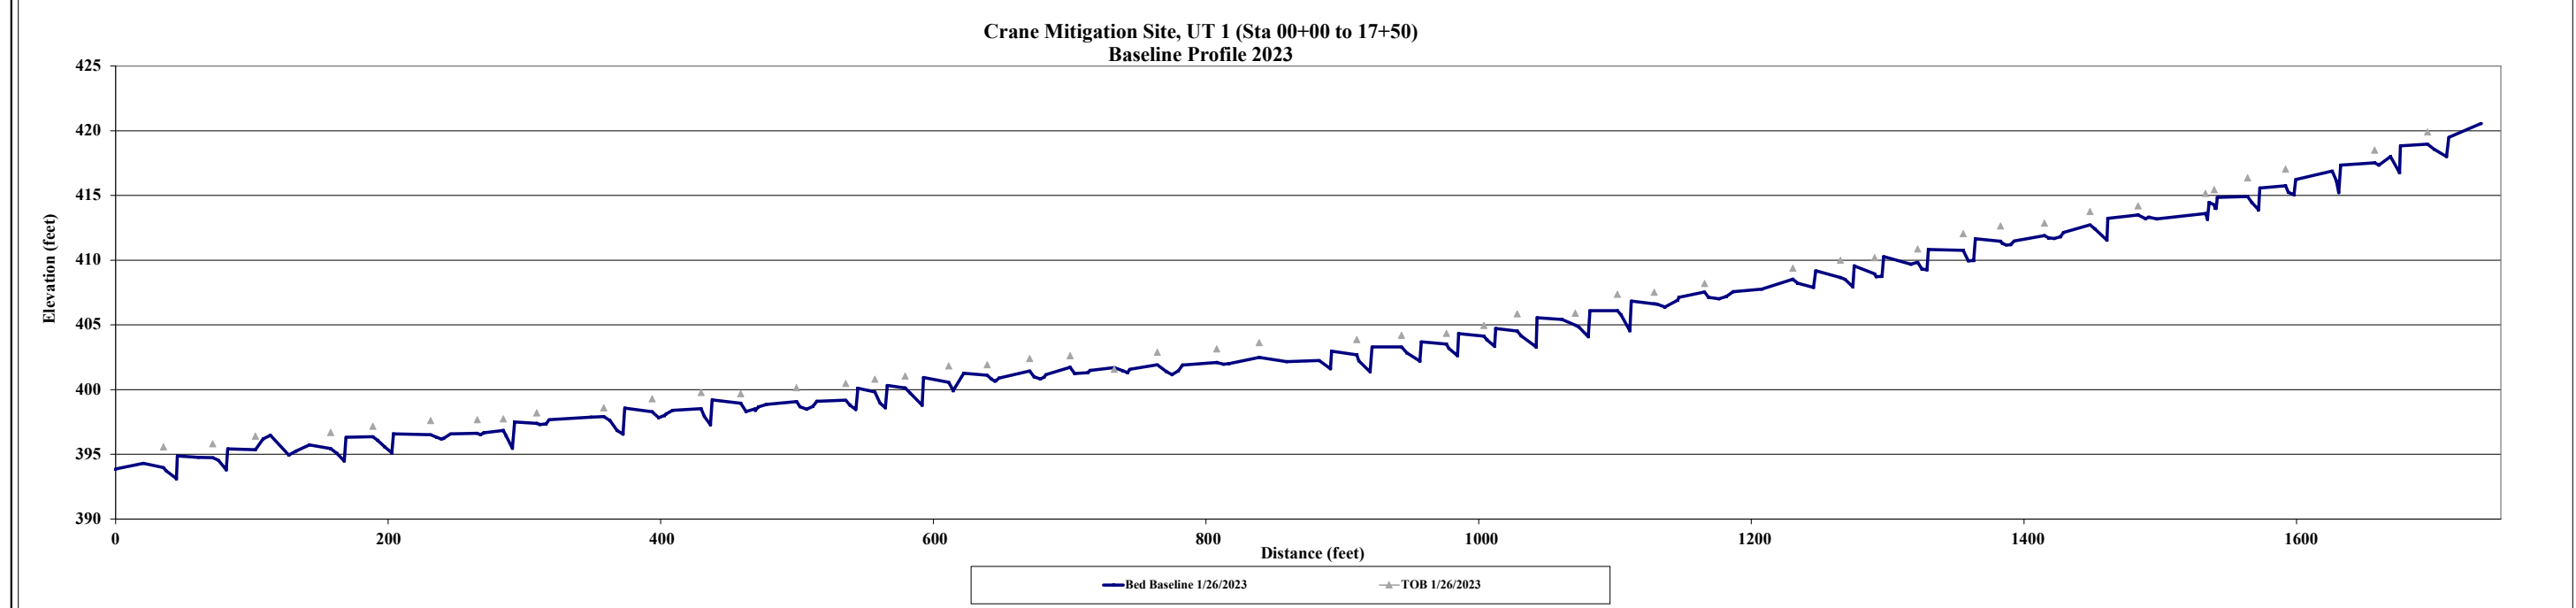

**Project Name** Crane Mitigation Site - Baseline (2023) Profile  
**Reach** UT 2 (Sta 00+00 to 05+00)  
**Feature** Profile  
**Date** 1/26/23  
**Crew** Perkinson, Smith


2023 Baseline Survey				As needed				As needed				As needed			
Station	Bed Elevation	Water Elevation	TOB	Station	Bed Elevation	Water Elevation	TOB	Station	Bed Elevation	Water Elevation	TOB	Station	Bed Elevation	Water Elevation	TOB
0	394.28		394.90												
4.45	393.94														
8.45	394.00														
11.87	394.46														
23.36	394.40		395.16												
27.82	394.04														
33.94	393.35														
36.13	394.81														
52.20	394.73		395.58												
56.01	394.50														
60.33	394.48														
61.81	394.58														
79.53	394.49		395.59												
82.86	393.45														
86.22	393.16														
87.05	394.92														
97.68	394.88		396.04												
99.73	394.77														
103.03	394.76														
116.39	395.24		396.09												
118.56	394.09														
122.72	394.05														
123.63	395.63														
135.62	395.44		396.60												
137.87	394.70														
141.39	393.97														
142.37	396.01														
150.27	395.62		396.27												

Crane Mitigation Site, UT 2 (Sta 00+00 to 05+00)  
Baseline Profile 2023

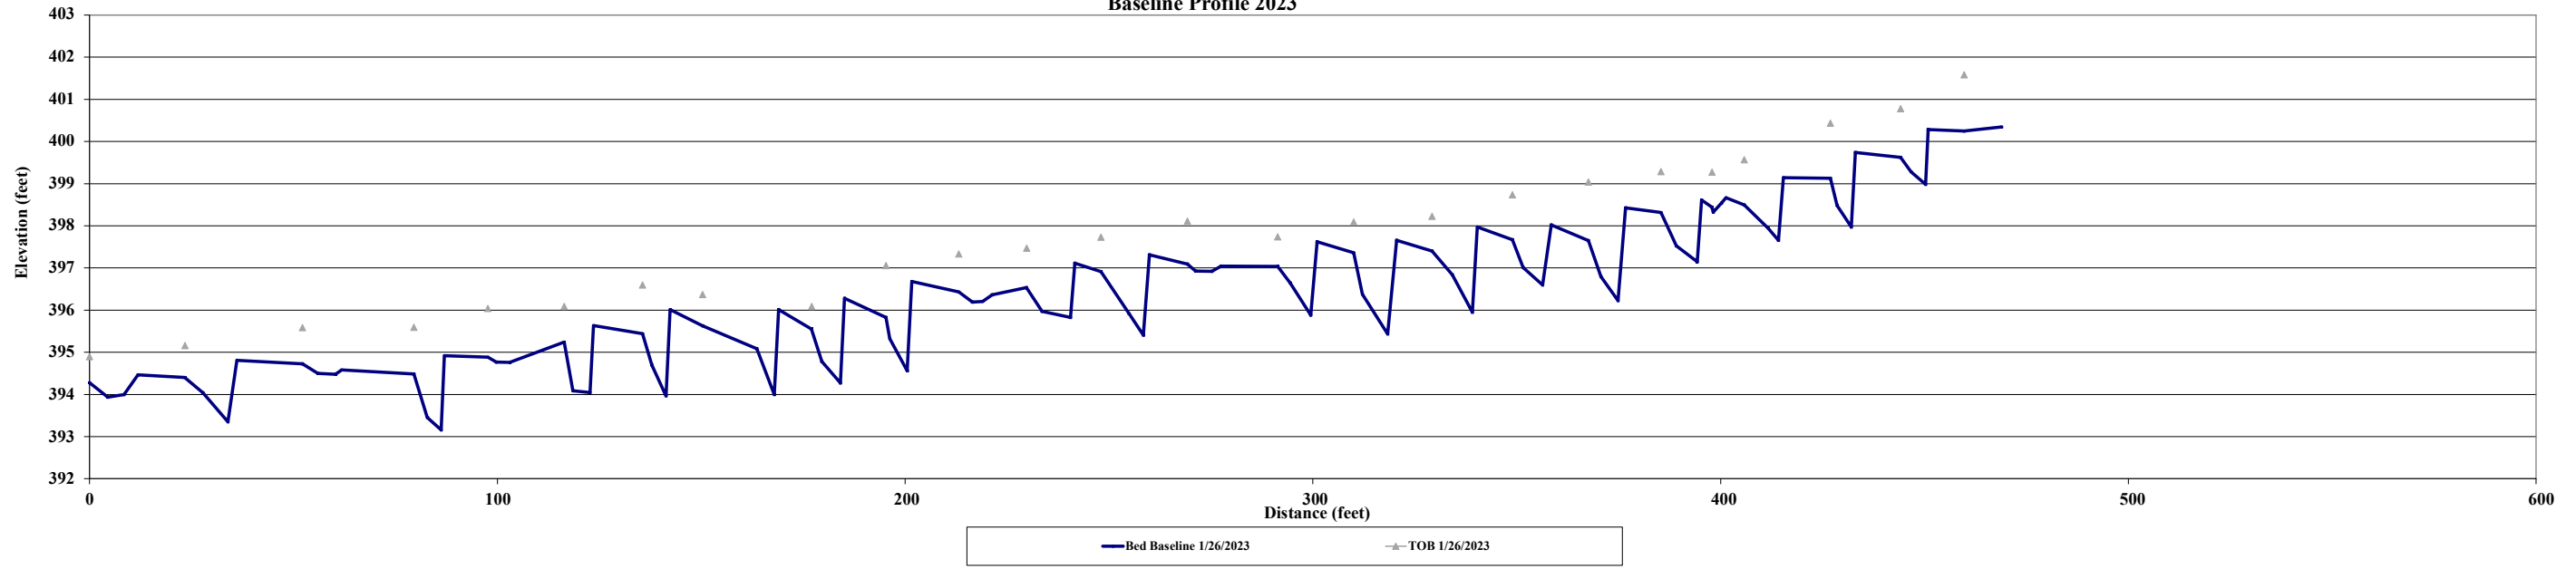

<b>Project Name</b>	Crane Mitigation Site - Baseline (2023) Profile
<b>Reach</b>	UT 3 (Sta 00+00 to 05+50)
<b>Feature</b>	Profile
<b>Date</b>	1/26/23
<b>Crew</b>	Perkinson, Smith

2023 Baseline Survey				As needed				As needed				As needed			
Station	Bed Elevation	Water Elevation	TOB	Station	Bed Elevation	Water Elevation	TOB	Station	Bed Elevation	Water Elevation	TOB	Station	Bed Elevation	Water Elevation	TOB
0.00	398.81														
8.88	398.50		399.19												
9.83	398.49														
12.71	398.58														
14.29	398.60														
22.21	398.73		399.14												
23.47	398.27														
28.17	398.32														
29.64	398.60														
40.01	398.70		399.26												
42.78	398.62														
44.63	398.54														
47.05	398.55														
49.10	399.00														
56.38	399.02		399.44												
58.18	398.72														
61.77	398.62														
66.00	398.93														
66.93	399.20														
76.56	399.29		399.78												
78.56	399.02														
81.97	398.89														
83.08	398.97														
93.54	399.05		399.76												
95.14	398.82														
100.85	398.16														
101.55	399.73														
107.40	399.48		400.00												

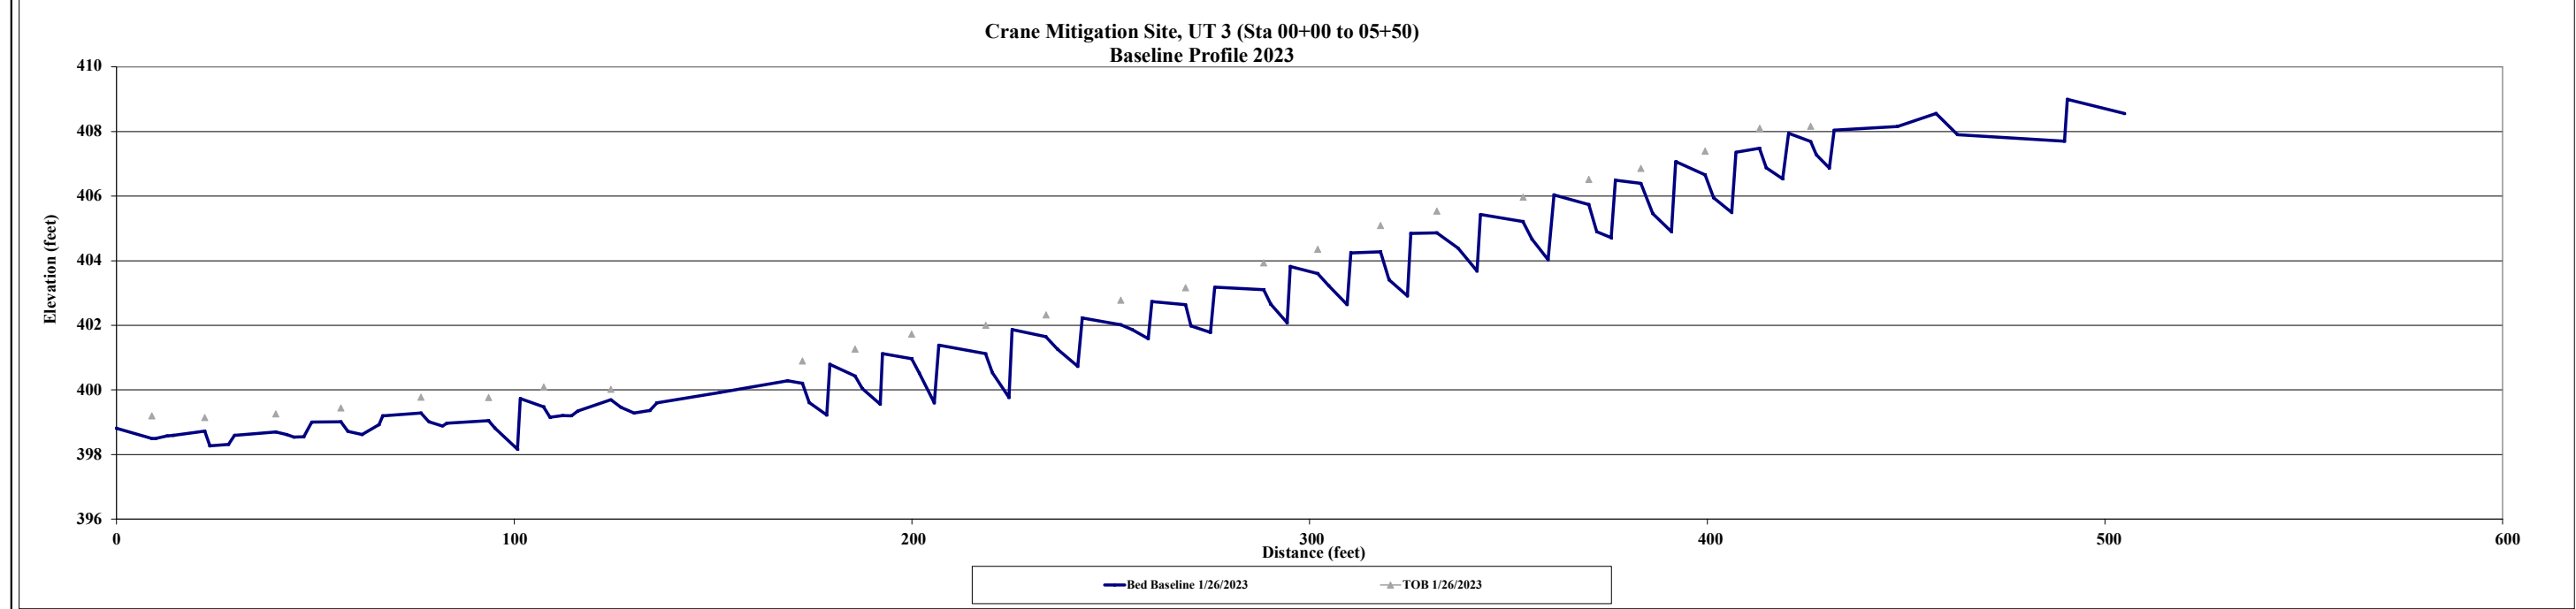




**Project Name** Crane Mitigation Site - Baseline (2023) Profile  
**Reach** UT 4 (Sta 00+00 to 04+50)  
**Feature** Profile  
**Date** 1/26/23  
**Crew** Perkinson, Smith


2023 Baseline Survey				As needed				As needed				As needed			
Station	Bed Elevation	Water Elevation	TOB	Station	Bed Elevation	Water Elevation	TOB	Station	Bed Elevation	Water Elevation	TOB	Station	Bed Elevation	Water Elevation	TOB
0.0	394.75														
13.5	394.97														
22.2	395.00		395.83												
23.8	394.56														
27.1	394.19														
27.8	395.50														
37.5	395.25		396.19												
39.7	394.82														
41.7	394.75														
42.6	395.87														
57.8	395.58														
73.6	395.83		396.44												
75.2	395.46														
79.0	395.49														
80.4	395.65														
88.6	395.69		396.54												
92.6	395.14														
97.7	394.57														
98.9	396.29														
108.7	396.13		397.06												
110.5	395.53														
113.9	395.97														
114.9	396.62														
130.8	396.48		397.47												
133.2	395.76														
136.3	396.00														
137.6	397.18														
150.2	396.07		397.57												

Crane Mitigation Site, UT 4 (Sta 00+00 to 04+50)  
Baseline Profile 2023

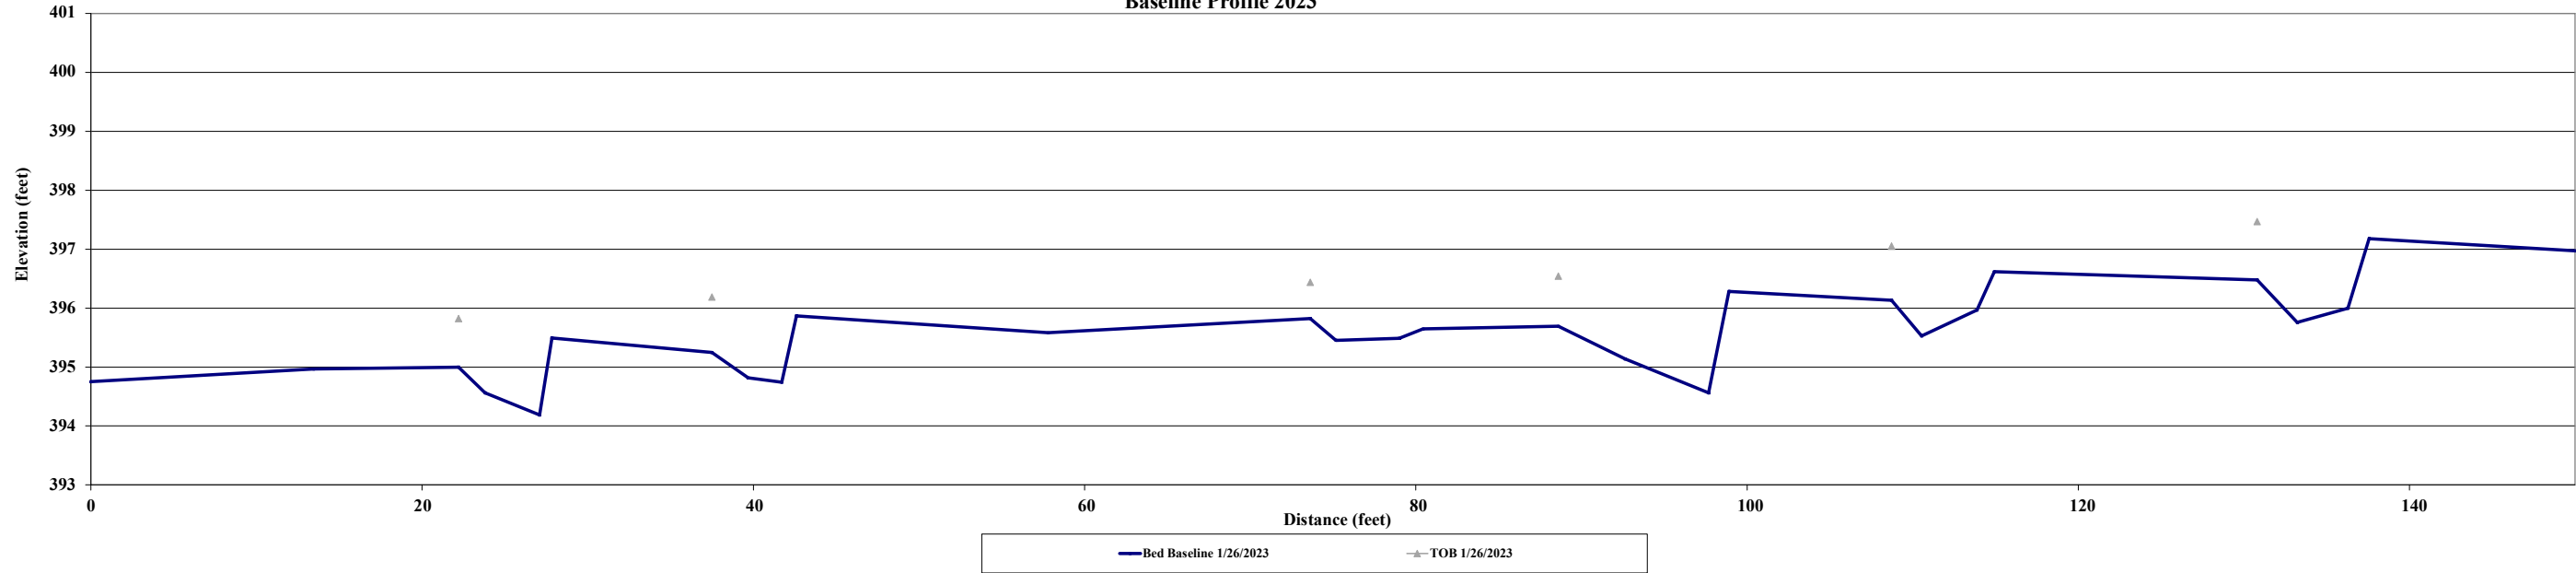

<b>Project Name</b>	Crane Mitigation Site - Baseline (2023) Profile
<b>Reach</b>	UT 5 (Sta 00+00 to 02+50)
<b>Feature</b>	Profile
<b>Date</b>	1/26/23
<b>Crew</b>	Perkinson, Smith

2023 Baseline Survey				As needed				As needed				As needed			
Station	Bed Elevation	Water Elevation	TOB	Station	Bed Elevation	Water Elevation	TOB	Station	Bed Elevation	Water Elevation	TOB	Station	Bed Elevation	Water Elevation	TOB
0.00	405.30														
25.13	405.35		406.27												
28.24	405.22														
32.78	405.20														
37.61	405.62														
45.39	405.42		406.51												
49.00	405.51														
53.94	405.46														
56.10	405.53														
72.60	405.47		406.31												
74.01	405.03														
79.62	404.52														
80.81	405.97														
96.46	405.48		406.45												
99.14	405.10														
103.70	404.16														
105.05	406.00														
120.25	405.90		406.73												
123.21	405.55														
132.98	405.49														
136.06	405.86														
144.95	405.95		407.00												
147.95	405.74														
155.63	405.25														
157.06	406.55														
173.62	406.26		407.09												
175.71	406.00														
180.70	405.22														

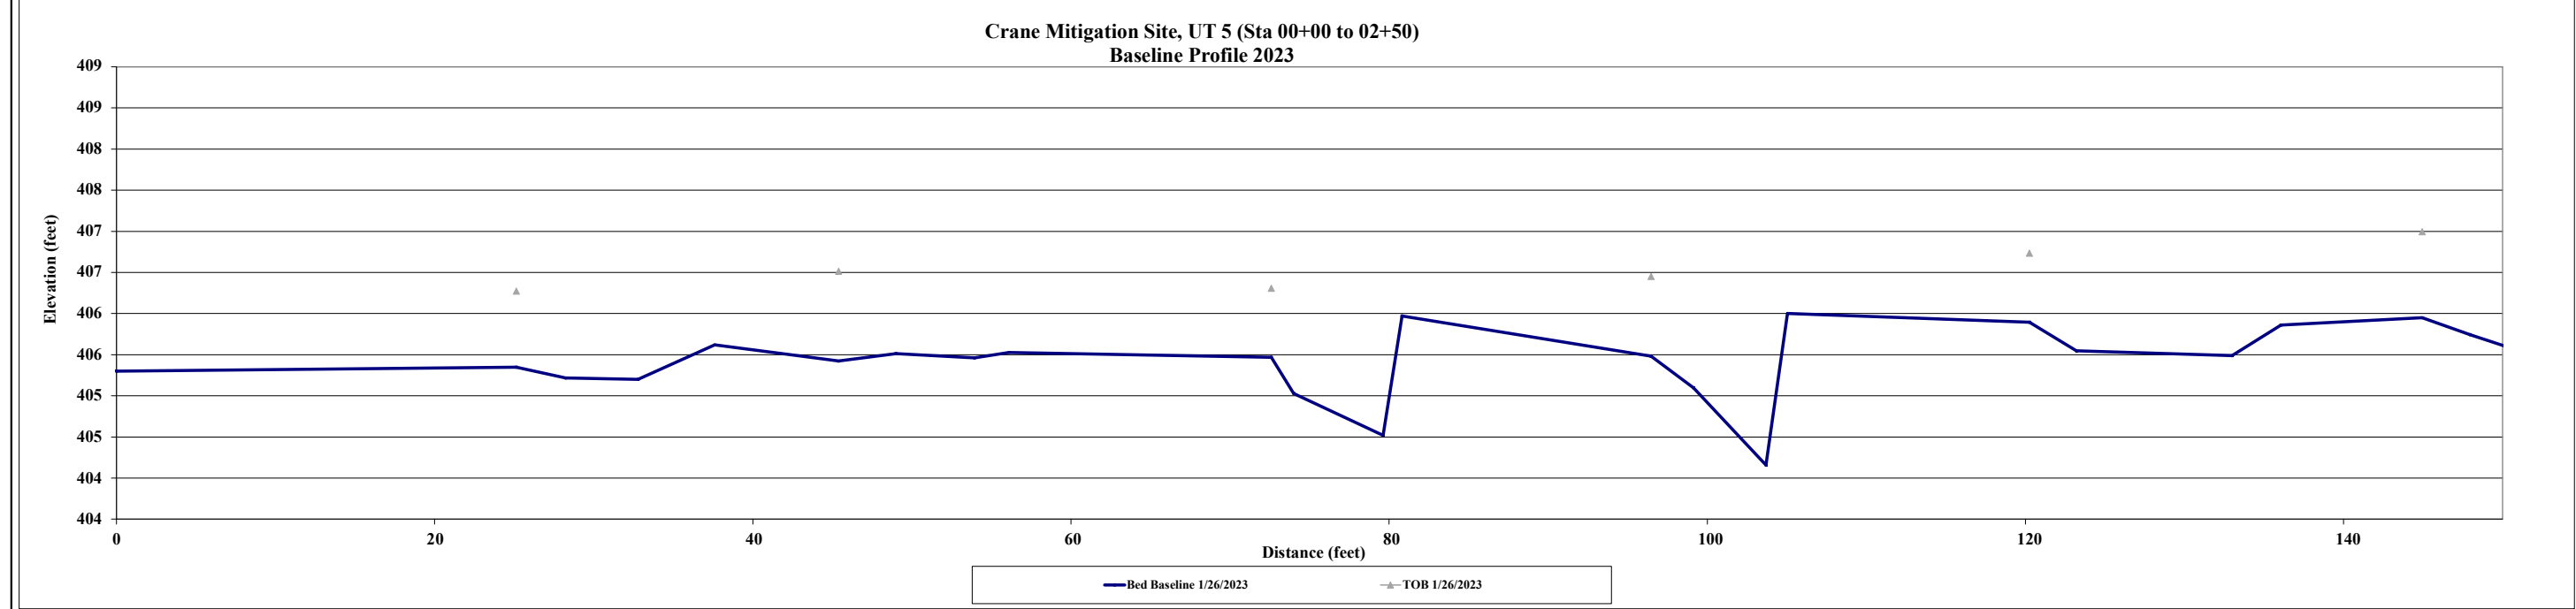

**Table 9A. Baseline Stream Data Summary  
Crane - UT 1**

Parameter	Pre-Existing Condition (applicable)					Design		Monitoring Baseline (MY0)		
	Min	Mean	Med	Max	n	Min	Max	Min	Max	n
<b>Riffle Only</b>										
Bankfull Width (ft)	4.3	6.7		12.5		7.7	8.9	8.5	11.0	3
Floodprone Width (ft)	9	75		100		50	150	100	100	3
Bankfull Mean Depth (ft)	0.4	0.9		1.2		0.6	0.6	0.6	0.6	3
Bankfull Max Depth (ft)	0.9	1.8		2.9		0.7	1	0.9	1.0	3
Bankfull Cross Sectional Area (ft <sup>2</sup> )	5	5		5		5	5	5.1	6.7	3
Width/Depth Ratio	3.6	10.6		31.3		12	16	13.9	17.9	3
Entrenchment Ratio	1.6	13		23.3		6.5	16.8	9.1	11.8	3
Bank Height Ratio	<b>1</b>	<b>1.7</b>		<b>2.8</b>		<b>1</b>	<b>1.3</b>	<b>1.0</b>	<b>1.0</b>	<b>3</b>
Max part size (mm) mobilized at bankfull										
Rosgen Classification	Eg 5					Ce 5		Ce 5		
Bankfull Discharge (cfs)	19					19		19		
Sinuosity (ft)	1.03					1.1		1.1		
Water Surface Slope (Channel) (ft/ft)	0.0179					0.0167		0.0167		
Other										

**Table 9B. Baseline Stream Data Summary  
Crane - UT 2**

Parameter	Pre-Existing Condition (applicable)					Design		Monitoring Baseline (MY0)		
	Min	Mean	Med	Max	n	Min	Max	Min	Max	n
<b>Riffle Only</b>										
Bankfull Width (ft)	2.2	3.3		4.8		4.8	5.5	7.2	7.2	1
Floodprone Width (ft)	5	7		12		25	75	50.0	50.0	1
Bankfull Mean Depth (ft)	0.4	0.6		0.8		0.3	0.4	0.5	0.5	1
Bankfull Max Depth (ft)	0.6	1		1.4		0.4	0.6	1.0	1.0	1
Bankfull Cross Sectional Area (ft <sup>2</sup> )	1.9	1.9		1.9		1.9	1.9	3.8	3.8	1
Width/Depth Ratio	2.8	6		12		12	16	13.8	13.8	1
Entrenchment Ratio	1.8	2.1		2.5		5.2	13.6	6.9	6.9	1
Bank Height Ratio	<b>2.2</b>	<b>2.5</b>		<b>3.1</b>		<b>1</b>	<b>1.3</b>	<b>1.0</b>	<b>1.0</b>	<b>1</b>
Max part size (mm) mobilized at bankfull										
Rosgen Classification	G 5					Ce 5		Ce 5		
Bankfull Discharge (cfs)	6.6					6.6		6.6		
Sinuosity (ft)	1.09					1.1		1.1		
Water Surface Slope (Channel) (ft/ft)	0.0145					0.0144		0.0144		
Other										

**Table 9C. Baseline Stream Data Summary  
Crane - UT 3**

Parameter	Pre-Existing Condition (applicable)					Design		Monitoring Baseline		
	Min	Mean	Med	Max	n	Min	Max	Min	Max	n
<b>Riffle Only</b>										
Bankfull Width (ft)	2.1	3.4		4.2		3.8	4.4	7.8	7.8	1
Floodprone Width (ft)	4	23		50		25	75	50.0	50.0	1
Bankfull Mean Depth (ft)	0.3	0.4		0.6		0.3	0.3	0.5	0.5	1
Bankfull Max Depth (ft)	0.6	0.8		1.1		0.4	0.5	0.8	0.8	1
Bankfull Cross Sectional Area (ft <sup>2</sup> )	1.2	1.2		1.2		1.2	1.2	3.9	3.9	1
Width/Depth Ratio	3.5	10.1		14		12	16	15.6	15.6	1
Entrenchment Ratio	1.3	8.1		23.8		6.6	17.1	6.4	6.4	1
Bank Height Ratio	<b>2</b>	<b>4</b>		<b>7.2</b>		<b>1</b>	<b>1.3</b>	<b>1.0</b>	<b>1.0</b>	<b>1</b>
Max part size (mm) mobilized at bankfull										
Rosgen Classification	Eg 5					Ce 5		Ce 5		
Bankfull Discharge (cfs)	4.2					4.2		4.2		
Sinuosity (ft)	1.01					1.1		1.1		
Water Surface Slope (Channel) (ft/ft)	0.0287					0.0264		0.0264		
Other										

**Table 9D. Baseline Stream Data Summary  
Crane - UT 4**

Parameter	Pre-Existing Condition (applicable)					Design		Monitoring Baseline		
	Min	Mean	Med	Max	n	Min	Max	Min	Max	n
<b>Riffle Only</b>										
Bankfull Width (ft)	1.8	3.3		4.8		3.9	4.6	4.7	7.5	2
Floodprone Width (ft)	8	50		26		50	100	75.0	75.0	2
Bankfull Mean Depth (ft)	0.3	0.5		0.7		0.3	0.3	0.3	0.4	2
Bankfull Max Depth (ft)	0.4	0.8		1.2		0.4	0.5	0.5	0.6	2
Bankfull Cross Sectional Area (ft <sup>2</sup> )	1.3	1.3		1.3		1.3	1.3	1.4	2.7	2
Width/Depth Ratio	2.6	8.9		16		12	16	15.6	20.8	2
Entrenchment Ratio	1.2	9.8		15.6		6.1	15.8	9.9	16.0	2
Bank Height Ratio	<b>1.3</b>	<b>1.9</b>		<b>2.8</b>		<b>1</b>	<b>1.3</b>	<b>1.0</b>	<b>1.0</b>	<b>2</b>
Max part size (mm) mobilized at bankfull										
Rosgen Classification	Eg 5					Ce 5		Ce 5		
Bankfull Discharge (cfs)	4.5					4.5		4.5		
Sinuosity (ft)	1.01					1.1		1.1		
Water Surface Slope (Channel) (ft/ft)	0.0145					0.0133		0.0133		
Other										

**Table 9E. Baseline Stream Data Summary  
Crane - UT 5**

Parameter	Pre-Existing Condition (applicable)					Design		Monitoring Baseline		
	Min	Mean	Med	Max	n	Min	Max	Min	Max	n
<b>Riffle Only</b>										
Bankfull Width (ft)	3.7	4.1		4.7		6.1	7	10.3	10.3	1
Floodprone Width (ft)	6	8		11		50	150	100.0	100.0	1
Bankfull Mean Depth (ft)	0.6	0.7		0.8		0.4	0.5	0.4	0.4	1
Bankfull Max Depth (ft)	0.8	1		1.2		0.6	0.8	0.9	0.9	1
Bankfull Cross Sectional Area (ft <sup>2</sup> )	3.1	3.1		3.1		3.1	3.1	4.4	4.4	1
Width/Depth Ratio	4.6	5.8		7.8		12	16	24.2	24.2	1
Entrenchment Ratio	1.3	1.9		2.6		8.2	21.3	9.7	9.7	1
Bank Height Ratio	<b>1.8</b>	<b>2.9</b>		<b>4.8</b>		<b>1</b>	<b>1.3</b>	<b>1.0</b>	<b>1.0</b>	<b>1</b>
Max part size (mm) mobilized at bankfull										
Rosgen Classification	Ge 5					Ce 5		Ce 5		
Bankfull Discharge (cfs)	11.3					11.3		11.3		
Sinuosity (ft)	1.01					1.1		1.1		
Water Surface Slope (Channel) (ft/ft)	0.0149					0.0136		0.0136		
Other										

**Table 10A. Monitoring Data - Cross Section Morphology Monitoring Summary**  
(Crane/ DMS:100165) UT 1, UT 2, and UT 4

	UT 2 - Cross Section 1 (Pool)							UT 2 - Cross Section 2 (Riffle)							UT 4 - Cross Section 3 (Riffle)							UT 4 - Cross Section 4 (Pool)							UT 4 - Cross Section 5 (Riffle)						
	MY0	MY1	MY2	MY3	MY5	MY7	MY+	MY0	MY1	MY2	MY3	MY5	MY7	MY+	MY0	MY1	MY2	MY3	MY5	MY7	MY+	MY0	MY1	MY2	MY3	MY5	MY7	MY+	MY0	MY1	MY2	MY3	MY5	MY7	MY+
Bankfull Elevation (ft) - Based on AB-Bankfull Area	388.48							388.92						388.85							388.94							391.96							
Bank Height Ratio_Based on AB Bankfull Area	NA							1.00						1.00						NA							1.00								
Thalweg Elevation	387.36							387.916						388.238						388.06							391.43								
LTOB <sup>2</sup> Elevation	388.48							388.918						388.85						388.94							391.96								
LTOB <sup>2</sup> Max Depth (ft)	1.12							1.00						0.61						0.88							0.53								
LTOB <sup>2</sup> Cross Sectional Area (ft <sup>2</sup> )	5.1							3.8						2.7						3.0							1.4								
	UT 4 - Cross Section 6 (Pool)							UT 1 - Cross Section 7 (Riffle)							UT 1 - Cross Section 8 (Pool)																				
	MY0	MY1	MY2	MY3	MY5	MY7	MY+	MY0	MY1	MY2	MY3	MY5	MY7	MY+	MY0	MY1	MY2	MY3	MY5	MY7	MY+														
Bankfull Elevation (ft) - Based on AB-Bankfull Area	392.04							389.84						389.72																					
Bank Height Ratio_Based on AB Bankfull Area	NA							1.00						NA																					
Thalweg Elevation	391.06							388.831						388.24																					
LTOB <sup>2</sup> Elevation	392.04							389.842						389.72																					
LTOB <sup>2</sup> Max Depth (ft)	0.99							1.01						1.48																					
LTOB <sup>2</sup> Cross Sectional Area (ft <sup>2</sup> )	3.0							6.7						9.7																					
								The above morphology parameters reflect the 2018 guidance that arose from the mitigation technical workgroup consisting of DMS, the IRT and industry mitigation providers/practitioners. The outcome resulted in the focus on three primary morphological parameters of interest for the purposes of tracking channel change moving forward. They are the bank height ratio using a constant As-built bankfull area and the cross sectional area and max depth based on each years low top of bank. These are calculated as follows: <b>1 - Bank Height Ratio (BHR)</b> takes the As-built bankfull area as the basis for adjusting each subsequent years bankfull elevation. For example if the As-built bankfull area was 10 ft2, then the MY1 bankfull elevation would be adjusted until the calculated bankfull area within the MY1 cross section survey = 10 ft2. The BHR would then be calculated with the difference between the low top of bank (LTOB) elevation for MY1 and the thalweg elevation for MY1 in the numerator with the difference between the MY1 bankfull elevation and the MY1 thalweg elevation in the denominator. This same process is then carried out in each successive year. <b>2 - LTOB Area and Max depth</b> - These are based on the LTOB elevation for each years survey (The same elevation used for the LTOB in the BHR calculation). Area below the LTOB elevation will be used and tracked for each year as above. The difference between the LTOB elevation and the thalweg elevation (same as in the BHR calculation) will be recroded and tracked above as LTOB max depth.																											
Bankfull Elevation (ft) - Based on AB-Bankfull Area																																			
Bank Height Ratio_Based on AB Bankfull Area																																			
Thalweg Elevation																																			
LTOB <sup>2</sup> Elevation																																			
LTOB <sup>2</sup> Max Depth (ft)																																			
LTOB <sup>2</sup> Cross Sectional Area (ft <sup>2</sup> )																																			

Note: The smaller the channel the closer the survey measurements are to their limit of reliable detection, therefore inter-annual variation in morphological measurement (as a percentage) is by default magnified as channel size decreases. Some of the variability above is the result of this factor and some is due to the large amount of depositional sediments observed.

**Table 10B. Monitoring Data - Cross Section Morphology Monitoring Summary**  
(Crane/ DMS:100165) UT 1, UT 3, and UT 5

	UT 3 - Cross Section 9 (Riffle)							UT 3 - Cross Section 10 (Pool)							UT 1 - Cross Section 11 (Riffle)							UT 1 - Cross Section 12 (Pool)							UT 5 - Cross Section 13 (Riffle)						
	MY0	MY1	MY2	MY3	MY5	MY7	MY+	MY0	MY1	MY2	MY3	MY5	MY7	MY+	MY0	MY1	MY2	MY3	MY5	MY7	MY+	MY0	MY1	MY2	MY3	MY5	MY7	MY+	MY0	MY1	MY2	MY3	MY5	MY7	MY+
Bankfull Elevation (ft) - Based on AB-Bankfull Area	394.72							394.40						395.05						395.00						399.13									
Bank Height Ratio_Based on AB Bankfull Area	1.00							NA						1.00						NA						1.00									
Thalweg Elevation	393.90							391.936						394.18						393.69						398.21									
LTOB <sup>2</sup> Elevation	394.72							394.399						395.05						395.00						399.13									
LTOB <sup>2</sup> Max Depth (ft)	0.82							2.46						0.87						1.31						0.92									
LTOB <sup>2</sup> Cross Sectional Area (ft <sup>2</sup> )	3.9							5.3						5.1						8.0						4.4									
	UT 5 - Cross Section 14 (Pool)							UT 1 - Cross Section 15 (Riffle)							UT 1 - Cross Section 16 (Pool)																				
	MY0	MY1	MY2	MY3	MY5	MY7	MY+	MY0	MY1	MY2	MY3	MY5	MY7	MY+	MY0	MY1	MY2	MY3	MY5	MY7	MY+														
Bankfull Elevation (ft) - Based on AB-Bankfull Area	398.95							408.40						408.81																					
Bank Height Ratio_Based on AB Bankfull Area	NA							1.00						NA																					
Thalweg Elevation	398.20							407.442						406.67																					
LTOB <sup>2</sup> Elevation	398.95							408.401						408.81																					
LTOB <sup>2</sup> Max Depth (ft)	0.75							0.96						2.14																					
LTOB <sup>2</sup> Cross Sectional Area (ft <sup>2</sup> )	4.0							5.8						12.9																					
								The above morphology parameters reflect the 2018 guidance that arose from the mitigation technical workgroup consisting of DMS, the IRT and industry mitigation providers/practitioners. The outcome resulted in the focus on three primary morphological parameters of interest for the purposes of tracking channel change moving forward. They are the bank height ratio using a constant As-built bankfull area and the cross sectional area and max depth based on each years low top of bank. These are calculated as follows: <b>1 - Bank Height Ratio (BHR)</b> takes the As-built bankfull area as the basis for adjusting each subsequent years bankfull elevation. For example if the As-built bankfull area was 10 ft2, then the MY1 bankfull elevation would be adjusted until the calculated bankfull area within the MY1 cross section survey = 10 ft2. The BHR would then be calculated with the difference between the low top of bank (LTOB) elevation for MY1 and the thalweg elevation for MY1 in the numerator with the difference between the MY1 bankfull elevation and the MY1 thalweg elevation in the denominator. This same process is then carried out in each successive year. <b>2 - LTOB Area and Max depth</b> - These are based on the LTOB elevation for each years survey (The same elevation used for the LTOB in the BHR calculation). Area below the LTOB elevation will be used and tracked for each year as above. The difference between the LTOB elevation and the thalweg elevation (same as in the BHR calculation) will be recroded and tracked above as LTOB max depth.																											
Bankfull Elevation (ft) - Based on AB-Bankfull Area																																			
Bank Height Ratio_Based on AB Bankfull Area																																			
Thalweg Elevation																																			
LTOB <sup>2</sup> Elevation																																			
LTOB <sup>2</sup> Max Depth (ft)																																			
LTOB <sup>2</sup> Cross Sectional Area (ft <sup>2</sup> )																																			

Note: The smaller the channel the closer the survey measurements are to their limit of reliable detection, therefore inter-annual variation in morphological measurement (as a percentage) is by default magnified as channel size decreases. Some of the variability above is the result of this factor and some is due to the large amount of depositional sediments observed.

## **Appendix D: Hydrologic Data**

### Groundwater Gauge Soil Profiles

**AXIOM ENVIRONMENTAL, INC**

218 Snow Avenue  
 Raleigh, North Carolina 27603  
 919-215-1693



# SOIL BORING LOG

Date: 2/14/2023

Project/Site: 20-032/Crane

County, State: Lee, North Carolina

Sampling Point/  
 Coordinates: GW-1 35.363918, -79.223289

Investigator: W. Grant Lewis

Soil Series: \_\_\_\_\_

Notes:

Depth (inches)	Matrix		Mottling		Type	Location	Texture
	Color	%	Color	%			
0-8	10 YR 4/2	100	-	-	-	-	Sand
8-24	10 YR 4/1	95	10 YR 4/6	5	C	M	Sandy Clay Loam
24+	4/10G	90	10 YR 4/6	10	C	M	Sandy Clay Loam

Type: C=Concentration, D=Depletion, RM=Reduced Matrix, MS=Masked Sand Grains. Location: PL=Pore Lining, M=Matrix.

North Carolina Licensed Soil Scientist

Number: 1233

Signature: *W Grant Lewis*

Name/Print: W. Grant Lewis



**AXIOM ENVIRONMENTAL, INC**

218 Snow Avenue  
 Raleigh, North Carolina 27603  
 919-215-1693



# SOIL BORING LOG

Date: 2/14/2023

Project/Site: 20-032/Crane

County, State: Lee, North Carolina

Sampling Point/  
 Coordinates: GW-2 35.364841, -79.224065

Investigator: W. Grant Lewis

Soil Series: \_\_\_\_\_

Notes:

Depth (inches)	Matrix		Mottling		Type	Location	Texture
	Color	%	Color	%			
0-8	10 YR 3/1	100	-	-	-	-	Sandy Loam
8-12	10 YR 5/1	97	10 YR 4/6	3	C	M	Sandy Loam
12+	10 YR 5/1	95	10 YR 4/6	5	C	M	Sandy Clay Loam

Type: C=Concentration, D=Depletion, RM=Reduced Matrix, MS=Masked Sand Grains. Location: PL=Pore Lining, M=Matrix.

North Carolina Licensed Soil Scientist

Number: 1233

Signature: *W Grant Lewis*

Name/Print: W. Grant Lewis

**AXIOM ENVIRONMENTAL, INC**

218 Snow Avenue  
 Raleigh, North Carolina 27603  
 919-215-1693



# SOIL BORING LOG

Date: 2/14/2023

Project/Site: 20-032/Crane

County, State: Lee, North Carolina

Sampling Point/  
 Coordinates: GW-3 35.365244, -79.223755

Investigator: W. Grant Lewis

Soil Series: \_\_\_\_\_

Notes:

Depth (inches)	Matrix		Mottling		Type	Location	Texture
	Color	%	Color	%			
0-18	10 YR 3/1	100	-	-	-	-	Sandy Loam
18-20	10 YR 3/1	95	10 YR 4/6	5	C	M	Sandy Clay Loam
20+	4/5BG	100	-	-	-	-	Sandy Clay Loam

Type: C=Concentration, D=Depletion, RM=Reduced Matrix, MS=Masked Sand Grains. Location: PL=Pore Lining, M=Matrix.

North Carolina Licensed Soil Scientist

Number: 1233

Signature: *W Grant Lewis*

Name/Print: W. Grant Lewis

**AXIOM ENVIRONMENTAL, INC**

218 Snow Avenue  
 Raleigh, North Carolina 27603  
 919-215-1693



# SOIL BORING LOG

Date: 2/14/2023

Project/Site: 20-032/Crane

County, State: Lee, North Carolina

Sampling Point/  
 Coordinates: GW-4 35.365381, -79.223935

Investigator: W. Grant Lewis

Soil Series: \_\_\_\_\_

Notes:

Depth (inches)	Matrix		Mottling		Type	Location	Texture
	Color	%	Color	%			
0-3	10 YR 3/1	100	-	-	-	-	Sandy Loam
3-8	10 YR 6/3	100	-	-	-	-	Sand
8+	10 YR 7/2	90	10 YR 5/6	10	C	M	Sandy Loam

Type: C=Concentration, D=Depletion, RM=Reduced Matrix, MS=Masked Sand Grains. Location: PL=Pore Lining, M=Matrix.

North Carolina Licensed Soil Scientist

Number: 1233

Signature: *W Grant Lewis*

Name/Print: W. Grant Lewis

**AXIOM ENVIRONMENTAL, INC**

218 Snow Avenue  
 Raleigh, North Carolina 27603  
 919-215-1693



# SOIL BORING LOG

Date: 2/14/2023

Project/Site: 20-032/Crane

County, State: Lee, North Carolina

Sampling Point/  
 Coordinates: GW-5 35.365311, -79.224294

Investigator: W. Grant Lewis

Soil Series: \_\_\_\_\_

Notes:

Depth (inches)	Matrix		Mottling		Type	Location	Texture
	Color	%	Color	%			
0-30+	10 YR 2/1	100	-	-	-	-	Sandy Clay Loam

Type: C=Concentration, D=Depletion, RM=Reduced Matrix, MS=Masked Sand Grains. Location: PL=Pore Lining, M=Matrix.

North Carolina Licensed Soil Scientist

Number: 1233

Signature: *W Grant Lewis*

Name/Print: W. Grant Lewis

**AXIOM ENVIRONMENTAL, INC**

218 Snow Avenue  
 Raleigh, North Carolina 27603  
 919-215-1693



**SOIL BORING LOG**

Date: 2/14/2023

Project/Site: 20-032/Crane

County, State: Lee, North Carolina

Sampling Point/  
 Coordinates: GW-6 35.365957, -79.223721

Investigator: W. Grant Lewis

Soil Series: \_\_\_\_\_

Notes:

Depth (inches)	Matrix		Mottling		Type	Location	Texture
	Color	%	Color	%			
0-24+	10 YR 3/1	100	-	-	-	-	Silty Clay Loam

Type: C=Concentration, D=Depletion, RM=Reduced Matrix, MS=Masked Sand Grains. Location: PL=Pore Lining, M=Matrix.

North Carolina Licensed Soil Scientist

Number: 1233

Signature: *W Grant Lewis*

Name/Print: W. Grant Lewis

**AXIOM ENVIRONMENTAL, INC**

218 Snow Avenue  
 Raleigh, North Carolina 27603  
 919-215-1693



# SOIL BORING LOG

Date: 2/14/2023

Project/Site: 20-032/Crane

County, State: Lee, North Carolina

Sampling Point/  
 Coordinates: GW-7 35.36660, -79.224025

Investigator: W. Grant Lewis

Soil Series: \_\_\_\_\_

Notes:

Depth (inches)	Matrix		Mottling		Type	Location	Texture
	Color	%	Color	%			
0-4	10 YR 3/1	100	-	-	-	-	Sandy Clay Loam
4-10	10 YR 4/1	95	10 YR 4/6	5	C	M	Sandy Clay Loam
10-24+	10 YR 4/1	90	10 YR 4/6	10	C	M	Sandy Clay Loam

Type: C=Concentration, D=Depletion, RM=Reduced Matrix, MS=Masked Sand Grains. Location: PL=Pore Lining, M=Matrix.

North Carolina Licensed Soil Scientist

Number: 1233

Signature: *W Grant Lewis*

Name/Print: W. Grant Lewis

**AXIOM ENVIRONMENTAL, INC**

218 Snow Avenue  
 Raleigh, North Carolina 27603  
 919-215-1693



# SOIL BORING LOG

Date: 2/14/2023

Project/Site: 20-032/Crane

County, State: Lee, North Carolina

Sampling Point/  
 Coordinates: GW-8 35.366688, -79.223695

Investigator: W. Grant Lewis

Soil Series: \_\_\_\_\_

Notes:

Depth (inches)	Matrix		Mottling		Type	Location	Texture
	Color	%	Color	%			
0-8	10 YR 4/1	100	-	-	-	-	Sandy Loam
8-12	10 Yr 4/2	100	-	-	-	-	Sandy Loam
12-24	10 YR 4/2	93	10 YR 4/6	7	C	M	Sandy Clay Loam
24+	10 YR 4/2	90	10 YR 4/6	10	C	M	Sandy Clay Loam

Type: C=Concentration, D=Depletion, RM=Reduced Matrix, MS=Masked Sand Grains. Location: PL=Pore Lining, M=Matrix.

North Carolina Licensed Soil Scientist

Number: 1233

Signature: *W Grant Lewis*

Name/Print: W. Grant Lewis

**AXIOM ENVIRONMENTAL, INC**

218 Snow Avenue  
 Raleigh, North Carolina 27603  
 919-215-1693



# SOIL BORING LOG

Date: 2/14/2023

Project/Site: 20-032/Crane

County, State: Lee, North Carolina

Sampling Point/  
 Coordinates: GW-9 35.366699, -79.223292

Investigator: W. Grant Lewis

Soil Series: \_\_\_\_\_

Notes:

Depth (inches)	Matrix		Mottling		Type	Location	Texture
	Color	%	Color	%			
0-30+	10 YR 2/1	100	-	-	-	-	Sandy Clay Loam

Type: C=Concentration, D=Depletion, RM=Reduced Matrix, MS=Masked Sand Grains. Location: PL=Pore Lining, M=Matrix.

North Carolina Licensed Soil Scientist

Number: 1233

Signature: *W Grant Lewis*

Name/Print: W. Grant Lewis



**AXIOM ENVIRONMENTAL, INC**

218 Snow Avenue  
Raleigh, North Carolina 27603  
919-215-1693



# SOIL BORING LOG

Date: 2/14/2023

Project/Site: 20-032/Crane

County, State: Lee, North Carolina

Sampling Point/  
Coordinates: GW-10 35.366487, -79.222511

Investigator: W. Grant Lewis

Soil Series: \_\_\_\_\_

Notes:

Depth (inches)	Matrix		Mottling		Type	Location	Texture
	Color	%	Color	%			
0-20	10 YR 3/1	100	-	-	-	-	Silty Clay Loam
20+	4/5 BG	100	-	-	-	-	Silty Clay Loam

Type: C=Concentration, D=Depletion, RM=Reduced Matrix, MS=Masked Sand Grains. Location: PL=Pore Lining, M=Matrix.

North Carolina Licensed Soil Scientist

Number: 1233

Signature: *W Grant Lewis*

Name/Print: W. Grant Lewis

**AXIOM ENVIRONMENTAL, INC**

218 Snow Avenue  
Raleigh, North Carolina 27603  
919-215-1693



# SOIL BORING LOG

Date: 2/14/2023

Project/Site: 20-032/Crane

County, State: Lee, North Carolina

Sampling Point/  
Coordinates: GW-11 35.366820, -79.222421

Investigator: W. Grant Lewis

Soil Series: \_\_\_\_\_

Notes:

Depth (inches)	Matrix		Mottling		Type	Location	Texture
	Color	%	Color	%			
0-8	10 YR 3/1	100	-	-	-	-	Silty Clay Loam
8-30	4/5 BG	100	-	-	-	-	Silty Clay Loam

Type: C=Concentration, D=Depletion, RM=Reduced Matrix, MS=Masked Sand Grains. Location: PL=Pore Lining, M=Matrix.

North Carolina Licensed Soil Scientist

Number: 1233

Signature: *W Grant Lewis*

Name/Print: W. Grant Lewis

**AXIOM ENVIRONMENTAL, INC**

218 Snow Avenue  
Raleigh, North Carolina 27603  
919-215-1693



# SOIL BORING LOG

Date: 2/14/2023

Project/Site: 20-032/Crane

County, State: Lee, North Carolina

Sampling Point/  
Coordinates: GW-12 35.367102, -79.222764

Investigator: W. Grant Lewis

Soil Series: \_\_\_\_\_

Notes:

Depth (inches)	Matrix		Mottling		Type	Location	Texture
	Color	%	Color	%			
0-24+	10 YR 3/1	100	-	-	-	-	Sandy Clay Loam

Type: C=Concentration, D=Depletion, RM=Reduced Matrix, MS=Masked Sand Grains. Location: PL=Pore Lining, M=Matrix.

North Carolina Licensed Soil Scientist

Number: 1233

Signature: *W Grant Lewis*

Name/Print: W. Grant Lewis

**AXIOM ENVIRONMENTAL, INC**

218 Snow Avenue  
 Raleigh, North Carolina 27603  
 919-215-1693



# SOIL BORING LOG

Date: 2/14/2023

Project/Site: 20-032/Crane

County, State: Lee, North Carolina

Sampling Point/  
 Coordinates: GW13 35.367350, -79.223216

Investigator: W. Grant Lewis

Soil Series: \_\_\_\_\_

Notes:

Depth (inches)	Matrix		Mottling		Type	Location	Texture
	Color	%	Color	%			
0-4	10 YR 3/1	100	-	-	-	-	Sandy Clay Loam
4-18	10 YR 4/2	93	10 YR 4/6	7	C	M	Sandy Clay Loam
18+	10 YR 5/1	100	-	-	-	-	Sandy Clay Loam

Type: C=Concentration, D=Depletion, RM=Reduced Matrix, MS=Masked Sand Grains. Location: PL=Pore Lining, M=Matrix.

North Carolina Licensed Soil Scientist

Number: 1233

Signature: *W Grant Lewis*

Name/Print: W. Grant Lewis

**AXIOM ENVIRONMENTAL, INC**

218 Snow Avenue  
 Raleigh, North Carolina 27603  
 919-215-1693



# SOIL BORING LOG

Date: 2/14/2023

Project/Site: 20-032/Crane

County, State: Lee, North Carolina

Sampling Point/  
 Coordinates: GW14 35.367330, -79.224318

Investigator: W. Grant Lewis

Soil Series: \_\_\_\_\_

Notes:

Depth (inches)	Matrix		Mottling		Type	Location	Texture
	Color	%	Color	%			
0-12	10 YR 2/1	100	-	-	-	-	Sandy Loam
12-30+	10 YR 5/2	97	10 YR 4/6	3	C	M	Sandy Loam

Type: C=Concentration, D=Depletion, RM=Reduced Matrix, MS=Masked Sand Grains. Location: PL=Pore Lining, M=Matrix.

North Carolina Licensed Soil Scientist

Number: 1233

Signature: *W Grant Lewis*

Name/Print: W. Grant Lewis

**AXIOM ENVIRONMENTAL, INC**

218 Snow Avenue  
 Raleigh, North Carolina 27603  
 919-215-1693



# SOIL BORING LOG

Date: 2/14/2023

Project/Site: 20-032/Crane

County, State: Lee, North Carolina

Sampling Point/  
 Coordinates: GW15 35.367921, -79.223351

Investigator: W. Grant Lewis

Soil Series: \_\_\_\_\_

Notes:

Depth (inches)	Matrix		Mottling		Type	Location	Texture
	Color	%	Color	%			
0-4	10 YR 2/1	100	-	-	-	-	Sandy Loam
4-8	10 YR 4/1	100	-	-	-	-	Sandy Loam
8-20+	10 YR 3/1	100	-	-	-	-	Sandy Clay Loam

Type: C=Concentration, D=Depletion, RM=Reduced Matrix, MS=Masked Sand Grains. Location: PL=Pore Lining, M=Matrix.

North Carolina Licensed Soil Scientist

Number: 1233

Signature: *W Grant Lewis*

Name/Print: W. Grant Lewis

## Appendix E: Project Timeline and Contact Info

Table 11. Project Timeline

Table 12. Project Contacts

**Table 11. Project Timeline**

<b>Activity or Deliverable</b>	<b>Data Collection Complete</b>	<b>Task Completion or Deliverable Submission</b>
Project Instituted	NA	30-Jul-20
Mitigation Plan Approved	NA	14-Feb-22
Construction (Grading) Completed	NA	15-Jul-22
Planting Completed	NA	3-Feb-23
As-built Survey Completed	NA	1-Mar-23
MY-0 Baseline Report	Jan-23	Mar-23
MY1+ Monitoring Reports		
Remediation Items (e.g. beaver removal, supplements, repairs etc.)		
Encroachment		

**Table 12. Project Contacts**

<b>Crane Site/100165</b>	
<b>Provider</b>  <b>Mitigation Provider POC</b>	Restoration Systems, LLC 1101 Haynes Street, Suite 211 Raleigh, NC 27604 Ray Holz 919-755-9490
<b>Designer</b>  <b>Primary project design POC</b>	Axiom Environmental, Inc. 218 Snow Ave Raleigh, NC 27603 Grant Lewis 919-215-1693
<b>Construction Contractor</b>  <b>Primary construction POC</b>	Land Mechanics Designs, Inc. 126 Circle G Lane Willow Spring, NC 27592 Charles Hill 919-639-6132



## Appendix F: Record Drawings (As-Built Survey)

# NC DEPARTMENT OF ENVIRONMENTAL QUALITY DIVISION OF MITIGATION SERVICES

## AS-BUILT DRAWINGS CRANE MITIGATION SITE LEE COUNTY, NORTH CAROLINA DATE: MAY 2, 2023

### REVISIONS

NO.	DATE	DESCRIPTION
1	05.02.2023	NCDMS AS-BUILT COMMENTS


### SHEET INDEX

C1.00	EASEMENT AND CONTROL POINTS EXHIBIT
C1.01	INDEX OF SYMBOLS
C1.02	PROJECT OVERVIEW
C1.03	SITE MONITORING LAYOUT
C1.04 - C1.07	SITE GRADING EXHIBITS
C5.00 - C5.05	UT1 PLAN AND PROFILE
C5.06 - C5.08	UT2 PLAN AND PROFILE
C5.09 - C5.11	UT3 PLAN AND PROFILE
C5.12 - C5.13	UT4 PLAN AND PROFILE
C5.14 - C5.15	UT5 PLAN AND PROFILE
L2.00 - L2.03	FENCING PLAN
L5.00	PLANTING PLAN
L5.01	PLANTING/SEEDING TABLES

SITE DATA TABLE	
RIVER BASIN	CAPE FEAR
8-DIGIT HUC	03030004
TOTAL DISTURBED AREA	30.9 AC
DMS PROJECT ID NO.	100165
FULL DELIVERY CONTRACT NO.	0302-01
USACE ACTION ID NO.	SAW-2020-01401
DWR PROJECT NO.	20201292
RFP NO.	16-20190302
COORDINATE SYSTEM	NAD83 NORTH CAROLINA STATE PLANES, US FOOT

### MITIGATION SUMMARY

TRIBUTARY	PROPOSED LENGTH
UT1	2428
UT2	525
UT3	463
UT4	422
UT5	243

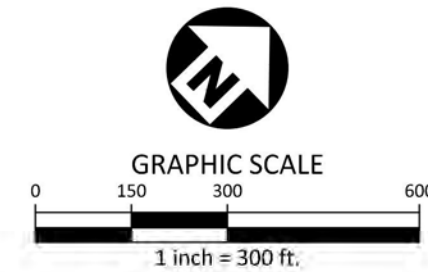

TOTAL DISTURBED AREA = 30.9 AC.



RESTORATION LEVEL	STREAM (LF)	RIPARIAN WETLAND (AC)	NON-RIPARIAN WETLAND (AC)
RESTORATION	3165	-	-
ENHANCEMENT II	915	-	-
REESTABLISHMENT	-	8.815	-
REHABILITATION	-	0.683	-
ENHANCEMENT	-	10.646	-
TOTALS	4180	20.144	-
MITIGATION UNITS	3533	14.593	-

\*TOTAL STREAM MITIGATION UNITS INCLUDE UNITS FROM THE WIDER BUFFER TOOL

\*STRAIGHT-LINE VALLEY LENGTH IS USED FOR UT1-R1 CREDIT CALCULATION

\*WETLAND REHABILITATION, ENHANCEMENT, PRESERVATION, AND SOME RE-ESTABLISHMENT ARE NOT CREDIT GENERATING.



The John R. McAdams Company, Inc.  
2905 Meridian Parkway  
Durham, NC 27713  
  
phone 919.361.5000  
fax 919.361.2269  
license number: C-0293, C-187  
  
www.mcadamsc.com

AXIOM ENVIRONMENTAL, INC  
218 SNOW AVENUE  
RALEIGH, NC 27603  
CONTACT: GRANT LEWIS  
PHONE: 919.215.1693



### CLIENT


RESTORATION SYSTEMS, LLC  
1101 HAYNES ST, SUITE 211  
RALEIGH, NC 27604  
CONTACT: WORTH CREECH  
PHONE: 919.389.3888



**GENERAL NOTES:**



1. COORDINATE SYSTEM: NAD83 NORTH CAROLINA STATE PLANES, US FOOT
2. TOPOGRAPHY AND SPOT ELEVATIONS SHOWN ARE FROM AN ACTUAL FIELD SURVEY COMPLETED BY K2 DESIGN GROUP.
3. PLANIMETRICS, UTILITIES, INVERTS AND BUILDING INFORMATION (SHOWN FOR REFERENCE) WAS COMPILED FROM AUTOCAD FILES PROVIDED TO MCADAMS FROM OTHERS. MCADAMS MAKES NO WARRANTY ABOUT THE ACCURACY OF THE INFORMATION SHOWN PROVIDED BY OTHERS.
4. PRIOR TO CONSTRUCTION, THE SITE CONTRACTOR SHALL FIELD VERIFY ALL SUBSURFACE INFORMATION IN THE PROJECT AREA TO ENSURE ITS ACCURACY AND DETERMINE ITS ACTUAL FIELD LOCATION.

CONTROL POINT LOCATIONS			
CONTROL POINT	NORTHING	EASTING	ELEVATION
1000	588051.4748	1934363.0374	427.77
2000	587894.5162	1933401.5353	403.58
3000	588128.5384	1933110.0405	401.83
4000	589182.9861	1933744.0866	432.14
5000	588511.6462	1934642.2517	428.97

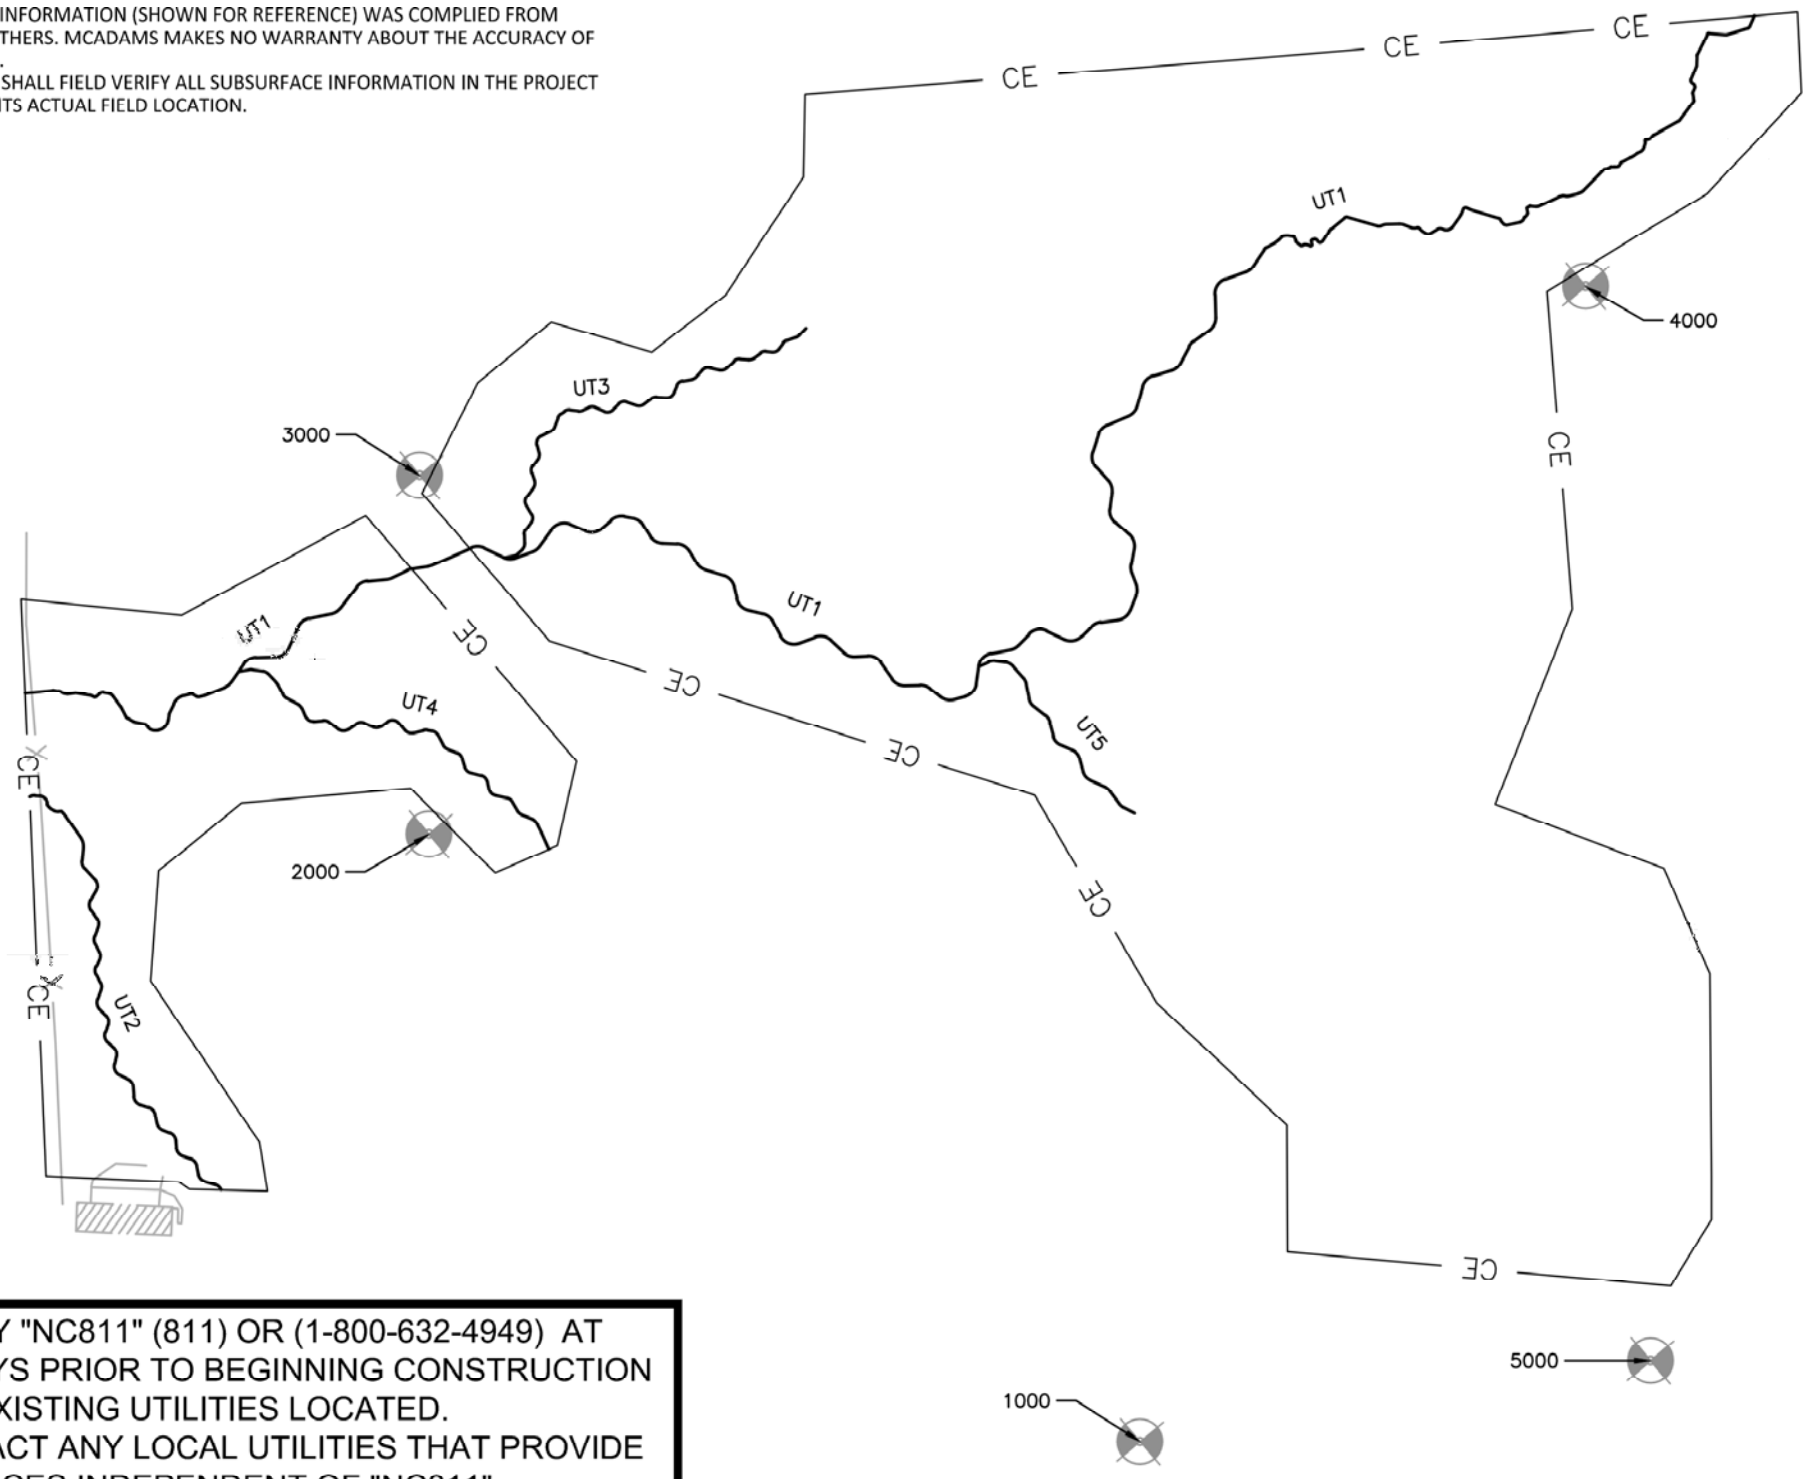

**Know what's below.  
Call before you dig.**

CONTRACTOR SHALL NOTIFY "NC811" (811) OR (1-800-632-4949) AT LEAST 3 FULL BUSINESS DAYS PRIOR TO BEGINNING CONSTRUCTION OR EXCAVATION TO HAVE EXISTING UTILITIES LOCATED. CONTRACTOR SHALL CONTACT ANY LOCAL UTILITIES THAT PROVIDE THEIR OWN LOCATOR SERVICES INDEPENDENT OF "NC811". REPORT ANY DISCREPANCIES TO THE ENGINEER IMMEDIATELY.

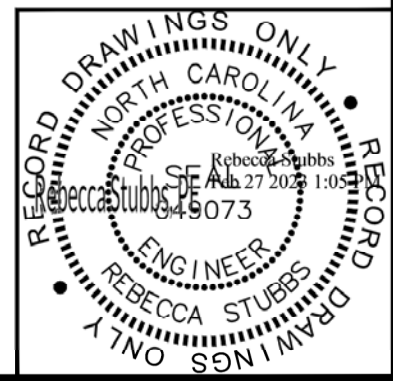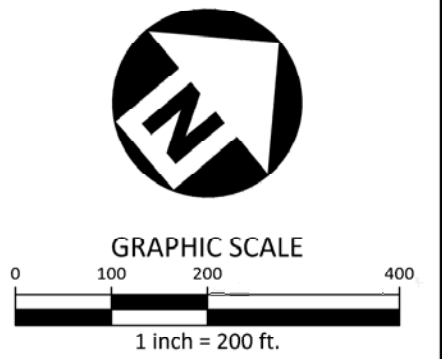

The John R. McAdams Company, Inc.  
2905 Meridian Parkway  
Durham, NC 27713  
  
phone 919. 361. 5000  
fax 919. 361. 2269  
license number: C-0293, C-187  
  
www.mcadamsco.com

**CRANE MITIGATION SITE**  
AS-BUILT DRAWINGS  
LEE COUNTY, NORTH CAROLINA



**PLAN INFORMATION**  
PROJECT NO. 2021110220  
FILENAME C1  
CHECKED BY RAS  
DRAWN BY RHW  
SCALE 1"=200'  
DATE 02.17.2023


**CONSERVATION EASEMENT AND CONTROL POINTS**  
  
**C1.00**

**EXISTING / PROPOSED LEGEND AND SYMBOLS**

	PROPOSED CONSERVATION EASEMENT
	PROPERTY LINE
	EXISTING MAJOR CONTOUR
	EXISTING MINOR CONTOUR
	EXISTING STREAM CENTERLINE
	EXISTING TOP OF BANK
	EXISTING FENCING
	PROPOSED STREAM CENTERLINE
	PROPOSED RIFFLE
	PROPOSED LOG CROSS VANE
	PROPOSED LOG VANE
	PROPOSED SILL STEP
	PROPOSED LOG SILL
	WETLAND ENHANCEMENT
	WETLAND REHABILITATION
	WETLAND RE-ESTABLISHMENT

**AS-BUILT LEGEND AND SYMBOLS**

	MAJOR CONTOUR
	MINOR CONTOUR
	STREAM CENTERLINE
	TOP OF BANK
	FENCE
	LOG CROSS VANE
	LOG VANE
	LOG SILL STEP
	MONITORING - VEGETATION PLOT
	MONITORING - CROSS SECTION
	MONITORING - STREAM GAGUE
	MONITORING - GROUNDWATER WELL
	MONITORING - RAIN GAGUE

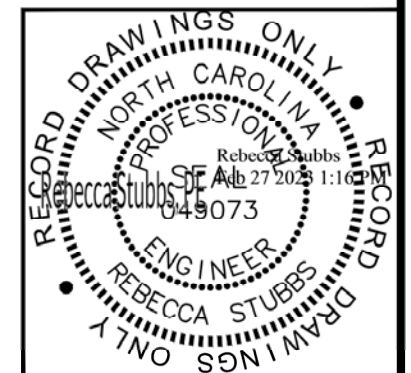

The John R. McAdams Company, Inc.  
 2905 Meridian Parkway  
 Durham, NC 27713  
 phone 919. 361. 5000  
 fax 919. 361. 2269  
 license number: C-0293, C-187  
 www.mcadamsco.com

**CRANE MITIGATION SITE**  
 AS-BUILT DRAWINGS  
 LEE COUNTY, NORTH CAROLINA






**PLAN INFORMATION**

PROJECT NO. 2021110220  
 FILENAME C1  
 CHECKED BY RAS  
 DRAWN BY RHW  
 SCALE  
 DATE 02.17.2023

**LEGEND AND SYMBOLS**

**C1.01**

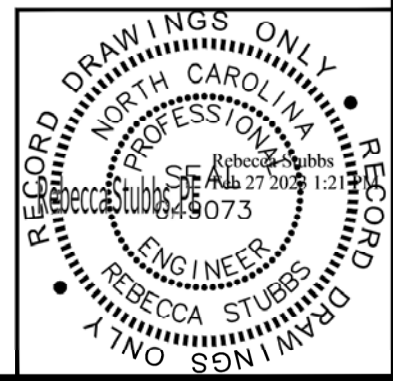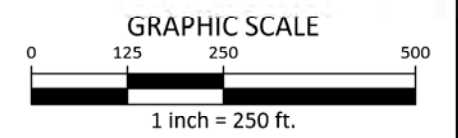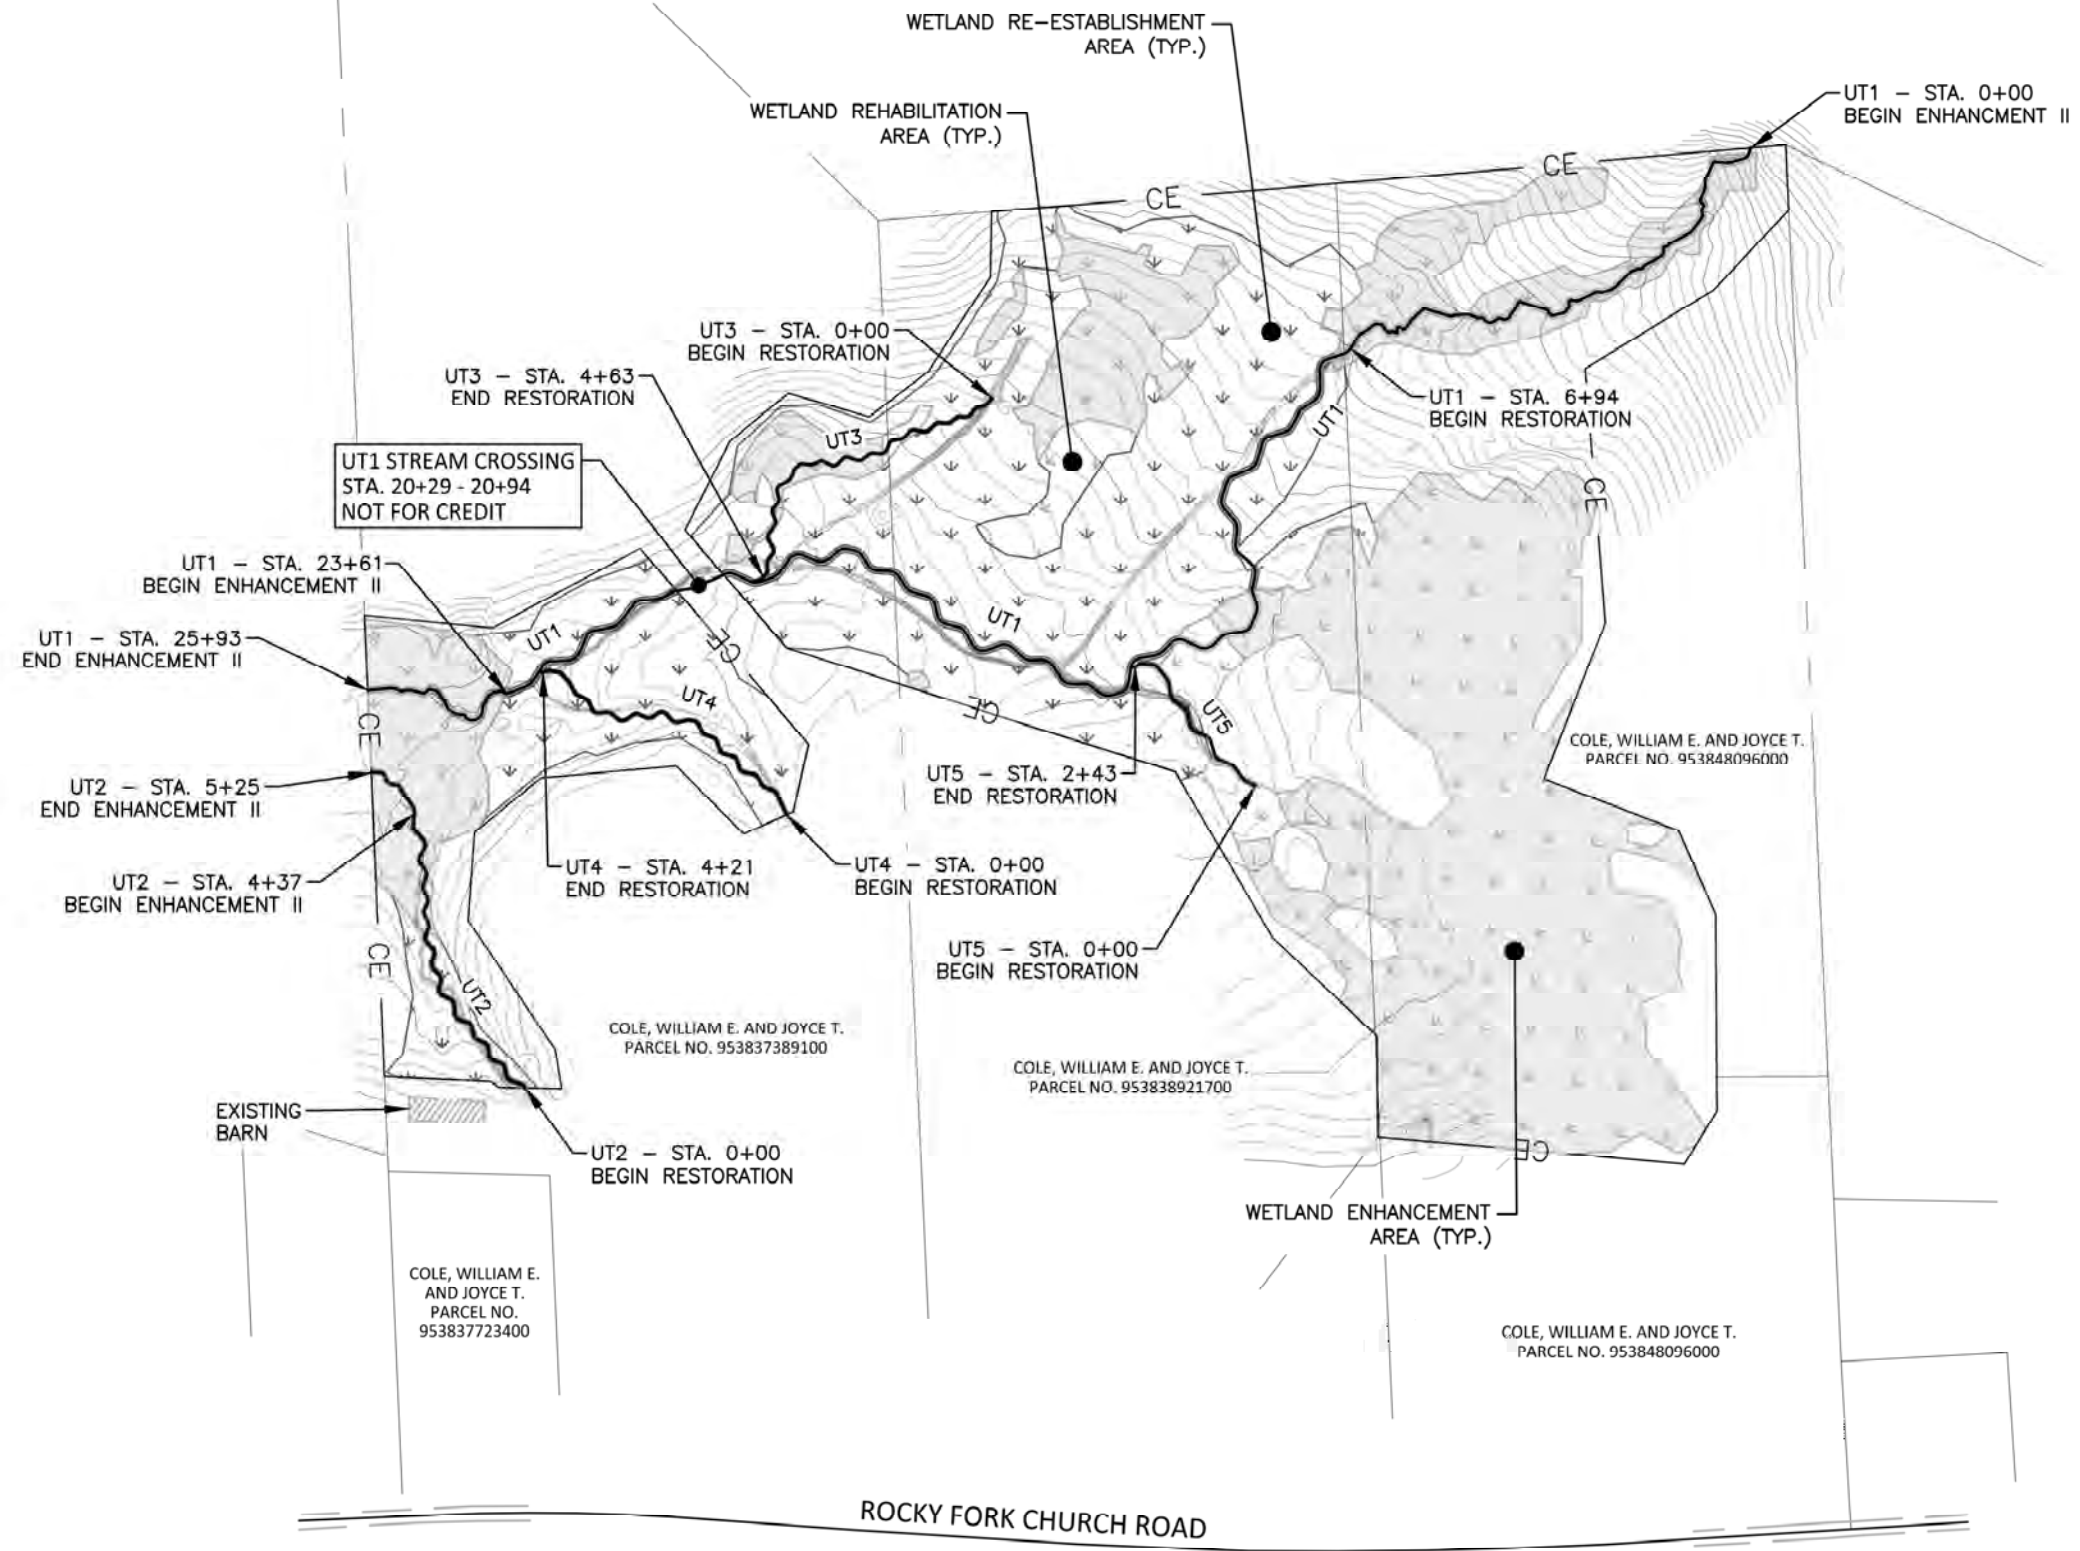

The John R. McAdams Company, Inc.  
2905 Meridian Parkway  
Durham, NC 27713

phone 919. 361. 5000  
fax 919. 361. 2269  
license number: C-0293, C-187

www.mcadamsco.com

**CRANE MITIGATION SITE**  
AS-BUILT DRAWINGS  
LEE COUNTY, NORTH CAROLINA






**PLAN INFORMATION**

PROJECT NO.	2021110220
FILENAME	C1
CHECKED BY	RAS
DRAWN BY	RHW
SCALE	1"=250'
DATE	02.17.2023

**PROJECT OVERVIEW**

**C1.02**

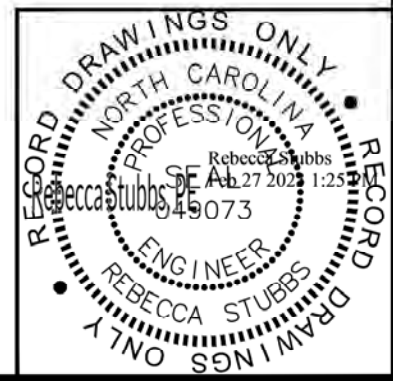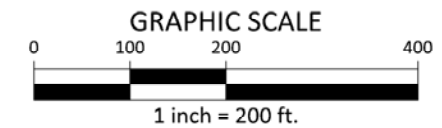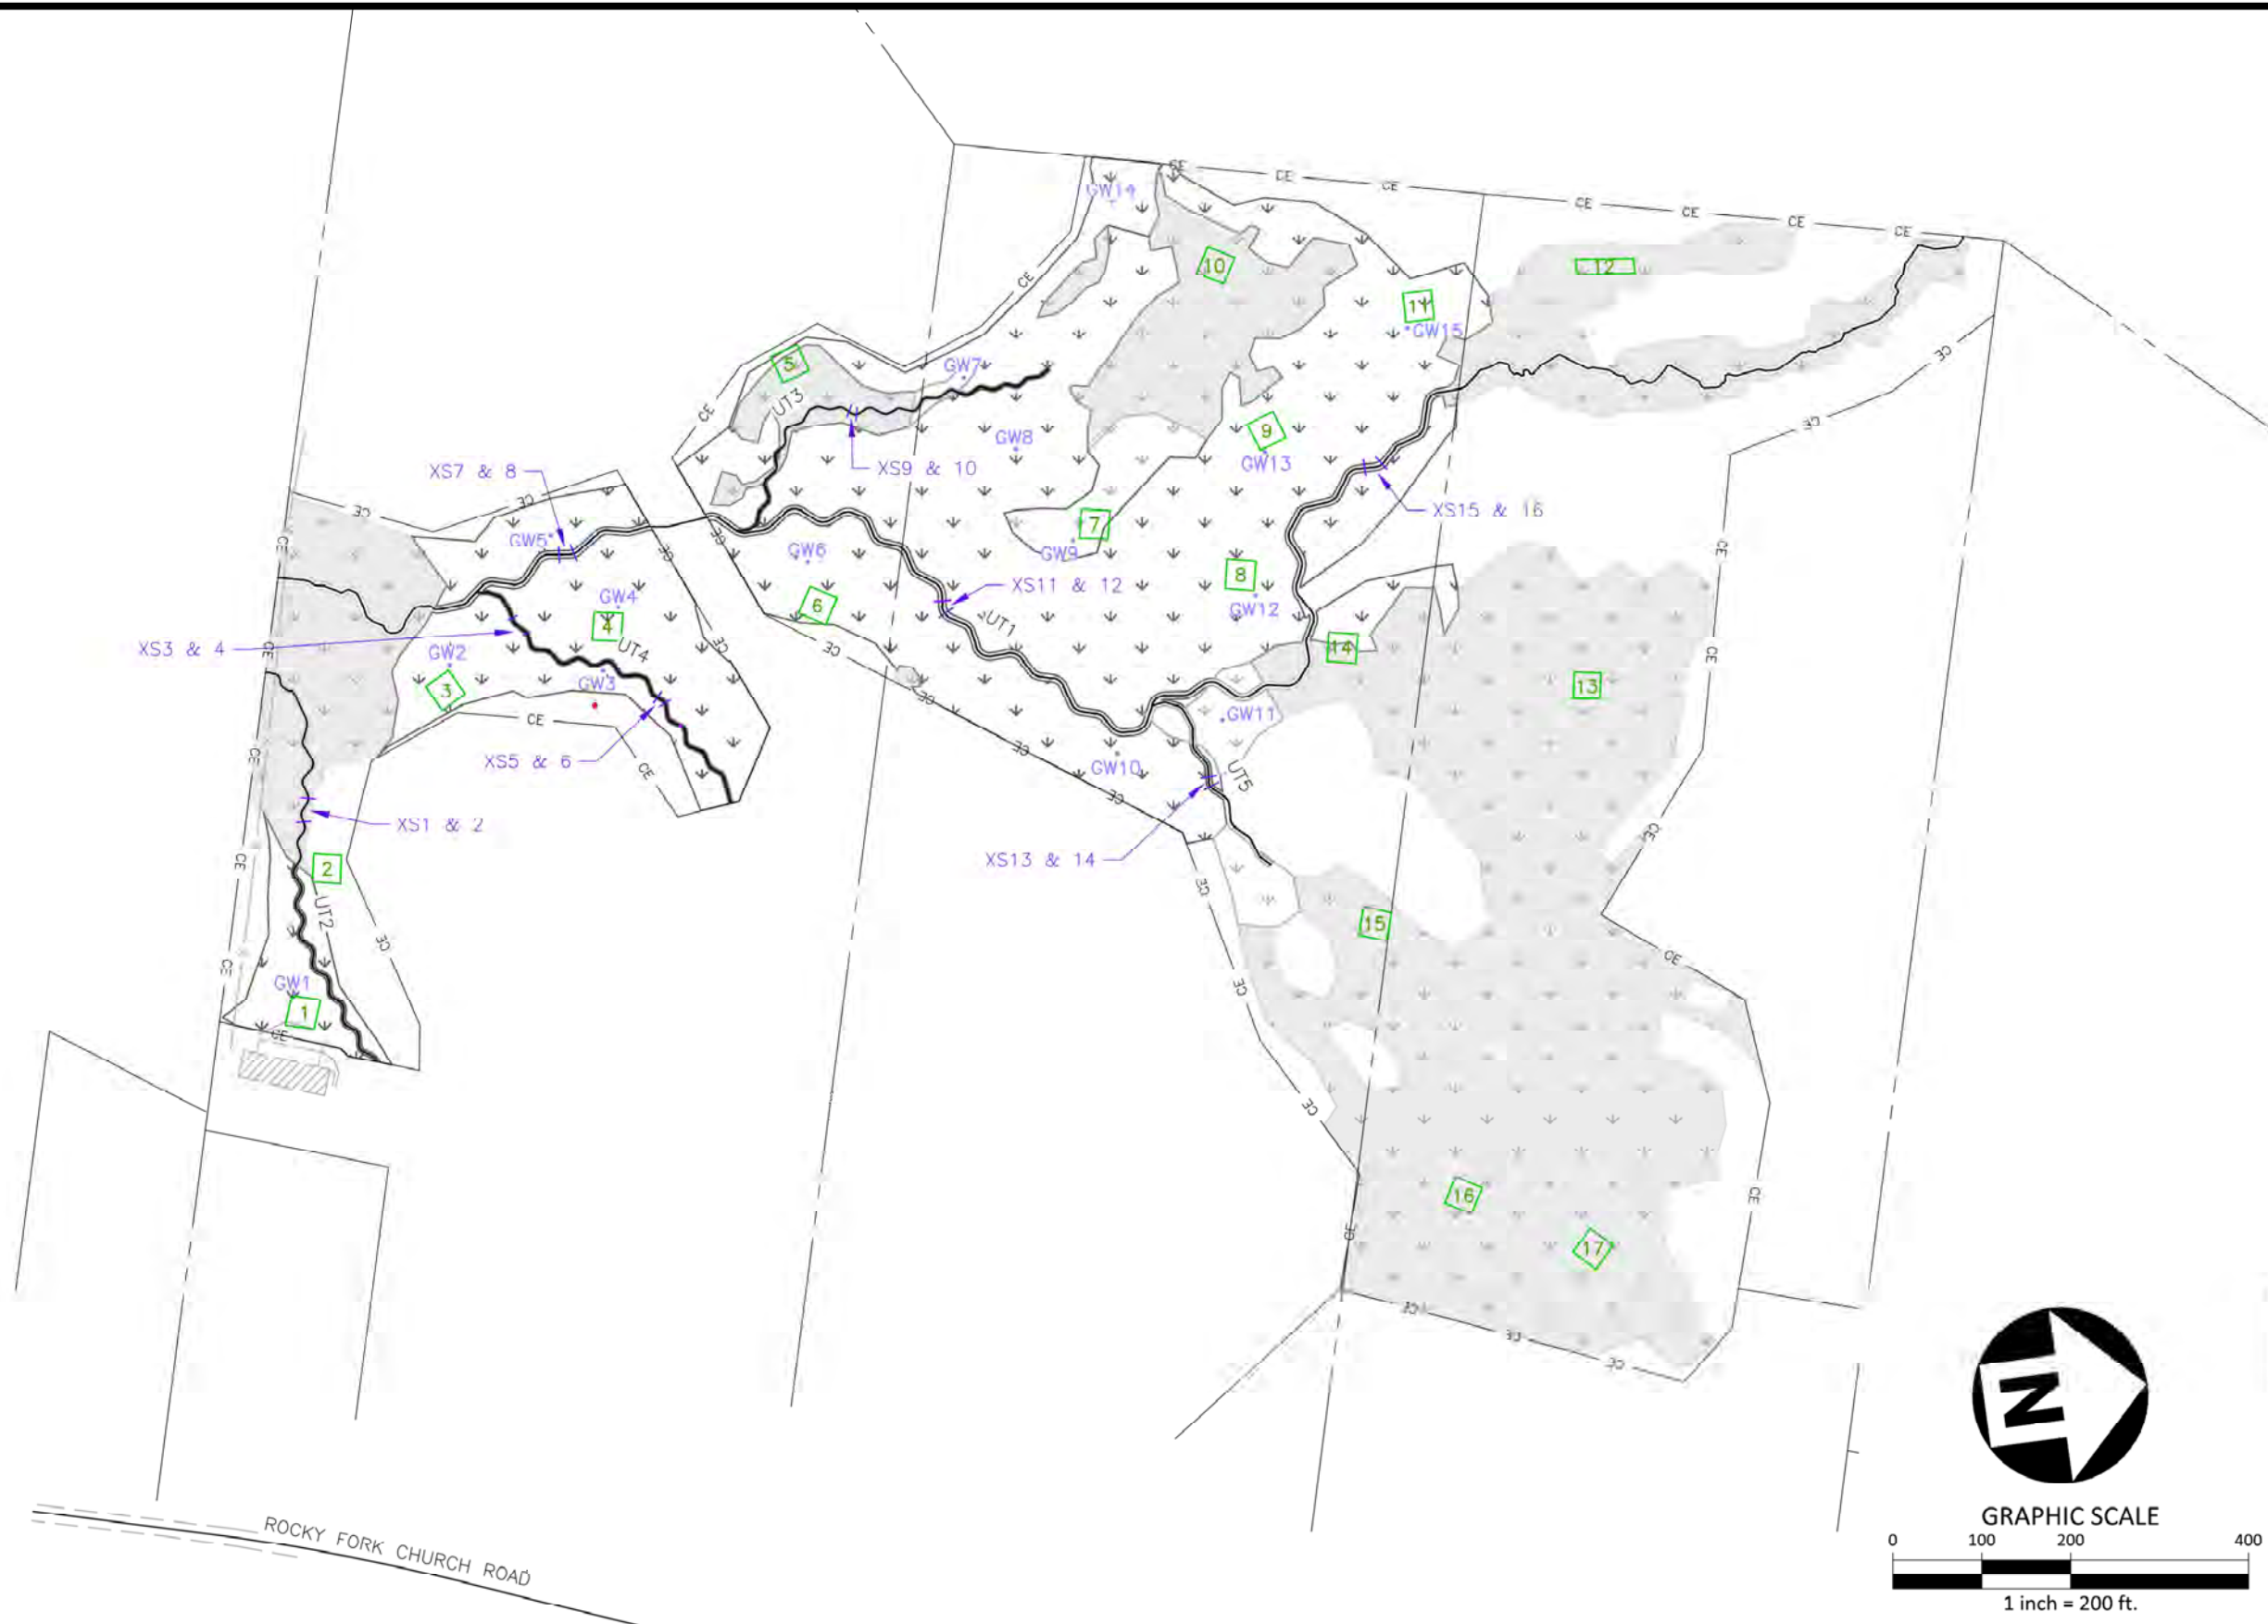


The John R. McAdams Company, Inc.  
2905 Meridian Parkway  
Durham, NC 27713

phone 919. 361. 5000  
fax 919. 361. 2269  
license number: C-0293, C-187

www.mcadamsco.com

## CRANE MITIGATION SITE




AS-BUILT DRAWINGS  
LEE COUNTY, NORTH CAROLINA



PLAN INFORMATION	
PROJECT NO.	2021110220
FILENAME	C3
CHECKED BY	RAS
DRAWN BY	RHW
SCALE	1"=200'
DATE	02.17.2023

## SITE MONITORING LAYOUT

# C1.03

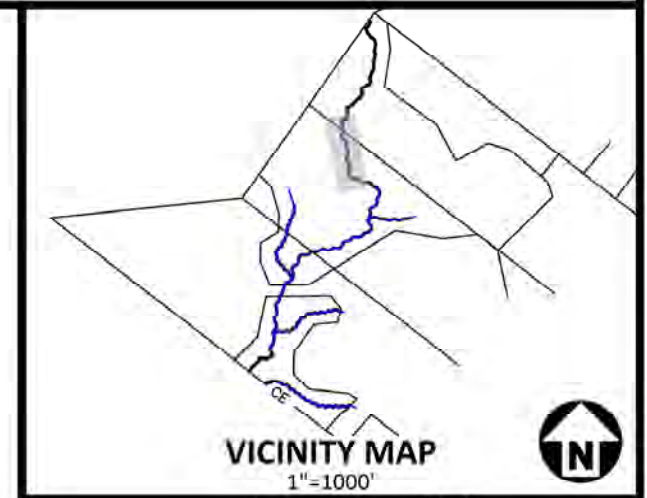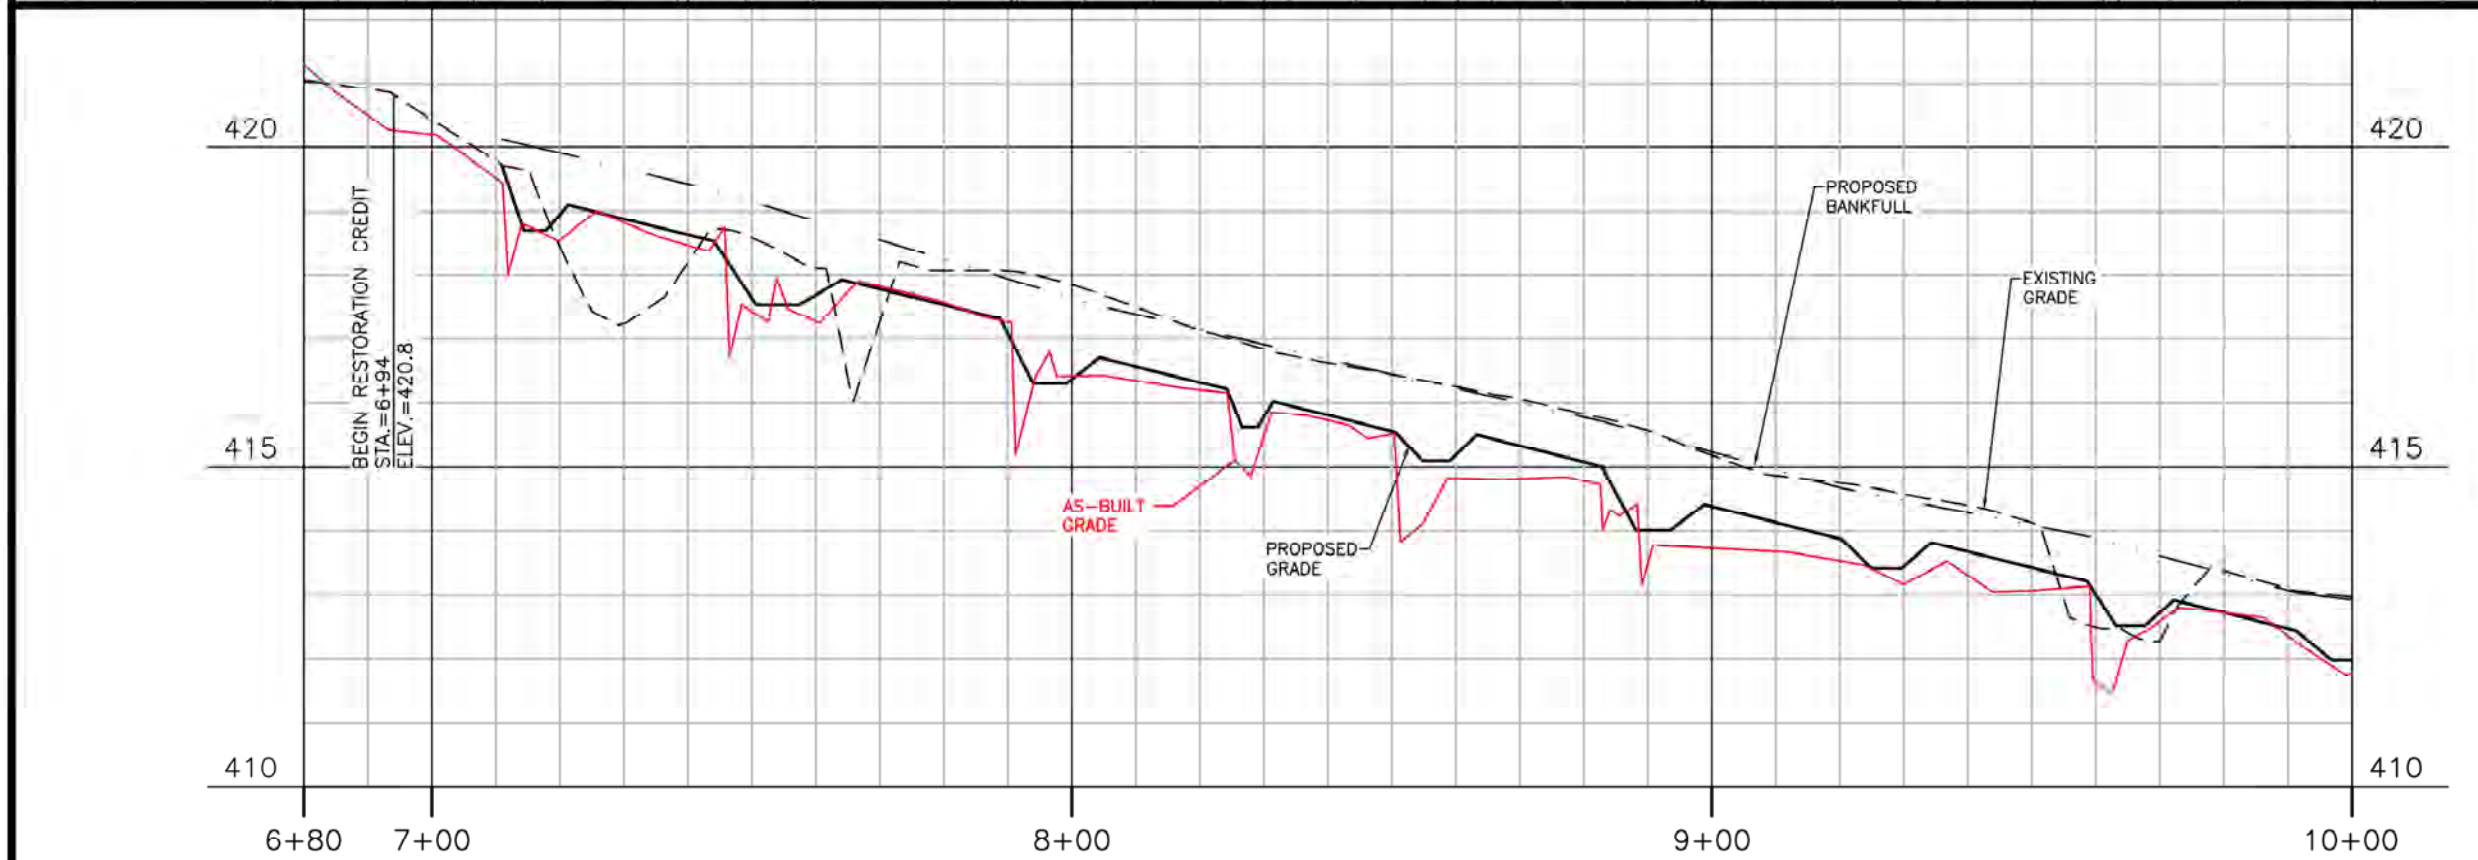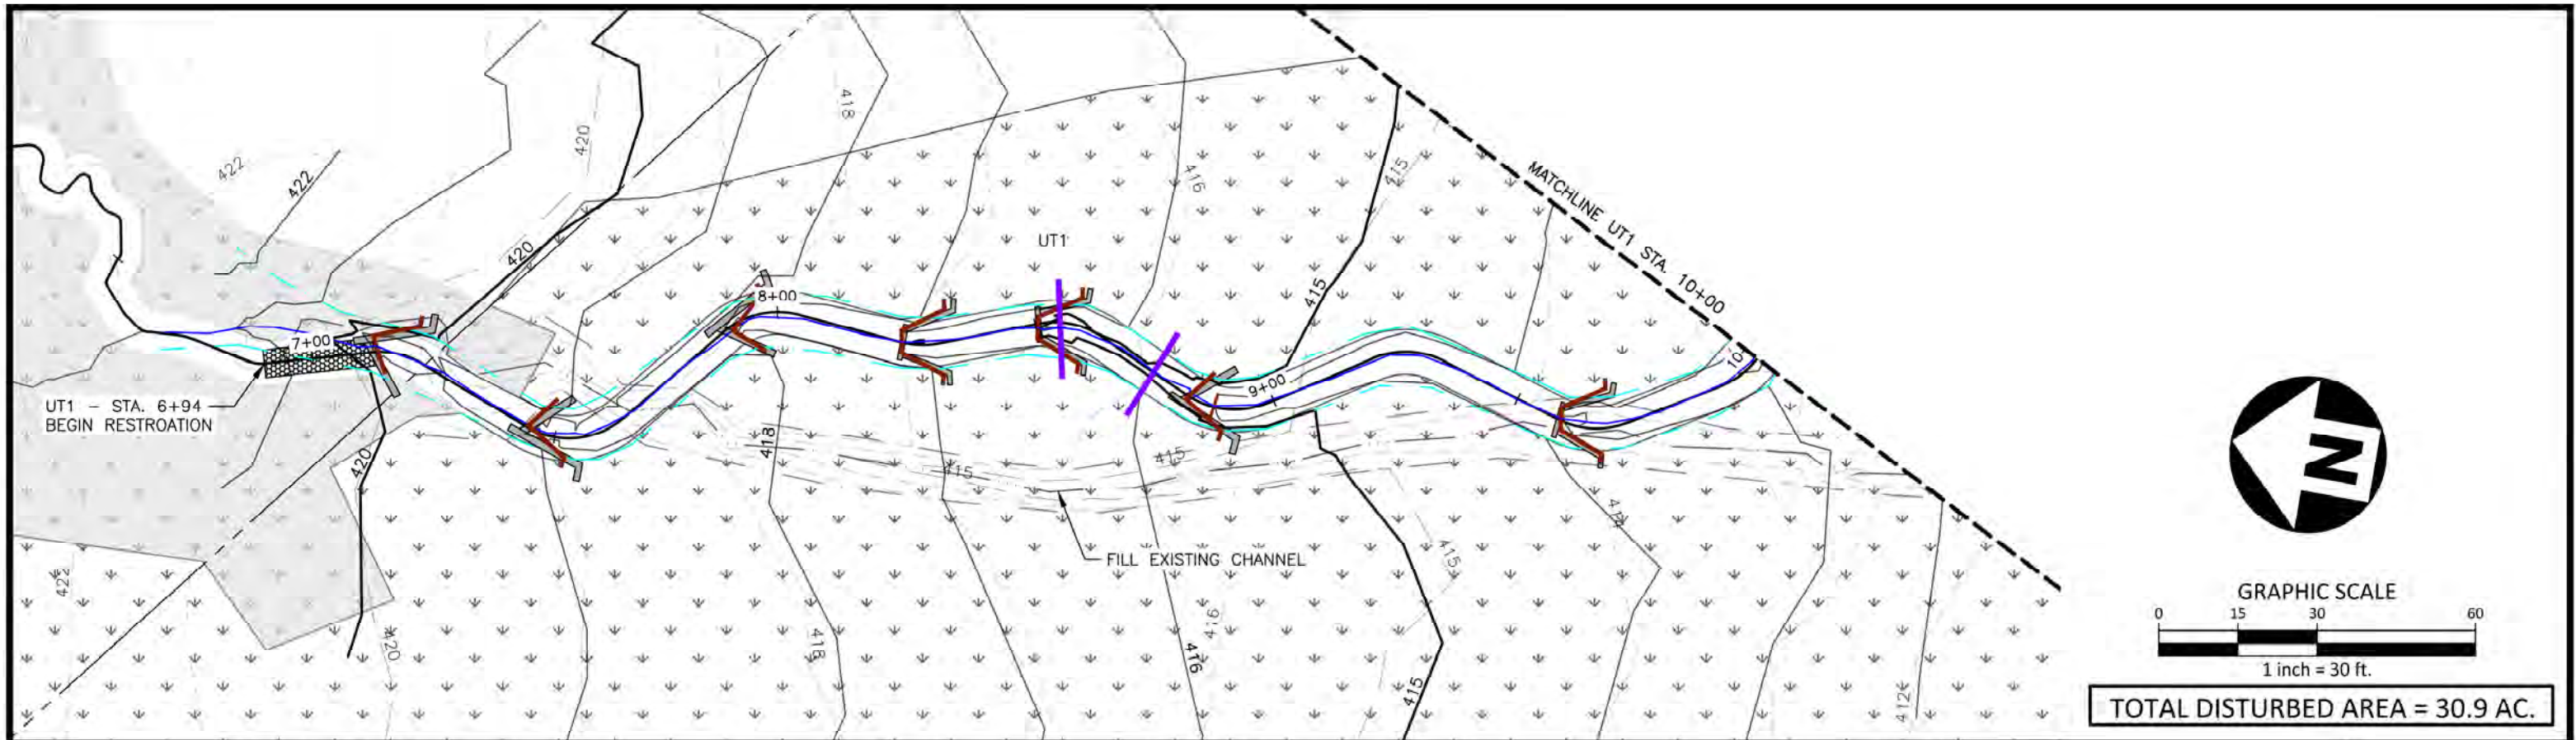


**McADAMS**  
The John R. McAdams Company, Inc.  
2905 Meridian Parkway  
Durham, NC 27713  
phone 919. 361. 5000  
fax 919. 361. 2269  
license number: C-0293, C-187  
www.mcadamsco.com

**CRANE MITIGATION SITE**  
AS-BUILT DRAWINGS  
LEE COUNTY, NORTH CAROLINA






**PLAN INFORMATION**  
PROJECT NO. 2021110220  
FILENAME P1  
CHECKED BY RAS  
DRAWN BY RHW  
SCALE 1"=30'  
DATE 02.17.2023

**PLAN AND PROFILE**  
UT1 STA 6+80 - 10+00  
**C5.00**

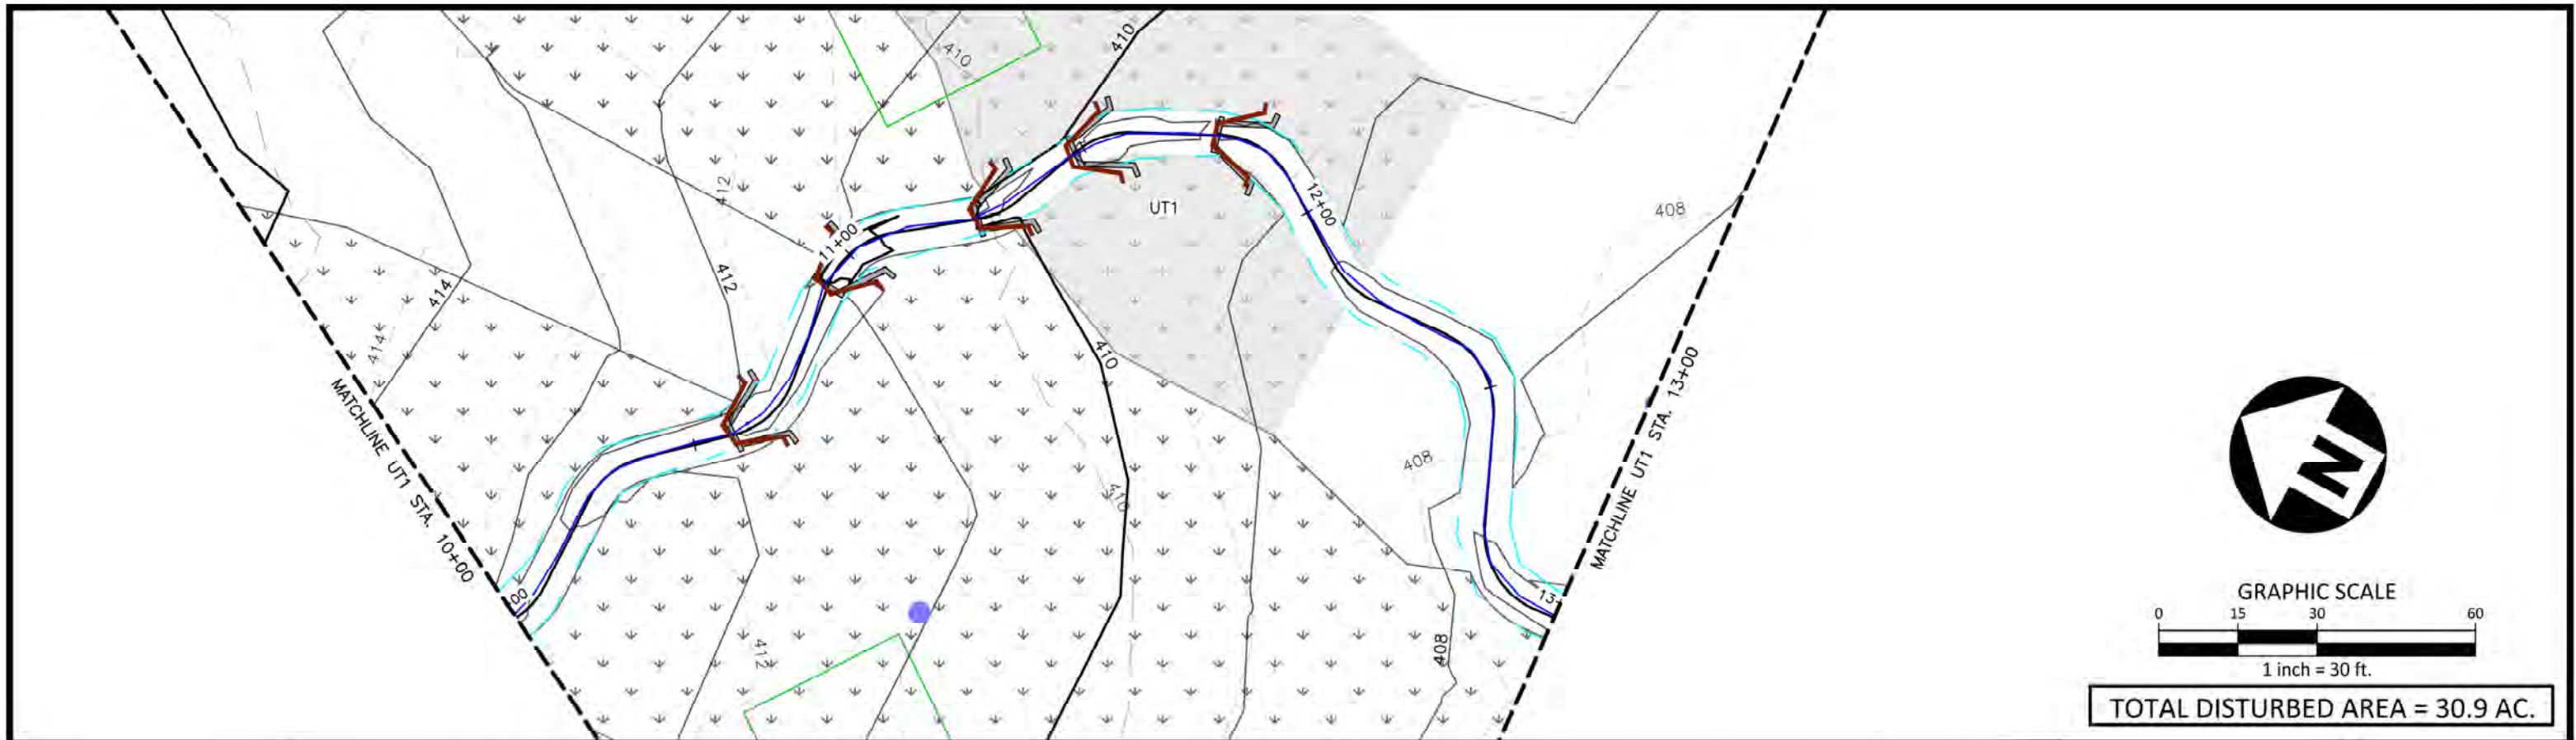

TOTAL DISTURBED AREA = 30.9 AC.

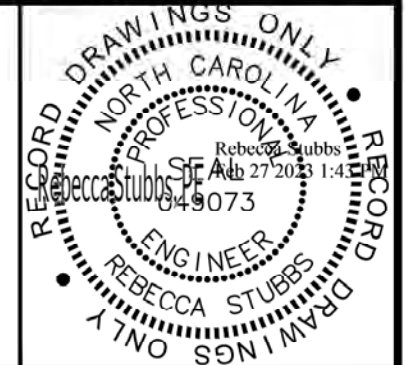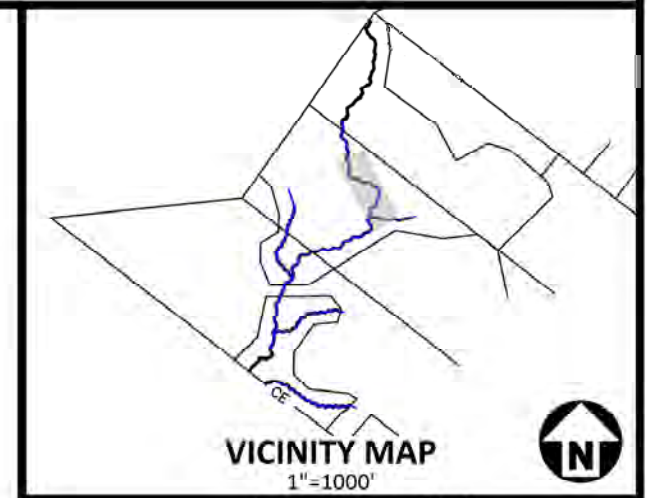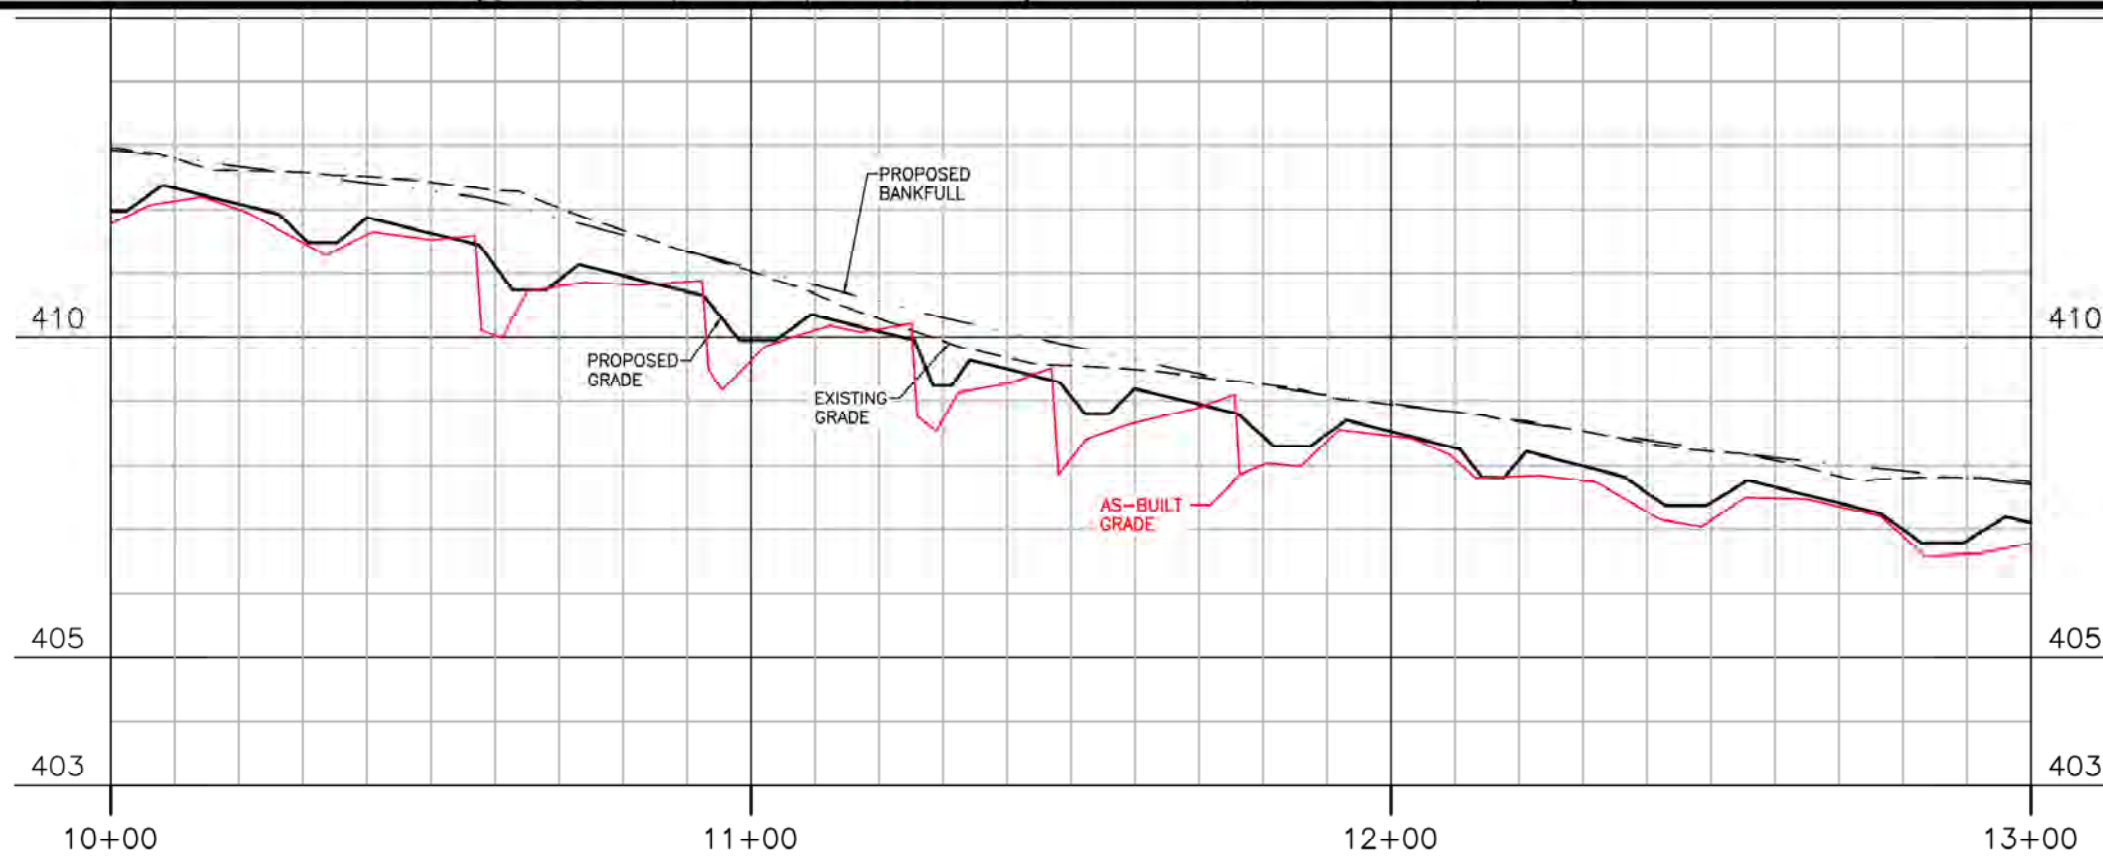

**McADAMS**  
 The John R. McAdams Company, Inc.  
 2905 Meridian Parkway  
 Durham, NC 27713  
 phone 919. 361. 5000  
 fax 919. 361. 2269  
 license number: C-0293, C-187  
 www.mcadamsco.com



**CRANE MITIGATION SITE**  
 AS-BUILT DRAWINGS  
 LEE COUNTY, NORTH CAROLINA






**PLAN INFORMATION**  
 PROJECT NO. 2021110220  
 FILENAME P1  
 CHECKED BY RAS  
 DRAWN BY RHW  
 SCALE 1"=30'  
 DATE 02.17.2023

**PLAN AND PROFILE**  
 UT1 STA 10+00 - 13+00  
**C5.01**



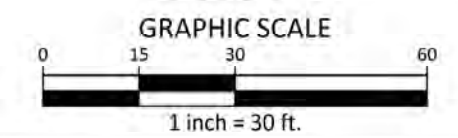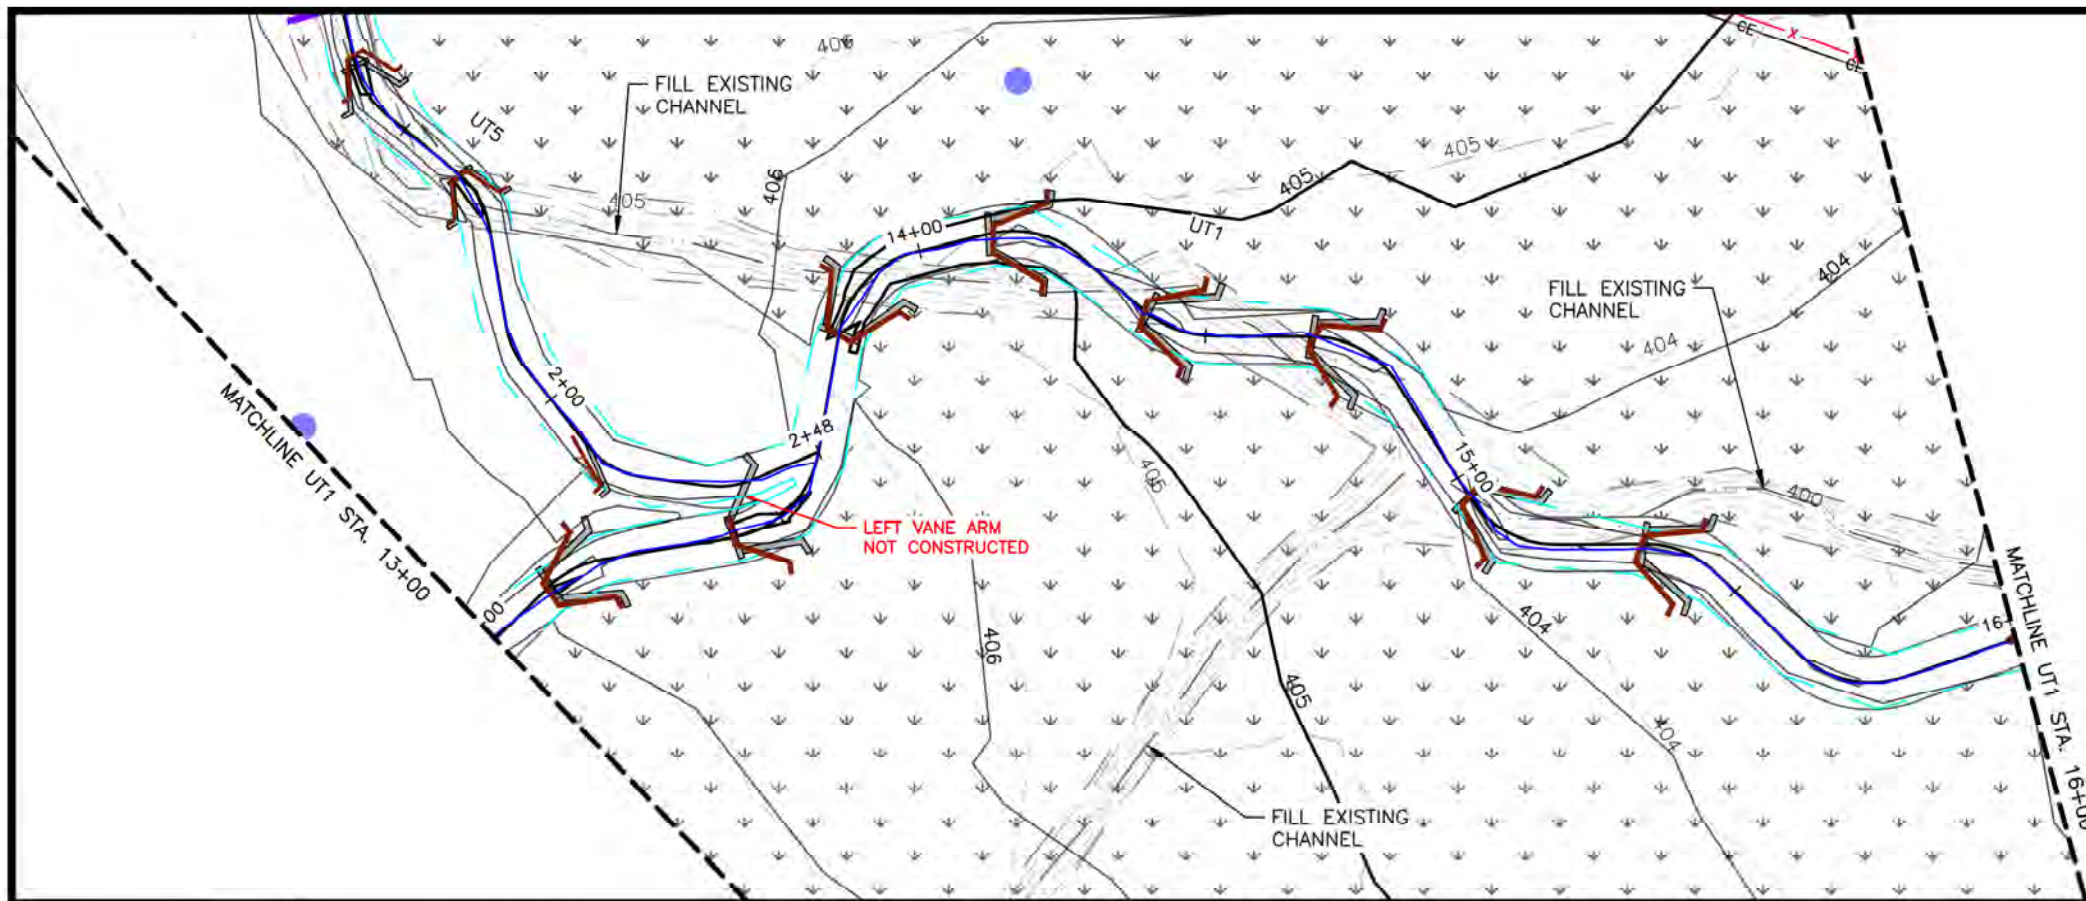

TOTAL DISTURBED AREA = 30.9 AC.

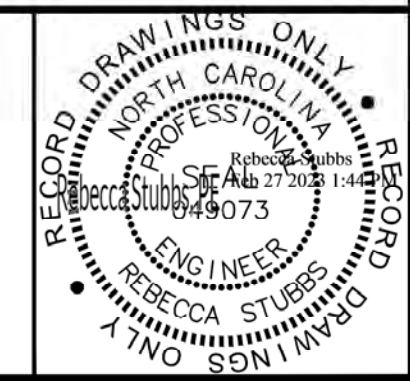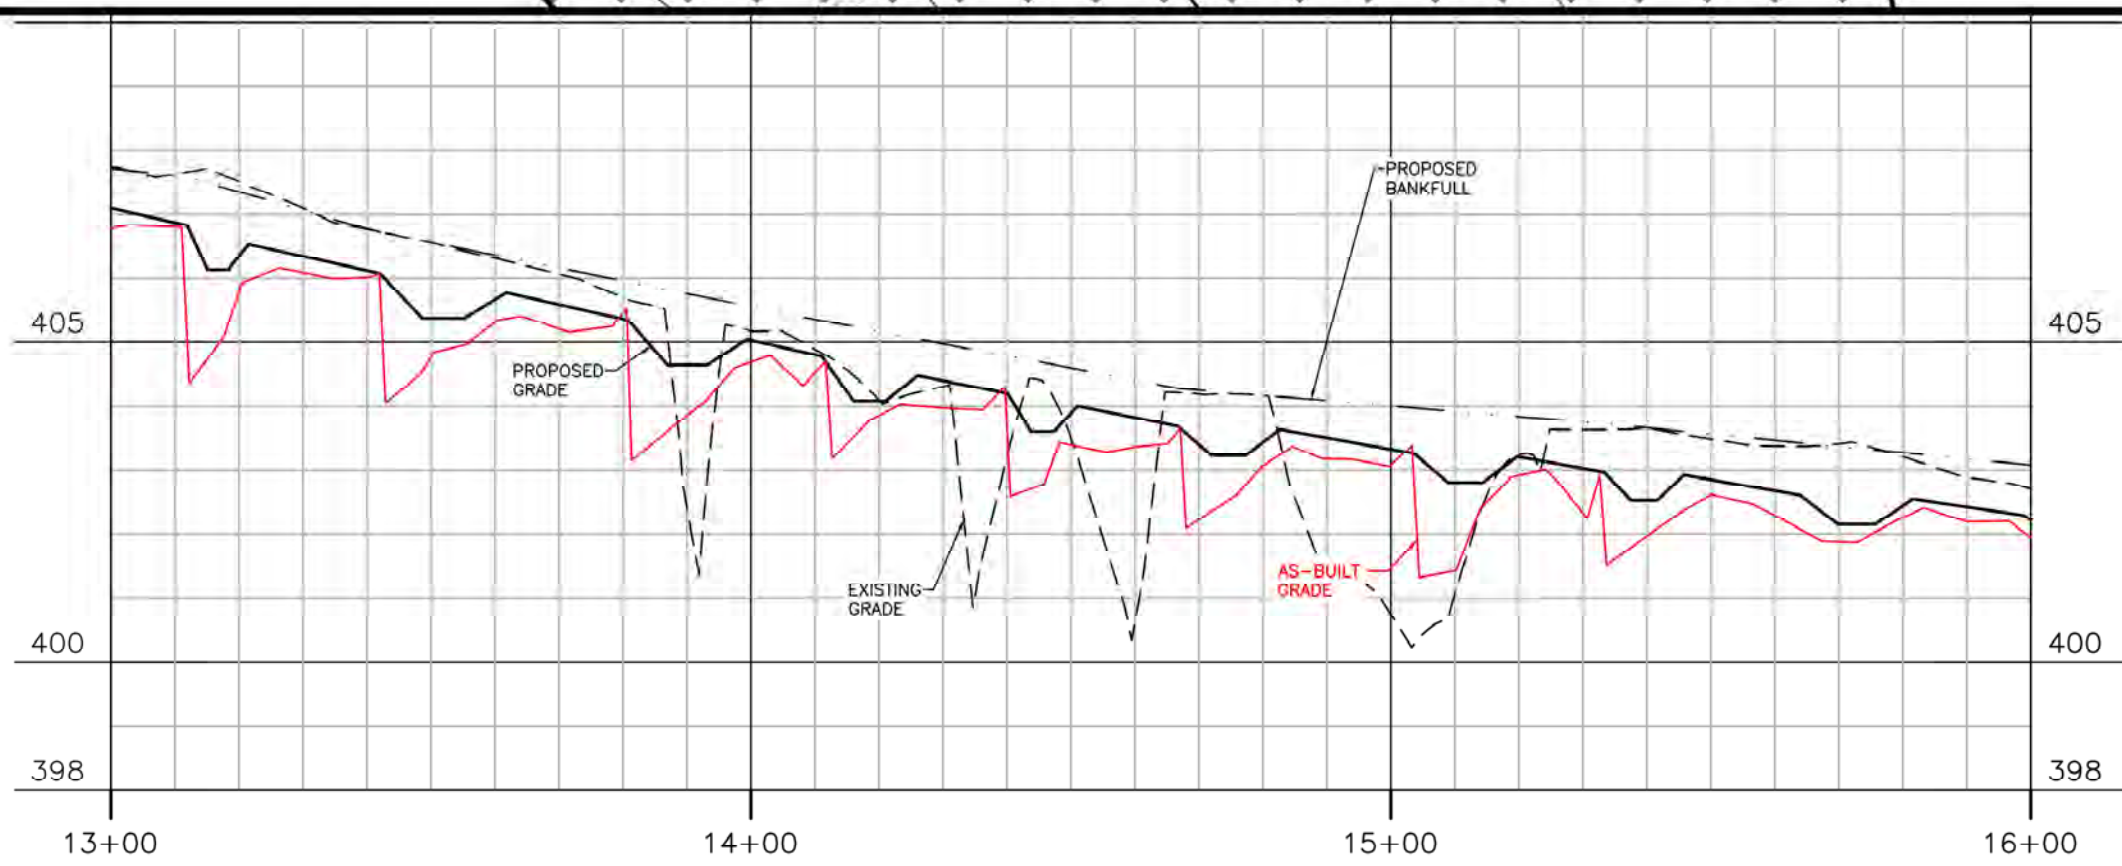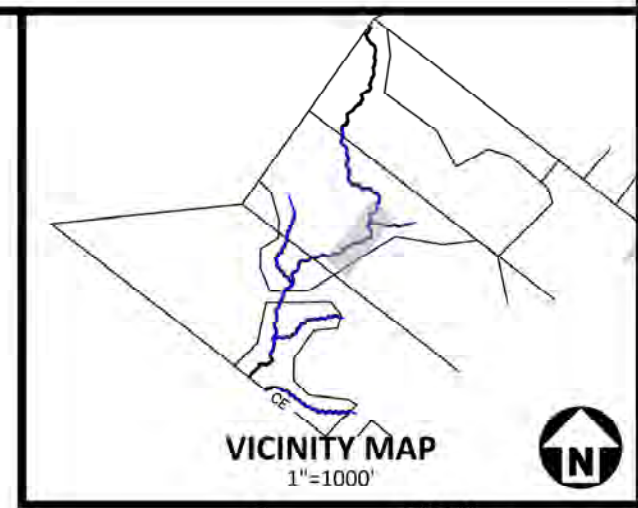


The John R. McAdams Company, Inc.  
2905 Meridian Parkway  
Durham, NC 27713

phone 919. 361. 5000  
fax 919. 361. 2269  
license number: C-0293, C-187

www.mcadamsco.com

## CRANE MITIGATION SITE

AS-BUILT DRAWINGS  
LEE COUNTY, NORTH CAROLINA





**PLAN INFORMATION**




PROJECT NO. 2021110220  
FILENAME P1  
CHECKED BY RAS  
DRAWN BY RHW  
SCALE 1"=30'  
DATE 02.17.2023

**PLAN AND PROFILE**  
UT1 STA 13+00 - 16+00

# C5.02

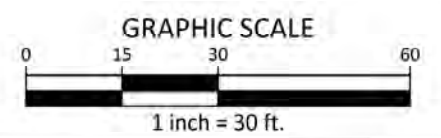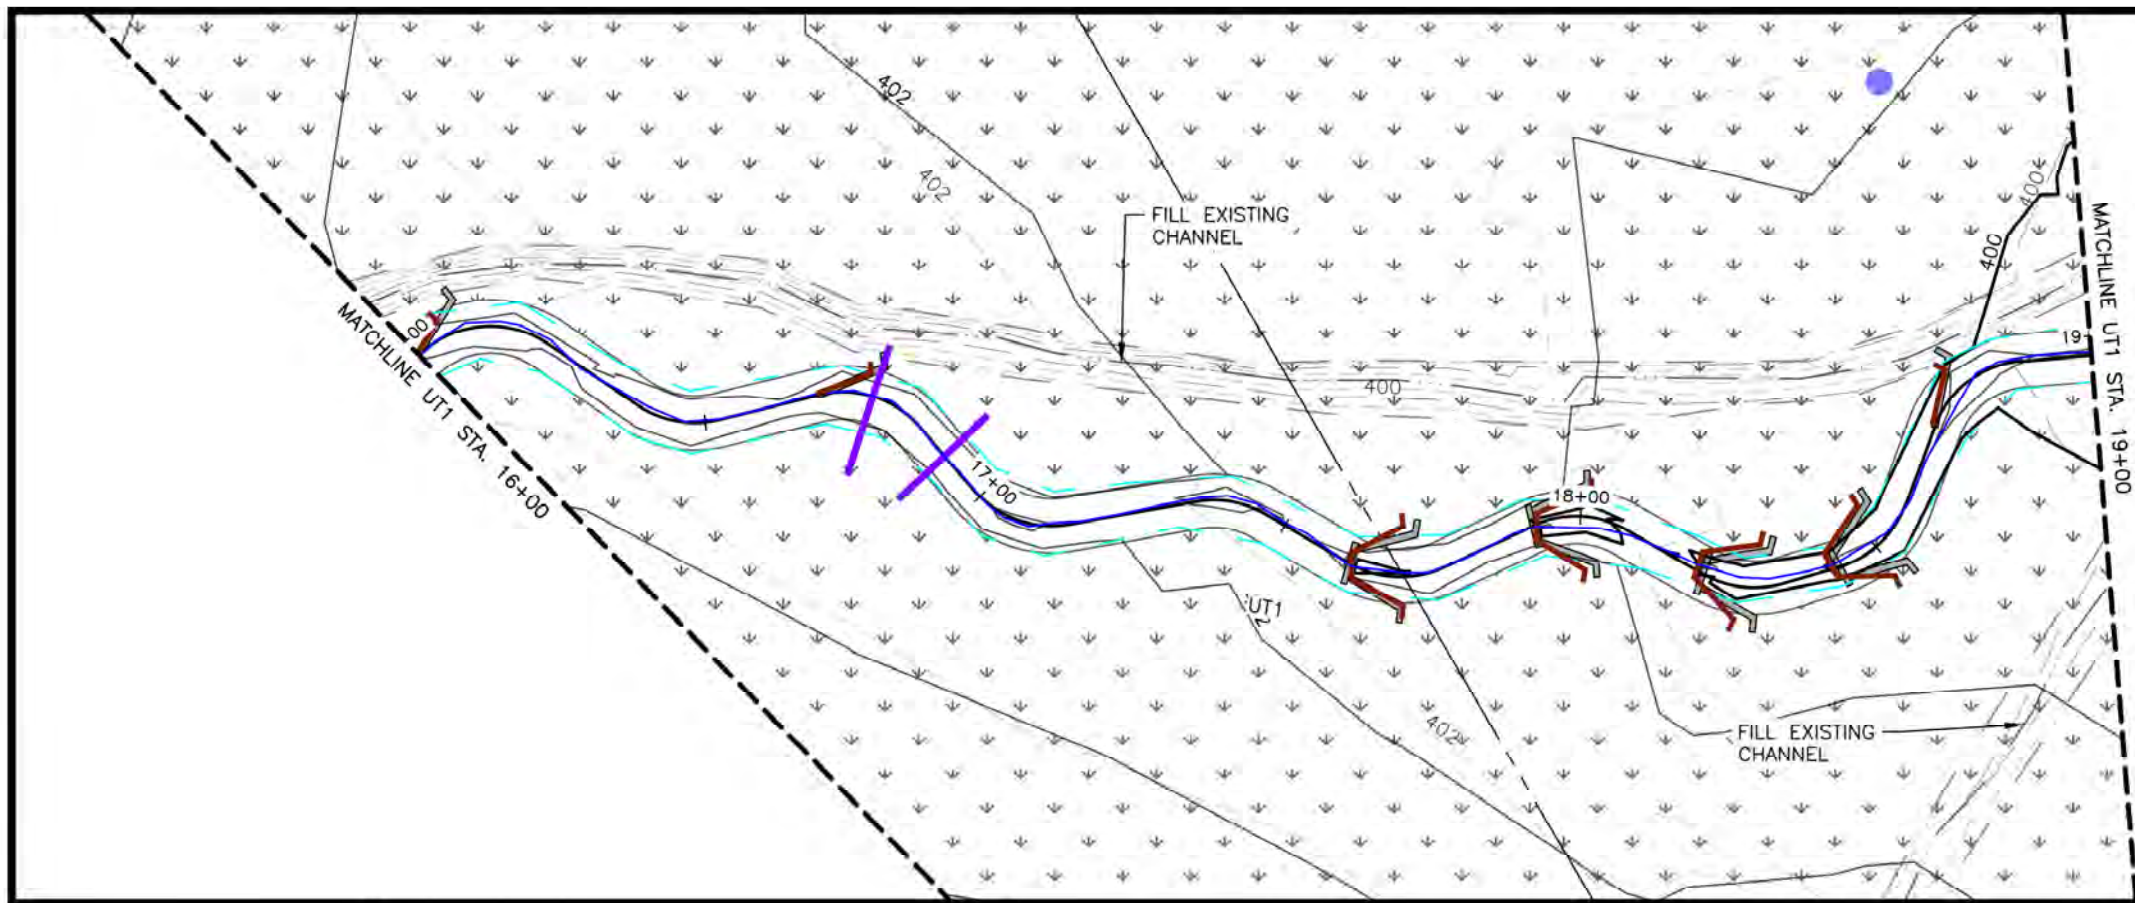

TOTAL DISTURBED AREA = 30.9 AC.

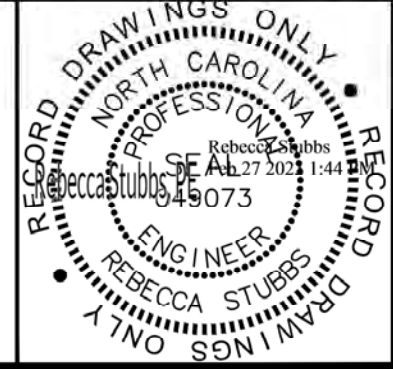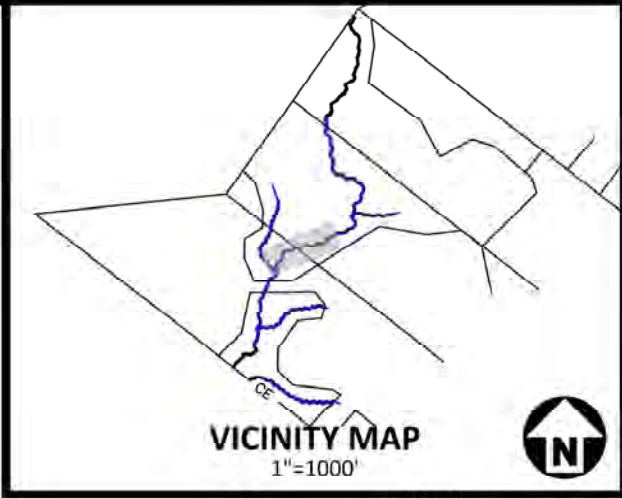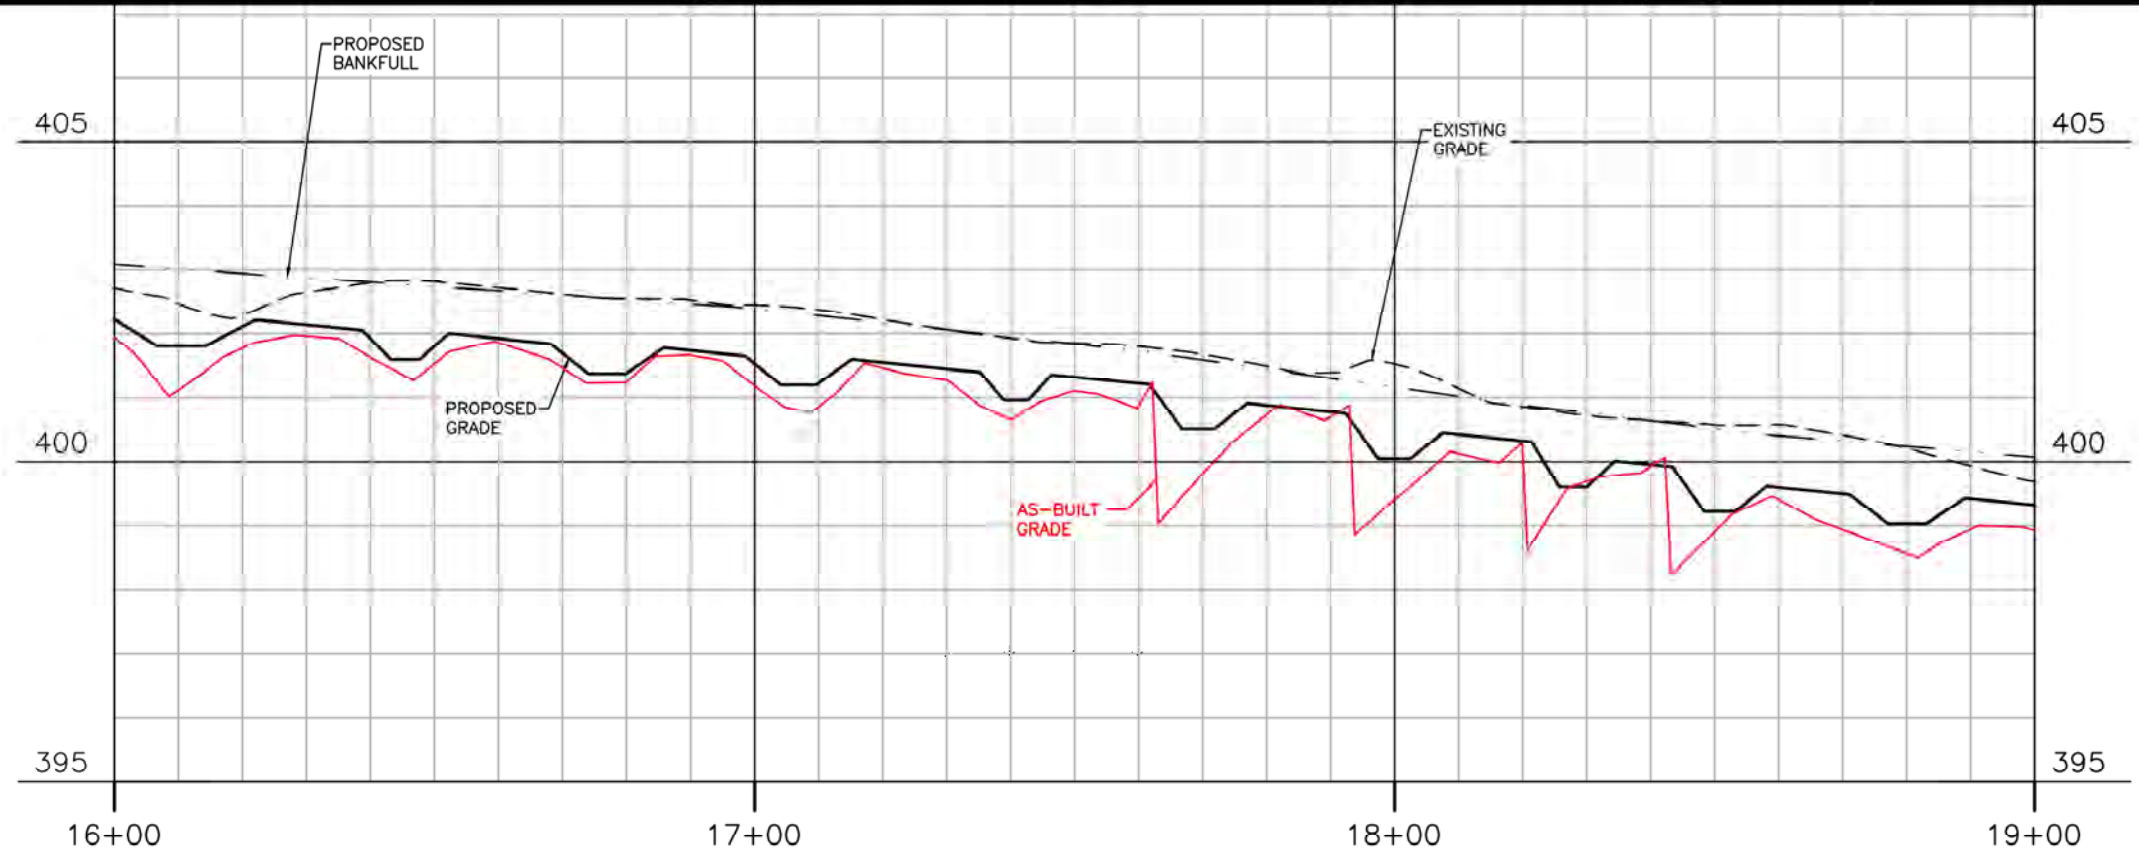


The John R. McAdams Company, Inc.  
2905 Meridian Parkway  
Durham, NC 27713

phone 919. 361. 5000  
fax 919. 361. 2269  
license number: C-0293, C-187  
www.mcadamsco.com

## CRANE MITIGATION SITE

AS-BUILT DRAWINGS  
LEE COUNTY, NORTH CAROLINA





**PLAN INFORMATION**




PROJECT NO.	2021110220
FILENAME	P1
CHECKED BY	RAS
DRAWN BY	RHW
SCALE	1"=30'
DATE	02.17.2023

**PLAN AND PROFILE**  
UT1 STA 16+00 - 19+00

# C5.03

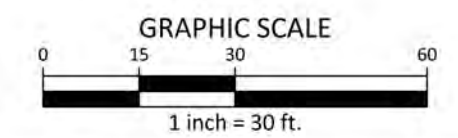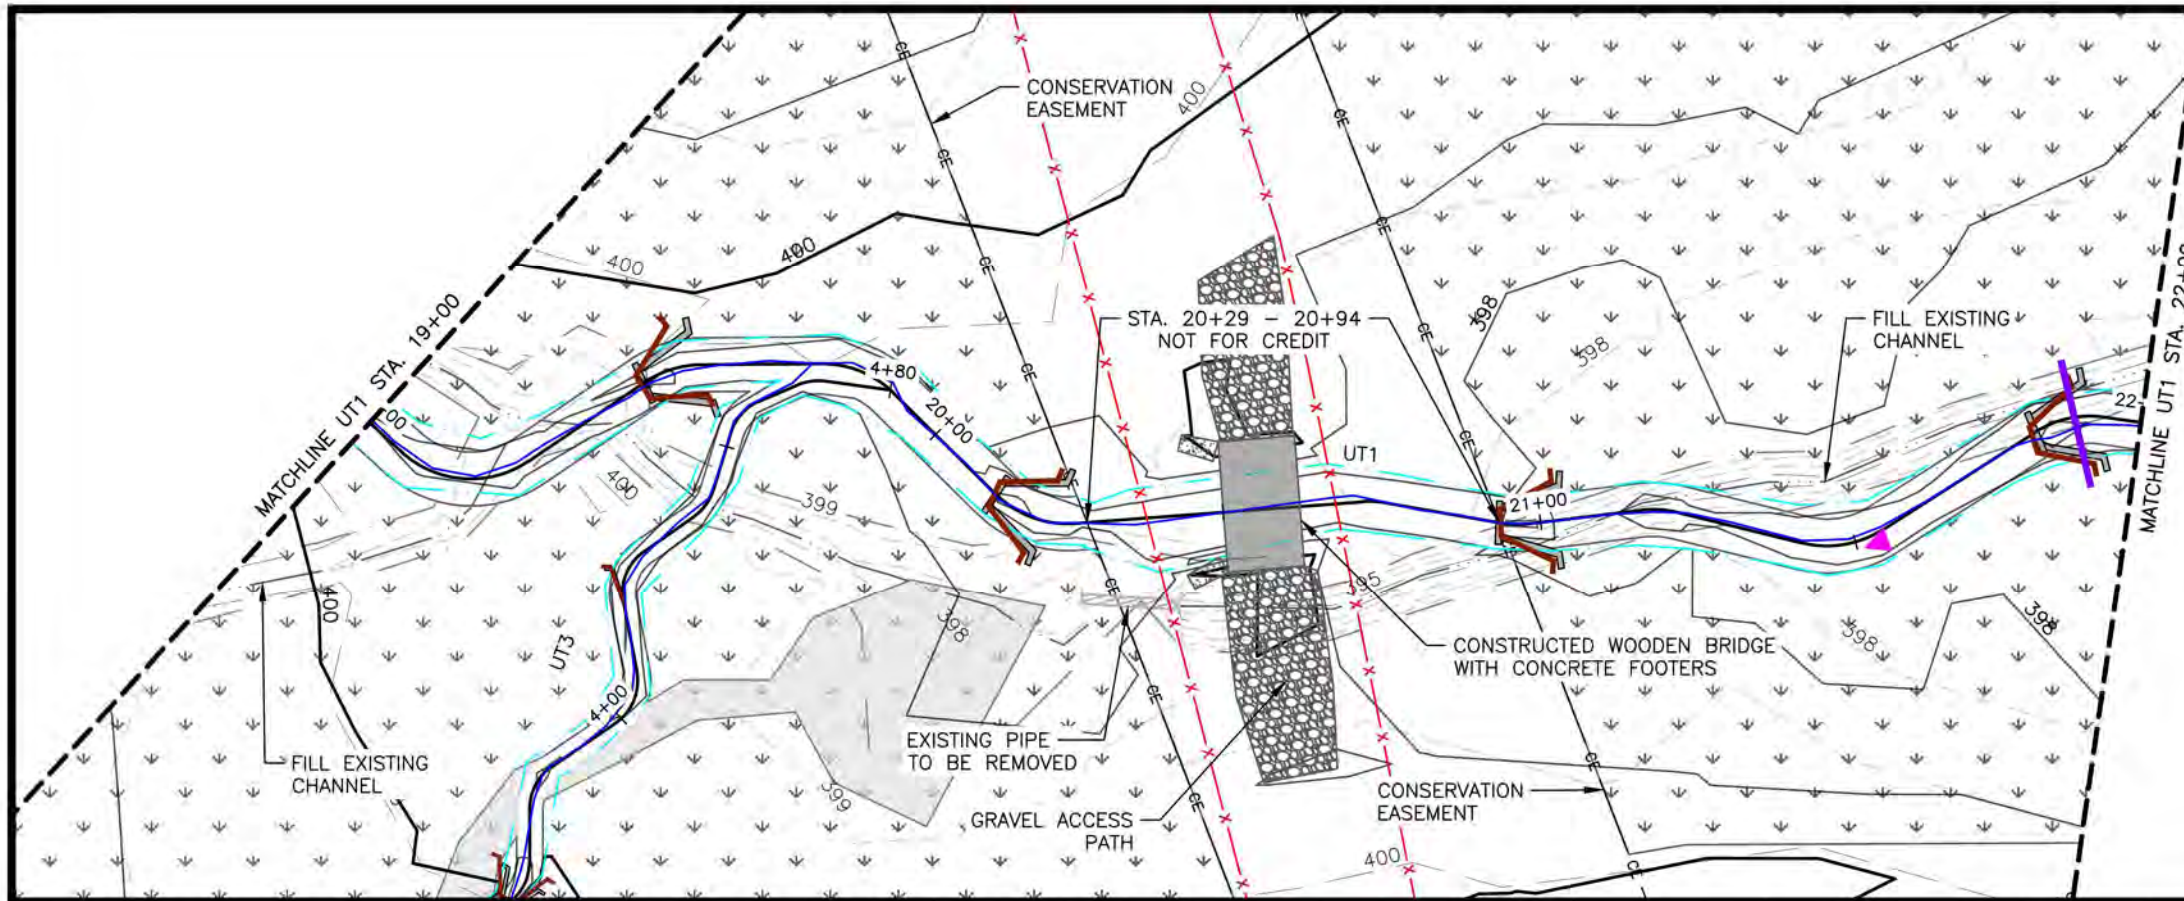

**TOTAL DISTURBED AREA = 30.9 AC.**

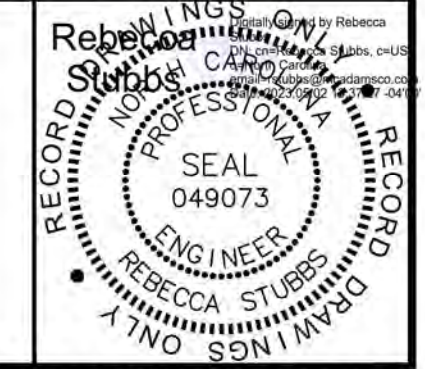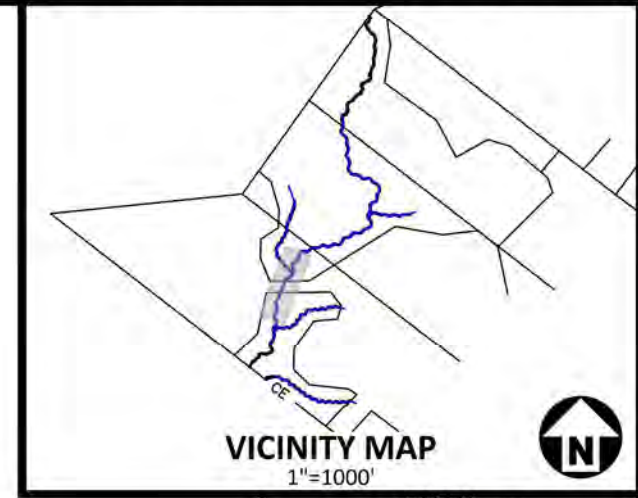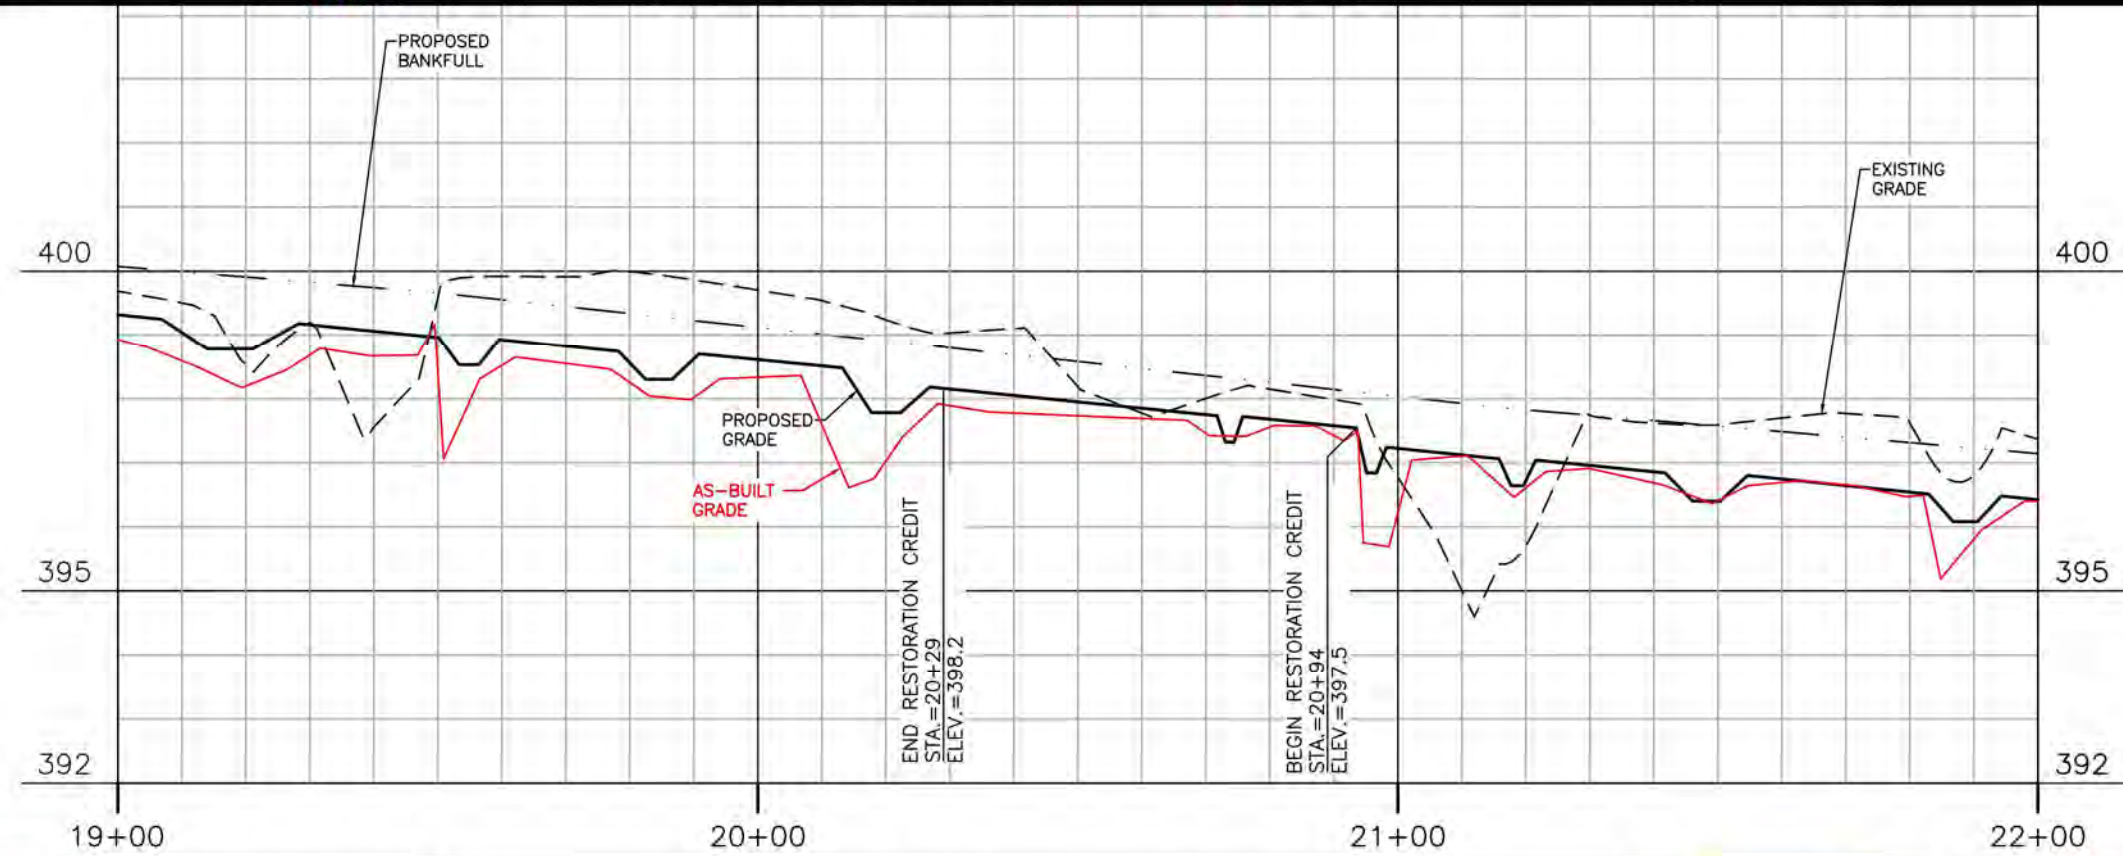


The John R. McAdams Company, Inc.  
2905 Meridian Parkway  
Durham, NC 27713

phone 919. 361. 5000  
fax 919. 361. 2269  
license number: C-0293, C-187

www.mcadamsco.com

**CRANE MITIGATION SITE**  
AS-BUILT DRAWINGS  
LEE COUNTY, NORTH CAROLINA





**PLAN INFORMATION**




PROJECT NO. 2021110220  
FILENAME P1  
CHECKED BY RAS  
DRAWN BY RHW  
SCALE 1"=30'  
DATE 05.02.2023

**PLAN AND PROFILE**  
UT1 STA 19+00 - 22+00

**C5.04**

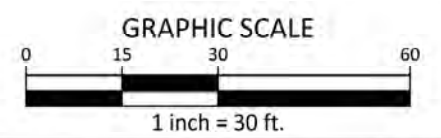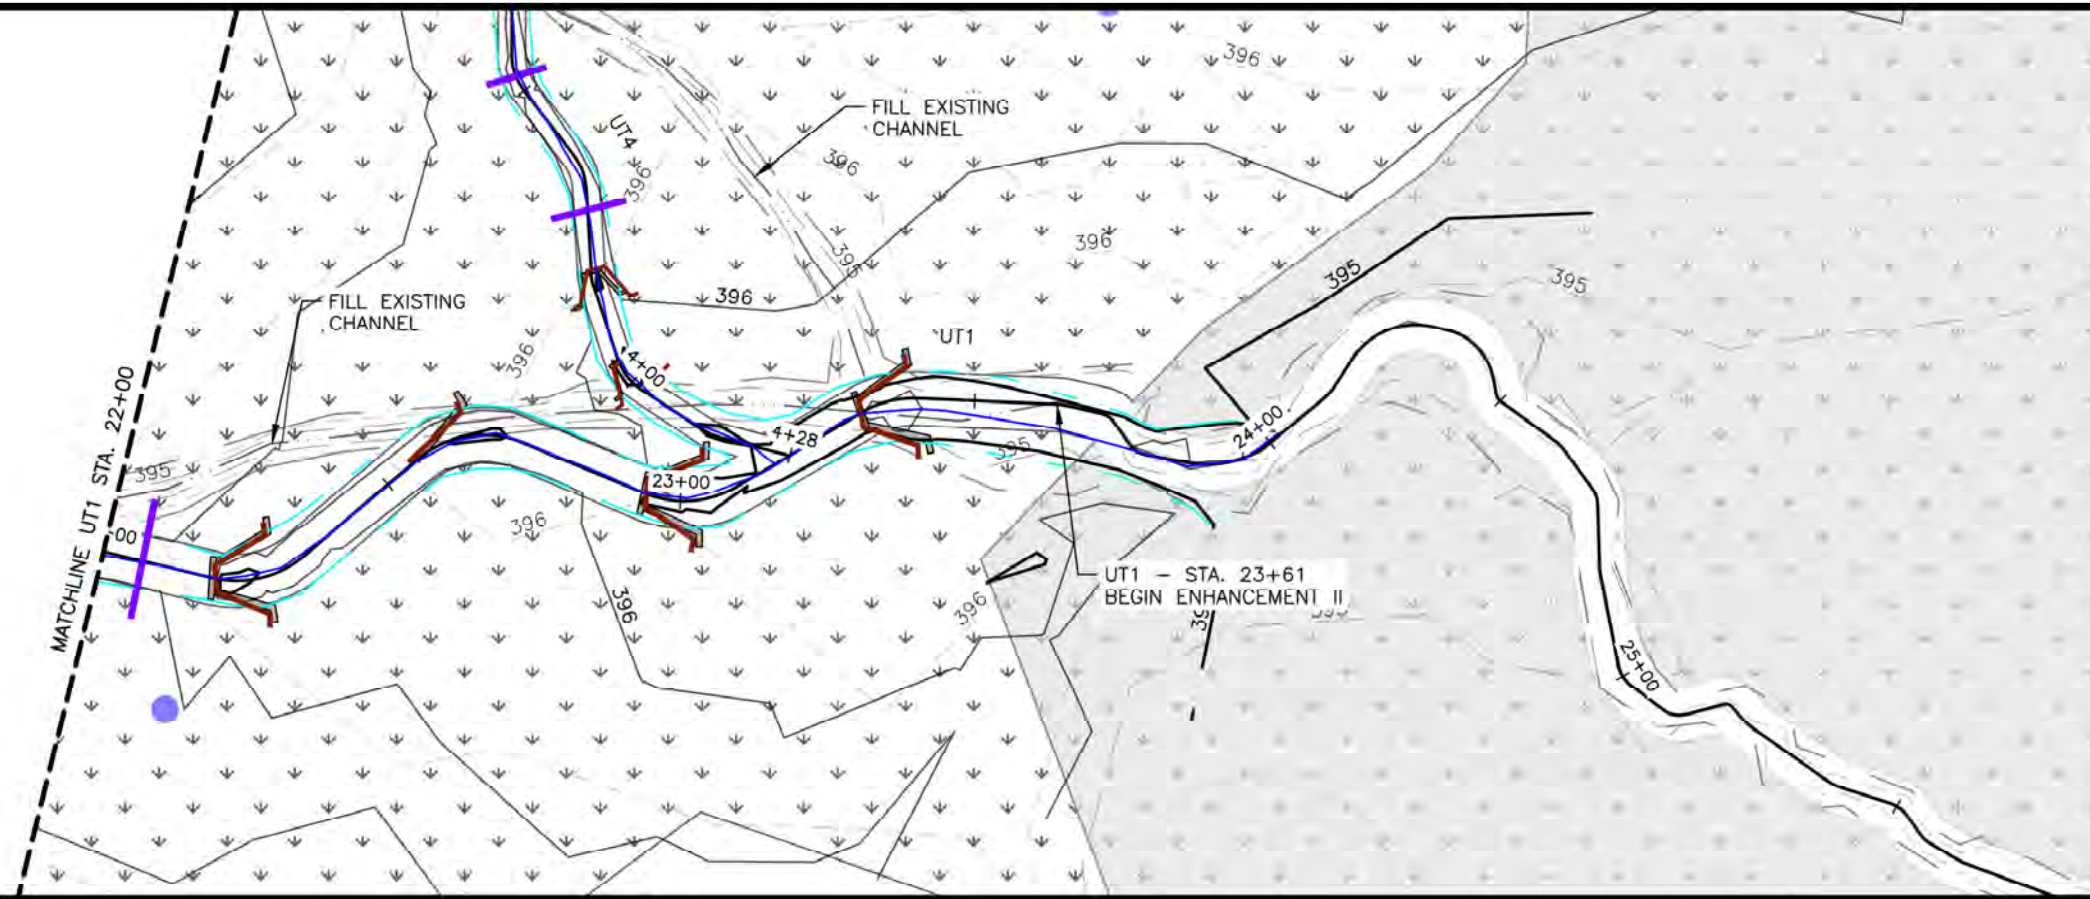

TOTAL DISTURBED AREA = 30.9 AC.

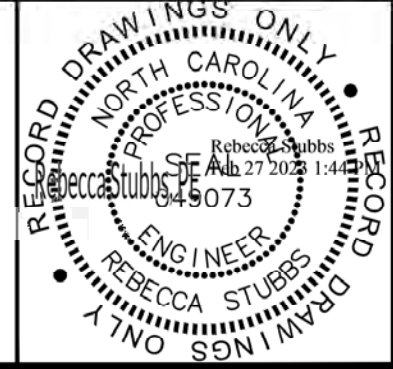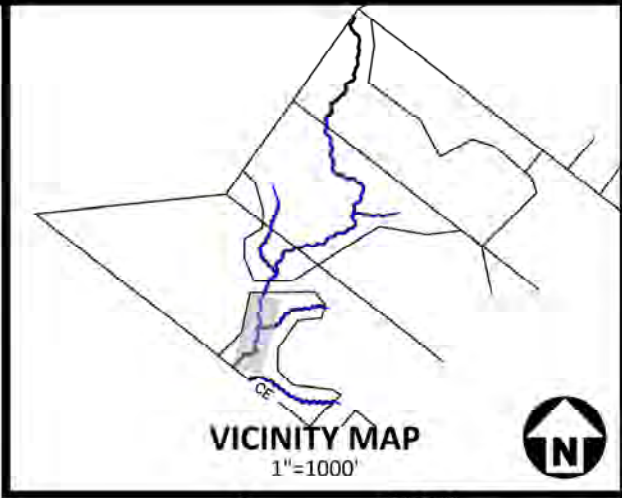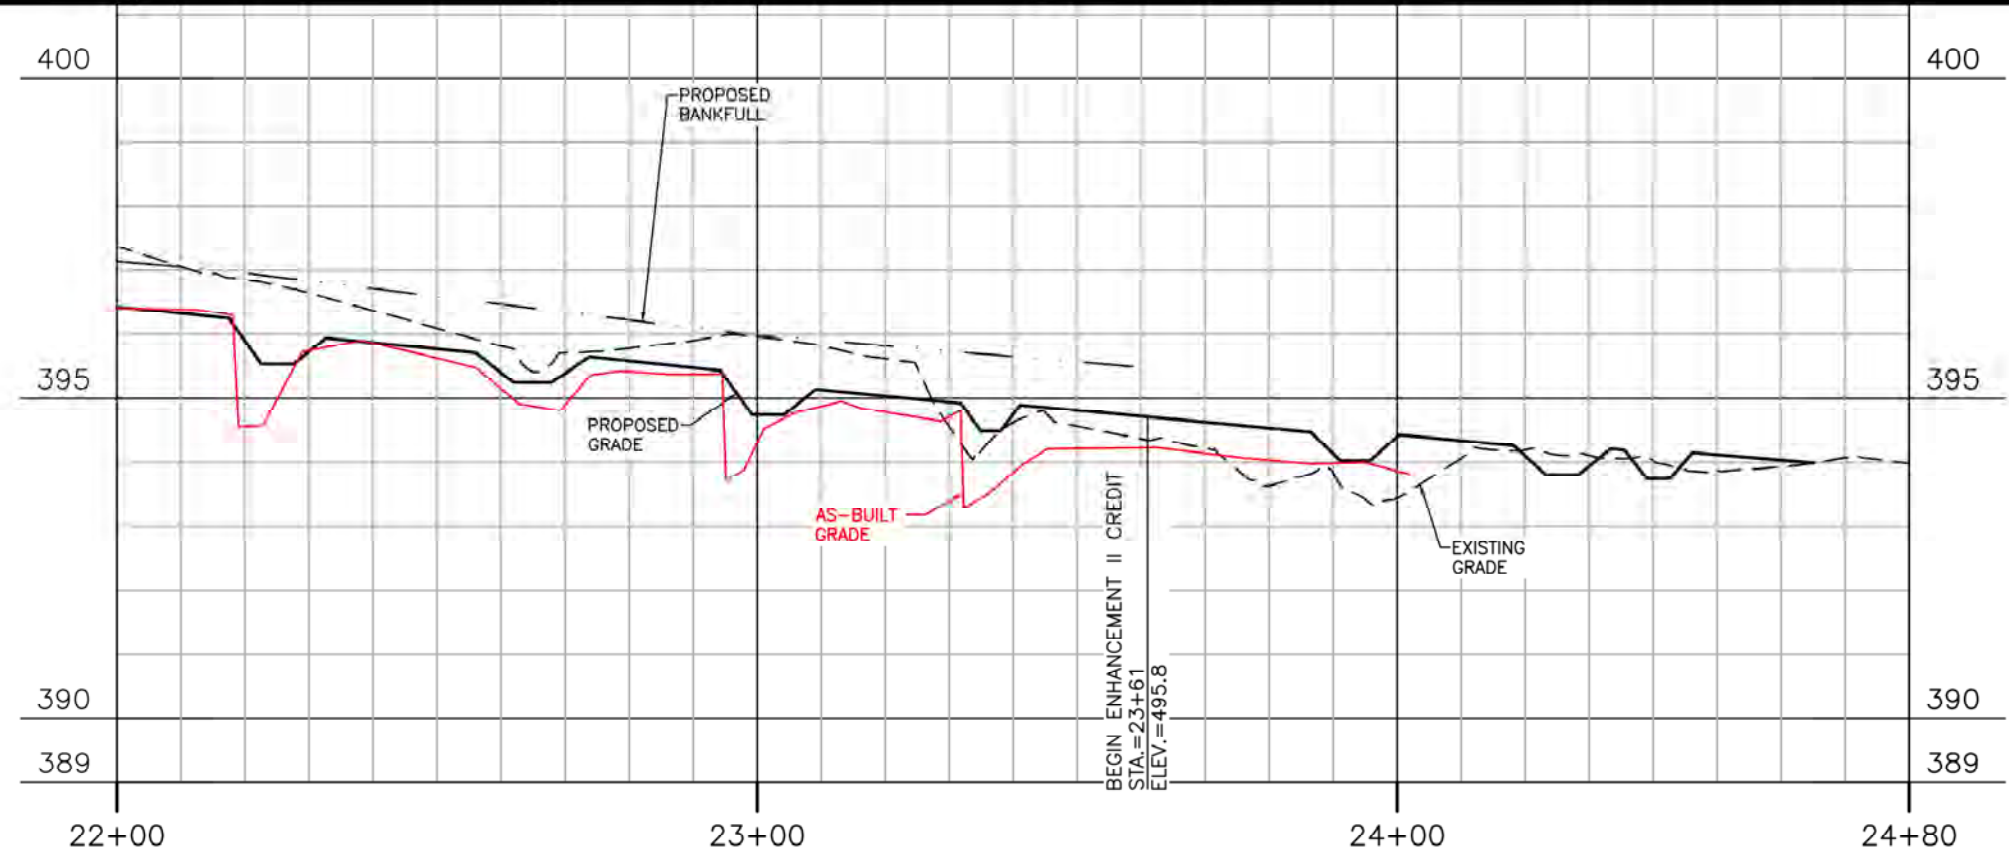


The John R. McAdams Company, Inc.  
2905 Meridian Parkway  
Durham, NC 27713

phone 919. 361. 5000  
fax 919. 361. 2269  
license number: C-0293, C-187  
www.mcadamsco.com

## CRANE MITIGATION SITE

AS-BUILT DRAWINGS  
LEE COUNTY, NORTH CAROLINA




**PLAN INFORMATION**


PROJECT NO. 2021110220  
FILENAME P1  
CHECKED BY RAS  
DRAWN BY RHW  
SCALE 1"=30'  
DATE 02.17.2023

**PLAN AND PROFILE**  
UT1 STA 22+00 - 24+80

# C5.05

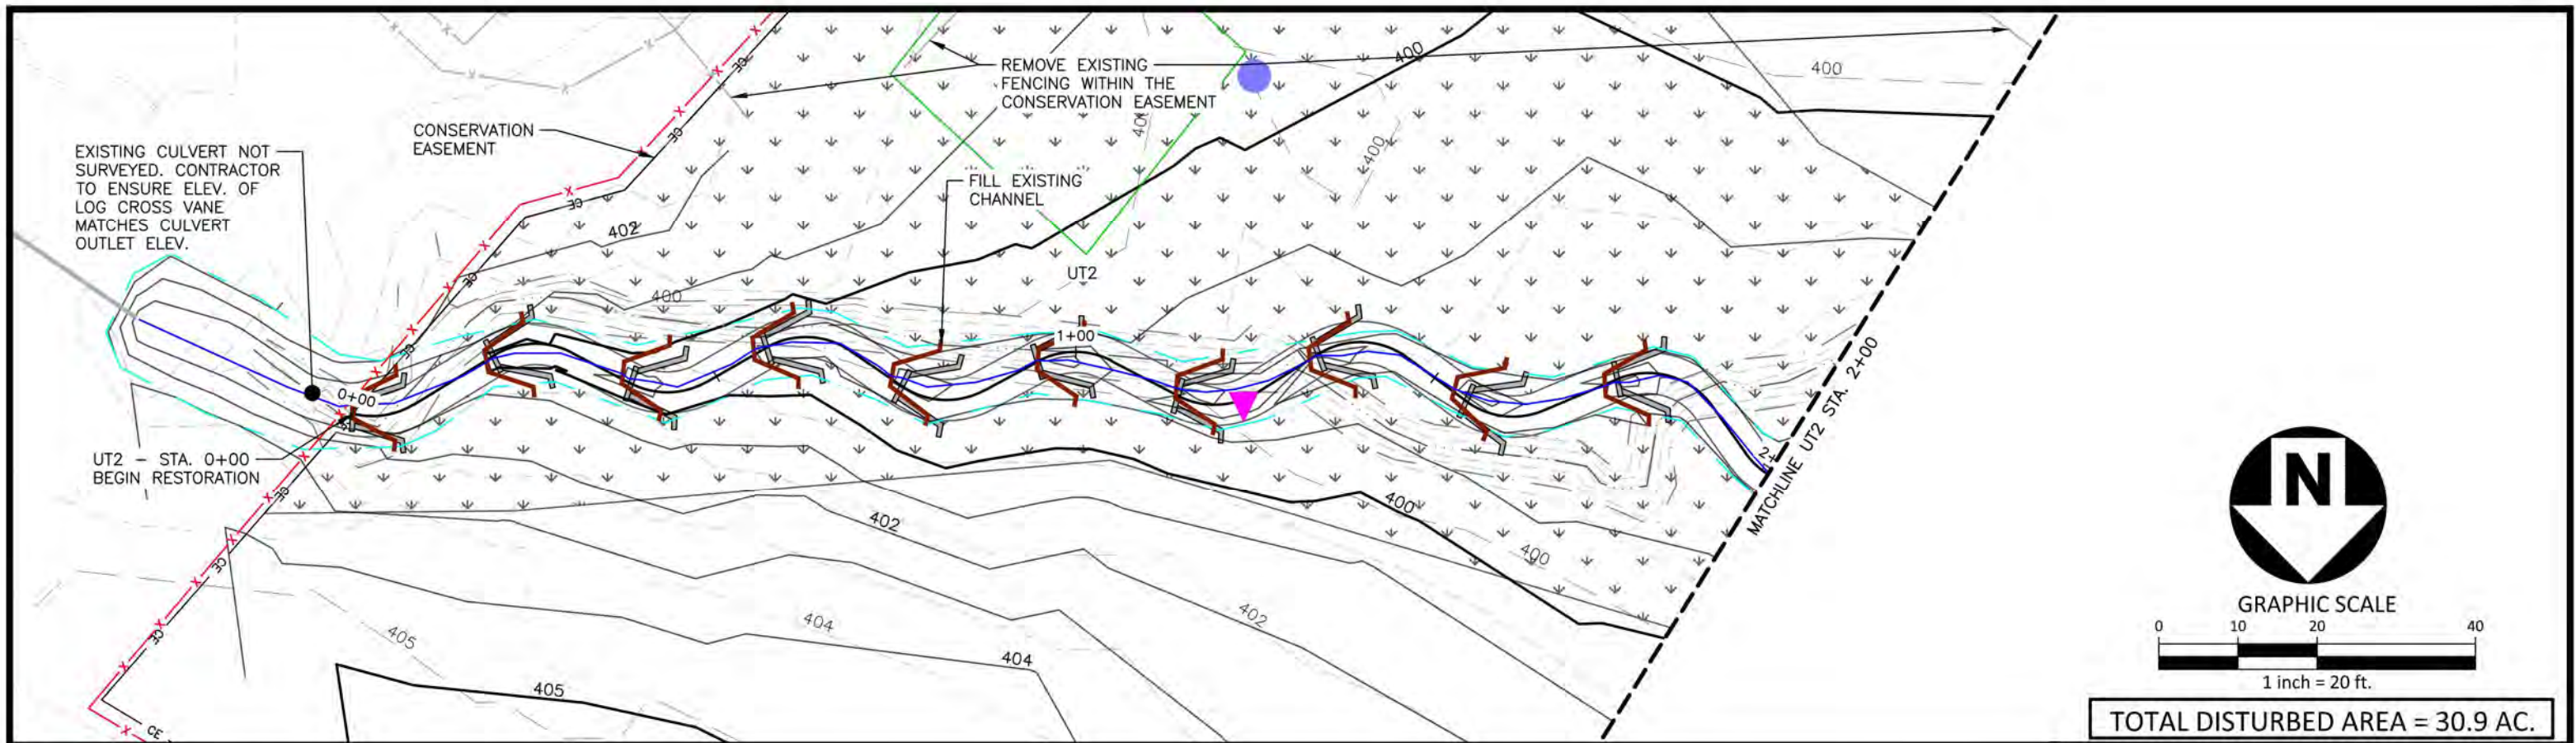

TOTAL DISTURBED AREA = 30.9 AC.

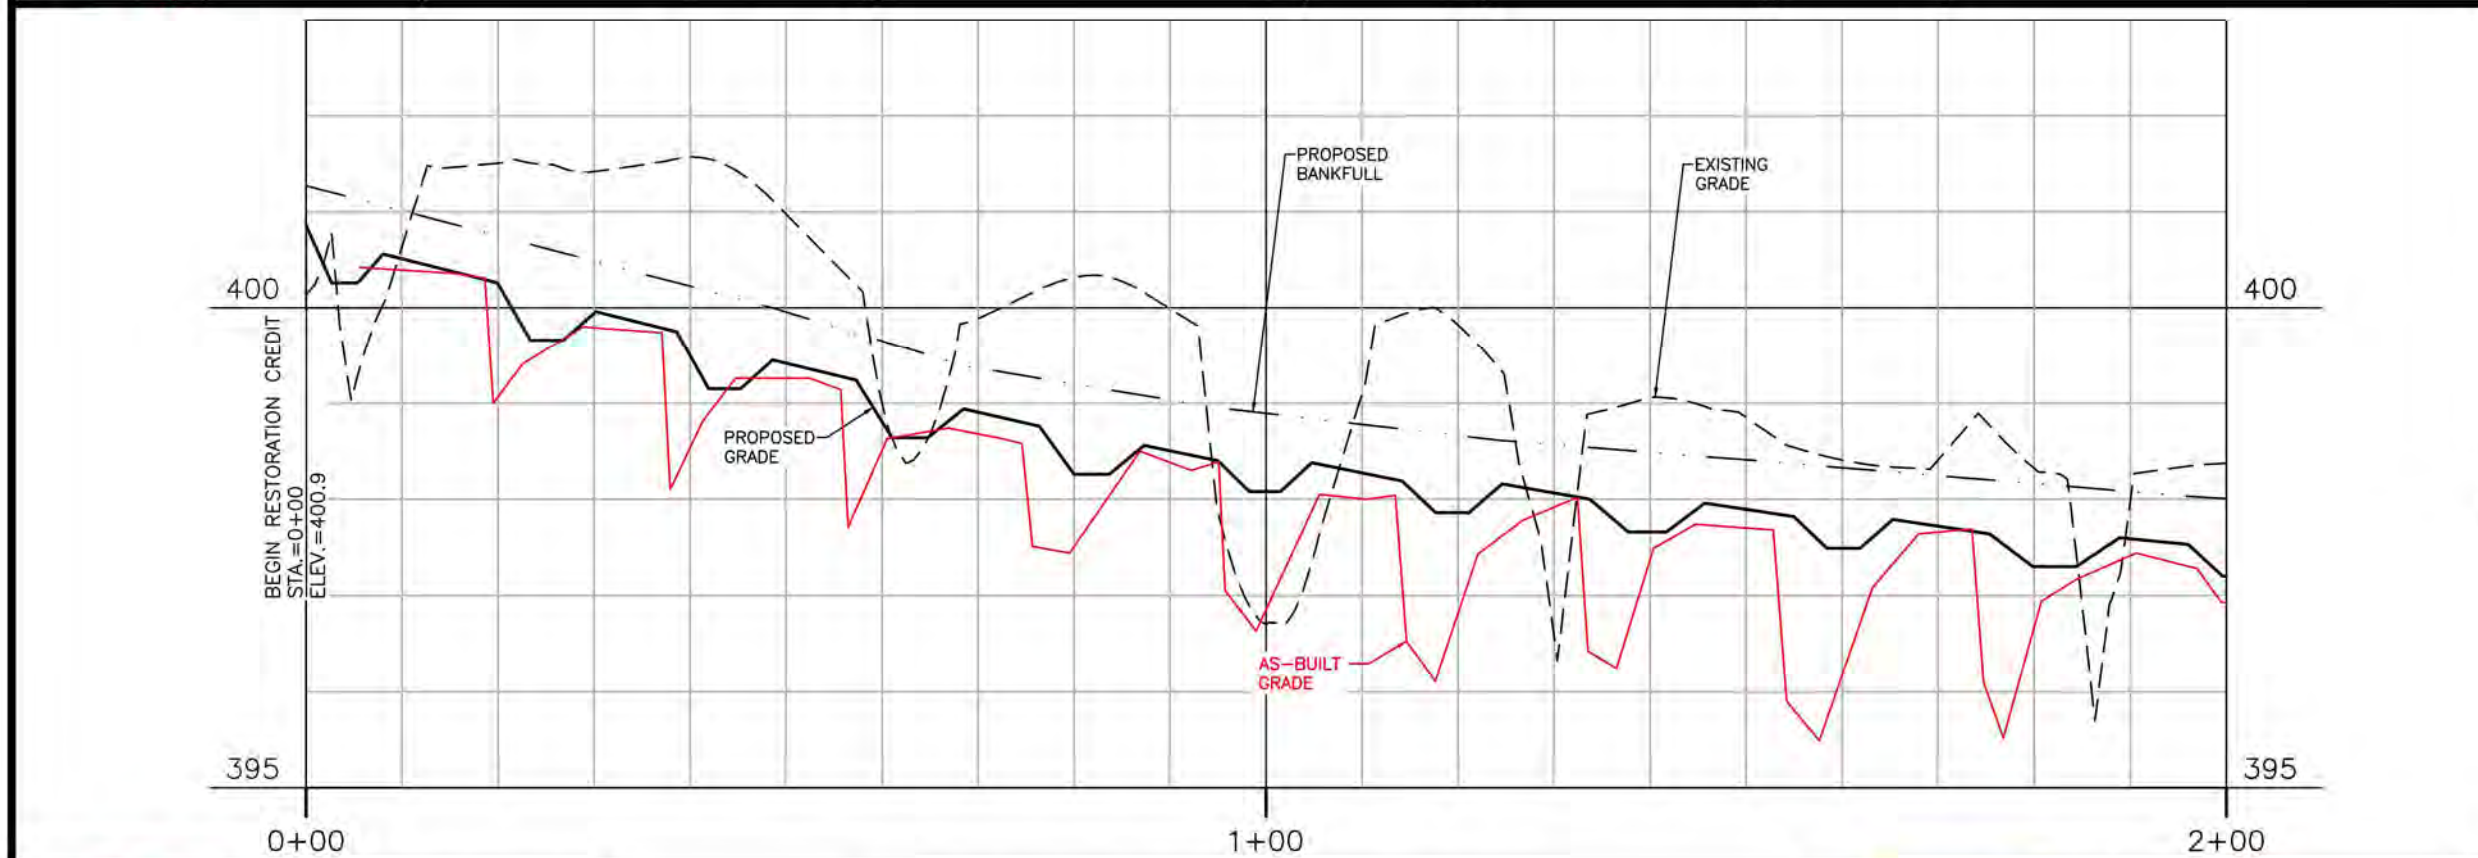


The John R. McAdams Company, Inc.  
2905 Meridian Parkway  
Durham, NC 27713

phone 919. 361. 5000  
fax 919. 361. 2269  
license number: C-0293, C-187

www.mcadamsco.com

## CRANE MITIGATION SITE

AS-BUILT DRAWINGS  
LEE COUNTY, NORTH CAROLINA





**PLAN INFORMATION**



PROJECT NO.	2021110220
FILENAME	P1
CHECKED BY	RAS
DRAWN BY	RHW
SCALE	1"=20'
DATE	05.02.2023

**PLAN AND PROFILE**  
UT2 STA 0+00 - 2+00

# C5.06

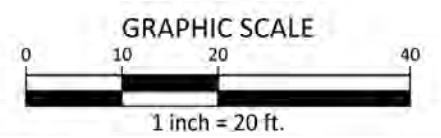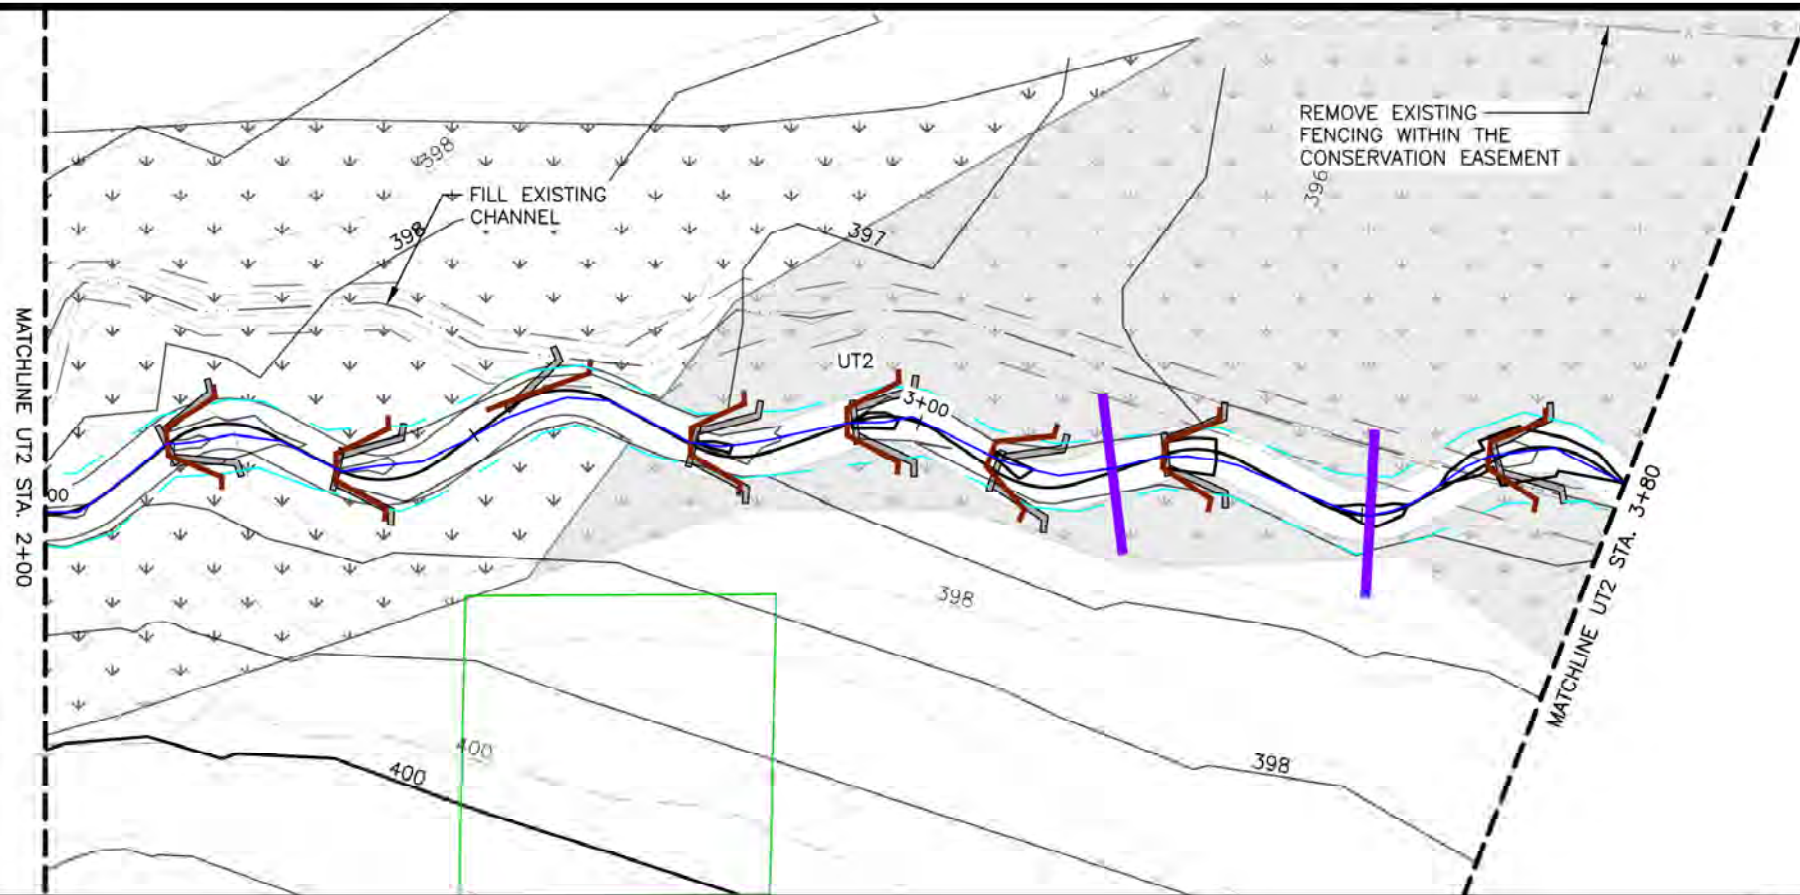

TOTAL DISTURBED AREA = 30.9 AC.

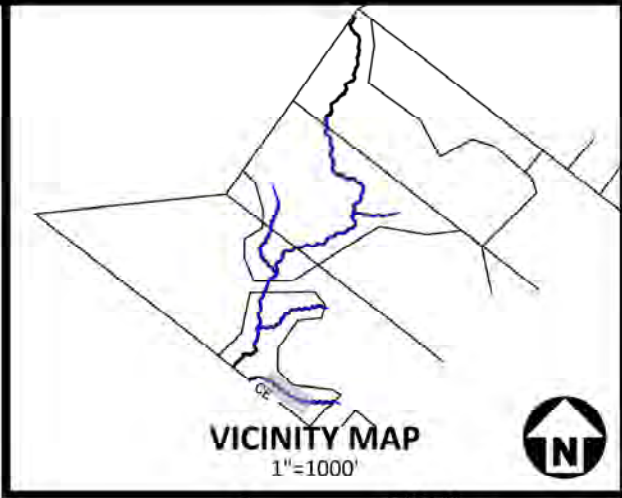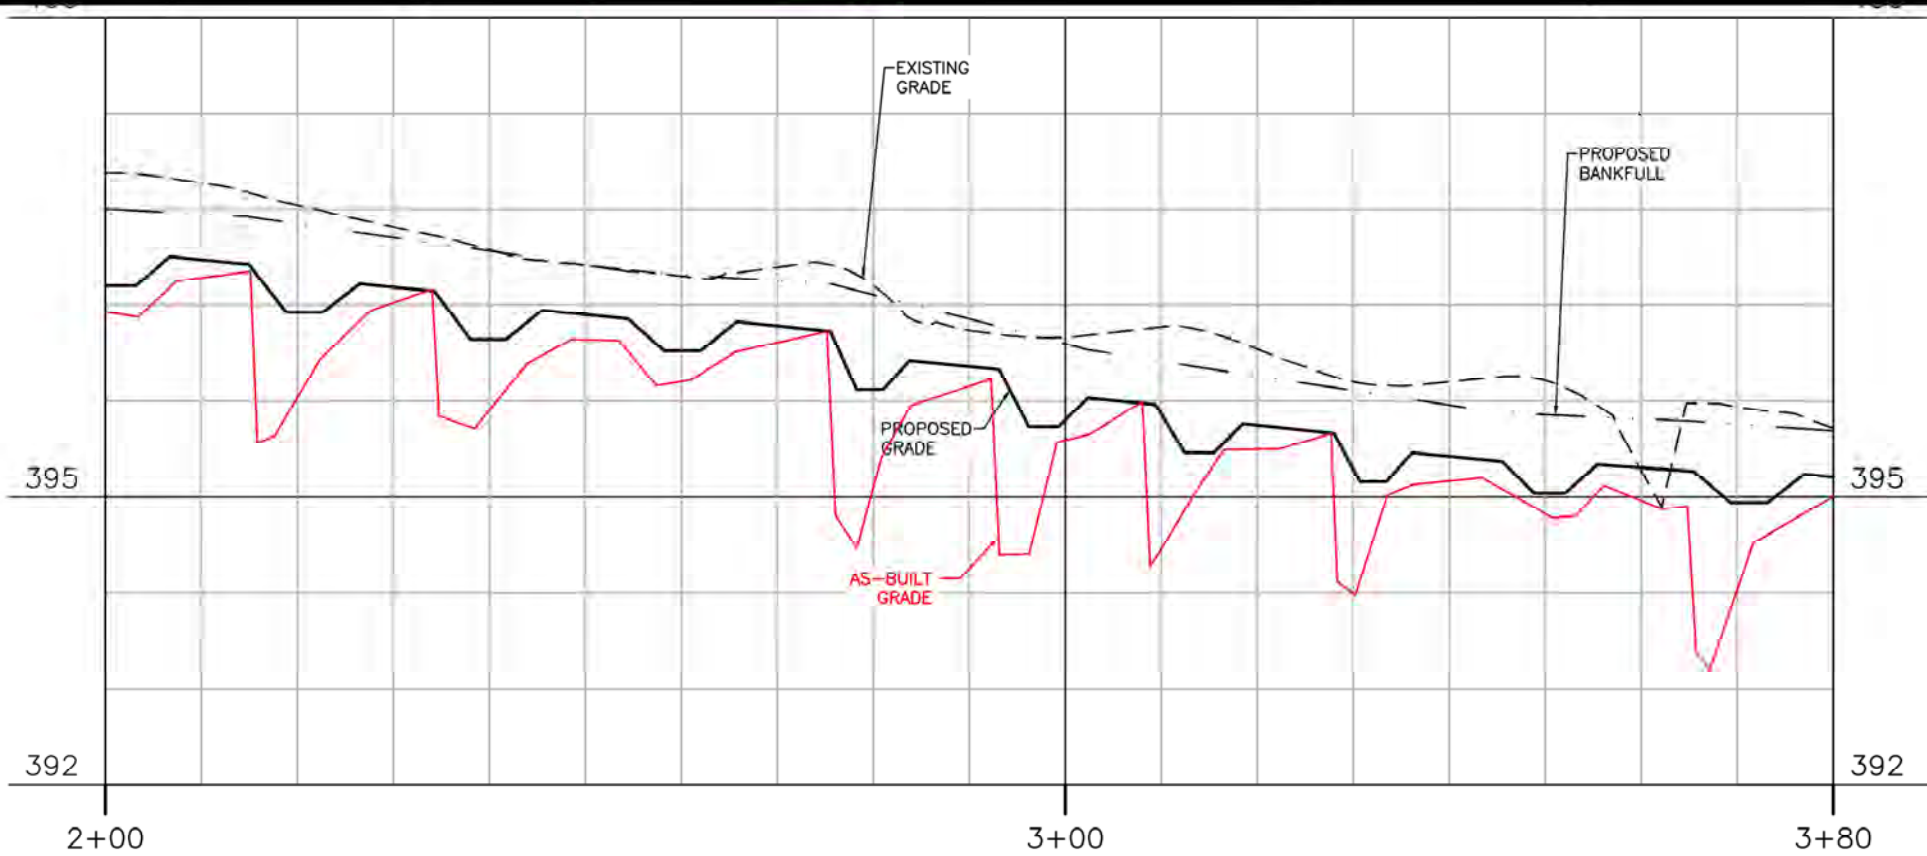


The John R. McAdams Company, Inc.  
2905 Meridian Parkway  
Durham, NC 27713

phone 919. 361. 5000  
fax 919. 361. 2269  
license number: C-0293, C-187

www.mcadamsco.com

## CRANE MITIGATION SITE

AS-BUILT DRAWINGS  
LEE COUNTY, NORTH CAROLINA







**PLAN INFORMATION**

PROJECT NO. 2021110220  
FILENAME P1  
CHECKED BY RAS  
DRAWN BY RHW  
SCALE 1"=20'  
DATE 02.17.2023




**PLAN AND PROFILE**  
UT2 STA 2+00 - 3+80

# C5.07

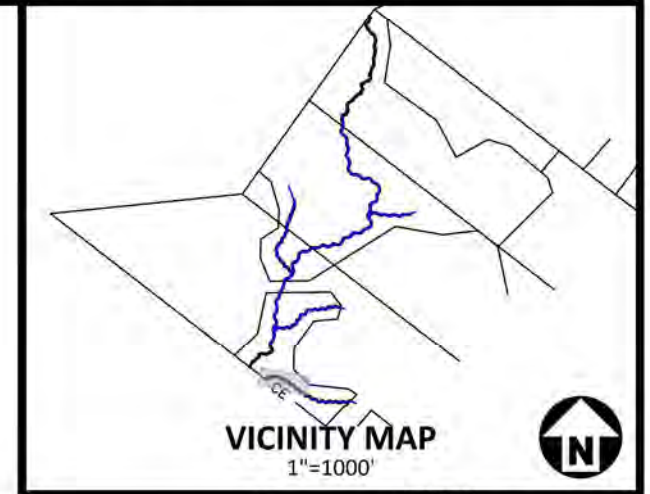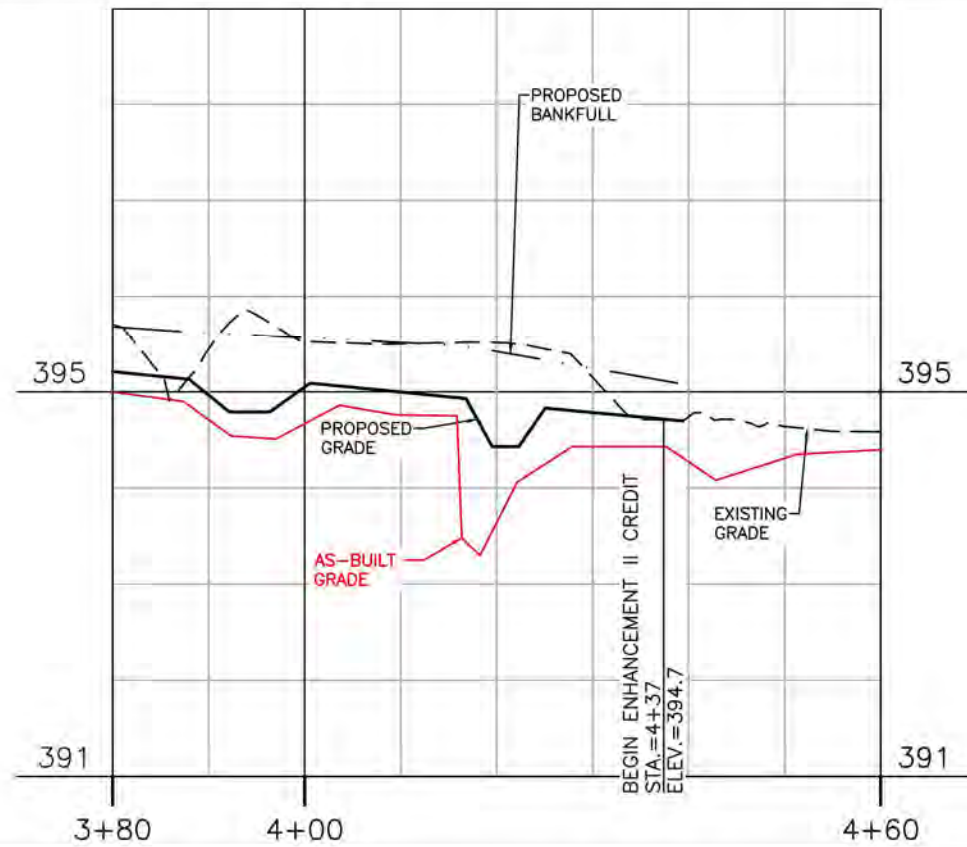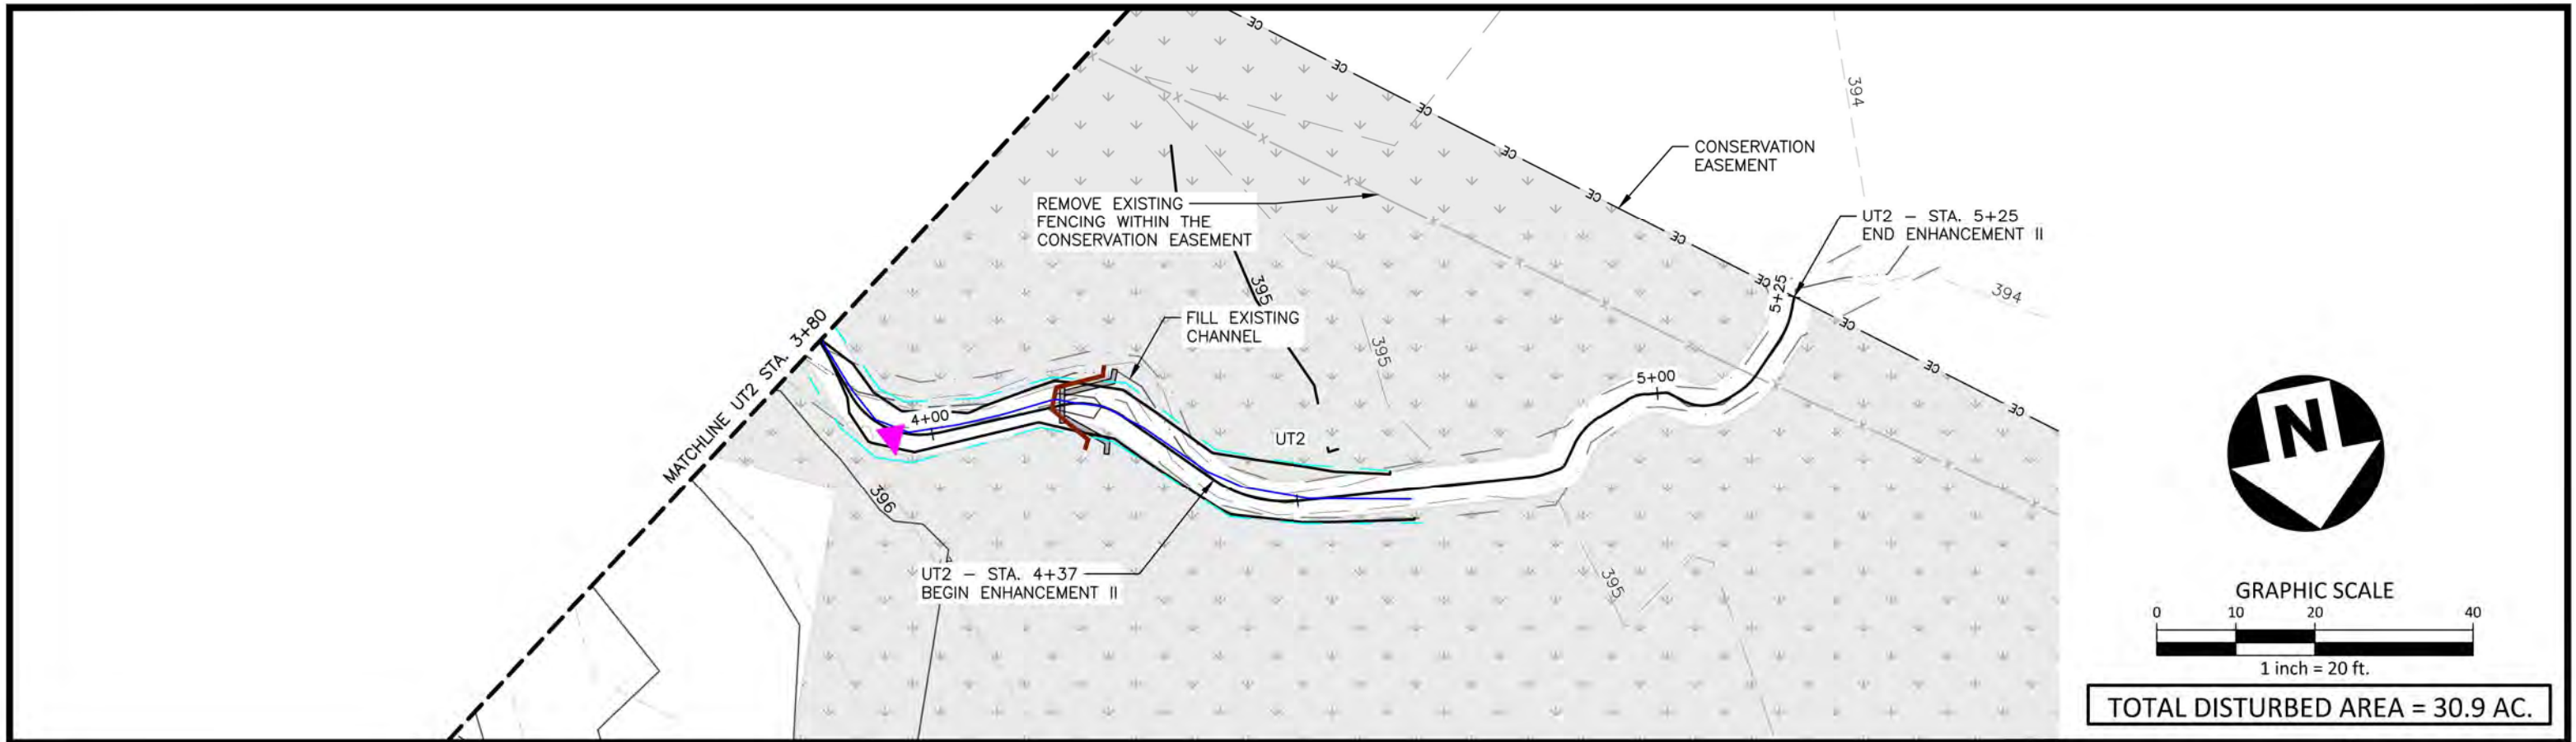

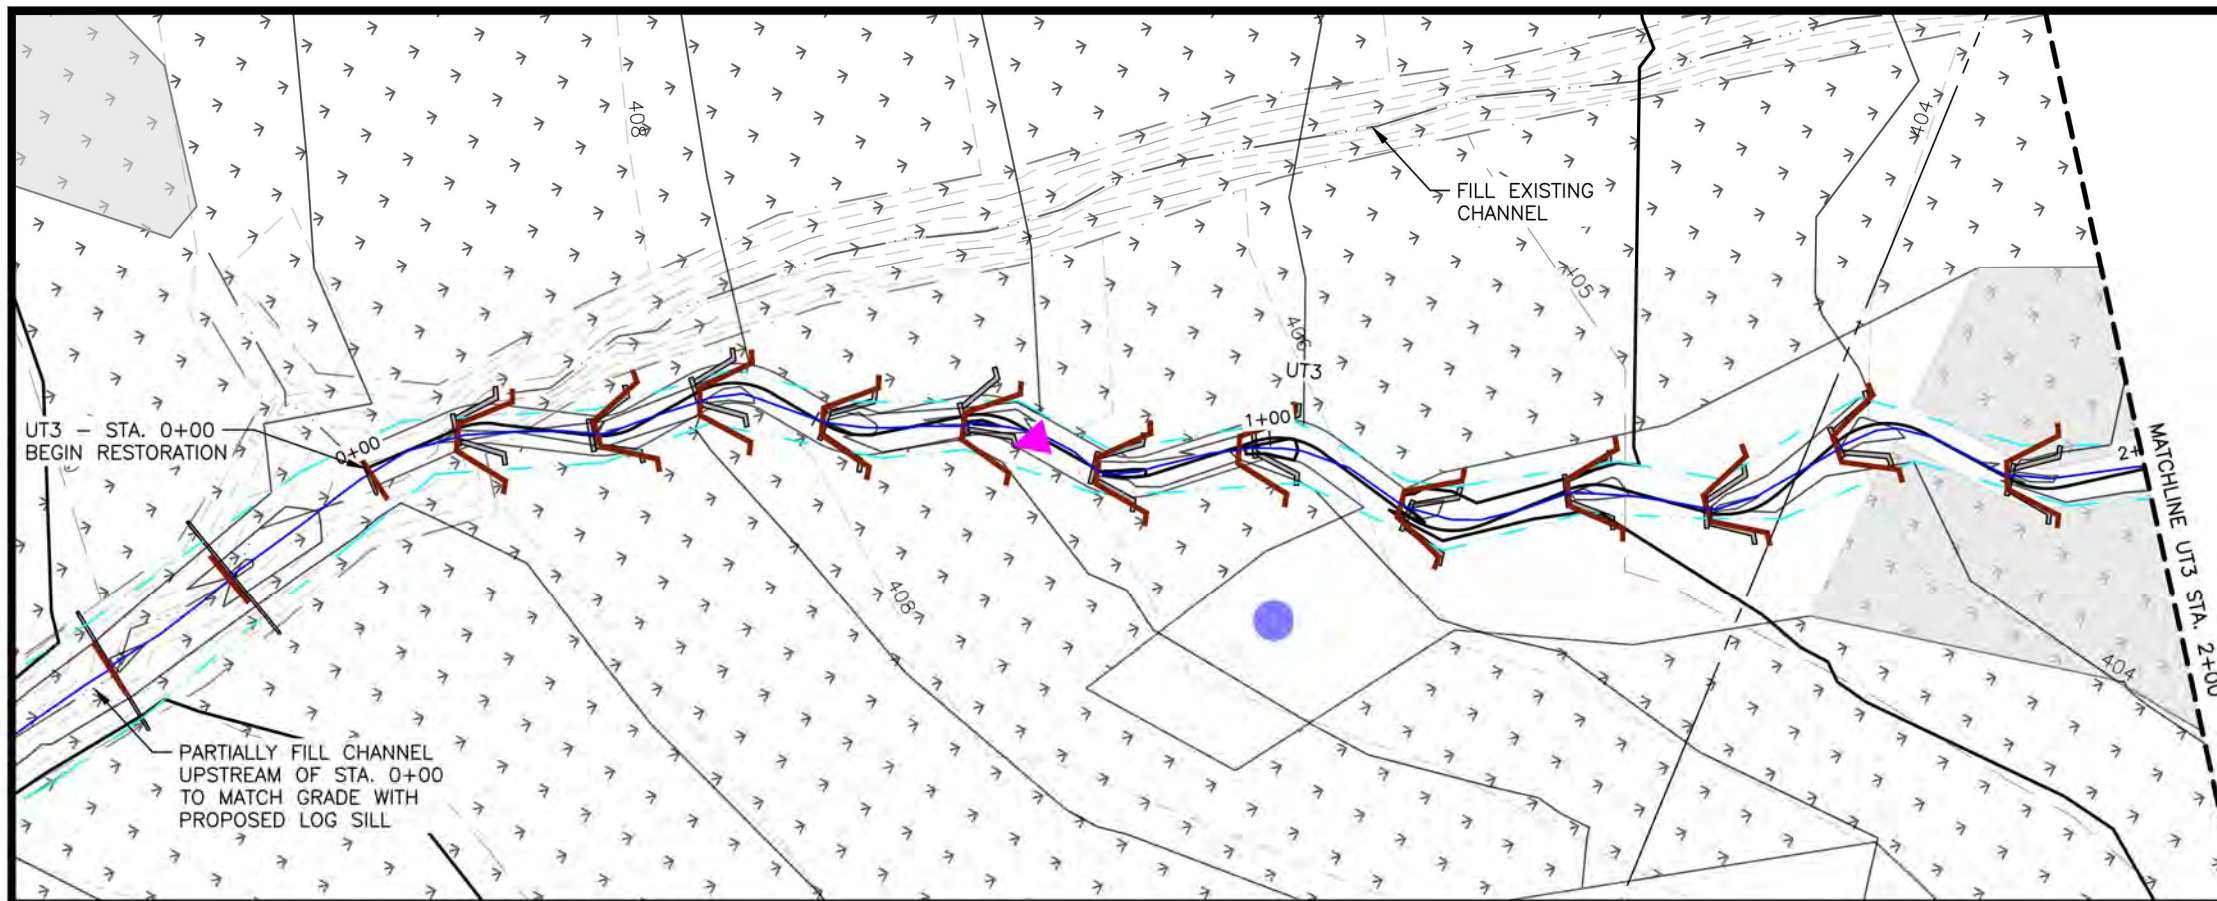

TOTAL DISTURBED AREA = 30.9 AC.

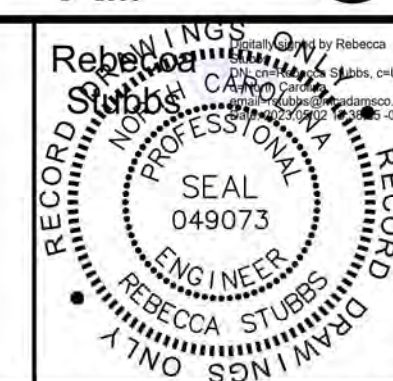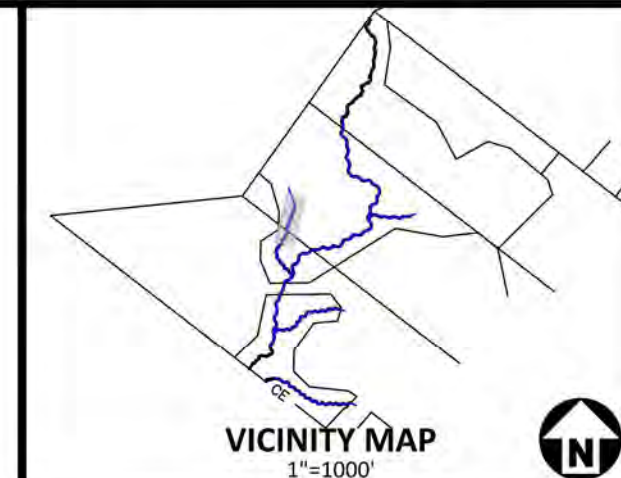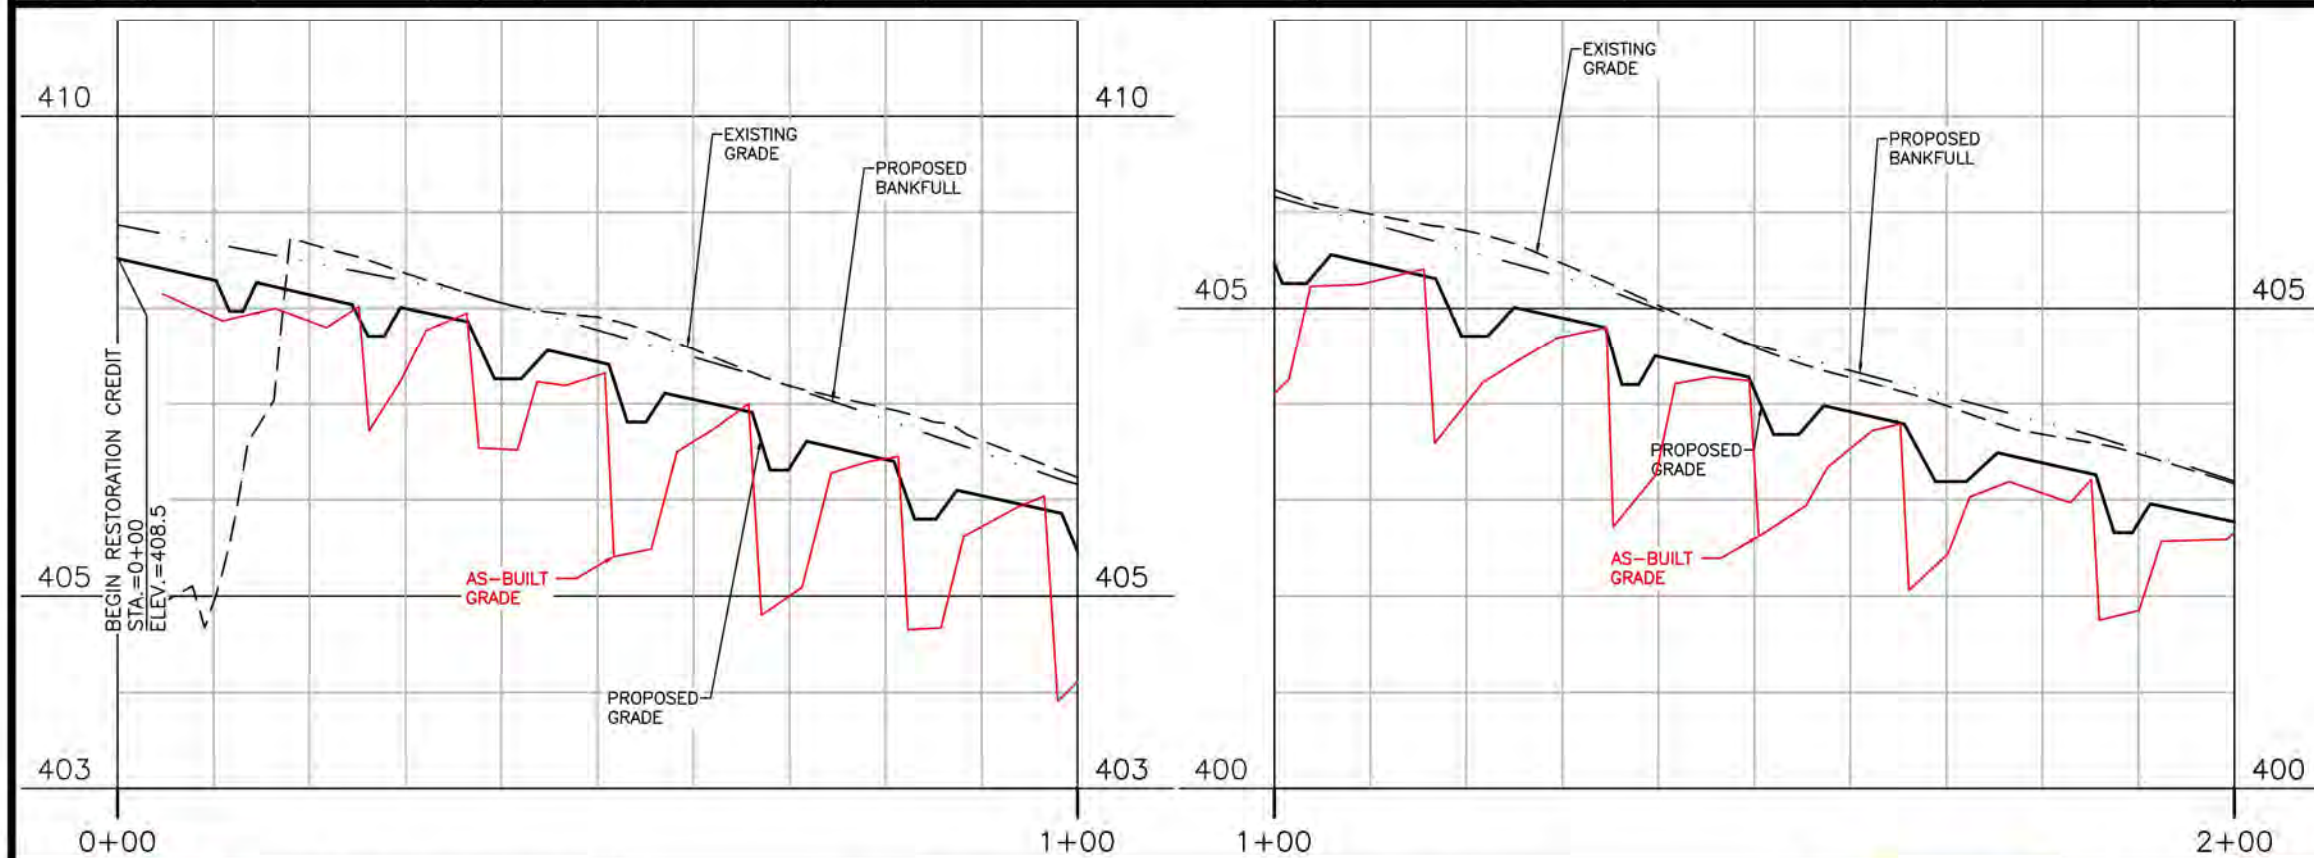



The John R. McAdams Company, Inc.  
2905 Meridian Parkway  
Durham, NC 27713

phone 919. 361. 5000  
fax 919. 361. 2269  
license number: C-0293, C-187

www.mcadamsco.com

## CRANE MITIGATION SITE

AS-BUILT DRAWINGS  
LEE COUNTY, NORTH CAROLINA

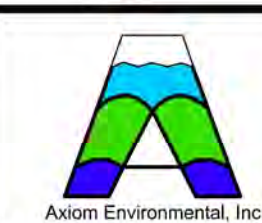



PLAN INFORMATION	
PROJECT NO.	2021110220
FILENAME	P1
CHECKED BY	RAS
DRAWN BY	RHW
SCALE	1"=20'
DATE	05.02.2023

## PLAN AND PROFILE



UT3 STA 0+00 - 2+00

# C5.09




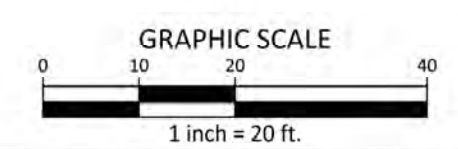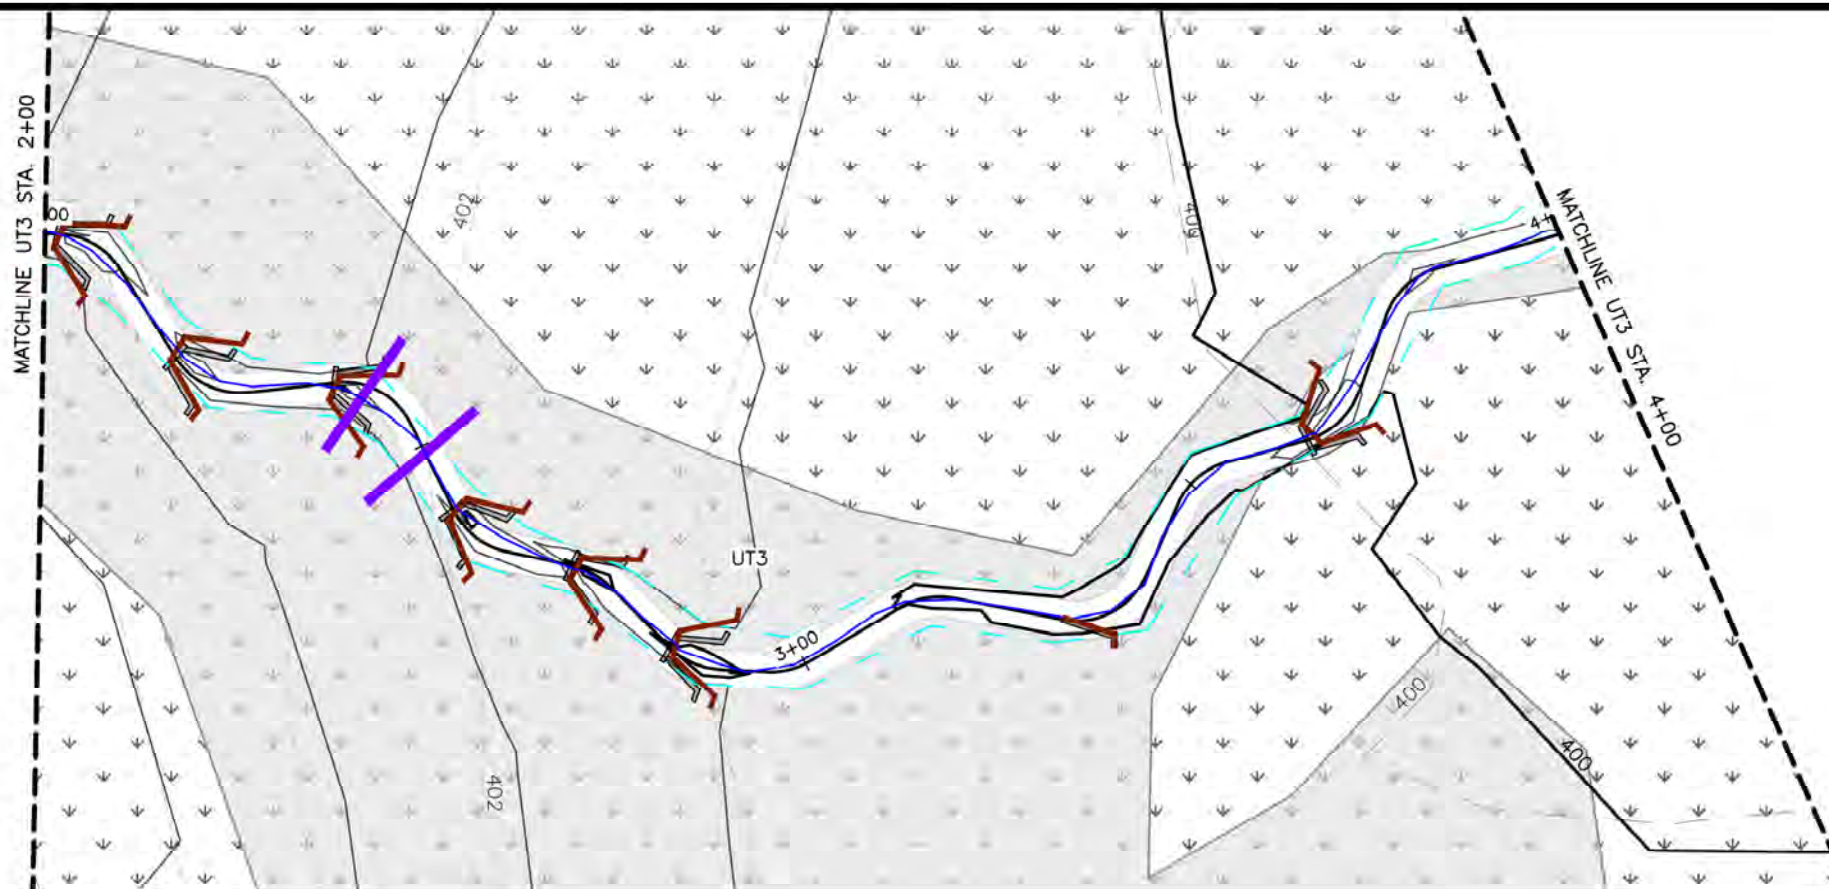

TOTAL DISTURBED AREA = 30.9 AC.

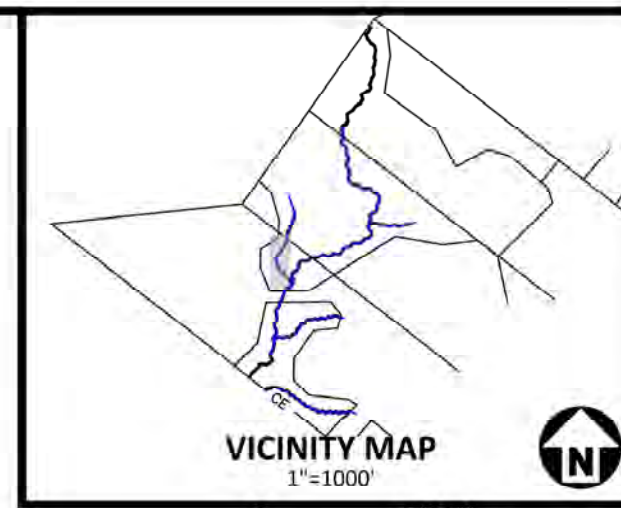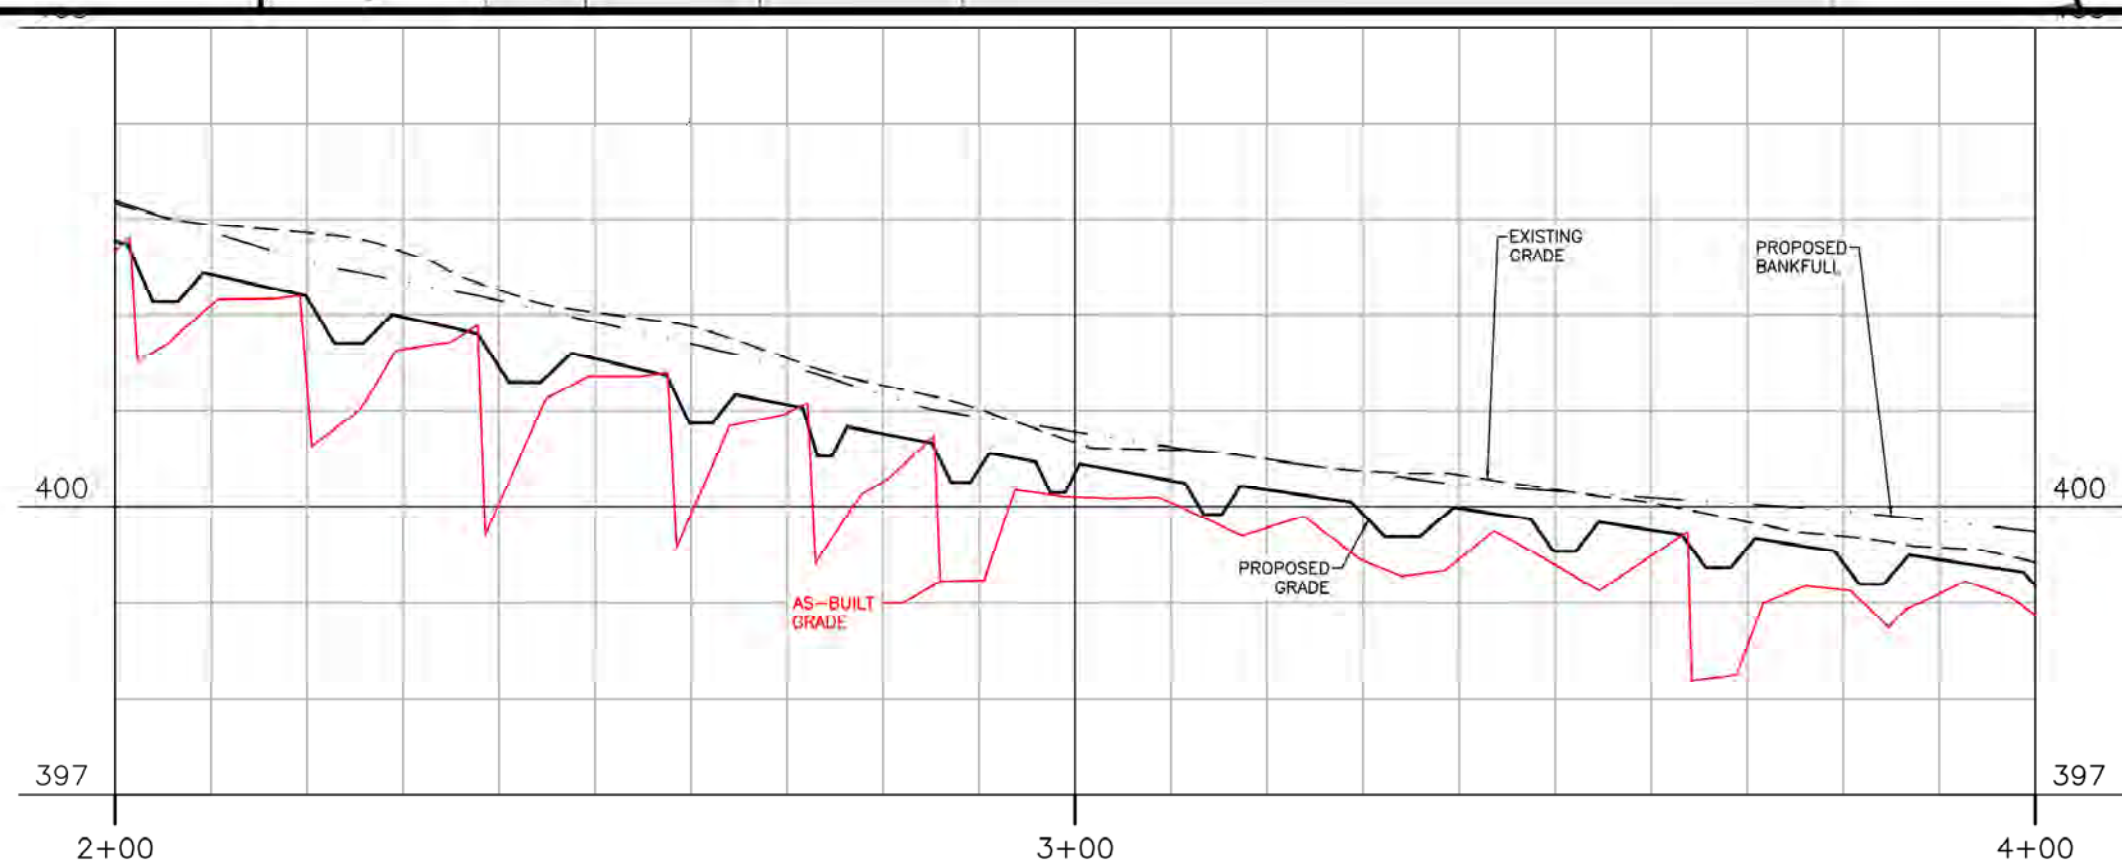

VICINITY MAP  
1"=1000'

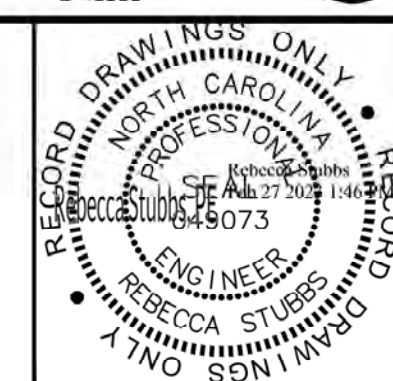


The John R. McAdams Company, Inc.  
2905 Meridian Parkway  
Durham, NC 27713

phone 919. 361. 5000  
fax 919. 361. 2269  
license number: C-0293, C-187  
www.mcadamsco.com

## CRANE MITIGATION SITE

AS-BUILT DRAWINGS  
LEE COUNTY, NORTH CAROLINA





**PLAN INFORMATION**




PROJECT NO.	2021110220
FILENAME	P1
CHECKED BY	RAS
DRAWN BY	RHW
SCALE	1"=20'
DATE	02.17.2023

**PLAN AND PROFILE**  
UT3 STA 2+00 - 4+00

# C5.10

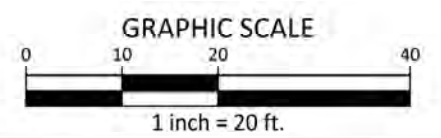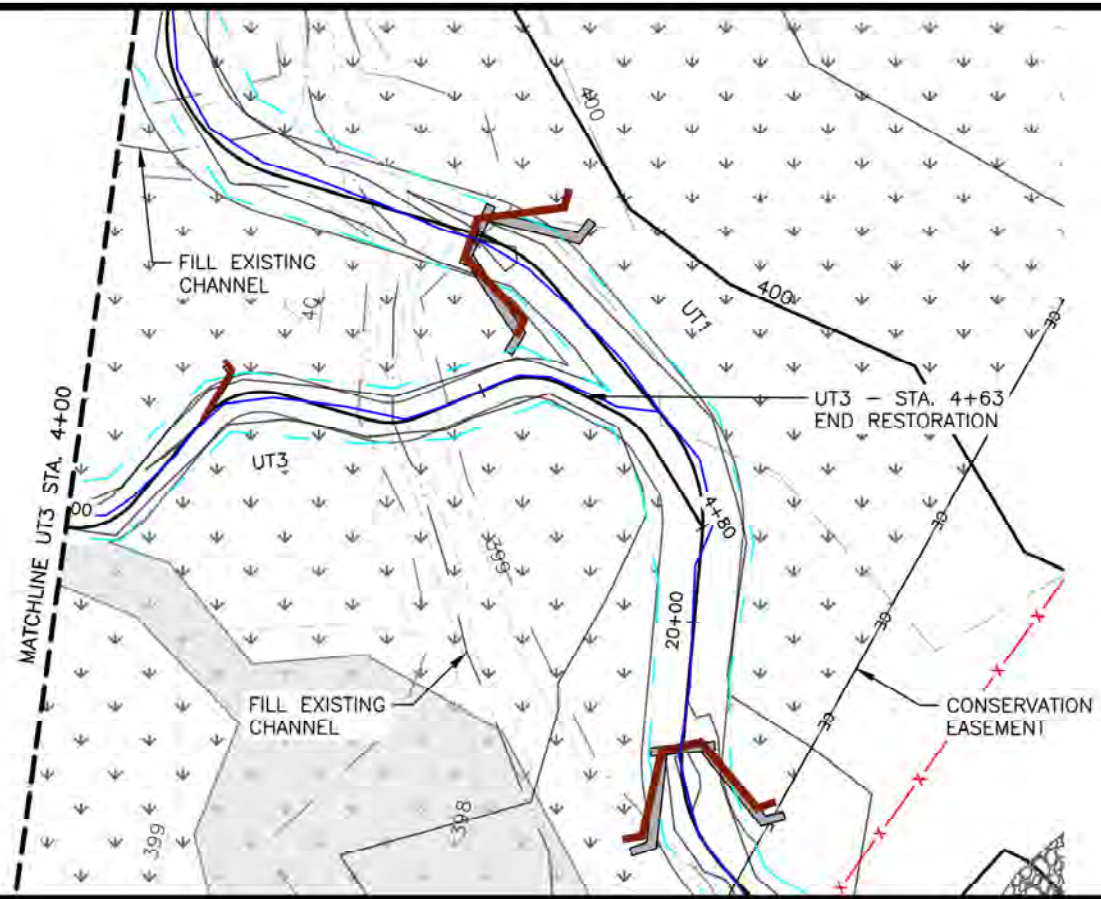

TOTAL DISTURBED AREA = 30.9 AC.

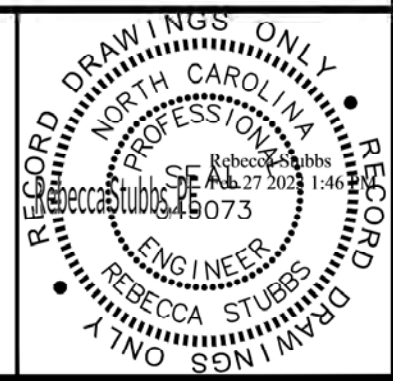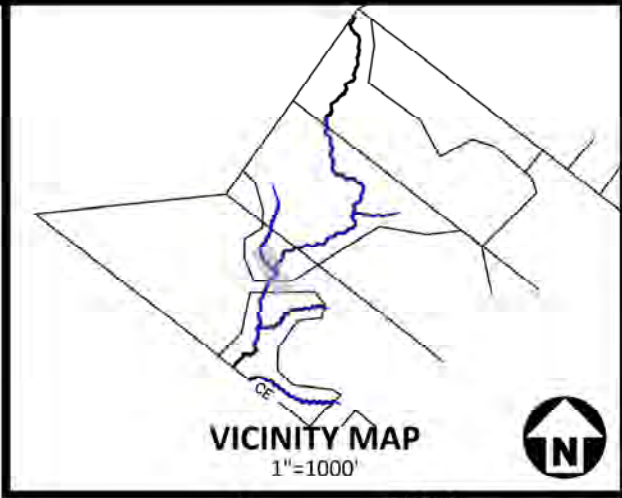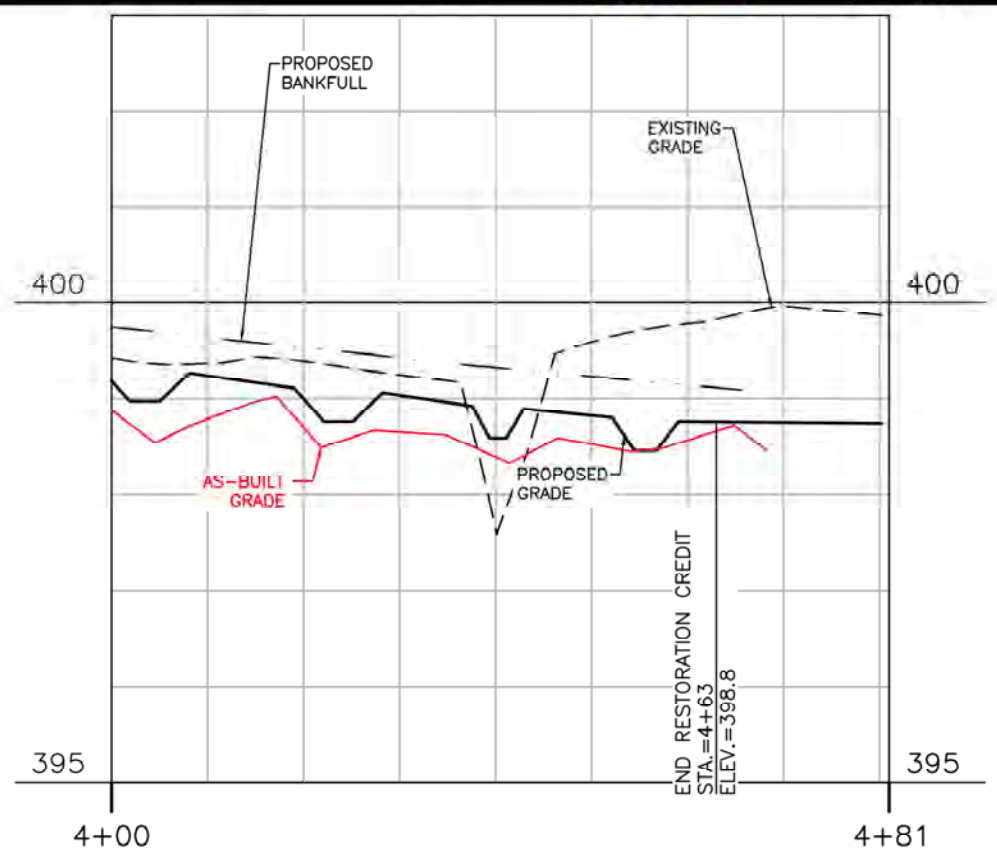


The John R. McAdams Company, Inc.  
2905 Meridian Parkway  
Durham, NC 27713

phone 919. 361. 5000  
fax 919. 361. 2269  
license number: C-0293, C-187

www.mcadamsco.com

**CRANE MITIGATION SITE**  
AS-BUILT DRAWINGS  
LEE COUNTY, NORTH CAROLINA




**PLAN INFORMATION**



PROJECT NO. 2021110220  
FILENAME P1  
CHECKED BY RAS  
DRAWN BY RHW  
SCALE 1"=20'  
DATE 02.17.2023

**PLAN AND PROFILE**  
UT3 STA 4+00 - 4+81

**C5.11**

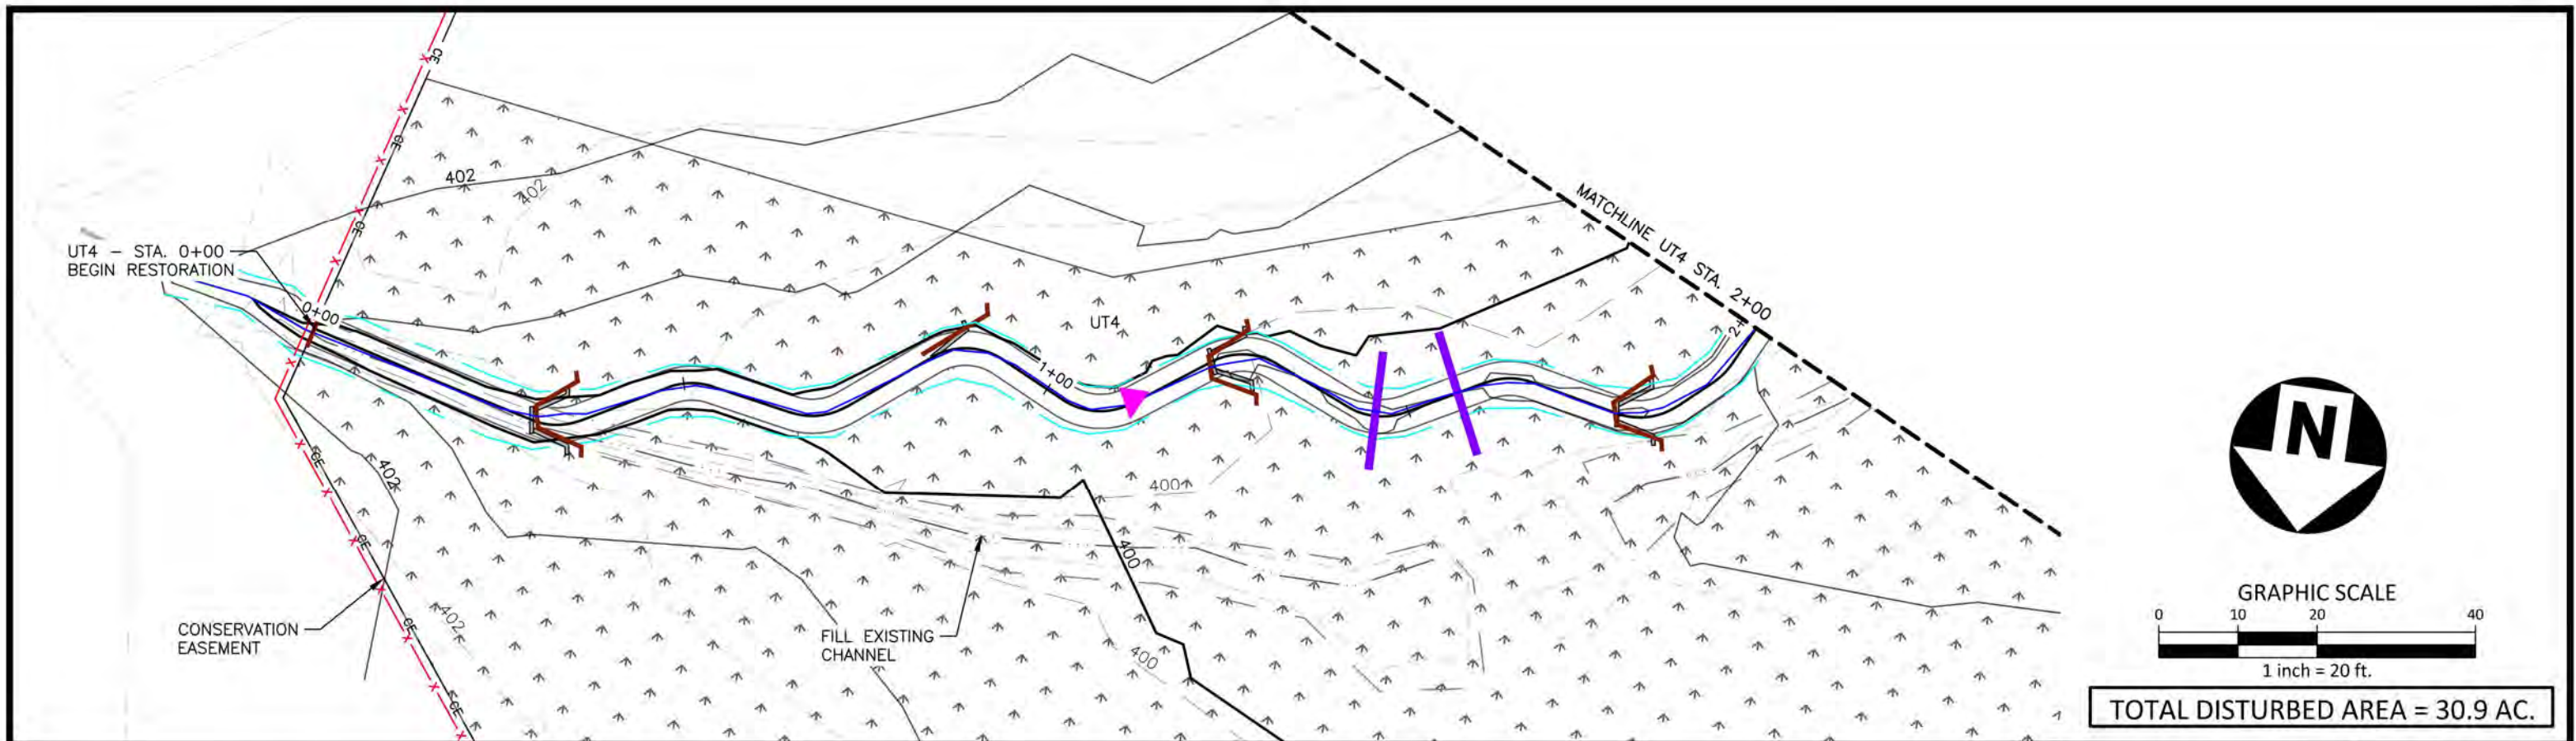

TOTAL DISTURBED AREA = 30.9 AC.

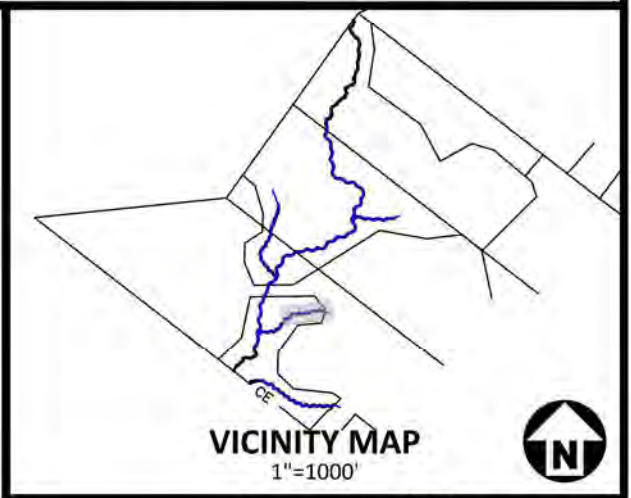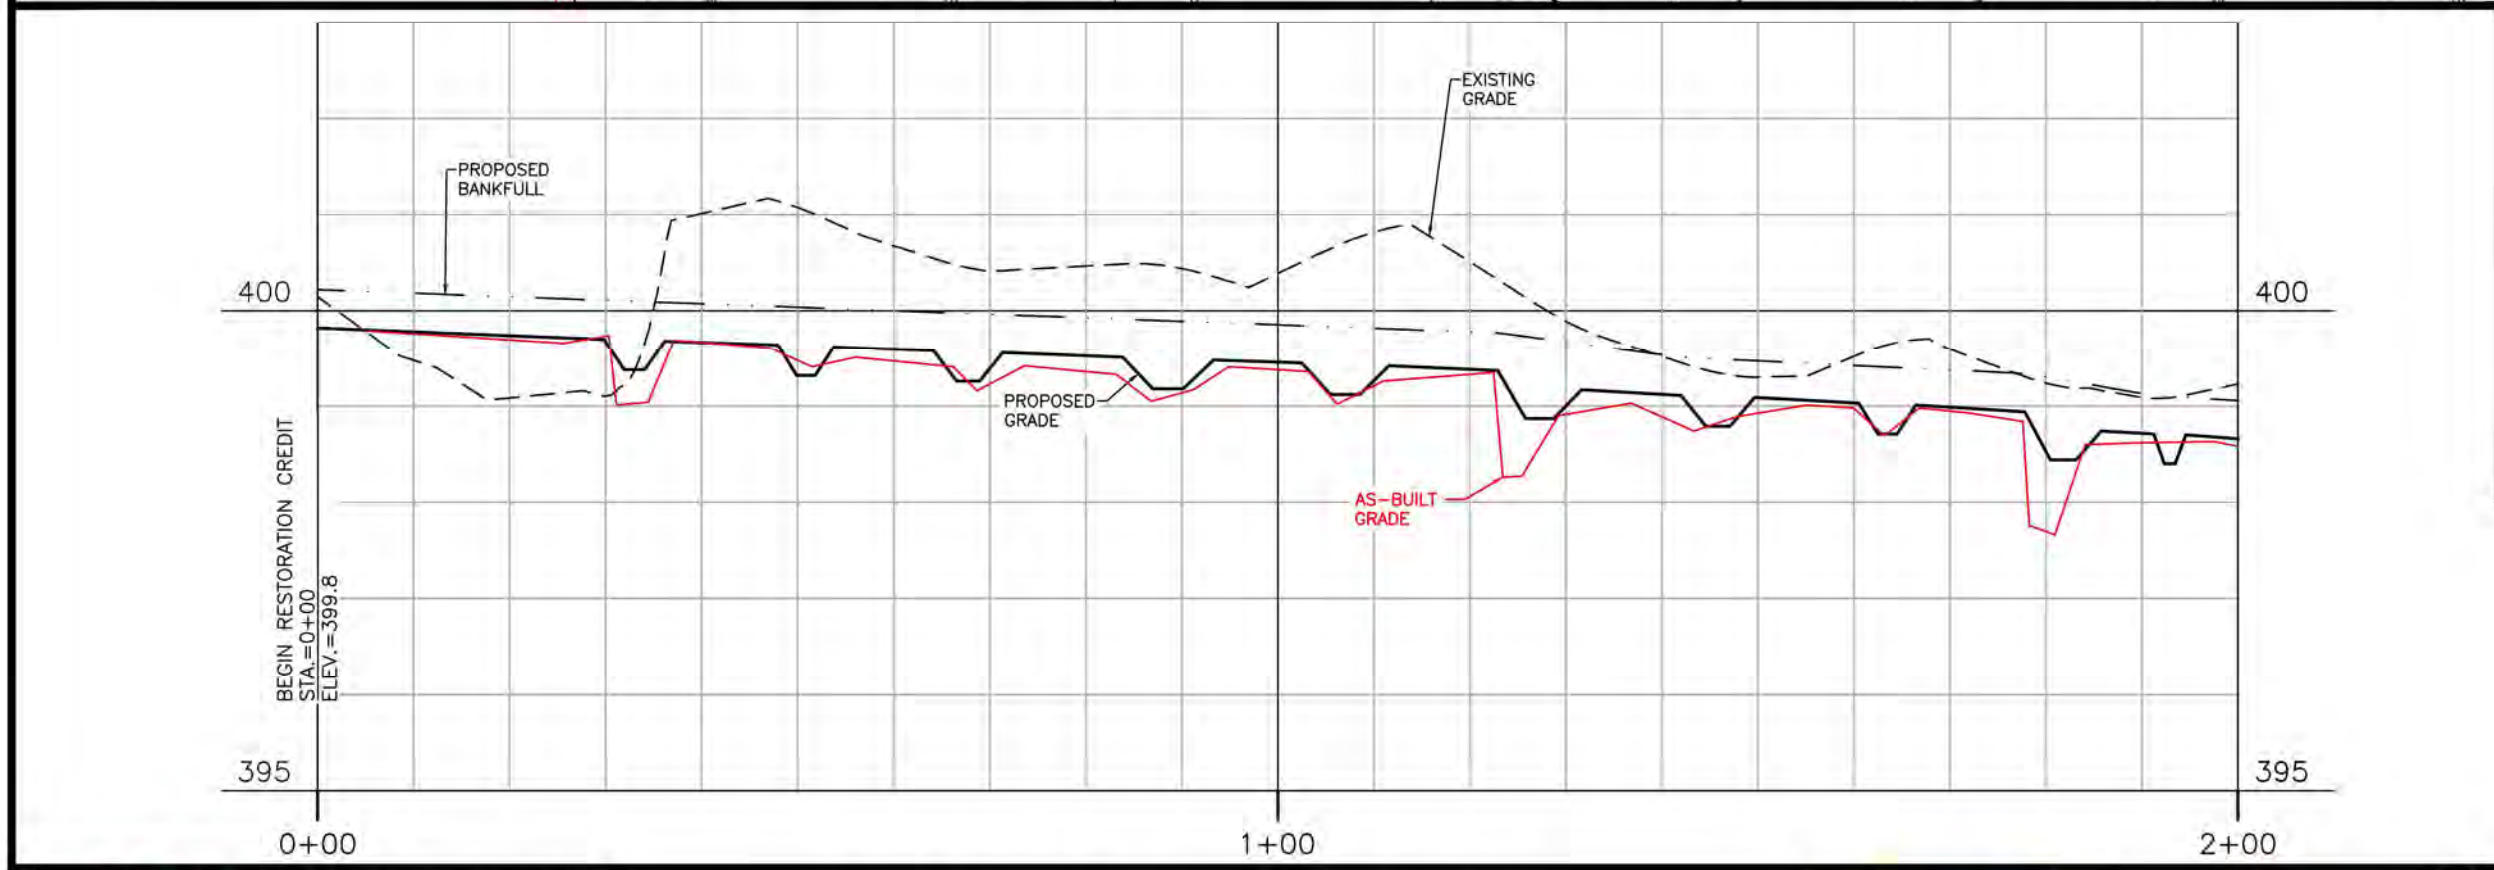

Rebecca Stubbs  
 PROFESSIONAL SEAL  
 049073  
 ENGINEER  
 REBECCA STUBBS  
 RECORD DRAWINGS ONLY





**McADAMS**  
 The John R. McAdams Company, Inc.  
 2905 Meridian Parkway  
 Durham, NC 27713  
 phone 919. 361. 5000  
 fax 919. 361. 2269  
 license number: C-0293, C-187  
 www.mcadamsco.com

**CRANE MITIGATION SITE**  
 AS-BUILT DRAWINGS  
 LEE COUNTY, NORTH CAROLINA



**PLAN INFORMATION**  
 PROJECT NO. 2021110220  
 FILENAME P1  
 CHECKED BY RAS  
 DRAWN BY RHW  
 SCALE 1"=20'  
 DATE 05.02.2023

**PLAN AND PROFILE**  
 UT4 STA 0+00 - 2+00  
**C5.12**

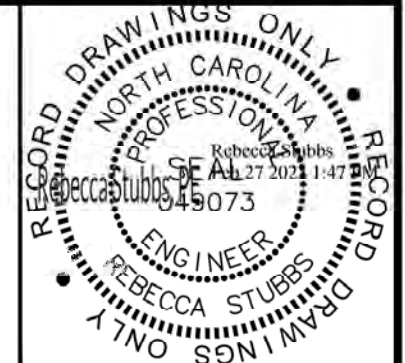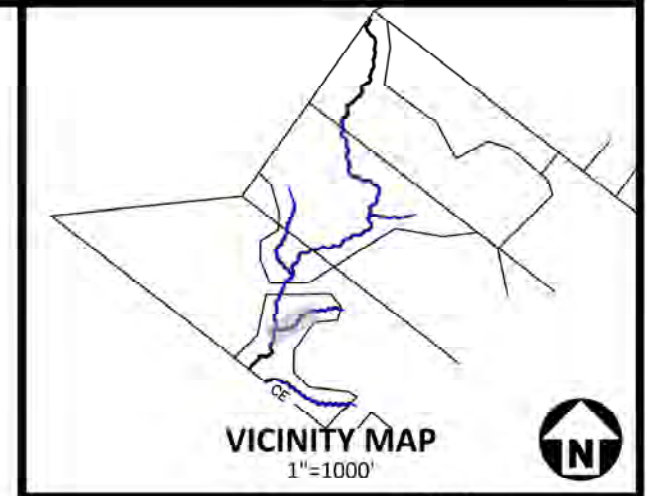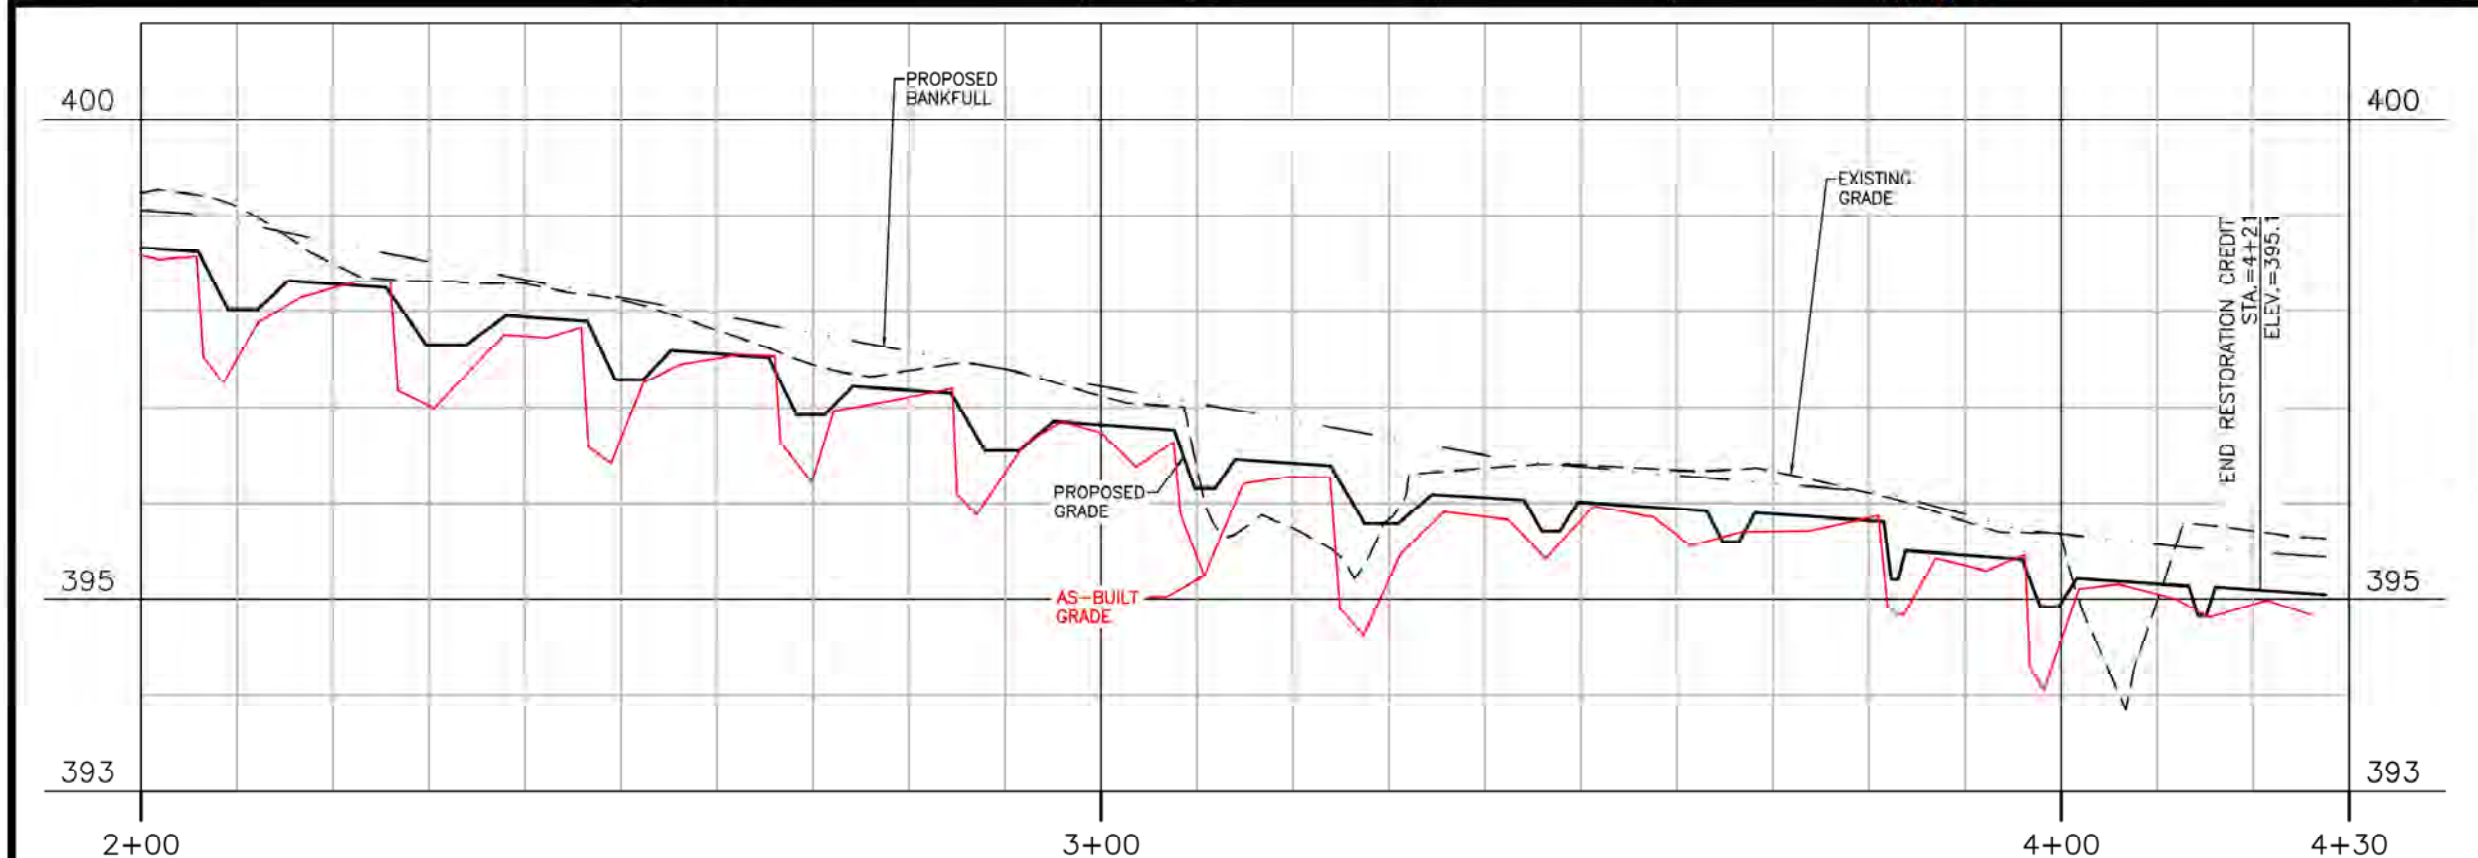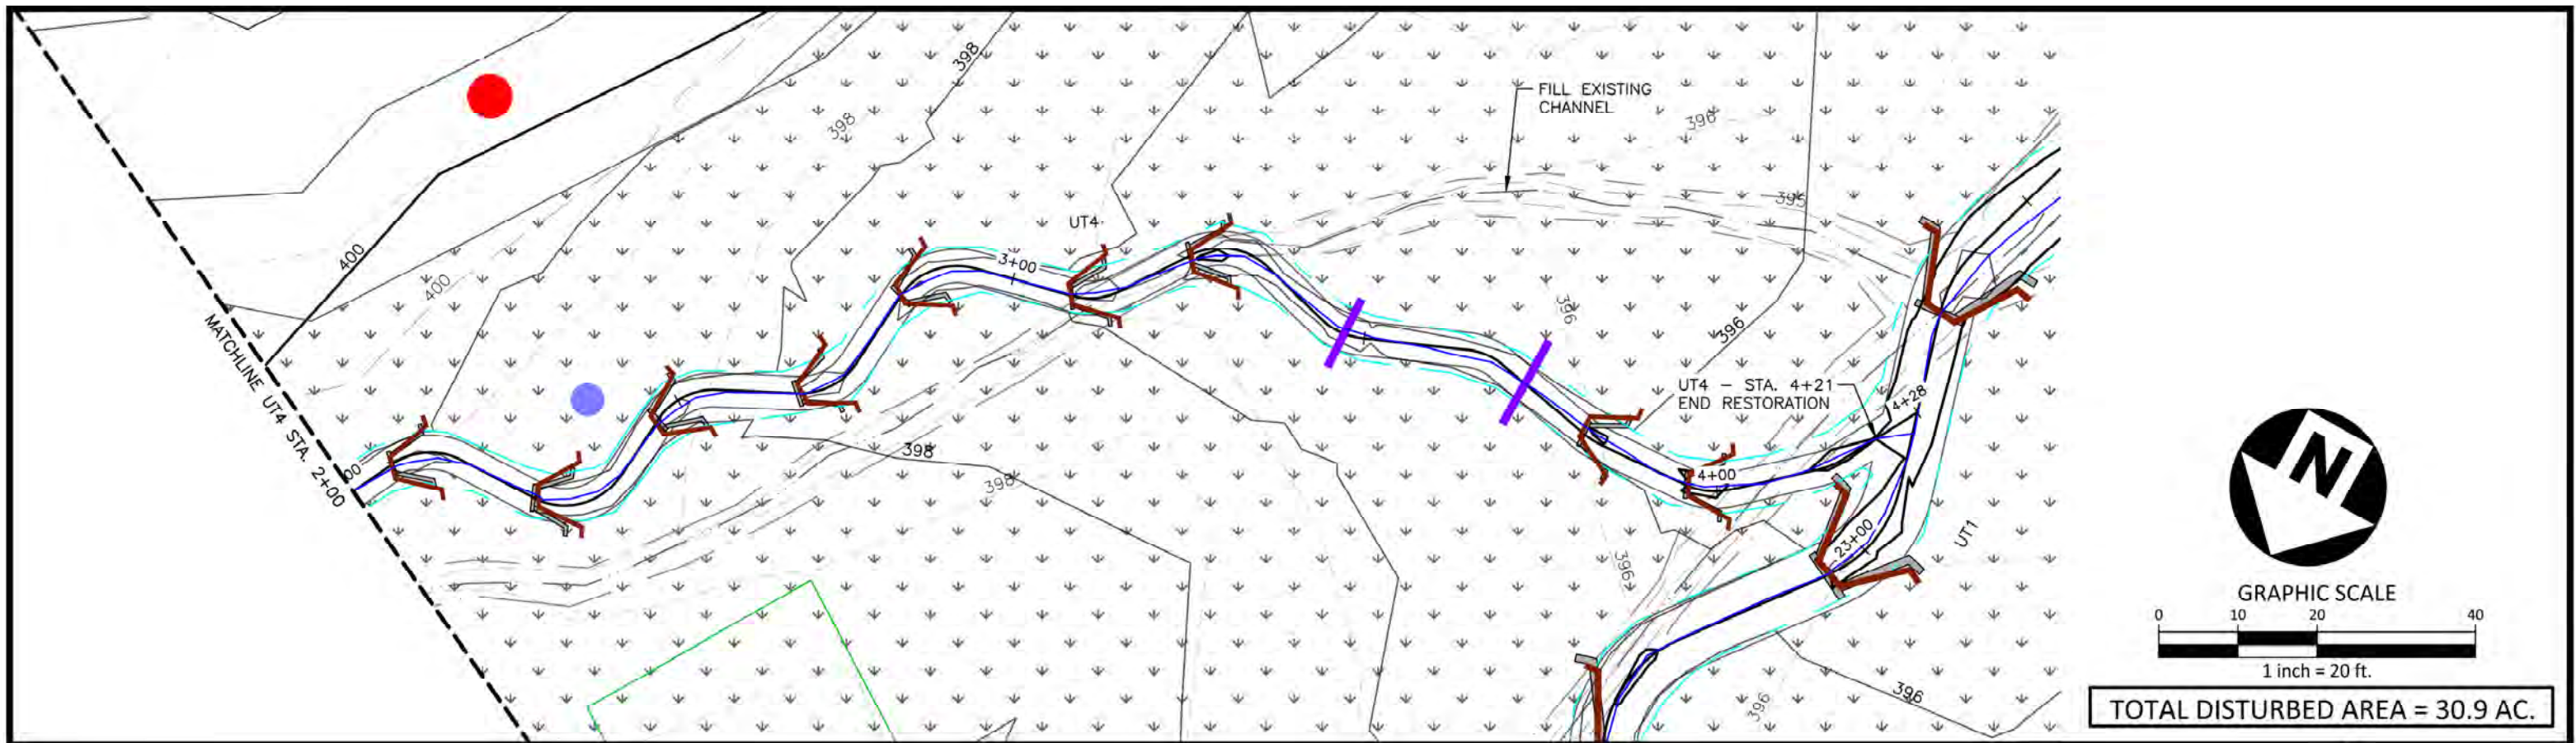




  
**McADAMS**  
 The John R. McAdams Company, Inc.  
 2905 Meridian Parkway  
 Durham, NC 27713  
 phone 919. 361. 5000  
 fax 919. 361. 2269  
 license number: C-0293, C-187  
 www.mcadamsco.com

**CRANE MITIGATION SITE**  
 AS-BUILT DRAWINGS  
 LEE COUNTY, NORTH CAROLINA



**PLAN INFORMATION**  
 PROJECT NO. 2021110220  
 FILENAME P1  
 CHECKED BY RAS  
 DRAWN BY RHW  
 SCALE 1"=20'  
 DATE 02.17.2023

**PLAN AND PROFILE**  
 UT4 STA 2+00 - 4+28  
**C5.13**

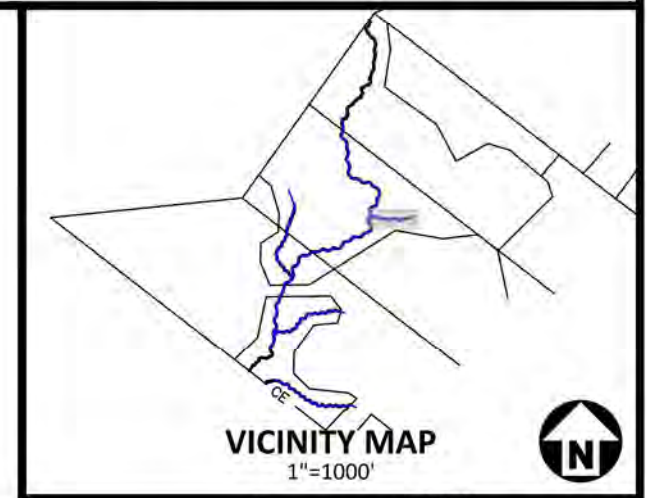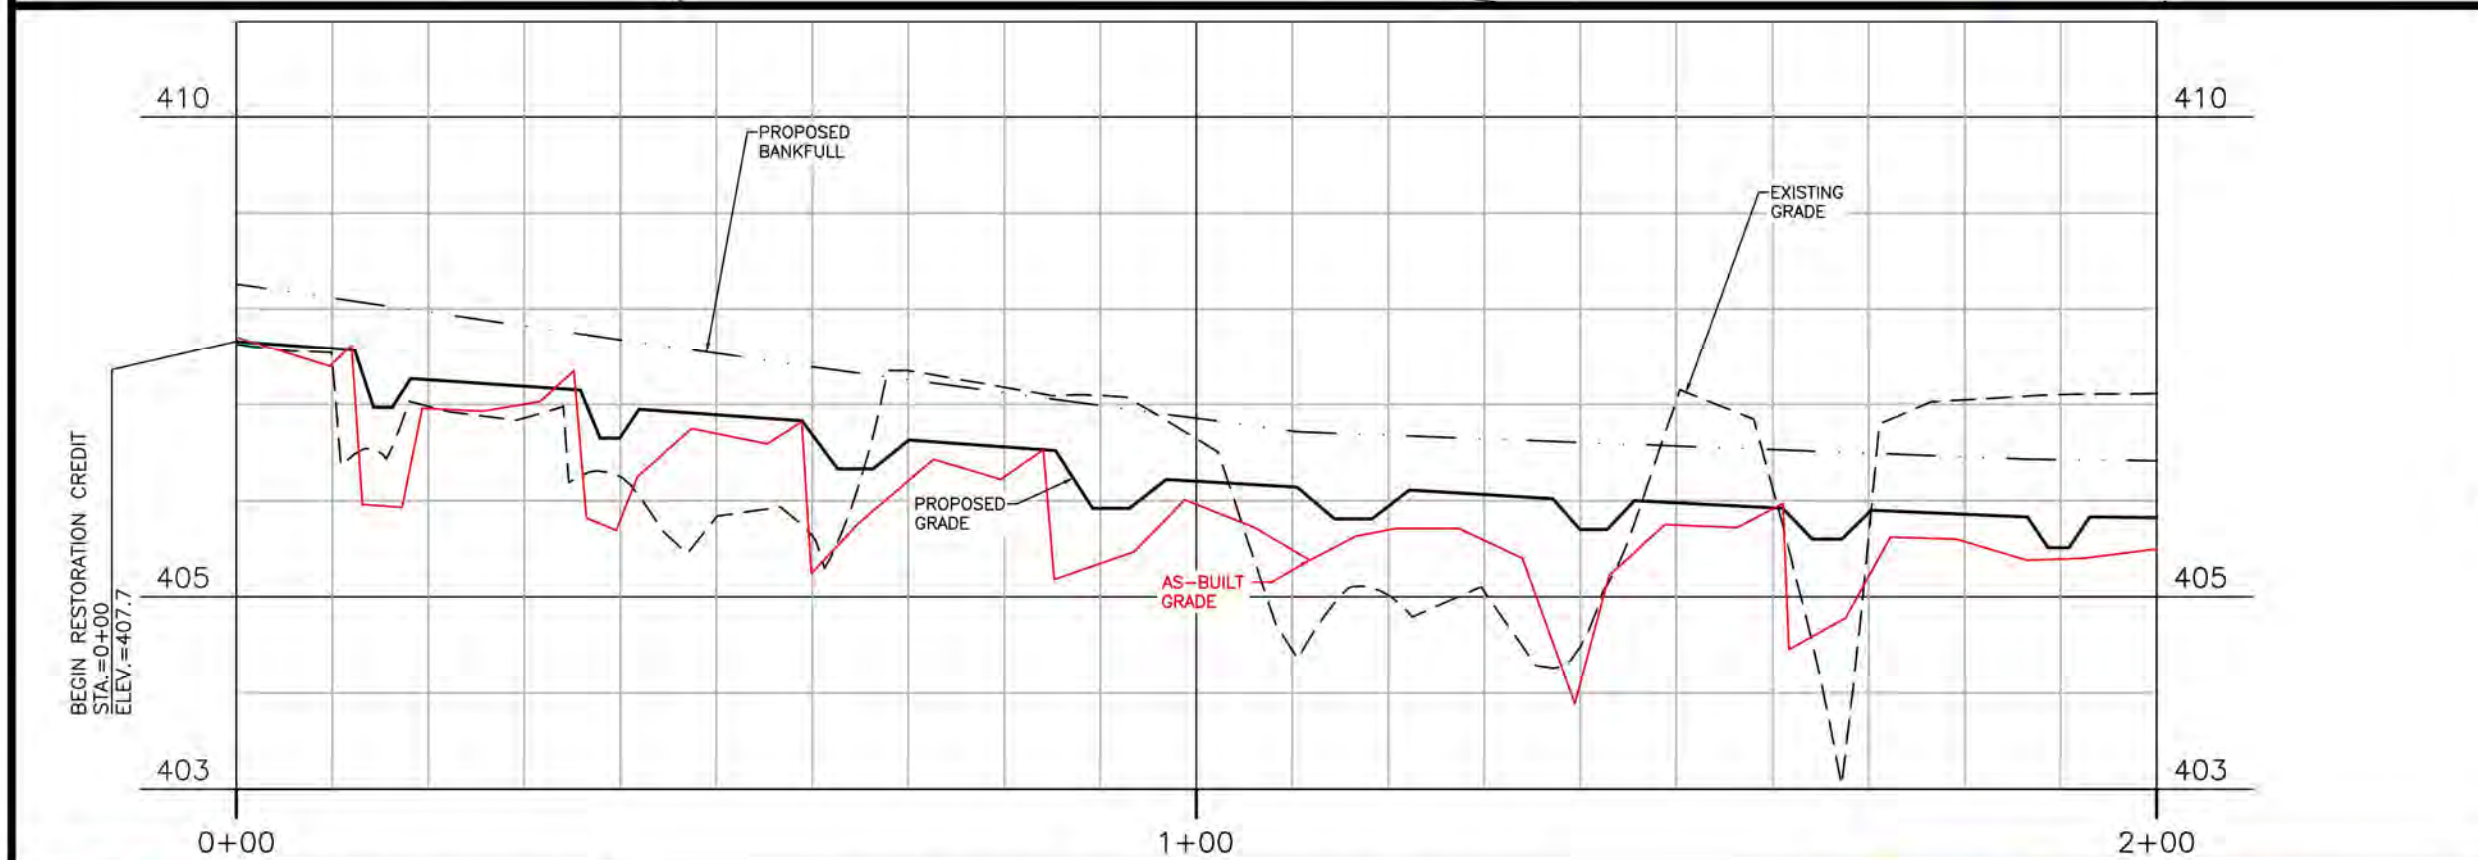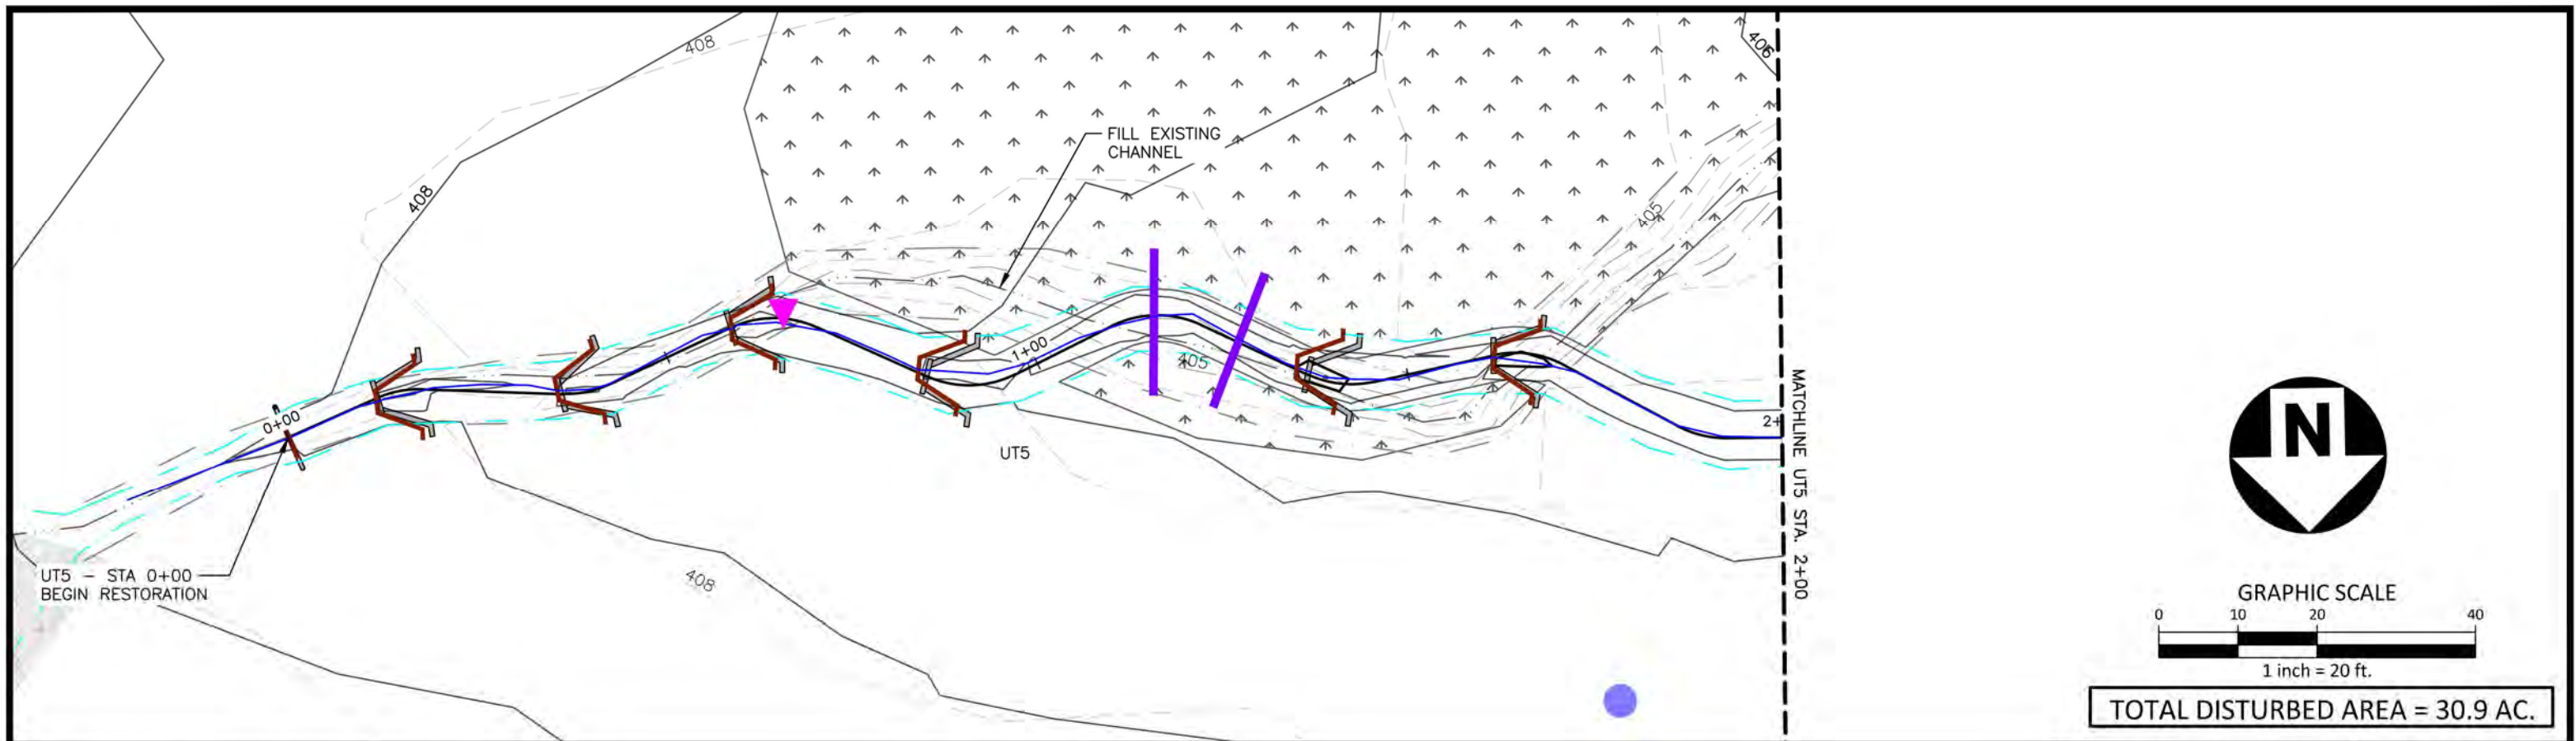

Digitally signed by Rebecca Stubbs, DN: cn=Rebecca Stubbs, c=US, email=stubbs@mcadamsco.com, serial=20230502133806-040  
 RECORD DRAWINGS ONLY  
 REBECCA STUBBS  
 PROFESSIONAL ENGINEER  
 SEAL  
 049073  
 RECORD DRAWINGS ONLY

  
**McADAMS**  
 The John R. McAdams Company, Inc.  
 2905 Meridian Parkway  
 Durham, NC 27713  
 phone 919. 361. 5000  
 fax 919. 361. 2269  
 license number: C-0293, C-187  
 www.mcadamsco.com



**CRANE MITIGATION SITE**  
**AS-BUILT DRAWINGS**  
 LEE COUNTY, NORTH CAROLINA

  
**RESTORATION SYSTEMS LLC**



  
 Axiom Environmental, Inc.

**PLAN INFORMATION**  
 PROJECT NO. 2021110220  
 FILENAME P1  
 CHECKED BY RAS  
 DRAWN BY RHW  
 SCALE 1"=20'  
 DATE 05.02.2023


**PLAN AND PROFILE**  
 UT5 STA 0+00 - 2+00  
**C5.14**

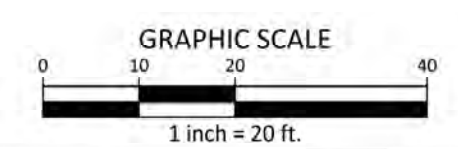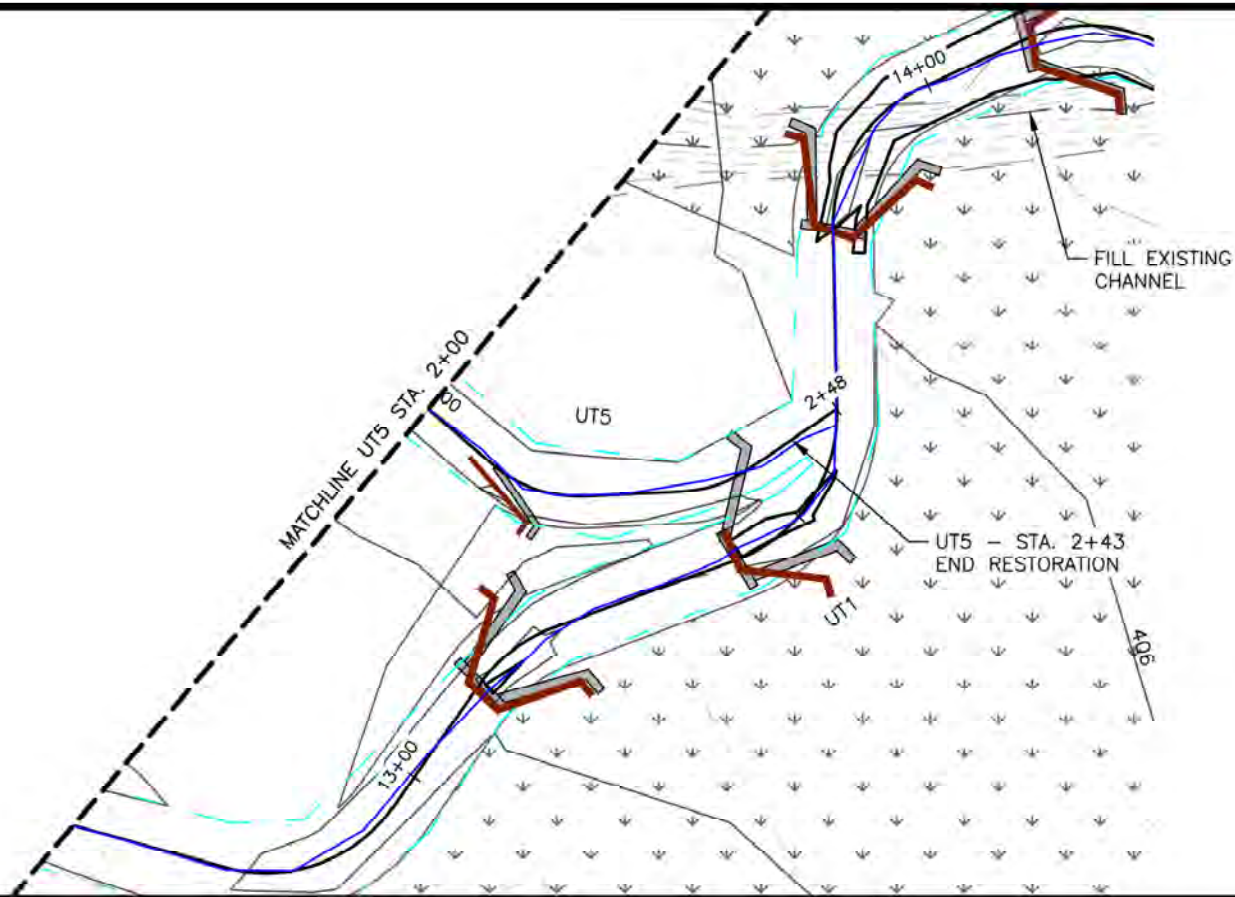

TOTAL DISTURBED AREA = 30.9 AC.

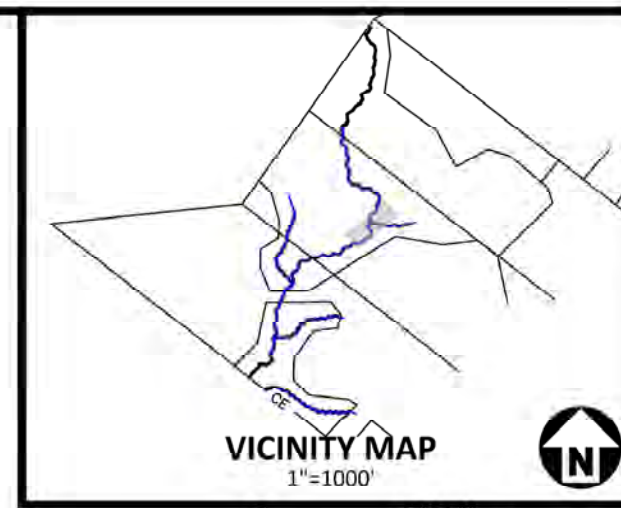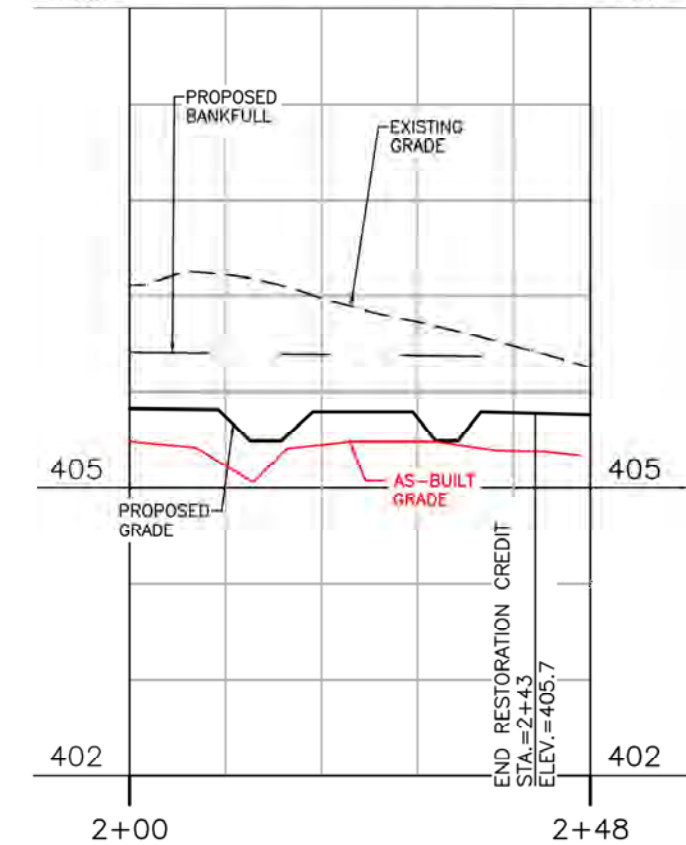

VICINITY MAP  
1"=1000'

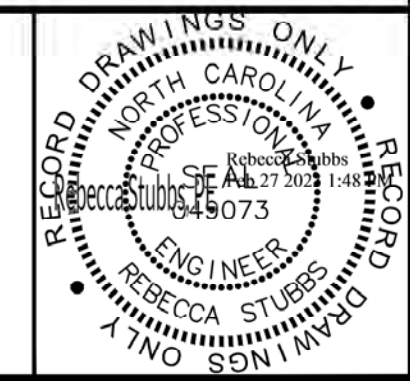


The John R. McAdams Company, Inc.  
2905 Meridian Parkway  
Durham, NC 27713

phone 919. 361. 5000  
fax 919. 361. 2269  
license number: C-0293, C-187

www.mcadamsco.com

**CRANE MITIGATION SITE**  
AS-BUILT DRAWINGS  
LEE COUNTY, NORTH CAROLINA





**PLAN INFORMATION**

PROJECT NO. 2021110220  
FILENAME P1  
CHECKED BY RAS  
DRAWN BY RHW  
SCALE 1"=20'  
DATE 02.17.2023


**PLAN AND PROFILE**  
UT5 STA 2+00 - 2+48

**C5.15**

○—○— PROPOSED FIVE-STRAND BARBED WIRE FENCE  
 x—x—x—x— CONSTRUCTED FIVE-STRAND BARBED WIRE FENCE

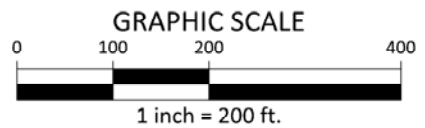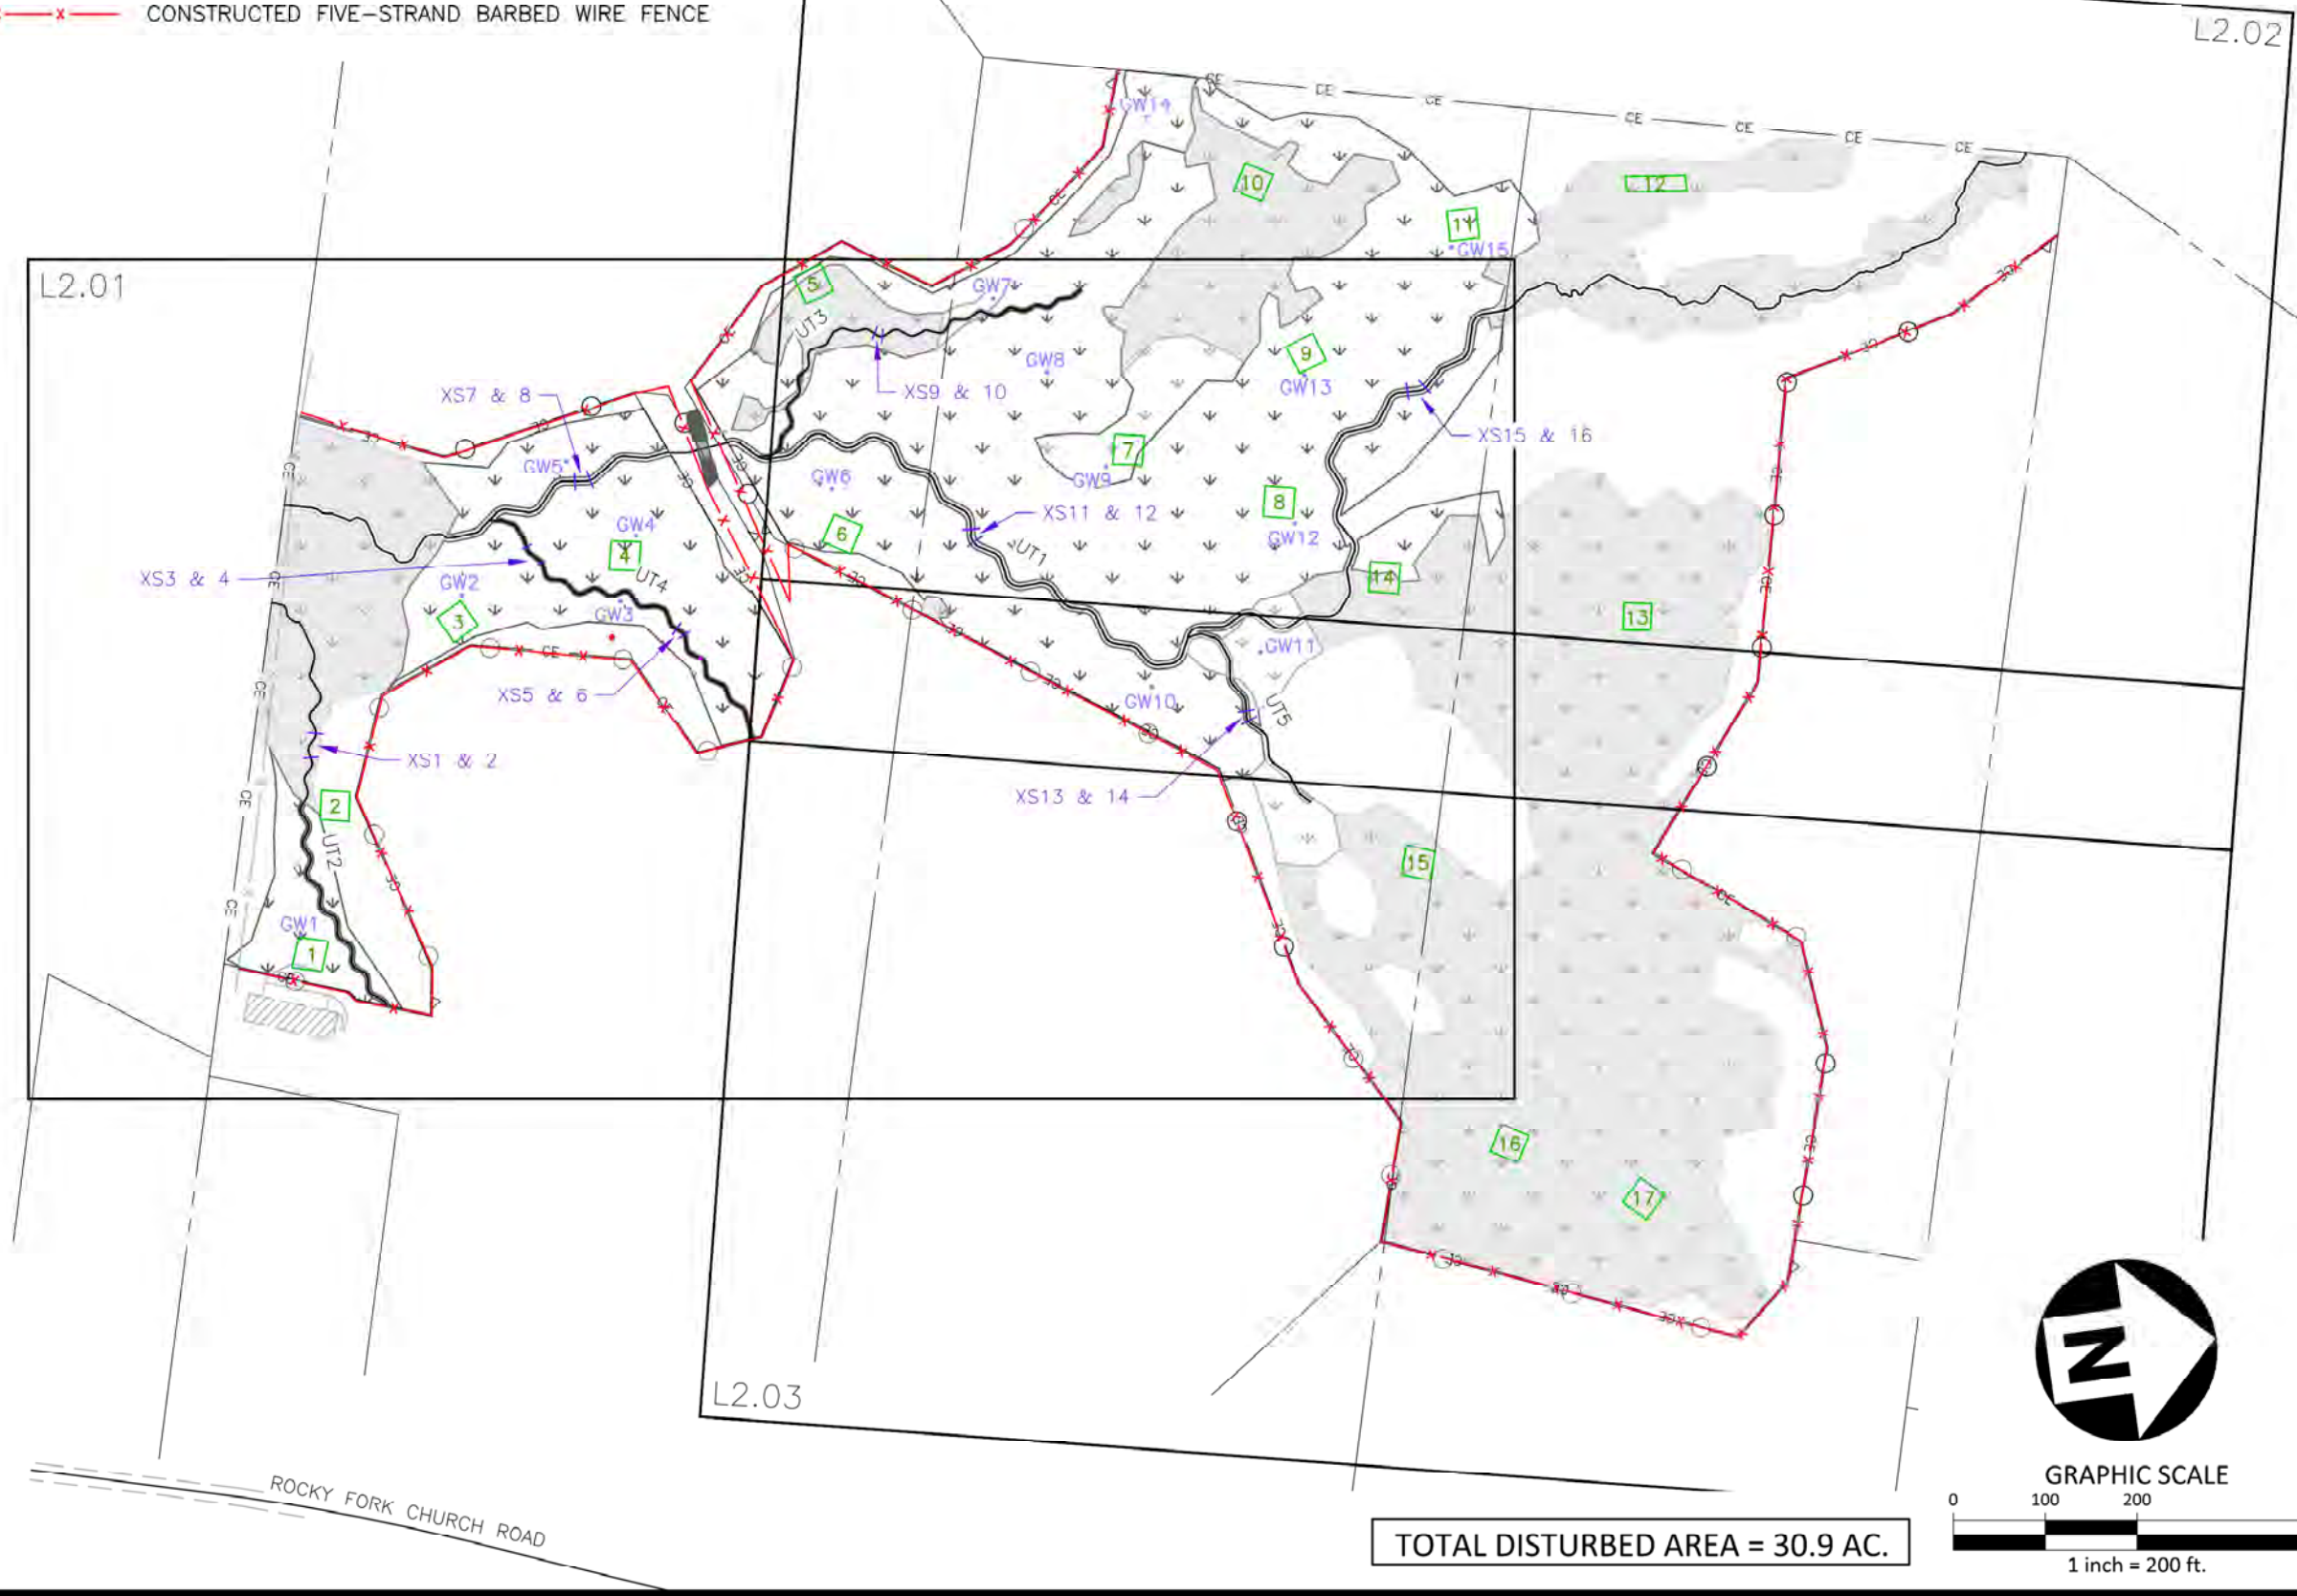

TOTAL DISTURBED AREA = 30.9 AC.

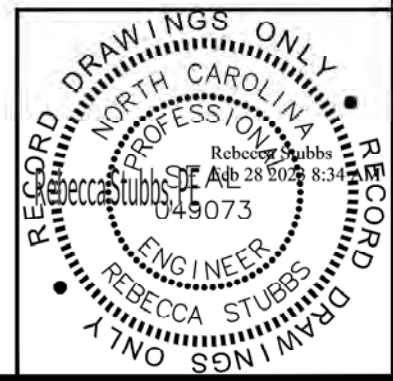


The John R. McAdams Company, Inc.  
 2905 Meridian Parkway  
 Durham, NC 27713  
 phone 919. 361. 5000  
 fax 919. 361. 2269  
 license number: C-0293, C-187  
 www.mcadamsco.com


**CRANE MITIGATION SITE**  
 AS-BUILT DRAWINGS  
 LEE COUNTY, NORTH CAROLINA



**PLAN INFORMATION**

PROJECT NO.	2021110220
FILENAME	L2
CHECKED BY	RAS
DRAWN BY	RHW
SCALE	1"=200'
DATE	02.17.2023

**FENCING PLAN OVERVIEW**  
**L2.00**

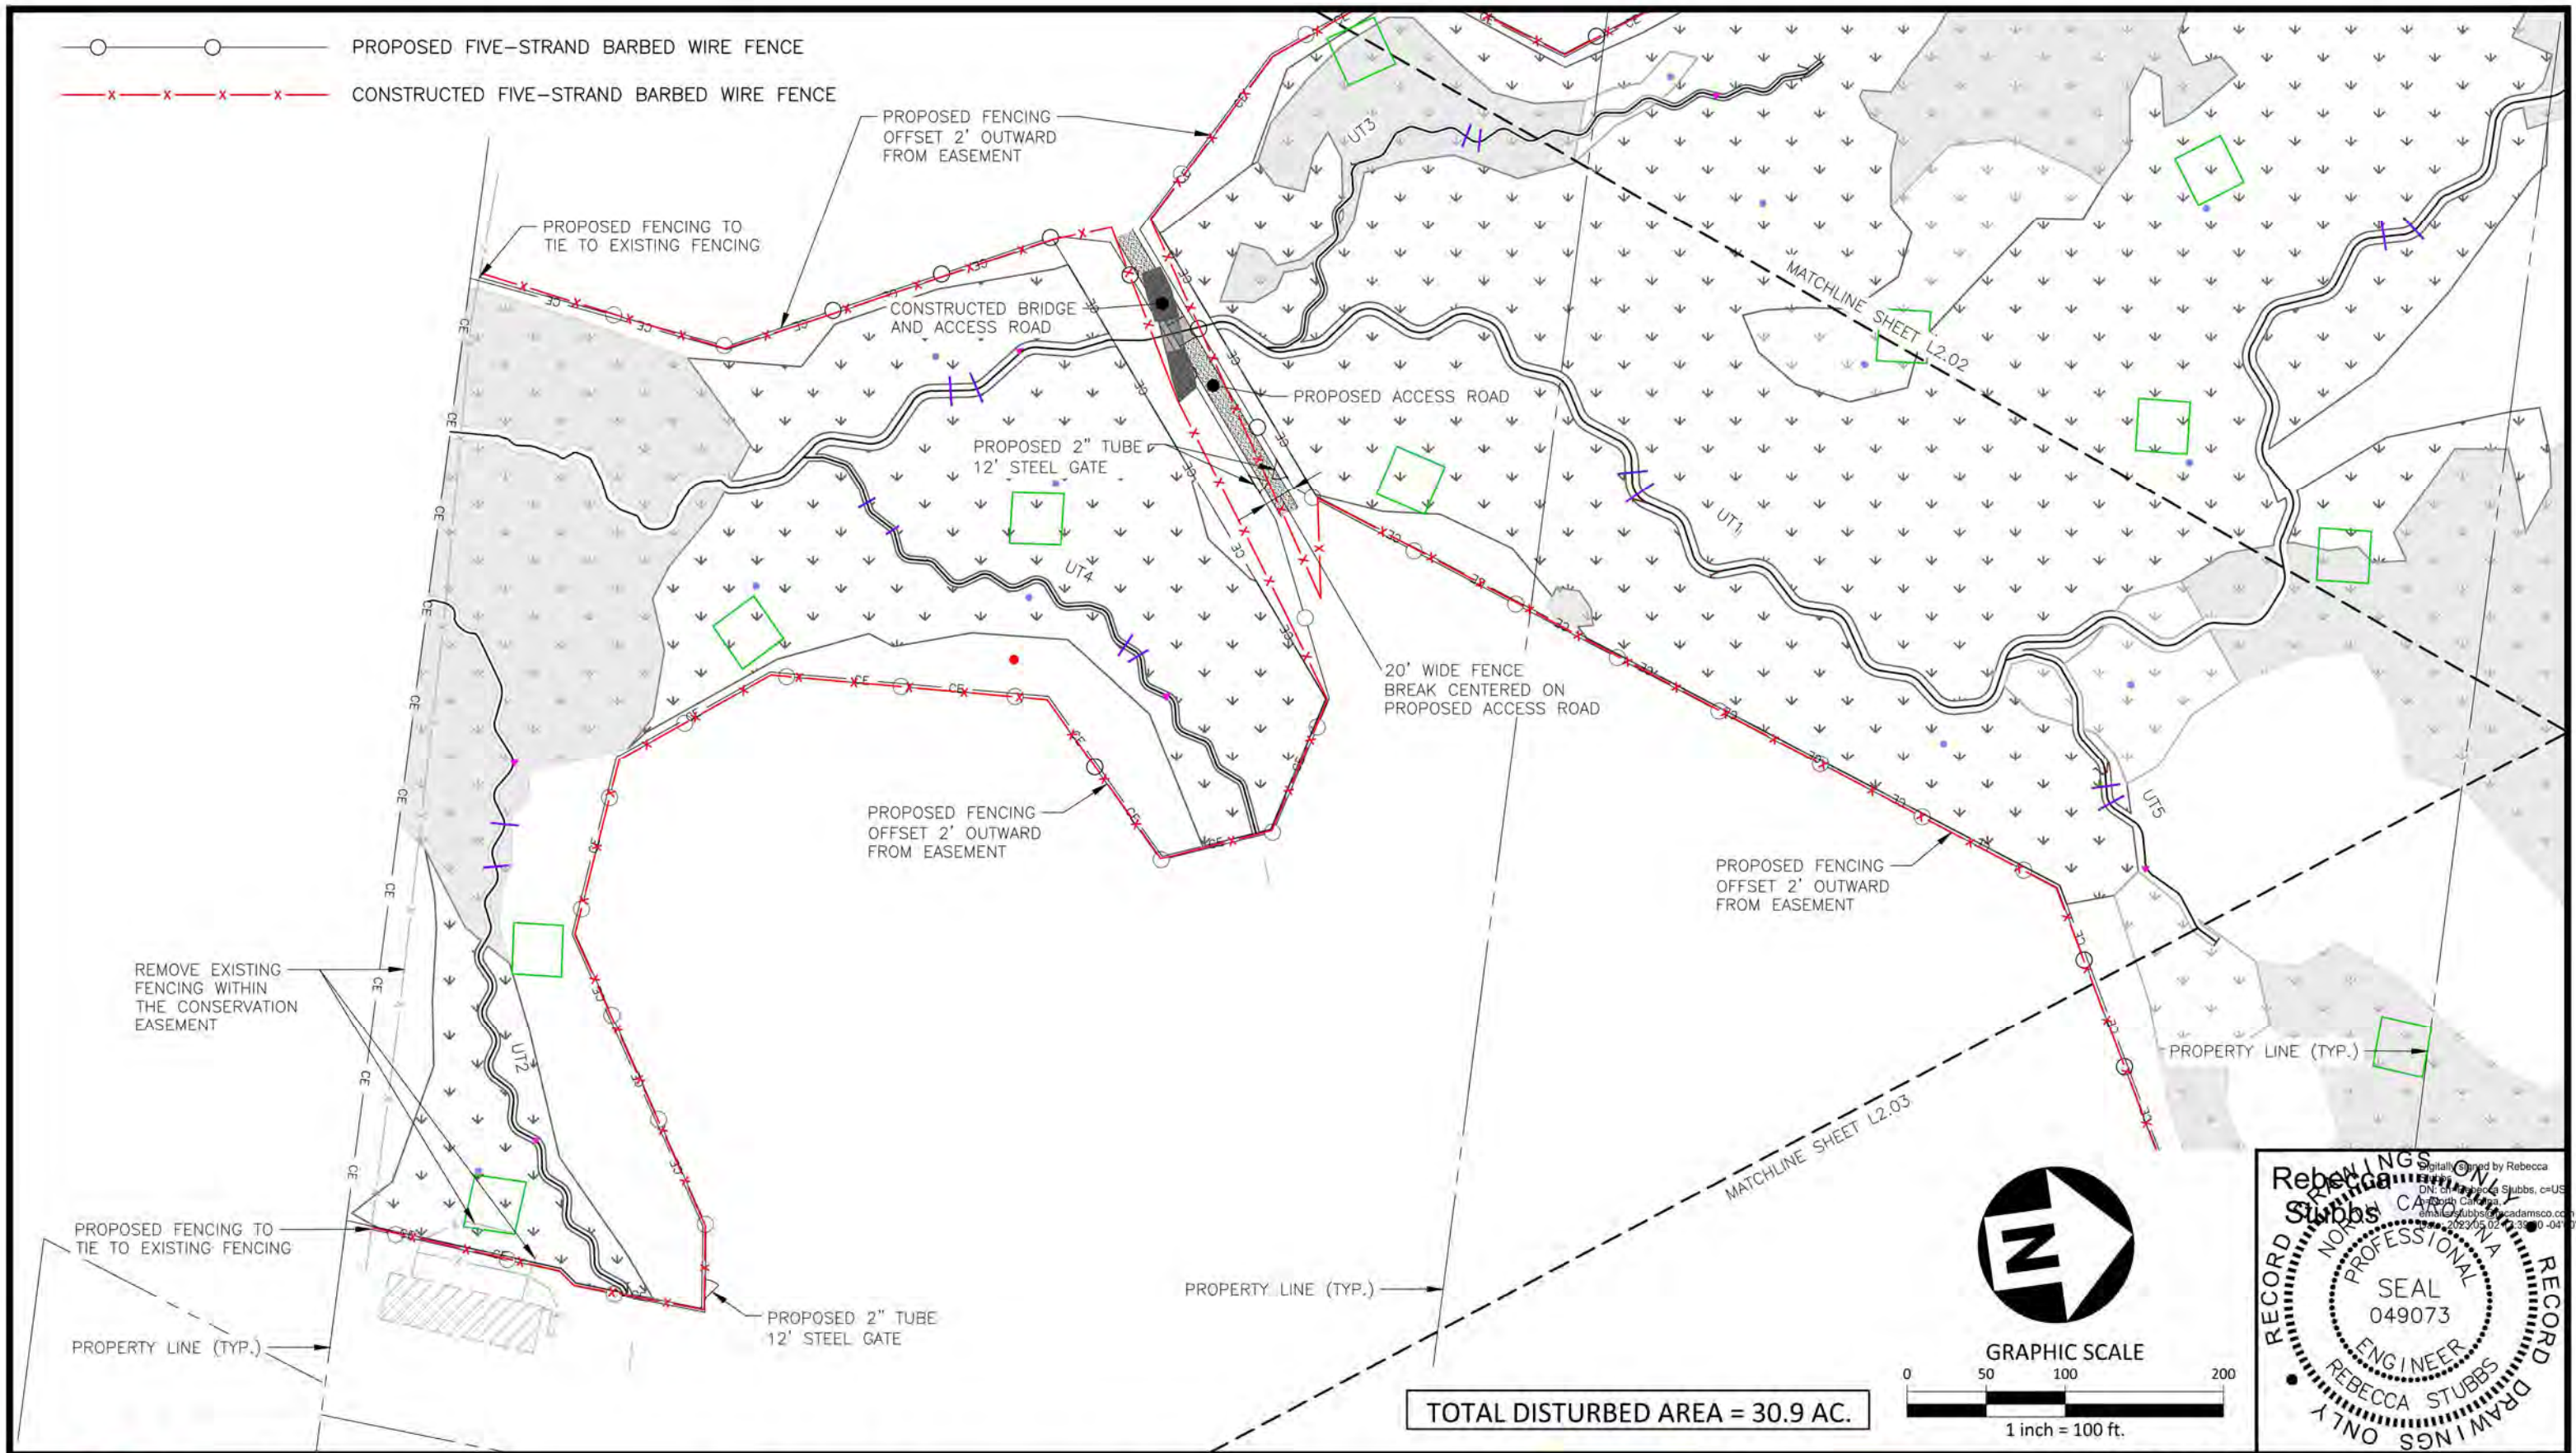

The John R. McAdams Company, Inc.  
 2905 Meridian Parkway  
 Durham, NC 27713  
 phone 919. 361. 5000  
 fax 919. 361. 2269  
 license number: C-0293, C-187  
 www.mcadamsco.com



**CRANE MITIGATION SITE**  
 AS-BUILT DRAWINGS  
 LEE COUNTY, NORTH CAROLINA




**PLAN INFORMATION**  
 PROJECT NO. 2021110220  
 FILENAME L2  
 CHECKED BY RAS  
 DRAWN BY RHW  
 SCALE 1"=100'  
 DATE 05.02.2023

**FENCING PLAN**  
**L2.01**



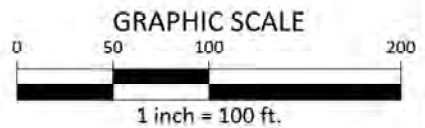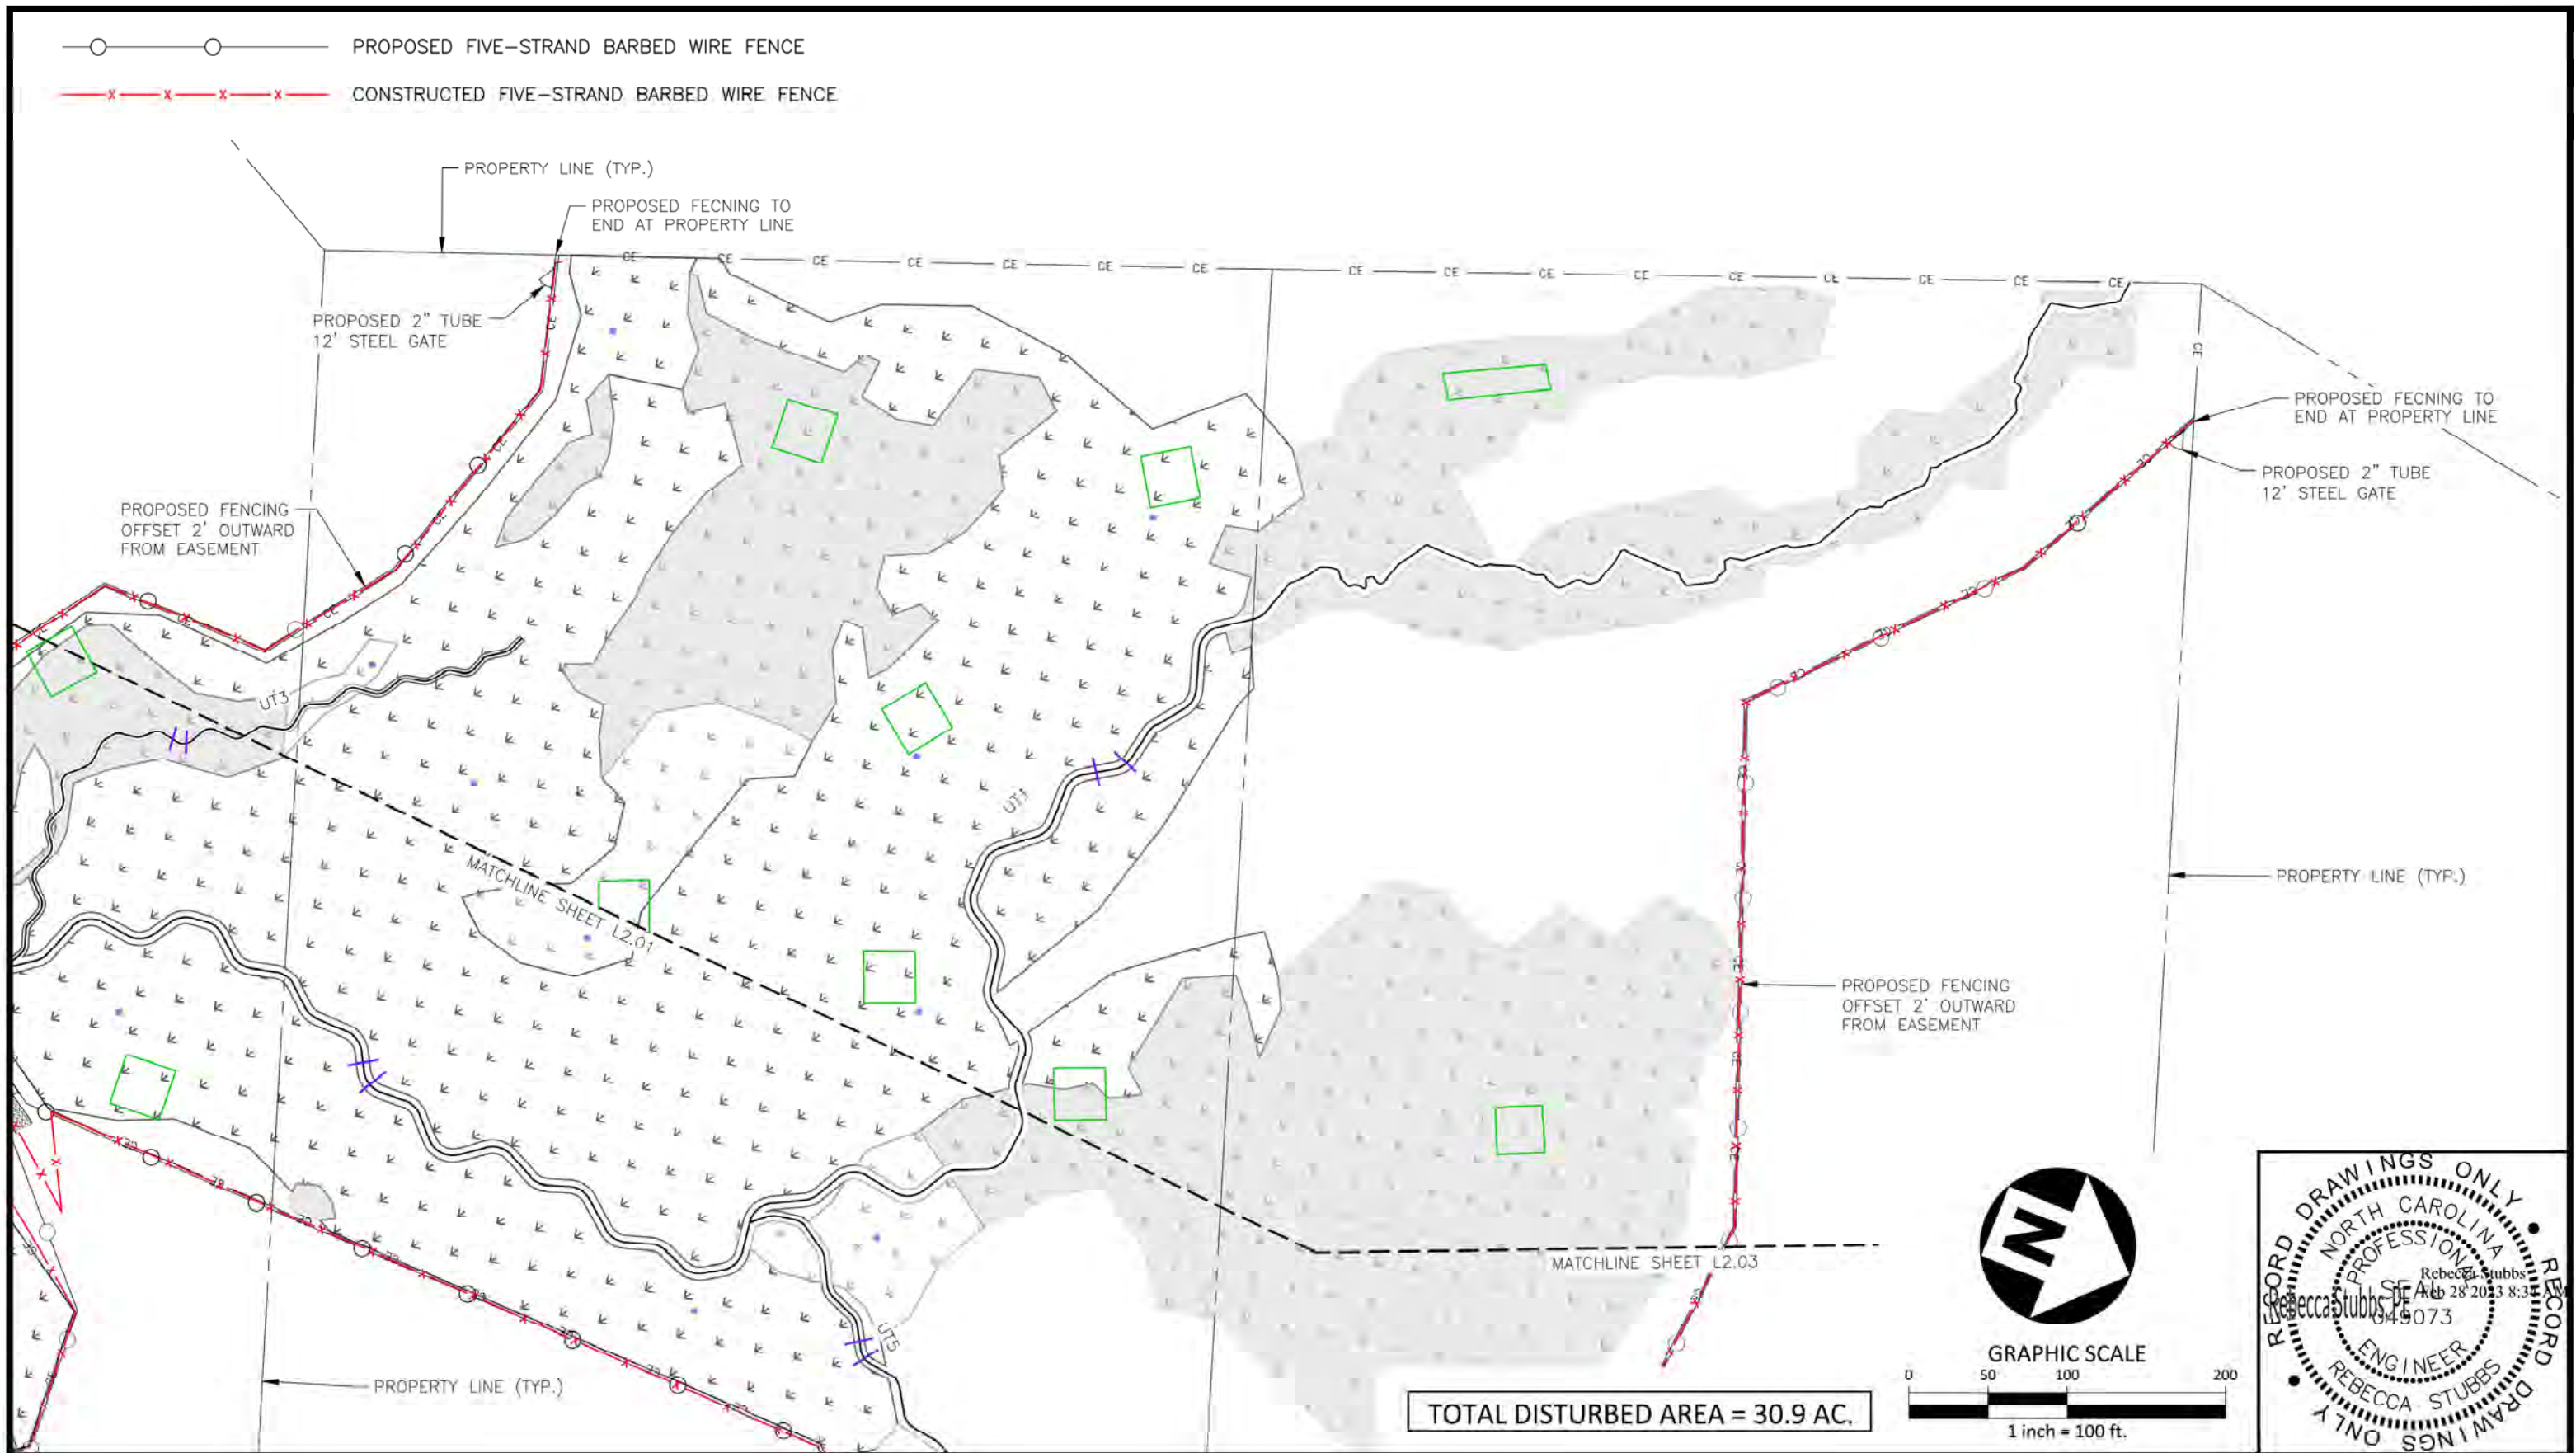

TOTAL DISTURBED AREA = 30.9 AC.

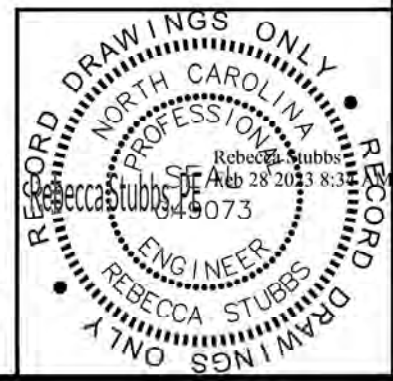


The John R. McAdams Company, Inc.  
2905 Meridian Parkway  
Durham, NC 27713

phone 919. 361. 5000  
fax 919. 361. 2269  
license number: C-0293, C-187

www.mcadamsco.com

## CRANE MITIGATION SITE


AS-BUILT DRAWINGS  
LEE COUNTY, NORTH CAROLINA



PLAN INFORMATION	
PROJECT NO.	2021110220
FILENAME	L2
CHECKED BY	RAS
DRAWN BY	RHW
SCALE	1"=100'
DATE	02.17.2023

## FENCING PLAN

# L2.02

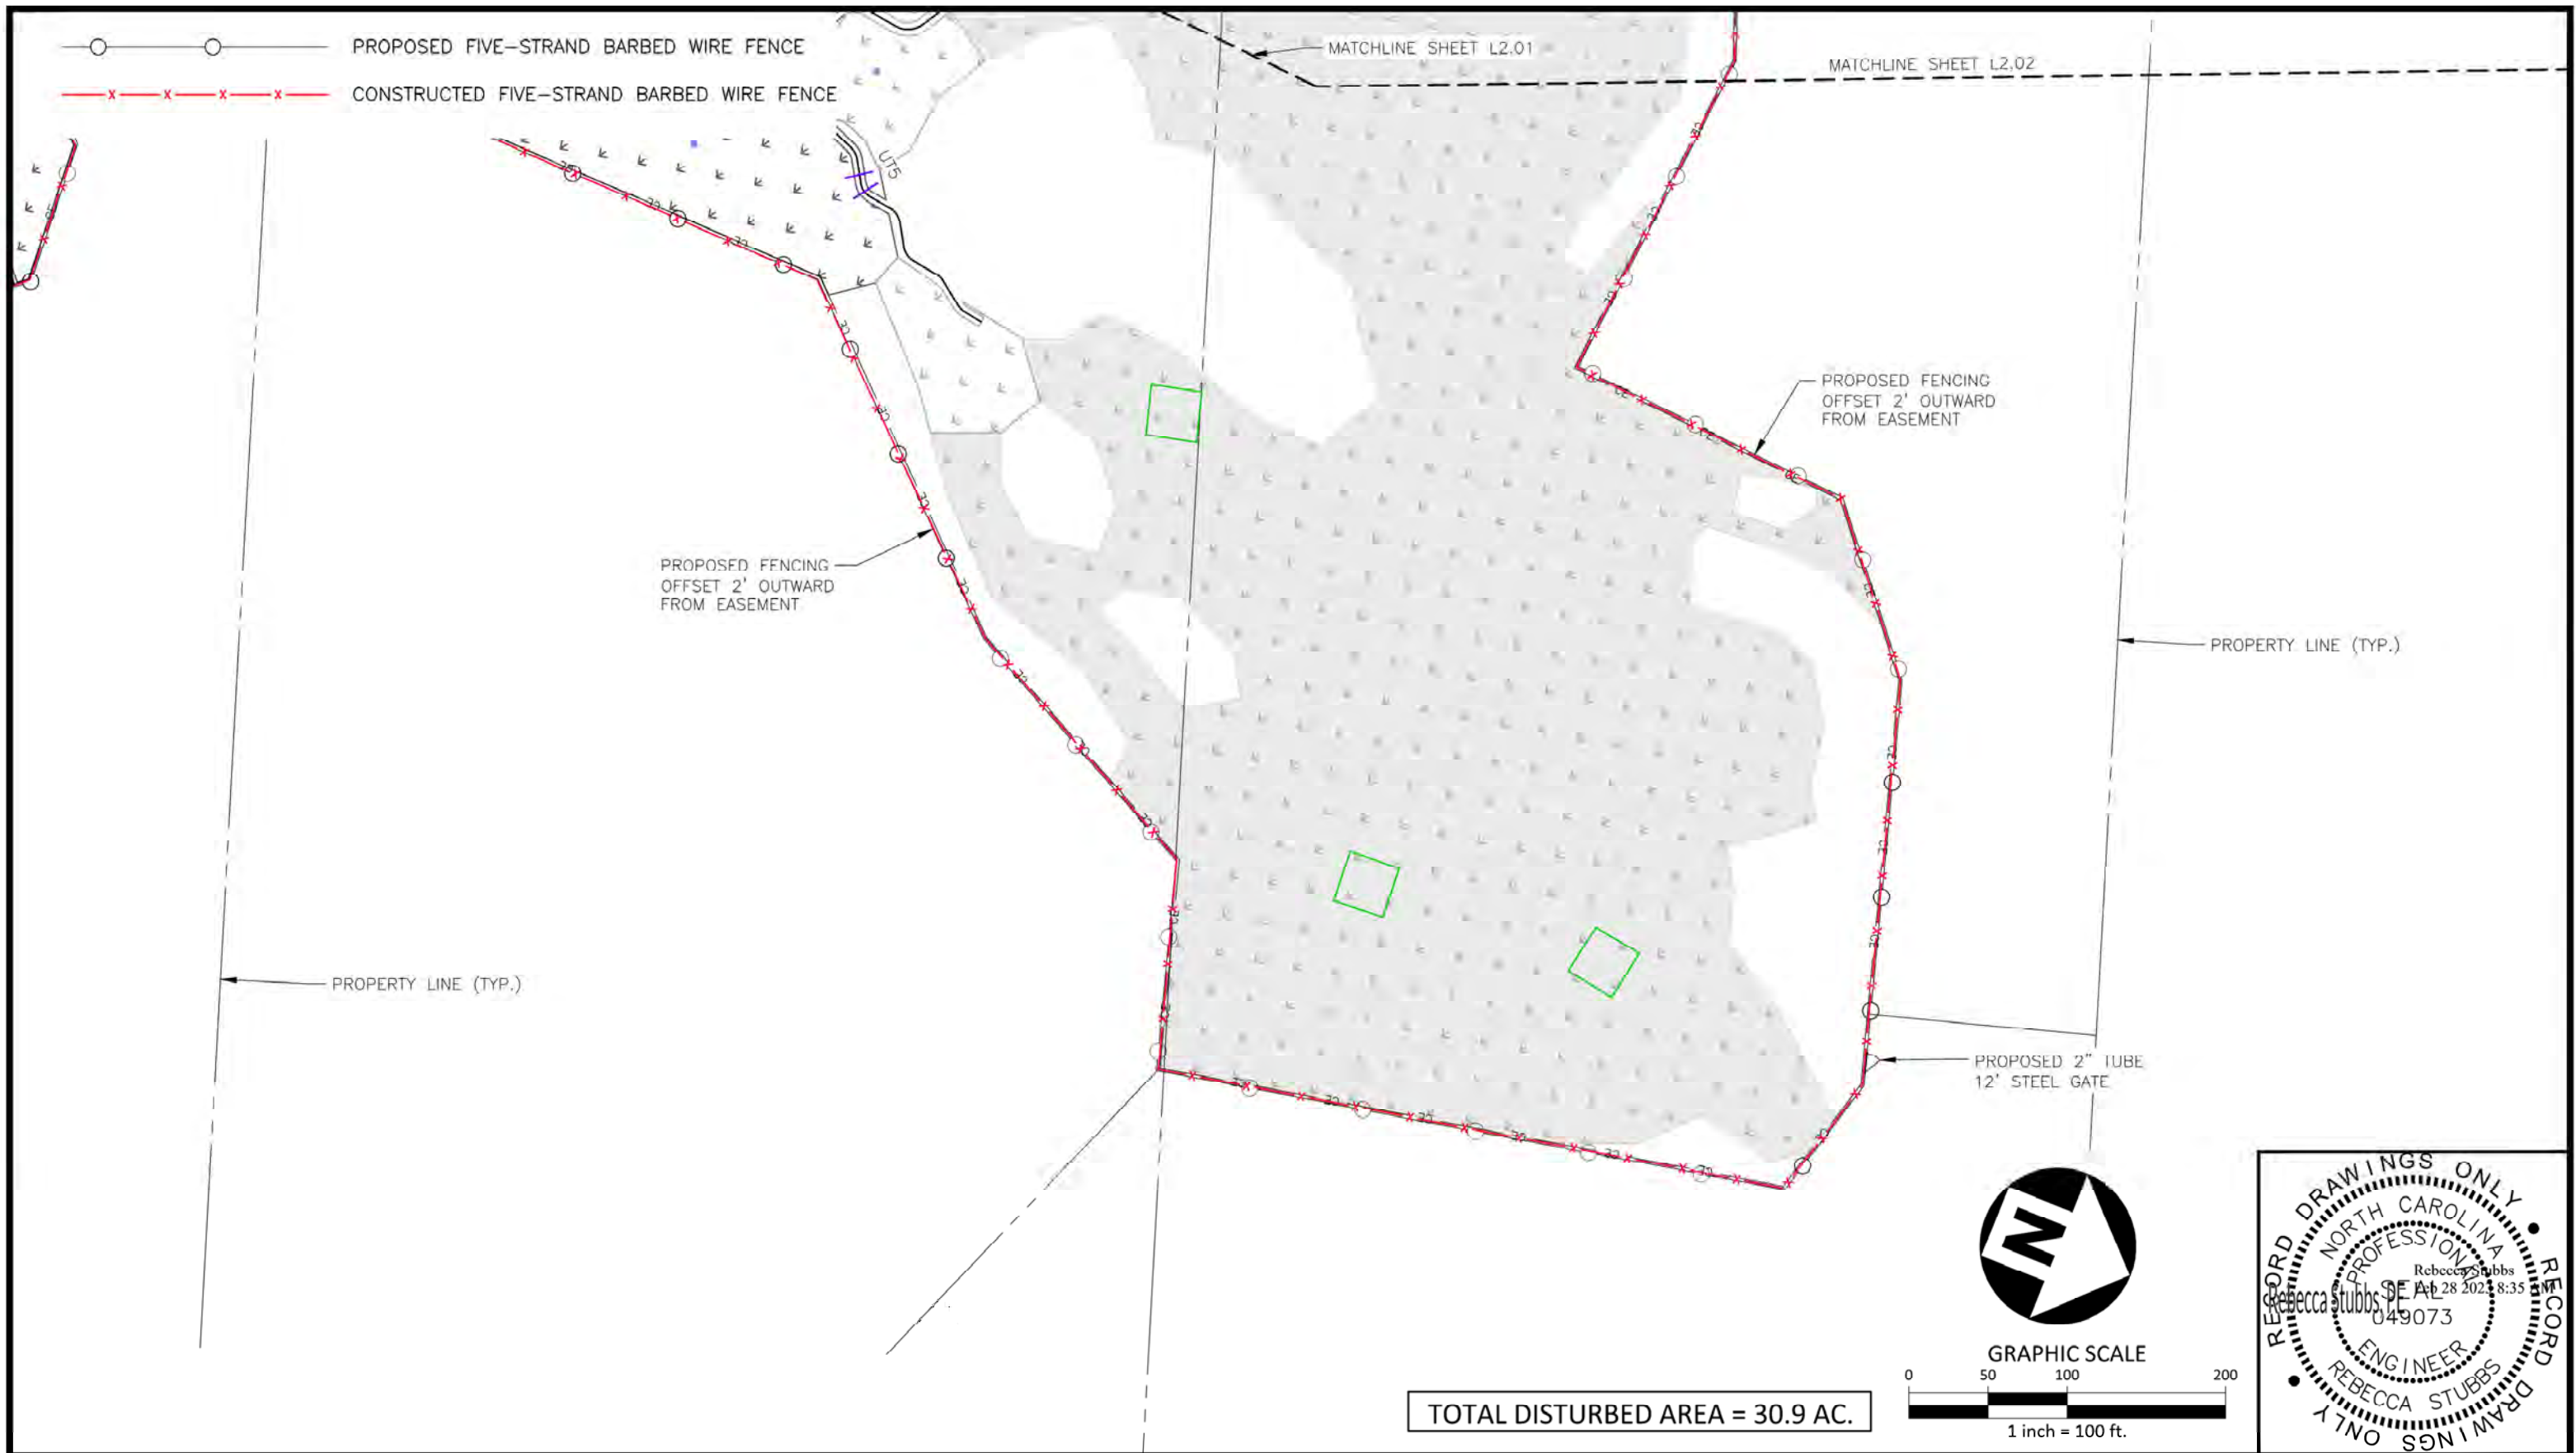

The John R. McAdams Company, Inc.  
 2905 Meridian Parkway  
 Durham, NC 27713

phone 919. 361. 5000  
 fax 919. 361. 2269  
 license number: C-0293, C-187

www.mcadamsco.com

**CRANE MITIGATION SITE**  
 AS-BUILT DRAWINGS  
 LEE COUNTY, NORTH CAROLINA



**PLAN INFORMATION**

PROJECT NO. 2021110220  
 FILENAME L2  
 CHECKED BY RAS  
 DRAWN BY RHW  
 SCALE 1"=100'  
 DATE 02.17.2023

**FENCING PLAN**


**L2.03**

Site Planted As Proposed

Vegetation Association		Coastal Plain Bottomland Hardwood Forest*		Coastal Plain Small Stream Swamp*		Stream-side Assemblage**		TOTAL
Area (acres)		8		15.4		2.8		26.2
Species	Indicator Status	# planted*	% of total	# planted*	% of total	# planted**	% of total	# planted
Swamp black gum ( <i>Nyssa biflora</i> )	OBL	0	0.00%	1000	9.50%	0	0.00%	1000
Bald cypress ( <i>Taxodium distichum</i> )	UBL	500	9.20%	1000	9.50%	0	0.00%	1500
Tupelo gum ( <i>Nyssa aquatica</i> )	OBL	0	0.00%	1000	9.50%	0	0.00%	1000
Black gum ( <i>Nyssa sylvatica</i> )	FAC	500	9.20%	1000	9.50%	700	9.20%	2200
Silky dogwood ( <i>Cornus amomum</i> )	FACW	0	0.00%	0	0.00%	1500	19.70%	1500
Sweetbay ( <i>Magnolia virginiana</i> )	FACW	0	0.00%	1000	9.50%	0	0.00%	1000
Red bay ( <i>Persea borbonia</i> )	FAC	250	4.60%	500	4.80%	0	0.00%	750
River birch ( <i>Betula nigra</i> )	FACW	500	9.20%	500	4.80%	1500	19.70%	2500
Hackberry ( <i>Celtis occidentalis</i> )	FACW	300	5.50%	500	4.80%	400	5.30%	1200
American elm ( <i>Ulmus americana</i> )	FACW	300	5.50%	500	4.80%	800	10.50%	1600
Tulip poplar ( <i>Liriodendron tulipifera</i> )	FAC	300	5.50%	500	4.80%	800	10.50%	1600
Sycamore ( <i>Platanus occidentalis</i> )	FACW	300	5.50%	500	4.80%	800	10.50%	1600
Swamp chestnut oak ( <i>Quercus Michauxii</i> )	FACW	300	5.50%	500	4.80%	0	0.00%	800
Water oak ( <i>Quercus nigra</i> )	FAC	500	9.20%	300	2.90%	400	5.30%	1200
Laurel oak ( <i>Quercus larifolia</i> )	FACW	300	5.50%	500	4.80%	0	0.00%	800
Cherrybark oak ( <i>Quercus pagoda</i> )	FAC	200	3.70%	0	0.00%	400	5.30%	600
Willow oak ( <i>Quercus phellos</i> )	FACW	300	5.50%	500	4.80%	0	0.00%	800
Shumard oak ( <i>Quercus shumardii</i> )	FACW	300	5.50%	500	4.80%	0	0.00%	800
Shagbark hickory ( <i>Carya ovata</i> )	FACU	300	5.50%	0	0.00%	0	0.00%	300
Bitternut hickory ( <i>Carya cordiformis</i> )	FAC	300	5.50%	200	1.90%	300	3.90%	800
<b>TOTAL</b>		<b>5450</b>		<b>10500</b>		<b>7600</b>		<b>23550</b>


\* Planted at a density of 680 stems/acre.

\*\* Planted at a density of 2720 stems/acre.

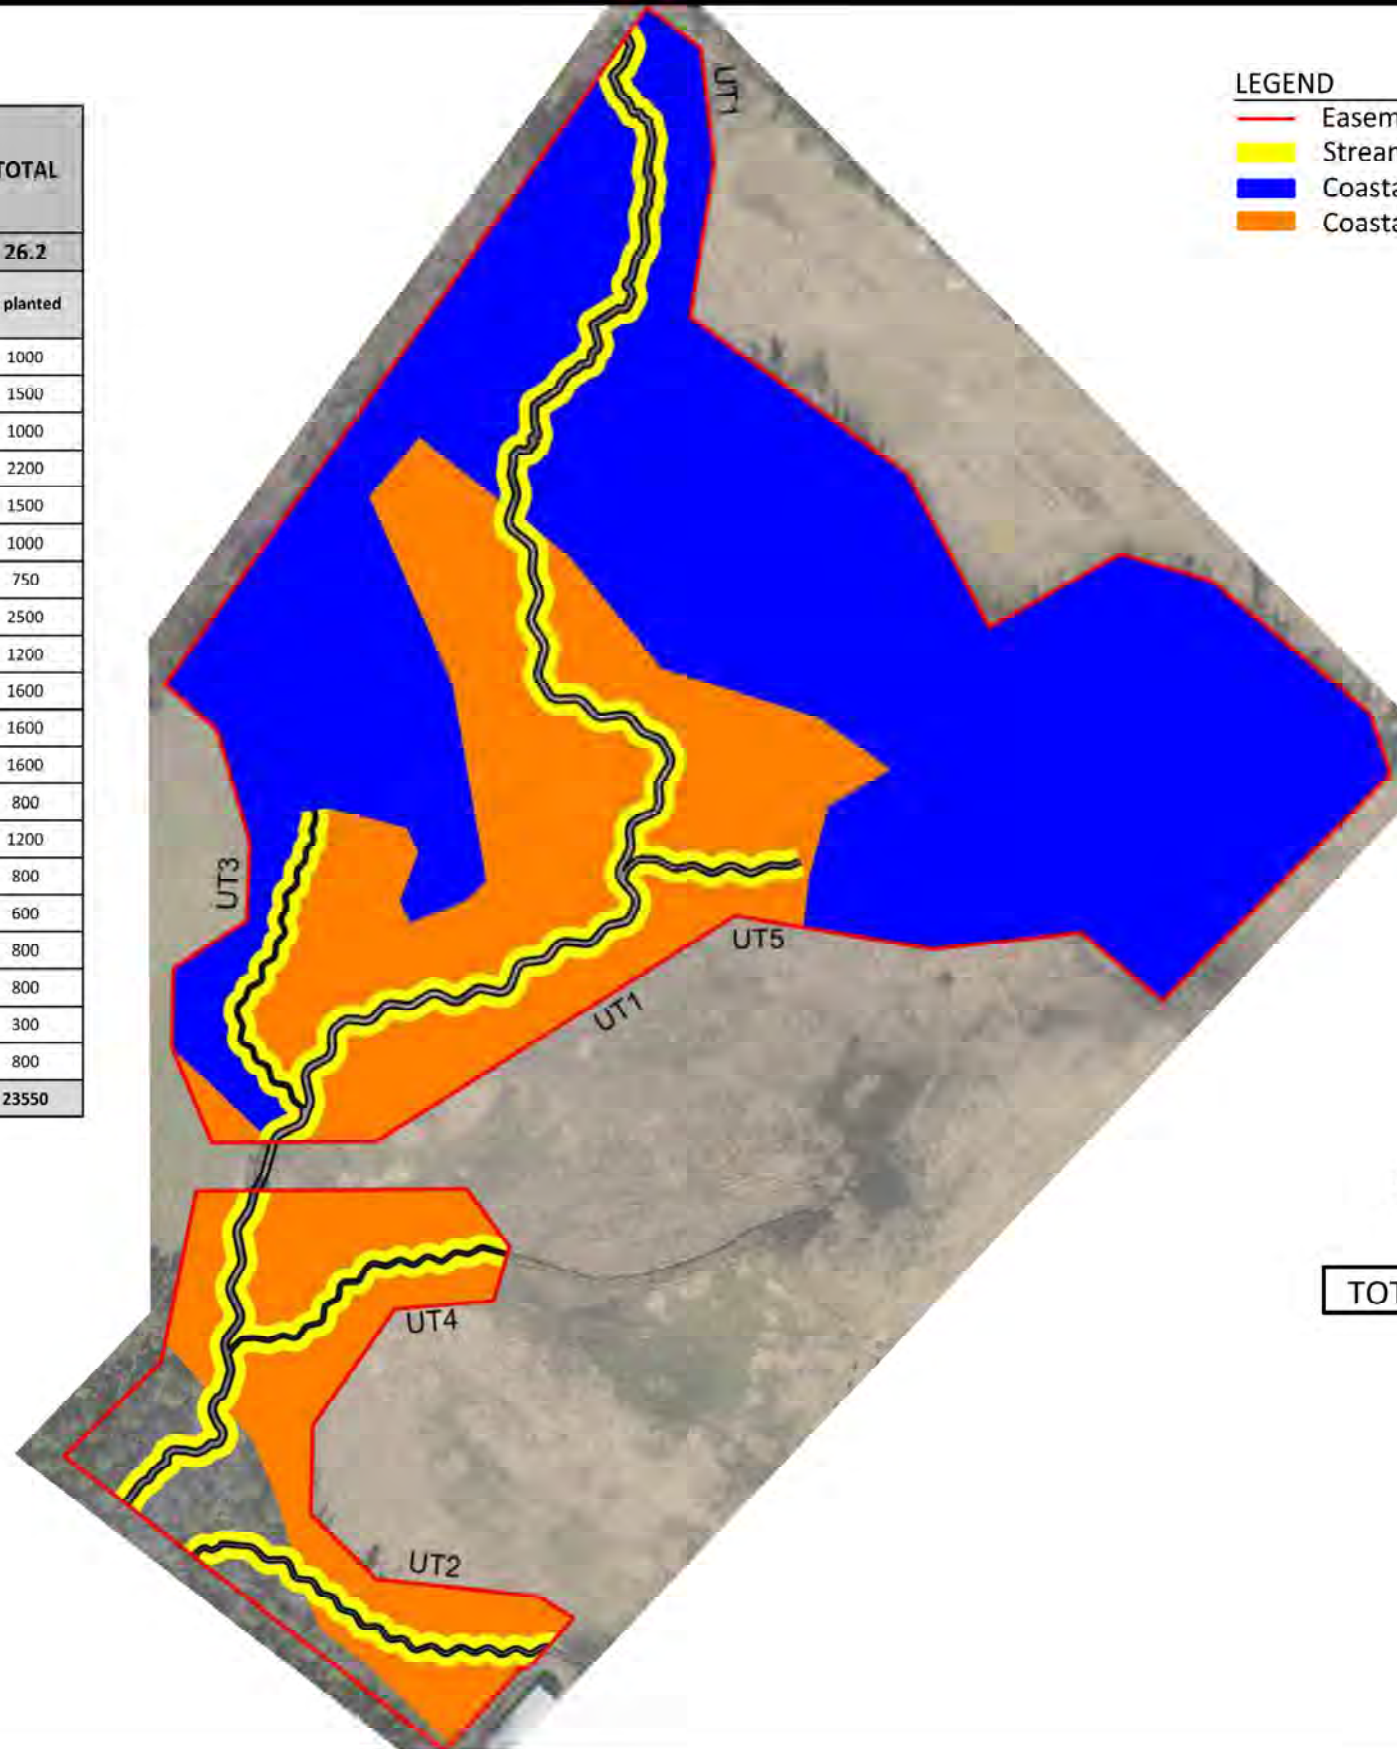

LEGEND

- Easement Boundary = ~27.7 ac
- Stream-side Assemblage
- Coastal Plain Small Stream Swamp
- Coastal Plain Bottomland Hardwood Forest

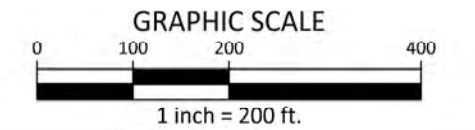

TOTAL DISTURBED AREA = 30.9 AC.



The John R. McAdams Company, Inc.  
2905 Meridian Parkway  
Durham, NC 27713  
  
phone 919. 361. 5000  
fax 919. 361. 2269  
license number: C-0293, C-187  
  
www.mcadamsco.com

**CRANE MITIGATION SITE**  
AS-BUILT DRAWINGS  
LEE COUNTY, NORTH CAROLINA



**PLAN INFORMATION**  
PROJECT NO. 2021110220  
FILENAME L1  
CHECKED BY RAS  
DRAWN BY RHW  
SCALE 1"=200'  
DATE 02.17.2023

**PLANTING PLAN**  
**L5.00**

**TEMPORARY SEEDING SCHEDULE:**

TEMPORARY SEEDING SHALL BE APPLIED AS NEEDED DURING CONSTRUCTION TO STABILIZE BARE OR DISTURBED AREAS OF SOIL AND AT THE COMPLETION OR ALL GRADING AND EARTHWORK ACTIVITIES WITHIN A PARTICULAR AREA OF THE SITE. PERMANENT SEED MAY BE DISTRIBUTED WITH TEMPORARY SEED UPON THE FINAL APPLICATION OF TEMPORARY SEED.

**SEEDING METHODS**

1. EVENLY APPLY SEED USING A CYCLONE SEEDER, DRILL, CULTIPACKER SEEDER, OR HYDROSEEDER. THIS MUST BE DONE WITHIN 48 HOURS OF LAND DISTURBING ACTIVITIES.
2. MULCH WITH CLEAN WHEAT STRAW.
3. AFTER SEEDING, APPLY MULCH TO AREAS UNDER HARSH CONDITIONS SUCH AS AREAS THAT HAVE BEEN GRADED, OR THOSE WHICH WILL RECEIVE CONCENTRATED FLOWS. AREAS CONSIDERED TO BE UNDER HARSH CONDITIONS WILL BE CONSIDERED THE AREAS GRADED FOR THE WETLAND VALLEY.
4. RESEED AND MULCH AREAS WHERE SEEDLING EMERGENCE IS LESS THAN 80% COVERAGE, OR WHERE EROSION OCCURS, AS SOON AS POSSIBLE. DO NOT MOW. PROTECT FROM TRAFFIC AS MUCH AS POSSIBLE.

**NOTES**

1. TEMPORARY ANNUAL SEED SELECTION SHOULD BE BASED ON SEASON OF PROJECT INSTALLATION.
2. A SINGLE SPECIES FOR TEMPORARY COVER IS ACCEPTABLE
3. IN SOME CASES WHERE SEASONS OVERLAP, A MIXTURE OF TWO OR MORE SPECIES MAY BE NECESSARY. HOWEVER, APPLICATION RATES SHOULD NOT EXCEED THE TOTAL RECOMMENDED RATE PER ACRE.
4. TEMPORARY SEED SHOULD BE MIXED AND APPLIED SIMULTANEOUSLY WITH THE PERMANENT SEED MIX IF OPTIMAL PLANTING DATES ALLOW.

**PERMANENT SEEDING SCHEDULE:**

**PLANT MATERIAL SELECTION**

1. REFER TO THE TABLES ON THIS SHEET FOR APPROPRIATE SELECTION OF NATIVE PERMANENT SEEDS.
2. PERMANENT SEED MIXTURE SHOULD BE APPLIED USING AN APPLICATION RATE AND METHOD RECOMMENDED BY THE NURSERY.

**SEEDBED PREPARATION**

1. DISTURBED SOILS WITHIN THE RIPARIAN AREAS MUST BE AMMENDED TO PROVIDE AN OPTIMUM ENVIRONMENT FOR SEED GERMINATION AND SEEDLING GROWTH.
2. THE pH OF THE SOIL MUST BE SUCH THAT IT IS NOT TOXIC AND NUTRIENTS ARE AVAILABLE
3. SOIL ANALYSIS SHOULD BE PERFORMED TO DETERMINE NUTRIENT AND LIME NEEDS OF EACH SITE.
4. APPROPRIATE pH LEVELS ARE BETWEEN 5.5 AND 7.0
5. RIPARIAN BUFFERS REGULATED FOR NUTRIENT MANAGEMENT MAY BE LIMITED TO A SINGLE APPLICATION OF FERTILIZER.
6. SUITABLE MECHANICAL MEANS SUCH AS DISKING, RAKING, AND HARROWING MUST BE EMPLOYED TO LOOSEN COMPACTED SOILS PRIOR TO SEEDING.

**PLANTING**

1. APPLY SEED UNIFORMLY WITH A CYCLONE SEEDER, DROP-TYPE SPREADER, DRILL, OR HYDROSEEDER ON A FIRM, FRIABLE SEEDBED.
2. IN FINE SOILS, SEEDS SHOULD BE DRILLED 0.25-0.5 INCHES. IN COARSE SAND SOILS, SEEDS SHOULD BE PLANTED NO MORE THAN 0.75 INCHES.

**MULCH**


1. MULCH ALL PLANTING AREAS IMMEDIATELY AFTER SEEDING.
2. IF PLANTING ON STREAMBANKS STEEPER THAN 10% OR OTHER AREAS SUBJECT TO FLOODING, A BIODEGRADABLE ROLLED EROSION CONTROL PRODUCT IS RECOMMENDED TO HOLD SEED AND SOIL IN PLACE.

**MAINTENANCE**

1. THE RECOMMENDED PERMANENT GRASS SPECIES MAY REQUIRE TWO YEARS FOR ESTABLISHMENT DEPENDING ON SITE CONDITIONS.
2. INSPECT SEEDED AREAS FOR FAILURE AND MAKE NECESSARY REPAIRS, SOIL AMENDMENTS, AND RE-SEEDINGS.
3. IF WEEDY EXOTIC SPECIES HAVE TAKEN OVER AREAS AFTER THE FIRST GROWING SEASON, THE INVASIVE SPECIES MUST BE ERADICATED TO ALLOW STABLE SPECIES TO GROW.
4. MONITORING THE SITE UNTIL LONG-TERM STABILITY HAS BEEN ESTABLISHED.

Temporary Seed (Erosion and Sediment Control)			
Species	Application Rate	Application Date	Notes
<del>Secale cereale (Grain Rye)</del>	<del>130 lbs. per acre</del>	<del>Year-round</del>	<del>Disturbed or stockpile areas</del>
Urochloa ramosa (Brown Top Millet)	40-15 lbs. per acre	May - September	Near stream channels/banks Applied to the entire site

Permanent Seed- Sitewide @ 2 lbs /acre		
Species	Species	Species
Agrostis hyemalis	Desmodium canadense	<del>Lespedeza capitata</del>
<del>Agrostis perennans</del>	Echinacea purpurea	Liatris spicata
Bidens aristosa	Elymus virginicus	Monarda fistulosa
Carex albolutescens	Eupatorium coelestinum	Panicum anceps
Carex lupulina	<del>Eupatorium perfoliatum</del>	Panicum clandestinum
<del>Carex vulpinoidea</del>	Helianthus angustifolius	Rudbeckia hirta
Chamaecrista fasciculata	Heliopsis helianthoides	Senna hebecarpa
Chamaecrista nictitans	Hibiscus moscheutos	Tridens flavus
Coreopsis lanceolata	<del>Juncus effusus</del>	Verbena hastata
Coreopsis tinctoria	<del>Juncus tenuis</del>	
Eupatorium fistulosum	Panicum dichotomiflorum	Panicum rigidulum
Pycnanthemum tenuifolium		

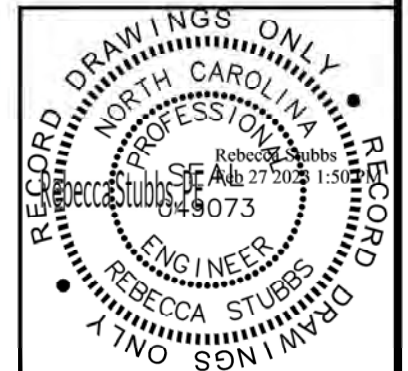

The John R. McAdams Company, Inc.  
2905 Meridian Parkway  
Durham, NC 27713  
  
phone 919. 361. 5000  
fax 919. 361. 2269  
license number: C-0293, C-187  
  
www.mcadamsco.com

**CRANE MITIGATION SITE**  
AS-BUILT DRAWINGS  
LEE COUNTY, NORTH CAROLINA



**PLAN INFORMATION**  
PROJECT NO. 2021110220  
FILENAME L1  
CHECKED BY RAS  
DRAWN BY RHW  
SCALE NTS  
DATE 02.17.2023

**PLANTING AND SEEDING TABLES**  
**L5.01**