

MY00 FINAL MONITORING REPORT

**Dales Creek Restoration Site
Buncombe County, North Carolina
French Broad River Basin - 06010105**

DMS Project #100128

DMS Contract #7910

DMS RFP #16-007724 (Issue Date: November 13, 2018)

USACE AID #: SAW 2019-00834 DWR #: 20190864

Monitoring Data Collected: 2022



Prepared for:

NC Department of Environmental Quality
Division of Mitigation Services
1652 Mail Service Center
Raleigh, NC 27699



Monitoring and Design Firm

Prepared by:



KCI Associates of North Carolina, PC
4505 Falls of Neuse Road
Suite 400
Raleigh, NC 27609
(919) 783-9214

Project Contact: Adam Spiller
Email: adam.spiller@kci.com



MEMORANDUM

Date: September 1, 2022
To: Harry Tsomides, DMS Project Manager
From: Adam Spiller, Project Manager
KCI Associates of North Carolina, PA
Subject: MY-00 Monitoring Report Comments
Dales Creek DMS #7910, Contract 100128
French Broad River Basin CU 06010105
Buncombe County, North Carolina

Please find below our responses in italics to the MY-00 Monitoring Report comments from NCDMS received on August 15, 2022 for the Dales Creek Restoration Site.

1. “As Built Plans” should be labelled as “Record Drawings” or “As-Built Record Drawings” to indicate these are the drawings of record.
KCI Response: “As-Built Plans” have been changed to “As-Built Record Drawings”.
2. A PLS-sealed as built survey is needed for the project.
KCI Response: This has been provided with the final deliverables.
3. Crossing area fencing was not accurately depicted on the as built. Please include the installed fence layer and existing fence layer on the CCPV, as built survey, and record drawings. The installed fence should be a surveyed layer to verify correct placement. Any fencing or features no longer present should not appear on the as built survey.
KCI Response: The surveyed fence layer has been provided with the final deliverables.
4. Planting tables show no deviations from the Mitigation Plan. Please verify that plant species and quantities did not deviate from the approved list. If there is a deviation from the approved planting plan, this should be noted as redline changes to these tables.
KCI Response: There were no deviations from the approved planting plan from the Mitigation Plan.
5. Please remember to include photo stations of the stream/culvert conditions at each of the installed culverts.
KCI Response: Photos of the stream/culvert conditions at each of the installed crossings will be provided starting in MY01.
6. Any hydrologic features for example the wet /grassy swales that was installed to accommodate floodplain drainage from the concrete ring waterer. The waterers should be shown in the survey as well. Please include these features on the as-built, CCPV and include a feature shape file in the digital deliverable.
KCI Response: These features have been included in both the as-built and CCPV.

7. The easement signage that was put on the posts looks hastily installed. The corners are not pinned down and many signs are loose or have been bent haphazardly over the barb wire to get the screws in after the wiring was installed. The screws are not the ideal type as they will rust soon and pop through the holes as the heads are barely bigger than the holes. Recommend that KCI re-evaluate installed signage and update where possible. The frequency of postings along the unfenced segment is appreciated. The fencing itself and the fencepost placements just outside the corner caps look great.

KCI Response: KCI will take this into account on future projects and will replace any signs that fall off over the course of monitoring.

8. Invasives need treating (e.g., oriental bittersweet, princess tree, privet, rose); dense in some areas. When does KCI plan to conduct the next treatment?

KCI Response: Invasives on site were treated on August 23, 2022. KCI will continue to monitor invasives on the site and treat as necessary.

Digital Deliverable Comments:

1. The centerline or thalweg must be submitted with attribute data that includes reach names and breaks.

KCI Response: Reach names have been added to the attribute table of the appropriate shapefiles.

Sincerely,



Adam Spiller
Project Manager

TABLE OF CONTENTS

Project Summary	1
Table 1. Project Mitigation Quantities and Credits.....	1
Current Conditions Planview	2
Table 2. Goals, Performance, and Results	3
Table 3. Project Attributes Table	4
Baseline Conditions	5
References.....	5

Appendix A – Visual Assessment Data

Table 4. Visual Stream Stability Assessment.....	7
Table 5. Visual Vegetation Assessment.....	10
Photo Reference Points	11
Vegetation Plot Photos.....	13

Appendix B – Vegetation Plot Data

Table 6. Vegetation Plot Data.....	15
Table 7. Vegetation Performance Standards Summary Table	16

Appendix C – Stream Geomorphology Data

Table 8. Baseline Stream Data Summary	18
Table 9. Cross-Section Morphology Monitoring Summary	20
Cross-Section Plots	21
Longitudinal Profile Plots	27

Appendix D – Project Timeline and Contact Info

Table 10. Project Timeline.....	31
Table 11. Project Contacts	31

Appendix E – As-Built Plan Sheets




As-Built Plan Sheets	33
----------------------------	----

PROJECT SUMMARY

The Dales Creek Restoration Site (DCRS) was completed in April 2022 and restored and enhanced a total of 3,978 linear feet of stream. The DCRS is a riparian system in the French Broad River Basin (06010105 8-digit cataloging unit) in Buncombe County, North Carolina. The site’s natural hydrologic regime has been substantially modified through livestock impacts and removal of the riparian buffer. This site offers the chance to restore streams impacted by pasture and agriculture to a stable headwater ecosystem with a functional riparian buffer and floodplain access, while also reducing incoming nutrients from livestock. Project planting and construction were completed in April 2022 and the monitoring components were installed in April 2022.

Table 1. Dales Creek Restoration Site (ID-100128) Project Mitigation Quantities and Credits

Project Segment	Original Mitigation Plan Ft/Ac	As-Built Ft/ Ac	Original Mitigation Category	Original Restoration Level	Original Mitigation Ratio (X:1)	Credits	Comments
Stream							
UT1 Reach 1	967	967	Cool	EII	5.00000	193.400	
UT1 Reach 2	332	332	Cool	EII	2.50000	132.800	
UT1 Reach 3	488	478	Cool	EI	1.50000	325.333	
UT1 Reach 4	873	869	Cool	EI	1.50000	582.000	Crossing exception at STA 31+37 to 32+03
UT2	343	343	Cool	EII	2.50000	137.200	
UT3	396	388	Cool	R	1.00000	396.000	Crossing exception at STA 302+79 to 303+43
UT4 Reach 1	56	58	Cool	EII	2.50000	22.400	
UT4 Reach 2	134	134	Cool	EII	5.00000	26.800	
UT5 Reach 1	290	290	Cool	EII	2.50000	116.000	
UT5 Reach 2	99	99	Cool	EII	5.00000	19.800	
					Total:	1,951.733	
Project Credits							
Restoration Level	Stream			Riparian Wetland	Non-Riparian Wetland	Coastal Marsh	
	Warm	Cool	Cold				
Restoration		396.000					
Re-establishment							
Rehabilitation							
Enhancement							
Enhancement I		907.333					
Enhancement II		648.400					
Creation							
Preservation							
Total		1951.733					

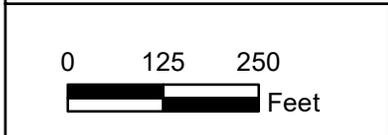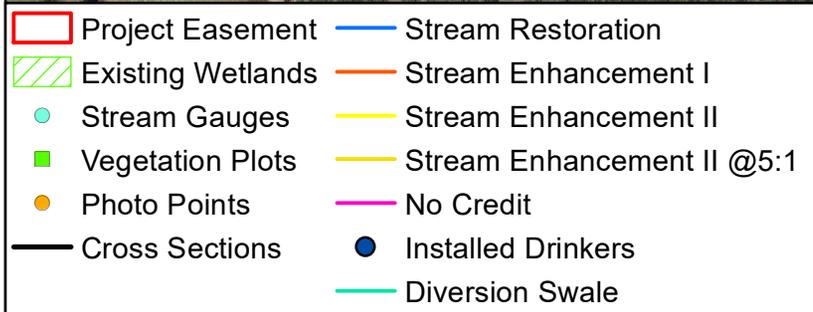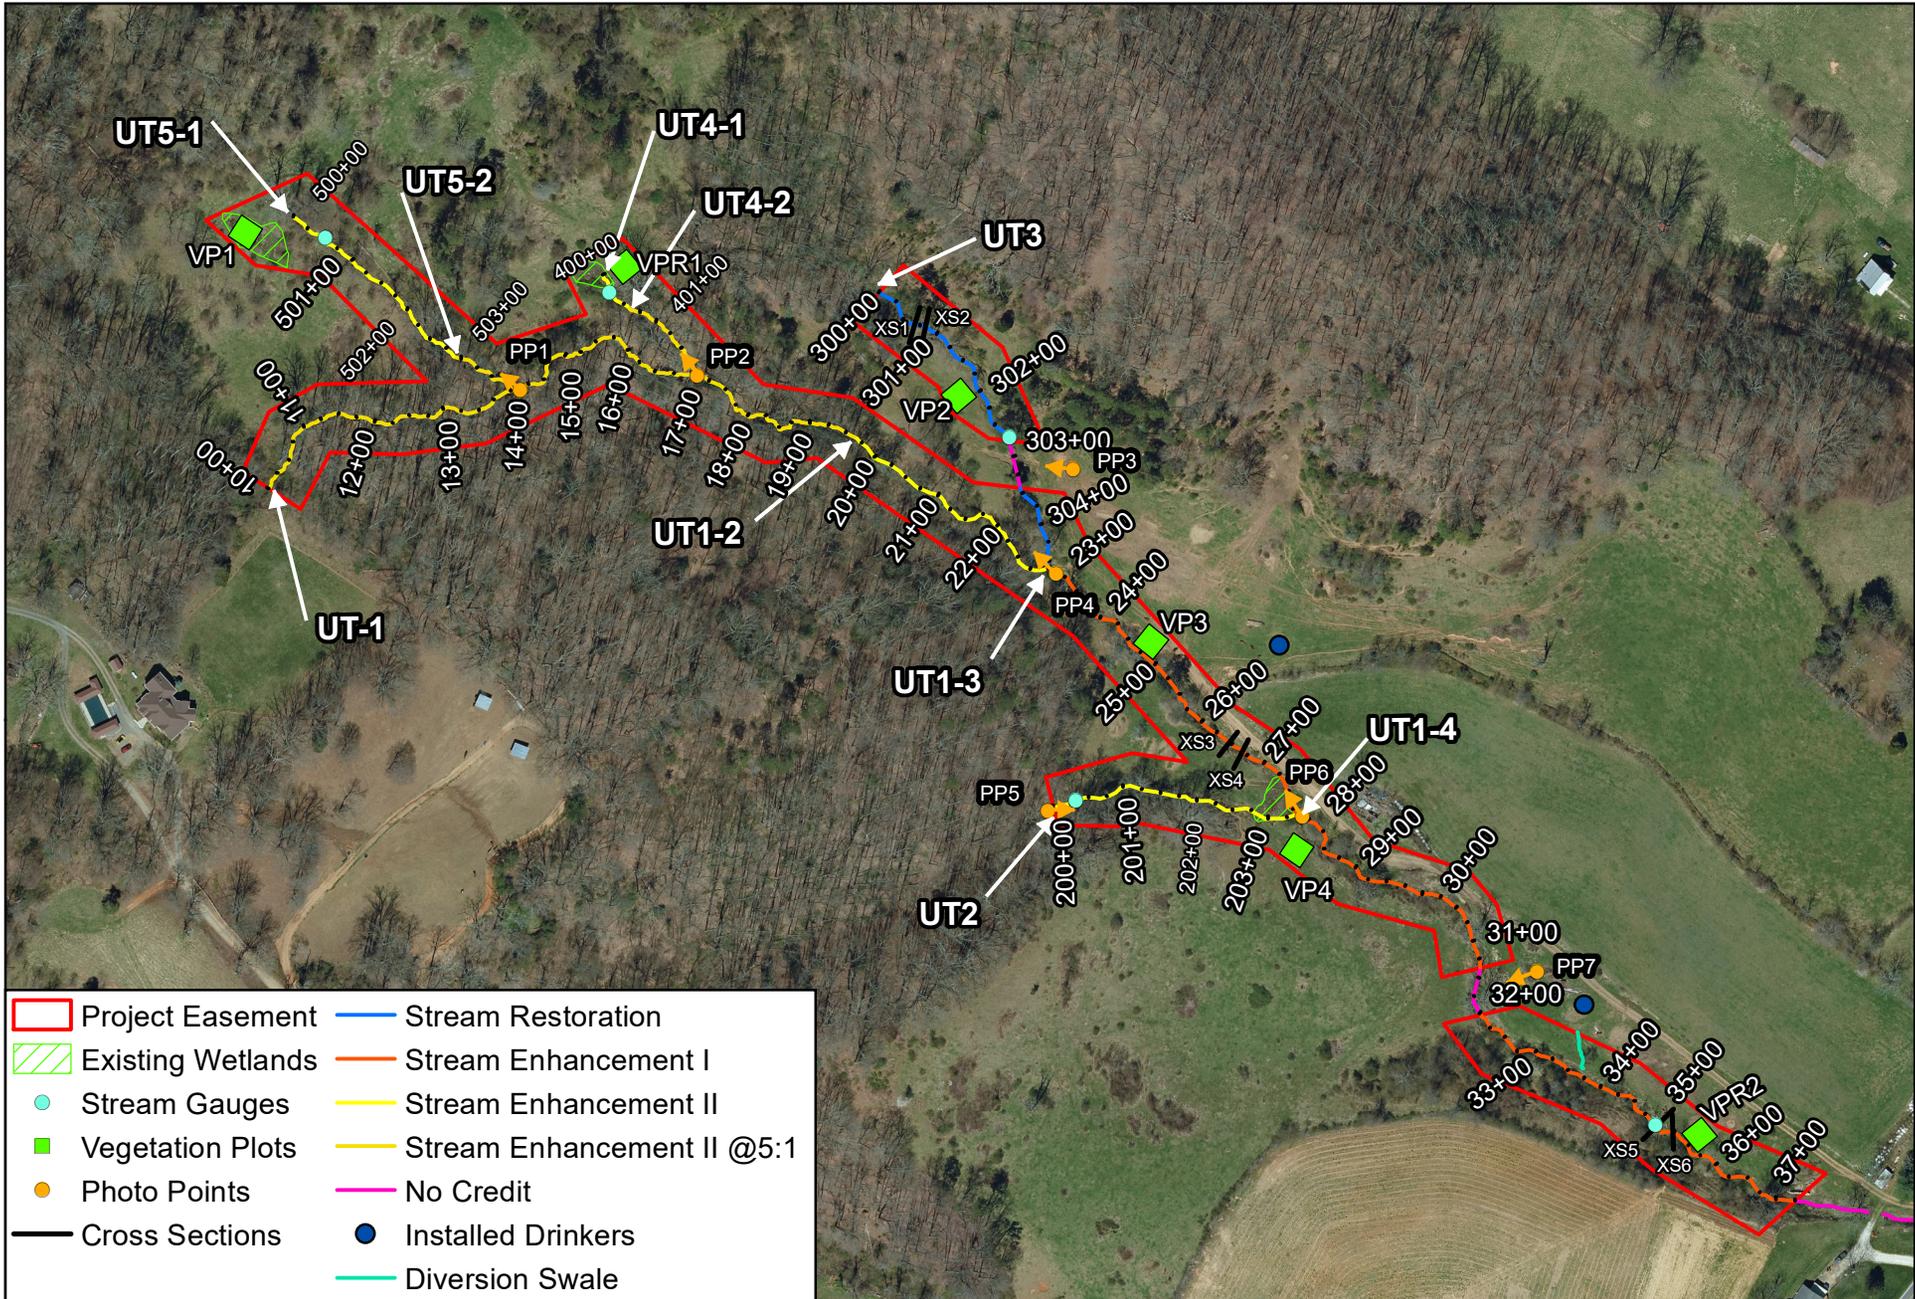

CURRENT CONDITIONS PLAN VIEW
DALES CREEK RESTORATION SITE
BUNCOMBE COUNTY, NC

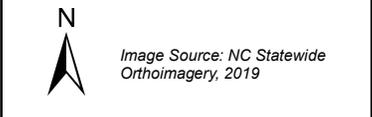


Table 2. Dales Creek Restoration Site (ID-100128) Goals, Performance and Results

Goal	Objective/Treatment	Likely Functional Uplift	Performance Criteria	Measurement	Cumulative Monitoring Results
Restore channelized and livestock impacted streams to stable B-type channels	<ul style="list-style-type: none"> -Relocate or stabilize channelized and/or incised streams to connect to a floodplain or floodprone area -Install a bankfull-sized channel cross-section - Create bedform diversity with pools, riffles, and habitat structures 	Dispersion of high flows on the floodplain, increase in biogeochemical cycling within the system, and recharging of riparian wetlands.	BHR<1.2, ER>2.2, and no change >10% in BHR or ER between monitoring events; 4 bankfull events; continuous flow for at least 30 days each year	6 cross-section surveys, 5 pressure transducer stream gauges (measuring bankfull events on UT1-4 and stream flow on UT2, UT3, UT4, and UT5), annual visual inspection of stream banks and bed	
Restore a forested riparian buffer to provide bank stability filtration and shading	<ul style="list-style-type: none"> -Fence out livestock to reduce nutrient, bacterial, and sediment impacts from adjacent grazing and farming practices to the project tributaries. -Plant the site with native trees and shrubs and a herbaceous seed mix 	Reduction in floodplain sediment inputs from runoff, increased bank stability, increased LWD and organic material in streams.	Survival rate of 320 stems per acre at MY3, 260 planted stems per acre at MY5, and 210 stems per acre at MY7.	6 vegetation monitoring plots, annual visual inspection of fencing and vegetation condition (including vigor and presence of invasive species)	

Table 3. Dales Creek Restoration Site (ID-100128) Project Attribute Table

Project Name	Dales Creek Restoration Site		
County	Buncombe County		
Project Area (acres)	7.692		
Project Coordinates (latitude and longitude decimal degrees)	35.5991°N, -82.7466°W		
Project Watershed Summary Information			
Physiographic Province	Mountain		
River Basin	French Broad		
USGS Hydrologic Unit 8-digit	06010105		
DWR Sub-basin	04/03/02		
Project Drainage Area (acres)	139		
Project Drainage Area Percentage of Impervious Area	<1%		
Land Use Classification	Forest (73%), Pasture/Farmland (26%), and Low-density Residential Development (1%).		
Reach Summary Information			
Parameters	All Reaches Combined		
Pre-project length (feet)	4,114		
Post-project (feet)	4,088		
Valley confinement (Confined, moderately confined, unconfined)	Partially confined to confined		
Drainage area (acres)	139		
Perennial, Intermittent, Ephemeral	Intermittent – Perennial		
NCDWR Water Quality Classification	C		
Dominant Stream Classification (existing)	F4		
Dominant Stream Classification (proposed)	B4a		
Dominant Evolutionary class (Simon) if applicable	Stage IV		
Regulatory Considerations			
Parameters	W1	W2	W3
Pre-project (acres)	0.07	0.03	0.04
Post-project (acres)	0.07	0.03	0.04
Wetland Type (non-riparian, riparian)	Riparian	Riparian	Riparian
Mapped Soil Series	Toecan-Tusquitee Complex	Toecan-Tusquitee Complex	Tate
Soil Hydric Status	Non-hydric	Non-hydric	Non-hydric
Regulatory Considerations			
Parameters	Applicable?	Resolved?	Supporting Docs?
Water of the United States - Section 404	Yes	Yes	SAW-2019-00834
Water of the United States - Section 401	Yes	Yes	DWR# 19-0864
Endangered Species Act	Yes	Yes	USFWS
Historic Preservation Act	No	N/A	NCSHPO
Coastal Zone Management Act (CZMA or CAMA)	No	N/A	N/A
Essential Fisheries Habitat	No	N/A	N/A

BASELINE CONDITIONS

The site was planted in April 2022. The baseline vegetation monitoring was conducted on April 27, 2022. All six vegetation monitoring plots had greater than 320 stems/acre and at least four native species. Baseline monitoring was conducted during dormancy, so some of the stems were not identified to species. During MY01, these trees will be identified to species.

The baseline longitudinal profile and cross-sections were surveyed in April 2022. The baseline survey found that the stream was constructed as designed and all structures were installed as planned with one small exception. A small section of UT3 (approximately STA 301+75) was realigned to better fit the onsite conditions. The profile and cross-section survey found that the dimension and profile of the stream are as designed, with some small variation as is typical for stream restoration projects.

REFERENCES

- NCDENR, Ecosystem Enhancement Program. 2009. French Broad River Basin Restoration Priorities 2009. Raleigh, NC. <https://deq.nc.gov/media/8060/download>
- NCDEQ, Division of Mitigation Services. June 2017. "As-built Baseline Monitoring Report Format, Data and Content Requirement."
https://files.nc.gov/ncdeq/Mitigation%20Services/Document%20Management%20Library/Guidance%20and%20Template%20Documents/6_AB_Baseline_Rep_Templ_June%202017.pdf
- NCIRT. October 24, 2016. "Wilmington District Stream and Wetland Compensatory Mitigation Update." <https://saw-reg.usace.army.mil/PN/2016/Wilmington-District-Mitigation-Update.pdf>
- USACE, Sprecher, S. W.; Warne, A. G. 2000. "Accessing and Using Meteorological Data to Evaluate Wetland Hydrology."
<https://ntrl.ntis.gov/NTRL/dashboard/searchResults/titleDetail/ADA378910.xhtml>

APPENDIX A

Visual Assessment Data

Table 4. Dales Creek Resotration Site (ID-100128) Visual Stream Stability Assessment

Reach UT1 Reach 3
 Assessed Stream Length 488
 Assessed Bank Length 976

Major Channel Category		Metric	Number Stable, Performing as Intended	Total Number in As-built	Amount of Unstable Footage	% Stable, Performing as Intended
Bank	Surface Scour/Bare Bank	Bank lacking vegetative cover resulting simply from poor growth and/or surface scour			0	100%
	Toe Erosion	Bank toe eroding to the extent that bank failure appears likely. Does <u>NOT</u> include undercuts that are modest, appear sustainable and are providing habitat.			0	100%
	Bank Failure	Fluvial and geotechnical - rotational, slumping, calving, or collapse			0	100%
Totals					0	100%
Structure	Grade Control	Grade control structures exhibiting maintenance of grade across the sill.	4	4		100%
	Bank Protection	Bank erosion within the structures extent of influence does <u>not</u> exceed 15%. (See guidance for this table in DMS monitoring guidance document)	4	4		100%

Table 4. Dales Creek Resotration Site (ID-100128) Visual Stream Stability Assessment

Reach UT1 Reach 4
 Assessed Stream Length 873
 Assessed Bank Length 1746

Major Channel Category		Metric	Number Stable, Performing as Intended	Total Number in As-built	Amount of Unstable Footage	% Stable, Performing as Intended
Bank	Surface Scour/Bare Bank	Bank lacking vegetative cover resulting simply from poor growth and/or surface scour			0	100%
	Toe Erosion	Bank toe eroding to the extent that bank failure appears likely. Does <u>NOT</u> include undercuts that are modest, appear sustainable and are providing habitat.			0	100%
	Bank Failure	Fluvial and geotechnical - rotational, slumping, calving, or collapse			0	100%
Totals					0	100%
Structure	Grade Control	Grade control structures exhibiting maintenance of grade across the sill.	N/A	N/A		N/A
	Bank Protection	Bank erosion within the structures extent of influence does <u>not</u> exceed 15%. (See guidance for this table in DMS monitoring guidance document)	N/A	N/A		N/A

Table 4. Dales Creek Restoration Site (ID-100128) Visual Stream Stability Assessment

Reach UT3
 Assessed Stream Length 396
 Assessed Bank Length 792

Major Channel Category		Metric	Number Stable, Performing as Intended	Total Number in As-built	Amount of Unstable Footage	% Stable, Performing as Intended
Bank	Surface Scour/Bare Bank	Bank lacking vegetative cover resulting simply from poor growth and/or surface scour			0	100%
	Toe Erosion	Bank toe eroding to the extent that bank failure appears likely. Does <u>NOT</u> include undercuts that are modest, appear sustainable and are providing habitat.			0	100%
	Bank Failure	Fluvial and geotechnical - rotational, slumping, calving, or collapse			0	100%
Totals					0	100%
Structure	Grade Control	Grade control structures exhibiting maintenance of grade across the sill.	1	1		100%
	Bank Protection	Bank erosion within the structures extent of influence does <u>not</u> exceed 15%. (See guidance for this table in DMS monitoring guidance document)	1	1		100%

Table 5. Dales Creek Restoration Site (ID-100128) Visual Vegetation Assessment

Planted acreage

4.11

Vegetation Category	Definitions	Mapping Threshold	Combined Acreage	% of Planted Acreage
Bare Areas	Very limited cover of both woody and herbaceous material.	0.10 acres	0.00	0.0%
Low Stem Density Areas	Woody stem densities clearly below target levels based on current MY stem count criteria.	0.10acres	0.00	0.0%
Total			0.00	0.0%
Areas of Poor Growth Rates	Planted areas where average height is not meeting current MY Performance Standard.	0.10 acres	0.00	0.0%
Cumulative Total			0.00	0.0%

Easement Acreage

7.69

Vegetation Category	Definitions	Mapping Threshold	Combined Acreage	% of Easement Acreage
Invasive Areas of Concern	Invasives may occur outside of planted areas and within the easement and will therefore be calculated against the total easement acreage. Include species with the potential to directly outcompete native, young, woody stems in the short-term or community structure for existing communities. Species included in summation above should be identified in report summary.	0.10 acres	*	#VALUE!
Easement Encroachment Areas	Encroachment may be point, line, or polygon. Encroachment to be mapped consists of any violation of restrictions specified in the conservation easement. Common encroachments are mowing, cattle access, vehicular access. Encroachment has no threshold value as will need to be addressed regardless of impact area.	none	# Encroachments noted	

*Invasive mapping was not performed in MY00. Invasive species were treated on August 23, 2022, after the visual assessment was performed. Full mapping of any remaining invasive species will begin in MY01.

Photo Reference Photos



PP1 – MY-00 – 4/27/22



PP2 – MY-00 – 4/27/22



PP3 – MY-00 – 4/27/22



PP4 – MY-00 – 4/27/22



PP5 – MY-00 – 4/27/22



PP6 – MY-00 – 4/27/22



PP7 – MY-00 – 4/27/22

Vegetation Monitoring Plot Photos



Vegetation Plot 1 – MY-00 – 7/14/22*



Vegetation Plot 2 – MY-00 – 4/27/22



Vegetation Plot 3 – MY-00 – 4/27/22



Vegetation Plot 4 – MY-00 – 4/27/22



Vegetation Plot R1 – MY-00 – 4/27/22



Vegetation Plot R2 – MY-00 - 4/27/22

*Photo taken 7/14/22, plot data collected 5/2/22

APPENDIX B

Vegetation Plot Data

Table 6. Vegetation Plot Data
Dales Creek Restoration Site (ID-100128)

	Scientific Name	Common Name	Tree/Shrub	Indicator Status	Veg Plot 1 F		Veg Plot 2 F		Veg Plot 3 F		Veg Plot 4 F		Veg Plot 1 R	Veg Plot 2 R
					Planted	Total	Planted	Total	Planted	Total	Planted	Total	Total	Total
Species Included in Approved Mitigation Plan	<i>Aesculus flava</i>	yellow buckeye	Tree	FACU					3	3	2	2	3	5
	<i>Alnus serrulata</i>	hazel alder	Tree	FACW	2	2								
	<i>Betula lenta</i>	sweet birch	Tree	FACU	3	3	2	2	2	2	3	3	5	
	<i>Carpinus caroliniana</i>	American hornbeam	Tree	FAC	4	4								
	<i>Carya sp.</i>	hickory	Tree								1	1		
	<i>Cornus amomum</i>	silky dogwood	Shrub	FACW	9	9								
	<i>Liriodendron tulipifera</i>	tuliptree	Tree	FACU			4	4			2	2	2	3
	other	unknown	Tree				4	4	13	13	3	3	6	
	<i>Platanus occidentalis</i>	American sycamore	Tree	FACW			4	4	1	1	1	1		2
	<i>Quercus falcata</i>	southern red oak	Tree	FACU							1	1		
	<i>Quercus rubra</i>	northern red oak	Tree	FACU									1	
<i>Quercus sp.</i>	oak	Tree				7	7	5	5	9	9	9	7	
Sum	Performance Standard				18	18	21	21	24	24	22	22	26	17
Mitigation Plan Performance Standard	Current Year Stem Count				18		21		24		22		26	17
	Stems/Acre				729		850		931		891		1052	688
	Species Count				4		5		5		8		6	4
	Dominant Species Composition (%)				50		33		54		41		35	41
	Average Plot Height (ft.)				2		1		1		1		1	1
% Invasives				0		0		0		0		0	0	
Post Mitigation Plan Performance	Current Year Stem Count				18		21		24		22		26	17
	Stems/Acre				729		850		931		891		1052	688
	Species Count				4		5		5		8		6	4
	Dominant Species Composition (%)				50		33		54		41		35	41

- 1). Bolded species are proposed for the current monitoring year, italicized species are not approved, and a regular font indicates that the species has been approved.
- 2). The "Species Included in Approved Mitigation Plan" section contains only those species that were included in the original approved mitigation plan. The "Post Mitigation Plan Species" section includes species that are being proposed through a mitigation plan addendum for the current monitoring year (bolded), species that have been approved in prior monitoring years through a mitigation plan addendum (regular font), and species that are not approved (italicized).
- 3). The "Mitigation Plan Performance Standard" section is derived only from stems included in the original mitigation plan, whereas the "Post Mitigation Plan Performance Standard" includes data from mitigation plan approved, post mitigation plan approved, and proposed stems.

Planted Acreage	4.11
Date of Initial Plant	4/11/2022
Date(s) of Supplemental Plant(s)	
Date(s) Mowing	
Date of Current Survey	4/27/2022
Plot size (ACRES)	0.0247

Table 7. Vegetation Performance Standards Summary Table
Dales Creek Restoration Site (ID-100128)

Vegetation Performance Standards Summary Table												
	Veg Plot 1 F				Veg Plot 2 F				Veg Plot 3 F			
	Stems/Ac.	Av. Ht. (ft)	# Species	% Invasives	Stems/Ac.	Av. Ht. (ft)	# Species	% Invasives	Stems/Ac.	Av. Ht. (ft)	# Species	% Invasives
Monitoring Year 7												
Monitoring Year 5												
Monitoring Year 3												
Monitoring Year 2												
Monitoring Year 1												
Monitoring Year 0	729	2	4	0	850	1	5	0	931	1	5	0
	Veg Plot Group 4 F				Veg Plot Group 1 R				Veg Plot Group 2 R			
	Stems/Ac.	Av. Ht. (ft)	# Species	% Invasives	Stems/Ac.	Av. Ht. (ft)	# Species	% Invasives	Stems/Ac.	Av. Ht. (ft)	# Species	% Invasives
Monitoring Year 7												
Monitoring Year 5												
Monitoring Year 3												
Monitoring Year 2												
Monitoring Year 1												
Monitoring Year 0	891	1	8	0	1052	1	6	0	688	1	4	0

APPENDIX C

Stream Geomorphology Data

**Table 8. Baseline Stream Data Summary
Dales Creek, UT1 Reach 3**

Parameter	Pre-Existing Condition (if applicable)					Design		Monitoring Baseline (MY0)		
	Min	Mean	Med	Max	n	Min	Max	Min	Max	n
Riffle Only										
Bankfull Width (ft)	4.6			22.2	2	6.8		4.9		1
Floodprone Width (ft)	8.9			26.0	2	18.3		11.7		1
Bankfull Mean Depth (ft)	0.3			0.8	2	0.5		0.3		1
Bankfull Max Depth (ft)	0.4			1.2	2	0.8		0.6		1
Bankfull Cross Sectional Area (ft ²)	3.5			6.3	2	3.4		1.7		1
Width/Depth Ratio	6.0			77.7	2	13.5		14.7		1
Entrenchment Ratio	1.2			2.0	2	2.7		2.4		1
Bank Height Ratio	1.7			3.8	2	1.0		1.0		1
Max part size (mm) mobilized at bankfull	151					111		74		
Rosgen Classification	G4/B4a					B4a		B4a		
Bankfull Discharge (cfs)	24.5					24.7		24.7		
Sinuosity (ft)	1.1					1.1		1.1		
Water Surface Slope (Channel) (ft/ft)	0.074					0.074		0.075		
Other										

**Table 8. Baseline Stream Data Summary
Dales Creek, UT1 Reach 4**

Parameter	Pre-Existing Condition (if applicable)					Design		Monitoring Baseline (MY0)		
	Min	Mean	Med	Max	n	Min	Max	Min	Max	n
Riffle Only										
Bankfull Width (ft)	5.1	6.9	7.3	7.8	4	8.0		8.6		1
Floodprone Width (ft)	10.1	13.3	12.8	17.4	4	20		27.9		1
Bankfull Mean Depth (ft)	0.5	0.7	0.7	0.8	4	0.6		0.9		1
Bankfull Max Depth (ft)	1.0	1.1	1.1	1.1	4	0.9		1.4		1
Bankfull Cross Sectional Area (ft ²)	3.8	3.4	4.2	5.3	4	4.8		7.8		1
Width/Depth Ratio	6.3	11.2	11.2	16.1	4	13.2		9.5		1
Entrenchment Ratio	1.4	2.0	1.9	2.6	4	2.5		3.2		1
Bank Height Ratio	1.0	2.4	1.4	6.0	4	1.0		1.0		1
Max part size (mm) mobilized at bankfull	79					84		121		
Rosgen Classification	G4/B4a					B4a		B4a		
Bankfull Discharge (cfs)	27.7					31.2		31.2		
Sinuosity (ft)	1.1					1.1		1.1		
Water Surface Slope (Channel) (ft/ft)	0.048					0.048		0.047		
Other										

**Table 8. Baseline Stream Data Summary
Dales Creek, UT3**

Parameter	Pre-Existing Condition (if applicable)					Design		Monitoring Baseline (MY0)		
	Min	Mean	Med	Max	n	Min	Max	Min	Max	n
Riffle Only										
Bankfull Width (ft)	2.0	3.4	2.9	6.3	5	5.0		4.7		1
Floodprone Width (ft)	3.0	6.2	5.5	12.6	5	15.5		18.7		1
Bankfull Mean Depth (ft)	0.3	0.4	0.4	0.5	5	0.4		0.5		1
Bankfull Max Depth (ft)	0.4	0.6	0.6	0.8	5	0.6		0.9		1
Bankfull Cross Sectional Area (ft ²)	1.0	1.2	1.2	1.6	5	1.9		2.3		1
Width/Depth Ratio	3.8	10.0	7.1	24.6	5	13.5		9.5		1
Entrenchment Ratio	1.2	1.9	1.6	3.3	5	3.1		4.0		1
Bank Height Ratio	1.0	2.4	1.9	4.9	5	1.0		1.0		1
Max part size (mm) mobilized at bankfull	100					115		147		
Rosgen Classification	G4					B4a		B4a		
Bankfull Discharge (cfs)	6.6					12.9		12.9		
Sinuosity (ft)	1.1					1.1		1.1		
Water Surface Slope (Channel) (ft/ft)	0.104					0.105		0.108		
Other										

Table 9. Cross-section Morphology Monitoring Summary
Dales Creek Restoration Site (ID-100128)

	Cross Section 1 (Riffle - UT3)							Cross Section 2 (Pool - UT3)						
	MY0	MY1	MY2	MY3	MY5	MY7	MY+	MY0	MY1	MY2	MY3	MY5	MY7	MY+
Bankfull Elevation (ft) - Based on AB-Bankfull Area	2356.7							2355.3						
Bank Height Ratio - Based on AB Bankfull Area	1.0							---						
Thalweg Elevation	2355.8							2354.5						
LTOB Elevation	2356.7							2355.3						
LTOB Max Depth (ft)	0.9							0.9						
LTOB Cross Sectional Area (ft ²)	2.3							2.8						
	Cross Section 3 (Riffle - UT1-3)							Cross Section 4 (Pool - UT1-3)						
	MY0	MY1	MY2	MY3	MY5	MY7	MY+	MY0	MY1	MY2	MY3	MY5	MY7	MY+
Bankfull Elevation (ft) - Based on AB-Bankfull Area	2286.9							2285.8						
Bank Height Ratio - Based on AB Bankfull Area	1.0							---						
Thalweg Elevation	2286.3							2284.8						
LTOB Elevation	2286.9							2285.8						
LTOB Max Depth (ft)	0.6							1.1						
LTOB Cross Sectional Area (ft ²)	1.7							3.0						
	Cross Section 5 (Riffle - UT1-4)							Cross Section 6 (Pool - UT1-4)						
	MY0	MY1	MY2	MY3	MY5	MY7	MY+	MY0	MY1	MY2	MY3	MY5	MY7	MY+
Bankfull Elevation (ft) - Based on AB-Bankfull Area	2242.6							2241.4						
Bank Height Ratio - Based on AB Bankfull Area	1.0							---						
Thalweg Elevation	2241.2							2240.6						
LTOB Elevation	2242.6							2241.4						
LTOB Max Depth (ft)	1.4							0.7						
LTOB Cross Sectional Area (ft ²)	7.8							2.8						


Cross-Section Plots

River Basin:	French Broad
Site:	Dales Creek
XS ID	XS1
Drainage Area (sq mi):	0.02
Date:	4/28/2022
Field Crew:	TS, KB



Station	Elevation
0.0	2358.72
0.1	2358.51
2.2	2358.26
2.8	2357.98
3.6	2357.76
4.8	2357.36
6.1	2356.95
6.6	2356.83
7.6	2356.99
8.5	2356.90
9.3	2356.73
10.0	2356.57
10.6	2356.42
10.8	2356.00
11.1	2355.89
11.5	2355.81
12.0	2355.81
12.3	2355.93
13.0	2356.14
13.3	2356.44
14.2	2356.80
14.7	2357.00
15.5	2357.02
17.1	2357.11
18.3	2357.02
19.8	2357.39
21.0	2357.38
22.4	2357.58
25.1	2358.54
26.2	2358.70
27.1	2358.94
28.1	2359.01
28.1	2359.26

SUMMARY DATA	
Bankfull Elevation (ft) - Based on AB-Bankfull Area	2356.731
Bankfull Cross-Sectional Area:	2.3
LTOB Cross-Sectional Area:	2.3
Bankfull Width:	4.7
Flood Prone Area Elevation:	2357.66
Flood Prone Width:	18.7
LTOB Max Depth	0.9
LTOB Mean Depth	0.5
W / D Ratio:	9.5
Entrenchment Ratio:	4.0
Bank Height Ratio:	1.0
Thalweg Elevation:	2355.81

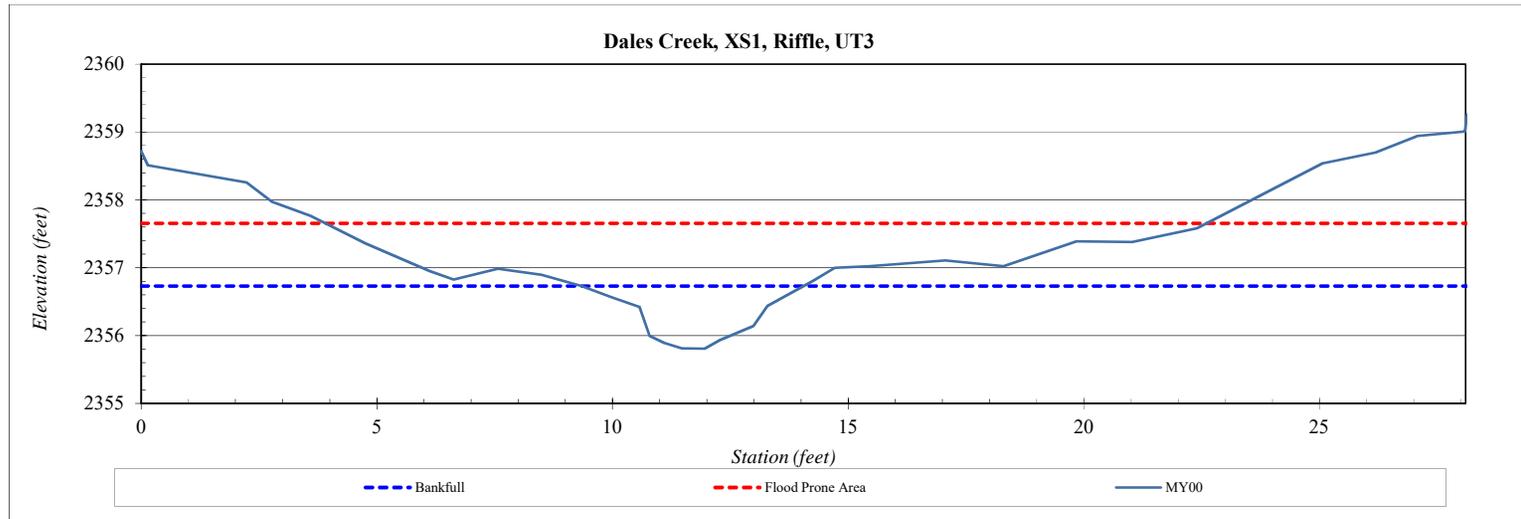


Cross-Section Plots

River Basin:	French Broad
Site:	Dales Creek
XS ID	XS2
Drainage Area (sq mi):	0.02
Date:	4/28/2022
Field Crew:	TS, KB



Station	Elevation
0.0	2357.99
0.2	2357.72
2.3	2357.27
3.2	2356.67
4.4	2356.03
5.1	2355.77
6.1	2355.72
7.5	2355.66
8.5	2355.55
9.3	2355.32
9.8	2354.97
10.4	2354.77
10.7	2354.74
11.4	2354.46
11.5	2354.68
12.3	2354.71
12.9	2354.67
13.5	2354.82
14.3	2354.98
15.2	2355.53
15.7	2355.75
16.6	2355.70
17.8	2355.80
18.7	2355.87
20.2	2355.77
21.3	2355.91
22.1	2356.37
23.3	2356.30
26.0	2356.99
28.3	2356.99
30.5	2357.07
30.5	2357.34

SUMMARY DATA	
Bankfull Elevation (ft) - Based on AB-Bankfull Area	2355.55
Bankfull Cross-Sectional Area:	4.2
LTOB Cross-Sectional Area:	4.2
Bankfull Width:	6.8
Flood Prone Area Elevation:	---
Flood Prone Width:	---
LTOB Max Depth	1.1
LTOB Mean Depth	0.6
W / D Ratio:	---
Entrenchment Ratio:	---
Bank Height Ratio:	---
Thalweg Elevation:	2354.46

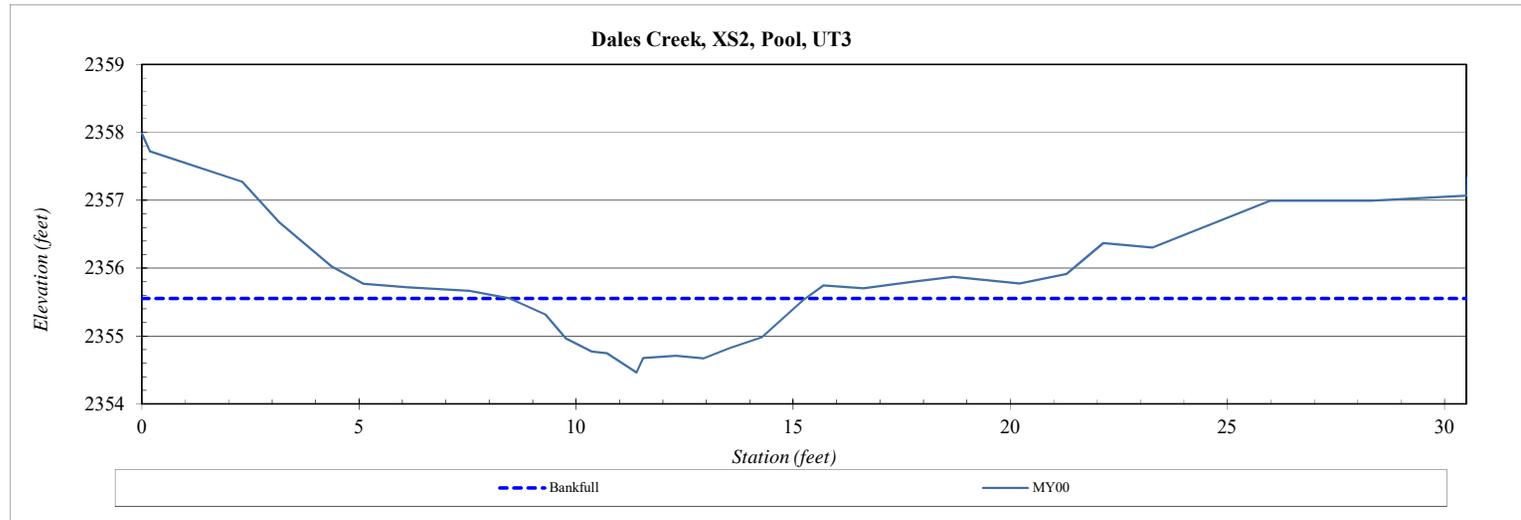


Cross-Section Plots

River Basin:	French Broad
Site:	Dales Creek
XS ID	XS3
Drainage Area (sq mi):	0.15
Date:	4/28/2022
Field Crew:	TS, KB



Station	Elevation
0.0	2292.87
0.1	2292.50
2.9	2292.00
4.6	2290.89
7.6	2289.36
9.9	2288.25
11.2	2287.93
13.2	2287.59
14.5	2287.43
15.7	2287.46
16.1	2287.44
16.6	2287.19
17.5	2286.79
17.9	2286.67
18.2	2286.50
18.3	2286.42
18.9	2286.48
19.6	2286.30
20.1	2286.40
20.8	2286.33
21.2	2286.57
21.3	2286.60
21.7	2286.64
22.3	2286.85
22.9	2286.85
24.3	2286.71
25.6	2286.84
27.3	2287.10
28.8	2287.91
30.8	2289.05
33.2	2290.66
35.0	2292.03
37.3	2293.31
38.9	2293.90
41.0	2294.16
43.6	2294.45

SUMMARY DATA	
Bankfull Elevation (ft) - Based on AB-Bankfull Area	2286.85
Bankfull Cross-Sectional Area:	1.7
LTOB Cross-Sectional Area:	1.7
Bankfull Width:	4.9
Flood Prone Area Elevation:	2287.41
Flood Prone Width:	11.7
LTOB Max Depth	0.6
LTOB Mean Depth	0.3
W / D Ratio:	14.7
Entrenchment Ratio:	2.4
Bank Height Ratio:	1.0
Thalweg Elevation:	2286.30

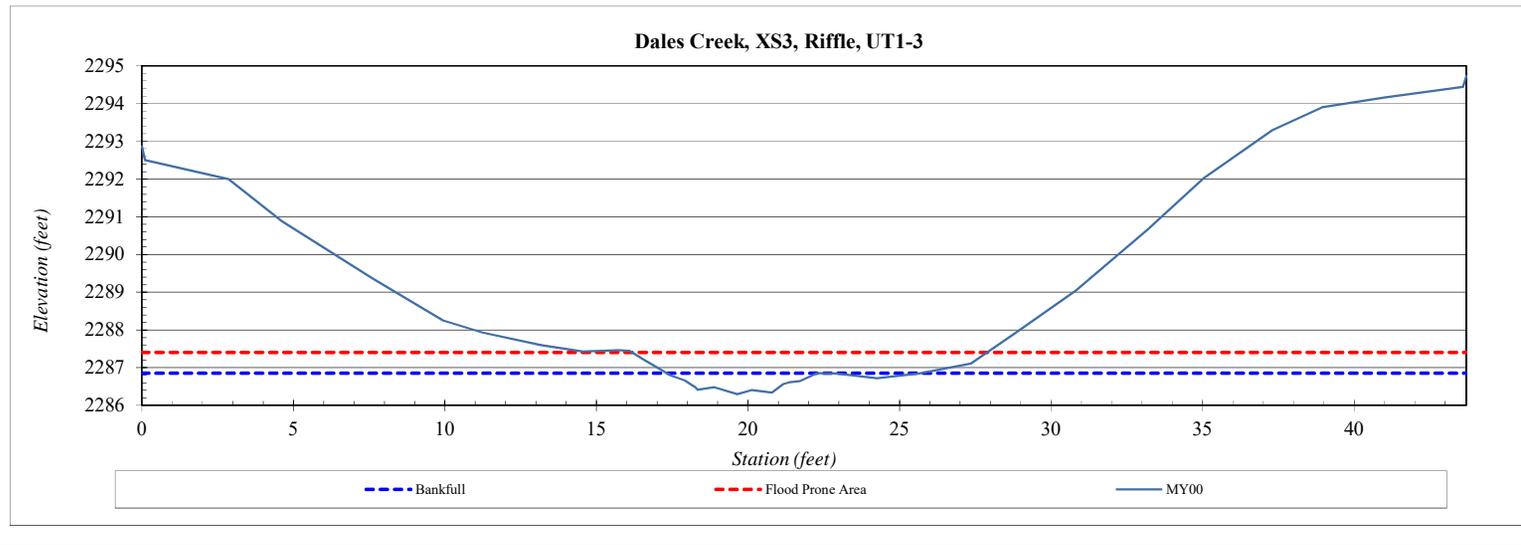


Cross-Section Plots

River Basin:	French Broad
Site:	Dales Creek
XS ID	XS4
Drainage Area (sq mi):	0.15
Date:	4/28/2022
Field Crew:	TS, KB



Station	Elevation
0.0	2292.14
0.2	2291.66
2.6	2291.23
5.4	2290.43
6.7	2289.87
8.7	2289.46
10.4	2289.39
11.1	2288.97
13.3	2287.58
14.6	2286.98
15.7	2287.02
16.1	2286.28
16.5	2285.96
17.2	2285.05
17.8	2285.02
18.3	2284.79
18.8	2284.81
19.3	2285.01
19.7	2285.04
20.0	2285.15
20.6	2285.85
21.2	2285.87
22.9	2286.04
25.1	2286.24
26.7	2286.44
28.4	2287.13
29.9	2287.67
31.8	2288.57
33.8	2289.64
37.2	2291.36
39.2	2292.20
41.3	2293.21
42.3	2293.28
45.1	2293.31
45.2	2293.67

SUMMARY DATA	
Bankfull Elevation (ft) - Based on AB-Bankfull Area	2285.85
Bankfull Cross-Sectional Area:	3.0
LTOB Cross-Sectional Area:	3.0
Bankfull Width:	4.0
Flood Prone Area Elevation:	---
Flood Prone Width:	---
LTOB Max Depth	1.1
LTOB Mean Depth	0.7
W / D Ratio:	---
Entrenchment Ratio:	---
Bank Height Ratio:	---
Thalweg Elevation:	2284.79

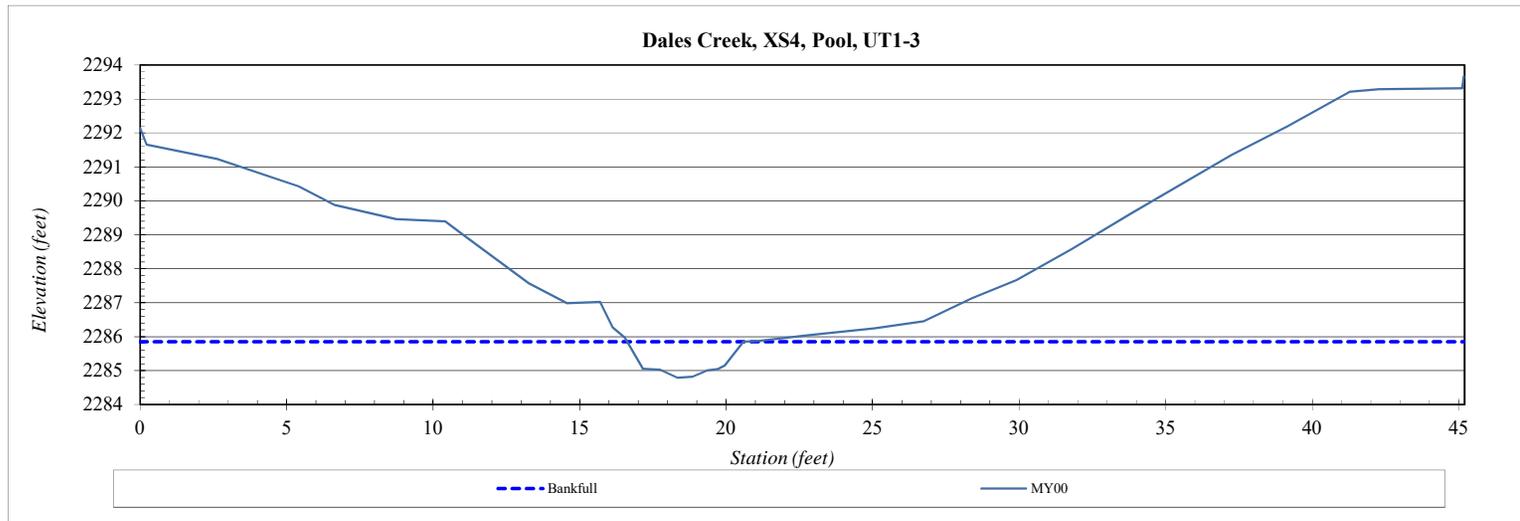


Cross-Section Plots

River Basin:	French Broad
Site:	Dales Creek
XS ID	XS5
Drainage Area (sq mi):	0.22
Date:	4/28/2022
Field Crew:	TS, KB



Station	Elevation
0.0	2243.59
0.0	2243.25
2.8	2243.10
7.1	2242.98
10.4	2242.74
12.6	2242.77
13.2	2242.55
13.6	2242.63
14.2	2242.35
14.8	2242.04
15.5	2241.83
16.0	2241.48
16.3	2241.21
16.9	2241.20
17.8	2241.20
18.7	2241.37
19.3	2241.36
20.0	2241.47
21.4	2242.32
22.2	2242.61
22.7	2242.84
23.1	2242.76
24.2	2242.88
25.9	2242.96
26.6	2243.36
27.6	2243.84
29.3	2245.06
30.2	2245.20
30.3	2245.57

SUMMARY DATA	
Bankfull Elevation (ft) - Based on AB-Bankfull Area	2242.63
Bankfull Cross-Sectional Area:	7.8
LTOB Cross-Sectional Area:	7.8
Bankfull Width:	8.6
Flood Prone Area Elevation:	2244.07
Flood Prone Width:	27.9
LTOB Max Depth	1.4
LTOB Mean Depth	0.9
W / D Ratio:	9.5
Entrenchment Ratio:	3.2
Bank Height Ratio:	1.0
Thalweg Elevation:	2241.20

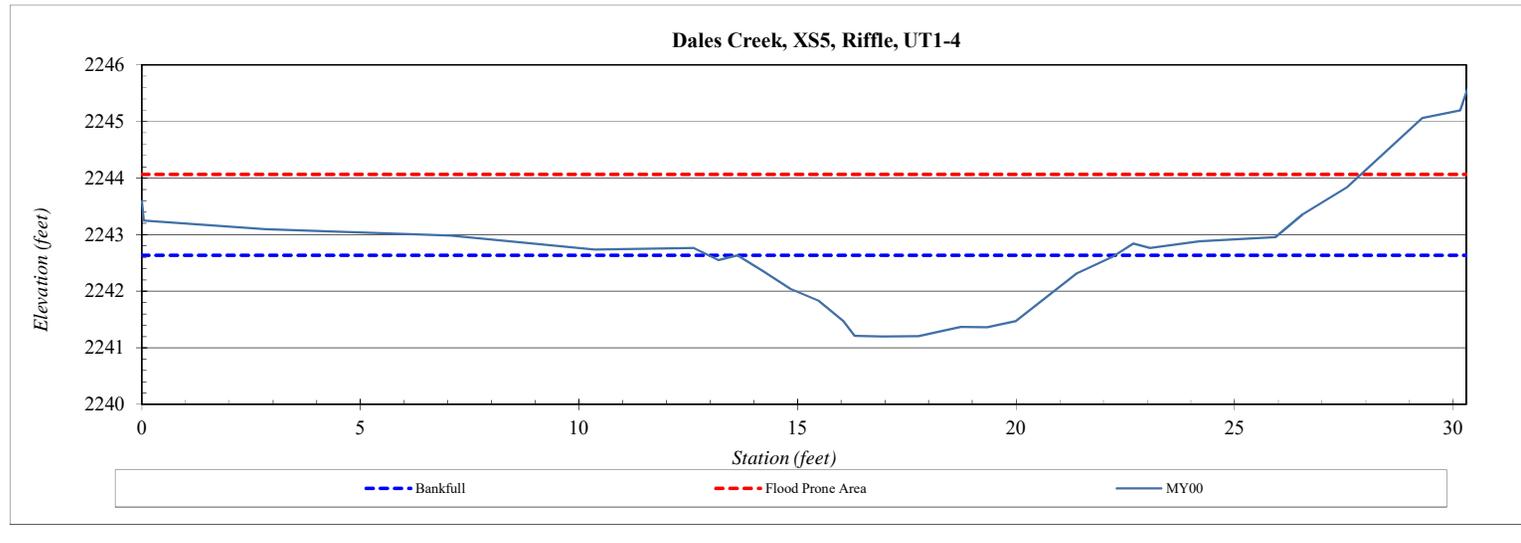


Cross-Section Plots

River Basin:	French Broad
Site:	Dales Creek
XS ID	XS6
Drainage Area (sq mi):	0.22
Date:	4/28/2022
Field Crew:	TS, KB




Station	Elevation
0.0	2243.59
0.0	2243.30
2.5	2243.10
6.2	2242.95
8.2	2242.84
9.8	2242.59
11.4	2242.57
11.8	2242.55
12.4	2242.32
13.2	2241.89
14.1	2241.34
14.5	2241.19
14.8	2240.95
15.3	2240.66
15.7	2240.65
16.1	2240.65
16.5	2240.83
16.9	2240.84
17.5	2240.94
18.0	2240.93
18.8	2241.00
19.5	2241.03
20.2	2241.39
20.9	2241.40
22.6	2241.43
25.1	2241.47
27.7	2241.68
31.0	2241.44
34.1	2241.53
36.1	2241.81
36.9	2241.91
38.2	2242.25
39.7	2242.45
39.8	2242.89


SUMMARY DATA	
Bankfull Elevation (ft) - Based on AB-Bankfull Area	2241.39
Bankfull Cross-Sectional Area:	2.8
LTOB Cross-Sectional Area:	2.8
Bankfull Width:	6.2
Flood Prone Area Elevation:	---
Flood Prone Width:	---
LTOB Max Depth	0.7
LTOB Mean Depth	0.4
W / D Ratio:	---
Entrenchment Ratio:	---
Bank Height Ratio:	---
Thalweg Elevation:	2240.65

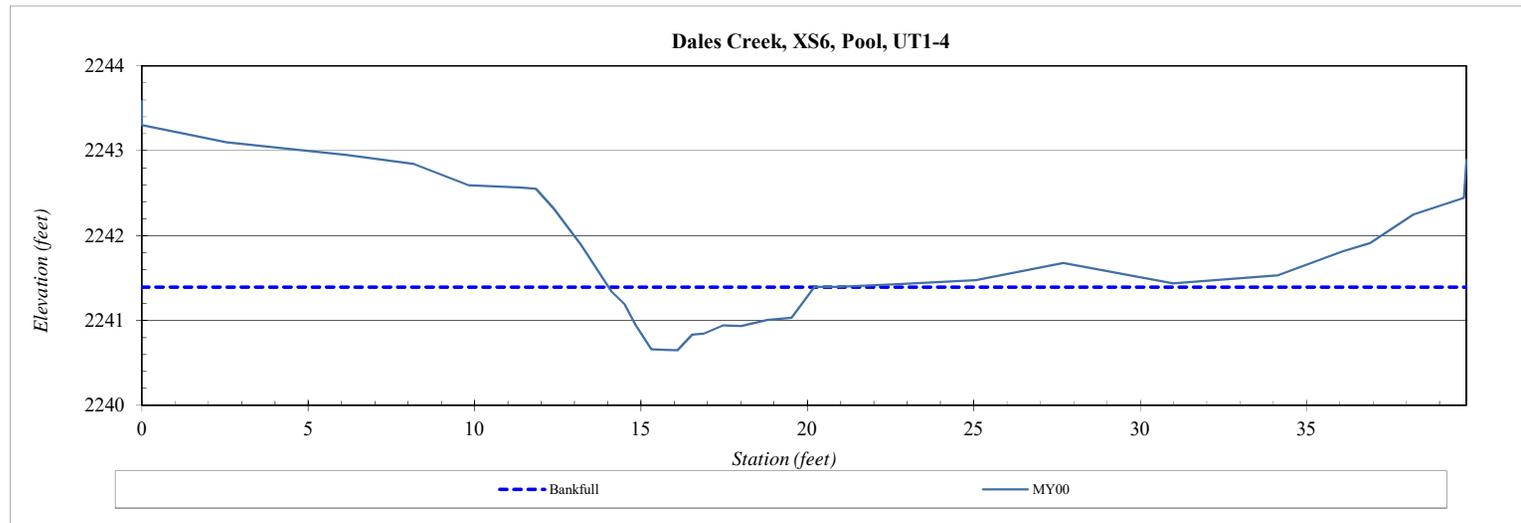


Longitudinal Profile
Dales Creek Restoration Site - UT1-3
Monitoring Year 00, 2022

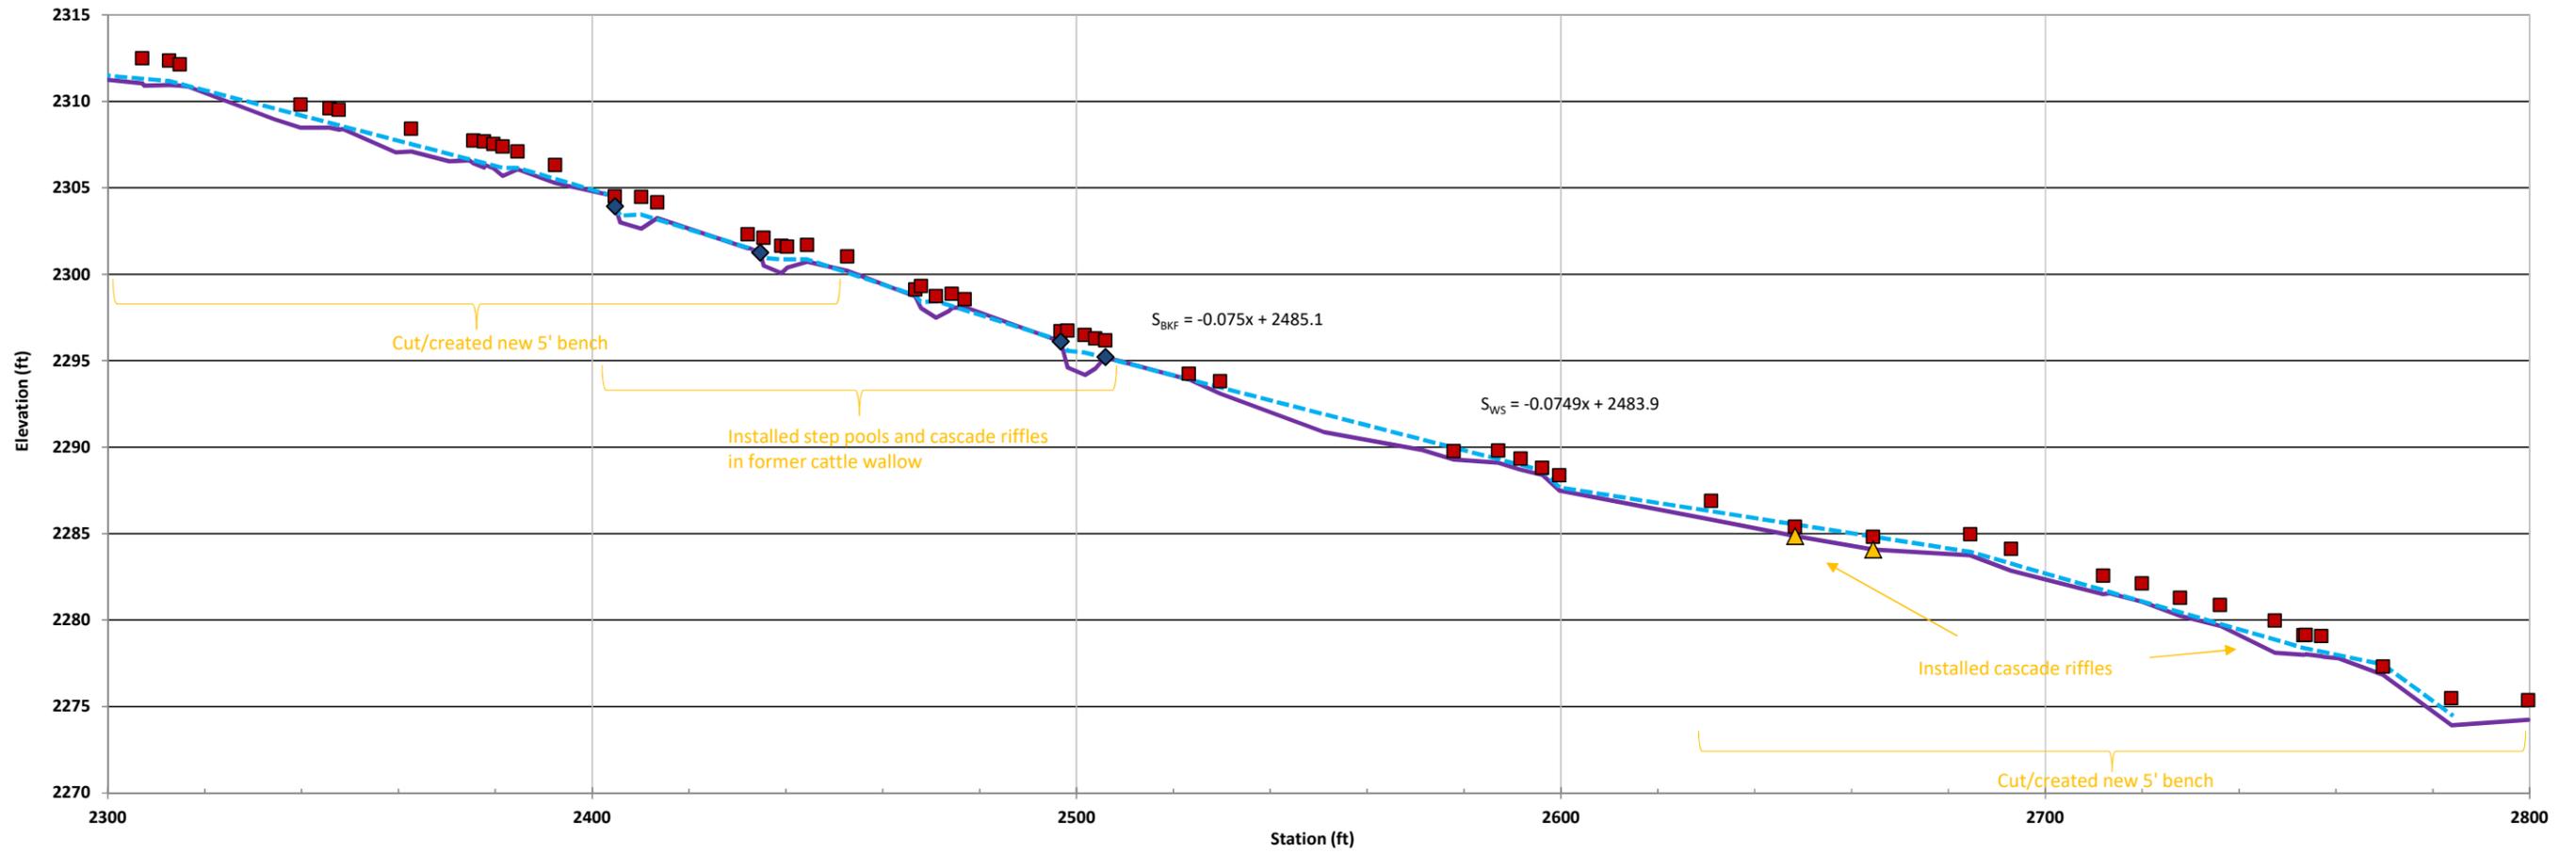

Longitudinal Profile
Dales Creek Restoration Site - UT1-4
Monitoring Year 00, 2022

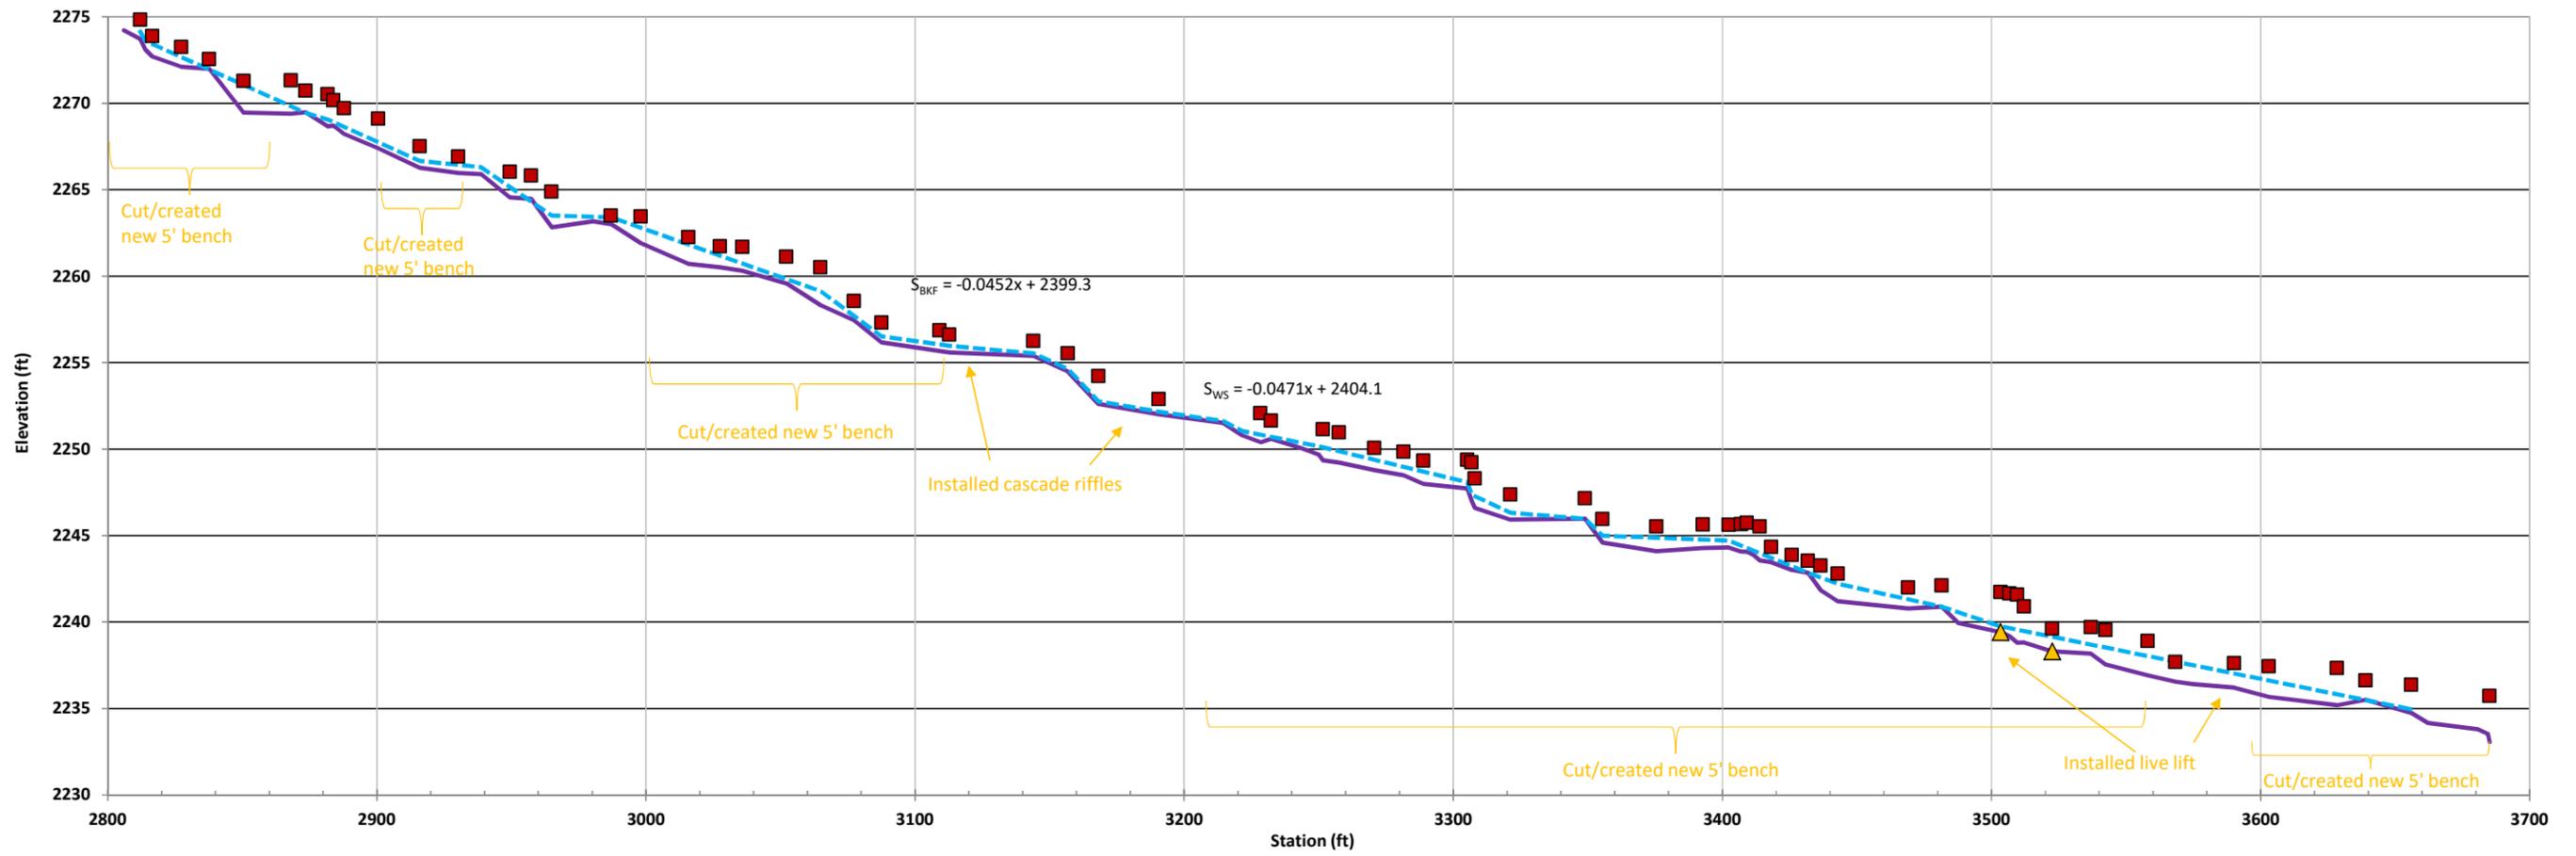

Longitudinal Profile
Dales Creek Restoration Site - T1
Monitoring Year 00, 2022

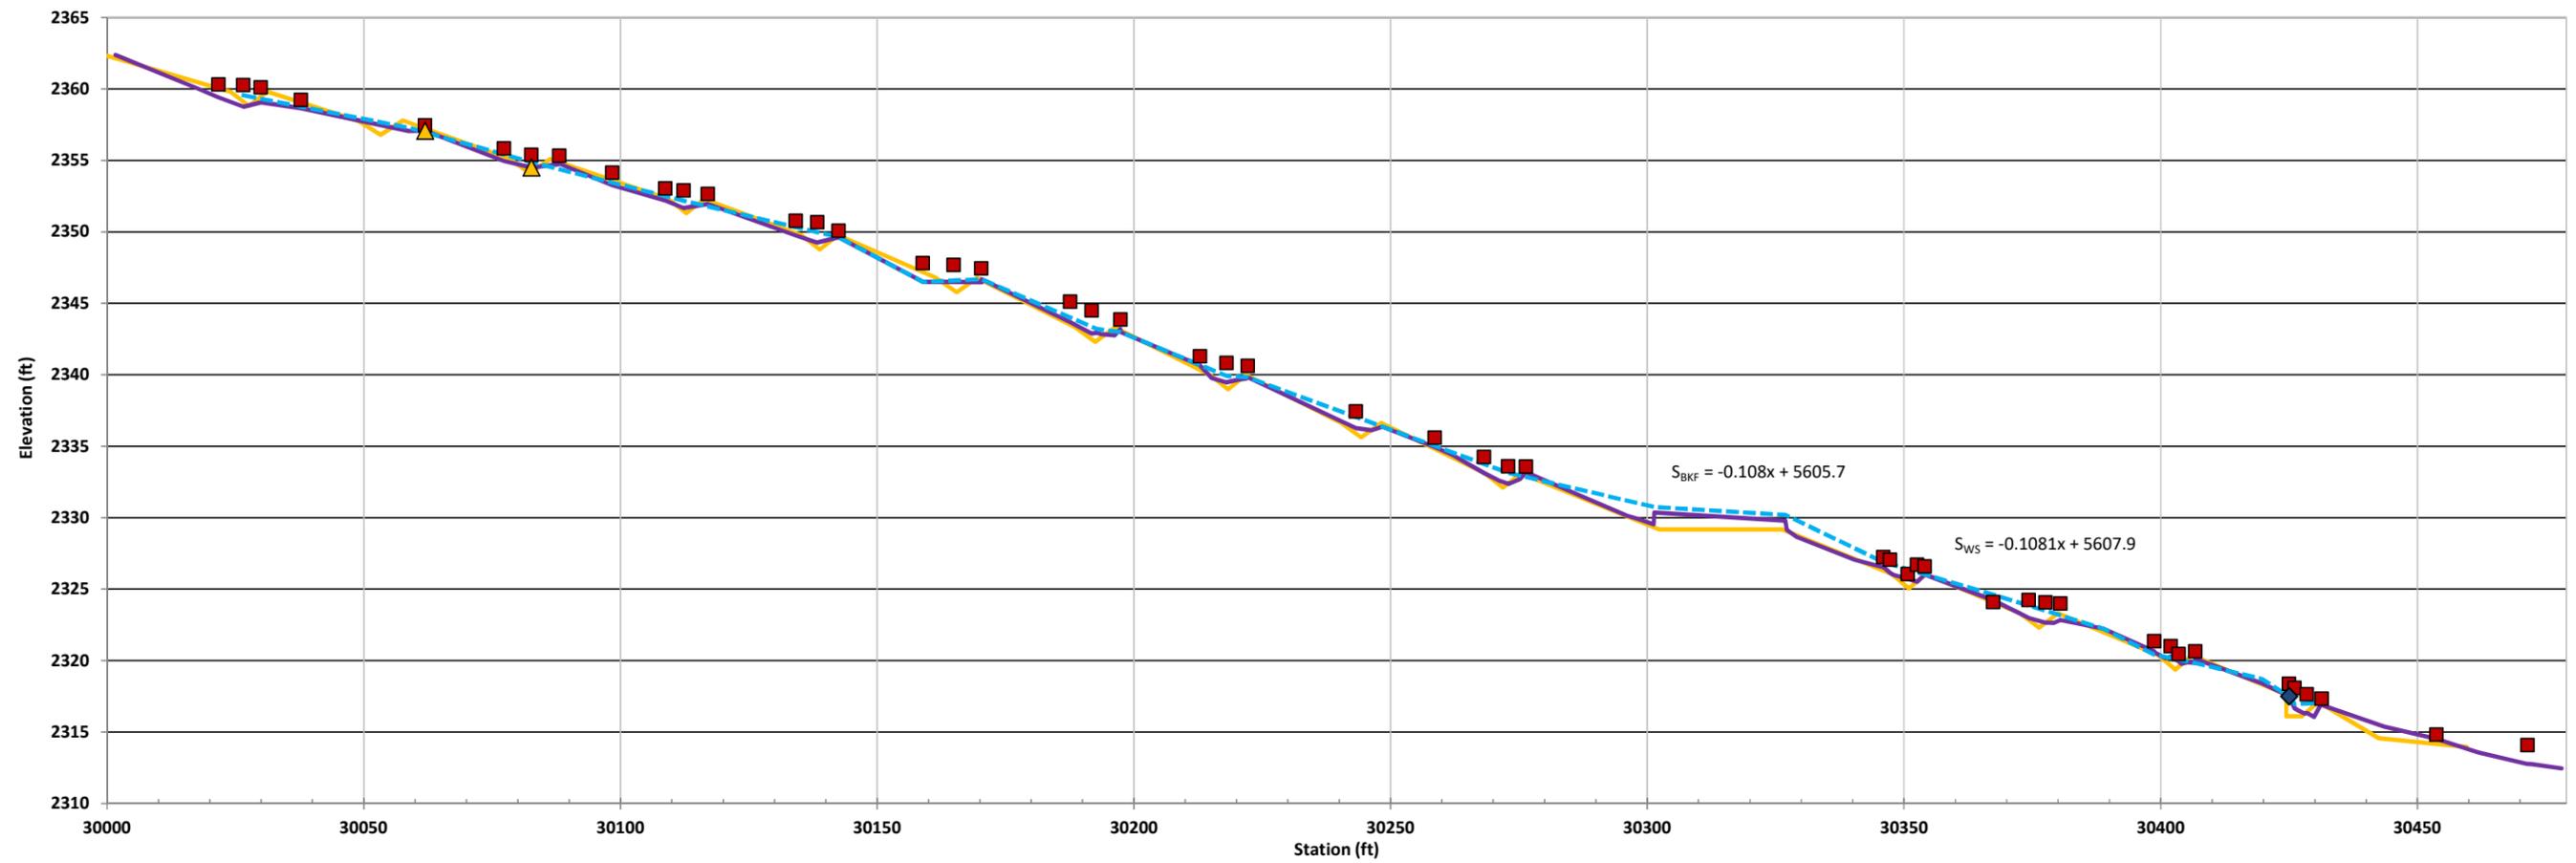

APPENDIX D

Project Timeline and Contact Info

Table 10. Project Activity & Reporting History Dales Creek Restoration Site, DMS Project #100128		
Activity or Report	Data Collection Complete	Actual Completion or Delivery
Site Instituted		May 23, 2019
Mitigation Plan		Feb. 19, 2021
Final Design - Construction Plans		Aug. 25, 2021
Construction Grading Completed		April 1, 2022
Planting Completed		April 11, 2022
As-built Survey		April 29, 2022
Baseline Monitoring/Report		May 2022
Vegetation Monitoring	April 27, 2022	
Stream Survey	April 28, 2022	
Invasive Species Treatment		August 23, 2022

Table 11. Project Contacts Dales Creek Restoration Site, DMS Project #100128	
Design Firm	KCI Associates of North Carolina, PC 4505 Falls of Neuse Road Suite 400 Raleigh, NC 27609 Contact: Mr. Adam Spiller Phone: (919) 278-2512 Fax: (919) 783-9266
Construction Contractor	Chatham Civil Contracting, LLC 811 Archie Johnson Road Siler City, NC 27344 Contact: Mr. Stephen James Phone: (919)704-4442
Planting Contractor	Shenandoah Habitats 1983 Jefferson Highway Waynesboro, VA 22980 Contact: Mr. David Coleman Phone: (540) 941-0067
Monitoring Performers	
	KCI Associates of North Carolina, PC 4505 Falls of Neuse Road Suite 400 Raleigh, NC 27609 Contact: Mr. Adam Spiller

APPENDIX E

As-Built Plan Sheets


STATE	CONTRACT NUMBER	SHEET NO.	TOTAL SHEETS
N.C.	7910	1	10

REVISIONS	SEPTEMBER 2022

NCDEQ DIVISION OF MITIGATION SERVICES

DALE'S CREEK RESTORATION SITE


BUNCOMBE COUNTY, NORTH CAROLINA
 FRENCH BROAD RIVER BASIN
 CATALOGING UNIT 06010105
 (LAT 35.5970 / LON -82.7427)

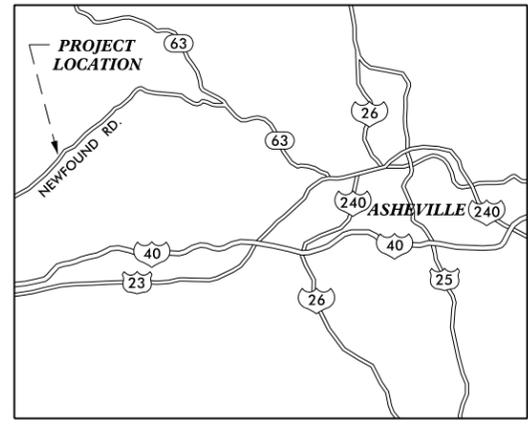

VICINITY MAP
 NOT TO SCALE

RECORD DRAWINGS

AS-BUILT DATA TAKEN FROM AS-BUILT SURVEY COMPLETED BY KCI ASSOCIATES OF NC, P.A. SURVEYING COMPLETED ON APRIL 29, 2022. PLEASE SEE SEPARATE AS-BUILT SUBMISSION FOR MORE DETAILS.

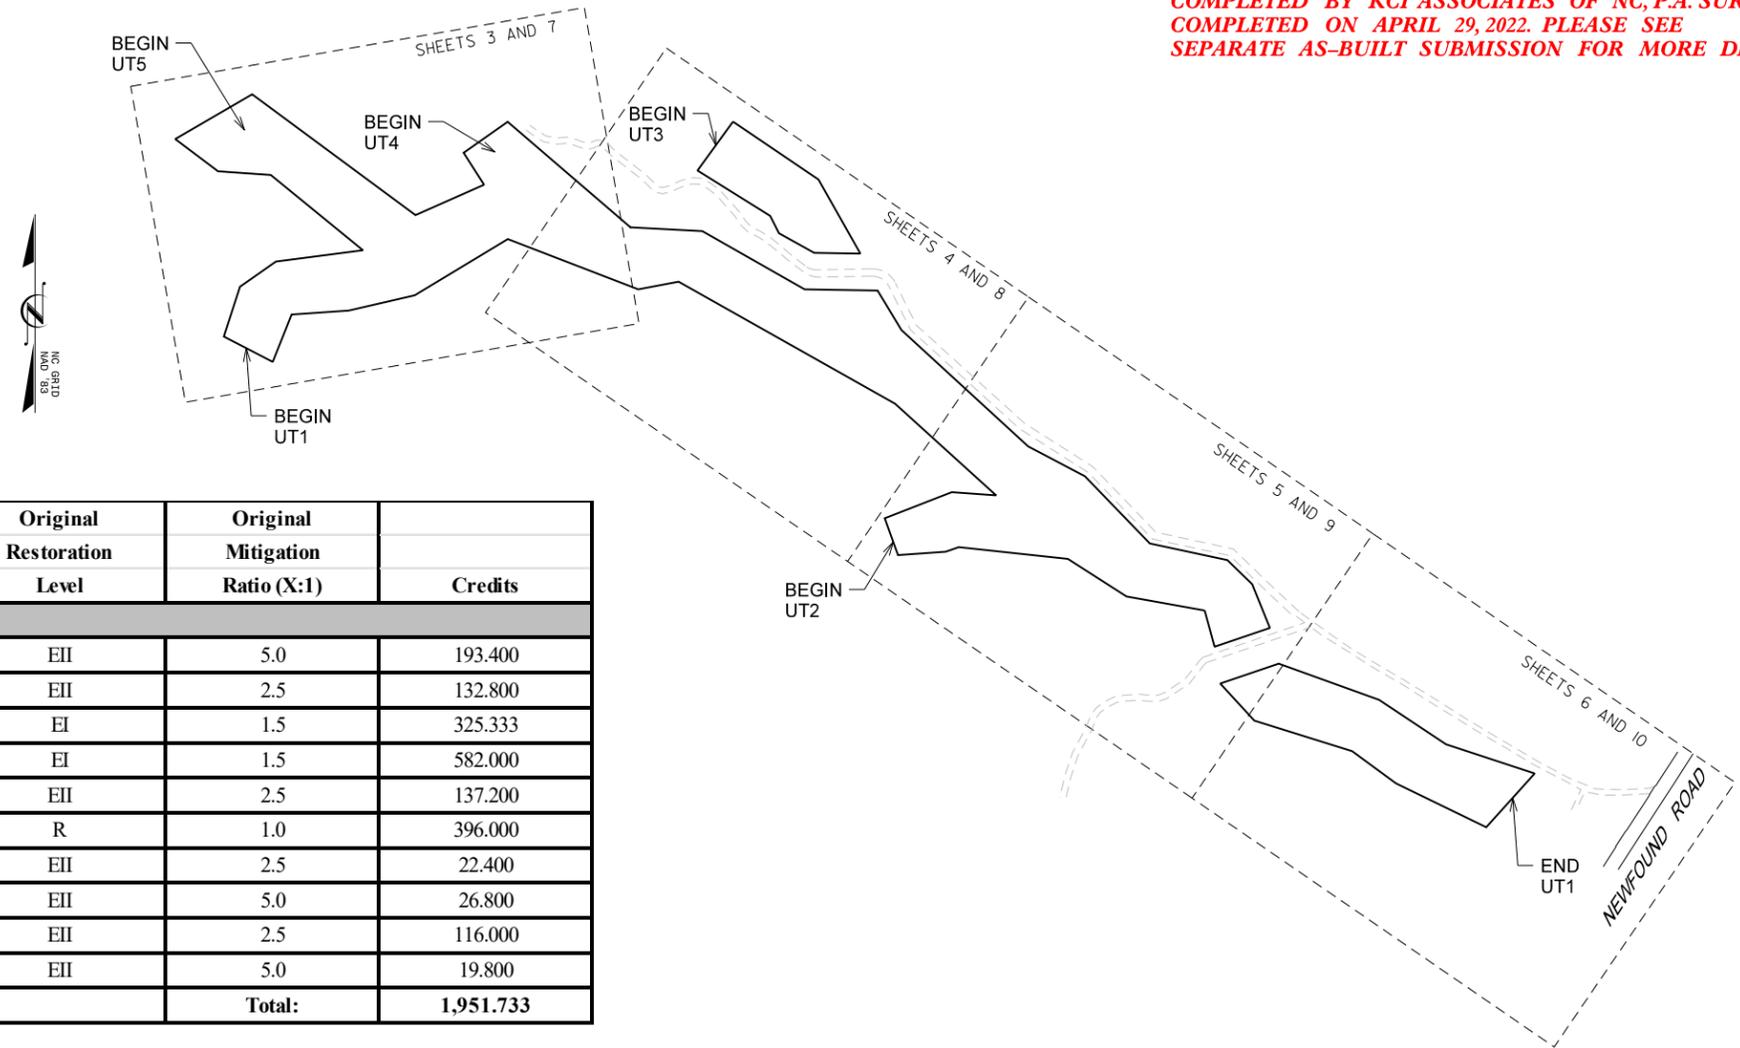

PROJECT DATA:

Project Segmen	Original Mitigation Plan Ft/Ac	As-Built Ft/ Ac	Original Mitigation Category	Original Restoration Level	Original Mitigation Ratio (X:1)	Credits
Stream						
UT1 Reach 1	967	967	Cool	EII	5.0	193.400
UT1 Reach 2	332	332	Cool	EII	2.5	132.800
UT1 Reach 3	488	478	Cool	EI	1.5	325.333
UT1 Reach 4	873	869	Cool	EI	1.5	582.000
UT2	343	343	Cool	EII	2.5	137.200
UT3	396	388	Cool	R	1.0	396.000
UT4 Reach 1	56	58	Cool	EII	2.5	22.400
UT4 Reach 2	134	134	Cool	EII	5.0	26.800
UT5 Reach 1	290	290	Cool	EII	2.5	116.000
UT5 Reach 2	99	99	Cool	EII	5.0	19.800
Total:						1,951.733

KCI JOB# : 161904754

CONTRACT #: 7910

DIRECTIONS TO SITE

FROM ASHEVILLE, TAKE U.S. 74 ATL. USE THE TWO RIGHT LANES TO TAKE A RIGHT ONTO NC-63 WEST. TURN LEFT ONTO NEWFOUND ROAD. AFTER 6 MILES, THE STREAM PROJECT ENTRANCE WILL BE ON ON THE RIGHT ,JUST BEFORE THE DRIVEWAY AT 1281 NEWFOUND RD.

INDEX OF SHEETS

- 1 TITLE SHEET
- 2 GENERAL NOTES & PROJECT LEGEND
- 3-6 SITE PLAN
- 7-10 PLANTING PLAN



Prepared for:
 HARRY TSOIMIDES
 DMS PROJECT MANAGER

Prepared by:
 KRISTIN E. KNIGHT, PE
 PROJECT ENGINEER
 ALEX FRENCH
 PROJECT DESIGNER

PROJECT ENGINEER



SIGNATURE: 09-29-2022 P.E.

GENERAL NOTES:

BEARINGS AND DISTANCES:
 ALL BEARINGS ARE NAD 1983 GRID BEARINGS.
 ALL DISTANCES AND COORDINATES SHOWN ARE HORIZONTAL
 (GROUND) VALUES.

DEVIATIONS, ADDITIONS, AND SUBTRACTIONS TO ORIGINAL CONSTRUCTION
 PLANS AND ANY ADDITIONAL NOTES ARE MARKED IN RED.

CONTROL POINTS:

POINT	NORTHING	EASTING	ELEV.
101	693167.61	887709.51	2229.57
102	692666.28	887349.42	2242.21
103	693239.58	887436.71	2239.08
104	693185.23	887309.98	2264.79
105	693421.72	887149.68	2259.88
106	693407.22	886967.13	2279.77
107	693511.76	887037.65	2267.77
108	693624.14	886950.28	2275.15
109	693715.56	886844.99	2282.49
110	693790.30	886620.74	2306.39
111	693884.84	886706.61	2301.23
112	694034.92	886498.46	2320.02
113	694128.04	886509.55	2334.48
114	694260.40	886359.34	2353.97
117	693817.87	887511.07	2316.43
118	693750.94	887696.20	2307.26
119	692919.62	887227.77	2259.50



09-29-2022

PROJECT LEGEND:

Designed Thalweg w/Approximate Bankfull Limits		Vegetation Plot	
As-Built Thalweg w/Approximate Bankfull Limits		Photo Point	
Installed Riffle Enhancement		Stream Gauge	
Installed Riffle Grade Control		Cross-section	
Installed Cascade Riffle		Minor Contour Line (1ft.)	
Installed Step Pool		Major Contour Line (5ft.)	
Installed Live Lift		Overhead Utility	
Filled Existing Channel		Installed Fencing	
		Installed Drinkers	


NO.	SYMBOL	DESCRIPTION	DATE
A		REVISED PER DMS COMMENTS	SEP 2022



DALE'S CREEK
 RESTORATION SITE
Record Drawings
 BUNCOMBE COUNTY, NORTH CAROLINA

DATE: MAY 2022
 SCALE: N.T.S.

GENERAL
 NOTES &
 PROJECT
 LEGEND

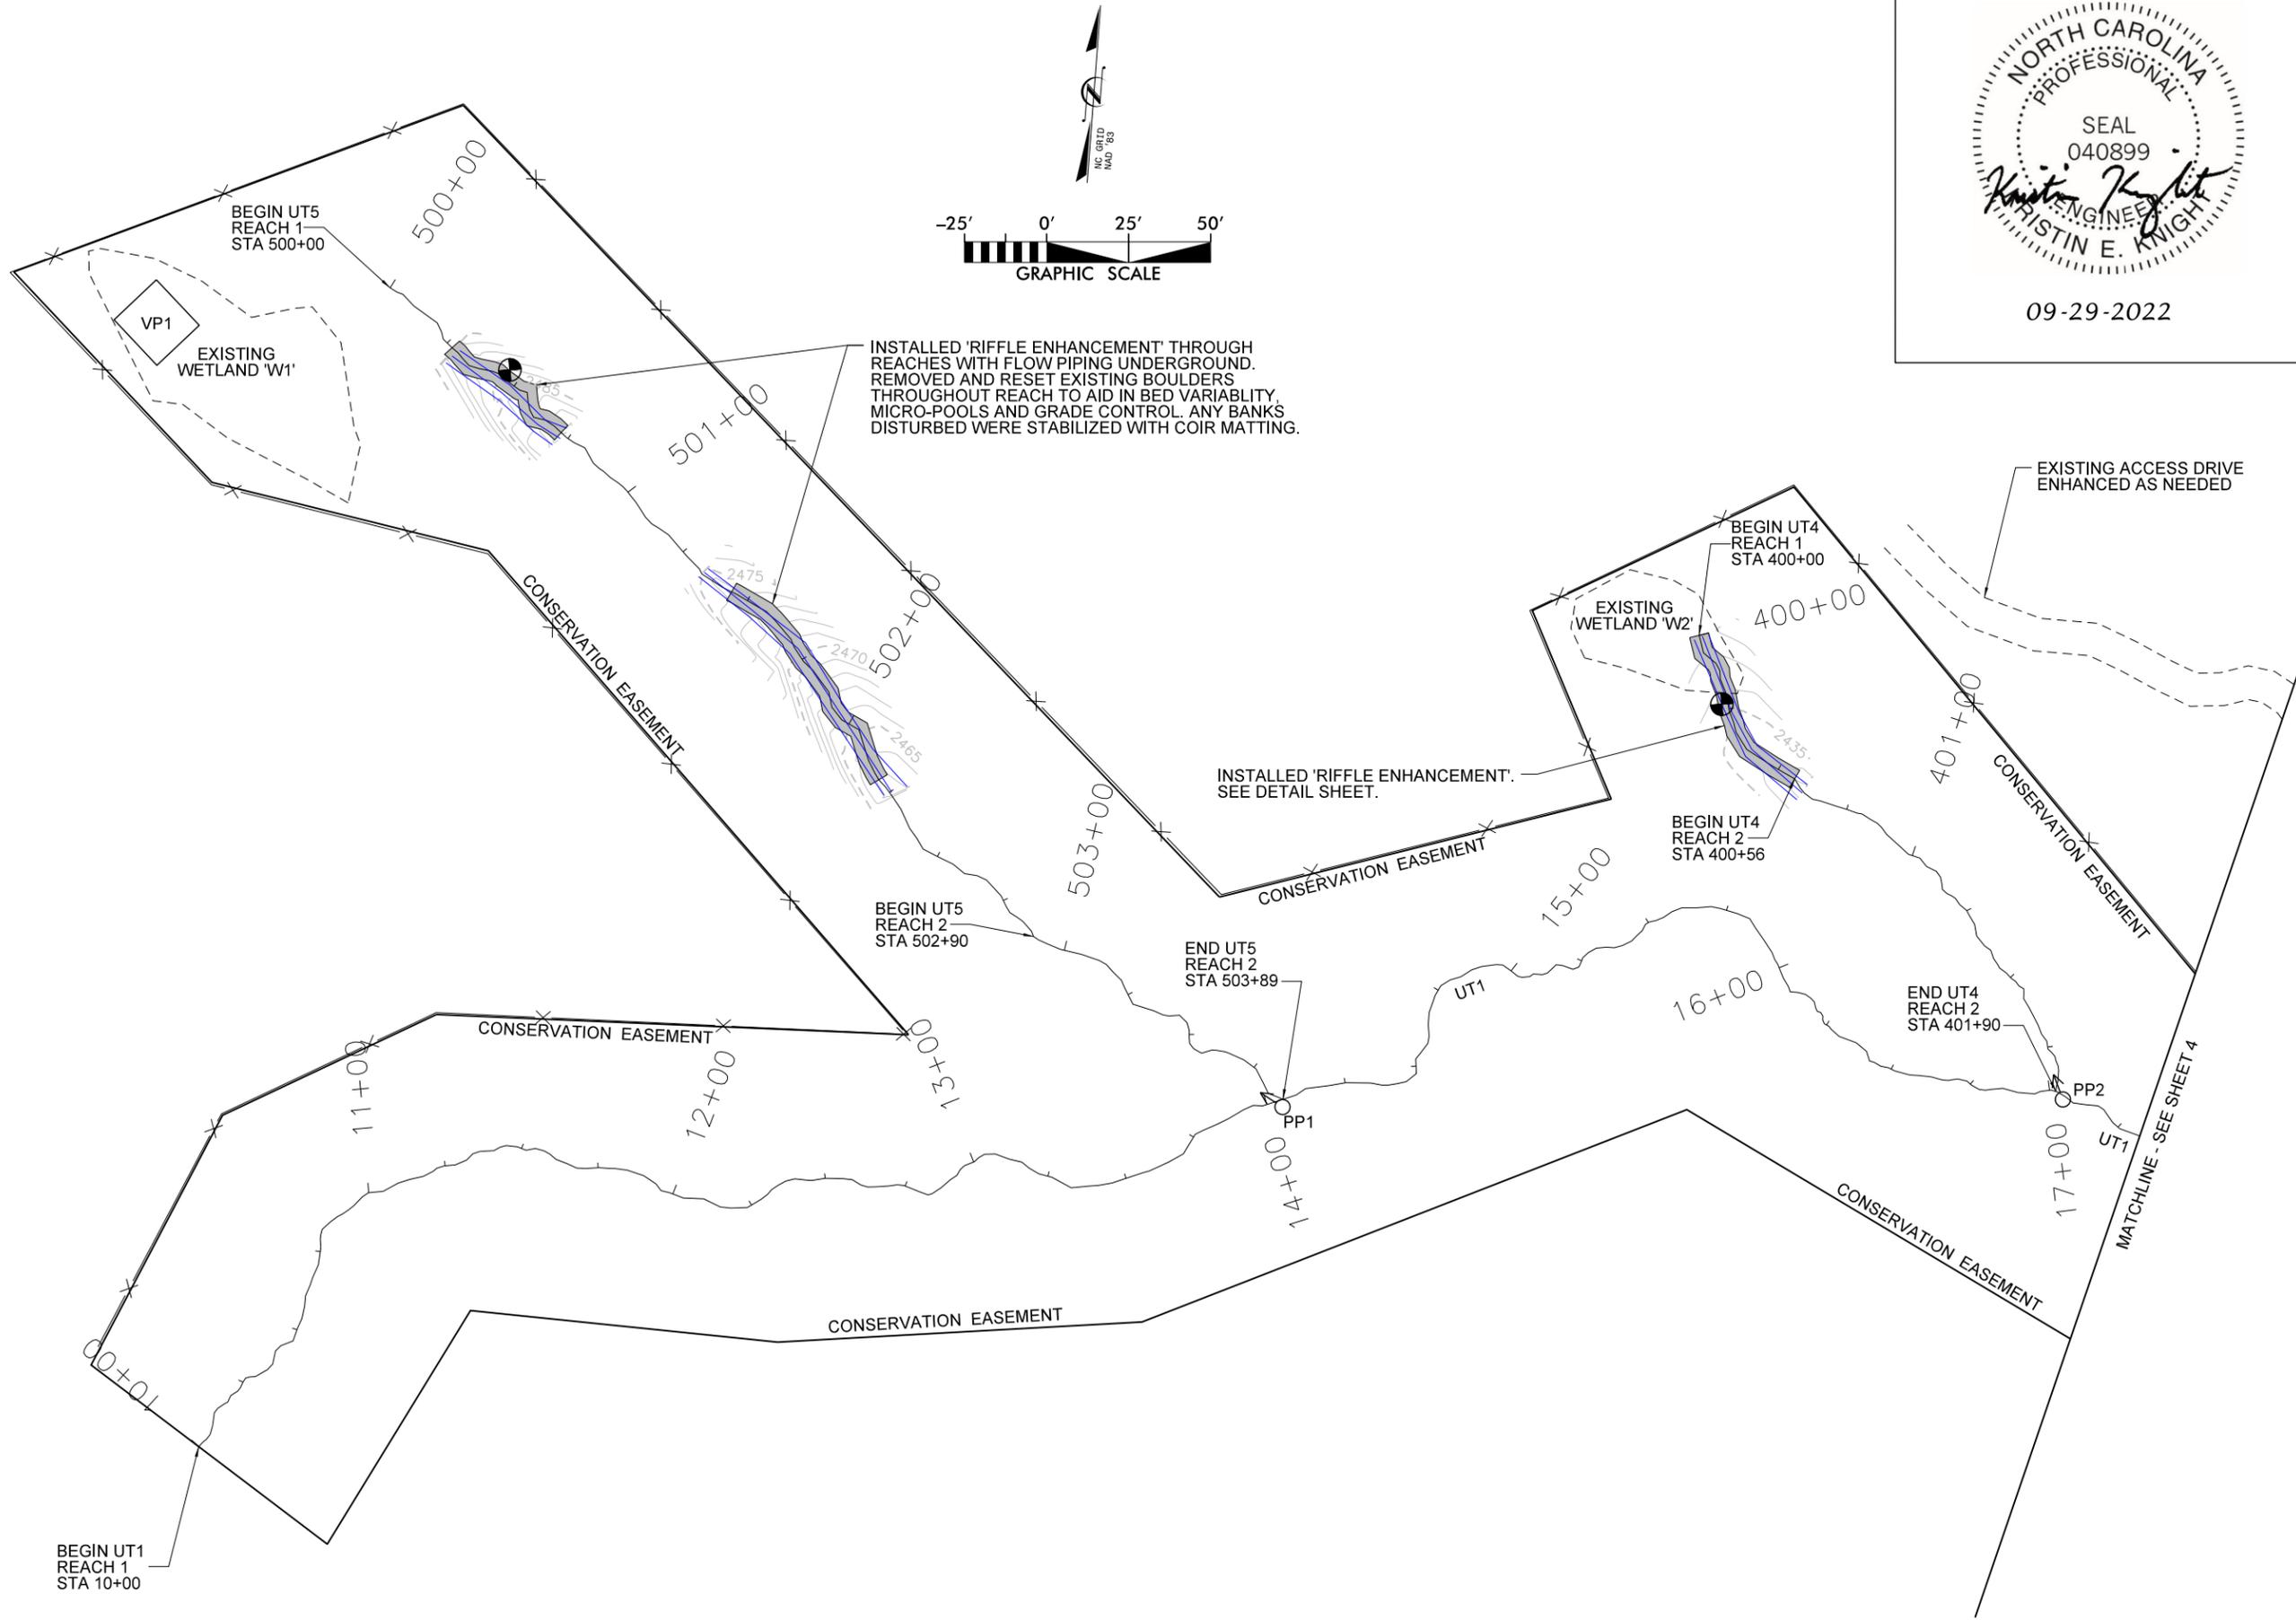

INSTALLED 'RIFFLE ENHANCEMENT' THROUGH REACHES WITH FLOW PIPING UNDERGROUND. REMOVED AND RESET EXISTING BOULDERS THROUGHOUT REACH TO AID IN BED VARIABILITY, MICRO-POOLS AND GRADE CONTROL. ANY BANKS DISTURBED WERE STABILIZED WITH COIR MATTING.

INSTALLED 'RIFFLE ENHANCEMENT'. SEE DETAIL SHEET.

EXISTING ACCESS DRIVE ENHANCED AS NEEDED



09-29-2022


REVISED PER	DATE	DESCRIPTION
A	SEP 2022	REVISED PER DMS COMMENTS




DALE'S CREEK RESTORATION SITE
Record Drawings
 BUNCOMBE COUNTY, NORTH CAROLINA

DATE: MAY 2022
 SCALE: GRAPHIC

SITE PLAN

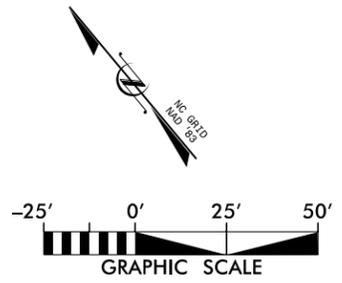

REVISED PER DMS COMMENTS	SYMBOL	DESCRIPTION	DATE

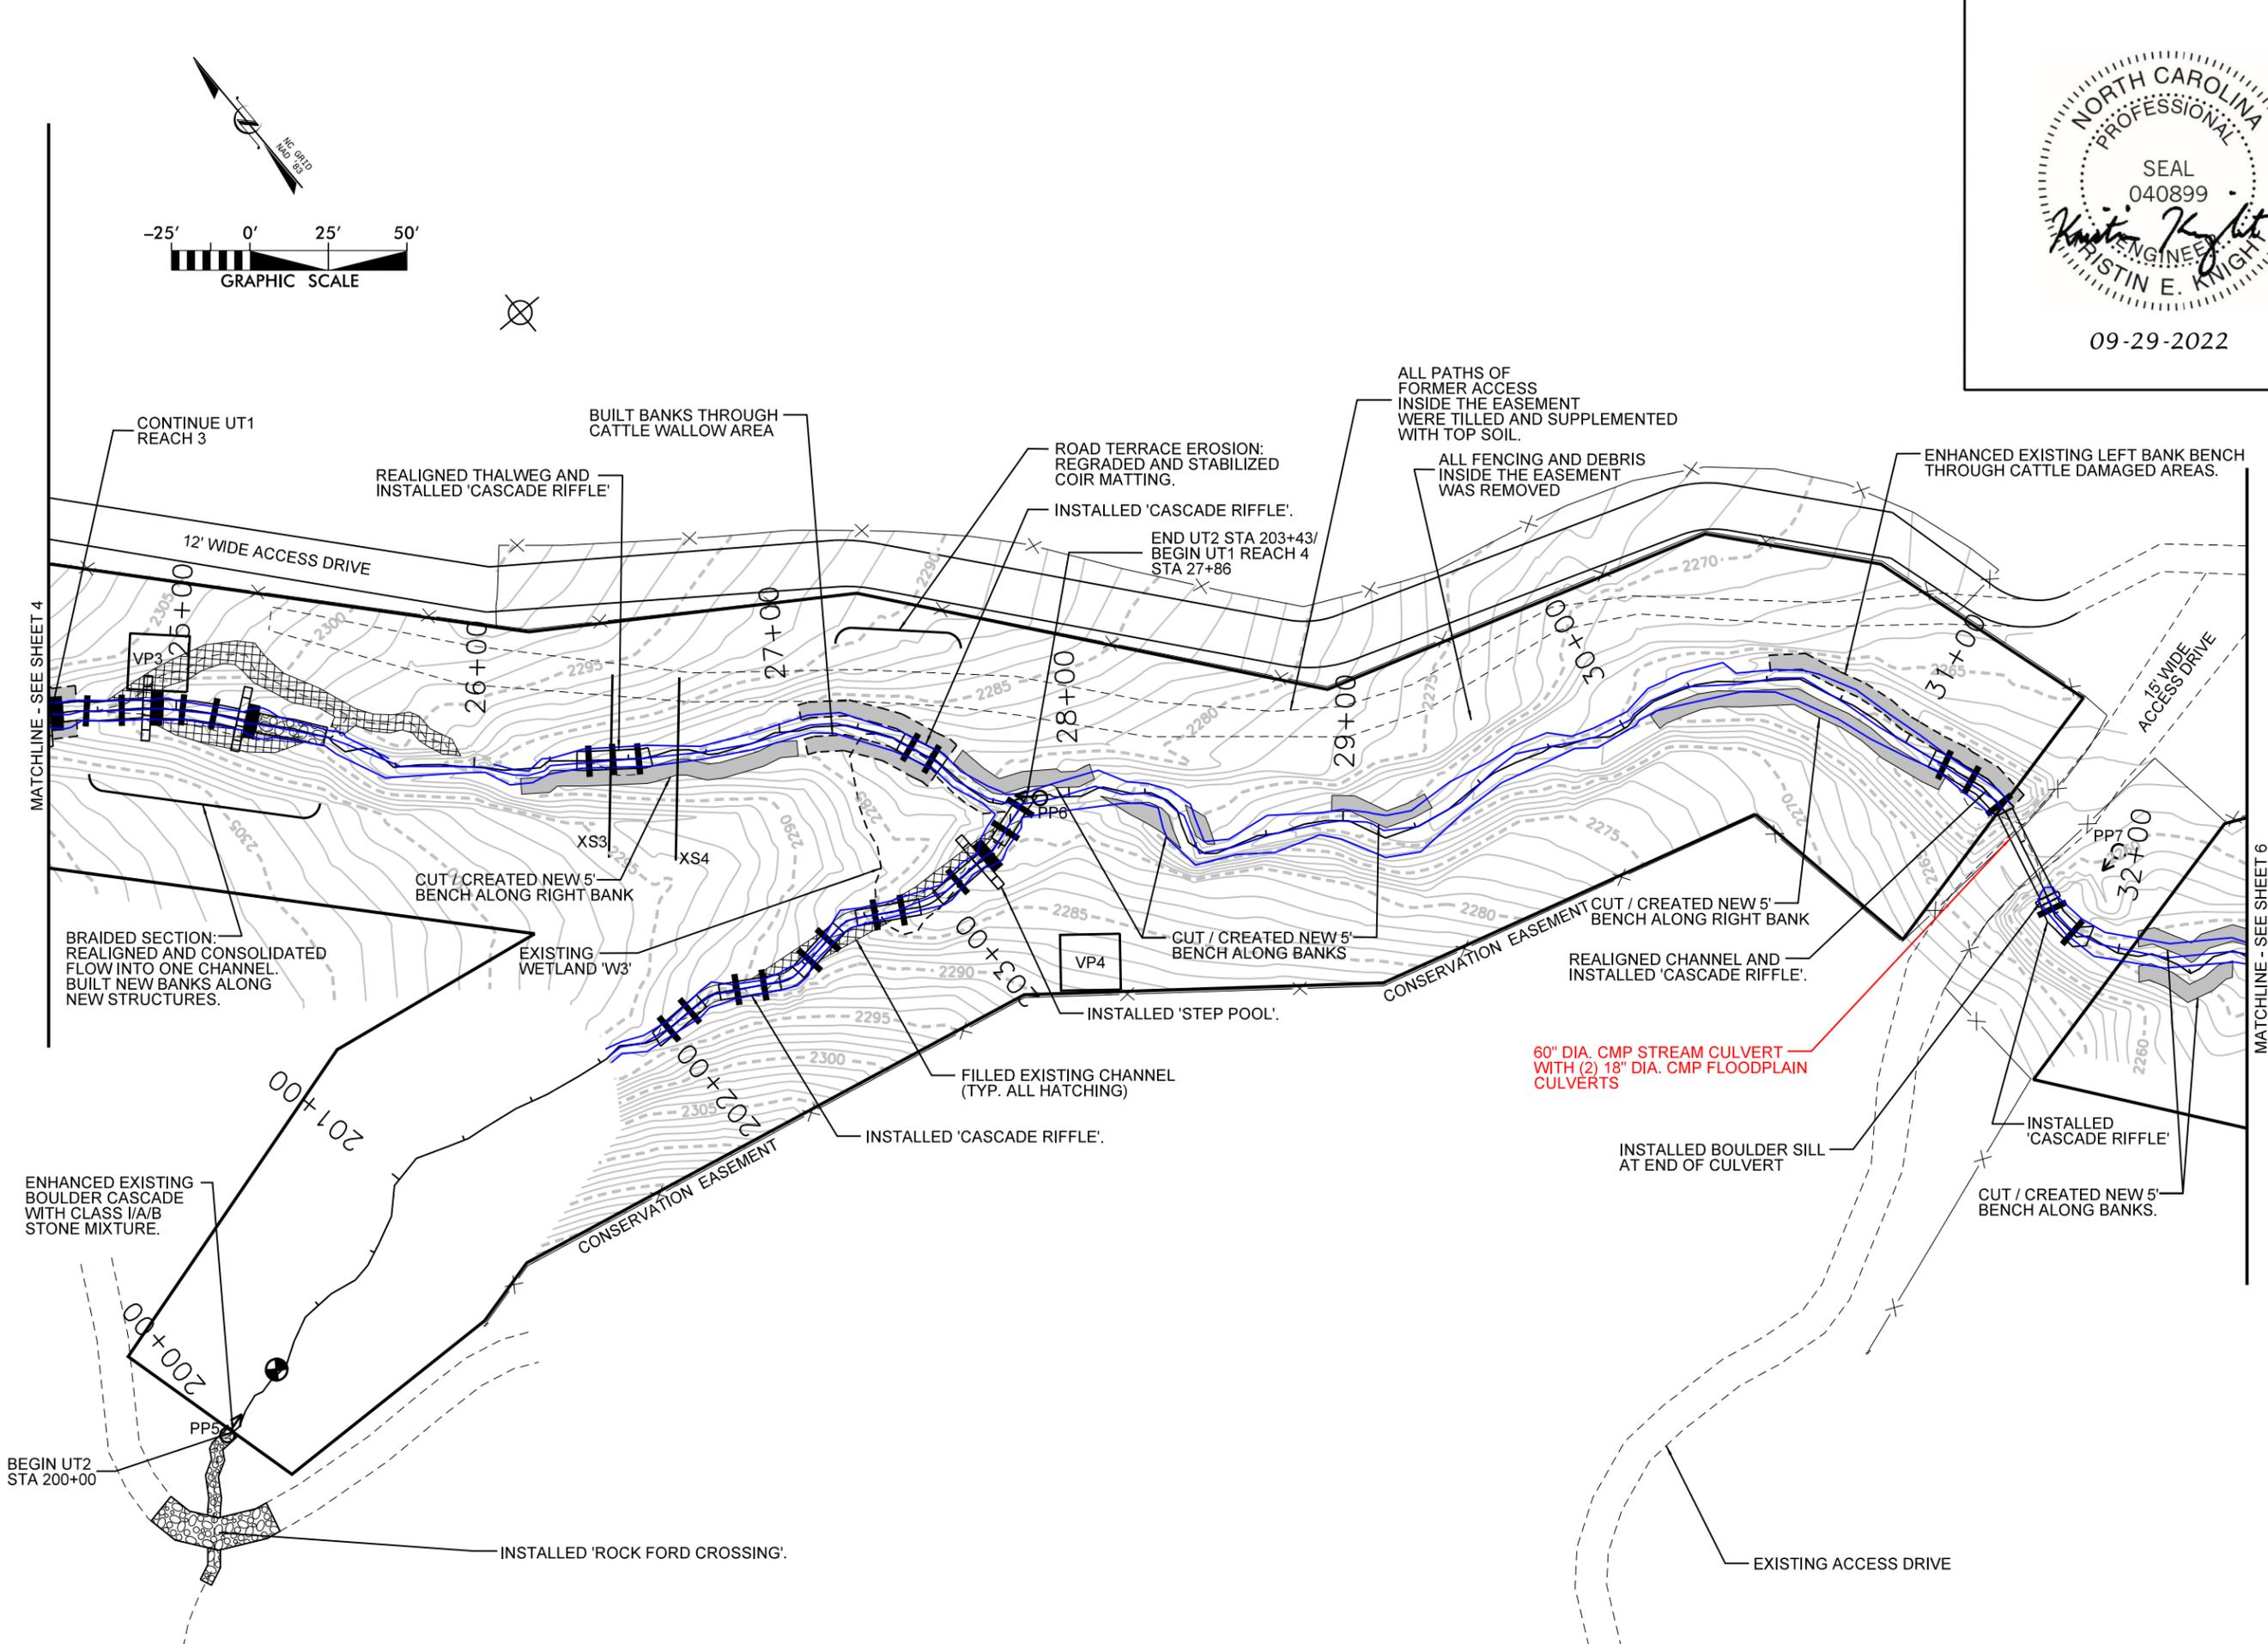

KCI
ASSOCIATES OF NC
ENGINEERS • PLANNERS • SCIENTISTS
4505 FALLS OF NEUSE ROAD, SUITE 400
RALEIGH, NORTH CAROLINA 27609

DALE'S CREEK RESTORATION SITE
Record Drawings
BUNCOMBE COUNTY, NORTH CAROLINA

DATE: MAY 2022
SCALE: GRAPHIC

SITE PLAN



09-29-2022


REVISED PER DIS COMMENTS	SYMBOL	DESCRIPTION	DATE



DALE'S CREEK RESTORATION SITE
Record Drawings
 BUNCOMBE COUNTY, NORTH CAROLINA

DATE: MAY 2022
 SCALE: GRAPHIC

PLANTING PLAN
 SHEET 7 OF 10

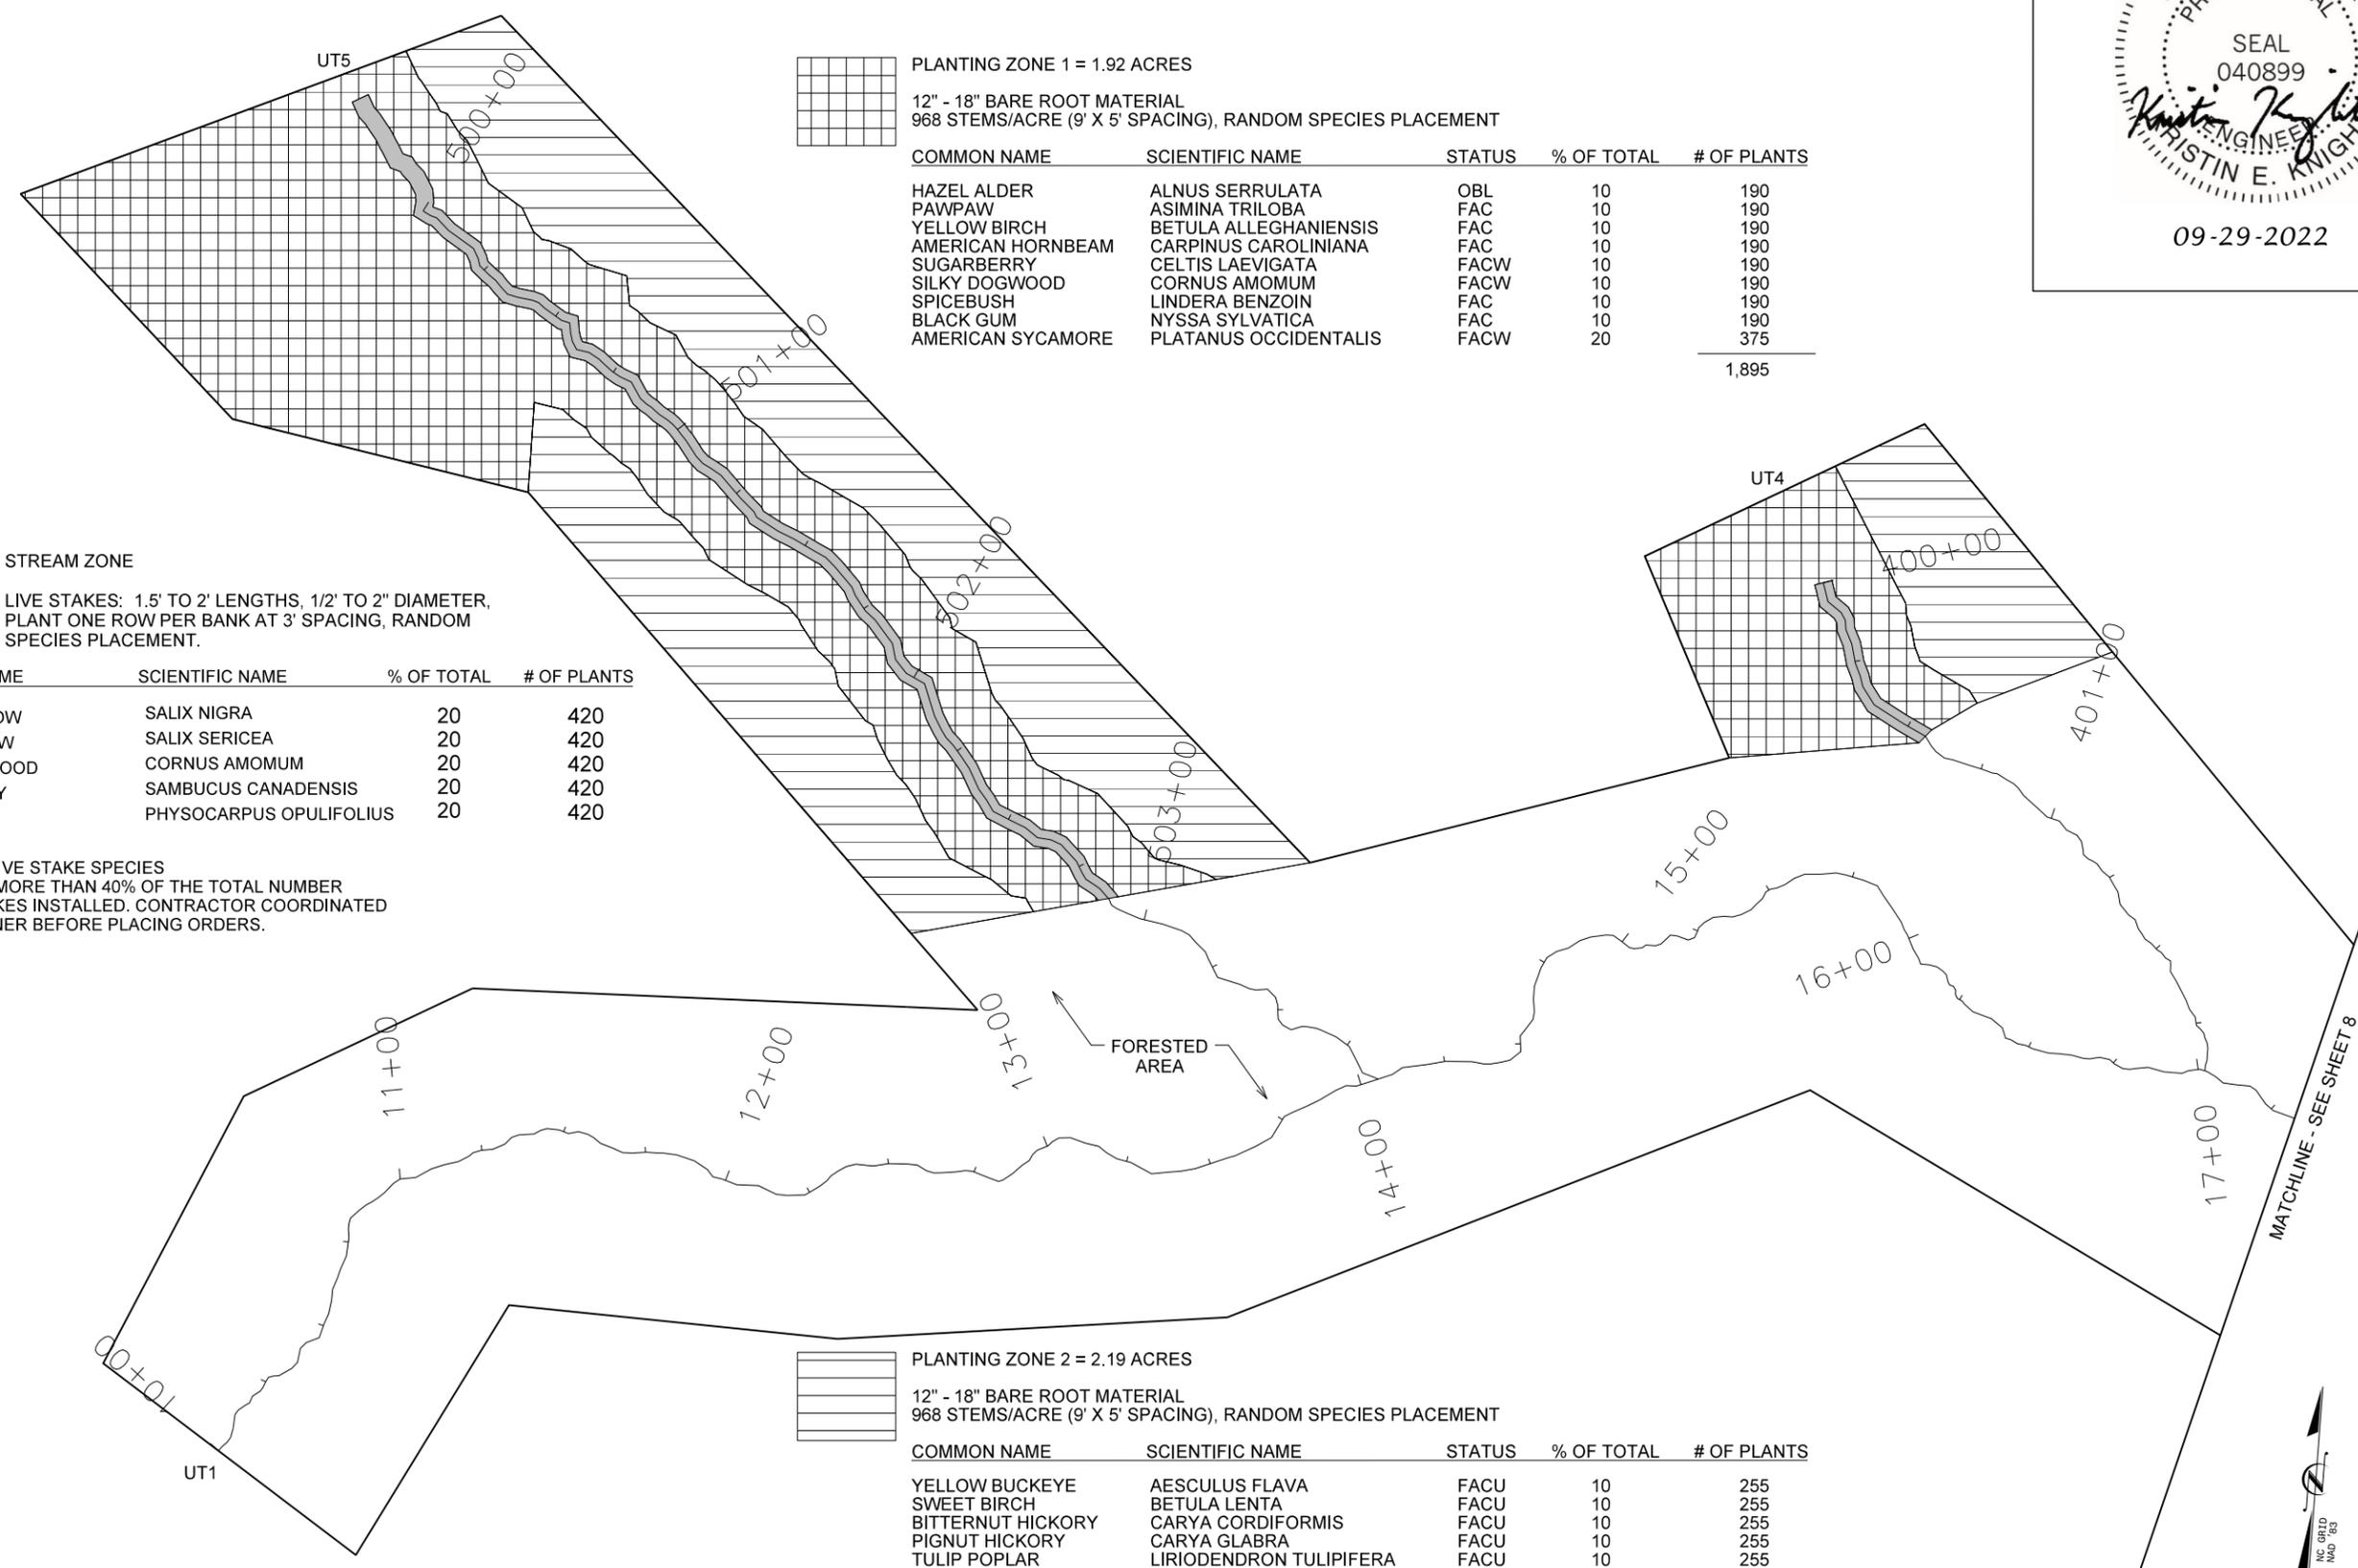

PLANTING ZONE 1 = 1.92 ACRES
 12" - 18" BARE ROOT MATERIAL
 968 STEMS/ACRE (9' X 5' SPACING), RANDOM SPECIES PLACEMENT

COMMON NAME	SCIENTIFIC NAME	STATUS	% OF TOTAL	# OF PLANTS
HAZEL ALDER	ALNUS SERRULATA	OBL	10	190
PAWPAW	ASIMINA TRILOBA	FAC	10	190
YELLOW BIRCH	BETULA ALLEGHANIENSIS	FAC	10	190
AMERICAN HORNBEAM	CARPINUS CAROLINIANA	FAC	10	190
SUGARBERRY	CELTIS LAEVIGATA	FACW	10	190
SILKY DOGWOOD	CORNUS AMOMUM	FACW	10	190
SPICEBUSH	LINDERA BENZOIN	FAC	10	190
BLACK GUM	NYSSA SYLVATICA	FAC	10	190
AMERICAN SYCAMORE	PLATANUS OCCIDENTALIS	FACW	20	375
				1,895


STREAM ZONE
 LIVE STAKES: 1.5' TO 2' LENGTHS, 1/2" TO 2" DIAMETER,
 PLANT ONE ROW PER BANK AT 3' SPACING, RANDOM SPECIES PLACEMENT.



COMMON NAME	SCIENTIFIC NAME	% OF TOTAL	# OF PLANTS
BLACK WILLOW	SALIX NIGRA	20	420
SILKY WILLOW	SALIX SERICEA	20	420
SILKY DOGWOOD	CORNUS AMOMUM	20	420
ELDERBERRY	SAMBUCUS CANADENSIS	20	420
NINEBARK	PHYSOCARPUS OPULIFOLIUS	20	420



NO SINGLE LIVE STAKE SPECIES COMPOSED MORE THAN 40% OF THE TOTAL NUMBER OF LIVE STAKES INSTALLED. CONTRACTOR COORDINATED WITH DESIGNER BEFORE PLACING ORDERS.

PLANTING ZONE 2 = 2.19 ACRES
 12" - 18" BARE ROOT MATERIAL
 968 STEMS/ACRE (9' X 5' SPACING), RANDOM SPECIES PLACEMENT

COMMON NAME	SCIENTIFIC NAME	STATUS	% OF TOTAL	# OF PLANTS
YELLOW BUCKEYE	AESCULUS FLAVA	FACU	10	255
SWEET BIRCH	BETULA LENTA	FACU	10	255
BITTERNUT HICKORY	CARYA CORDIFORMIS	FACU	10	255
PIGNET HICKORY	CARYA GLABRA	FACU	10	255
TULIP POPLAR	LIRIODENDRON TULIPIFERA	FACU	10	255
AMERICAN SYCAMORE	PLATANUS OCCIDENTALIS	FACW	10	255
WHITE OAK	QUERCA ALBA	FACU	10	255
SOUTHERN RED OAK	QUERCUS FALCATA	FACU	10	255
CHESTNUT OAK	QUERCUS MONTANA	UPL	10	255
NORTHERN RED OAK	QUERCUS RUBRA	FACU	10	255
				2,550

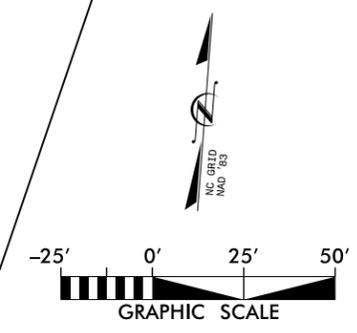

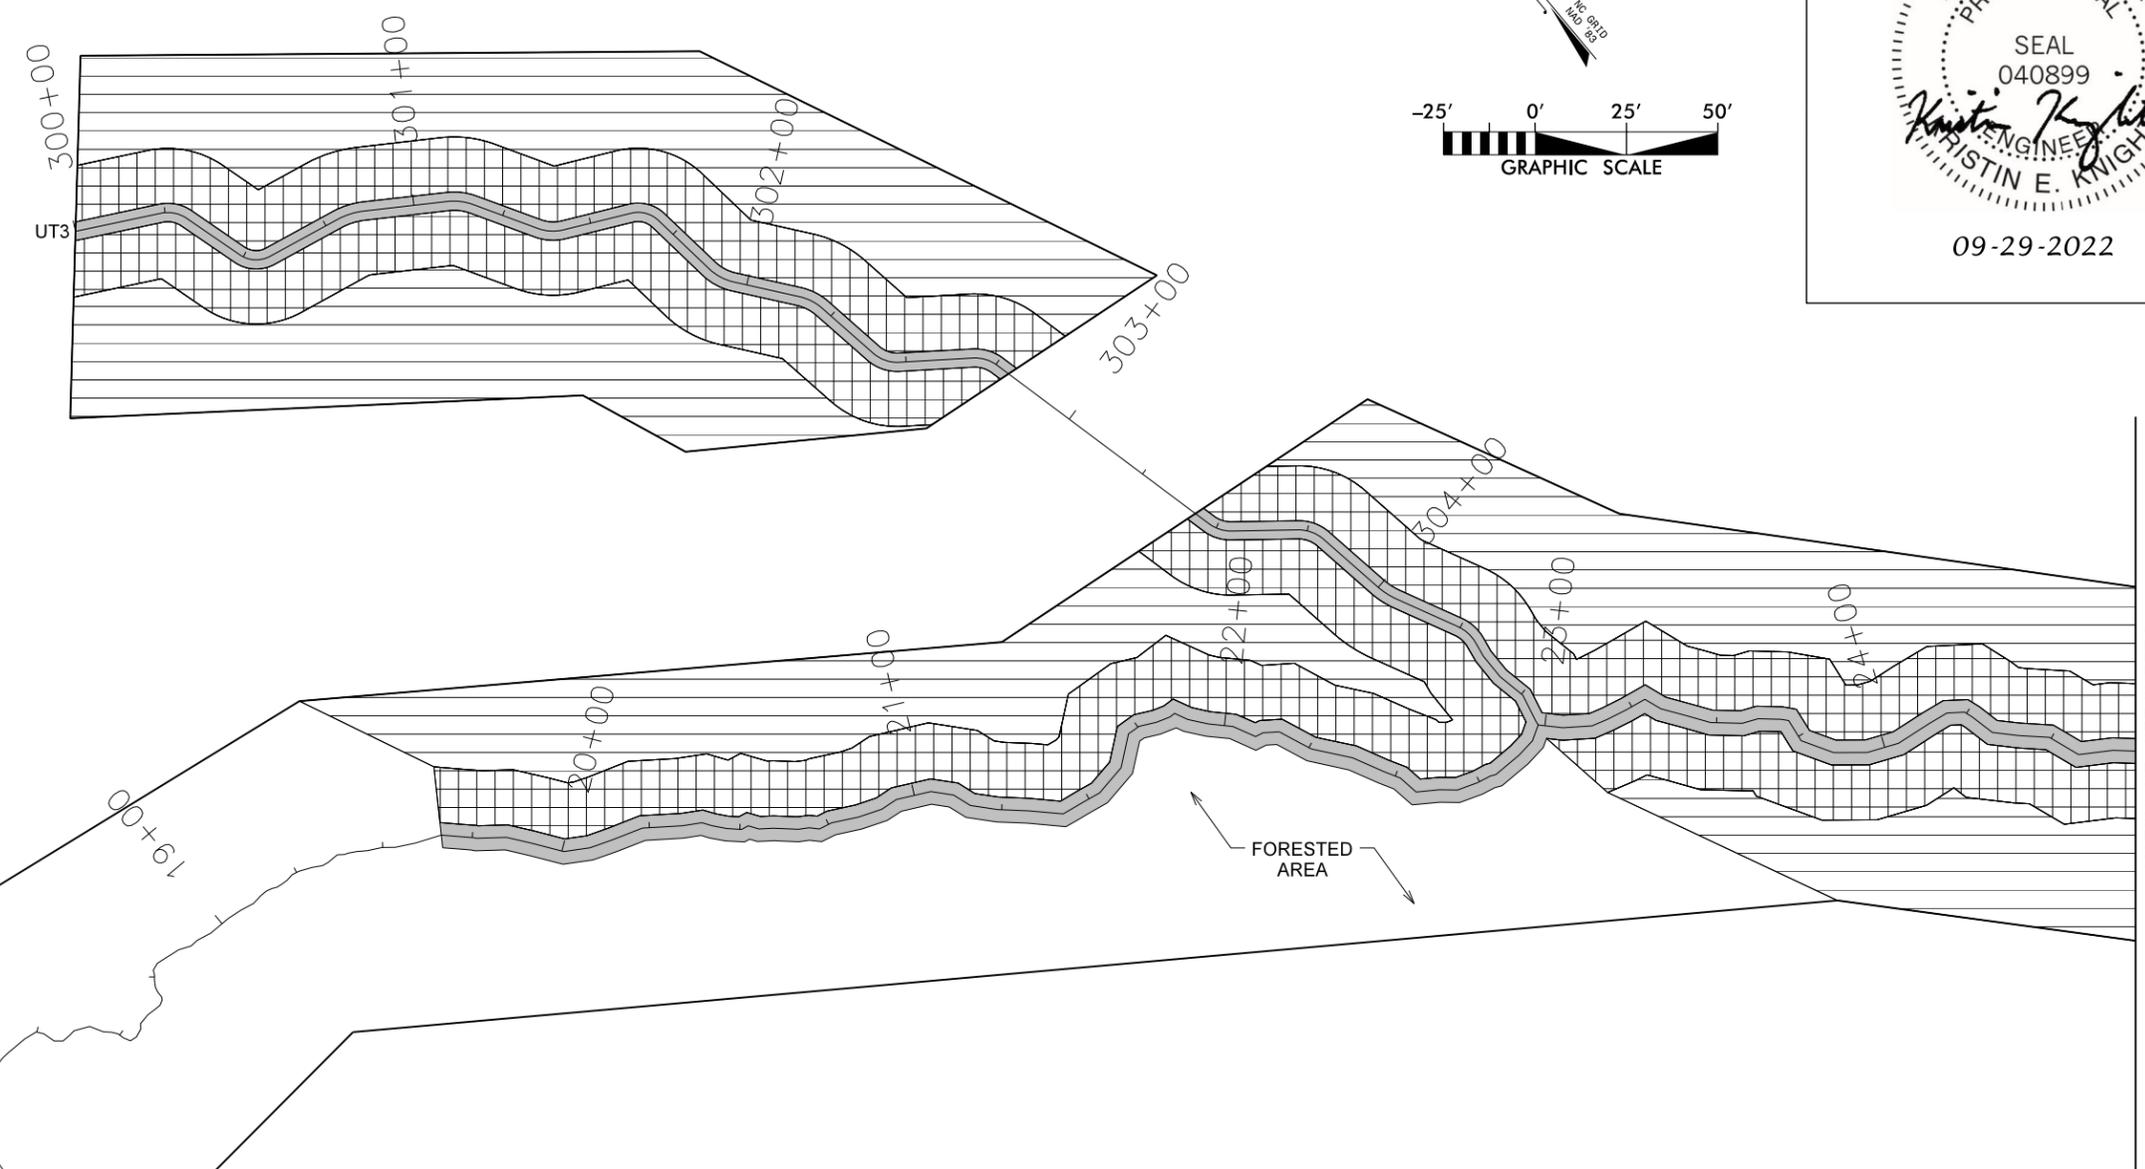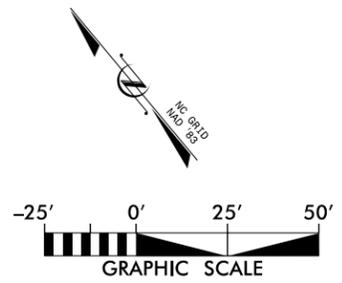

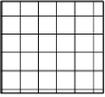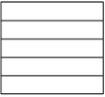-  PLANTING ZONE 1
-  PLANTING ZONE 2
-  STREAM ZONE

* NOTE: SEE SHEET 7 FOR PLANTING QUANTITIES


REVISED PER DMS COMMENTS	SYMBOL	DESCRIPTION	DATE




DALE'S CREEK
RESTORATION SITE
Record Drawings
BUNCOMBE COUNTY, NORTH CAROLINA


DATE: MAY 2022
SCALE: GRAPHIC

PLANTING
PLAN

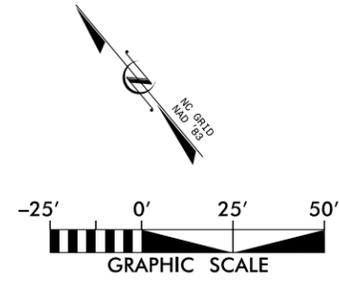

REVISED PER DMS COMMENTS	SYMBOL	DESCRIPTION	DATE

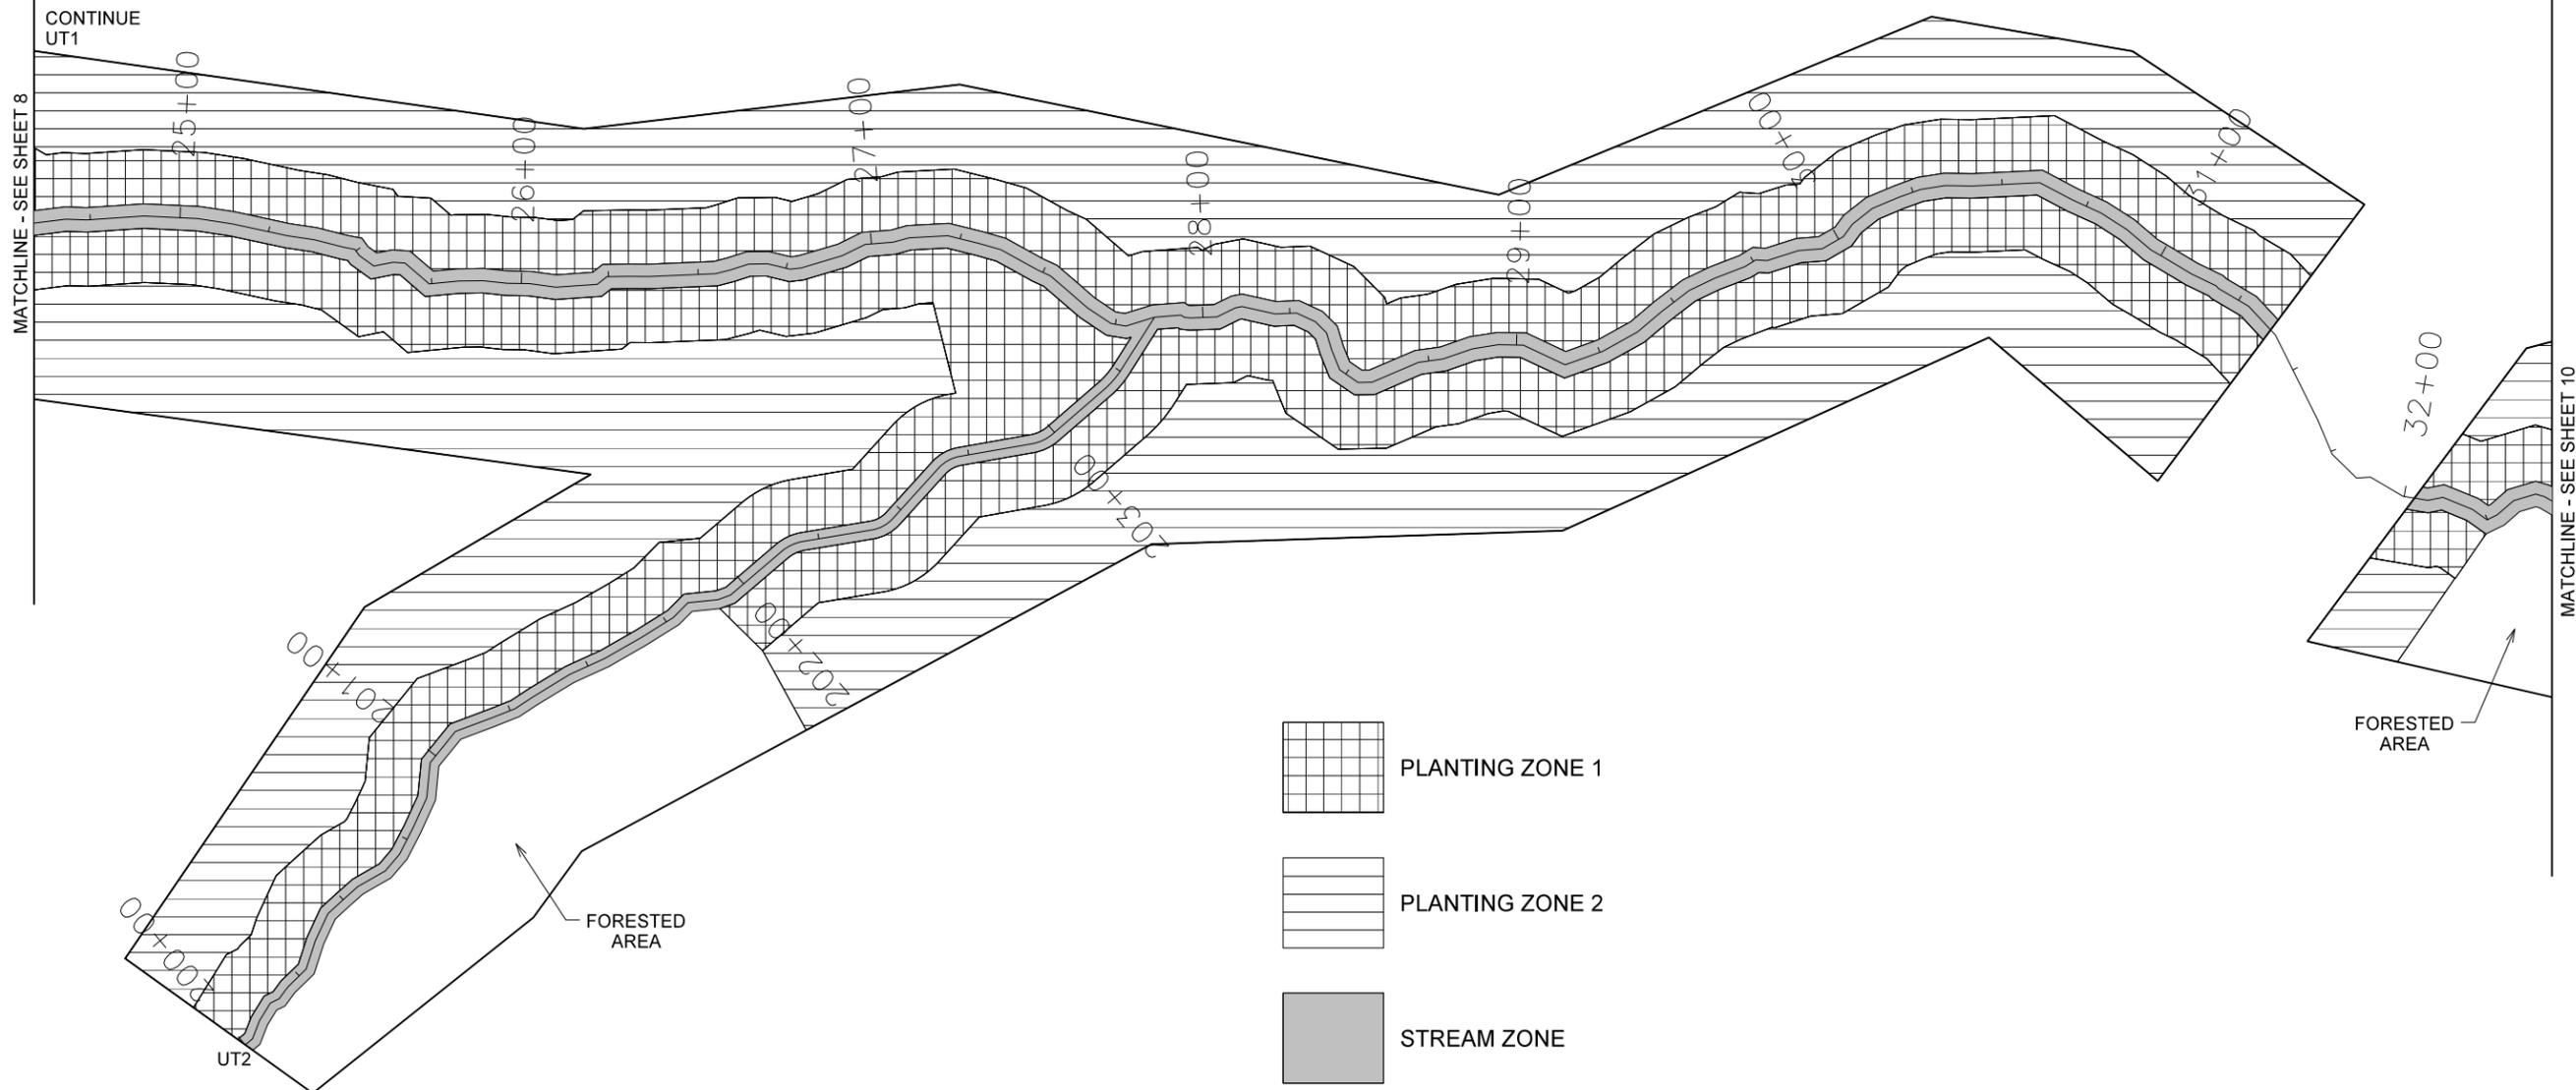

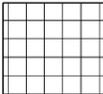-  PLANTING ZONE 1
-  PLANTING ZONE 2
-  STREAM ZONE

* NOTE: SEE SHEET 7 FOR PLANTING QUANTITIES





DALE'S CREEK RESTORATION SITE
Record Drawings
 BUNCOMBE COUNTY, NORTH CAROLINA



DATE: MAY 2022
 SCALE: GRAPHIC

PLANTING PLAN



09-29-2022

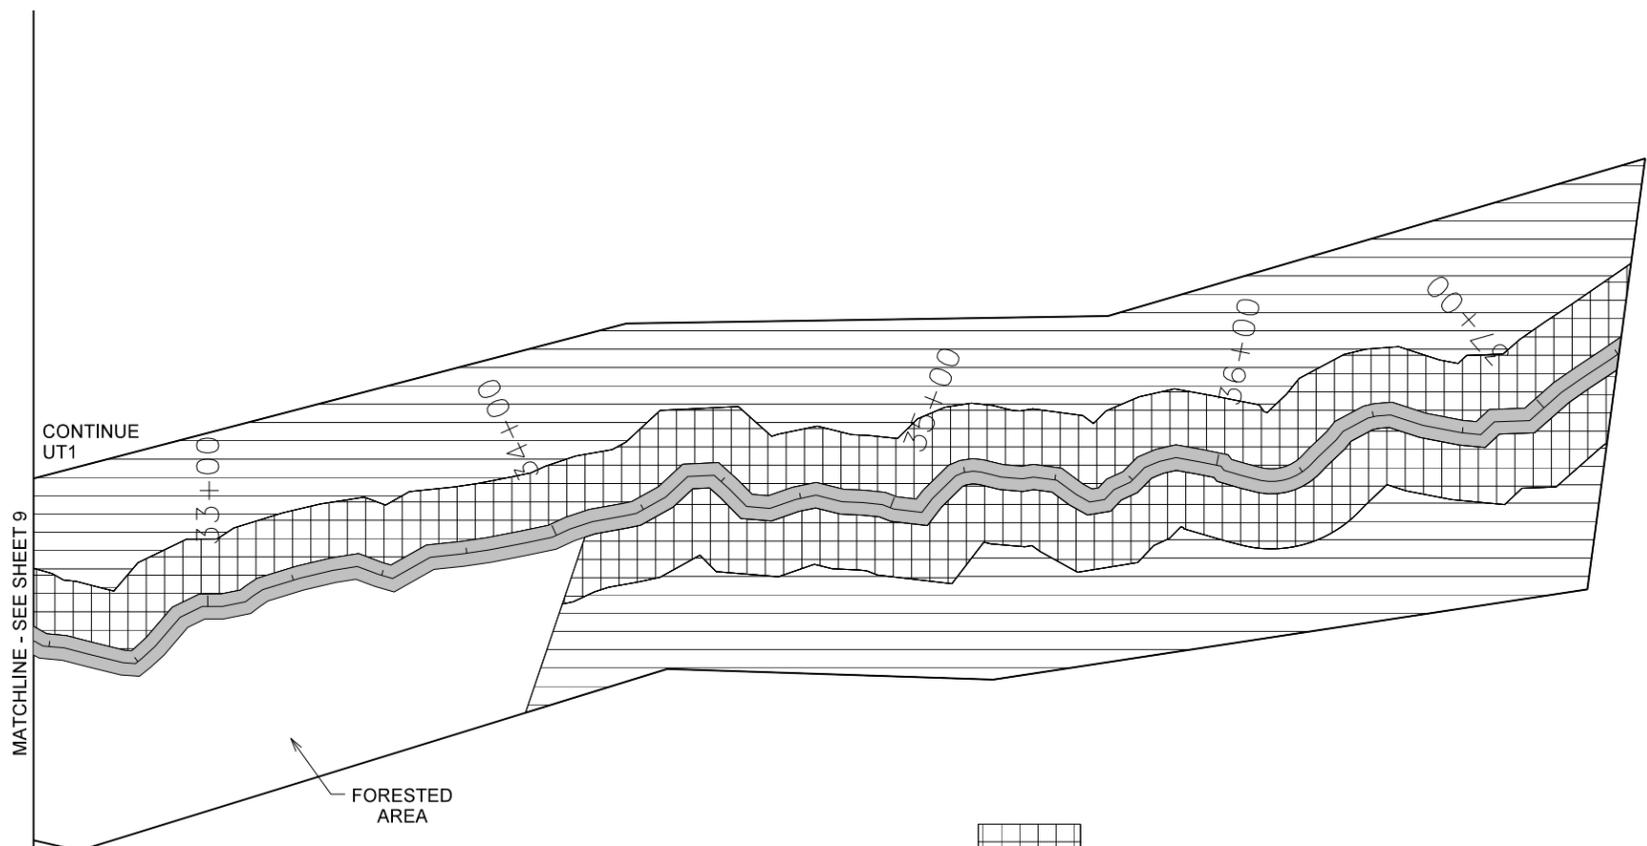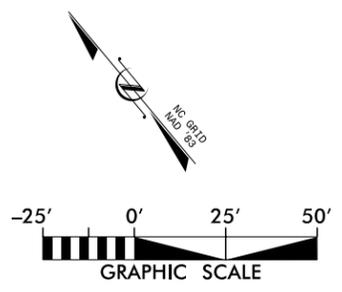

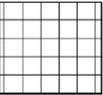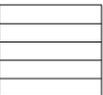-  PLANTING ZONE 1
-  PLANTING ZONE 2
-  STREAM ZONE

*NOTE: SEE SHEET 7 FOR PLANTING QUANTITIES

NO.	DATE	DESCRIPTION	BY



DALE'S CREEK
RESTORATION SITE
Record Drawings
BUNCOMBE COUNTY, NORTH CAROLINA

DATE: MAY 2022
SCALE: GRAPHIC

PLANTING
PLAN