


PROJECT: BISHOP SITE STREAM AND WETLAND RESTORATION

# BISHOP SITE STREAM AND WETLAND RESTORATION

## ANSON COUNTY, NORTH CAROLINA

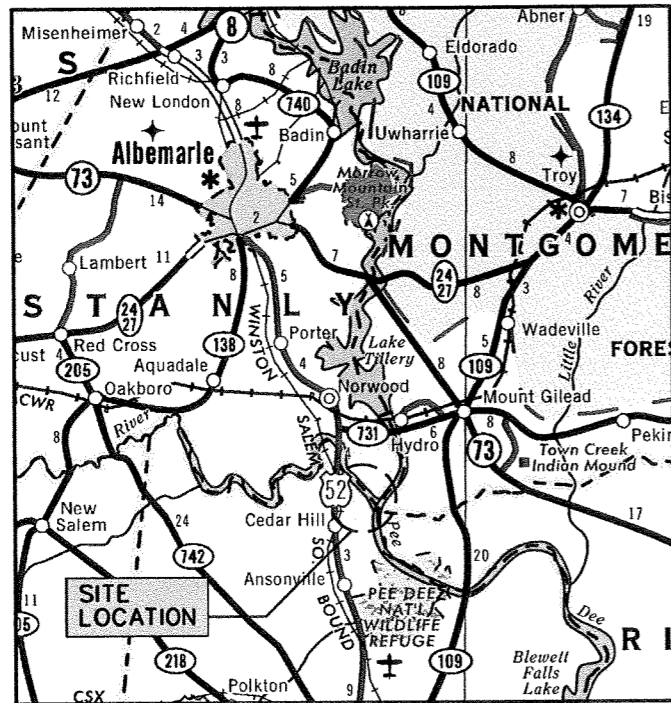


LOCATION MAP  
NOT TO SCALE

**LOCATION:**

SITE IS LOCATED IN NORTHERN ANSON COUNTY, APPROXIMATELY 3 MILES NORTH OF THE TOWN OF ANSONVILLE AND APPROXIMATELY 1.5 MILES EAST OF THE TOWN OF CEDAR HILL NEAR THE CONFLUENCE OF THE ROCKY RIVER AND THE PEE DEE RIVER.

**TYPE OF WORK: STREAM AND WETLAND RESTORATION / ENHANCEMENT**


- STREAM RESTORATION / ENHANCEMENT
- WETLAND RESTORATION / ENHANCEMENT
- IN-STREAM STRUCTURES
- FLOODPLAIN GRADING
- NEW CHANNEL CONSTRUCTION
- SITE PLANTING

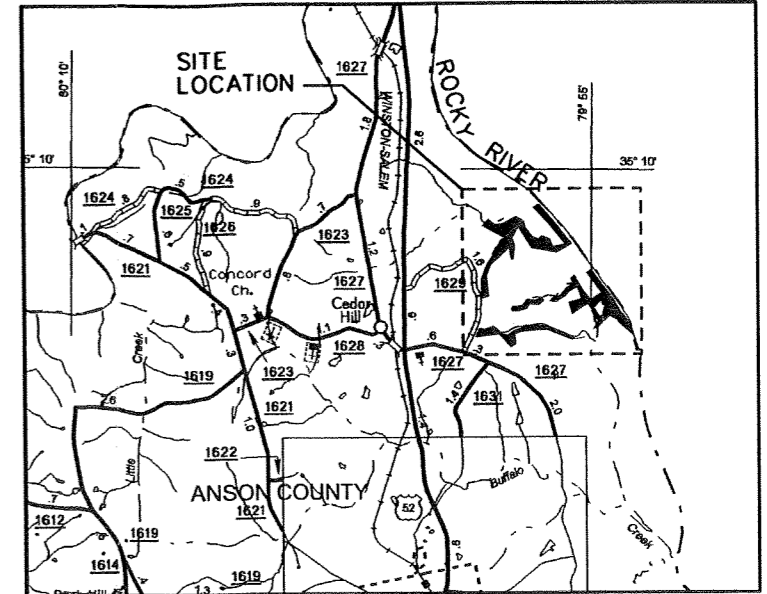

VICINITY MAP  
NOT TO SCALE

⊕ LATITUDE: 35° 09' 13.82"  
LONGITUDE: 80° 06' 12.46"

The elevation data utilized in the Bishop As-Built Plans was developed by Barry D Davis Surveying, 1503 Old Charlotte Rd., Albemarle, NC 28001 under the supervision of Barry D. Davis, PLS L-4384

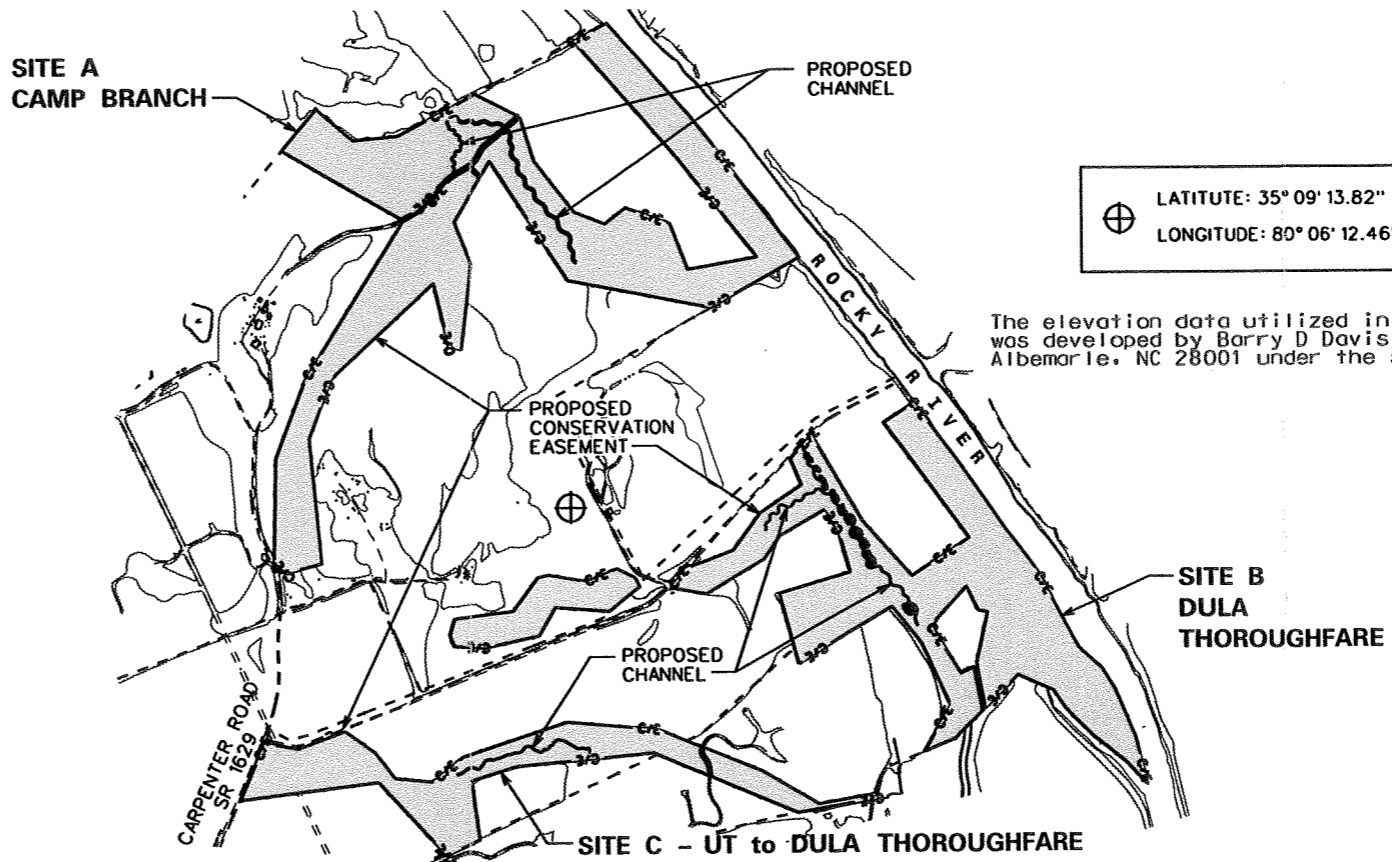

**CAMP BRANCH:**

CONSERVATION EASEMENT AREA: 94.9± ACRES  
AREA OF DISTURBANCE: 22.4± ACRES


**DULA THOROUGHFARE:**

CONSERVATION EASEMENT AREA: 70.8± ACRES  
AREA OF DISTURBANCE: 24.6± ACRES

**UT to DULA THOROUGHFARE:**

CONSERVATION EASEMENT AREA: 33.7± ACRES  
AREA OF DISTURBANCE: 11.3± ACRES

Prepared in the office of:

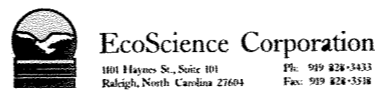

ENGINEER: DAVID G. MODLIN  
PROJECT MANAGER: JAMES D. COOPER

SEAL:



Prepared for:

ECOSYSTEM ENHANCEMENT PROGRAM  
Raleigh, North Carolina

No.	Revisions	Date
1	REV'D SHEETS A-2B, A-3, B-2B, B-3, C-2B, C-3	09/29/05 JDC
2	AS-BUILT	JULY 2007

Desn. By: JDC	Dwn. By: MAF	Ckd. By: EBB
Date: JUL 2007		
ESC Project No: 04-212		

SHEET
1

## INDEX OF SHEETS

- 1: TITLE SHEET
- 1A: INDEX OF SHEETS / GENERAL NOTES
- 1B: ELEMENT SYMBOLOLOGY
- 2: SITE ACCESS

### CAMP BRANCH

- A: CONSTRUCTION SEQUENCE
- A-1: MORPHOLOGICAL TABLE / SHEAR STRESS TABLE
- A-1A: POOL RADIUS TABLE / RIFFLE TABLE
- A-2: TYPICAL SECTIONS
- A-2A, A-2B: GENERAL DETAILS
- A-2C: NEW CHANNEL CENTERLINE DATA
- A-3: SUMMARY OF QUANTITIES / SUMMARY OF EARTHWORK
- A-4: EXISTING CONDITIONS
- A-5: NEW CHANNEL LAYOUT
- A-6, A-6A: SITE PLAN
- A-7: PROFILE - CAMP BRANCH -C- CHANNEL
- A-7A: AS-BUILT PROFILE - CAMP BRANCH -C- CHANNEL
- A-8: PROFILE - UT to CAMP BRANCH -A- CHANNEL
- A-8A: AS-BUILT PROFILE - UT to CAMP BRANCH -A- CHANNEL
- A-EC1, A-EC1A: EROSION CONTROL PLAN
- A-EC2: EROSION CONTROL DETAILS
- A-L1: PLANTING PLAN
- X1-X4: CROSS-SECTIONS
- X1A-X4A: AS-BUILT CROSS-SECTIONS

### DULA THOROUGHFARE

- B: CONSTRUCTION SEQUENCE
- B-1: RADIUS TABLE / SHEAR STRESS TABLE
- B-2: TYPICAL SECTIONS / GENERAL DETAILS
- B-2A, B-2B: GENERAL DETAILS
- B-2C: NEW CHANNEL CENTERLINE DATA
- B-3: SUMMARY OF QUANTITIES / SUMMARY OF EARTHWORK
- B-4: EXISTING CONDITIONS
- B-5: NEW CHANNEL LAYOUT
- B-6: SITE PLAN
- B-7: PROFILE - DULA THOROUGHFARE -T- CHANNEL
- B-7A: AS-BUILT PROFILE - DULA THOROUGHFARE -T- CHANNEL
- B-8: PROFILE - DULA THOROUGHFARE -D- CHANNEL
- B-8A: AS-BUILT PROFILE - DULA THOROUGHFARE -D- CHANNEL
- B-EC1: EROSION CONTROL PLAN
- B-EC2: EROSION CONTROL DETAILS
- B-L1: PLANTING PLAN
- X5-X7: CROSS-SECTIONS
- X5A-X7A: AS-BUILT CROSS-SECTIONS

### UT TO DULA THOROUGHFARE

- C: CONSTRUCTION SEQUENCE
- C-1: MORPHOLOGICAL TABLE / STRUCTURE TABLE - NOT APPLICABLE
- C-2: TYPICAL SECTIONS
- C-2A, C-2B: GENERAL DETAILS
- C-3: SUMMARY OF QUANTITIES / SUMMARY OF EARTHWORK
- C-4: EXISTING CONDITIONS
- C-5: NEW CHANNEL LAYOUT - NOT APPLICABLE
- C-6: SITE PLAN
- C-7: PROFILE - UT TO DULLA THOROUGHFARE - NOT APPLICABLE
- C-EC1: EROSION CONTROL PLAN
- C-EC2: EROSION CONTROL DETAILS
- C-L1: PLANTING PLAN
- X: CROSS-SECTIONS - NOT APPLICABLE

## GENERAL NOTES

1. ALL WORK SHALL BE PERFORMED IN ACCORDANCE WITH THE FOLLOWING STANDARDS:
  - A) NORTH CAROLINA DEPARTMENT OF TRANSPORTATION "STANDARD SPECIFICATIONS FOR ROADS AND STRUCTURES, ENGLISH" DATED JANUARY 2002, AND ANY SUPPLEMENTS THERETO ISSUED PRIOR TO THE DATE OF RECEIPT OF BIDS.
  - B) NORTH CAROLINA DEPARTMENT OF TRANSPORTATION "ROADWAY STANDARD DRAWINGS, ENGLISH" DATED JANUARY 2002 AND ANY SUPPLEMENTS ISSUED THERETO PRIOR TO THE DATE OF RECEIPT OF BIDS.
  - C) REQUIREMENTS OF THE DEPARTMENT OF ENVIRONMENT AND NATURAL RESOURCES.
2. ALL CONSERVATION EASEMENT CORNER MARKERS HAVE BEEN PLACED BY OTHERS. THE CONTRACTOR SHOULD CONFIRM THE CONSERVATION EASEMENT BOUNDARIES BEFORE COMMENCING WORK.
3. CONTRACTOR SHALL FIELD VERIFY EXISTING CONDITIONS AND DIMENSIONS WHICH AFFECT NEW WORK PRIOR TO ANY CONSTRUCTION.
4. THE CONTRACTOR IS SOLELY RESPONSIBLE FOR ALL SAFETY ACCORDING TO CURRENT OSHA REGULATIONS.
5. THE CONTRACTOR IS RESPONSIBLE FOR AVOIDING ANY DISTURBANCE OR DAMAGE TO UTILITIES AND SHALL BE RESPONSIBLE FOR IMMEDIATELY REPAIRING ANY DAMAGES AT A COST INCIDENT TO THIS CONTRACT. CALL BEFORE YOU DIG --- 1-800-632-4949.
6. THE EXISTING CHANNELS TO BE FILLED SHALL BE FILLED TO THE MAXIMUM EXTENT FEASIBLE WITH MATERIAL EXCAVATED FROM ON-SITE AND STOCKPILED ADJACENT TO REACHES OF THE OLD CHANNEL. DISTURBANCES SHALL BE PROTECTED IN ACCORDANCE WITH THE APPROVED SEDIMENT AND EROSION CONTROL PLAN.
7. SILT FENCE SHALL BE PLACED BETWEEN STOCKPILE AREAS AND THE EXISTING CHANNEL AND SHALL BE INSTALLED ACCORDING TO THE APPROVED SEDIMENT AND EROSION CONTROL PLAN.
8. THE CONTRACTOR MAY UTILIZE THE DESIGNATED STAGING AREA AND THE AREA INSIDE THE PROPOSED CONSERVATION EASEMENT FOR STAGING AND STOCKPILING EQUIPMENT AND MATERIALS.
9. THE COORDINATE SYSTEM IS THE NAD 83 STATE PLANE GRID. THE VERTICAL DATUM IS BASED ON NVD 1929.
10. EXISTING GRAVEL ACCESS ROADS WILL BE LEFT IN "AS IS OR BETTER" CONDITION. STONE, CLASS ABC, HAS BEEN ESTIMATED AND INCLUDED IN THE QUANTITY ESTIMATES SHOULD EXISTING GRAVEL ROADS NEED REPAIR AT THE PROJECT CONCLUSION. AN ALLOWANCE OF 3 INCHES OF CLASS ABC STONE AND 16-FOOT WIDTH OF EXISTING ROAD WERE ESTIMATED FOR THE ENTIRE LENGTH OF EXISTING ACCESS ROADS. FINAL PAY QUANTITIES WILL BE ON ACTUAL QUANTITIES USED FOR IMPROVED EXISTING ACCESS ROADS.
11. SHOULD ACCESS ROADS AS SHOWN ON THE PLAN SHEETS REQUIRE IMPROVEMENT, CLASS A STONE AND FILTER FABRIC HAVE BEEN ESTIMATED AND INCLUDED IN THE QUANTITY ESTIMATE. AN ALLOWANCE OF 480 TONS OF CLASS A STONE AND 1333 SQUARE YARDS OF FILTER FABRIC WERE ESTIMATED PER 1000 FEET OF 12-FOOT WIDE IMPROVED ACCESS ROAD. QUANTITIES ESTIMATED ALLOW FOR IMPROVING THE ENTIRE LENGTH OF EACH ACCESS ROAD SHOWN ASSUMING WORST CASE WEATHER CONDITIONS. FINAL PAY QUANTITIES WILL BE ON ACTUAL QUANTITIES USED FOR IMPROVED ACCESS ROADS. THE PROPOSED ACCESS ROADS WILL BE REMOVED OR REMAIN AS INDICATED ON PLAN SHEET 2.
12. THE BISHOP SITE STREAM / WETLAND RESTORATION PROJECT DRAINAGE IS SHOWN ON FIRM MAP NO. 3702840050B. THE PROJECT IS IN FLOOD ZONE A. NO DETAILED FLOOD STUDY HAS BEEN PERFORMED FOR THIS AREA OF ANSON COUNTY.
13. ALL ELEVATIONS AND GRADING POINTS WERE DERIVED FROM TOPOGRAPHIC MAPPING PROVIDED TO ECOSCIENCE CORPORATION BY THE OWNER. SUPPLEMENTAL SURVEYING WAS PROVIDED BY K2 DESIGN, GOLDSBORO, NC. THE GRADING PLAN AND SPECIFIED ELEVATIONS, AS SHOWN, ARE RELATIVE TO THIS TOPOGRAPHIC MAPPING. TOPOGRAPHIC DISCREPANCIES IDENTIFIED AS A RESULT OF FIELD SURVEYS DURING CONSTRUCTION MAY BE ADJUSTED AT THE DISCRETION OF THE PROJECT MANAGER. ALSO, EARTHWORK QUANTITY ESTIMATES WERE DERIVED FROM ELEVATION CONTOURS SHOWN ON THESE PLANS.



EcoScience  
Corporation

Raleigh, North Carolina

#### REVISIONS

1 AS-BUILT - JULY 2007



Client:



Project:

**BISHOP SITE  
STREAM /  
WETLAND  
RESTORATION  
PLAN**

ANSON COUNTY,  
NORTH CAROLINA

Title:

**INDEX OF  
SHEETS /  
GENERAL NOTES**

Des. By:

Des. By:

JDC

MAF

Ckd. By:

Date:

EBB

JUL 2007

Scale:

NO SCALE

ESC Project No.:

04-212

SHEET

**1A**

# ECOSCIENCE CORPORATION ELEMENT SYMBOLOGY



## TOPOGRAPHY & HYDROGRAPHY

MAJOR CONTOUR .....	
MINOR CONTOUR .....	
GRAVEL / DIRT ROAD .....	
PAVED ROAD .....	
WETLAND / SWAMP .....	
DIRECTION OF FLOW .....	
EXISTING STREAM .....	
EXISTING WETLAND BOUNDARY .....	
HIGH QUALITY WETLAND BOUNDARY .....	
MEDIUM QUALITY WETLAND BOUNDARY .....	
LOW QUALITY WETLAND BOUNDARY .....	
PROPOSED WETLAND BOUNDARY .....	
EXISTING SPOT ELEVATION .....	
PROPOSED SPOT ELEVATION .....	

## BOUNDARIES, PROPERTIES, AND EASEMENTS

COUNTY LINE .....	
CITY LINE .....	
PROPERTY LINE .....	
EXISTING IRON PIN .....	
RIGHT OF WAY .....	
PROPERTY MONUMENT .....	
PARCEL NUMBER .....	
ESC BENCHMARK .....	
NCDOT MONUMENT .....	
UTILITY EASEMENT .....	
POWER LINE .....	
EXISTING EASEMENT .....	
PROPOSED CONSERVATION EASEMENT .....	

## BUILDINGS & OTHER STRUCTURES

BUILDINGS .....	
WELL .....	
BRIDGE .....	
BOX CULVERT OR TUNNEL .....	
CULVERT .....	
BRIDGE WING WALL, HEAD WALL, AND END WALL .....	
HEAD AND END WALL .....	
PIPE CULVERT .....	
FOOTBRIDGE .....	
DRAINAGE BOXES .....	
EXISTING FENCE .....	
POWER POLE .....	
TELEPHONE POLE .....	
POWER LINE TOWER .....	
SANITARY SEWER MANHOLE .....	
STORM SEWER MANHOLE .....	
SANITARY SEWER .....	
STORM SEWER .....	
FOOTBRIDGE .....	
TRAIL, FOOTPATH .....	
RAIL ROAD .....	

## VEGETATION

SINGLE TREE .....	
SINGLE SHRUB .....	
EXISTING WOODS LINE .....	


## PROPOSED FEATURES AND STRUCTURES

PROPOSED CONSTRUCTION ENTRANCE .....	
PROPOSED ROCK SILL .....	

## PROPOSED FEATURES AND STRUCTURES

RADIUS OF CURVATURE CENTER MARK .....	
CHANNEL FORD .....	
CROSS-VANE .....	
MODIFIED CROSS-VANE .....	
J-HOOK VANE .....	
STEP CROSS-VANE .....	
LOG VANE .....	
ROOT WAD .....	
TEMPORARY STAGING AREA, SOIL STOCKPILING .....	
NEW CHANNEL .....	
BORROW AREA .....	
CHANNEL BACKFILL .....	
MEANDER REVETMENT .....	
RIPRAP APRON .....	
IMPERVIOUS CHANNEL BLOCK .....	
TOP OF RIFFLE .....	
BOTTOM OF RIFFLE .....	
CONSTRUCTED BERM .....	
PROPOSED WOVEN WIRE FENCE .....	
PROPOSED BARBED WIRE FENCE .....	
PROPOSED SAFETY FENCE .....	
PROPOSED SILT FENCE .....	
PROPOSED MAJOR CONTOURS .....	
PROPOSED MINOR CONTOURS .....	
PROPOSED DIVERSION DITCH .....	
LIMITS OF DISTURBANCE .....	
PROPOSED ACCESS ROAD .....	
PROPOSED CLEARING LIMITS .....	
PROPOSED STONE OUTLET .....	

REVISIONS

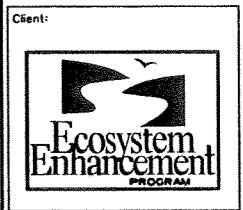

Client: **Ecosystem Enhancement Program**

Project: **BISHOP SITE STREAM / WETLAND RESTORATION PLAN**

ANSON COUNTY, NORTH CAROLINA

Title: **ELEMENT SYMBOLOGY**

Dwn. By: JDC	Dwn. By: MAF
Ckd. By: DGM	Date: JUN 2005

Scale: NO SCALE

ESC Project No.: 04-212

SHEET  
**1B**



EcoScience Corporation

Raleigh, North Carolina

REVISIONS

NO.	DATE	DESCRIPTION



Client:



Project:

BISHOP SITE STREAM / WETLAND RESTORATION PLAN

ANSON COUNTY, NORTH CAROLINA

Title:

SITE ACCESS

Des. By:

Own. By:

JDC

MAF

Chk. By:

Date:

DGM

JUN 2005

Scale:

AS SHOWN

ESC Project No.:



04-212

SHEET

2

BENCHMARKS

LOCATION	TYPE	EASTING	NORTHING	REVISED ELEVATION
ESC BM 1	CEMENT W/ LAG BOLT	1672518.796	515161.114	206.01
ESC BM 2	CEMENT W/ LAG BOLT	1672852.724	514653.341	202.27
ESC BM 3	CEMENT W/ LAG BOLT	1673187.346	514144.998	201.47
ESC BM 4	CEMENT W/ LAG BOLT	1673813.981	513828.702	202.78
ESC BM 5	CEMENT W/ LAG BOLT	1672463.892	514762.773	206.94
NCDOT BM 1	RR SPIKE IN TREE	1671382.477	509938.956	301.35
NCDOT BM 2	RR SPIKE IN TREE	1672682.638	514987.957	206.48
NCDOT BM 3	RR SPIKE IN TREE	1675041.642	513968.682	207.56
NCDOT BM 4	RR SPIKE IN TREE	1674222.110	509949.013	254.46
NCDOT BM 5	RR SPIKE IN TREE	1675694.438	511289.397	203.47
NCDOT BM 6	RR SPIKE IN TREE	1676655.908	510132.466	203.90

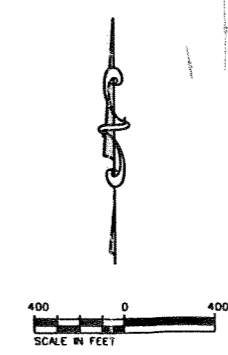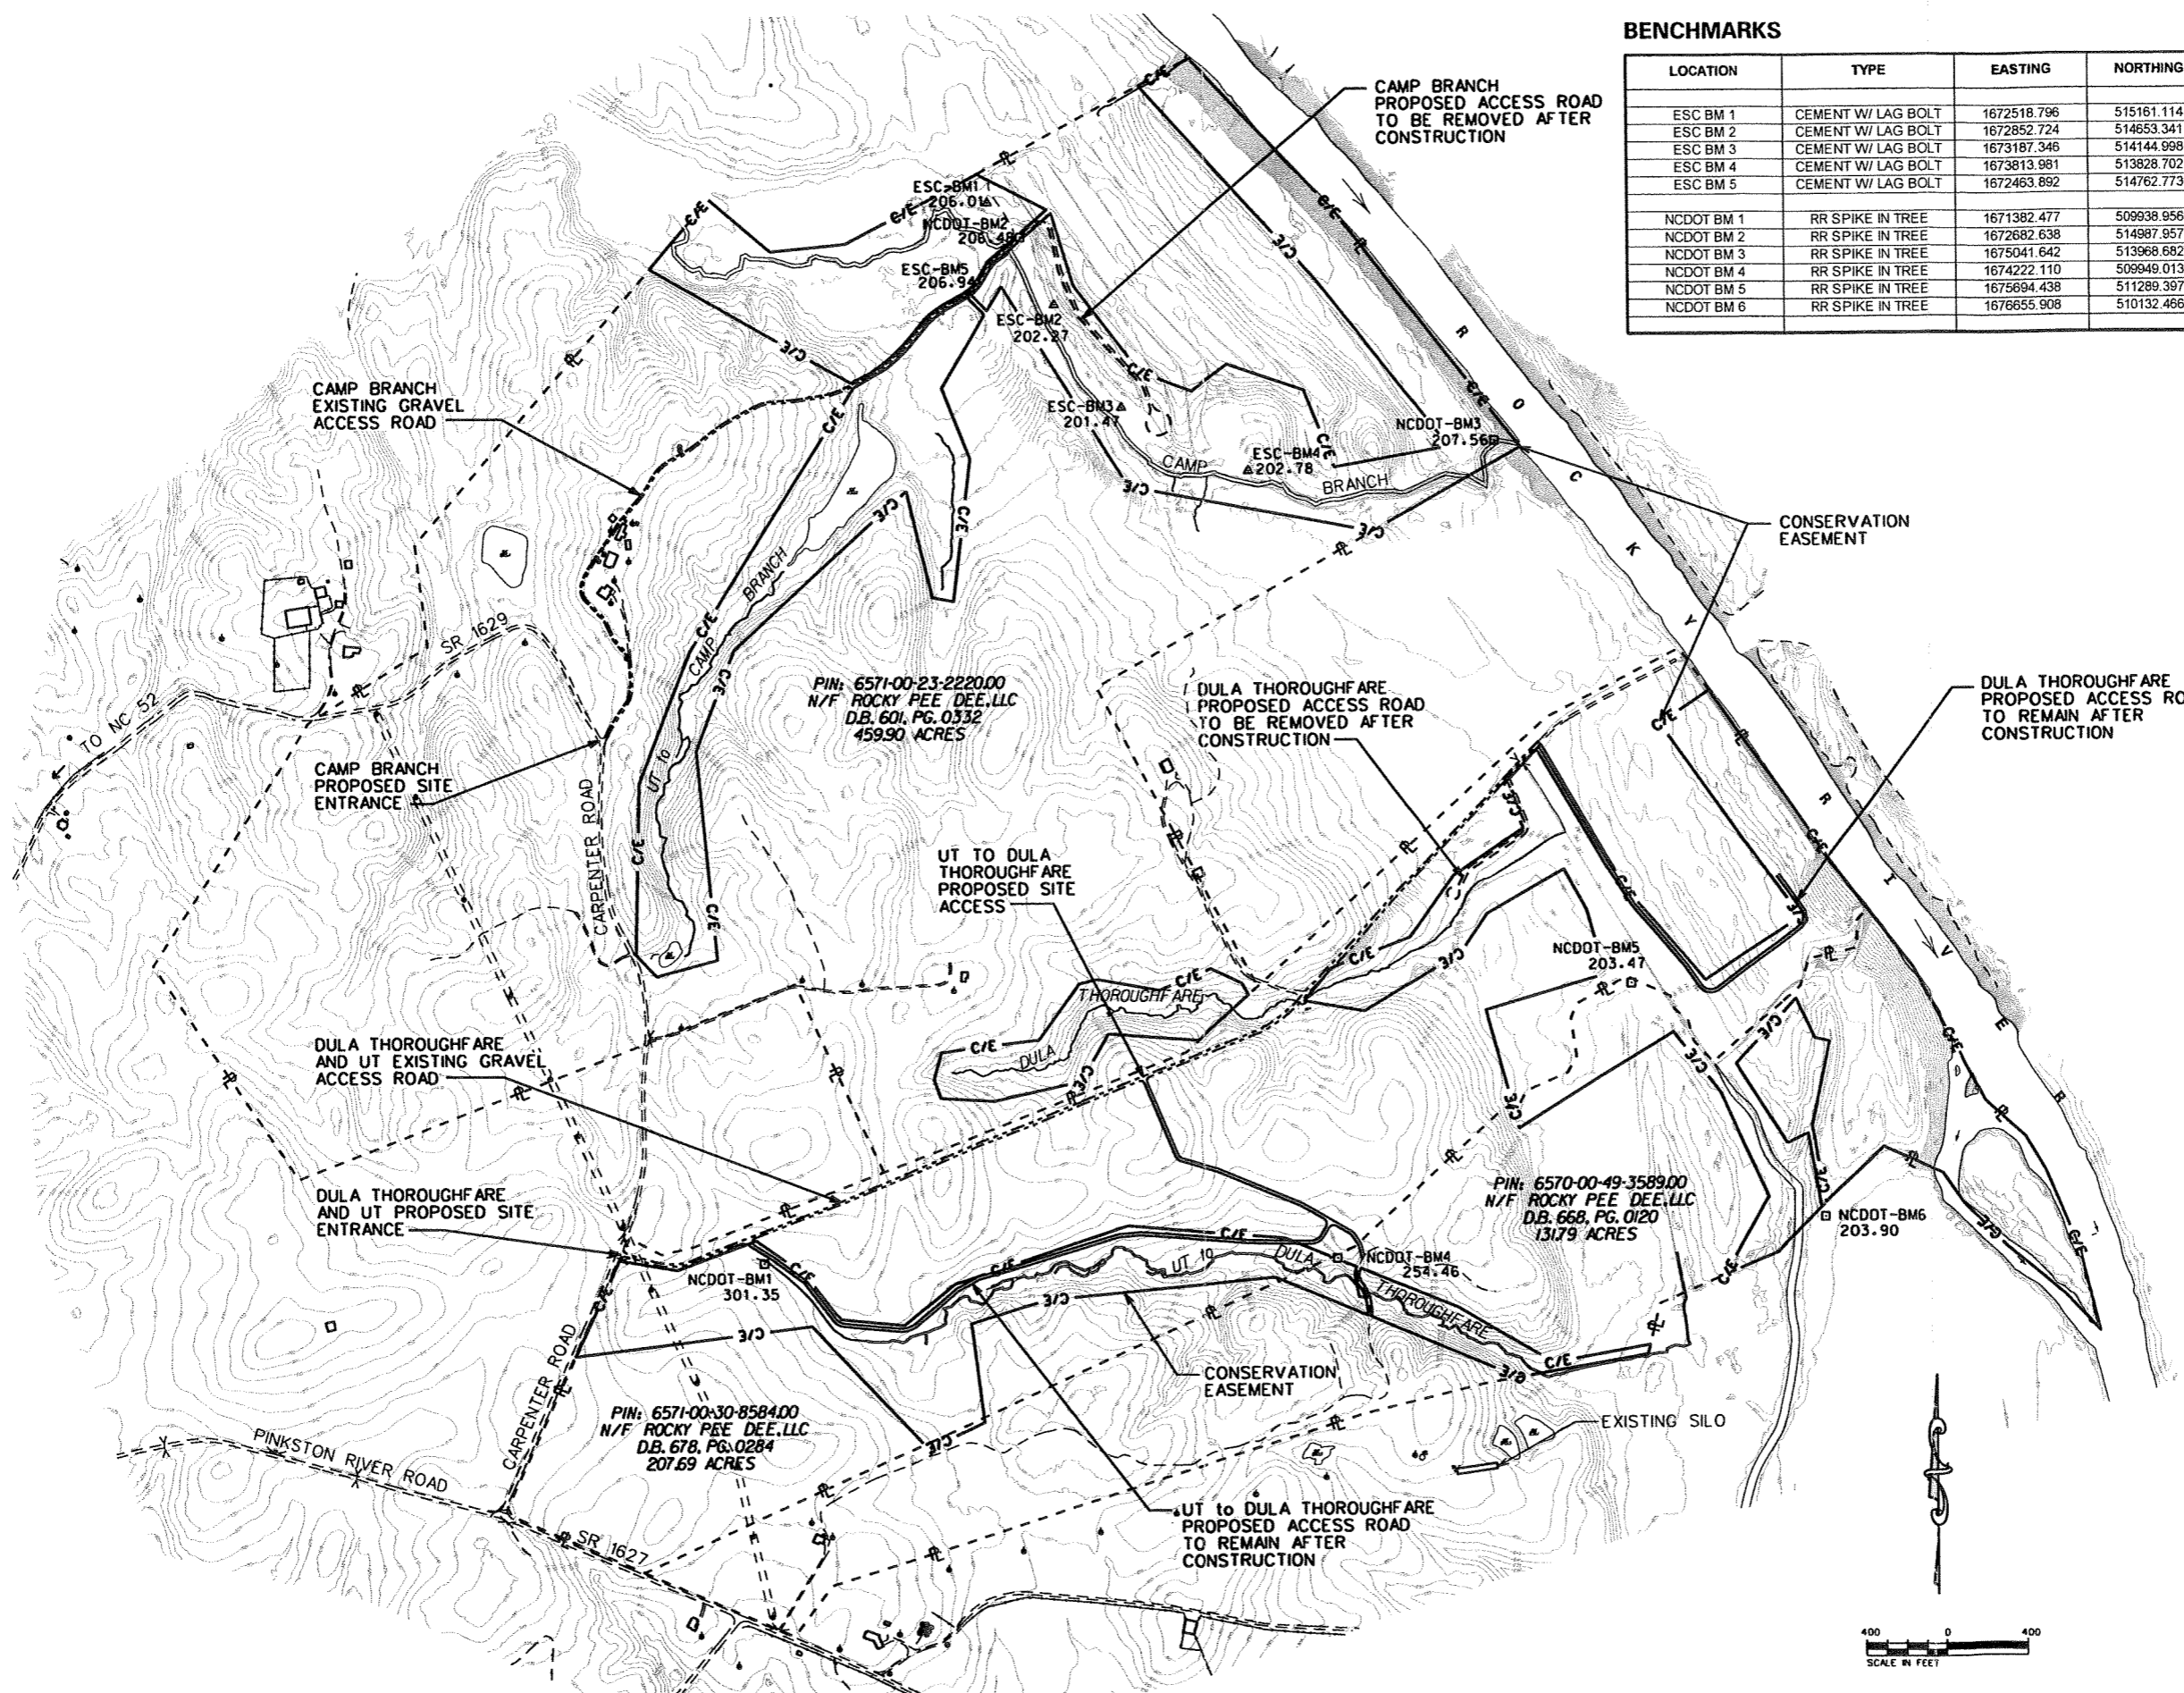



## CONSTRUCTION SEQUENCE

1. MOBILIZE EQUIPMENT AND MATERIALS TO CAMP BRANCH SITE.
2. ESTABLISH ACCESS ROADS AND STAGING AREAS AS DEPICTED ON THE PLANS OR AS DIRECTED BY THE PROJECT MANAGER AND MARK CONSTRUCTION EQUIPMENT ACCESS LOCATIONS WITH VISIBLE MARKERS. CONSTRUCTION EQUIPMENT SHALL BE MAINTAINED AND SERVICED WITHIN THE LIMITS OF THE ESTABLISHED STAGING AREAS. THE CONTRACTOR SHALL BE RESPONSIBLE FOR MAINTAINING ALL STAGING AREAS IN AN ENVIRONMENTALLY SENSITIVE MANNER.
3. INSTALL IMPROVEMENTS TO SITE ACCESS ROAD IF REQUIRED AND INSTALL TEMPORARY EROSION CONTROL MEASURES (I.E., SILT FENCE, STONE OUTLETS, ETC.) AS REQUIRED.
4. AT THE END OF EACH DAY OF CONSTRUCTION, THE CONTRACTOR SHALL PROVIDE TEMPORARY SEED AND MULCH AND APPLY COIR FIBER MATTING, AS APPROPRIATE, TO ALL DISTURBED AREAS. IN ADDITION, THE CONTRACTOR SHALL BE RESPONSIBLE FOR MAINTAINING ALL TEMPORARY EROSION CONTROL MEASURES ON A DAILY BASIS THROUGHOUT THE CONSTRUCTION PERIOD.
5. THE UT TO CAMP BRANCH SHALL BE DUG IN THE DRY EASTWARD FROM THE EXISTING ACCESS ROAD AND CONNECTED TO CAMP BRANCH. THE EXISTING LOW AREA PARALLEL TO THE UT SHALL BE FILLED WITH MATERIAL FROM THE UT EXCAVATION.
6. CAMP BRANCH AND THE ASSOCIATED FLOODPLAIN WORK SHALL BE DUG IN THE DRY WITH THE WASTE MATERIAL TEMPORARILY STOCKPILED BETWEEN THE PROPOSED CHANNEL AND THE EXISTING CHANNEL. THE PROPOSED PERMANENT FORD SHALL BE CONSTRUCTED AT THIS TIME, ALSO IN THE DRY. IT IS ASSUMED THE CONNECTION AT THE BOTTOM END OF THE PROJECT CAN BE MADE AT THIS TIME WITHOUT CONSEQUENCES.
7. A PUMP-AROUND OPERATION SHALL BE PROVIDED JUST ABOVE THE DIVERGENCE OF EXISTING CAMP BRANCH AND THE PROPOSED CAMP BRANCH TO FACILITATE THE CONSTRUCTION OF THE PROPOSED CHANNEL BLOCK AND CONNECTION OF EXISTING CAMP BRANCH TO THE NEW CHANNEL.
8. THE EXISTING CAMP BRANCH SHALL BE BACKFILLED WITH THE STOCKPILED MATERIAL FROM THE EXCAVATION OF THE NEW CHANNEL. THE EXISTING DITCH SECTION PARALLELING THE EXISTING ACCESS ROAD SHALL BE EXTENDED TO TIE TO THE NEW LOCATION CAMP BRANCH. NO WORK IS ANTICIPATED AT THE PIPE AT THE BREAK IN THE CONSERVATION EASEMENT.
9. THE PROPOSED FORD ACROSS THE EXISTING ACCESS ROAD AT THE UT TO CAMP BRANCH SHALL BE CONSTRUCTED FOLLOWED BY THE PROPOSED CHANNEL BLOCK. THE PURPOSE OF THE BLOCK IS TO DIRECT FLOW FROM THE UT HEADWATER ALONG THE NEW UT CHANNEL TO CAMP BRANCH.
10. THE CONTRACTOR SHALL COMPACT THE PROPOSED FILL IN THE FILLED CHANNELS TO 90 PERCENT PROCTOR. THE PROPOSED CHANNEL BLOCKS SHALL HAVE A CORE OF IMPERVIOUS SELECT MATERIAL AS SPECIFIED IN THE PROJECT DETAIL AND SPECIAL PROVISIONS.
11. THE CONTRACTOR SHALL PLACE FINAL WASTE MATERIAL IN AREAS DESIGNATED ON THE PLANS AND AT THE DIRECTION OF THE PROJECT MANAGER. STOCKPILE AREAS SHALL BE PROTECTED BY SILT FENCING AS APPROPRIATE.
12. ONCE CONSTRUCTION IS COMPLETE, THE CONTRACTOR SHALL REMOVE ALL CONSTRUCTION MATERIALS FROM THE CONSERVATION EASEMENT, DISPOSE OF THEM IN AN APPROVED DUMP SITE AND SCARIFY ANY COMPACTED AREAS AS DIRECTED BY THE PROJECT MANAGER. TO COMPLETE SEEDING AND MULCHING, ALL DISTURBED AREAS SHALL BE DISKED OR PLOWED TO CREATE MICRO TOPOGRAPHY TO THE SATISFACTION OF THE PROJECT MANAGER AND PERMANENTLY SEEDED AND MULCHED. STONE APPLIED TO ACCESS ROADS, IF ANY, SHALL REMAIN OR BE REMOVED AS INDICATED ON PLAN SHEET 2.

### INDEX OF SHEETS


#### CAMP BRANCH




- A: CONSTRUCTION SEQUENCE
- A-1: MORPHOLOGICAL TABLE / SHEAR STRESS TABLE
- A-1A: POOL RADIUS TABLE / RIFFLE TABLE
- A-2: TYPICAL SECTIONS
- A-2A, A-2B: GENERAL DETAILS
- A-2C: NEW CHANNEL CENTERLINE DATA
- A-3: SUMMARY OF QUANTITIES / SUMMARY OF EARTHWORK
- A-4: EXISTING CONDITIONS
- A-5: NEW CHANNEL LAYOUT
- A-6, A-6A: SITE PLAN
- A-7: PROFILE - CAMP BRANCH -C- CHANNEL
- A-7A: AS-BUILT PROFILE - CAMP BRANCH -C- CHANNEL
- A-8: PROFILE - UT to CAMP BRANCH -A- CHANNEL
- A-8A: AS-BUILT PROFILE - UT to CAMP BRANCH -A- CHANNEL
- A-EC1, A-EC1A: EROSION CONTROL PLAN
- A-EC2: EROSION CONTROL DETAILS
- A-L1: PLANTING PLAN
- X1-X4: CROSS-SECTIONS
- X1A-X4A: AS-BUILT CROSS-SECTIONS

# SITE A CAMP BRANCH


**TYPE OF WORK: STREAM AND WETLAND RESTORATION / ENHANCEMENT**

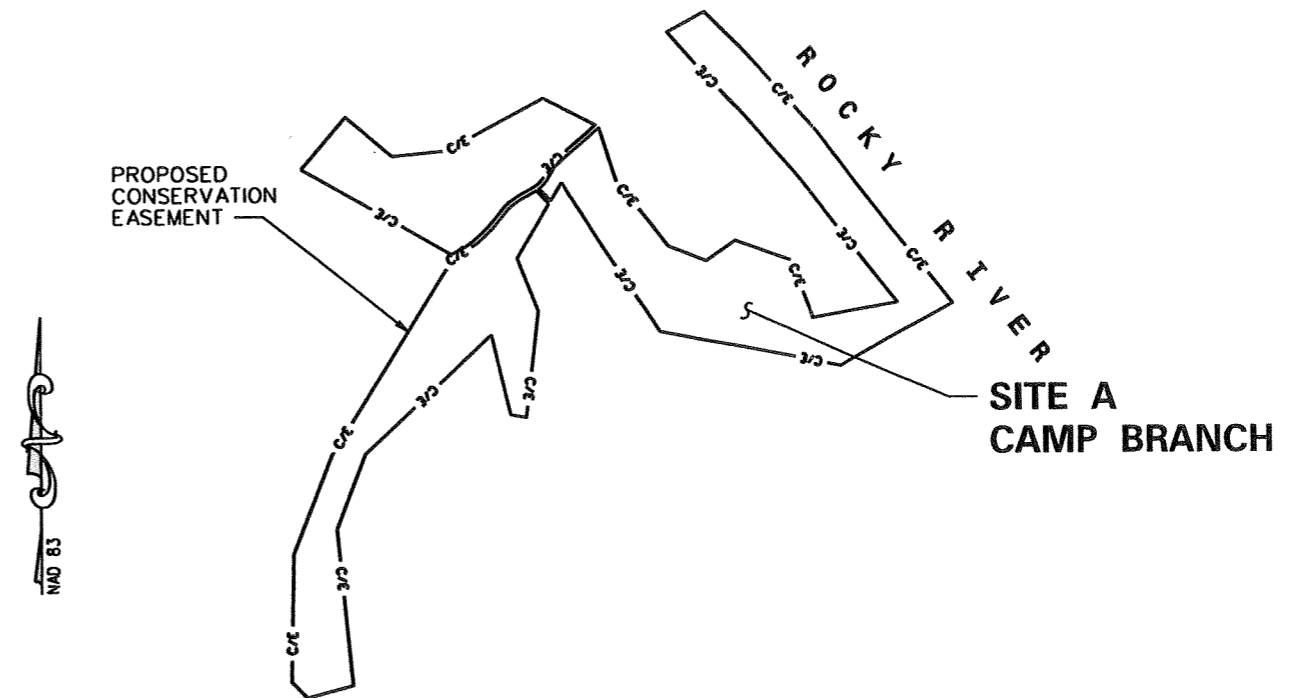- STREAM RESTORATION / ENHANCEMENT
- FLOODPLAIN GRADING
- NEW CHANNEL CONSTRUCTION
- SITE PLANTING



Prepared in the office of:		Prepared for:		Dsn. By:	Dwn. By:	Ckd. By:									
 <b>EcoScience Corporation</b> <small>1101 Hayes St., Suite 101 Raleigh, North Carolina 27604</small>		 <b>ECOSYSTEM ENHANCEMENT PROGRAM</b> <small>Raleigh, North Carolina</small>		JDC	MAF	EBB									
<b>ENGINEER:</b> DAVID G. MODLIN  <b>PROJECT MANAGER:</b> JAMES D. COOPER		SEAL:  		Date: <b>JUL 2007</b>											
				ESC Project No: 04-212											
				SHEET <b>A</b>											
		<table border="1" style="width: 100%; border-collapse: collapse;"> <thead> <tr> <th>No.</th> <th>Revisions</th> <th>Date</th> </tr> </thead> <tbody> <tr> <td>1</td> <td>REV'D SHEETS A-2B, A-3,</td> <td>09/29/05 JDC</td> </tr> <tr> <td>2</td> <td>AS-BUILT</td> <td>JULY 2007</td> </tr> </tbody> </table>		No.	Revisions	Date	1	REV'D SHEETS A-2B, A-3,	09/29/05 JDC	2	AS-BUILT	JULY 2007			
No.	Revisions	Date													
1	REV'D SHEETS A-2B, A-3,	09/29/05 JDC													
2	AS-BUILT	JULY 2007													

REVISIONS

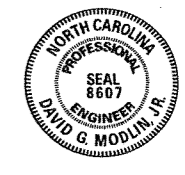

Client:



Project:

**BISHOP SITE  
STREAM /  
WETLAND  
RESTORATION  
PLAN**

ANSON COUNTY,  
NORTH CAROLINA

Title:

**TYPICAL  
SECTIONS**

**CAMP BRANCH**

Des. By: JDC      Des. By: MAF


Ckd. By: DGM      Date: JUN 2005

Scale: NO SCALE


ESC Project No.: 04-212

SHEET

**A-2**

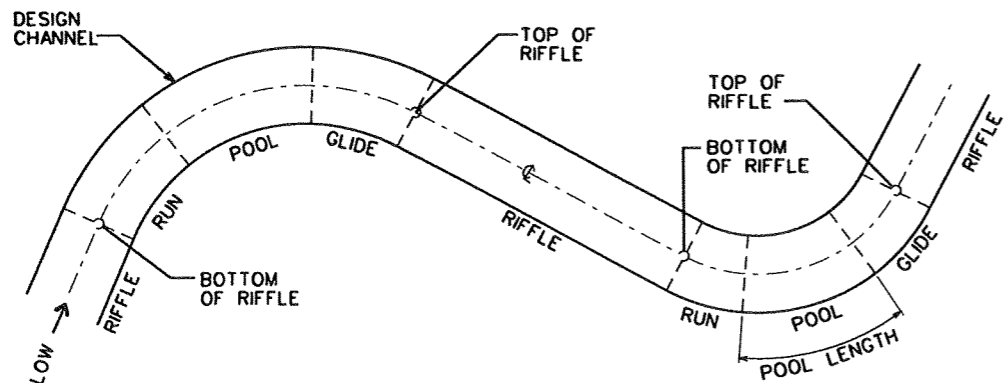


**TYPICAL CHANNEL PLAN VIEW**

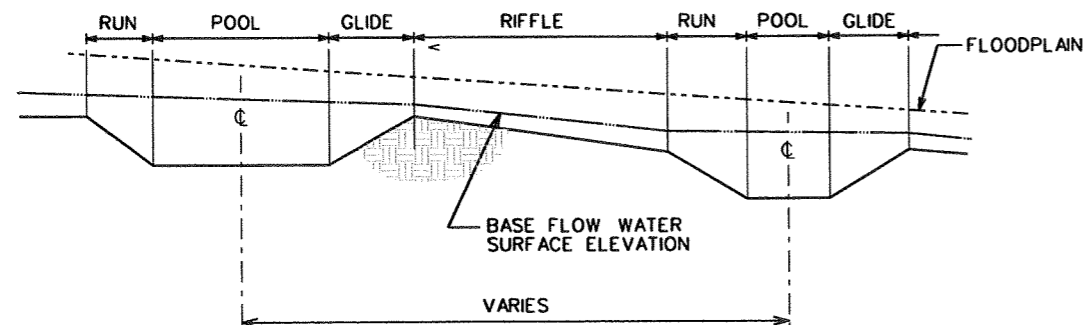


**TYPICAL CHANNEL PROFILE**



CROSS-SECTION DIMENSIONS							
REACH	Wbkf (ft.)	Wbot (ft.) Riffle	Driff (ft.)	Wpool (ft.)	Wbot (ft.) Pool	Dpool (ft.)	Width/Depth Ratio
CAMP BRANCH	19	11	2	25	10	3	11.9
UT TO CAMP BRANCH	6	2.8	0.8	8	2.5	1.1	10

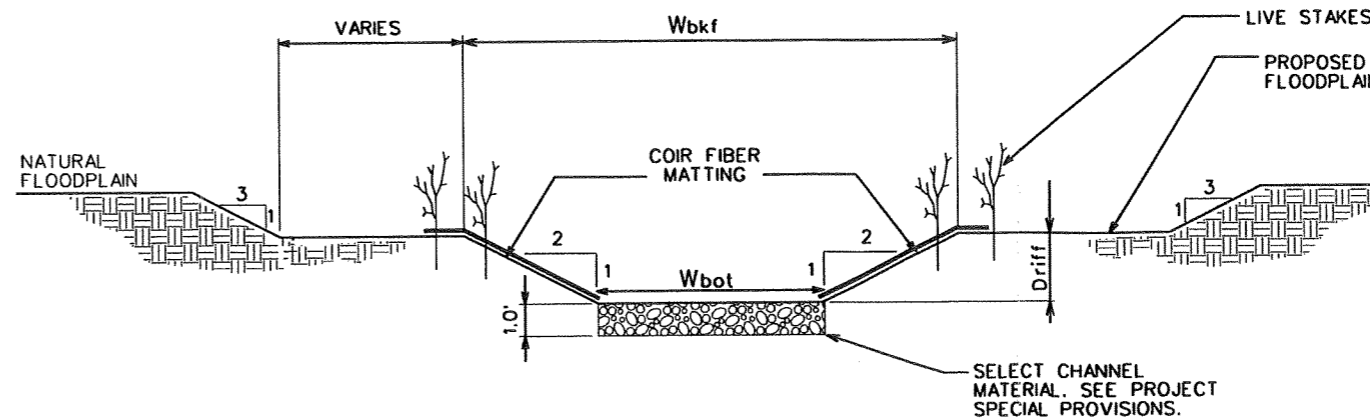

**TYPICAL RIFFLE CROSS-SECTION**

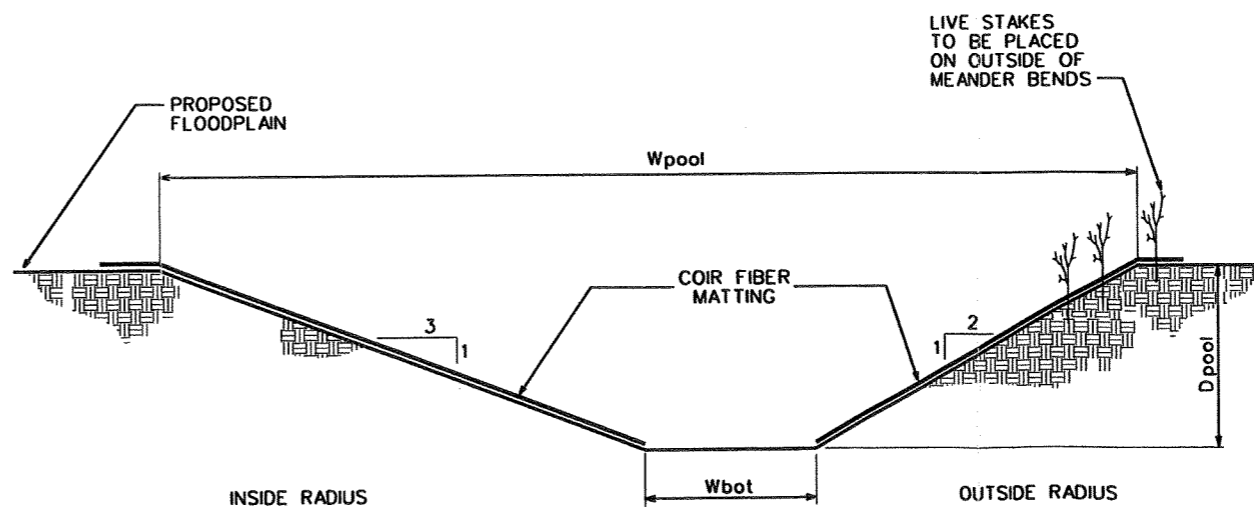

**TYPICAL POOL CROSS-SECTION**

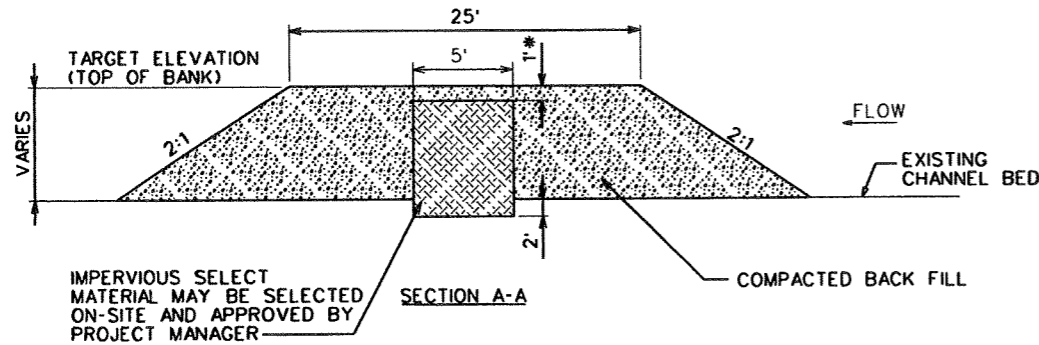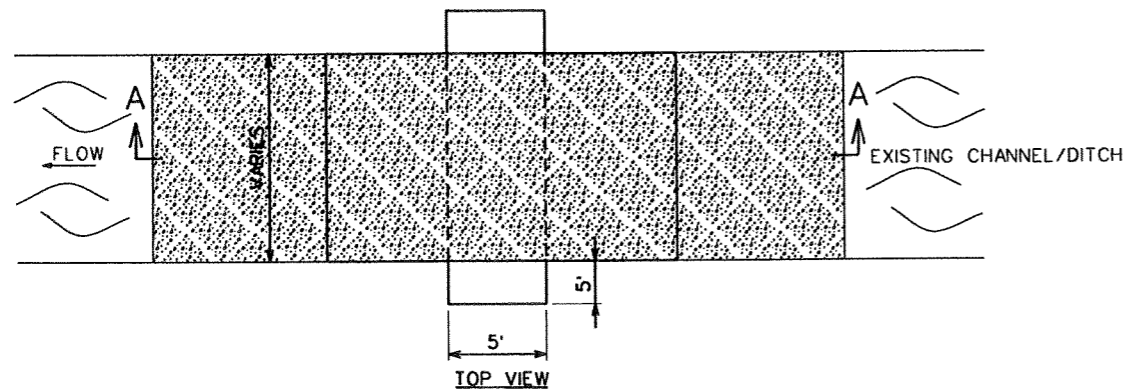

**NOTES:**

1. CHANNEL PLUG WILL BE INITIALLY FILLED WITH AVAILABLE WASTE AND COMPACTED TO NINETY-FIVE PERCENT STANDARD PROCTOR.
2. THEN A CENTRAL PORTION FIVE FEET WIDE WILL BE REMOVED AND REPLACED WITH IMPERVIOUS SELECT MATERIAL (SEE SPECIAL PROVISIONS).
3. THE IMPERVIOUS SELECT MATERIAL WILL BE KEYED INTO THE ORIGINAL BANK A MINIMUM OF FIVE FEET AND INTO THE ORIGINAL BED A MINIMUM OF TWO FEET.

**IMPERVIOUS CHANNEL BLOCK  
CAMP BRANCH**

**IMPERVIOUS CHANNEL BLOCK  
UT to CAMP BRANCH**


**NOTES:**

1. THE IMPERVIOUS SELECT MATERIAL WILL BE KEYED INTO THE ORIGINAL BANK A MINIMUM OF TWO FEET AND INTO THE ORIGINAL BED A MINIMUM OF ONE FOOT.
- \* 2. IN THE UT TO CAMP BRANCH CHANNEL ONLY, THE IMPERVIOUS SELECT MATERIAL SHALL EXTEND TO THE TOP OF THE IMPERVIOUS CHANNEL BLOCK AND HAVE NO BACKFILL LAYER ON TOP.


**NOTES:**

1. CONTRACTOR TO EXCAVATE APPROXIMATELY ONE FOOT DEEP CHANNEL FOR PERMANENT STREAM CROSSING.
2. LAY FILTER FABRIC ALONG ENTIRE LENGTH OF BED.
3. FILL WITH EIGHT INCHES OF "CLASS A" STONE, FOLLOWED BY FOUR INCHES OF #4 STONE TO BRING FINISHED GRADE UP TO LEVEL OF PROPOSED STREAM BED.

**PERMANENT CHANNEL FORD  
UT to CAMP BRANCH**

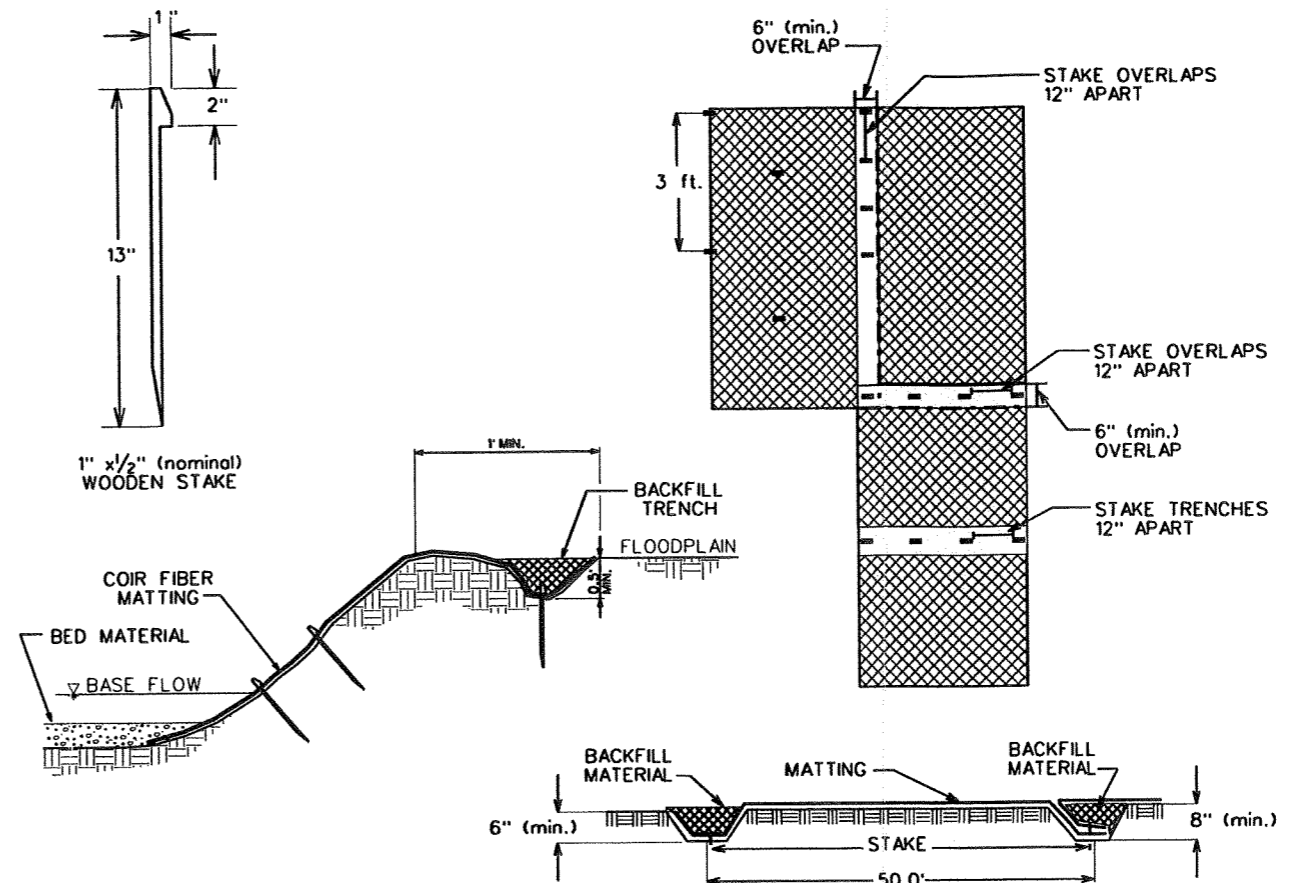

**COIR FIBER MATTING DETAIL**

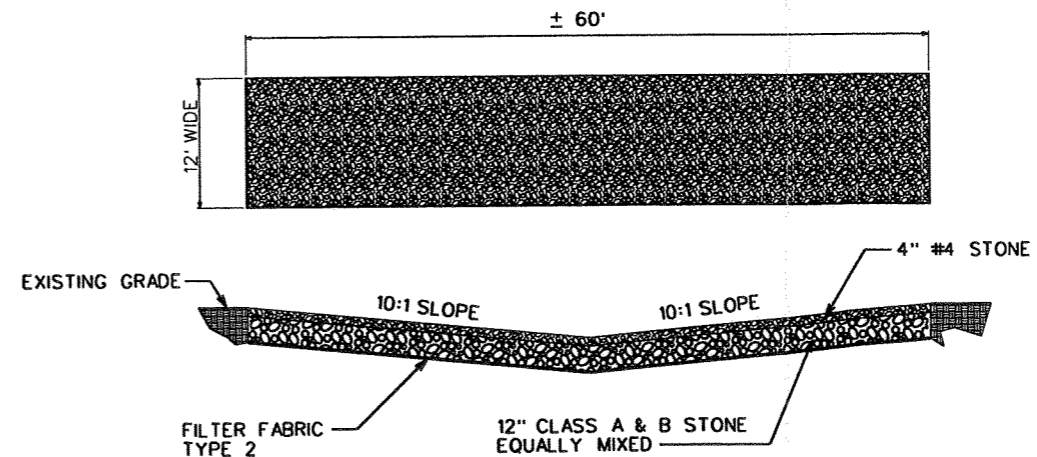

**NOTES:**

1. CONTRACTOR TO EXCAVATE APPROXIMATELY SIXTEEN INCHES DEEP CHANNEL FOR PERMANENT STREAM CROSSING.
2. LAY FILTER FABRIC ALONG ENTIRE LENGTH OF BED.
3. FILL WITH TWELVE INCHES OF "CLASS A" AND "CLASS B" STONE EQUALLY MIXED, FOLLOWED BY FOUR INCHES OF #4 STONE TO BRING FINISHED GRADE UP TO LEVEL OF PROPOSED STREAM BED.

**PERMANENT CHANNEL FORD  
CAMP BRANCH**



**EcoScience Corporation**

Raleigh, North Carolina

**REVISIONS**

No.	Description



Client:



Project:

**BISHOP SITE  
STREAM /  
WETLAND  
RESTORATION  
PLAN**

ANSON COUNTY,  
NORTH CAROLINA

Title:

**GENERAL  
DETAILS**

**CAMP BRANCH**

Des. By:

Dwn. By:

JDC

MAF

Ckd. By:

Date:

DGM

JUN 2005

Scale:


NO SCALE

ESC Project No.:

04-212


SHEET

**A-2A**

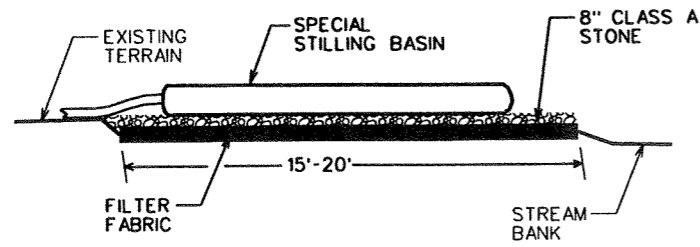

- NOTE:**
1. WHEN PUMPING CLEAN WATER, THE CONTRACTOR MAY PROVIDE A STABILIZED OUTLET BY OMITTING THE SPECIAL STILLING BASIN AND PROVIDING THE ROCK PAD AS SHOWN WITH MINIMUM DIMENSIONS 10 FEET WIDE BY 15 FEET LONG.

**SPECIAL STILLING BASIN  
WITH ROCK PAD**

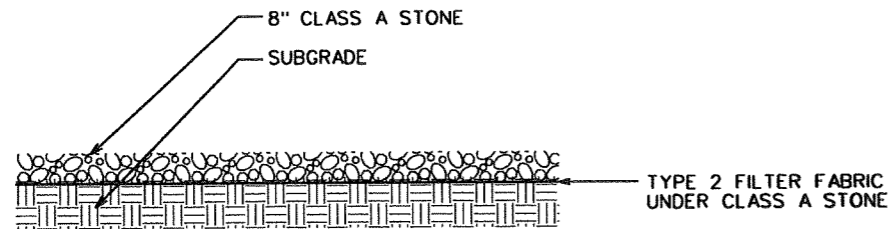


- NOTES:**
1. THIS IS THE MINIMUM ACCEPTABLE SECTION.

**ACCESS ROAD SECTION DETAIL  
SUGGESTED OR EQUIVALENT**

- NOTES:**
1. ALL EXCAVATION SHALL BE PERFORMED IN ONLY DRY OR ISOLATED SECTIONS OF CHANNEL.
  2. IMPERVIOUS DIKES ARE TO BE USED TO ISOLATE WORK FROM STREAM FLOW WHEN NECESSARY.
  3. ALL GRADED AREAS SHALL BE STABILIZED WITHIN 24 HOURS.
  4. MAINTENANCE OF STREAM FLOW OPERATIONS SHALL BE INCIDENTAL TO THE WORK. THIS INCLUDES POLYETHYLENE SHEETING, DIVERSION PIPES, PUMPS AND HOSES.
  5. PUMPS AND HOSES SHALL BE OF SUFFICIENT SIZE TO DEWATER THE WORK AREA.

- SEQUENCE OF CONSTRUCTION FOR TYPICAL WORK AREA**
1. INSTALL SPECIAL STILLING BASIN(S).
  2. INSTALL UPSTREAM PUMP AND TEMPORARY FLEXIBLE HOSE.
  3. PLACE UPSTREAM IMPERVIOUS DIKE AND BEGIN PUMPING OPERATIONS FOR STREAM DIVERSION.
  4. PLACE DOWNSTREAM IMPERVIOUS DIKE AND PUMPING APPARATUS. DEWATER ENTRAPPED AREA. AREA TO BE DEWATERED SHALL BE EQUAL TO ONE DAY'S WORK.
  5. PERFORM STREAM RESTORATION WORK IN ACCORDANCE WITH THE PLANS.
  6. EXCAVATE ANY ACCUMULATED SILT AND DEWATER BEFORE REMOVAL OF IMPERVIOUS DIKES. REMOVE IMPERVIOUS DIKES, PUMPS, AND TEMPORARY FLEXIBLE HOSE. (DOWNSTREAM IMPERVIOUS DIKES FIRST).
  7. ALL GRADING AND STABILIZATION MUST BE COMPLETED AT THE END OF EACH DAY WITHIN THE PUMP AROUND AREAS BETWEEN THE IMPERVIOUS DIKES. THE IMPERVIOUS DIKE LOCATIONS AS SHOWN ON THIS SHEET ONLY SHOW THE UPPER AND LOWER EXTENT OF WORK FOR EACH STREAM SEGMENT. THE CONTRACTOR IS RESPONSIBLE FOR DETERMINING THE LOCATION OF THE IMPERVIOUS DIKE(S) FOR EACH DAY'S WORK.
  8. REMOVE SPECIAL STILLING BASIN(S) AND BACKFILL. STABILIZE DISTURBED AREA WITH SEED AND MULCH.

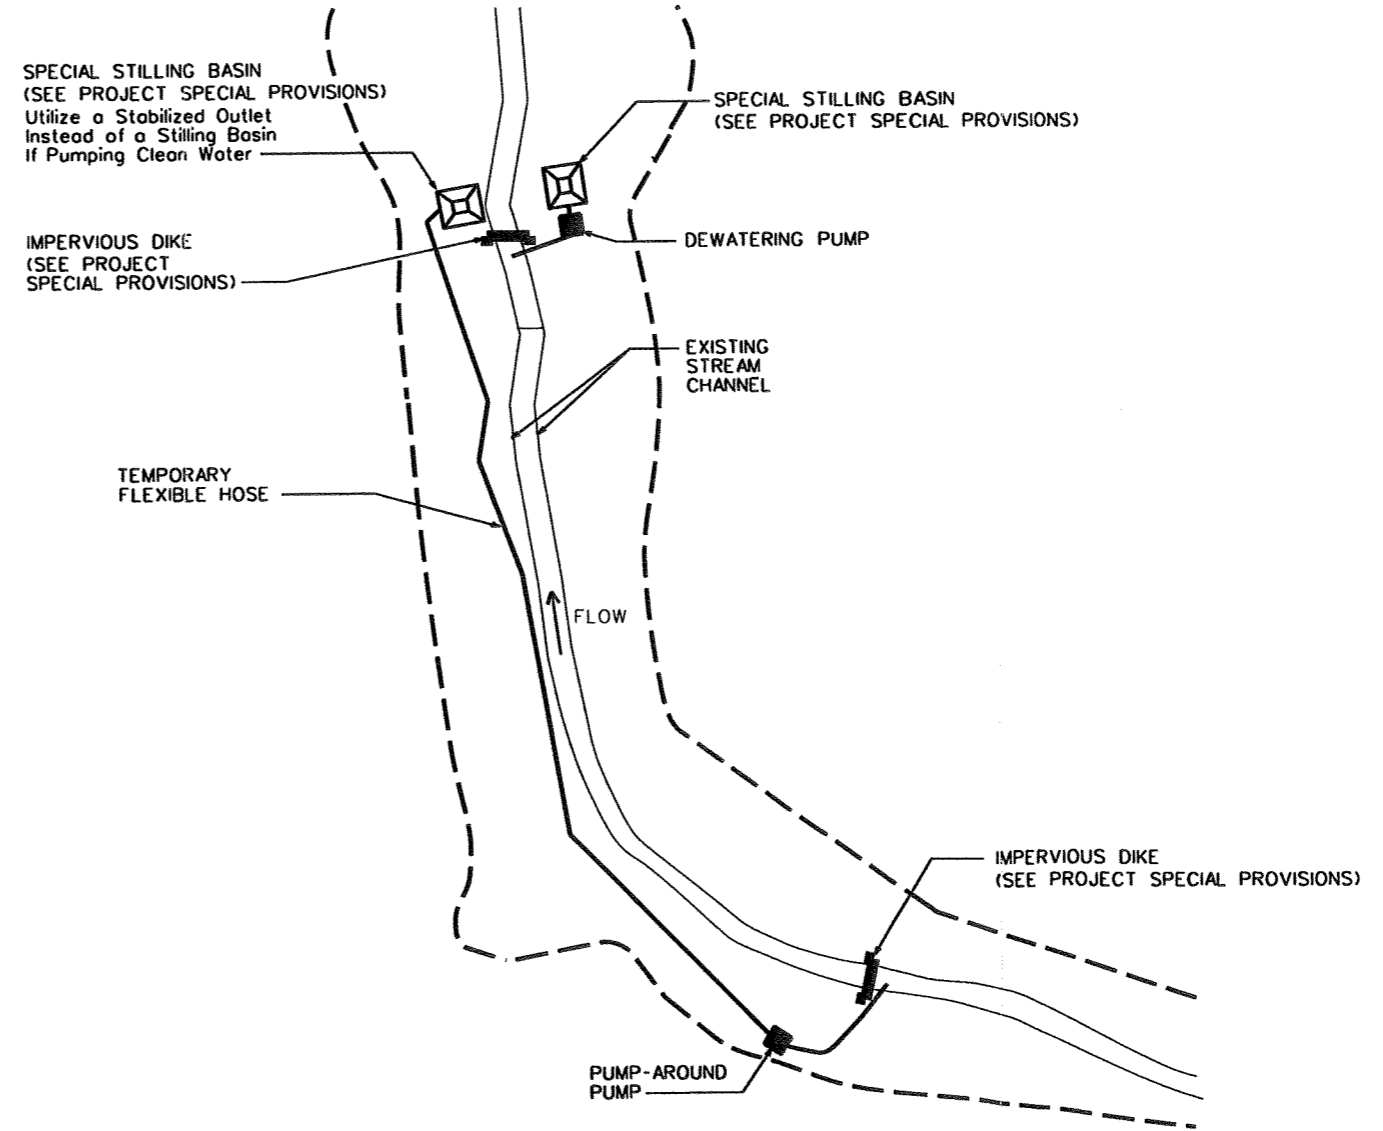

**TYPICAL PUMP-AROUND OPERATION**

REVISIONS	
1	LAND QUALITY COMMENTS



Client:  
**BISHOP SITE  
STREAM /  
WETLAND  
RESTORATION  
PLAN**

Project:  
ANSON COUNTY,  
NORTH CAROLINA

Title:  
**GENERAL  
DETAILS  
CAMP BRANCH**

Dsn. By: JDC	Dwn. By: MAF
Ckd. By: DGM	Date: JUN 2005

Scale:  
**NO SCALE**


ESC Project No.:  
04-212

SHEET  
**A-2B**



**-A- CHANNEL CURVE DATA  
UT to CAMP BRANCH**

<p><b>1</b> P.J. Sta. 0+38.01 D = 74° 16' 25.56" (RT) T = 12.12 L = 20.74 R = 16.00 P.C. Sta. 0+25.90 P.T. Sta. 0+46.64 Back = N 32° 49' 26.38" W Ahead = N 41° 26' 59.18" E</p>	<p><b>6</b> P.J. Sta. 2+18.05 D = 68° 01' 30.30" (LT) T = 12.82 L = 22.56 R = 19.00 P.C. Sta. 2+05.23 P.T. Sta. 2+27.79 Back = N 64° 33' 32.57" E Ahead = N 03° 27' 57.74" W</p>	<p><b>11</b> P.J. Sta. 4+02.54 D = 76° 33' 52.49" (RT) T = 12.63 L = 21.38 R = 16.00 P.C. Sta. 3+89.91 P.T. Sta. 4+11.29 Back = N 66° 47' 17.71" W Ahead = N 09° 46' 34.78" E</p>	<p><b>16</b> P.J. Sta. 5+72.19 D = 40° 25' 16.56" (LT) T = 6.99 L = 13.40 R = 19.00 P.C. Sta. 5+65.19 P.T. Sta. 5+78.60 Back = N 03° 18' 56.67" W Ahead = N 43° 44' 13.22" W</p>
<p><b>2</b> P.J. Sta. 0+68.07 D = 78° 08' 07.12" (LT) T = 13.80 L = 23.18 R = 17.00 P.C. Sta. 0+54.27 P.T. Sta. 0+77.45 Back = N 41° 26' 59.18" E Ahead = N 36° 41' 07.94" W</p>	<p><b>7</b> P.J. Sta. 2+56.22 D = 98° 30' 42.01" (RT) T = 18.57 L = 27.51 R = 16.00 P.C. Sta. 2+37.64 P.T. Sta. 2+65.15 Back = N 03° 27' 57.74" W Ahead = S 84° 57' 15.73" E</p>	<p><b>12</b> P.J. Sta. 4+39.19 D = 89° 27' 54.33" (LT) T = 16.84 L = 26.54 R = 17.00 P.C. Sta. 4+22.35 P.T. Sta. 4+48.89 Back = N 09° 46' 34.78" E Ahead = N 79° 41' 19.55" W</p>	<p><b>17</b> P.J. Sta. 6+05.94 D = 72° 37' 10.89" (RT) T = 22.05 L = 38.02 R = 30.00 P.C. Sta. 5+83.90 P.T. Sta. 6+21.92 Back = N 43° 44' 13.22" W Ahead = N 28° 52' 57.67" E</p>
<p><b>3</b> P.J. Sta. 0+97.92 D = 79° 07' 21.88" (RT) T = 14.87 L = 24.86 R = 18.00 P.C. Sta. 0+83.05 P.T. Sta. 0+107.90 Back = N 36° 41' 07.94" W Ahead = N 42° 26' 13.94" E</p>	<p><b>8</b> P.J. Sta. 2+98.33 D = 106° 02' 32.52" (LT) T = 22.58 L = 31.46 R = 17.00 P.C. Sta. 2+75.75 P.T. Sta. 3+07.21 Back = S 84° 57' 15.73" E Ahead = N 10° 59' 48.25" W</p>	<p><b>13</b> P.J. Sta. 4+76.92 D = 89° 36' 31.86" (RT) T = 14.90 L = 23.46 R = 15.00 P.C. Sta. 4+62.03 P.T. Sta. 4+85.49 Back = N 79° 41' 19.55" W Ahead = N 09° 55' 12.31" E</p>	<p><b>18</b> P.J. Sta. 1+67.58 D = 67° 04' 22.94" (LT) T = 28.01 L = 49.41 R = 42.00 P.C. Sta. 1+39.57 P.T. Sta. 1+88.98 Back = S 48° 30' 51.66" E Ahead = N 64° 04' 45.40" E</p>
<p><b>4</b> P.J. Sta. 1+40.33 D = 110° 29' 10.11" (LT) T = 21.62 L = 28.93 R = 15.00 P.C. Sta. 1+18.72 P.T. Sta. 1+47.64 Back = N 42° 26' 13.94" E Ahead = N 68° 02' 56.17" W</p>	<p><b>9</b> P.J. Sta. 3+29.71 D = 55° 58' 42.87" (RT) T = 10.63 L = 19.54 R = 20.00 P.C. Sta. 3+19.09 P.T. Sta. 3+38.63 Back = N 10° 59' 48.25" W Ahead = N 44° 58' 54.61" E</p>	<p><b>14</b> P.J. Sta. 5+16.43 D = 109° 44' 43.75" (LT) T = 28.43 L = 38.31 R = 20.00 P.C. Sta. 4+88.00 P.T. Sta. 5+26.31 Back = N 09° 55' 12.31" E Ahead = S 80° 10' 28.56" W</p>	<p><b>4</b> P.J. Sta. 2+35.99 D = 56° 54' 01.41" (RT) T = 27.09 L = 49.66 R = 50.00 P.C. Sta. 2+08.90 P.T. Sta. 2+58.56 Back = N 64° 04' 45.40" E Ahead = S 59° 01' 13.19" E</p>
<p><b>5</b> P.J. Sta. 1+94.54 D = 132° 36' 28.74" (RT) T = 38.73 L = 39.35 R = 17.00 P.C. Sta. 1+55.81 P.T. Sta. 1+95.15 Back = N 68° 02' 56.17" W Ahead = N 64° 33' 32.57" E</p>	<p><b>10</b> P.J. Sta. 3+73.48 D = 111° 46' 12.33" (LT) T = 20.67 L = 27.31 R = 14.00 P.C. Sta. 3+52.81 P.T. Sta. 3+80.12 Back = N 44° 58' 54.61" E Ahead = N 65° 47' 17.71" W</p>	<p><b>15</b> P.J. Sta. 5+48.99 D = 96° 30' 34.77" (RT) T = 20.17 L = 30.32 R = 18.00 P.C. Sta. 5+28.82 P.T. Sta. 5+59.14 Back = S 80° 10' 28.56" W Ahead = N 03° 18' 56.67" W</p>	<p><b>5</b> P.J. Sta. 2+95.41 D = 40° 20' 31.79" (LT) T = 16.90 L = 32.39 R = 46.00 P.C. Sta. 2+78.51 P.T. Sta. 3+10.90 Back = S 59° 01' 13.19" E Ahead = N 80° 38' 15.02" E</p>


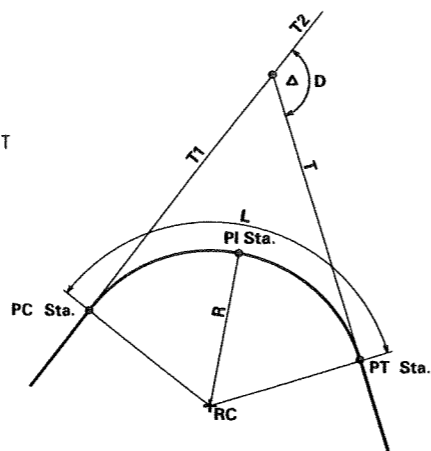


PI Sta. = center of pool  
 Δ = deflection angle (Δ) between tangent lines T2 and T1 measured along direction of travel  
 L = arc/pool length  
 T/T1 = tangent length  
 R = radius of curvature  
 PC Sta. = point of curvature (where arc/pool begins)  
 PT Sta. = point of terminus (where arc/pool ends)

**-C- CHANNEL CURVE DATA  
CAMP BRANCH**

<p><b>1</b> P.J. Sta. 0+36.53 D = 60° 16' 42.22" (LT) T = 34.84 L = 63.12 R = 60.00 P.C. Sta. 0+01.69 P.T. Sta. 0+64.82 Back = S 49° 04' 03.77" E Ahead = N 70° 39' 14.00" E</p>	<p><b>6</b> P.J. Sta. 3+72.28 D = 55° 40' 21.65" (RT) T = 30.10 L = 55.39 R = 57.00 P.C. Sta. 3+42.18 P.T. Sta. 3+97.57 Back = N 80° 38' 15.02" E Ahead = S 43° 41' 23.33" E</p>	<p><b>11</b> P.J. Sta. 7+58.99 D = 64° 20' 30.56" (RT) T = 25.16 L = 44.92 R = 40.00 P.C. Sta. 7+33.83 P.T. Sta. 7+78.75 Back = S 48° 24' 21.44" E Ahead = S 15° 56' 09.12" W</p>	<p><b>16</b> P.J. Sta. 11+22.86 D = 61° 14' 41.94" (LT) T = 37.88 L = 68.41 R = 64.00 P.C. Sta. 10+84.98 P.T. Sta. 11+53.39 Back = Due South Ahead = S 61° 14' 41.94" E</p>	<p><b>21</b> P.J. Sta. 15+75.23 D = 85° 33' 33.31" (RT) T = 53.67 L = 86.61 R = 58.00 P.C. Sta. 15+21.55 P.T. Sta. 16+08.17 Back = S 68° 59' 42.35" E Ahead = S 16° 33' 50.97" W</p>
<p><b>2</b> P.J. Sta. 1+12.69 D = 60° 49' 54.34" (RT) T = 24.66 L = 44.59 R = 42.00 P.C. Sta. 0+88.03 P.T. Sta. 1+32.62 Back = N 70° 39' 14.00" E Ahead = S 48° 30' 51.66" E</p>	<p><b>7</b> P.J. Sta. 4+98.65 D = 60° 58' 29.93" (RT) T = 34.74 L = 62.79 R = 59.00 P.C. Sta. 4+63.92 P.T. Sta. 5+26.70 Back = S 43° 41' 23.33" E Ahead = S 17° 17' 06.60" W</p>	<p><b>12</b> P.J. Sta. 8+34.31 D = 73° 40' 37.61" (LT) T = 46.45 L = 79.73 R = 62.00 P.C. Sta. 7+87.86 P.T. Sta. 8+67.59 Back = S 15° 56' 09.12" W Ahead = S 07° 44' 28.49" E</p>	<p><b>17</b> P.J. Sta. 12+12.29 D = 46° 23' 08.26" (RT) T = 32.56 L = 61.53 R = 76.00 P.C. Sta. 11+79.73 P.T. Sta. 12+41.26 Back = S 61° 14' 41.94" E Ahead = S 14° 51' 33.69" E</p>	<p><b>22</b> P.J. Sta. 16+54.66 D = 59° 35' 37.24" (LT) T = 25.77 L = 46.81 R = 45.00 P.C. Sta. 16+28.89 P.T. Sta. 16+75.70 Back = S 16° 33' 50.97" W Ahead = S 43° 01' 46.27" E</p>
<p><b>3</b> P.J. Sta. 1+67.58 D = 67° 04' 22.94" (LT) T = 28.01 L = 49.41 R = 42.00 P.C. Sta. 1+39.57 P.T. Sta. 1+88.98 Back = S 48° 30' 51.66" E Ahead = N 64° 04' 45.40" E</p>	<p><b>8</b> P.J. Sta. 5+57.00 D = 57° 04' 22.74" (LT) T = 22.30 L = 40.84 R = 41.00 P.C. Sta. 5+34.70 P.T. Sta. 5+75.54 Back = S 17° 17' 06.60" W Ahead = S 39° 47' 16.14" E</p>	<p><b>13</b> P.J. Sta. 9+07.54 D = 55° 03' 41.31" (RT) T = 24.21 L = 44.57 R = 46.00 P.C. Sta. 8+83.34 P.T. Sta. 9+27.90 Back = S 07° 44' 28.49" E Ahead = S 02° 13' 47.17" E</p>	<p><b>18</b> P.J. Sta. 12+85.22 D = 50° 09' 50.65" (LT) T = 23.87 L = 44.65 R = 51.00 P.C. Sta. 12+61.35 P.T. Sta. 13+06.00 Back = S 14° 51' 33.69" E Ahead = S 65° 01' 24.33" E</p>	<p><b>23</b> P.J. Sta. 17+11.39 D = 55° 38' 51.63" (RT) T = 23.75 L = 43.71 R = 45.00 P.C. Sta. 16+87.64 P.T. Sta. 17+31.34 Back = S 43° 01' 46.27" E Ahead = S 12° 37' 05.36" W</p>
<p><b>4</b> P.J. Sta. 2+35.99 D = 56° 54' 01.41" (RT) T = 27.09 L = 49.66 R = 50.00 P.C. Sta. 2+08.90 P.T. Sta. 2+58.56 Back = N 64° 04' 45.40" E Ahead = S 59° 01' 13.19" E</p>	<p><b>9</b> P.J. Sta. 6+04.53 D = 64° 08' 12.21" (RT) T = 25.06 L = 44.78 R = 40.00 P.C. Sta. 5+79.47 P.T. Sta. 6+24.25 Back = S 39° 47' 16.14" E Ahead = S 24° 20' 56.07" W</p>	<p><b>14</b> P.J. Sta. 9+78.87 D = 68° 42' 44.90" (LT) T = 27.34 L = 47.97 R = 40.00 P.C. Sta. 9+51.53 P.T. Sta. 9+99.50 Back = S 02° 13' 47.17" E Ahead = S 70° 56' 32.07" E</p>	<p><b>19</b> P.J. Sta. 13+73.31 D = 57° 07' 16.21" (RT) T = 28.85 L = 52.84 R = 53.00 P.C. Sta. 13+44.47 P.T. Sta. 13+97.30 Back = S 65° 01' 24.33" E Ahead = S 07° 54' 08.12" E</p>	<p><b>24</b> P.J. Sta. 17+73.61 D = 71° 17' 34.89" (LT) T = 33.71 L = 58.48 R = 47.00 P.C. Sta. 17+39.90 P.T. Sta. 17+98.38 Back = S 12° 37' 05.36" W Ahead = S 58° 40' 29.53" E</p>
<p><b>5</b> P.J. Sta. 2+95.41 D = 40° 20' 31.79" (LT) T = 16.90 L = 32.39 R = 46.00 P.C. Sta. 2+78.51 P.T. Sta. 3+10.90 Back = S 59° 01' 13.19" E Ahead = N 80° 38' 15.02" E</p>	<p><b>10</b> P.J. Sta. 6+72.41 D = 72° 45' 17.51" (LT) T = 42.73 L = 73.65 R = 58.00 P.C. Sta. 6+29.68 P.T. Sta. 7+03.33 Back = S 24° 20' 56.07" W Ahead = S 48° 24' 21.44" E</p>	<p><b>15</b> P.J. Sta. 10+50.09 D = 70° 56' 32.07" (RT) T = 29.21 L = 50.77 R = 41.00 P.C. Sta. 10+20.87 P.T. Sta. 10+71.64 Back = S 70° 56' 32.07" E Ahead = Due South</p>	<p><b>20</b> P.J. Sta. 14+67.39 D = 61° 05' 34.23" (LT) T = 37.77 L = 68.24 R = 64.00 P.C. Sta. 14+29.62 P.T. Sta. 14+97.86 Back = S 07° 54' 08.12" E Ahead = S 68° 59' 42.35" E</p>	

NOTE:  
FOR NEW CHANNEL LAYOUT, SEE SHEET A-5.

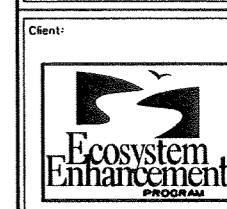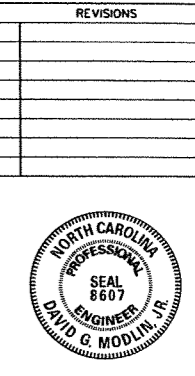

Client:  
 Project:  
**BISHOP SITE  
 STREAM /  
 WETLAND  
 RESTORATION  
 PLAN**  
 ANSON COUNTY,  
 NORTH CAROLINA

Title:  
**NEW CHANNEL  
 CENTERLINE  
 DATA  
 CAMP BRANCH**

Dsn. By: JDC  
 Dwn. By: MAF  
 Ckd. By: DGM  
 Date: JUN 2005  
 Scale: NO SCALE  
 ESC Project No.: 04-212

SHEET  
**A-2C**



**SUMMARY OF QUANTITIES**

**CAMP BRANCH -C- CHANNEL  
AND UT TO CAMP BRANCH -A- CHANNEL**

SUMMARY OF QUANTITIES				
Bishop Site Stream/Wetland Restoration - Camp Branch				
ITEM	SPEC	ITEM DESCRIPTION	QUANTITIES	UNIT
1	SP1	Mobilization	1	LS
2	SP2	Construction Surveying	1	LS
3	SP3	Grading	1	LS
4	1056	Filter Fabric, Type 2	1850	SY
5	1605	Temporary Silt Fence	3520	LF
6	1610	Stone for Erosion Control, Class A	675	TON
7	1610	Stone for Erosion Control, Class B	90	TON
8	1610	Stone for Erosion Control, No. 4	30	TON
9	1610	Stone for Erosion Control, ABC	925	TON
10	1610	Stone for Erosion Control, No. 57	40	TON
11	1615	Temporary Mulching	15	ACR
12	1620	Seed for Temporary Seeding	975	LB
13	1620	Fertilizer for Temporary Seeding	2.25	TON
14	1630	Silt Excavation	300	CY
15	1660	Permanent Seeding and Mulching	15	ACR
16	1661	Seed for Repair Seeding	325	LB
17	1661	Fertilizer for Repair Seeding	0.75	TON
18	1662	Supplemental Seeding	325	LB
19	SP6	Coir Fiber Matting, 900 gm	4000	SY
20	SP8	Impervious Select Material	150	CY
21	SP9	Pump Around Operation	1	LS
22	SP10	Special Stilling Basin	2	EA
23	SP12	Bare Root Seedlings	30450	EA
24	SP13	Live Staking	4700	EA
25	SP14	Invasive Plant Removal	1	LS
26	SP5	Safety Fence	400	LF
27	SP16	Channel Substrate	350	TON
28	SP17	Disking/Scarification	10	ACR

Estimates do include quantities for Class A stone and filter fabric for improved on-site access roads if required by weather conditions. The quantities are approximately 480 T of Class A Stone and 1333 SY filter fabric per 1000 linear feet of 12-foot wide improved access road as shown on the plans. ABC Stone is estimated to leave existing farm road in "AS IS or BETTER" condition. Note that all quantities are estimates for information and bid comparison purposes only.



**EcoScience Corporation**

Raleigh, North Carolina

REVISIONS

QUANTITIES REVISED



Client:



Project:

**BISHOP SITE  
STREAM /  
WETLAND  
RESTORATION  
PLAN**

ANSON COUNTY,  
NORTH CAROLINA

Title:

**SUMMARY OF  
QUANTITIES /  
SUMMARY OF  
EARTHWORK**

**CAMP BRANCH**

Dsn. By:

Dwn. By:

JDC

MAF

Ckd. By:

Date:

DGM

JUN 2005

Scale:

NO SCALE

ESC Project No.:

04-212

SHEET

**A-3**

**SUMMARY OF EARTHWORK**

**QUANTITIES IN CUBIC YARDS**

**UT to CAMP BRANCH -A- CHANNEL**

Xsection	Total Cut		EXCAVATION	Total Fill		FILL	BORROW	WASTE
	sq ft	cu ft		sq ft	cu ft + %			
0	3.3	0		0	0			
80	5.3	344.0	13	1.3	52.0	62	0	10
133	8.7	371.0	14	5.9	190.8	229	8	5
228	5.7	684.0	25	4.5	494.0	593	22	3
320	5.7	524.4	19	2.8	335.8	403	15	4
436	5.7	661.2	24	3.1	342.2	411	15	9
600	5.7	934.8	35	0.0	254.2	305	11	23
		3519	130		1669	74	0	56
								56
Project Total			130					56

APPROXIMATE QUANTITIES ONLY. UNCLASSIFIED EXCAVATION, BORROW EXCAVATION, FINE GRADING AND CLEARING AND GRUBBING WILL BE PAID FOR AT THE CONTRACT LUMP SUM PRICE FOR "GRADING." A SHRINKAGE FACTOR OF 1.2 WAS ASSUMED.

**CAMP BRANCH -C- CHANNEL**

Xsection	Total Cut		EXCAVATION	Total Fill		FILL	BORROW	WASTE
	sq ft	cu ft		sq ft	cu ft + %			
0	250.4	0		0	0			
120	136.6	23220.0	860	15.8	948.0	1138	42	818
260	157.2	20566.0	762	23.3	2737.0	3284	122	640
420	222.8	30400.0	1126	55.7	6320.0	7584	281	845
560	211.7	30415.0	1126	33.0	6209.0	7451	276	851
680	134.0	20742.0	768	81.8	6888.0	8266	306	462
760	163.2	11888.0	440	83.9	6628.0	7954	295	146
820	208.2	11142.0	413	80.9	4944.0	5933	220	193
900	259.2	18696.0	692	44.6	5020.0	6024	223	469
1060	192.3	36120.0	1338	94.8	11152.0	13382	496	842
1120	200.1	11772.0	436	112.4	6216.0	7459	276	160
1280	205.2	32424.0	1201	138.6	20080.0	24096	892	308
1360	291.5	19868.0	736	128.4	10680.0	12816	475	261
1460	307.1	29930.0	1109	178.6	15350.0	18420	682	426
1560	365.5	33630.0	1246	127.2	15290.0	18348	680	566
1700	517.9	61838.0	2290	108.8	16520.0	19824	734	1556
1800	512.3	51510.0	1908	0.0	5440.0	6528	242	1666
1810	0.0	2561.5	95	0.0	0.0	0	0	95
		446723	16545		140422	6241	0	10304
								10304
Project Total			16545					10304

APPROXIMATE QUANTITIES ONLY. UNCLASSIFIED EXCAVATION, BORROW EXCAVATION, FINE GRADING AND CLEARING AND GRUBBING WILL BE PAID FOR AT THE CONTRACT LUMP SUM PRICE FOR "GRADING." A SHRINKAGE FACTOR OF 1.2 WAS ASSUMED.



EcoScience Corporation

Raleigh, North Carolina

REVISIONS



Client:



Project:

### BISHOP SITE STREAM / WETLAND RESTORATION PLAN

ANSON COUNTY,  
NORTH CAROLINA

Title:

### EXISTING CONDITIONS

### CAMP BRANCH

Dsn. By:

Dwn. By:

JDC

MAF

Ckd. By:

Date:

DGM

JUN 2005

Scale:


AS SHOWN

ESC Project No.:

04-212


SHEET

# A-4

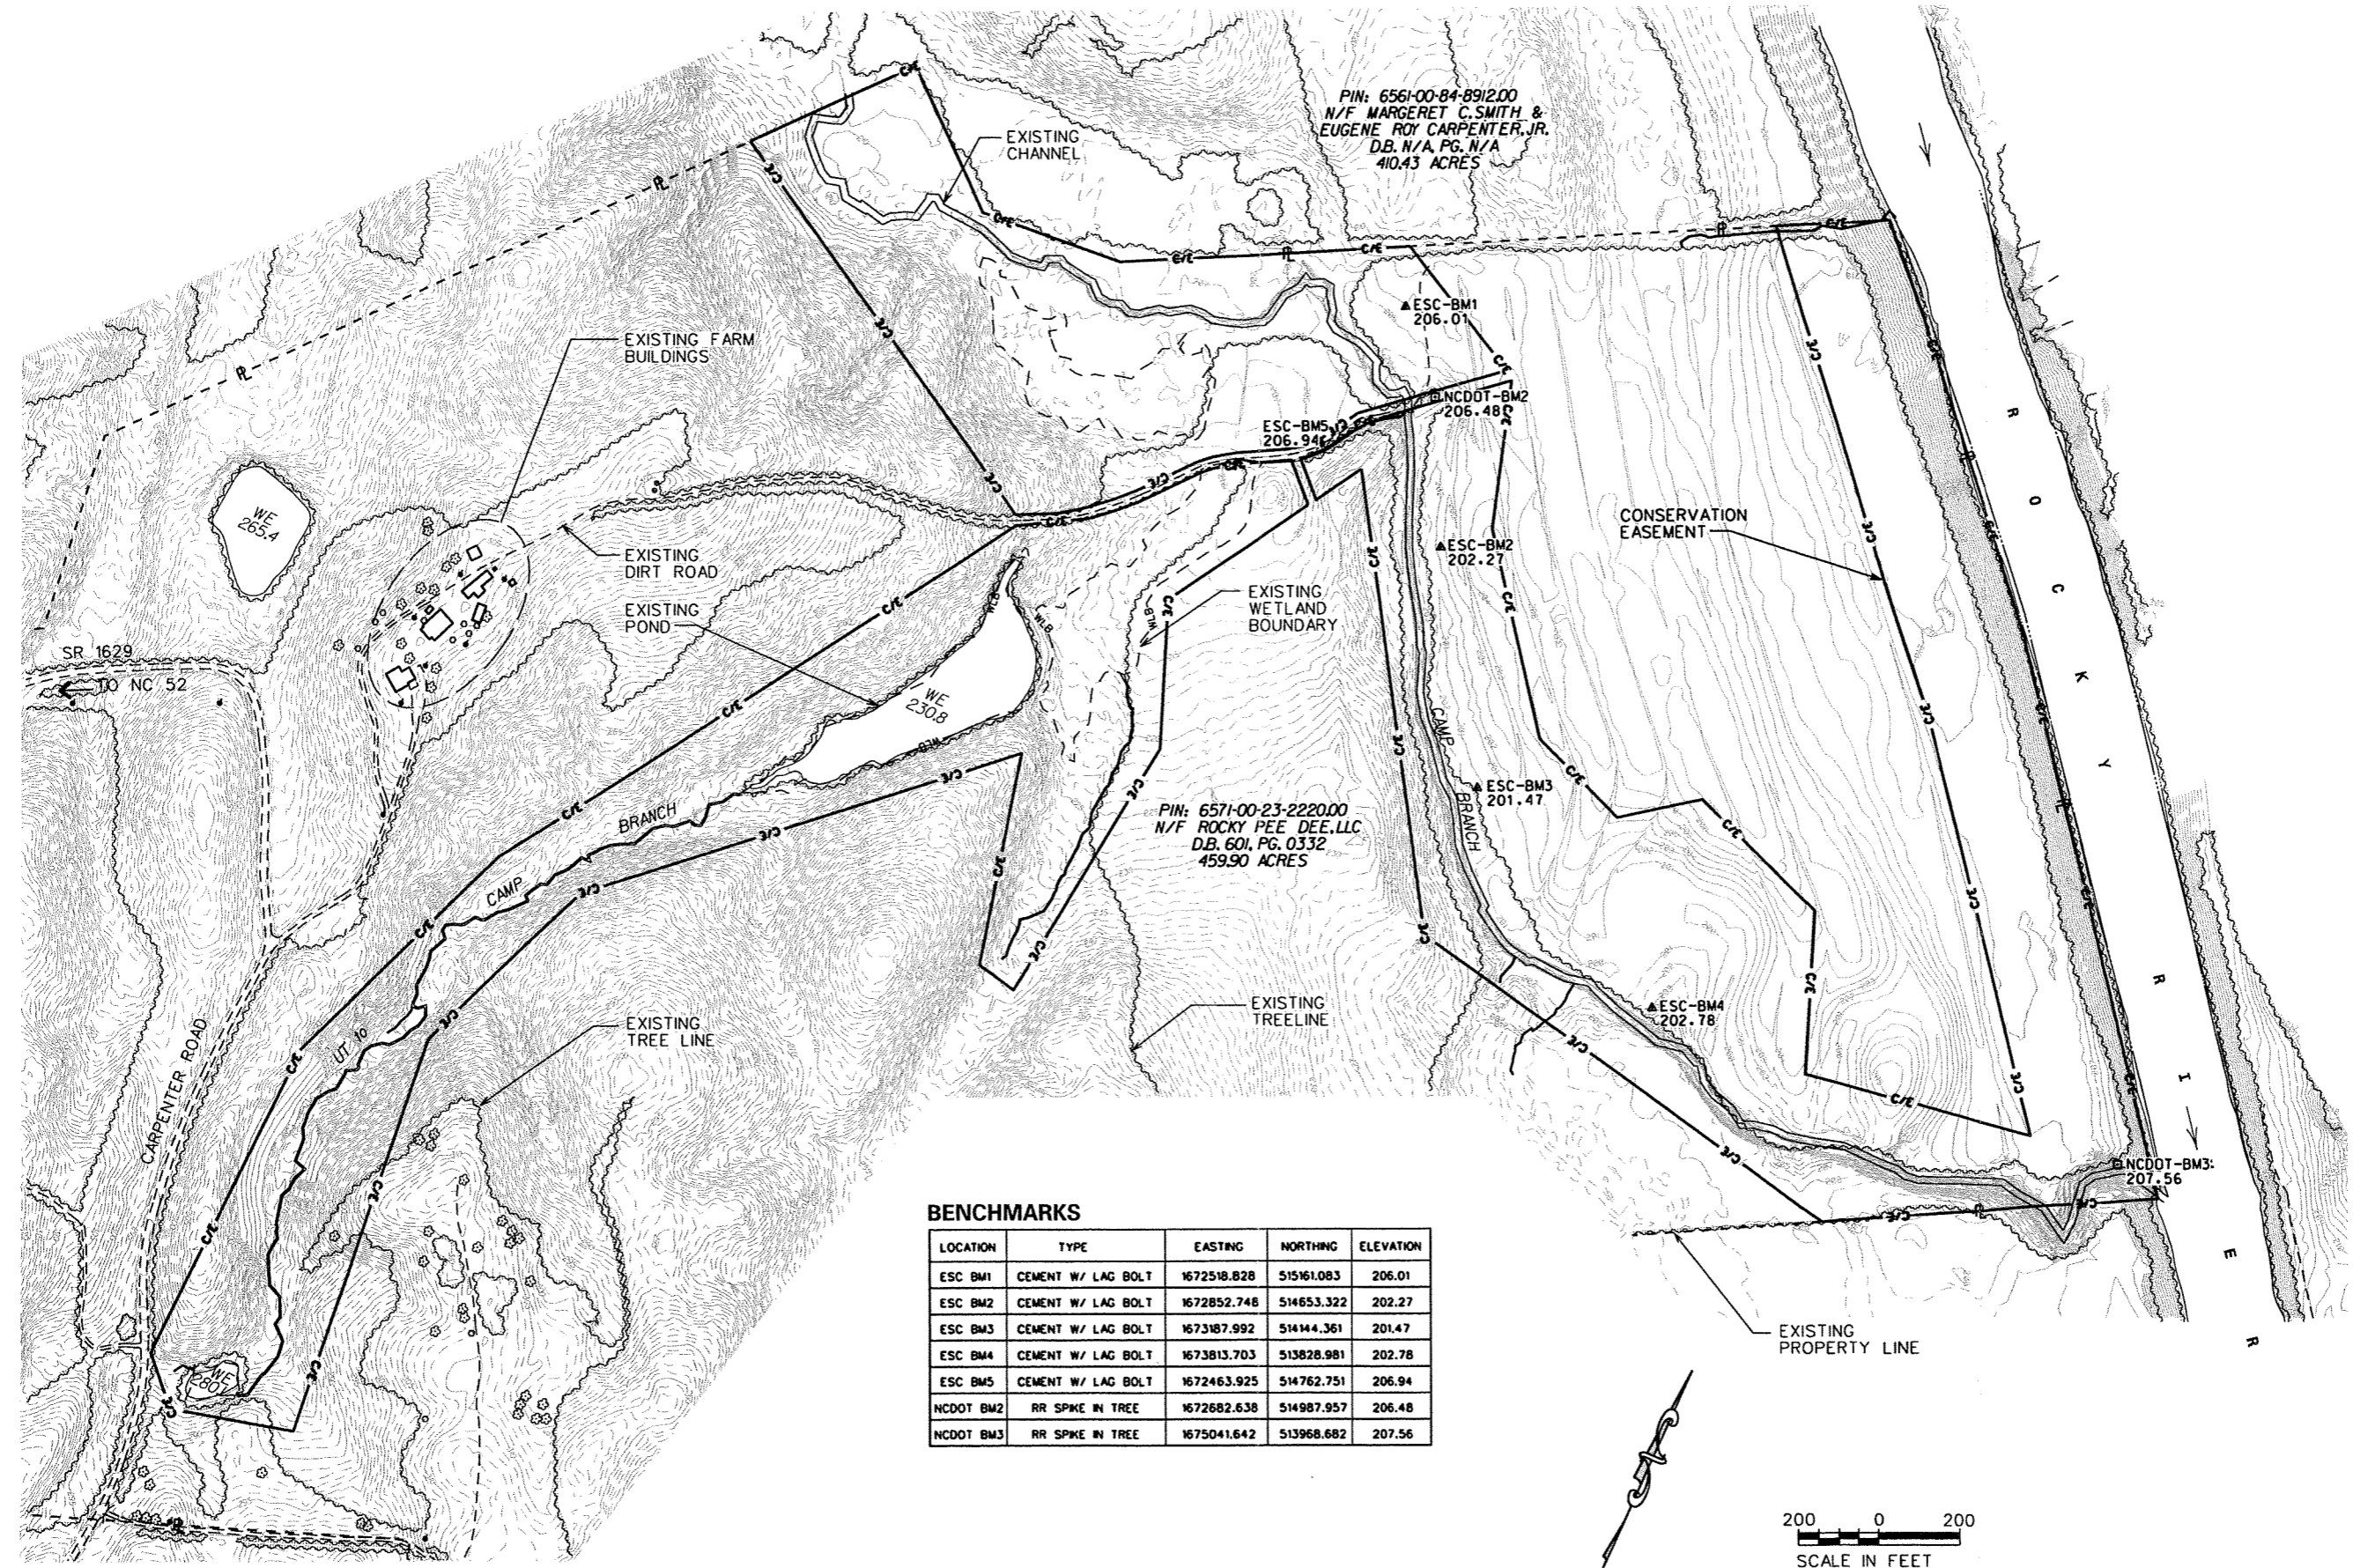

#### BENCHMARKS

LOCATION	TYPE	EASTING	NORTHING	ELEVATION
ESC BM1	CEMENT W/ LAG BOLT	1672518.828	515161.083	206.01
ESC BM2	CEMENT W/ LAG BOLT	1672852.748	514653.322	202.27
ESC BM3	CEMENT W/ LAG BOLT	1673187.992	51444.361	201.47
ESC BM4	CEMENT W/ LAG BOLT	1673813.703	513828.981	202.78
ESC BM5	CEMENT W/ LAG BOLT	1672463.925	514762.751	206.94
NCDOT BM2	RR SPKE IN TREE	1672682.638	514987.957	206.48
NCDOT BM3	RR SPKE IN TREE	1675041.642	513968.682	207.56


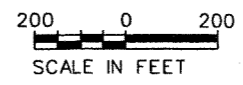


PIN: 6561-00-84-89/2.00  
N/F MARGERET C. SMITH &  
EUGENE ROY CARPENTER, JR.  
D.B. N/A, PG. N/A  
410.43 ACRES

PIN: 6571-00-23-2220.00  
N/F ROCKY PEE DEE, LLC  
D.B. 601, PG. 0332  
459.90 ACRES

**NOTE:**  
FOR POOL CURVE DATA, SEE SHEET A-2C.


- [ 1 ] NEW CHANNEL POOL LOCATION
- ( 1 ) NEW CHANNEL RIFFLE LOCATION

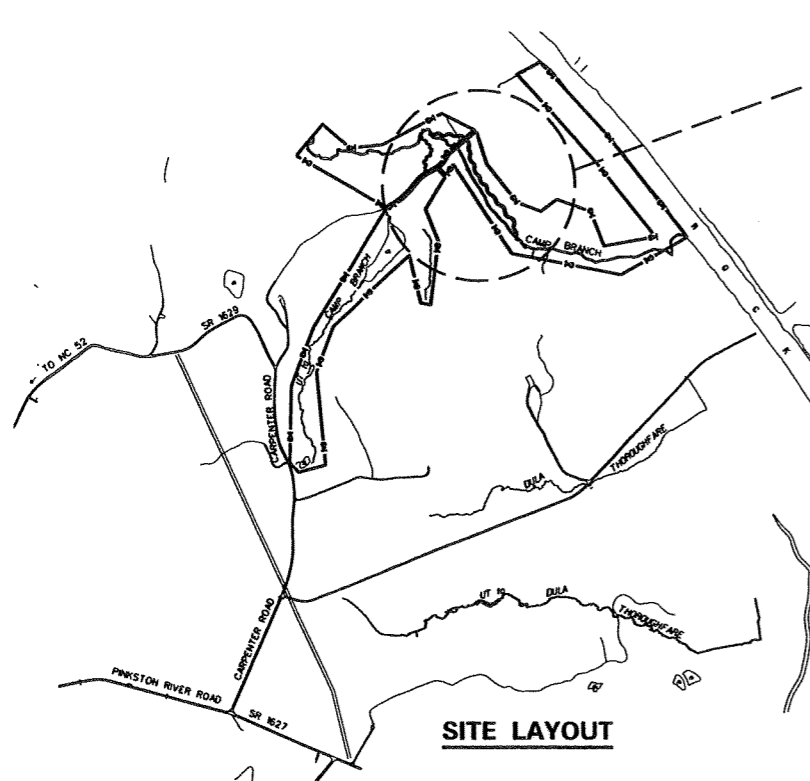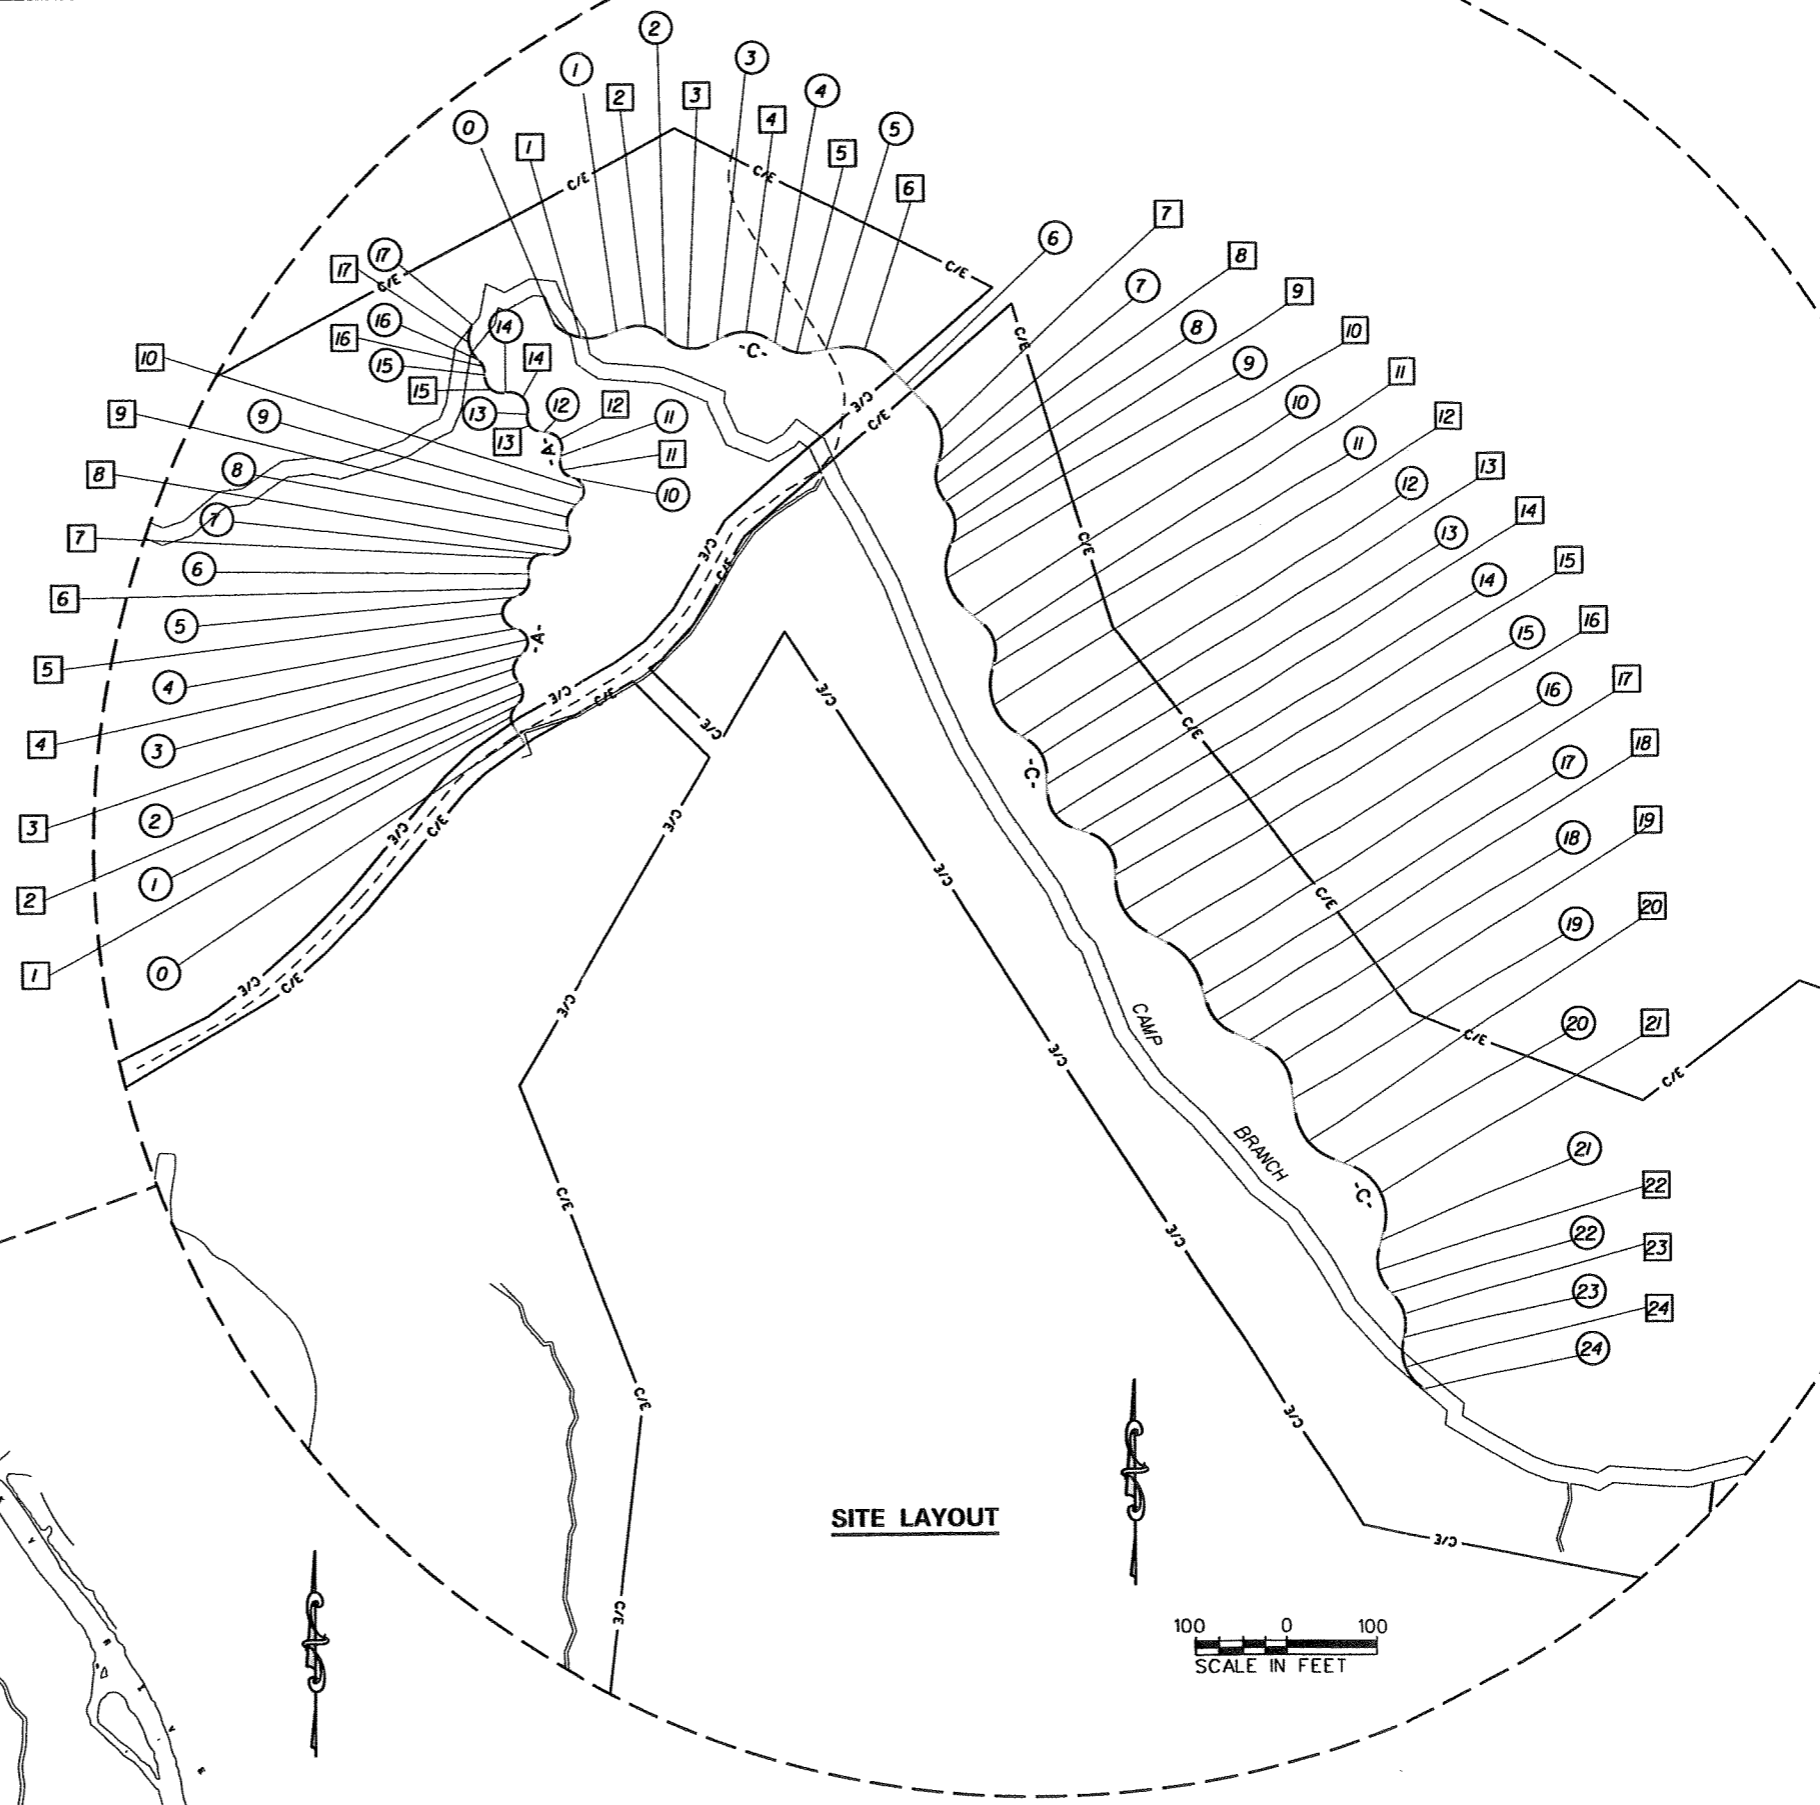

1000 0 1000  
SCALE IN FEET



REVISIONS

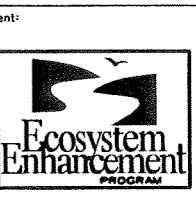


Client:  
**BISHOP SITE  
STREAM /  
WETLAND  
RESTORATION  
PLAN**  
  
ANSON COUNTY,  
NORTH CAROLINA

Title:  
**NEW CHANNEL  
LAYOUT  
CAMP BRANCH**

Desn. By: JDC	Dwn. By: MAF
Ckd. By: DGM	Date: JUN 2005
Scale: AS SHOWN	
ESC Project No.: 04-212	

SHEET  
**A-5**



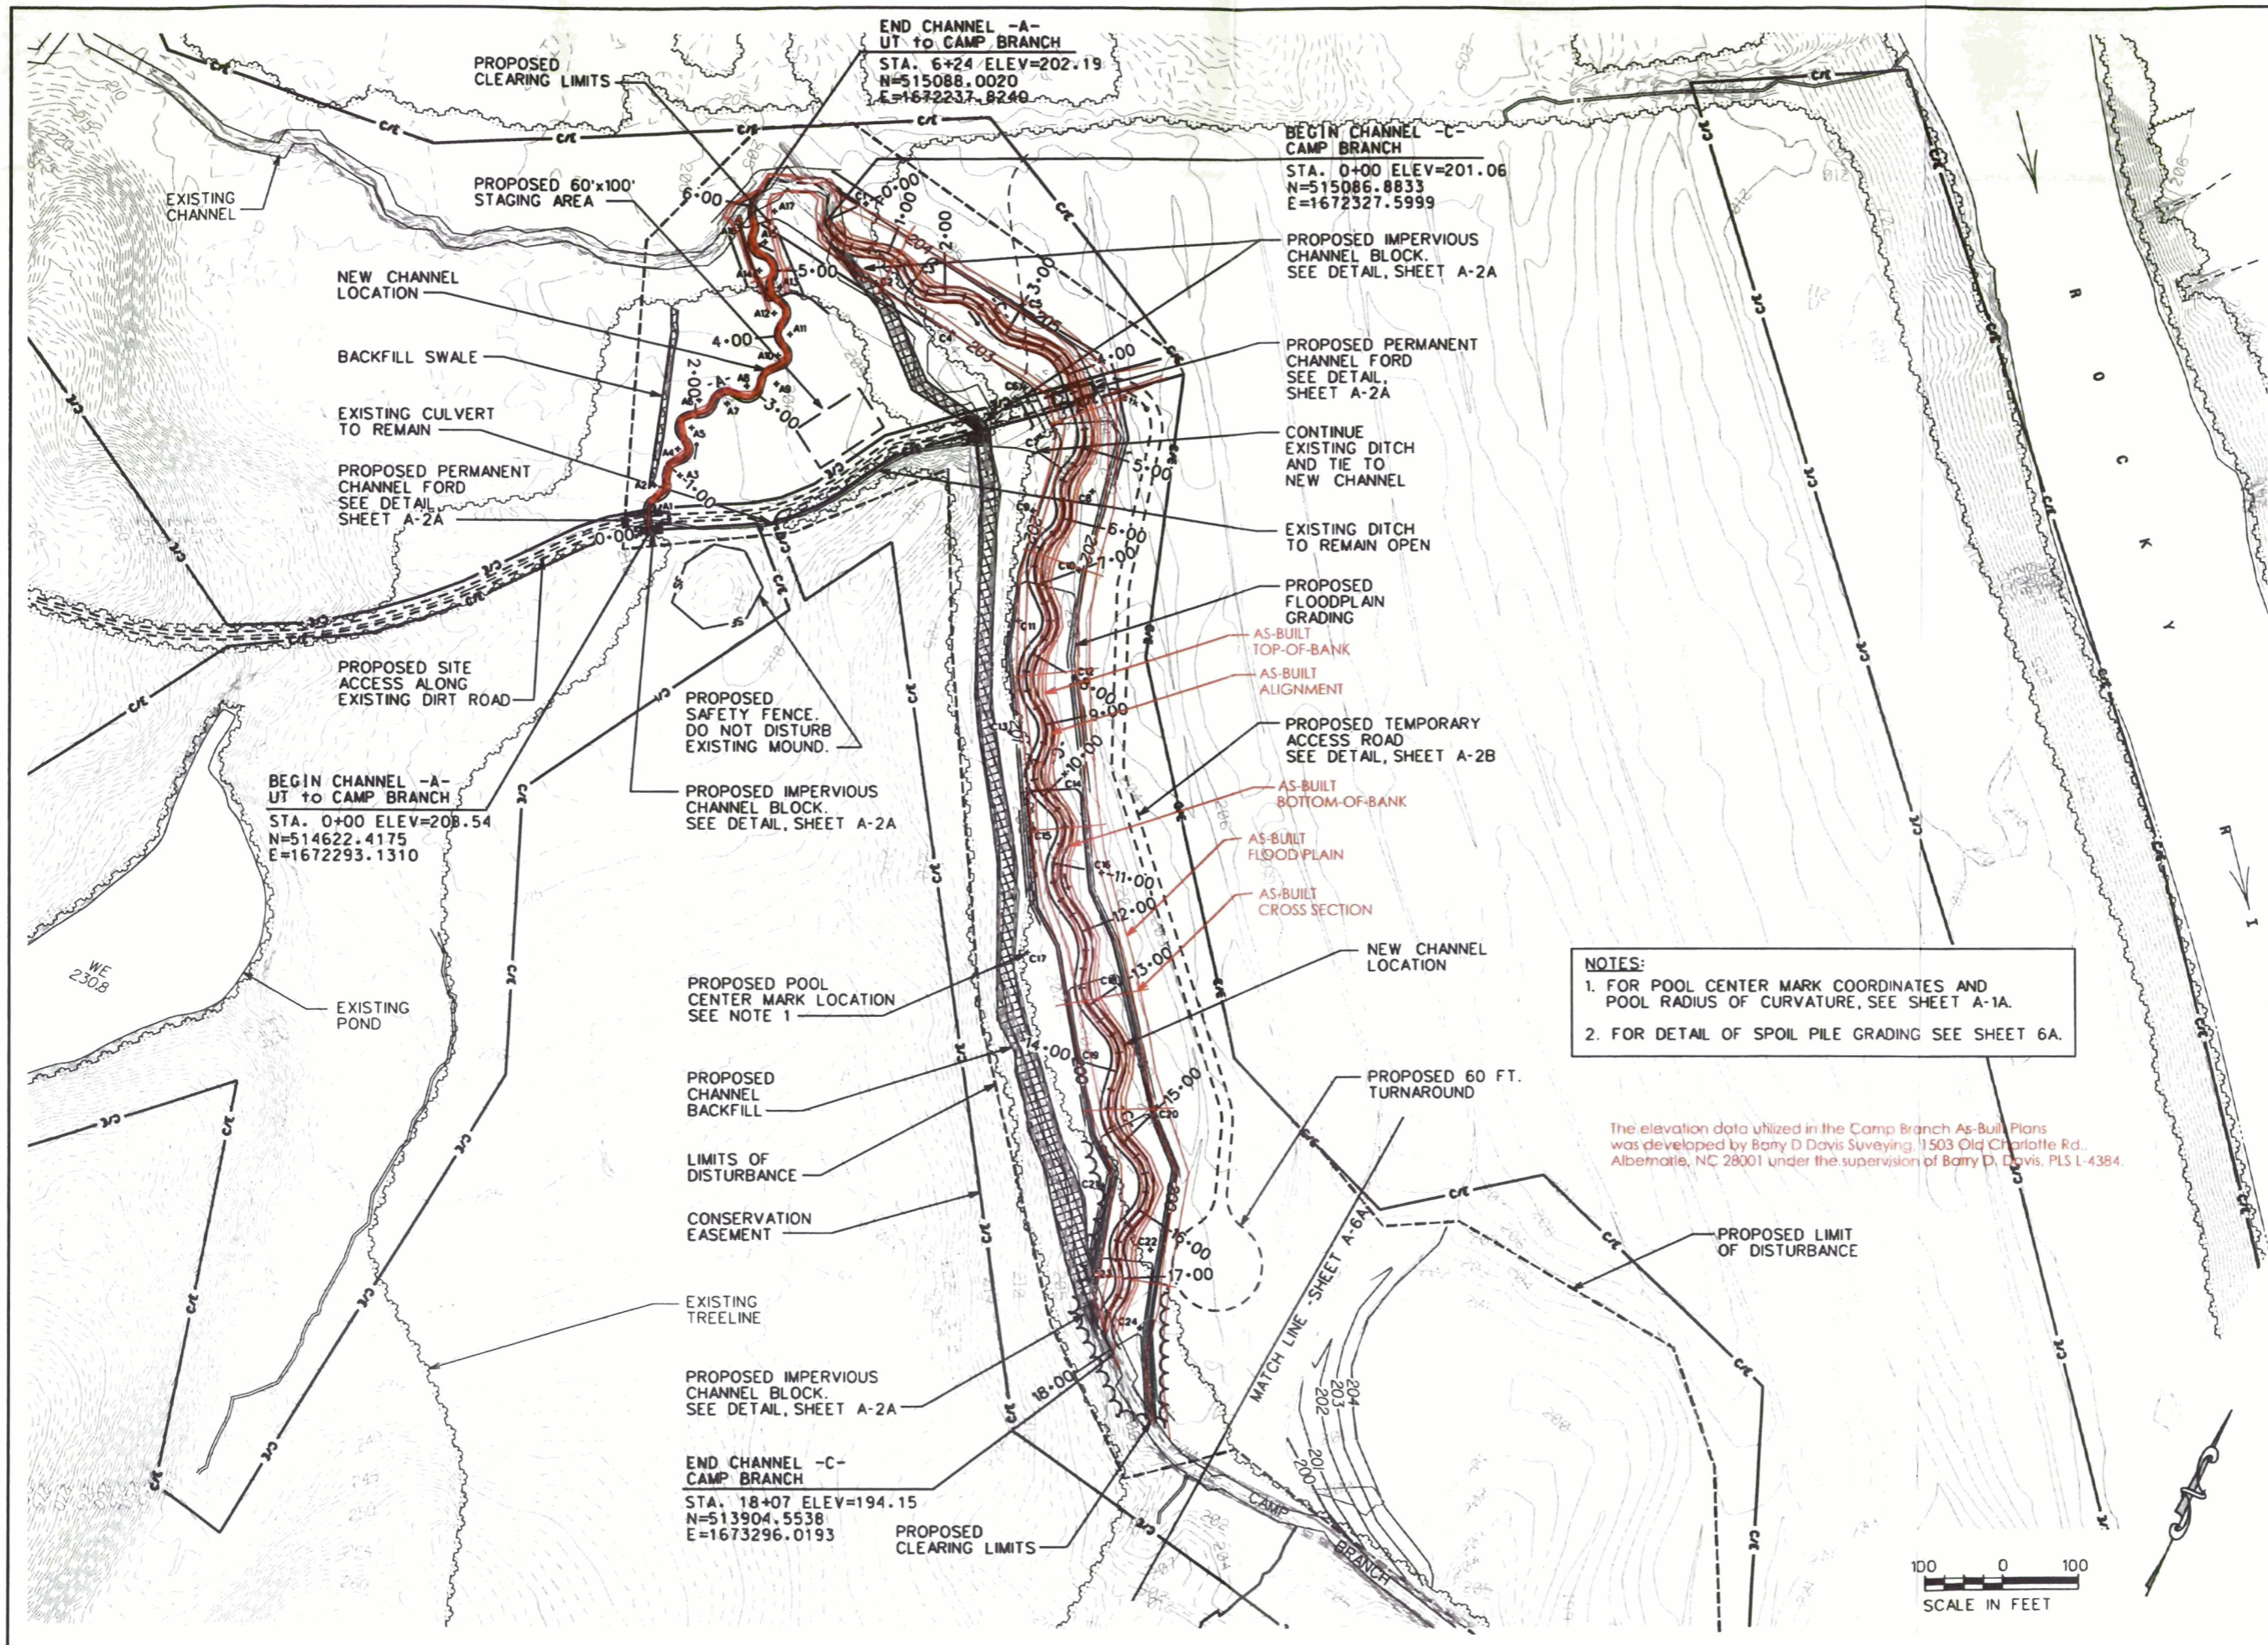

END CHANNEL -A-  
UT to CAMP BRANCH  
STA. 6+24 ELEV=202.19  
N=515088.0020  
E=1672237.8240


BEGIN CHANNEL -C-  
CAMP BRANCH  
STA. 0+00 ELEV=201.06  
N=515086.8833  
E=1672327.5999

BEGIN CHANNEL -A-  
UT to CAMP BRANCH  
STA. 0+00 ELEV=208.54  
N=514622.4175  
E=1672293.1310

END CHANNEL -C-  
CAMP BRANCH  
STA. 18+07 ELEV=194.15  
N=513904.5538  
E=1673296.0193

**NOTES:**  
1. FOR POOL CENTER MARK COORDINATES AND POOL RADIUS OF CURVATURE, SEE SHEET A-1A.  
2. FOR DETAIL OF SPOIL PILE GRADING SEE SHEET 6A.

The elevation data utilized in the Camp Branch As-Built Plans was developed by Barry D Davis Surveying, 1503 Old Charlotte Rd, Albemarle, NC 28001 under the supervision of Barry D. Davis, PLS L-4384.

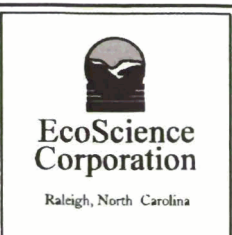

REVISIONS

1	AS-BUILT - JULY 2007
---	----------------------



Project:  
**BISHOP SITE  
STREAM /  
WETLAND  
RESTORATION  
PLAN**  
ANSON COUNTY,  
NORTH CAROLINA


Title:  
**SITE PLAN  
CAMP BRANCH**

Des. By: JDC MAF  
Crd. By: EBB  
Date: JUL 2007

Scale: AS SHOWN  
ESC Project No.: 04-212

SHEET  
**A-6**





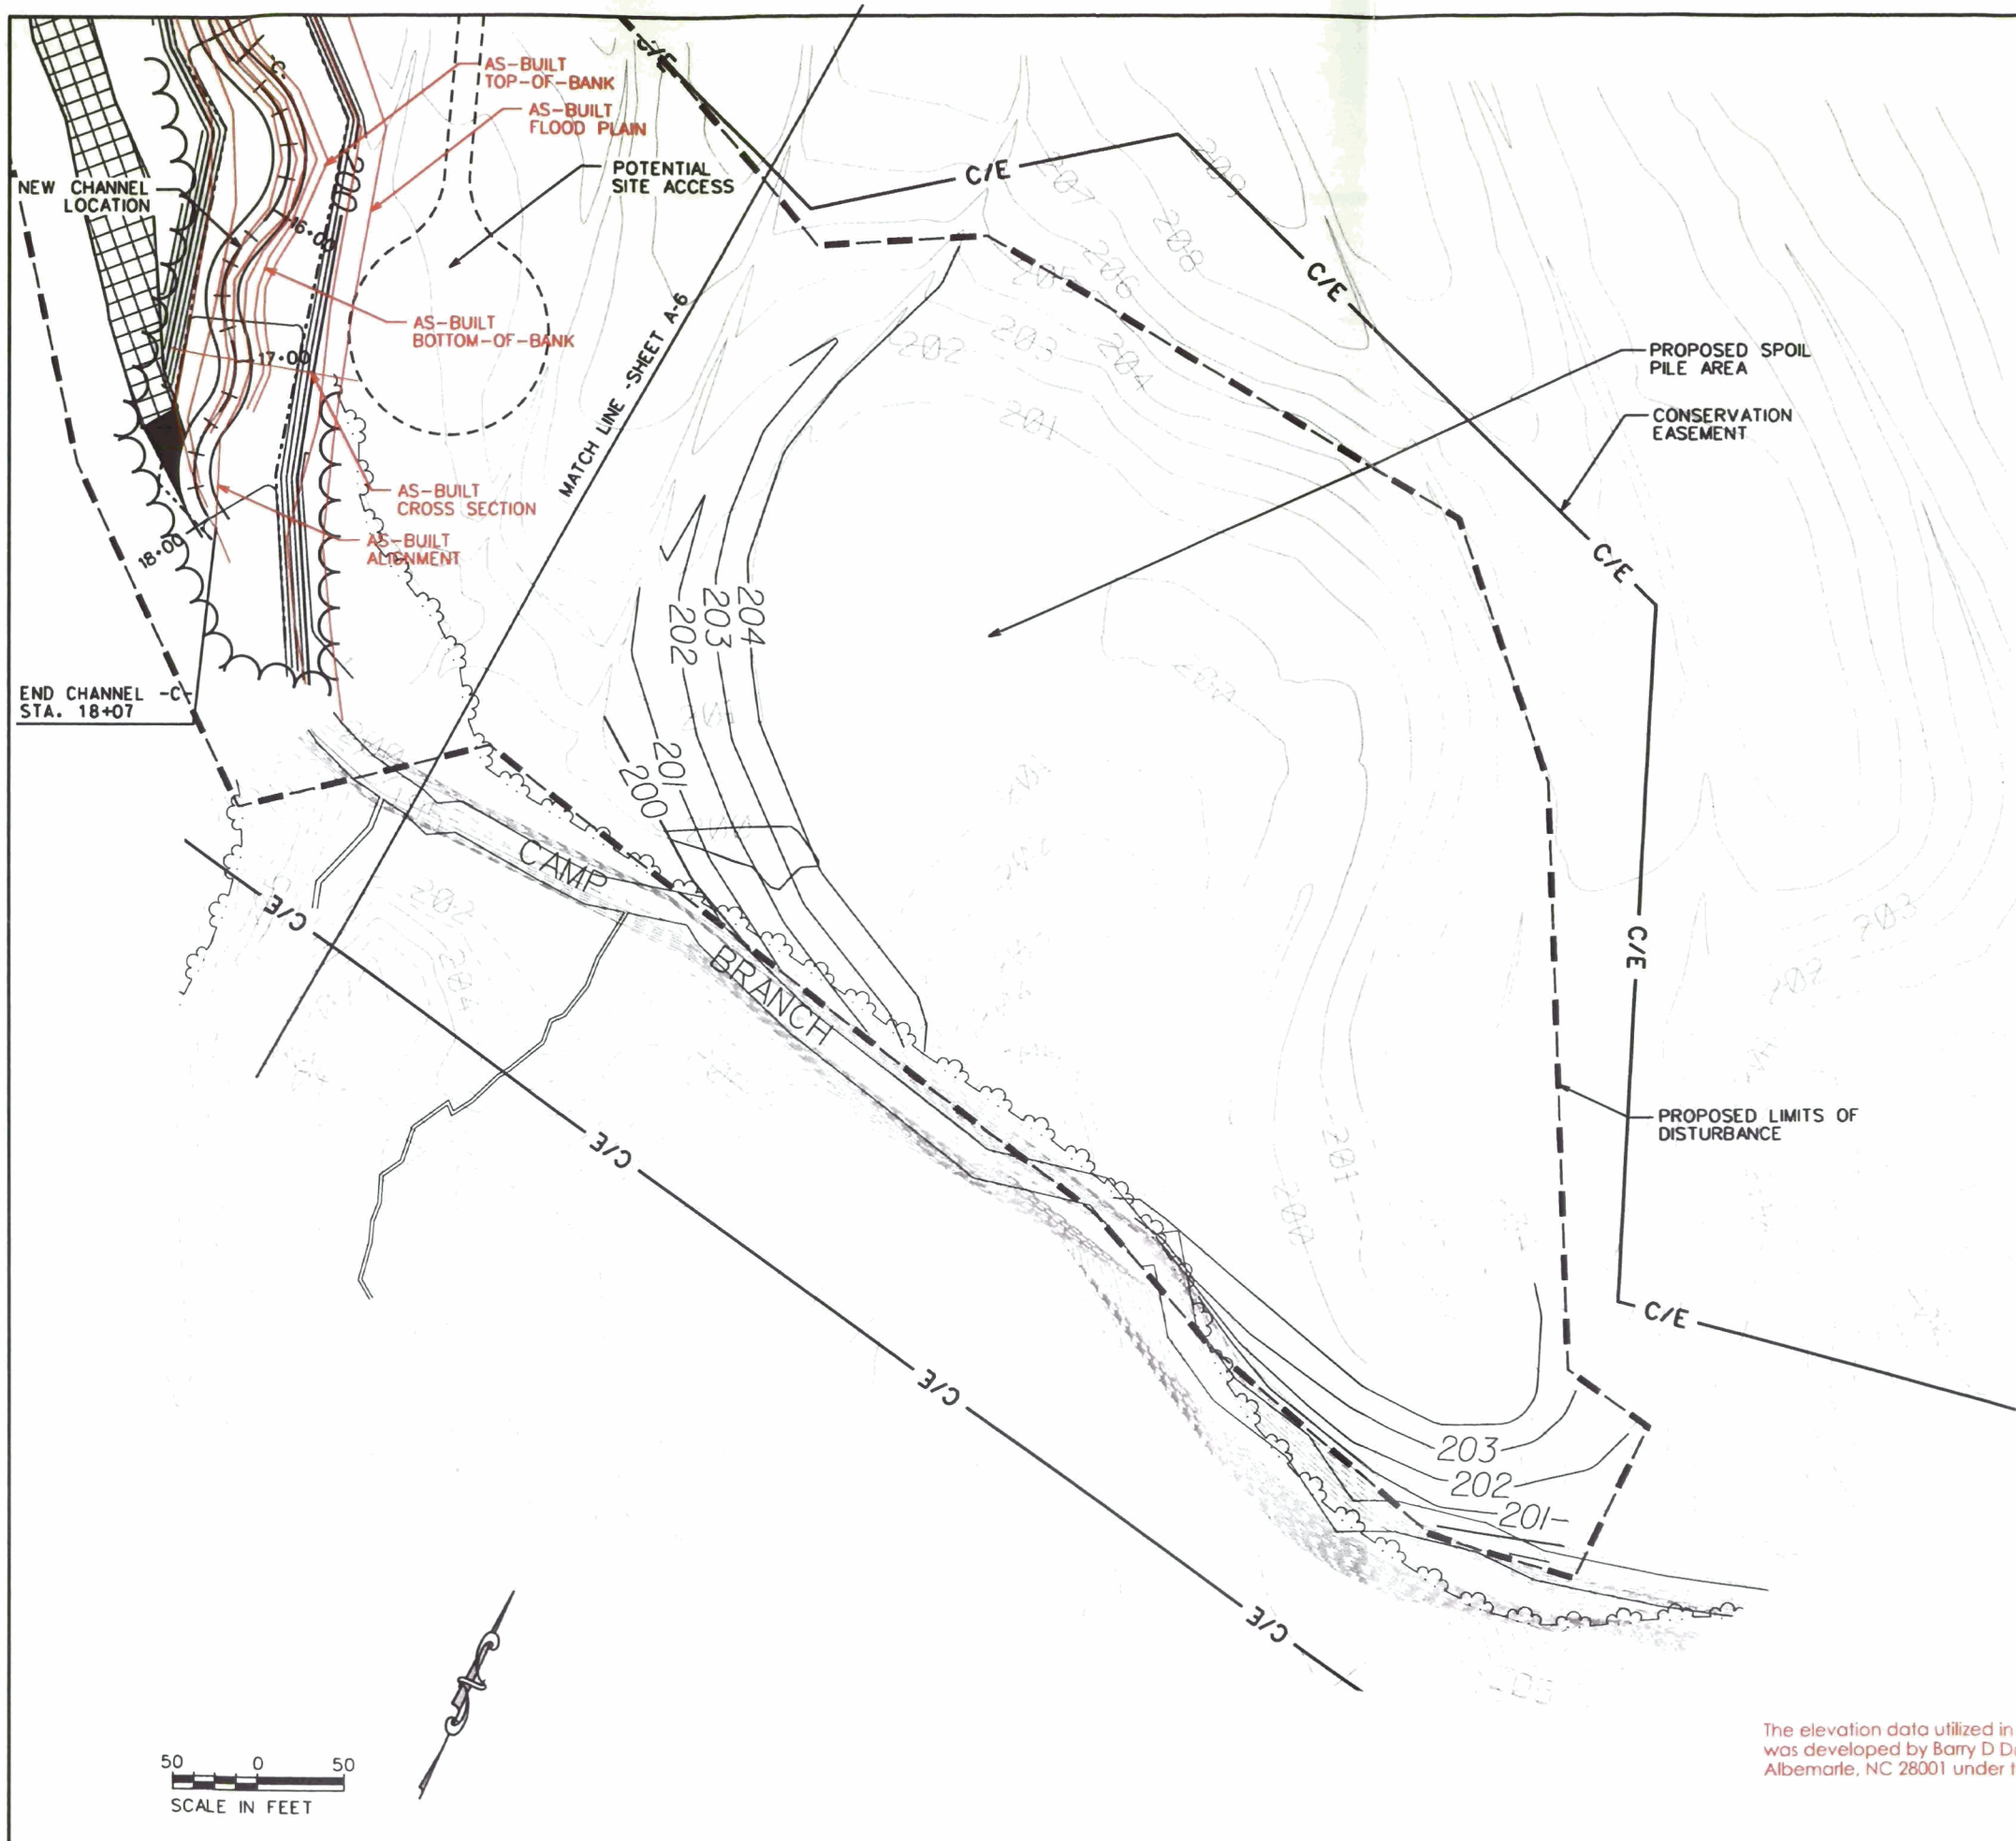

The elevation data utilized in the Camp Branch As-Built Plans was developed by Barry D Davis Surveying, 1503 Old Charlotte Rd., Albemarle, NC 28001 under the supervision of Barry D. Davis, PLS L-4384.



REVISIONS	
1	AS-BUILT - JULY 2007

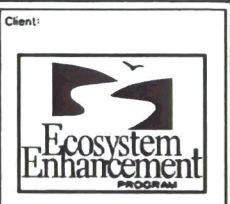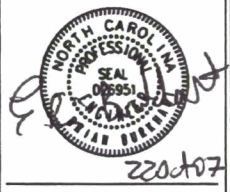

Client:

Project:

**BISHOP SITE  
STREAM /  
WETLAND  
RESTORATION  
PLAN**

ANSON COUNTY,  
NORTH CAROLINA

Title:

**SITE PLAN**

**CAMP BRANCH**

Dsn. By:	Dwn. By:
JDC	MAF
Clk. By:	Date:
EBB	JUL 2007
Scale:	
AS SHOWN	
ESC Project No.:	
04-212	

SHEET

**A-6A**





ECOSYSTEM ENHANCEMENT PROGRAM

BISHOP SITE STREAM AND WETLAND RESTORATION CAMP BRANCH

EXISTING AND PROPOSED PROFILE -C- CHANNEL

Legend:  
 - - - - - EXISTING FLOOD PLAN  
 - - - - - PROPOSED FLOOD PLAN  
 ——— PROPOSED BED ELEVATION  
 TR15 TOP OF RIFFLE  
 P15 POOL

A-7

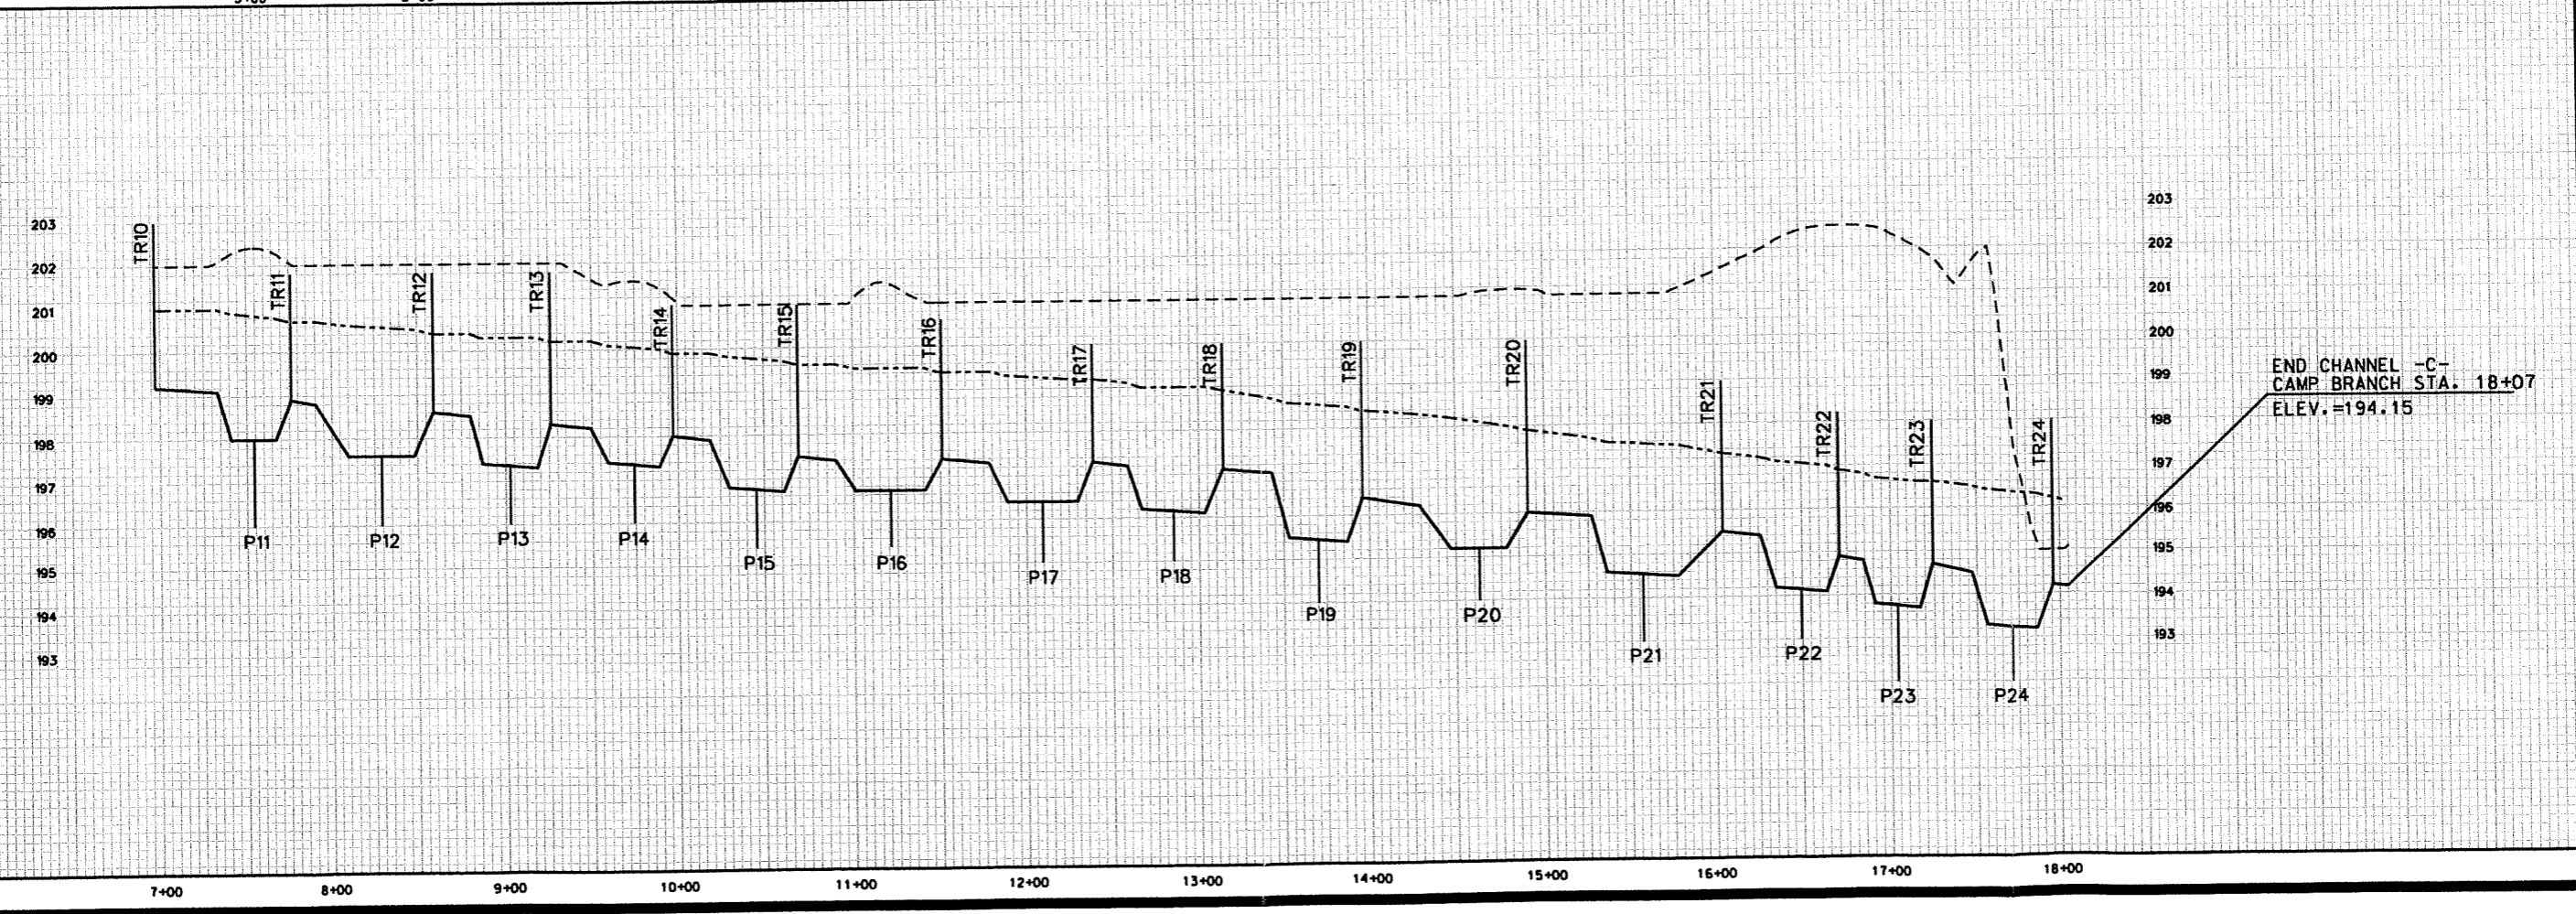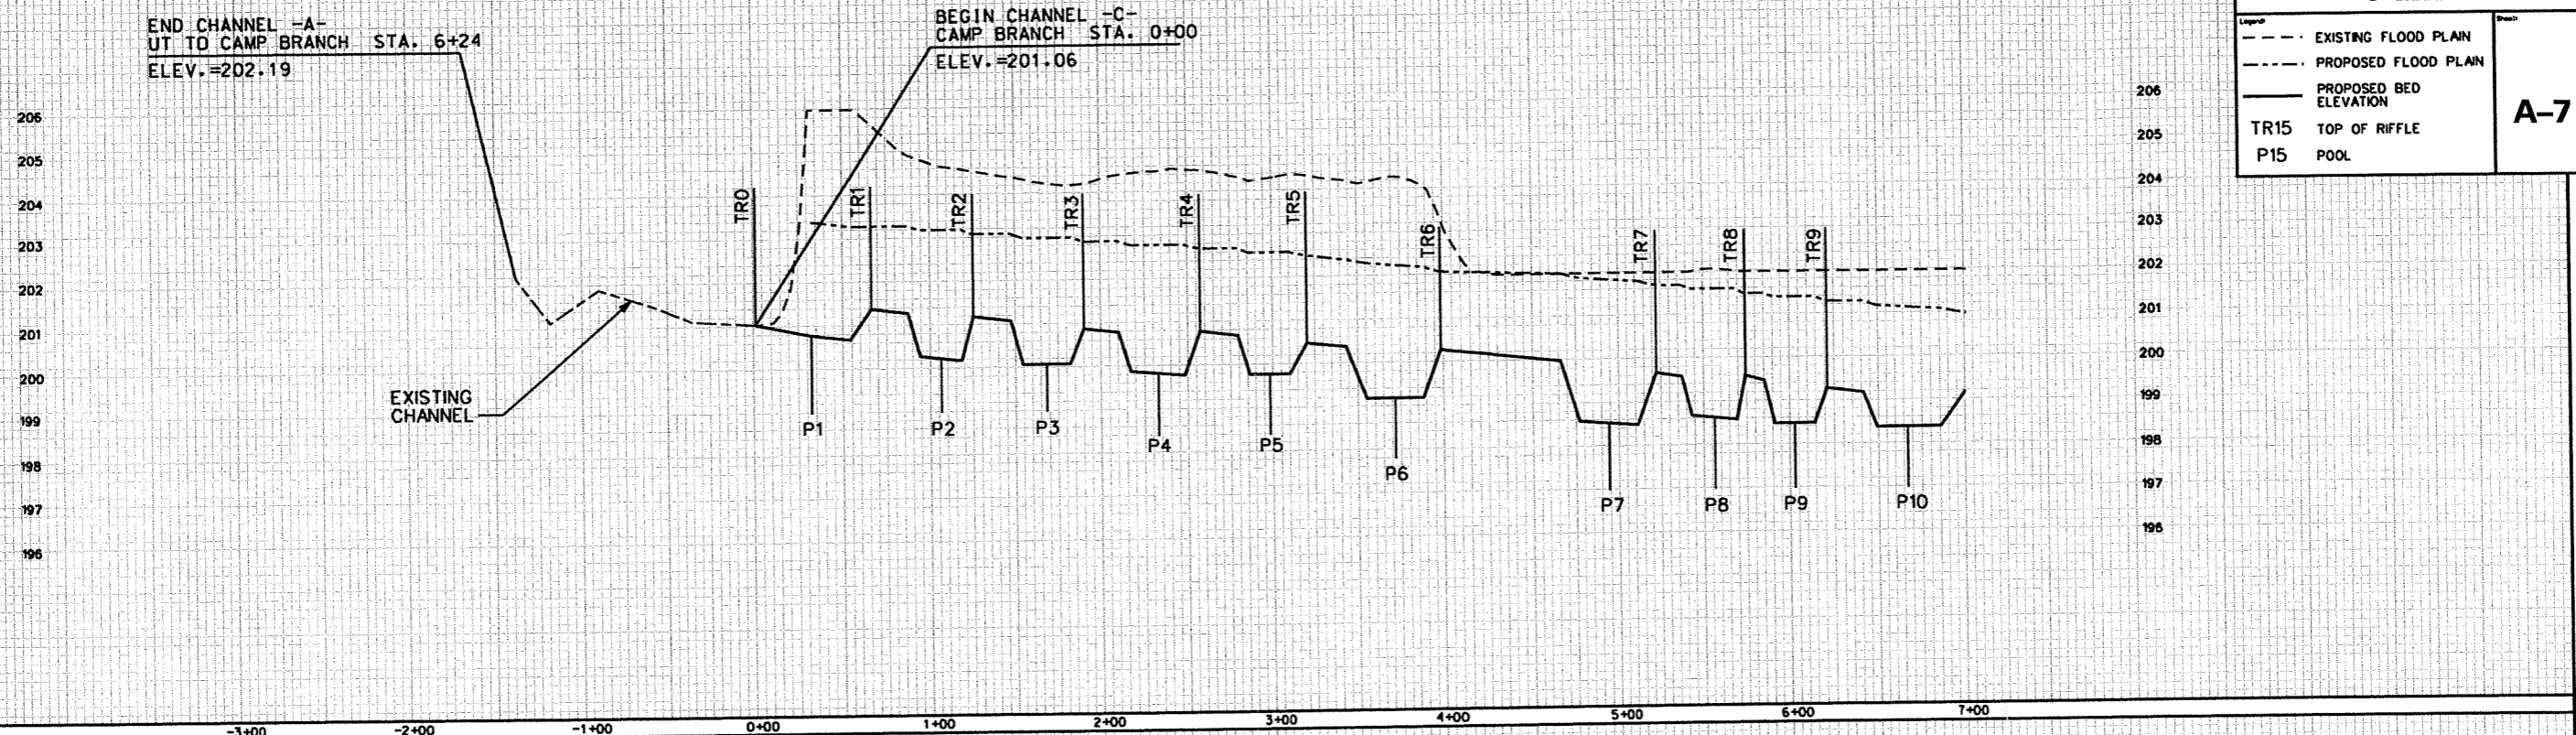




ECOSYSTEM ENHANCEMENT PROGRAM

BISHOP SITE STREAM AND WETLAND RESTORATION  
 CAMP BRANCH


EXISTING AND PROPOSED PROFILE  
 -C- CHANNEL

- SURVEY AS-BUILT
- - - FLOOD PLAIN
- BED ELEVATION
- TR15 TOP OF RIFFLE
- P15 POOL

A-7A

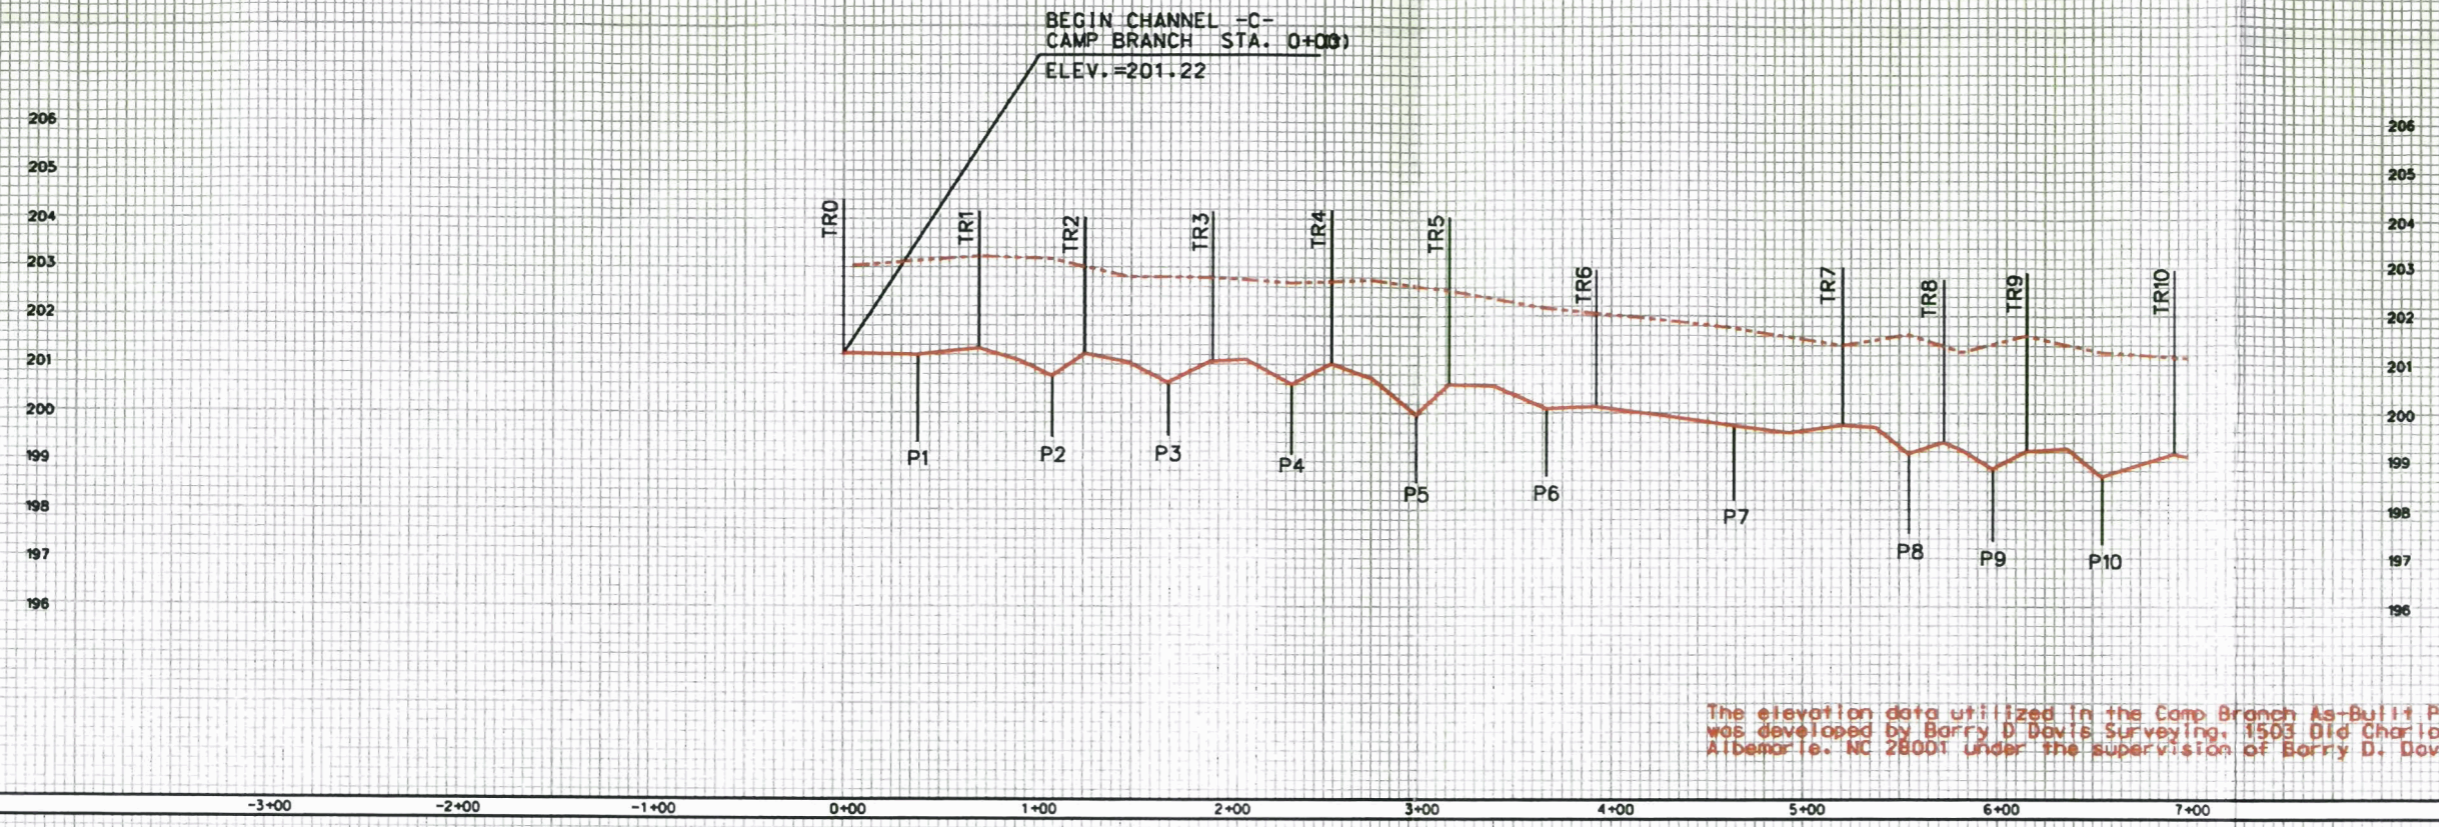


The elevation data utilized in the Camp Branch As-Built Plans was developed by Barry D. Davis Surveying, 1503 Old Charlotte Rd., Albemarle, NC 28001 under the supervision of Barry D. Davis, PLS L-4384

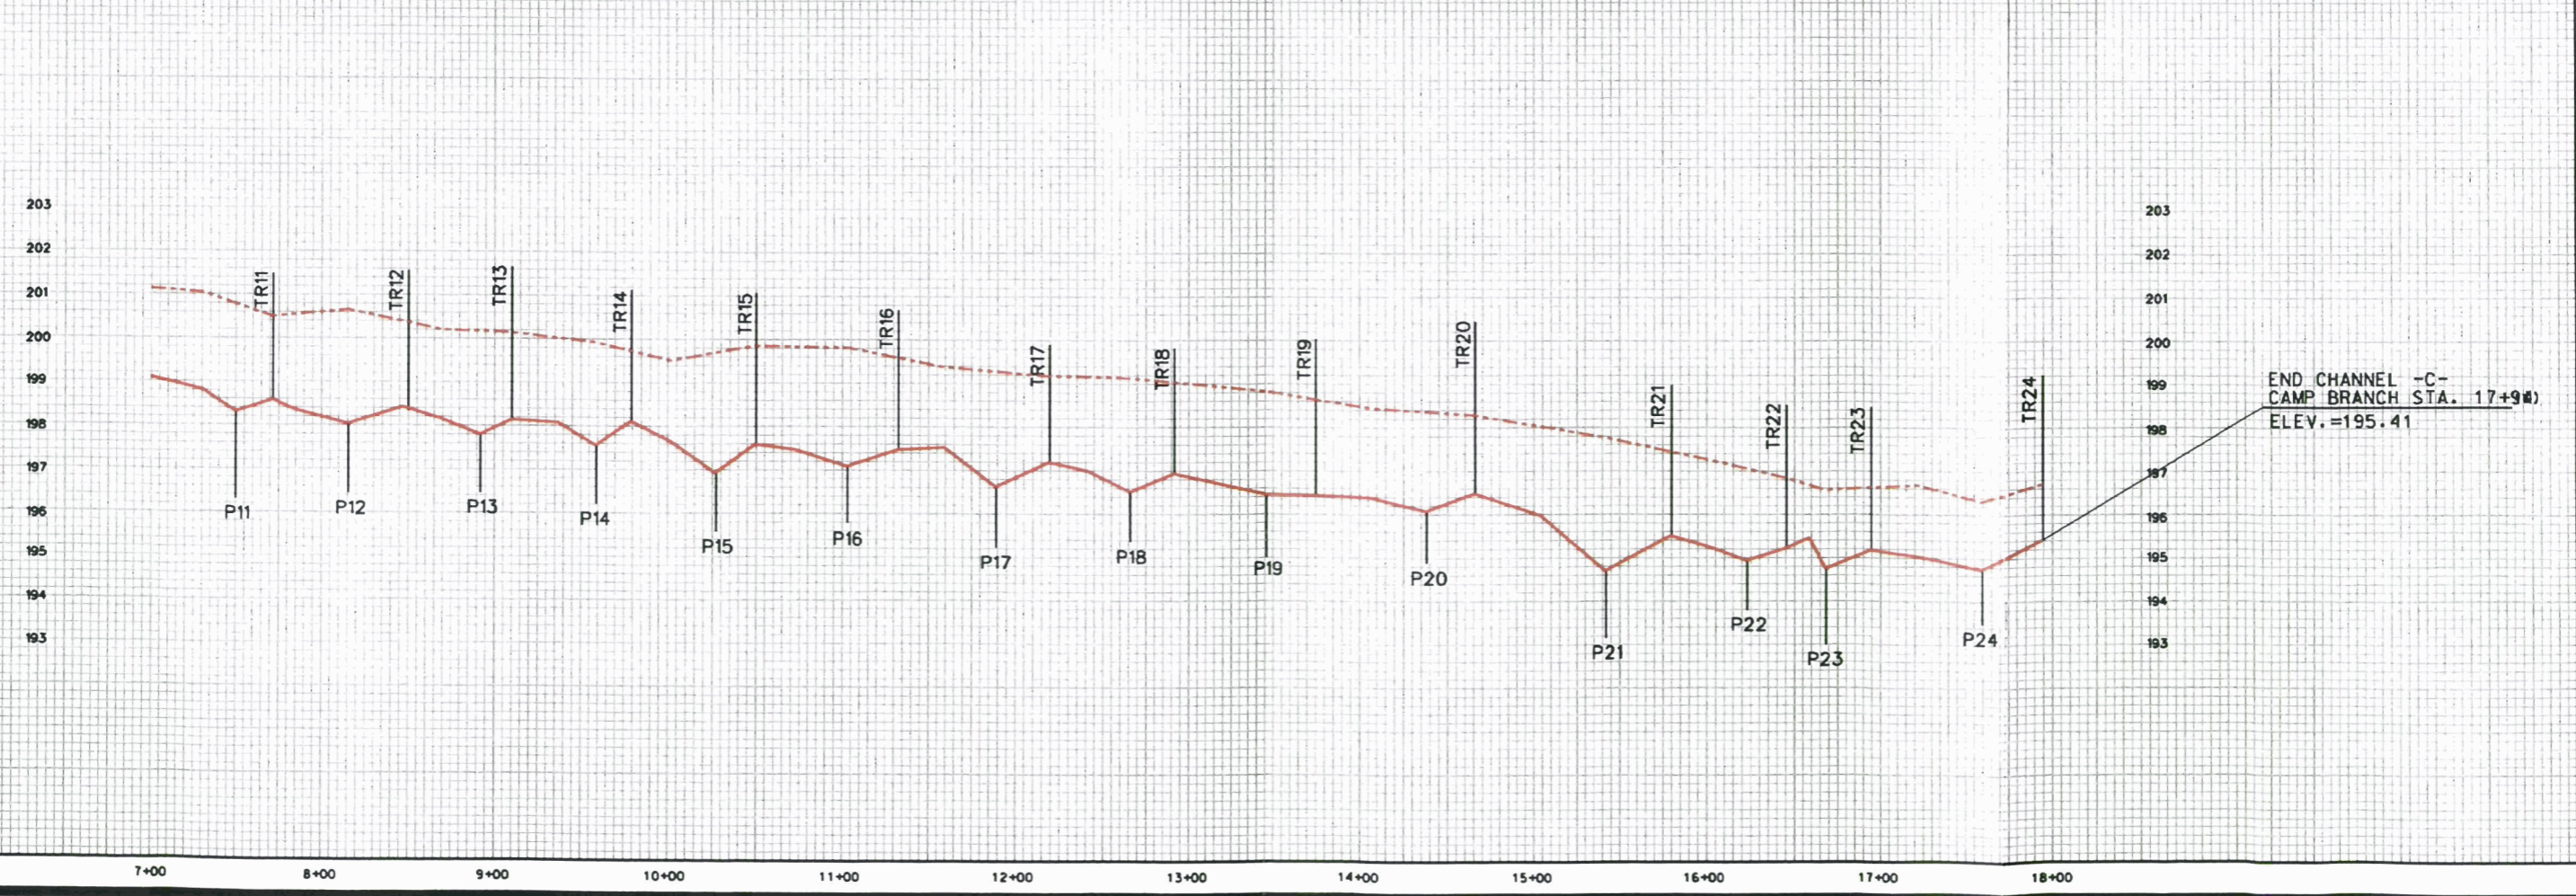



Project #	04-212	Date	JUN 2005	Scale	AS SHOWN
Des. By	MAF	Chk. By	JDC	Drawn By	DGM
Client	ECOSYSTEM ENHANCEMENT PROGRAM				
Project	BISHOP SITE STREAM AND WETLAND RESTORATION UT TO CAMP BRANCH				
Title	EXISTING AND PROPOSED PROFILE -A- CHANNEL				
Legend	- - - - - EXISTING FLOOD PLAN - - - - - PROPOSED FLOOD PLAN ——— PROPOSED BED ELEVATION TR15 TOP OF RIFFLE P15 POOL				Sheet
					A-8

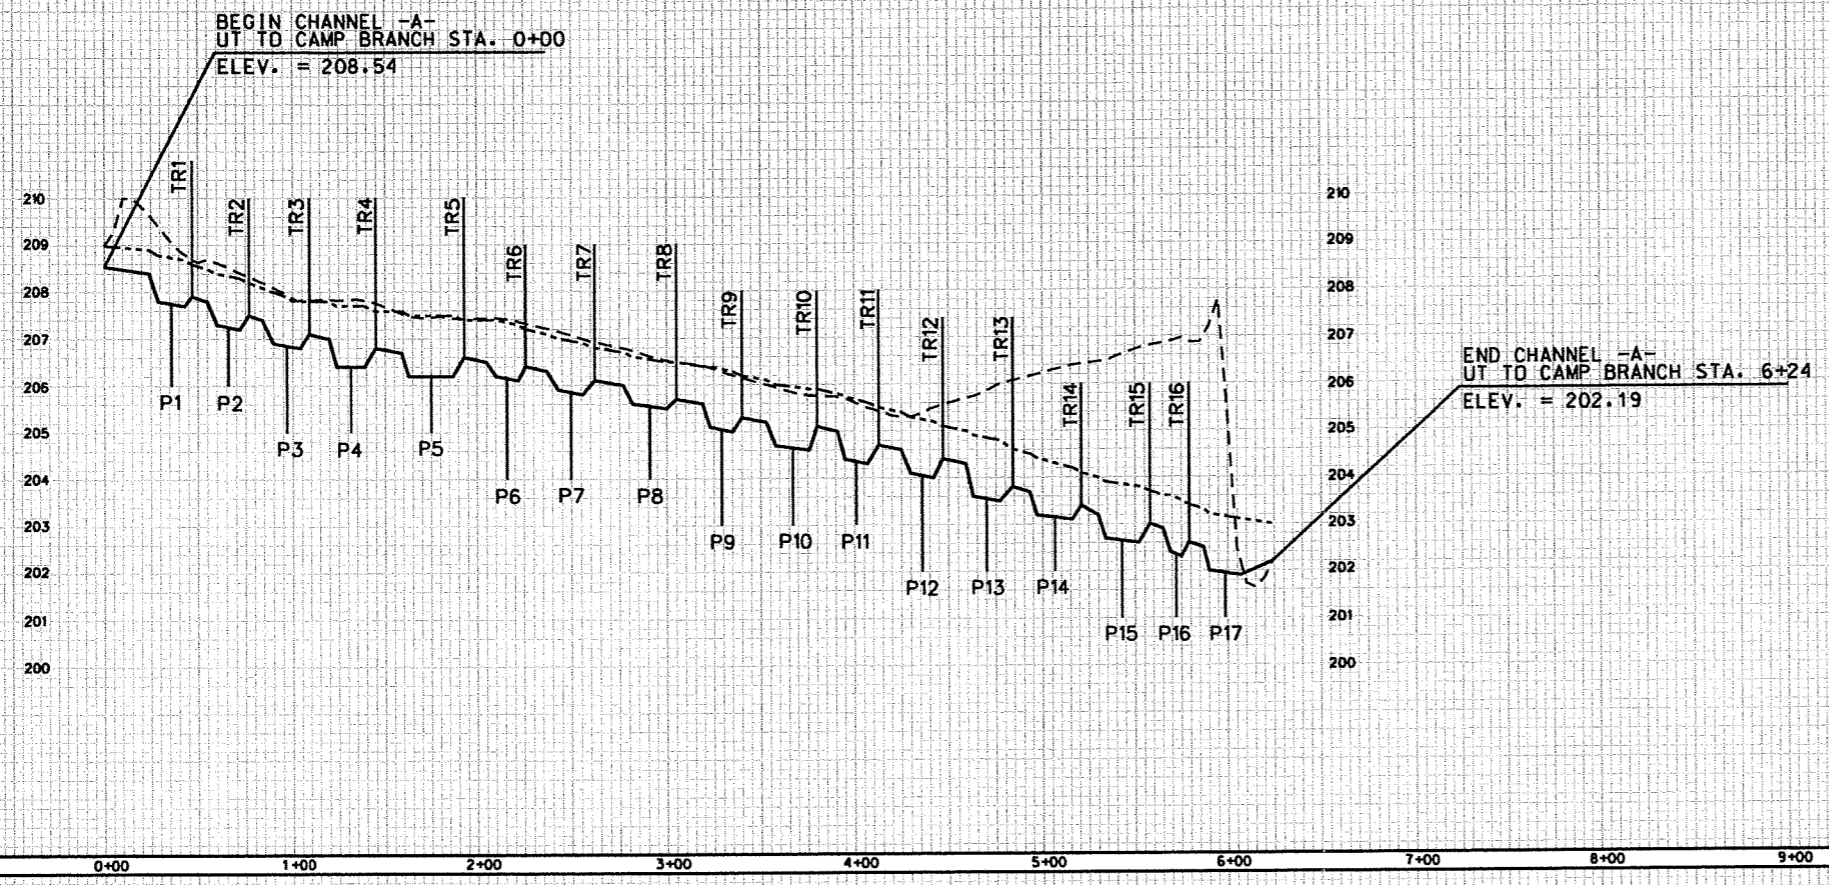




ECOSYSTEM ENHANCEMENT PROGRAM

Project BISHOP SITE STREAM AND WETLAND RESTORATION UT TO CAMP BRANCH


Profile EXISTING AND PROPOSED PROFILE -A- CHANNEL

Legend	Survey AS-BUILT	Sheet
	FLOOD PLAN	
	BED ELEVATION	
	TR15 TOP OF RIFFLE	A-8A
	P15 POOL	

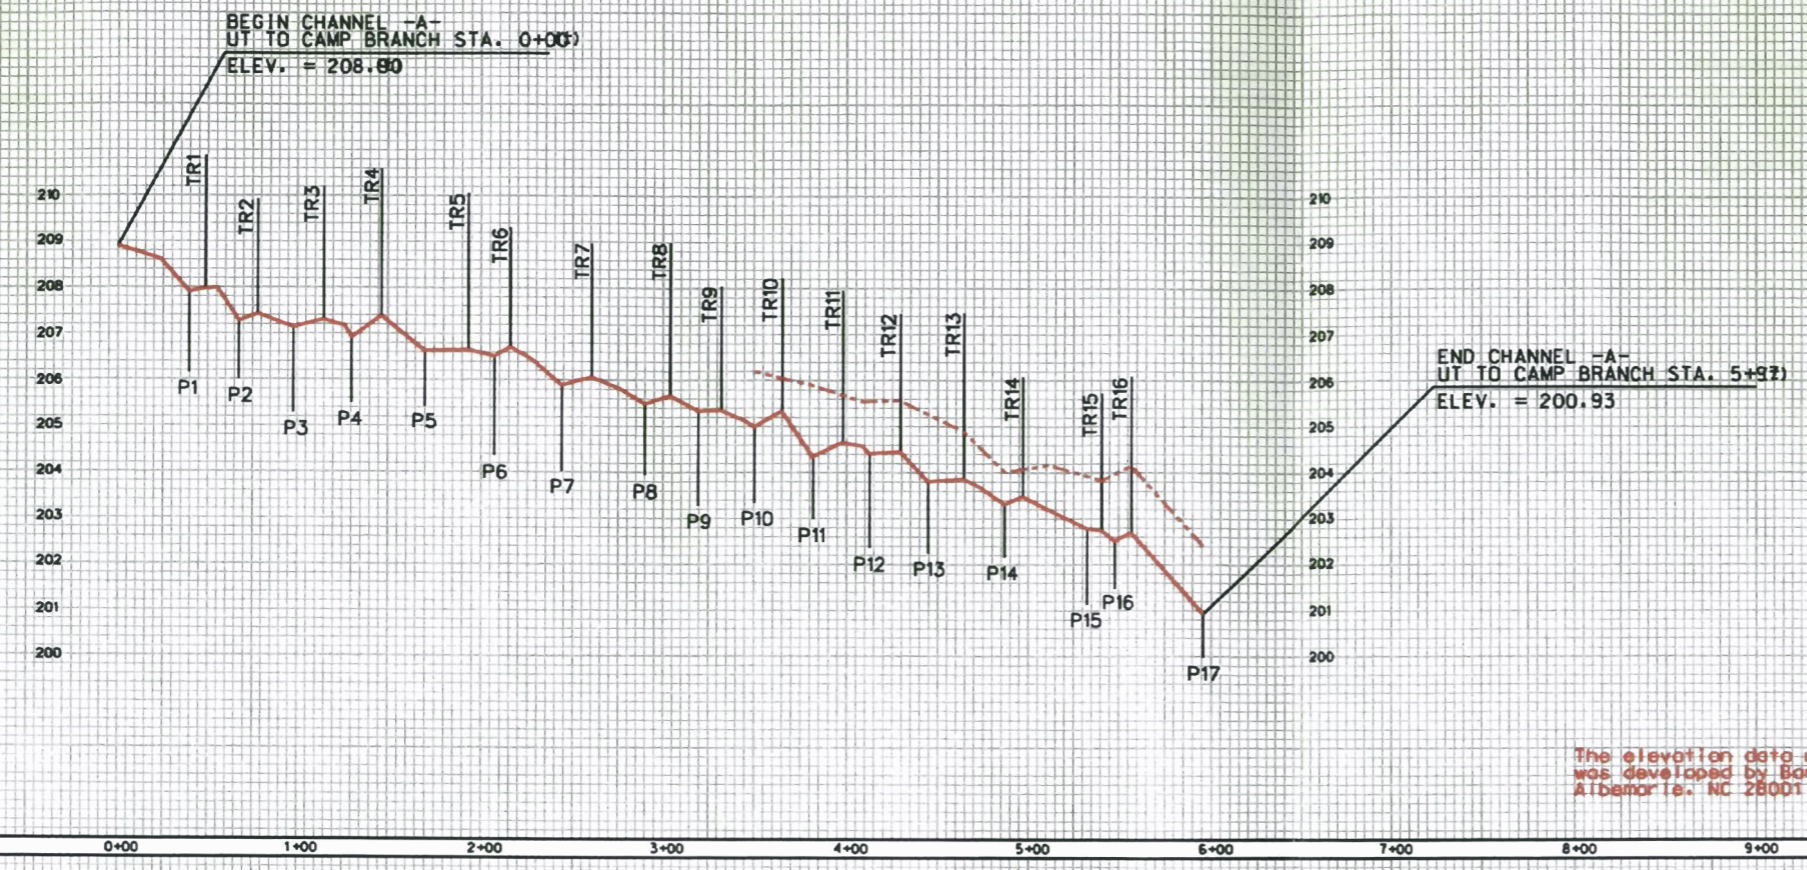

The elevation data utilized in the Camp Branch As-Built Plans was developed by Barry D. Davis Surveying, 1503 Old Charlotte Rd., Albemarle, NC 28001 under the supervision of Barry D. Davis, PLS L-4384



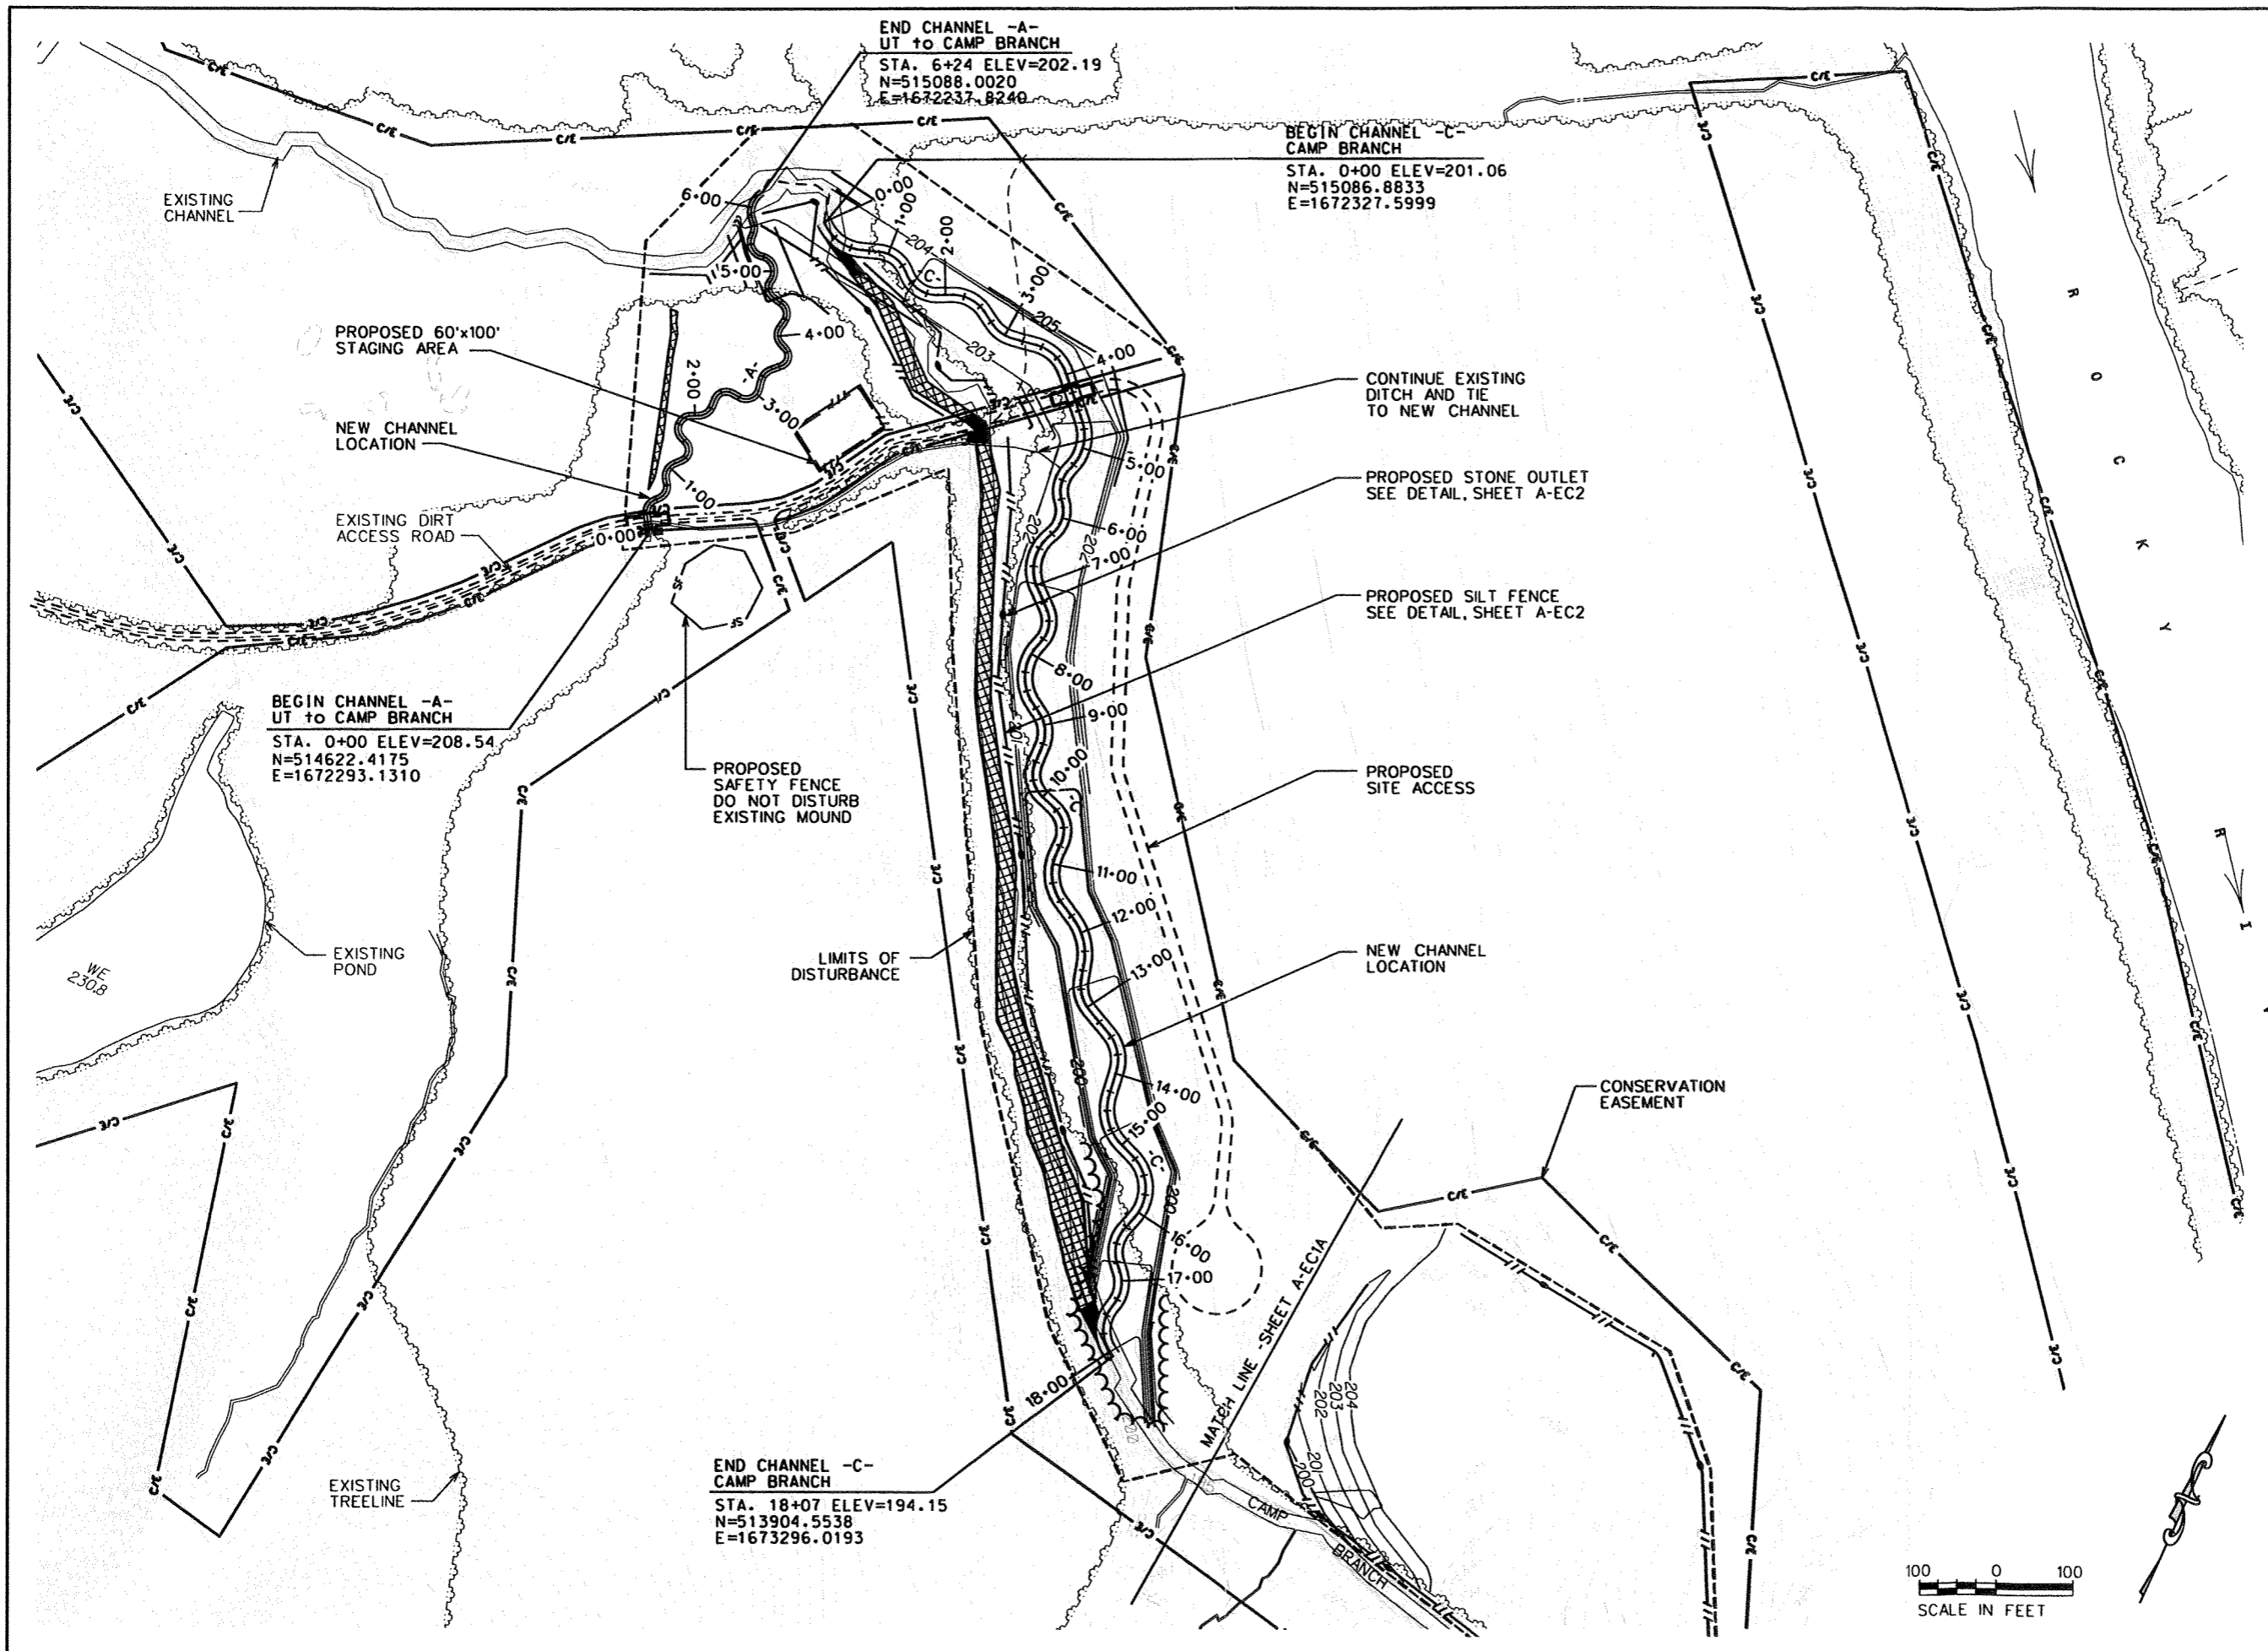

END CHANNEL -A-  
UT to CAMP BRANCH  
STA. 6+24 ELEV=202.19  
N=515088.0020  
E=1672237.8240


BEGIN CHANNEL -C-  
CAMP BRANCH  
STA. 0+00 ELEV=201.06  
N=515086.8833  
E=1672327.5999

BEGIN CHANNEL -A-  
UT to CAMP BRANCH  
STA. 0+00 ELEV=208.54  
N=514622.4175  
E=1672293.1310

END CHANNEL -C-  
CAMP BRANCH  
STA. 18+07 ELEV=194.15  
N=513904.5538  
E=1673296.0193



REVISIONS

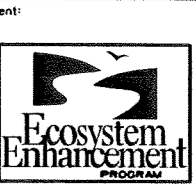Client:

**BISHOP SITE  
STREAM /  
WETLAND  
RESTORATION  
PLAN**

ANSON COUNTY,  
NORTH CAROLINA

Project:


**EROSION  
CONTROL  
PLAN**

**CAMP BRANCH**


Dsn. By: JDC  
Ckd. By: DGM  
Date: JUN 2005

Scale: AS SHOWN  
ESC Project No.: 04-212

SHEET  
**A-EC1**

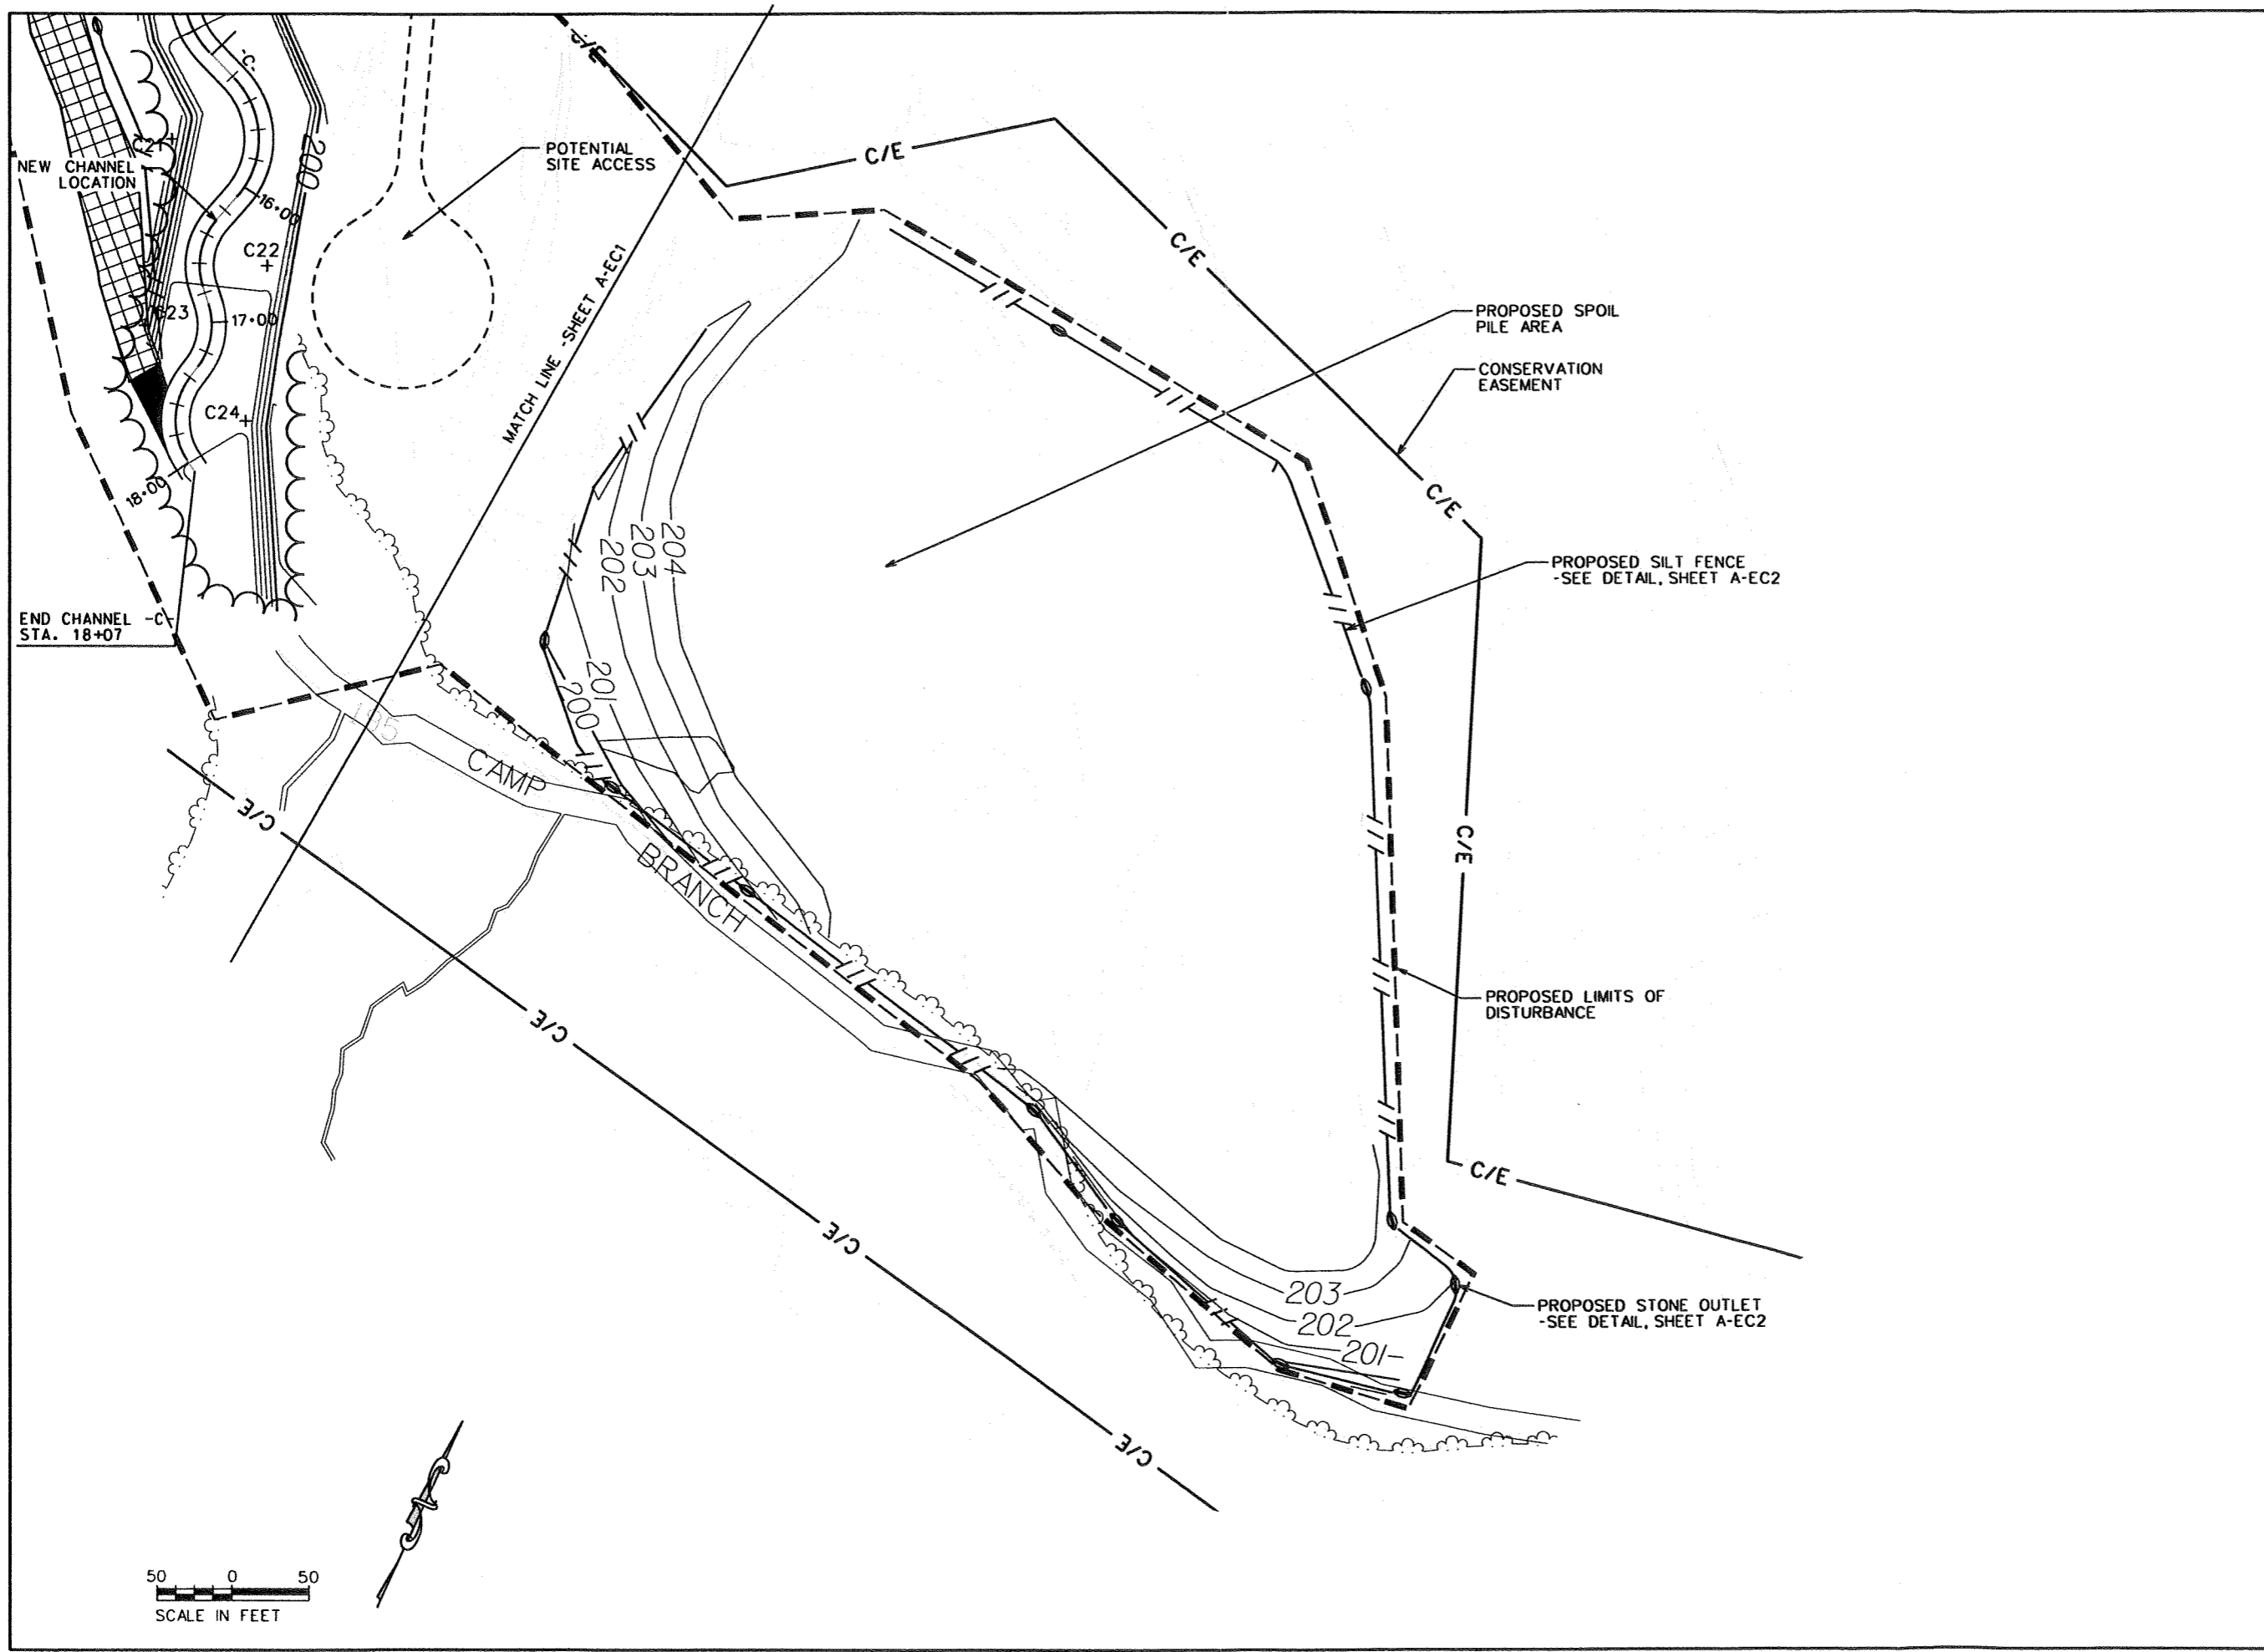

REVISIONS

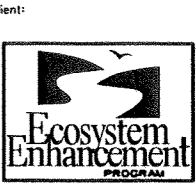Project:

**BISHOP SITE  
STREAM /  
WETLAND  
RESTORATION  
PLAN**

ANSON COUNTY,  
NORTH CAROLINA

Title:

**EROSION  
CONTROL  
PLAN**

**CAMP BRANCH**

Des. By:	JDC	Dwn. By:	MAF
Ckd. By:	DGM	Date:	JUN 2005




Scale: AS SHOWN

ESC Project No.: 04-212

SHEET



**A-EC1A**



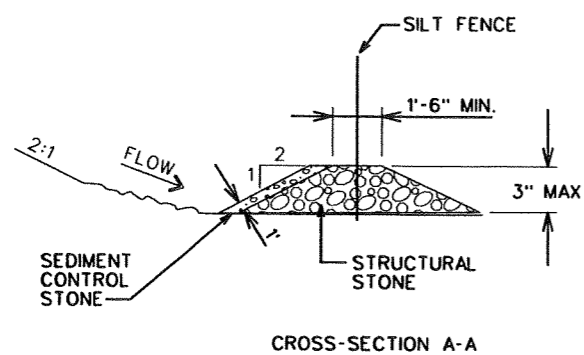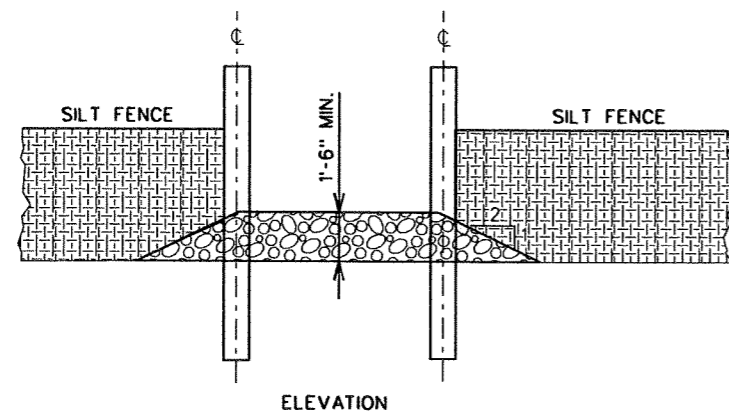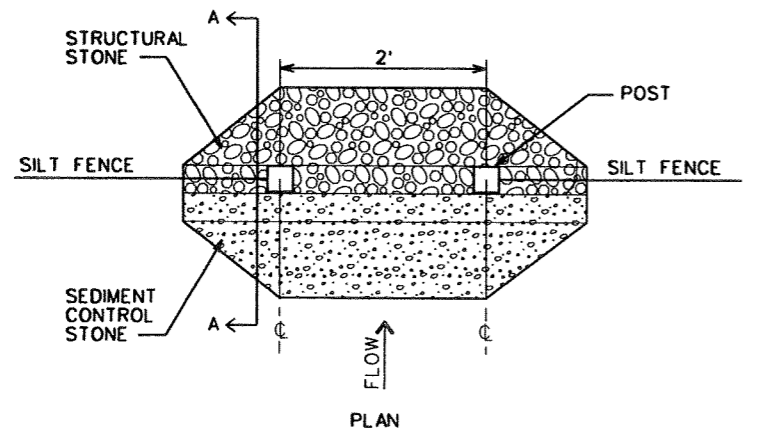

- NOTES:**
1. STRUCTURAL STONE SHALL BE CLASS B STONE FOR EROSION CONTROL PURPOSES.
  2. SEDIMENT CONTROL STONE SHALL BE NO. 5 OR NO. 57 STONE.

**STONE OUTLET DETAIL**

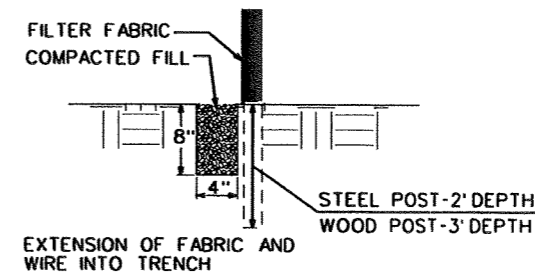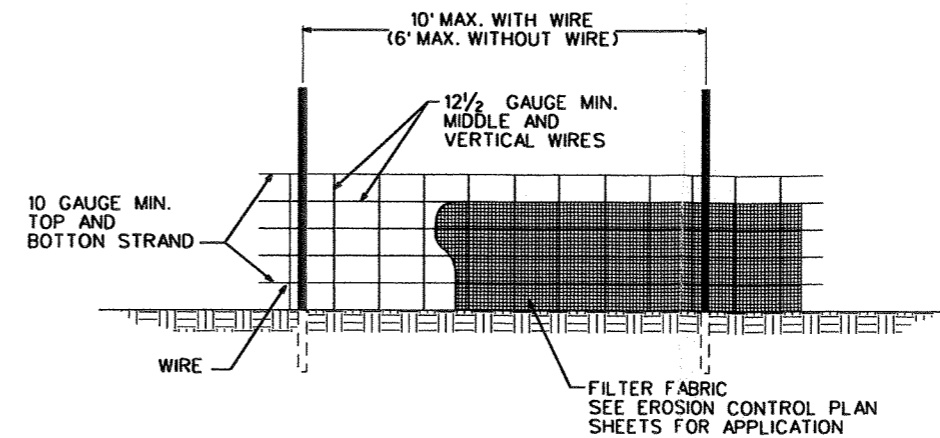


- NOTES:**
1. USE WIRE A MINIMUM OF 32 INCHES IN WIDTH AND WITH A MINIMUM OF 6 LINE WIRES WITH 12 INCH STAY SPACING.
  2. USE FILTER FABRIC A MINIMUM OF 36 INCHES IN WIDTH AND FASTEN ADEQUATELY TO THE WIRE AS DIRECTED BY THE ENGINEER.
  3. PROVIDE 5 FOOT STEEL POST OF THE SELF-FASTENER ANGLE STEEL TYPE.
  4. USE 6 FOOT WOOD POST WITH 3 INCH DIAMETER.

NCDOT BMP'S FOR CONSTRUCTION AND MAINTENANCE ACTIVITIES, 5.1.1, AUGUST 2003

**TEMPORARY SILT FENCE**  
NCDOT STD, DWG. 1605.01

REVISIONS

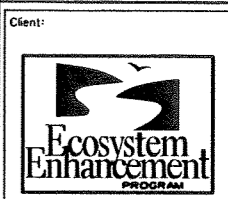

Client:  
**BISHOP SITE  
STREAM /  
WETLAND  
RESTORATION  
PLAN**

Project:  
ANSON COUNTY,  
NORTH CAROLINA

Title:  
**EROSION  
CONTROL  
DETAILS**

**CAMP BRANCH**

Des. By: JDC	Dwn. By: MAF
Ckd. By: DGM	Date: JUN 2005


Scale:  
**NO SCALE**

ESC Project No.:  
04-212


SHEET  
**A-EC2**

Species <sup>1</sup>	Common Name	Number Planted	% of Total	Number Planted	% of Total	Number Planted	% of Total	Number Planted	% of Total	Number Planted	Number Planted
<i>Quercus michauxii</i>	swamp chestnut oak	2056	9					20	6	2076	2100
<i>Ulmus americana</i>	American elm	1599	7					33	10	1632	2500
<i>Celtis laevigata</i>	sugarberry	1599	7					20	6	1619	3100
<i>Fraxinus pennsylvanica</i>	green ash	1599	7					20	6	1619	2500
<i>Carya ovata</i>	shagbark hickory	1599	7					20	6	1619	1700
<i>Quercus phellos</i>	willow oak	2056	9					20	6	2076	2100
<i>Nyssa biflora</i>	swamp tupelo	1599	7					20	6	1619	2500
<i>Platanus occidentalis</i>	sycamore	1599	7					20	6	1619	1700
<i>Quercus nigra</i>	water oak	1599	7					20	6	1619	2500
<i>Carya cordiformis</i>	bitter-nut hickory	1599	7					20	6	1619	
<i>Quercus pagoda</i>	cherrybark oak	1599	7					20	6	1619	1700
<i>Carpinus caroliniana</i>	musclewood	1599	7					33	10	1632	
<i>Asimina triloba</i>	pawpaw	1371	6					33	10	1404	1400
<i>Ilex opaca</i>	American holly	1371	6			212	8	33	10	1616	
<i>Arundinaria gigantea</i>	giant cane			370	8					370	
<i>Betula nigra</i>	river birch			555	12					555	1600
<i>Cornus amomum</i>	silky dogwood			555	12					555	1600
<i>Alnus serrulata</i>	tag alder			555	12					555	
<i>Cephalanthus occidentalis</i>	buttonbush			462	10					462	1500
<i>Sambucus canadensis</i>	elderberry			555	12					555	
<i>Viburnum dentatum</i>	arrow-wood			462	10					462	
<i>Viburnum nudum</i>	possum-haw			555	12					555	
<i>Vaccinium corymbosum</i>	highbush blueberry			555	12					555	
<i>Fagus grandifolia</i>	American beech					371	14			371	400
<i>Carya tomentosa</i>	mockernut hickory					318	12			318	400
<i>Carya glabra</i>	sweet pignut hickory					318	12			318	400
<i>Quercus alba</i>	white oak					424	16			424	500
<i>Quercus rubra</i>	northern red oak					371	14			371	400
<i>Quercus falcata</i>	southern red oak					371	14			371	400
<i>Cornus florida</i>	dogwood					265	10			265	300
<b>Total</b>		<b>22844</b>	<b>100</b>	<b>4624</b>	<b>100</b>	<b>2650</b>	<b>100</b>	<b>332</b>	<b>100</b>	<b>30450</b>	<b>31300</b>



<sup>1</sup>All stems are assumed to be bare-root seedlings

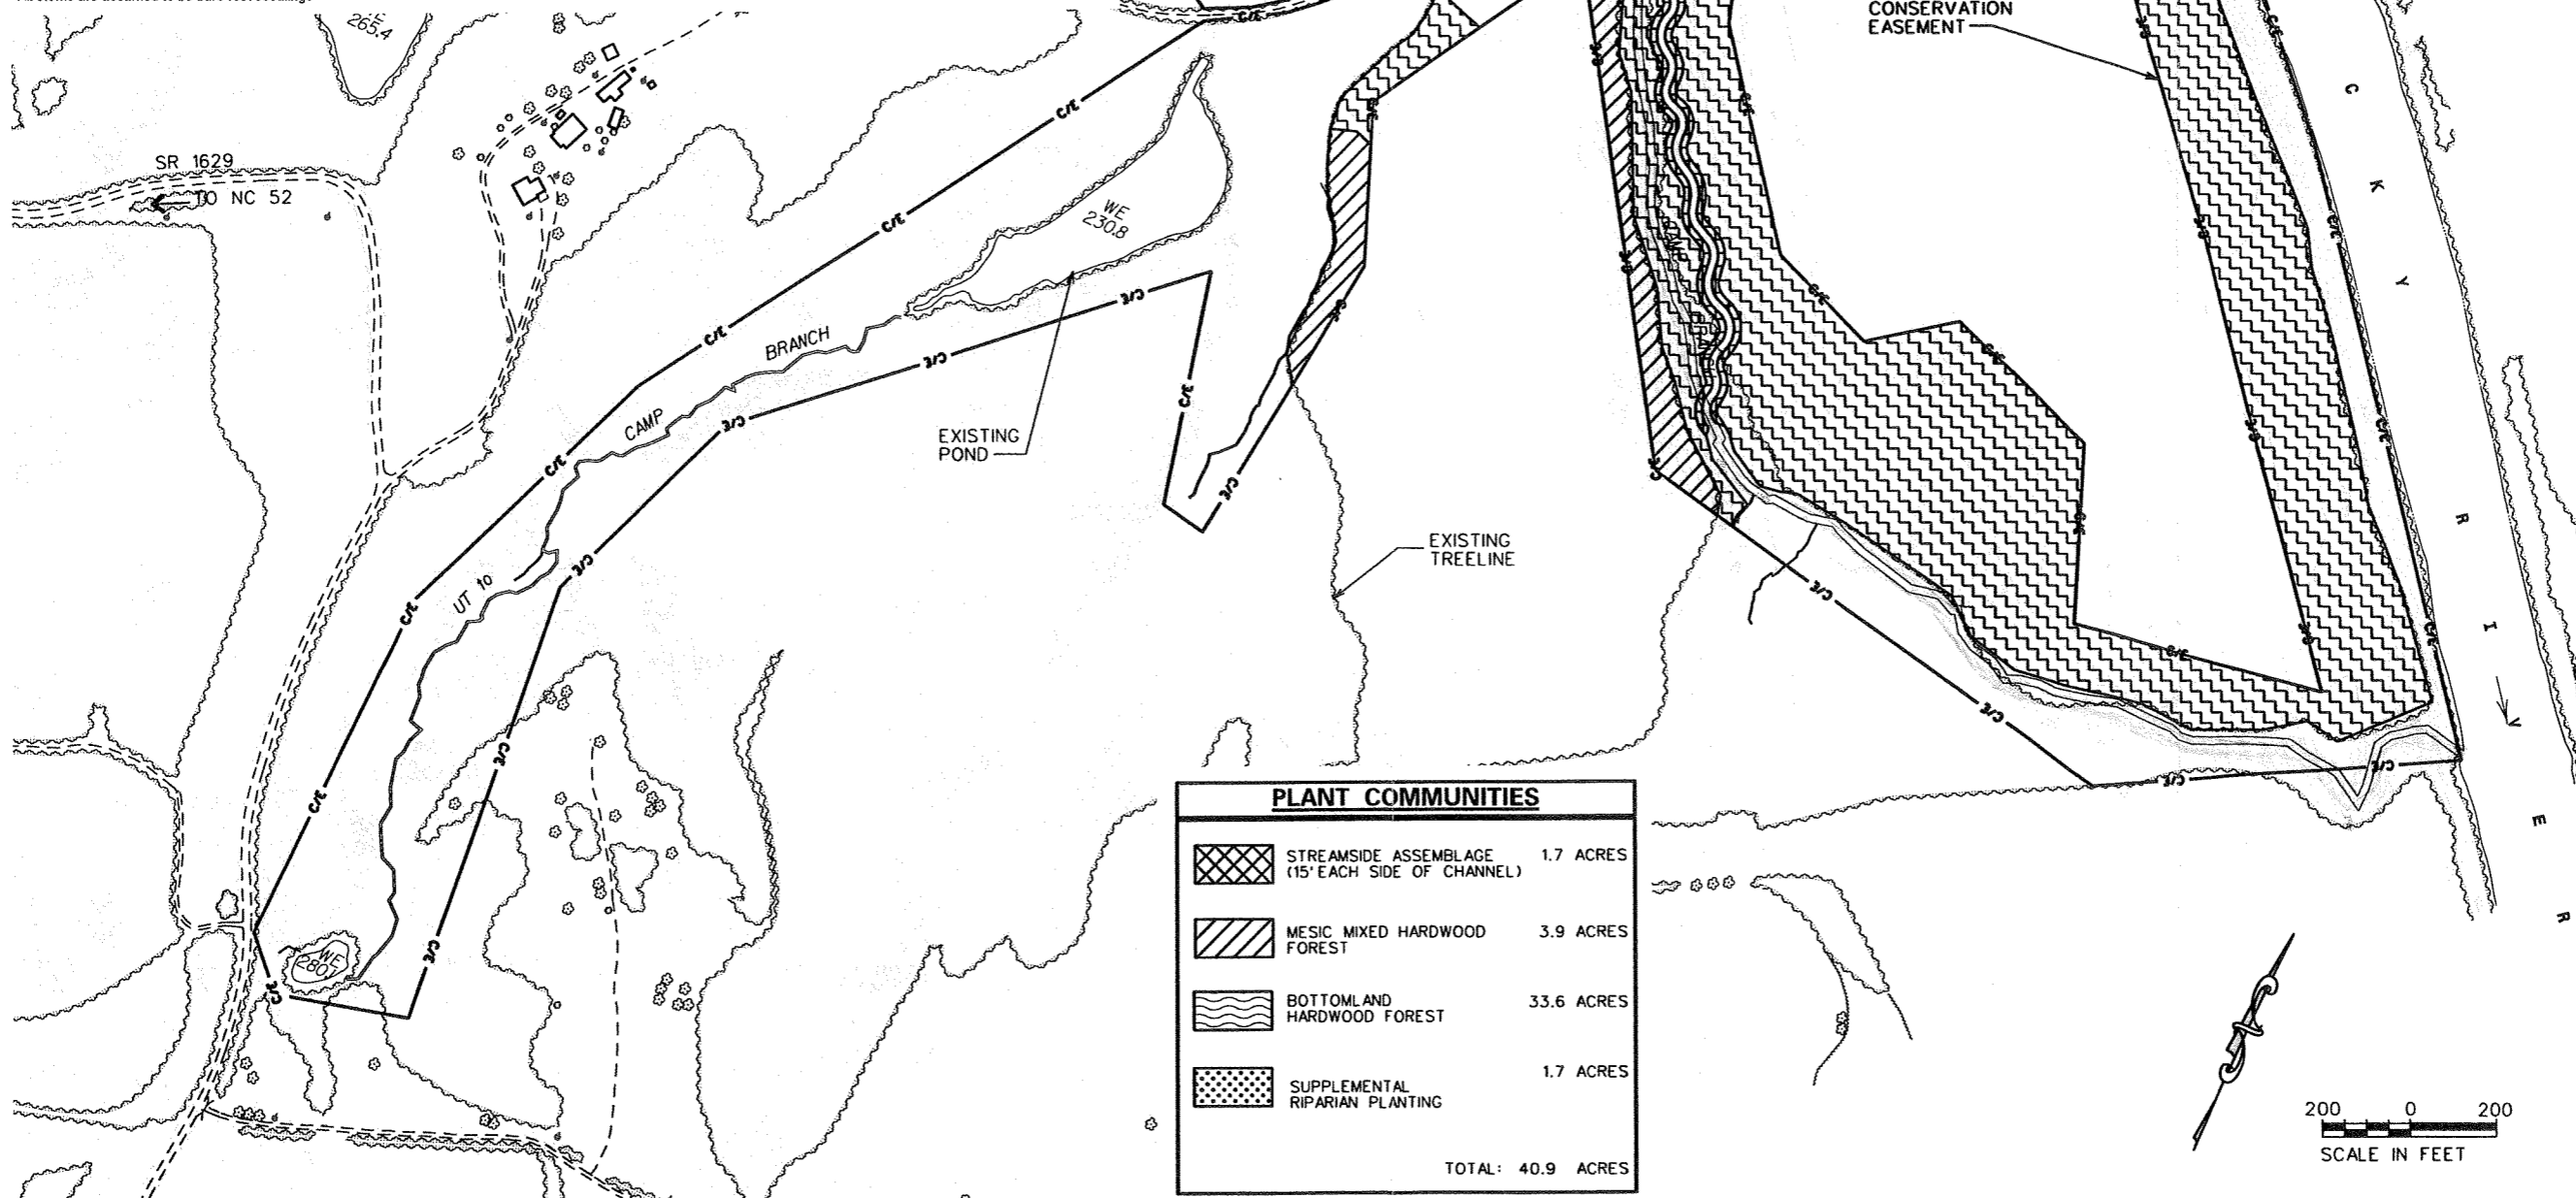

PLANT COMMUNITIES		
	STREAMSIDE ASSEMBLAGE (15' EACH SIDE OF CHANNEL)	1.7 ACRES
	MESIC MIXED HARDWOOD FOREST	3.9 ACRES
	BOTTOMLAND HARDWOOD FOREST	33.6 ACRES
	SUPPLEMENTAL RIPARIAN PLANTING	1.7 ACRES
TOTAL: 40.9 ACRES		

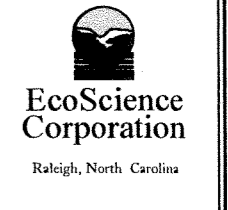

REVISIONS	
1	AS-BUILT - JULY 2007

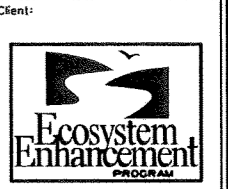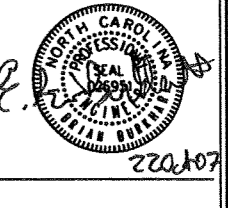

Client:  
 Project:  
**BISHOP SITE  
 STREAM /  
 WETLAND  
 RESTORATION  
 PLAN**  
 ANSON COUNTY,  
 NORTH CAROLINA

Title:  
**PLANTING  
 PLAN**  
**CAMP BRANCH**

Dsn. By: JDC  
 MAF  
 Ckd. By: EBB  
 Date: JUL 2007

Scale: AS SHOWN  
 ESC Project No.: 04-212


SHEET  
**A-L1**

**ECOSYSTEM ENHANCEMENT PROGRAM**

**BISHOP SITE STREAM AND WETLAND RESTORATION CAMP BRANCH**

**CROSS-SECTIONS -C- CHANNEL** **X1**


Legend:  
--- EXISTING GRADE  
— PROPOSED GRADE

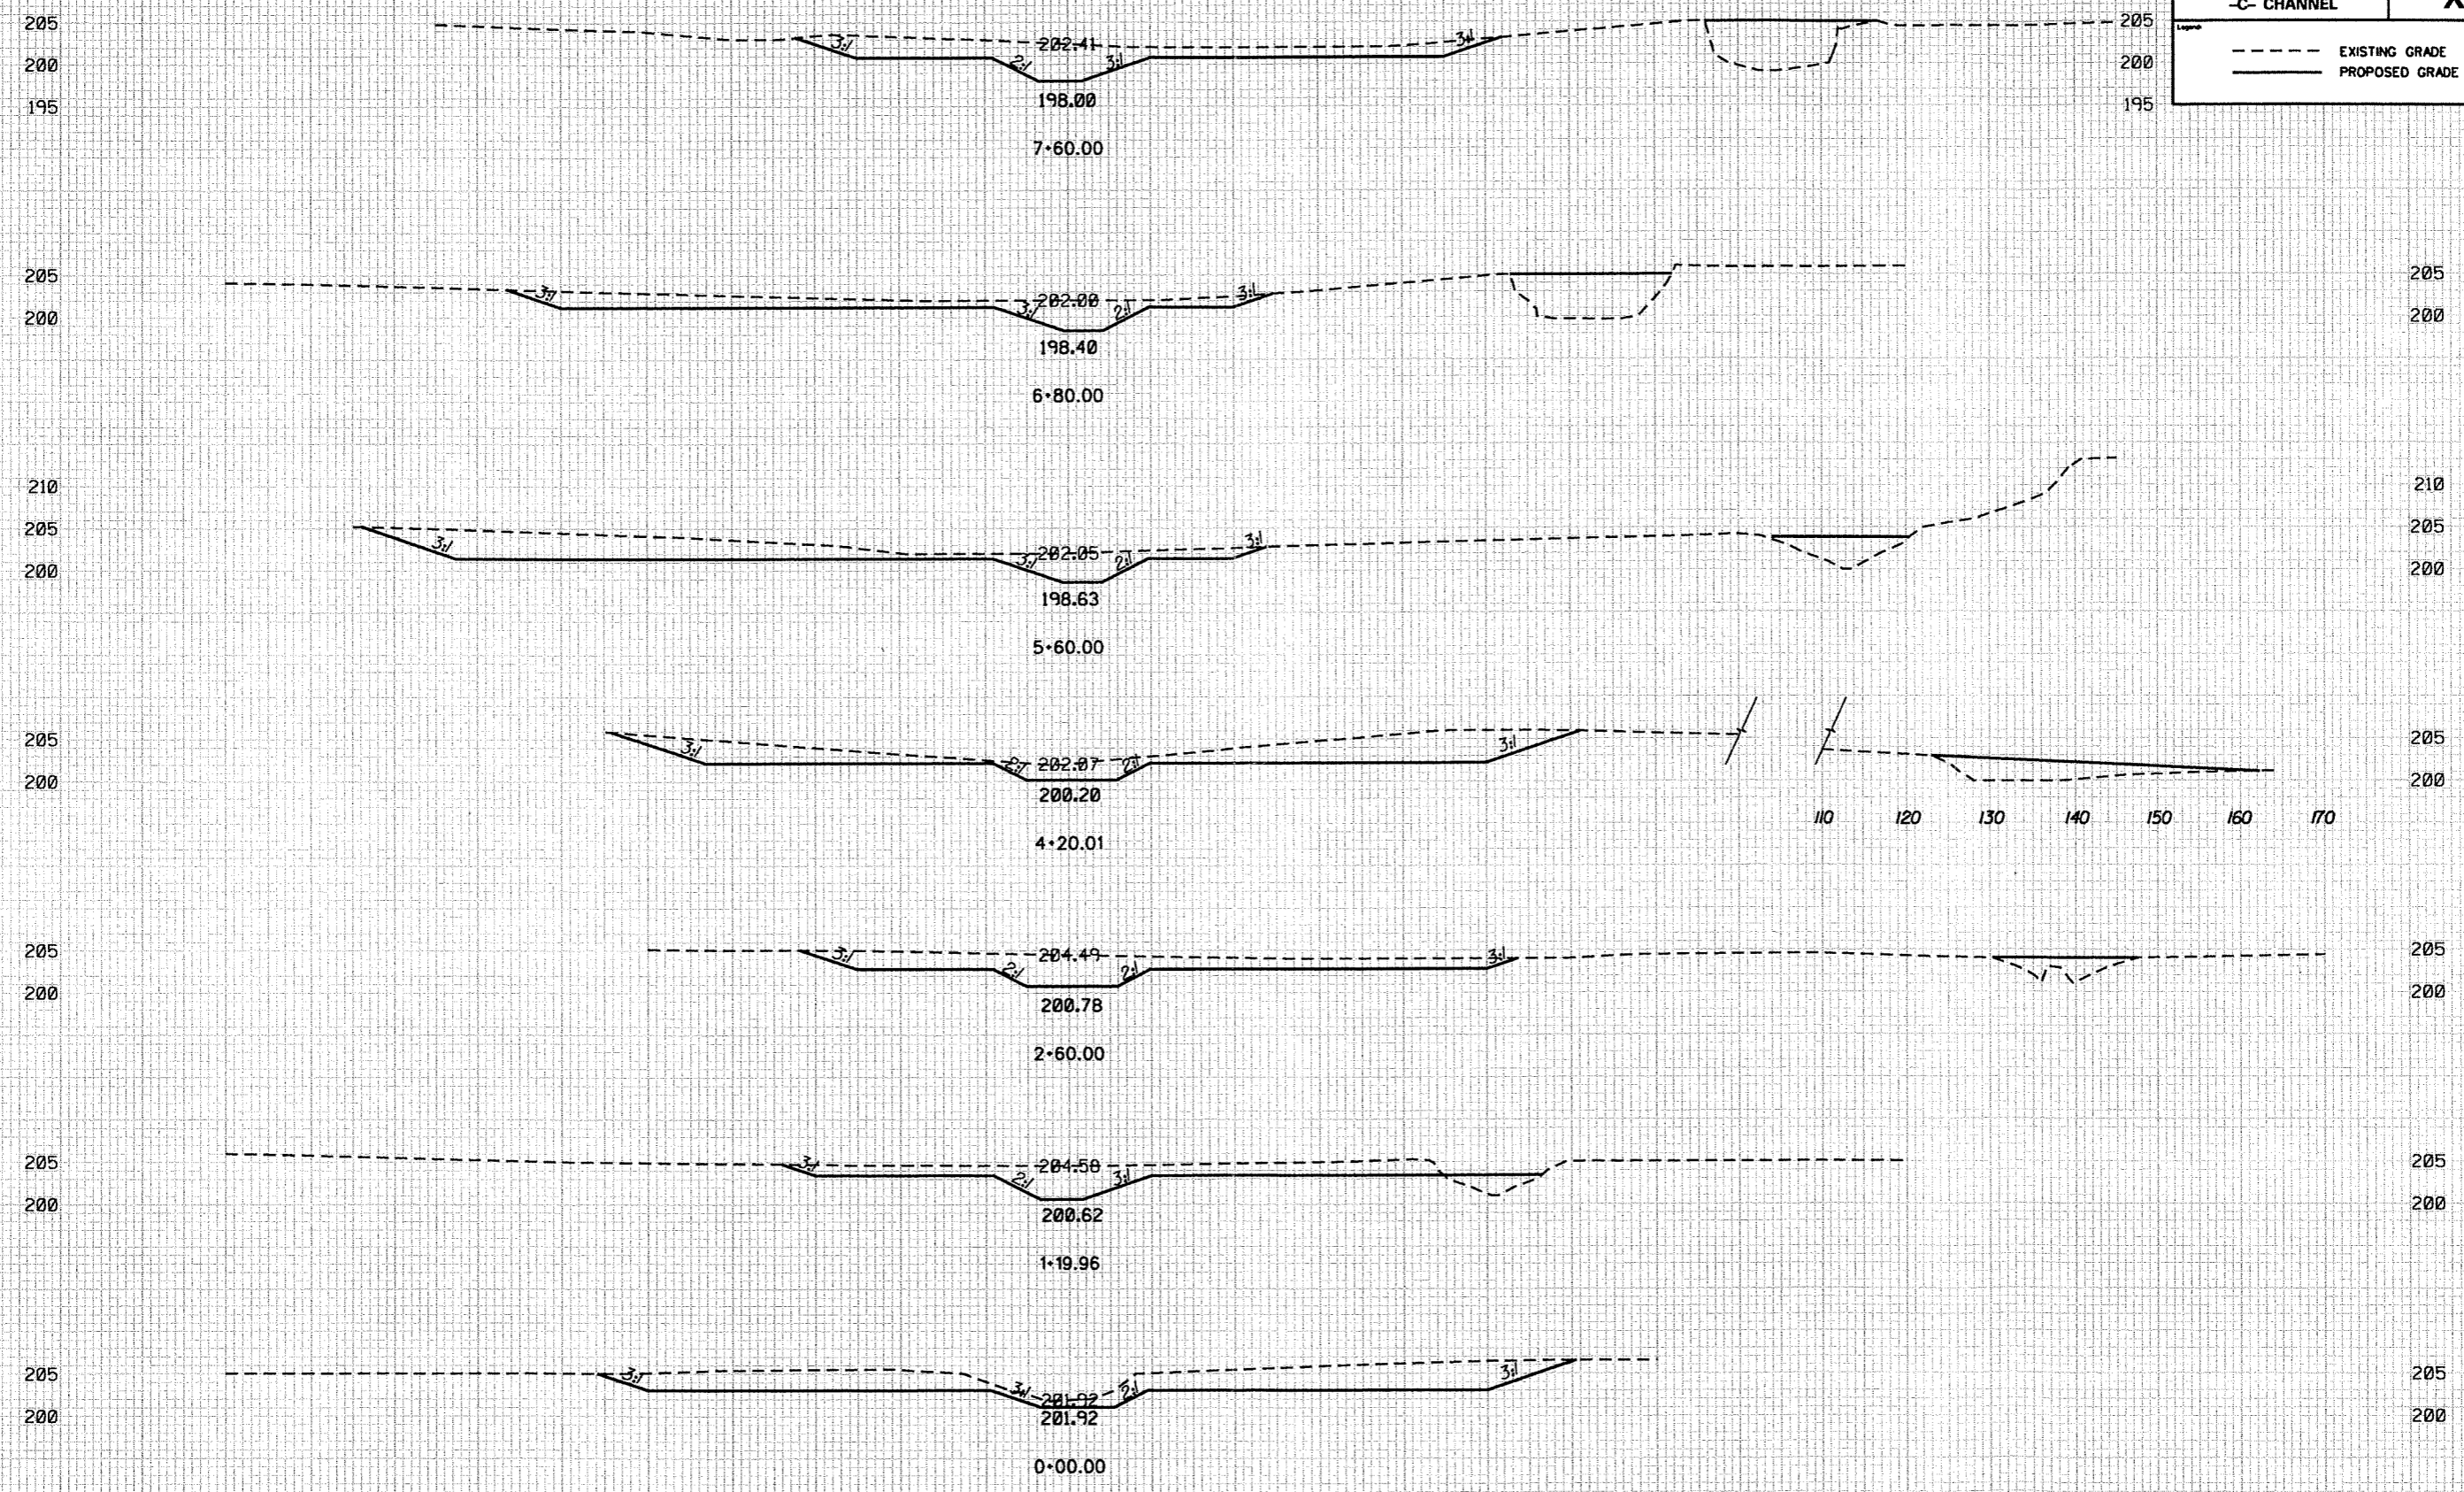



80 70 60 50 40 30 20 10 0 10 20 30 40 50 60 70 80

Project #	04-212	Date	JULY 2007
Drawn By	JFH	Check By	JDC
Scale	AS SHOWN	Author	EBB
ECOSYSTEM ENHANCEMENT PROGRAM			
BISHOP SITE STREAM AND WETLAND RESTORATION CAMP BRANCH			
CROSS-SECTIONS -C- CHANNEL		X1A	
Legend			
— SURVEY AS-BUILT GRADE			

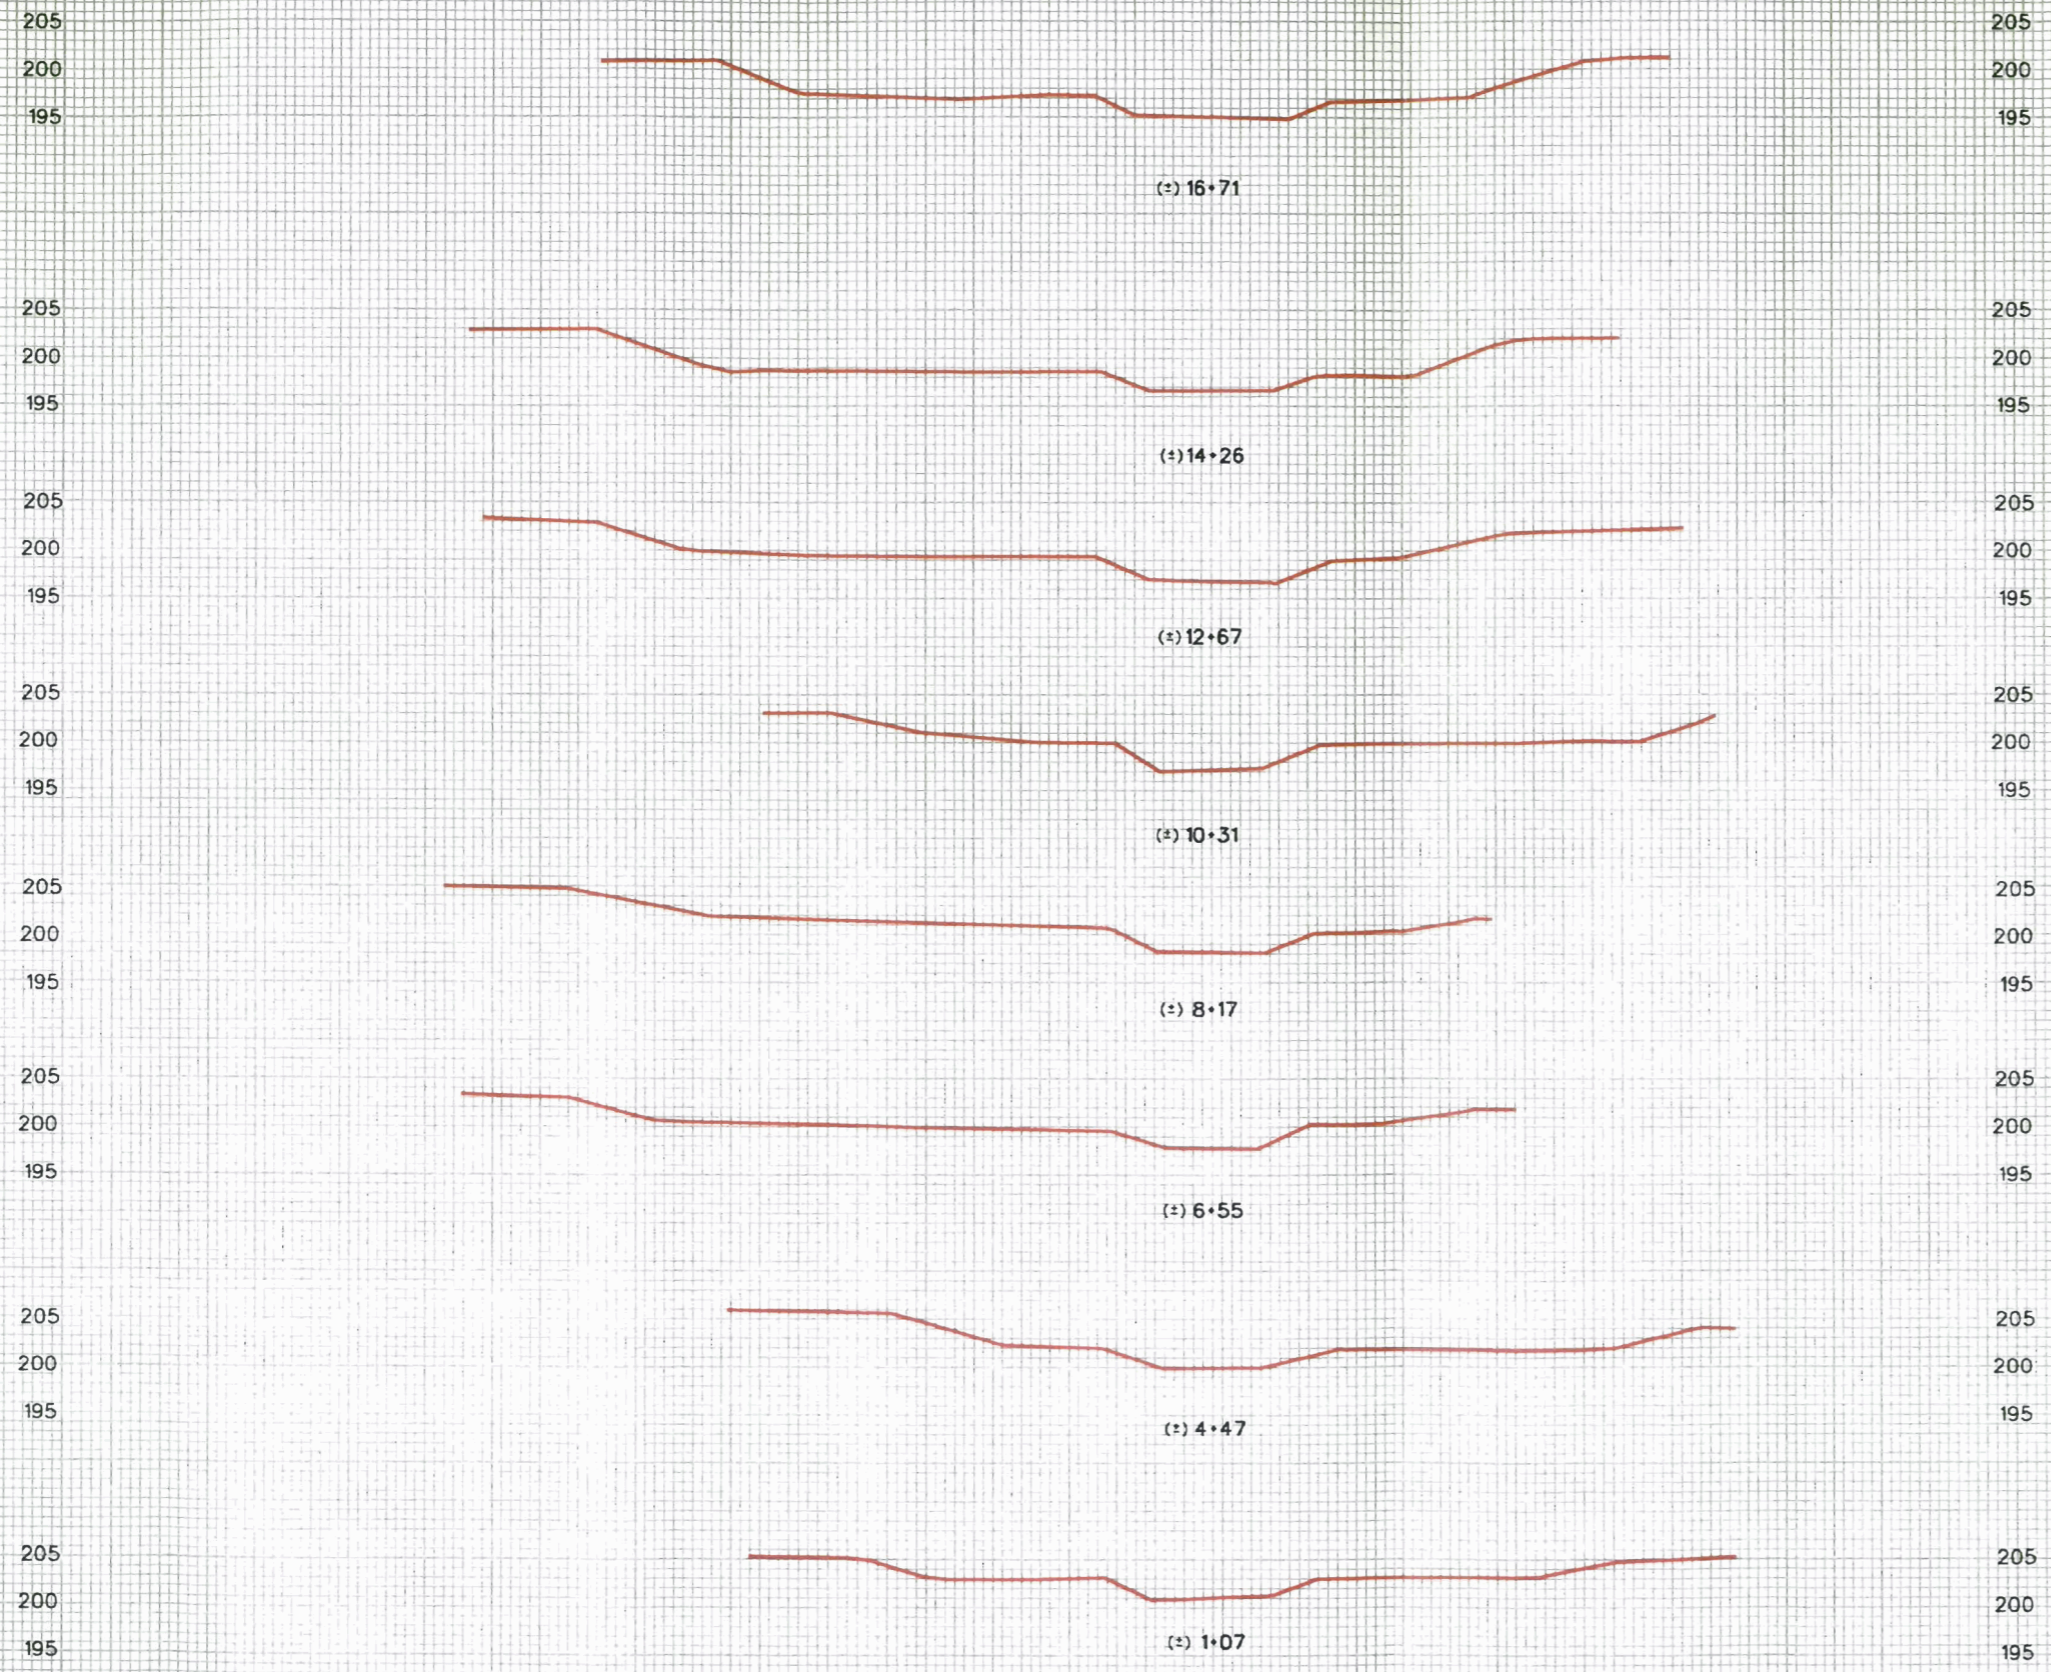


The elevation data utilized in the Camp Branch As-Built Plans was developed by Barry D Davis Surveying, 1503 Old Charlotte Rd., Albemarle, NC 28001 under the supervision of Barry D. Davis, PLS L-4384

80 70 60 50 40 30 20 10 0 10 20 30 40 50 60 70 80




Client: ECOSYSTEM ENHANCEMENT PROGRAM  
 Project: BISHOP SITE STREAM AND WETLAND RESTORATION CAMP BRANCH  
 Title: CROSS-SECTIONS -C- CHANNEL Sheet: X2  
 Legend:  
 - - - - - EXISTING GRADE  
 \_\_\_\_\_ PROPOSED GRADE

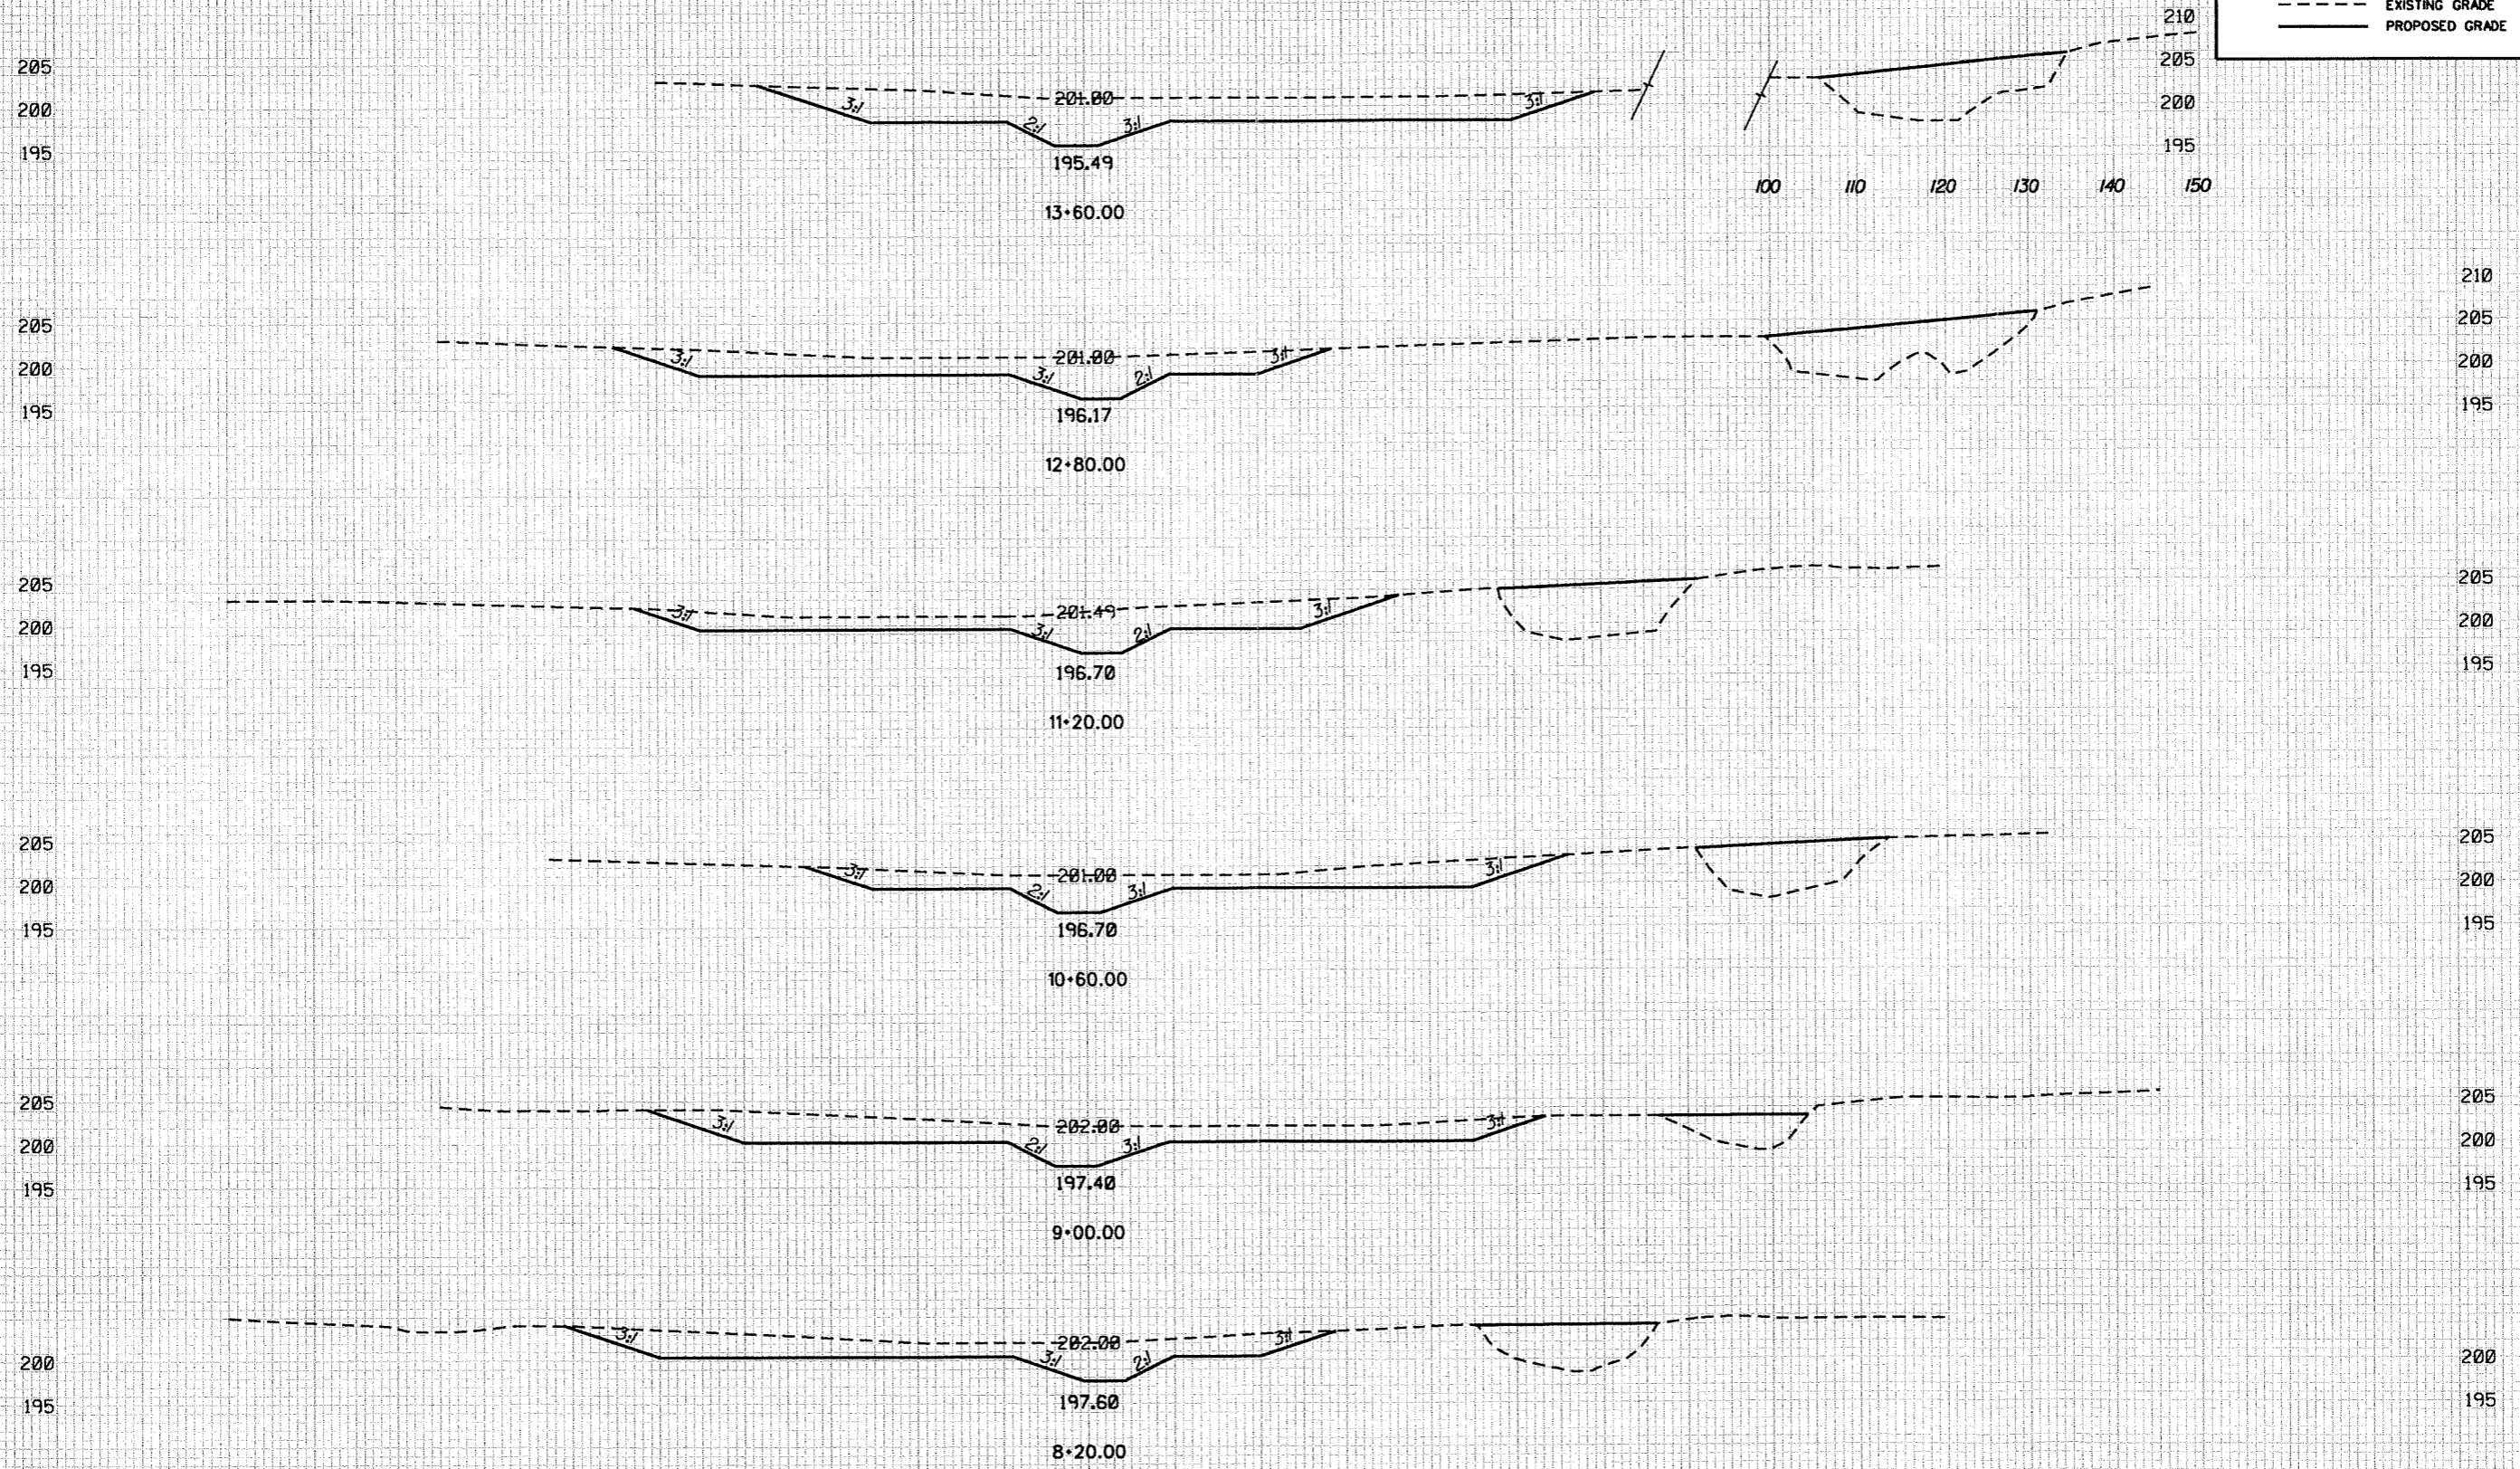




Project #	04-212	Date	JUN 2005
Des. By	MAF	Chk. By	JDC
Scale	AS SHOWN		
Client			
ECOSYSTEM ENHANCEMENT PROGRAM			
Project			
BISHOP SITE STREAM AND WETLAND RESTORATION CAMP BRANCH			
Title			
CROSS-SECTIONS -C- CHANNEL		Sheet	
		X3	
Legend			
---		EXISTING GRADE	
—		PROPOSED GRADE	

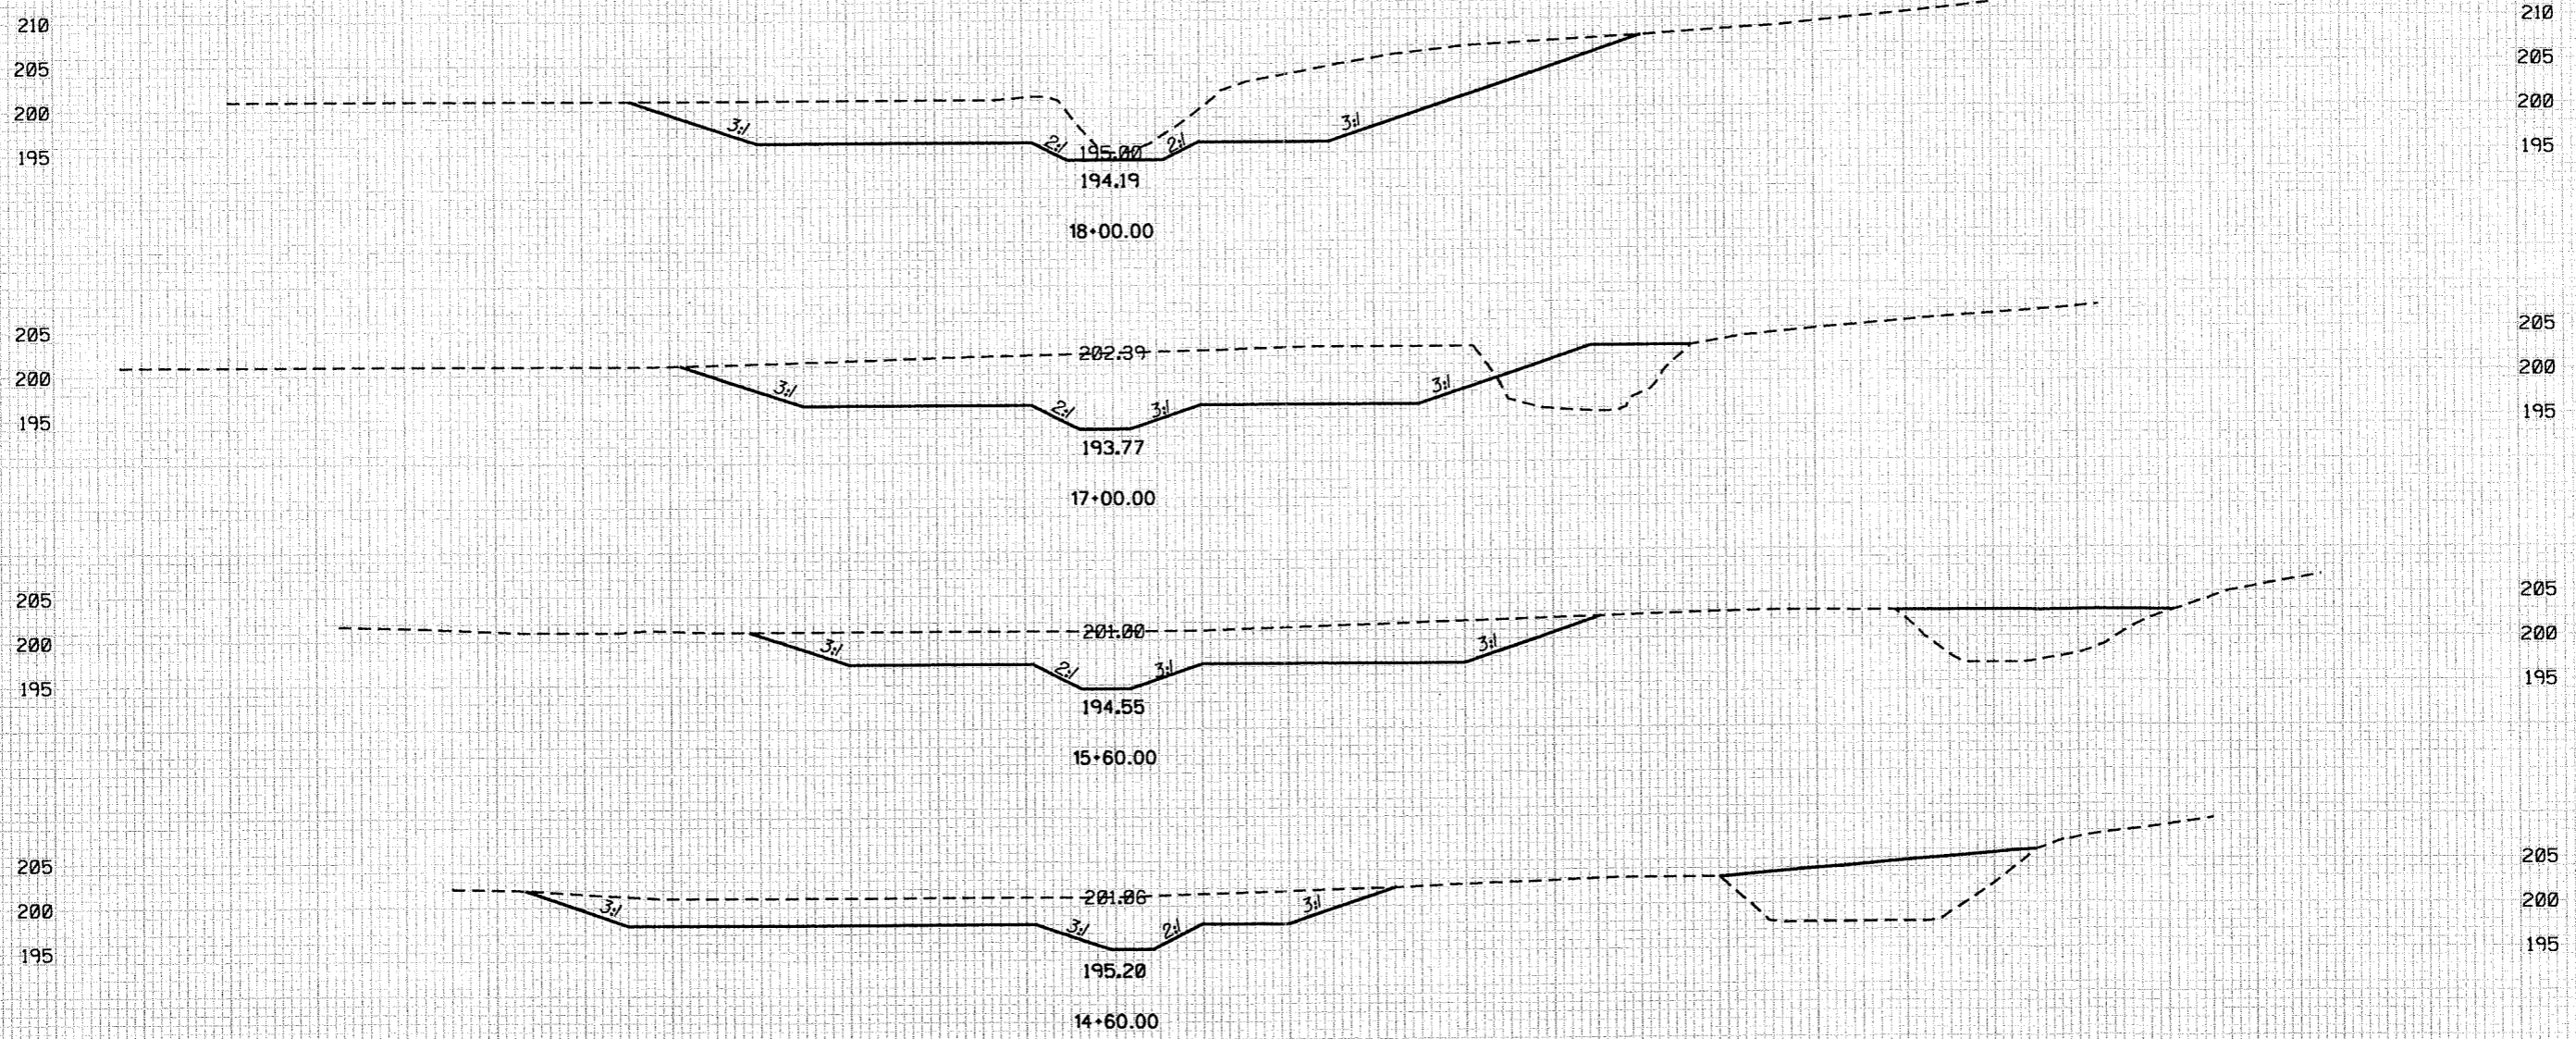



Client: ECOSYSTEM ENHANCEMENT PROGRAM  
Project: BISHOP SITE STREAM AND WETLAND RESTORATION CAMP BRANCH  
Title: CROSS-SECTIONS -A- CHANNEL X4  
Legend:  
- - - - - EXISTING GRADE  
————— PROPOSED GRADE

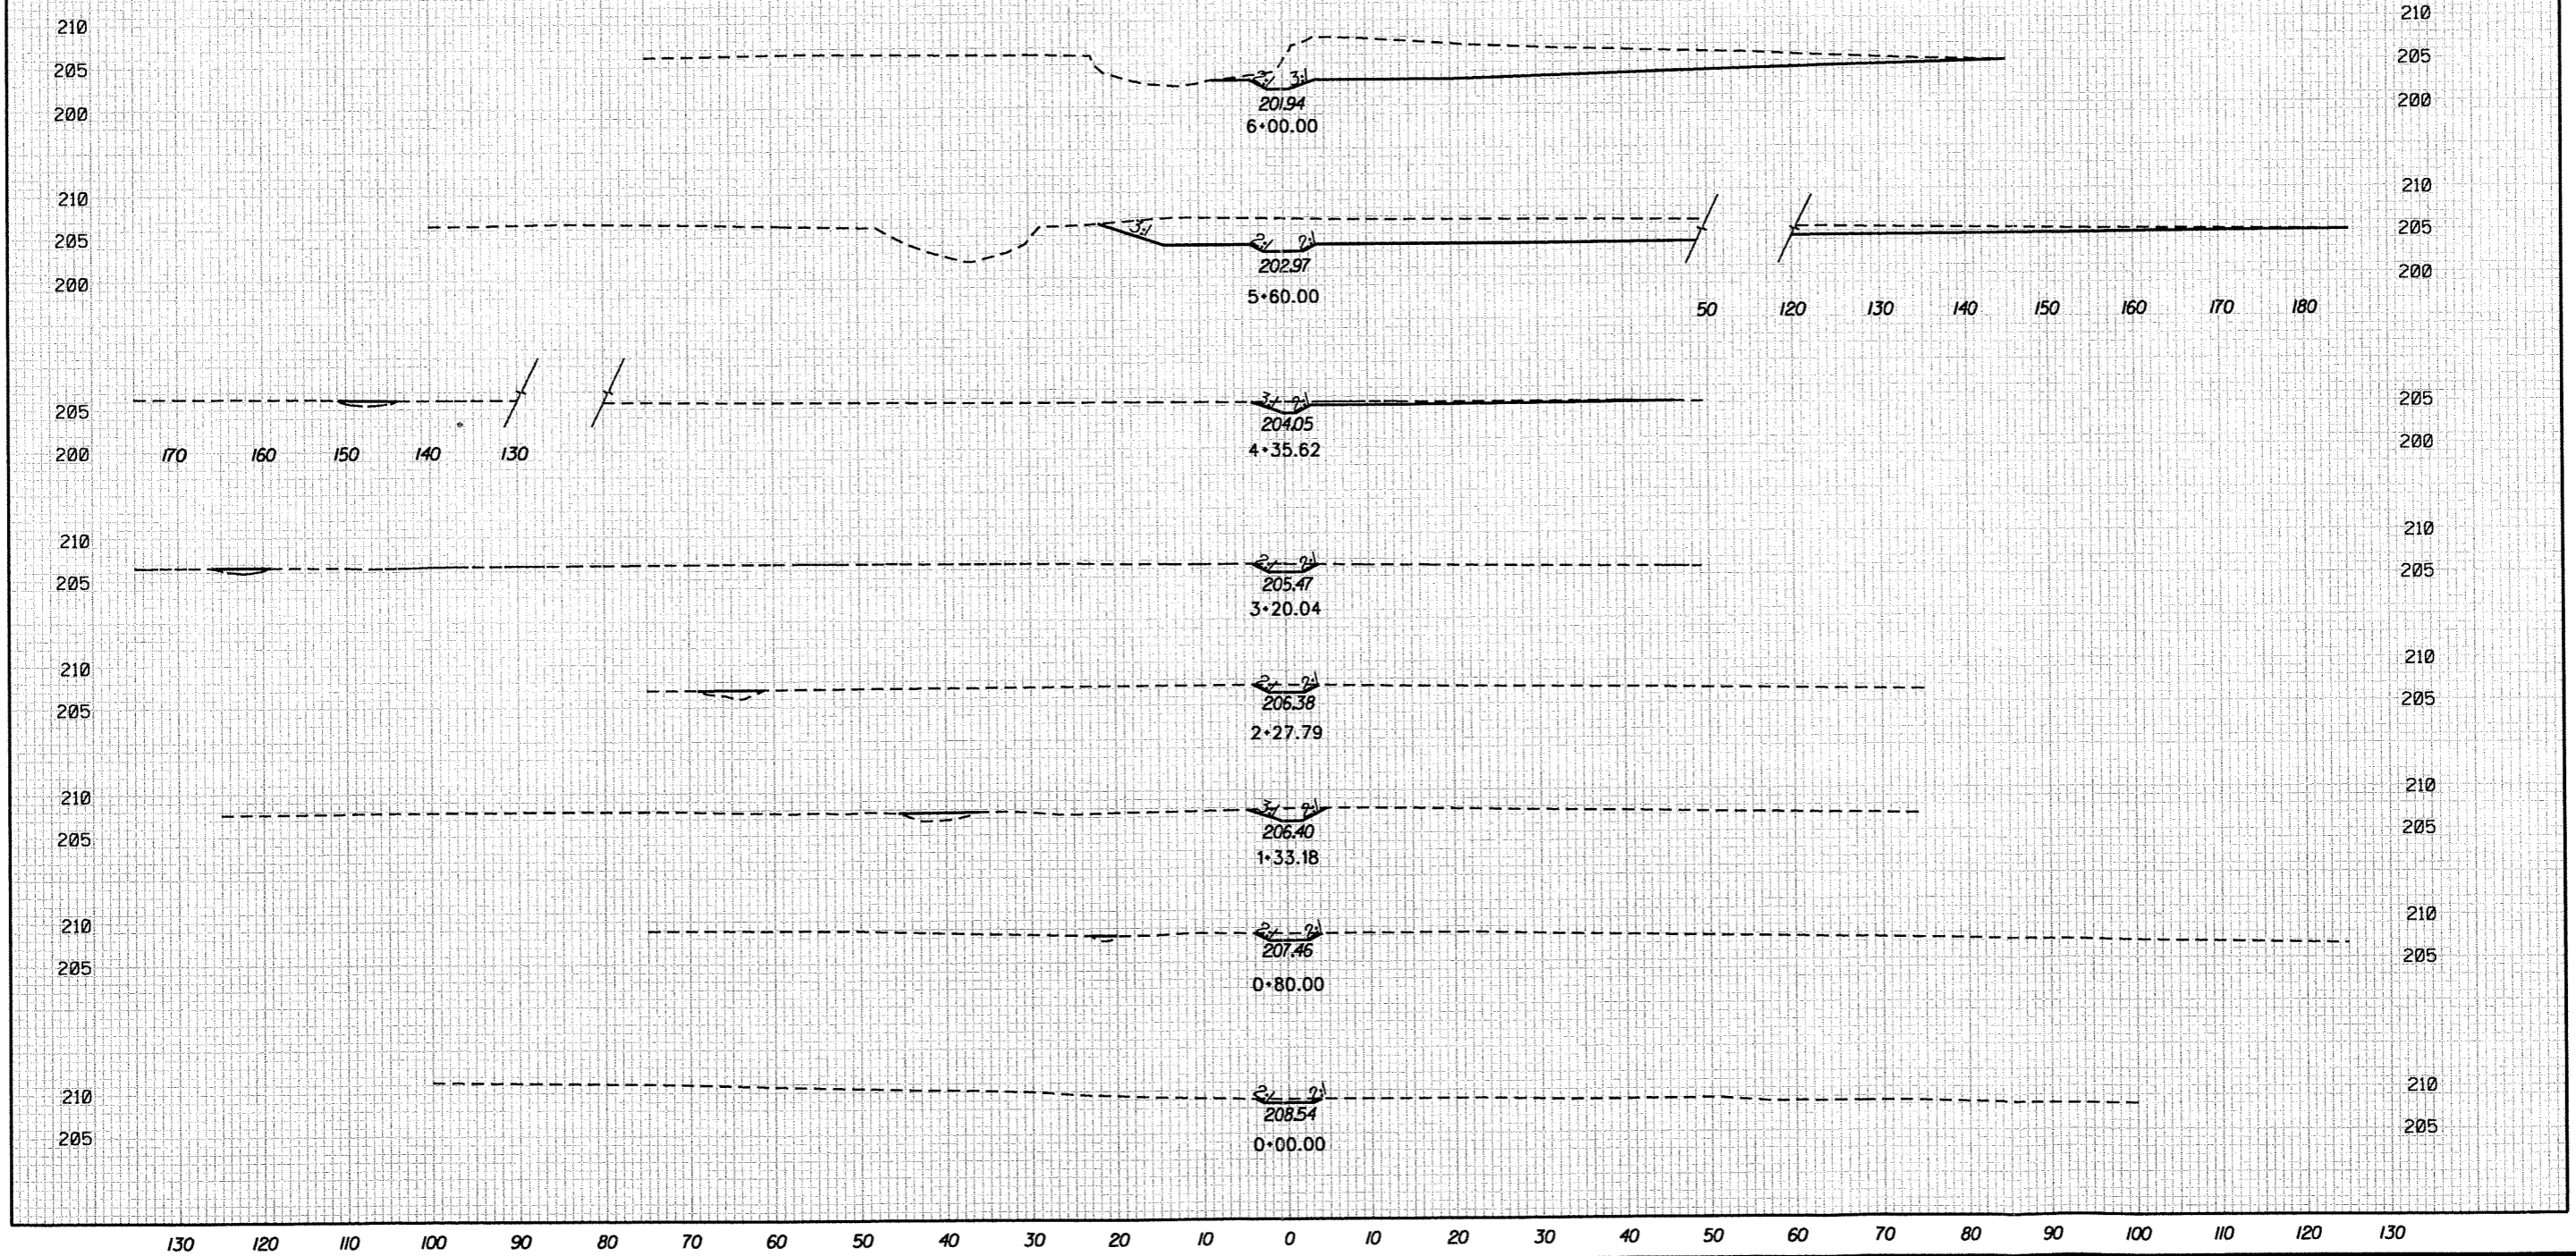



70 60 50 40 30 20 10 0 10 20 30 40 50 60 70

Project #		04-212		Date		JULY 2007	
Drawn By	JFH	Check By	JDC	Scale	AS SHOWN		
Client							
ECOSYSTEM ENHANCEMENT PROGRAM							
Project							
BISHOP SITE STREAM AND WETLAND RESTORATION CAMP BRANCH							
Title						Sheet	
CROSS-SECTIONS -A- CHANNEL						X4A	
Legend							
— SURVEY AS-BUILT GRADE							

205  
200

205  
200

(±) 4.71

The elevation data utilized in the Camp Branch As-Built Plans was developed by Barry D. Davis Surveying, 1503 Old Charlotte Rd., Albemarle, NC 28001 under the supervision of Barry D. Davis, PLS L-4384

70 60 50 40 30 20 10 0 10 20 30 40 50 60 70




**CONSTRUCTION SEQUENCE**

1. MOBILIZE EQUIPMENT AND MATERIALS TO DULA SITE.
2. ESTABLISH ACCESS ROADS AND STAGING AREAS AS DEPICTED ON THE PLANS OR AS DIRECTED BY THE PROJECT MANAGER AND MARK CONSTRUCTION EQUIPMENT ACCESS LOCATIONS WITH VISIBLE MARKERS. CONSTRUCTION EQUIPMENT SHALL BE MAINTAINED AND SERVICED WITHIN THE LIMITS OF THE ESTABLISHED STAGING AREAS. THE CONTRACTOR SHALL BE RESPONSIBLE FOR MAINTAINING ALL STAGING AREAS IN AN ENVIRONMENTALLY SENSITIVE MANNER.
3. INSTALL IMPROVEMENTS TO SITE ACCESS ROAD IF REQUIRED AND INSTALL TEMPORARY EROSION CONTROL MEASURES (I.E., SILT FENCE, STONE OUTLETS, ETC.) AS REQUIRED.
4. AT THE END OF EACH DAY OF CONSTRUCTION, THE CONTRACTOR SHALL PROVIDE TEMPORARY SEED AND MULCH AND APPLY COIR FIBER MATTING, AS APPROPRIATE, TO ALL DISTURBED AREAS. IN ADDITION, THE CONTRACTOR SHALL BE RESPONSIBLE FOR MAINTAINING ALL TEMPORARY EROSION CONTROL MEASURES ON A DAILY BASIS THROUGHOUT THE CONSTRUCTION PERIOD.
5. INSTALL PUMP-AROUND OPERATION JUST BELOW THE CONFLUENCE OF THE WEST PORTION OF DULA THOROUGHFARE (-D-) WITH THE EASTERN PORTION (-T-). ALL WORK BELOW THIS POINT SHALL BE CONSTRUCTED IN THE "DRY". THIS INCLUDES THE FLOODPLAIN GRADING, THE DEVELOPMENT OF THE VERNAL POOLS AND THE EXCAVATION OF THE PROPOSED CHANNEL. THE CONTRACTOR SHALL INITIATE THE PUMP-AROUND OPERATION ON A SCHEDULE THAT EFFICIENTLY PROSECUTES PROJECT WORK.
6. THE CONTRACTOR SHALL COMPACT THE PROPOSED FILL IN THE FILLED CHANNELS TO 90 PERCENT PROCTOR. THE PROPOSED CHANNEL BLOCKS SHALL HAVE A CORE OF IMPERVIOUS SELECT MATERIAL AS SPECIFIED IN THE PROJECT DETAIL AND SPECIAL PROVISIONS. THE VERNAL POOL AT APPROXIMATE STATION 19+00 SHALL BE "NOTCHED" TO DIRECT OVERFLOW TOWARD THE NEW CHANNEL.
7. INSTALL PUMP-AROUND OPERATIONS ABOVE STATION 0+00 ON THE WESTERN PORTION OF DULA THOROUGHFARE (-D-) AND ABOVE STATION 0+00 AT CULVERT AT THE BEGINNING OF THE EASTERN SECTION (-T-). THESE PUMP-AROUNDS MAY DIRECT PROPERLY TREATED WATER TO THE NEWLY CREATED STABILIZED CHANNEL AND THE PROPOSED WORK SHALL BE CONSTRUCTED IN THE "DRY".
8. THE CONTRACTOR SHALL PLACE BORROW MATERIAL IN AREAS DESIGNATED ON THE PLANS AND AT THE DIRECTION OF THE PROJECT MANAGER. STOCKPILE AREAS SHALL BE PROTECTED BY SILT FENCING AS APPROPRIATE.
9. ONCE CONSTRUCTION IS COMPLETE THE CONTRACTOR SHALL REMOVE ALL CONSTRUCTION MATERIALS FROM THE CONSERVATION EASEMENT, DISPOSE OF THEM IN AN APPROVED DUMP SITE, AND SCARIFY ANY COMPACTED AREAS AS DIRECTED BY THE PROJECT MANAGER. TO COMPLETE PERMANENT SEEDING AND MULCHING, ALL DISTURBED AREAS SHALL BE DISKED OR PLOWED TO CREATE MICRO TOPOGRAPHY TO THE SATISFACTION OF THE PROJECT MANAGER AND PERMANENTLY SEEDED AND MULCHED. STONE APPLIED TO ACCESS ROAD, IF ANY, SHALL REMAIN OR BE REMOVED AS INDICATED ON PLAN SHEET 2.

# SITE B DULA THOROUGHFARE

**TYPE OF WORK: STREAM AND WETLAND RESTORATION / ENHANCEMENT**

- STREAM RESTORATION / ENHANCEMENT
- FLOODPLAIN GRADING
- WETLAND RESTORATION / ENHANCEMENT
- NEW CHANNEL CONSTRUCTION
- SITE PLANTING

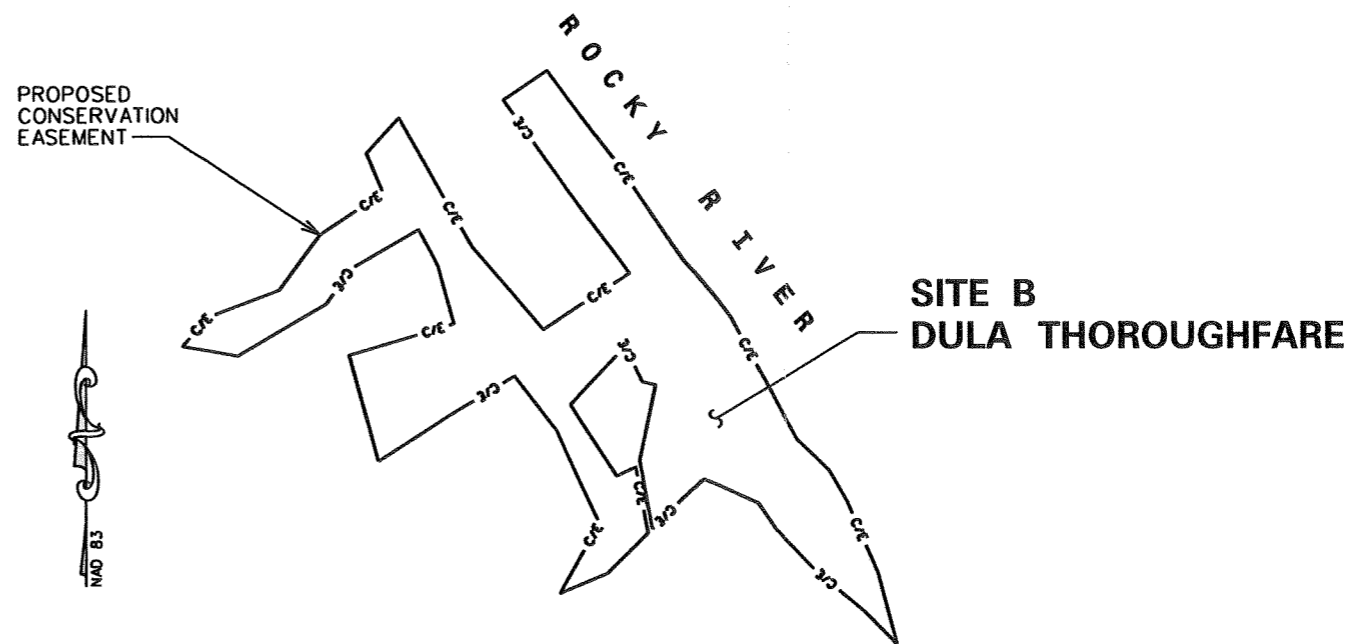

**INDEX OF SHEETS**

**DULA THOROUGHFARE**

- B: CONSTRUCTION SEQUENCE**
- B-1: RADIUS TABLE / SHEAR STRESS TABLE**
- B-2: TYPICAL SECTIONS / GENERAL DETAILS**
- B-2A, B-2B: GENERAL DETAILS**
- B-2C: NEW CHANNEL CENTERLINE DATA**
- B-3: SUMMARY OF QUANTITIES / SUMMARY OF EARTHWORK**
- B-4: EXISTING CONDITIONS**
- B-5: NEW CHANNEL LAYOUT**
- B-6: SITE PLAN**
- B-7: PROFILE - DULA THOROUGHFARE -T- CHANNEL**
- B-7A: AS-BUILT PROFILE - DULA THOROUGHFARE -T- CHANNEL**
- B-8: PROFILE - DULA THOROUGHFARE -D- CHANNEL**
- B-8A: AS BUILT PROFILE - DULA THOROUGHFARE -D- CHANNEL**
- B-EC1: EROSION CONTROL PLAN**
- B-EC2: EROSION CONTROL DETAILS**
- B-L1: PLANTING PLAN**
- X5-X7: CROSS-SECTIONS**
- X5A-X7A: AS-BUILT CROSS-SECTIONS**

<p style="text-align: center; font-size: small;">Prepared in the office of:</p> <div style="text-align: center;"> <p><b>EcoScience Corporation</b>  <small>101 Hayes St., Suite 101    Ph: 919 828-3433              Raleigh, North Carolina 27604    Fax: 919 828-3518</small></p> </div> <p><b>ENGINEER:</b> <u>DAVID G. MODLIN</u></p> <p><b>PROJECT MANAGER:</b> <u>JAMES D. COOPER</u></p>	<p><b>SEAL:</b></p> <p style="text-align: right; font-size: small;">7/20/07</p>	<p style="text-align: center; font-size: small;">Prepared for:</p> <div style="text-align: center;"> <p><b>ECOSYSTEM ENHANCEMENT PROGRAM</b>  <small>Raleigh, North Carolina</small></p> </div> <table border="1" style="width: 100%; border-collapse: collapse; font-size: x-small;"> <tr> <th style="width: 5%;">No.</th> <th style="width: 75%;">Revisions</th> <th style="width: 20%;">Date</th> </tr> <tr> <td style="text-align: center;">1</td> <td>REV'D SHEETS B-2B, B-3</td> <td style="text-align: center;">09/29/05 JDC</td> </tr> <tr> <td style="text-align: center;">2</td> <td>AS-BUILT</td> <td style="text-align: center;">JUL 2007</td> </tr> </table>	No.	Revisions	Date	1	REV'D SHEETS B-2B, B-3	09/29/05 JDC	2	AS-BUILT	JUL 2007	<table border="1" style="width: 100%; border-collapse: collapse;"> <tr> <td style="width: 33%;">Dsn. By: JDC</td> <td style="width: 33%;">Dwn. By: JDC</td> <td style="width: 33%;">Ckd. By: EBB</td> </tr> <tr> <td colspan="3">Date: JUL 2007</td> </tr> <tr> <td colspan="3">ESC Project No: 04-212</td> </tr> <tr> <td colspan="3" style="text-align: center; font-size: 2em; font-weight: bold;">SHEET  B</td> </tr> </table>	Dsn. By: JDC	Dwn. By: JDC	Ckd. By: EBB	Date: JUL 2007			ESC Project No: 04-212			SHEET  B		
No.	Revisions	Date																						
1	REV'D SHEETS B-2B, B-3	09/29/05 JDC																						
2	AS-BUILT	JUL 2007																						
Dsn. By: JDC	Dwn. By: JDC	Ckd. By: EBB																						
Date: JUL 2007																								
ESC Project No: 04-212																								
SHEET  B																								