

**East Tarboro Canal Stream Restoration Project
Edgecombe County
North Carolina**

**CU: 03020103
SCO# 030603101
EEP Project No. 123**



**Year 2 Monitoring Report
November 15, 2009**

Prepared for:



North Carolina Department of Environment and Natural Resources
Ecosystem Enhancement Program
Parker Lincoln Building
2728 Capital Boulevard, Suite 1H-103
Raleigh, NC 27606

**East Tarboro Canal Stream Restoration Project
Edgecombe County
North Carolina**

**CU: 03020103
SCO# 030603101
EEP Project No. 123**

**Year 2 Monitoring Report
November 15, 2009**

Prepared by:



Rummel, Klepper & Kahl, LLP
900 Ridgefield Drive
Suite 350
Raleigh, NC 27609

2.0 Table of Contents

1.0 Title Page	i
2.0 Table of Contents.....	ii
3.0 Executive Summary/Project Abstract.....	1
4.0 Methodology	2
5.0 References	3
6.0 Project Condition and Monitoring Data Appendices	4
Appendix A. General Figures and Plan Views	
Appendix B. General Project Tables	
Appendix C. Vegetation Assessment Data	
Appendix D. Stream Assessment Data	

3.0 EXECUTIVE SUMMARY/PROJECT ABSTRACT

Project goals and objectives for the East Tarboro Canal stream restoration project included:

The project had the following objectives:

- Enhance over 1,800 linear feet of stream on East Tarboro Canal along Reach 1 and restore approximately 2,900 linear feet of East Tarboro Canal along Reach 2.
- Create a limited floodplain for East Tarboro Canal below its natural floodplain to allow access during flood events (Reach 1).
- Construct a new floodplain at a lower elevation (Reach 2).

While project goals included:

- Provide a stable stream channel that neither aggrades nor degrades while maintaining its dimension, pattern, and profile with the capacity to transport its watershed's water and sediment load.
- Improve water quality and reduce erosion.
- Improve aquatic habitat with the use of natural material stabilization structures such as root wads, rock vanes, woody debris, and a riparian buffer.
- Provide a native stream buffer that will increase bank stability, improve wildlife habitat, and eliminate or reduce exotic invasive plant infestations and increase the aesthetic value by transforming the unvegetated ditch into a function stream buffer.

Thirteen (13) permanent vegetation plots were established and used in annual vegetation monitoring. Overall, the site is exceeding the minimum success requirements. As per the mitigation plan, the vegetative success criteria are based on the US Army Corps of Engineers Stream Mitigation Guidelines (USACE, 2003). The final vegetative success criteria will be the survival of 260 5-year old planted woody stems per acre at the end of the year 5 monitoring period. Monitoring for 2009 revealed that vegetation plots VP1, VP4, VP9 and VP13 fall below the minimum success requirements. VP1 has been mowed and other areas within the conservation easement along Reach 2 have been mowed also (Vegetation problem areas are shown on the Integrated Plan View map in Appendix D). Vegetation plots VP2, VP3, VP5, VP6, VP7, VP8, VP10, VP11, and VP12 meet or exceed minimum success requirements. Vegetation plot locations are identified in Appendix C.

Overall the East Tarboro Canal Stream Restoration Site is performing adequately. Channel dimension and pattern are similar to as-built conditions with the exception of the structure failure at station 21+50 and sediment erosion, both identified on Figure 2. Upon review of channel longitudinal profile, cross sections, and designed dimensions, both Reach 1 and Reach 2 channel profiles appear to be holding grade and maintaining bedform features. Stream reaches at East Tarboro Canal are stable and are showing few signs of instability. Reach 2 has a structure that is in need of immediate attention. Photos and location of these areas are shown in Figure 2.

Wetland restoration or enhancement was not a part of the East Tarboro Canal Stream Restoration Site. Therefore, no wetland monitoring is required.

Summary information/data related to the occurrence of items such as beaver or encroachment and statistics related to performance of various project and monitoring elements can be found in the tables and figures in the report appendices. Narrative background and supporting information formerly found in these reports can be found in the mitigation and restoration plan documents available on EEP's website. All raw data supporting the tables and figures in the appendices is available from EEP upon request.

4.0 METHODOLOGY

Vegetative sample plots were quantitatively monitored during the first growing season. One (1) 100m² plot was established for Reach 1 and twelve (12) 100m² plots were established for Reach 2 for a total of thirteen (13) plots. Species composition, density, vigor and survival were monitored. Each plot corner is permanently located with rebar. Year 2 vegetation monitoring was completed in October 2009 utilizing the Carolina Vegetation Survey (CVS) – EEP protocol Level 1 (version 4.1). Baseline data provided was not completed utilizing the CVS-EEP protocol, therefore some data will be skewed.

Stream monitoring was completed by utilizing total station survey along with Rosgen Level II techniques to determine stream stability and performance. The annual cross-sectional survey included points surveyed at all breaks in slope, including top of bank, bankfull, inner berm, edge of water, and thalweg, if the features were present. Longitudinal profile survey was conducted for the entire length of the restored channel for both Reach 1 and Reach 2. Measurements included thalweg, water surface, and bankfull. All surveys were complete using existing onsite benchmarks.

Photo monitoring was conducted by walking each stream reach and taking photos at each predetermined photo point location using a digital camera.

5.0 References

USACOE (2003). *Stream Mitigation Guidelines*. USACOE, USEPA, NCWRC, NCDENR-DWQ.

USACOE (1987). *Corps of Engineers Wetlands Delineation Manual*. Tech report Y-87-1. AD/A176.

Rosgen, D.L. (1996) *Applied River Morphology*. Wildland Hydrology books, Pagosa Springs, CO.

Lee, M.T., R.K. Peet, S.D. Roberts, T.R. Wentworth. (2006). CVS-EEP Protocol for Recording Vegetation Version 4.0

6.0 Project Condition and Monitoring Data Appendices

APPENDIX A

Directions to site: From Raleigh take US 64 east to exit 486 (Hwy 258). Take to intersection with S. Main St and turn left. Take S. Main St north across the Tar River and to the intersection with Martin Luther King Jr. Drive. Turn right on Battle Ave and take to dead end. Reach 1 of project occurs at dead end. If travelling to Reach 2, cross the Tar River on S. Main St to intersection with E. St. James St. Turn right on E. St. James St and take to intersection with E. Tarboro Canal (immediately past intersection with Oakland St.)




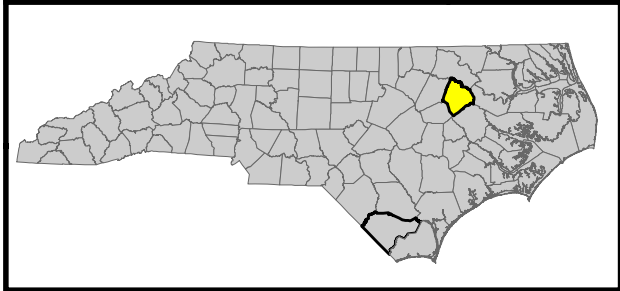




FIGURE 1
 Site Location Map
 East Tarboro Canal Stream Restoration Project
 EEP No. 123
 Edgcombe County, North Carolina
 November 2009

FIGURE 2a

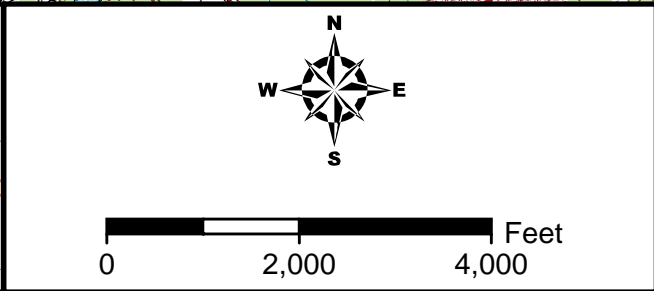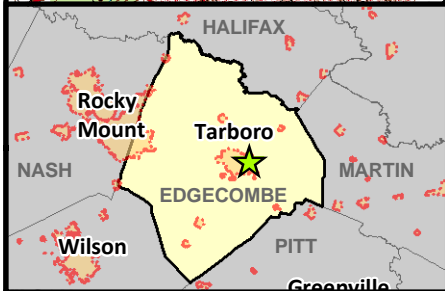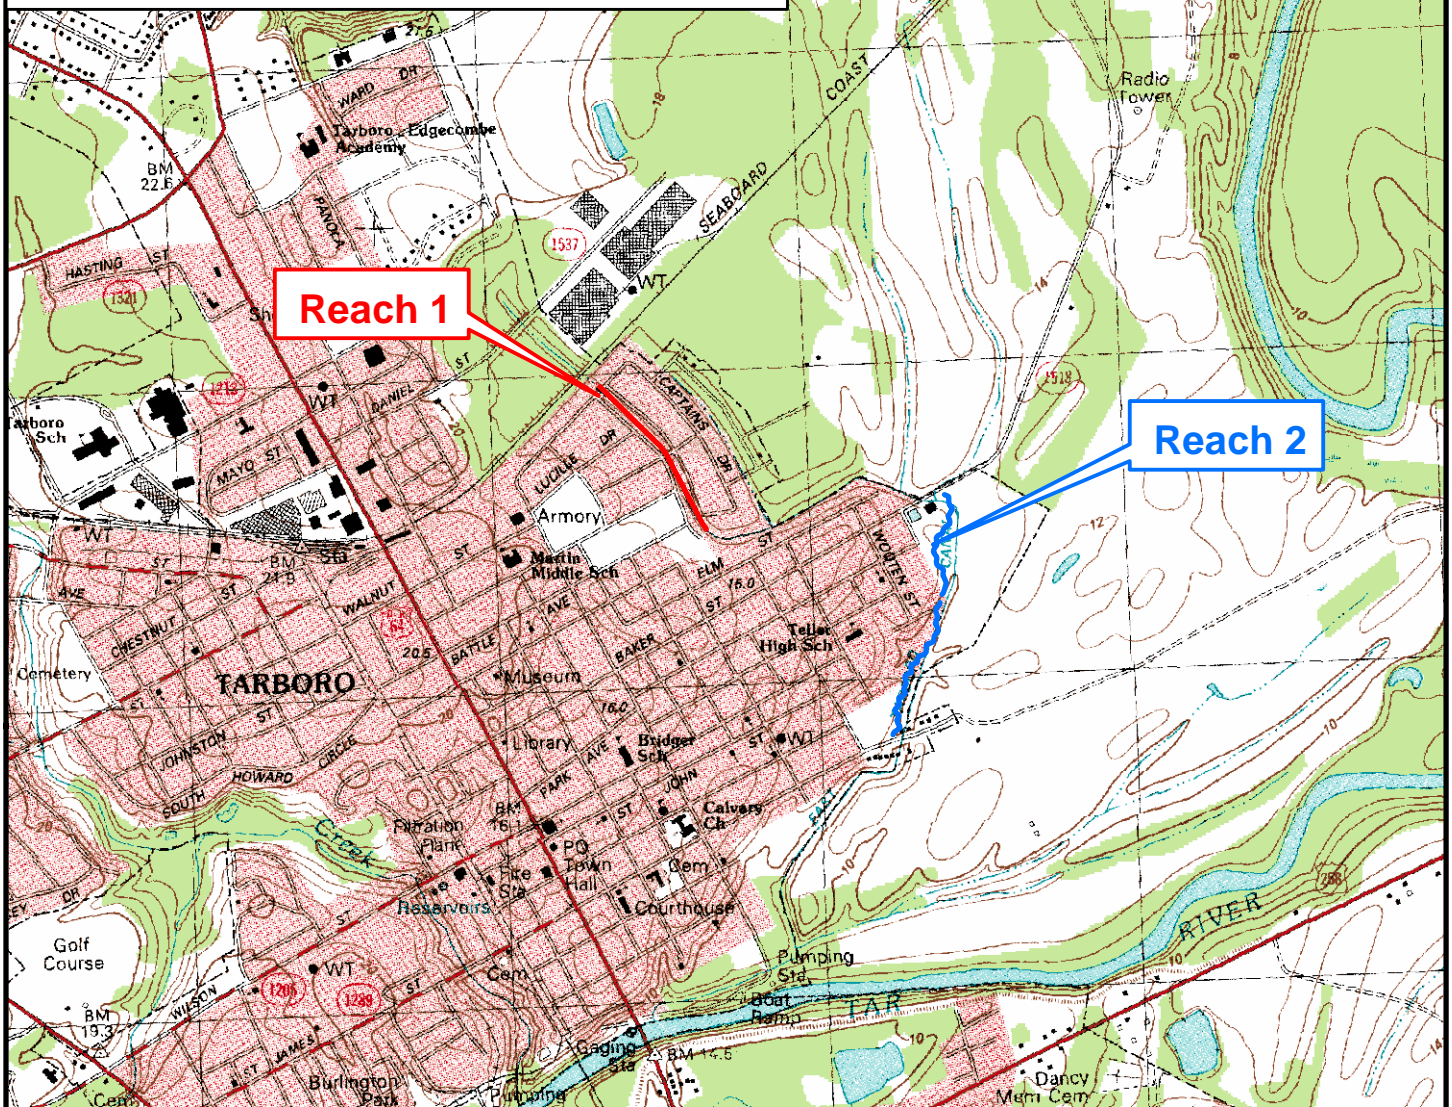

Current Conditions Plan View
Reach 1

East Tarboro Canal
Stream Restoration Project
EEP No. 123
Edgecombe County, North Carolina

Legend

-  Stream Thalweg
-  Cross Section

Vegetation Monitoring Counts

-  Less Than 320 Stems per Acre
-  More Than 320 Stems per Acre



November 2009







FIGURE 2b



Current Conditions Plan View
Reach 2

East Tarboro Canal
Stream Restoration Project
EEP No. 123
Edgecombe County, North Carolina

Legend

-  Stream Thalweg
-  Cross Section

Vegetation Monitoring Counts

-  Less Than 320 Stems per Acre
-  More Than 320 Stems per Acre



APPENDIX B

Table 1. Project Restoration Components East Tarboro Canal Stream Mitigation Site EEP Project No: 123					
Project Segment/Reach ID	Mitigation Type	Approach	Linear Footage	Stationing	Comment
Reach 1	Enhancement 1	N/A	1,869	10+00 to 28+69	Instream structures and vegetated buffers
Reach 2	Restoration	Priority 2	2,933	10+00 to 39+33	Instream structures and vegetated Buffers

Table 2. Project Activity and Reporting History East Tarboro Canal Stream Restoration - EEP Project No. 123		
Activity or Report	Data Collection Complete	Actual Completion or Delivery
Restoration Plan	NA	January 2005
Final Design - 90%	NA	May 2005
Construction	Jan 2007	February 2007
Temporary S&E mix applied to entire project area	Jan 2007	Jan 2007
Permanent seed mix applied to entire project area	Jan 2007	Jan 2007
Containerized and B&B plantings	Jan 2007	Jan 2007
Mitigation Plan / As-built (Year 0 Monitoring - baseline)	April 2007	June 2007
Year 1 Monitoring	Nov 2008	Jan 2009
Year 2 Monitoring	Oct 2009	Nov 2009
Year 3 Monitoring	NA	NA
Year 4 Monitoring	NA	NA
Year 5 Monitoring	NA	NA

Table 3. Project Contacts Table
East Tarboro Canal Stream Restoration - EEP Project No. 123

Designer	Earth Tech 701 Corporate Center Drive Suite 475 Raleigh, NC 27607
Primary project design POC	
Construction Contractor	Shamrock Environmental Corporation P.O. Box 14987 Greensboro, NC 27415 Mike Granson (336)-375-1989
Construction contractor POC	
Planting Contractor	Shamrock Environmental Corporation P.O. Box 14987 Greensboro, NC 27415 Mike Granson (336)-375-1989
Planting Contractor POC	
Seeding Contractor	Shamrock Environmental Corporation P.O. Box 14987 Greensboro, NC 27415 Mike Granson (336)-375-1989
Seeding Contractor POC	
Seed Mix Sources	contact Shamrock Environmental Corporation
Nursery Stock Suppliers	Mellow Marsh Farm 1312 Woody Store Road Siler City, NC 27344 (919) 742-1200
Monitoring Performers (MY1 and MY2)	Rummel, Klepper, and Kahl, LLP 900 Ridgefield Drive Suite 250 Raleigh, NC 27609
Stream Monitoring POC	Pete Stafford (919)878-9560
Vegetation Monitoring POC	Pete Stafford (919)878-9560
Wetland Monitoring POC	NA

**Table 4. Project Attribute Table
East Tarboro Canal Restoration Site - EEP Project No. 123**

Project County	Edgecombe
Drainage Area	2.78 sq mi
Drainage impervious cover estimate (%)	10 percent
Stream Order	1 st /2nd
Physiographic Region	Coastal Plain
Ecoregion	Southeastern Floodplains and Low Terraces
Rosgen Classification of As-built	Reach 1 –NA, Reach 2 – C5
Cowardin Classification	Riverine
Dominant soil types	Grantham-Urban land complex
	Portsmouth fine sandy loam
	Roanoke Loam
Reference site ID	UT to Mill Creek
USGS HUC for Project	03020103
USGS HUC for Reference	Unnamed tributary to Mill Creek (03020201)
NCDWQ Subbasin for Project	030303
NCDWQ Subbasin for Reference	Unnamed tributary to Mill Creek (030404)
NCDWQ Classification for Project	East Tarboro Canal (C, NSW)
NCDWQ Classification for Reference	Unnamed tributary to Mill Creek (C, NSW)
Any portion of any project segment 303d listed?	No
Any portion of any project segment upstream of a 303d listed segment?	No
Reasons for 303d listing or stressor	N/A
Percent of project easement fenced	0%

APPENDIX C

Appendix C – Vegetation Data Assessment

Table 5. Vegetation Plot Mitigation Success Summary Table			
Tract	Vegetation Plot ID	Vegetation Survival Threshold Met?	Tract Mean
Reach 1	VP1	N	0%
Reach 2	VP2	Y	75%
Reach 2	VP3	Y	
Reach 2	VP4	N	
Reach 2	VP5	Y	
Reach 2	VP6	Y	
Reach 2	VP7	Y	
Reach 2	VP8	Y	
Reach 2	VP9	N	
Reach 2	VP10	Y	
Reach 2	VP11	Y	
Reach 2	VP12	Y	
Reach 2	VP13	N	

Appendix C- Vegetation Plot Photos (all photos recorded on October 28, 2009)



Vegetation Plot 1



Vegetation Plot 2

Photos recorded on October 28, 2009



Vegetation Plot 3, November 10, 2008 (2009 Digital Photo Damaged)



Vegetation Plot 4

Photos recorded on October 28, 2009



Vegetation Plot 5



Vegetation Plot 6

Photos recorded on October 28, 2009



Vegetation Plot 7



Vegetation Plot 8

Photos recorded on October 28, 2009



Vegetation Plot 9



Vegetation Plot 10

Photos recorded on October 28, 2009



Vegetation Plot 11



Vegetation Plot 12

Photos recorded on October 28, 2009



Vegetation Plot 13

Photos recorded on October 28, 2009

Appendix C - Vegetation Metadata

Table 6. Vegetation Metadata Table East Tarboro Canal Mitigation Site EEP No: 123	
Report Prepared By	William (Pete) Stafford
Date Prepared	11/06/2009 9:49 am
Database Name	EastTarboroCanal.mdb
Database Location	C:\Documents and Settings\pstafford\Desktop\CVS Veg Data
Computer Name	STAFFORDP
Description Worksheets In This Document	
Metadata	This worksheet, which is a summary of the project data.
Planted	Each project is listed with its PLANTED stems, for each year. This excludes live stakes and lists stems per acre.
Total Stems	Each Project is listed with its total stems for each year. This includes live stakes, all planted stems, and all natural/volunteer stems. Listed in stems per acre.
Plots	List of Plots surveyed
Vigor	Frequency distribution of vigor classes
Vigor by Species	Frequency distribution of vigor classes listed by species
Damage	List of most frequent damage classes with number of occurrences and percent of total stems impacted by each
Damage by Species	Damage values tallied by type for each species
Damage by Plot	Damage values tallied by type for each plot
Planted Stems by Plot	Count of planted living stems of each species for each plot; dead and missing stems are excluded
Project Summary	
EEP Project Number	123
Project Name	East Tarboro Canal
Description	Stream Restoration
River Basin	Tar-Pamlico
Length (ft)	
Stream to Edge width (ft)	
Area (sq. m)	
Required Plots (calculated)	
Sampled Plots	13

Appendix C - Stem Count Total and Planted Species by Plot and Species

		CURRENT DATA (MY2 2009)																								ANNUAL MEANS										
		Plot 1		Plot 2		Plot 3		Plot 4		Plot 5		Plot 6		Plot 7		Plot 8		Plot 9		Plot 10		Plot 11		Plot 12		Plot 13		Current Mean		MY1 (2008)		AB (2007)				
Scientific Name	Common Name	Type	P	T	P	T	P	T	P	T	P	T	P	T	P	T	P	T	P	T	P	T	P	T	P	T	P	T	P	T	P	T	P	T		
<i>Alnus serrulata</i>	Tag Alder	s	*		*		*		*		*	1	*		*		*		*	1	*		*		*	1	*		*		*	3	*	2	*	*
<i>Betula nigra</i>	River Birch	t	*		*		*		*		*		*		*		*		*		*		*		*		*	2	*		*	2	*	2	*	*
<i>Callicarpa americana</i>	Beautyberry	s	*		*	2	*		*	1	*		*	2	*		*		*		*		*		*		*		*	5	*	5	*	*		
<i>Cephalanthus</i>	Buttonbush	s	*		*	1	*		*		*		*		*		*		*		*		*		*		*		*	1	*	1	*	*		
<i>Cornus amomum</i>	Silky Dogwood	t	*		*	1	*	1	*		*		*		*		*	1	*		*		*		*		*		*	3	*	3	*	*		
<i>Cornus florida</i>	Dogwood	t	*		*		*		*		*		*		*		*		*		*	1	*		*		*		*	1	*	1	*	*		
<i>Fraxinus pennsylvanica</i>	Green Ash	t	*		*	1	*	3	*		*	2	*		*	2	*	1	*	1	*	2	*		*		*		*	12	*	15	*	*		
<i>Itea virginica</i>	Sweetspire	s	*		*		*		*		*		*		*		*		*		*		*	1	*		*		*	1	*	2	*	*		
<i>Myrica</i>	Wax Myrtle	s	*		*	3	*		*	1	*		*	1	*		*		*		*	2	*	2	*	2	*	2	*	13	*	21	*	*		
<i>Quercus laurifolia</i>	Laurel Oak	t	*		*		*		*		*		*		*		*		*		*	1	*		*		*		*	1	*	3	*	*		
<i>Quercus lyrata</i>	Overcup Oak	t	*		*		*	1	*		*		*		*	2	*		*		*		*	1	*		*		*	4	*	1	*	*		
<i>Quercus pagoda</i>	Cherrybark Oak	t	*		*		*	2	*		*		*		*	2	*		*		*	4	*		*		*		*	8	*	7	*	*		
<i>Quercus palustris</i>	Pin Oak	t	*		*		*		*		*		*	1	*		*		*		*		*		*		*		*	1	*	2	*	*		
<i>Quercus phellos</i>	Willow Oak	t	*		*		*		*		*		*		*		*		*		*		*		*	2	*		*	2	*	4	*	*		
<i>Rosa palustris</i>	Rose	s	*		*		*	1	*		*		*		*	1	*	1	*		*		*	1	*		*		*	4	*	7	*	*		
<i>Salix caroliniana</i>	Willow	t	*		*		*		*		*	4	*		*		*		*		*		*		*		*		*	4	*	4	*	*		
<i>Taxodium distichum</i>	Cypress	s	*		*	1	*		*		*		*		*		*		*		*		*		*		*		*	1	*	1	*	*		
Unknown			*		*		*	1	*	1	*		*	1	*	1	*	2	*		*		*	3	*	4	*	1	*	14	*	47	*	*		
		Plot Area (acres)	0.025		0.025		0.025		0.025		0.025		0.025		0.025		0.025		0.025		0.025		0.025		0.025											
*No baseline data for this project		Species Count		0		6		6		3		3		4		5		4		3		6		4		3		3		18		18				
Type = Tree or Shrub		Stem Count		0		9		9		3		7		5		8		5		6		8		8		7		5		80		128				
P = Planted, T = Total		Stems/Acre		0		360		360		120		280		200		320		200		240		320		320		280		200		320		512				

APPENDIX D

Appendix D – Stream Station Photos (all photos recorded on October 28, 2009)



Photo Station 1. Beginning of Reach 1



Photo Station 2. Reach 1 Culvert upstream

Photos recorded on October 28, 2009



Photo Station 3. Reach 1 Culvert Downstream



Photo Station 4. End of Reach 1 Upstream

Photos recorded on October 28, 2009



Photo Station 5. Beginning of Reach 2 Downstream



Photo Station 6. Beginning of Reach 2

Photos recorded on October 28, 2009



Photo Station 7. Wilson Street Crossing Upstream



Photo Station 8. Wilson Street Crossing – Downstream

Photos recorded on October 28, 2009



Photo Station 9. Culvert Upstream



Photo Station 10. Pool Culvert Downstream

Photos recorded on October 28, 2009



Photo Station 11. Reach 2 End of Project

Photos recorded on October 28, 2009

Appendix D – Table 8 Visual Morphological Stability Assessment

Table 8. Visual Morphological Stability Assessment East Tarboro Canal Stream Restoration Site EEP Project No. 123 Reach 1						
Feature Category	Metric (per As-built and reference baselines)	(# Stable) Number Performing as Intended	Total Number per As-built	Total Number/Feet in Unstable State	% Perform in Stable Condition	Feature Perform. Mean or Total
A. Riffles	1. Present?	17	17	0.00	100.00	
	2. Armor stable (eg no displacement?)	NA	NA	0.00	NA	
	3. Facet grade appears stable?	17	17	0.00	100.00	
	4. Minimal evidence of embedding/fining?	17	17	0.00	100.00	
	5. Length appropriate?	17	17	0.00	100.00	100
B. Pools	1. Present? (e.g. not subject to severe aggrad. or migrat.?)	16	16	0.00	100.00	
	2. Sufficiently deep (Max Pool D:Mean Bkf > 1.6?)	16	16	0.00	100.00	
	3. Length appropriate?	16	16	0.00	100.00	100
C. Thalweg	1. Upstream of meander bend (run/inflection) centering?	NA	NA	NA		
	2. Downstream of meander (glide/inflection) centering?	NA	NA	NA		NA
D. Meanders	1. Outer bend in state of limited/controlled erosion?	1	1	0.00	100.00	
	2. Of those eroding, # w/concomitant point bar formation?	1	1	0.00	100.00	
	3. Apparent Rc within spec?	1	1	0.00	100.00	
	4. Sufficient floodplain access and relief?	1	1	0.00	100.00	100
E. Bed General	1. General channel bed aggradation areas (bar formation)	1800	1800	0.00	100.00	
	2. Channel bed degradation - areas of increasing down-cutting or head-cutting?	1800	1800	0.00	100.00	100
F. Bank	1. Actively eroding, wasting, or slumping bank?	1800	1800	0.00	100.00	100
G. Vanes	1. Free of back or arm scour?	7	7	0.00	100.00	
	2. Height appropriate?	7	7	0.00	100.00	
	3. Angle and geometry appear appropriate?	7	7	0.00	100.00	
	4. Free of piping or other structural failures?	7	7	0.00	100.00	100
H. Wads/Boulders	1. Free of scour?	NA	NA	NA	NA	
	2. Footing stable?	NA	NA	NA	NA	NA

**Table 8. Visual Morphological Stability Assessment
East Tarboro Canal Stream Restoration Site EEP Project No. 123
Reach 2**

Feature Category	Metric (per As-built and reference baselines)	(# Stable) Number Performing as Intended	Total Number per As-built	Total Number/Feet in Unstable State	% Perform in Stable Condition	Feature Perform. Mean or Total
A. Riffles	1. Present?	42	44	0	95.00	
	2. Armor stable (eg no displacement?)	NA	NA	NA	NA	
	3. Facet grade appears stable?	44	44	0	100.00	
	4. Minimal evidence of embedding/fining?	44	44	0	100.00	
	5. Length appropriate?	44	44	0	100.00	95
B. Pools	1. Present? (e.g. not subject to severe aggrad. or migrat.?)	41	42	1	97.62	
	2. Sufficiently deep (Max Pool D:Mean Bkf > 1.6?)	42	42	1	97.62	
	3. Length appropriate?	42	42	0	100.00	98
C. Thalweg	1. Upstream of meander bend (run/inflection) centering?	NA	NA	NA		
	2. Downstream of meander (glide/inflection) centering?	NA	NA	NA		NA
D. Meanders	1. Outer bend in state of limited/controlled erosion?	44	44	0	100.00	
	2. Of those eroding, # w/concomitant point bar formation?	44	44	0	100.00	
	3. Apparent Rc within spec?	44	44	0	100.00	
	4. Sufficient floodplain access and relief?	44	44	0	100.00	100.00
E. Bed General	1. General channel bed aggradation areas (bar formation)	2733	2933	0	93.18	
	2. Channel bed degradation - areas of increasing down-cutting or head-cutting?	2933	2933	0	100.00	93.18
F. Bank	1. Actively eroding, wasting, or slumping bank?	2933	2933	0	99.61	100
G. Vanes	1. Free of back or arm scour?	19	19	0	100.00	
	2. Height appropriate?	19	19	0	100.00	
	3. Angle and geometry appear appropriate?	19	19	0	100.00	
	4. Free of piping or other structural failures?	19	19	0	100.00	100
H. Wads/Boulders	1. Free of scour?	NA	NA	0	100.00	
	2. Footing stable?	NA	NA	0	100.00	100

Appendix D – Verification of Bankfull Events

Table 9. Verification of Bankfull Events			
East Tarboro Canal Stream Restoration Site - EEP Project No. 123			
Date of Data Collection	Date of Occurrence	Method	Photo
October 29, 2009	September/October 2009	Visual Observation	Stream Photos 6


Project Name	East Tarboro Canal
Cross Section	#1
Feature	
Date	Aug-09
Crew	Tutt, Stafford

As-Built Survey			2008 Survey			2009 Survey			2010 Survey			2011 Survey			2012 Survey		
Station	Elevation	Notes	Station	Elevation	Notes	Station	Elevation	Notes	Station	Elevation	Notes	Station	Elevation	Notes	Station	Elevation	Notes
0	52.65	LPIN	0.00	52.49		0.00	52.65										
5	52.56		7.24	52.25		5.74	52.41										
7	52.47		11.63	50.65		10.14	51.11										
9.7	51.86		15.53	48.78		14.83	48.86										
15	48.89		22.38	48.15		15.85	48.72										
21.4	48.68	BKF	24.31	47.82		20.65	48.75										
24.1	47.32		24.66	47.41		22.05	47.89										
24.7	47.22	LEW	26.42	46.91		23.91	47.24										
26.2	46.78	TW	28.01	46.82		26.79	46.71										
27.6	46.91		28.44	47.10		30.06	47.51										
29	46.81		30.09	47.19		30.63	49.08										
29.9	47.19	REW	30.41	47.92		33.98	50.47										
31.00	47.460		30.92	48.61		38.26	52.19										
31.90	49.120		40.32	52.28		49.82	52.80										
33.60	49.980		49.00	52.88													
38.20	52.180																
41.00	52.440																
49.70	52.850	RPIN															



Photo of Cross-Section #1 - Looking Downstream

	AsBuilt	2008	2009	2010	2011	2012
Area	13.72	11.5	13.40			
Width	10.26	13.3	13.60			
Mean Depth	1.34	0.9	1.00			
Max Depth	1.90	1.8	2.00			
W/D	7.66	14.8	13.90			

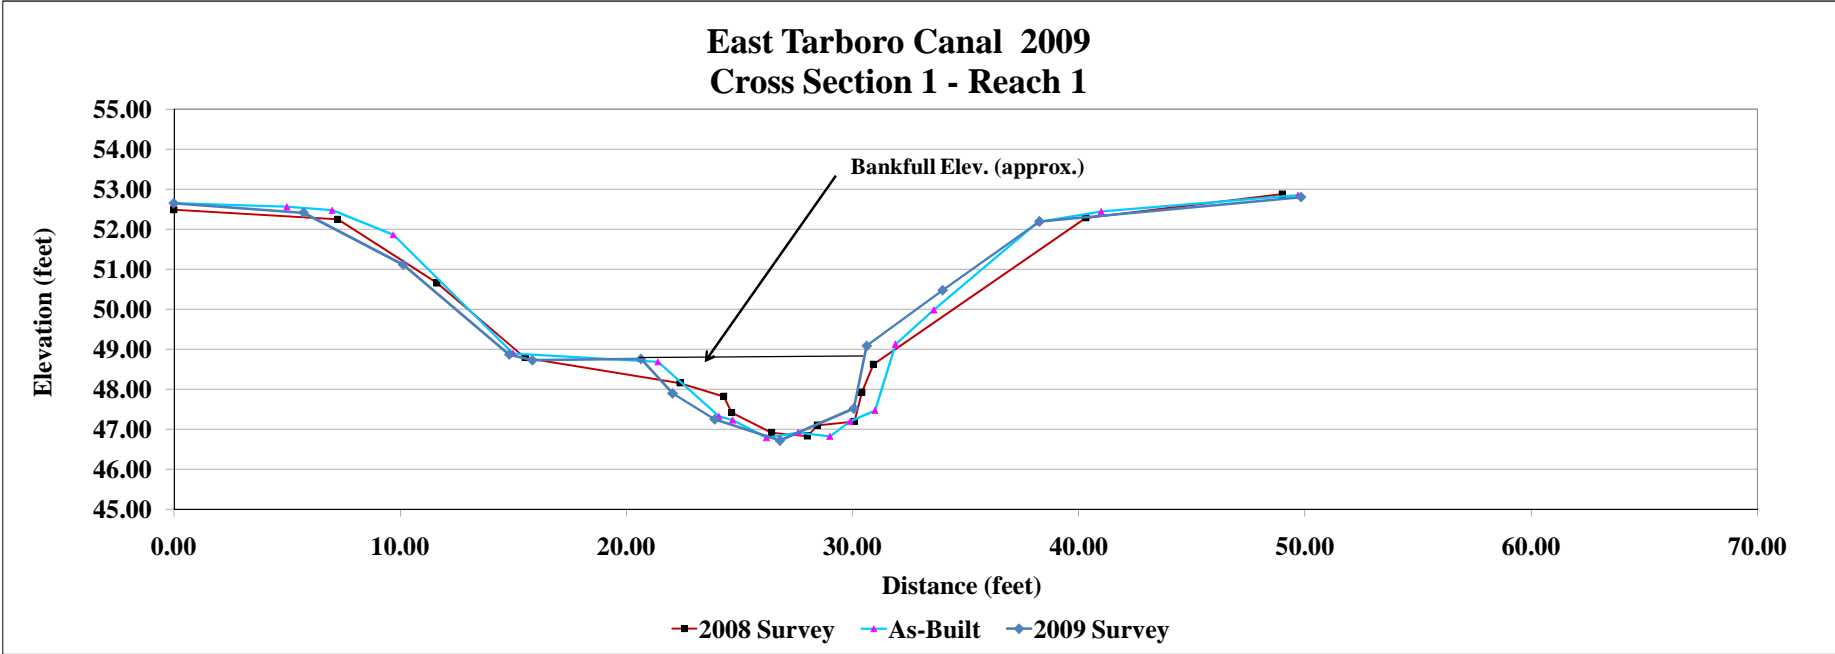


Project Name	East Tarboro Canal
Cross Section	#2
Feature	
Date	Aug-09
Crew	Tutt, Stafford

As-Built Survey			2008 Survey			2009 Survey			2010 Survey			2011 Survey			2012 Survey		
Station	Elevation	Notes	Station	Elevation	Notes	Station	Elevation	Notes	Station	Elevation	Notes	Station	Elevation	Notes	Station	Elevation	Notes
0.00	51.77	LPIN	0.00	51.77		0.00	51.69										
9.00	51.62		6.00	51.72		8.34	51.58										
10.00	51.32		11.12	51.58		9.01	51.58										
14.00	48.8		15.20	48.82		13.46	49.61										
19.00	48.43	BKF	18.38	48.07		16.20	48.52										
21.00	47.65		18.85	47.55		20.48	48.39										
21.80	46.91	LEW	21.17	47.18		21.76	48.12										
23.00	46.25		26.50	45.28		26.81	45.29										
24.30	45.92		30.62	48.72		29.77	47.54										
25.50	45.86		33.75	49.72		30.85	48.01										
26.80	45.58	TW	36.60	52.46		33.63	49.67										
27.70	46.03		49.16	53.19		40.80	53.11										
27.70	46.93	REW				51.10	52.45										
28.80	48.09																
31.50	48.81																
37.30	52.58																
42.00	53.4																
50.00	52.48	RPIN															



Photo of Cross-Section #2 - Looking Downstream

	AsBuilt	2008	2009	2010	2011	2012
Area	17.13	12.70	15.40			
Width	11.07	9.40	11.20			
Mean Depth	1.55	1.40	1.40			
Max Depth	2.85	2.80	3.10			
W/D	7.14	7.00	8.20			

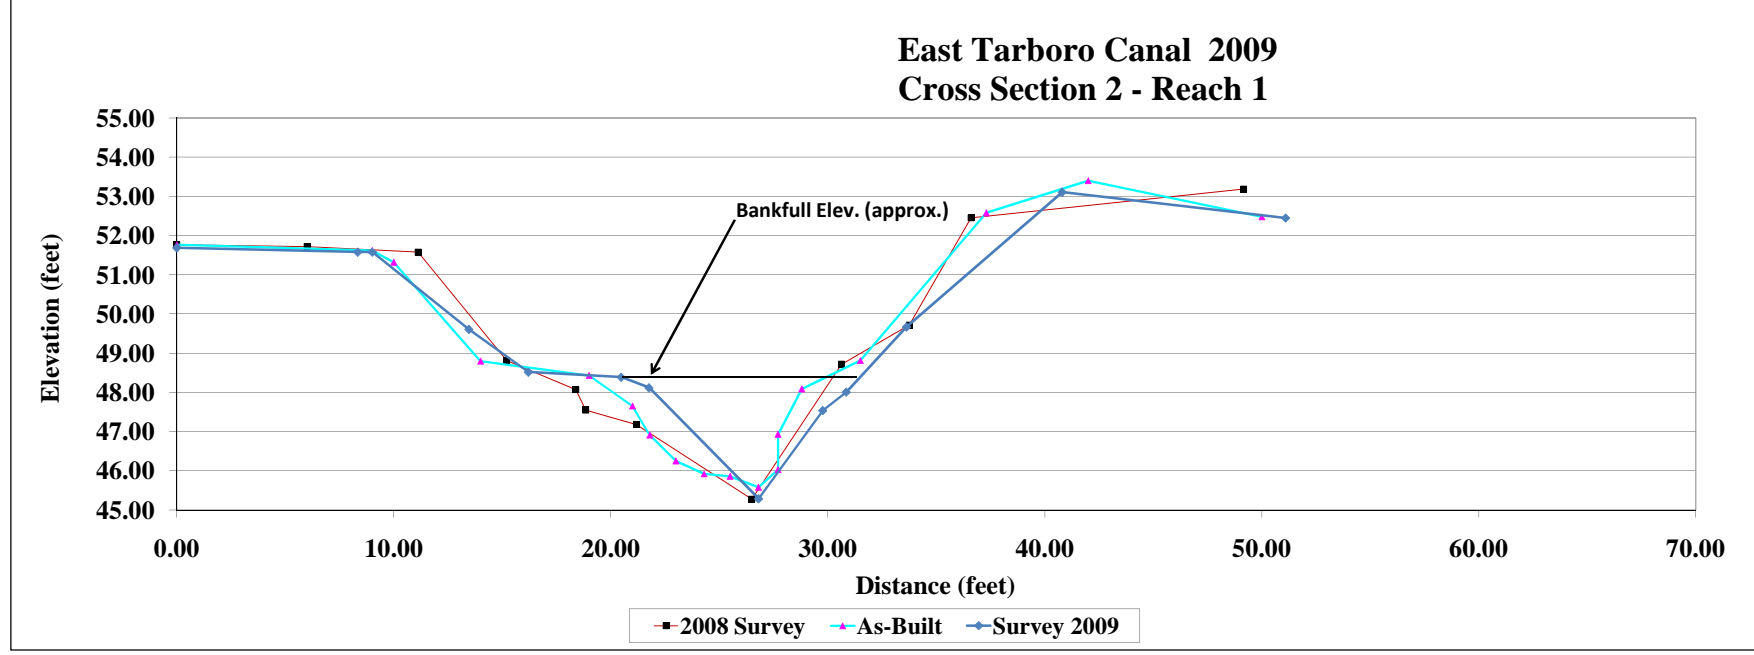

Project Name East Tarboro Canal
 Cross Section #3
 Feature
 Date Aug-09
 Crew Tutt, Stafford


As-Built Survey			2008		2009		2010		2011		2012	
Station	Elev.	Notes	Station	Elevation Notes	Station	Elevation Notes	Station	Elevation Notes	Station	Elevation Notes	Station	Elevation Notes
0	52.05	LPIN	0.00	52.25	0.00	52.12						
5	52.03		5.10	51.82	3.57	51.97						
7.4	51.24		7.46	50.53	6.95	51.69						
8	50.55		13.05	47.91	14.28	47.75						
14	47.6		18.62	47.76	16.81	47.51						
19.2	47.35	BKF	20.35	47.33	19.18	47.60						
22.1	46.08		21.78	46.07	21.13	46.97						
22.3	46.08	LEW	25.19	45.94	22.26	46.25						
24.5	45.67		26.22	46.11	25.68	45.53						
26	45.59	TW	29.58	46.17	30.55	46.46						
29	45.77		30.37	47.47	31.06	47.53						
29.8	45.91		35.94	51.30	32.18	47.99						
29.9	46.07	REW	51.02	52.30	34.37	49.43						
30.6	47.23				37.44	51.39						
31.6	47.77				50.37	52.38						
36	51.11											
38	51.52											
44	51.88											
50	52.3	RPIN										



Photo of Cross-Section #3 - Looking Downstream

	AsBuilt	2008	2009	2010	2011	2012
Area	14.78	14.30	14.20			
Width	11.62	10.90	11.20			
Mean Depth	1.27	1.30	1.30			
Max Depth	1.76	1.80	2.00			
W/D	9.15	8.40	8.80			

East Tarboro Canal 2009 Cross Section 3 - Reach 1

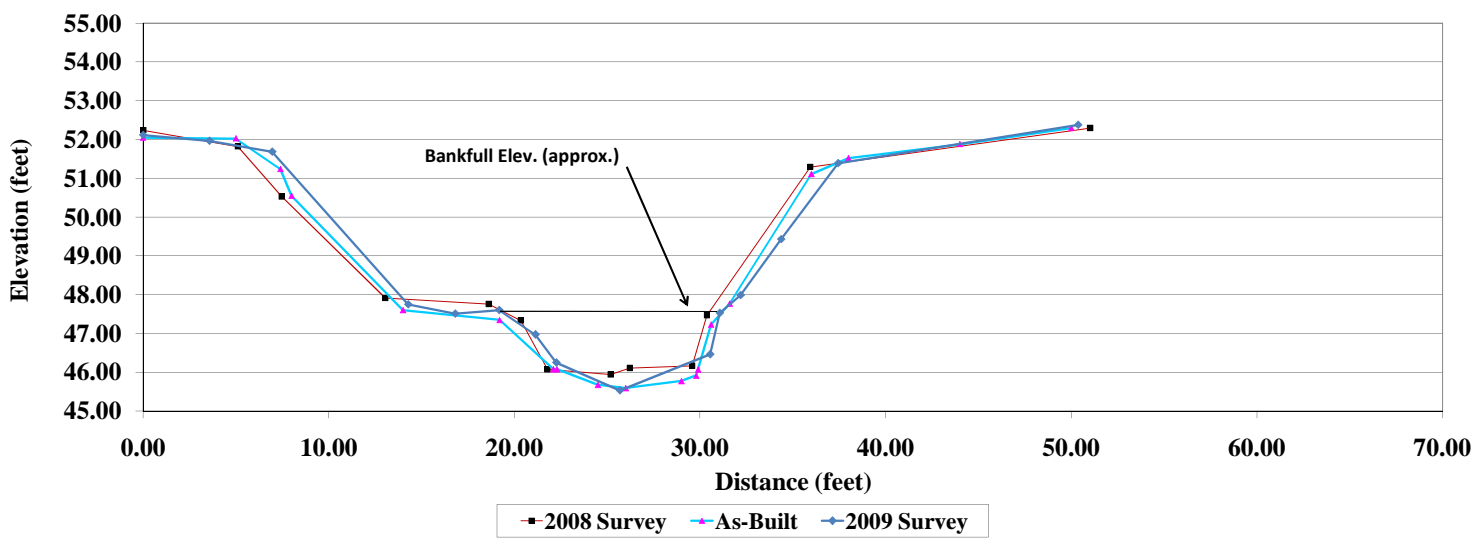


Project Name	East Tarboro Canal
Cross Section	#4
Feature	Riffle
Date	Aug-09
Crew	Tutt, Stafford

As-Built Survey			2008			2009			2010			2011			2012		
Station	Elevation	Notes	Station	Elevation	Notes	Station	Elevation	Notes	Station	Elevation	Notes	Station	Elevation	Notes	Station	Elevation	Notes
0	52.64	LPIN	0.00	52.79		0.00	52.62										
6.4	52.31		5.74	52.56		6.56	52.26										
10.5	50.4		9.85	50.65		11.92	49.64										
15.8	47.4		15.26	47.41		15.78	47.24										
17.4	46.93		20.71	47.03		18.07	46.94										
21	46.74	BKF	21.71	46.51		20.15	47.07										
22	46.33		22.56	46.26		21.92	46.82										
22.6	45.83	LEW	27.14	44.80		22.77	46.18										
24.8	45.16		29.78	46.08		26.73	44.98										
26.3	45.14		31.96	47.04		26.90	44.97										
27.4	45.04	TW	32.85	47.85		29.65	46.21										
29	45.47		34.91	48.43		33.33	47.46										
29.8	45.81	REW	39.99	52.71		40.50	52.61										
31	46.14		49.83	52.80		50.97	52.67										
32	46.67																
32.4	47.43																
34.4	48.18																
39.3	52.45																
44	52.63																
50	52.49	RPIN															



Photo of Cross-Section #4 - Looking Downstream

	AsBuilt	2008	2009	2010	2011	2012
Area	12.05	12.60	12.03			
Width	11.04	10.90	14.48			
Mean Depth	1.09	1.20	0.83			
Max Depth	1.70	2.20	2.13			
W/D	10.13	9.40	17.40			

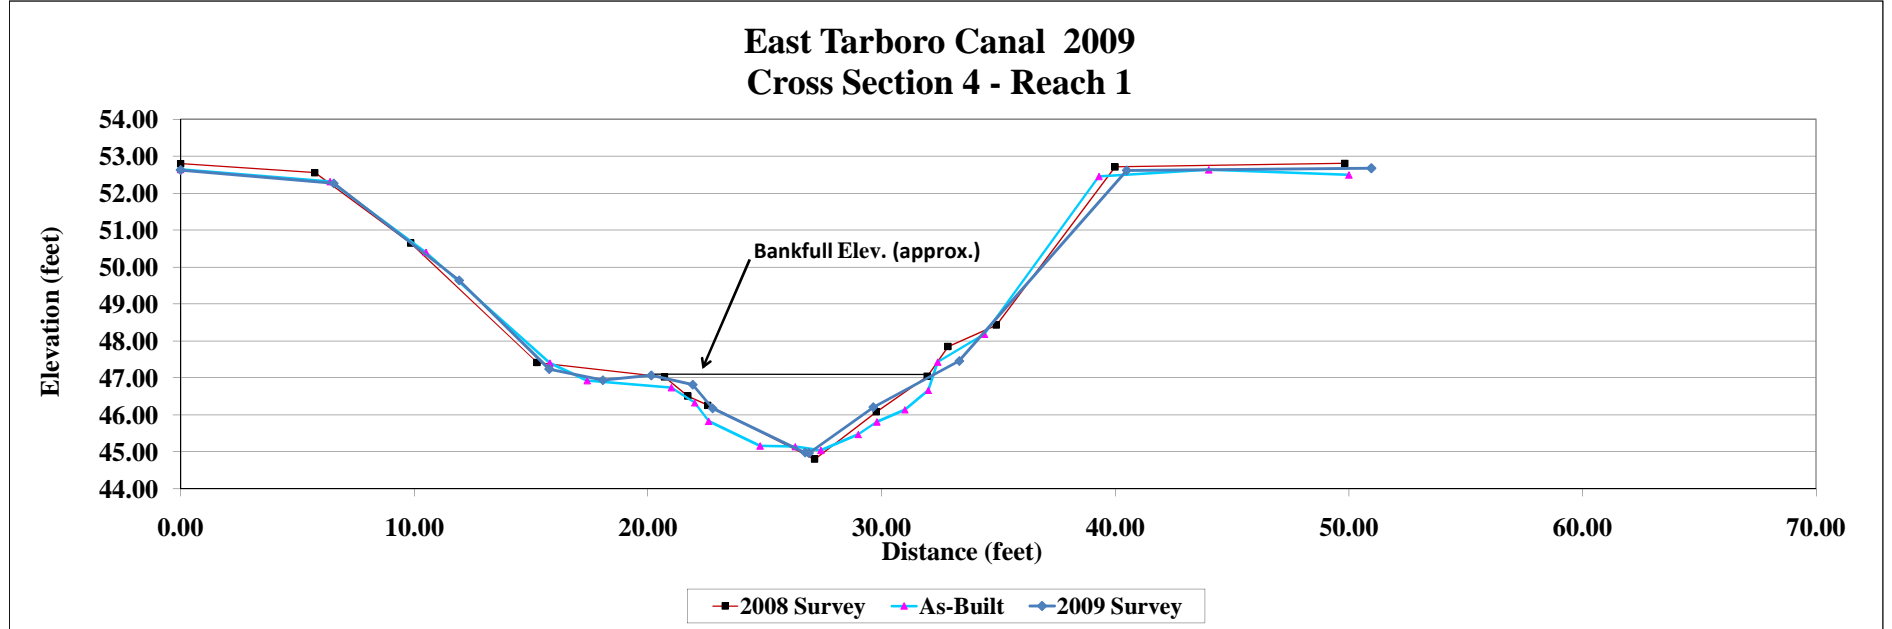


Project Name	East Tarboro Canal
Cross Section	#5
Feature	
Date	Aug-09
Crew	Tutt, Stafford

As-Built Survey			2008 Survey			2009 Survey			2010 Survey			2011 Survey			2012 Survey		
Station	Elevation	Notes	Station	Elevation	Notes	Station	Elevation	Notes	Station	Elevation	Notes	Station	Elevation	Notes	Station	Elevation	Notes
0	53.93	LPIN	0.00	54.16		0.00	54.57										
13	47.46		11.84	48.41		2.33	53.90										
16.2	46.23		16.20	46.73		11.87	47.69										
17.2	45.85		16.93	46.34		17.07	46.01										
17.4	44.92		18.89	44.38		17.51	44.29										
19.6	44.56	LEW	21.06	43.93		21.53	44.28										
20.7	43.99		24.01	44.25		26.28	44.50										
21.3	43.84	TW	26.04	44.22		28.56	46.43										
22.8	44.25		28.11	45.13		33.8	46.65										
24	44.56	REW	29.76	46.70		40.85	49.71										
26	45.38		33.94	46.74		50.36	52.87										
27.7	46.28	BKF	35.91	47.15		60.76	53.61										
33	46.56		41.89	49.39													
49	52.63		47.53	51.53													
53	53.25		63.25	53.64													
60	53.49	RPIN															



Photo of Cross-Section #5 - Looking Downstream

	AsBuilt	2008	2009	2010	2011	2012
Area	16.42	25.60	15.33			
Width	11.63	13.00	10.08			
Mean Depth	1.41	2.80	1.52			
Max Depth	2.44	2.00	1.74			
W/D	8.25	6.60	6.60			

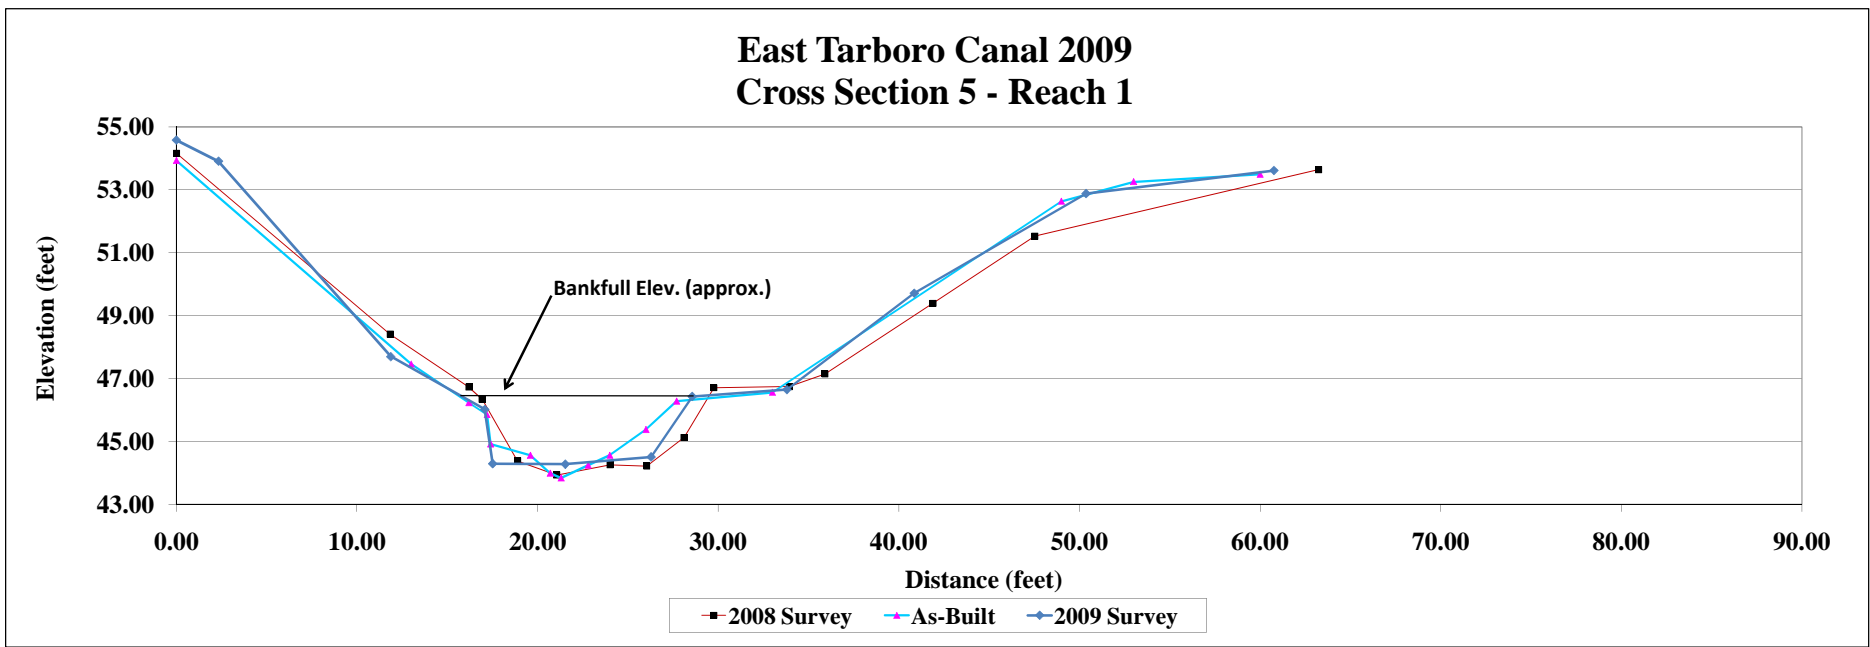

Project Name	East Tarboro Canal
Cross Section	#6
Feature	
Date	Aug-09
Crew	Tut, Stafford


As-Built Survey			2008 Survey			2009 Survey			2010 Survey			2011 Survey			2012 Survey		
Station	Elevation	Notes	Station	Elevation	Notes	Station	Elevation	Notes	Station	Elevation	Notes	Station	Elevation	Notes	Station	Elevation	Notes
0.00	36.45	LPIN	0.00	36.32		0.00	36.35										
20	36.3		25.08	36.14		22.07	36.27										
35	35.94	BKF	38.26	35.74		38.88	35.68										
40	35.67		45.82	35.29		42.86	35.35										
47	35.04		52.03	34.49		45.30	35.25										
48.4	34.65		57.78	34.33		48.03	34.92										
49.5	34.63	LEW	59.72	34.73		50.69	34.52										
49.8	34.49		62.08	35.58		52.16	34.46										
50.8	34.19	TW	63.97	35.99		52.77	34.70										
52	34.22		68.53	36.35		55.50	34.74										
55	34.3		94.15	36.33		59.02	34.84										
57.6	34.27		116.05	35.92		62.67	35.27										
58.6	34.54					65.29	35.83										
58.6	34.64	REW				68.58	36.43										
59	34.87					86.79	36.35										
60.9	35.07					100.38	36.44										
67	36.27																
69	36.36																
80	36.39																
100	36.54	RPIN															



Photo of Cross-Section #6 - Looking Downstream

	AsBuilt	2008	2009	2010	2011	2012
Area	26.95	24.00	25.46			
Width	30.32	36.60	35.51			
Mean Depth	0.89	0.67	0.72			
Max Depth	1.75	1.60	1.54			
W/D	34.07	55.70	49.50			

East Tarboro Canal 2009 Cross Section 6 - Reach 2

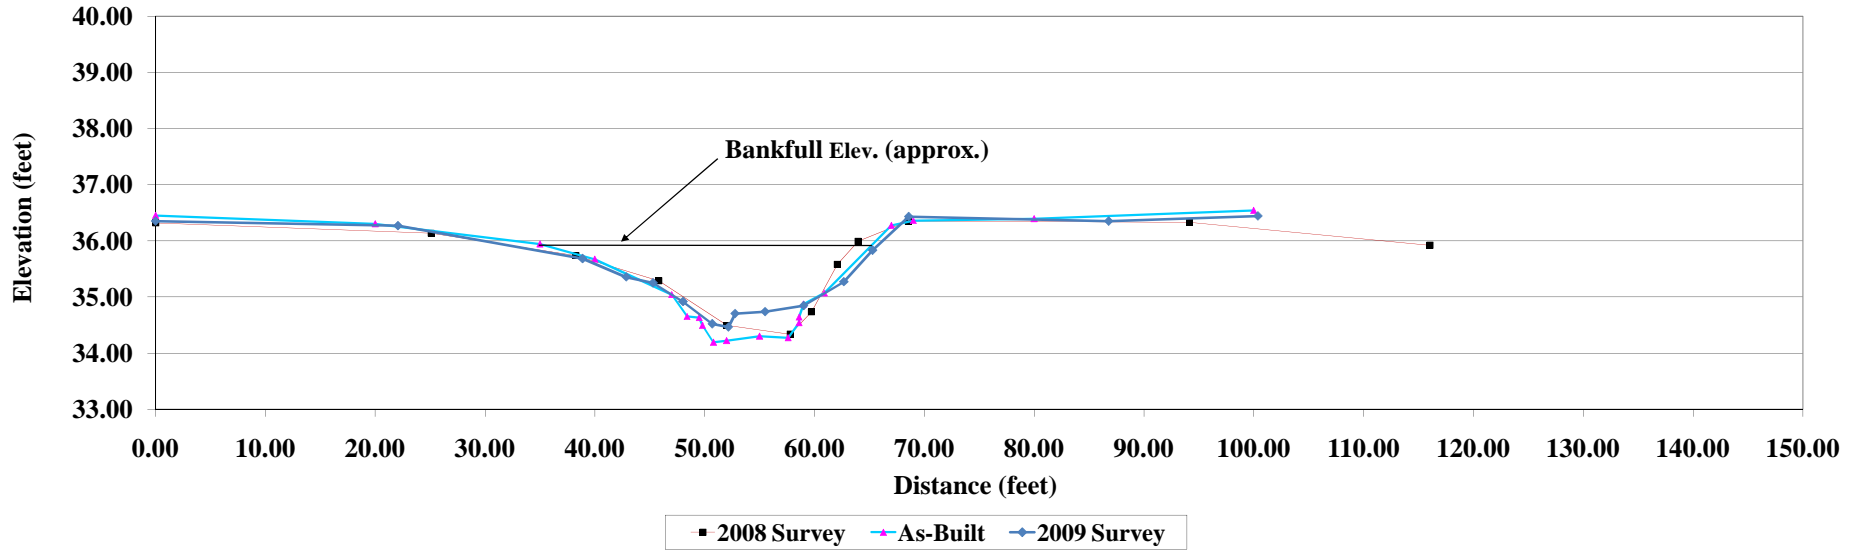


Project Name	East Tarboro Canal
Cross Section	#7
Feature	
Date	Aug-09
Crew	Tut, Stafford

As-Built Survey			2008 Survey			2009 Survey			2010 Survey			2011 Survey			2012 Survey		
Station	Elevation	Notes	Station	Elevation	Notes	Station	Elevation	Notes	Station	Elevation	Notes	Station	Elevation	Notes	Station	Elevation	Notes
0	37.79	LPIN	0.00	37.79		0.00	37.63										
3	37.65		12.00	36.02		2.53	37.53										
14.8	35.73		38.87	36.45		14.64	35.63										
22	35.83		42.91	35.76		26.68	36.02										
32	36.46		46.03	34.92		36.11	36.13										
37	36.39		49.94	32.08		40.69	36.53										
40.5	36.77		52.84	33.91		43.26	35.89										
43	36.24		53.48	34.38		44.70	35.44										
45.2	35.57		56.17	34.94		48.57	32.17										
46.6	34.43	LEW	61.09	35.45		53.95	34.40										
46.9	32.79		70.47	35.99		55.15	34.52										
48	32.6	TW	100.00	36.26		57.45	34.88										
49	32.75					60.11	35.27										
51	33.06					64.10	35.63										
52	33.33					72.13	35.90										
52.6	33.81					100.66	36.04										
54.1	34.41	REW															
57	35.25																
66	36.1	BKF															
80	36.17																
90	36.07																
100	36.26	RPIN															



Photo of Cross-Section #7 - Looking Upstream

	AsBuilt	2008	2009	2010	2011	2012
Area	31.22	30.00	19.60			
Width	22.54	26.80	23.54			
Mean Depth	1.39	1.10	0.83			
Max Depth	3.50	4.20	3.72			
W/D	16.22	23.90	29.00			

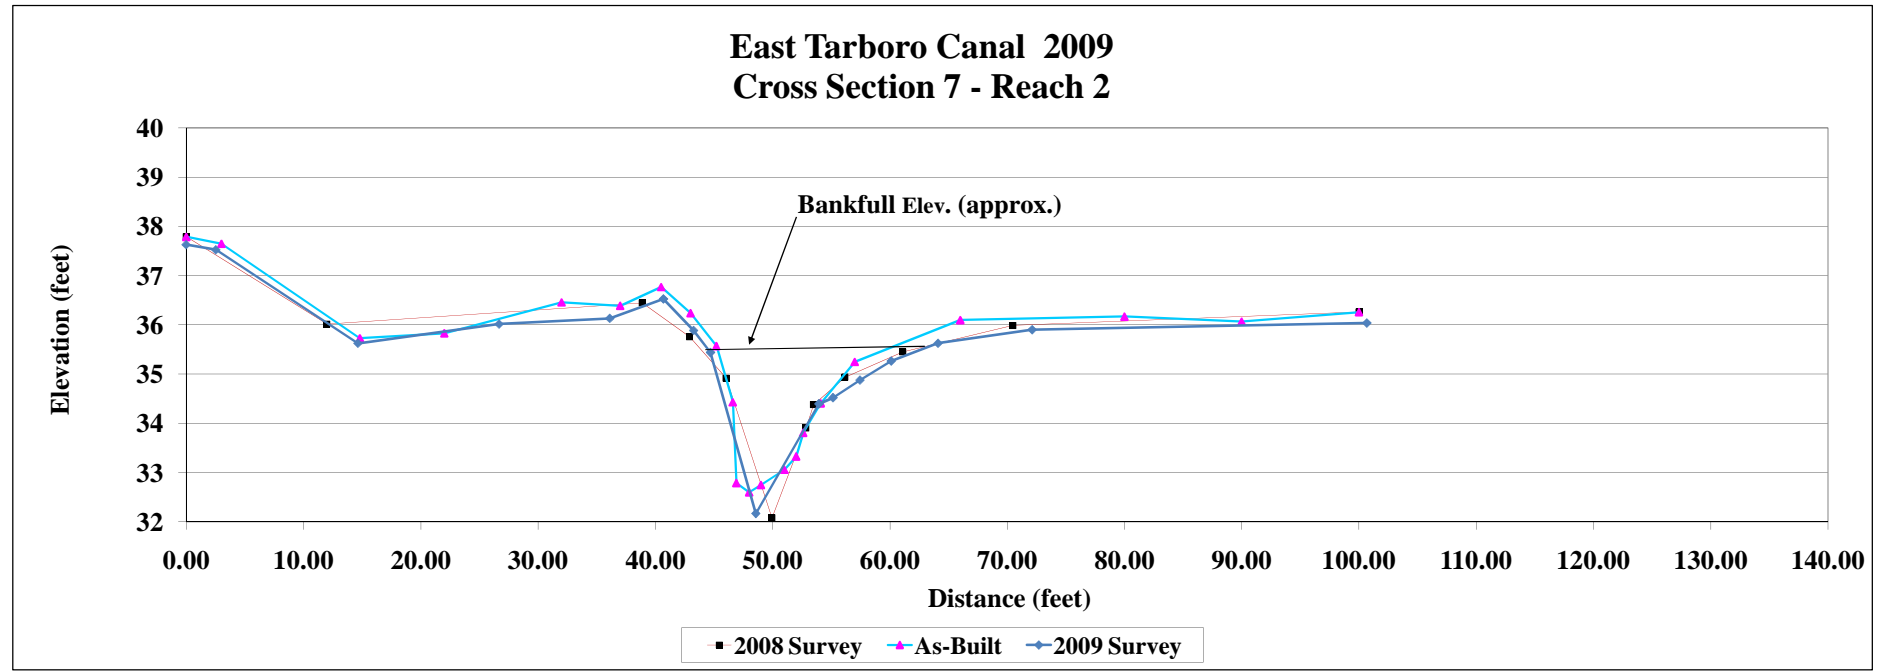


Project Name	East Tarboro Canal
Cross Section	#8
Feature	
Date	Aug-09
Crew	Tutt, Stafford

As-Built Survey			2008 Survey			2009 Survey			2010 Survey			2011 Survey			2012 Survey		
Station	Elevation	Notes	Station	Elevation	Notes	Station	Elevation	Notes	Station	Elevation	Notes	Station	Elevation	Notes	Station	Elevation	Notes
0	36.03	LPIN	0.00	35.76		0.00	35.74										
20	36.02		27.39	35.90		13.34	35.73										
34	36.02		40.41	35.77		34.02	35.98										
39	35.92		44.41	34.53		41.21	35.24										
40	35.88		46.63	33.80		44.22	34.27										
42	35.56		48.09	32.65		47.75	32.68										
44.8	34.47	LEW	52.77	34.69		50.42	34.23										
45.4	33.71		53.36	34.95		51.31	34.48										
46	33.52		55.78	35.28		55.22	35.63										
48	33.38	TW	56.84	35.66		63.30	36.00										
50.2	33.46		63.32	36.38		74.01	36.86										
50.5	33.66		75.55	36.82													
51	34.35																
51.5	34.47	REW															
56.6	35.98	BKF															
64	36.2																
66	36.39																
75	37.18	RPIN															



Photo of Cross-Section #8 - Looking Downstream

	AsBuilt	2008	2009	2010	2011	2012
Area	22.99	12.10	14.30			
Width	20.60	12.70	15.13			
Mean Depth	1.12	1.00	0.95			
Max Depth	2.60	3.00	2.61			
W/D	18.39	13.30	16.00			

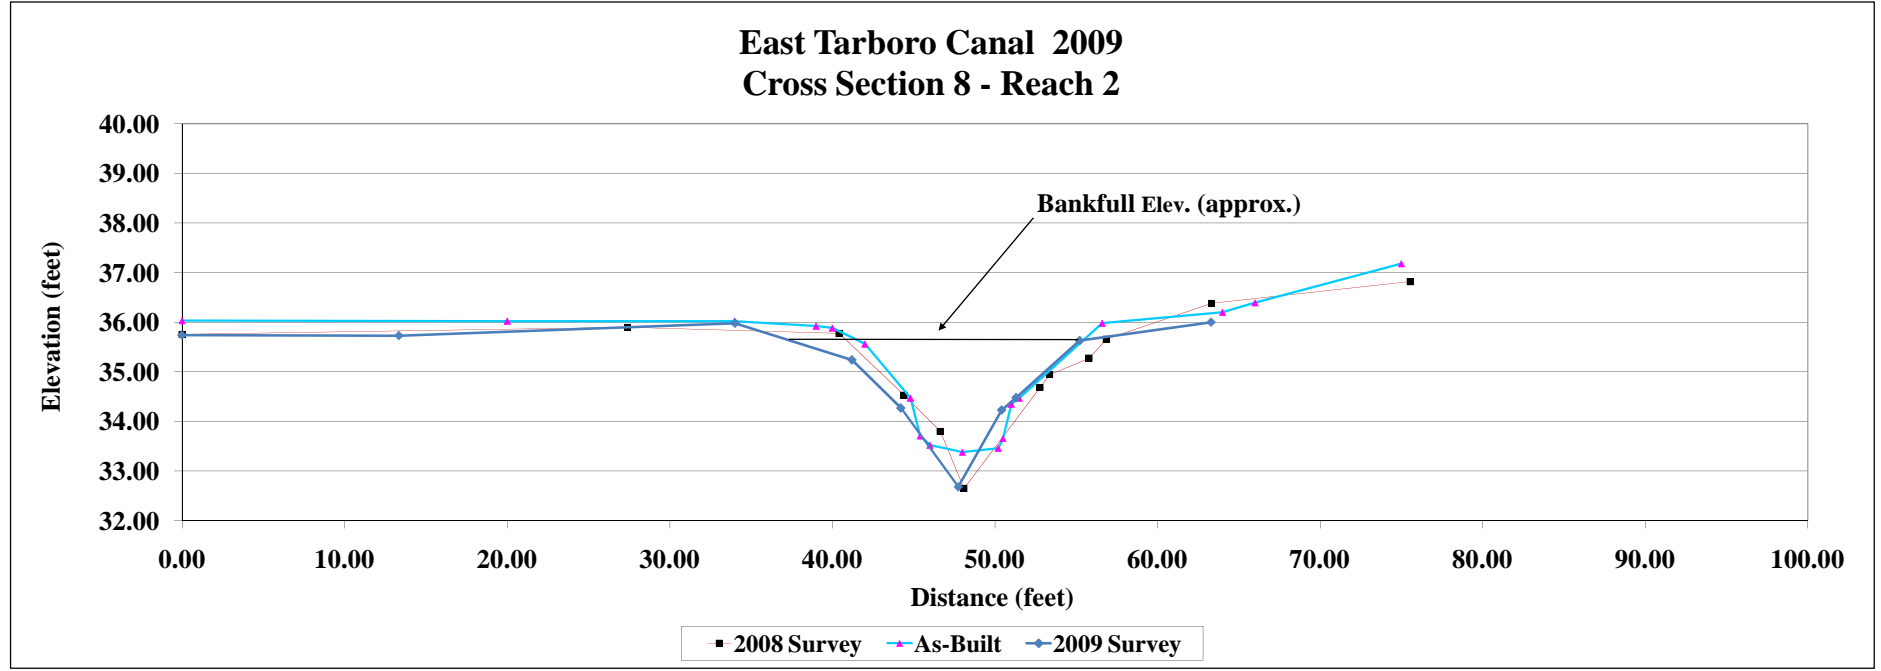


Project Name	East Tarboro Canal
Cross Section	#9
Feature	
Date	Aug-09
Crew	Tutt, Stafford

As-Built Survey			2008 Survey			2009 Survey			2010 Survey			2011 Survey			2012 Survey		
Station	Elevation	Notes	Station	Elevation	Notes	Station	Elevation	Notes	Station	Elevation	Notes	Station	Elevation	Notes	Station	Elevation	Notes
0	34.41	LPIN	0.00	34.40		0.00	34.22										
20	34.44		31.81	34.84		10.00	34.22										
37	34.39		38.72	34.32		38.76	34.19										
42	34.61		39.90	33.24		50.10	30.60										
45	35.08		54.34	30.37		54.90	32.61										
47	34.51		57.17	32.15		55.85	32.99										
48.2	34		58.59	33.23		58.96	33.90										
49.2	32.08	LEW	60.90	33.91		65.41	34.26										
51	31.03	TW	65.70	34.41		77.54	34.01										
51.8	31.1		76.79	34.12		97.90	34.21										
53.1	31.71		99.09	34.35													
54.5	31.73																
55	32.08	REW															
58	32.74																
63	34																
67	34.24	BKF															
80	34.07																
90	34.1																
100	34.25																
101.4	34.25	RPIN															



Photo of Cross-Section #9 - Looking Downstream

	AsBuilt	2008	2009	2010	2011	2012
Area	27.34	22.11	23.30			
Width	19.36	34.70	14.00			
Mean Depth	1.41	0.50	1.70			
Max Depth	3.21	4.90	3.30			
W/D	13.73	66.90	8.40			

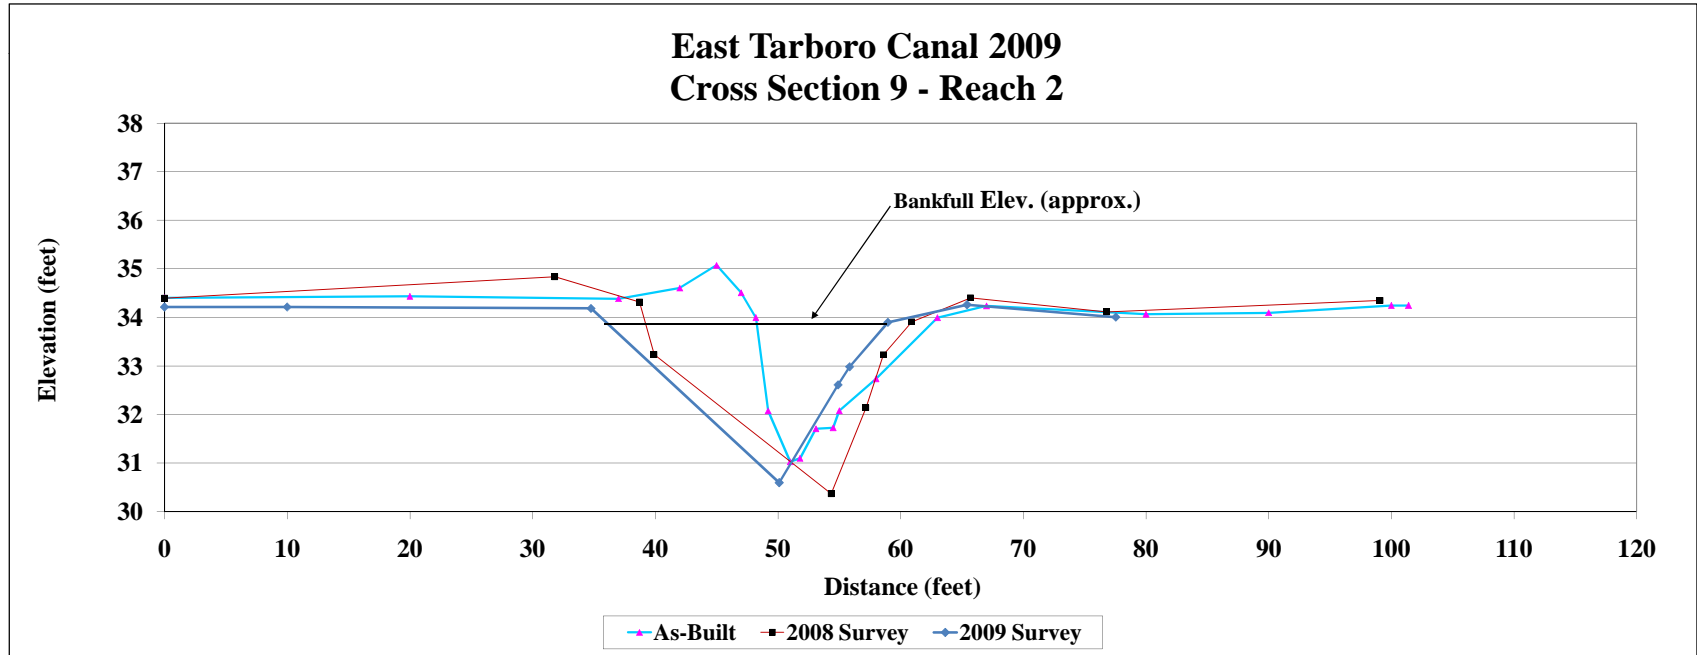


Project Name	East Tarboro Canal
Cross Section	#10
Feature	
Date	Aug-09
Crew	Tutt, Stafford

As-Built Survey			2008		2009		2010		2011		2012	
Station	Elevation	Notes	Station	Elevation	Station	Elevation	Station	Elevation	Station	Elevation	Station	Elevation
0	33.78	LPIN	0.00	33.78	0.00	33.79						
10	33.86		25.81	34.00	32.90	33.86						
20	33.83		38.28	33.73	40.35	33.58						
36	33.92		40.74	33.33	43.73	33.01						
38	33.82		44.20	32.16	45.54	32.59						
41	33.37		45.45	31.53	46.89	31.04						
44	32.82		46.60	30.99	53.95	32.69						
45.1	32.25		51.25	31.75	56.42	33.00						
45.6	31.68	LEW	51.99	32.46	58.23	33.70						
45.6	31.52		52.72	32.62	76.34	33.94						
46.8	31.13	TW	53.86	32.89	100.78	33.88						
48	31.21		54.66	33.16								
49.6	31.26		59.39	33.85								
50.8	31.28		99.61	34.07								
51.2	31.67	REW										
53	32.36											
55.3	32.99											
59	33.76	BKF										
66	33.83											
71	33.89											
82	34.21											
92	34.14											
100	33.84	RPIN										



Photo of Cross-Section #10 - Looking Downstream

	AsBuilt	2008	2009	2010	2011	2012
Area	25.78	21.60	19.96			
Width	20.60	22.70	19.52			
Mean Depth	1.25	1.00	1.02			
Max Depth	2.63	2.90	2.66			
W/D	16.48	23.80	19.10			

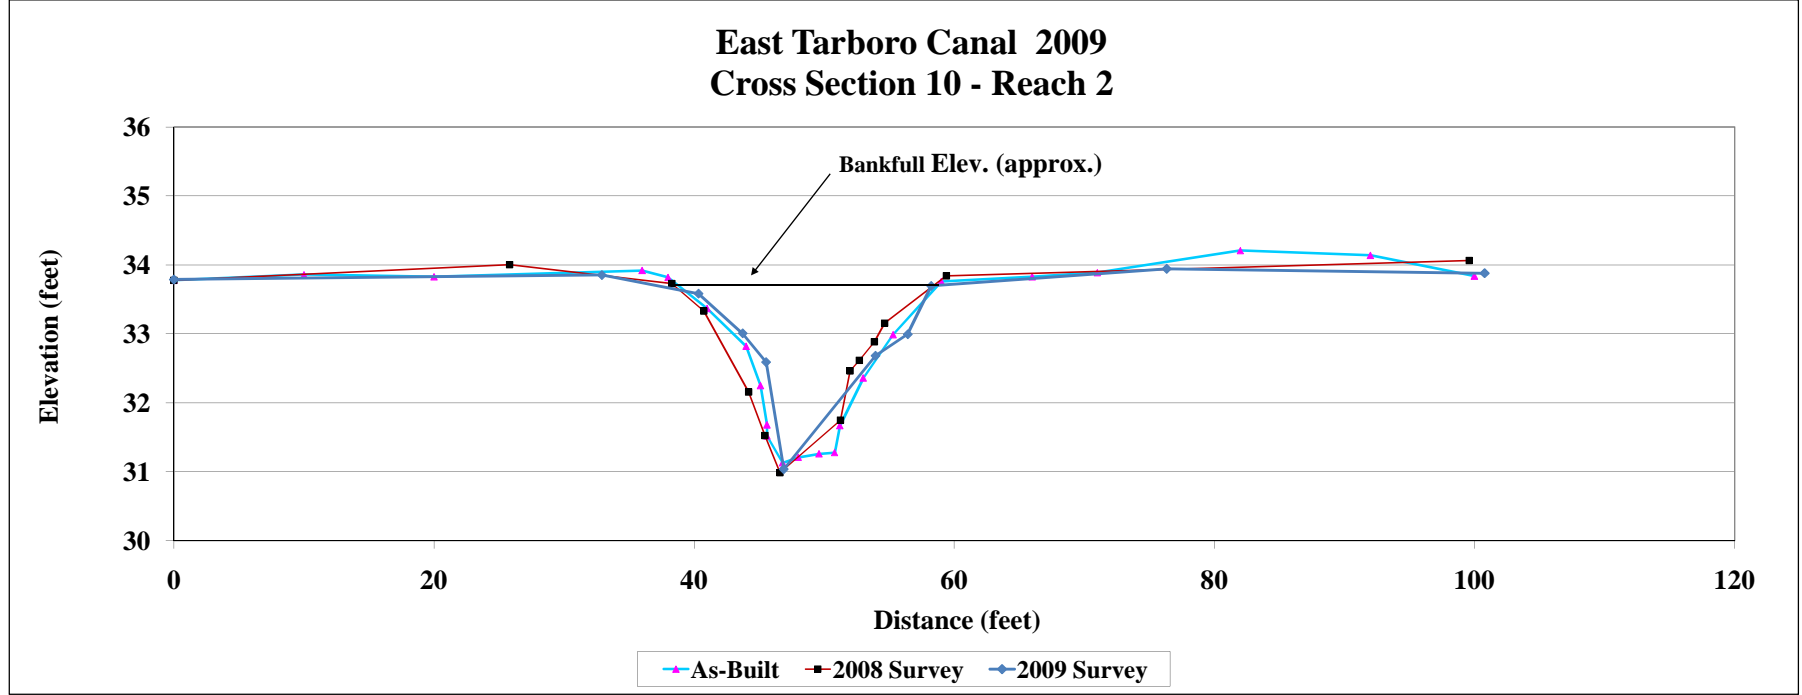


Project Name	East Tarboro Canal
Cross Section	#11
Feature	
Date	Aug-09
Crew	Tutt, Stafford

As-Built Survey			2008		2009		2010		2011		2012	
Station	Elevation	Notes	Station	Elevation	Station	Elevation	Station	Elevation	Station	Elevation	Station	Elevation
0	34.73	LPIN	100.86	33.99	0.00	34.72						
7	33.02		95.21	33.37	0.31	34.83						
20	33.19		62.08	33.82	6.82	33.21						
37	33.06	BKF	55.44	33.17	17.23	33.22						
45	31.42		53.68	32.85	34.84	33.11						
47.4	31.13	LEOW	52.99	32.31	40.96	32.63						
50	30.77		51.53	32.06	43.29	32.37						
51	30.58		49.29	30.12	45.86	32.19						
52	30.38	TW	45.72	31.37	51.42	30.16						
53.8	30.67		43.52	32.00	55.18	32.64						
53.8	31.15	REOW	38.01	33.01	55.96	32.75						
54.1	32.53		26.25	33.39	57.21	33.24						
56	33.08		4.14	33.41	58.84	33.44						
62	33.56		0.00	34.63	63.32	33.62						
70	33.59				80.80	33.48						
90	33.27				96.16	33.27						
96	33.24				101.71	33.94						
100	33.83	RPIN										



Photo of Cross-Section #11 - Looking Downstream

	AsBuilt	2008	2009	2010	2011	2012
Area	26.71	18.20	18.07			
Width	18.93	15.10	18.77			
Mean Depth	1.41	1.20	0.96			
Max Depth	2.68	2.90	2.94			
W/D	13.43	12.60	19.50			

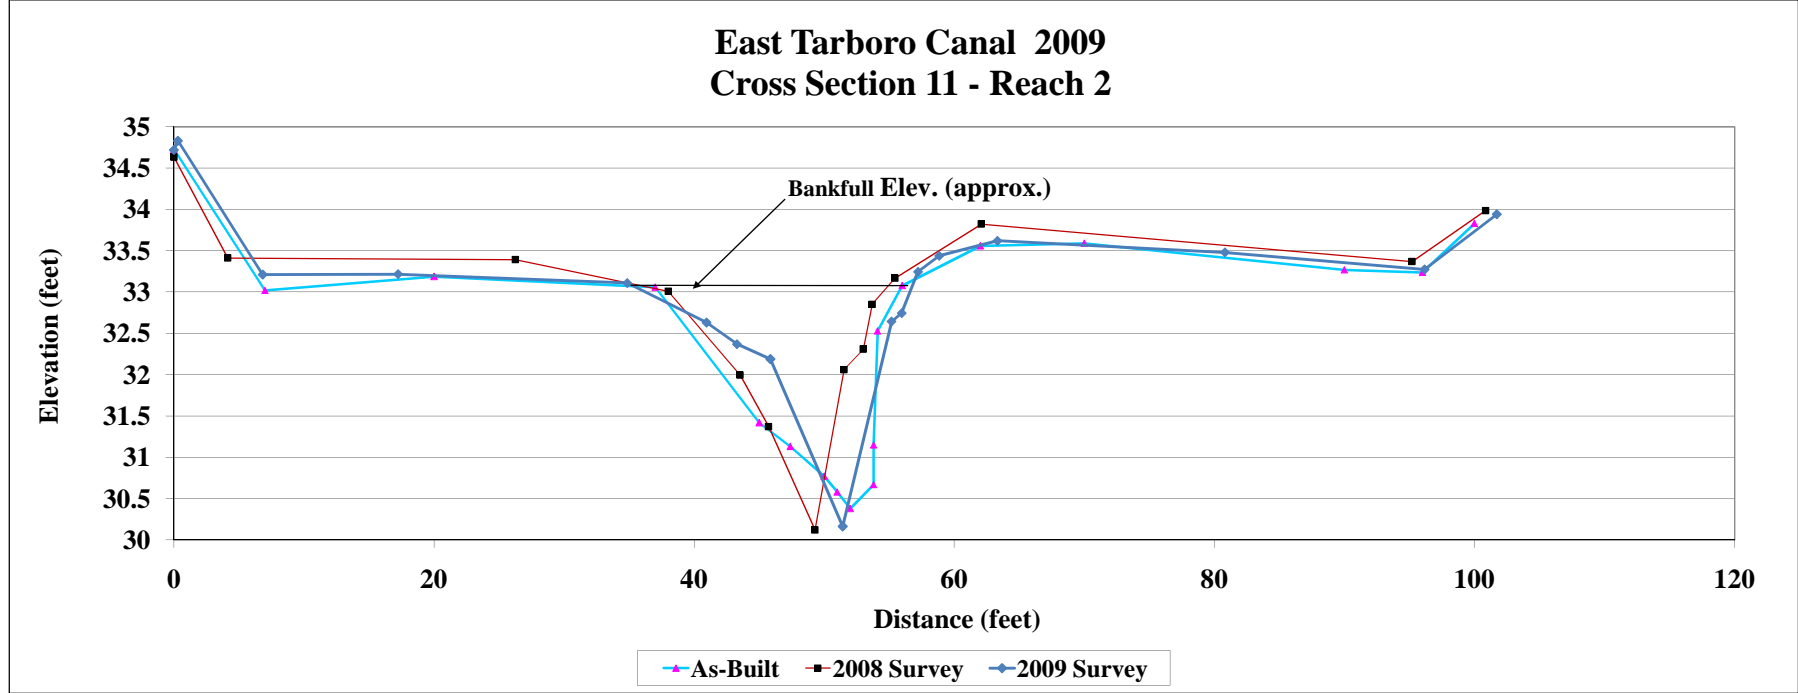


Project Name	East Tarboro Canal
Cross Section	#12
Feature	
Date	Aug-09
Crew	Tutt, Stafford

As-Built Survey			2008		2009		2010		2011		2012	
Station	Elevation	Notes	Station	Elevation	Station	Elevation	Station	Elevation	Station	Elevation	Station	Elevation
0	34.74	LPIN	0	32.54	0.00	32.02						
7.4	32.83		21.01	32.262	26.33	32.62						
13.8	32.64		31.01	32.855	36.95	32.55						
15.8	32.13		39.38	32.3439	40.97	32.13						
17.3	31.47		40.89	31.545	41.73	31.88						
21	31.13		42.18	31.3237	42.96	29.83						
26.3	31.47		42.76	30.9748	45.59	29.83						
29	32.58		44.28	29.9971	50.82	31.56						
37	32.78		48.01	31.2924	51.74	32.02						
41	31.67		49.82	31.9828	53.33	32.00						
42.2	31.04	LEW	52.41	32.6088	59.54	32.82						
43	30.42		57.65	33.074	75.48	32.48						
45.3	30.24	TW	67.42	32.814	101.87	32.86						
47	30.41		100.49	32.896								
48.7	30.53											
49	31.04	REW										
55	32.76	BKF										
69	32.72											
80	32.76											
99	32.76											
100	32.97	RPIN										



Photo of Cross-Section #12 - Looking Downstream

	AsBuilt	2008	2009	2010	2011	2012
Area	24.83	12.90	14.28			
Width	18.13	15.60	17.98			
Mean Depth	1.37	0.80	0.79			
Max Depth	2.52	2.30	2.18			
W/D	13.23	18.90	22.60			

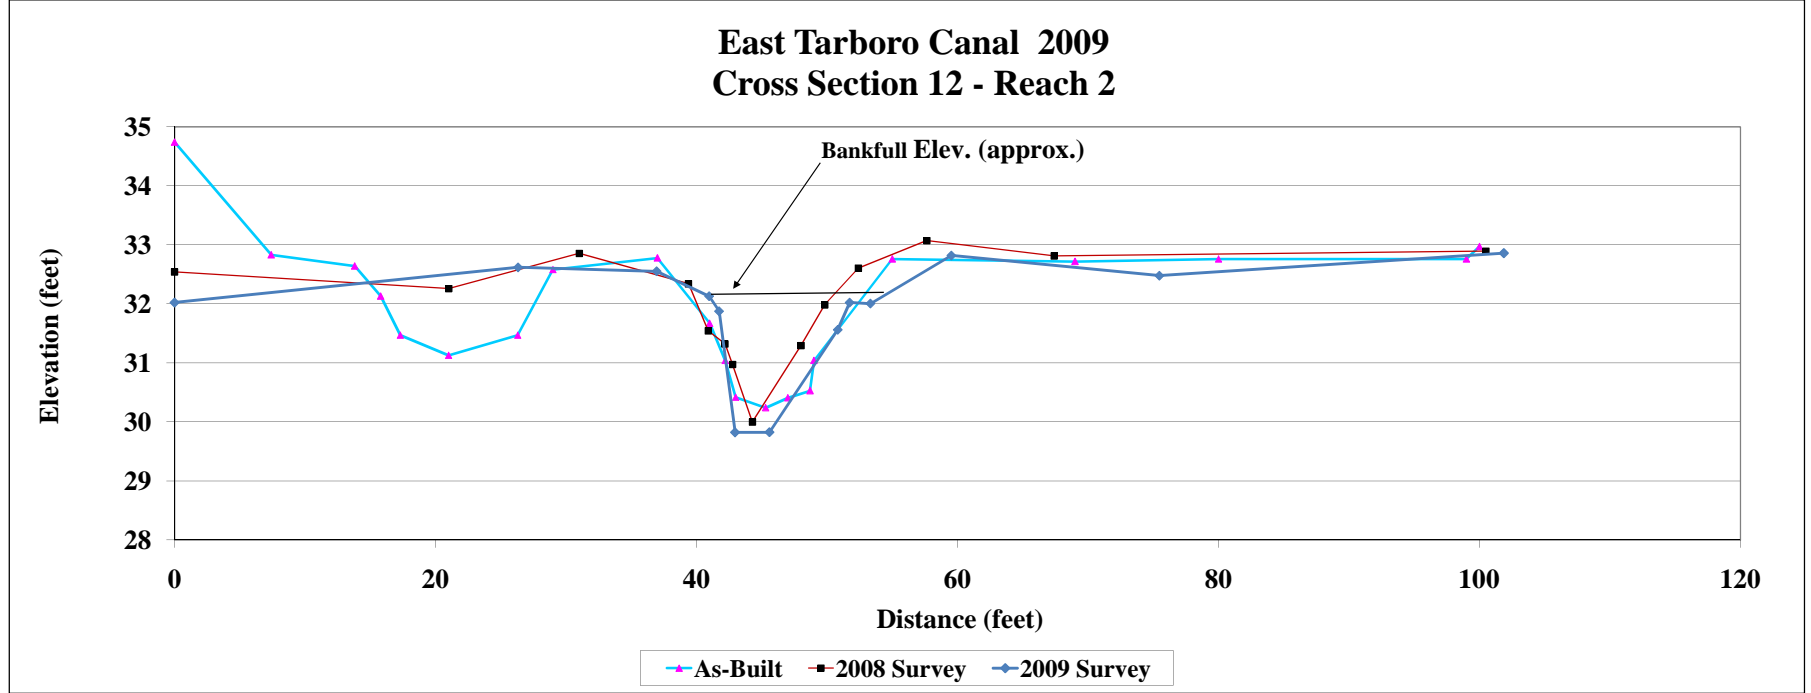


Project Name	East Tarboro Canal
Cross Section	#13
Feature	
Date	Aug-09
Crew	Tutt, Stafford

As-Built Survey			2008		2009		2010		2011		2012	
Station	Elevation	Notes	Station	Elevation	Station	Elevation	Station	Elevation	Station	Elevation	Station	Elevation
0	32.41	LPIN	0.00	32.50	0.00	32.02						
5	32.16		27.52	32.15	32.66	32.03						
26	32.04		41.46	32.04	46.73	31.47						
40	31.92	BKF	45.78	31.55	48.77	31.15						
49	31.14		47.33	31.09	55.98	29.21						
51.4	30.34	LEW	49.27	30.34	59.84	30.70						
52.7	29.68		52.64	30.73	61.89	30.92						
55	29.54		55.19	29.67	63.12	31.35						
57.8	28.96	TW	57.49	29.30	69.6	32.89						
58.6	29.22		58.70	30.30	93.82	32.12						
59.1	30.36	REW	59.76	31.12	105.18	35.08						
60	30.95		61.62	31.24								
61.3	31.89		62.70	31.84								
69	32.92		68.18	32.82								
80	32.32		92.94	32.27								
92.4	32.32		108.00	35.50								
100	34.44	RPIN										




Photo of Cross-Section #13 - Looking Downstream

	AsBuilt	2008	2009	2010	2011	2012
Area	26.73	13.50	11.43			
Width	21.52	9.60	10.99			
Mean Depth	1.24	1.40	1.04			
Max Depth	2.96	2.70	2.26			
W/D	17.35	6.90	10.60			

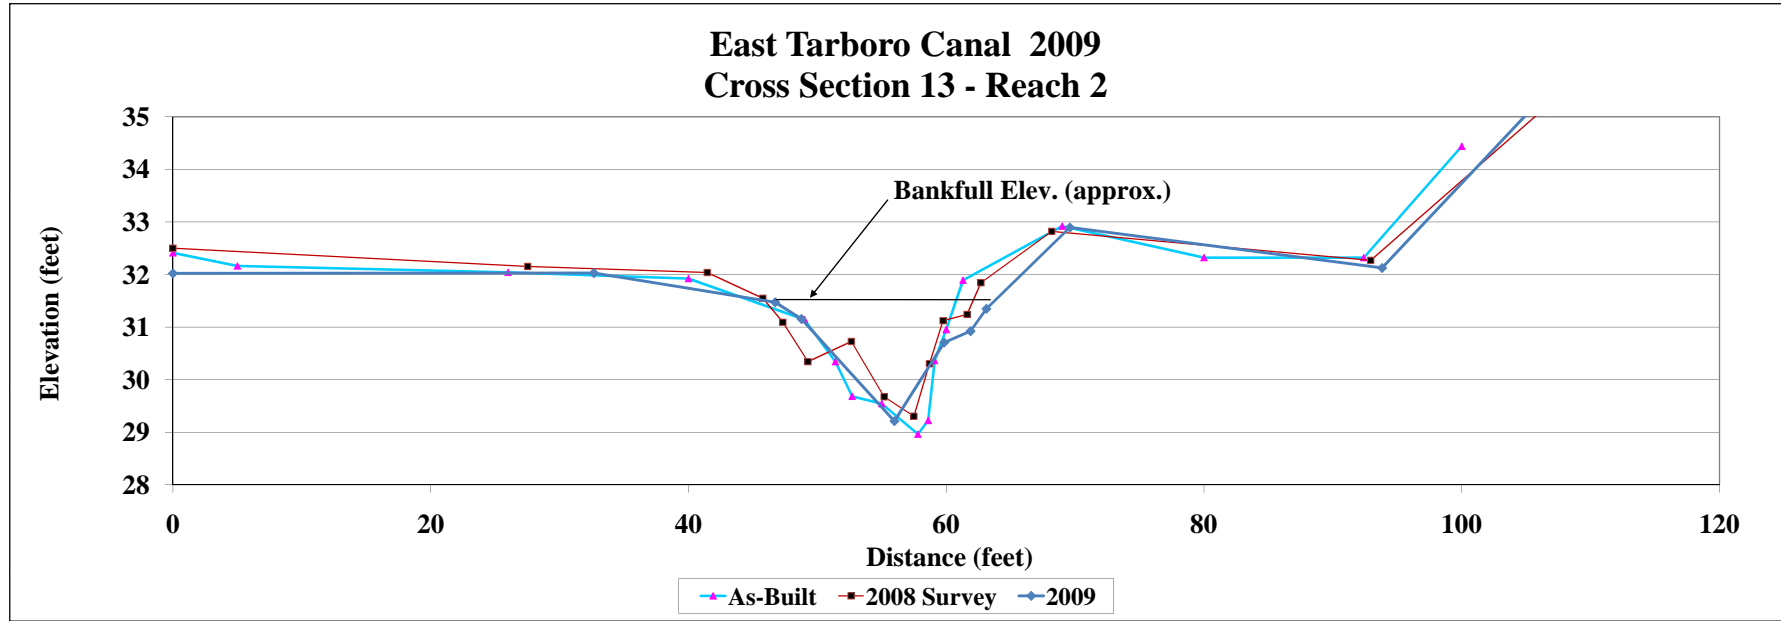


East Tarboro Canal
Longitudinal Profile
Reach 1
Station 00 to 1000

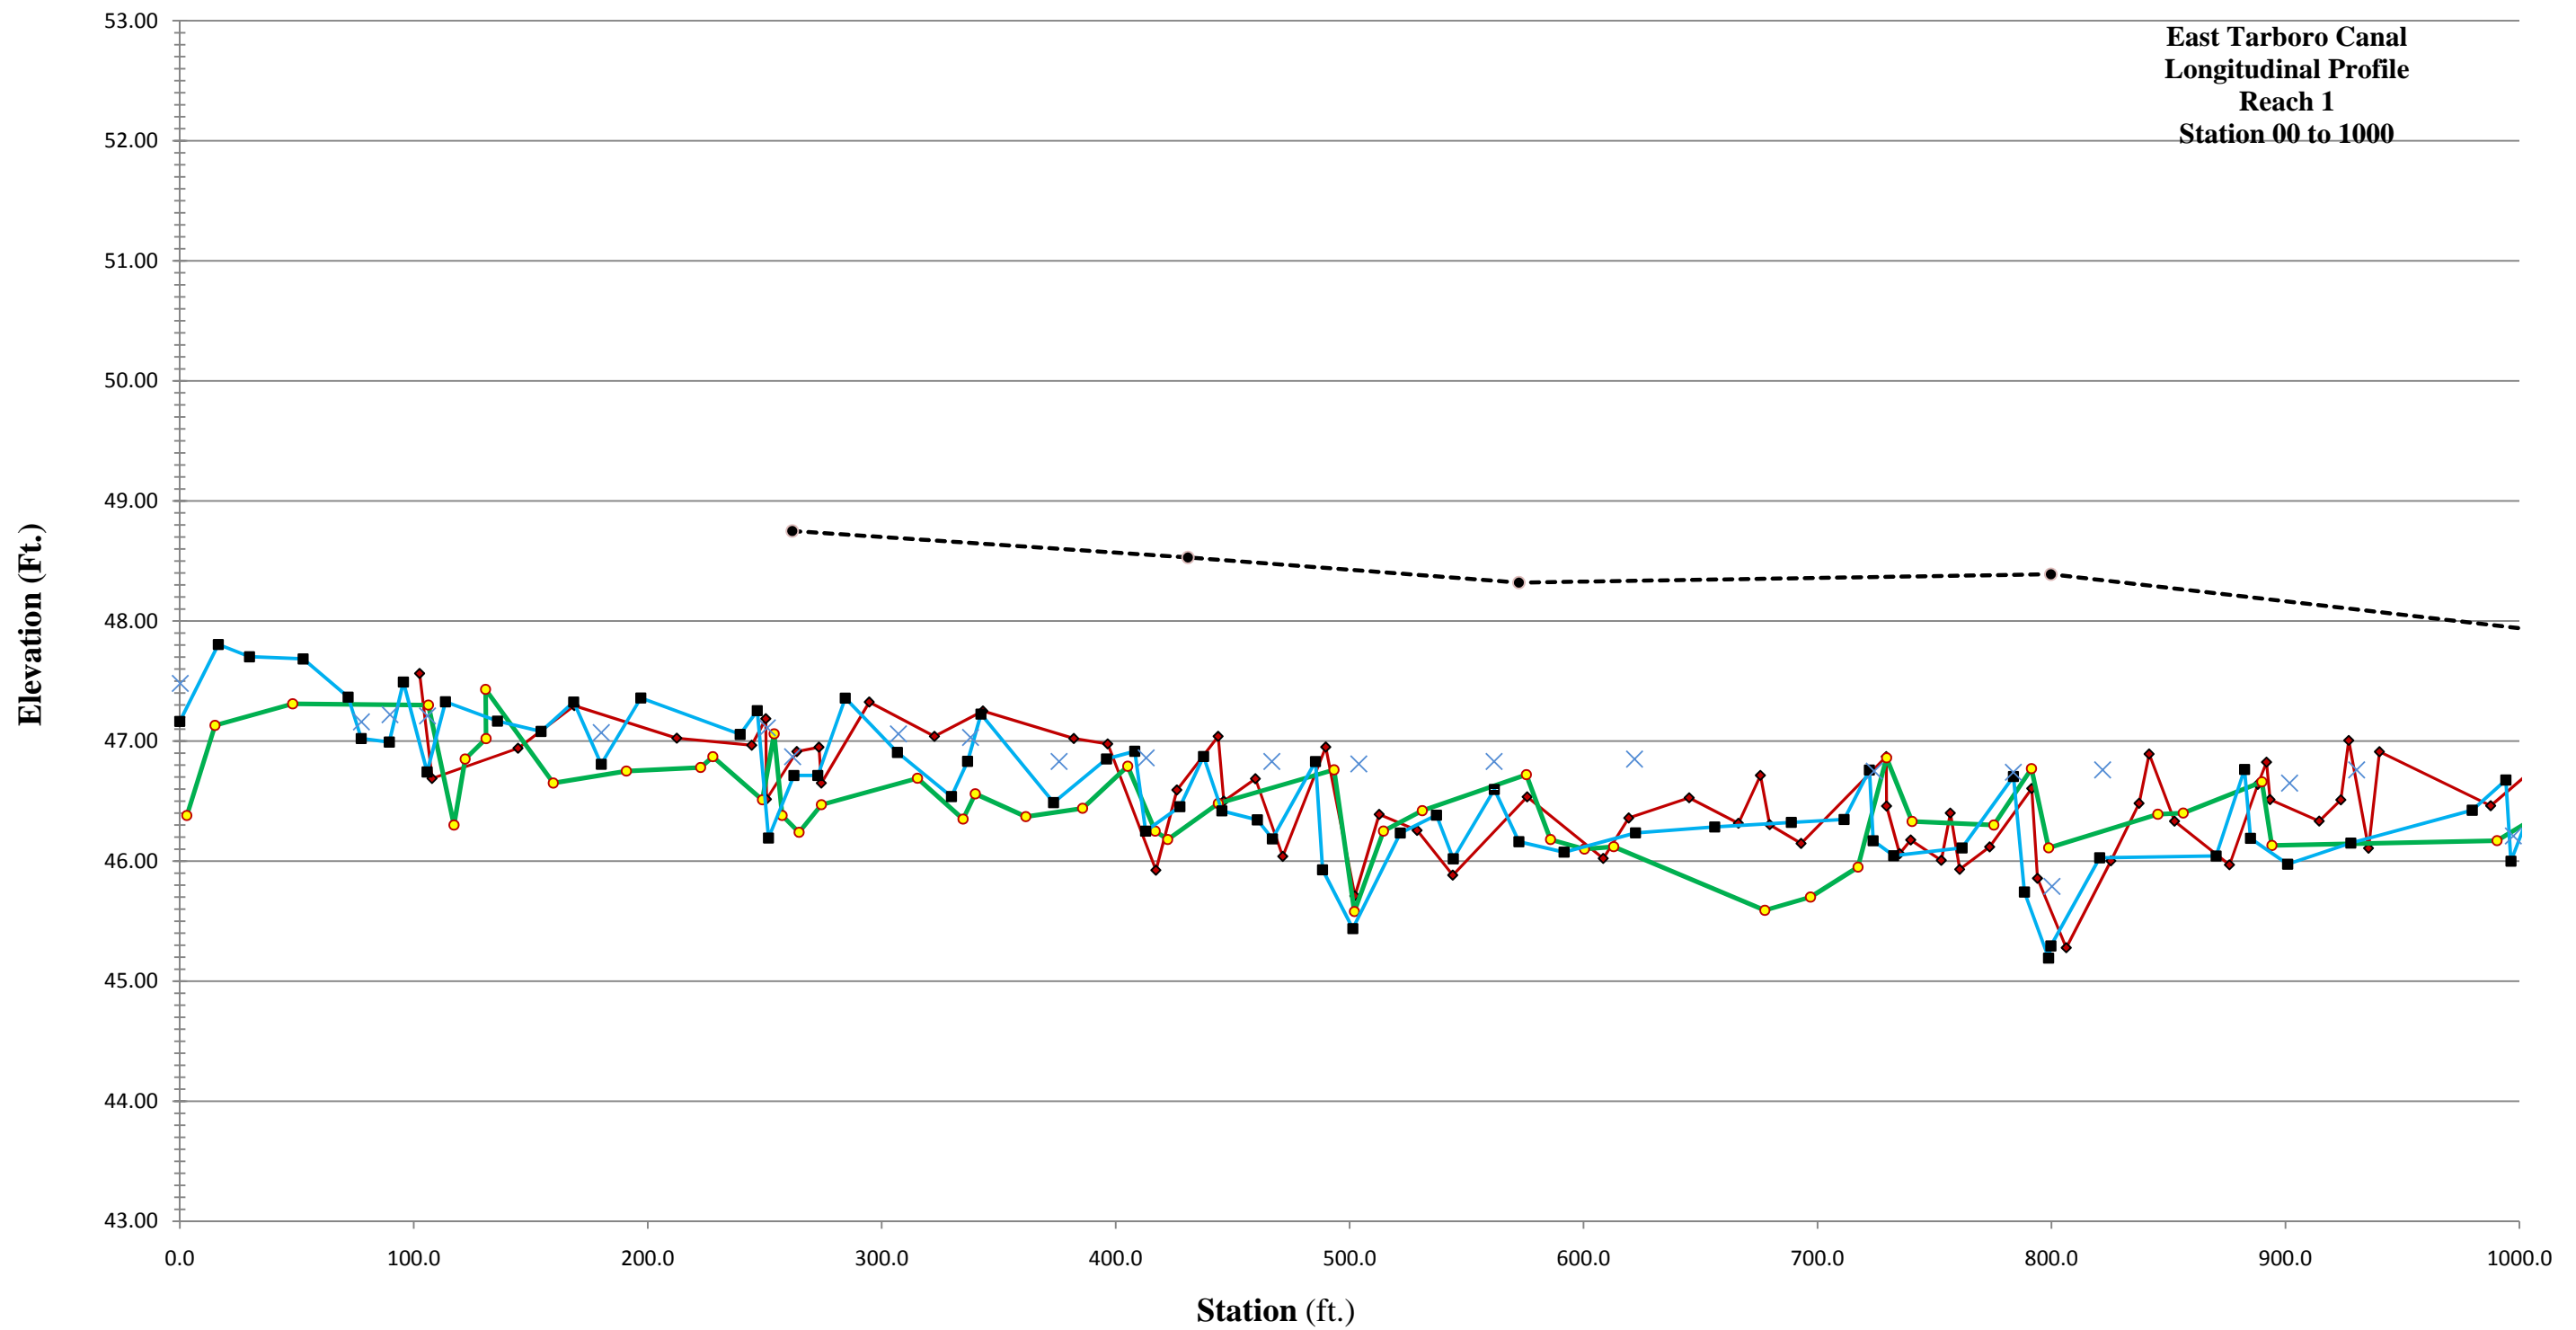


◆ 2008 Thalweg ● As-Built ■ 2009 Thalweg - - ● - - 2009 Bankfull × 2009 Water Surface

East Tarboro Canal
Longitudinal Profile
Reach 1
Station 1000 to 1600

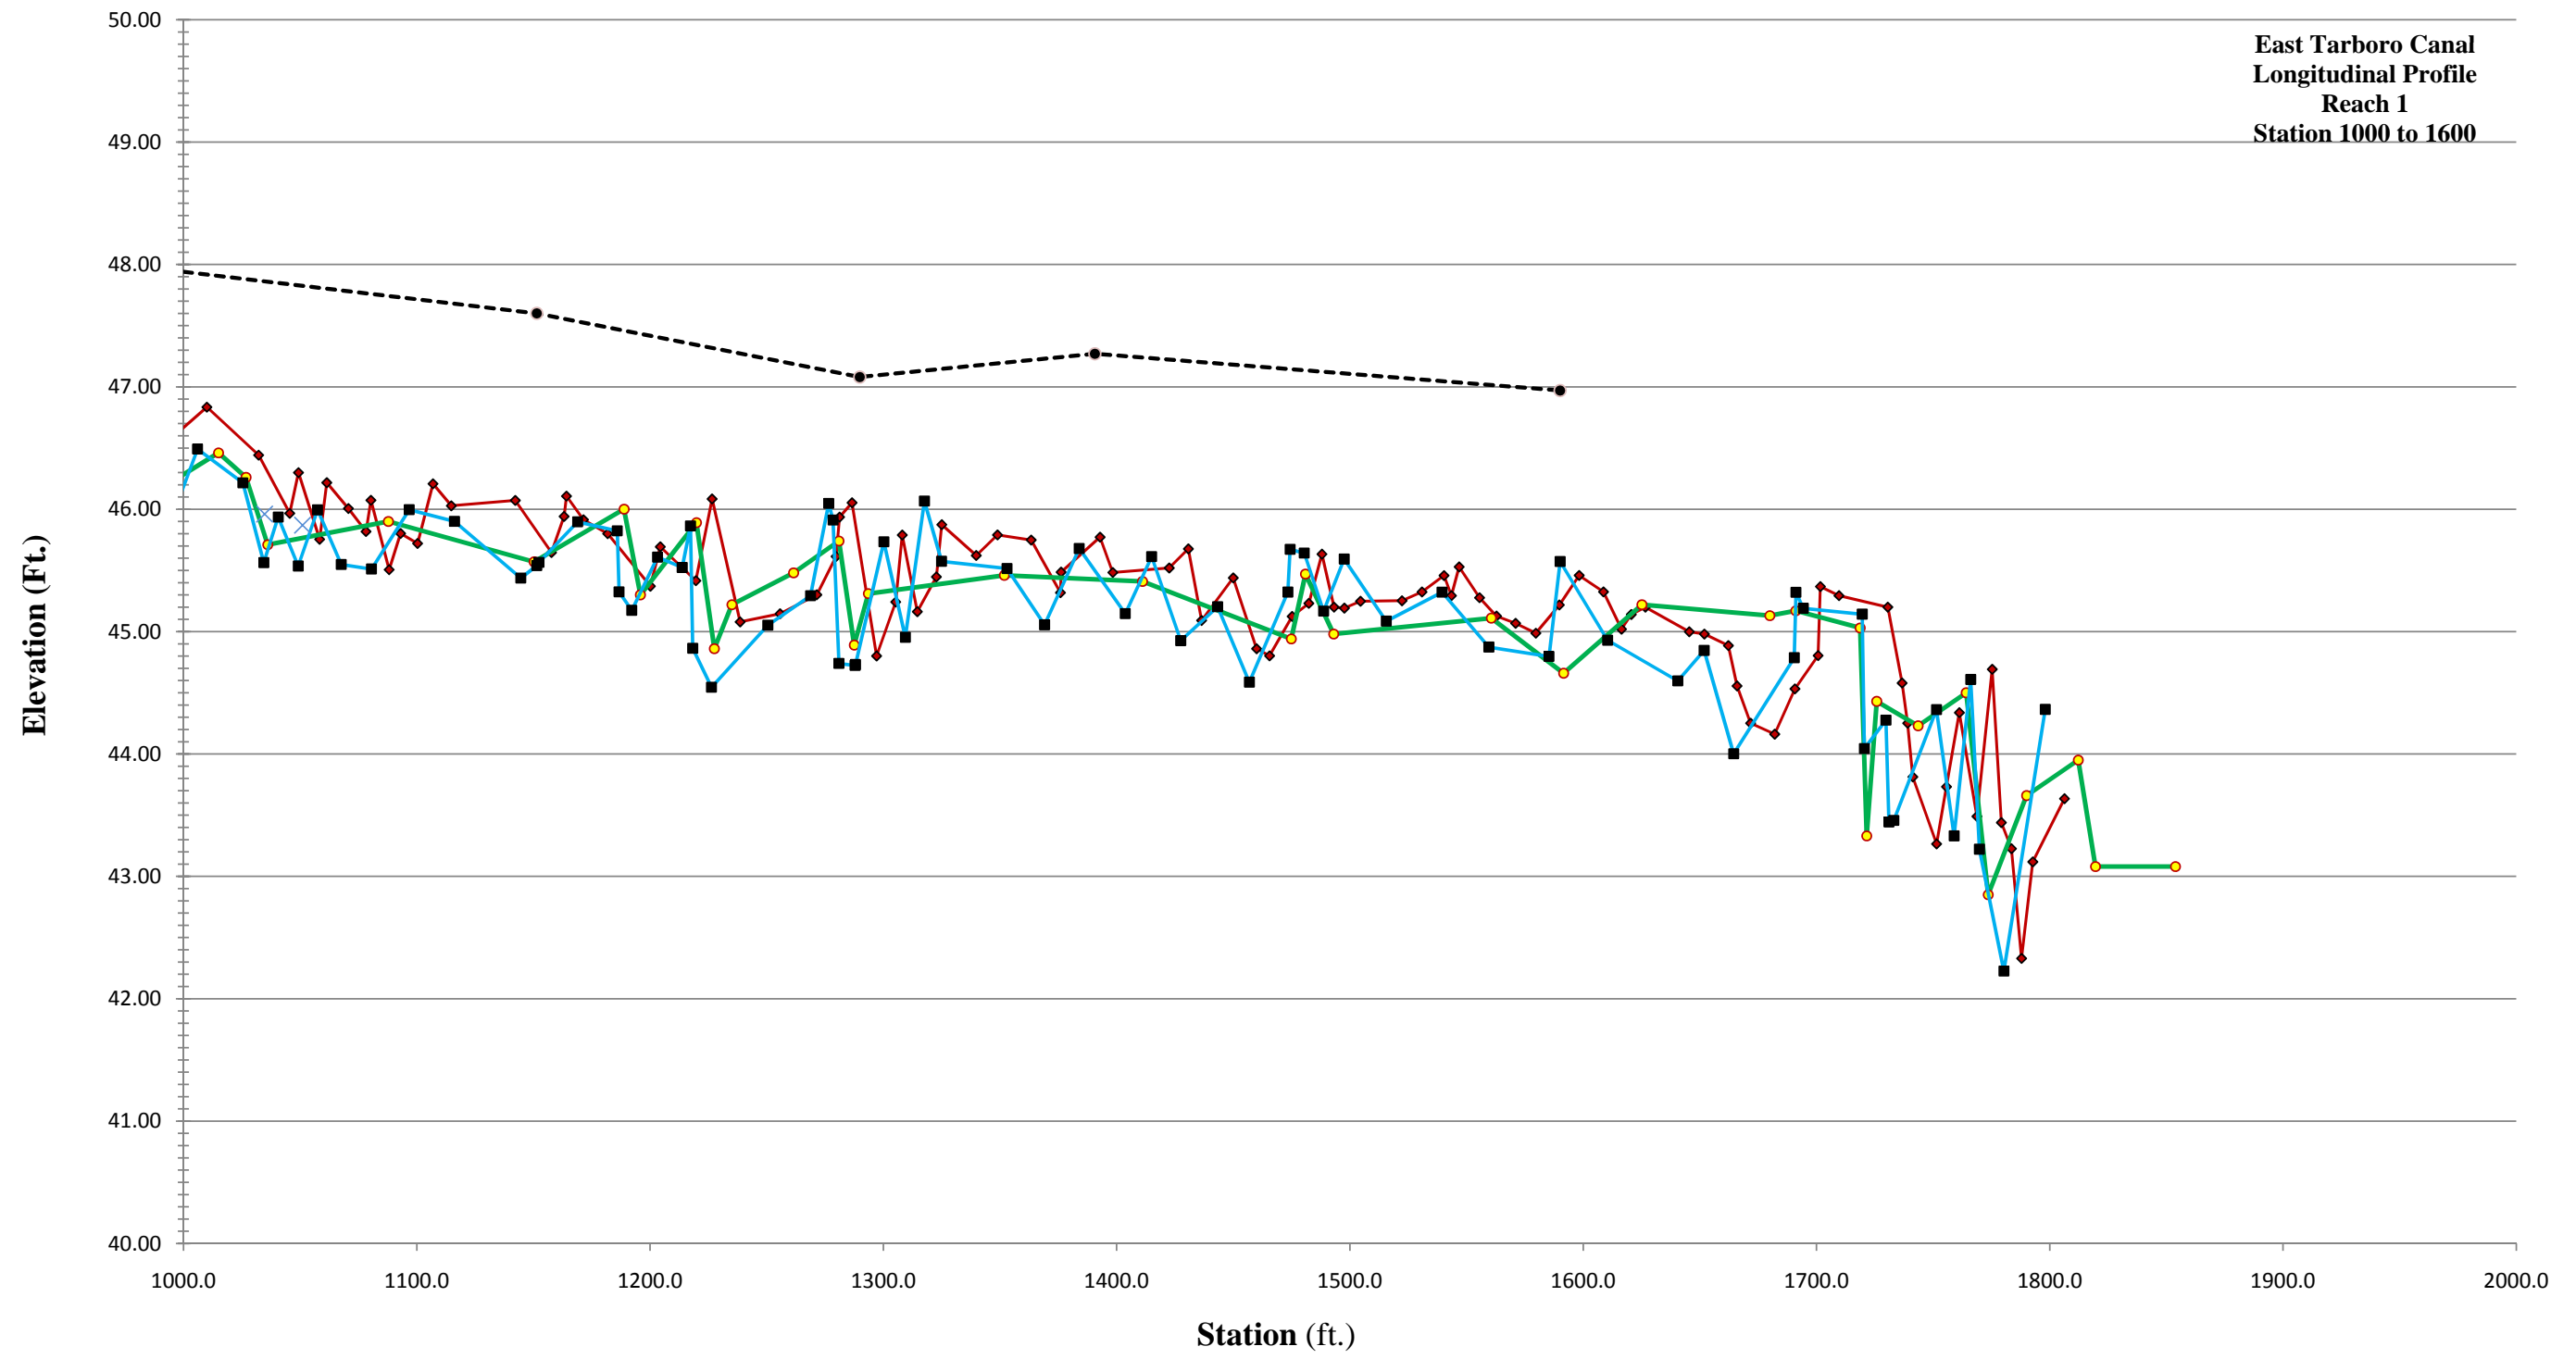


2008 Thalweg As-Built 2009 Thalweg 2009 Bankfull 2009 Water Surface

**East Tarboro Canal
Longitudinal Profile
Reach 2
Station 00 to 1600**

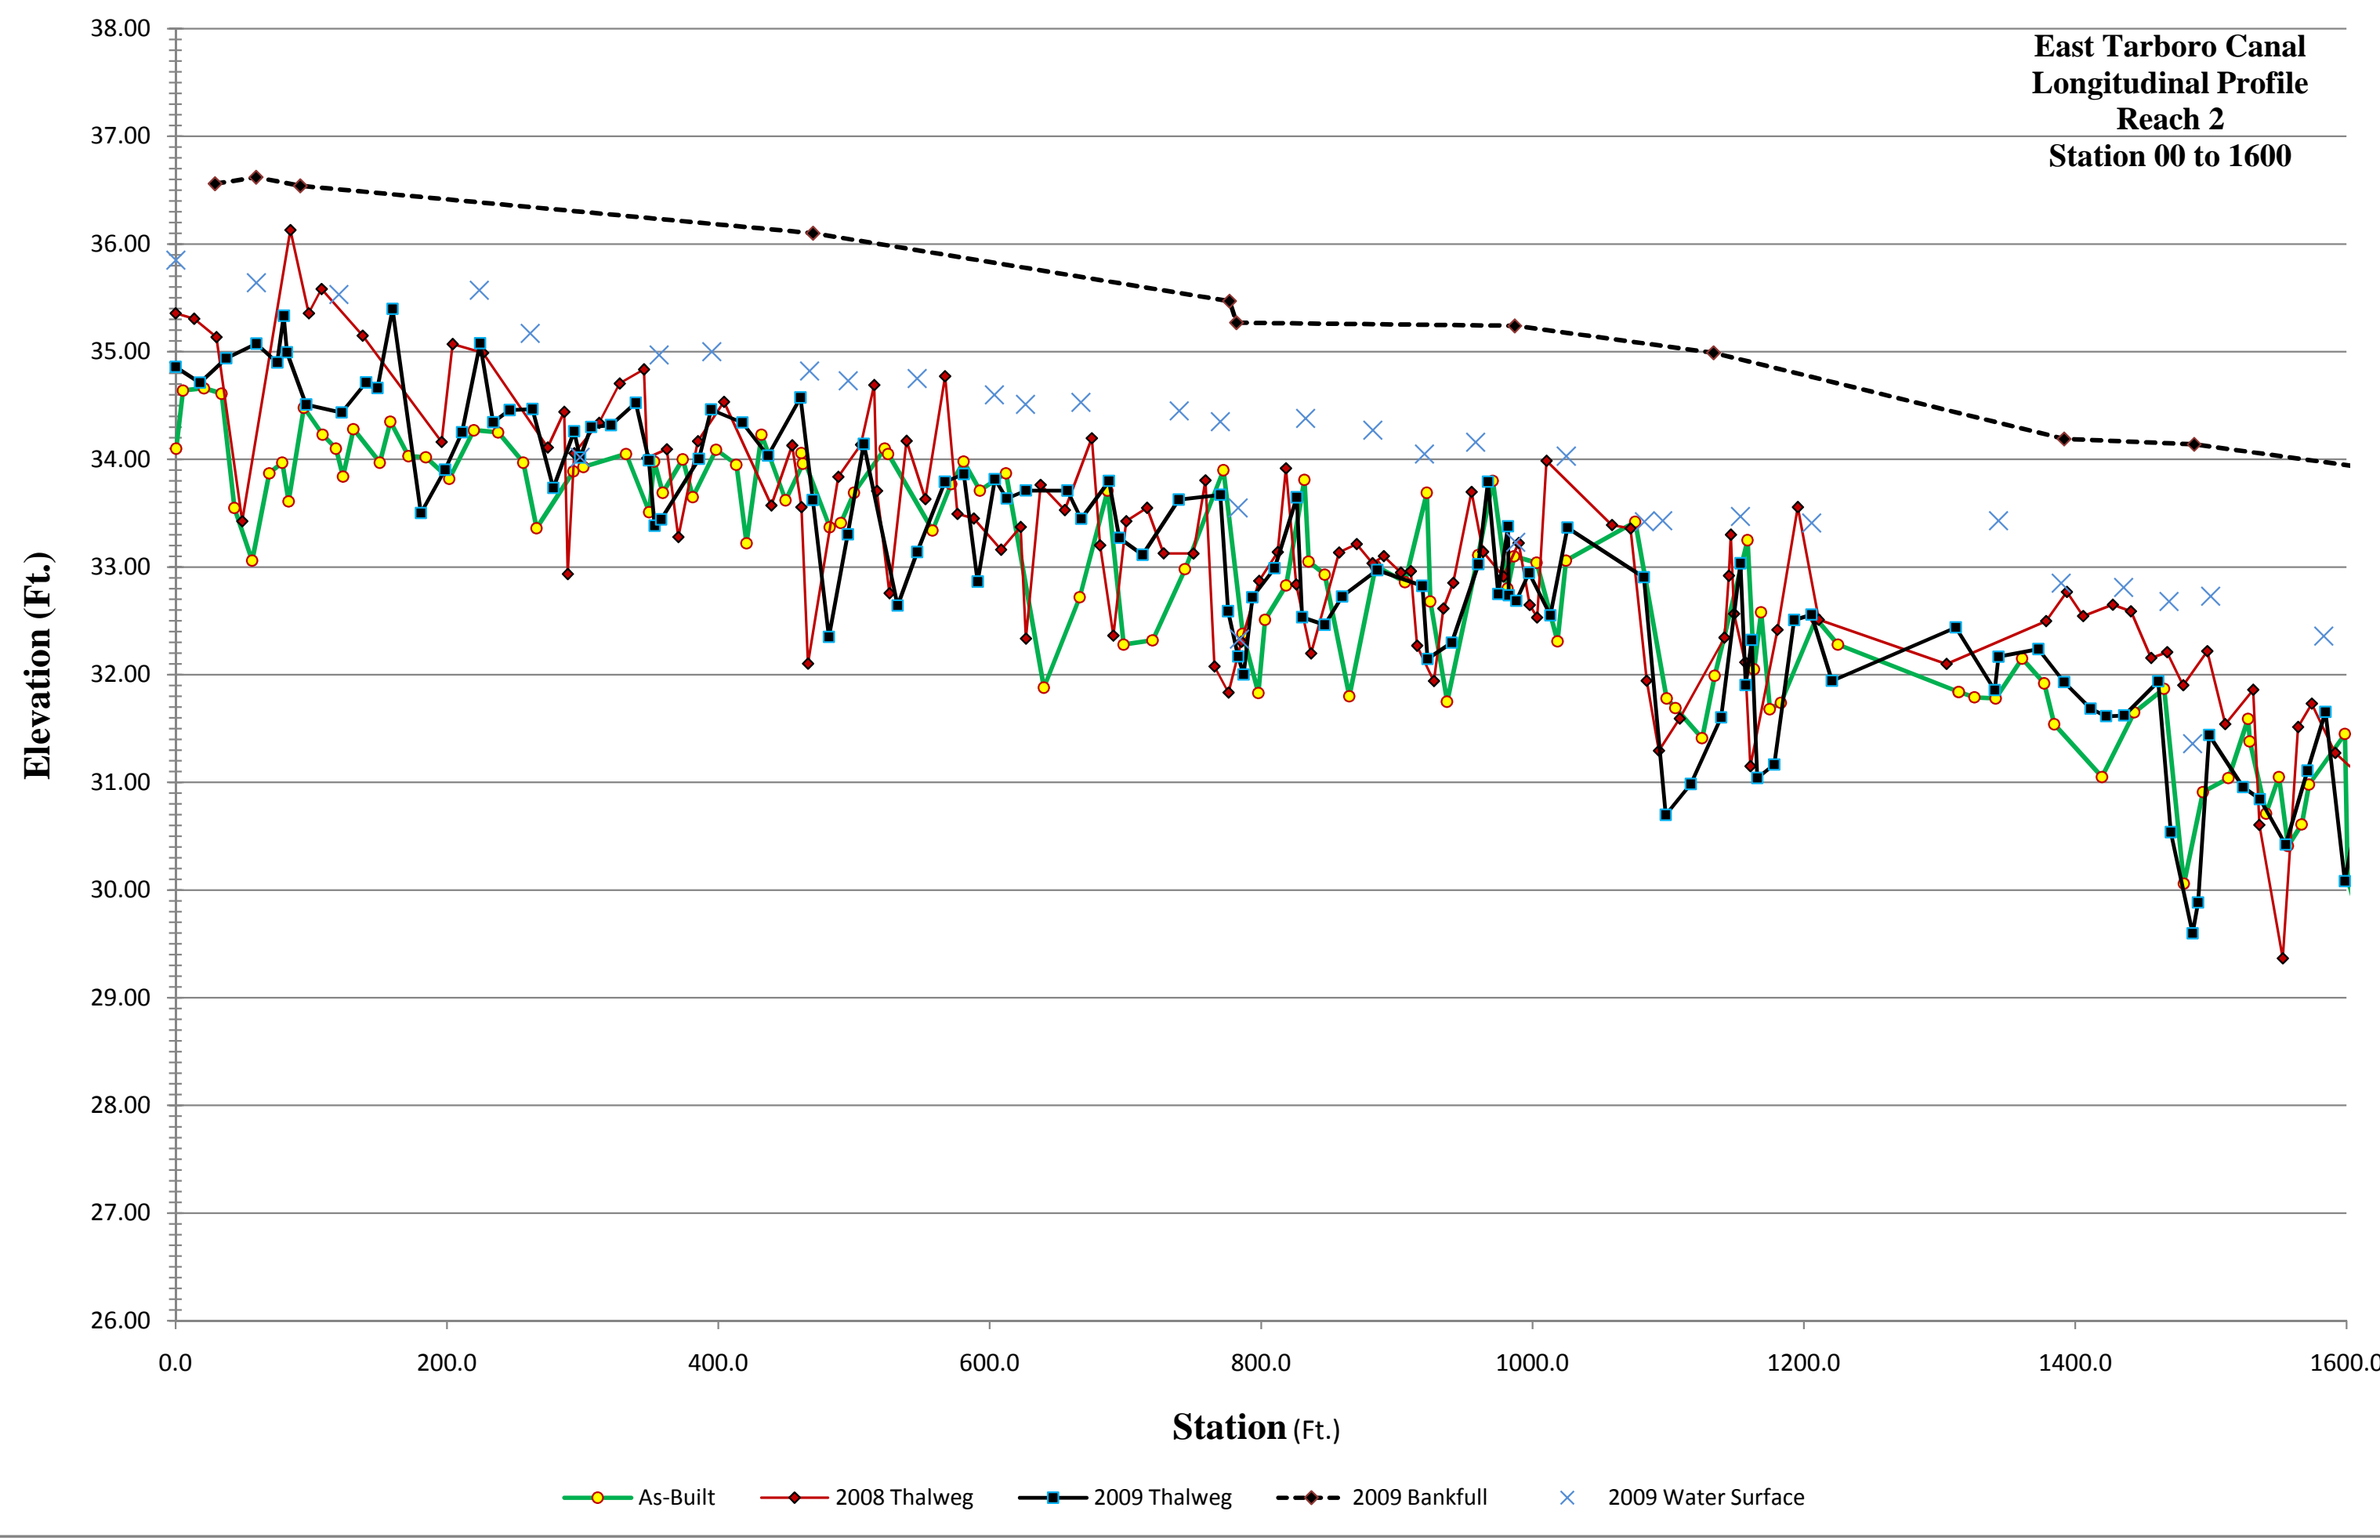


As-Built 2008 Thalweg 2009 Thalweg 2009 Bankfull 2009 Water Surface

**East Tarboro Canal
Longitudinal Profile
Reach 2
Station 1600 to 3200**

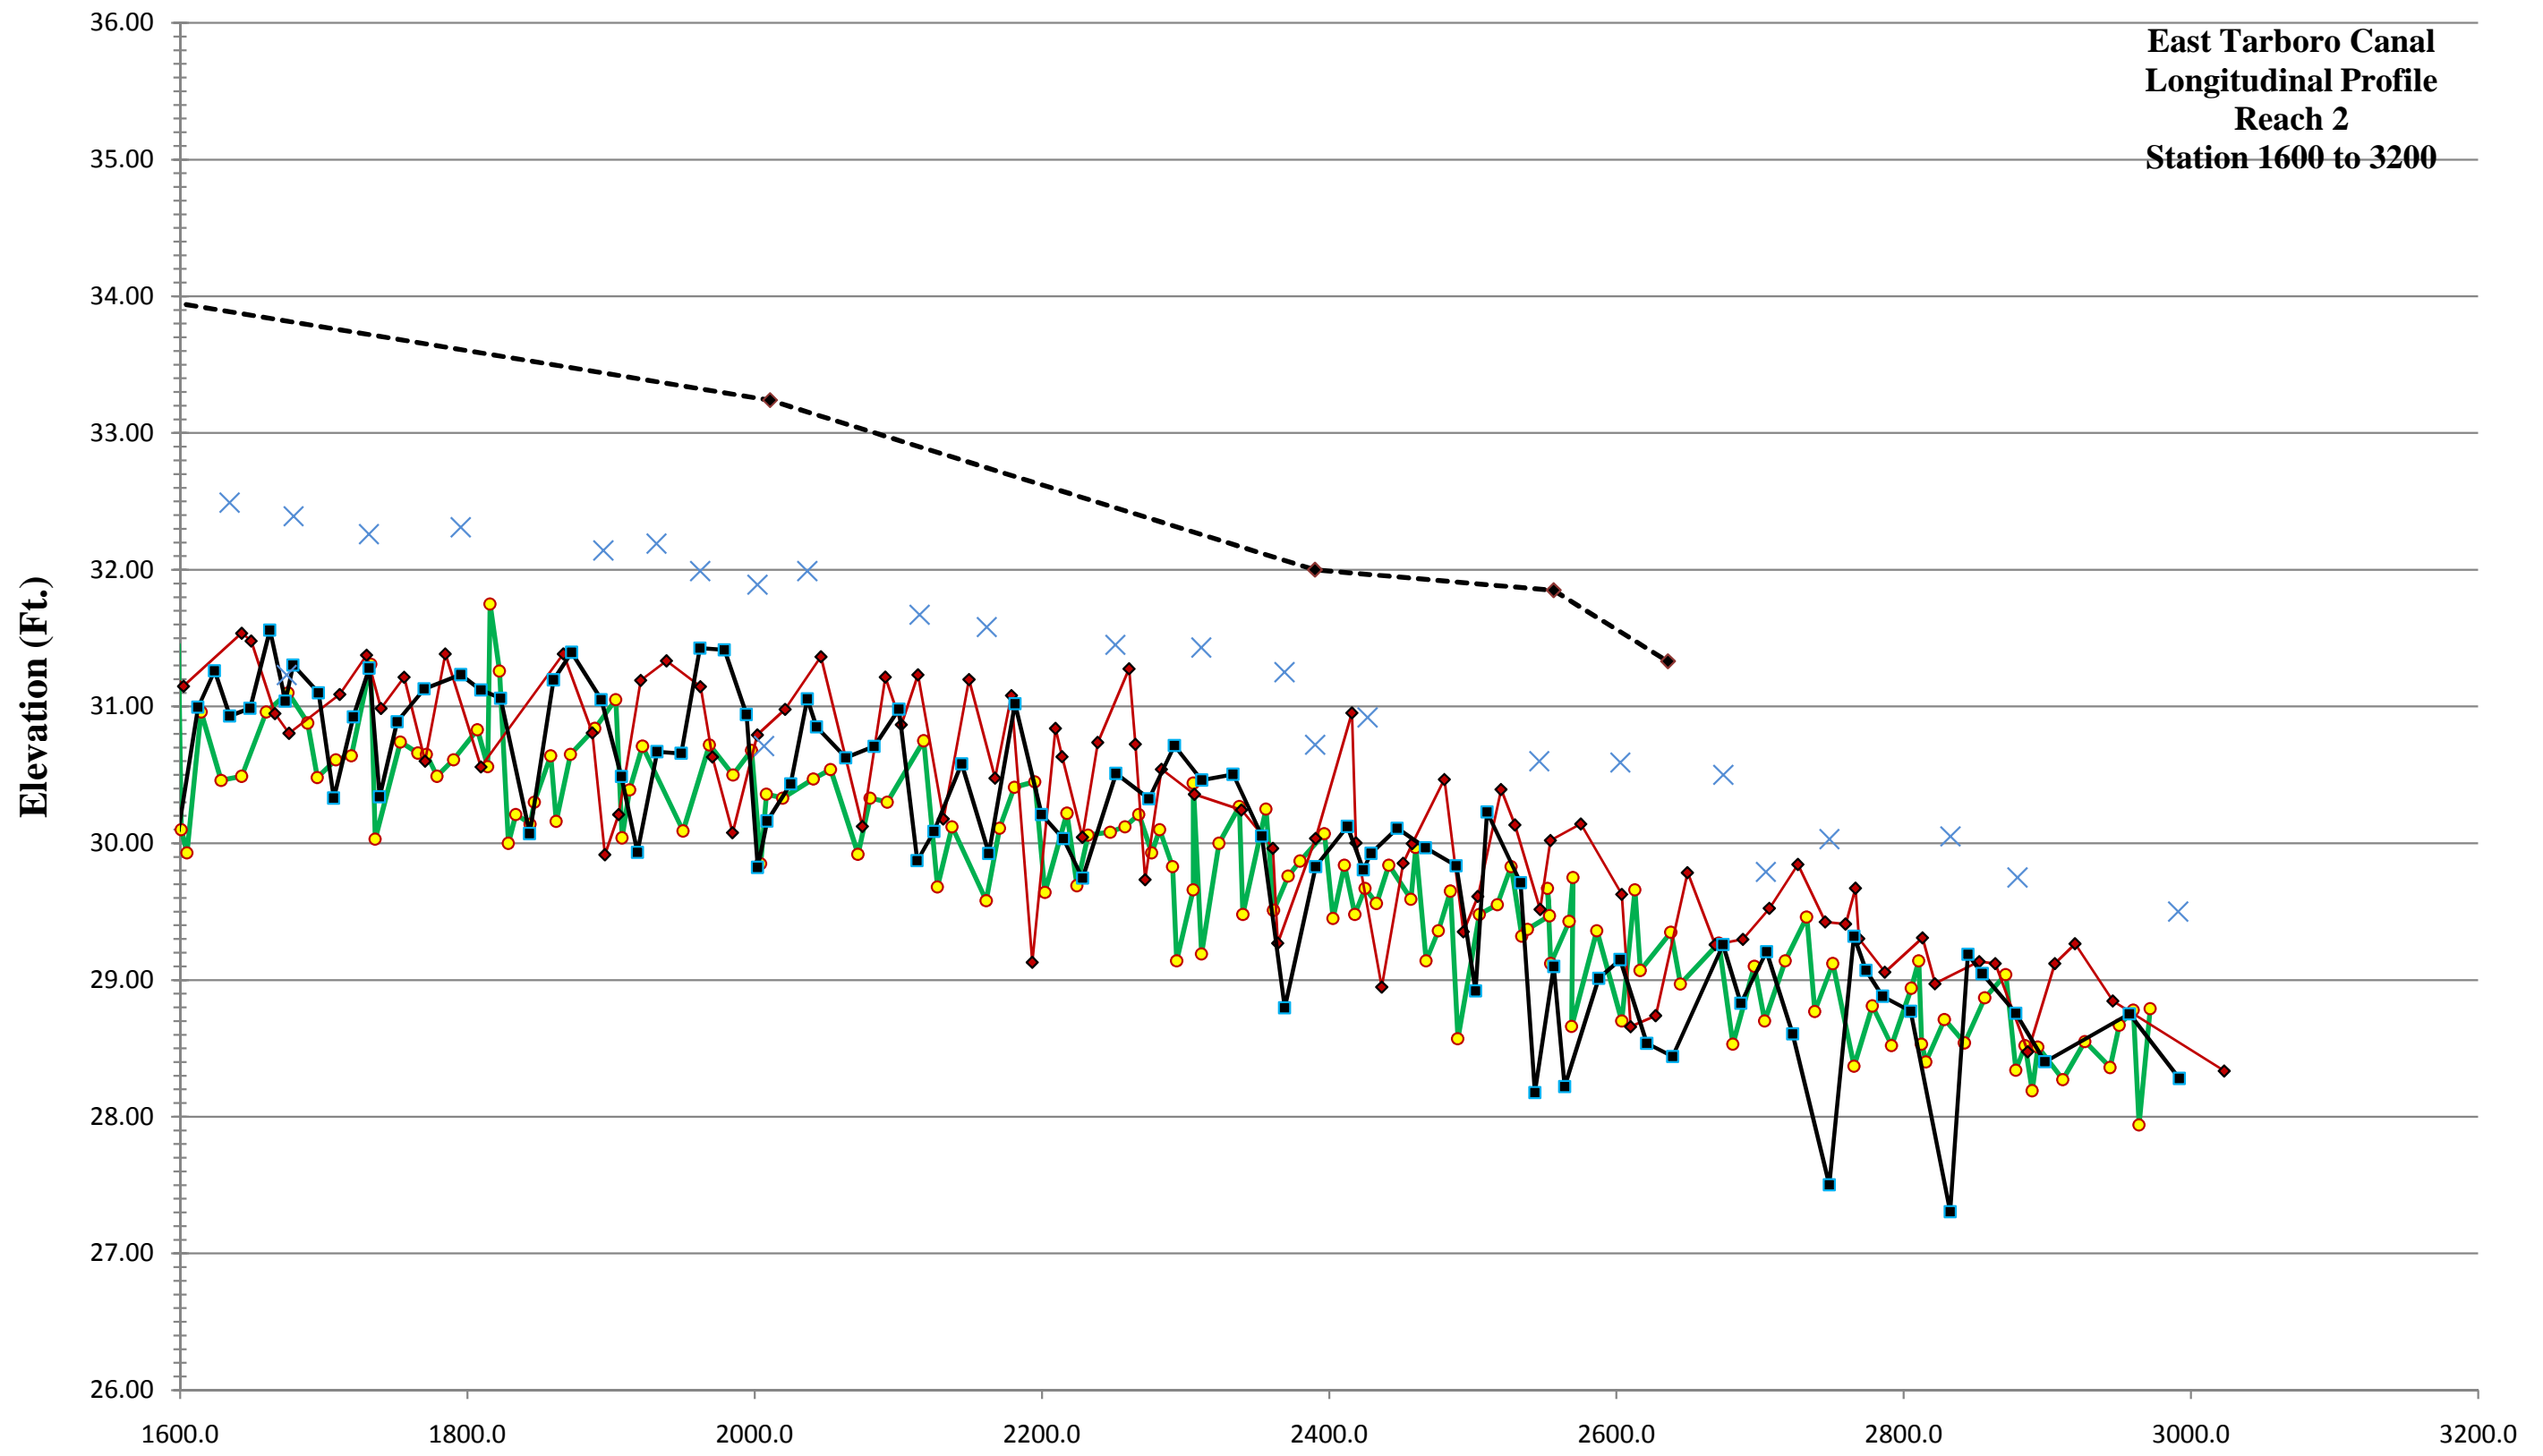


As-Built 2008 Thalweg 2009 Thalweg 2009 Bankfull 2009 Water Surface


Cross Section 1		
Material	Size Range (mm)	Count
silt/clay	0 - 0.062	40
very fine sand	0.062 - 0.125	26
fine sand	0.125 - 0.25	19
medium sand	0.25 - 0.5	11
coarse sand	0.5 - 1	2
very coarse sand	1 - 2	1
very fine gravel	2 - 4	1
fine gravel	4 - 6	0
fine gravel	6 - 8	0
medium gravel	8 - 11	0
medium gravel	11 - 16	
coarse gravel	16 - 22	
coarse gravel	22 - 32	
very coarse gravel	32 - 45	
very coarse gravel	45 - 64	
small cobble	64 - 90	
medium cobble	90 - 128	
large cobble	128 - 180	
very large cobble	180 - 256	
small boulder	256 - 362	
small boulder	362 - 512	
medium boulder	512 - 1024	
large boulder	1024 - 2048	
very large boulder	2048 - 4096	
total particle count:		100
bedrock	-----	
clay hardpan	-----	
detritus/wood	-----	
artificial	-----	
total count:		100
Note: Cross Section 1		

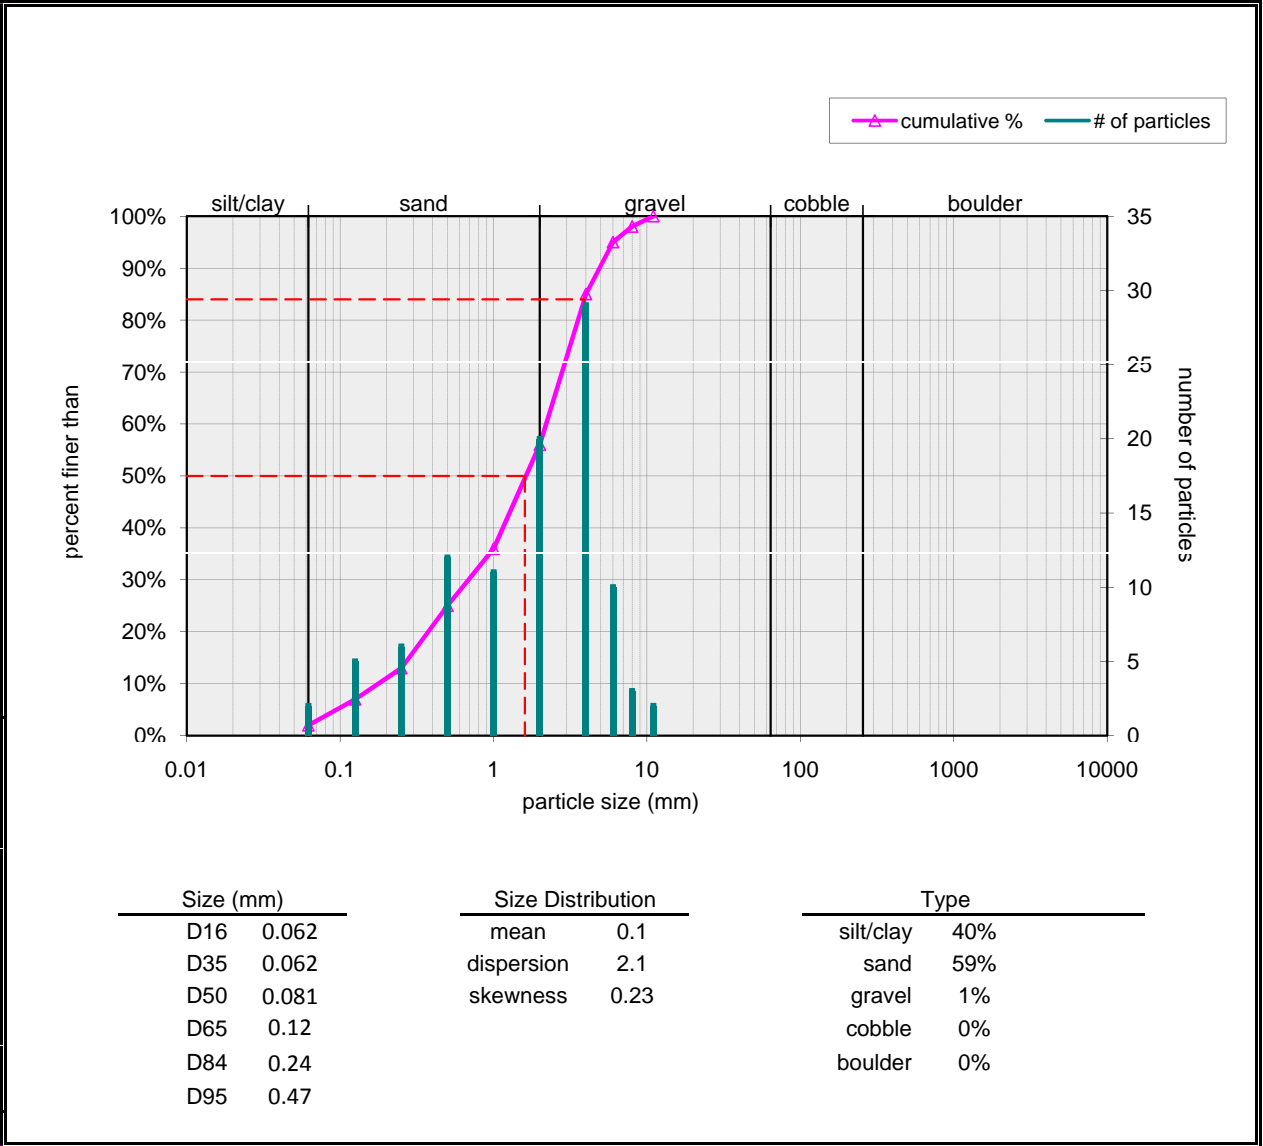


Cross Section 2		
Material	Size Range (mm)	Count
silt/clay	0 - 0.062	32
very fine sand	0.062 - 0.125	21
fine sand	0.125 - 0.25	19
medium sand	0.25 - 0.5	15
coarse sand	0.5 - 1	6
very coarse sand	1 - 2	3
very fine gravel	2 - 4	1
fine gravel	4 - 6	2
fine gravel	6 - 8	0
medium gravel	8 - 11	1
medium gravel	11 - 16	
coarse gravel	16 - 22	
coarse gravel	22 - 32	
very coarse gravel	32 - 45	
very coarse gravel	45 - 64	
small cobble	64 - 90	
medium cobble	90 - 128	
large cobble	128 - 180	
very large cobble	180 - 256	
small boulder	256 - 362	
small boulder	362 - 512	
medium boulder	512 - 1024	
large boulder	1024 - 2048	
very large boulder	2048 - 4096	
total particle count:		100
bedrock	-----	
clay hardpan	-----	
detritus/wood	-----	
artificial	-----	
total count:		100
Note: Cross Section 2		

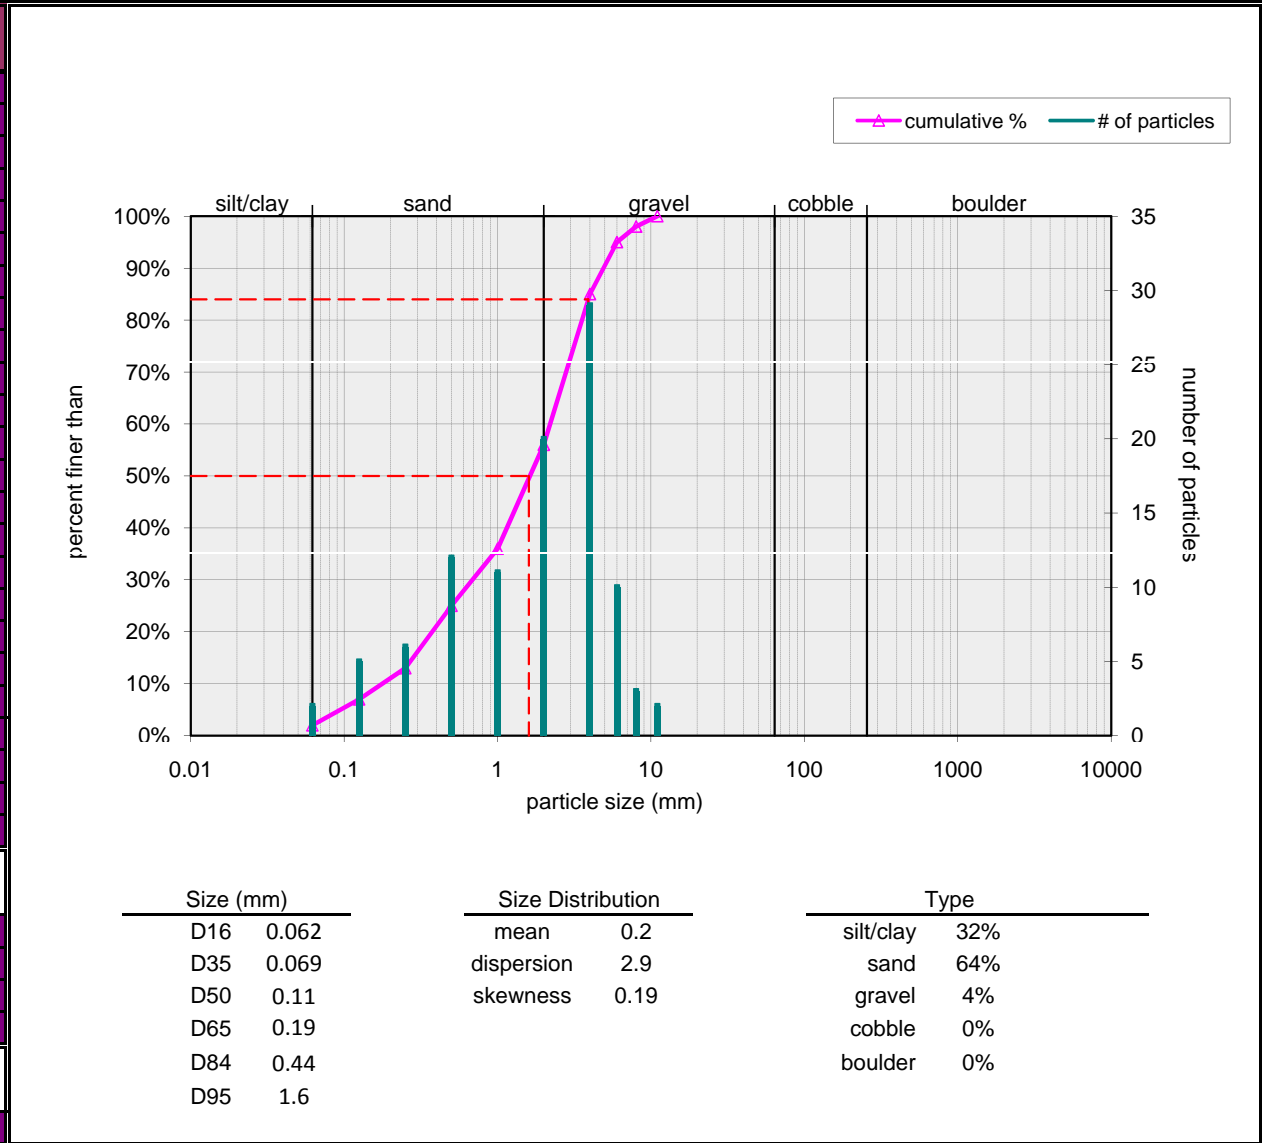


Cross Section 3		
Material	Size Range (mm)	Count
silt/clay	0 - 0.062	29
very fine sand	0.062 - 0.125	35
fine sand	0.125 - 0.25	12
medium sand	0.25 - 0.5	17
coarse sand	0.5 - 1	3
very coarse sand	1 - 2	2
very fine gravel	2 - 4	0
fine gravel	4 - 6	1
fine gravel	6 - 8	1
medium gravel	8 - 11	0
medium gravel	11 - 16	
coarse gravel	16 - 22	
coarse gravel	22 - 32	
very coarse gravel	32 - 45	
very coarse gravel	45 - 64	
small cobble	64 - 90	
medium cobble	90 - 128	
large cobble	128 - 180	
very large cobble	180 - 256	
small boulder	256 - 362	
small boulder	362 - 512	
medium boulder	512 - 1024	
large boulder	1024 - 2048	
very large boulder	2048 - 4096	
total particle count:		100
bedrock	-----	
clay hardpan	-----	
detritus/wood	-----	
artificial	-----	
total count:		100
Note: Cross Section 3		

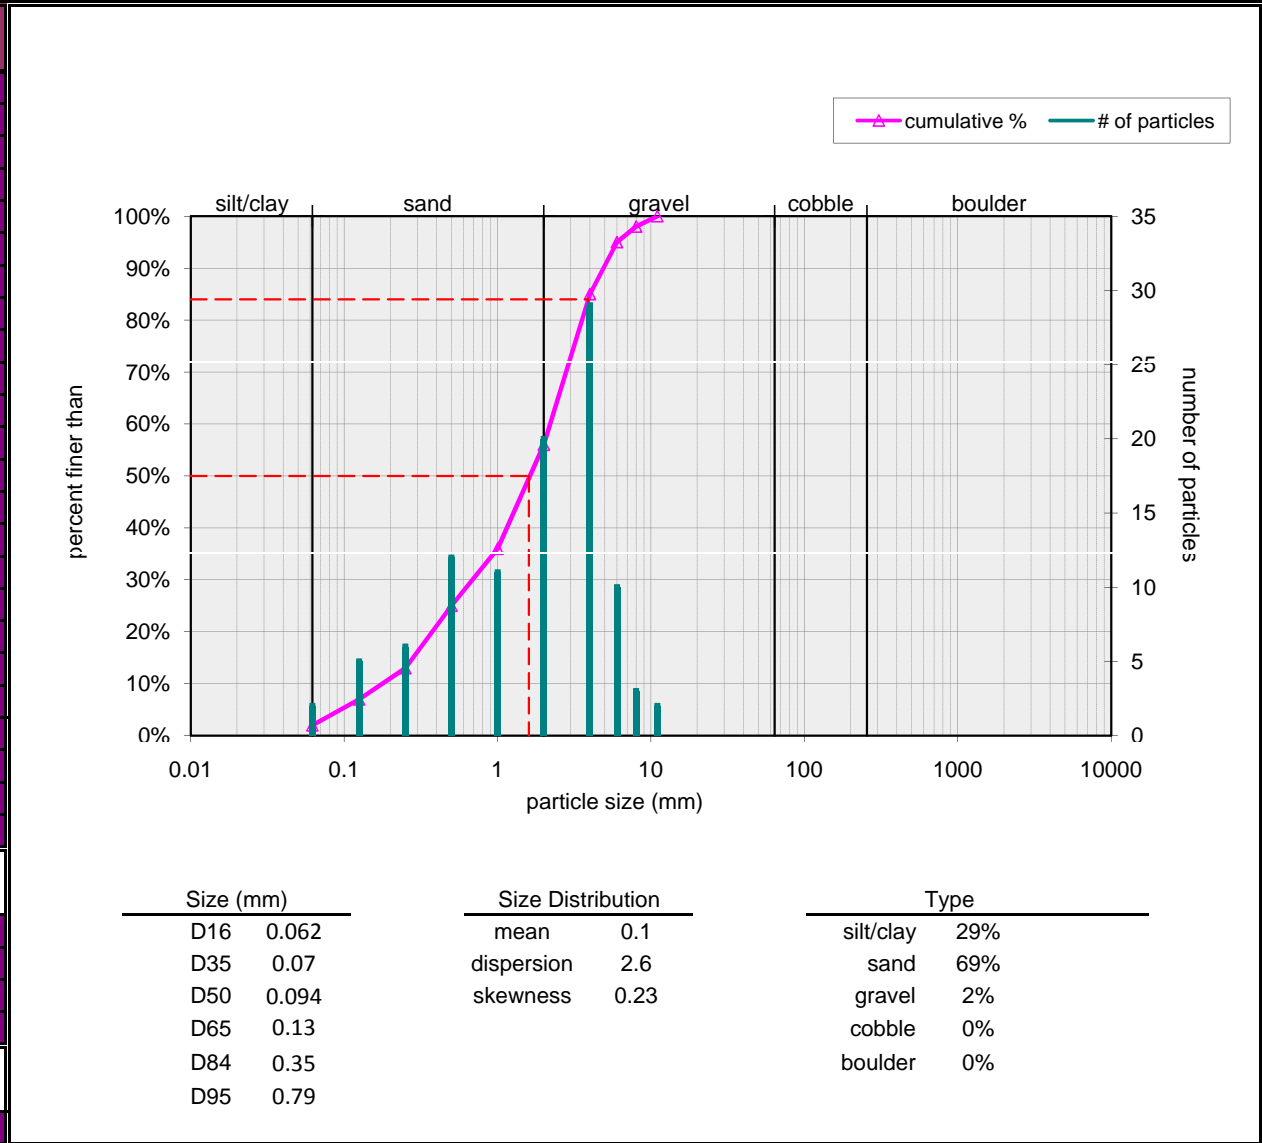


Cross Section 4		
Material	Size Range (mm)	Count
silt/clay	0 - 0.062	30
very fine sand	0.062 - 0.125	29
fine sand	0.125 - 0.25	22
medium sand	0.25 - 0.5	13
coarse sand	0.5 - 1	3
very coarse sand	1 - 2	2
very fine gravel	2 - 4	1
fine gravel	4 - 6	
fine gravel	6 - 8	
medium gravel	8 - 11	
medium gravel	11 - 16	
coarse gravel	16 - 22	
coarse gravel	22 - 32	
very coarse gravel	32 - 45	
very coarse gravel	45 - 64	
small cobble	64 - 90	
medium cobble	90 - 128	
large cobble	128 - 180	
very large cobble	180 - 256	
small boulder	256 - 362	
small boulder	362 - 512	
medium boulder	512 - 1024	
large boulder	1024 - 2048	
very large boulder	2048 - 4096	
total particle count:		100
bedrock	-----	
clay hardpan	-----	
detritus/wood	-----	
artificial	-----	
total count:		100
Note: Cross Section 4		

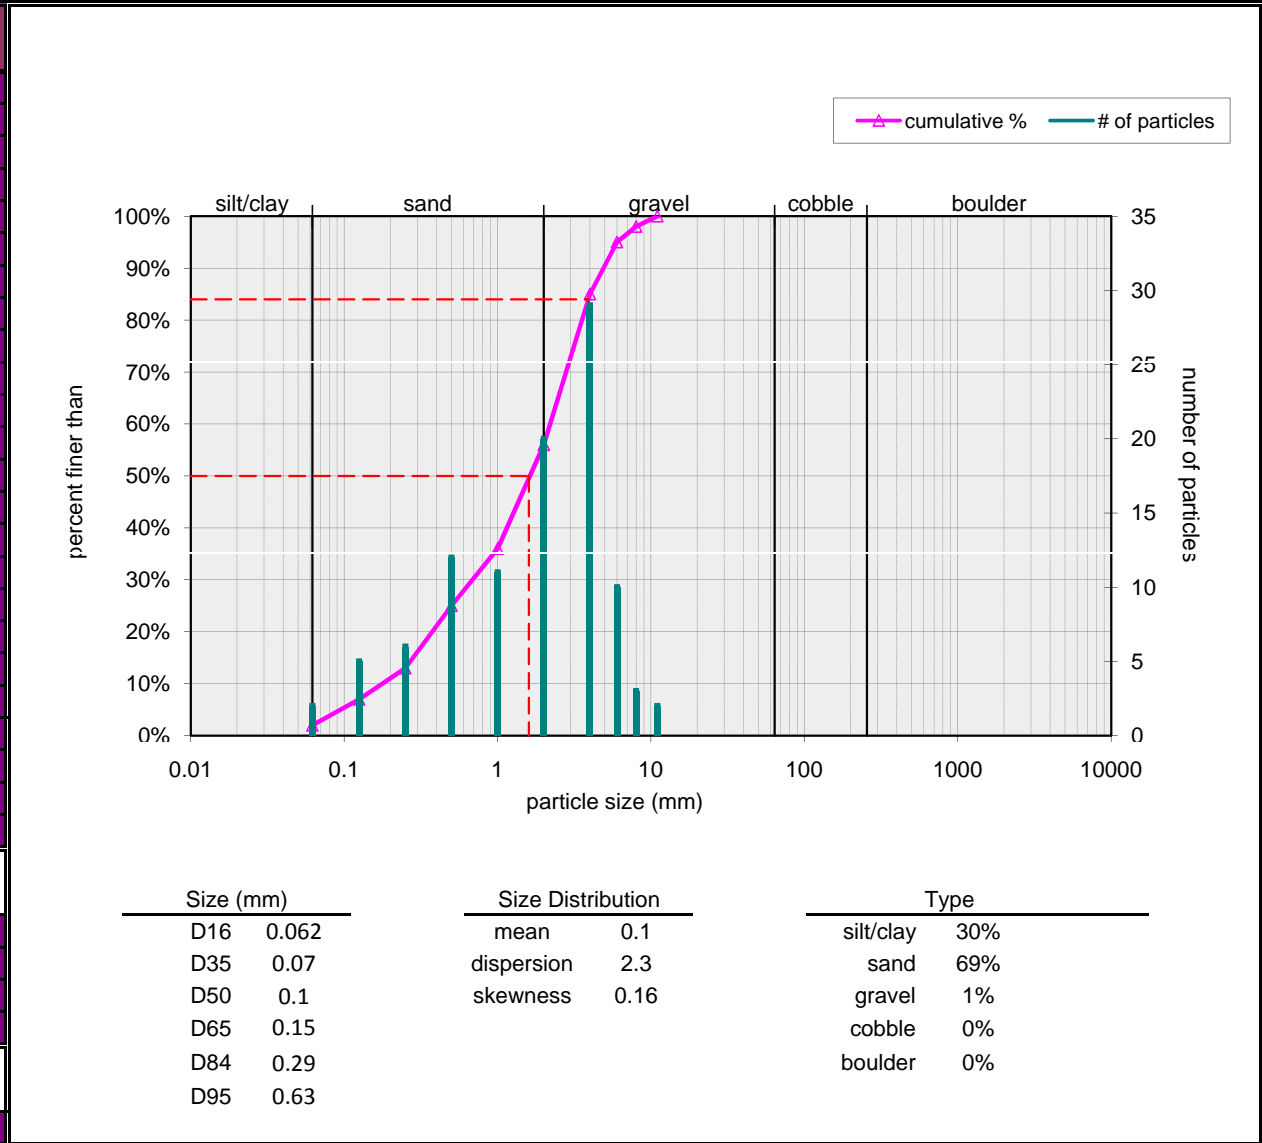


Cross Section 5		
Material	Size Range (mm)	Count
silt/clay	0 - 0.062	19
very fine sand	0.062 - 0.125	36
fine sand	0.125 - 0.25	20
medium sand	0.25 - 0.5	12
coarse sand	0.5 - 1	9
very coarse sand	1 - 2	1
very fine gravel	2 - 4	1
fine gravel	4 - 6	1
fine gravel	6 - 8	1
medium gravel	8 - 11	
medium gravel	11 - 16	
coarse gravel	16 - 22	
coarse gravel	22 - 32	
very coarse gravel	32 - 45	
very coarse gravel	45 - 64	
small cobble	64 - 90	
medium cobble	90 - 128	
large cobble	128 - 180	
very large cobble	180 - 256	
small boulder	256 - 362	
small boulder	362 - 512	
medium boulder	512 - 1024	
large boulder	1024 - 2048	
very large boulder	2048 - 4096	
total particle count:		100
bedrock	-----	
clay hardpan	-----	
detritus/wood	-----	
artificial	-----	
total count:		100
Note: Cross Section 5		

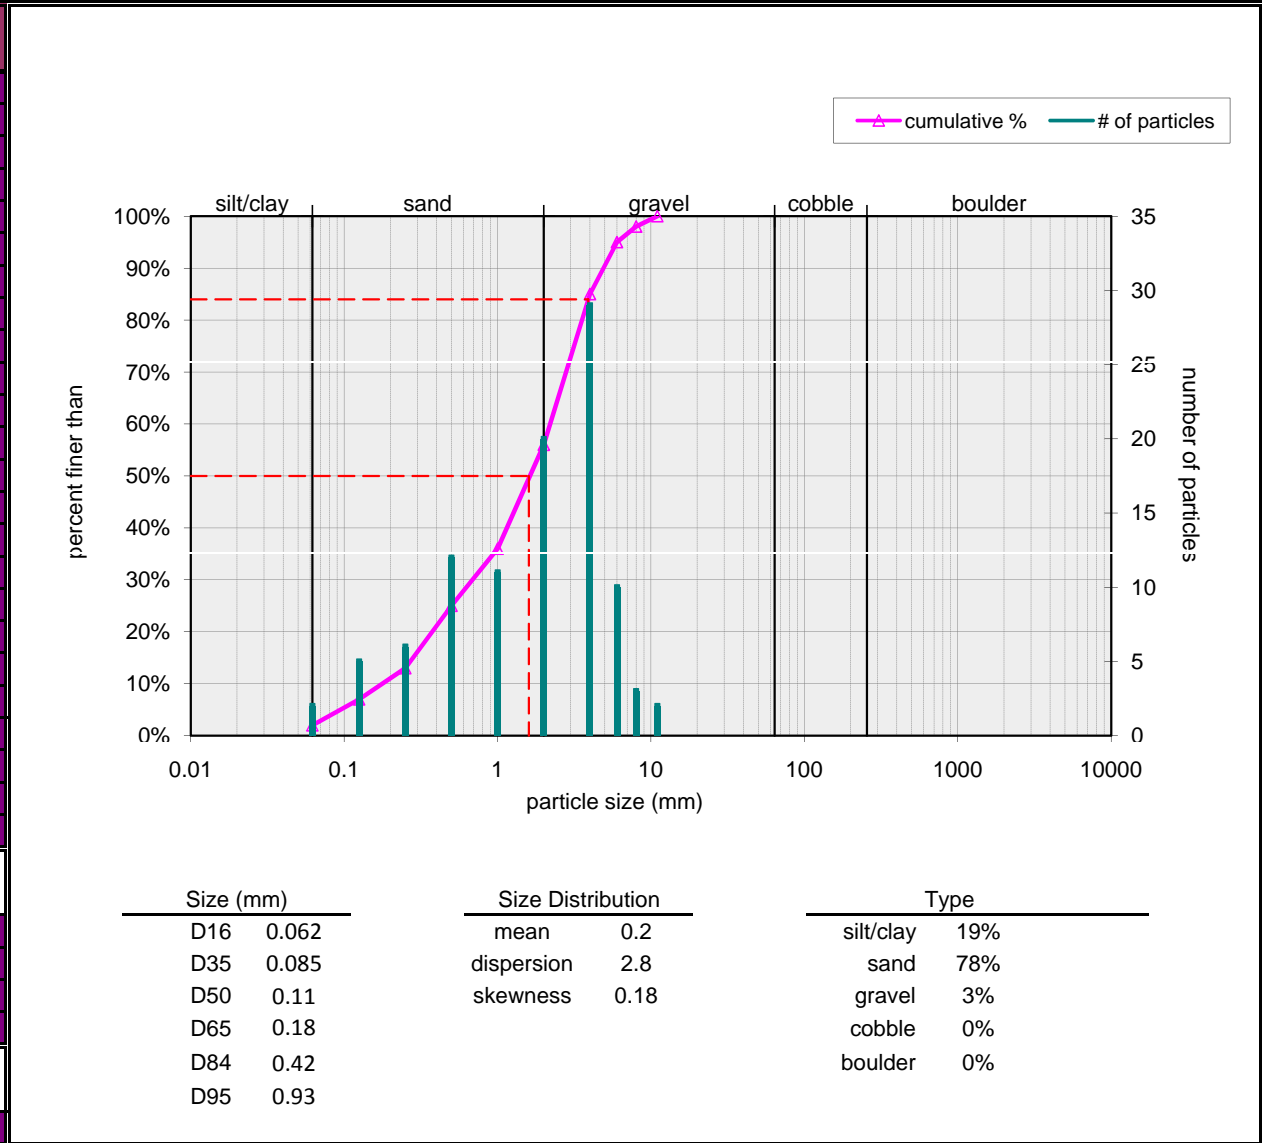


Cross Section 6		
Material	Size Range (mm)	Count
silt/clay	0 - 0.062	18
very fine sand	0.062 - 0.125	21
fine sand	0.125 - 0.25	27
medium sand	0.25 - 0.5	20
coarse sand	0.5 - 1	6
very coarse sand	1 - 2	2
very fine gravel	2 - 4	3
fine gravel	4 - 6	0
fine gravel	6 - 8	1
medium gravel	8 - 11	
medium gravel	11 - 16	
coarse gravel	16 - 22	
coarse gravel	22 - 32	
very coarse gravel	32 - 45	
very coarse gravel	45 - 64	
small cobble	64 - 90	
medium cobble	90 - 128	
large cobble	128 - 180	
very large cobble	180 - 256	
small boulder	256 - 362	
small boulder	362 - 512	
medium boulder	512 - 1024	
large boulder	1024 - 2048	
very large boulder	2048 - 4096	
total particle count:		98
bedrock	-----	
clay hardpan	-----	
detritus/wood	-----	
artificial	-----	
total count:		98
Note: Cross Section 6		

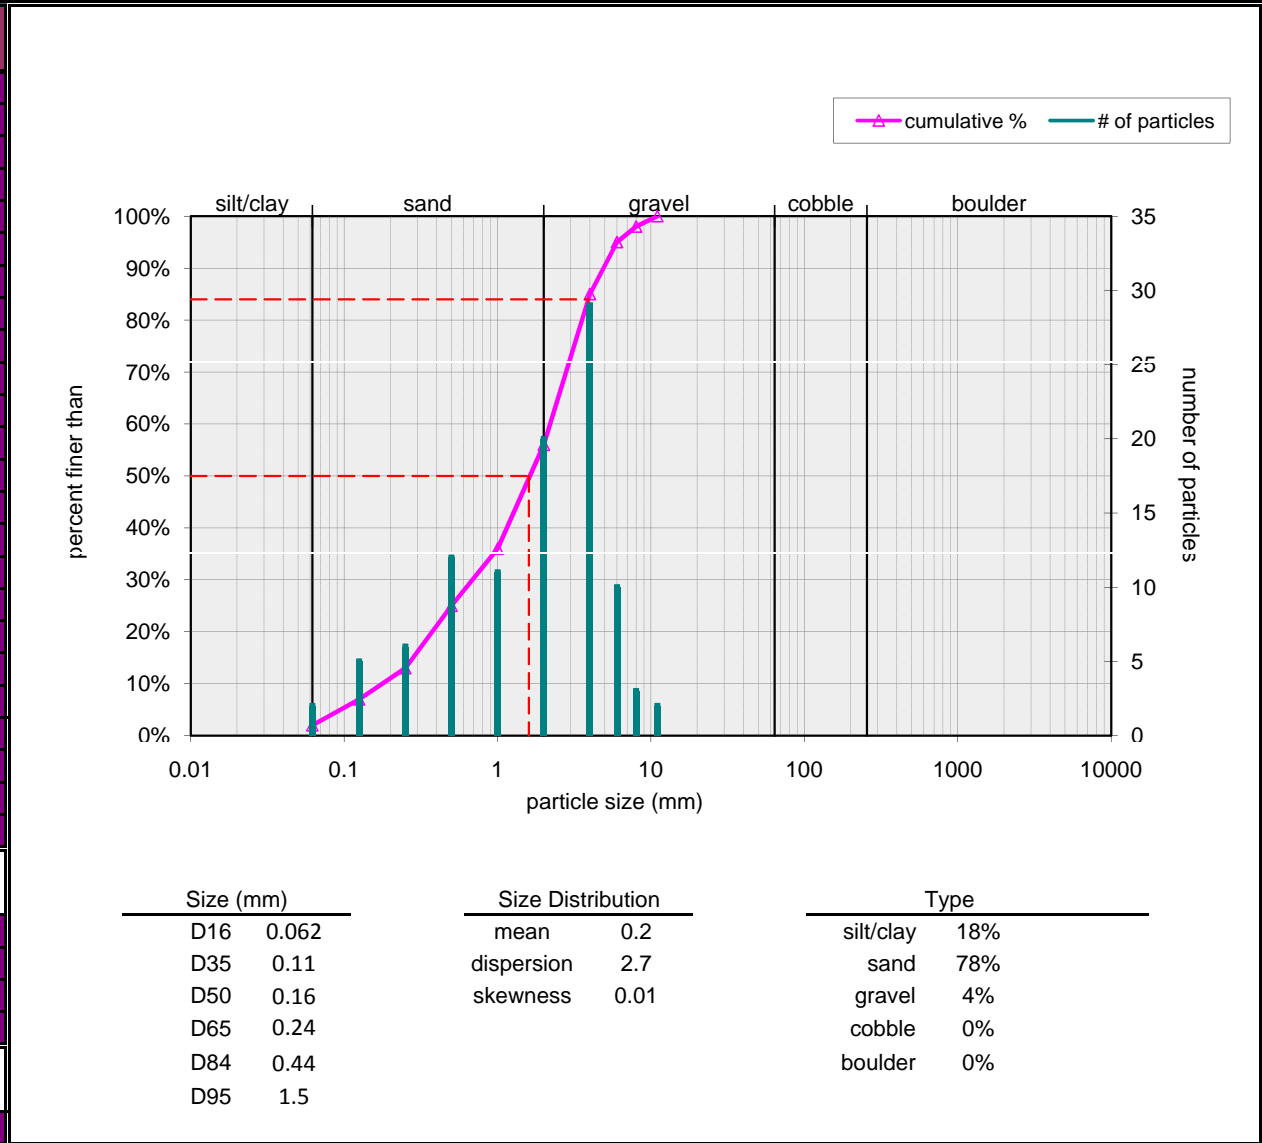


Cross Section 7		
Material	Size Range (mm)	Count
silt/clay	0 - 0.062	38
very fine sand	0.062 - 0.125	30
fine sand	0.125 - 0.25	17
medium sand	0.25 - 0.5	9
coarse sand	0.5 - 1	2
very coarse sand	1 - 2	3
very fine gravel	2 - 4	0
fine gravel	4 - 6	0
fine gravel	6 - 8	1
medium gravel	8 - 11	
medium gravel	11 - 16	
coarse gravel	16 - 22	
coarse gravel	22 - 32	
very coarse gravel	32 - 45	
very coarse gravel	45 - 64	
small cobble	64 - 90	
medium cobble	90 - 128	
large cobble	128 - 180	
very large cobble	180 - 256	
small boulder	256 - 362	
small boulder	362 - 512	
medium boulder	512 - 1024	
large boulder	1024 - 2048	
very large boulder	2048 - 4096	
total particle count:		100
bedrock	-----	
clay hardpan	-----	
detritus/wood	-----	
artificial	-----	
total count:		100
Note: Cross Section 7		

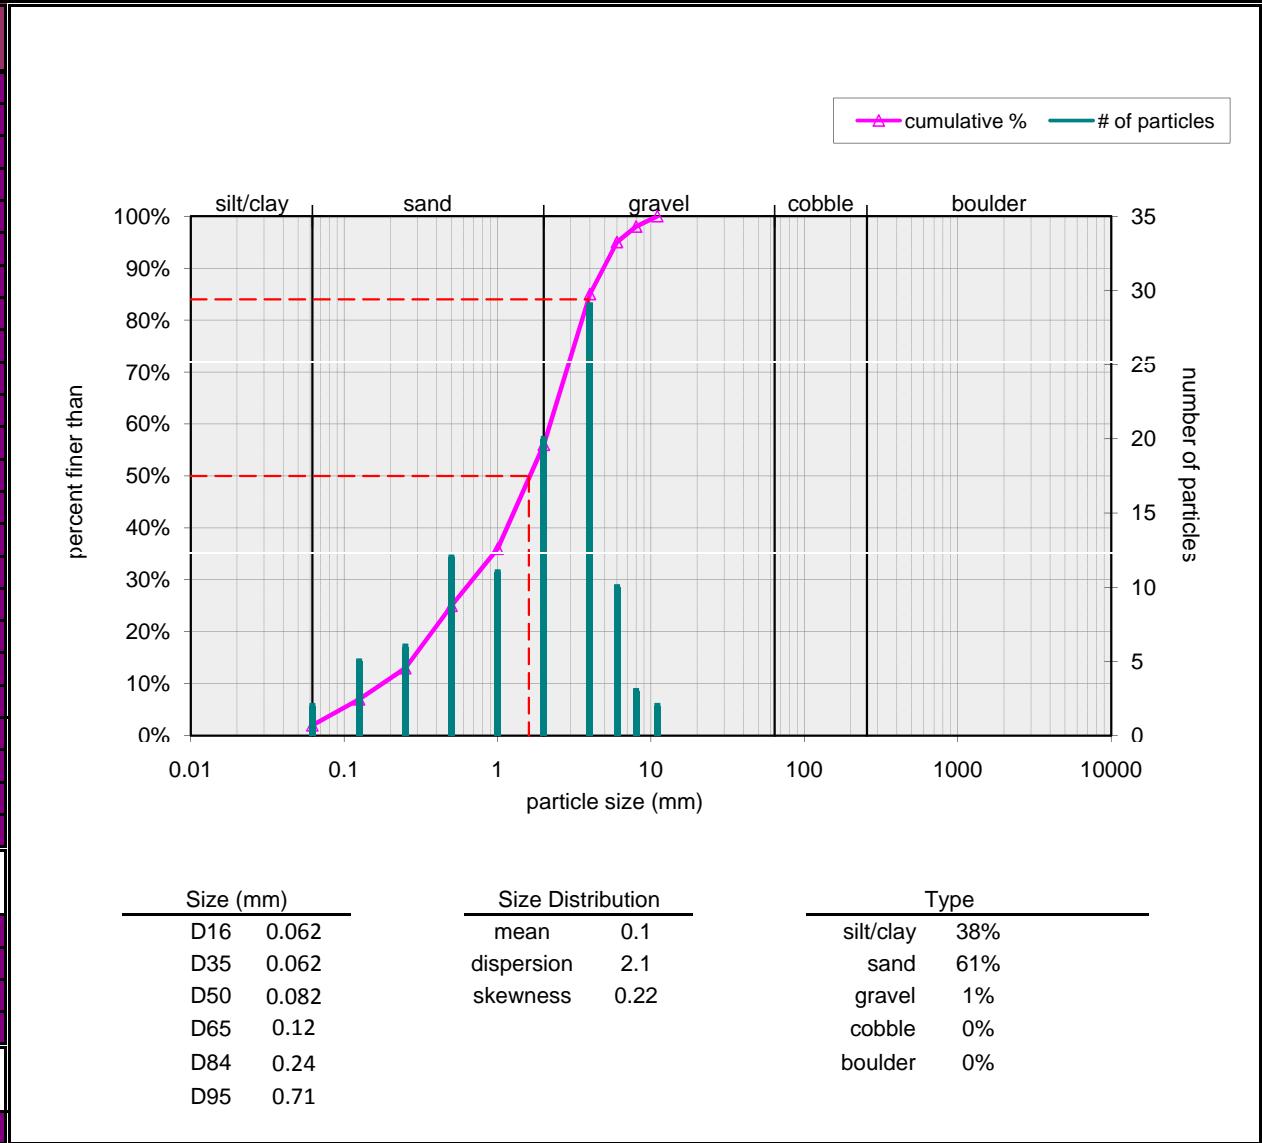

Cross Section 8		
Material	Size Range (mm)	Count
silt/clay	0 - 0.062	23
very fine sand	0.062 - 0.125	18
fine sand	0.125 - 0.25	22
medium sand	0.25 - 0.5	21
coarse sand	0.5 - 1	7
very coarse sand	1 - 2	7
very fine gravel	2 - 4	1
fine gravel	4 - 6	1
fine gravel	6 - 8	
medium gravel	8 - 11	
medium gravel	11 - 16	
coarse gravel	16 - 22	
coarse gravel	22 - 32	
very coarse gravel	32 - 45	
very coarse gravel	45 - 64	
small cobble	64 - 90	
medium cobble	90 - 128	
large cobble	128 - 180	
very large cobble	180 - 256	
small boulder	256 - 362	
small boulder	362 - 512	
medium boulder	512 - 1024	
large boulder	1024 - 2048	
very large boulder	2048 - 4096	
total particle count:		100
bedrock	-----	
clay hardpan	-----	
detritus/wood	-----	
artificial	-----	
total count:		100
Note: Cross Section 8		

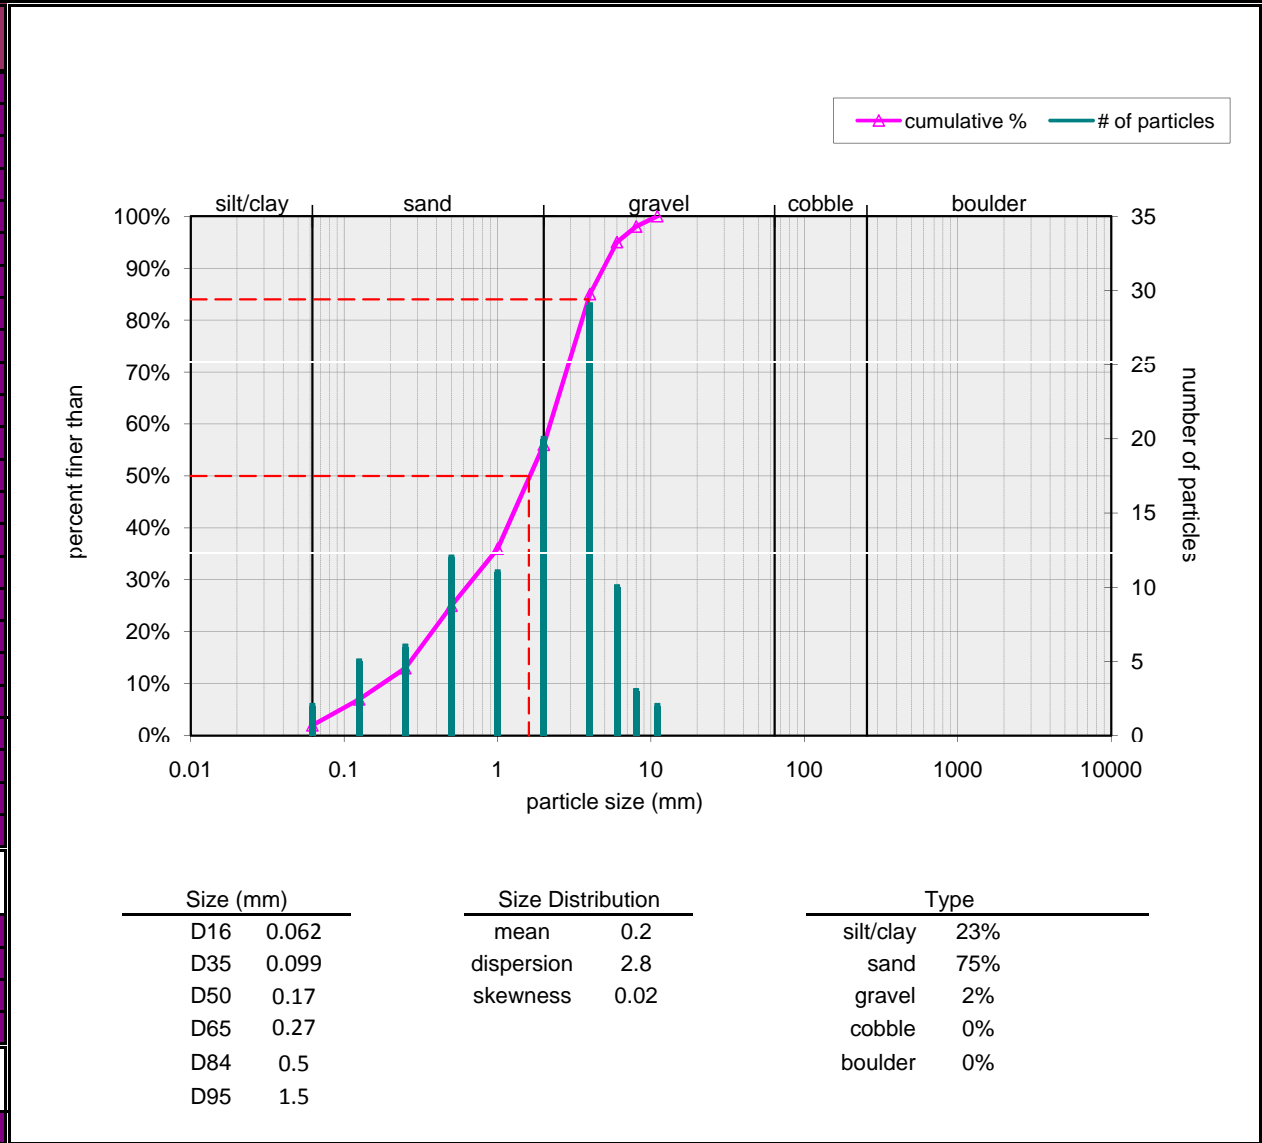


Cross Section 9		
Material	Size Range (mm)	Count
silt/clay	0 - 0.062	10
very fine sand	0.062 - 0.125	12
fine sand	0.125 - 0.25	7
medium sand	0.25 - 0.5	6
coarse sand	0.5 - 1	9
very coarse sand	1 - 2	23
very fine gravel	2 - 4	22
fine gravel	4 - 6	9
fine gravel	6 - 8	1
medium gravel	8 - 11	1
medium gravel	11 - 16	
coarse gravel	16 - 22	
coarse gravel	22 - 32	
very coarse gravel	32 - 45	
very coarse gravel	45 - 64	
small cobble	64 - 90	
medium cobble	90 - 128	
large cobble	128 - 180	
very large cobble	180 - 256	
small boulder	256 - 362	
small boulder	362 - 512	
medium boulder	512 - 1024	
large boulder	1024 - 2048	
very large boulder	2048 - 4096	
total particle count:		100
bedrock	-----	
clay hardpan	-----	
detritus/wood	-----	
artificial	-----	
total count:		100
Note: Cross Section 9		

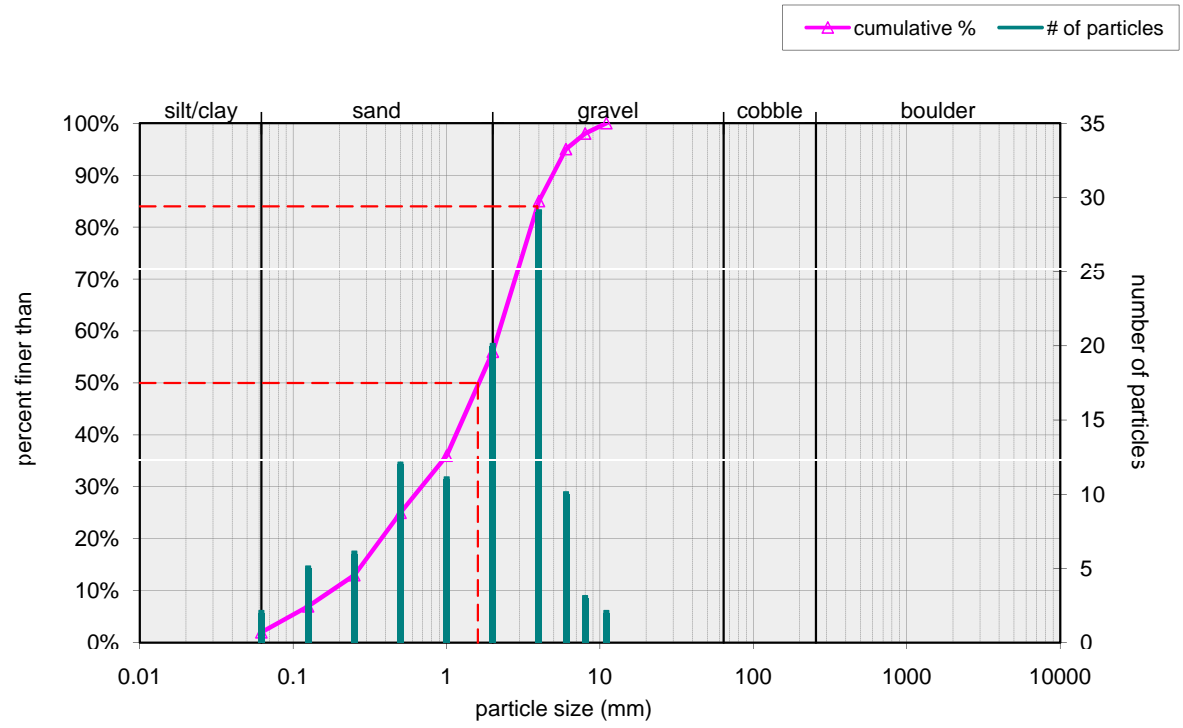


Size (mm)	Size Distribution	Type
D16 0.088	mean 0.5	silt/clay 10%
D35 0.5	dispersion 8.2	sand 57%
D50 1.2	skewness -0.27	gravel 33%
D65 1.9		cobble 0%
D84 3.4		boulder 0%
D95 5.2		


Cross Section 10		
Material	Size Range (mm)	Count
silt/clay	0 - 0.062	3
very fine sand	0.062 - 0.125	2
fine sand	0.125 - 0.25	4
medium sand	0.25 - 0.5	9
coarse sand	0.5 - 1	17
very coarse sand	1 - 2	23
very fine gravel	2 - 4	22
fine gravel	4 - 6	19
fine gravel	6 - 8	0
medium gravel	8 - 11	0
medium gravel	11 - 16	1
coarse gravel	16 - 22	
coarse gravel	22 - 32	
very coarse gravel	32 - 45	
very coarse gravel	45 - 64	
small cobble	64 - 90	
medium cobble	90 - 128	
large cobble	128 - 180	
very large cobble	180 - 256	
small boulder	256 - 362	
small boulder	362 - 512	
medium boulder	512 - 1024	
large boulder	1024 - 2048	
very large boulder	2048 - 4096	
total particle count:		100
bedrock	-----	
clay hardpan	-----	
detritus/wood	-----	
artificial	-----	
total count:		100
Note: Cross Section 10		

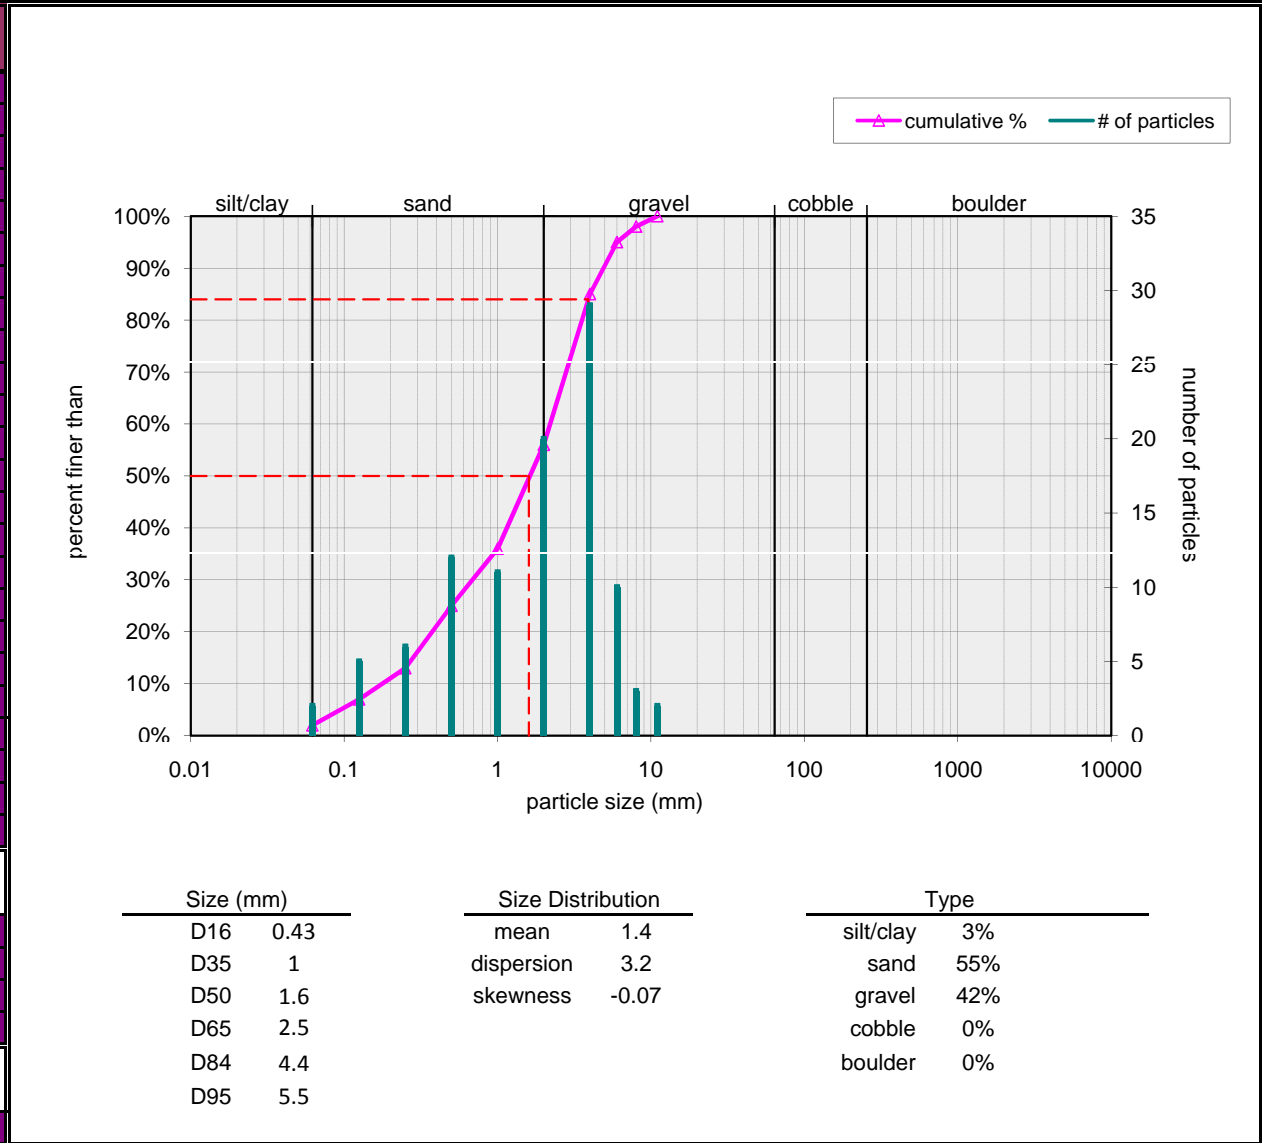

Cross Section 11		
Material	Size Range (mm)	Count
silt/clay	0 - 0.062	7
very fine sand	0.062 - 0.125	4
fine sand	0.125 - 0.25	2
medium sand	0.25 - 0.5	11
coarse sand	0.5 - 1	19
very coarse sand	1 - 2	18
very fine gravel	2 - 4	20
fine gravel	4 - 6	15
fine gravel	6 - 8	2
medium gravel	8 - 11	2
medium gravel	11 - 16	
coarse gravel	16 - 22	
coarse gravel	22 - 32	
very coarse gravel	32 - 45	
very coarse gravel	45 - 64	
small cobble	64 - 90	
medium cobble	90 - 128	
large cobble	128 - 180	
very large cobble	180 - 256	
small boulder	256 - 362	
small boulder	362 - 512	
medium boulder	512 - 1024	
large boulder	1024 - 2048	
very large boulder	2048 - 4096	
total particle count:		100
bedrock	-----	
clay hardpan	-----	
detritus/wood	-----	
artificial	-----	
total count:		100
Note: Cross Section 11		

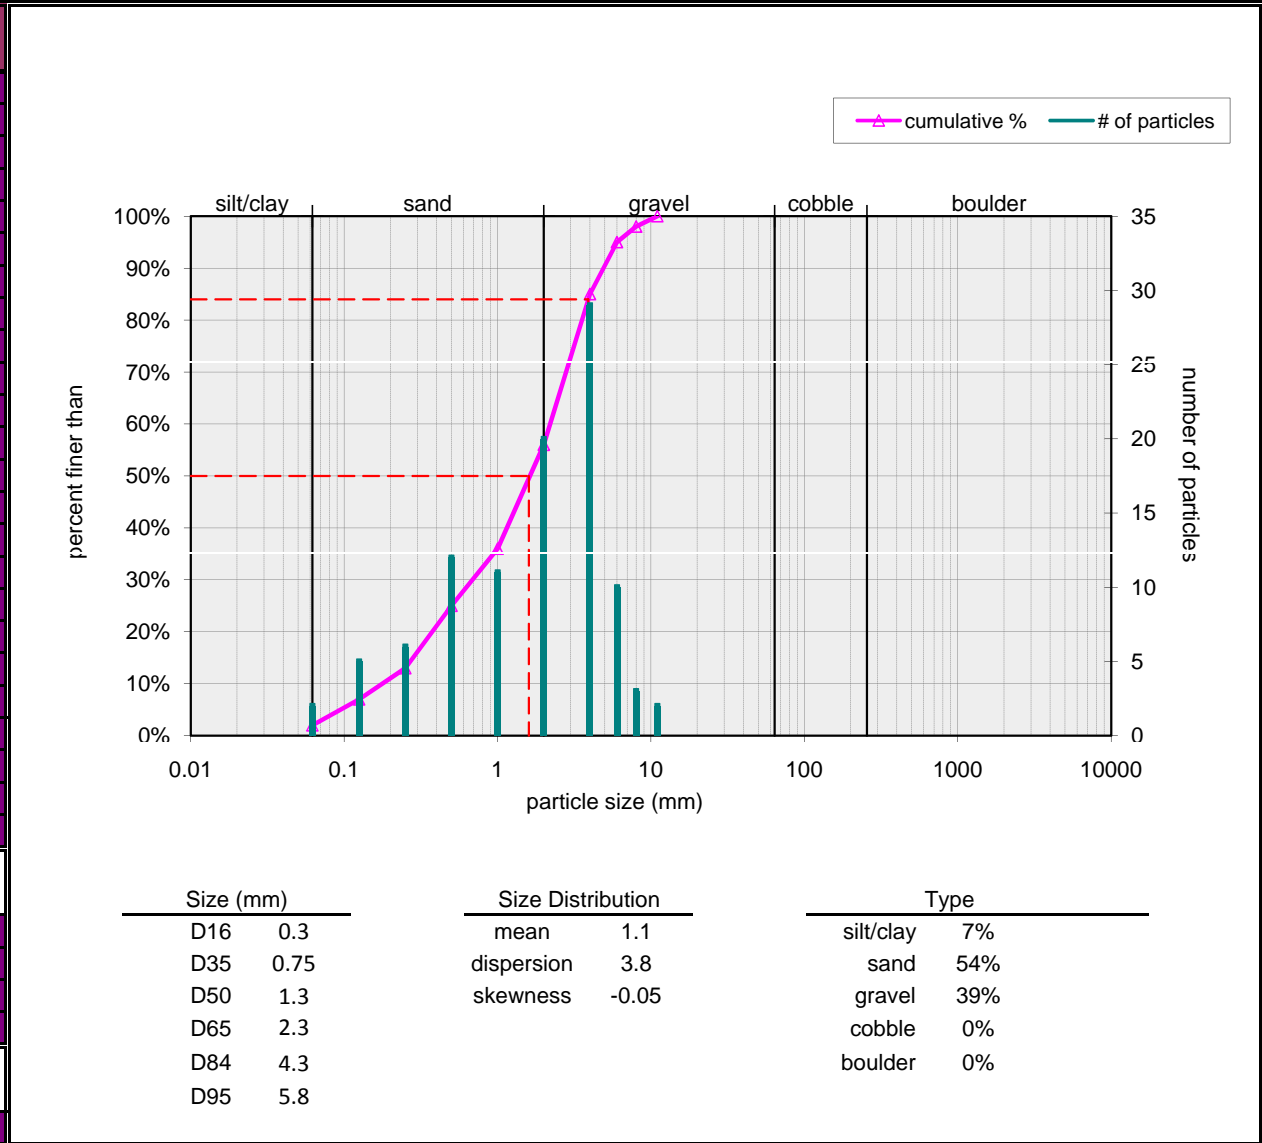

Cross Section 12		
Material	Size Range (mm)	Count
silt/clay	0 - 0.062	7
very fine sand	0.062 - 0.125	13
fine sand	0.125 - 0.25	15
medium sand	0.25 - 0.5	30
coarse sand	0.5 - 1	14
very coarse sand	1 - 2	11
very fine gravel	2 - 4	4
fine gravel	4 - 6	5
fine gravel	6 - 8	0
medium gravel	8 - 11	0
medium gravel	11 - 16	1
coarse gravel	16 - 22	
coarse gravel	22 - 32	
very coarse gravel	32 - 45	
very coarse gravel	45 - 64	
small cobble	64 - 90	
medium cobble	90 - 128	
large cobble	128 - 180	
very large cobble	180 - 256	
small boulder	256 - 362	
small boulder	362 - 512	
medium boulder	512 - 1024	
large boulder	1024 - 2048	
very large boulder	2048 - 4096	
total particle count:		100
bedrock	-----	
clay hardpan	-----	
detritus/wood	-----	
artificial	-----	
total count:		100
Note: Cross Section 12		

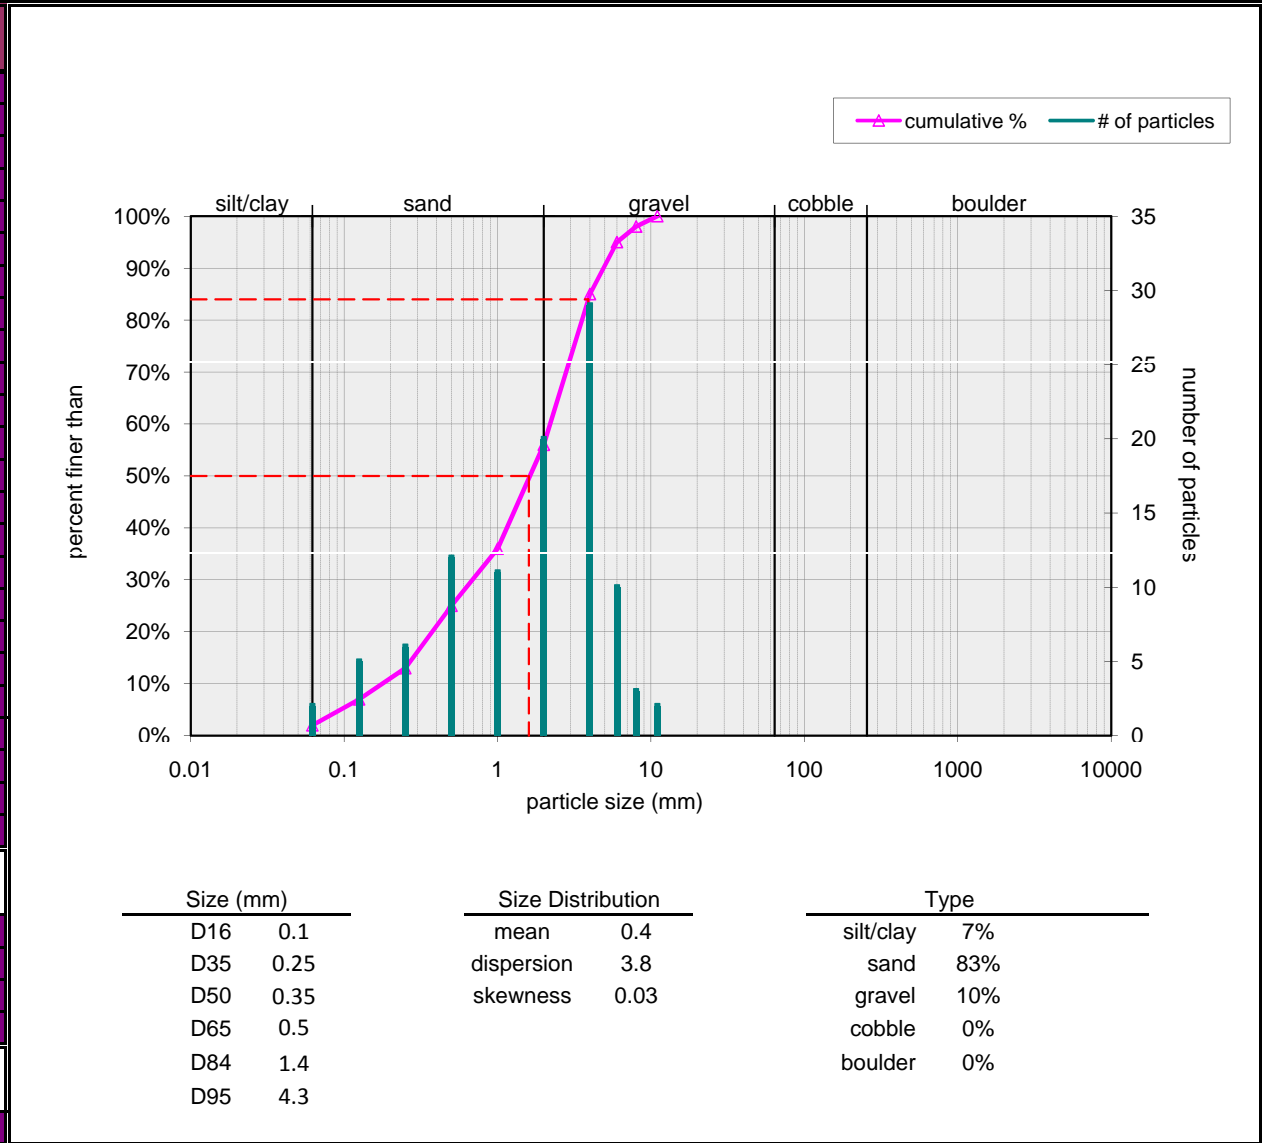


Cross Section 13

Material	Size Range (mm)	Count
silt/clay	0 - 0.062	2
very fine sand	0.062 - 0.125	5
fine sand	0.125 - 0.25	6
medium sand	0.25 - 0.5	12
coarse sand	0.5 - 1	11
very coarse sand	1 - 2	20
very fine gravel	2 - 4	29
fine gravel	4 - 6	10
fine gravel	6 - 8	3
medium gravel	8 - 11	2
medium gravel	11 - 16	
coarse gravel	16 - 22	
coarse gravel	22 - 32	
very coarse gravel	32 - 45	
very coarse gravel	45 - 64	
small cobble	64 - 90	
medium cobble	90 - 128	
large cobble	128 - 180	
very large cobble	180 - 256	
small boulder	256 - 362	
small boulder	362 - 512	
medium boulder	512 - 1024	
large boulder	1024 - 2048	
very large boulder	2048 - 4096	

total particle count:		100
bedrock	-----	
clay hardpan	-----	
detritus/wood	-----	
artificial	-----	

total count: 100

Note: Cross Section 13

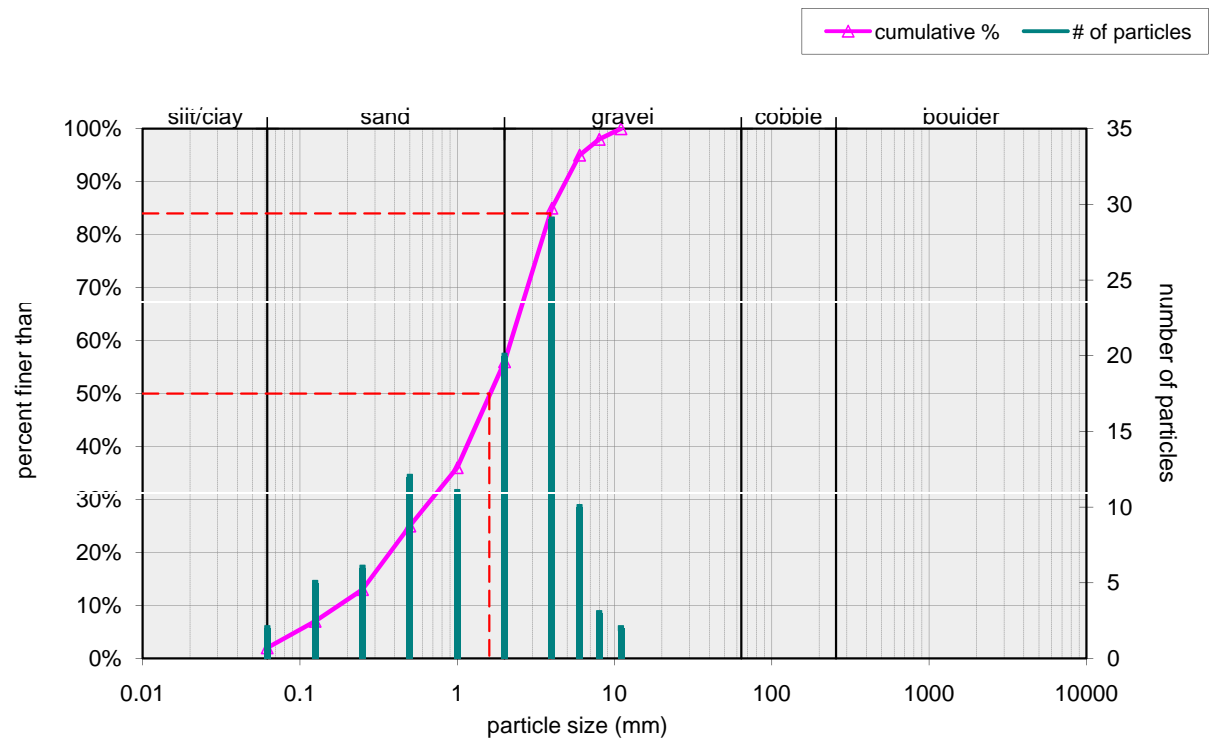

Size (mm)		Size Distribution		Type	
D16	0.3	mean	1.1	silt/clay	2%
D35	0.94	dispersion	3.9	sand	54%
D50	1.6	skewness	-0.16	gravel	44%
D65	2.5			cobble	0%
D84	3.9			boulder	0%
D95	6				