

SURVEY FOR
SEI ENVIRONMENTAL, INC.
TOPOGRAPHIC ASBLUT SURVEY
ELLERBEE CREEK
HILLDALE GOLF COURSE
 DURHAM, NC

SEAL




DURHAM COUNTY	TOWNSHIP	PN	1. DRAWN LFL	ADD. PROFILE	DATE	BY	DESCRIPTION	REVISIONS

DRAWN BY: LFL
 APPROVED BY: REB
 CHECKED BY: JP
 DATE: 02/11/05

TREE TABLE

T2096	18"	CEDAR
T2172	20"	MAPLE
T2178	30"	OAK
T2179	30"	OAK
T2940	12"	CEDAR
T2941	12"	TWIN CEDAR
T2942	14"	CEDAR
T3290	10"	CEDAR
T3297	24"	PINE
T3299	14"	GUM
T3300	20"	GUM
T3322	10"	TRIPLET CEDAR
T3564	12"	PEAR
T4909	34"	PINE
T4913	22"	PINE
T4914	25"	PINE
T4916	18"	CEDAR

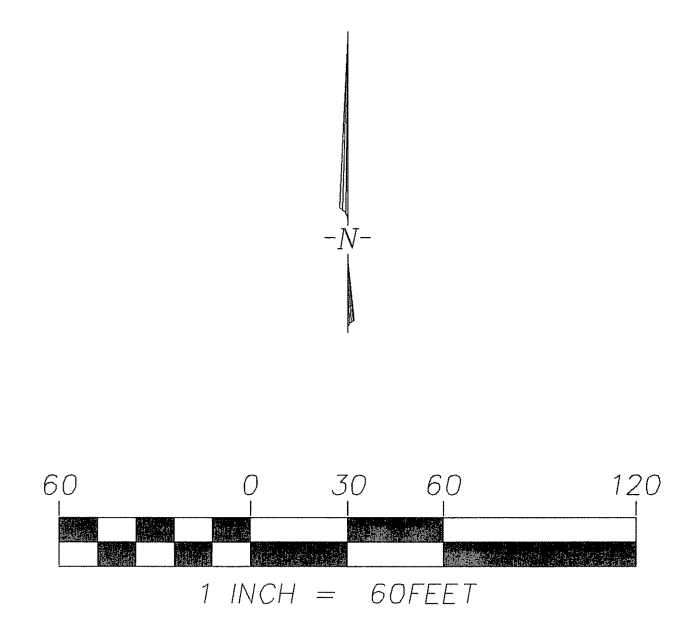

LEGEND


- CONTROL IRON FOUND
- 36" RCP REINFORCED CONCRETE PIPE
- ⊕ TBM BENCHMARK
- ~ TREE LINE
- ▨ RIP RAP
- ⌓ ROCK STRUCTURE
- ROOT WAD
- THALWEG
- - - LEFT BANKFULL
- - - RIGHT BANKFULL

I, Lawrence F. Lee III, hereby certify that this Topographic Survey map was prepared under my supervision, that the survey was conducted under my supervision according to the Standards of Practice for Land Surveying in North Carolina; that this survey is a Class A topographic survey, and the vertical error does not exceed .10 times the square root of the number of miles run from the reference datum; witness my hand and seal this 25TH day of MARCH, 2005.


Lawrence F. Lee III
Lawrence F. Lee III, PLS L-3884

NOTES


- 1) Horizontal and vertical datum taken from approved construction drawings by Stantec, dated 07/18/03.
- 2) Lowest bankfull shown in profile for clarity.

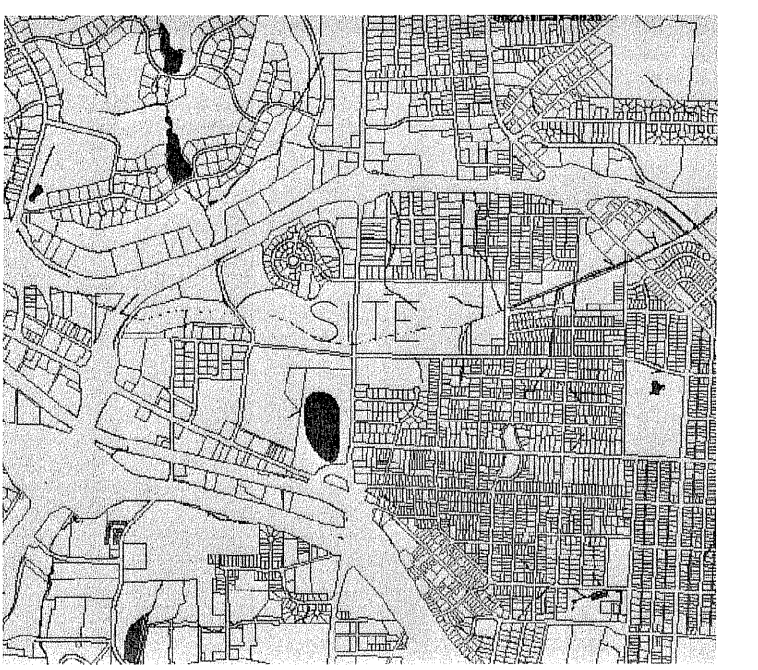

VICINITY MAP
NOT TO SCALE

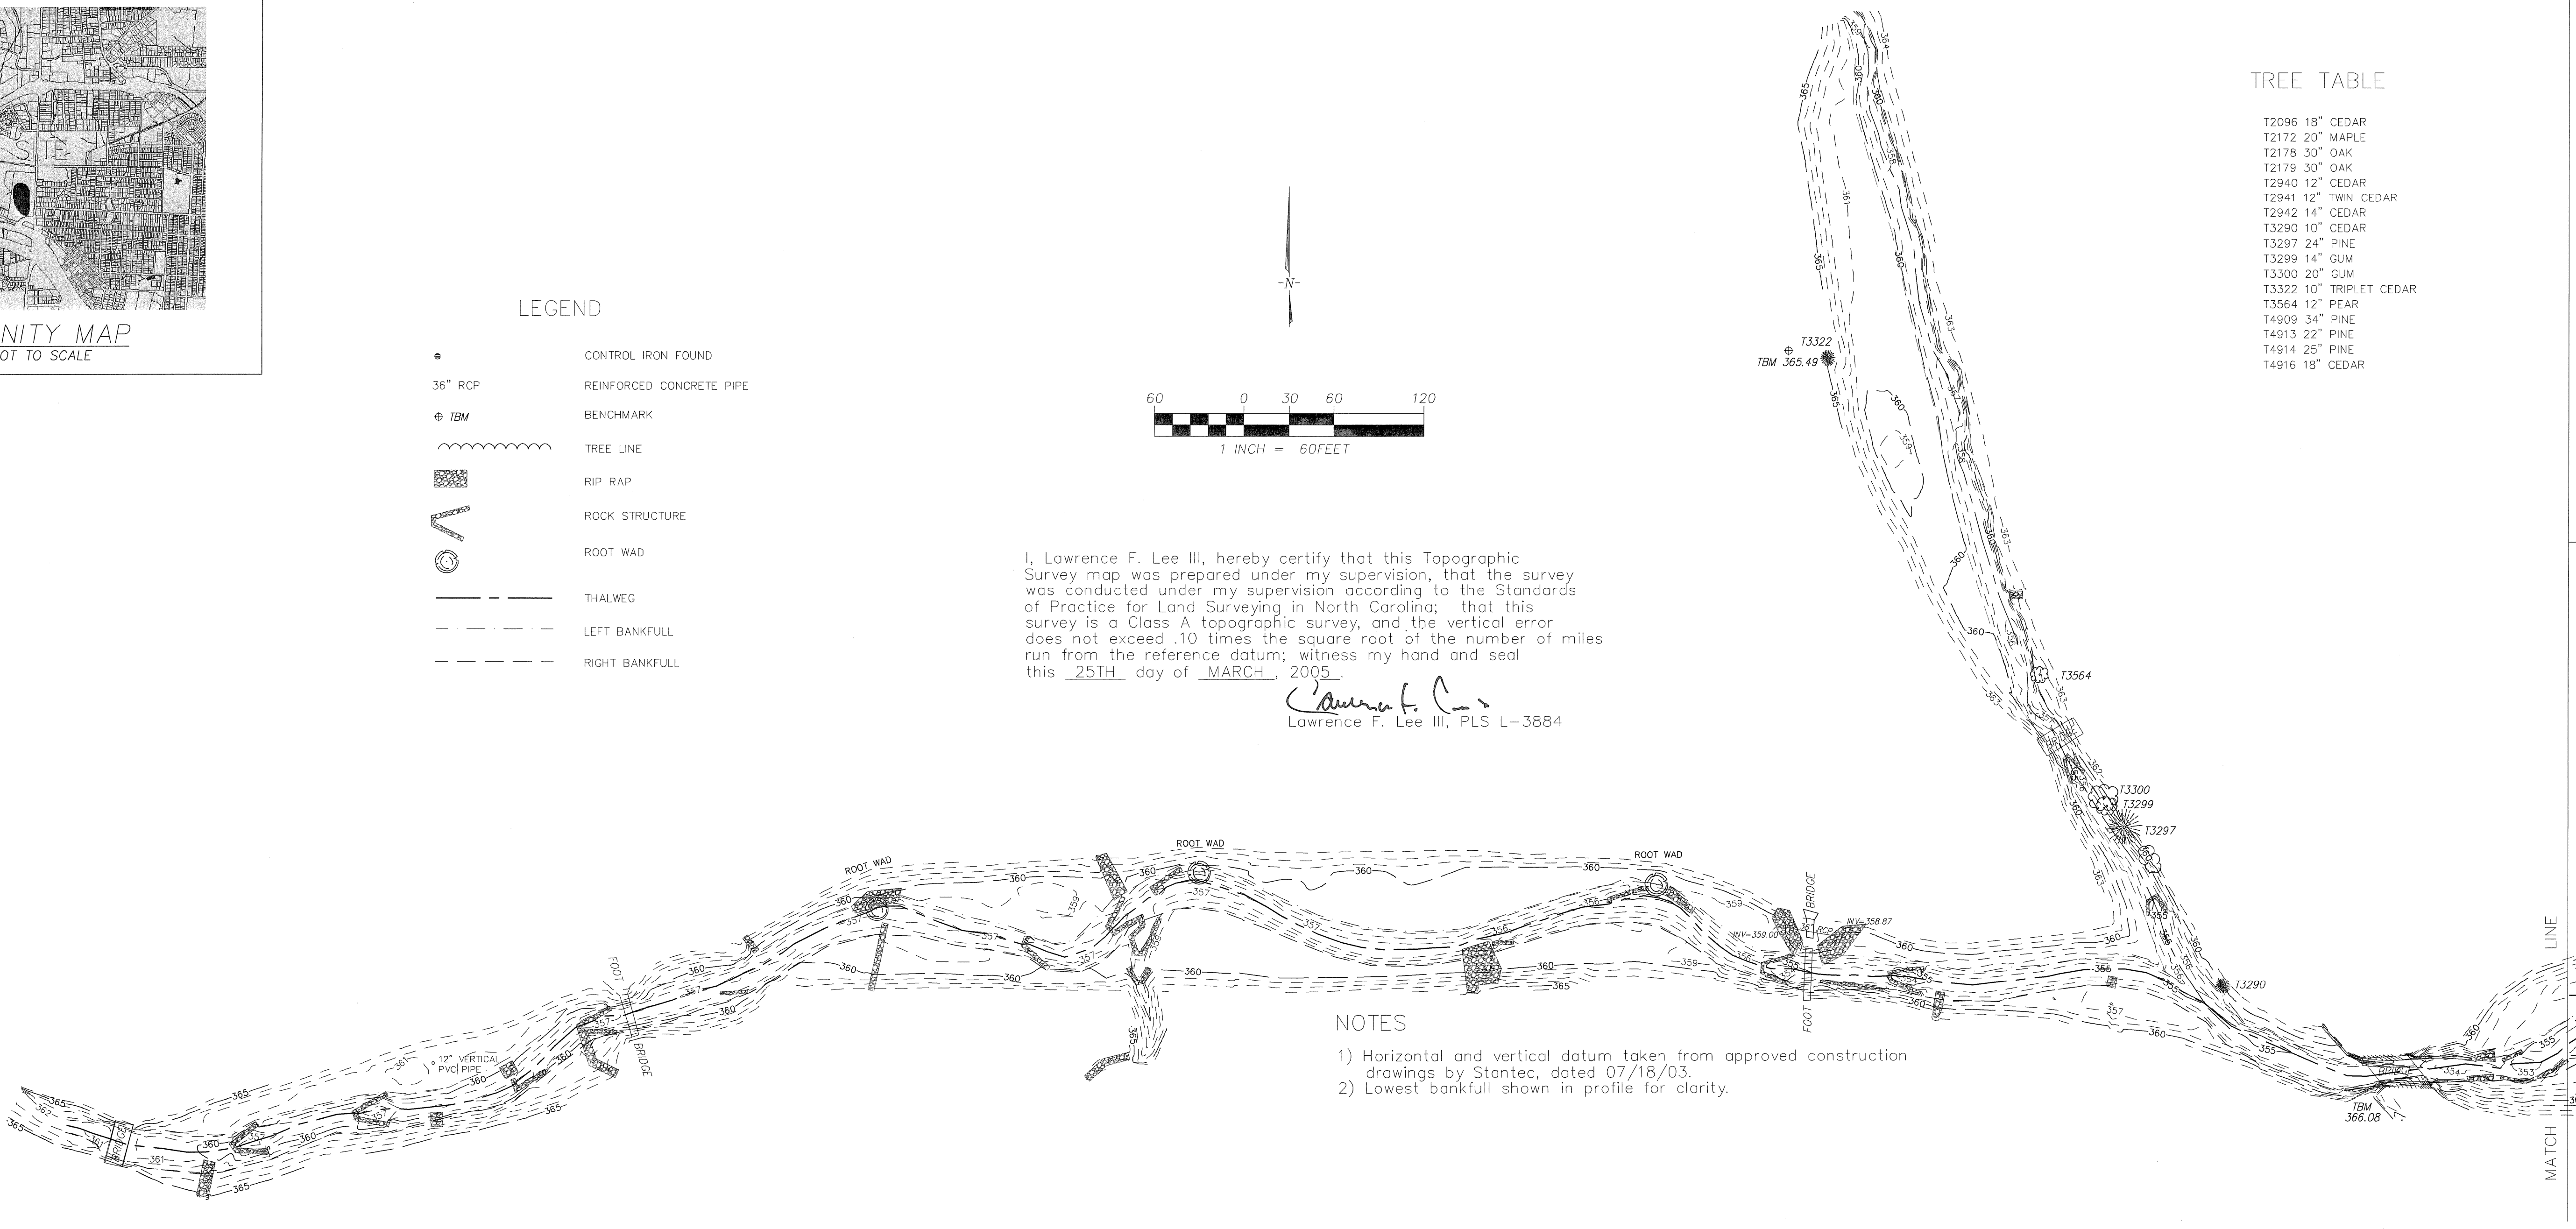

PROFILE MAIN LINE HORIZONTAL SCALE
1"=60'
VERTICAL SCALE
1"=60'

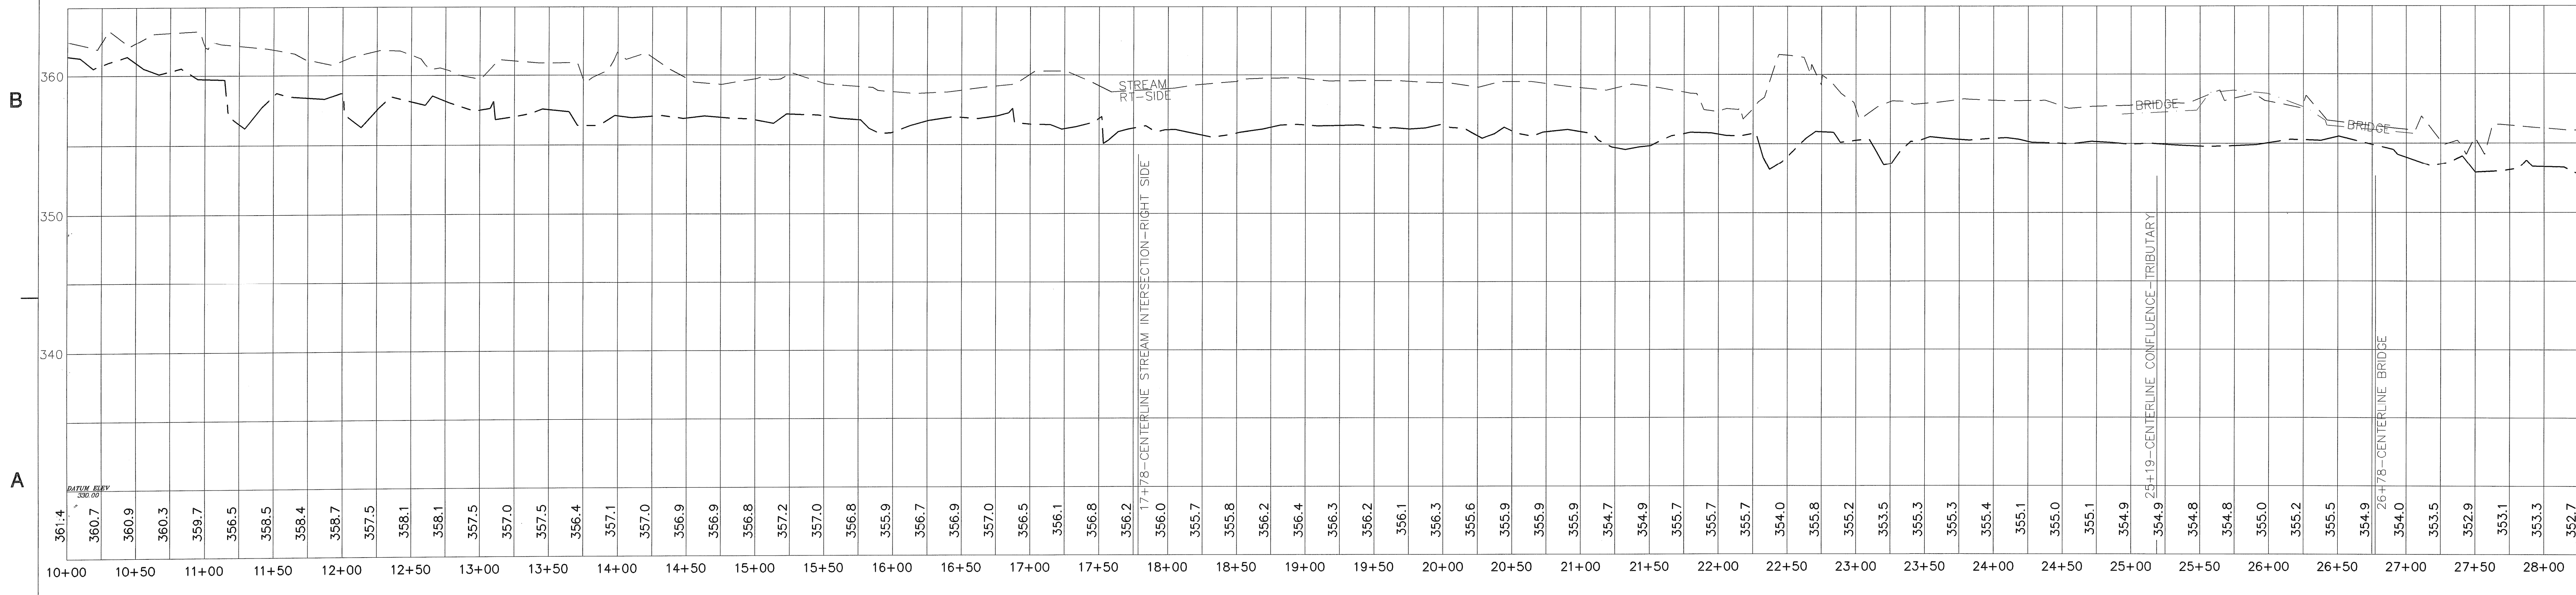




VICINITY MAP
NOT TO SCALE


TREE TABLE

T2096	18"	CEDAR
T2172	20"	MAPLE
T2178	30"	OAK
T2179	30"	OAK
T2940	12"	CEDAR
T2941	12"	TWIN CEDAR
T2942	14"	CEDAR
T3290	10"	CEDAR
T3297	24"	PINE
T3299	14"	GUM
T3300	20"	GUM
T3322	10"	TRIPLET CEDAR
T3564	12"	PEAR
T4909	34"	PINE
T4913	22"	PINE
T4914	25"	PINE
T4916	18"	CEDAR

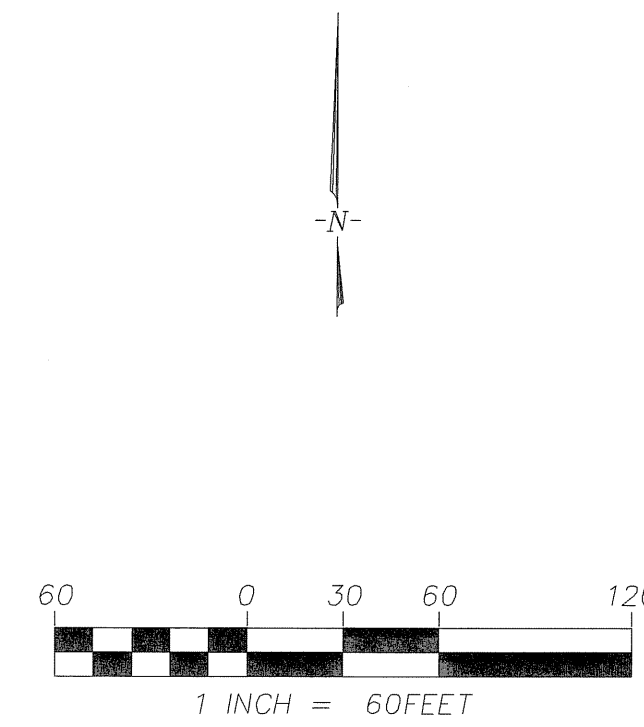

LEGEND

•	CONTROL IRON FOUND
36" RCP	REINFORCED CONCRETE PIPE
⊕ TBM	BENCHMARK
~	TREE LINE
▨	RIP RAP
⊠	ROCK STRUCTURE
⊙	ROOT WAD
---	THALWEG
- - -	LEFT BANKFULL
- - -	RIGHT BANKFULL

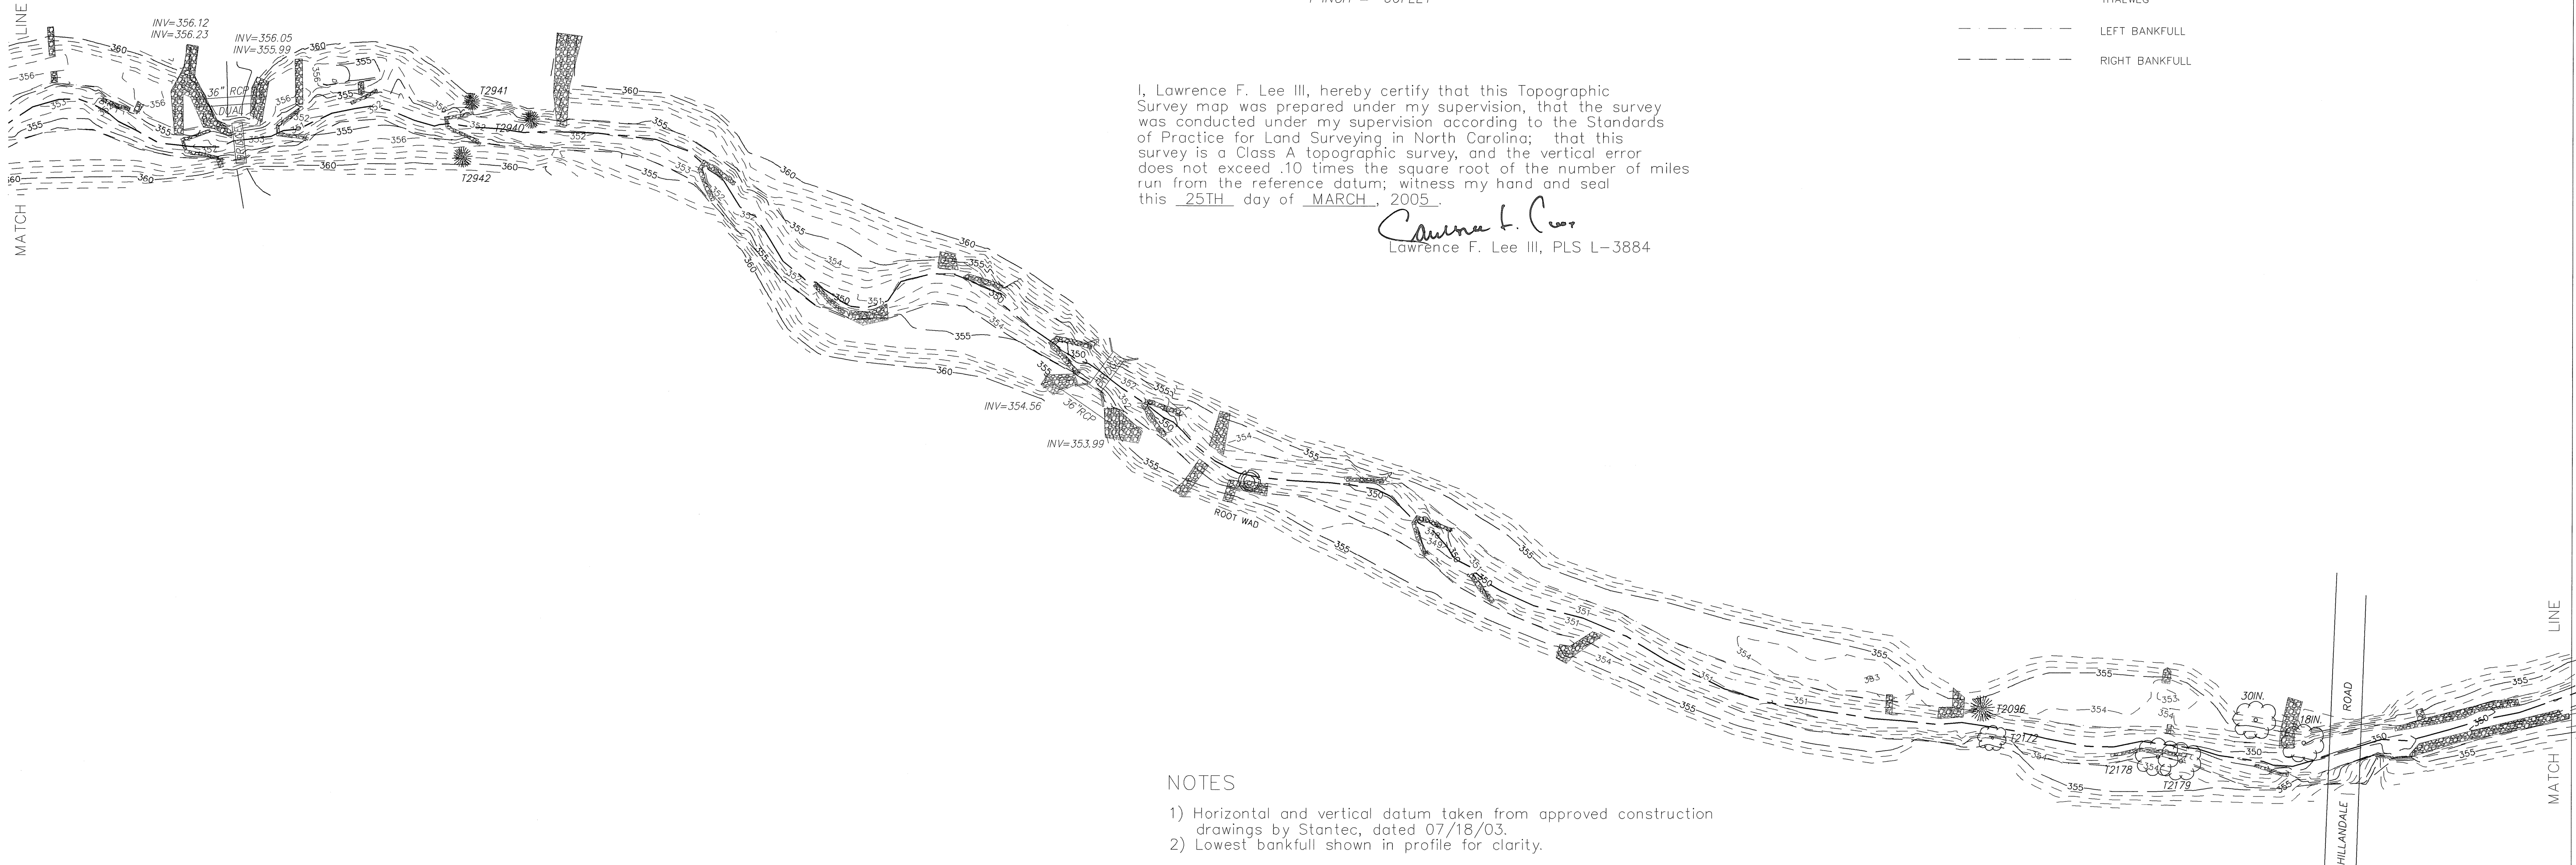

I, Lawrence F. Lee III, hereby certify that this Topographic Survey map was prepared under my supervision, that the survey was conducted under my supervision according to the Standards of Practice for Land Surveying in North Carolina; that this survey is a Class A topographic survey, and the vertical error does not exceed .10 times the square root of the number of miles run from the reference datum; witness my hand and seal this 25TH day of MARCH, 2005.

Lawrence F. Lee III
Lawrence F. Lee III, PLS L-3884


NOTES

- 1) Horizontal and vertical datum taken from approved construction drawings by Stantec, dated 07/18/03.
- 2) Lowest bankfull shown in profile for clarity.

PROFILE MAIN LINE

HORIZONTAL SCALE
1"=60'

VERTICAL SCALE
1"=60'

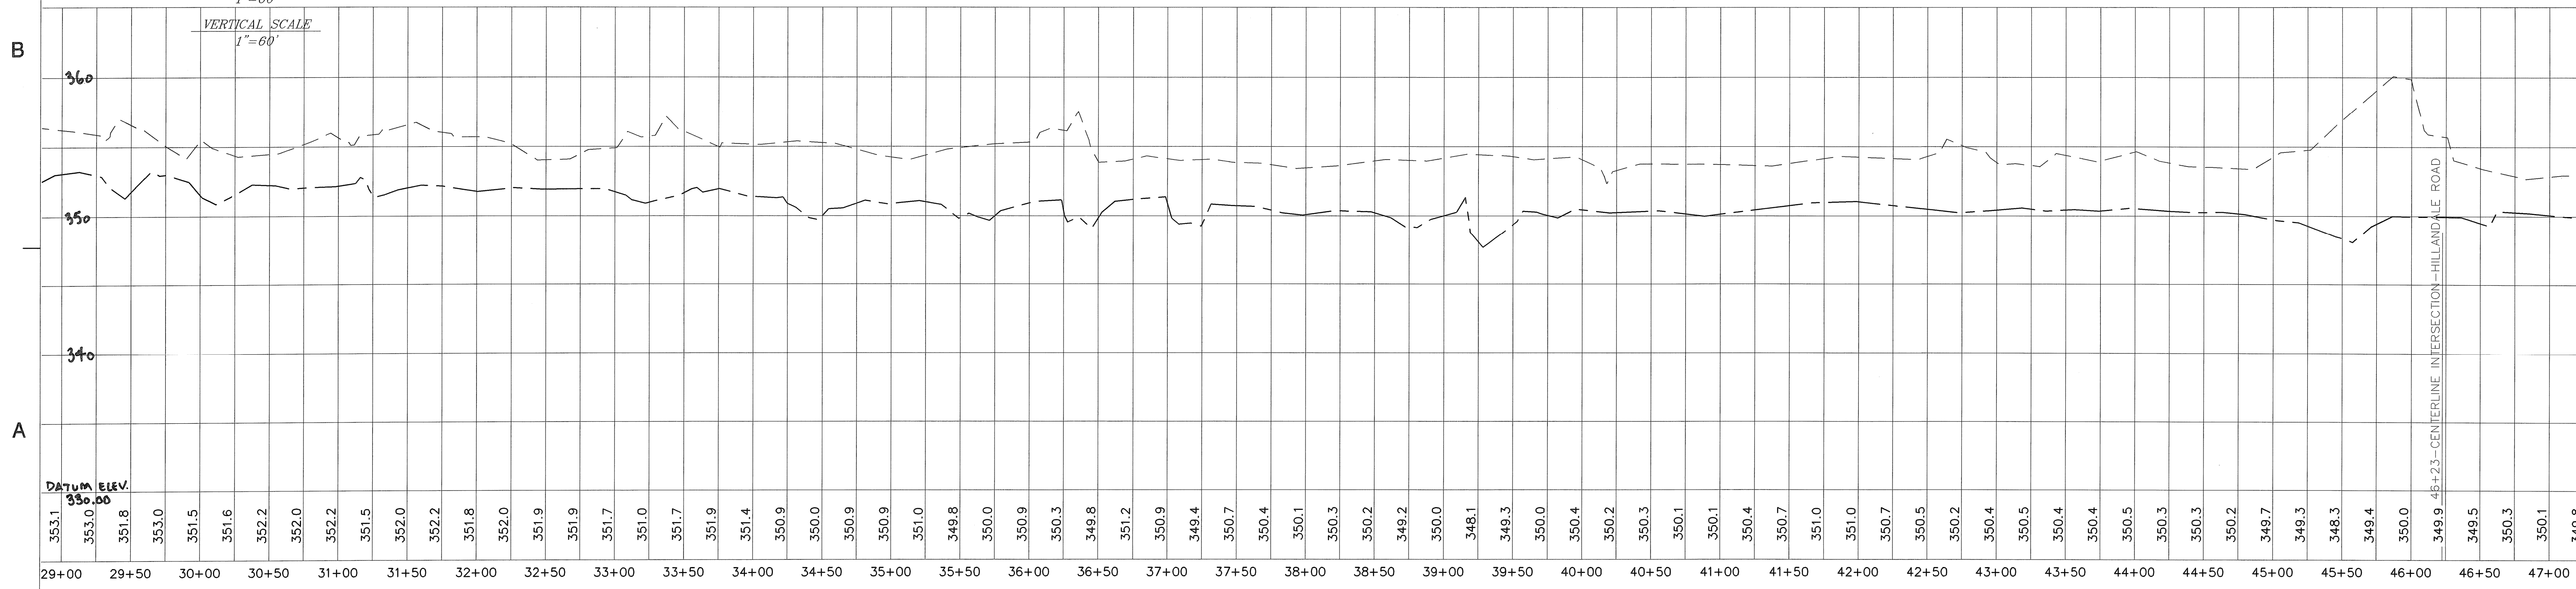

Dewberry
Dewberry & Davis, Inc.
2301 REAWOODS DRIVE
SUITE 200
RALEIGH, NC 27607
PHONE: 919.881.9939
FAX: 919.881.9923

SURVEY FOR
SEI ENVIRONMENTAL, INC.
TOPOGRAPHIC ASBUILT SURVEY
 ELLERBEE CREEK
 HILLDALE GOLF COURSE
 DURHAM, NC




DURHAM COUNTY	
TOWNSHIP	
FW	
DRAWN BY	LFL
APPROVED BY	REB
CHECKED BY	JJP
DATE	02/11/05
1	1/24/05 LFL ADD PROFILE
2	DATE EPT DESCRIPTION
	REVISIONS

E
D
C
B
A



VICINITY MAP
NOT TO SCALE

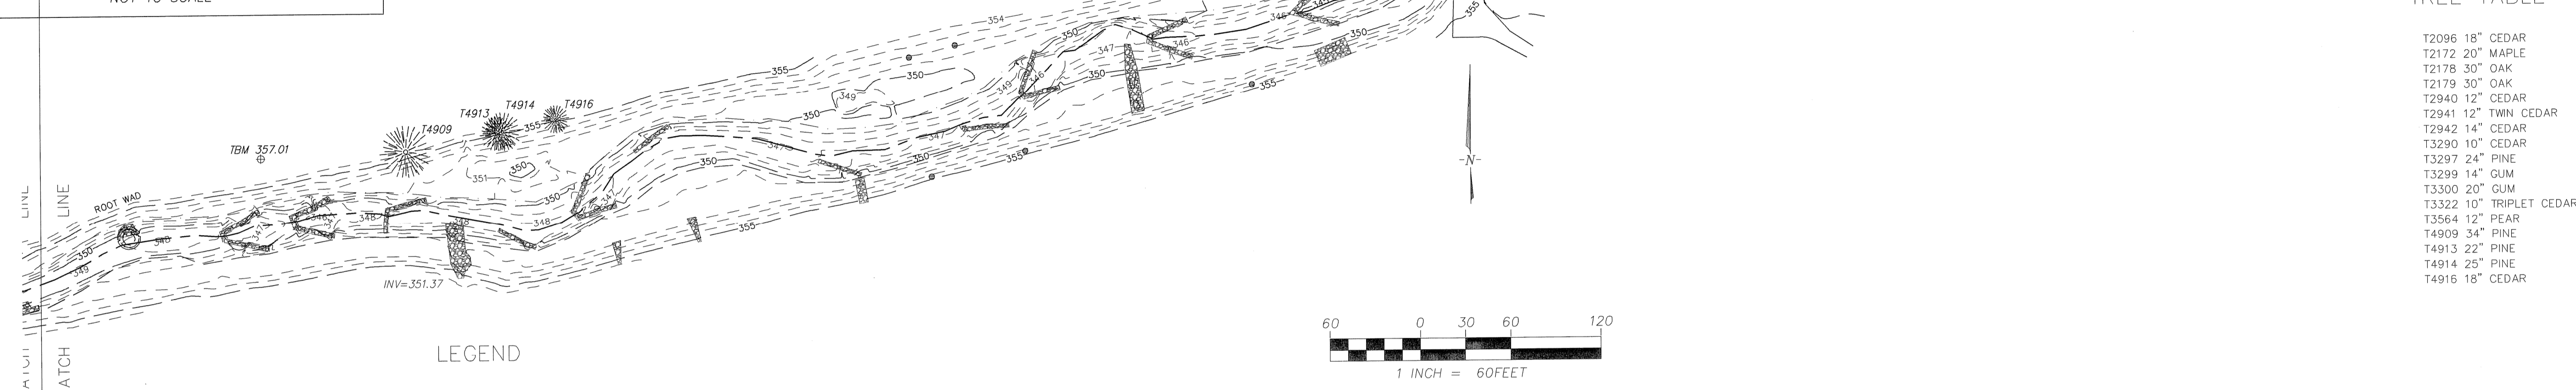

LEGEND

- CONTROL IRON FOUND
- 36" RCP REINFORCED CONCRETE PIPE
- ⊕ TBM BENCHMARK
- ~ TREE LINE
- ▒ RIP RAP
- ⚓ ROCK STRUCTURE
- /○ ROOT WAD
- THALWEG
- - - LEFT BANKFULL
- - - RIGHT BANKFULL

I, Lawrence F. Lee III, hereby certify that this Topographic Survey map was prepared under my supervision, that the survey was conducted under my supervision according to the Standards of Practice for Land Surveying in North Carolina; that this survey is a Class A topographic survey, and the vertical error does not exceed .10 times the square root of the number of miles run from the reference datum; witness my hand and seal this 24TH day of MARCH, 2005.

Lawrence F. Lee III
 Lawrence F. Lee III, PLS L-3884


NOTES

- 1) Horizontal and vertical datum taken from approved construction drawings by Stantec, dated 07/18/03.
- 2) Lowest bankfull shown in profile for clarity.

TREE TABLE

T2096	18" CEDAR
T2172	20" MAPLE
T2178	30" OAK
T2179	30" OAK
T2940	12" CEDAR
T2941	12" TWIN CEDAR
T2942	14" CEDAR
T3290	10" CEDAR
T3297	24" PINE
T3299	14" GUM
T3300	20" GUM
T3322	10" TRIPLET CEDAR
T3564	12" PEAR
T4909	34" PINE
T4913	22" PINE
T4914	25" PINE
T4916	18" CEDAR

PROFILE MAIN LINE
 HORIZONTAL SCALE
 1" = 60'
 VERTICAL SCALE
 1" = 60'

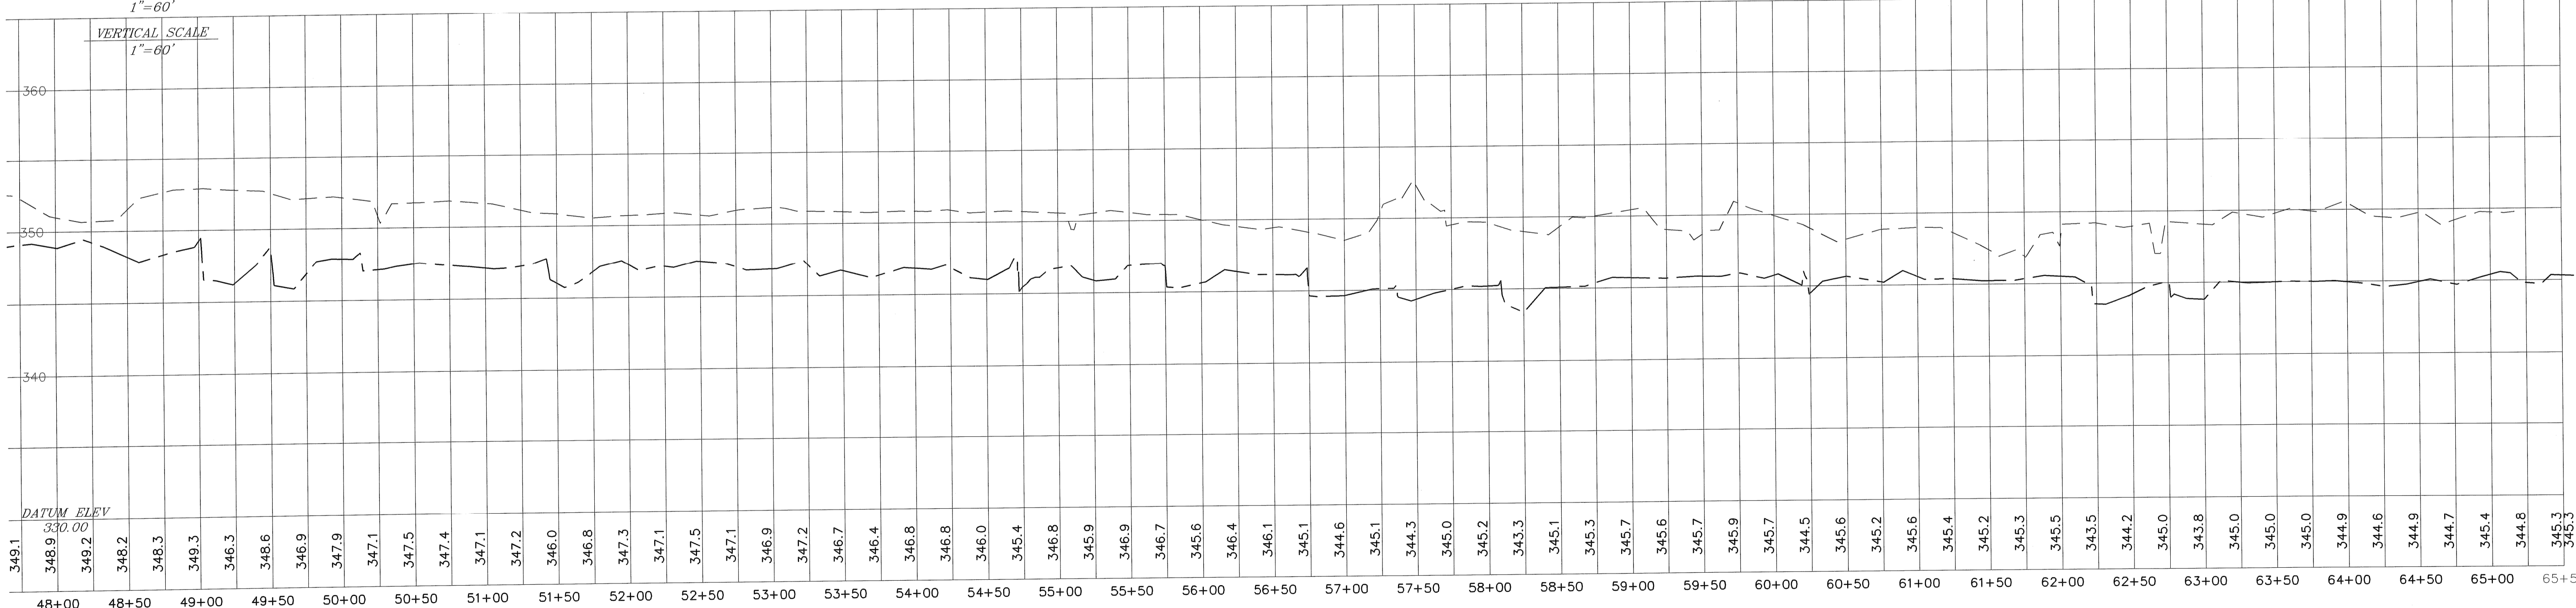

SURVEY FOR
SEI ENVIRONMENTAL, INC.
TOPOGRAPHIC ASBUILT SURVEY
 ELLERBEE CREEK
 HILLDALE GOLF COURSE
 DURHAM, NC



DRAWN BY	APPROVED BY	CHECKED BY	DATE
LFL	REB	JP	02/11/05

