

Farrar Dairy Stream and Wetland Restoration Site

Mitigation Plan

Contract # D06002



KCI Technologies, Inc.
Landmark Center II, Suite 220
4601 Six Forks Road
Raleigh, NC 27609



NCDENR-EEP
1652 Mail Service Center
Raleigh, NC 27699-1652

August 2009



**Landmark Center II, Suite 220
4601 Six Forks Road
Raleigh, NC 27609
Phone: (919) 783-9214
Fax: (919) 783-9266**

**Project Manager: Tim Morris
Email: tim.morris@kci.com**

TABLE OF CONTENTS

1.0 PROJECT BACKGROUND1

1.1 Location and Setting 1

1.2 Project Goals and Objectives 1

1.3 Project Structure, Restoration Type and Approach 1

 1.3.1 Project Streams 1

 1.3.2 Project Wetlands 3

1.4 Project History, Contacts and Data 7

2.0 PROJECT MONITORING / AS-BUILT CONDITIONS9

2.1 Monitoring Features 9

2.2 Monitoring Guidelines 9

2.3 As-Built Conditions 9

3.0 SUCCESS CRITERIA21

3.1 Stream Stability 21

3.2 Vegetation 22

3.3 Hydrology 22

4.0 MAINTENANCE AND CONTINGENCY PLAN22

FIGURES

Figure 1. Project Site Vicinity Map 2

Figure 2. Farrar Dairy Stream and Wetland Restoration Site Map 6

TABLES

Table 1. Project Restoration Components 5

Table 2. Project Activity and Reporting History 7

Table 3. Project Contact Table 7

Table 4. Project Background Table 8

Table 5. Baseline Stream Summary 10-18

Table 6. Morphology and Hydraulic Monitoring Summary 19-20

Table 7. Planted Stem Density by Plot 21

APPENDICES

Appendix A. As-Built Plans

Appendix B. Cross-Section Plots and Pebble Counts

Appendix C. Longitudinal Profiles

Appendix D. Vegetation Data

Appendix E. Photo Points

EXECUTIVE SUMMARY

The Farrar Dairy Site is located in the Sand Hills physiographic province in Harnett County, North Carolina. The project will provide mitigation for stream and wetland impacts within the 8-digit hydrologic cataloging unit 03030004 in the Cape Fear River Basin by restoring, enhancing, and preserving 13,044 linear feet of stream and 112 acres of wetland, generating 11,881 stream mitigation units (SMU's) and 64.06 wetland mitigation units (WMU's). The goals of the project include restoring the riparian buffers and forested wetlands as well as creating a stable stream and wetland complex through an interconnected floodplain corridor. In order to achieve these goals, the project objectives included connecting the new stream planform to its original floodplain, filling and plugging ditches in the drained hydric soils to restore saturated hydrologic conditions, planting a functional Coastal Plain Small Swamp Stream community to create an effective riparian buffer and wetland complex, and removing cattle from the riparian areas with livestock exclusion fencing.

The project watershed drains from the northeast toward the southeast with a contributing area of approximately 5.7 square miles at the downstream limits. The rural watershed faces low to moderate development pressure from the surrounding area. The stream and wetland design along with the restoration plan were completed in May 2008, construction began in October 2008, and the site was planted prior to the 2009 growing season.

The stream restoration included eight separate reaches, which were either enhanced or restored using a combination of Priority 1 and 2 approaches. The wetland mitigation is comprised of five areas that combine preservation, enhancement, and restoration. In-stream structures, such as step pools and log drops were used to control grade throughout the restored stream's profile. The main channel through the site, the North Prong of Anderson Creek (NPAC), was restored to a C5 type channel, while its associated tributaries were restored or enhanced to C5/B5c, E5, and C5 type channels. The as-built survey and baseline monitoring found only minimal deviations from the designed cross-sections and profile. During construction, several large rain events caused minor problem areas on the restored stream channels. These issues and the repairs associated with them caused some small alterations to the stream profiles and dimension. These changes have been recorded on the as-built site plan. Since construction, the site has become well vegetated and the streams have remained stable throughout the storm events that have occurred since construction was completed.

The wetlands on the site were restored, enhanced, and preserved. The Priority 1 stream restoration restored the hydrology to the wetlands adjacent to the stream. Along with the restoration of these previously drained wetlands, other wetlands were enhanced by removing berms, treating invasive species, creating microtopography, and partially filling open water impoundments. The stream buffer and wetland restoration and enhancement areas were planted with bare root trees and shrubs and live stakes in March 2009.

The site will be monitored for at least five years beginning in 2009 through 2013 or until the success criteria are achieved. Reports will be submitted to the EEP each year. The planted riparian buffer and wetland must meet the success criteria of a site average of 320 planted stems/acre at the end of the monitoring period based on the vegetation monitoring plots. The baseline monitoring counted an average of 640 stems/acre in the 15 stream vegetation monitoring plots and 543 stems/acre in the 30 wetland vegetation monitoring plots. The water table of the restored wetlands must be within 12" of the soils surface continuously for at least 5% (12 days) of the 240-day growing season. Wetland hydrology will be monitored with a system of automatic gauges that record water table depth. Stream success will be assessed utilizing measurements of stream dimension, pattern, and profile as well as through site photographs. Two bankfull events also must occur on the restored streams over the monitoring period in separate monitoring years.

1.0 PROJECT BACKGROUND

1.1 Location and Setting

The Farrar Dairy Site occupies portions of nine parcels. The site is located off of Farrar Dairy Road in southern Hartnett County, North Carolina, and approximately is 8.5 miles southwest of Lillington, North Carolina (Figure 1). To reach the site from Raleigh, drive south out of Raleigh on US 401 toward Fuquay-Varina, continuing south from Fuquay-Varina on US-401/US-421 toward Lillington. Turn right onto NC-210 and continue south through Lillington for approximately 6.5 miles to Darroch Road. Turn right onto Darroch Road and continue approximately 3 miles to Powell Farm Road. Turn left onto Powell Farm Road, drive approximately 1.5 miles and the entrance to the site will be on the left through the driveway of the red ranch style home.

1.2 Project Goals and Objectives

The project goals are to:

- Restore the site's riparian buffers and forested wetlands.
- Create a stable stream and wetland complex through an interconnected floodplain corridor.

In order to meet these goals, the following objectives were accomplished:

- Connected the new stream planform to its original floodplain.
- Fill and plug ditches in the drained hydric soils to restore saturated hydrologic conditions to the upper soil horizons.
- Plant a functional Coastal Plain Small Swamp Stream community to create an effective riparian buffer and wetland complex.
- Exclude livestock from the riparian and wetland areas with fencing.

1.3 Project Structure, Restoration Type and Approach

The project streams at the Farrar Dairy Site had become degraded primarily through poor grazing management and vegetation removal. Historically, the mainstem of the NPAC was altered to maximize the use of an agricultural field adjacent to Powell Farm Road. The other significant hydrologic alterations to the site included ditching wetlands and straightening the incoming tributaries to more efficiently convey water through the property. Due to the clearing of the riparian areas, the streams were experiencing significant bank erosion prior to restoration. Severe incision was also occurring on almost all of the reaches. In addition to the ditching that was installed in the historic wetlands, ponds were also built to attract migratory waterfowl. To correct these problems, restoration and enhancement of 13,044 linear feet of channel and 112 acres of wetlands were accomplished utilizing a Priority 1 approach for the stream (Table 1).

1.3.1 Project Streams

The three design reaches of NPAC were restored using a Priority 1 approach, creating a stable C5 channel. The reach breaks are separated by the confluences with T2 and T3. Following the Priority 1 approach, the channel was relocated to its historic location and the bed elevation was brought up reconnecting the stream to the original floodplain. At Station 10+00, the restored channel begins online at the culvert under Powell Farm Road. At Station 21+00, the channel leaves the pre-restoration location and flows through the adjacent forest in the location of its historic channel. The new channel comes back online at the end of the project at Station 76+00.

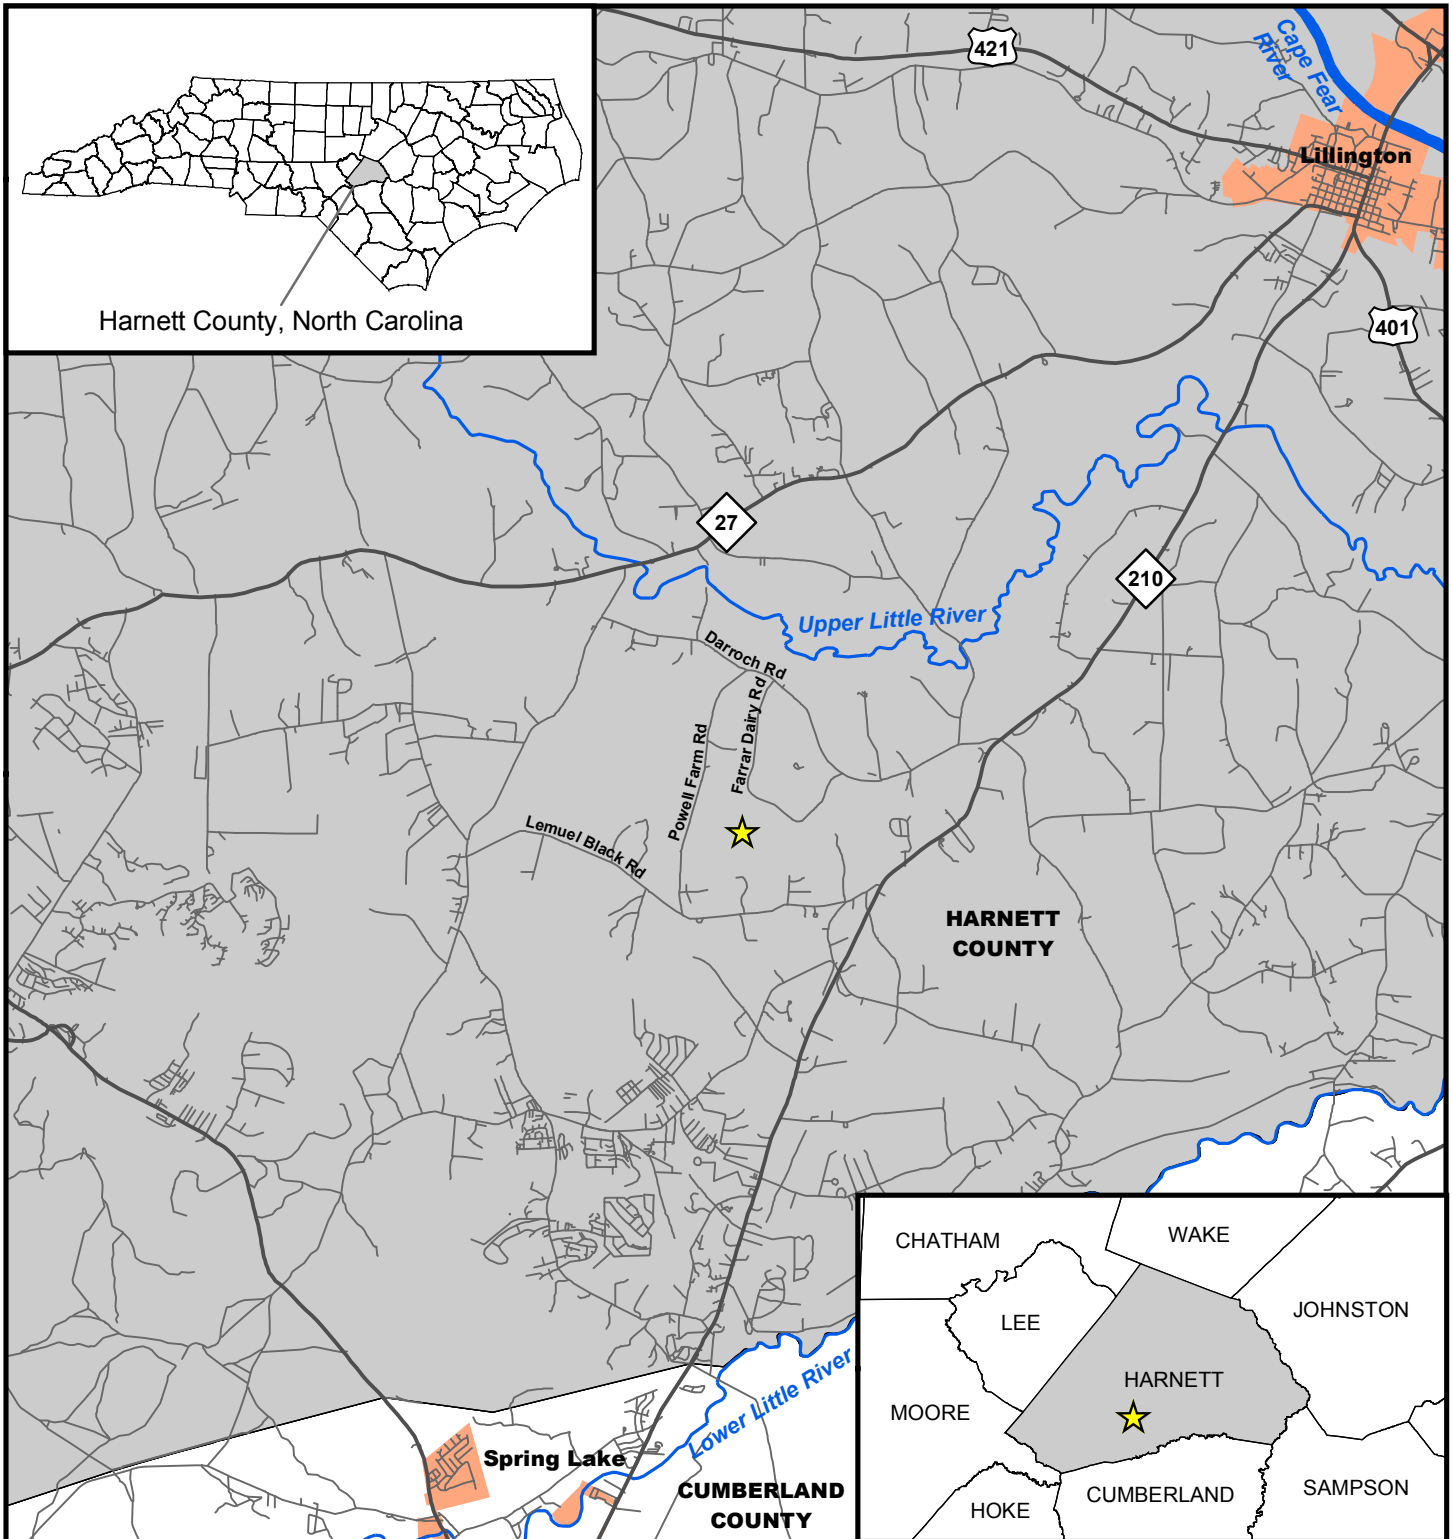









Figure 1. Vicinity Map

-  Project Site Location
-  Major Roads
-  Other Roads
-  Major Rivers
-  Municipalities
-  County Boundaries



1:126,720

1 inch equals 2 miles

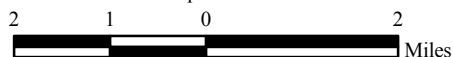

T1.1 and T1.2 (Station 80+00 to 88+25 and Station 90+00 to 99+80, respectively) were both restored to C5/B5c headwater channels. At the confluence of these two channels, T1 begins. T1 (Station 100+00 to 108+84) was restored using the same approach as T1.1 and T1.2. A 31'-wide easement exception occurs at Station 101+00, where a ford crossing was installed for the landowner. The restoration created a new planform, profile, and dimension and increased the sinuosity of these previously straightened channels with a combination of Priority 1 and 2 approaches. Grade control structures such as log sills and step pools were installed along the new channels to create a stable profile. This restoration created a bankfull bench in entrenched sections and reconnected the stream to the existing floodplain in others.

T2 was divided into two reaches based on the changing slope of the tributary. T2A (Station 110+00 to 115+00) was restored to a C5/B5c stream and T2B (Station 115+00 to 120+22) was restored to an E5 stream type. The hydrologic source for the channel is a seep at the top of T2A. The restoration created a new planform, profile, and dimension and increased the sinuosity of the previously straightened channel with a combination of Priority 1 and 2 approaches. Grade control structures such as log sills and step pools were installed along the new channels to create a stable profile. This restoration created a bankfull bench in some places and reconnected the stream to the existing floodplain in others.

T3 (Station 130+00 to 141+67) is comprised of a single reach that was restored to a C5 channel. This channel was restored using a Priority 1 approach, with a new planform, profile, and dimension being reconnected to the original floodplain. Two drainage ditches that were adjacent to T3 were filled, reestablishing T3 as the primary hydrologic feature in this area.

T4 is separated into two reaches. The first reach (Station 150+00 to 151+80) was enhanced (EII) by planting portions of the easement that had been logged and removing significant amounts of logging debris that had accumulated in the channel, creating unstable conditions. The second reach (Station 151+80 to 164+20) is preservation. Near Station 162+00, the stream flows out of the easement for approximately 100 feet, but then comes back into the easement. The stationing continues from where the stream left the easement.

In-stream structures, including log sills, log drops, riffle grade controls, and offset rock cross vanes, were used to stabilize the restored channels. These structures are designed to reduce bank erosion, influence secondary circulation in the near-bank region of stream bends, provide grade control and promote efficient sediment transport. The log sill and log drop structures enhance in-stream pool habitat by creating a scouring obstruction, maintaining pool depths and providing habitat cover. Coir fiber matting, seeding, and mulching were used to provide temporary stabilization on the newly graded stream banks and live stakes were planted to provide long term rooting strength to the stream banks.

1.3.2 Project Wetlands

Wetland Area 1 preserves approximately 46 acres of well vegetated palustrine forested, scrub-shrub and emergent wetlands that are along the floodplain of the NPAC. The preservation area is dominated by various wetland sedges, rushes and persistent emergent vegetation, but also contains large scrub-shrub alder thickets that are permanently inundated.

Starting from the west and continuing to the east, Wetland Area 2 is located in the general vicinity of Tributary 1. Portions of this area, which is comprised of six wetlands separated by the restored stream, were historically cleared as part of the site's agricultural operations. This area was enhanced through the planting of bare root material. This wetland also borders the restored NPAC, and because NPAC has been reconnected to its floodplain, overbank flooding inundates the adjacent wetlands.

Enhancement in Wetland Area 3 took place in the central portion of the site. The area includes a shallow pond and adjacent overbank areas of the NPAC. Wetland Area 3 is located adjacent to a section of NPAC where overbank flows will have regular access to the floodplain, thus restoring hydrology to the wetlands. This area was planted with wetland trees and shrubs and graded to eliminate the man-made berms that impounded excess surface water.

Wetland Area 4 is located in an area that was heavily manipulated by the landowner to create a series of shallow impoundments intended to attract migratory waterfowl. The impoundments contain water control structures that allowed the landowner to manipulate water levels within the impoundments. These ponds were regraded to create a mosaic of vegetated wet hummocks throughout the wetland. Wetland W4 serves as a transitional area between the ponded features and the wetland preservation area. This area was planted with bare root seedlings and treated to control invasive species.

Wetland Area 5 includes all the site's restored wetlands. These areas are within the floodplain of the NPAC and its tributaries, which had historically been hydrologically altered to allow for agricultural production. Four main construction techniques were utilized to restore these wetland areas:

1. Raising the elevation of the NPAC and its tributaries to re-establish an active floodplain connected to the adjacent wetlands.
2. Filling existing ditches and removing tile drains to discourage rapid groundwater discharge to surface water receptors.
3. Scarifying the top 0.5' of organic surface soil to re-establish soil structure and allow for increased surface storage (microtopography). This material was not removed from the site, but simply re-worked to maximize the ability of the surface soils to retain surface and groundwater hydrology.
4. Planting species of wetland plants and shrubs.

Table 1 below provides a summary of the mitigation actions and units generated from this project.

Table 1. Project Restoration Components

Farrar Dairy Site

Project Streams

Project Segment / Reach ID	Pre- Project Footage	Mitigation Type	Approach	As - Built Footage	As-Built Stationing	Stream Mitigation Units	Comment
NPAC	4,565	Restoration	P1	6,746	10+00-77+46	6,714*	The stream was relocated with a new planform, profile, and dimension.
T1.1	864	Restoration	P1/2	825	80+00-88+25	825	The stream was relocated with a new planform, profile, and dimension.
T1.2	995	Restoration	P1/2	980	90+00-99+80	980	The stream was relocated with a new planform, profile, and dimension.
T1	389	Restoration	P1/2	884	100+00-108+84	853*	The stream was relocated with a new planform, profile, and dimension.
T2A	977	Restoration	P1/2	500	110+00-115+00	500	The stream was relocated with a new planform, profile, and dimension.
T2B		Restoration	P1/2	522	115+00-120+22	522	The stream was relocated with a new planform, profile, and dimension.
T3	1,335	Restoration	P1	1,167	130+00-141+67	1,167	The stream was relocated with a new planform, profile, and dimension.
T4.1	180	Enhancement II	-	180	150+00-151+80	72	The logged portions of the easement were planted and problematic logging debris was removed from the stream channel.
T4.2	1,240	Preservation	-	1,240	151+80-164+20	248	
Total				13,044		11,881	

* Easement exceptions for landowner ford crossings were excluded for these calculations.

Project Wetlands

Project Segment	Primary Soil Type	Mitigation Type	Acreage	Community Type	Wetland Mitigation Units	Comment
Area 1	Wehadkee	Preservation	45.93	Coastal Plain Small Stream Swamp	9.19	Protected by permanent conservation easement.
Area 2	Wehadkee	Enhancement	6.88	Coastal Plain Small Stream Swamp	3.44	The unvegetated portions of the wetland were planted and the hydrology was enhanced by the adjacent Priority 1 stream restoration.
Area 3	Wehadkee	Enhancement	2.57	Coastal Plain Small Stream Swamp	1.29	The unvegetated portions of the wetland were planted and the berms of a waterfowl impoundment were removed to enhance the hydrology.
Area 4	Wehadkee	Enhancement	12.67	Coastal Plain Small Stream Swamp	6.34	The unvegetated portions of the wetland were planted and the spoil from a waterfowl impoundment was distributed through the area to provide topographic relief through the wetland.
Area 5	Wehadkee	Restoration	43.8	Coastal Plain Small Stream Swamp	43.8	The unvegetated portions of the wetland were planted and hydrology was restored by filling ditches and by reconnecting the wetland to the floodplain of NPAC.

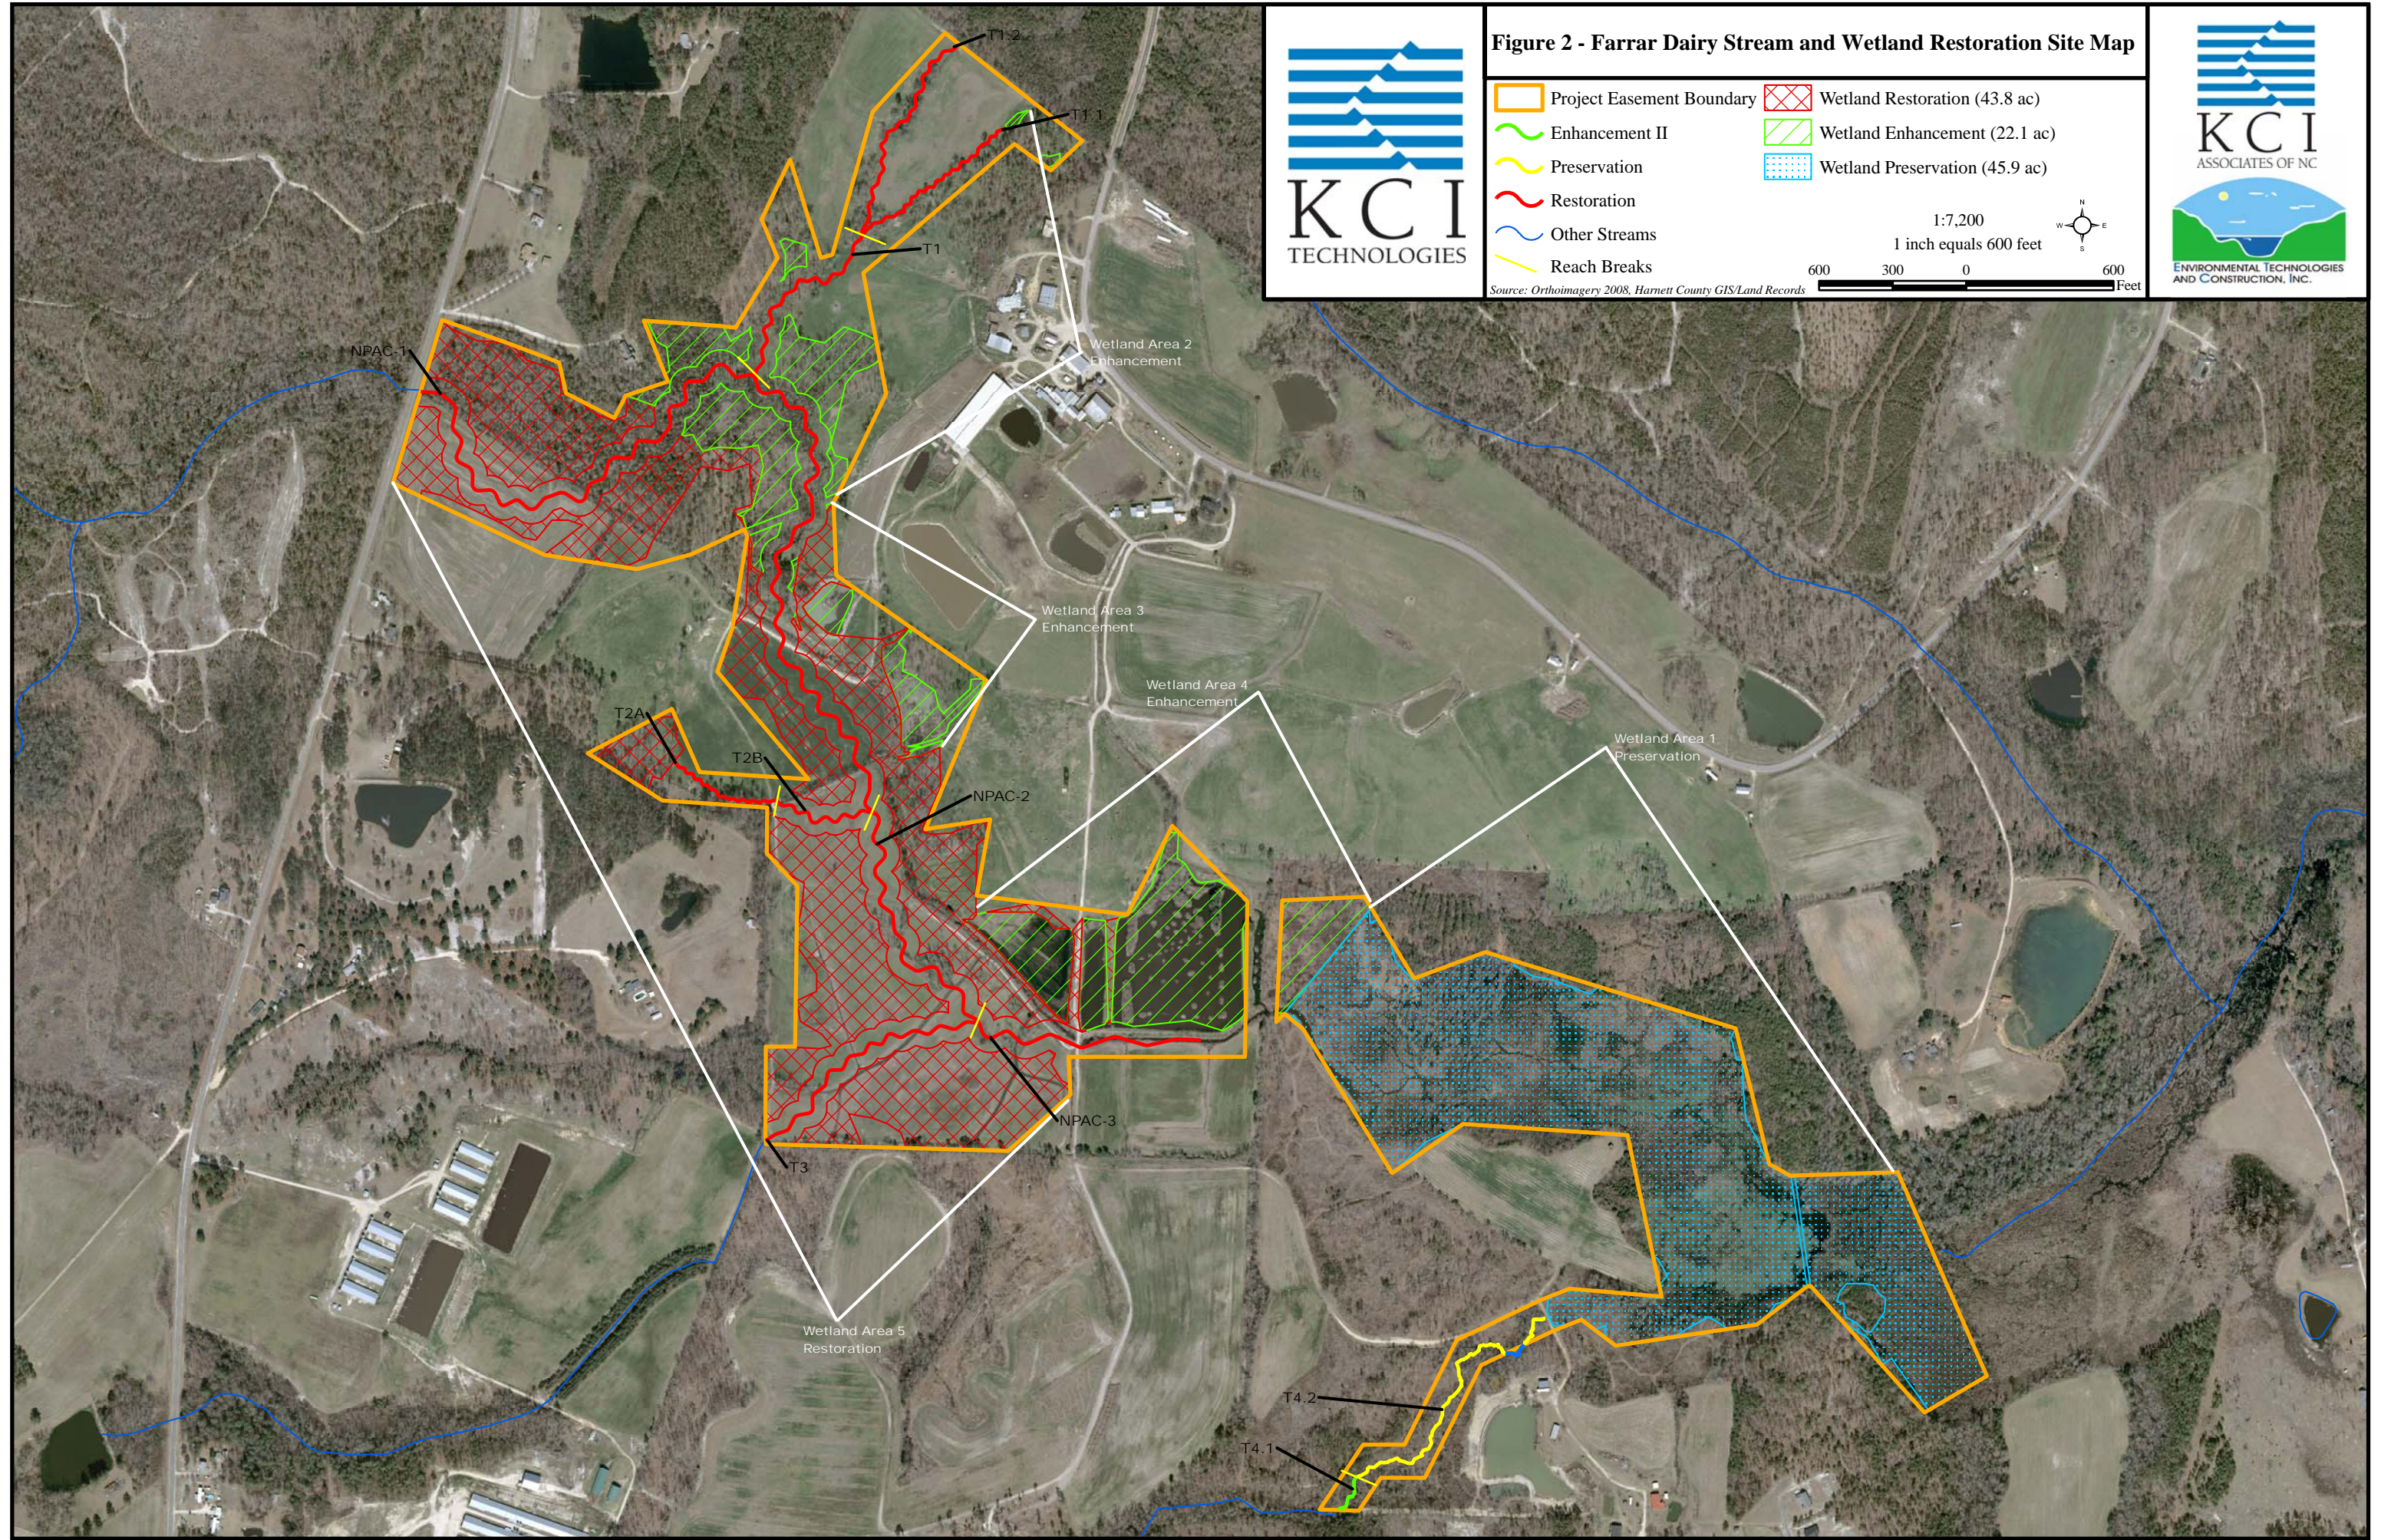


Figure 2 - Farrar Dairy Stream and Wetland Restoration Site Map

Project Easement Boundary	Wetland Restoration (43.8 ac)
Enhancement II	Wetland Enhancement (22.1 ac)
Preservation	Wetland Preservation (45.9 ac)
Restoration	
Other Streams	
Reach Breaks	

Scale: 1:7,200
1 inch equals 600 feet

Source: Orthoimagery 2008, Hamett County GIS/Land Records



1.4 Project History, Contacts and Data

Table 2. Project Activity and Reporting History Farrar Dairy Site		
Activity or Report	Data Collection Complete	Completion or Delivery
Restoration Plan	2007	May 08
Final Design	2007	May 08
Construction	N/A	Mar 09
Planting - Stream and Wetland	N/A	Mar 09
Mitigation Plan / As-Built (Year 0 Monitoring - Baseline)	May 09	Jun 09

Table 3. Project Contact Table Farrar Dairy Site	
Design Firm	KCI Technologies, Inc. Landmark Center II, Suite 220 4601 Six Forks Rd. Raleigh, NC 27609 Contact: Mr. Tim Morris Phone: (919) 278-2512 Fax: (919) 783-9266
Construction Contractor	Land Mechanics, Inc. 126 Circle G Lane Willow Springs, NC 27592 Contact: Mr. Lloyd Glover Phone: (919) 639-6132 Fax: (919) 639-7079
Planting Contractor	Bruton Nurseries and Landscapes PO Box 1197 Freemont, NC 27830 Contact: Mr. Charlie Bruton Phone: (919) 242-6555
Monitoring Performers	
MY-00 - MY-05	KCI Technologies, Inc. Landmark Center II, Suite 220 4601 Six Forks Rd. Raleigh, NC 27609 Contact: Mr. Adam Spiller Phone: (919) 278-2514 Fax: (919) 783-9266

Table 4. Project Background Table		
Farrar Dairy Site		
Project County	Harnett County	
Physiographic Region	Coastal Plain	
Ecoregion	Sand Hills	
Project River Basin	Cape Fear	
USGS HUC for Project and Reference	03030004110010 (Anderson Creek)	
	03030004150050 (Little Rockfish Creek - reference)	
	03030002050100 (UT to Wilkinson Creek - reference)	
NCDWQ Sub-basin for Project and Reference	03-06-14 (Anderson Creek)	
	03-06-15 (Little Rockfish Creek - reference)	
	03-06-04 (UT to Wilkinson Creek - reference)	
Drainage Area	5.7 sq. mi.	
Stream Order	First and Second Order	
Watershed Type (Rural, Urban, Developing, etc.)	Rural	
Watershed LULC Distribution	Urban	<1%
	Ag-Row Crop	21%
	Ag-Livestock	1%
	Forested	72%
	Water/Wetlands	6%
Watershed impervious cover (%)	3%	
Rosgen Classification of As-built (Stream)	C5 (NPAC)	
	C5/B5c (T1.1, T1.2, T1, T2A, T2B, T3, T4)	
NCDWQ Classification for Project	Class C (Anderson Creek)	
Within EEP Watershed Plan?	No	
Any portion of the project segment upstream of a 303d listed segment?	No	
Reasons for 303d Listing or Stressor	N/A	
Total project acreage of easement	166.9 Acres	
Total planted acreage	93.0 Acres	
WRC Class (Warm, Cool, Cold)	Warm	
Species of concern, endangered etc.	None	
Pre-construction Beaver activity?	Yes	
Dominant Soil Types	Wehadkee loam and Gilead sandy loam	
% of Project Easement Fenced	85%	

2.0 PROJECT MONITORING / AS-BUILT CONDITIONS

2.1 Monitoring Features

Permanent monuments, marking monitoring feature locations, were established on-site. The beginning and end of each permanent cross-section was marked with rebar monuments. Vegetation plots were installed with flagged metal conduit at each corner and a flagged PVC pipe was installed at the photo corner. Two automatic recording gauges were installed along the NPAC to record water levels indicating when bankfull events occur. Eight automatic recording gauges were installed in the site's wetlands, seven in the wetland restoration areas and one in the preservation wetland, as a reference, to record hydrology data throughout the growing season. The locations of these monitoring features and the permanent photo points are marked in the As-Built Plan (Appendix A).

2.2 Monitoring Guidelines

Stream data will be calculated from the monitored longitudinal profiles and cross-sections (Tables 5 and 6). Twenty-nine permanent cross-sections were established and will be used to evaluate stream dimension: 12 cross-sections on NPAC, 3 cross-sections each on T1.1, T1.2, T1, and 4 cross-sections each on T2 and T3. Pebble counts will be performed at each cross-section (Appendix B). Cross-sections will be surveyed each year using a total station in order to calculate data such as area and width to depth ratio. A total of over 4,850 linear feet of longitudinal profile will be surveyed. The monitored longitudinal profile will be split into seven representative portions. Two profiles will be taken along the NPAC and will be 1,500 and 600 feet long, while the profiles along T1.1, T1.2, T1, T2, and T3 will be approximately 500 feet each. The profiles will be surveyed with a total station and will record elevations of bed features, water surface levels, and bankfull elevations (Appendix C). Various morphological parameters will be calculated from this information such as bankfull slopes, pool-to-pool spacing, and feature lengths. Stem counts of planted trees and shrubs will be conducted in 15 10 meter x 10 meter vegetation monitoring plots along the stream (Appendix D). These 15 plots will be monitored per the CVS-EEP vegetation monitoring guidelines. Stem counts of planted trees and shrubs will also be conducted in 20 10 meter x 10 meter vegetation monitoring plots in the restored and enhanced wetlands (Appendix D). The stream and wetland gauges on-site will be checked and/or downloaded every other month. The stream gauges will be analyzed to ascertain whether bankfull events have occurred and the wetland gauges will be analyzed to determine if the wetland success criteria is being met. Visual monitoring of the stream, wetland, and riparian buffer will be conducted with annual site walks and site photos will be taken from 30 permanent photo points located throughout the site (Appendix E).

2.3 As-Built Conditions

Baseline stream monitoring data were collected throughout April and May 2009. Any changes made to the design during construction are documented on the As-Built Site Plan in Appendix A. Most of the project was constructed as designed, but field conditions caused small adjustments to be made. Large rain events during construction caused small instabilities in isolated portions of the stream bed and banks. These areas were stabilized with structures, which are indicated on the As-Built Plan.

Table 5 below compares the designed morphological values and ratios to the as-built values and ratios. There are some differences between the design and as-built conditions, but they represent deviations that occurred during construction and not changes from the proposed design. None of these differences should affect the stability of the stream. The table also shows that all of the reaches were restored to streams with a bank height ratio of 1.0 and a stable width to depth ratio.

The wetlands were built as designed. The baseline vegetation data and well installation occurred in April and May of 2009.

Table 5a. NPAC-1 Baseline Stream Summary

Farrar Dairy Site

Parameter	Pre-Existing Condition					Reference Reach(es) Data					Design			As-built			
	Min	Mean	Med	Max	n	Min	Mean	Med	Max	n	Min	Mean	Max	Min	Mean	Max	n
Dimension - Riffle																	
Bankfull Width (ft)	13.9	16.9	14.8	24.3	4	19.5	20.3			2	19.0			18.4	19.6	20.7	4
Floodprone Width (ft)	20	32	24	60	4			300		2	>60			>60	>60	>60	4
Bankfull Mean Depth (ft)	1.2	1.9	2.1	2.2	4			2.3		2	1.6			1.4	1.5	1.6	4
Bankfull Max Depth (ft)	2.5	2.7	2.7	3.0	4	3.0	3.3			2	2.4			2.3	2.5	2.7	4
Bankfull Cross-Sectional Area (ft ²)	30.0	30.2	30.2	30.2	4	45.4	47.3			2	30.0			26.5	29.1	32.2	4
Width/Depth Ratio	6.4	10.1	7.3	19.6	4	8.4	8.8			2	12.0			12.4	13.2	14.4	4
Entrenchment Ratio	1.3	2.3	1.8	4.3	4	14.3	14.9			2	>3.0			>3.0	>3.0	>3.0	4
Bank Height Ratio	1.0	1.9	2.1	2.5	4			1.0		2	1.0			1.0	1.0	1.0	4
Pattern																	
Channel Beltwidth (ft)	*					25					35			35			60
Radius of Curvature (ft)	*					22					20			20			35
Rc:Bankfull width (ft/ft)	*					1.0					1.1			1.0			1.8
Meander Wavelength (ft)	*					119					95			95			150
Meander Width Ratio	*					1.2					1.8			1.8			3.1
Profile																	
Riffle Length (ft)																	
Riffle Slope (ft/ft)	0.0030			0.0210		0.0010					0.0034			0.0007	0.0034	0.0098	20
Pool Length (ft)	8			42		27					20			9	30	57	20
Pool Spacing (ft)	60			97		68					65			62	79	99	20
Substrate and Transport Parameters																	
SC% / Sa% / G% / C% / B% / Be%	0% / 100% / 0% / 0% / 0% / 0%					6% / 81% / 15% / 0% / 0% / 0%								7% / 57% / 32% / 3% / 0% / 1%			
d16 / d35 / d50 / d84 / d95 (mm)						0.0 / 0.18 / 0.25 / 1.8 / 9.0								0.12 / 0.28 / 0.42 / 1.1 / 4.5			
Additional Reach Parameters																	
Channel length (ft)	2,179					620					4,541			4,528			
Drainage Area (SM)	3.92					16.48					3.92			3.92			
Rosgen Classification	C/E5					E5					C5			C5			
Sinuosity	1.00					1.30					1.30			1.39			
Water Surface Slope (ft/ft)	0.0040					0.0020					0.0020			0.0020			

*There was no defined pattern for the NPAC due to the stream being channelized.

_The As-built Dimension is from the monitored riffle cross-sections on this reach.

_The As-built Pattern and Profile data is calculated from the monitored longitudinal profile for NPAC which contains parts of both NPAC 1 and 2.

Table 5b. NPAC-2 Baseline Stream Summary

Farrar Dairy Site

Parameter	Pre-Existing Condition					Reference Reach(es) Data					Design			As-built			
	Min	Mean	Med	Max	n	Min	Mean	Med	Max	n	Min	Mean	Max	Min	Mean	Max	n
Dimension - Riffle																	
Bankfull Width (ft)			13.2		1	19.5	20.3		21.0	2	19.6			19.5	21.1	22.6	2
Floodprone Width (ft)			>75		1			300		2	>60			>60	>60	>60	2
Bankfull Mean Depth (ft)			2.4		1			2.3		2	1.6			1.6	1.7	1.8	2
Bankfull Max Depth (ft)			3.9		1	3.0	3.3		3.5	2	2.4			2.7	3.1	3.4	2
Bankfull Cross-Sectional Area (ft ²)			31.2		1	45.4	47.3		49.1	2	32.0			35.8	35.9	35.9	2
Width/Depth Ratio			5.6		1	8.4	8.8		9.1	2	12.0			10.6	12.5	14.3	2
Entrenchment Ratio			5.7		1	14.3	14.9		15.4	2	>3.0			>3.0	>3.0	>3.0	2
Bank Height Ratio			1.0		1			1.0		2	1.0			1.0	1.0	1.0	2
Pattern																	
Channel Beltwidth (ft)	*					25			36		35			35	60		60
Radius of Curvature (ft)	*					22			36		20			20	35		35
Rc:Bankfull width (ft/ft)	*					1.0			1.8		1.0			1.0	1.8		1.7
Meander Wavelength (ft)	*					119			32.5		95			95	150		150
Meander Width Ratio	*					1.2			1.8		1.8			1.7	3.1		2.8
Profile																	
Riffle Length (ft)																	
Riffle Slope (ft/ft)	0.0030			0.0210		0.0010			0.0080		0.0037		0.0075	0.0007	0.0099	0.0236	7
Pool Length (ft)	8			42		27			81		20		40	14	23	41	8
Pool Spacing (ft)	60			97		68			123		50		80	61	74	93	8
Substrate and Transport Parameters																	
SC% / Sa% / G% / C% / B% / Be%	0% / 100% / 0% / 0% / 0% / 0%					6% / 81% / 15% / 0% / 0% / 0%											
d16 / d35 / d50 / d84 / d95 (mm)						0.0 / 0.18 / 0.25 / 1.8 / 9.0								0.062 / 0.11 / 0.32 / 1.7 / 3.5			
Additional Reach Parameters																	
Channel length (ft)		985						620					1,185		1,212		
Drainage Area (SM)		4.65						16.48					4.65		4.65		
Rosgen Classification		C/E5						E5					C5		C5		
Sinuosity		1.00						1.30					1.30		1.25		
Water Surface Slope (ft/ft)		0.0040						0.0020					0.0030		0.0039		

*There was no defined pattern for the NPAC due to the stream being channelized.

_The As-built Dimension is from the monitored riffle cross-sections on this reach.

_The As-built Pattern and Profile data is calculated from the monitored longitudinal profile for NPAC which contains parts of both NPAC 1 and 2.

**Table 5c. NPAC-3 Baseline Stream Summary
Farrar Dairy Site**

Parameter	Pre-Existing Condition					Reference Reach(es) Data					Design			As-built		
	Min	Mean	Med	Max	n	Min	Mean	Med	Max	n	Min	Max	Min	Mean	Max	n
Dimension - Riffle																
Bankfull Width (ft)			13.2		1	19.5	20.3		21.0	2	21.0			24.2		1
Floodprone Width (ft)			>75		1			300		2	>60			>60		1
Bankfull Mean Depth (ft)			2.4		1			2.3		2	1.7			2.3		1
Bankfull Max Depth (ft)			3.9		1	3.0	3.3		3.5	2	2.6			3.6		1
Bankfull Cross-Sectional Area (ft ²)			31.2		1	45.4	47.3		49.1	2	36.7			55.8		1
Width/Depth Ratio			5.6		1	8.4	8.8		9.1	2	12.0			10.5		1
Entrenchment Ratio			5.7		1	14.3	14.9		15.4	2	>3.0			>3.0		1
Bank Height Ratio			1.0		1			1.0		2	1.0			1.0		1
Pattern																
Channel Beltwidth (ft)	*					25			36		35		60			60
Radius of Curvature (ft)	*					22			36		20		35			36
Rc:Bankfull width (ft/ft)	*					1.0			1.8		1.0		1.7			1.5
Meander Wavelength (ft)	*					119			32.5		105		265			265
Meander Width Ratio	*					1.2			1.8		1.7		2.9			2.5
Profile																
Riffle Length (ft)																
Riffle Slope (ft/ft)	0.0030			0.0210		0.0010			0.0080		0.0040		0.0054			
Pool Length (ft)	8			42		27			81		10		40			
Pool Spacing (ft)	60			97		68			123		85		145			
Substrate and Transport Parameters																
SC% / Sa% / G% / C% / B% / Be%	0% / 100% / 0% / 0% / 0% / 0%					6%	81%	15%	0%	0%	0%			21%	45%	31%
d16 / d35 / d50 / d84 / d95 (mm)						0.0	0.18	0.25	1.8	9.0				0.062	0.11	0.32
Additional Reach Parameters																
Channel length (ft)		880							620				998			1,006
Drainage Area (SM)		4.82							16.48				4.82			4.82
Rosgen Classification		C/E5							E5				C5			C5
Sinuosity		1.00							1.30				1.30			1.09
Water Surface Slope (ft/ft)		0.0040							0.0020				0.0030			

*There was no defined pattern for the NPAC due to the stream being channelized.

The As-built Dimension is from the monitored riffle cross-sections on this reach.

While the as-built survey was completed on NPAC-3 and revealed that the stream was built as designed, the monitored detailed longitudinal profile for

NPAC does not run through NPAC-3, so no detailed profile data is available for the as-built portion of this table.

Table 5d. T1.1 Baseline Stream Summary

Farrar Dairy Site

Parameter	Pre-Existing Condition						Reference Reach(es) Data						Design			As-built			
	Min	Mean	Med	Max	n		Min	Mean	Med	Max	n	Min	Max	Mean	Min	Max	Mean	n	
Dimension - Riffle																			
Bankfull Width (ft)	3.5	4.3		5.0	2		7.7	7.9	7.7	8.3	3	4.5		6.4	5.9		6.4	6.9	2
Floodprone Width (ft)	6	11		15	2		13	14	13	16	3	>9		22.5	15.9		22.5	29.0	2
Bankfull Mean Depth (ft)	0.4	0.5		0.6	2		0.7	0.8	0.8	0.9	3	0.5		0.4	0.3		0.4	0.4	2
Bankfull Max Depth (ft)	0.9	1.0		1.1	2		1.1	1.3	1.3	1.4	3	0.7		0.7	0.6		0.7	0.7	2
Bankfull Cross-Sectional Area (ft ²)	2.0	2.0		2.0	2		6.1	6.4	6.2	7.0	3	2.0		2.4	2.3		2.4	2.4	2
Width/Depth Ratio	6.2	9.4		12.5	2		8.5	9.8	9.6	11.4	3	10.0		17.5	15.1		17.5	19.8	2
Entrenchment Ratio	1.7	7.4		13.0	2		1.6	1.9	2.1	2.1	3	>2		3.6	2.3		3.6	4.9	2
Bank Height Ratio	1.7	3.1		4.4	2				1.0		3	1.0		1.0	1.0		1.0	1.0	2
Pattern																			
Channel Beltwidth (ft)	10			21					22			13	17		13			17	
Radius of Curvature (ft)	6			13			11			23		8	13		8			13	
Rc:Bankfull width (ft/ft)	0.7			2.5			1.0			3.0		1.8	2.9		1.3			2.0	
Meander Wavelength (ft)	42			44			49			59		30	45		30			45	
Meander Width Ratio	1.1			4.1			2.0			2.9		2.9	3.8		2.0			2.7	
Riffle																			
Riffle Length (ft)	#														8		14	21	22
Riffle Slope (ft/ft)	#						0.0120			0.0280		0.0170	0.0180		0		0.0144	0.0380	22
Pool Length (ft)	#						5			9		2	5		2		5	7	21
Pool Spacing (ft)	#											15	30		19		25	31	21
Substrate and Transport Parameters																			
SC% / Sa% / G% / C% / B% / Be%	0% / 100% / 0% / 0% / 0% / 0%						0% / 100% / 0% / 0% / 0%								13% / 64% / 23% / 0% / 0% / 0%				
d16 / d35 / d50 / d84 / d95 (mm)															0.07 / 0.14 / 0.29 / 8.6 / 15				
Additional Reach Parameters																			
Channel length (ft)		864						204					827				825		
Drainage Area (SM)		0.02						0.15					0.02				0.02		
Rosgen Classification		G5						B4c					C5/B5c				C5		
Sinuosity		1.12						1.20					1.13				1.12		
Water Surface Slope (ft/ft)		0.0240						0.0120					0.0140				0.0131		

No flow during survey, therefore these dimensions were not recorded.

Table 5e. T1.2 Baseline Stream Summary

Farrar Dairy Site

Parameter	Pre-Existing Condition						Reference Reach(es) Data						Design			As-built		
	Min	Mean	Med	Max	n		Min	Mean	Med	Max	n	Min	Max		Min	Mean	Max	n
Dimension - Riffle																		
Bankfull Width (ft)	3.6	5.0		6.4	2		7.7	7.9	7.7	8.3	3	7.6			6.9	7.6	8.3	2
Floodprone Width (ft)	7	34		60	2		13	14	13	16	3	>15.2			26.0	36	45.9	2
Bankfull Mean Depth (ft)	0.9	1.3		1.6	2		0.7	0.8	0.8	0.9	3	0.8			0.7	0.8	0.8	2
Bankfull Max Depth (ft)	2.1	2.2		2.2	2		1.1	1.3	1.3	1.4	3	1.2			1.2	1.2	1.2	2
Bankfull Cross-Sectional Area (ft ²)	5.8	5.8		5.8	2		6.1	6.4	6.2	7.0	3	5.8			5.2	5.5	5.7	2
Width/Depth Ratio	2.2	4.7		7.1	2		8.5	9.8	9.6	11.4	3	10.0			9.2	10.7	12.1	2
Entrenchment Ratio	2.0	5.7		9.4	2		1.6	1.9	2.1	2.1	3	>2			3.8	4.7	5.5	2
Bank Height Ratio	1.1	1.6		2.0	2				1.0		3	1.0			1.0	1.0	1.0	2
Pattern																		
Channel Beltwidth (ft)	22			34					22			17	26		17		26	
Radius of Curvature (ft)	8			11			11			23		13	20		13		20	
Rc:Bankfull width (ft/ft)	1.4			3.7			1.0			3.0		1.7	2.6		1.7		2.6	
Meander Wavelength (ft)	54			74			49			59		54	75		54		75	
Meander Width Ratio	3.9			11.3			2.0			2.9		2.2	3.4		2.2		3.4	
Profile																		
Riffle Length (ft)	#														21	25	35	14
Riffle Slope (ft/ft)	#						0.0120			0.0280		0.0150	0.0180		0.0115	0.0178	0.0234	14
Pool Length (ft)	#						5			9		4	9		3	6	13	14
Pool Spacing (ft)	#											20	40		29	37	50	14
Substrate and Transport Parameters																		
SC% / Sa% / G% / C% / B% / Be%	0% / 100% / 0% / 0% / 0% / 0%						0% / 100% / 0% / 0% / 0% / 0%						22% / 76% / 3% / 0% / 0% / 0%					
d16 / d35 / d50 / d84 / d95 (mm)													0.062 / 0.079 / 0.1 / 0.22 / 0.44					
Additional Reach Parameters																		
Channel length (ft)	1,006						620						986					
Drainage Area (SM)	0.10						16.48						0.10					
Rosgen Classification	G5						E5						C5/B5c					
Sinuosity	1.10						1.30						1.14					
Water Surface Slope (ft/ft)	0.0130						0.0020						0.0130					

No flow during survey, therefore these dimensions were not recorded.

Table Sf. T1 Baseline Stream Summary

Parameter	Pre-Existing Condition					Reference Reach(es) Data					Design			As-built			
	Min	Mean	Med	Max	n	Min	Mean	Med	Max	n	Min	Max	Mean	Min	Max	Mean	n
Dimension - Riffle																	
Bankfull Width (ft)	^					7.7	7.9	7.7	8.3	3	10.0		9.5	8.6	10.3	9.5	2
Floodprone Width (ft)	^					13	14	13	16	3	>20		>60	>60	>60	>60	2
Bankfull Mean Depth (ft)	^					0.7	0.8	0.8	0.9	3	1.0		1.0	0.9	1.0	1.0	2
Bankfull Max Depth (ft)	^					1.1	1.3	1.3	1.4	3	1.6		1.8	1.7	1.8	1.9	2
Bankfull Cross-Sectional Area (ft ²)	^					6.1	6.4	6.2	7.0	3	10.0		9.0	8.2	9.0	9.0	2
Width/Depth Ratio	^					8.5	9.8	9.6	11.4	3	10.0		10.0	9.0	10.0	10.0	2
Entrenchment Ratio	^					1.6	1.9	2.1	2.1	3	>2		>3.0	>3.0	>3.0	>3.0	2
Bank Height Ratio	^							1.0		3	1.0		1.0	1.0	1.0	1.0	2
Pattern																	
Channel Beltwidth (ft)	8			16				22			23	40		23			40
Radius of Curvature (ft)	6			20		11			23		15	25		15			25
Rc:Bankfull width (ft/ft)	^					1.0			3.0		1.5	2.5		1.6			2.6
Meander Wavelength (ft)	22			50		49			59		55	90		55			90
Meander Width Ratio	^					2.0			2.9		2.3	4.0		2.4			4.2
Profile																	
Riffle Length (ft)	^													6	24		37
Riffle Slope (ft/ft)	^					0.0120			0.0280		0.0150	0.0180		0.0077	0.0184		0.0350
Pool Length (ft)	^					5			9		5	12		3	9		21
Pool Spacing (ft)	^										35	55		37	46		59
Substrate and Transport Parameters																	
SC% / Sa% / G% / C% / B% / Be%	0% / 100% / 0% / 0% / 0% / 0%					0% / 100% / 0% / 0% / 0% / 0%					22% / 76% / 3% / 0% / 0% / 0%						
d16 / d35 / d50 / d84 / d95 (mm)											0.062 / 0.079 / 0.1 / 0.22 / 0.44						
Additional Reach Parameters																	
Channel length (ft)	370					620					881						
Drainage Area (SM)	0.18					16.48					0.18						
Rosgen Classification	DA5					E5					C5/B5c						
Sinuosity	1.19					1.30					1.21						
Water Surface Slope (ft/ft)	0.0100					0.0020					0.0110						

^ These existing conditions data were not collected on T1.

Table 5g. T2A Baseline Stream Summary

Parameter	Pre-Existing Condition					Reference Reach(es) Data					Design			As-built		
	Min	Mean	Med	Max	n	Min	Mean	Med	Max	n	Min	Max	Mean	Min	Max	n
Dimension - Riffle																
Bankfull Width (ft)			3.6		1	7.7	7.9	7.7	8.3	3	5.0		5.7			1
Floodprone Width (ft)			4		1	13	14	13	16	3	>10		30			1
Bankfull Mean Depth (ft)			0.7		1	0.7	0.8	0.8	0.9	3	0.5		0.5			1
Bankfull Max Depth (ft)			1.0		1	1.1	1.3	1.3	1.4	3	0.8		0.8			1
Bankfull Cross-Sectional Area (ft ²)			2.5		1	6.1	6.4	6.2	7.0	3	2.5		2.8			1
Width/Depth Ratio			5.2		1	8.5	9.8	9.6	11.4	3	10.0		11.6			1
Entrenchment Ratio			1.1		1	1.6	1.9	2.1	2.1	3	>2		5.3			1
Bank Height Ratio			3.5		1			1.0		3	1.0		1.0			1
Pattern																
Channel Beltwidth (ft)	*							22			11	17		11	17	17
Radius of Curvature (ft)	*					11			23		8	10		8	10	10
Rc:Bankfull width (ft/ft)	*					1.0			3.0		1.6	2.0		1.4	1.8	1.8
Meander Wavelength (ft)	*					49			59		35	45		35	45	45
Meander Width Ratio	*					2.0			2.9		2.2	3.4		1.9	3.0	3.0
Profile																
Riffle Length (ft)	#													8	15	28
Riffle Slope (ft/ft)	#					0.012			0.028		0.016	0.018		#	#	#
Pool Length (ft)	#					5			9		2	6		2	7	28
Pool Spacing (ft)	#										15	25		14	31	70
Substrate and Transport Parameters																
SC% / Sa% / G% / C% / B% / Be%																
d16 / d35 / d50 / d84 / d95 (mm)																
Additional Reach Parameters																
Channel length (ft)			423					620				500				500
Drainage Area (SM)			0.04					16.48				0.04				0.04
Rosgen Classification			G5					E5				C5/B5c				C5/B5c
Sinuosity			1.00					1.30				1.16				1.13
Water Surface Slope (ft/ft)			0.0260					0.0020				0.0180				#

No flow during survey, therefore these dimensions were not recorded.

*There was no defined pattern for T2 due to the stream being channelized.

Table 5h. T2B Baseline Stream Summary

Parameter	Pre-Existing Condition					Reference Reach(es) Data					Design			As-built		
	Min	Mean	Med	Max	n	Min	Mean	Med	Max	n	Min	Max	Min	Mean	Max	n
Dimension - Riffle																
Bankfull Width (ft)			4.5		1	6.7	7.2	7.1	7.9	3	5.3			5.2		1
Floodprone Width (ft)			8		1	34	63	68	88	3	>25			>60		1
Bankfull Mean Depth (ft)			0.6		1	0.7	0.9	0.9	1.0	3	0.5			0.5		1
Bankfull Max Depth (ft)			0.9		1	1.1	1.2	1.1	1.3	3	0.8			0.8		1
Bankfull Cross-Sectional Area (ft ²)			2.5		1	5.7	6.1	5.8	6.7	3	2.6			2.5		1
Width/Depth Ratio			8.1		1	7.4	8.9	8.0	11.3	3	11.0			10.8		1
Entrenchment Ratio			1.8		1	4.9	8.8	8.6	13	3	>2.4			>3.0		1
Bank Height Ratio			3.2		1			1.0		3	1.0			1.0		1
Pattern																
Channel Beltwidth (ft)	*					15			48		23		40		23	40
Radius of Curvature (ft)	*					21			47		15		20		15	20
Rc:Bankfull width (ft/ft)	*					2.7			7.0		2.8		3.8		2.9	3.8
Meander Wavelength (ft)	*					43			84		70		90		70	90
Meander Width Ratio	*					1.9			7.2		4.3		7.5		4.4	7.7
Profile																
Riffle Length (ft)	#														8	15
Riffle Slope (ft/ft)	#										0.0090		0.0170		#	#
Pool Length (ft)	#										10		30		2	7
Pool Spacing (ft)	#										30		40		14	31
Substrate and Transport Parameters																
SC% / Sa% / G% / C% / B% / Be%																
d16 / d35 / d50 / d84 / d95 (mm)																
Additional Reach Parameters																
Channel length (ft)			554						529				509			522
Drainage Area (SM)			0.04						0.35				0.04			0.04
Rosgen Classification			G5						E5				E5			E5
Sinuosity			1.22						1.30				1.22			1.23
Water Surface Slope (ft/ft)			0.0080						0.0070				0.0080			#

*There was no defined pattern for T2 due to the stream being channelized.
 # No flow during survey, therefore these dimensions were not recorded.

Table 5i. T3 Baseline Stream Summary

Farrar Dairy Site

Parameter	Pre-Existing Condition						Reference Reach(es) Data						Design			As-built			
	Min	Mean	Med	Max	n		Min	Mean	Med	Max	n		Min	Max		Min	Mean	Max	n
Dimension - Riffle																			
Bankfull Width (ft)	12.3	15.9		19.5	2		19.5	20.3		21.0	2		15.5			14.9	16.7	18.4	2
Floodprone Width (ft)	50			>70	2			300			2		>31			>60	>60	>60	2
Bankfull Mean Depth (ft)	1.0	1.3		1.6	2			2.3			2		1.3			1.2	1.2	1.2	2
Bankfull Max Depth (ft)	2.3	2.8		3.2	2		3.0	3.3		3.5	2		2.0			1.9	1.9	1.9	2
Bankfull Cross-Sectional Area (ft ²)	20.0	20.1		20.1	2		45.4	47.3		49.1	2		20.0			18.4	19.9	21.4	2
Width/Depth Ratio	7.6	13.3		18.9	2		8.4	8.8		9.1	2		12.0			12.1	14.0	15.8	2
Entrenchment Ratio	3.6	3.9		4.1	2		14.3	14.9		15.4	2		>2			>3	>3	>3	2
Bank Height Ratio	1.0	1.2		1.4	2			1.0			2		1.0			1.0	1.0	1.0	2
Pattern																			
Channel Beltwidth (ft)	*						25			36			35			35			45
Radius of Curvature (ft)	*						22			36			20			20			28
Rc:Bankfull width (ft/ft)	*						1.0			1.8			1.3			1.2			1.7
Meander Wavelength (ft)	*						119			325			80			80			125
Meander Width Ratio	*						1.2			1.8			2.3			2.1			2.7
Profile																			
Riffle Length (ft)	#															12	21	35	11
Riffle Slope (ft/ft)	#						0.0130			0.0280			0.0020			0	0.0023	0.0058	11
Pool Length (ft)	#						3			25			12			3	13	21	9
Pool Spacing (ft)	#						30			59			45			45	64	115	9
Substrate and Transport Parameters																			
SC% / Sa% / G% / C% / B% / Be%							6% / 81% / 15% / 0% / 0%												
d16 / d35 / d50 / d84 / d95 (mm)							0.0 / 0.18 / 0.25 / 1.8 / 9.0												
Additional Reach Parameters																			
Channel length (ft)							1,335			620						1,151			1,167
Drainage Area (SM)							0.39			16.48						0.39			0.39
Rosgen Classification							C5/E5			E5						C5			C5
Sinuosity							1.00			1.30						1.17			1.17
Water Surface Slope (ft/ft)							0.0020			0.0020						0.0030			0.0211

*There was no defined pattern for T3 due to the stream being channelized.

No flow during survey, therefore these dimensions were not recorded.

Table 6a. Morphology and Hydraulic Monitoring Summary

Farrar Dairy Site

Parameter	X-Section 1	X-Section 2	X-Section 3	X-Section 4	X-Section 5	X-Section 6	X-Section 7	X-Section 8	X-Section 9	X-Section 10
	Riffle	Pool	Riffle	Pool	Riffle	Pool	Riffle	Riffle	Pool	Riffle
Reach	NPAC-1	NPAC-1	NPAC-1	NPAC-1	NPAC-1	NPAC-1	NPAC-1	NPAC-2	NPAC-2	NPAC-2
Dimension										
Bankfull Width (ft)	19.6	20.9	19.6	18.9	18.4	20.4	20.7	19.5	22.9	22.6
Floodprone Width (ft)	>60	-	>60	-	>60	-	>60	>60	-	>60
Bankfull Mean Depth (ft)	1.6	1.4	1.4	1.3	1.4	1.3	1.6	1.8	1.6	1.6
Bankfull Max Depth (ft)	2.4	3.3	2.5	2.8	2.3	3.0	2.7	3.4	3.4	2.7
Bankfull Cross-Sectional Area (ft ²)	31.0	29.2	26.6	24.7	26.5	26.6	32.2	35.9	36.0	35.8
Bankfull Width/Depth Ratio	12.4	-	14.4	-	12.8	-	13.3	10.6	-	14.3
Bankfull Entrenchment Ratio	>3.0	-	>3.0	-	>3.0	-	>3.0	>3.0	-	>3.0
Bankfull Bank Height Ratio	1.0	-	1.0	-	1.0	-	1.0	1.0	-	1.0
Substrate										
d50 (mm)	0.076	0.088	0.062	0.54	0.083	0.12	0.062	0.062	0.11	0.064
d84 (mm)	0.22	0.65	0.11	0.82	0.37	0.29	0.098	0.067	0.66	3.1
Parameter										
X-Section 11	X-Section 12	X-Section 13	X-Section 14	X-Section 15	X-Section 16	X-Section 17	X-Section 18	X-Section 19	X-Section 20	X-Section 20
Riffle	Pool	Riffle	Pool	Riffle	Pool	Riffle	Riffle	Pool	Riffle	Riffle
NPAC-3	NPAC-3	T1.1	T1.1	T1.1	T1.2	T1.2	T1.2	T1.1	T1.2	T1
Dimension										
Bankfull Width (ft)	24.2	22.3	6.9	7.1	5.9	8.9	8.3	6.9	9.5	10.3
Floodprone Width (ft)	>60	-	15.9	-	29	-	45.9	26	-	>60
Bankfull Mean Depth (ft)	2.3	1.9	0.3	0.7	0.4	0.7	0.7	0.8	1.1	0.9
Bankfull Max Depth (ft)	3.6	3.2	0.7	1.3	0.6	1.6	1.2	1.2	2.4	1.9
Bankfull Cross-Sectional Area (ft ²)	55.8	42.0	2.4	5.1	2.3	6.4	5.7	5.2	10.9	9.7
Bankfull Width/Depth Ratio	10.5	-	19.8	-	15.1	-	12.1	9.2	-	10.9
Bankfull Entrenchment Ratio	>3.0	-	2.3	-	4.9	-	5.5	3.8	-	>3.0
Bankfull Bank Height Ratio	1.0	-	1.0	-	1.0	-	1.0	1.0	-	1.0
Substrate										
d50 (mm)	0.71	0.35	0.062	0.062	0.062	0.31	0.062	0.062	0.062	0.062
d84 (mm)	0.9	0.45	0.072	0.062	0.088	0.48	0.083	0.098	0.12	0.1

Table 6b. Morphology and Hydraulic Monitoring Summary continued

Farrar Dairy Site		X-Section 21	X-Section 22	X-Section 23	X-Section 24	X-Section 25	X-Section 26	X-Section 27	X-Section 28	X-Section 29
Parameter		Riffle	Pool	Riffle	Pool	Riffle	Riffle	Pool	Pool	Riffle
Reach		T1	T2	T2	T2	T2	T3	T3	T3	T3
Dimension										
Bankfull Width (ft)		8.6	7.5	5.7	7.1	5.2	18.4	19.2	23.3	14.9
Floodprone Width (ft)		>60	-	30	-	>60	>60	-	-	>60
Bankfull Mean Depth (ft)		1.0	0.7	0.5	0.6	0.5	1.2	1.3	1.2	1.2
Bankfull Max Depth (ft)		1.7	1.1	0.8	1.1	0.8	1.9	2.5	2.6	1.9
Bankfull Cross-Sectional Area (ft ²)		8.2	5.1	2.8	4.2	2.5	21.4	24.2	29.1	18.4
Bankfull Width/Depth Ratio		9.0	-	11.6	-	10.8	15.8	-	-	12.1
Bankfull Entrenchment Ratio		>3.0	-	5.3	-	>3.0	>3.0	-	-	>3.0
Bankfull Bank Height Ratio		1.0	-	1.0	-	1.0	1.0	-	-	1.0
Substrate										
d50 (mm)		0.53	0.062	0.062	0.062	0.062	0.062	0.062	0.062	0.062
d84 (mm)		2.0	0.062	16.0	0.062	0.062	0.092	0.1	0.062	0.062

Baseline vegetation monitoring data were collected in April 2009. Plot photos from all the vegetation plots can be found in Appendix D.

The results of the baseline monitoring show an average of 640 stems/acre sampled along the stream buffer and 543 stems/acre sampled in the wetland plots (Table 7 and Appendix D). An attempt to identify all trees was made, but since monitoring was conducted while the trees were dormant, many were unidentifiable. All trees will be positively identified during first year monitoring.

Table 7. Planted Stem Density by Plot							
Farrar Dairy Site							
Stream Plots							
Plot Number	Density (stems/ac)		Plot Number	Density (stems/ac)		Plot Number	Density (stems/ac)
1	880		6	560		11	680
2	720		7	840		12	520
3	320		8	560		13	720
4	840		9	600		14	520
5	760		10	520		15	560
Wetland Plots							
Plot Number	Density (stems/ac)		Plot Number	Density (stems/ac)		Plot Number	Density (stems/ac)
16	400		26	520		36	640
17	560		27	480		37	480
18	400		28	480		38	520
19	1,000		29	520		39	520
20	520		30	440		40	600
21	520		31	440		41	600
22	840		32	400		42	680
23	920		33	440		43	480
24	520		34	480		44	560
25	440		35	400		45	480

3.0 SUCCESS CRITERIA

3.1 Stream Stability

Cross-section measurements should show little or no change from the as-built cross-sections. Annual measurements of the longitudinal profile should indicate a stable bedform with little change from the as-built survey. Sediment transport should remain relatively unchanged with respect to aggradation and deposition of sediments. In sand channels, like the project streams, it is expected that in normal sand channel dynamics large amounts of sand may move through the system as dunes on the stream bottom. These dune features may cause some variations in the monitored cross-sections and profiles, but these will be evaluated to determine whether they are minor adjustments associated with normal sediment transport or whether they indicate movement toward an unstable condition. If any changes occur, they will be discussed within the yearly monitoring reports.

3.2 Vegetation

Stream and wetland vegetation must meet a minimum survival success rate of 320 stems/acre after five years. If monitoring indicates that the specified survival rate is not being met, appropriate corrective actions will be developed, which could include invasive species control, the removal of dead/dying plants, and replanting.

3.3 Hydrology

Within the five-year monitoring period, a minimum of two bankfull events on the restored streams must occur in separate years. If stream gauge data reveal that this criterion is not met, probable causes for this will be determined.

Using criteria from the 1987 Corps Wetland Delineation Manual as a guide, the objective for the wetland restoration site is to establish continuous saturated or inundated hydrologic conditions for at least 12.5 percent of the growing season as defined by NRCS. If soil and vegetation data support a wetland determination, wetland hydrology may also be considered established (as per the 1987 Corps Manual) if well data from the site, or wetland hydrology indicators determine that the water table is within 12 inches of the soil surface for between 5% and 12.5% of the growing season during normal weather conditions. A “normal” year is based on NRCS climatological data for Harnett County, and using the 30th to 70th percentile thresholds as the range of normal, as documented in the USACE Technical Report “Assessing and Using Meteorological Data to Evaluate Wetland Hydrology, April 2000.” According to the Harnett County Soil Survey, the growing season is considered to extend from March 16 to November 11, yielding 240 days. Therefore, success will be achieved if the water table is within 12 inches of the soil surface for at least 12 consecutive days during the growing season.

4.0 MAINTENANCE AND CONTINGENCY PLAN

The site will be monitored for any problem areas that could arise and any such issues will be dealt with according to severity. Site maintenance may include reinstallation of coir matting, removal of debris from the channel, stabilization of bank erosion with protective structures, or adjustments to in-stream structures. Any maintenance activities will be documented in the yearly monitoring reports.

Appendix A
As-Built Plans


KCI JOB# : 12065438

CONTRACT #: D06002

STATE OF NORTH CAROLINA
ECOSYSTEM ENHANCEMENT PROGRAM

STATE	CONTRACT NUMBER	SHEET NO.	TOTAL SHEETS
N.C.	D06002	1	31


A	SUBMITTED WITH MITIGATION PLAN	DATE	APPROVED
1%	DESCRIPTION	DATE	APPROVED
REVISIONS			

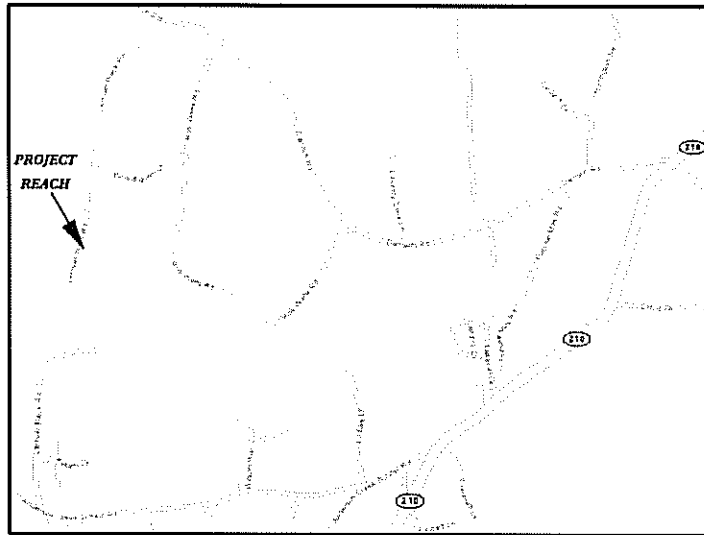

VICINITY MAP
NOT TO SCALE

DIRECTIONS TO SITE


PROCEED SOUTH OUT OF RALEIGH ON US 401/US-42/CAPITAL DRIVE TOWARDS FUQUAY-VARINA, CONTINUING SOUTH FROM FUQUAY-VARINA ON US-401/US-42 TOWARDS LILLINGTON. TURN RIGHT ONTO NC-210 AND CONTINUE SOUTH THROUGH LILLINGTON FOR APPROXIMATELY 6.5 MILES TO DARROCH ROAD. TURN RIGHT ONTO DARROCH ROAD AND CONTINUE APPROXIMATELY 3 MILES TO POWELL FARM ROAD. TURN LEFT ONTO POWELL FARM ROAD, DRIVE APPROXIMATELY 1.5 MILES AND THE ENTRANCE TO THE SITE WILL BE ON THE LEFT THROUGH THE DRIVEWAY OF THE RED RANCH STYLE HOME.

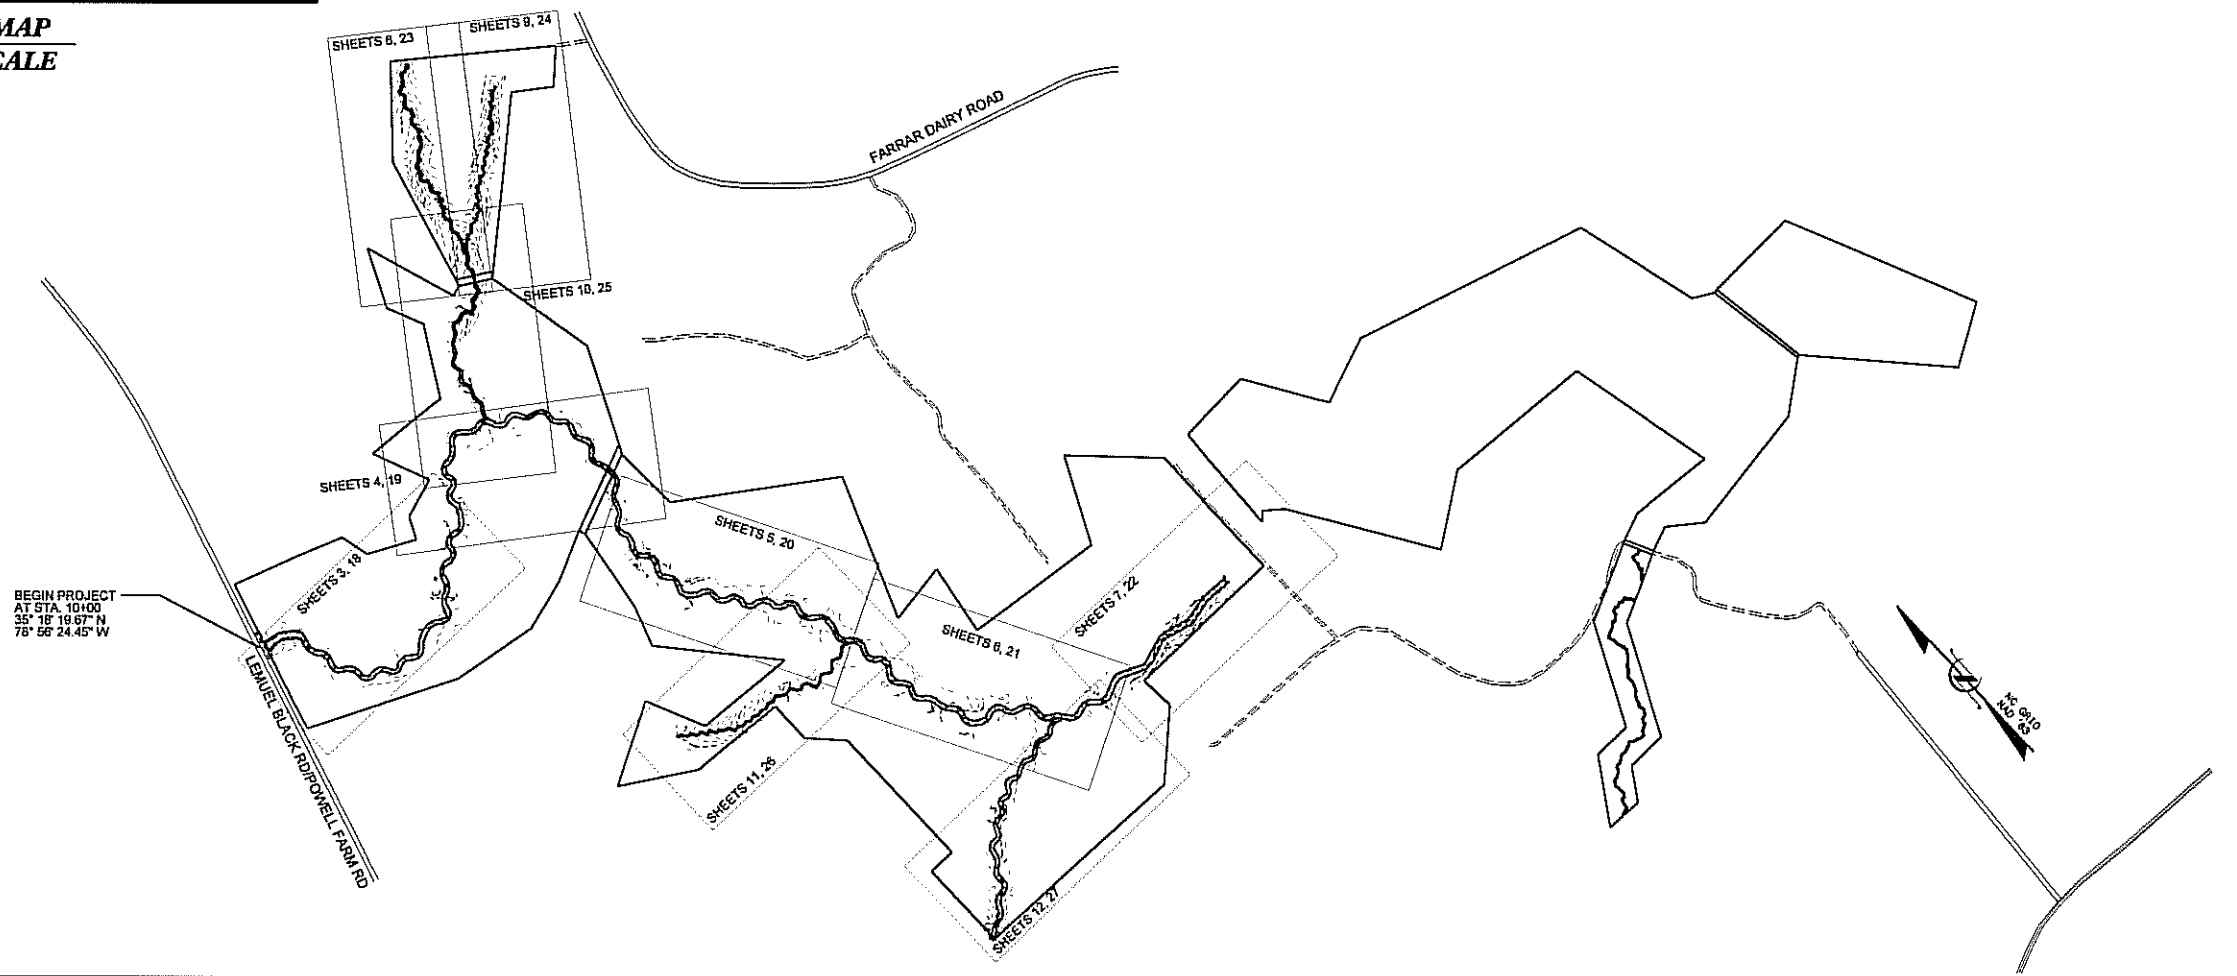

INDEX OF SHEETS

- 1 TITLE SHEET
- 2 AS-BUILT LEGEND
- 3 THRU 17 AS-BUILT SITE PLAN
- 18 THRU 21 MONITORING PLAN VIEW
- 22 THRU 31 AS-BUILT PLANTING PLAN

GRAPHIC SCALES

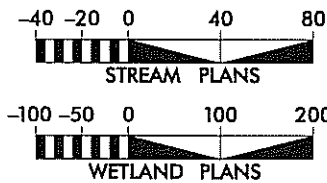

PROJECT DATA

STREAM RESTORATION LENGTH = 11,624 FEET
 STREAM ENHANCEMENT II LENGTH = 180 FEET
 STREAM PRESERVATION LENGTH = 1,240 FEET
 WETLAND ENHANCEMENT = 22.3 ACRES
 WETLAND PRESERVATION = 45.9 ACRES
 WETLAND RESTORATION = 43.8 ACRES

Prepared in the Office of:




KCI Associates
of North Carolina, P.A.
SUITE 220 LANDMARK CENTER II, 4601 SIX FORKS RD., RALEIGH, NC
ENGINEERS • PLANNERS • ECOLOGISTS

TIM MORRIS
WETLAND DESIGN

TIM MORRIS / ALEX FRENCH
NATURAL CHANNEL DESIGN

PROJECT ENGINEER

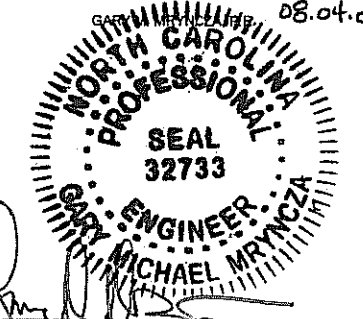

SIGNATURE: [Signature]

P.E.




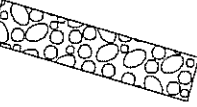

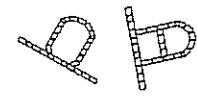


Prepared for:







GUY PEARCE
CONTRACT ADMINISTRATOR

PROJECT LEGEND

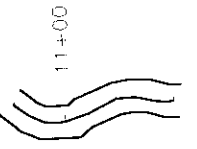
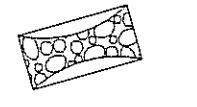
STREAM RESTORATION

- As-Built Thalweg, Stationing, and Top of Bank 
- As-Built Riffle Grade Control/Constructed Riffle 
- As-Built Stone Toe Protection 
- As-Built Ford Crossing 
- As-Built Drainage Stabilization 
- As-Built Boulder Step Pools 
- As-Built Log Drop 
- As-Built Log Sill 


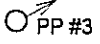
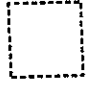
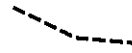

WETLAND MITIGATION

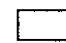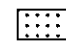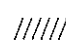- As-Built Microtopography 
- As-Built Deep Harrowing 
- As-Built Filled Ditches 
- As-Built Seep Stabilization 

TOPOGRAPHY

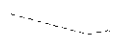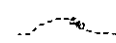
- As-Built Minor Contour Line 
- As-Built Major Contour Line 

MONITORING


- Cross-Section 
- Photo Point 
- Vegetation Plots 
- Longitudinal Profile 
- Monitoring Gauge 

AS-BUILT NOTE:

THE AS-BUILT SITE PLAN (SHEETS 3-17) DEPICTS THE AS-BUILT CONDITIONS. ANY DEVIATIONS FROM THE DESIGN PLANS ARE SPECIFICALLY CALLED OUT WITH NOTES. IF THERE ARE NO ASSOCIATED NOTES WITH A SPECIFIC SECTION, THEN THAT SECTION WAS BUILT AS DESIGNED.

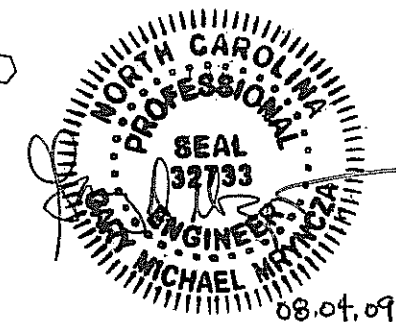


NO.	REVISIONS	DATE	APPEND
1	REVISIONS		
2			
3			
4			
5			
6			
7			
8			
9			
10			

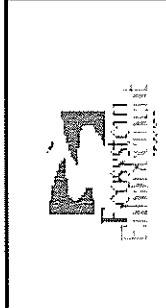


KCI
ASSOCIATES OF NC
ENGINEERS • PLANNERS • SCIENTISTS
460 SIX FORKS ROAD
RALEIGH, NORTH CAROLINA 27609

FARRAR DAIRY
STREAM AND WETLAND MITIGATION
LILLINGTON, HARNETT COUNTY, NORTH CAROLINA

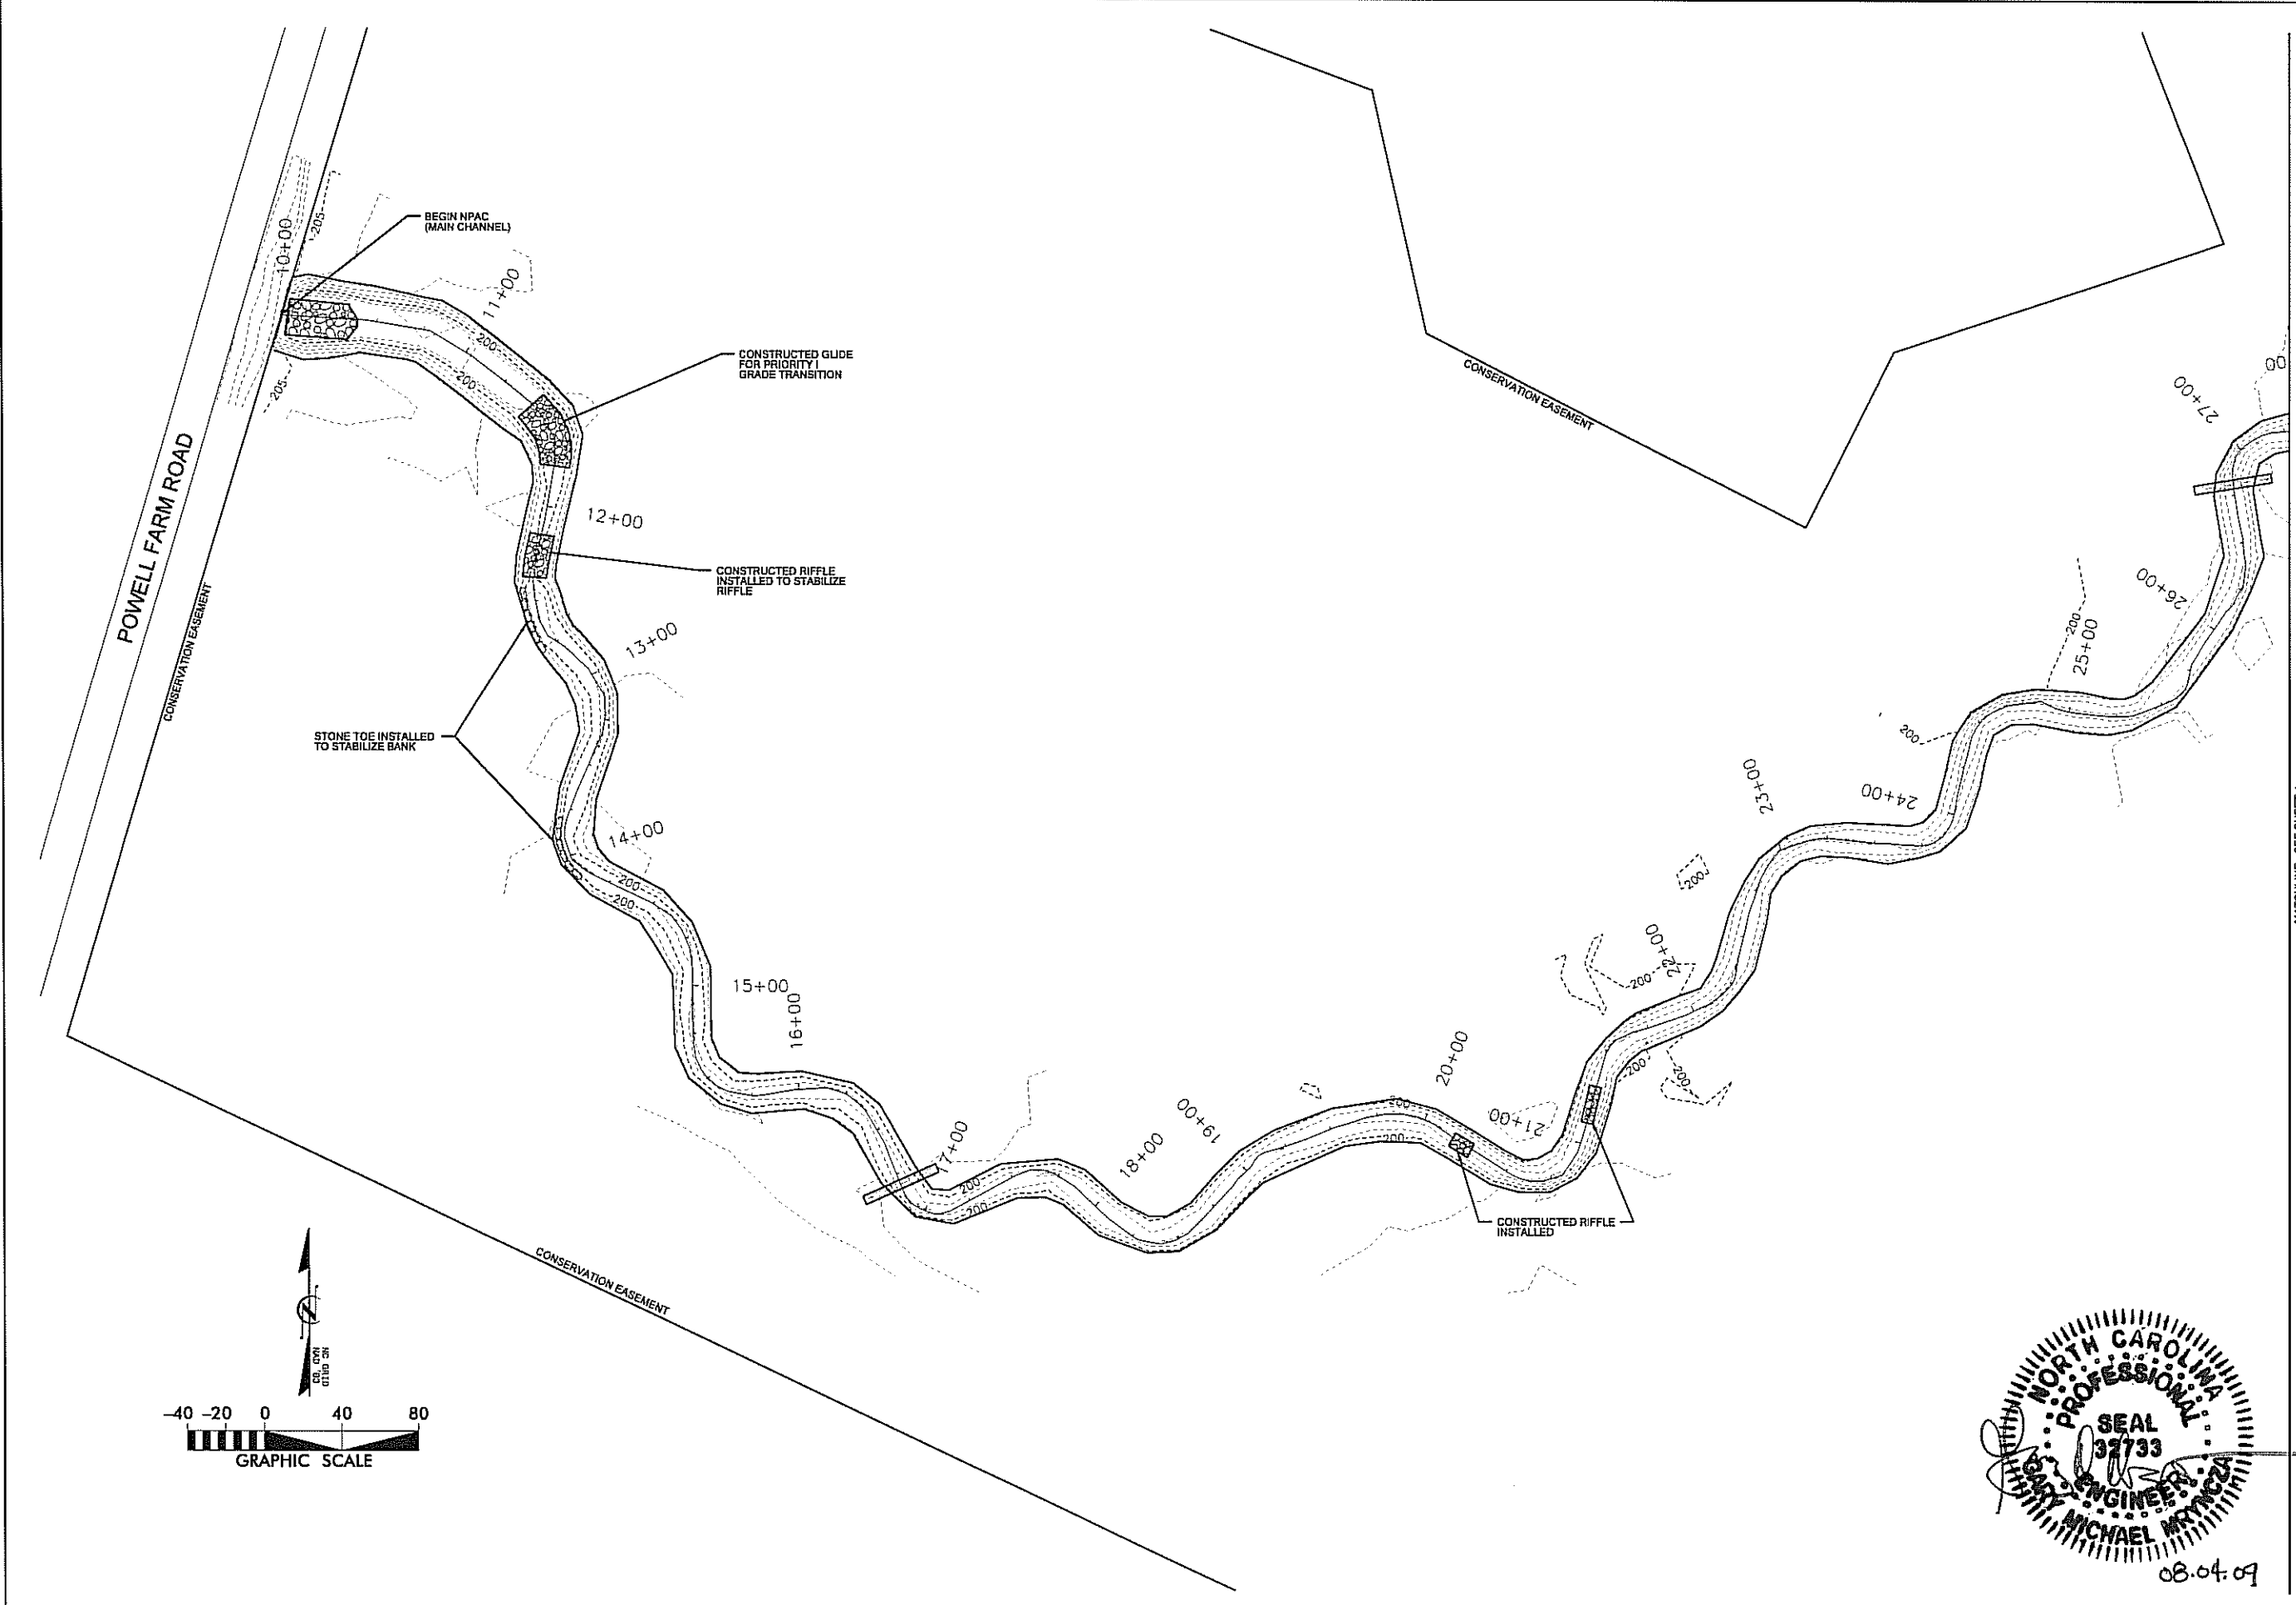

DATE: JUNE 2009

SYMBOL	DESCRIPTION	DATE	APPROVED
A	SUBMITTED WITH MITIGATION PLAN		

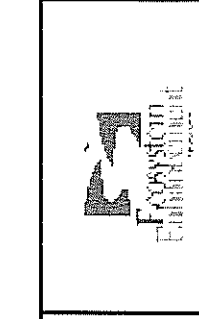

KCI
 ASSOCIATES OF NC
 ENGINEERS • PLANNERS • SCIENTISTS


4601 SIX FORKS ROAD
 RALEIGH, NORTH CAROLINA 27609

FARRAR DAIRY
 STREAM AND WETLAND MITIGATION
 LILLINGTON, HARNETT COUNTY, NORTH CAROLINA
 NPAC - STATION 10+00 TO STATION 27+17

DATE: JUNE 2009
 SCALE: 1"=40'

AS-BUILT
 SITE PLAN




SHEET 3 OF 31

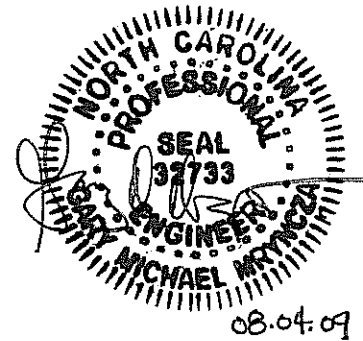


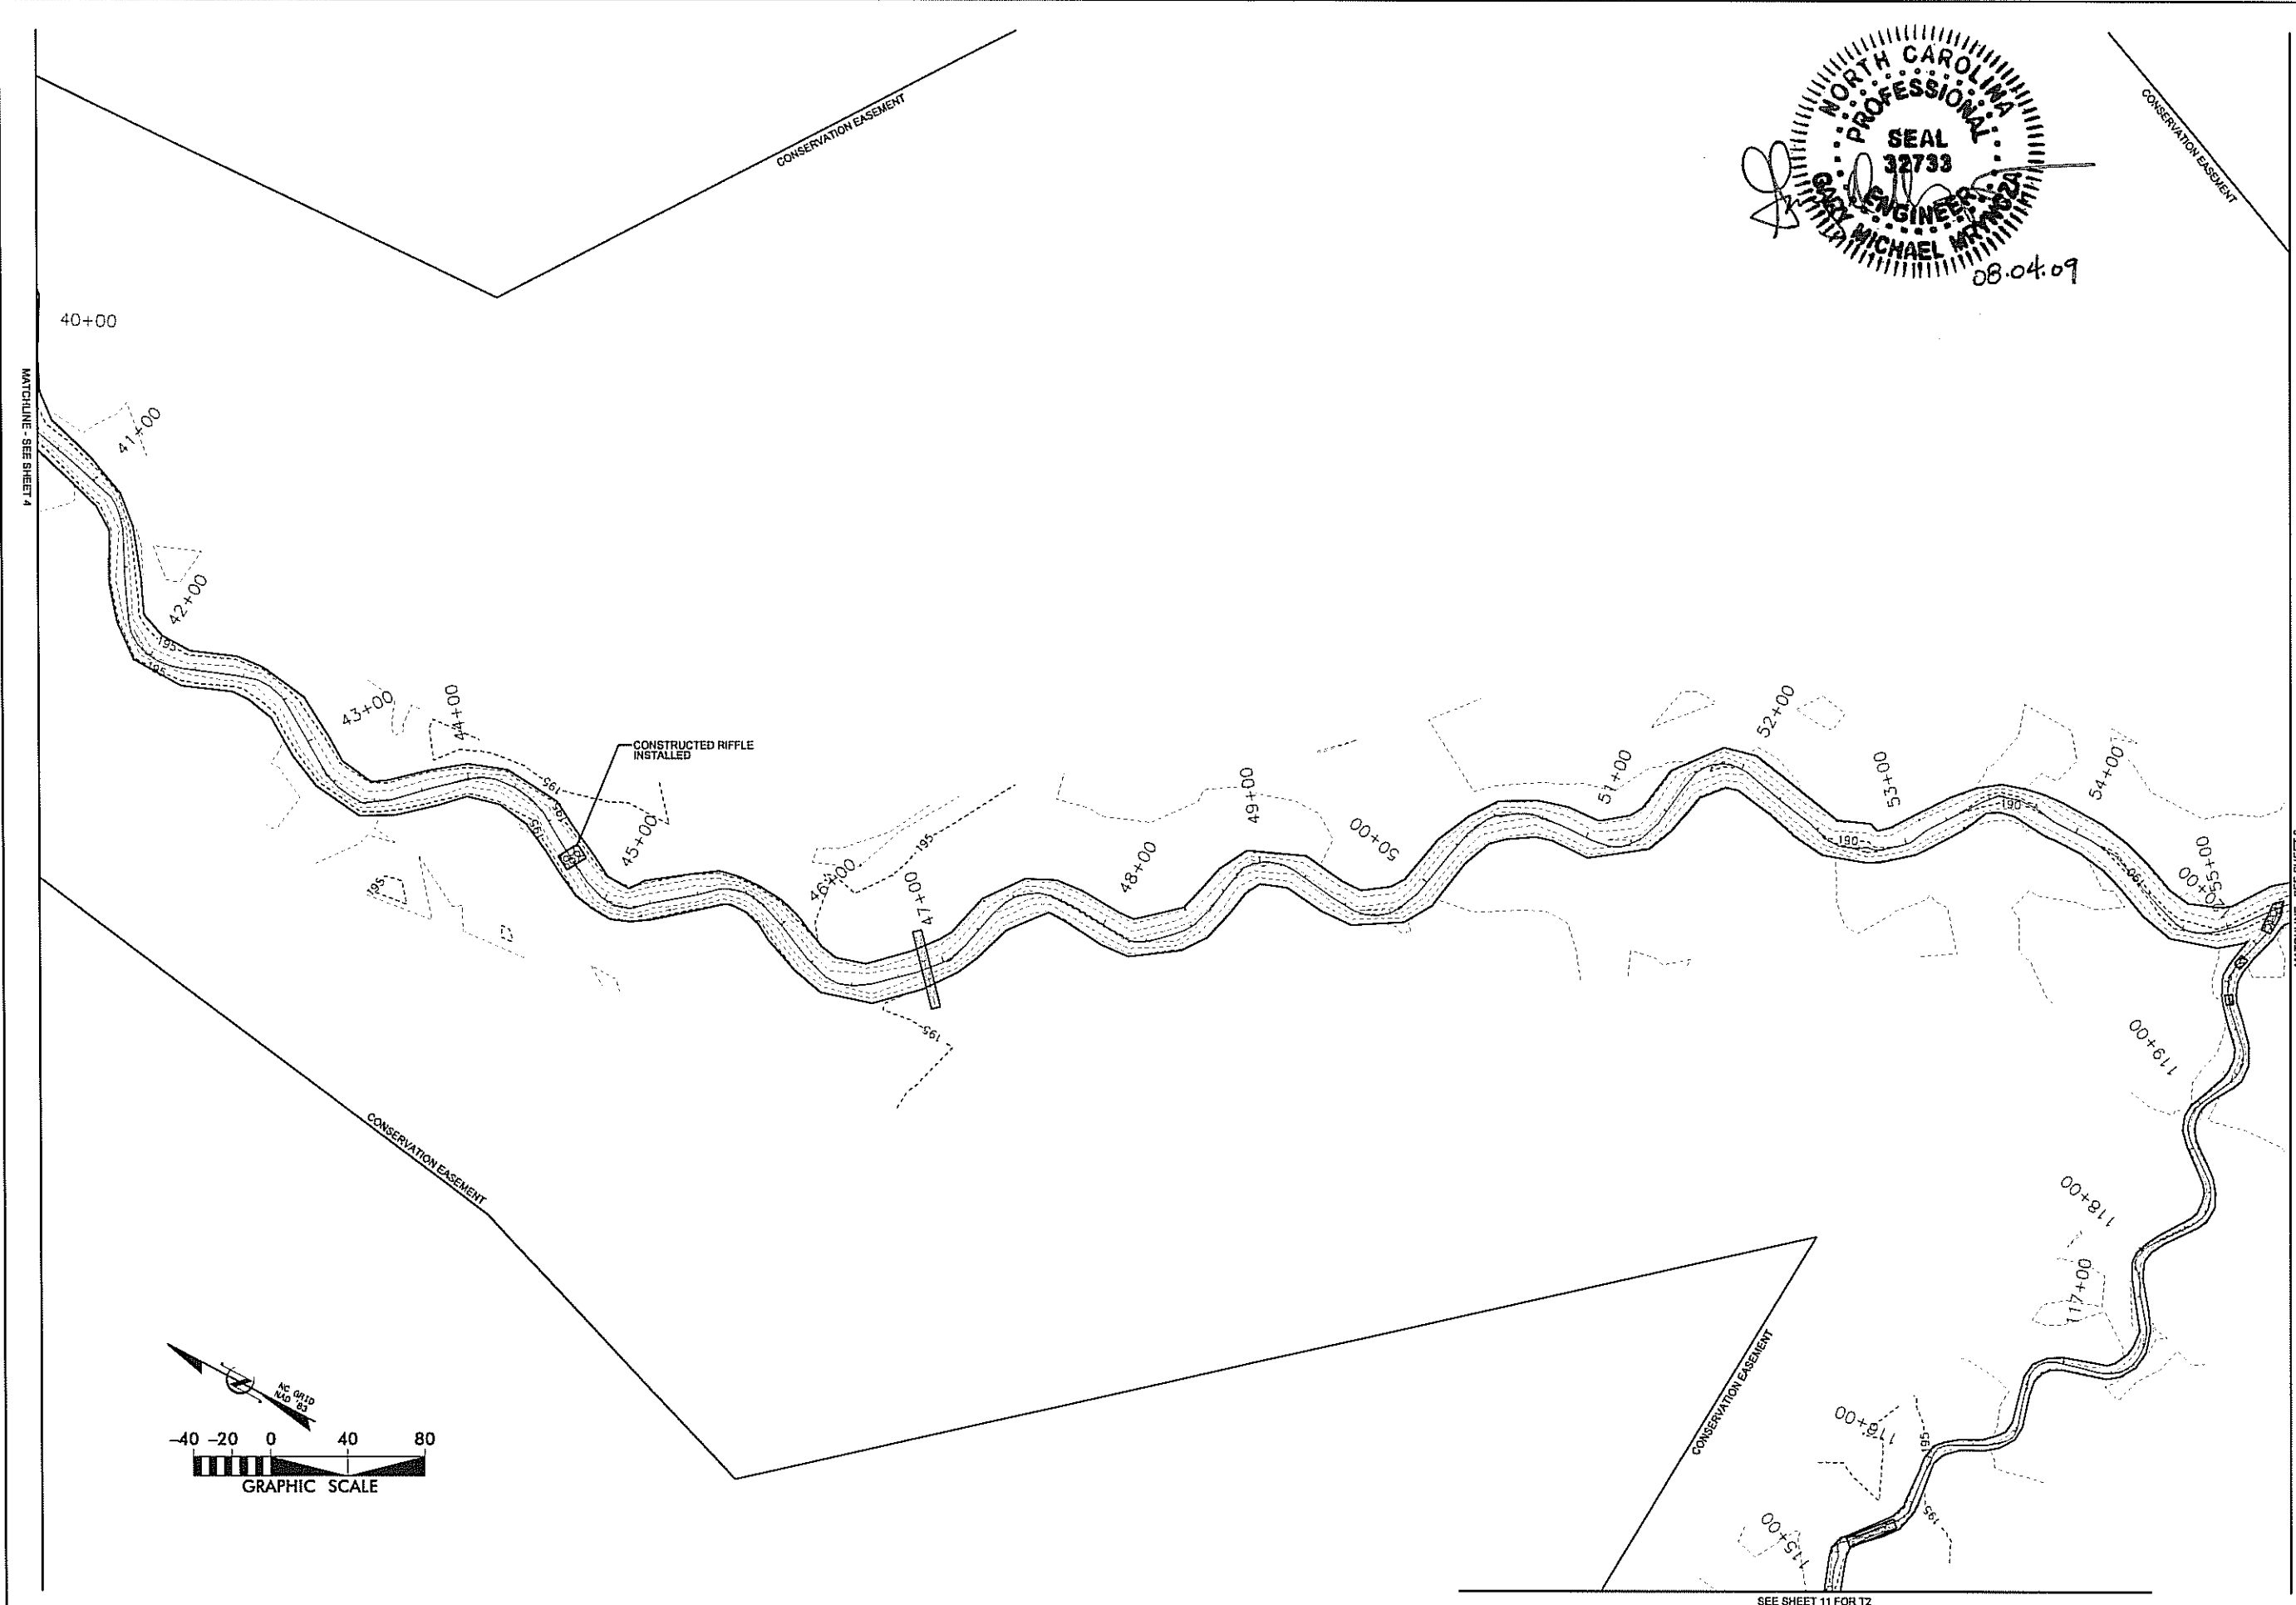
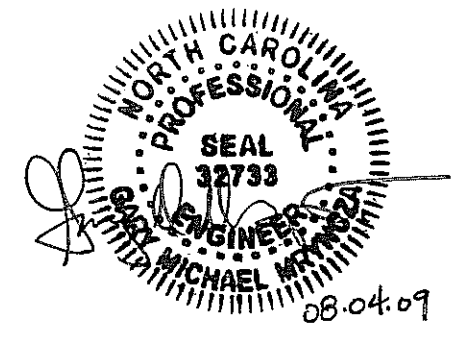
SEE SHEETS 8-10 FOR T1.1, T1.2, AND T1

CONSERVATION EASEMENT

CONSERVATION EASEMENT

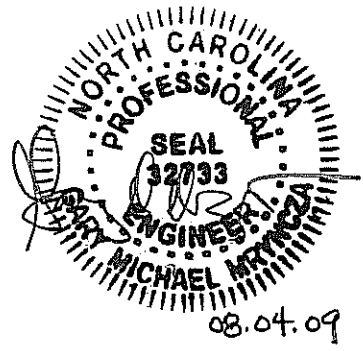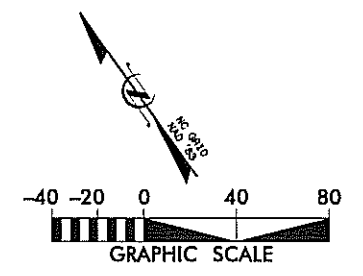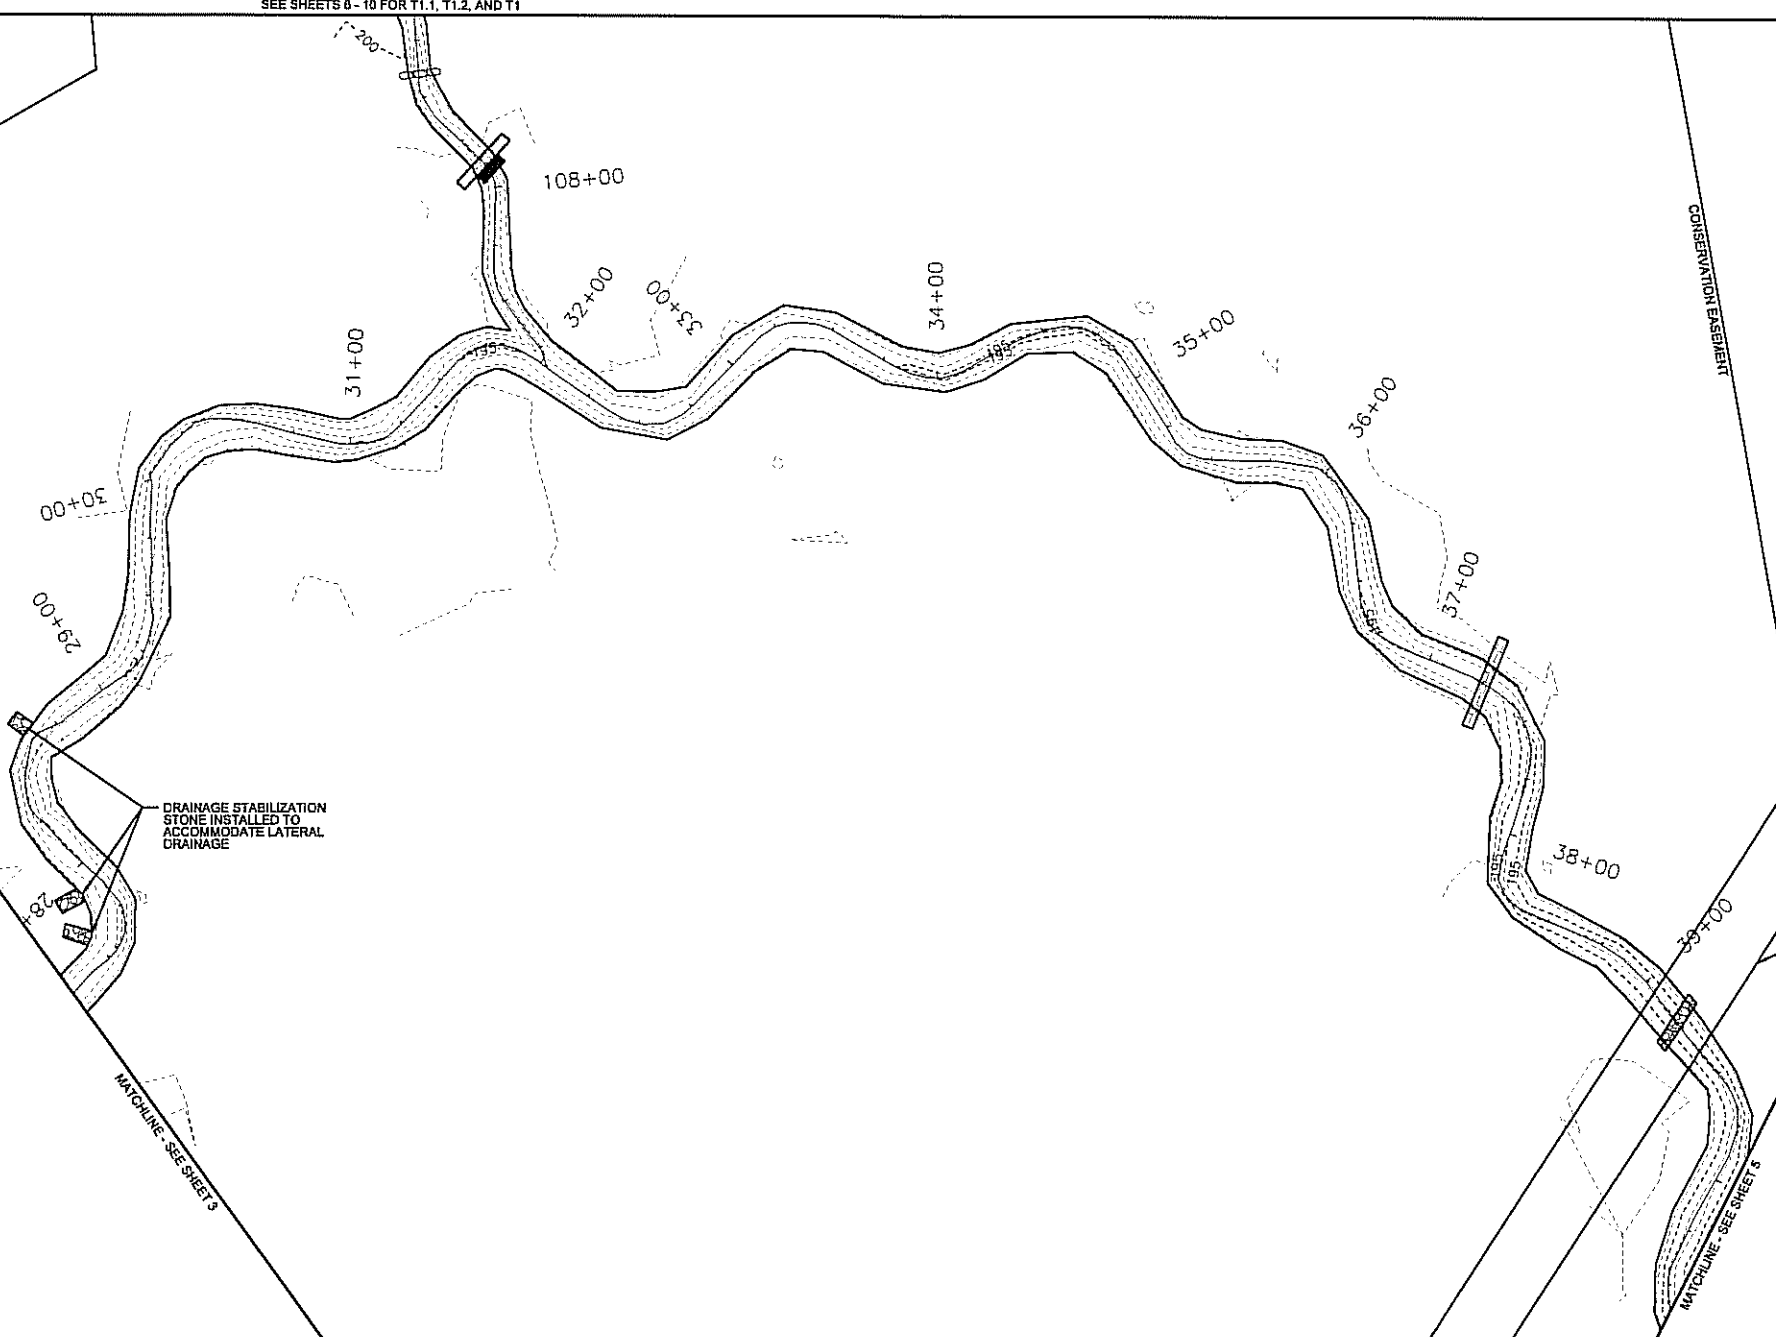

SUBMITTED WITH MITIGATION PLAN		APPROVED	
DATE	DATE	DATE	DATE
JUNE 2009			
REVISIONS			
NO.	DESCRIPTION	DATE	APPROVED
 KCI ASSOCIATES OF NC ENGINEERS • PLANNERS • SCIENTISTS 450 SIX FORKS ROAD RALEIGH, NORTH CAROLINA 27609			
FARRAR DAIRY STREAM AND WETLAND MITIGATION LILLINGTON, HARNETT COUNTY, NORTH CAROLINA NPAC - STATION 27+17 TO STATION 40+51			
DATE: JUNE 2009		SCALE: 1"=40'	
AS-BUILT SITE PLAN			
SHEET 4 OF 31			



NO.	DATE	DESCRIPTION	APPROVED
1	JUNE 2009	SUBMITTED WITH MITIGATION PLAN	



KCI
 ASSOCIATES OF NC, INC.
 ENGINEERS • PLANNERS • SCIENTISTS
 460 SIX FORKS ROAD
 RALEIGH, NORTH CAROLINA 27609

**FARRAR DAIRY
 STREAM AND WETLAND MITIGATION**
 LILLINGTON, HARNETT COUNTY, NORTH CAROLINA
 NPAC - STATION 40+51 TO STATION 56+39

DATE: JUNE 2009
 SCALE: 1"=40'

AS-BUILT
 SITE PLAN

SHEET 5 OF 31

SEE SHEET 11 FOR T2

MATCHLINE - SEE SHEET 5

MATCHLINE - SEE SHEET 7



CONSERVATION EASEMENT

CONSERVATION EASEMENT

CONSERVATION EASEMENT



SEE SHEET 12 FOR T3

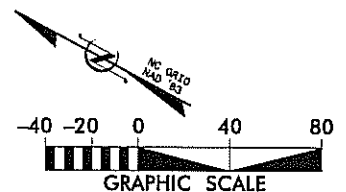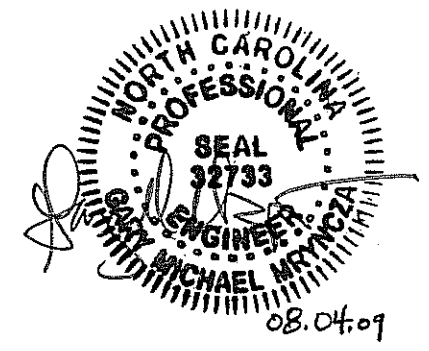

NO.	DATE	BY	REVISIONS
1	JUNE 2009		




KCI
ASSOCIATES OF NC
ENGINEERS • PLANNERS • SCIENTISTS
4501 SIX FORKS ROAD
RALEIGH, NORTH CAROLINA 27609

FARRAR DAIRY
STREAM AND WETLAND MITIGATION
LILLINGTON, HARNETT COUNTY, NORTH CAROLINA
NPAC - STATION 55+39 TO STATION 69+51



DATE: JUNE 2009
SCALE: 1"=40'
AS-BUILT
SITE PLAN
SHEET 6 OF 31

MATCHLINE - SEE SHEET 0

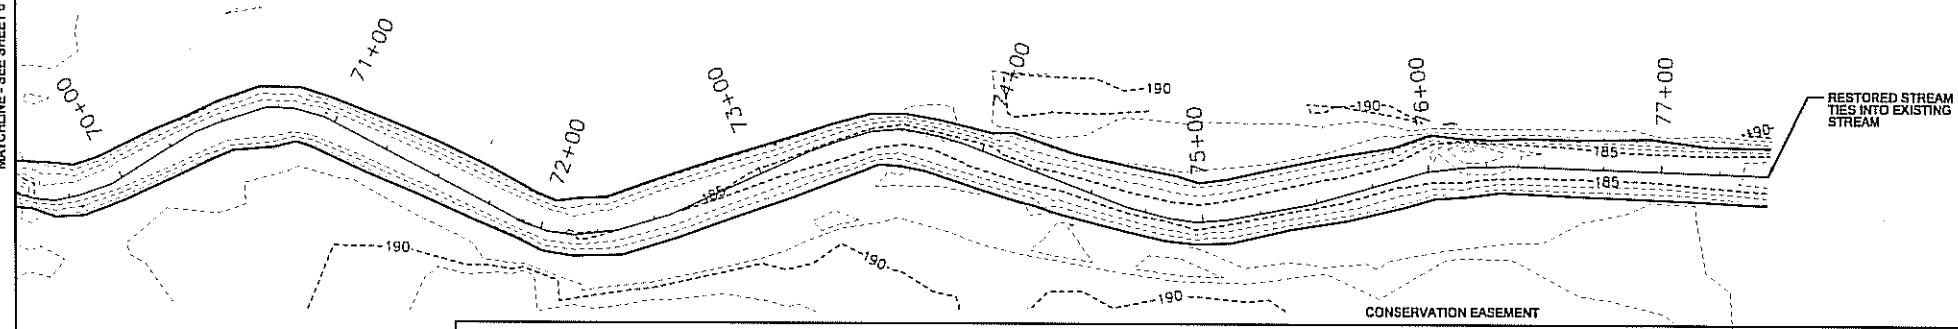






CONSERVATION EASEMENT

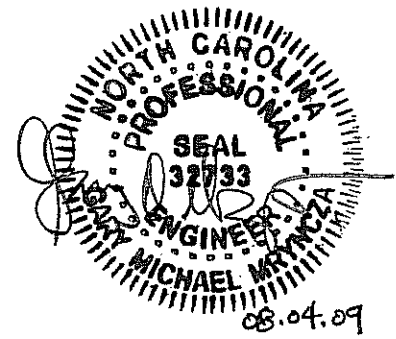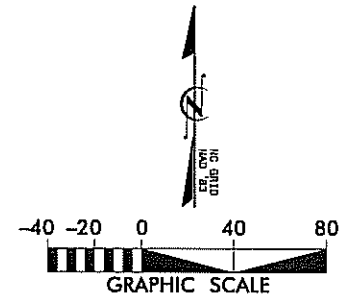CONSERVATION EASEMENT



CONSERVATION EASEMENT

DATE: JUNE 2009		DATE: JUNE 2009	
SCALE: 1"=40'		DATE: DEC 2008	
AS-BUILT SITE PLAN		REVISIONS	
SHEET 7 OF 31		NO.	
		DESCRIPTION	
		DATE	
		APPROVED	
 KCI ASSOCIATES OF NC ENGINEERS • PLANNERS • SCIENTISTS 460 SIX FORKS ROAD RALEIGH, NORTH CAROLINA 27609		 FARRAR DAIRY FARMHOUSE	
FARRAR DAIRY STREAM AND WETLAND MITIGATION LILLINGTON, HARNETT COUNTY, NORTH CAROLINA NPAC - STATION 69+51 TO STATION 77+46			

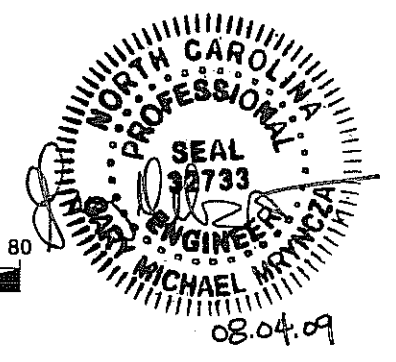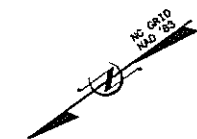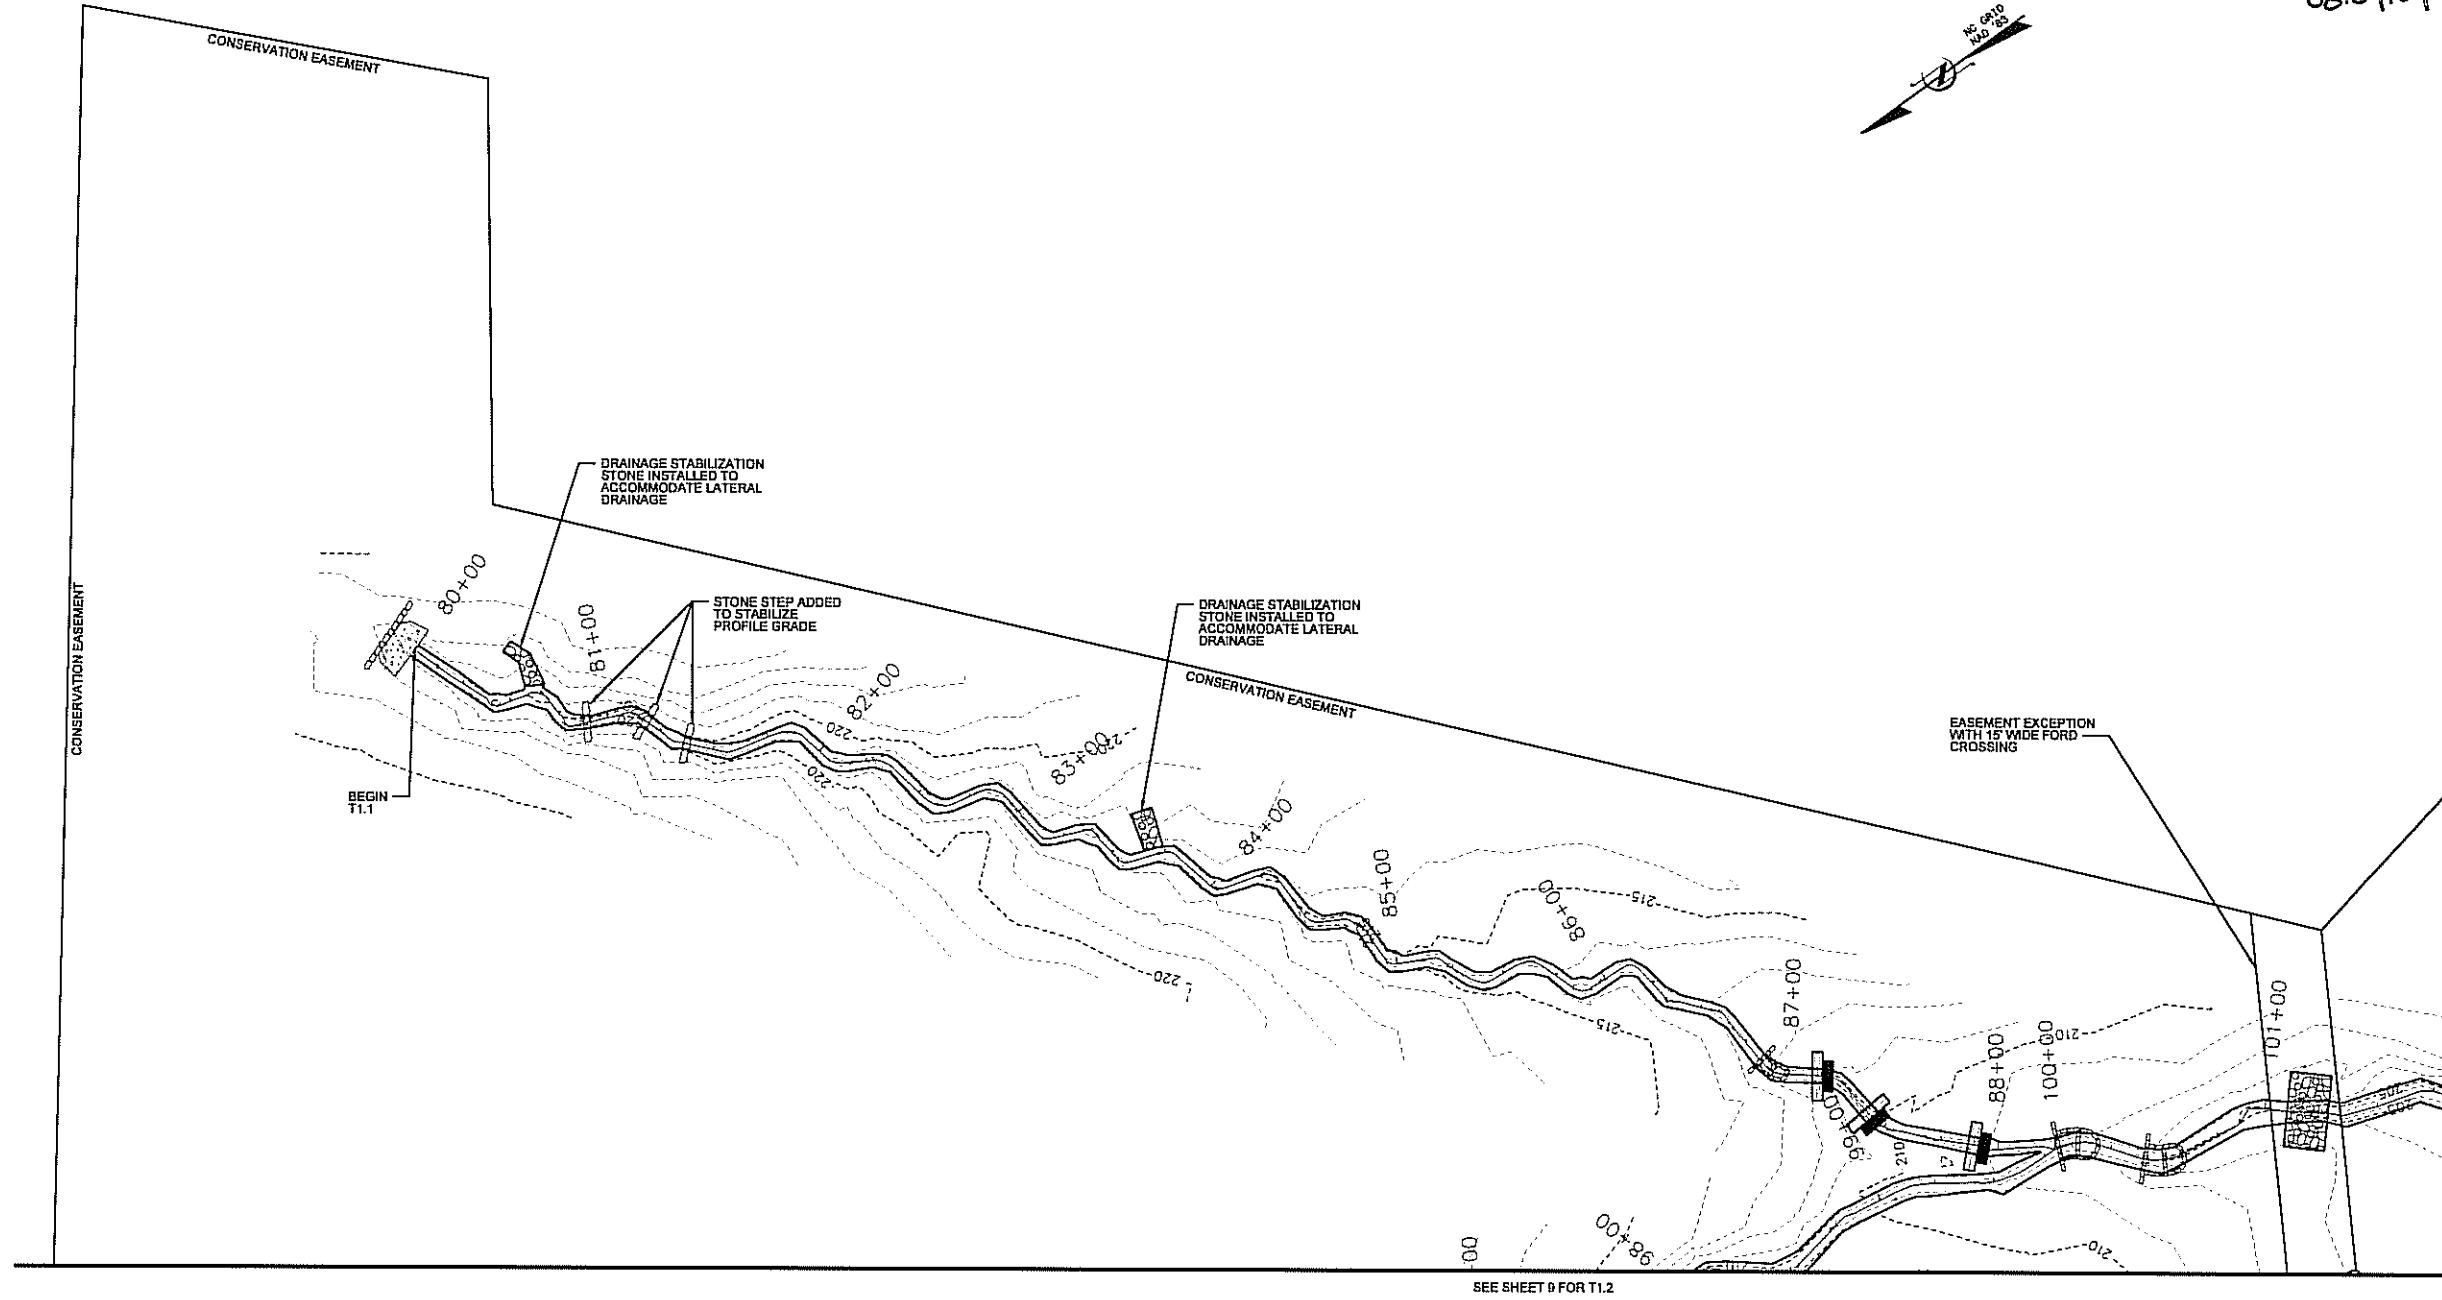

NO.	DATE	DESCRIPTION	APPROVED
1	JUNE 2009	SUBMITTED WITH MITIGATION PLAN	





KCI
ASSOCIATES OF NC
ENGINEERS • PLANNERS • SCIENTISTS
160 SIX FORKS ROAD
RALEIGH, NORTH CAROLINA 27609

**FARRAR DAIRY
STREAM AND WETLAND MITIGATION**
LILLINGTON, HARNETT COUNTY, NORTH CAROLINA
T1.1 - STATION 80+00 TO STATION 88+25


DATE: JUNE 2009
SCALE: 1"=40'

AS-BUILT
SITE PLAN

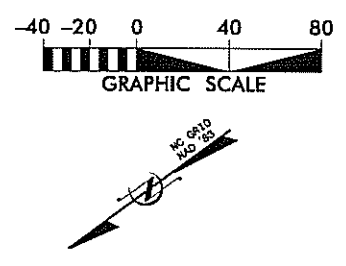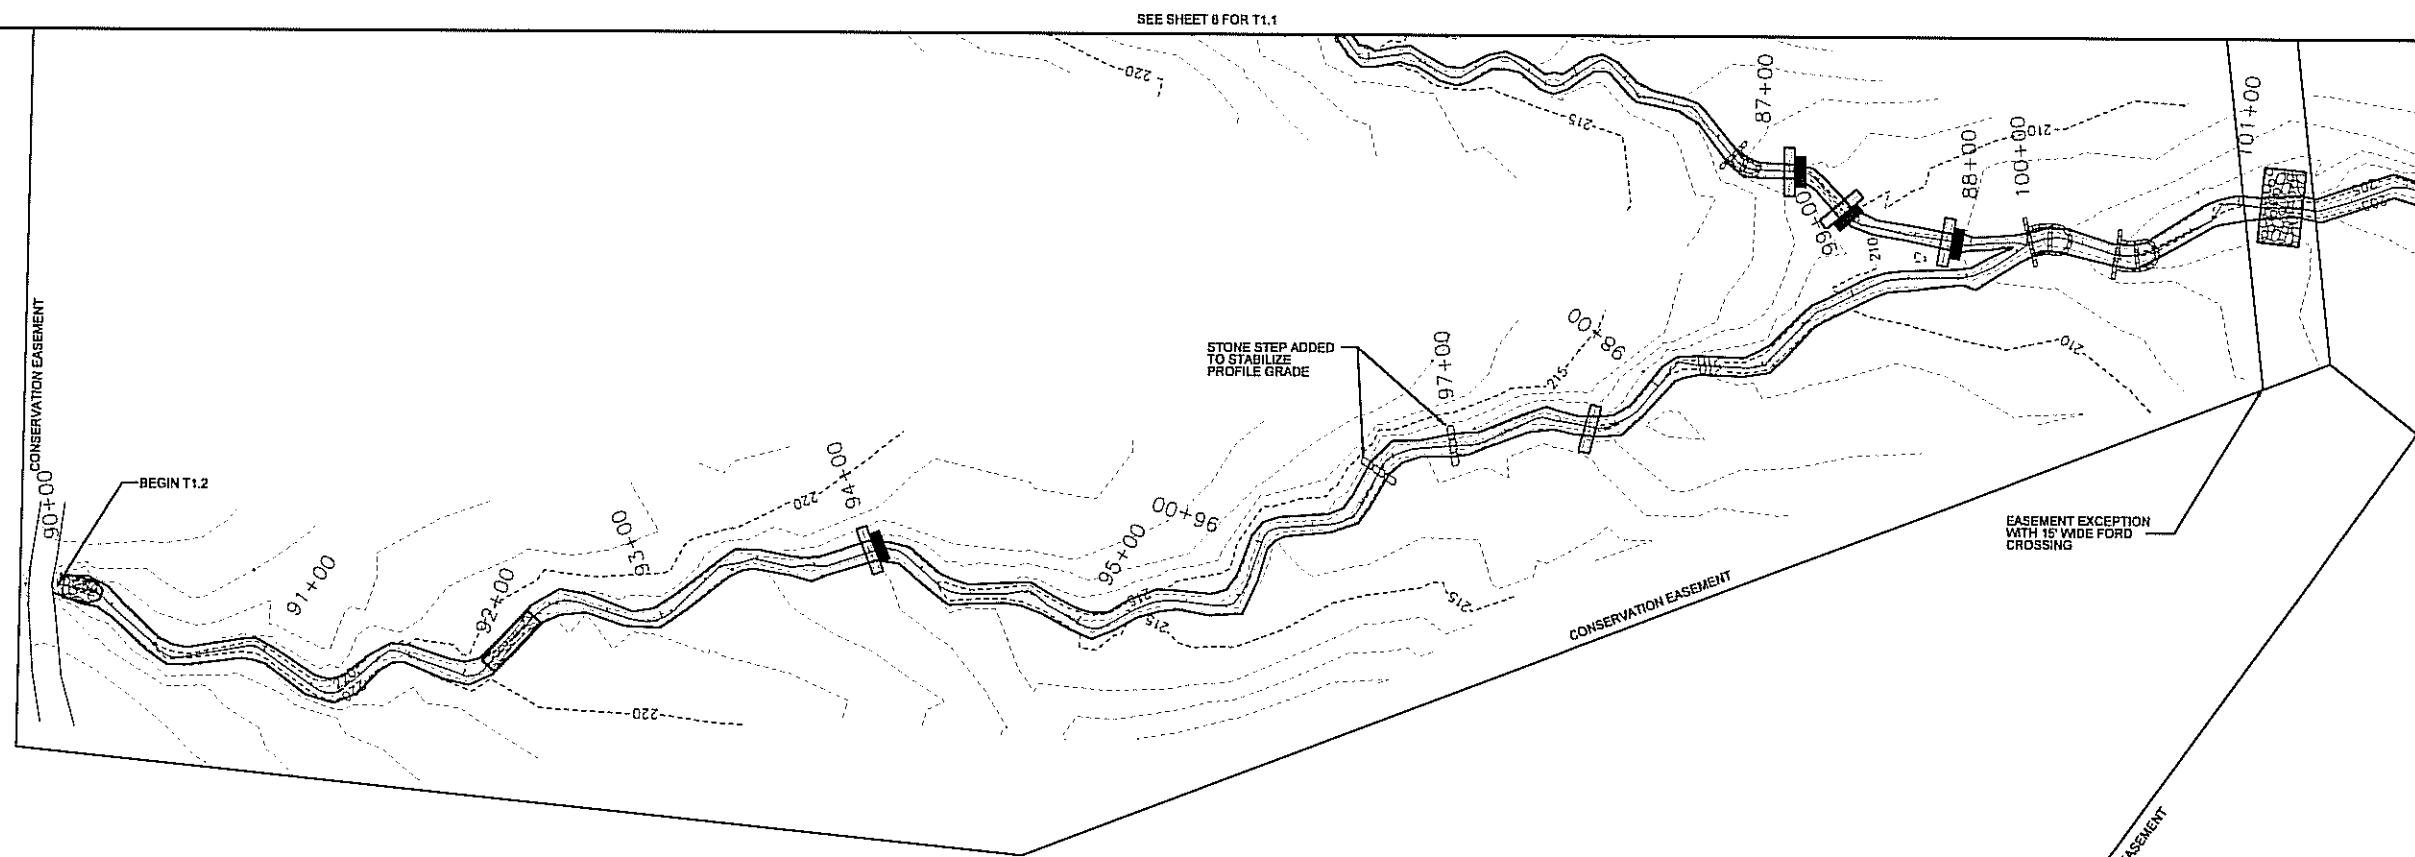

MICHAEL MYTYCA
 08.04.09




SUBMITTED WITH MITIGATION PLAN		REVISIONS	
NO.	DESCRIPTION	DATE	APPROVED
		JUNE 2009	

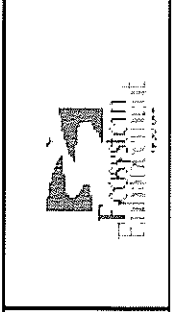

KCI ASSOCIATES OF NC
 ENGINEERS • PLANNERS • SCIENTISTS
 460 SIX FORKS ROAD
 RALEIGH, NORTH CAROLINA 27609

**FARRAR DAIRY
 STREAM AND WETLAND MITIGATION**
 LILLINGTON, HARNETT COUNTY, NORTH CAROLINA
 T1.2 - STATION 90+00 TO STATION 99+80

DATE: JUNE 2009
 SCALE: 1"=40'
 AS-BUILT
 SITE PLAN

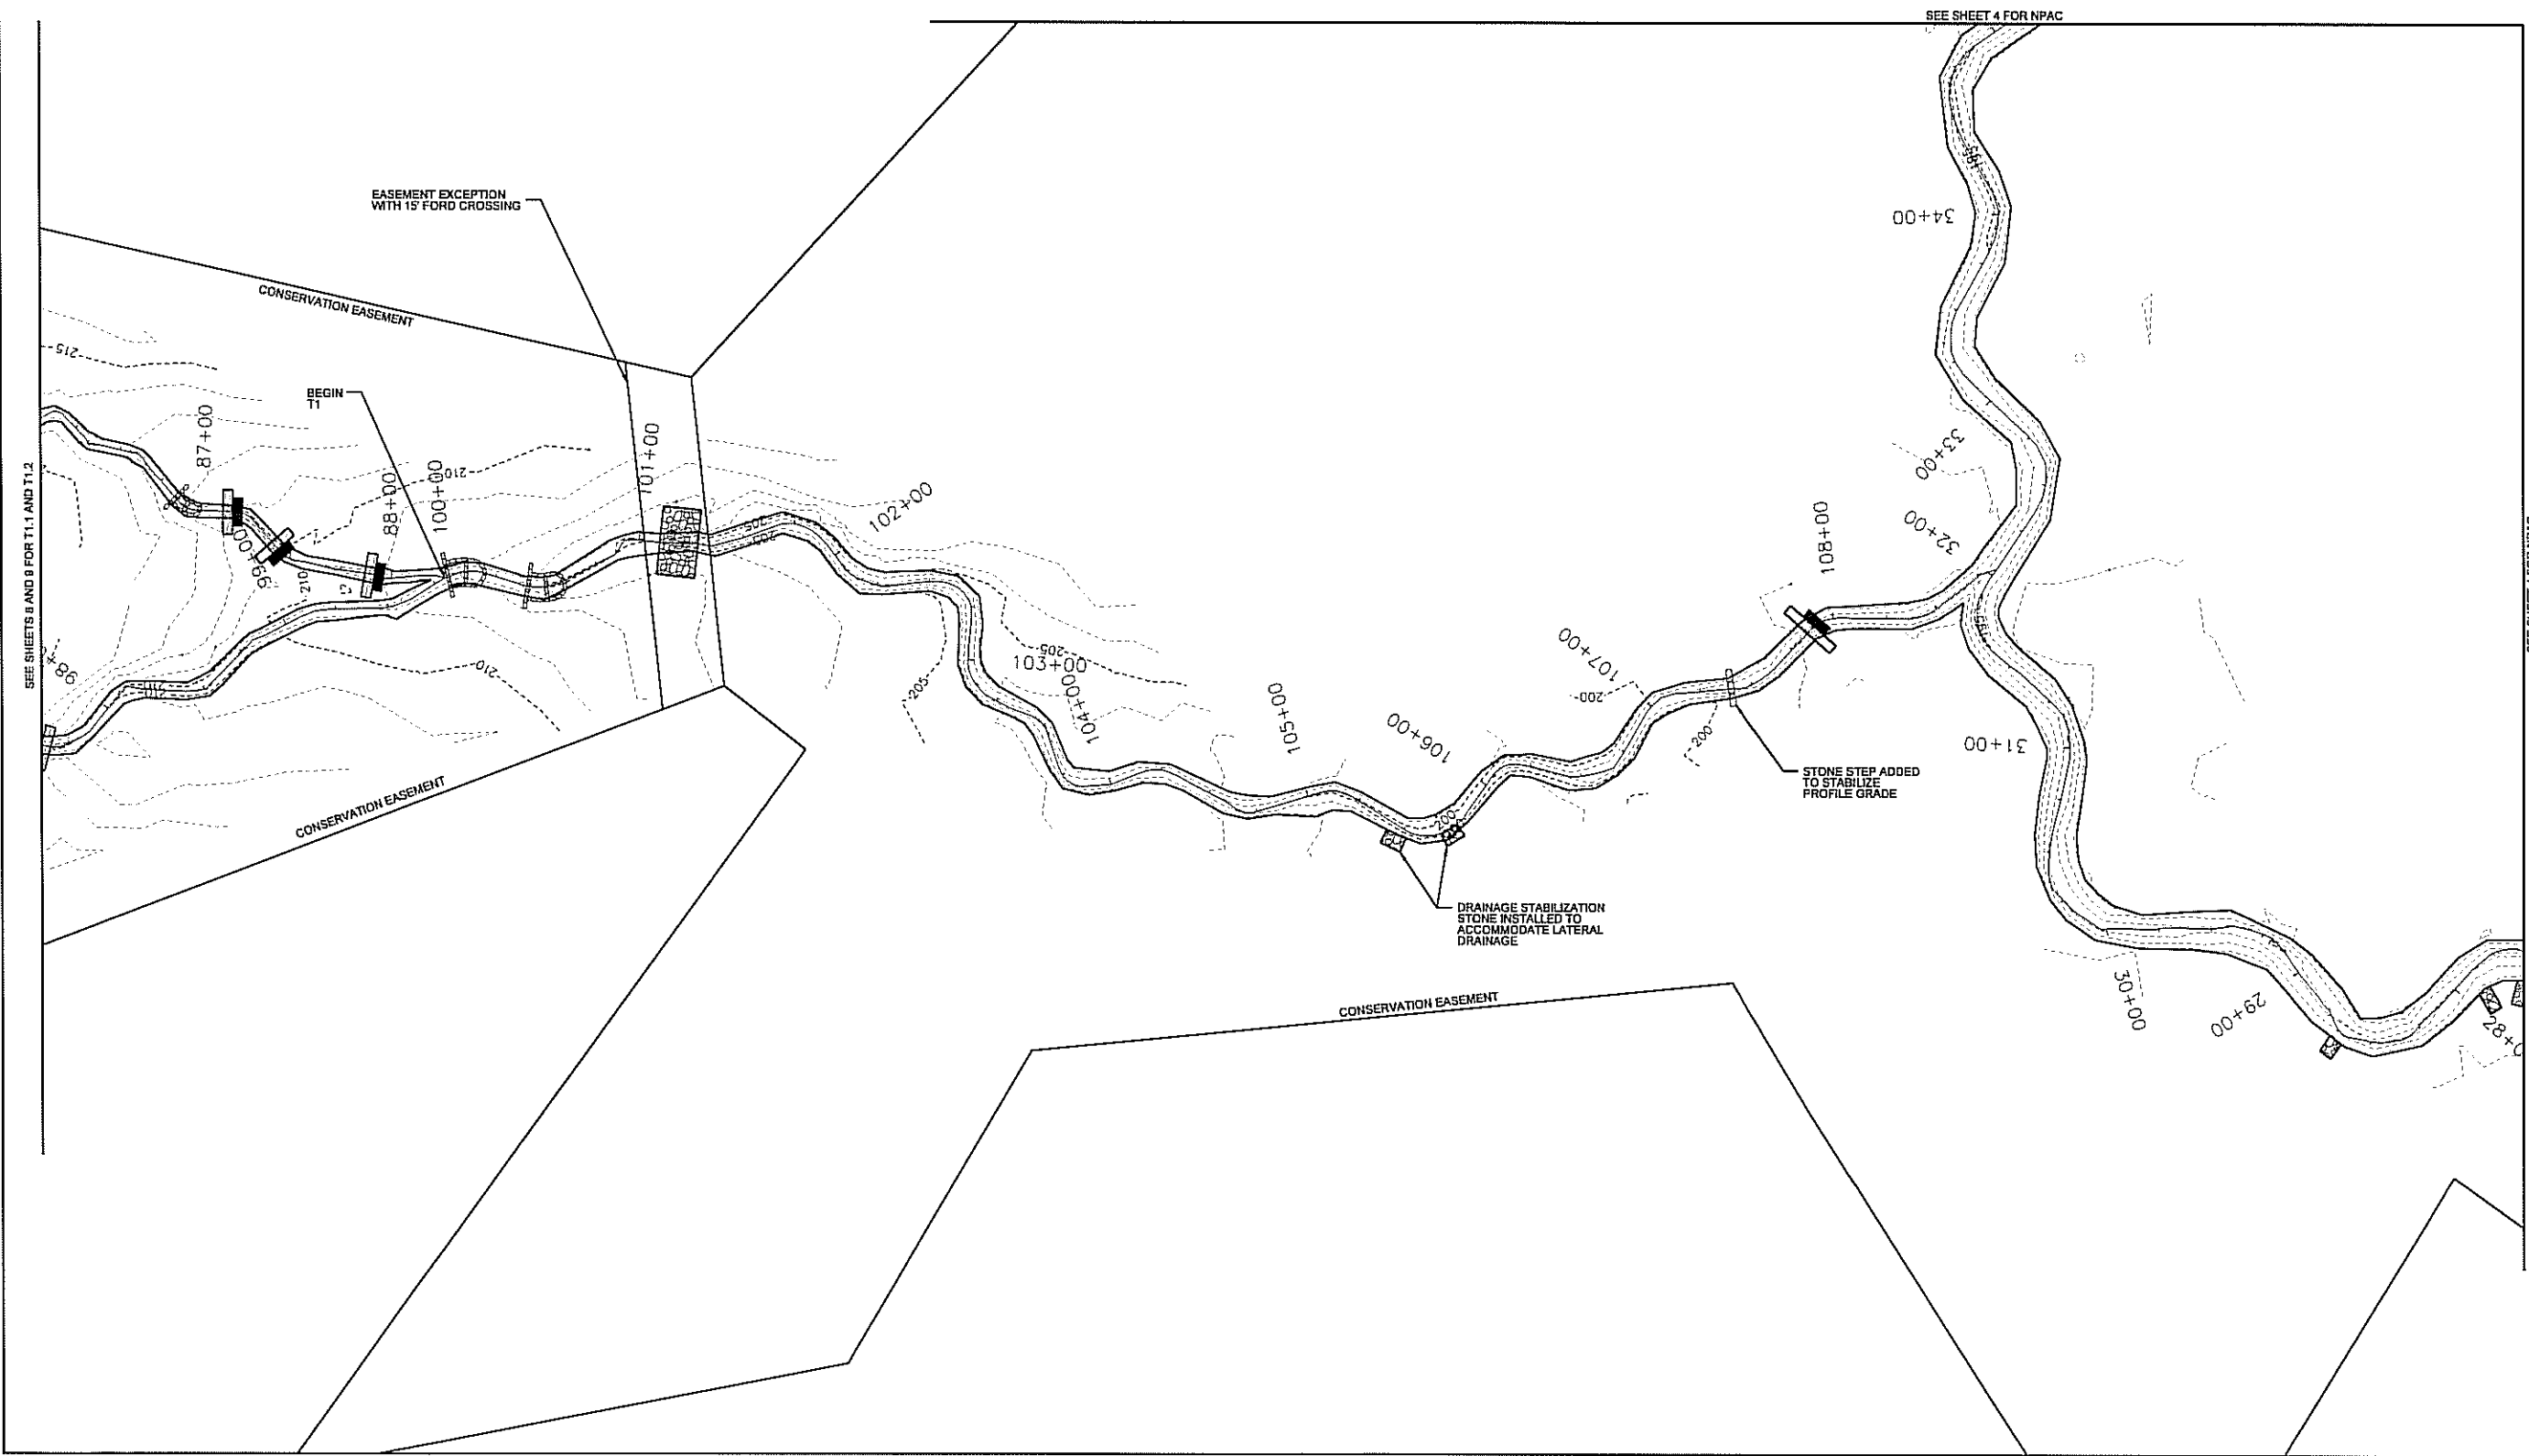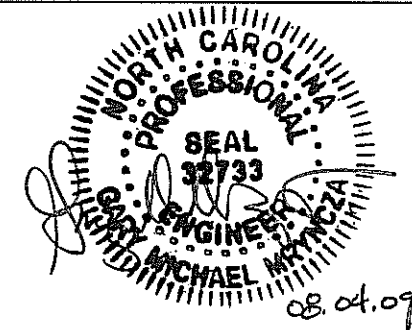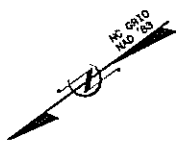


NO.	DATE	DESCRIPTION	BY	APPROVED
1	JUNE 2009	SUBMITTED WITH MITIGATION PLAN		



KCI
 ASSOCIATES OF NC
 ENGINEERS • PLANNERS • SCIENTISTS
 480 SIX FORKS ROAD
 RALEIGH, NORTH CAROLINA 27609

**FARRAR DAIRY
 STREAM AND WETLAND MITIGATION**
 LILLINGTON, HARNETT COUNTY, NORTH CAROLINA
 T1 - STATION 100+00 TO STATION 108+84

DATE: JUNE 2009
 SCALE: 1"=40'
**AS-BUILT
 SITE PLAN**
 SHEET 10 OF 31

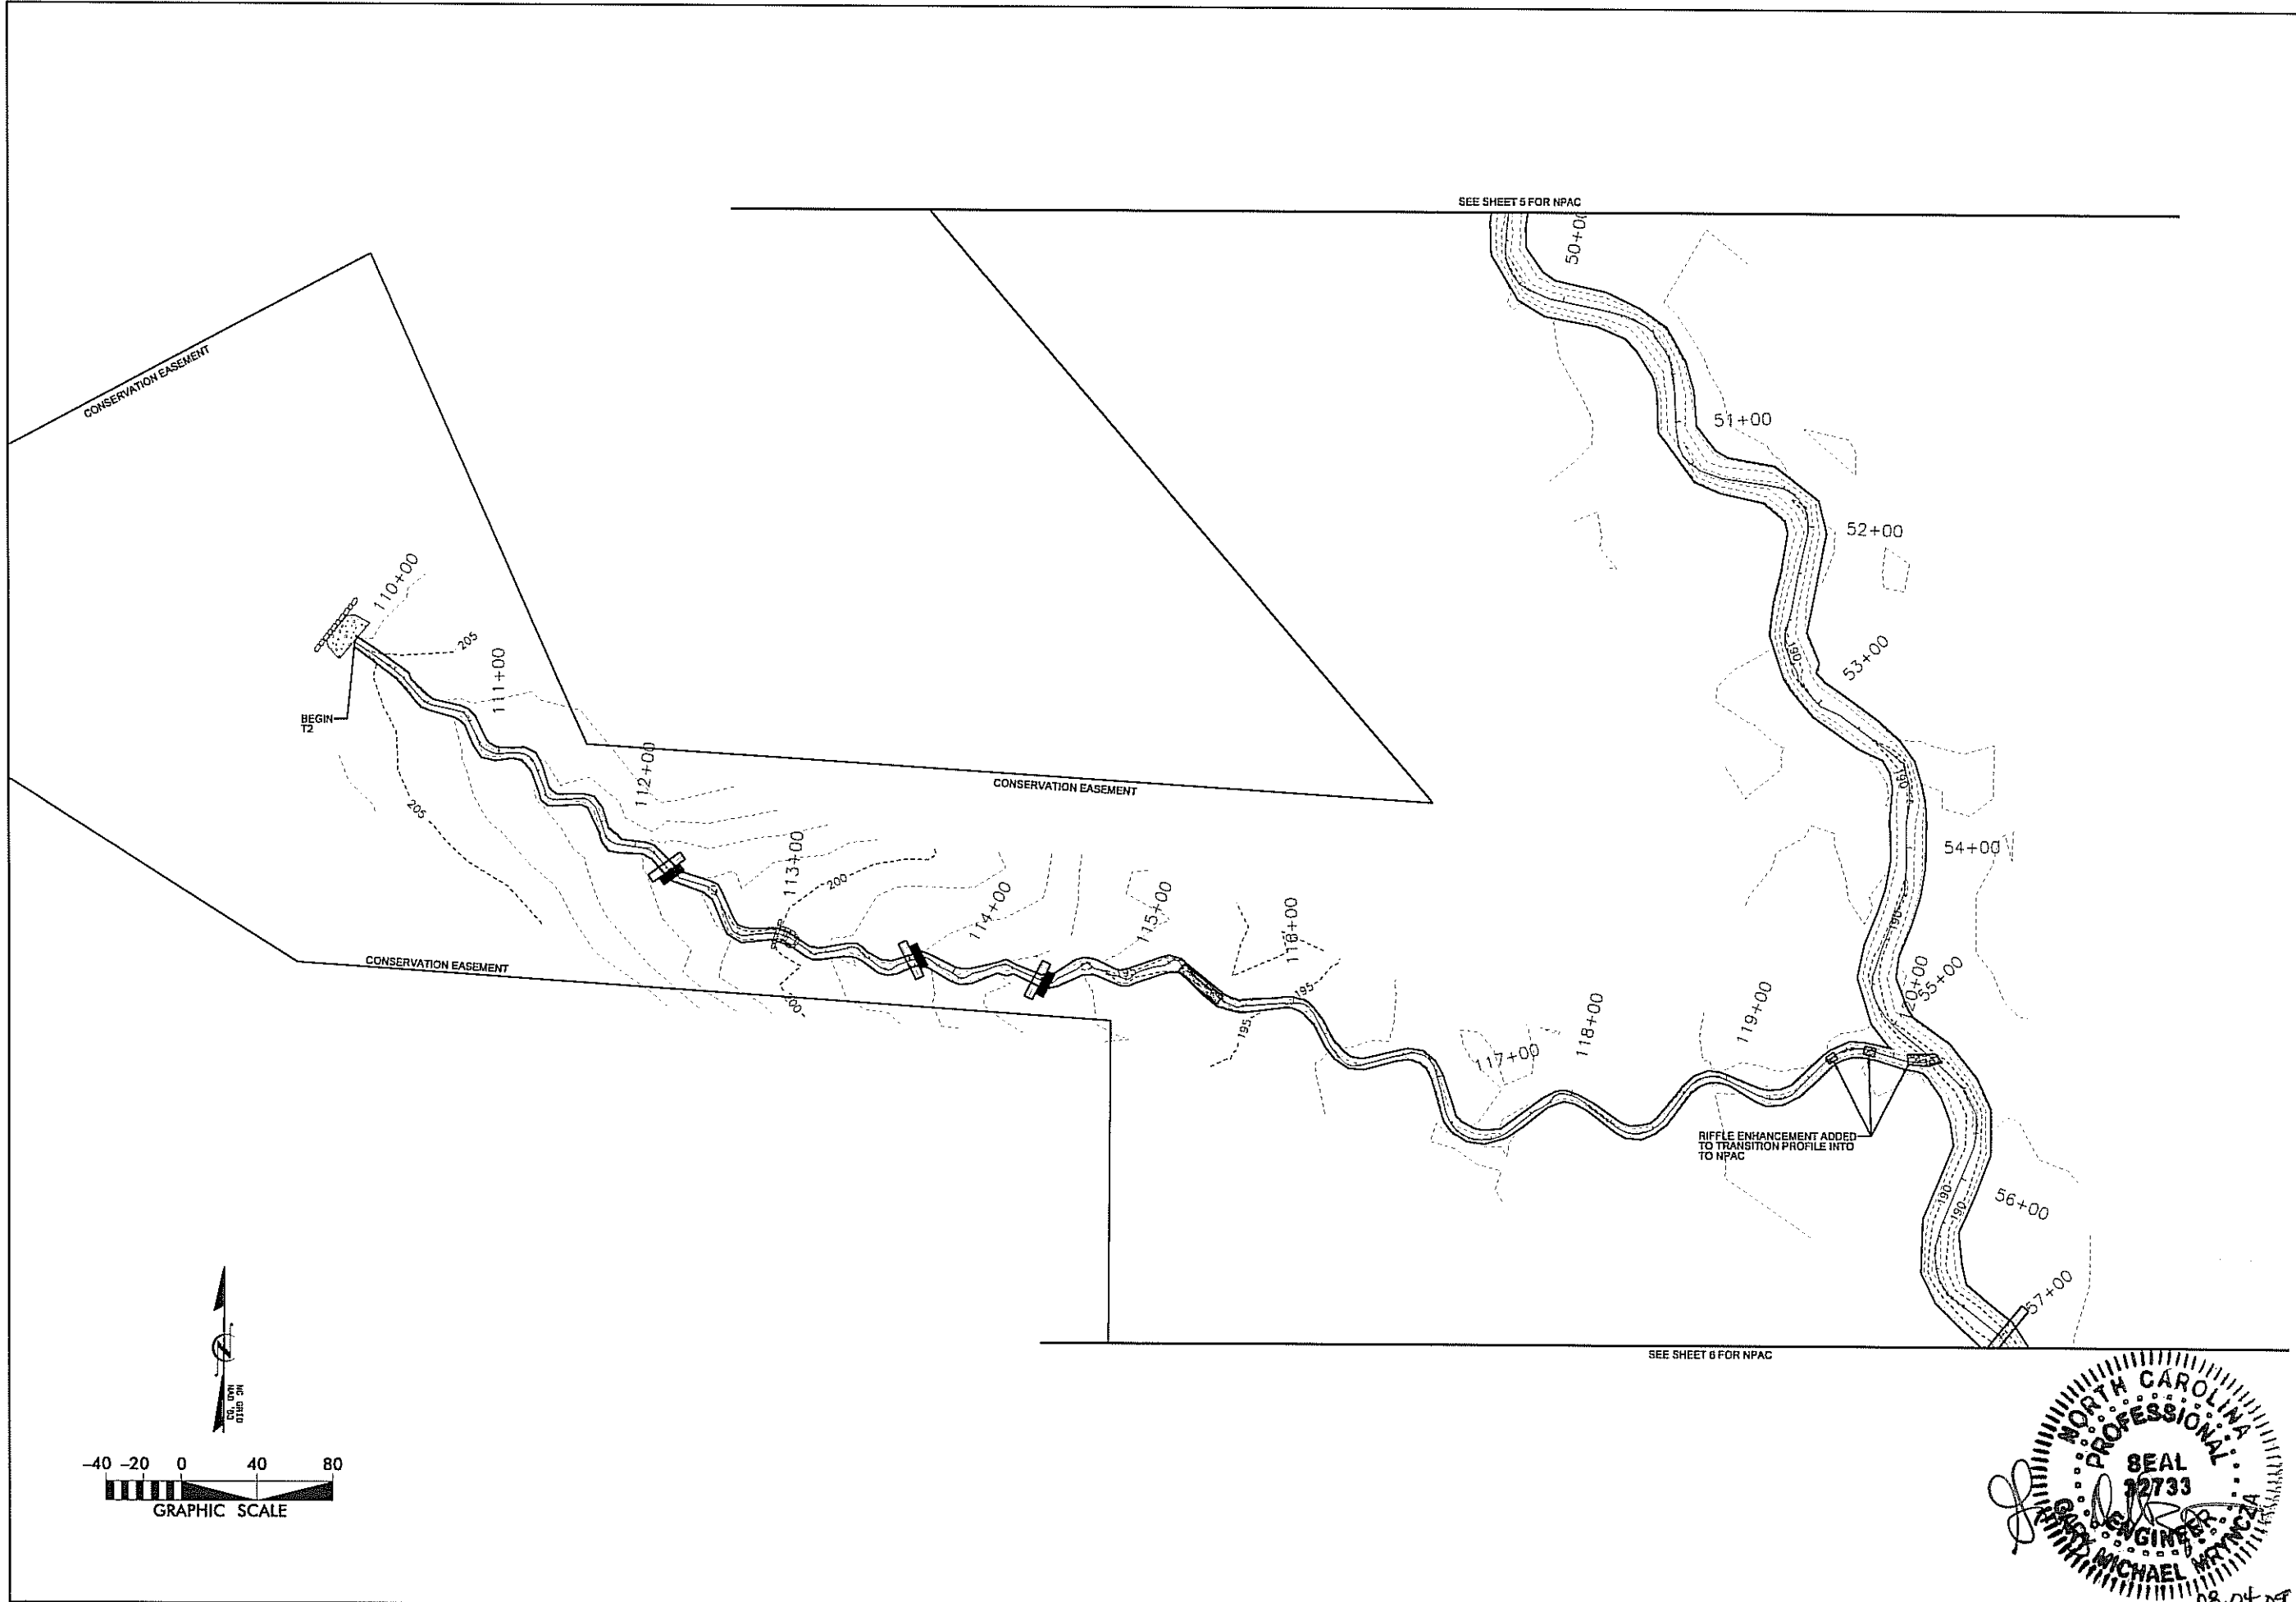


NO.	DATE	DESCRIPTION	BY	APP'D



KCI
ASSOCIATES OF NC
ENGINEERS • PLANNERS • SCIENTISTS
460 SIX FORKS ROAD
RALEIGH, NORTH CAROLINA 27609

**FARRAR DAIRY
STREAM AND WETLAND MITIGATION**
LILLINGTON, HARNETT COUNTY, NORTH CAROLINA
T2 - STATION 110+00 TO STATION 120+22



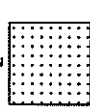
DATE: JUNE 2009	SCALE: 1"=40'
AS-BUILT SITE PLAN	
SHEET 11	OF 31



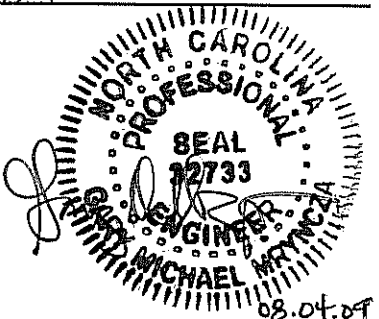



08.04.09



REVISIONS

WETLAND MITIGATION TYPE

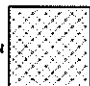- RESTORATION 
- ENHANCEMENT 
- PRESERVATION 

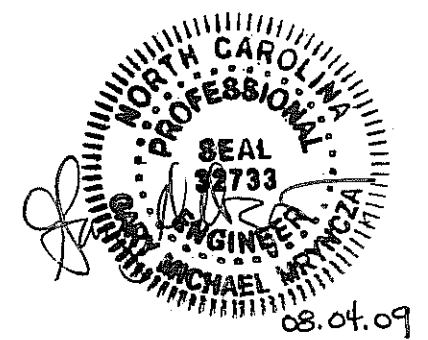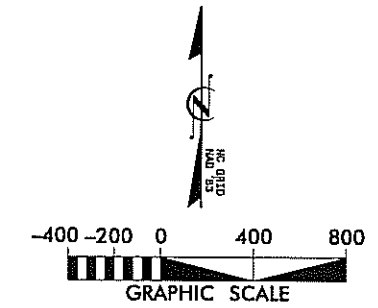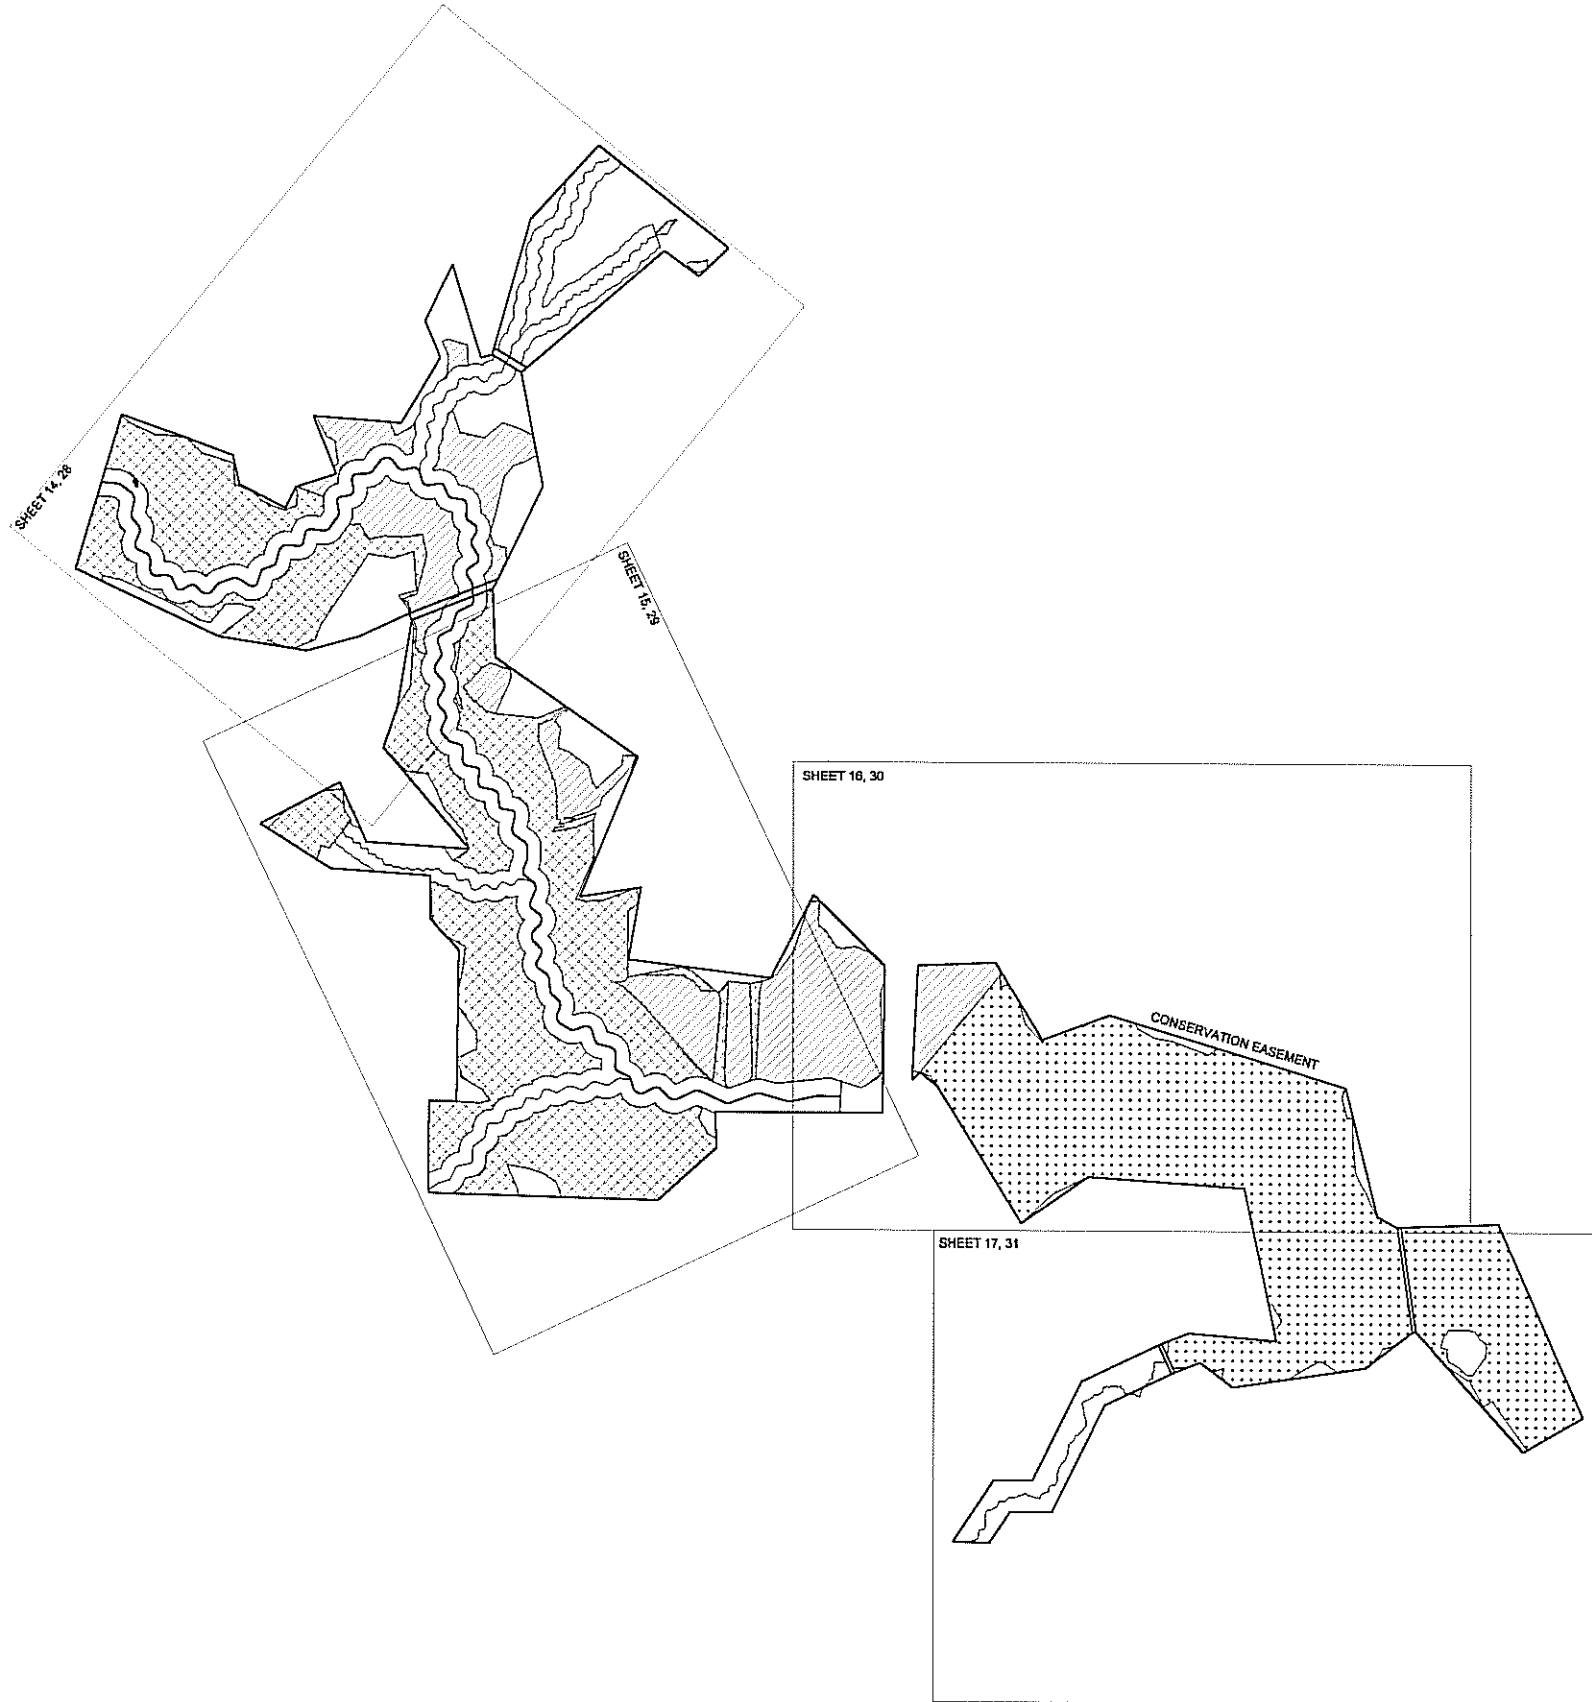

SUBMITTED WITH MITIGATION PLAN		DATE	
A		JUNE 2009	
SYMBOL	DESCRIPTION	DATE	APPROVED
REVISIONS			
			
KCI ASSOCIATES OF NC ENGINEERS • PLANNERS • SCIENTISTS 460 SIX FORKS ROAD RALEIGH, NORTH CAROLINA 27609			
FARRAR DAIRY STREAM AND WETLAND MITIGATION LILLINGTON, HARNETT COUNTY, NORTH CAROLINA			
DATE: JUNE 2009		SCALE: 1"=400'	
AS-BUILT WETLAND OVERVIEW			
SHEET 13		OF 31	

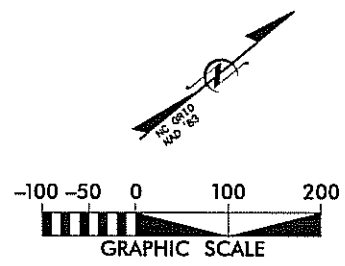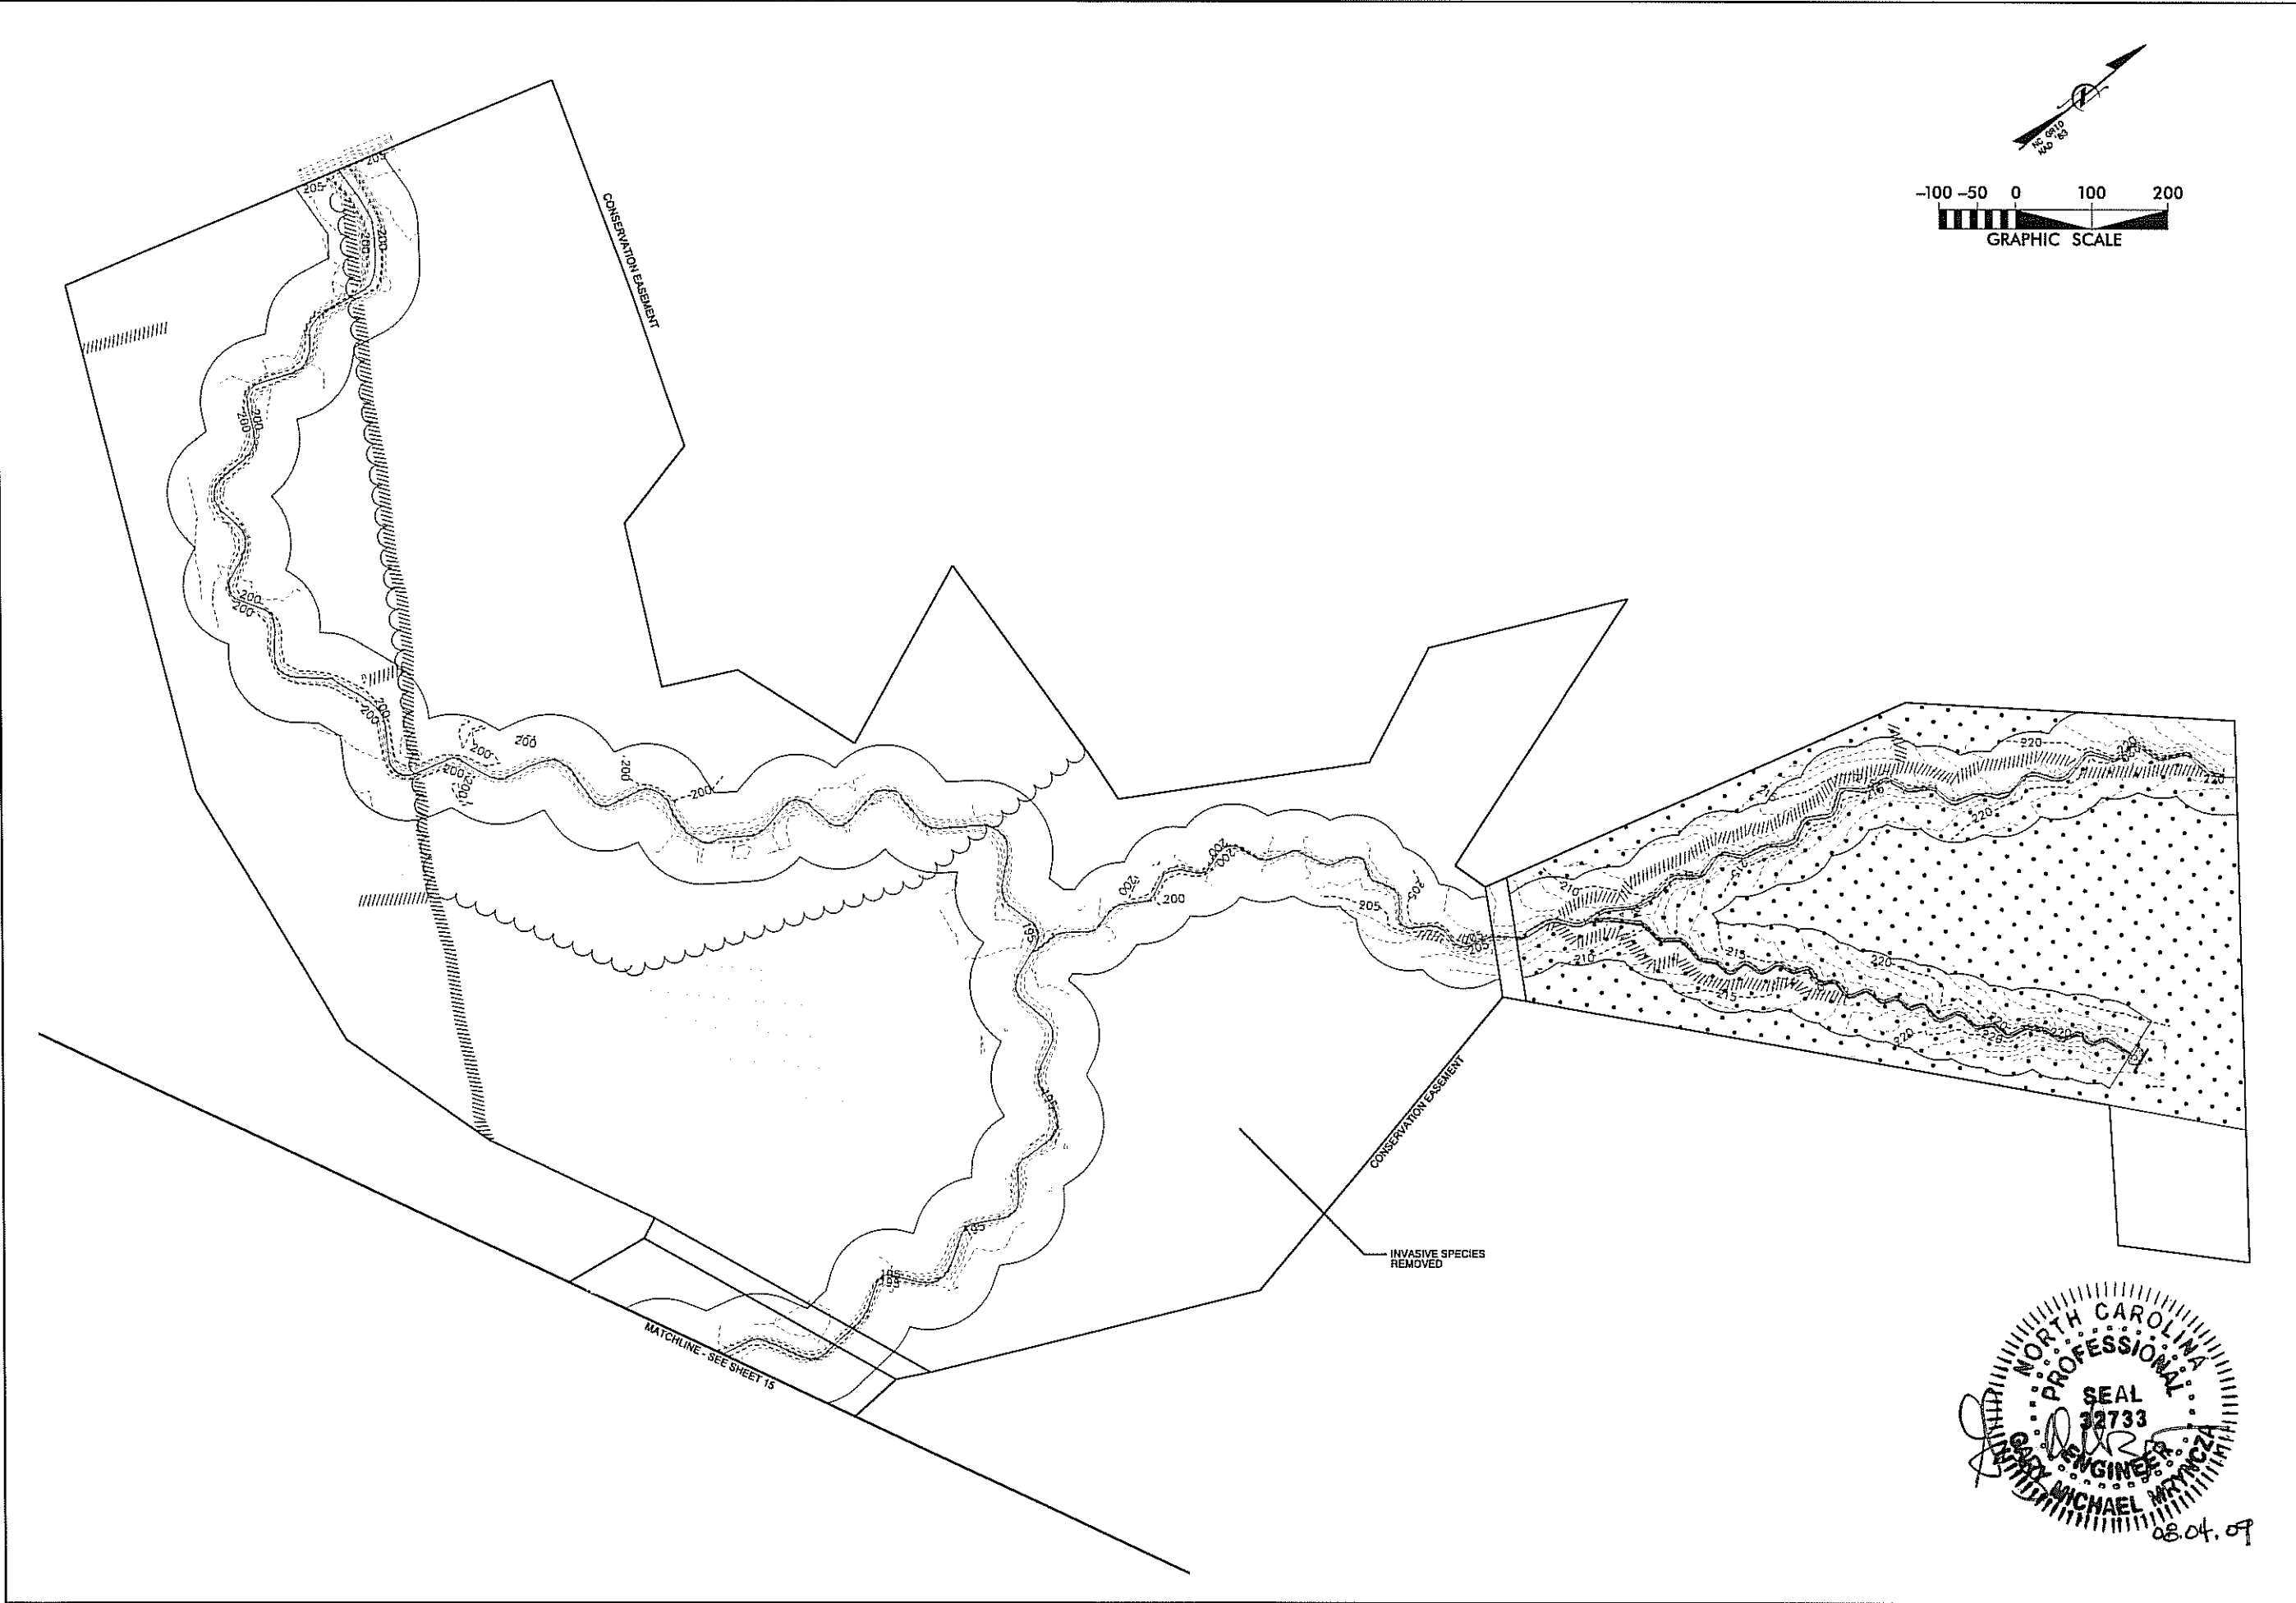


NO.	DATE	DESCRIPTION	BY	APP'D
1	JUNE 2009	SUBMITTED WITH MITIGATION PLAN		




KCI
 ASSOCIATES OF NC
 ENGINEERS • PLANNERS • SCIENTISTS
 460 SIX FORKS ROAD
 RALEIGH, NORTH CAROLINA 27609

**FARRAR DAIRY
 STREAM AND WETLAND MITIGATION**
 LILLINGTON, HARNETT COUNTY, NORTH CAROLINA



DATE: JUNE 2009
 SCALE: 1"=100'
 AS-BUILT
 WETLAND
 SITE PLAN
 SHEET 14 OF 31

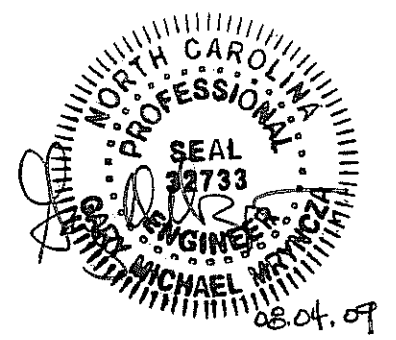



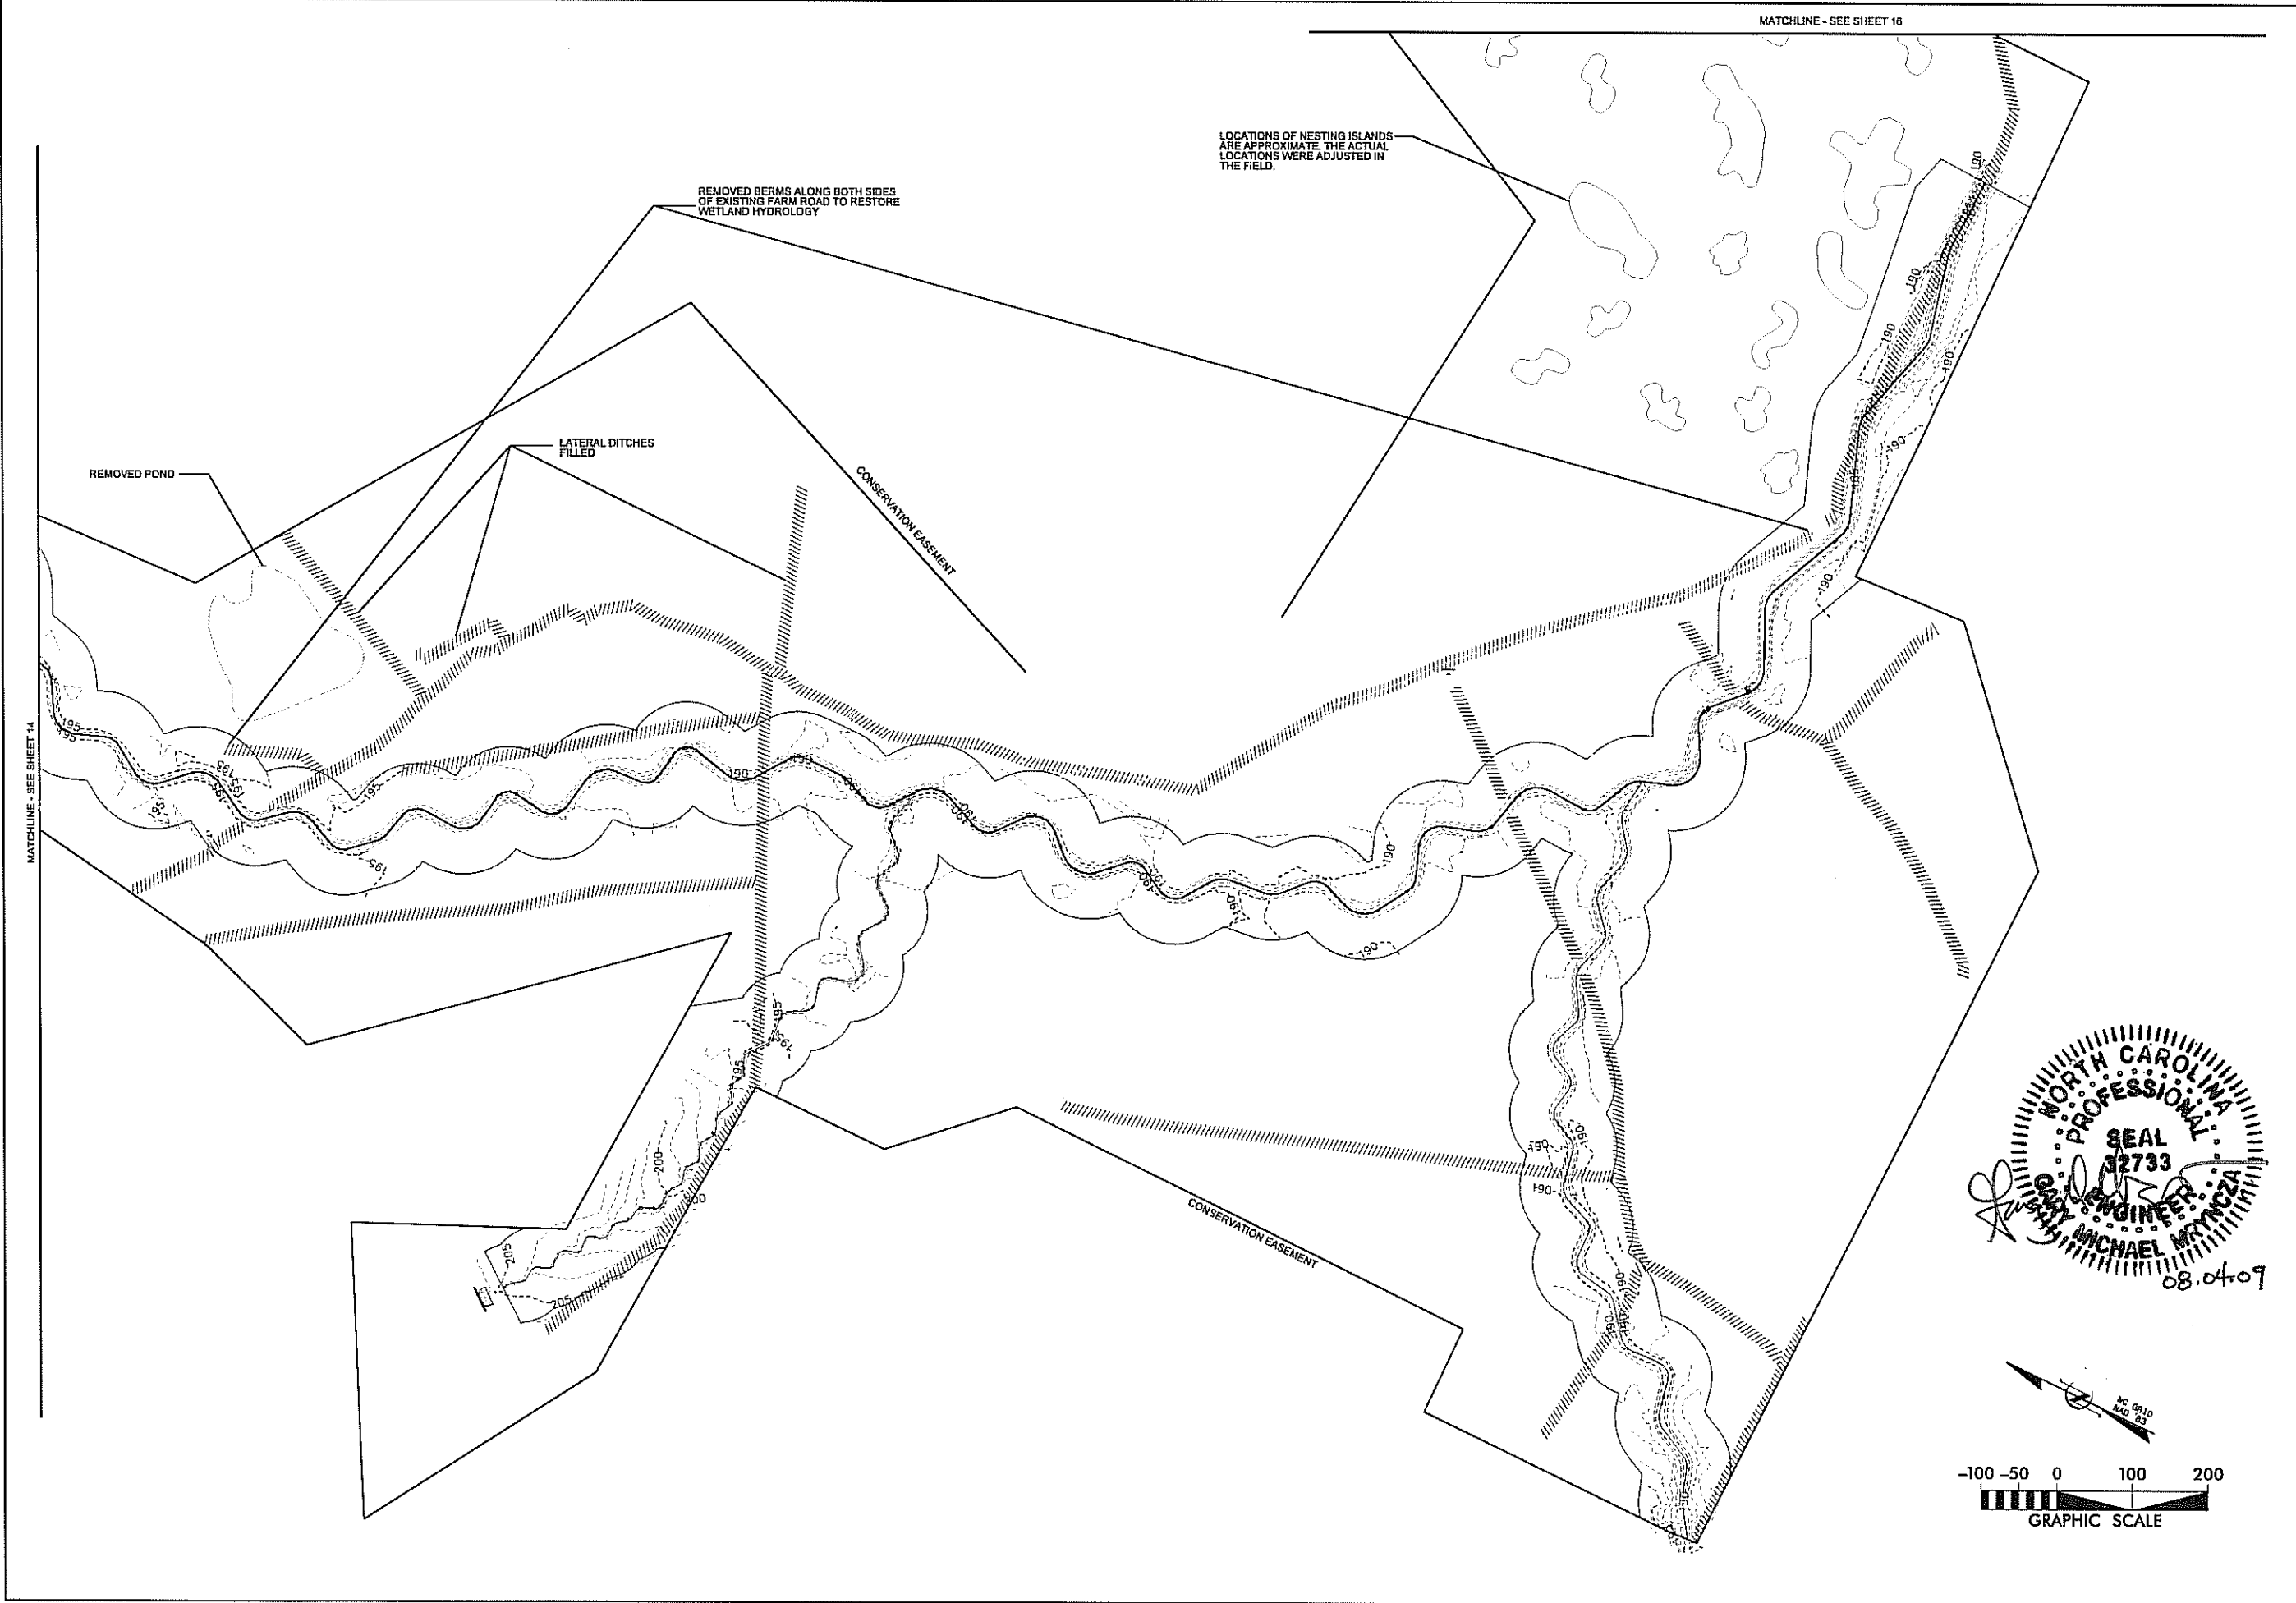


MATCHLINE - SEE SHEET 16


MATCHLINE - SEE SHEET 14

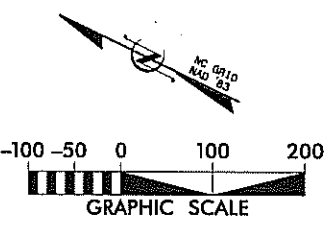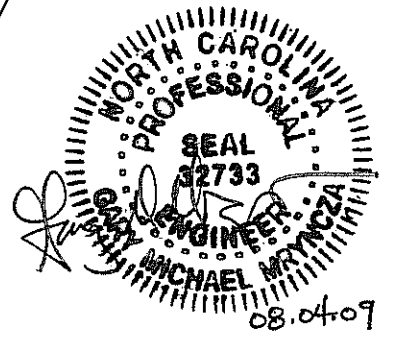

DATE: JUNE 2009		APPROVED	
SCALE: 1"=100'		DATE	
AS-BUILT WETLAND SITE PLAN		REVISIONS	
SHEET 15 OF 31		NO.	DESCRIPTION
FARRAR DAIRY MITIGATION STREAM AND WETLAND MITIGATION LILLINGTON, HARNETT COUNTY, NORTH CAROLINA		DATE	
KCI ASSOCIATES & SCIENTISTS ENGINEERS • PLANNERS • SCIENTISTS 460 SIX FORKS ROAD RALEIGH, NORTH CAROLINA 27609		DATE	
FARRAR DAIRY MITIGATION PROJECT		DATE	
SUBMITTED WITH MITIGATION PLAN		DATE	
JUNE 2009		DATE	

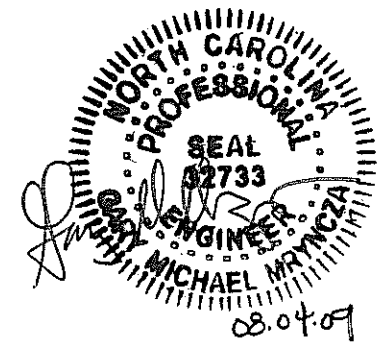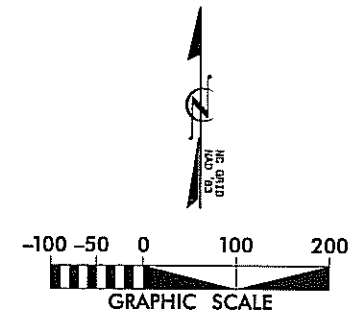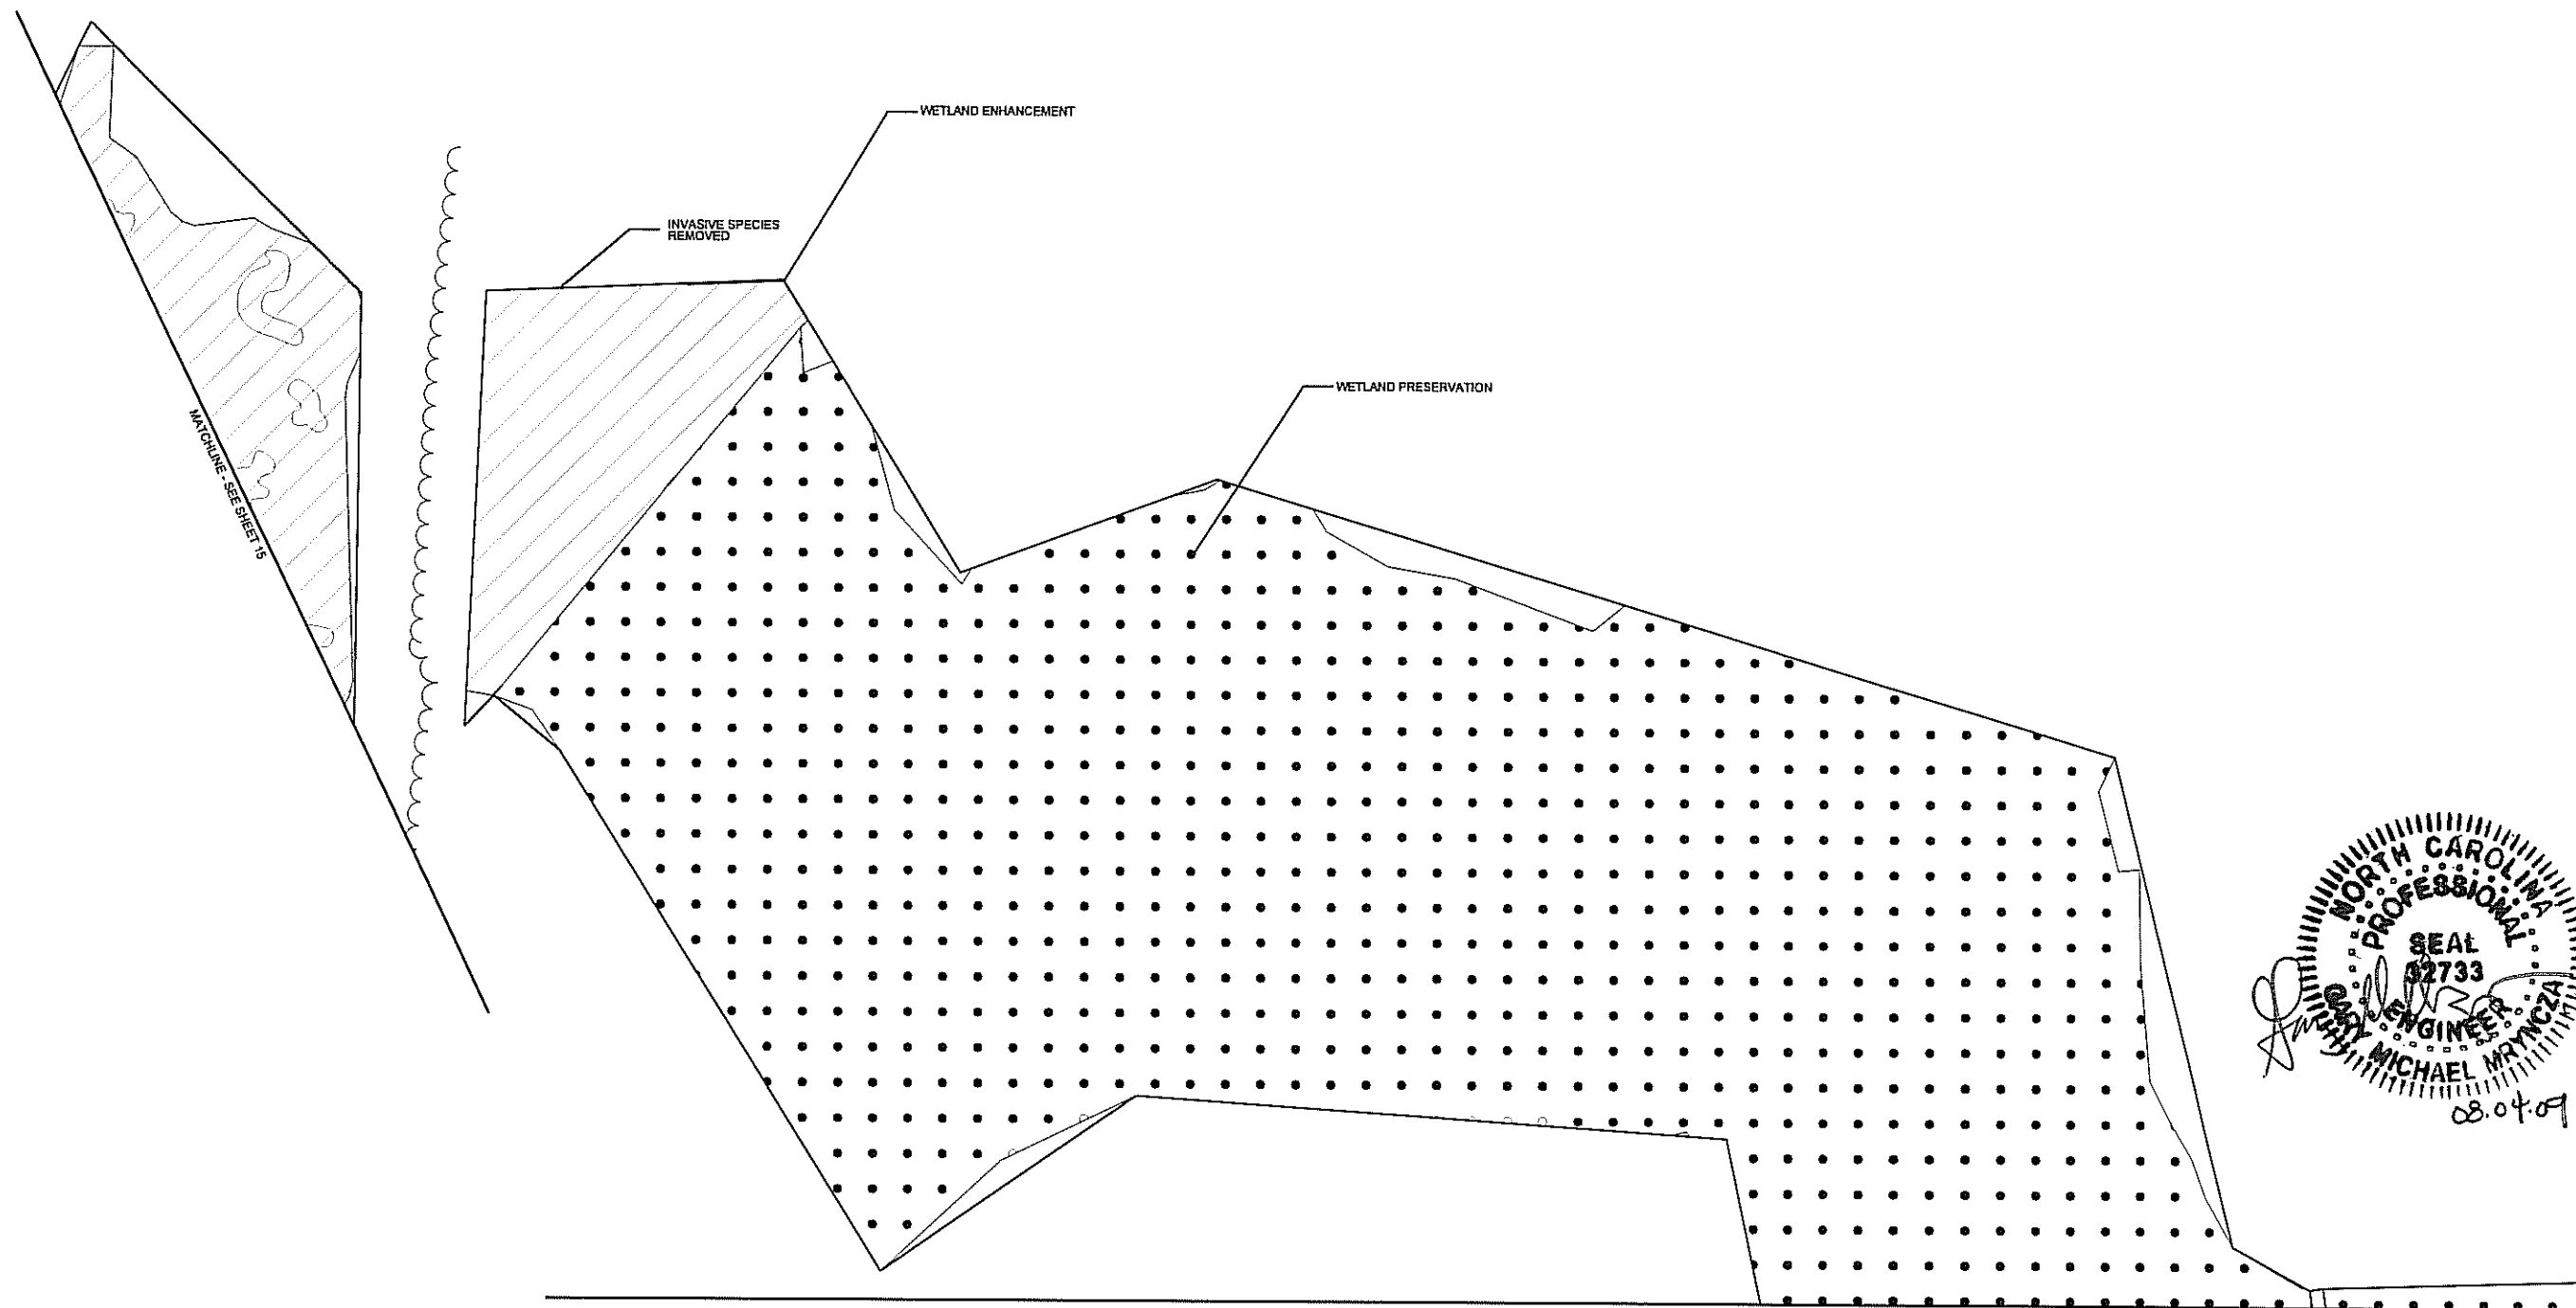

NO.	DESCRIPTION	DATE	APPROVED
A	SUBMITTED WITH MITIGATION PLAN	JUNE 2009	

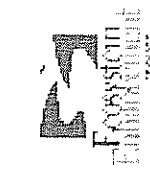

KCI
ASSOCIATES OF NC
ENGINEERS • PLANNERS • SCIENTISTS
460 SIX FORKS ROAD
RALEIGH, NORTH CAROLINA 27609

FARRAR DAIRY
STREAM AND WETLAND MITIGATION
LILLINGTON, HARNETT COUNTY, NORTH CAROLINA

DATE: JUNE 2009
SCALE: 1"=100'
AS-BUILT
WETLAND
SITE PLAN
SHEET 10 OF 31

MATCHLINE - SEE SHEET 16

WETLAND PRESERVATION

CONSERVATION EASEMENT

EASEMENT EXCEPTION

CONSERVATION EASEMENT



EASEMENT EXCEPTION

T4.2 STREAM PRESERVATION

REFERENCE WETLAND GAUGE

T4 REACH BREAK

T4.1 STREAM ENHANCEMENT II

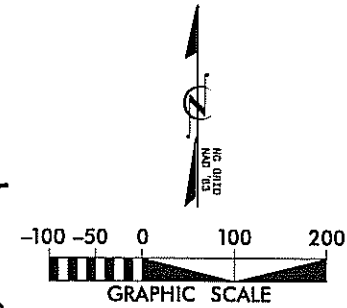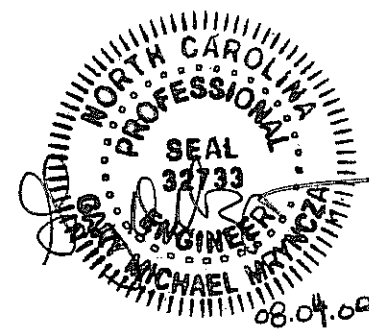




SUBMITTED WITH MITIGATION PLAN		REVISIONS	
NO.	DATE	DESCRIPTION	APPROVED
1	JUNE 2009		



KCI
ASSOCIATES OF NC
ENGINEERS • PLANNERS • SCIENTISTS
4601 SIX FORKS ROAD
RALEIGH, NORTH CAROLINA 27609

FARRAR DAIRY
STREAM AND WETLAND MITIGATION
LILLINGTON, HARNETT COUNTY, NORTH CAROLINA

DATE: JUNE 2009
SCALE: 1"=100'
AS-BUILT WETLAND SITE PLAN
SHEET 17 OF 31

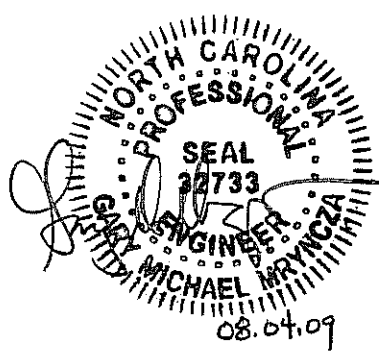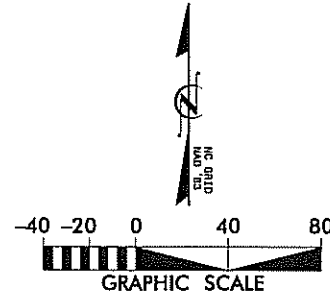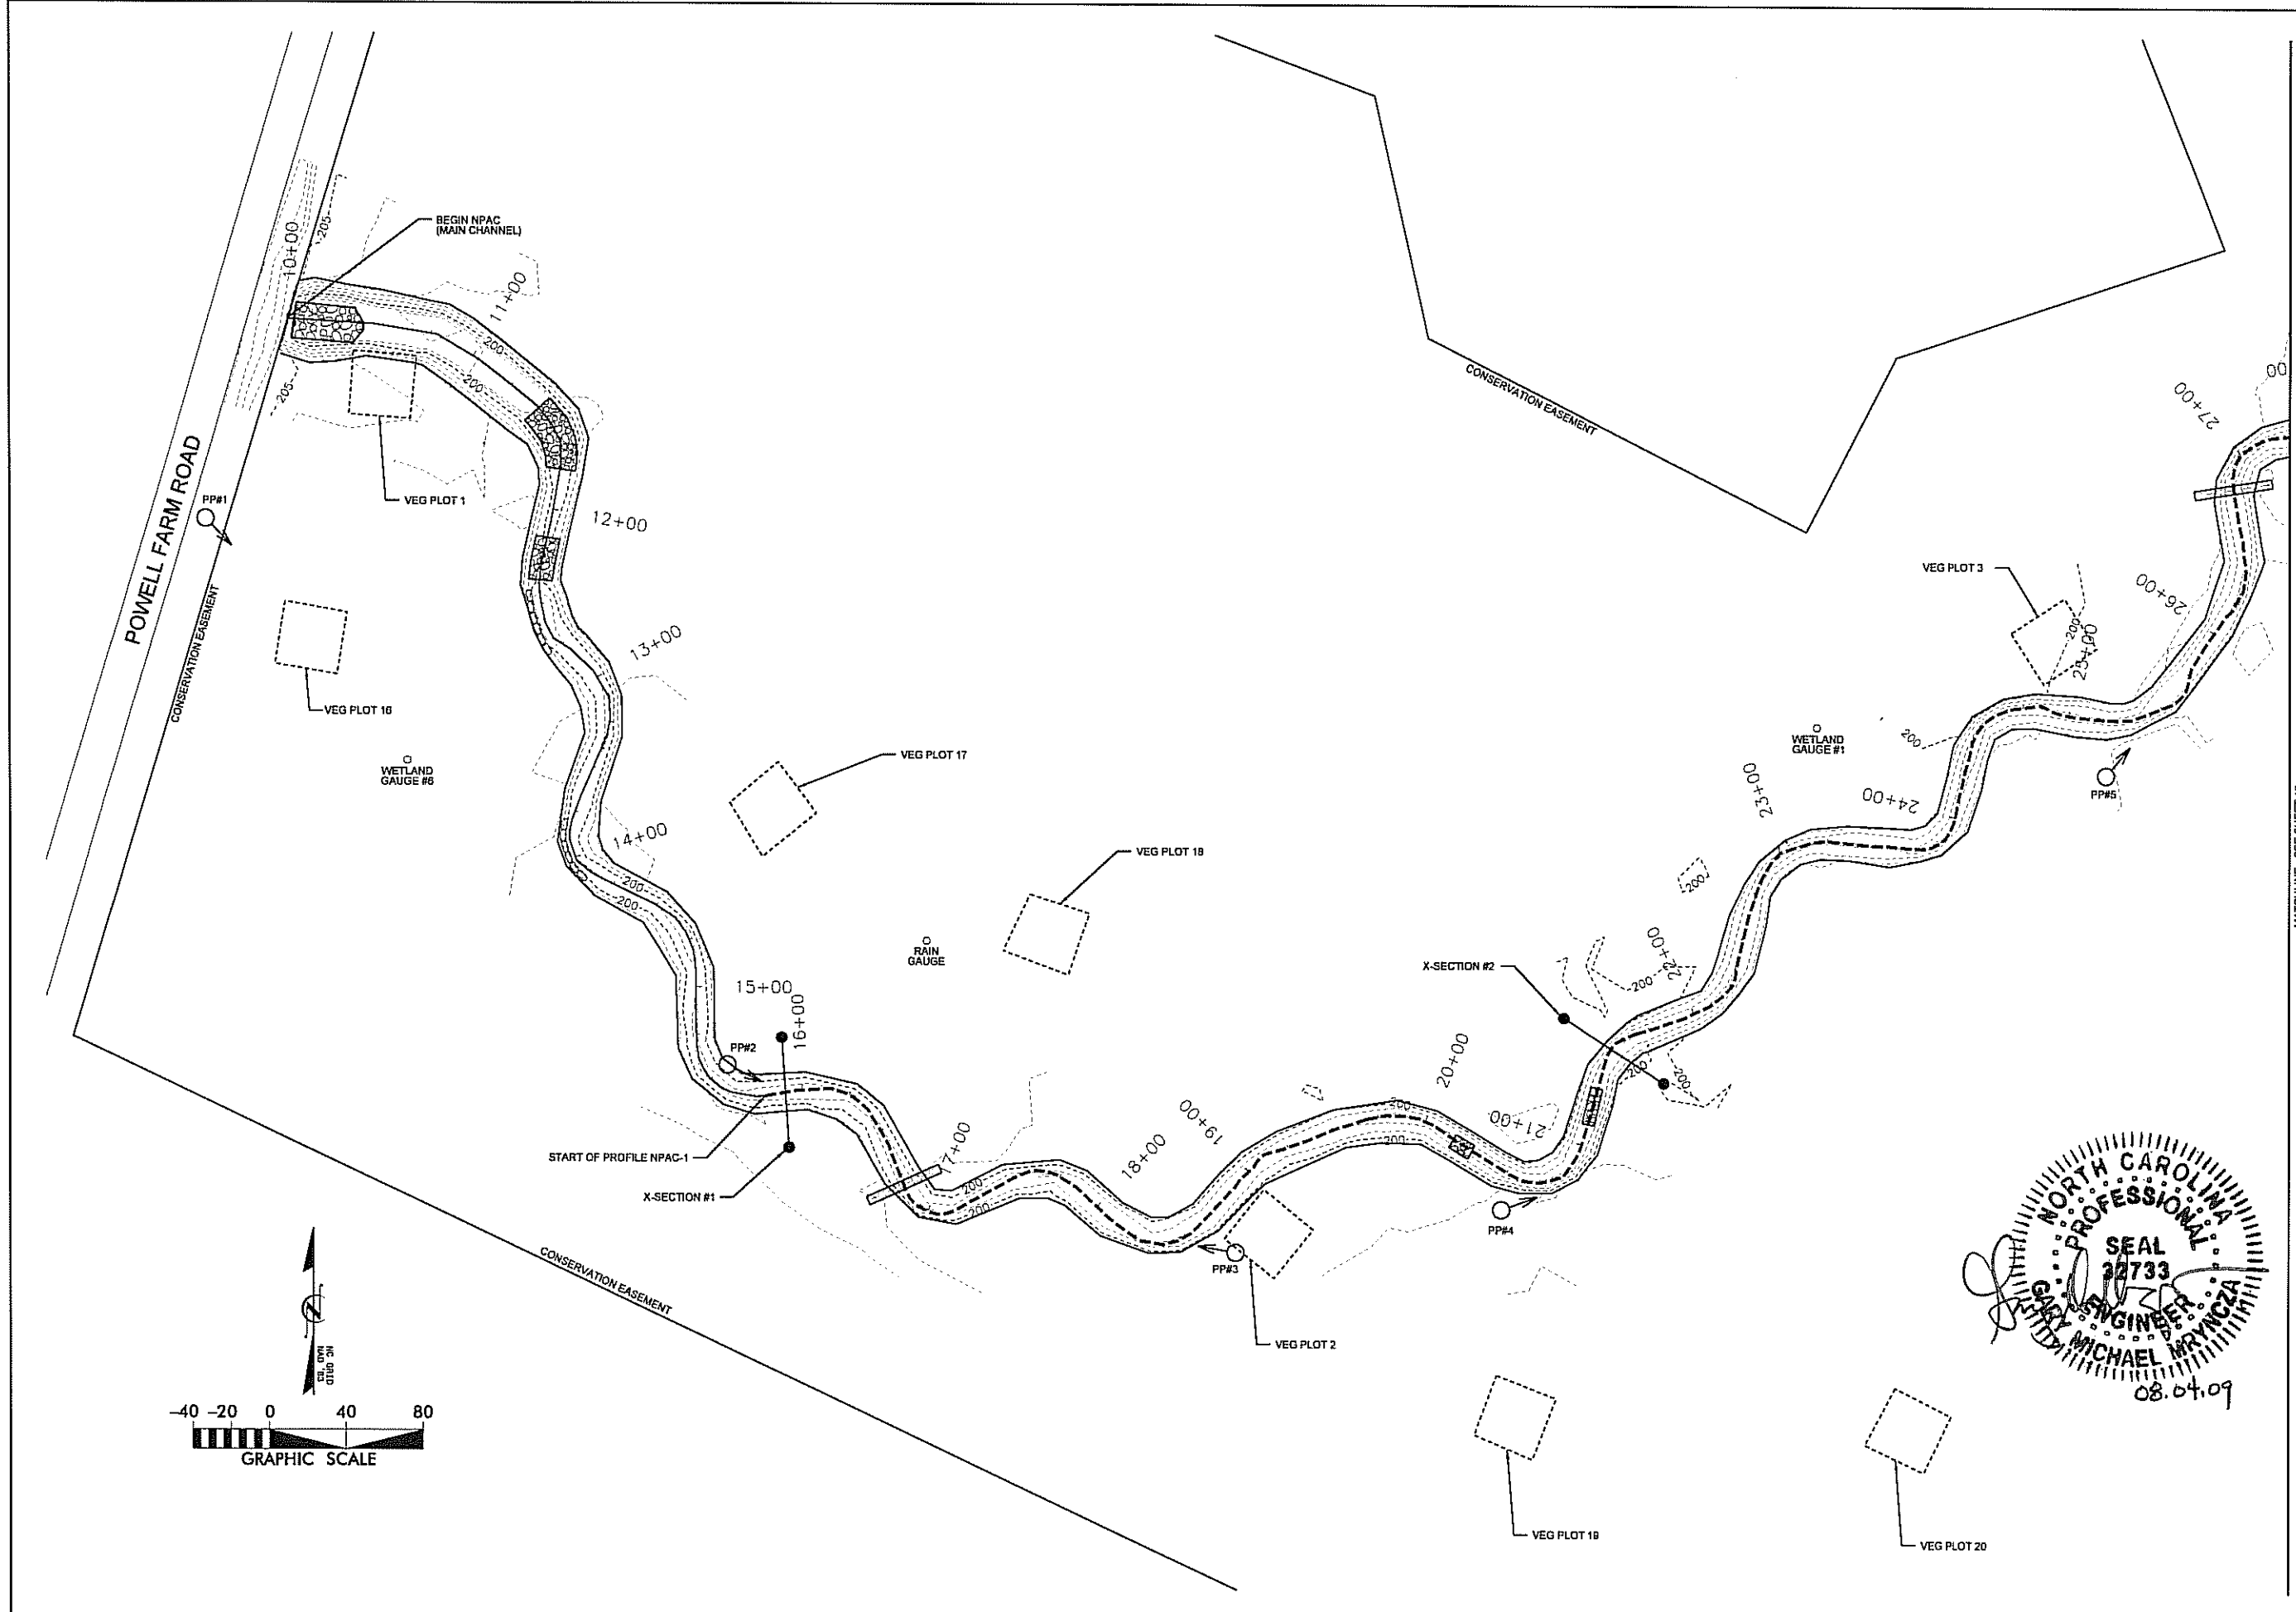

KCI
 ASSOCIATES OF NC
 ENGINEERS • PLANNERS • SCIENTISTS
 4605X FORKS ROAD
 RALEIGH, NORTH CAROLINA 27609



FARRAR DAIRY
 STREAM AND WETLAND MITIGATION
 LILLINGTON, HARNETT COUNTY, NORTH CAROLINA
 NPAC - STATION 10+00 TO STATION 27+17

DATE: JUNE 2009
 SCALE: 1"=40'
 MONITORING
 PLAN VIEW
 SHEET 18 OF 31

SUBMITTED WITH MITIGATION PLAN		REVISIONS	
NO.	DATE	DESCRIPTION	APPROVED
1	JUNE 2009		

MATCHLINE - SEE SHEET 18



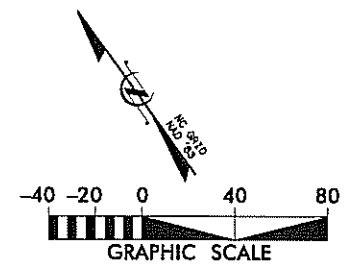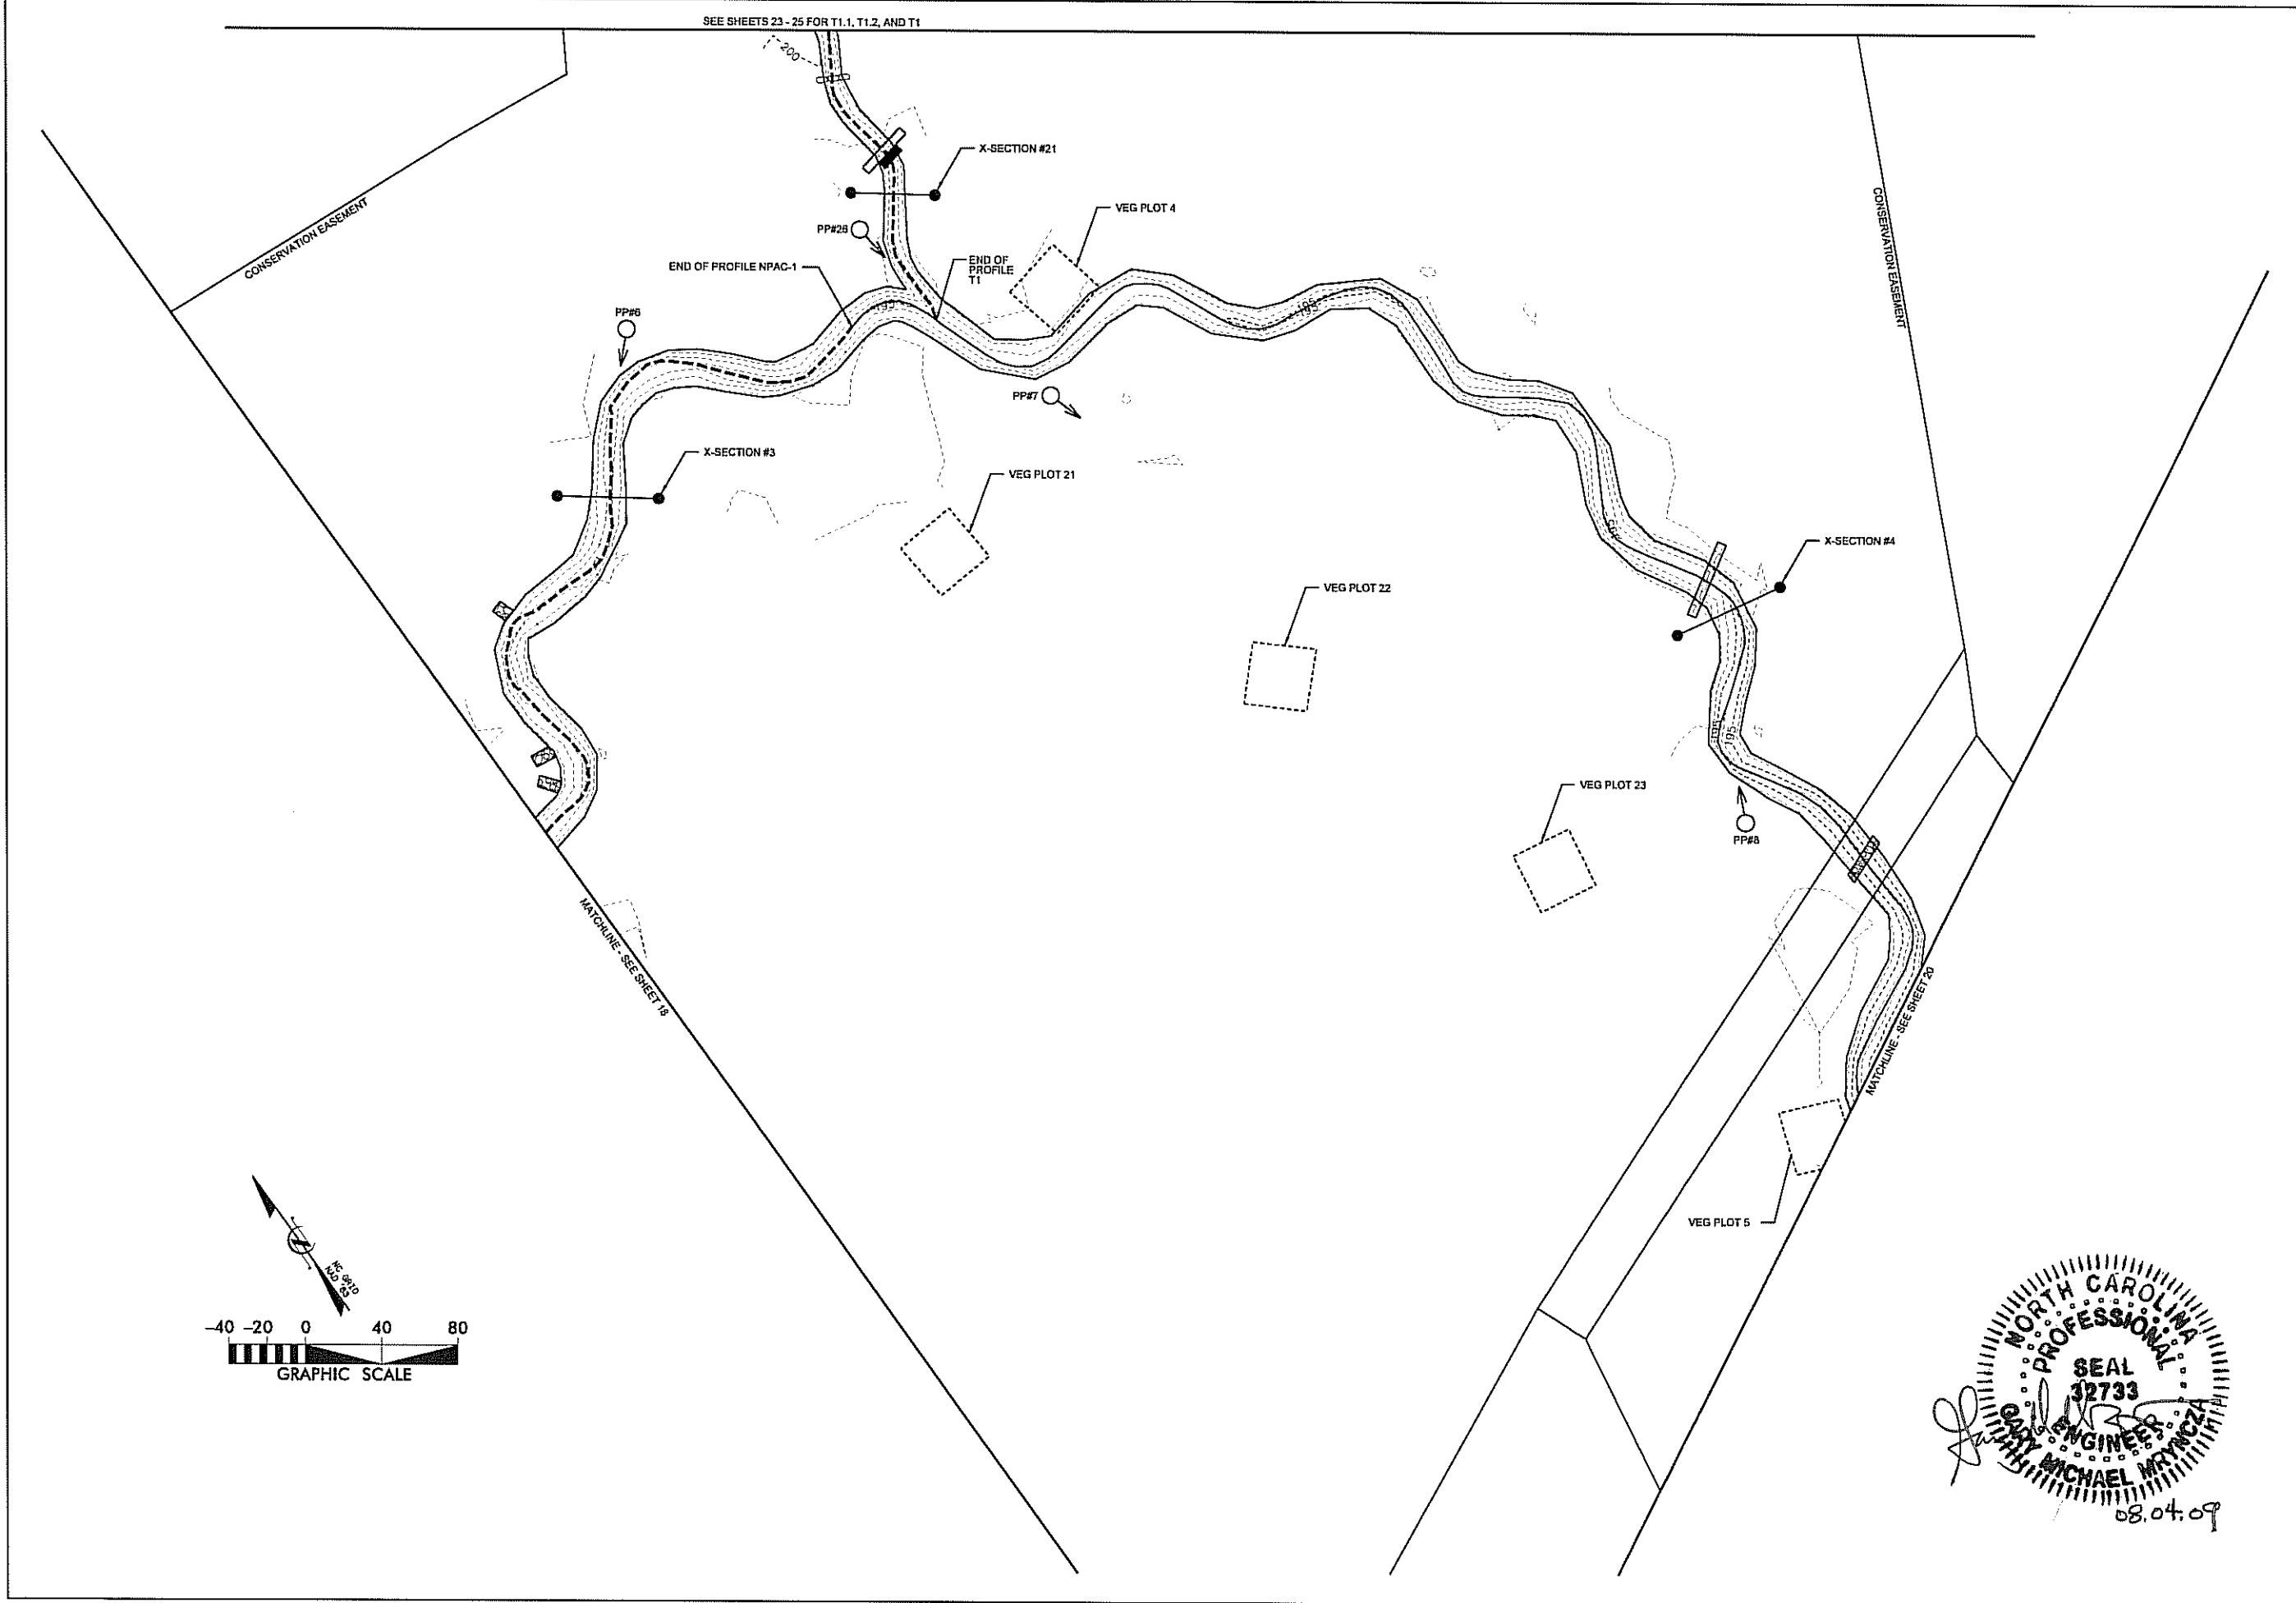

NORTH CAROLINA
 PROFESSIONAL SEAL
 32733
 CIVIL ENGINEER
 MICHAEL MYNCA
 08.04.09

SEE SHEETS 23 - 25 FOR T1.1, T1.2, AND T1

CONSERVATION EASEMENT

CONSERVATION EASEMENT

MATCHLINE - SEE SHEET 19

MATCHLINE - SEE SHEET 20



SUBMITTED WITH MITIGATION PLAN		JUNE 2009
DATE	APPROVED	
REVISIONS		
NO.	DESCRIPTION	DATE




KCI
 ASSOCIATES OF NC
 ENGINEERS • PLANNERS • SCIENTISTS
 460 SIX FORKS ROAD
 RALEIGH, NORTH CAROLINA 27609

**FARRAR DAIRY
 STREAM AND WETLAND MITIGATION**
 LILLINGTON, HARNETT COUNTY, NORTH CAROLINA
 NPAC - STATION 27+17 TO STATION 40+51

DATE: JUNE 2009
 SCALE: 1"=40'
**MONITORING
 PLAN VIEW**
 SHEET 10 OF 31

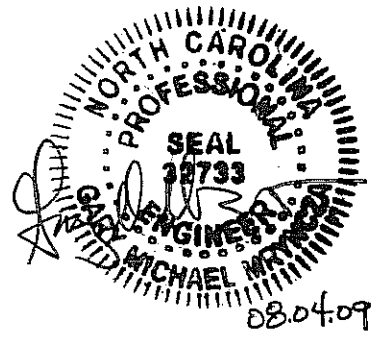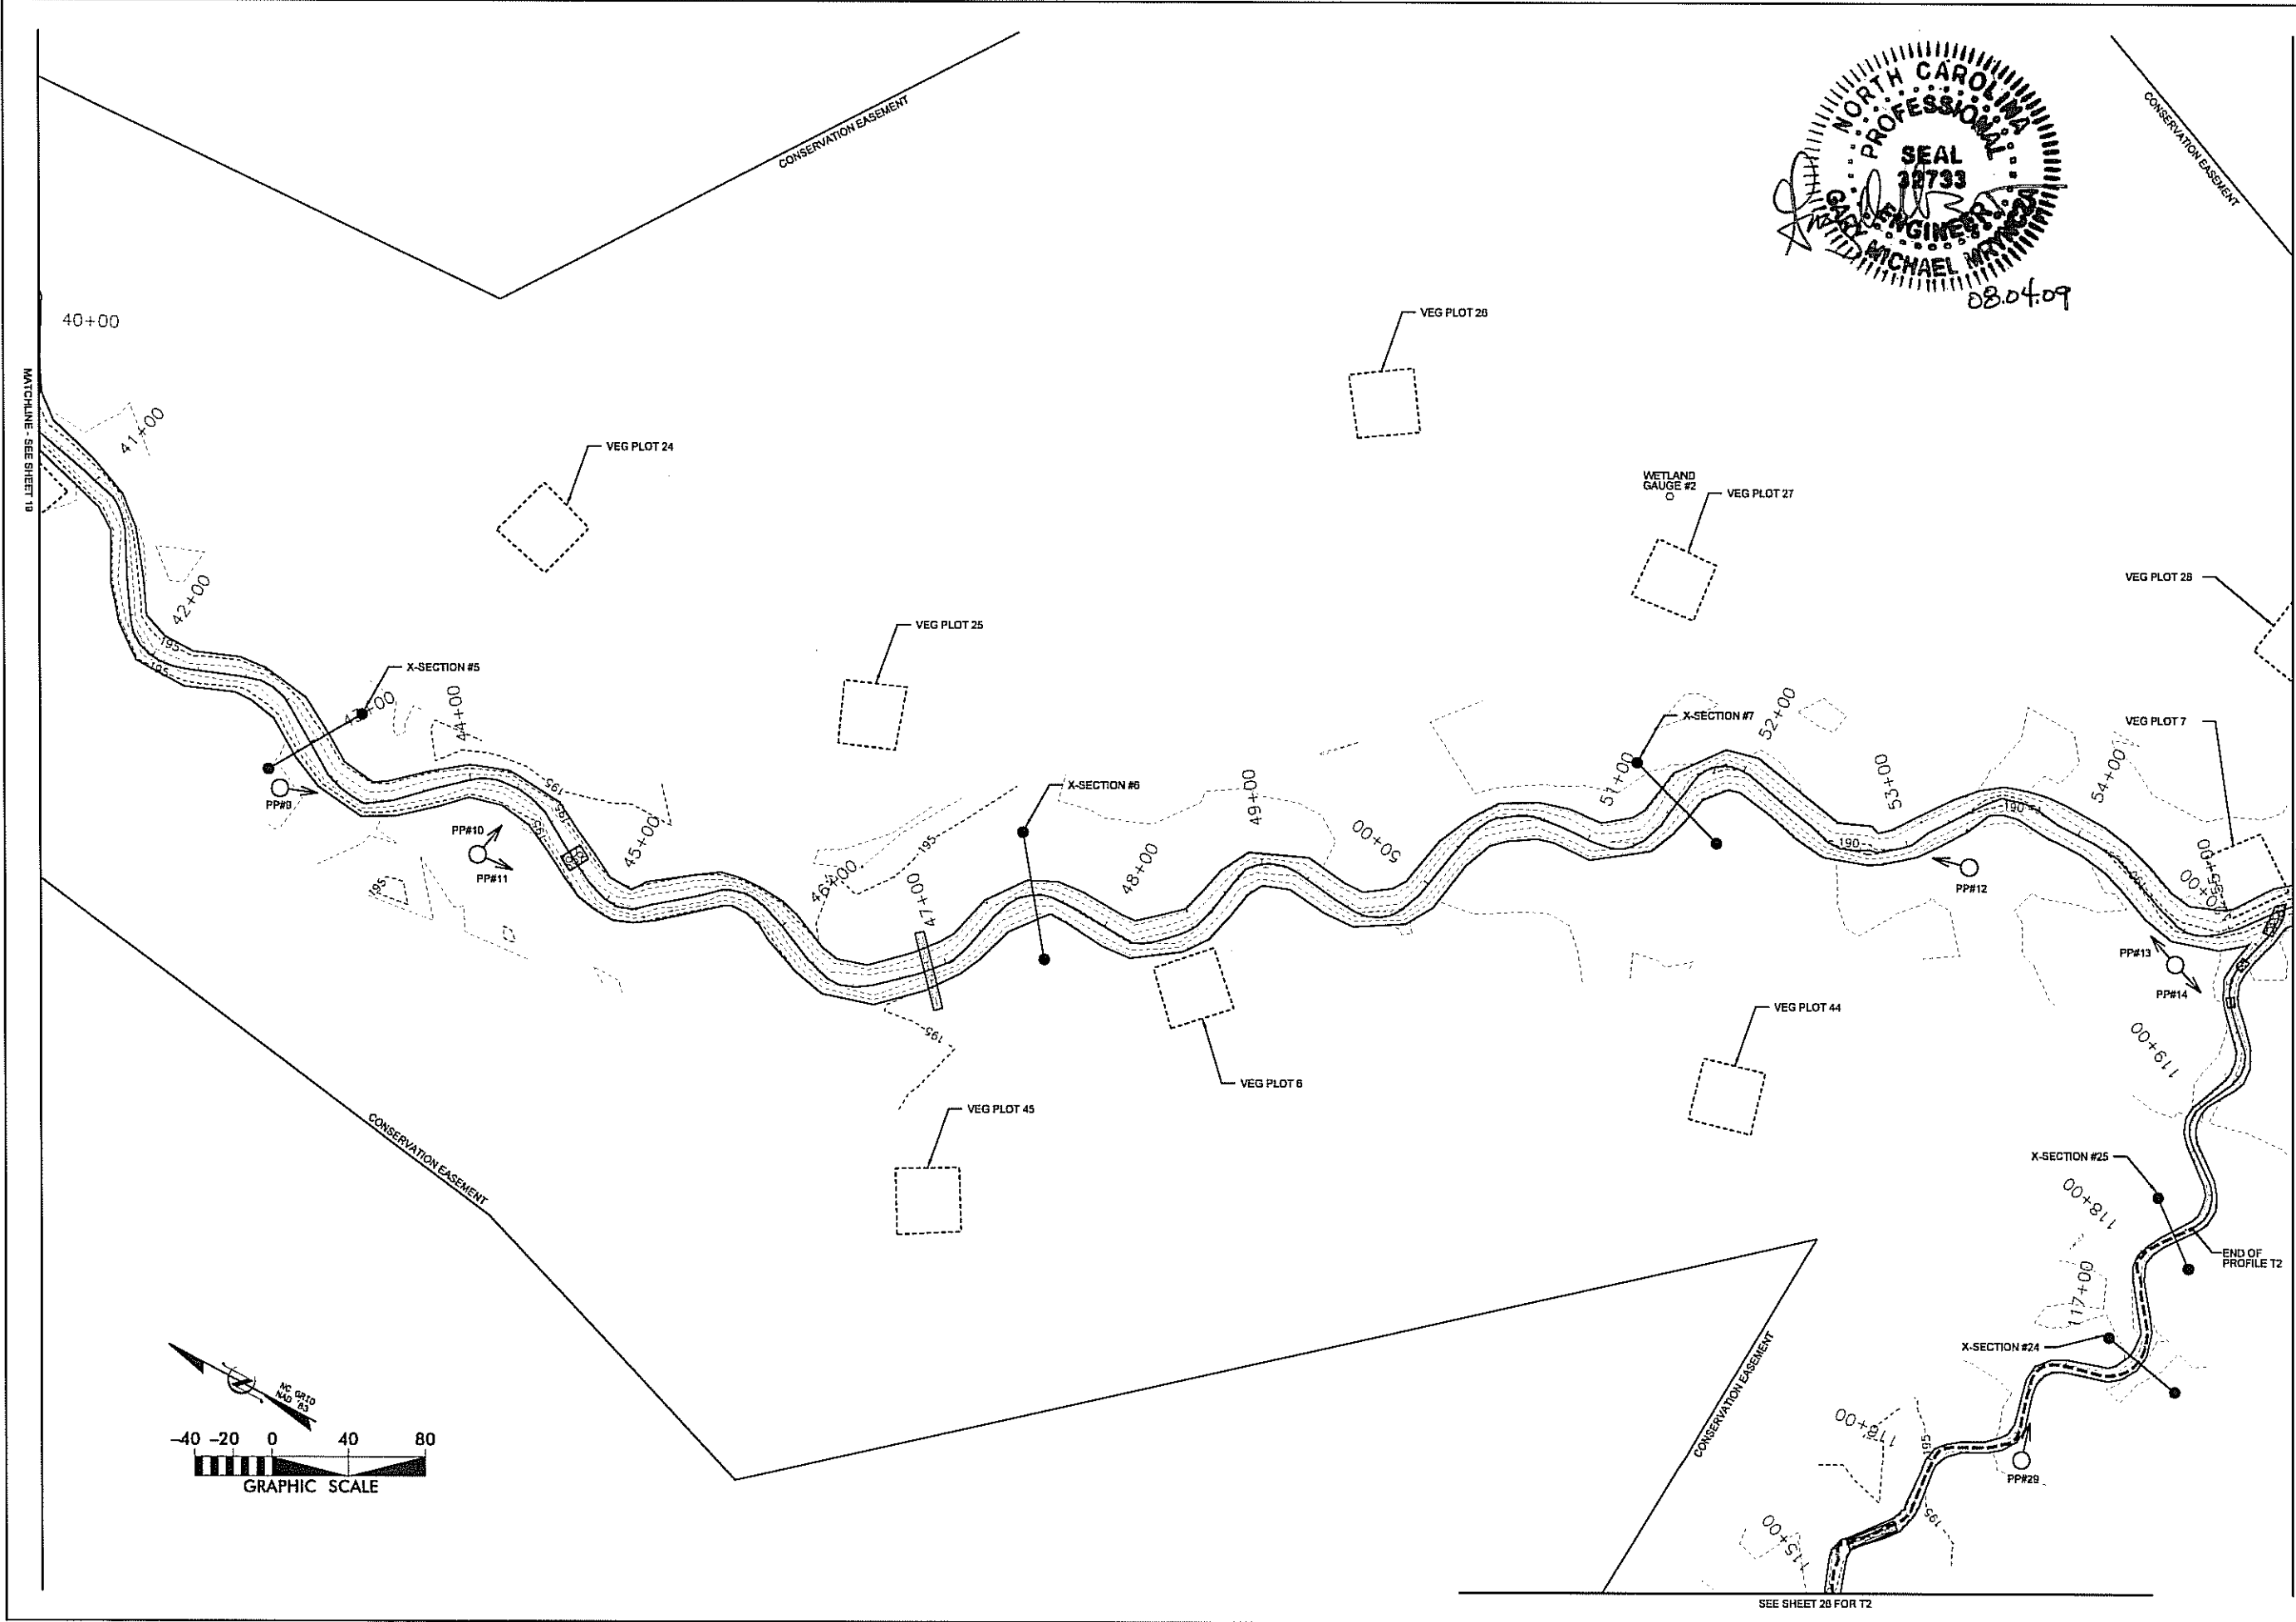



REVISIONS	
NO.	DATE

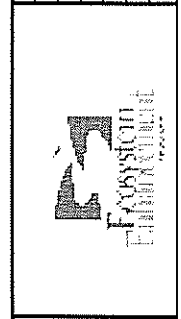


KCI
ASSOCIATES OF P.C.
ENGINEERS • PLANNERS • SCIENTISTS
4601 SIX FORKS ROAD
RALEIGH, NORTH CAROLINA 27609

**FARRAR DAIRY
STREAM AND WETLAND MITIGATION**
LILLINGTON, HARNETT COUNTY, NORTH CAROLINA
NPAC - STATION 40+51 TO STATION 58+39

DATE: JUNE 2009
SCALE: 1"=40'
**MONITORING
PLAN VIEW**
SHEET 20 OF 31

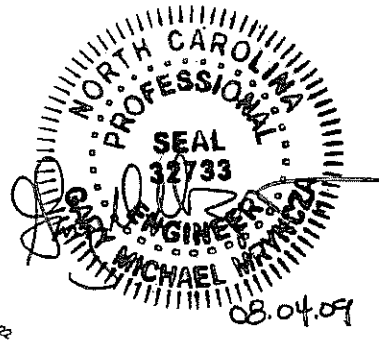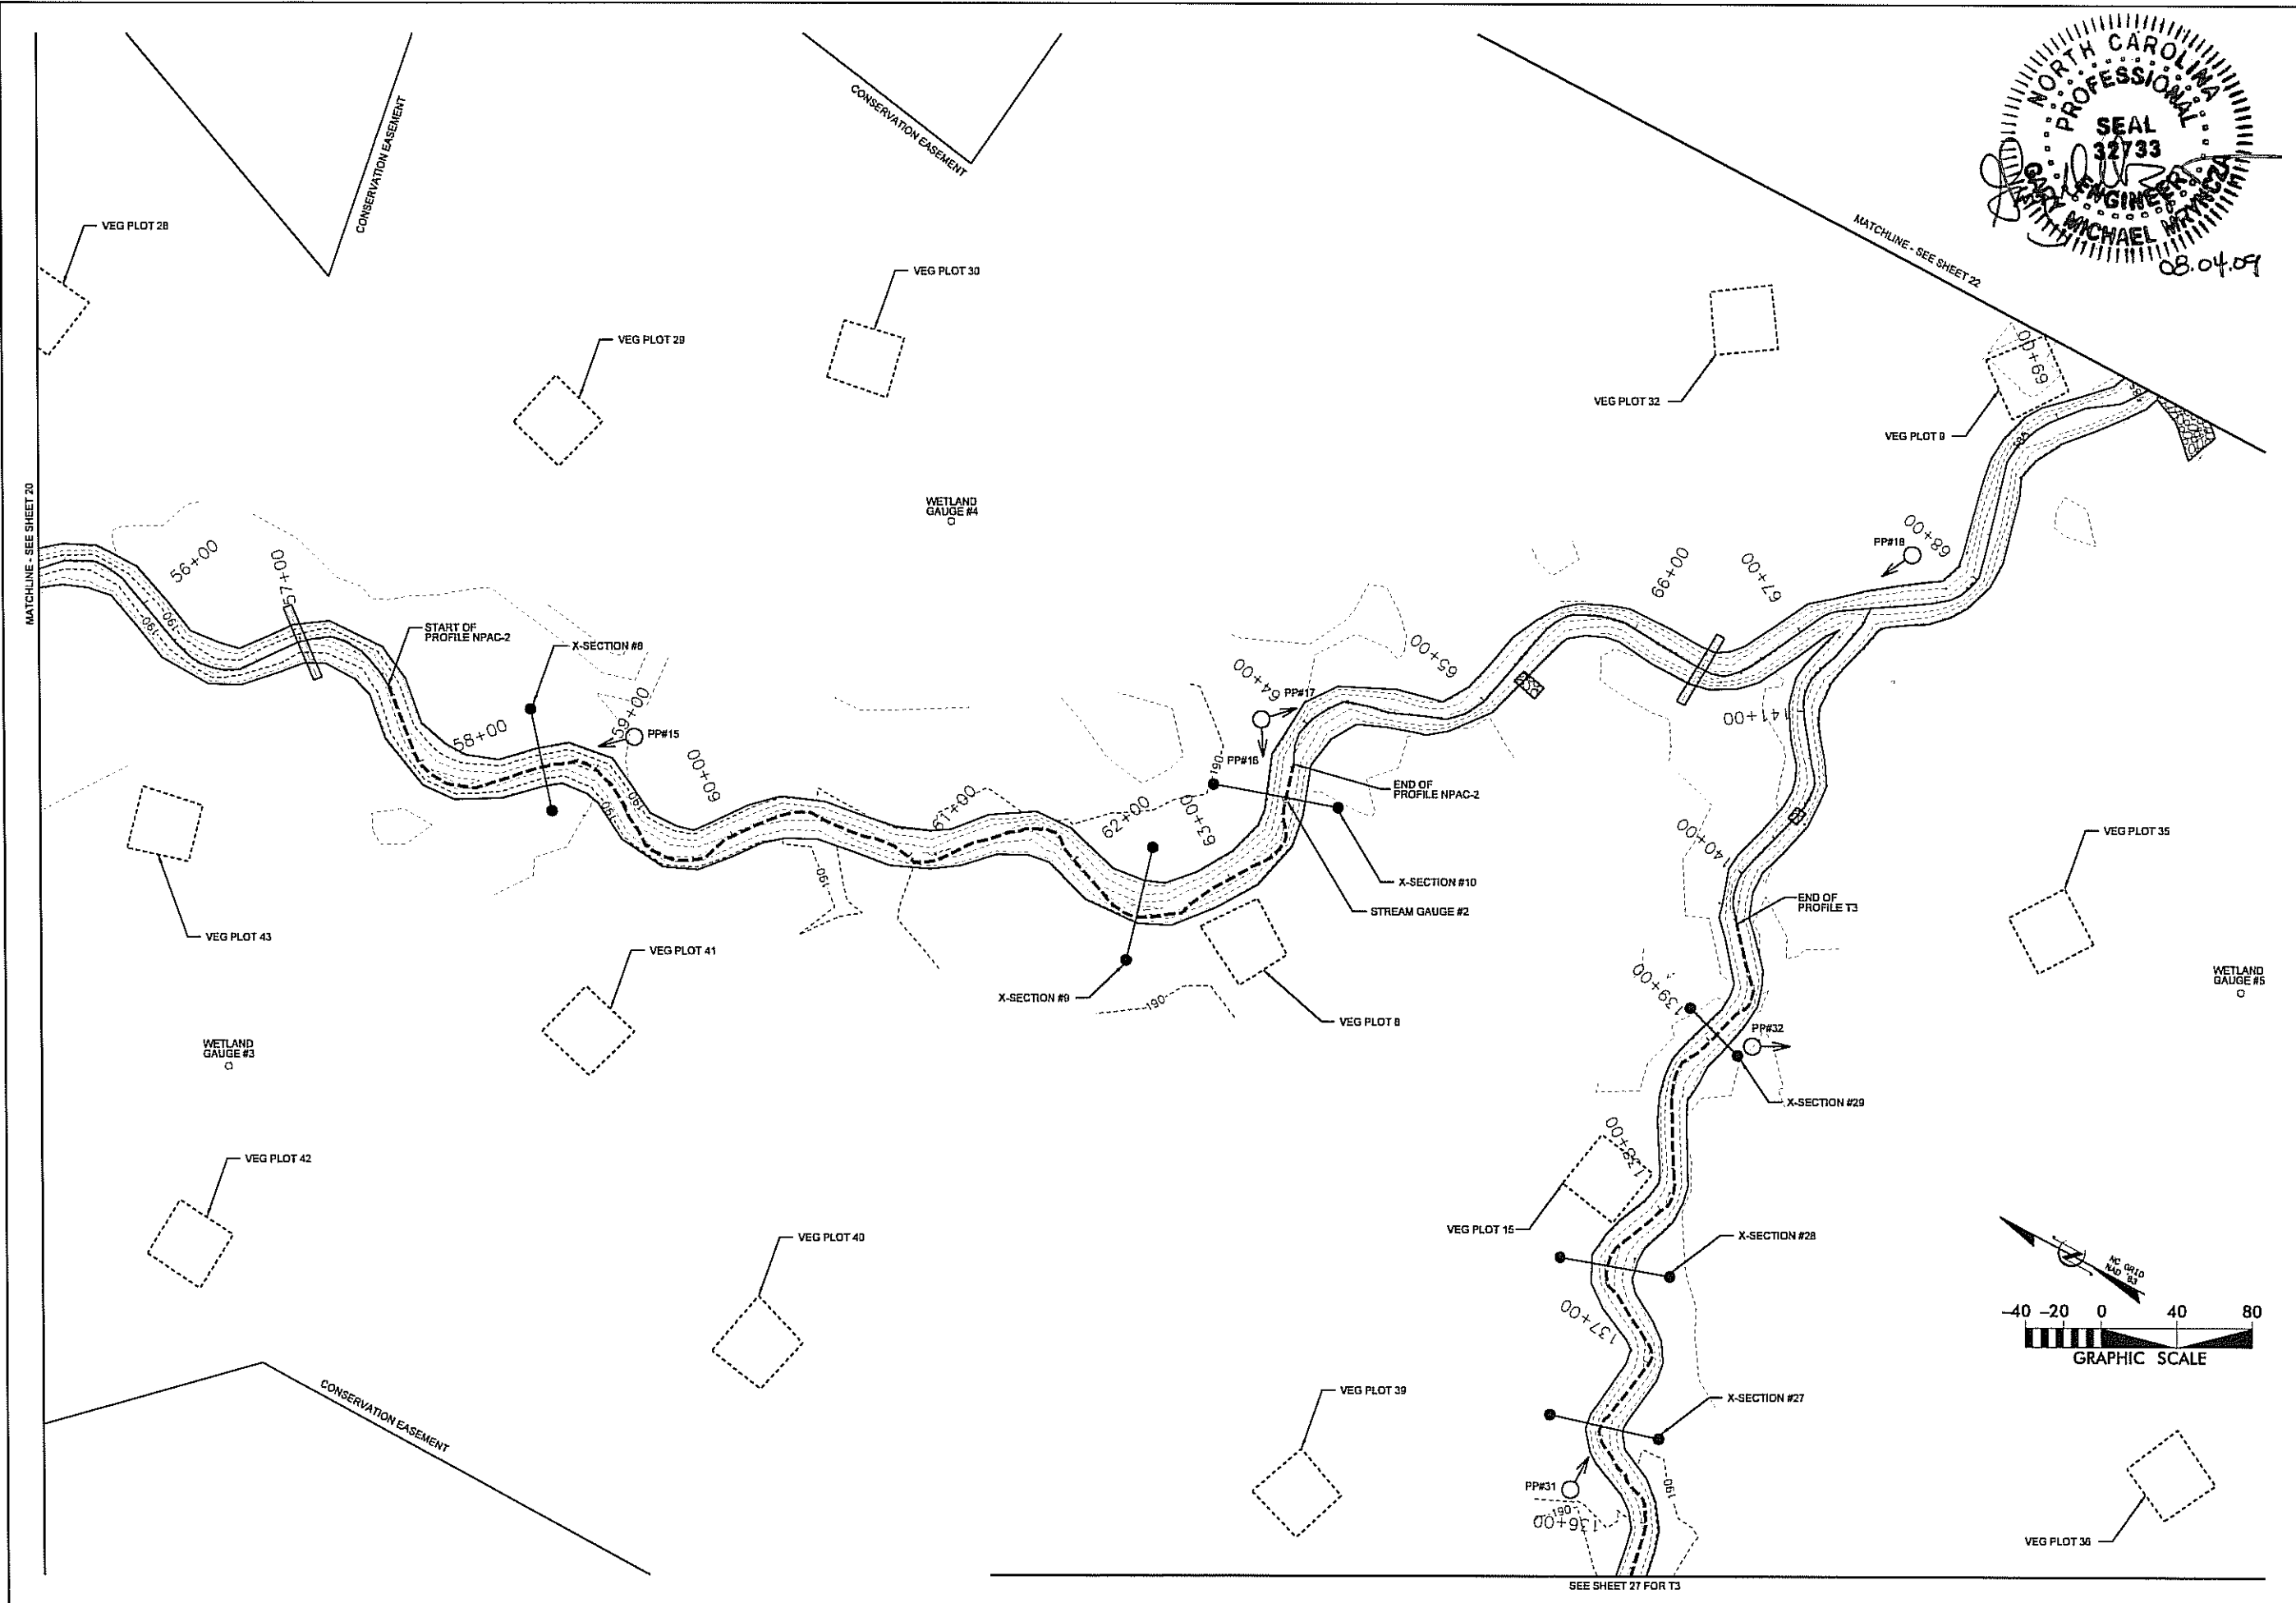


NO.	DATE	DESCRIPTION	BY	CHKD	APPROVED
1	JUNE 2009	SUBMITTED WITH MITIGATION PLAN			

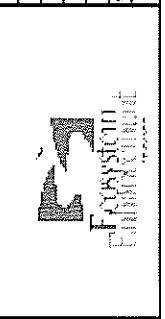




KCI
 ASSOCIATES OF NC
 ENGINEERS • PLANNERS • SCIENTISTS
 460 SIX FORKS ROAD
 RALEIGH, NORTH CAROLINA 27609

**FARRAR DAIRY
 STREAM AND WETLAND MITIGATION**
 LILLINGTON, HARNETT COUNTY, NORTH CAROLINA
 NPAC - STATION 55+39 TO STATION 69+51


DATE: JUNE 2009
SCALE: 1"=40'
MONITORING PLAN VIEW
SHEET 21 OF 31

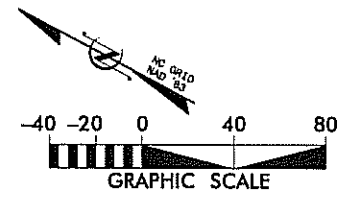

MATCHLINE - SEE SHEET 21

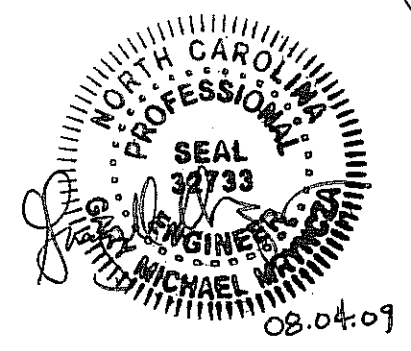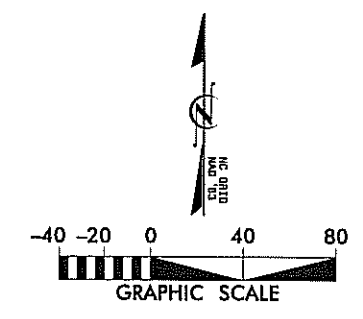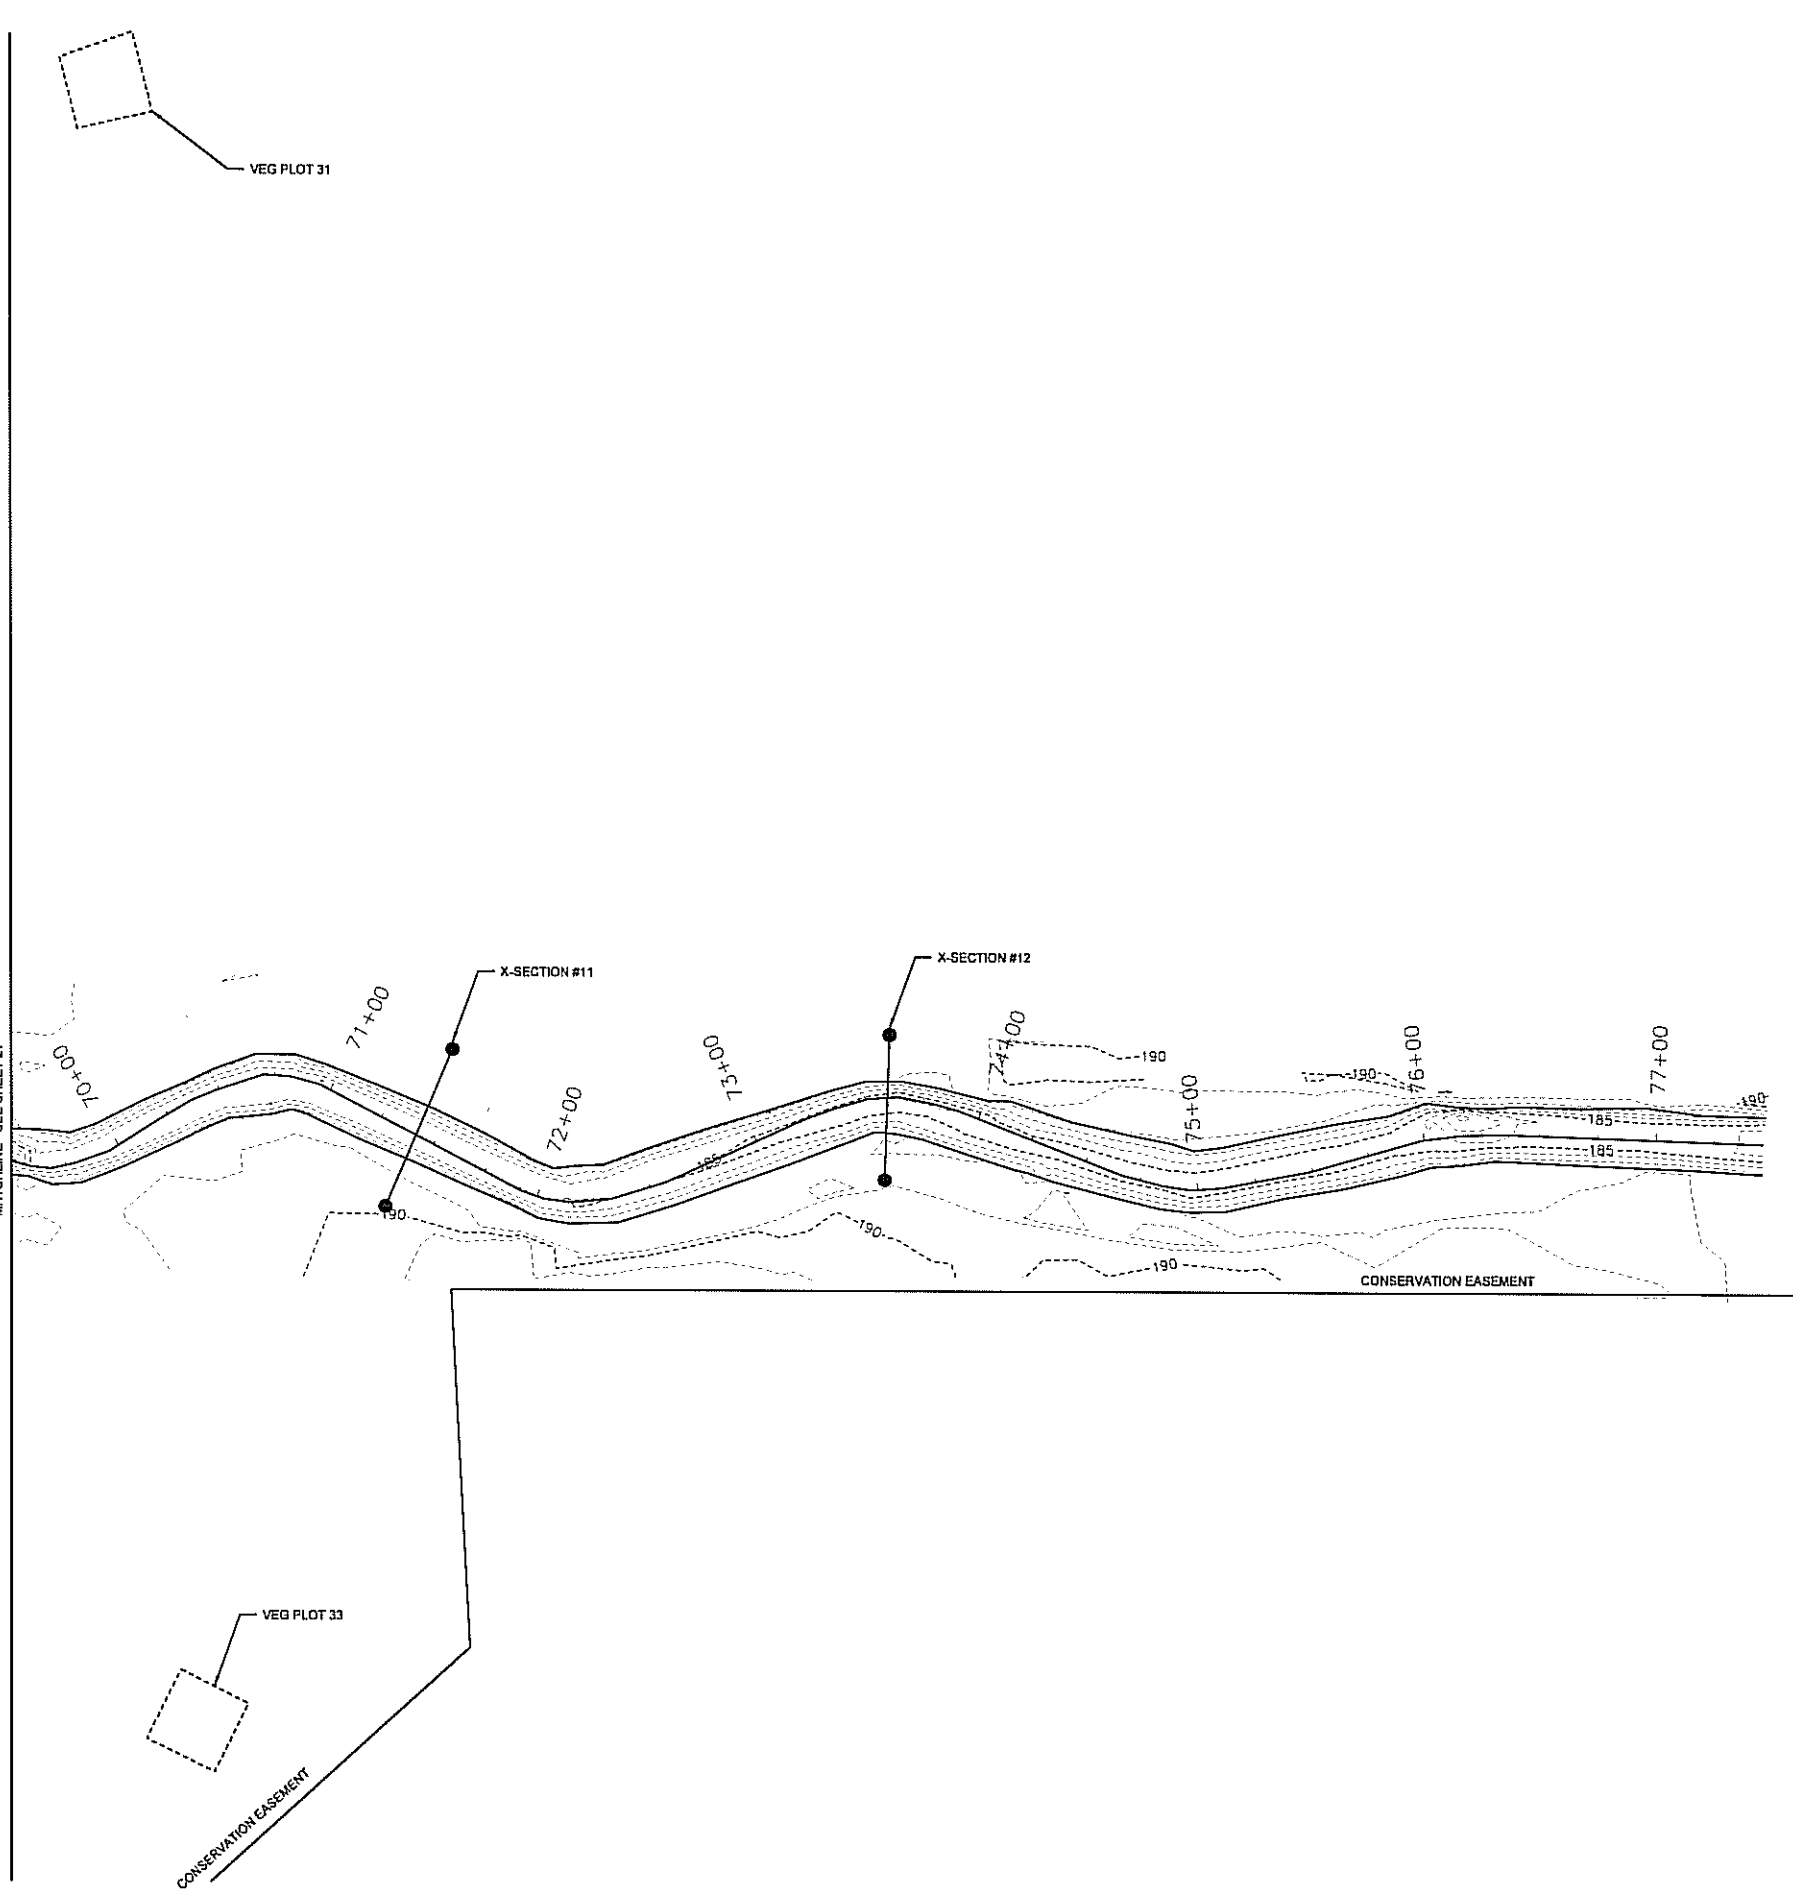





SUBMITTED WITH MITIGATION PLAN		JUNE 2009
A	REVISOR	DATE
B	REVISOR	DATE
C	REVISOR	DATE
D	REVISOR	DATE
E	REVISOR	DATE
F	REVISOR	DATE
G	REVISOR	DATE
H	REVISOR	DATE
I	REVISOR	DATE
J	REVISOR	DATE
K	REVISOR	DATE
L	REVISOR	DATE
M	REVISOR	DATE
N	REVISOR	DATE
O	REVISOR	DATE
P	REVISOR	DATE
Q	REVISOR	DATE
R	REVISOR	DATE
S	REVISOR	DATE
T	REVISOR	DATE
U	REVISOR	DATE
V	REVISOR	DATE
W	REVISOR	DATE
X	REVISOR	DATE
Y	REVISOR	DATE
Z	REVISOR	DATE

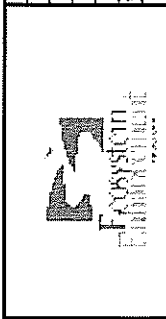


KCI
ASSOCIATES OF NC
ENGINEERS • PLANNERS • SCIENTISTS
460 SIX FORKS ROAD
RALEIGH, NORTH CAROLINA 27609

FARRAR DAIRY
STREAM AND WETLAND MITIGATION
LILLINGTON, HARNETT COUNTY, NORTH CAROLINA
NPAC - STATION 69+51 TO STATION 77+46

DATE: JUNE 2009
SCALE: 1"=40'
MONITORING
PLAN VIEW
SHEET 22 OF 31

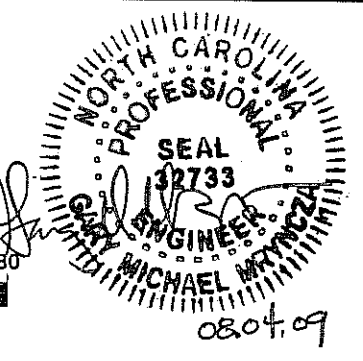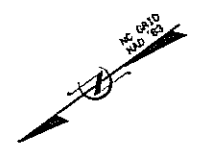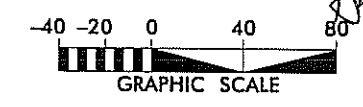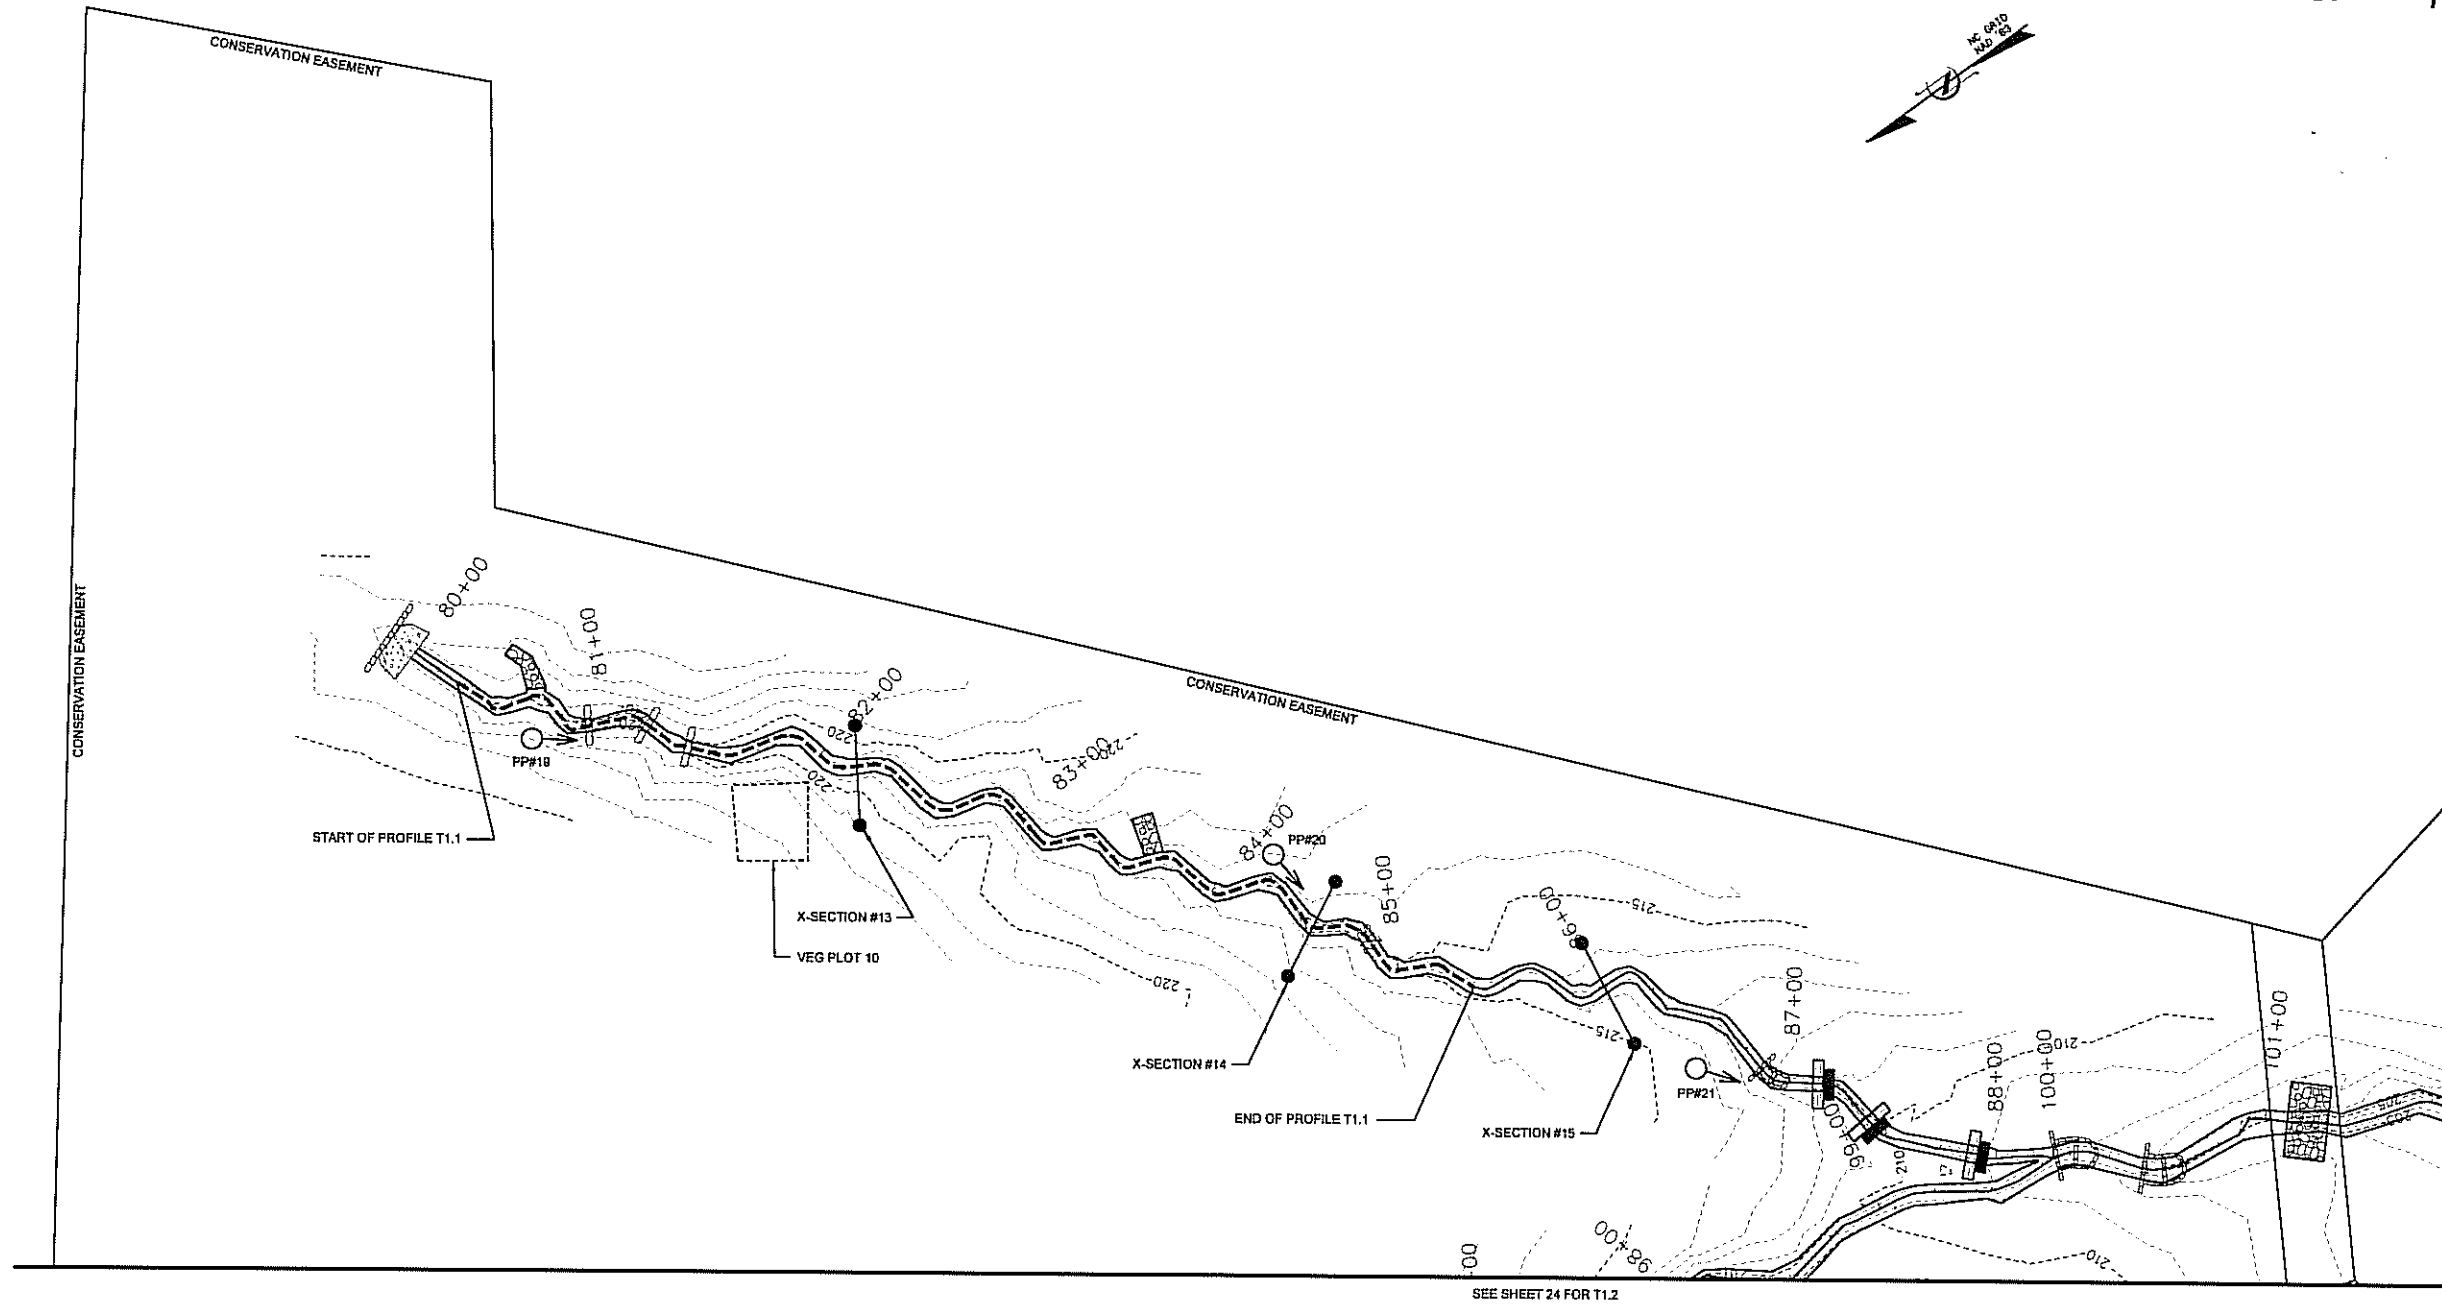


NO.	DATE	DESCRIPTION	BY	APPROVED
A	JUNE 2009	SUBMITTED WITH MITIGATION PLAN		

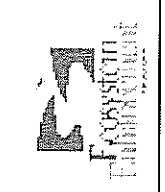

KCI
KCI ASSOCIATES OF NC
ENGINEERS • PLANNERS • SCIENTISTS
4601 SIX FORKS ROAD
RALEIGH, NORTH CAROLINA 27609

**FARRAR DAIRY
STREAM AND WETLAND MITIGATION**
LILLINGTON, HARNETT COUNTY, NORTH CAROLINA
T1.1 - STATION 80+00 TO STATION 88+25

DATE: JUNE 2009
SCALE: 1"=40'
**MONITORING
PLAN VIEW**
SHEET 23 OF 31

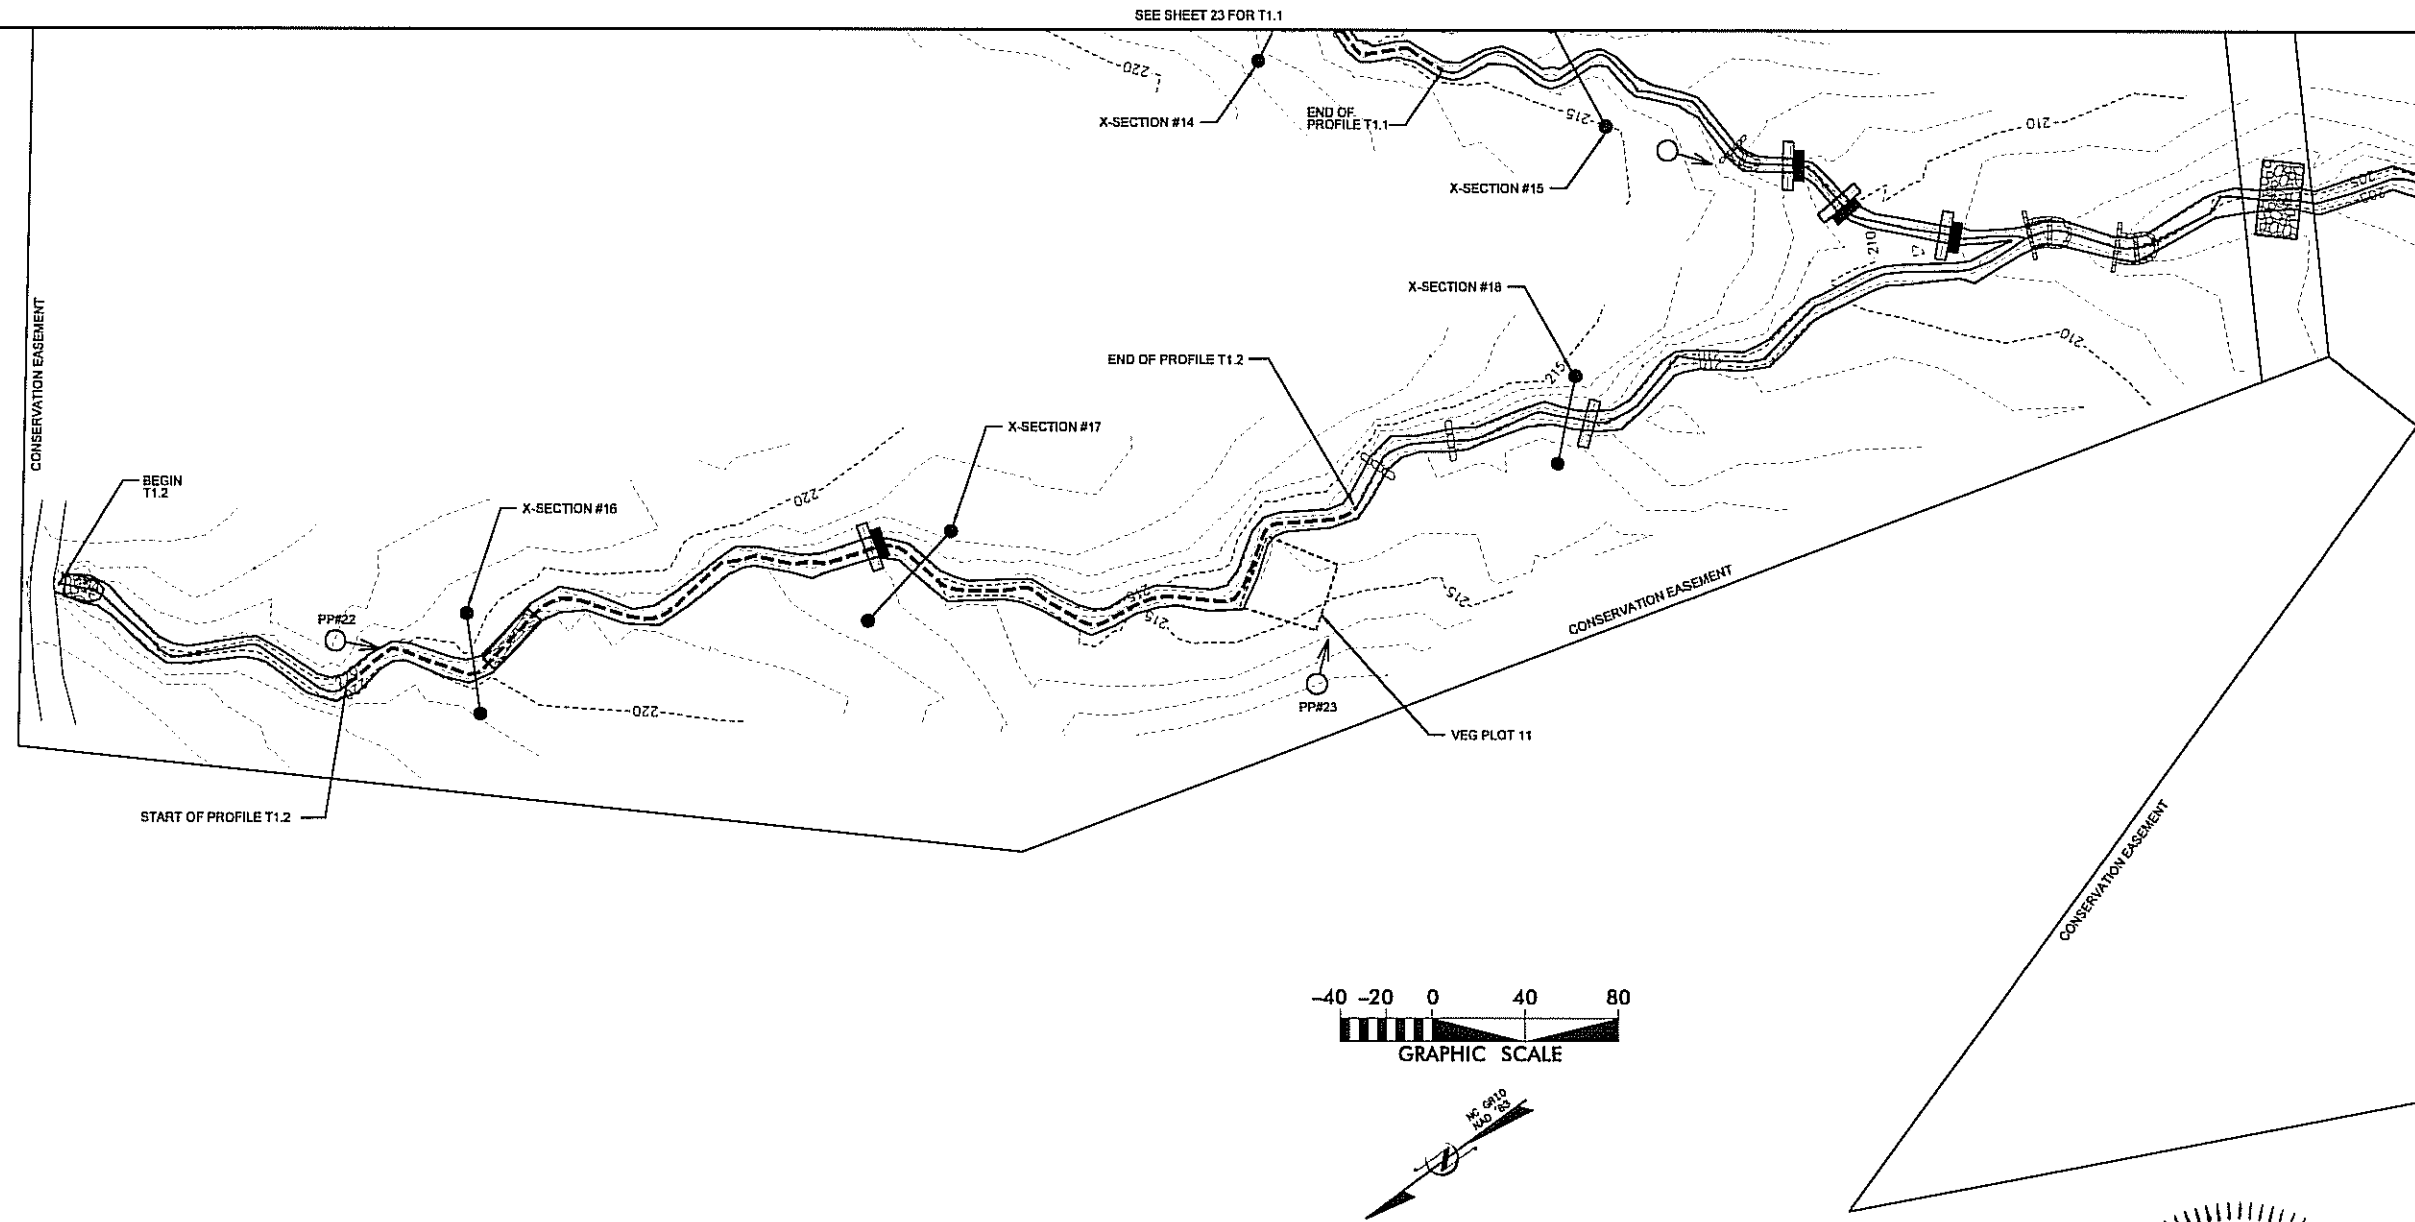

SEE SHEET 25 FOR T1

SUBMITTED WITH MITIGATION PLAN		REVISIONS	
DATE	DESCRIPTION	DATE	DESCRIPTION
JUNE 2009			




KCI
ASSOCIATES OF NC
ENGINEERS • PLANNERS • SCIENTISTS
460 SIX FORKS ROAD
RALEIGH, NORTH CAROLINA 27609





FARRAR DAIRY
STREAM AND WETLAND MITIGATION
LILLINGTON, HARNETT COUNTY, NORTH CAROLINA
T1.2 - STATION 90+00 TO STATION 99+80

DATE: JUNE 2009
SCALE: 1"=40'

MONITORING
PLAN VIEW

SHEET 24 OF 31

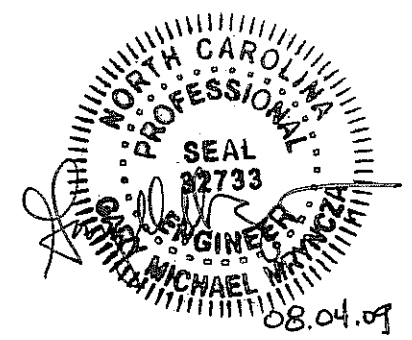

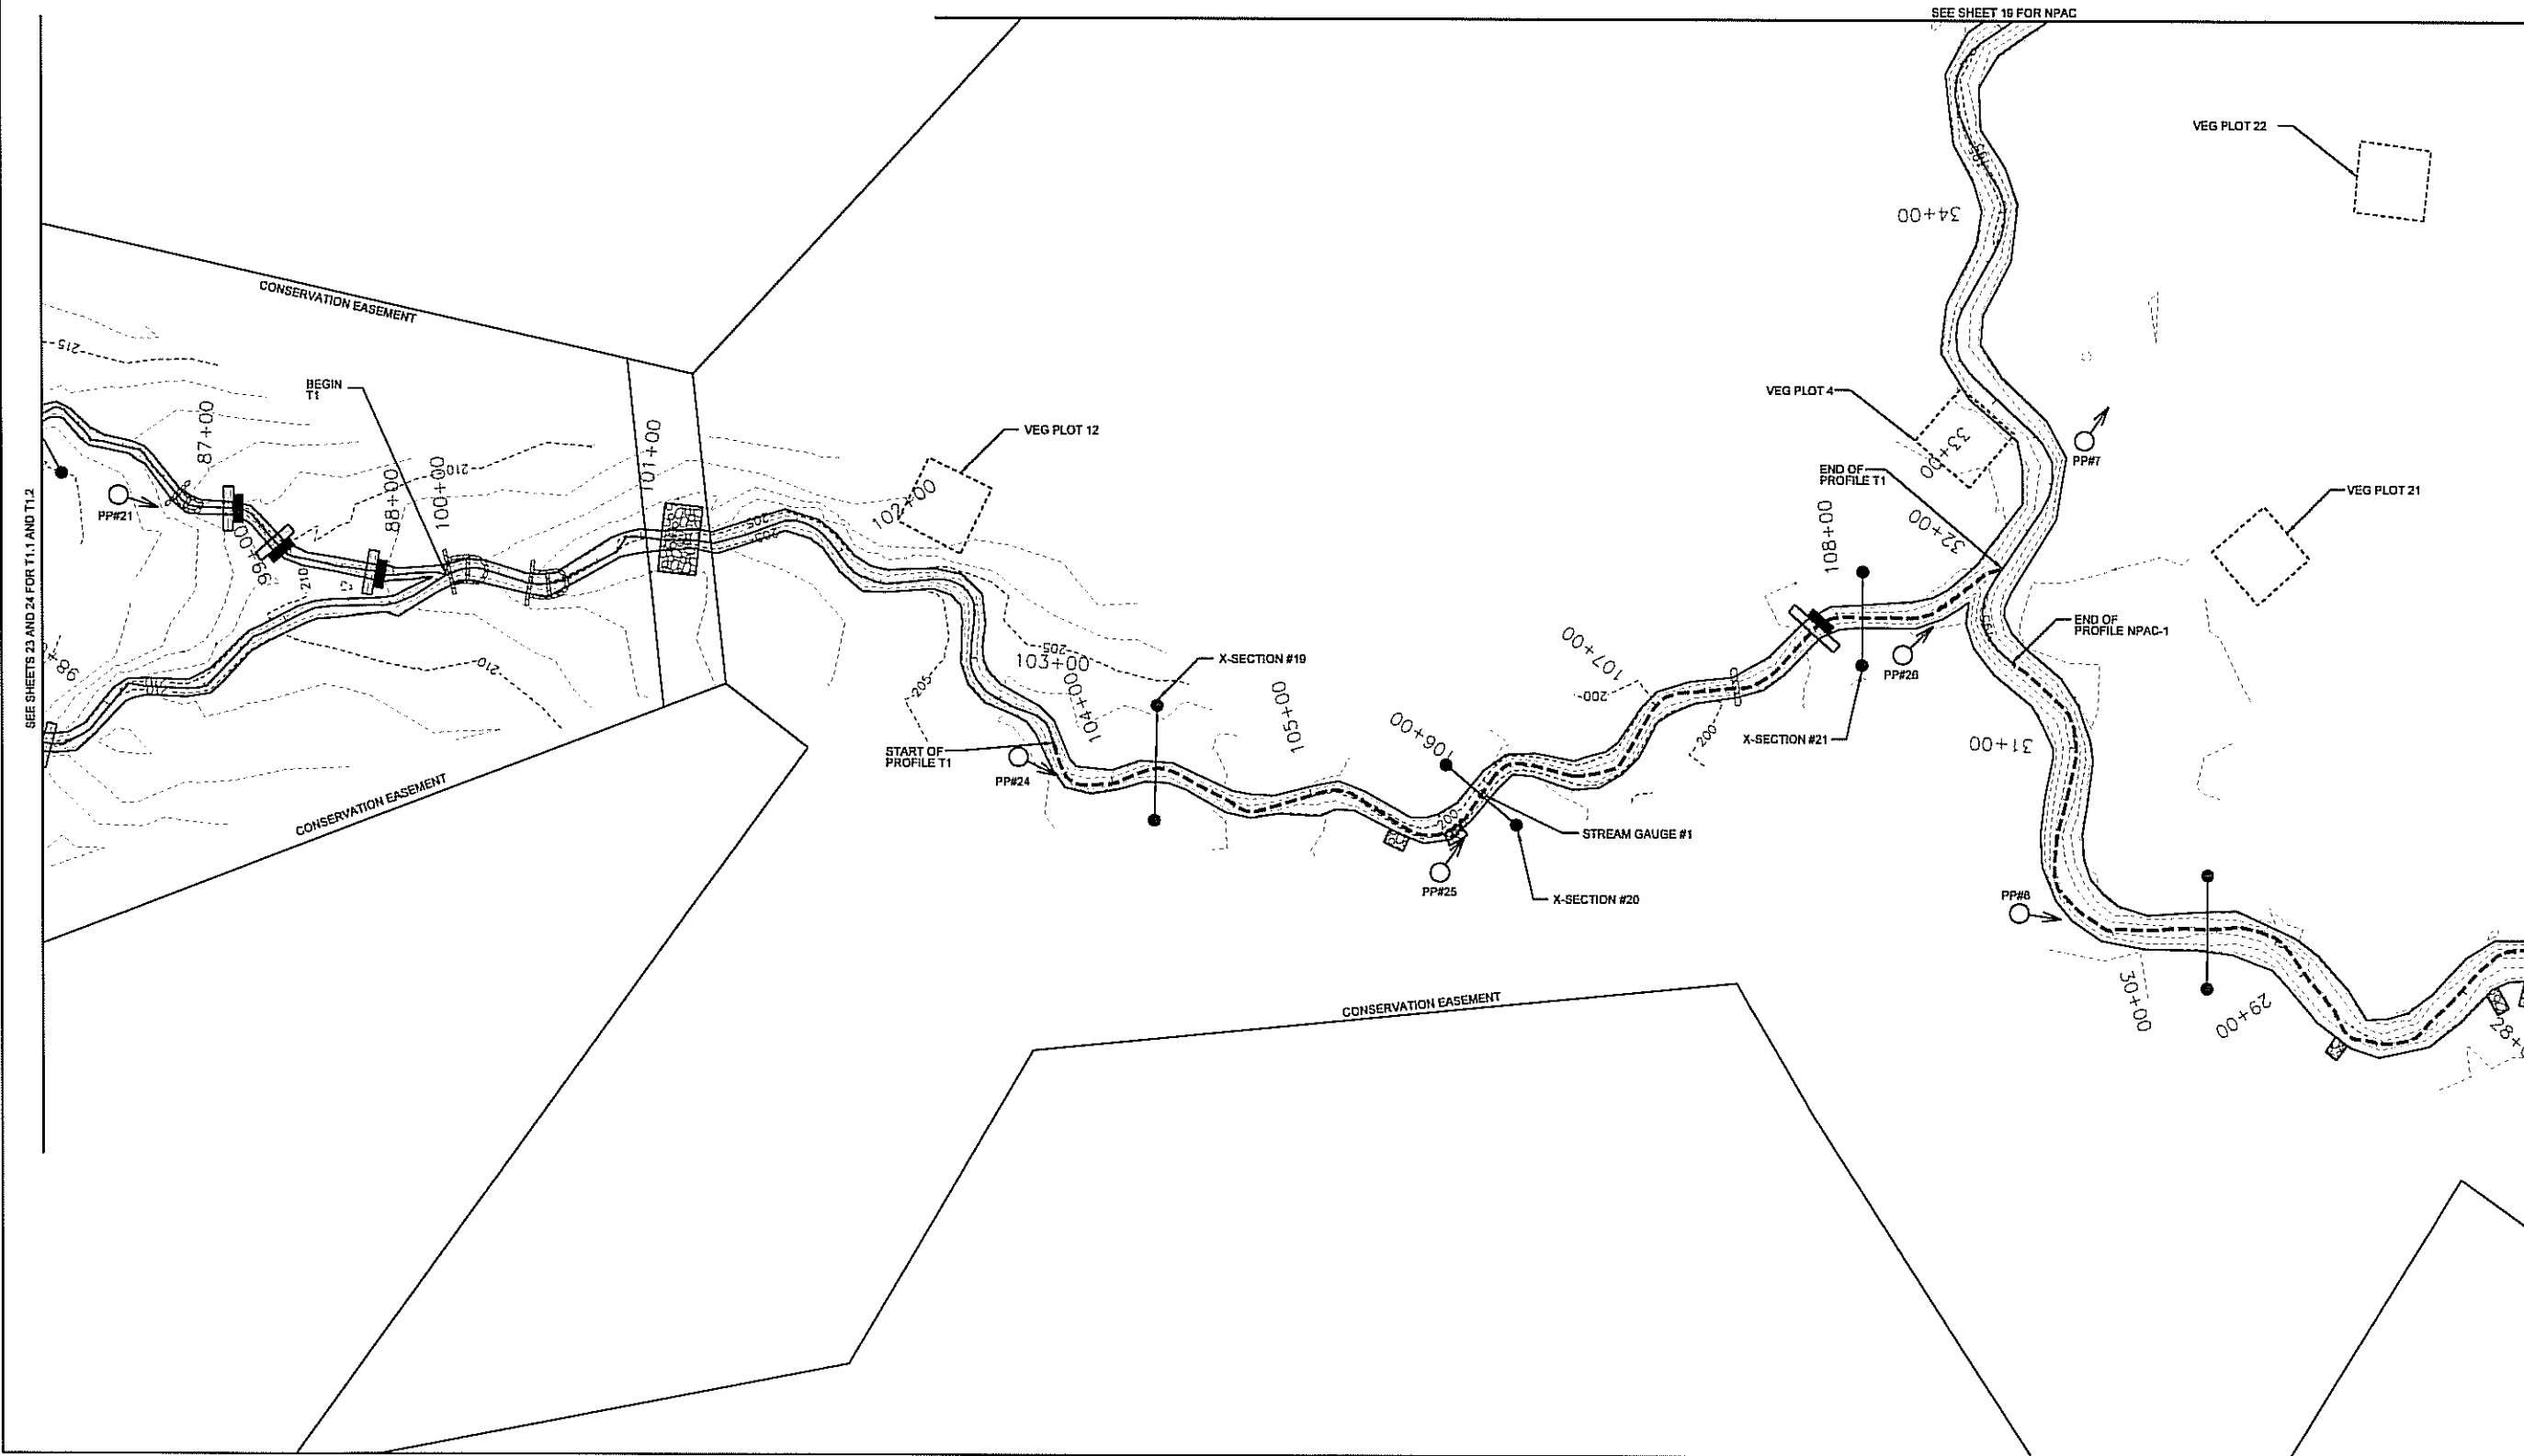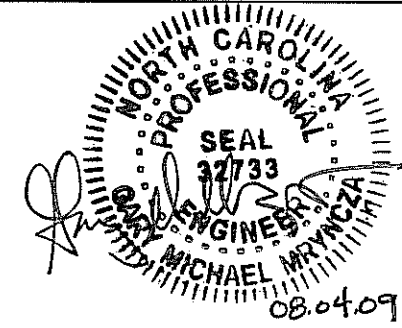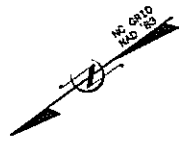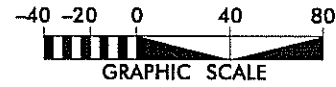

SEE SHEET 18 FOR NPAC

SEE SHEET 19 FOR NPAC



NO.	DATE	DESCRIPTION	BY	APP'D
1	JUNE 2009	SUBMITTED WITH MITIGATION PLAN		




KCI
 ASSOCIATES OF NC
 ENGINEERS • PLANNERS • SCIENTISTS
 4605 W. FORK ROAD
 RALEIGH, NORTH CAROLINA 27609

**FARRAR DAIRY
 STREAM AND WETLAND MITIGATION**
 LILLINGTON, HARNETT COUNTY, NORTH CAROLINA
 T1 - STATION 100+00 TO STATION 108+84

DATE: JUNE 2009
 SCALE: 1"=40'
**MONITORING
 PLAN VIEW**
 SHEET 25 OF 31

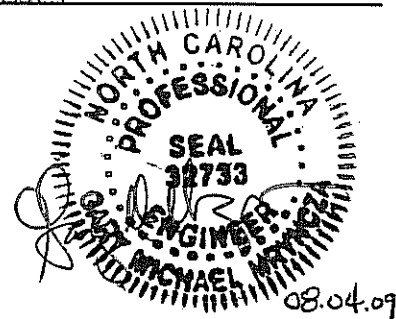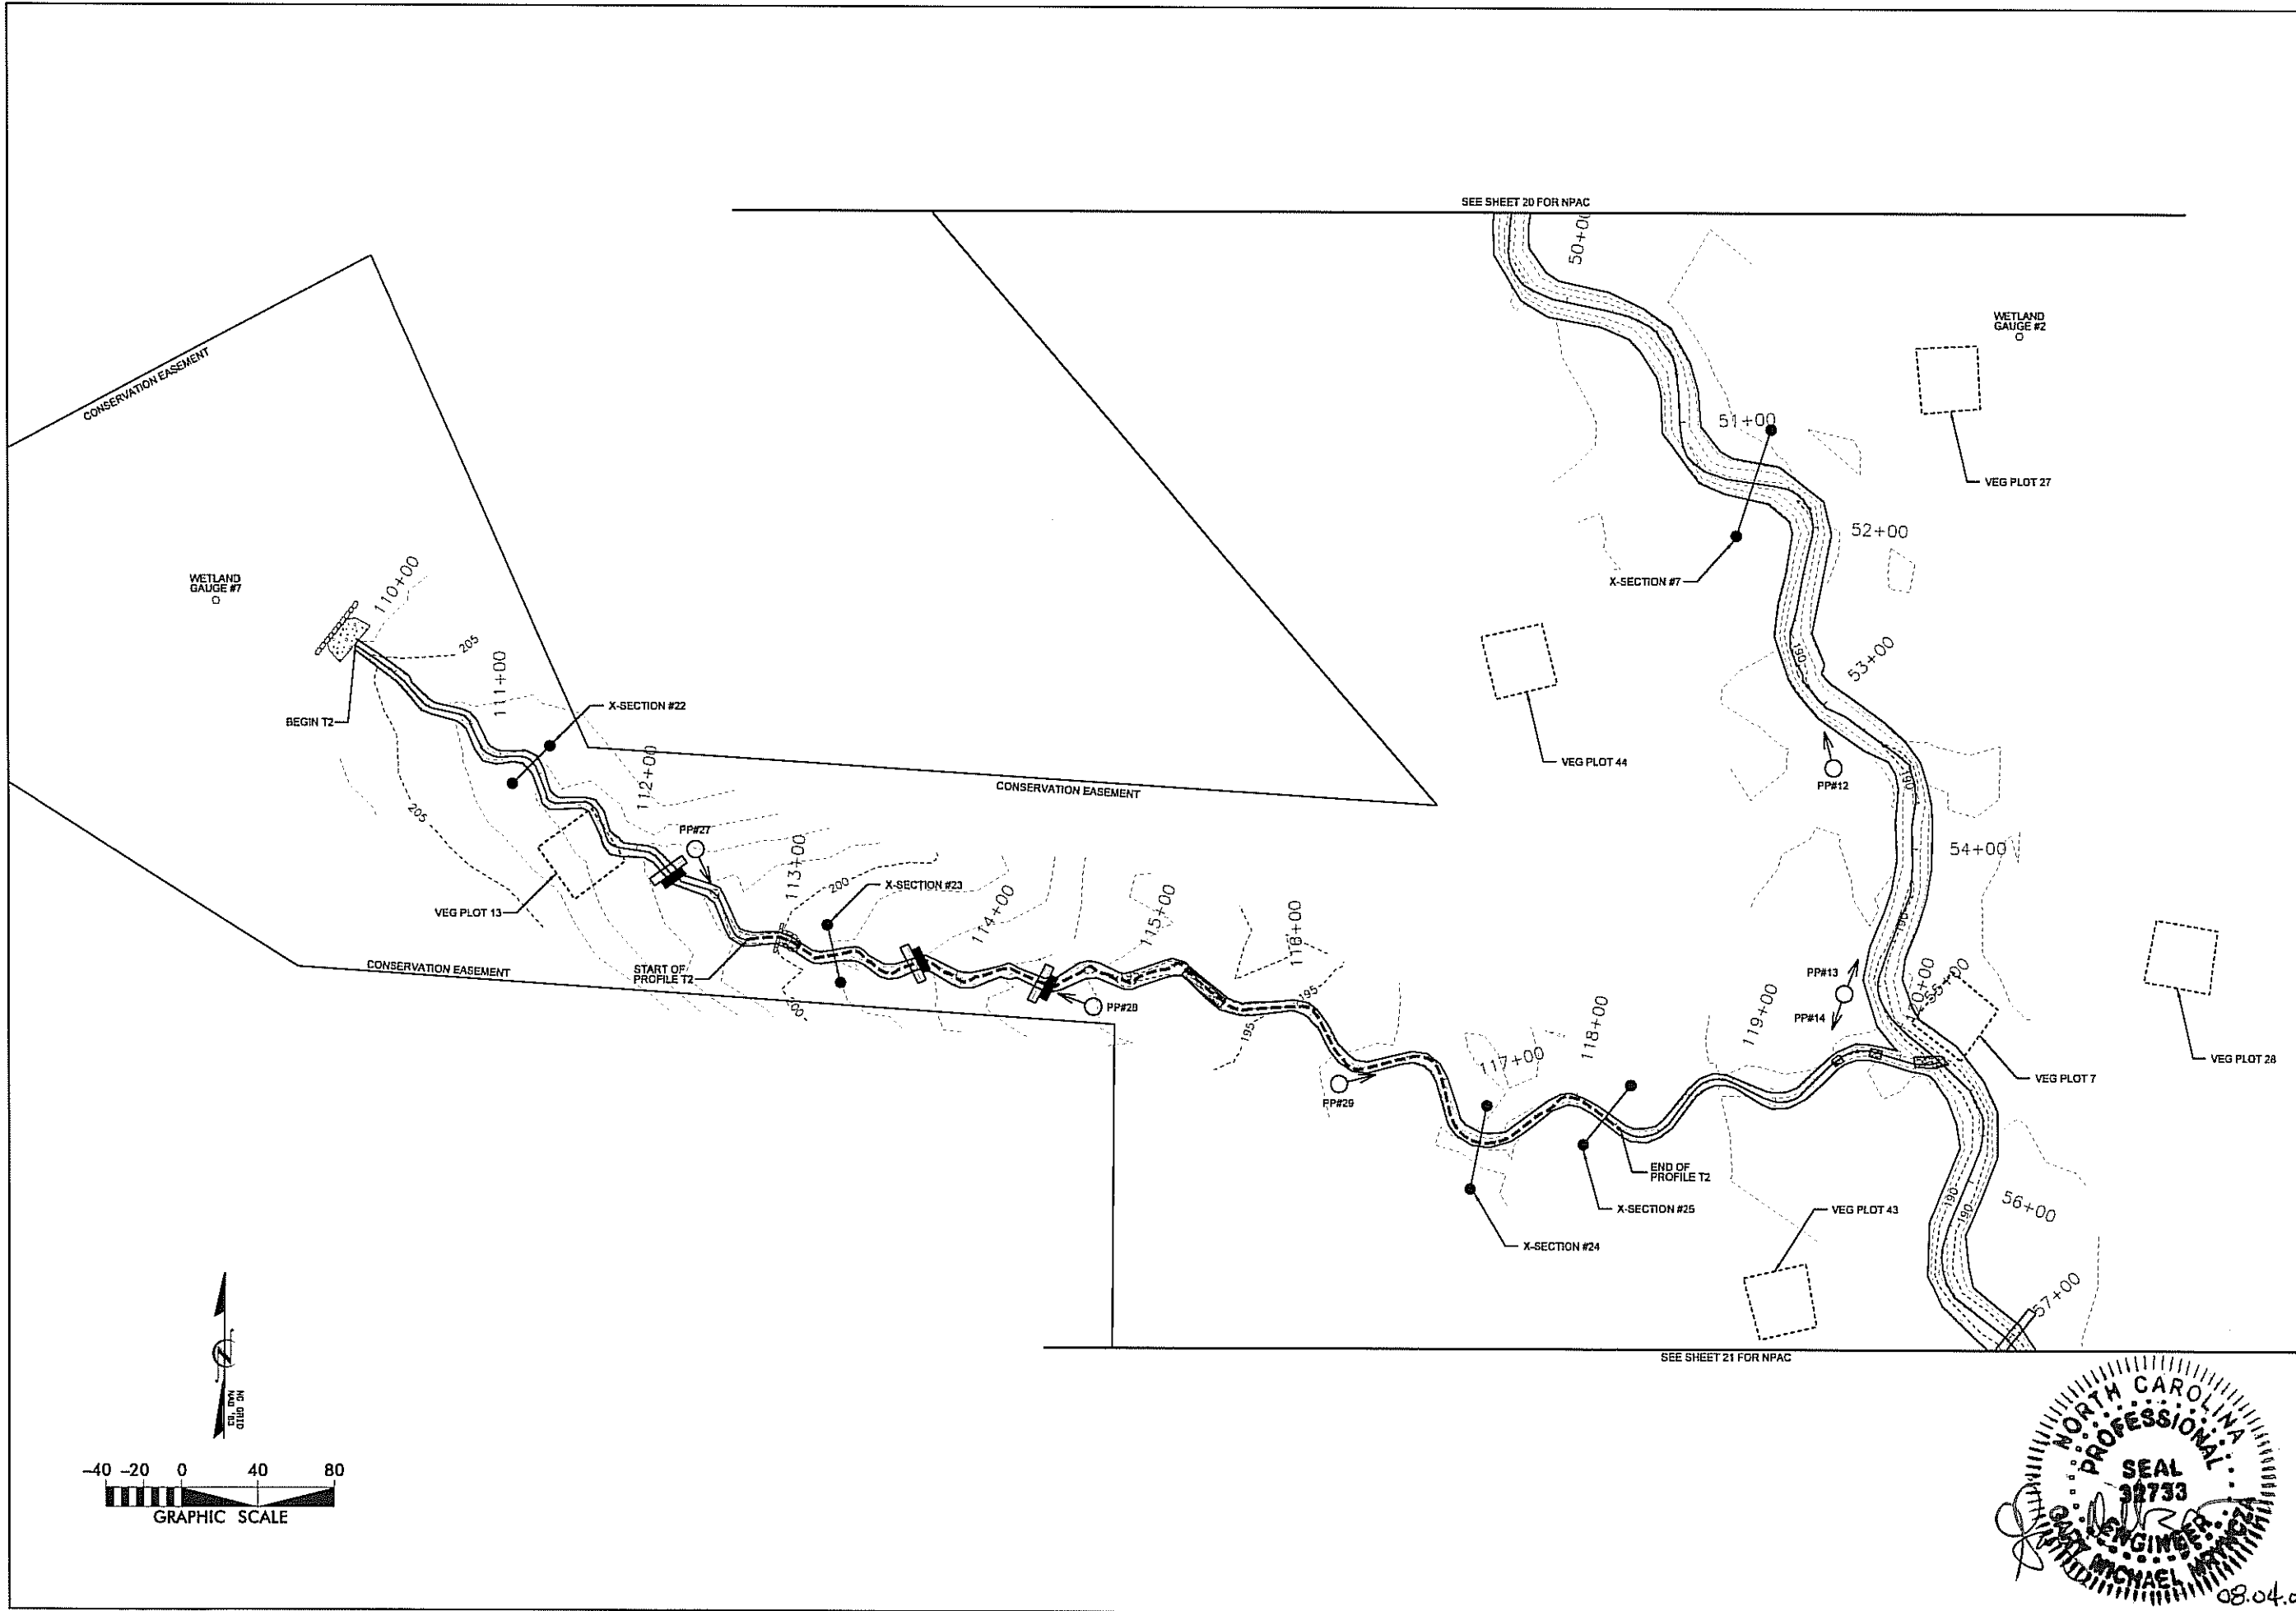




SUBMITTED WITH MITIGATION PLAN		REVISIONS	
NO.	DATE	NO.	DESCRIPTION
1	JUNE 2009		

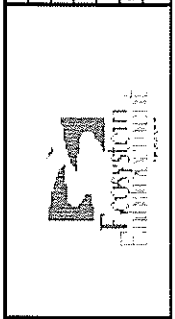


KCI
ASSOCIATES OF NC
ENGINEERS • PLANNERS • SCIENTISTS
4505X FORK ROAD
RALEIGH, NORTH CAROLINA 27609

**FARRAR DAIRY
STREAM AND WETLAND MITIGATION**
LILLINGTON, HARNETT COUNTY, NORTH CAROLINA
T2 - STATION 110+00 TO STATION 120+22

DATE: JUNE 2009
SCALE: 1"=40'
MONITORING
PLAN VIEW
SHEET 28 OF 31

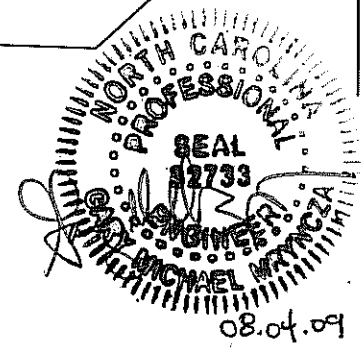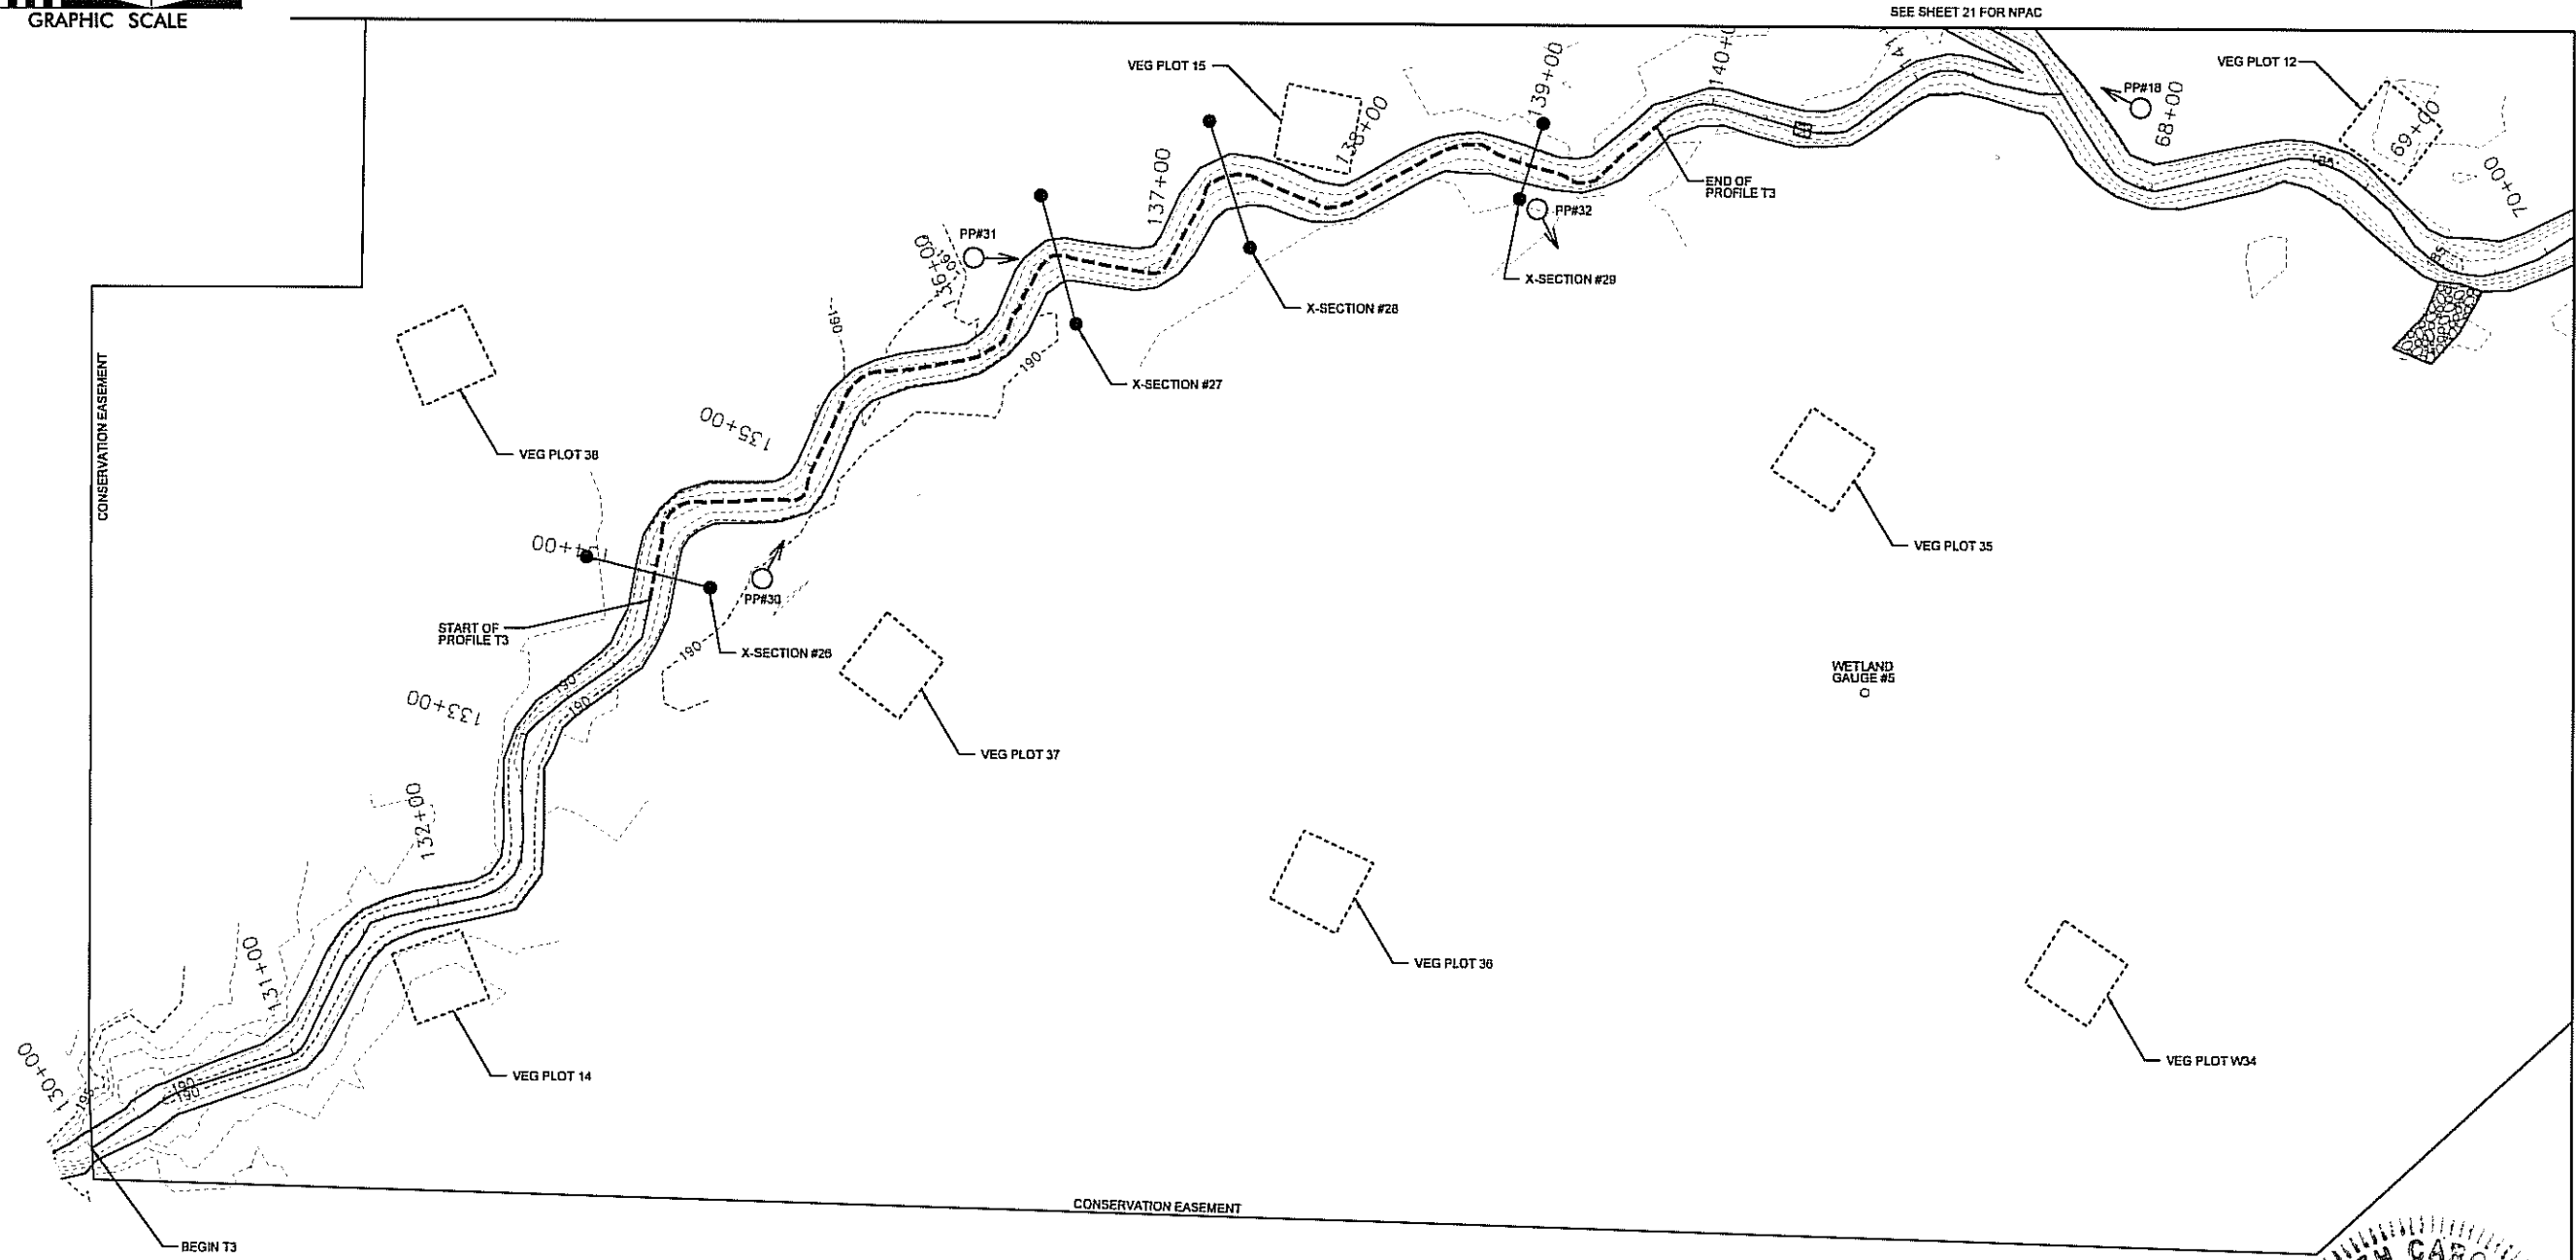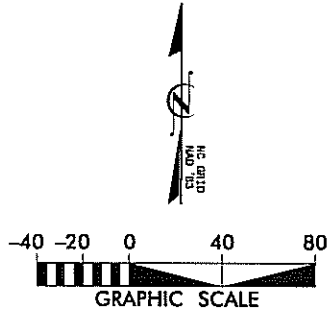

REVISIONS	
NO.	DESCRIPTION
1	DATE: JUNE 2009
2	DATE: JUNE 2009
3	DATE: JUNE 2009
4	DATE: JUNE 2009
5	DATE: JUNE 2009
6	DATE: JUNE 2009
7	DATE: JUNE 2009
8	DATE: JUNE 2009
9	DATE: JUNE 2009
10	DATE: JUNE 2009

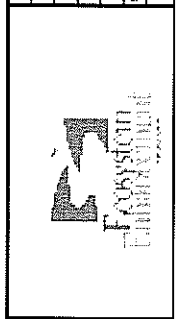

KCI
ASSOCIATES OF NC
ENGINEERS • PLANNERS • SCIENTISTS


460 SIX FORKS ROAD
RALEIGH, NORTH CAROLINA 27609

FARRAR DAIRY
STREAM AND WETLAND MITIGATION
LILLINGTON, HARNETT COUNTY, NORTH CAROLINA
T3 - STATION 130+00 TO STATION 141+67

DATE: JUNE 2009
SCALE: 1"=40'

MONITORING
PLAN VIEW

SHEET 27 OF 31

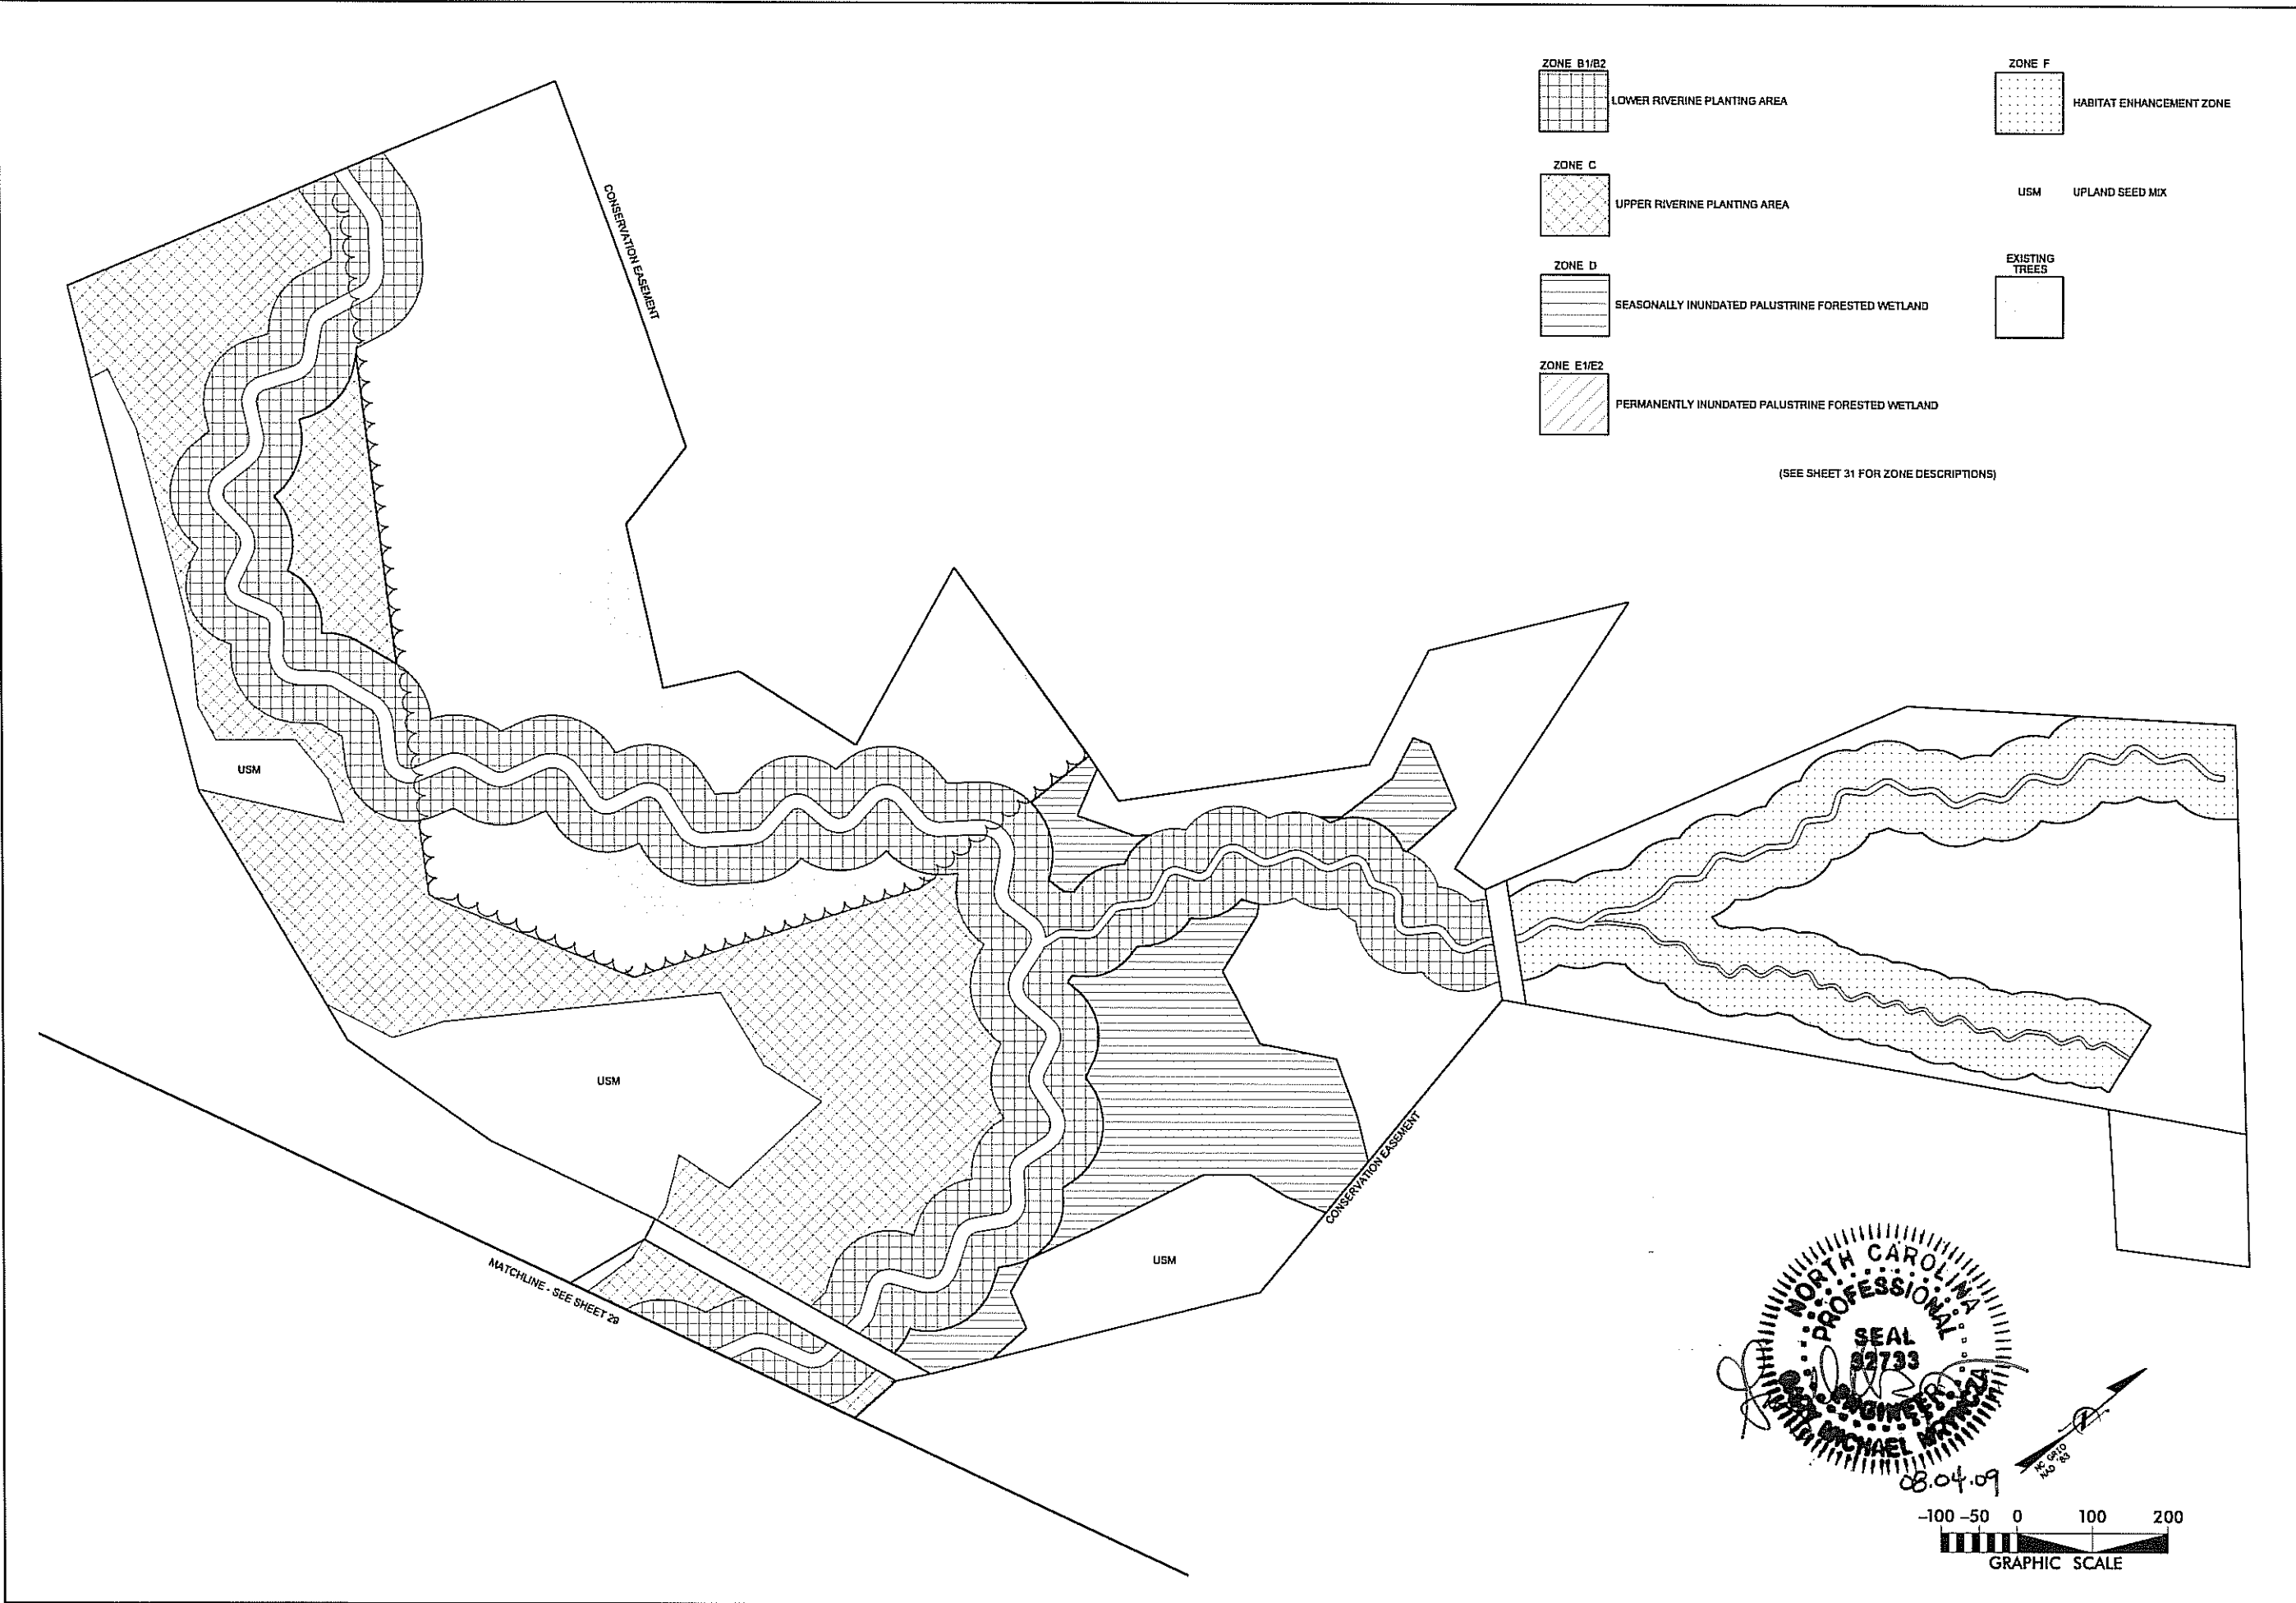

ZONE B1/B2
 LOWER RIVERINE PLANTING AREA

ZONE C
 UPPER RIVERINE PLANTING AREA

ZONE D
 SEASONALLY INUNDATED PALUSTRINE FORESTED WETLAND

ZONE E1/E2
 PERMANENTLY INUNDATED PALUSTRINE FORESTED WETLAND

ZONE F
 HABITAT ENHANCEMENT ZONE

USM UPLAND SEED MIX


EXISTING TREES

(SEE SHEET 31 FOR ZONE DESCRIPTIONS)

PROFESSIONAL SEAL
 NORTH CAROLINA
 ENGINEER
 MICHAEL MATTHEWS
 08.04.09
 NO. 2793

GRAPHIC SCALE
 -100 -50 0 100 200

NO.	DATE	DESCRIPTION	BY	APPROVED
1	JUNE 2009	SUBMITTED WITH MITIGATION PLAN		

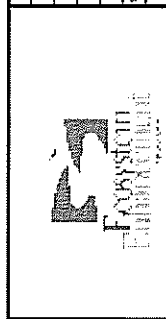

4601 SIX FORKS ROAD
 RALEIGH, NORTH CAROLINA 27609

**FARRAR DAIRY
 STREAM AND WETLAND MITIGATION**
 LILLINGTON, HARNETT COUNTY, NORTH CAROLINA

ZONE B1/E2



LOWER RIVERINE PLANTING AREA

ZONE F



HABITAT ENHANCEMENT ZONE

ZONE C



UPPER RIVERINE PLANTING AREA

USM

UPLAND SEED MIX

ZONE D



SEASONALLY INUNDATED PALUSTRINE FORESTED WETLAND

EXISTING TREES



ZONE E1/E2



PERMANENTLY INUNDATED PALUSTRINE FORESTED WETLAND

(SEE SHEET 31 FOR ZONE DESCRIPTIONS)

USM

USM

CONSERVATION EASEMENT

USM




USM

USM

USM

MATCHLINE - SEE SHEET 30

MATCHLINE - SEE SHEET 28

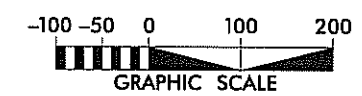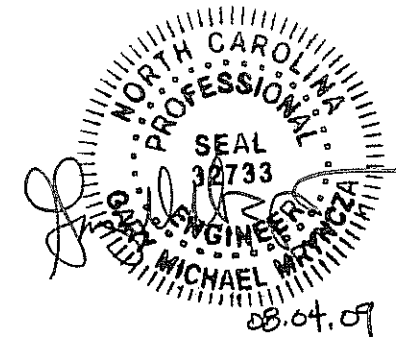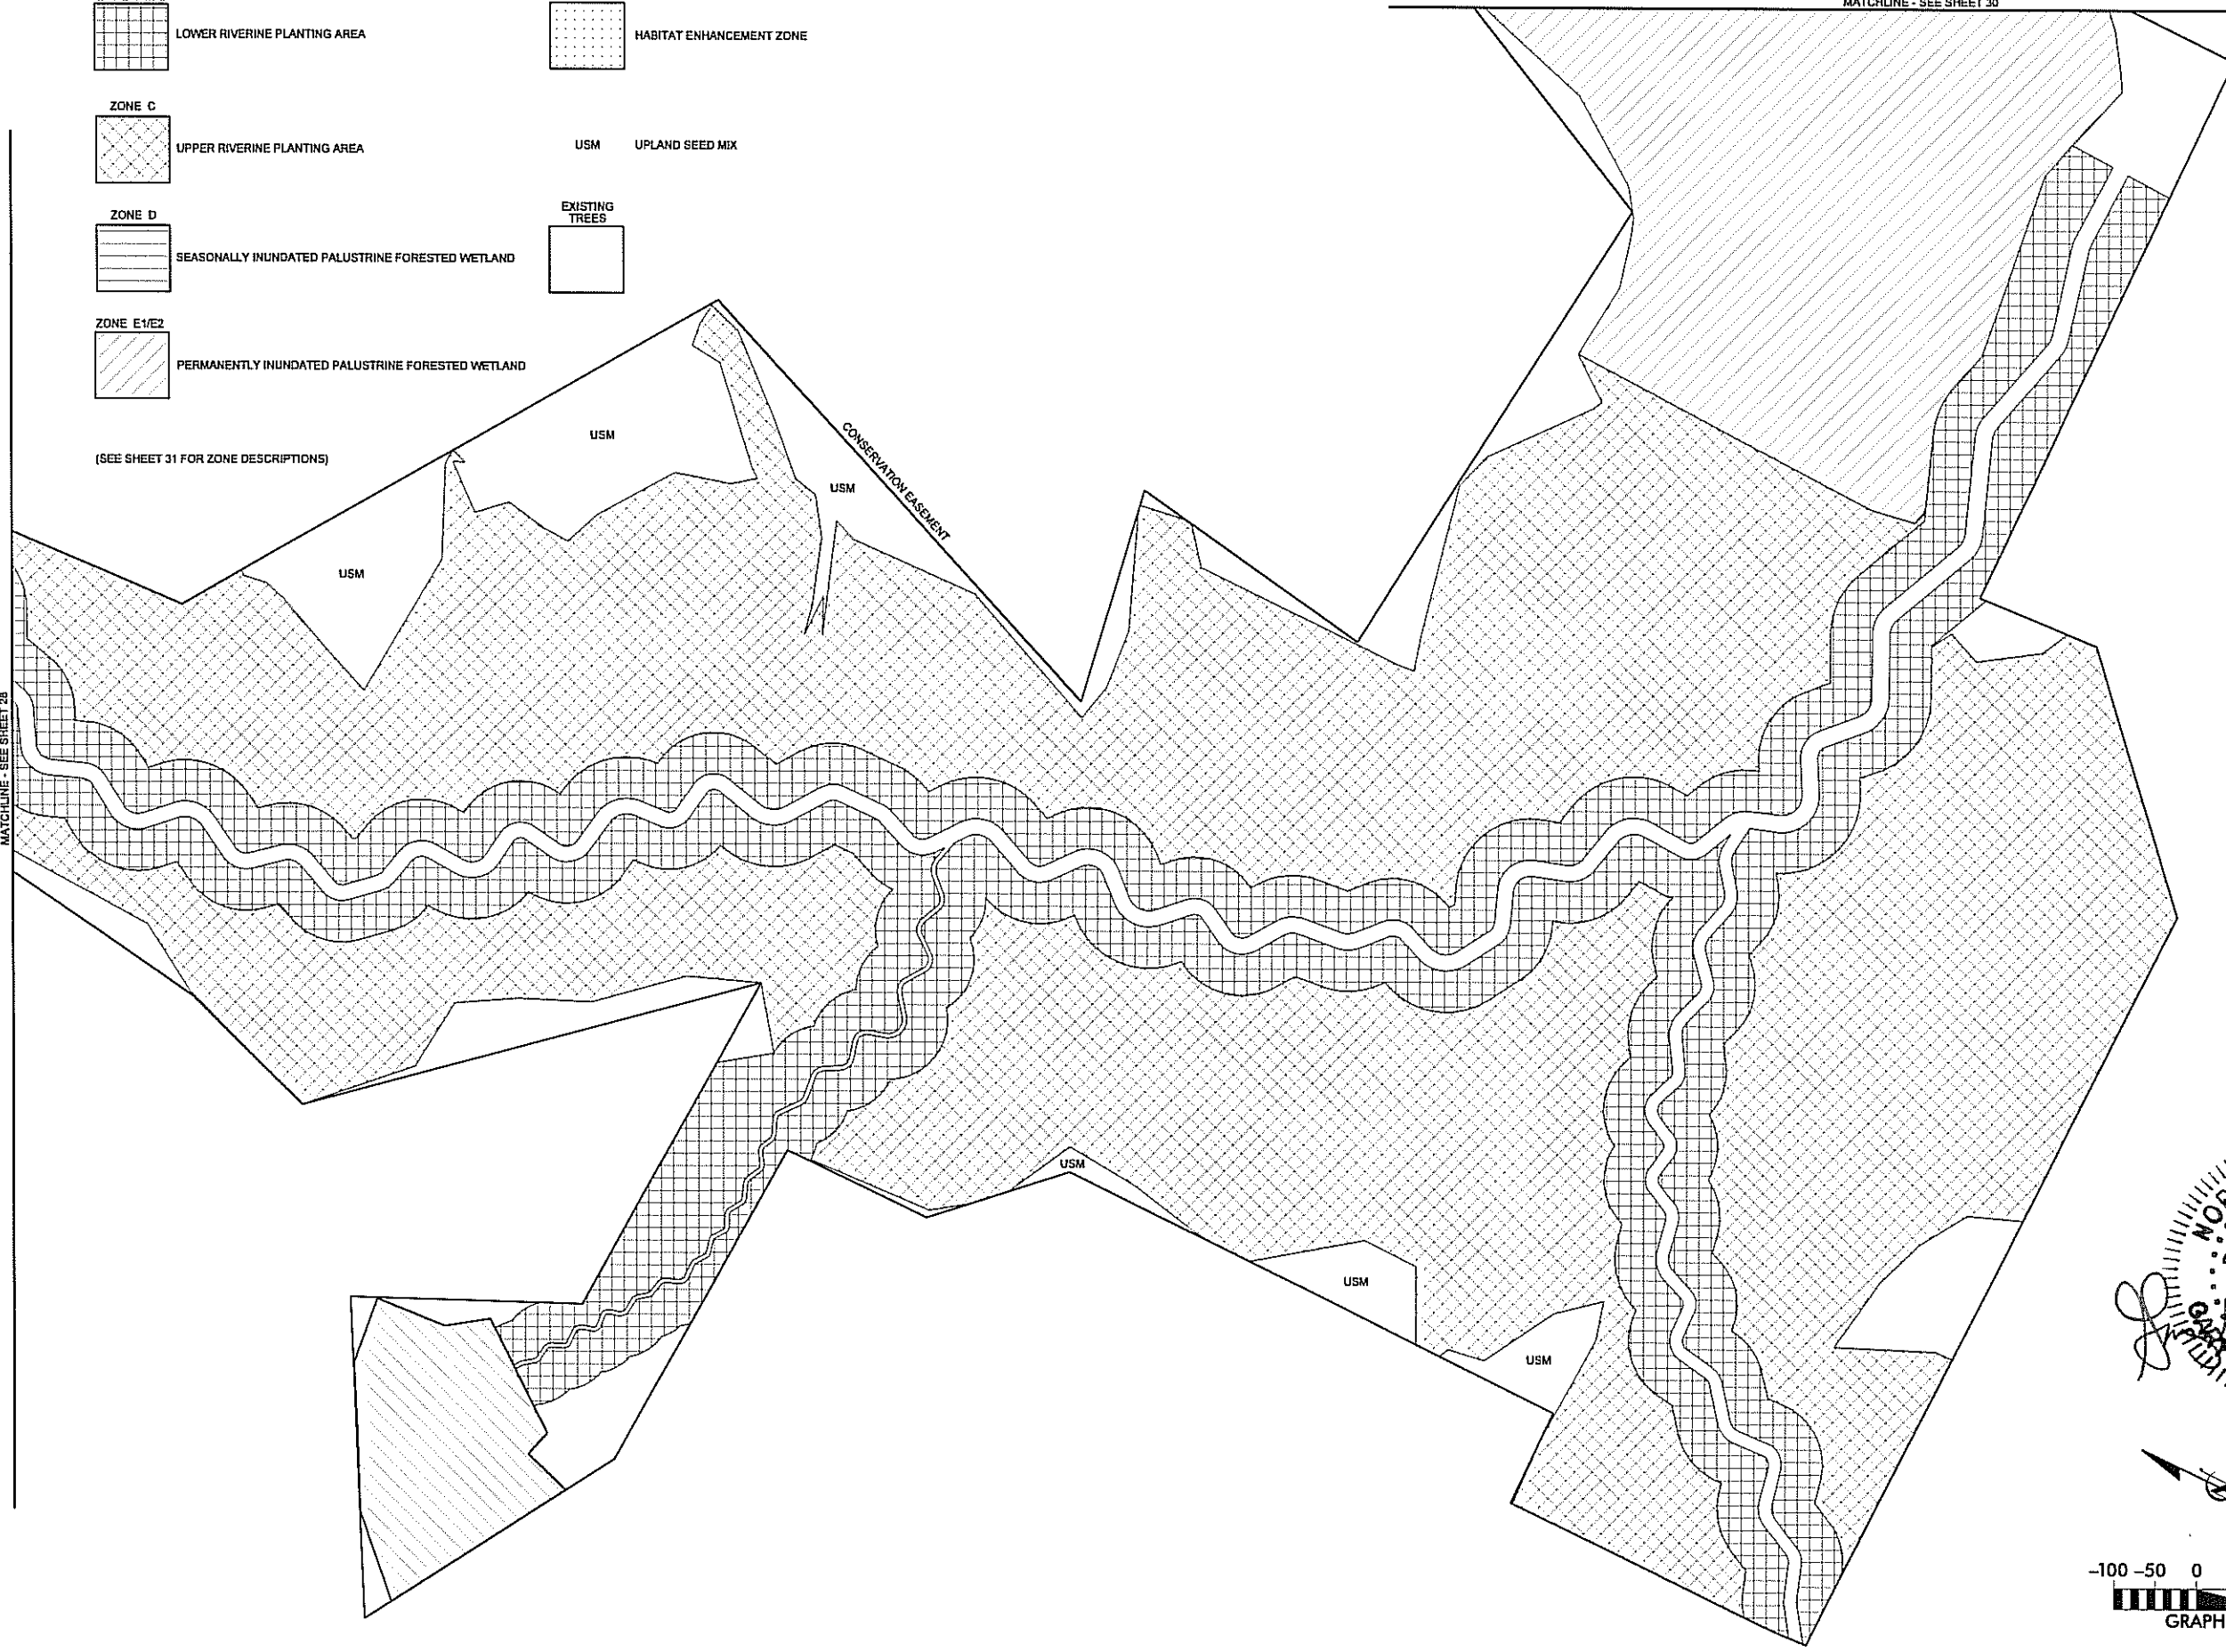







SUBMITTED WITH MITIGATION PLAN		REVISIONS	
DATE	DESCRIPTION	DATE	APPROVED
JUNE 2009			





KCI
ASSOCIATES OF NC
ENGINEERS • PLANNERS • SCIENTISTS
4501 GOLF FORKS ROAD
RALEIGH, NORTH CAROLINA 27609

FARRAR DAIRY
STREAM AND WETLAND MITIGATION
LILLINGTON, HARNETT COUNTY, NORTH CAROLINA

DATE: JUNE 2009
SCALE: 1"=100'
AS-BUILT
PLANTING
PLAN
SHEET 29 OF 31

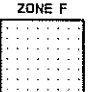- 
ZONE B1/B2
 LOWER RIVERINE PLANTING AREA
- 
ZONE C
 UPPER RIVERINE PLANTING AREA
- 
ZONE D
 SEASONALLY INUNDATED PALUSTRINE FORESTED WETLAND
- 
ZONE E1/E2
 PERMANENTLY INUNDATED PALUSTRINE FORESTED WETLAND
- 
ZONE F
 HABITAT ENHANCEMENT ZONE
- USM UPLAND SEED MIX
- 
 EXISTING TREES


(SEE SHEET 31 FOR ZONE DESCRIPTIONS)

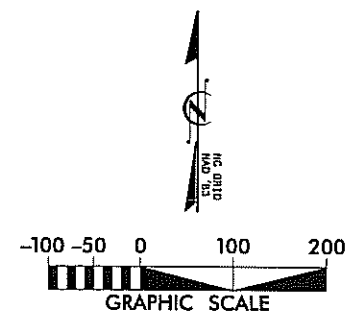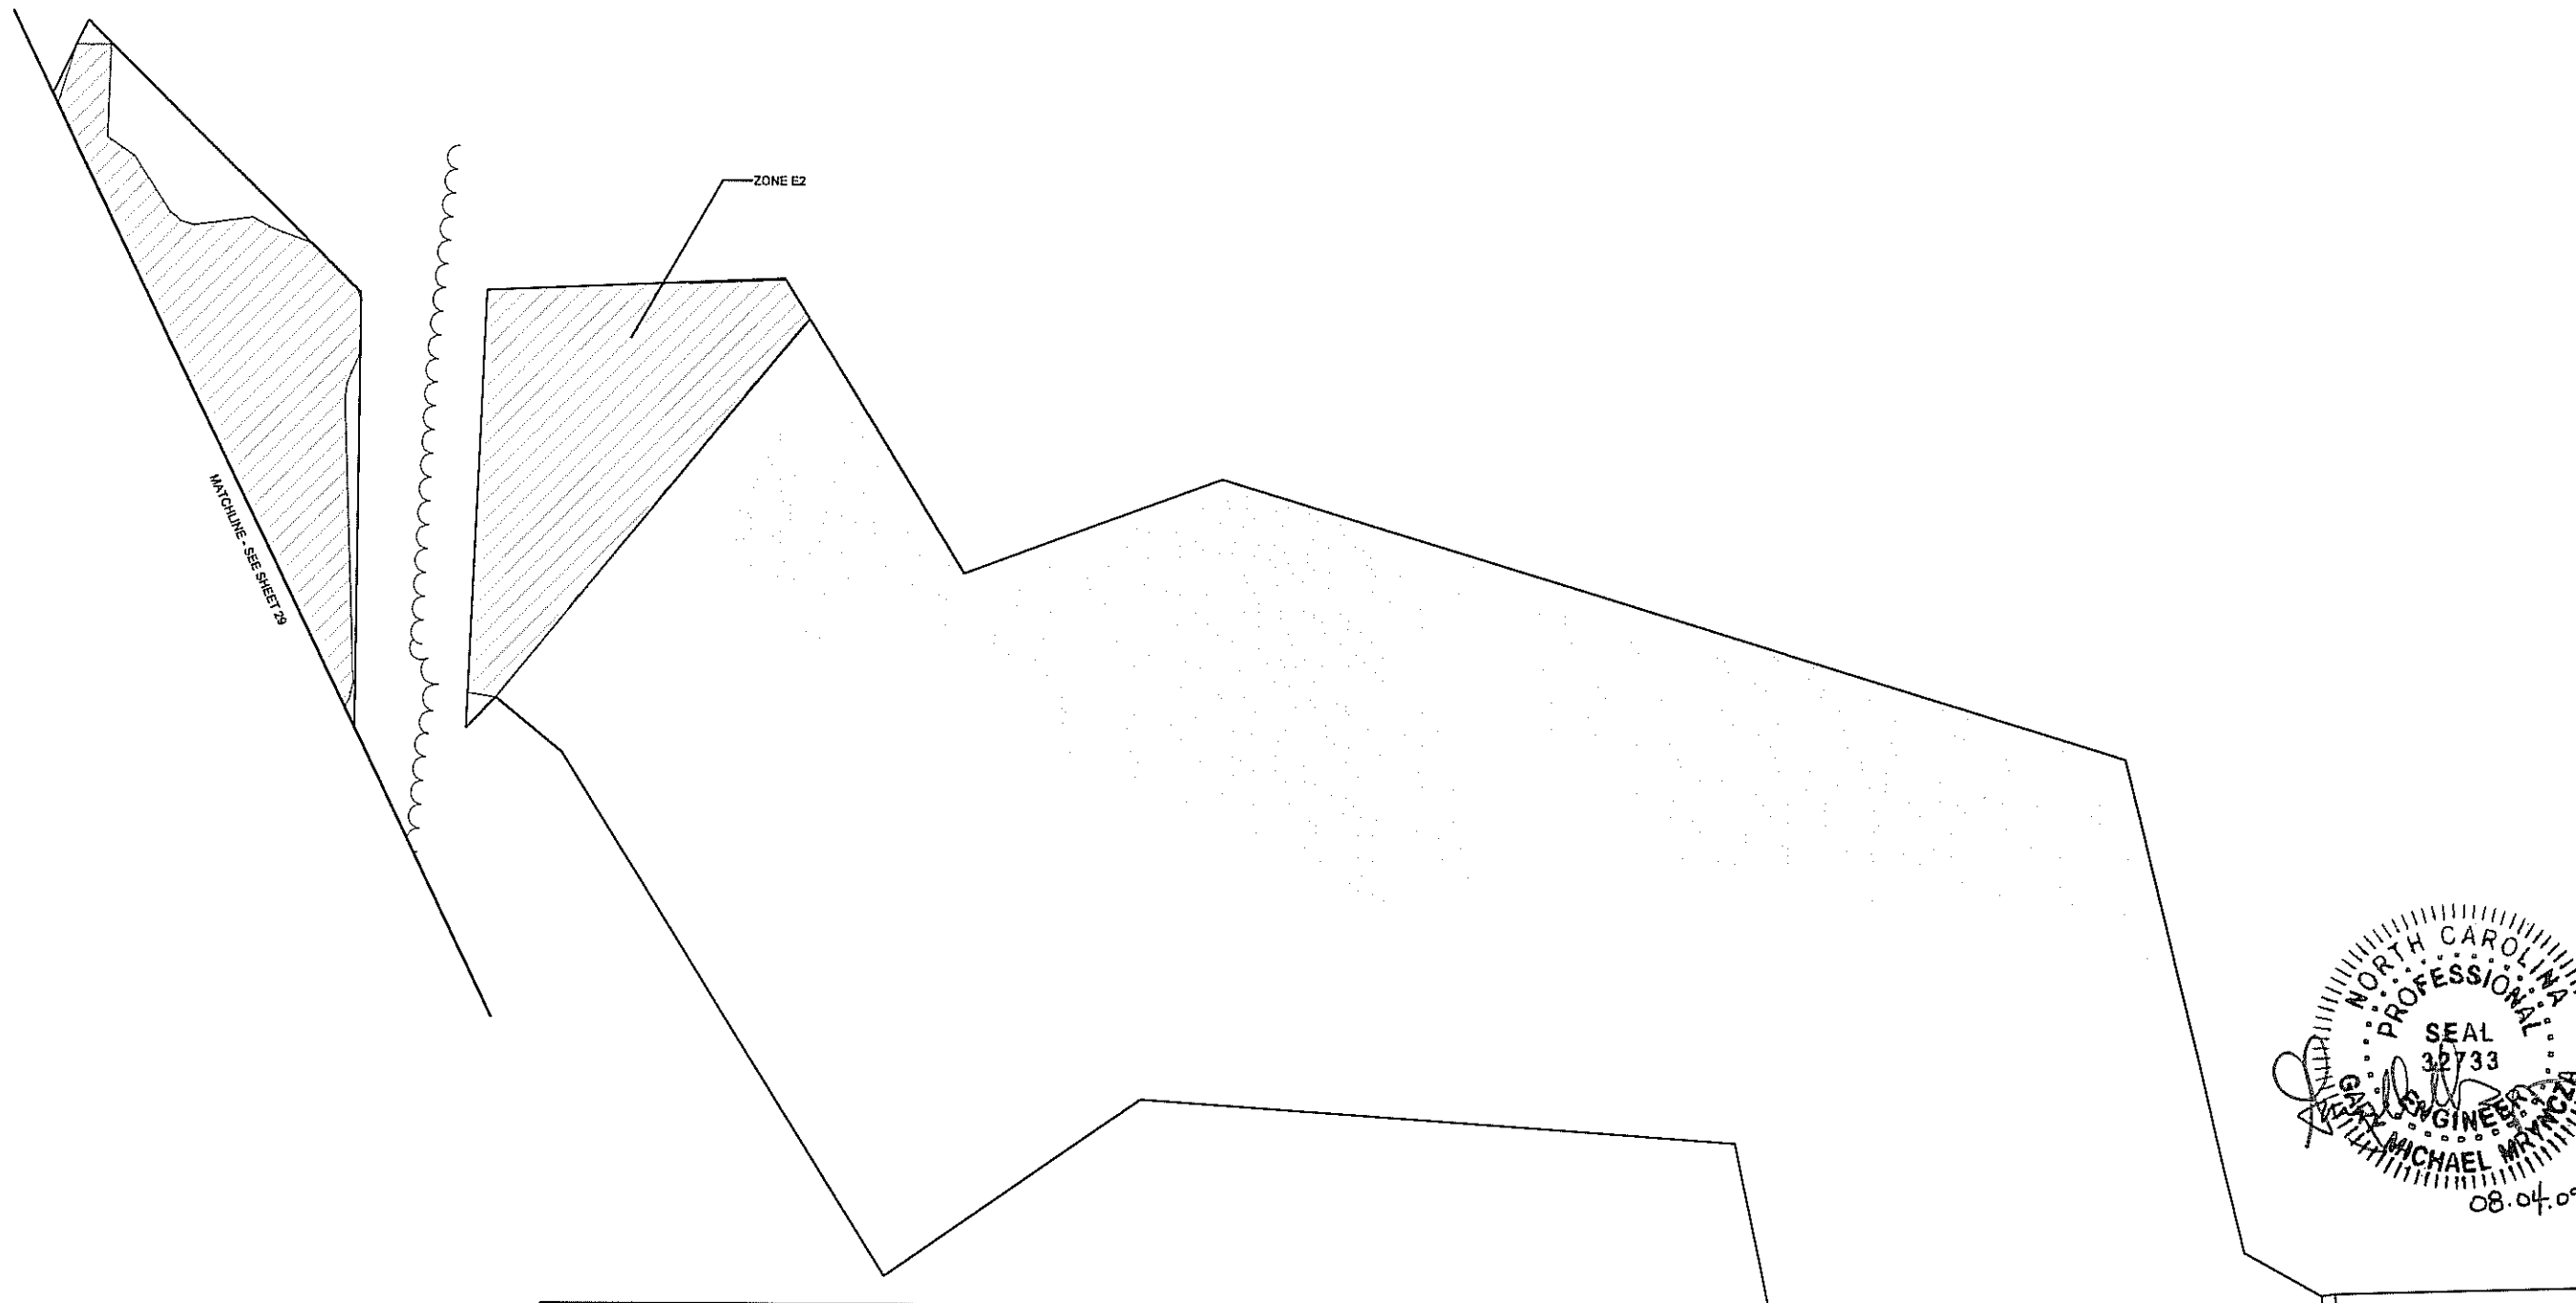


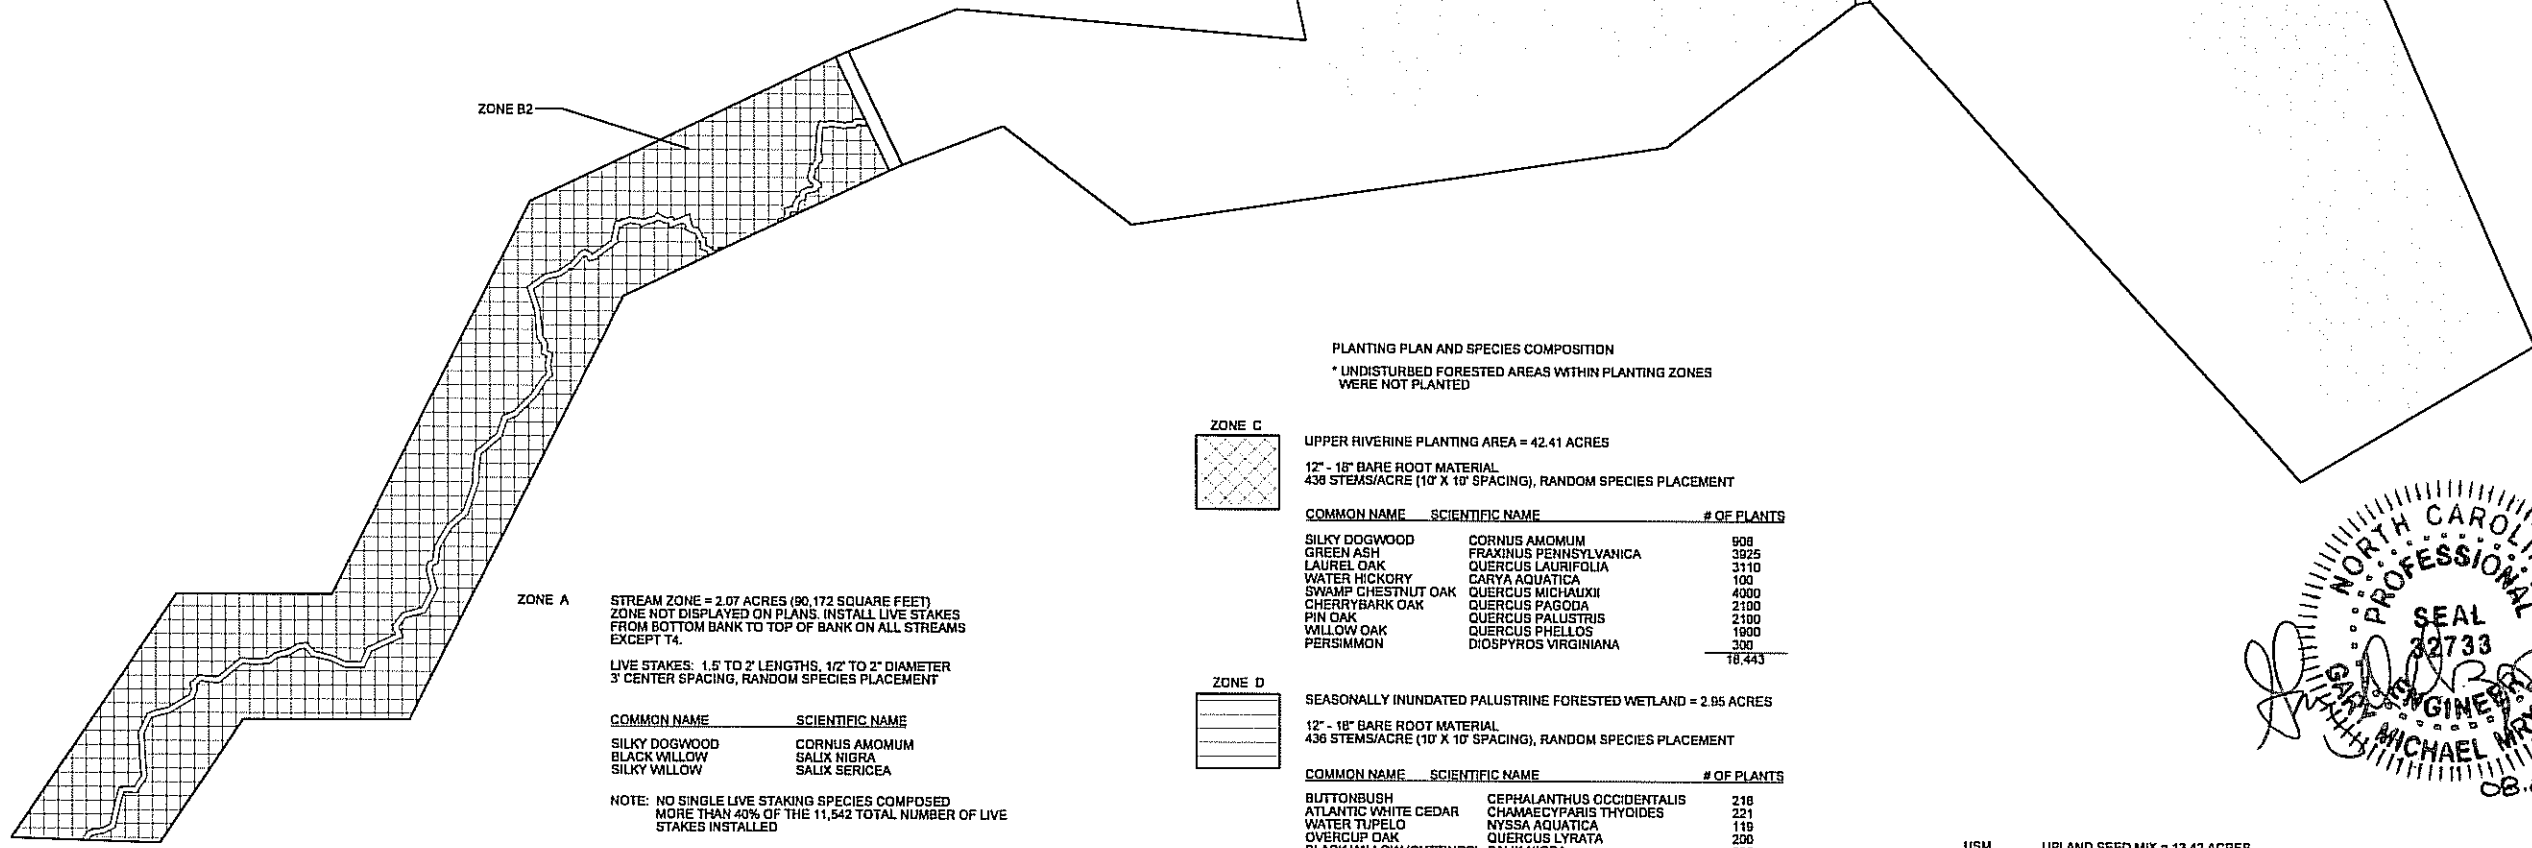
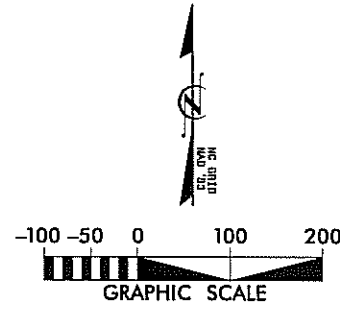
MATCHLINE - SEE SHEET 29

ZONE E2

MATCHLINE - SEE SHEET 31

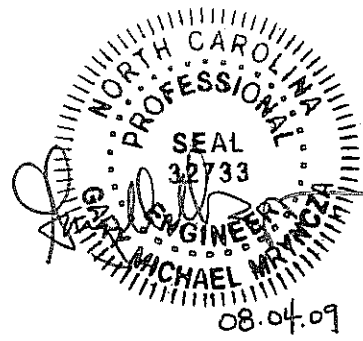

SUBMITTED WITH MITIGATION PLAN		DATE: JUNE 2009	
A			
REVISIONS		DATE	APPROVED
			
KCI ASSOCIATES OF NC ENGINEERS • PLANNERS • SCIENTISTS 460 SIX FORKS ROAD RALEIGH, NORTH CAROLINA 27609			
FARRAR DAIRY STREAM AND WETLAND MITIGATION LILLINGTON, HARNETT COUNTY, NORTH CAROLINA			
DATE: JUNE 2009		SCALE: 1"=100'	
AS-BUILT PLANTING PLAN			
SHEET 30		OF 31	



PLANTING PLAN AND SPECIES COMPOSITION
 * UNDISTURBED FORESTED AREAS WITHIN PLANTING ZONES WERE NOT PLANTED



UPPER RIVERINE PLANTING AREA = 42.41 ACRES

12" - 18" BARE ROOT MATERIAL
 438 STEMS/ACRE (10' X 10' SPACING), RANDOM SPECIES PLACEMENT

COMMON NAME	SCIENTIFIC NAME	# OF PLANTS
SILKY DOGWOOD	CORNUS AMOMUM	908
GREEN ASH	FRAXINUS PENNSYLVANICA	3925
LAUREL OAK	QUERCUS LAURIFOLIA	3110
WATER HICKORY	CARYA AQUATICA	100
SWAMP CHESTNUT OAK	QUERCUS MICHALUXII	4000
CHERRYBARK OAK	QUERCUS PAGODA	2100
PIN OAK	QUERCUS PALUSTRIS	2100
WILLOW OAK	QUERCUS PHELLOS	1900
PERSIMMON	DIOSPYROS VIRGINIANA	300
		18,443



SEASONALLY INUNDATED PALUSTRINE FORESTED WETLAND = 2.95 ACRES

12" - 18" BARE ROOT MATERIAL
 436 STEMS/ACRE (10' X 10' SPACING), RANDOM SPECIES PLACEMENT

COMMON NAME	SCIENTIFIC NAME	# OF PLANTS
BUTTONBUSH	CEPHALANTHUS OCCIDENTALIS	218
ATLANTIC WHITE CEDAR	CHAMAECYPARIS THYOIDES	221
WATER TUPELO	NYSSA AQUATICA	119
OVERCUP OAK	QUERCUS LYRATA	200
BLACK WILLOW (CUTTINGS)	SALIX NIGRA	308
BALD CYPRESS	TAXODIUM DISTICHUM	342
		1,408



E1 - WETLAND RESTORATION
 PERMANENTLY INUNDATED PALUSTRINE FORESTED WETLAND = 8.43 ACRES
 PLANT ALL OF ZONE E AS E1 UNLESS OTHERWISE INDICATED

12" - 18" BARE ROOT MATERIAL
 436 STEMS/ACRE (10' X 10' SPACING), RANDOM SPECIES PLACEMENT

COMMON NAME	SCIENTIFIC NAME	# OF PLANTS
ATLANTIC WHITE CEDAR	CHAMAECYPARIS THYOIDES	840
BLACK WILLOW (CUTTINGS)	SALIX NIGRA	1406
BALD CYPRESS	TAXODIUM DISTICHUM	1562
		3,808

E2 - WETLAND ENHANCEMENT
 PERMANENTLY INUNDATED PALUSTRINE FORESTED WETLAND = 2.25 ACRES

12" - 18" BARE ROOT MATERIAL
 100 STEMS/ACRE (10' X 10' SPACING), RANDOM SPECIES PLACEMENT

COMMON NAME	SCIENTIFIC NAME	# OF PLANTS
ATLANTIC WHITE CEDAR	CHAMAECYPARIS THYOIDES	51
BLACK WILLOW (CUTTINGS)	SALIX NIGRA	56
BALD CYPRESS	TAXODIUM DISTICHUM	90
		233



HABITAT ENHANCEMENT ZONE = 4.03 ACRES

12" - 18" BARE ROOT MATERIAL
 436 STEMS/ACRE (10' X 10' SPACING), RANDOM SPECIES PLACEMENT

COMMON NAME	SCIENTIFIC NAME	# OF PLANTS
SUGARBERRY	CELTIS LAEVIGATA	250
PERSIMMON	DIOSPYROS VIRGINIANA	300
YELLOW POPLAR	LIRIODENDRON TULIPIFERA	400
SYCAMORE	PLATANUS OCCIDENTALIS	300
WHITE OAK	QUERCUS ALBA	500
		1,750

USM UPLAND SEED MIX = 13.42 ACRES


SEED/ACRE	COMMON NAME	SCIENTIFIC NAME
5 LBS	BUCKWHEAT	FAGOPYRUM ESCULENTUM
5 LBS	SUNFLOWER	HELIANTHUS SPECIES
5 LBS	GRAIN SORGHUM	SORGHUM BICOLOR
5 LBS	BROWNTOP MILLET	UROCHLOA RAMDSEA
20 LBS/ACRE		

WSM WETLAND SEED MIX = 71.34 ACRES


SEED/ACRE	COMMON NAME	SCIENTIFIC NAME
1.25 LBS	ORCHARD GRASS	DACTYLUS GLOMERATA
1.25 LBS	BIG BLUESTEM	ANDROPOGON GERARDI
1.25 LBS	VIRGINIA WILD RYE	ELYMUS VIRGINICUS
1.25 LBS	RIVER OATS	CHASMANTHIUM LATIFOLIUM
1.25 LBS	PURPLE TOP	VERBENA BONARIENSIS
0.25 LBS	DEER TONGUE	Panicum CLADESTINUM
0.25 LBS	SWITCH GRASS	Panicum VIRGATUM
0.25 LBS	RYE GRAIN	SECALE CEREALE
25 LBS/ACRE		



DO NOT PLANT IN FORESTED AREAS UNLESS OTHERWISE INDICATED.

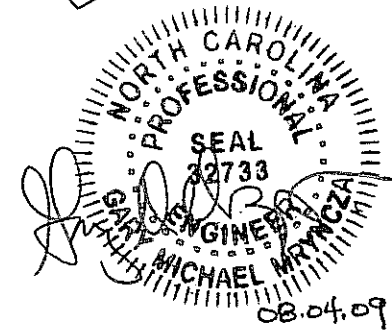

NO.	DATE	DESCRIPTION	BY	APPROVED
1	JUNE 2009	SUBMITTED WITH MITIGATION PLAN		

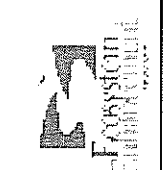

KCI
 ASSOCIATES OF NC
 ENGINEERS • PLANNERS • SCIENTISTS
 4601 SIX FORKS ROAD
 RALEIGH, NORTH CAROLINA 27609

**FARRAR DAIRY
 STREAM AND WETLAND MITIGATION**
 LILLINGTON, HARNETT COUNTY, NORTH CAROLINA

Appendix B

Cross-Section Plots and Pebble Counts


River Basin:	Cape Fear
Watershed:	Farrar Dairy
XS ID	XS-1, Riffle, NPAC-1
Drainage Area (sq mi):	3.92
Date:	4/23/2009
Field Crew:	A. French, B. Roberts



Stream Type C5

SUMMARY DATA	
Bankfull Elevation:	201.3
Bankfull Cross-Sectional Area:	31.0
Bankfull Width:	19.6
Flood Prone Area Elevation:	203.7
Flood Prone Width:	>60
Max Depth at Bankfull:	2.4
Mean Depth at Bankfull:	1.6
W / D Ratio:	12.4
Entrenchment Ratio:	>3.0
Bank Height Ratio:	1.0

Station	Elevation
0.0	201.79
0.3	201.38
3.8	201.32
5.9	201.54
11.7	201.24
15.4	201.42
18.7	201.49
22.1	200.25
23.6	199.49
24.9	198.99
27.0	198.85
29.5	198.84
31.3	198.89
33.6	199.18
34.8	199.80
37.3	200.81
38.5	201.25
43.2	201.25
49.8	201.11
56.0	201.10
57.3	201.40

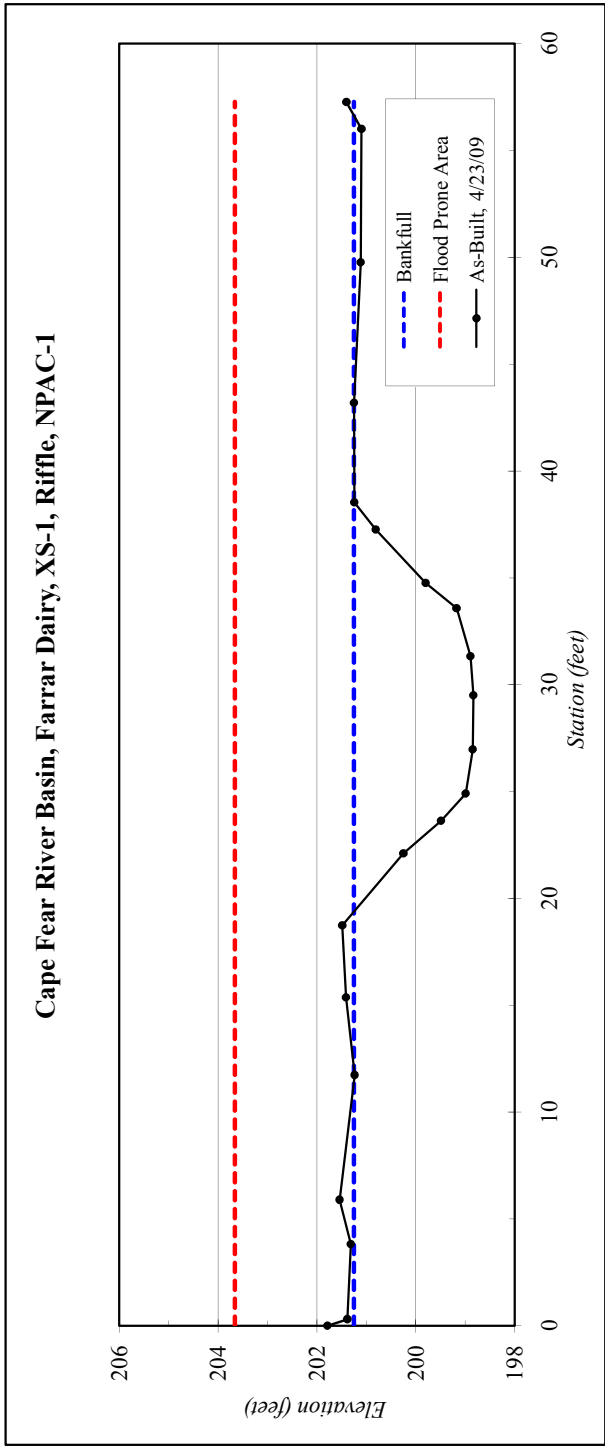


River Basin:	Cape Fear
Watershed:	Farrar Dairy
XS ID	XS-2, Pool, NPAC-1
Drainage Area (sq mi):	3.92
Date:	4/23/2009
Field Crew:	A. French, B. Roberts



Stream Type C5

SUMMARY DATA	
Bankfull Elevation:	200.3
Bankfull Cross-Sectional Area:	29.2
Bankfull Width:	20.9
Flood Prone Area Elevation:	-
Flood Prone Width:	-
Max Depth at Bankfull:	3.3
Mean Depth at Bankfull:	1.4
W / D Ratio:	-
Entrenchment Ratio:	-
Bank Height Ratio:	-

Station	Elevation
0.0	200.69
0.1	200.39
4.3	200.35
7.0	200.61
9.2	200.41
14.8	200.24
20.3	200.48
24.7	200.19
26.5	200.25
28.8	198.72
29.7	198.11
30.5	196.98
31.3	197.11
31.9	197.33
32.6	197.33
33.5	197.57
34.7	197.58
35.9	198.03
37.5	198.75
39.5	199.33
44.4	200.02
50.5	200.54
56.0	200.44
62.2	200.38
62.3	200.69

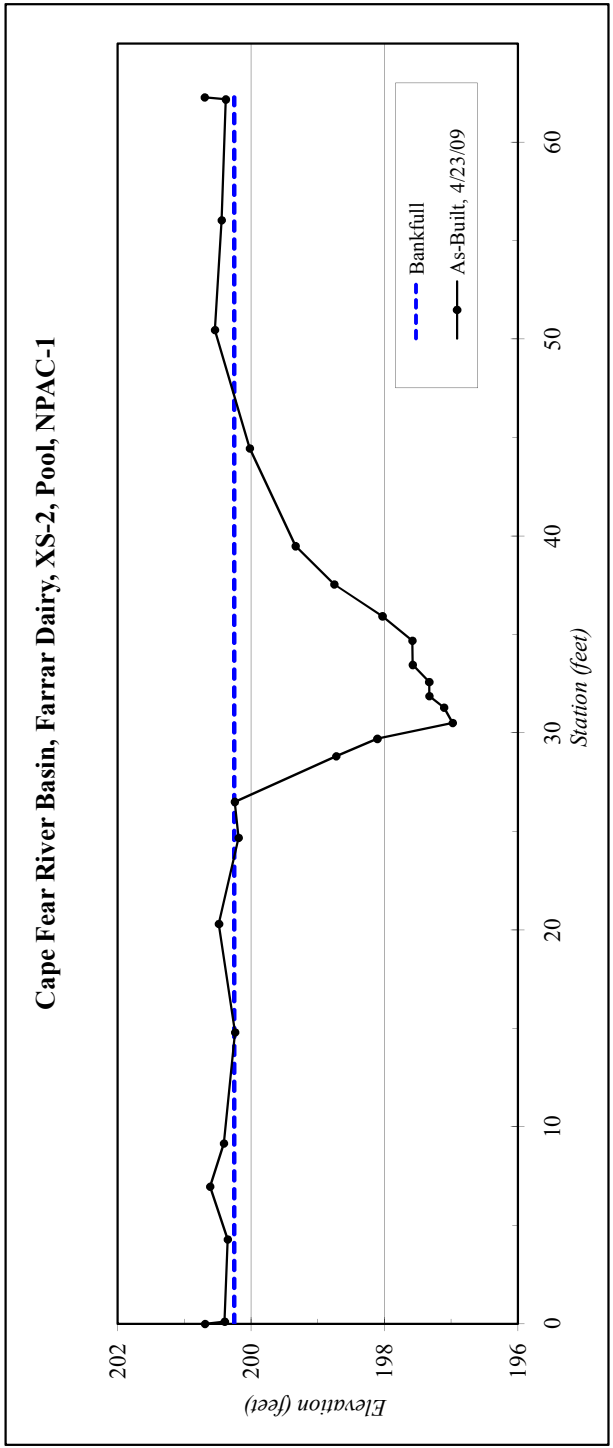


River Basin:	Cape Fear
Watershed:	Farrar Dairy
XS ID	XS-3, Riffle, NPAC-1
Drainage Area (sq mi):	3.92
Date:	4/28/2009
Field Crew:	B. Roberts, A. Davis



Stream Type C5

SUMMARY DATA	
Bankfull Elevation:	198.4
Bankfull Cross-Sectional Area:	26.6
Bankfull Width:	19.6
Flood Prone Area Elevation:	200.9
Flood Prone Width:	>60
Max Depth at Bankfull:	2.5
Mean Depth at Bankfull:	1.4
W / D Ratio:	14.4
Entrenchment Ratio:	>3.0
Bank Height Ratio:	1.0

Station	Elevation
0.0	199.38
0.2	198.95
5.8	198.82
10.9	198.48
14.7	198.44
18.5	198.51
20.0	198.12
20.8	197.60
22.5	196.94
24.6	196.67
25.7	196.50
26.8	196.15
28.0	195.84
29.4	196.12
30.6	196.40
32.8	196.42
34.0	197.31
34.7	197.42
36.1	198.00
38.7	198.36
42.3	198.45
46.1	198.50
51.0	198.25
52.8	198.31
52.9	198.63

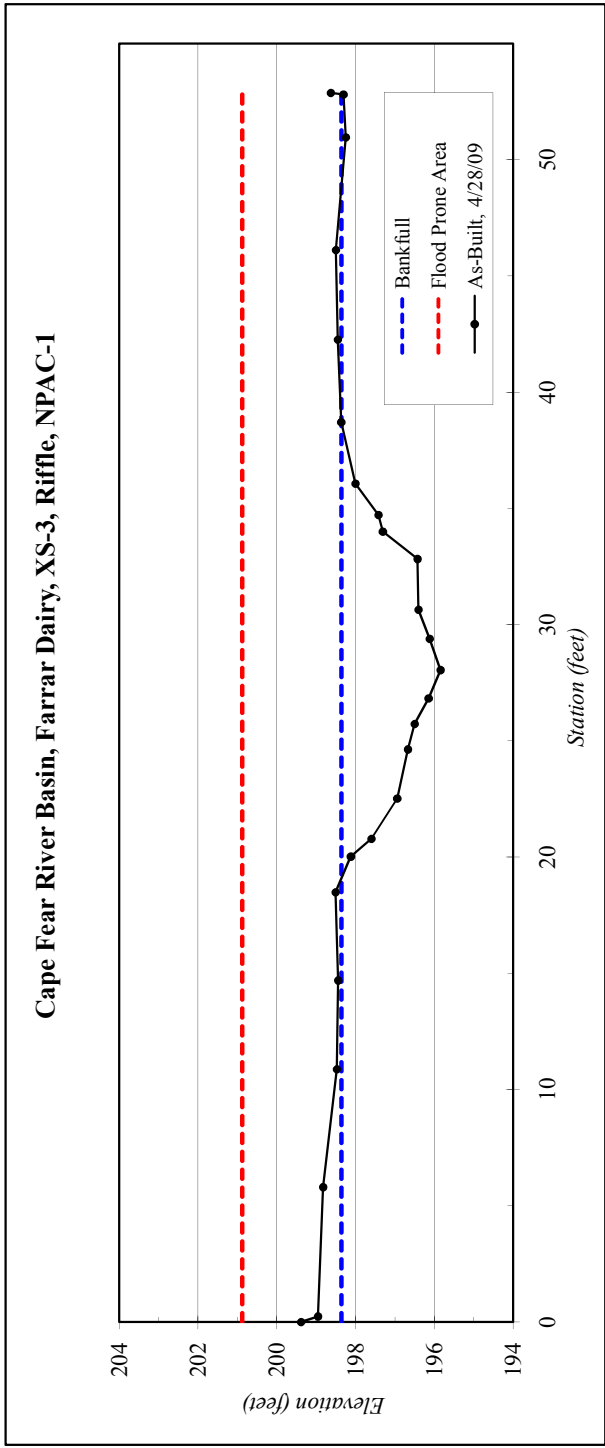


River Basin:	Cape Fear
Watershed:	Farrar Dairy
XS ID	XS-4, Pool, NPAC-1
Drainage Area (sq mi):	4.10
Date:	4/28/2009
Field Crew:	B. Roberts, A. Davis




Stream Type C5

Station	Elevation
0.0	196.89
0.2	196.65
3.1	196.81
8.4	196.96
13.3	197.00
17.6	197.05
18.9	196.73
20.4	196.38
21.0	196.15
21.7	195.68
22.4	194.86
23.0	194.24
23.6	194.26
25.1	194.56
26.5	194.78
27.6	194.80
29.4	195.38
31.3	196.02
34.4	196.53
38.7	197.33
42.4	197.42
43.5	197.61
50.6	197.28
54.4	197.53
58.9	197.63
59.1	197.87

SUMMARY DATA	
Bankfull Elevation:	197.1
Bankfull Cross-Sectional Area:	24.7
Bankfull Width:	18.9
Flood Prone Area Elevation:	-
Flood Prone Width:	-
Max Depth at Bankfull:	2.8
Mean Depth at Bankfull:	1.3
W / D Ratio:	-
Entrenchment Ratio:	-
Bank Height Ratio:	-

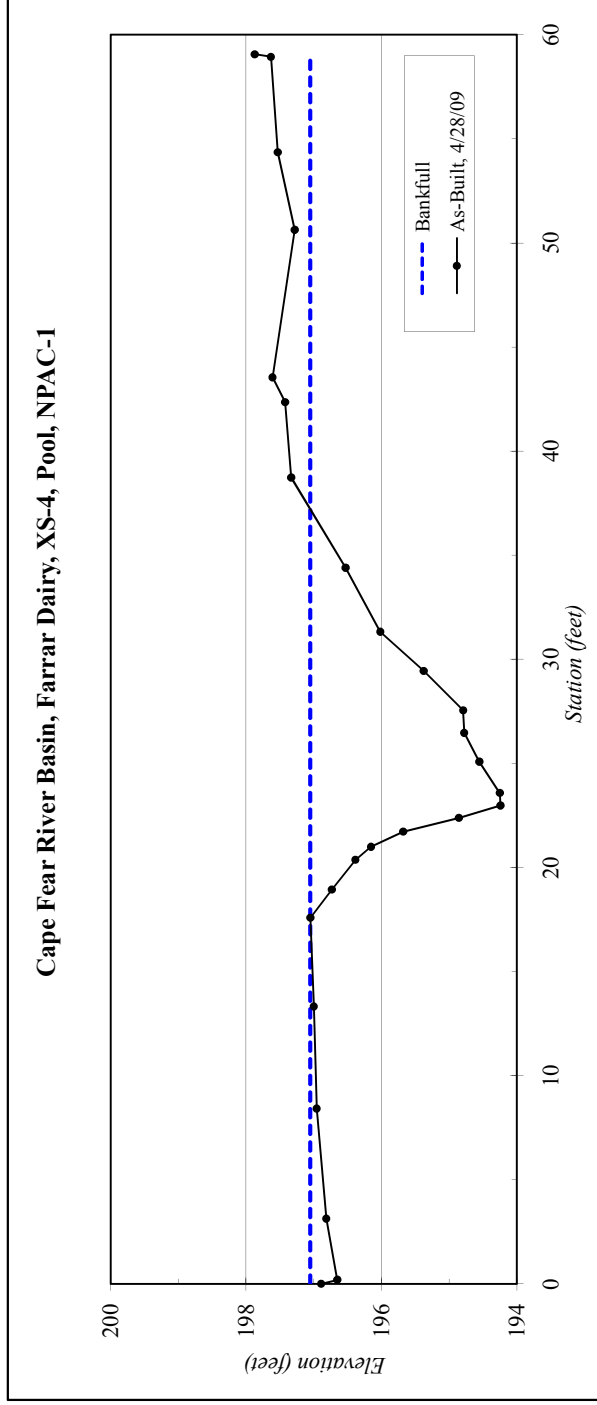

River Basin:	Cape Fear
Watershed:	Farrar Dairy
XS ID	XS-5, Riffle, NPAC-1
Drainage Area (sq mi):	4.10
Date:	4/28/2009
Field Crew:	B. Roberts, A. Davis

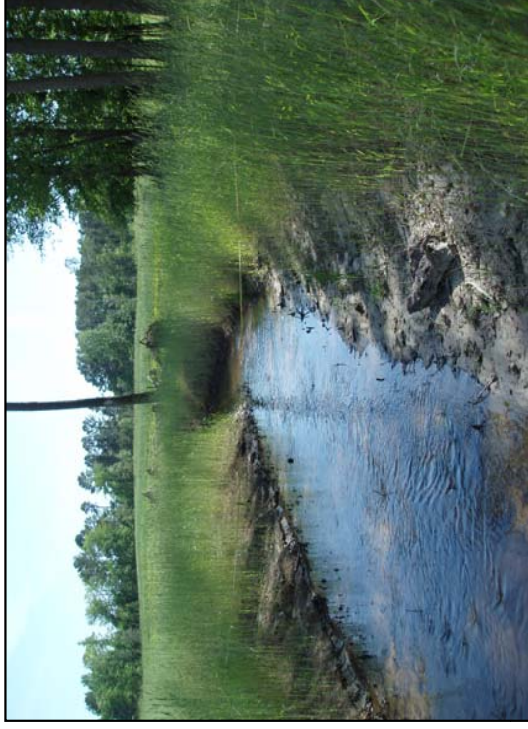


Stream Type C5

SUMMARY DATA	
Bankfull Elevation:	195.5
Bankfull Cross-Sectional Area:	26.5
Bankfull Width:	18.4
Flood Prone Area Elevation:	197.7
Flood Prone Width:	>60
Max Depth at Bankfull:	2.3
Mean Depth at Bankfull:	1.4
W / D Ratio:	12.8
Entrenchment Ratio:	>3.0
Bank Height Ratio:	1.0

Station	Elevation
0.0	195.99
0.8	195.55
5.5	195.04
7.4	195.29
9.4	195.36
11.2	195.57
14.3	195.52
16.8	195.67
20.5	195.45
21.8	195.09
23.5	194.53
24.9	194.07
26.0	193.52
27.8	193.38
30.0	193.16
32.1	193.22
33.4	193.51
34.8	193.83
36.7	194.50
38.6	195.38
40.6	195.92
44.8	195.90
50.3	195.96
55.2	195.96
56.5	195.93
56.6	196.25

Cape Fear River Basin, Farrar Dairy, XS-5, Riffle, NPAC-1

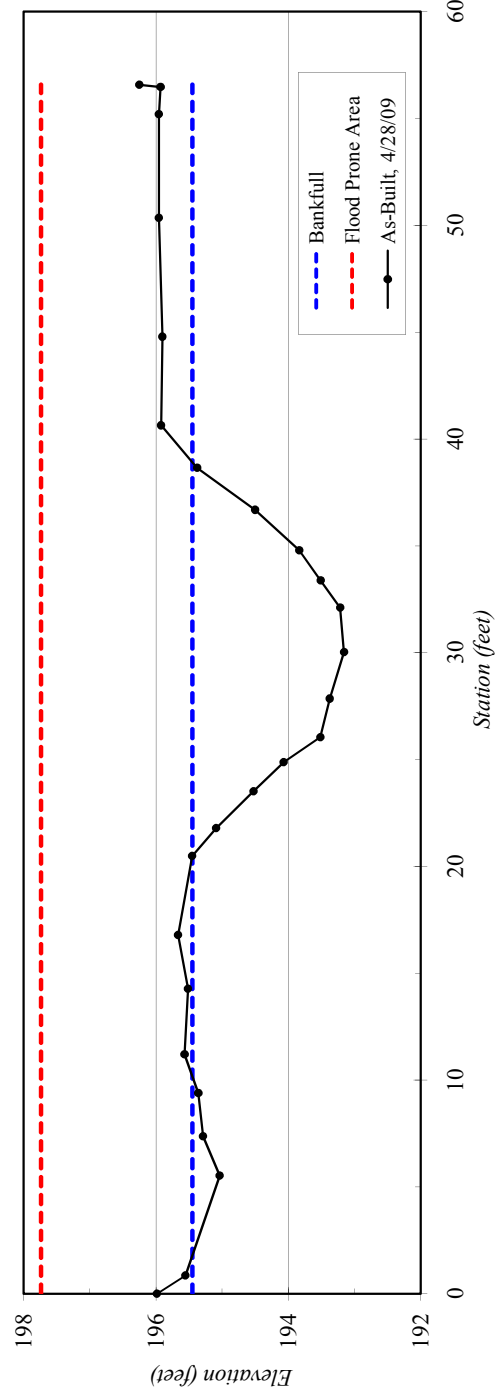


River Basin:	Cape Fear
Watershed:	Farrar Dairy
XS ID	XS-6, Pool, NPAC-1
Drainage Area (sq mi):	4.1
Date:	5/8/2009
Field Crew:	A. French, K. O'Briant



Stream Type C5

SUMMARY DATA	
Bankfull Elevation:	194.5
Bankfull Cross-Sectional Area:	26.6
Bankfull Width:	20.4
Flood Prone Area Elevation:	-
Flood Prone Width:	-
Max Depth at Bankfull:	3.0
Mean Depth at Bankfull:	1.3
W / D Ratio:	-
Entrenchment Ratio:	-
Bank Height Ratio:	-

Station	Elevation
0.0	194.68
0.5	194.44
5.5	194.51
12.8	194.69
18.4	194.64
25.2	194.51
26.9	194.00
28.4	193.42
29.8	192.80
30.4	192.08
31.2	191.64
31.8	191.49
32.4	191.68
33.4	192.10
35.0	192.28
36.5	192.81
38.1	192.96
39.6	193.71
41.9	193.96
44.5	194.43
47.1	194.63
51.6	194.60
58.2	194.65
66.4	194.49
67.0	194.83

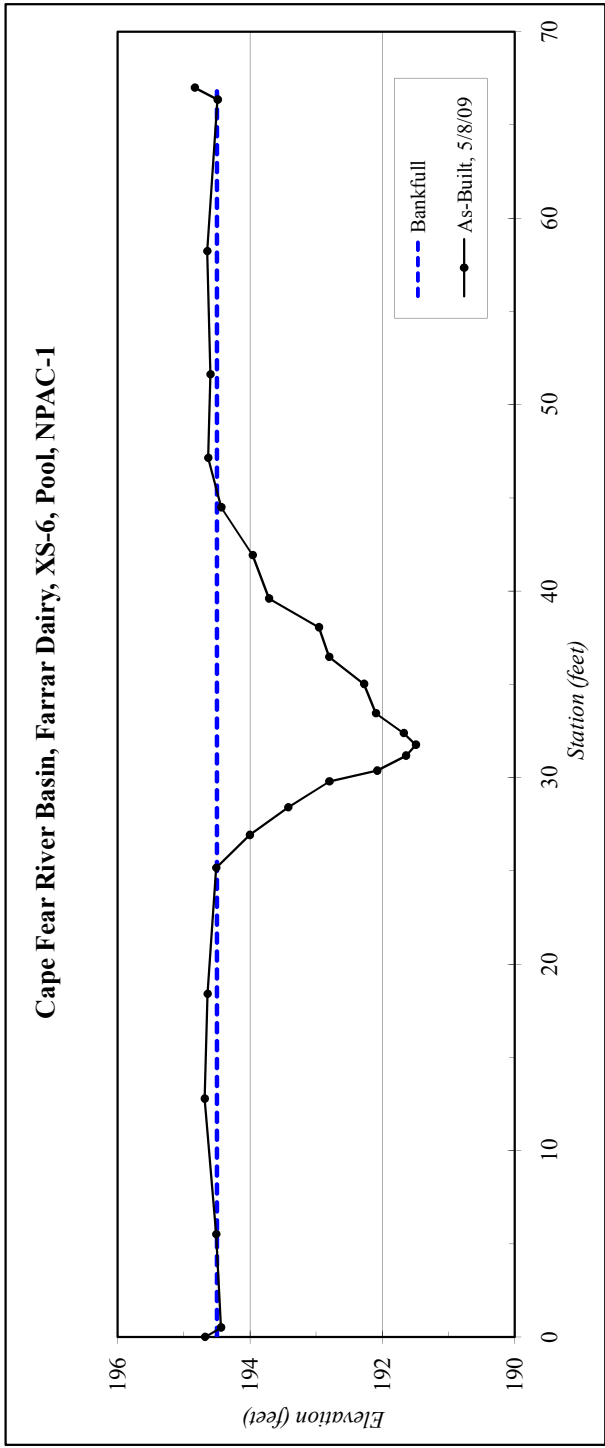


River Basin:	Cape Fear
Watershed:	Farrar Dairy
XS ID	XS-7, Riffle, NPAC-1
Drainage Area (sq mi):	4.1
Date:	5/8/2009
Field Crew:	A. French, K. O'Briant



Stream Type C5

SUMMARY DATA	
Bankfull Elevation:	193.4
Bankfull Cross-Sectional Area:	32.2
Bankfull Width:	20.7
Flood Prone Area Elevation:	196.1
Flood Prone Width:	>60
Max Depth at Bankfull:	2.7
Mean Depth at Bankfull:	1.6
W / D Ratio:	13.3
Entrenchment Ratio:	>3.0
Bank Height Ratio:	1.0

Station	Elevation
0.0	193.42
0.6	192.96
9.7	193.22
14.8	193.16
17.8	193.41
19.6	192.92
21.6	192.34
24.0	191.65
26.1	191.21
27.9	190.88
29.1	190.71
30.3	190.86
32.1	190.93
33.6	191.40
35.7	192.39
37.6	193.17
38.8	193.49
41.6	193.58
48.2	193.61
53.4	193.63
58.0	193.68
58.6	194.05

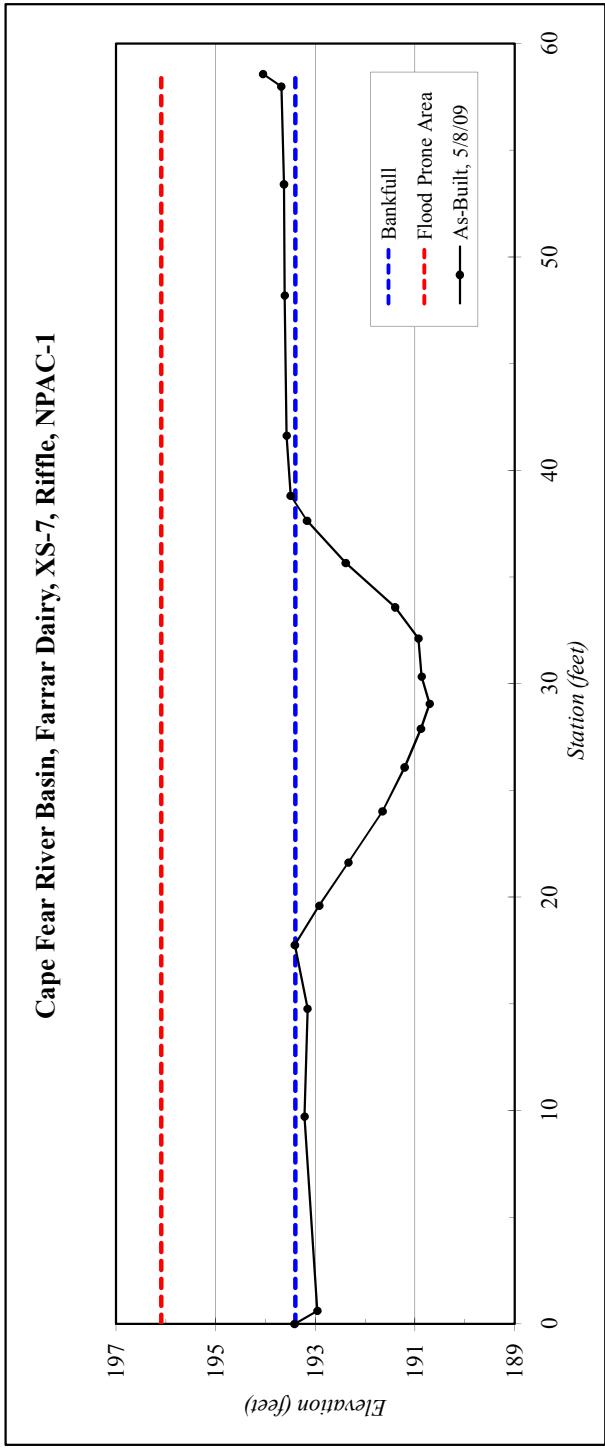


River Basin:	Cape Fear
Watershed:	Farrar Dairy
XS ID	XS-8, Riffle, NPAC-2
Drainage Area (sq mi):	4.1
Date:	5/8/2009
Field Crew:	A. French, K. O'Briant



Stream Type C5

SUMMARY DATA	
Bankfull Elevation:	191.4
Bankfull Cross-Sectional Area:	35.9
Bankfull Width:	19.5
Flood Prone Area Elevation:	194.9
Flood Prone Width:	>60
Max Depth at Bankfull:	3.4
Mean Depth at Bankfull:	1.8
W / D Ratio:	10.6
Entrenchment Ratio:	>3.0
Bank Height Ratio:	1.0

Station	Elevation
0.0	191.94
0.5	191.38
3.3	191.05
7.5	191.38
12.7	191.37
18.1	191.48
22.2	191.48
24.2	190.72
26.8	189.64
28.4	189.15
28.8	188.84
29.7	188.61
31.1	188.23
31.9	188.03
32.7	188.14
33.9	188.51
35.3	188.77
36.4	189.00
37.0	189.64
38.6	190.33
40.0	190.95
41.8	191.44
46.0	191.38
50.4	191.33
54.0	191.31
54.6	191.62

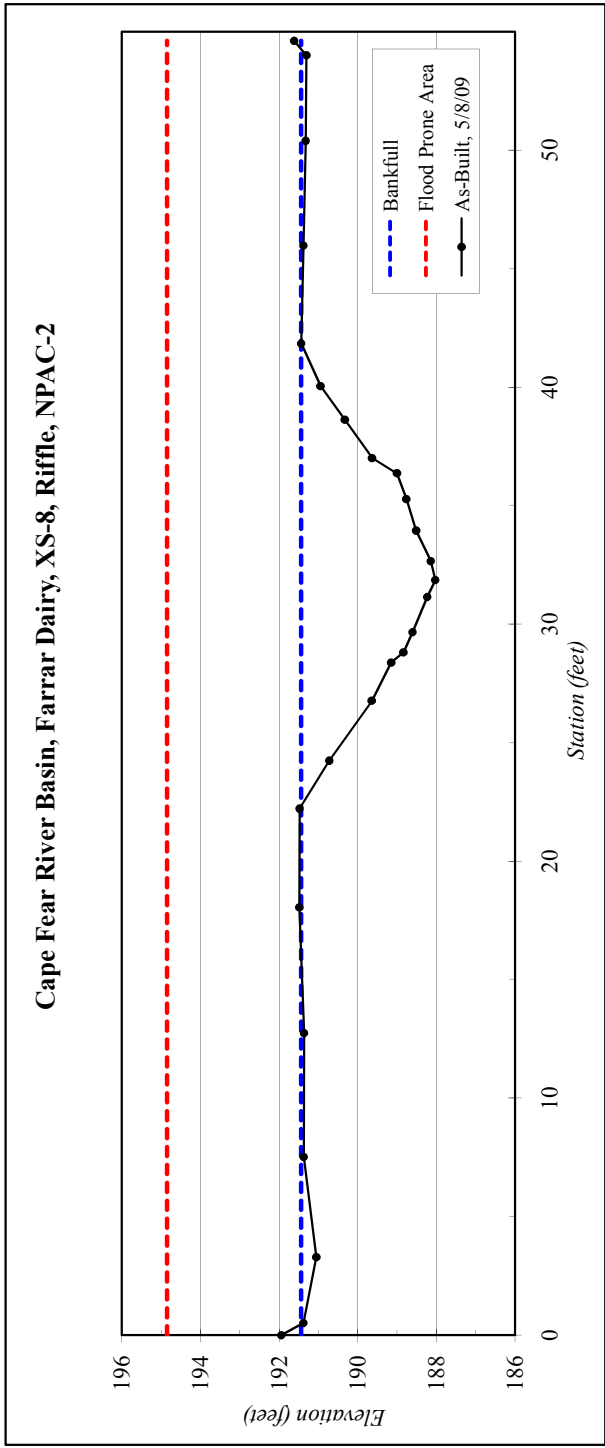


River Basin:	Cape Fear
Watershed:	Farrar Dairy
XS ID	XS-9_Pool, NPAC-2
Drainage Area (sq mi):	4.65
Date:	5/8/2009
Field Crew:	A. French, K. O'Briant



Stream Type C5

SUMMARY DATA	
Bankfull Elevation:	189.7
Bankfull Cross-Sectional Area:	36.0
Bankfull Width:	22.9
Flood Prone Area Elevation:	-
Flood Prone Width:	-
Max Depth at Bankfull:	3.4
Mean Depth at Bankfull:	1.6
W / D Ratio:	-
Entrenchment Ratio:	-
Bank Height Ratio:	-

Station	Elevation
0.0	189.78
0.5	189.46
5.9	189.49
12.3	189.56
17.7	189.66
20.7	189.21
23.6	188.91
26.7	188.46
28.7	187.83
30.8	187.30
31.8	186.87
33.2	186.67
35.0	186.42
35.9	186.24
37.2	186.84
38.6	188.55
39.9	189.36
41.0	189.81
44.8	189.82
52.2	189.78
60.2	189.78
60.8	189.95

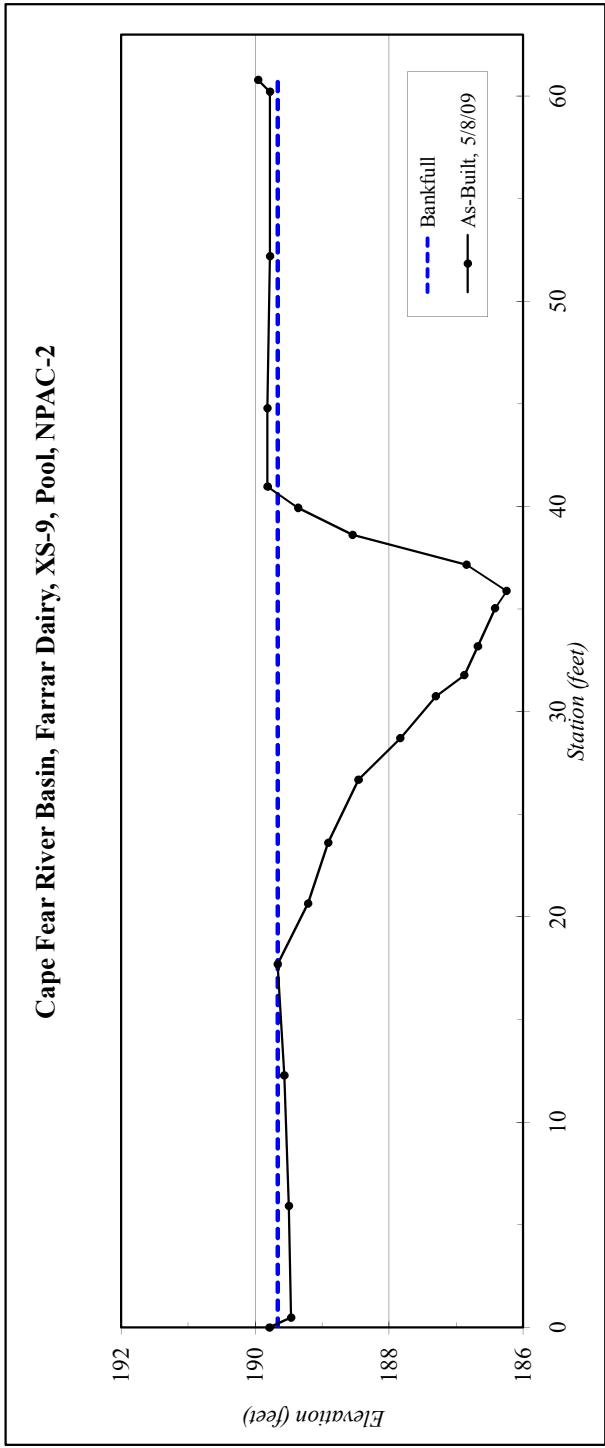

River Basin:	Cape Fear
Watershed:	Farrar Dairy
XS ID	XS-10, Riffle, NPAC-2
Drainage Area (sq mi):	4.65
Date:	5/8/2009
Field Crew:	A. French, K. O'Briant




Stream Type C5

SUMMARY DATA	
Bankfull Elevation:	189.3
Bankfull Cross-Sectional Area:	35.8
Bankfull Width:	22.6
Flood Prone Area Elevation:	192.1
Flood Prone Width:	>60
Max Depth at Bankfull:	2.7
Mean Depth at Bankfull:	1.6
W / D Ratio:	14.3
Entrenchment Ratio:	>3.0
Bank Height Ratio:	1.0

Station	Elevation
0.0	190.66
0.6	190.29
5.5	189.96
11.8	189.76
20.6	189.61
27.4	189.28
30.3	188.68
32.7	187.89
33.6	187.25
35.5	186.90
37.1	186.74
38.6	186.60
39.6	186.62
41.4	186.73
44.1	187.14
44.2	187.60
46.1	188.26
48.7	189.34
52.3	189.33
57.9	189.32
65.9	189.30
66.5	189.59

Cape Fear River Basin, Farrar Dairy, XS-10, Riffle, NPAC-2

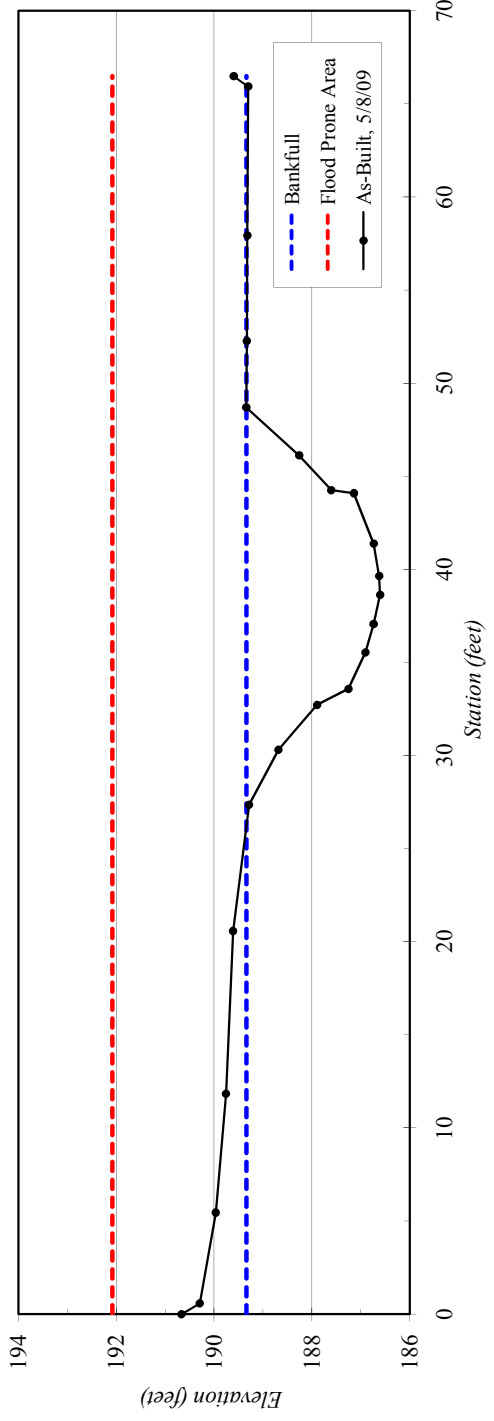

River Basin:	Cape Fear
Watershed:	Farrar Dairy
XS ID	XS-11, Riffle, NPAC-3
Drainage Area (sq mi):	4.82
Date:	5/18/2009
Field Crew:	A. French, K. O'Briant




Stream Type C5

SUMMARY DATA	
Bankfull Elevation:	189.1
Bankfull Cross-Sectional Area:	55.8
Bankfull Width:	24.2
Flood Prone Area Elevation:	192.6
Flood Prone Width:	>60
Max Depth at Bankfull:	3.6
Mean Depth at Bankfull:	2.3
W / D Ratio:	10.5
Entrenchment Ratio:	>3.0
Bank Height Ratio:	1.0

Station	Elevation
0.0	189.23
0.4	188.99
8.8	188.71
18.1	189.00
24.9	189.06
26.9	189.08
29.1	188.32
31.1	187.66
32.9	186.70
34.4	185.71
35.8	185.64
38.0	185.73
40.2	185.77
41.9	185.63
43.4	185.55
44.4	185.48
45.3	185.86
46.6	186.84
48.2	187.64
49.8	188.37
51.0	189.05
58.6	189.18
66.6	189.35
72.5	189.55
73.6	189.82

Cape Fear River Basin, Farrar Dairy, XS-11, Riffle, NPAC-3

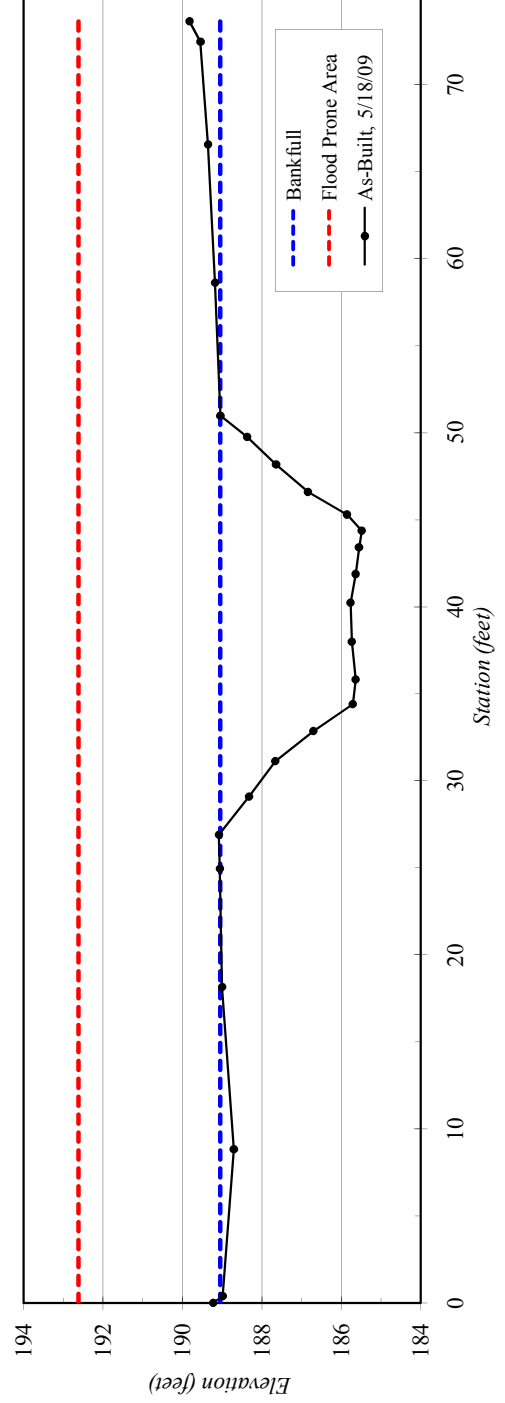


River Basin:	Cape Fear
Watershed:	Farrar Dairy
XS ID	XS-12, Pool, NPAC-3
Drainage Area (sq mi):	4.82
Date:	5/18/2009
Field Crew:	A. French, K. O'Briant



Stream Type C5

SUMMARY DATA	
Bankfull Elevation:	188.2
Bankfull Cross-Sectional Area:	42.0
Bankfull Width:	22.3
Flood Prone Area Elevation:	-
Flood Prone Width:	-
Max Depth at Bankfull:	3.2
Mean Depth at Bankfull:	1.9
W / D Ratio:	-
Entrenchment Ratio:	-
Bank Height Ratio:	-

Station	Elevation
0.0	189.00
0.3	188.61
6.7	188.68
11.5	188.59
16.0	188.34
20.3	188.18
21.2	187.60
22.7	186.83
23.6	186.25
24.6	185.55
25.2	185.02
25.7	185.14
26.4	185.30
28.4	185.42
31.5	185.56
33.7	185.59
36.1	185.82
37.0	186.61
37.8	186.84
39.1	187.33
40.7	187.85
42.3	188.25
46.5	188.17
49.8	187.96
52.5	188.07
55.3	188.21
59.7	188.35
62.1	188.58
62.7	188.92

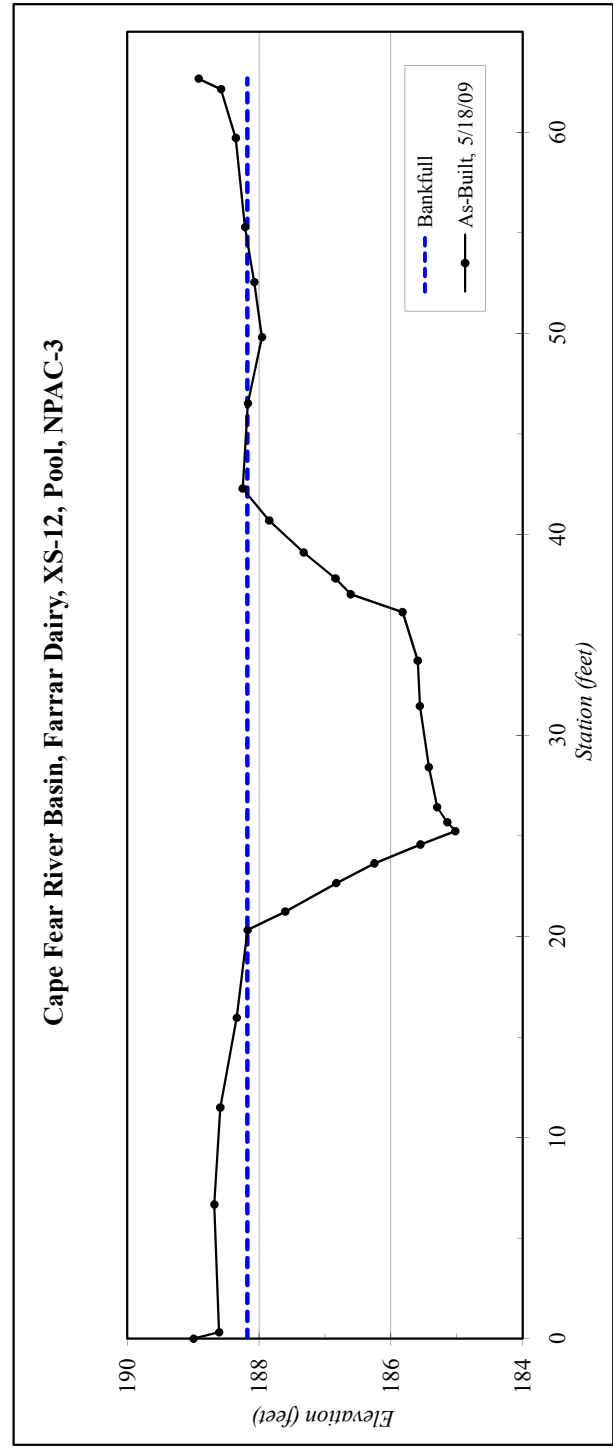


River Basin:	Cape Fear
Watershed:	Farrar Dairy
XS ID	XS-13, Riffle, T1.1
Drainage Area (sq mi):	0.02
Date:	4/29/2009
Field Crew:	A. French, B. Roberts



Stream Type C5

SUMMARY DATA		
Bankfull Elevation:		218.9
Bankfull Cross-Sectional Area:		2.4
Bankfull Width:		6.9
Flood Prone Area Elevation:		219.6
Flood Prone Width:		15.9
Max Depth at Bankfull:		0.7
Mean Depth at Bankfull:		0.3
W / D Ratio:		19.8
Entrenchment Ratio:		2.3
Bank Height Ratio:		1.0

Station	Elevation
0.0	221.84
0.2	221.65
3.7	221.16
7.1	220.56
10.5	219.84
11.8	219.39
13.0	219.07
14.5	218.92
15.6	218.66
16.5	218.44
16.7	218.33
17.2	218.25
17.6	218.11
18.2	218.24
18.8	218.34
19.8	218.60
21.6	218.86
24.0	218.98
26.7	219.55
30.7	220.27
35.4	220.81
40.2	221.07
42.9	221.18
43.1	221.43

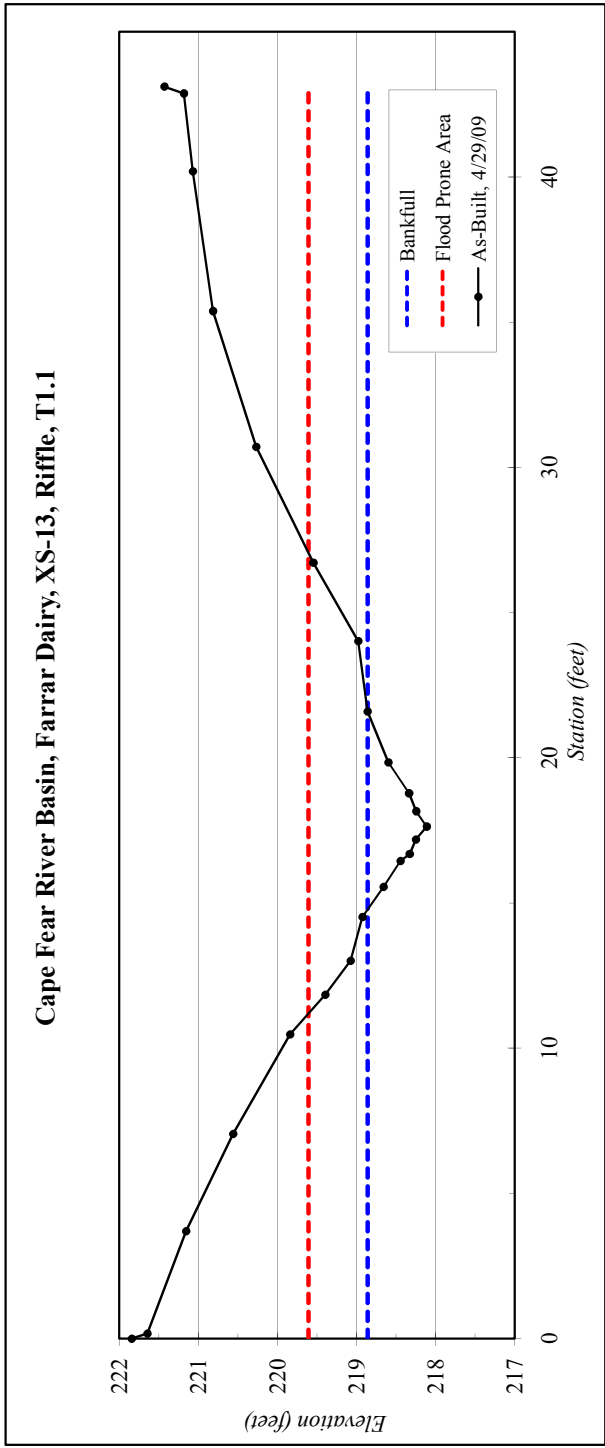


River Basin:	Cape Fear
Watershed:	Farrar Dairy
XS ID	XS-14, Pool, T1.1
Drainage Area (sq mi):	0.02
Date:	4/29/2009
Field Crew:	A. French, B. Roberts



Stream Type C5

SUMMARY DATA	
Bankfull Elevation:	215.6
Bankfull Cross-Sectional Area:	5.1
Bankfull Width:	7.1
Flood Prone Area Elevation:	-
Flood Prone Width:	-
Max Depth at Bankfull:	1.3
Mean Depth at Bankfull:	0.7
W / D Ratio:	-
Entrenchment Ratio:	-
Bank Height Ratio:	-

Station	Elevation
0.0	216.93
0.2	216.63
4.8	216.51
9.4	216.33
12.5	216.22
14.9	216.23
15.9	215.83
16.9	215.70
18.2	215.59
19.4	215.29
20.4	214.85
21.1	214.31
22.2	214.23
23.2	214.39
24.1	215.04
25.0	215.51
26.1	215.75
28.6	215.78
30.2	216.35
33.1	216.95
37.8	217.18
42.2	217.23
45.4	217.36
45.7	217.74

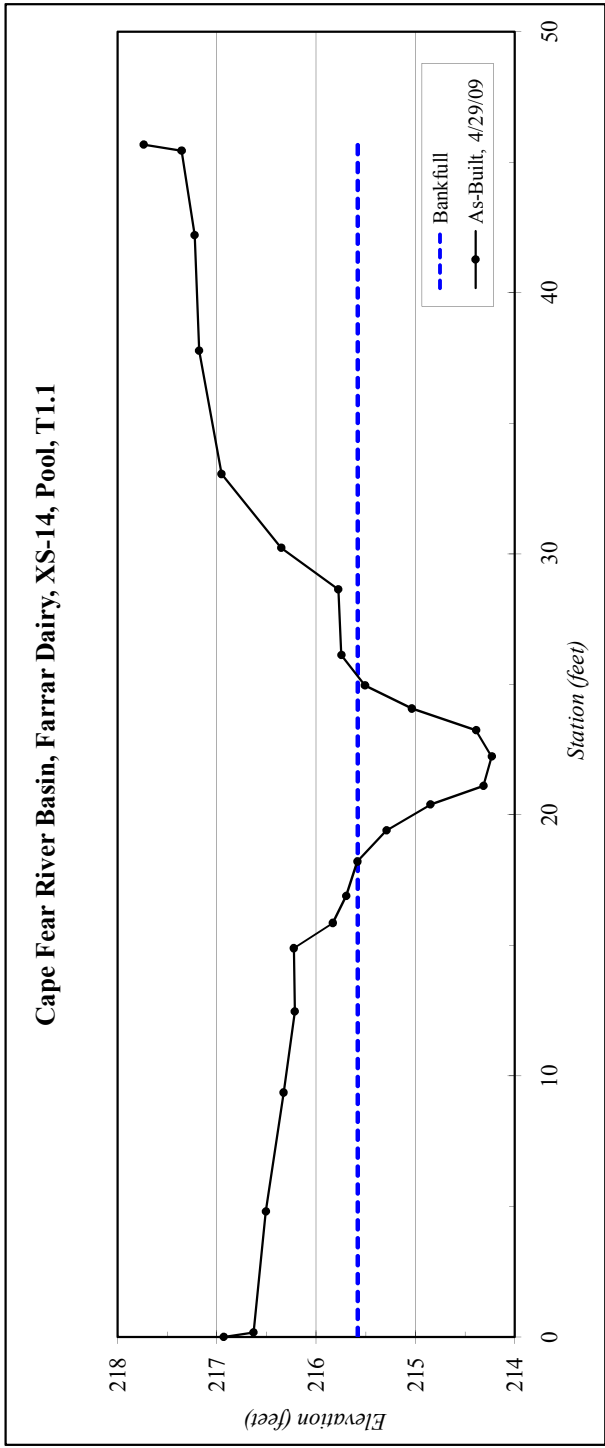


River Basin:	Cape Fear
Watershed:	Farrar Dairy
XS ID	XS-15, Riffle, T1.1
Drainage Area (sq mi):	0.02
Date:	4/29/2009
Field Crew:	A. French, B. Roberts



Stream Type C5

SUMMARY DATA	
Bankfull Elevation:	213.7
Bankfull Cross-Sectional Area:	2.3
Bankfull Width:	5.9
Flood Prone Area Elevation:	214.3
Flood Prone Width:	29
Max Depth at Bankfull:	0.6
Mean Depth at Bankfull:	0.4
W / D Ratio:	15.1
Entrenchment Ratio:	4.9
Bank Height Ratio:	1.0

Station	Elevation
0.0	214.25
0.2	213.96
5.0	214.03
10.1	213.91
13.9	214.30
15.4	214.07
16.2	213.85
17.8	213.82
18.8	213.54
20.0	213.09
20.6	213.05
21.1	213.06
21.7	213.09
22.5	213.21
23.5	213.50
24.2	213.69
26.2	213.79
28.3	214.18
30.6	214.54
35.5	215.12
40.7	215.49
45.1	215.37
48.4	215.28
48.9	215.59

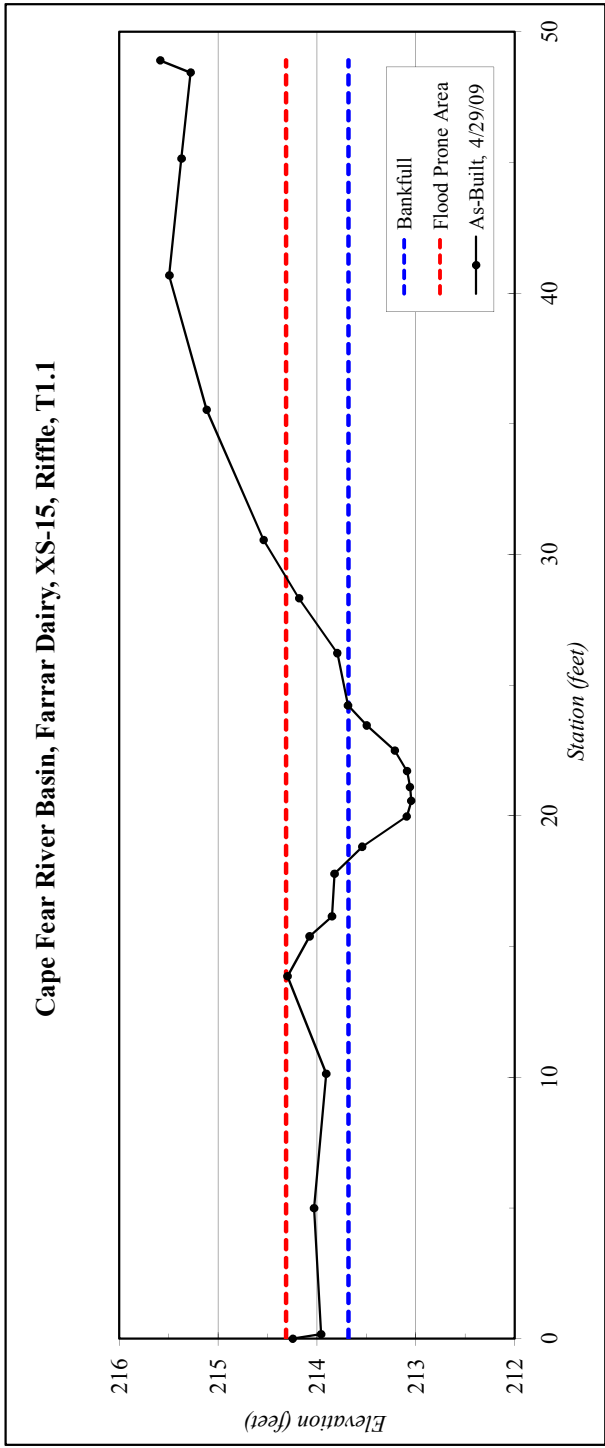


River Basin:	Cape Fear
Watershed:	Farrar Dairy
XS ID	XS-16, Pool, T1.2
Drainage Area (sq mi):	0.10
Date:	4/29/2009
Field Crew:	A. French, B. Roberts



Stream Type C5

SUMMARY DATA	
Bankfull Elevation:	219.6
Bankfull Cross-Sectional Area:	6.4
Bankfull Width:	8.9
Flood Prone Area Elevation:	-
Flood Prone Width:	-
Max Depth at Bankfull:	1.6
Mean Depth at Bankfull:	0.7
W / D Ratio:	-
Entrenchment Ratio:	-
Bank Height Ratio:	-

Station	Elevation
0.0	220.78
0.3	220.46
4.9	220.39
8.9	220.38
13.3	220.34
17.5	220.11
19.9	219.79
21.0	219.57
21.9	219.43
23.2	218.91
24.1	218.80
24.9	218.74
25.6	218.36
26.3	218.06
26.8	218.27
27.7	218.79
28.6	219.18
29.5	219.64
31.1	219.83
33.7	220.32
36.4	220.84
40.0	221.07
43.7	221.07

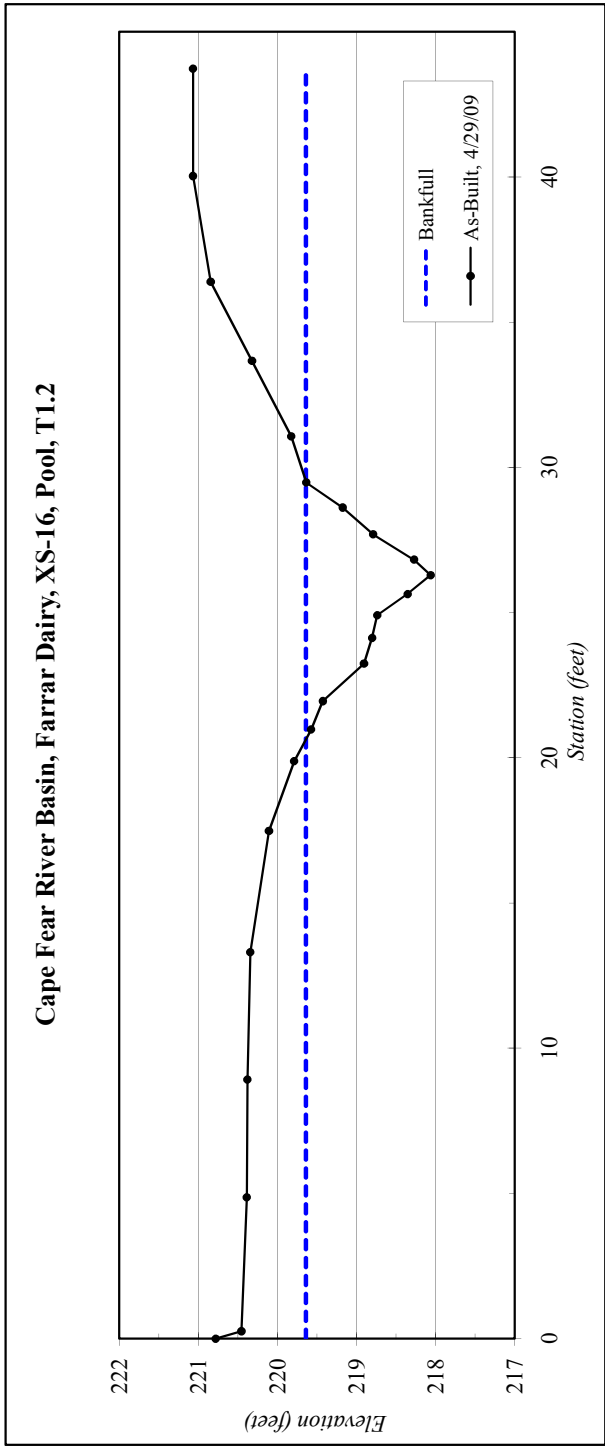


River Basin:	Cape Fear
Watershed:	Farrar Dairy
XS ID	XS-17, Riffle, T1.2
Drainage Area (sq mi):	0.10
Date:	4/29/2009
Field Crew:	A. French, B. Roberts



Stream Type C5

SUMMARY DATA	
Bankfull Elevation:	216.4
Bankfull Cross-Sectional Area:	5.7
Bankfull Width:	8.3
Flood Prone Area Elevation:	217.6
Flood Prone Width:	45.9
Max Depth at Bankfull:	1.2
Mean Depth at Bankfull:	0.7
W / D Ratio:	12.1
Entrenchment Ratio:	5.5
Bank Height Ratio:	1.0

Station	Elevation
0.0	218.77
0.2	218.43
2.1	218.47
4.6	218.19
7.1	217.60
9.7	216.93
12.3	216.71
14.7	216.53
16.5	216.15
17.3	215.78
18.3	215.40
19.1	215.17
20.0	215.31
20.8	215.45
21.5	215.56
22.5	215.94
23.6	216.42
25.5	216.61
28.8	216.88
32.8	217.08
38.7	217.18
44.5	217.30
49.2	217.55
52.8	217.64
53.0	217.94

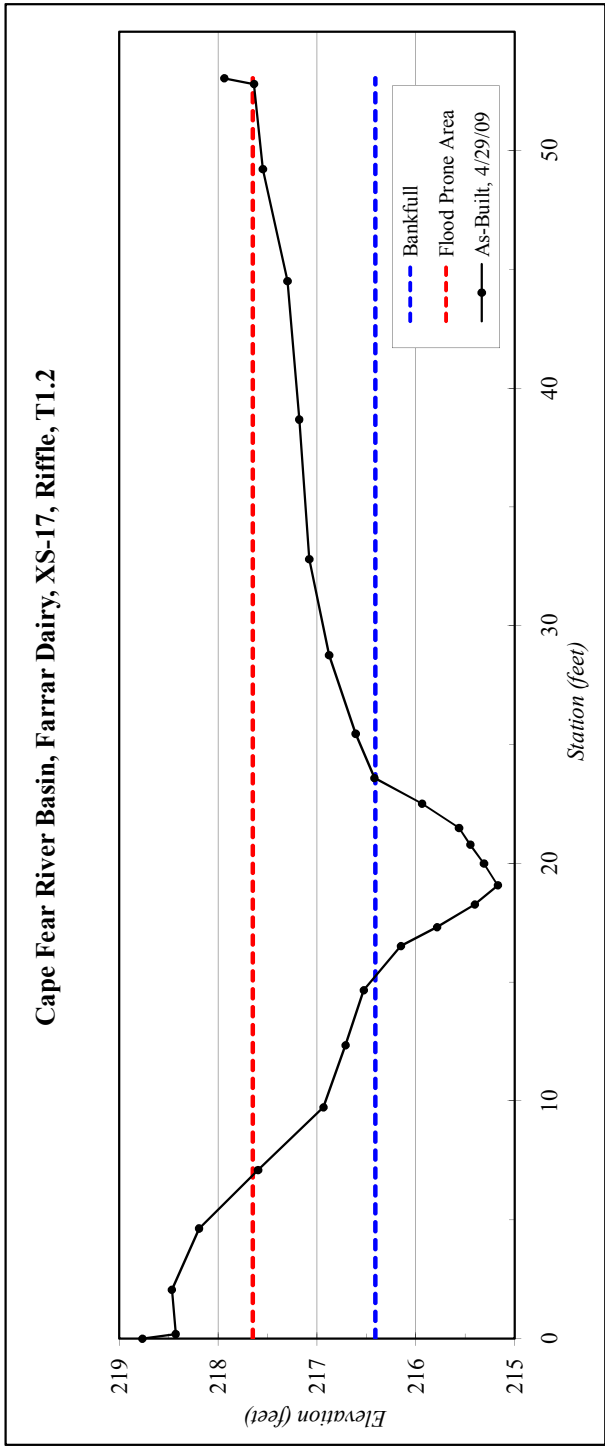


River Basin:	Cape Fear
Watershed:	Farrar Dairy
XS ID	XS-18, Riffle, T1.2
Drainage Area (sq mi):	0.10
Date:	4/29/2009
Field Crew:	A. French, B. Roberts



Stream Type E5

SUMMARY DATA	
Bankfull Elevation:	212.0
Bankfull Cross-Sectional Area:	5.2
Bankfull Width:	6.9
Flood Prone Area Elevation:	213.3
Flood Prone Width:	26
Max Depth at Bankfull:	1.2
Mean Depth at Bankfull:	0.8
W / D Ratio:	9.2
Entrenchment Ratio:	3.8
Bank Height Ratio:	1.0

Station	Elevation
0.0	215.37
0.2	215.01
2.3	214.82
4.3	214.13
7.6	213.46
10.7	212.71
11.8	212.31
13.9	212.27
15.0	212.02
16.0	211.65
16.8	211.06
17.6	210.82
18.4	210.80
19.3	210.85
19.7	210.90
20.5	211.42
21.7	212.05
23.5	212.31
26.1	212.43
28.7	212.92
32.7	213.08
36.2	213.51
38.4	213.58
38.6	213.85

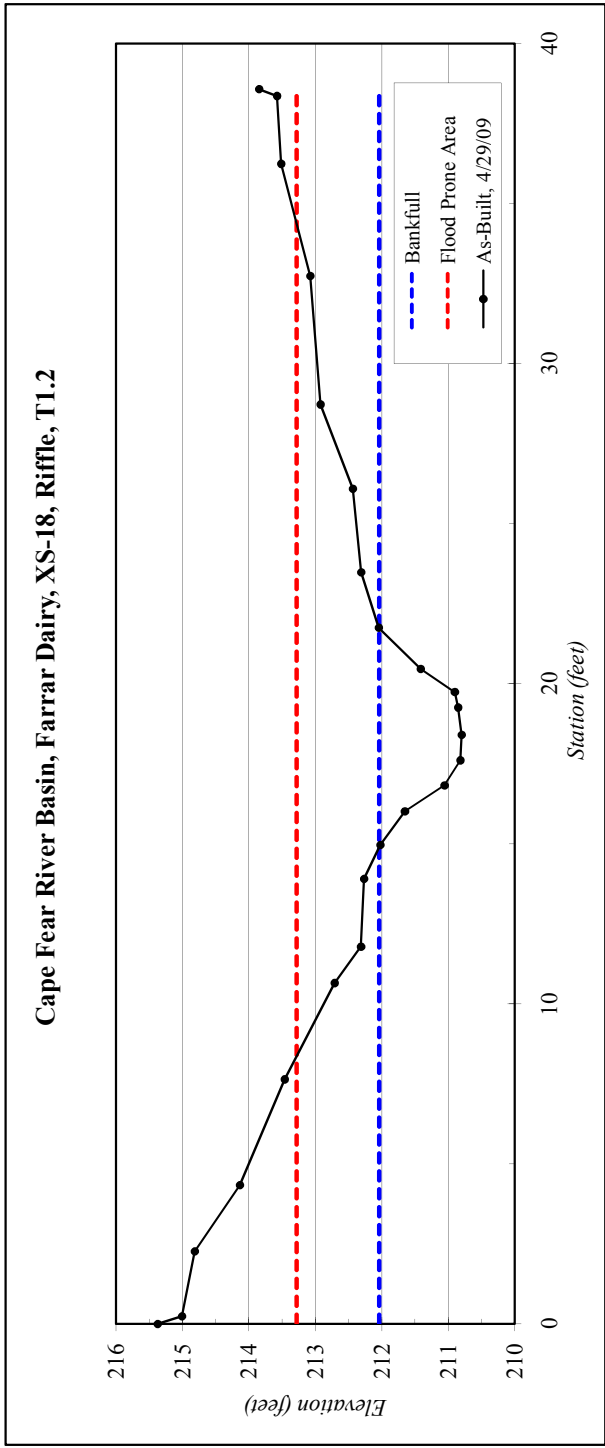


River Basin:	Cape Fear
Watershed:	Farrar Dairy
XS ID	XS-19, Pool, T1
Drainage Area (sq mi):	0.18
Date:	4/30/2009
Field Crew:	A. French, B. Roberts



Stream Type E5

SUMMARY DATA	
Bankfull Elevation:	203.2
Bankfull Cross-Sectional Area:	10.9
Bankfull Width:	9.5
Flood Prone Area Elevation:	-
Flood Prone Width:	-
Max Depth at Bankfull:	2.4
Mean Depth at Bankfull:	1.1
W / D Ratio:	-
Entrenchment Ratio:	-
Bank Height Ratio:	-

Station	Elevation
0.0	204.35
0.2	203.96
7.2	203.44
14.6	203.38
23.0	203.24
25.5	203.23
26.9	202.60
28.0	201.83
28.7	201.23
29.3	200.87
30.1	200.84
30.6	201.19
31.2	201.51
32.5	202.20
34.2	202.99
36.1	203.50
38.6	203.37
43.5	203.53
47.0	203.58
50.8	203.66
53.6	203.82
53.9	204.16

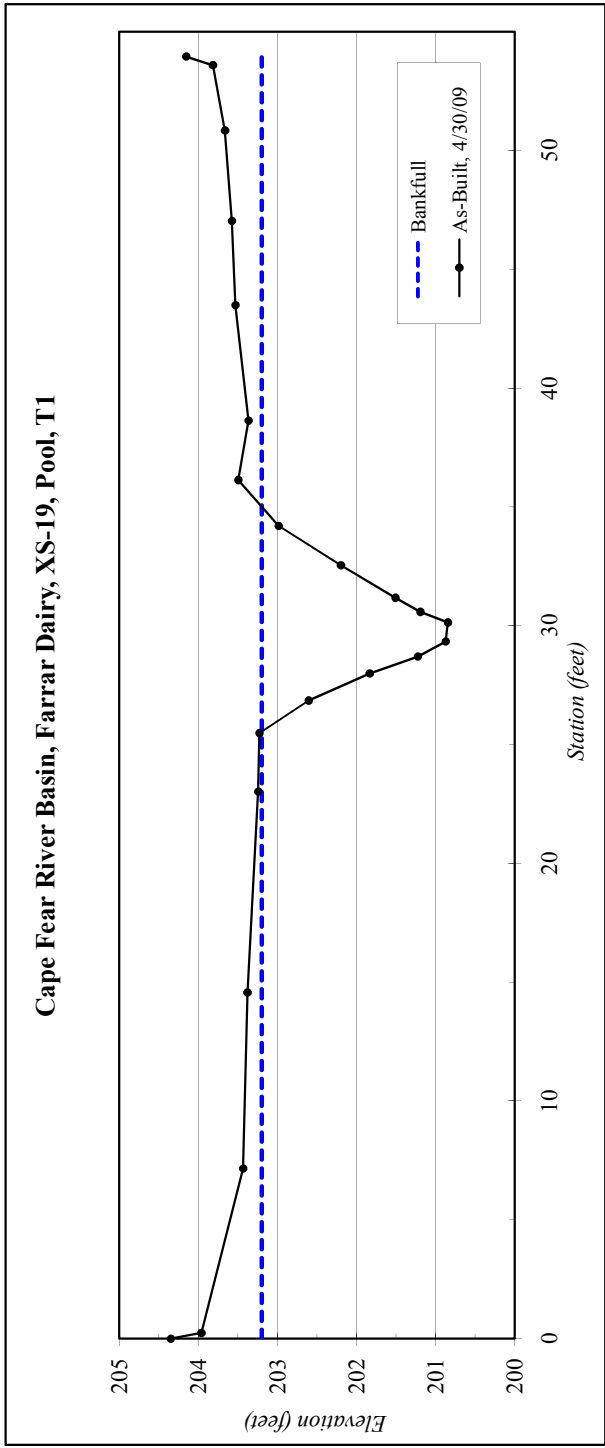


River Basin:	Cape Fear
Watershed:	Farrar Dairy
XS ID	XS-20, Riffle, T1
Drainage Area (sq mi):	0.18
Date:	4/30/2009
Field Crew:	A. French, B. Roberts



Stream Type E5

SUMMARY DATA	
Bankfull Elevation:	201.0
Bankfull Cross-Sectional Area:	9.7
Bankfull Width:	10.3
Flood Prone Area Elevation:	202.9
Flood Prone Width:	>60
Max Depth at Bankfull:	1.9
Mean Depth at Bankfull:	0.9
W / D Ratio:	10.9
Entrenchment Ratio:	>3.0
Bank Height Ratio:	1.0

Station	Elevation
0.0	201.90
0.2	201.62
4.3	201.51
8.9	201.40
11.7	201.35
13.3	201.09
15.6	201.05
16.9	200.85
18.2	200.42
19.4	199.79
20.0	199.42
20.8	199.24
21.3	199.10
21.9	199.11
22.5	199.16
23.7	200.07
24.8	200.52
26.3	200.99
28.4	201.16
30.5	201.35
34.3	201.33
40.1	201.10
43.3	201.53
43.6	201.93

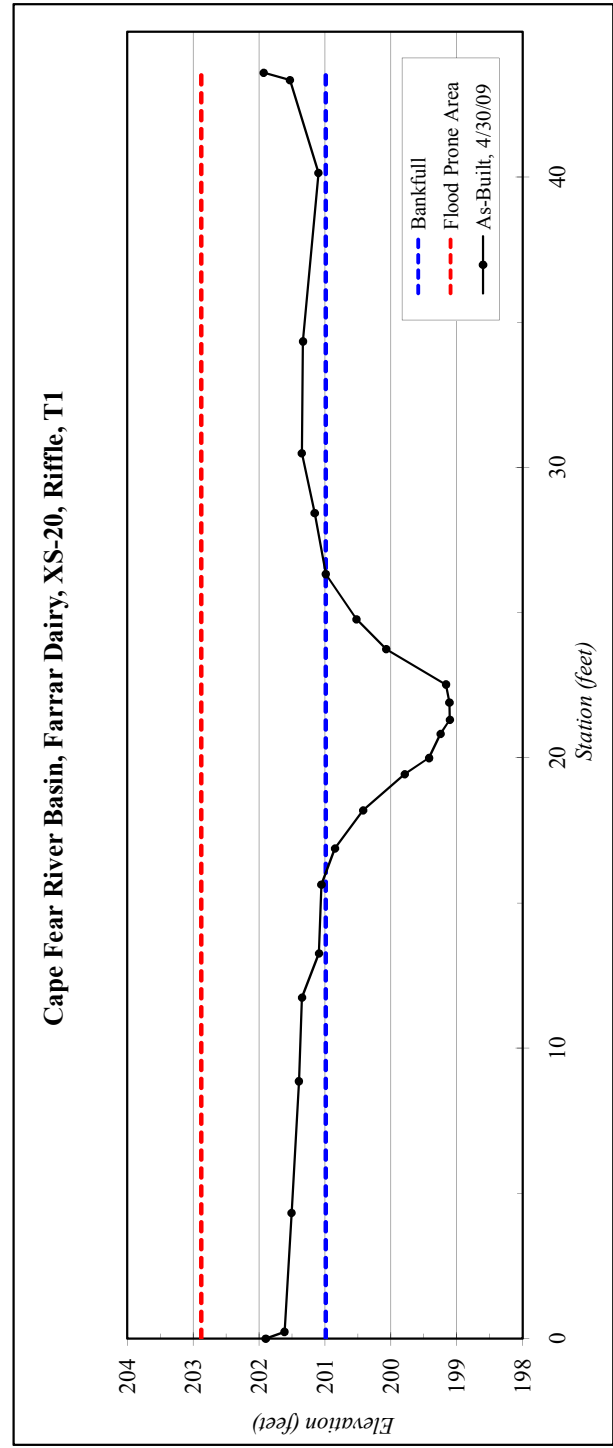


River Basin:	Cape Fear
Watershed:	Farrar Dairy
XS ID	XS-21, Riffle, T1
Drainage Area (sq mi):	0.18
Date:	4/28/2009
Field Crew:	B. Roberts, A. Davis



Stream Type E5

SUMMARY DATA	
Bankfull Elevation:	198.3
Bankfull Cross-Sectional Area:	8.2
Bankfull Width:	8.6
Flood Prone Area Elevation:	200.0
Flood Prone Width:	>60
Max Depth at Bankfull:	1.7
Mean Depth at Bankfull:	1.0
W / D Ratio:	9.0
Entrenchment Ratio:	>3.0
Bank Height Ratio:	1.0

Station	Elevation
0.0	198.58
1.1	198.53
4.4	198.66
7.6	198.52
10.8	198.48
13.1	198.52
15.1	198.52
16.5	198.47
18.0	197.81
18.8	197.47
19.3	197.06
20.3	197.01
21.1	196.87
21.4	196.64
22.5	196.79
22.9	196.88
23.4	197.46
24.5	197.83
25.5	198.33
26.6	198.46
28.5	198.44
31.4	198.70
34.0	198.70
36.8	198.63
40.1	198.75
42.9	198.73
44.0	199.09

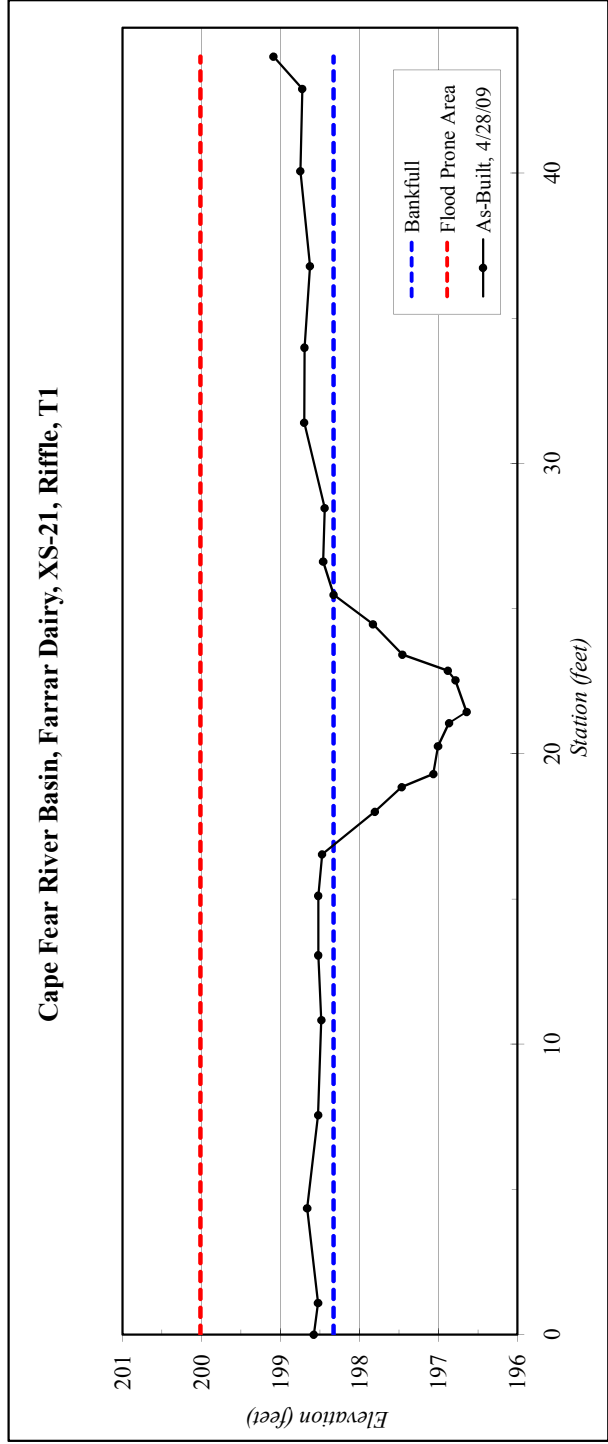


River Basin:	Cape Fear
Watershed:	Farrar Dairy
XS ID	XS-22, Pool, T2A
Drainage Area (sq mi):	0.04
Date:	5/8/2009
Field Crew:	A. French, K. O'Briant



Stream Type E5

SUMMARY DATA	
Bankfull Elevation:	203.2
Bankfull Cross-Sectional Area:	5.1
Bankfull Width:	7.5
Flood Prone Area Elevation:	-
Flood Prone Width:	-
Max Depth at Bankfull:	1.1
Mean Depth at Bankfull:	0.7
W / D Ratio:	-
Entrenchment Ratio:	-
Bank Height Ratio:	-

Station	Elevation
0.0	203.86
0.5	203.49
3.1	203.57
4.8	203.35
7.0	203.38
8.3	203.23
9.1	202.99
10.0	202.53
10.9	202.14
11.9	202.12
13.1	202.11
14.0	202.48
14.7	202.79
15.8	203.21
17.2	203.30
19.6	203.54
23.8	203.43
27.5	203.64
27.9	203.97

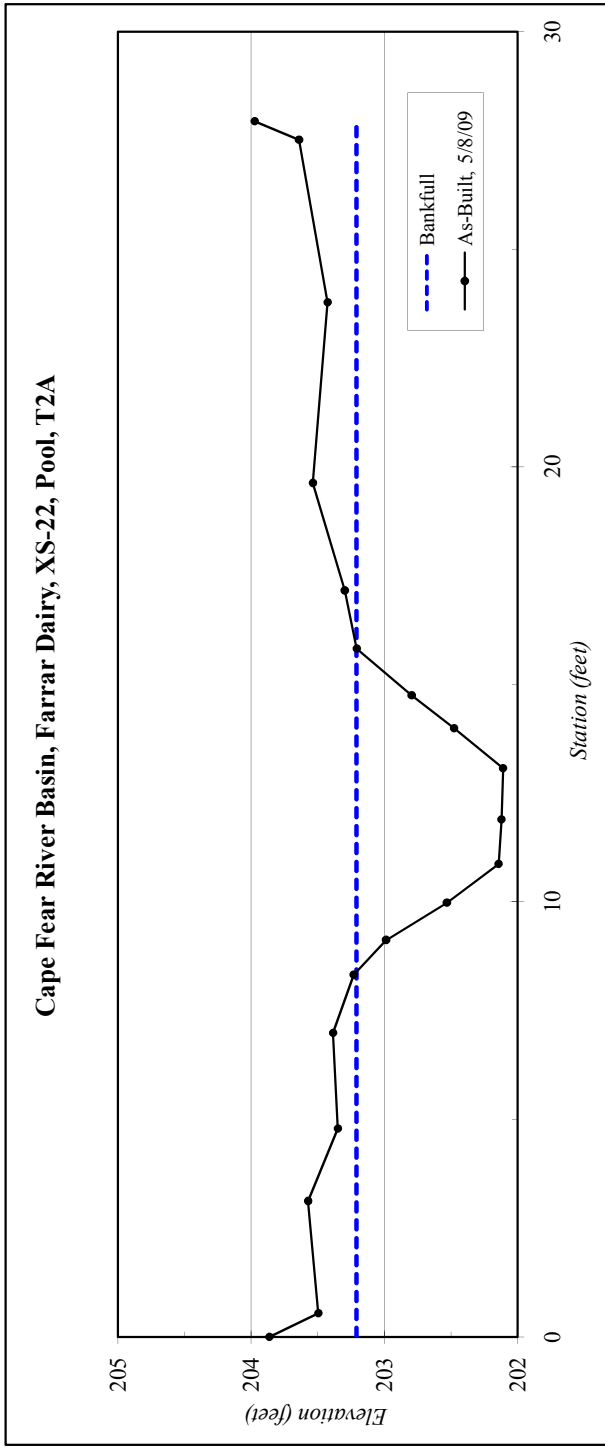

River Basin:	Cape Fear
Watershed:	Farrar Dairy
XS ID	XS-23, Riffle, T2A
Drainage Area (sq mi):	0.04
Date:	5/8/2009
Field Crew:	A. French, K. O'Briant




Stream Type E5

SUMMARY DATA	
Bankfull Elevation:	199.0
Bankfull Cross-Sectional Area:	2.8
Bankfull Width:	5.7
Flood Prone Area Elevation:	199.8
Flood Prone Width:	30
Max Depth at Bankfull:	0.8
Mean Depth at Bankfull:	0.5
W / D Ratio:	11.6
Entrenchment Ratio:	5.3
Bank Height Ratio:	1.0

Station	Elevation
0.0	200.06
0.8	199.71
6.3	199.50
10.2	199.09
12.5	199.12
13.8	199.02
14.5	198.65
15.0	198.39
15.6	198.27
16.3	198.23
16.9	198.23
17.8	198.48
19.0	198.94
20.5	199.21
21.9	199.53
25.8	199.78
28.2	199.64
30.7	199.53
31.0	199.87

Cape Fear River Basin, Farrar Dairy, XS-23, Riffle, T2A

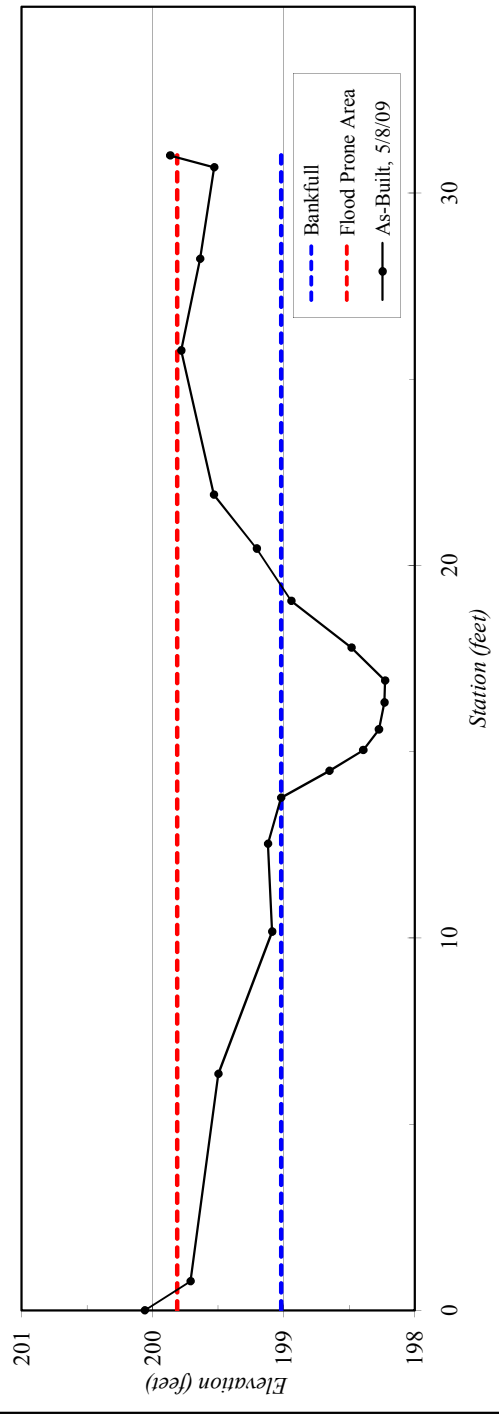


River Basin:	Cape Fear
Watershed:	Farrar Dairy
XS ID	XS-24, Pool, T2B
Drainage Area (sq mi):	0.04
Date:	5/8/2009
Field Crew:	A. French, K. O'Briant



Station	Elevation
0.0	193.34
0.9	193.05
4.4	193.17
9.4	193.14
14.2	193.05
15.0	192.95
16.2	192.59
17.4	192.26
18.1	192.05
18.9	191.96
19.8	191.88
20.3	192.28
21.1	192.74
21.7	193.02
28.3	193.06
36.1	193.27
43.7	193.52
44.4	193.79

SUMMARY DATA	
Bankfull Elevation:	193.0
Bankfull Cross-Sectional Area:	4.2
Bankfull Width:	7.1
Flood Prone Area Elevation:	-
Flood Prone Width:	-
Max Depth at Bankfull:	1.1
Mean Depth at Bankfull:	0.6
W / D Ratio:	-
Entrenchment Ratio:	-
Bank Height Ratio:	-

Stream Type: E5

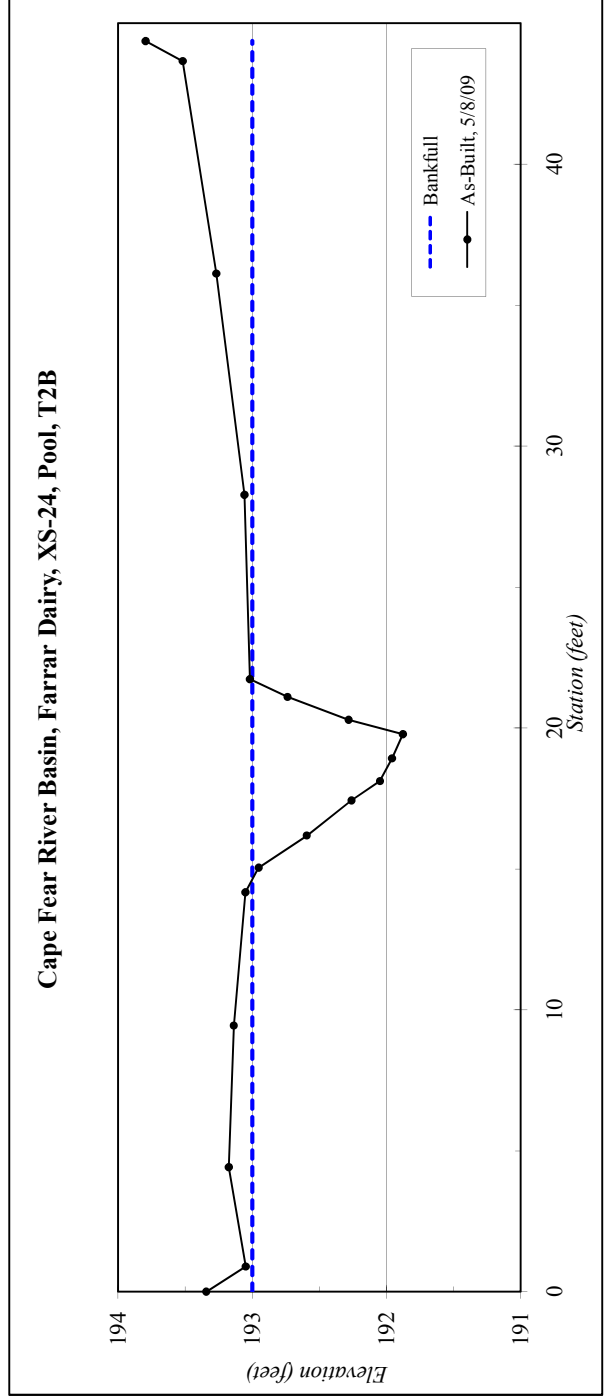


River Basin:	Cape Fear
Watershed:	Farrar Dairy
XS ID	XS-25, Riffle, T2B
Drainage Area (sq mi):	0.04
Date:	5/8/2009
Field Crew:	A. French, K. O'Briant



Stream Type E5

SUMMARY DATA	
Bankfull Elevation:	192.8
Bankfull Cross-Sectional Area:	2.5
Bankfull Width:	5.2
Flood Prone Area Elevation:	193.5
Flood Prone Width:	>60
Max Depth at Bankfull:	0.8
Mean Depth at Bankfull:	0.5
W / D Ratio:	10.8
Entrenchment Ratio:	>3.0
Bank Height Ratio:	1.0

Station	Elevation
0.0	193.00
0.9	192.70
8.0	192.80
15.2	192.85
19.0	192.84
19.5	192.62
20.4	192.28
21.1	192.10
21.7	192.00
22.6	192.12
23.6	192.32
24.4	192.77
27.9	192.84
33.8	192.85
39.2	192.63
39.9	192.86

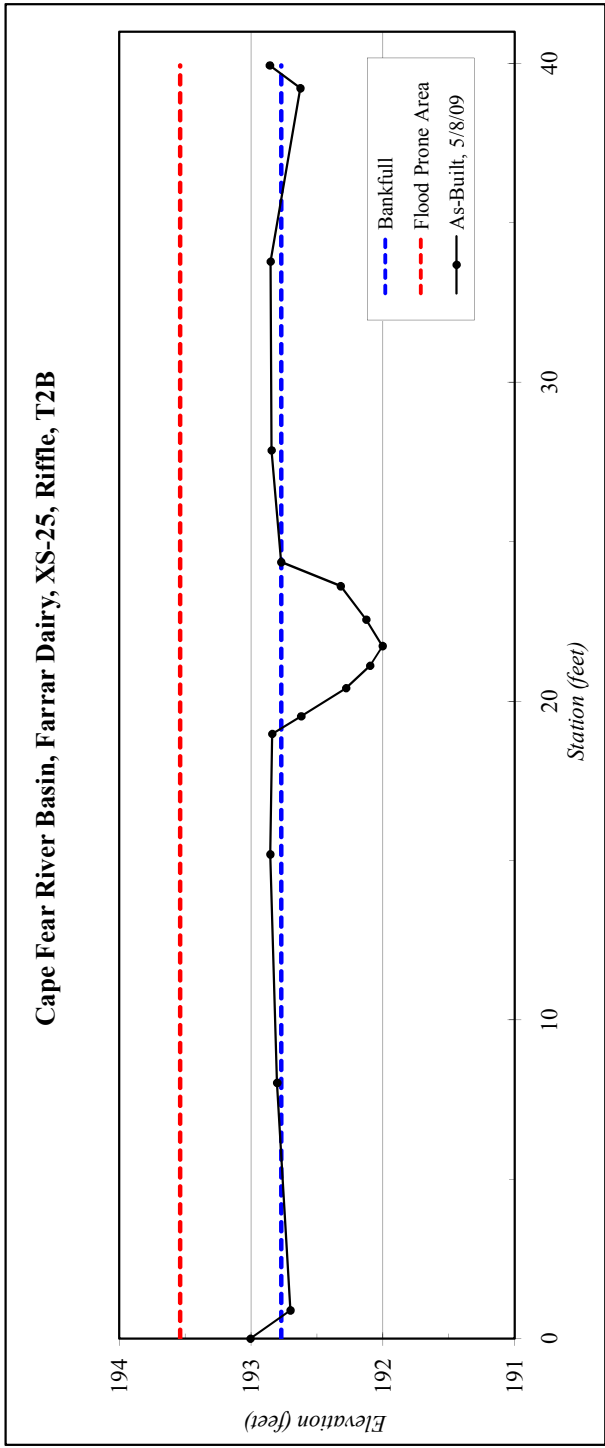


River Basin:	Cape Fear
Watershed:	Farrar Dairy
XS ID	XS-26, Riffle, T3
Drainage Area (sq mi):	0.39
Date:	5/8/2009
Field Crew:	A. French, K. O'Briant



Stream Type C5

SUMMARY DATA	
Bankfull Elevation:	190.5
Bankfull Cross-Sectional Area:	21.4
Bankfull Width:	18.4
Flood Prone Area Elevation:	192.4
Flood Prone Width:	>60
Max Depth at Bankfull:	1.9
Mean Depth at Bankfull:	1.2
W / D Ratio:	15.8
Entrenchment Ratio:	>3.0
Bank Height Ratio:	1.0

Station	Elevation
0.0	191.60
0.8	191.22
7.6	191.15
15.0	190.78
22.5	190.48
24.9	189.60
27.0	189.07
29.0	188.76
30.4	188.63
31.3	188.57
32.6	188.61
33.0	188.73
34.2	188.89
35.3	189.13
36.6	189.34
38.3	189.81
40.2	190.42
43.0	190.68
47.4	190.61
51.8	190.61
55.9	190.50
56.4	190.77

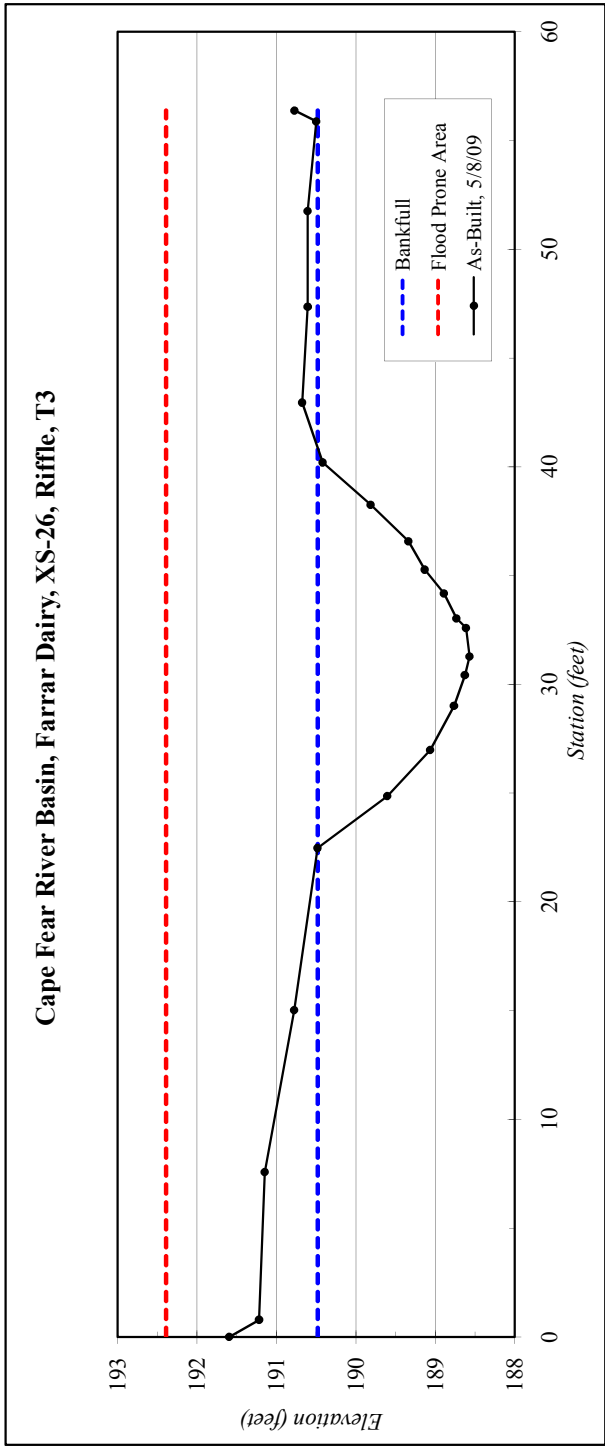


River Basin:	Cape Fear
Watershed:	Farrar Dairy
XS ID	XS-27, Pool, T3
Drainage Area (sq mi):	0.39
Date:	5/8/2009
Field Crew:	A. French, K. O'Briant



Stream Type C5

SUMMARY DATA	
Bankfull Elevation:	189.8
Bankfull Cross-Sectional Area:	24.2
Bankfull Width:	19.2
Flood Prone Area Elevation:	-
Flood Prone Width:	-
Max Depth at Bankfull:	2.5
Mean Depth at Bankfull:	1.3
W / D Ratio:	-
Entrenchment Ratio:	-
Bank Height Ratio:	-

Station	Elevation
0.0	189.87
1.1	189.66
9.2	189.80
15.8	189.89
20.6	189.78
22.4	189.18
24.2	188.53
25.5	187.84
26.5	187.66
27.8	187.29
28.4	187.56
29.4	187.49
30.6	187.84
32.0	188.28
33.3	188.38
35.0	188.72
37.1	189.25
39.1	189.70
41.3	189.93
46.4	190.16
51.6	189.98
58.5	189.96
58.9	190.29

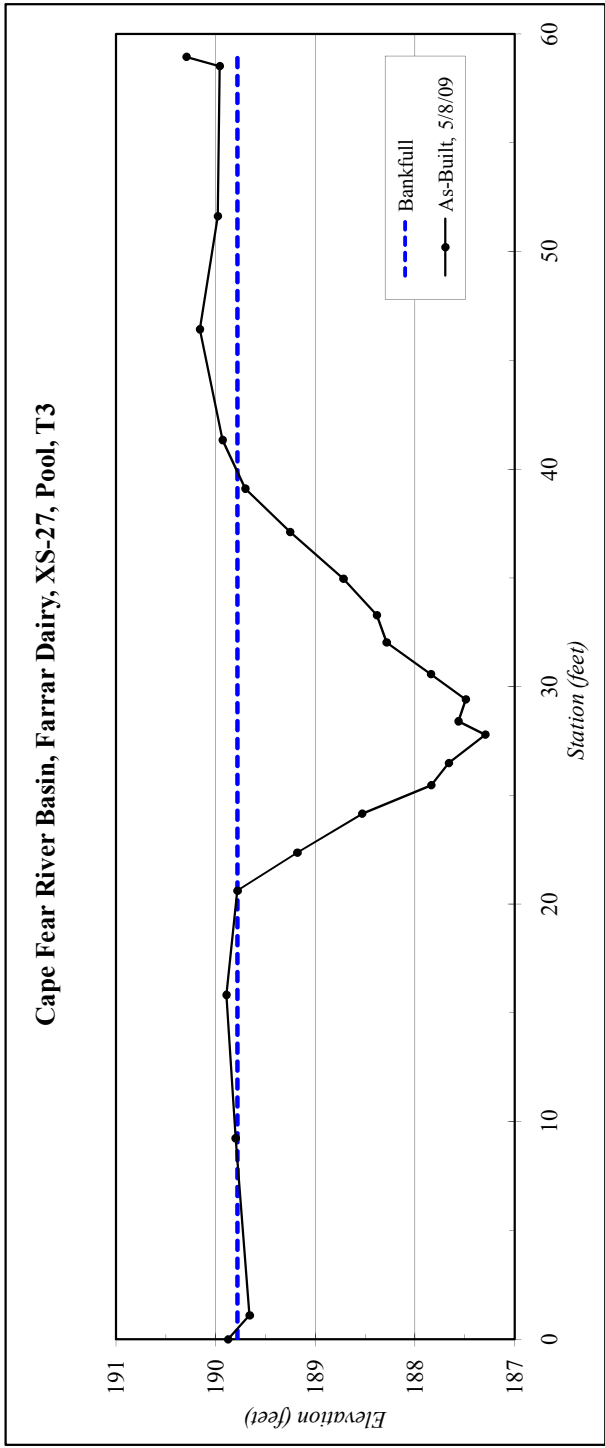


River Basin:	Cape Fear
Watershed:	Farrar Dairy
XS ID	XS-28, Pool, T3
Drainage Area (sq mi):	0.39
Date:	5/8/2009
Field Crew:	A. French, K. O'Briant



Stream Type C5

SUMMARY DATA	
Bankfull Elevation:	189.3
Bankfull Cross-Sectional Area:	29.1
Bankfull Width:	23.3
Flood Prone Area Elevation:	-
Flood Prone Width:	-
Max Depth at Bankfull:	2.6
Mean Depth at Bankfull:	1.2
W / D Ratio:	-
Entrenchment Ratio:	-
Bank Height Ratio:	-

Station	Elevation
0.0	189.60
1.0	189.35
7.4	189.35
13.5	189.35
16.3	189.26
17.6	188.96
19.1	188.53
21.0	188.09
21.9	187.89
23.6	187.39
25.4	186.72
26.2	186.67
27.3	186.88
28.7	187.23
30.4	187.82
32.3	187.92
33.8	188.18
35.8	188.47
37.7	188.95
40.4	189.41
43.3	189.51
46.2	189.72
51.0	189.69
57.9	189.47
58.8	189.72

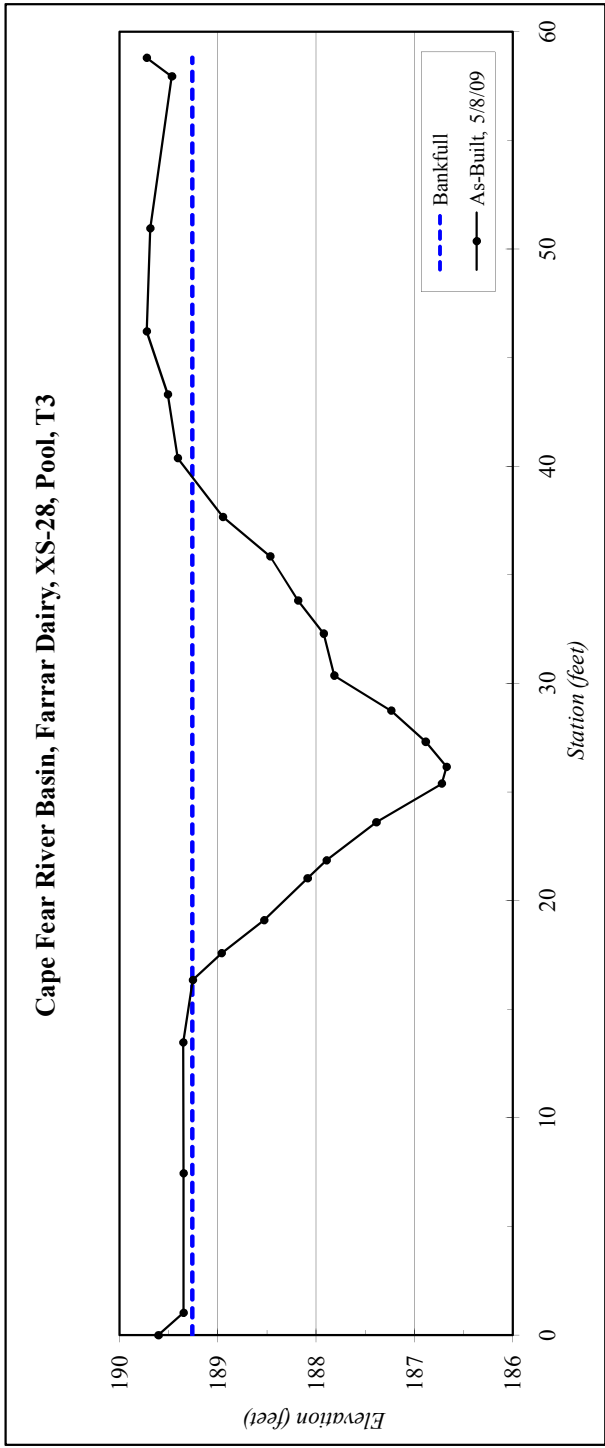


River Basin:	Cape Fear
Watershed:	Farrar Dairy
XS ID	XS-29, Riffle, T3
Drainage Area (sq mi):	0.39
Date:	5/8/2009
Field Crew:	A. French, K. O'Briant



Stream Type C5

SUMMARY DATA	
Bankfull Elevation:	189.3
Bankfull Cross-Sectional Area:	18.4
Bankfull Width:	14.9
Flood Prone Area Elevation:	191.2
Flood Prone Width:	>60
Max Depth at Bankfull:	1.9
Mean Depth at Bankfull:	1.2
W / D Ratio:	12.1
Entrenchment Ratio:	>3.0
Bank Height Ratio:	1.0

Station	Elevation
0.0	189.32
0.5	188.98
4.1	189.32
10.0	189.35
11.8	189.26
12.6	188.86
14.1	188.44
15.8	187.76
17.0	187.58
18.4	187.42
19.7	187.31
20.4	187.41
21.9	187.65
24.1	188.13
25.5	188.67
27.2	189.48
28.9	189.67
31.2	189.74
34.5	189.64
35.1	189.97

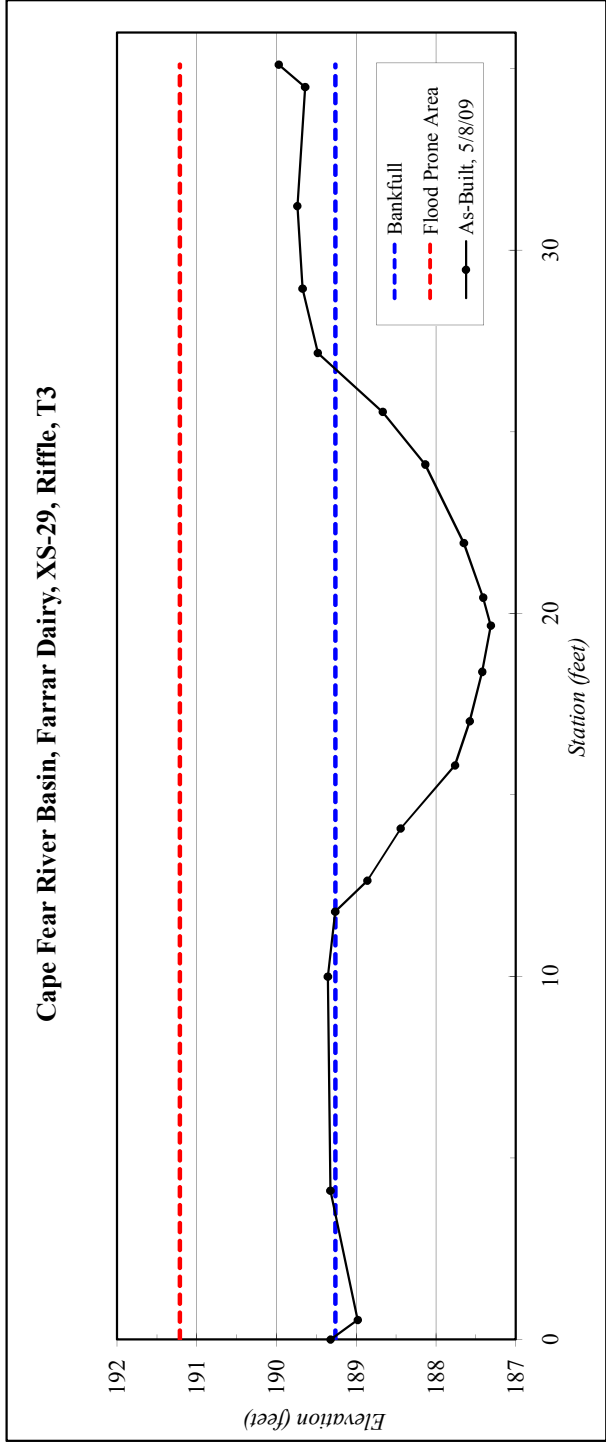


Cross-Section 1 Riffle - As-Built

Particle	Millimeter	S/C	Count
Silt/Clay	< 0.062	S/C	40
Very Fine	.062 - .125	S	34
Fine	.125 - .25	A	12
Medium	.25 - .50	N	2
Coarse	.50 - 1	D	2
Very Coarse	1 - 2	S	
Very Fine	2 - 4		1
Fine	4 - 5.7	G	
Fine	5.7 - 8	R	
Medium	8 - 11.3	A	6
Medium	11.3 - 16	V	3
Coarse	16 - 22.6	E	
Coarse	22.6 - 32	L	
Very Coarse	32 - 45	S	
Very Coarse	45 - 64		
Small	64 - 90	C	
Small	90 - 128	O	
Large	128 - 180	B	
Large	180 - 256	L	
Small	256 - 362	B	
Small	362 - 512	L	
Medium	512 - 1024	D	
Lrg- Very Lrg	1024 - 2048	R	
Bedrock	>2048	BDRK	
Total			100

Note:

Particle Size Distribution
Fairr Dairy
XS 1 Riffle

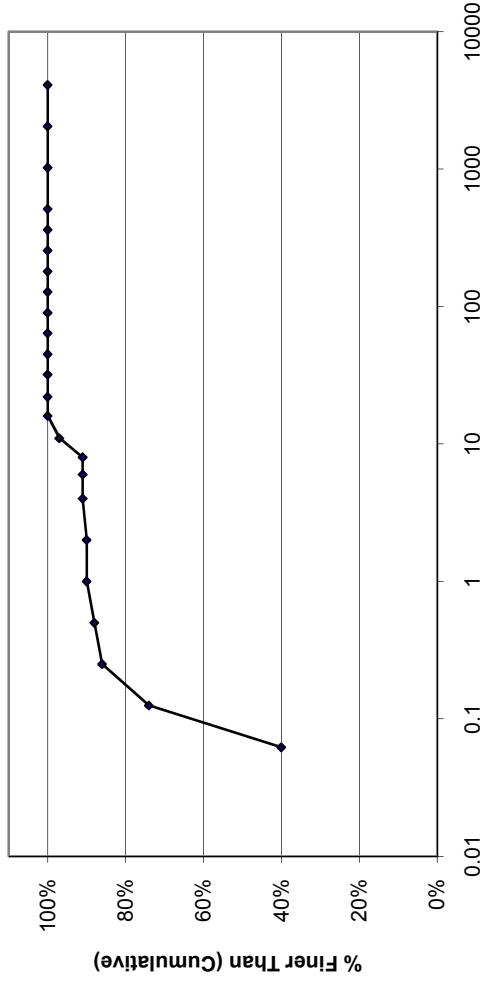


As Built

Size (mm)	
D16	0.062
D35	0.062
D50	0.076
D65	0.1
D84	0.22
D95	9.9

Size Distribution	
mean	0.1
dispersion	2.1
skewness	0.25

Type	Percentage
silt/clay	40%
sand	50%
gravel	10%
cobble	0%
boulder	0%
bedrock	0%
hardpan	0%
wood/det	0%
artificial	0%

Cross-Section 2 Pool - As-Built			
Particle	Millimeter	S/C	Count
Silt/Clay	< 0.062	S/C	38
Very Fine	.062 - .125	S	24
Fine	.125 - .25	A	5
Medium	.25 - .50	N	14
Coarse	.50 - 1	D	8
Very Coarse	1 - 2	S	11
Very Fine	2 - 4		
Fine	4 - 5.7	G	
Fine	5.7 - 8	R	
Medium	8 - 11.3	A	
Medium	11.3 - 16	V	
Coarse	16 - 22.6	E	
Coarse	22.6 - 32	L	
Very Coarse	32 - 45	S	
Very Coarse	45 - 64		
Small	64 - 90	C	
Small	90 - 128	O	
Large	128 - 180	B	
Large	180 - 256	L	
Small	256 - 362	B	
Small	362 - 512	L	
Medium	512 - 1024	D	
Lrg- Very Lrg	1024 - 2048	R	
Bedrock	>2048	BDRK	
Total			100

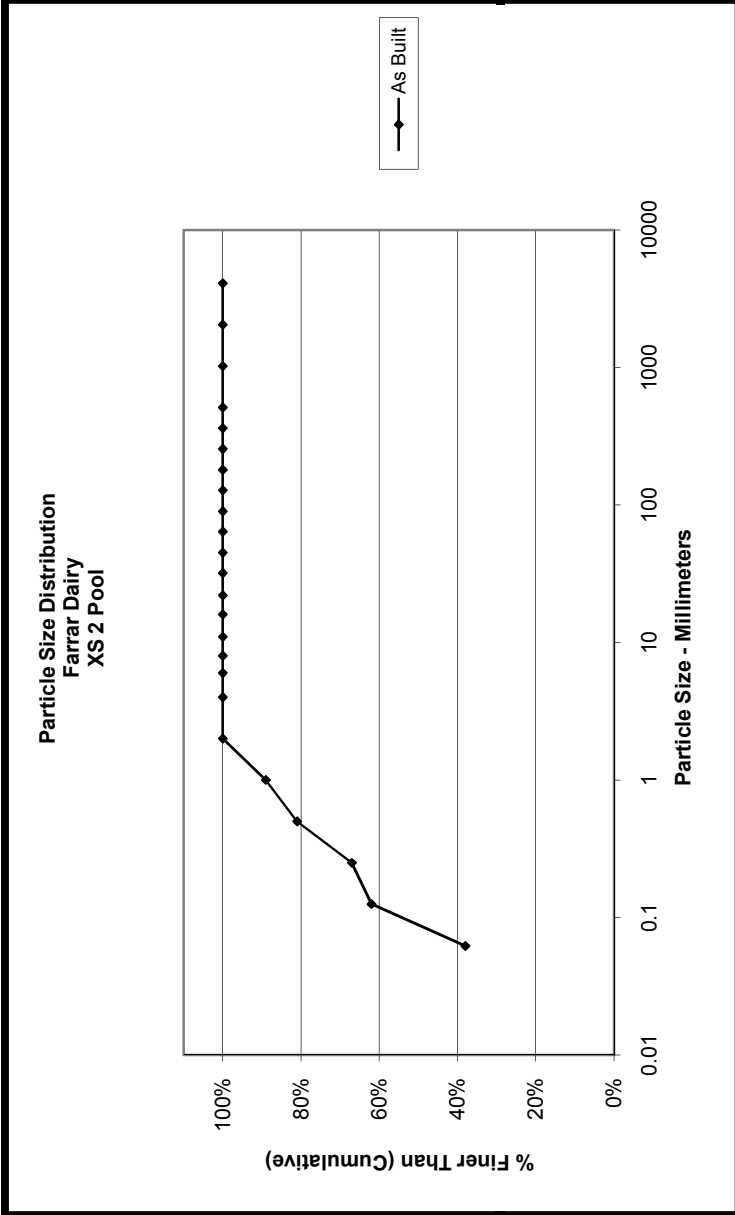

Size (mm)	Size Distribution	Type
D16	0.062	silt/clay
D35	0.062	sand
D50	0.088	gravel
D65	0.19	cobble
D84	0.65	boulder
D95	1.5	bedrock
	mean	hardpan
	dispersion	wood/det
	skewness	artificial
	0.2	
	4.4	
	0.35	


Size (mm)	Percentage
silt/clay	38%
sand	62%
gravel	0%
cobble	0%
boulder	0%
bedrock	0%
hardpan	0%
wood/det	0%
artificial	0%

Note:

Cross-Section 3 Riffle - As-Built			
Particle	Millimeter	S/C	Count
Silt/Clay	< 0.062	S/C	55
Very Fine	.062 - .125	S	37
Fine	.125 - .25	A	6
Medium	.25 - .50	N	
Coarse	.50 - 1	D	1
Very Coarse	1 - 2	S	1
Very Fine	2 - 4		
Fine	4 - 5.7	G	
Fine	5.7 - 8	R	
Medium	8 - 11.3	A	
Medium	11.3 - 16	V	
Coarse	16 - 22.6	E	
Coarse	22.6 - 32	L	
Very Coarse	32 - 45	S	
Very Coarse	45 - 64		
Small	64 - 90	C	
Small	90 - 128	O	
Large	128 - 180	B	
Large	180 - 256	L	
Small	256 - 362	B	
Small	362 - 512	L	
Medium	512 - 1024	D	
Lrg- Very Lrg	1024 - 2048	R	
Bedrock	>2048	BDRK	
Total			100

Note:

Particle Size Distribution
Farrar Dairy
XS 3 Riffle

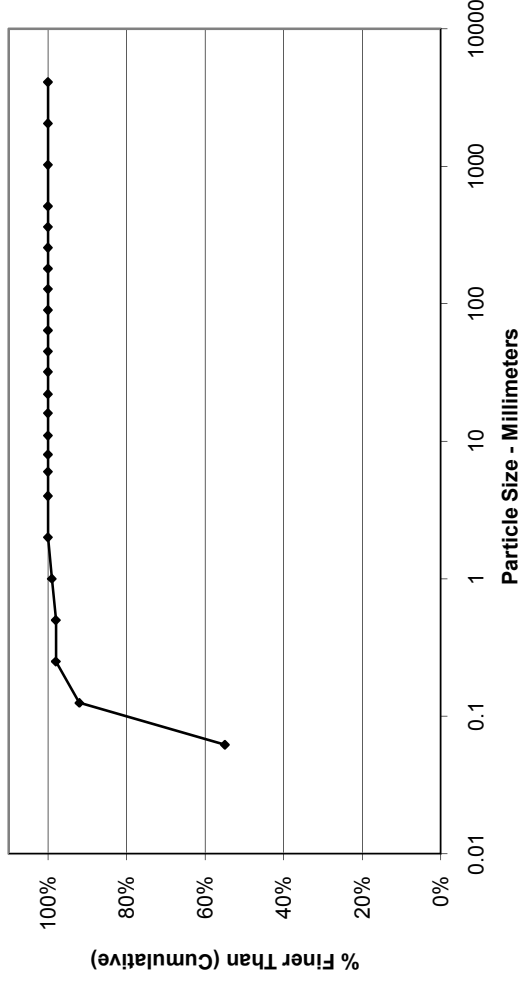

As Built

Size (mm)

D16	0.062
D35	0.062
D50	0.062
D65	0.075
D84	0.11
D95	0.18

Size Distribution

mean	0.1
dispersion	1.4
skewness	0.25


Type

silt/clay	55%
sand	45%
gravel	0%
cobble	0%
boulder	0%
bedrock	0%
hardpan	0%
wood/det	0%
artificial	0%

Cross-Section 4 Pool - As-Built

Particle	Millimeter	Count
Silt/Clay	< 0.062	8
Very Fine	.062 - .125	16
Fine	.125 - .25	5
Medium	.25 - .50	15
Coarse	.50 - 1	56
Very Coarse	1 - 2	
Very Fine	2 - 4	
Fine	4 - 5.7	
Fine	5.7 - 8	
Medium	8 - 11.3	
Medium	11.3 - 16	
Coarse	16 - 22.6	
Coarse	22.6 - 32	
Very Coarse	32 - 45	
Very Coarse	45 - 64	
Small	64 - 90	
Small	90 - 128	
Large	128 - 180	
Large	180 - 256	
Small	256 - 362	
Small	362 - 512	
Medium	512 - 1024	
Lrg- Very Lrg	1024 - 2048	
Bedrock	>2048	
Total		100

Particle Size Distribution
Farrar Dairy
XS 4 Pool

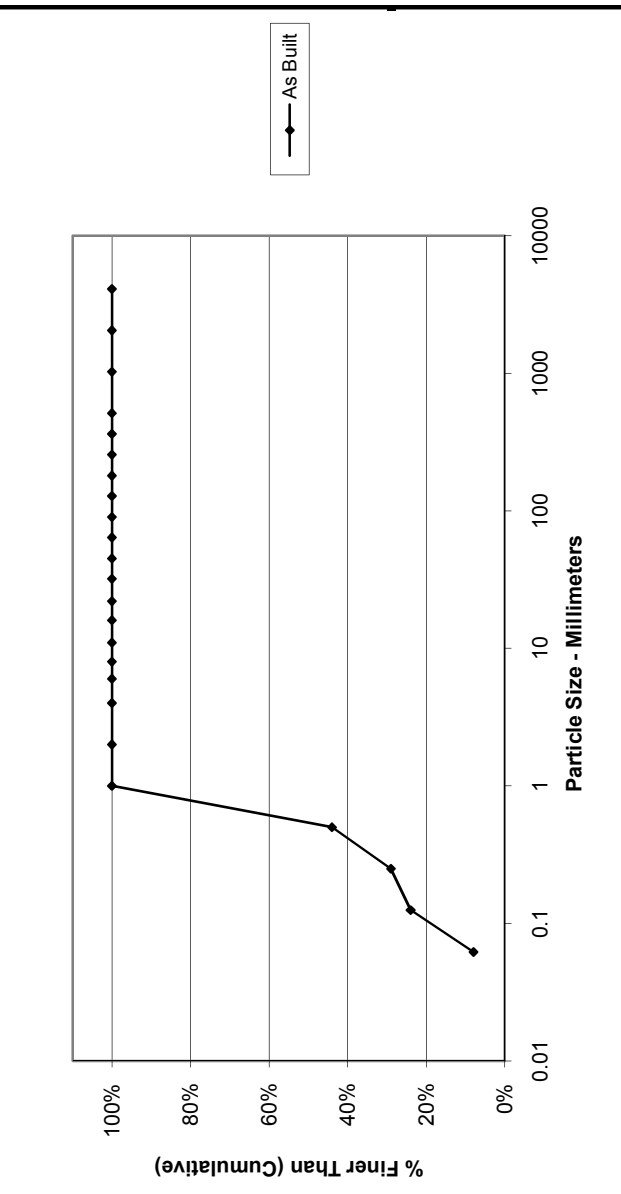


Size (mm)	Size Distribution	Type
D16	0.088	silt/clay
D35	0.33	sand
D50	0.54	gravel
D65	0.65	cobble
D84	0.82	boulder
D95	0.94	bedrock
	mean	hardpan
	dispersion	wood/det
	skewness	artificial
	0.3	
	3.8	
	-0.31	
	8%	
	92%	
	0%	
	0%	
Note:

Cross-Section 5 Riffle - As-Built			
Particle	Millimeter	S/C	Count
Silt/Clay	< 0.062	S/C	41
Very Fine	.062 - .125	S	22
Fine	.125 - .25	A	
Medium	.25 - .50	N	37
Coarse	.50 - 1	D	
Very Coarse	1 - 2	S	
Very Fine	2 - 4		
Fine	4 - 5.7	G	
Fine	5.7 - 8	R	
Medium	8 - 11.3	A	
Medium	11.3 - 16	V	
Coarse	16 - 22.6	E	
Coarse	22.6 - 32	L	
Very Coarse	32 - 45	S	
Very Coarse	45 - 64		
Small	64 - 90	C	
Small	90 - 128	O	
Large	128 - 180	B	
Large	180 - 256	L	
Small	256 - 362	B	
Small	362 - 512	L	
Medium	512 - 1024	D	
Lrg- Very Lrg	1024 - 2048	R	
Bedrock	>2048	BDRK	
Total			100

Particle Size Distribution
Farrar Dairy
XS 5 Riffle

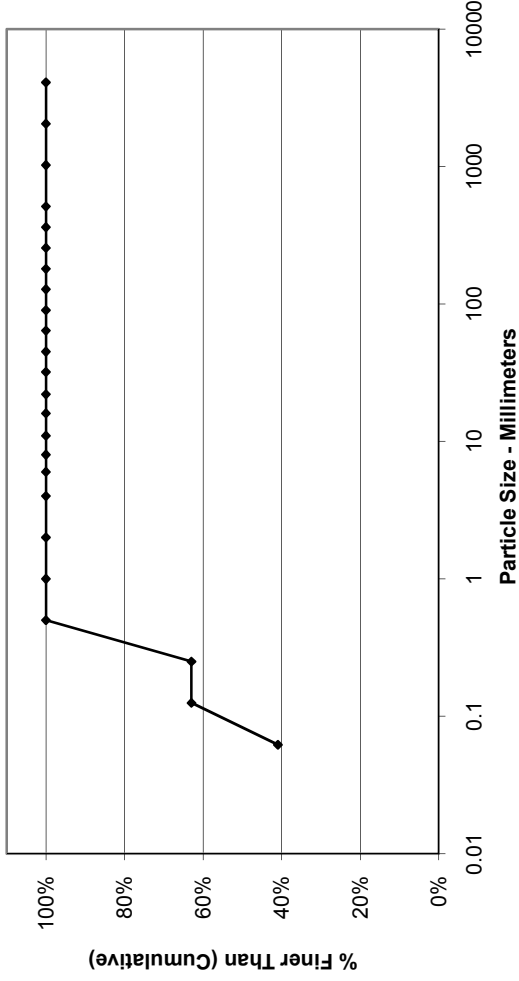

Size (mm)	Count
D16	0.062
D35	0.062
D50	0.083
D65	0.26
D84	0.37
D95	0.46

Size Distribution	
mean	0.2
dispersion	2.9
skewness	0.30

Type	Percentage
silt/clay	41%
sand	59%
gravel	0%
cobble	0%
boulder	0%
bedrock	0%
hardpan	0%
wood/det	0%
artificial	0%


Note:

Cross-Section 6 Pool - As-Built

Particle	Millimeter	S/C	Count
Silt/Clay	< 0.062	S/C	37
Very Fine	.062 - .125	S	14
Fine	.125 - .25	A	30
Medium	.25 - .50	N	14
Coarse	.50 - 1	D	4
Very Coarse	1 - 2	S	1
Very Fine	2 - 4		
Fine	4 - 5.7	G	
Fine	5.7 - 8	R	
Medium	8 - 11.3	A	
Medium	11.3 - 16	V	
Coarse	16 - 22.6	E	
Coarse	22.6 - 32	L	
Very Coarse	32 - 45	S	
Very Coarse	45 - 64		
Small	64 - 90	C	
Small	90 - 128	O	
Large	128 - 180	B	
Large	180 - 256	L	
Small	256 - 362	B	
Small	362 - 512	L	
Medium	512 - 1024	D	
Lrg- Very Lrg	1024 - 2048	R	
Bedrock	>2048	BDRK	
Total			100

Note:

Particle Size Distribution
Farrar Dairy
XS 6 Pool

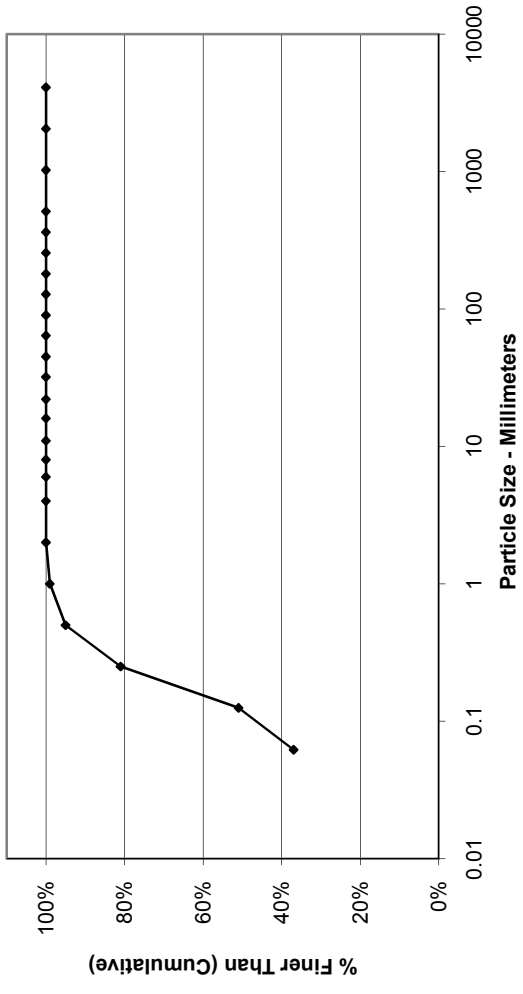


As Built

Size (mm)	Value
D16	0.062
D35	0.062
D50	0.12
D65	0.17
D84	0.29
D95	0.5

Size Distribution	
mean	0.1
dispersion	2.2
skewness	0.06


Type	Percentage
silt/clay	37%
sand	63%
gravel	0%
cobble	0%
boulder	0%
bedrock	0%
hardpan	0%
wood/det	0%
artificial	0%

Cross-Section 7 Riffle - As-Built			
Particle	Millimeter	S/C	Count
Silt/Clay	< 0.062	S/C	53
Very Fine	.062 - .125	S	47
Fine	.125 - .25	A	
Medium	.25 - .50	N	
Coarse	.50 - 1	D	
Very Coarse	1 - 2	S	
Very Fine	2 - 4		
Fine	4 - 5.7	G	
Fine	5.7 - 8	R	
Medium	8 - 11.3	A	
Medium	11.3 - 16	V	
Coarse	16 - 22.6	E	
Coarse	22.6 - 32	L	
Very Coarse	32 - 45	S	
Very Coarse	45 - 64		
Small	64 - 90	C	
Small	90 - 128	O	
Large	128 - 180	B	
Large	180 - 256	L	
Small	256 - 362	B	
Small	362 - 512	L	
Medium	512 - 1024	D	
Lrg- Very Lrgl	1024 - 2048	R	
Bedrock	>2048	BDRK	
Total			100

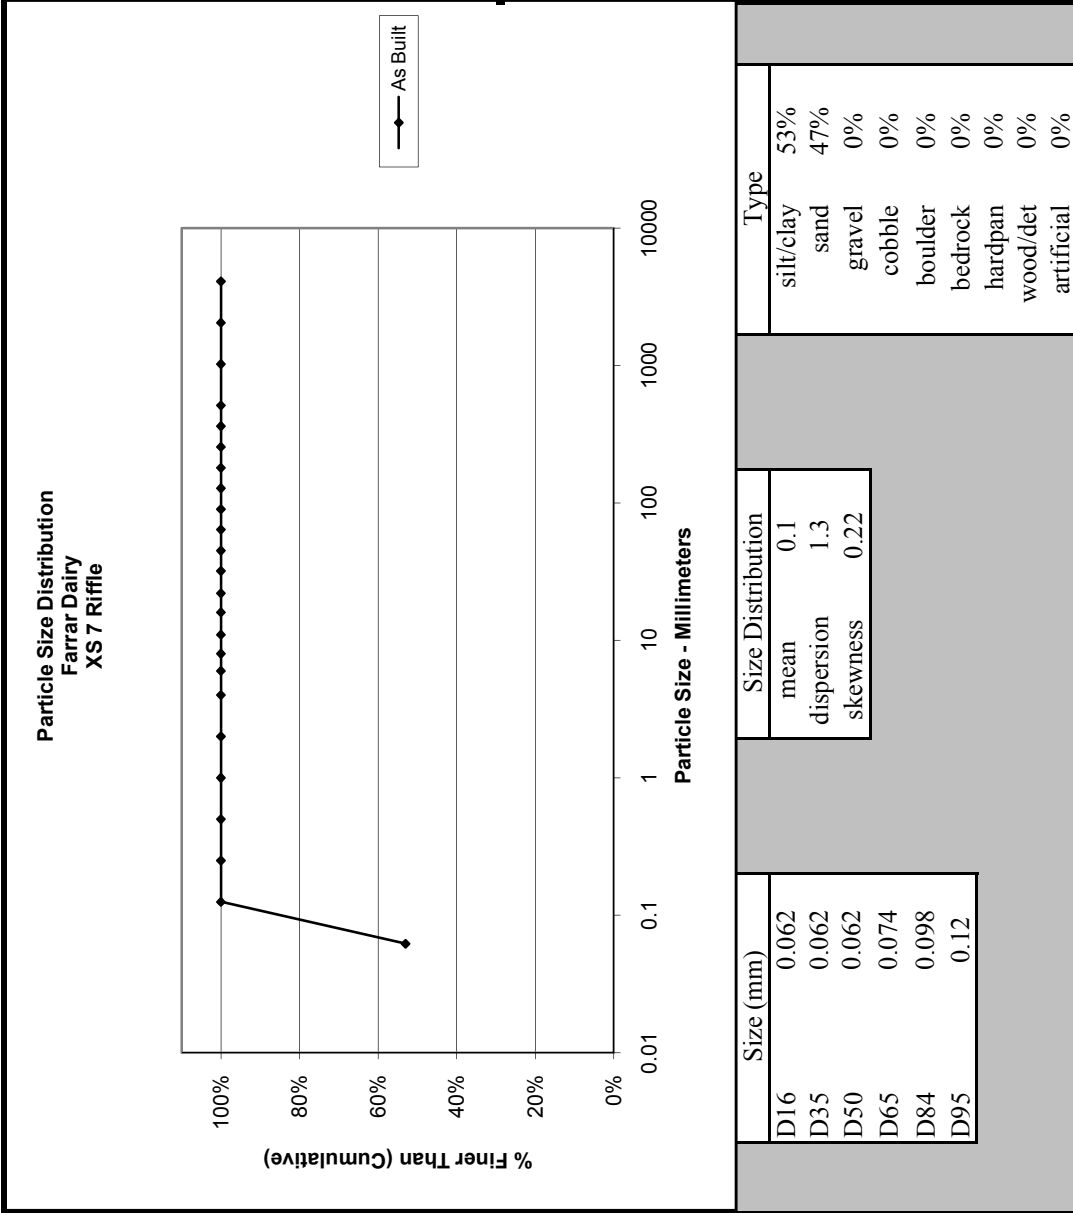

Note:

Cross-Section 8 Riffle - As-Built			
Particle	Millimeter	S/C	Count
Silt/Clay	< 0.062	S/C	82
Very Fine	.062 - .125	S	18
Fine	.125 - .25	A	
Medium	.25 - .50	N	
Coarse	.50 - 1	D	
Very Coarse	1 - 2	S	
Very Fine	2 - 4		
Fine	4 - 5.7	G	
Fine	5.7 - 8	R	
Medium	8 - 11.3	A	
Medium	11.3 - 16	V	
Coarse	16 - 22.6	E	
Coarse	22.6 - 32	L	
Very Coarse	32 - 45	S	
Very Coarse	45 - 64		
Small	64 - 90	C	
Small	90 - 128	O	
Large	128 - 180	B	
Large	180 - 256	L	
Small	256 - 362	B	
Small	362 - 512	L	
Medium	512 - 1024	D	
Lrg- Very Lrg	1024 - 2048	R	
Bedrock	>2048	BDRK	
Total			100

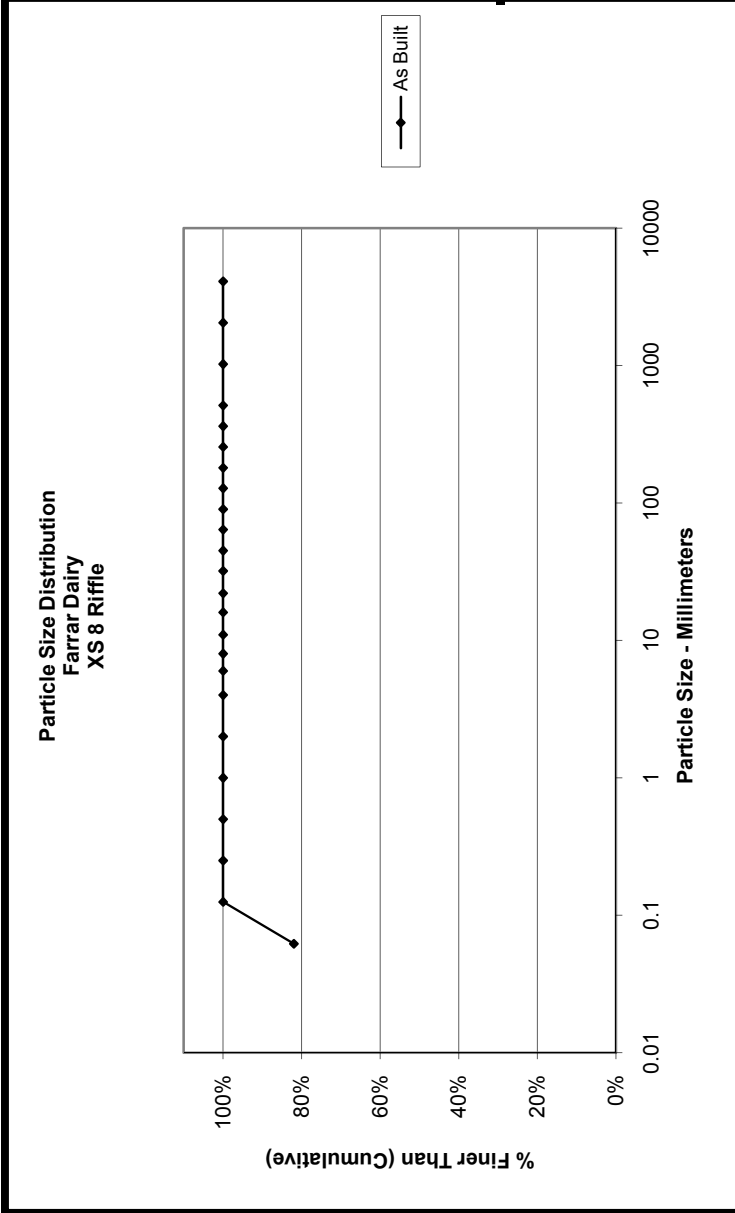


Size (mm)	Size Distribution	Type
D16	0.062	silt/clay
D35	0.062	sand
D50	0.062	gravel
D65	0.062	cobble
D84	0.067	boulder
D95	0.1	bedrock
	mean 0.1	hardpan
	dispersion 1.0	wood/det
	skewness 0.09	artificial

Note:

Cross-Section 9 Pool - As-Built			
Particle	Millimeter		Count
Silt/Clay	< 0.062	S/C	31
Very Fine	.062 - .125	S	24
Fine	.125 - .25	A	2
Medium	.25 - .50	N	20
Coarse	.50 - 1	D	20
Very Coarse	1 - 2	S	3
Very Fine	2 - 4		
Fine	4 - 5.7	G	
Fine	5.7 - 8	R	1
Medium	8 - 11.3	A	
Medium	11.3 - 16	V	
Coarse	16 - 22.6	E	
Coarse	22.6 - 32	L	
Very Coarse	32 - 45	S	
Very Coarse	45 - 64		
Small	64 - 90	C	
Small	90 - 128	O	
Large	128 - 180	B	
Large	180 - 256	L	
Small	256 - 362	B	
Small	362 - 512	L	
Medium	512 - 1024	D	
Lrg- Very Lrg	1024 - 2048	R	
Bedrock	>2048	BDRK	
Total			101


Note:

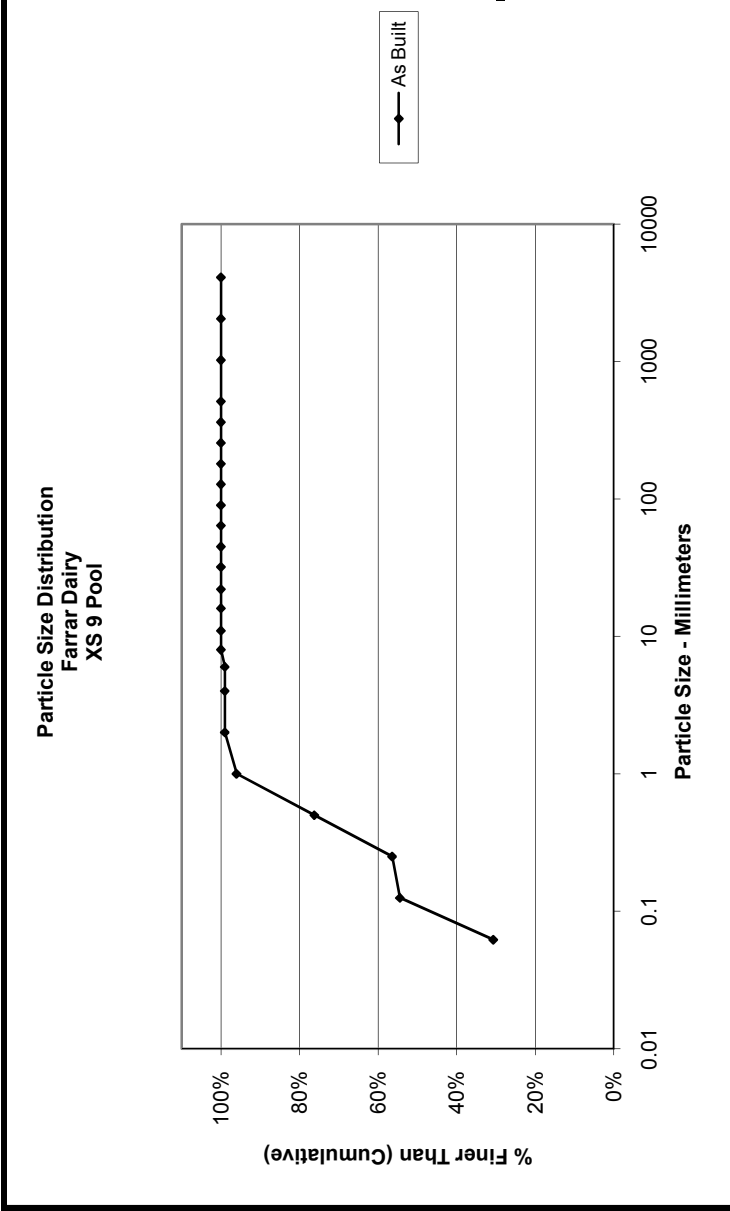

Size (mm)		Size Distribution		Type	
D16	0.062	mean	0.2	silt/clay	31%
D35	0.07	dispersion	3.9	sand	68%
D50	0.11	skewness	0.26	gravel	1%
D65	0.34			cobble	0%
D84	0.66			boulder	0%
D95	0.96			bedrock	0%
				hardpan	0%
				wood/det	0%
				artificial	0%

Cross-Section 10 Riffle - As-Built			
Particle	Millimeter	S/C	Count
Silt/Clay	< 0.062	S/C	45
Very Fine	.062 - .125	S	18
Fine	.125 - .25	A	1
Medium	.25 - .50	N	3
Coarse	.50 - 1	D	6
Very Coarse	1 - 2	S	3
Very Fine	2 - 4		2
Fine	4 - 5.7	G	3
Fine	5.7 - 8	R	5
Medium	8 - 11.3	A	1
Medium	11.3 - 16	V	1
Coarse	16 - 22.6	E	2
Coarse	22.6 - 32	L	2
Very Coarse	32 - 45	S	
Very Coarse	45 - 64		
Small	64 - 90	C	
Small	90 - 128	O	
Large	128 - 180	B	
Large	180 - 256	L	
Small	256 - 362	B	
Small	362 - 512	L	
Medium	512 - 1024	D	
Lrg- Very Lrg	1024 - 2048	R	
Bedrock	>2048	BDRK	
Total			92

Particle Size Distribution
Farrar Dairy
XS 10 Riffle

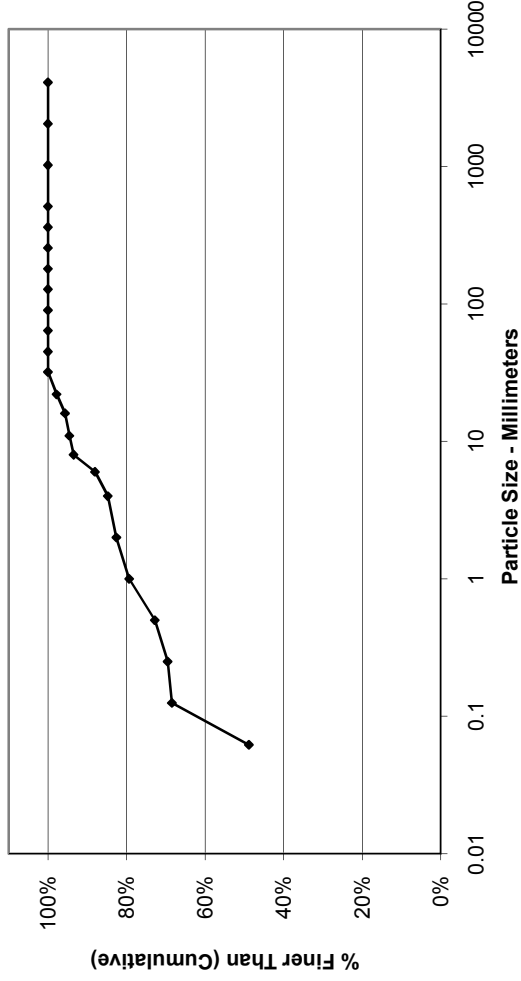


Size (mm)	Count
D16	0.062
D35	0.062
D50	0.064
D65	0.11
D84	3.1
D95	13

Size Distribution	
mean	0.4
dispersion	24.7
skewness	0.64

Type	Percentage
silt/clay	49%
sand	34%
gravel	17%
cobble	0%
boulder	0%
bedrock	0%
hardpan	0%
wood/det	0%
artificial	0%


Note:

Cross-Section 11 Riffle - As-Built				Count
Particle	Millimeter	S/C		
Silt/Clay	< 0.062	S/C		
Very Fine	.062 - .125	S		
Fine	.125 - .25	A		
Medium	.25 - .50	N		
Coarse	.50 - 1	D		100
Very Coarse	1 - 2	S		
Very Fine	2 - 4			
Fine	4 - 5.7	G		
Fine	5.7 - 8	R		
Medium	8 - 11.3	A		
Medium	11.3 - 16	V		
Coarse	16 - 22.6	E		
Coarse	22.6 - 32	L		
Very Coarse	32 - 45	S		
Very Coarse	45 - 64			
Small	64 - 90	C		
Small	90 - 128	O		
Large	128 - 180	B		
Large	180 - 256	L		
Small	256 - 362	B		
Small	362 - 512	L		
Medium	512 - 1024	D		
Lrg- Very Lrg	1024 - 2048	R		
Bedrock	>2048	BDRK		
Total				100

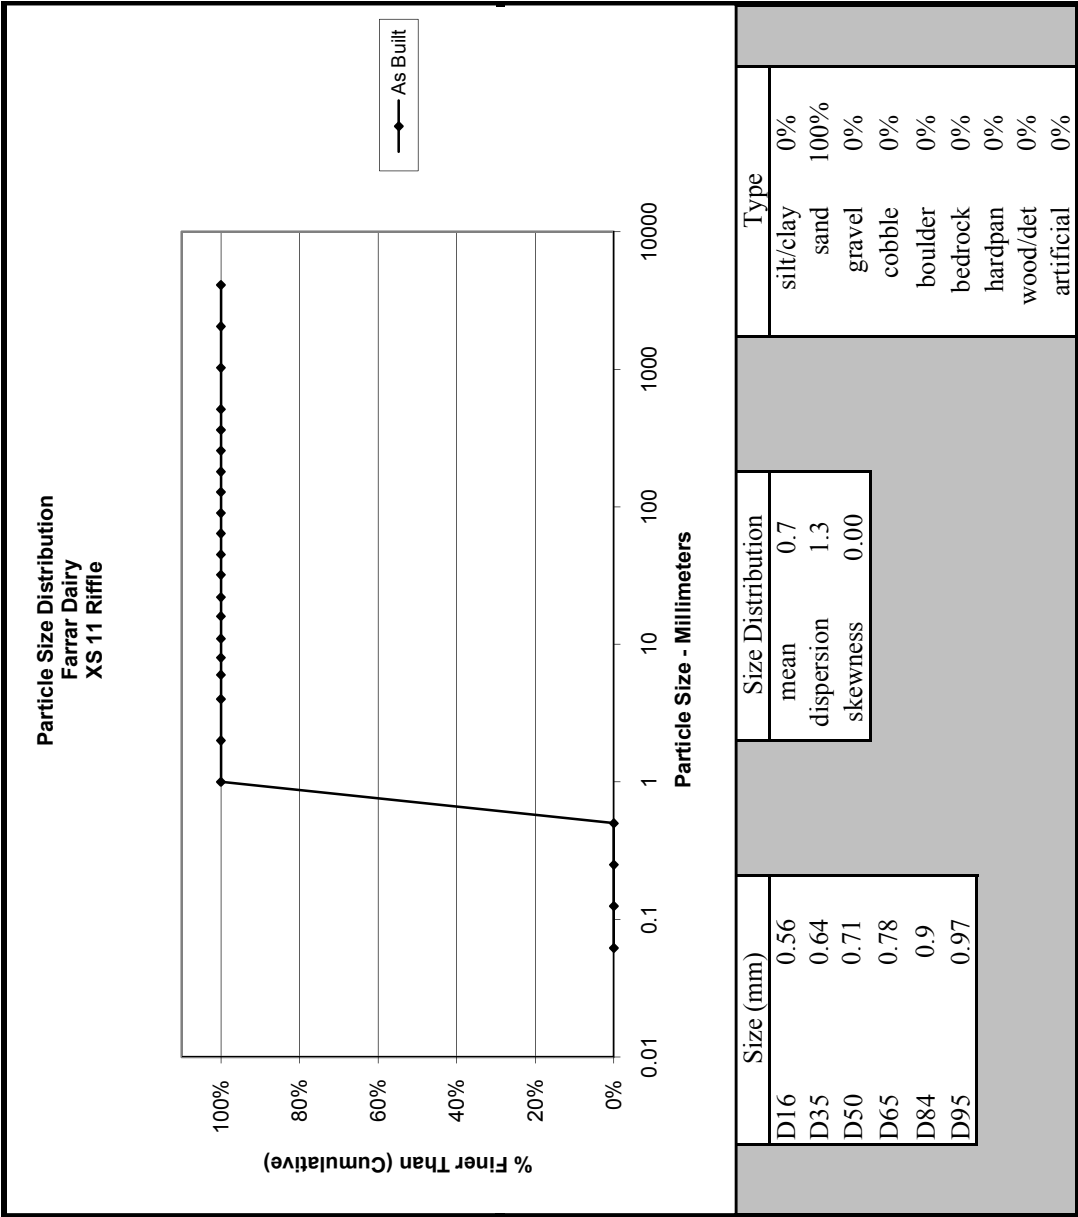

Note:


Cross-Section 12 Pool - As-Built			
Particle	Millimeter		Count
Silt/Clay	< 0.062	S/C	
Very Fine	.062 - .125	S	
Fine	.125 - .25	A	
Medium	.25 - .50	N	100
Coarse	.50 - 1	D	
Very Coarse	1 - 2	S	
Very Fine	2 - 4		
Fine	4 - 5.7	G	
Fine	5.7 - 8	R	
Medium	8 - 11.3	A	
Medium	11.3 - 16	V	
Coarse	16 - 22.6	E	
Coarse	22.6 - 32	L	
Very Coarse	32 - 45	S	
Very Coarse	45 - 64		
Small	64 - 90	C	
Small	90 - 128	O	
Large	128 - 180	B	
Large	180 - 256	L	
Small	256 - 362	B	
Small	362 - 512	L	
Medium	512 - 1024	D	
Lrg- Very Lrg	1024 - 2048	R	
Bedrock	>2048	BDRK	
		Total	100

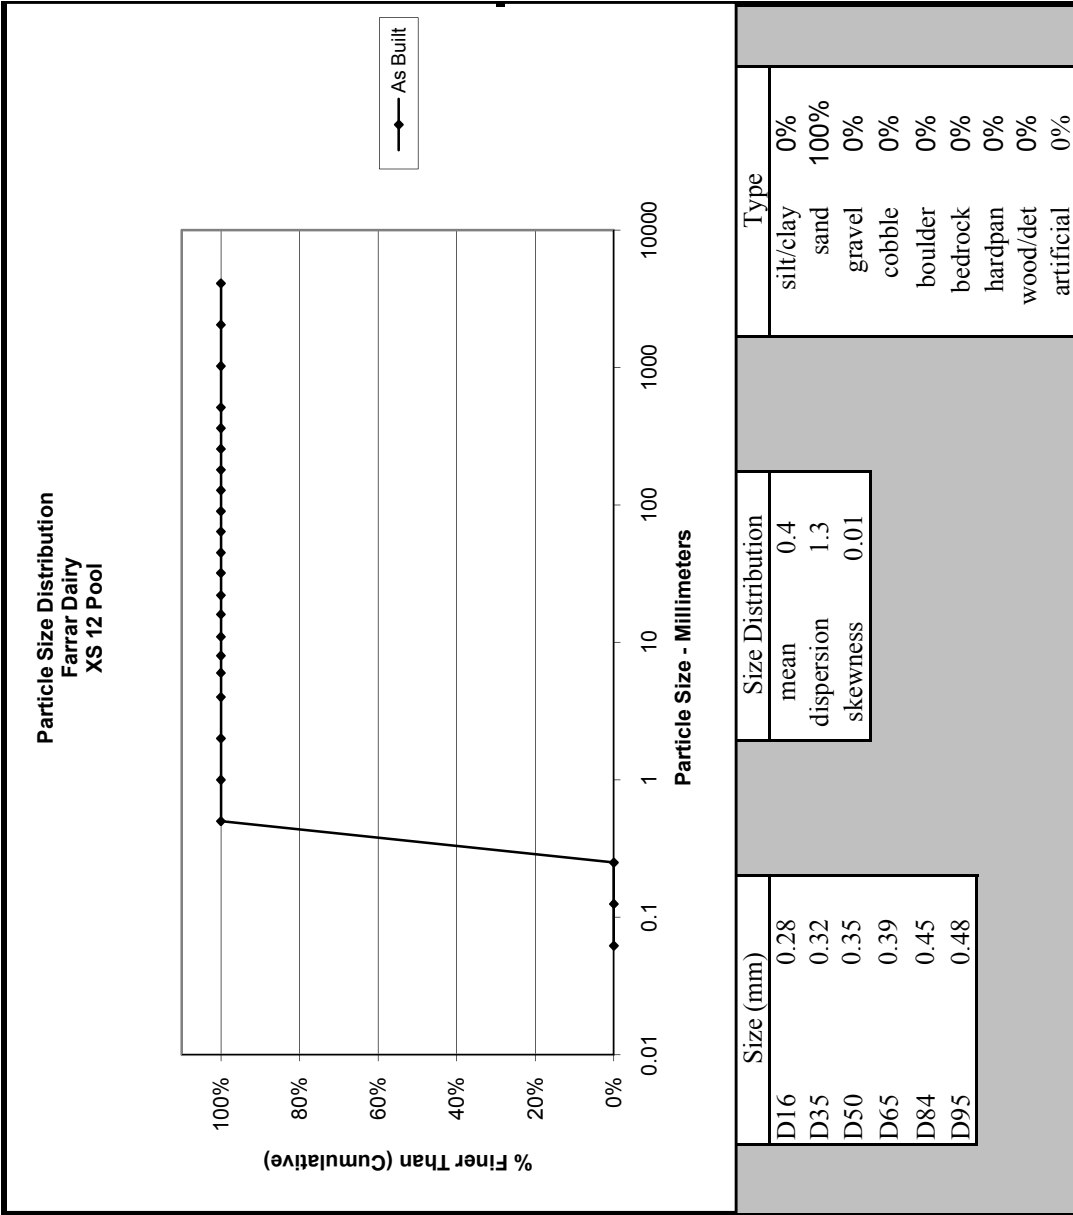

Note:

Cross-Section 13 Riffle - As-Built			
Particle	Millimeter	S/C	Count
Silt/Clay	< 0.062	S/C	80
Very Fine	.062 - .125	S	18
Fine	.125 - .25	A	
Medium	.25 - .50	N	
Coarse	.50 - 1	D	2
Very Coarse	1 - 2	S	
Very Fine	2 - 4		
Fine	4 - 5.7	G	
Fine	5.7 - 8	R	
Medium	8 - 11.3	A	
Medium	11.3 - 16	V	
Coarse	16 - 22.6	E	
Coarse	22.6 - 32	L	
Very Coarse	32 - 45	S	
Very Coarse	45 - 64		
Small	64 - 90	C	
Small	90 - 128	O	
Large	128 - 180	B	
Large	180 - 256	L	
Small	256 - 362	B	
Small	362 - 512	L	
Medium	512 - 1024	D	
Lrg- Very Lrg	1024 - 2048	R	
Bedrock	>2048	BDRK	
Total			100

Particle Size Distribution
Farrar Dairy
XS 13 Riffle

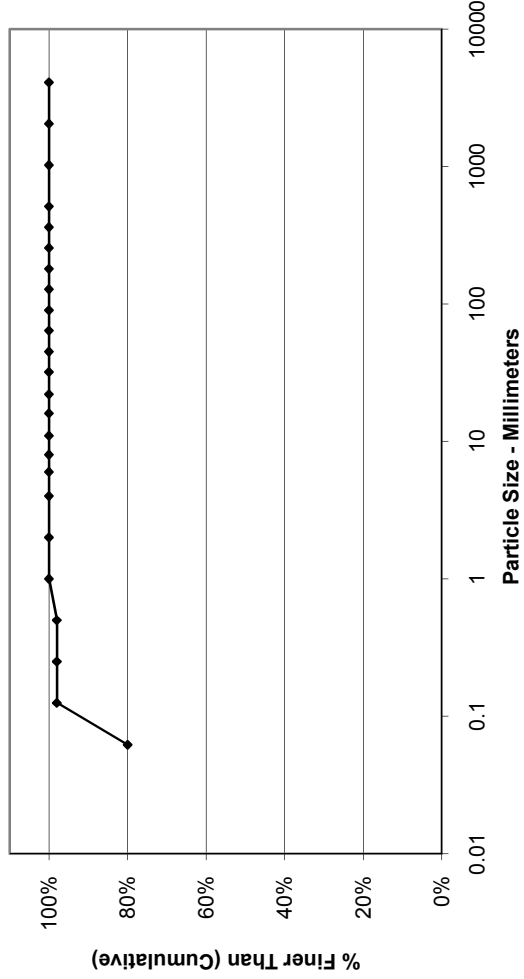


Size (mm)	Count
D16	0.062
D35	0.062
D50	0.062
D65	0.062
D84	0.072
D95	0.11

Size Distribution	
mean	0.1
dispersion	1.1
skewness	0.13

Type	Percentage
silt/clay	80%
sand	20%
gravel	0%
cobble	0%
boulder	0%
bedrock	0%
hardpan	0%
wood/det	0%
artificial	0%

Note:


Cross-Section 14 Pool - As-Built			
Particle	Millimeter	S/C	Count
Silt/Clay	< 0.062		95
Very Fine	.062 - .125	S	5
Fine	.125 - .25	A	
Medium	.25 - .50	N	
Coarse	.50 - 1	D	
Very Coarse	1 - 2	S	
Very Fine	2 - 4		
Fine	4 - 5.7	G	
Fine	5.7 - 8	R	
Medium	8 - 11.3	A	
Medium	11.3 - 16	V	
Coarse	16 - 22.6	E	
Coarse	22.6 - 32	L	
Very Coarse	32 - 45	S	
Very Coarse	45 - 64		
Small	64 - 90	C	
Small	90 - 128	O	
Large	128 - 180	B	
Large	180 - 256	L	
Small	256 - 362	B	
Small	362 - 512	L	
Medium	512 - 1024	D	
Lrg- Very Lrg	1024 - 2048	R	
Bedrock	>2048	BDRK	
Total			100

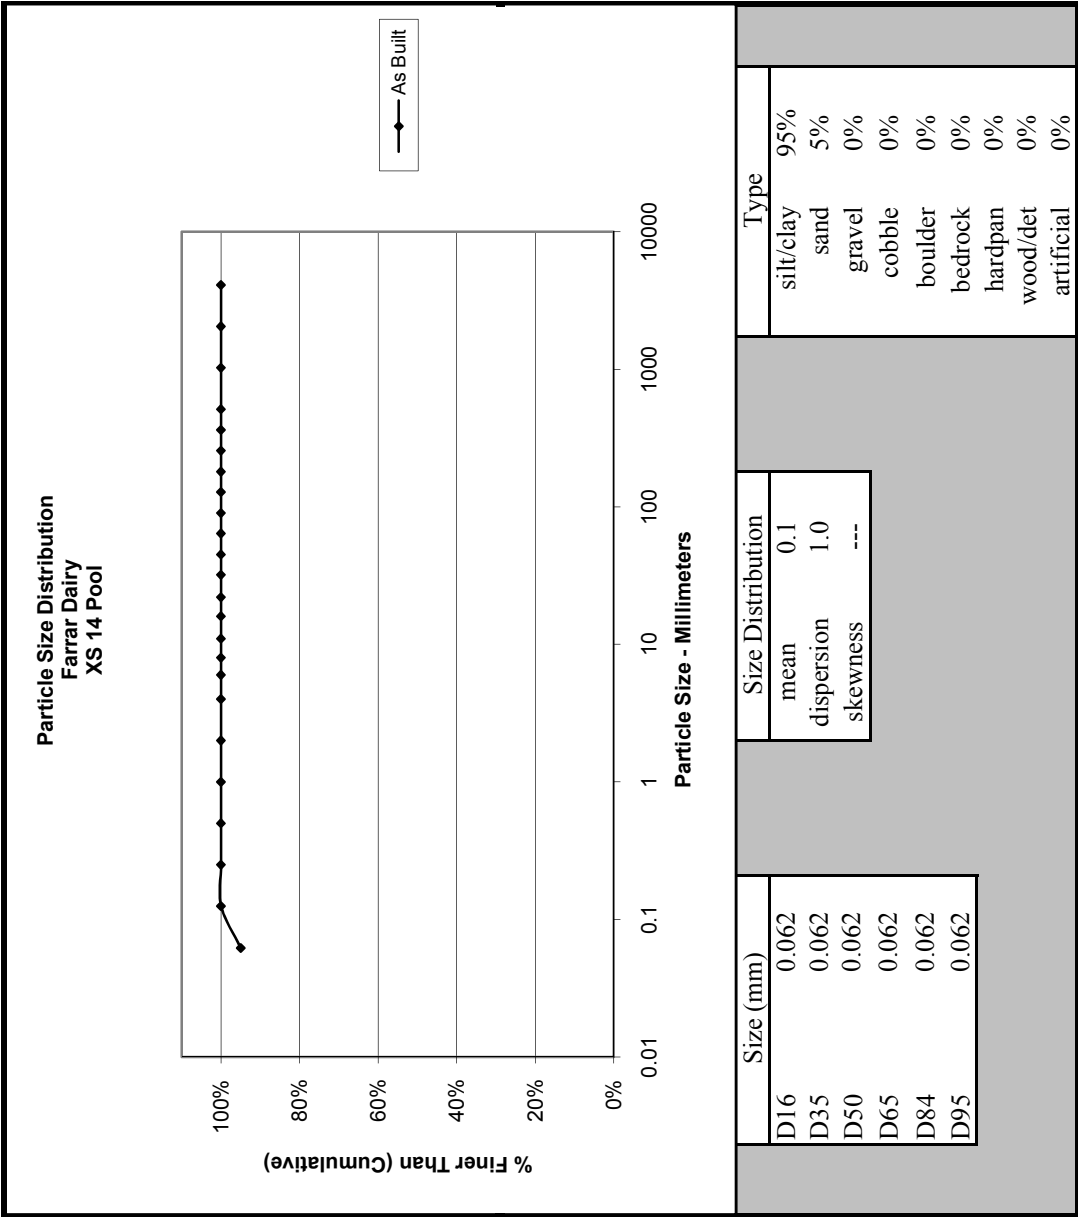


Note:

Cross-Section 15 Riffle - As-Built			
Particle	Millimeter	S/C	Count
Silt/Clay	< 0.062	S/C	72
Very Fine	.062 - .125	S	24
Fine	.125 - .25	A	
Medium	.25 - .50	N	
Coarse	.50 - 1	D	1
Very Coarse	1 - 2	S	
Very Fine	2 - 4		
Fine	4 - 5.7	G	
Fine	5.7 - 8	R	
Medium	8 - 11.3	A	
Medium	11.3 - 16	V	1
Coarse	16 - 22.6	E	2
Coarse	22.6 - 32	L	
Very Coarse	32 - 45	S	
Very Coarse	45 - 64		
Small	64 - 90	C	
Small	90 - 128	O	
Large	128 - 180	B	
Large	180 - 256	L	
Small	256 - 362	B	
Small	362 - 512	L	
Medium	512 - 1024	D	
Lrg- Very Lrg	1024 - 2048	R	
Bedrock	>2048	BDRK	
Total			100

Note:

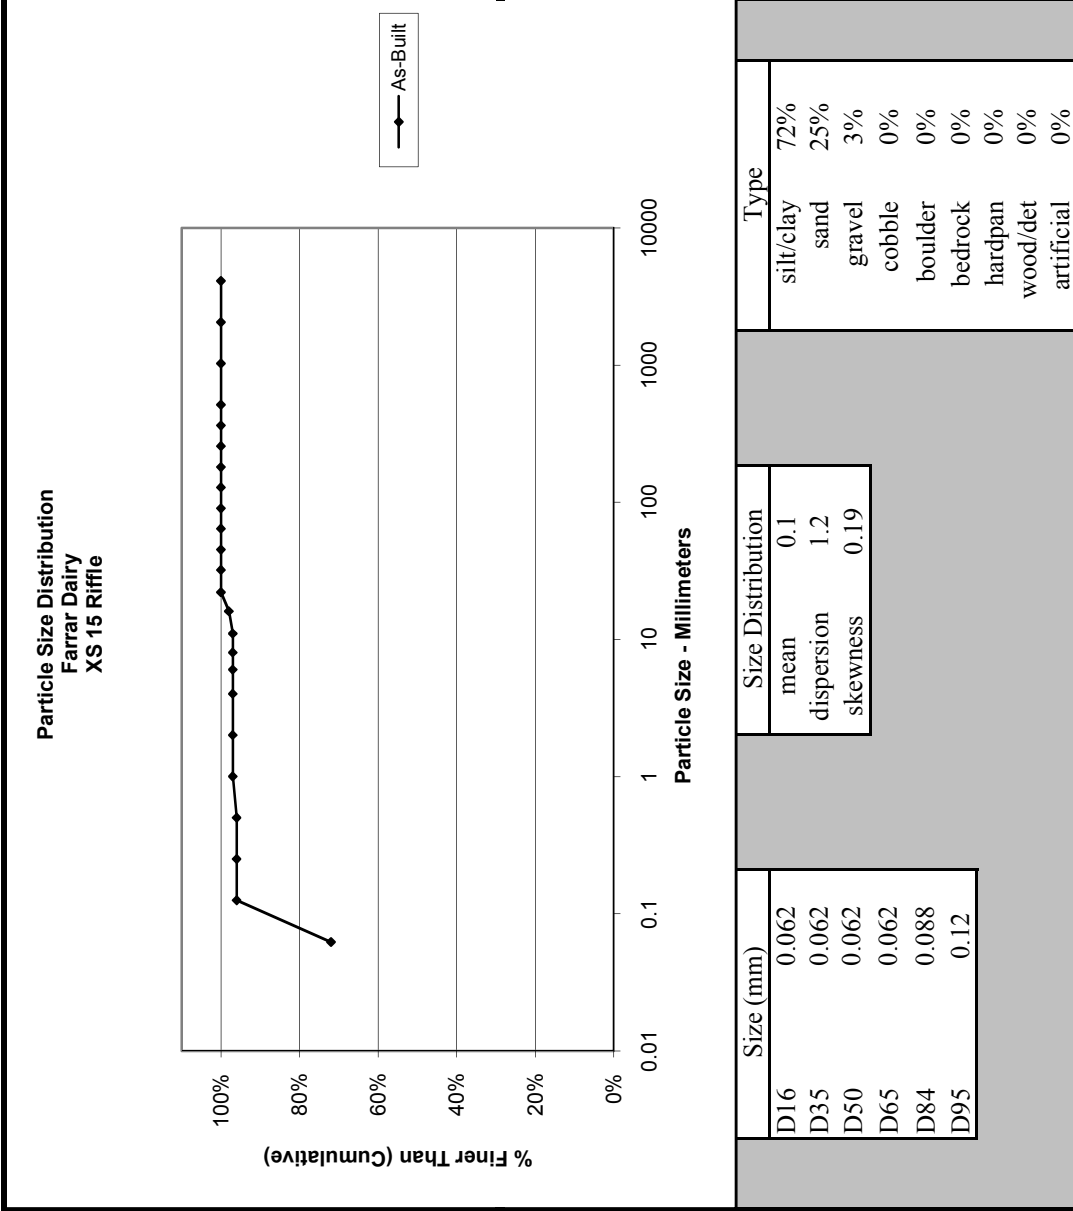


Cross-Section 16 Pool - As-Built				
Particle	Millimeter	S/C	Count	
Silt/Clay	< 0.062	S/C	19	
Very Fine	.062 - .125	S	13	
Fine	.125 - .25	A		
Medium	.25 - .50	N	55	
Coarse	.50 - 1	D	13	
Very Coarse	1 - 2	S		
Very Fine	2 - 4			
Fine	4 - 5.7	G		
Fine	5.7 - 8	R		
Medium	8 - 11.3	A		
Medium	11.3 - 16	V		
Coarse	16 - 22.6	E		
Coarse	22.6 - 32	L		
Very Coarse	32 - 45	S		
Very Coarse	45 - 64			
Small	64 - 90	C		
Small	90 - 128	O		
Large	128 - 180	B		
Large	180 - 256	L		
Small	256 - 362	B		
Small	362 - 512	L		
Medium	512 - 1024	D		
Lrg- Very Lrg	1024 - 2048	R		
Bedrock	>2048	BDRK		
		Total	100	

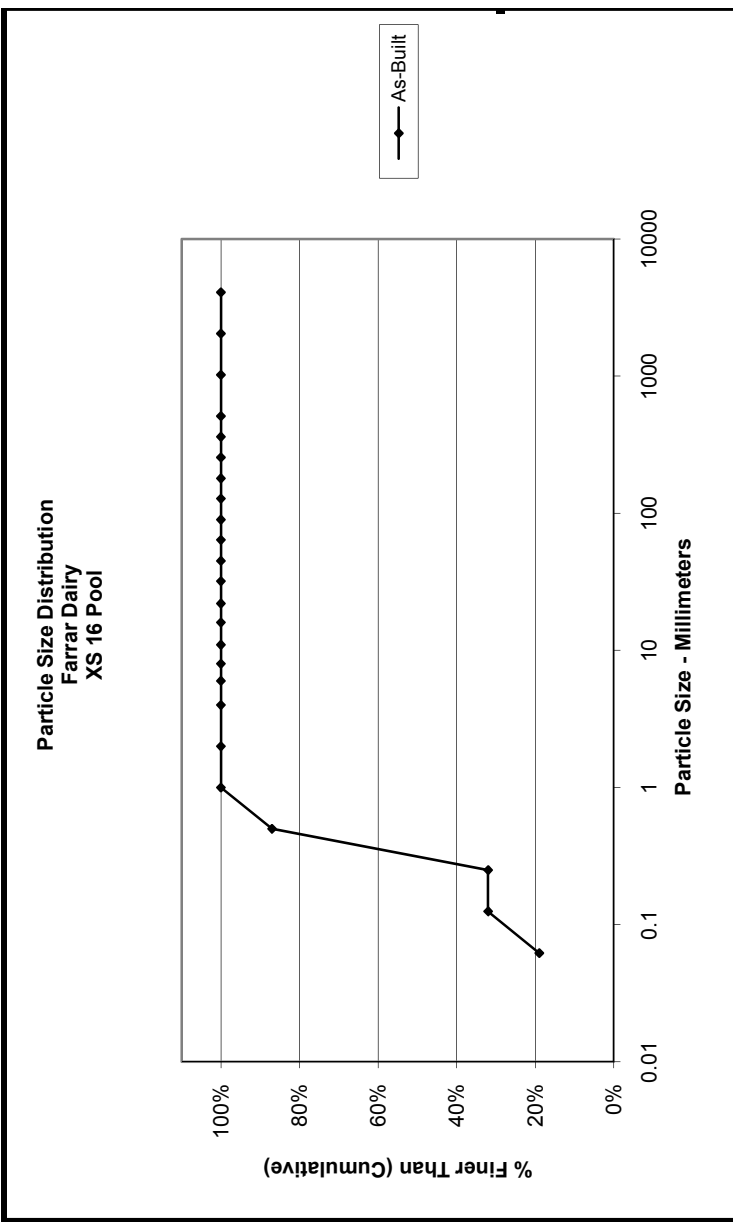

Size (mm)	Size Distribution	Type
D16	0.062	silt/clay
D35	0.26	sand
D50	0.31	gravel
D65	0.38	cobble
D84	0.48	boulder
D95	0.77	bedrock
	mean 0.2	hardpan
	dispersion 3.3	wood/det
	skewness -0.27	artificial
		19%
		81%
		0%
		0%
Note:

Cross-Section 17 Riffle - As-Built			
Particle	Millimeter	Count	
Silt/Clay	< 0.062	73	S/C
Very Fine	.062 - .125	27	S
Fine	.125 - .25		A
Medium	.25 - .50		N
Coarse	.50 - 1		D
Very Coarse	1 - 2		S
Very Fine	2 - 4		
Fine	4 - 5.7		G
Fine	5.7 - 8		R
Medium	8 - 11.3		A
Medium	11.3 - 16		V
Coarse	16 - 22.6		E
Coarse	22.6 - 32		L
Very Coarse	32 - 45		S
Very Coarse	45 - 64		
Small	64 - 90		C
Small	90 - 128		O
Large	128 - 180		B
Large	180 - 256		L
Small	256 - 362		B
Small	362 - 512		L
Medium	512 - 1024		D
Lrg- Very Lrgl	1024 - 2048		R
Bedrock	>2048		BDRK
		Total	100

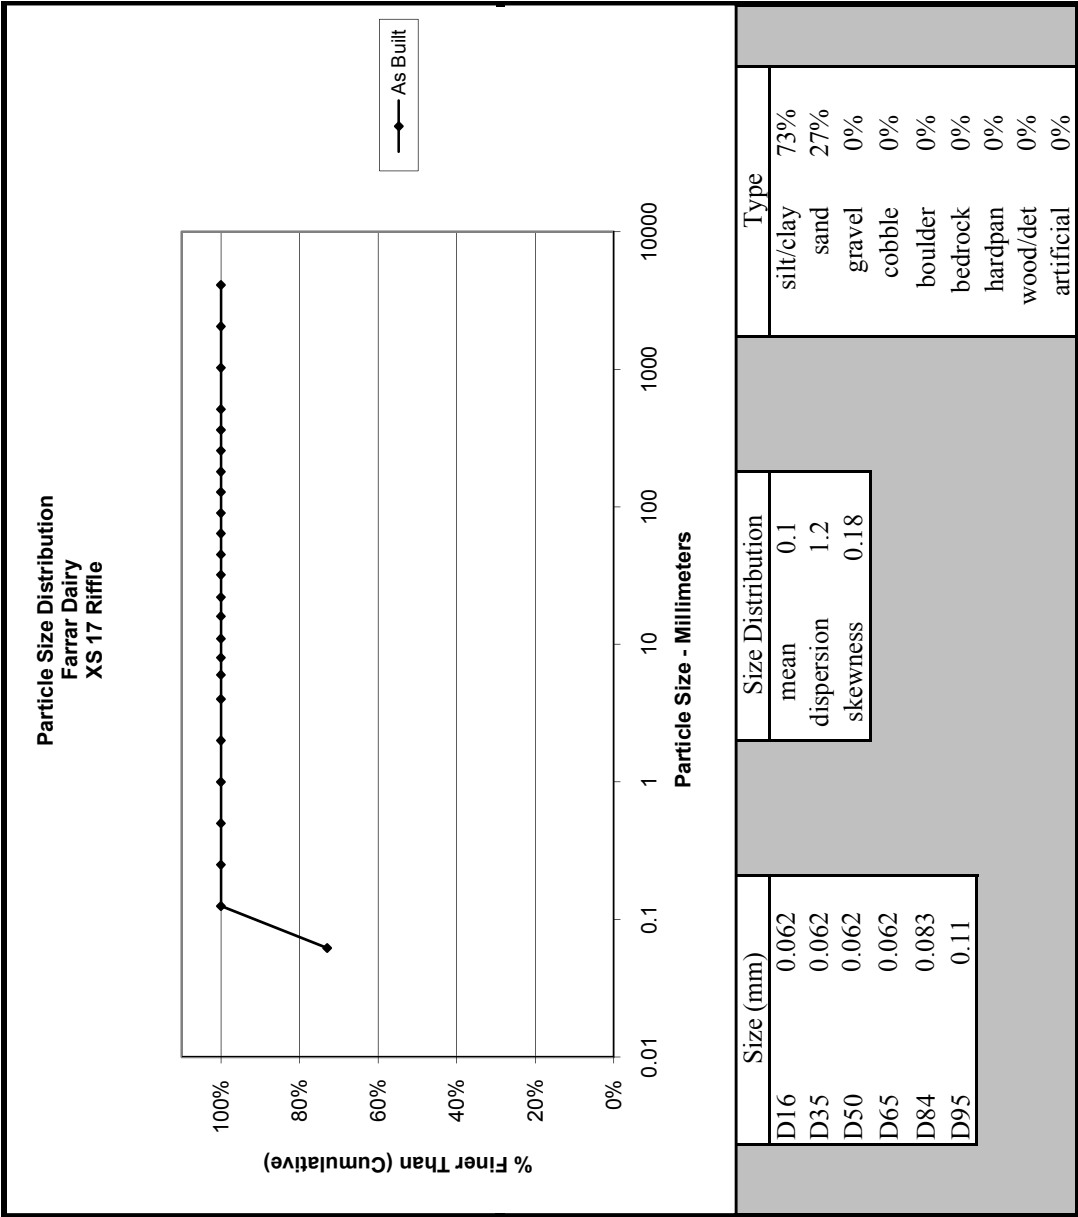

Note:

Cross-Section 18 Riffle - As-Built			
Particle	Millimeter	S/C	Count
Silt/Clay	< 0.062	S/C	57
Very Fine	.062 - .125	S	41
Fine	.125 - .25	A	
Medium	.25 - .50	N	
Coarse	.50 - 1	D	2
Very Coarse	1 - 2	S	
Very Fine	2 - 4		
Fine	4 - 5.7	G	
Fine	5.7 - 8	R	
Medium	8 - 11.3	A	
Medium	11.3 - 16	V	
Coarse	16 - 22.6	E	
Coarse	22.6 - 32	L	
Very Coarse	32 - 45	S	
Very Coarse	45 - 64		
Small	64 - 90	C	
Small	90 - 128	O	
Large	128 - 180	B	
Large	180 - 256	L	
Small	256 - 362	B	
Small	362 - 512	L	
Medium	512 - 1024	D	
Lrg- Very Lrg	1024 - 2048	R	
Bedrock	>2048	BDRK	
Total			100

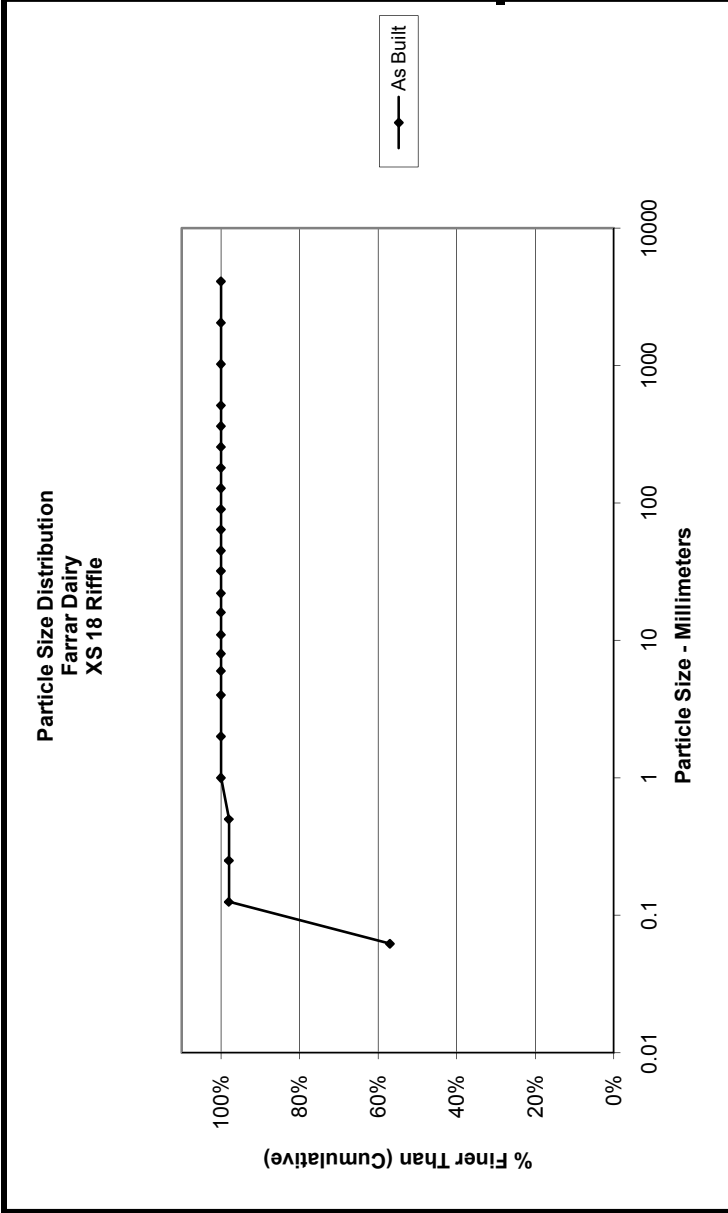


Size (mm)	Size Distribution	Type
D16	0.062	silt/clay
D35	0.062	sand
D50	0.062	gravel
D65	0.071	cobble
D84	0.098	boulder
D95	0.12	bedrock
	mean 0.1	hardpan
	dispersion 1.3	wood/det
	skewness 0.22	artificial

Size (mm)	Percentage
silt/clay	57%
sand	43%
gravel	0%
cobble	0%
boulder	0%
bedrock	0%
hardpan	0%
wood/det	0%
artificial	0%

Note:

Cross-Section 19 Pool - As-Built			
Particle	Millimeter	S/C	Count
Silt/Clay	< 0.062	S/C	62
Very Fine	.062 - .125	S	23
Fine	.125 - .25	A	2
Medium	.25 - .50	N	2
Coarse	.50 - 1	D	
Very Coarse	1 - 2	S	2
Very Fine	2 - 4		1
Fine	4 - 5.7	G	
Fine	5.7 - 8	R	2
Medium	8 - 11.3	A	5
Medium	11.3 - 16	V	1
Coarse	16 - 22.6	E	
Coarse	22.6 - 32	L	
Very Coarse	32 - 45	S	
Very Coarse	45 - 64		
Small	64 - 90	C	
Small	90 - 128	O	
Large	128 - 180	B	
Large	180 - 256	L	
Small	256 - 362	B	
Small	362 - 512	L	
Medium	512 - 1024	D	
Lrg- Very Lrg	1024 - 2048	R	
Bedrock	>2048	BDRK	
Total			100


Note:

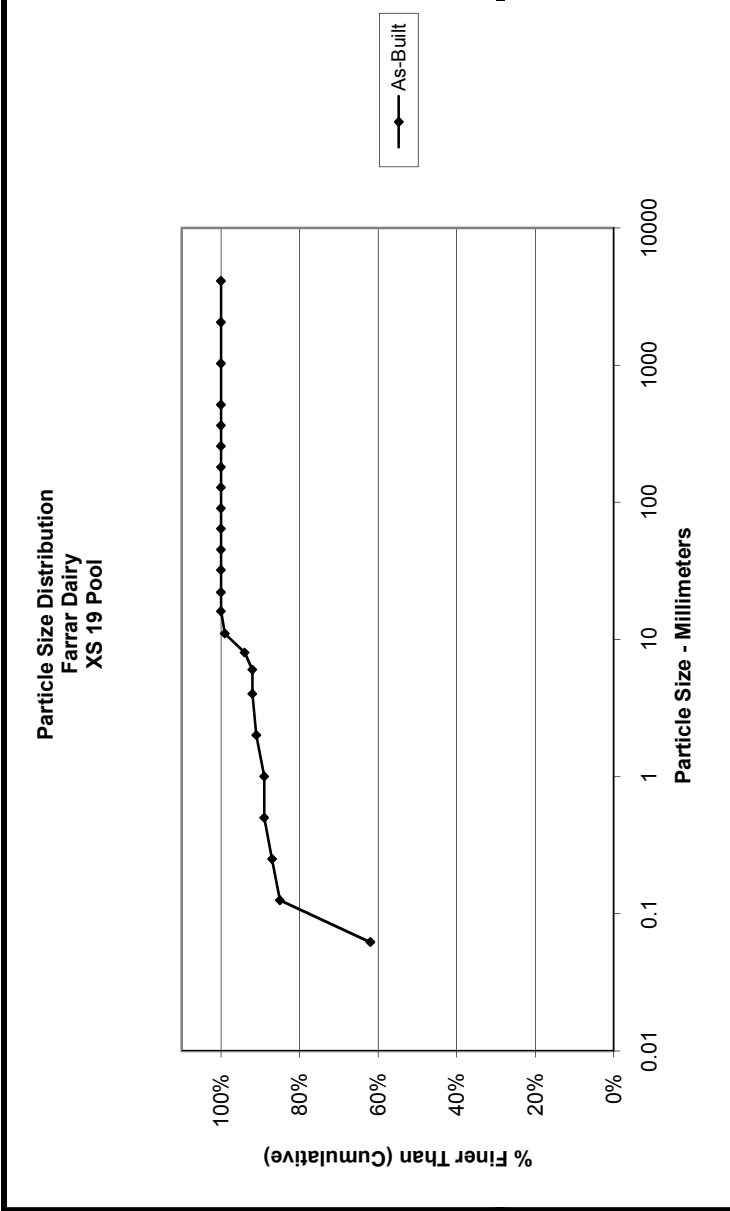

Size (mm)	Size Distribution	Type
D16	0.062	silt/clay
D35	0.062	sand
D50	0.062	gravel
D65	0.068	cobble
D84	0.12	boulder
D95	8.5	bedrock
mean		0.1
dispersion		1.5
skewness		0.27
62%		silt/clay
29%		sand
9%		gravel
0%		cobble
0%		boulder
0%		bedrock
0%		hardpan
0%		wood/det
0%		artificial

Cross-Section 20 Riffle - As-Built			
Particle	Millimeter	S/C	Count
Silt/Clay	< 0.062	S/C	65
Very Fine	.062 - .125	S	28
Fine	.125 - .25	A	
Medium	.25 - .50	N	5
Coarse	.50 - 1	D	1
Very Coarse	1 - 2	S	
Very Fine	2 - 4		1
Fine	4 - 5.7	G	
Fine	5.7 - 8	R	
Medium	8 - 11.3	A	
Medium	11.3 - 16	V	
Coarse	16 - 22.6	E	
Coarse	22.6 - 32	L	
Very Coarse	32 - 45	S	
Very Coarse	45 - 64		
Small	64 - 90	C	
Small	90 - 128	O	
Large	128 - 180	B	
Large	180 - 256	L	
Small	256 - 362	B	
Small	362 - 512	L	
Medium	512 - 1024	D	
Lrg- Very Lrg	1024 - 2048	R	
Bedrock	>2048	BDRK	
Total			100

Note:

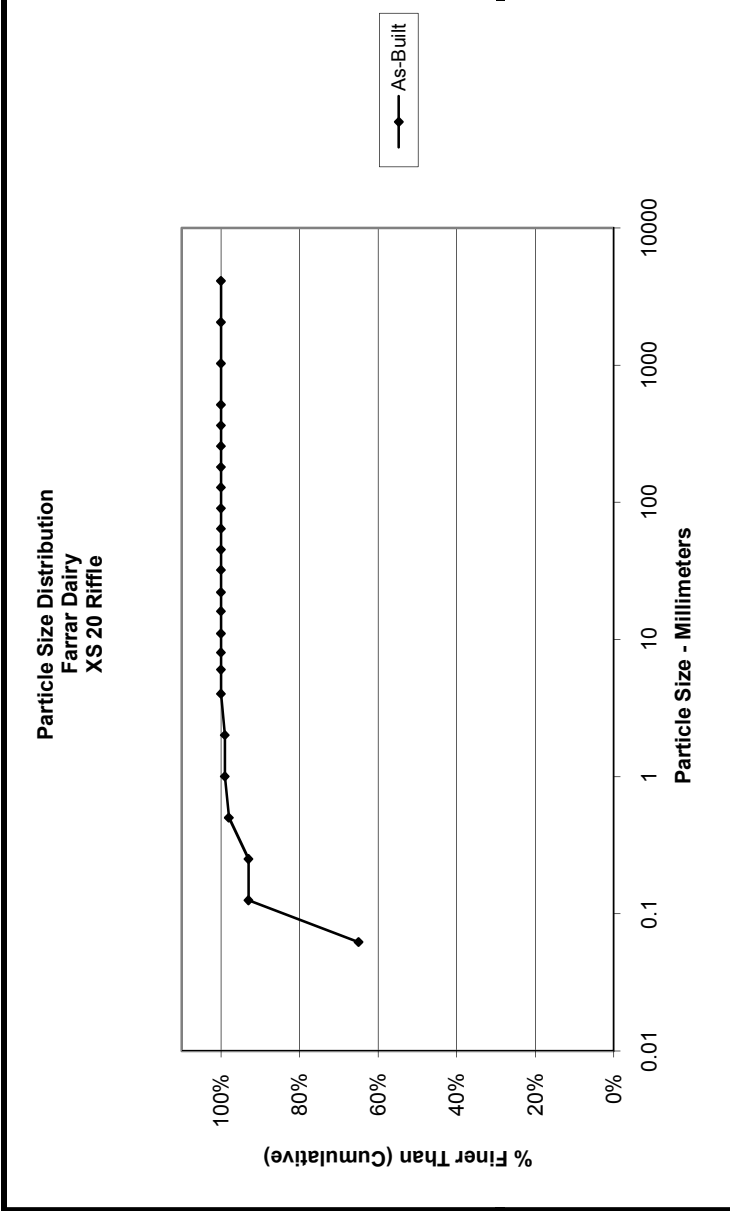


Size (mm)	Count
D16	0.062
D35	0.062
D50	0.062
D65	0.062
D84	0.1
D95	0.33

Size Distribution	
mean	0.1
dispersion	1.3
skewness	0.23

Type	Percentage
silt/clay	65%
sand	34%
gravel	1%
cobble	0%
boulder	0%
bedrock	0%
hardpan	0%
wood/det	0%
artificial	0%

Cross-Section 21 Riffle - As-Built			
Particle	Millimeter	S/C	Count
Silt/Clay	< 0.062	S/C	22
Very Fine	.062 - .125	S	20
Fine	.125 - .25	A	1
Medium	.25 - .50	N	6
Coarse	.50 - 1	D	13
Very Coarse	1 - 2	S	22
Very Fine	2 - 4		4
Fine	4 - 5.7	G	
Fine	5.7 - 8	R	2
Medium	8 - 11.3	A	2
Medium	11.3 - 16	V	7
Coarse	16 - 22.6	E	1
Coarse	22.6 - 32	L	
Very Coarse	32 - 45	S	
Very Coarse	45 - 64		
Small	64 - 90	C	
Small	90 - 128	O	
Large	128 - 180	B	
Large	180 - 256	L	
Small	256 - 362	B	
Small	362 - 512	L	
Medium	512 - 1024	D	
Lrg- Very Lrg	1024 - 2048	R	
Bedrock	>2048	BDRK	
Total			100

Particle Size Distribution
Farrar Dairy
XS 21 Riffle

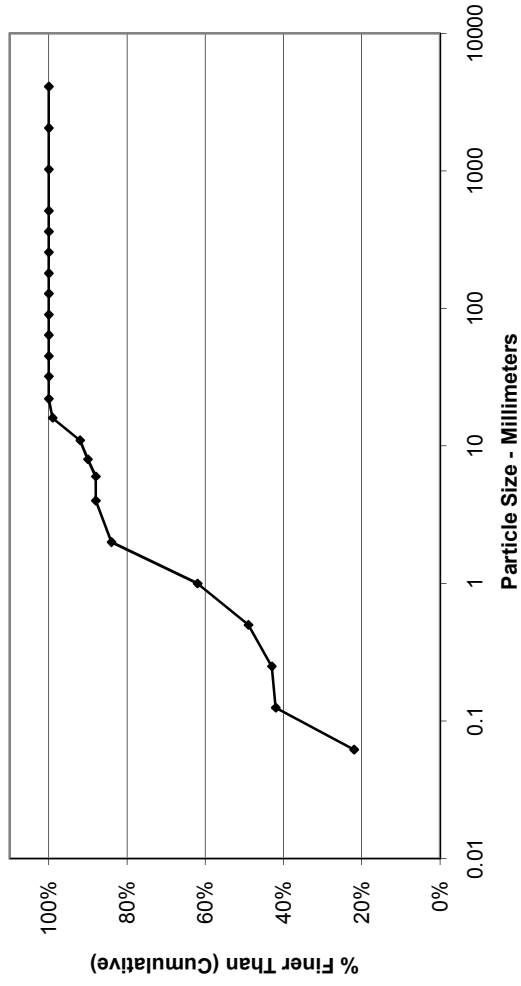


Size (mm)	Count
D16	0.062
D35	0.098
D50	0.53
D65	1.1
D84	2
D95	13

Size Distribution	
mean	0.4
dispersion	6.2
skewness	-0.14

Type	Percentage
silt/clay	22%
sand	62%
gravel	16%
cobble	0%
boulder	0%
bedrock	0%
hardpan	0%
wood/det	0%
artificial	0%

Note:


Cross-Section 22 Pool - As-Built				Count
Particle	Millimeter	S/C		100
Silt/Clay	< 0.062	S		
Very Fine	.062 - .125	A		
Fine	.125 - .25	N		
Medium	.25 - .50	D		
Coarse	.50 - 1	S		
Very Coarse	1 - 2			
Very Fine	2 - 4			
Fine	4 - 5.7	G		
Fine	5.7 - 8	R		
Medium	8 - 11.3	A		
Medium	11.3 - 16	V		
Coarse	16 - 22.6	E		
Coarse	22.6 - 32	L		
Very Coarse	32 - 45	S		
Very Coarse	45 - 64			
Small	64 - 90	C		
Small	90 - 128	O		
Large	128 - 180	B		
Large	180 - 256	L		
Small	256 - 362	B		
Small	362 - 512	L		
Medium	512 - 1024	D		
Lrg- Very Lrg	1024 - 2048	R		
Bedrock	>2048	BDRK		
Total				100

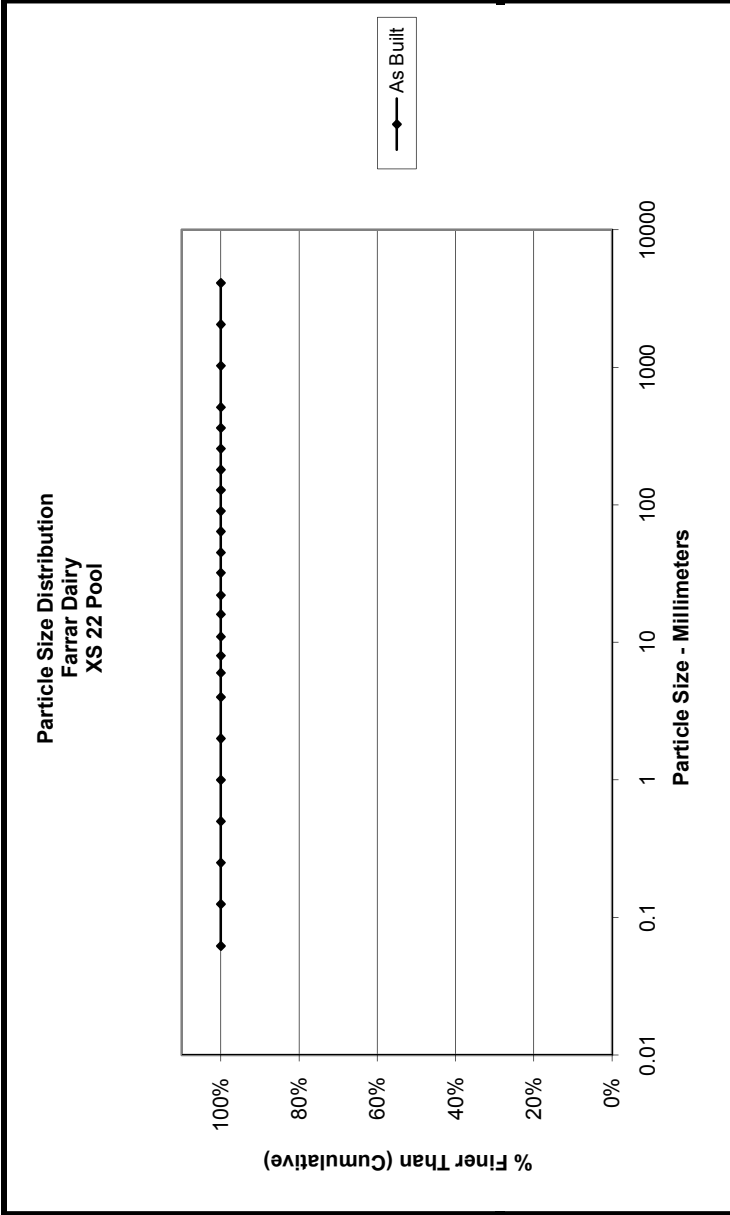

Size (mm)	Size Distribution	Type
D16	mean 0.1	silt/clay 100%
D35	dispersion 1.0	sand 0%
D50	skewness ---	gravel 0%
D65		cobble 0%
D84		boulder 0%
D95		bedrock 0%
		hardpan 0%
		wood/det 0%
		artificial 0%

Note:

Cross-Section 23 Riffle - As-Built			
Particle	Millimeter	S/C	Count
Silt/Clay	< 0.062	S/C	80
Very Fine	.062 - .125	S	
Fine	.125 - .25	A	
Medium	.25 - .50	N	
Coarse	.50 - 1	D	
Very Coarse	1 - 2	S	
Very Fine	2 - 4		3
Fine	4 - 5.7	G	
Fine	5.7 - 8	R	
Medium	8 - 11.3	A	1
Medium	11.3 - 16	V	1
Coarse	16 - 22.6	E	5
Coarse	22.6 - 32	L	7
Very Coarse	32 - 45	S	1
Very Coarse	45 - 64		
Small	64 - 90	C	2
Small	90 - 128	O	
Large	128 - 180	B	
Large	180 - 256	L	
Small	256 - 362	B	
Small	362 - 512	L	
Medium	512 - 1024	D	
Lrg- Very Lrg	1024 - 2048	R	
Bedrock	>2048	BDRK	
Total			100

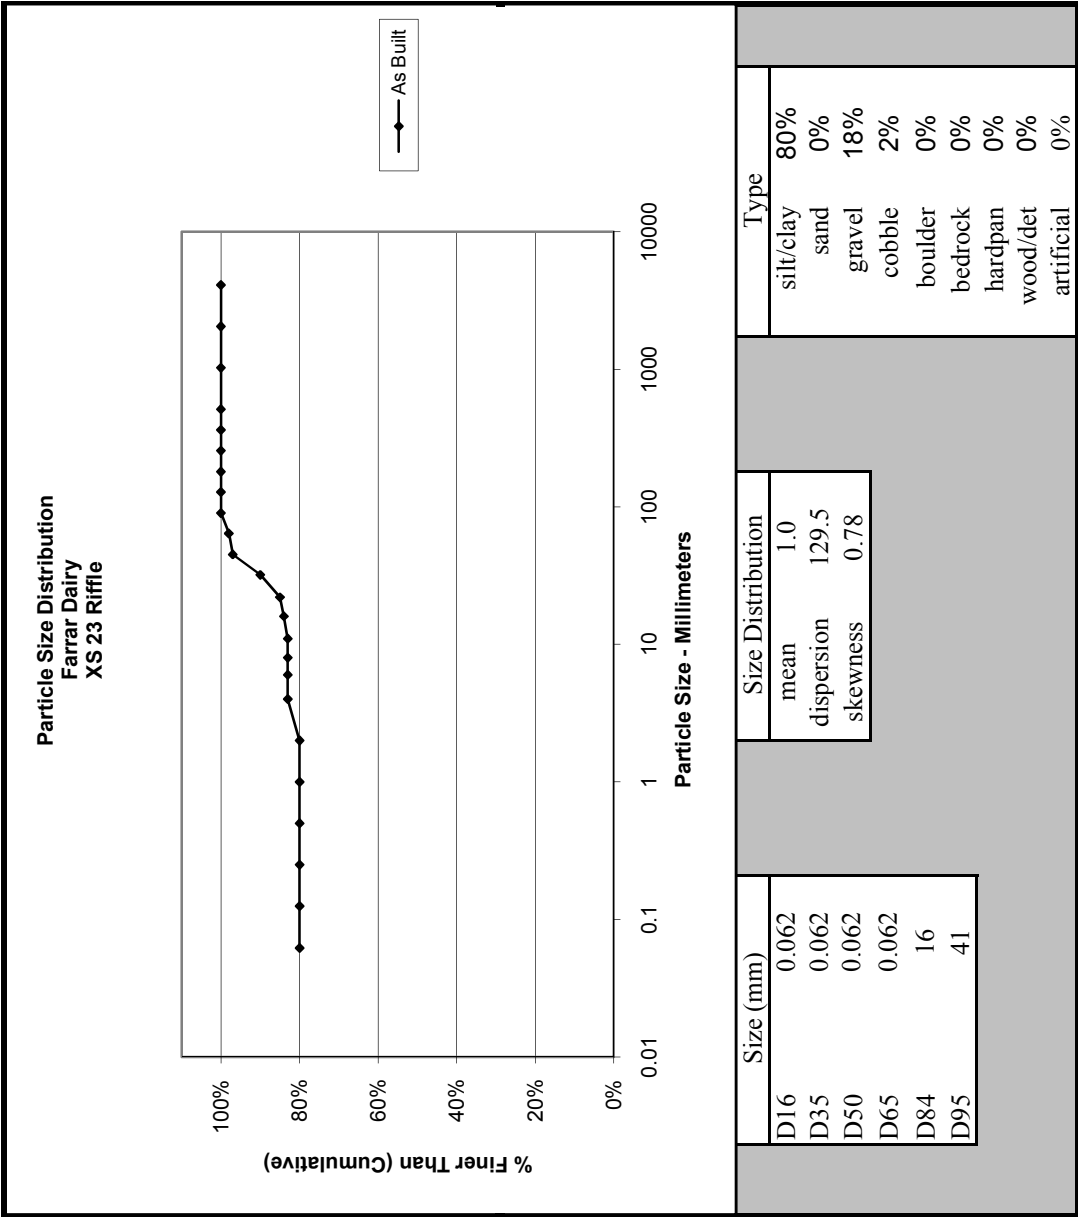


Note:

Cross-Section 24 Pool - As-Built				Count
Particle	Millimeter	S/C		100
Silt/Clay	< 0.062	S/C		
Very Fine	.062 - .125	S		
Fine	.125 - .25	A		
Medium	.25 - .50	N		
Coarse	.50 - 1	D		
Very Coarse	1 - 2	S		
Very Fine	2 - 4			
Fine	4 - 5.7	G		
Fine	5.7 - 8	R		
Medium	8 - 11.3	A		
Medium	11.3 - 16	V		
Coarse	16 - 22.6	E		
Coarse	22.6 - 32	L		
Very Coarse	32 - 45	S		
Very Coarse	45 - 64			
Small	64 - 90	C		
Small	90 - 128	O		
Large	128 - 180	B		
Large	180 - 256	L		
Small	256 - 362	B		
Small	362 - 512	L		
Medium	512 - 1024	D		
Lrg- Very Lrg	1024 - 2048	R		
Bedrock	>2048	BDRK		
Total				100

Note:

Particle Size Distribution
Farrar Dairy
XS 24 Pool

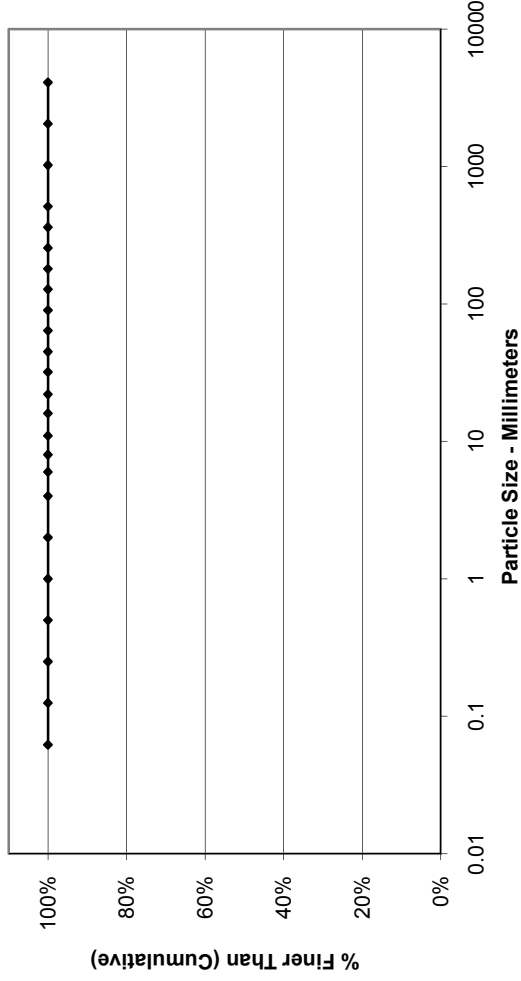


Size (mm)	
D16	0.062
D35	0.062
D50	0.062
D65	0.062
D84	0.062
D95	0.062

Size Distribution	
mean	0.1
dispersion	1.0
skewness	---


Type	
silt/clay	100%
sand	0%
gravel	0%
cobble	0%
boulder	0%
bedrock	0%
hardpan	0%
wood/det	0%
artificial	0%

Cross-Section 25 Riffle - As-Built				Count
Particle	Millimeter	S/C		100
Silt/Clay	< 0.062	S/C		
Very Fine	.062 - .125	S		
Fine	.125 - .25	A		
Medium	.25 - .50	N		
Coarse	.50 - 1	D		
Very Coarse	1 - 2	S		
Very Fine	2 - 4			
Fine	4 - 5.7	G		
Fine	5.7 - 8	R		
Medium	8 - 11.3	A		
Medium	11.3 - 16	V		
Coarse	16 - 22.6	E		
Coarse	22.6 - 32	L		
Very Coarse	32 - 45	S		
Very Coarse	45 - 64			
Small	64 - 90	C		
Small	90 - 128	O		
Large	128 - 180	B		
Large	180 - 256	L		
Small	256 - 362	B		
Small	362 - 512	L		
Medium	512 - 1024	D		
Lrg- Very Lrg	1024 - 2048	R		
Bedrock	>2048	BDRK		
Total				100

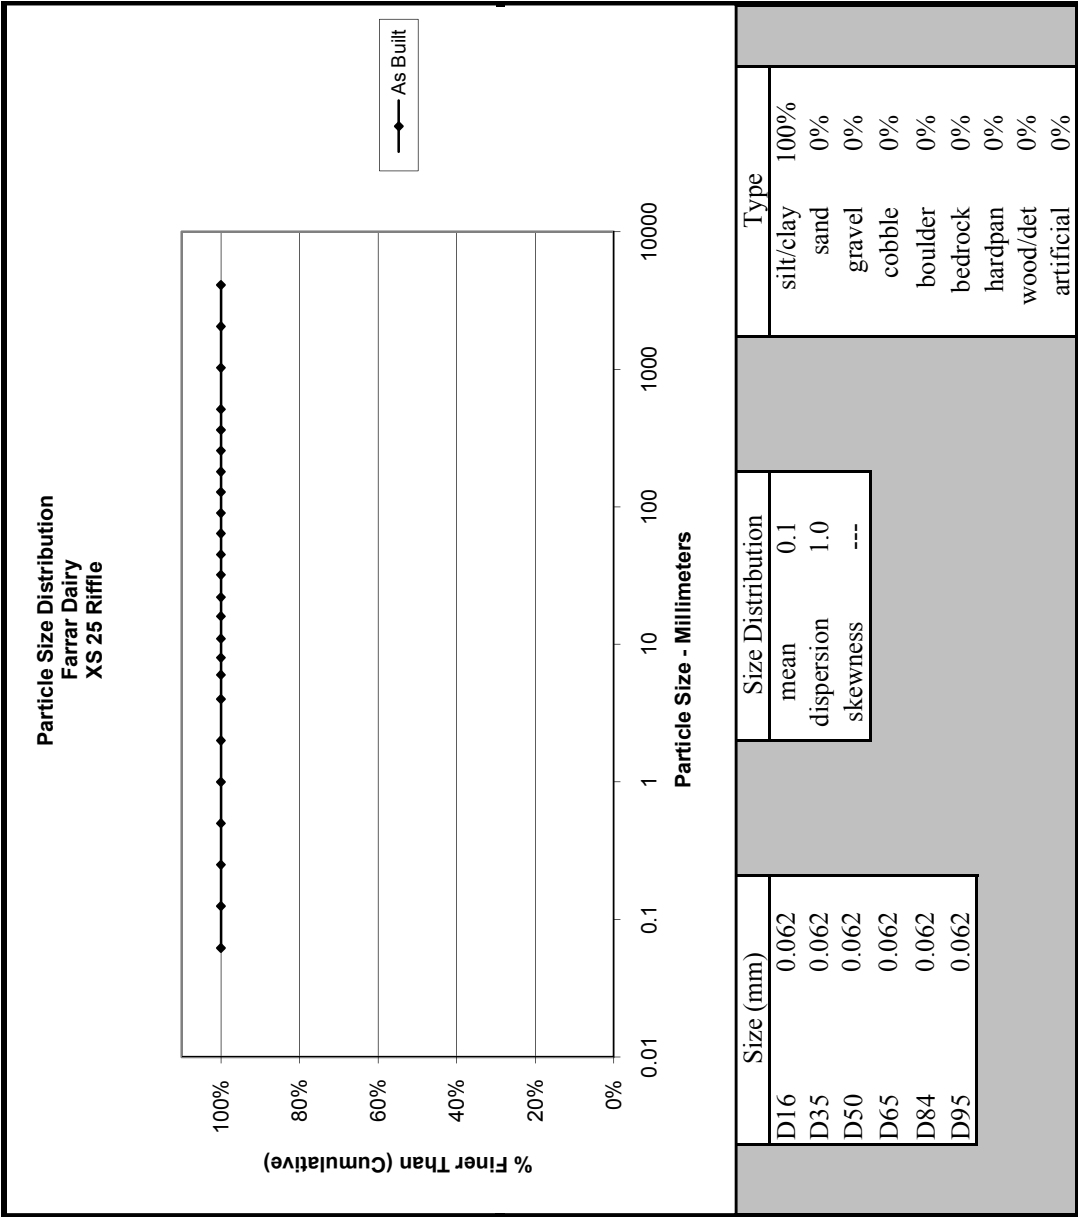

Note:


Cross-Section 26 Riffle - As-Built			
Particle	Millimeter	Count	
Silt/Clay	< 0.062	70	S/C
Very Fine	.062 - .125	25	S
Fine	.125 - .25		A
Medium	.25 - .50		N
Coarse	.50 - 1		D
Very Coarse	1 - 2		S
Very Fine	2 - 4		
Fine	4 - 5.7	2	G
Fine	5.7 - 8		R
Medium	8 - 11.3	2	A
Medium	11.3 - 16		V
Coarse	16 - 22.6	1	E
Coarse	22.6 - 32		L
Very Coarse	32 - 45		S
Very Coarse	45 - 64		
Small	64 - 90		C
Small	90 - 128		O
Large	128 - 180		B
Large	180 - 256		L
Small	256 - 362		B
Small	362 - 512		L
Medium	512 - 1024		D
Lrg- Very Lrgl	1024 - 2048		R
Bedrock	>2048		BDRK
		100	Total

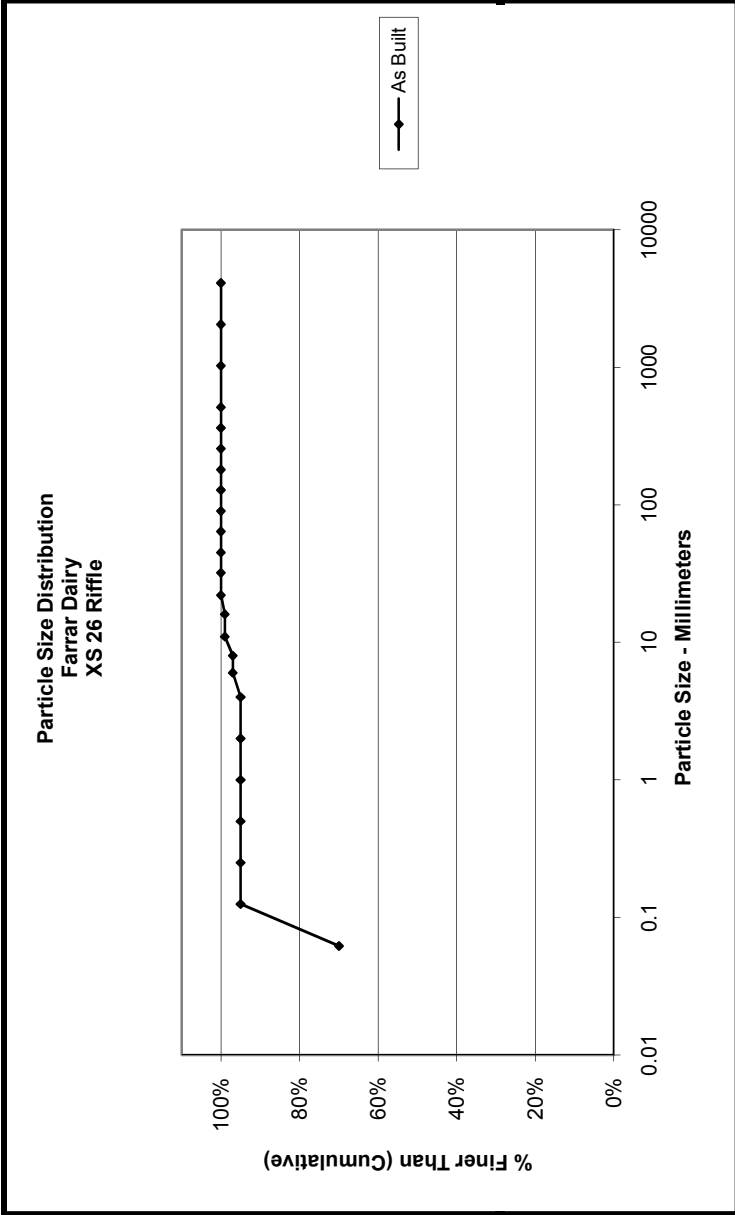

Size (mm)	Size Distribution	Type
D16	mean 0.1	silt/clay 70%
D35	dispersion 1.2	sand 25%
D50	skewness 0.21	gravel 5%
D65		cobble 0%
D84		boulder 0%
D95		bedrock 0%
		hardpan 0%
		wood/det 0%
		artificial 0%

Note:

Cross-Section 27 Pool - As-Built			
Particle	Millimeter	Count	
Silt/Clay	< 0.062	S/C	50
Very Fine	.062 - .125	S	50
Fine	.125 - .25	A	
Medium	.25 - .50	N	
Coarse	.50 - 1	D	
Very Coarse	1 - 2	S	
Very Fine	2 - 4		
Fine	4 - 5.7	G	
Fine	5.7 - 8	R	
Medium	8 - 11.3	A	
Medium	11.3 - 16	V	
Coarse	16 - 22.6	E	
Coarse	22.6 - 32	L	
Very Coarse	32 - 45	S	
Very Coarse	45 - 64		
Small	64 - 90	C	
Small	90 - 128	O	
Large	128 - 180	B	
Large	180 - 256	L	
Small	256 - 362	B	
Small	362 - 512	L	
Medium	512 - 1024	D	
Lrg- Very Lrgl	1024 - 2048	R	
Bedrock	>2048	BDRK	
		Total	100

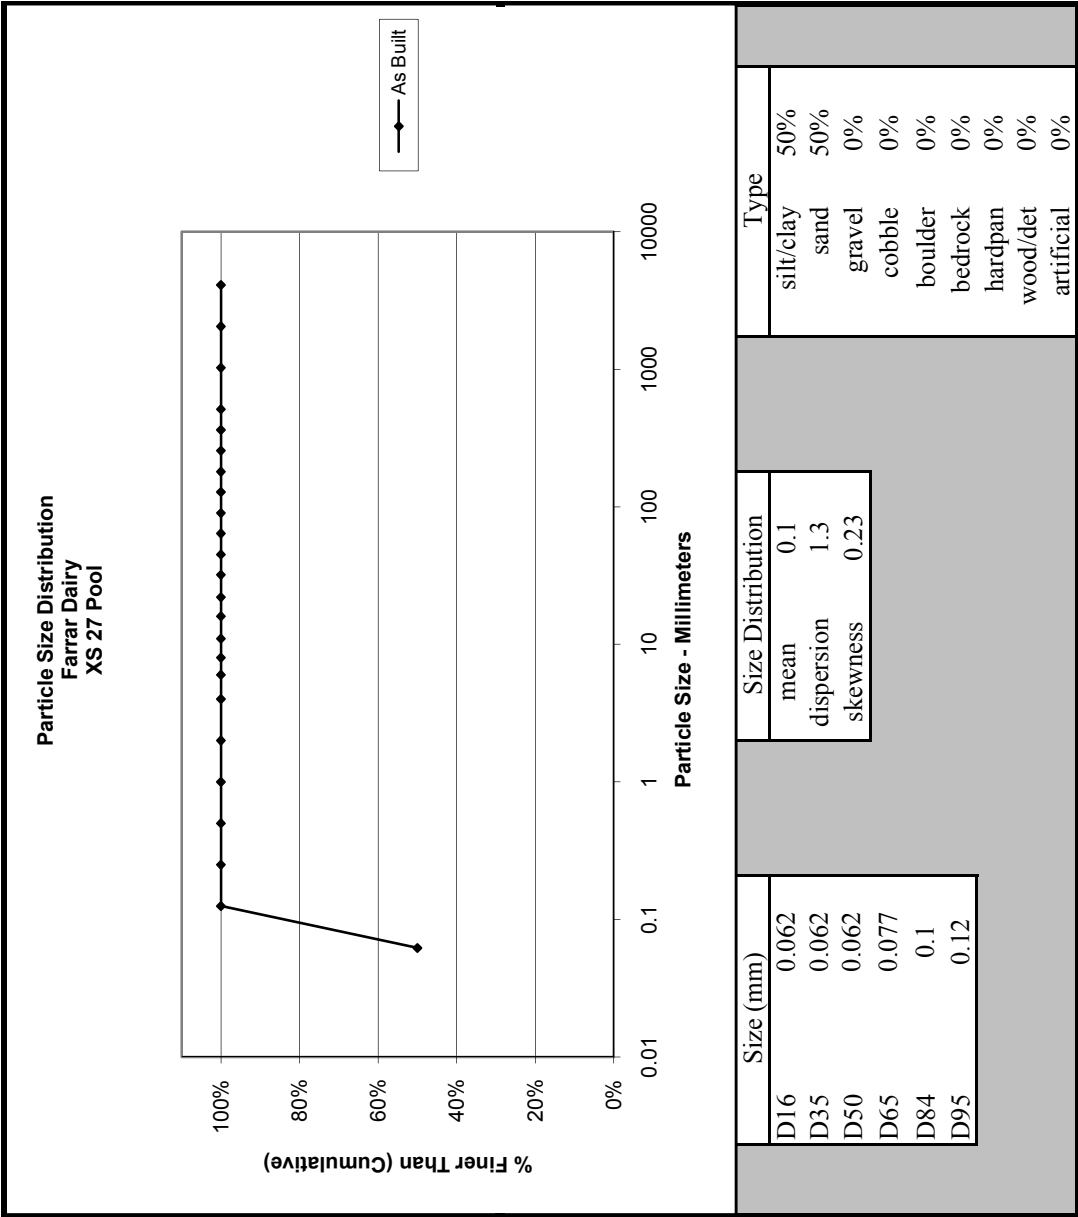


Note:

Cross-Section 28 Pool - As-Built				Count
Particle	Millimeter	S/C		100
Silt/Clay	< 0.062	S/C		
Very Fine	.062 - .125	S		
Fine	.125 - .25	A		
Medium	.25 - .50	N		
Coarse	.50 - 1	D		
Very Coarse	1 - 2	S		
Very Fine	2 - 4			
Fine	4 - 5.7	G		
Fine	5.7 - 8	R		
Medium	8 - 11.3	A		
Medium	11.3 - 16	V		
Coarse	16 - 22.6	E		
Coarse	22.6 - 32	L		
Very Coarse	32 - 45	S		
Very Coarse	45 - 64			
Small	64 - 90	C		
Small	90 - 128	O		
Large	128 - 180	B		
Large	180 - 256	L		
Small	256 - 362	B		
Small	362 - 512	L		
Medium	512 - 1024	D		
Lrg- Very Lrg	1024 - 2048	R		
Bedrock	>2048	BDRK		
Total				100

Note:

Particle Size Distribution
Farrar Dairy
XS 28 Pool

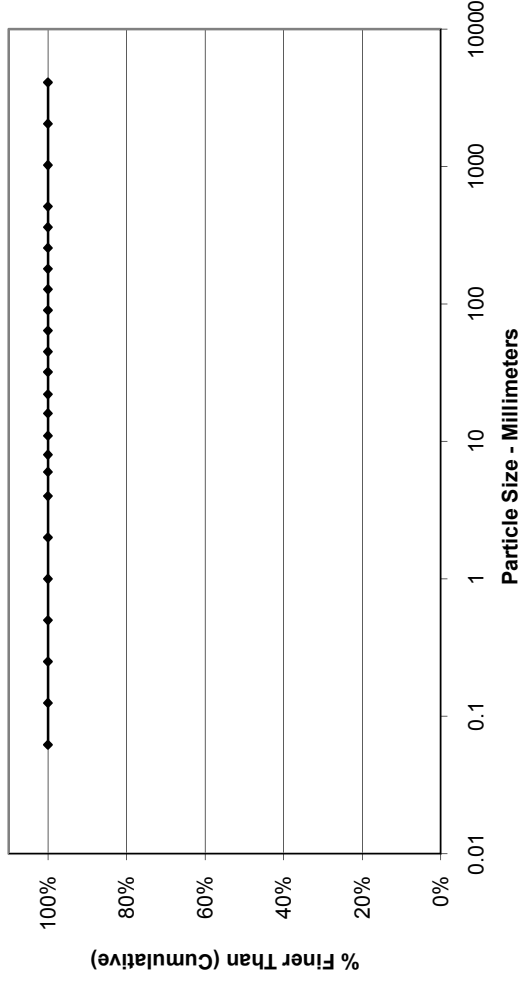


Size (mm)	0.062	0.062	0.062	0.062	0.062	0.062
D16	0.062					
D35		0.062				
D50			0.062			
D65				0.062		
D84					0.062	
D95						0.062

Size Distribution	
mean	0.1
dispersion	1.0
skewness	---

Type	100%
silt/clay	100%
sand	0%
gravel	0%
cobble	0%
boulder	0%
bedrock	0%
hardpan	0%
wood/det	0%
artificial	0%

Cross-Section 29 Riffle - As-Built			
Particle	Millimeter	S/C	Count
Silt/Clay	< 0.062	S/C	97
Very Fine	.062 - .125	S	
Fine	.125 - .25	A	
Medium	.25 - .50	N	
Coarse	.50 - 1	D	
Very Coarse	1 - 2	S	
Very Fine	2 - 4		
Fine	4 - 5.7	G	1
Fine	5.7 - 8	R	
Medium	8 - 11.3	A	2
Medium	11.3 - 16	V	
Coarse	16 - 22.6	E	
Coarse	22.6 - 32	L	
Very Coarse	32 - 45	S	
Very Coarse	45 - 64		
Small	64 - 90	C	
Small	90 - 128	O	
Large	128 - 180	B	
Large	180 - 256	L	
Small	256 - 362	B	
Small	362 - 512	L	
Medium	512 - 1024	D	
Lrg- Very Lrg	1024 - 2048	R	
Bedrock	>2048	BDRK	
Total			100


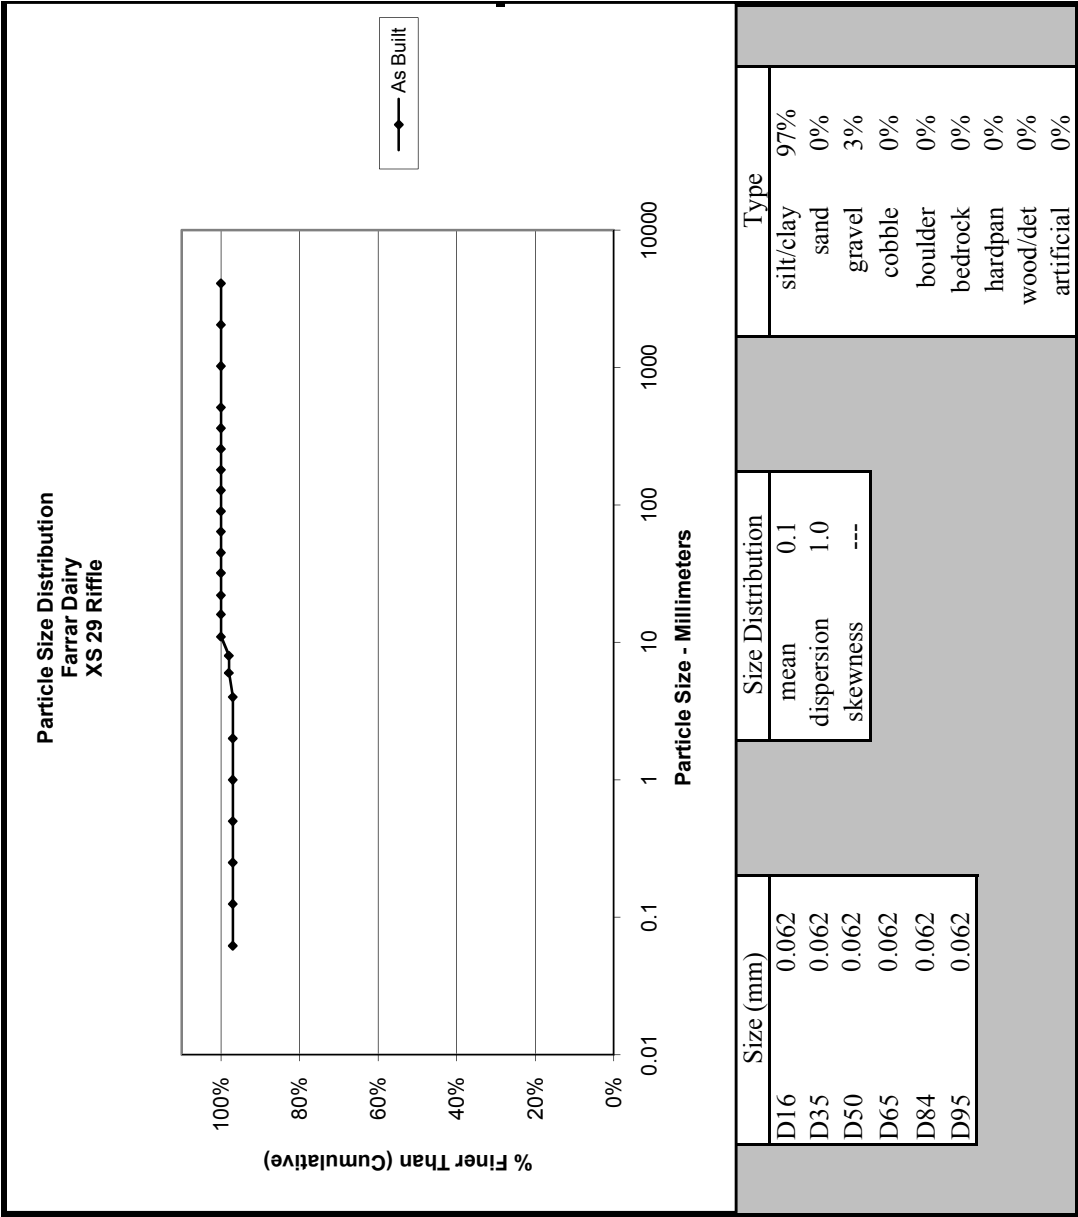


Note:



Appendix C

Longitudinal Profiles


Farrar Dairy Longitudinal Profile
NPAC-1, As-Built
Stations 15+75 - 31+75

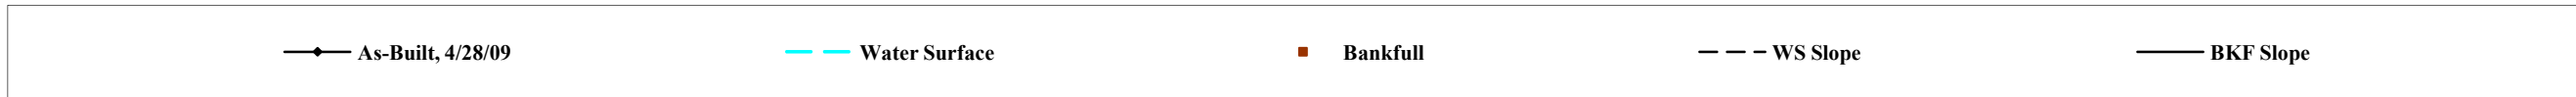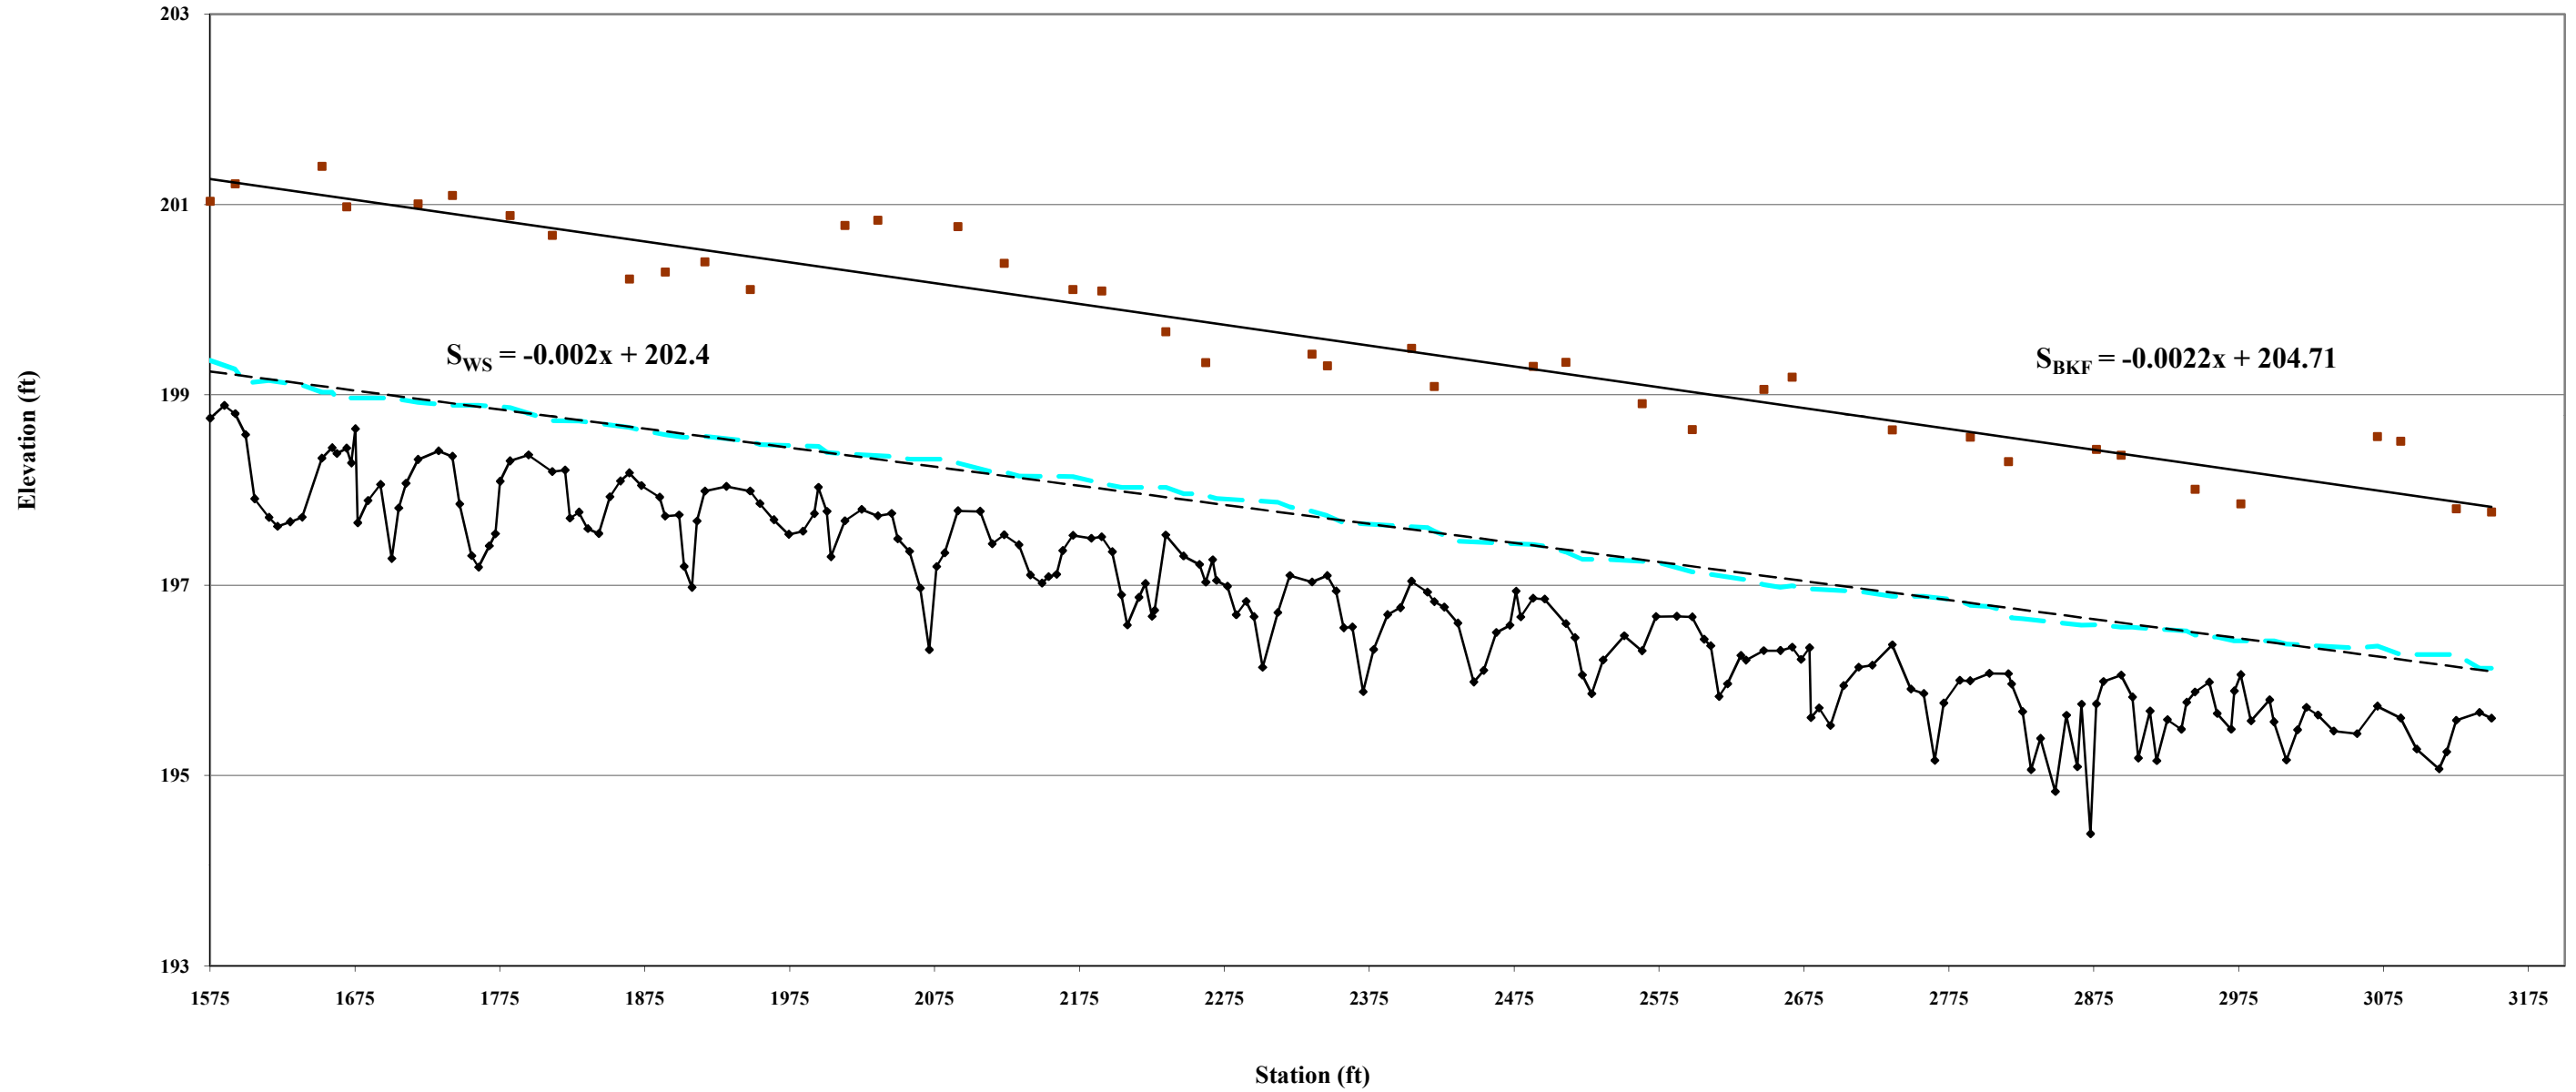


Farrar Dairy Longitudinal Profile
NPAC-2, As-Built
Stations 57+55 - 63+77

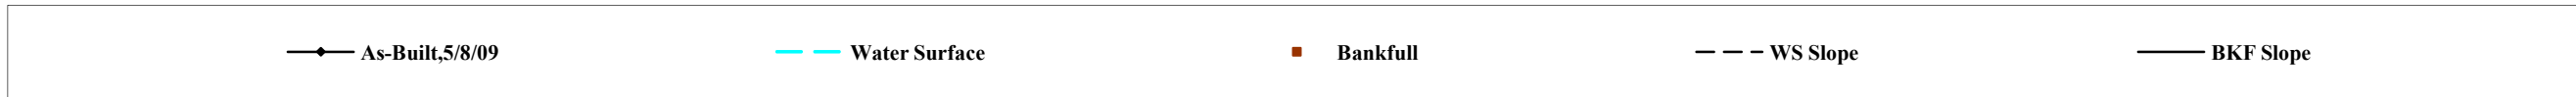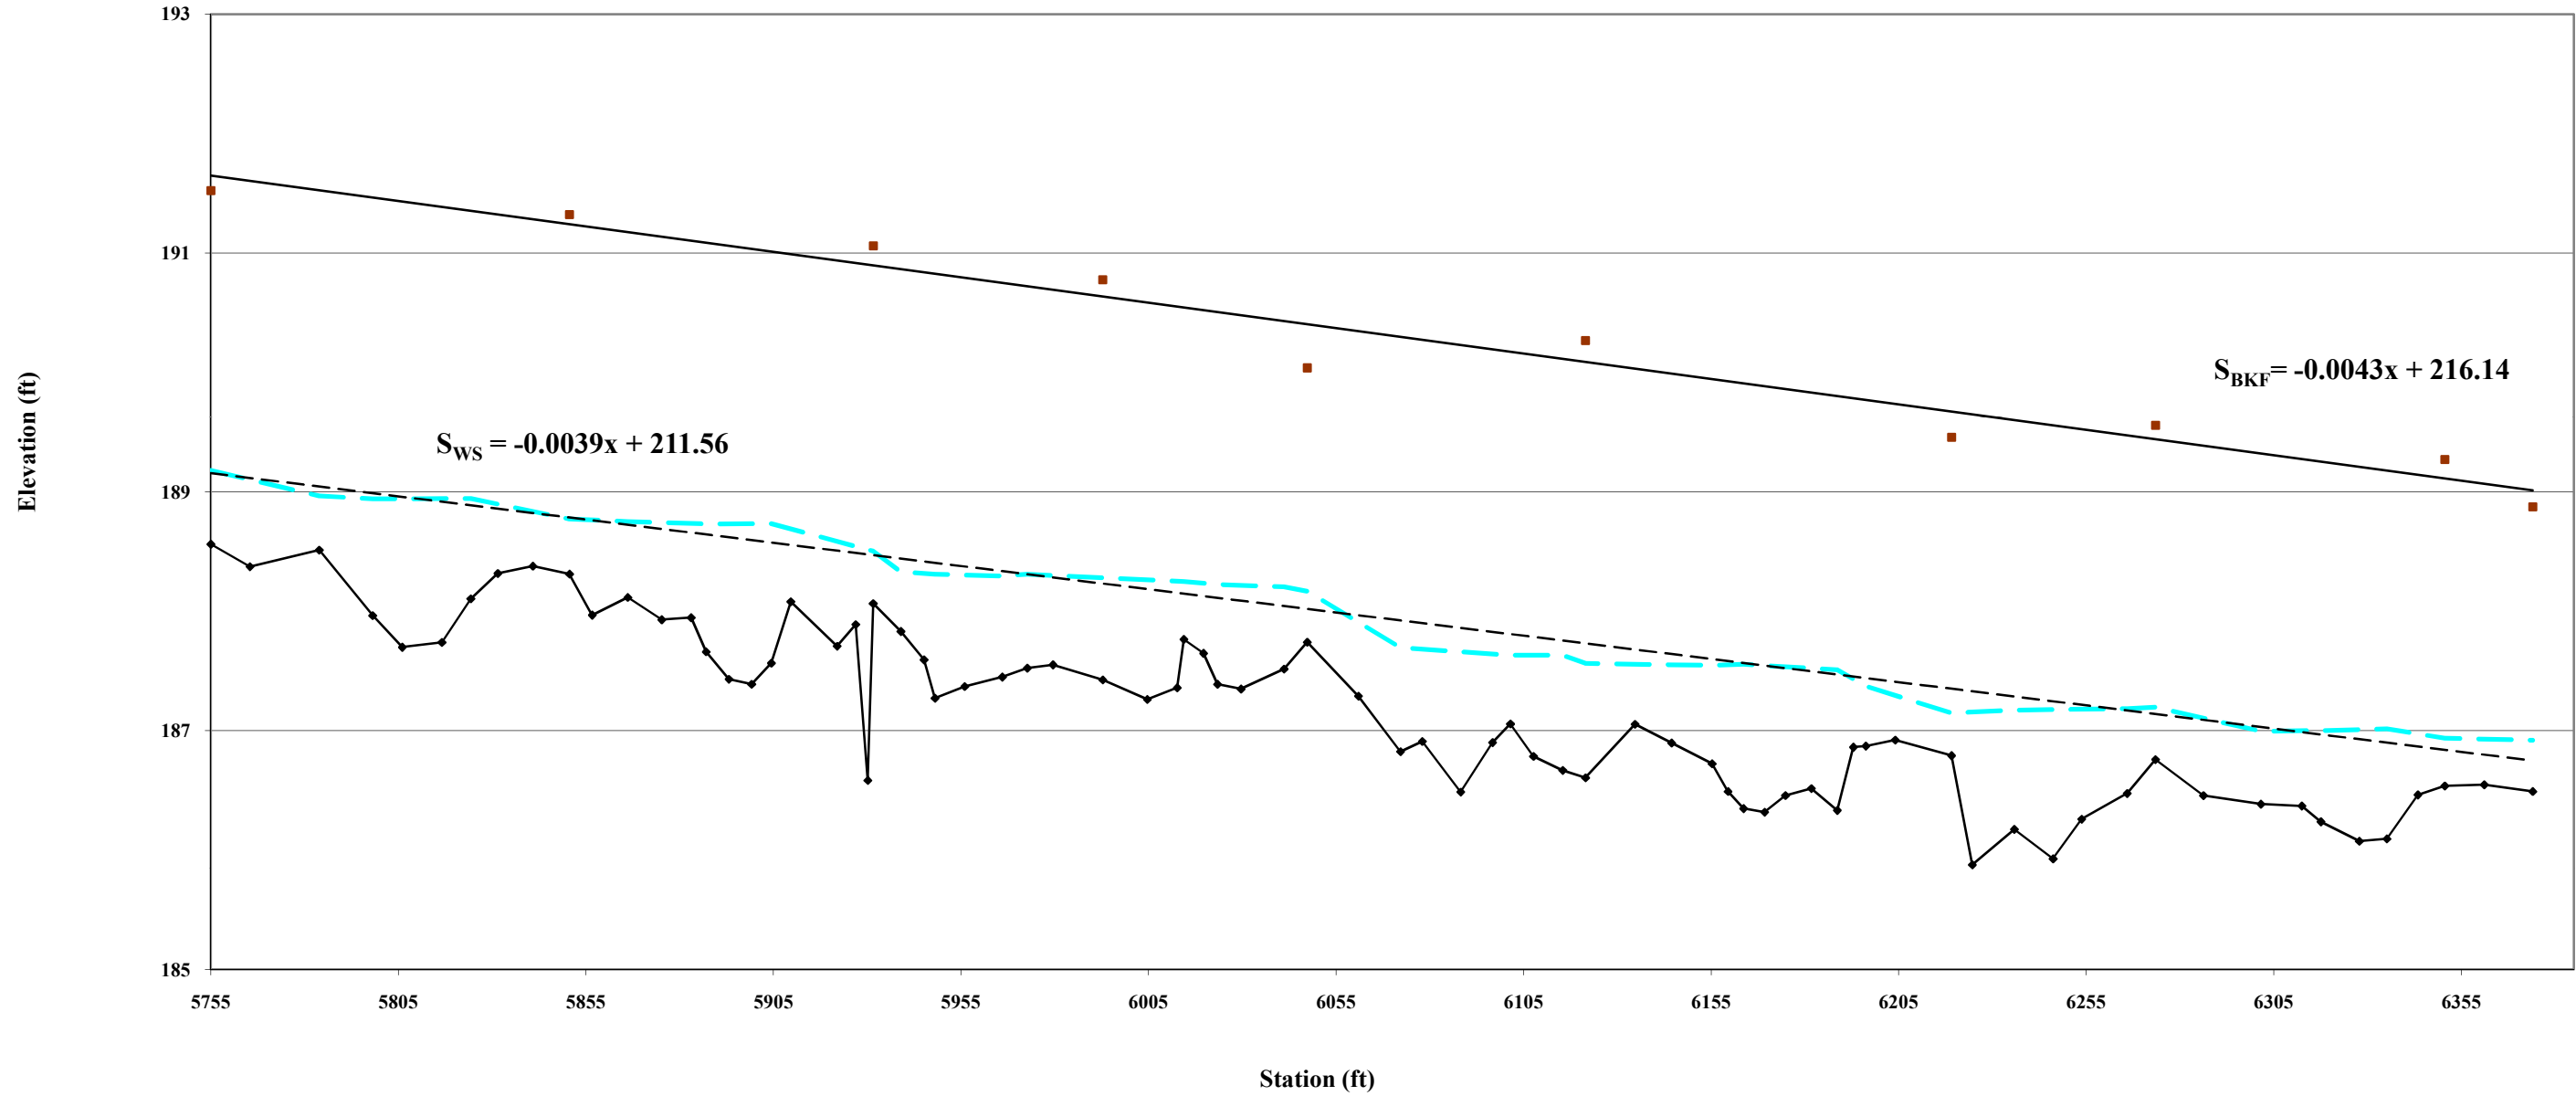


Farrar Dairy Longitudinal Profile
Tributary 1.1, As-Built
Stations 80+25 - 85+75

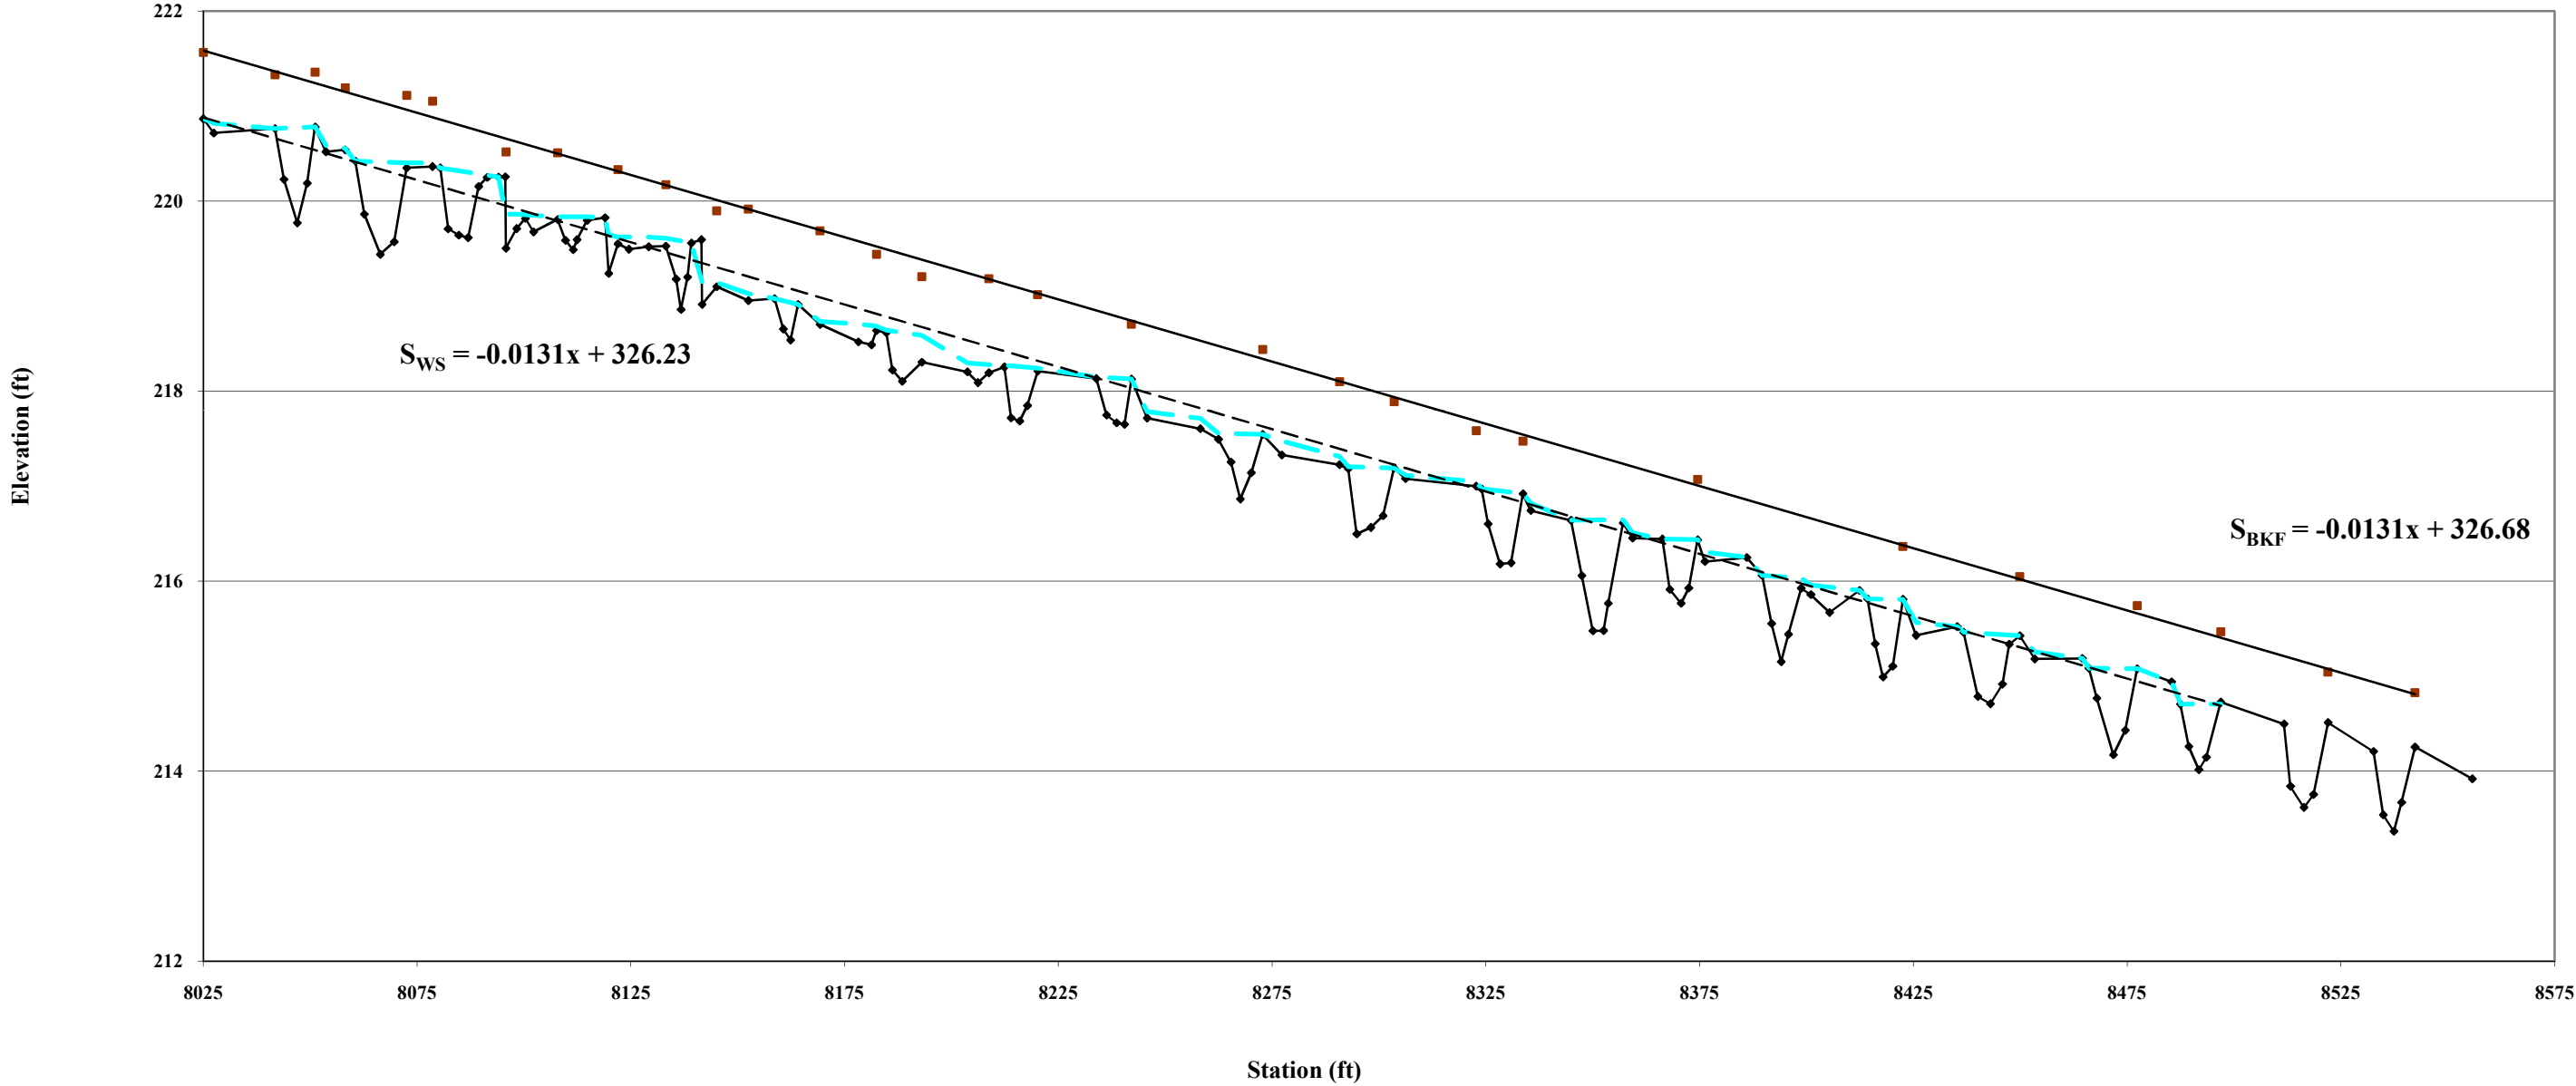


Farrar Dairy Longitudinal Profile
Tributary 1.2, As-Built
Stations 91+45 - 96+70

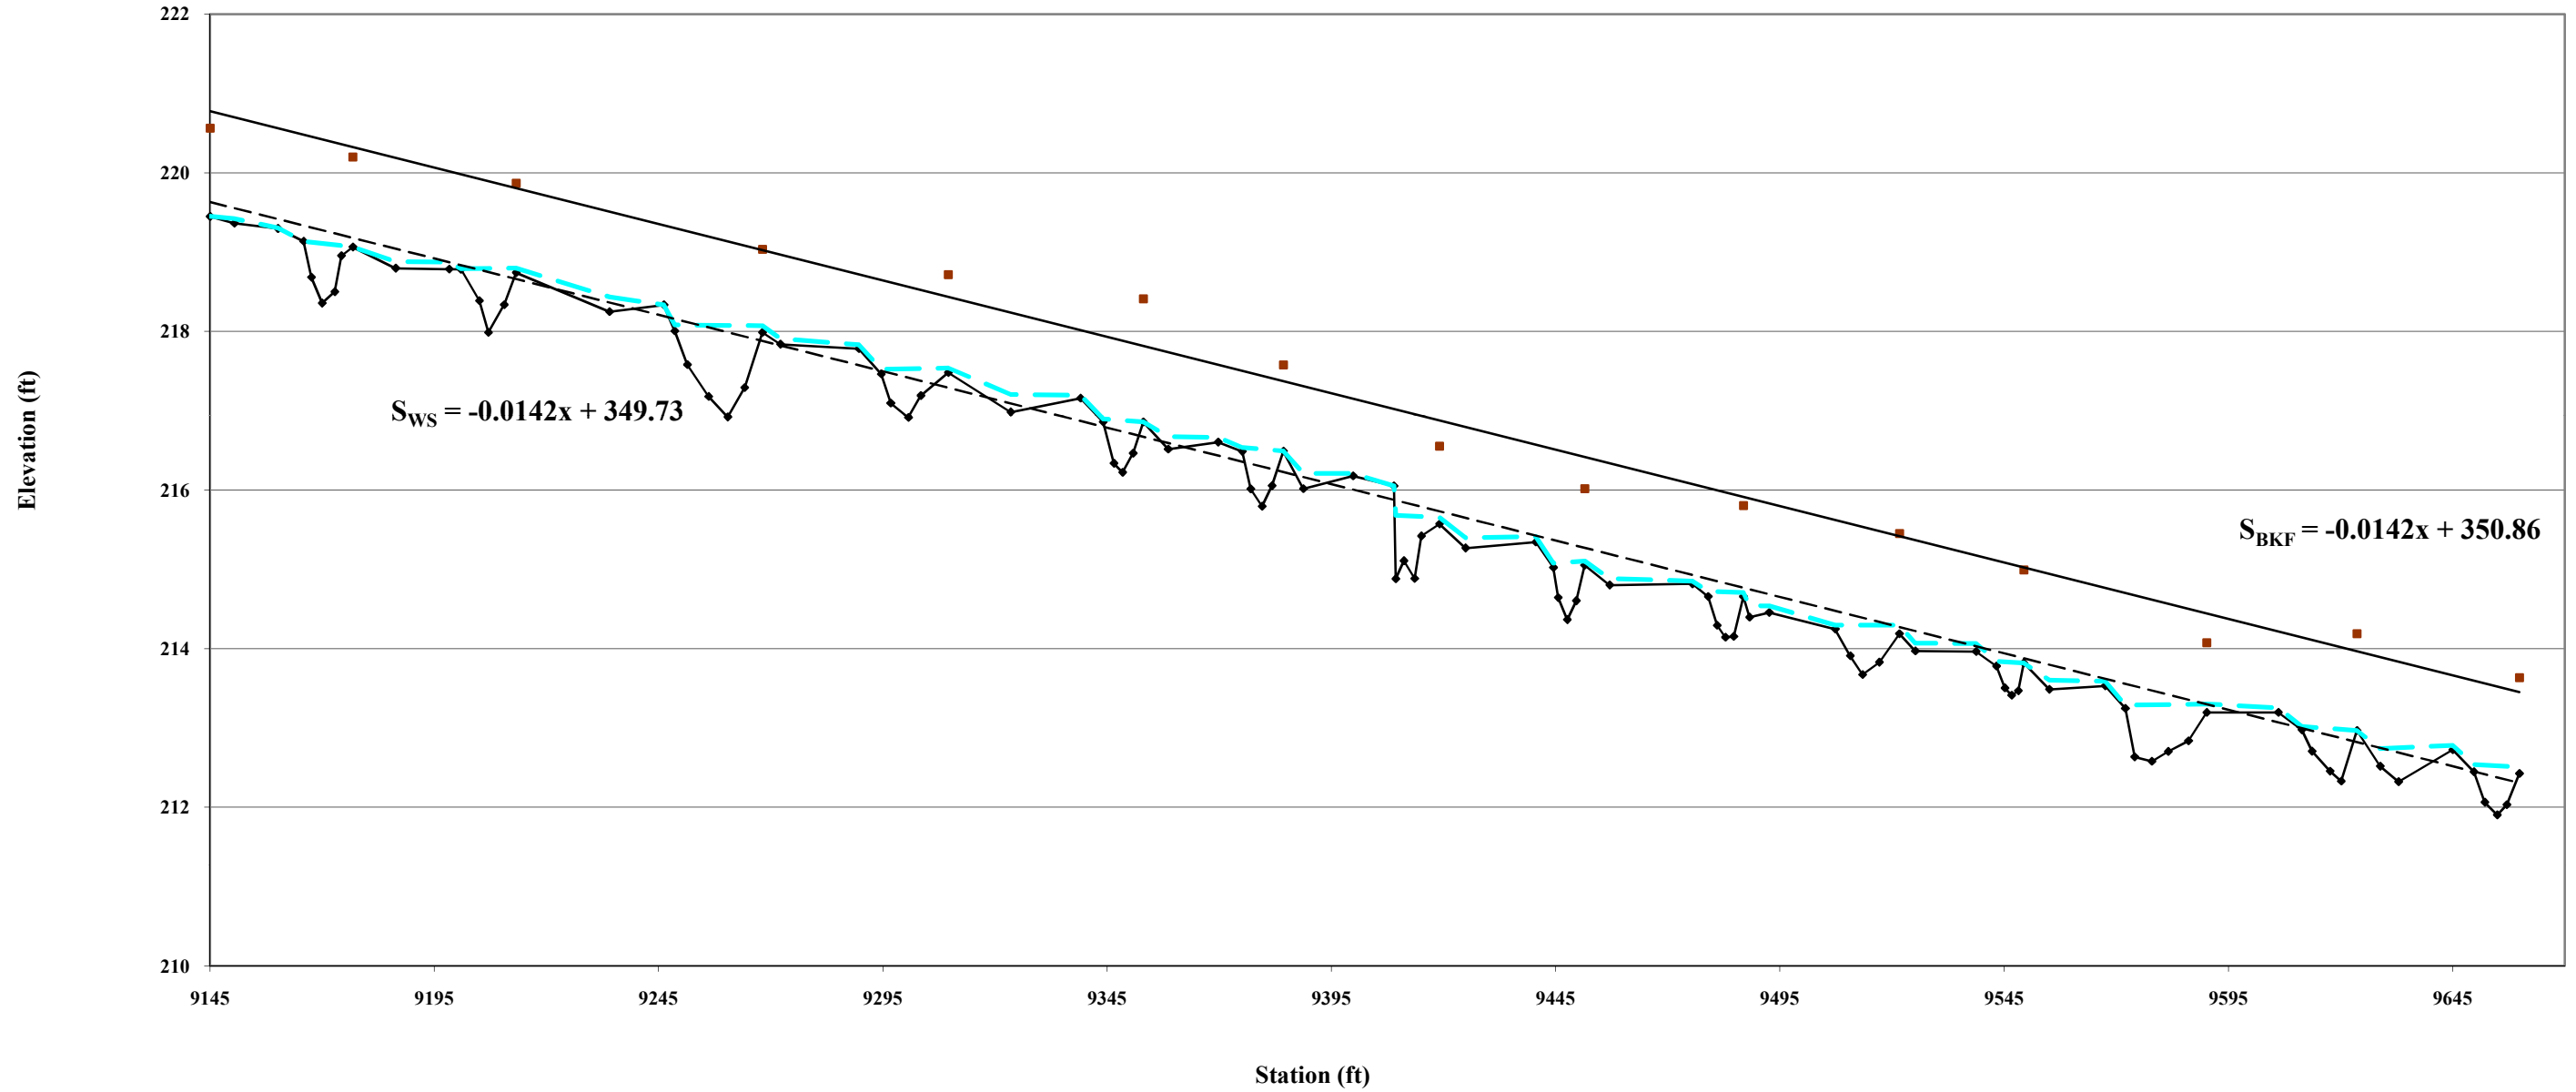

**Longitudinal Profile
Tributary 1, As-Built
Stations 103+50 - 108+77**

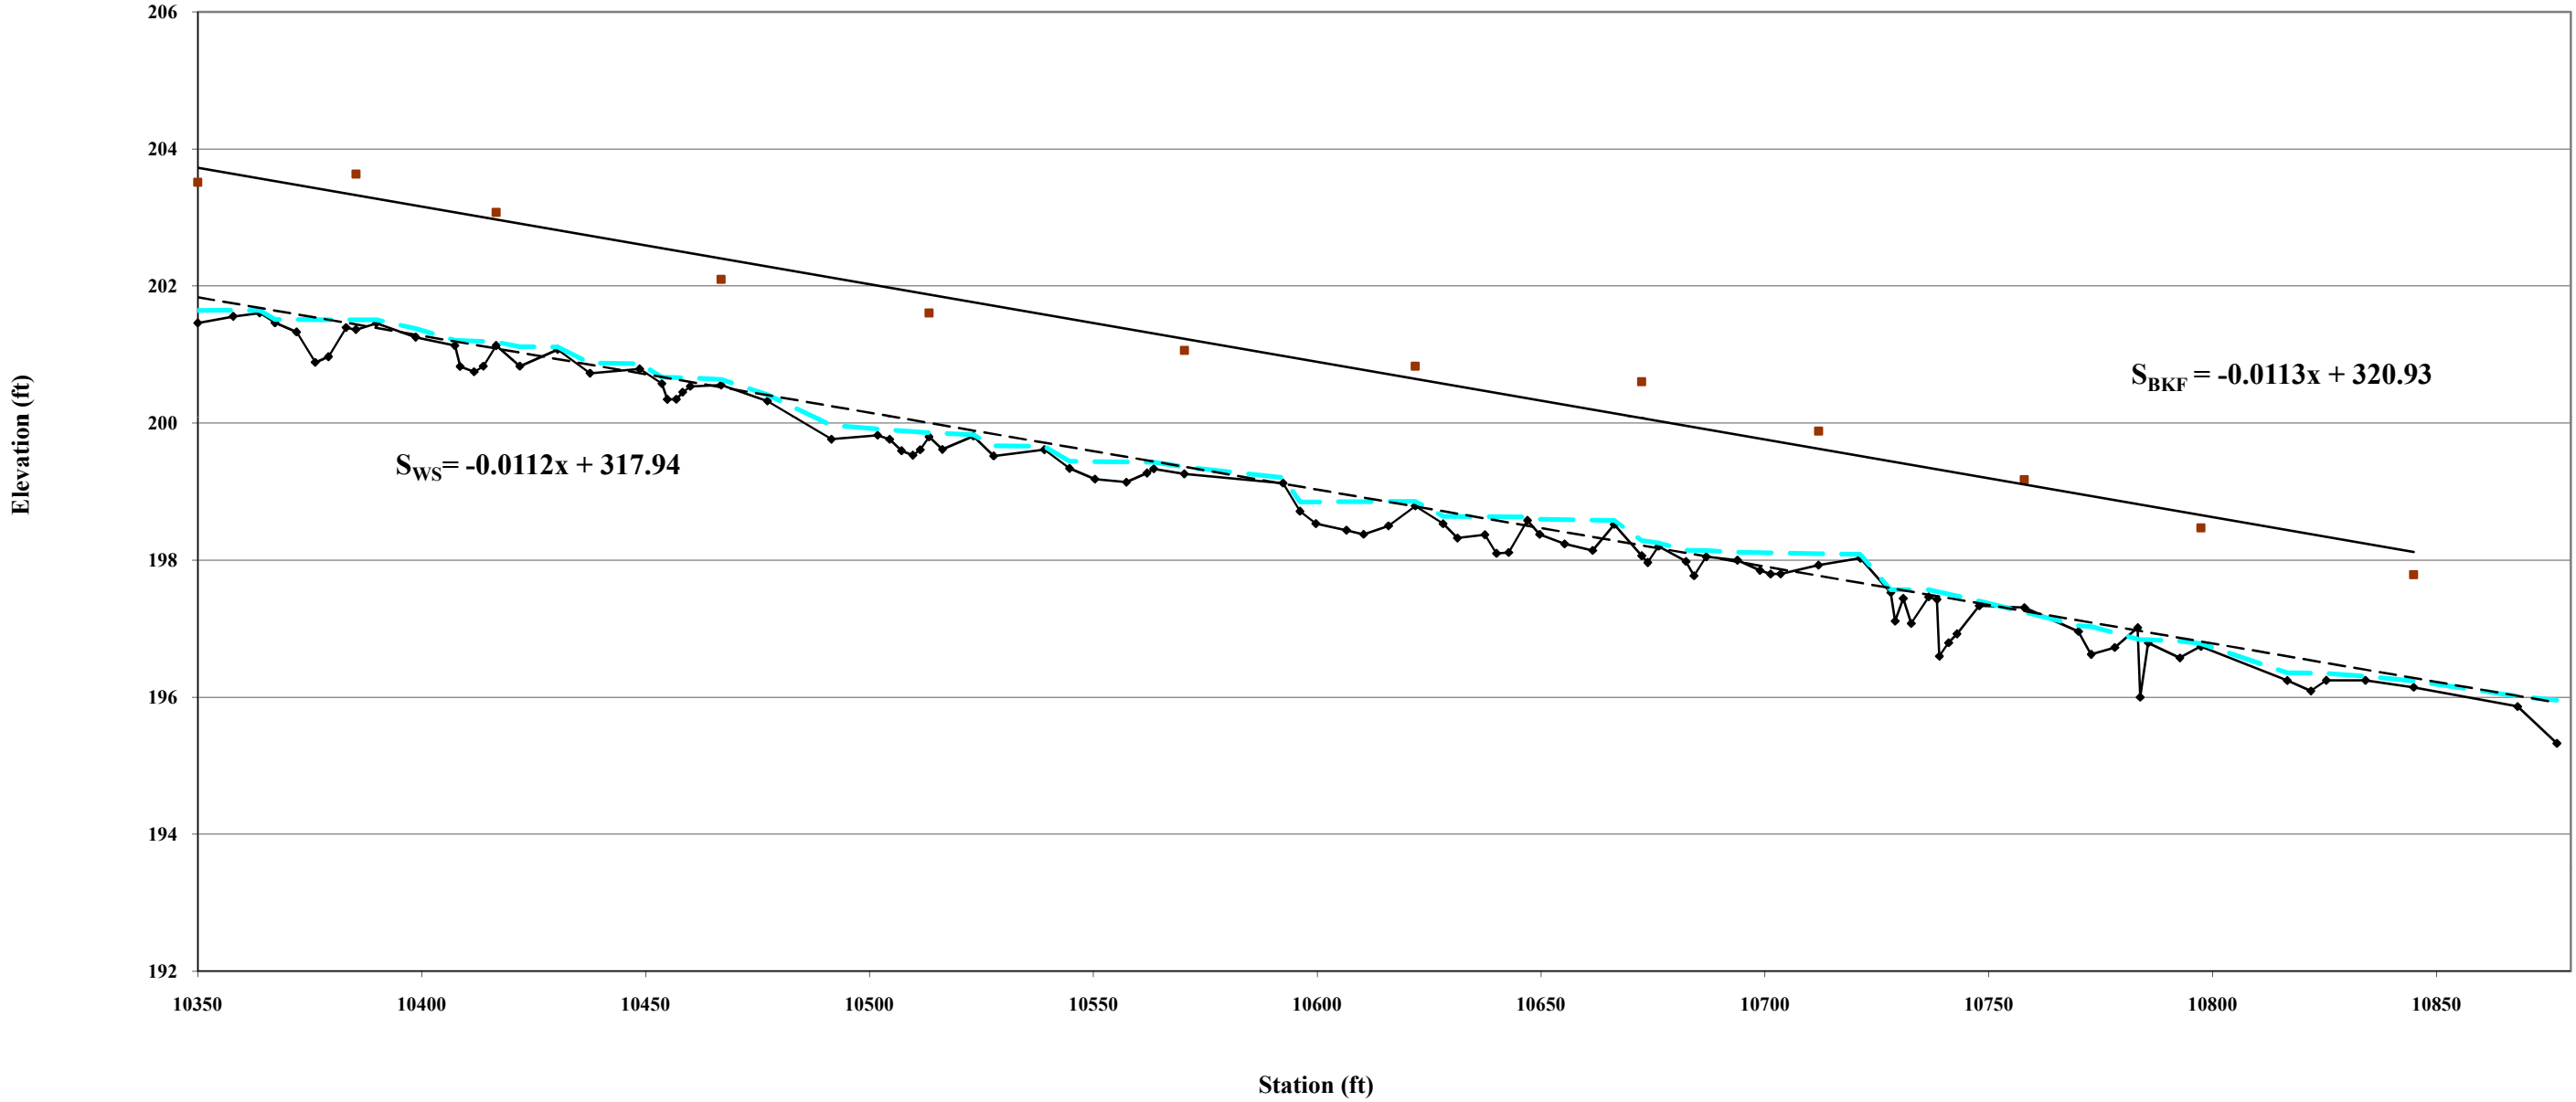


**Longitudinal Profile
Tributary 2, As-Built
Stations 112+80 - 118+37**

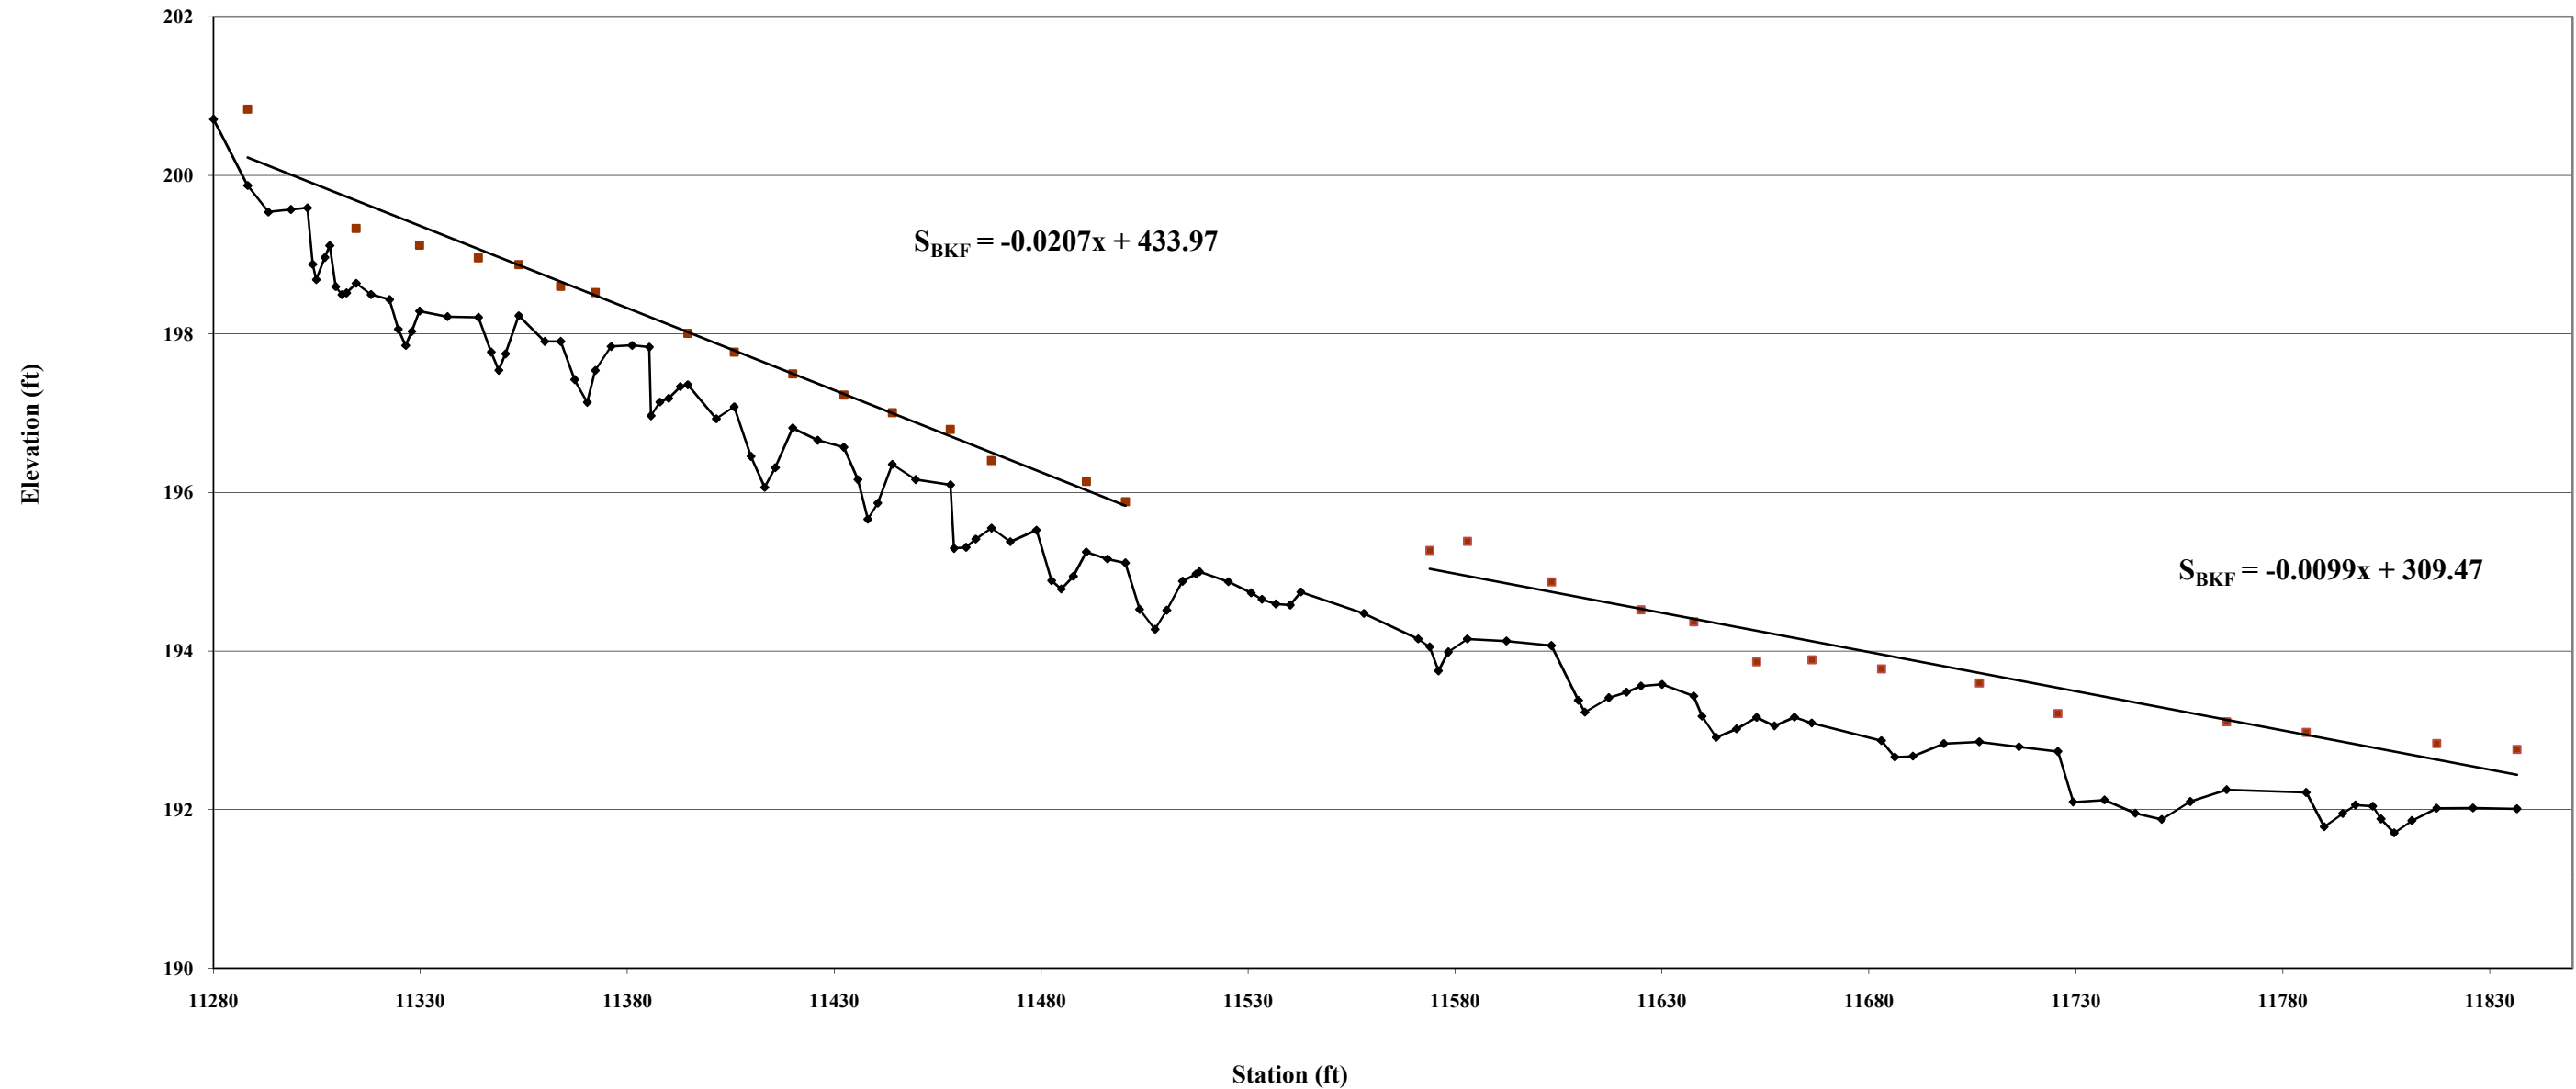

*No WS due to no flow in channel during survey.

**Longitudinal Profile
Tributary 3, As-Built
Stations 133+85 - 139+73**

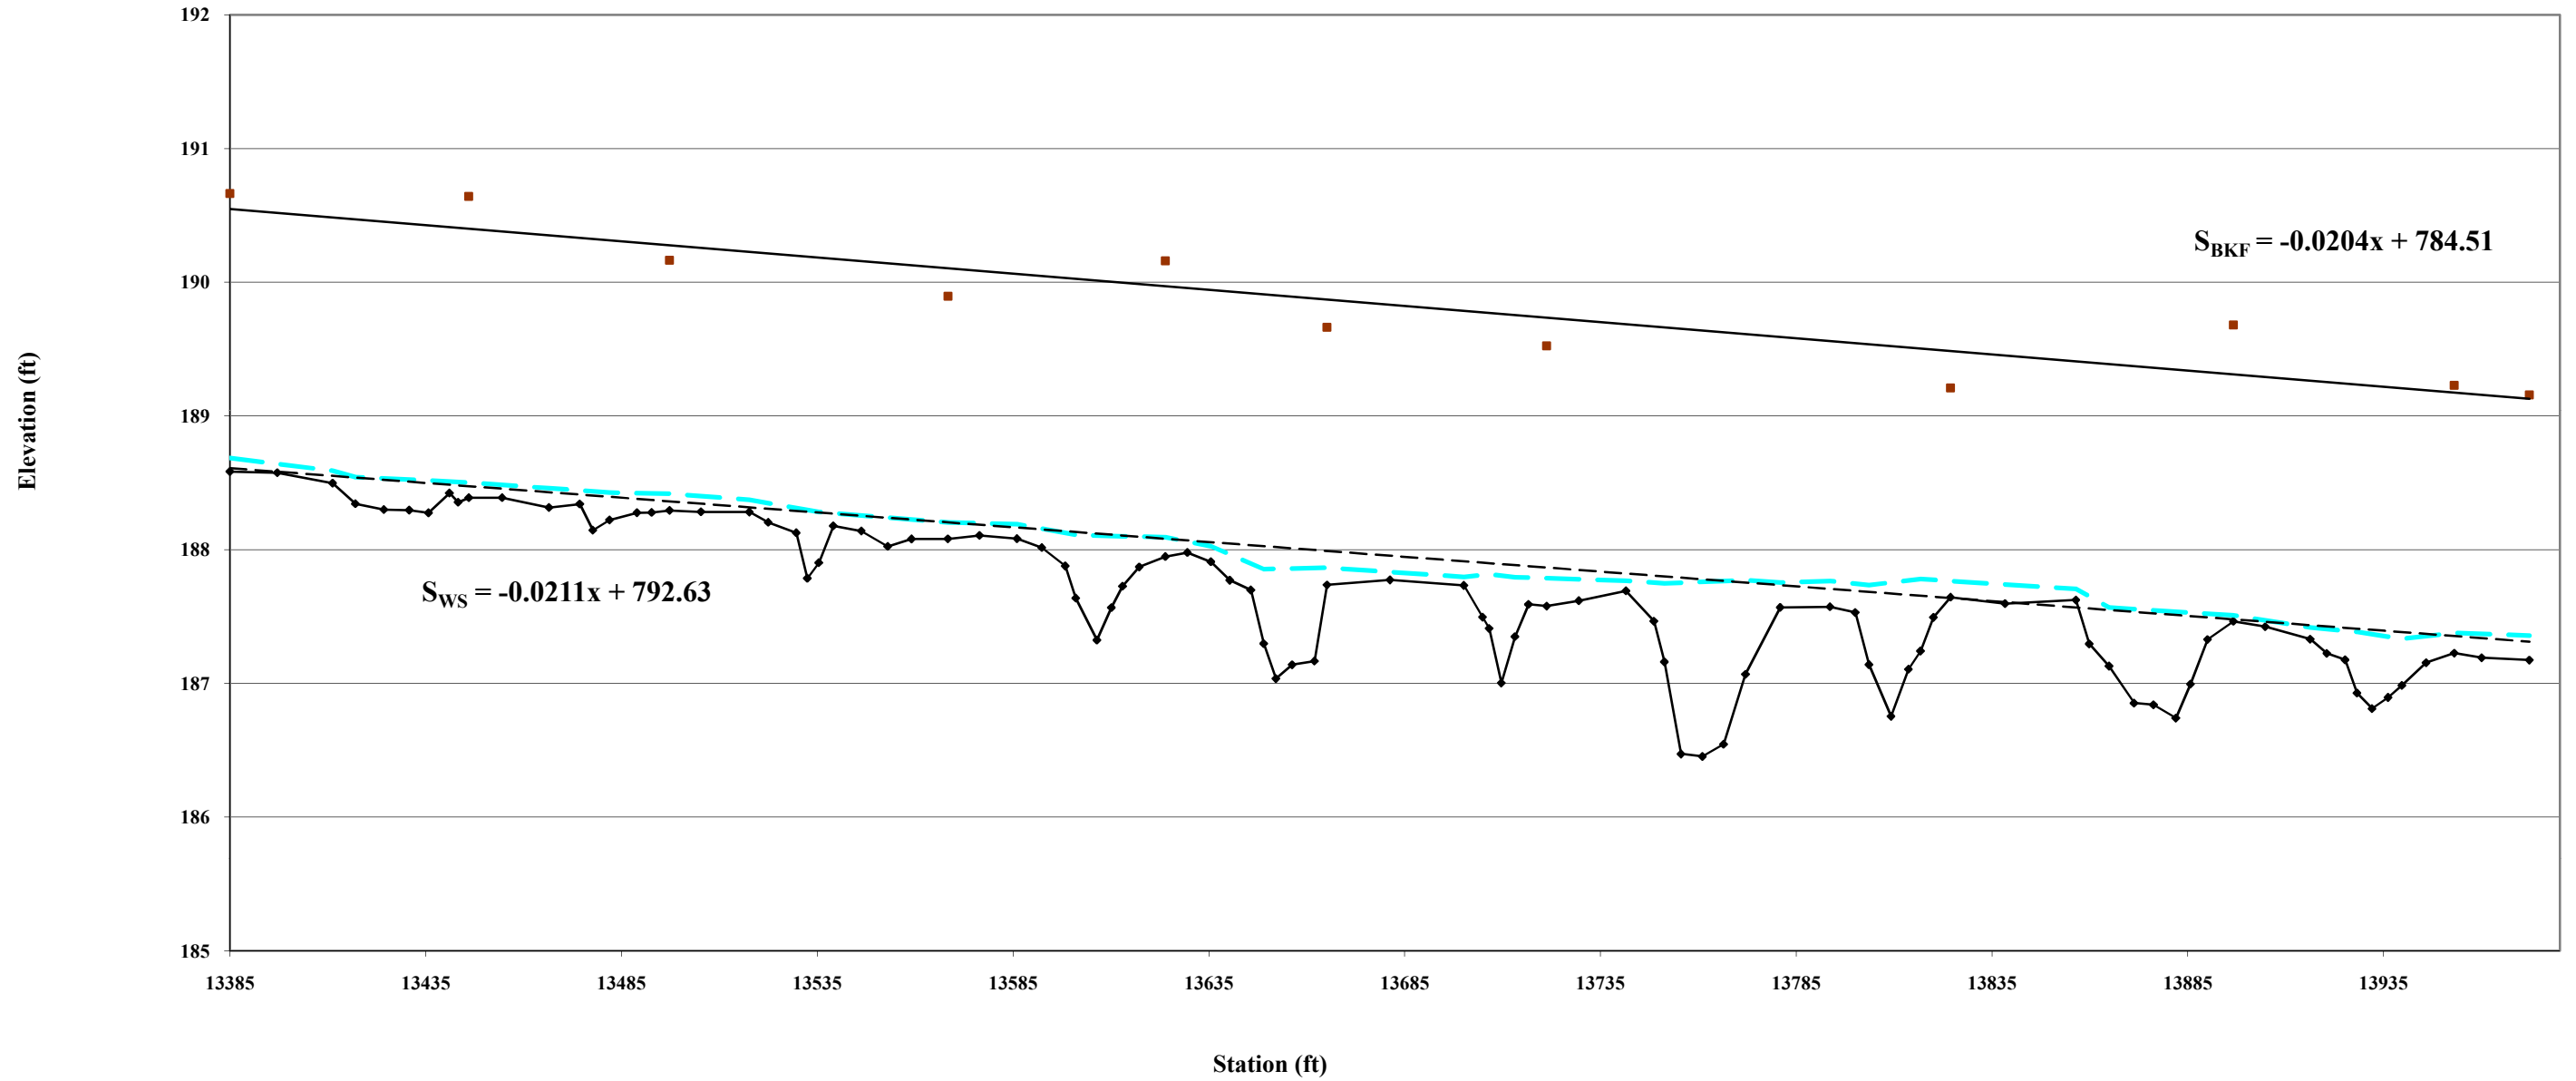

Appendix D

Vegetation Data

Table D1. Stream Buffer Stem Density By Plot

Project Name: Farrar Dairy Stream and Wetland Restoration

Date : 3/25/09

Crew : B. Roberts

Plot #	River Birch <i>Betula nigra</i>	Beautyberry <i>Callicarpa americana</i>	Sugarberry <i>Celtis laevigata</i>	Silky Dogwood <i>Cornus amomum</i>	Green Ash <i>Fraxinus pennsylvanica</i>	Tulip Poplar <i>Liriodendron tulipifera</i>	Sycamore <i>Platanus occidentalis</i>	Oak sp. <i>Quercus sp.</i>	Laurel Oak <i>Quercus laurifolia</i>	Overcup Oak <i>Quercus lyrata</i>	Willow Oak <i>Quercus phellos</i>	Willow sp. <i>Salix sp.</i>	Black Willow <i>Salix nigra</i>	Elderberry <i>Sambucus canadensis</i>	Unknown	Total (As-Built)	Density-(As-Built)
1	3		1	12				2							4	22	880
2	1	4			4				3	1	3				2	18	720
3			2					1							5	8	320
4	4		1	12	1			2							1	21	840
5	1	1	1	3	2			4							7	19	760
6	3			7				1	2						1	14	560
7	3		2	4	2							9	1			21	840
8	5		3	1	4						1					14	560
9	10	5														15	600
10						1	3	6		1					2	13	520
11				2		4		2		1		4		4		17	680
12	6				4										3	13	520
13	6				2							4		6		18	720
14	7			3	2										1	13	520
15	5	5		2	1										1	14	560
Total Average Density (Stems/Acre)																	640

Stream and Wetland Vegetation Plot Photos



Vegetation Plot 1 – As-Built – 3/23/09



Vegetation Plot 2 – As-Built – 3/23/09



Vegetation Plot 3 – As-Built – 3/23/09



Vegetation Plot 4 – As-Built – 3/23/09



Vegetation Plot 5 – As-Built – 3/24/09

Farrar Dairy Stream and Wetland Restoration Site
Contract #D06002



Vegetation Plot 6 – As-Built – 3/24/09

KCI Technologies, Inc.
Mitigation Plan



Vegetation Plot 7 – As-Built – 3/24/09



Vegetation Plot 8 – As-Built – 3/25/09



Vegetation Plot 9 – As-Built – 3/25/09



Vegetation Plot 10 – As-Built – 3/23/09



Vegetation Plot 11 – As-Built – 3/23/09



Vegetation Plot 12 – As-Built – 3/23/09




Vegetation Plot 13 – As-Built – 3/24/09



Vegetation Plot 14 – As-Built – 3/25/09



Vegetation Plot 15 – As-Built – 3/25/09

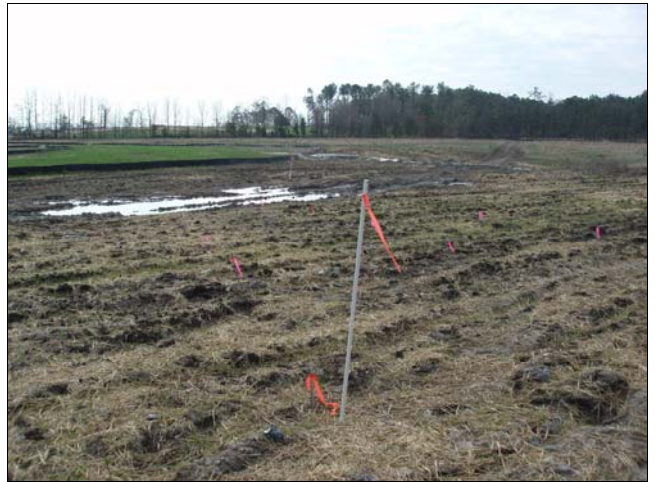

Vegetation Plot 16 – As-Built – 3/23/09



Vegetation Plot 17 – As-Built – 3/23/09



Vegetation Plot 18 – As-Built – 3/23/09



Vegetation Plot 19 – As-Built – 3/23/09



Vegetation Plot 20 – As-Built – 3/23/09



Vegetation Plot 21 – As-Built – 3/23/09



Vegetation Plot 22 – As-Built – 3/23/09




Vegetation Plot 23 – As-Built – 3/24/09



Vegetation Plot 24 – As-Built – 3/24/09



Vegetation Plot 25 – As-Built – 3/24/09

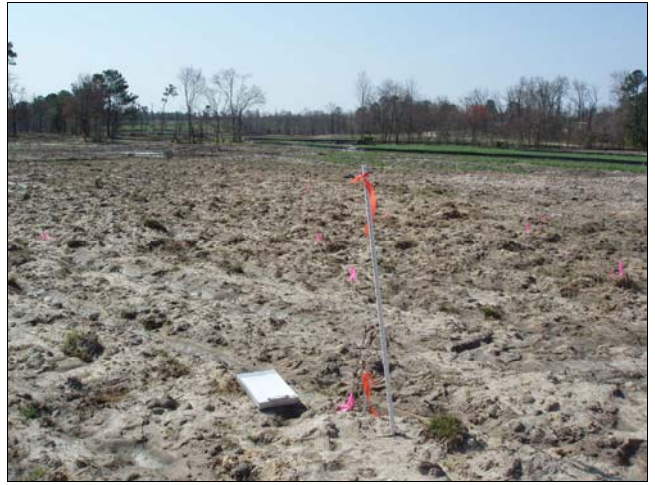

Vegetation Plot 26 – As-Built – 3/24/09




Vegetation Plot 27 – As-Built – 3/24/09



Vegetation Plot 28 – As-Built – 3/24/09



Vegetation Plot 29 – As-Built – 3/24/09

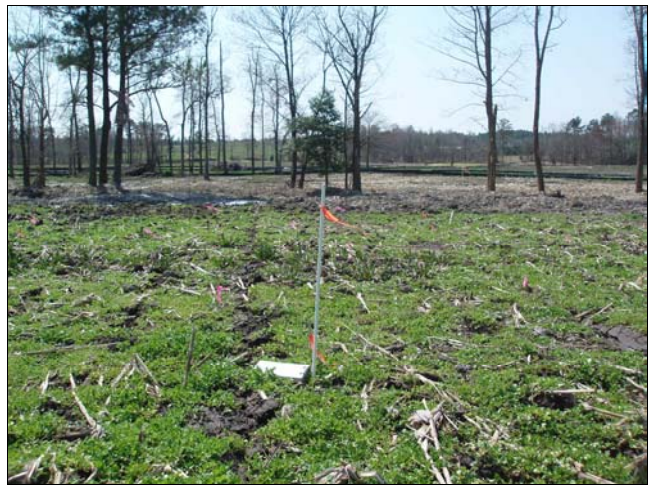

Vegetation Plot 30 – As-Built – 3/24/09



Vegetation Plot 31 – As-Built – 3/25/09



Vegetation Plot 32 – As-Built – 3/25/09



Vegetation Plot 33 – As-Built – 3/25/09



Vegetation Plot 34 – As-Built – 3/25/09



Vegetation Plot 35 – As-Built – 3/25/09



Vegetation Plot 36 – As-Built – 3/25/09



Vegetation Plot W37 – As-Built – 3/25/09



Vegetation Plot 38 – As-Built – 3/25/09



Vegetation Plot 39 – As-Built – 3/25/09




Vegetation Plot 40 – As-Built – 3/24/09



Vegetation Plot 41 – As-Built – 3/24/09




Vegetation Plot 42 – As-Built – 3/24/09

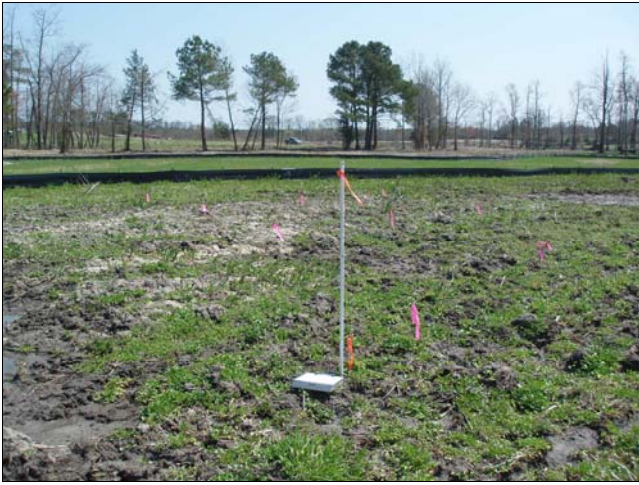

Vegetation Plot 43 – As-Built – 3/24/09



Vegetation Plot 44 – As-Built – 3/24/09

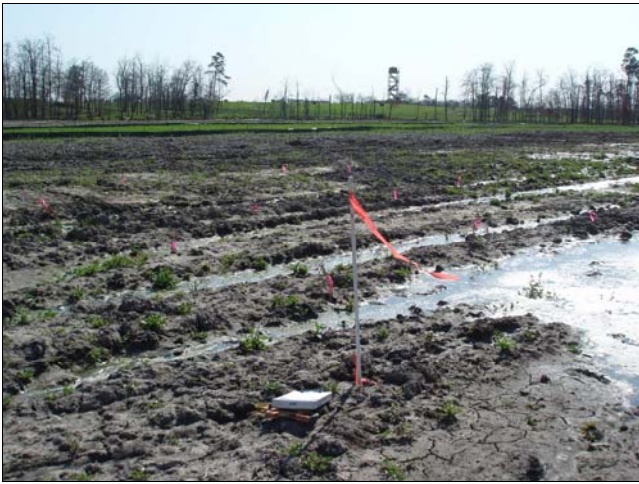

Vegetation Plot 45 – As-Built – 3/24/09

Appendix E

Photo Points

Stream and Wetland Photo Points



PP 1 – As-Built – 5/28/09



PP 2 – As-Built – 5/28/09



PP 3 – As-Built – 5/28/09



PP 4 – As-Built – 5/28/09



PP 5 – As-Built – 5/28/09

*Farrar Dairy Stream and Wetland Restoration Site
Contract #D06002*



PP 6 – As-Built – 5/28/09

*KCI Technologies, Inc.
Mitigation Plan*



PP 7 – As-Built – 5/28/09



PP 8 – As-Built – 5/28/09



PP 9 – As-Built – 5/28/09



PP 10 – As-Built – 5/28/09



PP 11 – As-Built – 5/28/09



PP 12 – As-Built – 5/28/09



PP 13 – As-Built – 5/28/09



PP 14 – As-Built – 5/28/09



PP 15 – As-Built – 5/28/09



PP 16 – As-Built – 5/28/09



PP 17 – As-Built – 5/28/09



PP 18 – As-Built – 5/28/09



PP 19 – As-Built – 5/28/09



PP 20 – As-Built – 5/28/09



PP 21 – As-Built – 5/28/09



PP 22 – As-Built – 5/28/09



PP 23 – As-Built – 5/28/09



PP 24 – As-Built – 5/28/09



PP 25 – As-Built – 5/28/09



PP 26 – As-Built – 5/28/09



PP 27 – As-Built – 5/28/09



PP 28 – As-Built – 5/28/09



PP 29 – As-Built – 5/28/09



PP 30 – As-Built – 5/28/09



PP 31 – As-Built – 5/28/09



PP 32 – As-Built – 5/28/09



PP 33 – As-Built – 5/28/09



PP 34 – As-Built – 5/28/09



PP 35 – As-Built – 5/28/09