

Fletcher Stream and Wetland Mitigation Site

As-Built Baseline Monitoring Report

FINAL

Fletcher Stream and Wetland Mitigation Site

NCDMS Contract No. 006997

NCDMS Project No. 100004

DWR# 16-1076

USACE Action ID: SAW-2016-02205

Henderson County, North Carolina

Data Collected: February 1st, 2019 – March 20th, 2019

Date Submitted: April 29th, 2019



Submitted to:

NCDEQ-Division of Mitigation Services
1652 Mail Service Center Raleigh N C 27699-1652

This Page Intentionally Left Blank

Prepared for:



37 Haywood Street, Suite 100
Asheville, NC 28801

Prepared by:



EQUINOX

balance through proper planning

37 Haywood Street, Suite 100
Asheville, NC 28801

This Page Intentionally Left Blank

May 13th, 2019

Harry Tsomides
Project Manager
DENR Division of Mitigation Services
5 Ravenscroft Dr., #102
Asheville, NC 28801

Subject: Draft As-Built Baseline Monitoring Report (Task 6)
Fletcher Site Mitigation Project, Henderson County
French Broad River CU 06010105
DMS Project ID No. 100004 / DEQ Contract #006997

Dear Mr. Tsomides,

Equinox/EWS has reviewed and addressed the comments for the draft As-Built Baseline Monitoring Report and Record Drawings for the Fletcher Site Mitigation Project. This deliverable documents stream and wetland restoration, enhancement and preservation assets totaling 10,011.3 Stream Mitigation Units (SMU) and 8.91 riparian Wetland Mitigation Units (WMU). Comments provided by NCDMS on May 8th, 2019 are listed below with red text indicating how each was addressed:

Section 1.3 - Project Success Criteria

ER standard from mitigation plan (Table 18) is not mentioned. **Included in Table 18 from approved mitigation plan.**

Continuous 30-day annual surface flow standard from mitigation plan (Table 18) for tributaries is not mentioned. **Included in Table 18 from approved mitigation plan.**

Vegetation – indicate that the CVS method will be used (per mitigation plan). **Added to Table 18 from approved mitigation plan.**

Hydrology – indicate that the four bank full events must occur in separate years. **Included in Table 18 from approved mitigation plan.**

Approved mitigation plan indicated a success hydroperiod of 12%; however the as built report states that the project success criterion is 10%. Please correct to reflect the approved mitigation plan hydroperiod of 12%. **Included in Table 18 from approved mitigation plan.**

For simplicity and clarity DMS recommends inserting Table 18 (Performance Standards) from mitigation plan if all monitoring performance standards moving forward are being maintained, and indicating no changes; if any variations/omissions from the mitigation plan are being proposed it needs to be explained in detail which ones, and why.

For simplicity as mentioned above, Table 18 from the approved Fletcher Site Mitigation Plan was added to the Fletcher Site As-Built Report. The only change to the table was noting that Carolina Vegetation Survey (CVS) methodology will be used to record and calculate data.

Section 1.4 – Mitigation Components

It is indicated that as-built credits are based on centerline stream lengths from the as-built plan; however the table credits are based on the approved mitigation plan. Please update this section accordingly. **This section was updated to note that the credits are based on the Approved Fletcher Site Mitigation Plan.**

Section 1.5 – Restoration Type and Approach

Fletcher Creek subsection, paragraph 1 – future tense is used to explain what will happen; please use past tense appropriately to explain what happened. **In the Fletcher Creek subsection, paragraph 1 has been updated to past tense.**

Section 1.6 – As Built Record Drawings

It is indicated that a sealed set of record drawings are located in Appendix E, however only the sealed as-built survey (Kee) is present in Appendix E. Please add the sealed record drawings (Stantec) to Appendix E. **The sealed record drawing has been added to the report.**

Many items on this list are not apparent as callouts on the record drawing sheets; please clarify. **Please review the bulleted section 1.7 – As-Built Record Drawings. This gives the description of all of the deviations that were deemed significant by the designer.**

There are some inconsistencies in this list, for example Raccoon Branch Reach 1c (STA 214+30 to 214+90), five sills appear to have been deleted according to sheet AB-17, not three as indicated. **Between STA 214+30 and 214+90 only 3 log sills were omitted. The stationing has been updated to 214+00 to 214+00 to add the additional two log sills that were omitted upstream.**

There are several headwater channels noted as being extended; what necessitated these reach extensions? **Site conditions had changed from initial survey during a very wet year, a field call was made to extend the headwater channel upstream to help stabilize the channel. The previous text it located in the as-built report in section 1.7- As-Built Record Drawings.**

Weston Creek Reach 1B – Indicates 700 LF of Added Base Ditch With Rip Rap Transition; is this the channel that was intended to be backfilled (see Fill pattern on sheets 35/36 from the Mitigation Plan)? If so, please explain this variation from the design. Was it partially filled or just abandoned and left in place to drain the adjacent field? **The ditch was partially filled because water was still traveling onsite from the adjacent field. A rip-rap transitions down to Hoopers Creek was installed to help stabilize the channel. The previous text it located in the as-built report in section 1.7- As-Built Record Drawings.**

Table 1 (Assets)

Please finish table edits requested in the May 7, 2019 email from me. All cold/cool designations, credit summations, etc. need to be accurate. **The newly revised Table 1 (Assets) has been added to the report. Cold/cool designations and credit summations are accurate.**

General

Monitoring is not mentioned or summarized in the report; any changes to the monitoring plan from the approved mitigation plan should be captured in the report and summarized so the reader understands exactly what has changed, and why. DMS recommends including Mitigation Plan Table 19 (Monitoring Plan Components) and annotating or footnoting any changes, and explaining the rationale behind any changes (quantity per reach veg plots, gauge types, etc.), or a simple bulleted summary and explanation of variations from the approved mitigation plan monitoring approach. **The Monitoring Plan Components table from the approved Fletcher Site Mitigation Plan has been added to the report. Asterisks have been added to the report where changes from the Approved Fletcher Site Mitigation Plan were made and a description of these changes and rationale has been written under the table.**

Monitoring Features Maps – Recommend using different symbols for the four hydrology monitoring types (blue circles with black symbols); they are hard to distinguish on the printed sheets. **The colors for these different symbols on the Monitoring Features Map has been updated.**

As Built Survey

No comments – looks great, thank you. **N/A**

Record Drawings

Please include the record set in the report appendix and generate as part of the single PDF document for posting. **Sealed record set has been added to the As-Built report.**

Monitoring features need not be shown as red lines on the record set since they appear on the as built survey; recommend that any changes to monitoring features be summarized in the report (see previous comment). **Monitoring features remain on the record drawings. Any changes from the Approved Fletcher Site Mitigation Plan are listed in section 1.3 – Monitoring Plan Components.**

In general, while the project appears to have been built according to the design with no major variations in lengths, approaches, crossings etc., the record drawing red lines appear to be a copy-and-paste from the as-built survey showing widespread changes. This makes the record set very hard to distinguish minor variations within reason, from more significant changes such as stream extensions, structure type changes and upstream/downstream movements, and other variations that are useful to helping the reader determine field decisions that affected the project design and outcome more meaningfully. DMS recommends reviewing the record drawings and focusing on any deviations from the design outside the range of tolerance for normal variation between design and as built condition; for example, many of the red lines show structure elevation changes of mere inches (in one case, 0.03 feet, or less than half an inch); this would seemingly save the designer time as well on future projects. **This has been noted and will be addressed for future projects.**

Record set should include planting plan deviations (shown as red lines) from Mitigation Plan sheets P2 through P2a, since it appears multiple species substitutions were made; at a minimum, planting plan changes from mitigation plan to as built conditions should be listed and explained in the report. Two species were entered incorrectly during vegetation data entry into the Carolina Vegetation Survey (CVS) data entry tool. ***Acer negundo***

was entered incorrectly as *acer nigrum* and *sambucus canadensis* was entered incorrectly as *salix caroliniana*. The stems/ acre numbers did not change for any of the plots or the site as a whole. All vegetation tables throughout the report have been updated to reflect these changes.

The Equinox project manager for this project is Mr. Drew Alderman. His contact is as follows:

Natural Resource Specialist
Equinox
37 Haywood Street
Asheville, NC 28801
Office: 828-253-6856 ext. 213
Fax: 828-253-8256

Sincerely,



Drew Alderman

Table of Contents

1.0	Project Summary.....	1
1.1.	Project Setting and Background.....	1
1.2.	Project Goals and Objectives	1
1.3.	Monitoring Plan Components	3
1.4.	Project Performance Standards	4
1.5.	Mitigation Components.....	6
1.6.	Restoration Type and Approach	6
1.7.	As-Built Record Drawings.....	8
1.8.	Vicinity Map	10
2.0	References.....	11
	Appendix A Background Tables	12
	Appendix B Visual Assessment Data.....	17
	Appendix C Vegetation Plot Data	79
	Appendix D Stream Measurement and Geomorphology Data	85
	Appendix E As-Built Survey and Record Drawings Plan Set.....	171

This Page Intentionally Left Blank

1.0 PROJECT SUMMARY

1.1. Project Setting and Background

The Fletcher Stream and Wetland Mitigation Site (Fletcher Site) is located in the French Broad River Basin (CU 06010105). The Fletcher Site also lies within the lower portion of the Cane Creek (HUC 060101050703) watershed which is identified as a Targeted Local Watershed (TLW) according to the 2009 French Broad River Basin Restoration Priorities (RBRP) Plan. Project work at the Fletcher Site was completed in March 2019, and included construction, planting, monitoring feature installation, and fence installation. Through the project work, a total of 9,528 linear feet were restored, 896 linear feet were enhanced through Enhancement II activities, 1,249 linear feet were preserved, and 8.91 acres for wetland were re-established. The Fletcher Site generated a total of 10,011.300 SMU's and 8.910 WMU's. Refer to Table 1 for the project components and mitigation credit information and Figure 2 for the Project Asset Map.

Historic land use at the Fletcher Site has consisted primarily of agriculture and livestock grazing. Additional land use practices, including the excavation of drainage ditches, maintenance and removal of riparian vegetation, and the relocating, dredging, and straightening of on-site streams have contributed to unstable channel characteristics, degraded water quality, and degradation of prior wetlands. Previous stream conditions at the site consisted of incised channels with unstable banks and a limited riparian buffer width. Fletcher Creek and Coates Branch flow through active pastures with livestock access to the streams. The floodplain adjacent to Weston Creek contains approximately 8.91 acres of mapped hydric soils that have been farmed for produce. Previous ditching and farming activities eliminated jurisdictional wetlands. The completed project restored ecological function to the existing streams, wetlands, and riparian corridor by returning streams to a proper relationship with the floodplain, excluding cattle from the riparian buffer, eliminating drainage ditches and spoil piles, removing invasive species, and re-vegetating the riparian buffer with native plant species appropriate for the valley and the watershed conditions. Grading activities improved the groundwater hydrology of the onsite wetlands, increased hydrologic access of the floodplain for overbank flows, and provided attenuation of flood flows.

This project is protected by a 34.81 acre conservation easement and is located approximately 1.1 miles southeast of Fletcher, NC in Henderson County at 35.422278° N, -82.486183° W. The Fletcher Site is bounded by agricultural land and is bisected by Jackson Road.

1.2. Project Goals and Objectives

The project goals address stressors identified in the TLW and priority subwatershed, as outline in the Final Mitigation Plan, and include:

- Provide a network of streams with natural, stable forms that support proper stream functions;
- Improve groundwater hydrology to support recovery of native riparian vegetation;
- Reduce sediment inputs from eroding stream banks to reduce fine sediment loads and percentage of fines in the bed-material load;
- Restore proper sediment transport to support channel stability and bedform diversity;
- Improve substrate quality to facilitate hyporheic flow and support aquatic communities;
- Improve quantity, quality, and diversity of habitats to support healthy aquatic communities;
- Reduce pollutant inputs to the project streams (fecal coliform, nitrogen, phosphorus) to restore a balance to proper nutrient cycles;

- Improve riparian vegetation community to provide temperature regulation of the stream, provide a future source of organic inputs, and aid in long-term channel bank stability;
- Restore areas of former riparian wetlands so that the hydrology and soils will support wetland vegetative communities and wildlife;
- Improve landscape connectivity that allows space for biotic and abiotic process and provides a source and sink for natural populations; and,
- Prevent the site from future impacts of development and agricultural issues.

The following objectives are proposed for accomplishing the above listed goals as outlined in the Final Mitigation Plan:

- Construct stream channels that will maintain proper dimension, pattern, and profile and meet jurisdictional status;
- Construct streams with proper bankfull to floodplain relationship;
- Construct streams that provide naturally stable dimensions and stabilize constructed banks with appropriate bioengineering;
- Construct streams that maintain an appropriate sediment transport balance with the sediment that is supplied by the watershed so that the overall stream profile neither aggrades nor degrades over time;
- Create and improve stream bedform diversity by constructing pools of varied depths and riffles of varied slopes;
- Construct stable riffles that provide an improved diversity of bed material clast and a reduction in fines relative to existing conditions;
- Construct in-stream habitat features from native material to provide diversity of habitat;
- Prevent cattle from access to the streams and riparian areas by installing exclusion fencing;
- Install BMP's in concentrated runoff areas that drain agricultural fields;
- Provide a buffer from agricultural activities and row crops;
- Plant native climax tree species and understory species in the riparian zone;
- Reconstruct stream channels that are properly connected to the riparian wetlands;
- Re-grade topography to eliminate ditches and drainage features;
- Plant native wetland tree and shrub species; and,
- Establish a conservation easement that provides a minimum buffer from future activities in the adjacent watershed.

1.3. Monitoring Plan Components

The monitoring plan from the approved Fletcher Mitigation Site Mitigation Plan is listed below. Changes from the approved Mitigation Plan are denoted with an asterisk (*) and are explained in the next paragraph.

Fletcher Mitigation Site Monitoring Plan Components					
Parameter	Method	Quantity	Frequency	Notes	
Dimension	Rifle Cross Sections	Fletcher Reach 1 (3)	Years 1, 2, 3, 5 & 7		
		Fletcher Reach 2 (4)			
		Raccoon Reach 1 (1)			
		Coates Reach 1 (3)			
		Weston Reach 1 (3)			
	Pool Cross Sections	Fletcher Reach 1 (3)*	Years 1, 2, 3, 5 & 7		Bank pins will be installed only in areas of concern
		Fletcher Reach 2 (4)			
		Raccoon Reach 1 (1)			
Coates Reach 1 (3)*					
Pattern	Visual Inspection	None	Bi-annual	Bank pins will be installed only in areas of concern	
		None	Bi-annual	Additional profile measurements may be required if problems are identified during the monitoring period	
Substrate	Pebble Counts	Fletcher Reach 1 (3)	Years 1, 2, 3, 5 & 7		
		Fletcher Reach 2 (4)			
		Raccoon Reach 1 (1)*			
		Coates Reach 1 (3)			
		Weston Reach 1 (3)			
Surface Water Hydrology	Crest Gauge	Fletcher Reach 1 (1)	Bi-annual	The devices will be inspected on a semi-annual basis to document the occurrence of bankfull events on the project	
		Fletcher Reach 2 (1)			
		Raccoon Reach 1 (0)*			
		Coates Reach 1 (1)			
		Weston Reach 1 (1)			
	Continuous Gauge	Fletcher Reach 2 (1)	Bi-annual		
		Raccoon Reach 1 (1)			
		Coates Reach 1 (1)			
Groundwater Hydrology	Groundwater Gauges	Weston R1 (11)	Annual	Data will be downloaded on a monthly basis during the growing season	
		Vegetation	Vegetation Plots	Fletcher Reach 1 (7)*	Annual
Fletcher Reach 2 (6)*					
Raccoon Reach 1 (2)					
Coates Reach 1 (4)					
Weston Reach 1 (7)					
Invasive and Nuisance Vegetation	Visual	N/a	Semi-annual	Approximate locations of invasive and nuisance vegetation and the occurrence of beaver dams will be mapped	
Project Boundary	Visual	N/a	Semi-annual	Locations of fence damage, vegetation damage, boundary encroachments, etc. will be mapped	

* Indicates change from Mitigation Plan

Originally in the Fletcher Mitigation Site approved Mitigation Plan there were no pool cross-sections from both Fletcher Reach 1 and Coates Reach 1. One additional pool cross-section was added on both Fletcher Reach 1 and Coates Reach 1 during the as-built. Additionally, there was no pebble count listed for Raccoon Reach 1 in the approved Mitigation Plan. One pebble count was added to Raccoon Reach 1 during the as-built. Lastly, no crest gauge was installed on Raccoon Reach 1. The continuous stage

recorder will act as a crest gauge recording events above the surveyed bankfull elevation at the continuous stage recorder's location. Lastly, due to landscape constraints within the easement, an additional vegetation monitoring plot was added to Fletcher Reach 1 and one vegetation monitoring plot was removed from Fletcher Reach 2. The total number of vegetation monitoring plots for the Fletcher Mitigation Site did not change.

1.4. Project Performance Standards

The stream restoration performance standards for the project will follow accepted and approved criteria based on the Final Mitigation Plan for the Fletcher Mitigation Site (2018). Performance standards conform with the performance criteria provided in The Fletcher Site Mitigation Plan which references the DMS Stream and Wetland Mitigation Plan Template and Guidance (October 2015), the Annual Monitoring Template (April 2015), and the Closeout Report Template (v2.1 March 2015). Performance criteria will be evaluated throughout the seven-year monitoring period; however, if all performance criteria has been successfully met and at least two bankfull or significant geomorphic events have occurred a request will be submitted to discontinue stream and/or vegetation monitoring after five years. The table below provides a list of the performance standards associated with each project objective along with a description of the monitoring approach.

Fletcher Mitigation Site Project Performance Standards		
Objective	Performance Standard	Monitoring Approach
Construct stream channels that will maintain proper dimension, pattern, and profile, and meet jurisdictional status.	<ul style="list-style-type: none"> Riffle section W/D ratios should remain within the range of the appropriate stream type. BHR should not exceed 1.2. BHR should not change more than 10% in any given monitoring interval. Changes that do occur should indicate a trend toward stability. Entrenchment Ratios should be ≥ 2.2 for C/E channels and ≥ 1.4 for B channels. Document continuous flow in tributaries for at least 30 consecutive days in each year. 	<ul style="list-style-type: none"> Survey of select cross sections and visual assessment. Continuous stage recorders for base flow on tributaries.
Construct streams with proper bankfull to floodplain relationship.	Four bankfull events or greater, in separate years, will be documented during the monitoring period.	Crest gauges, continuous stage recorders, and debris lines.
Construct streams that provide naturally stable dimensions and stabilize constructed banks with appropriate bioengineering.	Channel banks should generally remain stable. Where bank migration does occur, it should not exceed 20% of the bankfull width for the duration of the monitoring.	Visual assessment and bank pin monitoring as necessary.
Construct streams that maintain an appropriate sediment transport balance with the sediment that is supplied by the watershed so that the overall stream profile neither aggrades nor degrades over time.	Profile adjustments should not indicate significant aggradation or degradation. BHR requirements as stated above.	Resurvey of longitudinal profile if visual assessment indicates potential instability.
Create and improve stream bedform diversity by constructing pools of varied depths and riffles of varied slopes	Profile should maintain a diversity of depths expressed in riffle/pool forms.	Visual assessment
Construct stable riffles that provide an improved diversity of bed material clast and a reduction in fines relative to existing conditions	Substrate material should progress towards or maintain coarser material in riffles and runs with finer material present in pools and glides.	Pebble count measurements at surveyed cross sections
Construct in-stream habitat features from native material to provide a diversity of habitats	In-stream habitat structures should remain intact and functional.	Visual assessment
Prevent cattle from access to the streams and riparian areas by installing exclusion fencing.	Exclusion fencing should remain intact and effective at preventing livestock access.	Visual assessment
Install BMP's in concentrated runoff areas that drain agricultural fields.	None. No maintenance will be performed on BMP's.	None
Provide a buffer from agricultural activities and row crops.	Record conservation easement prior to implementation.	None
Plant native climax tree species and understory species in the riparian zone.	Minimum of 320 stems/ac present at MY-3. Minimum of 260 stems/ac present at MY-5. Minimum of 210 stems/ac present at MY-7.	<ul style="list-style-type: none"> Vegetation plots Carolina Vegetation Survey (CVS) methodology will be used to record data and calculate stems/ac.
Reconstruct stream channels that are properly connected to the riparian wetlands.	Groundwater elevation within 12 inches of the ground surface for 12% of the growing season.	Groundwater monitoring gauges
Re-grade topography to eliminate ditches and drainage features.	Groundwater elevation within 12 inches of the ground surface for 12% of the growing season.	Groundwater monitoring gauges
Plant native wetland tree and shrub species.	Minimum of 320 stems/ac present at MY-3. Minimum of 260 stems/ac present at MY-5. Minimum of 210 stems/ac present at MY-7.	<ul style="list-style-type: none"> Vegetation plots Carolina Vegetation Survey (CVS) methodology will be used to record data and calculate stems/ac.
Establish a conservation easement that provides a minimum buffer from future activities in the adjacent watershed.	Record conservation easement prior to implementation.	None

* Table is based on the approved Fletcher Mitigation Plan; No changes to performance standards, success criteria, or monitoring protocol were made.

1.5. Mitigation Components

The Fletcher Site generated 10,011 SMUs and 8.91 WMUs. Refer to Figure 2 for the project component/ asset map for a visual description of the project assets and Table 1 for project components and mitigation credit information for the Fletcher Site. These credits are based on the Approved Fletcher Site Mitigation Plan.

1.6. Restoration Type and Approach

Boulder and log structures were used to provide vertical stability to the channel, assist in maintaining riffle, run and pool features and to provide habitat features. Run structures were generally placed at the tail-of-riffles to support the upstream riffle grade. Log sills were used in a similar fashion on smaller streams or on flatter grade reaches. Log J-hooks were used to shift the flow away from the outside banks on selected meander bends. Brush-toe structures were installed on the outside of certain meander bends to provide bank stability, increase bank roughness, and provide aquatic habitat.

Re-establishment of the wetlands involved the removal of any overburden material to expose the underlying buried hydric soils. Wetland hydrology was restored by raising the stream bed elevations and filling in the floodplain drainage ditches. Additional grading activities included harvesting usable topsoil material for re-use on portions of the re-graded floodplain, removal of spoil berms, and grading macro-topography to provide for additional retention of surface water and increased habitat diversity. Enhancement of existing wetlands involved stabilizing wetland hydrology and replanting. All Re-establishment areas will be ripped to remove effects of past compaction and planted with native wetland vegetation. Invasive species will be removed and a riparian wetland vegetation community will be established.

Fletcher Creek

The approach for Fletcher Creek Reach 1 was to raise the stream grade so that the proposed bankfull coincides with the partial terrace which lies 18 to 24 inches below the high terrace. This was accomplished by maintaining as much of the existing alignment features as possible. Where practical the high terrace was graded back to form a gentle cross-sloped valley form. This approach allowed the saving several large trees that occupy the lower terrace and exposed the buried 'A' horizon soils adjacent to the channel.

Along Reach 2 the channel was partially raised although the target elevation is not as evident as it is in Reach 1. The upstream end of Reach 2 was so severely degraded that relic terrace features were generally lost. The pre-construction stream assessment identified several stabilized valley slope features that roughly coincide with slope projections of the broader valley form. These features were incorporated into the channel configuration to provide a new channel and valley form. Through the downstream end of Reach 2(A) a high bank feature provided a relatively consistent target for matching the proposed bankfull elevation. The conceptual approach for Reach 2(B) was to reconstruct the channel with a slightly raised bed. Significantly raising the bed elevation through this reach was limited by the grade of the upstream culvert and the relative low slope of the channel.

Raccoon Branch

On Raccoon Branch Reach 1(D) the conceptual approach was to relocate the channel into a natural low in the valley which lies to the left of the present eroded gully. This approach involved removal of the existing cross pipe which will assist in retaining baseflow in the channel.

Coates Branch

The approach for Coates Branch was in three parts. On Reach 1(B) restoration activities included reshaping the valley and filling in the ditch to form a new headwater stream and valley configuration. Along Reach 1(C) the restoration activities included raising the stream to an elevation that is consistent with the buried 'A' horizon, approximately 18 to 24 inches below the terrace. The upper valley slope was graded back to allow for the construction of a small stream/wetland complex with the broader valley form. The intention was to mimic a scenario of an abandoned larger channel that has evolved into a wetland with a small feeder stream. This is a fairly common scenario in the mountain region where past landslides or debris fans have altered primary stream courses and left relic channel forms. Restoration activities on Reach 1(D) included raising the streambed to allow hydrologic connection to the floodplain and Fletcher Creek.

Weston Branch

The conceptual approach for Weston Creek was linked to the restoration approach for the adjacent wetlands. Weston Creek was relocated back into the area that has been mapped as hydric soils. Restoration activities were completed by filling in the existing ditch, removing the berm between the ditch and the field, and regrading portions of the field to provide more suitable wetland topography and grade. The stream channel meanders across the reshaped field to maximize the hydraulic connection between the stream and the restored wetlands.

Fletcher Creek Wetlands (Area A, B, and C)

The enhancement activities on the Fletcher Creek wetlands included primarily planting appropriate wetland vegetation and removing stressors. Wetlands A and B had headcuts that are migrating upstream and threatening to impact groundwater hydrology. These headcuts were stabilized with log sills. Wetland C was protected with exclusion fencing to eliminate the livestock impacts. Additionally, a drainage pipe that was placed to form a stream crossing was removed from this area.

Weston Creek Wetlands (Area D)

The restoration approach for Area D was to re-establish wetland conditions throughout the area identified as having hydric soils. This was accomplished by returning Weston Creek to a stream course that meanders across the proposed wetland area and eliminating topographic features that were detrimental to functioning wetlands. This included grading down existing berm and spoil areas along with filling in existing ditches. Additionally, the overall topography was reshaped to eliminate agriculture furrows and create macro-depressional areas.

1.7. As-Built Record Drawings

A sealed set of the record drawings are located in Appendix E. Adjustments from the design plans are listed below.

Fletcher Creek – Reach 1B

- Sta 106+70 – Alignment Deviation

Fletcher Creek – Reach 1C

- Sta 115+70 - 117+20 – Alignment Deviation
- Sta 124+13 – Alignment Deviation

Fletcher Creek – Reach 2A

- Sta 126+38 – 127+65 – Alignment Deviation
- Sta 132+20 – 133+91 - Alignment Deviation
- Sta 134+22 – Structure shifted upstream
- Sta 136+10 – 137+15 – Alignment Deviation

Fletcher Creek – Reach 2B

- Sta 155+92 – Shifted Piped Crossing Downstream
- Sta 156+27 – Added Brush Run

Raccoon Branch – Reach 1C

- Sta 212+00 – Omitted Debris Placement
- Sta 212+10 – Deleted Log Sill, Headwater Channel Extended Upstream; Site conditions had changed from initial survey during a very wet year, a field call was made to extend the headwater channel upstream to help stabilize the channel.
- Sta 213+01 – Added Log Sill
- Sta 214+00 – 214+90 – Deleted 5 Log Sills, Headwater Channel Extended Upstream; Site conditions had changed from initial survey during a very wet year, a field call was made to extend the headwater channel upstream to help stabilize the channel.

Raccoon Branch – Reach 1D

- Sta 215+00 – 219+11 – Alignment Deviation

Weston Creek – Reach 1B

- Partially filled base ditch along eastern side of easement; ditch was partially filled because water was still traveling onsite from adjacent field. A rip-rap transition down to Hoopers Creek was installed to help stabilize the channel.


Coates Branch – Reach 1A

- Sta 300+00 – 300+35 – Headwater Channel Extended Downstream
- Sta 300+50 – 300+70 – Headwater Channel Shortened
- Sta 301+50 – 302+25 – Headwater Channel Extended, log sill deleted
- Sta 302+75 – Headwater Channel Extended Downstream
- Sta 303+40 – 307+00 – Alignment Deviation
- Sta 308+25 – 309+00 – Alignment Deviation
- Sta 311+75 – 315+25 – Alignment Deviation
- Sta 316+50 – 319+25 – Alignment Deviation

Weston Creek – Reach 1B

- Sta 420+20 – Added Coir Base Ditch
- Sta 421+00 – 428+00 – Added Base Ditch With Rip Rap Transition

1.8. Vicinity Map

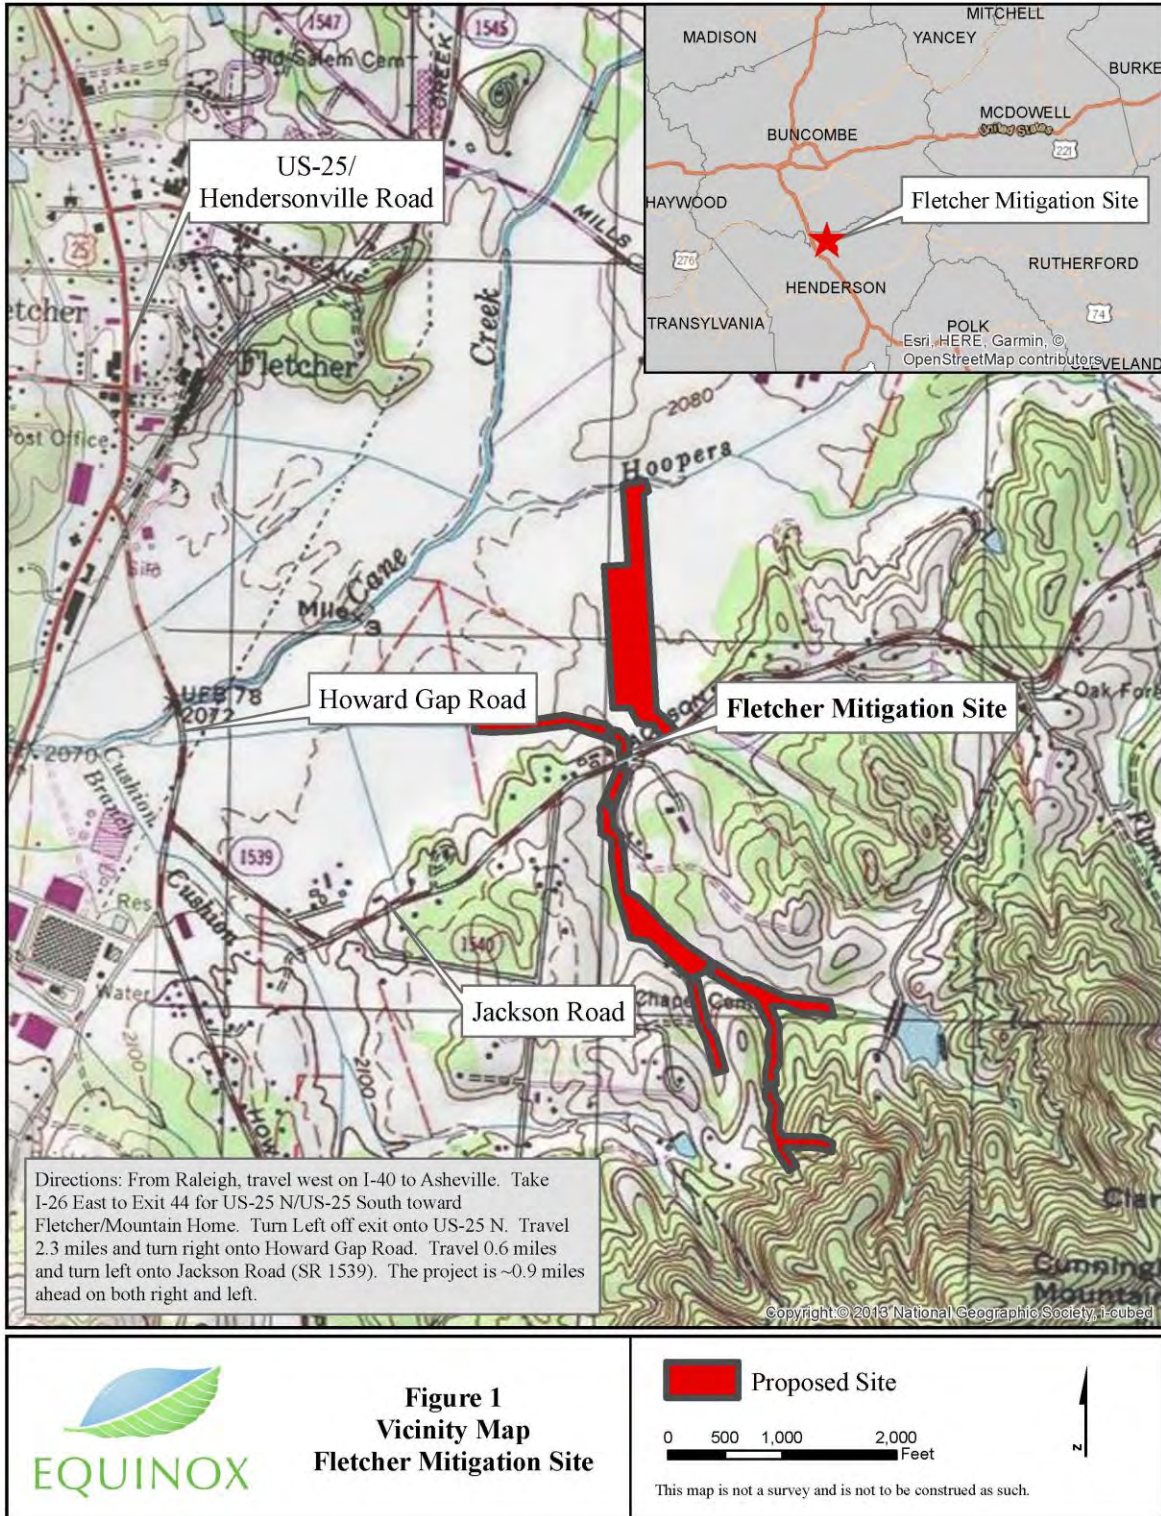

2.0 REFERENCES

Kee Mapping and Survey. 2019. As-Built Survey of Fletcher Creek Restoration Project. Prepared for EW Solutions.

Stantec Consulting, Inc. 2018. Final Mitigation Plan – Fletcher Mitigation Site. . Prepared for North Carolina Department of Environmental Quality, Division of Mitigation Services. DMS Project No. 100004.

Lee, Michael T., R.K. Peet, S.D. Roberts, and T.R. Wentworth. 2008. CVS-EEP Protocol for Recording Vegetation, Version 4.2 (<http://cvs.bio.unc.edu/methods.htm>)

Appendix A

Background Tables

**Table 1. Project Mitigation Assets and Components
Fletcher Mitigation Site**

Project Segment	Existing Footage or Acreage	Mitigation Plan Footage or Acreage	Mitigation Category	Restoration Level	Priority Level	Mitigation Ratio (X:1)	Mitigation Plan Credits*	As-Built Centerline Footage or Acreage [^]	Comments
Fletcher Creek 1a	607	461	Cool	EII	NA	2.5	184.400	461	
Fletcher Creek 1b	498	377	Cool	R	PI	1.0	377.000	378	
Fletcher Creek 1c	1,791	1,540	Cool	R	PI	1.0	1,540.000	1,507	Less 51' for crossing
Fletcher Creek 2a	1,587	1,296	Cool	R	PI/ PII	1.0	1,296.000	1,290	Less 33' for utility crossing; Less than 30' buffer for 86 LF
Fletcher Creek 2b	1,586	1,470	Cool	R	PII	1.0	1,470.000	1,558	Less 33' for outlet protection and 51' and 73' for 2 crossings
Raccoon Branch 1a	489	489	Cool	P	NA	10.0	48.900	489	.001 ac temporary impact to Wetland A
Raccoon Branch 1b	461	461	Cool	P	NA	10.0	46.100	461	.006 ac temporary impact to Wetland B
Raccoon Branch 1c	208	153	Cool	EII	NA	2.5	61.200	153	Less 53' for crossing; Stream length not included in wetlands
Raccoon Branch 1d	354	448	Cool	R	PI	1.0	448.000	440	
Pine Branch 1	380	299	Cool	P	NA	10.0	29.900	299	
Coates Branch Reach 1a	292	282	Cool	EII	NA	2.5	112.800	282	
Coates Branch Reach 1b	598	606	Cool	R	PI	1.0	606.000	598	.016 ac temporary impact to Wetland D
Coates Branch Reach 1c	727	708	Cool	R	PI	1.0	708.000	702	Less 44' for crossing
Coates Branch Reach 1d	318	325	Cool	R	PI	1.0	325.000	321	
Weston Creek 1a	1,645	1,954	Cool	R	PI	1.0	1,954.000	1,916	Less 29' for ROW and outlet protection
Weston Creek 1b	708	804	Cool	R	PI	1.0	804.000	798	
Wetland A	0.03	0.03	RNR	Enh		NC	NC	NC	0.001 ac temporary impact to Wetland A
Wetland B	0.11	0.11	RNR	Enh		NC	NC	NC	0.006 ac temporary impact to Wetland A
Wetland D	0.05	0.05	RNR	Enh		NC	NC	NC	0.016 ac temporary impact to Wetland A
Wetland E	8.910	8.9	RNR	Re-Est		1.0	8.910	8.910	

* Mitigation plan credits account for breaks in conservation easements and are based on design stream stationing and taken from the approved mitigation plan. Mitigation plan credits are the same as the approved mitigation plan.

[^] Based on centerline calculations from the as-built survey, accounts for breaks in conservation easement and utility right-of-ways.

Project Credits

Restoration Level	Stream			Riparian Wetland		Non-Rip	Coastal
	Warm	Cool	Cold	Riverine	Non-Riv	Wetland	Marsh
Restoration	-	6770.000	2758.000	-	-	-	-
Re-establishment				-	8.910	-	-
Rehabilitation				-	-	-	-
Enhancement				-	-	-	-
Enhancement I	-	-	-				
Enhancement II	-	358.400	-				
Creation							
Preservation	-	124.900	-	-	-	-	
Total Credits [%]	-	7253.300	2758.000	-	8.910	-	-

[%] Project credits reflect the sum of credits outlined in the approved mitigation plan.

Table 2. Project Activity and Reporting History Fletcher Mitigation Site		
Activity or Report	Data Collection Complete	Completion or Delivery
Mitigation Plan	Feb - 2018	Feb - 2018
Mitigation Plan Addendum	-	-
Final Design - Construction Plans	-	Mar - 2018
Construction	-	Mar - 2019
Temporary S&E Mix Applied	-	Mar - 2019
Permanent Seed Mix Applied	-	Mar - 2019
Bare Root and Live Stake Plantings	-	Mar- 2019
Baseline Monitoring Document (Year 0 Monitoring - Baseline)	Mar - 2019	Apr - 2019
Stream Assessment	Mar - 2019	Apr - 2019
Vegetation Assessment	Mar - 2019	
Year 1 Monitoring		
Year 2 Monitoring		
Year 3 Monitoring		
Year 4 Monitoring		
Year 5 Monitoring		
Year 6 Monitoring		
Year 7 Monitoring		

Table 3. Project Contacts	
Fletcher Mitigation Site	
Prime Contractor	EW Solutions 37 Haywood Street, Suite 100 Asheville, NC 28801 David Tuch (828) 253-6856
Designer	Stantec Consulting, Inc 56 College Street, Suite 201 Asheville, North Carolina 28801 Grant Ginn (828) 449-1930
Construction Contractor (North Side)	Penland Contracting, Inc 300 NP&L Loop Franklin, NC 28734 Lewis Penland (828) 421-1753
Construction Contractor (South Side)	Baker Construction 1000 Bat Cave Road Old Fort, NC 28762 Charles Baker (828) 668-5060
Seeding Contractor (North Side)	Penland Contracting, Inc 300 NP&L Loop Franklin, NC 28734 Lewis Penland (828) 421-1753
Seeding Contractor (South Side)	Baker Construction 1000 Bat Cave Road Old Fort, NC 28762 Charles Baker (828) 668-5060
Planting Contractor	Equinox 37 Haywood St. Asheville, North Carolina 28801 Owen Carson (828) 253-6856
As-built Surveys	Kee Mapping 88 Central Ave. Asheville, NC 28801 Brad Kee (828) 575-9021
Seeding Mix Source	SESSCO LLC 209 Cane Creek Rd Fletcher, NC 28732 (828) 654-8991
Live Stakes	Mellow Marsh Farms 1312 Woody Store Road Siler City, NC 27344 (919) 742-1200
Monitoring Performers (Y0)- 2019	Equinox 37 Haywood St. Asheville, North Carolina 28801 Drew Alderman (828) 253-6856

Table 4. Project Baseline Information and Attributes


Project Information																	
Project Name		Fletcher Stream and Wetland Mitigation Site															
County		Henderson															
Project Area (acres)		34.8															
Project Coordinates (latitude and longitude)		35.422278° N, -82.486183° W															
Project Watershed Summary Information																	
Physiographic Province		Blue Ridge															
River Basin		French Broad River															
USGS Hydrologic Unit 8-digit	6010105	USGS Hydrologic Unit 14-digit	06010105040010														
DWR Sub-basin		04-03-02															
Project Drainage Area (acres)		0.52 Fletcher Creek / 0.37 Weston Branch															
Project Drainage Area Percentage of Impervious Area		< 1%															
CGIA Land Use Classification		Agricultural															
Reach Summary Information																	
Parameters	Fletcher Creek 1A	Fletcher Creek 1B	Fletcher Creek 1C	Fletcher Creek 2A	Fletcher Creek 2B	Raccoon Branch 1A	Raccoon Branch 1B	Raccoon Branch 1C	Raccoon Branch 1D	Pine Branch	Coats Branch 1A	Coats Branch 1B	Coats Branch 1C	Coats Branch 1D	Weston Creek 1A	Weston Creek 1B	
Length of Reach (linear feet) ^	457	380	1,541	1,299	1,511	489	461	153	440	304	284	601	708	325	1,982	825	
Valley Confinement (Rosgen)	II	II	II	II	VIII	II	II	II	II	II	II	II	II	II	VIII	VIII	
Drainage area (miles ²)	0.30	0.30	0.37	0.49	0.52	0.01	0.03	0.04	0.04	0.01	0.02	0.03	0.04	0.07	0.30	0.37	
Perennial, Intermittent, Ephemeral	Perennial	Perennial	Perennial	Perennial	Perennial	Intermittent	Perennial	Perennial	Perennial	Perennial	Intermittent	Perennial	Perennial	Perennial	Perennial	Perennial	
NCDWR Water Quality Classification	C	C	C	C	C	C	C	C	C	C	C	C	C	C	C: Tr	C: Tr	
Stream Classification (existing)	G	G	B, F, G	B, G	B, E, G	B	B	B, G	B, G	B	B, G	B, G	B, F, G	B	E, G	E, G	
Stream Classification (proposed)	B4	B4	B4	B4	B5	B4	B4	B4	B4	B4	B4	B4	B4	B4	C5	C5	
FEMA classification	-	-	-	-	-	-	-	-	-	-	-	-	-	-	-	-	
Wetland Summary Information																	
Parameters	Wetland A			Wetland B			Wetland D			Wetland E							
Size of Wetland (acres)	0.03			0.11			0.05			8.91							
Wetland Type (non-riparian, riparian riverine or riparian non-riverine)	Riparian			Riparian			Riparian			Riparian							
Mapped Soil Series	-			-			-			Ha							
Drainage class	-			-			-			poorly							
Soil Hydric Status	Hydric			Hydric			Hydric			Hydric							
Source of Hydrology	Spring			Spring			Spring			Groundwater							
Hydrologic Impairment	Agriculture/ Livestock Grazing			Agriculture/ Livestock Grazing			Agriculture/ Livestock Grazing			Agriculture							
Native vegetation community	Mountain Alluvial Forest			Mountain Alluvial Forest			Mountain Alluvial Forest			Mountain Alluvial Forest							
Percent composition of exotic invasive vegetation	15%			15%			15%			1%							
Regulatory Considerations																	
Regulation	Applicable ?	Resolved?					Supporting Documentation										
Waters of the United States – Section 404	Yes	Yes					Jurisdictional Determination										
Waters of the United States – Section 401	Yes	Yes					Jurisdictional Determination										
Endangered Species Act	Yes	Yes					ERTR										
Historic Preservation Act	No	N/A					ERTR										
Coastal Zone Management Act (CZMA)/ Coastal Area Management Act (CAMA)	No	N/A					N/A										
FEMA Floodplain Compliance	Yes	Yes					Yes										
Essential Fisheries Habitat	No	N/A					N/A										

^ Based on actual thalweg calculations from the as-built survey, accounts for breaks in conservation easement and utility right-of-ways.

Appendix B
Visual Assessment Data

This Page Intentionally Left Blank

Figure 2. Asset Map

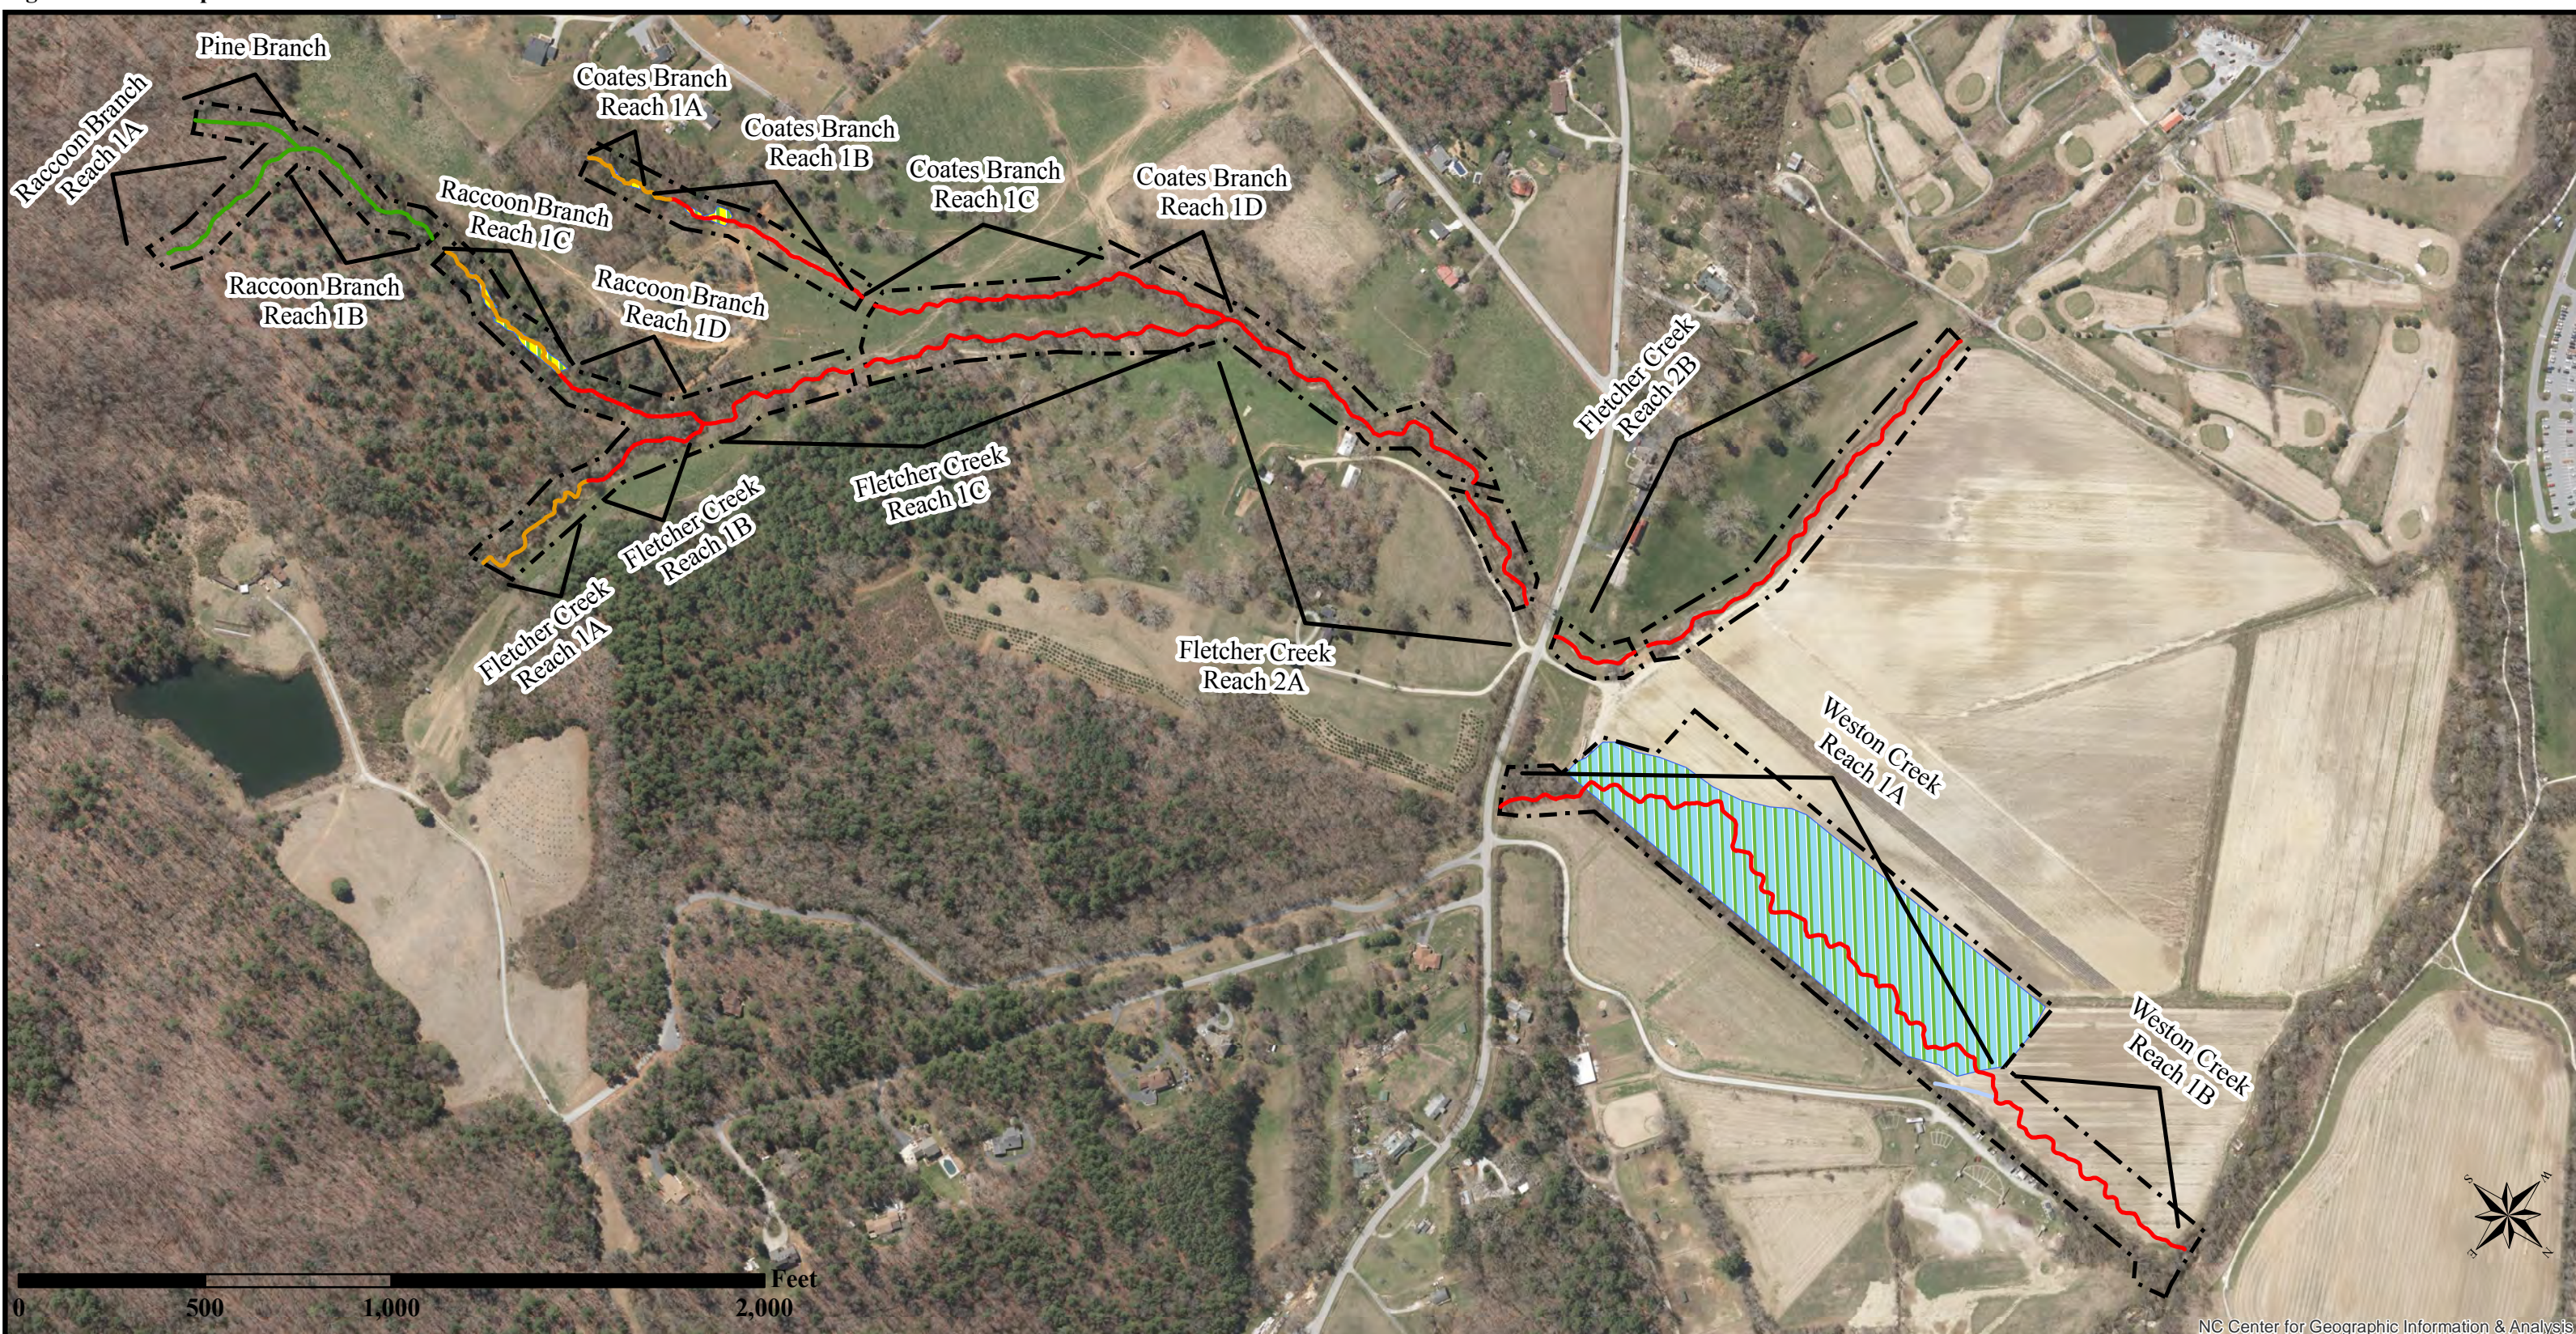

NC Center for Geographic Information & Analysis

Prepared for

Figure 2. Asset Map
 Fletcher Restoration Site
 Monitoring Year 0
 Henderson County, NC
 NCDMS Contract No.: 006997
 NCDMS Project No.: 100004
 April 2019

Stream Asset Type


- Restoration
- Enhancement II
- Preservation
- No Credit
- Wetland Re-Establishment
- Wetland Enhancement (No Credit)

Notes:
 1) Baseline Data Provided by Kee Mapping

Prepared by

This Page Intentionally Left Blank

Figure 3. Monitoring Features Map

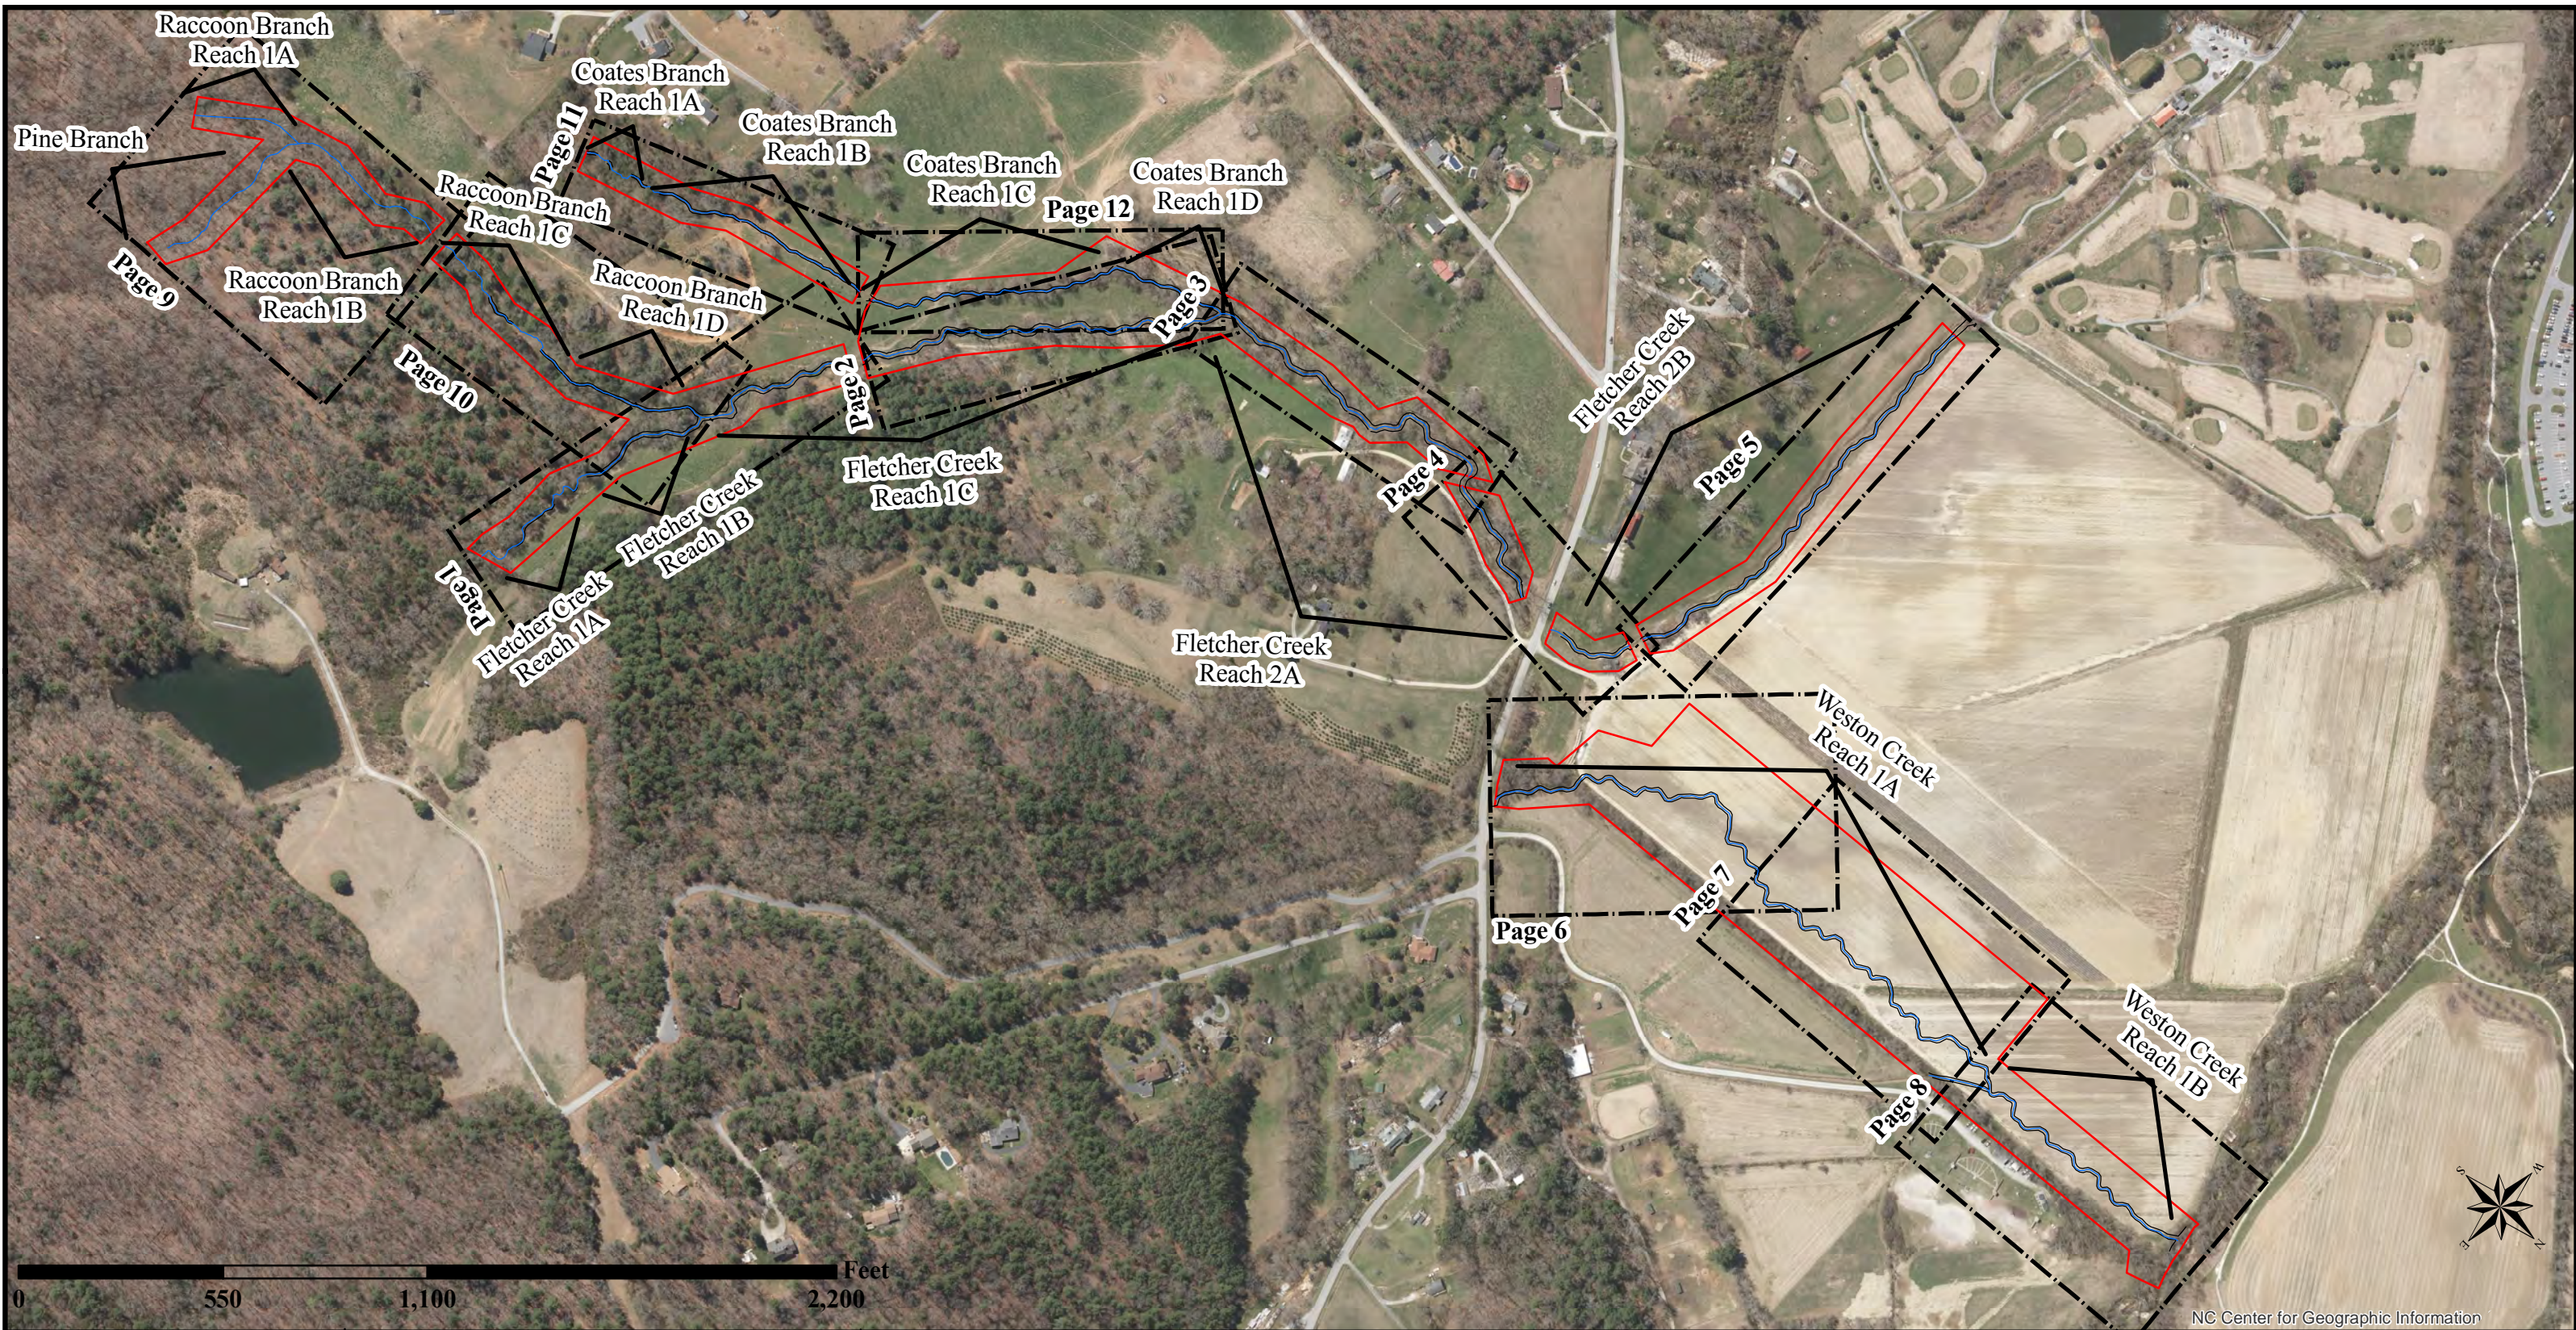





NC Center for Geographic Information

Prepared for



Figure 3. Monitoring Features Map
 Fletcher Mitigation Site
 Monitoring Year 0
 Henderson County, NC
 NCDMS Contract No.: 006997
 NCDMS Project No.: 100004
 April 2019
 Overview

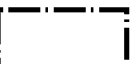
	Easement		As-Built Top of Bank
	Map Pages		As-Built Thalweg

Notes:
 1) Baseline Data Provided by Kee Mapping

Prepared by



Figure 3. Monitoring Features Map

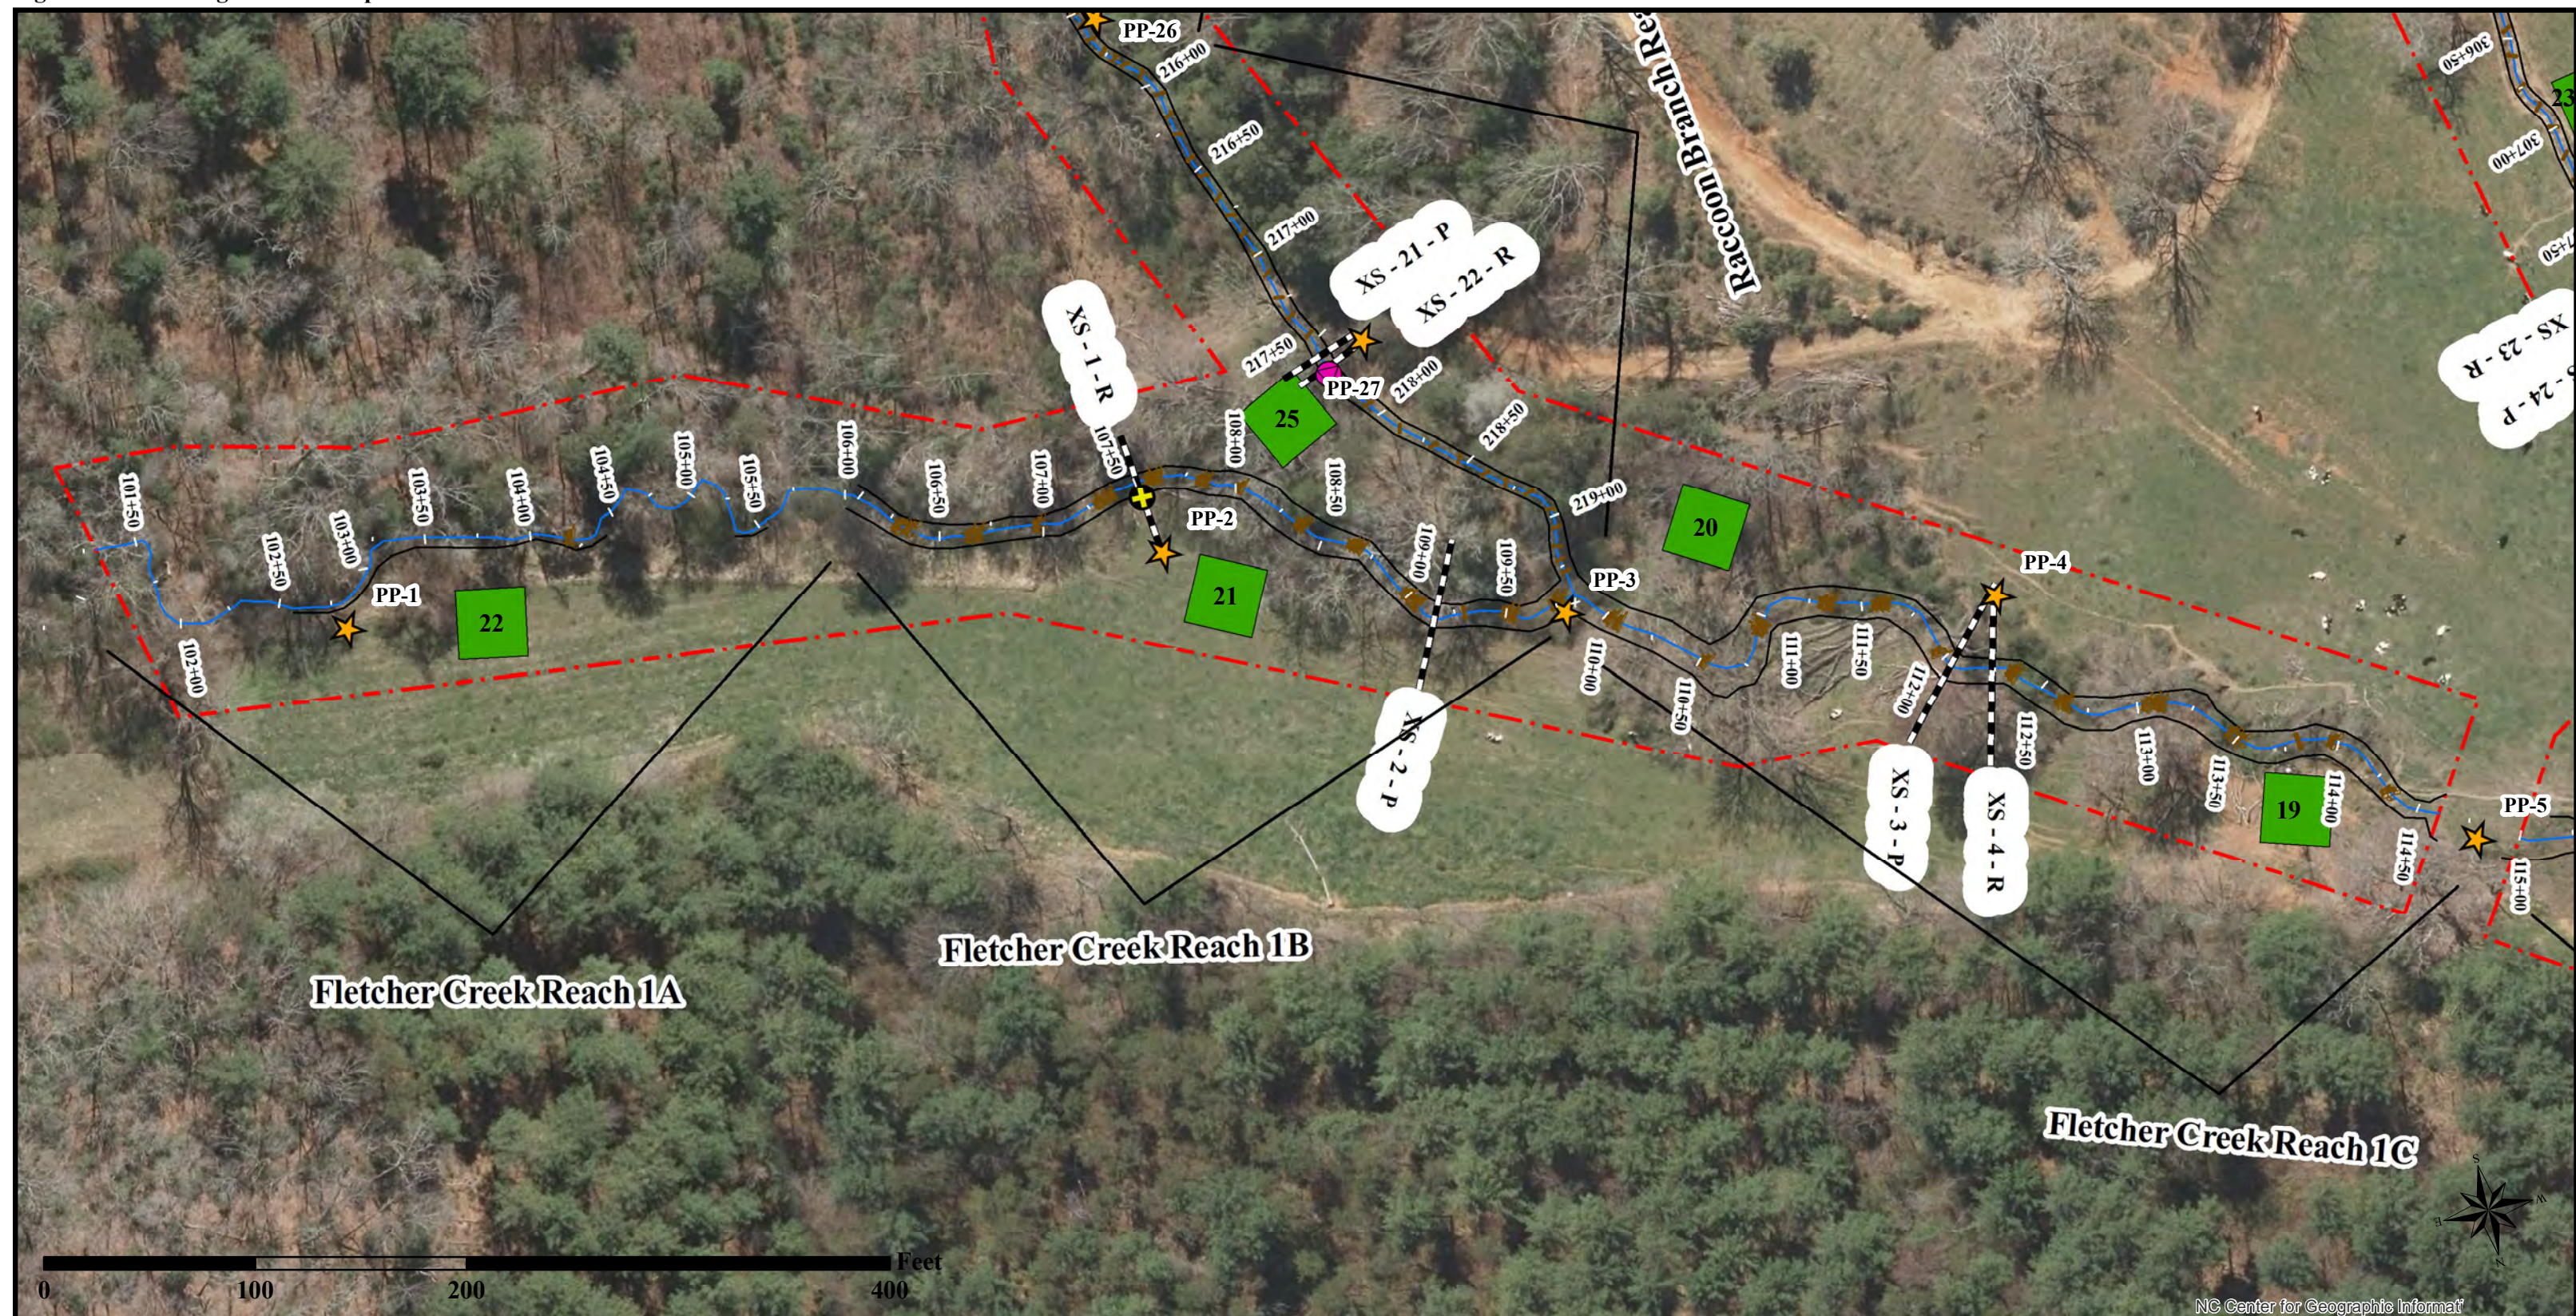

NC Center for Geographic Information

Prepared for



Figure 3. Monitoring Features Map
 Fletcher Mitigation Site
 Monitoring Year 0
 Henderson County, NC
 NCDMS Contract No.: 006997
 NCDMS Project No.: 100004
 April 2019
 Sheet 1 of 12


- | | | |
|----------------------------------|----------------------|---------------------------|
| Easement | As-Built Top of Bank | Photo Point |
| Wetland Re-Establishment | As-Built Thalweg | Continuous Stage Recorder |
| Wetlands Enhancement (No Credit) | Cross-Section | Crest Gauge |
| Vegetation Plot | | Groundwater Gauge |
| | | Rain Gauge |

Notes:
 1) Baseline Data Provided by Kee Mapping

Prepared by



Figure 3. Monitoring Features Map

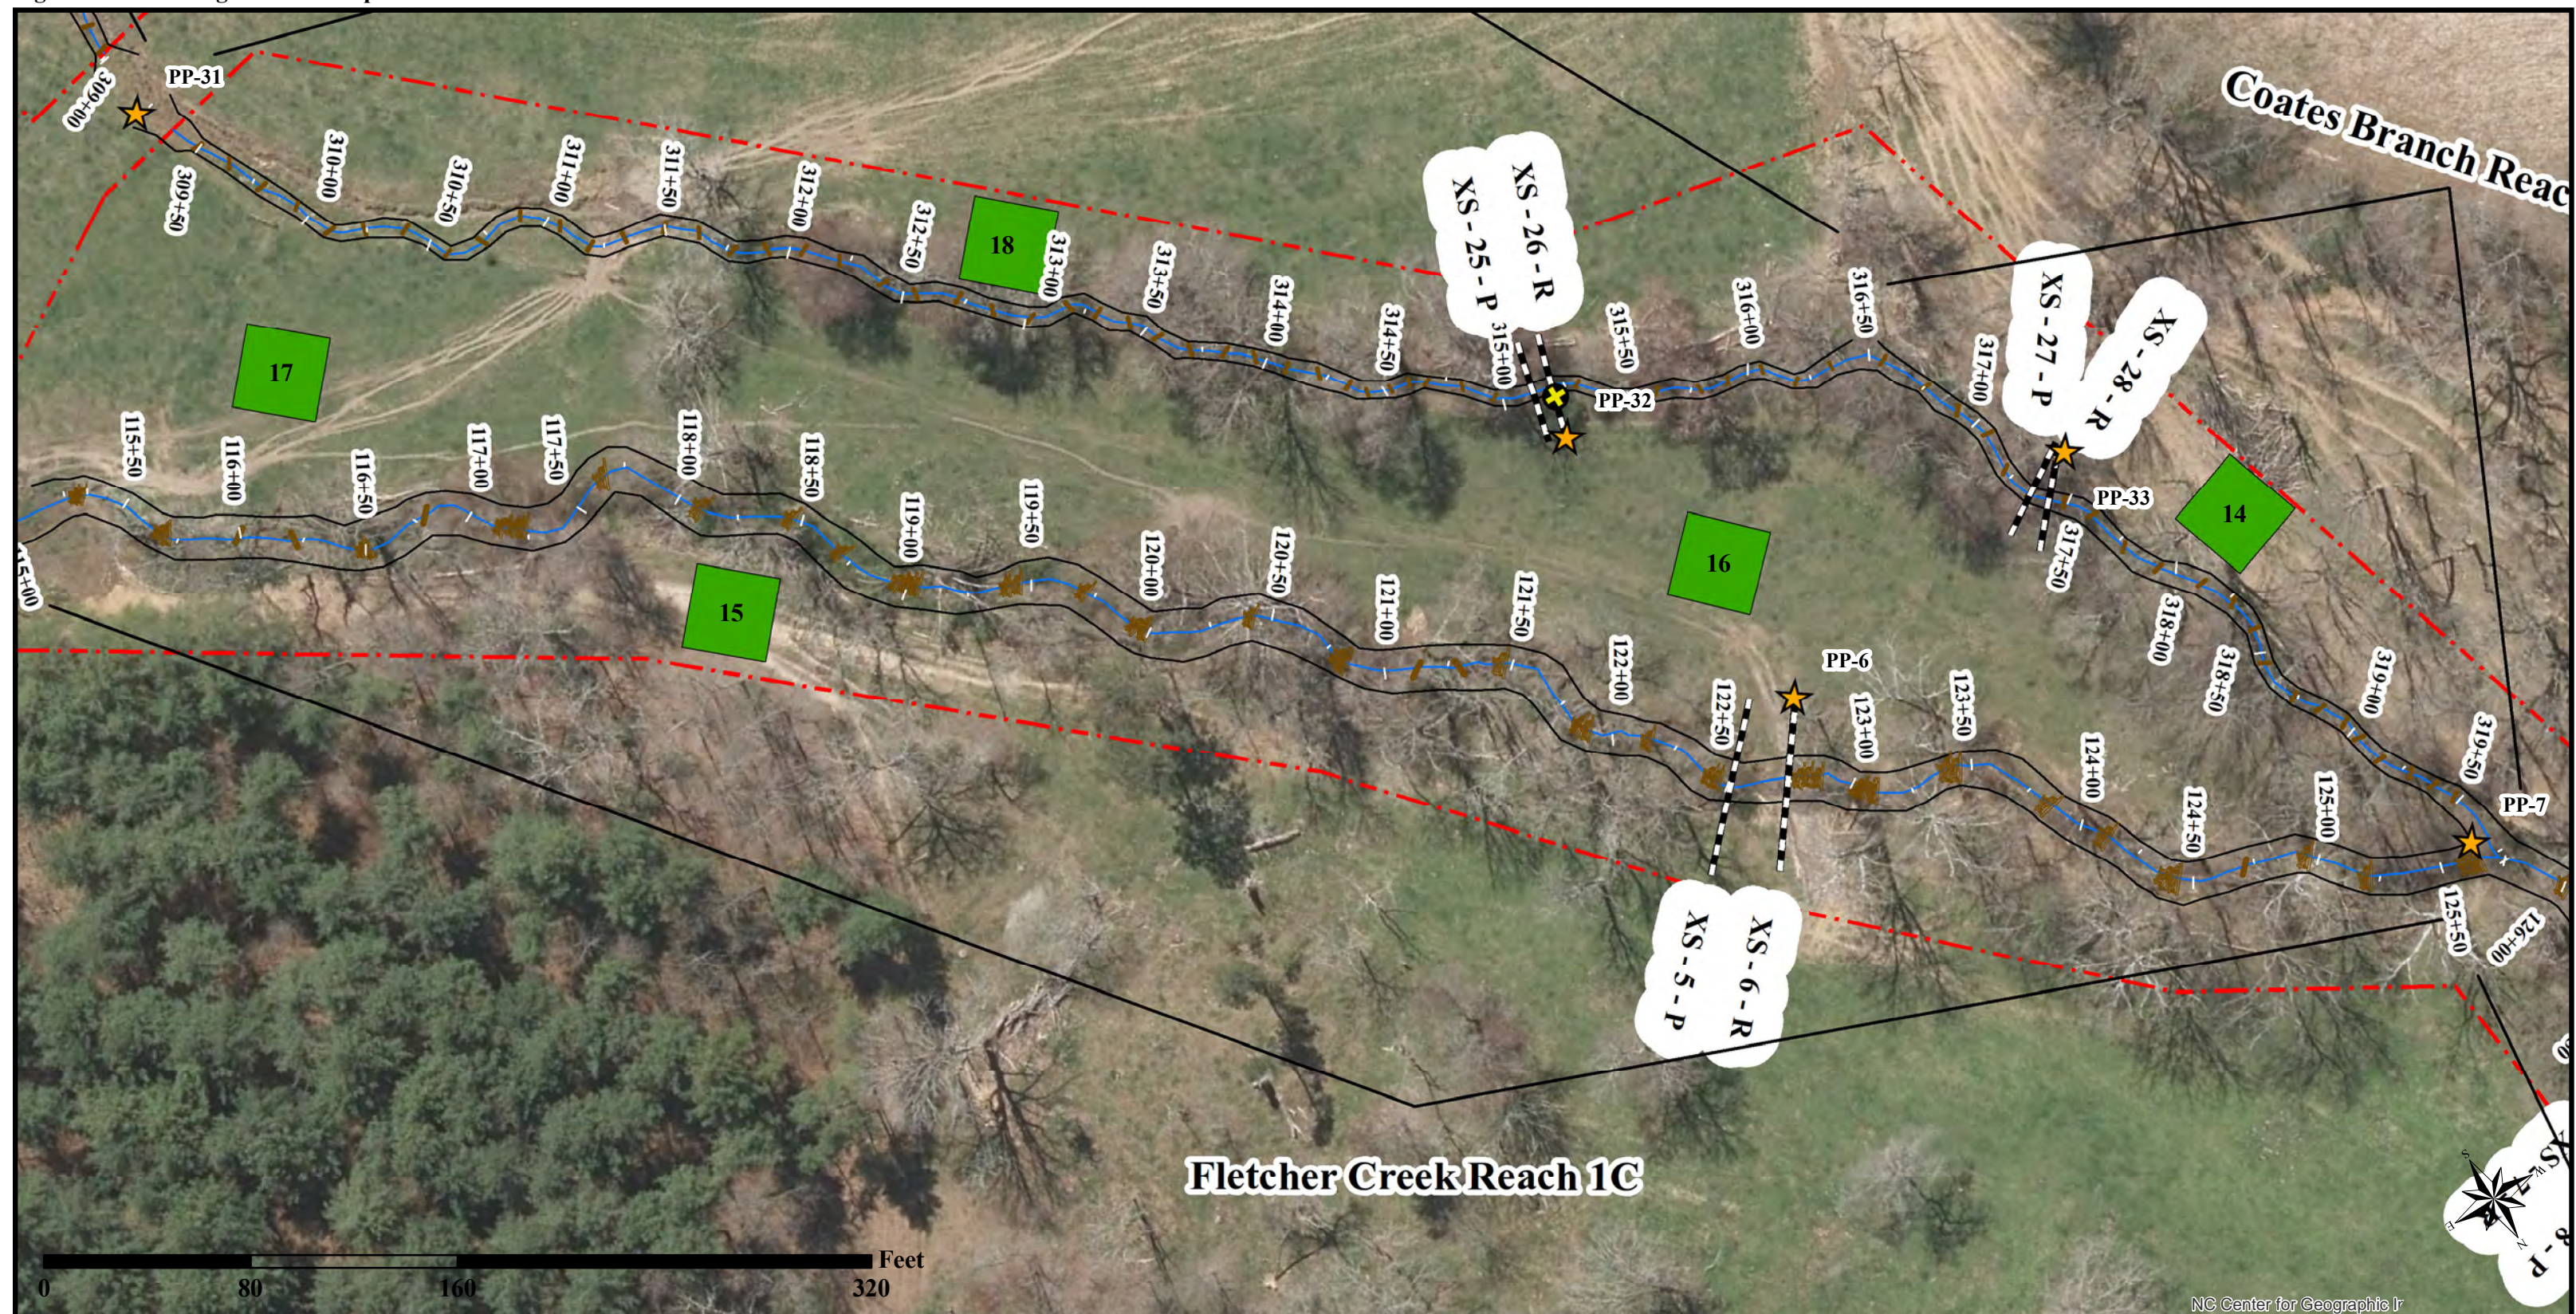

NC Center for Geographic I

Prepared for



Figure 3. Monitoring Features Map
 Fletcher Mitigation Site
 Monitoring Year 0
 Henderson County, NC
 NCDMS Contract No.: 006997
 NCDMS Project No.: 100004
 April 2019
 Sheet 2 of 12

- Easement
- Wetland Re-Establishment
- Wetlands Enhancement (No Credit)
- Vegetation Plot
- As-Built Top of Bank
- As-Built Thalweg
- Cross-Section
- ★ Photo Point
- Continuous Stage Recorder
- + Crest Gauge
- Groundwater Gauge
- ⊙ Rain Gauge

Notes:
 1) Baseline Data Provided by Kee Mapping

Prepared by



Figure 3. Monitoring Features Map



Fletcher Creek Reach 2A

Prepared for




Figure 3. Monitoring Features Map
 Fletcher Mitigation Site
 Monitoring Year 0
 Henderson County, NC
 NCDMS Contract No.: 006997
 NCDMS Project No.: 100004
 April 2019
 Sheet 3 of 12

- | | | |
|----------------------------------|----------------------|---------------------------|
| Easement | As-Built Top of Bank | Photo Point |
| Wetland Re-Establishment | As-Built Thalweg | Continuous Stage Recorder |
| Wetlands Enhancement (No Credit) | Cross-Section | Crest Gauge |
| Vegetation Plot | | Groundwater Gauge |
| | | Rain Gauge |

Notes:
 1) Baseline Data Provided by Kee Mapping

Prepared by

Figure 3. Monitoring Features Map

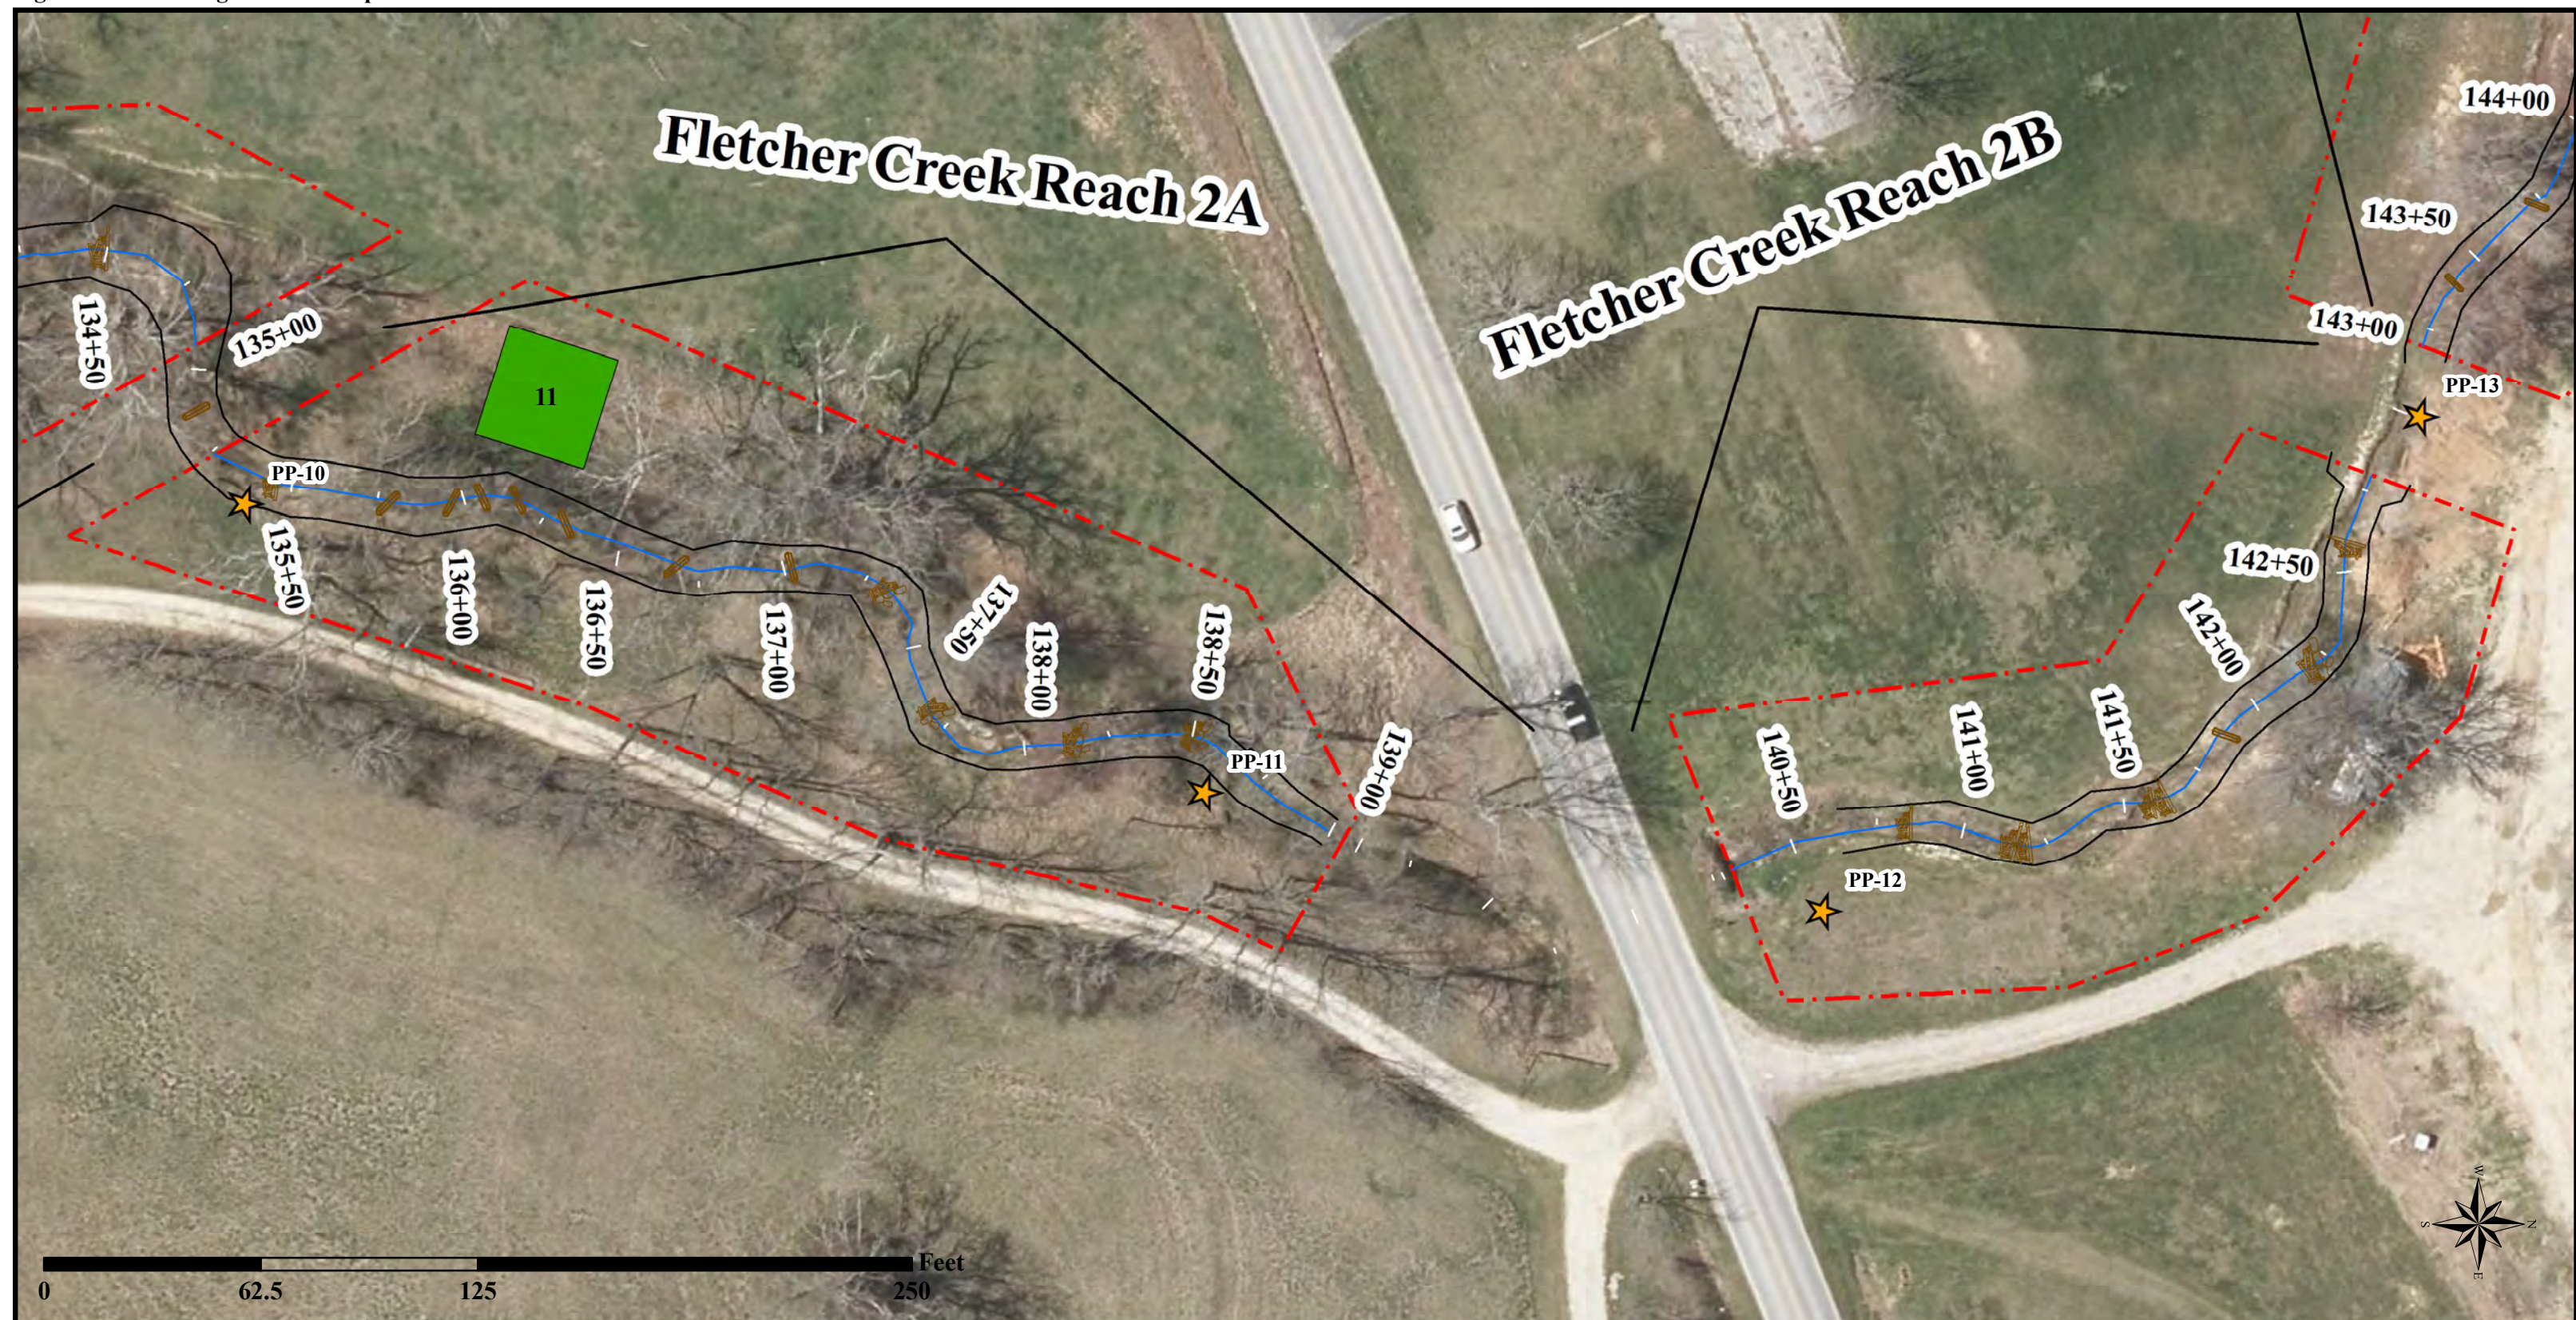

Prepared for



Figure 3. Monitoring Features Map
 Fletcher Mitigation Site
 Monitoring Year 0
 Henderson County, NC
 NCDMS Contract No.: 006997
 NCDMS Project No.: 100004
 April 2019
 Sheet 4 of 12


- | | | |
|----------------------------------|----------------------|---------------------------|
| Easement | As-Built Top of Bank | Photo Point |
| Wetland Re-Establishment | As-Built Thalweg | Continuous Stage Recorder |
| Wetlands Enhancement (No Credit) | Cross-Section | Crest Gauge |
| Vegetation Plot | | Groundwater Gauge |
| | | Rain Gauge |

Notes:
 1) Baseline Data Provided by Kee Mapping

Prepared by



Figure 3. Monitoring Features Map

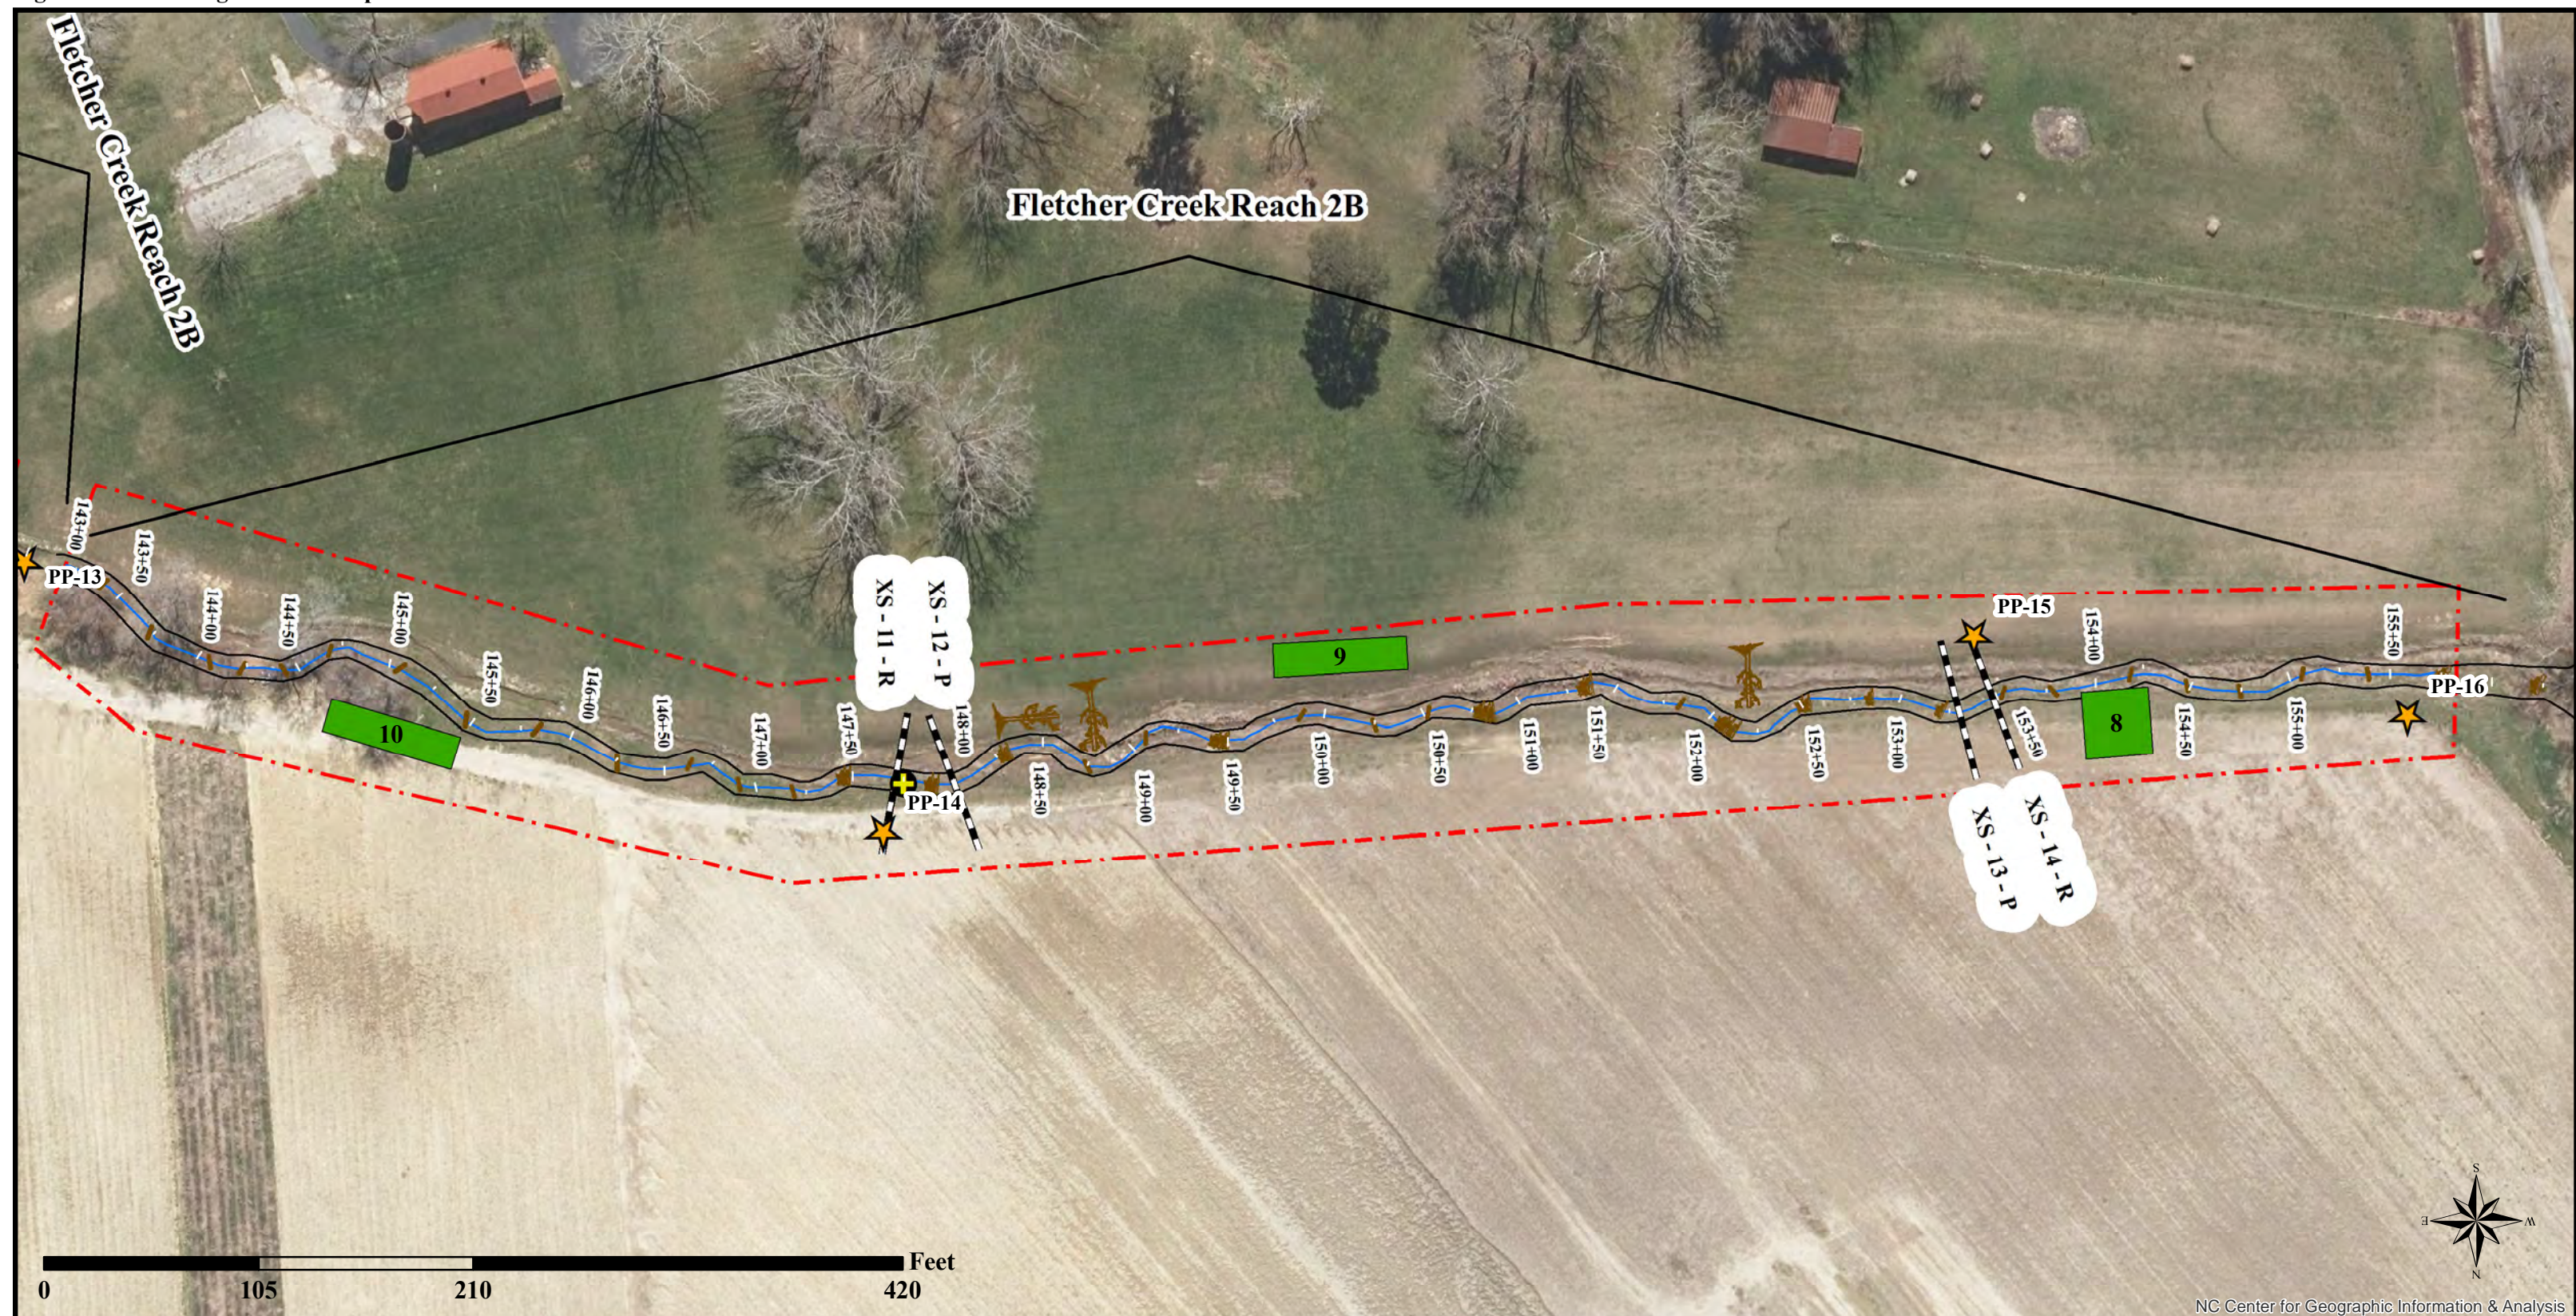

NC Center for Geographic Information & Analysis

Prepared for



Figure 3. Monitoring Features Map
 Fletcher Mitigation Site
 Monitoring Year 0
 Henderson County, NC
 NCDMS Contract No.: 006997
 NCDMS Project No.: 100004
 April 2019
 Sheet 5 of 12


- | | | |
|----------------------------------|----------------------|---------------------------|
| Easement | As-Built Top of Bank | Photo Point |
| Wetland Re-Establishment | As-Built Thalweg | Continuous Stage Recorder |
| Wetlands Enhancement (No Credit) | Cross-Section | Crest Gauge |
| Vegetation Plot | | Groundwater Gauge |
| | | Rain Gauge |

Notes:
 1) Baseline Data Provided by Kee Mapping

Prepared by



Figure 3. Monitoring Features Map

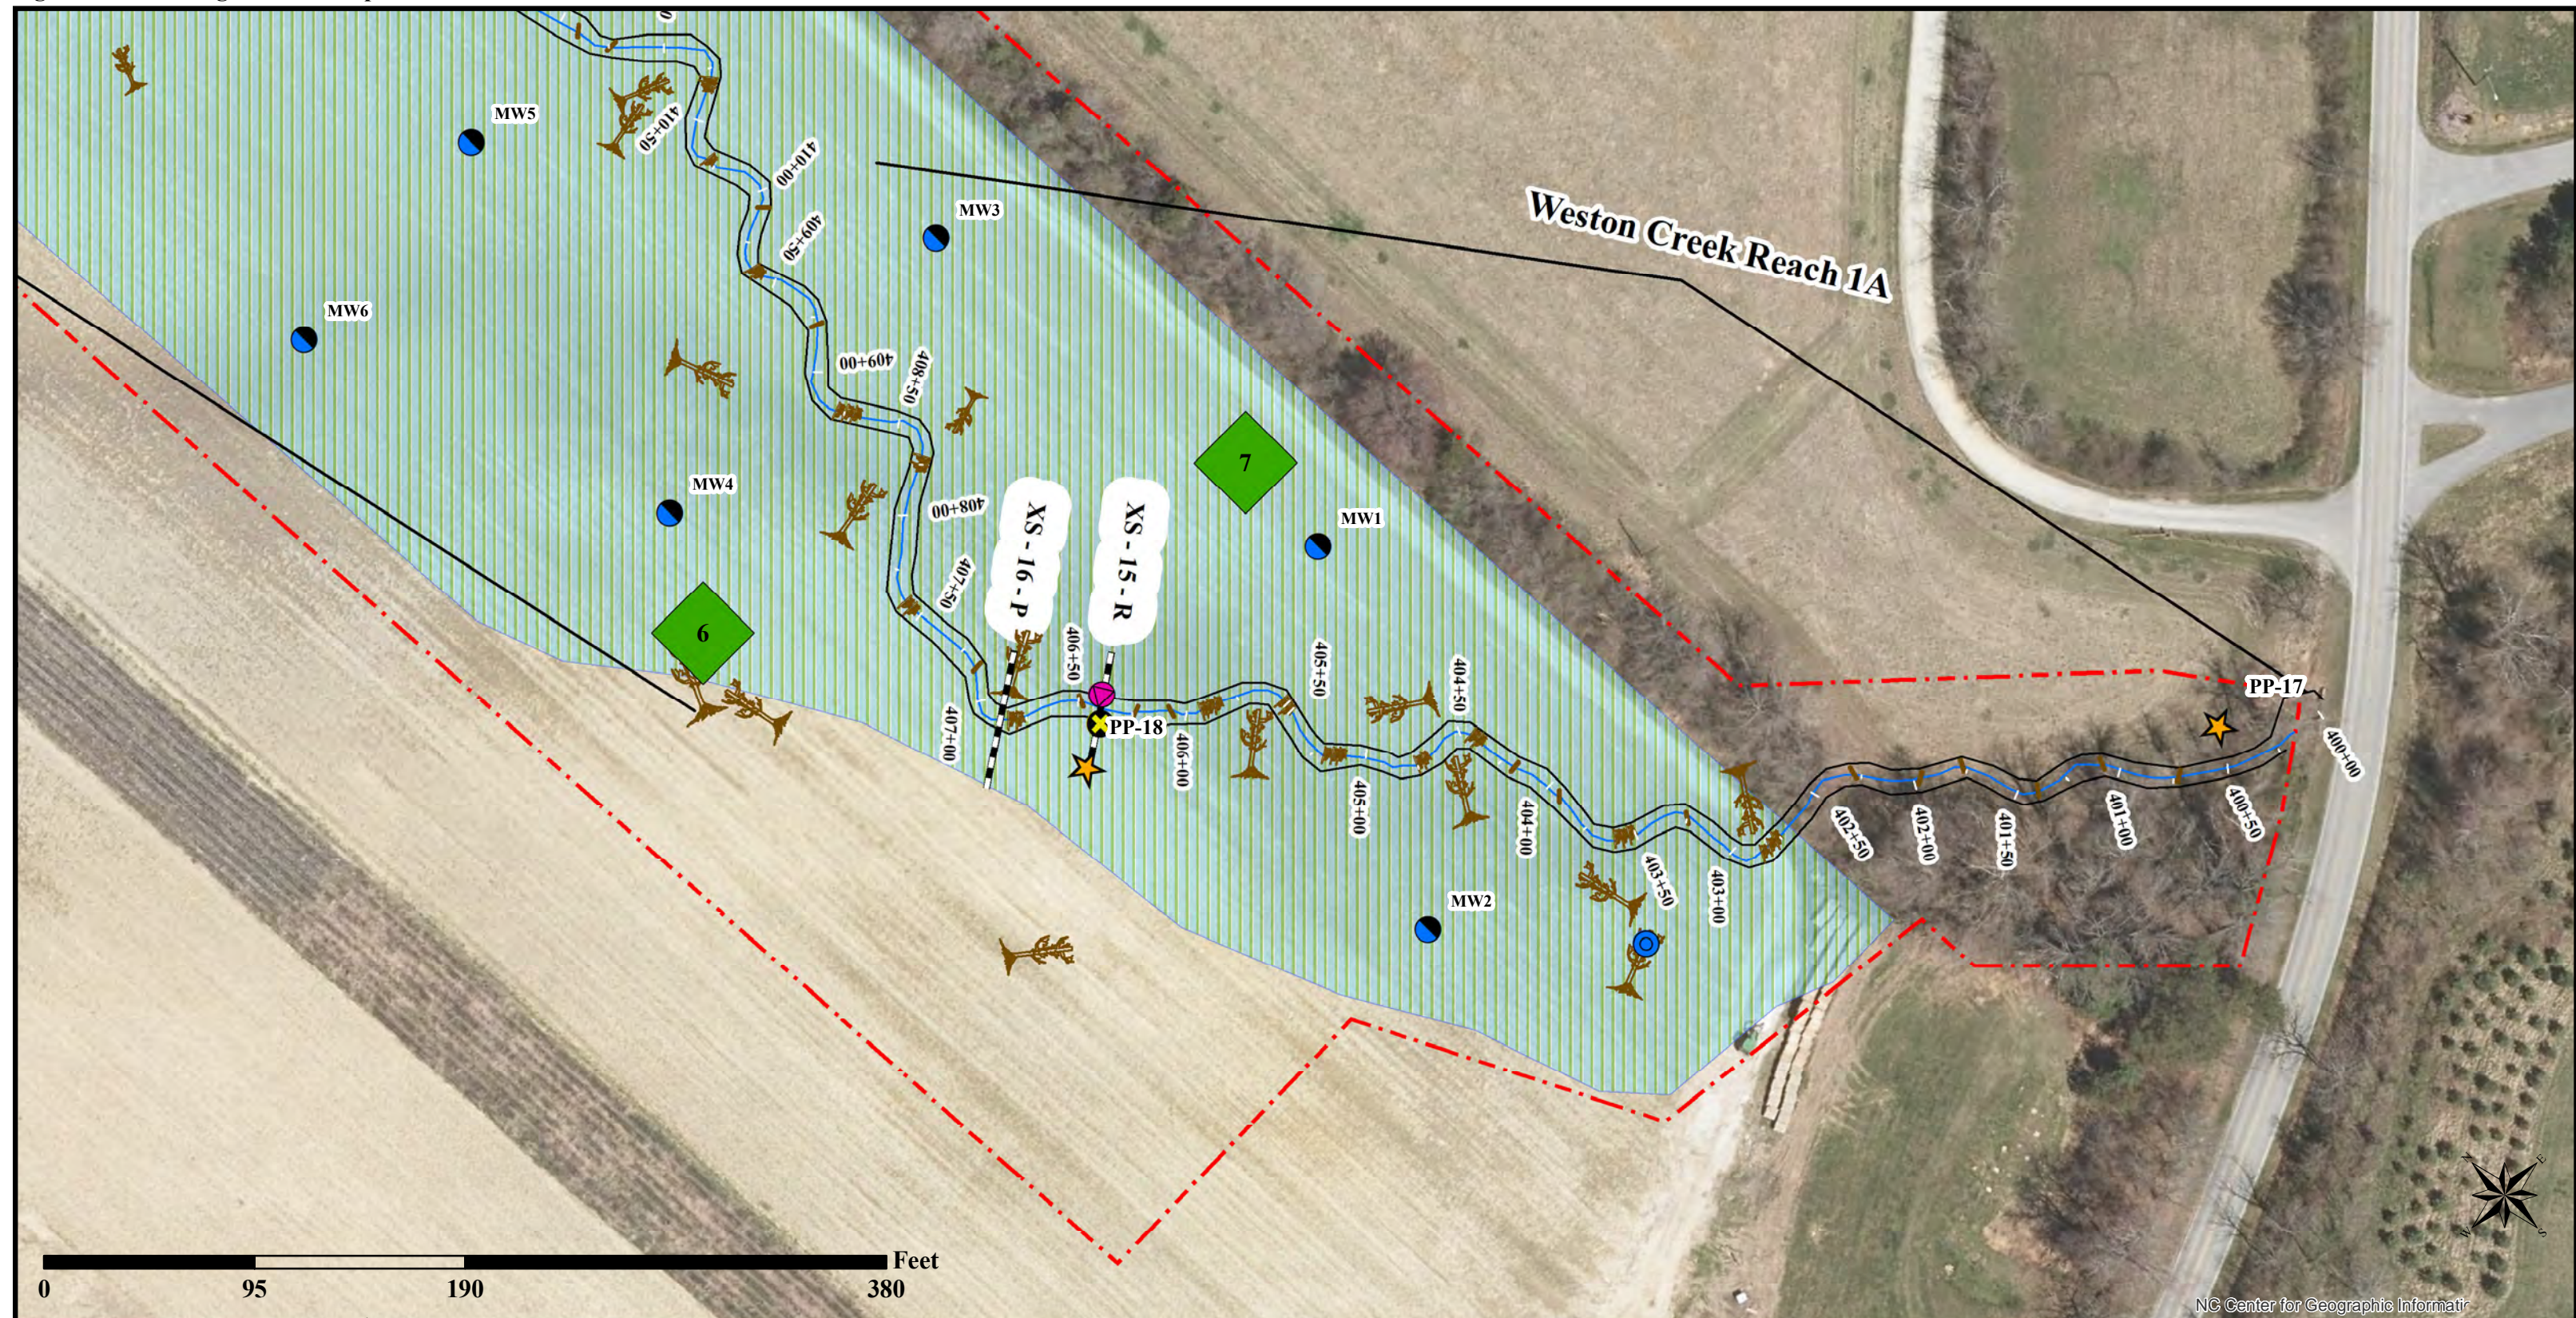

NC Center for Geographic Information

Prepared for



Figure 3. Monitoring Features Map
 Fletcher Mitigation Site
 Monitoring Year 0
 Henderson County, NC
 NCDMS Contract No.: 006997
 NCDMS Project No.: 100004
 April 2019
 Sheet 6 of 12


- | | | |
|----------------------------------|----------------------|---------------------------|
| Easement | As-Built Top of Bank | Photo Point |
| Wetland Re-Establishment | As-Built Thalweg | Continuous Stage Recorder |
| Wetlands Enhancement (No Credit) | Cross-Section | Crest Gauge |
| Vegetation Plot | | Groundwater Gauge |
| | | Rain Gauge |

Notes:
 1) Baseline Data Provided by Kee Mapping

Prepared by



Figure 3. Monitoring Features Map

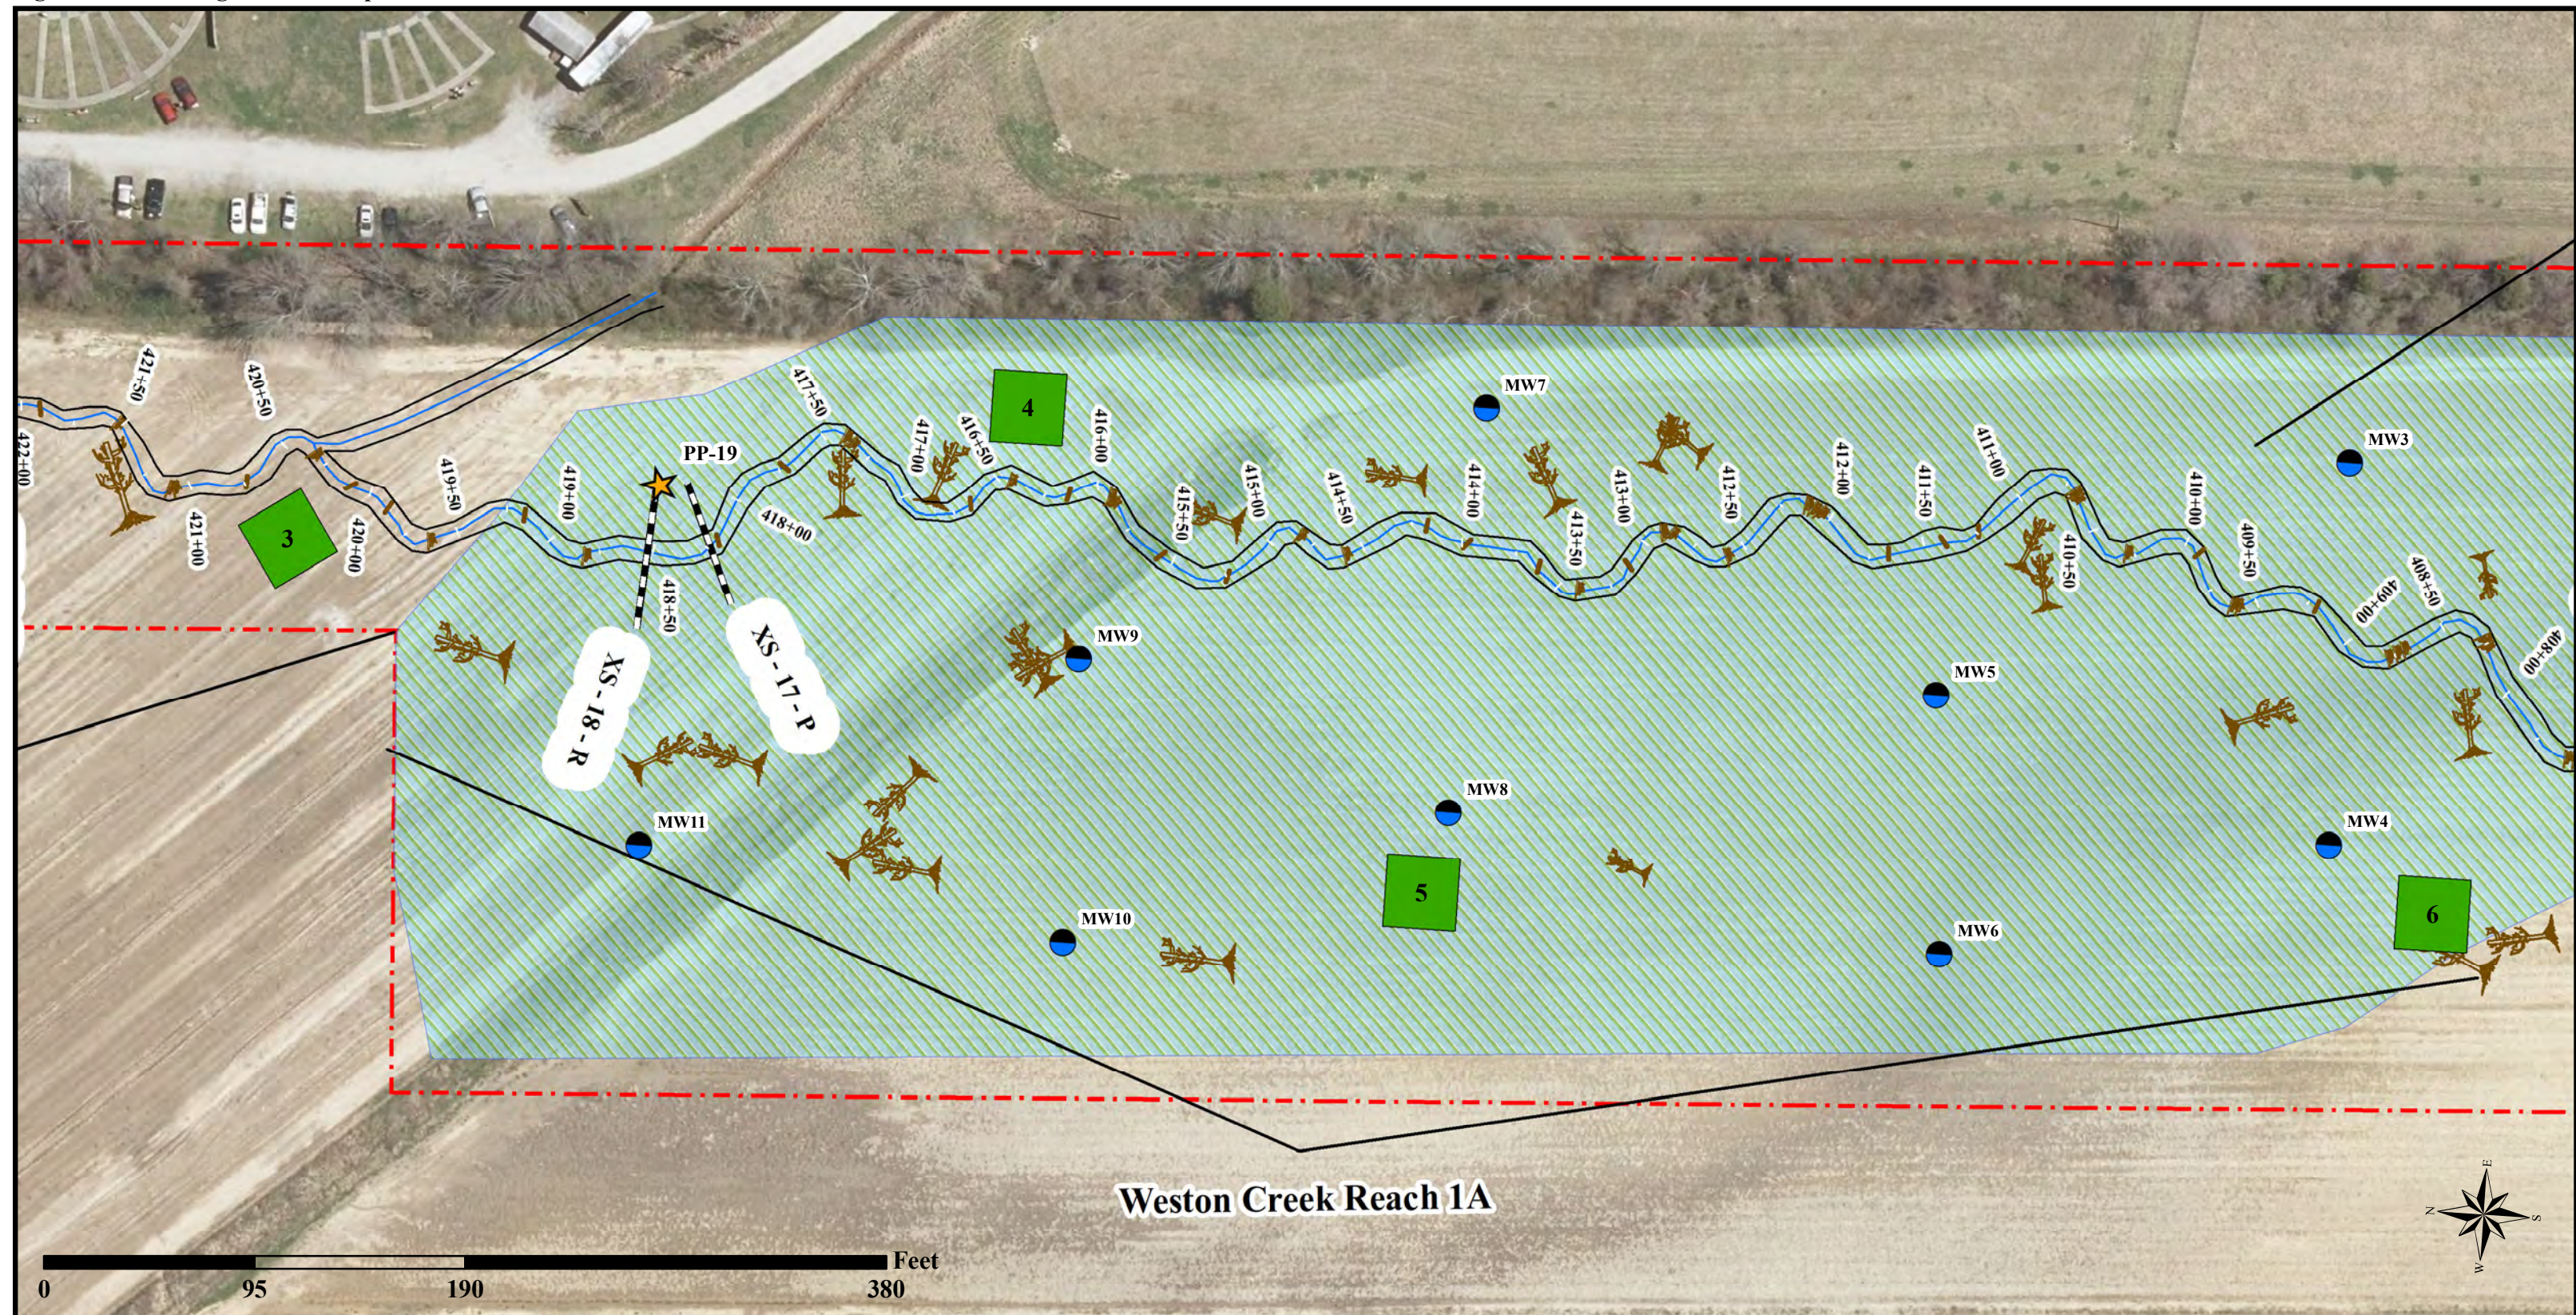

Prepared for



Figure 3. Monitoring Features Map
 Fletcher Mitigation Site
 Monitoring Year 0
 Henderson County, NC
 NCDMS Contract No.: 006997
 NCDMS Project No.: 100004
 April 2019
 Sheet 7 of 12


- | | | |
|----------------------------------|----------------------|---------------------------|
| Easement | As-Built Top of Bank | Photo Point |
| Wetland Re-Establishment | As-Built Thalweg | Continuous Stage Recorder |
| Wetlands Enhancement (No Credit) | Cross-Section | Crest Gauge |
| Vegetation Plot | | Groundwater Gauge |
| | | Rain Gauge |

Notes:
 1) Baseline Data Provided by Kee Mapping

Prepared by



Figure 3. Monitoring Features Map

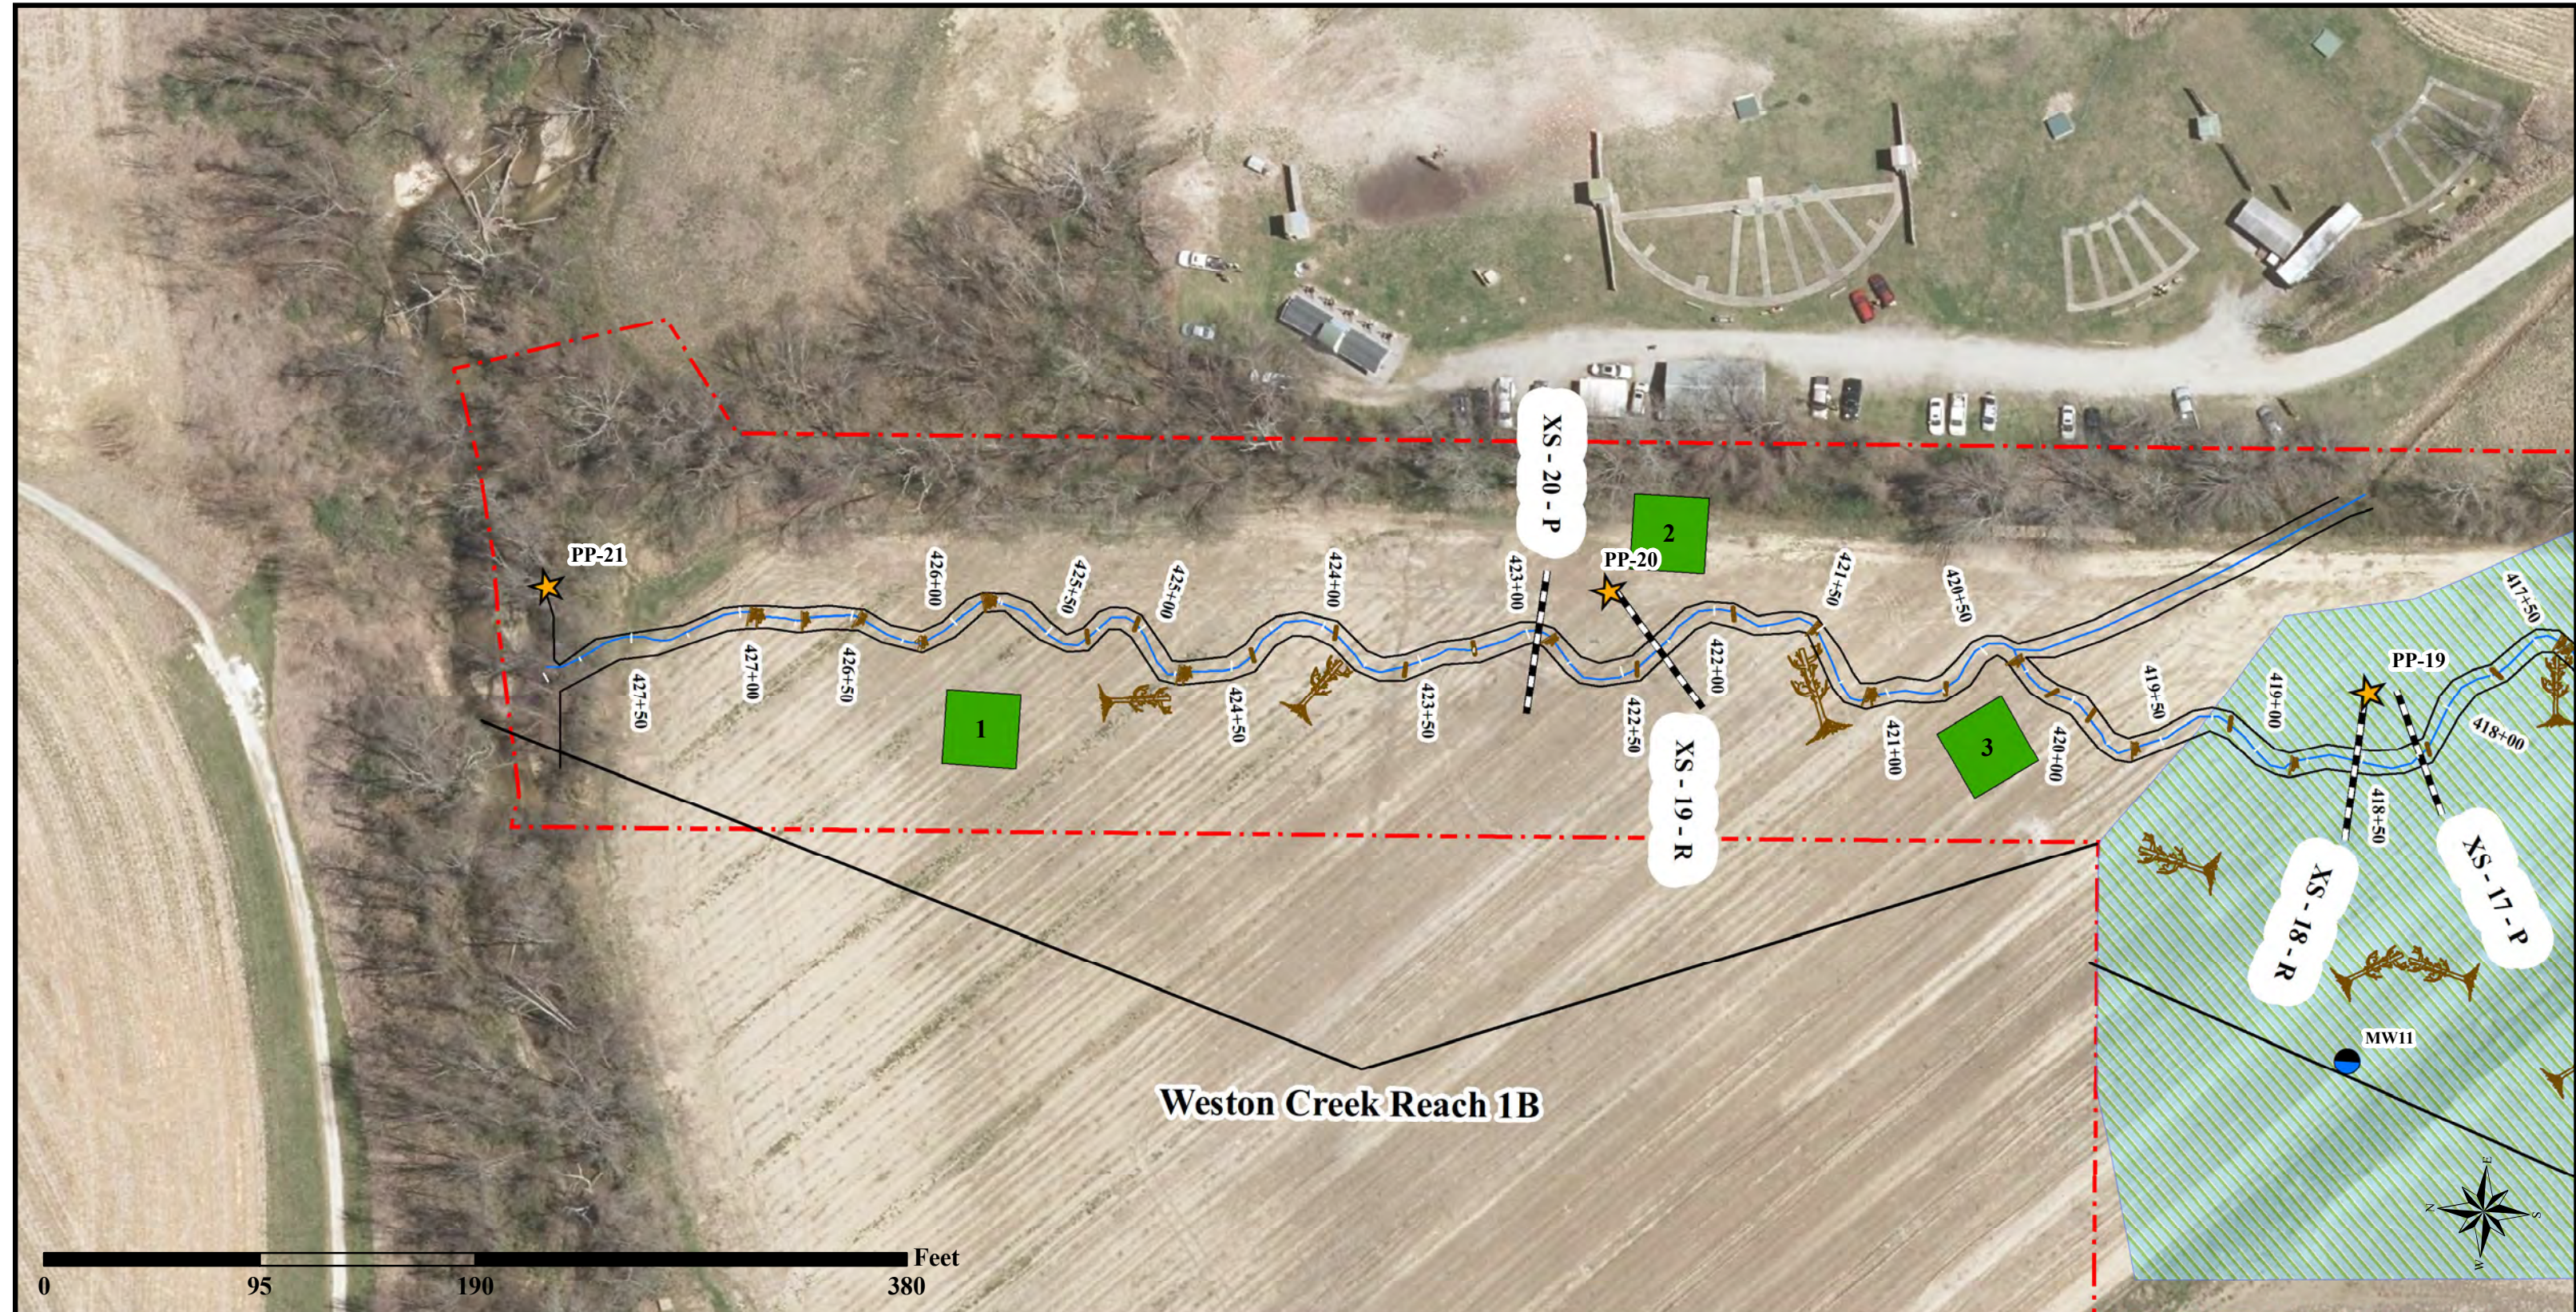

Weston Creek Reach 1B

0 95 190 380 Feet

Prepared for



Figure 3. Monitoring Features Map
 Fletcher Mitigation Site
 Monitoring Year 0
 Henderson County, NC
 NCDMS Contract No.: 006997
 NCDMS Project No.: 100004
 April 2019
 Sheet 8 of 12


- Easement
- Wetland Re-Establishment
- Wetlands Enhancement (No Credit)
- Vegetation Plot
- As-Built Top of Bank
- As-Built Thalweg
- Cross-Section
- ★ Photo Point
- ★ Continuous Stage Recorder
- + Crest Gauge
- Groundwater Gauge
- Rain Gauge

Notes:
 1) Baseline Data Provided by Kee Mapping

Prepared by



Figure 3. Monitoring Features Map

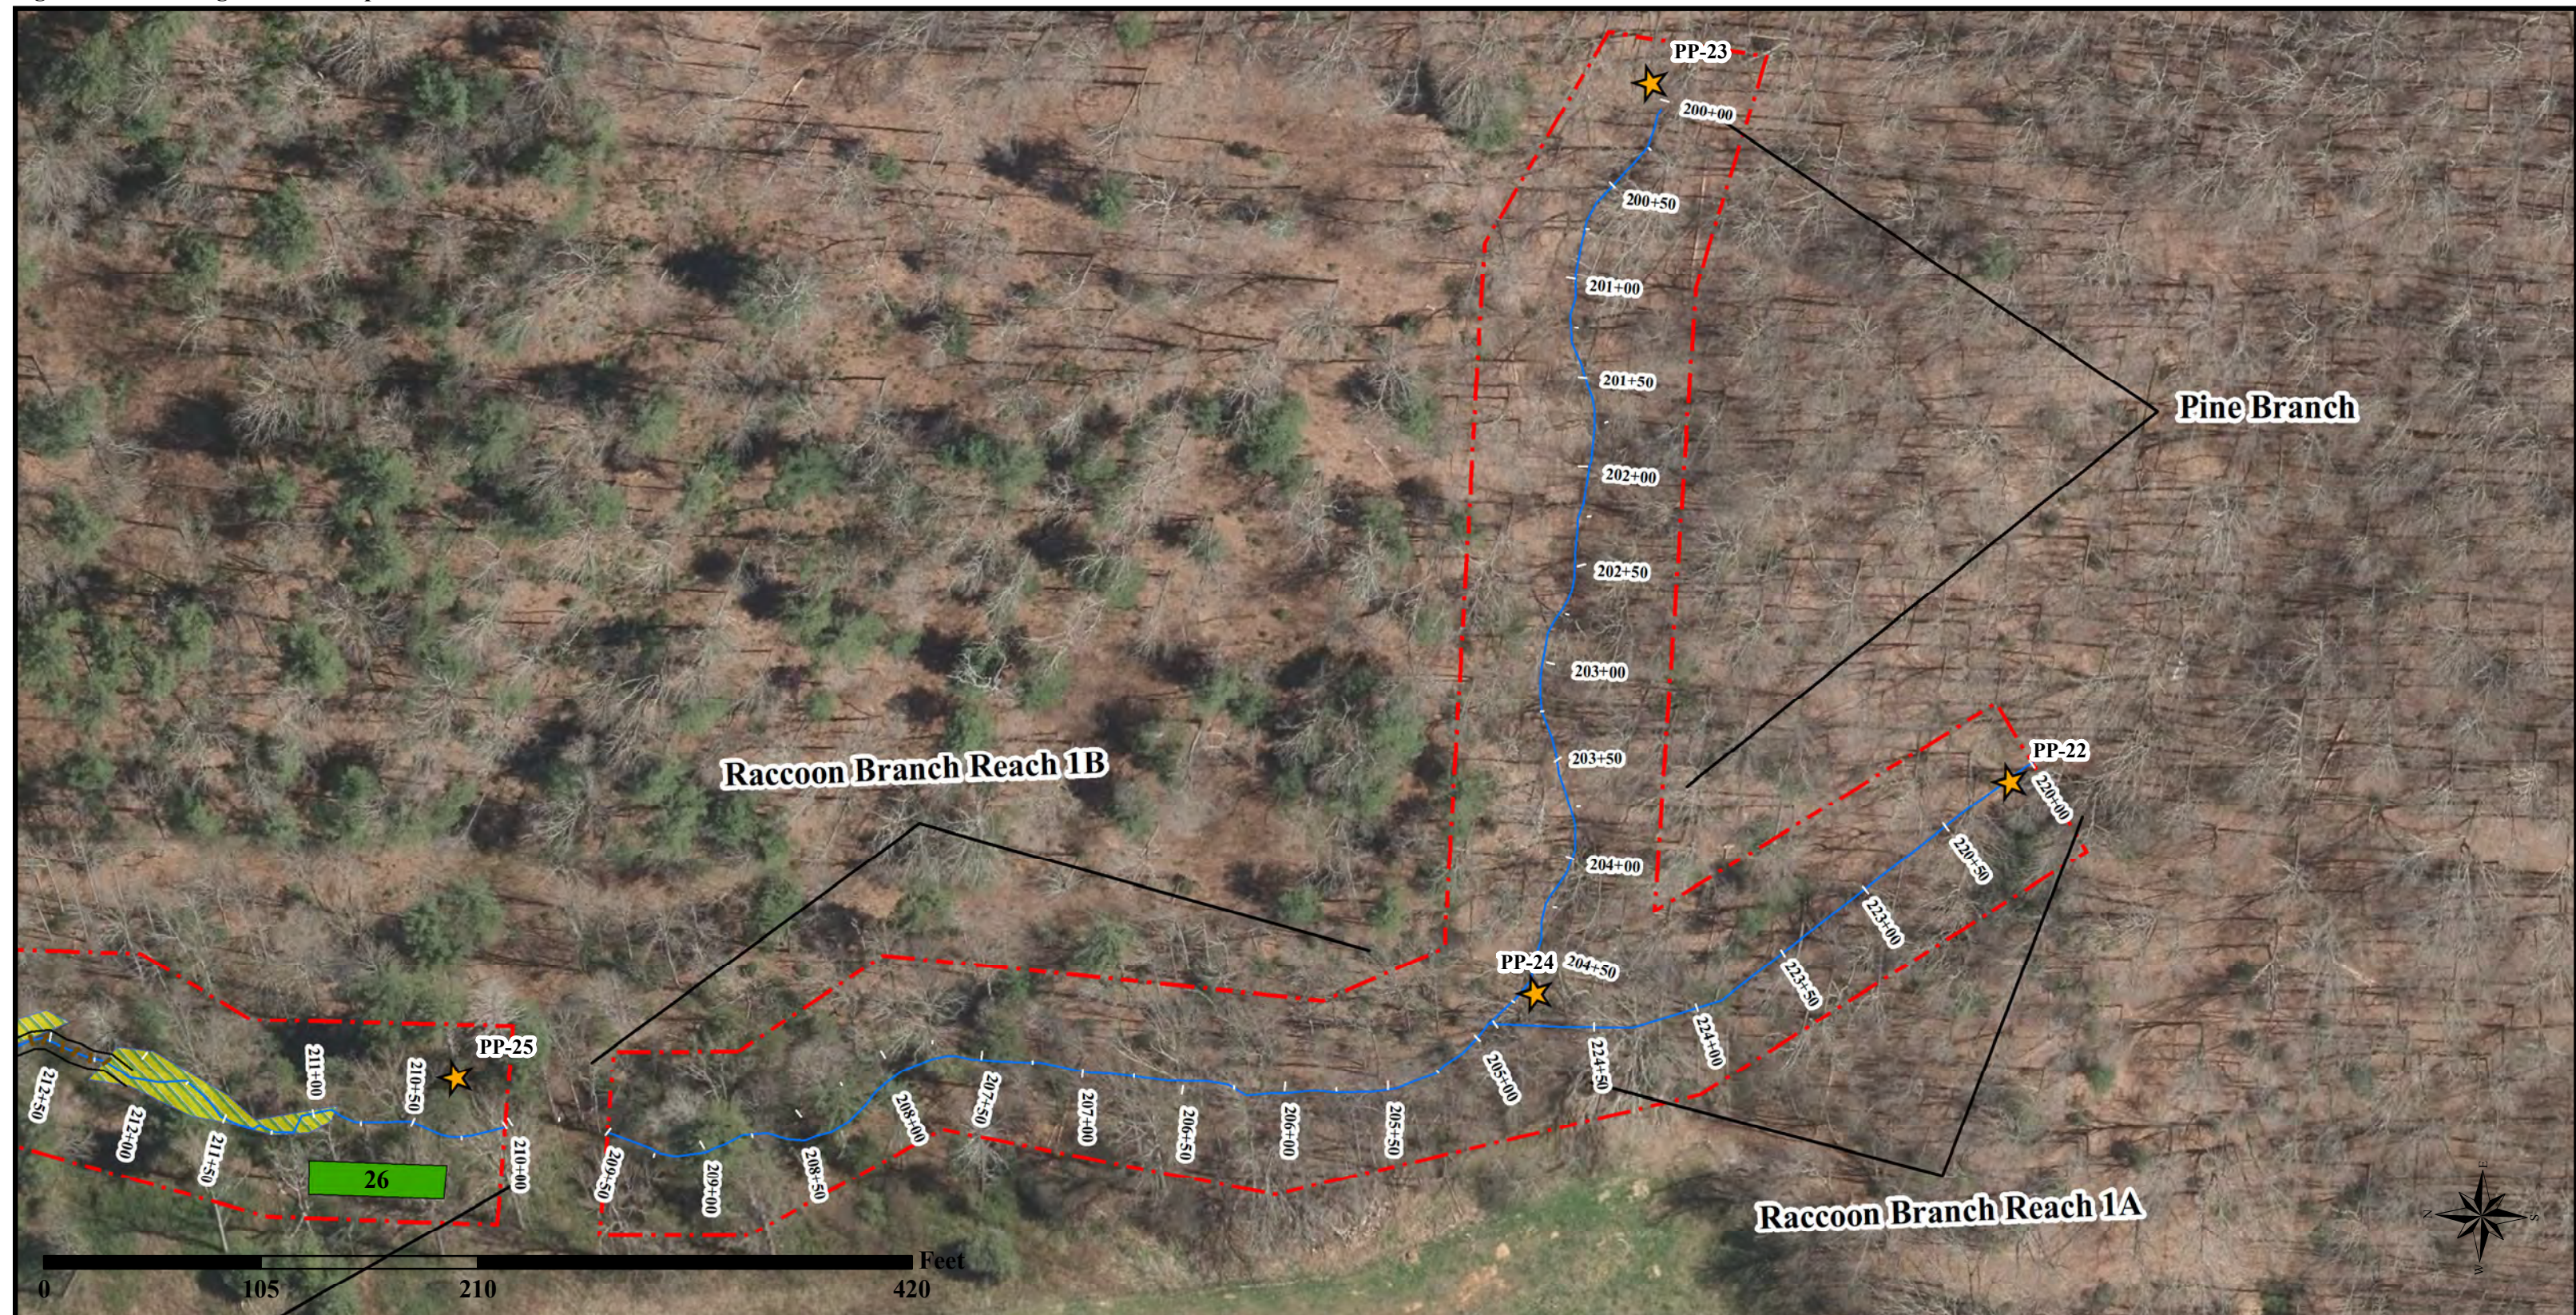

Prepared for



Figure 3. Monitoring Features Map
 Fletcher Mitigation Site
 Monitoring Year 0
 Henderson County, NC
 NCDMS Contract No.: 006997
 NCDMS Project No.: 100004
 April 2019
 Sheet 9 of 12


- | | | |
|----------------------------------|----------------------|---------------------------|
| Easement | As-Built Top of Bank | Photo Point |
| Wetland Re-Establishment | As-Built Thalweg | Continuous Stage Recorder |
| Wetlands Enhancement (No Credit) | Cross-Section | Crest Gauge |
| Vegetation Plot | | Groundwater Gauge |
| | | Rain Gauge |

Notes:
 1) Baseline Data Provided by Kee Mapping

Prepared by



Figure 3. Monitoring Features Map

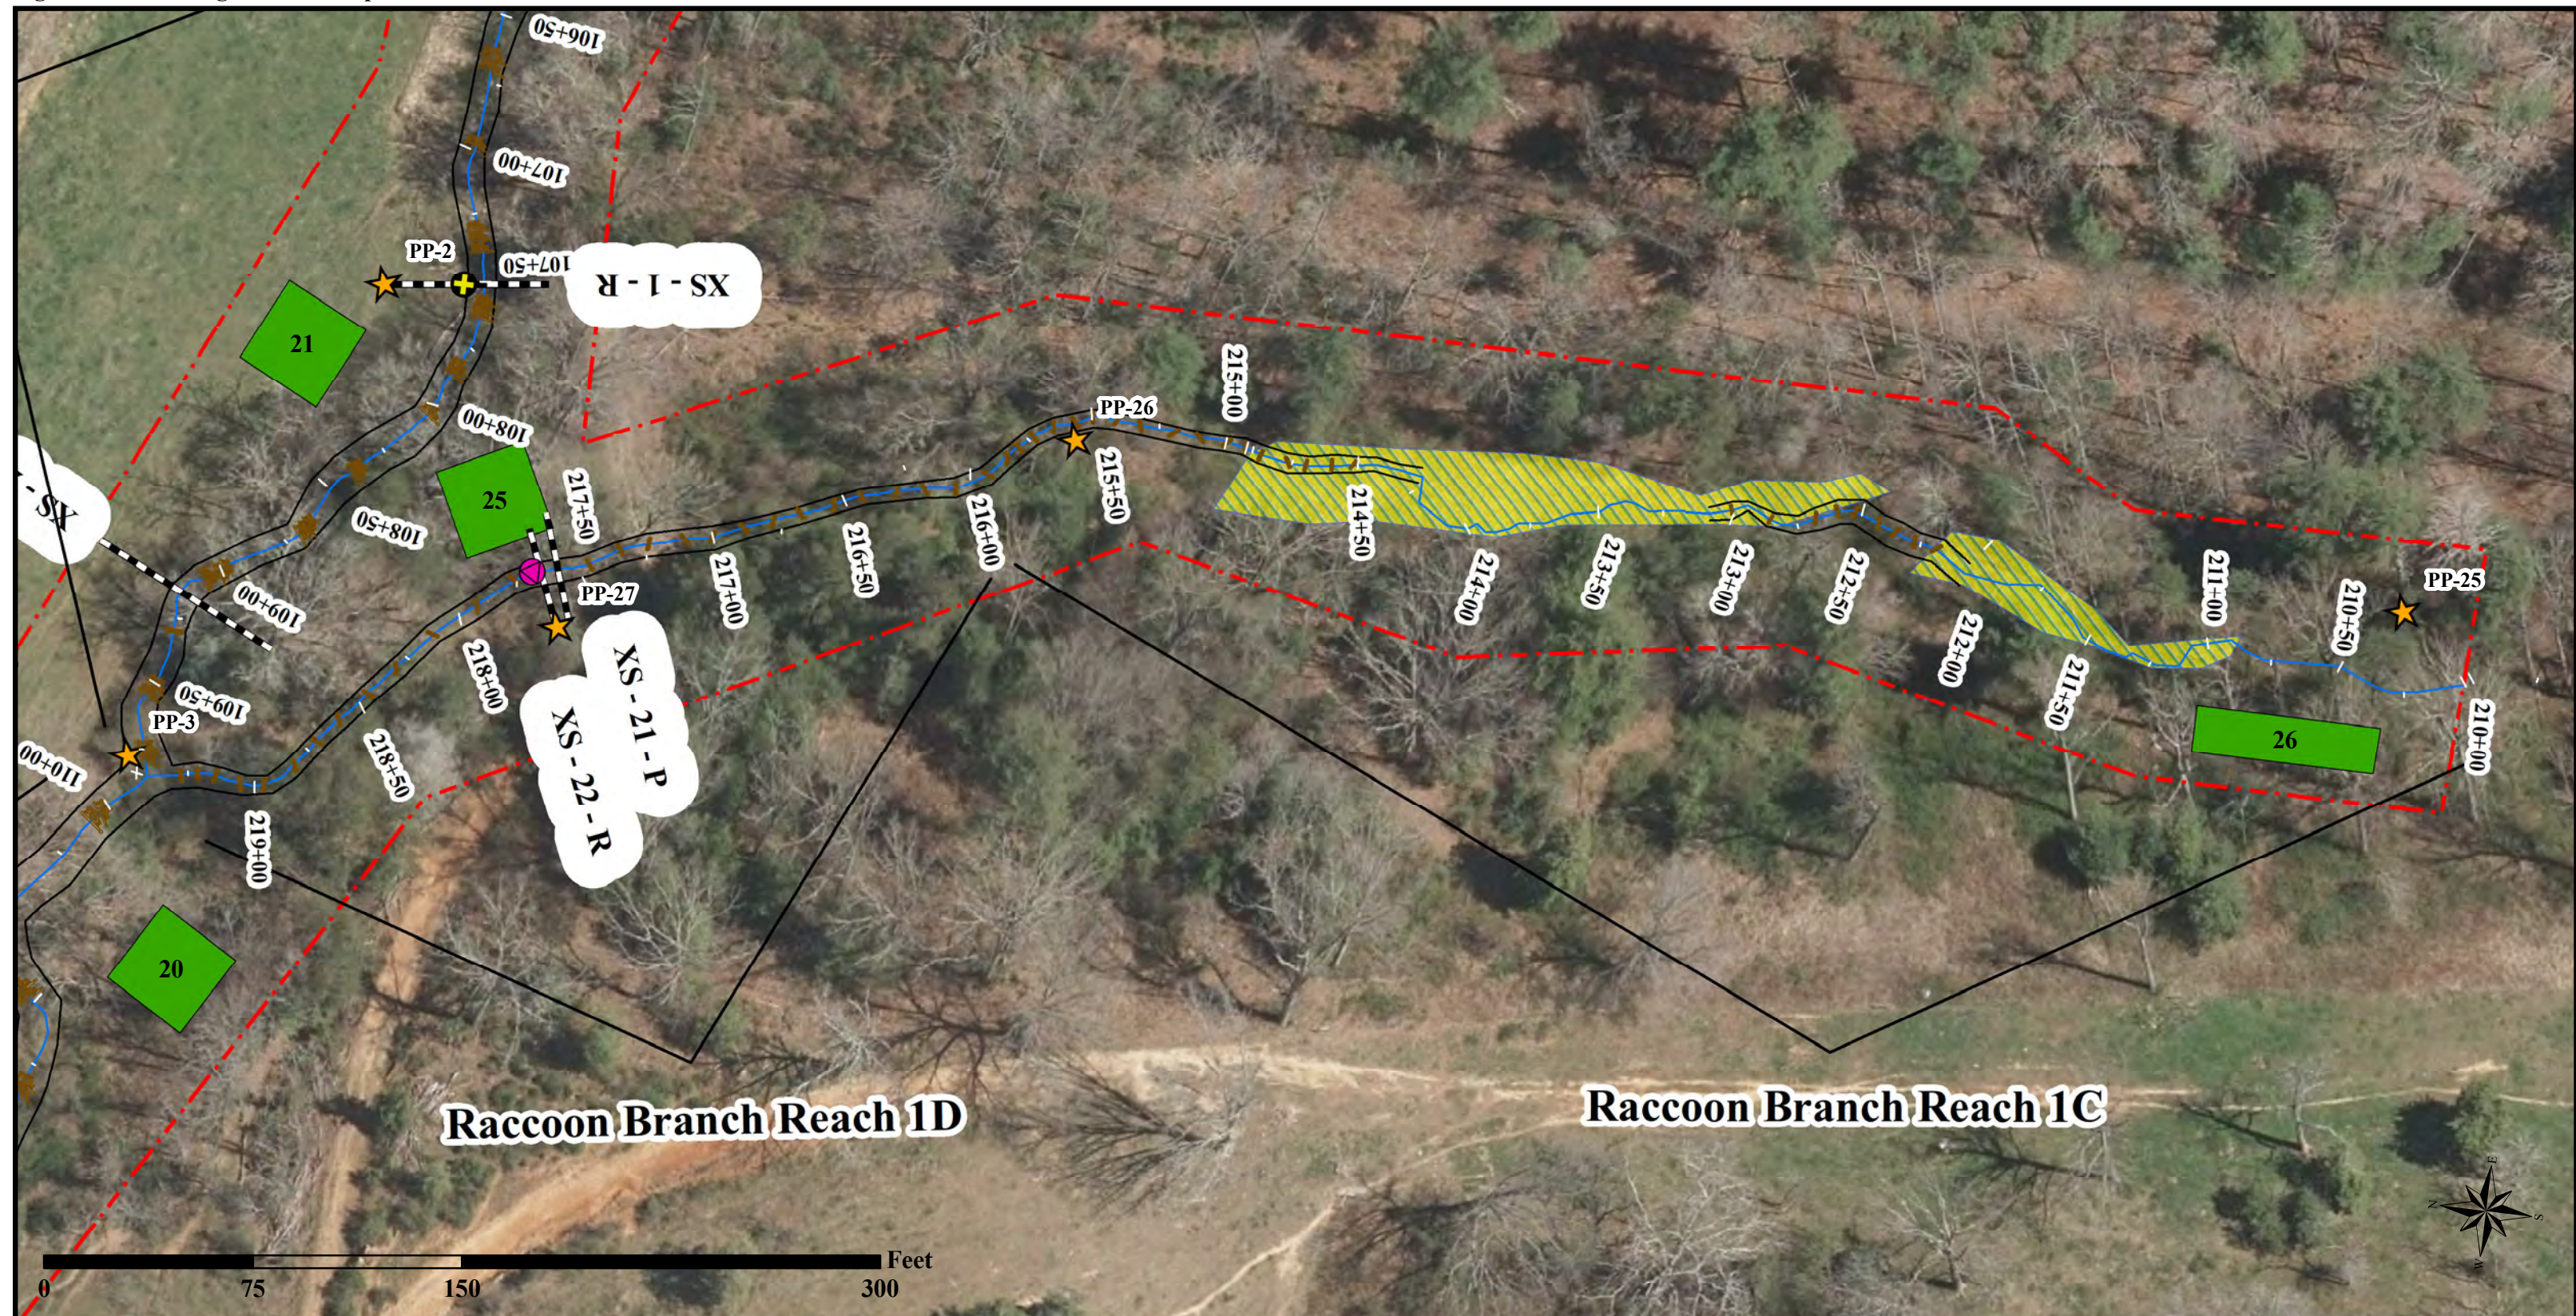

Prepared for



Figure 3. Monitoring Features Map
 Fletcher Mitigation Site
 Monitoring Year 0
 Henderson County, NC
 NCDMS Contract No.: 006997
 NCDMS Project No.: 100004
 April 2019
 Sheet 10 of 12


- | | | |
|----------------------------------|----------------------|---------------------------|
| Easement | As-Built Top of Bank | Photo Point |
| Wetland Re-Establishment | As-Built Thalweg | Continuous Stage Recorder |
| Wetlands Enhancement (No Credit) | Cross-Section | Crest Gauge |
| Vegetation Plot | | Groundwater Gauge |
| | | Rain Gauge |

Notes:
 1) Baseline Data Provided by Kee Mapping

Prepared by



Figure 3. Monitoring Features Map

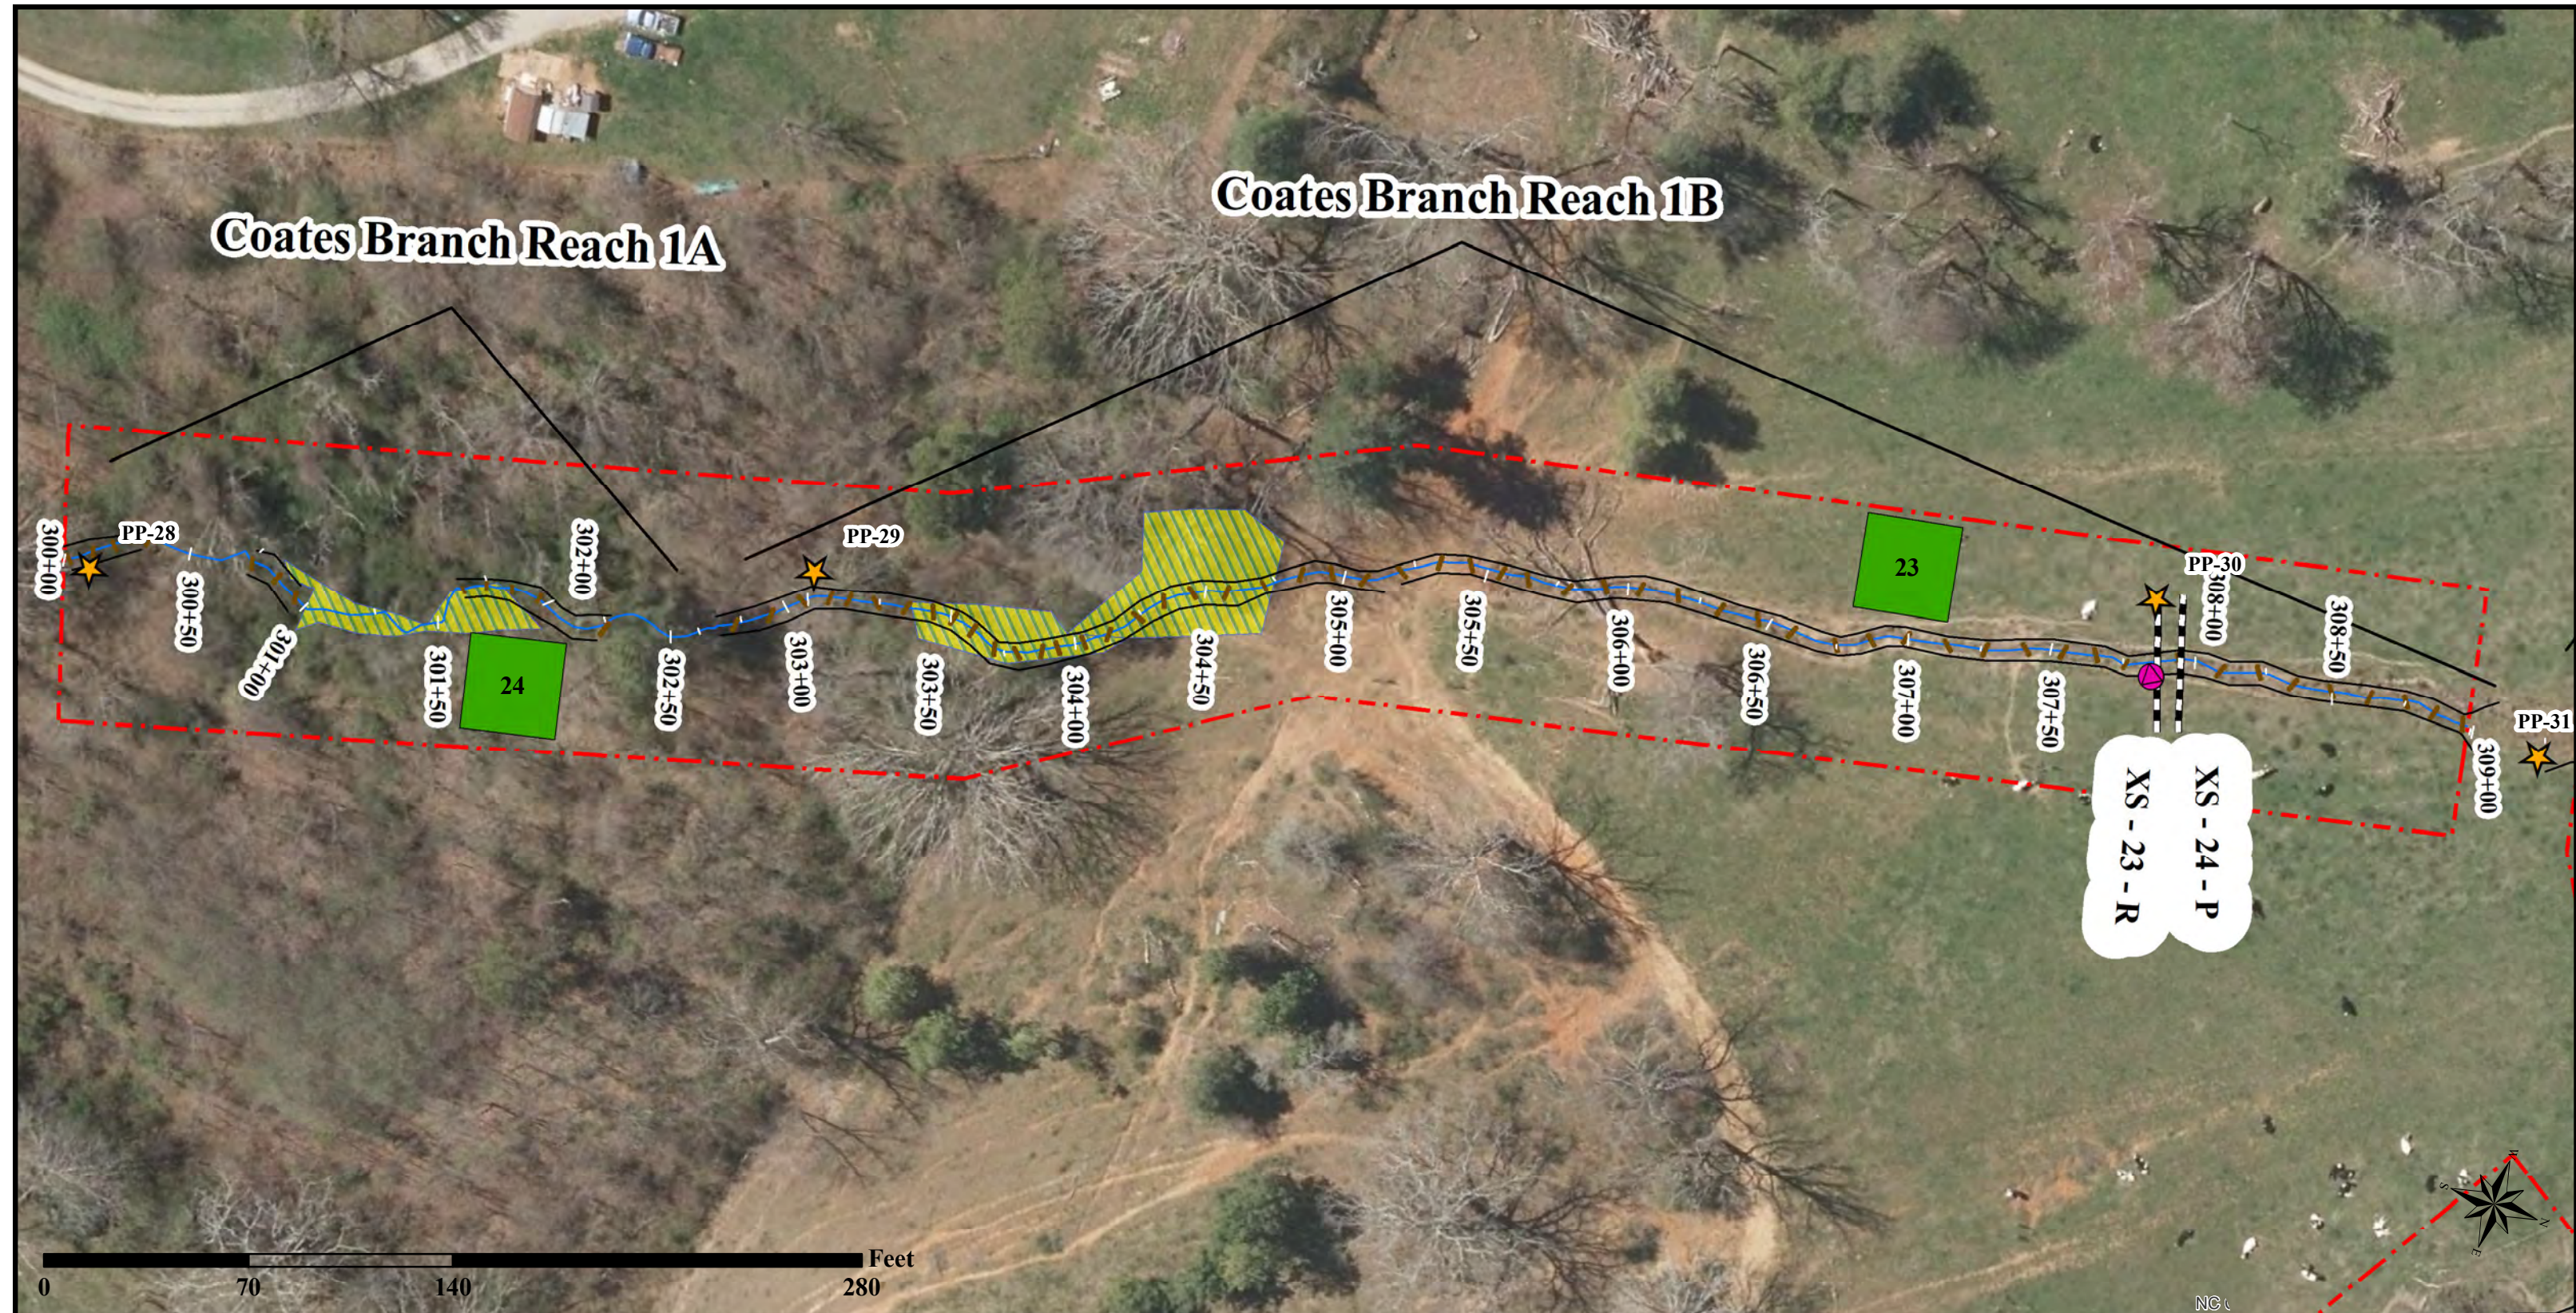

Prepared for



Figure 3. Monitoring Features Map
 Fletcher Mitigation Site
 Monitoring Year 0
 Henderson County, NC
 NCDMS Contract No.: 006997
 NCDMS Project No.: 100004
 April 2019
 Sheet 11 of 12

- | | | |
|----------------------------------|----------------------|---------------------------|
| Easement | As-Built Top of Bank | Photo Point |
| Wetland Re-Establishment | As-Built Thalweg | Continuous Stage Recorder |
| Wetlands Enhancement (No Credit) | Cross-Section | Crest Gauge |
| Vegetation Plot | | Groundwater Gauge |
| | | Rain Gauge |

Notes:
 1) Baseline Data Provided by Kee Mapping

Prepared by



Figure 3. Monitoring Features Map



NC Center for Geographic Information

Prepared for



Figure 3. Monitoring Features Map
 Fletcher Mitigation Site
 Monitoring Year 0
 Henderson County, NC
 NCDMS Contract No.: 006997
 NCDMS Project No.: 100004
 April 2019
 Sheet 12 of 12

- Easement
- Wetland Re-Establishment
- Wetlands Enhancement (No Credit)
- Vegetation Plot
- As-Built Top of Bank
- As-Built Thalweg
- Cross-Section
- ★ Photo Point
- ⊕ Continuous Stage Recorder
- + Crest Gauge
- Groundwater Gauge
- ⊙ Rain Gauge

Notes:
 1) Baseline Data Provided by Kee Mapping

Prepared by



This Page Intentionally Left Blank

Vegetation Plot Photos



Vegetation Monitoring Plot 1



Vegetation Monitoring Plot 2



Vegetation Monitoring Plot 3



Vegetation Monitoring Plot 4



Vegetation Monitoring Plot 5



Vegetation Monitoring Plot 6



Vegetation Monitoring Plot 7



Vegetation Monitoring Plot 8



Vegetation Monitoring Plot 9



Vegetation Monitoring Plot 10



Vegetation Monitoring Plot 11



Vegetation Monitoring Plot 12



Vegetation Monitoring Plot 13



Vegetation Monitoring Plot 14



Vegetation Monitoring Plot 15



Vegetation Monitoring Plot 16



Vegetation Monitoring Plot 17



Vegetation Monitoring Plot 18



Vegetation Monitoring Plot 19



Vegetation Monitoring Plot 20



Vegetation Monitoring Plot 21



Vegetation Monitoring Plot 22



Vegetation Monitoring Plot 23



Vegetation Monitoring Plot 24



Vegetation Monitoring Plot 25



Vegetation Monitoring Plot 26

Permanent Photo Stations



Fletcher Creek 1A – Permanent Photo Station 1
Looking Upstream



Fletcher Creek 1A – Permanent Photo Station 1
Looking Downstream



Fletcher Creek 1B – Permanent Photo Station 2
Looking Upstream



Fletcher Creek 1B – Permanent Photo Station 2
Looking Downstream



Coats Branch 1B – Permanent Photo Station 30
Looking Upstream



Coats Branch 1B – Permanent Photo Station 30
Looking Downstream



Coats Branch 1B – Permanent Photo Station 31
Looking Upstream from Crossing



Coats Branch 1C – Permanent Photo Station 31
Looking Downstream from Crossing



Coats Branch 1C – Permanent Photo Station 32
Looking Upstream



Coats Branch 1C – Permanent Photo Station 32
Looking Downstream



Coats Branch 1D – Permanent Photo Station 33
Looking Upstream



Coats Branch 1D – Permanent Photo Station 33
Looking Downstream

This Page Intentionally Left Blank

Appendix C

Vegetation Plot Data

This Page Intentionally Left Blank

Table 5. Current Plot Data (MY0) 2019

Fletcher Mitigation Site

Current Plot Data (MY0 2019)

Scientific Name	Common Name	Species Type	Plot 1			Plot 2			Plot 3			Plot 4			Plot 5			Plot 6			Plot 7			Plot 8			Plot 9			Plot 10			Plot 11			Plot 12			Plot 13			Plot 14			Plot 15			Plot 16								
			Pno	LS	T	Pno	LS	T	Pno	LS	T	Pno	LS	T	Pno	LS	T	Pno	LS	T	Pno	LS	T	Pno	LS	T	Pno	LS	T	Pno	LS	T	Pno	LS	T	Pno	LS	T	Pno	LS	T	Pno	LS	T												
Acer negundo	Box Elder	Tree	3	3	3	3	3	3	3	3	3	6	6	6	2	2	2	2	2	2	2	2	2	2	2	2	3	3	3				7	7	7	1	1	1	4	4	4	2	2	2	2	2	2	3	3	3						
Aronia arbutifolia	Red Chokeberry	Shrub																																																						
Asimina triloba	Common Pawpaw	Shrub Tree										1	1	1																															2	2	2									
Betula nigra	River Birch	Tree	3	3	3	5	5	5	2	2	2							4	4	4	3	3	3	2	2	2	2	2	2	1	1	1	4	4	4	5	5	5	5	5	5	4	4	4	7	7	7	2	2	2						
Carpinus caroliniana	American Hornbeam	Shrub Tree	1	1	1				4	4	4				4	4	4	3	3	3				2	2	2	4	4	4				1	1	1				2	2	2	4	4	4	4	4	4	4	4	4						
Cephalanthus occidentalis	Buttonbush	Shrub Tree																																											4	4	4									
Cornus amomum	Silky Dogwood	Shrub Tree										1	1	1	3	3	3							2	2	2	1	1	1							4	4	4										2	2	2						
Fraxinus pennsylvanica	Green Ash	Tree	7	7	7	3	3	3	4	4	4				4	4	4	1	1	1	2	2	2	6	6	6	3	3	3	3	3	3	3	3	3	3	3	3	1	1	1	2	2	2	3	3	3	4	4	4	3	3	3			
Lindera benzoin	Northern Spicebush	Shrub Tree	1	1	1							3	3	3				1	1	1							4	4	4	2	2	2																								
Liriodendron tulipifera	Tulip Poplar	Tree	3	3	3	4	4	4				1	1	1							1	1	1	4	4	4	5	5	5				1	1	1							1	1	1				2	2	2	1	1	1			
Platanus occidentalis	Sycamore	Tree				4	4	4	2	2	2	3	3	3	1	1	1	1	1	1	1	1	1	2	2	2	3	3	3	6	6	6	6	6	6	4	4	4				3	3	3	6	6	6							3	3	3
Salix sericea	Silky Willow	Shrub Tree																																								1	1	1				2	2	2						
Sambucus canadensis	Common Elderberry	Shrub Tree										1	1	1							3	3	3	2	2	2																						3	3	3						
Stem count			18	18	18	19	19	19	15	15	15	15	15	15	15	15	15	15	15	15	14	14	14	21	21	21	24	24	24	19	19	19	17	17	17	11	11	11	14	14	14	17	17	17	22	22	22	24	24	24						
size (ares)			1			1			1			1			1			1			1			1			1			1			1			1			1			1			1			1								
size (ACRES)			0.02			0.02			0.02			0.02			0.02			0.02			0.02			0.02			0.02			0.02			0.02			0.02			0.02			0.02			0.02											
Species count			6	6	6	5	5	5	5	5	5	6	6	6	6	6	6	7	7	7	7	7	7	7	7	7	6	6	6	5	5	5	6	6	6	4	4	4	6	6	6	5	5	5	6	6	6	9	9	9						
Stems per ACRE			728	728	728	769	769	769	607	607	607	607	607	607	607	607	607	607	607	607	567	567	567	850	850	850	971	971	971	769	769	769	688	688	688	445	445	445	567	567	567	688	688	688	890	890	890	971	971	971						

Table 5. Current Plot Data (MY0) 2019

Fletcher Mitigation Site

Current Plot Data (MY0 2019)

Scientific Name	Common Name	Species Type	Plot 17			Plot 18			Plot 19			Plot 20			Plot 21			Plot 22			Plot 23			Plot 24			Plot 25			Plot 26			Annual Means					
			Pno	LS	T	Pno	LS	T	Pno	LS	T	Pno	LS	T	Pno	LS	T	Pno	LS	T	Pno	LS	T	Pno	LS	T	Pno	LS	T	Pno	LS	T						
Acer negundo	Box Elder	Tree	3	3	3	10	10	10	2	2	2	1	1	1	3	3	3	4	4	4																66	66	66
Aronia arbutifolia	Red Chokeberry	Shrub													1	1	1																3	3	3	4	4	4
Asimina triloba	Common Pawpaw	Shrub Tree							1	1	1	5	5	5	3	3	3				2	2	2	4	4	4	3	3	3	7	7	7	28	28	28			
Betula nigra	River Birch	Tree	1	1	1	2	2	2				5	5	5	6	6	6	1	1	1																64	64	64
Carpinus caroliniana	American Hornbeam	Shrub Tree	1	1	1	4	4	4	4	4	4													13	13	13				1	1	1	52	52	52			
Cephalanthus occidentalis	Buttonbush	Shrub Tree							2	2	2				1	1	1				1	1	1	1	1	1	1	1	1	4	4	4	14	14	14			
Cornus amomum	Silky Dogwood	Shrub Tree													1	1	1							1	1	1	1	1	1	4	4	4	20	20	20			
Fraxinus pennsylvanica	Green Ash	Tree	4	4	4	2	2	2	1	1	1	3	3	3	3	3	3	2	2	2							3	3	3							67	67	67
Lindera benzoin	Northern Spicebush	Shrub Tree							2	2	2				2	2	2	2	2	2							5	5	5	2	2	2	1	1	1	25	25	25
Liriodendron tulipifera	Tulip Poplar	Tree				1	1	1	2	2	2	3	3	3	1	1	1	1	1	1																31	31	31
Platanus occidentalis	Sycamore	Tree	3	3	3	1	1	1	4	4	4				1	1	1	7	7	7																60	60	60
Salix sericea	Silky Willow	Shrub Tree	1	1	1				2	2	2	1	1	1				1	1	1							1	1	1	2	2	2	11	11	11			
Sambucus canadensis	Common Elderberry	Shrub Tree	2	2	2																												11	11	11			
Stem count			15	15	15	20	20	20	20	20	20	18	18	18	22	22	22	18	18	18	17	17	17	14	14	14	11	11	11	18	18	18	453	453	453			
size (ares)			1			1			1			1			1			1			1			1			1			1			1			26		
size (ACRES)			0.02			0.02			0.02			0.02			0.02			0.02			0.02			0.02			0.02			0.02			0.02			0.64		
Species count			7	7	7	6	6	6	9	9	9	6	6	6	10	10	10	7	7	7	4	4	4	5	5	5	5	5	5	6	6	6	13	13	13			
Stems per ACRE			607	607	607	809	809	809	809	809	809	728	728	728	890	890	890	728	728	728	688	688	688	567	567	567	445	445	445	728	728	728	705	705	705			

P=Planted, T=Planted & Volunteer

Color for Density

- Exceeds requirements by 10%
- Exceeds requirements, but by less than 10%
- Fails to meet requirements, by less than 10%
- Fails to meet requirements by more than 10%

This Page Intentionally Left Blank

Table 6. Vegetation Plot Criteria Attainment Fletcher Mitigation Site		
Vegetation Plot ID	Vegetation Survival Threshold Met?	Tract Mean
1	Yes	100%
2	Yes	
3	Yes	
This Page Intentionally Left Blank


Appendix D
Stream Measurement and Geomorphology Data

This Page Intentionally Left Blank

Project Name: Fletcher Mitigation Site
Reach Name: Fletcher Creek Reach 1B

XS Number: 1
XS Type: Riffle

Station: 107+51

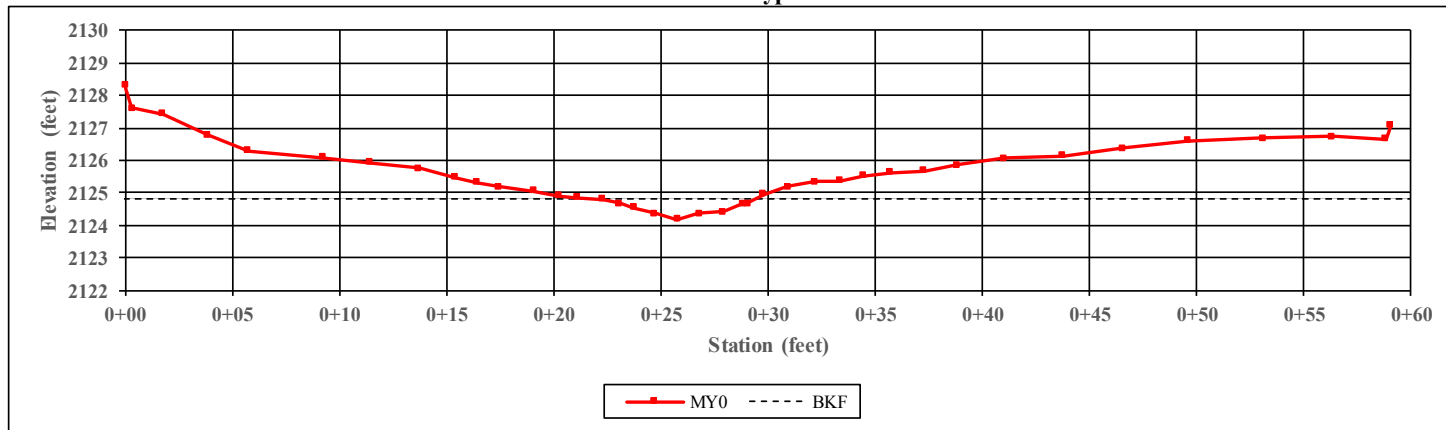

CHANNEL DIMENSIONS SUMMARY	MY0	MY1	MY2	MY3	MY4	MY5	MY6	MY7
Bankful Width (ft)	7.1	-	-	-	-	-	-	-
Floodprone Width (ft)	20.0	-	-	-	-	-	-	-
Bankfull Mean Depth (ft)	0.3	-	-	-	-	-	-	-
Bankfull Max Depth (ft)	0.6	-	-	-	-	-	-	-
Bankfull Cross-Sectional Area (ft ²)	2.3	-	-	-	-	-	-	-
Width/Depth Ratio	21.4	-	-	-	-	-	-	-
Entrenchment Ratio	2.8	-	-	-	-	-	-	-
Bank Height Ratio	1.0	-	-	-	-	-	-	-
Low Top of Bank Depth (ft)	0.6	-	-	-	-	-	-	-



Left Descending Bank




Right Descending Bank

Project Name: Fletcher Mitigation Site
Reach Name: Fletcher Creek Reach 1B

XS Number: 2
XS Type: Pool

Station: 109+16

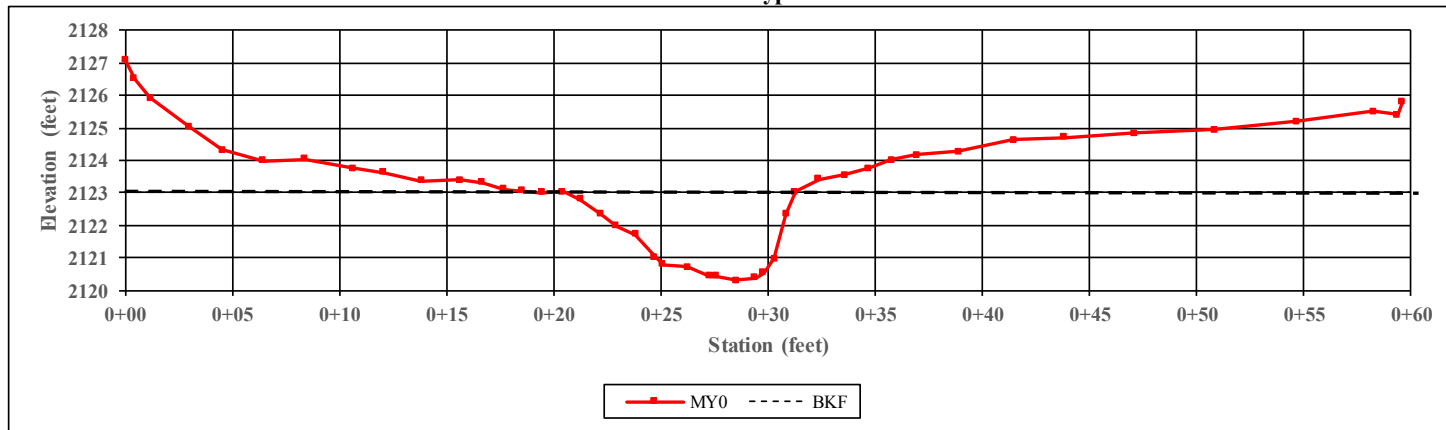

CHANNEL DIMENSIONS SUMMARY	MY0	MY1	MY2	MY3	MY4	MY5	MY6	MY7
Bankful Width (ft)	10.9	-	-	-	-	-	-	-
Floodprone Width (ft)	60.0	-	-	-	-	-	-	-
Bankfull Mean Depth (ft)	1.7	-	-	-	-	-	-	-
Bankfull Max Depth (ft)	2.7	-	-	-	-	-	-	-
Bankfull Cross-Sectional Area (ft ²)	18.3	-	-	-	-	-	-	-
Width/Depth Ratio	6.5	-	-	-	-	-	-	-
Entrenchment Ratio	5.5	-	-	-	-	-	-	-
Bank Height Ratio	1.0	-	-	-	-	-	-	-
Low Top of Bank Depth (ft)	2.7	-	-	-	-	-	-	-



Left Descending Bank




Right Descending Bank

Project Name: Fletcher Mitigation Site
Reach Name: Fletcher Creek Reach 1C

XS Number: 3
XS Type: Pool

Station: 112+04

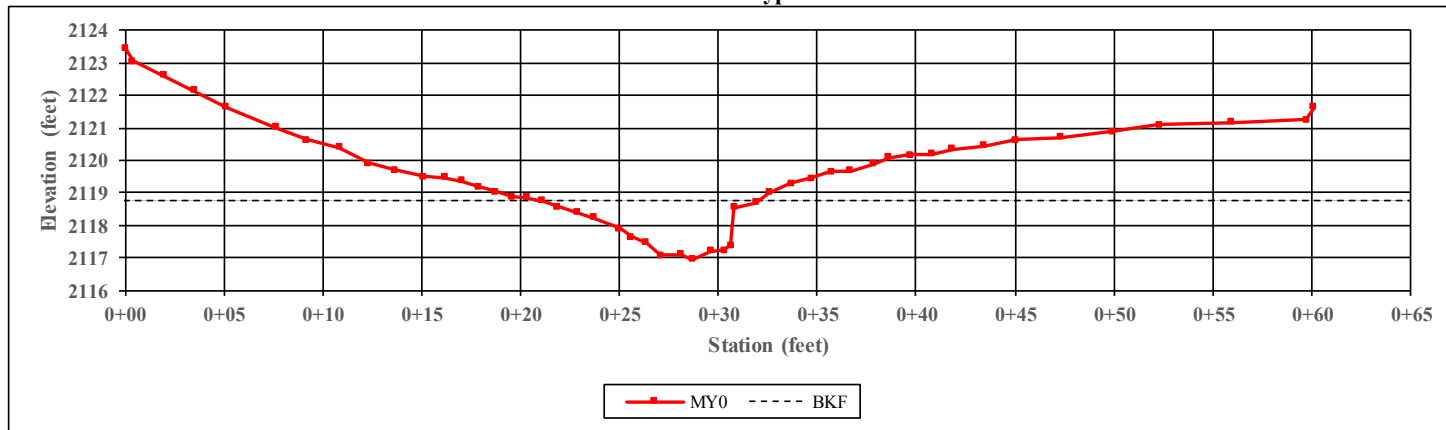

CHANNEL DIMENSIONS SUMMARY	MY0	MY1	MY2	MY3	MY4	MY5	MY6	MY7
Bankful Width (ft)	10.9	-	-	-	-	-	-	-
Floodprone Width (ft)	40.0	-	-	-	-	-	-	-
Bankfull Mean Depth (ft)	0.9	-	-	-	-	-	-	-
Bankfull Max Depth (ft)	1.8	-	-	-	-	-	-	-
Bankfull Cross-Sectional Area (ft ²)	10.3	-	-	-	-	-	-	-
Width/Depth Ratio	11.6	-	-	-	-	-	-	-
Entrenchment Ratio	3.7	-	-	-	-	-	-	-
Bank Height Ratio	1.0	-	-	-	-	-	-	-
Low Top of Bank Depth (ft)	1.8	-	-	-	-	-	-	-



Left Descending Bank




Right Descending Bank

Project Name: Fletcher Mitigation Site
Reach Name: Fletcher Creek Reach 1C

XS Number: 4
XS Type: Riffle

Station: 112+24

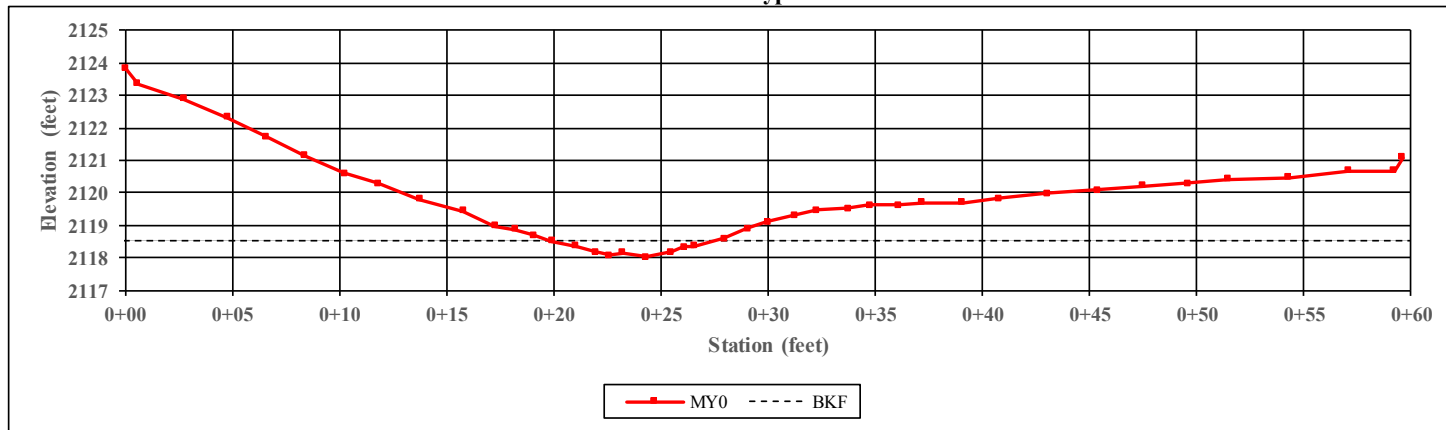

CHANNEL DIMENSIONS SUMMARY	MY0	MY1	MY2	MY3	MY4	MY5	MY6	MY7
Bankful Width (ft)	7.6	-	-	-	-	-	-	-
Floodprone Width (ft)	10.0	-	-	-	-	-	-	-
Bankfull Mean Depth (ft)	0.3	-	-	-	-	-	-	-
Bankfull Max Depth (ft)	0.5	-	-	-	-	-	-	-
Bankfull Cross-Sectional Area (ft ²)	2.1	-	-	-	-	-	-	-
Width/Depth Ratio	27.6	-	-	-	-	-	-	-
Entrenchment Ratio	1.3	-	-	-	-	-	-	-
Bank Height Ratio	1.0	-	-	-	-	-	-	-
Low Top of Bank Depth (ft)	0.5	-	-	-	-	-	-	-



Left Descending Bank




Right Descending Bank

Project Name: Fletcher Mitigation Site
Reach Name: Fletcher Creek Reach 1C

XS Number: 5
XS Type: Pool

Station: 122+51

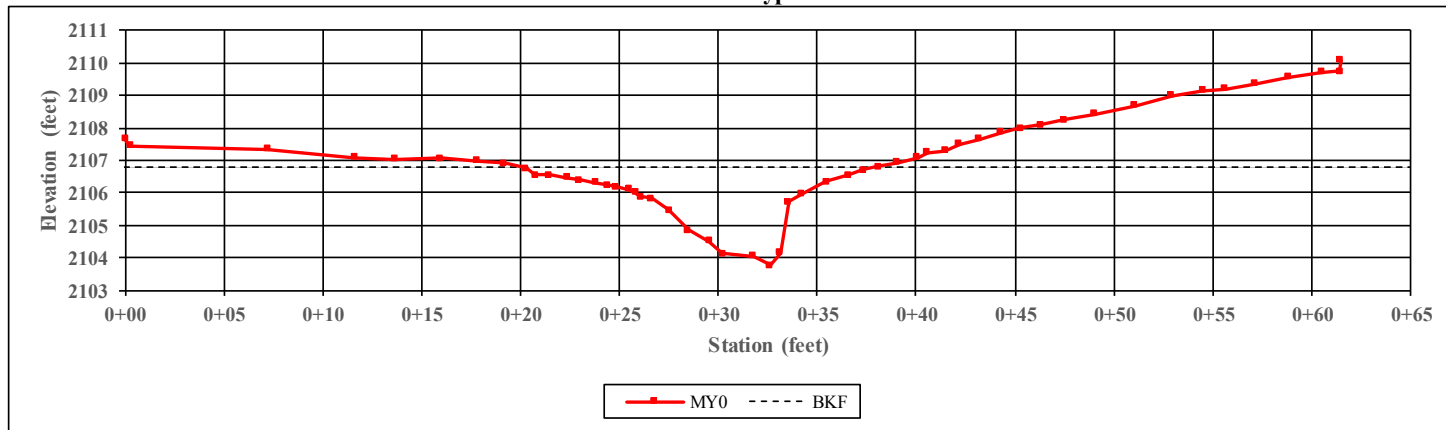

CHANNEL DIMENSIONS SUMMARY	MY0	MY1	MY2	MY3	MY4	MY5	MY6	MY7
Bankful Width (ft)	16.6	-	-	-	-	-	-	-
Floodprone Width (ft)	60.0	-	-	-	-	-	-	-
Bankfull Mean Depth (ft)	1.2	-	-	-	-	-	-	-
Bankfull Max Depth (ft)	3.0	-	-	-	-	-	-	-
Bankfull Cross-Sectional Area (ft ²)	20.3	-	-	-	-	-	-	-
Width/Depth Ratio	13.7	-	-	-	-	-	-	-
Entrenchment Ratio	3.6	-	-	-	-	-	-	-
Bank Height Ratio	1.0	-	-	-	-	-	-	-
Low Top of Bank Depth (ft)	3.0	-	-	-	-	-	-	-



Left Descending Bank




Right Descending Bank

Project Name: Fletcher Mitigation Site
Reach Name: Fletcher Creek Reach 1C

XS Number: 6
XS Type: Riffle

Station: 122+74

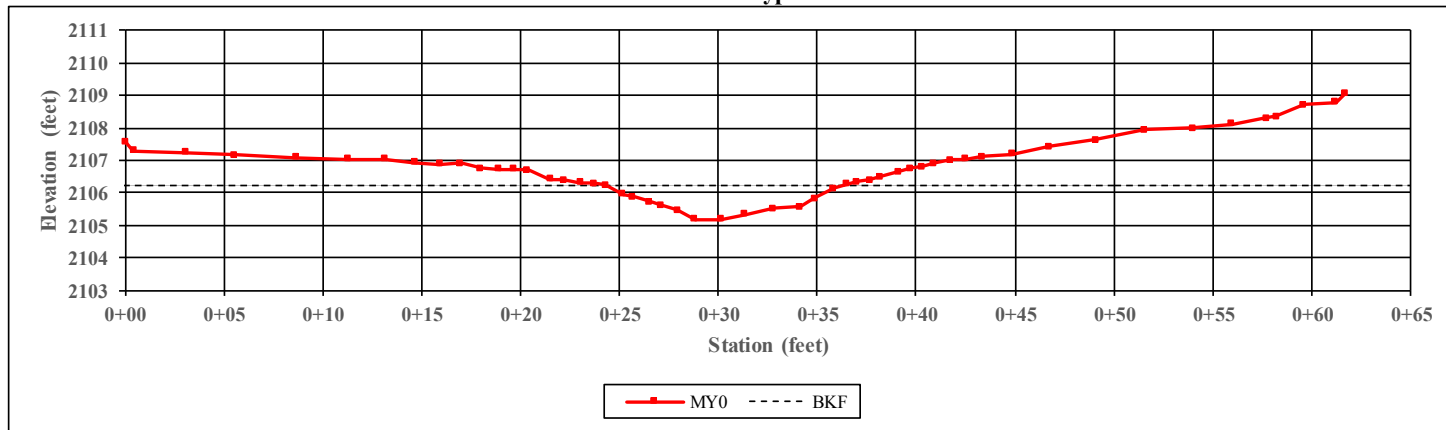

CHANNEL DIMENSIONS SUMMARY	MY0	MY1	MY2	MY3	MY4	MY5	MY6	MY7
Bankful Width (ft)	12.0	-	-	-	-	-	-	-
Floodprone Width (ft)	50.0	-	-	-	-	-	-	-
Bankfull Mean Depth (ft)	0.6	-	-	-	-	-	-	-
Bankfull Max Depth (ft)	1.0	-	-	-	-	-	-	-
Bankfull Cross-Sectional Area (ft ²)	7.5	-	-	-	-	-	-	-
Width/Depth Ratio	19.2	-	-	-	-	-	-	-
Entrenchment Ratio	4.2	-	-	-	-	-	-	-
Bank Height Ratio	1.0	-	-	-	-	-	-	-
Low Top of Bank Depth (ft)	1.2	-	-	-	-	-	-	-



Left Descending Bank




Right Descending Bank

Project Name: Fletcher Mitigation Site
Reach Name: Fletcher Creek Reach 2A

XS Number: 7
XS Type: Riffle

Station: 126+85

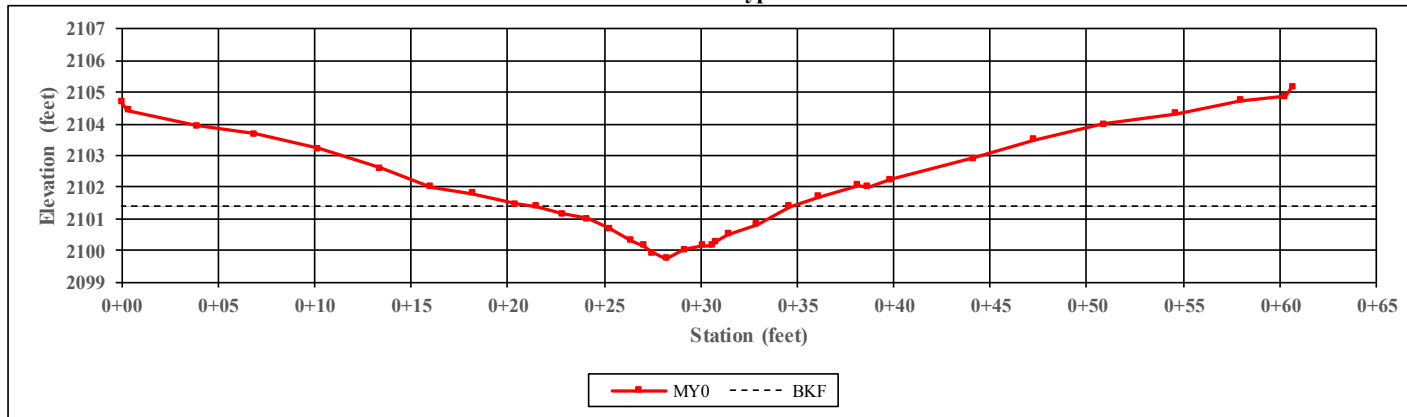

CHANNEL DIMENSIONS SUMMARY		MY0	MY1	MY2	MY3	MY4	MY5	MY6	MY7
Bankful Width (ft)		13.1	-	-	-	-	-	-	-
Floodprone Width (ft)		35.0	-	-	-	-	-	-	-
Bankfull Mean Depth (ft)		0.8	-	-	-	-	-	-	-
Bankfull Max Depth (ft)		1.6	-	-	-	-	-	-	-
Bankfull Cross-Sectional Area (ft ²)		10.4	-	-	-	-	-	-	-
Width/Depth Ratio		16.5	-	-	-	-	-	-	-
Entrenchment Ratio		2.7	-	-	-	-	-	-	-
Bank Height Ratio		1.0	-	-	-	-	-	-	-
Low Top of Bank Depth (ft)		1.6	-	-	-	-	-	-	-



Left Descending Bank




Right Descending Bank

Project Name: Fletcher Mitigation Site
Reach Name: Fletcher Creek Reach 2A

XS Number: 8
XS Type: Pool

Station: 127+03

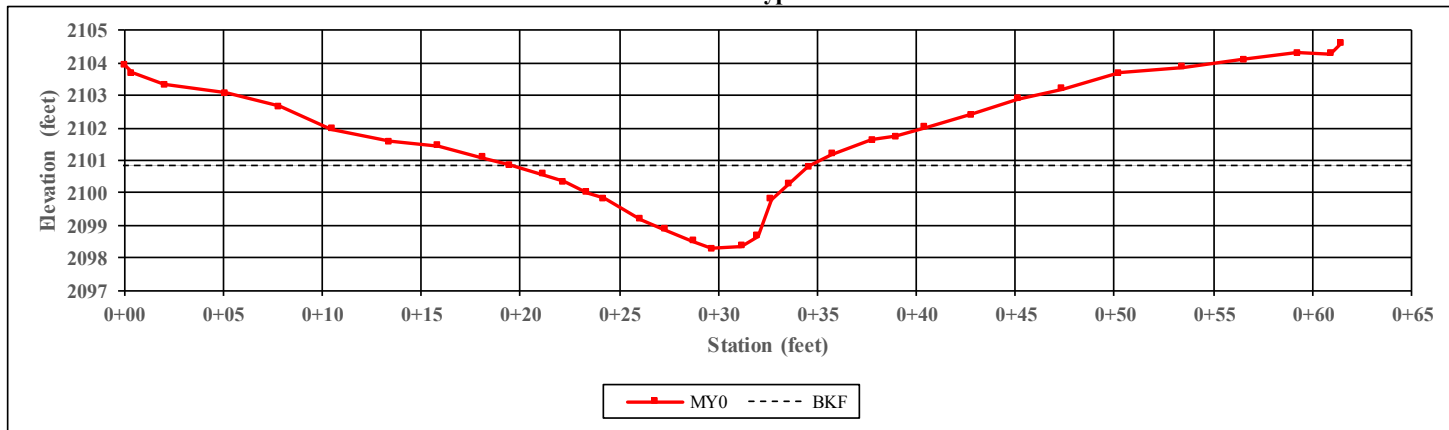

CHANNEL DIMENSIONS SUMMARY	MY0	MY1	MY2	MY3	MY4	MY5	MY6	MY7
Bankful Width (ft)	15.3	-	-	-	-	-	-	-
Floodprone Width (ft)	50.0	-	-	-	-	-	-	-
Bankfull Mean Depth (ft)	1.3	-	-	-	-	-	-	-
Bankfull Max Depth (ft)	2.6	-	-	-	-	-	-	-
Bankfull Cross-Sectional Area (ft ²)	20.5	-	-	-	-	-	-	-
Width/Depth Ratio	11.4	-	-	-	-	-	-	-
Entrenchment Ratio	3.3	-	-	-	-	-	-	-
Bank Height Ratio	1.0	-	-	-	-	-	-	-
Low Top of Bank Depth (ft)	2.6	-	-	-	-	-	-	-



Left Descending Bank




Right Descending Bank

Project Name: Fletcher Mitigation Site
Reach Name: Fletcher Creek Reach 2A

XS Number: 9
XS Type: Pool

Station: 133+19

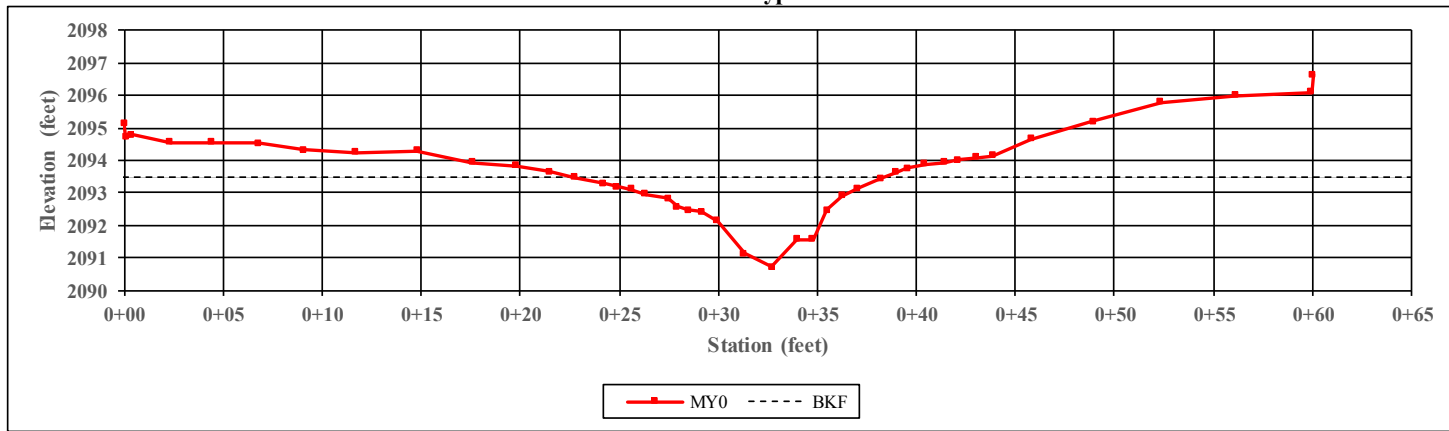

CHANNEL DIMENSIONS SUMMARY	MY0	MY1	MY2	MY3	MY4	MY5	MY6	MY7
Bankful Width (ft)	15.6	-	-	-	-	-	-	-
Floodprone Width (ft)	60.0	-	-	-	-	-	-	-
Bankfull Mean Depth (ft)	1.1	-	-	-	-	-	-	-
Bankfull Max Depth (ft)	2.8	-	-	-	-	-	-	-
Bankfull Cross-Sectional Area (ft ²)	16.9	-	-	-	-	-	-	-
Width/Depth Ratio	14.4	-	-	-	-	-	-	-
Entrenchment Ratio	3.9	-	-	-	-	-	-	-
Bank Height Ratio	1.0	-	-	-	-	-	-	-
Low Top of Bank Depth (ft)	2.8	-	-	-	-	-	-	-



Left Descending Bank




Right Descending Bank

Project Name: Fletcher Mitigation Site
Reach Name: Fletcher Creek Reach 2A

XS Number: 10
XS Type: Riffle

Station: 133+36

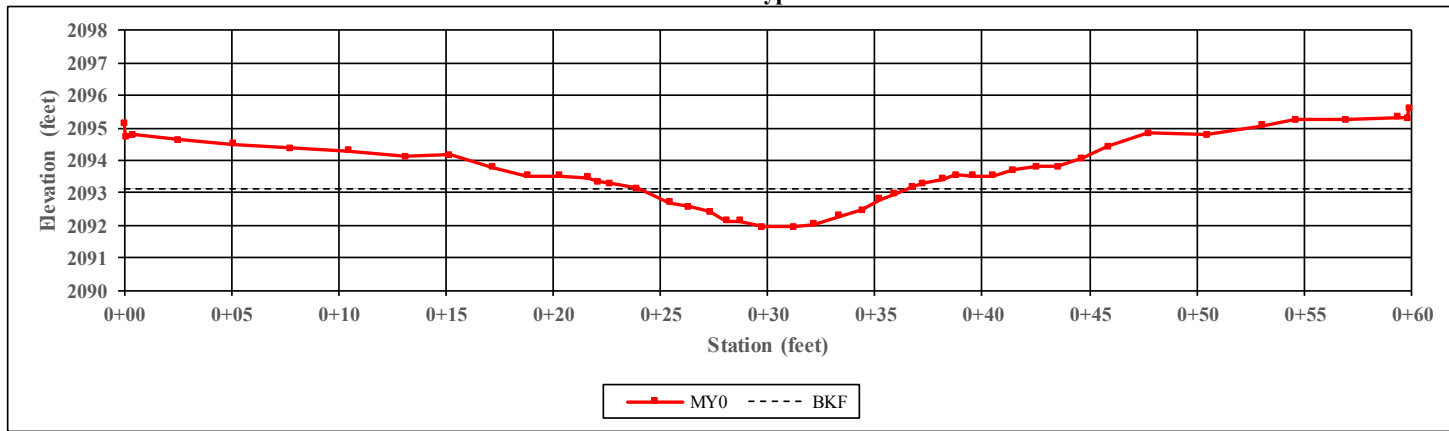

CHANNEL DIMENSIONS SUMMARY	MY0	MY1	MY2	MY3	MY4	MY5	MY6	MY7
Bankful Width (ft)	12.6	-	-	-	-	-	-	-
Floodprone Width (ft)	50.0	-	-	-	-	-	-	-
Bankfull Mean Depth (ft)	0.7	-	-	-	-	-	-	-
Bankfull Max Depth (ft)	1.2	-	-	-	-	-	-	-
Bankfull Cross-Sectional Area (ft ²)	9.2	-	-	-	-	-	-	-
Width/Depth Ratio	17.4	-	-	-	-	-	-	-
Entrenchment Ratio	4.0	-	-	-	-	-	-	-
Bank Height Ratio	1.0	-	-	-	-	-	-	-
Low Top of Bank Depth (ft)	1.5	-	-	-	-	-	-	-



Left Descending Bank




Right Descending Bank

Project Name: Fletcher Mitigation Site
Reach Name: Fletcher Creek Reach 2B

XS Number: 11
XS Type: Riffle

Station: 147+71

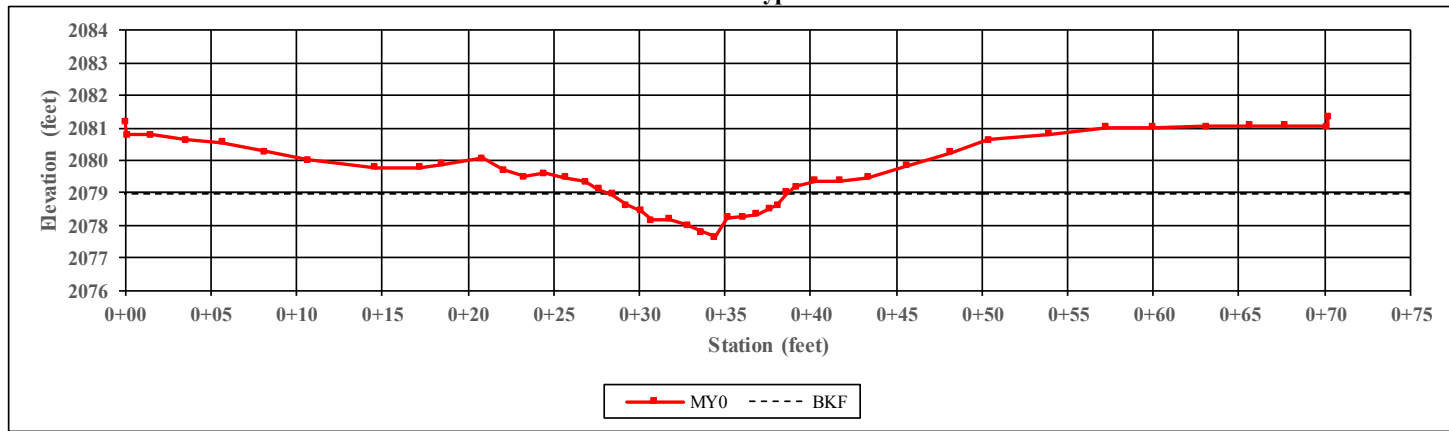

CHANNEL DIMENSIONS SUMMARY	MY0	MY1	MY2	MY3	MY4	MY5	MY6	MY7
Bankful Width (ft)	10.2	-	-	-	-	-	-	-
Floodprone Width (ft)	40.0	-	-	-	-	-	-	-
Bankfull Mean Depth (ft)	0.7	-	-	-	-	-	-	-
Bankfull Max Depth (ft)	1.3	-	-	-	-	-	-	-
Bankfull Cross-Sectional Area (ft ²)	7.1	-	-	-	-	-	-	-
Width/Depth Ratio	14.6	-	-	-	-	-	-	-
Entrenchment Ratio	3.9	-	-	-	-	-	-	-
Bank Height Ratio	1.0	-	-	-	-	-	-	-
Low Top of Bank Depth (ft)	1.3	-	-	-	-	-	-	-



Left Descending Bank




Right Descending Bank

Project Name: Fletcher Mitigation Site
Reach Name: Fletcher Creek Reach 2B

XS Number: 12
XS Type: Pool

Station: 148+00

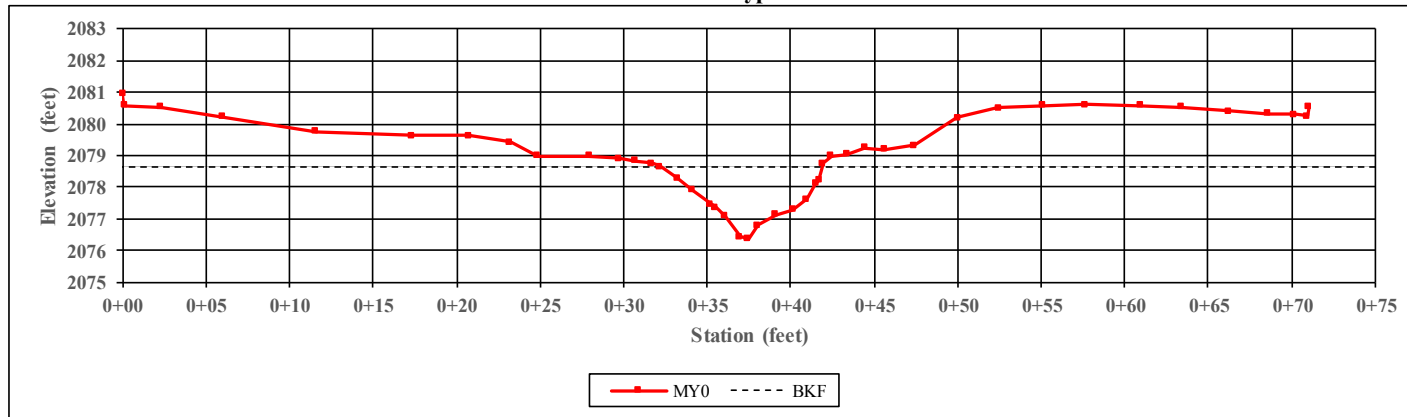

CHANNEL DIMENSIONS SUMMARY		MY0	MY1	MY2	MY3	MY4	MY5	MY6	MY7
Bankfull Width (ft)		9.7	-	-	-	-	-	-	-
Floodprone Width (ft)		70.0	-	-	-	-	-	-	-
Bankfull Mean Depth (ft)		1.2	-	-	-	-	-	-	-
Bankfull Max Depth (ft)		2.3	-	-	-	-	-	-	-
Bankfull Cross-Sectional Area (ft ²)		11.7	-	-	-	-	-	-	-
Width/Depth Ratio		8.1	-	-	-	-	-	-	-
Entrenchment Ratio		7.2	-	-	-	-	-	-	-
Bank Height Ratio		1.0	-	-	-	-	-	-	-
Low Top of Bank Depth (ft)		2.3	-	-	-	-	-	-	-



Left Descending Bank




Right Descending Bank

Project Name: Fletcher Mitigation Site
Reach Name: Fletcher Creek Reach 2B

XS Number: 13
XS Type: Pool

Station: 153+30

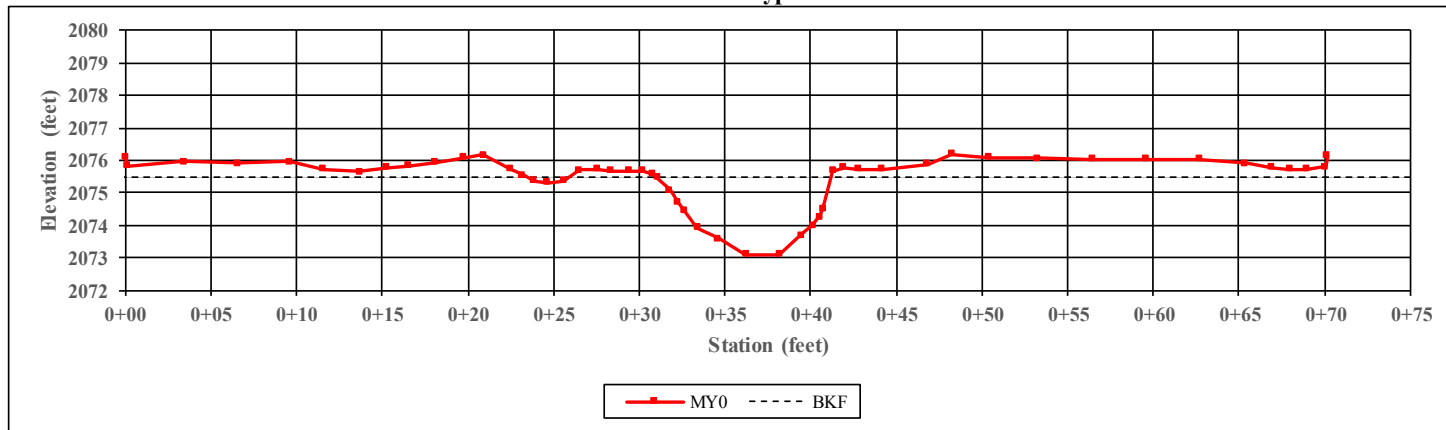

CHANNEL DIMENSIONS SUMMARY	MY0	MY1	MY2	MY3	MY4	MY5	MY6	MY7
Bankful Width (ft)	10.1	-	-	-	-	-	-	-
Floodprone Width (ft)	70.0	-	-	-	-	-	-	-
Bankfull Mean Depth (ft)	1.6	-	-	-	-	-	-	-
Bankfull Max Depth (ft)	2.4	-	-	-	-	-	-	-
Bankfull Cross-Sectional Area (ft ²)	16.4	-	-	-	-	-	-	-
Width/Depth Ratio	6.2	-	-	-	-	-	-	-
Entrenchment Ratio	6.9	-	-	-	-	-	-	-
Bank Height Ratio	1.0	-	-	-	-	-	-	-
Low Top of Bank Depth (ft)	2.4	-	-	-	-	-	-	-



Left Descending Bank




Right Descending Bank

Project Name: Fletcher Mitigation Site
Reach Name: Fletcher Creek Reach 2B

XS Number: 14
XS Type: Riffle

Station: 153+48

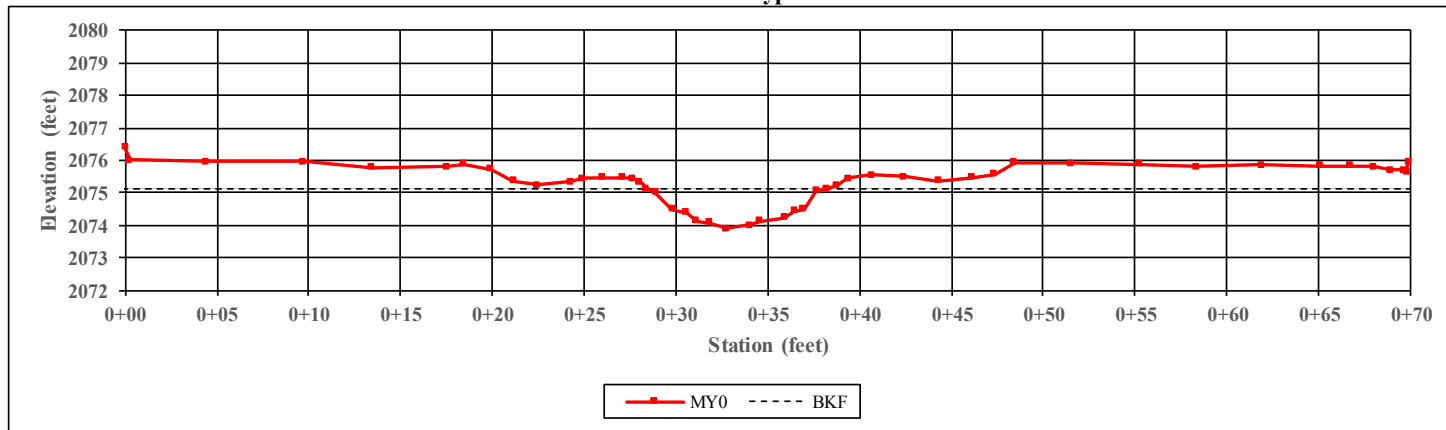

CHANNEL DIMENSIONS SUMMARY	MY0	MY1	MY2	MY3	MY4	MY5	MY6	MY7
Bankful Width (ft)	9.8	-	-	-	-	-	-	-
Floodprone Width (ft)	70.0	-	-	-	-	-	-	-
Bankfull Mean Depth (ft)	0.8	-	-	-	-	-	-	-
Bankfull Max Depth (ft)	1.2	-	-	-	-	-	-	-
Bankfull Cross-Sectional Area (ft ²)	7.6	-	-	-	-	-	-	-
Width/Depth Ratio	12.6	-	-	-	-	-	-	-
Entrenchment Ratio	7.2	-	-	-	-	-	-	-
Bank Height Ratio	1.0	-	-	-	-	-	-	-
Low Top of Bank Depth (ft)	1.2	-	-	-	-	-	-	-



Left Descending Bank




Right Descending Bank

Project Name: Fletcher Mitigation Site
Reach Name: Weston Creek Reach 1A

XS Number: 15
XS Type: Riffle

Station: 406+40

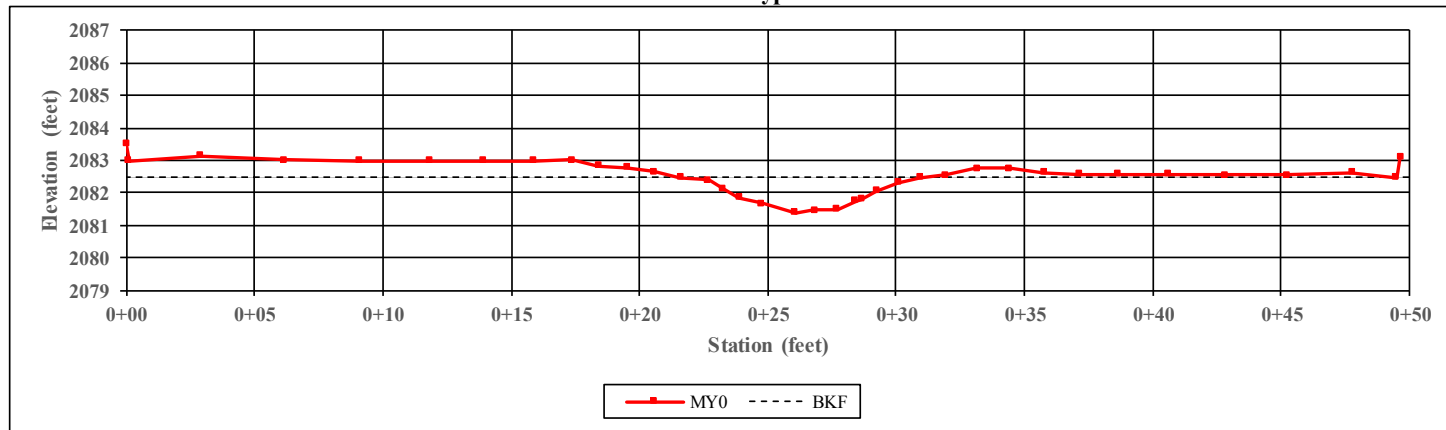

CHANNEL DIMENSIONS SUMMARY	MY0	MY1	MY2	MY3	MY4	MY5	MY6	MY7
Bankful Width (ft)	9.1	-	-	-	-	-	-	-
Floodprone Width (ft)	50.0	-	-	-	-	-	-	-
Bankfull Mean Depth (ft)	0.6	-	-	-	-	-	-	-
Bankfull Max Depth (ft)	1.1	-	-	-	-	-	-	-
Bankfull Cross-Sectional Area (ft ²)	5.4	-	-	-	-	-	-	-
Width/Depth Ratio	15.5	-	-	-	-	-	-	-
Entrenchment Ratio	5.5	-	-	-	-	-	-	-
Bank Height Ratio	1.0	-	-	-	-	-	-	-
Low Top of Bank Depth (ft)	1.1	-	-	-	-	-	-	-



Left Descending Bank




Right Descending Bank

Project Name: Fletcher Mitigation Site
Reach Name: Weston Creek Reach 1A

XS Number: 16
XS Type: Pool

Station: 406+87

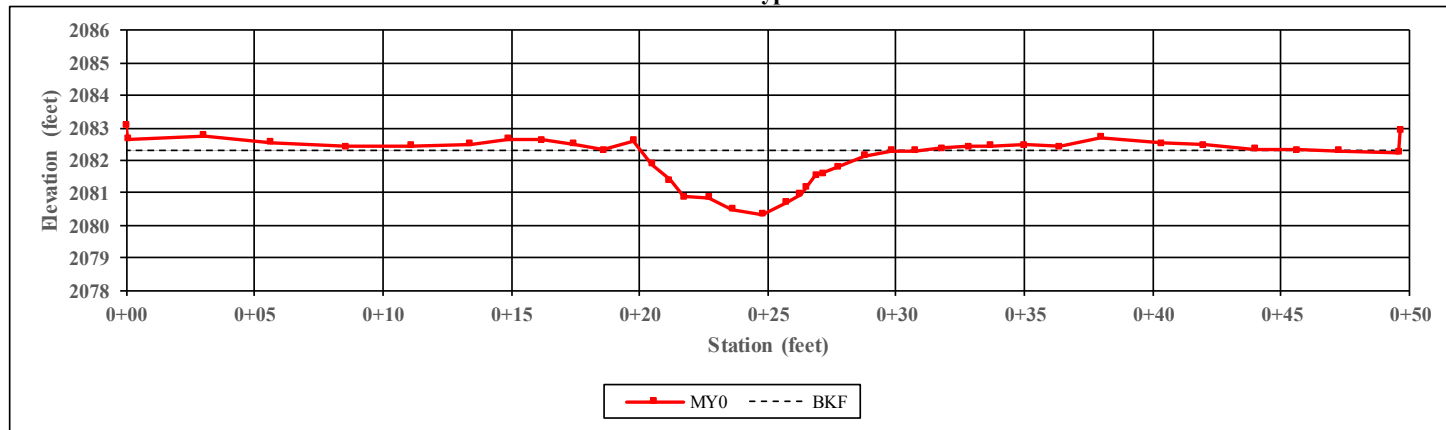

CHANNEL DIMENSIONS SUMMARY	MY0	MY1	MY2	MY3	MY4	MY5	MY6	MY7
Bankful Width (ft)	9.7	-	-	-	-	-	-	-
Floodprone Width (ft)	50.0	-	-	-	-	-	-	-
Bankfull Mean Depth (ft)	1.1	-	-	-	-	-	-	-
Bankfull Max Depth (ft)	2.0	-	-	-	-	-	-	-
Bankfull Cross-Sectional Area (ft ²)	10.4	-	-	-	-	-	-	-
Width/Depth Ratio	9.1	-	-	-	-	-	-	-
Entrenchment Ratio	5.1	-	-	-	-	-	-	-
Bank Height Ratio	1.0	-	-	-	-	-	-	-
Low Top of Bank Depth (ft)	2.0	-	-	-	-	-	-	-



Left Descending Bank




Right Descending Bank

Project Name: Fletcher Mitigation Site
Reach Name: Weston Creek Reach 1A

XS Number: 17
XS Type: Pool

Station: 418+23

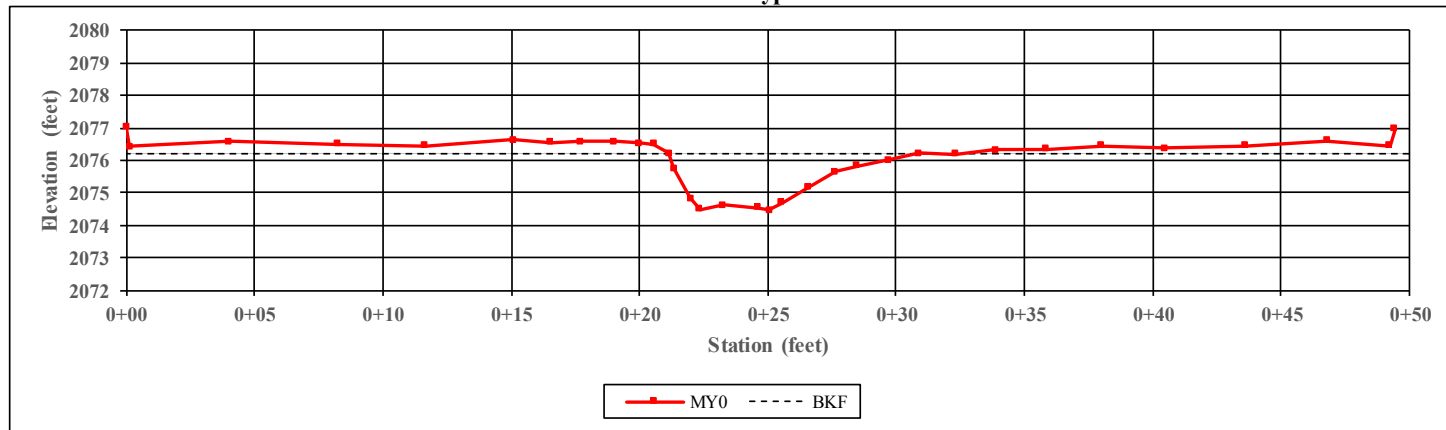

CHANNEL DIMENSIONS SUMMARY	MY0	MY1	MY2	MY3	MY4	MY5	MY6	MY7
Bankful Width (ft)	9.8	-	-	-	-	-	-	-
Floodprone Width (ft)	50.0	-	-	-	-	-	-	-
Bankfull Mean Depth (ft)	1.0	-	-	-	-	-	-	-
Bankfull Max Depth (ft)	1.7	-	-	-	-	-	-	-
Bankfull Cross-Sectional Area (ft ²)	9.4	-	-	-	-	-	-	-
Width/Depth Ratio	10.1	-	-	-	-	-	-	-
Entrenchment Ratio	5.1	-	-	-	-	-	-	-
Bank Height Ratio	1.0	-	-	-	-	-	-	-
Low Top of Bank Depth (ft)	1.7	-	-	-	-	-	-	-



Left Descending Bank




Right Descending Bank

Project Name: Fletcher Mitigation Site
Reach Name: Weston Creek Reach 1A

XS Number: 18
XS Type: Riffle

Station: 418+53

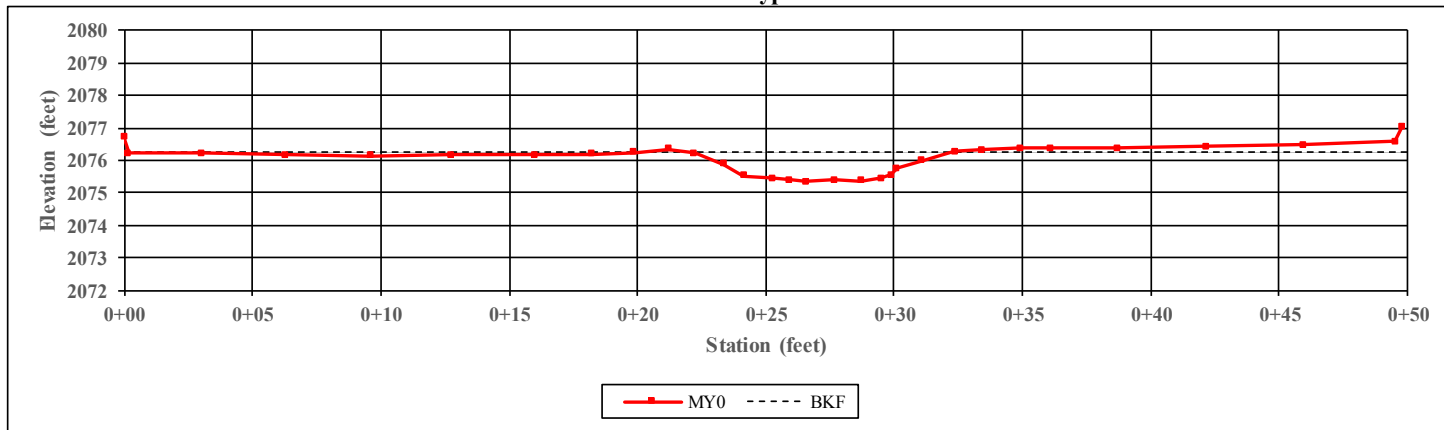

CHANNEL DIMENSIONS SUMMARY	MY0	MY1	MY2	MY3	MY4	MY5	MY6	MY7
Bankful Width (ft)	10.4	-	-	-	-	-	-	-
Floodprone Width (ft)	50.0	-	-	-	-	-	-	-
Bankfull Mean Depth (ft)	0.6	-	-	-	-	-	-	-
Bankfull Max Depth (ft)	0.9	-	-	-	-	-	-	-
Bankfull Cross-Sectional Area (ft ²)	6.2	-	-	-	-	-	-	-
Width/Depth Ratio	17.4	-	-	-	-	-	-	-
Entrenchment Ratio	4.8	-	-	-	-	-	-	-
Bank Height Ratio	1.0	-	-	-	-	-	-	-
Low Top of Bank Depth (ft)	0.9	-	-	-	-	-	-	-



Left Descending Bank




Right Descending Bank

Project Name: Fletcher Mitigation Site
Reach Name: Weston Creek Reach 1B

XS Number: 19
XS Type: Riffle

Station: 422+31

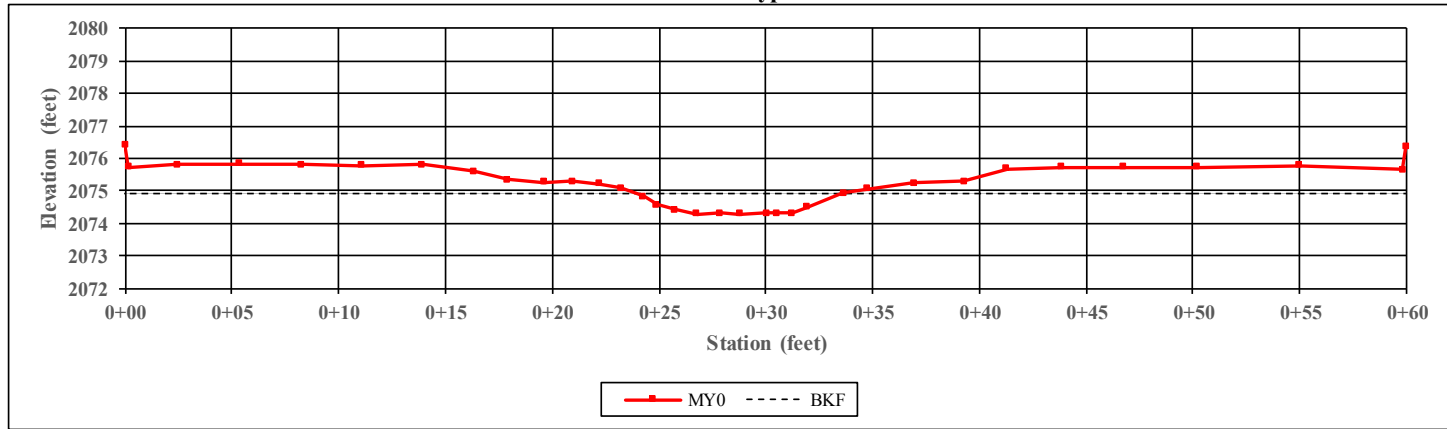

CHANNEL DIMENSIONS SUMMARY	MY0	MY1	MY2	MY3	MY4	MY5	MY6	MY7
Bankful Width (ft)	9.7	-	-	-	-	-	-	-
Floodprone Width (ft)	40.0	-	-	-	-	-	-	-
Bankfull Mean Depth (ft)	0.5	-	-	-	-	-	-	-
Bankfull Max Depth (ft)	0.7	-	-	-	-	-	-	-
Bankfull Cross-Sectional Area (ft ²)	4.7	-	-	-	-	-	-	-
Width/Depth Ratio	20.4	-	-	-	-	-	-	-
Entrenchment Ratio	4.1	-	-	-	-	-	-	-
Bank Height Ratio	1.0	-	-	-	-	-	-	-
Low Top of Bank Depth (ft)	0.7	-	-	-	-	-	-	-



Left Descending Bank




Right Descending Bank

Project Name: Fletcher Mitigation Site
Reach Name: Weston Creek Reach 1B

XS Number: 20
XS Type: Pool

Station: 422+95

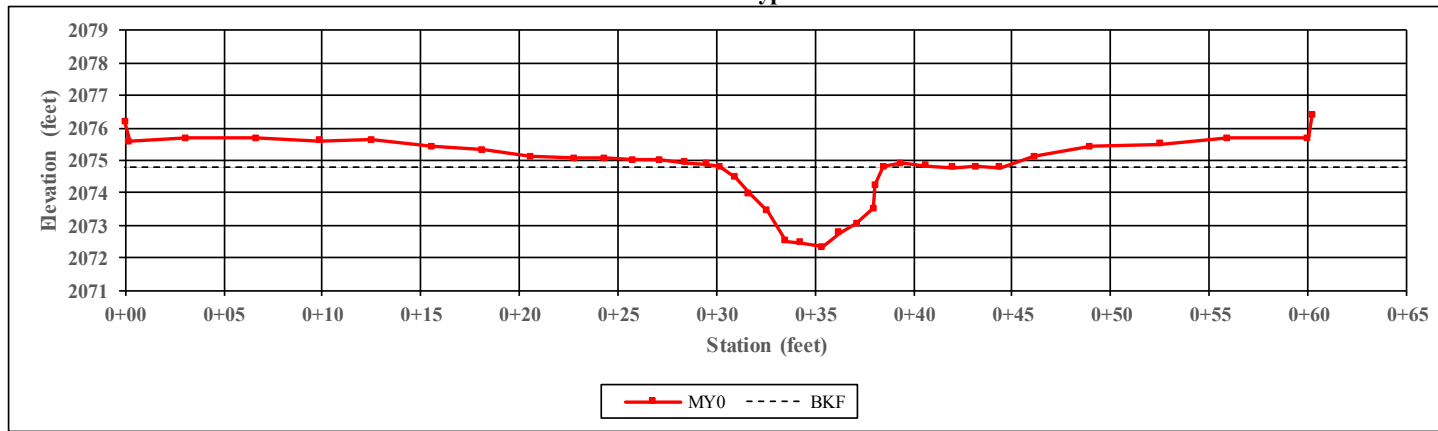

CHANNEL DIMENSIONS SUMMARY	MY0	MY1	MY2	MY3	MY4	MY5	MY6	MY7
Bankful Width (ft)	8.3	-	-	-	-	-	-	-
Floodprone Width (ft)	60.0	-	-	-	-	-	-	-
Bankfull Mean Depth (ft)	1.5	-	-	-	-	-	-	-
Bankfull Max Depth (ft)	2.5	-	-	-	-	-	-	-
Bankfull Cross-Sectional Area (ft ²)	12.7	-	-	-	-	-	-	-
Width/Depth Ratio	5.4	-	-	-	-	-	-	-
Entrenchment Ratio	7.2	-	-	-	-	-	-	-
Bank Height Ratio	1.0	-	-	-	-	-	-	-
Low Top of Bank Depth (ft)	2.5	-	-	-	-	-	-	-



Left Descending Bank




Right Descending Bank

Project Name: Fletcher Mitigation Site
Reach Name: Raccoon Branch 1D

XS Number: 21
XS Type: Pool

Station: 217+59

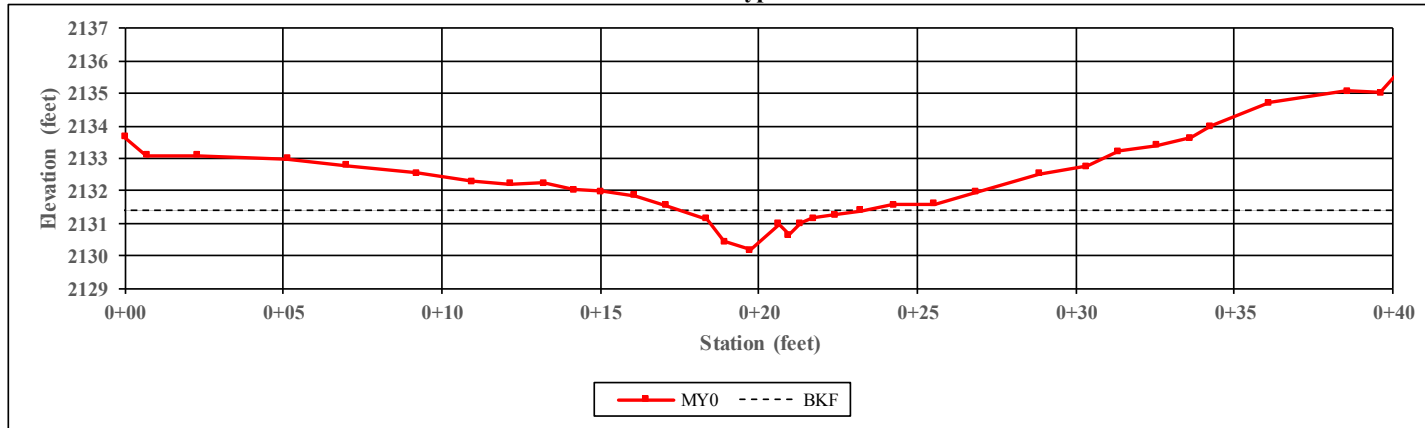

CHANNEL DIMENSIONS SUMMARY	MY0	MY1	MY2	MY3	MY4	MY5	MY6	MY7
Bankful Width (ft)	5.6	-	-	-	-	-	-	-
Floodprone Width (ft)	20.0	-	-	-	-	-	-	-
Bankfull Mean Depth (ft)	0.5	-	-	-	-	-	-	-
Bankfull Max Depth (ft)	1.2	-	-	-	-	-	-	-
Bankfull Cross-Sectional Area (ft ²)	2.7	-	-	-	-	-	-	-
Width/Depth Ratio	11.6	-	-	-	-	-	-	-
Entrenchment Ratio	3.6	-	-	-	-	-	-	-
Bank Height Ratio	1.0	-	-	-	-	-	-	-
Low Top of Bank Depth (ft)	1.2	-	-	-	-	-	-	-



Left Descending Bank




Right Descending Bank

Project Name: Fletcher Mitigation Site
Reach Name: Raccoon Branch 1D

XS Number: 22
XS Type: Riffle

Station: 217+65

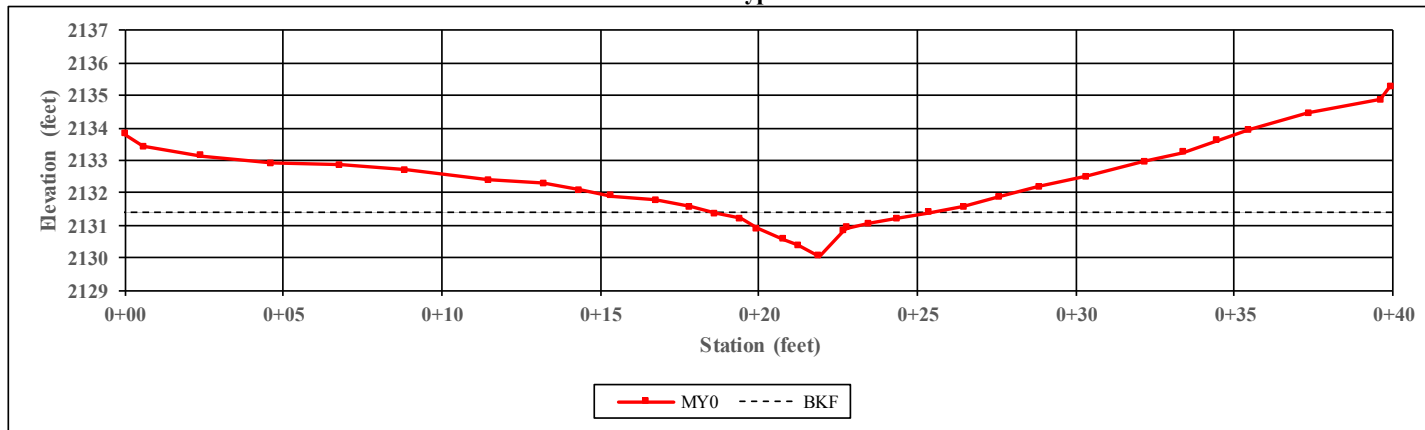

CHANNEL DIMENSIONS SUMMARY	MY0	MY1	MY2	MY3	MY4	MY5	MY6	MY7
Bankful Width (ft)	6.9	-	-	-	-	-	-	-
Floodprone Width (ft)	20.0	-	-	-	-	-	-	-
Bankfull Mean Depth (ft)	0.5	-	-	-	-	-	-	-
Bankfull Max Depth (ft)	1.3	-	-	-	-	-	-	-
Bankfull Cross-Sectional Area (ft ²)	3.4	-	-	-	-	-	-	-
Width/Depth Ratio	13.8	-	-	-	-	-	-	-
Entrenchment Ratio	2.9	-	-	-	-	-	-	-
Bank Height Ratio	1.0	-	-	-	-	-	-	-
Low Top of Bank Depth (ft)	1.3	-	-	-	-	-	-	-



Left Descending Bank




Right Descending Bank

Project Name: Fletcher Mitigation Site
Reach Name: Coats Branch 1B

XS Number: 23
XS Type: Riffle

Station: 307+87

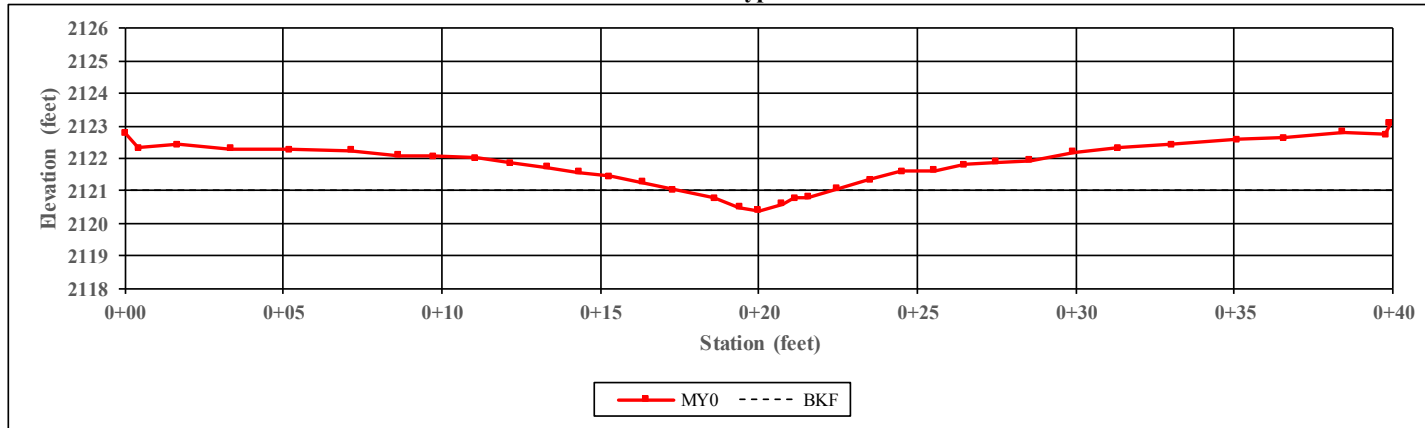

CHANNEL DIMENSIONS SUMMARY	MY0	MY1	MY2	MY3	MY4	MY5	MY6	MY7
Bankful Width (ft)	5.2	-	-	-	-	-	-	-
Floodprone Width (ft)	15.0	-	-	-	-	-	-	-
Bankfull Mean Depth (ft)	0.3	-	-	-	-	-	-	-
Bankfull Max Depth (ft)	0.7	-	-	-	-	-	-	-
Bankfull Cross-Sectional Area (ft ²)	1.6	-	-	-	-	-	-	-
Width/Depth Ratio	16.5	-	-	-	-	-	-	-
Entrenchment Ratio	2.9	-	-	-	-	-	-	-
Bank Height Ratio	1.0	-	-	-	-	-	-	-
Low Top of Bank Depth (ft)	0.7	-	-	-	-	-	-	-



Left Descending Bank




Right Descending Bank

Project Name: Fletcher Mitigation Site
Reach Name: Coats Branch 1B

XS Number: 24
XS Type: Pool

Station: 307+95

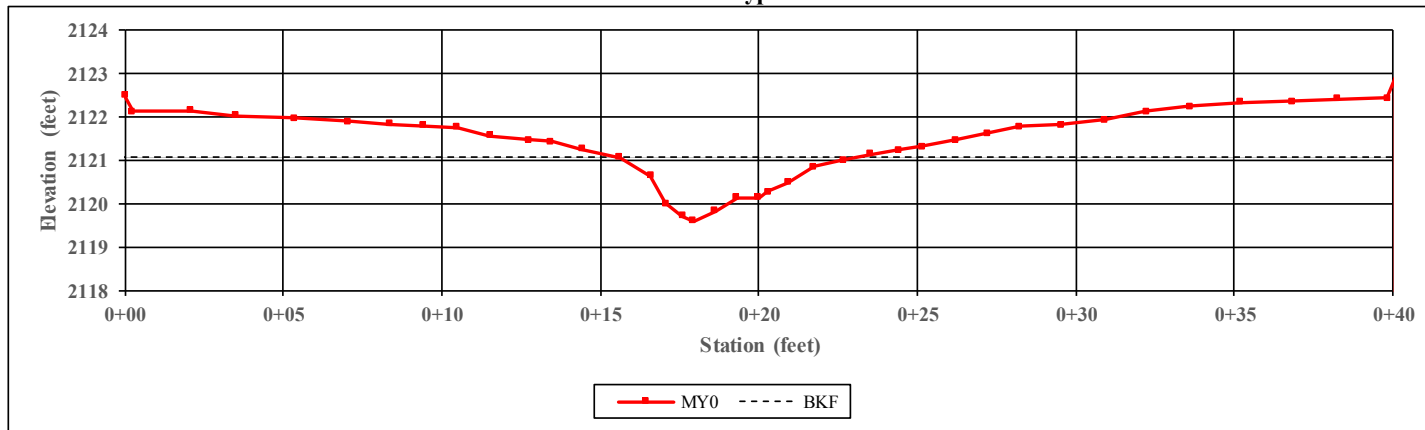

CHANNEL DIMENSIONS SUMMARY	MY0	MY1	MY2	MY3	MY4	MY5	MY6	MY7
Bankful Width (ft)	7.4	-	-	-	-	-	-	-
Floodprone Width (ft)	40.0	-	-	-	-	-	-	-
Bankfull Mean Depth (ft)	0.7	-	-	-	-	-	-	-
Bankfull Max Depth (ft)	1.5	-	-	-	-	-	-	-
Bankfull Cross-Sectional Area (ft ²)	5.1	-	-	-	-	-	-	-
Width/Depth Ratio	10.7	-	-	-	-	-	-	-
Entrenchment Ratio	5.4	-	-	-	-	-	-	-
Bank Height Ratio	1.0	-	-	-	-	-	-	-
Low Top of Bank Depth (ft)	1.5	-	-	-	-	-	-	-



Left Descending Bank




Right Descending Bank

Project Name: Fletcher Mitigation Site
Reach Name: Coats Branch 1C

XS Number: 25
XS Type: Pool

Station: 315+12

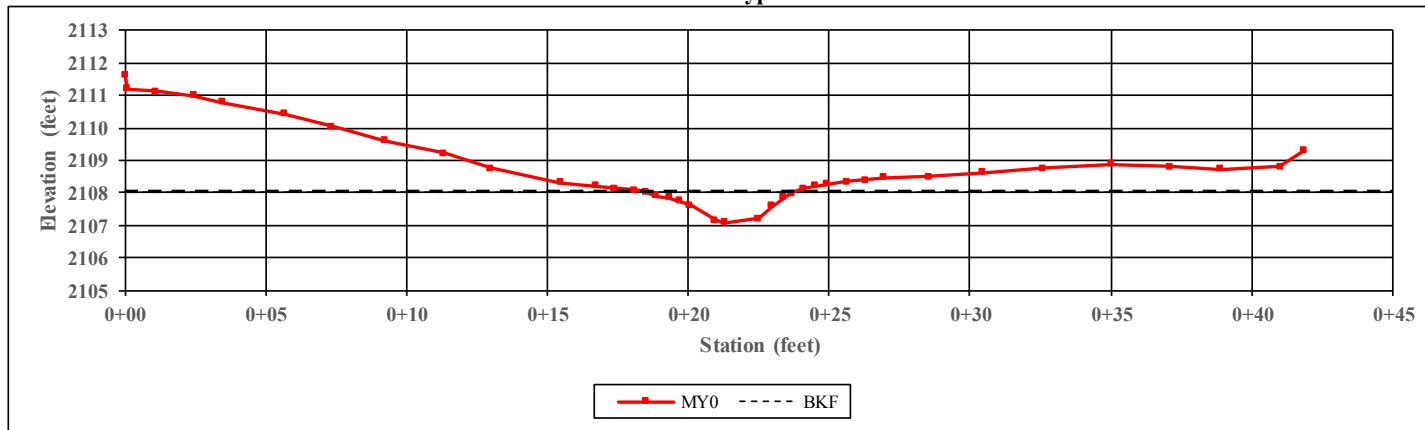

CHANNEL DIMENSIONS SUMMARY	MY0	MY1	MY2	MY3	MY4	MY5	MY6	MY7
Bankful Width (ft)	5.3	-	-	-	-	-	-	-
Floodprone Width (ft)	20.0	-	-	-	-	-	-	-
Bankfull Mean Depth (ft)	0.5	-	-	-	-	-	-	-
Bankfull Max Depth (ft)	0.9	-	-	-	-	-	-	-
Bankfull Cross-Sectional Area (ft ²)	2.7	-	-	-	-	-	-	-
Width/Depth Ratio	10.5	-	-	-	-	-	-	-
Entrenchment Ratio	3.8	-	-	-	-	-	-	-
Bank Height Ratio	1.0	-	-	-	-	-	-	-
Low Top of Bank Depth (ft)	0.9	-	-	-	-	-	-	-



Left Descending Bank




Right Descending Bank

Project Name: Fletcher Mitigation Site
Reach Name: Coats Branch 1C

XS Number: 26
XS Type: Riffle

Station: 315+20

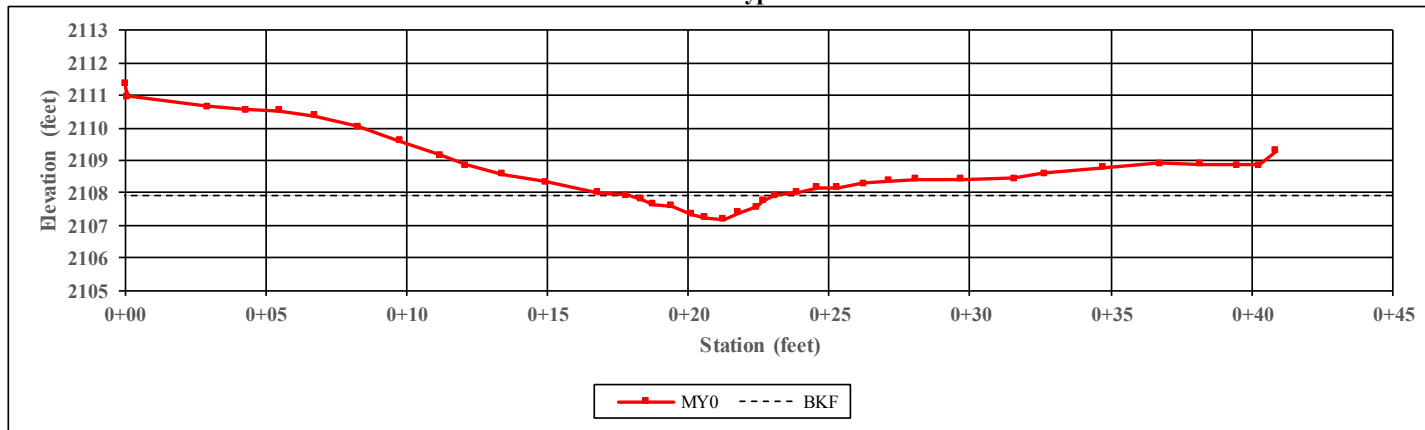

CHANNEL DIMENSIONS SUMMARY	MY0	MY1	MY2	MY3	MY4	MY5	MY6	MY7
Bankful Width (ft)	5.4	-	-	-	-	-	-	-
Floodprone Width (ft)	20.0	-	-	-	-	-	-	-
Bankfull Mean Depth (ft)	0.4	-	-	-	-	-	-	-
Bankfull Max Depth (ft)	0.8	-	-	-	-	-	-	-
Bankfull Cross-Sectional Area (ft ²)	2.2	-	-	-	-	-	-	-
Width/Depth Ratio	13.5	-	-	-	-	-	-	-
Entrenchment Ratio	3.7	-	-	-	-	-	-	-
Bank Height Ratio	1.0	-	-	-	-	-	-	-
Low Top of Bank Depth (ft)	0.8	-	-	-	-	-	-	-



Left Descending Bank




Right Descending Bank

Project Name: Fletcher Mitigation Site
Reach Name: Coats Branch 1D

XS Number: 27
XS Type: Pool

Station: 317+35

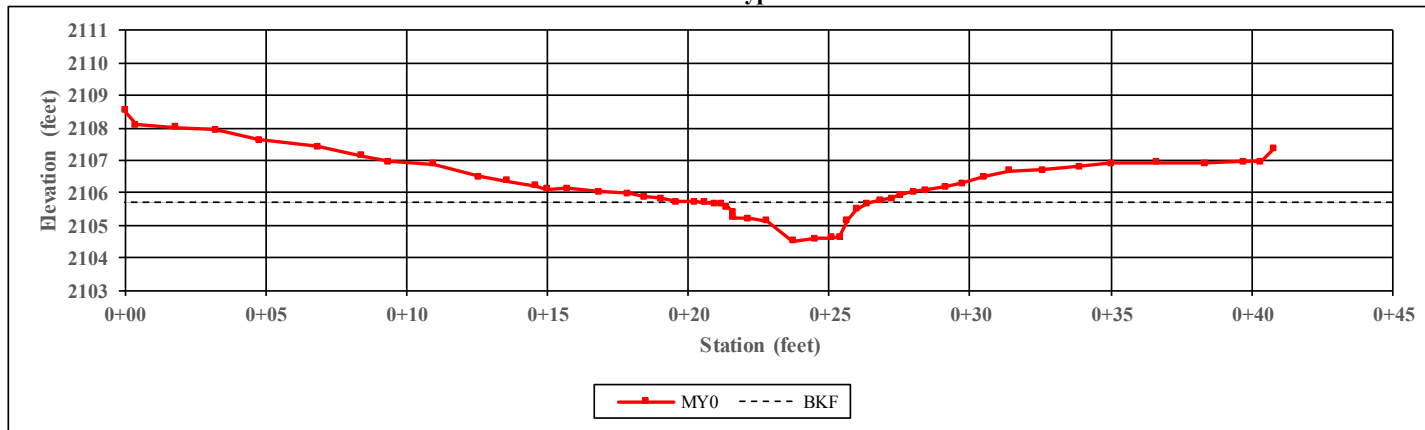

CHANNEL DIMENSIONS SUMMARY	MY0	MY1	MY2	MY3	MY4	MY5	MY6	MY7
Bankful Width (ft)	5.9	-	-	-	-	-	-	-
Floodprone Width (ft)	25.0	-	-	-	-	-	-	-
Bankfull Mean Depth (ft)	0.6	-	-	-	-	-	-	-
Bankfull Max Depth (ft)	1.2	-	-	-	-	-	-	-
Bankfull Cross-Sectional Area (ft ²)	3.7	-	-	-	-	-	-	-
Width/Depth Ratio	9.2	-	-	-	-	-	-	-
Entrenchment Ratio	4.3	-	-	-	-	-	-	-
Bank Height Ratio	1.0	-	-	-	-	-	-	-
Low Top of Bank Depth (ft)	1.2	-	-	-	-	-	-	-



Left Descending Bank




Right Descending Bank

Project Name: Fletcher Mitigation Site
Reach Name: Coats Branch 1D

XS Number: 28
XS Type: Riffle

Station: 317+42

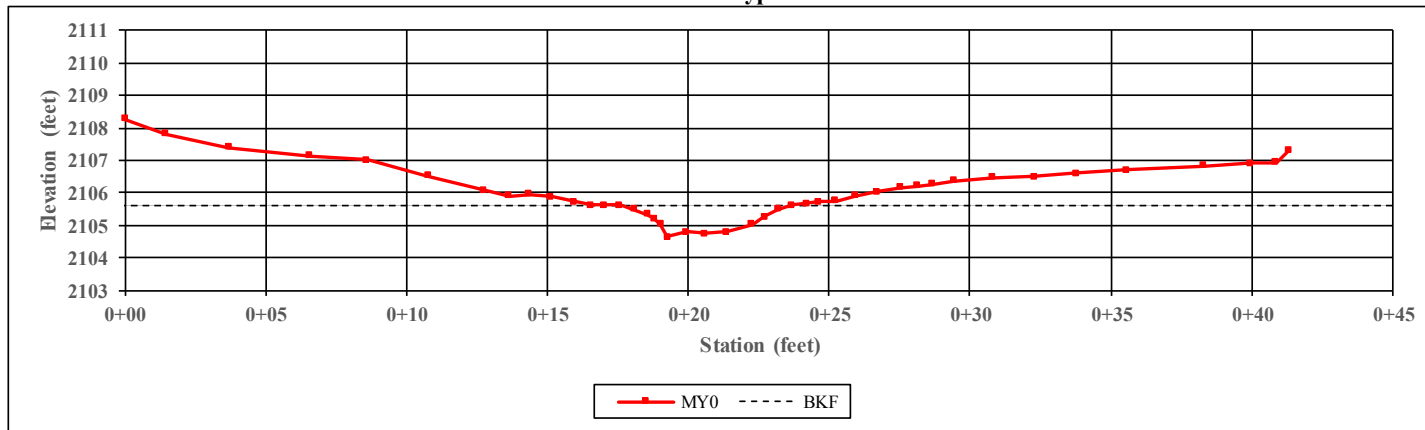

CHANNEL DIMENSIONS SUMMARY	MY0	MY1	MY2	MY3	MY4	MY5	MY6	MY7
Bankful Width (ft)	6.1	-	-	-	-	-	-	-
Floodprone Width (ft)	25.0	-	-	-	-	-	-	-
Bankfull Mean Depth (ft)	0.5	-	-	-	-	-	-	-
Bankfull Max Depth (ft)	1.0	-	-	-	-	-	-	-
Bankfull Cross-Sectional Area (ft ²)	3.3	-	-	-	-	-	-	-
Width/Depth Ratio	11.4	-	-	-	-	-	-	-
Entrenchment Ratio	4.1	-	-	-	-	-	-	-
Bank Height Ratio	1.0	-	-	-	-	-	-	-
Low Top of Bank Depth (ft)	1.0	-	-	-	-	-	-	-




Left Descending Bank




Right Descending Bank


**Fletcher Mitigation Site - Fletcher Creek 1B
Longitudinal Profile
Stationing 106+07 to 109+84**

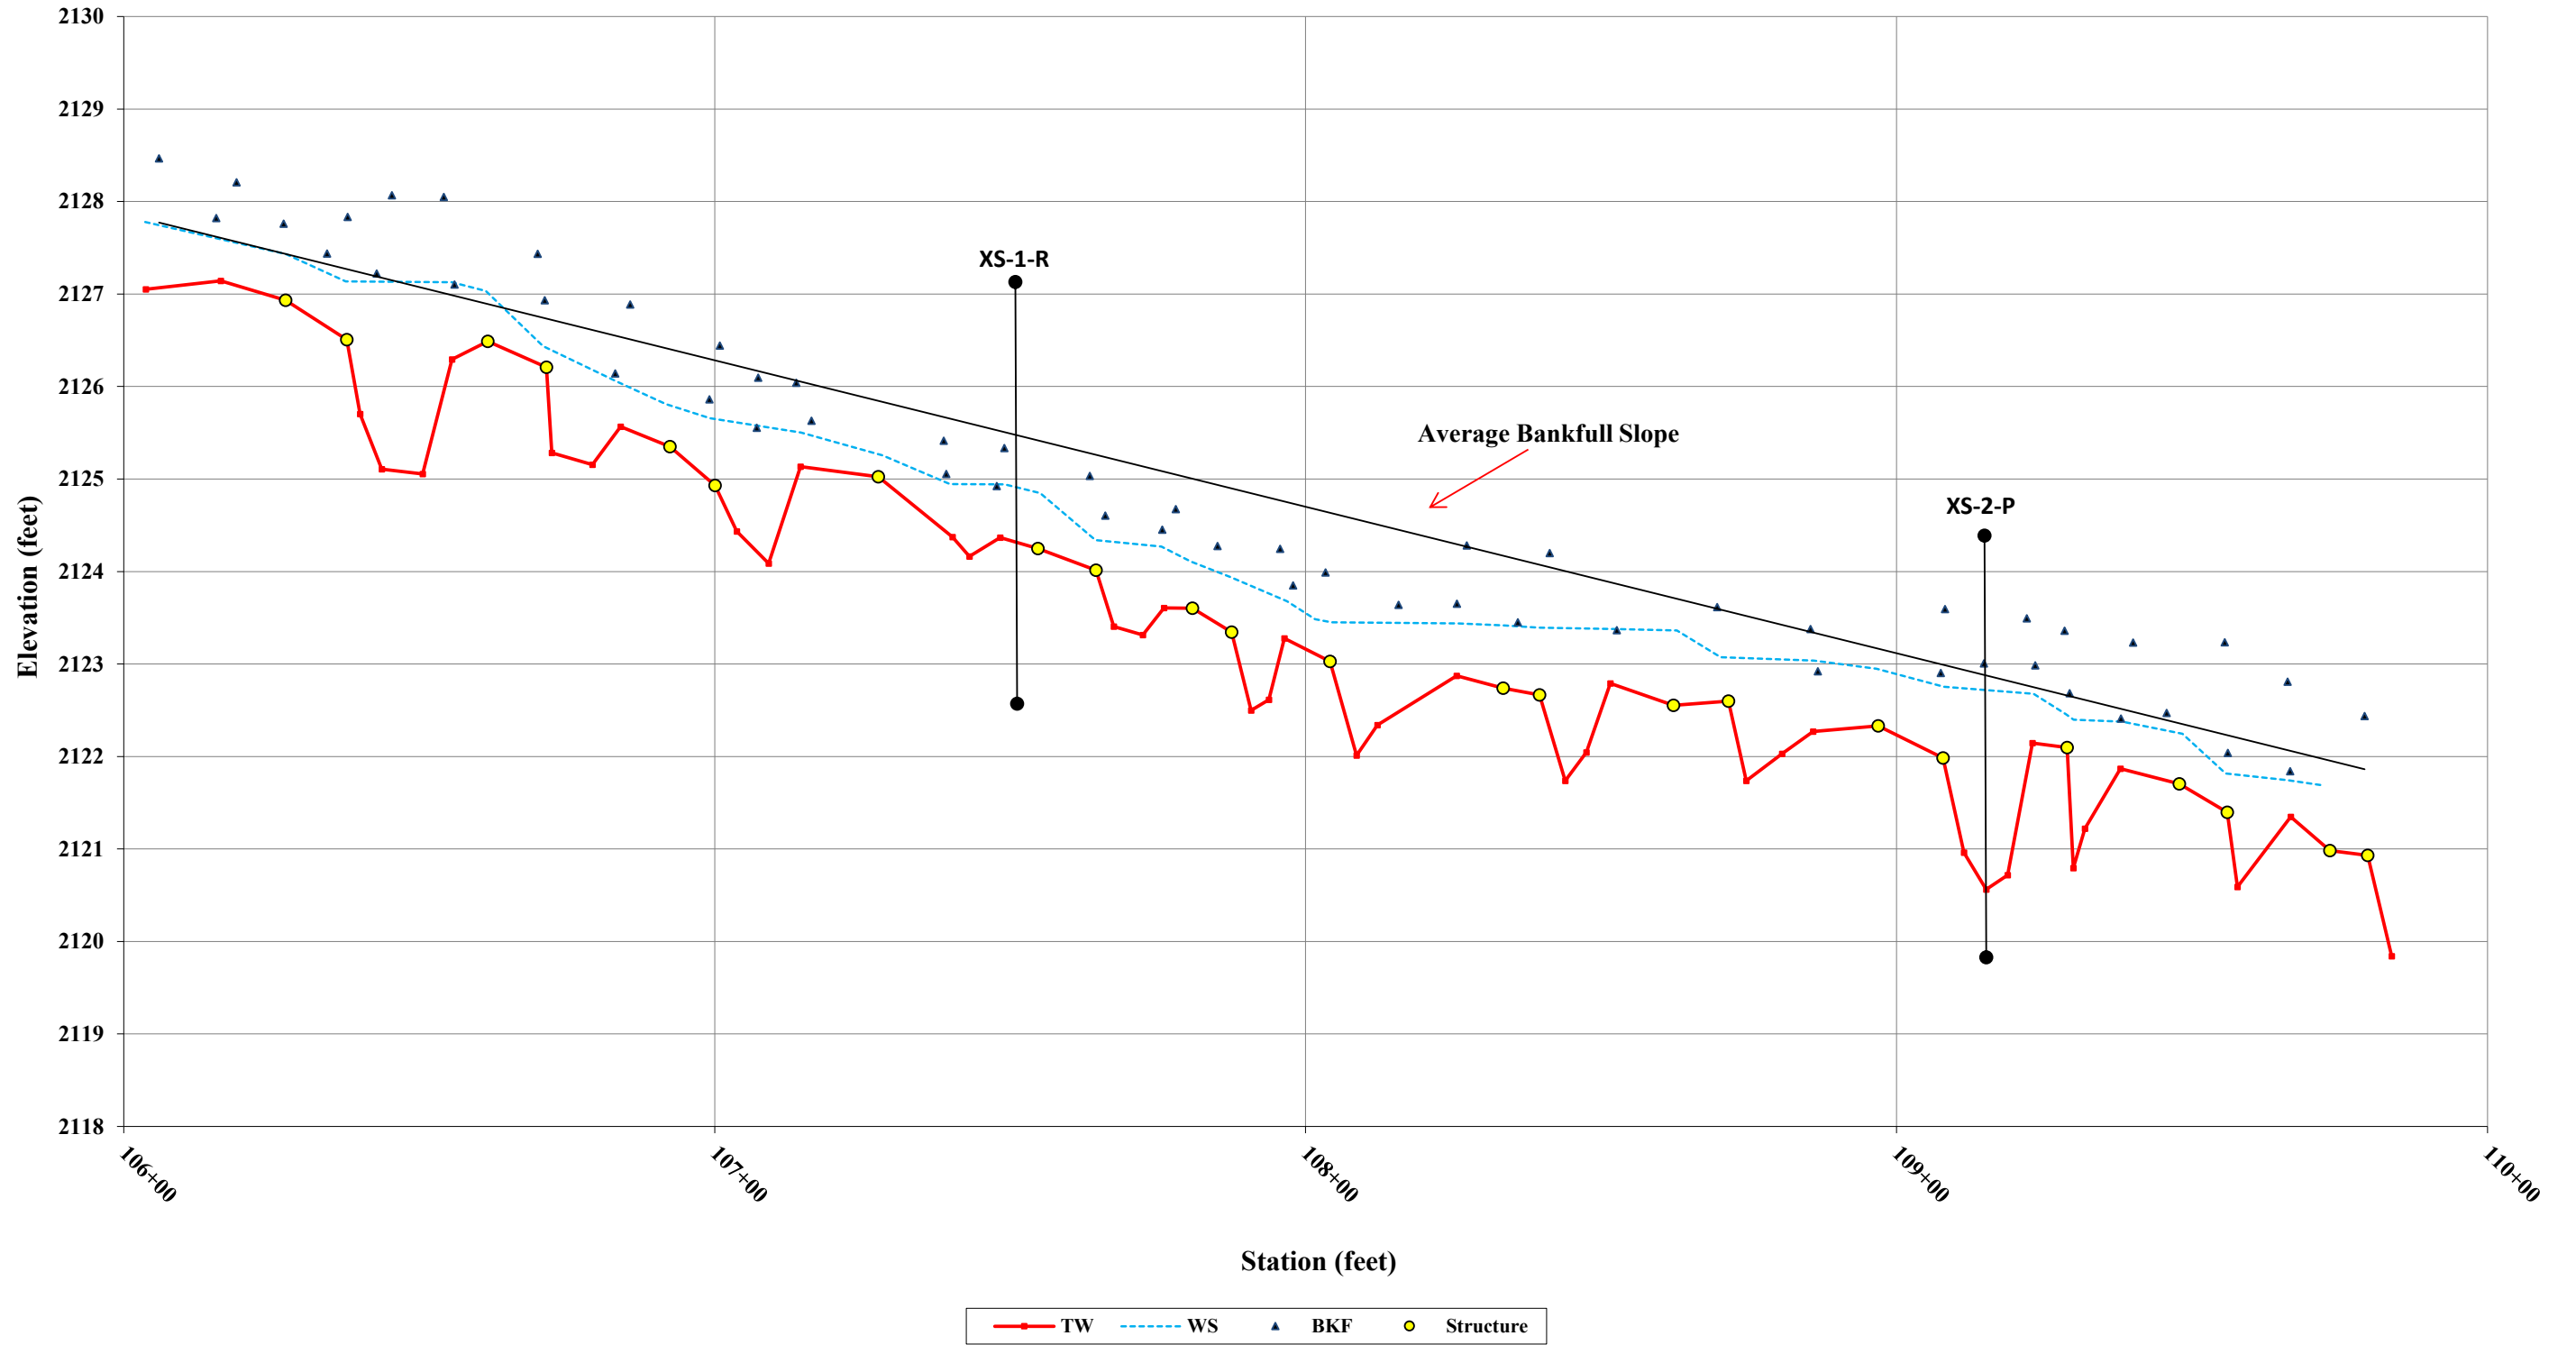


Fletcher Mitigation Site - Fletcher Creek 1C
 Longitudinal Profile
 Stationing 109+84 to 125+75

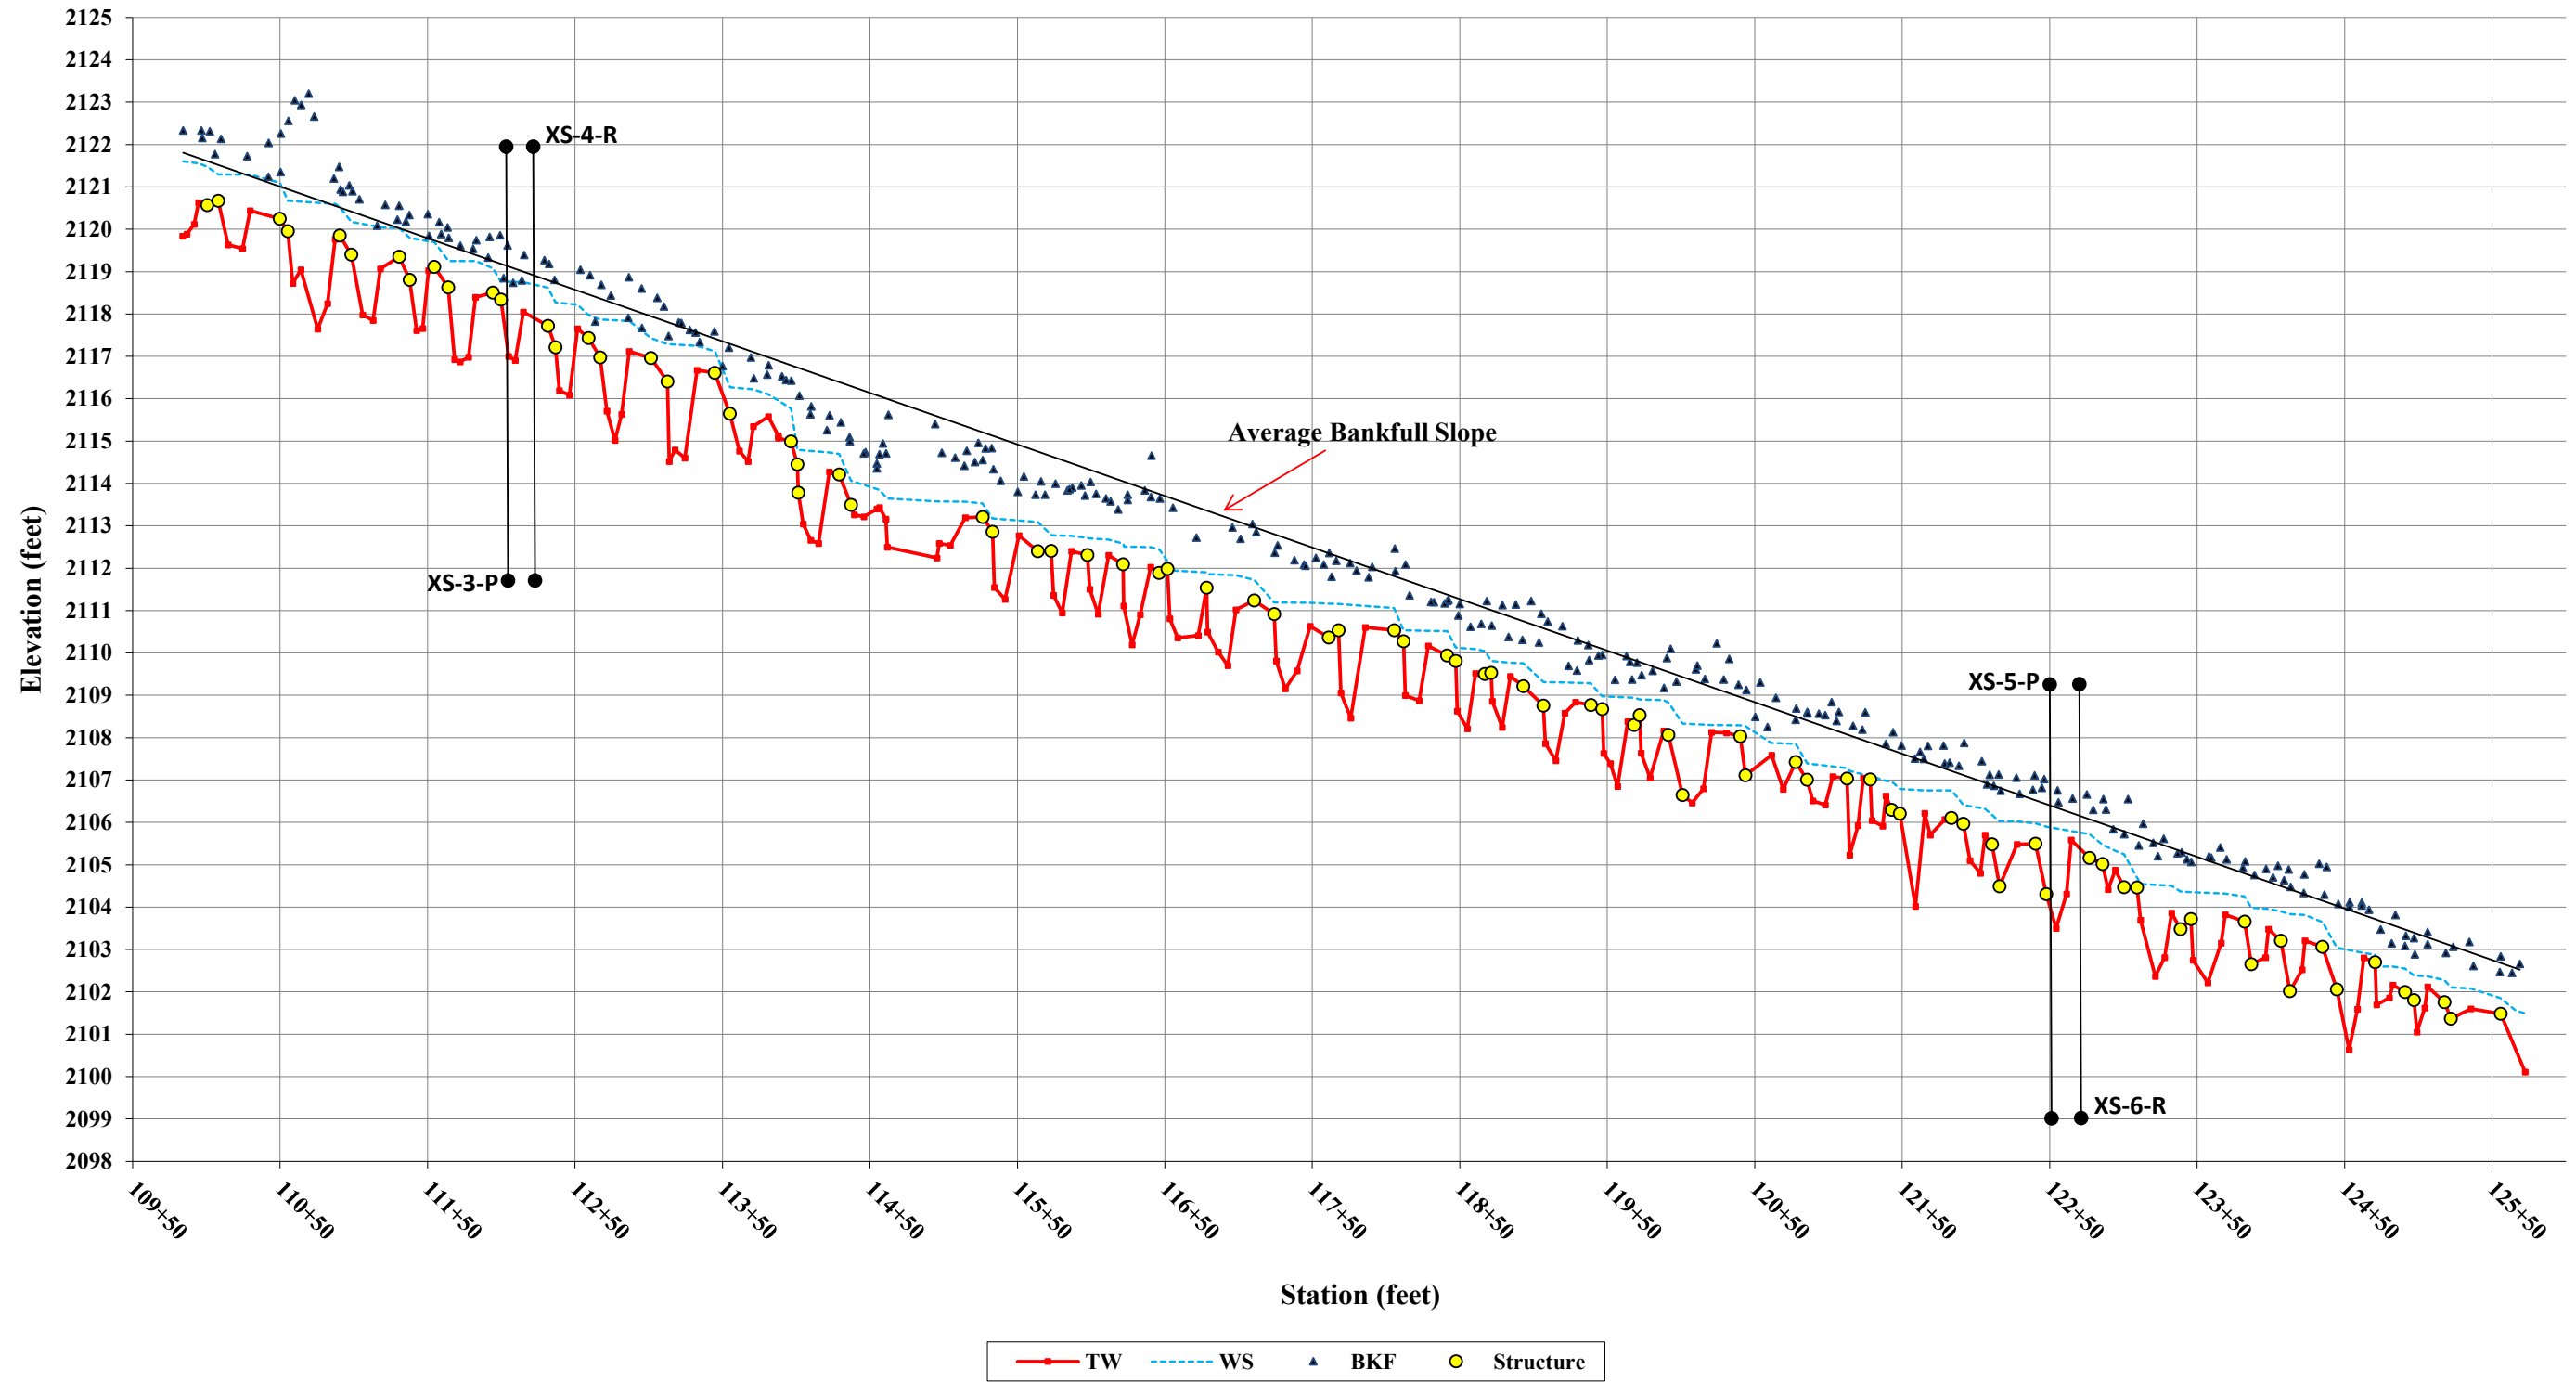


Fletcher Mitigation Site - Fletcher Creek 2A
 Longitudinal Profile
 Stationing 125+75 to 139+04

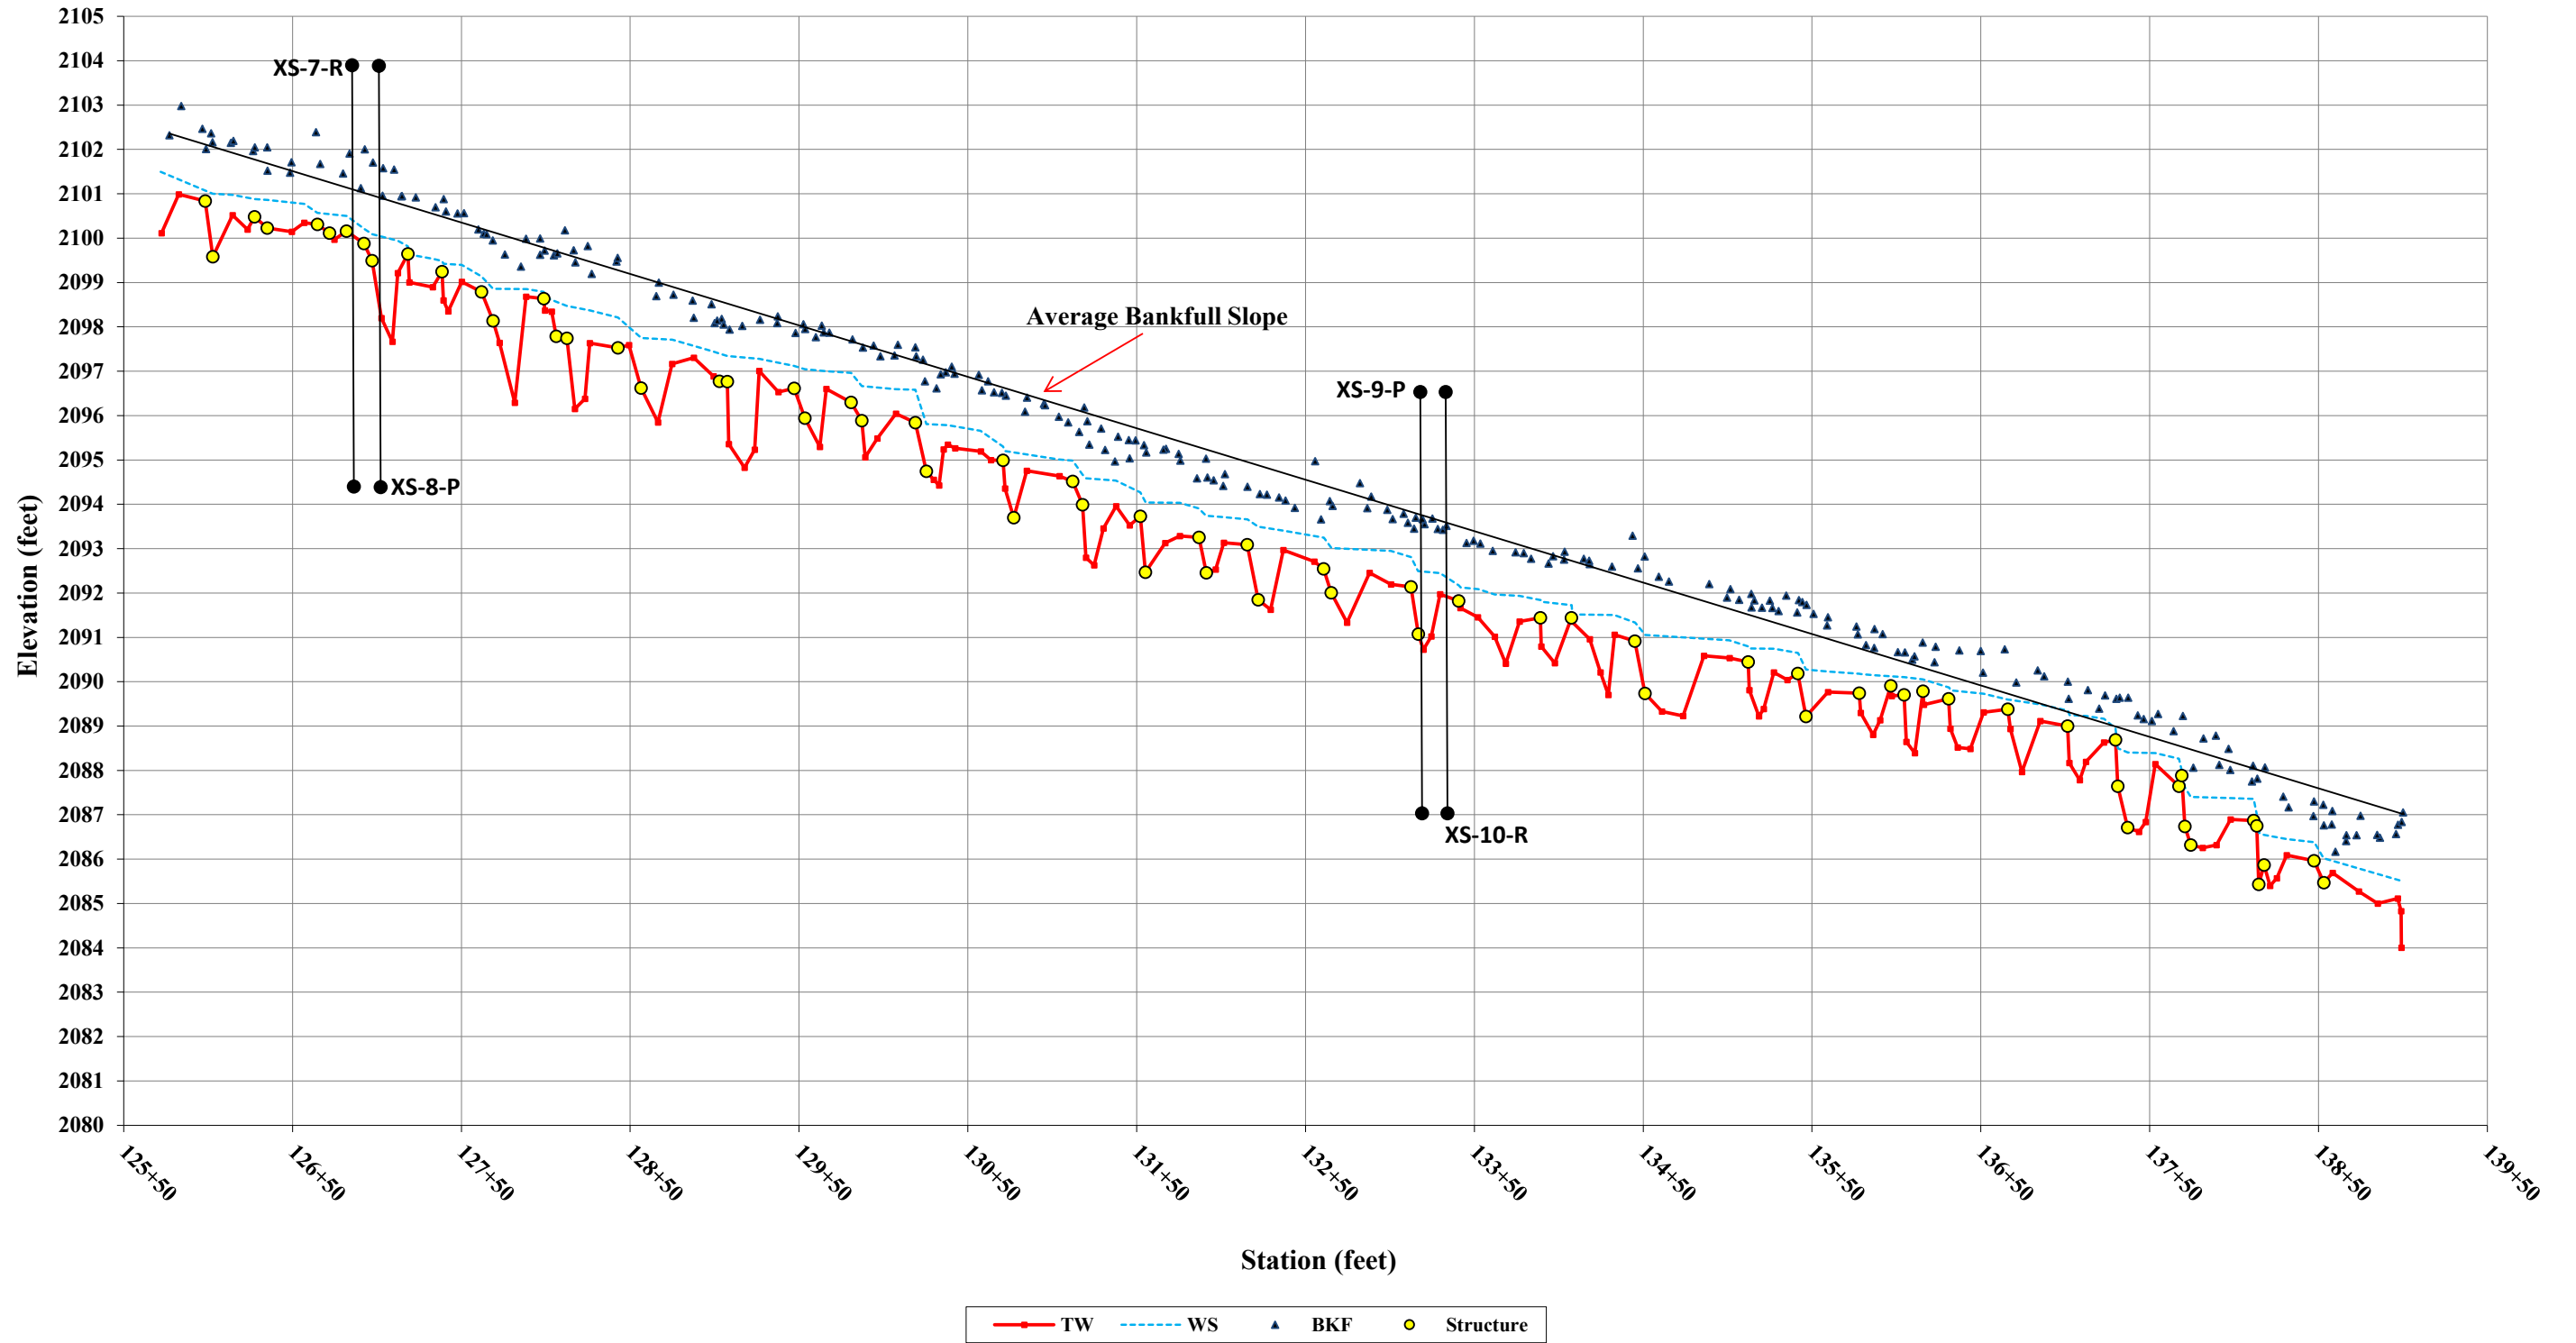


Fletcher Mitigation Site - Fletcher Creek 2B
 Longitudinal Profile
 Stationing 140+28 to 156+55

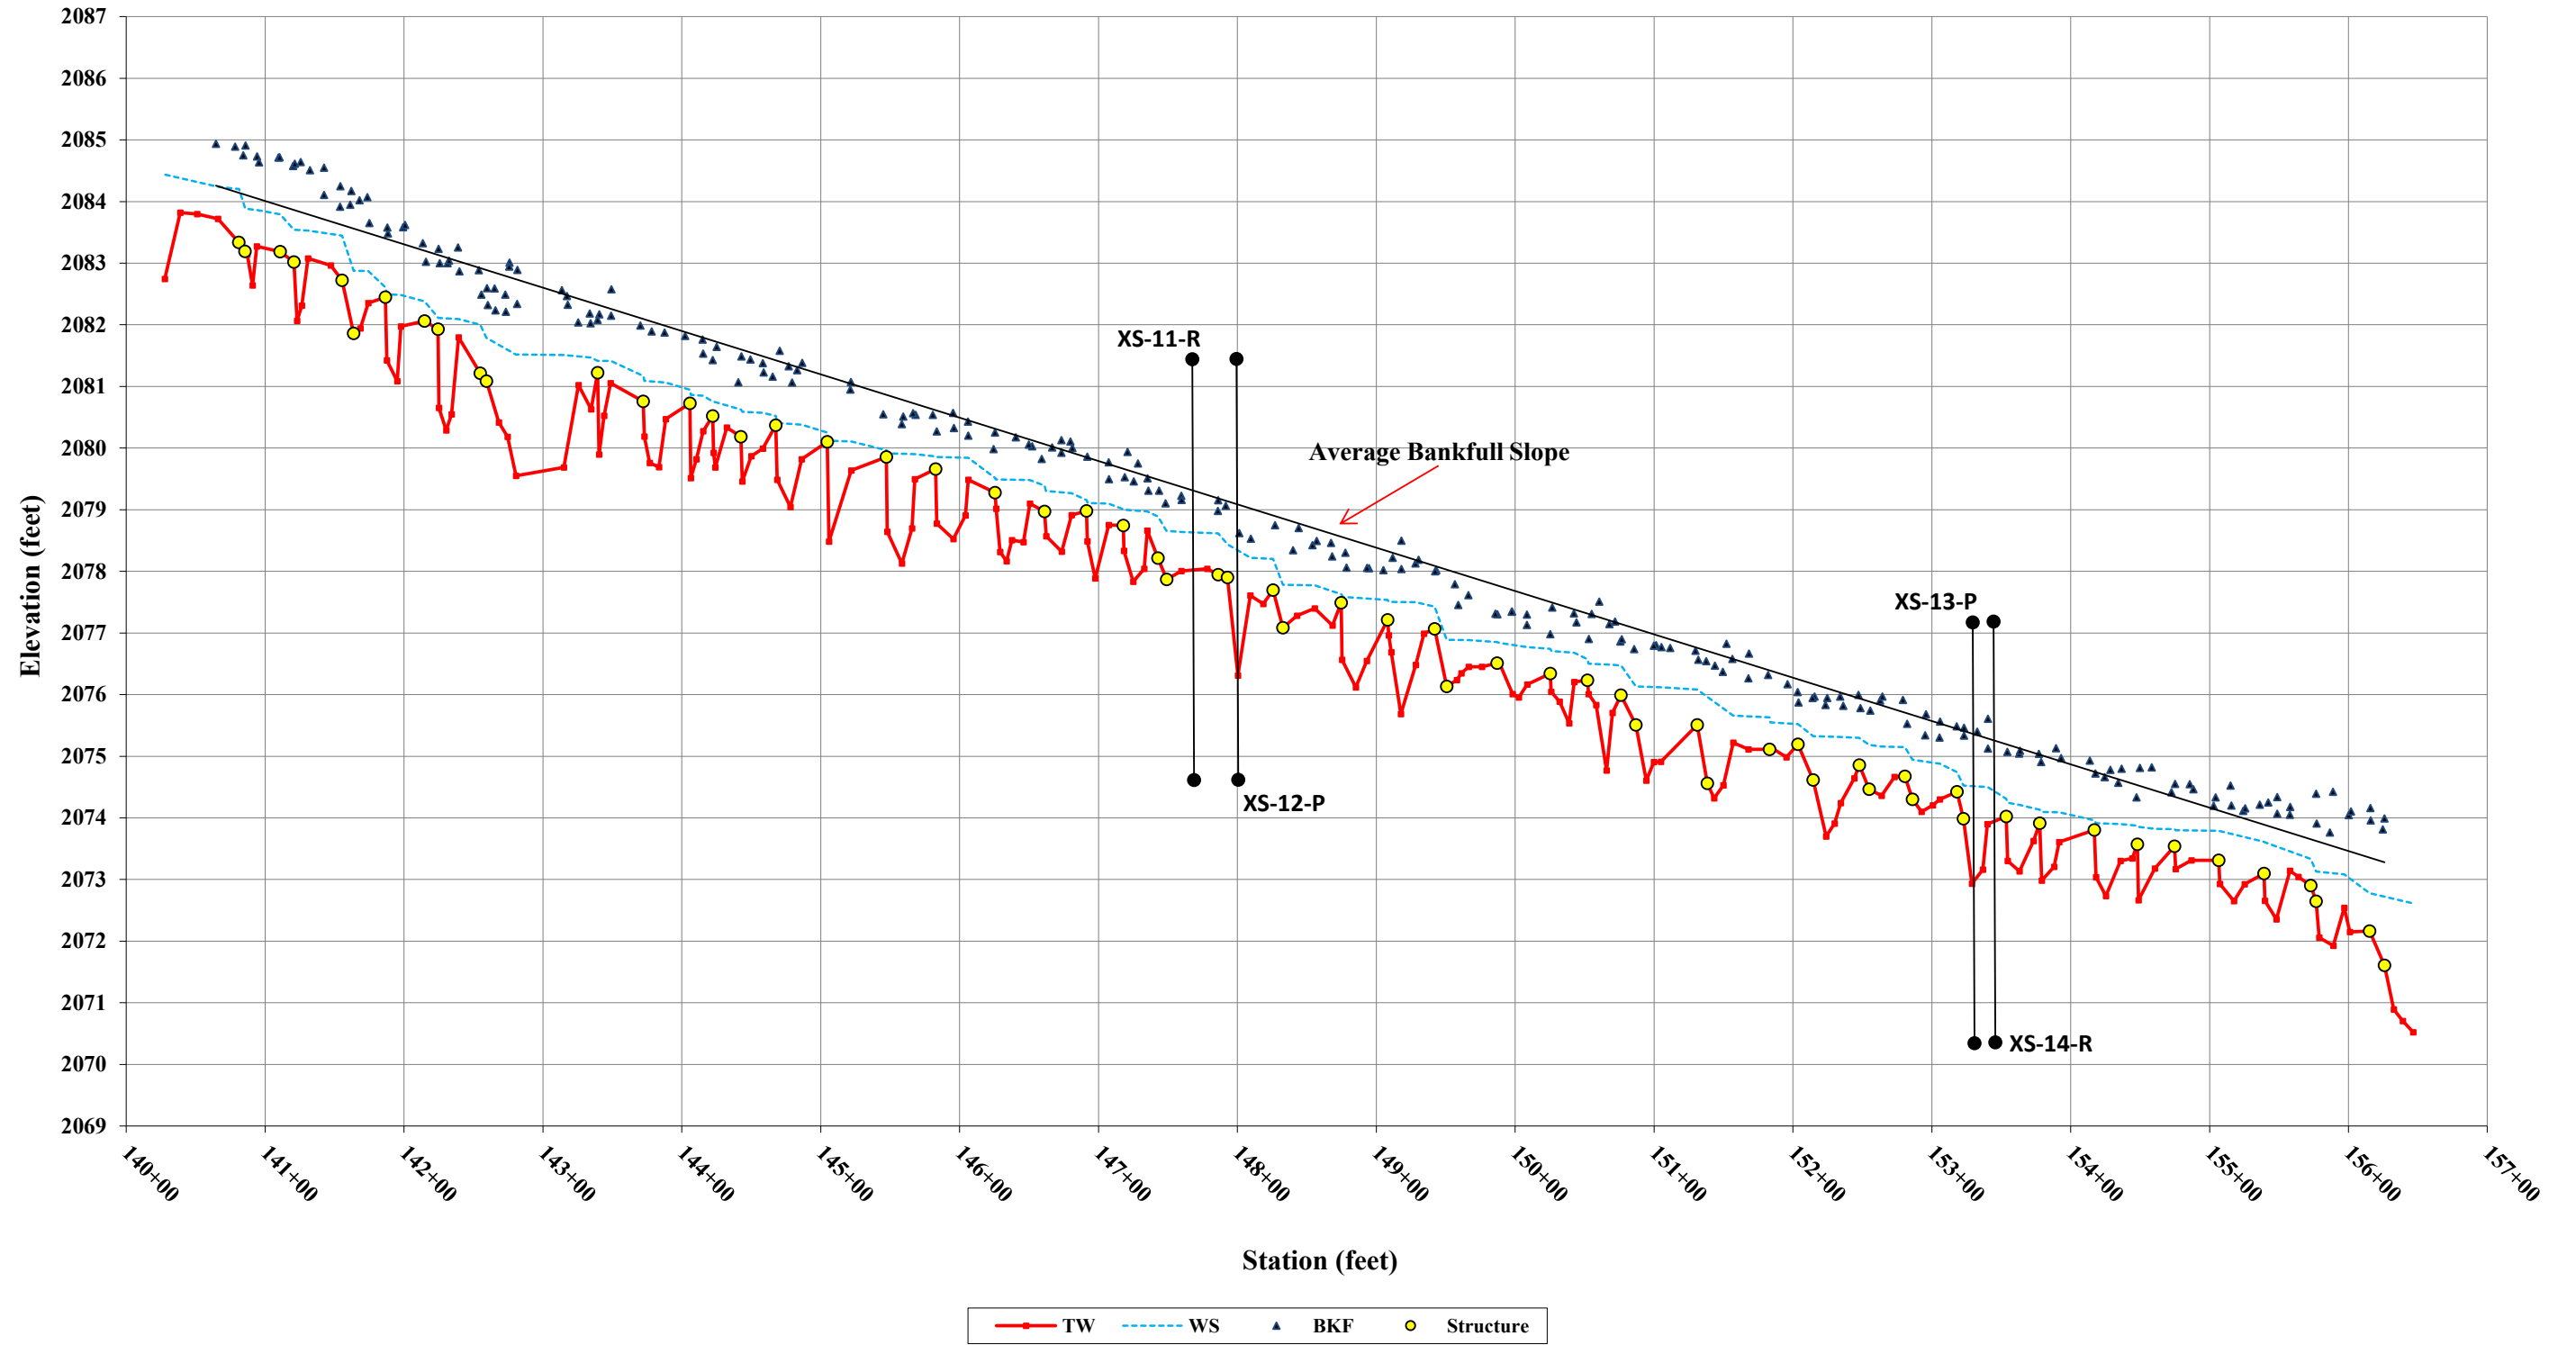


**Fletcher Mitigation Site - Weston Creek 1A
Longitudinal Profile
Stationing 400+00 to 419+83**

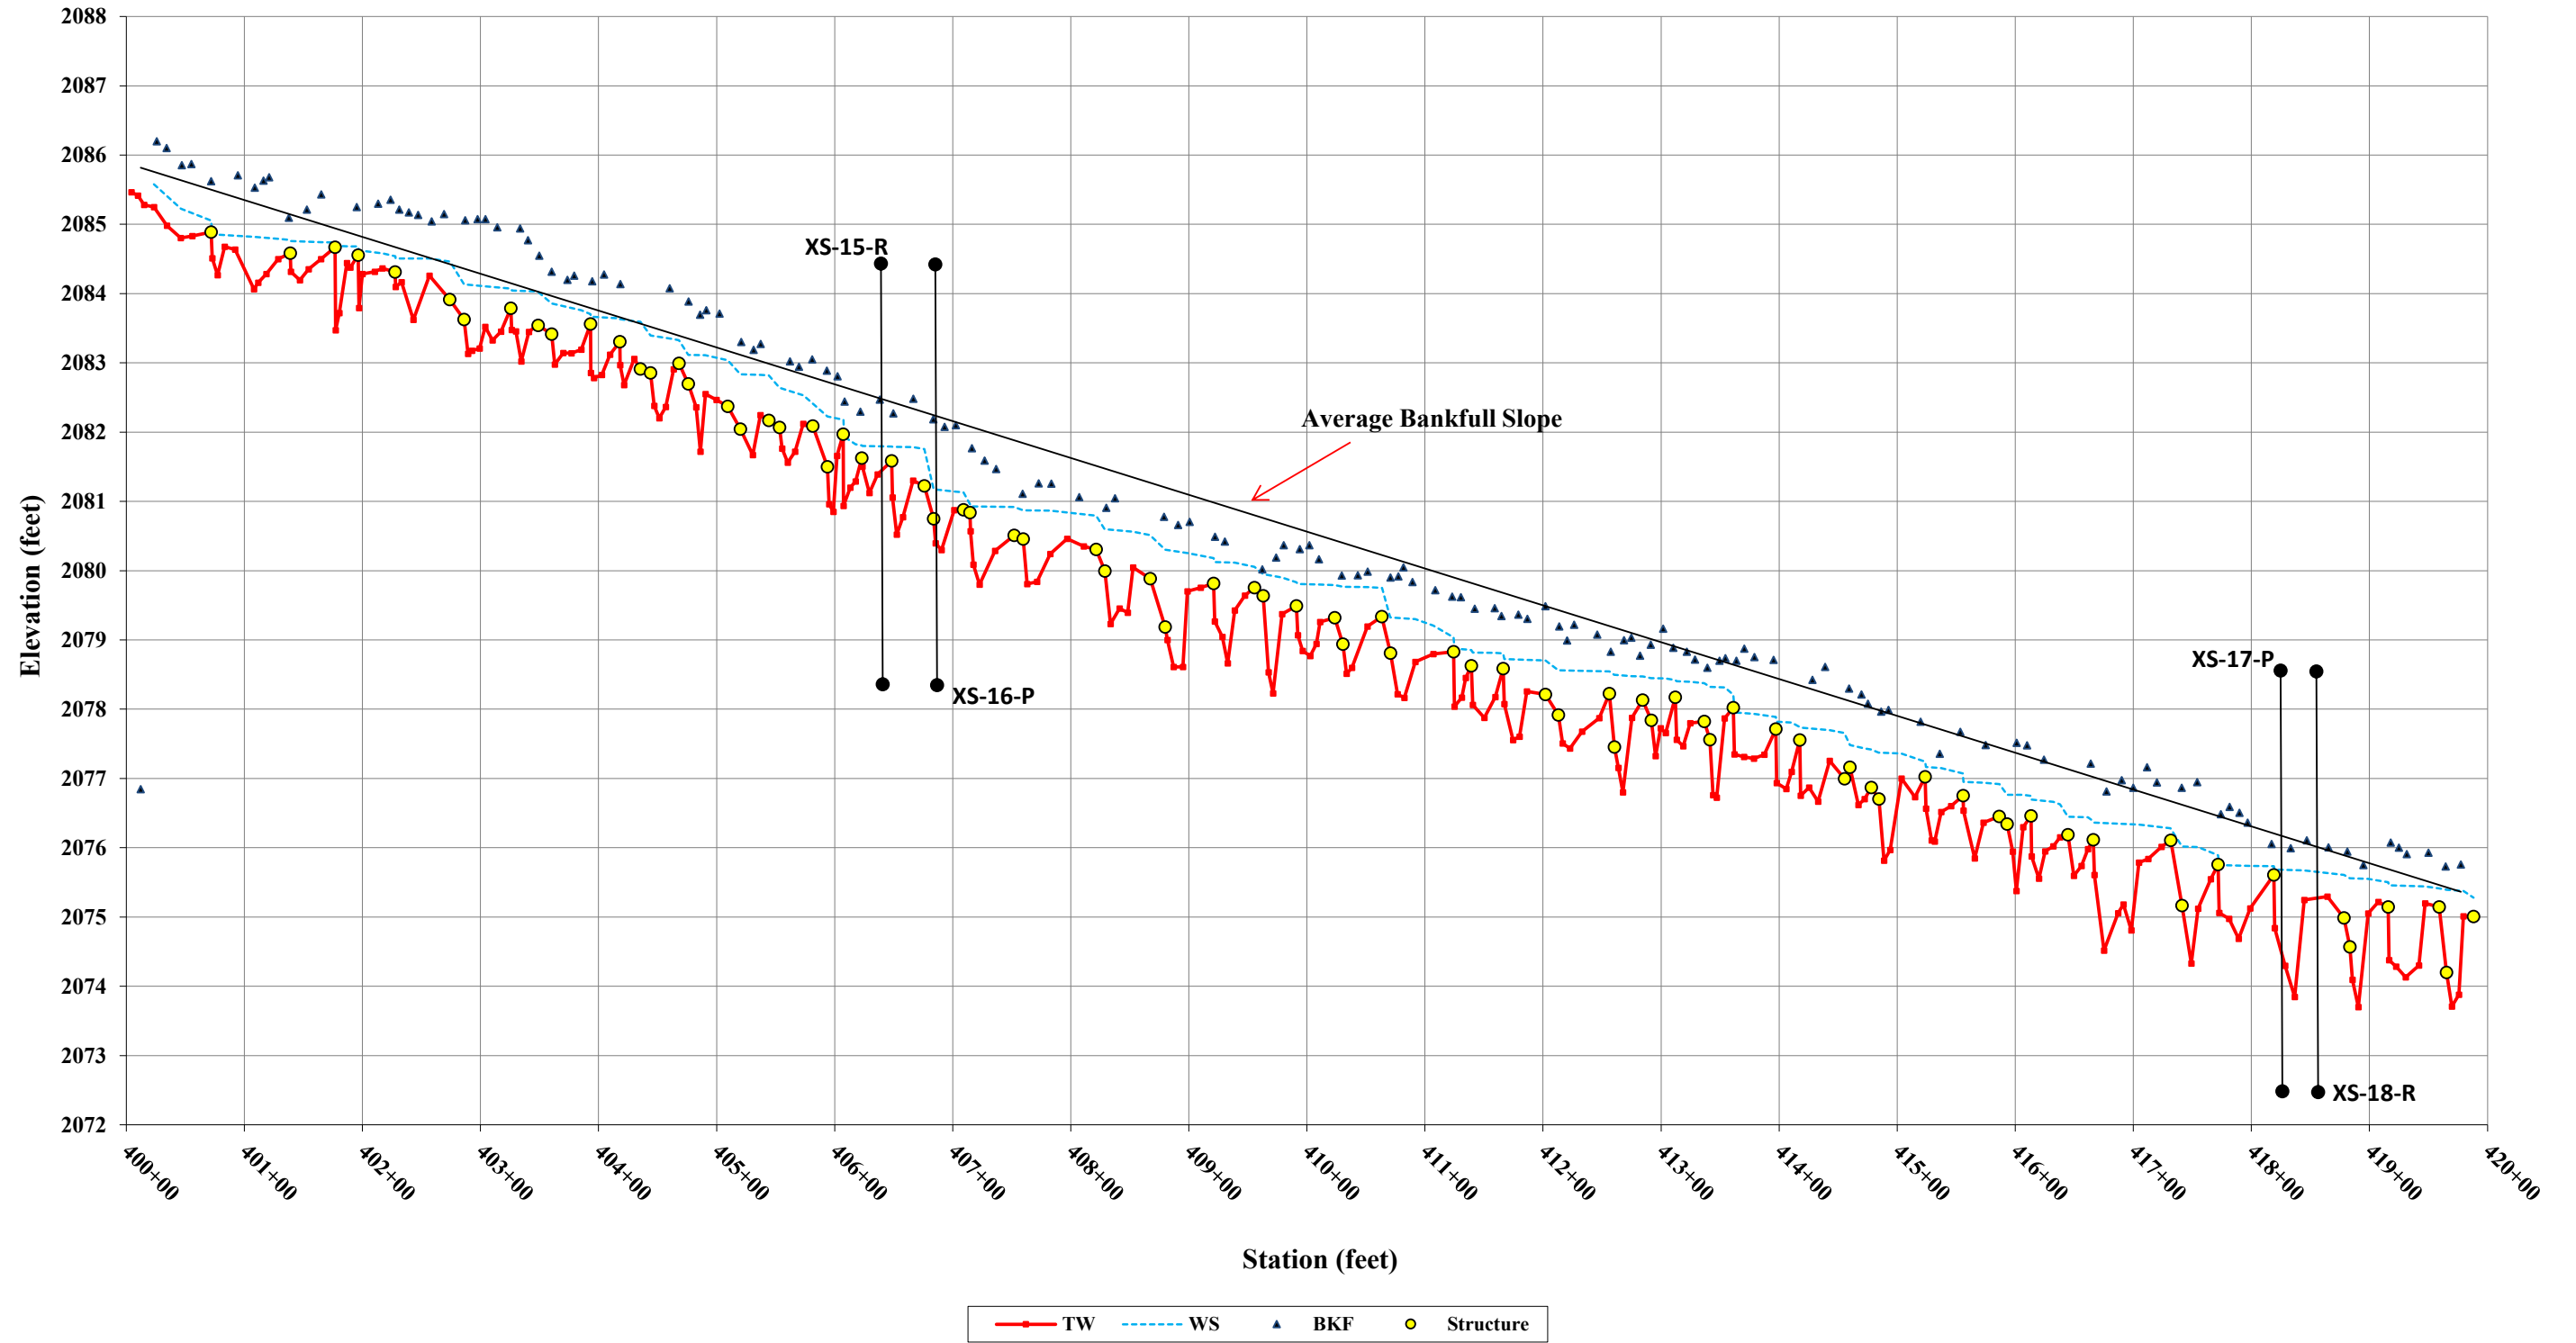


Fletcher Mitigation Site - Weston Creek 1B
 Longitudinal Profile
 Stationing 419+83 to 427+87

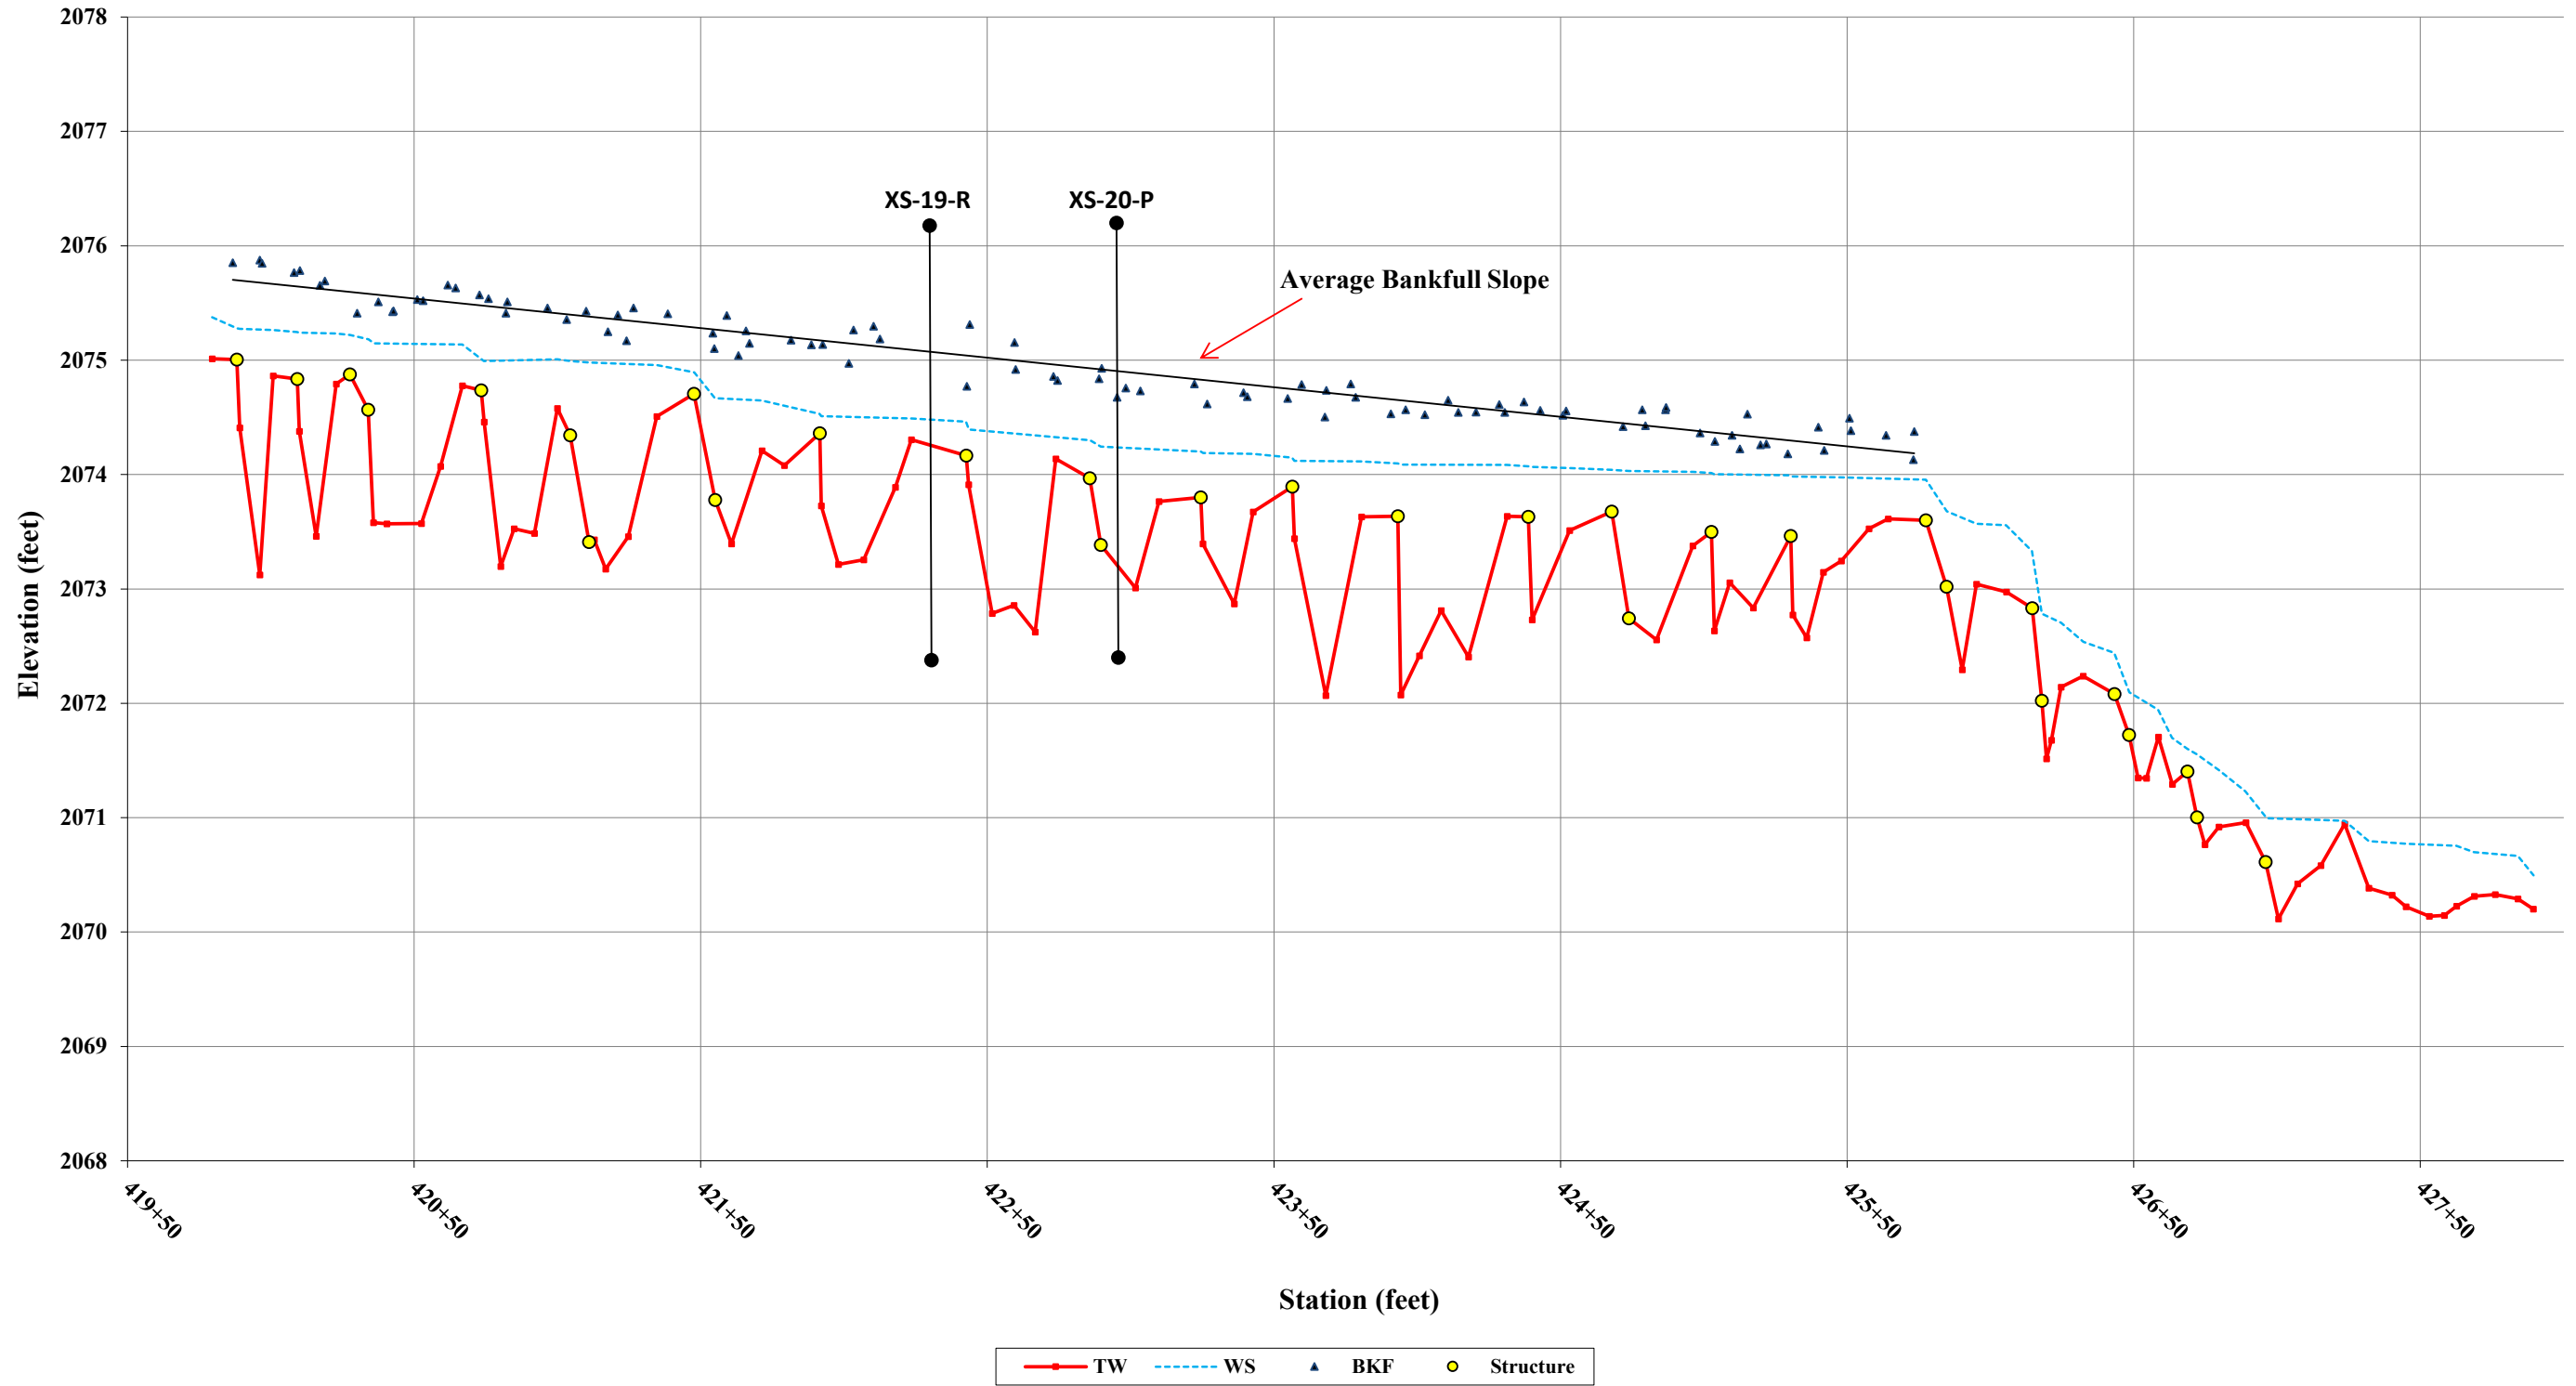


Fletcher Mitigation Site - Raccoon Branch 1D
 Longitudinal Profile
 Stationing 214+92 to 219+40

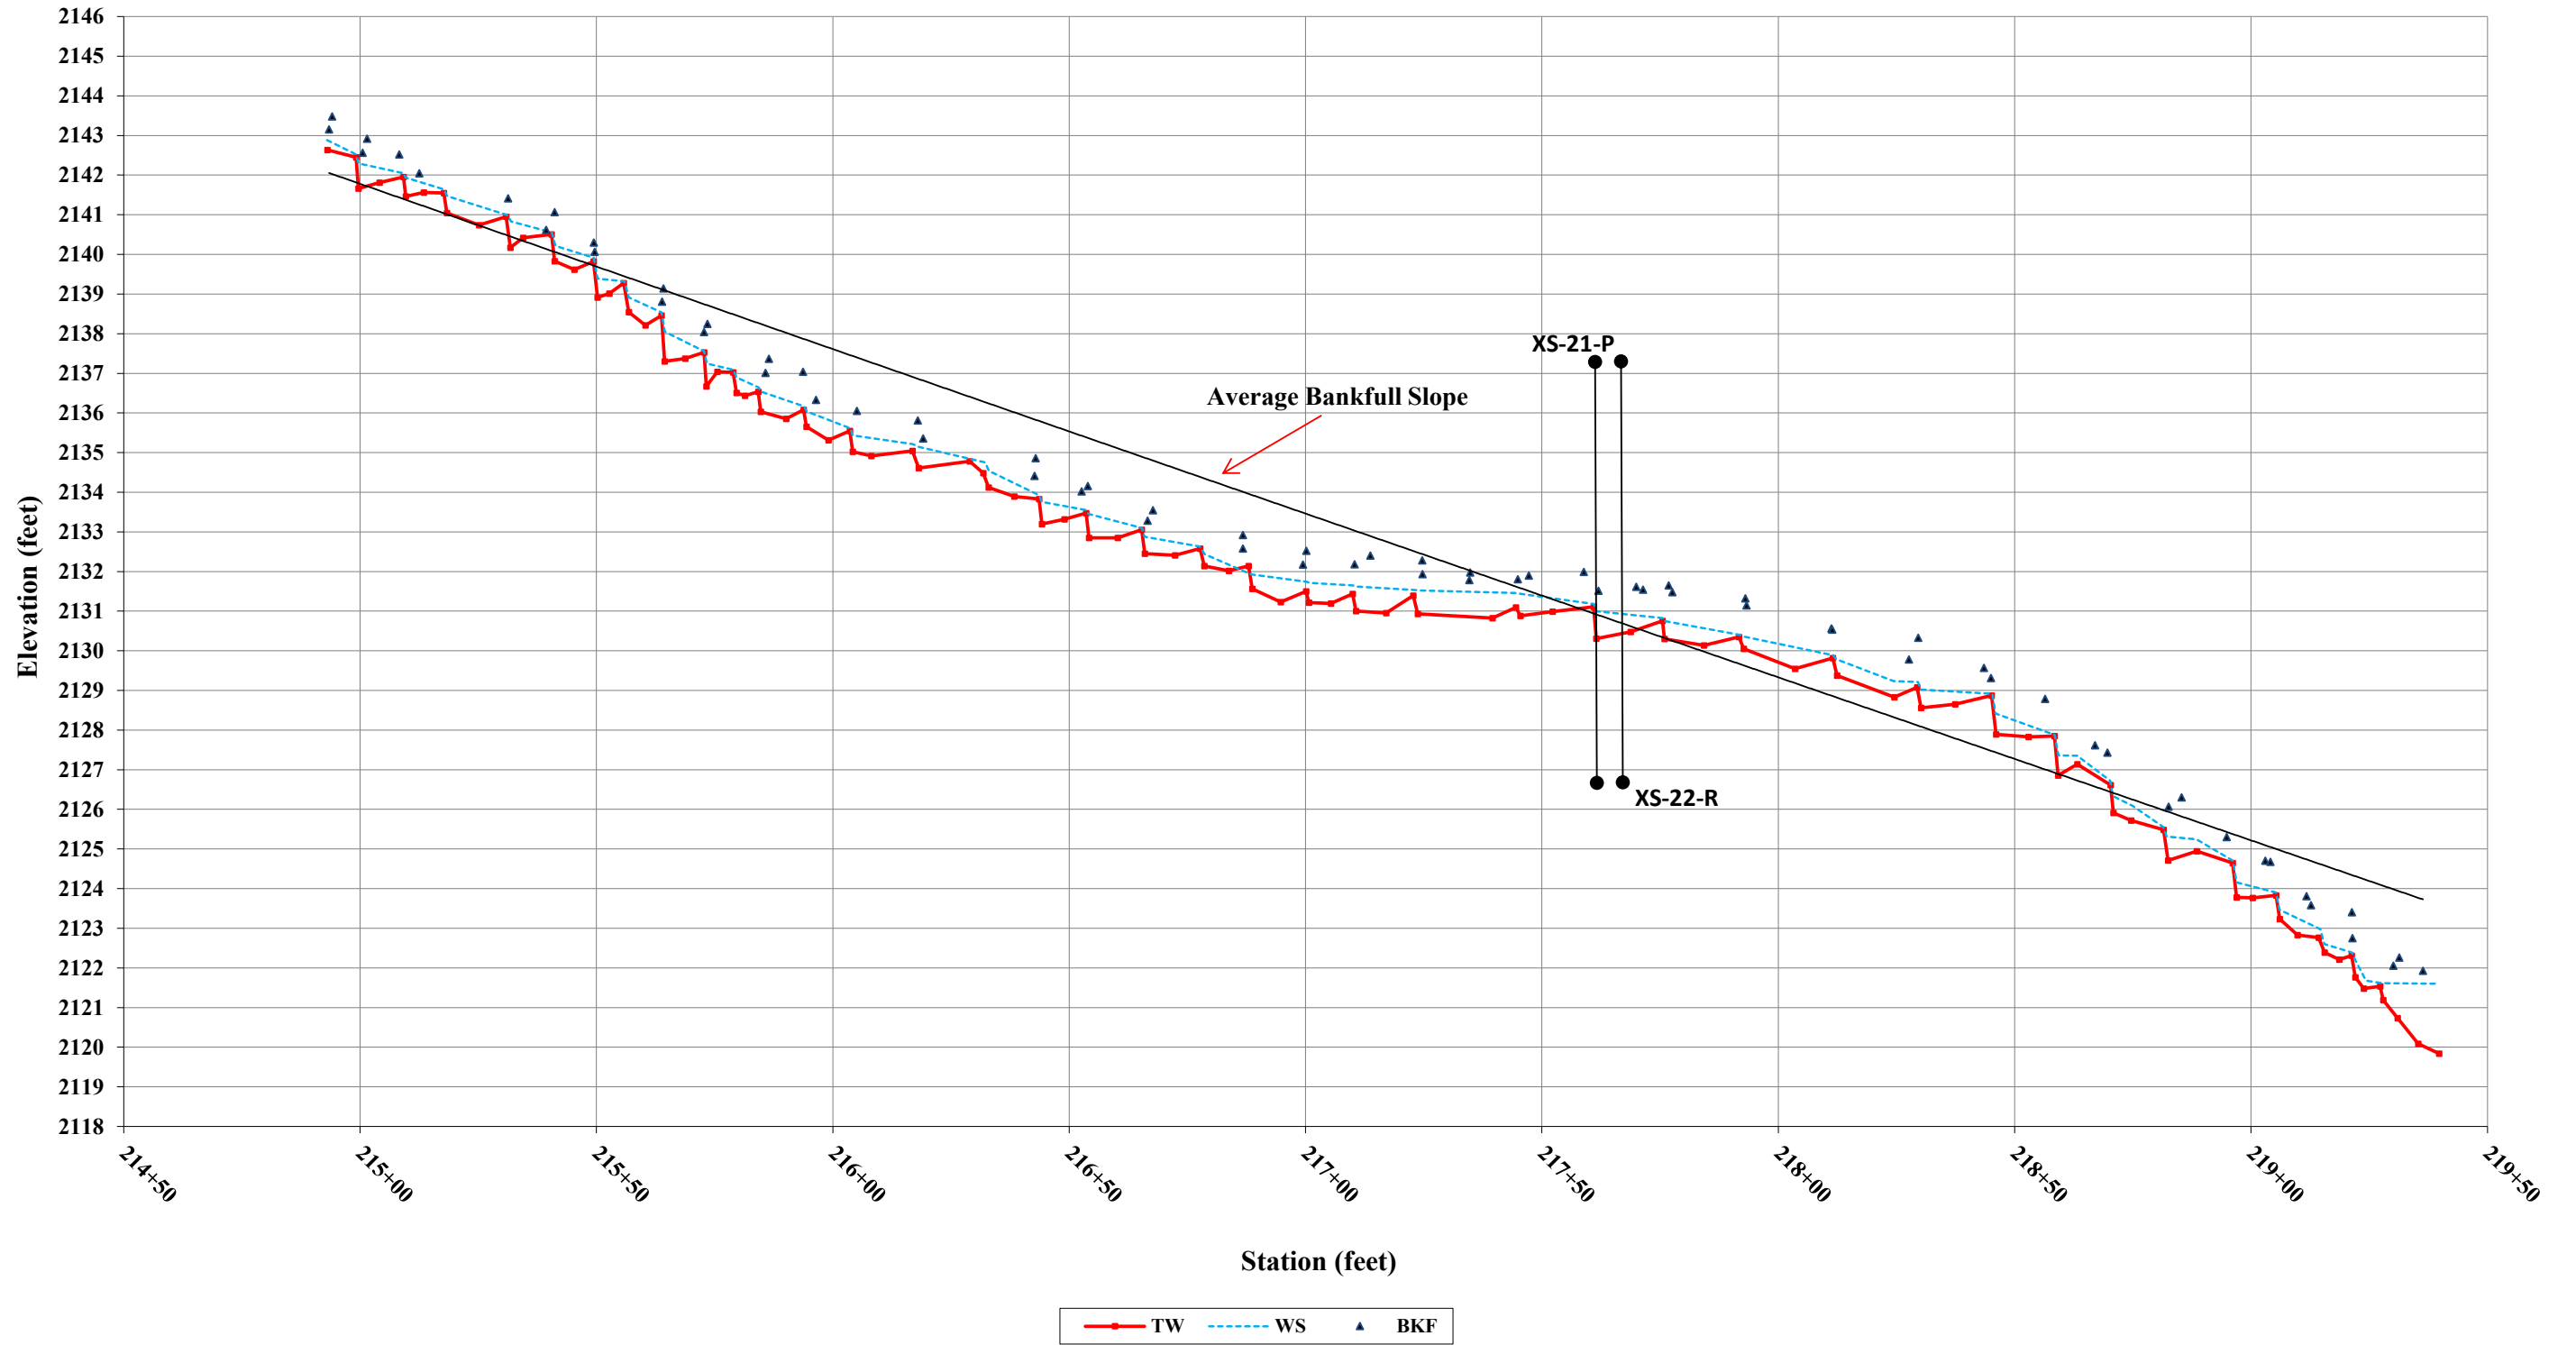


**Fletcher Mitigation Site - Coats Branch 1B
Longitudinal Profile
Stationing 302+92 to 308+98**

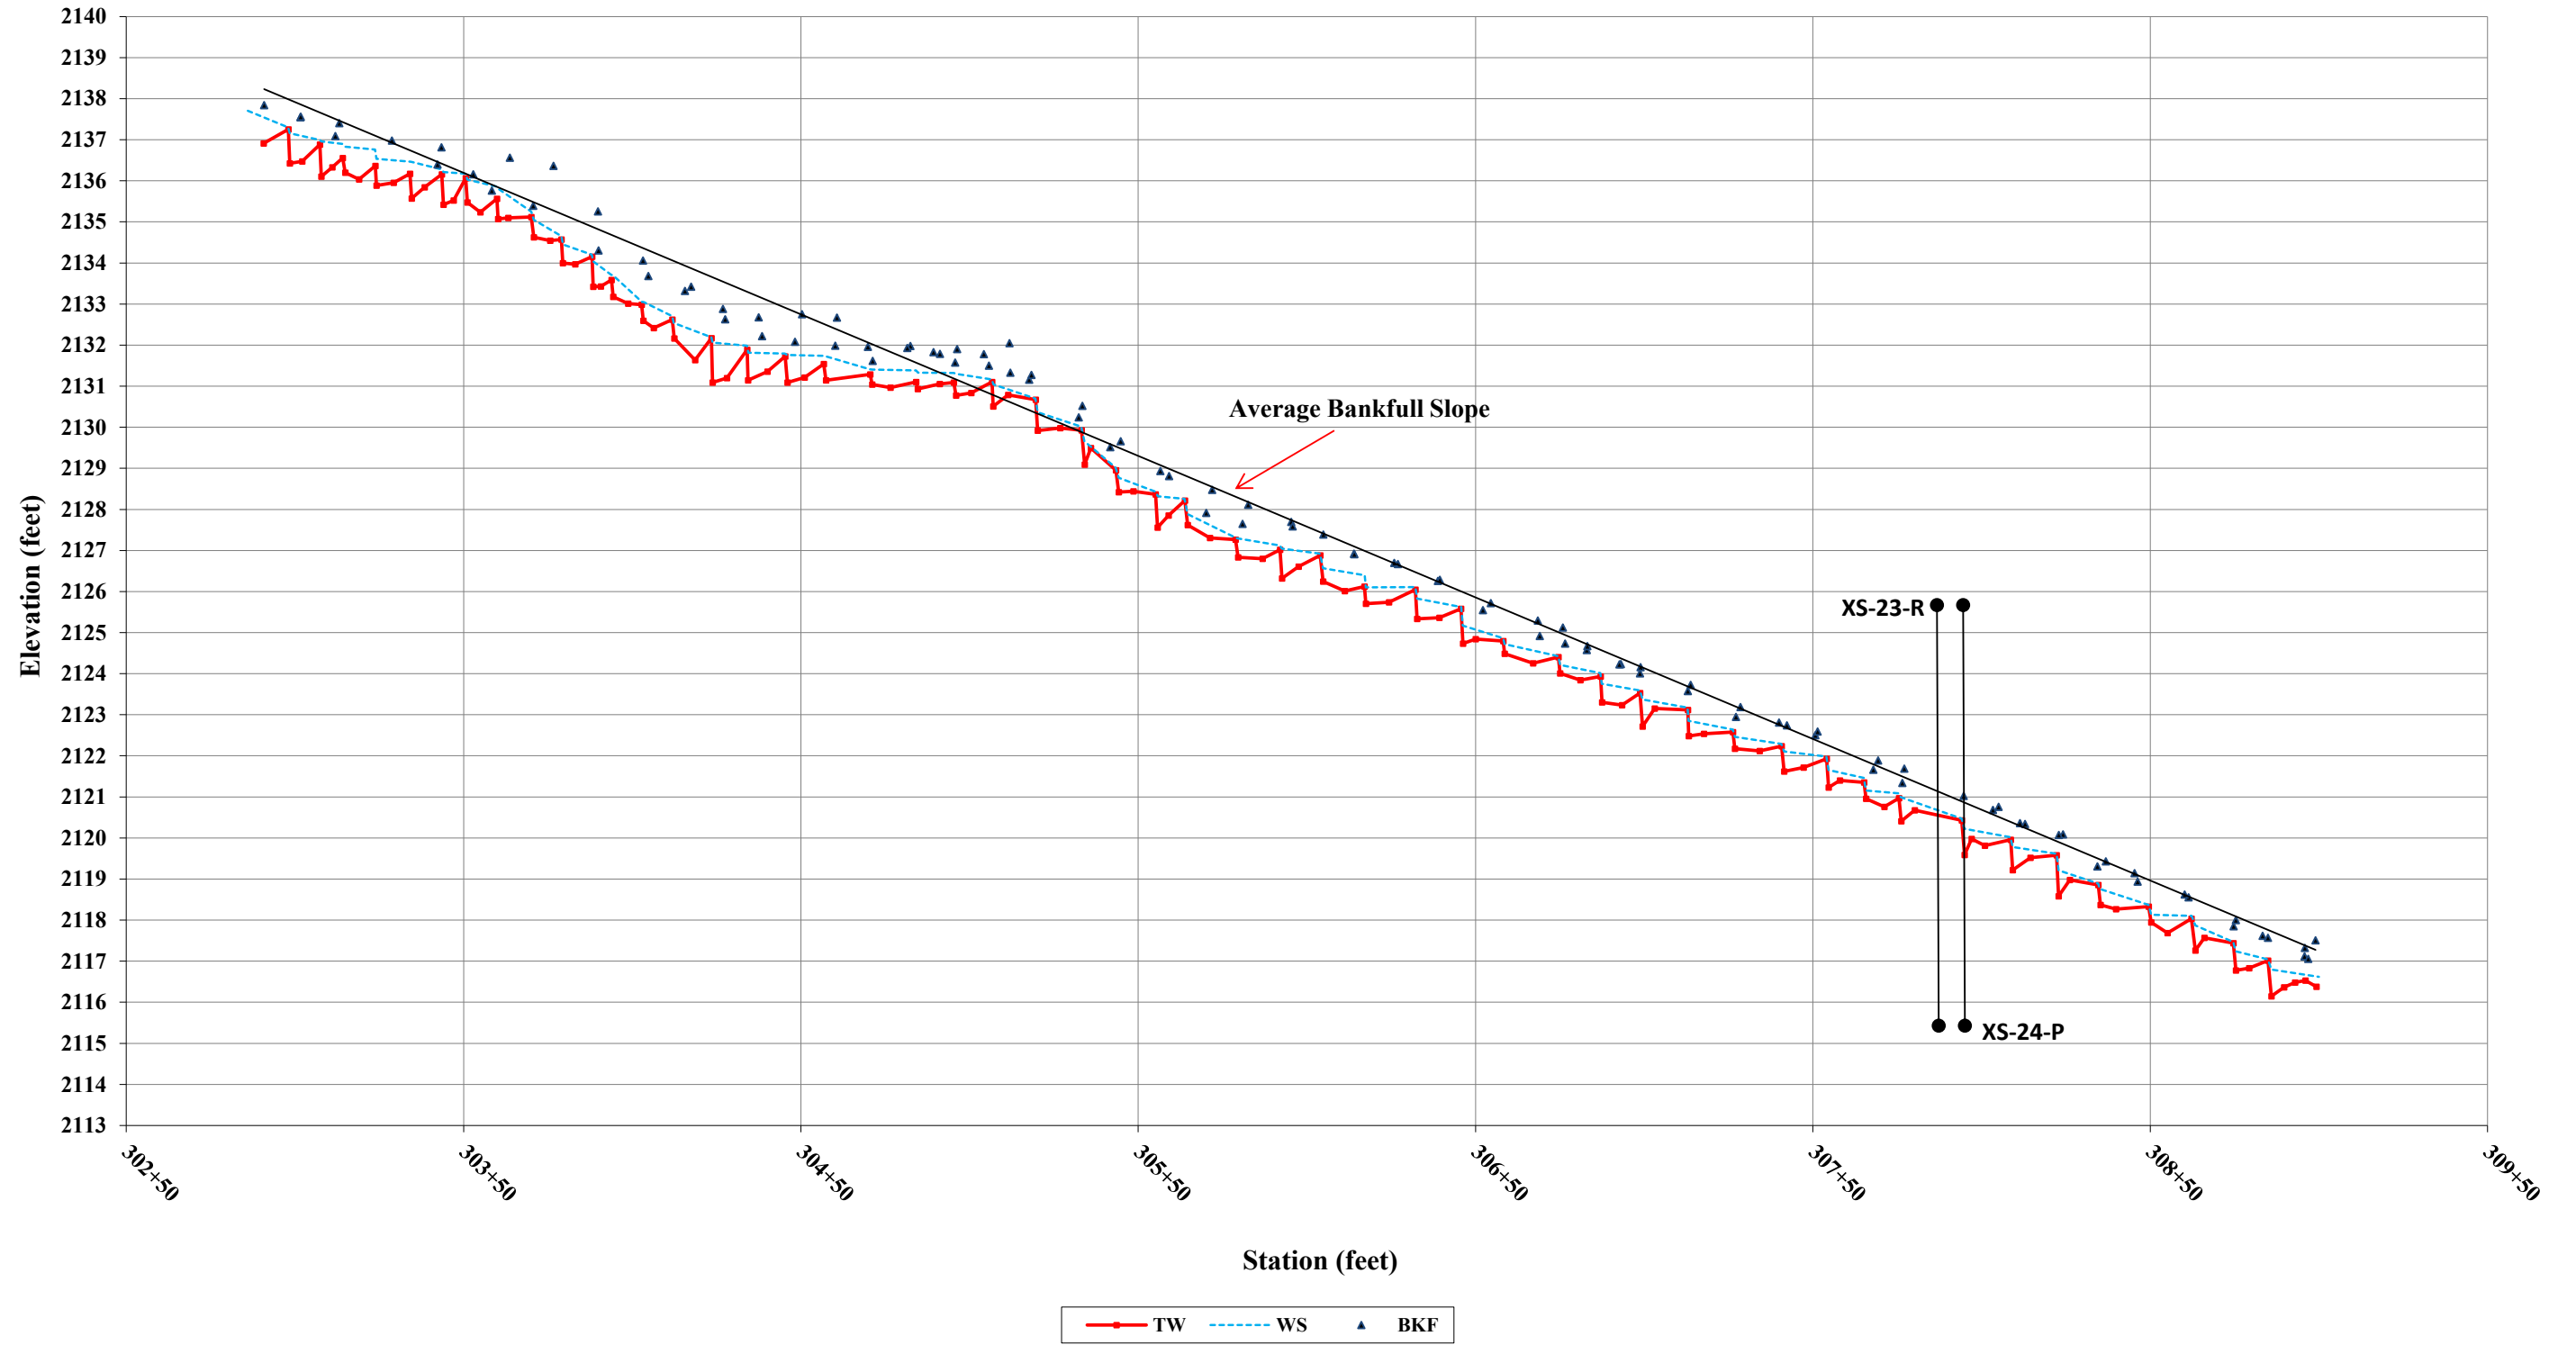



Fletcher Mitigation Site - Coats Branch 1C
Longitudinal Profile
Stationing 308+98 to 316+50

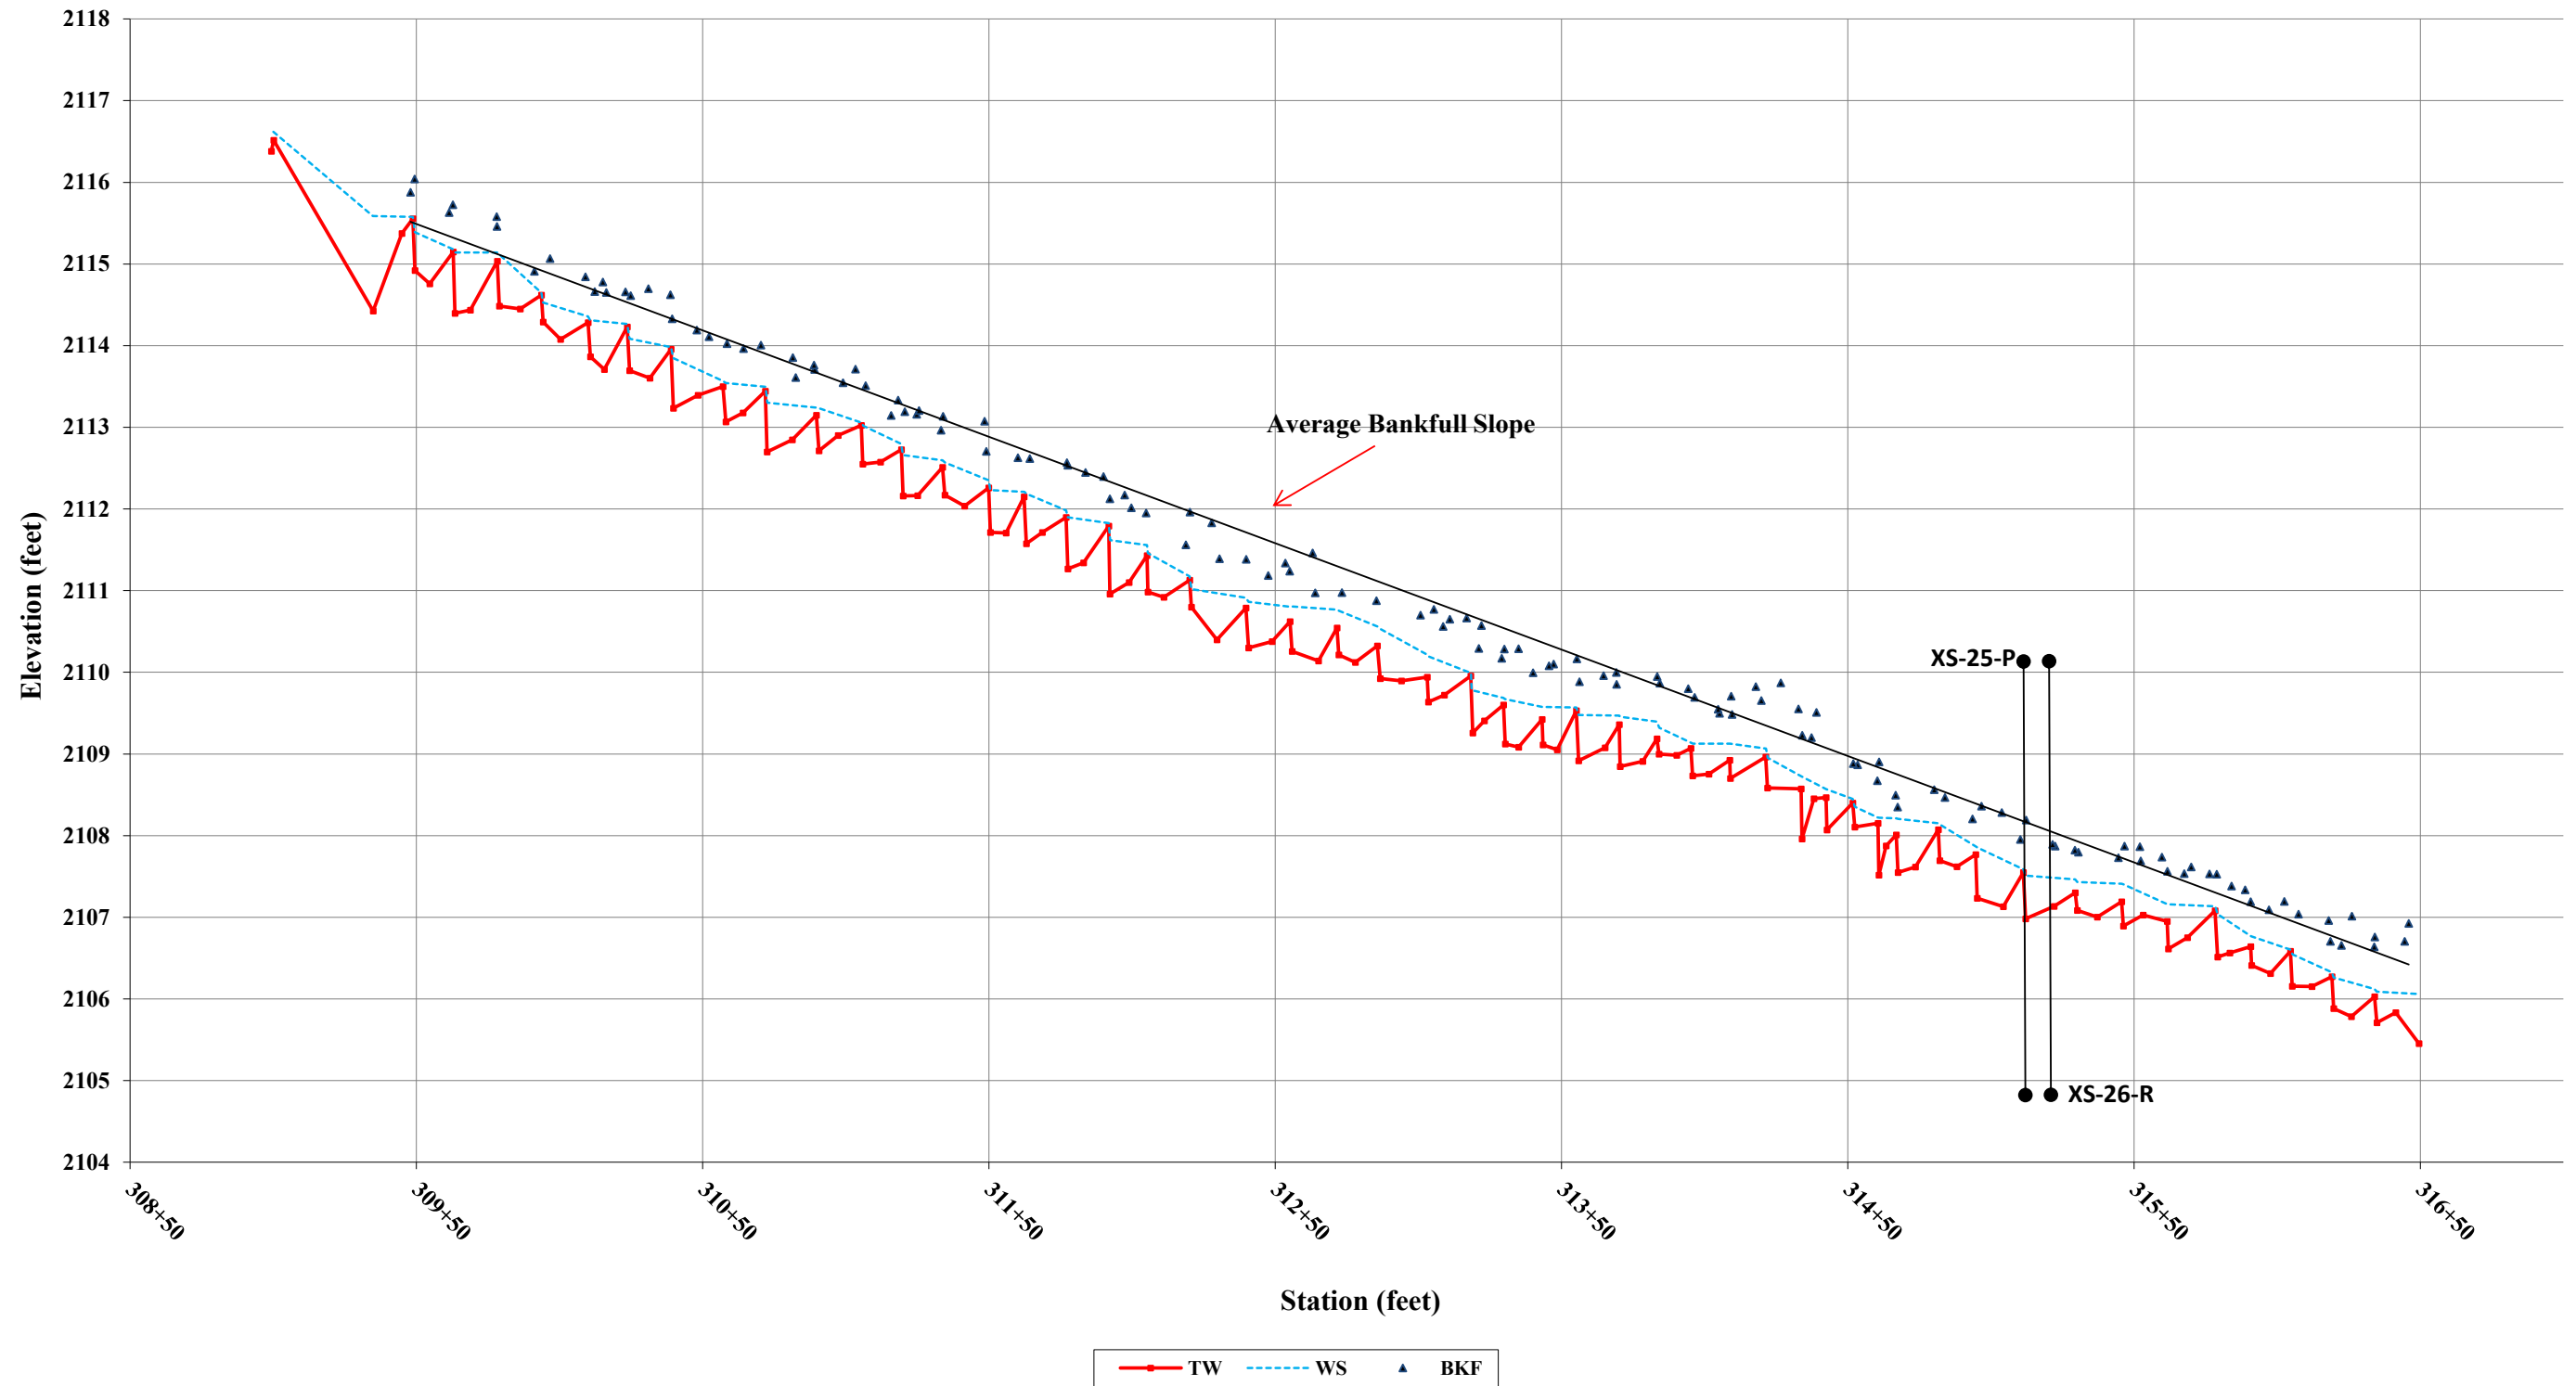



**Fletcher Mitigation Site - Coats Branch 1D
Longitudinal Profile
Stationing 316+50 to 319+75**

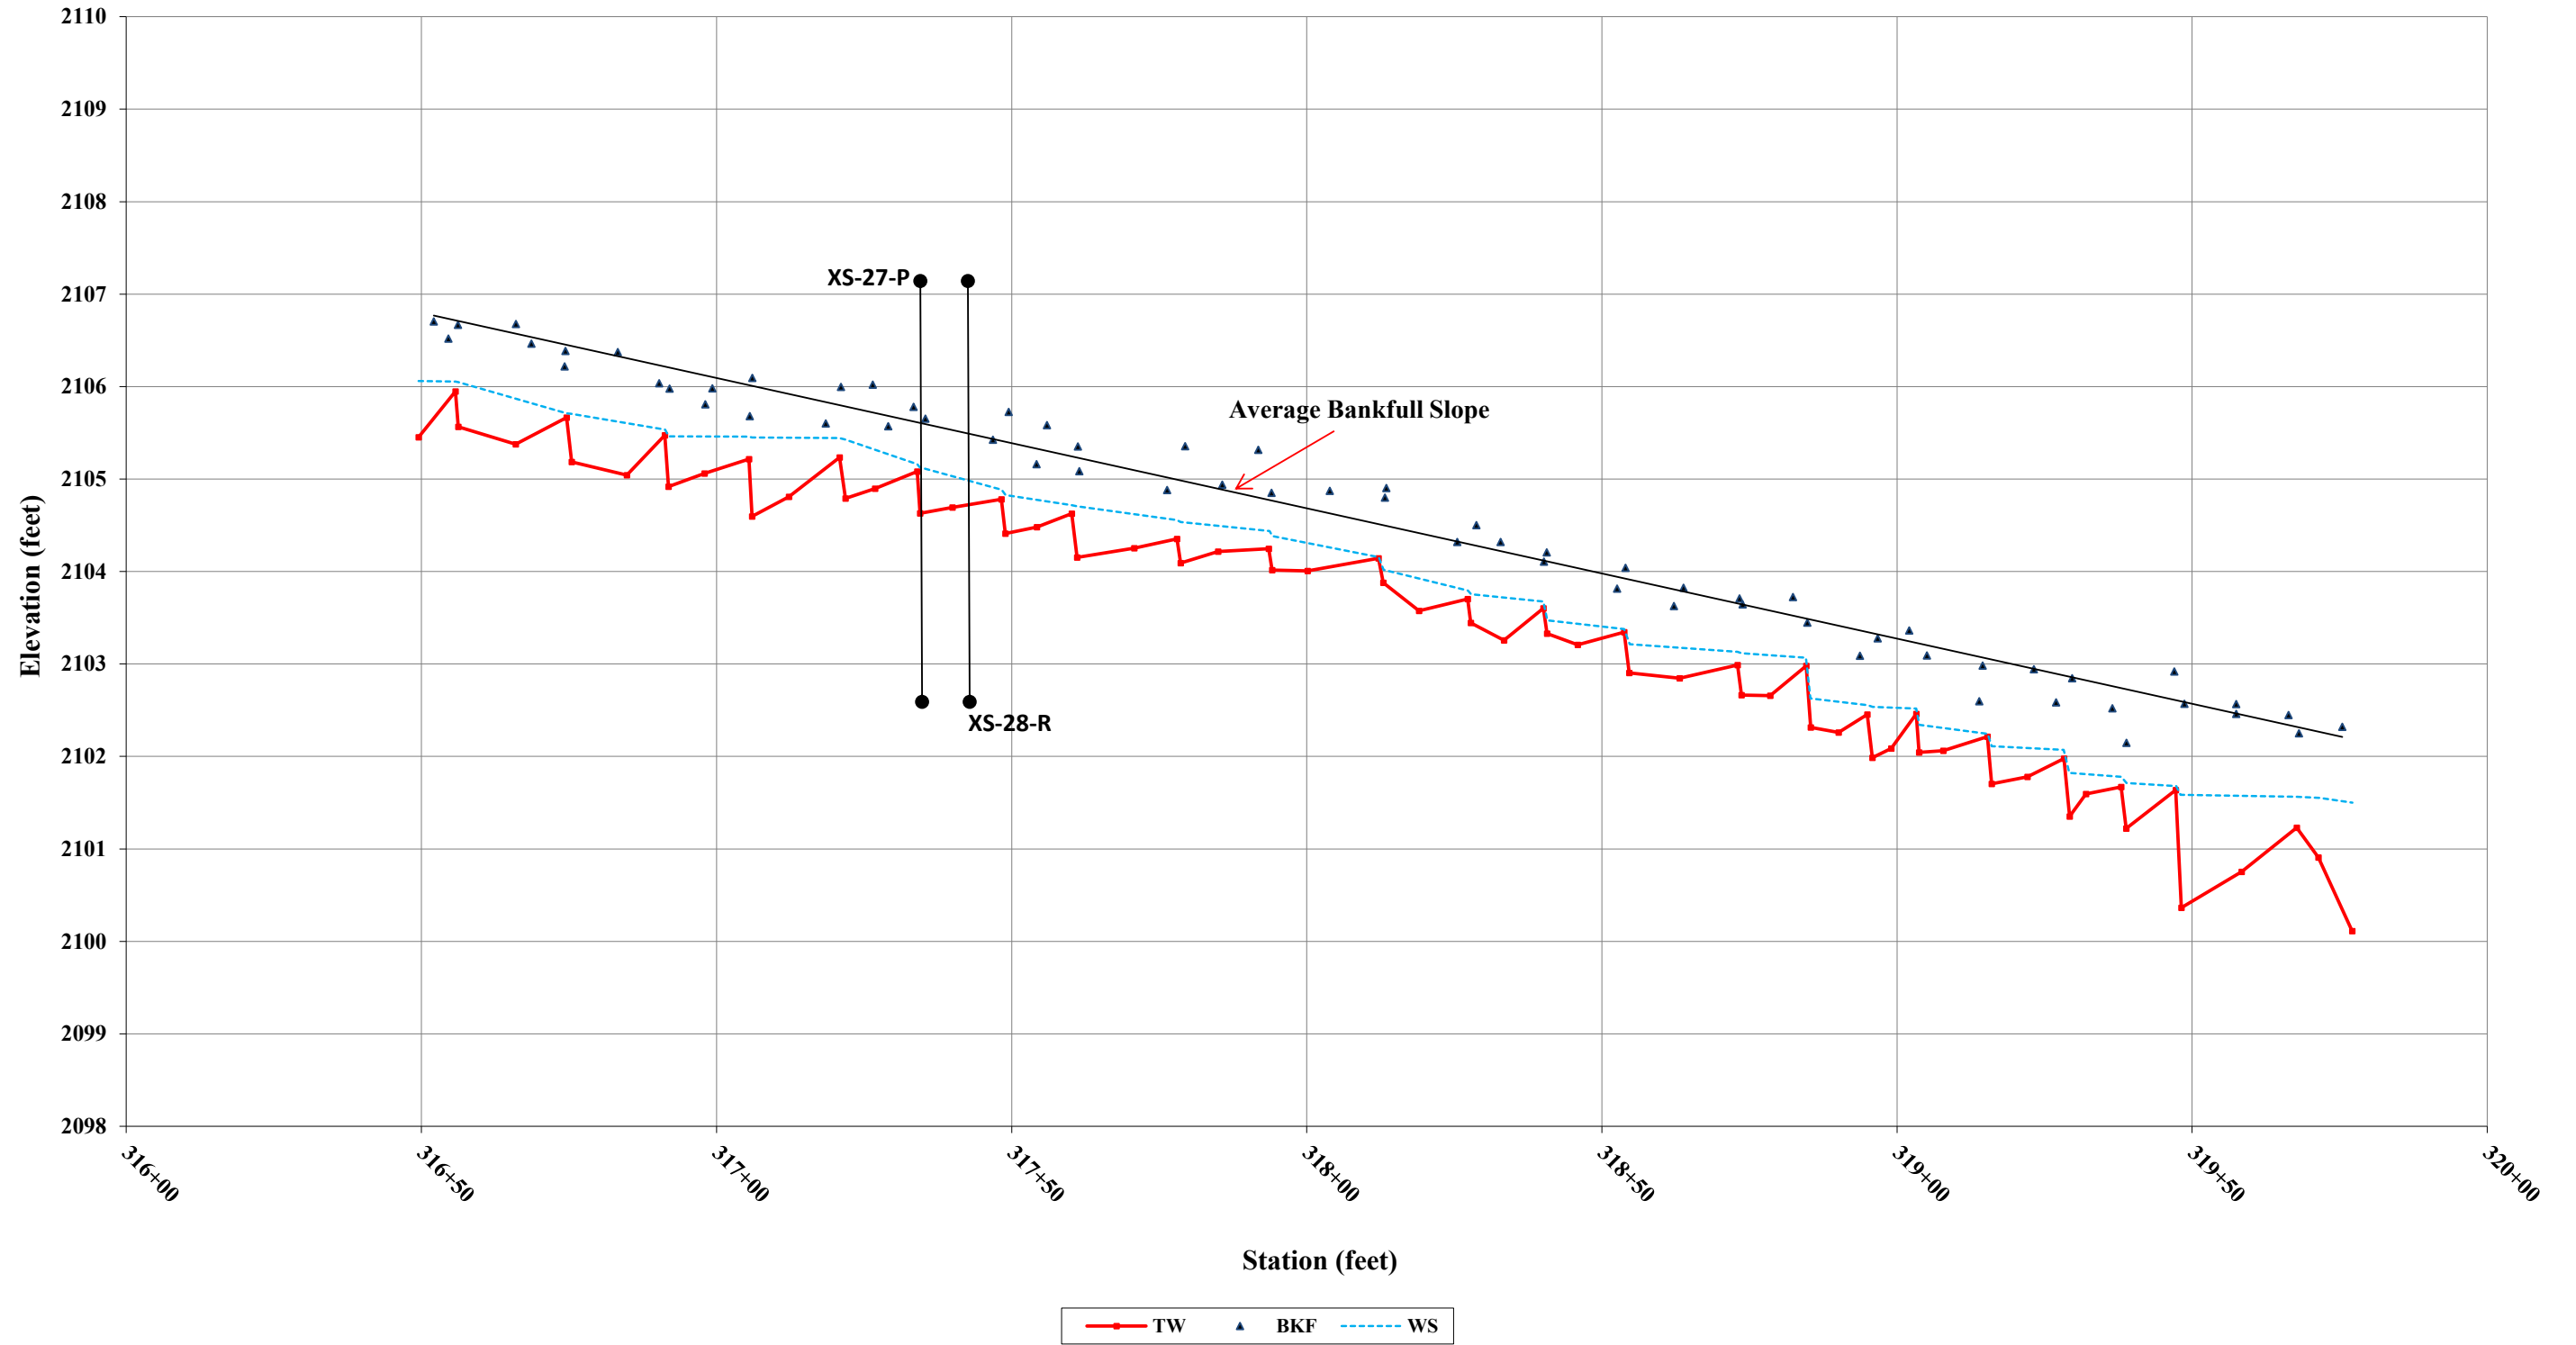



Fletcher Mitigation Site			
Cross Section 1 - Riffle			
Monitoring Year - 2019; MY0			
Bed Surface Material Particle Size Class (mm)	Number	% Individual	% Cumulative
0 - 0.062	0	0.0%	0%
0.062 - 0.125	0	0.0%	0%
0.125 - 0.25	0	0.0%	0%
0.25 - 0.5	0	0.0%	0%
0.5 - 1.0	3	2.9%	3%
1 - 2	11	10.5%	13%
2 - 4	6	5.7%	19%
4 - 8	17	16.2%	35%
8 - 16	27	25.7%	61%
16 - 32	22	21.0%	82%
32 - 64	18	17.1%	99%
64-128	1	1.0%	100%
128-256	0	0.0%	100%
256-512	0	0.0%	100%
512-1024	0	0.0%	100%
1024-2048	0	0.0%	100%
2048-4096	0	0.0%	100%
Bedrock	0	0.0%	100%
Total	105	100%	100%
		Summary Data	
		D50	12
		D84	34
		D95	50

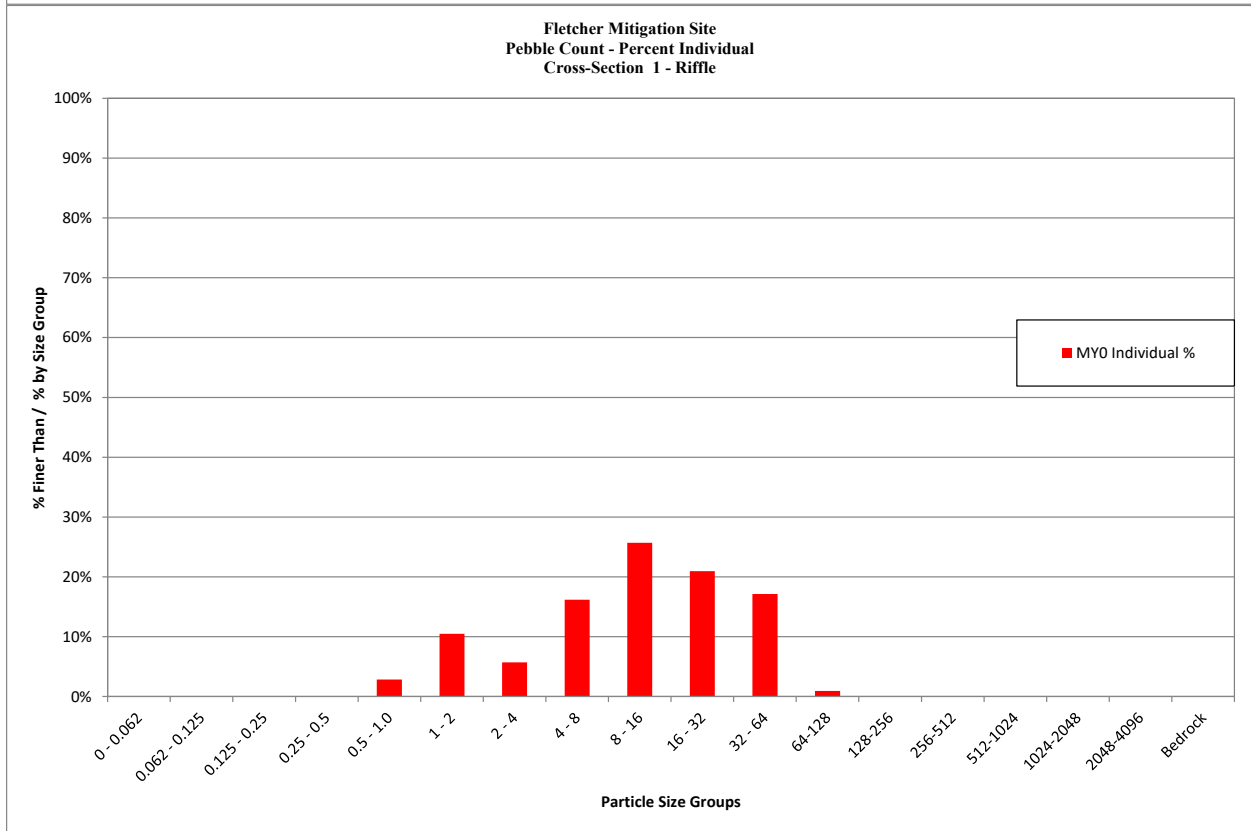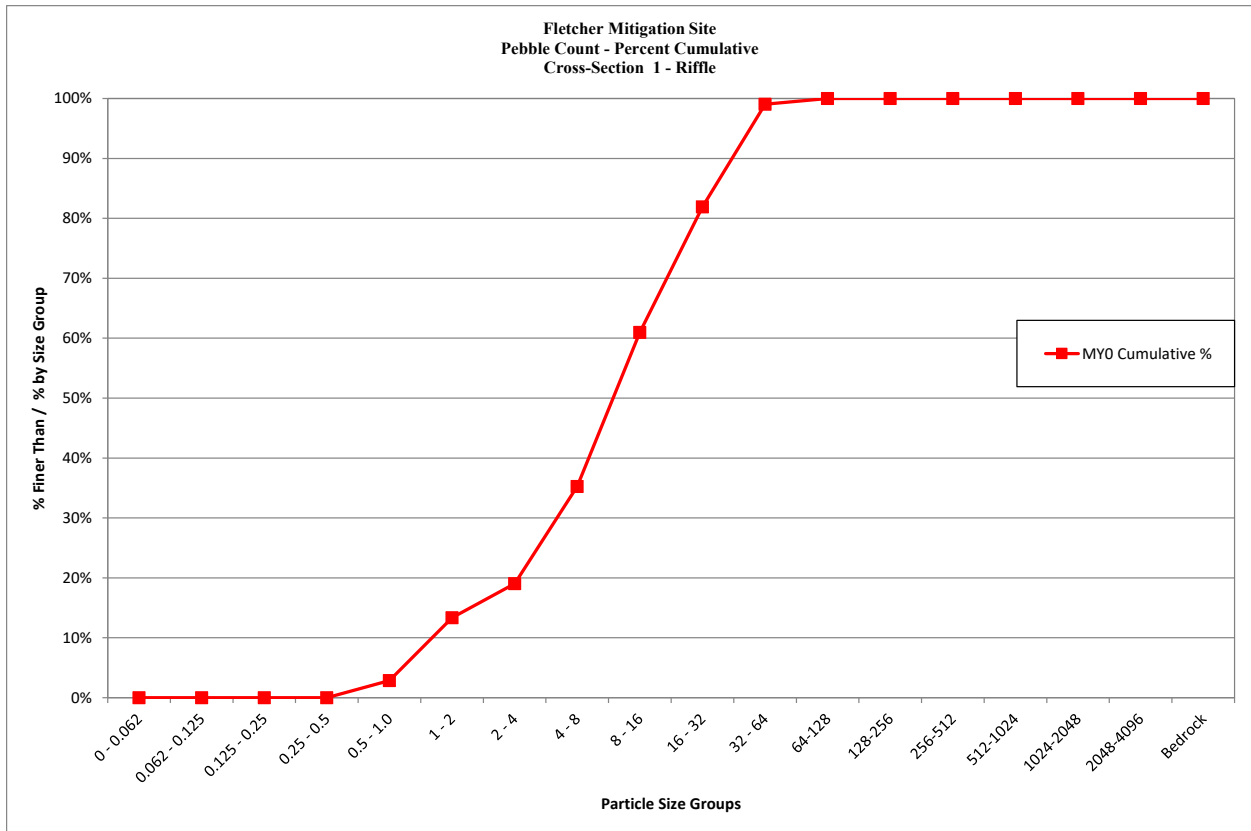



Fletcher Mitigation Site			
Cross Section 4 - Riffle			
Monitoring Year - 2019; MY0			
Bed Surface Material Particle Size Class (mm)	Number	% Individual	% Cumulative
0 - 0.062	5	4.8%	5%
0.062 - 0.125	2	1.9%	7%
0.125 - 0.25	0	0.0%	7%
0.25 - 0.5	1	1.0%	8%
0.5 - 1.0	1	1.0%	9%
1 - 2	13	12.4%	21%
2 - 4	3	2.9%	24%
4 - 8	9	8.6%	32%
8 - 16	14	13.3%	46%
16 - 32	17	16.2%	62%
32 - 64	38	36.2%	98%
64-128	1	1.0%	99%
128-256	1	1.0%	100%
256-512	0	0.0%	100%
512-1024	0	0.0%	100%
1024-2048	0	0.0%	100%
2048-4096	0	0.0%	100%
Bedrock	0	0.0%	100%
Total	105	100%	100%
		Summary Data	
		D50	18
		D84	49
		D95	60

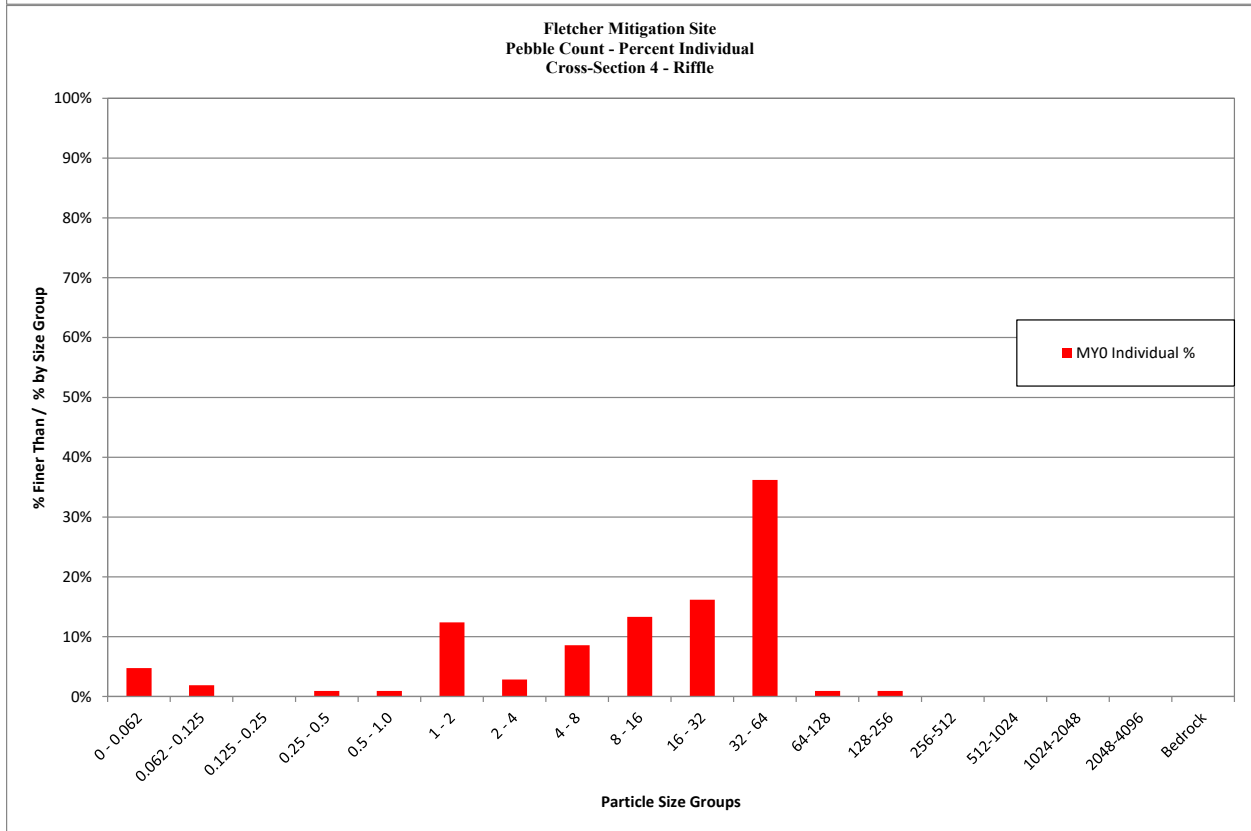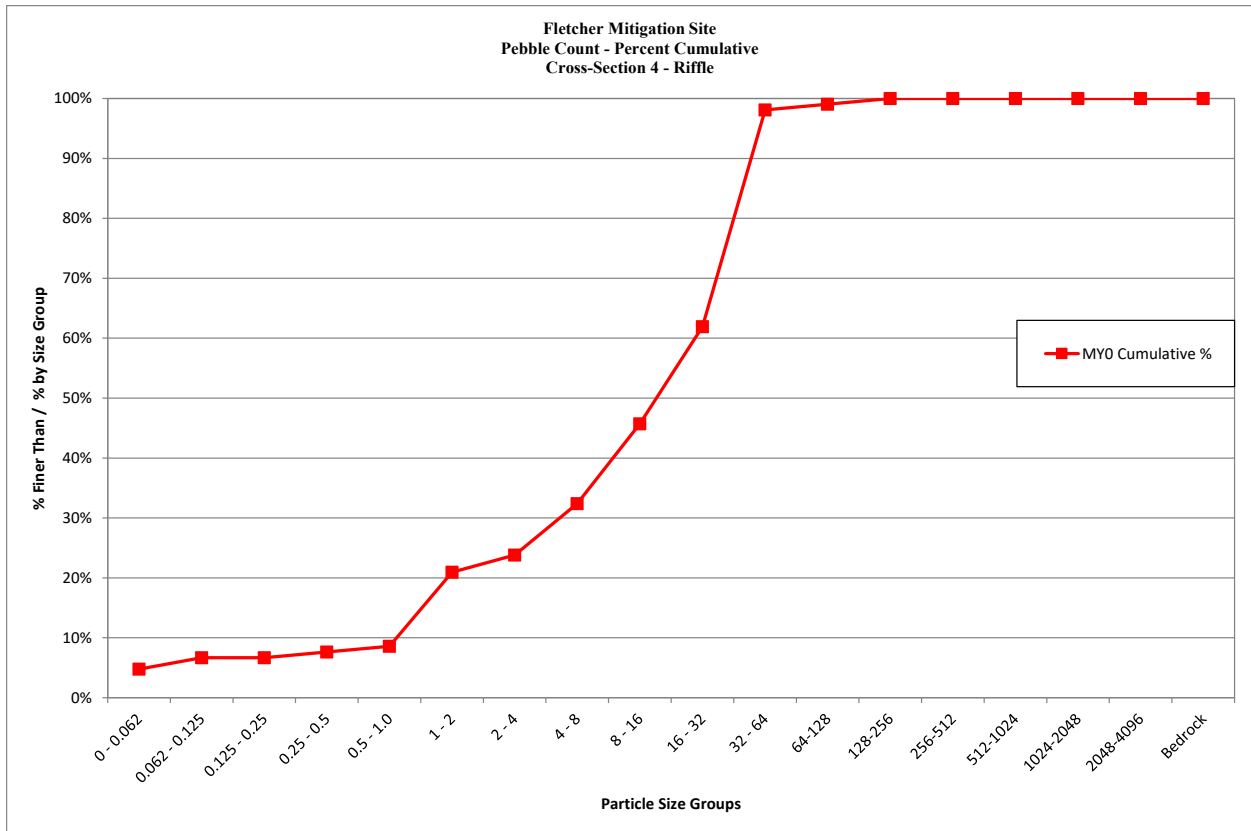



Fletcher Mitigation Site			
Cross Section 6 - Riffle			
Monitoring Year - 2019; MY0			
Bed Surface Material Particle Size Class (mm)	Number	% Individual	% Cumulative
0 - 0.062	0	0.0%	0%
0.062 - 0.125	0	0.0%	0%
0.125 - 0.25	0	0.0%	0%
0.25 - 0.5	0	0.0%	0%
0.5 - 1.0	0	0.0%	0%
1 - 2	3	2.9%	3%
2 - 4	3	2.9%	6%
4 - 8	7	6.7%	12%
8 - 16	31	29.5%	42%
16 - 32	26	24.8%	67%
32 - 64	30	28.6%	95%
64-128	4	3.8%	99%
128-256	1	1.0%	100%
256-512	0	0.0%	100%
512-1024	0	0.0%	100%
1024-2048	0	0.0%	100%
2048-4096	0	0.0%	100%
Bedrock	0	0.0%	100%
Total	105	100%	100%
		Summary Data	
		D50	19
		D84	46
		D95	64

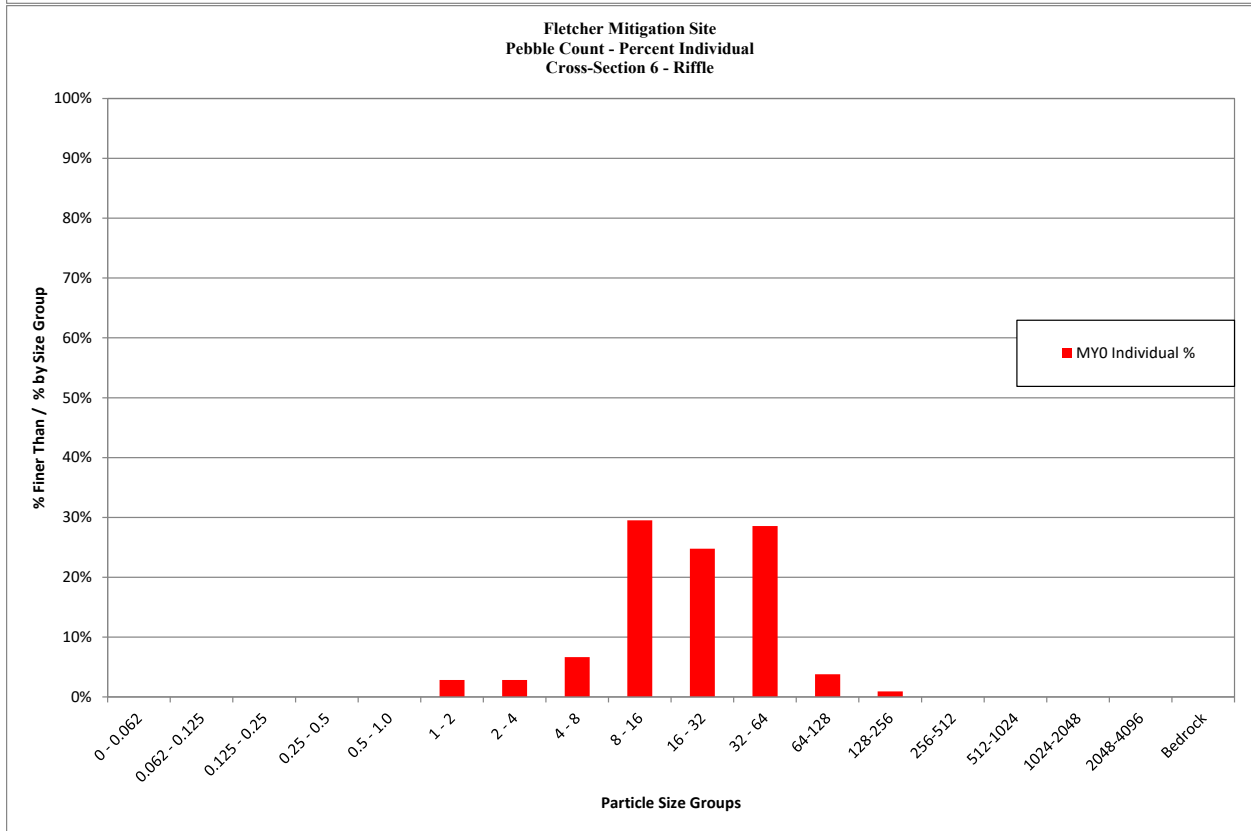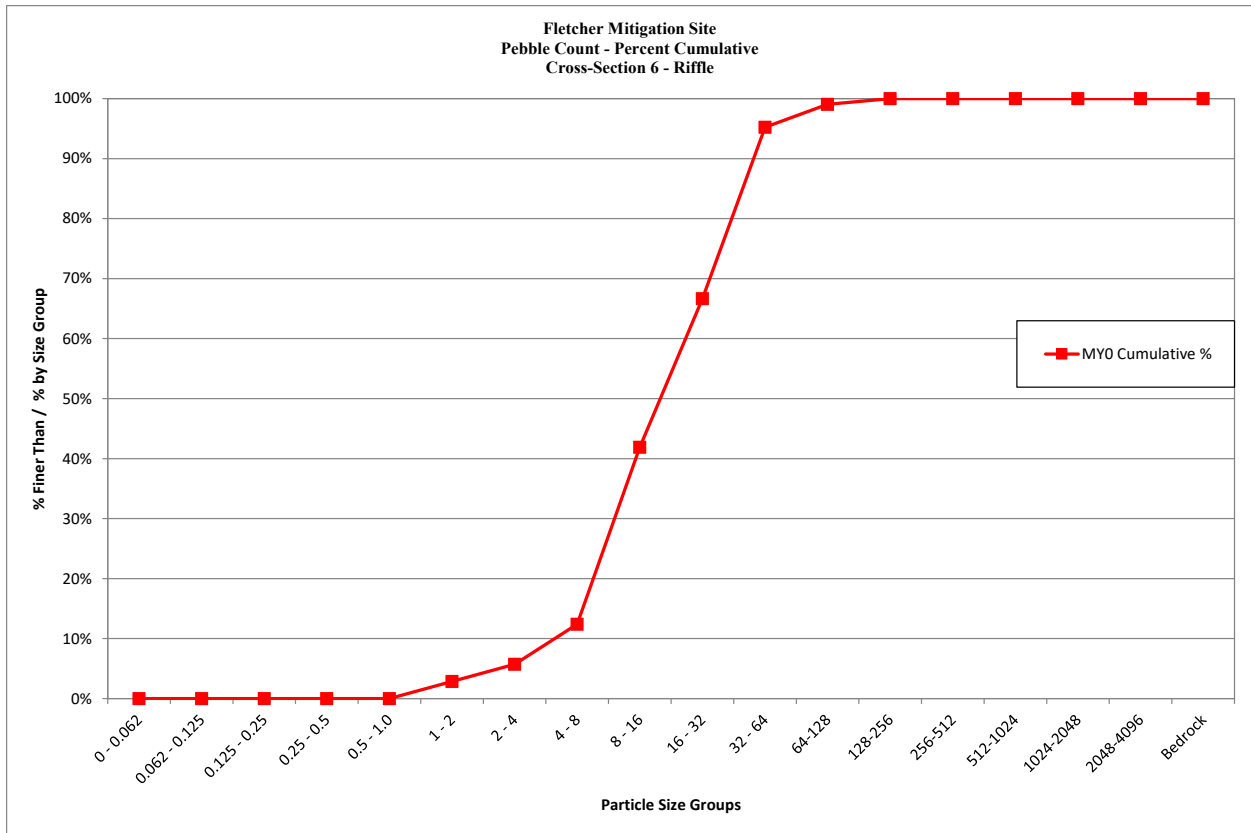



Fletcher Mitigation Site			
Cross Section 7 - Riffle			
Monitoring Year - 2019; MY0			
Bed Surface Material Particle Size Class (mm)	Number	% Individual	% Cumulative
0 - 0.062	0	0.0%	0%
0.062 - 0.125	0	0.0%	0%
0.125 - 0.25	0	0.0%	0%
0.25 - 0.5	0	0.0%	0%
0.5 - 1.0	0	0.0%	0%
1 - 2	4	3.8%	4%
2 - 4	4	3.8%	8%
4 - 8	11	10.5%	18%
8 - 16	23	21.9%	40%
16 - 32	34	32.4%	72%
32 - 64	24	22.9%	95%
64-128	3	2.9%	98%
128-256	2	1.9%	100%
256-512	0	0.0%	100%
512-1024	0	0.0%	100%
1024-2048	0	0.0%	100%
2048-4096	0	0.0%	100%
Bedrock	0	0.0%	100%
Total	105	100%	100%
		Summary Data	
		D50	20
		D84	40
		D95	63

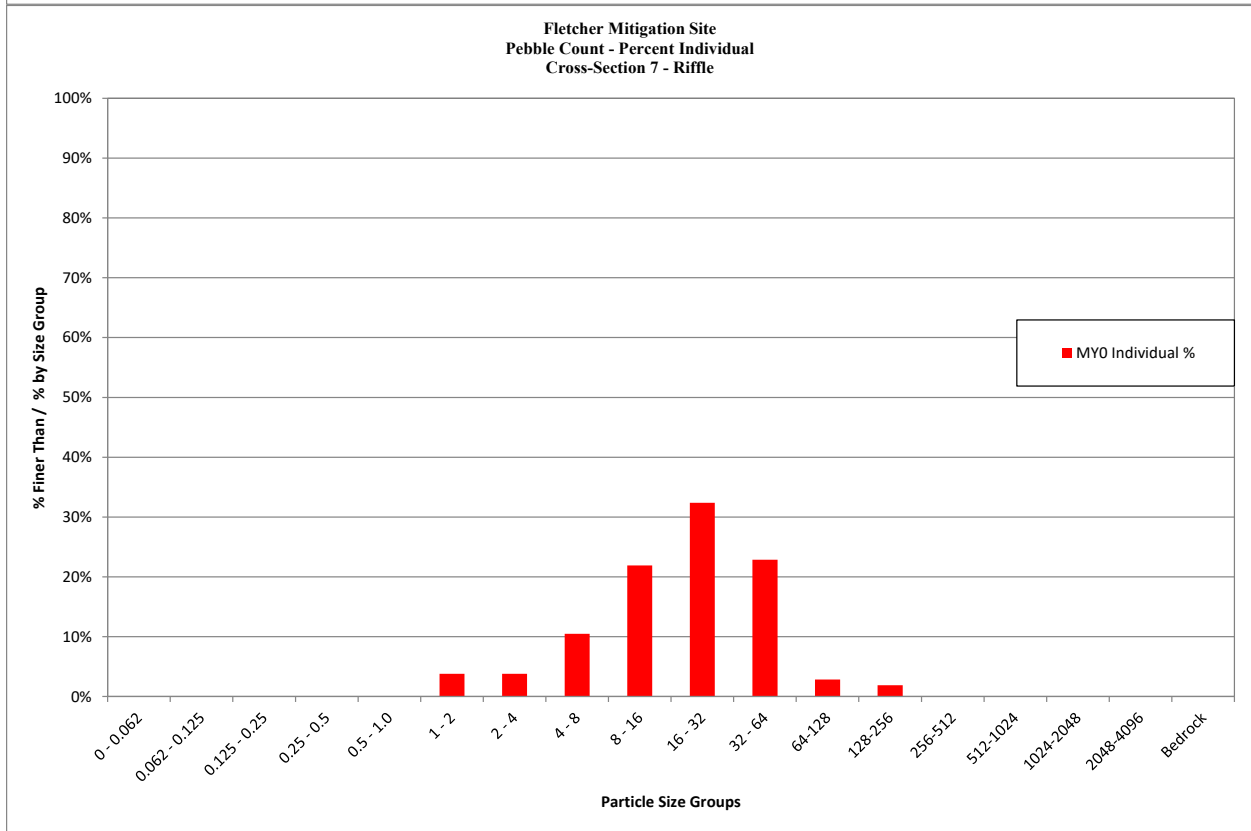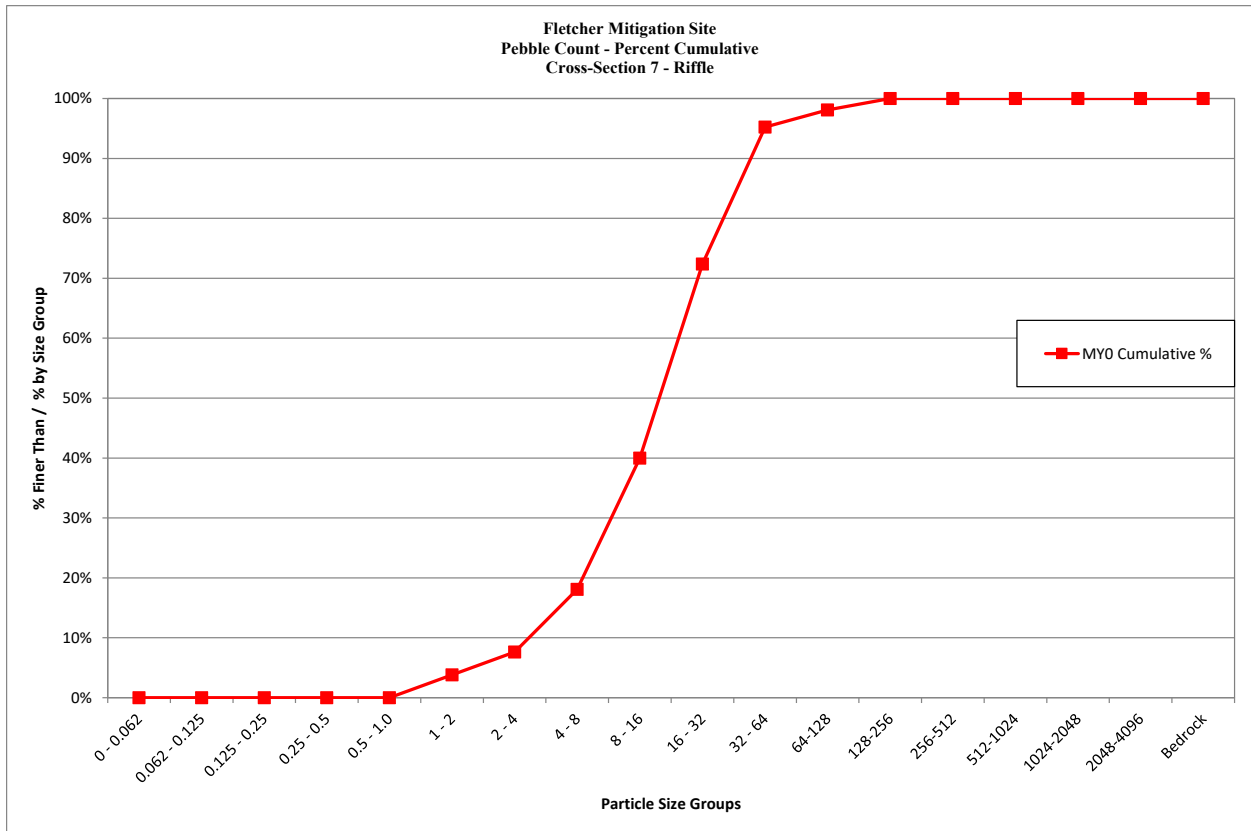



Fletcher Mitigation Site			
Cross Section 10 - Riffle			
Monitoring Year - 2019; MY0			
Bed Surface Material Particle Size Class (mm)	Number	% Individual	% Cumulative
0 - 0.062	1	0.9%	1%
0.062 - 0.125	5	4.5%	5%
0.125 - 0.25	0	0.0%	5%
0.25 - 0.5	2	1.8%	7%
0.5 - 1.0	2	1.8%	9%
1 - 2	11	10.0%	19%
2 - 4	8	7.3%	26%
4 - 8	7	6.4%	33%
8 - 16	17	15.5%	48%
16 - 32	13	11.8%	60%
32 - 64	42	38.2%	98%
64-128	2	1.8%	100%
128-256	0	0.0%	100%
256-512	0	0.0%	100%
512-1024	0	0.0%	100%
1024-2048	0	0.0%	100%
2048-4096	0	0.0%	100%
Bedrock	0	0.0%	100%
Total	110	100%	100%
		Summary Data	
		D50	18
		D84	45
		D95	59

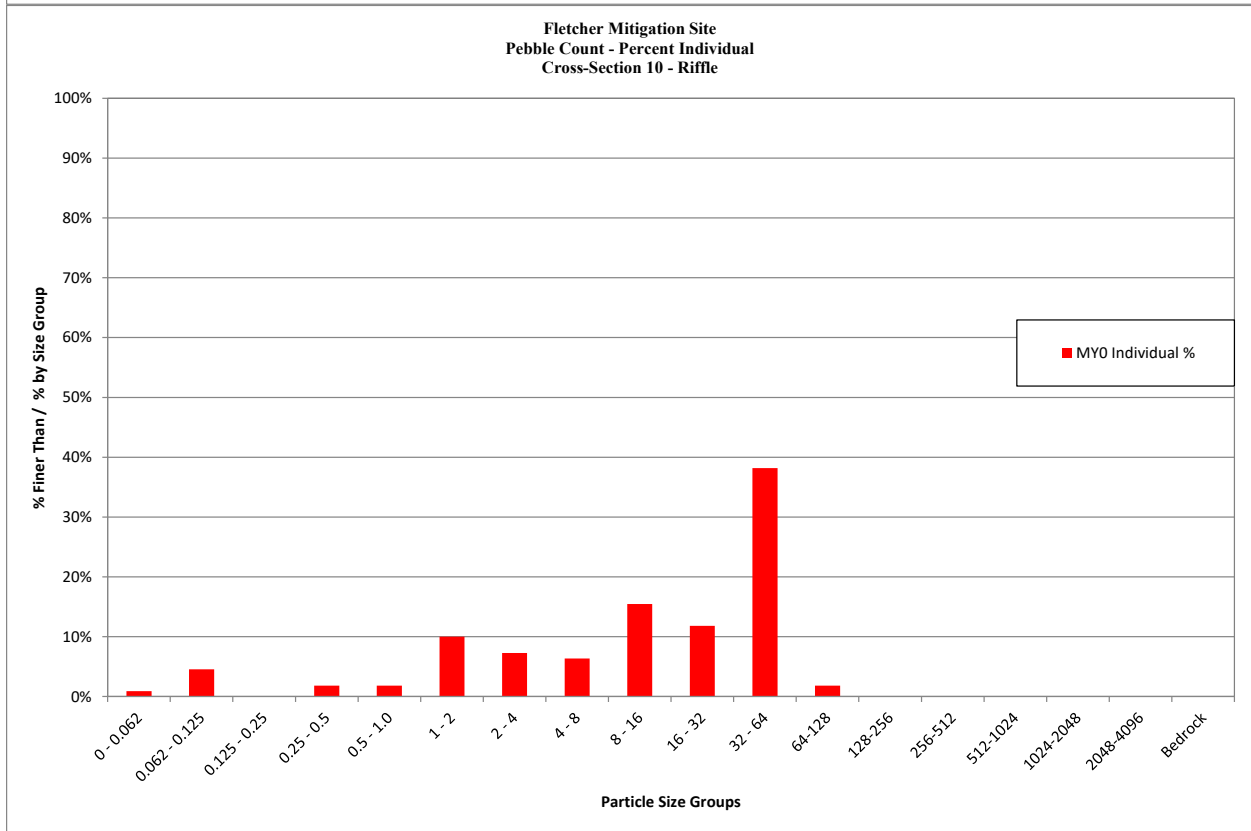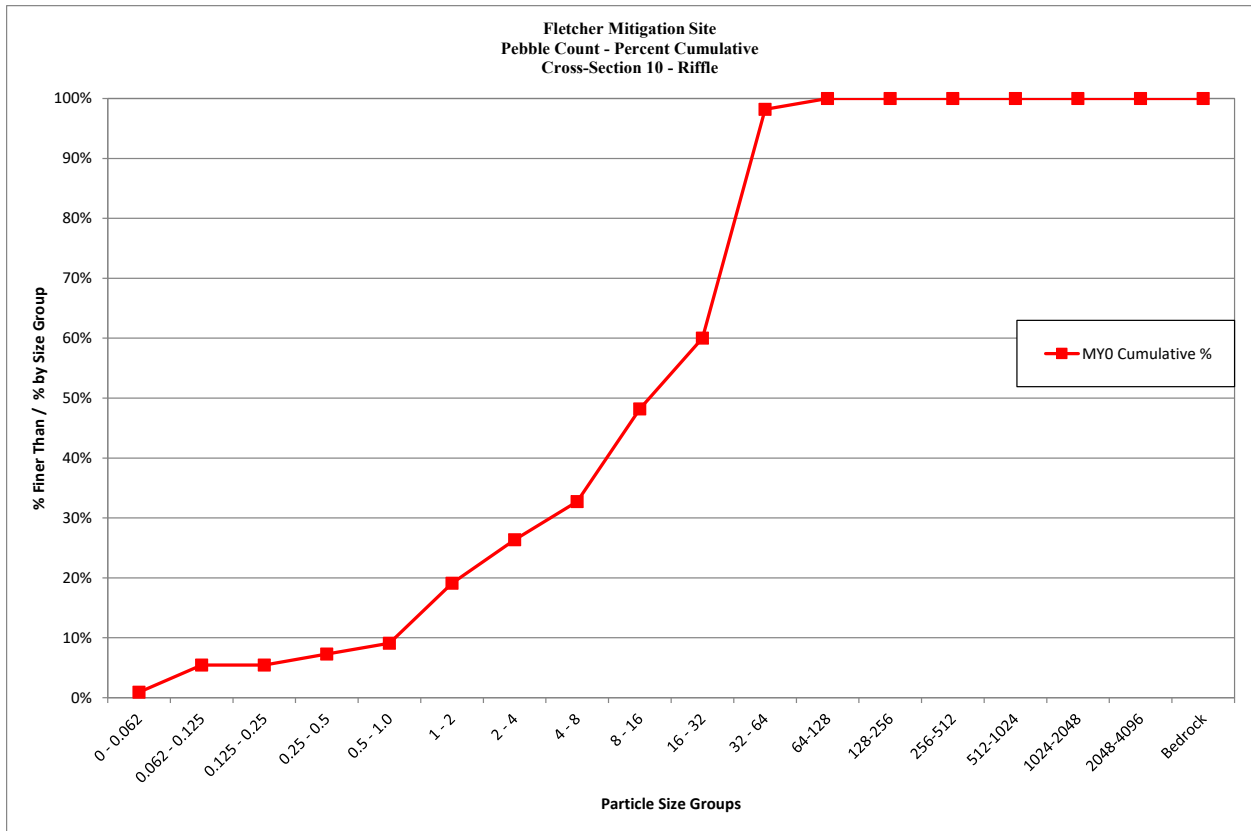



Fletcher Mitigation Site			
Cross Section 11 - Riffle			
Monitoring Year - 2019; MY0			
Bed Surface Material Particle Size Class (mm)	Number	% Individual	% Cumulative
0 - 0.062	11	10.6%	11%
0.062 - 0.125	7	6.7%	17%
0.125 - 0.25	1	1.0%	18%
0.25 - 0.5	3	2.9%	21%
0.5 - 1.0	5	4.8%	26%
1 - 2	15	14.4%	40%
2 - 4	6	5.8%	46%
4 - 8	9	8.7%	55%
8 - 16	9	8.7%	63%
16 - 32	22	21.2%	85%
32 - 64	10	9.6%	94%
64-128	5	4.8%	99%
128-256	1	1.0%	100%
256-512	0	0.0%	100%
512-1024	0	0.0%	100%
1024-2048	0	0.0%	100%
2048-4096	0	0.0%	100%
Bedrock	0	0.0%	100%
Total	104	100%	100%
		Summary Data	
		D50	5.5
		D84	31
		D95	70

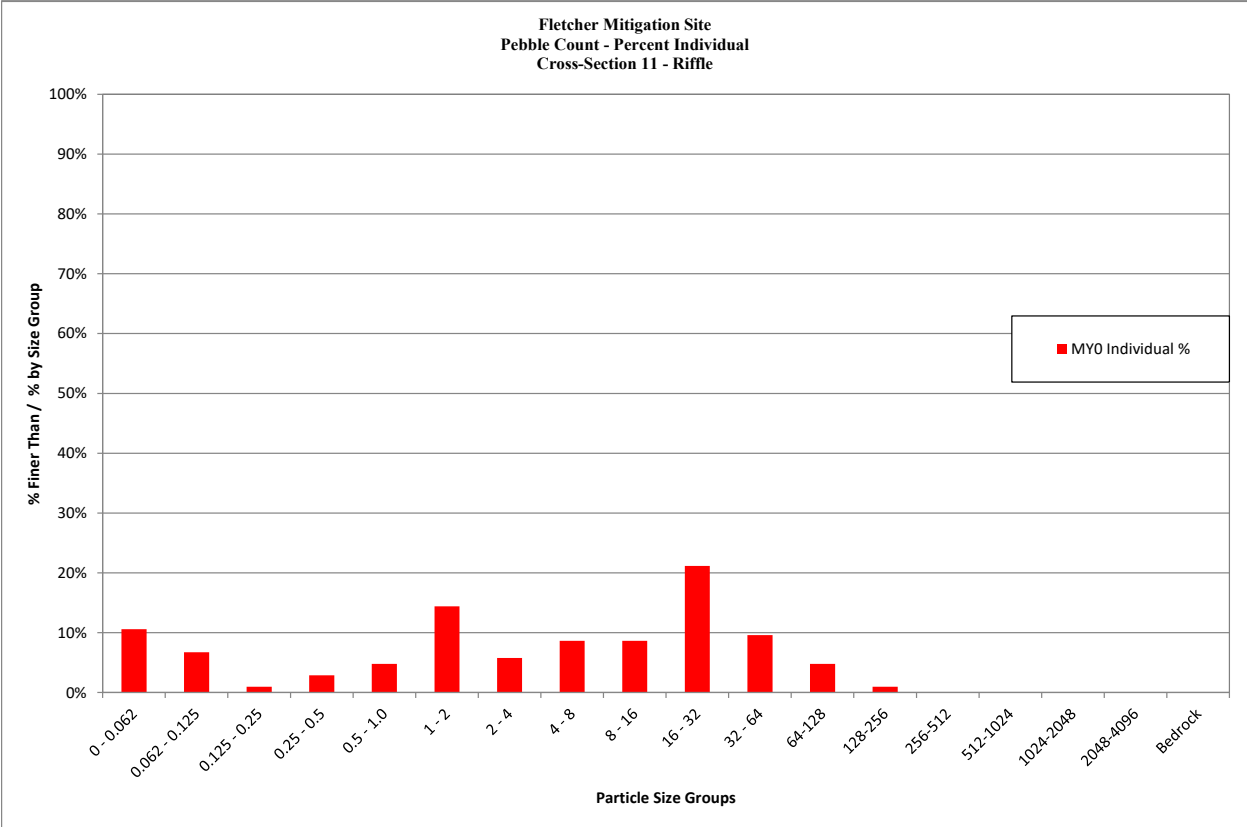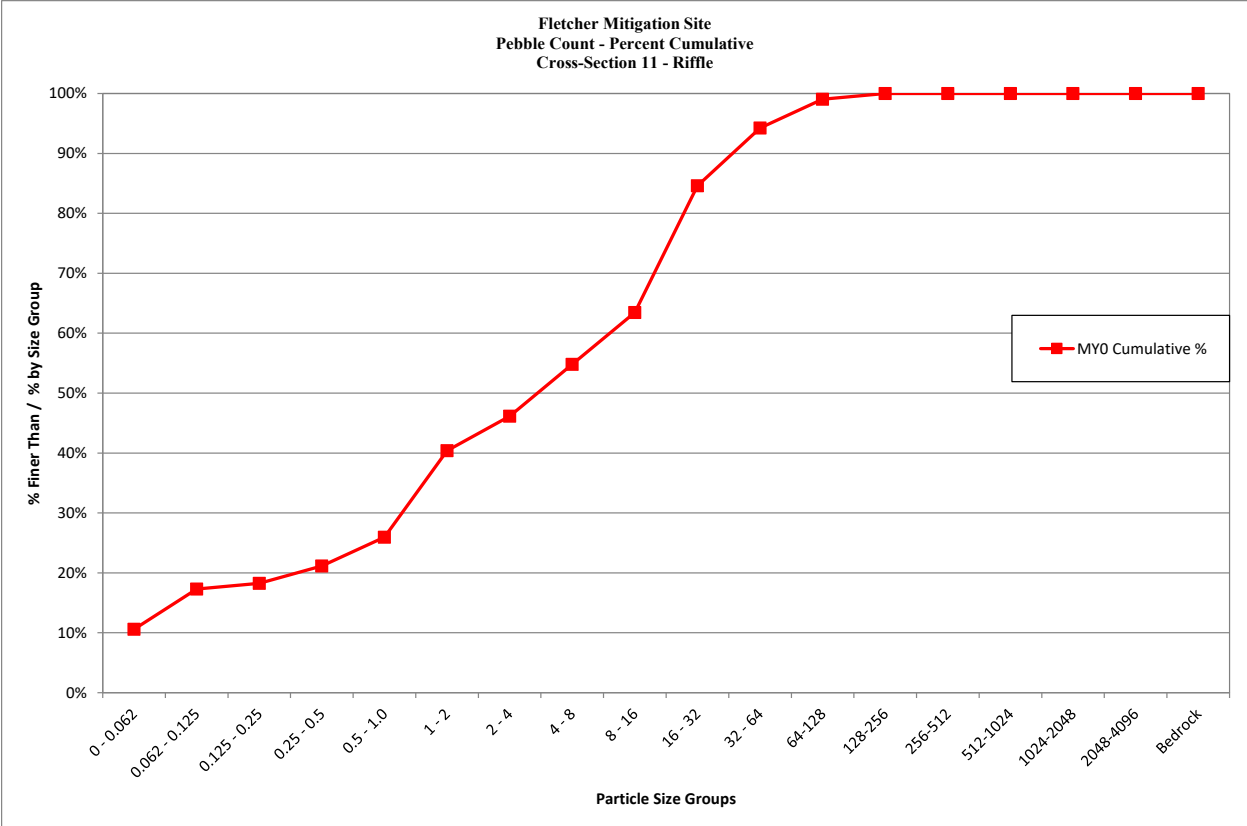



Fletcher Mitigation Site			
Cross Section 14 - Riffle			
Monitoring Year - 2019; MY0			
Bed Surface Material Particle Size Class (mm)	Number	% Individual	% Cumulative
0 - 0.062	5	4.7%	5%
0.062 - 0.125	0	0.0%	5%
0.125 - 0.25	3	2.8%	8%
0.25 - 0.5	0	0.0%	8%
0.5 - 1.0	1	0.9%	8%
1 - 2	8	7.5%	16%
2 - 4	2	1.9%	18%
4 - 8	6	5.7%	24%
8 - 16	23	21.7%	45%
16 - 32	26	24.5%	70%
32 - 64	28	26.4%	96%
64-128	3	2.8%	99%
128-256	1	0.9%	100%
256-512	0	0.0%	100%
512-1024	0	0.0%	100%
1024-2048	0	0.0%	100%
2048-4096	0	0.0%	100%
Bedrock	0	0.0%	100%
Total	106	100%	100%
		Summary Data	
		D50	18
		D84	43
		D95	61

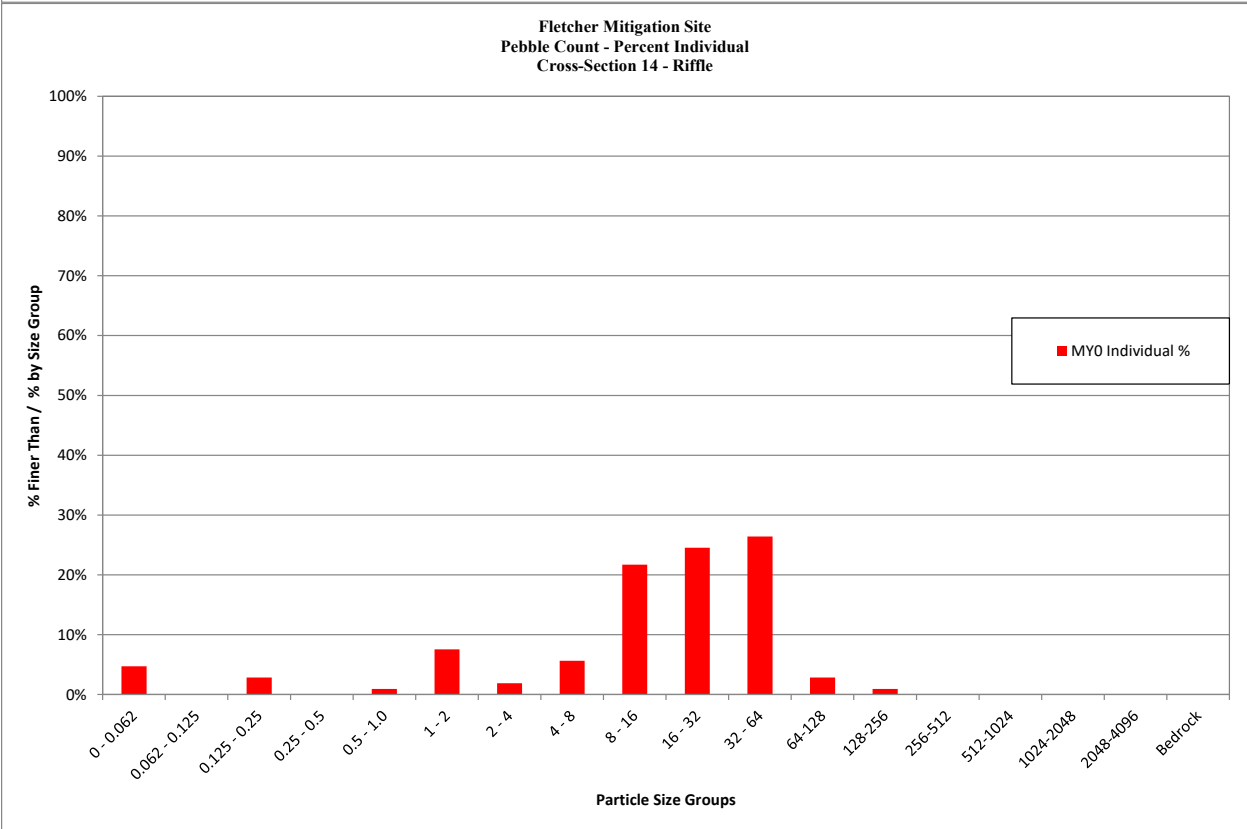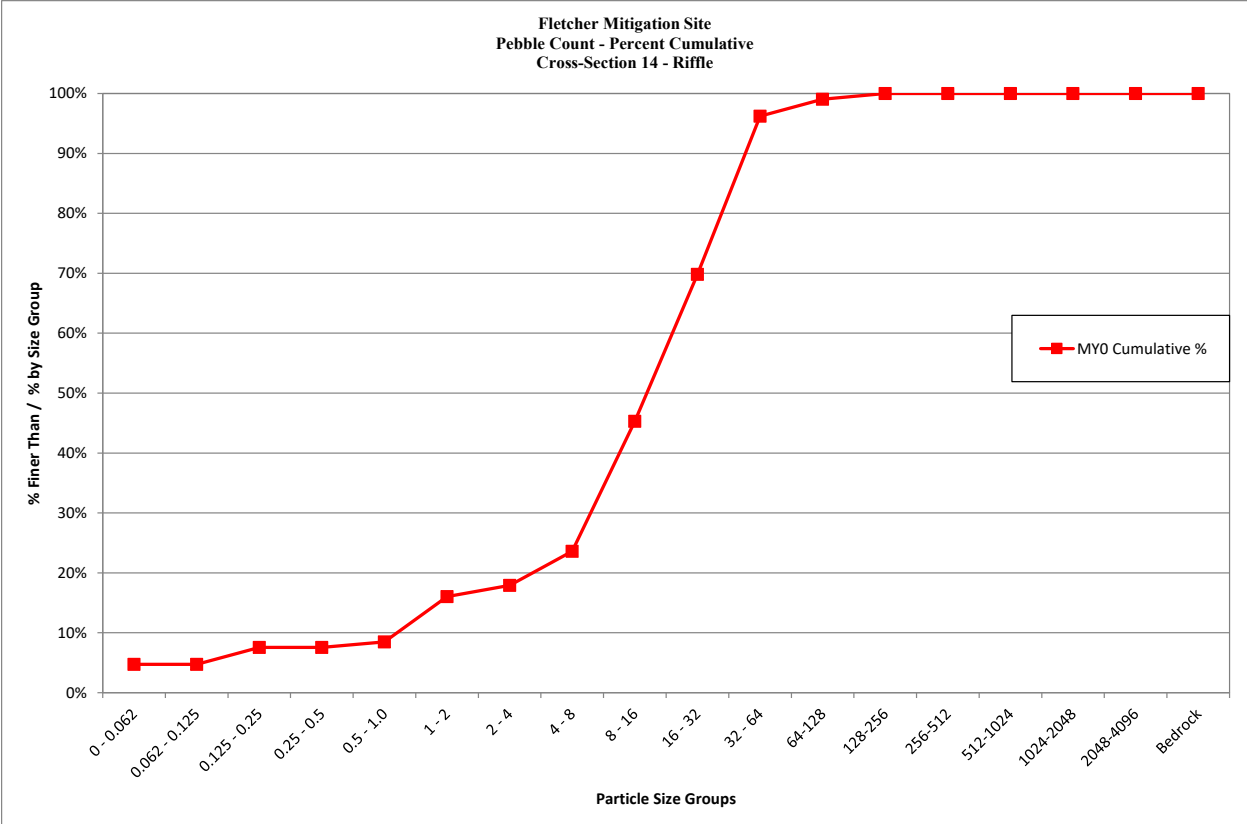



Fletcher Mitigation Site			
Cross Section 15 - Riffle			
Monitoring Year - 2019; MY0			
Bed Surface Material Particle Size Class (mm)	Number	% Individual	% Cumulative
0 - 0.062	11	10.7%	11%
0.062 - 0.125	13	12.6%	23%
0.125 - 0.25	0	0.0%	23%
0.25 - 0.5	7	6.8%	30%
0.5 - 1.0	4	3.9%	34%
1 - 2	28	27.2%	61%
2 - 4	16	15.5%	77%
4 - 8	11	10.7%	87%
8 - 16	10	9.7%	97%
16 - 32	2	1.9%	99%
32 - 64	1	1.0%	100%
64-128	0	0.0%	100%
128-256	0	0.0%	100%
256-512	0	0.0%	100%
512-1024	0	0.0%	100%
1024-2048	0	0.0%	100%
2048-4096	0	0.0%	100%
Bedrock	0	0.0%	100%
Total	103	100%	100%
		Summary Data	
		D50	1.5
		D84	6.2
		D95	14

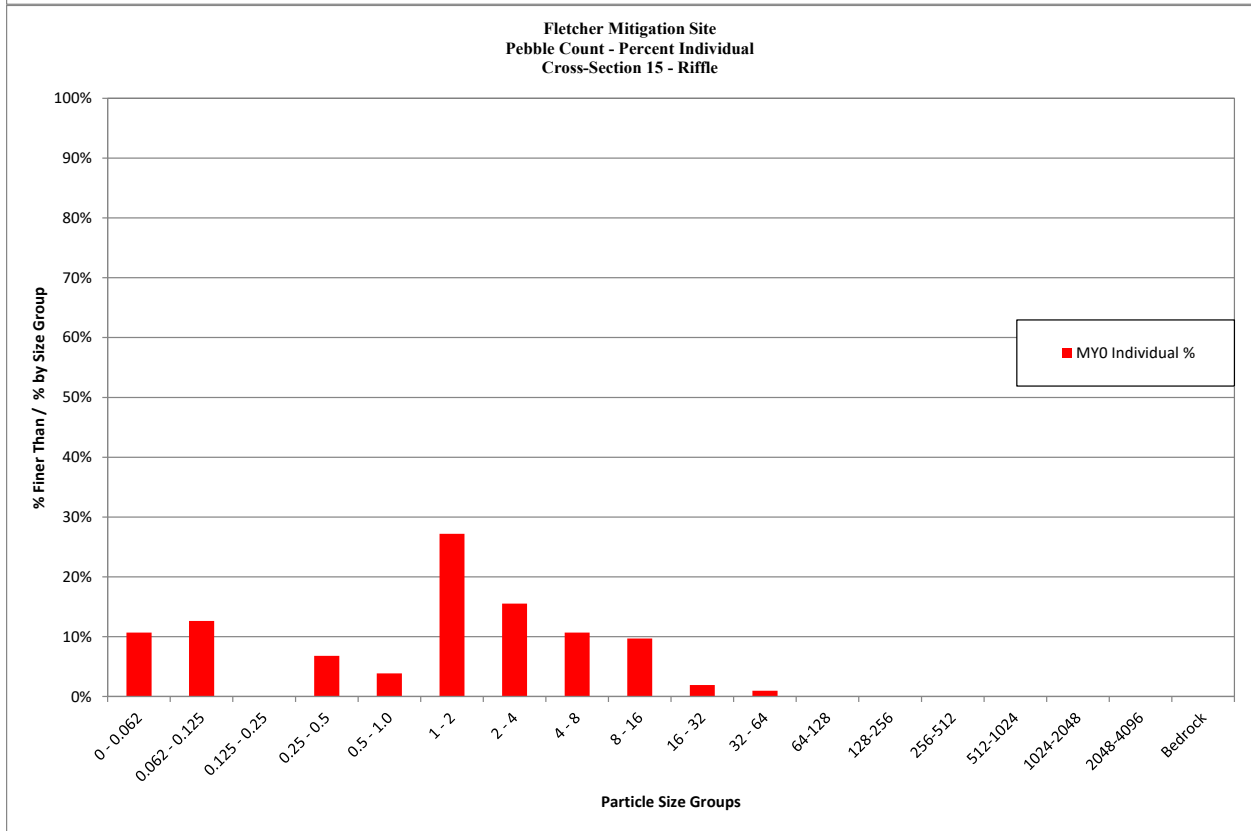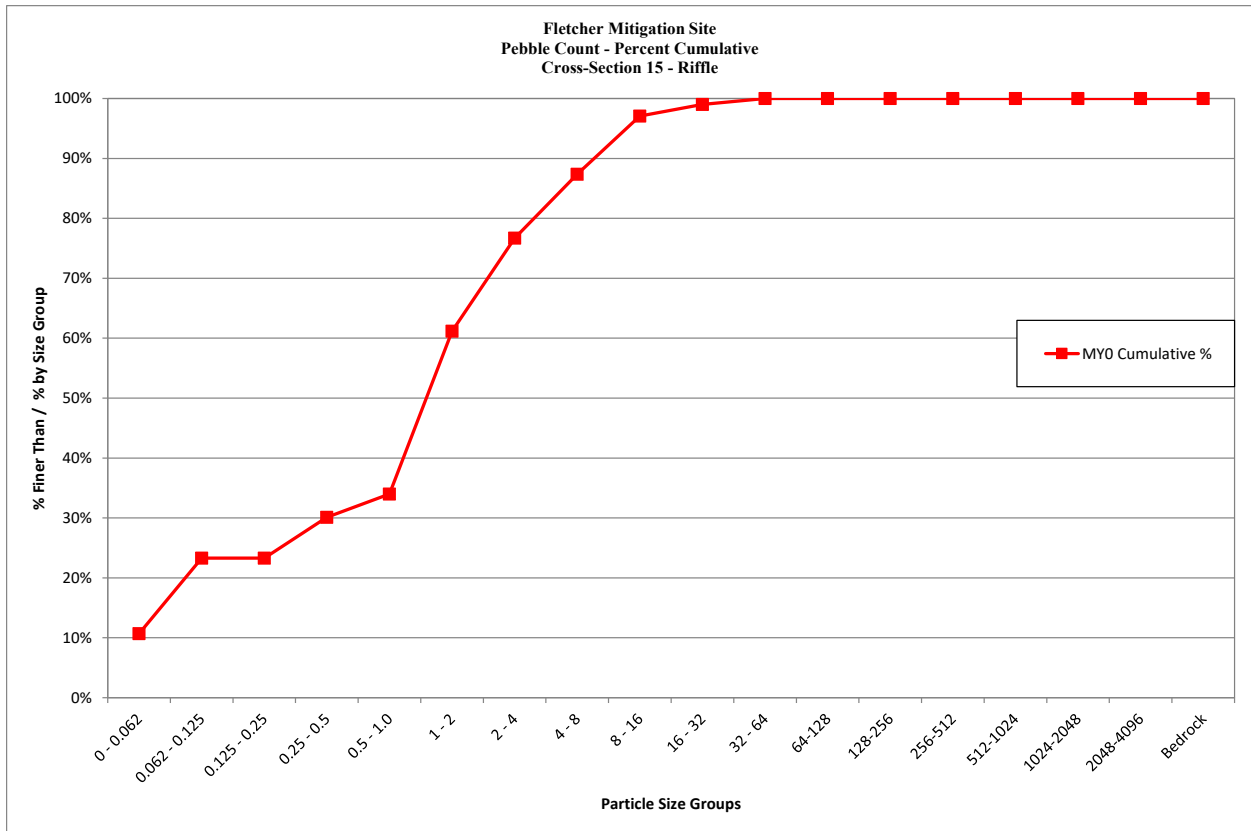



Fletcher Mitigation Site			
Cross Section 18 - Riffle			
Monitoring Year - 2019; MY0			
Bed Surface Material Particle Size Class (mm)	Number	% Individual	% Cumulative
0 - 0.062	20	18.9%	19%
0.062 - 0.125	4	3.8%	23%
0.125 - 0.25	1	0.9%	24%
0.25 - 0.5	0	0.0%	24%
0.5 - 1.0	7	6.6%	30%
1 - 2	8	7.5%	38%
2 - 4	15	14.2%	52%
4 - 8	28	26.4%	78%
8 - 16	23	21.7%	100%
16 - 32	0	0.0%	100%
32 - 64	0	0.0%	100%
64-128	0	0.0%	100%
128-256	0	0.0%	100%
256-512	0	0.0%	100%
512-1024	0	0.0%	100%
1024-2048	0	0.0%	100%
2048-4096	0	0.0%	100%
Bedrock	0	0.0%	100%
Total	106	100%	100%
		Summary Data	
		D50	3.6
		D84	9
		D95	12

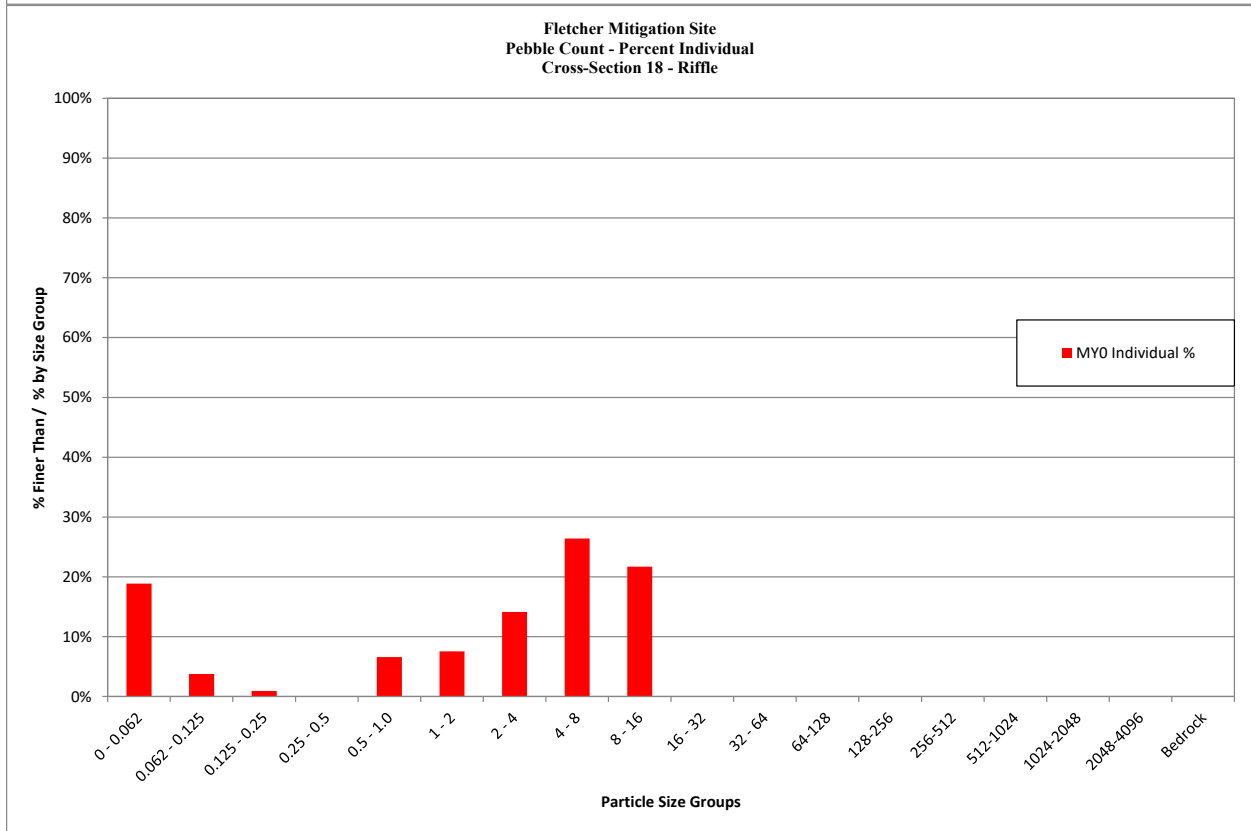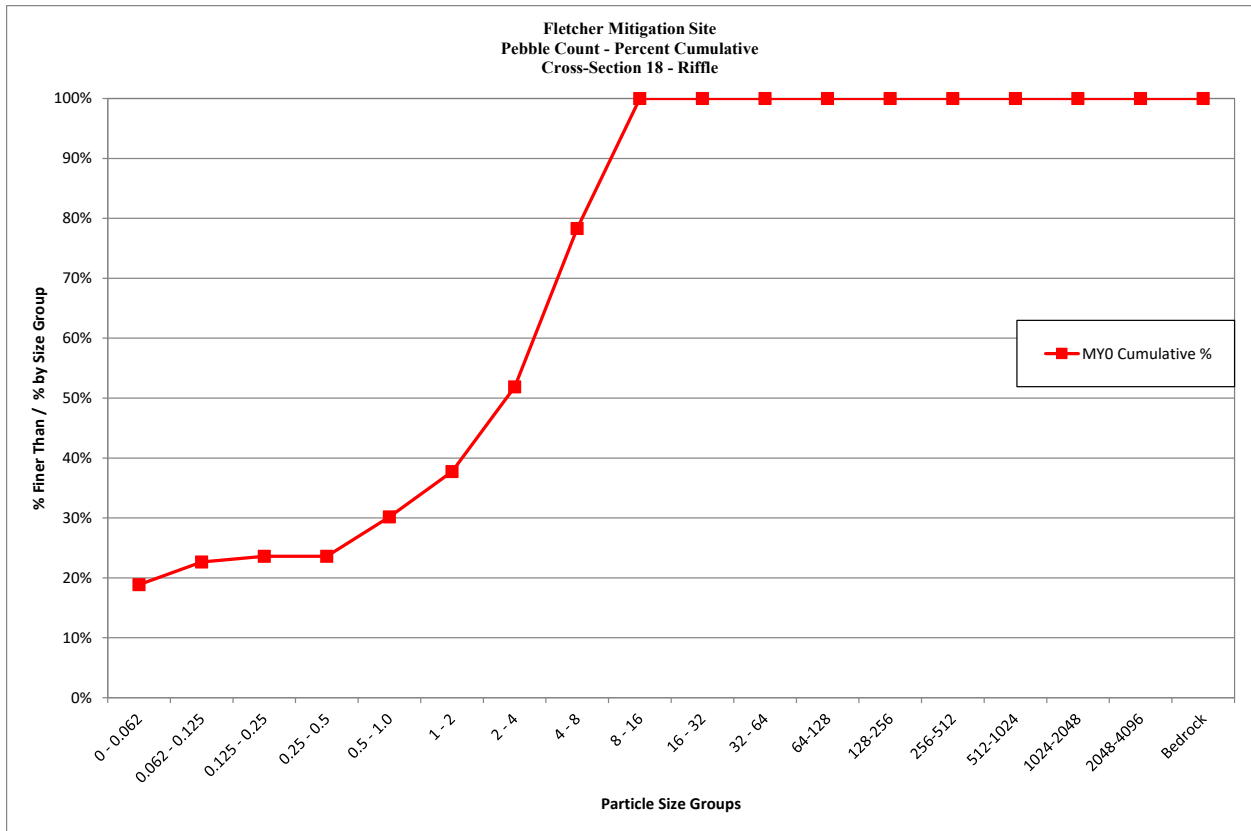



Fletcher Mitigation Site			
Cross Section 19 - Riffle			
Monitoring Year - 2019; MY0			
Bed Surface Material Particle Size Class (mm)	Number	% Individual	% Cumulative
0 - 0.062	8	7.6%	8%
0.062 - 0.125	4	3.8%	11%
0.125 - 0.25	2	1.9%	13%
0.25 - 0.5	4	3.8%	17%
0.5 - 1.0	5	4.8%	22%
1 - 2	35	33.3%	55%
2 - 4	7	6.7%	62%
4 - 8	19	18.1%	80%
8 - 16	18	17.1%	97%
16 - 32	3	2.9%	100%
32 - 64	0	0.0%	100%
64-128	0	0.0%	100%
128-256	0	0.0%	100%
256-512	0	0.0%	100%
512-1024	0	0.0%	100%
1024-2048	0	0.0%	100%
2048-4096	0	0.0%	100%
Bedrock	0	0.0%	100%
Total	105	100%	100%
		Summary Data	
		D50	1.8
		D84	9.3
		D95	15

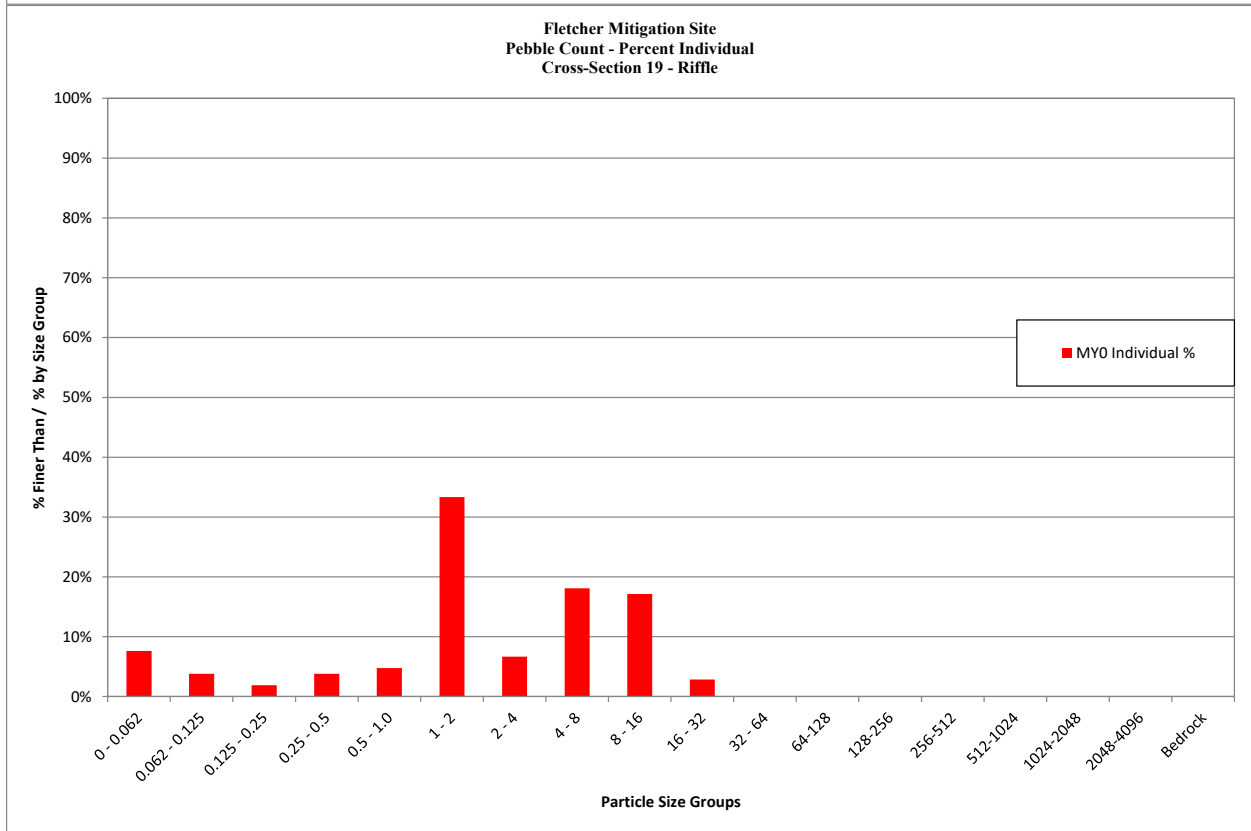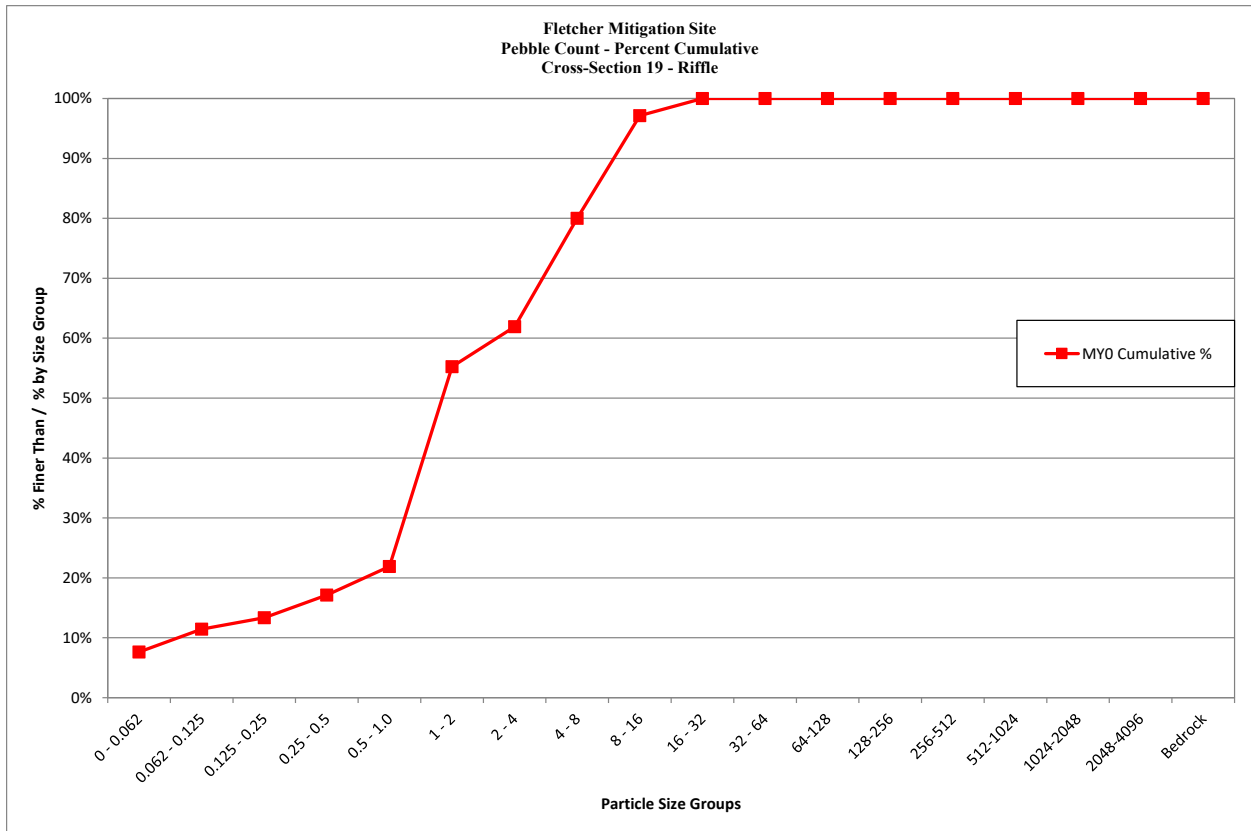



Fletcher Mitigation Site			
Cross Section 22 - Riffle			
Monitoring Year - 2019; MY0			
Bed Surface Material Particle Size Class (mm)	Number	% Individual	% Cumulative
0 - 0.062	105	100.0%	100%
0.062 - 0.125	0	0.0%	100%
0.125 - 0.25	0	0.0%	100%
0.25 - 0.5	0	0.0%	100%
0.5 - 1.0	0	0.0%	100%
1 - 2	0	0.0%	100%
2 - 4	0	0.0%	100%
4 - 8	0	0.0%	100%
8 - 16	0	0.0%	100%
16 - 32	0	0.0%	100%
32 - 64	0	0.0%	100%
64-128	0	0.0%	100%
128-256	0	0.0%	100%
256-512	0	0.0%	100%
512-1024	0	0.0%	100%
1024-2048	0	0.0%	100%
2048-4096	0	0.0%	100%
Bedrock	0	0.0%	100%
Total	105	100%	100%
		Summary Data	
		D50	0.062
		D84	0.062
		D95	0.062

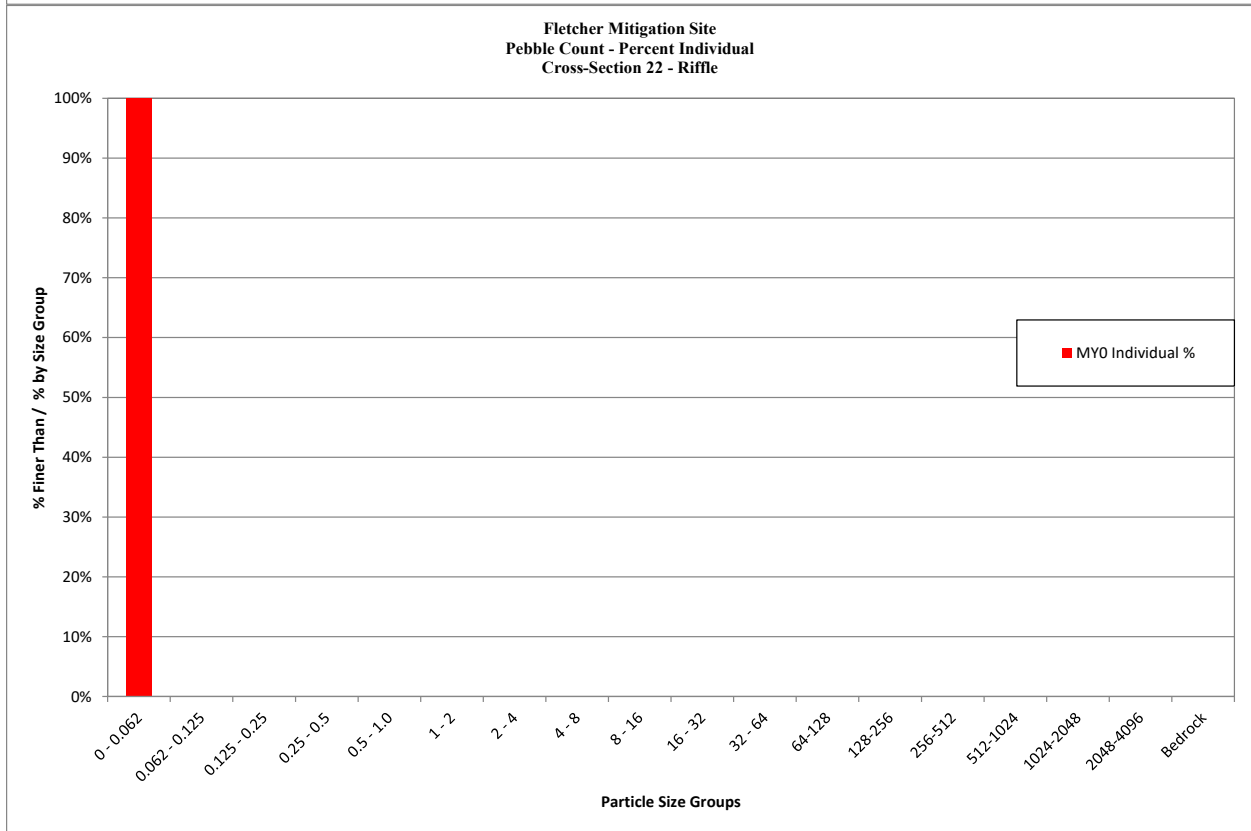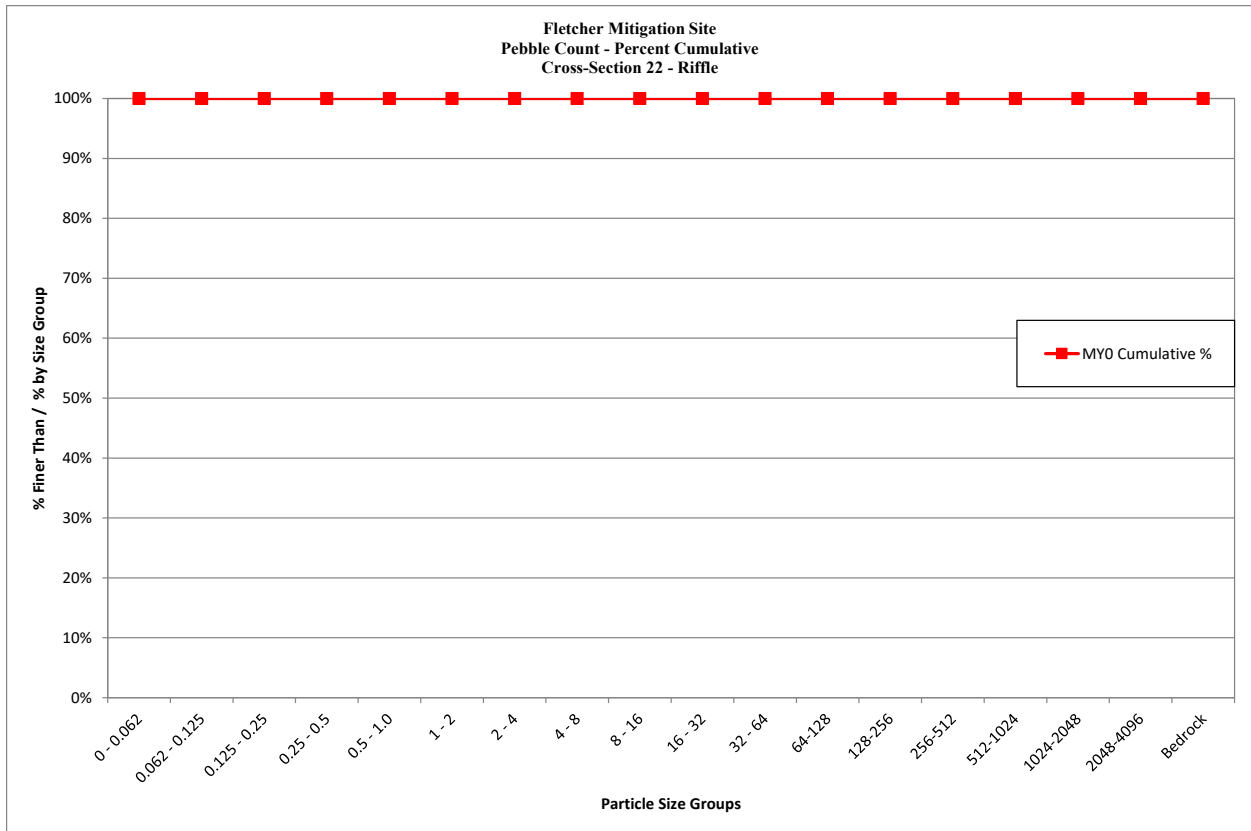

Fletcher Mitigation Site			
Cross Section 23 - Riffle			
Monitoring Year - 2019; MY0			
Bed Surface Material Particle Size Class (mm)	Number	% Individual	% Cumulative
0 - 0.062	18	16.8%	17%
0.062 - 0.125	0	0.0%	17%
0.125 - 0.25	0	0.0%	17%
0.25 - 0.5	0	0.0%	17%
0.5 - 1.0	5	4.7%	21%
1 - 2	13	12.1%	34%
2 - 4	2	1.9%	36%
4 - 8	5	4.7%	40%
8 - 16	12	11.2%	51%
16 - 32	12	11.2%	63%
32 - 64	34	31.8%	94%
64-128	6	5.6%	100%
128-256	0	0.0%	100%
256-512	0	0.0%	100%
512-1024	0	0.0%	100%
1024-2048	0	0.0%	100%
2048-4096	0	0.0%	100%
Bedrock	0	0.0%	100%
Total	107	100%	100%
		Summary Data	
		D50	15
		D84	48
		D95	69

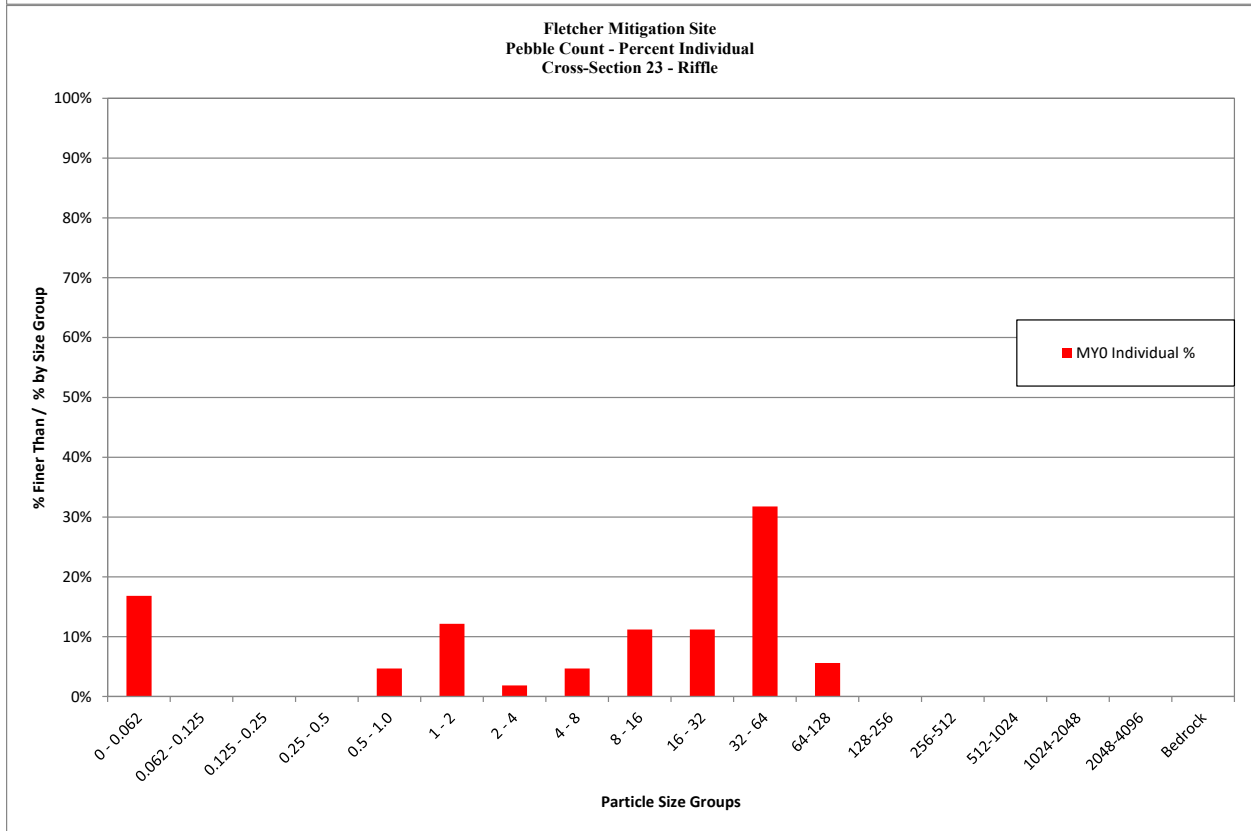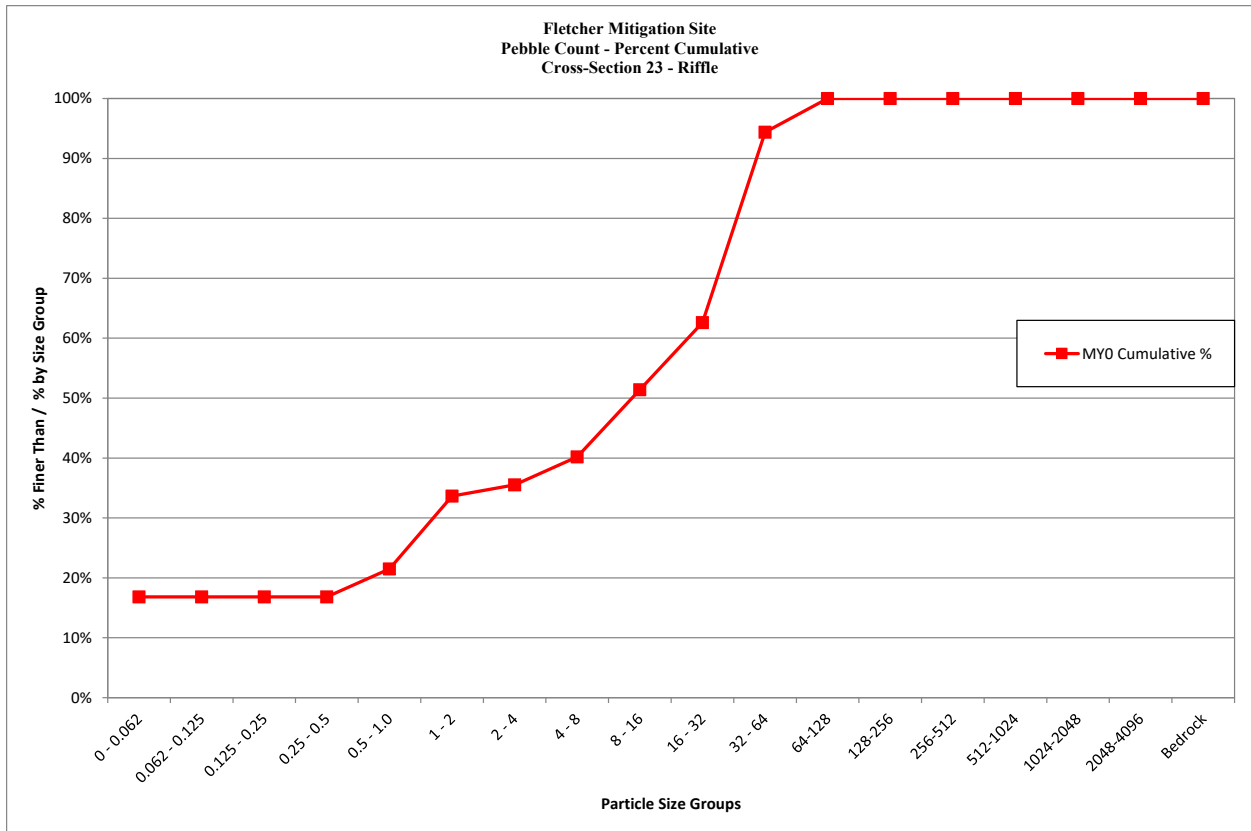

Fletcher Mitigation Site			
Cross Section 26 - Riffle			
Monitoring Year - 2019; MY0			
Bed Surface Material Particle Size Class (mm)	Number	% Individual	% Cumulative
0 - 0.062	14	13.0%	13%
0.062 - 0.125	19	17.6%	31%
0.125 - 0.25	16	14.8%	45%
0.25 - 0.5	7	6.5%	52%
0.5 - 1.0	4	3.7%	56%
1 - 2	23	21.3%	77%
2 - 4	10	9.3%	86%
4 - 8	3	2.8%	89%
8 - 16	8	7.4%	96%
16 - 32	0	0.0%	96%
32 - 64	4	3.7%	100%
64-128	0	0.0%	100%
128-256	0	0.0%	100%
256-512	0	0.0%	100%
512-1024	0	0.0%	100%
1024-2048	0	0.0%	100%
2048-4096	0	0.0%	100%
Bedrock	0	0.0%	100%
Total	108	100%	100%
		Summary Data	
		D50	0.41
		D84	3.4
		D95	13

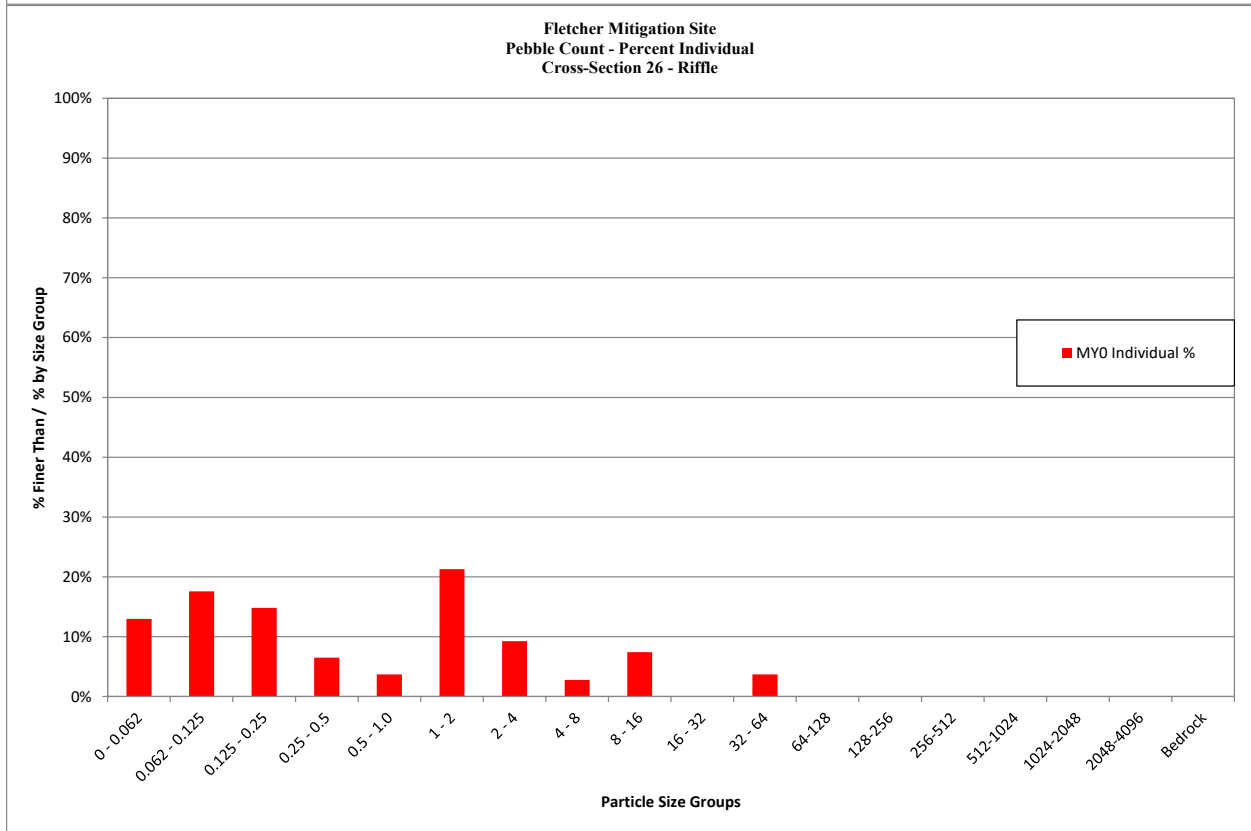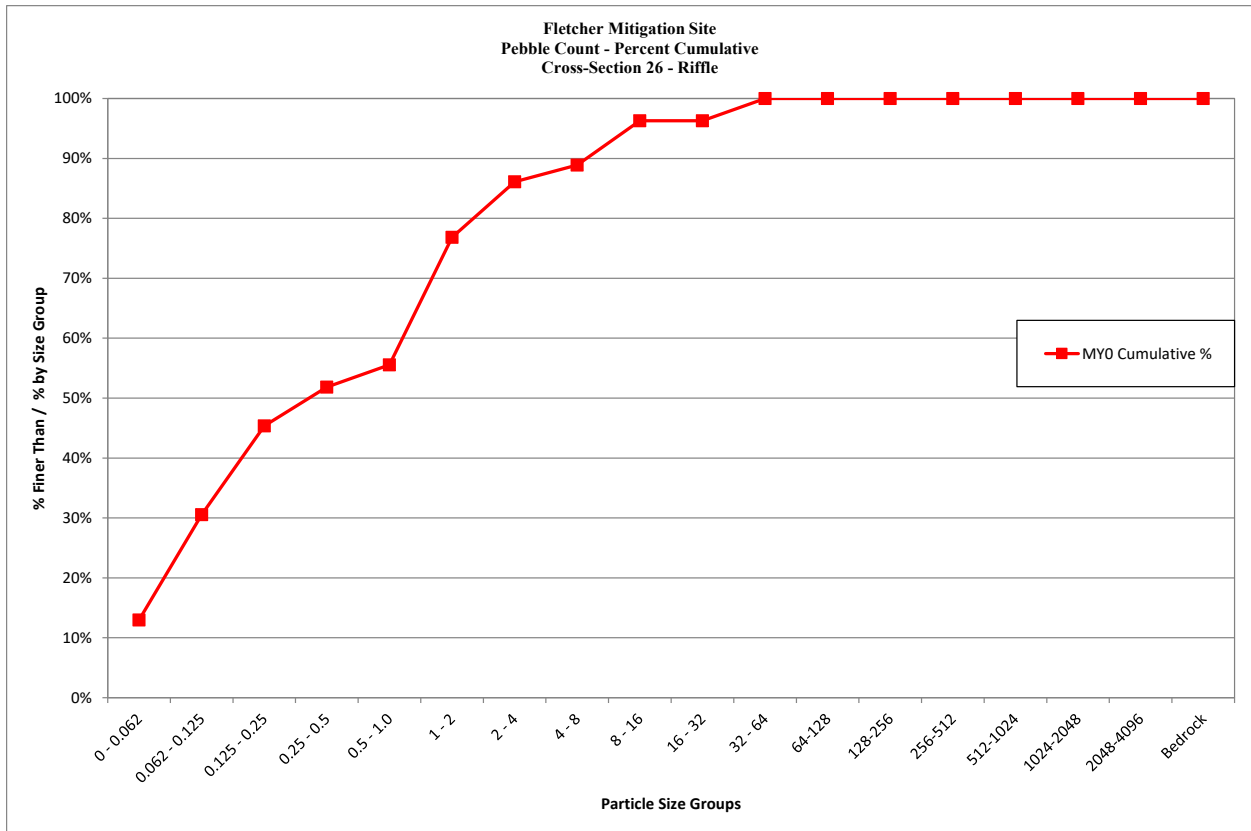

Fletcher Mitigation Site			
Cross Section 28 - Riffle			
Monitoring Year - 2019; MY0			
Bed Surface Material Particle Size Class (mm)	Number	% Individual	% Cumulative
0 - 0.062	22	20.0%	20%
0.062 - 0.125	4	3.6%	24%
0.125 - 0.25	0	0.0%	24%
0.25 - 0.5	0	0.0%	24%
0.5 - 1.0	4	3.6%	27%
1 - 2	23	20.9%	48%
2 - 4	2	1.8%	50%
4 - 8	4	3.6%	54%
8 - 16	2	1.8%	55%
16 - 32	6	5.5%	61%
32 - 64	25	22.7%	84%
64-128	17	15.5%	99%
128-256	1	0.9%	100%
256-512	0	0.0%	100%
512-1024	0	0.0%	100%
1024-2048	0	0.0%	100%
2048-4096	0	0.0%	100%
Bedrock	0	0.0%	100%
Total	110	100%	100%
		Summary Data	
		D50	4
		D84	65
		D95	87

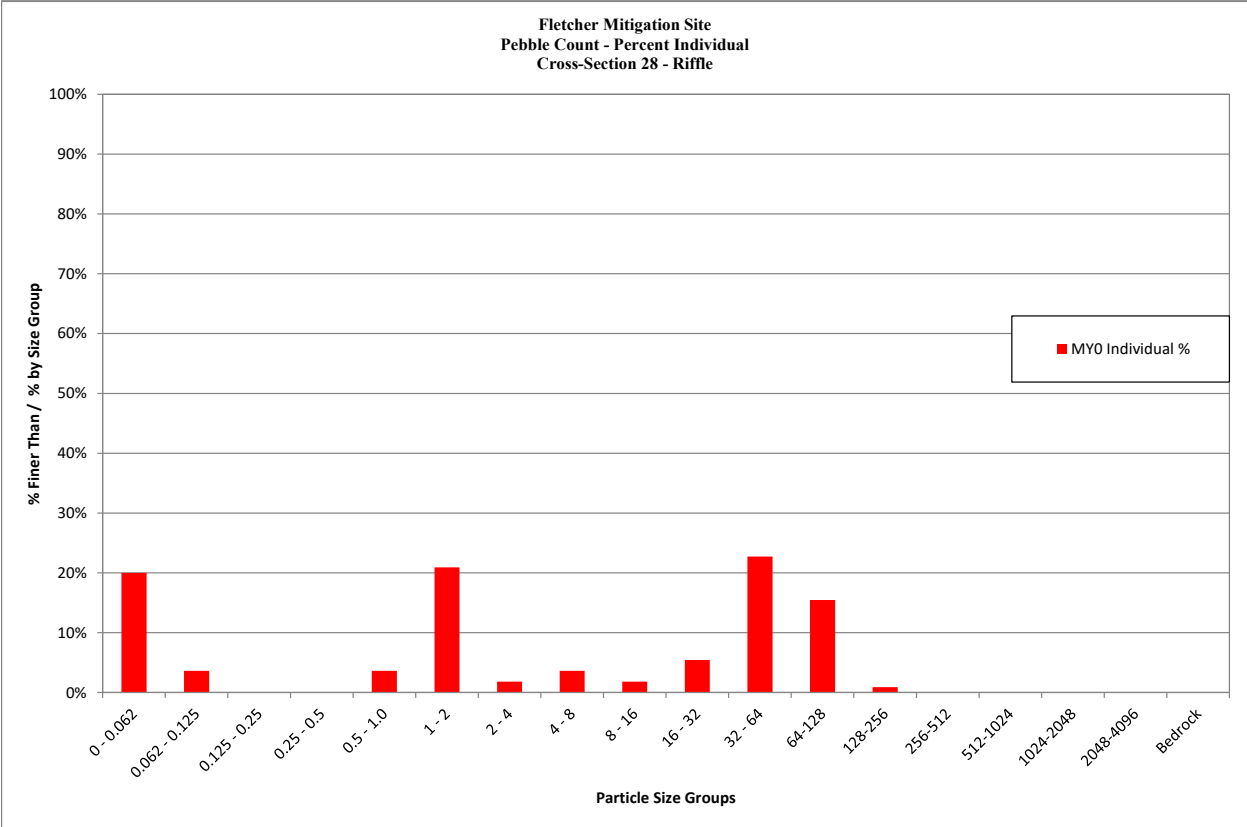
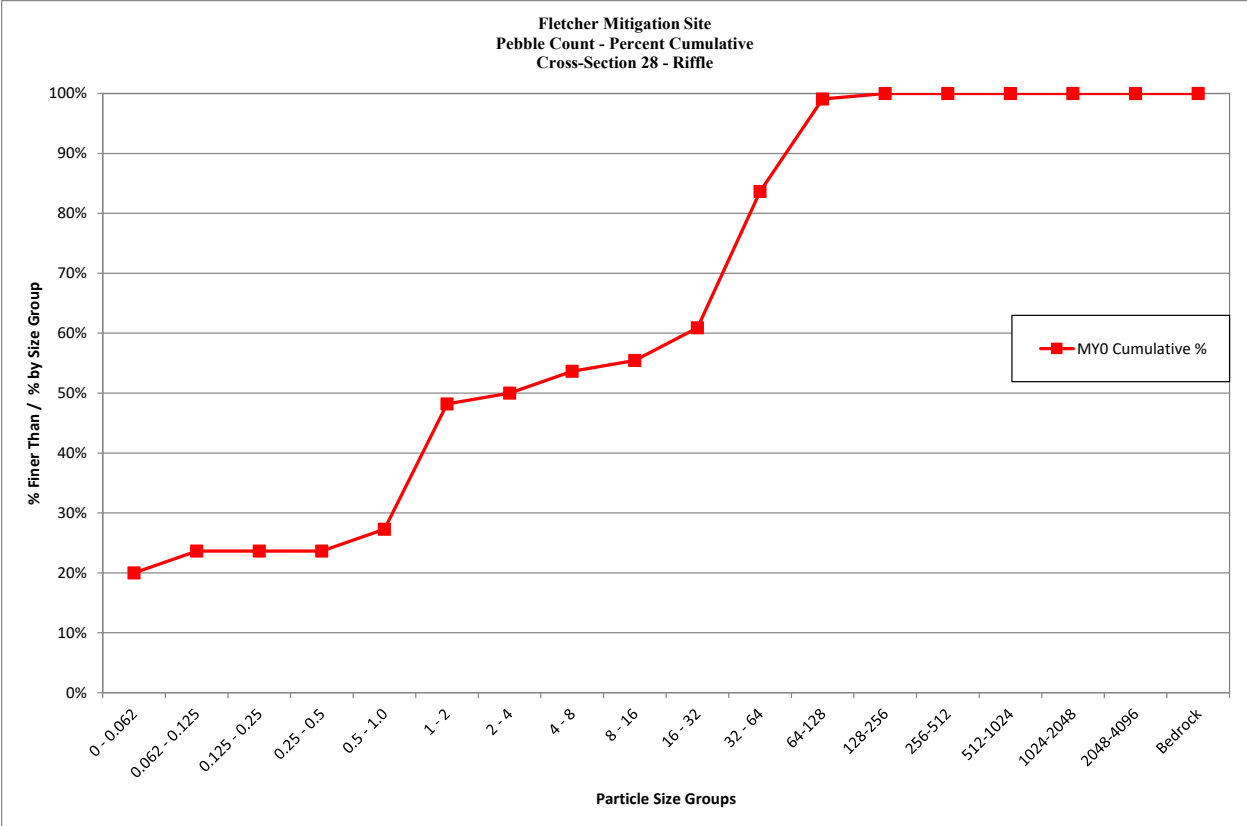


Table 7. Baseline Stream Data Summary Fletcher Mitigation Site - Fletcher Creek Reach 1B (380 feet *)																													
Parameter	Regional Curve			Pre-Existing Condition					Reference Reach Data					Design			As-Built/ Baseline												
Dimension & Substrate - Riffle	LL	UL	Eq.	Min	Mean	Med	Max	SD	N	Min	Mean	Med	Max	SD	N	Min	Mean	Max	Min	Mean	Med	Max	SD	N					
Bankfull Width (ft)	-	-	-	6.1	-	-	8.0	-	-	14.7	-	-	19.5	-	-	-	-	8.7	-	-	7.1	-	-	1					
Floodprone Width (ft)				-	-	-	-	-	-	-	-	-	-	-	-	-	-	-	-	-	20.0	-	-	1					
Bankfull Mean Depth (ft)				-	-	-	-	-	-	-	-	-	-	-	-	-	-	0.6	-	-	0.3	-	-	1					
Bankfull Max Depth (ft)				0.7	-	-	0.8	-	-	1.2	-	-	1.4	-	-	-	-	0.9	-	-	0.6	-	-	1					
Bankfull Cross Sectional Area (ft ²)				4.4	-	-	6.2	-	-	18.0	-	-	27.2	-	-	-	-	5.5	-	-	2.3	-	-	1					
Width/Depth Ratio				8.5	-	-	10.5	-	-	12.0	-	-	14	-	-	-	-	13.6	-	-	21.4	-	-	1					
Entrenchment Ratio				1.1	-	-	2.1	-	-	1.4	-	-	1.5	-	-	-	-	2.4	-	-	2.8	-	-	1					
Bank Height Ratio				-	-	-	-	-	-	-	-	-	-	-	-	-	-	-	-	-	1.0	-	-	1					
d50 (mm)				6.0	-	-	11.0	-	-	60.0	-	-	125	-	-	-	-	-	-	-	12.0	-	-	1					
Profile																													
Riffle Length (ft)				-	-	-	-	-	-	-	-	-	-	-	-	-	-	-	-	-	4.8	8.5	8.0	13.1	2.5	13			
Riffle Slope (ft/ft)				-	-	-	-	-	-	-	-	-	-	-	-	-	-	-	-	-	0.002	0.018	0.014	0.044	0.013	13			
Pool Length (ft)				-	-	-	-	-	-	-	-	-	-	-	-	-	-	-	-	-	5.1	9.6	9.7	14.4	2.8	12			
Pool Max Depth (ft)				-	-	-	-	-	-	-	-	-	-	-	-	-	-	-	-	-	1.4	-	1.2	2.0	1.9	0.5	12		
Pool Spacing (ft)				-	-	-	-	-	-	-	-	-	-	-	-	-	-	-	-	-	23.4	-	39.0	14.6	27.9	29.4	40.5	8.0	11
Pattern																													
Channel Belt Width (ft)				-	-	-	-	-	-	-	-	-	-	-	-	-	-	10.3	13.7	17.2	17.7	18.2	17.8	19.0	0.7	3			
Radius of Curvature (ft)				-	-	-	-	-	-	-	-	-	-	-	-	-	-	14.0	-	21.0	17.0	22.7	25.0	26.0	4.9	3			
Rc: Bankfull Width (ft/ft)				-	-	-	-	-	-	-	-	-	-	-	-	-	-	-	-	-	2.0	2.6	2.9	3.0	0.6	3			
Meander Wavelength (ft)				-	-	-	-	-	-	-	-	-	-	-	-	-	-	-	-	-	17.7	18.2	17.8	19.1	0.8	3			
Meander Width Ratio				-	-	-	-	-	-	-	-	-	-	-	-	-	-	-	-	-	2.5	-	2.0	2.1	2.0	2.2	0.1	3	
Substrate, Bed and Transport Parameters																													
Reach Shear Stress (Competency) lb/ft ²																													
Max Part Size (mm) Mobilized at Bankfull																													
Stream Power (Transport Capacity) W/m ²																													
Additional Reach Parameters																													
Drainage Area (mi ²)							0.30						2.35					0.30											
Rosgen Classification							G						B4					B4											
Bankfull Velocity (fps)							2.3 - 3.6						-					-											
Bankfull Discharge (cfs)							22.0						-					15.0											
Valley Length (ft)							-						-					-											
* Channel Thalweg Length (ft)							-						-					-											
^ Channel Centerline (ft)							-						-					-											
Sinuosity							-						-					1.11											
Water Surface Slope (ft/ft)							0.008 - 0.018						0.011 - 0.018					0.016											
Bankfull Slope (ft/ft)							-						-					-											
Bankfull Floodplain Area (acres)							-						-					-											
% of Reach with Eroding Banks							-						-					-											
Channel Stability or Habitat Metric							Unstable						-					-											
Biological or Other							-						-					-											

* Channel Thalweg Length (ft): Based on actual thalweg calculations from the as-built survey, accounts for breaks in conservation easement and utility right-of-ways.

^ Channel Centerline (ft): Based on stream centerline stationing from design stream stationing; accounts for breaks in conservation easement and utility right-of-ways.

- Information unavailable.

Non-Applicable.

Table 7 Cont'd. Baseline Stream Data Summary																									
Fletcher Mitigation Site - Fletcher Creek Reach 1C (1,541 feet *)																									
Parameter	Regional Curve			Pre-Existing Condition						Reference Reach Data						Design			As-Built/ Baseline						
Dimension & Substrate - Riffle	LL	UL	Eq.	Min	Mean	Med	Max	SD	N	Min	Mean	Med	Max	SD	N	Min	Mean	Max	Min	Mean	Med	Max	SD	N	
Bankfull Width (ft)	-	-	-	6.3	-	-	9.3	-	-	14.7	-	-	19.5	-	-	9.4	-	7.6	9.8	9.8	12.0	3.1	2		
Floodprone Width (ft)				-	-	-	-	-	-	-	-	-	-	-	-	10.0	30.0	30.0	50.0	50.0	28.3	2			
Bankfull Mean Depth (ft)				-	-	-	-	-	-	-	-	-	-	-	-	0.7	-	0.3	0.5	0.5	0.6	0.2	2		
Bankfull Max Depth (ft)				0.6	-	-	0.9	-	-	1.2	-	-	1.4	-	-	0.9	-	0.5	0.8	0.8	1.0	0.4	2		
Bankfull Cross Sectional Area (ft ²)				4.9	-	-	7.5	-	-	18.0	-	-	27.2	-	-	6.4	-	2.1	4.8	4.8	7.5	3.8	2		
Width/Depth Ratio				8.2	-	-	16.6	-	-	12.0	-	-	14	-	-	13.8	-	19.2	23.4	23.4	27.6	6.0	2		
Entrenchment Ratio				1.3	-	-	1.7	-	-	1.4	-	-	1.5	-	-	2.4	-	1.3	2.7	2.7	4.2	2.0	2		
Bank Height Ratio				-	-	-	-	-	-	-	-	-	-	-	-	-	-	1.0	1.0	1.0	1.0	0.0	2		
d50 (mm)				5.0	-	-	14.0	-	-	60.0	-	-	125	-	-	-	-	18.0	18.5	19.0	19.0	0.71	2		
Profile																									
Riffle Length (ft)				-	-	-	-	-	-	-	-	-	-	-	-	-	-	3.4	10.9	11.1	21.1	4.9	44		
Riffle Slope (ft/ft)				-	-	-	-	-	-	-	-	-	-	-	-	-	-	0.000	0.009	0.007	0.029	0.008	44		
Pool Length (ft)				-	-	-	-	-	-	-	-	-	-	-	-	-	-	6.3	13.1	12.8	29.0	4.6	44		
Pool Max Depth (ft)				-	-	-	-	-	-	-	-	-	-	-	-	1.4	-	1.5	2.8	2.8	4.0	0.6	44		
Pool Spacing (ft)				-	-	-	-	-	-	-	-	-	-	-	31.0	-	51.7	13.5	35.0	34.4	96.1	13.5	43		
Pattern																									
Channel Belt Width (ft)				-	-	-	-	-	-	-	-	-	-	-	11.2	15.0	18.7	18.7	20.2	19.7	22.3	1.9	3		
Radius of Curvature (ft)				-	-	-	-	-	-	-	-	-	-	-	15.0	-	22.0	17.2	21.0	20.6	25.3	4.1	3		
Rc: Bankfull Width (ft/ft)				-	-	-	-	-	-	-	-	-	-	-	-	-	-	1.8	2.2	2.2	2.7	0.5	3		
Meander Wavelength (ft)				-	-	-	-	-	-	-	-	-	-	-	-	-	-	18.7	20.2	19.7	22.3	1.9	3		
Meander Width Ratio				-	-	-	-	-	-	-	-	-	-	-	-	-	2.9	-	2.0	2.1	2.1	2.4	0.2	3	
Substrate, Bed and Transport Parameters																									
Reach Shear Stress (Competency) lb/ft ²							-											-							
Max Part Size (mm) Mobilized at Bankfull							-											-							
Stream Power (Transport Capacity) W/m ²							-											-							
Additional Reach Parameters																									
Drainage Area (mi ²)							0.37						2.35					0.37							
Rosgen Classification							B, F, G						B4					B4					B4		
Bankfull Velocity (fps)							-						-					-							
Bankfull Discharge (cfs)							-	25.0					-					18.0							
Valley Length (ft)																							1,436		
* Channel Thalweg Length (ft)																							1,541		
^ Channel Centerline (ft)																							1,540		
Sinuosity							1.24											1.10					1.10		
Water Surface Slope (ft/ft)							0.009 - 0.015						0.011 - 0.018					0.012					0.012		
Bankfull Slope (ft/ft)							-						-					-					0.012		
Bankfull Floodplain Area (acres)							-						-					-							
% of Reach with Eroding Banks							-						-					-							
Channel Stability or Habitat Metric							Unstable						-					-							
Biological or Other							-						-					-							

* Channel Thalweg Length (ft): Based on actual thalweg calculations from the as-built survey, accounts for breaks in conservation easement and utility right-of-ways.

^ Channel Centerline (ft): Based on stream centerline stationing from design stream stationing, accounts for breaks in conservation easement and utility right-of-ways.

- Information unavailable.

Non-Applicable.

Table 7 Cont'd. Baseline Stream Data Summary Fletcher Mitigation Site - Fletcher Creek Reach 2A (1,299 feet *)																										
Parameter	Regional Curve			Pre-Existing Condition						Reference Reach Data						Design			As-Built/ Baseline							
Dimension & Substrate - Riffle	LL	UL	Eq.	Min	Mean	Med	Max	SD	N	Min	Mean	Med	Max	SD	N	Min	Mean	Max	Min	Mean	Med	Max	SD	N		
Bankfull Width (ft)	-	-	-	4.9	-	-	7.9	-	-	14.7	-	-	19.5	-	-	10.4	-	-	12.6	12.9	12.9	13.1	0.3	2		
Floodprone Width (ft)	-	-	-	-	-	-	-	-	-	-	-	-	-	-	-	-	-	-	35.0	42.5	42.5	50.0	10.6	2		
Bankfull Mean Depth (ft)	-	-	-	-	-	-	-	-	-	-	-	-	-	-	-	0.7	-	-	0.7	0.8	0.8	0.8	0.0	2		
Bankfull Max Depth (ft)	-	-	-	0.8	-	-	1.1	-	-	1.2	-	-	1.4	-	-	1.0	-	-	1.2	1.4	1.4	1.6	0.3	2		
Bankfull Cross Sectional Area (ft ²)	-	-	-	4.8	-	-	7.9	-	-	18.0	-	-	27.2	-	-	7.6	-	-	9.2	9.8	9.8	10.4	0.9	2		
Width/Depth Ratio	-	-	-	5.0	-	-	9.1	-	-	12.0	-	-	14	-	-	14.2	-	-	16.5	17.0	17.0	17.4	0.6	2		
Entrenchment Ratio	-	-	-	1.4	-	-	1.9	-	-	1.4	-	-	1.5	-	-	2.4	-	-	2.7	3.3	3.3	4.0	0.9	2		
Bank Height Ratio	-	-	-	-	-	-	-	-	-	-	-	-	-	-	-	-	-	-	1.0	1.0	1.0	1.0	0.0	2		
d50 (mm)	-	-	-	9.0	-	-	14.0	-	-	60.0	-	-	125.0	-	-	-	-	-	18.0	19.0	20.0	20.0	1.4	2		
Profile																										
Riffle Length (ft)	-	-	-	-	-	-	-	-	-	-	-	-	-	-	-	-	-	-	5.3	16.0	14.6	32.2	6.7	35		
Riffle Slope (ft/ft)	-	-	-	-	-	-	-	-	-	-	-	-	-	-	-	-	-	-	0.001	0.010	0.008	0.028	0.007	35		
Pool Length (ft)	-	-	-	-	-	-	-	-	-	-	-	-	-	-	-	-	-	-	5.58	10.8	10.2	25.3	4.2	34		
Pool Max Depth (ft)	-	-	-	-	-	-	-	-	-	-	-	-	-	-	-	1.5	-	-	1.2	2.5	2.6	3.7	0.7	34		
Pool Spacing (ft)	-	-	-	-	-	-	-	-	-	-	-	-	-	-	-	34.2	-	57.2	9.4	36.8	37.5	52.2	9.4	33		
Pattern																										
Channel Belt Width (ft)	-	-	-	-	-	-	-	-	-	-	-	-	-	-	-	12.6	16.8	21.0	23.8	24.5	24.1	25.5	0.9	3		
Radius of Curvature (ft)	-	-	-	-	-	-	-	-	-	-	-	-	-	-	-	17.0	-	25.0	16.8	22.1	19.8	29.6	6.7	3		
Rc: Bankfull Width (ft/ft)	-	-	-	-	-	-	-	-	-	-	-	-	-	-	-	-	-	-	1.6	2.1	1.9	2.8	0.6	3		
Meander Wavelength (ft)	-	-	-	-	-	-	-	-	-	-	-	-	-	-	-	-	-	-	23.8	24.5	24.1	25.5	0.9	3		
Meander Width Ratio	-	-	-	-	-	-	-	-	-	-	-	-	-	-	-	3.5	-	-	2.3	2.4	2.3	2.5	0.1	3		
Substrate, Bed and Transport Parameters																										
Reach Shear Stress (Competency) lb/ft ²				-						-						-			-							
Max Part Size (mm) Mobilized at Bankfull				-						-						-			-							
Stream Power (Transport Capacity) W/m ²				-						-						-			-							
Additional Reach Parameters																										
Drainage Area (mi ²)				0.49						2.35						0.49										
Rosgen Classification				B, G						B4						B4			B4							
Bankfull Velocity (fps)	-			2.0 - 3.4						-						-										
Bankfull Discharge (cfs)	-			32.0						-						22.0										
Valley Length (ft)				-						-						-			1,158							
* Channel Thalweg Length (ft)				-						-						-			1,299							
^ Channel Centerline (ft)				-						-						-			1,296							
Sinuosity				1.35						-						1.17			1.15							
Water Surface Slope (ft/ft)				0.005 - 0.014						0.011 - 0.018						0.012			0.011							
Bankfull Slope (ft/ft)				-						-						-			0.012							
Bankfull Floodplain Area (acres)				-						-						-										
% of Reach with Eroding Banks				-						-						-										
Channel Stability or Habitat Metric				Severe						-						-										
Biological or Other				-						-						-										

* Channel Thalweg Length (ft): Based on actual thalweg calculations from the as-built survey, accounts for breaks in conservation easement and utility right-of-ways.

^ Channel Centerline (ft): Based on stream centerline stationing from design stream stationing; accounts for breaks in conservation easement and utility right-of-ways.

- Information unavailable.

Non-Applicable.

Table 7 Cont'd. Baseline Stream Data Summary Fletcher Mitigation Site - Fletcher Creek Reach 2B (1,510 feet *)																									
Parameter	Regional Curve			Pre-Existing Condition						Reference Reach Data						Design			As-Built/ Baseline						
Dimension & Substrate - Riffle	LL	UL	Eq.	Min	Mean	Med	Max	SD	N	Min	Mean	Med	Max	SD	N	Min	Mean	Max	Min	Mean	Med	Max	SD	N	
Bankfull Width (ft)	-	-	-	4.4	-	-	10.7	-	-	14.7	-	-	19.5	-	-	10.6	-	9.8	10.0	10.0	10.2	0.3	2		
Floodprone Width (ft)	-	-	-	-	-	-	-	-	-	-	-	-	-	-	-	-	-	-	40.0	55.0	55.0	70.0	21.2	2	
Bankfull Mean Depth (ft)	-	-	-	-	-	-	-	-	-	-	-	-	-	-	-	0.7	-	0.7	0.7	0.7	0.8	0.1	2		
Bankfull Max Depth (ft)	-	-	-	0.7	-	-	1.0	-	-	1.2	-	-	1.4	-	-	1.0	-	1.2	1.3	1.3	1.3	0.1	2		
Bankfull Cross Sectional Area (ft ²)	-	-	-	3.3	-	-	7.2	-	-	18.0	-	-	27.2	-	-	7.9	-	7.1	7.4	7.4	7.6	0.3	2		
Width/Depth Ratio	-	-	-	5.2	-	-	15.7	-	-	12.0	-	-	14	-	-	14.3	-	12.6	13.6	13.6	14.6	1.4	2		
Entrenchment Ratio	-	-	-	1.4	-	-	5.9	-	-	1.4	-	-	1.5	-	-	2.3	-	3.9	5.5	5.5	7.2	2.3	2		
Bank Height Ratio	-	-	-	-	-	-	-	-	-	-	-	-	-	-	-	-	-	1.0	1.0	1.0	1.0	0.0	2		
d50 (mm)	-	-	-	-	5.0	-	-	-	-	60.0	-	-	125.0	-	-	-	-	5.5	11.8	18.0	18.0	8.8	2		
Profile																									
Riffle Length (ft)	-	-	-	-	-	-	-	-	-	-	-	-	-	-	-	-	-	5.3	16.0	14.6	32.2	6.7	35		
Riffle Slope (ft/ft)	-	-	-	-	-	-	-	-	-	-	-	-	-	-	-	-	-	0.001	0.010	0.008	0.028	0.007	35		
Pool Length (ft)	-	-	-	-	-	-	-	-	-	-	-	-	-	-	-	-	-	5.58	10.8	10.2	25.3	4.2	34		
Pool Max Depth (ft)	-	-	-	-	-	-	-	-	-	-	-	-	-	-	-	1.5	-	1.2	2.5	2.6	3.7	0.7	34		
Pool Spacing (ft)	-	-	-	-	-	-	-	-	-	-	-	-	-	-	-	35.0	-	58.3	9.4	36.8	37.5	52.2	9.4	33	
Pattern																									
Channel Belt Width (ft)	-	-	-	-	-	-	-	-	-	-	-	-	-	-	-	12.9	17.2	21.5	18.0	19.9	19.2	22.6	2.4	3	
Radius of Curvature (ft)	-	-	-	-	-	-	-	-	-	-	-	-	-	-	-	17.0	-	26.0	23.5	25.3	24.8	27.5	2.0	3	
Rc: Bankfull Width (ft/ft)	-	-	-	-	-	-	-	-	-	-	-	-	-	-	-	-	-	2.2	2.4	2.3	2.6	0.2	3		
Meander Wavelength (ft)	-	-	-	-	-	-	-	-	-	-	-	-	-	-	-	-	-	17.9	19.9	19.2	22.6	2.4	3		
Meander Width Ratio	-	-	-	-	-	-	-	-	-	-	-	-	-	-	-	-	-	2.6	-	1.7	1.9	1.8	2.1	0.2	3
Substrate, Bed and Transport Parameters																									
Reach Shear Stress (Competency) lb/ft ²				-						-															
Max Part Size (mm) Mobilized at Bankfull				-						-															
Stream Power (Transport Capacity) W/m ²				-						-															
Additional Reach Parameters																									
Drainage Area (mi ²)				0.52						2.35						0.52									
Rosgen Classification				B, E, G						B4						B5			B5						
Bankfull Velocity (fps)	-			1.8 - 2.7						-						-									
Bankfull Discharge (cfs)	-			33.0						-						23.0									
Valley Length (ft)				-						-						-			1,467						
* Channel Thalweg Length (ft)				-						-						-			1,510						
^ Channel Centerline (ft)				-						-						-			1,470						
Sinuosity				1.03						-						1.10			1.10						
Water Surface Slope (ft/ft)				0.004 - 0.01						0.011 - 0.018						0.007			0.011						
Bankfull Slope (ft/ft)				-						-						-			0.012						
Bankfull Floodplain Area (acres)				-						-						-									
% of Reach with Eroding Banks				-						-						-									
Channel Stability or Habitat Metric				Unstable						-						-									
Biological or Other				-						-						-									

* Channel Thalweg Length (ft): Based on actual thalweg calculations from the as-built survey, accounts for breaks in conservation easement and utility right-of-ways.

^ Channel Centerline (ft): Based on stream centerline stationing from design stream stationing; accounts for breaks in conservation easement and utility right-of-ways.

- Information unavailable.

Non-Applicable.

Table 7 Cont'd. Baseline Stream Data Summary Fletcher Mitigation Site - Weston Creek Reach 1A (1,982 feet *)																										
Parameter	Regional Curve			Pre-Existing Condition						Reference Reach Data						Design			As-Built/ Baseline							
Dimension & Substrate - Riffle	LL	UL	Eq.	Min	Mean	Med	Max	SD	N	Min	Mean	Med	Max	SD	N	Min	Mean	Max	Min	Mean	Med	Max	SD	N		
Bankfull Width (ft)	-	-	-	4.5	-	-	6.3	-	-	6.3	-	-	10.7	-	-	-	-	8.6	-	9.1	9.8	9.8	10.4	0.9	2	
Floodprone Width (ft)	-	-	-	-	-	-	-	-	-	-	-	-	-	-	-	-	-	-	-	-	-	-	-	-	-	
Bankfull Mean Depth (ft)	-	-	-	-	-	-	-	-	-	-	-	-	-	-	-	-	-	0.6	-	0.6	0.6	0.6	0.6	0.0	2	
Bankfull Max Depth (ft)	-	-	-	0.6	-	-	0.7	-	-	1.0	-	-	1.2	-	-	-	-	0.9	-	0.9	1.0	1.0	1.1	0.1	2	
Bankfull Cross Sectional Area (ft ²)	-	-	-	2.7	-	-	4.6	-	-	7.7	-	-	10.0	-	-	-	-	5.5	-	5.4	5.8	5.8	6.2	0.6	2	
Width/Depth Ratio	-	-	-	7.4	-	-	10.0	-	-	6.0	-	-	11.0	-	-	-	-	13.6	-	15.5	16.4	16.4	17.4	1.3	2	
Entrenchment Ratio	-	-	-	1.6	-	-	2.6	-	-	2.3	-	-	4.8	-	-	-	-	4.6	-	4.8	5.1	5.1	5.5	0.5	2	
Bank Height Ratio	-	-	-	-	-	-	-	-	-	-	-	-	-	-	-	-	-	-	-	1.0	1.0	1.0	1.0	0.0	2	
d50 (mm)	-	-	-	1.0	-	-	4.0	-	-	13.0	-	-	17.0	-	-	-	-	-	-	1.5	2.6	3.6	3.6	1.5	2	
Profile																										
Riffle Length (ft)	-	-	-	-	-	-	-	-	-	-	-	-	-	-	-	-	-	-	-	4.3	13.3	11.9	38.6	7.8	55	
Riffle Slope (ft/ft)	-	-	-	-	-	-	-	-	-	-	-	-	-	-	-	-	-	-	-	0.000	0.004	0.002	0.017	0.004	55	
Pool Length (ft)	-	-	-	-	-	-	-	-	-	-	-	-	-	-	-	-	-	-	-	5.7	13.1	12.8	26.1	4.3	54	
Pool Max Depth (ft)	-	-	-	-	-	-	-	-	-	-	-	-	-	-	-	-	-	1.4	-	1.1	1.7	1.7	2.6	0.4	54	
Pool Spacing (ft)	-	-	-	-	-	-	-	-	-	-	-	-	-	-	-	-	-	43.0	-	60.2	8.9	35.7	34.4	72.9	12.0	53
Pattern																										
Channel Belt Width (ft)	-	-	-	-	-	-	-	-	-	-	-	-	-	-	-	-	-	13.7	27.4	34.3	24.8	27.0	27.2	29.0	2.1	3
Radius of Curvature (ft)	-	-	-	-	-	-	-	-	-	-	-	-	-	-	-	-	-	10.0	-	17.0	11.0	14.3	14.6	17.4	3.2	3
Rc: Bankfull Width (ft/ft)	-	-	-	-	-	-	-	-	-	-	-	-	-	-	-	-	-	-	-	-	1.3	1.7	1.7	2.0	0.4	3
Meander Wavelength (ft)	-	-	-	-	-	-	-	-	-	-	-	-	-	-	-	-	-	-	-	24.5	26.9	27.2	29.0	2.3	3	
Meander Width Ratio	-	-	-	-	-	-	-	-	-	-	-	-	-	-	-	-	-	2.9	-	2.9	3.1	3.2	3.4	0.2	3	
Substrate, Bed and Transport Parameters																										
Reach Shear Stress (Competency) lb/ft ²																										
Max Part Size (mm) Mobilized at Bankfull																										
Stream Power (Transport Capacity) W/m ²																										
Additional Reach Parameters																										
Drainage Area (mi ²)				0.30						0.25						0.30										
Rosgen Classification				E, G						E4						C5			C5							
Bankfull Velocity (fps)				1.8 - 2.2																						
Bankfull Discharge (cfs)				21.0												15.0										
Valley Length (ft)																			1,616							
* Channel Thalweg Length (ft)																			1,982							
^ Channel Centerline																			1,954							
Sinuosity				1.01						1.60						1.24			1.24							
Water Surface Slope (ft/ft)				0.006 - 0.009						0.008						0.005			0.005							
Bankfull Slope (ft/ft)																			0.005							
Bankfull Floodplain Area (acres)																										
% of Reach with Eroding Banks																										
Channel Stability or Habitat Metric				Unstable																						
Biological or Other																										

* Channel Thalweg Length (ft): Based on actual thalweg calculations from the as-built survey, accounts for breaks in conservation easement and utility right-of-ways.

^ Channel Centerline (ft): Based on stream centerline stationing from design stream stationing; accounts for breaks in conservation easement and utility right-of-ways.

- Information unavailable.

Non-Applicable.

Table 7 Cont'd. Baseline Stream Data Summary Fletcher Mitigation Site - Weston Creek Reach 1B (825 feet *)																											
Parameter	Regional Curve			Pre-Existing Condition						Reference Reach Data						Design			As-Built/ Baseline								
Dimension & Substrate - Riffle	LL	UL	Eq.	Min	Mean	Med	Max	SD	N	Min	Mean	Med	Max	SD	N	Min	Mean	Max	Min	Mean	Med	Max	SD	N			
Bankfull Width (ft)	-	-	-	4.5	-	-	9.6	-	-	6.3	-	-	10.7	-	-	-	-	9.4	-	-	9.7	-	-	-	1		
Floodprone Width (ft)	-	-	-	-	-	-	-	-	-	-	-	-	-	-	-	-	-	-	-	-	40.0	-	-	-	1		
Bankfull Mean Depth (ft)	-	-	-	-	-	-	-	-	-	-	-	-	-	-	-	-	-	0.7	-	-	0.5	-	-	-	1		
Bankfull Max Depth (ft)	-	-	-	0.6	-	-	1.0	-	-	1.0	-	-	1.2	-	-	-	-	0.9	-	-	0.7	-	-	-	1		
Bankfull Cross Sectional Area (ft ²)	-	-	-	3.8	-	-	7.8	-	-	7.7	-	-	10	-	-	-	-	6.3	-	-	4.7	-	-	-	1		
Width/Depth Ratio	-	-	-	5.3	-	-	11.9	-	-	6.0	-	-	11	-	-	-	-	3.3	-	-	20.4	-	-	-	1		
Entrenchment Ratio	-	-	-	1.3	-	-	2.2	-	-	2.3	-	-	4.8	-	-	-	-	4.3	-	-	4.1	-	-	-	1		
Bank Height Ratio	-	-	-	-	-	-	-	-	-	-	-	-	-	-	-	-	-	-	-	-	1.0	-	-	-	1		
d50 (mm)	-	-	-	1.0	-	-	4.0	-	-	13.0	-	-	17.0	-	-	-	-	-	-	-	1.8	-	-	-	-		
Profile																											
Riffle Length (ft)	-	-	-	-	-	-	-	-	-	-	-	-	-	-	-	-	-	-	-	-	4.5	12.3	12.1	29.1	5.9	21	
Riffle Slope (ft/ft)	-	-	-	-	-	-	-	-	-	-	-	-	-	-	-	-	-	-	-	-	0.000	0.007	0.002	0.031	0.008	21	
Pool Length (ft)	-	-	-	-	-	-	-	-	-	-	-	-	-	-	-	-	-	-	-	-	5.6	14.8	14.0	26.8	6.9	21	
Pool Max Depth (ft)	-	-	-	-	-	-	-	-	-	-	-	-	-	-	-	-	-	1.4	-	-	1.4	2.0	2.0	2.7	0.3	21	
Pool Spacing (ft)	-	-	-	-	-	-	-	-	-	-	-	-	-	-	-	-	-	47.0	-	-	65.8	19.7	35.2	34.8	68.4	12.1	20
Pattern																											
Channel Belt Width (ft)	-	-	-	-	-	-	-	-	-	-	-	-	-	-	-	-	-	14.9	29.9	37.3	27.3	28.4	28.1	29.9	1.3	3	
Radius of Curvature (ft)	-	-	-	-	-	-	-	-	-	-	-	-	-	-	-	-	-	11.0	-	19.0	15.8	19.5	18.2	24.5	4.5	3	
Rc: Bankfull Width (ft/ft)	-	-	-	-	-	-	-	-	-	-	-	-	-	-	-	-	-	-	-	-	1.7	2.1	1.9	2.6	0.5	3	
Meander Wavelength (ft)	-	-	-	-	-	-	-	-	-	-	-	-	-	-	-	-	-	-	-	-	27.3	28.4	28.1	29.9	1.3	3	
Meander Width Ratio	-	-	-	-	-	-	-	-	-	-	-	-	-	-	-	-	-	3.3	-	-	2.9	3.0	3.0	3.2	0.1	3	
Substrate, Bed and Transport Parameters																											
Reach Shear Stress (Competency) lb/ft ²	-	-	-	-	-	-	-	-	-	-	-	-	-	-	-	-	-	-	-	-	-	-	-	-	-	-	
Max Part Size (mm) Mobilized at Bankfull	-	-	-	-	-	-	-	-	-	-	-	-	-	-	-	-	-	-	-	-	-	-	-	-	-	-	
Stream Power (Transport Capacity) W/m ²	-	-	-	-	-	-	-	-	-	-	-	-	-	-	-	-	-	-	-	-	-	-	-	-	-	-	
Additional Reach Parameters																											
Drainage Area (mi ²)	-	-	-	-	-	-	0.37	-	-	-	-	-	0.25	-	-	-	-	0.37	-	-	-	-	-	-	-	-	
Rosgen Classification	-	-	-	-	-	-	G, E	-	-	-	-	-	E4	-	-	-	-	C5	-	-	-	-	-	-	-	C5	
Bankfull Velocity (fps)	-	-	-	-	-	-	1.8 - 2.3	-	-	-	-	-	-	-	-	-	-	-	-	-	-	-	-	-	-	-	
Bankfull Discharge (cfs)	-	-	-	-	-	-	25.0	-	-	-	-	-	-	-	-	-	-	18.0	-	-	-	-	-	-	-	-	
Valley Length (ft)	-	-	-	-	-	-	-	-	-	-	-	-	-	-	-	-	-	-	-	-	-	-	-	-	-	708	
* Channel Thalweg Length (ft)	-	-	-	-	-	-	-	-	-	-	-	-	-	-	-	-	-	-	-	-	-	-	-	-	-	825	
^ Channel Centerline (ft)	-	-	-	-	-	-	-	-	-	-	-	-	-	-	-	-	-	-	-	-	-	-	-	-	-	804	
Sinuosity	-	-	-	-	-	-	1.01	-	-	-	-	-	1.60	-	-	-	-	1.20	-	-	-	-	-	-	-	1.17	
Water Surface Slope (ft/ft)	-	-	-	-	-	-	0.005 - 0.007	-	-	-	-	-	0.0080	-	-	-	-	0.009	-	-	-	-	-	-	-	0.0024	
Bankfull Slope (ft/ft)	-	-	-	-	-	-	-	-	-	-	-	-	-	-	-	-	-	-	-	-	-	-	-	-	-	0.0026	
Bankfull Floodplain Area (acres)	-	-	-	-	-	-	-	-	-	-	-	-	-	-	-	-	-	-	-	-	-	-	-	-	-	-	
% of Reach with Eroding Banks	-	-	-	-	-	-	-	-	-	-	-	-	-	-	-	-	-	-	-	-	-	-	-	-	-	-	
Channel Stability or Habitat Metric	-	-	-	-	-	-	Unstable	-	-	-	-	-	-	-	-	-	-	-	-	-	-	-	-	-	-	-	
Biological or Other	-	-	-	-	-	-	-	-	-	-	-	-	-	-	-	-	-	-	-	-	-	-	-	-	-	-	

* Channel Thalweg Length (ft): Based on actual thalweg calculations from the as-built survey, accounts for breaks in conservation easement and utility right-of-ways.

^ Channel Centerline (ft): Based on stream centerline stationing from design stream stationing; accounts for breaks in conservation easement and utility right-of-ways.

- Information unavailable.

Non-Applicable.

Table 7 Cont'd. Baseline Stream Data Summary Fletcher Mitigation Site - Raccoon Branch Reach 1D (440 feet *)																												
Parameter	Regional Curve			Pre-Existing Condition					Reference Reach Data					Design			As-Built/ Baseline											
Dimension & Substrate - Rifle	LL	UL	Eq.	Min	Mean	Med	Max	SD	N	Min	Mean	Med	Max	SD	N	Min	Mean	Max	Min	Mean	Med	Max	SD	N				
Bankfull Width (ft)	-	-	-	1.8	-	-	3.4	-	-	14.7	-	-	19.5	-	-	-	-	6.1	-	-	6.9	-	-	1				
Floodprone Width (ft)	-	-	-	-	-	-	-	-	-	-	-	-	-	-	-	-	-	-	-	-	20	-	-	1				
Bankfull Mean Depth (ft)	-	-	-	-	-	-	-	-	-	-	-	-	-	-	-	-	-	0.3	-	-	0.5	-	-	1				
Bankfull Max Depth (ft)	-	-	-	0.1	-	-	0.2	-	-	1.2	-	-	1.4	-	-	-	-	0.5	-	-	1.34	-	-	1				
Bankfull Cross Sectional Area (ft ²)	-	-	-	0.4	-	-	0.6	-	-	18	-	-	27.2	-	-	-	-	2.1	-	-	3.42	-	-	1				
Width/Depth Ratio	-	-	-	8.0	-	-	25.7	-	-	12	-	-	14.0	-	-	-	-	17.8	-	-	13.8	-	-	1				
Entrenchment Ratio	-	-	-	1.7	-	-	2.1	-	-	1.4	-	-	1.5	-	-	-	-	2.3	-	-	2.91	-	-	1				
Bank Height Ratio	-	-	-	-	-	-	-	-	-	-	-	-	-	-	-	-	-	-	-	-	1.0	-	-	1				
d50 (mm)	-	-	-	1.0	-	-	2.0	-	-	60.0	-	-	125.0	-	-	-	-	-	-	-	0.062	-	-	1				
Profile																												
Rifle Length (ft)	-	-	-	-	-	-	-	-	-	-	-	-	-	-	-	-	-	-	-	1.5	4.5	4.2	7.9	1.7	38.0			
Rifle Slope (ft/ft)	-	-	-	-	-	-	-	-	-	-	-	-	-	-	-	-	-	-	-	0.003	0.033	0.030	0.085	0.021	38.0			
Pool Length (ft)	-	-	-	-	-	-	-	-	-	-	-	-	-	-	-	-	-	-	-	1.7	5.4	5.0	12.7	2.6	37.0			
Pool Max Depth (ft)	-	-	-	-	-	-	-	-	-	-	-	-	-	-	-	-	-	-	-	0.8	0.6	1.0	1.1	1.4	0.2	37.0		
Pool Spacing (ft)	-	-	-	-	-	-	-	-	-	-	-	-	-	-	-	-	-	-	-	20.1	-	33.6	4.1	12.1	11.2	28.8	5.5	35.0
Pattern																												
Channel Belt Width (ft)	-	-	-	-	-	-	-	-	-	-	-	-	-	-	-	-	-	6.5	8.7	10.9	6.7	7.5	7.0	8.7	1.1	3		
Radius of Curvature (ft)	-	-	-	-	-	-	-	-	-	-	-	-	-	-	-	-	-	9.0	-	13.0	7.9	10.1	8.5	13.9	3.3	3		
Rc: Bankfull Width (ft/ft)	-	-	-	-	-	-	-	-	-	-	-	-	-	-	-	-	-	1.2	1.6	1.3	2.2	0.6	0.6	3				
Meander Wavelength (ft)	-	-	-	-	-	-	-	-	-	-	-	-	-	-	-	-	-	-	-	-	6.7	7.5	7.0	8.7	1.1	3		
Meander Width Ratio	-	-	-	-	-	-	-	-	-	-	-	-	-	-	-	-	-	2.5	-	1.1	1.2	1.1	1.4	0.1	3			
Substrate, Bed and Transport Parameters																												
Reach Shear Stress (Competency) lb/ft ²																												
Max Part Size (mm) Mobilized at Bankfull																												
Stream Power (Transport Capacity) W/m ²																												
Additional Reach Parameters																												
Drainage Area (mi ²)				0.04					2.35					0.04														
Rosgen Classification				B, G					B4					B4			B4											
Bankfull Velocity (fps)	-	-	-	2.4 - 3.4																								
Bankfull Discharge (cfs)	-	-	-	4.0										3.0														
Valley Length (ft)																	413											
* Channel Thalweg Length (ft)																	440											
^ Channel Centerline (ft)																	448											
Sinuosity				1.09										1.05			1.08											
Water Surface Slope (ft/ft)				0.048 - 0.092					0.011 - 0.018					0.048			0.040											
Bankfull Slope (ft/ft)																	0.041											
Bankfull Floodplain Area (acres)																												
% of Reach with Eroding Banks																												
Channel Stability or Habitat Metric				Unstable																								
Biological or Other																												

* Channel Thalweg Length (ft): Based on actual thalweg calculations from the as-built survey, accounts for breaks in conservation easement and utility right-of-ways.

^ Channel Centerline (ft): Based on stream centerline stationing from design stream stationing; accounts for breaks in conservation easement and utility right-of-ways.

- Information unavailable.

Non-Applicable.

Table 7 Cont'd. Baseline Stream Data Summary																									
Fletcher Mitigation Site - Coats Branch Reach 1B (601 feet *)																									
Parameter	Regional Curve			Pre-Existing Condition						Reference Reach Data						Design			As-Built/ Baseline						
Dimension & Substrate - Rifle	LL	UL	Eq.	Min	Mean	Med	Max	SD	N	Min	Mean	Med	Max	SD	N	Min	Mean	Max	Min	Mean	Med	Max	SD	N	
Bankfull Width (ft)	-	-	-	0.9	-	-	1.3	-	-	14.7	-	-	19.5	-	-	5.7	-	-	5.2	-	-	-	-	1	
Floodprone Width (ft)	-	-	-	-	-	-	-	-	-	-	-	-	-	-	-	-	-	-	15.0	-	-	-	-	1	
Bankfull Mean Depth (ft)	-	-	-	-	-	-	-	-	-	-	-	-	-	-	-	0.3	-	-	0.3	-	-	-	-	1	
Bankfull Max Depth (ft)	-	-	-	0.2	-	-	0.3	-	-	1.2	-	-	1.4	-	-	0.5	-	-	0.7	-	-	-	-	1	
Bankfull Cross Sectional Area (ft ²)	-	-	-	0.2	-	-	0.3	-	-	18	-	-	27.2	-	-	1.8	-	-	1.6	-	-	-	-	1	
Width/Depth Ratio	-	-	-	5.1	-	-	5.6	-	-	12	-	-	14.0	-	-	17.9	-	-	16.5	-	-	-	-	1	
Entrenchment Ratio	-	-	-	2.0	-	-	2.8	-	-	1.4	-	-	1.5	-	-	2.4	-	-	2.9	-	-	-	-	1	
Bank Height Ratio	-	-	-	-	-	-	-	-	-	-	-	-	-	-	-	-	-	-	1.0	-	-	-	-	1	
d50 (mm)	-	-	-	1.0	-	-	2.0	-	-	60.0	-	-	125.0	-	-	-	-	-	15.0	-	-	-	-	1	
Profile																									
Rifle Length (ft)	-	-	-	-	-	-	-	-	-	-	-	-	-	-	-	-	-	-	3.0	6.5	6.3	14.0	2.1	52	
Rifle Slope (ft/ft)	-	-	-	-	-	-	-	-	-	-	-	-	-	-	-	-	-	-	0.000	0.020	0.016	0.072	0.016	52	
Pool Length (ft)	-	-	-	-	-	-	-	-	-	-	-	-	-	-	-	1.2	3.4	3.2	6.3	1.2	1.2	1.2	1.2	51	
Pool Max Depth (ft)	-	-	-	-	-	-	-	-	-	-	-	-	-	-	-	0.8	-	0.24	1.2	1.1	2.5	0.4	51		
Pool Spacing (ft)	-	-	-	-	-	-	-	-	-	-	-	-	-	-	18.8	-	31.4	5.8	11.7	12	18.7	2.5	50		
Pattern																									
Channel Belt Width (ft)	-	-	-	-	-	-	-	-	-	-	-	-	-	-	-	6.1	8.1	10.2	9.7	10.6	10.5	11.5	0.9	3	
Radius of Curvature (ft)	-	-	-	-	-	-	-	-	-	-	-	-	-	-	-	8.0	-	12.0	9.0	11.0	12.0	12.1	1.8	3	
Rc: Bankfull Width (ft/ft)	-	-	-	-	-	-	-	-	-	-	-	-	-	-	-	1.5	1.9	-	2.1	2.1	2.1	0.3	3		
Meander Wavelength (ft)	-	-	-	-	-	-	-	-	-	-	-	-	-	-	-	-	-	-	9.7	10.6	10.5	11.5	0.9	3	
Meander Width Ratio	-	-	-	-	-	-	-	-	-	-	-	-	-	-	-	2.5	-	1.7	1.9	1.8	2.0	0.1	3		
Substrate, Bed and Transport Parameters																									
Reach Shear Stress (Competency) lb/ft ²																									
Max Part Size (mm) Mobilized at Bankfull																									
Stream Power (Transport Capacity) W/m ²																									
Additional Reach Parameters																									
Drainage Area (mi ²)				0.03						2.4						0.03			B4						
Rosgen Classification				B, G						B4						B4			B4						
Bankfull Velocity (fps)	-	-	-	1.7 - 2.0																					
Bankfull Discharge (cfs)	-	-	-	3.0												2.0									
Valley Length (ft)																			597						
* Channel Thalweg Length (ft)																			601						
^ Channel Centerline (ft)																			606						
Sinuosity				1.08												1.04			1.05						
Water Surface Slope (ft/ft)				0.03 - 0.034						0.011 - 0.018						0.033			0.033						
Bankfull Slope (ft/ft)																			0.033						
Bankfull Floodplain Area (acres)																									
% of Reach with Eroding Banks																									
Channel Stability or Habitat Metric				Severe																					
Biological or Other																									

* Channel Thalweg Length (ft): Based on actual thalweg calculations from the as-built survey, accounts for breaks in conservation easement and utility right-of-ways.

^ Channel Centerline (ft): Based on stream centerline stationing from design stream stationing; accounts for breaks in conservation easement and utility right-of-ways.

- Information unavailable.

Non-Applicable.

Table 7 Cont'd. Baseline Stream Data Summary																									
Fletcher Mitigation Site - Coats Branch Reach 1C (708 feet *)																									
Parameter	Regional Curve			Pre-Existing Condition						Reference Reach Data						Design			As-Built/ Baseline						
Dimension & Substrate - Rifle	LL	UL	Eq.	Min	Mean	Med	Max	SD	N	Min	Mean	Med	Max	SD	N	Min	Mean	Max	Min	Mean	Med	Max	SD	N	
Bankfull Width (ft)	-	-	-	1.9	-	-	3.4	-	-	14.7	-	-	19.5	-	-	6.0	-	-	5.4	-	-	-	-	1	
Floodprone Width (ft)	-	-	-	-	-	-	-	-	-	-	-	-	-	-	-	-	-	20.0	-	-	-	-	-	1	
Bankfull Mean Depth (ft)	-	-	-	-	-	-	-	-	-	-	-	-	-	-	-	0.3	-	-	0.4	-	-	-	-	1	
Bankfull Max Depth (ft)	-	-	-	0.2	-	-	0.3	-	-	1.2	-	-	1.4	-	-	0.5	-	-	0.8	-	-	-	-	1	
Bankfull Cross Sectional Area (ft ²)	-	-	-	0.3	-	-	0.8	-	-	18	-	-	27.2	-	-	2.0	-	-	2.2	-	-	-	-	1	
Width/Depth Ratio	-	-	-	10.4	-	-	14.5	-	-	12	-	-	14.0	-	-	17.8	-	-	13.5	-	-	-	-	1	
Entrenchment Ratio	-	-	-	1.2	-	-	1.9	-	-	1.4	-	-	1.5	-	-	2.3	-	-	3.7	-	-	-	-	1	
Bank Height Ratio	-	-	-	-	-	-	-	-	-	-	-	-	-	-	-	-	-	-	1.0	-	-	-	-	1	
d50 (mm)	-	-	-	9.0	-	-	12.0	-	-	60.0	-	-	125.0	-	-	-	-	-	0.4	-	-	-	-	1	
Profile																									
Rifle Length (ft)	-	-	-	-	-	-	-	-	-	-	-	-	-	-	-	3.8	7.4	7.7	10.1	1.6	48				
Rifle Slope (ft/ft)	-	-	-	-	-	-	-	-	-	-	-	-	-	-	-	0.000	0.010	0.010	0.033	0.007	48				
Pool Length (ft)	-	-	-	-	-	-	-	-	-	-	-	-	-	-	-	1.2	4.6	4.2	7.3	1.4	48				
Pool Max Depth (ft)	-	-	-	-	-	-	-	-	-	-	-	-	-	-	-	0.8	-	0.6	1.0	1.0	1.4	0.2	48		
Pool Spacing (ft)	-	-	-	-	-	-	-	-	-	-	-	-	-	-	19.8	-	33.0	6.4	14.3	14.6	19.6	2.6	48		
Pattern																									
Channel Belt Width (ft)	-	-	-	-	-	-	-	-	-	-	-	-	-	-	6.5	8.6	10.8	10.9	11.7	11.6	12.5	0.8	3		
Radius of Curvature (ft)	-	-	-	-	-	-	-	-	-	-	-	-	-	-	9.0	-	13.0	7.0	8.8	7.2	12.1	2.9	3		
Rc: Bankfull Width (ft/ft)	-	-	-	-	-	-	-	-	-	-	-	-	-	-	-	1.2	1.5	1.2	2.1	0.5	3				
Meander Wavelength (ft)	-	-	-	-	-	-	-	-	-	-	-	-	-	-	-	-	-	10.9	12.1	11.6	13.7	1.5	3		
Meander Width Ratio	-	-	-	-	-	-	-	-	-	-	-	-	-	-	-	2.3	-	1.8	2.0	1.9	2.1	0.1	3		
Substrate, Bed and Transport Parameters																									
Reach Shear Stress (Competency) lb/ft ²	-	-	-	-	-	-	-	-	-	-	-	-	-	-	-	-	-	-	-	-	-	-	-	-	
Max Part Size (mm) Mobilized at Bankfull	-	-	-	-	-	-	-	-	-	-	-	-	-	-	-	-	-	-	-	-	-	-	-	-	
Stream Power (Transport Capacity) W/m ²	-	-	-	-	-	-	-	-	-	-	-	-	-	-	-	-	-	-	-	-	-	-	-	-	
Additional Reach Parameters																									
Drainage Area (mi ²)	-	-	-	-	-	-	0.04	-	-	-	-	2.4	-	-	-	0.04	-	-	-	-	-	-	-	-	
Rosgen Classification	-	-	-	-	-	-	B, F, G	-	-	-	-	B4	-	-	-	B4	-	-	-	-	-	-	-	B4	
Bankfull Velocity (fps)	-	-	-	-	-	-	0.9 - 1.8	-	-	-	-	-	-	-	-	-	-	-	-	-	-	-	-	-	
Bankfull Discharge (cfs)	-	-	-	-	-	-	4.0	-	-	-	-	-	-	-	-	3.0	-	-	-	-	-	-	-	-	
Valley Length (ft)	-	-	-	-	-	-	-	-	-	-	-	-	-	-	-	-	-	-	-	-	-	-	667		
* Channel Thalweg Length (ft)	-	-	-	-	-	-	-	-	-	-	-	-	-	-	-	-	-	-	-	-	-	-	708		
^ Channel Centerline (ft)	-	-	-	-	-	-	-	-	-	-	-	-	-	-	-	-	-	-	-	-	-	-	708		
Sinuosity	-	-	-	-	-	-	1.03	-	-	-	-	-	-	-	-	1.07	-	-	-	-	-	-	1.06		
Water Surface Slope (ft/ft)	-	-	-	-	-	-	0.009 - 0.021	-	-	-	-	0.011 - 0.018	-	-	-	0.015	-	-	-	-	-	-	0.013		
Bankfull Slope (ft/ft)	-	-	-	-	-	-	-	-	-	-	-	-	-	-	-	-	-	-	-	-	-	-	0.013		
Bankfull Floodplain Area (acres)	-	-	-	-	-	-	-	-	-	-	-	-	-	-	-	-	-	-	-	-	-	-	-		
% of Reach with Eroding Banks	-	-	-	-	-	-	-	-	-	-	-	-	-	-	-	-	-	-	-	-	-	-	-		
Channel Stability or Habitat Metric	-	-	-	-	-	-	Unstable	-	-	-	-	-	-	-	-	-	-	-	-	-	-	-	-		
Biological or Other	-	-	-	-	-	-	-	-	-	-	-	-	-	-	-	-	-	-	-	-	-	-	-		

* Channel Thalweg Length (ft): Based on actual thalweg calculations from the as-built survey, accounts for breaks in conservation easement and utility right-of-ways.

^ Channel Centerline (ft): Based on stream centerline stationing from design stream stationing; accounts for breaks in conservation easement and utility right-of-ways.

- Information unavailable.

Non-Applicable.

Table 7 Cont'd. Baseline Stream Data Summary																									
Fletcher Mitigation Site - Coats Branch Reach ID (325 feet *)																									
Parameter	Regional Curve			Pre-Existing Condition						Reference Reach Data						Design			As-Built/ Baseline						
Dimension & Substrate - Rifle	LL	UL	Eq.	Min	Mean	Med	Max	SD	N	Min	Mean	Med	Max	SD	N	Min	Mean	Max	Min	Mean	Med	Max	SD	N	
Bankfull Width (ft)	-	-	-	3.6	-	-	5.0	-	-	14.7	-	-	19.5	-	-	6.9	-	-	6.1	-	-	-	-	1	
Floodprone Width (ft)	-	-	-	-	-	-	-	-	-	-	-	-	-	-	-	-	-	25.0	-	-	-	-	-	1	
Bankfull Mean Depth (ft)	-	-	-	-	-	-	-	-	-	-	-	-	-	-	-	0.4	-	-	0.5	-	-	-	-	1	
Bankfull Max Depth (ft)	-	-	-	0.2	-	-	0.3	-	-	1.2	-	-	1.4	-	-	0.6	-	-	1.0	-	-	-	-	1	
Bankfull Cross Sectional Area (ft ²)	-	-	-	1.0	-	-	1.4	-	-	18	-	-	27.2	-	-	2.7	-	-	3.3	-	-	-	-	1	
Width/Depth Ratio	-	-	-	13.0	-	-	18.0	-	-	12	-	-	14.0	-	-	17.7	-	-	11.4	-	-	-	-	1	
Entrenchment Ratio	-	-	-	1.7	-	-	1.8	-	-	1.4	-	-	1.5	-	-	2.2	-	-	4.1	-	-	-	-	1	
Bank Height Ratio	-	-	-	-	-	-	-	-	-	-	-	-	-	-	-	-	-	-	1.0	-	-	-	-	1	
d50 (mm)	-	-	-	8.0	-	-	14.0	-	-	60.0	-	-	125.0	-	-	-	-	-	4.0	-	-	-	-	1	
Profile																									
Rifle Length (ft)	-	-	-	-	-	-	-	-	-	-	-	-	-	-	-	-	-	-	4.1	7.2	7.3	11.9	1.8	22	
Rifle Slope (ft/ft)	-	-	-	-	-	-	-	-	-	-	-	-	-	-	-	-	-	-	0.000	0.008	0.006	0.021	0.006	22	
Pool Length (ft)	-	-	-	-	-	-	-	-	-	-	-	-	-	-	-	-	-	-	1.8	4.6	4.4	8.1	1.8	22	
Pool Max Depth (ft)	-	-	-	-	-	-	-	-	-	-	-	-	-	-	-	0.9	-	-	0.6	1.1	1.1	2.2	0.3	22	
Pool Spacing (ft)	-	-	-	-	-	-	-	-	-	-	-	-	-	-	-	22.8	-	38.0	8.0	13.9	14.0	19.1	3.2	21	
Pattern																									
Channel Belt Width (ft)	-	-	-	-	-	-	-	-	-	-	-	-	-	-	-	7.4	9.9	12.3	11.5	12.7	12.8	13.8	1.2	3	
Radius of Curvature (ft)	-	-	-	-	-	-	-	-	-	-	-	-	-	-	-	10.0	-	15.0	4.7	7.0	7.2	9.2	2.3	3	
Rc: Bankfull Width (ft/ft)	-	-	-	-	-	-	-	-	-	-	-	-	-	-	-	-	-	-	0.7	1.0	1.0	1.3	0.3	3	
Meander Wavelength (ft)	-	-	-	-	-	-	-	-	-	-	-	-	-	-	-	-	-	-	11.5	12.5	12.1	13.8	1.2	3	
Meander Width Ratio	-	-	-	-	-	-	-	-	-	-	-	-	-	-	-	2.6	-	1.7	1.8	1.9	2.0	0.1	3		
Substrate, Bed and Transport Parameters																									
Reach Shear Stress (Competency) lb/ft ²																									
Max Part Size (mm) Mobilized at Bankfull																									
Stream Power (Transport Capacity) W/m ²																									
Additional Reach Parameters																									
Drainage Area (mi ²)				0.07						2.4						0.07									
Rosgen Classification				B						B4						B4			B4						
Bankfull Velocity (fps)	-	-	-	0.9 - 1.3																					
Bankfull Discharge (cfs)	-	-	-	7.0												5.0									
Valley Length (ft)																			311						
* Channel Thalweg Length (ft)																			325						
^ Channel Centerline (ft)																			325						
Sinuosity				1.05												1.12			1.05						
Water Surface Slope (ft/ft)				0.004 - 0.009						0.011 - 0.018						0.015			0.013						
Bankfull Slope (ft/ft)																			0.014						
Bankfull Floodplain Area (acres)																									
% of Reach with Eroding Banks																									
Channel Stability or Habitat Metric				Unstable																					
Biological or Other																									

* Channel Thalweg Length (ft): Based on actual thalweg calculations from the as-built survey, accounts for breaks in conservation easement and utility right-of-ways.

^ Channel Centerline (ft): Based on stream centerline stationing from design stream stationing; accounts for breaks in conservation easement and utility right-of-ways.

- Information unavailable.

Non-Applicable.

**Table 8. Monitoring Data - Dimensional Morphology Summary (Dimensional Parameters – Cross Sections)
Fletcher Mitigation Site**

Dimension	Cross Section 1 (Riffle) Fletcher Creek Reach 1B								Cross Section 2 (Pool) Fletcher Creek Reach 1B								Cross Section 3 (Pool) Fletcher Creek Reach 1C								Cross Section 4 (Riffle) Fletcher Creek Reach 1C								Cross Section 5 (Pool) Fletcher Creek Reach 1C							
	Base	MY1	MY2	MY3	MY4	MY5	MY6	MY7	Base	MY1	MY2	MY3	MY4	MY5	MY6	MY7	Base	MY1	MY2	MY3	MY4	MY5	MY6	MY7	Base	MY1	MY2	MY3	MY4	MY5	MY6	MY7	Base	MY1	MY2	MY3	MY4	MY5	MY6	MY7
Record Elevation (datum) Used	2124.8								2123.0								2118.8								2118.5								2106.8							
Low Bank Height Elevation (datum) Used	2124.8								2123.0								2118.8								2118.5								2106.8							
Bankfull Width (ft)	7.1								10.9							10.9								7.6								16.6								
Floodprone Width (ft)	20.0								60.0							40.0								10.0								60.0								
Bankfull Mean Depth (ft)	0.3								1.7							0.9								0.3								1.2								
Bankfull Max Depth (ft)	0.6								2.7							1.8								0.5								3.0								
Bankfull Cross Sectional Area (ft ²)	2.3								18.3							10.3								2.1								20.3								
Bankfull Width/Depth Ratio	21.4								6.5							11.6								27.6								13.7								
Bankfull Entrenchment Ratio	2.8								5.5							3.7								1.3								3.6								
Bankfull Bank Height Ratio	1.0								1.0							1.0								1.0								1.0								
Low Top of Bank Depth (ft)	0.6								2.7							1.8								0.5								3.0								
Dimension	Cross Section 6 (Riffle) Fletcher Creek Reach 1C								Cross Section 7 (Riffle) Fletcher Creek Reach 2A								Cross Section 8 (Pool) Fletcher Creek Reach 2A								Cross Section 9 (Pool) Fletcher Creek Reach 2A								Cross Section 10 (Riffle) Fletcher Creek Reach 2A							
	Base	MY1	MY2	MY3	MY4	MY5	MY6	MY7	Base	MY1	MY2	MY3	MY4	MY5	MY6	MY7	Base	MY1	MY2	MY3	MY4	MY5	MY6	MY7	Base	MY1	MY2	MY3	MY4	MY5	MY6	MY7	Base	MY1	MY2	MY3	MY4	MY5	MY6	MY7
Record Elevation (datum) Used	2106.2								2101.4								2100.9								2093.5								2093.1							
Low Bank Height Elevation (datum) Used	2106.2								2101.4								2100.9								2093.5								2093.1							
Bankfull Width (ft)	12.0								13.1							15.3								15.6								12.6								
Floodprone Width (ft)	50.0								35.0							50.0								60.0								50.0								
Bankfull Mean Depth (ft)	0.6								0.8							1.3								1.1								0.7								
Bankfull Max Depth (ft)	1.0								1.6							2.6								2.8								1.2								
Bankfull Cross Sectional Area (ft ²)	7.5								10.4							20.5								16.9								9.2								
Bankfull Width/Depth Ratio	19.2								16.5							11.4								14.4								17.4								
Bankfull Entrenchment Ratio	4.2								2.7							3.3								3.9								4.0								
Bankfull Bank Height Ratio	1.0								1.0							1.0								1.0								1.0								
Low Top of Bank Depth (ft)	1.2								1.6							2.6								2.8								1.5								
Dimension	Cross Section 11 (Riffle) Fletcher Creek Reach 2B								Cross Section 12 (Pool) Fletcher Creek Reach 2B								Cross Section 13 (Pool) Fletcher Creek Reach 2B								Cross Section 14 (Riffle) Fletcher Creek Reach 2B															
	Base	MY1	MY2	MY3	MY4	MY5	MY6	MY7	Base	MY1	MY2	MY3	MY4	MY5	MY6	MY7	Base	MY1	MY2	MY3	MY4	MY5	MY6	MY7	Base	MY1	MY2	MY3	MY4	MY5	MY6	MY7								
Record Elevation (datum) Used	2079.0								2078.6								2075.5								2075.1															
Low Bank Height Elevation (datum) Used	2079.0								2078.6								2075.5								2075.1															
Bankfull Width (ft)	10.2								9.7							10.1								9.8																
Floodprone Width (ft)	40.0								70.0							70.0								70.0																
Bankfull Mean Depth (ft)	0.7								1.2							1.6								0.8																
Bankfull Max Depth (ft)	1.3								2.3							2.4								1.2																
Bankfull Cross Sectional Area (ft ²)	7.1								11.7							16.4								7.6																
Bankfull Width/Depth Ratio	14.6								8.1							6.2								12.6																
Bankfull Entrenchment Ratio	3.9								7.2							6.9								7.2																
Bankfull Bank Height Ratio	1.0								1.0							1.0								1.0																
Low Top of Bank Depth (ft)	1.3								2.3							2.4								1.2																

**Table 8 Cont'd. Monitoring Data - Dimensional Morphology Summary (Dimensional Parameters – Cross Sections)
Fletcher Mitigation Site**

	Cross Section 15 (Riffle) Weston Creek 1A								Cross Section 16 (Pool) Weston Creek 1A								Cross Section 17 (Pool) Weston Creek 1A								Cross Section 18 (Riffle) Weston Creek 1A								Cross Section 19 (Riffle) Weston Creek 2B							
Dimension	Base	MY1	MY2	MY3	MY4	MY5	MY6	MY7	Base	MY1	MY2	MY3	MY4	MY5	MY6	MY7	Base	MY1	MY2	MY3	MY4	MY5	MY6	MY7	Base	MY1	MY2	MY3	MY4	MY5	MY6	MY7	Base	MY1	MY2	MY3	MY4	MY5	MY6	MY7
Record Elevation (datum) Used	2082.5								2082.3								2076.2								2076.3								2074.9							
Low Bank Height Elevation (datum) Used	2082.5								2082.3								2076.2								2076.3								2074.9							
Bankfull Width (ft)	9.1								9.7							9.8								10.4								9.7								
Floodprone Width (ft)	50.0								50.0							50.0								50.0								40.0								
Bankfull Mean Depth (ft)	0.6								1.1							1.0								0.6								0.5								
Bankfull Max Depth (ft)	1.1								2.0							1.7								0.9								0.7								
Bankfull Cross Sectional Area (ft ²)	5.4								10.4							9.4								6.2								4.7								
Bankfull Width/Depth Ratio	15.5								9.1							10.1								17.4								20.4								
Bankfull Entrenchment Ratio	5.5								5.1							5.1								4.8								4.1								
Bankfull Bank Height Ratio	1.0								1.0							1.0								1.0								1.0								
Low Top of Bank Depth (ft)	1.1								2.0							1.7								0.9								0.7								
	Cross Section 20 (Pool) Weston Creek 2B								Cross Section 21 (Pool) Raccoon Branch 1D								Cross Section 22 (Riffle) Raccoon Branch 1D								Cross Section 23 (Riffle) Coats Branch 1B								Cross Section 24 (Pool) Coats Branch 1B							
Dimension	Base	MY1	MY2	MY3	MY4	MY5	MY6	MY7	Base	MY1	MY2	MY3	MY4	MY5	MY6	MY7	Base	MY1	MY2	MY3	MY4	MY5	MY6	MY7	Base	MY1	MY2	MY3	MY4	MY5	MY6	MY7	Base	MY1	MY2	MY3	MY4	MY5	MY6	MY7
Record Elevation (datum) Used	2074.8								2131.4								2131.4								2121.0								2121.1							
Low Bank Height Elevation (datum) Used	2074.8								2131.4								2131.4								2121.0								2121.1							
Bankfull Width (ft)	8.3								5.6							6.9								5.2								7.4								
Floodprone Width (ft)	60.0								20.0							20.0								15.0								40.0								
Bankfull Mean Depth (ft)	1.5								0.5							0.5								0.3								0.7								
Bankfull Max Depth (ft)	2.5								1.2							1.3								0.7								1.5								
Bankfull Cross Sectional Area (ft ²)	12.7								2.7							3.4								1.6								5.1								
Bankfull Width/Depth Ratio	5.4								11.6							13.8								16.5								10.7								
Bankfull Entrenchment Ratio	7.2								3.6							2.9								2.9								5.4								
Bankfull Bank Height Ratio	1.0								1.0							1.0								1.0								1.0								
Low Top of Bank Depth (ft)	2.5								1.2							1.3								0.7								1.5								
	Cross Section 25 (Pool) Coats Branch 1C								Cross Section 26 (Riffle) Coats Branch 1C								Cross Section 27 (Pool) Coats Branch 1D								Cross Section 28 (Riffle) Coats Branch 1D															
Dimension	Base	MY1	MY2	MY3	MY4	MY5	MY6	MY7	Base	MY1	MY2	MY3	MY4	MY5	MY6	MY7	Base	MY1	MY2	MY3	MY4	MY5	MY6	MY7	Base	MY1	MY2	MY3	MY4	MY5	MY6	MY7								
Record Elevation (datum) Used	2108.0								2107.9								2105.7								2105.6															
Low Bank Height Elevation (datum) Used	2108.0								2107.9							2105.7								2105.6																
Bankfull Width (ft)	5.3								5.4							5.9								6.1																
Floodprone Width (ft)	20.0								20.0							25.0								25.0																
Bankfull Mean Depth (ft)	0.5								0.4							0.6								0.5																
Bankfull Max Depth (ft)	0.9								0.8							1.2								1.0																
Bankfull Cross Sectional Area (ft ²)	2.7								2.2							3.7								3.3																
Bankfull Width/Depth Ratio	10.5								13.5							9.2								11.4																
Bankfull Entrenchment Ratio	3.8								3.7							4.3								4.1																
Bankfull Bank Height Ratio	1.0								1.0							1.0								1.0																
Low Top of Bank Depth (ft)	0.9								0.8							1.2								1.0																

This Page Intentionally Left Blank

Appendix E
As-Built Survey and Record Drawings Plan Set

This Page Intentionally Left Blank


CERTIFICATE OF SURVEY AND ACCURACY

I, DREW VAN DUINKERKEN, CERTIFY THAT THE GROUND TOPOGRAPHIC SURVEY PORTION OF THIS PROJECT WAS COMPLETED UNDER MY DIRECT SUPERVISION FROM AN ACTUAL SURVEY MADE UNDER MY DIRECT SUPERVISION; THAT THIS SURVEY WAS PERFORMED AT THE 95% CONFIDENCE LEVEL TO MEET THE FEDERAL GEOGRAPHIC DATA COMMITTEE STANDARDS; THAT THIS SURVEY WAS PERFORMED TO THE CLASS A HORIZONTAL AND CLASS C VERTICAL WHERE APPLICABLE; THAT THE ORIGINAL DATA WAS OBTAINED BETWEEN THE DATES OF 12/17/18 & 03/22/19; THAT THE CONTOURS SHOWN AS BROKEN LINES MAY NOT MEET THE STATED STANDARD AND ALL COORDINATES ARE BASED ON NAD 83 (NSRS 2011) AND ALL ELEVATIONS ARE BASED ON NAVD 88; THAT THE GPS PORTION OF THIS PROJECT WAS TO PERFORM A GRID TIE TO THE NC STATE PLANE COORDINATE SYSTEM AND INFORMATION USED IS SHOWN & NOTED HEREON; THAT THIS MAP MEETS THE SPECIFICATIONS FOR TOPOGRAPHIC SURVEYS AS STATED IN TITLE 21, CHAPTER 56, SECTION .1606; THAT THIS MAP WAS NOT PREPARED IN ACCORDANCE WITH G.S. 47-30, AS AMENDED AND DOES NOT REPRESENT AN OFFICIAL BOUNDARY SURVEY.

GPS METADATA

SEE SURVEY CONTROL MAP FOR EW SOLUTIONS, LLC BY KEE MAPPING & SURVEYING, PA (LICENSE # C-3039); SIGNED, SEALED AND DATED ON JANUARY 12, 2017 BY NOLAN R. CARMACK, NC PLS (LICENSE #5076).


WITNESS MY ORIGINAL SIGNATURE, REGISTRATION NUMBER, AND SEAL THIS 26TH DAY OF APRIL, 2019, A.D.

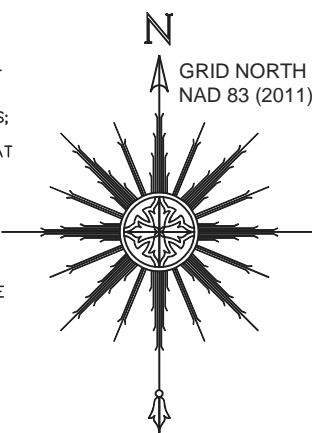

AN AS-BUILT SURVEY FOR: EW SOLUTIONS, LLC. "FLETCHER SITE MITIGATION PROJECT"

HENDERSON COUNTY, NORTH CAROLINA

THE STATE OF NORTH CAROLINA,
NCDEQ: DIVISION OF MITIGATION SERVICES
"FLETCHER SITE MITIGATION PROJECT"
SPO FILE NO's: 45-CZ, 45-DA, & 45-DB
SPO FILE NO's: 45-CY, 45-CX
DMS PROJECT NO. 100004

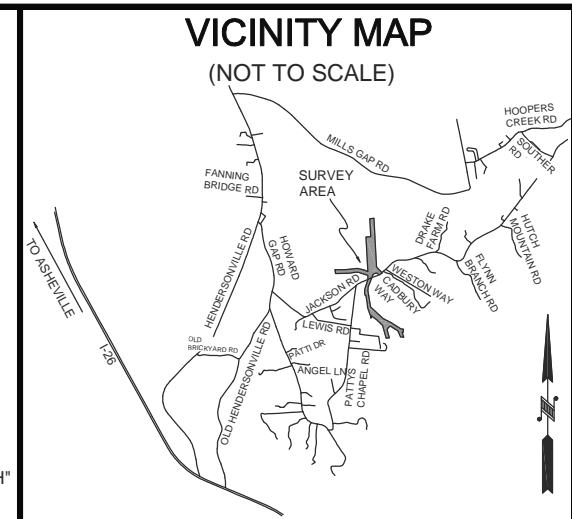

SHEET #	SHEET TITLE
1	COVER SHEET - FLETCHER SITE MITIGATION PROJECT
2	STREAM DATA: "BEGIN FLETCHER CREEK"
3	STREAM DATA: "FLETCHER CREEK INTERSECTION WITH RACCOON BRANCH"
4	STREAM DATA: "FLETCHER CREEK"
5	STREAM DATA: "FLETCHER CREEK"
6	STREAM DATA: "FLETCHER CREEK INTERSECTION WITH COATES BRANCH"
7	STREAM DATA: "FLETCHER CREEK"
8	STREAM DATA: "FLETCHER CREEK"
9	STREAM DATA: "FLETCHER CREEK"
10	STREAM DATA: "FLETCHER CREEK"
11	STREAM DATA: "FLETCHER CREEK"
12	STREAM DATA: "END FLETCHER CREEK"
13	STREAM DATA: "BEGIN RACCOON BRANCH"
14	STREAM DATA: "RACCOON BRANCH INTERSECTION WITH FLETCHER CREEK"
15	STREAM DATA: "BEGIN COATES BRANCH"
16	STREAM DATA: "COATES BRANCH"
17	STREAM DATA: "COATES BRANCH"
18	STREAM DATA: "COATES BRANCH INTERSECTION WITH FLETCHER CREEK"
19	STREAM DATA: "BEGIN WESTON CREEK"
20	STREAM DATA: "WESTON CREEK"
21	STREAM DATA: "WESTON CREEK"
22	STREAM DATA: "WESTON CREEK"
23	STREAM DATA: "WESTON CREEK"
24	STREAM DATA: "END WESTON CREEK"
25	STREAM DATA: "CROSS SECTION PROFILES 1-8"
26	STREAM DATA: "CROSS SECTION PROFILES 9-19"
27	STREAM DATA: "CROSS SECTION PROFILES 20-28"
28	STREAM DATA: "LONGITUDINAL PROFILE- FLETCHER CREEK"
29	STREAM DATA: "LONGITUDINAL PROFILE- FLETCHER CREEK"
30	STREAM DATA: "LONGITUDINAL PROFILE- FLETCHER CREEK"
31	STREAM DATA: "LONGITUDINAL PROFILE- FLETCHER CREEK"
32	STREAM DATA: "LONGITUDINAL PROFILE- RACCOON BRANCH"
33	STREAM DATA: "LONGITUDINAL PROFILE- COATES BRANCH"
34	STREAM DATA: "LONGITUDINAL PROFILE- COATES BRANCH"
35	STREAM DATA: "LONGITUDINAL PROFILE- WESTON CREEK"
36	STREAM DATA: "LONGITUDINAL PROFILE- WESTON CREEK"
37	STREAM DATA: "LONGITUDINAL PROFILE- WESTON CREEK"


SURVEYOR'S NOTES:

- ALL DISTANCES AND COORDINATES ARE GROUND MEASUREMENTS IN US SURVEY FEET UNLESS OTHERWISE NOTED.
- PROPERTY SUBJECT TO ALL EASEMENTS, RIGHT OF WAYS AND RESTRICTIONS THAT ARE RECORDED, UNRECORDED, WRITTEN AND UNWRITTEN.
- CONSERVATION EASEMENT BOUNDARIES SHOWN HEREON WERE TAKEN FROM A PLAT OF SURVEY ENTITLED: "A CONSERVATION EASEMENT SURVEY FOR THE STATE OF NORTH CAROLINA, NCDEQ: DIVISION OF MITIGATION SERVICES, "FLETCHER STREAM AND WETLAND SITE", PREPARED BY KEE MAPPING & SURVEYING, AND RECORDED IN PB 2017 SLIDES 10959, 10960 & 10961 OF THE HENDERSON COUNTY REGISTRY.
- HENDERSON COUNTY GIS WEBSITE USED TO IDENTIFY ADJOINING PROPERTY OWNERS.
- BY GRAPHIC DETERMINATION, A PORTION OF THE SUBJECT PROPERTY APPEARS TO LIE WITHIN A SPECIAL FLOOD HAZARD AREA (SFHA) AS DETERMINED BY THE F.E.M.A. MAP#s 3700966200J DATED 10/02/2008.
- STATE PLANE COORDINATES AND ELEVATIONS WERE DERIVED FROM THE CONTROL & EXISTING CONDITIONS TOPOGRAPHIC SURVEY PREPARED BY KEE MAPPING & SURVEYING. THE HORIZONTAL DATUM IS NAD 83 (2011) AND THE VERTICAL DATUM IS NAVD(88). ALL COORDINATES SHOWN HEREON ARE GROUND MEASUREMENTS IN US SURVEY FEET.
- UTILITIES WERE LOCATED BASED ON VISIBLE ABOVE GROUND STRUCTURES, THEREFORE THE LOCATION OF UNDERGROUND UTILITIES ARE APPROXIMATE OR MAY BE PRESENT AND NOT SHOWN HEREON. CALL 1-800-632-4949 BEFORE DIGGING.
- STATIONING FOR PLAN AND PROFILES ARE BASED OFF OF DESIGN CENTERLINES PROVIDED BY EW SOLUTIONS, LLC.
- CONTOUR INTERVAL: 1 FOOT
VERTICAL DATUM: NAVD 88
- AREA OF LIMITS OF DISTURBANC: 29.94 ACRES
- WETLANDS SHOWN HEREON WERE DELINEATED AND PROVIDED BY EW SOLUTIONS, LLC.



THIS DOCUMENT IS NOT VALID UNLESS SIGNED AND SEALED.

DocuSigned by:
Drew Van Duinkerken
DREW VAN DUINKERKEN, PLS L-5010

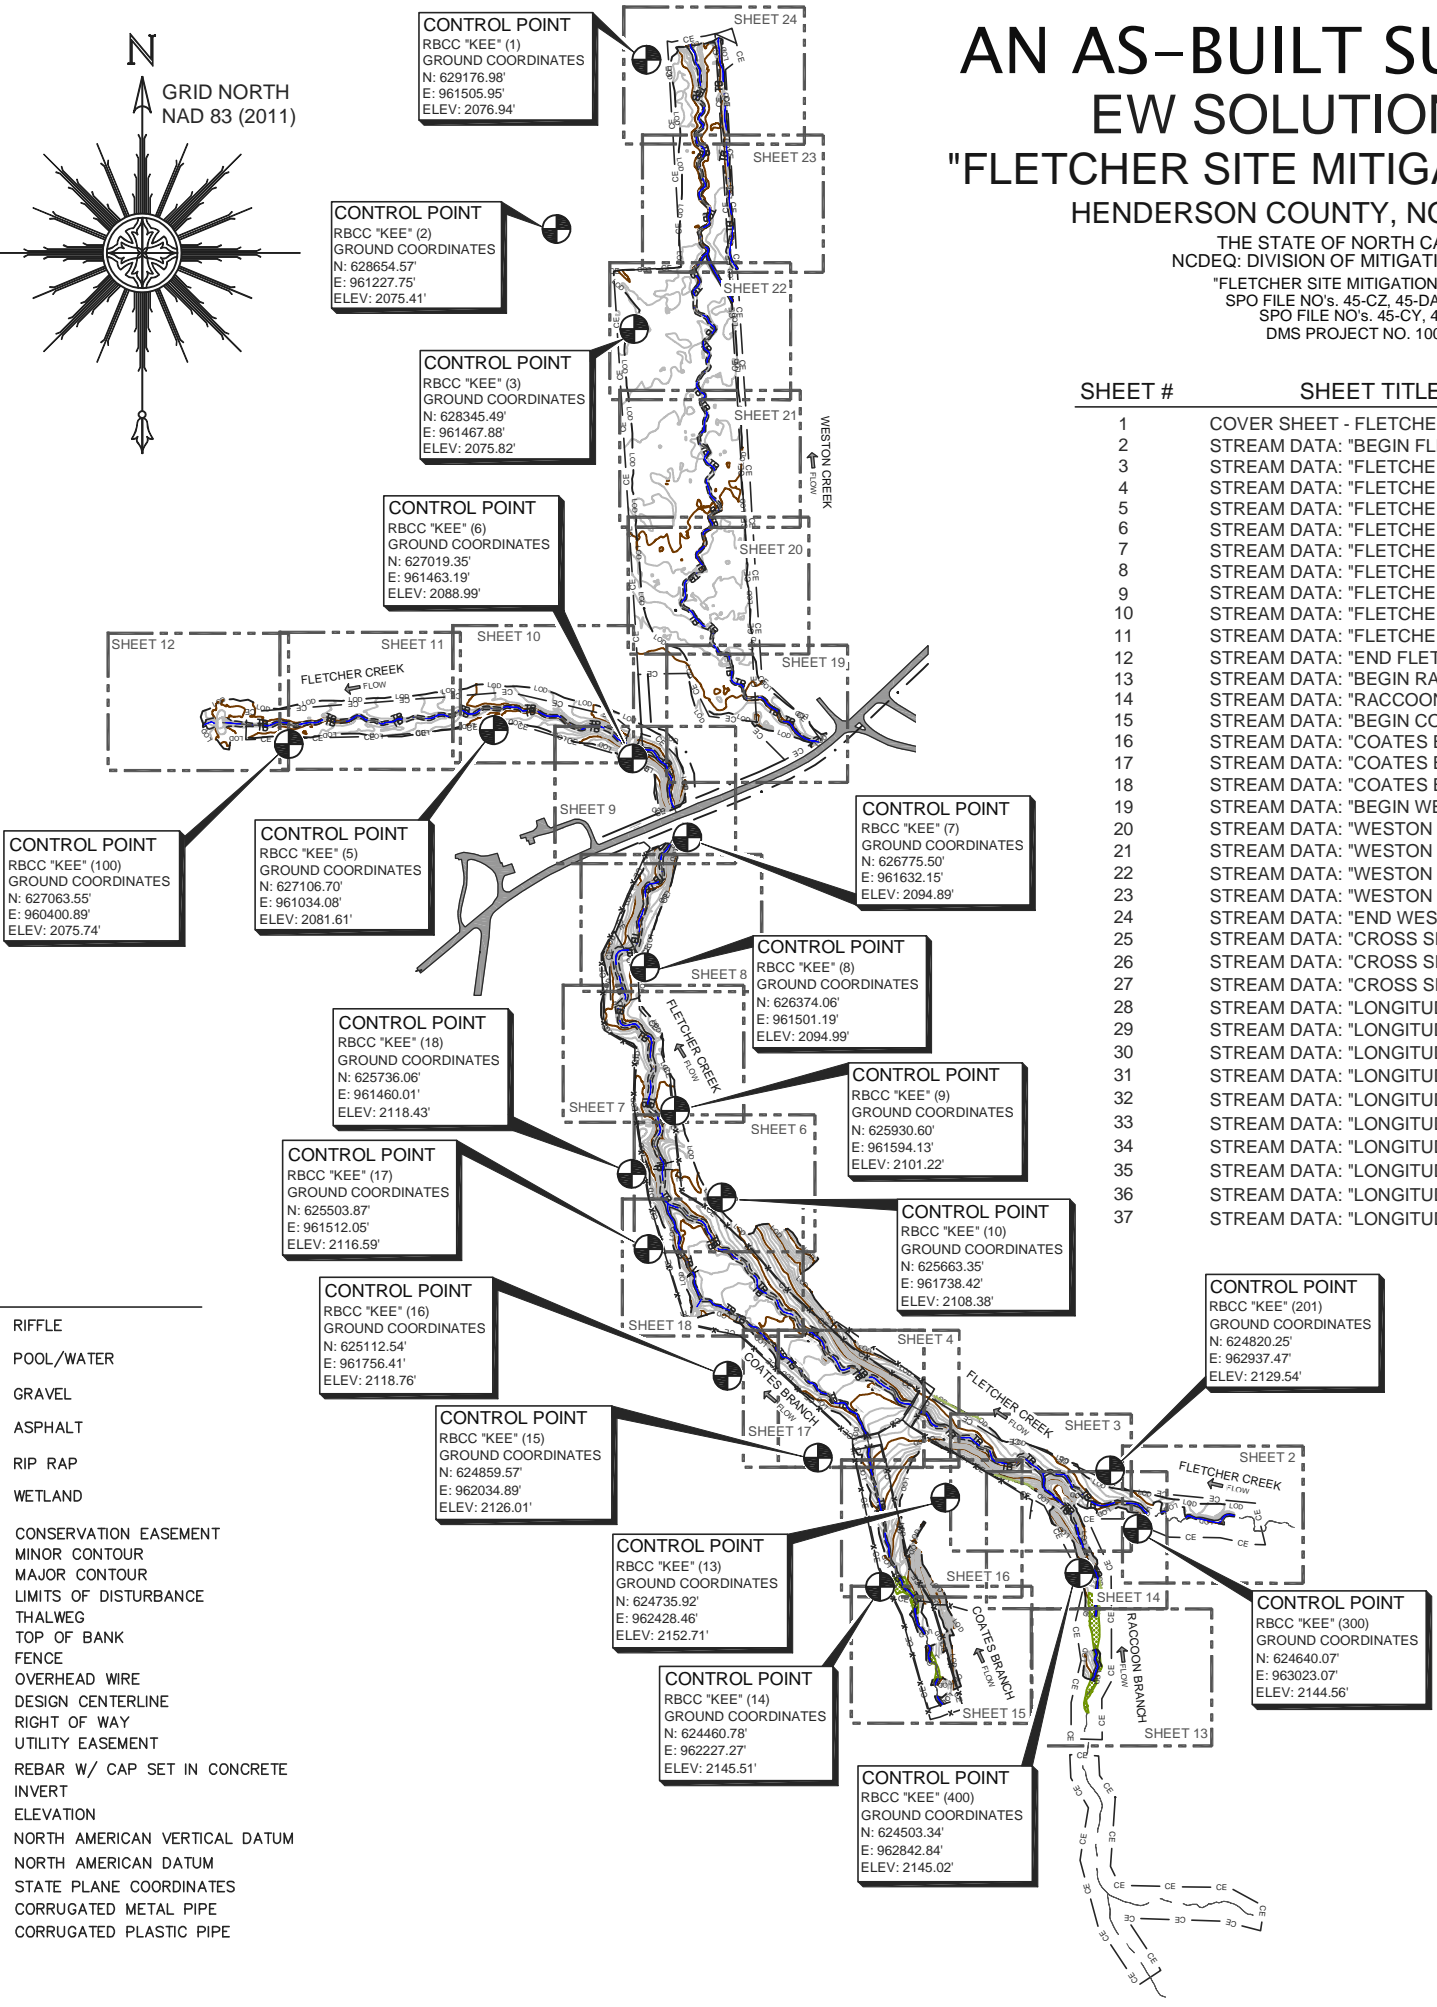

LEGEND

#	STRUCTURE NUMBER		RIFFLE
	5/8" RBCC (CROSS-SECTION REBAR)		POOL/WATER
	5/8" RBCC (AS NOTED)		GRAVEL
	GROUNDWATER GAUGE		ASPHALT
	GAUGE (AS NOTED)		RIP RAP
	UTILITY POLE		WETLAND
	DECIDUOUS TREE (AS NOTED)		CONSERVATION EASEMENT
	LOG SILL		MINOR CONTOUR
	BRUSH RUN W/ LOG		MAJOR CONTOUR
	BRUSH RUN W/ BOULDER		LIMITS OF DISTURBANCE
	FLOODPLAIN DEBRIS		THALWEG
	SOIL LIFT		TOP OF BANK
	BRUSH TOE		FENCE
			OVERHEAD WIRE
			DESIGN CENTERLINE
			RIGHT OF WAY
			UTILITY EASEMENT
			REBAR W/ CAP SET IN CONCRETE
			INVERT
			ELEVATION
			NAVD NORTH AMERICAN VERTICAL DATUM
			NAD NORTH AMERICAN DATUM
			SPC STATE PLANE COORDINATES
			CMP CORRUGATED METAL PIPE
			CPP CORRUGATED PLASTIC PIPE

THIS MAP IS NOT FOR RECORDATION, SALES, OR CONVEYANCES AND DOES NOT COMPLY WITH G.S. 47-30 MAPPING REQUIREMENTS.





SHEET SIZE: 11" X 17"

SHEET:

1 OF 37

P.O. Box 2566
Asheville, NC 28802
(828) 575-9021
www.keemap.com
License # C-3039

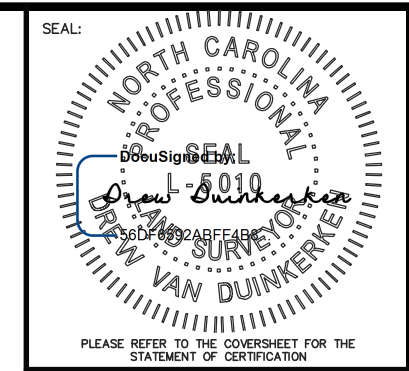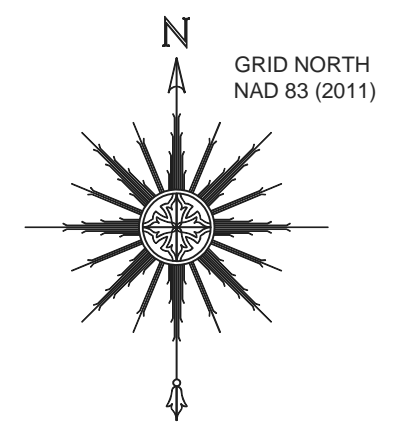

PLEASE REFER TO THE COVERSHEET FOR THE STATEMENT OF CERTIFICATION

NOTE: SEE SHEET 1 FOR SURVEYOR'S NOTES & LEGEND

ELEVATION DATUM: NAVD 88
CONTOUR INTERVAL: 1 FOOT

AN AS-BUILT SURVEY FOR:
EW SOLUTIONS, LLC.

SPO FILE NO's. 45-CZ, 45-DA, & 45-DB
SPO FILE NO's. 45-CY, 45-CX
DMS PROJECT NO. 100004

PROJECT:
**FLETCHER SITE
MITIGATION PROJECT**

SHEET TITLE:

STREAM DATA:
BEGIN FLETCHER CREEK


TOWNSHIP: FLETCHER	COUNTY: HENDERSON	STATE: NORTH CAROLINA
DRAWN BY: NH/JA	CHECKED BY: LDP/PBK	SURVEY BY: CB,NMH,LDP,JM,AC
SCALE: AS SHOWN	SURVEY DATES: 12/17/19 - 03/22/19	
JOB: #181142-AB	SHEET SIZE: (HALF SIZE) 11" X 17"	
#	DATE	REVISIONS

SHEET:
2 OF 37



P.O. Box 2566
Asheville, NC 28802
(828) 575-9021
www.keemap.com
License # C-3039

SHEET 3
SHEET 2

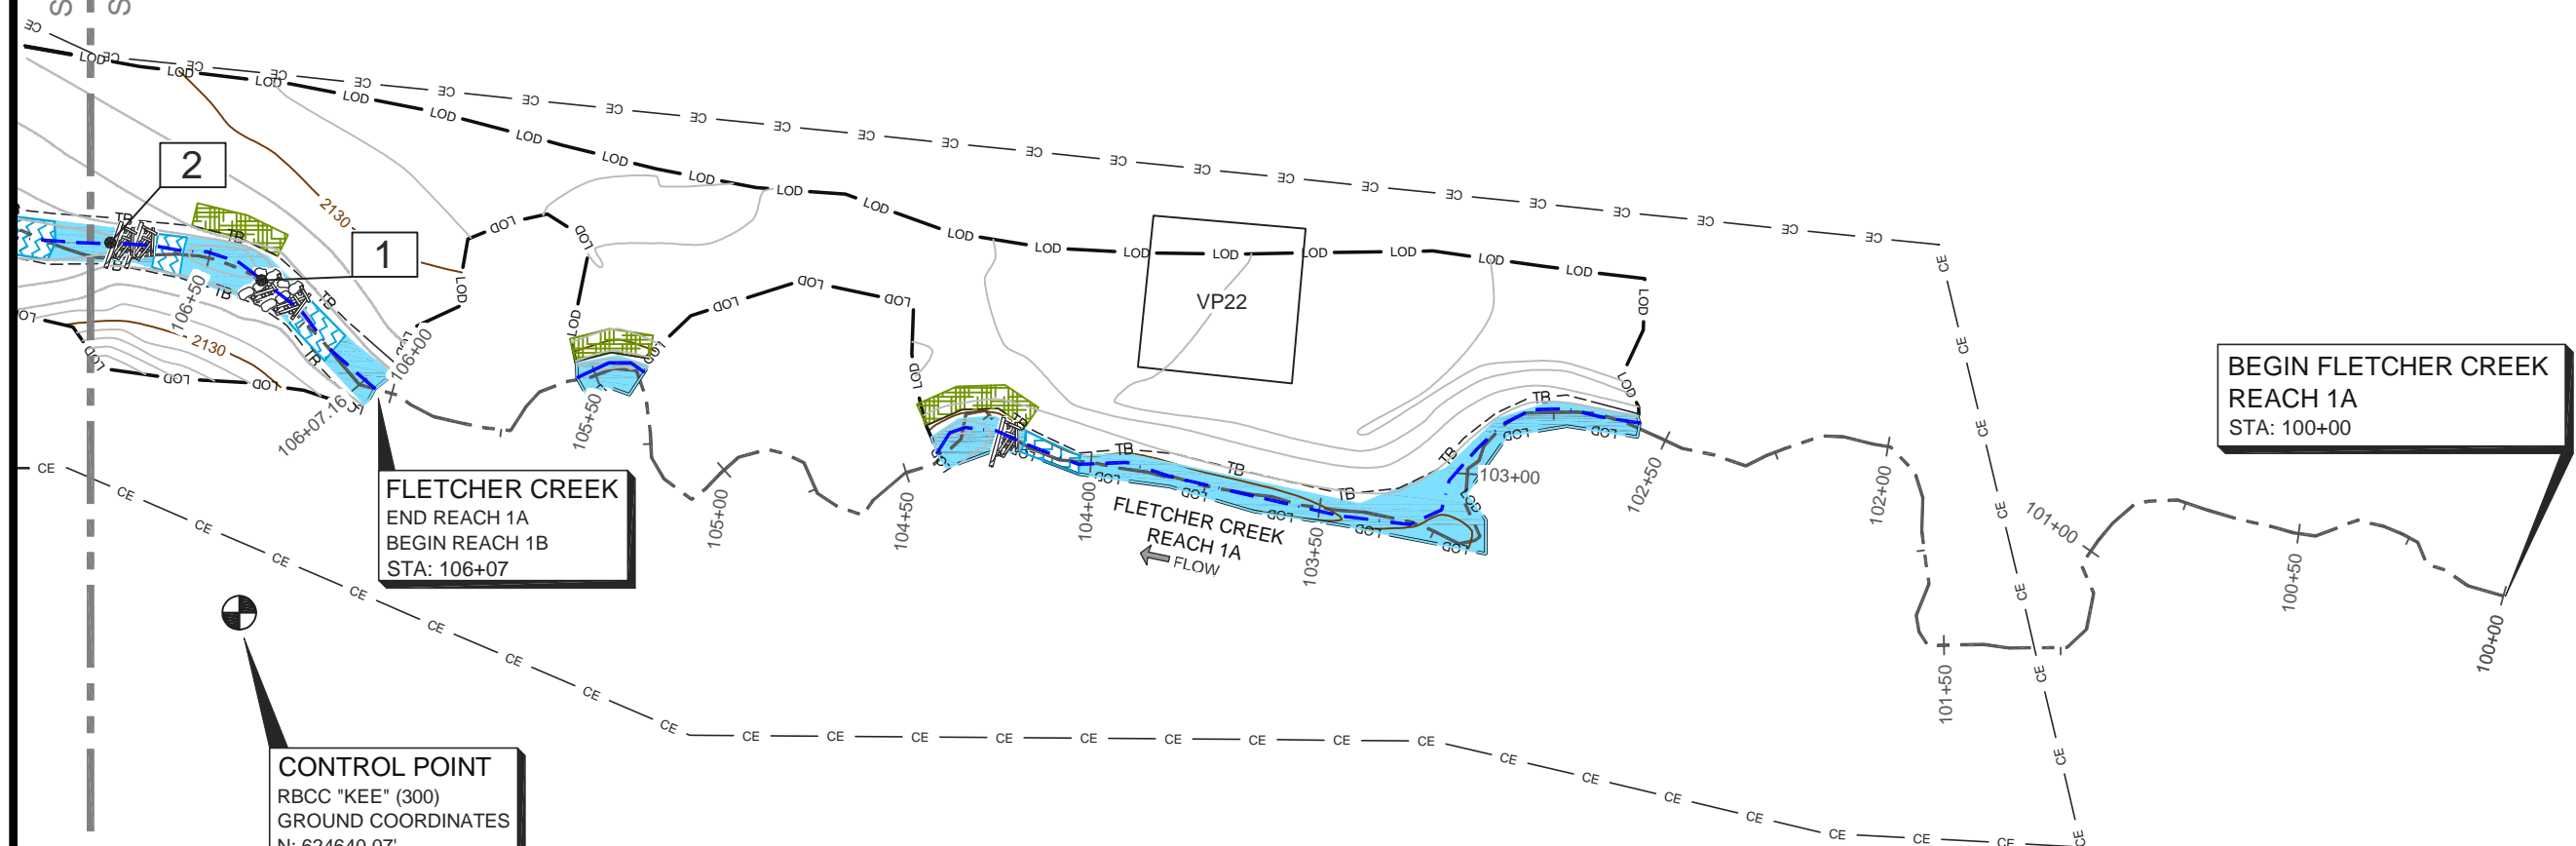

FLETCHER CREEK
END REACH 1A
BEGIN REACH 1B
STA: 106+07



BEGIN FLETCHER CREEK
REACH 1A
STA: 100+00

CONTROL POINT
RBCC "KEE" (300)
GROUND COORDINATES
N: 624640.07'
E: 963023.07'
ELEV: 2144.56'


#	ELEVATION	DESCRIPTION
1	2126.51	BRUSH RUN W/ BOULDER
2	2126.21	BRUSH RUN W/ LOG



ONE INCH = TWENTY FEET (FULL SIZE)
ONE INCH = FORTY FEET (HALF SIZE)

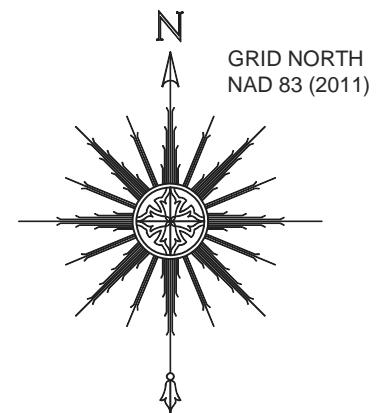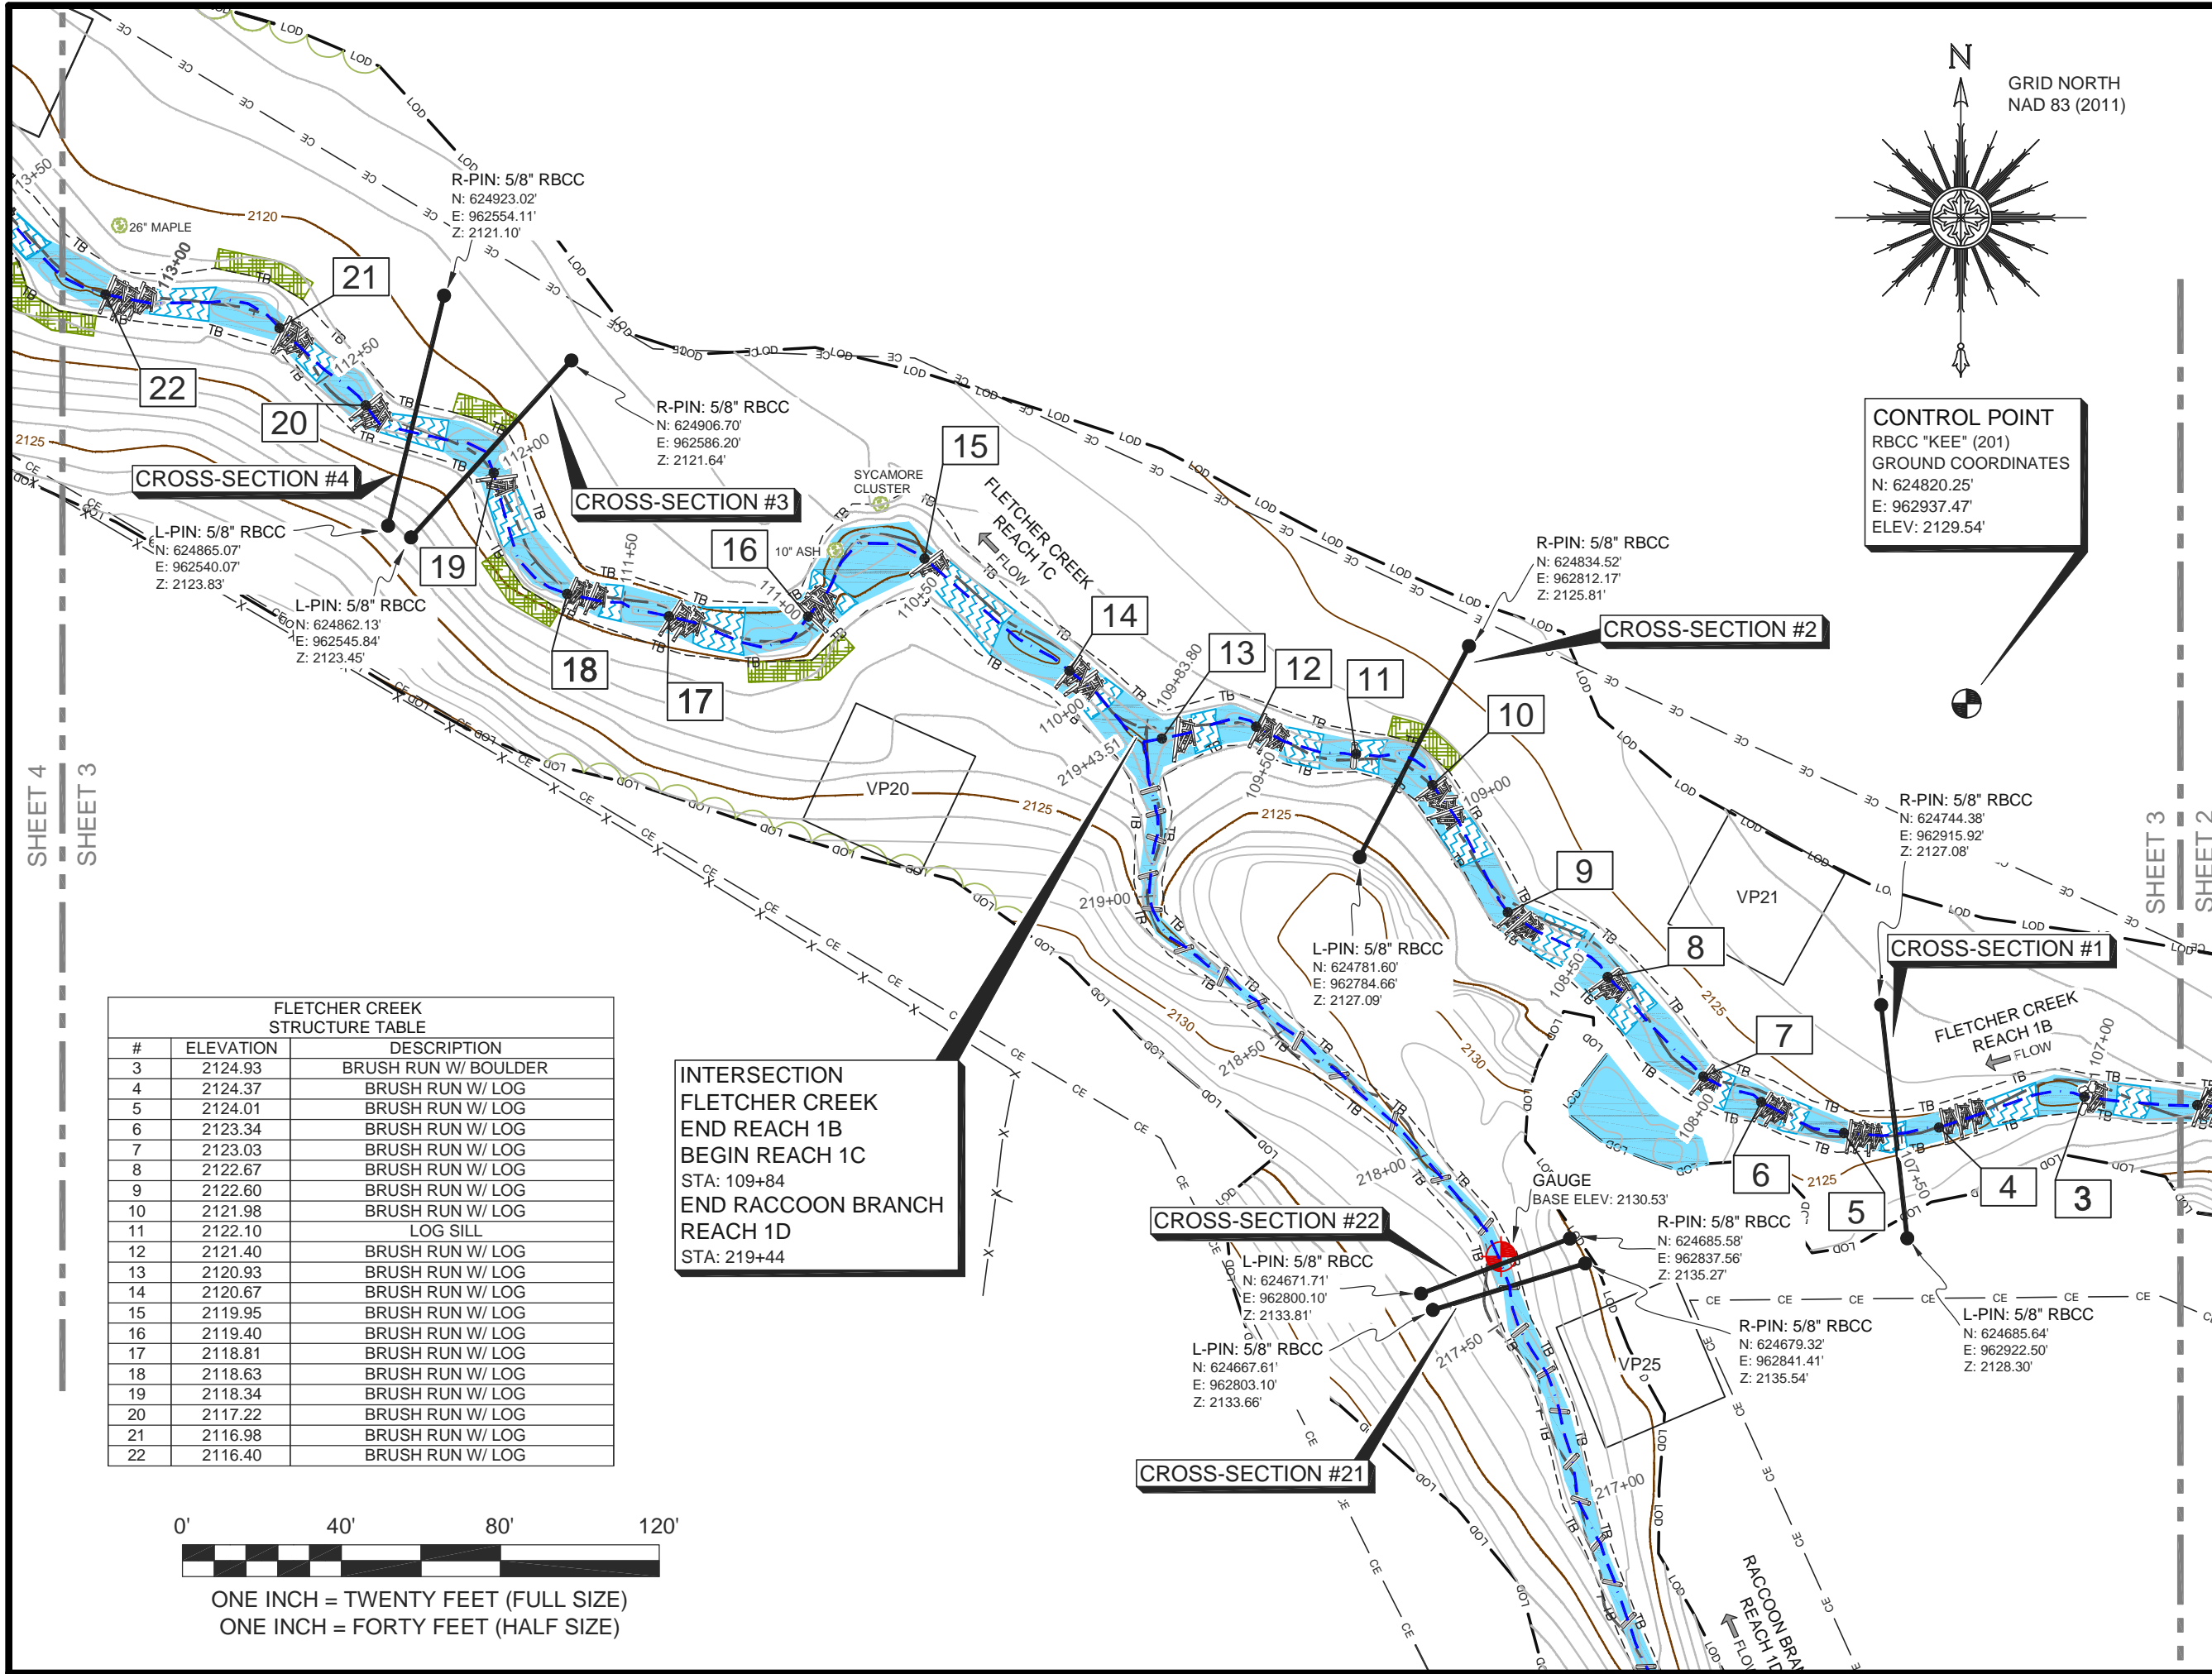

CONTROL POINT
 RBCC "KEE" (201)
 GROUND COORDINATES
 N: 624820.25'
 E: 962937.47'
 ELEV: 2129.54'

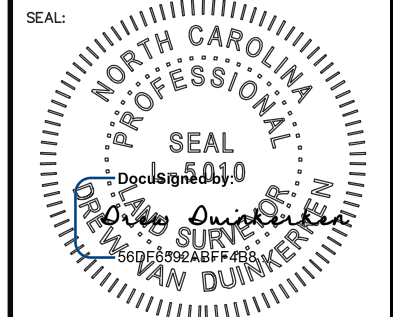

PLEASE REFER TO THE COVERSHEET FOR THE STATEMENT OF CERTIFICATION
 NOTE: SEE SHEET 1 FOR SURVEYOR'S NOTES & LEGEND

ELEVATION DATUM: NAVD 88
 CONTOUR INTERVAL: 1 FOOT

AN AS-BUILT SURVEY FOR:
 EW SOLUTIONS, LLC.

SPO FILE NO's. 45-CZ, 45-DA, & 45-DB
 SPO FILE NO's. 45-CY, 45-CX
 DMS PROJECT NO. 100004

PROJECT:
FLETCHER SITE MITIGATION PROJECT

SHEET TITLE:
 STREAM DATA:
 FLETCHER CREEK
 INTERSECTION WITH
 RACCOON BRANCH

TOWNSHIP: FLETCHER	COUNTY: HENDERSON	STATE: NORTH CAROLINA
DRAWN BY: NH/JA	CHECKED BY: LDP/PBK	SURVEY BY: CB,NMH,LDP,JM,AC
SCALE: AS SHOWN	SURVEY DATES: 12/17/19 - 03/22/19	
JOB: #1811142-AB	SHEET SIZE: (HALF SIZE) 11" X 17"	
#	DATE	REVISIONS


SHEET:
3 OF 37




P.O. Box 2566
 Asheville, NC 28802
 (828) 575-9021
 www.keemap.com
 License # C-3039

#	ELEVATION	DESCRIPTION
3	2124.93	BRUSH RUN W/ BOULDER
4	2124.37	BRUSH RUN W/ LOG
5	2124.01	BRUSH RUN W/ LOG
6	2123.34	BRUSH RUN W/ LOG
7	2123.03	BRUSH RUN W/ LOG
8	2122.67	BRUSH RUN W/ LOG
9	2122.60	BRUSH RUN W/ LOG
10	2121.98	BRUSH RUN W/ LOG
11	2122.10	LOG SILL
12	2121.40	BRUSH RUN W/ LOG
13	2120.93	BRUSH RUN W/ LOG
14	2120.67	BRUSH RUN W/ LOG
15	2119.95	BRUSH RUN W/ LOG
16	2119.40	BRUSH RUN W/ LOG
17	2118.81	BRUSH RUN W/ LOG
18	2118.63	BRUSH RUN W/ LOG
19	2118.34	BRUSH RUN W/ LOG
20	2117.22	BRUSH RUN W/ LOG
21	2116.98	BRUSH RUN W/ LOG
22	2116.40	BRUSH RUN W/ LOG



INTERSECTION
 FLETCHER CREEK
 END REACH 1B
 BEGIN REACH 1C
 STA: 109+84
 END RACCOON BRANCH
 REACH 1D
 STA: 219+44

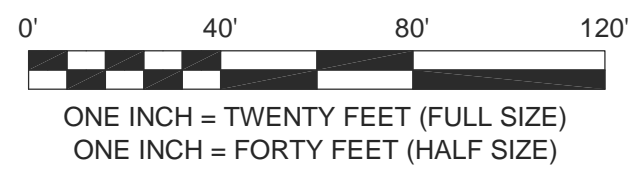

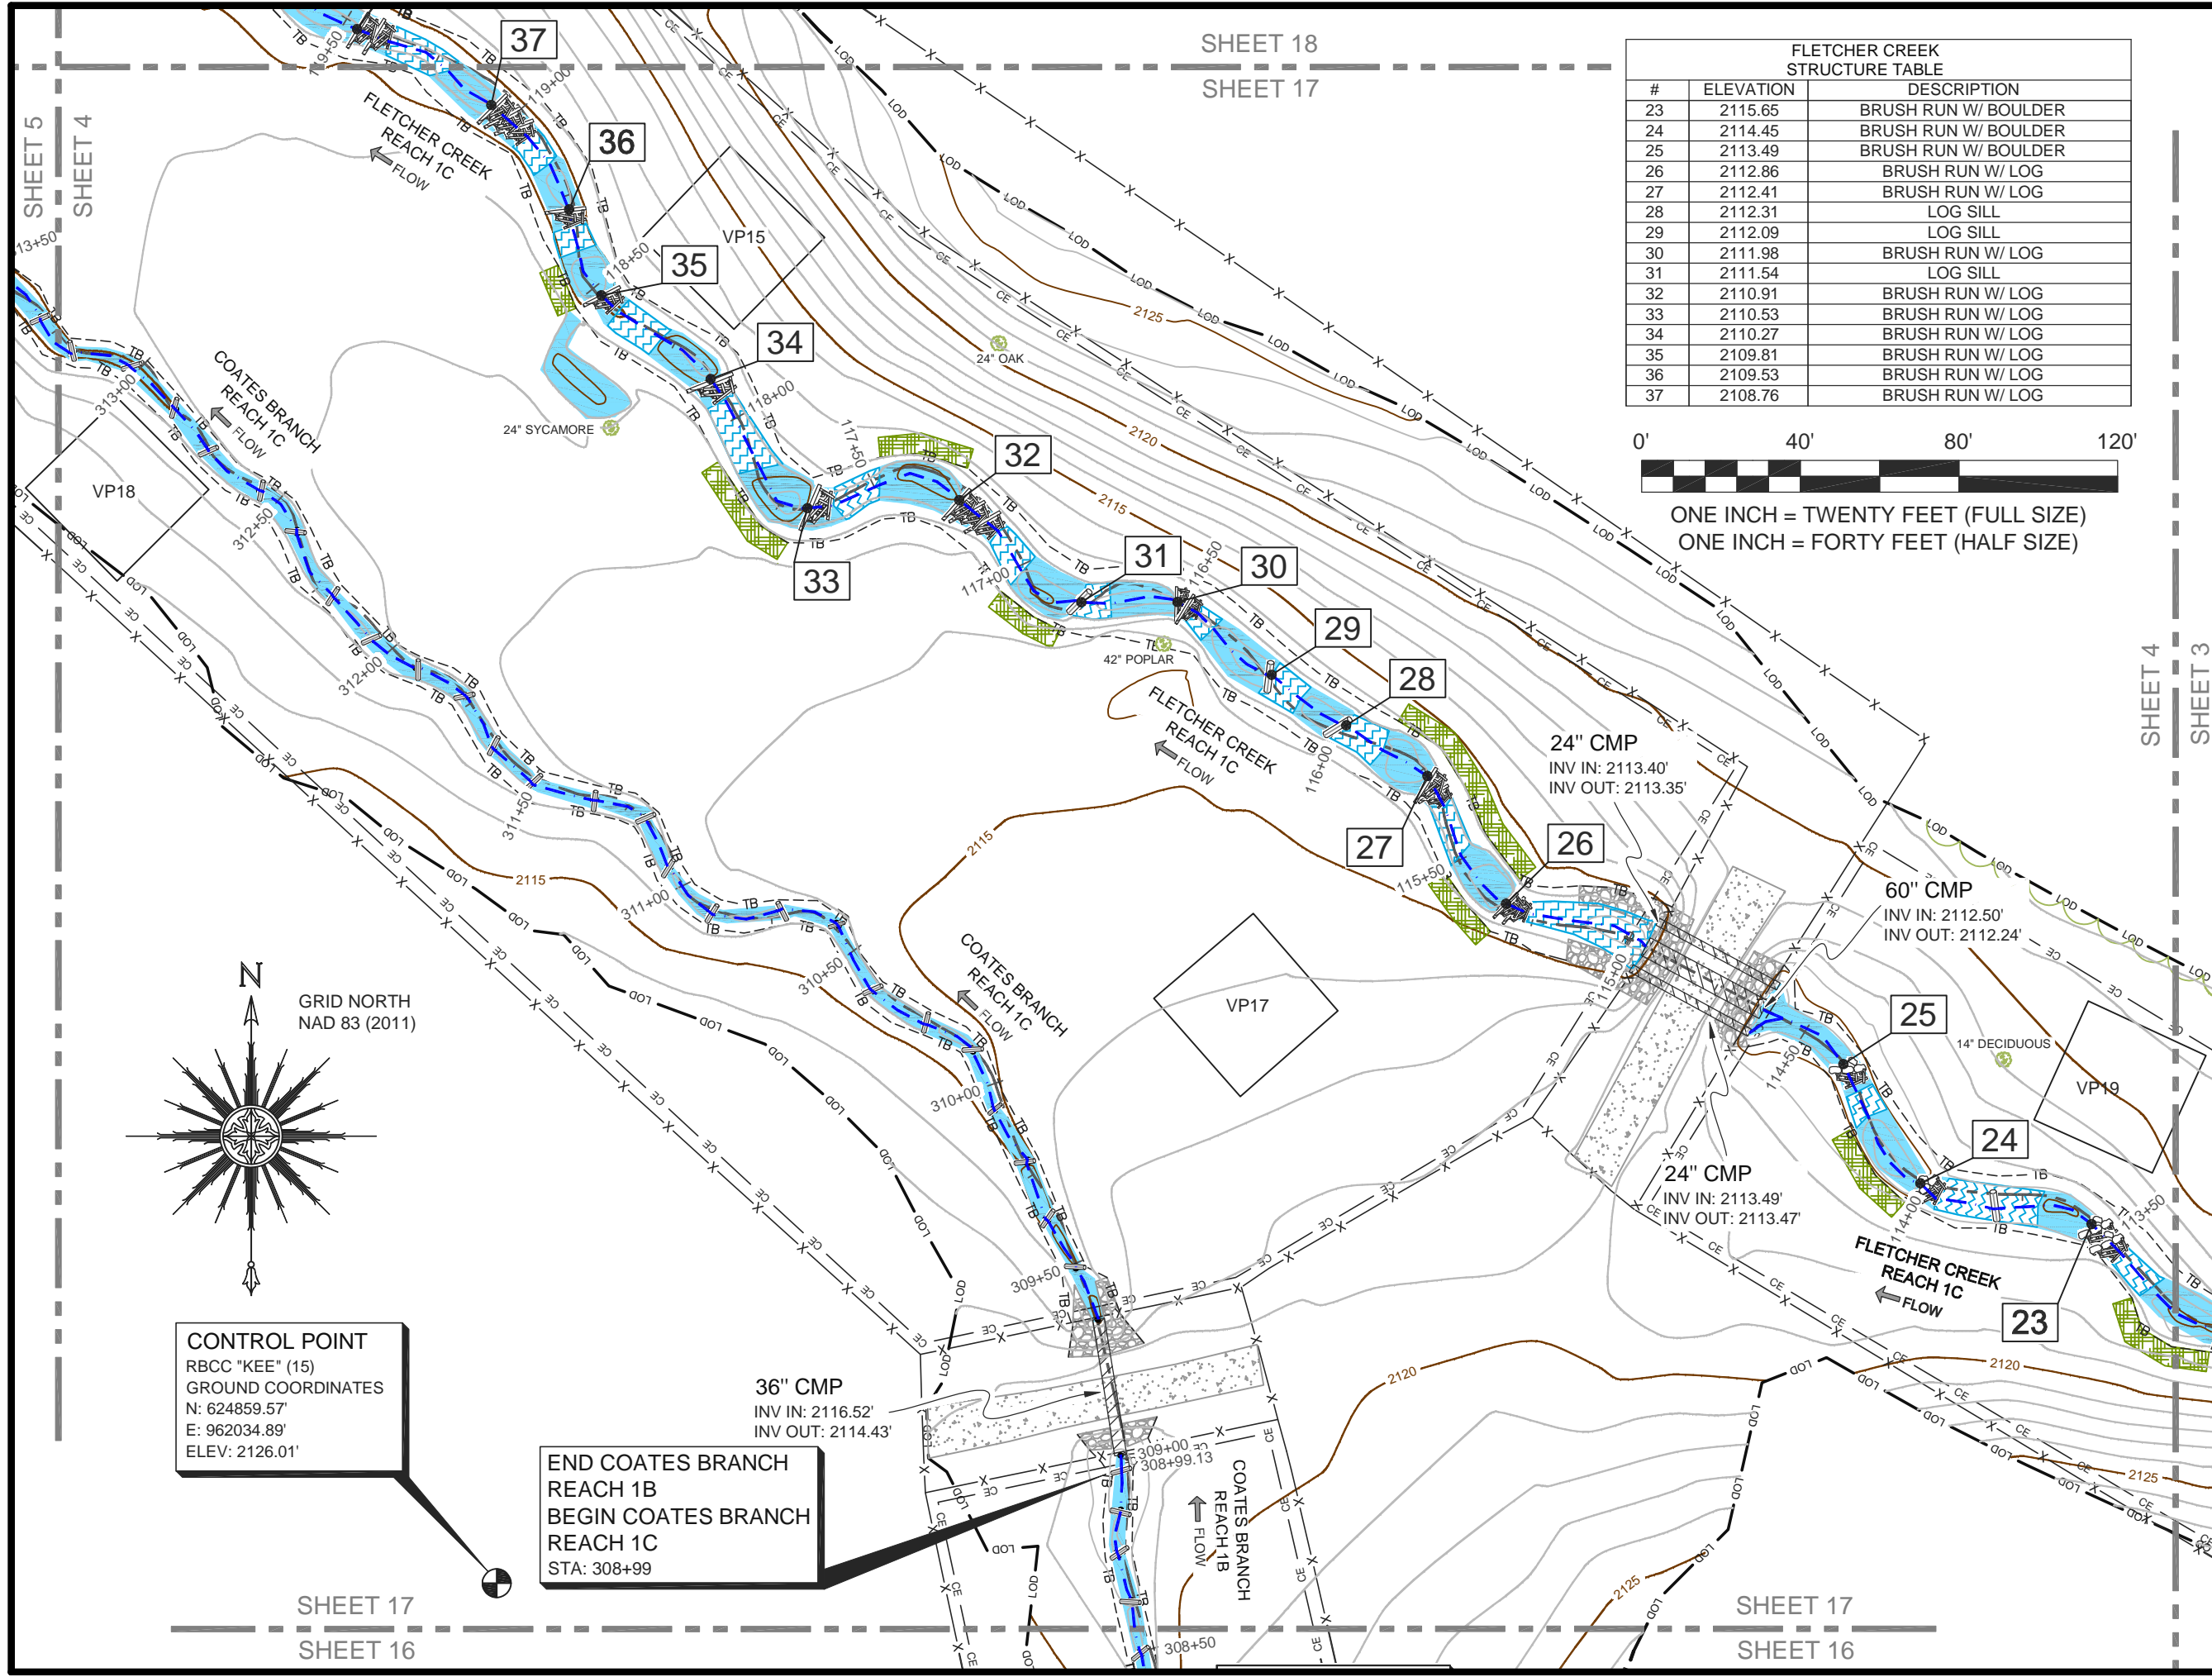

SHEET 18
SHEET 17

FLETCHER CREEK STRUCTURE TABLE		
#	ELEVATION	DESCRIPTION
23	2115.65	BRUSH RUN W/ BOULDER
24	2114.45	BRUSH RUN W/ BOULDER
25	2113.49	BRUSH RUN W/ BOULDER
26	2112.86	BRUSH RUN W/ LOG
27	2112.41	BRUSH RUN W/ LOG
28	2112.31	LOG SILL
29	2112.09	LOG SILL
30	2111.98	BRUSH RUN W/ LOG
31	2111.54	LOG SILL
32	2110.91	BRUSH RUN W/ LOG
33	2110.53	BRUSH RUN W/ LOG
34	2110.27	BRUSH RUN W/ LOG
35	2109.81	BRUSH RUN W/ LOG
36	2109.53	BRUSH RUN W/ LOG
37	2108.76	BRUSH RUN W/ LOG

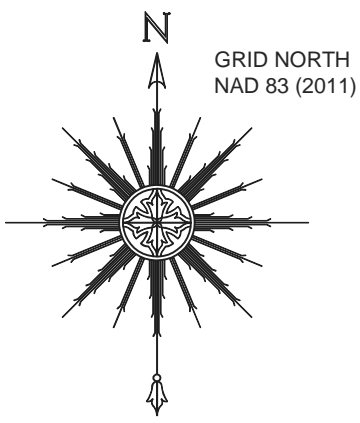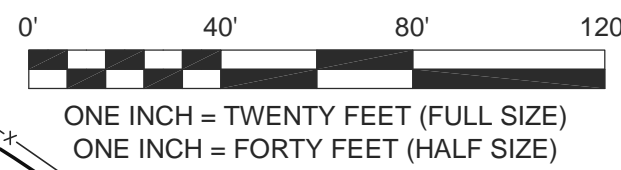

CONTROL POINT
RBCC "KEE" (15)
GROUND COORDINATES
N: 624859.57'
E: 962034.89'
ELEV: 2126.01'


36" CMP
INV IN: 2116.52'
INV OUT: 2114.43'

END COATES BRANCH REACH 1B
BEGIN COATES BRANCH REACH 1C
STA: 308+99

24" CMP
INV IN: 2113.40'
INV OUT: 2113.35'

60" CMP
INV IN: 2112.50'
INV OUT: 2112.24'

24" CMP
INV IN: 2113.49'
INV OUT: 2113.47'

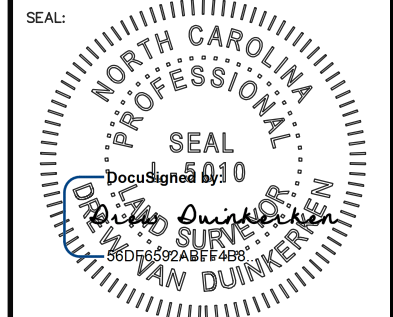

PLEASE REFER TO THE COVERSHEET FOR THE STATEMENT OF CERTIFICATION

NOTE: SEE SHEET 1 FOR SURVEYOR'S NOTES & LEGEND

ELEVATION DATUM: NAVD 88
CONTOUR INTERVAL: 1 FOOT

AN AS-BUILT SURVEY FOR:
EW SOLUTIONS, LLC.

SPO FILE NO's. 45-CZ, 45-DA, & 45-DB
SPO FILE NO's. 45-CY, 45-CX
DMS PROJECT NO. 100004

PROJECT:
FLETCHER SITE MITIGATION PROJECT

SHEET TITLE:
STREAM DATA:
FLETCHER CREEK

TOWNSHIP: FLETCHER	COUNTY: HENDESON	STATE: NORTH CAROLINA
DRAWN BY: NH/JA	CHECKED BY: LDP/PBK	SURVEY BY: CB,NMH,LDP,JM,AC
SCALE: AS SHOWN	SURVEY DATES: 12/17/19 - 03/22/19	
JOB: #1811142-AB	SHEET SIZE: 11" X 17"	

#	DATE	REVISIONS

SHEET:
4 OF 37




P.O. Box 2566
Asheville, NC 28802
(828) 575-9021
www.keemap.com
License # C-3039

SHEET 17
SHEET 16

SHEET 17
SHEET 16

SHEET 4
SHEET 3

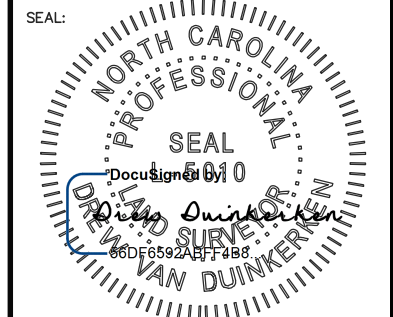

PLEASE REFER TO THE COVERSHEET FOR THE STATEMENT OF CERTIFICATION

NOTE: SEE SHEET 1 FOR SURVEYOR'S NOTES & LEGEND

ELEVATION DATUM: NAVD 88
CONTOUR INTERVAL: 1 FOOT

AN AS-BUILT SURVEY FOR:
EW SOLUTIONS, LLC.

SPO FILE NO's. 45-CZ, 45-DA, & 45-DB
SPO FILE NO's. 45-CY, 45-CX
DMS PROJECT NO. 100004

PROJECT:
**FLETCHER SITE
MITIGATION PROJECT**

SHEET TITLE:
**STREAM DATA:
FLETCHER CREEK**

TOWNSHIP: FLETCHER COUNTY: HENDERSON STATE: NORTH CAROLINA

DRAWN BY: NH/JA CHECKED BY: LDP/PBK SURVEY BY: CB,NMH,LDP,JM,AC


SCALE: AS SHOWN SURVEY DATES: 12/17/19 - 03/22/19

#	DATE	REVISIONS

SHEET:
5 OF 37



P.O. Box 2566
Asheville, NC 28802
(828) 575-9021
www.keemap.com
License # C-3039

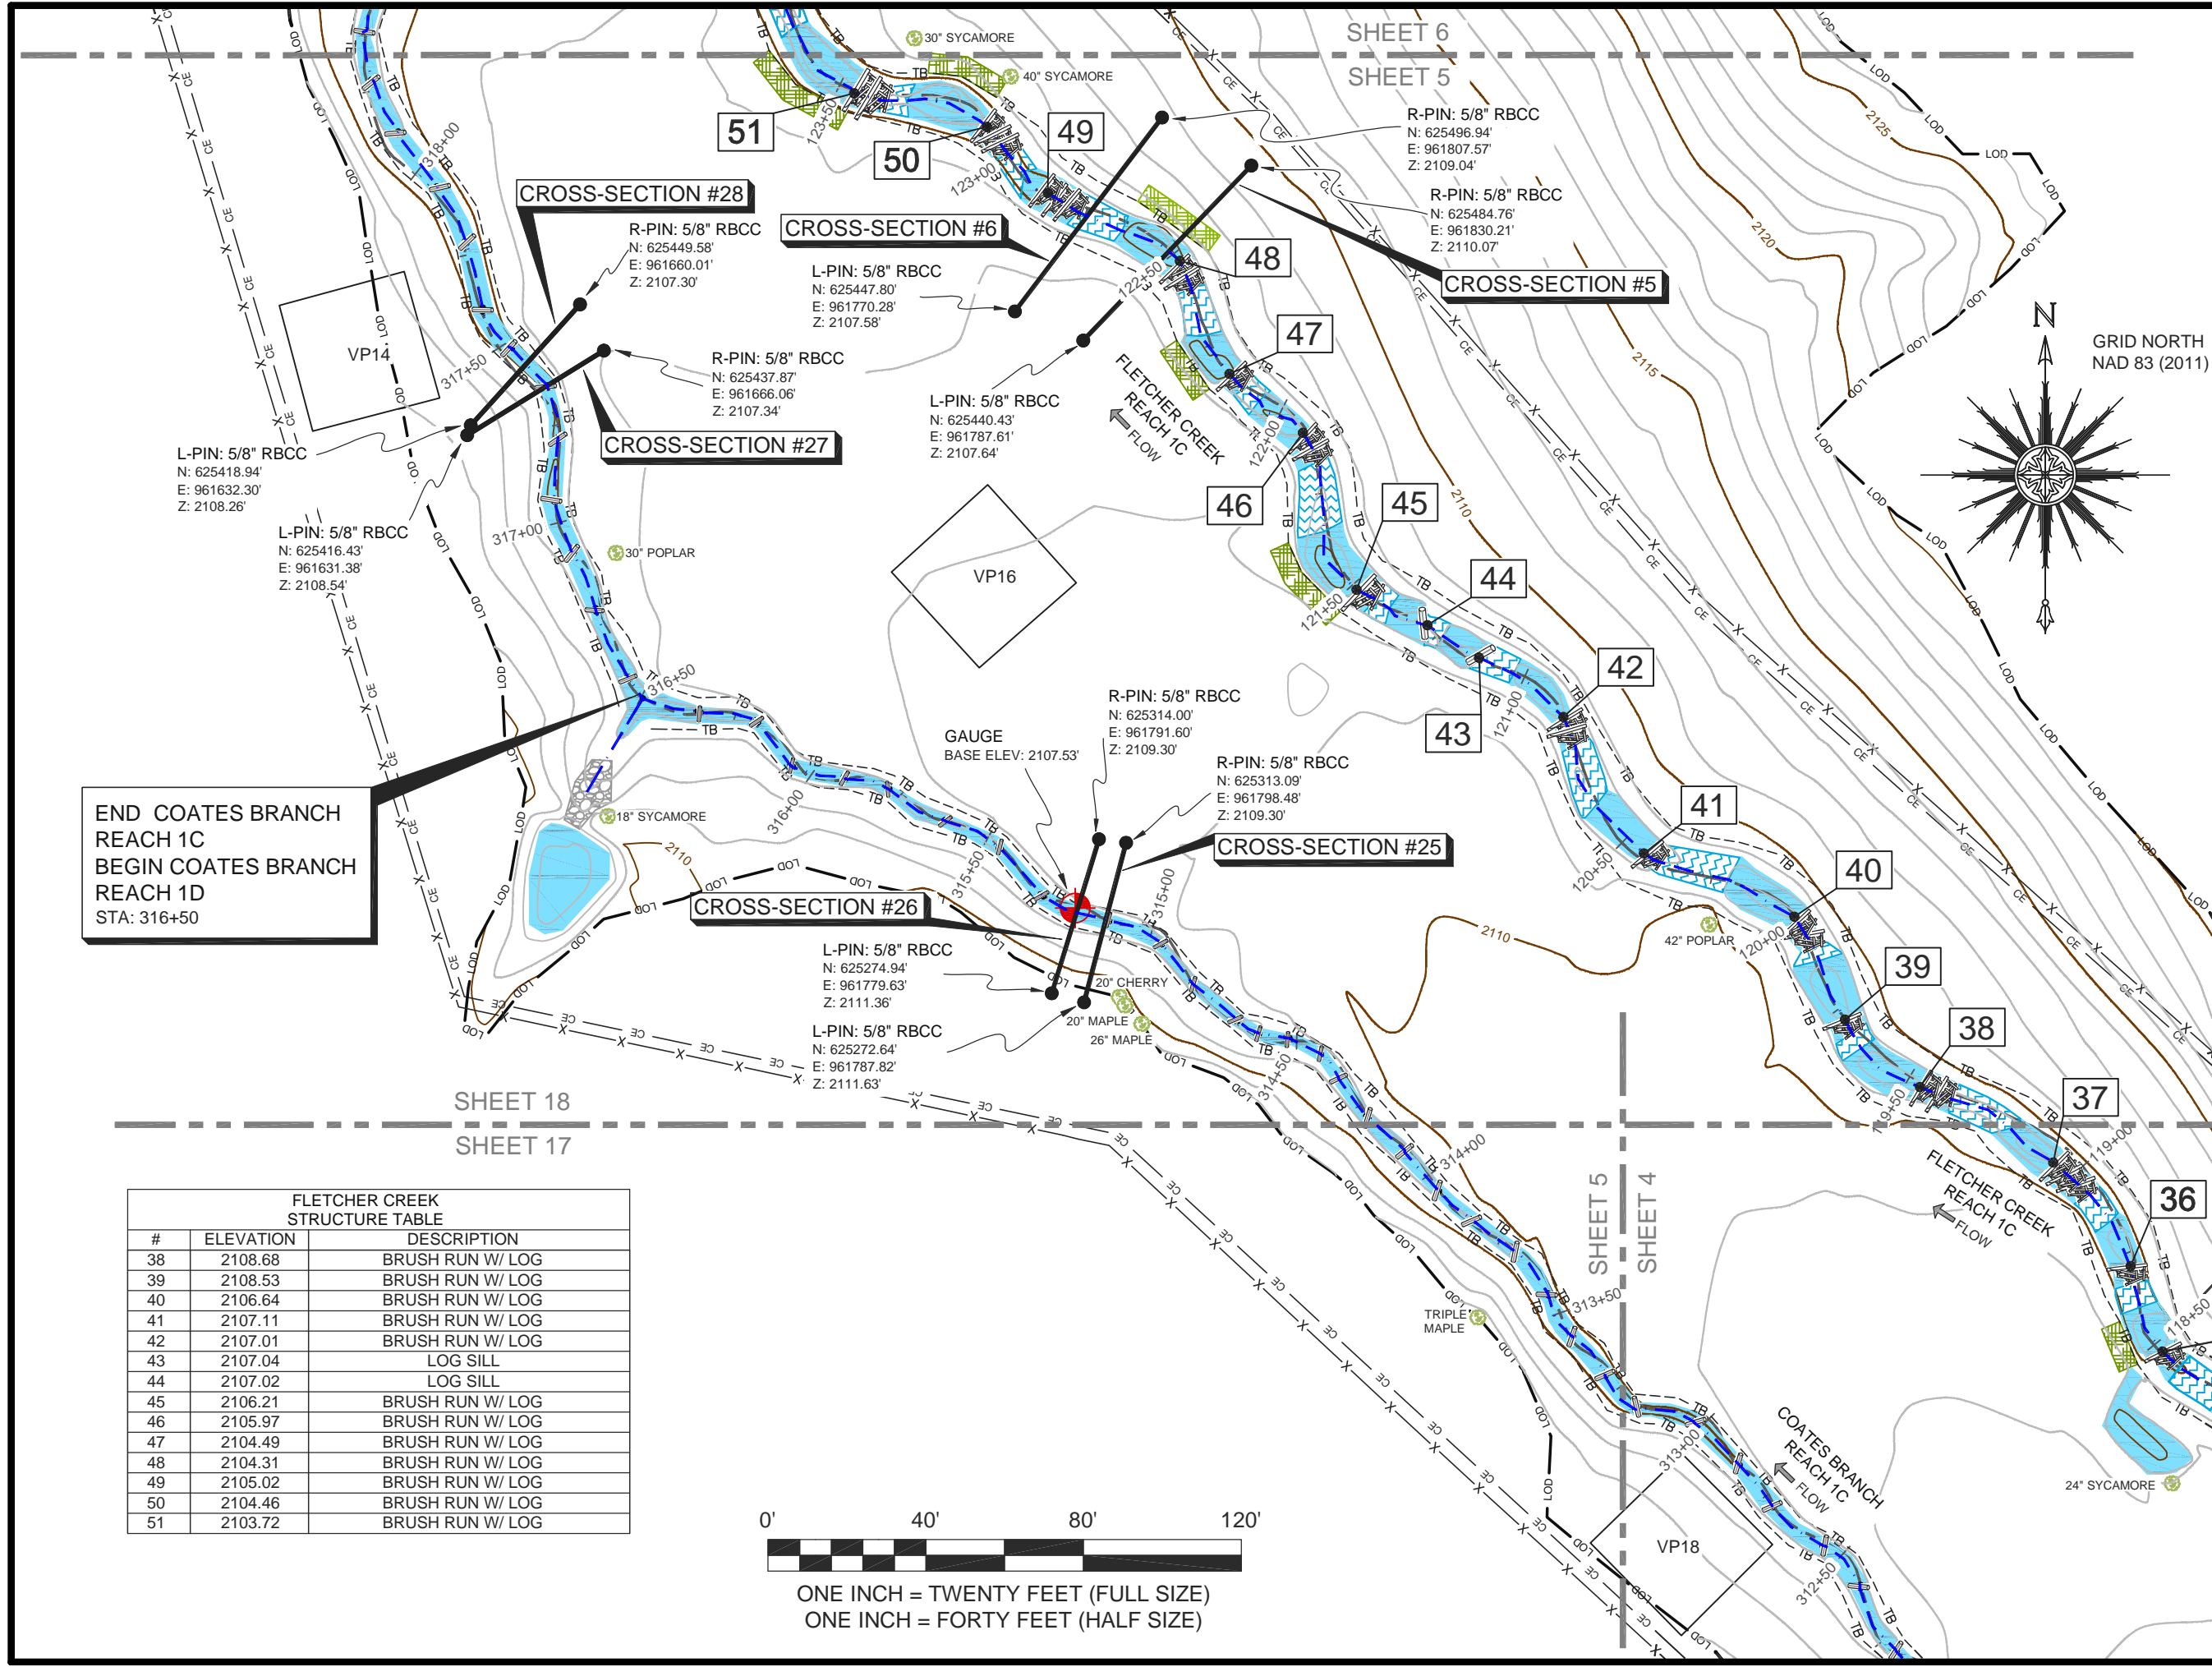



END COATES BRANCH
REACH 1C
BEGIN COATES BRANCH
REACH 1D
STA: 316+50

SHEET 18
SHEET 17

SHEET 5
SHEET 4

#	ELEVATION	DESCRIPTION
38	2108.68	BRUSH RUN W/ LOG
39	2108.53	BRUSH RUN W/ LOG
40	2106.64	BRUSH RUN W/ LOG
41	2107.11	BRUSH RUN W/ LOG
42	2107.01	BRUSH RUN W/ LOG
43	2107.04	LOG SILL
44	2107.02	LOG SILL
45	2106.21	BRUSH RUN W/ LOG
46	2105.97	BRUSH RUN W/ LOG
47	2104.49	BRUSH RUN W/ LOG
48	2104.31	BRUSH RUN W/ LOG
49	2105.02	BRUSH RUN W/ LOG
50	2104.46	BRUSH RUN W/ LOG
51	2103.72	BRUSH RUN W/ LOG


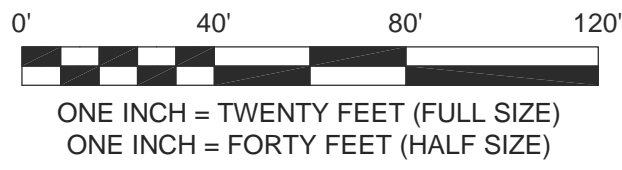


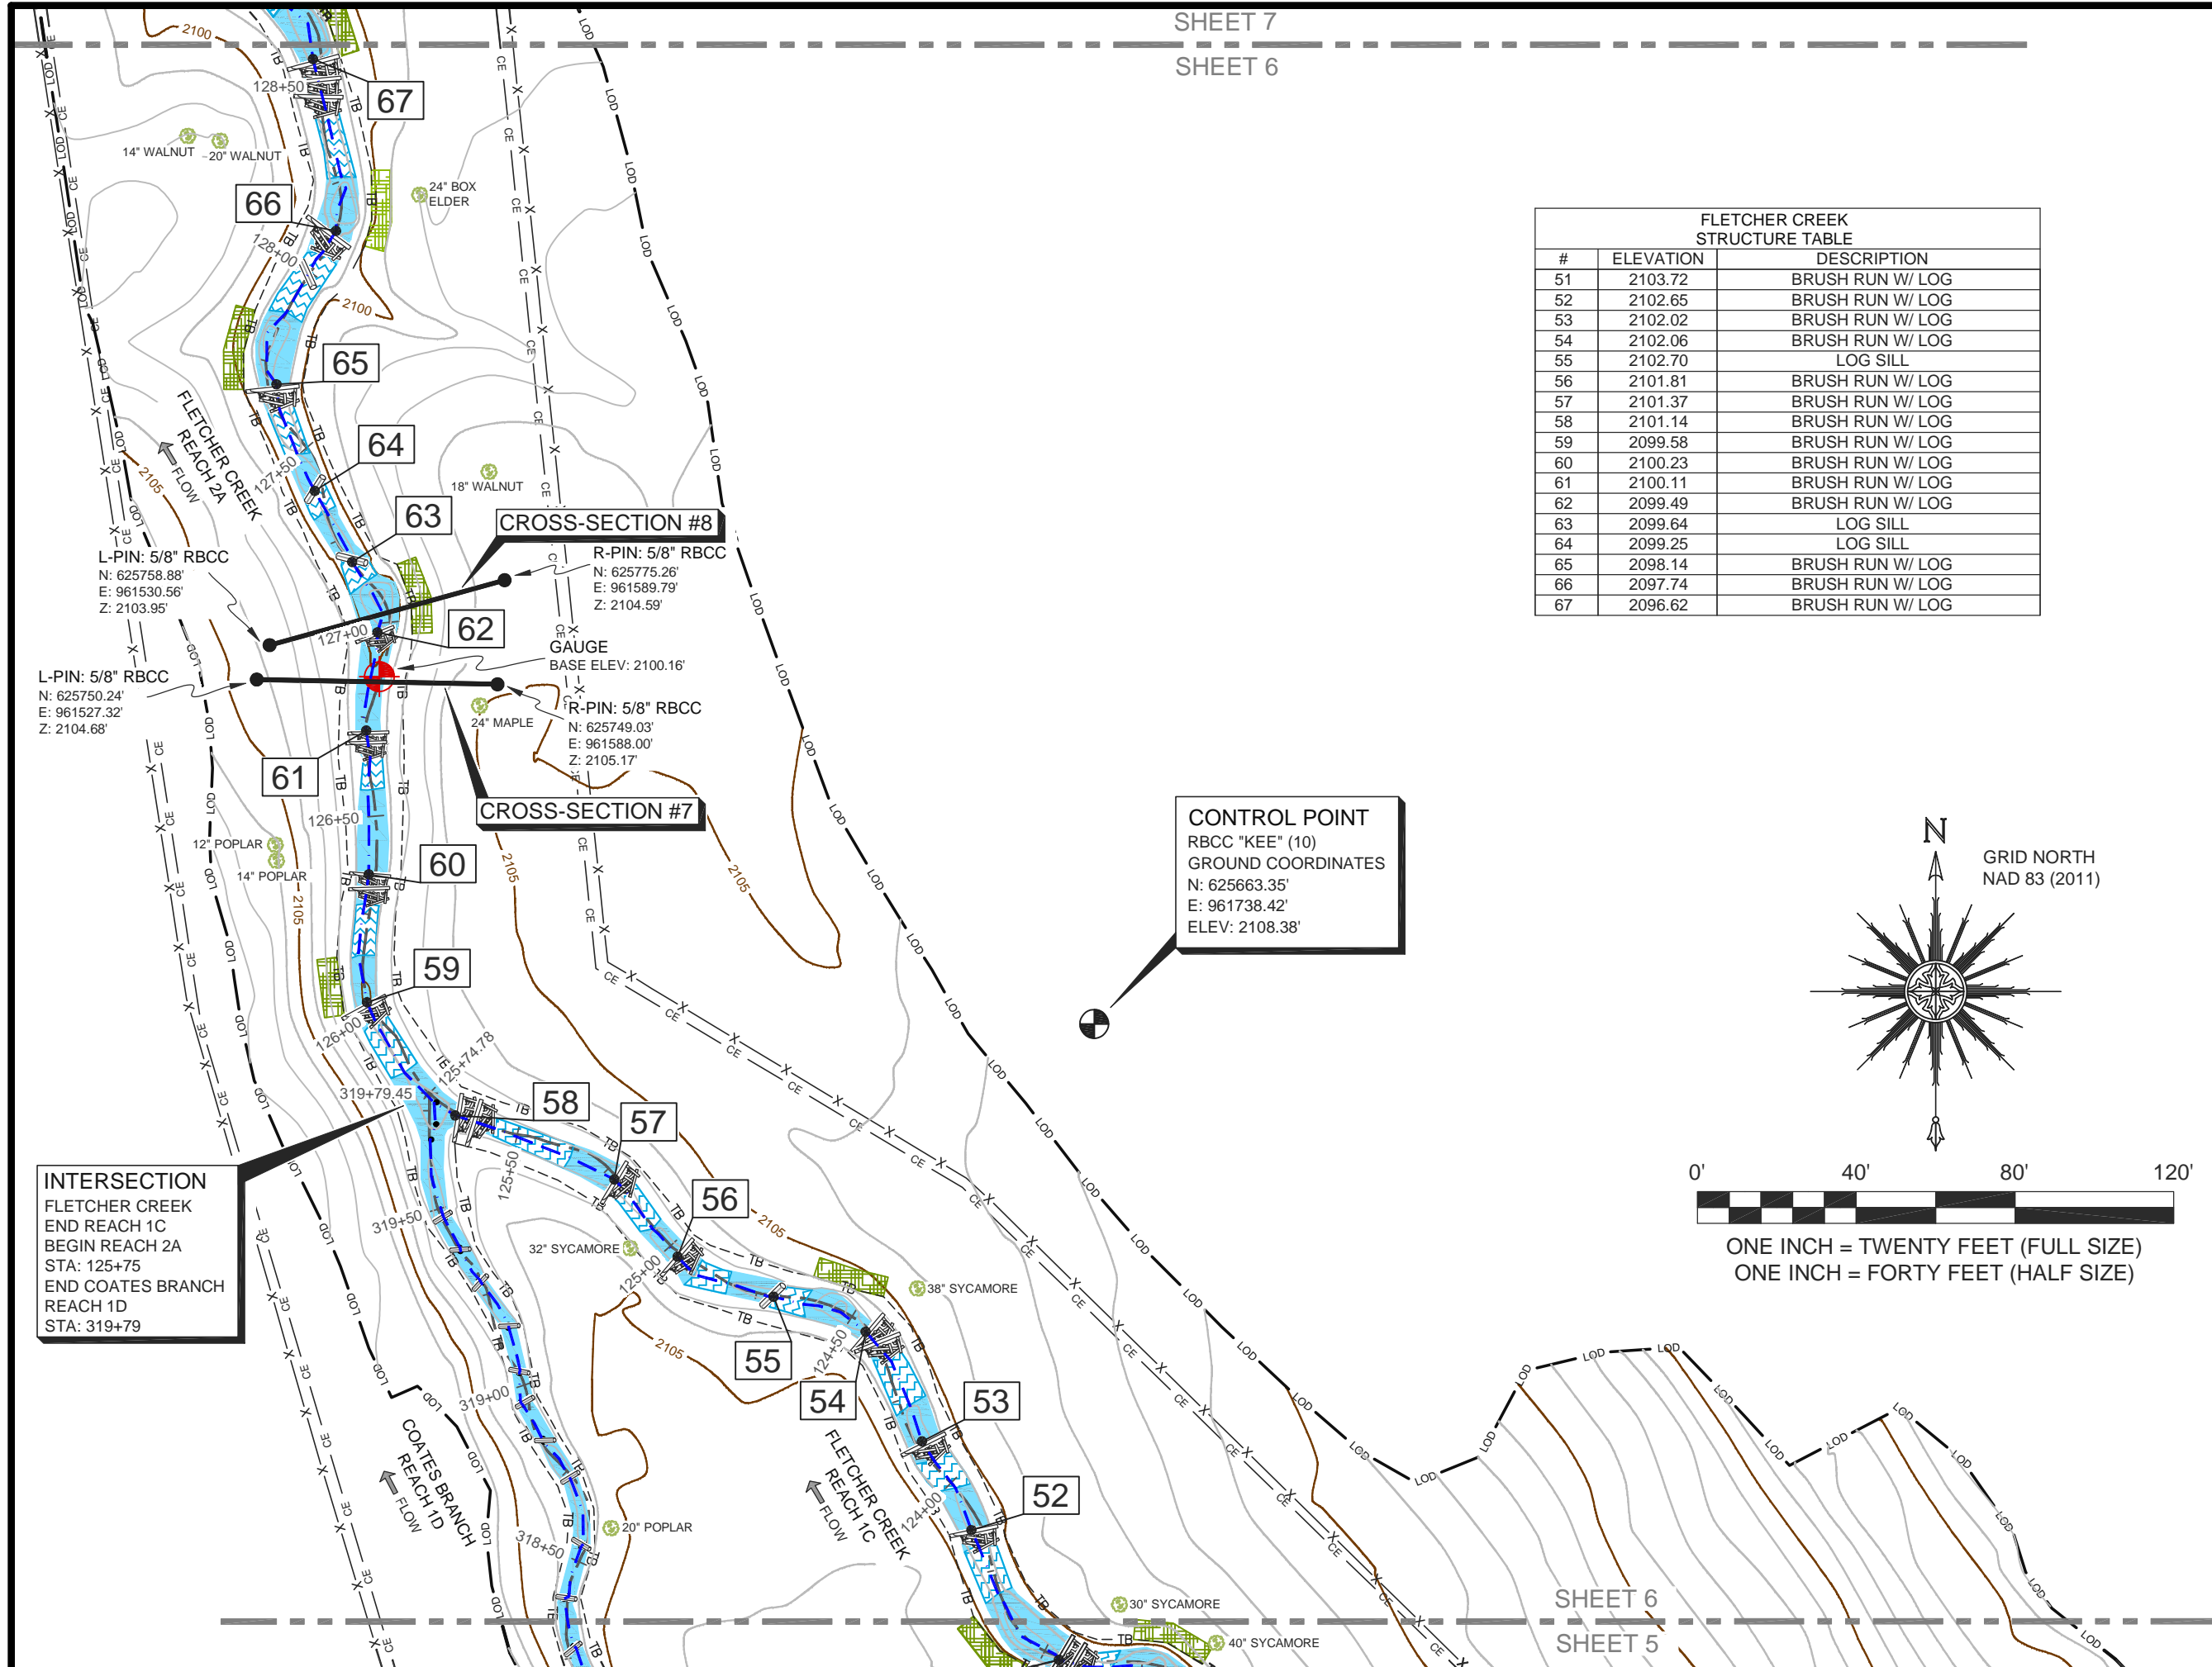

FLETCHER CREEK
STRUCTURE TABLE


#	ELEVATION	DESCRIPTION
51	2103.72	BRUSH RUN W/ LOG
52	2102.65	BRUSH RUN W/ LOG
53	2102.02	BRUSH RUN W/ LOG
54	2102.06	BRUSH RUN W/ LOG
55	2102.70	LOG SILL
56	2101.81	BRUSH RUN W/ LOG
57	2101.37	BRUSH RUN W/ LOG
58	2101.14	BRUSH RUN W/ LOG
59	2099.58	BRUSH RUN W/ LOG
60	2100.23	BRUSH RUN W/ LOG
61	2100.11	BRUSH RUN W/ LOG
62	2099.49	BRUSH RUN W/ LOG
63	2099.64	LOG SILL
64	2099.25	LOG SILL
65	2098.14	BRUSH RUN W/ LOG
66	2097.74	BRUSH RUN W/ LOG
67	2096.62	BRUSH RUN W/ LOG

CONTROL POINT
RBCC "KEE" (10)
GROUND COORDINATES
N: 625663.35'
E: 961738.42'
ELEV: 2108.38'

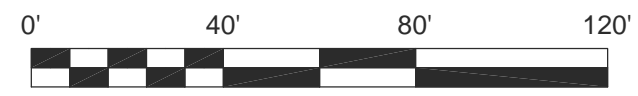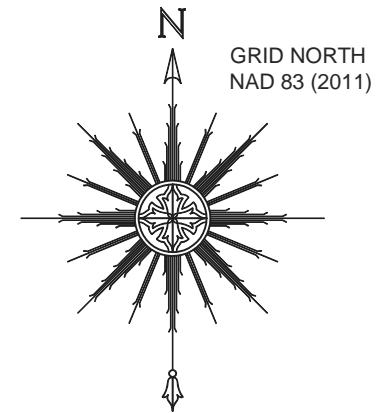

ONE INCH = TWENTY FEET (FULL SIZE)
ONE INCH = FORTY FEET (HALF SIZE)

INTERSECTION
FLETCHER CREEK
END REACH 1C
BEGIN REACH 2A
STA: 125+75
END COATES BRANCH
REACH 1D
STA: 319+79

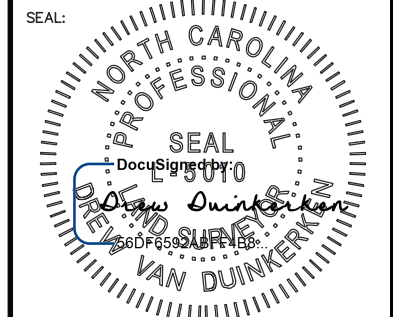

PLEASE REFER TO THE COVERSHEET FOR THE STATEMENT OF CERTIFICATION

NOTE: SEE SHEET 1 FOR SURVEYOR'S NOTES & LEGEND

ELEVATION DATUM: NAVD 88
CONTOUR INTERVAL: 1 FOOT

AN AS-BUILT SURVEY FOR:
EW SOLUTIONS, LLC.

SPO FILE NO's. 45-CZ, 45-DA, & 45-DB
SPO FILE NO's. 45-CY, 45-CX
DMS PROJECT NO. 100004

PROJECT:
FLETCHER SITE
MITIGATION PROJECT


SHEET TITLE:
STREAM DATA:
FLETCHER CREEK
INTERSECTION WITH
COATES BRANCH

TOWNSHIP: FLETCHER	COUNTY: HENDERSON	STATE: NORTH CAROLINA
DRAWN BY: NH/JA	CHECKED BY: LDP/PBK	SURVEY BY: CB,NMH,LDP,JM,AC
SCALE: AS SHOWN	SURVEY DATES: 12/17/19 - 03/22/19	
JOB: #1811142-AB	SHEET SIZE: (HALF SIZE) 11" X 17"	
#	DATE	REVISIONS

SHEET:
6 OF **37**



P.O. Box 2566
Asheville, NC 28802
(828) 575-9021
www.keemap.com
License # C-3039

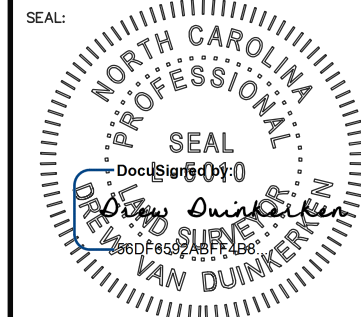

PLEASE REFER TO THE COVERSHEET FOR THE STATEMENT OF CERTIFICATION

NOTE: SEE SHEET 1 FOR SURVEYOR'S NOTES & LEGEND

ELEVATION DATUM: NAVD 88
CONTOUR INTERVAL: 1 FOOT

AN AS-BUILT SURVEY FOR:
EW SOLUTIONS, LLC.

SPO FILE NO's. 45-CZ, 45-DA, & 45-DB
SPO FILE NO's. 45-CY, 45-CX
DMS PROJECT NO. 100004

PROJECT:
FLETCHER SITE
MITIGATION PROJECT

SHEET TITLE:

STREAM DATA:
FLETCHER CREEK

TOWNSHIP: FLETCHER COUNTY: HENDERSON STATE: NORTH CAROLINA

DRAWN BY: NH/JA CHECKED BY: LDP/PBK SURVEY BY: CB,NMH,LDP,JM,AC


SCALE: AS SHOWN SURVEY DATES: 12/17/19 - 03/22/19
JOB: #181142-AB SHEET SIZE: (HALF SIZE) 11" X 17"

#	DATE	REVISIONS

SHEET: 8 OF 37





P.O. Box 2566
Asheville, NC 28802
(828) 575-9021
www.keemap.com
License # C-3039


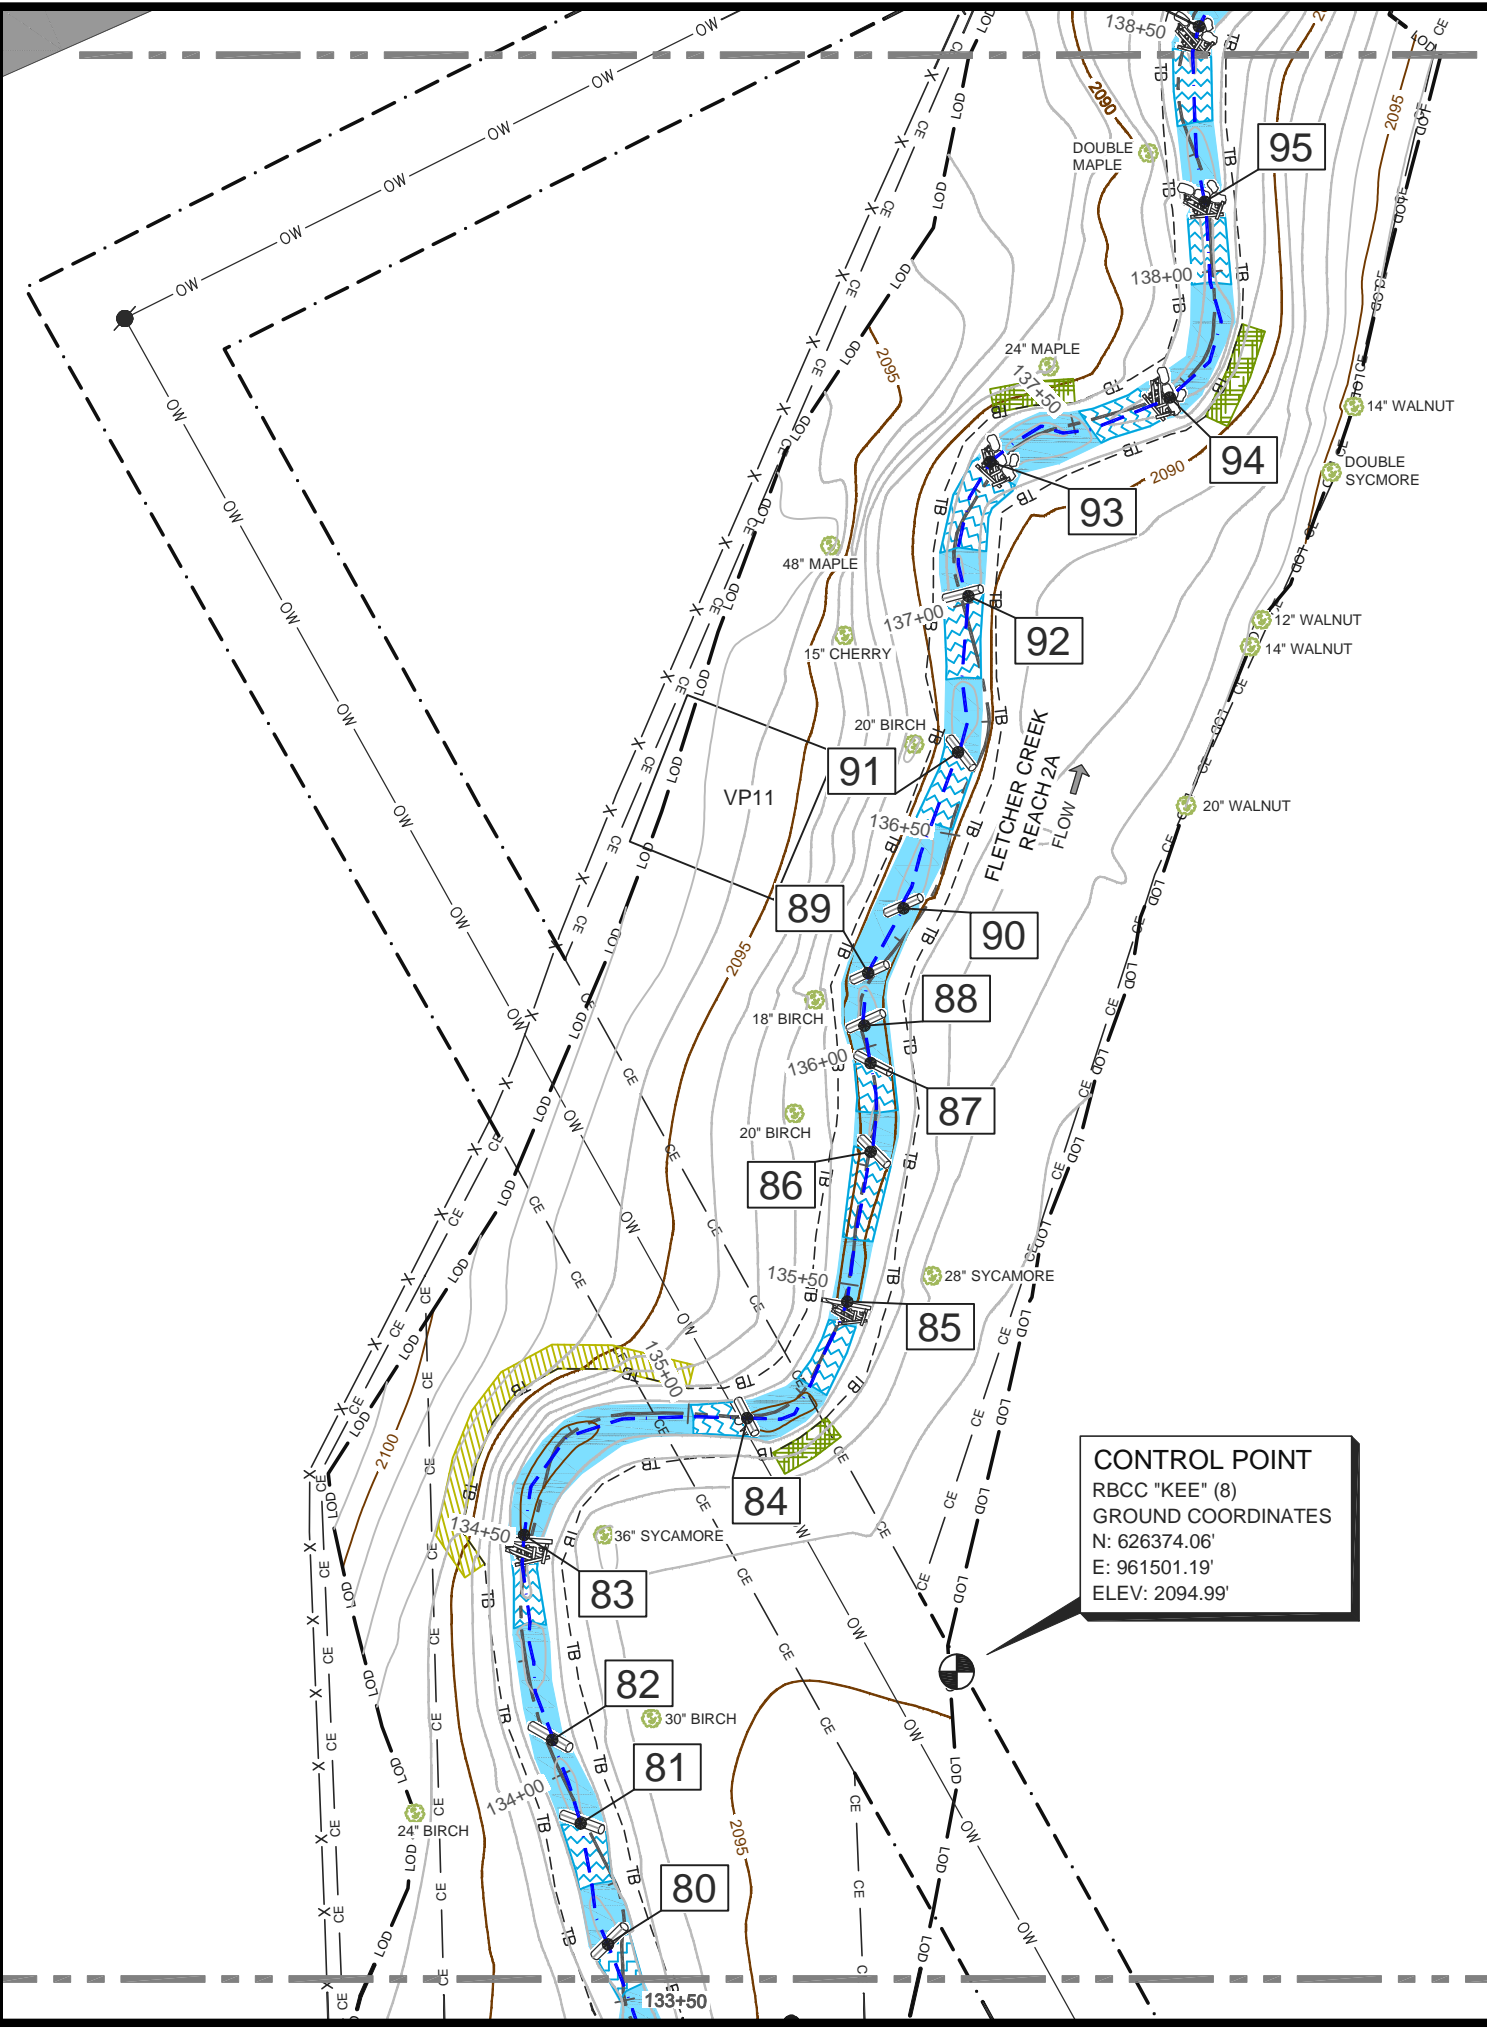


FLETCHER CREEK
STRUCTURE TABLE

#	ELEVATION	DESCRIPTION
80	2091.47	LOG SILL
81	2091.44	LOG SILL
82	2091.44	LOG SILL
83	2089.74	BRUSH RUN W/ LOG
84	2090.45	LOG SILL
85	2089.21	BRUSH RUN W/ LOG
86	2089.74	LOG SILL
87	2089.91	LOG SILL
88	2089.70	LOG SILL
89	2089.79	LOG SILL
90	2089.61	LOG SILL
91	2089.38	LOG SILL
92	2089.00	LOG SILL
93	2087.64	BRUSH RUN W/ BOULDER
94	2086.73	BRUSH RUN W/ BOULDER
95	2085.43	BRUSH RUN W/ BOULDER

CONTROL POINT
RBCC "KEE" (8)
GROUND COORDINATES
N: 626374.06'
E: 961501.19'
ELEV: 2094.99'

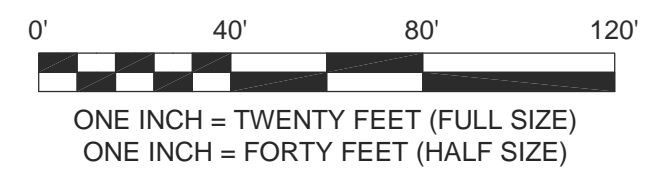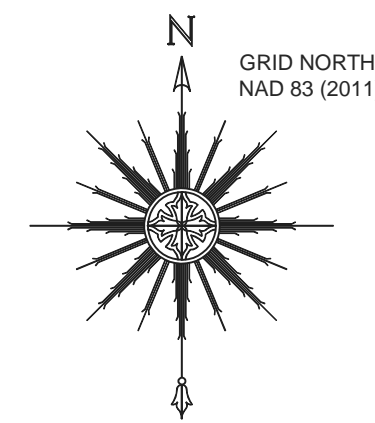

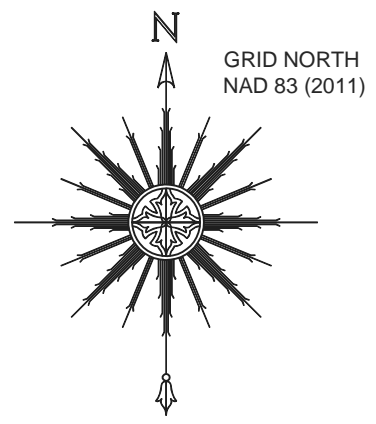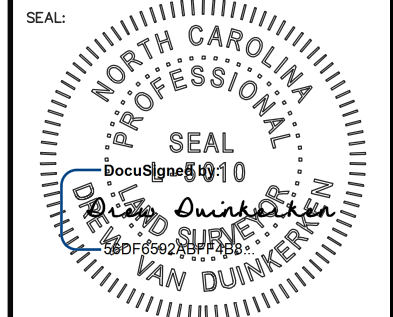

PLEASE REFER TO THE COVERSHEET FOR THE STATEMENT OF CERTIFICATION
NOTE: SEE SHEET 1 FOR SURVEYOR'S NOTES & LEGEND

ELEVATION DATUM: NAVD 88
CONTOUR INTERVAL: 1 FOOT

AN AS-BUILT SURVEY FOR:
EW SOLUTIONS, LLC.

SPO FILE NO's. 45-CZ, 45-DA, & 45-DB
SPO FILE NO's. 45-CY, 45-CX
DMS PROJECT NO. 100004

PROJECT:
FLETCHER SITE
MITIGATION PROJECT


SHEET TITLE:
STREAM DATA:
FLETCHER CREEK

TOWNSHIP: FLETCHER	COUNTY: HENDERSON	STATE: NORTH CAROLINA
DRAWN BY: NH/JA	CHECKED BY: LDP/PBK	SURVEY BY: CB,NMH,LDP,JM,AC
SCALE: AS SHOWN	SURVEY DATES: 12/17/19 - 03/22/19	
JOB: #1811142-AB	SHEET SIZE: (HALF SIZE) 11" X 17"	
#	DATE	REVISIONS

SHEET:
9 OF **37**




P.O. Box 2566
Asheville, NC 28802
(828) 575-9021
www.keemap.com
License # C-3039


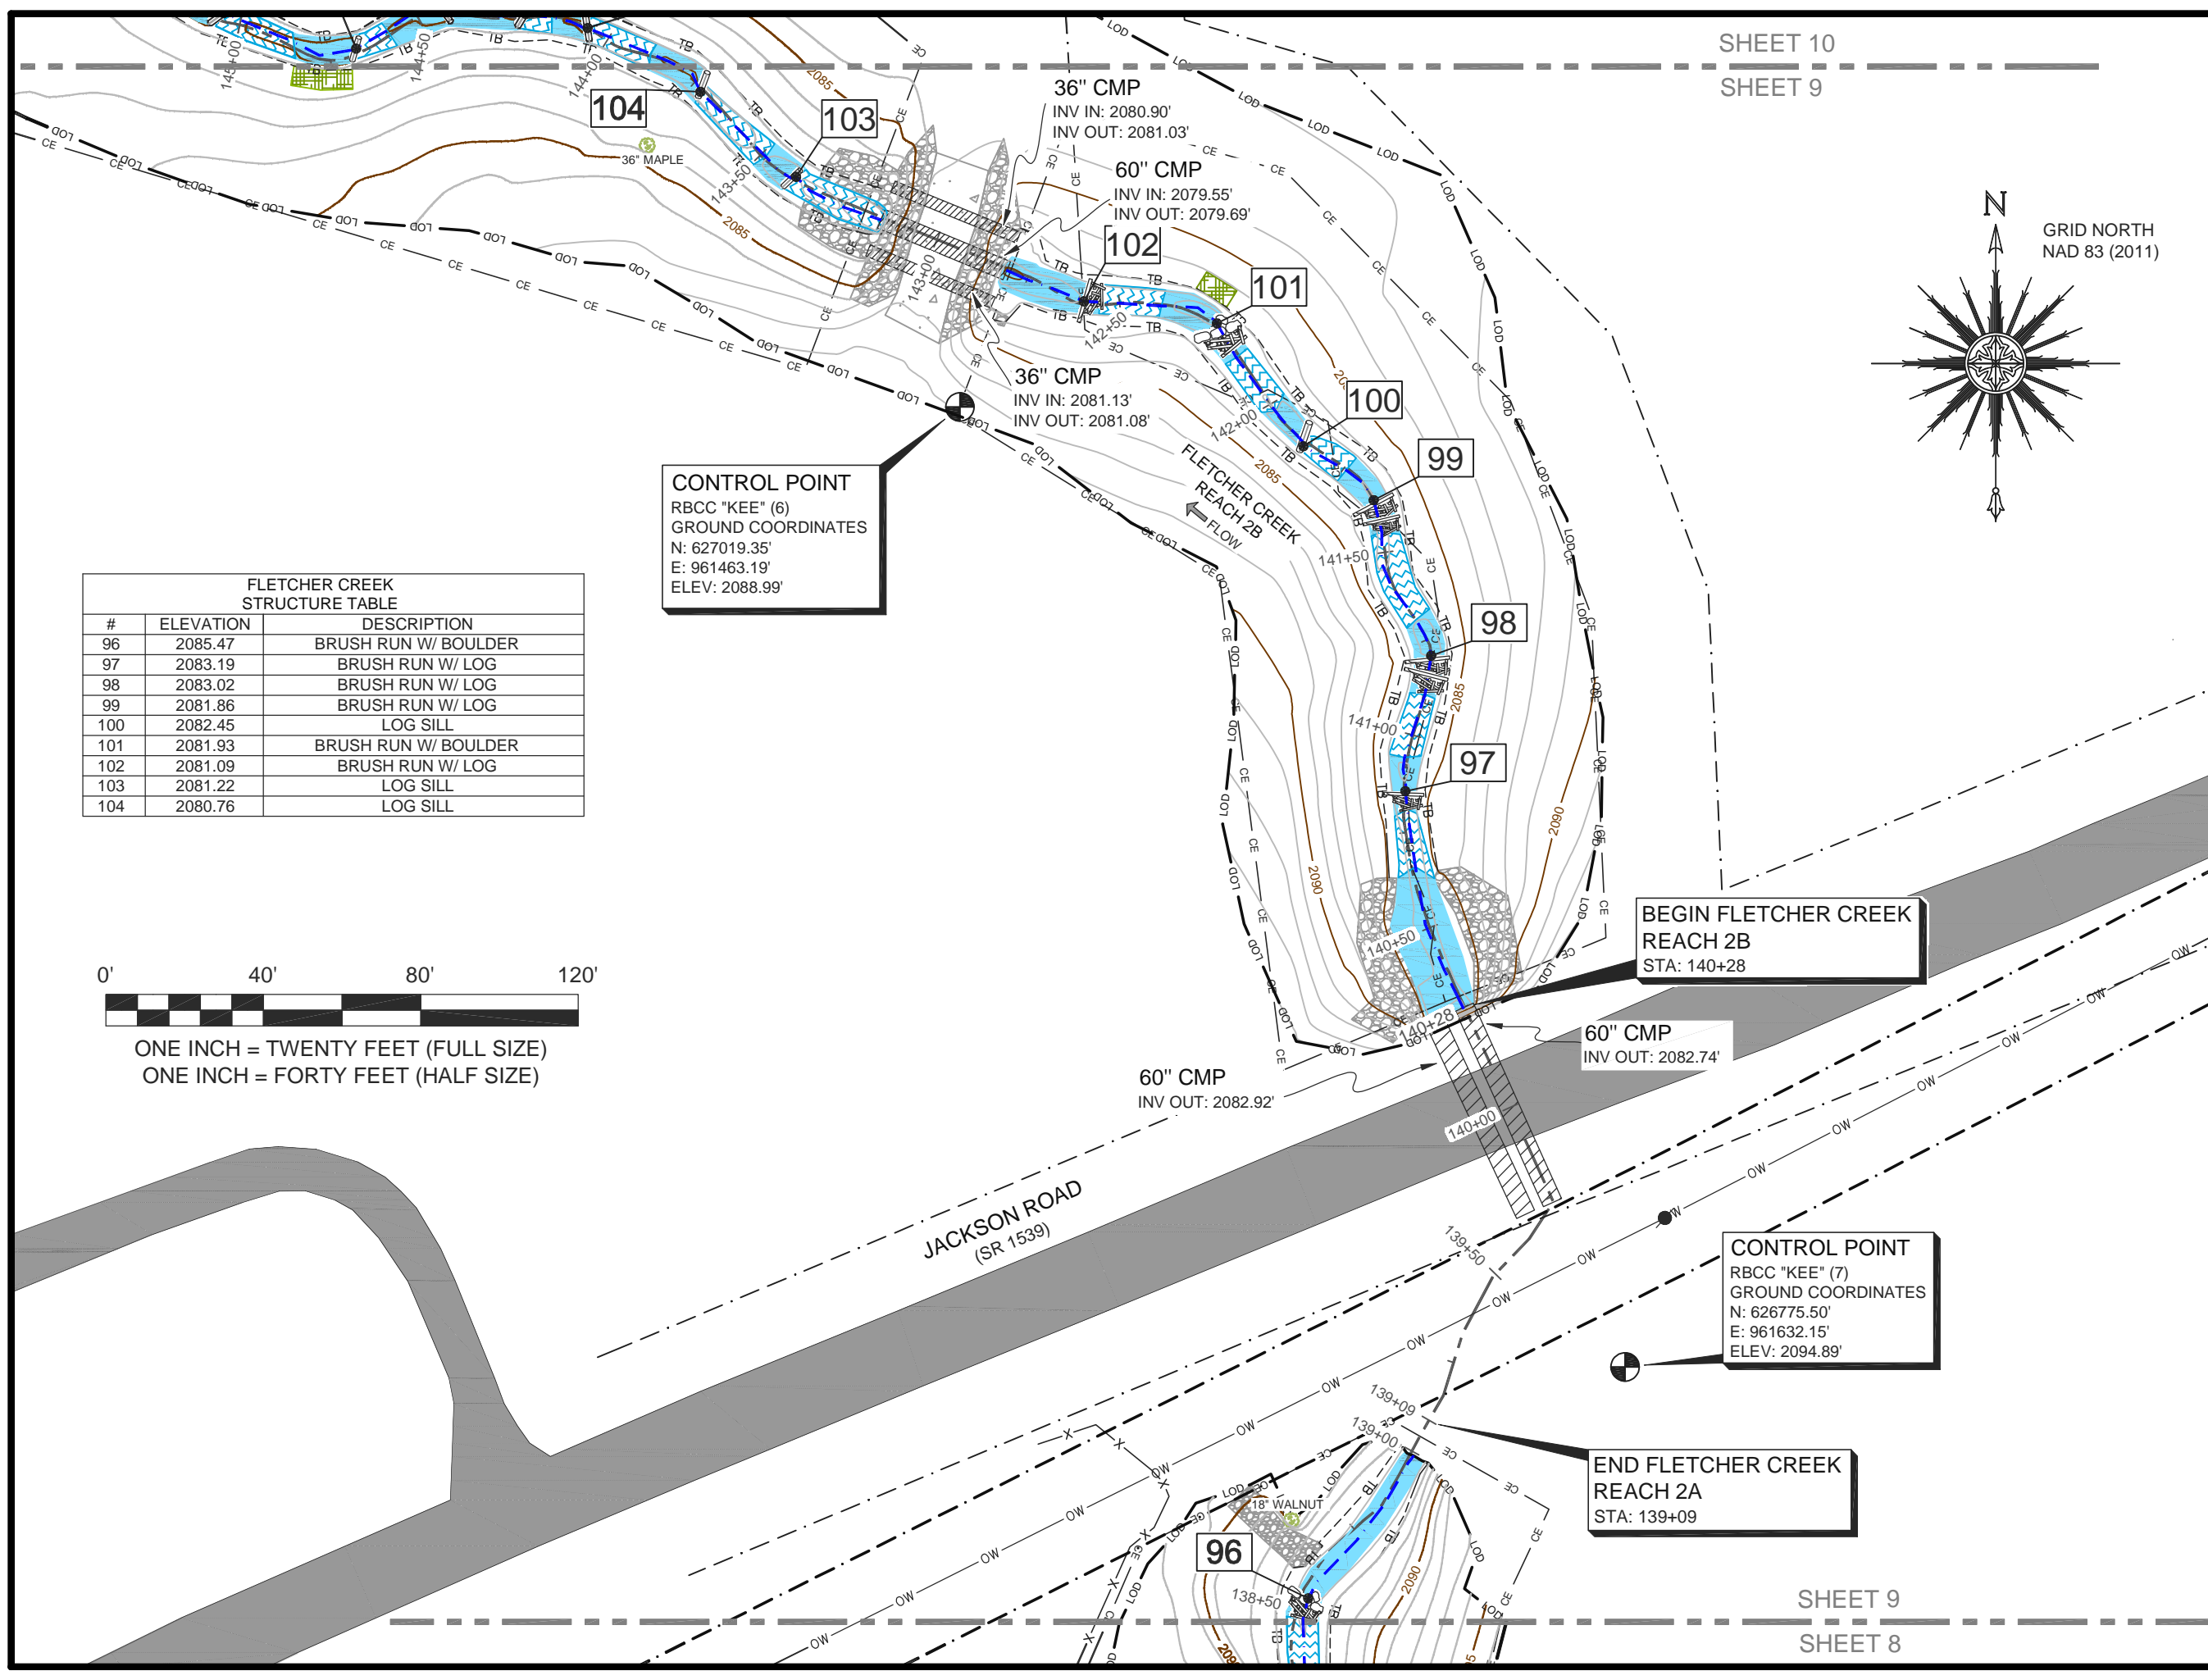


FLETCHER CREEK
STRUCTURE TABLE

#	ELEVATION	DESCRIPTION
96	2085.47	BRUSH RUN W/ BOULDER
97	2083.19	BRUSH RUN W/ LOG
98	2083.02	BRUSH RUN W/ LOG
99	2081.86	BRUSH RUN W/ LOG
100	2082.45	LOG SILL
101	2081.93	BRUSH RUN W/ BOULDER
102	2081.09	BRUSH RUN W/ LOG
103	2081.22	LOG SILL
104	2080.76	LOG SILL

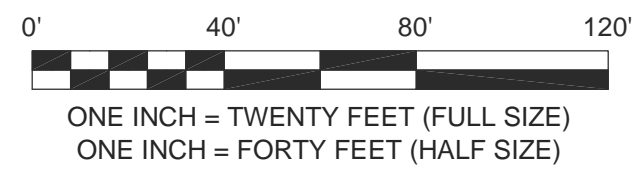

FLETCHER CREEK STRUCTURE TABLE		
#	ELEVATION	DESCRIPTION
105	2080.73	LOG SILL
106	2080.52	LOG SILL
107	2080.18	LOG SILL
108	2080.37	LOG SILL
109	2080.10	LOG SILL
110	2079.86	LOG SILL
111	2079.66	LOG SILL
112	2079.28	LOG SILL
113	2078.97	LOG SILL
114	2078.98	LOG SILL
115	2078.75	LOG SILL
116	2077.87	BRUSH RUN W/ LOG
117	2077.90	BRUSH RUN W/ LOG
118	2077.09	BRUSH RUN W/ LOG
119	2077.49	LOG SILL

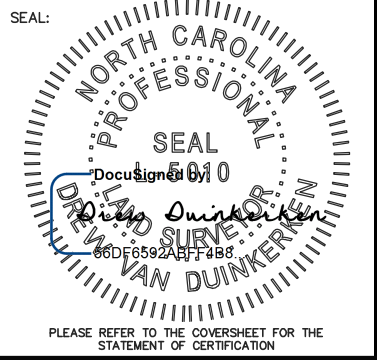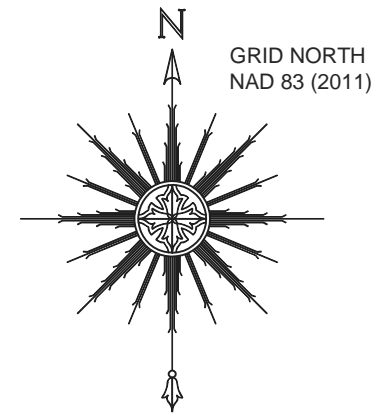

PLEASE REFER TO THE COVERSHEET FOR THE STATEMENT OF CERTIFICATION

NOTE: SEE SHEET 1 FOR SURVEYOR'S NOTES & LEGEND

ELEVATION DATUM: NAVD 88
CONTOUR INTERVAL: 1 FOOT

AN AS-BUILT SURVEY FOR:
EW SOLUTIONS, LLC.

SPO FILE NO's. 45-CZ, 45-DA, & 45-DB
SPO FILE NO's. 45-CY, 45-CX
DMS PROJECT NO. 100004

PROJECT:
FLETCHER SITE
MITIGATION PROJECT


SHEET TITLE:
STREAM DATA:
FLETCHER CREEK

TOWNSHIP: FLETCHER	COUNTY: HENDERSON	STATE: NORTH CAROLINA
DRAWN BY: NH/JA	CHECKED BY: LDP/PBK	SURVEY BY: CB,NMH,LDP,JM,AC
SCALE: AS SHOWN	SURVEY DATES: 12/17/19 - 03/22/19	
JOB: #1811142-AB	SHEET SIZE: (HALF SIZE) 11" X 17"	
#	DATE	REVISIONS


10 OF 37



P.O. Box 2566
Asheville, NC 28802
(828) 575-9021
www.keemap.com
License # C-3039

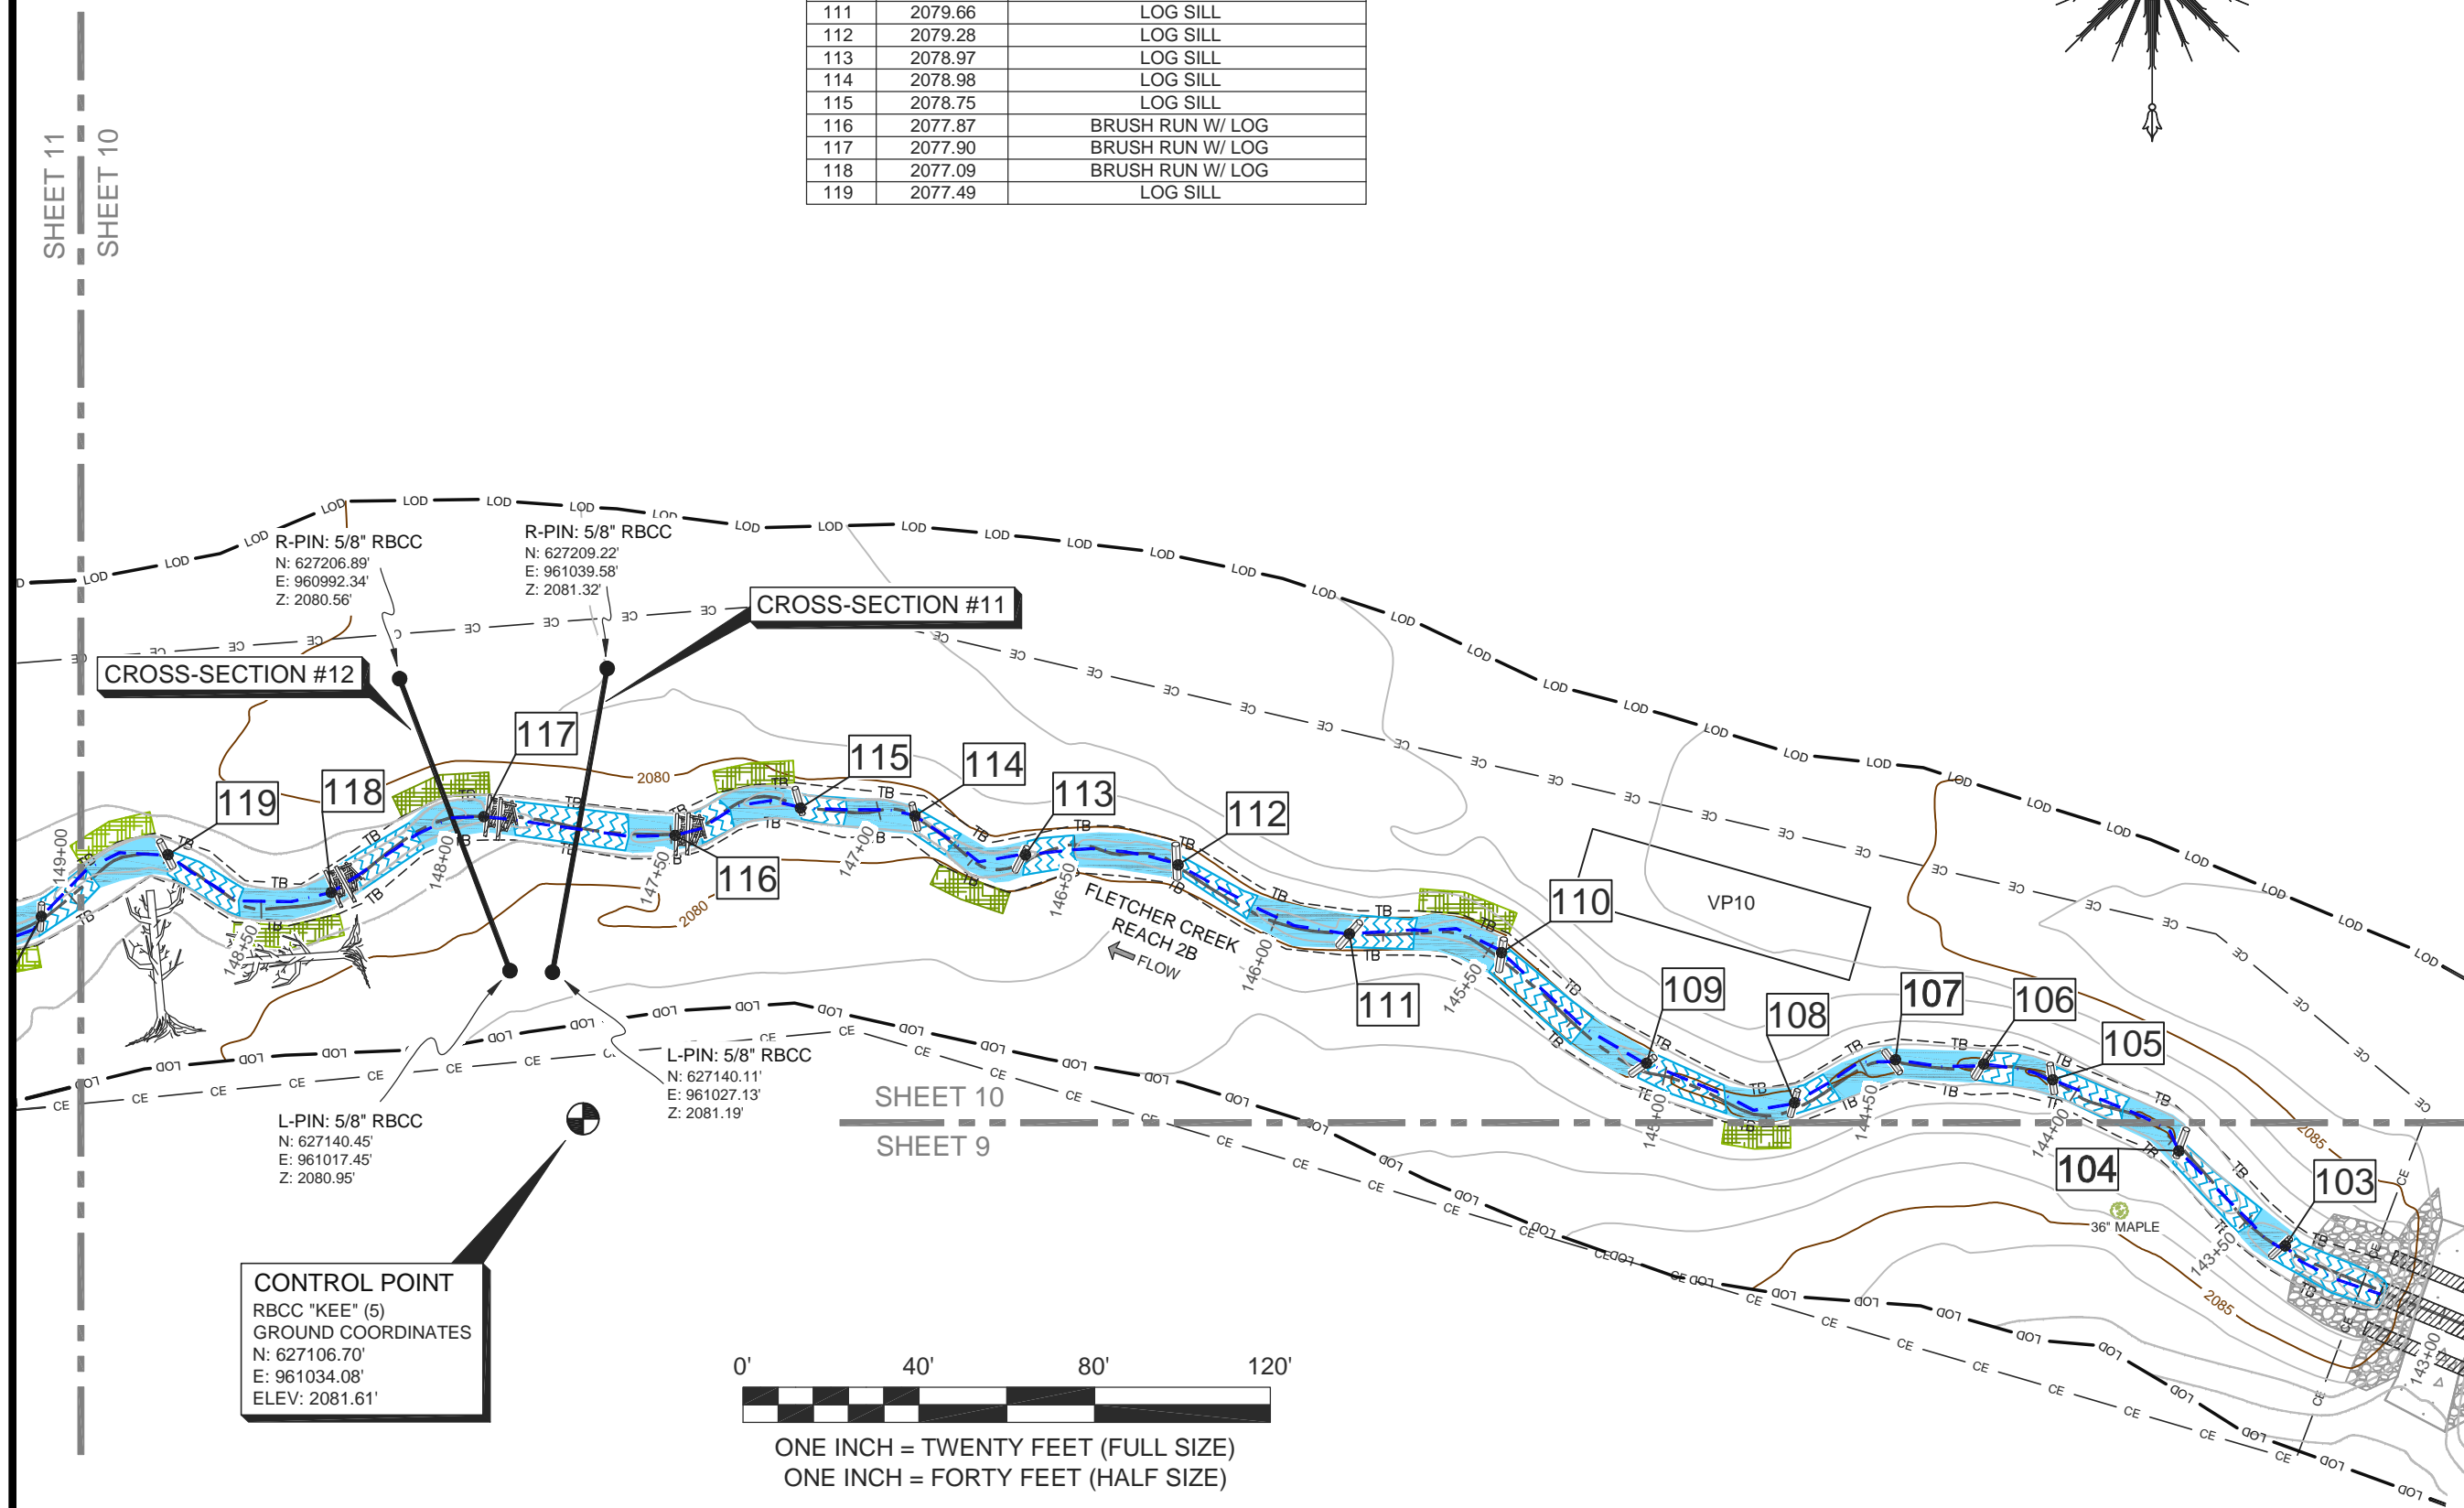

CONTROL POINT
RBCC "KEE" (5)
GROUND COORDINATES
N: 627106.70'
E: 961034.08'
ELEV: 2081.61'

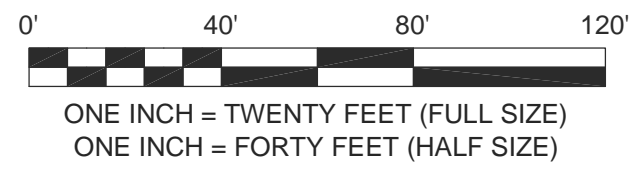

SHEET 11
SHEET 10

SHEET 10
SHEET 9

SEAL:

PLEASE REFER TO THE COVERSHEET FOR THE STATEMENT OF CERTIFICATION

NOTE: SEE SHEET 1 FOR SURVEYOR'S NOTES & LEGEND

ELEVATION DATUM: NAVD 88
CONTOUR INTERVAL: 1 FOOT

AN AS-BUILT SURVEY FOR:
EW SOLUTIONS, LLC.

SPO FILE NO's. 45-CZ, 45-DA, & 45-DB
SPO FILE NO's. 45-CY, 45-CX
DMS PROJECT NO. 100004

PROJECT:
**FLETCHER SITE
MITIGATION PROJECT**

SHEET TITLE:
STREAM DATA:
FLETCHER CREEK



TOWNSHIP: FLETCHER	COUNTY: HENDERSON	STATE: NORTH CAROLINA
DRAWN BY: NH/JA	CHECKED BY: LDP/PBK	SURVEY BY: CB,NMH,LDP,JM,AC
SCALE: AS SHOWN	SURVEY DATES: 12/17/19 - 03/22/19	
JOB: #181142-AB	SHEET SIZE: (HALF SIZE) 11" X 17"	
#	DATE	REVISIONS

SHEET:
11 OF 37




P.O. Box 2566
Asheville, NC 28802
(828) 575-9021
www.keemap.com
License # C-3039

#	ELEVATION	DESCRIPTION
120	2077.21	LOG SILL
121	2076.13	BRUSH RUN W/ LOG
122	2076.51	LOG SILL
123	2076.34	LOG SILL
124	2076.23	LOG SILL
125	2075.51	BRUSH RUN W/ LOG
126	2074.56	BRUSH RUN W/ LOG
127	2075.11	LOG SILL
128	2074.61	BRUSH RUN W/ LOG
129	2074.46	BRUSH RUN W/ LOG
130	2074.30	BRUSH RUN W/ LOG
131	2073.99	BRUSH RUN W/ LOG
132	2074.02	LOG SILL
133	2073.92	LOG SILL
134	2073.81	LOG SILL
135	2073.57	LOG SILL

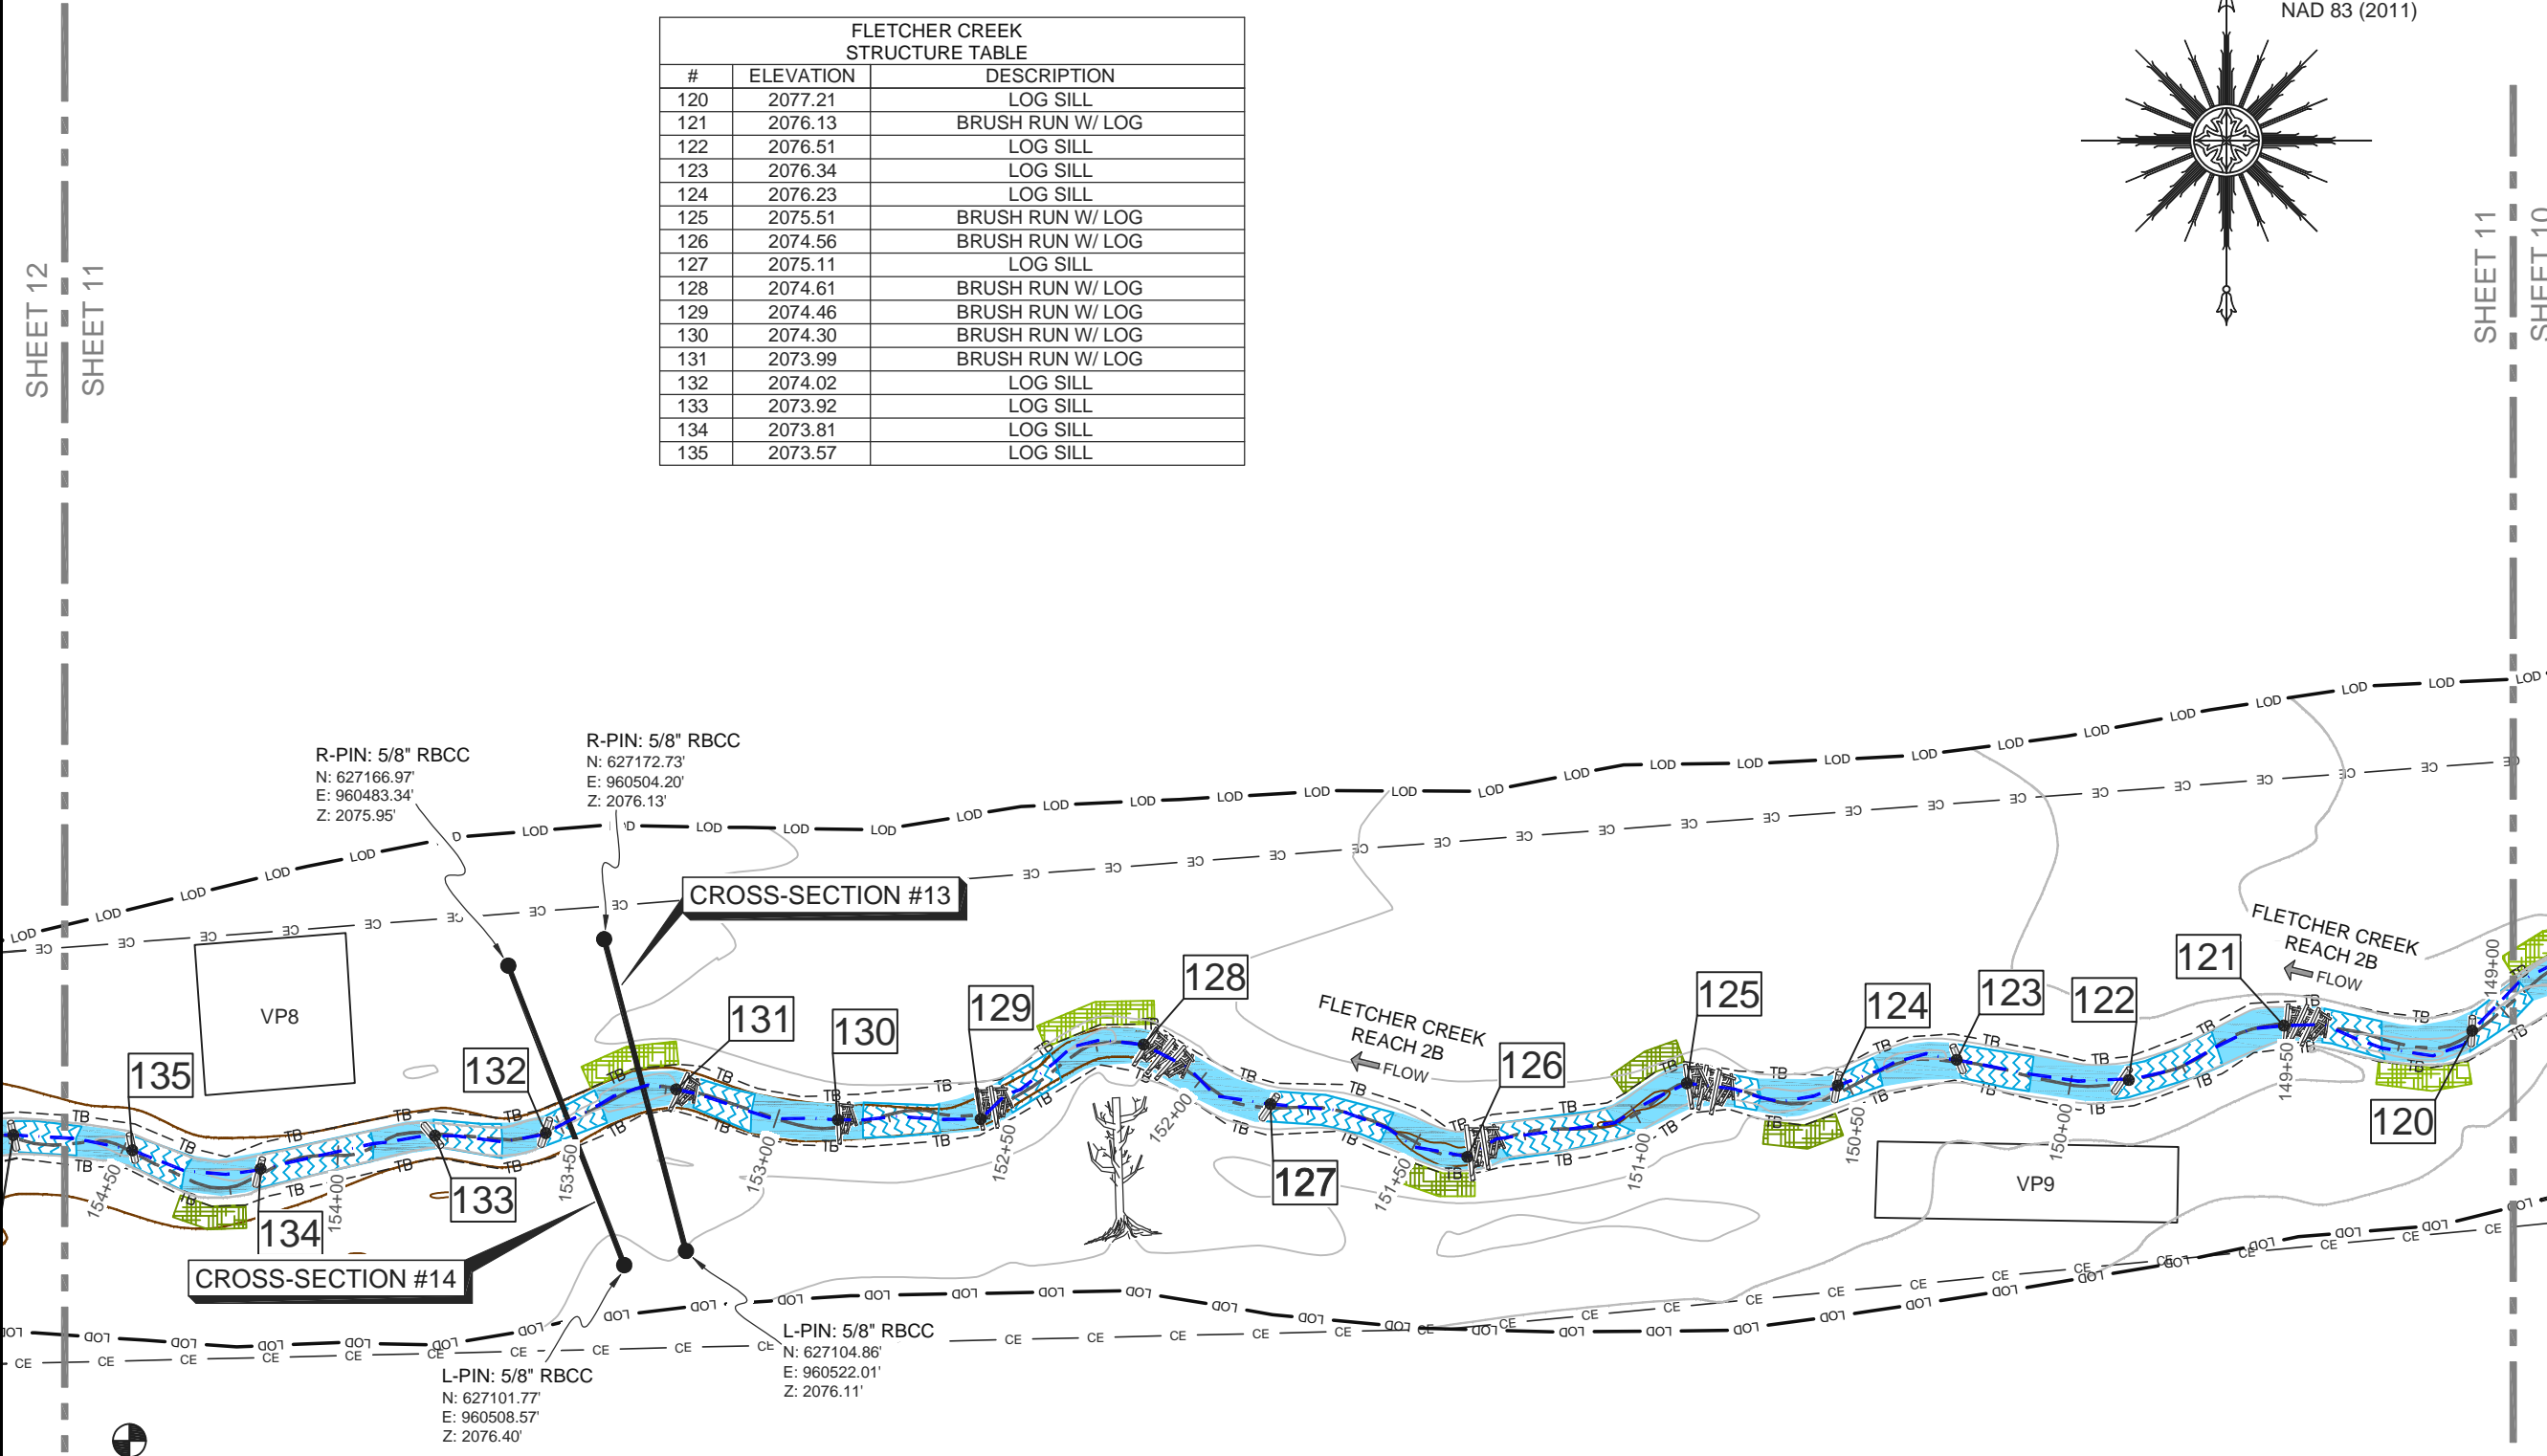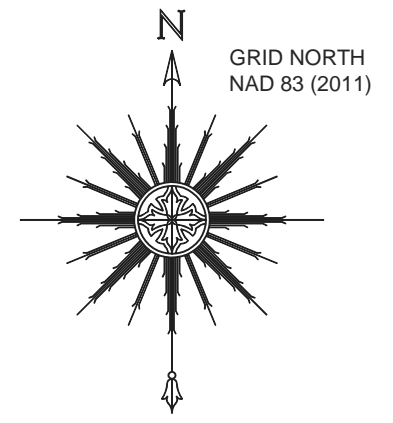



CONTROL POINT
RBCC "KEE" (100)
GROUND COORDINATES
N: 627063.55'
E: 960400.89'
ELEV: 2075.74'

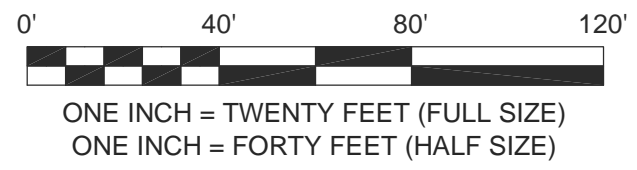

SHEET 12
SHEET 11

SHEET 11
SHEET 10

FLETCHER CREEK STRUCTURE TABLE		
#	ELEVATION	DESCRIPTION
136	2073.54	LOG SILL
137	2073.31	LOG SILL
138	2073.10	LOG SILL
139	2072.65	BRUSH RUN W/ BOULDER
140	2071.61	BRUSH RUN W/ BOULDER

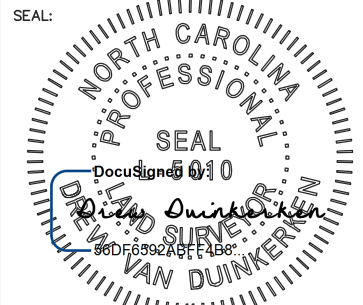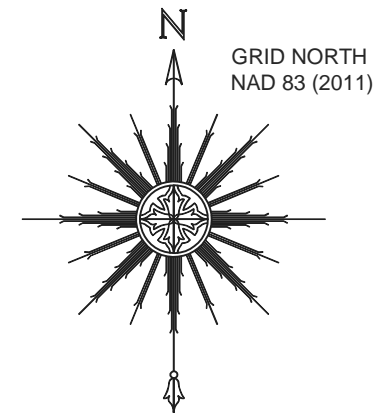

PLEASE REFER TO THE COVERSHEET FOR THE STATEMENT OF CERTIFICATION

NOTE: SEE SHEET 1 FOR SURVEYOR'S NOTES & LEGEND

ELEVATION DATUM: NAVD 88
CONTOUR INTERVAL: 1 FOOT

AN AS-BUILT SURVEY FOR:
EW SOLUTIONS, LLC.

SPO FILE NO's. 45-CZ, 45-DA, & 45-DB
SPO FILE NO's. 45-CY, 45-CX
DMS PROJECT NO. 100004

PROJECT:
**FLETCHER SITE
MITIGATION PROJECT**

SHEET TITLE:

STREAM DATA:
END FLETCHER CREEK

TOWNSHIP: FLETCHER COUNTY: HENDERSON STATE: NORTH CAROLINA

DRAWN BY: NH/JA CHECKED BY: LDP/PBK SURVEY BY: CB,NMH,LDP,JM,AC

SCALE: AS SHOWN SURVEY DATES: 12/17/19 - 03/22/19

JOB: #181142-AB SHEET SIZE: 11" X 17"


#	DATE	REVISIONS

SHEET:

12 OF 37



P.O. Box 2566
Asheville, NC 28802
(828) 575-9021
www.keemap.com
License # C-3039


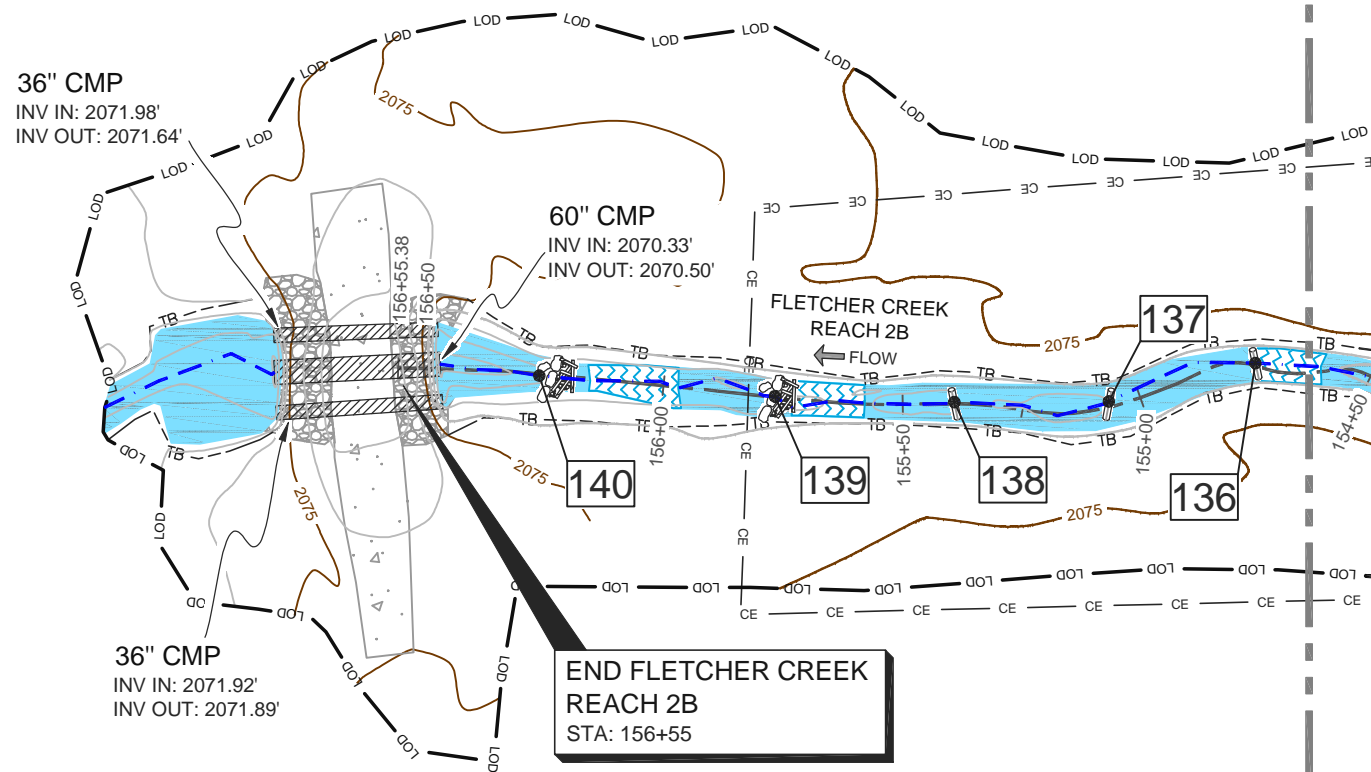


0' 40' 80' 120'



ONE INCH = TWENTY FEET (FULL SIZE)
ONE INCH = FORTY FEET (HALF SIZE)

SHEET 12
SHEET 11

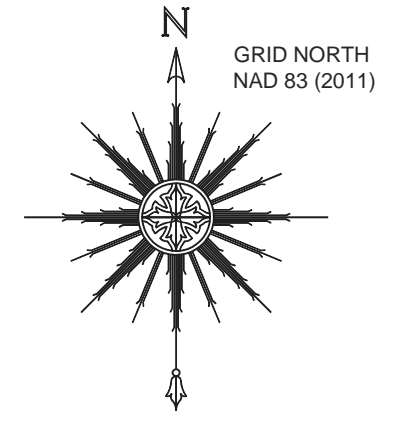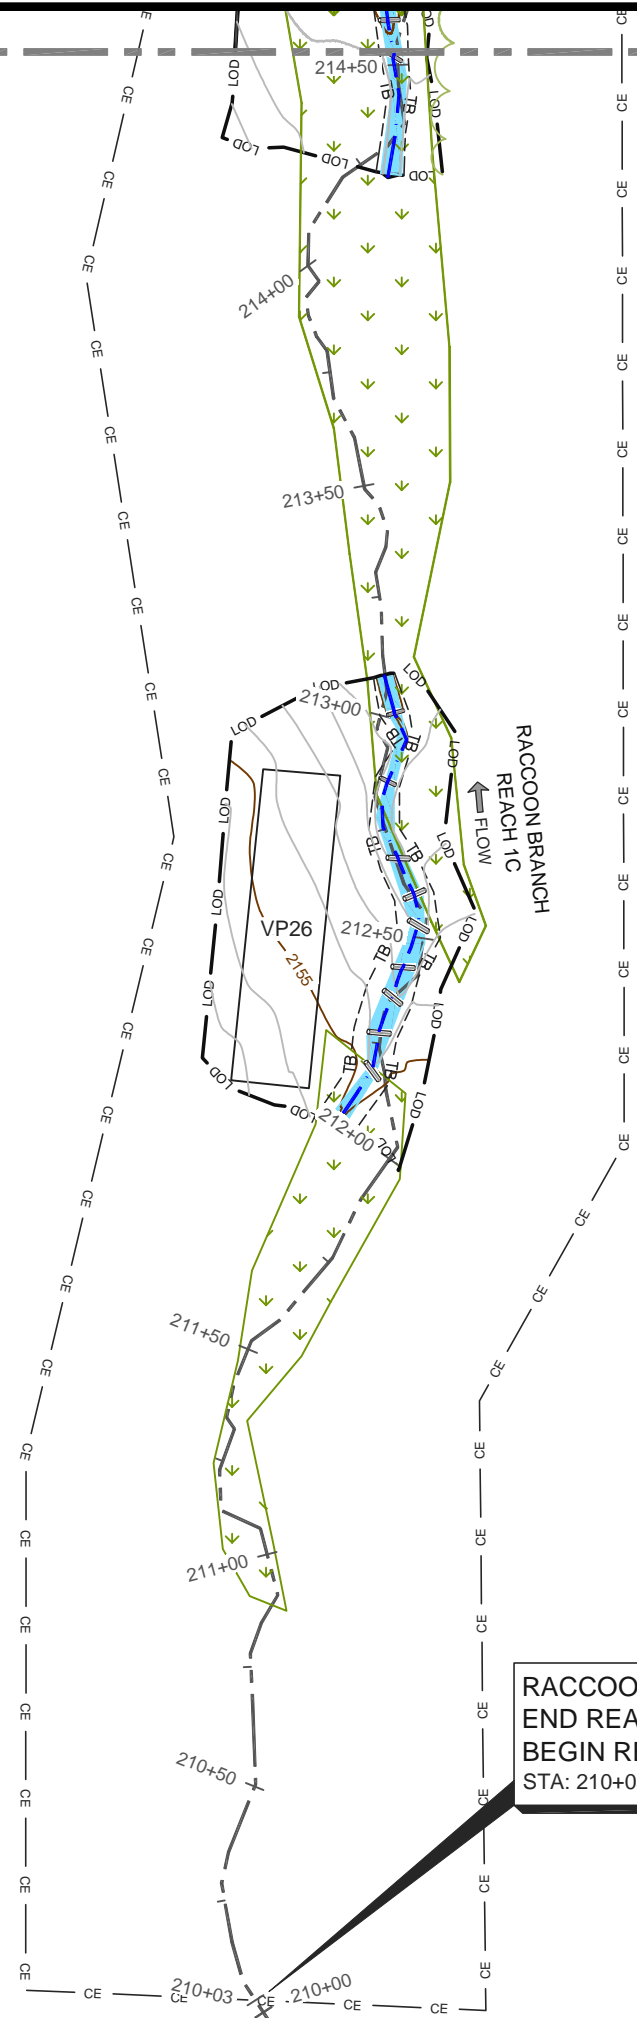

SEAL:

DocuSign ID: 0
Drew Van Duinkerken
68076592 AB FT, 4B8

PLEASE REFER TO THE COVERSHEET FOR THE STATEMENT OF CERTIFICATION

NOTE: SEE SHEET 1 FOR SURVEYOR'S NOTES & LEGEND

ELEVATION DATUM: NAVD 88
CONTOUR INTERVAL: 1 FOOT

AN AS-BUILT SURVEY FOR:
EW SOLUTIONS, LLC.

SPO FILE NO's. 45-CZ, 45-DA, & 45-DB
SPO FILE NO's. 45-CY, 45-CX
DMS PROJECT NO. 100004

PROJECT:
**FLETCHER SITE
MITIGATION PROJECT**

SHEET TITLE:


STREAM DATA:
BEGIN RACCOON BRANCH


TOWNSHIP: FLETCHER	COUNTY: HENDERSON	STATE: NORTH CAROLINA
DRAWN BY: NH/JA	CHECKED BY: LDP/PBK	SURVEY BY: CB,NMH,LDP,JM,AC
SCALE: AS SHOWN	SURVEY DATES: 12/17/19 - 03/22/19	
JOB: #181142-AB	SHEET SIZE: (HALF SIZE) 11" X 17"	
#	DATE	REVISIONS

SHEET:
13 OF 37



P.O. Box 2566
Asheville, NC 28802
(828) 575-9021
www.keemap.com
License # C-3039

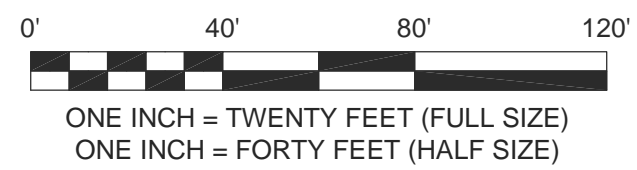

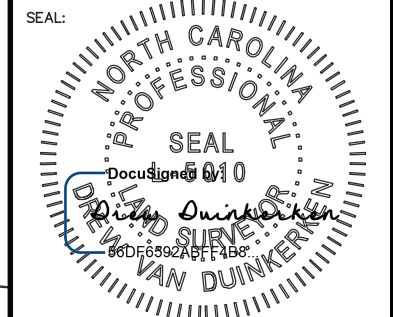

PLEASE REFER TO THE COVERSHEET FOR THE STATEMENT OF CERTIFICATION

NOTE: SEE SHEET 1 FOR SURVEYOR'S NOTES & LEGEND

ELEVATION DATUM: NAVD 88
CONTOUR INTERVAL: 1 FOOT

AN AS-BUILT SURVEY FOR:
EW SOLUTIONS, LLC.

SPO FILE NO's. 45-CZ, 45-DA, & 45-DB
SPO FILE NO's. 45-CY, 45-CX
DMS PROJECT NO. 100004

PROJECT:
FLETCHER SITE
MITIGATION PROJECT

SHEET TITLE:
STREAM DATA:
END RACCOON BRANCH
INTERSECTION WITH FLETCHER CREEK

TOWNSHIP: FLETCHER COUNTY: HENDERSON STATE: NORTH CAROLINA

DRAWN BY: NH/JA CHECKED BY: LDP/PBK SURVEY BY: CB,NMH,LDP,JM,AC

SCALE: AS SHOWN SURVEY DATES: 12/17/19 - 03/22/19


JOB: #1811142-AB SHEET SIZE: (HALF SIZE) 11" X 17"

#	DATE	REVISIONS

SHEET: 14 OF 37



P.O. Box 2566
Asheville, NC 28802
(828) 575-9021
www.keemap.com
License # C-3039

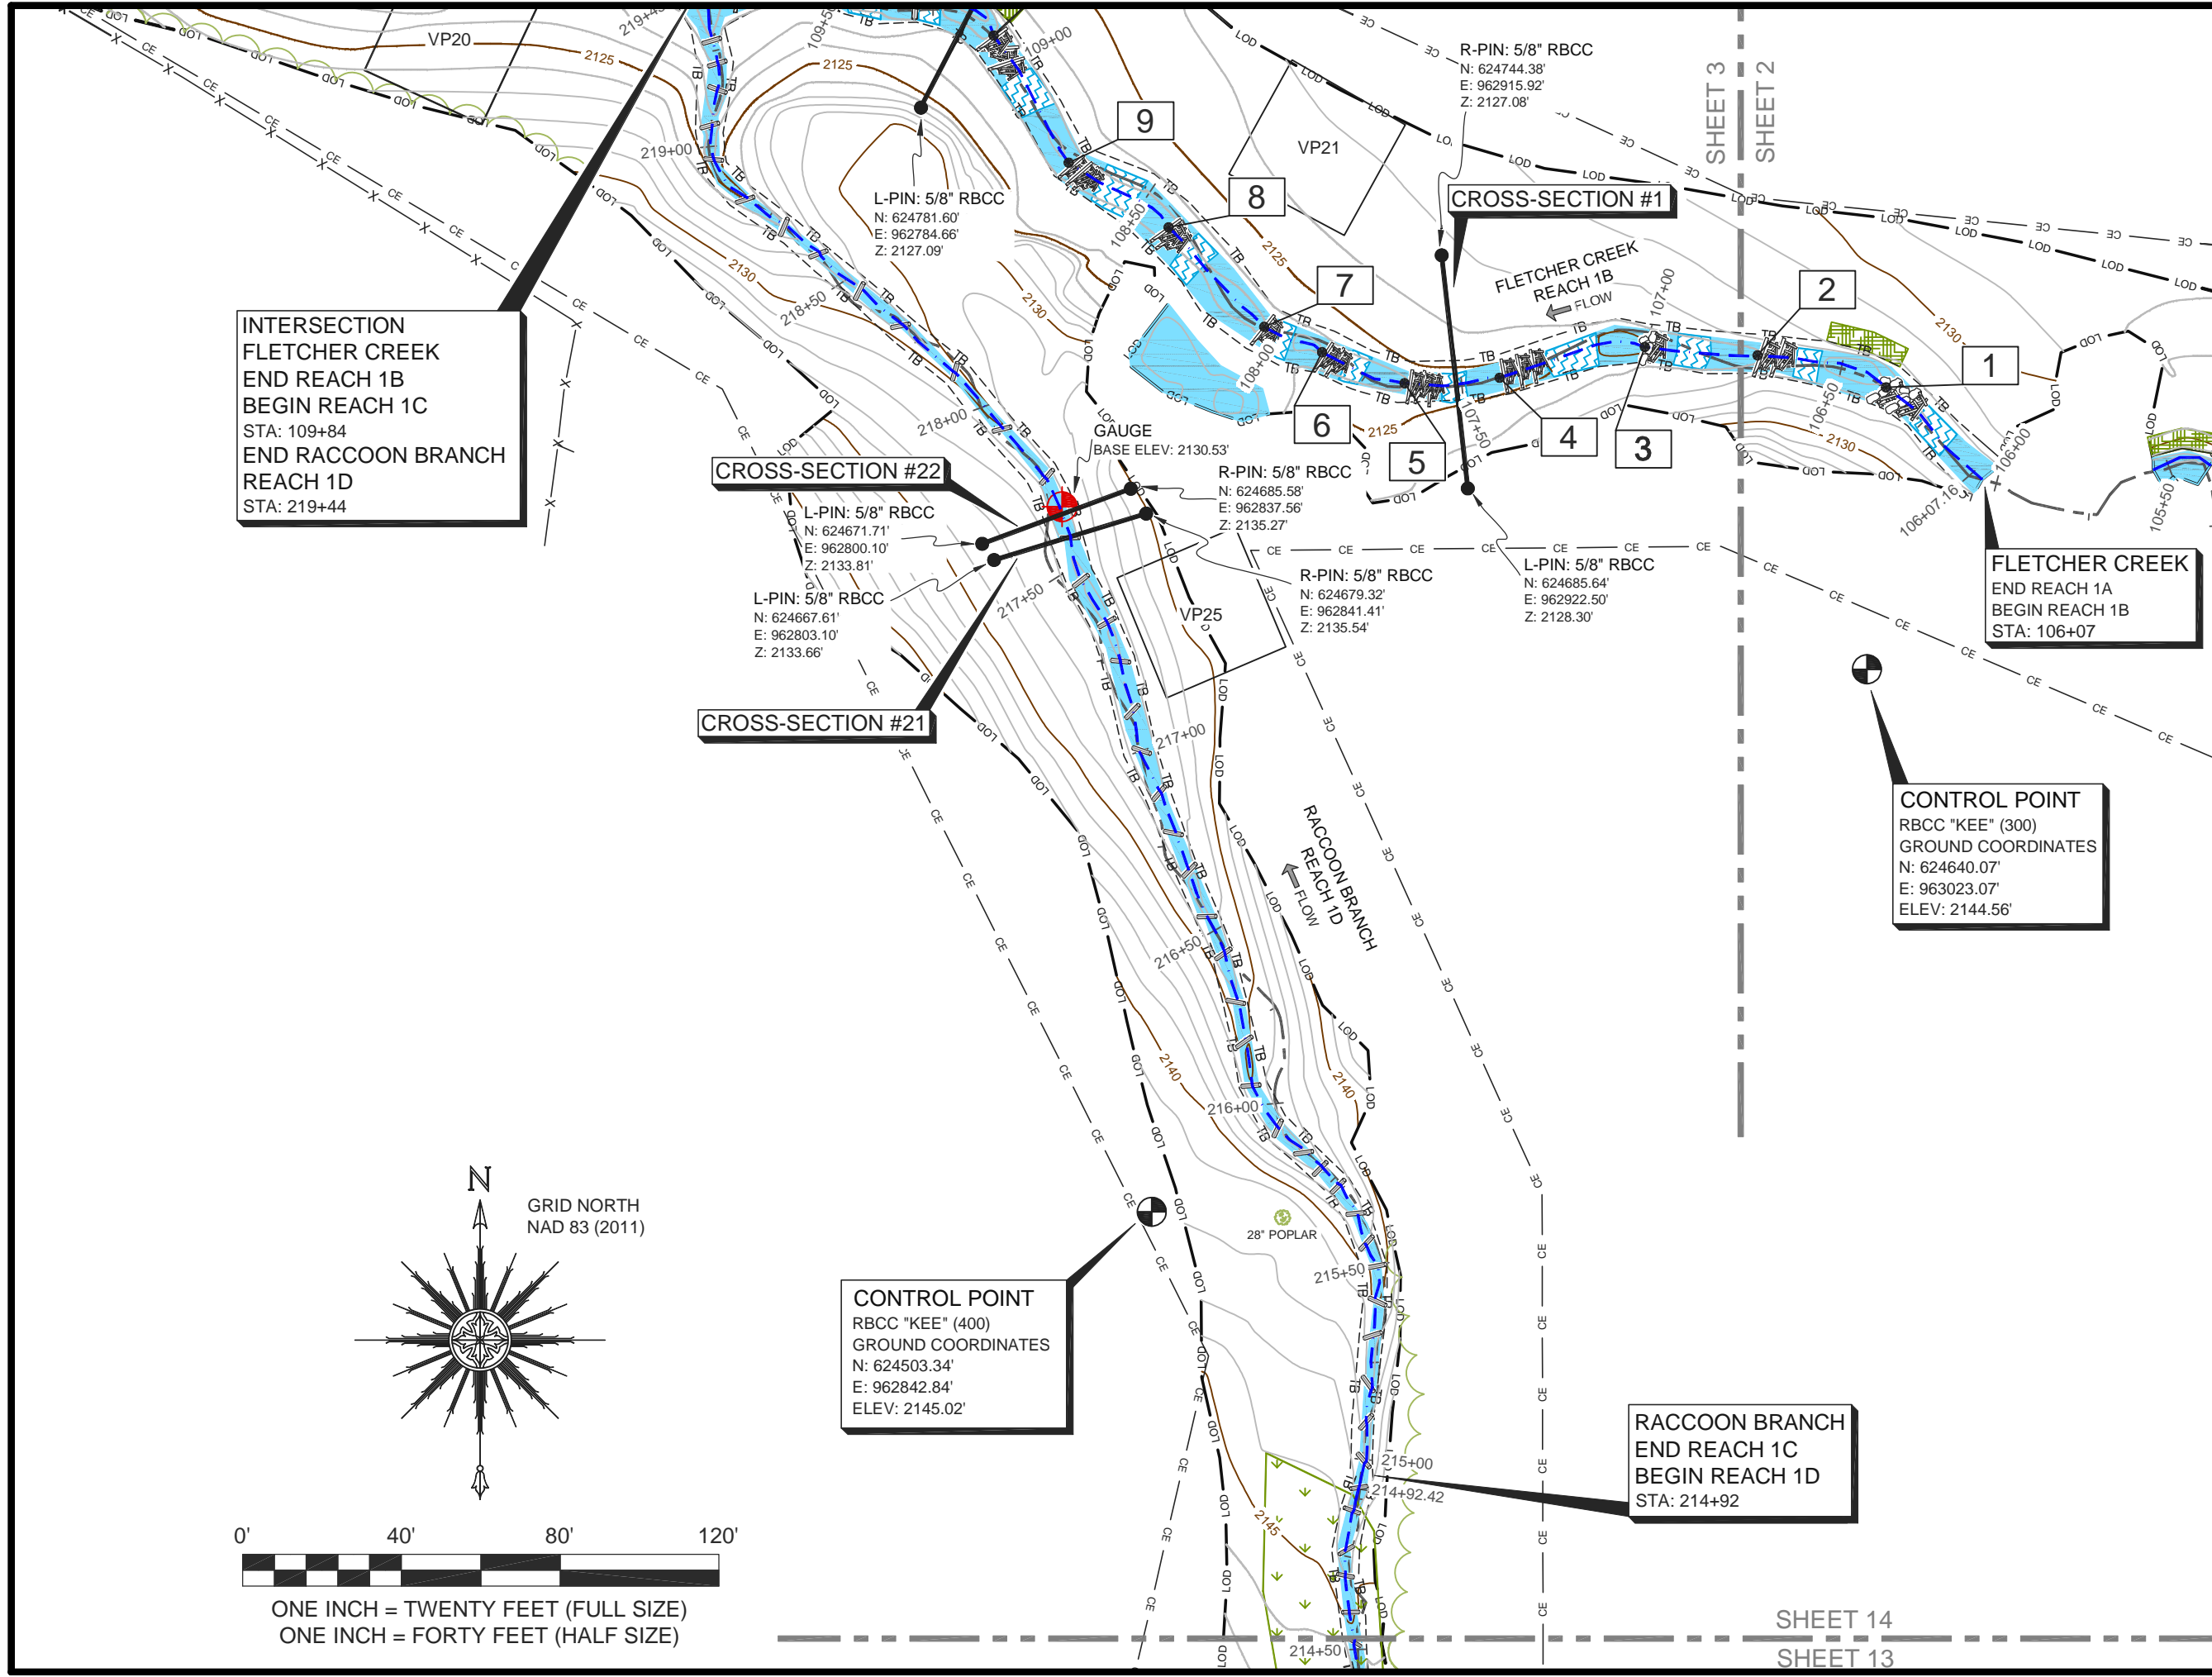

INTERSECTION
FLETCHER CREEK
END REACH 1B
BEGIN REACH 1C
STA: 109+84
END RACCOON BRANCH
REACH 1D
STA: 219+44

CROSS-SECTION #22

CROSS-SECTION #21


CROSS-SECTION #1

FLETCHER CREEK
END REACH 1A
BEGIN REACH 1B
STA: 106+07

CONTROL POINT
RBCC "KEE" (300)
GROUND COORDINATES
N: 624640.07'
E: 963023.07'
ELEV: 2144.56'

CONTROL POINT
RBCC "KEE" (400)
GROUND COORDINATES
N: 624503.34'
E: 962842.84'
ELEV: 2145.02'



RACCOON BRANCH
END REACH 1C
BEGIN REACH 1D
STA: 214+92

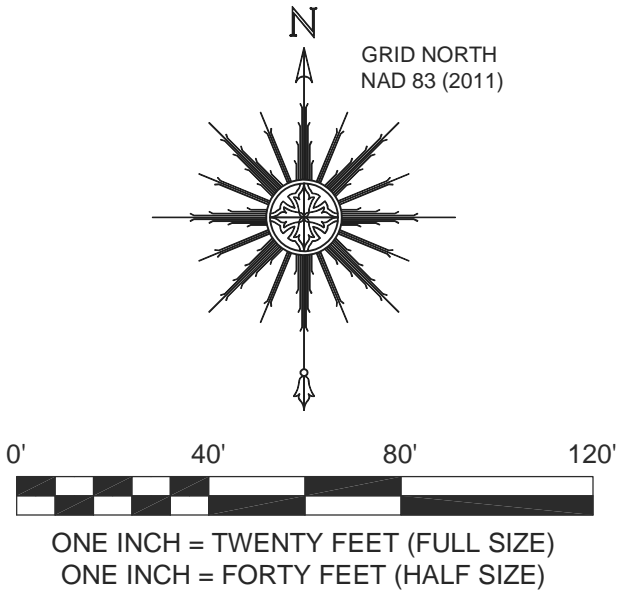

SHEET 14
SHEET 13

SHEET 16

SHEET 15

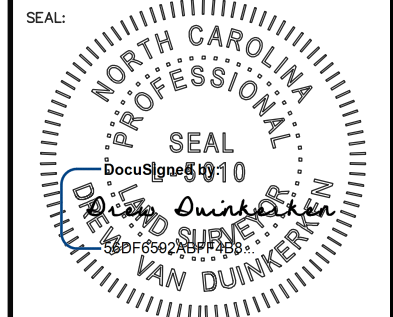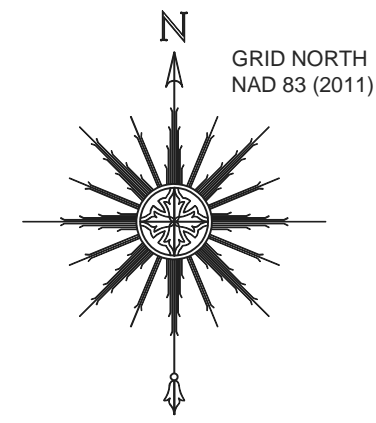

PLEASE REFER TO THE COVERSHEET FOR THE STATEMENT OF CERTIFICATION

NOTE: SEE SHEET 1 FOR SURVEYOR'S NOTES & LEGEND

ELEVATION DATUM: NAVD 88
CONTOUR INTERVAL: 1 FOOT

AN AS-BUILT SURVEY FOR:
EW SOLUTIONS, LLC.

SPO FILE NO's. 45-CZ, 45-DA, & 45-DB
SPO FILE NO's. 45-CY, 45-CX
DMS PROJECT NO. 100004

PROJECT:
FLETCHER SITE
MITIGATION PROJECT

SHEET TITLE:

STREAM DATA:
BEGIN COATES BRANCH

TOWNSHIP: FLETCHER COUNTY: HENDERSON STATE: NORTH CAROLINA

DRAWN BY: NH/JA CHECKED BY: LDP/PBK SURVEY BY: CB,NMH,LDP,JM,AC

SCALE: AS SHOWN SURVEY DATES: 12/17/19 - 03/22/19


JOB: #181142-AB SHEET SIZE: (HALF SIZE) 11" X 17"

#	DATE	REVISIONS

SHEET:
15 OF **37**





P.O. Box 2566
Asheville, NC 28802
(828) 575-9021
www.keemap.com
License # C-3039

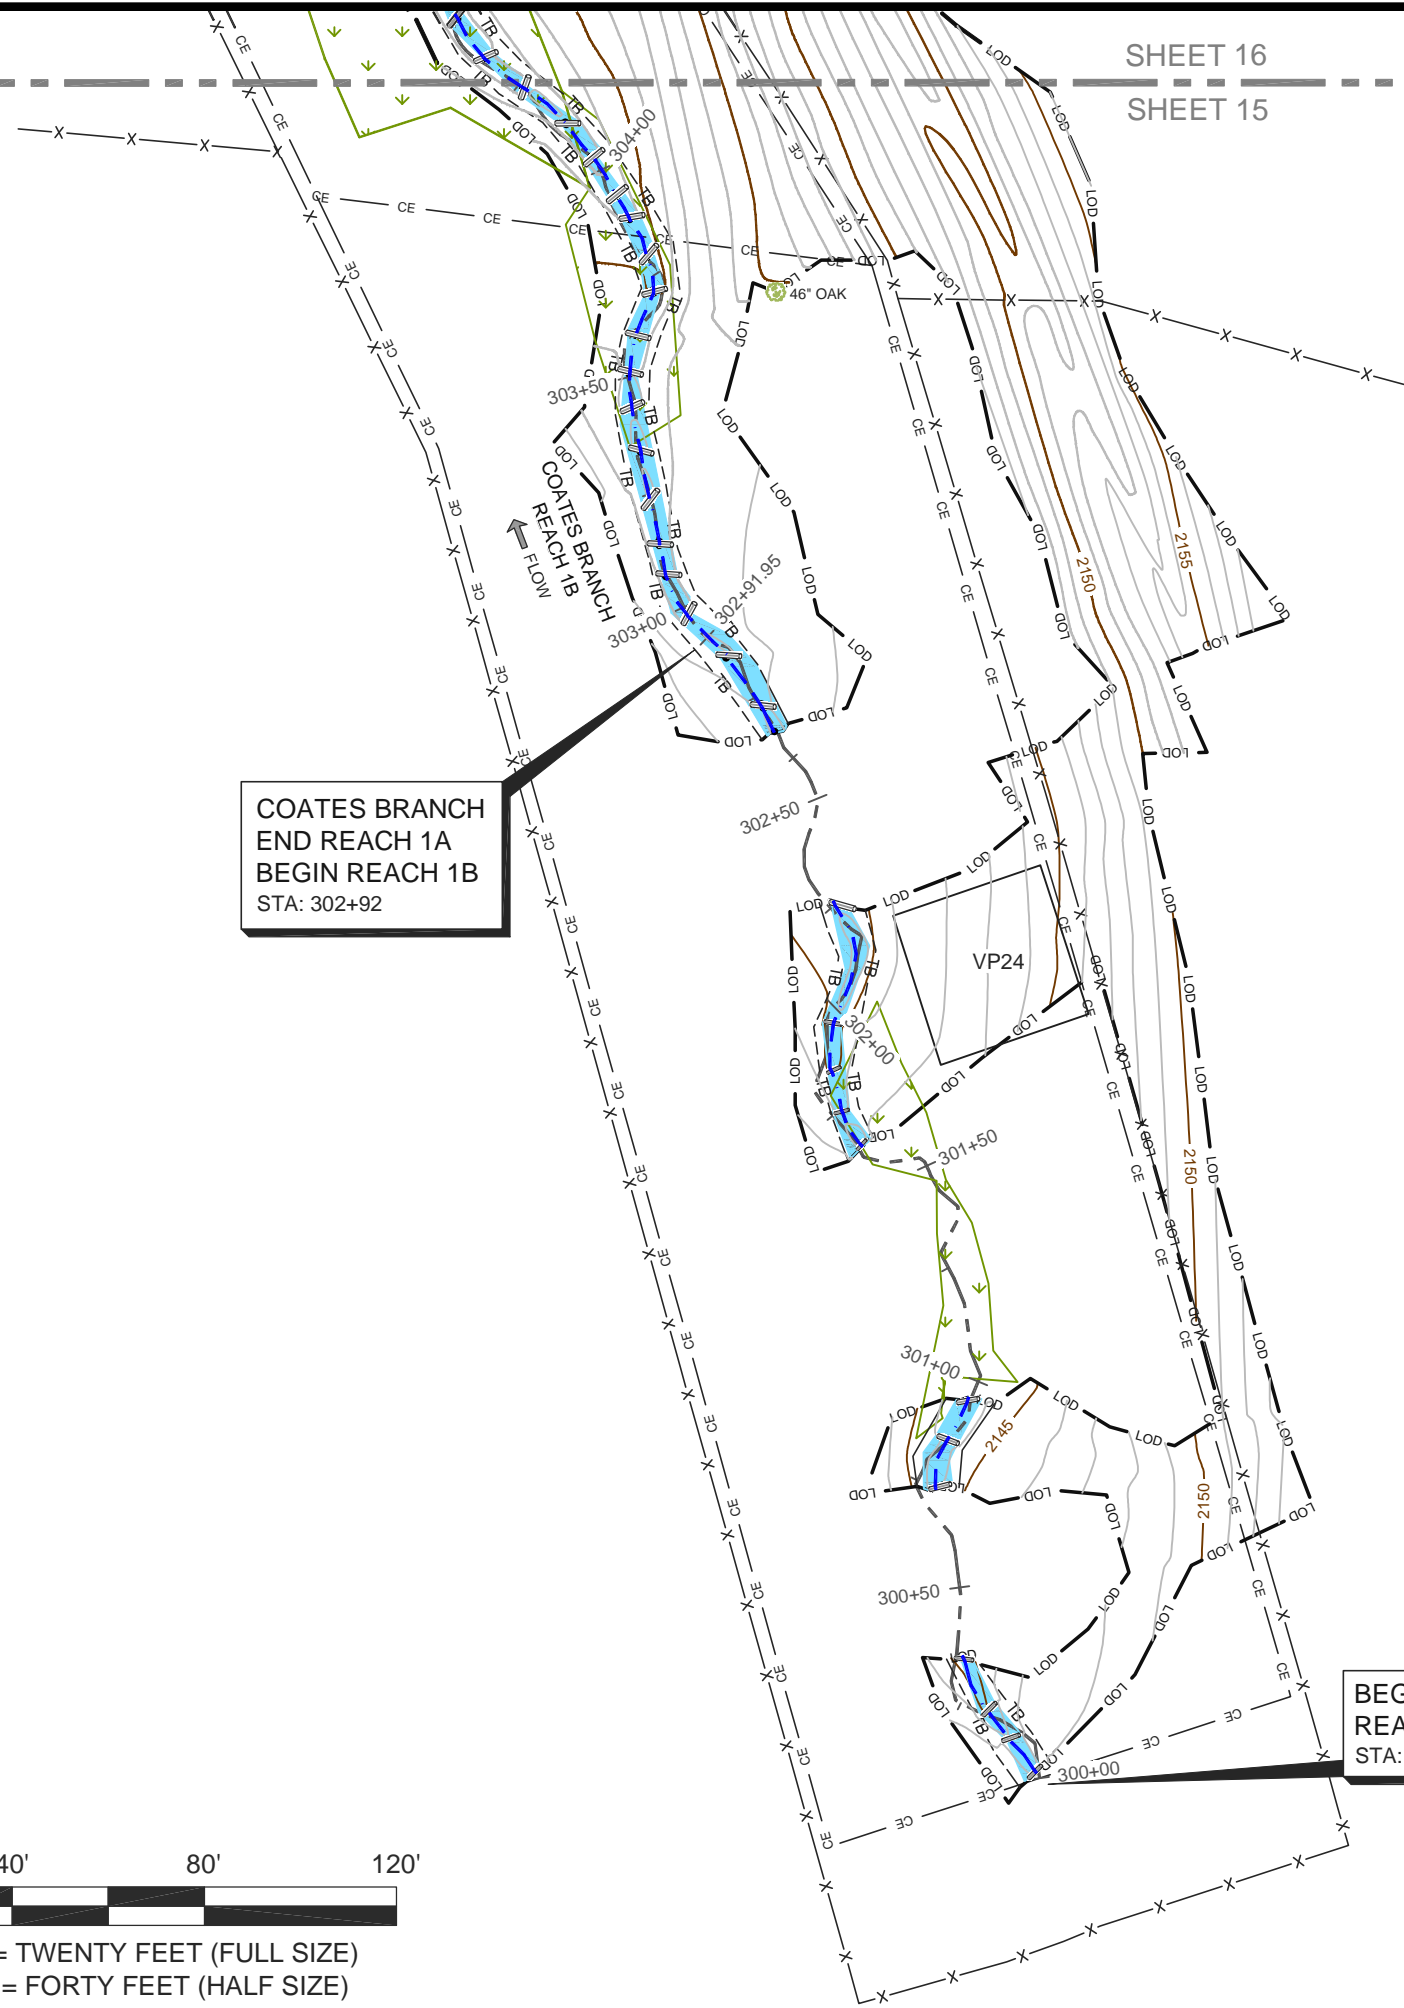

COATES BRANCH
END REACH 1A
BEGIN REACH 1B
STA: 302+92

BEGIN COATES BRANCH
REACH 1A
STA: 300+00

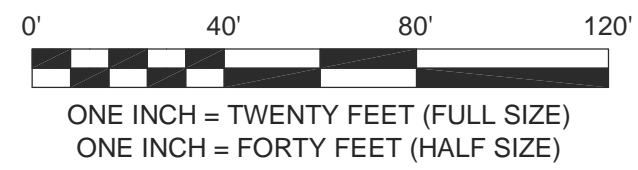

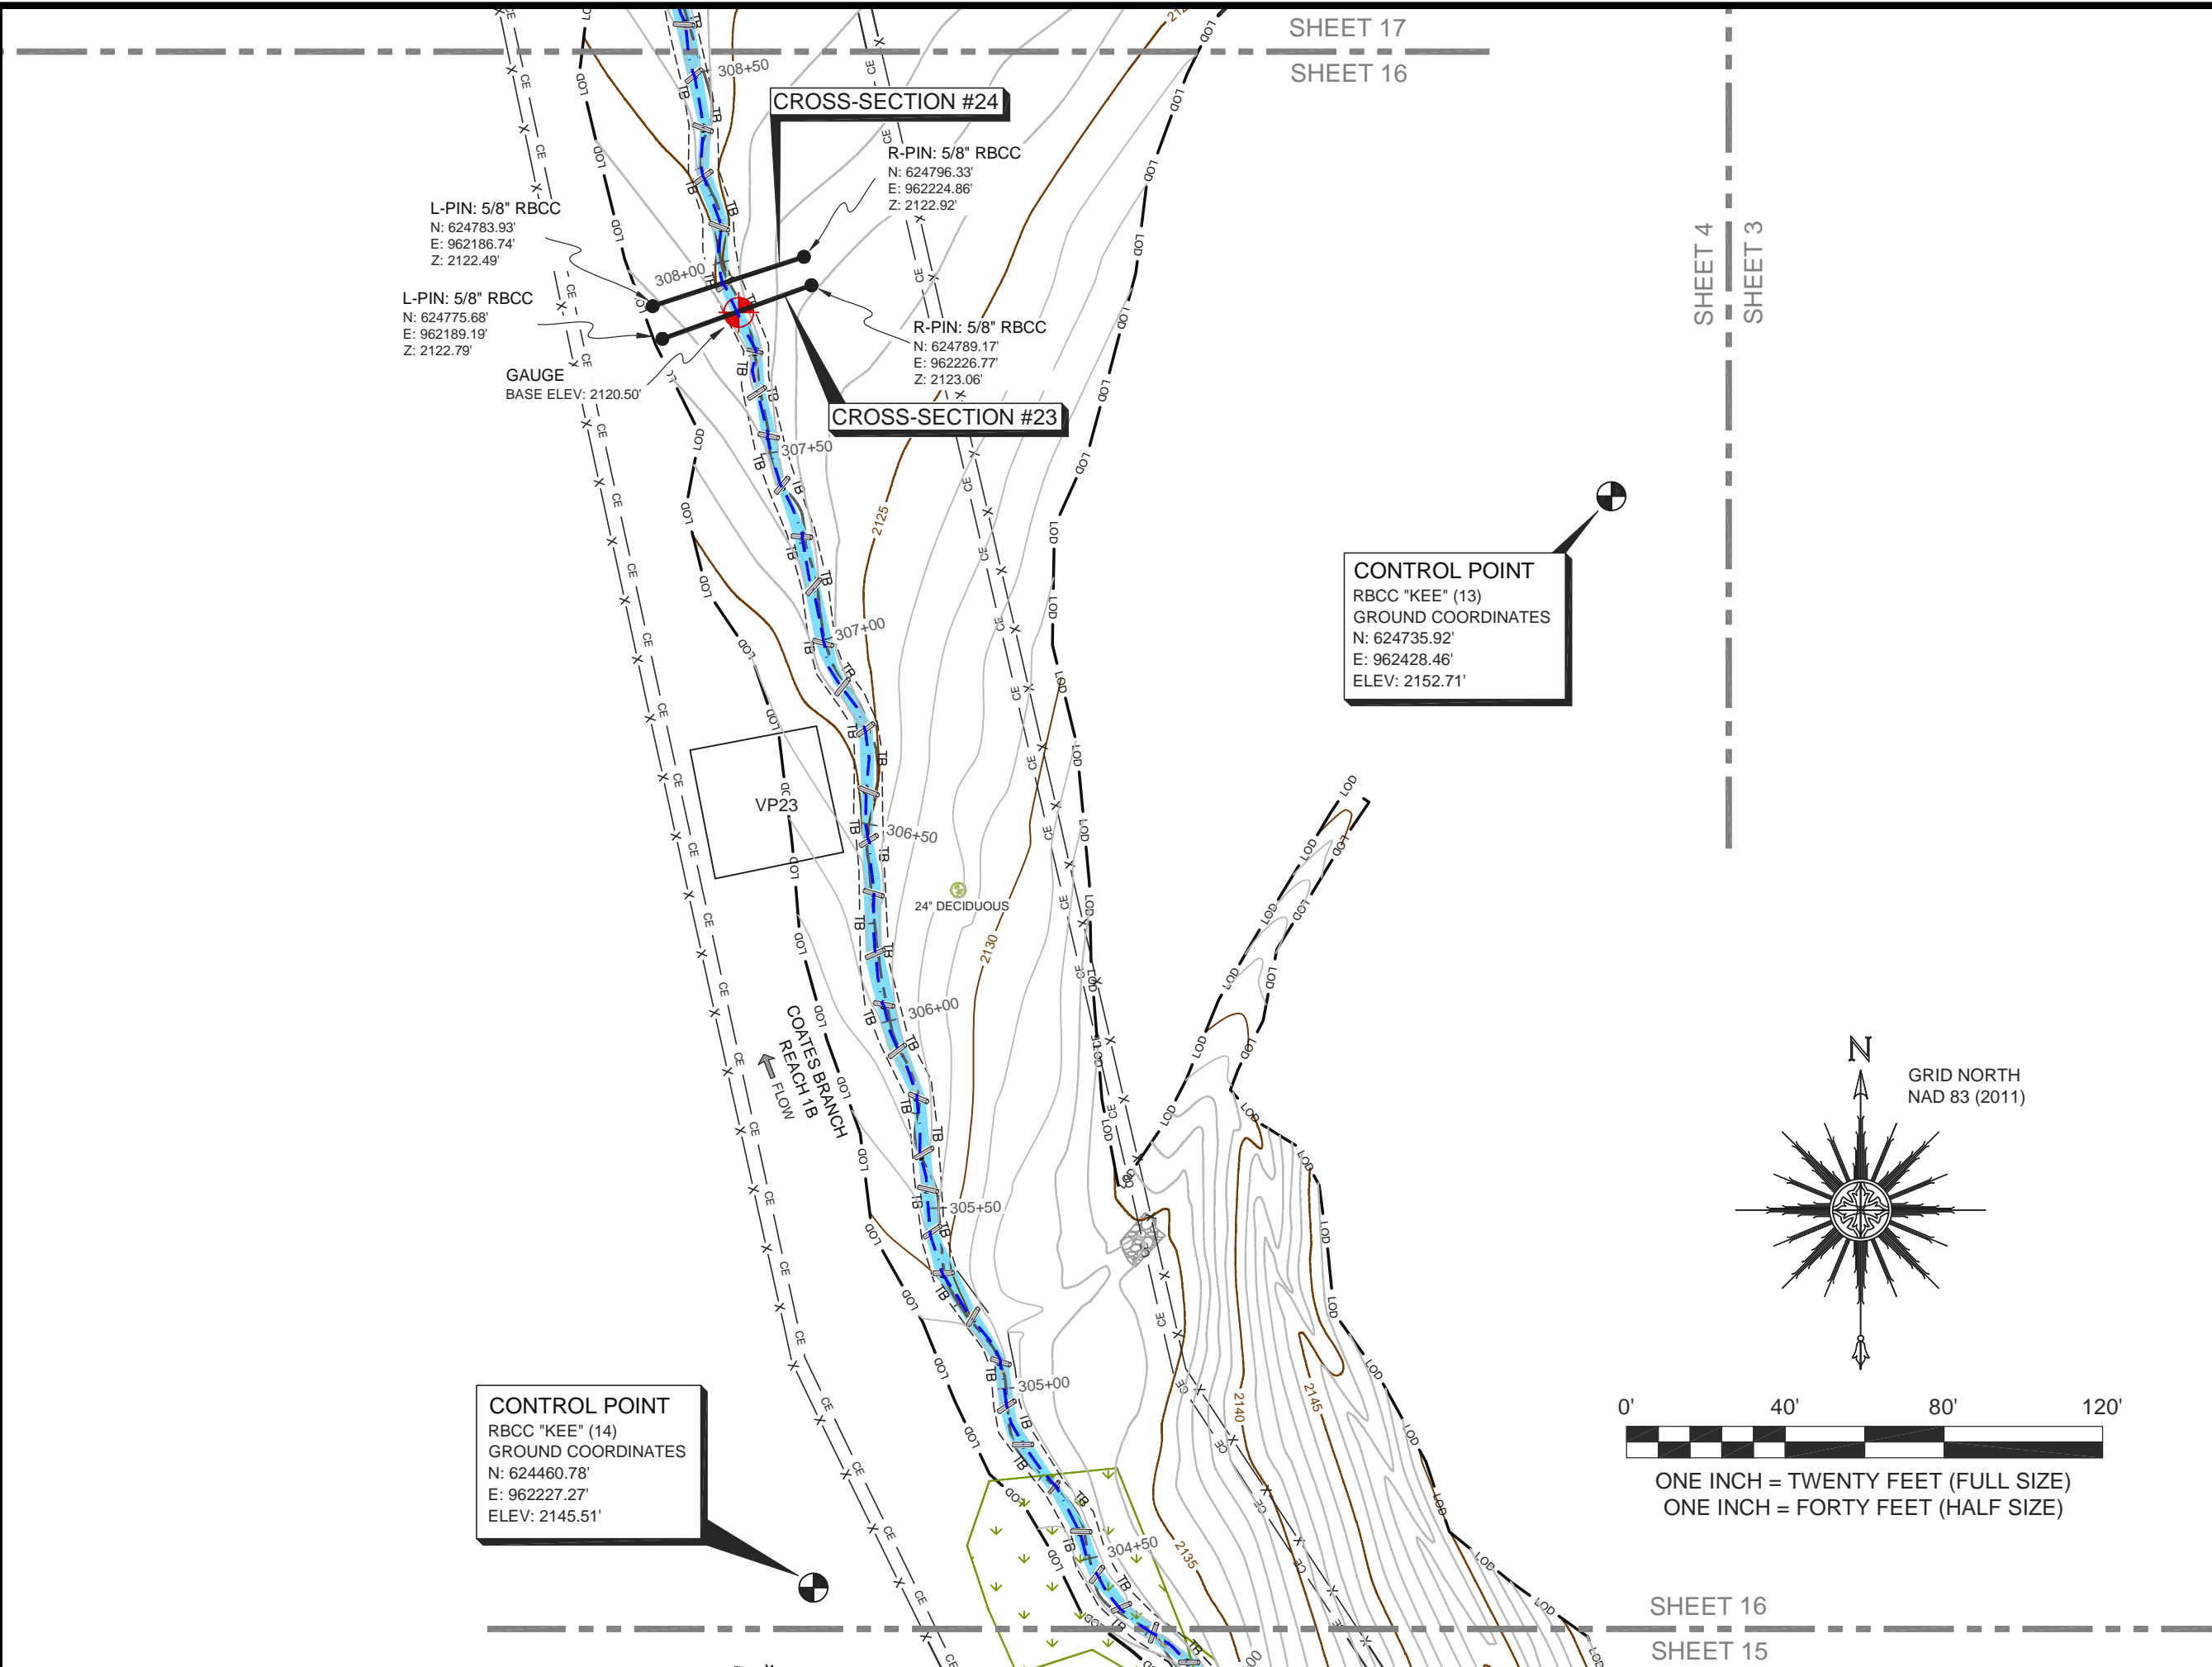

L-PIN: 5/8" RBCC
 N: 624783.93'
 E: 962186.74'
 Z: 2122.49'

L-PIN: 5/8" RBCC
 N: 624775.68'
 E: 962189.19'
 Z: 2122.79'

GAUGE
 BASE ELEV: 2120.50'

CROSS-SECTION #24

R-PIN: 5/8" RBCC
 N: 624796.33'
 E: 962224.86'
 Z: 2122.92'

CROSS-SECTION #23

R-PIN: 5/8" RBCC
 N: 624789.17'
 E: 962226.77'
 Z: 2123.06'




CONTROL POINT
 RBCC "KEE" (13)
 GROUND COORDINATES
 N: 624735.92'
 E: 962428.46'
 ELEV: 2152.71'

VP23

24" DECIDUOUS

COATES BRANCH
 REACH 1B
 FLOW

CONTROL POINT
 RBCC "KEE" (14)
 GROUND COORDINATES
 N: 624460.78'
 E: 962227.27'
 ELEV: 2145.51'

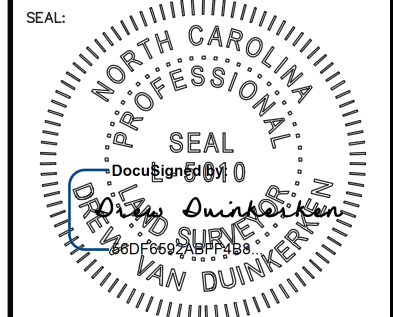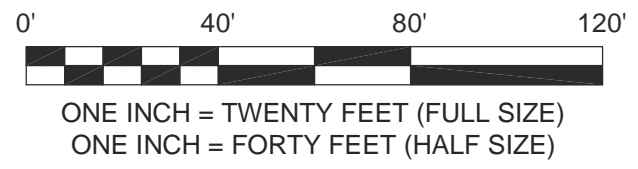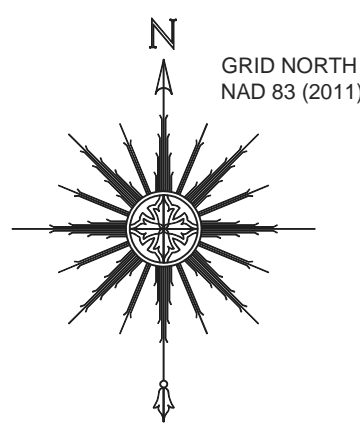

PLEASE REFER TO THE COVERSHEET FOR THE STATEMENT OF CERTIFICATION

NOTE: SEE SHEET 1 FOR SURVEYOR'S NOTES & LEGEND

ELEVATION DATUM: NAVD 88
 CONTOUR INTERVAL: 1 FOOT

AN AS-BUILT SURVEY FOR:
 EW SOLUTIONS, LLC.

SPO FILE NO's. 45-CZ, 45-DA, & 45-DB
 SPO FILE NO's. 45-CY, 45-CX
 DMS PROJECT NO. 100004

PROJECT:
 FLETCHER SITE
 MITIGATION PROJECT

SHEET TITLE:
 STREAM DATA:
 COATES BRANCH

TOWNSHIP: FLETCHER COUNTY: HENDERSON STATE: NORTH CAROLINA

DRAWN BY: NH/JA CHECKED BY: LDP/PBK SURVEY BY: CB,NMH,LDP,JM,AC

SCALE: AS SHOWN SURVEY DATES: 12/17/19 - 03/22/19

JOB: #181142-AB SHEET SIZE: (HALF SIZE) 11" X 17"

#	DATE	REVISIONS

SHEET: 16 OF 37



P.O. Box 2566
 Asheville, NC 28802
 (828) 575-9021
 www.keemap.com
 License # C-3039

SHEET 16


SHEET 15

SHEET 17

SHEET 16

SHEET 4

SHEET 3

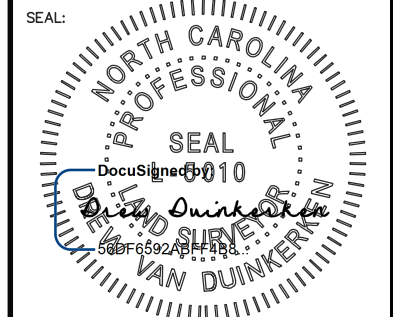

PLEASE REFER TO THE COVERSHEET FOR THE STATEMENT OF CERTIFICATION

NOTE: SEE SHEET 1 FOR SURVEYOR'S NOTES & LEGEND

ELEVATION DATUM: NAVD 88
CONTOUR INTERVAL: 1 FOOT

AN AS-BUILT SURVEY FOR:
EW SOLUTIONS, LLC.

SPO FILE NO's. 45-CZ, 45-DA, & 45-DB
SPO FILE NO's. 45-CY, 45-CX
DMS PROJECT NO. 100004

PROJECT:
FLETCHER SITE
MITIGATION PROJECT

SHEET TITLE:
STREAM DATA:
COATES BRANCH

TOWNSHIP: FLETCHER COUNTY: HENDERSON STATE: NORTH CAROLINA

DRAWN BY: NH/JA CHECKED BY: LDP/PBK SURVEY BY: CB,NMH,LDP,JM,AC



SCALE: AS SHOWN SURVEY DATES: 12/17/19 - 03/22/19
JOB: #1811142-AB SHEET SIZE: (HALF SIZE) 11" X 17"

#	DATE	REVISIONS

17 OF 37



P.O. Box 2566
Asheville, NC 28802
(828) 575-9021
www.keemap.com
License # C-3039

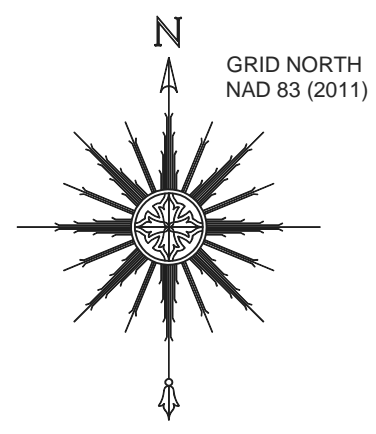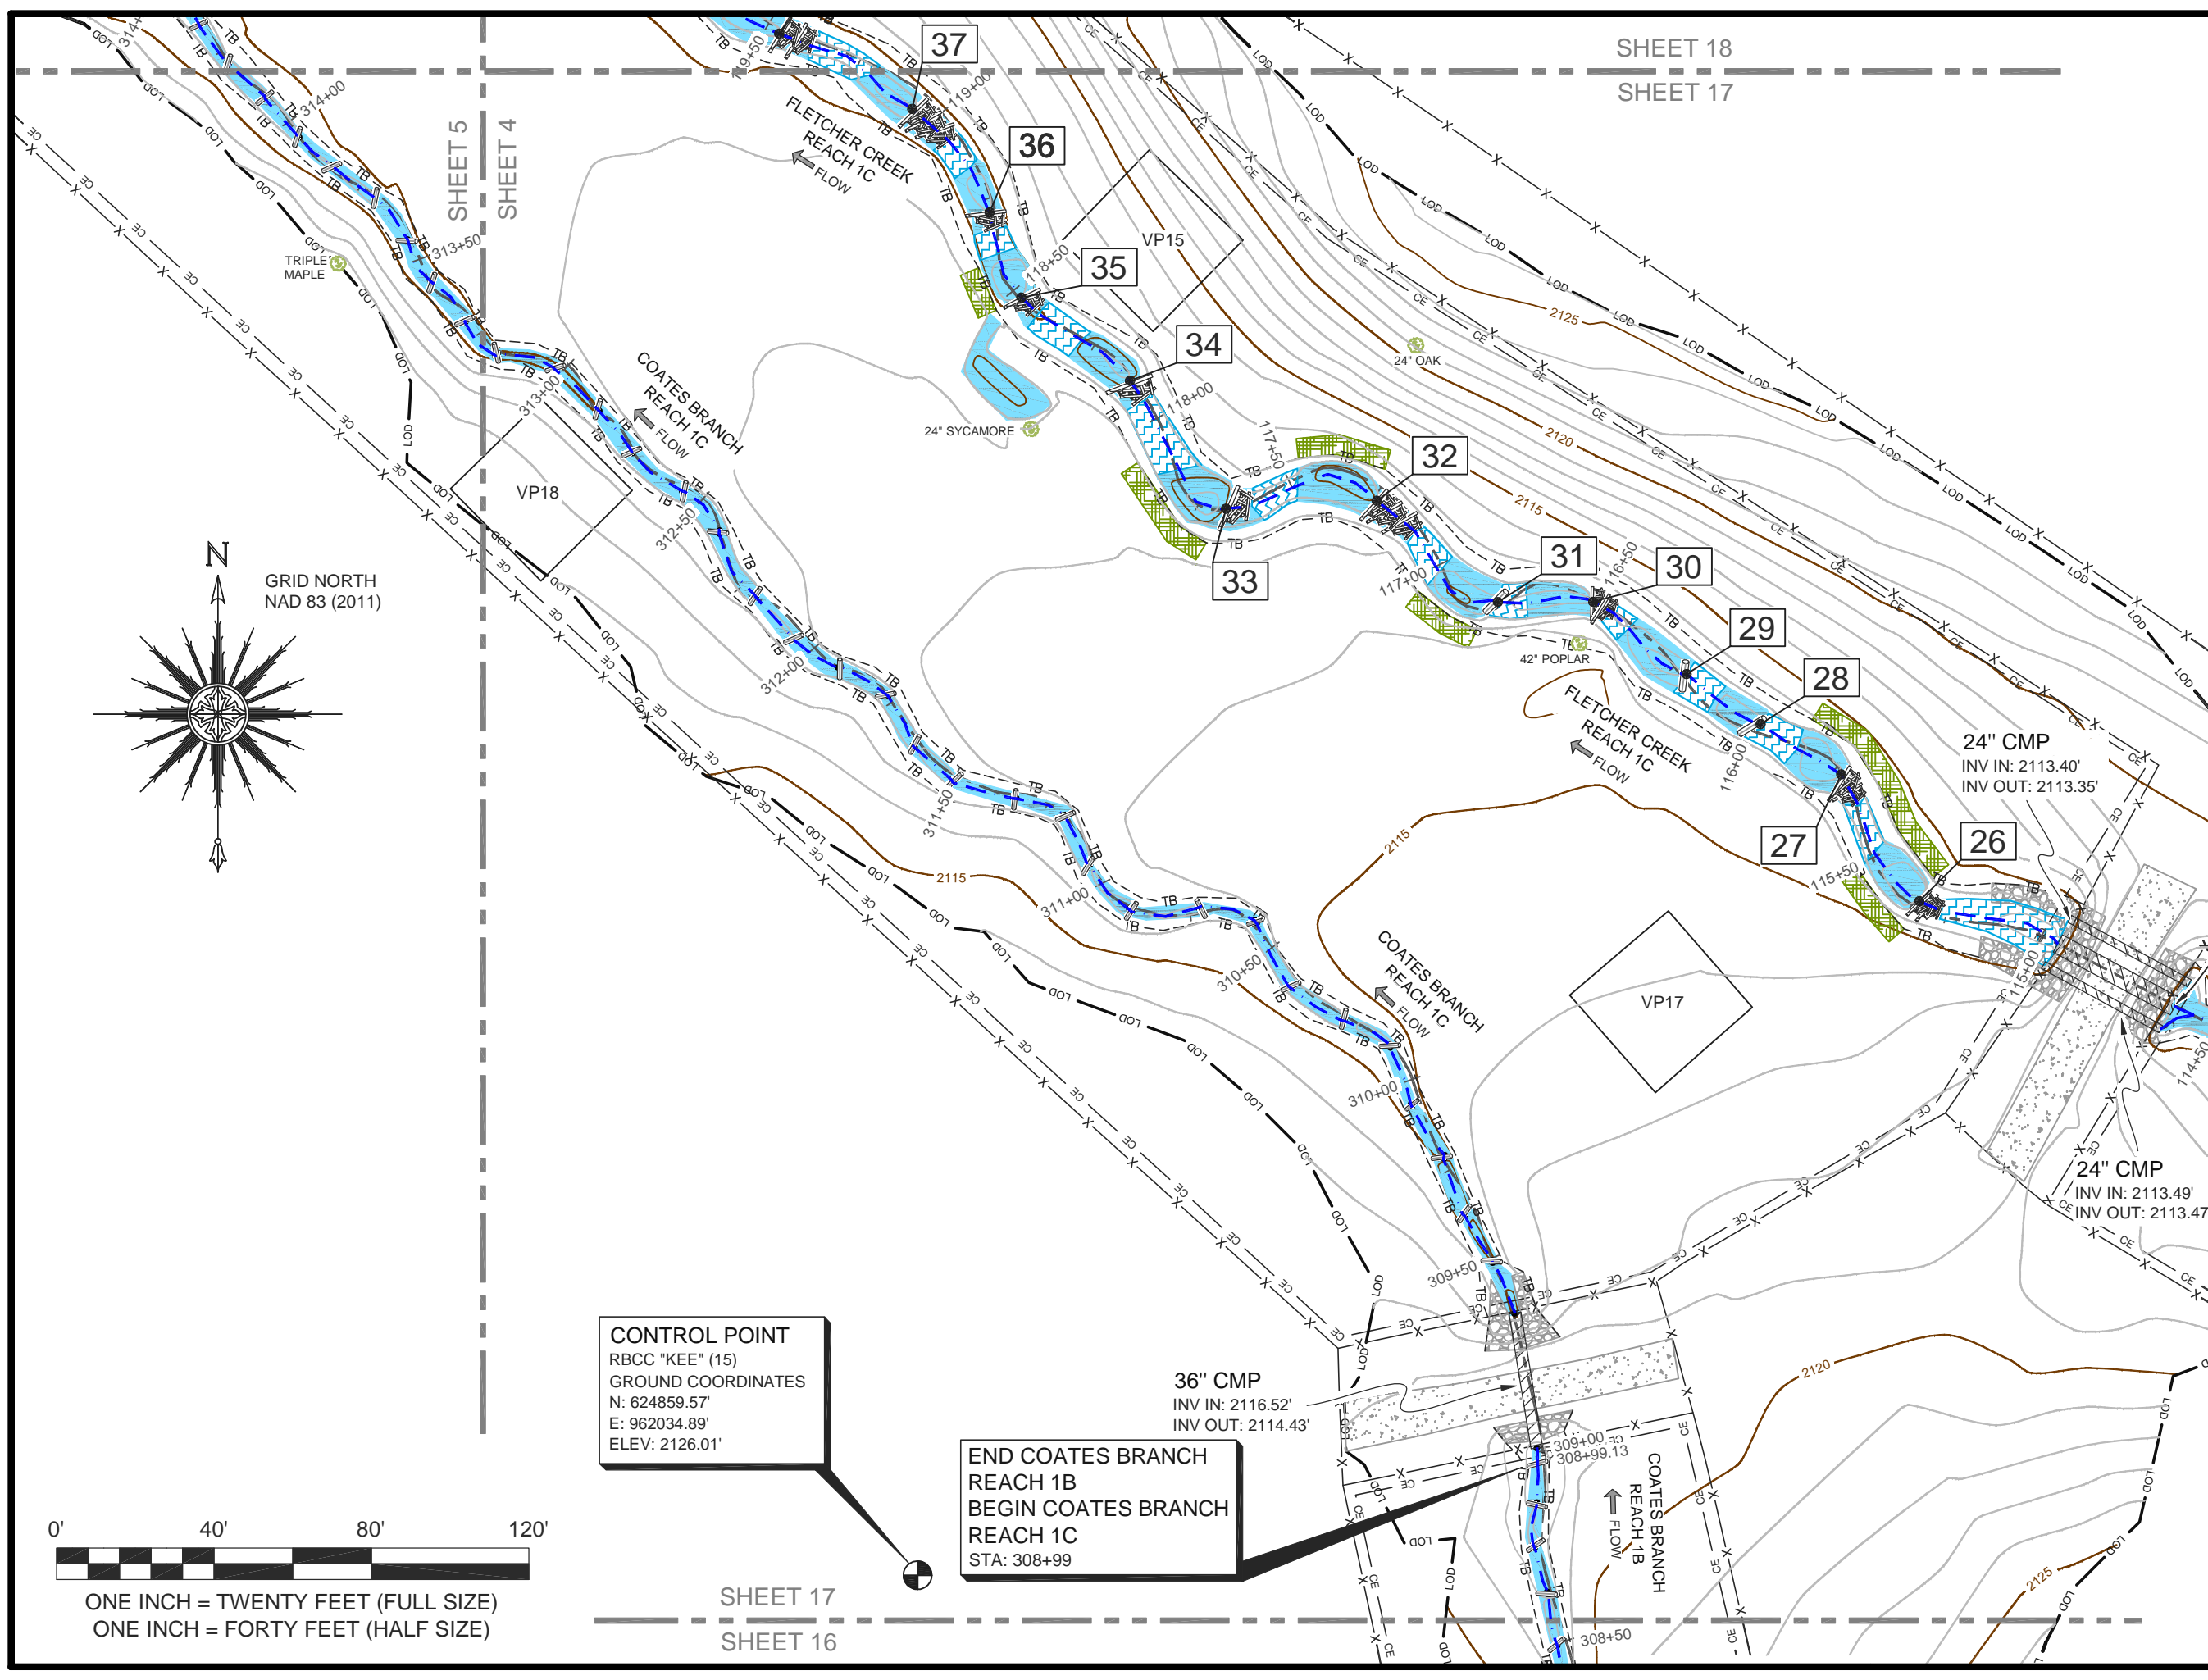

ONE INCH = TWENTY FEET (FULL SIZE)
ONE INCH = FORTY FEET (HALF SIZE)

CONTROL POINT
RBCC "KEE" (15)
GROUND COORDINATES
N: 624859.57'
E: 962034.89'
ELEV: 2126.01'

36" CMP
INV IN: 2116.52'
INV OUT: 2114.43'

**END COATES BRANCH REACH 1B
BEGIN COATES BRANCH REACH 1C**
STA: 308+99

24" CMP
INV IN: 2113.40'
INV OUT: 2113.35'

24" CMP
INV IN: 2113.49'
INV OUT: 2113.47'

SHEET 5
SHEET 4


SHEET 18
SHEET 17

SHEET 17
SHEET 16

INTERSECTION
 FLETCHER CREEK
 END REACH 1C
 BEGIN REACH 2A
 STA: 125+75
 END COATES BRANCH
 REACH 1D
 STA: 319+79

CONTROL POINT
 RBCC "KEE" (17)
 GROUND COORDINATES
 N: 625503.87'
 E: 961512.05'
 ELEV: 2116.59'



END COATES BRANCH
 REACH 1C
 BEGIN COATES BRANCH
 REACH 1D
 STA: 316+50

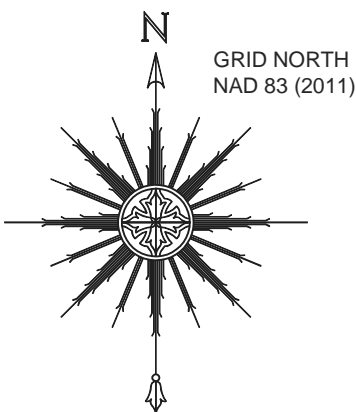

GRID NORTH
 NAD 83 (2011)



ONE INCH = TWENTY FEET (FULL SIZE)
 ONE INCH = FORTY FEET (HALF SIZE)

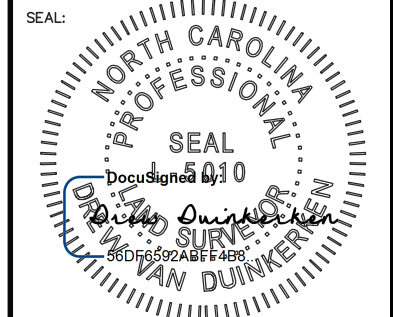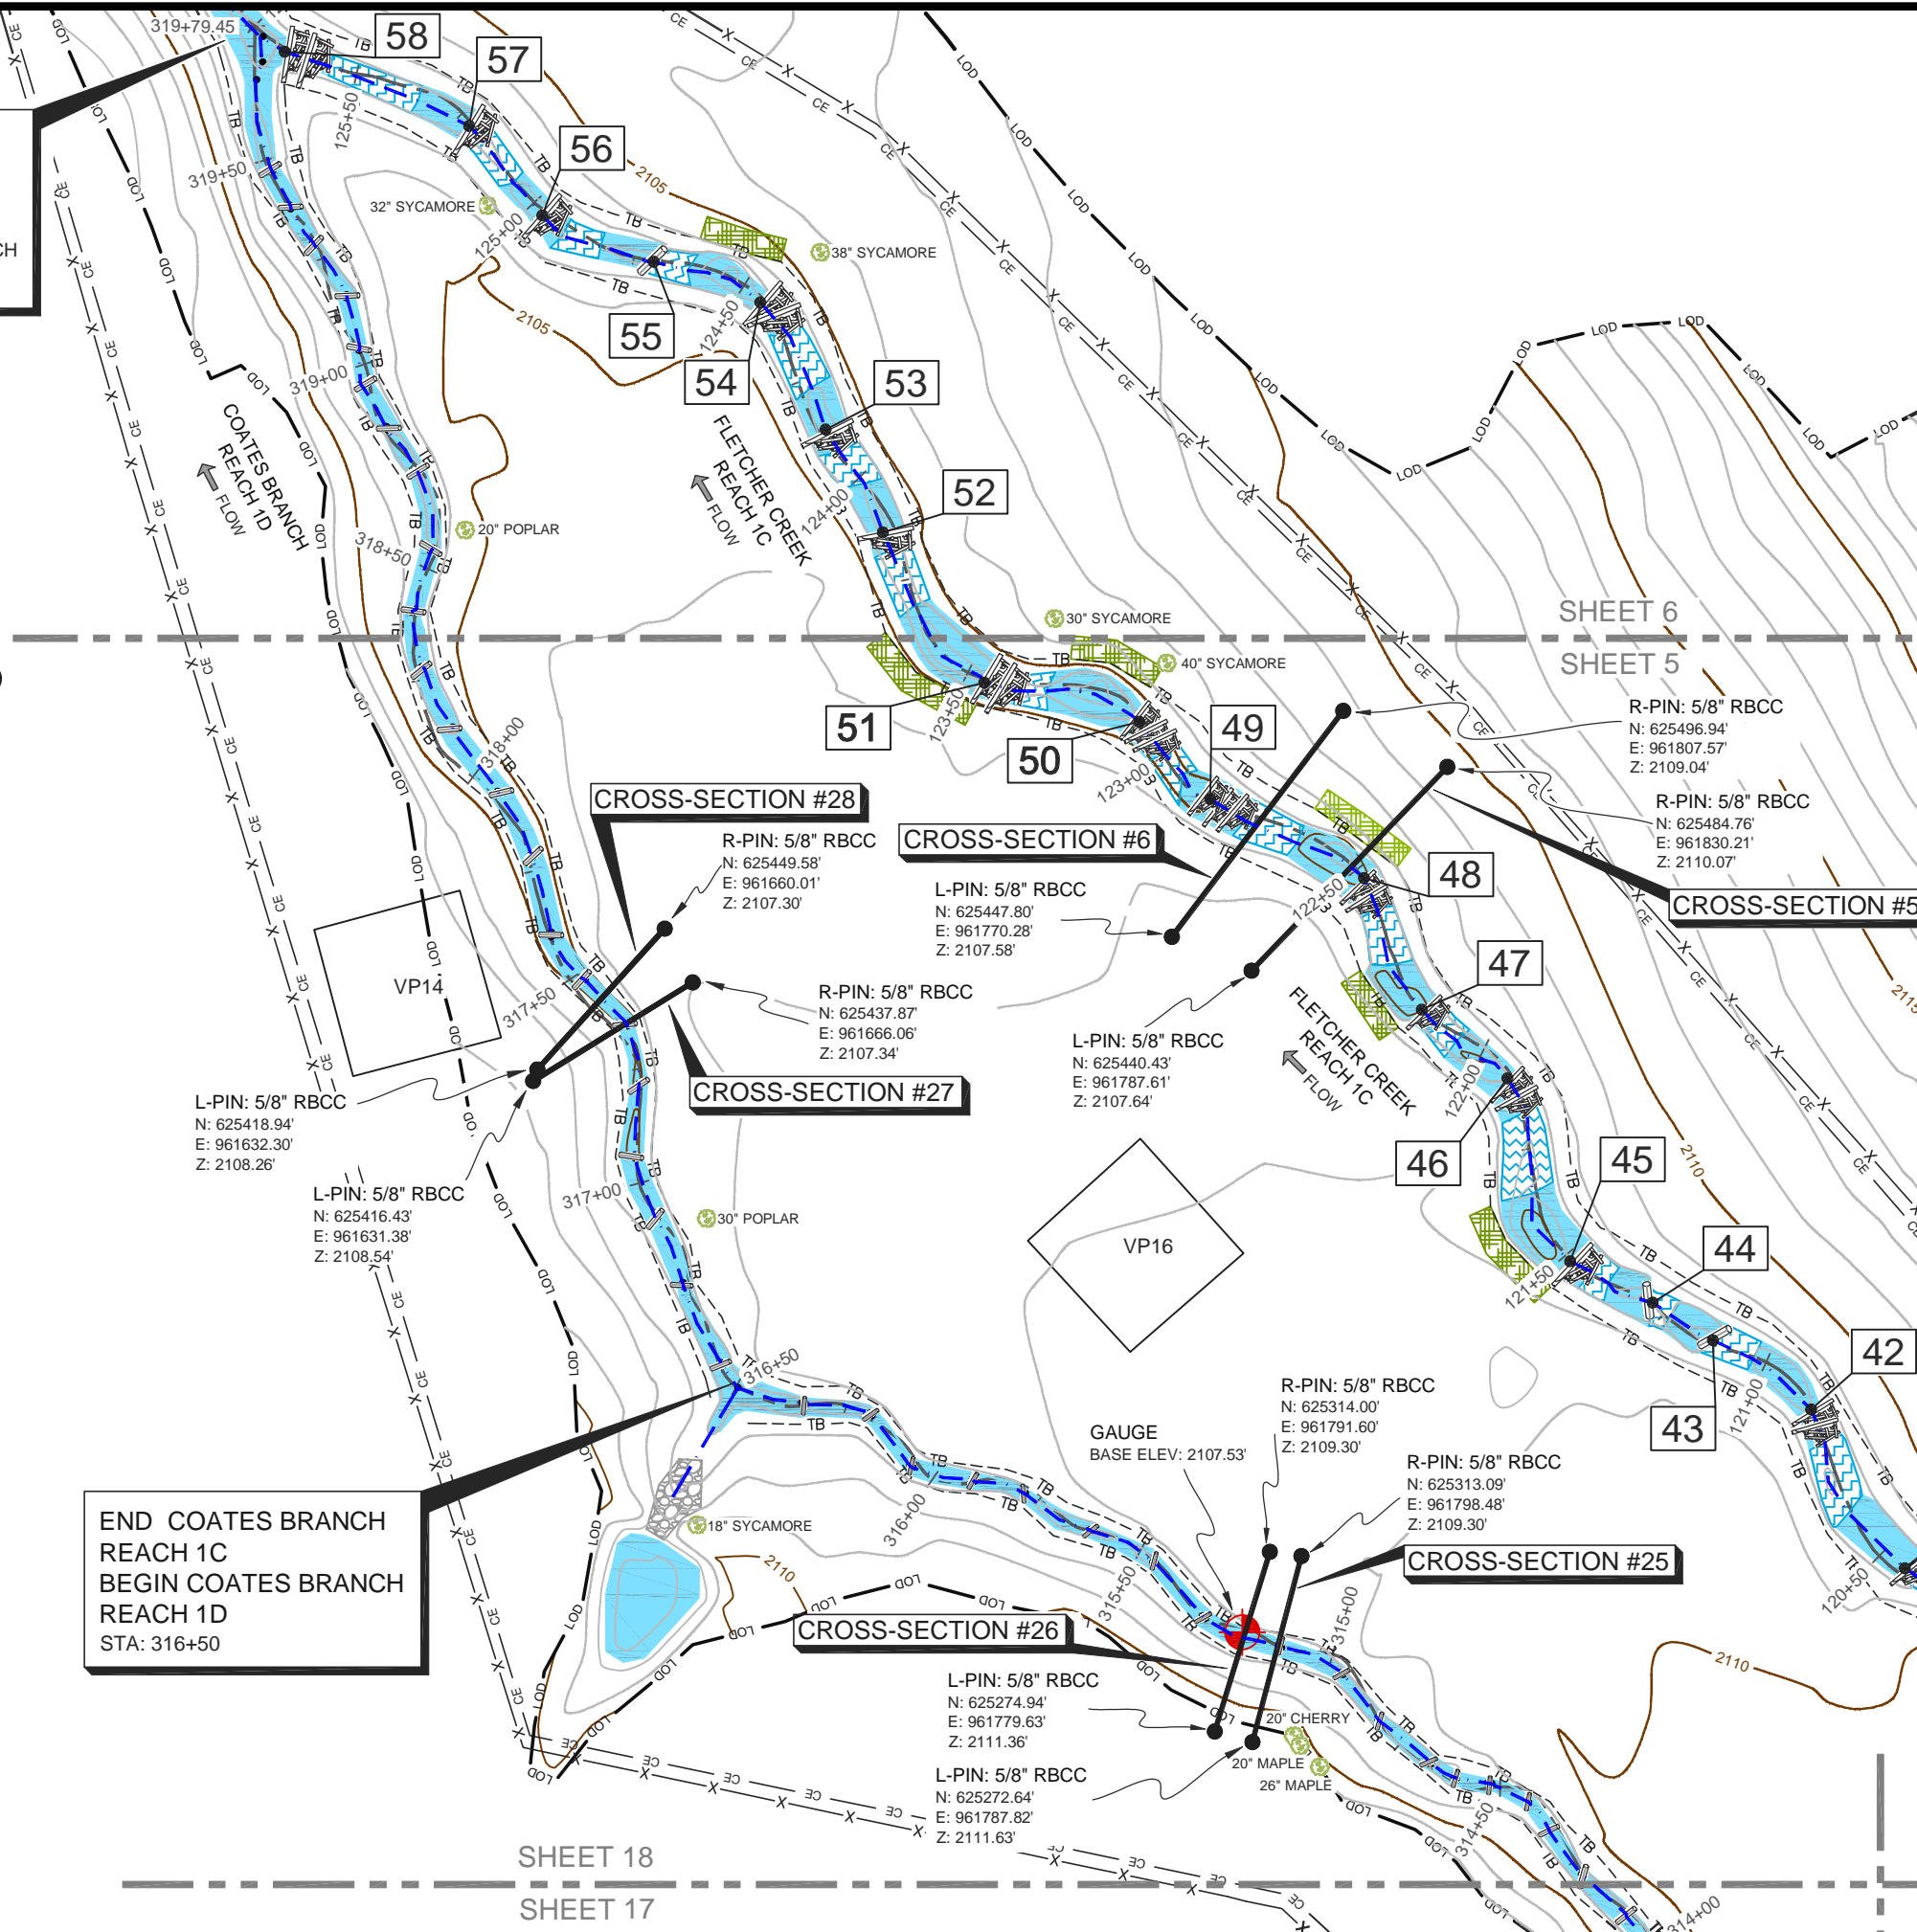

PLEASE REFER TO THE COVERSHEET FOR THE STATEMENT OF CERTIFICATION

NOTE: SEE SHEET 1 FOR SURVEYOR'S NOTES & LEGEND

ELEVATION DATUM: NAVD 88
 CONTOUR INTERVAL: 1 FOOT

AN AS-BUILT SURVEY FOR:
 EW SOLUTIONS, LLC.

SPO FILE NO's. 45-CZ, 45-DA, & 45-DB
 SPO FILE NO's. 45-CY, 45-CX
 DMS PROJECT NO. 100004

PROJECT:
**FLETCHER SITE
 MITIGATION PROJECT**

SHEET TITLE:
 STREAM DATA:
 END COATES BRANCH
 INTERSECTION WITH
 FLETCHER CREEK

TOWNSHIP: FLETCHER	COUNTY: HENDERSON	STATE: NORTH CAROLINA
DRAWN BY: NH/JA	CHECKED BY: LDP/PBK	SURVEY BY: CB,NMH,LDP,JM,AC
SCALE: AS SHOWN	SURVEY DATES: 12/17/19 - 03/22/19	
JOB: #1811142-AB	SHEET SIZE: (HALF SIZE) 11" X 17"	
#	DATE	REVISIONS

SHEET:
18 OF 37



P.O. Box 2566
 Asheville, NC 28802
 (828) 575-9021
 www.keemap.com
 License # C-3039

SHEET 18
 SHEET 17

SHEET 6
 SHEET 5

R-PIN: 5/8" RBCC
 N: 625496.94'
 E: 961807.57'
 Z: 2109.04'

R-PIN: 5/8" RBCC
 N: 625484.76'
 E: 961830.21'
 Z: 2110.07'

CROSS-SECTION #28
 R-PIN: 5/8" RBCC
 N: 625449.58'
 E: 961660.01'
 Z: 2107.30'

CROSS-SECTION #6
 L-PIN: 5/8" RBCC
 N: 625447.80'
 E: 961770.28'
 Z: 2107.58'

CROSS-SECTION #5

CROSS-SECTION #27
 R-PIN: 5/8" RBCC
 N: 625437.87'
 E: 961666.06'
 Z: 2107.34'

L-PIN: 5/8" RBCC
 N: 625440.43'
 E: 961787.61'
 Z: 2107.64'

L-PIN: 5/8" RBCC
 N: 625418.94'
 E: 961632.30'
 Z: 2108.26'

L-PIN: 5/8" RBCC
 N: 625416.43'
 E: 961631.38'
 Z: 2108.54'

R-PIN: 5/8" RBCC
 N: 625314.00'
 E: 961791.60'
 Z: 2109.30'



R-PIN: 5/8" RBCC
 N: 625313.09'
 E: 961798.48'
 Z: 2109.30'

CROSS-SECTION #26
 L-PIN: 5/8" RBCC
 N: 625274.94'
 E: 961779.63'
 Z: 2111.36'

L-PIN: 5/8" RBCC
 N: 625272.64'
 E: 961787.82'
 Z: 2111.63'

GAUGE
 BASE ELEV: 2107.53'

SHEET 20
SHEET 19

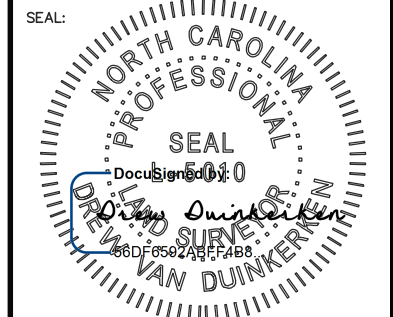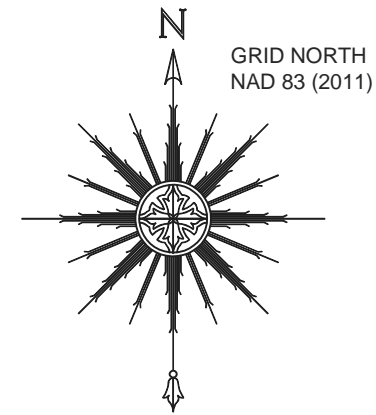

PLEASE REFER TO THE COVERSHEET FOR THE STATEMENT OF CERTIFICATION

NOTE: SEE SHEET 1 FOR SURVEYOR'S NOTES & LEGEND

ELEVATION DATUM: NAVD 88
CONTOUR INTERVAL: 1 FOOT

AN AS-BUILT SURVEY FOR:
EW SOLUTIONS, LLC.

SPO FILE NO's. 45-CZ, 45-DA, & 45-DB
SPO FILE NO's. 45-CY, 45-CX
DMS PROJECT NO. 100004

PROJECT:
FLETCHER SITE
MITIGATION PROJECT

SHEET TITLE:
STREAM DATA:
BEGIN WESTON CREEK

TOWNSHIP: FLETCHER COUNTY: HENDERSON STATE: NORTH CAROLINA

DRAWN BY: NH/JA CHECKED BY: LDP/PBK SURVEY BY: CB,NMH,LDP,JM,AC

SCALE: AS SHOWN SURVEY DATES: 12/17/19 - 03/22/19


JOB: #181142-AB SHEET SIZE: 11" X 17"

#	DATE	REVISIONS

SHEET:
19 OF **37**



P.O. Box 2566
Asheville, NC 28802
(828) 575-9021
www.keemap.com
License # C-3039

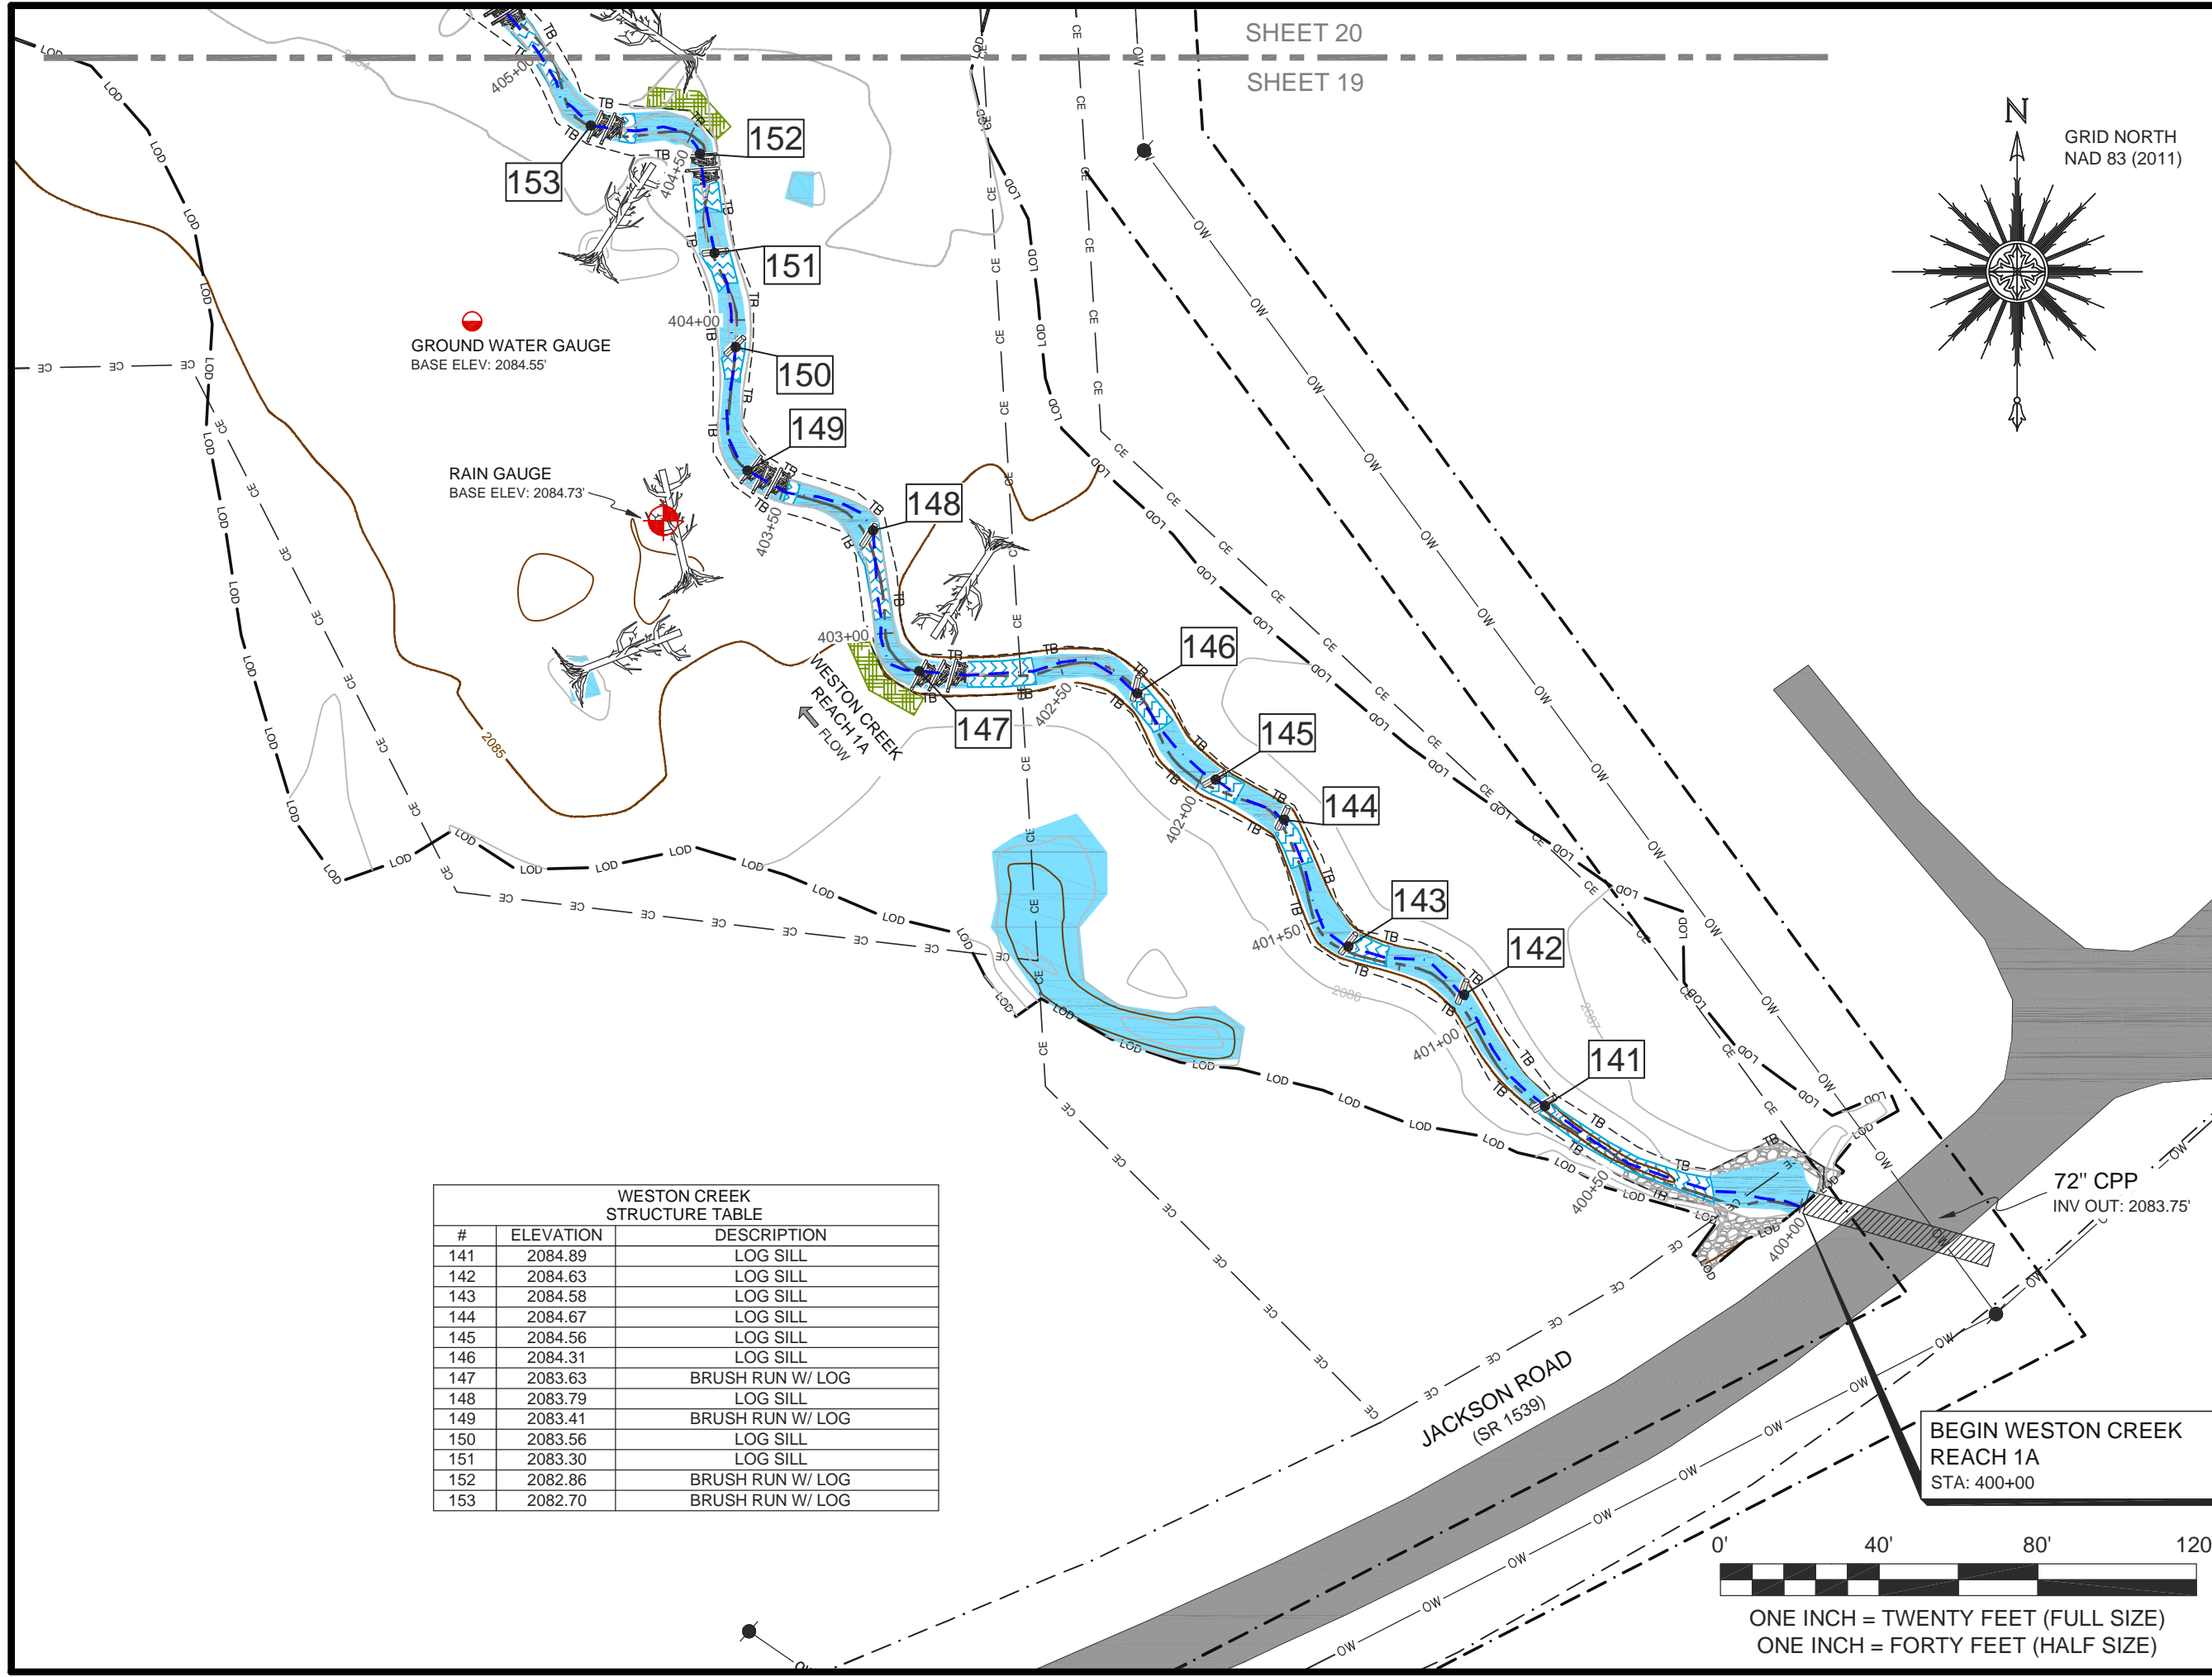

GROUND WATER GAUGE
BASE ELEV: 2084.55'

RAIN GAUGE
BASE ELEV: 2084.73'


WESTON CREEK
REACH 1A
FLOW


72" CPP
INV OUT: 2083.75'

BEGIN WESTON CREEK
REACH 1A
STA: 400+00

JACKSON ROAD
(SR 1539)




#	ELEVATION	DESCRIPTION
141	2084.89	LOG SILL
142	2084.63	LOG SILL
143	2084.58	LOG SILL
144	2084.67	LOG SILL
145	2084.56	LOG SILL
146	2084.31	LOG SILL
147	2083.63	BRUSH RUN W/ LOG
148	2083.79	LOG SILL
149	2083.41	BRUSH RUN W/ LOG
150	2083.56	LOG SILL
151	2083.30	LOG SILL
152	2082.86	BRUSH RUN W/ LOG
153	2082.70	BRUSH RUN W/ LOG

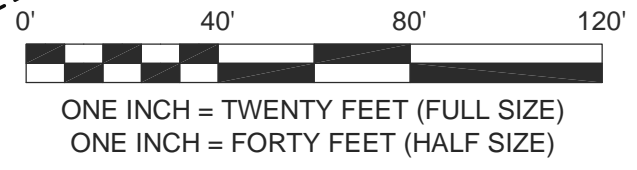

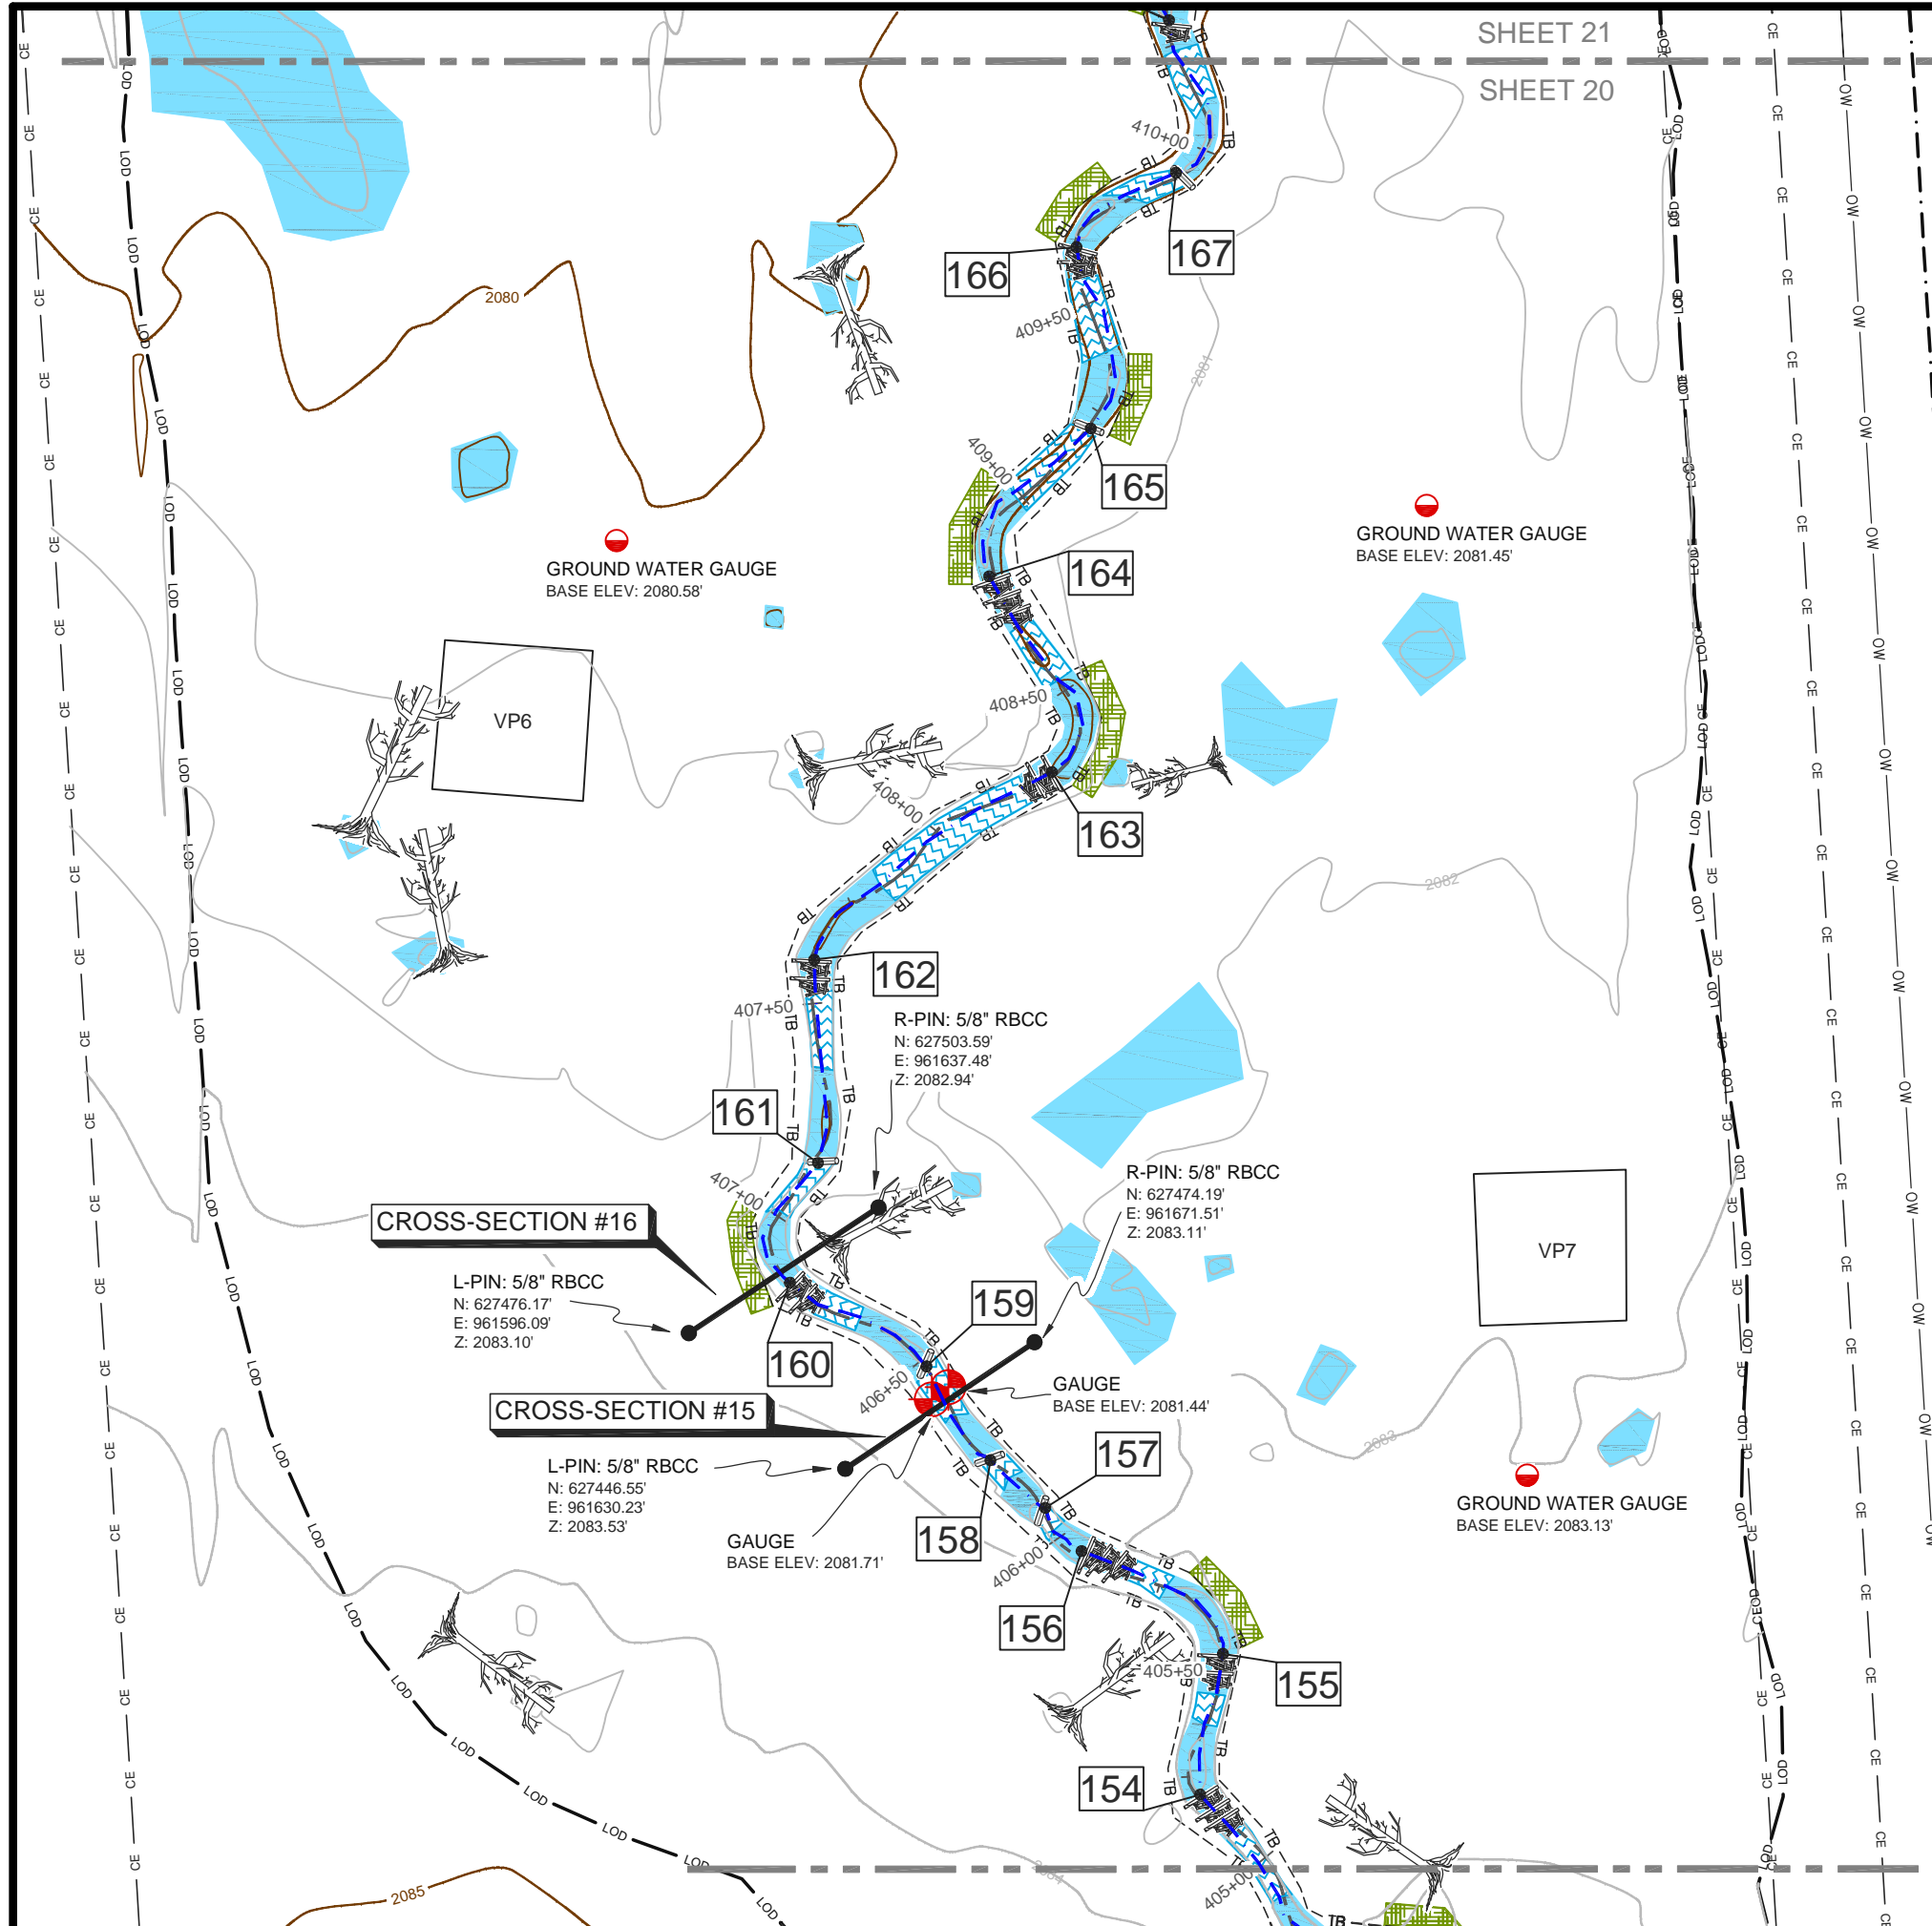

SHEET 21
SHEET 20

WESTON CREEK STRUCTURE TABLE		
#	ELEVATION	DESCRIPTION
154	2082.04	BRUSH RUN W/ LOG
155	2082.07	BRUSH RUN W/ LOG
156	2081.50	BRUSH RUN W/ LOG
157	2081.97	LOG SILL
158	2081.63	LOG SILL
159	2081.58	LOG SILL
160	2080.75	BRUSH RUN W/ LOG
161	2080.84	LOG SILL
162	2080.46	BRUSH RUN W/ LOG
163	2080.00	BRUSH RUN W/ LOG
164	2079.19	BRUSH RUN W/ LOG
165	2079.82	LOG SILL
166	2079.64	BRUSH RUN W/ LOG
167	2079.49	LOG SILL

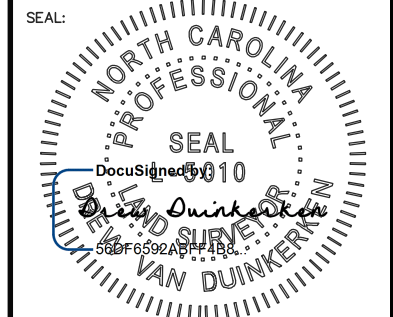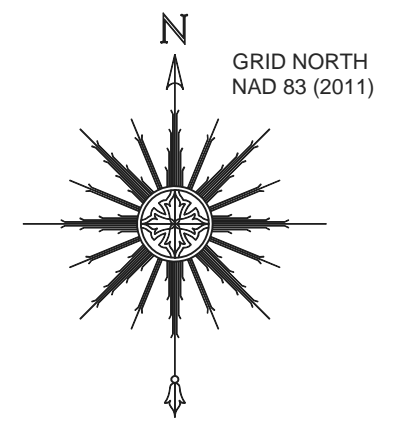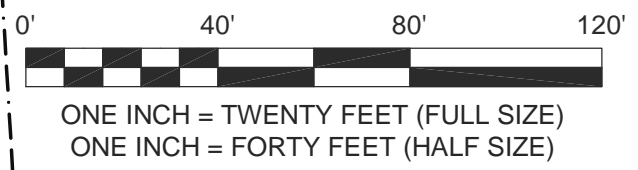

PLEASE REFER TO THE COVERSHEET FOR THE STATEMENT OF CERTIFICATION
NOTE: SEE SHEET 1 FOR SURVEYOR'S NOTES & LEGEND

ELEVATION DATUM: NAVD 88
CONTOUR INTERVAL: 1 FOOT

AN AS-BUILT SURVEY FOR:
EW SOLUTIONS, LLC.

SPO FILE NO's. 45-CZ, 45-DA, & 45-DB
SPO FILE NO's. 45-CY, 45-CX
DMS PROJECT NO. 100004

PROJECT:
FLETCHER SITE
MITIGATION PROJECT

SHEET TITLE:
STREAM DATA:
WESTON CREEK

TOWNSHIP: FLETCHER	COUNTY: HENDERSON	STATE: NORTH CAROLINA
DRAWN BY: NH/JA	CHECKED BY: LDP/PBK	SURVEY BY: CB,NMH,LDP,JM,AC
SCALE: AS SHOWN	SURVEY DATES: 12/17/19 - 03/22/19	
JOB: #181142-AB	SHEET SIZE: 11" X 17"	
#	DATE	REVISIONS


SHEET:
20 OF 37






P.O. Box 2566
Asheville, NC 28802
(828) 575-9021
www.keemap.com
License # C-3039

SHEET 20
SHEET 19

SHEET 22
SHEET 21

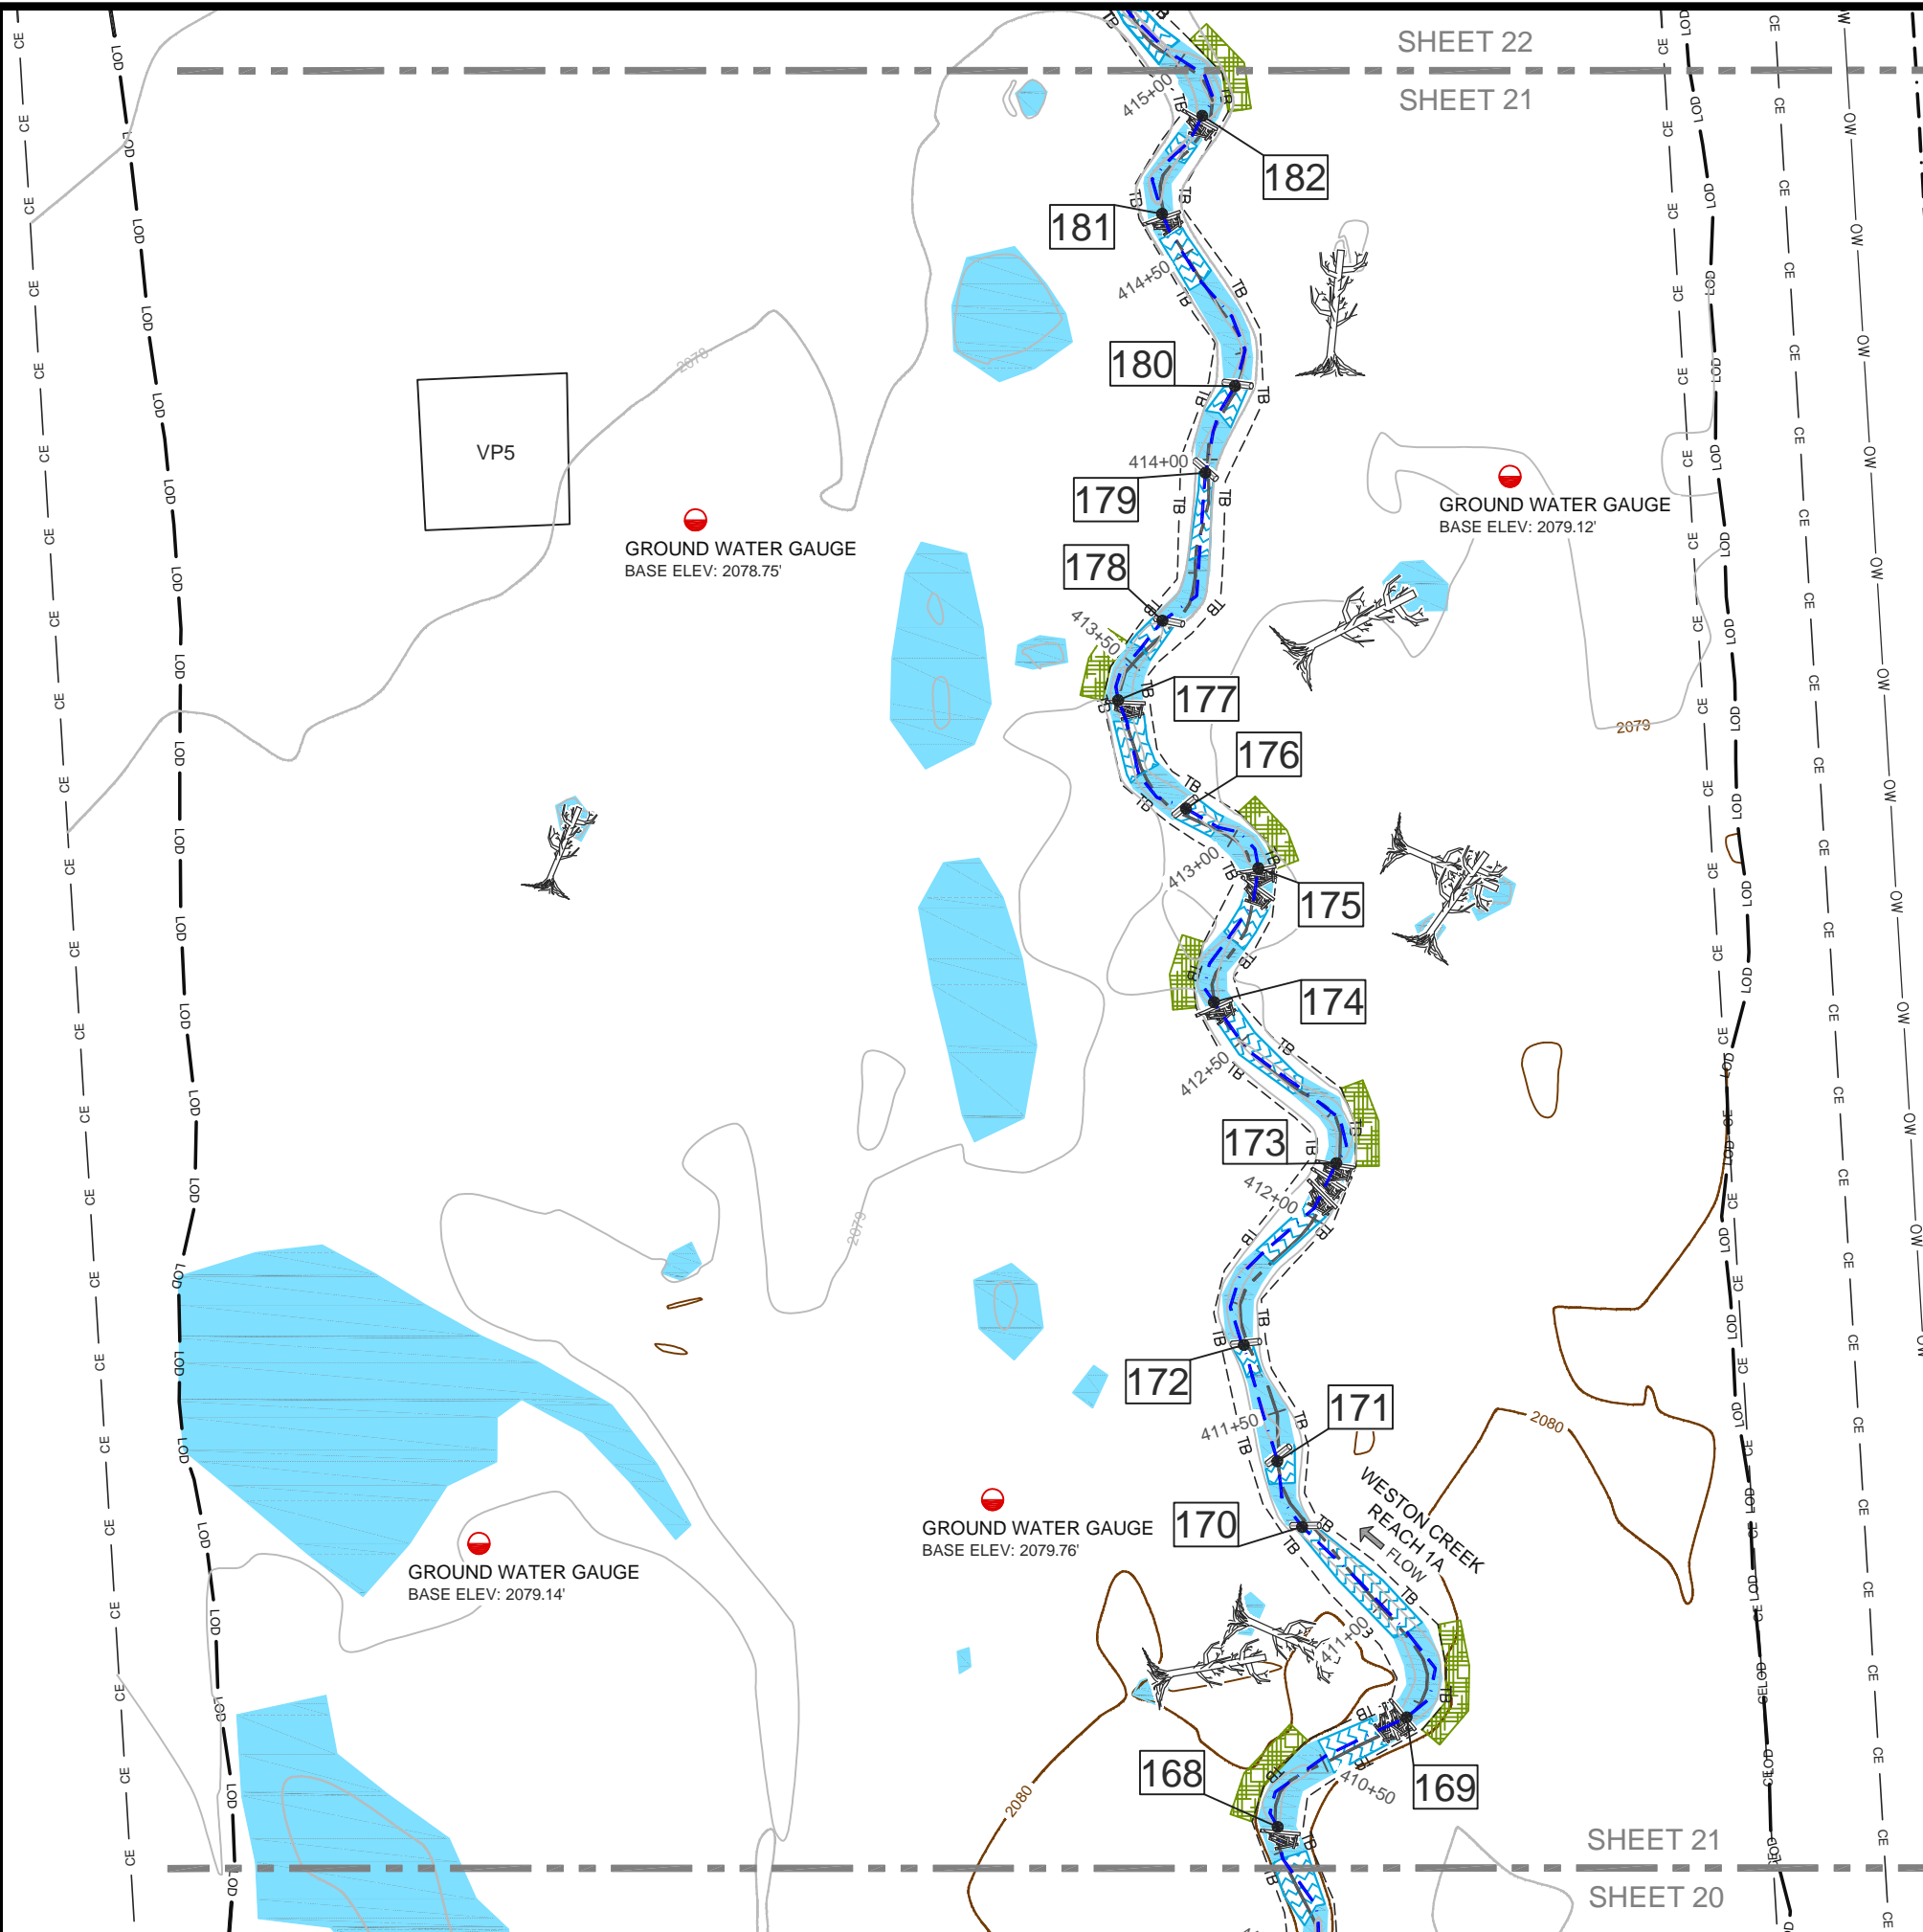

WESTON CREEK STRUCTURE TABLE		
#	ELEVATION	DESCRIPTION
168	2078.94	BRUSH RUN W/ LOG
169	2078.81	BRUSH RUN W/ LOG
170	2078.83	LOG SILL
171	2078.63	LOG SILL
172	2078.59	LOG SILL
173	2077.91	BRUSH RUN W/ LOG
174	2077.45	BRUSH RUN W/ LOG
175	2077.84	BRUSH RUN W/ LOG
176	2078.17	LOG SILL
177	2077.56	BRUSH RUN W/ LOG
178	2078.02	LOG SILL
179	2077.71	LOG SILL
180	2077.56	LOG SILL
181	2077.16	BRUSH RUN W/ LOG
182	2076.71	BRUSH RUN W/ LOG

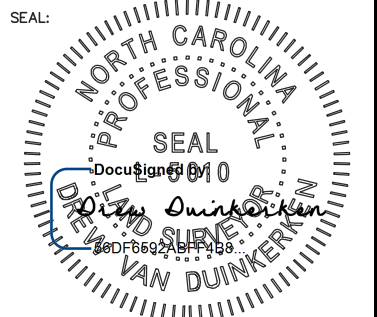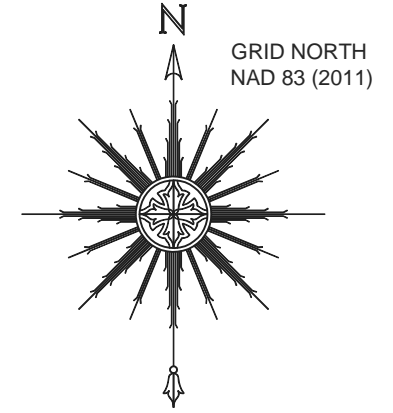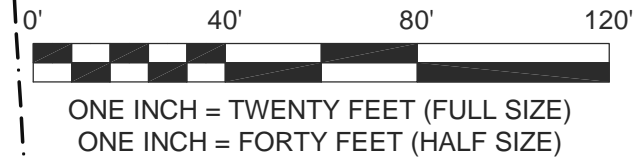

PLEASE REFER TO THE COVERSHEET FOR THE STATEMENT OF CERTIFICATION
NOTE: SEE SHEET 1 FOR SURVEYOR'S NOTES & LEGEND

ELEVATION DATUM: NAVD 88
CONTOUR INTERVAL: 1 FOOT

AN AS-BUILT SURVEY FOR:
EW SOLUTIONS, LLC.

SPO FILE NO's. 45-CZ, 45-DA, & 45-DB
SPO FILE NO's. 45-CY, 45-CX
DMS PROJECT NO. 100004

PROJECT:
FLETCHER SITE
MITIGATION PROJECT

SHEET TITLE:
STREAM DATA:
WESTON CREEK

TOWNSHIP: FLETCHER	COUNTY: HENDERSON	STATE: NORTH CAROLINA
DRAWN BY: NH/JA	CHECKED BY: LDP/PBK	SURVEY BY: CB,NMH,LDP,JM,AC
SCALE: AS SHOWN	SURVEY DATES: 12/17/19 - 03/22/19	
JOB: #1811142-AB	SHEET SIZE: (HALF SIZE) 11" X 17"	
#	DATE	REVISIONS

SHEET:
21 OF 37





P.O. Box 2566
Asheville, NC 28802
(828) 575-9021
www.keemap.com
License # C-3039

SHEET 21
SHEET 20



ONE INCH = TWENTY FEET (FULL SIZE)
ONE INCH = FORTY FEET (HALF SIZE)

WESTON CREEK STRUCTURE TABLE		
#	ELEVATION	DESCRIPTION
183	2077.02	LOG SILL
184	2076.75	LOG SILL
185	2076.34	BRUSH RUN W/ LOG
186	2076.46	LOG SILL
187	2076.19	BRUSH RUN W/ LOG
188	2076.11	LOG SILL
189	2075.16	BRUSH RUN W/ LOG
190	2075.76	LOG SILL
191	2075.61	LOG SILL
192	2074.57	BRUSH RUN W/ LOG
193	2075.15	LOG SILL
194	2074.20	BRUSH RUN W/ LOG

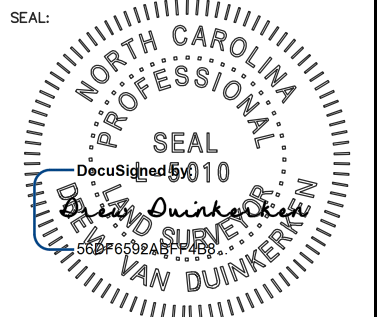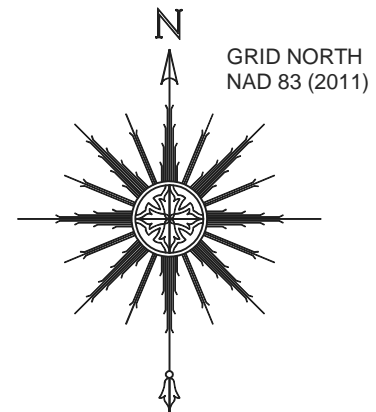

PLEASE REFER TO THE COVERSHEET FOR THE STATEMENT OF CERTIFICATION

NOTE: SEE SHEET 1 FOR SURVEYOR'S NOTES & LEGEND

ELEVATION DATUM: NAVD 88
CONTOUR INTERVAL: 1 FOOT

AN AS-BUILT SURVEY FOR:
EW SOLUTIONS, LLC.

SPO FILE NO's. 45-CZ, 45-DA, & 45-DB
SPO FILE NO's. 45-CY, 45-CX
DMS PROJECT NO. 100004

PROJECT:
FLETCHER SITE
MITIGATION PROJECT

SHEET TITLE:
STREAM DATA:
WESTON CREEK

TOWNSHIP: FLETCHER COUNTY: HENDERSON STATE: NORTH CAROLINA

DRAWN BY: NH/JA CHECKED BY: LDP/PBK SURVEY BY: CB,NMH,LDP,JM,AC

SCALE: AS SHOWN SURVEY DATES: 12/17/19 - 03/22/19


JOB: #181142-AB SHEET SIZE: 11" X 17"


#	DATE	REVISIONS

SHEET: 22 OF 37



P.O. Box 2566
Asheville, NC 28802
(828) 575-9021
www.keemap.com
License # C-3039

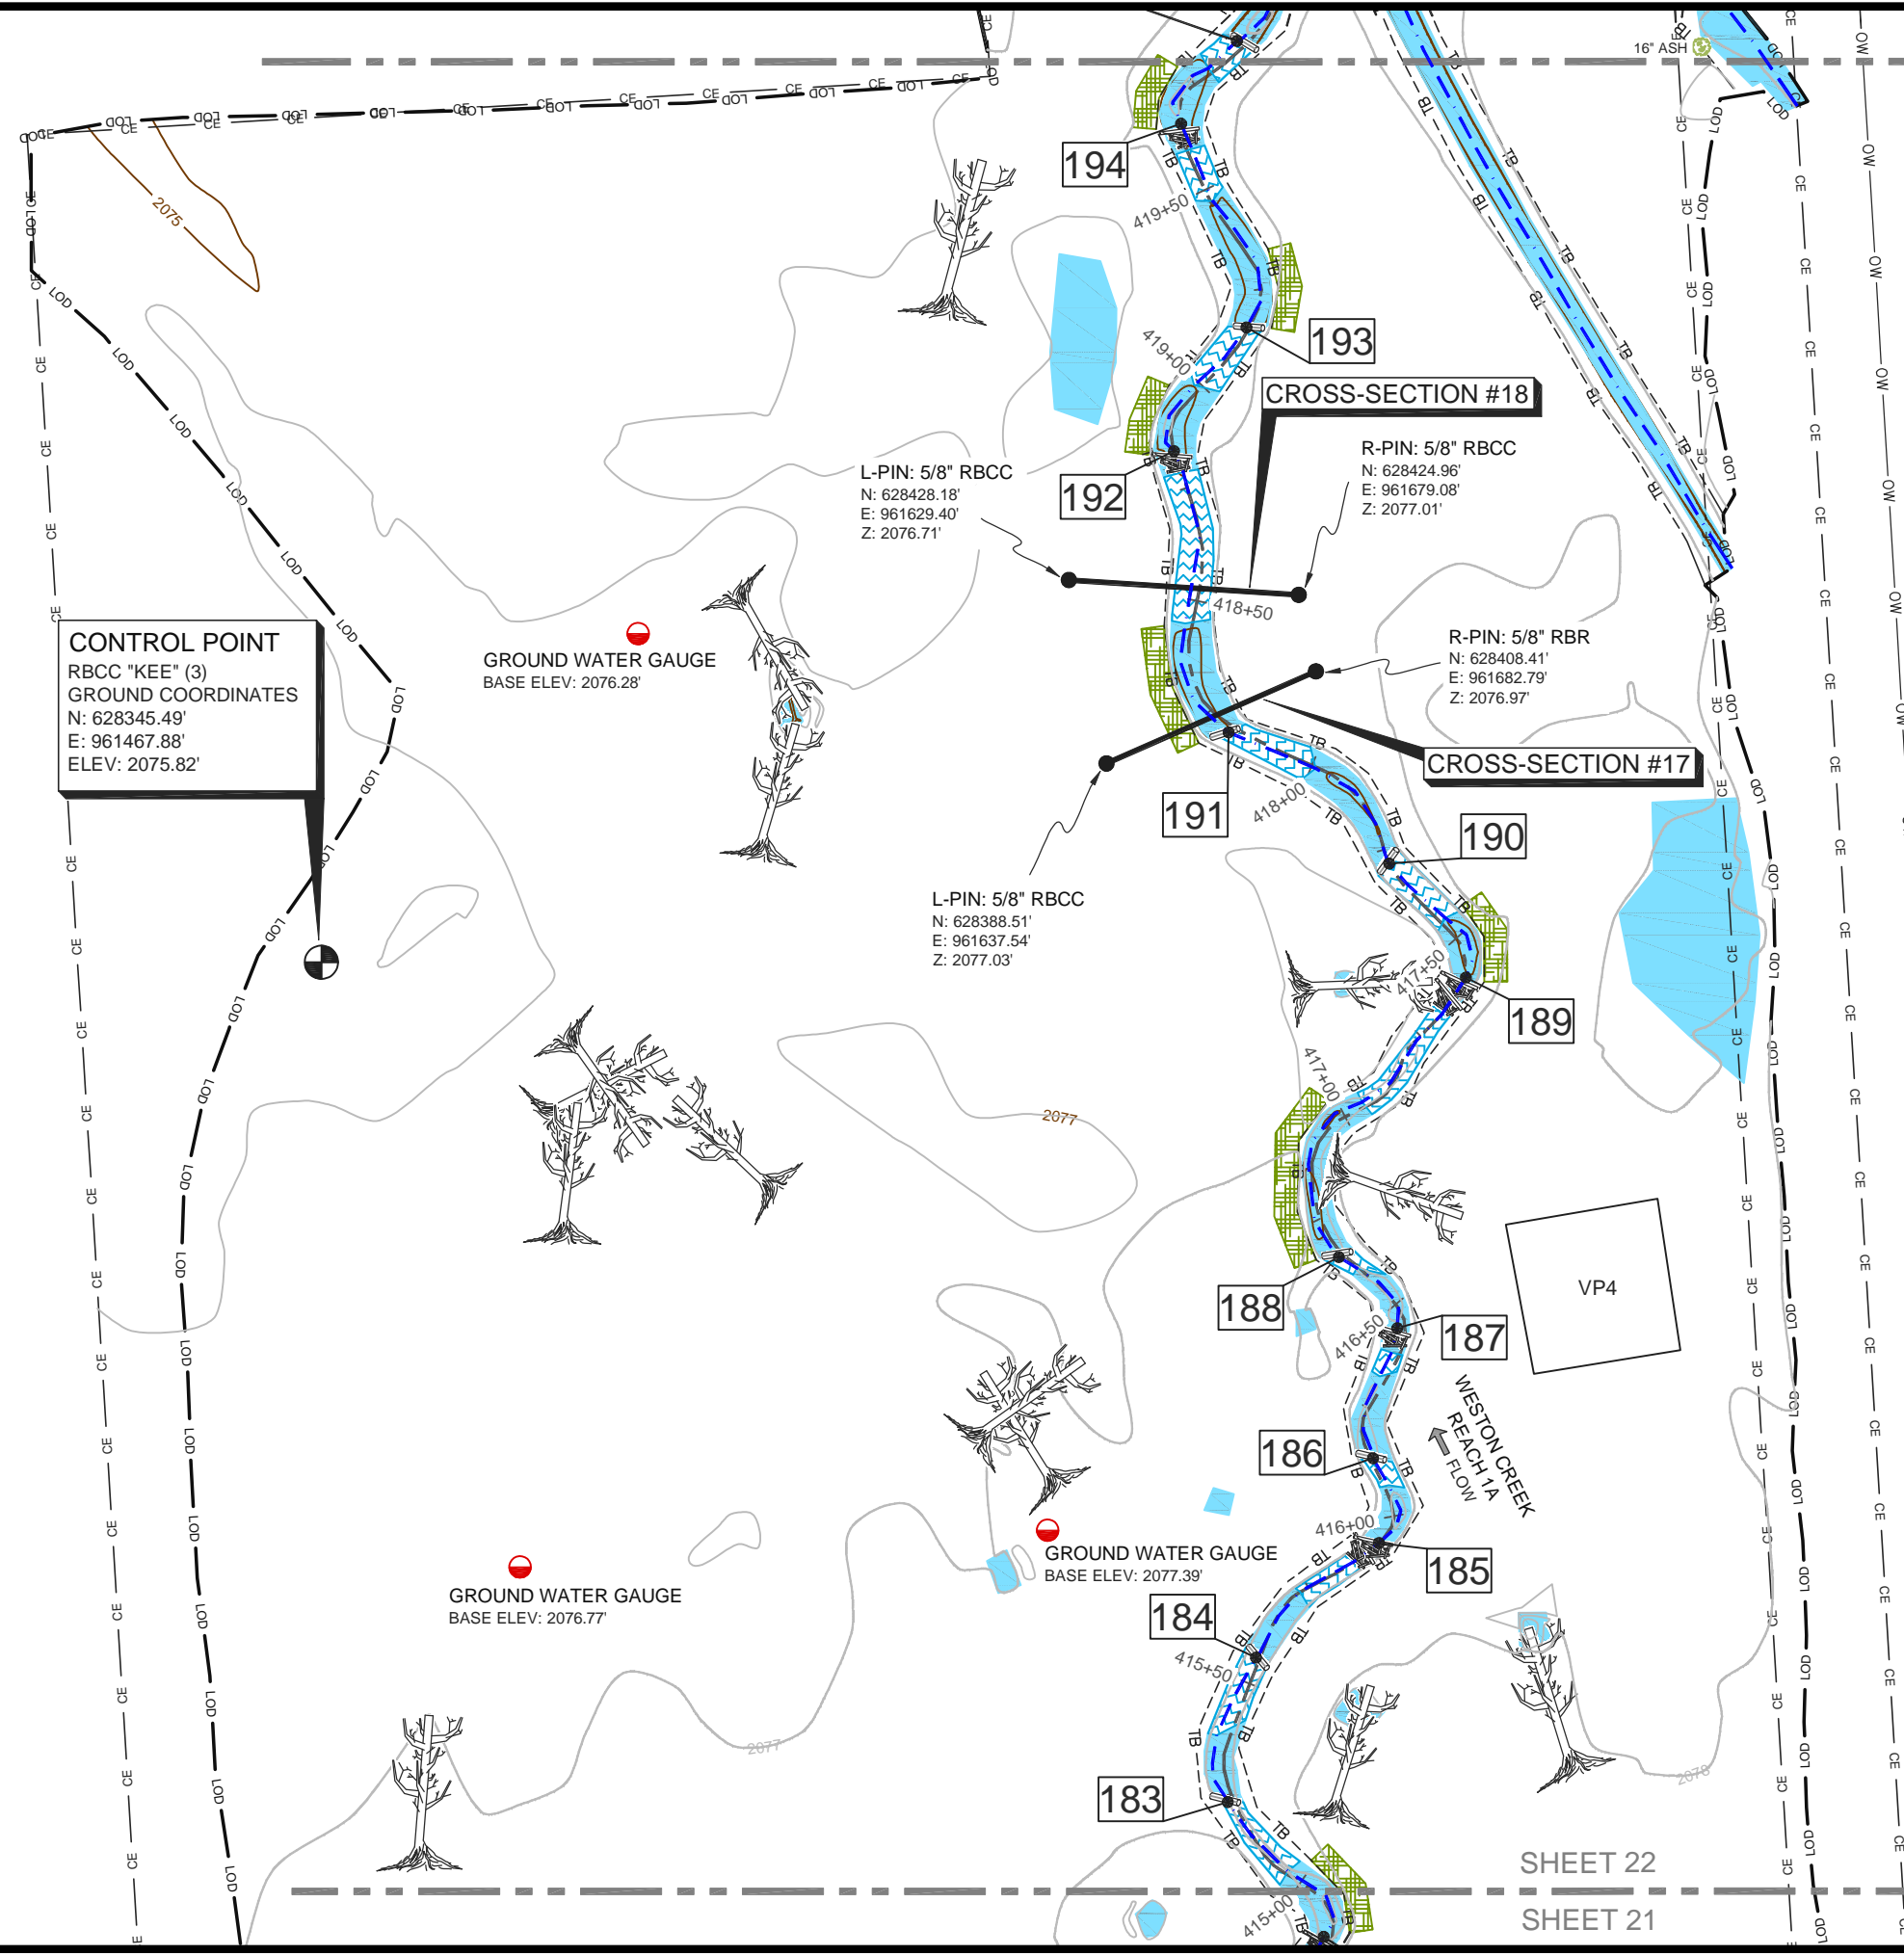

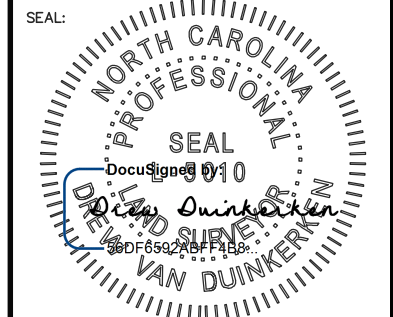

PLEASE REFER TO THE COVERSHEET FOR THE STATEMENT OF CERTIFICATION

NOTE: SEE SHEET 1 FOR SURVEYOR'S NOTES & LEGEND

ELEVATION DATUM: NAVD 88
CONTOUR INTERVAL: 1 FOOT

AN AS-BUILT SURVEY FOR:
EW SOLUTIONS, LLC.

SPO FILE NO's. 45-CZ, 45-DA, & 45-DB
SPO FILE NO's. 45-CY, 45-CX
DMS PROJECT NO. 100004

PROJECT:
FLETCHER SITE
MITIGATION PROJECT

SHEET TITLE:
STREAM DATA:
WESTON CREEK

TOWNSHIP: FLETCHER COUNTY: HENDERSON STATE: NORTH CAROLINA

DRAWN BY: NH/JA CHECKED BY: LDP/PBK SURVEY BY: CB,NMH,LDP,JM,AC

SCALE: AS SHOWN SURVEY DATES: 12/17/19 - 03/22/19

JOB: #181142-AB SHEET SIZE: (HALF SIZE) 11" X 17"

#	DATE	REVISIONS



SHEET: 23 OF 37



P.O. Box 2566
Asheville, NC 28802
(828) 575-9021
www.keemap.com
License # C-3039

WESTON CREEK STRUCTURE TABLE

#	ELEVATION	DESCRIPTION
195	2075.01	LOG SILL
196	2074.83	LOG SILL
197	2074.57	BRUSH RUN W/ LOG
198	2074.74	LOG SILL
199	2073.41	BRUSH RUN W/ LOG
200	2073.78	BRUSH RUN W/ LOG
201	2074.36	LOG SILL
202	2074.17	LOG SILL
203	2073.38	BRUSH RUN W/ LOG
204	2073.80	LOG SILL
205	2073.89	LOG SILL
206	2073.64	LOG SILL
207	2073.63	LOG SILL

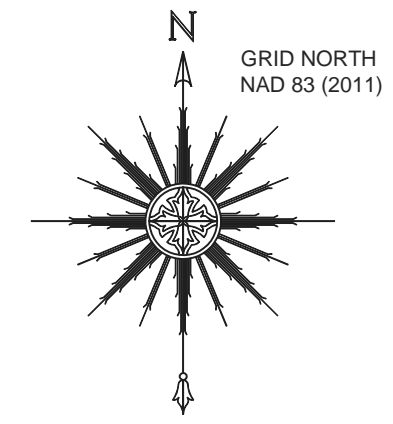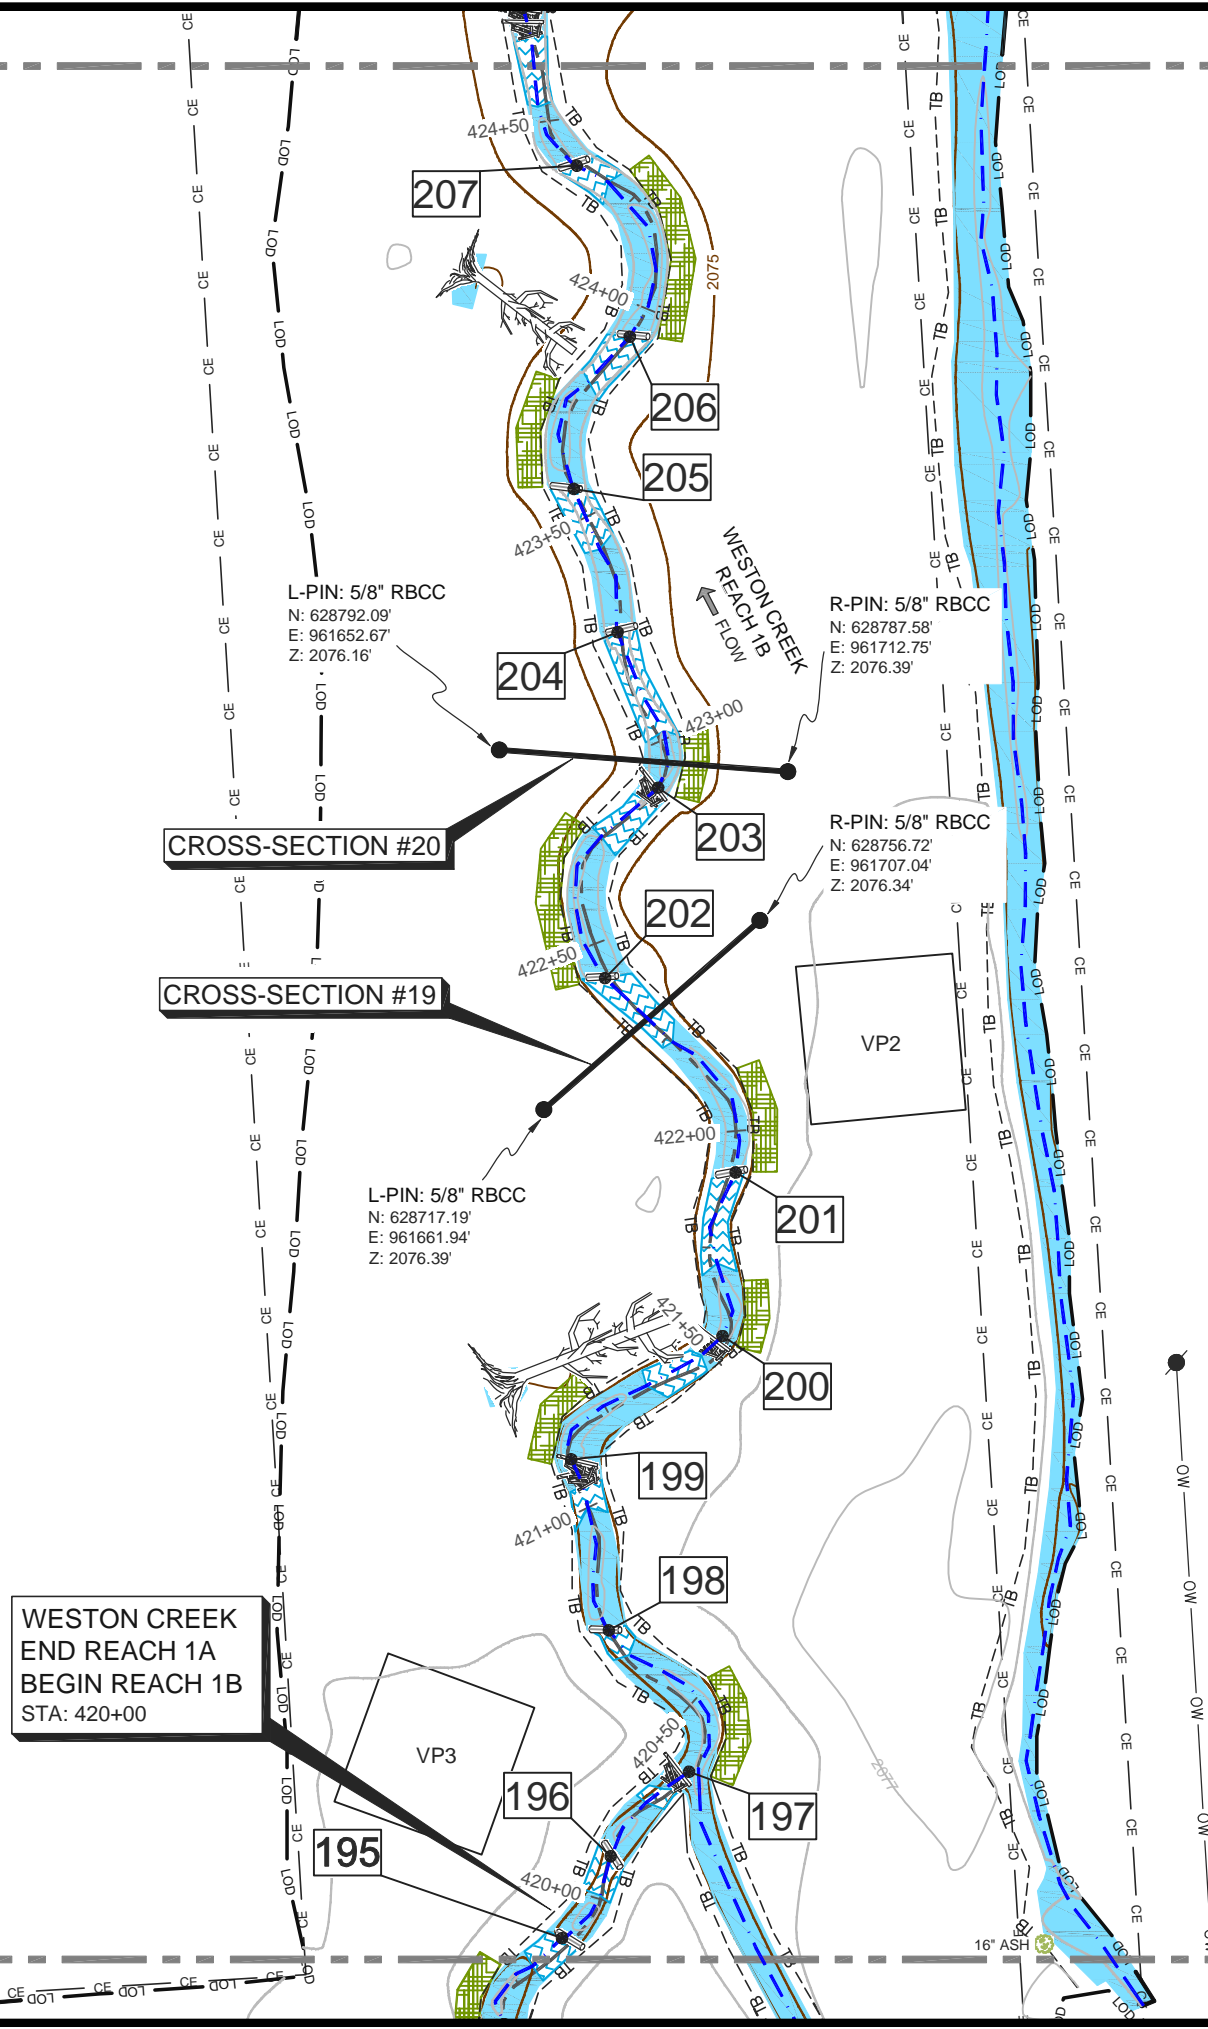



ONE INCH = TWENTY FEET (FULL SIZE)
ONE INCH = FORTY FEET (HALF SIZE)

CONTROL POINT
 RBCC "KEE" (1)
 GROUND COORDINATES
 N: 629176.98'
 E: 961505.95'
 ELEV: 2076.94'

**WESTON CREEK
 END REACH 1C**
 STA: 427+92

**WESTON CREEK
 END REACH 1B
 BEGIN REACH 1C**
 STA: 425+76

WESTON CREEK STRUCTURE TABLE		
#	ELEVATION	DESCRIPTION
208	2072.74	BRUSH RUN W/ LOG
209	2073.50	LOG SILL
210	2073.46	LOG SILL
211	2073.02	BRUSH RUN W/ LOG
212	2072.02	BRUSH RUN W/ BOULDER
213	2071.72	BRUSH RUN W/ LOG
214	2071.00	BRUSH RUN W/ LOG
215	2070.61	BRUSH RUN W/ LOG

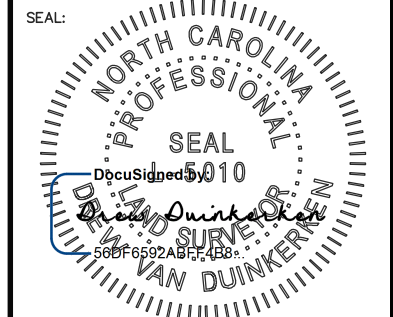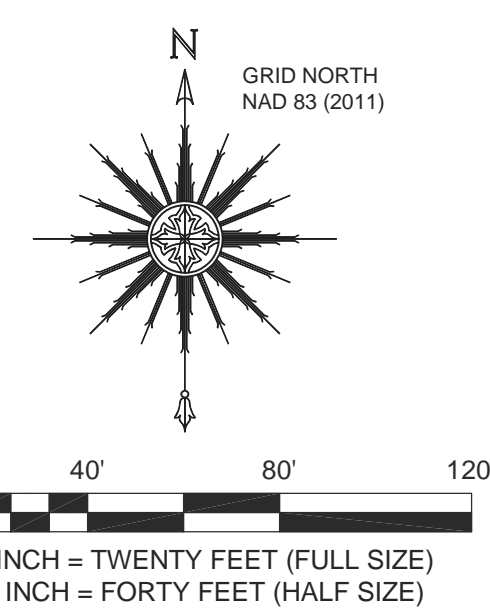

PLEASE REFER TO THE COVERSHEET FOR THE STATEMENT OF CERTIFICATION

NOTE: SEE SHEET 1 FOR SURVEYOR'S NOTES & LEGEND

ELEVATION DATUM: NAVD 88
 CONTOUR INTERVAL: 1 FOOT

AN AS-BUILT SURVEY FOR:
 EW SOLUTIONS, LLC.

SPO FILE NO's. 45-CZ, 45-DA, & 45-DB
 SPO FILE NO's. 45-CY, 45-CX
 DMS PROJECT NO. 100004

PROJECT:
**FLETCHER SITE
 MITIGATION PROJECT**

SHEET TITLE:
 STREAM DATA:
 END WESTON CREEK

TOWNSHIP: FLETCHER COUNTY: HENDERSON STATE: NORTH CAROLINA

DRAWN BY: NH/JA CHECKED BY: LDP/PBK SURVEY BY: CB,NMH,LDP,JM,AC

SCALE: AS SHOWN SURVEY DATES: 12/17/19 - 03/22/19

JOB: #181142-AB SHEET SIZE: (HALF SIZE) 11" X 17"


#	DATE	REVISIONS

SHEET:
24 OF 37



P.O. Box 2566
 Asheville, NC 28802
 (828) 575-9021
 www.keemap.com
 License # C-3039

SHEET 24
 SHEET 23

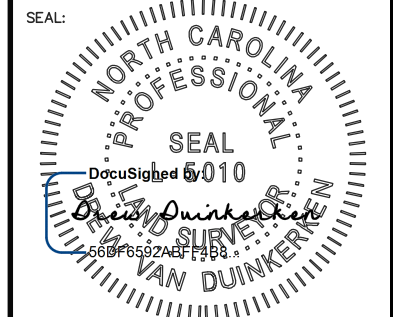

PLEASE REFER TO THE COVERSHEET FOR THE STATEMENT OF CERTIFICATION

NOTE: SEE SHEET 1 FOR SURVEYOR'S NOTES & LEGEND

ELEVATION DATUM: NAVD 88
CONTOUR INTERVAL: 1 FOOT

AN AS-BUILT SURVEY FOR:
EW SOLUTIONS, LLC.

SPO FILE NO's. 45-CZ, 45-DA, & 45-DB
SPO FILE NO's. 45-CY, 45-CX
DMS PROJECT NO. 100004

PROJECT:
FLETCHER SITE
MITIGATION PROJECT

SHEET TITLE:

STREAM DATA:
CROSS SECTION PROFILES
1-8

TOWNSHIP: FLETCHER	COUNTY: HENDERSON	STATE: NORTH CAROLINA
-----------------------	----------------------	--------------------------

DRAWN BY: NH/JA	CHECKED BY: LDP/PBK	SURVEY BY: CB,NMH,LDP,JM,AC
--------------------	------------------------	--------------------------------


SCALE: AS SHOWN	SURVEY DATES: 12/17/19 - 03/22/19
JOB: #181142-AB	SHEET SIZE: 11" X 17"

#	DATE	REVISIONS


SHEET:
25 OF **37**




P.O. Box 2566
Asheville, NC 28802
(828) 575-9021
www.keemap.com
License # C-3039

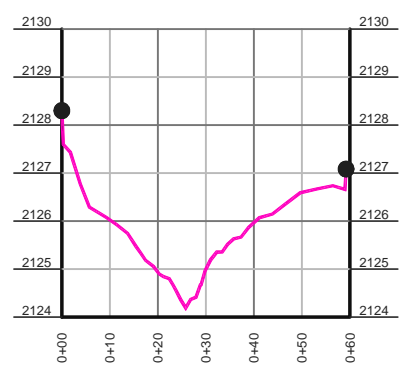


CROSS-SECTION #1-FLETCHER CREEK
HORIZONTAL SCALE: 1" = 40'
VERTICAL SCALE: 1" = 4'

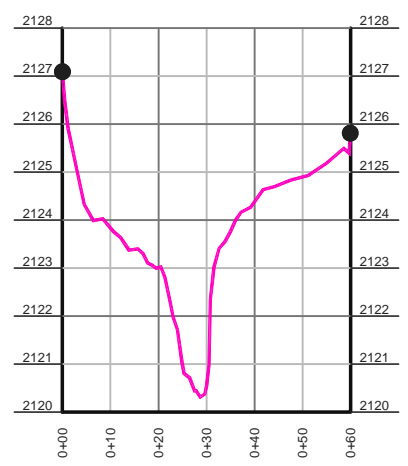


CROSS-SECTION #2-FLETCHER CREEK
HORIZONTAL SCALE: 1" = 40'
VERTICAL SCALE: 1" = 4'

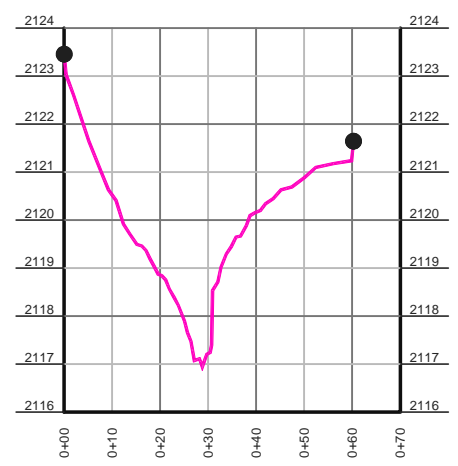


CROSS-SECTION #3-FLETCHER CREEK
HORIZONTAL SCALE: 1" = 40'
VERTICAL SCALE: 1" = 4'

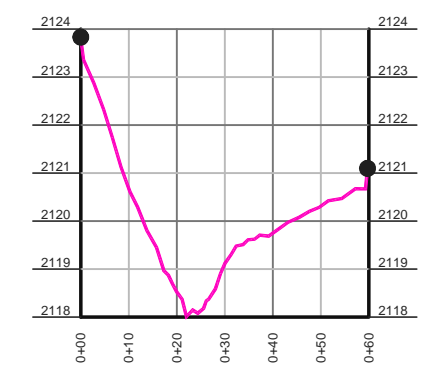


CROSS-SECTION #4-FLETCHER CREEK
HORIZONTAL SCALE: 1" = 40'
VERTICAL SCALE: 1" = 4'

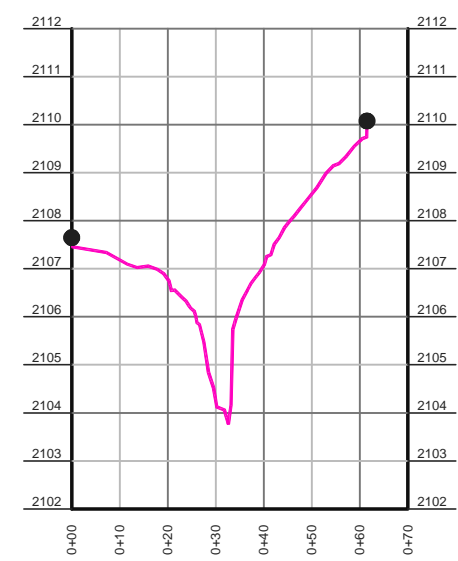


CROSS-SECTION #5-FLETCHER CREEK
HORIZONTAL SCALE: 1" = 40'
VERTICAL SCALE: 1" = 4'

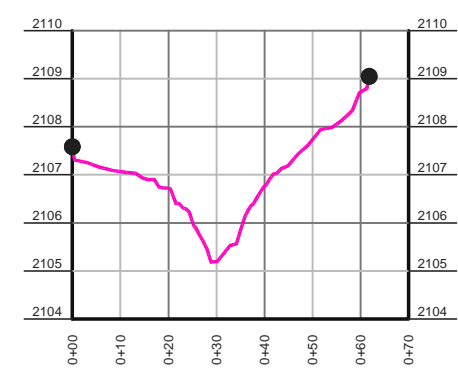

CROSS-SECTION #6-FLETCHER CREEK
HORIZONTAL SCALE: 1" = 40'
VERTICAL SCALE: 1" = 4'

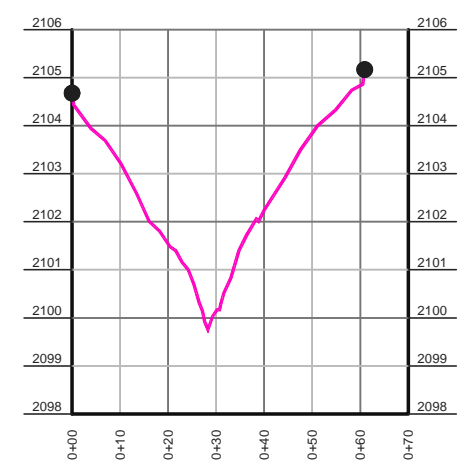


CROSS-SECTION #7-FLETCHER CREEK
HORIZONTAL SCALE: 1" = 40'
VERTICAL SCALE: 1" = 4'

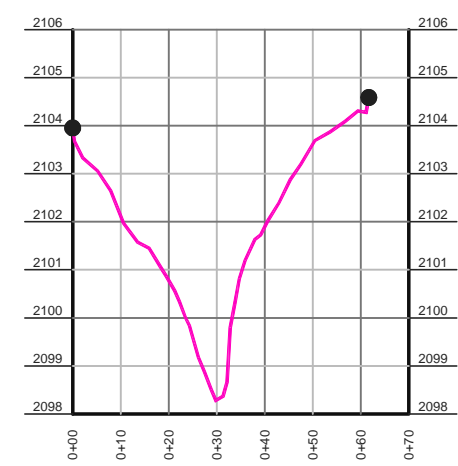


CROSS-SECTION #8-FLETCHER CREEK
HORIZONTAL SCALE: 1" = 40'
VERTICAL SCALE: 1" = 4'

LEGEND


- CROSS-SECTION REBAR

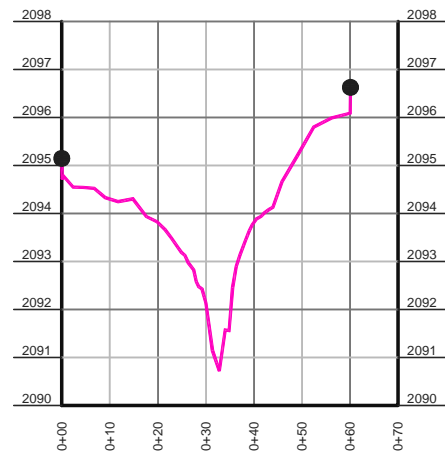


CROSS-SECTION #9-FLETCHER CREEK
 HORIZONTAL SCALE: 1" = 40'
 VERTICAL SCALE: 1" = 4'

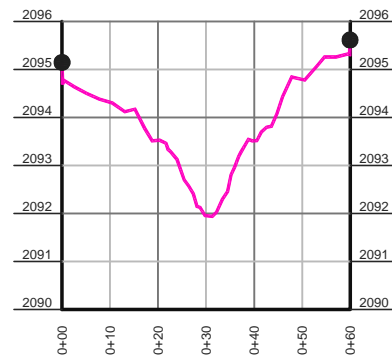


CROSS-SECTION #10-FLETCHER CREEK
 HORIZONTAL SCALE: 1" = 40'
 VERTICAL SCALE: 1" = 4'

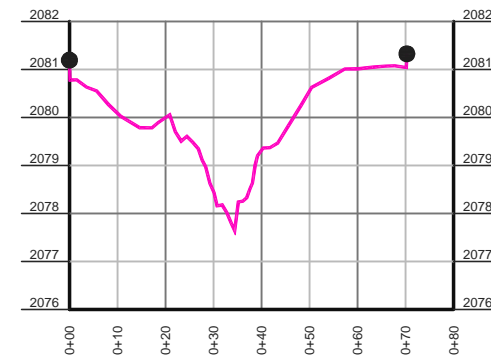


CROSS-SECTION #11-FLETCHER CREEK
 HORIZONTAL SCALE: 1" = 40'
 VERTICAL SCALE: 1" = 4'

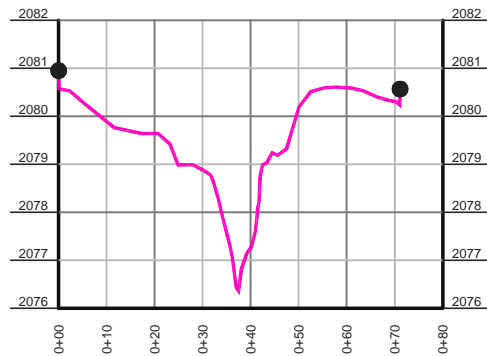


CROSS-SECTION #12-FLETCHER CREEK
 HORIZONTAL SCALE: 1" = 40'
 VERTICAL SCALE: 1" = 4'

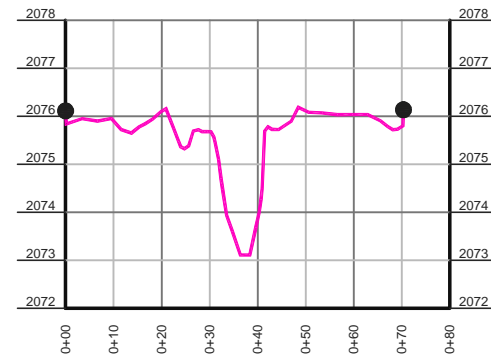


CROSS-SECTION #13-FLETCHER CREEK
 HORIZONTAL SCALE: 1" = 40'
 VERTICAL SCALE: 1" = 4'

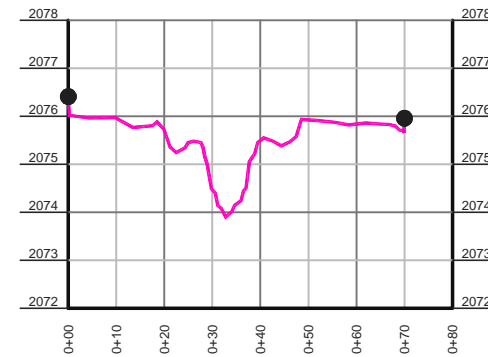


CROSS-SECTION #14-FLETCHER CREEK
 HORIZONTAL SCALE: 1" = 40'
 VERTICAL SCALE: 1" = 4'

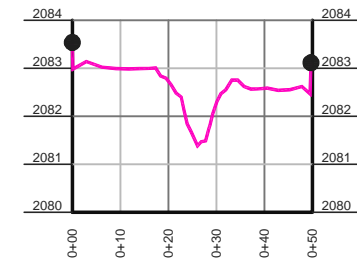


CROSS-SECTION #15-WESTON CREEK
 HORIZONTAL SCALE: 1" = 40'
 VERTICAL SCALE: 1" = 4'

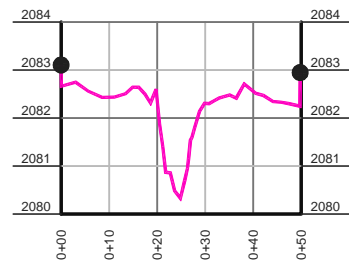


CROSS-SECTION #16-WESTON CREEK
 HORIZONTAL SCALE: 1" = 40'
 VERTICAL SCALE: 1" = 4'

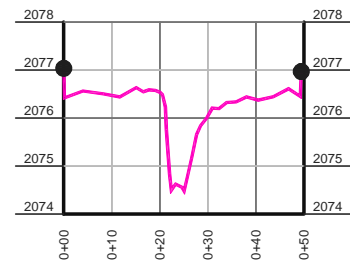

CROSS-SECTION #17-WESTON CREEK
 HORIZONTAL SCALE: 1" = 40'
 VERTICAL SCALE: 1" = 4'

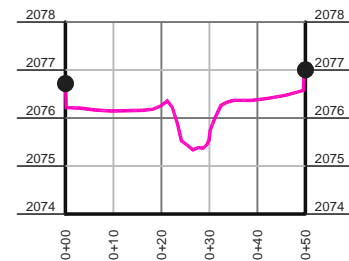

CROSS-SECTION #18-WESTON CREEK
 HORIZONTAL SCALE: 1" = 40'
 VERTICAL SCALE: 1" = 4'

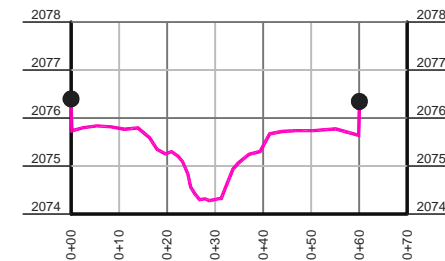


CROSS-SECTION #19-WESTON CREEK
 HORIZONTAL SCALE: 1" = 40'
 VERTICAL SCALE: 1" = 4'

LEGEND

● CROSS-SECTION REBAR

SEAL:

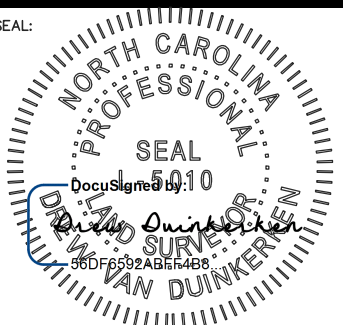

PLEASE REFER TO THE COVERSHEET FOR THE STATEMENT OF CERTIFICATION

NOTE: SEE SHEET 1 FOR SURVEYOR'S NOTES & LEGEND

ELEVATION DATUM: NAVD 88
 CONTOUR INTERVAL: 1 FOOT

AN AS-BUILT SURVEY FOR:
 EW SOLUTIONS, LLC.

SPO FILE NO's. 45-CZ, 45-DA, & 45-DB
 SPO FILE NO's. 45-CY, 45-CX
 DMS PROJECT NO. 100004

PROJECT:
 FLETCHER SITE
 MITIGATION PROJECT

SHEET TITLE:

STREAM DATA:
 CROSS SECTION PROFILES
 9-19

TOWNSHIP: FLETCHER COUNTY: HENDERSON STATE: NORTH CAROLINA

DRAWN BY: NH/JA CHECKED BY: LDP/PBK SURVEY BY: CB,NMH,LDP,JM,AC

SCALE: AS SHOWN SURVEY DATES: 12/17/19 - 03/22/19

JOB: #1811142-AB SHEET SIZE: (HALF SIZE) 11" X 17"


#	DATE	REVISIONS

SHEET:


26 OF 37




P.O. Box 2566
 Asheville, NC 28802
 (828) 575-9021
 www.keemap.com
 License # C-3039

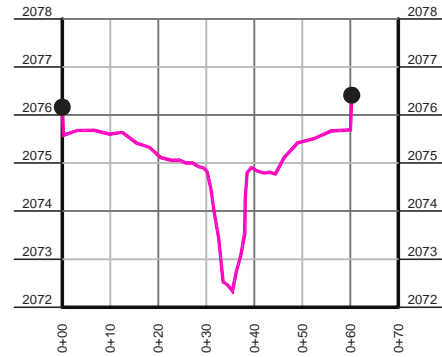


CROSS-SECTION #20-WESTON CREEK
 HORIZONTAL SCALE: 1" = 40'
 VERTICAL SCALE: 1" = 4'

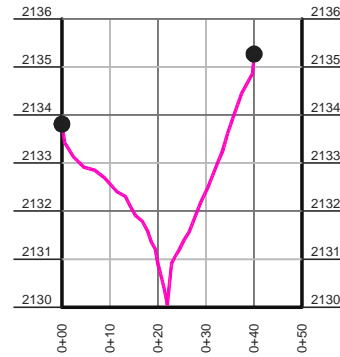


CROSS-SECTION #21-RACCOON BRANCH
 HORIZONTAL SCALE: 1" = 40'
 VERTICAL SCALE: 1" = 4'

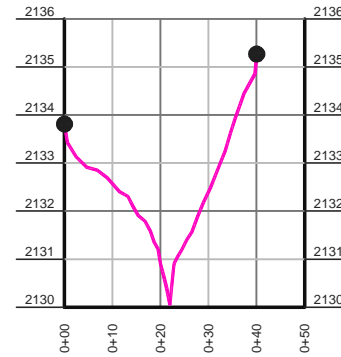


CROSS-SECTION #22-RACCOON BRANCH
 HORIZONTAL SCALE: 1" = 40'
 VERTICAL SCALE: 1" = 4'

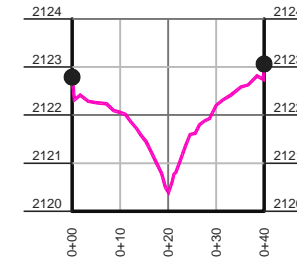


CROSS-SECTION #23-COATES BRANCH
 HORIZONTAL SCALE: 1" = 40'
 VERTICAL SCALE: 1" = 4'

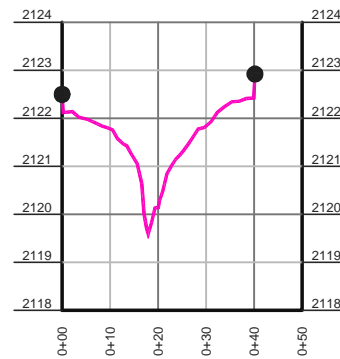


CROSS-SECTION #24-COATES BRANCH
 HORIZONTAL SCALE: 1" = 40'
 VERTICAL SCALE: 1" = 4'

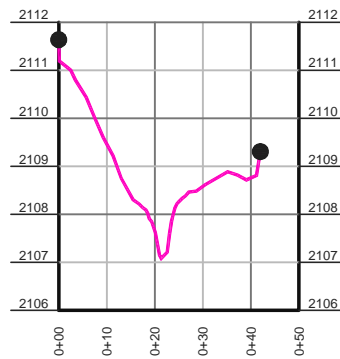


CROSS-SECTION #25-COATES BRANCH
 HORIZONTAL SCALE: 1" = 40'
 VERTICAL SCALE: 1" = 4'

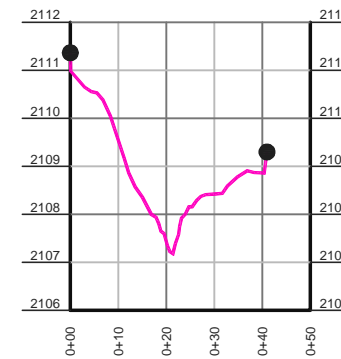

CROSS-SECTION #26-COATES BRANCH
 HORIZONTAL SCALE: 1" = 40'
 VERTICAL SCALE: 1" = 4'

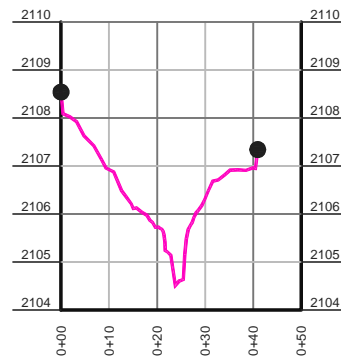

CROSS-SECTION #27-COATES BRANCH
 HORIZONTAL SCALE: 1" = 40'
 VERTICAL SCALE: 1" = 4'

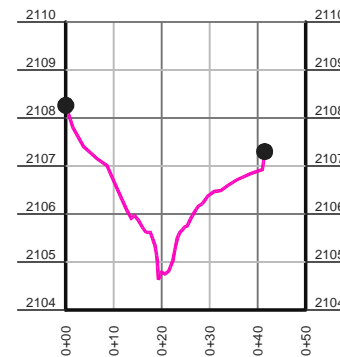


CROSS-SECTION #28-COATES BRANCH
 HORIZONTAL SCALE: 1" = 40'
 VERTICAL SCALE: 1" = 4'

LEGEND

- CROSS-SECTION REBAR

SEAL:

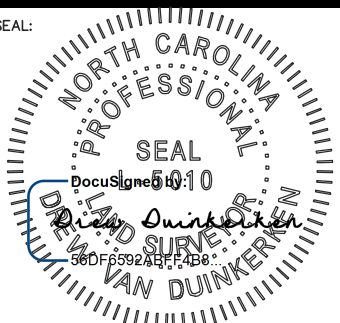

PLEASE REFER TO THE COVERSHEET FOR THE STATEMENT OF CERTIFICATION

NOTE: SEE SHEET 1 FOR SURVEYOR'S NOTES & LEGEND

ELEVATION DATUM: NAVD 88
 CONTOUR INTERVAL: 1 FOOT

AN AS-BUILT SURVEY FOR:
 EW SOLUTIONS, LLC.

SPO FILE NO's. 45-CZ, 45-DA, & 45-DB
 SPO FILE NO's. 45-CY, 45-CX
 DMS PROJECT NO. 100004

PROJECT:
 FLETCHER SITE
 MITIGATION PROJECT

SHEET TITLE:

STREAM DATA:
 CROSS SECTION PROFILES
 20-28

TOWNSHIP: FLETCHER COUNTY: HENDERSON STATE: NORTH CAROLINA

DRAWN BY: NH/JA CHECKED BY: LDP/PBK SURVEY BY: CB,NMH,LDP,JM,AC

SCALE: AS SHOWN SURVEY DATES: 12/17/19 - 03/22/19

JOB: #181142-AB SHEET SIZE: (HALF SIZE) 11" X 17"



#	DATE	REVISIONS

SHEET:

27 OF 37



P.O. Box 2566
 Asheville, NC 28802
 (828) 575-9021
 www.keemap.com
 License # C-3039

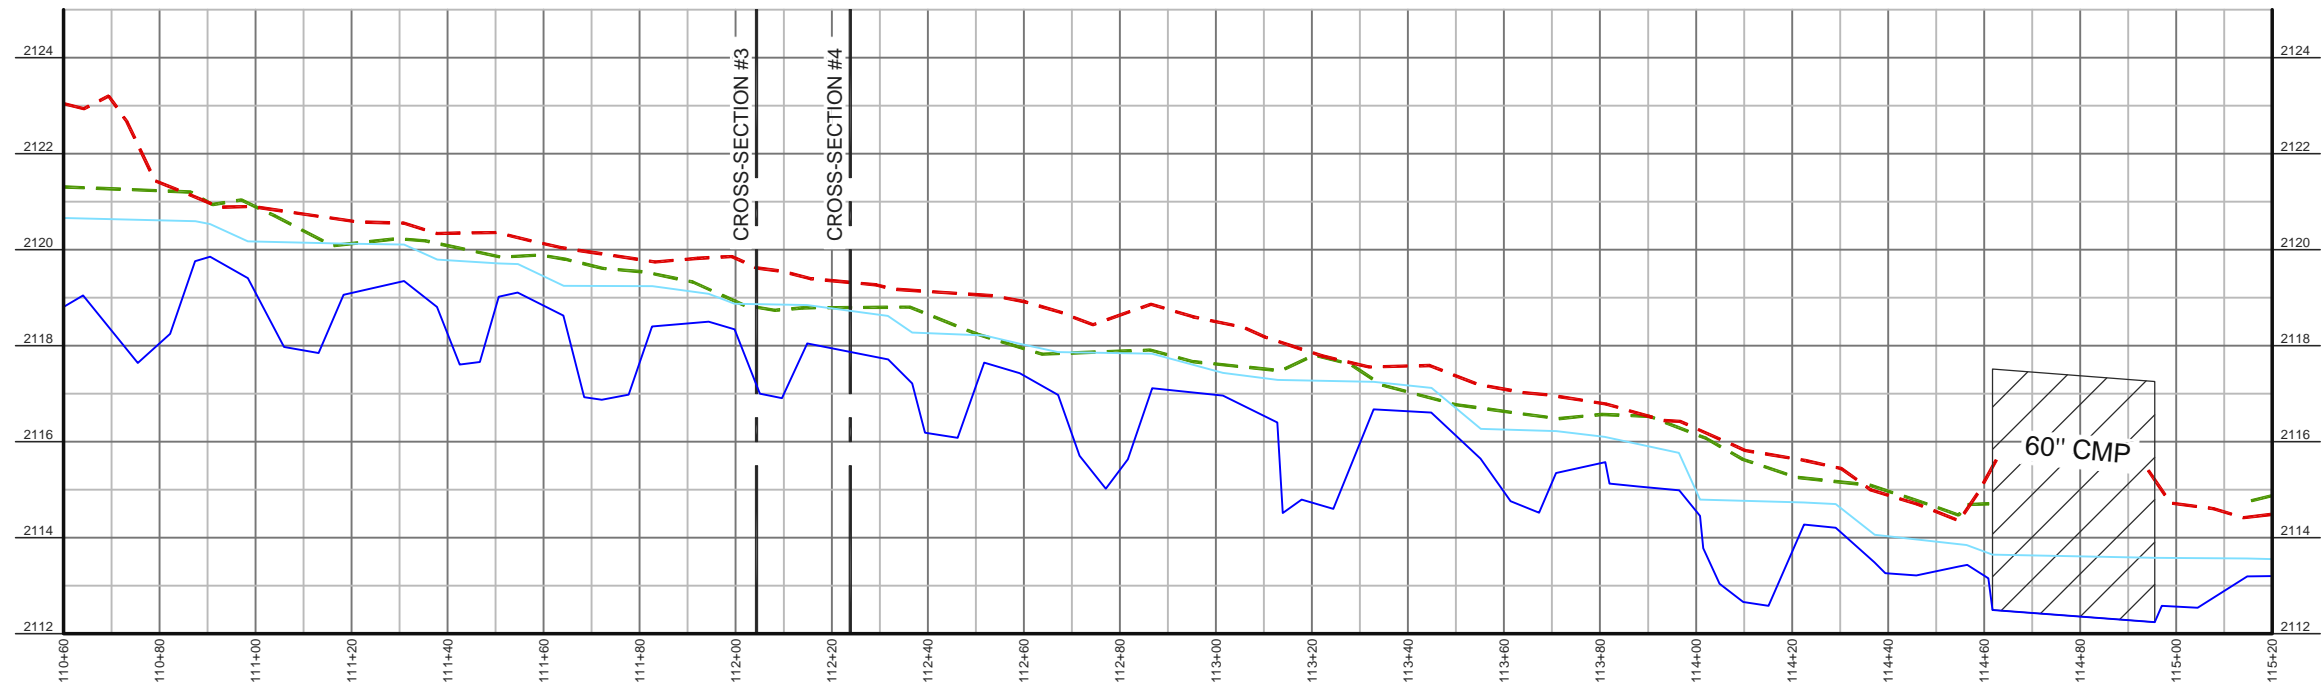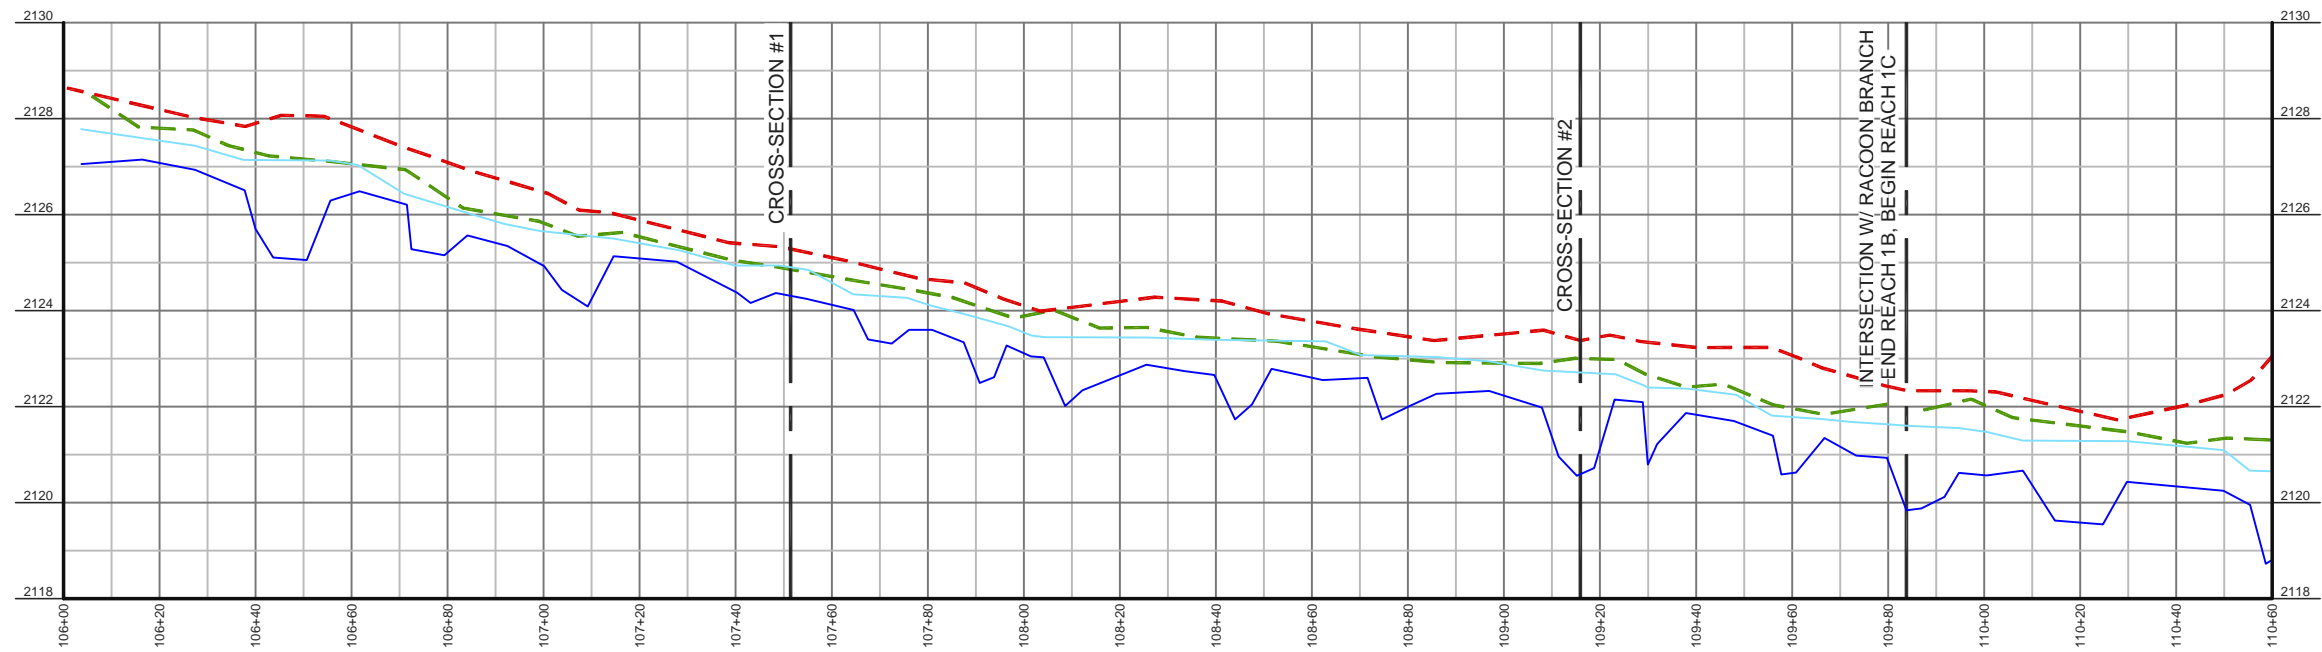


LONGITUDINAL PROFILE- FLETCHER CREEK

HORIZONTAL: 1" = 40'
 VERTICAL: 1" = 4'

LEGEND

- THALWEG
- WATER SURFACE
- - - RIGHT TOP OF BANK
- - - LEFT TOP OF BANK

SEAL:

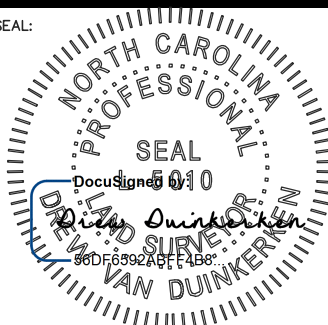

PLEASE REFER TO THE COVERSHEET FOR THE STATEMENT OF CERTIFICATION

NOTE: SEE SHEET 1 FOR SURVEYOR'S NOTES & LEGEND

ELEVATION DATUM: NAVD 88
 CONTOUR INTERVAL: 1 FOOT

AN AS-BUILT SURVEY FOR:
 EW SOLUTIONS, LLC.

SPO FILE NO's. 45-CZ, 45-DA, & 45-DB
 SPO FILE NO's. 45-CY, 45-CX
 DMS PROJECT NO. 100004

PROJECT:
 FLETCHER SITE
 MITIGATION PROJECT

SHEET TITLE:

STREAM DATA:
 LONGITUDINAL PROFILE
 FLETCHER CREEK

TOWNSHIP: FLETCHER	COUNTY: HENDERSON	STATE: NORTH CAROLINA
-----------------------	----------------------	--------------------------

DRAWN BY: NH/JA	CHECKED BY: LDP/PBK	SURVEY BY: CB,NMH,LDP,JM,AC
--------------------	------------------------	--------------------------------

SCALE: AS SHOWN	SURVEY DATES: 12/17/19 - 03/22/19
--------------------	--------------------------------------

JOB: #1811142-AB	SHEET SIZE: 11" X 17"
---------------------	--------------------------



#	DATE	REVISIONS

SHEET:

28 OF 37



P.O. Box 2566
 Asheville, NC 28802
 (828) 575-9021
 www.keemap.com
 License # C-3039

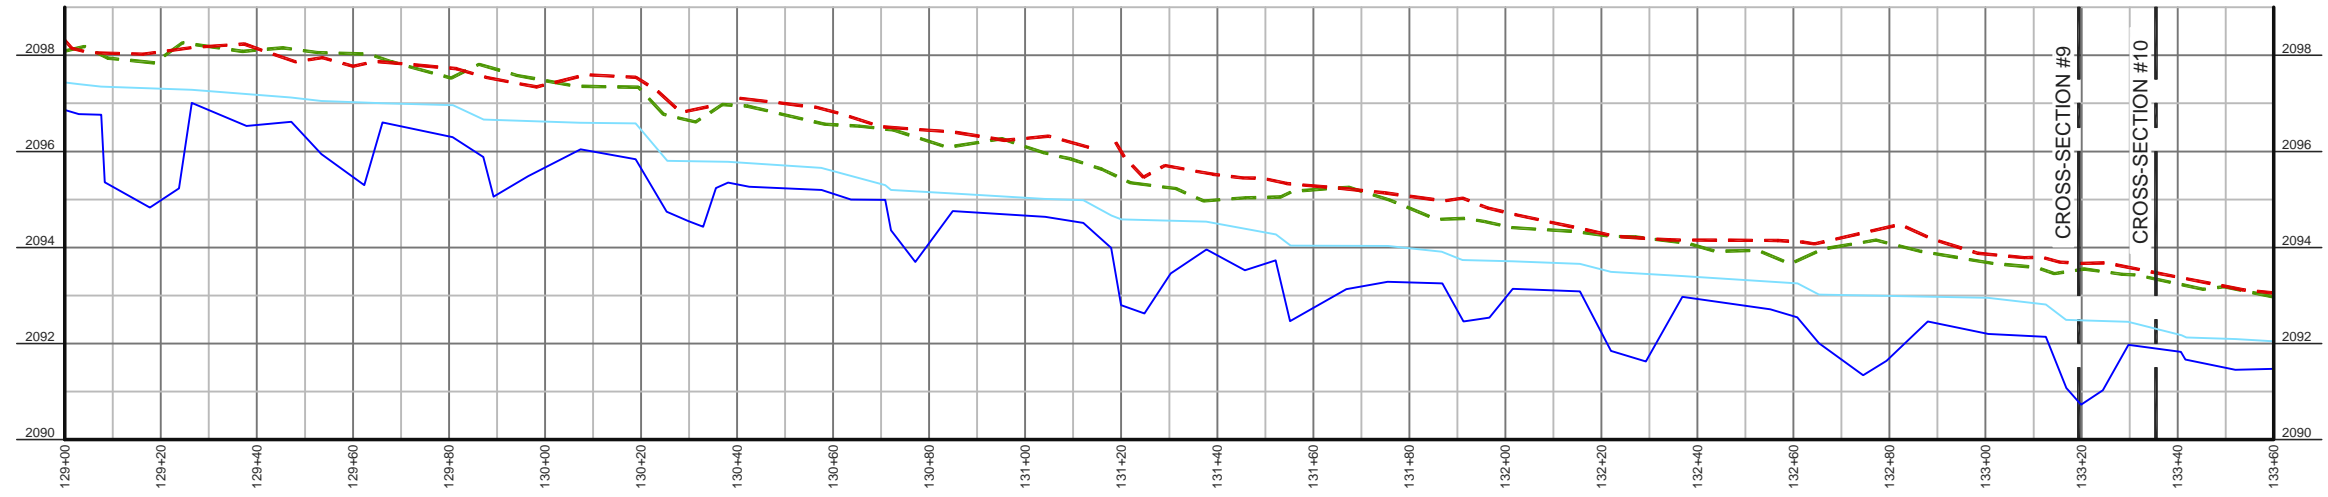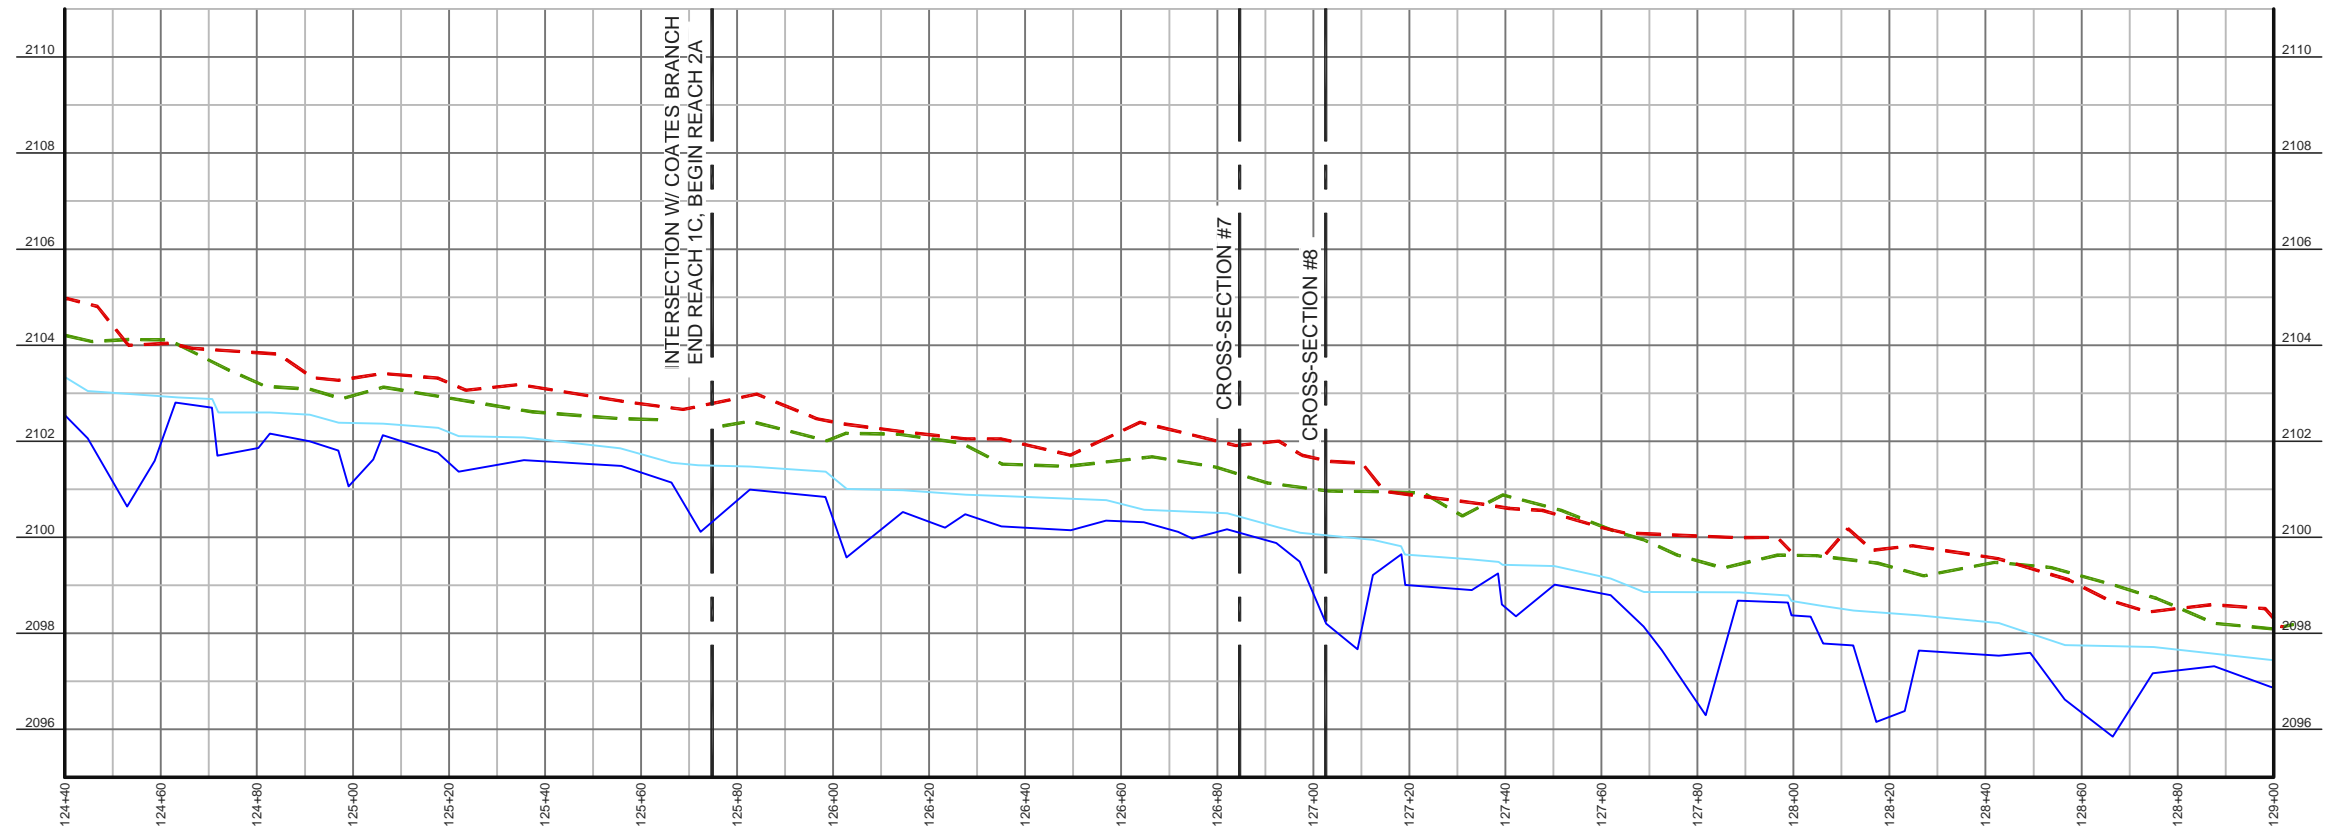


LONGITUDINAL PROFILE- FLETCHER CREEK

HORIZONTAL: 1" = 40'
 VERTICAL: 1" = 4'

LEGEND

- THALWEG
- WATER SURFACE
- - - RIGHT TOP OF BANK
- - - LEFT TOP OF BANK

SEAL:

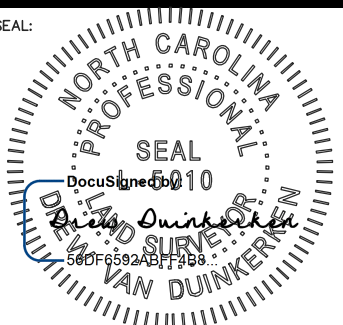

PLEASE REFER TO THE COVERSHEET FOR THE STATEMENT OF CERTIFICATION

NOTE: SEE SHEET 1 FOR SURVEYOR'S NOTES & LEGEND

ELEVATION DATUM: NAVD 88
 CONTOUR INTERVAL: 1 FOOT

AN AS-BUILT SURVEY FOR:
 EW SOLUTIONS, LLC.

SPO FILE NO's. 45-CZ, 45-DA, & 45-DB
 SPO FILE NO's. 45-CY, 45-CX
 DMS PROJECT NO. 100004

PROJECT:
**FLETCHER SITE
 MITIGATION PROJECT**

SHEET TITLE:

STREAM DATA:
 LONGITUDINAL PROFILE
 FLETCHER CREEK

TOWNSHIP: FLETCHER	COUNTY: HENDERSON	STATE: NORTH CAROLINA
-----------------------	----------------------	--------------------------

DRAWN BY: NH/JA	CHECKED BY: LDP/PBK	SURVEY BY: CB,NMH,LDP,JM,AC
--------------------	------------------------	--------------------------------

SCALE: AS SHOWN	SURVEY DATES: 12/17/19 - 03/22/19
--------------------	--------------------------------------

JOB: #1811142-AB	SHEET SIZE: 11" X 17"
---------------------	--------------------------



#	DATE	REVISIONS

SHEET:

29 OF **37**



P.O. Box 2566
 Asheville, NC 28802
 (828) 575-9021
 www.keemap.com
 License # C-3039

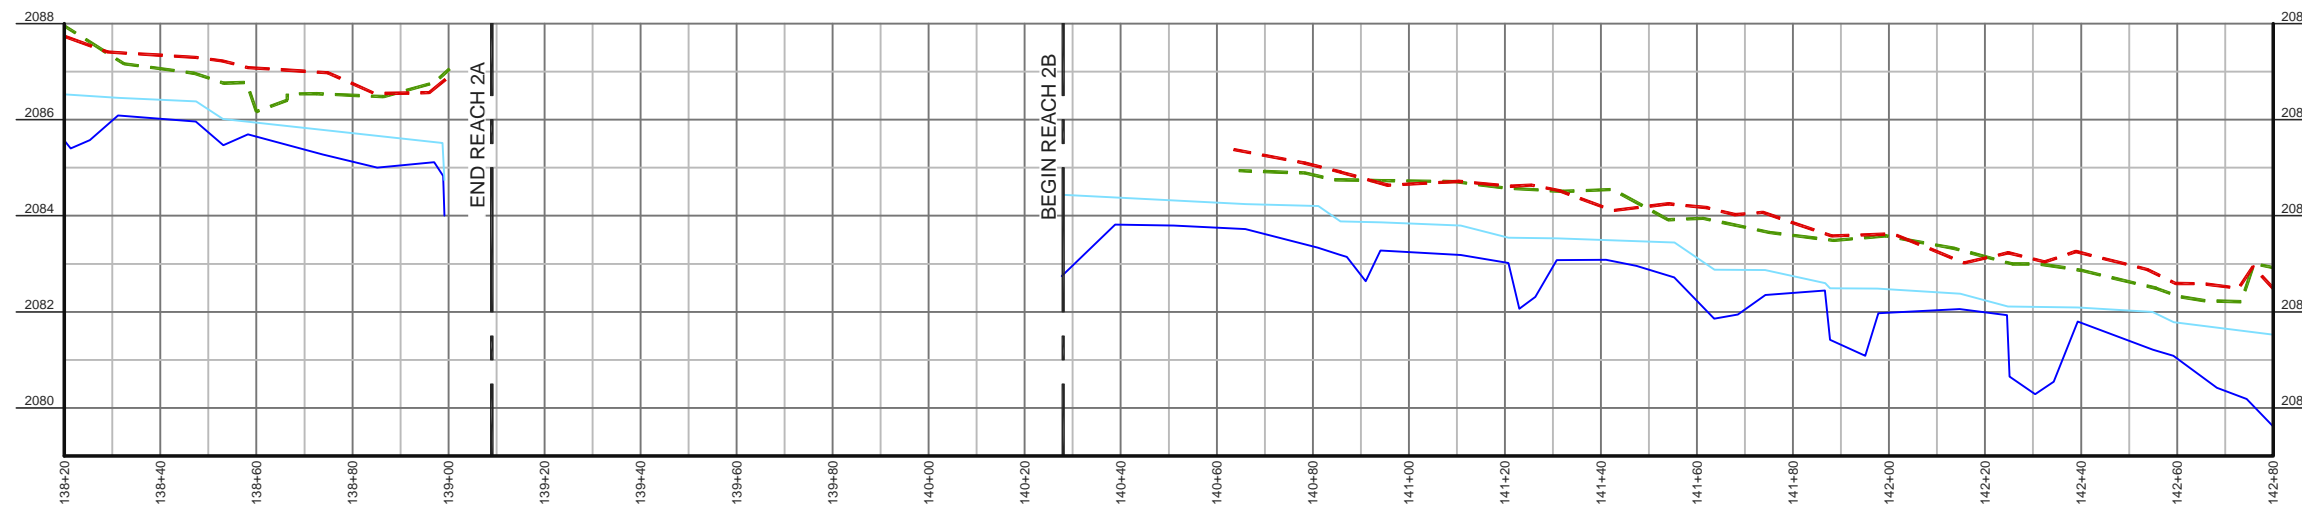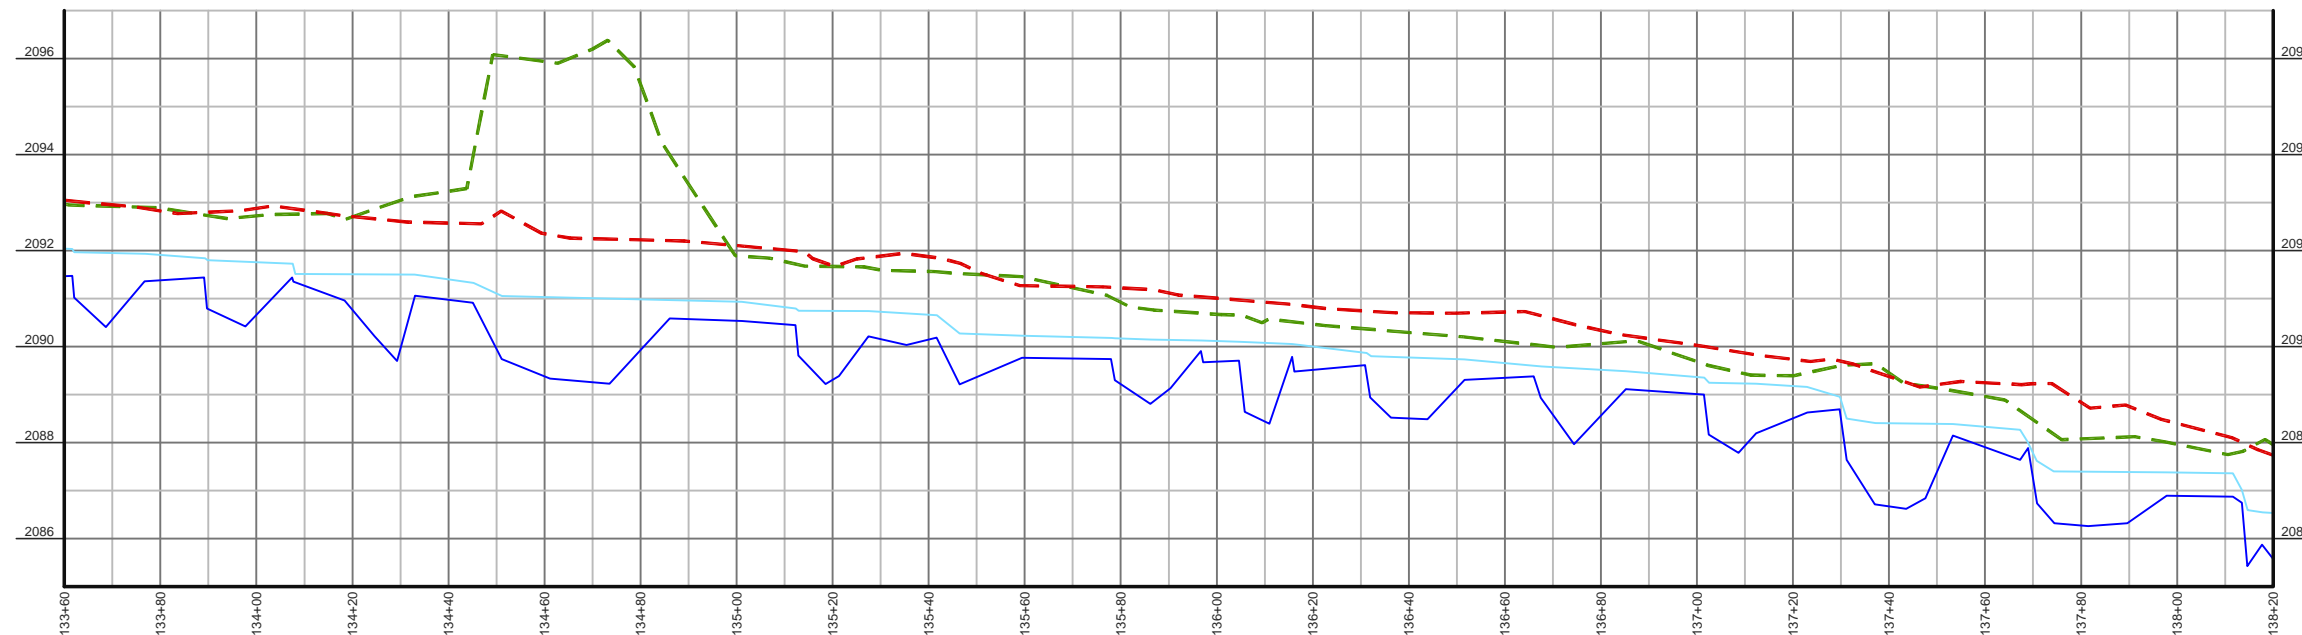


LONGITUDINAL PROFILE- FLETCHER CREEK

HORIZONTAL: 1" = 40'
 VERTICAL: 1" = 4'

LEGEND

- THALWEG
- WATER SURFACE
- - - RIGHT TOP OF BANK
- - - LEFT TOP OF BANK

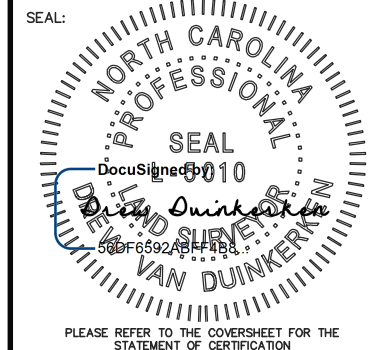

PLEASE REFER TO THE COVERSHEET FOR THE STATEMENT OF CERTIFICATION

NOTE: SEE SHEET 1 FOR SURVEYOR'S NOTES & LEGEND

ELEVATION DATUM: NAVD 88
 CONTOUR INTERVAL: 1 FOOT

AN AS-BUILT SURVEY FOR:
 EW SOLUTIONS, LLC.

SPO FILE NO's. 45-CZ, 45-DA, & 45-DB
 SPO FILE NO's. 45-CY, 45-CX
 DMS PROJECT NO. 100004

PROJECT:
**FLETCHER SITE
 MITIGATION PROJECT**

SHEET TITLE:

STREAM DATA:
 LONGITUDINAL PROFILE
 FLETCHER CREEK

TOWNSHIP: FLETCHER COUNTY: HENDERSON STATE: NORTH CAROLINA

DRAWN BY: NH/JA CHECKED BY: LDP/PBK SURVEY BY: CB,NMH,LDP,JM,AC

SCALE: AS SHOWN SURVEY DATES: 12/17/19 - 03/22/19




JOB: #1811142-AB SHEET SIZE: 11" X 17"

#	DATE	REVISIONS

SHEET:
30 OF 37



P.O. Box 2566
 Asheville, NC 28802
 (828) 575-9021
 www.keemap.com
 License # C-3039

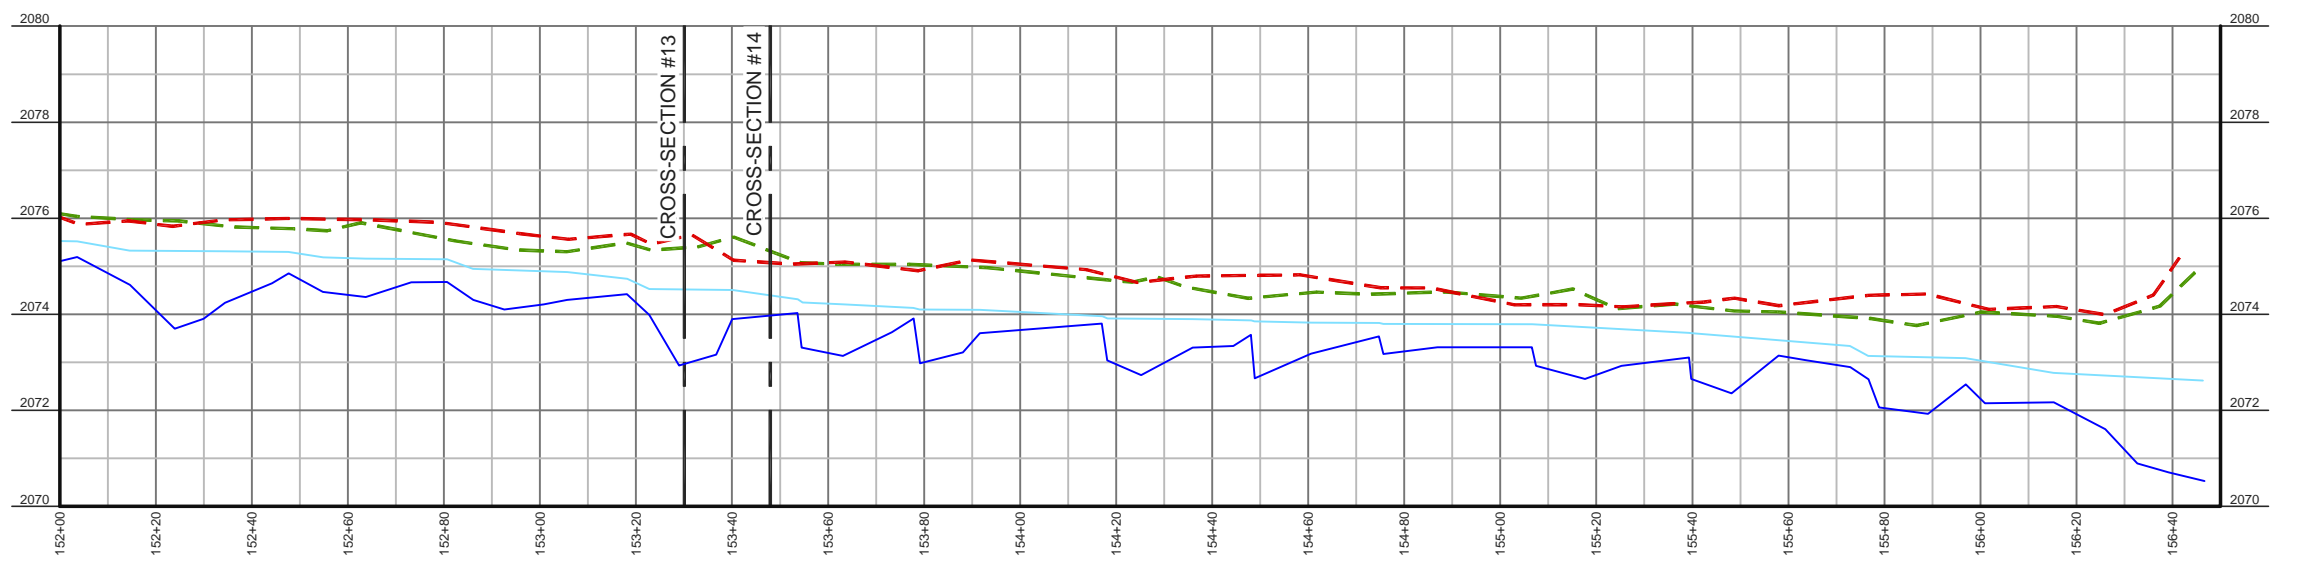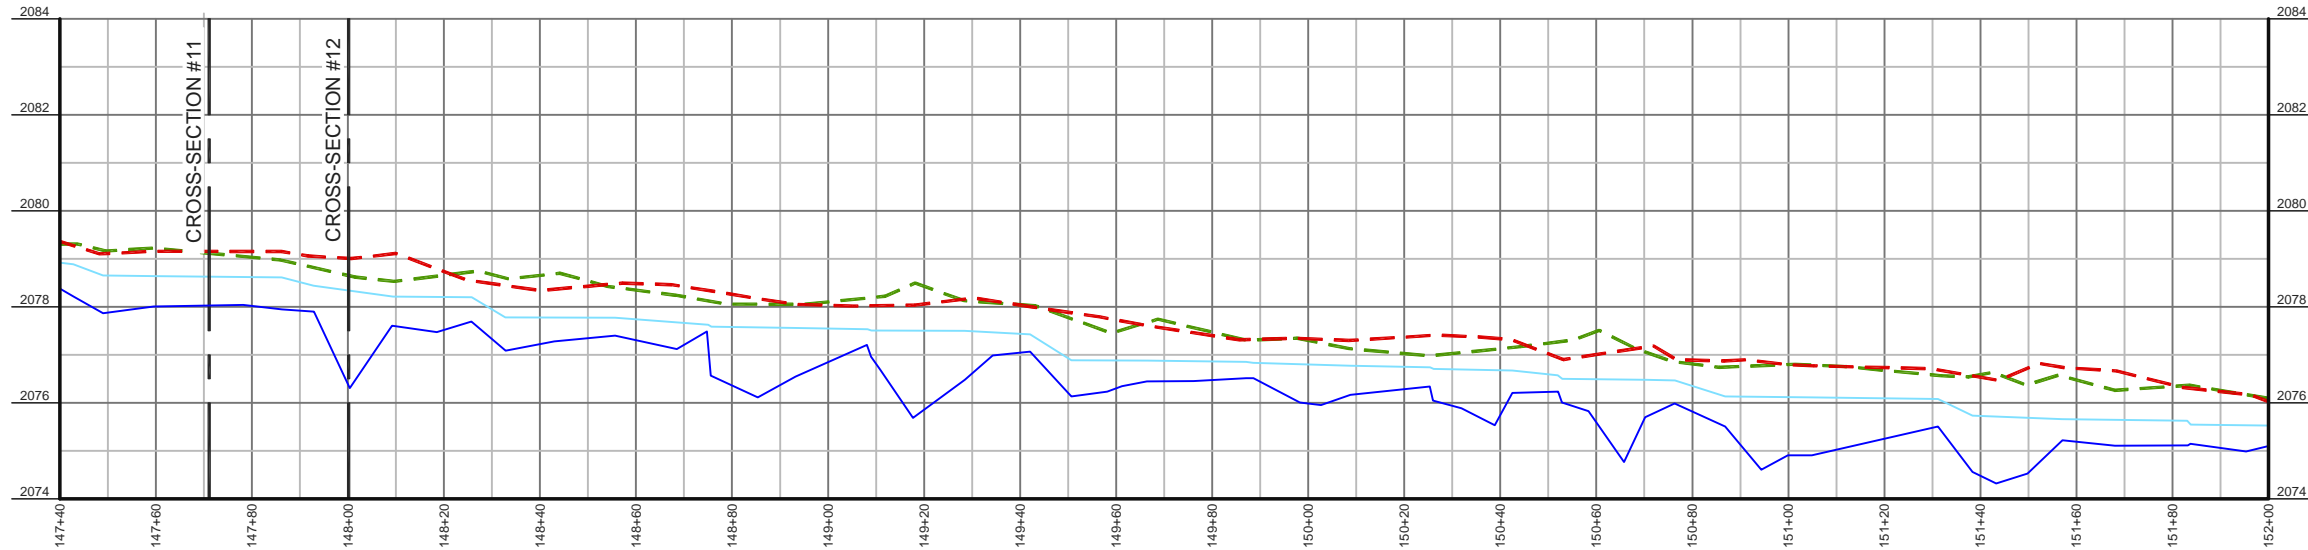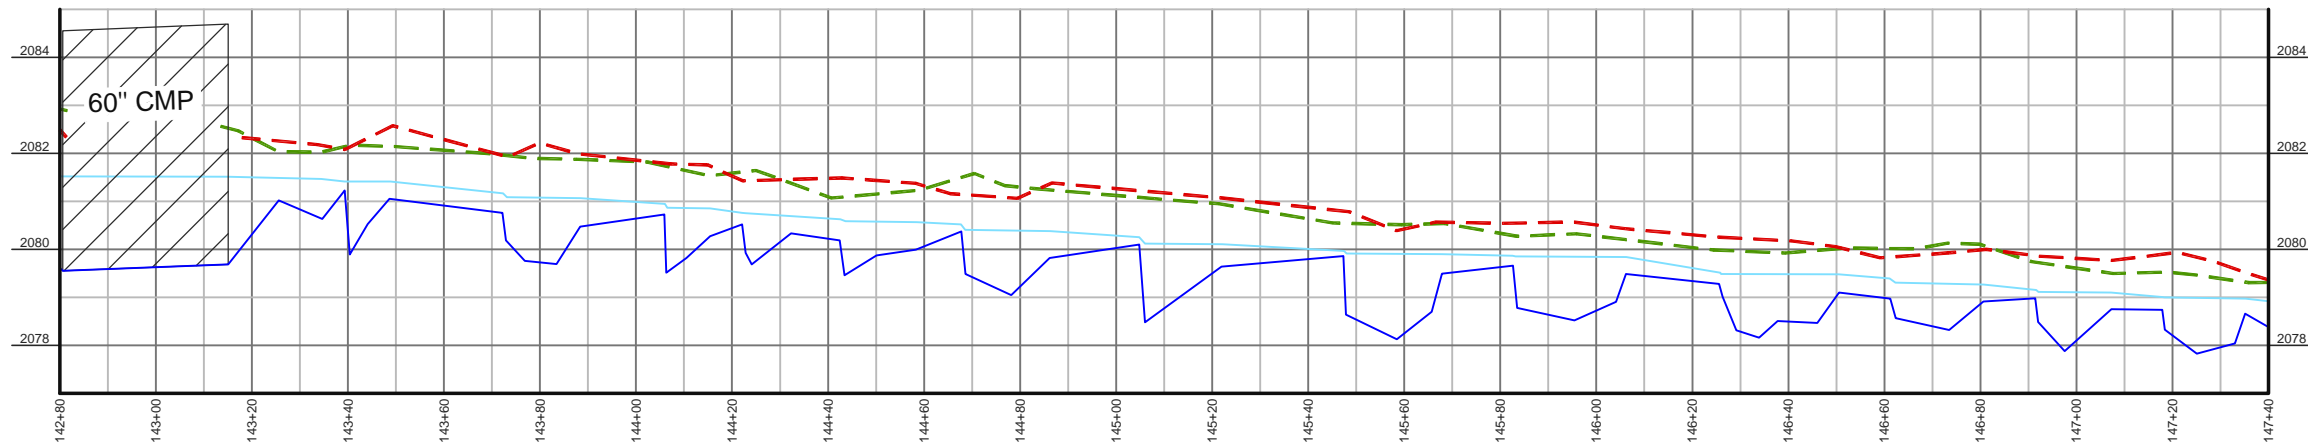

LONGITUDINAL PROFILE- FLETCHER CREEK
 HORIZONTAL: 1" = 40'
 VERTICAL: 1" = 4'

LEGEND

- THALWEG
- WATER SURFACE
- - - RIGHT TOP OF BANK
- - - LEFT TOP OF BANK

SEAL:

PLEASE REFER TO THE COVERSHEET FOR THE STATEMENT OF CERTIFICATION

NOTE: SEE SHEET 1 FOR SURVEYOR'S NOTES & LEGEND

ELEVATION DATUM: NAVD 88
 CONTOUR INTERVAL: 1 FOOT

AN AS-BUILT SURVEY FOR:
 EW SOLUTIONS, LLC.

SPO FILE NO's. 45-CZ, 45-DA, & 45-DB
 SPO FILE NO's. 45-CY, 45-CX
 DMS PROJECT NO. 100004

PROJECT:
**FLETCHER SITE
 MITIGATION PROJECT**


SHEET TITLE:
 STREAM DATA:
 LONGITUDINAL PROFILE
 FLETCHER CREEK

TOWNSHIP: FLETCHER	COUNTY: HENDERSON	STATE: NORTH CAROLINA
DRAWN BY: NH/JA	CHECKED BY: LDP/PBK	SURVEY BY: CB,NMH,LDP,JM,AC
SCALE: AS SHOWN	SURVEY DATES: 12/17/19 - 03/22/19	
JOB: #1811142-AB	SHEET SIZE: (HALF SIZE) 11" X 17"	
#	DATE	REVISIONS

SHEET:
31 OF **37**



P.O. Box 2566
 Asheville, NC 28802
 (828) 575-9021
 www.keemap.com
 License # C-3039

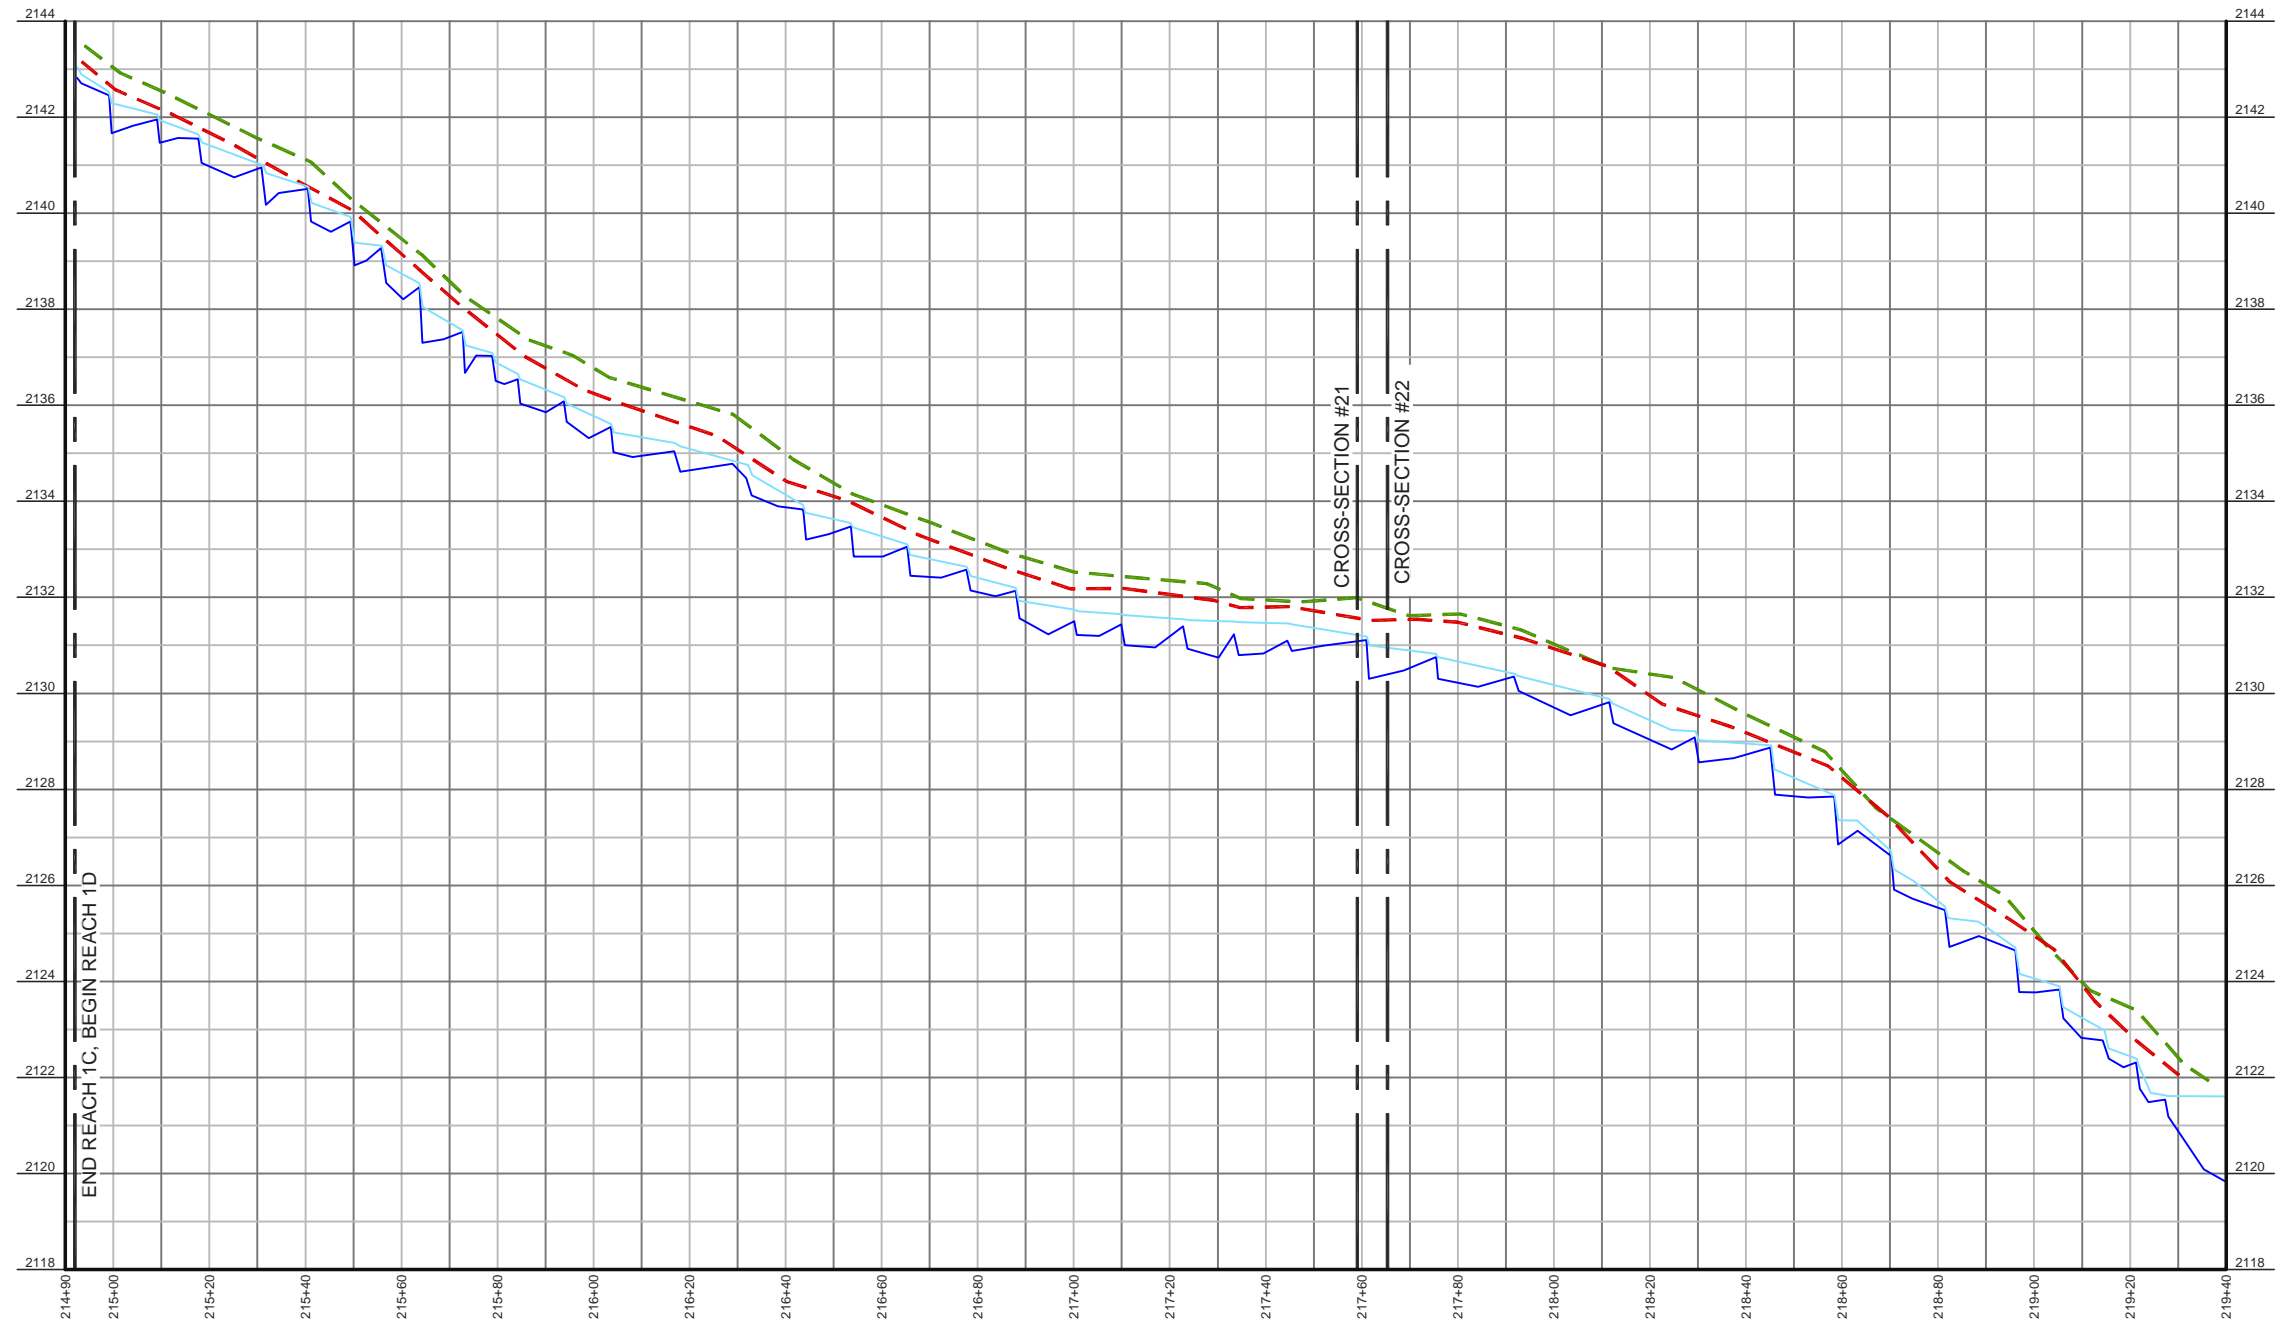


LONGITUDINAL PROFILE- RACCOON BRANCH
 HORIZONTAL: 1" = 40'
 VERTICAL: 1" = 4'

LEGEND

- THALWEG
- WATER SURFACE
- - - RIGHT TOP OF BANK
- - - LEFT TOP OF BANK

SEAL:

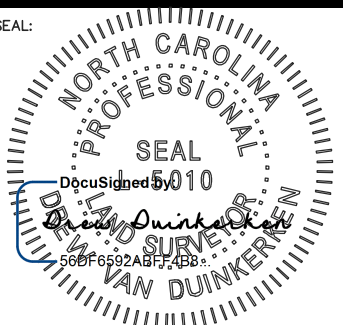

PLEASE REFER TO THE COVERSHEET FOR THE STATEMENT OF CERTIFICATION

NOTE: SEE SHEET 1 FOR SURVEYOR'S NOTES & LEGEND

ELEVATION DATUM: NAVD 88
 CONTOUR INTERVAL: 1 FOOT

AN AS-BUILT SURVEY FOR:
 EW SOLUTIONS, LLC.

SPO FILE NO's. 45-CZ, 45-DA, & 45-DB
 SPO FILE NO's. 45-CY, 45-CX
 DMS PROJECT NO. 100004

PROJECT:
 FLETCHER SITE
 MITIGATION PROJECT

SHEET TITLE:

STREAM DATA:
 LONGITUDINAL PROFILE
 RACCOON BRANCH

TOWNSHIP: FLETCHER	COUNTY: HENDERSON	STATE: NORTH CAROLINA
DRAWN BY: NH/JA	CHECKED BY: LDP/PBK	SURVEY BY: CB,NMH,LDP,JM,AC
SCALE: AS SHOWN	SURVEY DATES: 12/17/19 - 03/22/19	
JOB: #1811142-AB	SHEET SIZE: (HALF SIZE) 11" X 17"	



#	DATE	REVISIONS

SHEET:

32 OF 37



P.O. Box 2566
 Asheville, NC 28802
 (828) 575-9021
 www.keemap.com
 License # C-3039

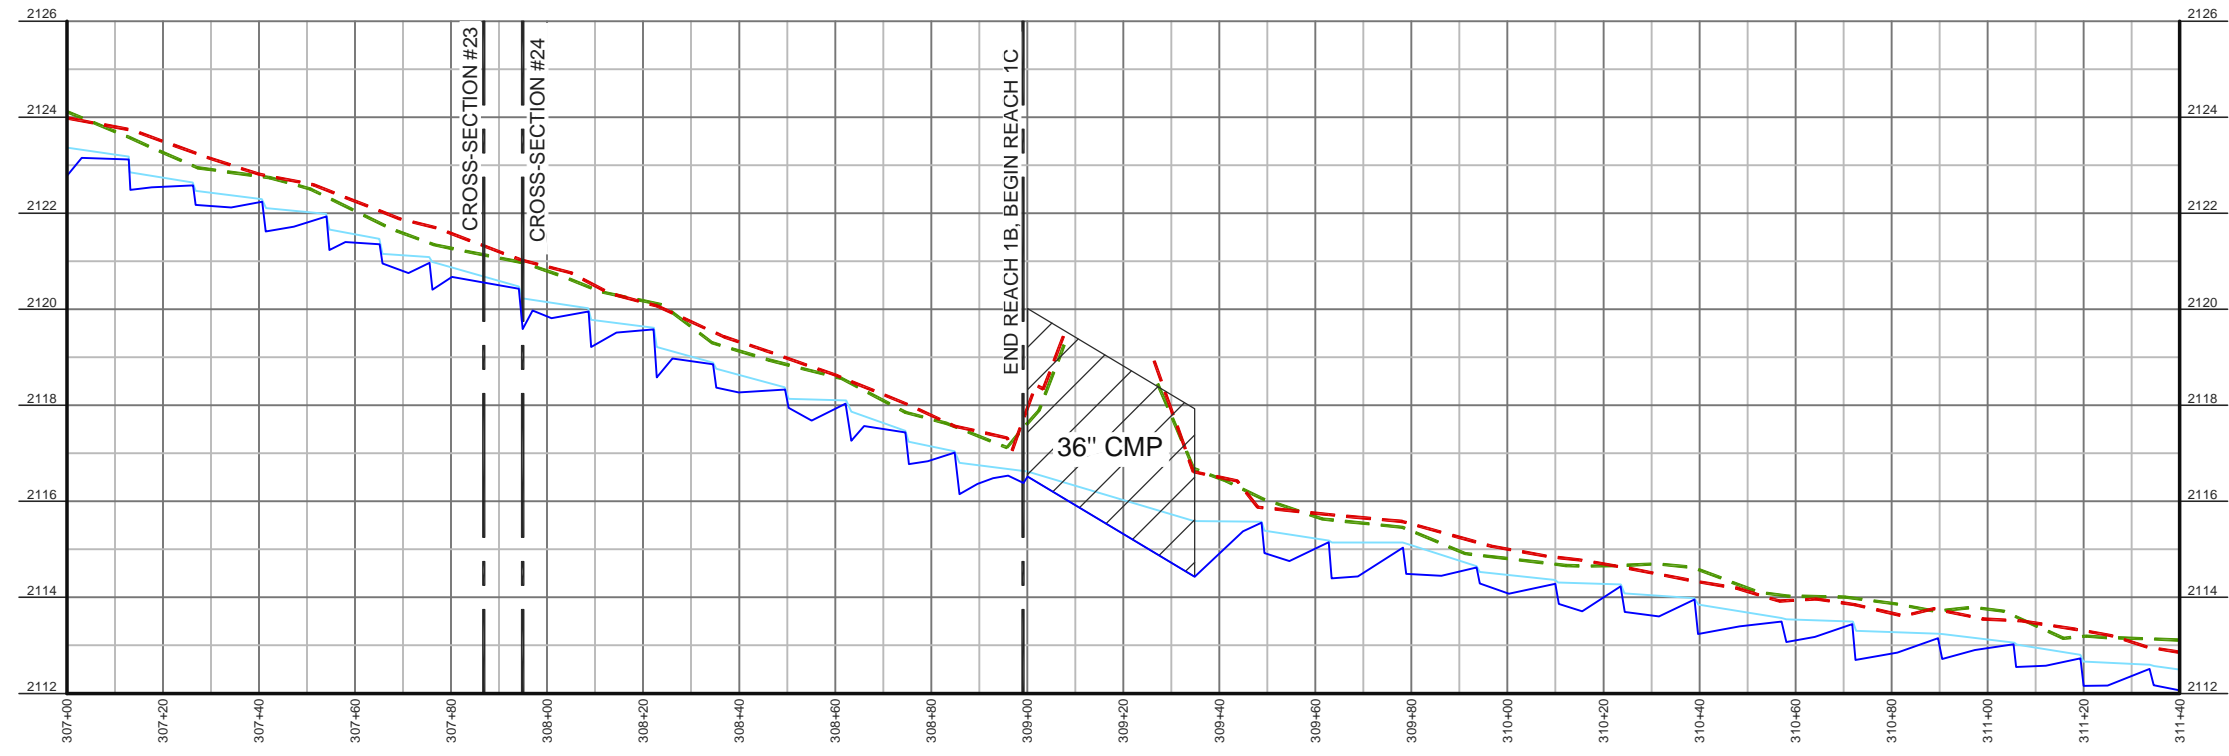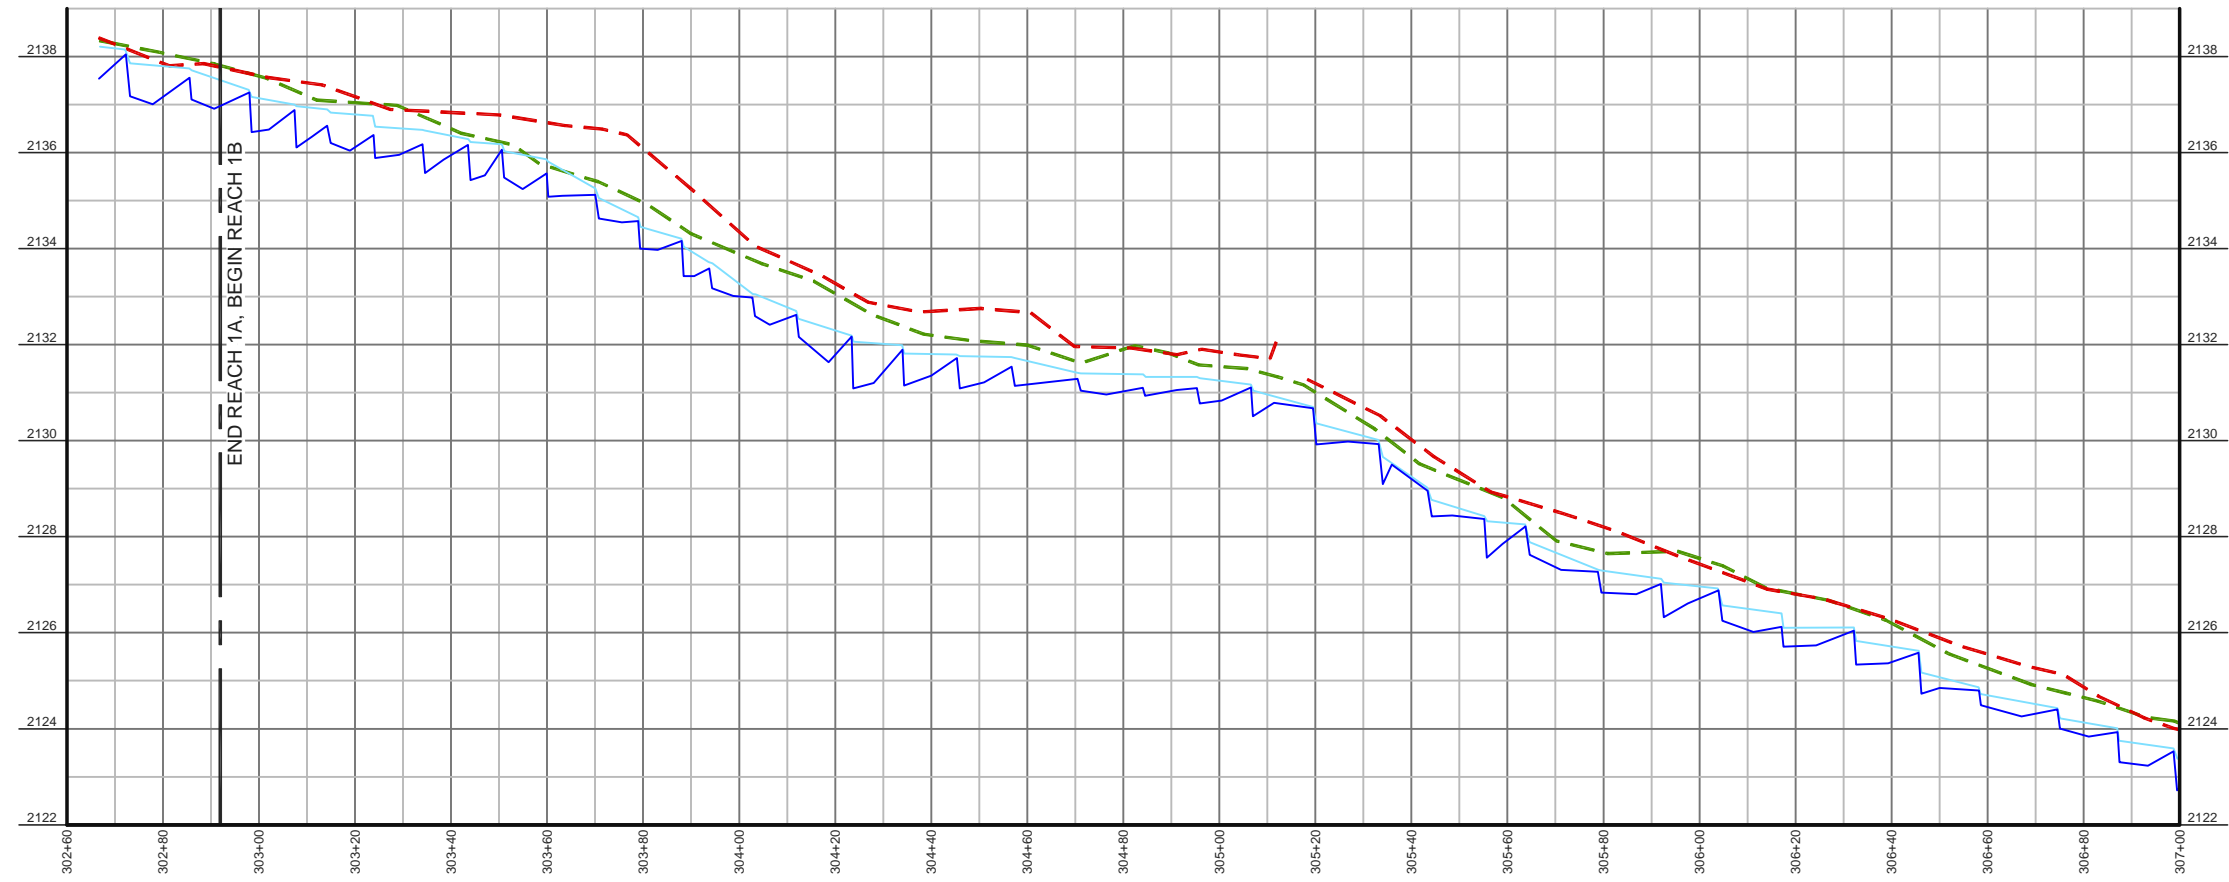

LONGITUDINAL PROFILE- COATES BRANCH
 HORIZONTAL: 1" = 40'
 VERTICAL: 1" = 4'

- LEGEND**
- THALWEG
 - WATER SURFACE
 - - - RIGHT TOP OF BANK
 - - - LEFT TOP OF BANK

SEAL:

PLEASE REFER TO THE COVERSHEET FOR THE STATEMENT OF CERTIFICATION

NOTE: SEE SHEET 1 FOR SURVEYOR'S NOTES & LEGEND

ELEVATION DATUM: NAVD 88
 CONTOUR INTERVAL: 1 FOOT

AN AS-BUILT SURVEY FOR:
 EW SOLUTIONS, LLC.

SPO FILE NO's. 45-CZ, 45-DA, & 45-DB
 SPO FILE NO's. 45-CY, 45-CX
 DMS PROJECT NO. 100004

PROJECT:
**FLETCHER SITE
 MITIGATION PROJECT**



SHEET TITLE:
 STREAM DATA:
 LONGITUDINAL PROFILE
 COATES BRANCH

TOWNSHIP: FLETCHER	COUNTY: HENDERSON	STATE: NORTH CAROLINA
DRAWN BY: NH/JA	CHECKED BY: LDP/PBK	SURVEY BY: CB,NMH,LDP,JM,AC
SCALE: AS SHOWN	SURVEY DATES: 12/17/19 - 03/22/19	
JOB: #181142-AB	SHEET SIZE: (HALF SIZE) 11" X 17"	
#	DATE	REVISIONS

SHEET:
33 OF 37



P.O. Box 2566
 Asheville, NC 28802
 (828) 575-9021
 www.keemap.com
 License # C-3039

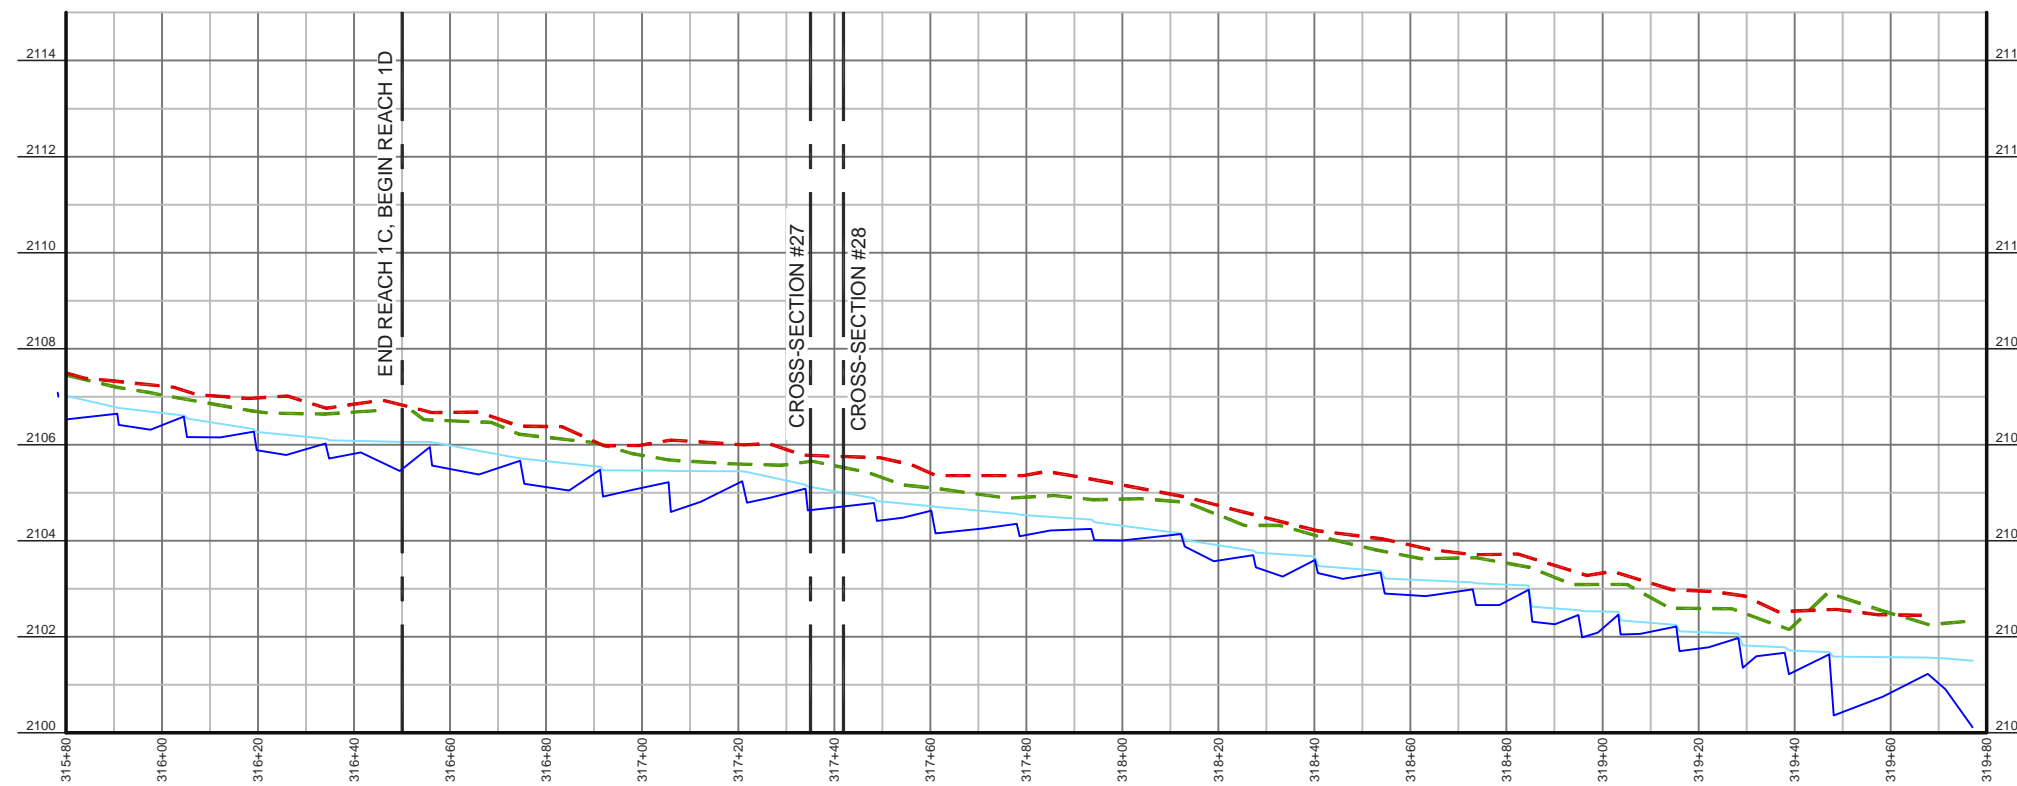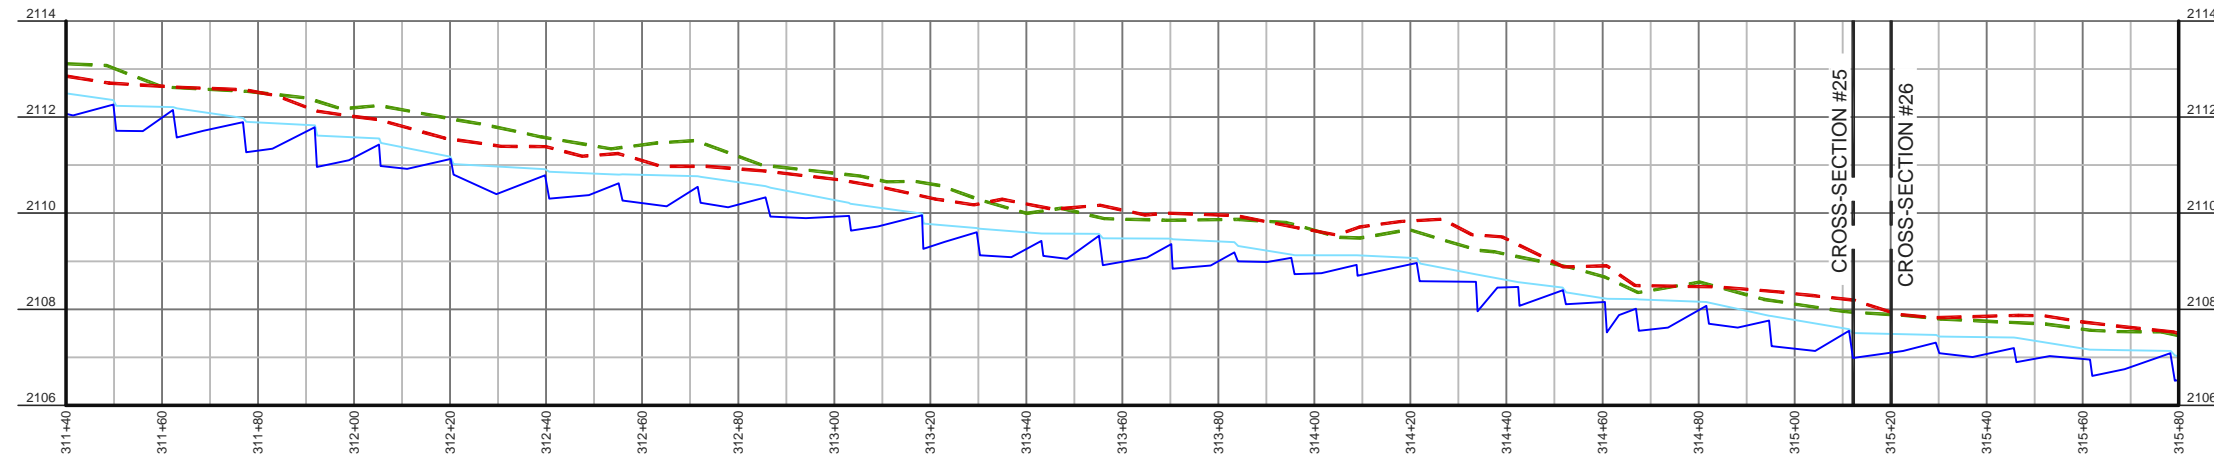


LONGITUDINAL PROFILE- COATES BRANCH

HORIZONTAL: 1" = 40'
 VERTICAL: 1" = 4'

LEGEND

- THALWEG
- WATER SURFACE
- - - RIGHT TOP OF BANK
- - - LEFT TOP OF BANK

SEAL:

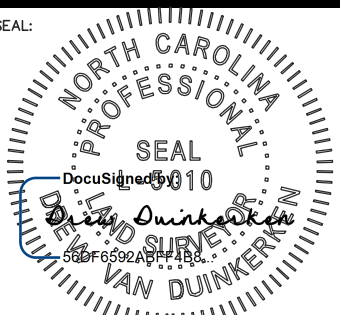

PLEASE REFER TO THE COVERSHEET FOR THE STATEMENT OF CERTIFICATION

NOTE: SEE SHEET 1 FOR SURVEYOR'S NOTES & LEGEND

ELEVATION DATUM: NAVD 88
 CONTOUR INTERVAL: 1 FOOT

AN AS-BUILT SURVEY FOR:
 EW SOLUTIONS, LLC.

SPO FILE NO's. 45-CZ, 45-DA, & 45-DB
 SPO FILE NO's. 45-CY, 45-CX
 DMS PROJECT NO. 100004

PROJECT:
**FLETCHER SITE
 MITIGATION PROJECT**

SHEET TITLE:

STREAM DATA:
 LONGITUDINAL PROFILE
 COATES BRANCH

TOWNSHIP: FLETCHER COUNTY: HENDERSON STATE: NORTH CAROLINA

DRAWN BY: NH/JA CHECKED BY: LDP/PBK SURVEY BY: CB,NMH,LDP,JM,AC

SCALE: AS SHOWN SURVEY DATES: 12/17/19 - 03/22/19

JOB: #1811142-AB SHEET SIZE: (HALF SIZE) 11" X 17"


#	DATE	REVISIONS

SHEET:

34 OF **37**



P.O. Box 2566
 Asheville, NC 28802
 (828) 575-9021
 www.keemap.com
 License # C-3039

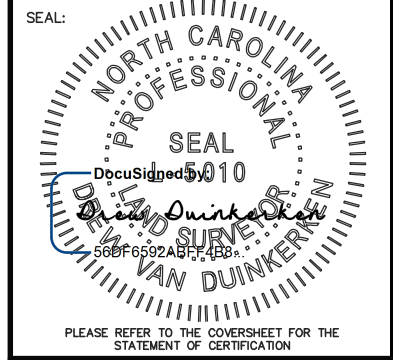

PLEASE REFER TO THE COVERSHEET FOR THE STATEMENT OF CERTIFICATION

NOTE: SEE SHEET 1 FOR SURVEYOR'S NOTES & LEGEND

ELEVATION DATUM: NAVD 88
 CONTOUR INTERVAL: 1 FOOT

AN AS-BUILT SURVEY FOR:
 EW SOLUTIONS, LLC.

SPO FILE NO's. 45-CZ, 45-DA, & 45-DB
 SPO FILE NO's. 45-CY, 45-CX
 DMS PROJECT NO. 100004

PROJECT:
 FLETCHER SITE
 MITIGATION PROJECT

SHEET TITLE:
 STREAM DATA:
 LONGITUDINAL PROFILE
 COATES BRANCH

TOWNSHIP: FLETCHER	COUNTY: HENDERSON	STATE: NORTH CAROLINA
-----------------------	----------------------	--------------------------

DRAWN BY: NH/JA	CHECKED BY: LDP/PBK	SURVEY BY: CB,NMH,LDP,JM,AC
--------------------	------------------------	--------------------------------



SCALE: AS SHOWN	SURVEY DATES: 12/17/19 - 03/22/19
JOB: #181142-AB	SHEET SIZE: (HALF SIZE) 11" X 17"

#	DATE	REVISIONS

SHEET:
 35 OF 37





P.O. Box 2566
 Asheville, NC 28802
 (828) 575-9021
 www.keemap.com
 License # C-3039

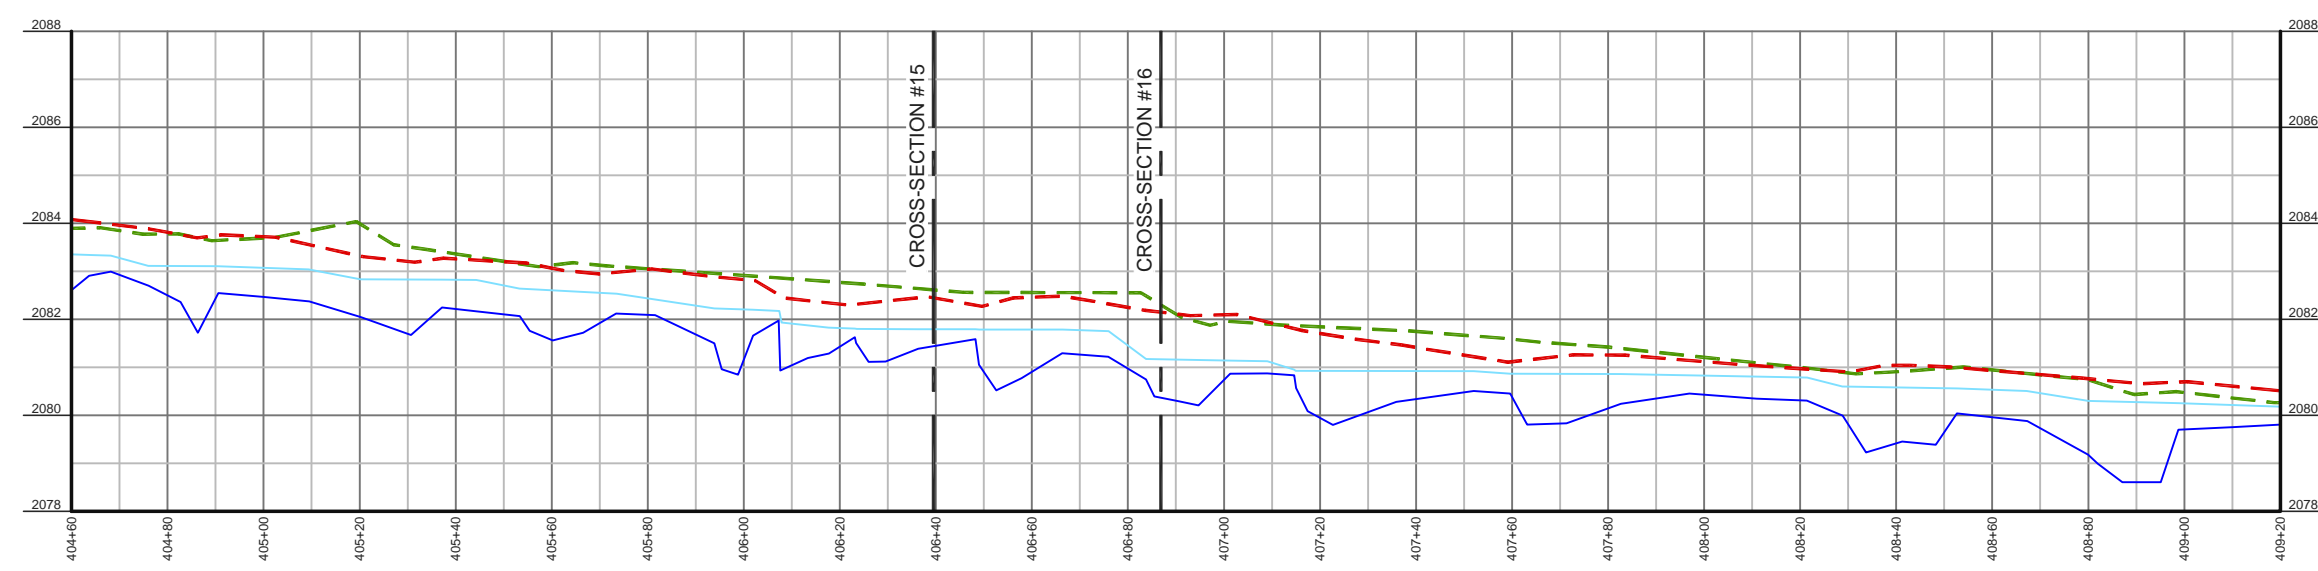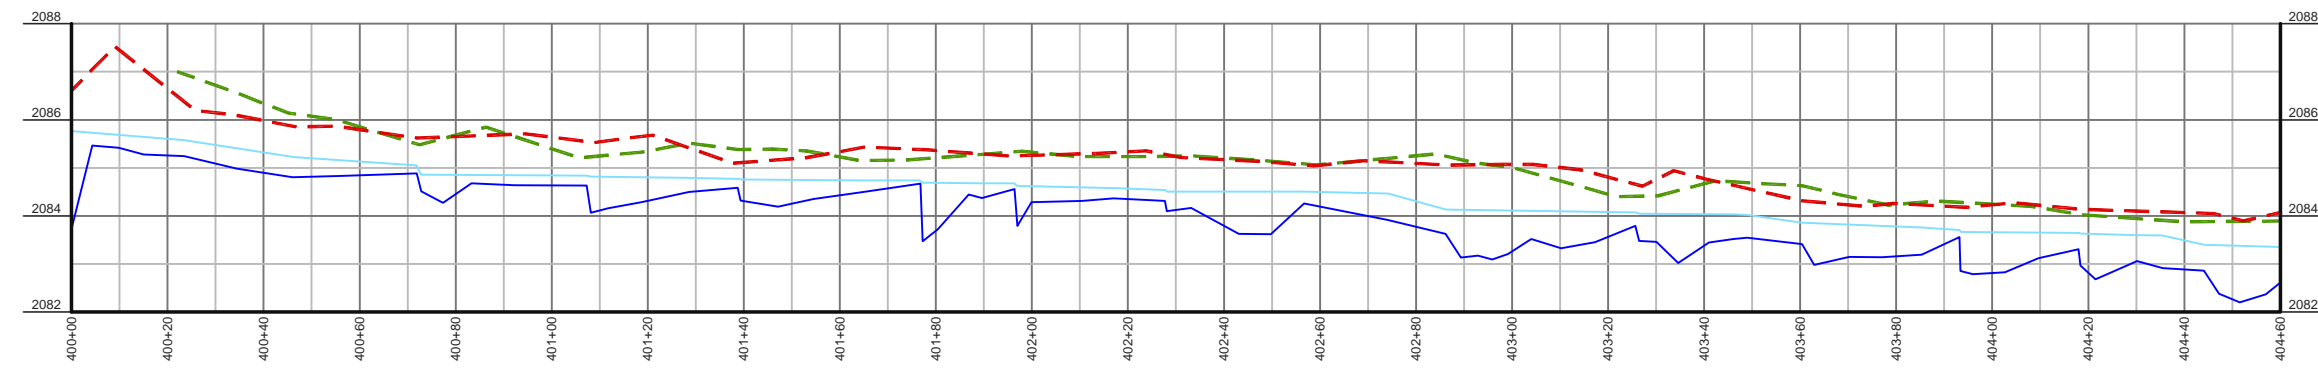

LONGITUDINAL PROFILE- WESTON CREEK
 HORIZONTAL: 1" = 40'
 VERTICAL: 1" = 4'

- LEGEND**
- THALWEG
 - WATER SURFACE
 - - - RIGHT TOP OF BANK
 - - - LEFT TOP OF BANK

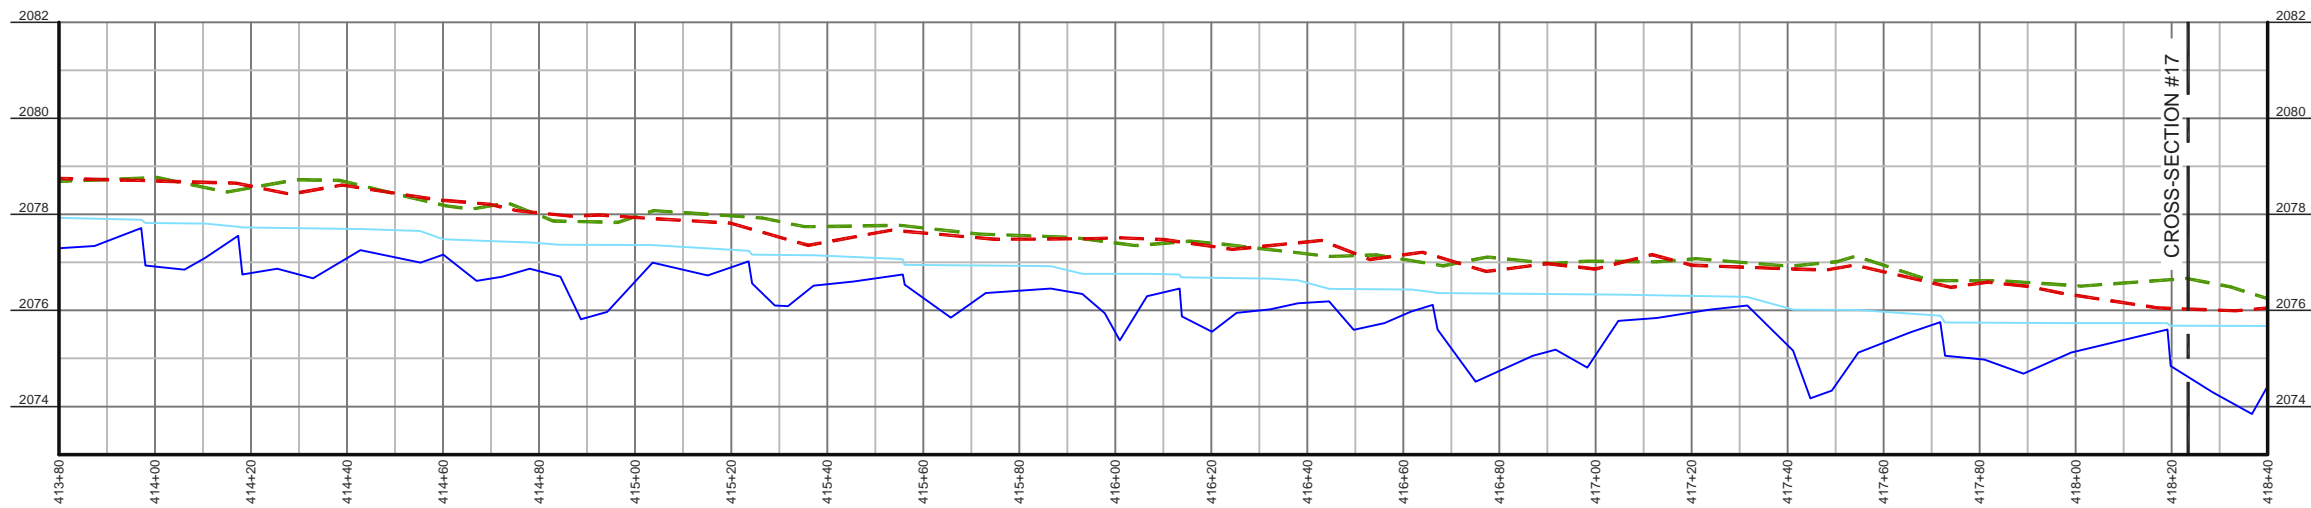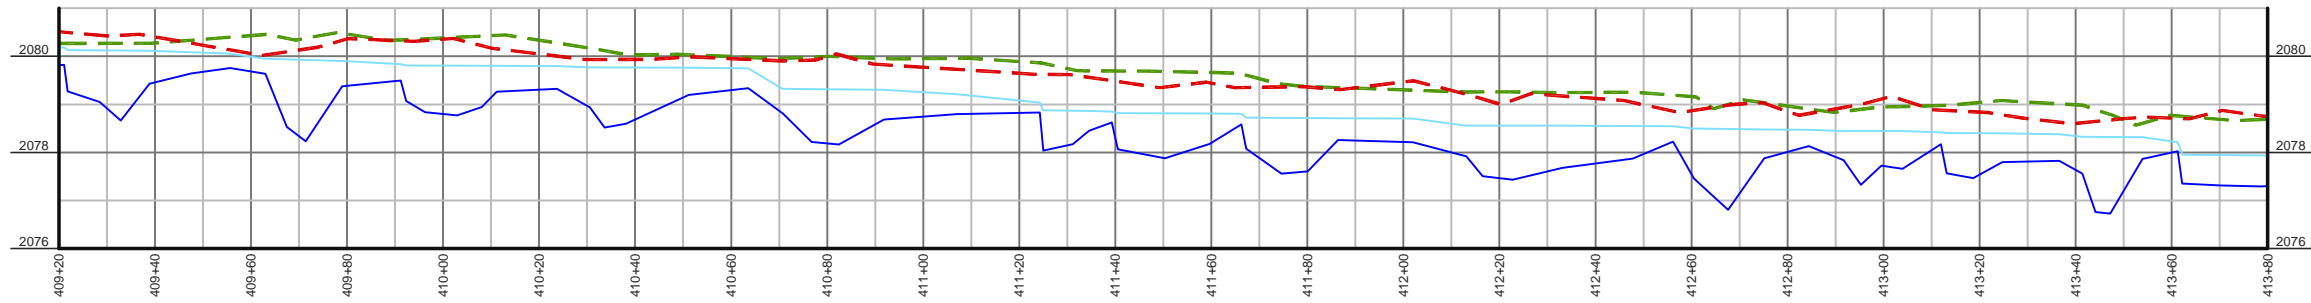


LONGITUDINAL PROFILE- WESTON CREEK
 HORIZONTAL: 1" = 40'
 VERTICAL: 1" = 4'

LEGEND

- THALWEG
- WATER SURFACE
- - - RIGHT TOP OF BANK
- - - LEFT TOP OF BANK

SEAL:

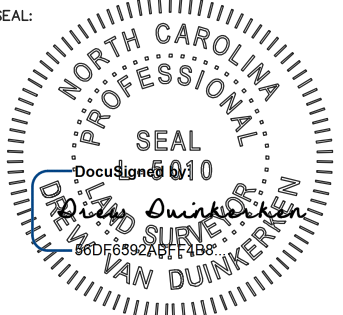

PLEASE REFER TO THE COVERSHEET FOR THE STATEMENT OF CERTIFICATION

NOTE: SEE SHEET 1 FOR SURVEYOR'S NOTES & LEGEND

ELEVATION DATUM: NAVD 88
 CONTOUR INTERVAL: 1 FOOT

AN AS-BUILT SURVEY FOR:
 EW SOLUTIONS, LLC.

SPO FILE NO's. 45-CZ, 45-DA, & 45-DB
 SPO FILE NO's. 45-CY, 45-CX
 DMS PROJECT NO. 100004

PROJECT:
 FLETCHER SITE
 MITIGATION PROJECT

SHEET TITLE:

STREAM DATA:
 LONGITUDINAL PROFILE
 WESTON CREEK

TOWNSHIP: FLETCHER	COUNTY: HENDERSON	STATE: NORTH CAROLINA
-----------------------	----------------------	--------------------------

DRAWN BY: NH/JA	CHECKED BY: LDP/PBK	SURVEY BY: CB,NMH,LDP,JM,AC
--------------------	------------------------	--------------------------------

SCALE: AS SHOWN	SURVEY DATES: 12/17/19 - 03/22/19
--------------------	--------------------------------------

JOB: #181142-AB	SHEET SIZE: 11" X 17"
--------------------	--------------------------



#	DATE	REVISIONS

SHEET:

36 OF 37



P.O. Box 2566
 Asheville, NC 28802
 (828) 575-9021
 www.keemap.com
 License # C-3039

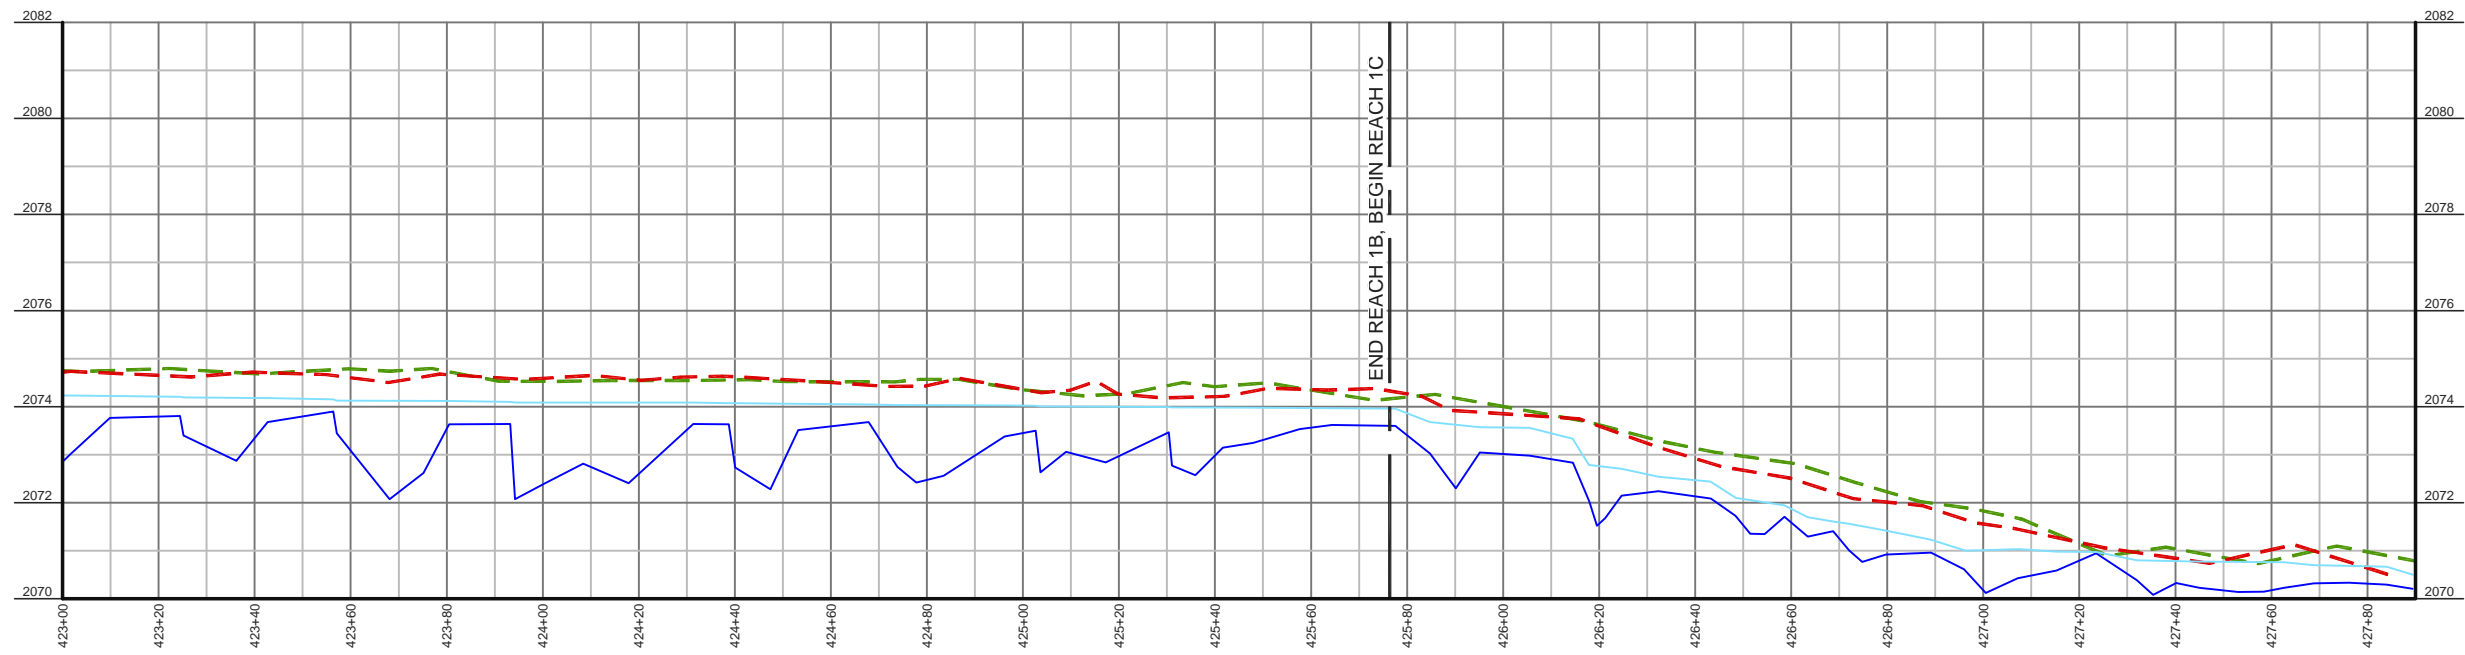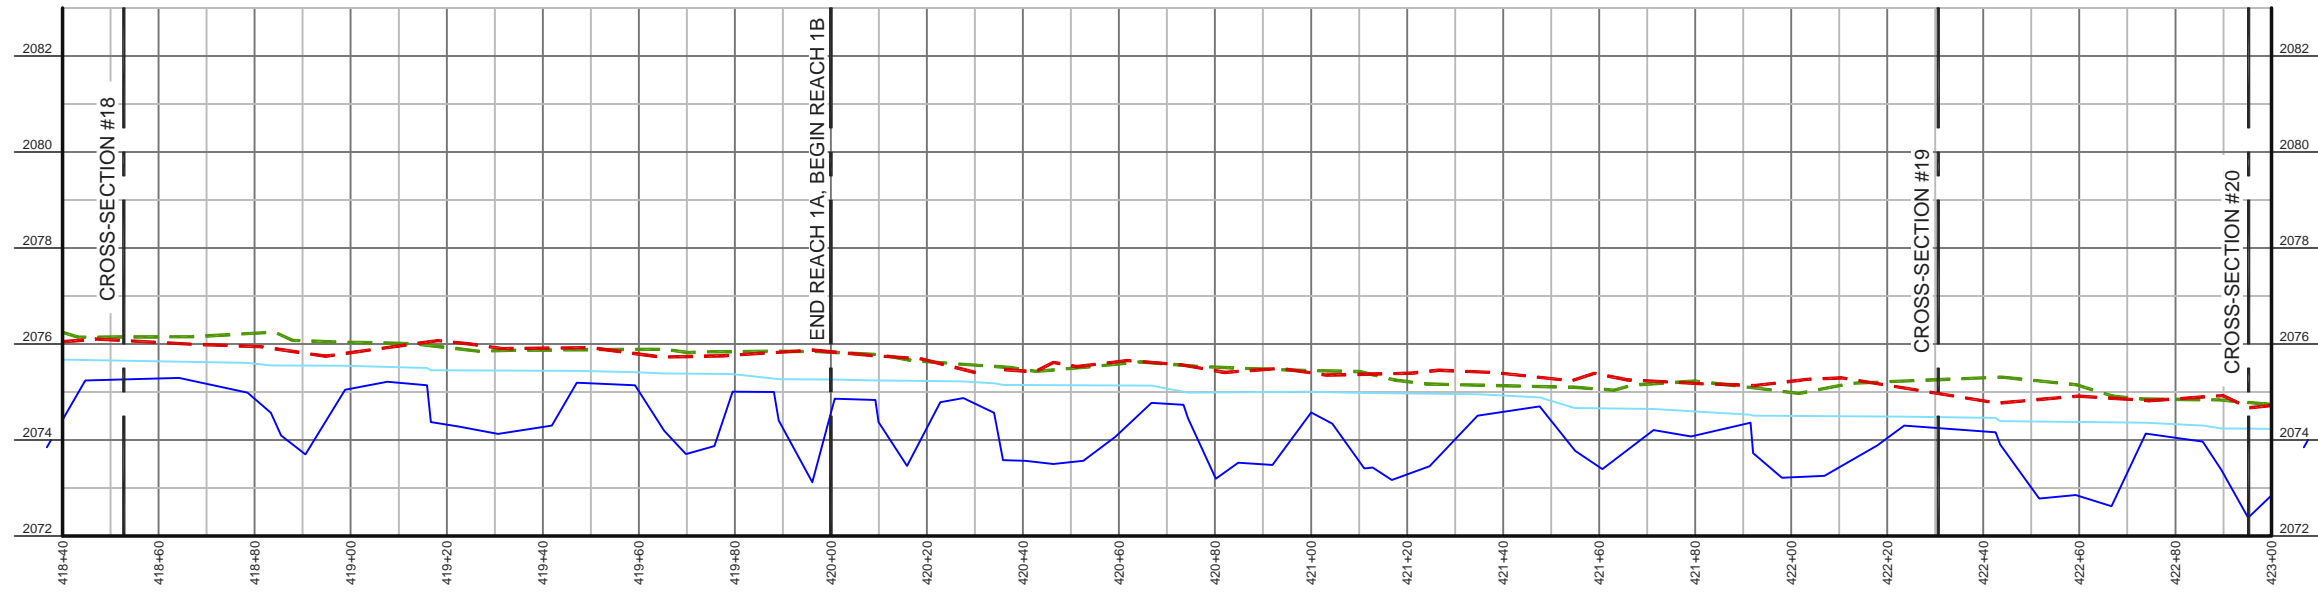

LONGITUDINAL PROFILE- WESTON CREEK


HORIZONTAL: 1" = 40'

VERTICAL: 1" = 4'

LEGEND

- THALWEG
- WATER SURFACE
- - - RIGHT TOP OF BANK
- - - LEFT TOP OF BANK

SEAL:

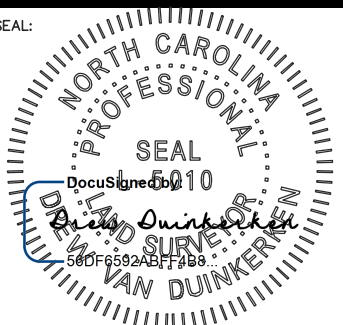

PLEASE REFER TO THE COVERSHEET FOR THE STATEMENT OF CERTIFICATION

NOTE: SEE SHEET 1 FOR SURVEYOR'S NOTES & LEGEND

ELEVATION DATUM: NAVD 88
CONTOUR INTERVAL: 1 FOOT

AN AS-BUILT SURVEY FOR:
EW SOLUTIONS, LLC.

SPO FILE NO's. 45-CZ, 45-DA, & 45-DB
SPO FILE NO's. 45-CY, 45-CX
DMS PROJECT NO. 100004

PROJECT:
**FLETCHER SITE
MITIGATION PROJECT**

SHEET TITLE:

STREAM DATA:
LONGITUDINAL PROFILE
WESTON CREEK

TOWNSHIP: FLETCHER	COUNTY: HENDERSON	STATE: NORTH CAROLINA
-----------------------	----------------------	--------------------------

DRAWN BY: NH/JA	CHECKED BY: LDP/PBK	SURVEY BY: CB,NMH,LDP,JM,AC
--------------------	------------------------	--------------------------------

SCALE: AS SHOWN	SURVEY DATES: 12/17/19 - 03/22/19
--------------------	--------------------------------------

JOB: #1811142-AB	SHEET SIZE: 11" X 17"
---------------------	--------------------------

#	DATE	REVISIONS

SHEET:

37 OF **37**



P.O. Box 2566
Asheville, NC 28802
(828) 575-9021
www.keemap.com
License # C-3039

