

# **Gray Farm Stream Restoration Monitoring Report – Year Three**

**Contract # D05016-2  
EEP Project # 92219**

**Iredell County, North Carolina**



**December 2008**

**Cataloging Unit – Catawba Basin 03050101**

**Prepared For:**



**1652 Mail Service Center  
Raleigh, NC 27699-1652**

## Table of Contents

<b>I. Executive Summary / Project Abstract</b> .....	<b>1</b>
<b>II. Project Background</b> .....	<b>2</b>
<b>1. Project Goals and Objectives</b> .....	<b>2</b>
<b>2. Project Structure, Restoration Type, and Approach</b> .....	<b>4</b>
<b>3. Location and Setting</b> .....	<b>5</b>
<b>4. Project History and Background</b> .....	<b>6</b>
<b>5. Monitoring Plan View</b> .....	<b>8</b>
<b>III. Project Condition and Monitoring Results</b> .....	<b>8</b>
<b>A. Vegetation Assessment</b> .....	<b>8</b>
<b>1. Problem Areas Plan View (Vegetation)</b> .....	<b>11</b>
<b>2. Vegetative Problem Areas Table Summary</b> .....	<b>12</b>
<b>3. Vegetative Problem Areas Plan View</b> .....	<b>12</b>
<b>B. Stream Assessment</b> .....	<b>12</b>
<b>1. Problem Areas Plan View (Stream)</b> .....	<b>13</b>
<b>2. Problem Areas Table Summary</b> .....	<b>13</b>
<b>3. Numbered Issues Photo Section</b> .....	<b>13</b>
<b>4. Fixed Photo Station Photos</b> .....	<b>14</b>
<b>5. Stability Assessment</b> .....	<b>14</b>
<b>6. Quantitative Measures Summary Tables</b> .....	<b>14</b>
<b>7. Benthic Macroinvertebrate Assessment</b> .....	<b>20</b>
<b>IV. Methodology Section</b> .....	<b>21</b>

### Tables

<b>Exhibit Table I.</b>	<b>Project Restoration Components</b> .....	<b>6</b>
<b>Exhibit Table II.</b>	<b>Project Activity and Reporting History</b> .....	<b>6</b>
<b>Exhibit Table III.</b>	<b>Project Contact Table</b> .....	<b>7</b>
<b>Exhibit Table IV.</b>	<b>Project Background Table</b> .....	<b>7</b>
<b>Exhibit Table V.</b>	<b>Verification of Bankfull Events</b> .....	<b>13</b>
<b>Exhibit Table VII.</b>	<b>Categorical Stream Feature Visual Stability Assessment</b> .....	<b>14</b>
<b>Exhibit Table VIII.</b>	<b>Baseline Morphology and Hydraulic Summary</b> .....	<b>16</b>
<b>Exhibit Table IX.</b>	<b>Morphology and Hydraulic Monitoring Summary</b> .....	<b>18</b>

## **Figure 1 - Project Vicinity Map**

### **Appendix A - Vegetation Raw Data**

- 1. Vegetation Survey Data Tables (V-1 – V-5)**
- 2. Vegetation Problem Area Table (A1)**
- 3. Vegetation Problem Area Photos**
- 4. Vegetation Monitoring Plot Photos**

### **Appendix B - Geomorphologic Raw Data**

- 1. Bankfull Events**
- 2. Stream Problem Area Table (B1)**
- 3. Representative Stream Problem Area Photos**
- 4. Stream Photo-Station Photos**
- 5. Exhibit Table B2 - Qualitative Visual Stability Assessment**
- 6. Annual Overlays of Cross Section Plots**
- 7. Annual Overlays of Longitudinal Plots**
- 8. Annual Overlays of Pebble Count Frequency Distribution Plots**

### **Appendix C - Benthic Macroinvertebrate Assessment Data**

### **Appendix D - Integrated Problem Area Plan View**

- 1. Monitoring and Problem Area Plan View, Reach 1**
- 2. Monitoring and Problem Area Plan View, Reach 2**

## **I. Executive Summary / Project Abstract**

The Gray Farm Stream Restoration project consists of two separate stream reaches (Reach 1 and Reach 2) along unnamed tributaries of Buffalo Shoals Creek, a tributary of the Catawba River (Cataloging Unit 03050101). The site is located approximately 10 miles due west of the City of Statesville in western Iredell County, NC. This restoration was contracted by Restoration Systems LLC (Contract # D05016-2) as a full-delivery project for the North Carolina Ecosystem Enhancement Program (NCEEP). This report summarizes the monitoring efforts for Year 3 (2008) of the Gray Farm Stream Restoration Project.

Restoration construction of Reach 2 began in early March 2006 and was completed in mid-April 2006. Restoration construction of Reach 1 began in mid-April 2006 and was completed in early July 2006. Demobilization and minor contractor punch list items were completed shortly thereafter. Installation of monitoring devices and As-built surveys for both reaches were performed as construction progressed.

Year 3 monitoring of the vegetated buffer was performed during the growing season of 2008 by Soil & Environmental Consultants, PA (S&EC). Stem counts were performed within the established vegetation monitoring plots, resulting in an average live stem density of approximately 445 stems per acre.

Physical monitoring of the restored channel for Year 3 consisted of the collection of cross-section and representative longitudinal profile data, in conjunction with visual stability assessment of the stream in the Fall of 2008. Collected data was then compared with As-built, Year 1 and Year 2 Monitoring data.

Based on Year 3 Monitoring results, the overall site has met the prescribed success criteria. Detailed analysis of the success of localized areas is discussed within.

Year 4 Monitoring will commence in January of 2009.

## II. Project Background

The Gray Farm Stream Restoration project is located in the Catawba River Basin within Hydrologic Cataloging Unit 03050101. The site consists of two separate reaches (Reach 1 and Reach 2) along unnamed tributaries of Buffalo Shoals Creek, a tributary of the Catawba River. The site is located approximately 10 miles due west of the City of Statesville in western Iredell County, NC.

The restoration project objective was to restore the impaired streams to appropriately sized stream channels that were stable and self-maintaining, and would not aggrade or degrade over time. Restoration was accomplished with Rosgen-based natural channel design procedures and techniques. Reach 1 restoration was a combination of a Priority I (reconnection of the channel with its historic floodplain) restoration and a Priority II (construction of a new floodplain at a lower elevation) restoration. Reach 2 was a Priority I restoration. Restoring an appropriate sinuosity lengthened both channels, thereby lowering their bankfull slopes.

Restoration construction of Reach 2 began in early March 2006 and was completed in mid-April 2006. Restoration construction of Reach 1 began in mid-April 2006 and was completed in early July 2006. The buffer of both reaches of the restored stream channel were planted with native tree and shrub species and seeded with a native grass seed mix. During construction, site topography and grading allowed for the creation of vernal pools, oxbows, or pocket wetlands within the riparian zone along the restored stream reaches. Planting operations were performed in April 2006. Supplemental planting was performed in December of 2006.

Demobilization and minor contractor punch list items were completed shortly after the completion of construction. Installation of monitoring devices and As-built surveys for both reaches were performed as construction progressed.

### 1. Project Goals and Objectives

The goals of the Gray Farm Stream Restoration project are:

- 1) Improve local water quality within the restored channel reaches as well as the downstream watercourses through;
  - a. The reduction of current channel and off site sediment loads by restoring appropriately sized channels with stable beds and banks.
  - b. The reduction of nutrient loads (both soil enhancement practices and cattle) from adjacent agricultural fields with a restored riparian buffer.
  - c. The reduction of water temperatures provided by shading of the channel from canopy species along with the resultant increase in oxygen content.

- 2) Improve local aquatic and terrestrial habitat and diversity within the restored channels and their vicinity through;
  - a. The formation of varying bed form within the channels to provide for fish, amphibian, and benthic species.
  - b. The restoration of a suitable riparian buffer corridor which will provide both vertical and horizontal structure and connectivity with adjacent upland areas.
  - c. The restoration of understory and canopy species which will provide forage, cover, and nesting for a variety of mammals, reptiles, and birds.
- 3) Improve local watershed conditions through the restoration of two low order streams (one first order, one second order) and the placement of permanent conservation easements.

Through the restoration process the following objectives were accomplished:

- 1) Restore approximately 7,610 linear feet of appropriately sized stream channel that is stable and self-maintaining, and will not aggrade or degrade over time. Restoration was accomplished with Rosgen-based natural channel design procedures and techniques.
- 2) Develop restored channels with the appropriate morphological characteristics (cross-sectional dimension, pattern, and longitudinal profile) utilizing collected reference reach data as a guide. Allow for no net loss of overall channel length in the process.
- 3) Create and/or improve bed form diversity (riffles, runs, pools, and glides) and improve aquatic and benthic macroinvertebrate habitat.
- 4) Construct a floodplain (or local bankfull bench) that is accessible at the proposed bankfull channel elevation.
- 5) Ensure channel and stream bank stabilization by integrating in-stream structures and native bank vegetation.
- 6) Establish a native forested and herbaceous riverine buffer plant community within a minimum width of 50 feet from the edge of the restored channel. This new community will be established in conjunction with the eradication of any existing exotic and/or undesirable plant species.
- 7) Improve water quality within the subject channels and the downstream receiving waters.

- 8) Supplement the education and conservation efforts for natural resources in Iredell County as indicated in program goals for the local Soil & Water Conservation District and the NC Cooperative Extension Service.

## **2. Project Structure, Restoration Type, and Approach**

The restoration project objective was to restore the impaired streams to appropriately sized stream channels that are stable and self-maintaining, and will not aggrade or degrade over time. Restoration was accomplished with Rosgen-based natural channel design procedures and techniques. Restoring an appropriate sinuosity lengthened both channels, thereby lowering their bankfull slope. A total of 8,004 linear feet of stream channel was restored onsite (8,004 SMU's).

### **Reach 1**

Reach 1 restoration was a combination of a Priority I restoration (reconnection of the channel with its historic floodplain) and a Priority II restoration (construction of a new floodplain at a lower elevation). Reach 1 consists of 5,813 linear feet (5,813 SMU's) of restored Type C4 channel. Approximately 800 linear feet of this length was previously inundated by an existing farm pond that was removed during the channel restoration. The pre-restoration length of this channel segment was approximately 4,340 linear feet.

One additional piped farm road crossing previously existed approximately 700 feet downstream of an existing dam and farm pond near the upper end of Reach 1. This piped crossing was removed and replaced with an at-grade in-stream crossing. Immediately downstream of the dam for a distance of approximately 1,000 feet, severe bank erosion, channel incision, and an over-widening of the stream channel had occurred. This degradation appeared in large part due to previous uncontrolled releases from the existing dam spillway.

The lower two thirds of the reach were characterized by overly steep and undercut banks. Significant localized erosion had occurred along this lower portion. Trees of large diameter lined the banks, many of which were undercut, suspended, or had collapsed into the stream. The channel had down cut and over widened in many locations along the reach allowing no access to its floodplain. The last 200 feet (approximately) of the pre-existing channel was not down cut due to a change in surrounding topography.

The upper portion of Reach 1 has demonstrated pool development since the as-built survey. Significant sediment entered the pools at the upper end of Reach 1 shortly after construction. This sediment came from upstream sources to the north of the restoration site including areas of cattle pasture and areas previously inundated due to the old pond. This sediment was flushed from the system during the first year, causing these pools to deepen to their previously excavated depth. During Monitoring Year 3, sediment from the upstream cattle pasture again entered the upper portion of Reach 1. The area between station 0+00 and station

3+00 contains significant sediment, pools have filled, and structures have been buried. From station 3+00 to station 4+50, sediment is present, but less severe, and the riffle-pool sequence is more easily observed. It is important to note that the cattle pasture north of the restoration site is not under the ownership of the Grays.

## **Reach 2**

Reach 2 was a Priority I restoration. Reach 2 consists of 2,191 linear feet (2,191 SMU's) of restored Type B4 channel. A small impoundment previously existed near the lower end of the reach; however, it was drained and removed a number of years prior to the channel restoration. A piped farm road crossing existed at roughly the same location (the old dam embankment). This was (and remains) the only existing crossing along the reach. The pre-restoration length of this channel segment was approximately 1,600 linear feet.

Throughout Reach 2, severe bank erosion, channel incision, and an over-widening of the stream channel had occurred. This impairment appeared in large part due to previous uncontrolled grazing operations. The reach was characterized by overly steep, sloughing, and undercut banks.

Significant localized erosion had occurred along the entire reach. Trees of large diameter lined the banks, many of which were undercut, suspended, or collapsed into the stream. The channel had down cut and over widened in many places along the reach allowing no access to its floodplain.

### **3. Location and Setting**

The Gray Farm Stream Restoration project is located in the Catawba River Basin, Cataloging Unit 03050101. The site consists of two separate reaches (Reach 1 and Reach 2) along unnamed tributaries of Buffalo Shoals Creek, a tributary of the Catawba River. The site is located approximately 10 miles due west of the City of Statesville in western Iredell County, NC.

Reach 1 is located immediately north of Bolick Road (SR 1532). Reach 2 is located immediately west of the intersection of New Sterling Road (SR 1525) and Gray House Road. The watershed areas for Reaches 1 and 2 are estimated at approximately 0.91 square miles (582 acres) and 0.085 square miles (54 acres) respectively. See attached Figure 1.



#### 4. Project History and Background

The following tables summarize the project history and background:

Exhibit Table I. Project Restoration Components Gray Farm Stream Restoration Site/EEP Project # 92219								
Project Segment or Reach ID	Existing Feet/Acres	Type	Approach	Footage or Acreage	Mitigation Ratio	Mitigation Units	Stationing	Comment
Reach I	3,000	R	PI	4,119	1:1	4,119	0+00 to 41+19	
Reach I	1,340	R	PII	1,694	1:1	1,694	41+19 to 58+13	
Reach II	1,600	R	PI	2,191	1:1	2,191	0+00 to 21+91	
Mitigation Unit Summations								
Stream (lf)	Riparian Wetland (Ac)	Nonriparian Wetland (Ac)	Total Wetland (Ac)	Buffer (Ac)	Comment			
8,004	N/A	N/A	N/A	18.38				

Exhibit Table II. Project Activity and Reporting History Gray Farm Stream Restoration Site/EEP Project # 92219		
Activity or Report	Data Collection Complete	Actual Completion or Delivery
Restoration Plan	Aug-05	Nov-05
Construction	Reach 1	Jul-06
	Reach 2	Apr-06
Temporary S&E mix applied to entire project area	Apr-06	Apr-06
Permanent seed mix applied to reach/segments 1 & 2	Apr-06	Apr-06
Plantings for reach/segments 1 & 2	Apr-06	Apr-06
Mitigation Plan / As-built (Year 0 Monitoring - baseline)	May-06	Jun-06
Year 1 Monitoring	Dec-06	Dec-06
Supplemental Planting	Dec-06	
Year 2 Monitoring	Nov-07	Dec-07
Year 3 Monitoring	Nov-08	Dec-08
Year 4 Monitoring		
Year 5 Monitoring		

<b>Exhibit Table III. Project Contact Table</b> <b>Gray Farm Stream Restoration Site/EEP Project # 92219</b>	
<b>Designer</b> Primary Project Design POC	Soil & Environmental Consultants, PA 11010 Raven Ridge Rd Raleigh, NC 27614 Patrick K. Smith, P.E. (919) 846-5900
<b>Construction Contractor</b> Construction Contractor POC	North State Environmental 2889 Lowery St. Winston-Salem, NC 27101 Darrell Westmoreland (336) 725-2010
<b>Planting Contractor</b> Planting Contractor POC	North State Environmental 2889 Lowery St. Winston-Salem, NC 27101 Darrell Westmoreland (336) 725-2010
<b>Seeding Contractor</b> Seeding Contractor POC	North State Environmental 2889 Lowery St. Winston-Salem, NC 27101 Darrell Westmoreland (336) 725-2010
<b>Monitoring Performers</b>	Soil & Environmental Consultants, PA 11010 Raven Ridge Rd. Raleigh, NC 2761
Stream Monitoring POC	David Gainey (919) 846-5900
Vegetation Monitoring POC	David Gainey (919) 846-5900

<b>Exhibit Table IV. Project Background Table</b> <b>Gray Farm Stream Restoration Site/EEP Project # 92219</b>	
Project County	Iredell
Drainage area	Reach 1 - 0.91 square miles (582 acres) Reach 2 - 0.085 square miles (54 acres)
Drainage impervious cover estimate (%)	< 20%
Stream Order	Reach 1 - 2nd order Reach 2 - 1st order
Physiographic Region	Piedmont
Ecoregion	Northern Inner Piedmont
Rosgen Classification of As-built	Reach 1 - C4 Reach 2 - B4
Cowardin Classification	N/A
Dominant soil types	Reach 1 - Cw, CxB Reach 2 - CsE2
Reference site ID	Reach 1 - Tributary of Turkey Creek Reach 2 - Basin Creek
USGS HUC for Project and Reference	3050101
NCDWQ Sub-basin for Project and Reference	Reach 1 - 03-08-32 / 03-04-02 Reach 2 - 03-08-32 / 03-07-01
NCDWQ classification for Project and Reference	Reach 1 - WS-IV; CA / C;NSW Reach 2 - WS-IV; CA / C; Tr; ORW
Any portion of any project segment 303d listed?	No
Any portion of any project segment upstream of a 303d listed segment?	No
Reasons for 303d listing or stressor	N/A
% of project easement fenced	Reach 1 – No Fence, Reach 2 - 100%

## **5. Monitoring Plan View**

Six (6) tree and shrub buffer vegetation plots (four (4) on Reach 1 and two (2) on Reach 2) and four (4) bank vegetation plots (two (2) on Reach 1 and two (2) on Reach 2) were established. All vegetation monitoring occurs within these plots throughout the monitoring period for as long as they continue to be representative of the community.

For all buffer monitoring plots, Level 1 of the Carolina Vegetation Survey-Ecosystem Enhancement Program (CVS-EEP) Protocol for Recording Vegetation was utilized for vegetation sampling in Years 1 and 2. Beginning in Year 3, Level 2 of the CVS-EEP protocol was utilized in order to record and report woody plant volunteers within vegetation monitoring plots along with planted stems. A corner of each vegetation monitoring plot will be used as a permanent photo point for vegetation monitoring photos. Locations of these photo points are shown on the attached Monitoring Plan View.

A total of five (5) benthic macroinvertebrate sampling stations was established during Year 3 Monitoring. Reach 1, Station 1 is located immediately upstream of the restored Reach 1. Reach 1, Station 2 is located within the restored Reach 1. Reach 1, Station 3 is located immediately downstream of the restored Reach 1. Reach 2, Station 1 is located within the restored Reach 2. Reach 2, station 2 is located immediately downstream of the restored Reach 2. Locations of these benthic macroinvertebrate sampling points for Year 3 are shown in Appendix D.1.

A total of seven (7) nested riffle and pool cross-section pairs was established along Reach 1, and two (2) nested riffle and pool cross-section pairs were established along Reach 2. Each cross-section also serves as a designated photo point that will be photographed annually.

The locations of all monitoring devices are shown in Appendix D.1 (Monitoring Plan View, Reaches 1 and 2).

## **III. Project Condition and Monitoring Results**

### **A. Vegetation Assessment**

The success of the adjacent riparian buffer will be based on the combined survival of tree and shrub species for the five-year monitoring period.

In order to be considered successful, survival of woody (tree and shrub) species planted within the restored buffers will be at least 320 stems/acre through year three, 288 stems/acre at year four, and 260 stems/acre at year five. The stem count will be based on an average of the stem counts of the evaluated tree and shrub buffer vegetation plots.

The success of the bank vegetation plots along the restored channels will be based on the survival of live stake (or other) bank plantings for the five-year

monitoring period. Survival of bank plantings will be based on a linear average of approximately 50 percent of the planted stems within the restoration reaches.

The approximately 18.4 acre restoration area was planted with various native hardwood tree and shrub species native to the area. Reaches 1 and 2 were planted in April 2006. Supplemental planting was performed in December of 2006.

The following tree species were planted in the Riparian Buffer Area:

- *Alnus serrulata* (Tag Alder)
- *Betula nigra* (River Birch)
- *Carpinus caroliniana* (Ironwood)
- *Fraxinus pennsylvanica* (Green Ash)
- *Ilex opaca* (American Holly)
- *Lindera benzoin* (Spicebush)
- *Liriodendron tulipifera* (Tulip Poplar)
- *Platanus occidentalis* (Sycamore)
- *Quercus michauxii* (Swamp Chestnut Oak)
- *Quercus nigra* (Water Oak)
- *Quercus phellos* (Willow Oak)
- *Viburnum nudum* (Possumhaw)

Stream banks were planted with live stakes in two offset rows. The following shrub species were planted as live stakes:

- *Cornus amomum* (Silky Dogwood)
- *Salix sericea* (Silky Willow)
- *Sambucus canadensis* (Elderberry)

As previously described, a total of six (6) buffer vegetation monitoring plots were established on site in 2006. The success criteria for the site require a minimum of 320 live stems per acre for the first three (3) years of monitoring. Year 3 vegetation monitoring shows 445 live stems per acre. Future buffer vegetation monitoring data will be compared with previous monitoring data to determine survival rates and stem densities for woody vegetation planted within the riparian buffer. Vegetation monitoring data for buffer plots was collected using Level 2 of the CVS-EEP monitoring protocol and is presented in Appendix A.

*NOTE: Level 2 of the CVS-EEP monitoring protocol includes both planted and natural (volunteer) woody stems. For this reason, volunteer specimens are included in the total number of species, as reflected in Tables V-2 through V-4. Table V- 5 (Stem Count by Plot and Species) does not include volunteer/natural woody stem data, only planted stems.*

Four (4) bank vegetation plots were also established (two on each reach) to monitor survival of live stake plantings along stream banks. Live stake survival is based on baseline data collected during Year 1 Monitoring in 2006. Future bank vegetation monitoring data will be compared with previous monitoring data to determine survival rates for live stakes planted along stream banks. Live stake survival from Monitoring Year 1 to Monitoring Year 3 for the site overall is approximately 80.3%, an increase from the Year 2 live stake survival percentage. We attribute this increase in live stake survival to revegetation and resprouting of numerous live stakes following the severe drought experienced during the previous growing season. Live stake counts by species and by plot are presented in the following tables:

2006 - REACH 1					
Common Name	Species	REACH 1		Species Total	% of Total
		BANK 1	BANK 2		
Silky Dogwood	Cornus amomum	12	17	29	39%
Silky Willow	Salix sericea	30	16	46	61%
	<b>TOTAL</b>	42	33	75	100%
2007 - REACH 1					
Common Name	Species	REACH 1		Species Total	% of Total
		BANK 1	BANK 2		
Silky Dogwood	Cornus amomum	4	9	13	27%
Silky Willow	Salix sericea	27	9	36	73%
	<b>TOTAL</b>	31	18	49	100%
	<b>Live Stake Survival =</b>	73.8%	54.5%	65.3%	
2008 - REACH 1					
Common Name	Species	REACH 1		Species Total	% of Total
		BANK 1	BANK 2		
Silky Dogwood	Cornus amomum	10	9	19	36%
Silky Willow	Salix sericea	30	4	34	64%
	<b>TOTAL</b>	40	13	53	100%
	<b>Live Stake Survival =</b>	95.2%	39.4%	70.7%	

2006 - REACH 2					
Common Name	Species	REACH 2		Species Total	% of Total
		BANK 1	BANK 2		
Silky Willow	Salix sericea	7	4	11	23%
Silky Dogwood	Cornus amomum	9	25	34	72%
Elderberry	Sambucus canadensis	0	2	2	4%
	<b>TOTAL</b>	16	31	47	100%
2007 - REACH 2					
Common Name	Species	REACH 2		Species Total	% of Total
		BANK 1	BANK 2		
Silky Willow	Salix sericea	6	4	10	29%
Silky Dogwood	Cornus amomum	5	20	25	71%
Elderberry	Sambucus canadensis	0	0	0	0%
	<b>TOTAL</b>	11	24	35	100%
	<b>Live Stake Survival =</b>	68.8%	77.4%	74.5%	
2008 - REACH 2					
Common Name	Species	REACH 2		Species Total	% of Total
		BANK 1	BANK 2		
Silky Willow	Salix sericea	7	4	11	24%
Silky Dogwood	Cornus amomum	8	25	33	73%
Elderberry	Sambucus canadensis	0	1	1	2%
	<b>TOTAL</b>	15	30	45	100%
	<b>Live Stake Survival =</b>	93.8%	96.8%	95.7%	

Although some vegetation plots showed an increase of live stakes following the drought conditions during the 2007 growing season, other plots did not. This lack of resurgence, especially in Reach 1 Bank Plot 2, is attributed to dense herbaceous vegetation along stream banks. Most surviving live stakes appear healthy and are growing vigorously.

Herbaceous vegetation varies widely throughout the restoration site. The native herbaceous species have become densely established and are dominant throughout the site. Herbaceous species observed along stream banks and in the buffer and wetlands onsite include:

- *Impatiens capensis* - Jewelweed
- *Juncus effusus* – Soft Rush
- *Leersia oryzoides* – Cutgrass
- *Mimulus ringens* - Monkeyflower
- *Carex spp.*- Sedges
- *Panicum virgatum* – Switchgrass
- *Sagittaria latifolia* – Duck Potato
- *Solidago sp.* – Goldenrod
- *Eupatorium capillifolium* – Dog-fennel
- *Eupatorium perfoliatum* - Boneset

## 1. Problem Areas Plan View (Vegetation)

During field inspections on May 19<sup>th</sup>, September 17<sup>th</sup> and November 19<sup>th</sup> and 20<sup>th</sup>, 2008, a total of fourteen localized areas of bare bank and floodplain were observed on Reaches 1 and 2. These areas appear to be due primarily to either

surface flows or poor soil conditions. Although a higher number of bare areas was observed during Monitoring Year 3 as compared to those observed during Monitoring Year 2, these areas are generally smaller and less severe. Several of the areas documented in Monitoring Year 2 have revegetated. Vegetation Problem Areas are shown on Sheets 6 through 9 (Reach 1) and Sheets 14 through 16 (Reach 2). Photos are included in Appendix A.

During Monitoring Year 2, small amounts of the non-natives Johnsongrass (*Sorghum halepense*) and tall fescue (*Lolium arundinaceum*) were observed at the edges of the buffer restoration areas that border the agricultural fields on both reaches. These populations have not become dominant, nor have they excluded native vegetation.

An area of Kudzu (*Pueraria lobata*) was noted at the site in early June 2007, on the west side of Reach 1 between stations 16+00 to 19+00. Although the majority of the kudzu was along and in the edge of the woods immediately outside the easement area, some had encroached into the easement area. The area (approximately 0.5 acre) was treated with the herbicide Transline (clopyralid) at a rate of one pint per acre in 2007. A small portion of this area was again treated in 2008. The area will continue to be monitored to determine if re-treatment is necessary. During 2008, a small area (approximately 0.009 acre) of Kudzu was observed immediately east of station 13+00, within the easement area. This area will also be monitored and treated if kudzu continues to encroach into the easement area.

While we will continue to monitor these areas, based on vegetative success criteria the overall site currently exhibits strong vegetative success.

## **2. Vegetative Problem Areas Table Summary**

Vegetative problem areas observed are shown in Table A1 in Appendix A.

## **3. Vegetative Problem Areas Plan View**

Vegetative problem areas are shown on Sheets 6 through 9 for Reach 1 and Sheets 14 through 16 for Reach 2 (Problem Area Plan View).

## **B. Stream Assessment**

A review of available on-line USGS gauge sites was performed to determine if a suitable surrogate gauges was present in the area. No nearby gauge was identified. The closest USGS gauge to the site was on the Lower Little River (near Healing Springs, NC, Gauge Identification Number 02142000) which is approximately 15 miles from the project site. Based on this large distance, significant disparity in watershed sizes, and topographic variation, it is unlikely that a conclusive determination regarding the number of bankfull events experienced on the restoration site could be made.

Based upon recommendations provided by NCEEP a crest gauge was installed on site (at Cross-section 3 on Reach 1). The gauge was installed in June of 2008 and checked during subsequent site visits for evidence of bankfull events. In addition, site observations during visits performed this monitoring year including wrack lines, staining of vegetation, displaced/flattened vegetation, and observable sediment deposition indicate that multiple overbank events have occurred. Photographs documenting overbank conditions during Monitoring Year 3 are attached in Appendix B. The dates of site visits where evidence of bankfull events were observed are listed in the table below.

<b>Exhibit Table V. Verification of Bankfull Events Gray Farm Stream Restoration Site/EEP Project # 92219</b>			
<b>Date of Data Collection</b>	<b>Date of Occurrence</b>	<b>Method</b>	<b>Photo #</b>
5/19/2008	Unknown	Onsite observations (wrack lines, staining of vegetation, displaced/flattened vegetation, and observable sediment deposition and select crest gauge readings)	n/a
6/25/2008	Unknown		n/a
8/26/2008	Unknown		n/a
9/17/2008	Unknown		1,2,4
11/19/2008	Unknown		3

### **1. Problem Areas Plan View (Stream)**

An assessment of channel stability was also performed on November 19<sup>th</sup> and 20<sup>th</sup>, 2008. Areas of concern that were observed and documented included some minor localized bank scour, buried structures, and stressed structures. Detail of such scour is evident in cross-section 6 (pool). These problem areas are shown on Sheets 6 through 9 for Reach 1 and Sheets 14 through 16 for Reach 2 (Problem Area Plan View). The minimal extent of scour and erosion around structures does not warrant repair at this time.

These areas will continue to be monitored, even though the site exhibits stable conditions and meets the requirements for physical success based on physical success criteria.

### **2. Problem Areas Table Summary**

Stream problem areas observed are shown in Table B1 in Appendix B.

### **3. Numbered Issues Photo Section**

Representative photos of each category of stream problem area are shown in Appendix B.



#### 4. Fixed Photo Station Photos

Photos from established photo stations (at each cross-section) were collected during the stream survey (November 2008). These photos are included in Appendix B.

#### 5. Stability Assessment

A visual qualitative assessment was performed to inspect channel facets, meanders, bed, banks, and installed structures. This visual assessment was confirmed and enhanced with a quantitative assessment of the physical stream survey. The goal of this assessment is to provide a percentage of the features listed in Table VII that are in a state of stability. Table VII was compiled from the data in Table B1 in Appendix B of this report.

<b>Table VIIa: Categorical Stream Feature Visual Stability Assessment Gray Farm Stream and Wetland Restoration Site/EEP Project # 92219 Reach 1</b>					
<b>Feature</b>	<b>MY-1 2006</b>	<b>MY-2 2007</b>	<b>MY-3 2008</b>	<b>MY-4 2009</b>	<b>MY-5 2010</b>
A. Riffles	100%	100%	98%		
B. Pools	100%	100%	100%		
C. Thalweg	99%	99%	99%		
D. Meanders	100%	100%	100%		
E. Bed General	96%	99%	99%		
F. Bank Condition	100%	99%	99%		
G. Vanes/ J Hooks, etc.	99%	98%	98%		
H. Wads and Boulders	N/A	N/A	N/A		

<b>Table VIIb: Categorical Stream Feature Visual Stability Assessment Gray Farm Stream and Wetland Restoration Site/EEP Project # 92219 Reach 2</b>					
<b>Feature</b>	<b>MY-1 2006</b>	<b>MY-2 2007</b>	<b>MY-3 2008</b>	<b>MY-4 2009</b>	<b>MY-5 2010</b>
A. Riffles	100%	100%	100%		
B. Pools	100%	100%	100%		
C. Thalweg	100%	100%	100%		
D. Meanders	99%	98%	98%		
E. Bed General	100%	100%	100%		
F. Bank Condition	100%	100%	99%		
G. Vanes/ J Hooks, etc.	99%	96%	95%		
H. Wads and Boulders	N/A	N/A	N/A		

#### 6. Quantitative Measures Summary Tables

The following tables (Table VIII and Table IX) summarize the quantitative data collected from the cross-sectional and representative longitudinal stream

survey. This data was analyzed and summarized, and then compared with baseline data types available for this project.

The Quantitative Morphology Tables illustrate the degree of departure, if any, of the current channel from the baseline data. Tables VIII and IX were compiled from the cross-section and profile raw data and plots located in Appendix B of this report.

**Table VIII. Baseline Morphology and Hydraulic Summary  
GRAY FARM STREAM RESTORATION SITE (EEP Project #92219)**

**REACH 1**

Parameter	Pre-Existing Condition			Project Reference Stream			Design			As-built		
	Min	Max	Avg.	Min	Max	Avg.	Min	Max	Avg.	Min	Max	Avg.
BF Width (ft)	15.77	15.77	15.77	32.08	32.08	32.08	15.2	15.2	15.2	13.62	19.48	16.02
Floodprone Width (ft)	19.41	52.54	20.39	100			47	90.34	47	37.49	89.67	61.53
BF Cross Sectional Area (ft <sup>2</sup> )	17.87	17.87	17.87	79.79	79.79	79.79	17.84	17.84	17.84	11.01	17.92	13.79
BF Mean Depth (ft)	1.13	1.13	1.13	2.49	2.49	2.49	1.17	1.17	1.17	0.7	0.94	0.86
BF Max Depth (ft)	1.49	1.49	1.49	3.61	3.61	3.61	1.71	1.71	1.71	1.36	2.04	1.61
Width/Depth Ratio	13.96	13.96	13.96	12.43	12.43	12.43	12.67	12.67	12.67	18.63	20.07	19.46
Entrenchment Ratio	1.29	1.29	1.29	3.47	3.47	3.47	3.09	3.09	3.09	2.75	4.6	3.84
Wetted Perimeter(ft)	16.52	16.52	16.52	34.8	34.8	34.8	16.01	16.01	16.01	13.26	16.41	15.67
Hydraulic radius (ft)	1.08			2.29			1.11			0.69	0.92	0.83
<b>Pattern</b>												
Channel Beltwidth (ft)	67.62	137.29	98.27	70.8	91.93	84.35	26.1	61.8	40.75	59.32	93.89	72.85
Radius of Curvature (ft)	64.8	121.04	81.58	13.36	36.57	26.56	19.97	37.85	28.23	16.64	40.88	25.73
Meander Wavelength (ft)	716.91	716.91	716.91	148.13	291.09	221.56	77.08	117.13	95.07	77.08	117.13	94.8
Meander Width ratio	4.29	8.71	6.23	2.21	2.87	2.63	1.72	4.07	2.68	3.7	5.86	4.55
<b>Profile</b>												
Riffle length (ft)	N/A	N/A	N/A	32.94	48.35	40.29	19.31	54.86	30.86	25.87	54.2	37.85
Riffle slope (ft/ft)	0.00632	0.00657	0.00647	0.00809	0.01395	0.01074	0.0057			0.00092	0.0187	0.0062
Pool length (ft)	93.8	159.47	119.6	8.96	41.09	26.43	22.9	33.17	29.66	7.41	244.47	23.01
Pool Slope (ft/ft)	N/A	N/A	N/A	N/A	N/A	N/A	0.0009	0.0029	0.0013	0.0007	0.0064	0.0016
Pool spacing (ft)	347.07	525.3	444	44.08	130.73	67.98	51.66	82.92	67.79	12.35	142	70.94
<b>Substrate</b>												
d50 (mm)	N/A	N/A	N/A	N/A	N/A	N/A	N/A	N/A	N/A	N/A	N/A	N/A
d84 (mm)	N/A	N/A	N/A	N/A	N/A	N/A	N/A	N/A	N/A	N/A	N/A	N/A
<b>Additional Reach Parameters</b>												
Valley Length (ft)	4258.3			648.35			4258.3			4258.3		
Channel Length (ft)	4939.628			758.58			5622			5813.3		
Sinuosity	1.16			1.17			1.29			1.36		
Water Surface Slope (ft/ft)	0.00647			0.01074			0.0057			0.00544		
BF slope (ft/ft)	0.00647			0.01074			0.0057			0.00544		
Rosgen Classification	F4			C4			C4			C4		
*Habitat Index	N/A			N/A			N/A			N/A		
*Macrobenthos	N/A			N/A			N/A			N/A		

**Table VIII. Baseline Morphology and Hydraulic Summary  
GRAY FARM STREAM RESTORATION SITE (EEP Project #92219)  
REACH 2**

Parameter	Pre-Existing Condition			Project Reference Stream			Design			As-built		
	Min	Max	Avg.	Min	Max	Avg.	Min	Max	Avg.	Min	Max	Avg.
BF Width (ft)	5.34	5.34	5.34	4.86	4.86	4.86	6.9	6.9	6.9	7.38	8.21	7.8
Floodprone Width (ft)	7.04	7.04	7.04	8.73	8.73	8.73	12.4	12.4	12.4	13.96	39.05	26.53
BF Cross Sectional Area (ft <sup>2</sup> )	3.88	3.88	3.88	1.94	1.94	1.94	3.96	3.96	3.96	4.14	6.77	5.46
BF Mean Depth (ft)	0.73	0.73	0.73	0.4	0.4	0.4	0.57	0.57	0.57	0.56	0.82	0.69
BF Max Depth (ft)	1.13	1.13	1.13	0.61	0.61	0.61	0.87	0.87	0.87	0.86	1.3	1.08
Width/Depth Ratio	7.32	7.32	7.32	12.15	12.15	12.15	12.11	12.11	12.11	1.01	13.18	11.3
Entrenchment Ratio	1.32	1.32	1.32	1.8	1.8	1.8	1.8	1.8	1.8	1.9	4.7	3.4
Wetted Perimeter(ft)	6.03	6.03	6.03	5.28	5.28	5.28	7.36	7.36	7.36	7.68	8.77	8.23
Hydraulic radius (ft)	0.64			0.37			0.94737	0.94737	0.94737	0.78261	1.11594	0.95652
<b>Pattern</b>												
Channel Beltwidth (ft)	43.58	68.11	54.22	6.97	22.7	13.32	9.49	16.5	12.65	11.83	22.05	16.96
Radius of Curvature (ft)	32.54	52.64	41.25	4.1	8.88	5.93	6.71	9.9	8.05	4.63	9.1	6.43
Meander Wavelength (ft)	209.46	394.66	334.46	22.47	68.78	46.57	31.6	37.12	34.08	27.51	34.72	31.75
Meander Width ratio	8.16	12.75	10.15	1.43	4.67	2.74	1.38	2.39	1.83	1.52	2.83	2.17
<b>Profile</b>												
Riffle length (ft)	N/A	N/A	N/A	5.52	7.6	6.39	4.93	7.24	5.88	3.36	11.6	5.6
Riffle slope (ft/ft)	0.0179	0.03688	0.02444	0.03022	0.05058	0.04025	0.0258			0.0053	0.0555	0.0279
Pool length (ft)	26.27	54.41	40.34	7.56	10.65	8.78	6.25	10.46	8.45	5.2	10.08	7.59
Pool Slope (ft/ft)	N/A	N/A	N/A	N/A	N/A	N/A	0.0017	0.0087	0.003	0.001	0.0092	0.0022
Pool spacing (ft)	125.7	474.65	265.15	20.17	70.04	46.72	15.73	23.84	19.22	9.43	28.94	19.51
<b>Substrate</b>												
d50 (mm)	N/A	N/A	N/A	N/A	N/A	N/A	N/A	N/A	N/A	N/A	N/A	N/A
d84 (mm)	N/A	N/A	N/A	N/A	N/A	N/A	N/A	N/A	N/A	N/A	N/A	N/A
<b>Additional Reach Parameters</b>												
Valley Length (ft)	1872			216.55			1872			1872		
Channel Length (ft)	1965.6			266.36			2114			2191		
Sinuosity	1.05			1.23			1.16			1.2		
Water Surface Slope (ft/ft)	0.0286			0.039			0.0258			0.025		
BF slope (ft/ft)	0.0286			0.039			0.0258			0.025		
Rosgen Classification	G4			B4			B4			B4		
*Habitat Index	N/A			N/A			N/A			N/A		
*Macrobenthos	N/A			N/A			N/A			N/A		

**Exhibit Table IX. Morphology and Hydraulic Monitoring Summary  
GRAY FARM STREAM RESTORATION SITE (EEP Project #92219)**

Parameter	REACH 1															
	RIFFLE 1				POOL 1				RIFFLE 2				POOL 2			
Dimension	AS BUILT	MY1	MY2	MY3	AS BUILT	MY1	MY2	MY3	AS BUILT	MY1	MY2	MY3	AS BUILT	MY1	MY2	MY3
	2006	2006	2007	2008	2006	2006	2007	2008	2006	2006	2007	2008	2006	2006	2007	2008
BF Width (ft)	15.34	11.25	11.58	10.89	22.32	20.84	24.21	20.82	13.62	11.33	16.89	14.78	20.84	20.41	26.66	19.85
Floodprone Width (ft)	54.53	50	50	50	61.28	62.34	62.92	62.65	59.9	60.26	60.01	59.8	57.43	58.07	57.82	57.47
BF Cross Sectional Area (ft <sup>2</sup> )	11.97	5.96	12.52	5.98	39.71	41.33	38.36	36.03	11.01	9.18	9.29	9.23	29.04	26.98	31.28	27.23
BF Mean Depth (ft)	0.78	0.53	0.6	0.55	1.78	1.98	1.58	1.73	0.81	0.68	0.55	0.62	1.39	1.32	1.17	1.37
BF Max Depth (ft)	1.39	0.87	1.42	1.26	3.29	3.47	3.61	3.58	1.53	1.25	1.46	1.6	2.89	2.74	3.63	3.04
Width/Depth Ratio	19.67	21.23	34.62	19.8	12.54	10.53	15.32	12.03	16.81	19.94	30.71	23.84	14.99	15.46	22.79	14.49
Entrenchment Ratio	3.56	4.44	2.41	4.59	2.75	2.99	2.6	3.01	4.4	4.45	3.55	4.05	2.76	2.85	2.17	2.89
Wetted Perimeter(ft)	15.67	11.41	21.04	11.21	23.83	22.42	25.37	22.41	13.97	13.82	17.34	15.21	21.83	21.52	26.62	22.24
Hydraulic radius (ft)	0.76	0.52	0.6	0.53	1.67	1.84	1.51	1.61	0.79	0.66	0.54	0.61	1.33	1.25	1.09	1.22
<b>Substrate</b>																
d50 (mm)	N/A	N/A	N/A	N/A	N/A	N/A	N/A	N/A	N/A	N/A	N/A	N/A	N/A	N/A	N/A	N/A
d84 (mm)	N/A	N/A	N/A	N/A	N/A	N/A	N/A	N/A	N/A	N/A	N/A	N/A	N/A	N/A	N/A	N/A

Parameter	REACH 1															
	RIFFLE 3				POOL 3				RIFFLE 4				POOL 4			
Dimension	AS BUILT	MY1	MY2	MY3	AS BUILT	MY1	MY2	MY3	AS BUILT	MY1	MY2	MY3	AS BUILT	MY1	MY2	MY3
	2006	2006	2007	2008	2006	2006	2007	2008	2006	2006	2007	2008	2006	2006	2007	2008
BF Width (ft)	12.94	12.1	13.55	12.89	20.75	21.49	22.08	21.98	15.7	19	17.9	18.01	20.28	21.29	24.79	19.85
Floodprone Width (ft)	89.67	89.64	89.86	89.54	61.38	61.32	61.04	61.15	66.39	66.2	66.27	66.51	65.77	65.75	66	65.83
BF Cross Sectional Area (ft <sup>2</sup> )	9.49	9.25	23.48	9.82	34.09	33.59	32.19	31.82	11.02	13.49	18.12	11.58	32.64	38.77	32.22	33.03
BF Mean Depth (ft)	0.73	0.76	0.48	0.76	1.64	1.56	1.46	1.45	0.7	0.71	0.4	0.64	1.61	1.82	1.3	1.66
BF Max Depth (ft)	1.41	1.36	1.64	1.44	3.03	2.83	2.94	2.78	1.36	1.41	1.3	1.37	2.79	3.2	2.83	2.83
Width/Depth Ratio	17.73	15.92	102.88	16.96	12.65	13.78	15.12	15.16	22.43	26.76	112.6	28.14	12.6	11.79	19.07	11.96
Entrenchment Ratio	6.93	7.41	1.82	6.94	2.96	2.85	2.76	2.78	4.23	3.48	1.47	3.69	3.24	3.09	2.66	3.32
Wetted Perimeter(ft)	13.26	12.46	49.83	13.27	21.78	22.45	23.01	22.94	16.01	19.29	45.45	18.39	21.59	22.97	26.04	21.21
Hydraulic radius (ft)	0.72	0.74	0.47	0.74	1.57	1.5	1.4	1.39	0.69	0.7	0.4	0.63	1.51	1.69	1.24	1.56
<b>Substrate</b>																
d50 (mm)	0.65	17	1.6	20	N/A	N/A	N/A	N/A	N/A	N/A	N/A	N/A	N/A	N/A	N/A	N/A
d84 (mm)	4	33	50	60	N/A	N/A	N/A	N/A	N/A	N/A	N/A	N/A	N/A	N/A	N/A	N/A

Parameter	REACH 1															
	RIFFLE 5				POOL 5				RIFFLE 6				POOL 6			
Dimension	AS BUILT	MY1	MY2	MY3	AS BUILT	MY1	MY2	MY3	AS BUILT	MY1	MY2	MY3	AS BUILT	MY1	MY2	MY3
	2006	2006	2007	2008	2006	2006	2007	2008	2006	2006	2007	2008	2006	2006	2007	2008
BF Width (ft)	15.63	14.32	16.03	13.84	26.27	23.03	22.33	24.07	17.01	14.54	24.63	19.03	18.59	21.11	19.69	22.85
Floodprone Width (ft)	72.27	64.56	73.17	72.59	68.23	68.53	68.67	68.48	50.57	60	60	49.29	60.15	62.76	63	66.56
BF Cross Sectional Area (ft <sup>2</sup> )	14.76	14.03	30.25	13.33	37.47	33.39	32.16	35.95	16	14.61	16.62	12.89	26.72	27.06	51.7	53
BF Mean Depth (ft)	0.94	0.98	0.59	0.96	1.43	1.45	1.144	1.49	0.94	1.01	0.67	0.68	1.44	1.28	2.63	2.32
BF Max Depth (ft)	1.67	2.27	2.19	1.99	2.75	3.08	3.12	3.23	1.56	1.49	1.43	1.31	2.83	3.14	4.82	4.71
Width/Depth Ratio	16.63	14.61	86.86	14.42	18.37	15.88	15.51	16.15	18.1	14.4	36.76	27.99	12.91	16.49	7.49	9.85
Entrenchment Ratio	4.62	4.51	1.43	5.24	2.6	2.98	3.08	2.85	2.97	4.13	2.44	2.59	3.24	2.97	3.2	2.91
Wetted Perimeter(ft)	16.14	15.28	52.22	14.88	27.26	24.24	23.58	25.72	17.42	15	24.92	19.32	20.27	22.27	23.49	27.89
Hydraulic radius (ft)	0.91	0.92	0.58	0.9	1.37	1.38	1.36	1.4	0.92	0.97	0.67	0.67	1.32	1.21	2.2	1.9
<b>Substrate</b>																
d50 (mm)	N/A	N/A	N/A	N/A	N/A	N/A	N/A	N/A	N/A	N/A	N/A	N/A	N/A	N/A	N/A	N/A
d84 (mm)	N/A	N/A	N/A	N/A	N/A	N/A	N/A	N/A	N/A	N/A	N/A	N/A	N/A	N/A	N/A	N/A

Parameter	REACH 1							
	RIFFLE 7				POOL 7			
Dimension	AS BUILT	MY1	MY2	MY3	AS BUILT	MY1	MY2	MY3
	2006	2006	2007	2008	2006	2006	2007	2008
BF Width (ft)	19.48	16.96	22.43	19.14	22.66	22.31	23.12	22.38
Floodprone Width (ft)	50	50	50	50	51.23	55	55	51
BF Cross Sectional Area (ft <sup>2</sup> )	17.92	15.49	16.94	15.82	42.08	38.22	36.39	35.4
BF Mean Depth (ft)	0.92	0.91	0.76	0.83	1.86	1.71	1.57	1.58
BF Max Depth (ft)	2.04	1.61	1.68	1.76	3.47	3.06	3.03	2.91
Width/Depth Ratio	21.17	18.64	29.51	23.06	12.18	13.03	14.73	14.16
Entrenchment Ratio	2.57	2.95	2.23	2.61	2.26	2.46	2.38	2.28
Wetted Perimeter(ft)	20.08	17.38	22.83	19.59	23.91	24.11	24.31	23.66
Hydraulic radius (ft)	0.89	0.89	0.74	0.81	1.76	1.59	1.5	1.5
<b>Substrate</b>								
d50 (mm)	N/A	N/A	N/A	N/A	N/A	N/A	N/A	N/A
d84 (mm)	N/A	N/A	N/A	N/A	N/A	N/A	N/A	N/A

REACH 1												
Parameter	As-built (2006)			MY-1 (2006)			MY-2 (2007)			MY-3 (2008)		
Pattern	Min	Max	Avg	Min	Max	Avg	Min	Max	Avg	Min	Max	Avg
Channel Beltwidth (ft)	59.32	93.89	72.85	58.48	96.38	71.67	58.96	97.33	72.54	35.42	103.28	67.02
Radius of Curvature (ft)	16.64	40.88	25.73	16.84	39.51	24.43	16.72	40.02	25.69	18.06	41.31	29.62
Meander Wavelength (ft)	77.08	117.13	94.8	76.54	118.26	91.85	75.94	120.96	92.17	81.64	125.68	102.42
Meander Width ratio	3.7	5.86	4.55	3.56	5.72	4.65	3.24	6.23	4.98	4.08	6.28	5.12
Profile												
Riffle length (ft)	25.87	54.2	37.85	19.31	54.86	30.86	22.15	58.62	34.61	17.03	56.21	34.53
Riffle slope (ft/ft)	0.00092	0.0187	0.0062	0.00125	0.01763	0.00883	0.0017	0.025	0.009	0.00115	0.033	0.01196
Pool length (ft)	7.41	244.47	23.01	14.19	31.92	24.11	15.64	34.81	26.84	23.86	56.25	38.65
Pool Slope (ft/ft)	0.0007	0.0064	0.0016	0.0007	0.0029	0.0012	0.0007	0.004	0.0017	0.0007	0.0033	0.0013
Pool spacing (ft)	12.35	142	70.94	52.58	159	88.05	45.21	148	85.94	44.7	172.7	92.69
Additional Reach Parameters												
Valley Length (ft)	4258.3			4258.3			4258.3			4258.3		
Channel Length (ft)	5813.3			5813.3			5813.3			5813.3		
Sinuosity	1.36			1.36			1.36			1.36		
Water Surface Slope (ft/ft)	0.00544			0.00544			0.00544			0.00544		
BF slope (ft/ft)	0.00544			0.00544			0.00544			0.00544		
Rosgen Classification	C4			C4			C4			C4		
Habitat Index*	N/A			N/A			N/A			N/A		
Macrobenthos*	N/A			N/A			N/A			N/A		

Parameter	REACH 2															
	RIFFLE 1				POOL 1				RIFFLE 2				POOL 2			
Dimension	AS BUILT	MY1	MY2	MY3	AS BUILT	MY1	MY2	MY3	AS BUILT	MY1	MY2	MY3	AS BUILT	MY1	MY2	MY3
BF Width (ft)	2006	2006	2007	2008	2006	2006	2007	2008	2006	2006	2007	2008	2006	2006	2007	2008
BF Width (ft)	7.38	7.61	10.66	8.67	18.44	17.46	22.47	20.95	8.21	7.6	9.16	8.98	9.59	10.03	5.56	3.56
Floodprone Width (ft)	23.08	26.25	29.56	25.54	46.7	46.7	46.7	46.78	39.05	26.17	26	40.5	54.65	51.62	54.65	54.65
BF Cross Sectional Area (ft <sup>2</sup> )	4.14	4.65	5.33	4.74	19.78	18.94	23.35	21.96	6.77	4.86	7.71	6.71	17.34	16.04	5.82	3.92
BF Mean Depth (ft)	0.56	0.61	0.5	0.55	1.07	1.09	1.04	1.05	0.82	0.64	0.84	0.75	1.81	1.6	1.05	1.1
BF Max Depth (ft)	0.86	0.98	1	0.94	2.6	2.64	2.63	2.58	1.3	1.19	1.47	1.23	3.2	2.88	1.54	1.63
Width/Depth Ratio	13.18	12.48	13.5	15.76	17.23	16.02	21.61	19.95	10.01	11.88	10.9	11.97	5.3	6.27	5.3	3.24
Entrenchment Ratio	3.13	1.84	2.77	2.95	2.53	2.67	2.08	2.23	4.76	3.44	2.84	4.51	5.7	5.15	9.8	15.37
Wetted Perimeter (ft)	7.68	7.92	10.91	8.94	20.58	19.14	24.19	22.77	8.77	8.01	9.68	9.36	12.14	11.79	6.8	5.41
Hydraulic radius (ft)	0.54	0.59	0.58	0.53	0.96	0.99	0.97	0.96	0.77	0.61	0.8	0.72	1.43	1.37	0.86	0.72
Substrate																
d50 (mm)	N/A	N/A	N/A	N/A	N/A	N/A	N/A	N/A	4.8	7	0.12	4	N/A	N/A	N/A	N/A
d84 (mm)	N/A	N/A	N/A	N/A	N/A	N/A	N/A	N/A	28	42	0.6	66	N/A	N/A	N/A	N/A

REACH 2												
Parameter	As-built (2006)			MY-1 (2006)			MY-2 (2007)			MY-3 (2008)		
Pattern	Min	Max	Avg	Min	Max	Avg	Min	Max	Avg	Min	Max	Avg
Channel Beltwidth (ft)	11.83	22.05	16.96	11.56	23.13	17.05	11.45	24.13	17.55	10.41	25.86	15.91
Radius of Curvature (ft)	4.63	9.1	6.43	4.776	9.84	6.32	4.7	9.7	6.1	3.85	11.5	7.38
Meander Wavelength (ft)	27.51	34.72	31.75	28.61	35.43	32.47	28.42	35.03	31.73	21.56	40.37	30.58
Meander Width ratio	1.52	2.83	2.17	1.43	2.94	2.33	1.48	2.95	2.41	2.70	5.05	3.82
Profile												
Riffle length (ft)	3.36	11.6	5.6	4.93	7.24	5.88	4.95	7.64	6.01	4.2	15.24	8.73
Riffle slope (ft/ft)	0.0053	0.0555	0.0279	0.0045	0.1073	0.0393	0.0049	0.0534	0.0325	0.00231	0.10249	0.037
Pool length (ft)	5.2	10.08	7.59	5.17	14.37	8.67	5	15.25	10.125	4.07	12.31	9.59
Pool Slope (ft/ft)	0.001	0.0092	0.0022	0.00087	0.00754	0.00253	0.00084	0.00253	0.00738	0.0009	0.01199	0.00236
Pool spacing (ft)	9.43	28.94	19.51	14.65	35.31	21.98	14.65	36.12	26.95	8.83	33.24	19.04
Additional Reach Parameters												
Valley Length (ft)	1872.37			1872.37			1872.37			1872.37		
Channel Length (ft)	2190.67			2190.67			2190.67			2190.67		
Sinuosity	1.2			1.2			1.2			1.2		
Water Surface Slope (ft/ft)	0.025			0.025			0.025			0.025		
BF slope (ft/ft)	0.025			0.025			0.025			0.025		
Rosgen Classification	B4			B4			B4			B4		
Habitat Index*	N/A			N/A			N/A			N/A		
Macrobenthos*	N/A			N/A			N/A			N/A		

## 7. Benthic Macroinvertebrate Assessment and Interpretation of Data

Year 3 benthic sampling was performed by professionals with the necessary DWQ certification credentials. Samples were preserved in the field in 95% denatured Ethyl alcohol. Following collection, samples were sent to Pennington and Associates, a certified laboratory, for identification. Year 3 results will be included in the Year 4 Monitoring Report.

As stated in the Gray Farm Stream Restoration Mitigation Report (July 2006), biological monitoring will be used as a general indicator of restoration success; however, no specific biological criteria apply to the success of the restoration reaches.

As previously described, benthic sampling was performed at five (5) sampling locations. Where possible, each monitoring station consisted of a riffle-pool sequence. At each station, the Qual-4 sampling method, as described in the NCDENR-DWQ's Standard Operating Procedures for Benthic Macroinvertebrates. The Qual-4 method consists of:

- 1 Kick Net Sample (from riffle)
- 1 Sweep Net Sample (from bank)
- 1 Leaf Pack Sample
- 1 Visual Observation Sample

Ephemeropteran, Plecopteran, and Trichopteran (EPT) taxa and abundance and NC Biotic Indices (NCBI), as well as a list of all taxa collected at each sampling point during previous monitoring years, are provided in Appendix C.

The Benthic Macroinvertebrate Assessment presented in this report is based on Year 2 benthic sampling conducted in October, 2007. Due to the late collection season for benthic macroinvertebrates (as recommended by Mr. Larry Eaton of NC-DWQ) and the time required to receive identified samples from the laboratory, Year 3 collection data is not yet available. Year 3 benthic sampling was conducted on November 20<sup>th</sup>, 2008, and will be presented as part of the Year 4 Monitoring Report. Year 3 benthic samples are currently being processed by Pennington and Associates.

Benthic data for Year 2 indicate that water quality within Reach 1 increases moving downstream. EPT taxa become more abundant, species diversity increases, and tolerant species decrease with distance from the uppermost portion of the site abutting the cow pasture and upstream degraded channel segment. These data indicate that the restoration of Reach 1 has been successful in improving water quality within the subject channels and the downstream receiving waters.


Within Reach 2, there were not enough macroinvertebrates with an assigned NCBI rating collected during Year 2 at Station 1, within the restoration reach, to make a determination of NCBI, and no EPT taxa were collected at Station

1; however, EPT taxa, species diversity and abundance increased between Station 1 and Station 2. Station 2 received the lowest NCBI score (4.49), indicating few tolerant taxa and relatively high water quality. Although inconclusive, data for Reach 2 are encouraging.

#### **IV. Methodology Section**

With the exception of the aforementioned use of Level 2 (Planted and Natural Woody Stems) of the CVS-EEP Vegetation Monitoring Protocol, no deviations from initially prescribed methodologies were implemented as a part of Monitoring Year 3 (2008) activities.



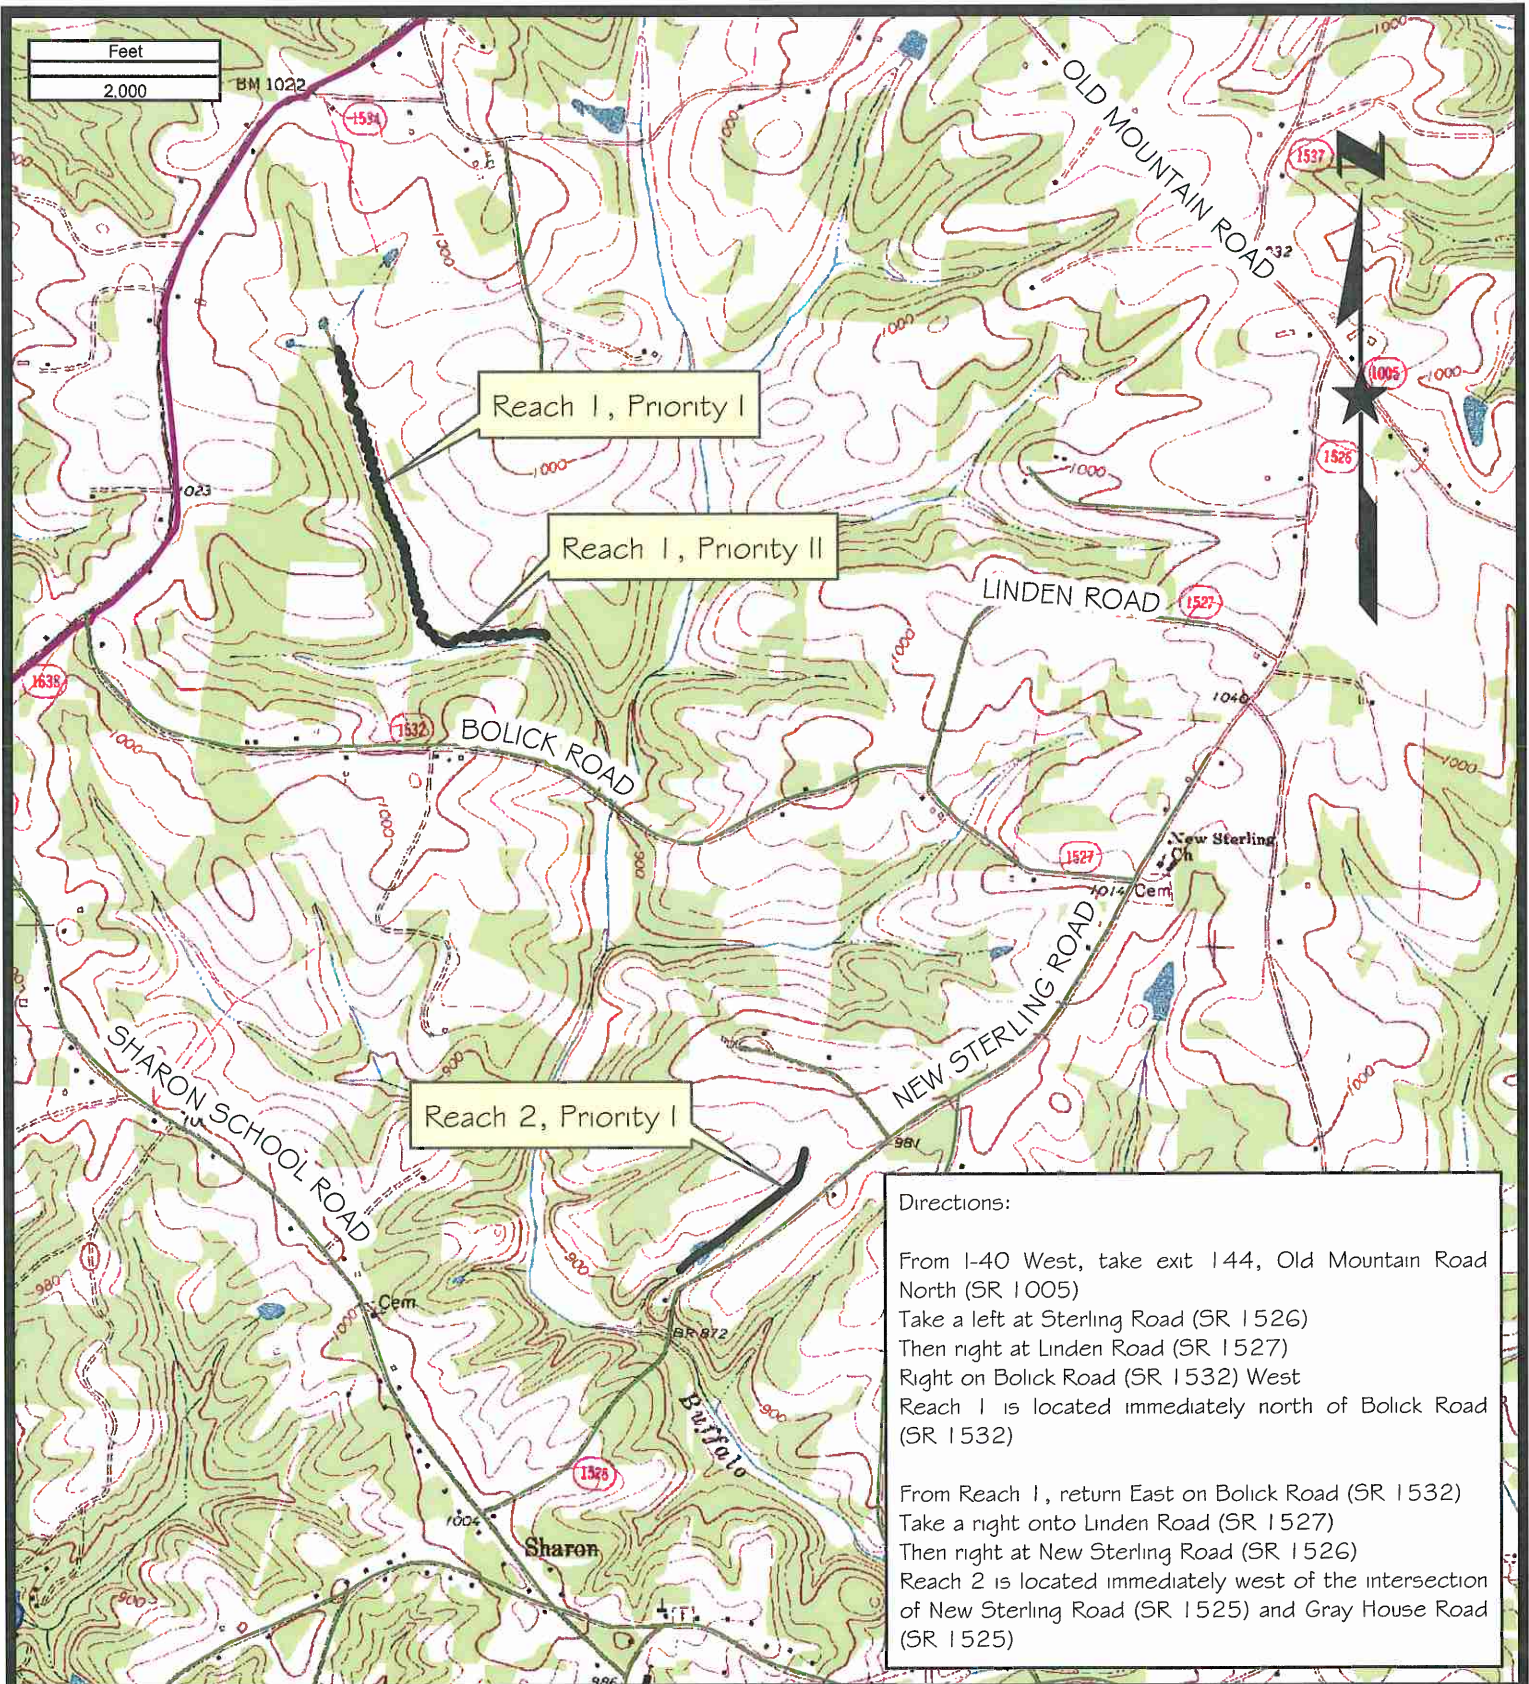

Directions:

From I-40 West, take exit 144, Old Mountain Road North (SR 1005)  
 Take a left at Sterling Road (SR 1526)  
 Then right at Linden Road (SR 1527)  
 Right on Bolick Road (SR 1532) West  
 Reach 1 is located immediately north of Bolick Road (SR 1532)

From Reach 1, return East on Bolick Road (SR 1532)  
 Take a right onto Linden Road (SR 1527)  
 Then right at New Sterling Road (SR 1526)  
 Reach 2 is located immediately west of the intersection of New Sterling Road (SR 1525) and Gray House Road (SR 1525)

Project Number:  
**9385.D9**

Project Manager:  
**DG**

Scale:  
**1" = 2,000'**

Date:  
**DECEMBER 2008**

Map Title:  
**Figure 1 - Project Location**

Gray Farm Stream Restoration Site  
 EEP Job # 92219  
 Iredell County, NC

Source:  
 Stony Point Quadrangle



Soil & Environmental Consultants, PA  
 11010 Hunters Ridge Rd • Raleigh, NC 27614  
 (919) 648-6602 • (919) 648-6467  
 Web Page: www.SandEC.com



**APPENDIX A**  
**VEGETATION RAW DATA**

APPENDIX A.1 –  
Vegetation Survey Data Tables

**Table V-1 – Vegetation Metadata**

**Report Prepared By** David Cooper  
**Date Prepared** 9/24/2008 12:09

**database name** DRAFT\_2008-Gray Farm-level2.mdb  
**database location** \\Sec2\jobs7-9k\9385.D7-D11\YEAR 3 - D9\MONITORING DATA

**DESCRIPTION OF WORKSHEETS IN THIS DOCUMENT-----**

----

**Metadata** This worksheet, which is a summary of the project and the project data.  
**Plots** List of plots surveyed.  
**Vigor** Frequency distribution of vigor classes.  
**Vigor by Spp** Frequency distribution of vigor classes listed by species.  
**Damage** List of most frequent damage classes with number of occurrences and percent of total stems impacted by each.  
**Damage by Spp** Damage values tallied by type for each species.  
**Damage by Plot** Damage values tallied by type for each plot.  
**Stem Count by Plot and Spp** Count of living stems of each species for each plot; dead and missing stems are excluded.

**PROJECT SUMMARY-----**

<b>Project Code</b>	<b>project Name</b>	<b>Description</b>	<b>length(ft)</b>	<b>stream-to-edge width (ft)</b>	<b>area (sq m)</b>	<b>Required Plots (calculated)</b>	<b>Sampled Plots</b>
GF1	Gray Farm Reach 1	Gray Farm stream restoration - Reach 1					4
GF2	Gray Farm Reach 2	Gray Farm stream restoration - Reach 2					2

**Table V-2 – Vegetation Vigor by Species**

	<b>Species</b>	<b>4</b>	<b>3</b>	<b>2</b>	<b>1</b>	<b>0</b>	<b>Missing</b>
	<b>Alnus serrulata</b>	2	2	1			2
	<b>Betula nigra</b>	2				1	1
	<b>Cornus amomum</b>		3				
	<b>Diospyros virginiana</b>						
	<b>Fraxinus pennsylvanica</b>	2	1				3
	<b>Quercus michauxii</b>					1	
	<b>Quercus nigra</b>						2
	<b>Quercus phellos</b>	4	3	10			
	<b>Salix nigra</b>						
	<b>Sambucus canadensis</b>						
	<b>Viburnum nudum</b>	1					1
	<b>Viburnum</b>		1				
	<b>Viburnum dentatum</b>	1					
	<b>Ilex opaca</b>			2			4
	<b>Betula lenta</b>						
	<b>Carpinus caroliniana</b>		1				
	<b>Juniperus virginiana</b>						
	<b>Quercus</b>						8
	<b>Quercus rubra</b>	2	1				
	<b>Lindera benzoin</b>				1		3
	<b>Liriodendron tulipifera</b>	2	1				3
	<b>Platanus occidentalis</b>	10	9	4		1	4
	<b>Prunus serotina</b>						
	<b>Acer negundo</b>						
	<b>Acer rubrum</b>						
TOT:	<b>25</b>	<b>26</b>	<b>22</b>	<b>17</b>	<b>1</b>	<b>3</b>	<b>31</b>

**Table V-3 – Vegetation Damage by Species**

	<b>Species</b>	<b>All Damage Categories</b>	<b>(no damage)</b>	<b>Deer</b>	<b>Insects</b>	<b>Unknown</b>	<b>(other damage)</b>
	Acer negundo	2	2				
	Acer rubrum	2	2				
	Alnus serrulata	7	6	1			
	Betula lenta	1	1				
	Betula nigra	4	3			1	
	Carpinus caroliniana	1	1				
	Cornus amomum	3		3			
	Diospyros virginiana	3	3				
	Fraxinus pennsylvanica	7	7				
	Ilex opaca	6	5				1
	Juniperus virginiana	1	1				
	Lindera benzoin	4	3		1		
	Liriodendron tulipifera	8	8				
	Platanus occidentalis	30	29			1	
	Prunus serotina	1	1				
	Quercus	8	8				
	Quercus michauxii	1				1	
	Quercus nigra	2	2				
	Quercus phellos	17	14			3	
	Quercus rubra	4	4				
	Salix nigra	1	1				
	Sambucus canadensis	2	2				
	Viburnum	1	1				
	Viburnum dentatum	1	1				
	Viburnum nudum	2	2				
<b>TOT:</b>	<b>25</b>	<b>119</b>	<b>107</b>	<b>4</b>	<b>1</b>	<b>6</b>	<b>1</b>

**Table V-4 – Vegetation Damage by Plot**

	plot	All Damage Categories	(no damage)	Deer	Insects	Unknown	(other damage)
	GFR1-01-buffer1-year:2	19	15	1		3	
	GFR1-01-buffer2-year:2	22	19		1	2	
	GFR1-01-buffer3-year:2	18	15	1		1	1
	GFR1-01-buffer4-year:2	17	15	2			
	GFR2-01-Buffer1-year:2	25	25				
	GFR2-01-Buffer2-year:2	18	18				
<b>TOT:</b>	<b>6</b>	<b>119</b>	<b>107</b>	<b>4</b>	<b>1</b>	<b>6</b>	<b>1</b>

**Table V-5 – Stem Count by Plot and Species**

	Species	Total Stems	# plots	avg# stems	Reach 1, Buffer Plot 1, Year 3	Reach 1, Buffer Plot 2, Year 3	Reach 1, Buffer Plot 3, Year 3	Reach 1, Buffer Plot 4, Year 3	Reach 2, Buffer Plot 1, Year 3	Reach 2, Buffer Plot 2, Year 3
	Alnus serrulata	5	4	1.25	2	1	1	1		
	Betula nigra	2	2	1			1	1		
	Carpinus caroliniana	1	1	1					1	
	Cornus amomum	3	2	1.5			1	2		
	Fraxinus pennsylvanica	3	3	1	1	1	1			
	Ilex opaca	2	2	1			1		1	
	Lindera benzoin	1	1	1		1				
	Liriodendron tulipifera	3	2	1.5		1				2
	Platanus occidentalis	23	6	3.83	2	2	9	7	2	1
	Quercus phellos	17	4	4.25	4	2			10	1
	Quercus rubra	3	2	1.5	2					1
	Viburnum	1	1	1		1				
	Viburnum dentatum	1	1	1						1
	Viburnum nudum	1	1	1		1				
<b>Tot</b>	<b>14</b>	<b>66</b>	<b>6</b>		<b>11</b>	<b>10</b>	<b>14</b>	<b>11</b>	<b>14</b>	<b>6</b>
<b>Total Plot Density (Stems Per Acre)</b>					<b>445</b>	<b>405</b>	<b>567</b>	<b>445</b>	<b>567</b>	<b>243</b>
<b>Average Plot Density (Stems Per Acre)</b>				<b>445</b>						

APPENDIX A.2 –  
Vegetation Problem Area Tables



Exhibit Table A1 - Vegetative Problem Areas

<b>Reach 1</b>			
<b>Feature/Issue</b>	<b>Station # / Range</b>	<b>Probable Cause</b>	<b>Photo #</b>
Bare Floodplain	0+00 - 0+50	Surface flow / Poor soil quality	1-2
	1+00 - 1+40	Surface flow / Poor soil quality	
	2+00 - 2+60	Surface flow / Poor soil quality	
	3+50 - 4+00	Surface flow / Poor soil quality	
	4+50 - 5+75	Surface flow / Poor soil quality	
	6+10 - 6+90	Surface flow / Poor soil quality	
	37+80 - 38+50	Surface flow / Poor soil quality	
	42+00 - 42+50	Surface flow / Poor soil quality	
	42+75 - 43+30	Surface flow / Poor soil quality	
Bare Bank	50+00 - 50+60	Surface flow / Poor soil quality	3
	40+70 - 41+00	Bank Scour	
<b>Reach 2</b>			
<b>Feature/Issue</b>	<b>Station # / Range</b>	<b>Probable Cause</b>	<b>Photo #</b>
Bare Floodplain	3+25 - 3+35	Surface flow / Poor soil quality	4
	5+30 - 5+50	Surface flow / Poor soil quality	
	20+75 - 20+85	Surface flow / Poor soil quality	

APPENDIX A.3 –  
Vegetation Problem Area Photos



**Photo 1 – Typical Bare Bench/Floodplain – Reach 1 – Year 3 (2008)**



**Photo 2 – Typical Bare Bench/Floodplain – Reach 1 – Year 3 (2008)**



**Photo 3 – Typical Bare Bank – Reach 1 – Year 3 (2008)**



**Photo 4 – Typical Bare Bench/Floodplain – Reach 2 – Year 3 (2008)**

APPENDIX A.4 –  
Vegetation Monitoring Plot Photos



**Vegetation Monitoring Plot—Reach 1—Buffer 1—Year 3 (2008)**



**Vegetation Monitoring Plot—Reach 1—Buffer 1—Year 2 (2007)**



**Vegetation Monitoring Plot—Reach 1—Buffer 1—Year 1 (2006)**



**Vegetation Monitoring Plot—Reach 1—Buffer 2—Year 3 (2008)**



**Vegetation Monitoring Plot—Reach 1—Buffer 2—Year 2 (2007)**





**Vegetation Monitoring Plot—Reach 1—Buffer 2—Year 1 (2006)**



**Vegetation Monitoring Plot—Reach 1—Buffer 3—Year 3 (2008)**



**Vegetation Monitoring Plot—Reach 1—Buffer 3—Year 2 (2007)**



**Vegetation Monitoring Plot—Reach 1—Buffer 3—Year 1 (2006)**



**Vegetation Monitoring Plot—Reach 1—Buffer 4—Year 3 (2008)**



**Vegetation Monitoring Plot—Reach 1—Buffer 4—Year 2 (2007)**



**Vegetation Monitoring Plot—Reach 1—Buffer 4—Year 1 (2006)**



**Vegetation Monitoring Plot—Reach 1—Bank 1—Year 3 (2008)**



**Vegetation Monitoring Plot—Reach 1—Bank 1—Year 2 (2007)**



**Vegetation Monitoring Plot—Reach 1—Bank 1—Year 1 (2006)**



**Vegetation Monitoring Plot—Reach 1—Bank 2—Year 3 (2008)**



**Vegetation Monitoring Plot—Reach 1—Bank 2—Year 2 (2007)**





**Vegetation Monitoring Plot—Reach 1—Bank 2—Year 1 (2006)**



**Vegetation Monitoring Plot—Reach 2—Buffer 1—Year 3 (2008)**



**Vegetation Monitoring Plot—Reach 2—Buffer 1—Year 2 (2007)**



**Vegetation Monitoring Plot—Reach 2—Buffer 1—Year 1 (2006)**



**Vegetation Monitoring Plot—Reach 2—Buffer 2—Year 3 (2008)**



**Vegetation Monitoring Plot—Reach 2—Buffer 2—Year 2 (2007)**




**Vegetation Monitoring Plot—Reach 2—Buffer 2—Year 1 (2006)**



**Vegetation Monitoring Plot—Reach 2—Bank 1—Year 3 (2008)**



**Vegetation Monitoring Plot—Reach 2—Bank 1—Year 2 (2007)**

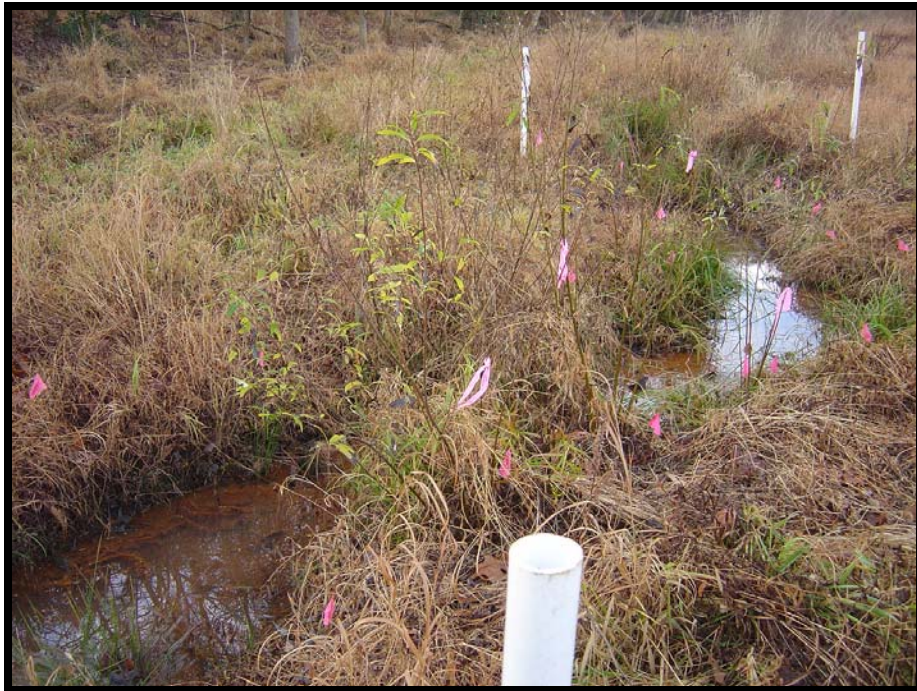

**Vegetation Monitoring Plot—Reach 2—Bank 1—Year 1 (2006)**



**Vegetation Monitoring Plot—Reach 2—Bank 2—Year 3 (2008)**



**Vegetation Monitoring Plot—Reach 2—Bank 2—Year 2 (2007)**





**Vegetation Monitoring Plot—Reach 2—Bank 2—Year 1 (2006)**

**APPENDIX B**

**GEOMORPHOLOGIC RAW DATA**

APPENDIX B.1 –

Bankfull Events



**Photo 1 – Reach 1 – Flattened Vegetation from Surface Flow**



**Photo 2 – Reach 1 – Wrack Pile at Corner of Buffer Monitoring Plot 3**



**Photo 3 – Reach 1 – Flattened Vegetation from Surface Flow**



**Photo 4 – Reach 2 – Flattened Vegetation from Surface Flow**

APPENDIX B.2 –

Stream Problem Area Table (Table B1)

Exhibit Table B1- Stream Problem Areas  
Gray Farm Stream Restoration Site/EEP Project #92219

**Reach 1**

<b>Feature Issue</b>	<b>Station numbers</b>	<b>Suspected Cause</b>	<b>Photo number</b>
Bank Scour	14+00	Surface flow	1-2
	24+75	Surface flow	
	32+60	Surface flow	
	40+75	Surface flow	
	43+05	Surface flow - Settling fill	
Structures	0+30	Buried Structure - Upstream Sediment	3
	1+50	Buried Structure - Upstream Sediment	
	24+75	Stressed structure - Bank Scour	2
	32+60	Stressed structure - Bank Scour	
	43+05	Stressed structure - Bank Scour	

**Reach 2**

<b>Feature Issue</b>	<b>Station numbers</b>	<b>Suspected Cause</b>	<b>Photo number</b>
Bank Scour	4+80	Surface flow	4
	6+00	Surface flow	
	16+60	Surface flow	
	12+70 - 12+80	Surface flow	
Undercut Bank	47+00 - 47+50	Increased water velocity from nearby tributary	5
Structures	4+80	Stressed structure - Bank Scour	4
	6+00	Stressed structure - Bank Scour	
	16+60	Stressed structure - Bank Scour	
	12+70 - 12+80	Stressed structures - Bank Scour	

APPENDIX B.3 –  
Stream Problem Area Photos





**Photo 1 – Typical Bank Scour – Reach 1 – Year 3 (2008)**



**Photo 2 – Typical Stressed Structure/Bank Scour – Reach 1 – Year 3 (2008)**



**Photo 3 – Typical Buried Structure from Off-Site Sediment Source – Reach 1 – Year 3 (2008)**



**Photo 4 – Typical Stressed Structure/Bank Scour – Reach 2 – Year 3 (2008)**



**Photo 5 – Undercut Bank – Reach 1 – Year 3 (2008)**

APPENDIX B.4 –  
Stream Photo-Station Photos



**Cross-Section 1— Reach 1—Riffle 1—Year 3 (2008)**



**Cross-Section 1— Reach 1—Riffle 1—Year 2 (2007)**



**Cross-Section 1— Reach 1—Riffle 1—Year 1 (2006)**



**Cross-Section 1— Reach 1—Pool 1—Year 3 (2008)**



**Cross-Section 1— Reach 1—Pool 1—Year 2 (2007)**



**Cross-Section 1— Reach 1—Pool 1—Year 1 (2006)**





**Cross-Section 2—Reach 1—Riffle 2—Year 3 (2008)**



**Cross-Section 2—Reach 1—Riffle 2—Year 2 (2007)**



**Cross-Section 2—Reach 1—Riffle 2—Year 1 (2006)**



**Cross-Section 2—Reach 1 - Pool 2—Year 3 (2008)**



**Cross-Section 2—Reach 1 - Pool 2—Year 2 (2007)**



**Cross-Section 2—Reach 1 - Pool 2—Year 1 (2006)**



**Cross-Section 3—Reach 1—Riffle 3—Year 3 (2008)**



**Cross-Section 3—Reach 1—Riffle 3—Year 2 (2007)**



**Cross-Section 3—Reach 1—Riffle 3—Year 1 (2006)**



**Cross-Section 3—Reach 1 - Pool 3—Year 3 (2008)**



**Cross-Section 3—Reach 1 - Pool 3—Year 2 (2007)**



**Cross-Section 3—Reach 1 - Pool 3—Year 1 (2006)**





**Cross-Section 2—Reach 2—Riffle 2—Year 1 (2006)**



**Cross-Section 2—Reach 2—Pool 2—Year 3 (2008)**



**Cross-Section 2—Reach 2—Pool 2—Year 2 (2007)**



**Cross-Section 2—Reach 2—Pool 2—Year 1 (2006)**



APPENDIX B.5 –

**Exhibit Table B2 - Qualitative Visual Stability Assessment**

Table B2 - Qualitative Visual Stability Assessment  
 Date: NOVEMBER 2008  
 GRAY FARM STREAM RESTORATION - REACH 1

Project # 9385.D9

Feature Category	Metric (per As-built and reference baselines)	(# stable) Number performing as intended	Total number per As-built	Total Number / feet in unstable state	% perfor. in stable condition	Feature Perform. Mean or Total
A. Riffles	1. Present?	34	34	NA	100%	
	2. Armor stable (e.g. no displacement)?	34	34	NA	100%	
	3. Facet grade appears stable?	33	34	NA	97%	
	4. Stable interval grade?	34	34	NA	100%	
	5. Feature spacing appropriate?	34	34	NA	100%	
	6. Minimal evidence of embedding/fining?	34	34	NA	100%	
	7. Depth appears appropriate for current discharge?	34	34	NA	100%	
	8. Length appropriate?	34	34	NA	100%	<b>100%</b>
B. Pools	1. Present? (e.g. not subject to severe aggradation?)	49	49	NA	100%	
	2. Sufficiently deep (Max Pool D:Mean Bkf>1.6)	49	49	NA	100%	
	3. Thalweg located outer bend?	49	49	NA	100%	
	4. Spacing appropriate?	49	49	NA	100%	
	5. Non-aggrading (not filling)?	49	49	NA	100%	
	6. Length appropriate?	49	49	NA	100%	<b>100%</b>
C. Thalweg	1. Upstream of meander bend (run/inflection) centering?	34	34	NA	100%	
	2. Downstream of meander (glide/inflection) centering?	33	34	NA	97%	<b>99%</b>
D. Meanders	1. Outer bend in state of limited/controlled erosion?	49	49	NA	100%	
	2. Of those eroding, # w/ concomitant point bar formation?	N/A	49	NA	N/A	
	3. Apparent Rc within spec?	49	49	NA	100%	
	4. Sufficient floodplain access and relief?	49	49	NA	100%	<b>100%</b>
E. Bed General	1. General channel bed aggradation areas (bar formation)	NA	NA	0	100%	
	2. Channel bed degradation - areas of increasing down cutting or head cutting?	NA	NA	75	98%	<b>99%</b>
G. Banks	1. Apparent scour points from channel processes	NA	NA	20	99%	
	2. Apparent cut points from overland flow	NA	NA	150	96%	
	3. Apparent cut or scour from flood water re-entry to channel (e.g. inadequate floodplain access?)	NA	NA	0	100%	
	4. Tension cracks	NA	NA	0	100%	
	5. Bank gradient in excess of 40%?	NA	NA	0	100%	
	6. Collapse/slumping	NA	NA	0	100%	
	7. Ratio of bank height: bankfull height elevated	NA	NA	0	100%	<b>99%</b>
H. Vanes	1. Free of back or arm scour?	27	28	N/A	96%	
	2. Height appropriate?	28	28	N/A	100%	
	3. Angle and geometry appear appropriate?	27	28	N/A	96%	
	4. Free of piping or other structural failures?	28	28	N/A	100%	<b>98%</b>
I. Wads/Boulders	1. Free of scour?	0	0	N/A	N/A	
	2. Footing stable?	0	0	N/A	N/A	<b>N/A</b>

Notes:

Table B2 - Qualitative Visual Stability Assessment  
 Date: NOVEMBER 2008  
 GRAY FARM STREAM RESTORATION - REACH 2

Project # 9385.D9


Feature Category	Metric (per As-built and reference baselines)	(# stable) Number performing as intended	Total number per As-built	Total Number / feet in unstable state	% perfor. in stable condition	Feature Perform. Mean or Total
A. Riffles	1. Present?	51	51	NA	100%	
	2. Armor stable (e.g. no displacement)?	51	51	NA	100%	
	3. Facet grade appears stable?	51	51	NA	100%	
	4. Stable interval grade?	51	51	NA	100%	
	5. Feature spacing appropriate?	51	51	NA	100%	
	6. Minimal evidence of embedding/fining?	51	51	NA	100%	
	7. Depth appears appropriate for current discharge?	51	51	NA	100%	
	8. Length appropriate?	51	51	NA	100%	<b>100%</b>
B. Pools	1. Present? (e.g. not subject to severe aggradation?)	52	52	NA	100%	
	2. Sufficiently deep (Max Pool D:Mean Bkf>1.6)	52	52	NA	100%	
	3. Thalweg located outer bend?	52	52	NA	100%	
	4. Spacing appropriate?	52	52	NA	N/A	
	5. Non-aggrading (not filling)?	52	52	NA	100%	
	6. Length appropriate?	52	52	NA	N/A	<b>100%</b>
C. Thalweg	1. Upstream of meander bend (run/inflection) centering?	51	51	NA	100%	
	2. Downstream of meander (glide/inflection) centering?	51	51	NA	100%	<b>100%</b>
D. Meanders	1. Outer bend in state of limited/controlled erosion?	50	52	NA	96%	
	2. Of those eroding, # w/ concomitant point bar formation?	N/A	N/A	NA	N/A	
	3. Apparent Rc within spec?	52	52	NA	100%	
	4. Sufficient floodplain access and relief?	52	52	NA	100%	<b>98%</b>
E. Bed General	1. General channel bed aggradation areas (bar formation)	NA	NA	0	100%	
	2. Channel bed degradation - areas of increasing down cutting or head cutting?	NA	NA	0	100%	<b>100%</b>
G. Banks	1. Apparent scour points from channel processes	NA	NA	20	98%	
	2. Apparent cut points from overland flow	NA	NA	0	100%	
	3. Apparent cut or scour from flood water re-entry to channel (e.g. inadequate floodplain access?)	NA	NA	0	100%	
	4. Tension cracks	NA	NA	0	100%	
	5. Bank gradient in excess of 40%?	NA	NA	0	100%	
	6. Collapse/slumping	NA	NA	0	100%	
	7. Ratio of bank height: bankfull height elevated	NA	NA	0	100%	<b>100%</b>
H. Vanes	1. Free of back or arm scour?	50	53	NA	94%	
	2. Height appropriate?	53	53	NA	100%	
	3. Angle and geometry appear appropriate?	51	53	NA	96%	
	4. Free of piping or other structural failures?	50	53	NA	94%	<b>96%</b>
I. Wads/Boulders	1. Free of scour?	0	0	NA	N/A	
	2. Footing stable?	0	0	NA	N/A	<b>N/A</b>

Notes:

APPENDIX B.6 –


**Annual Overlays of Cross Section Plots**

GRAY FARM STREAM RESTORATION  
REACH 1 - CROSS-SECTION 1 (RIFFLE)  
(STA. 4+25)

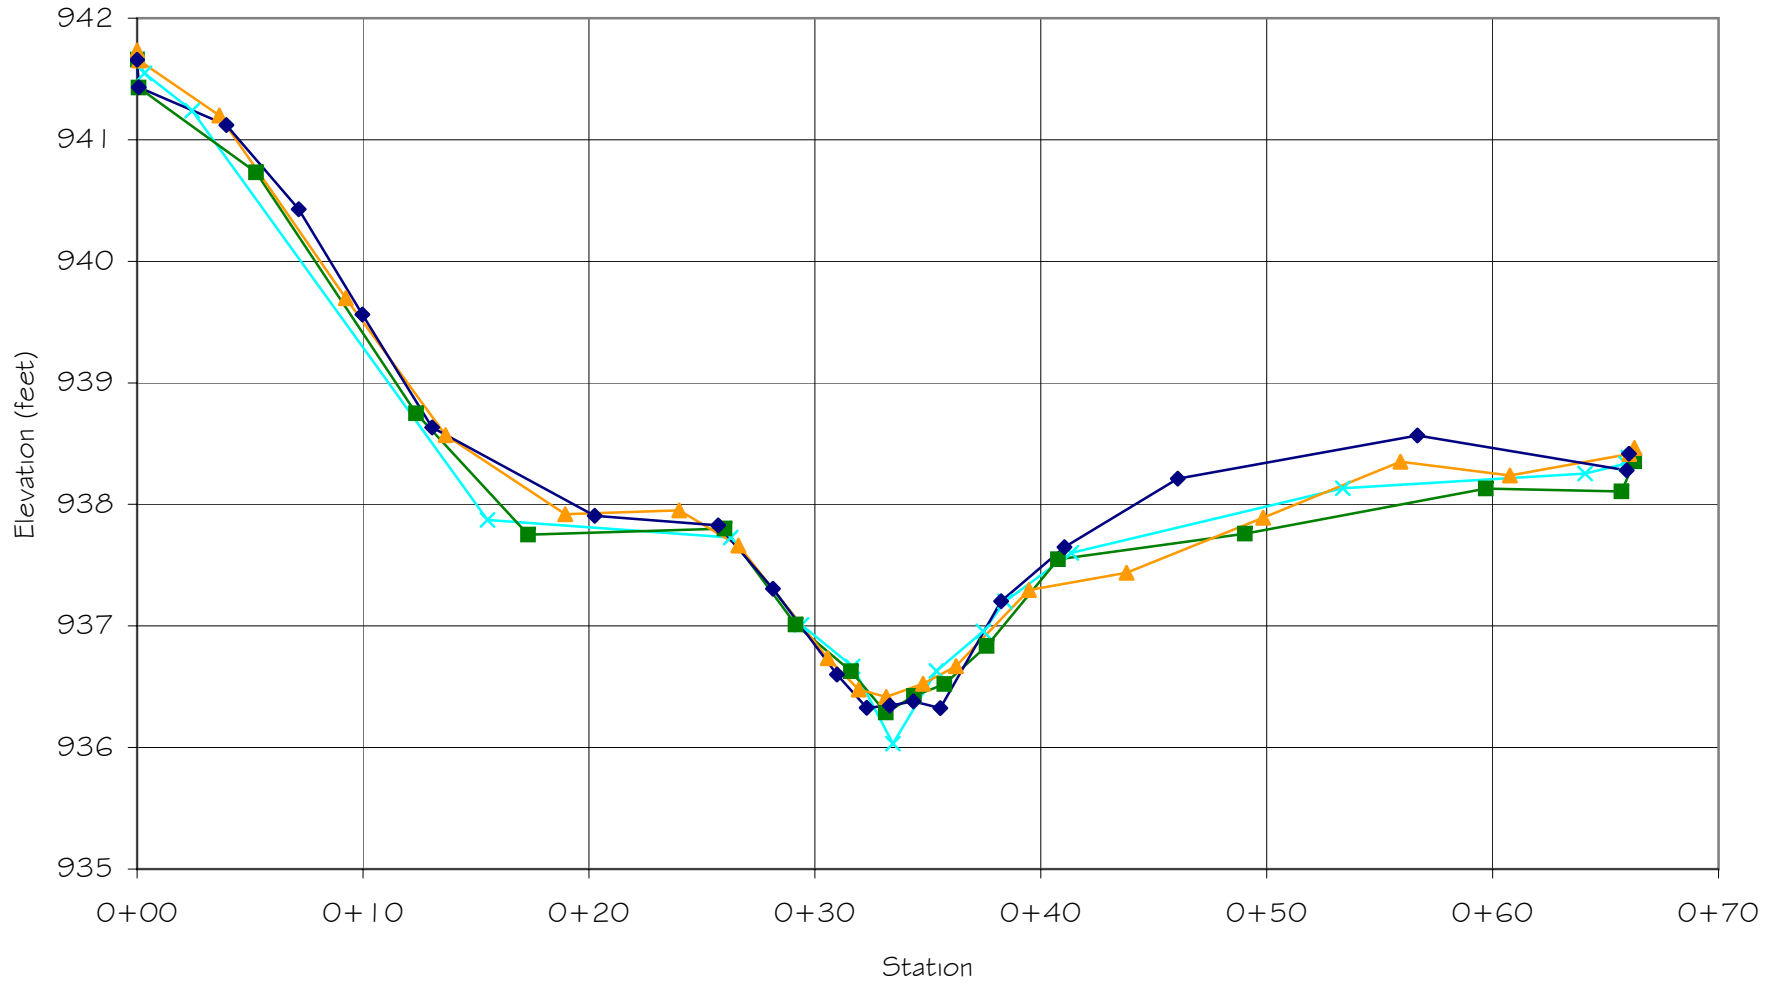


Year 3 Year 2 Year 1 As Built

GRAY FARM STREAM RESTORATION  
REACH 1 - CROSS-SECTION 1 (POOL)  
(STA. 4+65)

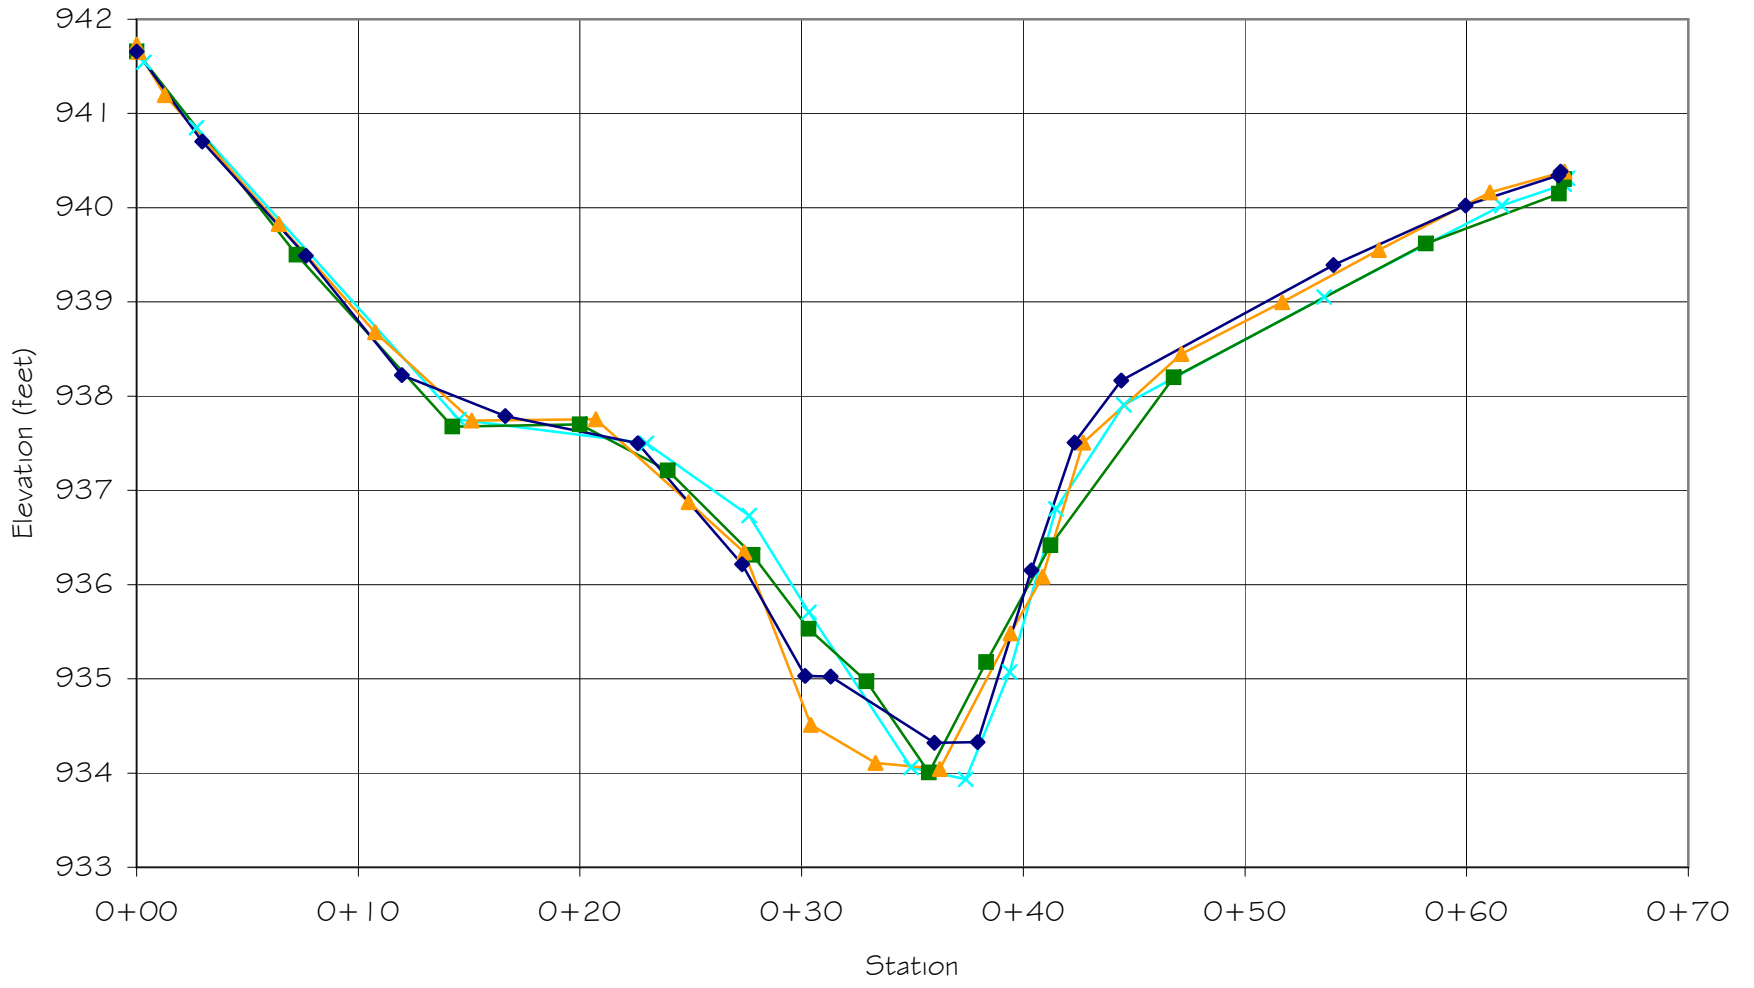


—x— Year 3    —■— Year 2    —▲— Year 1    —◆— As Built

GRAY FARM STREAM RESTORATION  
REACH 1 - CROSS-SECTION 2 (RIFFLE)  
(STA. 13+55)

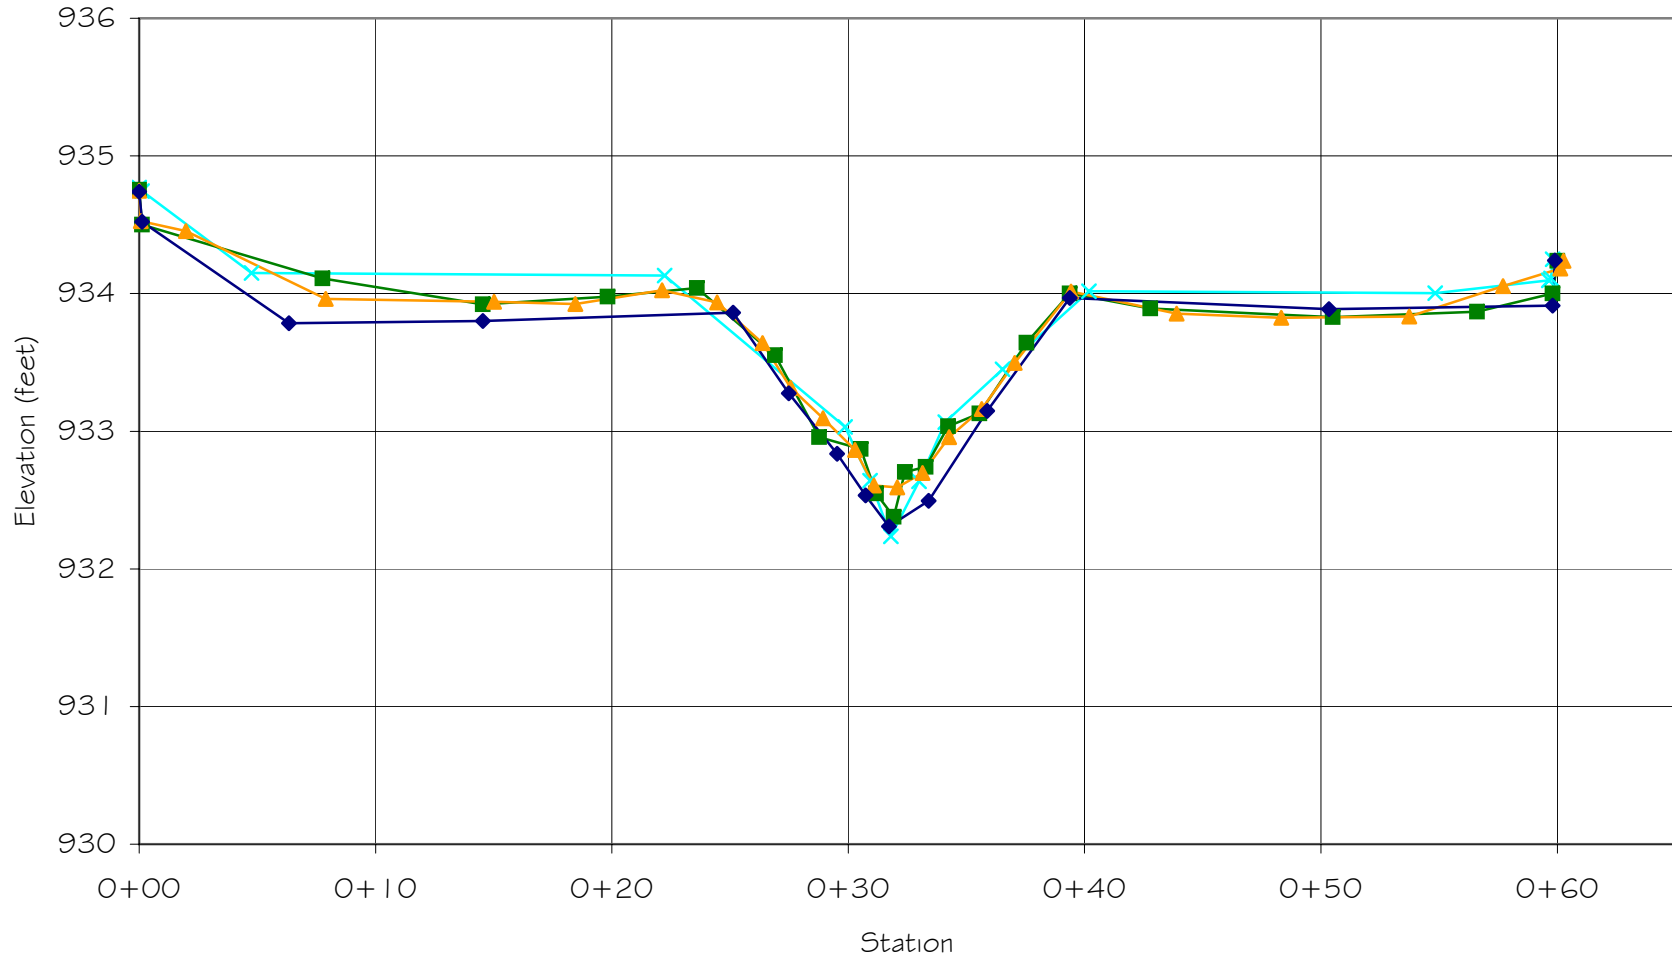

Year 3 Year 2 Year 1 As Built


GRAY FARM STREAM RESTORATION  
REACH 1 - CROSS-SECTION 2 (POOL)  
(STA. 13+90)

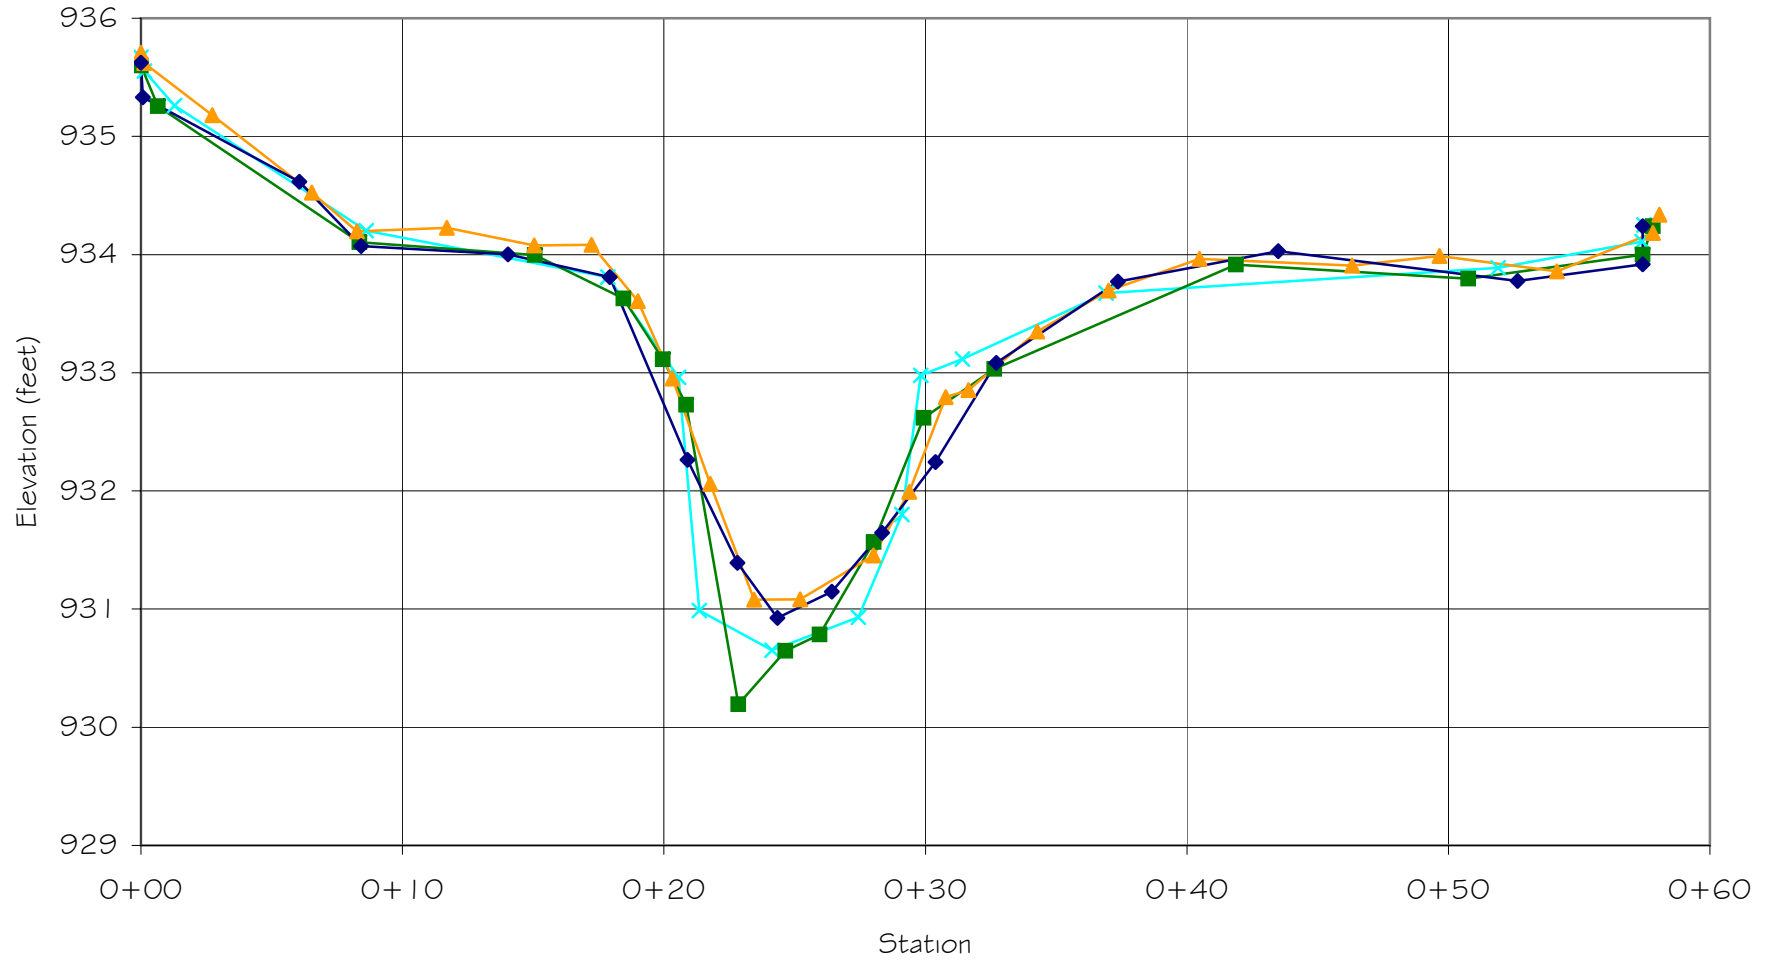


Year 3 Year 2 Year 1 As Built




GRAY FARM STREAM RESTORATION  
REACH 1 - CROSS-SECTION 3 (RIFFLE)  
(STA. 23+40)

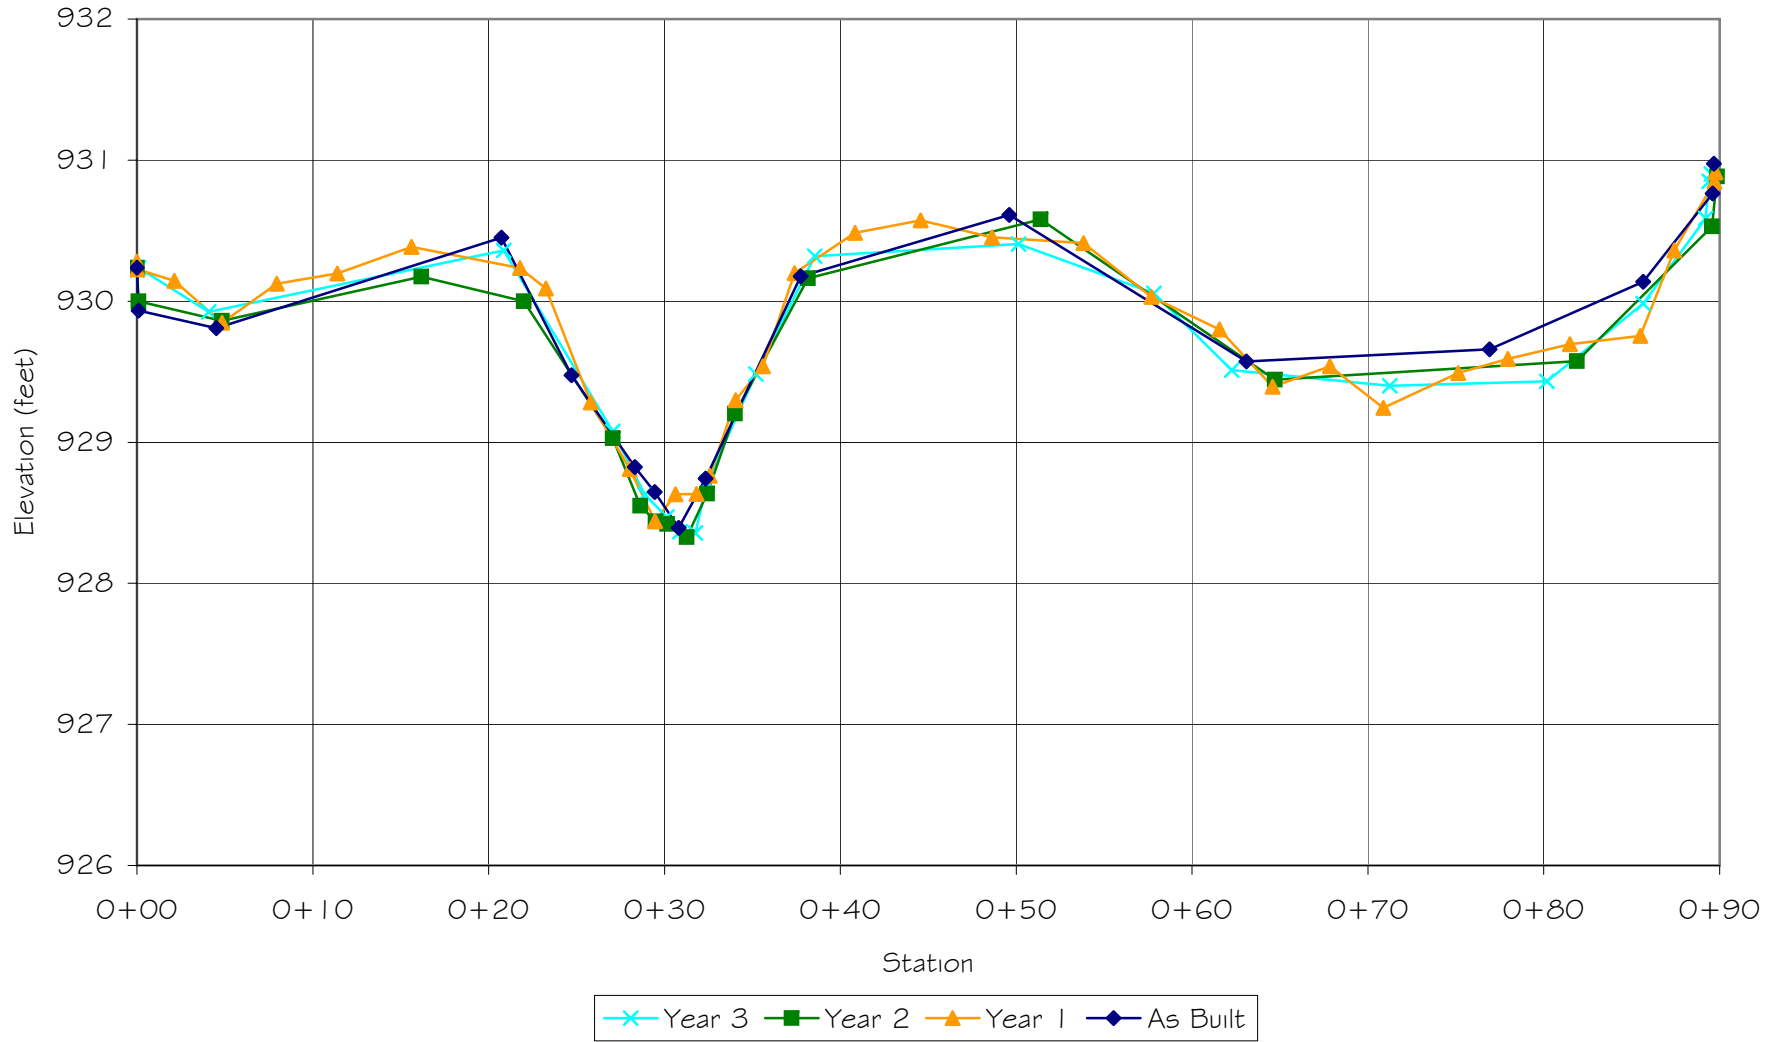


GRAY FARM STREAM RESTORATION  
REACH 1 - CROSS-SECTION 3 (POOL)  
(STA. 23+20)

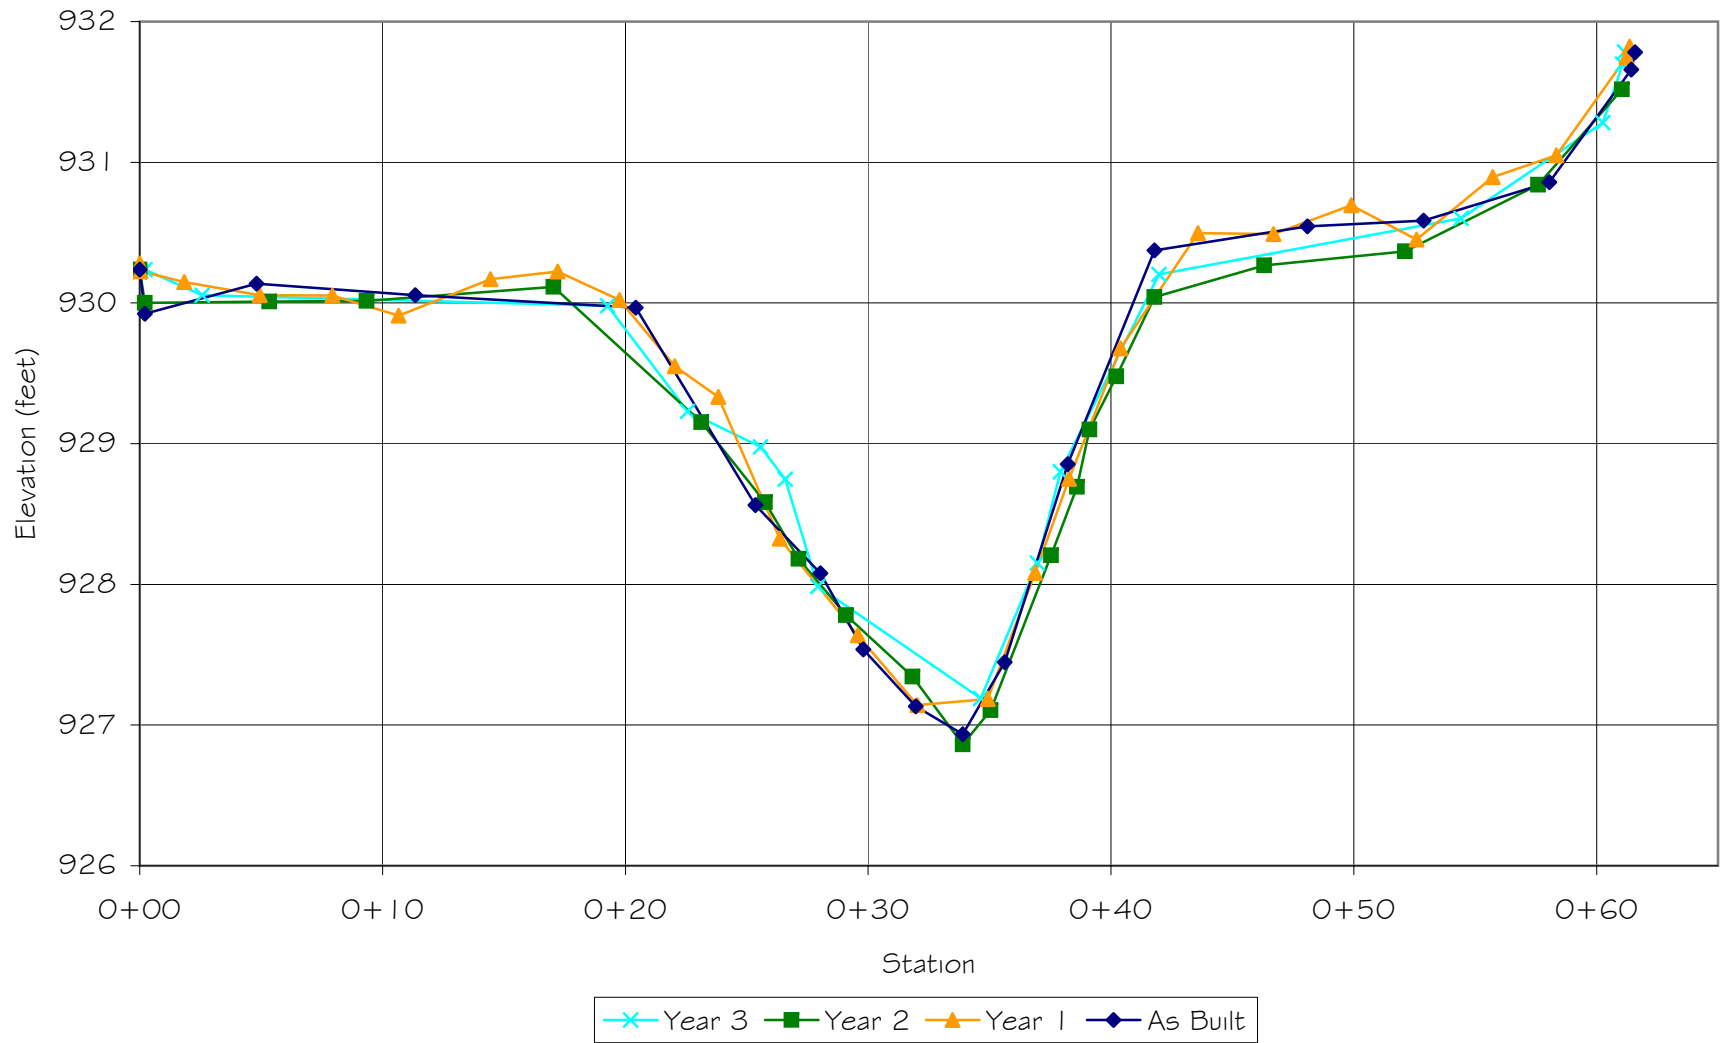


GRAY FARM STREAM RESTORATION  
REACH 1 - CROSS-SECTION 4 (RIFFLE)  
(STA. 32+95)

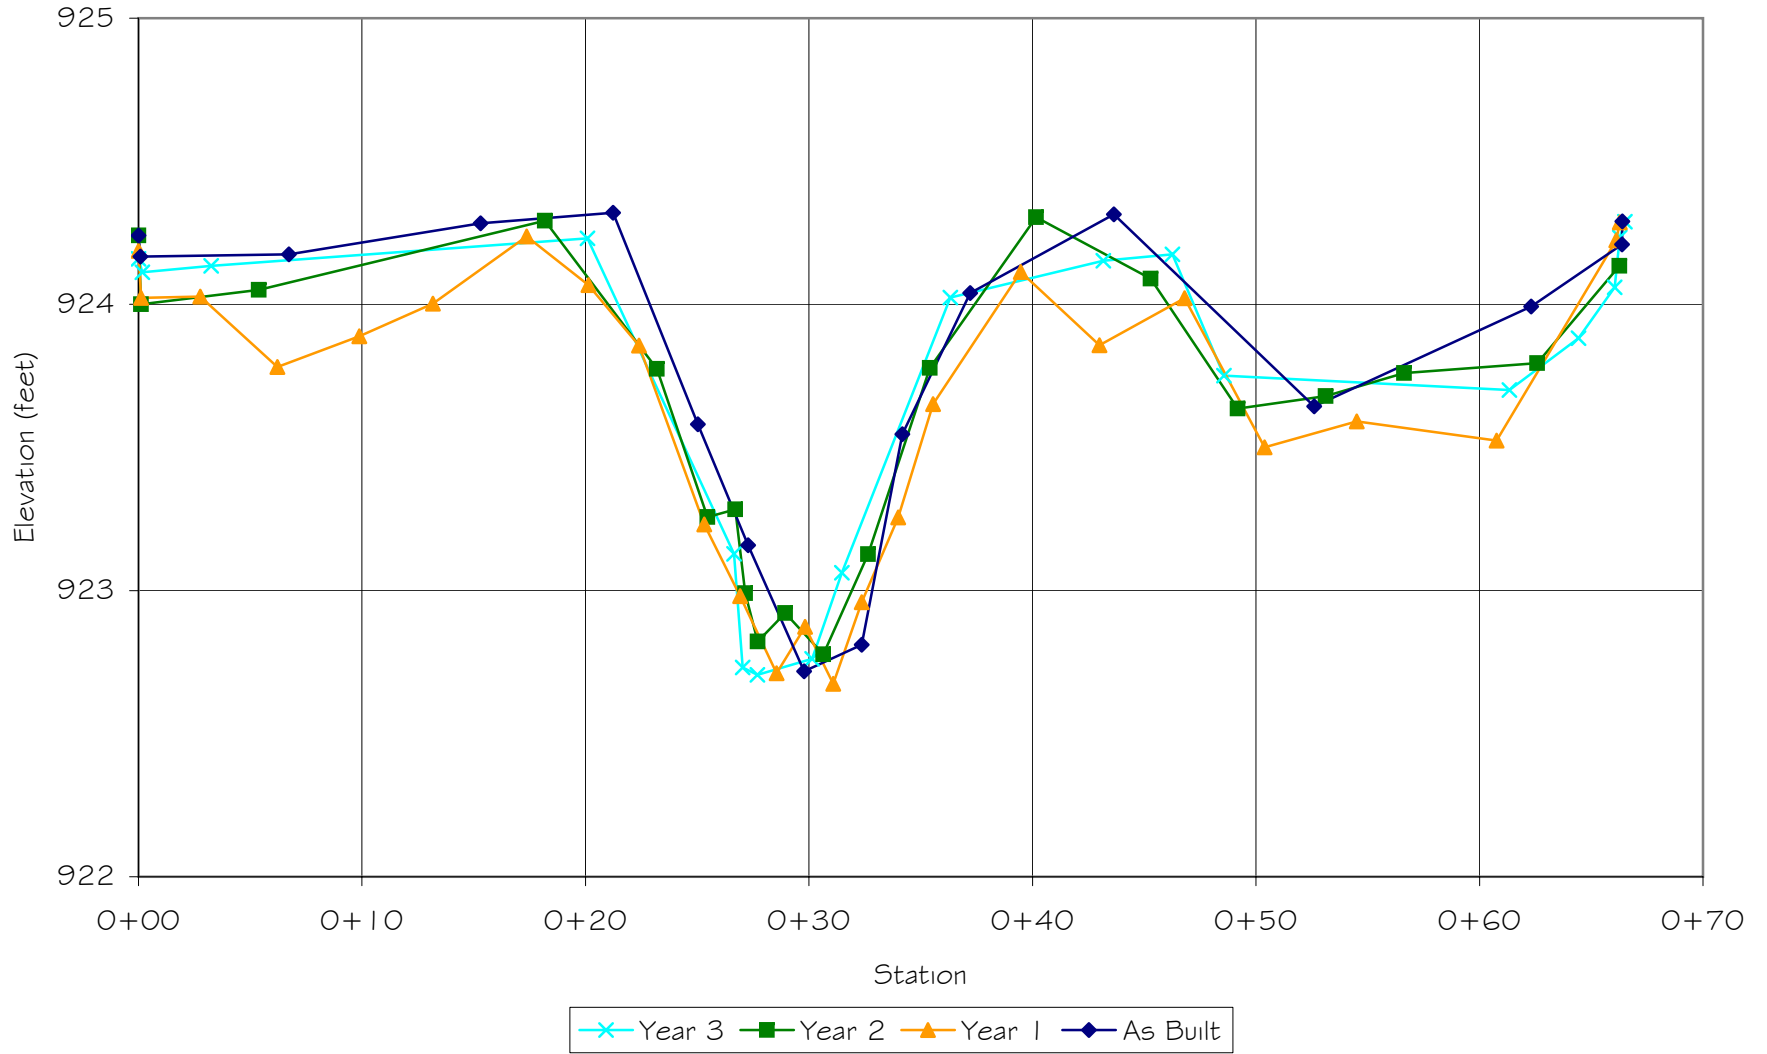

GRAY FARM STREAM RESTORATION  
REACH 1 - CROSS-SECTION 4 (POOL)  
(STA. 33+30)

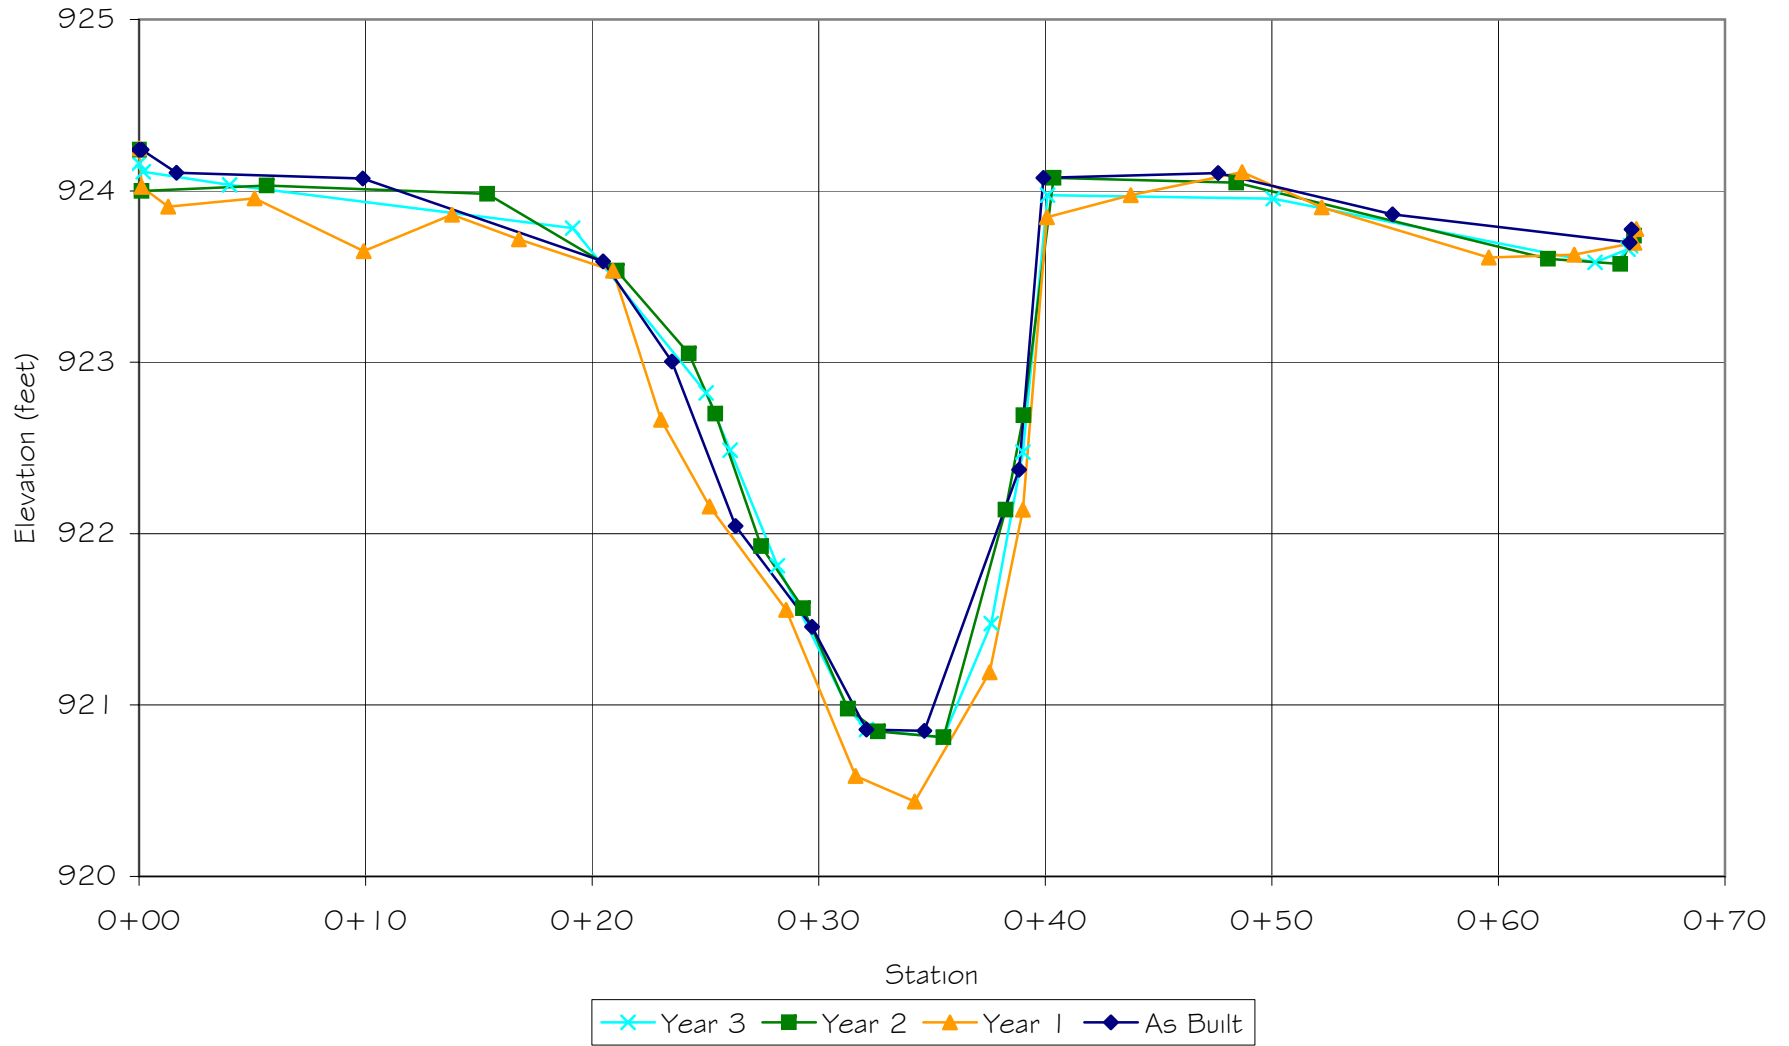


GRAY FARM STREAM RESTORATION  
REACH 1 - CROSS-SECTION 5 (RIFFLE)  
(STA. 39+30)

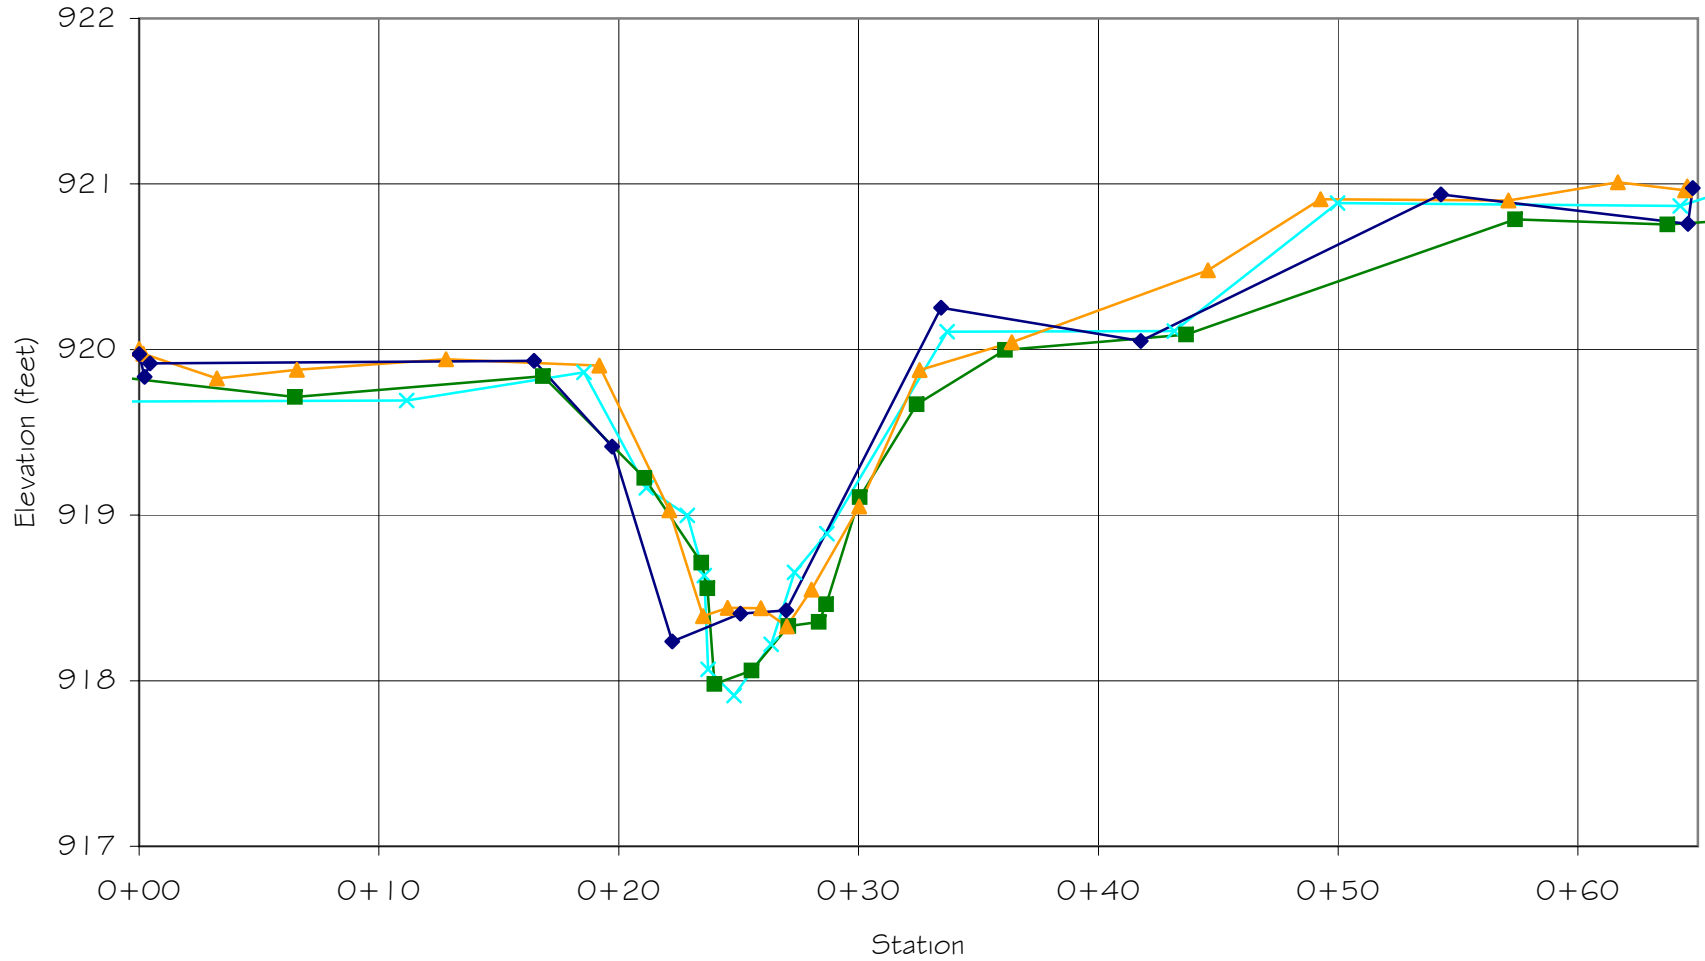


Year 3 Year 2 Year 1 As Built

GRAY FARM STREAM RESTORATION  
REACH 1 - CROSS-SECTION 5 (POOL)  
(STA. 38+95)

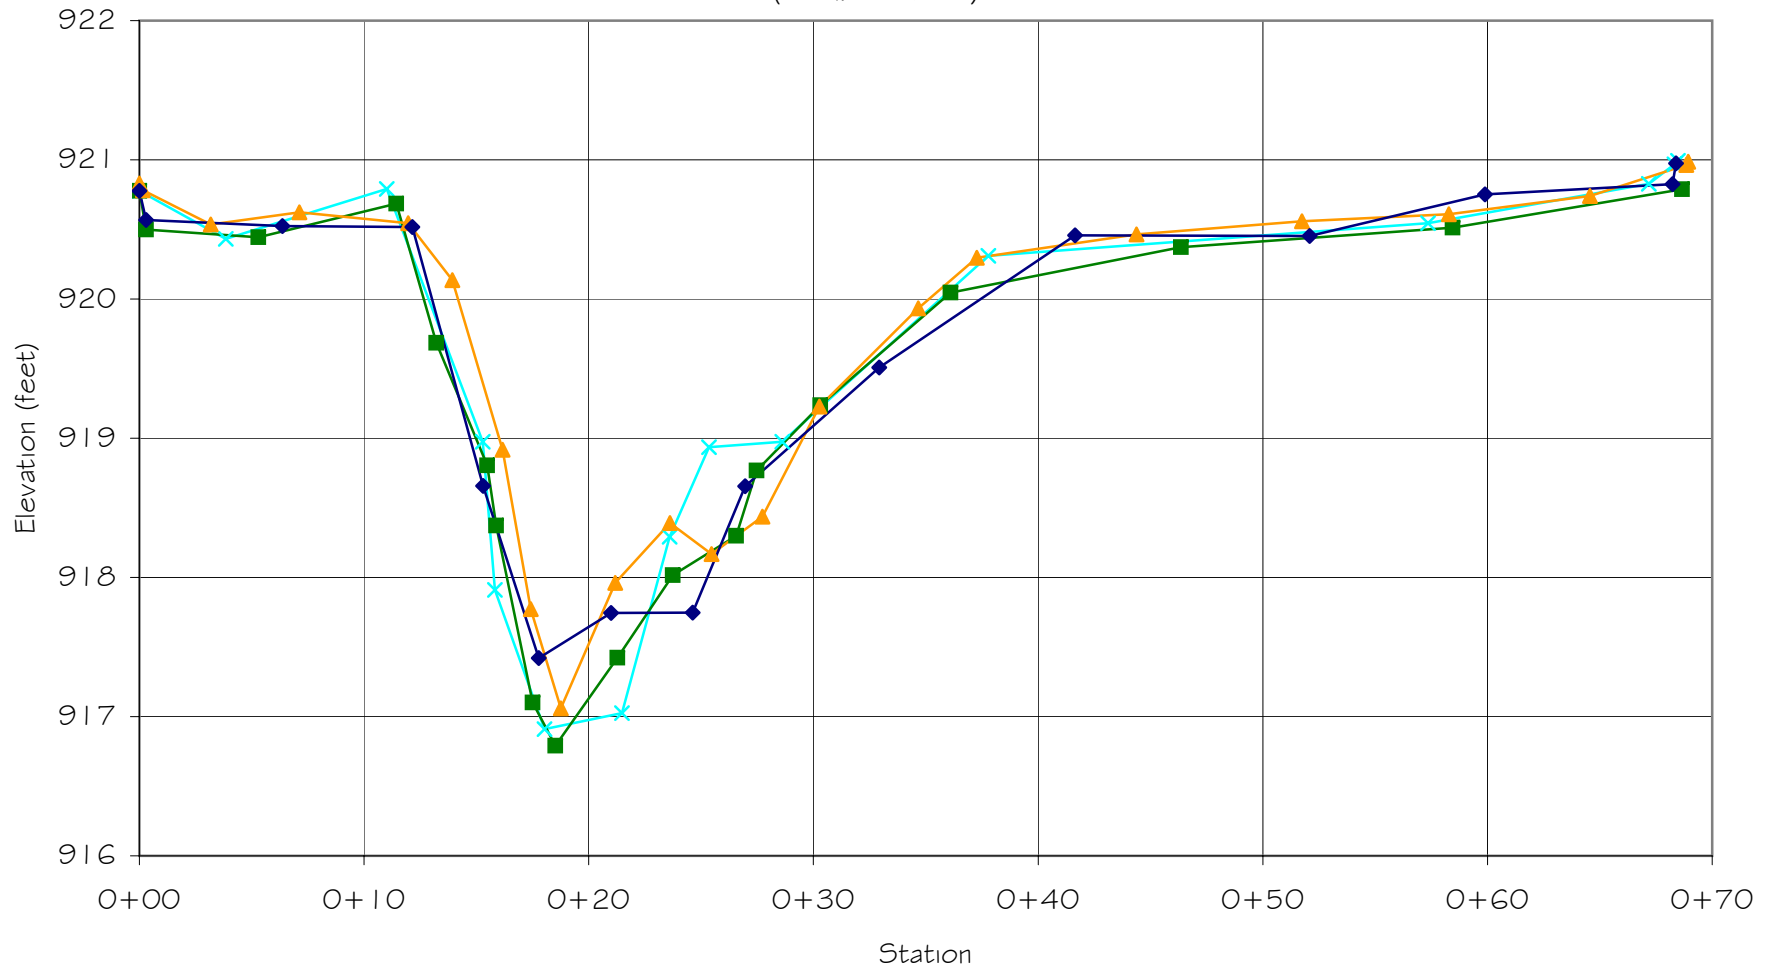


GRAY FARM STREAM RESTORATION  
REACH 1 - CROSS-SECTION 6 (RIFFLE)  
(STA. 42+80)

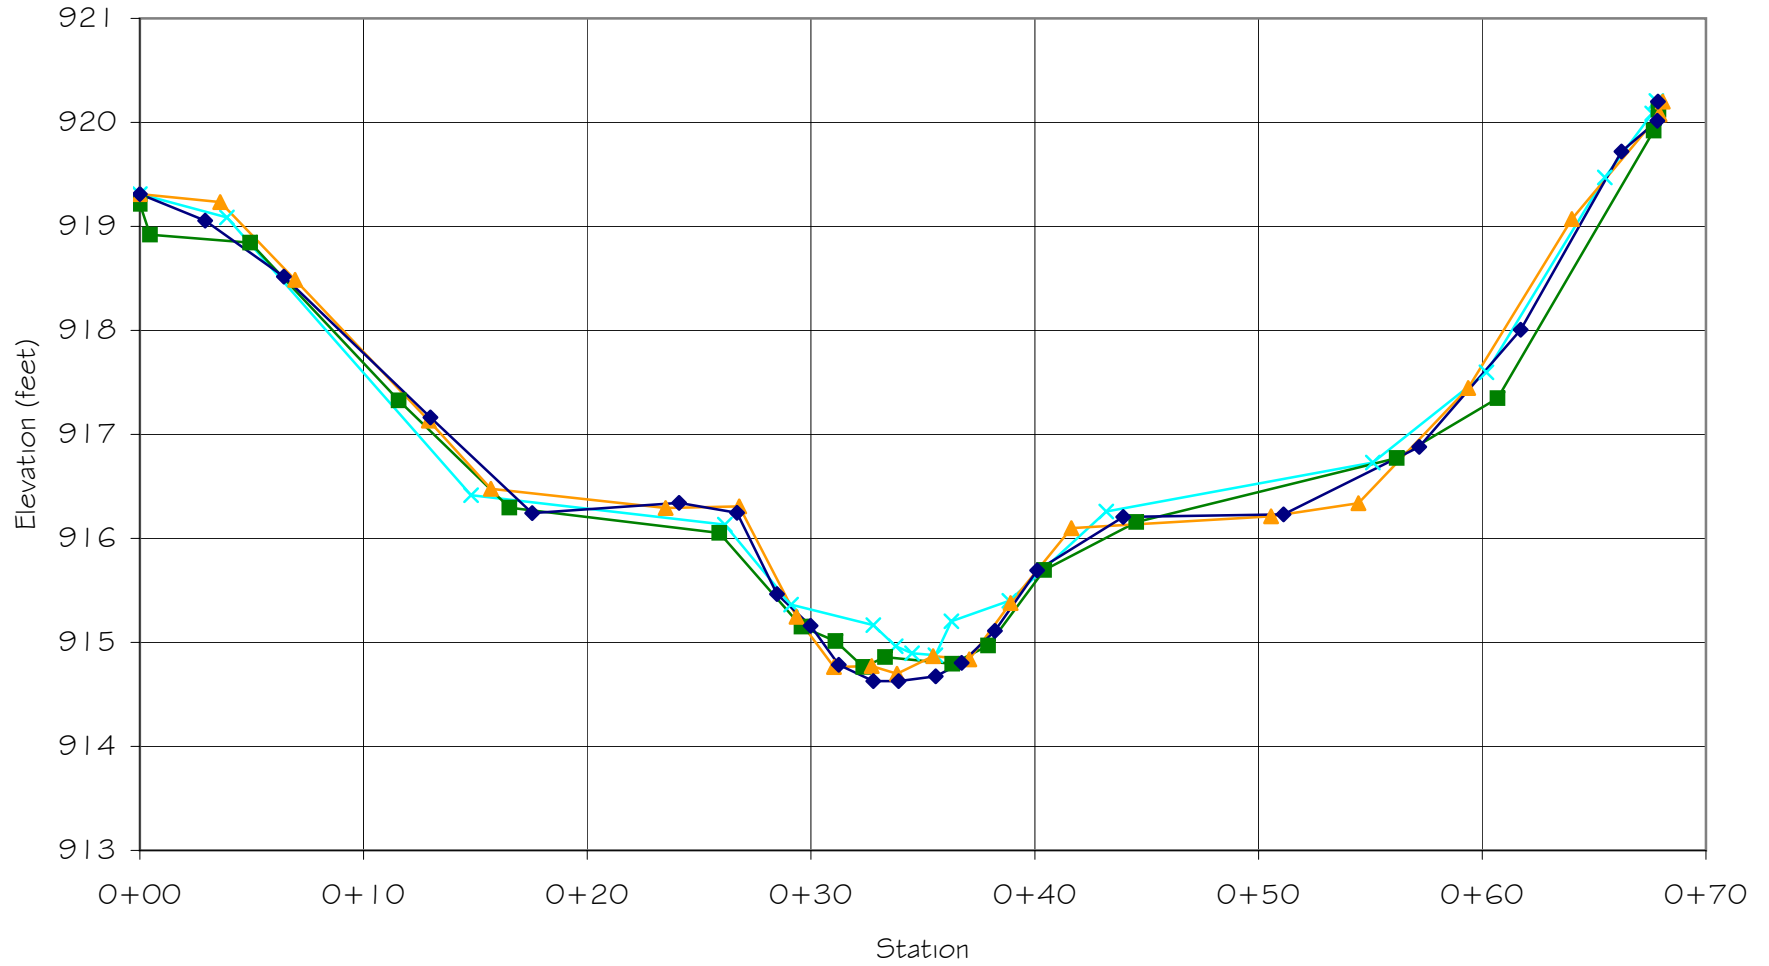

Year 3 Year 2 Year 1 As Built


GRAY FARM STREAM RESTORATION  
REACH 1 - CROSS-SECTION 6 (POOL)  
(STA. 43+10)

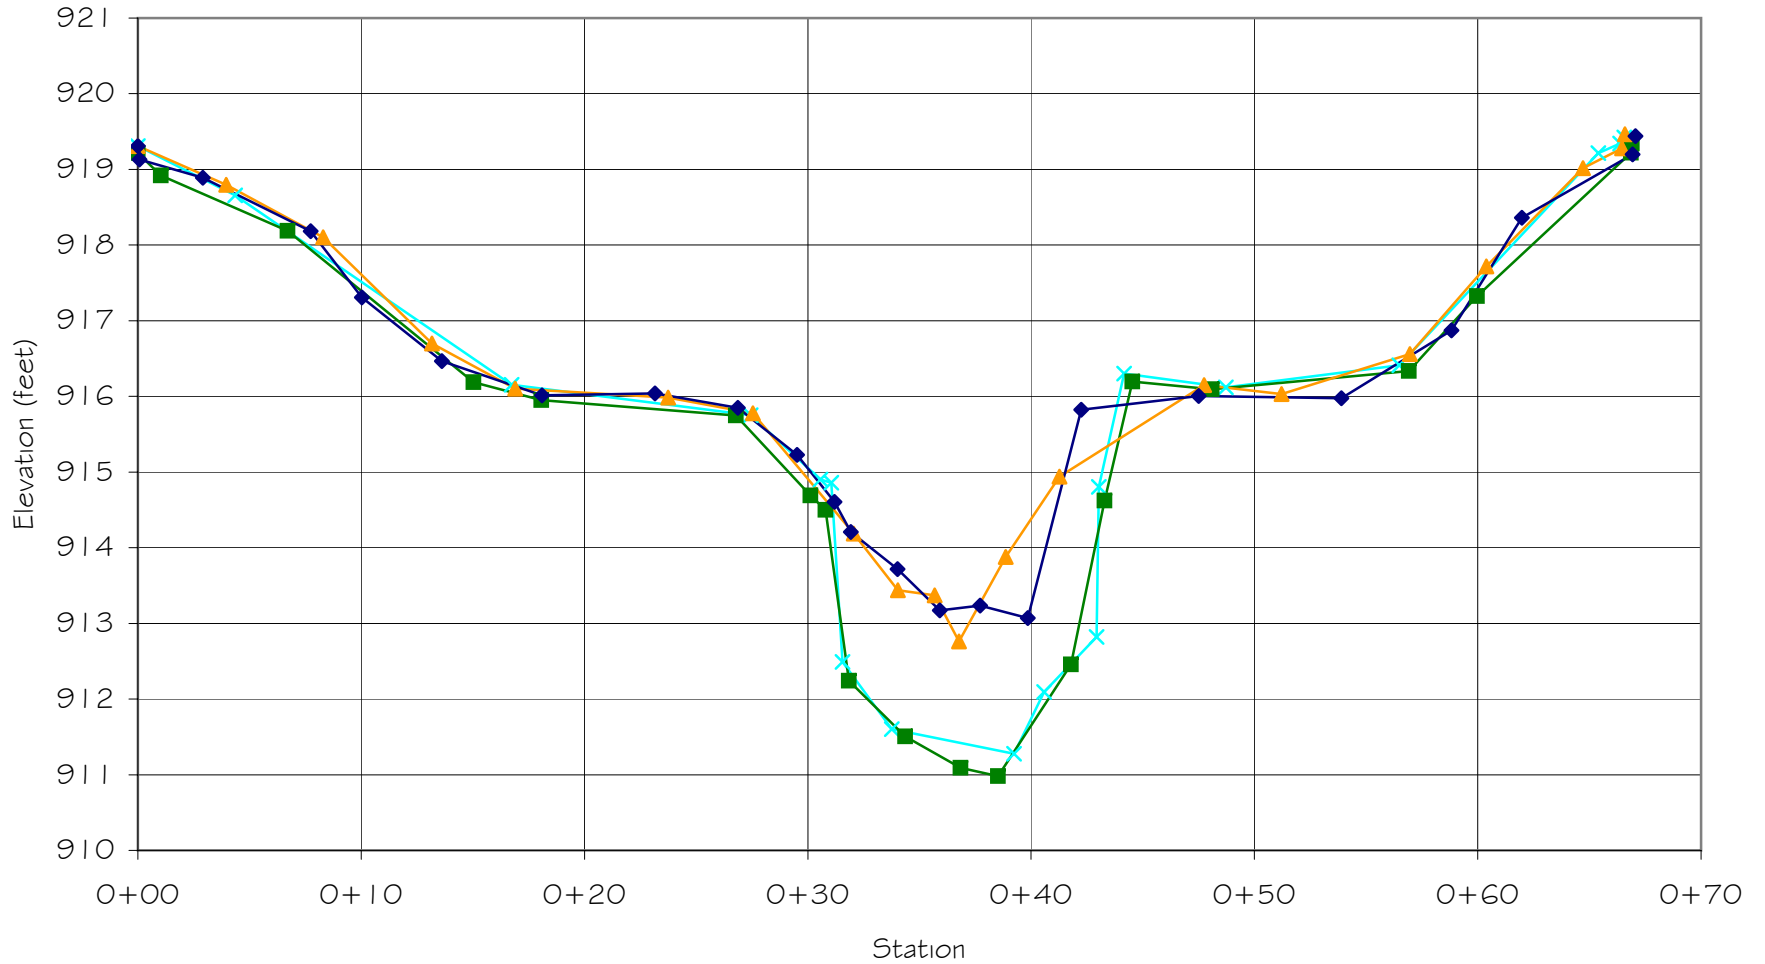

Year 3 Year 2 Year 1 As Built




GRAY FARM STREAM RESTORATION  
REACH 1 - CROSS-SECTION 7 (RIFFLE)  
(STA. 54+05)

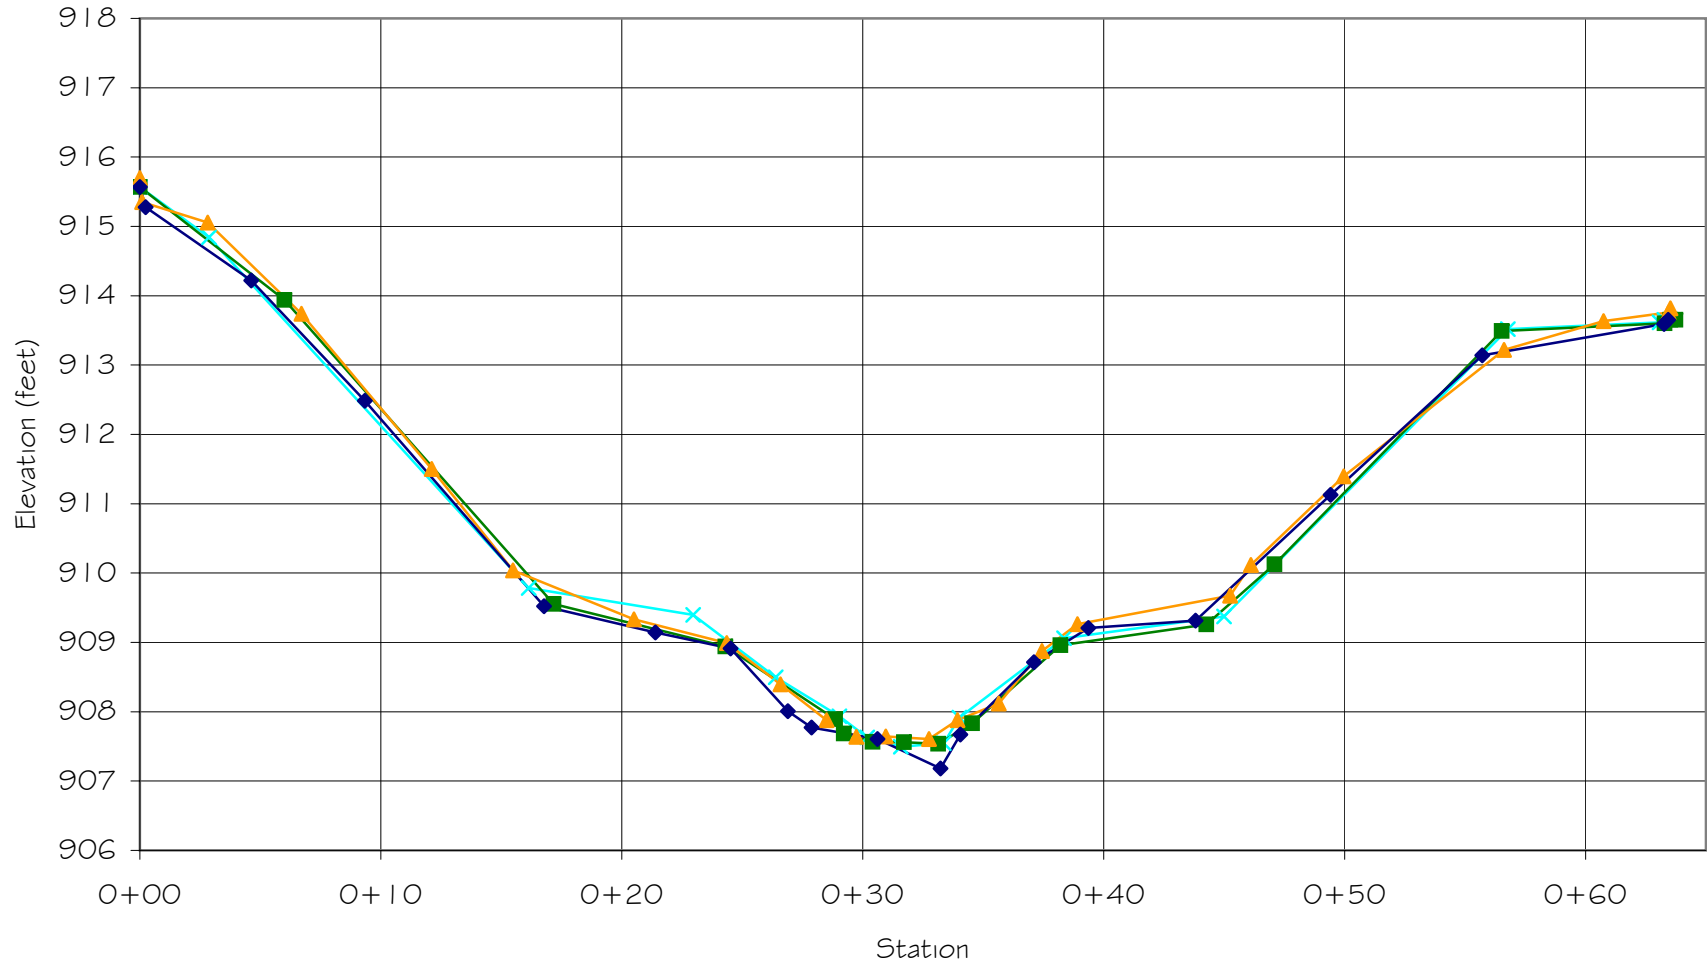


Year 3 Year 2 Year 1 As Built


GRAY FARM STREAM RESTORATION  
REACH 1 - CROSS-SECTION 7 (POOL)  
(STA. 54+45)

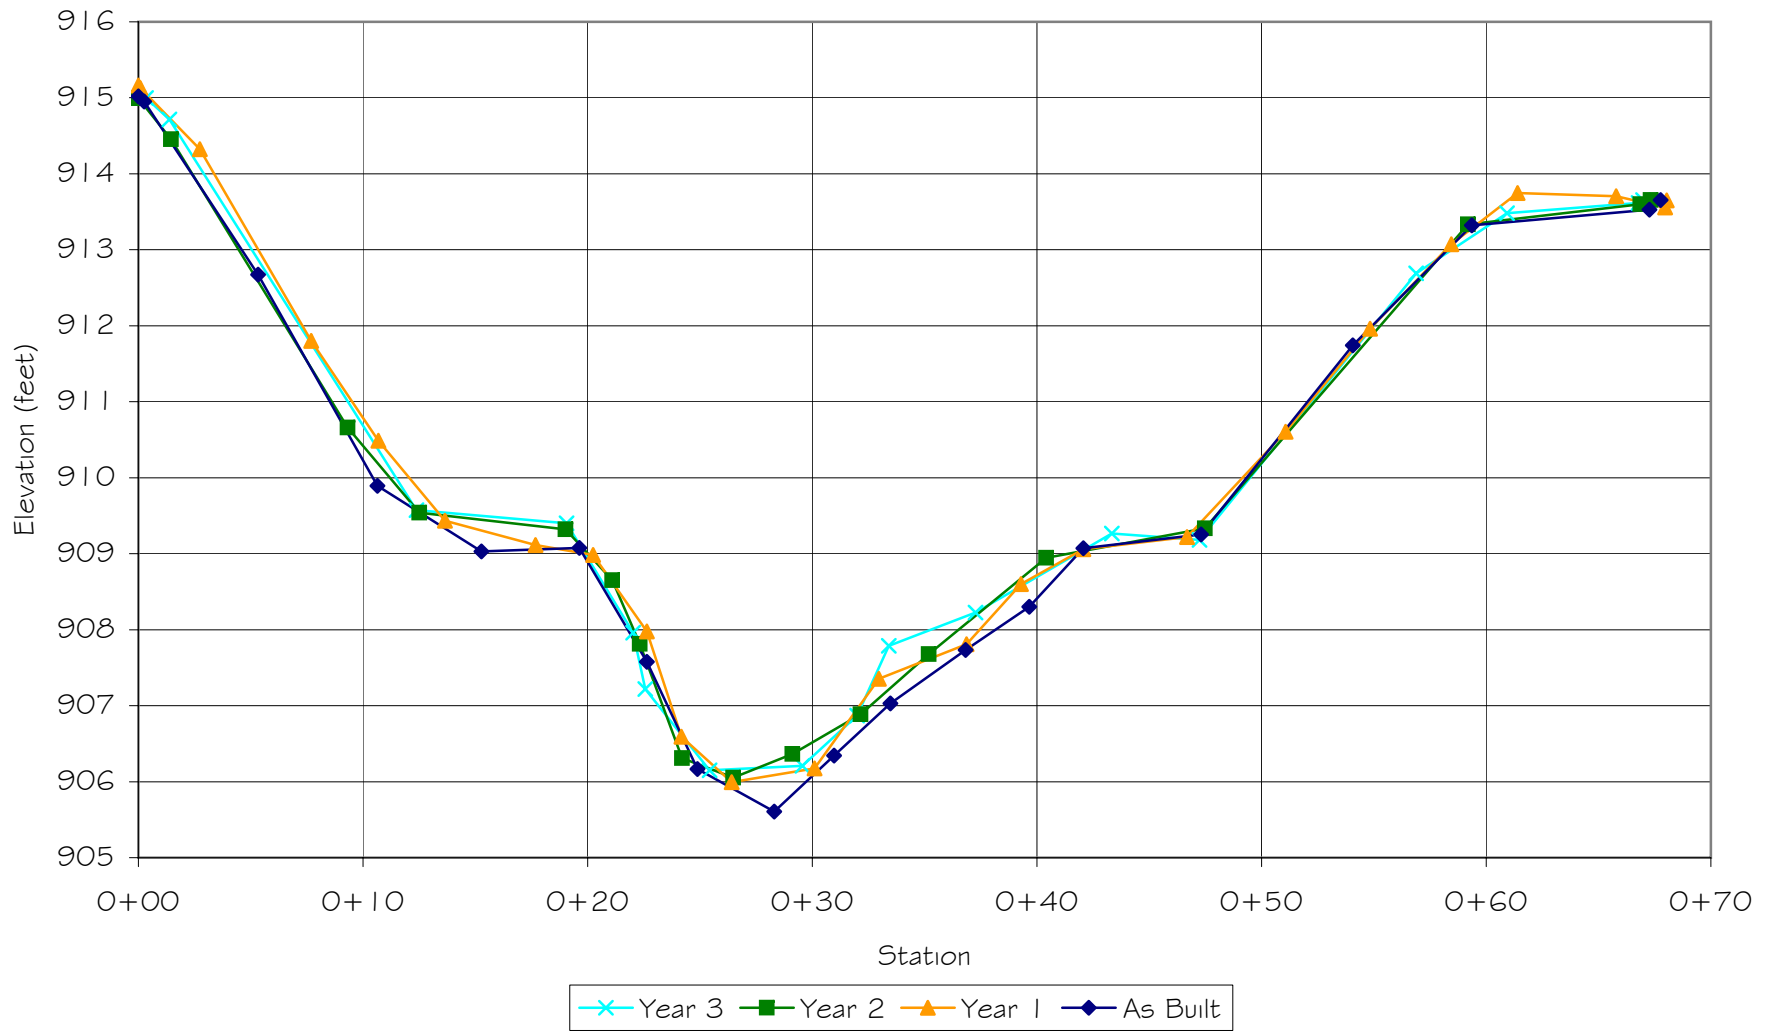


GRAY FARM STREAM RESTORATION  
REACH 2 - CROSS-SECTION 1 (RIFFLE)  
(STA. 6+30)

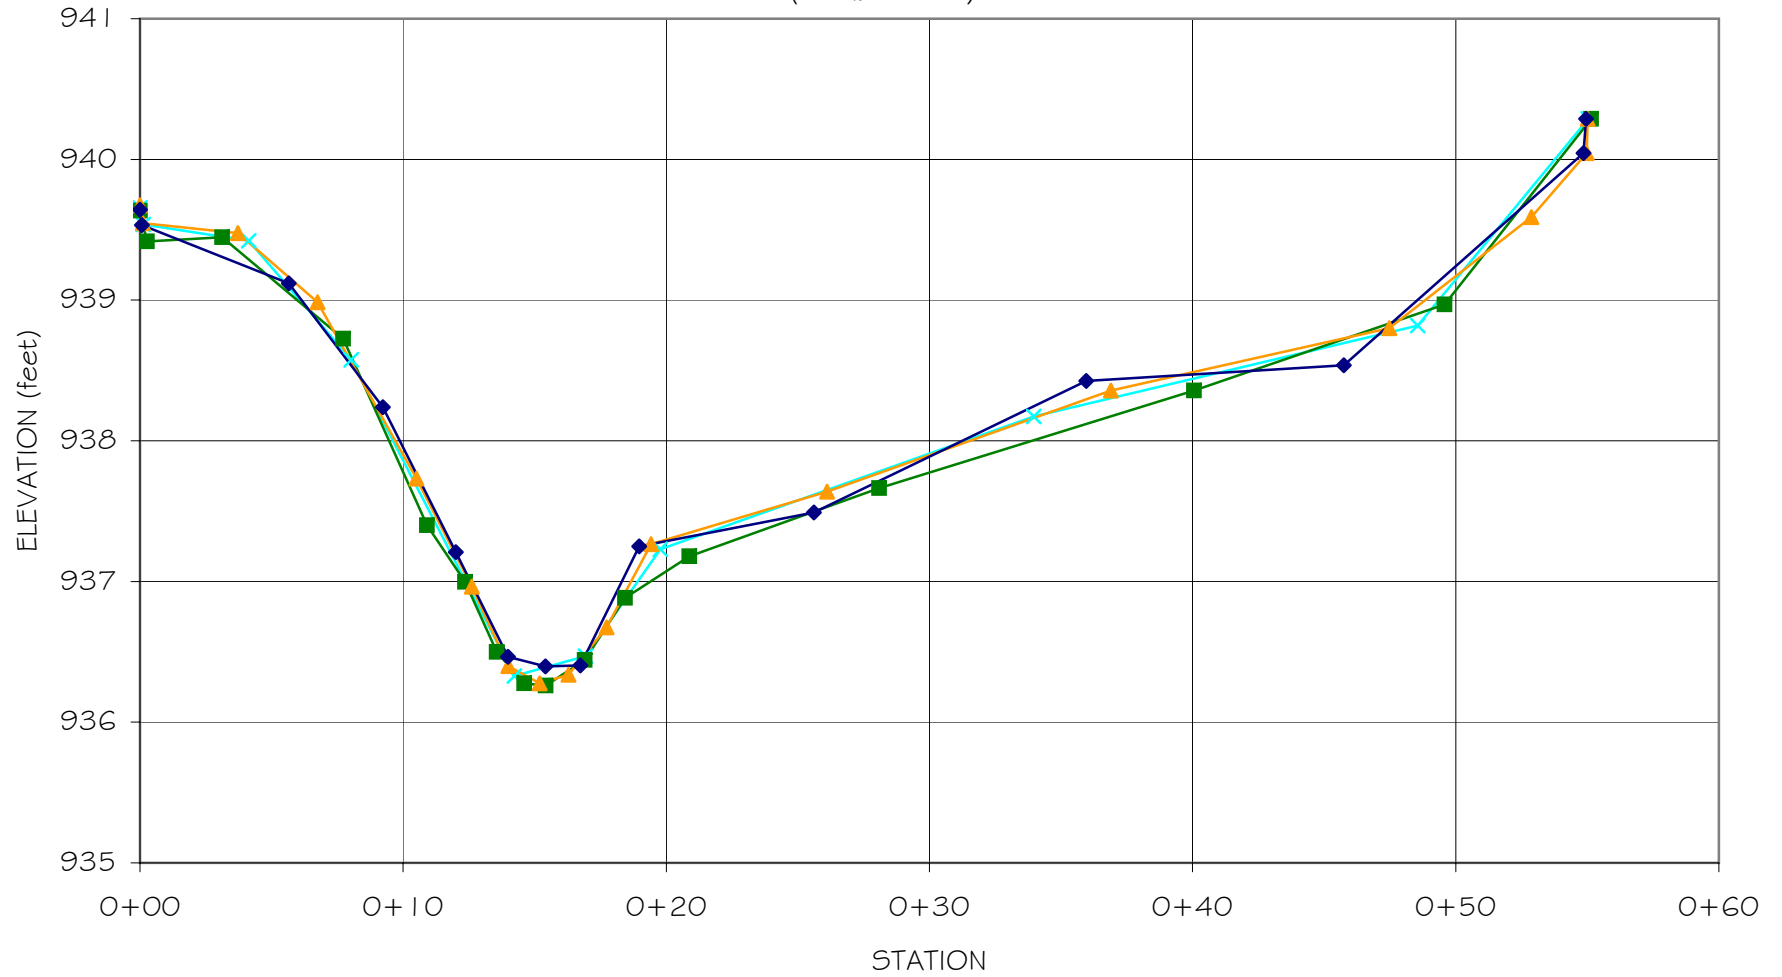

GRAY FARM STREAM RESTORATION  
REACH 2 - CROSS-SECTION 1 (POOL)  
(STA. 6+00)

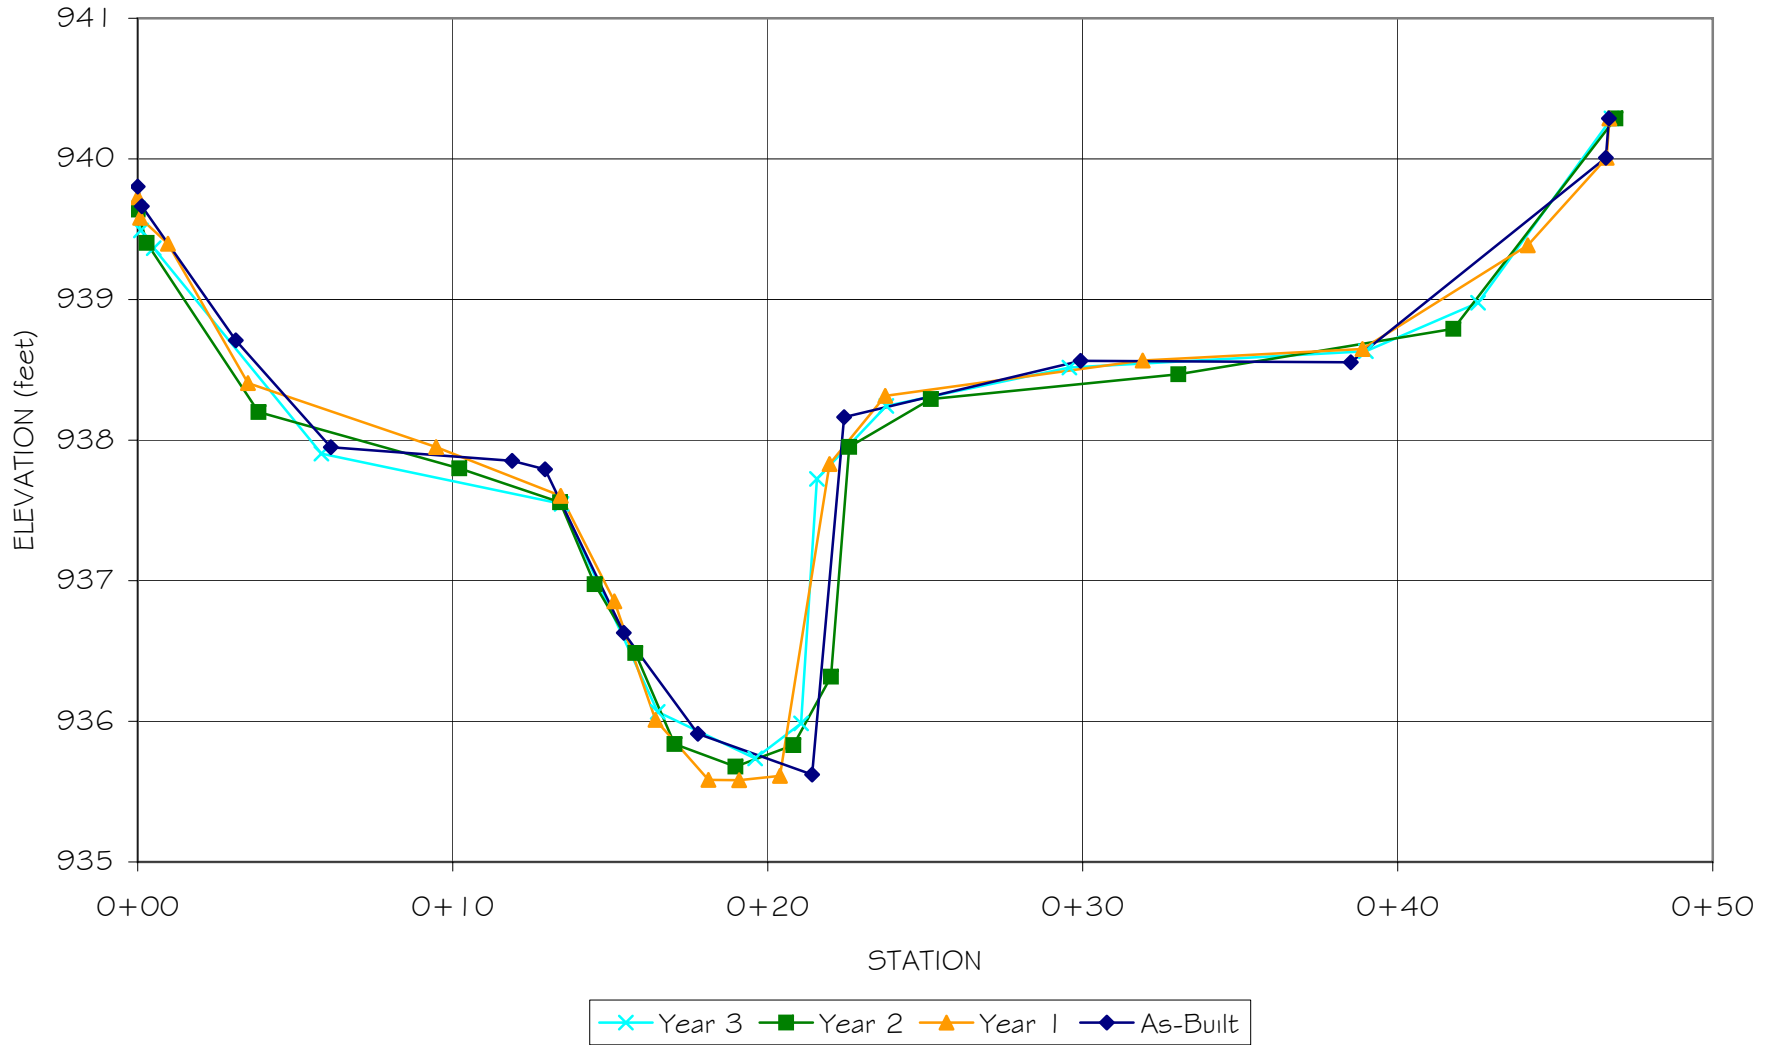


GRAY FARM STREAM RESTORATION  
REACH 2 - CROSS-SECTION 2 (RIFFLE)  
(STA. 19+30)

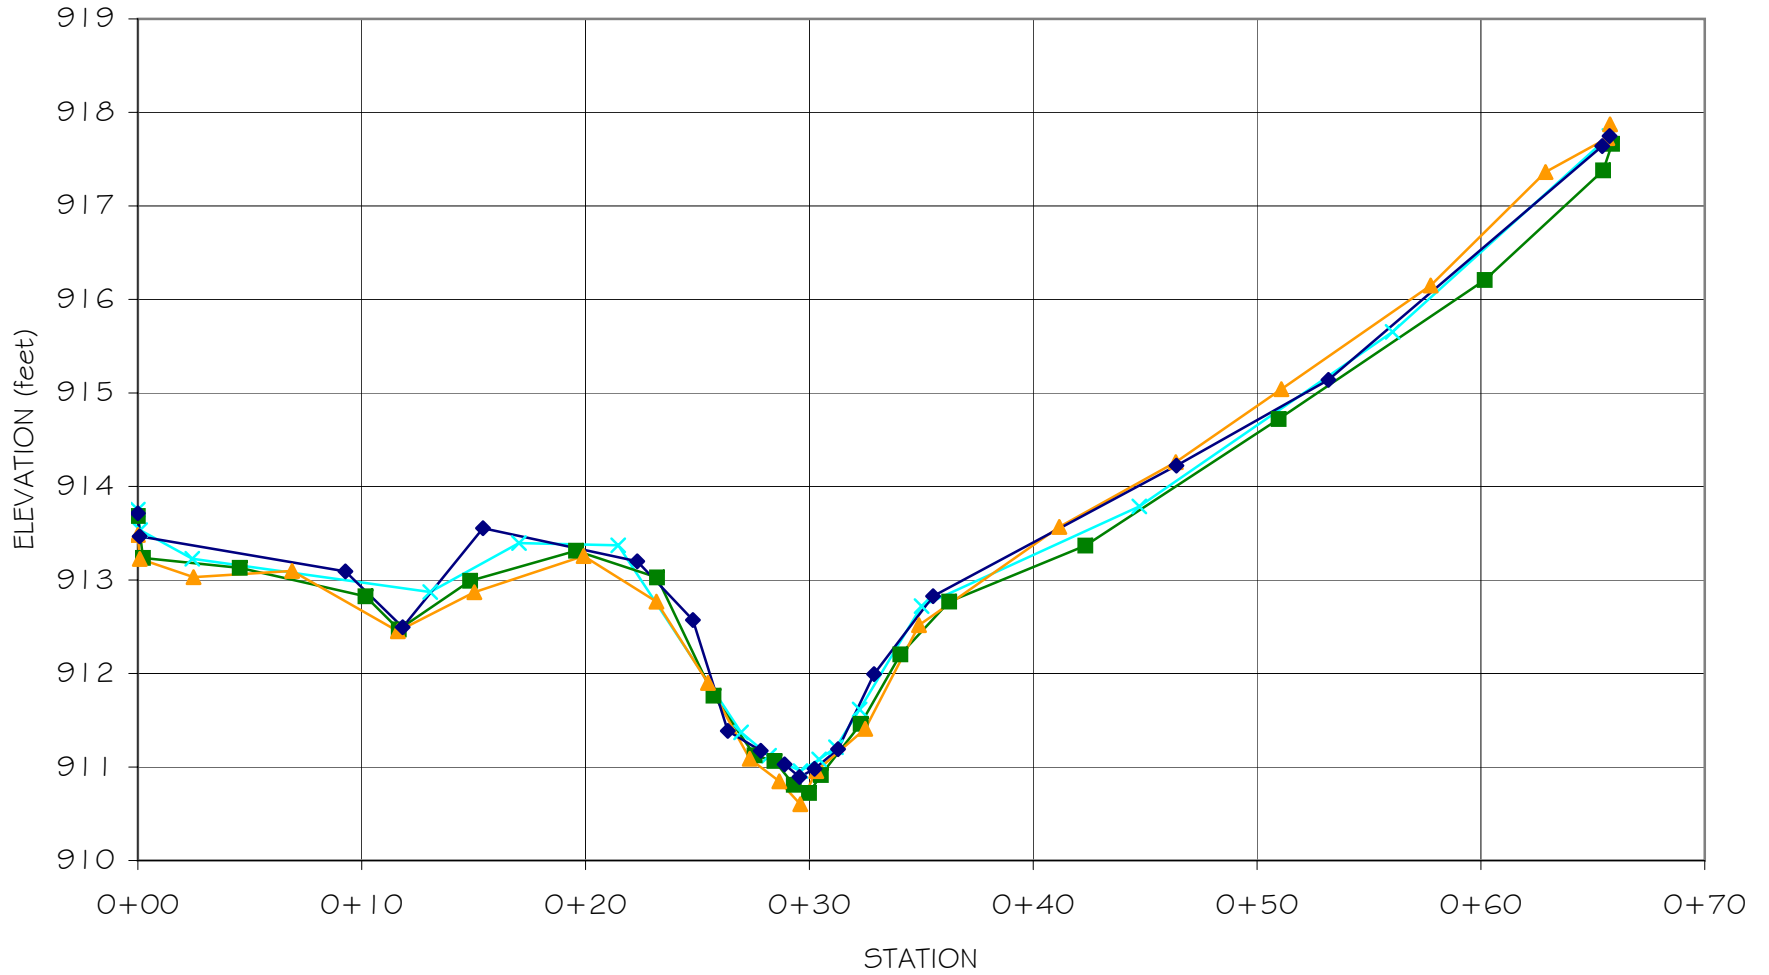

Year 3 Year 2 Year 1 As-Built


GRAY FARM STREAM RESTORATION  
REACH 2 - CROSS-SECTION 2 (POOL)  
(STA. 19+45)

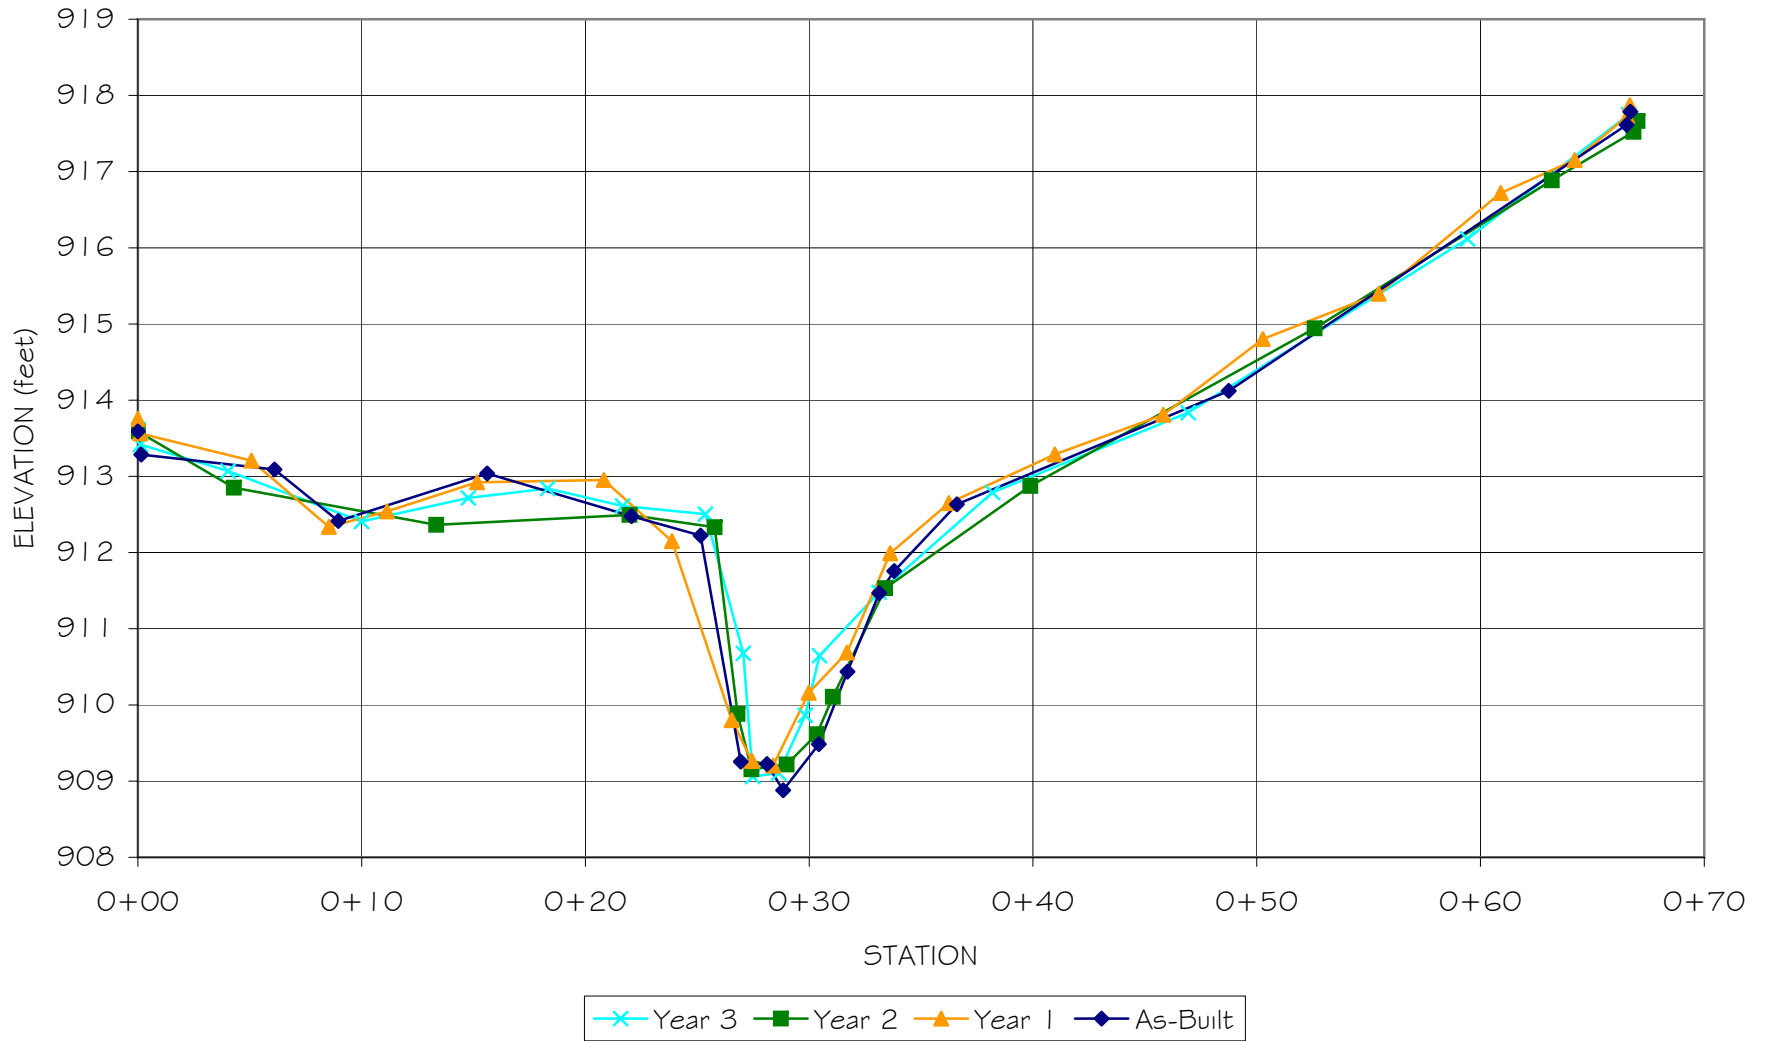

APPENDIX B.7 –


**Annual Overlays of Longitudinal Plots**

GRAY FARM STREAM RESTORATION  
REACH 1 - LONGITUDINAL PROFILE  
(STA. 0+00 TO 18+70)

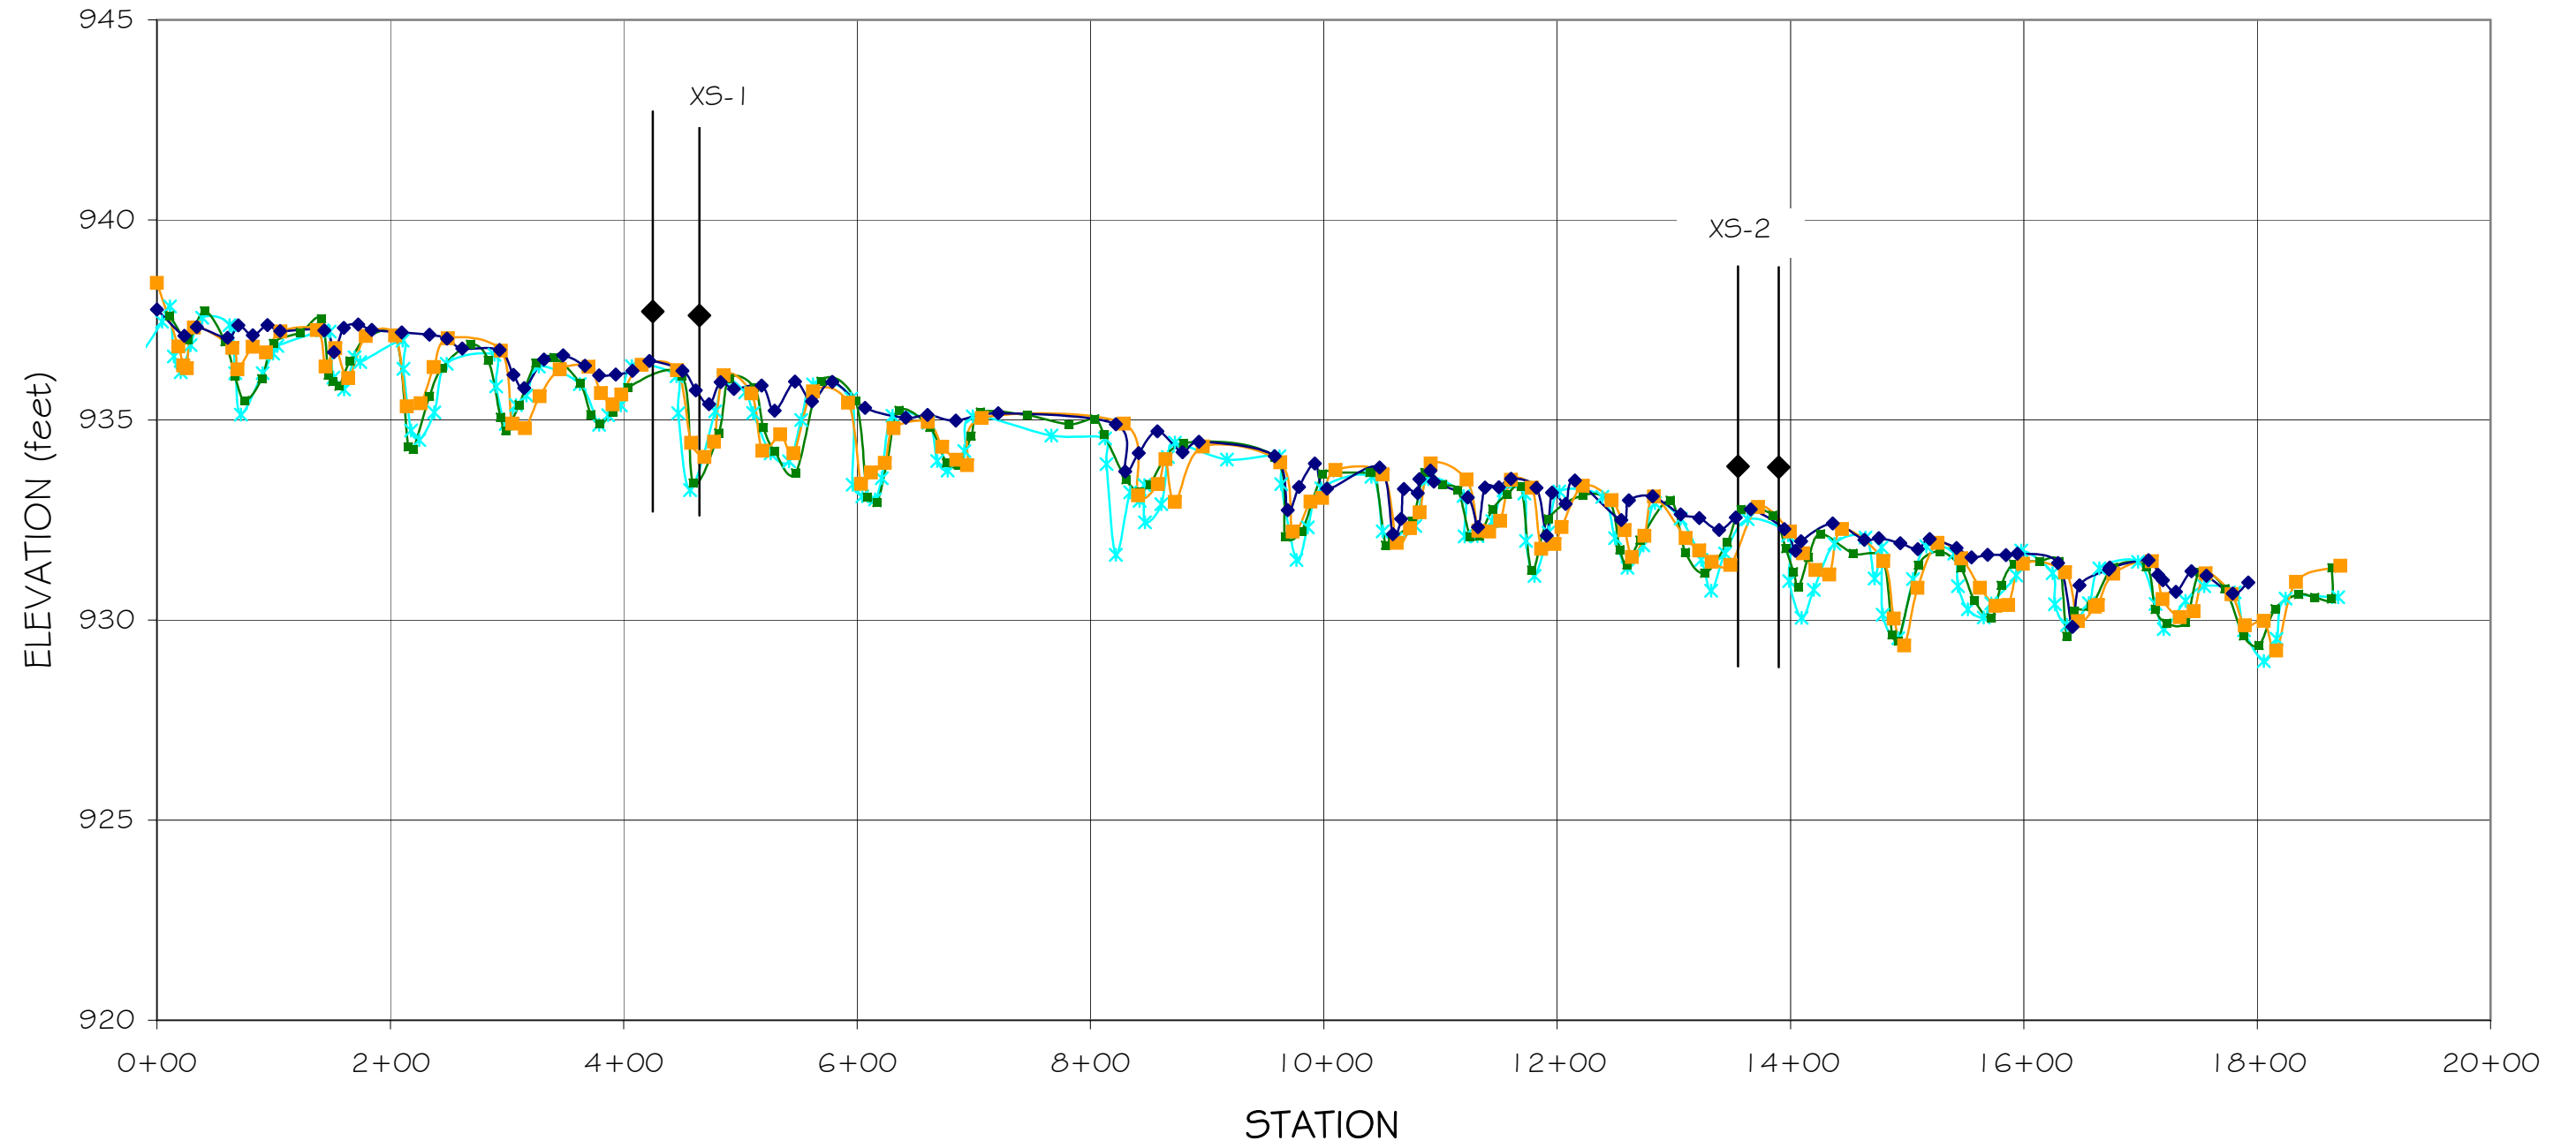





GRAY FARM STREAM RESTORATION  
REACH 1 - LONGITUDINAL PROFILE  
(STA. 37+50 TO 55+50)

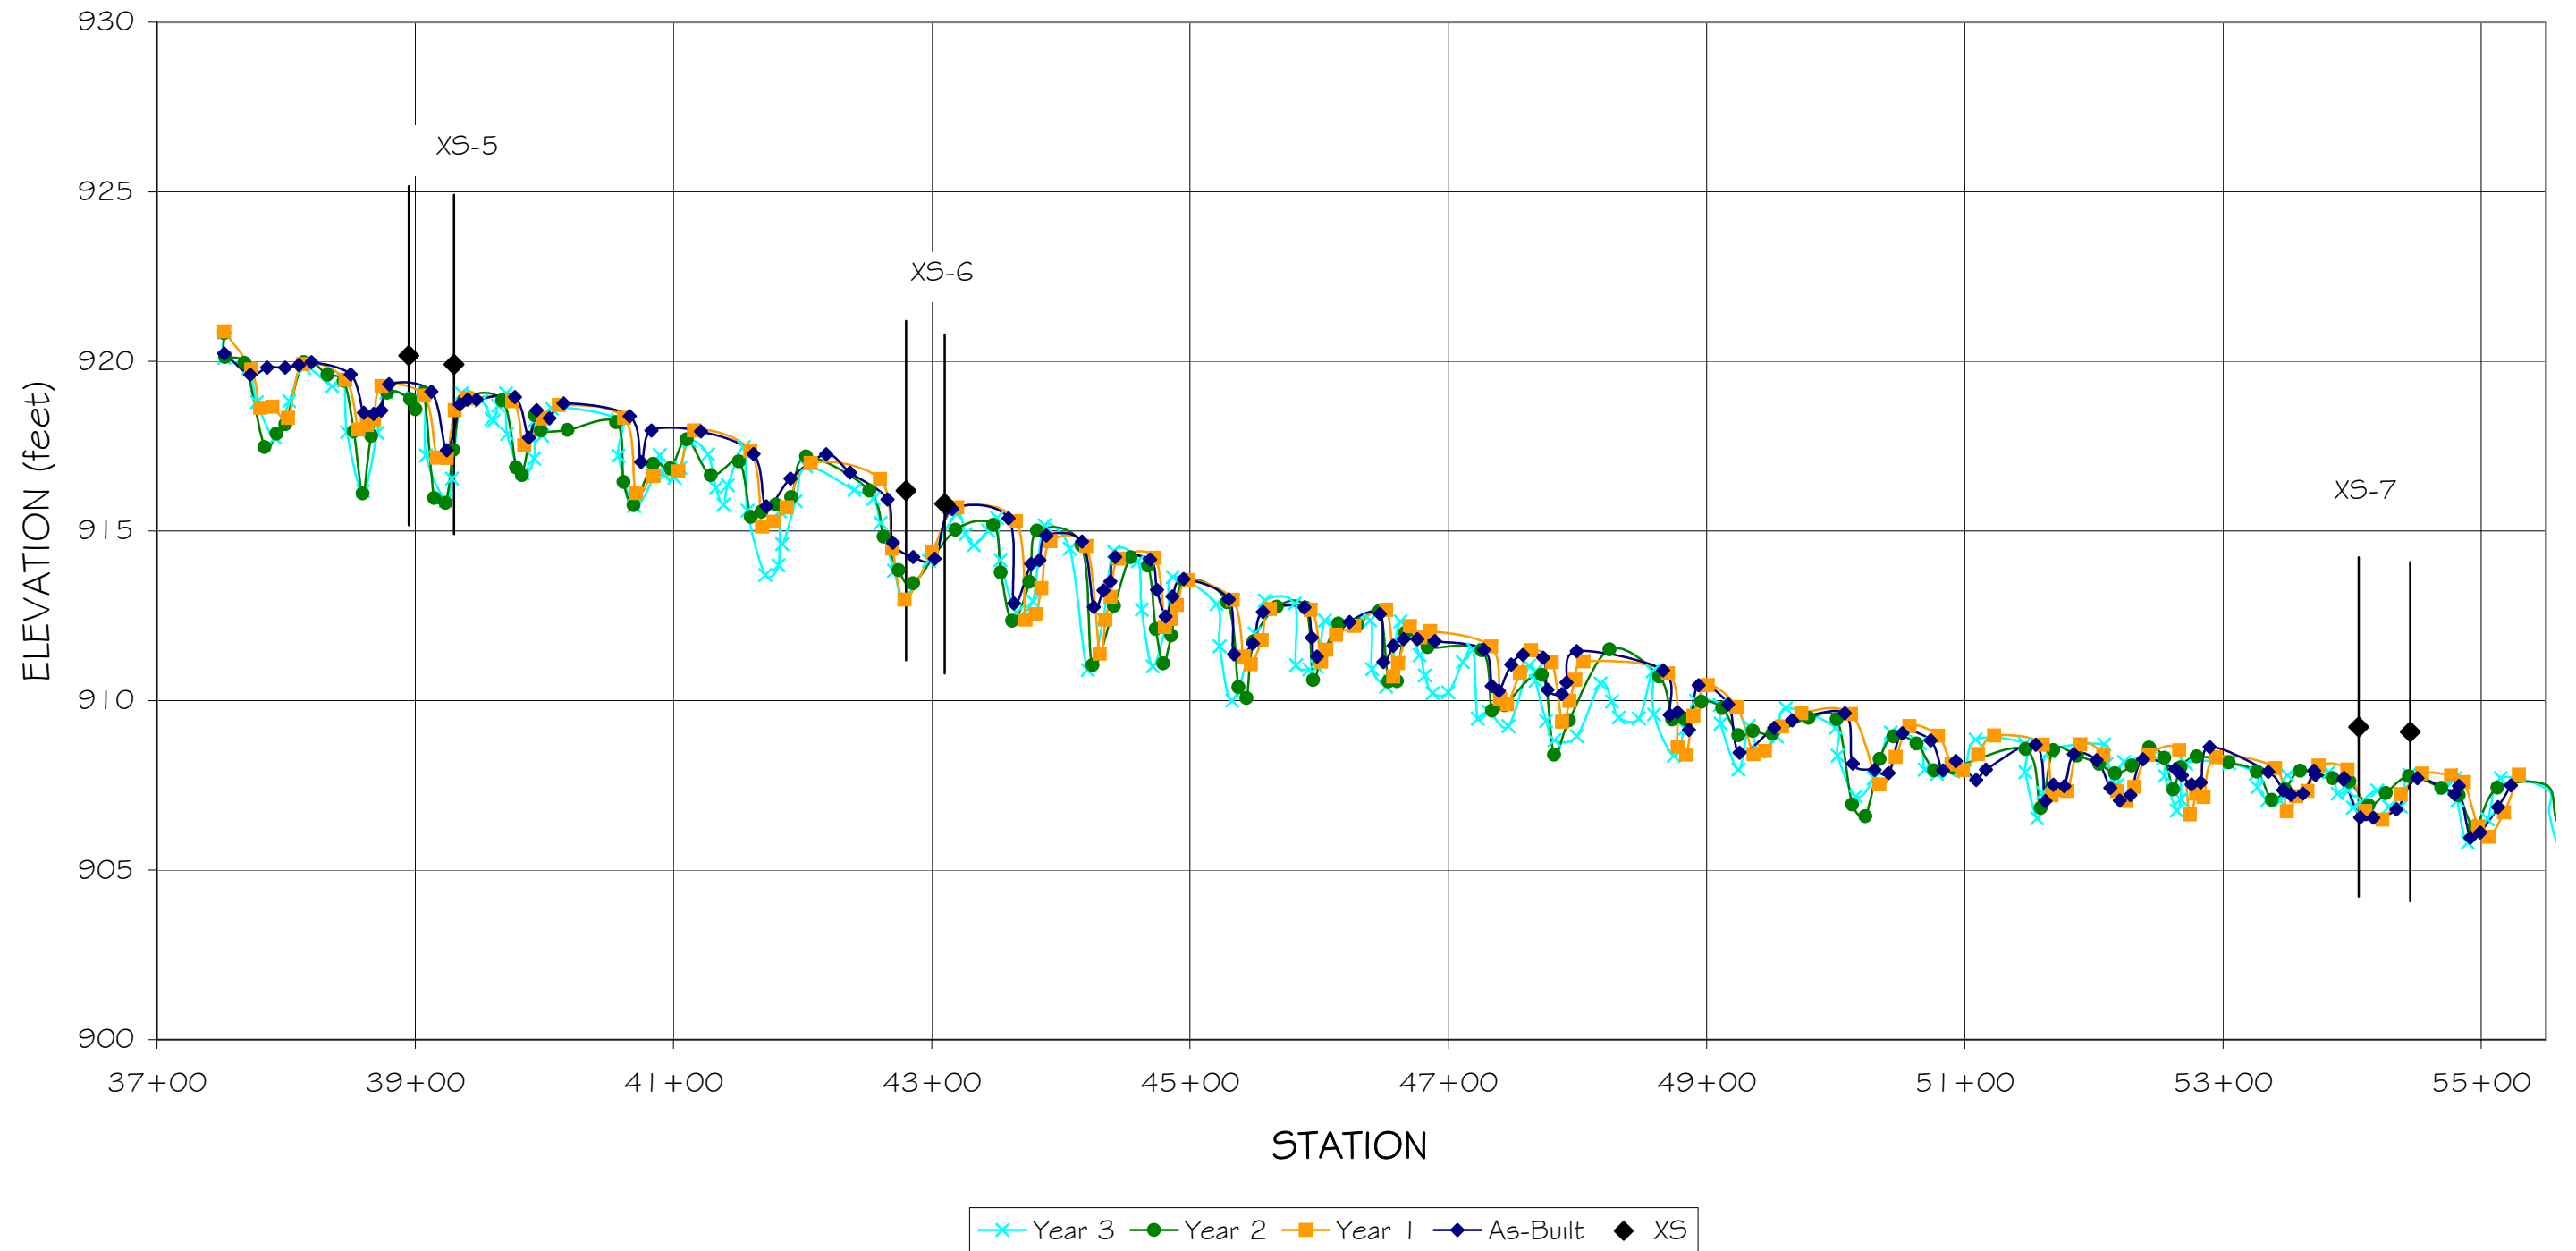

GRAY FARM STREAM RESTORATION  
REACH 2 - LONGITUDINAL PROFILE  
(STA. 4+65 TO 10+65)

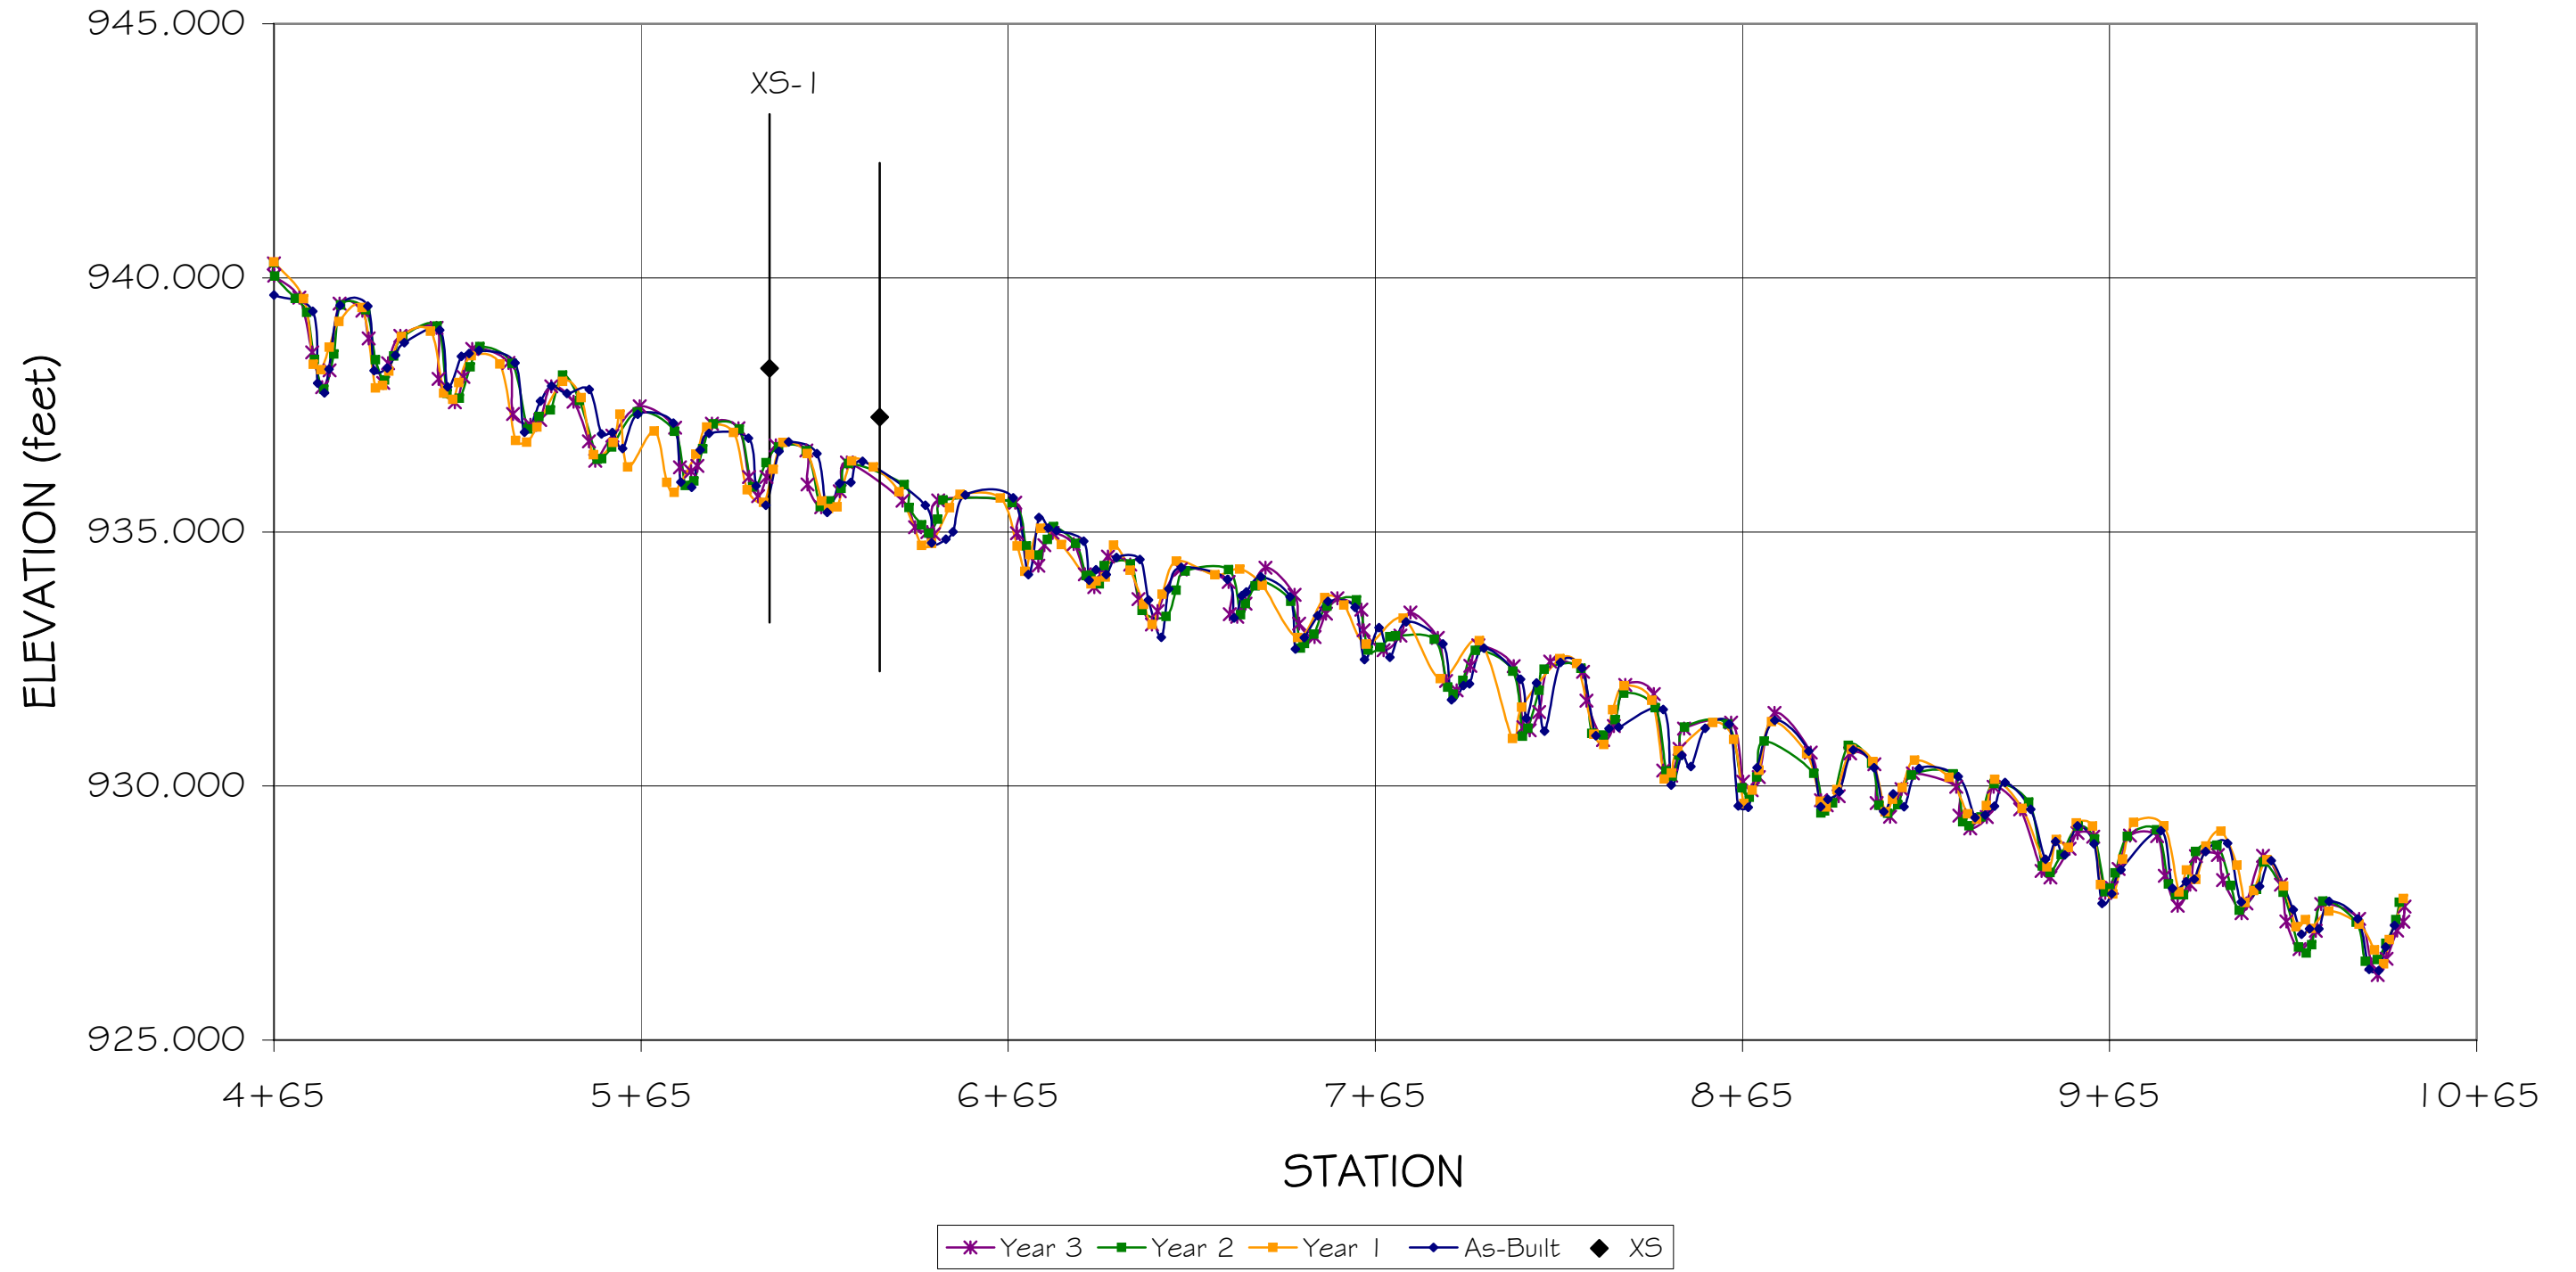

GRAY FARM STREAM RESTORATION  
REACH 2 - LONGITUDINAL PROFILE  
(STA. 15+68 TO 20+18)

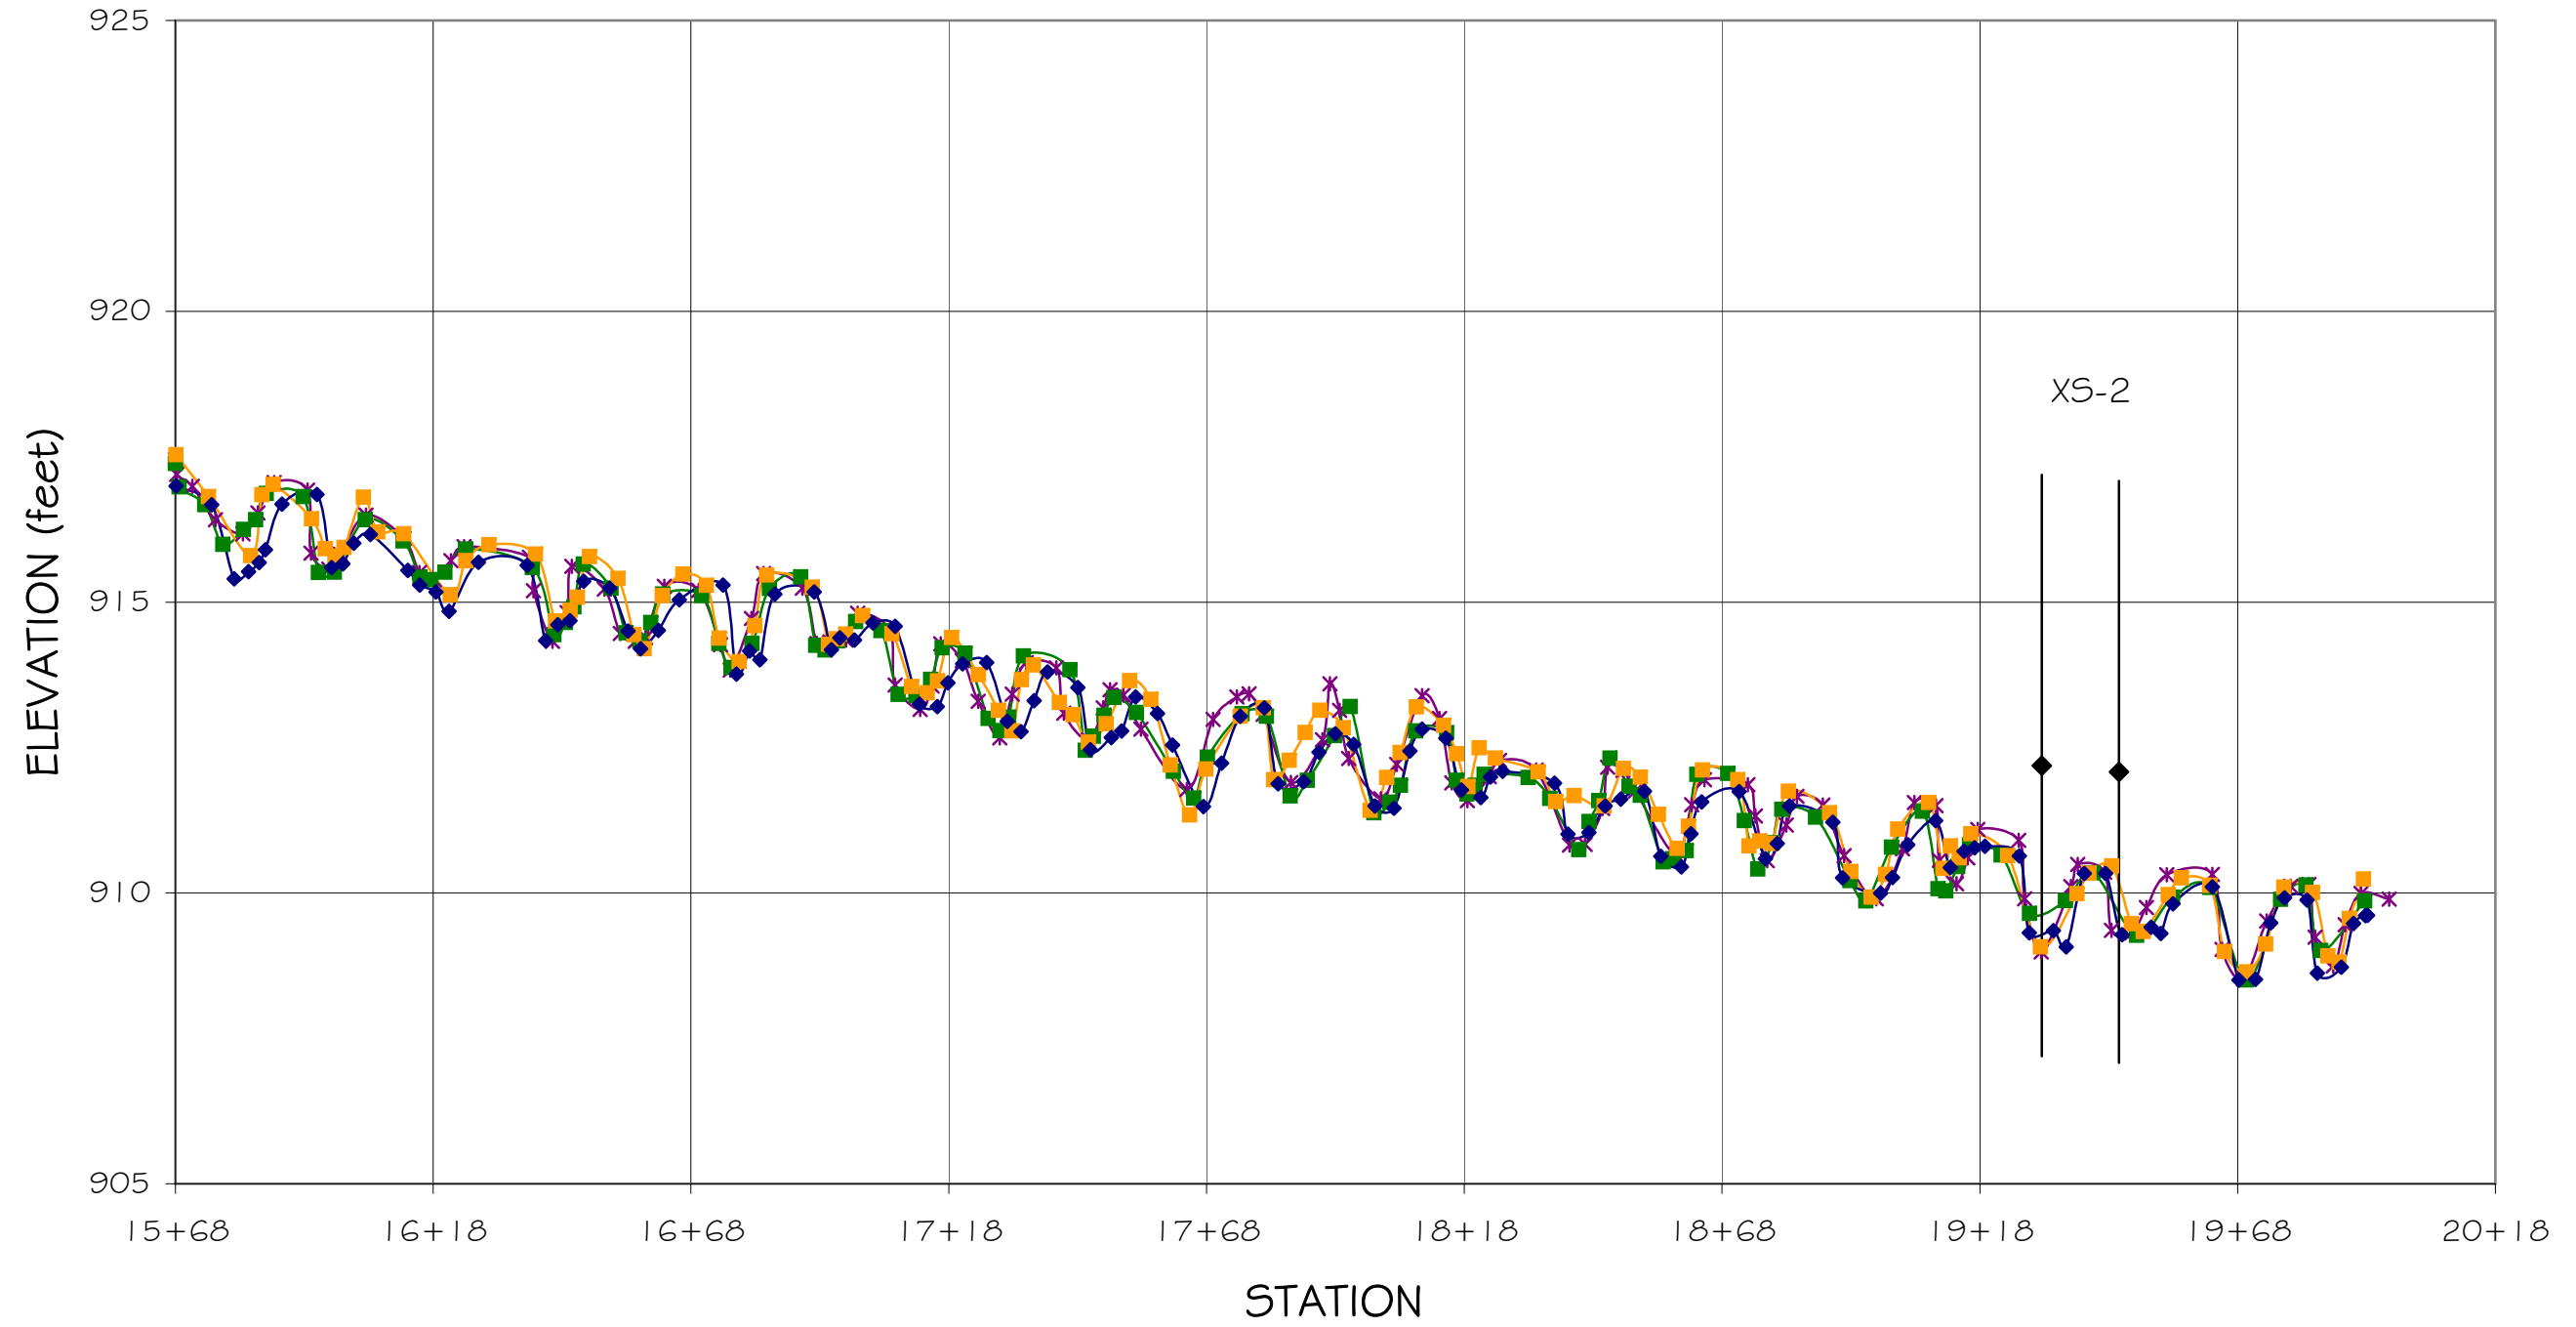


\* Year 3   ■ Year 2   ■ Year 1   ◆ As-Built   ◆ XS


APPENDIX B.8 –

**Annual Overlays of Pebble Count Frequency Distribution Plots**

Pebble Count, Gray Farm Reach 1

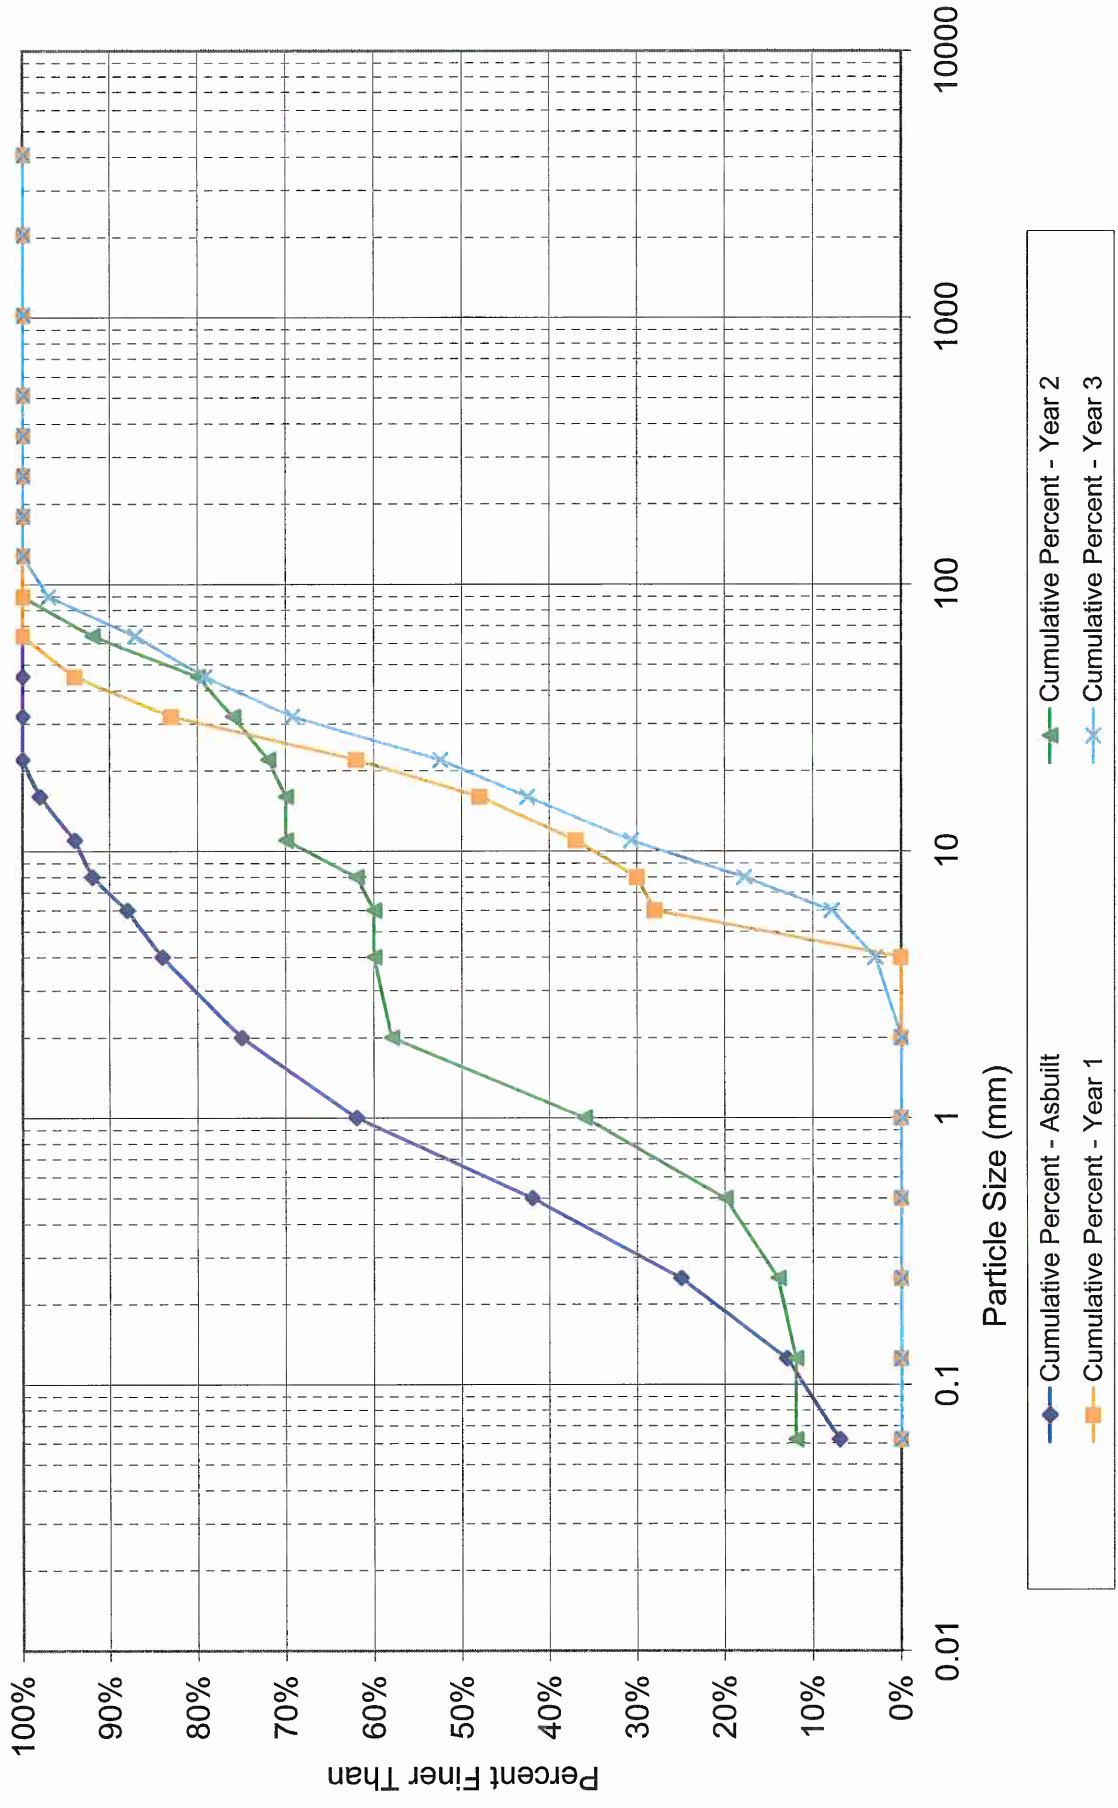


Pebble Count, Gray Farm Reach 2

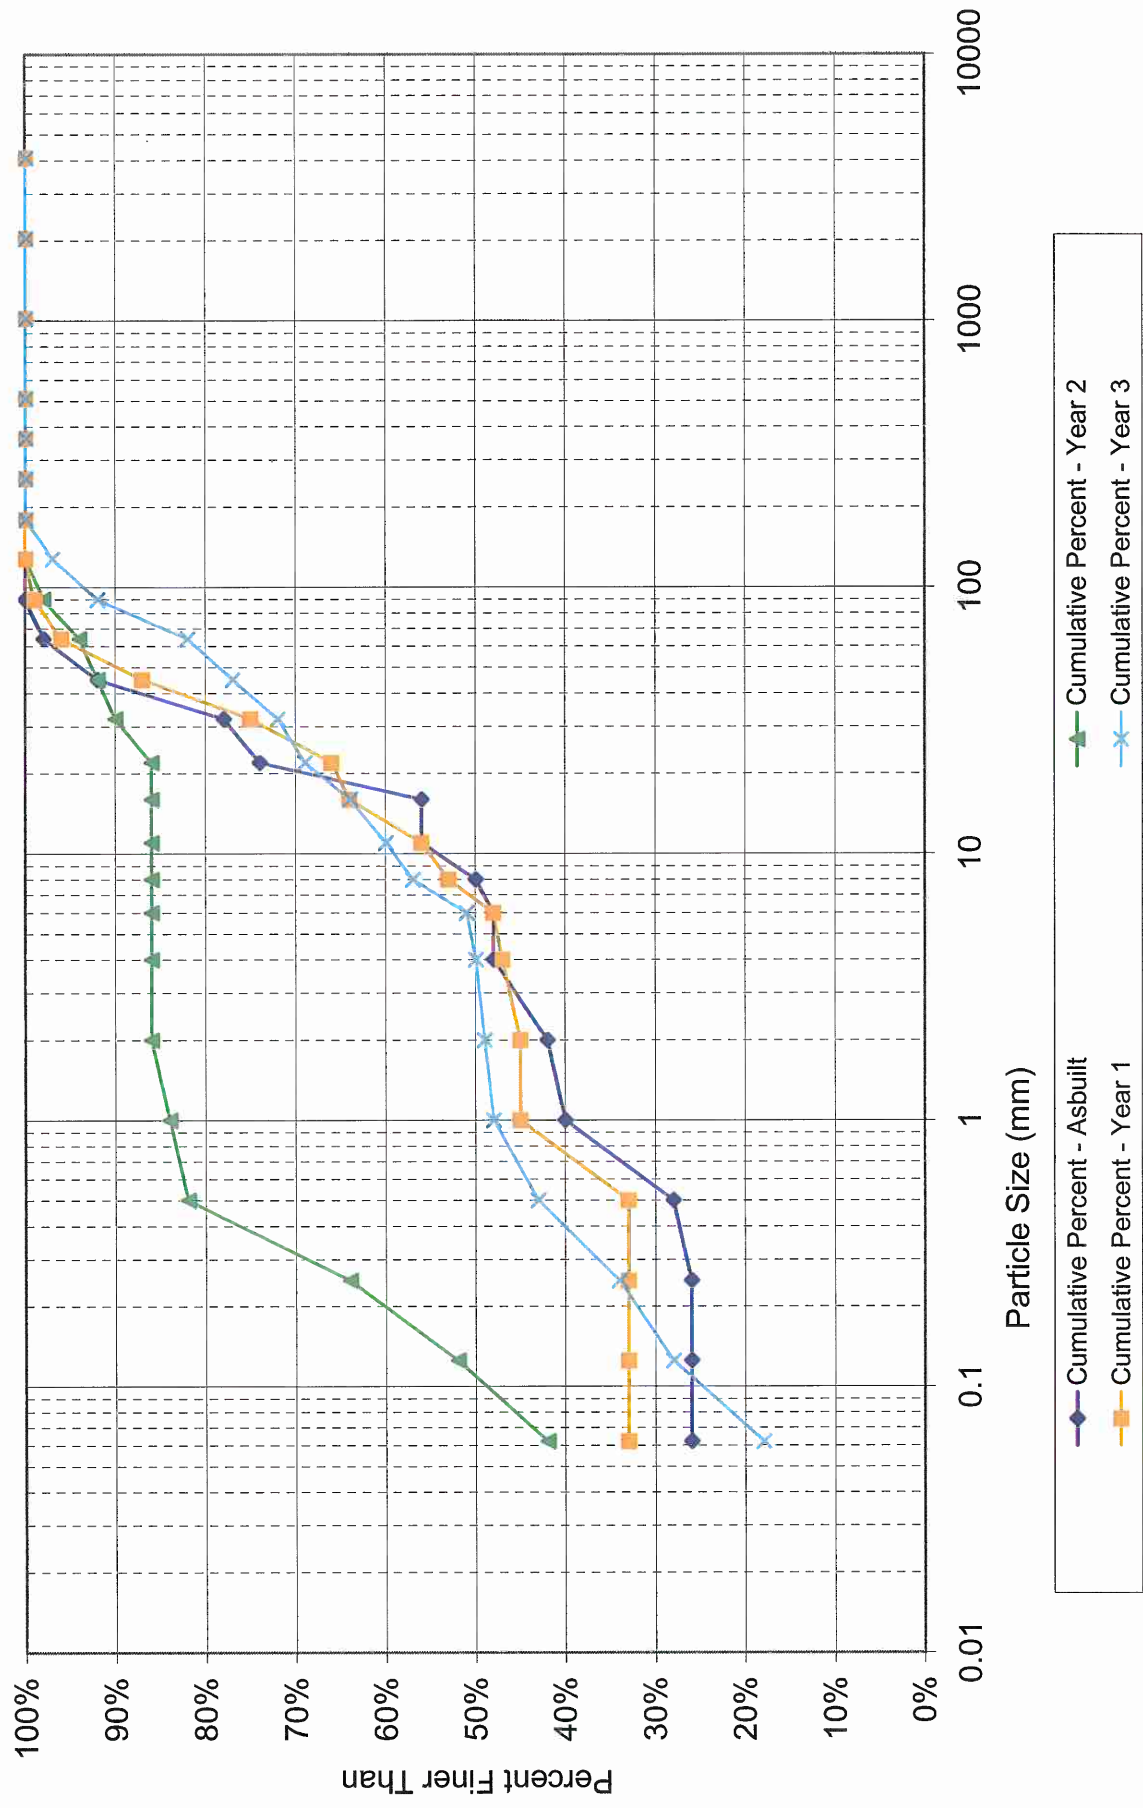

**APPENDIX C**


**BENTHIC MACROINVERTEBRATE ASSESSMENT DATA**

## Gray Farm Stream Restoration Benthic Analysis - Reach 1 Station 1

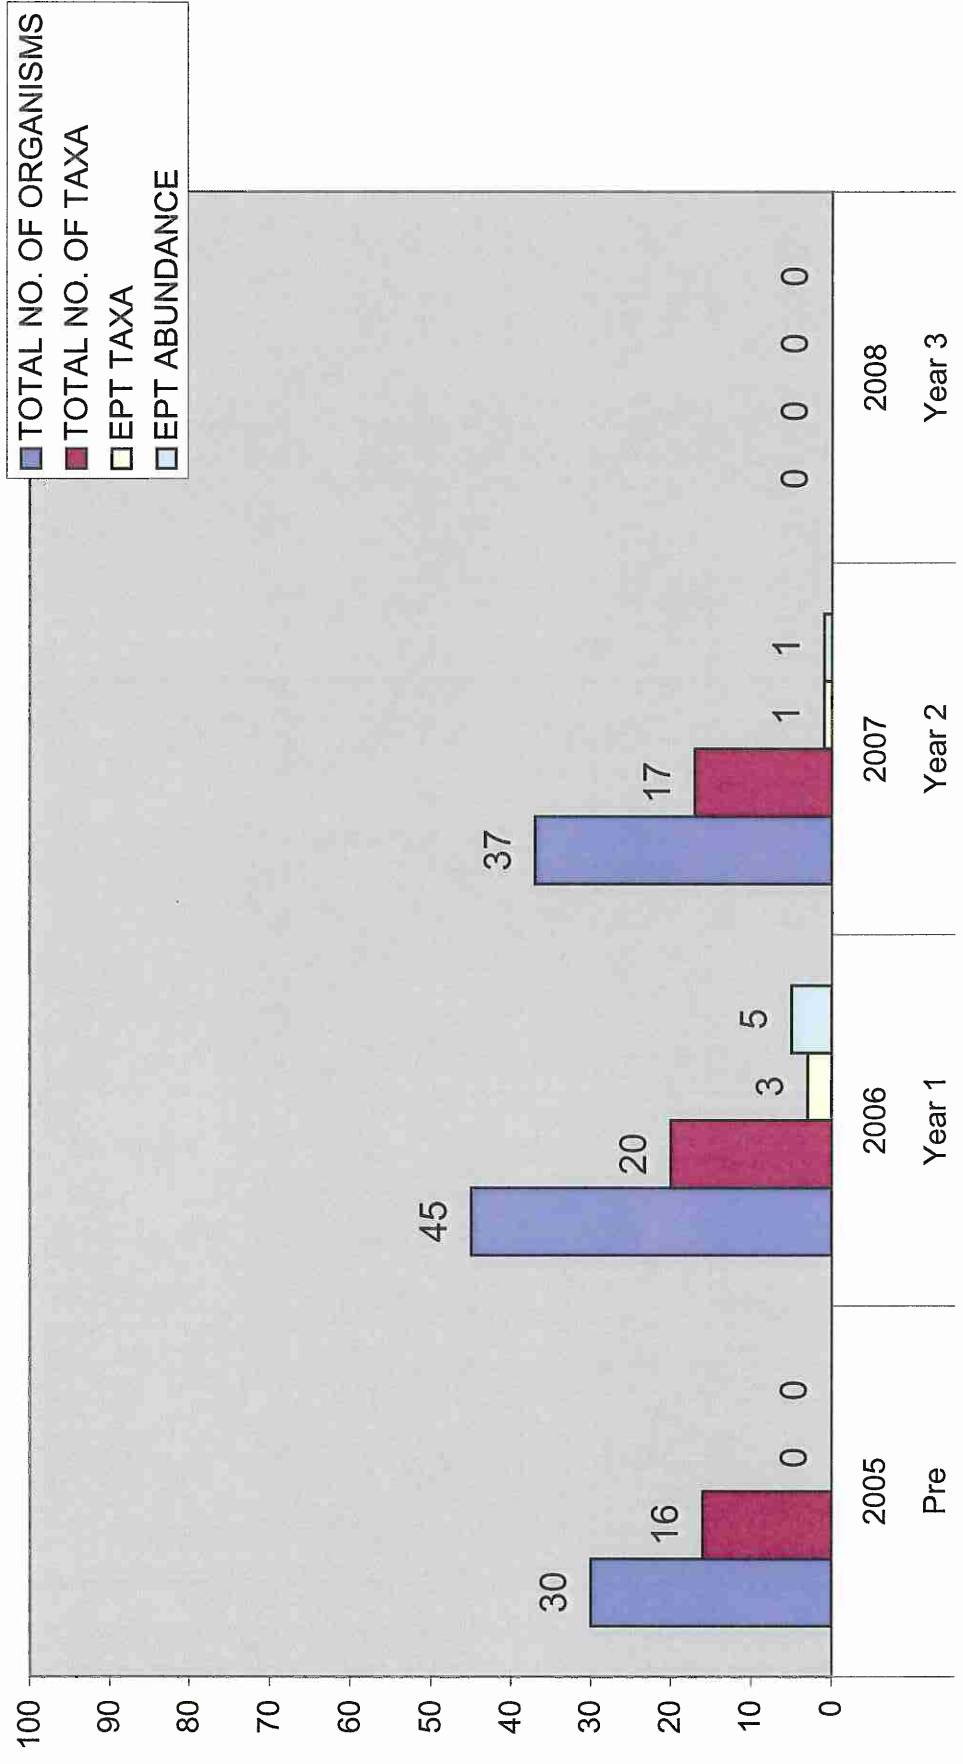





## Gray Farm Stream Restoration Benthic Analysis - Reach 1 Station 2

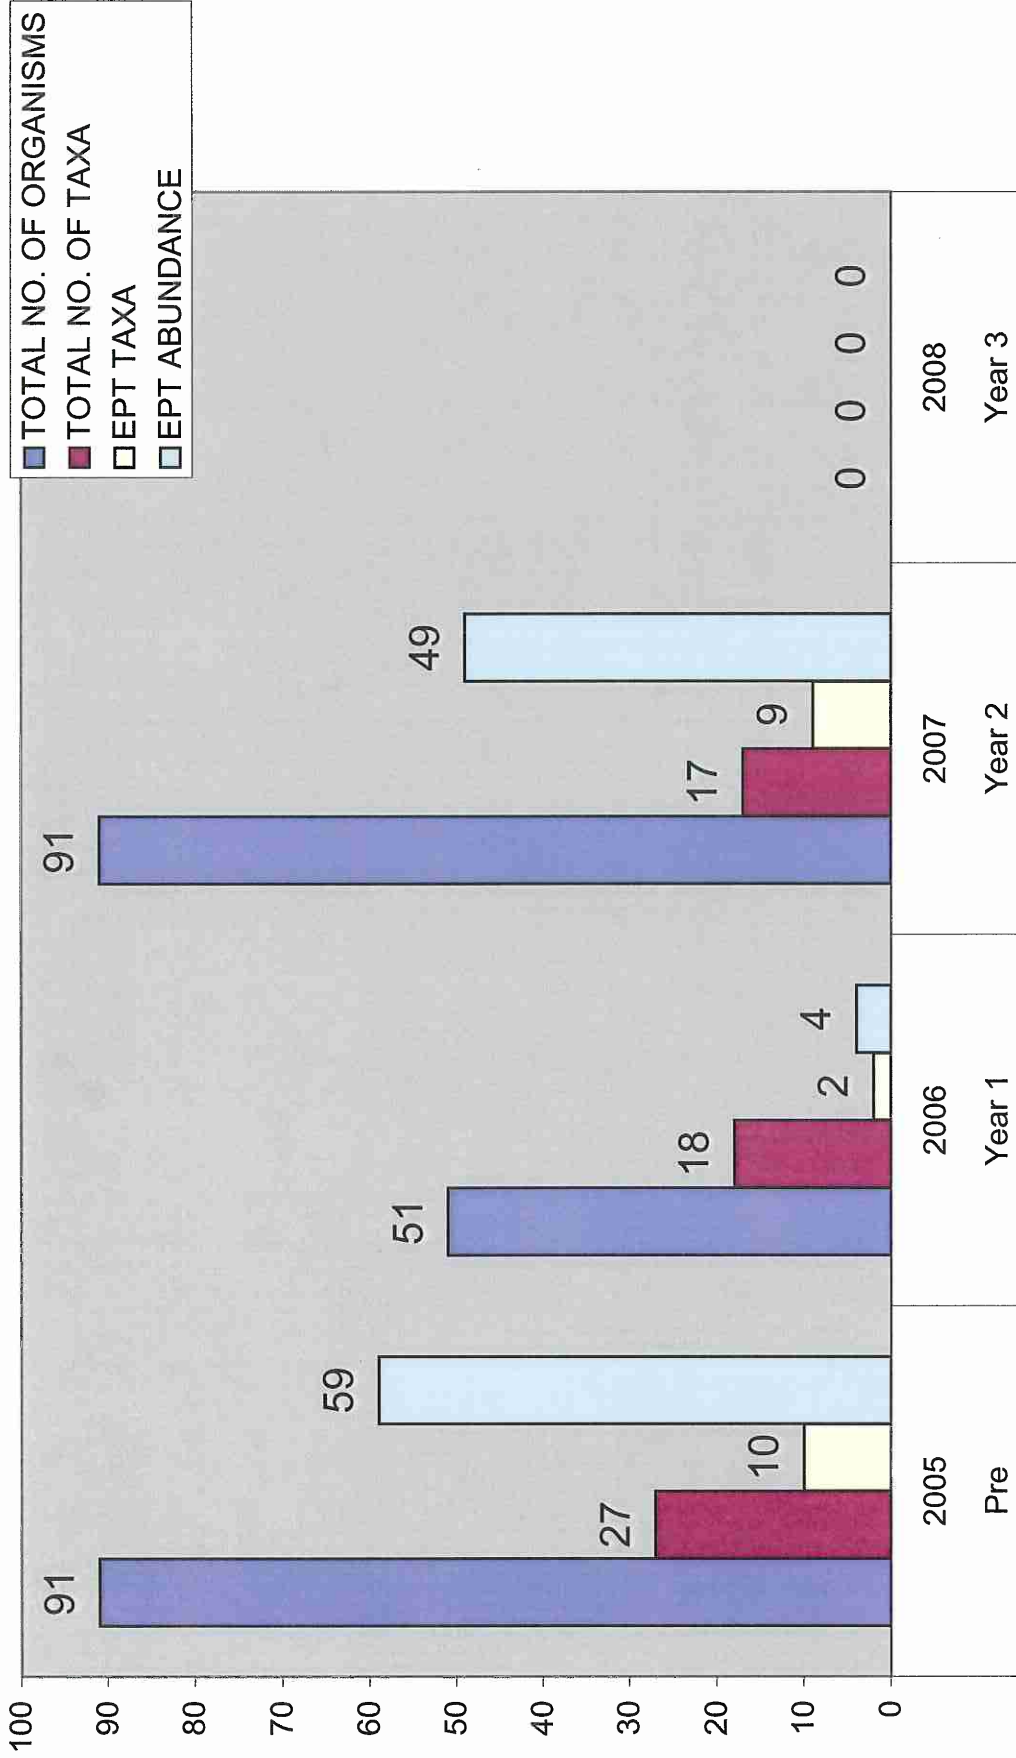


## Gray Farm Stream Restoration Benthic Analysis - Reach 1 Station 3

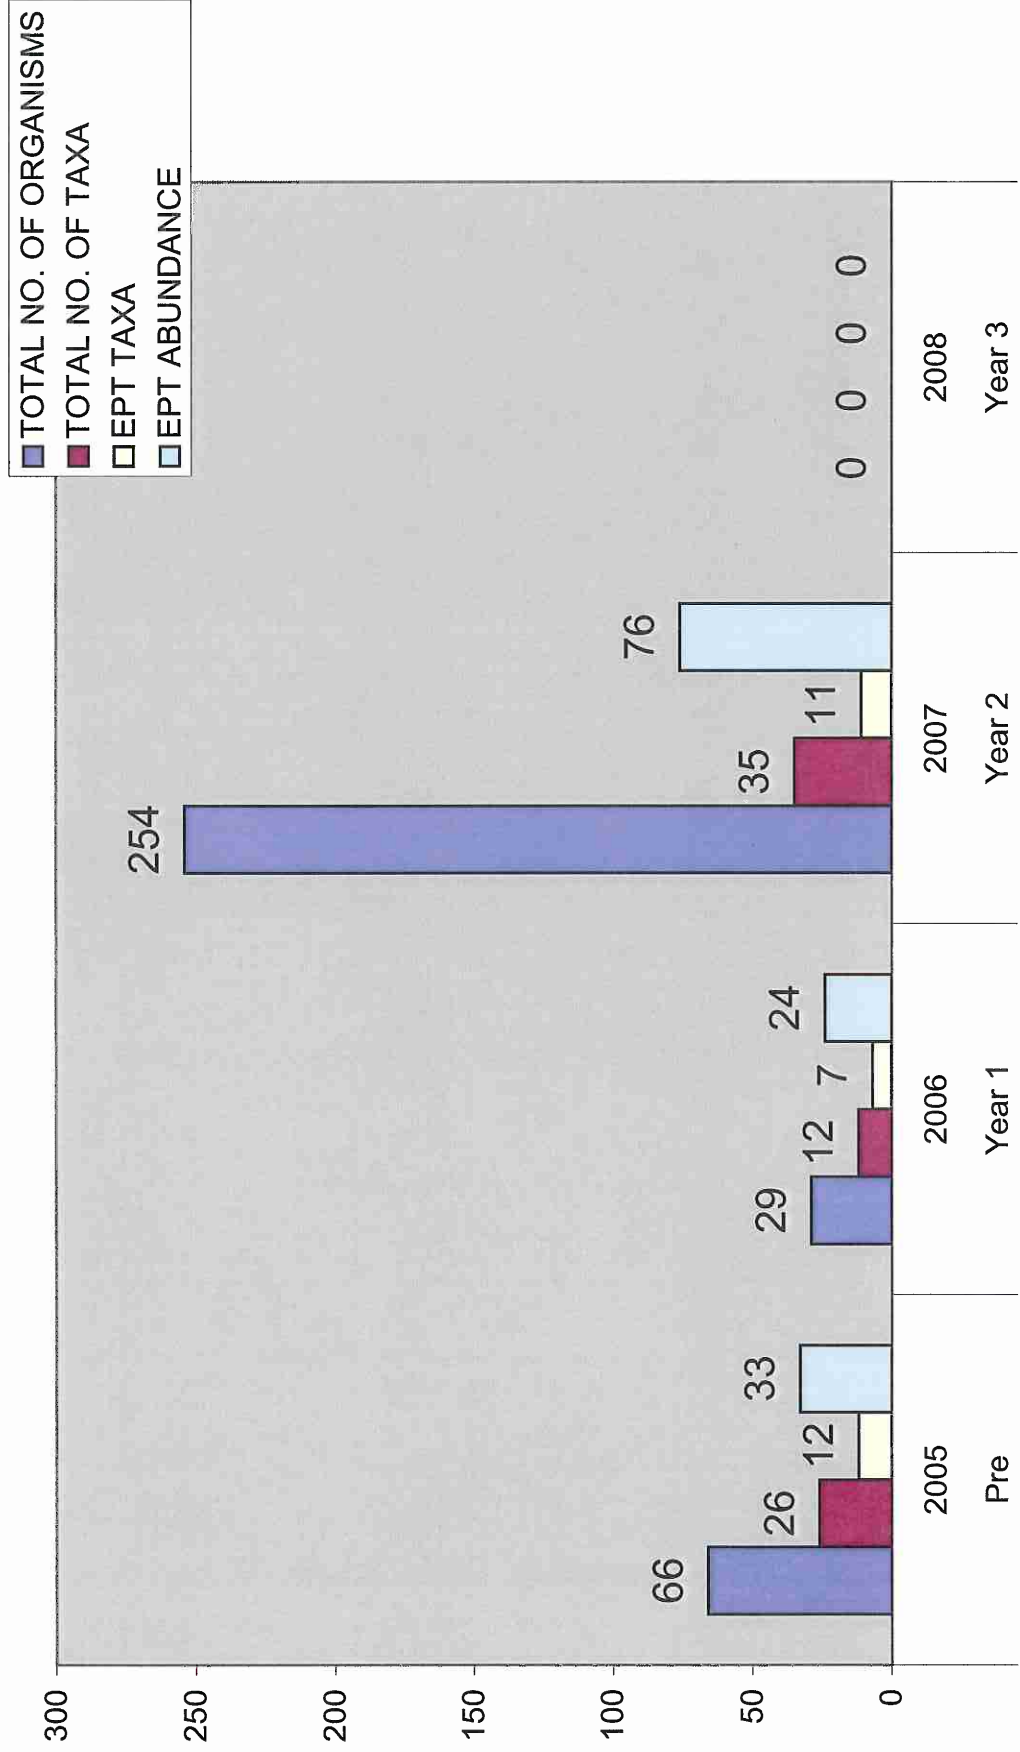

## Gray Farm Stream Restoration Benthic Analysis - Reach 2 Station 1

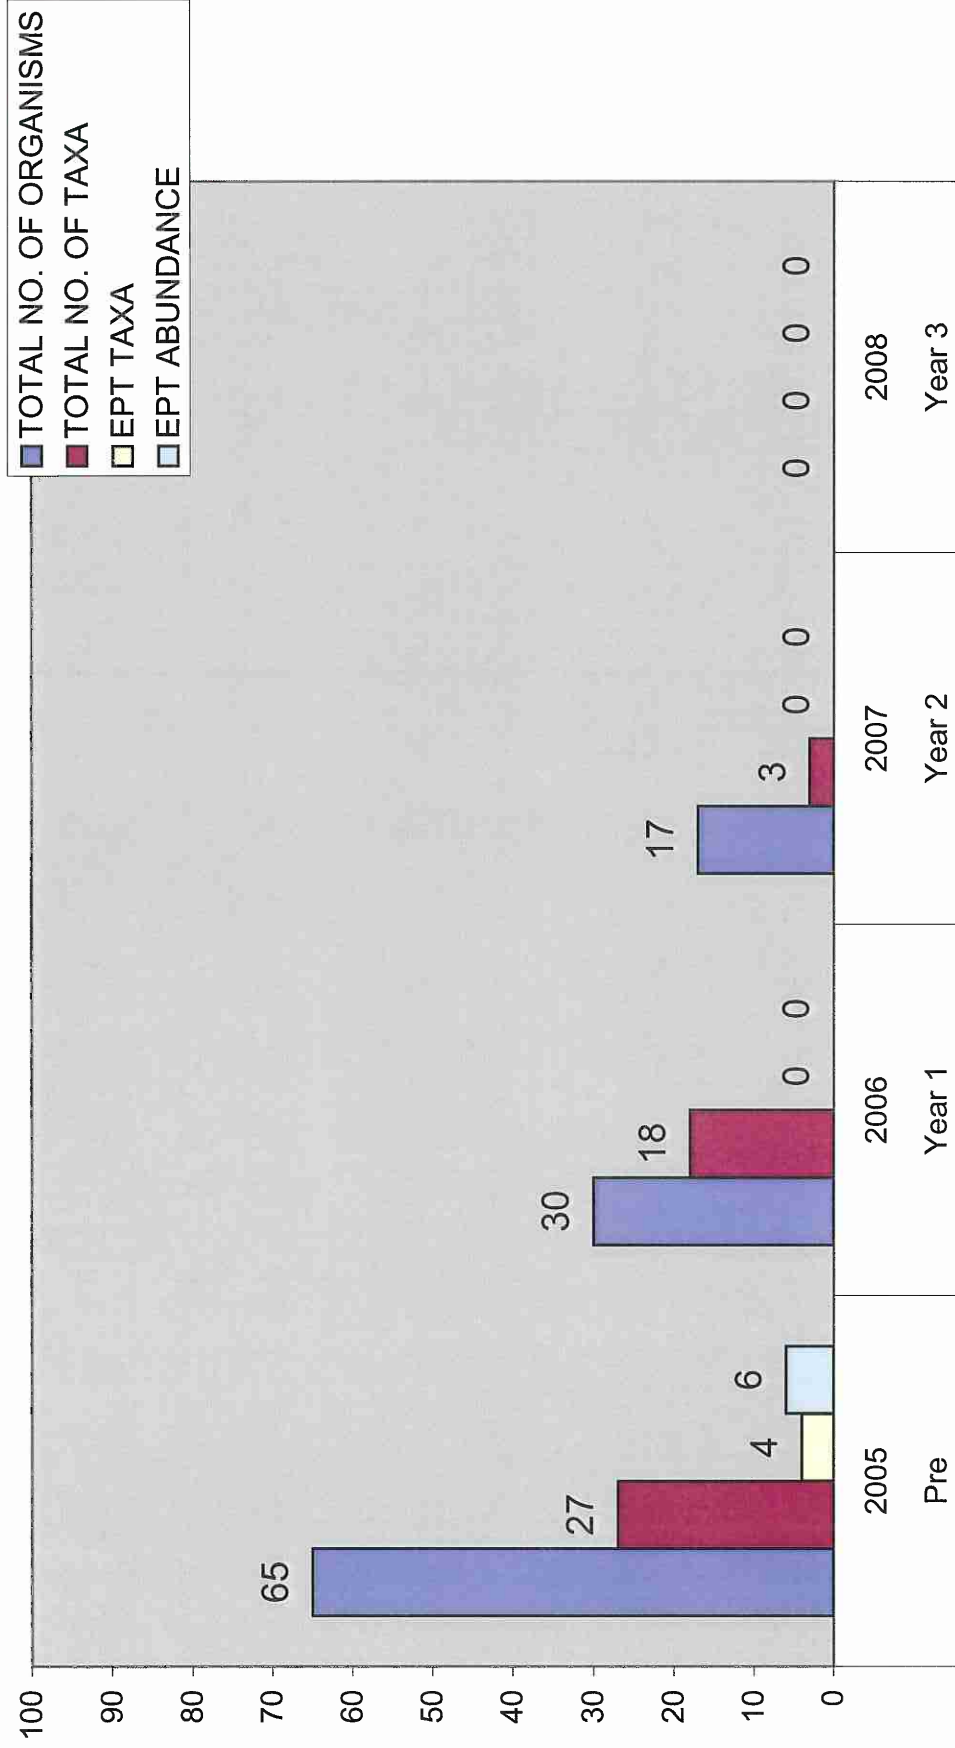

## Gray Farm Stream Restoration Benthic Analysis - Reach 2 Station 2

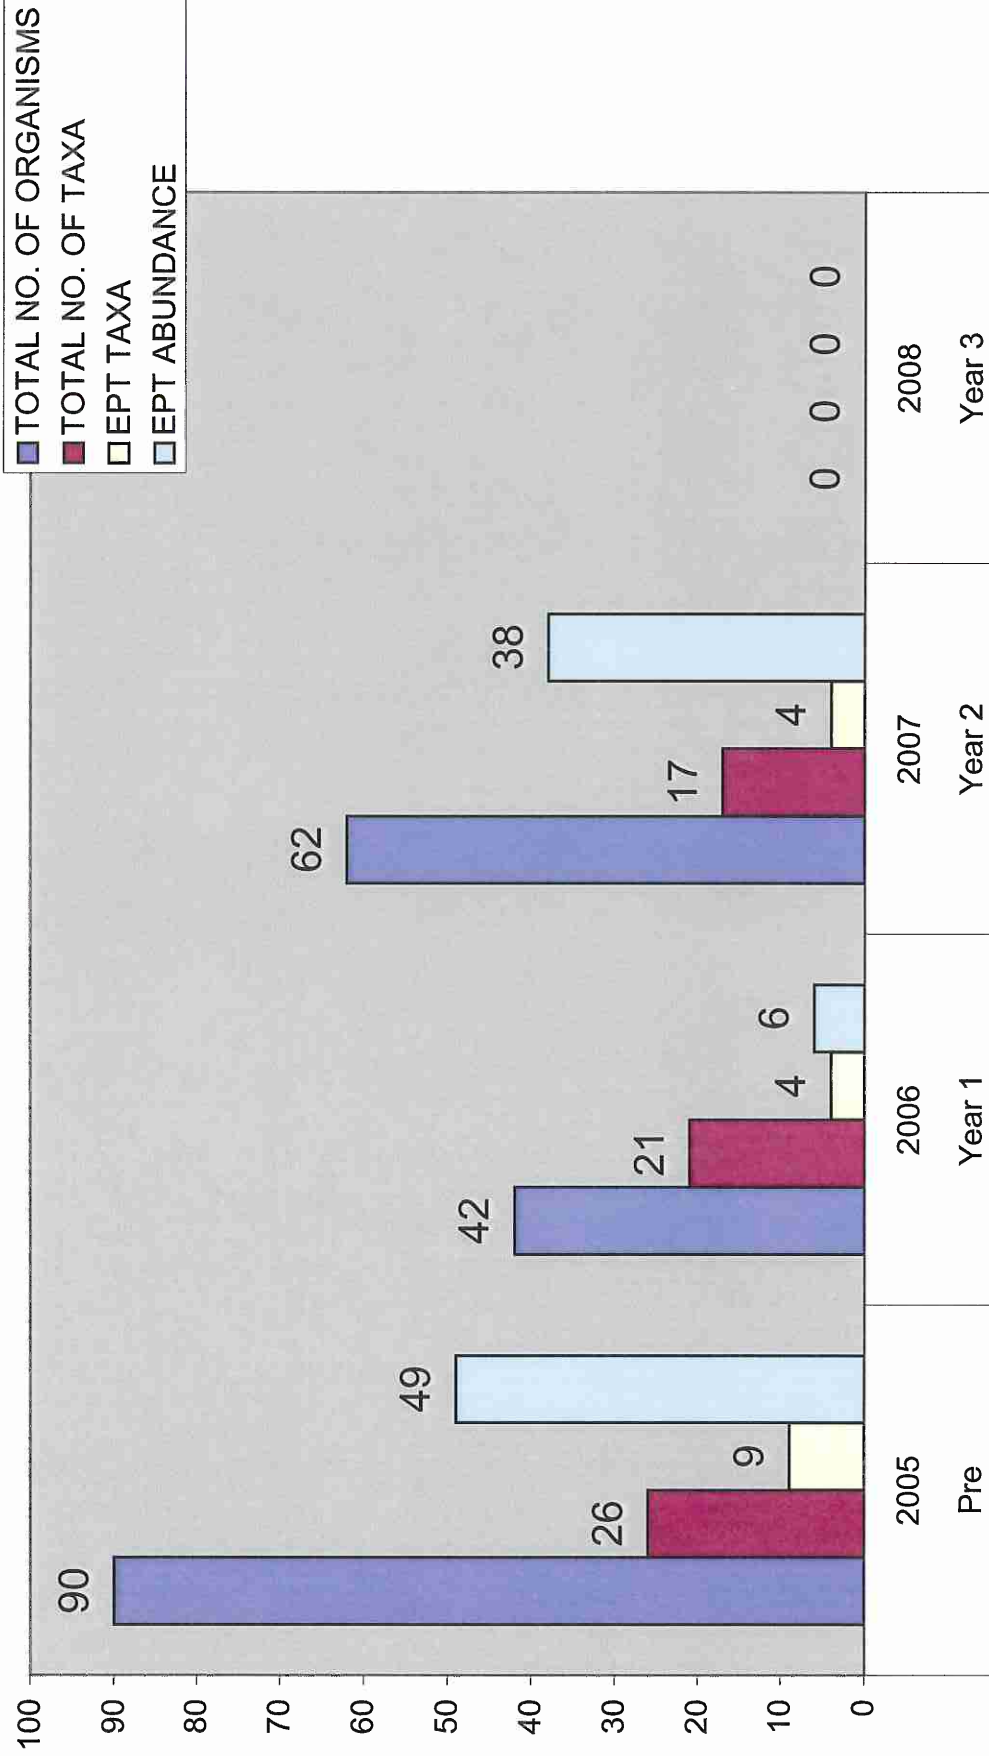





**APPENDIX D**

**INTEGRATED PROBLEM AREA PLAN VIEW**

APPENDIX D.1 –

Monitoring and Problem Area Plan View, Reach 1




**DRAWINGS PRINTED  
AT HALF-SCALE**

	RESTORED STREAM CHANNEL		EXISTING CONTOURS
	EXISTING NCDENR STREAMS		EXISTING DOT ROADS

- NOTES:
- SITE DATA AS DETERMINED BY LIMITED ENGINEERING SURVEY PERFORMED BY S&EC. (NCDENR STREAMS, LIDAR CONTOURS, AND NCDOT ROADS TAKEN FROM REFERENCE GIS LAYERS)
  - ALL LOCATIONS, ELEVATIONS, AND DIMENSIONS ARE APPROXIMATE.
  - ELEVATIONS ARE APPROXIMATE AND BASED ON AN ASSUMED ELEVATION OF 100' ADJUSTED TO MATCH 2 FOOT CONTOURS.

REACH 1 - RESTORATION SITE LAYOUT & KEYSHEET

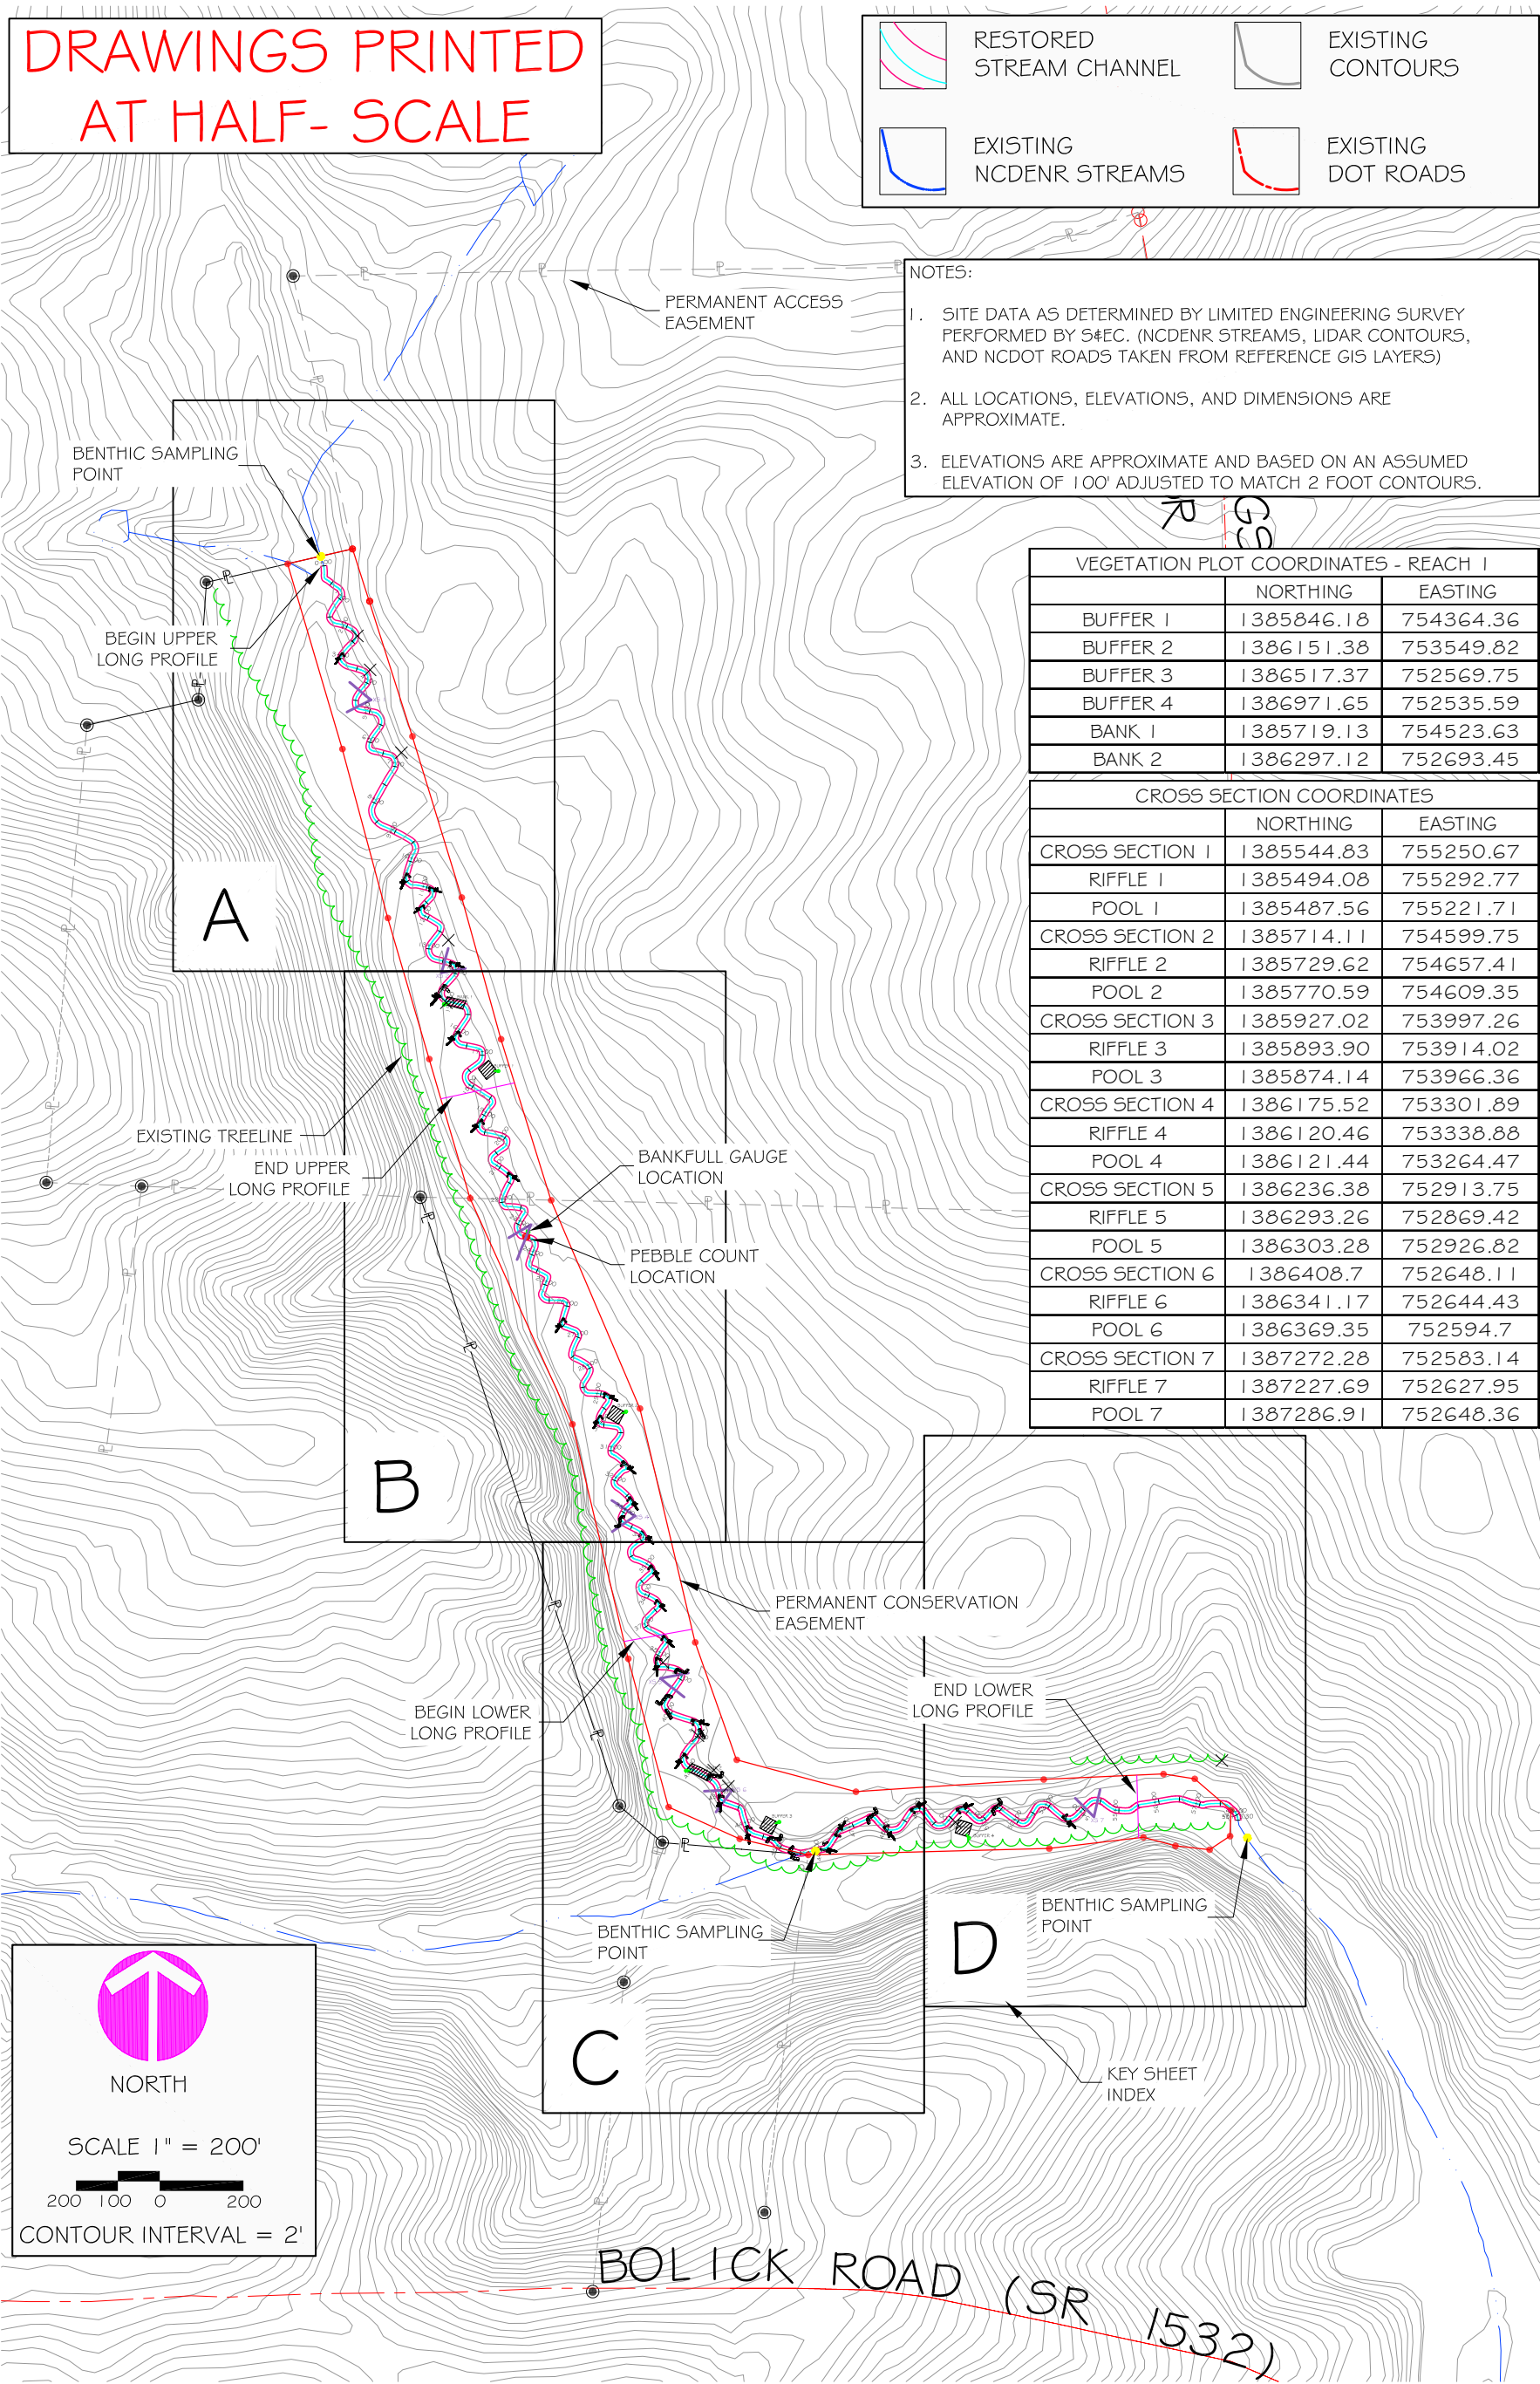

VEGETATION PLOT COORDINATES - REACH 1

	NORTHING	EASTING
BUFFER 1	1385846.18	754364.36
BUFFER 2	1386151.38	753549.82
BUFFER 3	1386517.37	752569.75
BUFFER 4	1386971.65	752535.59
BANK 1	1385719.13	754523.63
BANK 2	1386297.12	752693.45

CROSS SECTION COORDINATES

	NORTHING	EASTING
CROSS SECTION 1	1385544.83	755250.67
RIFFLE 1	1385494.08	755292.77
POOL 1	1385487.56	755221.71
CROSS SECTION 2	1385714.11	754599.75
RIFFLE 2	1385729.62	754657.41
POOL 2	1385770.59	754609.35
CROSS SECTION 3	1385927.02	753997.26
RIFFLE 3	1385893.90	753914.02
POOL 3	1385874.14	753966.36
CROSS SECTION 4	1386175.52	753301.89
RIFFLE 4	1386120.46	753338.88
POOL 4	1386121.44	753264.47
CROSS SECTION 5	1386236.38	752913.75
RIFFLE 5	1386293.26	752869.42
POOL 5	1386303.28	752926.82
CROSS SECTION 6	1386408.7	752648.11
RIFFLE 6	1386341.17	752644.43
POOL 6	1386369.35	752594.7
CROSS SECTION 7	1387272.28	752583.14
RIFFLE 7	1387227.69	752627.95
POOL 7	1387286.91	752648.36

**NORTH**

SCALE 1" = 200'

200 100 0 200

CONTOUR INTERVAL = 2'

REV.	DESCRIPTION	DATE	APP.

**S&EC**

**Soil & Environmental Consultants, PA**

11010 Raven Ridge Road • Raleigh, North Carolina 27614 • Phone: (919) 846-5900 • Fax: (919) 846-9467

www.SandEC.com

Project: GRAY FARM STREAM RESTORATION YEAR 3 MONITORING

Location: IREDELL CO., NC

Client: NC ECOSYSTEM ENHANCEMENT PROGRAM

Sheet Title: REACH 1 RESTORATION SITE LAYOUT & KEYSHEET

Project No.: 9385.D9


Proj. Mgr.: DG

Scale: 1" = 200'

Sheet No.: 1 OF 16


**NOTES:**

1. SITE DATA AS DETERMINED BY LIMITED ENGINEERING SURVEY PERFORMED BY S&EC. (NCDENR STREAMS, LIDAR CONTOURS, AND NCDOT ROADS TAKEN FROM REFERENCE GIS LAYERS)
2. ALL LOCATIONS, ELEVATIONS, AND DIMENSIONS ARE APPROXIMATE.
3. ELEVATIONS ARE APPROXIMATE AND BASED ON AN ASSUMED ELEVATION OF 100' ADJUSTED TO MATCH 2 FOOT CONTOURS.



**NORTH**






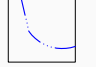
SCALE 1" = 50'








CONTOUR INTERVAL = 2'

DRAWINGS PRINTED  
AT HALF-SCALE

**LEGEND FOR  
ASBUILT FEATURES**

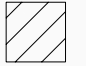
	RESTORED STREAM CHANNEL
	LOG J-HOOK (LJH)
	ROCK J-HOOK (RJH)
	CROSS ROCK VANE (CRV)
	CREATED/RESTORED WETLANDS
	EXISTING STREAMS

**LEGEND FOR  
MONITORING FEATURES**

	BUFFER VEGETATION PLOT
	BANK VEGETATION PLOT
	PERMANENT PHOTO POINT
	CROSS-SECTION LOCATION
	BENTHIC SAMPLING POINT

REACH 1 - MONITORING PLAN VIEW - A

A

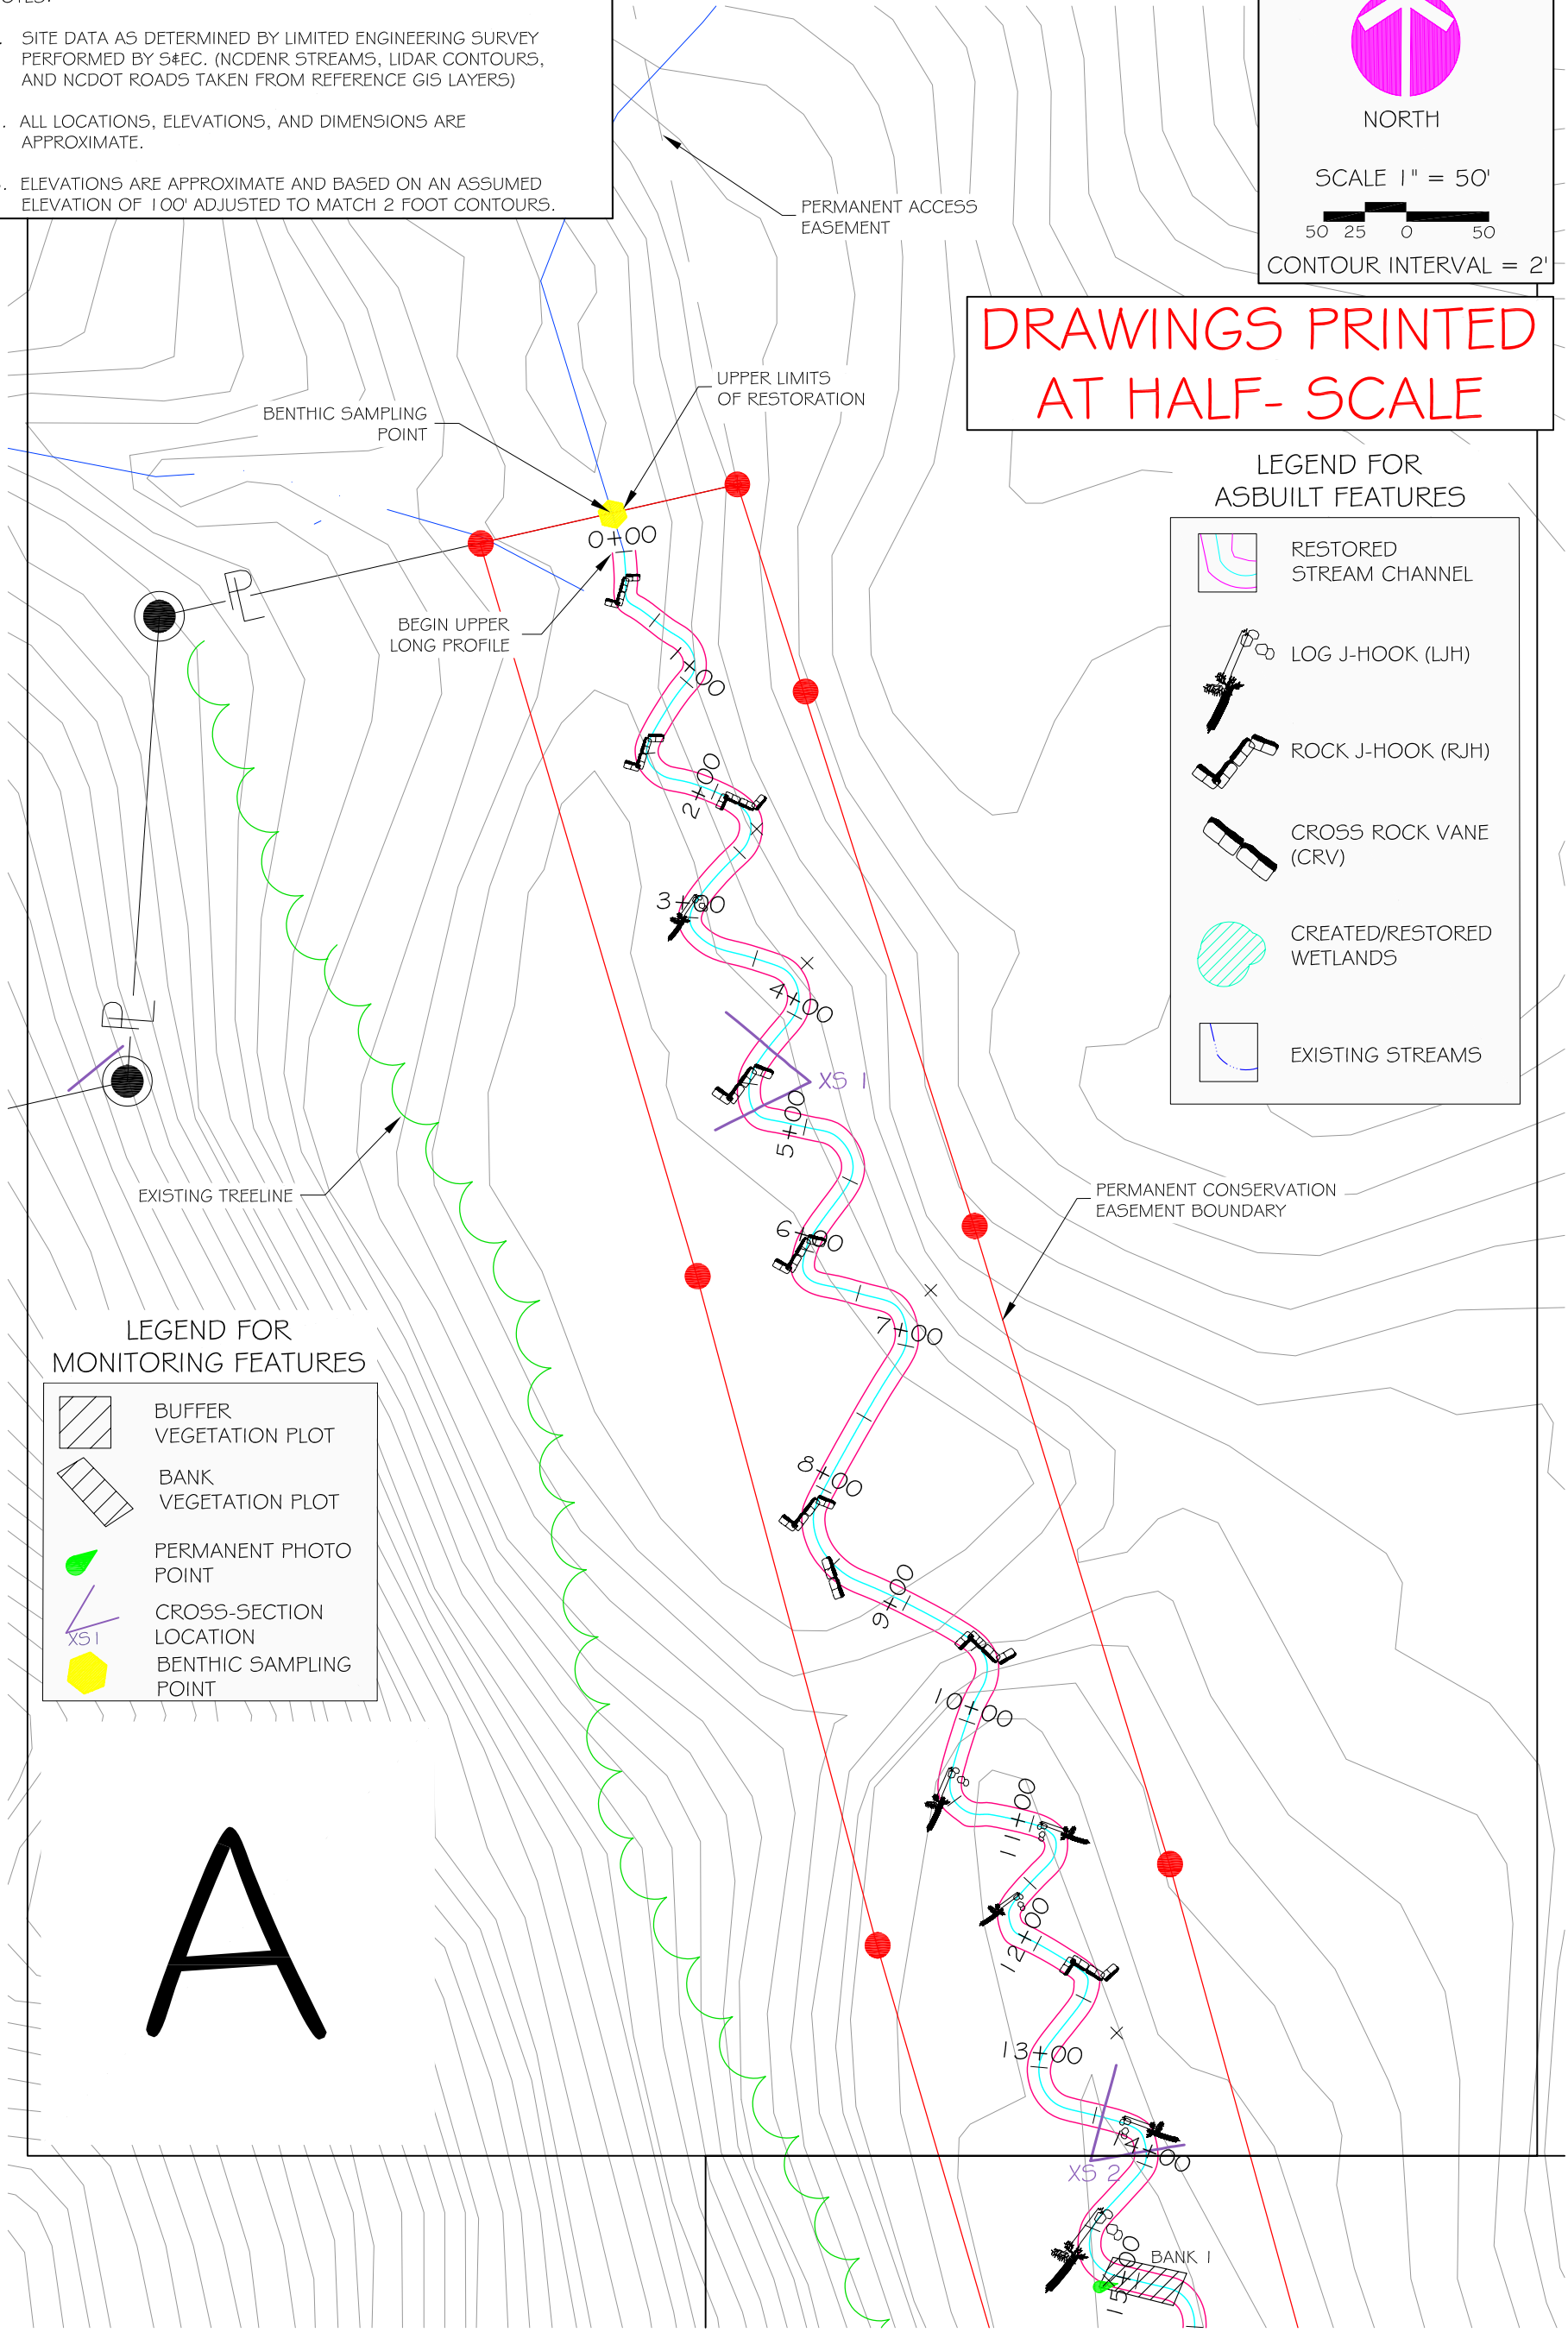

REVISIONS			
REV.	DESCRIPTION	DATE	APP.




Soil & Environmental Consultants, PA

11010 Raven Ridge Road • Raleigh, North Carolina 27614 • Phone: (919) 846-5900 • Fax: (919) 846-9467  
www.SandEC.com

Project:	GRAY FARM STREAM RESTORATION YEAR 3 MONITORING	Project No.:	9385.D9
Location:	IREDELL CO., NC	Client:	NC ECOSYSTEM ENHANCEMENT PROGRAM
Sheet Title:	REACH 1 - MONITORING PLAN VIEW - A	Scale:	1" = 50'
		Proj. Mgr.:	DG
		Drawn:	DGC
		Sheet No.:	2 OF 16

REACH 1 - MONITORING PLAN VIEW - B

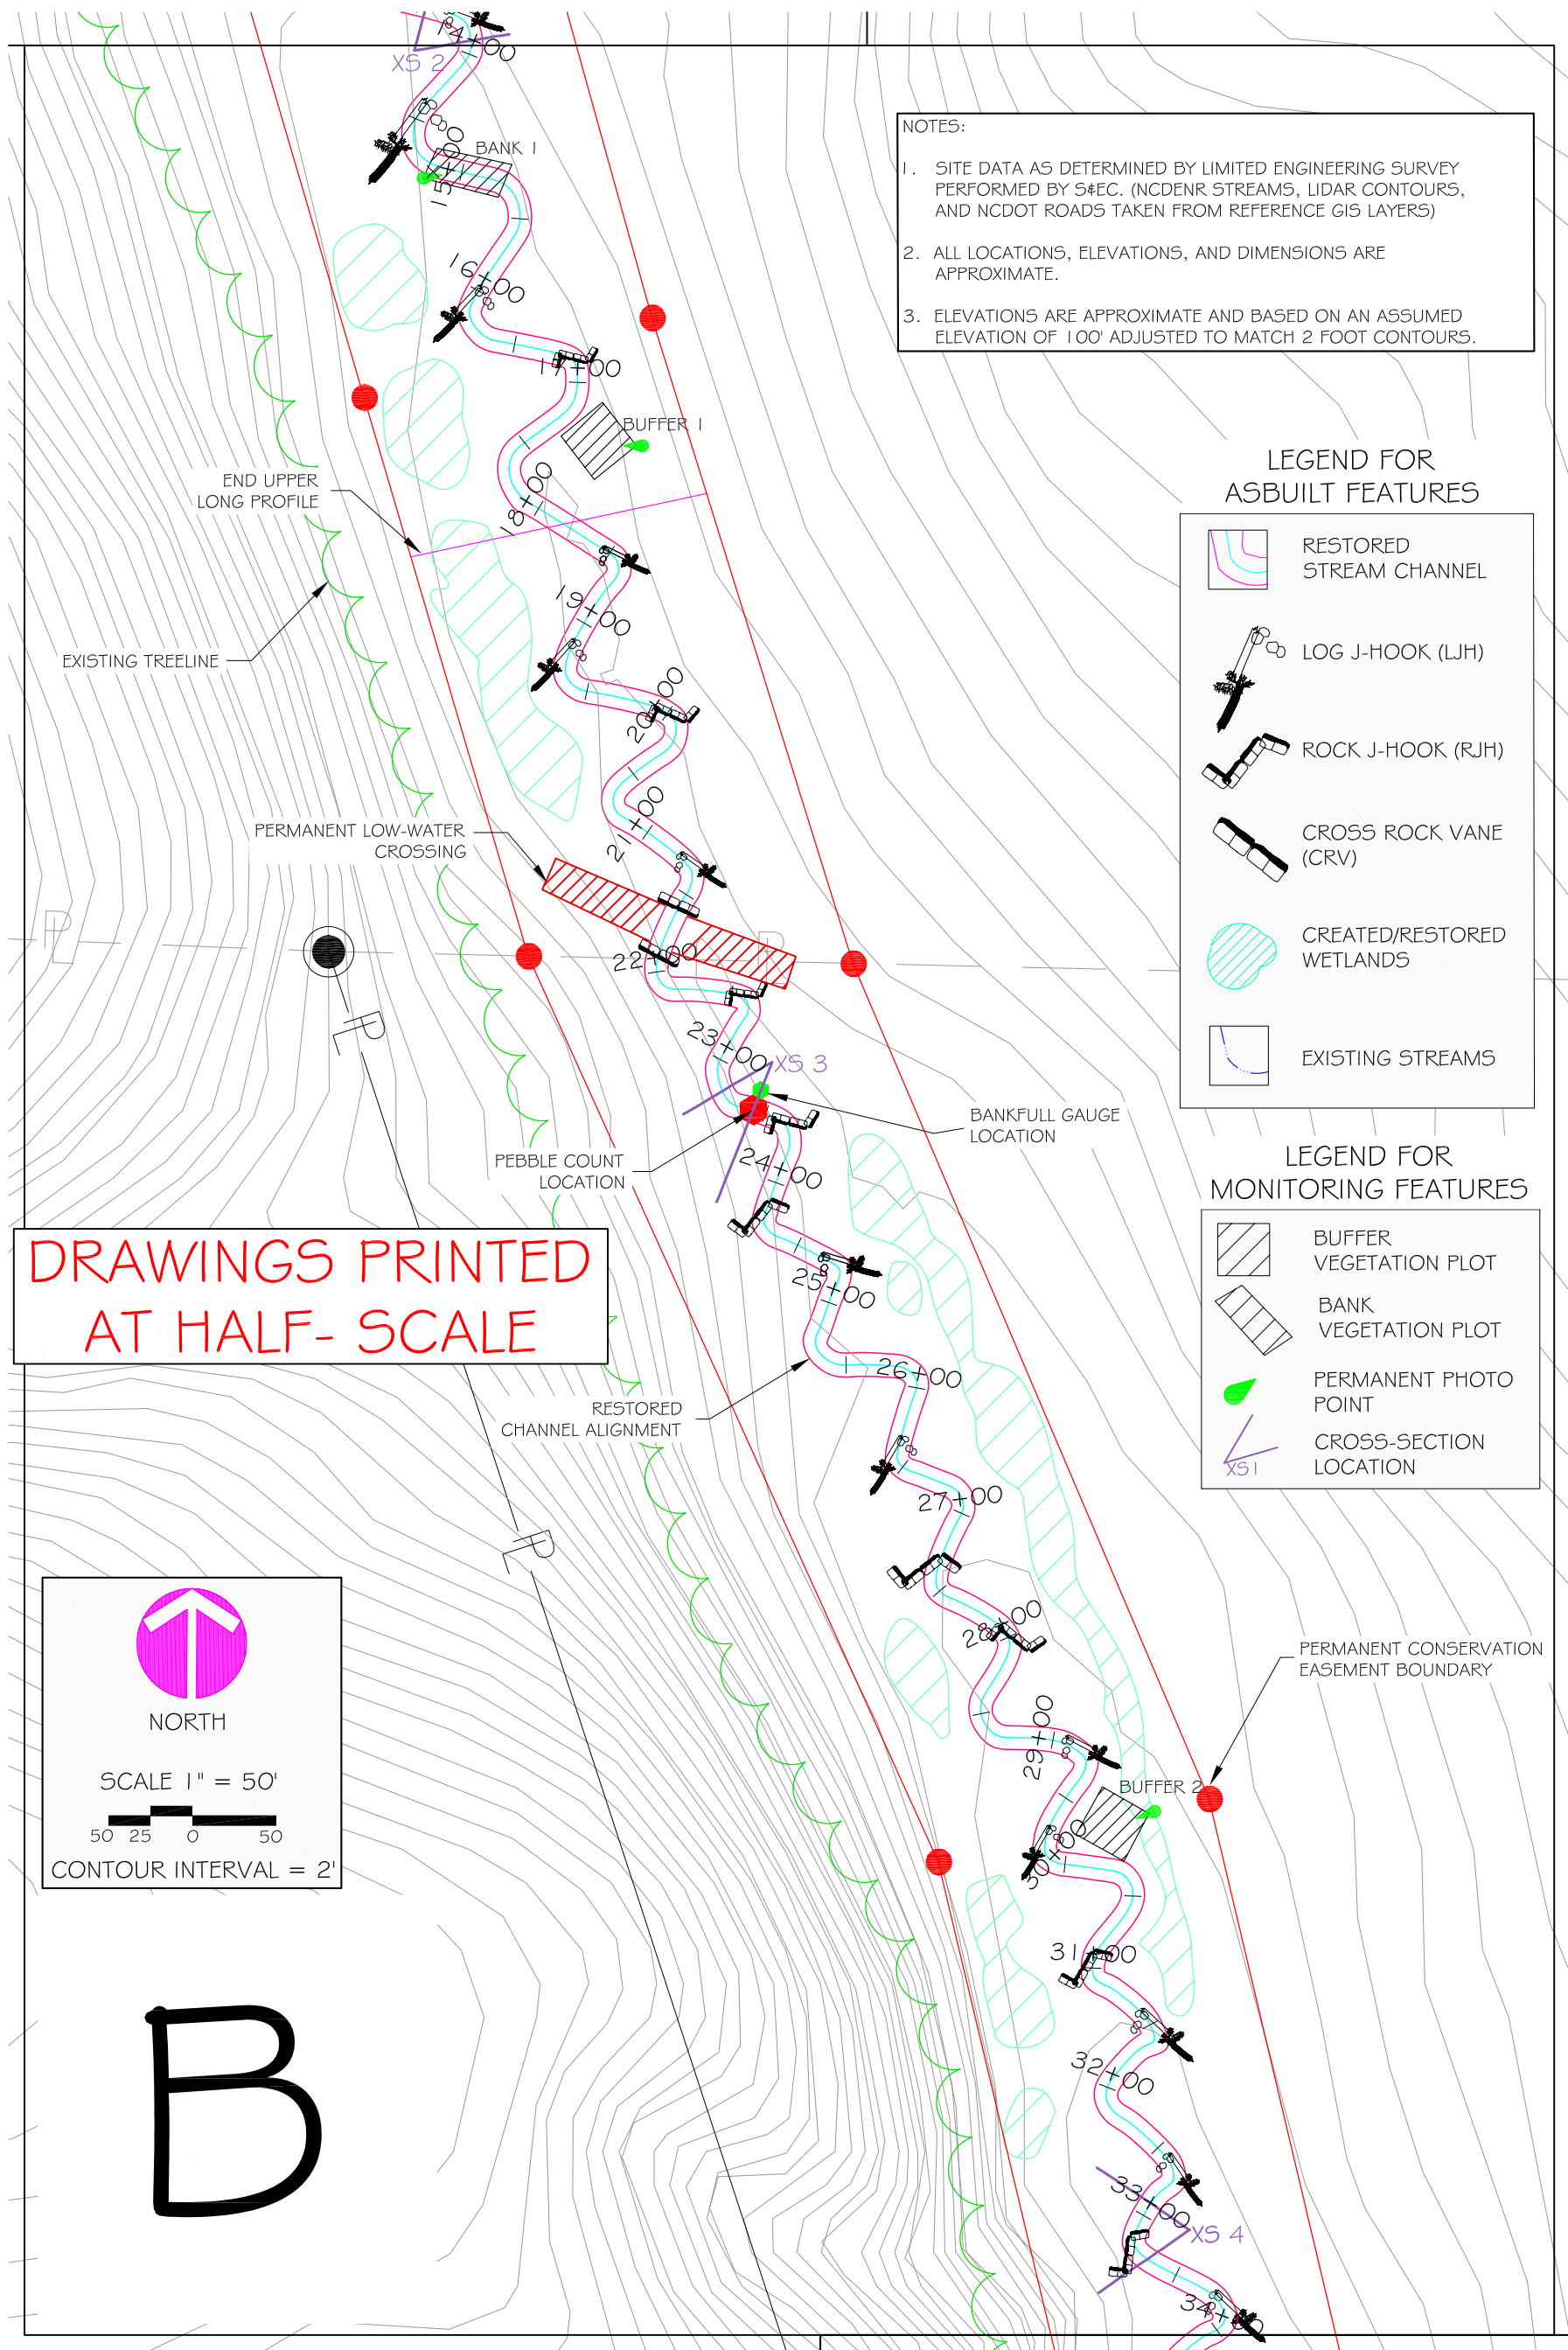

NOTES:

1. SITE DATA AS DETERMINED BY LIMITED ENGINEERING SURVEY PERFORMED BY S&EC. (NCDENR STREAMS, LIDAR CONTOURS, AND NCDOT ROADS TAKEN FROM REFERENCE GIS LAYERS)
2. ALL LOCATIONS, ELEVATIONS, AND DIMENSIONS ARE APPROXIMATE.
3. ELEVATIONS ARE APPROXIMATE AND BASED ON AN ASSUMED ELEVATION OF 100' ADJUSTED TO MATCH 2 FOOT CONTOURS.

**LEGEND FOR ASBUILT FEATURES**

- RESTORED STREAM CHANNEL
- LOG J-HOOK (LJH)
- ROCK J-HOOK (RJH)
- CROSS ROCK VANE (CRV)
- CREATED/RESTORED WETLANDS
- EXISTING STREAMS

**LEGEND FOR MONITORING FEATURES**

- BUFFER VEGETATION PLOT
- BANK VEGETATION PLOT
- PERMANENT PHOTO POINT
- CROSS-SECTION LOCATION

**DRAWINGS PRINTED AT HALF-SCALE**

**NORTH**

SCALE 1" = 50'

CONTOUR INTERVAL = 2'

**B**

REVISIONS			
REV.	DESCRIPTION	DATE	APP.



**Soil & Environmental Consultants, PA**  
 11010 Raven Ridge Road • Raleigh, North Carolina 27614 • Phone: (919) 846-5900 • Fax: (919) 846-9467  
 www.SandEC.com


Project: GRAY FARM STREAM RESTORATION YEAR 3 MONITORING  
 Location: IREDELL CO., NC  
 Client: NC ECOSYSTEM ENHANCEMENT PROGRAM  
 Sheet Title: REACH 1 - MONITORING PLAN VIEW - B

Project No.: 9385.D9  
 Proj. Mgr.: DG  
 Drawn: DGC  
 Scale: 1" = 50'  
 Sheet No.: 3 OF 16

# DRAWINGS PRINTED AT HALF-SCALE

- NOTES:
1. SITE DATA AS DETERMINED BY LIMITED ENGINEERING SURVEY PERFORMED BY S&EC. (NCDENR STREAMS, LIDAR CONTOURS, AND NCDOT ROADS TAKEN FROM REFERENCE GIS LAYERS)
  2. ALL LOCATIONS, ELEVATIONS, AND DIMENSIONS ARE APPROXIMATE.
  3. ELEVATIONS ARE APPROXIMATE AND BASED ON AN ASSUMED ELEVATION OF 100' ADJUSTED TO MATCH 2 FOOT CONTOURS.

## REACH 1 - MONITORING PLAN VIEW - C

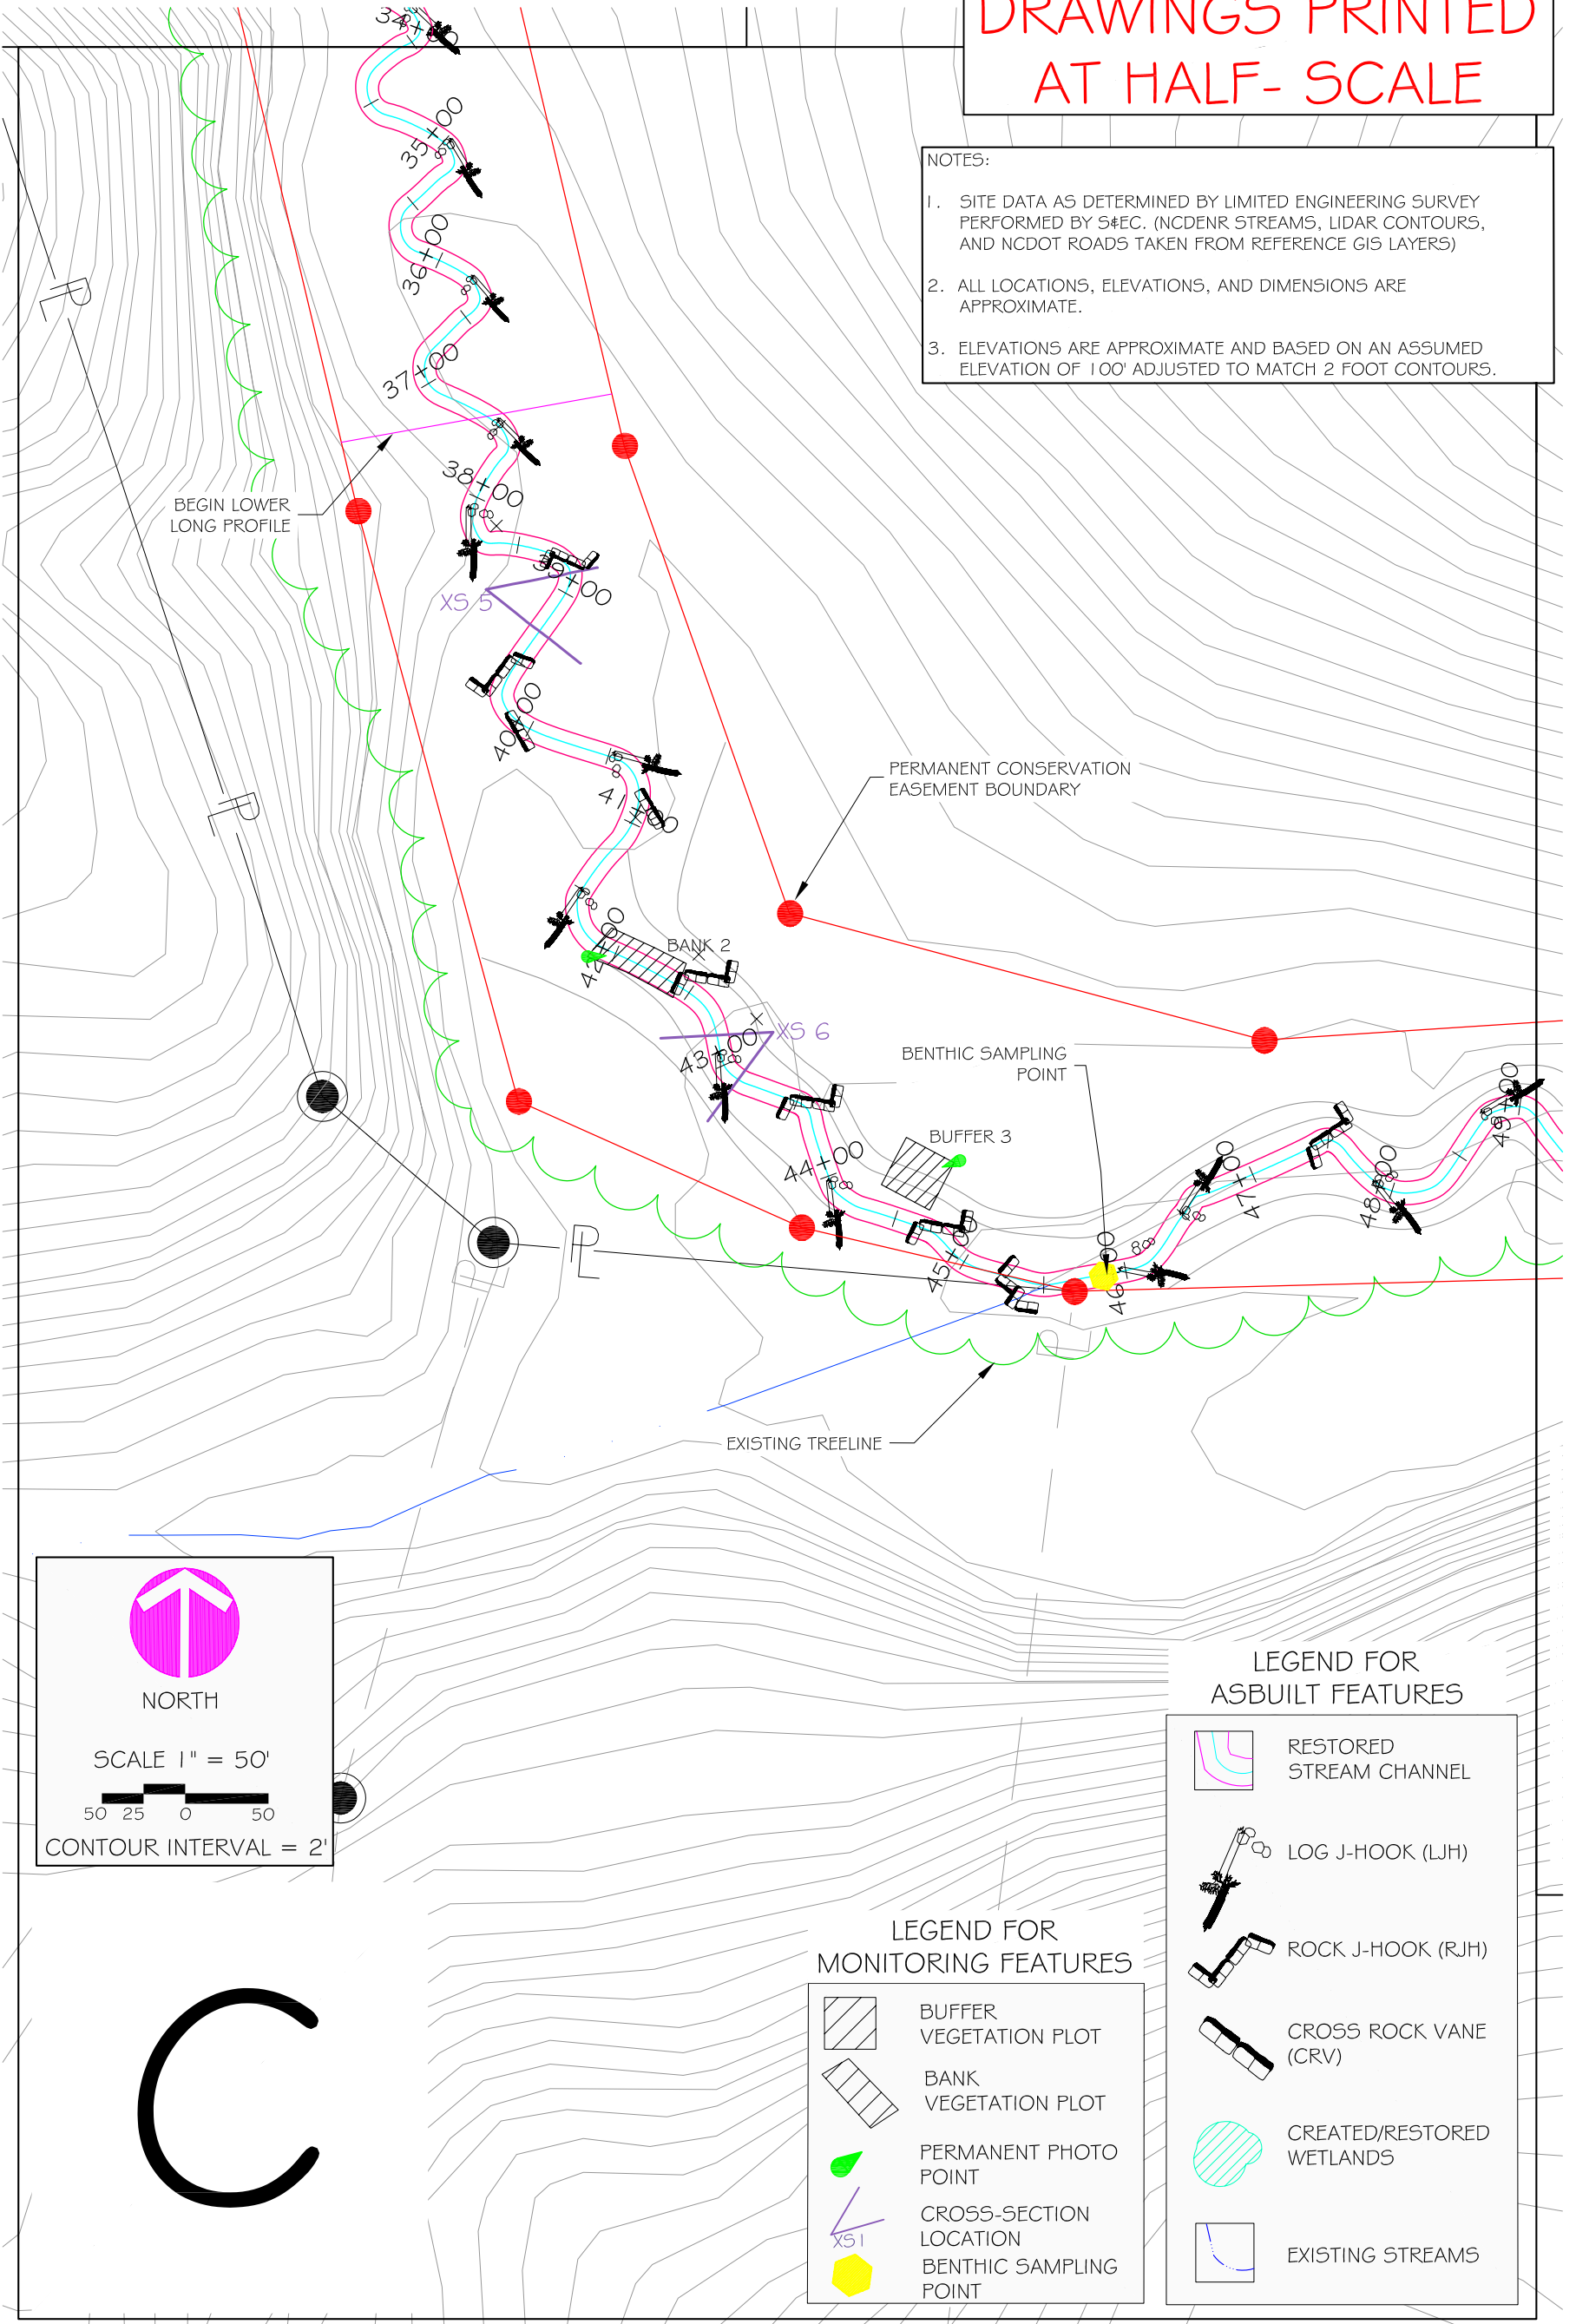

**NORTH**

SCALE 1" = 50'

50 25 0 50

CONTOUR INTERVAL = 2'

# C

### LEGEND FOR MONITORING FEATURES

- BUFFER VEGETATION PLOT
- BANK VEGETATION PLOT
- PERMANENT PHOTO POINT
- CROSS-SECTION LOCATION
- BENTHIC SAMPLING POINT

### LEGEND FOR ASBUILT FEATURES

- RESTORED STREAM CHANNEL
- LOG J-HOOK (LJH)
- ROCK J-HOOK (RJH)
- CROSS ROCK VANE (CRV)
- CREATED/RESTORED WETLANDS
- EXISTING STREAMS

REVISIONS			
REV.	DESCRIPTION	DATE	APPR.



**Soil & Environmental Consultants, PA**  
 11010 Raven Ridge Road • Raleigh, North Carolina 27614 • Phone: (919) 846-5900 • Fax: (919) 846-9467  
 www.SandEC.com

Project: GRAY FARM STREAM RESTORATION YEAR 3 MONITORING  
 Location: IREDELL CO., NC Client: NC ECOSYSTEM ENHANCEMENT PROGRAM  
 Sheet Title: REACH 1 - MONITORING PLAN VIEW - C

Project No.: 9385.D9  
 Proj. Mgr.: DG Drawn: DGC  
 Scale: 1" = 50'  
 Sheet No.: 4 OF 16

**NOTES:**

1. SITE DATA AS DETERMINED BY LIMITED ENGINEERING SURVEY PERFORMED BY S&EC. (NCDENR STREAMS, LIDAR CONTOURS, AND NCDOT ROADS TAKEN FROM REFERENCE GIS LAYERS)
2. ALL LOCATIONS, ELEVATIONS, AND DIMENSIONS ARE APPROXIMATE.
3. ELEVATIONS ARE APPROXIMATE AND BASED ON AN ASSUMED ELEVATION OF 100' ADJUSTED TO MATCH 2 FOOT CONTOURS.



NORTH

SCALE 1" = 50'

50 25 0 50

CONTOUR INTERVAL = 2'

DRAWINGS PRINTED  
AT HALF-SCALE


**LEGEND FOR  
ASBUILT FEATURES**

	RESTORED STREAM CHANNEL
	LOG J-HOOK (LJH)
	ROCK J-HOOK (RJH)
	CROSS ROCK VANE (CRV)
	CREATED/RESTORED WETLANDS
	EXISTING STREAMS

**LEGEND FOR  
MONITORING FEATURES**

	BUFFER VEGETATION PLOT
	BANK VEGETATION PLOT
	PERMANENT PHOTO POINT
	CROSS-SECTION LOCATION
	BENTHIC SAMPLING POINT

REACH 1 - MONITORING PLAN VIEW - D

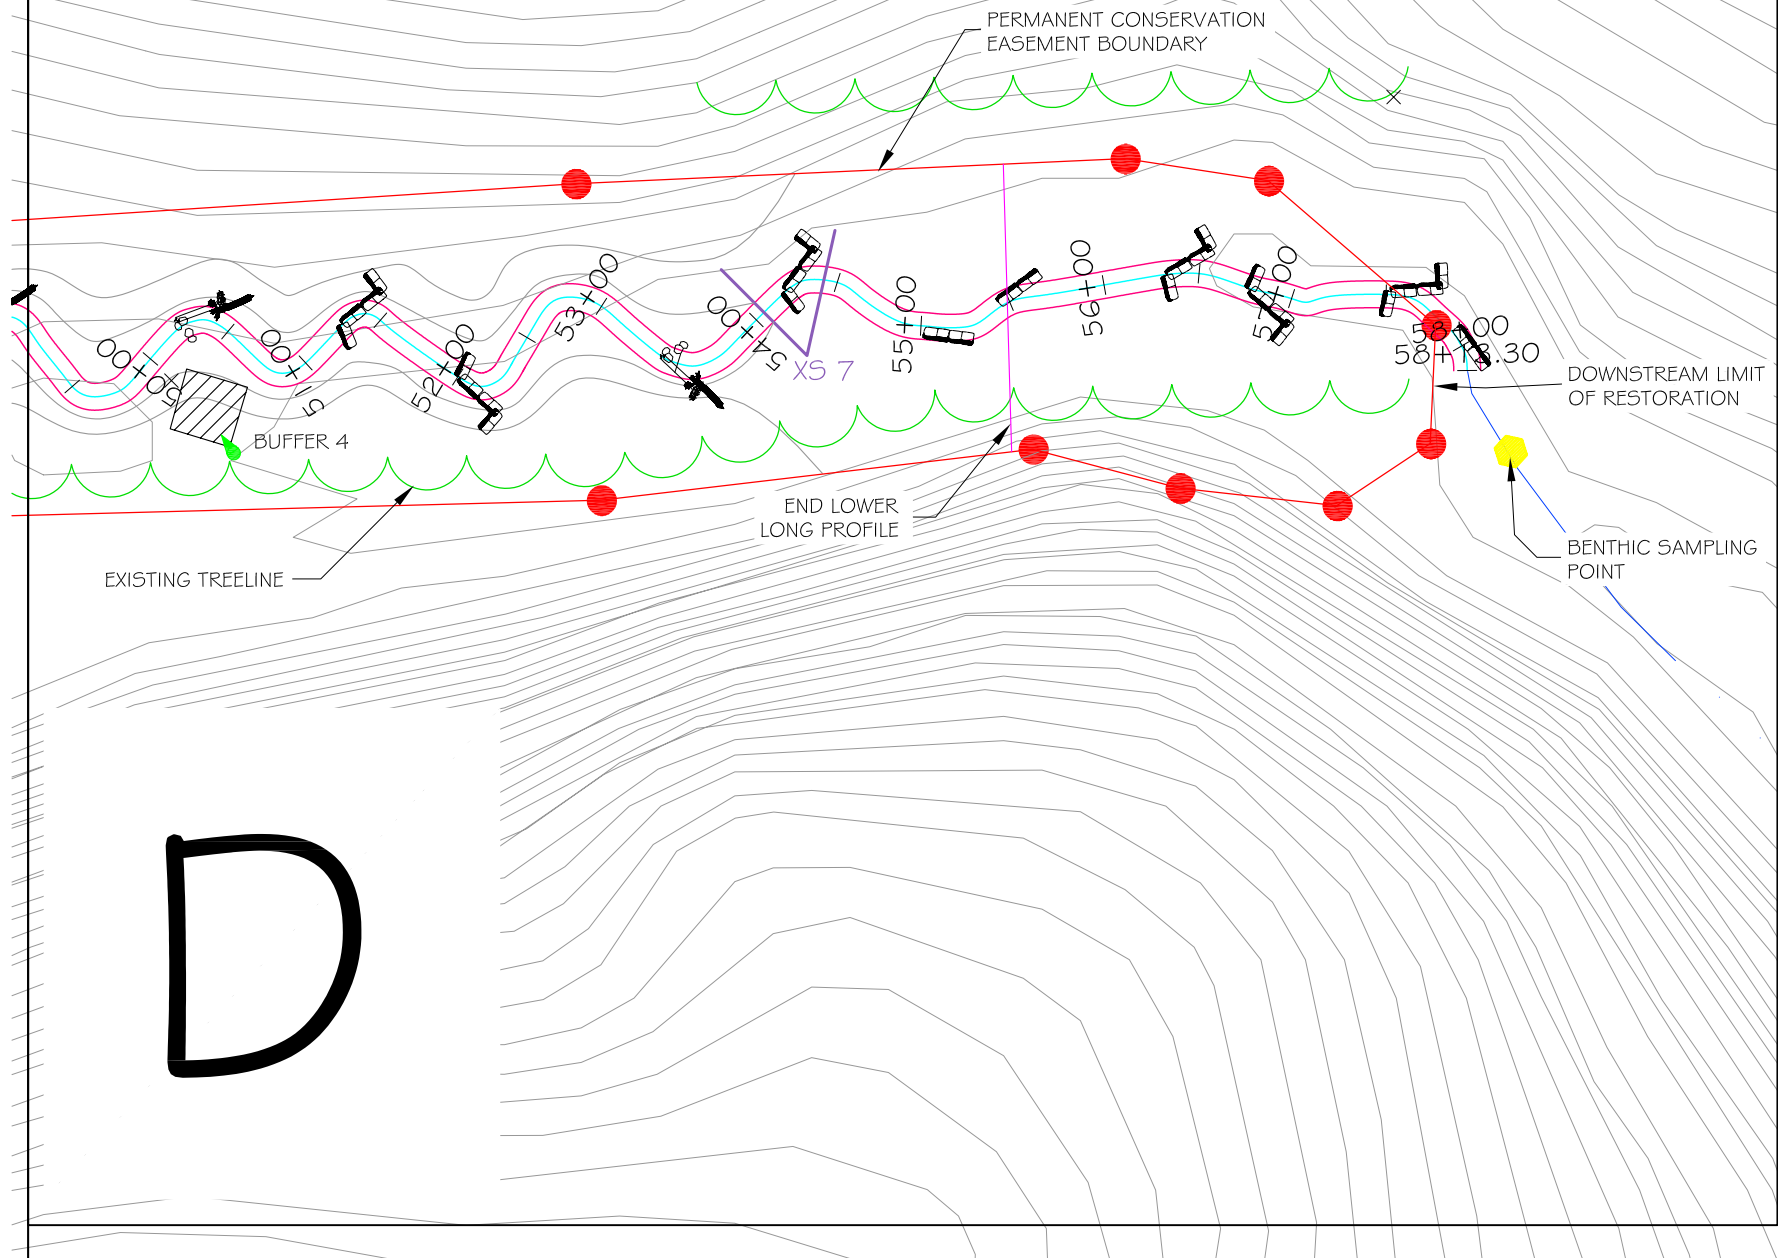

D

REVISIONS			
REV	DESCRIPTION	DATE	APP




**Soil & Environmental Consultants, PA**  
 11010 Raven Ridge Road • Raleigh, North Carolina 27614 • Phone: (919) 846-5900 • Fax: (919) 846-9467  
 www.SandEC.com

Project: GRAY FARM STREAM RESTORATION YEAR 3 MONITORING		Project No.: 9385.D9	
Location: IREDELL CO., NC		Client: NC ECOSYSTEM ENHANCEMENT PROGRAM	Proj. Mgr.: DG
Sheet Title: REACH 1 - MONITORING PLAN VIEW - D		Scale: 1" = 50'	Drawn: DGC
		Sheet No.: 5 OF 16	


**NOTES:**

1. SITE DATA AS DETERMINED BY LIMITED ENGINEERING SURVEY PERFORMED BY S&EC. (NCDENR STREAMS, LIDAR CONTOURS, AND NCDOT ROADS TAKEN FROM REFERENCE GIS LAYERS)
2. ALL LOCATIONS, ELEVATIONS, AND DIMENSIONS ARE APPROXIMATE.
3. ELEVATIONS ARE APPROXIMATE AND BASED ON AN ASSUMED ELEVATION OF 100' ADJUSTED TO MATCH 2 FOOT CONTOURS.



**NORTH**






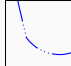
SCALE 1" = 50'




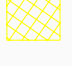


CONTOUR INTERVAL = 2'

DRAWINGS PRINTED AT HALF-SCALE

**LEGEND FOR ASBUILT FEATURES**


	RESTORED STREAM CHANNEL
	LOG J-HOOK (LJH)
	ROCK J-HOOK (RJH)
	CROSS ROCK VANE (CRV)
	CREATED/RESTORED WETLANDS
	EXISTING STREAMS

**PAPV LEGEND**

	STREAM PROBLEM AREAS-STRESSED
	VEGETATION PROBLEM AREAS-MODERATE
	SEDIMENT FROM UPSTREAM, HEAVY DEPOSITION
	SEDIMENT FROM UPSTREAM, MODERATE DEPOSITION

REACH 1 - PROBLEM AREA PLAN VIEW - A

A

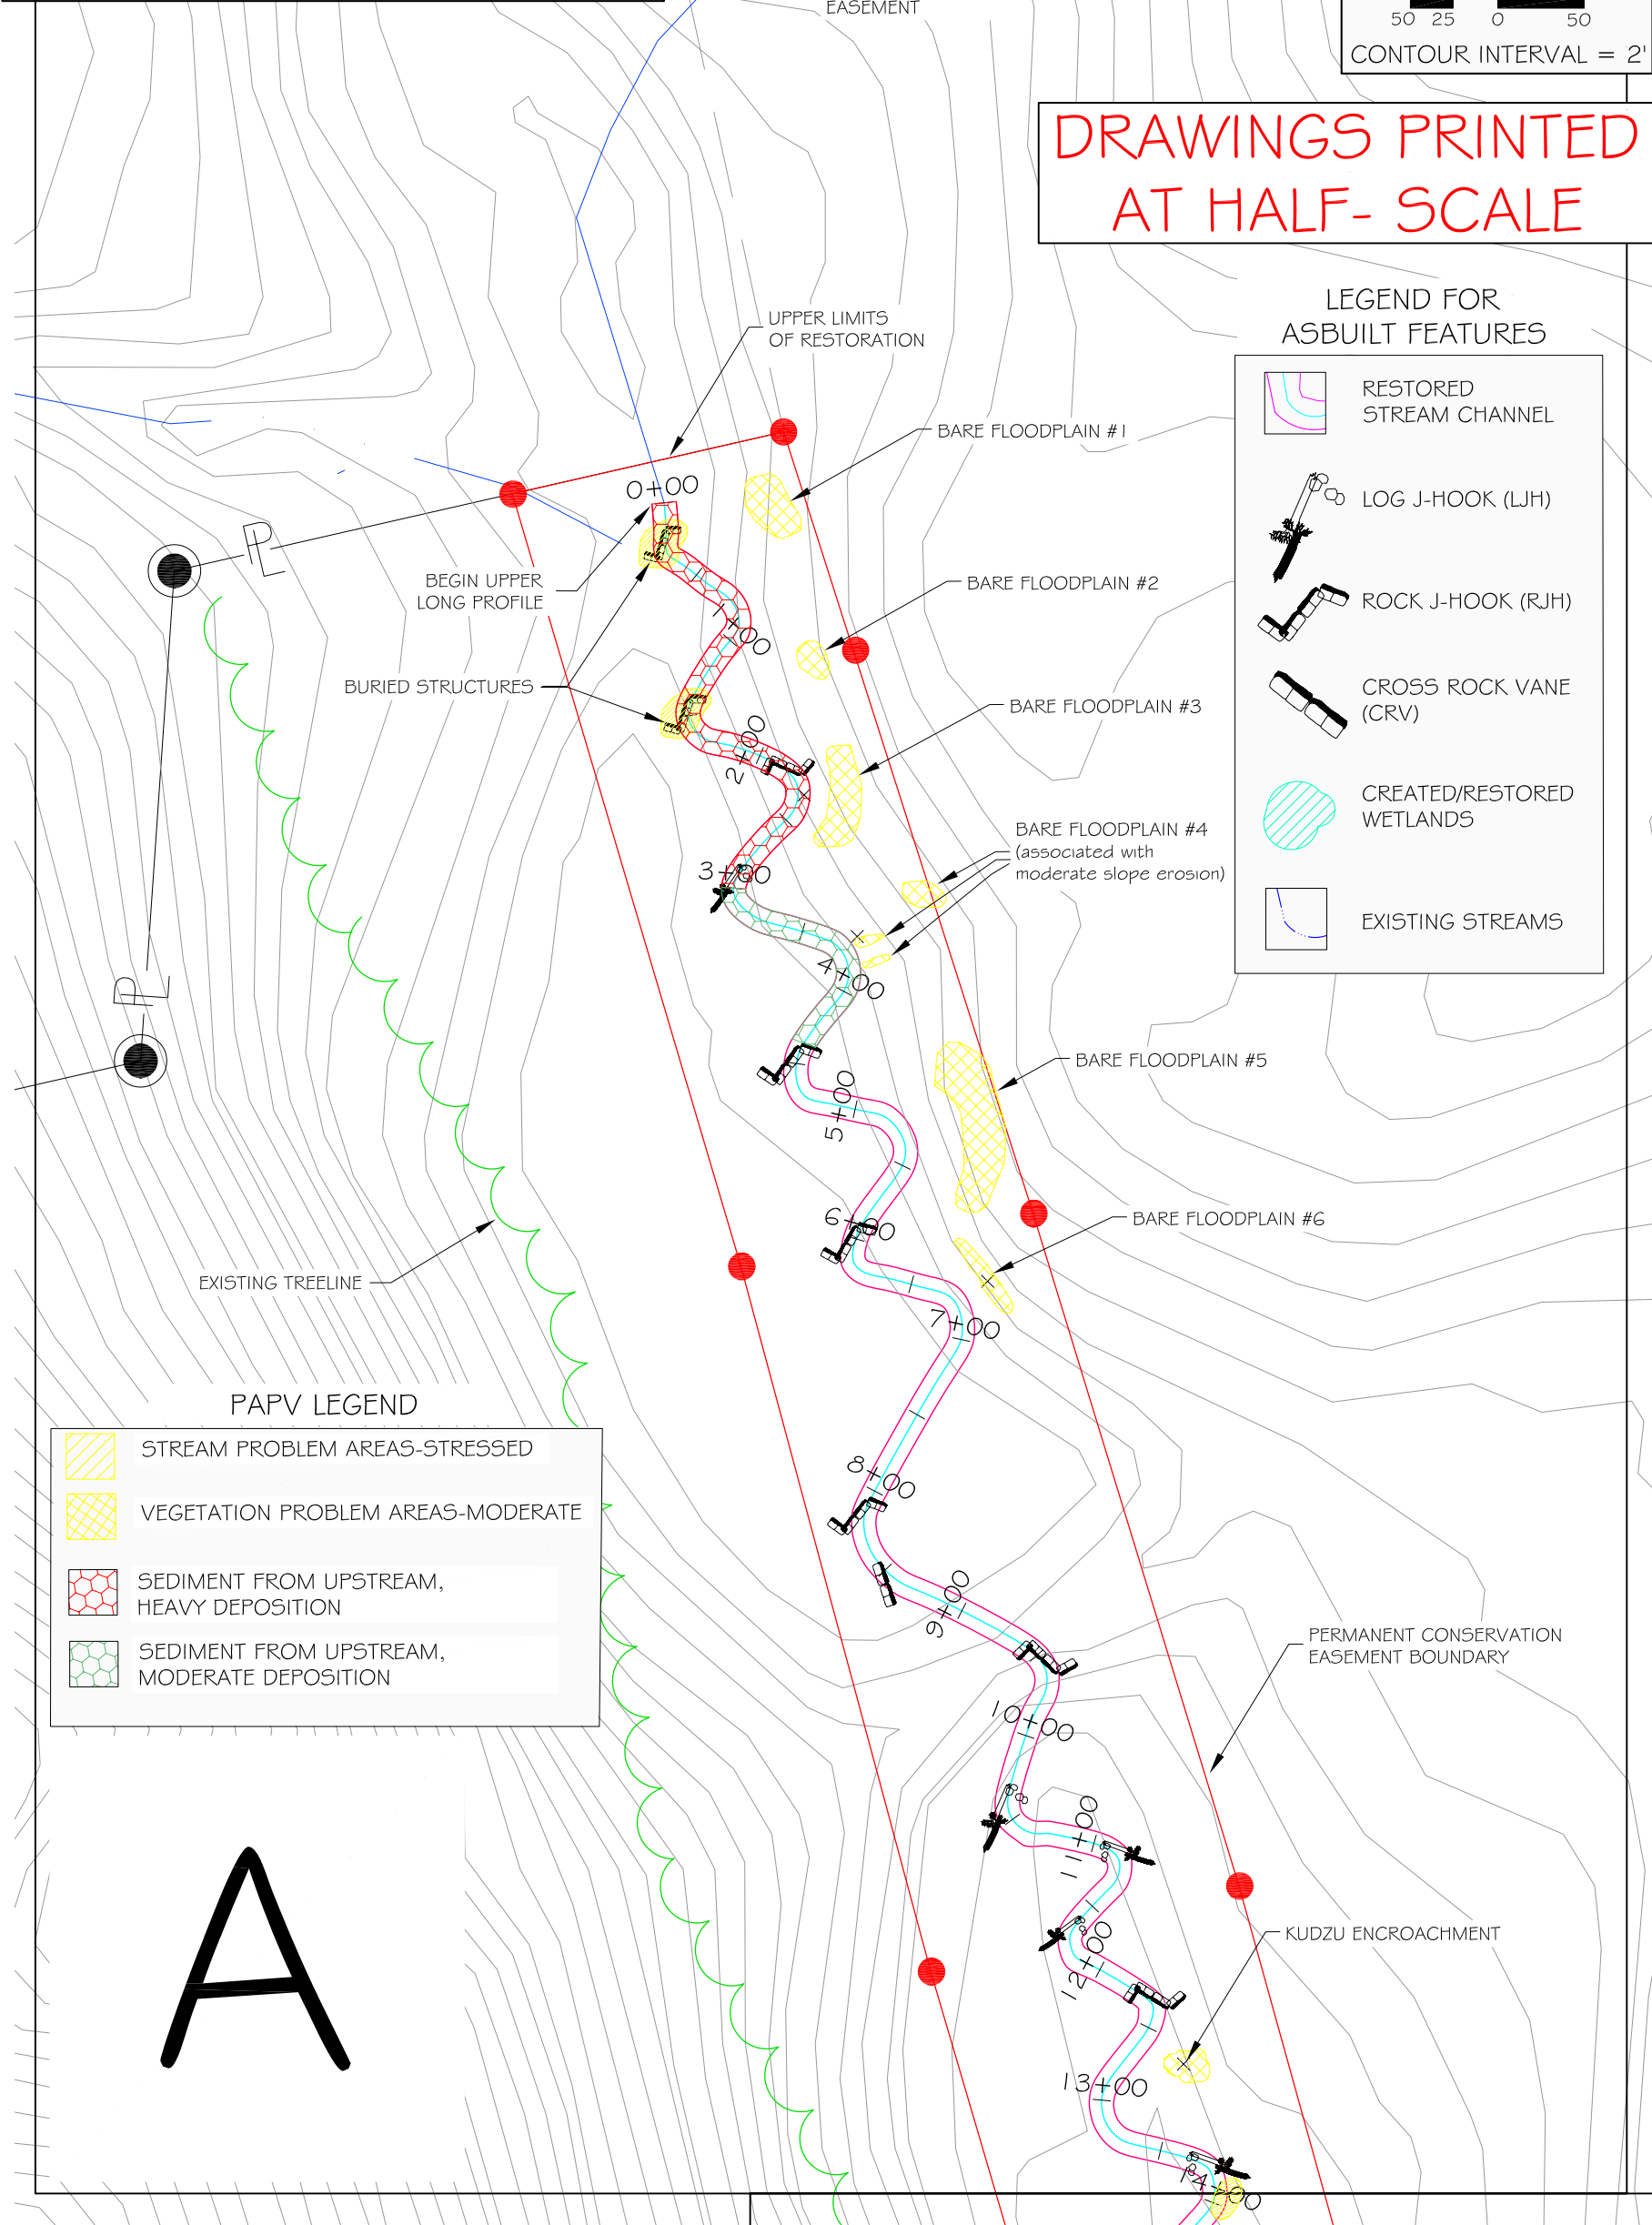


REVISIONS			
REV.	DESCRIPTION	DATE	APPR.



**Soil & Environmental Consultants, PA**  
 11010 Raven Ridge Road • Raleigh, North Carolina 27614 • Phone: (919) 846-5900 • Fax: (919) 846-9467  
 www.SandEC.com

Project:	GRAY FARM STREAM RESTORATION YEAR 3 MONITORING	Project No.:	9385.D9
Location:	IREDELL CO., NC	Client:	NC ECOSYSTEM ENHANCEMENT PROGRAM
Sheet Title:	REACH 1-PROBLEM AREA PLAN VIEW - A	Scale:	1" = 50'
		Proj. Mgr.:	DG
		Drawn:	DGC
		Sheet No.:	6 OF 16

REACH 1 - PROBLEM AREA PLAN VIEW - B

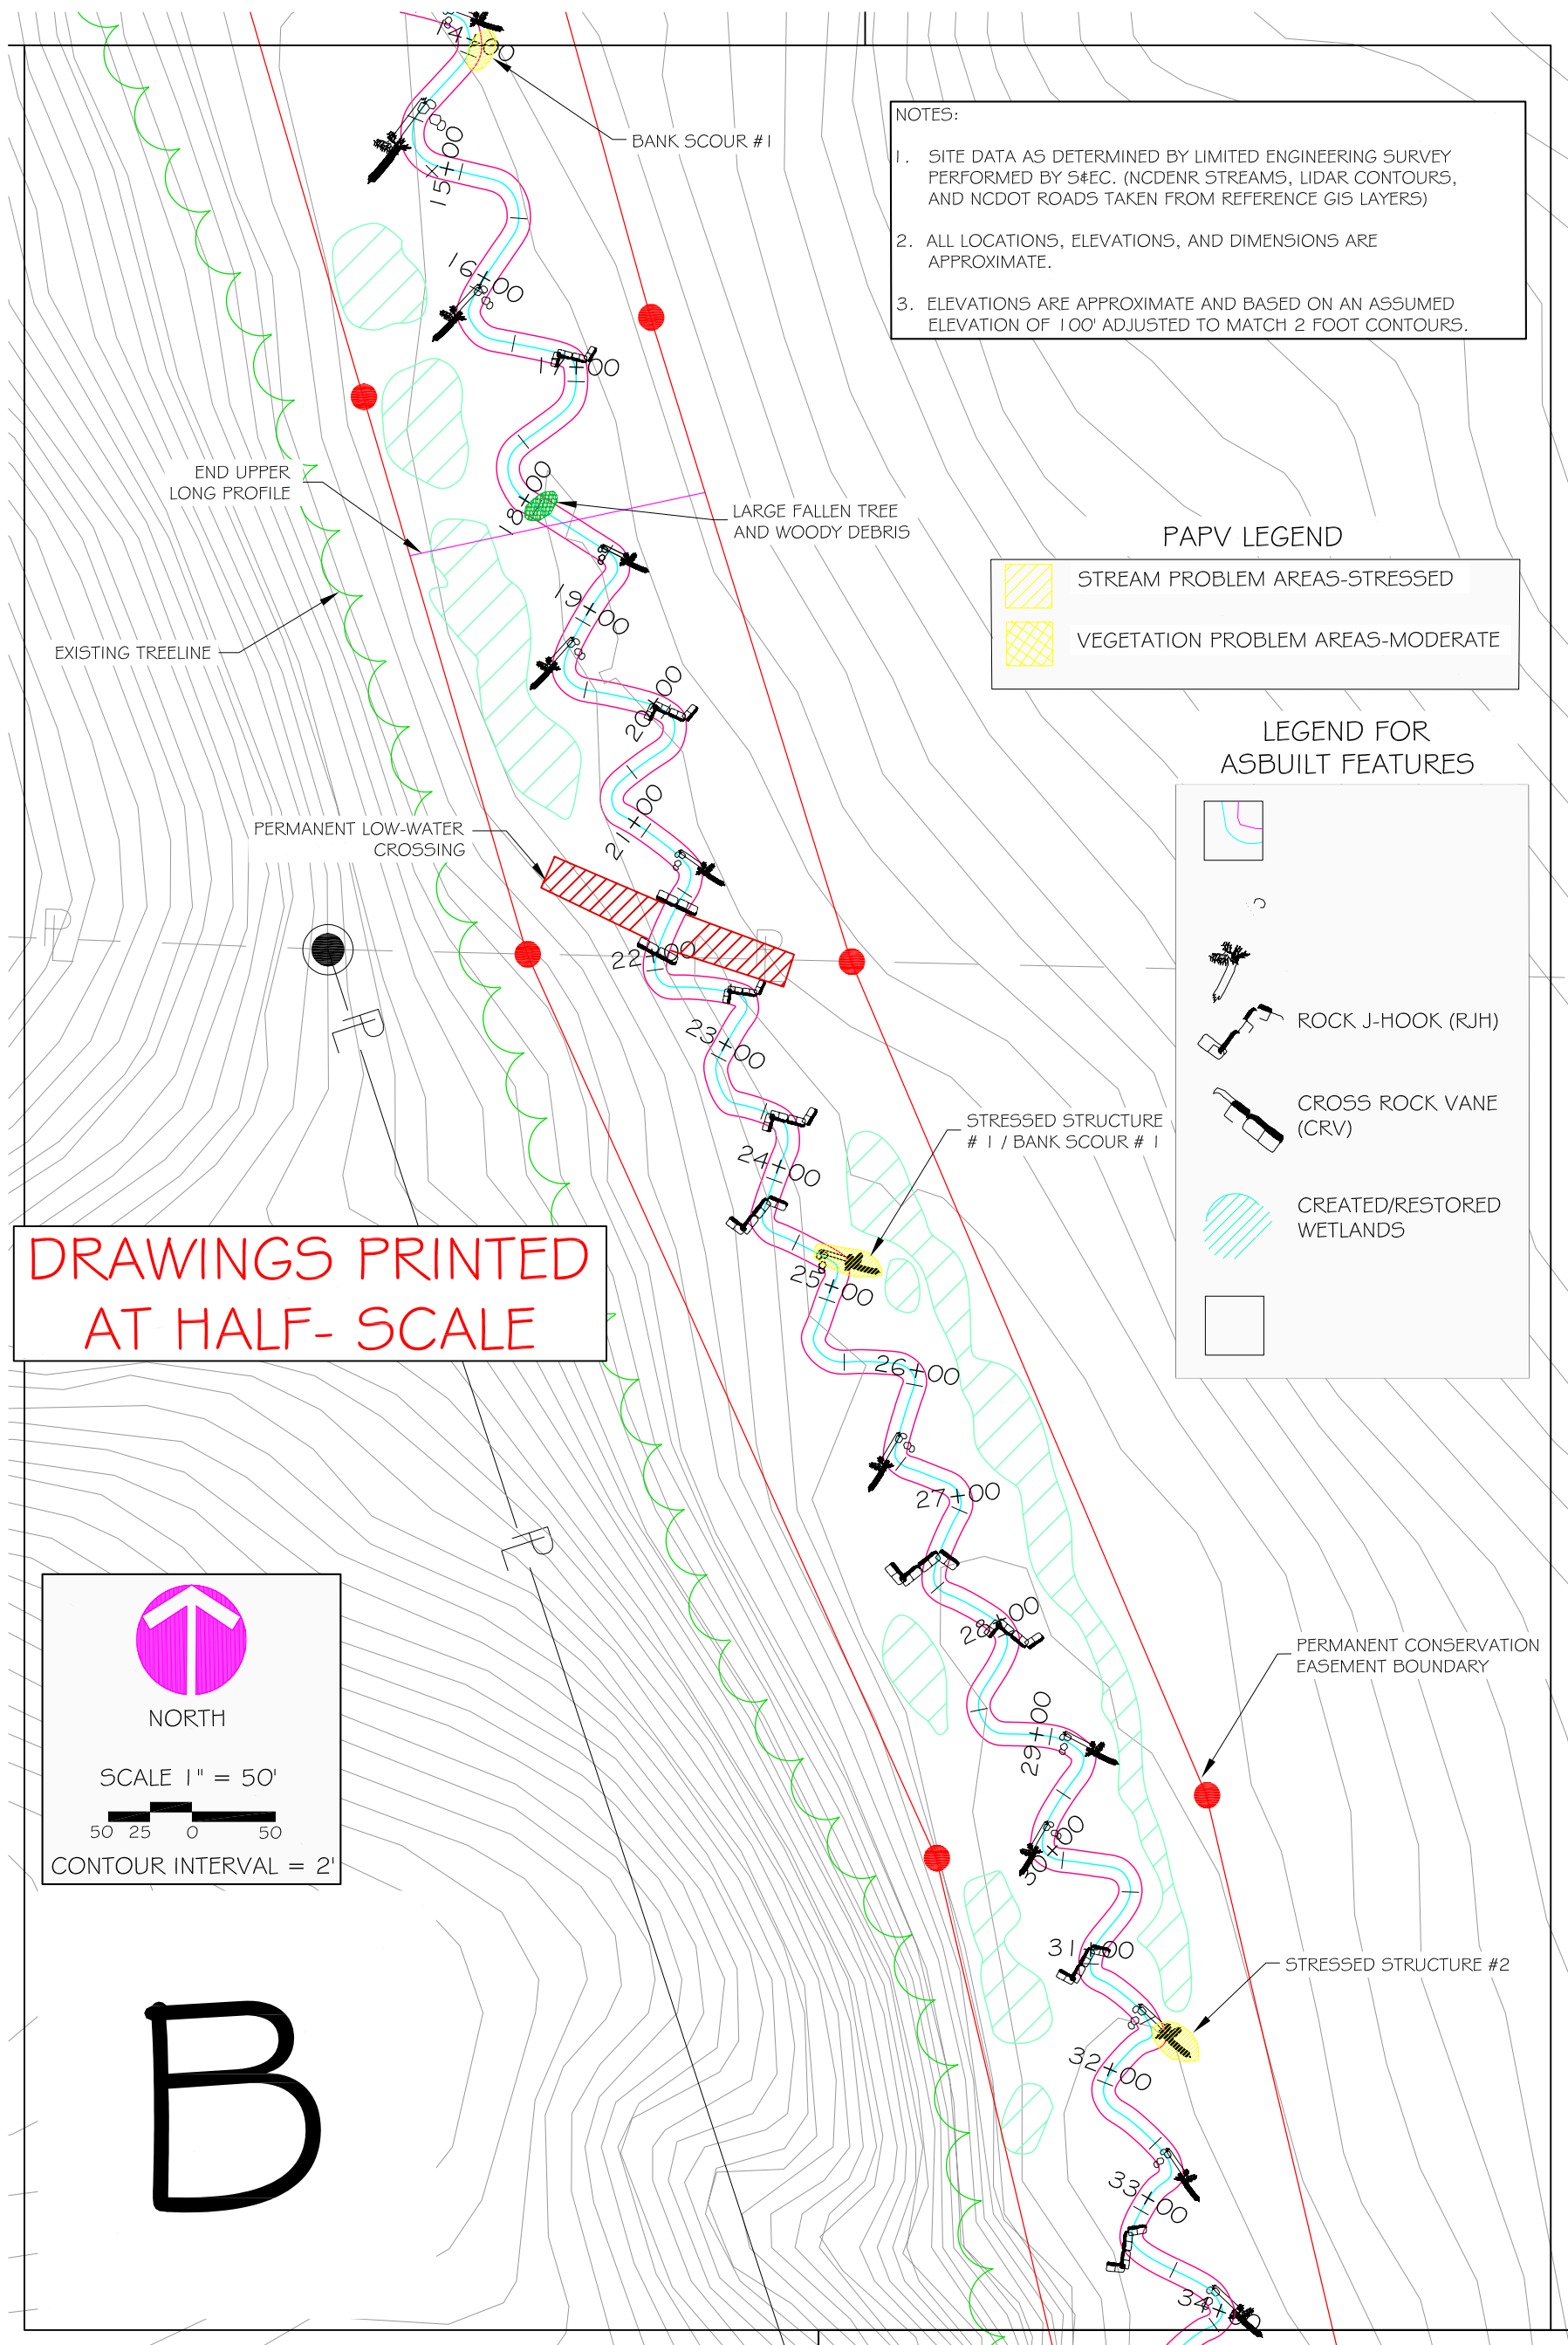

**NOTES:**

1. SITE DATA AS DETERMINED BY LIMITED ENGINEERING SURVEY PERFORMED BY S&EC. (NCDENR STREAMS, LIDAR CONTOURS, AND NCDOT ROADS TAKEN FROM REFERENCE GIS LAYERS)
2. ALL LOCATIONS, ELEVATIONS, AND DIMENSIONS ARE APPROXIMATE.
3. ELEVATIONS ARE APPROXIMATE AND BASED ON AN ASSUMED ELEVATION OF 100' ADJUSTED TO MATCH 2 FOOT CONTOURS.

**PAPV LEGEND**

- STREAM PROBLEM AREAS-STRESSED
- VEGETATION PROBLEM AREAS-MODERATE

**LEGEND FOR ASBUILT FEATURES**

- STREAM CHANNEL
- ROCK J-HOOK (RJH)
- CROSS ROCK VANE (CRV)
- CREATED/RESTORED WETLANDS
- PERMANENT CONSERVATION EASEMENT BOUNDARY

DRAWINGS PRINTED AT HALF-SCALE

NORTH

SCALE 1" = 50'

50 25 0 50

CONTOUR INTERVAL = 2'

B

REVISIONS			
REV.	DESCRIPTION	DATE	APP.



**Soil & Environmental Consultants, PA**  
 11010 Raven Ridge Road • Raleigh, North Carolina 27614 • Phone: (919) 846-5900 • Fax: (919) 846-7467  
 www.SandEC.com

Project: GRAY FARM STREAM RESTORATION YEAR 3 MONITORING  
 Location: IREDELL CO., NC  
 Sheet Title: REACH 1-PROBLEM AREA PLAN VIEW - B


Project No.: 9385.D9  
 Proj. Mgr.: DG  
 Scale: 1" = 50'  
 Sheet No.: 7 OF 16

**DRAWINGS PRINTED  
AT HALF-SCALE**

**NOTES:**

1. SITE DATA AS DETERMINED BY LIMITED ENGINEERING SURVEY PERFORMED BY S&EC. (NCDENR STREAMS, LIDAR CONTOURS, AND NCDOT ROADS TAKEN FROM REFERENCE GIS LAYERS)
2. ALL LOCATIONS, ELEVATIONS, AND DIMENSIONS ARE APPROXIMATE.
3. ELEVATIONS ARE APPROXIMATE AND BASED ON AN ASSUMED ELEVATION OF 100' ADJUSTED TO MATCH 2 FOOT CONTOURS.

REACH 1 - PROBLEM AREA PLAN VIEW - C

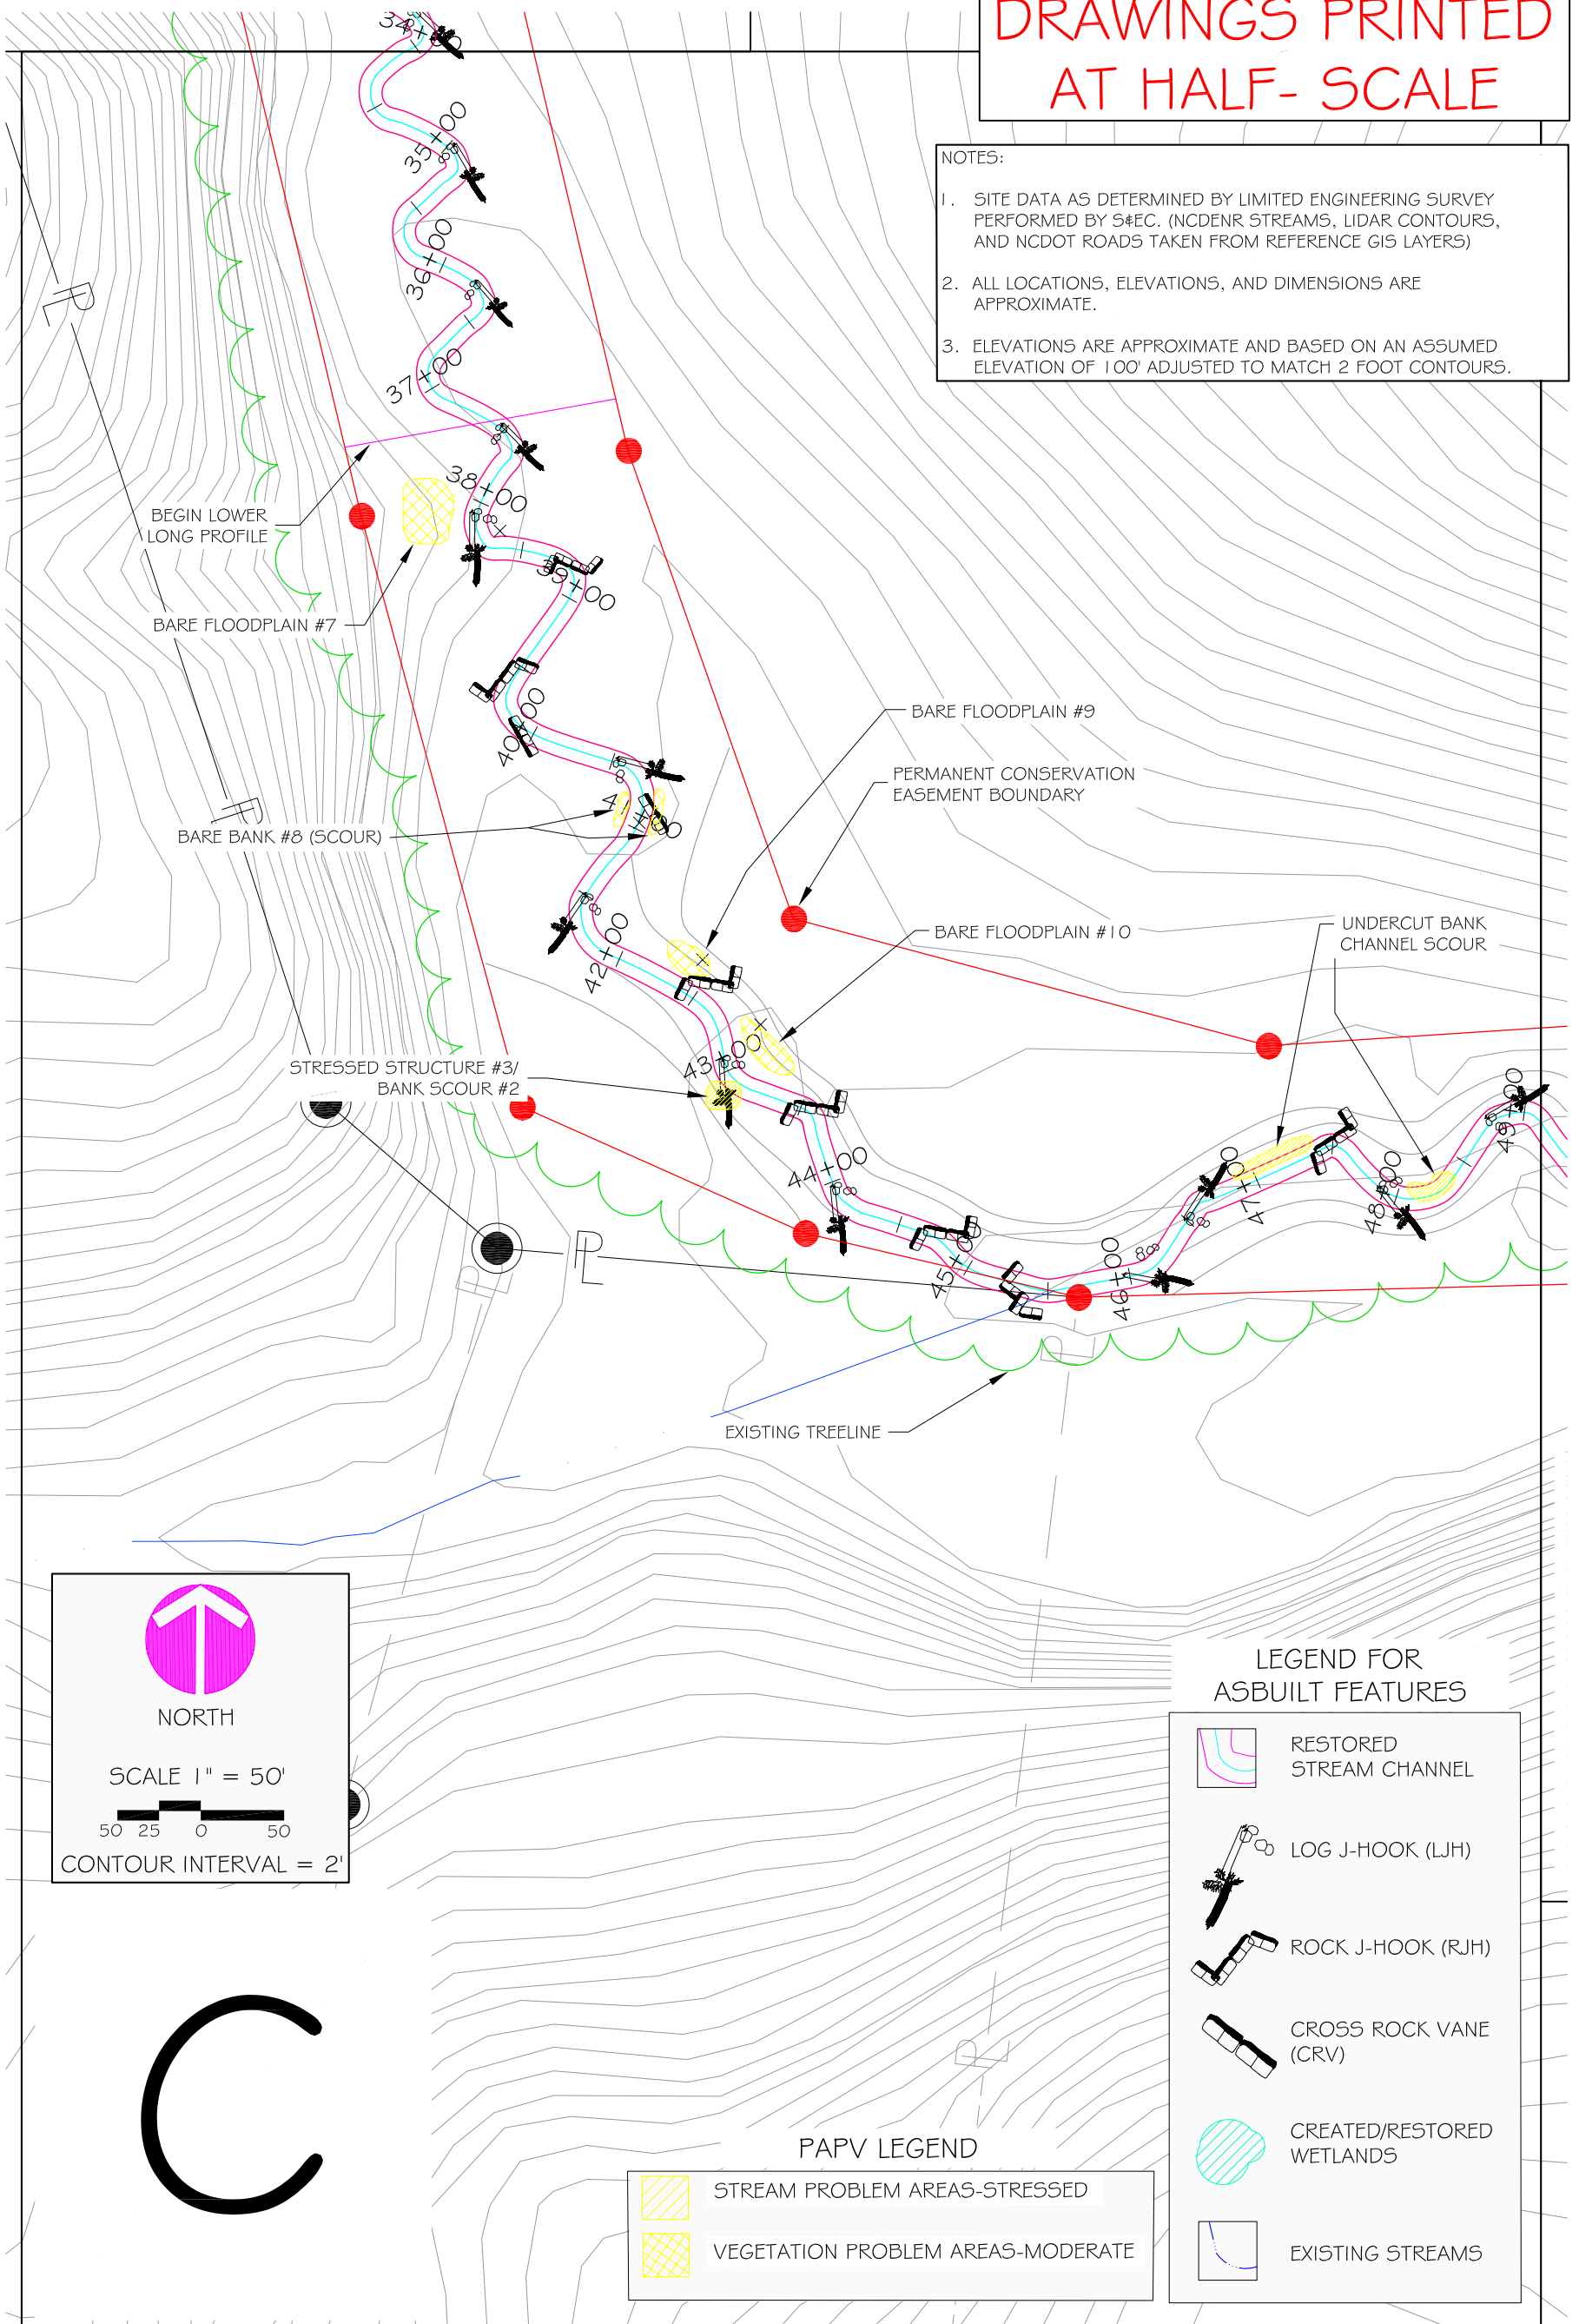

**NORTH**

SCALE 1" = 50'

50 25 0 50

CONTOUR INTERVAL = 2'

**C**

**LEGEND FOR ASBUILT FEATURES**

- RESTORED STREAM CHANNEL
- LOG J-HOOK (LJH)
- ROCK J-HOOK (RJH)
- CROSS ROCK VANE (CRV)
- CREATED/RESTORED WETLANDS
- EXISTING STREAMS

**PAPV LEGEND**

- STREAM PROBLEM AREAS-STRESSED
- VEGETATION PROBLEM AREAS-MODERATE

REVISIONS			
REV.	DESCRIPTION	DATE	APP.




**Soil & Environmental Consultants, PA**  
 11010 Raven Ridge Road • Raleigh, North Carolina 27614 • Phone: (919) 846-5900 • Fax: (919) 846-9467  
 www.SandEC.com

Project:	GRAY FARM STREAM RESTORATION YEAR 3 MONITORING	Project No.:	9385.D9
Location:	IREDELL CO., NC	Client:	NC ECOSYSTEM ENHANCEMENT PROGRAM
Sheet Title:	REACH 1-PROBLEM AREA PLAN VIEW - C	Scale:	1" = 50'
		Sheet No.:	8 OF 16




**NOTES:**

1. SITE DATA AS DETERMINED BY LIMITED ENGINEERING SURVEY PERFORMED BY S&EC. (NCDENR STREAMS, LIDAR CONTOURS, AND NCDOT ROADS TAKEN FROM REFERENCE GIS LAYERS)
2. ALL LOCATIONS, ELEVATIONS, AND DIMENSIONS ARE APPROXIMATE.
3. ELEVATIONS ARE APPROXIMATE AND BASED ON AN ASSUMED ELEVATION OF 100' ADJUSTED TO MATCH 2 FOOT CONTOURS.



**NORTH**







SCALE 1" = 50'




CONTOUR INTERVAL = 2'

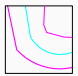DRAWINGS PRINTED  
AT HALF-SCALE


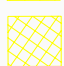
**LEGEND FOR  
ASBUILT FEATURES**

	RESTORED STREAM CHANNEL
	LOG J-HOOK (LJH)
	ROCK J-HOOK (RJH)
	CROSS ROCK VANE (CRV)
	CREATED/RESTORED WETLANDS
	EXISTING STREAMS

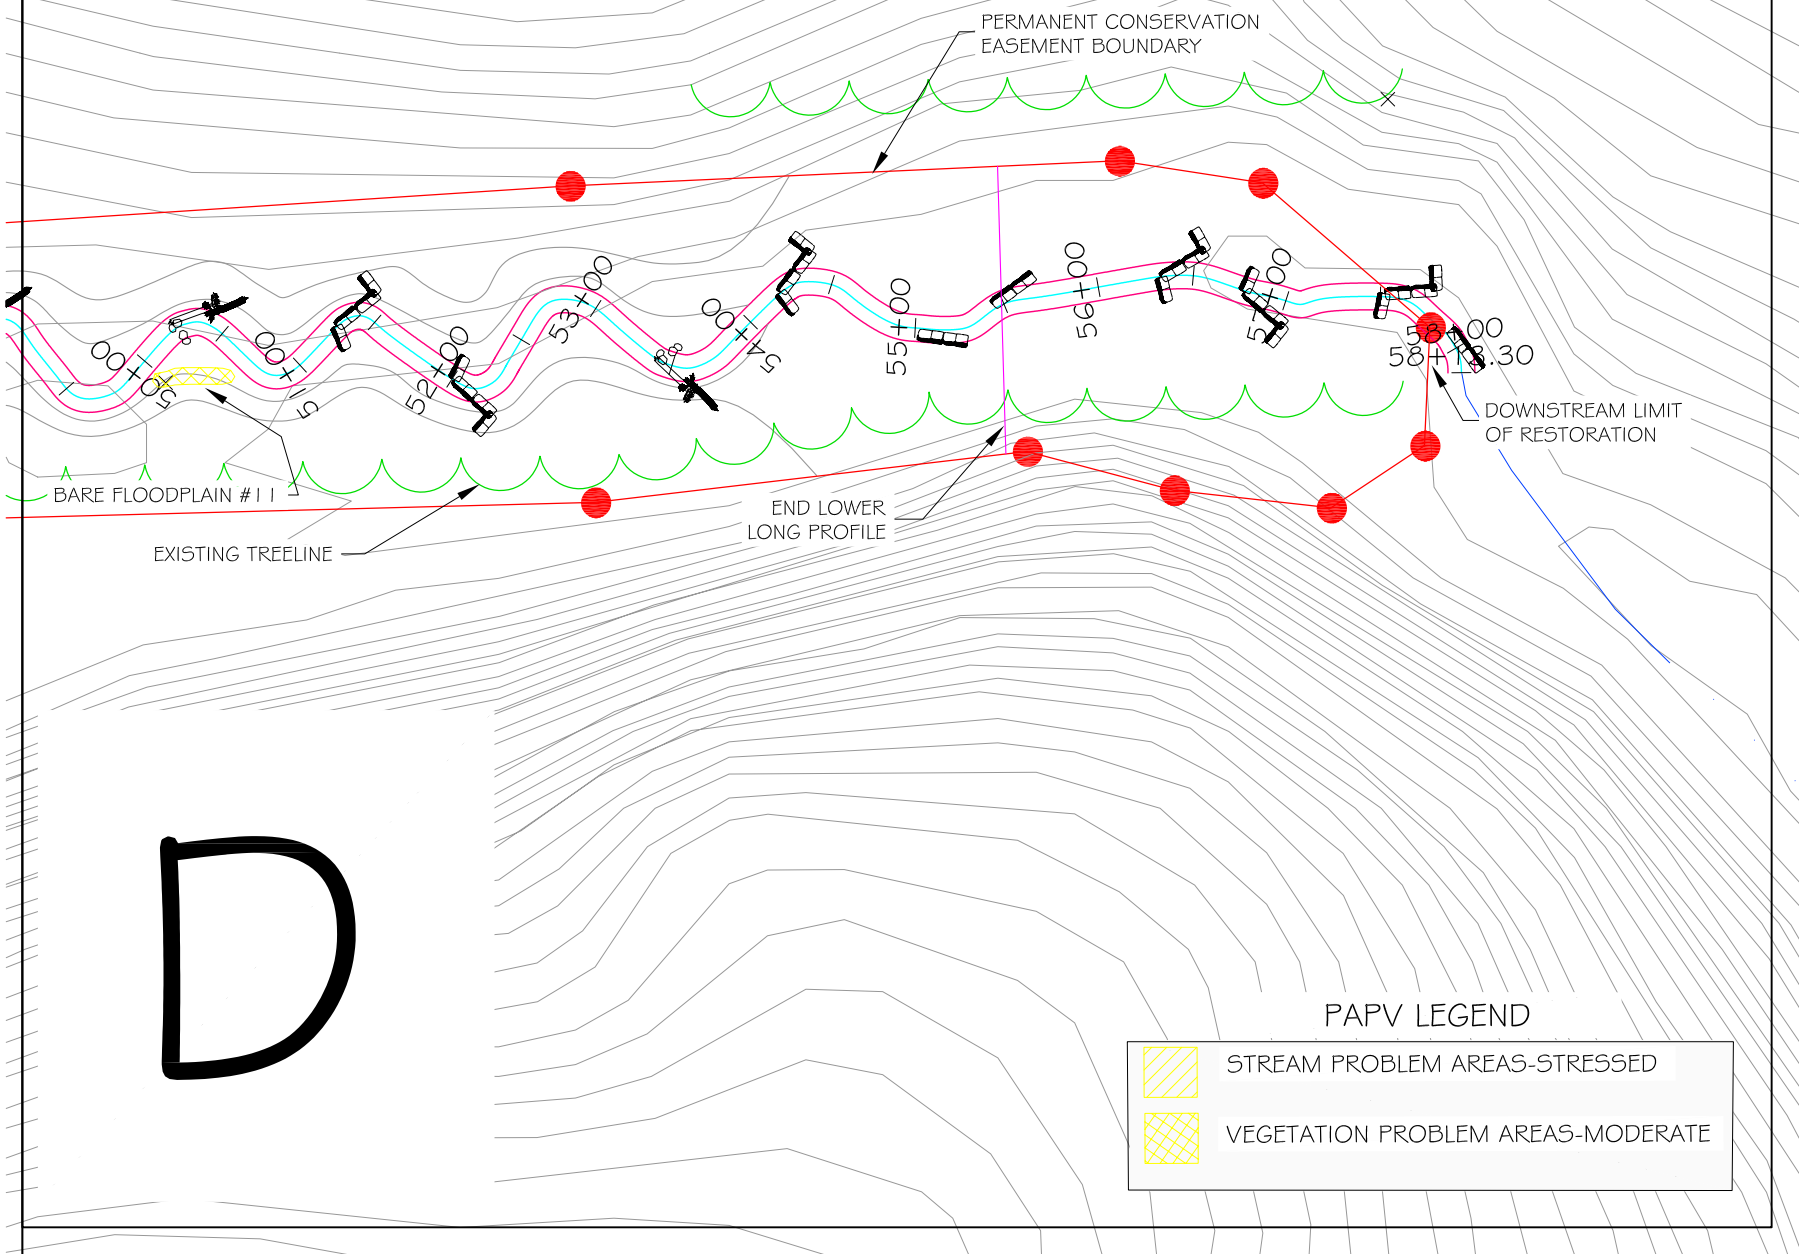

D

**PAPV LEGEND**

	STREAM PROBLEM AREAS-STRESSED
	VEGETATION PROBLEM AREAS-MODERATE

REVISIONS			
REV	DESCRIPTION	DATE	APPR



**Soil & Environmental Consultants, PA**

11010 Raven Ridge Road • Raleigh, North Carolina 27614 • Phone: (919) 846-5900 • Fax: (919) 846-9467

www.SandEC.com

Project:	GRAY FARM STREAM RESTORATION YEAR 3 MONITORING	Project No.:	9385.D9
Location:	IREDELL CO., NC	Client:	NC ECOSYSTEM ENHANCEMENT PROGRAM
Sheet Title:	REACH 1-PROBLEM AREA PLAN VIEW - D	Scale:	1" = 50'
		Sheet No.:	9 OF 16

APPENDIX D.2 –

Monitoring and Problem Area Plan View, Reach 2

**NOTES:**


1. SITE DATA AS DETERMINED BY LIMITED ENGINEERING SURVEY PERFORMED BY S&EC. (NCDENR STREAMS, LIDAR CONTOURS, AND NCDOT ROADS TAKEN FROM REFERENCE GIS LAYERS)
2. ALL LOCATIONS, ELEVATIONS, AND DIMENSIONS ARE APPROXIMATE.
3. ELEVATIONS ARE APPROXIMATE AND BASED ON AN ASSUMED ELEVATION OF 100' ADJUSTED TO MATCH 2 FOOT CONTOURS.

DRAWINGS PRINTED AT HALF-SCALE

MONITORING FEATURES COORDINATES - REACH 2		
	NORTHING	EASTING
CROSS SECTION 1	1390081.29	746853.93
RIFFLE 1	1390079.60	746799.51
POOL 1	1390109.67	746817.05
CROSS SECTION 2	1389209.56	746215.22
RIFFLE 2	1389254.69	746167.91
POOL 2	1389238.99	746155.98
BUFFER 1	1389961.86	746771.34
BUFFER 2	1389300.47	746281.07
BANK 1	1389733.94	746553.76
BANK 2	1389408.61	746305.49

	RESTORED STREAM CHANNEL		EXISTING CONTOURS
	EXISTING NCDENR STREAMS		EXISTING DOT ROADS

REACH 2 - RESTORATION SITE LAYOUT & KEYSHEET

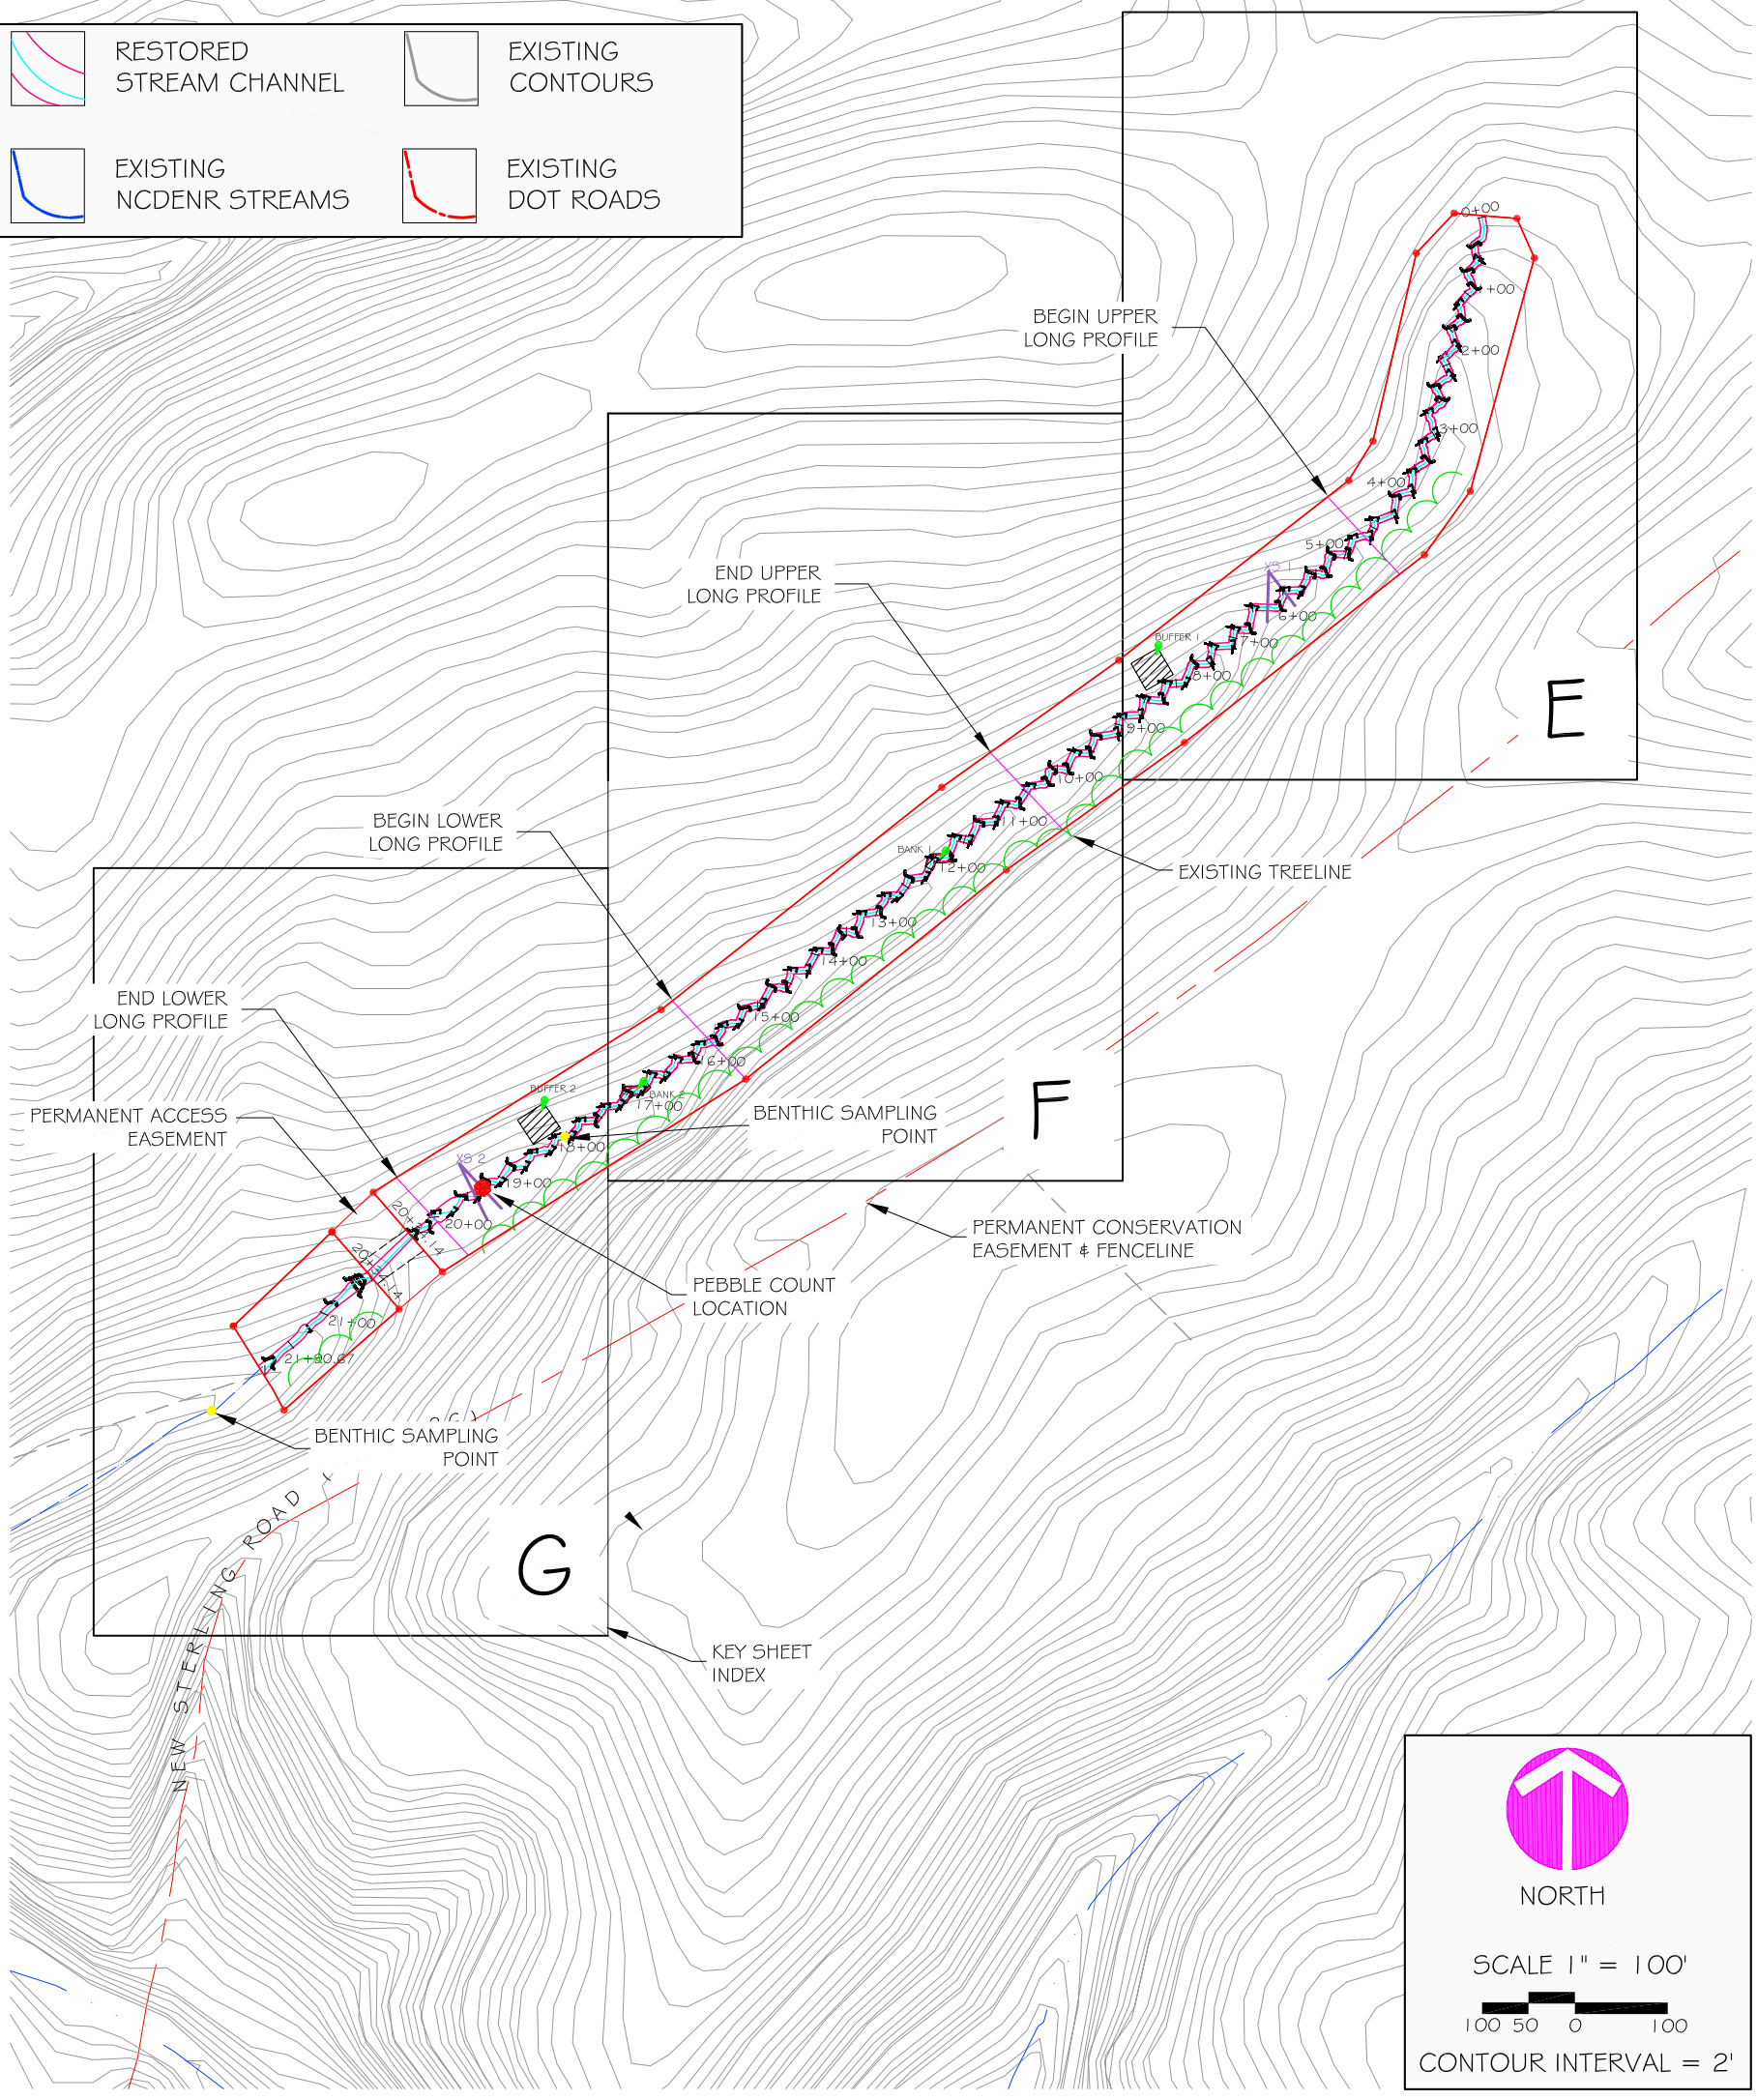

**NORTH**

SCALE 1" = 100'

CONTOUR INTERVAL = 2'

REVISIONS			
REV	DESCRIPTION	DATE	APP



Soil & Environmental Consultants, PA

11010 Raven Ridge Road • Raleigh, North Carolina 27614 • Phone: (919) 846-5900 • Fax: (919) 846-9467  
www.SandEC.com

Project:	GRAY FARM STREAM RESTORATION YEAR 3 MONITORING	Project No.:	9385.D9
Location:	IREDELL CO., NC	Client:	NC ECOSYSTEM ENHANCEMENT PROGRAM
Sheet Title:	REACH 2 - RESTORATION SITE LAYOUT & KEYSHEET	Scale:	1" = 100'
		Sheet No.:	10 OF 16

NOTES:

1. SITE DATA AS DETERMINED BY LIMITED ENGINEERING SURVEY PERFORMED BY S&EC. (NCDENR STREAMS, LIDAR CONTOURS, AND NCDOT ROADS TAKEN FROM REFERENCE GIS LAYERS)
2. ALL LOCATIONS, ELEVATIONS, AND DIMENSIONS ARE APPROXIMATE.
3. ELEVATIONS ARE APPROXIMATE AND BASED ON AN ASSUMED ELEVATION OF 100' ADJUSTED TO MATCH 2 FOOT CONTOURS.

DRAWINGS PRINTED  
AT HALF-SCALE



NORTH

SCALE 1" = 30'



CONTOUR INTERVAL = 2'


LEGEND FOR  
ASBUILT FEATURES

	RESTORED STREAM CHANNEL
	LOG J-HOOK (LJH)
	ROCK J-HOOK (RJH)
	CROSS ROCK VANE (CRV)
	CREATED/RESTORED WETLANDS
	EXISTING STREAMS

LEGEND FOR  
MONITORING FEATURES

	BUFFER VEGETATION PLOT
	BANK VEGETATION PLOT
	PERMANENT PHOTO POINT
	CROSS-SECTION LOCATION

REACH 2 - MONITORING PLAN VIEW - E

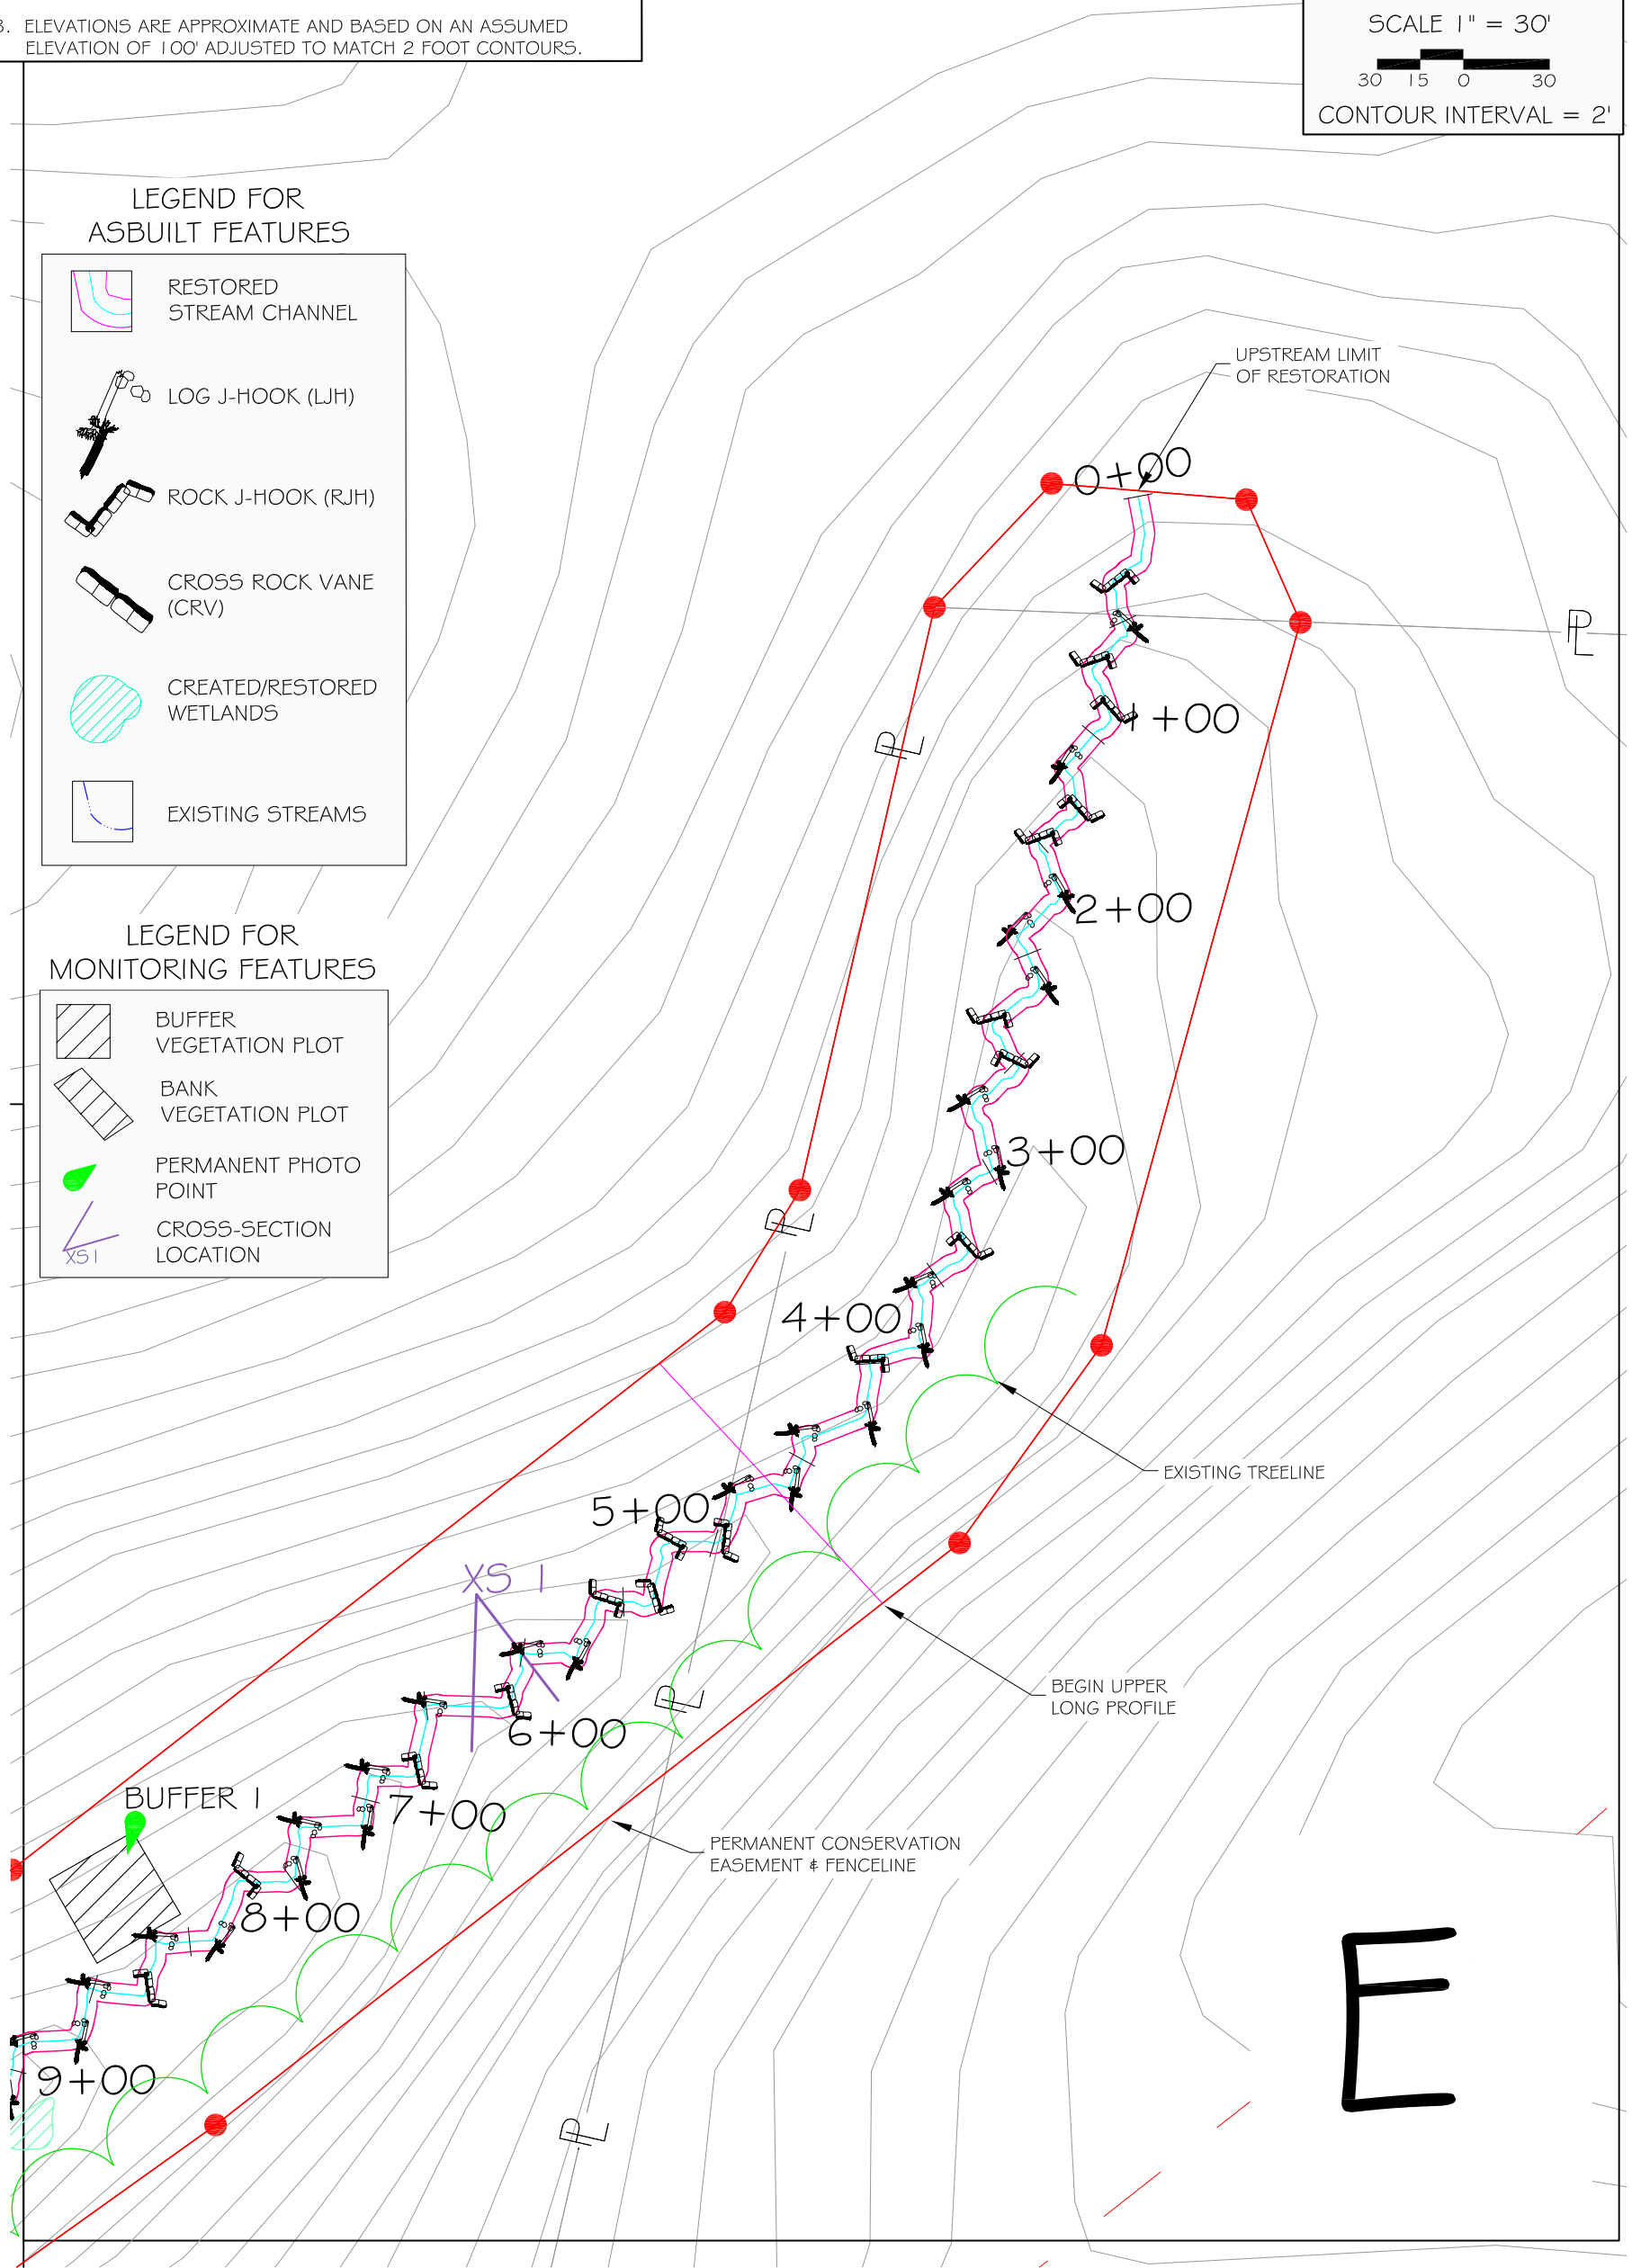

REVISIONS			
REV.	DESCRIPTION	DATE	APP.



**Soil & Environmental Consultants, PA**  
 11010 Raven Ridge Road • Raleigh, North Carolina 27614 • Phone: (919) 846-5900 • Fax: (919) 846-9467  
[www.SandEC.com](http://www.SandEC.com)

Project: GRAY FARM STREAM RESTORATION YEAR 3 MONITORING		Project No.: 9385.D9
Location: IREDELL CO., NC	Client: NC ECOSYSTEM ENHANCEMENT PROGRAM	Proj. Mgr.: DG
Sheet Title: REACH 2 - MONITORING PLAN VIEW - E	Scale: 1" = 30'	Drawn: DGC
		Sheet No.: 11 OF 16

NOTES:

1. SITE DATA AS DETERMINED BY LIMITED ENGINEERING SURVEY PERFORMED BY S&EC. (NCDENR STREAMS, LIDAR CONTOURS, AND NCDOT ROADS TAKEN FROM REFERENCE GIS LAYERS)
2. ALL LOCATIONS, ELEVATIONS, AND DIMENSIONS ARE APPROXIMATE.
3. ELEVATIONS ARE APPROXIMATE AND BASED ON AN ASSUMED ELEVATION OF 100' ADJUSTED TO MATCH 2 FOOT CONTOURS.

DRAWINGS PRINTED  
AT HALF-SCALE



NORTH

SCALE 1" = 30'



CONTOUR INTERVAL = 2'


LEGEND FOR  
ASBUILT FEATURES

- RESTORED STREAM CHANNEL
- LOG J-HOOK (LJH)
- ROCK J-HOOK (RJH)
- CROSS ROCK VANE (CRV)
- CREATED/RESTORED WETLANDS
- EXISTING STREAMS

LEGEND FOR  
MONITORING FEATURES

- BUFFER VEGETATION PLOT
- BANK VEGETATION PLOT
- PERMANENT PHOTO POINT
- CROSS-SECTION LOCATION

REACH 2 - MONITORING PLAN VIEW - F

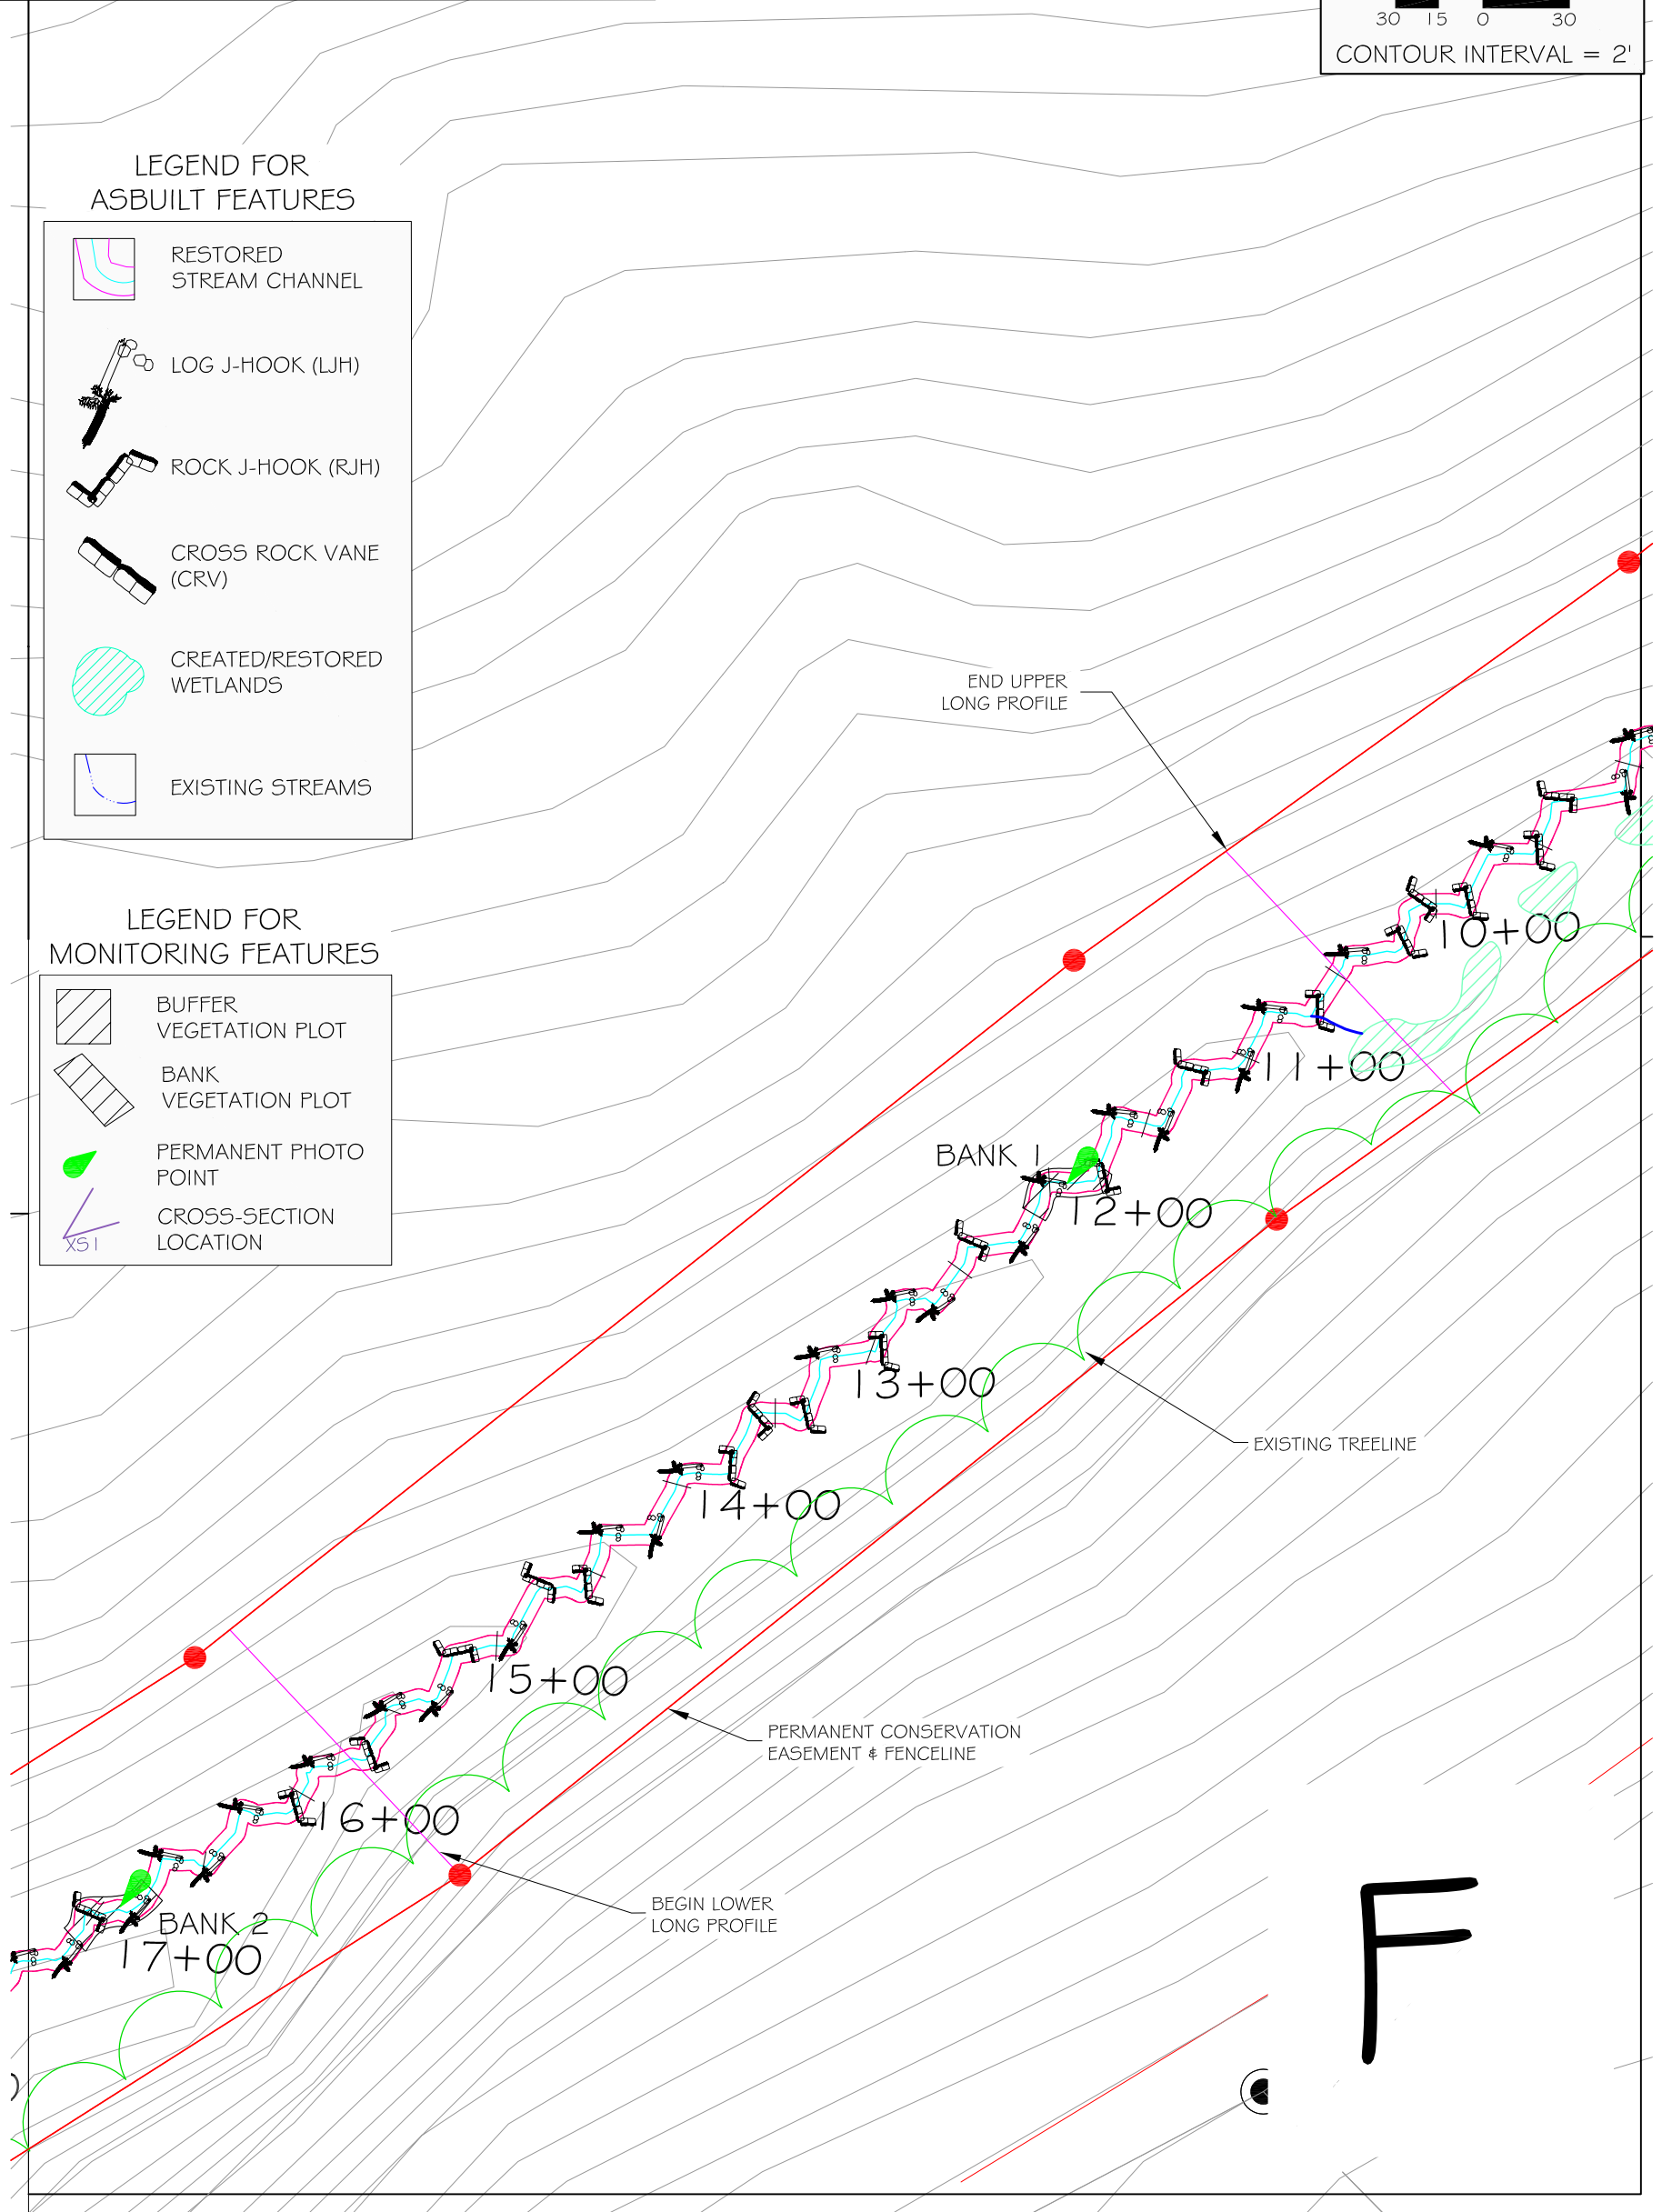

REVISIONS			
REV	DESCRIPTION	DATE	APPR




**Soil & Environmental Consultants, PA**  
 11010 Raven Ridge Road • Raleigh, North Carolina 27614 • Phone: (919) 846-5900 • Fax: (919) 846-9467  
 www.SandEC.com

Project:	GRAY FARM STREAM RESTORATION YEAR 3 MONITORING	Project No.:	9385.D9
Location:	IREDELL CO., NC	Client:	NC ECOSYSTEM ENHANCEMENT PROGRAM
Sheet Title:	REACH 2 - MONITORING PLAN VIEW - F	Scale:	1" = 30'
		Sheet No.:	12 OF 16

NOTES:


1. SITE DATA AS DETERMINED BY LIMITED ENGINEERING SURVEY PERFORMED BY S#EC. (NCDENR STREAMS, LIDAR CONTOURS, AND NCDOT ROADS TAKEN FROM REFERENCE GIS LAYERS)
2. ALL LOCATIONS, ELEVATIONS, AND DIMENSIONS ARE APPROXIMATE.
3. ELEVATIONS ARE APPROXIMATE AND BASED ON AN ASSUMED ELEVATION OF 100' ADJUSTED TO MATCH 2 FOOT CONTOURS.

DRAWINGS PRINTED  
AT HALF-SCALE









NORTH

SCALE 1" = 30'




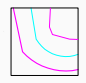


CONTOUR INTERVAL = 2'


LEGEND FOR ASBUILT FEATURES

-  RESTORED STREAM CHANNEL
-  LOG J-HOOK (LJH)
-  ROCK J-HOOK (RJH)
-  CROSS ROCK VANE (CRV)
-  CREATED/RESTORED WETLANDS
-  EXISTING STREAMS

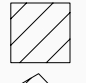LEGEND FOR MONITORING FEATURES

-  BUFFER VEGETATION PLOT
-  BANK VEGETATION PLOT
-  PERMANENT PHOTO POINT
-  CROSS-SECTION LOCATION

REACH 2 - MONITORING PLAN VIEW - G

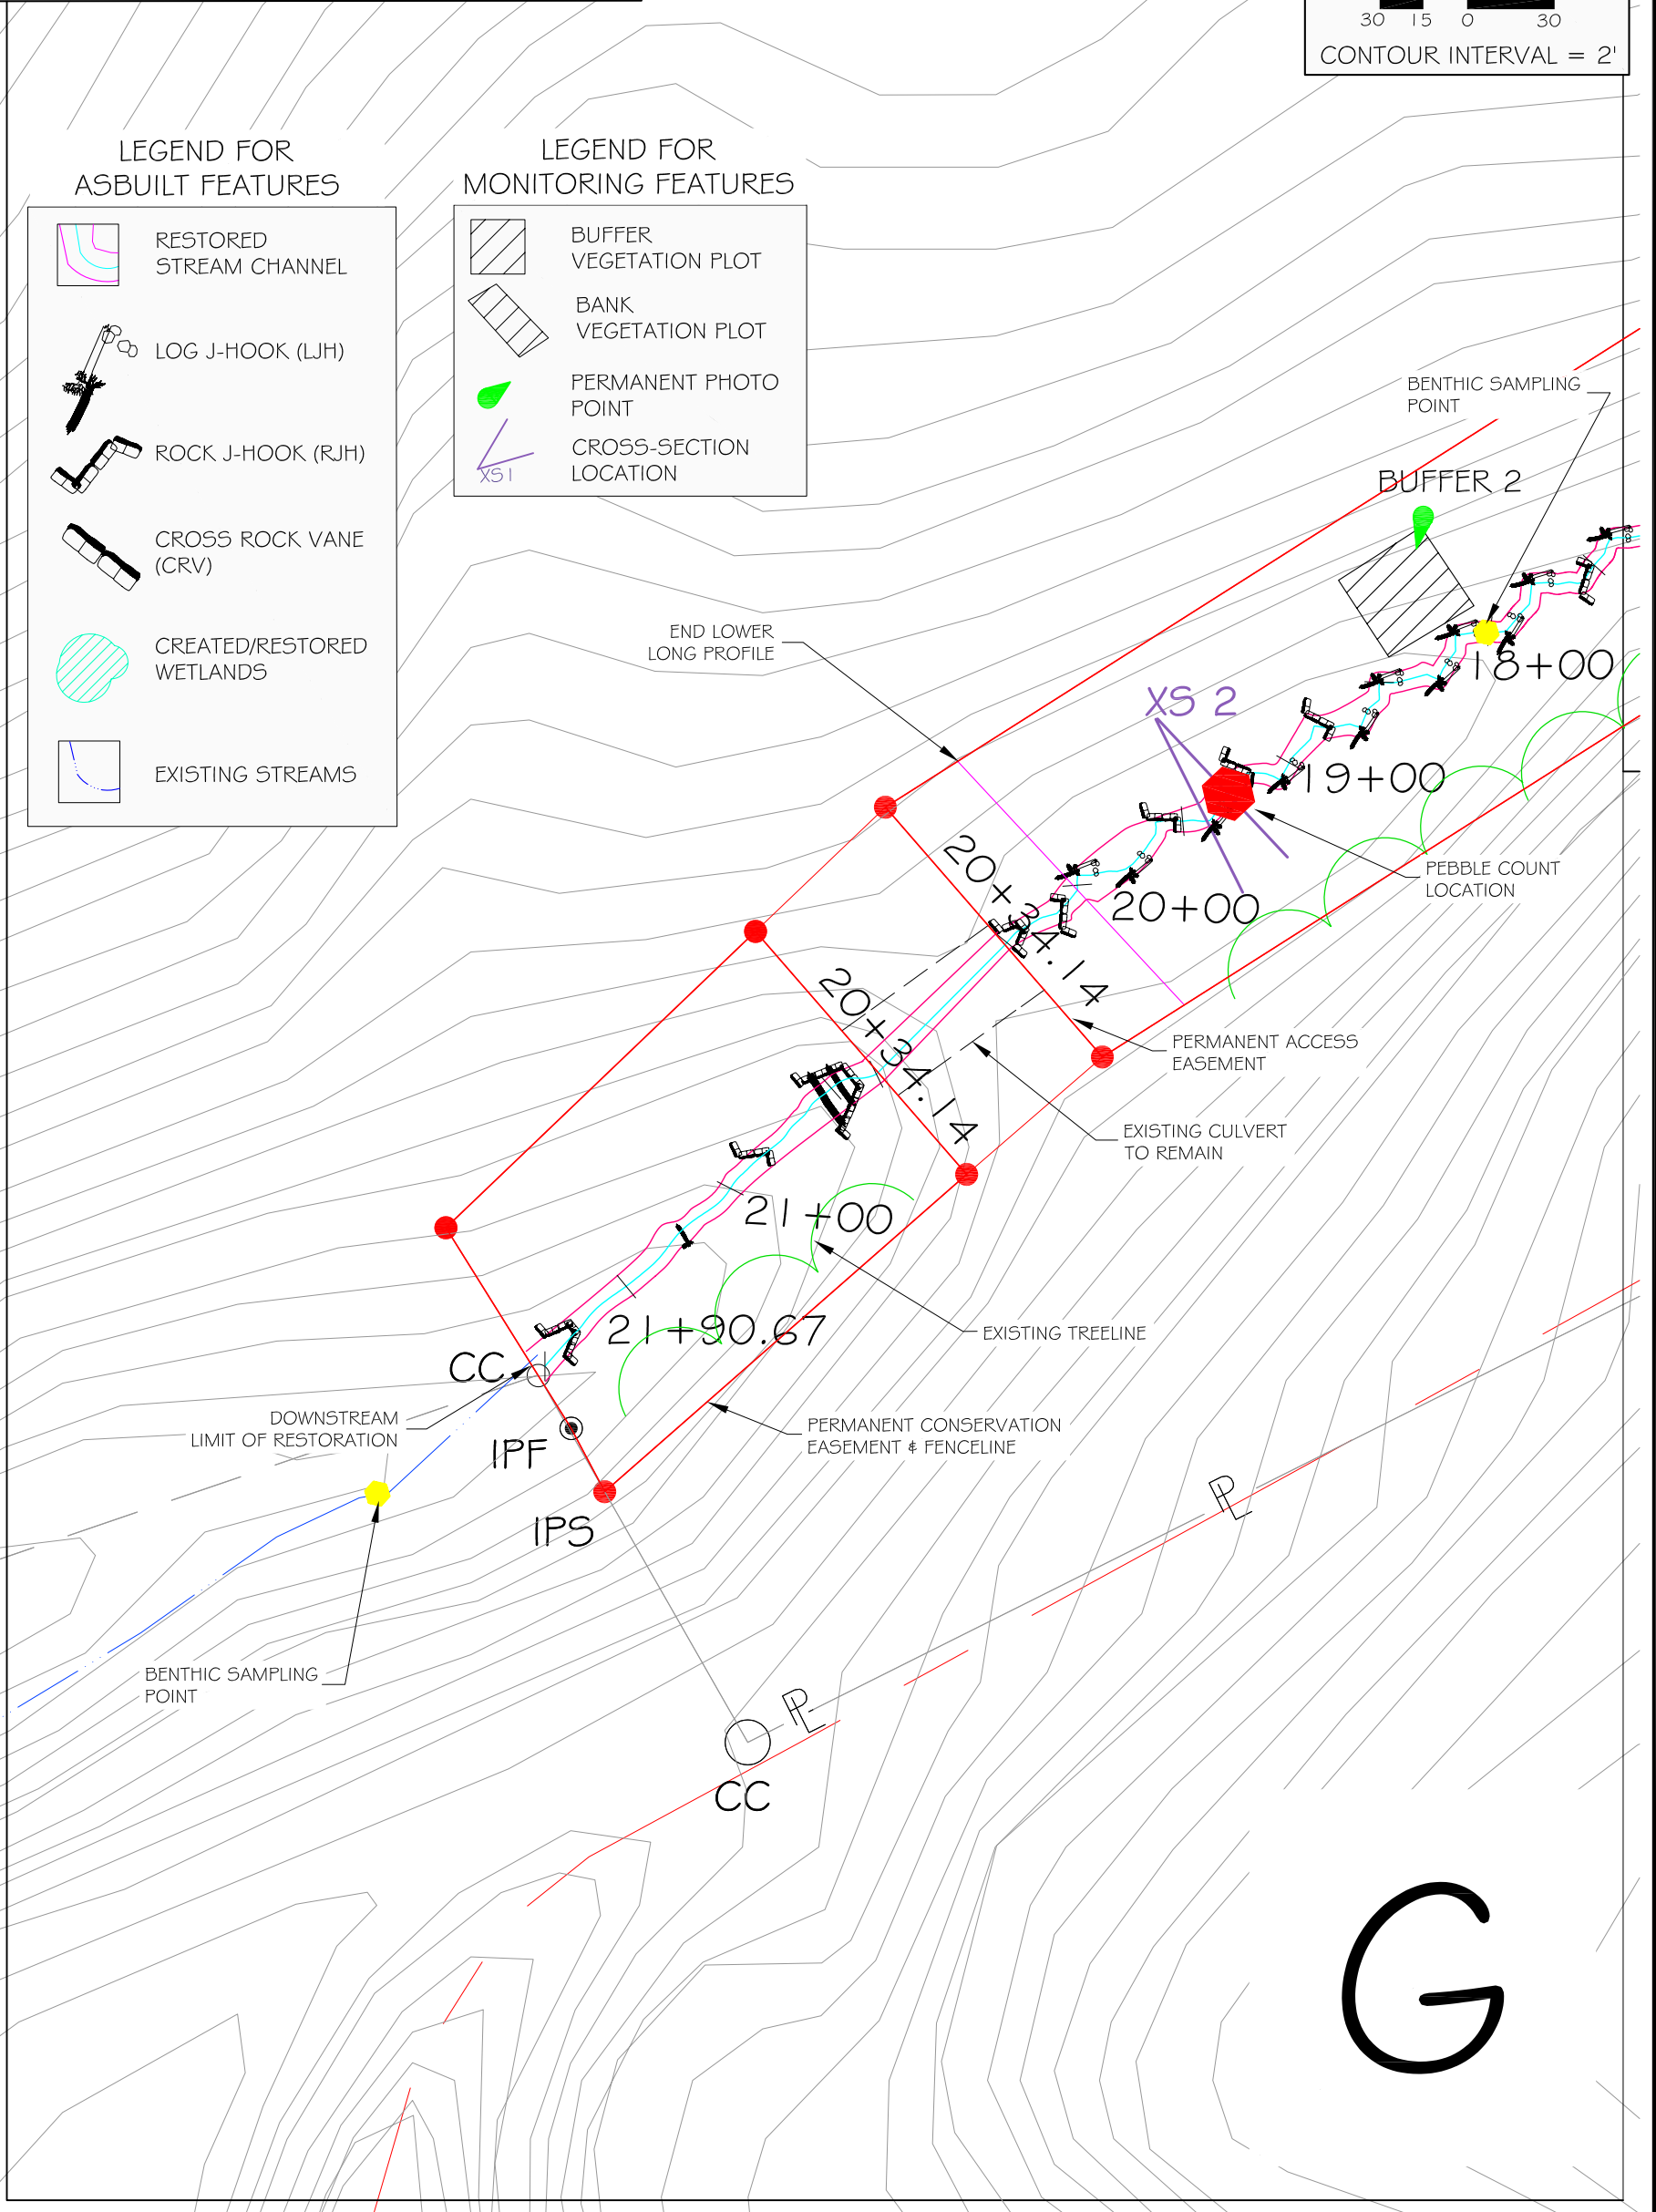

G

REVISIONS			
REV	DESCRIPTION	DATE	APP



**Soil & Environmental Consultants, PA**  
 11010 Raven Ridge Road • Raleigh, North Carolina 27614 • Phone: (919) 846-5900 • Fax: (919) 846-9467  
[www.SandEC.com](http://www.SandEC.com)


Project: GRAY FARM STREAM RESTORATION YEAR 3 MONITORING		Project No.: 9385.D9
Location: IREDELL CO., NC		Client: NC ECOSYSTEM ENHANCEMENT PROGRAM
Sheet Title: REACH 2 - MONITORING PLAN VIEW - G		Scale: 1" = 30'
		Sheet No.: 13 OF 16

DRAWINGS PRINTED  
AT HALF-SCALE



NORTH

SCALE 1" = 30'

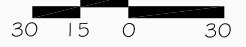

CONTOUR INTERVAL = 2'

- NOTES:
- SITE DATA AS DETERMINED BY LIMITED ENGINEERING SURVEY PERFORMED BY S&EC. (NCDENR STREAMS, LIDAR CONTOURS, AND NCDOT ROADS TAKEN FROM REFERENCE GIS LAYERS)
  - ALL LOCATIONS, ELEVATIONS, AND DIMENSIONS ARE APPROXIMATE.
  - ELEVATIONS ARE APPROXIMATE AND BASED ON AN ASSUMED ELEVATION OF 100' ADJUSTED TO MATCH 2 FOOT CONTOURS.


**LEGEND FOR ASBUILT FEATURES**

- RESTORED STREAM CHANNEL
- LOG J-HOOK (LJH)
- ROCK J-HOOK (RJH)
- CROSS ROCK VANE (CRV)
- CREATED/RESTORED WETLANDS
- EXISTING STREAMS

**PAPV LEGEND**

- STREAM PROBLEM AREAS-STRESSED
- VEGETATION PROBLEM AREAS-MODERATE

REACH 2 - PROBLEM AREA PLAN VIEW - E

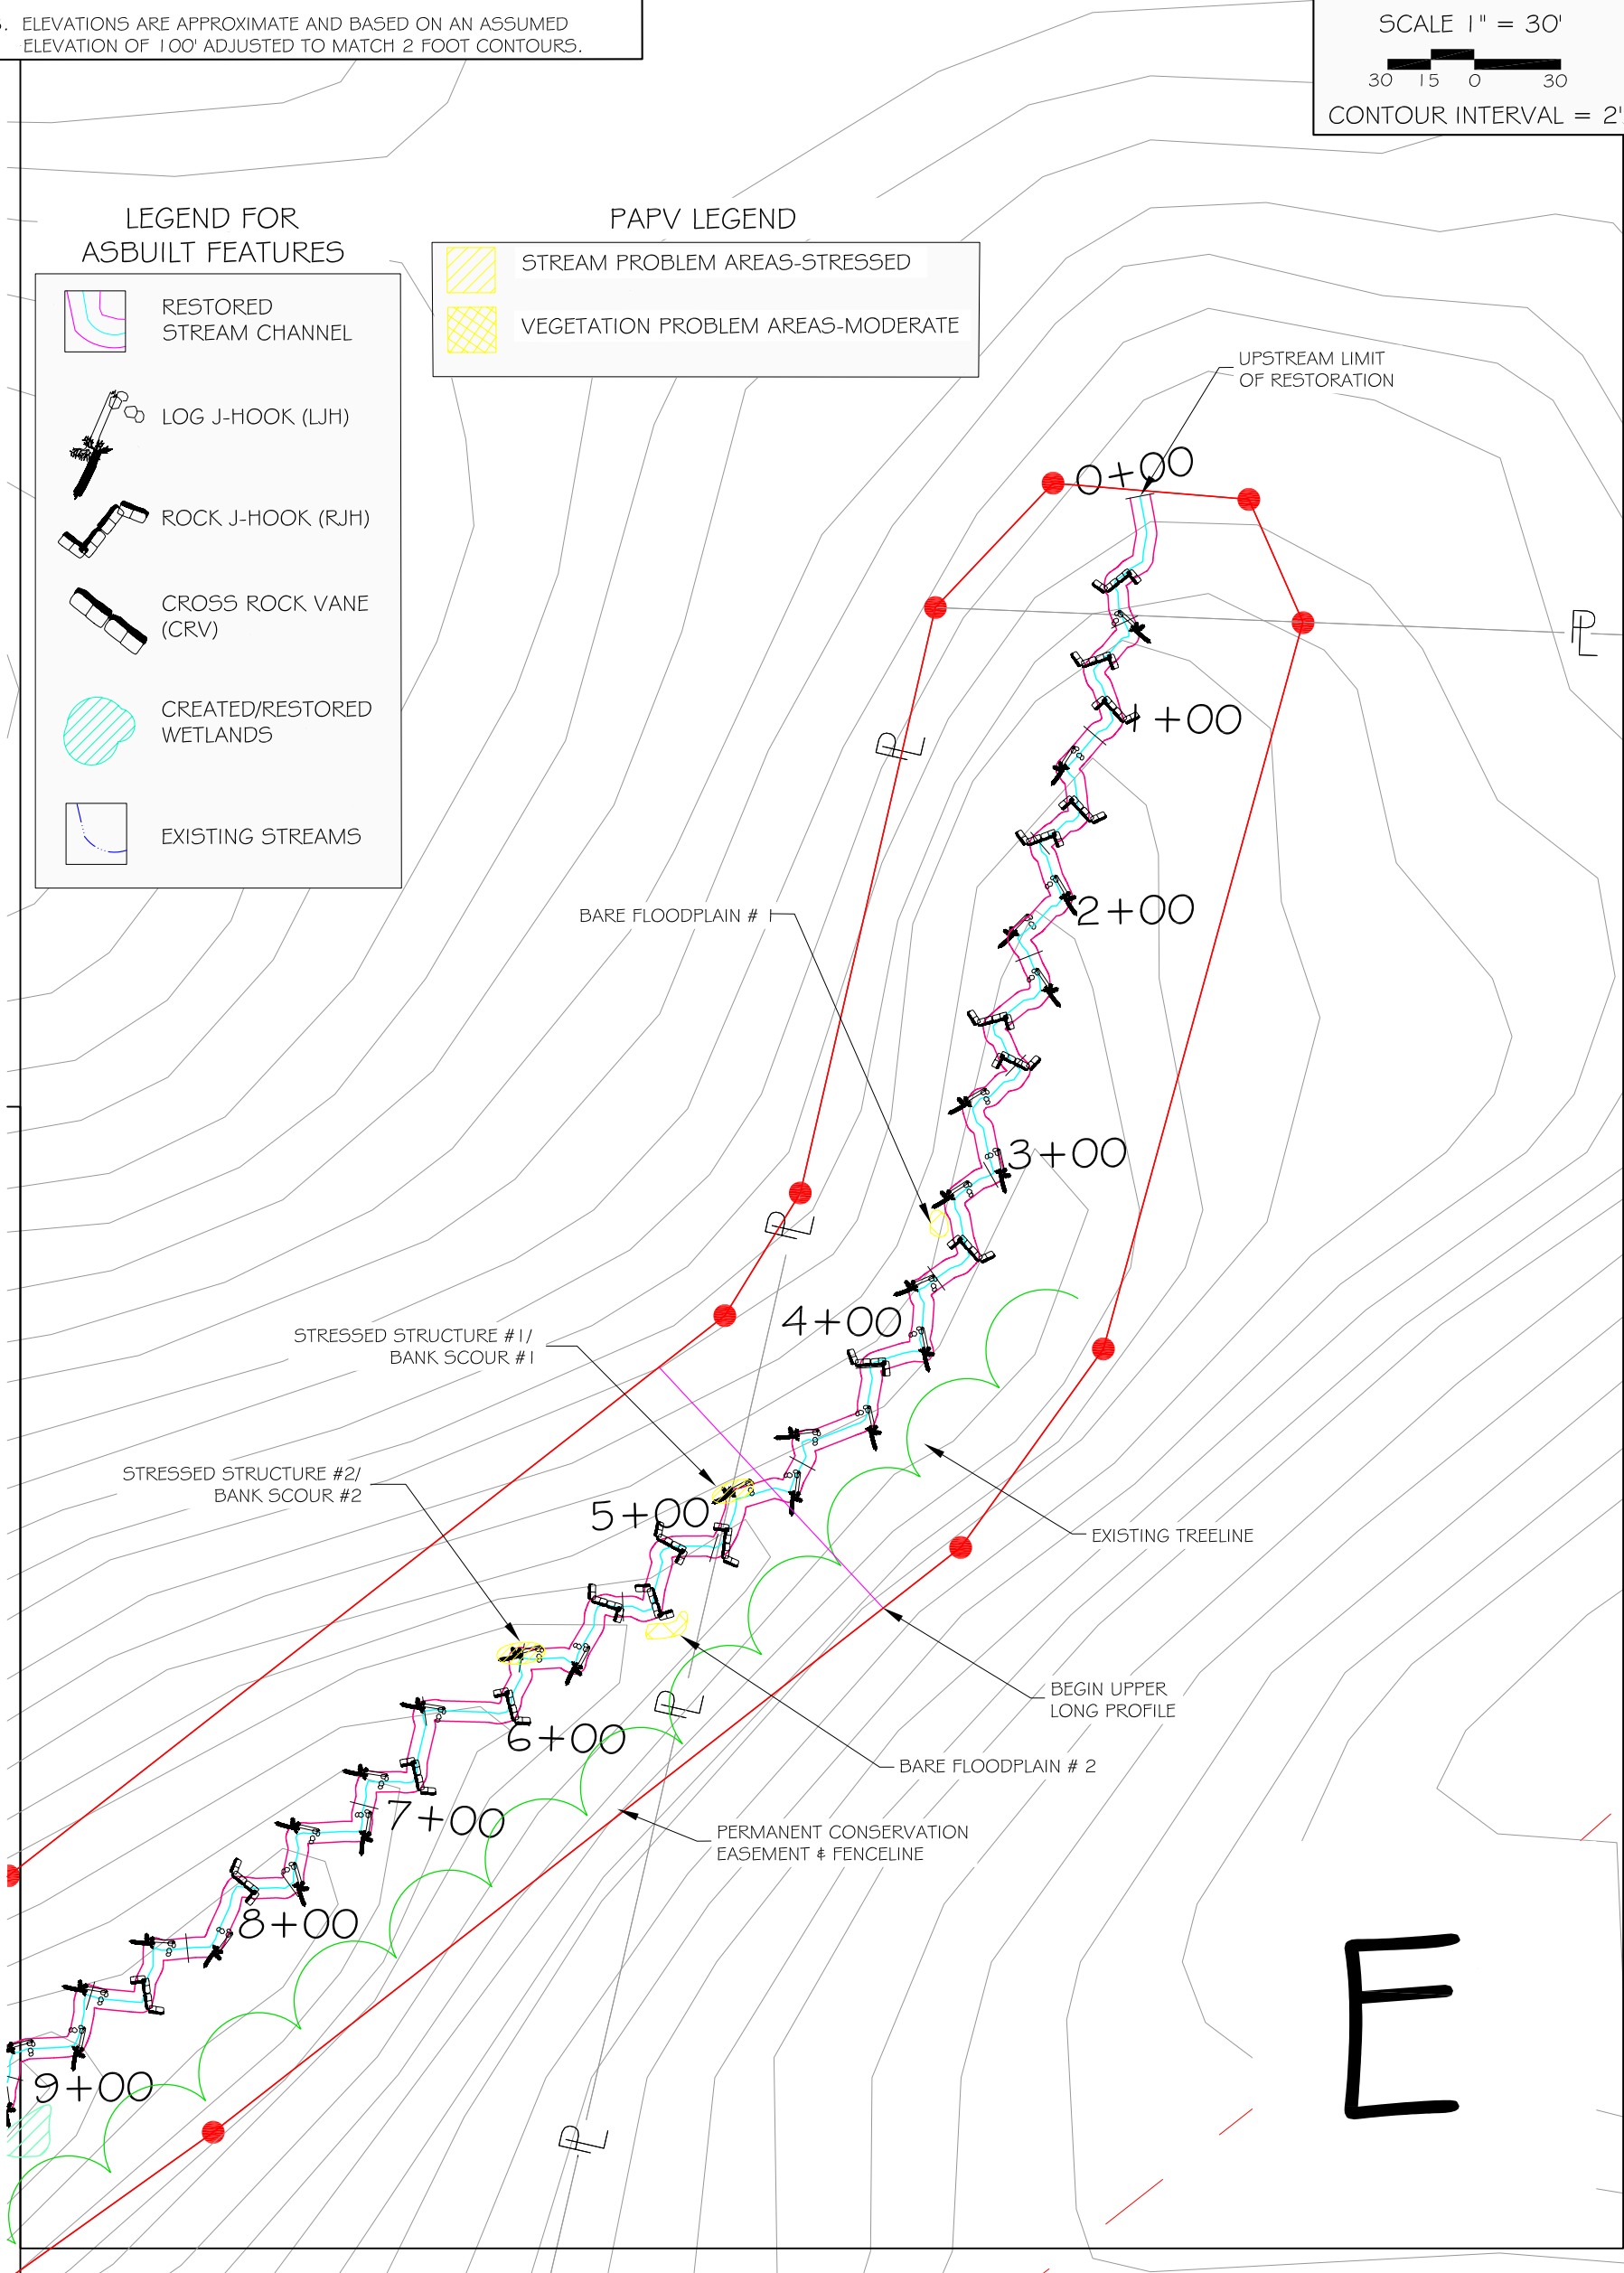

REVISIONS			
REV.	DESCRIPTION	DATE	APP.



**Soil & Environmental Consultants, PA**  
 11010 Raven Ridge Road • Raleigh, North Carolina 27614 • Phone: (919) 846-5900 • Fax: (919) 846-9467  
 www.SandEC.com


Project: GRAY FARM STREAM RESTORATION YEAR 3 MONITORING		Project No.: 9385.D9	
Location: IREDELL CO., NC		Client: NC ECOSYSTEM ENHANCEMENT PROGRAM	Proj. Mgr.: DG
Sheet Title: REACH 2-PROBLEM AREA PLAN VIEW - E		Scale: 1" = 30'	Drawn: DGC
		Sheet No.: 14 OF 16	

© 2008 Soil & Environmental Consultants, PA. All rights reserved.

**NOTES:**


1. SITE DATA AS DETERMINED BY LIMITED ENGINEERING SURVEY PERFORMED BY S&EC. (NCDENR STREAMS, LIDAR CONTOURS, AND NCDOT ROADS TAKEN FROM REFERENCE GIS LAYERS)
2. ALL LOCATIONS, ELEVATIONS, AND DIMENSIONS ARE APPROXIMATE.
3. ELEVATIONS ARE APPROXIMATE AND BASED ON AN ASSUMED ELEVATION OF 100' ADJUSTED TO MATCH 2 FOOT CONTOURS.

**DRAWINGS PRINTED  
AT HALF-SCALE**









**NORTH**

SCALE 1" = 30'



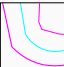

CONTOUR INTERVAL = 2'

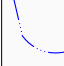
**LEGEND FOR ASBUILT FEATURES**

-  RESTORED STREAM CHANNEL
-  LOG J-HOOK (LJH)
-  ROCK J-HOOK (RJH)
-  CROSS ROCK VANE (CRV)
-  CREATED/RESTORED WETLANDS
-  EXISTING STREAMS

**PAPV LEGEND**

-  STREAM PROBLEM AREAS-STRESSED
-  VEGETATION PROBLEM AREAS-MODERATE

REACH 2 - PROBLEM AREA PLAN VIEW - F

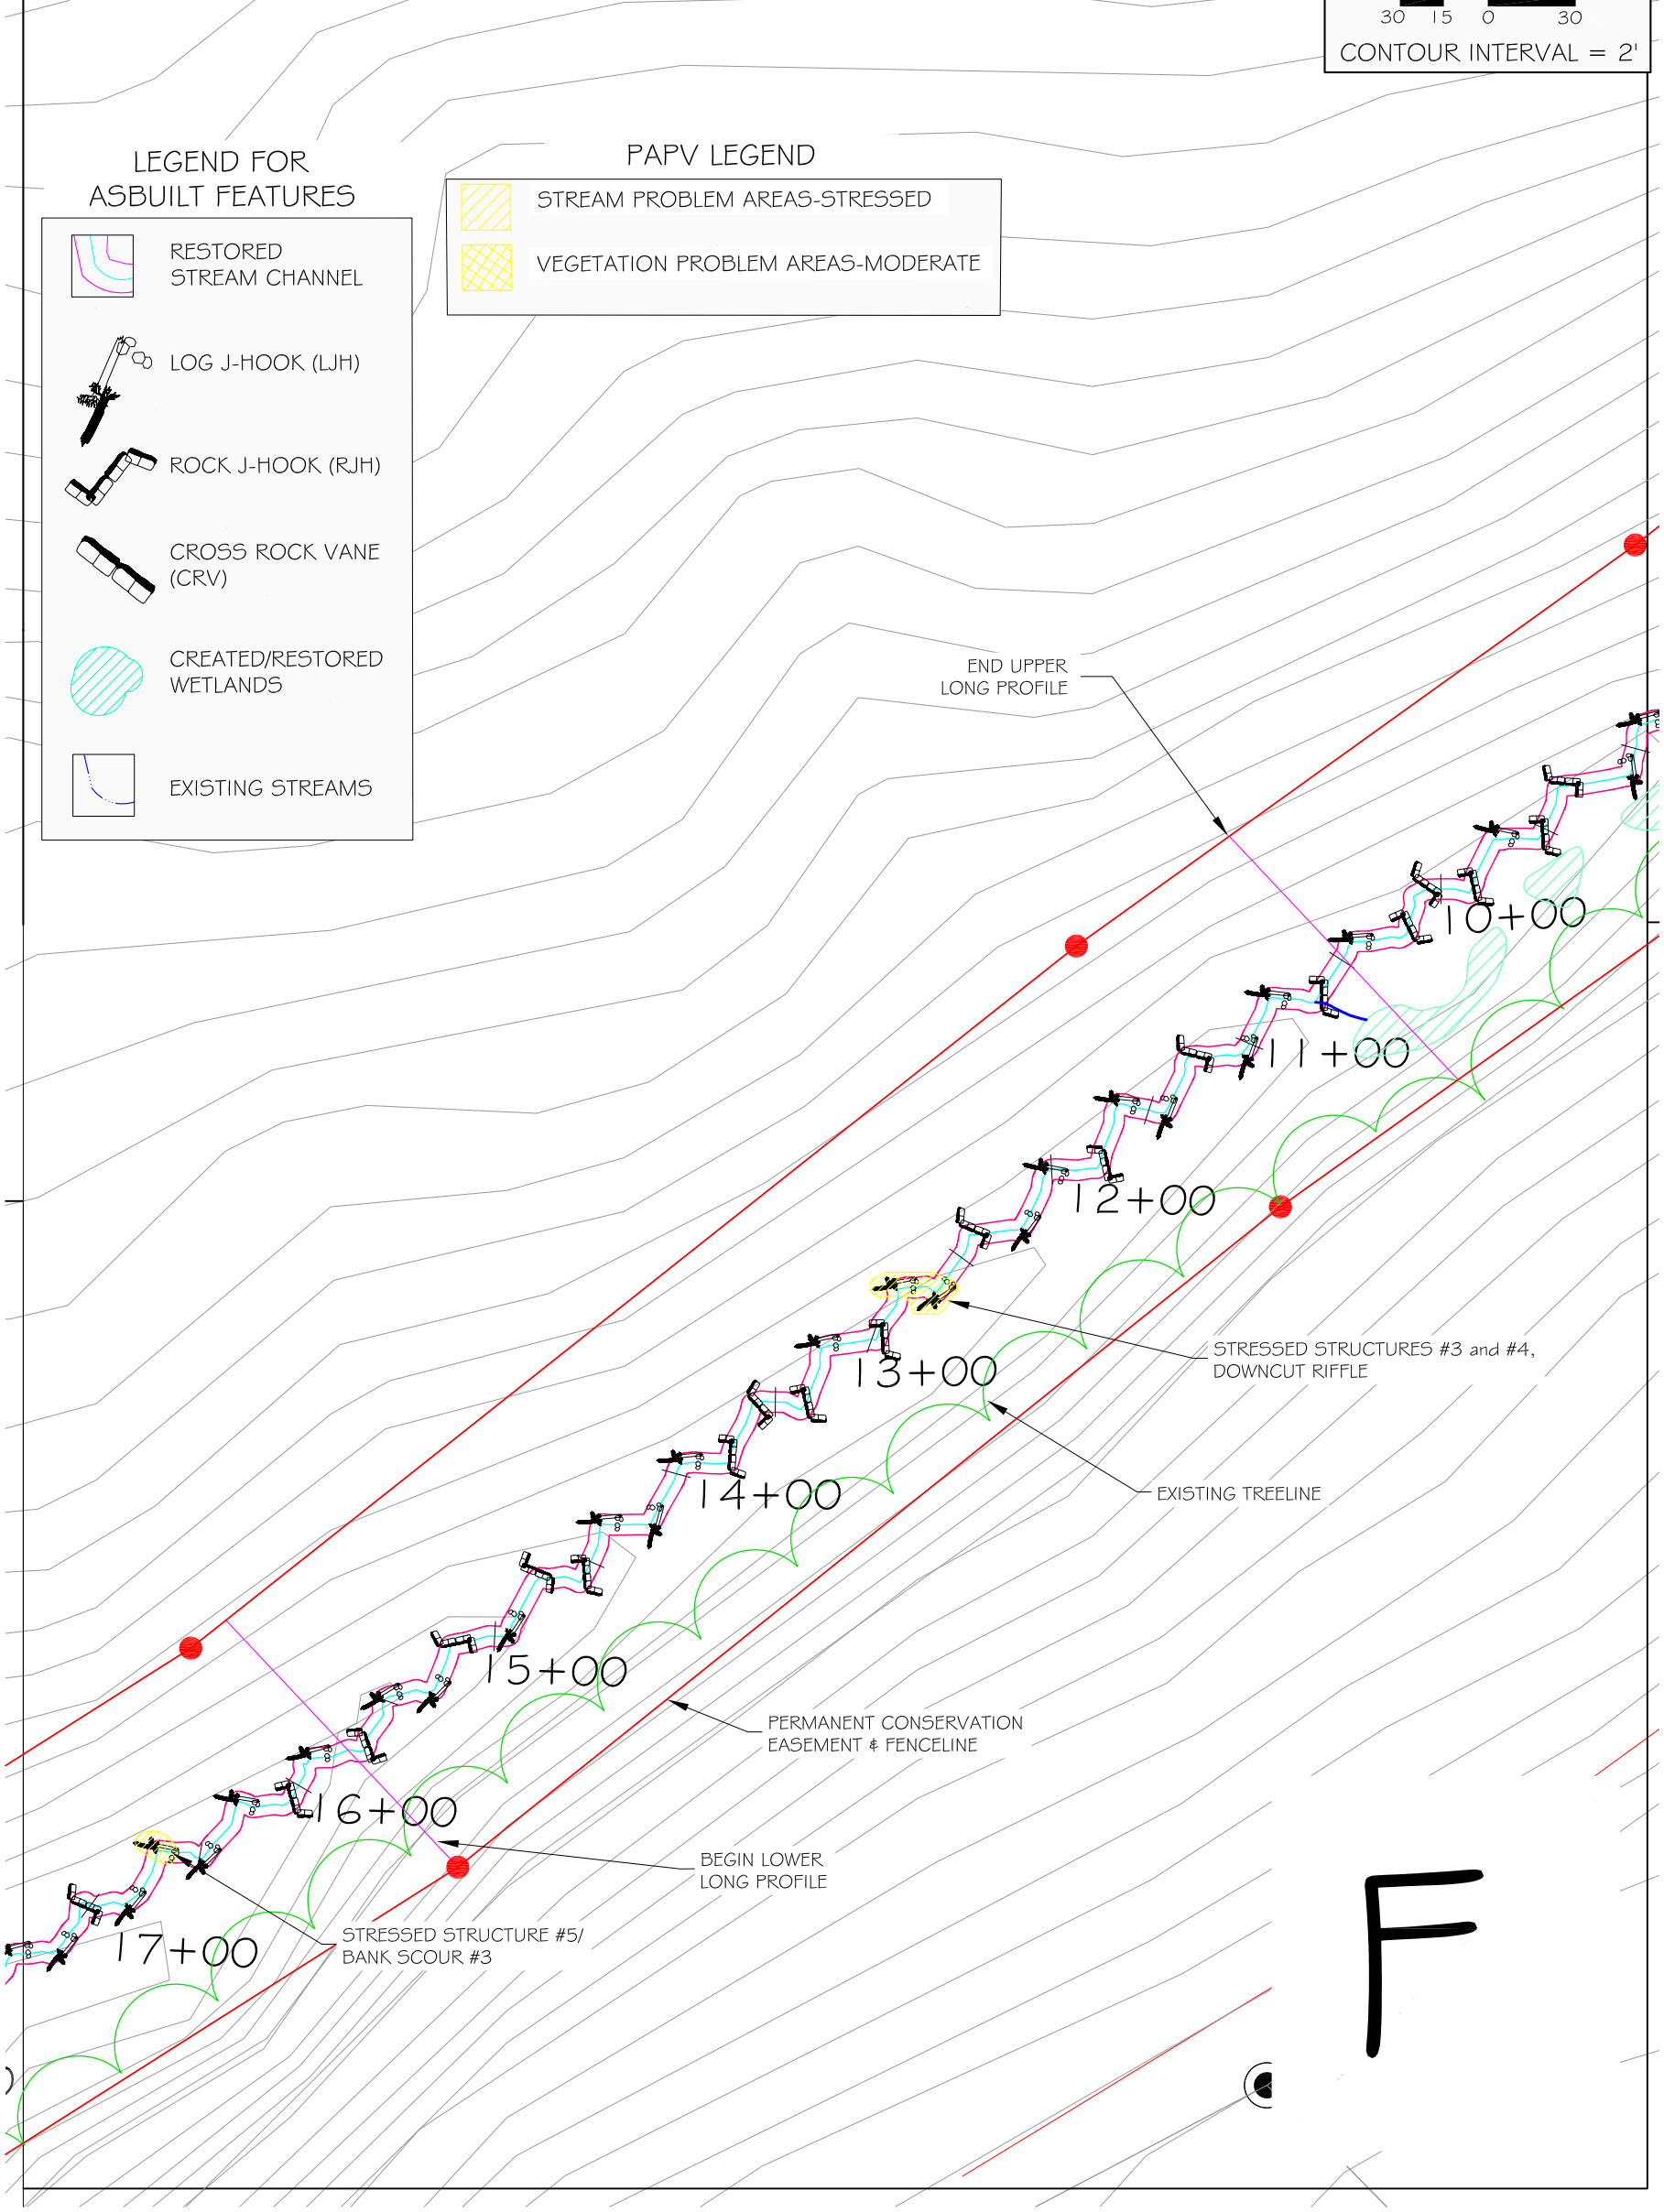

REVISIONS			
REV	DESCRIPTION	DATE	APPR



**Soil & Environmental Consultants, PA**  
 11010 Raven Ridge Road • Raleigh, North Carolina 27614 • Phone: (919) 846-5900 • Fax: (919) 846-9467  
 www.SandEC.com

Project: GRAY FARM STREAM RESTORATION YEAR 3 MONITORING		Project No.: 9385.D9
Location: IREDELL CO., NC	Client: NC ECOSYSTEM ENHANCEMENT PROGRAM	Proj. Mgr.: DG
Sheet Title: REACH 2-PROBLEM AREA PLAN VIEW - F		Drawn: DGC
		Scale: 1" = 30'
		Sheet No.: 15 OF 16



**NOTES:**

1. SITE DATA AS DETERMINED BY LIMITED ENGINEERING SURVEY PERFORMED BY S&EC. (NCDENR STREAMS, LIDAR CONTOURS, AND NCDOT ROADS TAKEN FROM REFERENCE GIS LAYERS)
2. ALL LOCATIONS, ELEVATIONS, AND DIMENSIONS ARE APPROXIMATE.
3. ELEVATIONS ARE APPROXIMATE AND BASED ON AN ASSUMED ELEVATION OF 100' ADJUSTED TO MATCH 2 FOOT CONTOURS.

**DRAWINGS PRINTED  
AT HALF-SCALE**



NORTH

SCALE 1" = 30'



CONTOUR INTERVAL = 2'


**LEGEND FOR  
ASBUILT FEATURES**

- RESTORED STREAM CHANNEL
- LOG J-HOOK (LJH)
- ROCK J-HOOK (RJH)
- CROSS ROCK VANE (CRV)
- CREATED/RESTORED WETLANDS
- EXISTING STREAMS

**PAPV LEGEND**

- STREAM PROBLEM AREAS-STRESSED
- VEGETATION PROBLEM AREAS-MODERATE

REACH 2 - PROBLEM AREA PLAN VIEW - G

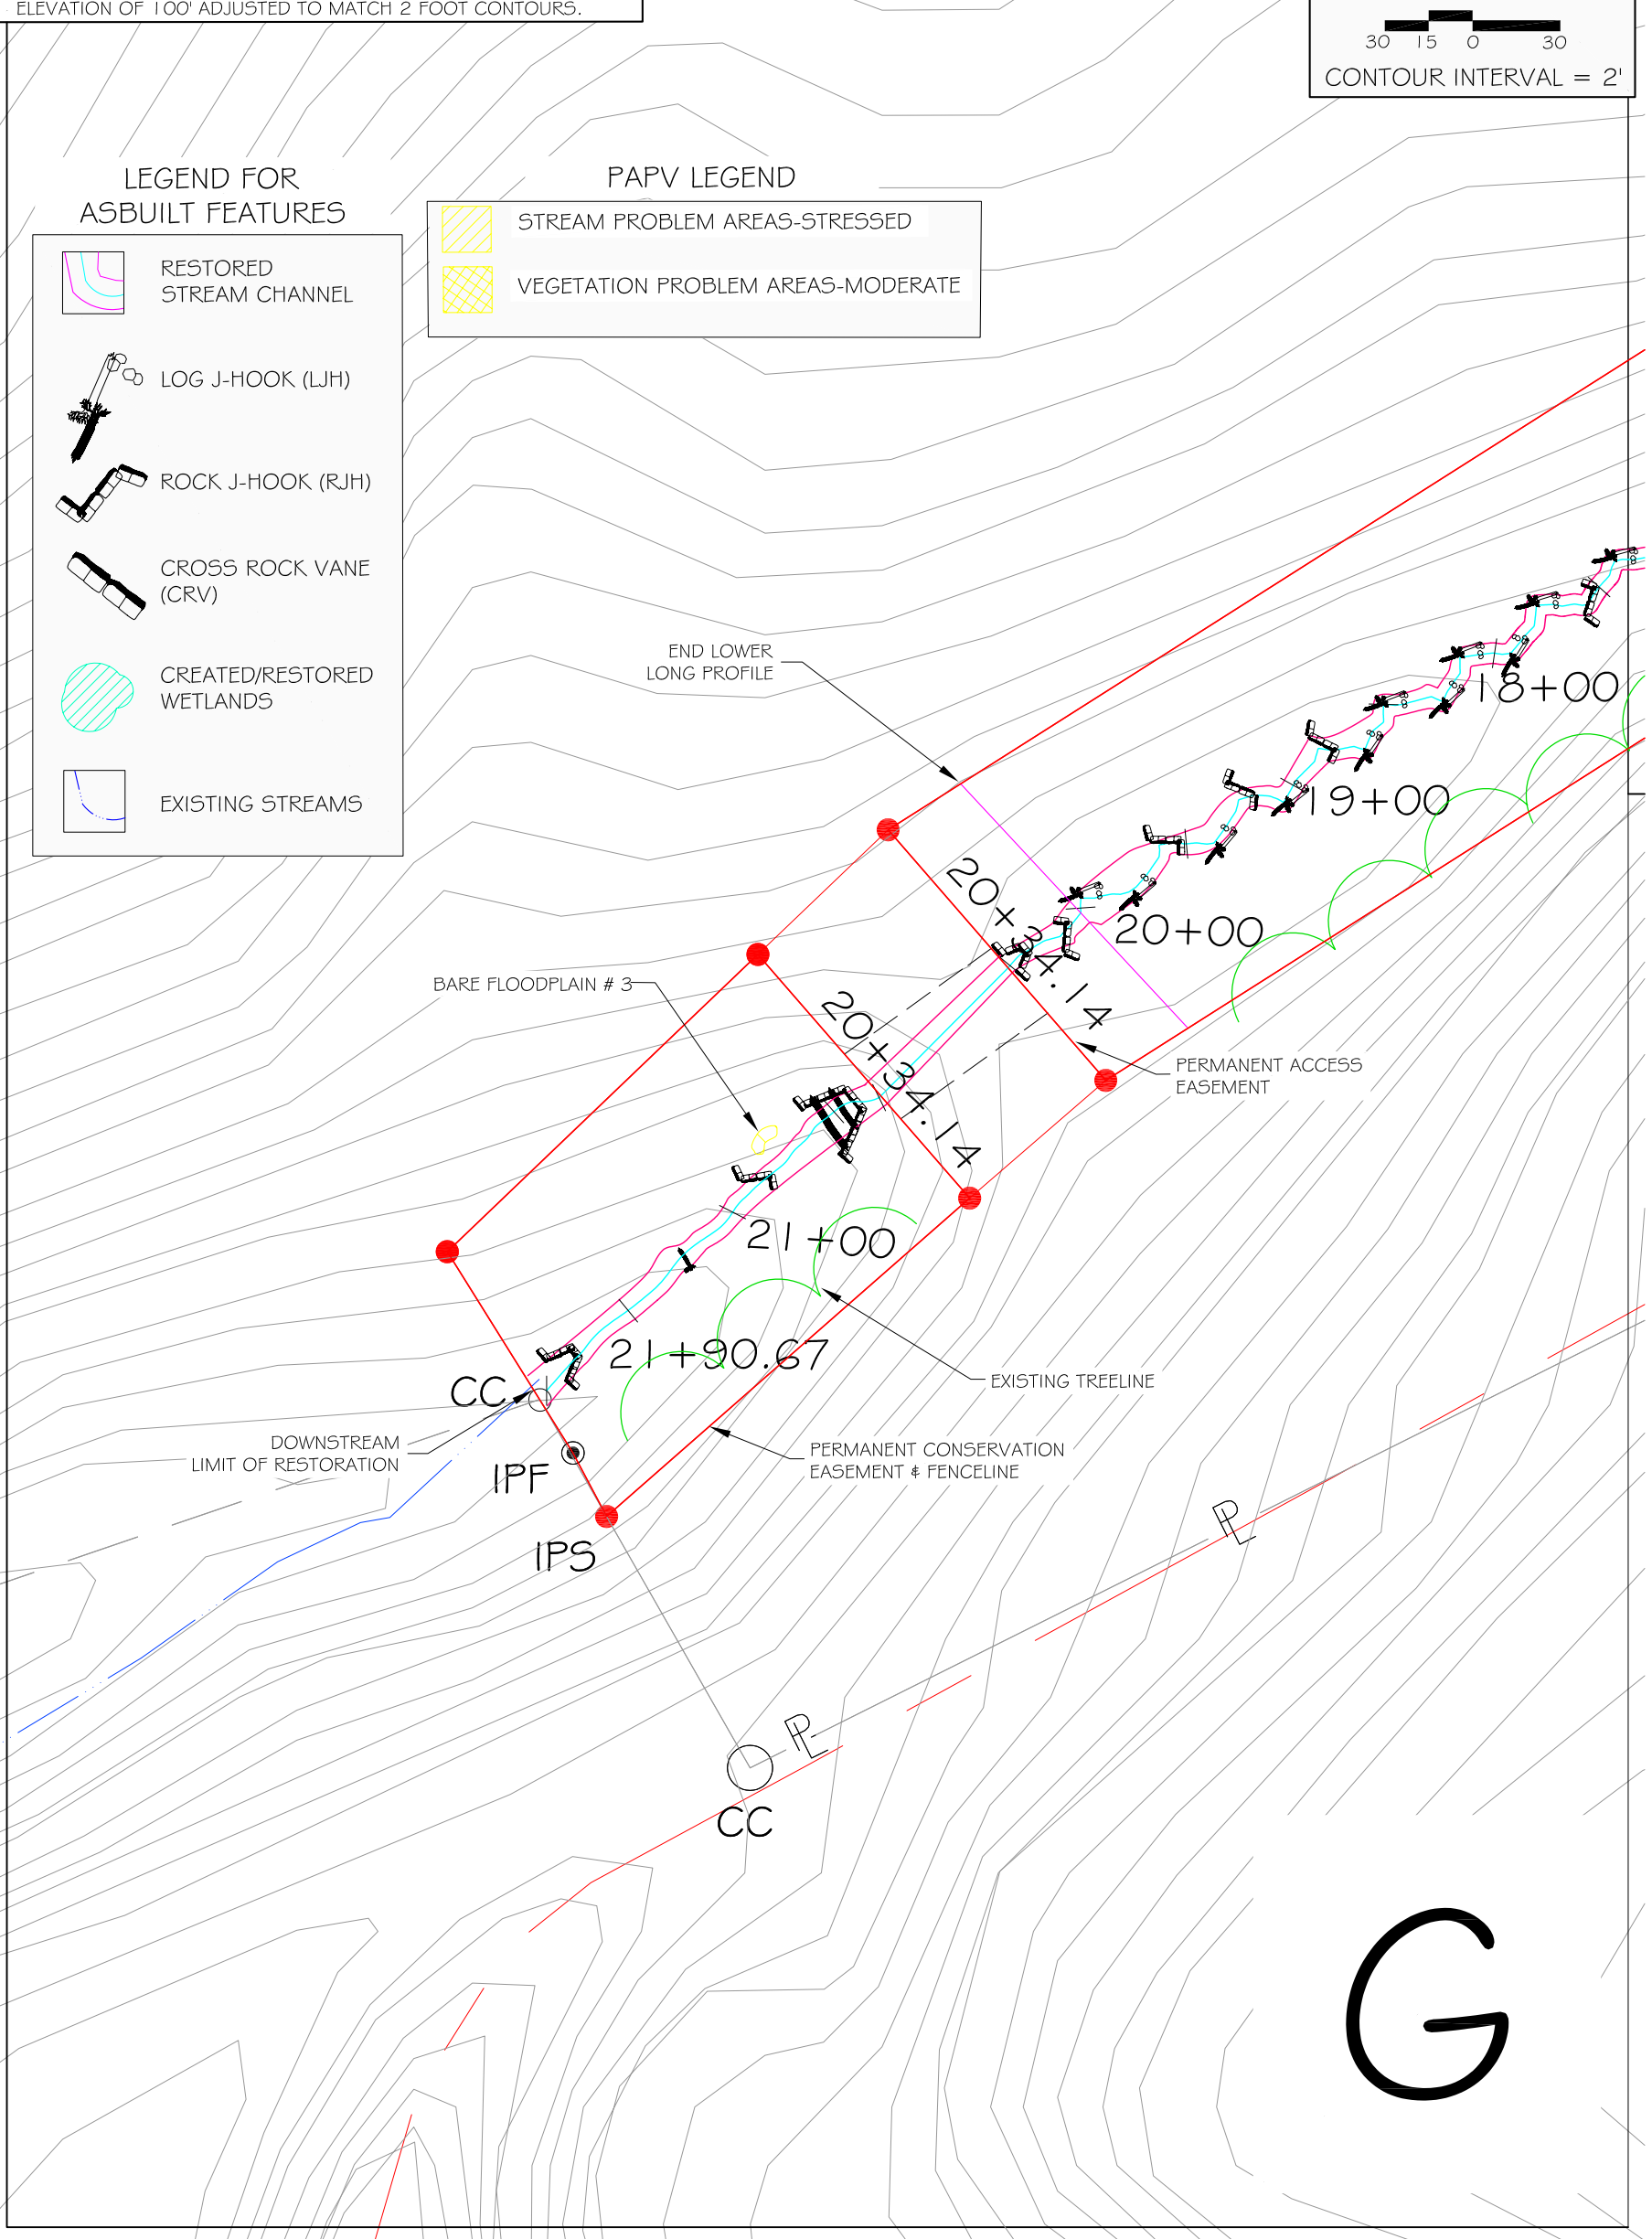

REVISIONS			
REV	DESCRIPTION	DATE	APP

**Soil & Environmental Consultants, PA**

11010 Raven Ridge Road • Raleigh, North Carolina 27614 • Phone: (919) 846-5900 • Fax: (919) 846-9467

www.SandEC.com

Project: GRAY FARM STREAM RESTORATION YEAR 3 MONITORING		Project No.: 9385.D9
Location: IREDELL CO., NC		Client: NC ECOSYSTEM ENHANCEMENT PROGRAM
Sheet Title: REACH 2-PROBLEM AREA PLAN VIEW - G		Scale: 1" = 30'
		Sheet No.: 16 OF 16