

Gregory Wetland and Stream Restoration As-Built Report Halifax County, NC

RECEIVED
MAY 25 2005
NC ECOSYSTEM
ENHANCEMENT PROGRAM

114

Prepared For:

EBX Neuse-I, LLC
220 Chatham Business Drive
Pittsboro, NC 27312



Prepared By:



8000 Regency Parkway
Suite 200
Cary, North Carolina 27511
Phone: 919.463.5488
Fax: 919.463.5490
www.buckengineering.com

May 2005

RECEIVED

SEP 27 2005

NC ECOSYSTEM
ENHANCEMENT PROGRAM

EXECUTIVE SUMMARY

This report is submitted to document completion of construction and planting on the Gregory wetland and stream restoration project. This report will also serve as a baseline for future monitoring reports submitted pursuant to the requirements set forth in the Gregory Site Stream and Wetland Restoration Plan.

The Gregory wetland and stream restoration site is located near the town of Halifax in Halifax County, North Carolina. The project is located entirely within the Tar-Pamlico River Basin. Ditches on the site were used to promote drainage when the land was under agricultural production. The objective of the project was to restore approximately 6,725 feet of stream channel and a minimum of 75 acres of prior-converted wetlands. The restoration involved the filling of drainage ditches and topographic manipulation to raise the local water table and restore the site hydrology. Surface water flow was routed from an existing drainage ditch to a new meandering channel constructed across the abandoned floodplain. The abandoned ditch was then filled. Several structures were installed to control streambed grade, reduce stresses on streambanks, and promote bedform sequences for increased habitat diversity. The design allows for flows larger than the bankfull flow to spread onto the floodplain, dissipating flow energies and reducing the stress on streambanks. Streambanks were stabilized using a combination of erosion matting, live staking, and transplants. Bare-root stems of eight tree species appropriate for small stream swamp ecosystems were planted at an average density of 695 stems per acre.

All grading activities and restoration practices were completed in January 2005. Planting of bare-root trees was also completed in January 2005. Installation of post-restoration monitoring wells on the site was completed in late January 2005. A total of 85.8 acres of wetland and 6,757 feet of stream channel were restored. Initial site observations and well data indicate that the site is performing well as a stream and wetland system.

TABLE OF CONTENTS

Executive Summary i
Introduction.....1
As-Built Report.....3
 Construction.....3
 Vegetation.....3
 Species Planted4
 General Observations.....4
Monitoring7
Reference8

LIST OF FIGURES

Figure 1. Project Vicinity Map2
Figure 2. As-Built Restoration Map.....6

LIST OF TABLES

Table 1. Project History1
Table 2. Tree Species Planted over the Gregory Restoration Site.....4
Table 3. Initial Planted Density of Trees for the Eight Vegetation Sampling Plots7

LIST OF APPENDICES

- Appendix 1: Photographs of the Project Site
- Appendix 2: As-Built Longitudinal Profile and Permanent Cross section Data
- Appendix 3: As-Built Plan Sheets

LIST OF PHOTOGRAPHS (APPENDIX 1)

Preconstruction Photographs

Photo PC1. Restoration area before construction activities began.

Photo PC2. Lateral field ditches before construction activities.

Construction Photographs

Photo C1. Restoration area during initial grading to design elevations.

Photo C2. A new section of stream channel (Reach 2) during excavation.

Completed Project Photographs

Photo P1. Transplants installed at a log weir.

Photo P2. Root wads and coir fiber matting installed around a meander bend for bank stabilization and habitat improvement.

Photo P3. A log weir at the beginning of Reach 1.

Photo P4. A constructed riffle near the end of Reach 1.

Photo P5. Middle portion of the project. Scarification and minor grading resulted in a diversity of hydrologic wetland conditions.

Photo P6. An area in the middle of the project after planting was completed.

INTRODUCTION

The Gregory wetland and stream restoration site is located near the town of Halifax in Halifax County, North Carolina (see Figure 1). The site has a past history of agricultural use consisting primarily of row crop agriculture. Ditches on the site were used to increase subsurface drainage when the land was under agricultural production.

Restoration of the Gregory site involved the restoration of a “small stream swamp” with associated “bottomland hardwood” and “cypress swamp” communities as described by Schafale and Weakley (1990). Restoration of the site involved the restoration of one stable meandering channel across the hydric farm fields on the site. The channel was designed and constructed using natural channel design techniques. Restoration also involved raising the local water table by filling the drainage ditches on-site and scarification of the fields and breaking of the local plow pan to provide increased surface storage of water.

The history of the project is summarized in Table 1.

Table 1. Project History

May 2004	Reference monitoring wells installed
June 2004	Approved Restoration Plan
October 2004	Construction began
January 2005	Construction completed
January 2005	Planting completed
January 2005	Post-construction monitoring wells installed
November 2005 (scheduled)	First monitoring report



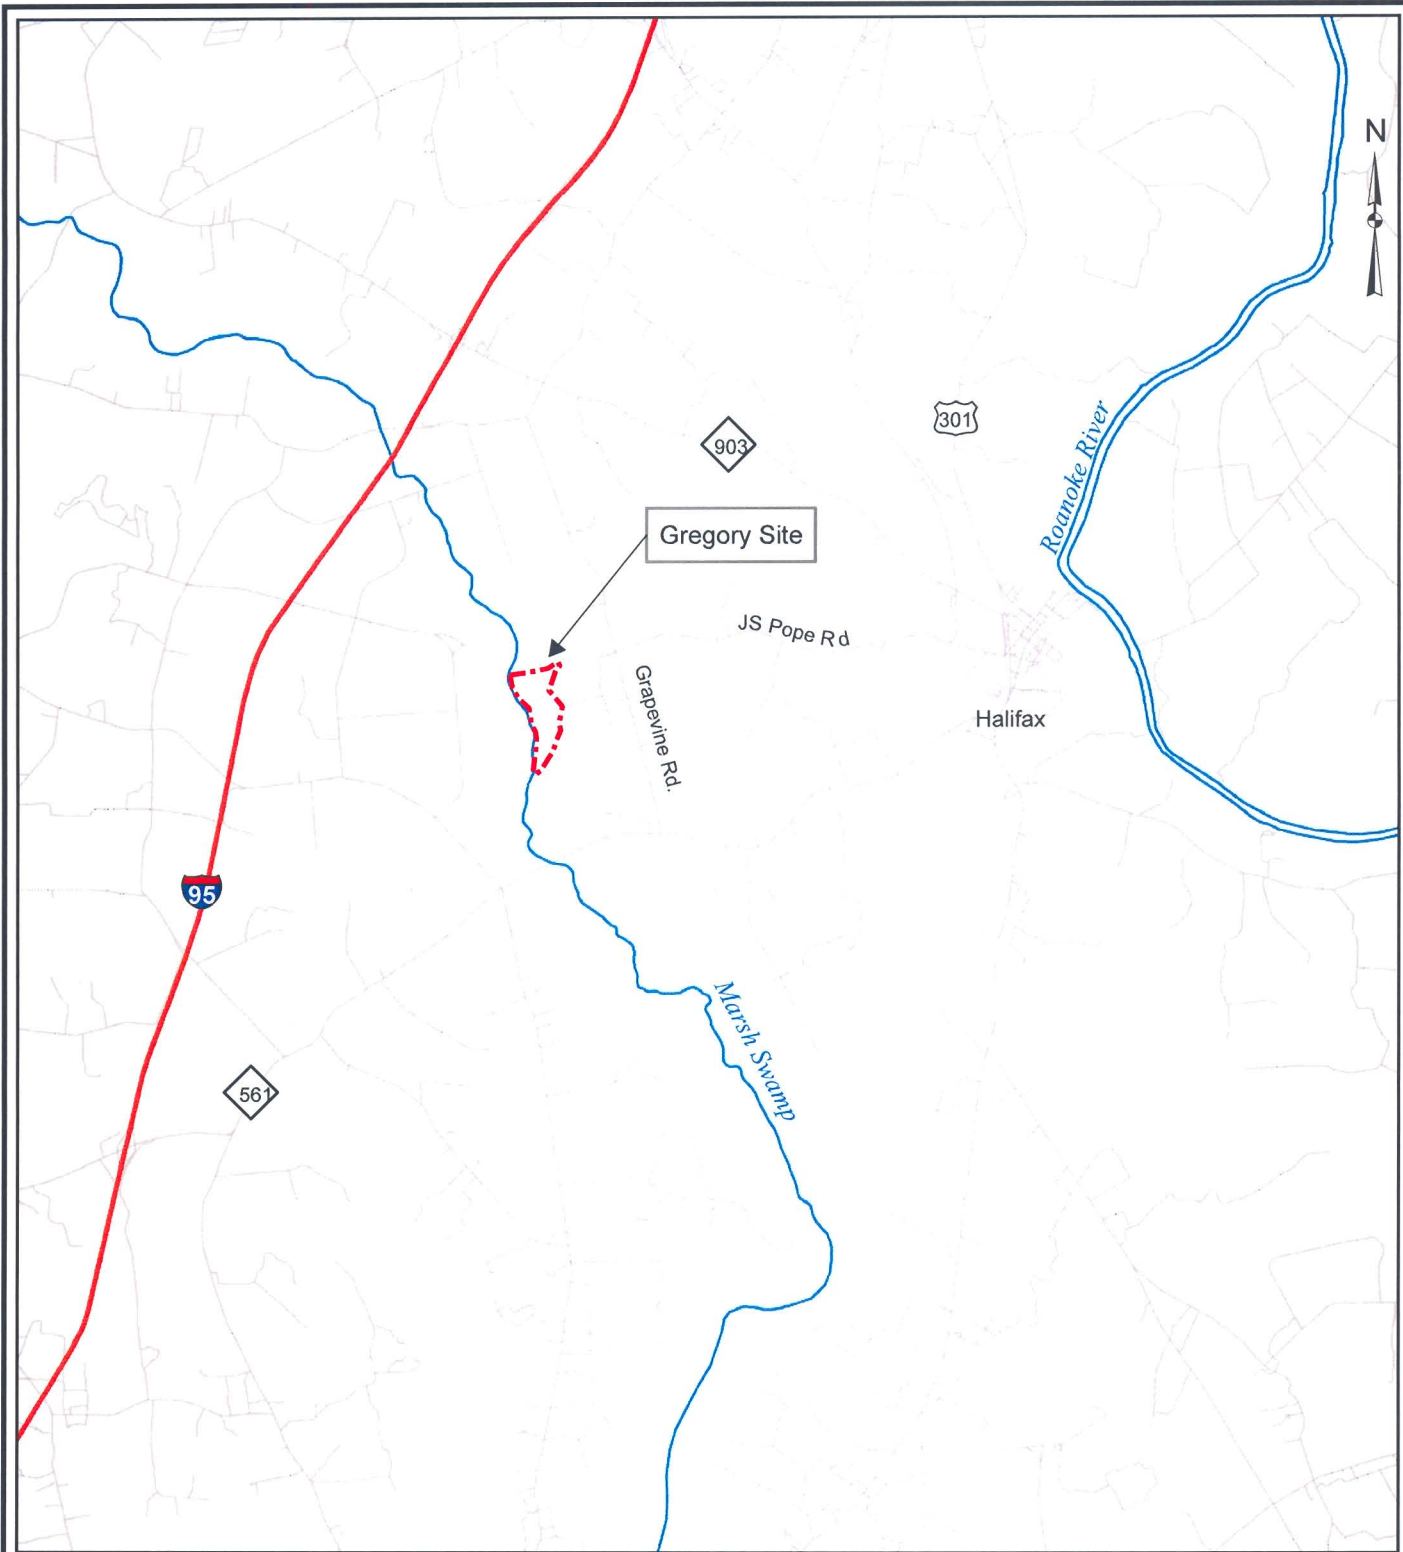


Figure 1. Project Vicinity Map

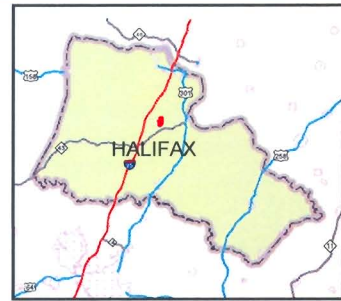

EBX Neuse-I, LLC
 220 Chatham Business Drive
 Pittsboro, NC 27312

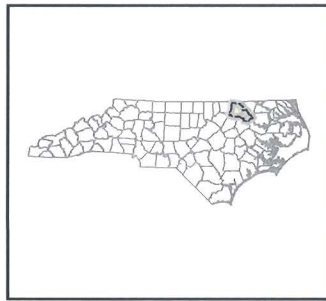

AS-BUILT REPORT

Construction

Construction activities, in accordance with the approved Restoration Plan for the site, began in October 2004 with construction stakeout, followed immediately by the establishment of access sites and stockpile areas. Materials were stockpiled as needed for the initial stages of construction.

The next step was the grading of the floodplain areas to reach design grades across the site. The excavated material was stockpiled in specified areas near field ditches that were to be filled. Where necessary, silt fencing was installed between stockpiles and the active ditches to prevent erosion of sediment into the channel. A berm was also constructed along the western bank of McCulloch's Ditch to provide access to the site and keep floodwaters onsite and off adjacent farmland.

Once the design floodplain grades were achieved, a new stream channel was sculpted and constructed. Construction of the new stream channel for Reach 1 began near station 10+62 and proceeded downstream. McCulloch's Ditch was plugged on both sides of Reach 2, where the new channel crossed the existing McCulloch's alignment. Upon completion of new channel segments, in-stream structures, matting, and transplants were installed, and the channel was prepared to accept flow from the old channel. Once fully prepared, temporary sediment traps at the downstream ends of the channels were removed, and water was turned into the newly constructed channel. Abandoned field ditches were immediately filled and graded.

The site was not disked for two reasons: disking equipment could not be pulled across the site due to muddy conditions, and it was determined that disking was not necessary for the purpose of increasing surface storage. Upon completion of earthmoving activities in each construction area, temporary and permanent seeding was applied according to the plans and specifications.

Vegetation

Earthmoving activities were completed in early January 2005. Live staking of the streambank areas and the spreading of the permanent seed mixture was completed in late January 2005, along with the planting of bare-root trees. The approved Restoration Plan for the Gregory site called for the planting of eight (8) bare-root tree species, which were planted as listed in Table 2 below. Based on information collected from sampling plots (data provided in Monitoring section), the average density of planted stems across the site was approximately 695 stems per acre.

Table 2. Tree Species Planted over the Gregory Restoration Site

Species Planted	
Willow oak	<i>Quercus phellos</i>
Swamp chestnut oak	<i>Quercus michauxii</i>
Laurel oak	<i>Quercus laurifolia</i>
Overcup oak	<i>Quercus lyrata</i>
Blackgum	<i>Nyssa sylvatica</i>
Swamp blackgum	<i>Nyssa biflora</i>
Green ash	<i>Fraxinus pennsylvanica</i>
Bald cypress	<i>Taxodium distichum</i>

General Observations

Despite extremely wet conditions, construction on the site proceeded with very few problems or changes to the proposed Restoration Plan.

Modifications made during construction involved the location and selection of in-stream structures and bank stabilization practices. Substitutions were made based on availability of materials and professional judgment. These changes are documented in the attached as-built drawings.

Several rainfall events occurred during construction, but the rainfall amounts and intensities were not large enough to cause significant erosion or problems with construction. The final as-built stream length for the project, as indicated on Sheet 1, was 6,757 feet, as compared to the 6,725 feet predicted in the Restoration Plan.

Based on early observations, the hydrology of the site has been altered to a much wetter regime than was present prior to construction. Ponding in isolated pockets on the site has been observed for extended periods after rainfall events.

Early observations also indicate that the vegetation treatments were effective at establishing ground cover quickly. Temporary seeding (rye grain) applied to streambanks beneath the erosion matting sprouted within two weeks of application and has provided good ground coverage. Live stakes and planted bare-root trees were beginning to bud when the growing season began.

The Restoration Plan predicted that approximately 75 acres of restoration were available on the site. Initial site indications during construction indicate that this area is greater. Figure 2 and Plan Sheets 10 and 11 show the revised wetland restoration acreage at 85.8 acres. Based on visual observations and preliminary well data, filling the drainage

ditches that once drained groundwater from the proposed restoration areas has caused the local water table to rise. The revised acreage will be confirmed through the monitoring process based on groundwater monitoring data.

MONITORING

The five-year monitoring plan for the Gregory restoration site includes criteria to evaluate the success of both the wetland and the stream components of the project. The specific locations of vegetation plots, monitoring wells, photo points, permanent cross sections, and rainfall and crest gauges are shown on the as-built drawings in Sheets 4 through 11.

Consistent with the Gregory site-specific Restoration Plan, seven vegetation plots (wetland plots are 0.05 acre and the stream plots are each 0.1 acre in size), seven automated monitoring wells, and four manual monitoring wells were established in areas that would represent a range of hydrologic conditions and community types across the restoration site.

The initial planted density within each of the seven vegetation monitoring plots is given in Table 3. The locations of the vegetation plots and the monitoring wells are shown on the as-built plan sheets.

Table 3. Initial Planted Density of Trees for the Eight Vegetation Sampling Plots

Sampling Plot No.	Counted Stems per Plot	Stems per Acre (extrapolated)
1	41	774
2	37	698
3	42	792
4	39	736
5	66	660
6	56	560
7	65	650

For monitoring stream success criteria, fourteen permanent cross sections and two crest gauges were installed. The permanent cross sections will be used to monitor channel dimension and bank erosion over time. The two crest gauges, one in each stream reach, will be used to document bankfull events. In addition, a complete longitudinal survey was completed for the restored stream channel after construction to provide a baseline for evaluating changes in bed conditions over time. The longitudinal profile included the elevations of all grade control structures. Permanent cross sections were also surveyed after construction to provide baseline data for monitoring. The longitudinal and permanent cross section data are provided in Appendix 2. The locations of the permanent cross sections and the crest gages are shown on the as-built plan sheets.

Monitoring success criteria applied to the Gregory site are provided in the site-specific Restoration Plan. Monitoring data will be provided in the monitoring report for Year 1.

REFERENCE

Schafale, M.P. and A.S. Weakley. 1990. *Classification of the Natural Communities of North Carolina, Third Approximation*. North Carolina Natural Heritage Program, Division of Parks and Recreation, NCDEHNR. Raleigh, North Carolina.

APPENDIX 1
PHOTOGRAPHS OF THE PROJECT SITE

PRECONSTRUCTION PHOTOGRAPHS



Photo PC1. Restoration area before construction activities began.



Photo PC2. Lateral field ditches before construction activities.

CONSTRUCTION PHOTOGRAPHS



Photo C1. Restoration area during initial grading to design elevations.



Photo C2. A new section of stream channel (Reach 2) during excavation.

COMPLETED PROJECT PHOTOGRAPHS



Photo P1. Transplants installed at a log weir.



Photo P2. Root wads and coir fiber matting installed around a meander bend for bank stabilization and habitat improvement.



Photo P3. A log weir at the beginning of Reach 1.



Photo P4. A constructed riffle near the end of Reach 1.




Photo P5. Middle portion of the project. Scarification and minor grading resulted in a diversity of hydrologic wetland conditions.




Photo P6. An area in the middle of the project after planting was completed.

APPENDIX 2
AS-BUILT LONGITUDINAL PROFILE AND PERMANENT CROSS SECTION DATA


Feature	Stream Type	BKF Area	BKF Width	BKF Depth	Max BKF Depth	W/D	BH Ratio	ER	BKF Elev	TOB Elev
Riffle	C	11.2	13.2	0.9	1.7	15.5	1.0	3.8	112.9	112.9

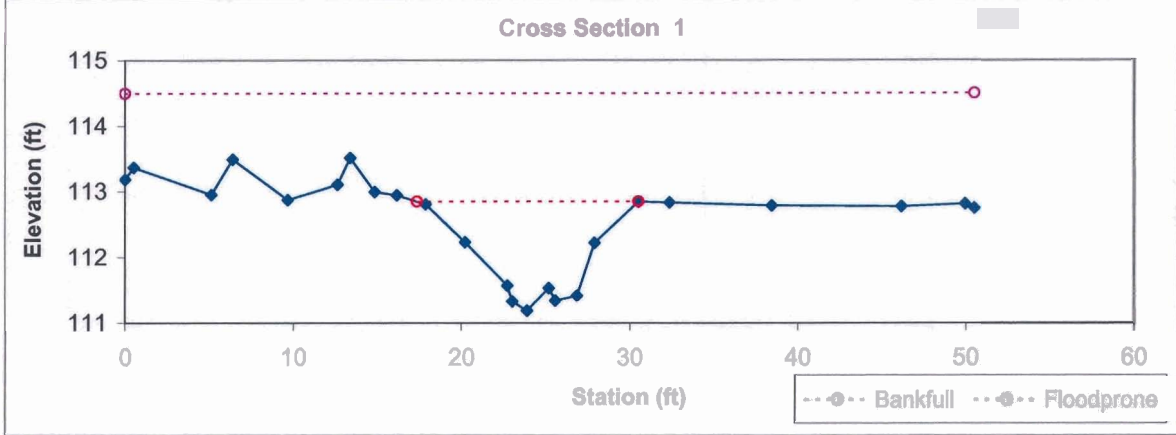


Feature	Stream Type	BKF Area	BKF Width	BKF Depth	Max BKF Depth	W/D	BH Ratio	ER	BKF Elev	TOB Elev
Riffle	C	4.2	9.5	0.5	0.8	21.1	1.0	5.4	109.4	109.4

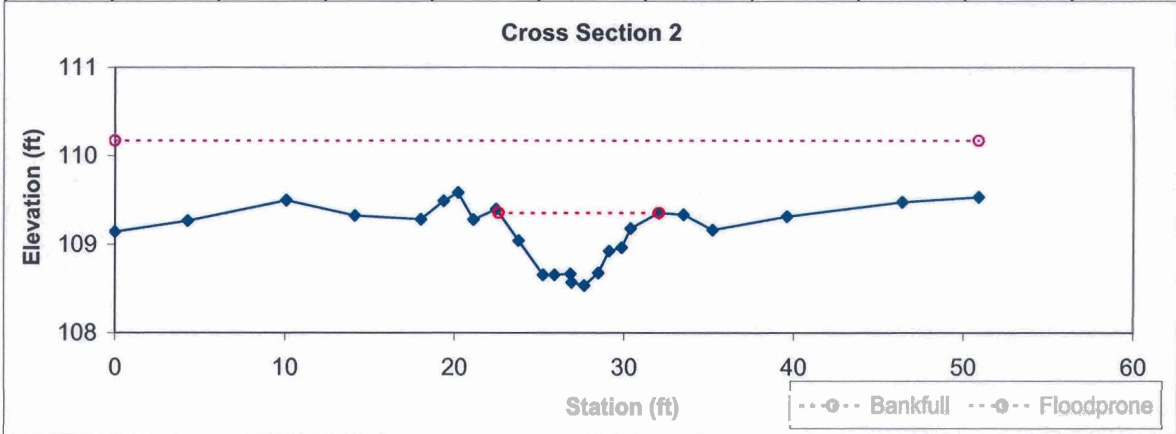

Feature	Stream Type	BKF Area	BKF Width	BKF Depth	Max BKF Depth	W/D	BH Ratio	ER	BKF Elev	TOB Elev
Pool		13.7	13.0	1.1	2.2	12.3	1.0	4.3	107.9	107.9

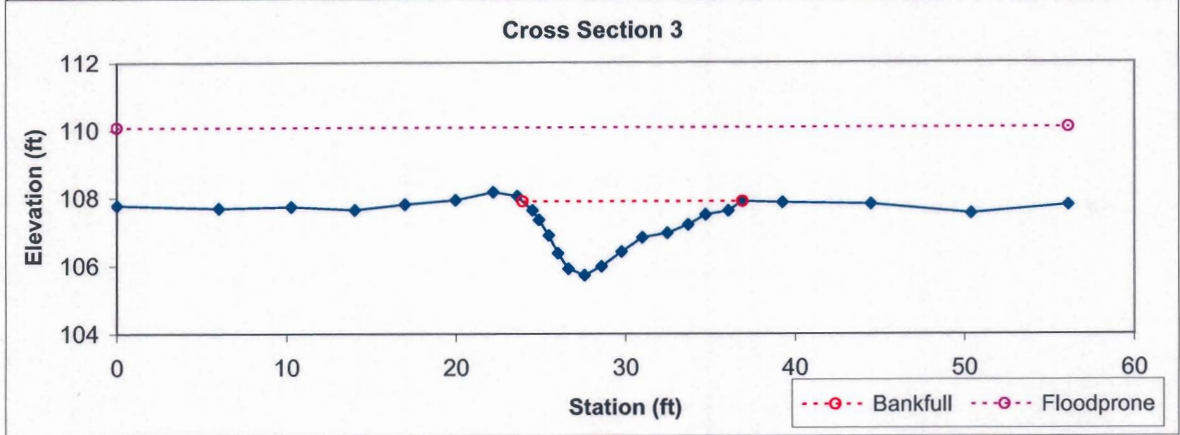


Feature	Stream Type	BKF Area	BKF Width	BKF Depth	Max BKF Depth	W/D	BH Ratio	ER	BKF Elev	TOB Elev
Riffle	C	4.9	9.1	0.6	1.0	16.6	1.0	5.6	107.1	107.1

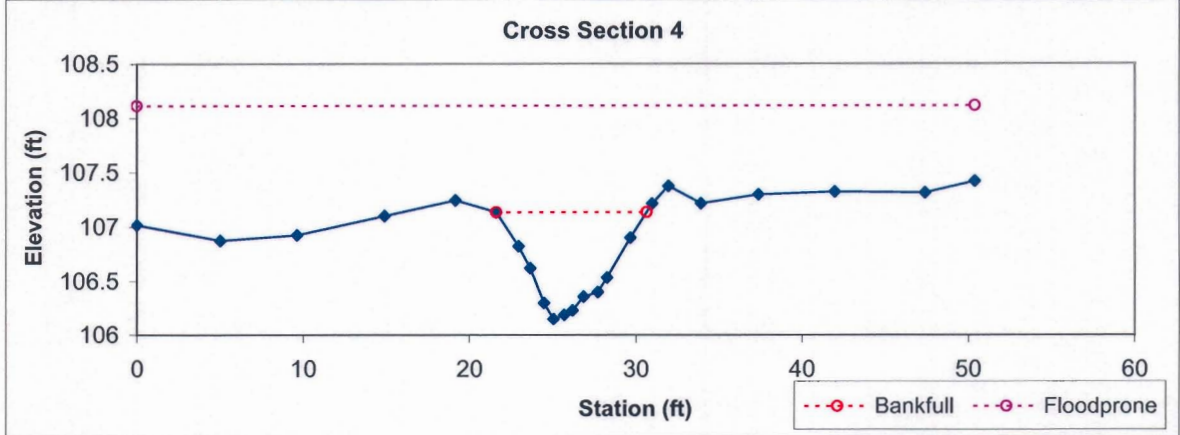


Feature	Stream Type	BKF Area	BKF Width	BKF Depth	Max BKF Depth	W/D	BH Ratio	ER	BKF Elev	TOB Elev
Pool		12.7	10.3	1.2	2.2	8.3	1.0	7.5	107.5	107.5

Cross Section 5

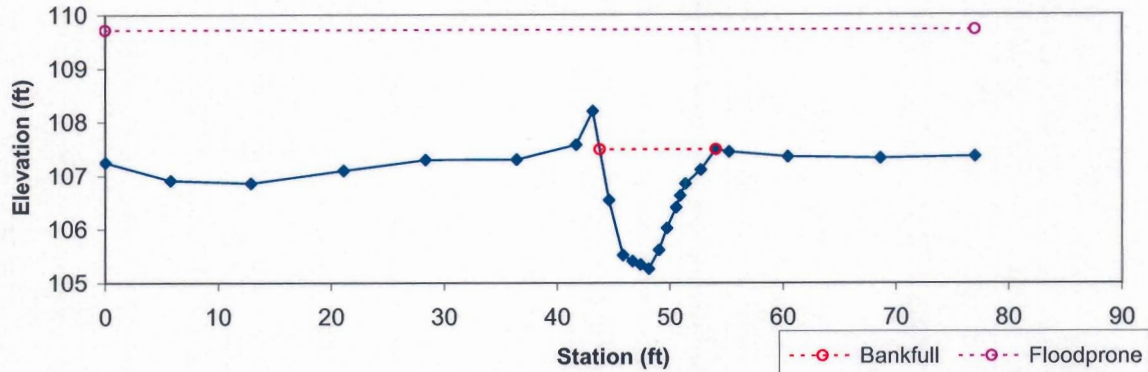


Feature	Stream Type	BKF Area	BKF Width	BKF Depth	Max BKF Depth	W/D	BH Ratio	ER	BKF Elev	TOB Elev
Pool		11.1	12.1	0.9	1.8	13.3	1.0	6.1	106.7	106.7

Cross Section 6

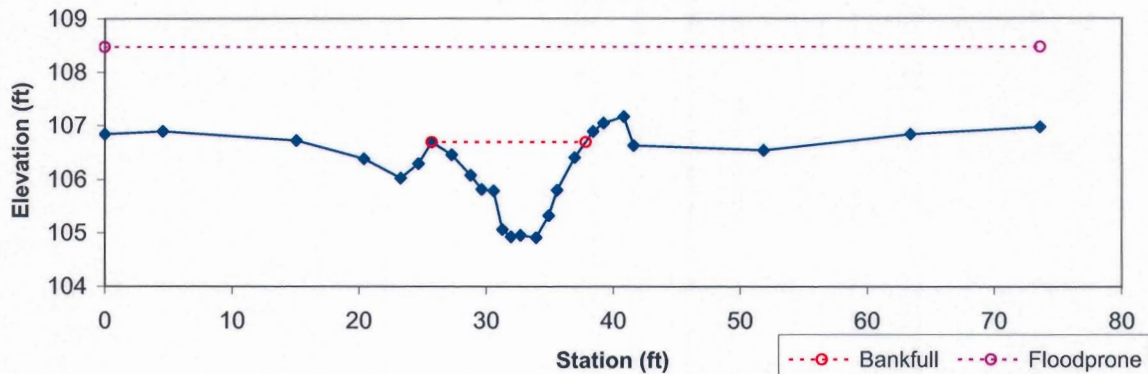


Feature	Stream Type	BKF Area	BKF Width	BKF Depth	Max BKF Depth	W/D	BH Ratio	ER	BKF Elev	TOB Elev
Riffle	C	9.2	12.1	0.8	1.3	15.9	1.0	4.5	106.4	106.4

Cross Section 7

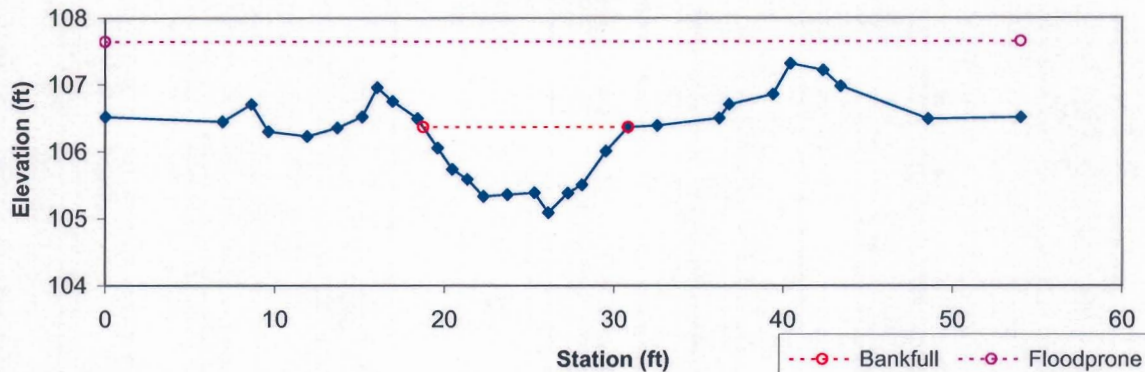


Feature	Stream Type	BKF Area	BKF Width	BKF Depth	Max BKF Depth	W/D	BH Ratio	ER	BKF Elev	TOB Elev
Pool		15.2	9.3	1.6	2.8	5.6	1.0	6.5	106.0	106.0


Cross Section 8

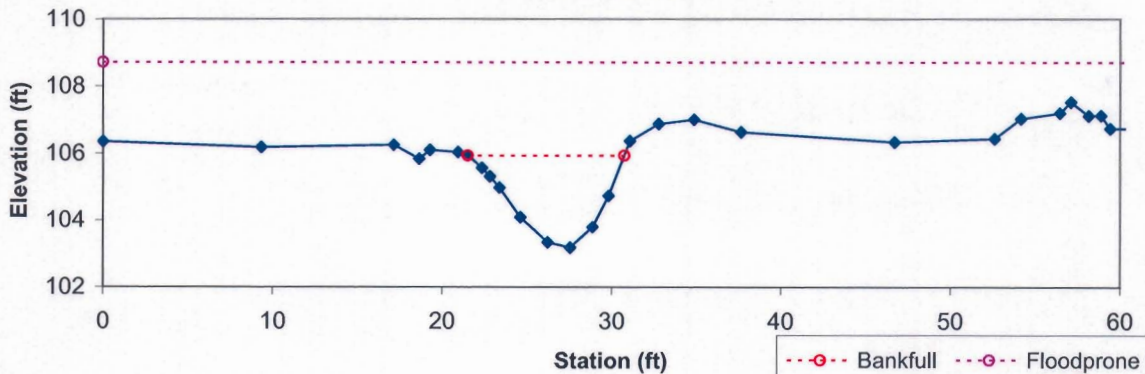

Feature	Stream Type	BKF Area	BKF Width	BKF Depth	Max BKF Depth	W/D	BH Ratio	ER	BKF Elev	TOB Elev
Riffle	C	1.8	5.2	0.3	0.5	15.1	1.0	9.3	105.4	105.4

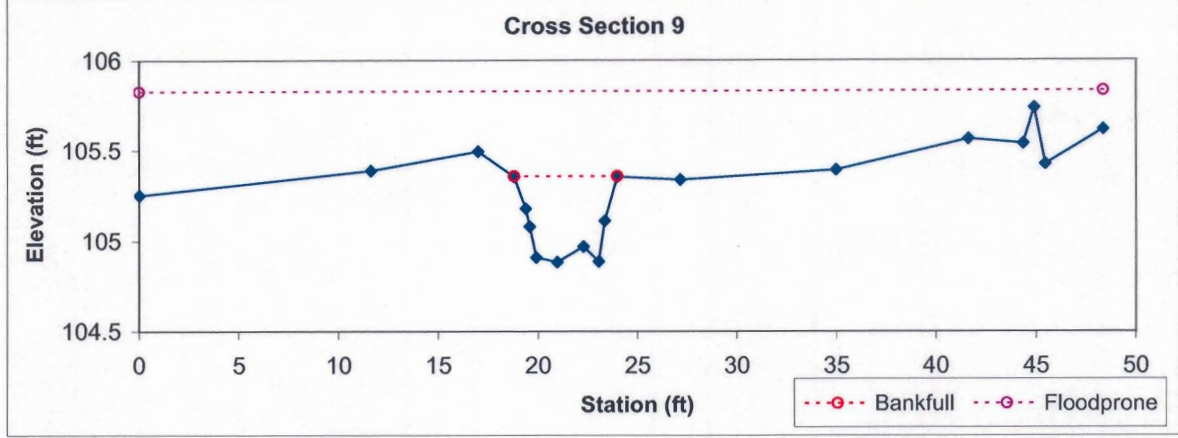


Feature	Stream Type	BKF Area	BKF Width	BKF Depth	Max BKF Depth	W/D	BH Ratio	ER	BKF Elev	TOB Elev
Riffle	C	6.3	10.9	0.6	1.3	18.9	1.0	5.1	105.6	105.6

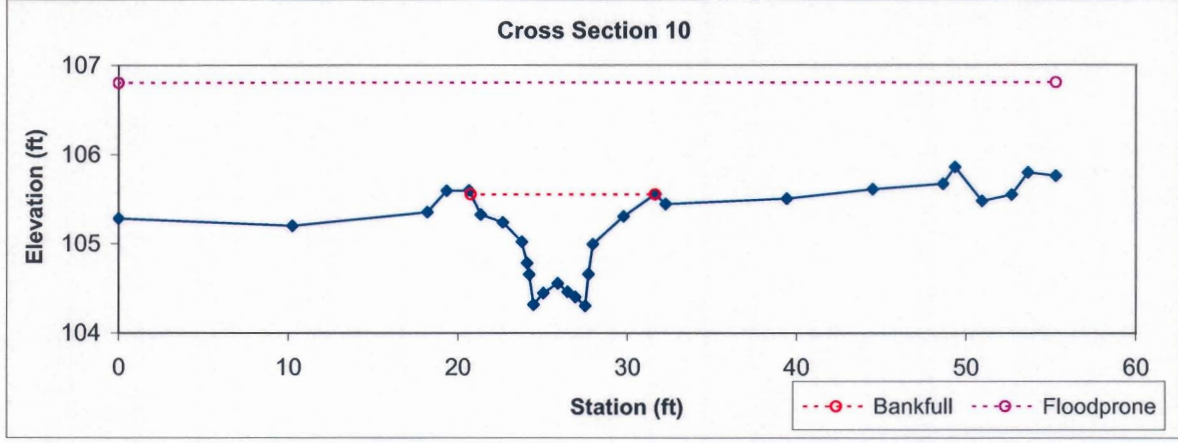


Feature	Stream Type	BKF Area	BKF Width	BKF Depth	Max BKF Depth	W/D	BH Ratio	ER	BKF Elev	TOB Elev
Pool		5.4	4.2	1.3	2.7	3.3	1.0	7.5	105.3	105.3

Cross Section 11

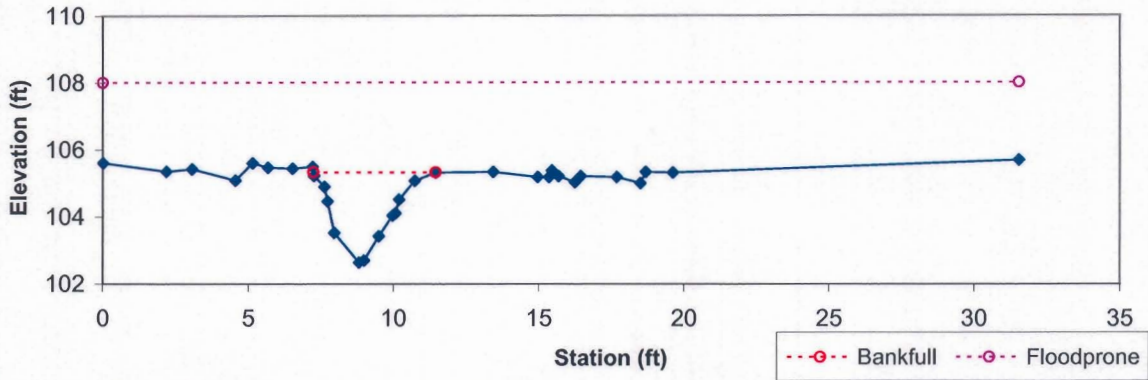


Feature	Stream Type	BKF Area	BKF Width	BKF Depth	Max BKF Depth	W/D	BH Ratio	ER	BKF Elev	TOB Elev
Riffle	C	4.4	11.0	0.4	0.9	27.5	1.0	7.2	104.2	104.2


Cross Section 12

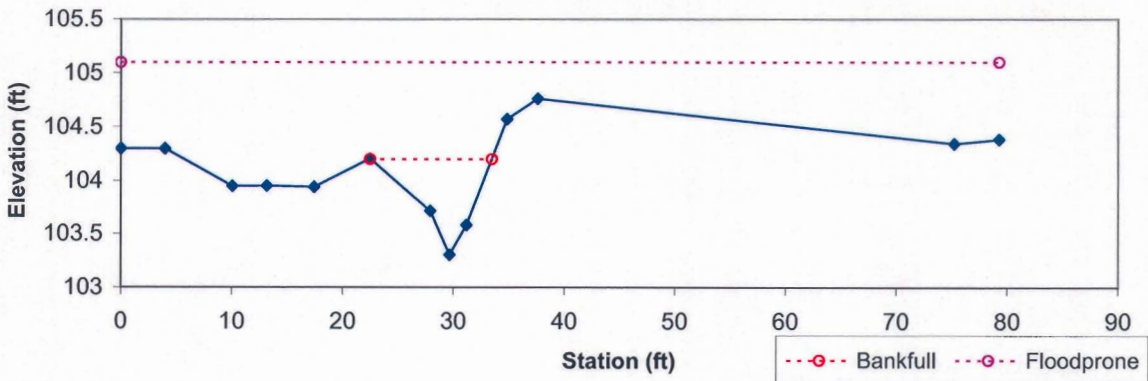


Feature	Stream Type	BKF Area	BKF Width	BKF Depth	Max BKF Depth	W/D	BH Ratio	ER	BKF Elev	TOB Elev
Pool		16.8	15.4	1.1	2.3	14.2	1.0	6.5	104.3	104.3

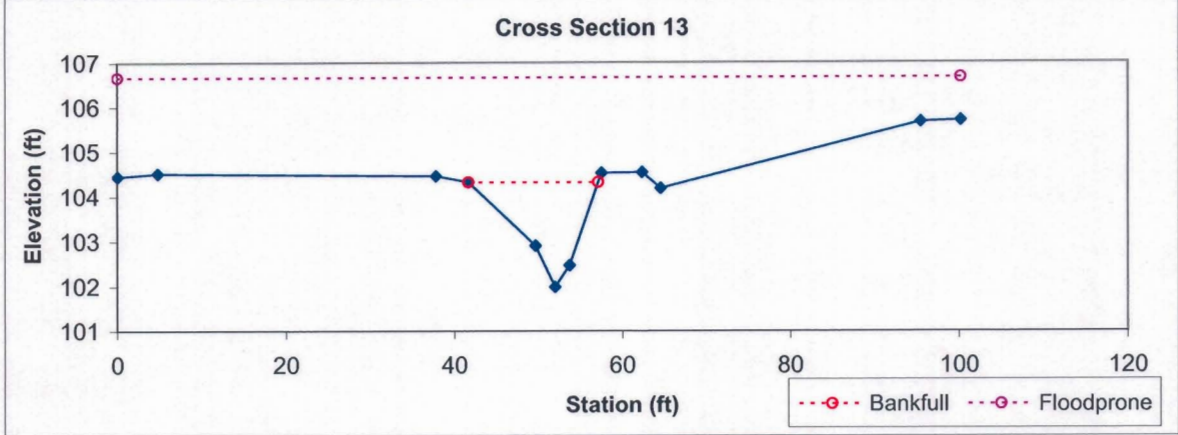


Feature	Stream Type	BKF Area	BKF Width	BKF Depth	Max BKF Depth	W/D	BH Ratio	ER	BKF Elev	TOB Elev
Riffle	C	7.9	15.0	0.5	1.3	28.4	1.0	5.7	103.9	103.9

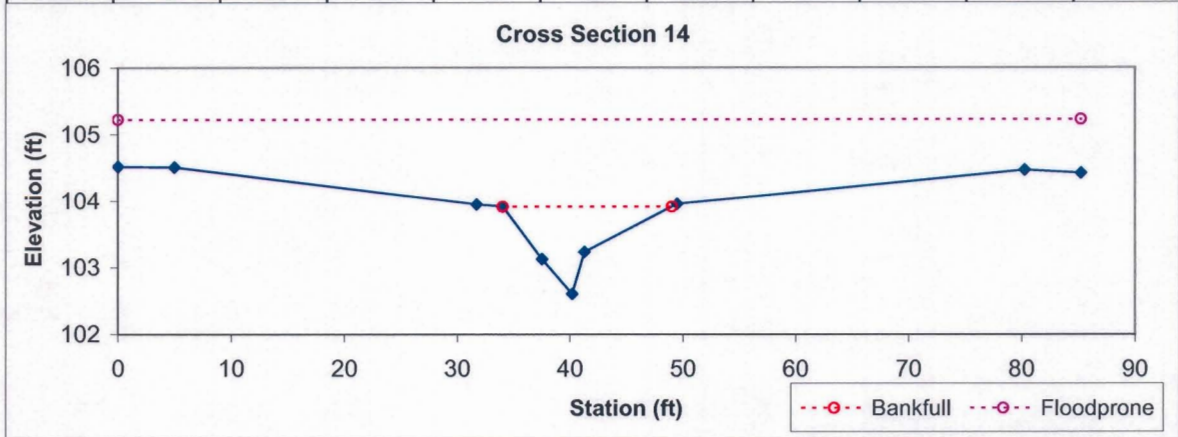

Gregory Profile Chart

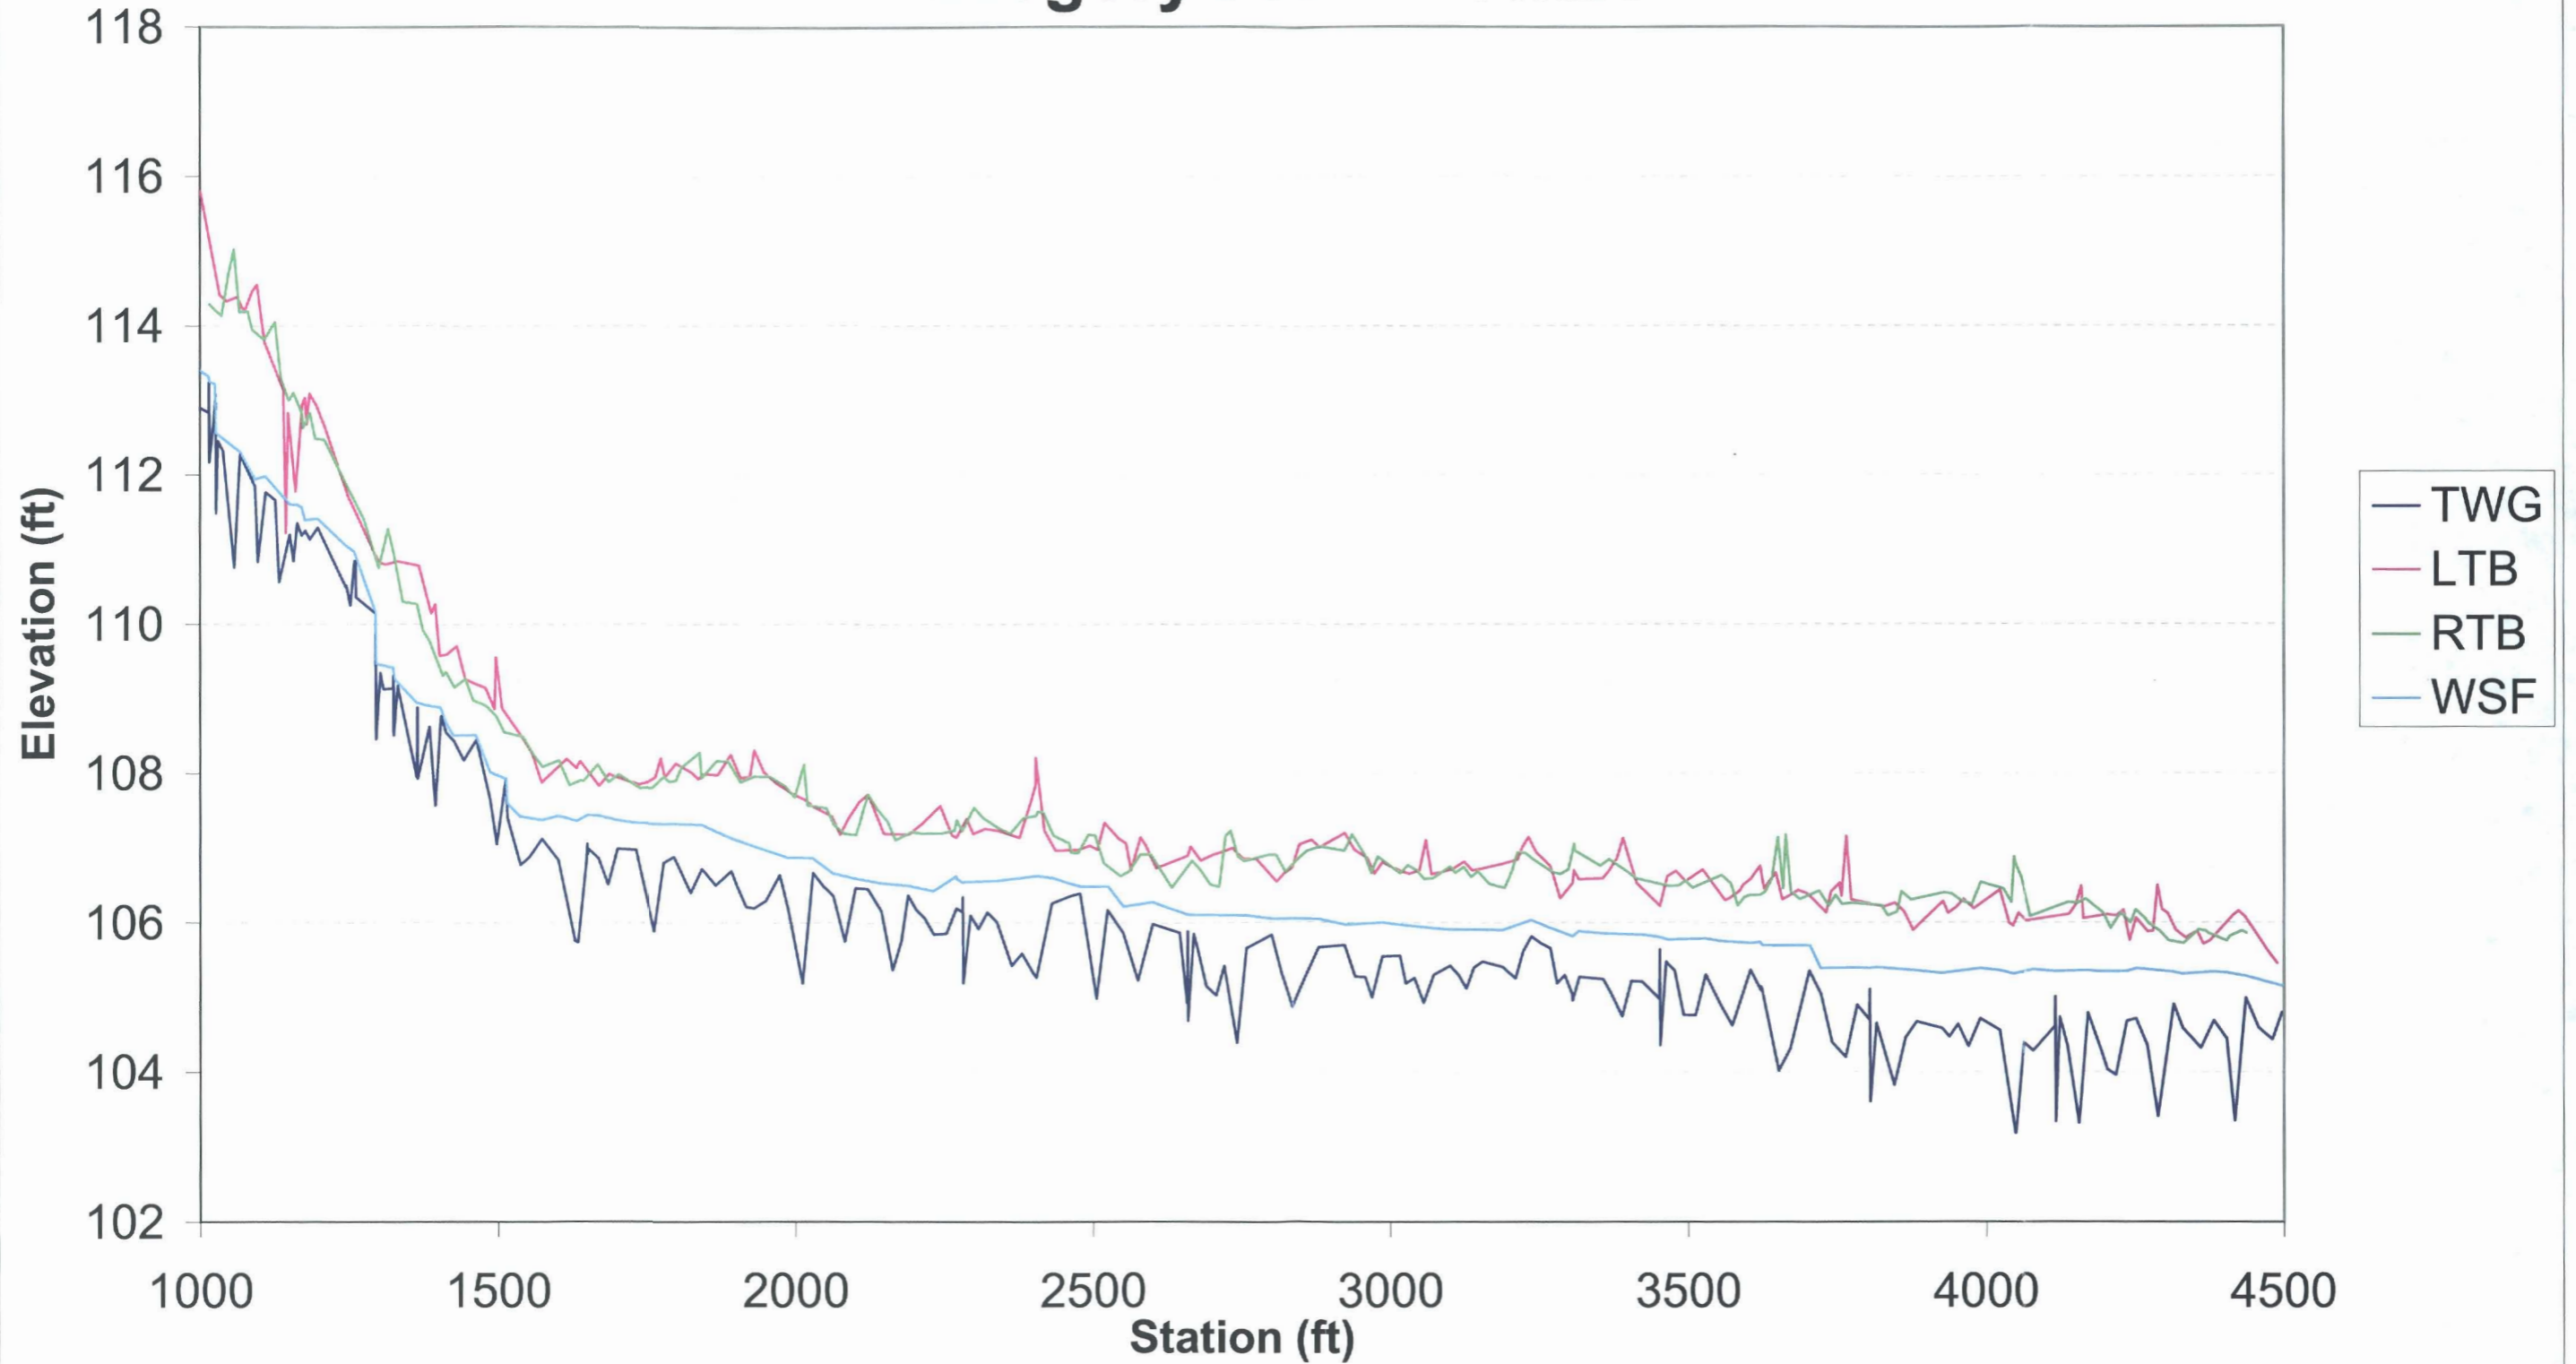

Gregory Profile Chart

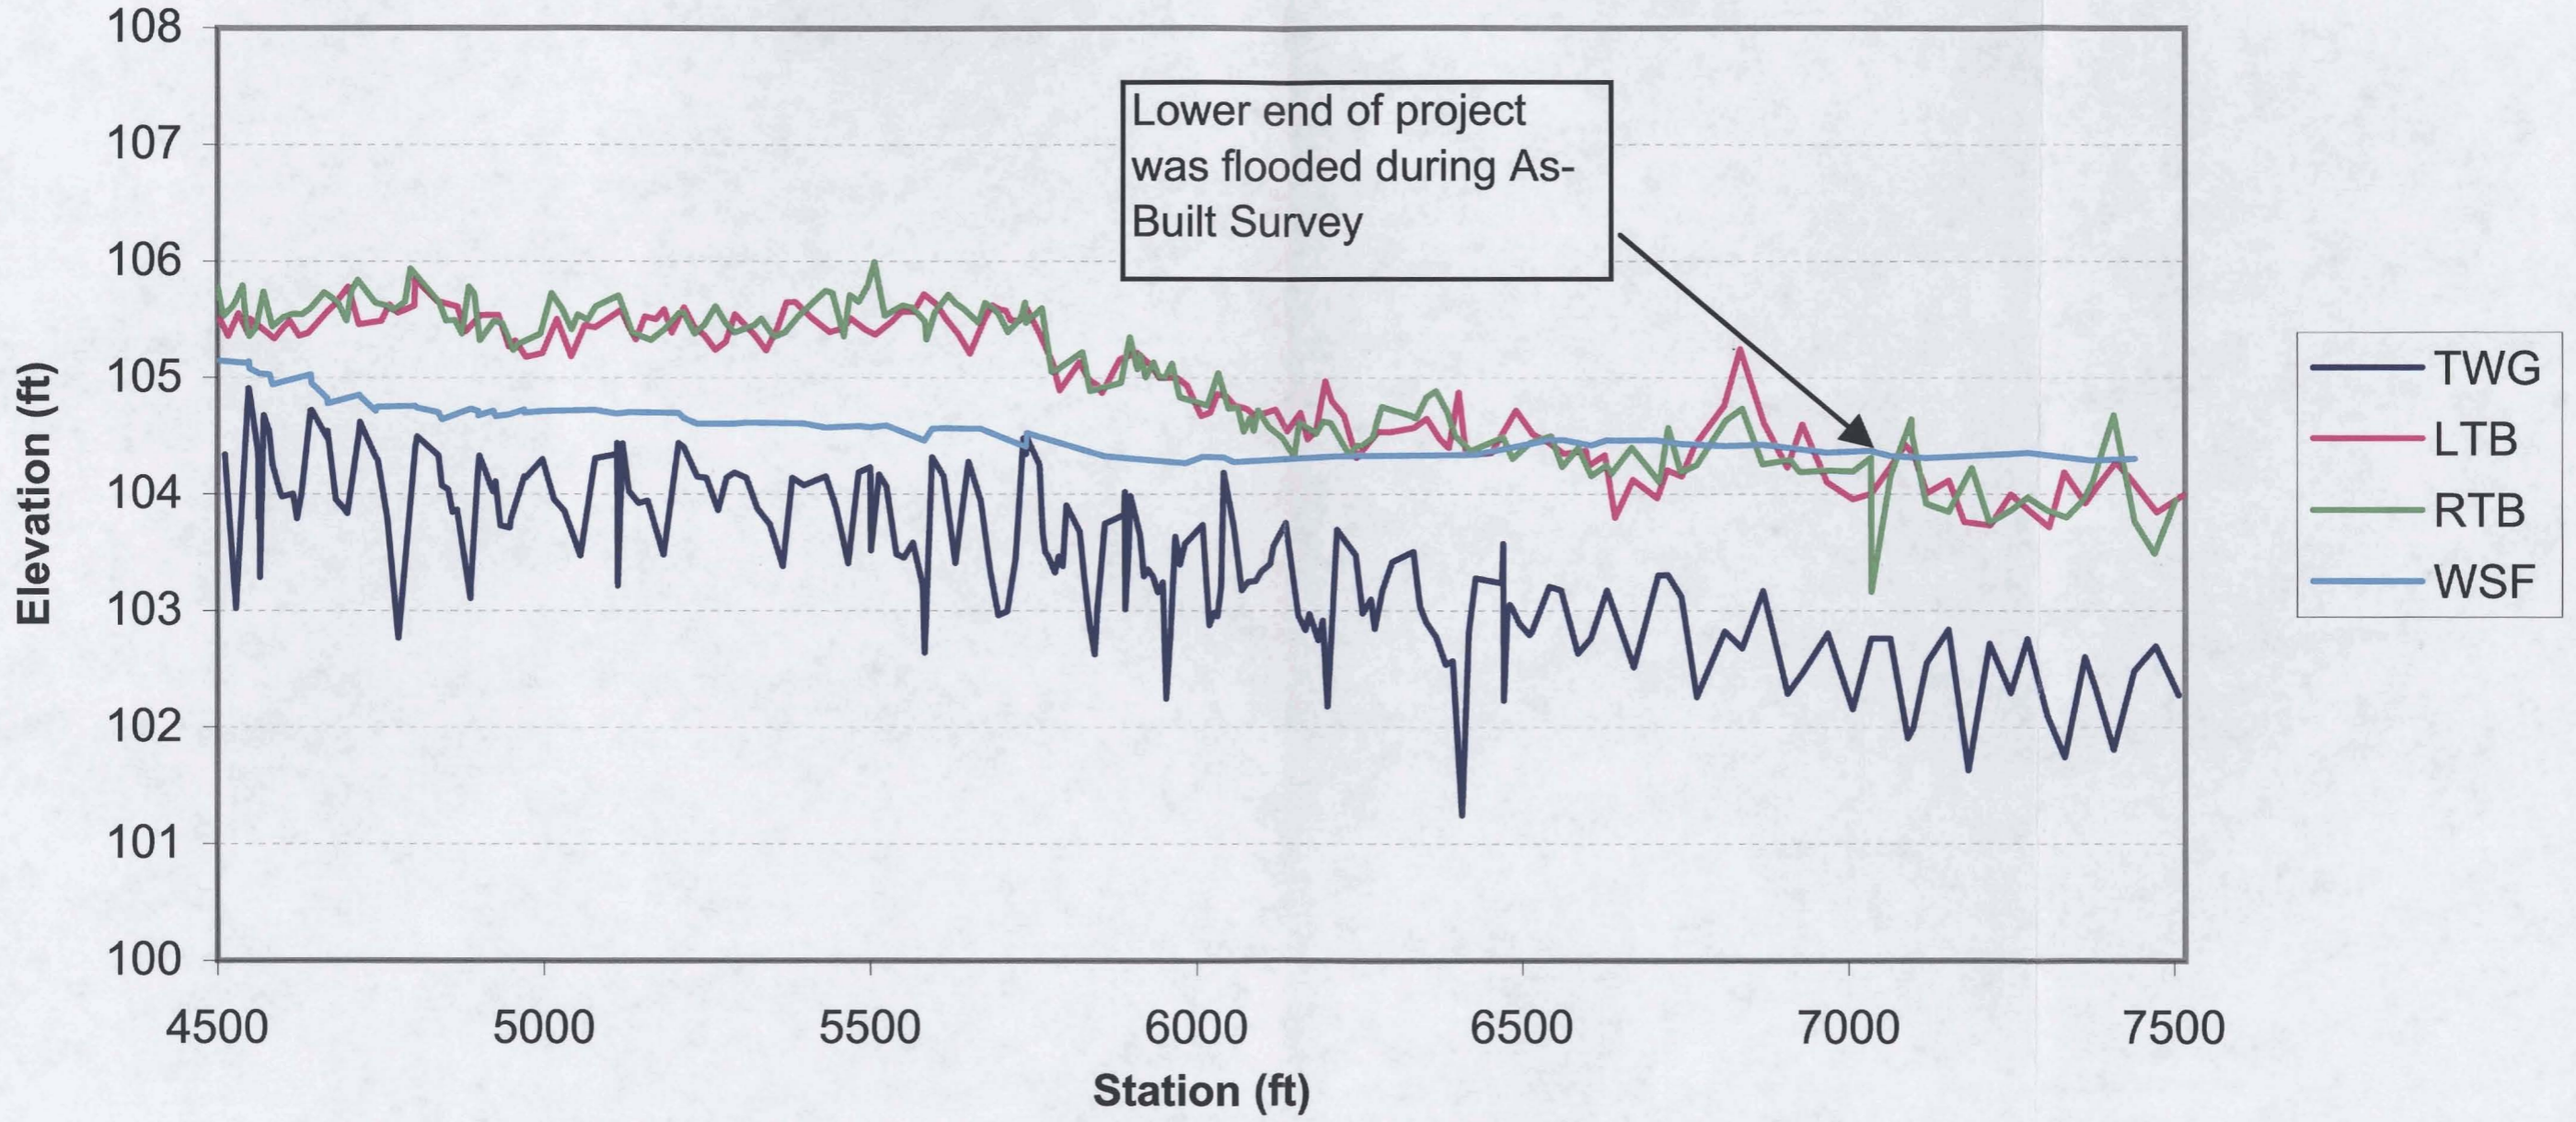


APPENDIX 3
AS-BUILT PLAN SHEETS

STATE	PROJECT REFERENCE NO.	SHEET NO.	TOTAL SHEETS
NC	170	1	12
NO.	DATE	CHECKED BY	APPROVED BY
1	06/03/06	JOHN HUTTON	KEVIN TWEEDY
1	06/10/06	DANIEL TAYLOR	DANIEL TAYLOR

**WETLAND & STREAM RESTORATION PROJECT
EBX NEUSE - I, LLC
GREGORY SITE**

HALIFAX COUNTY


LOCATION: OFF NCSR 561 NEAR HALIFAX
TYPE OF WORK: AS-BUILT

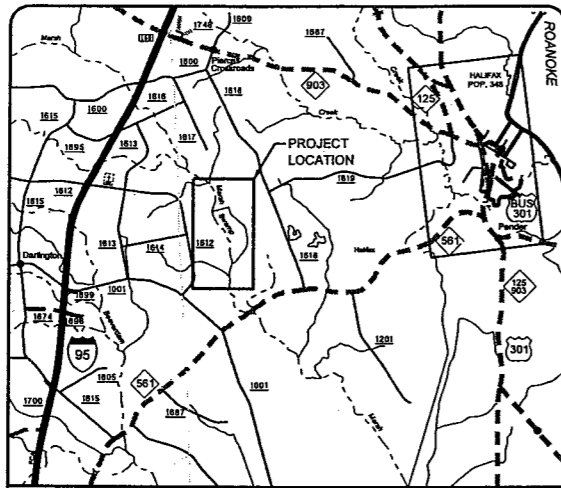

VICINITY MAP

INDEX OF SHEETS

- 1 TITLE SHEET
- 1-A SYMBOLOGY - BUCK ENGINEERING
VEGETATION SELECTION, AND
STANDARD SPECIFICATIONS
- 1-B SYMBOLOGY - NCDOT
- 2 TO 2-B STRUCTURE DETAILS
- 4 TO 9 AS-BUILT PLANS VIEWS
- 10-11 AS-BUILT GRADING PLANS

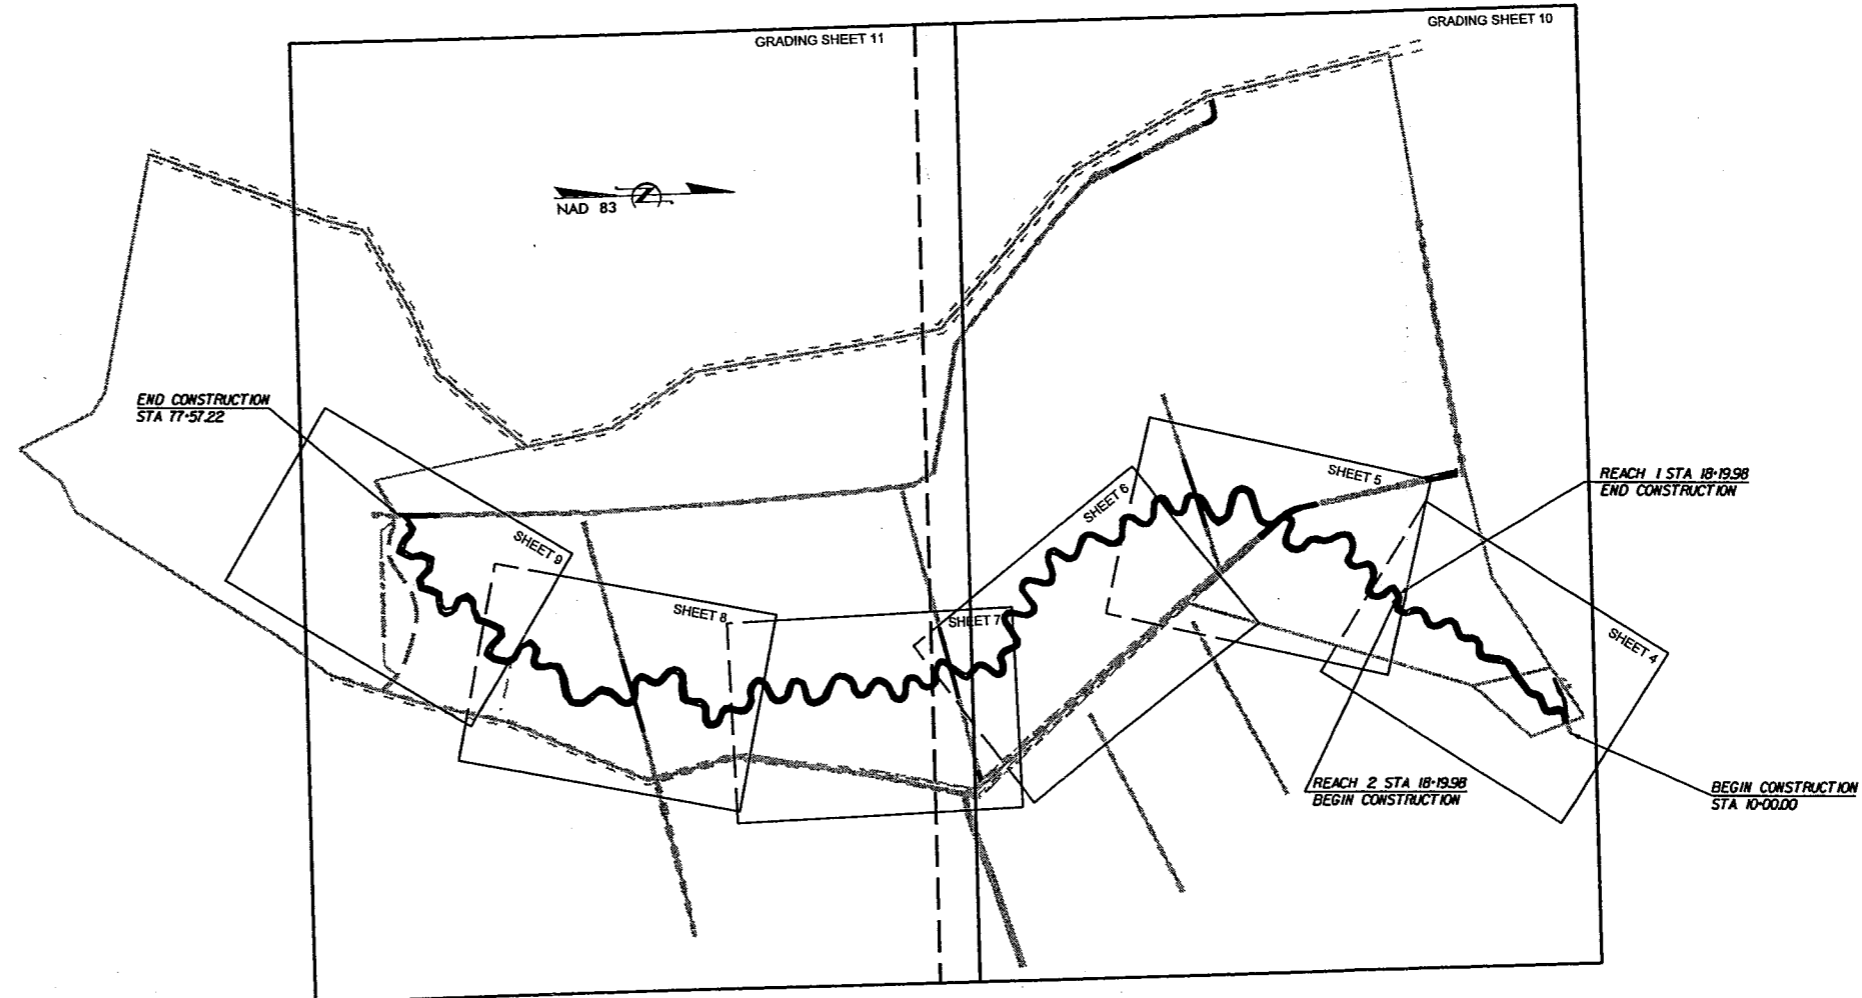

GREGORY SITE

PROJECT: 170

GRAPHIC SCALES



PROJECT SUMMARY

AS-BUILT STREAM LENGTH = 6757 FEET
AS-BUILT RESTORED WETLAND = 85.8 AC

PREPARED FOR THE OFFICE OF:

EBX NEUSE - I, LLC
220 CHATHAM BUSINESS DRIVE
PITTSBORO, NC 27312



EBX CONTACT:
TARA DISY ALDEN
PROJECT MANAGER

PREPARED IN THE OFFICE OF:



8000 Regency Parkway Suite 200
Cary, North Carolina 27511
Phone: 919-463-5468
Fax: 919-463-5490

JAN. 2005
COMPLETION DATE:

JOHN HUTTON
PROJECT MANAGER


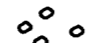

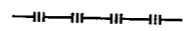
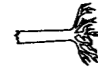
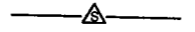












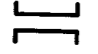


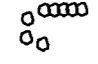


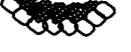

KEVIN TWEEDY, PE
PROJECT ENGINEER

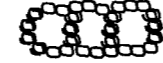PROJECT ENGINEER



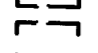


2/26/03

STREAM CONVENTIONAL SYMBOLS SUPERCEDES SHEET 1B

	LOG VANE		BOULDER CLUSTER
	LOG WEIR		SILT FENCE
	ROOT WAD		SAFETY FENCE
	LOG CROSS VANE		CONSERVATION EASEMENT
	J-HOOK		TRANSPLANTED VEGETATION
	ROCK VANE		ROCK STEP POOL
	TEMPORARY SILT CHECK		TREE REMOVAL
	FOOT BRIDGE		TREE PROTECTION
	TEMPORARY STREAM CROSSING		PLAY GROUND EQUIPMENT
	PERMANENT STREAM CROSSING		CONSTRUCTED RIFFLE
	ROCK CROSS VANE		TRANSPLANTS
	WING DEFLECTOR		FILL EXISTING CHANNEL
	DOUBLE WING DEFLECTOR		CONTROL POINT

VEGETATION SELECTION

BARE ROOT/CONTAINERIZED VEGETATION			
NOTE: CONTAINERIZED AND BARE ROOT VEGETATION SHALL BE INSTALLED RANDOMLY AT A RATE OF 680/ACRE FROM THE TOP OF THE STREAMBANK OUT TO THE EDGE OF REVEGETATION LIMITS			
COMMON NAME	SCIENTIFIC NAME	QUANTITY	Percentages
WILLOW OAK	QUERCUS PHELLOS	9700	14.2
SWAMP CHESTNUT OAK	QUERCUS MICHAUXII	9700	14.2
LAUREL OAK	QUERCUS LAURIFOLIA	9700	14.2
OVERCUP OAK	QUERCUS LYRATA	9700	14.2
BLACKGUM	NYSSA SYLVATICA	9700	14.2
SWAMP BLACKGUM	NYSSA BIFLORA	4850	7.1
GREEN ASH	FRAXINUS PENNSYLVANICA	10000	14.7
BALD CYPRESS	TAXODIUM DISTICHUM	4850	7.1
Total		68200	100.0
STREAMBANK PLANTING			
NOTE: LIVE STAKES SHALL BE INSTALLED RANDOMLY 2 TO 3 FEET APART ALONG THE STREAMBANKS FROM THE TOE OF THE BANK TO THE TOP OF BANK.			
COMMON NAME	SCIENTIFIC NAME		
BUTTONBUSH	CEPHALANTHUS OCCIDENTALIS		
SILKY WILLOW	SALIX SERICEA		
TEMPORARY SEED MIX			
NOTE: ALL DISTURBED AREAS WILL BE STABILIZED USING MULCH AND TEMPORARY SEED MIX			
COMMON NAME	RATE	PLANTING DATES	
ANNUAL RYE (COOL SEASON)	130 LBS/ACRE	SEPTEMBER TO MARCH	
MILLET (WARM SEASON)	45 LBS/ACRE	APRIL TO AUGUST	
RIPARIAN SEED MIX (PERMANENT)			
NOTE: RIPARIAN SEED MIX SHALL BE SEEDED AT A RATE OF 1/2 LB PER 1000 FT ² ALONG THE STREAMBANKS FROM THE TOE OF THE BANK TO THE TOP OF BANK.			
COMMON NAME	SCIENTIFIC NAME		
VIRGINIA WILDRYE	ELYMUS VIRGINICUS		
SWITCHGRASS	PANICUM VIRGATUM		
FOX SEDGE	CAREX VULPINOIDEA		
AMENDMENTS			
TYPE	RATE		
MULCHING	10 BALES PER 1000 FT ²		

PROJECT REFERENCE NO. 170	SHEET NO. 1-A
PROJECT ENGINEER	
	
APPROVED BY:  DATE: 5-24-05	
	

STANDARD SPECIFICATIONS

EROSION AND SEDIMENT CONTROL PLANNING AND DESIGN MANUAL DECEMBER 1993

- 6.60 TEMPORARY SEDIMENT TRAP
- 6.06 CONSTRUCTION ACCESS
- 6.62 SILT FENCE
- 6.70 TEMPORARY STREAM CROSSING (CULVERTED)

GENERAL NOTES

- The Contractor is required to install instream structures using a track hoe with a hydraulic thumb of sufficient size to move boulders 3ft X 3ft X 2ft (approximately 2 tons).
- The Contractor will be required to provide, at a minimum, two operators at all times during construction of the new stream channel. In general, one operator will cut the new channel with a track hoe, while the other operator follows and installs instream structures, bank stabilization practices, and transplants. During construction of the new stream channel, the contractor will be required to have two track hoes and one loader on-site.
- Construction is scheduled to begin October 2004.

S:\8\2005\Design\Plans\0170R-EBX_sya_1a.dgn
 5/18/2005 11:07:28 AM

STATE OF NORTH CAROLINA
DIVISION OF HIGHWAYS

CONVENTIONAL SYMBOLS

*S.U.E = SUBSURFACE UTILITY ENGINEER

ROADS & RELATED ITEMS

Edge of Pavement	----
Curb	----
Prop. Slope Stakes Cut	-----C-----
Prop. Slope Stakes Fill	-----F-----
Prop. Woven Wire Fence	○-----○
Prop. Chain Link Fence	□-----□
Prop. Barbed Wire Fence	◇-----◇
Prop. Wheelchair Ramp	WCR
Curb Cut for Future Wheelchair Ramp	CCFR
Exist. Guardrail	-----
Prop. Guardrail	-----
Equality Symbol	⊕
Pavement Removal	XXXXXX

RIGHT OF WAY

Baseline Control Point	◆
Existing Right of Way Marker	△
Exist. Right of Way Line wMarker	-----△-----
Prop. Right of Way Line with Proposed	-----▲-----
R/W Marker (Iron Pin & Cap)	▲
Prop. Right of Way Line with Proposed (Concrete or Granite) RW Marker	▲
Exist. Control of Access Line	○
Prop. Control of Access Line	○
Exist. Easement Line	-----E-----
Prop. Temp. Construction Easement Line	-----E-----
Prop. Temp. Drainage Easement Line	-----TDE-----
Prop. Perm. Drainage Easement Line	-----PDE-----

HYDROLOGY

Stream or Body of Water	-----
River Basin Buffer	-----RBB-----
Flow Arrow	→
Disappearing Stream	-----
Spring	○
Swamp Marsh	-----
Shoreline	-----
Falls, Rapids	-----
Prop Lateral, Tail, Head Ditches	-----

STRUCTURES

MAJOR	
Bridge, Tunnel, or Box Culvert	-----CONC-----
Bridge Wing Wall, Head Wall and End Wall	-----CONC WW-----

MINOR	
Head & End Wall	-----CONC HW-----
Pipe Culvert	=====
Footbridge	-----
Drainage Boxes	-----
Paved Ditch Gutter	-----CB-----

UTILITIES

Exist. Pole	•
Exist. Power Pole	○
Prop. Power Pole	○
Exist. Telephone Pole	○
Prop. Telephone Pole	○
Exist. Joint Use Pole	+
Prop. Joint Use Pole	+
Telephone Pedestal	□
UG Telephone Cable Hand Hold	□
Cable TV Pedestal	□
UG TV Cable Hand Hold	□
UG Power Cable Hand Hold	□
Hydrant	◆
Satellite Dish	◆
Exist. Water Valve	⊗
Sewer Clean Out	⊗
Power Manhole	⊕
Telephone Booth	⊕
Cellular Telephone Tower	⊕
Water Manhole	⊕
Light Pole	⊕
H-Frame Pole	⊕
Power Line Tower	⊕
Pole with Base	⊕
Gas Valve	⊕
Gas Meter	⊕
Telephone Manhole	⊕
Power Transformer	⊕
Sanitary Sewer Manhole	⊕
Storm Sewer Manhole	⊕
Tank; Water, Gas, Oil	⊕
Water Tank With Legs	⊕
Traffic Signal Junction Box	⊕
Fiber Optic Splice Box	⊕
Television or Radio Tower	⊕
Utility Power Line Connects to Traffic Signal Lines Cut Into the Pavement	-----TS-----

Recorded Water Line	-----
Designated Water Line (S.U.E.*)	-----
Sanitary Sewer	-----SS-----
Recorded Sanitary Sewer Force Main	-----FSS-----
Designated Sanitary Sewer Force Main(S.U.E.*)	-----FSS-----
Recorded Gas Line	-----G-----
Designated Gas Line (S.U.E.*)	-----G-----
Storm Sewer	-----S-----
Recorded Power Line	-----P-----
Designated Power Line (S.U.E.*)	-----P-----
Recorded Telephone Cable	-----T-----
Designated Telephone Cable (S.U.E.*)	-----T-----
Recorded U/G Telephone Conduit	-----TC-----
Designated U/G Telephone Conduit (S.U.E.*)	-----TC-----
Unknown Utility (S.U.E.*)	-----TUTL-----
Recorded Television Cable	-----TV-----
Designated Television Cable (S.U.E.*)	-----TV-----
Recorded Fiber Optics Cable	-----FO-----
Designated Fiber Optics Cable (S.U.E.*)	-----FO-----
Exist. Water Meter	○
UG Test Hole (S.U.E.*)	⊗
Abandoned According to U/G Record	ATTUR
End of Information	E.O.I.

BOUNDARIES & PROPERTIES

State Line	-----
County Line	-----
Township Line	-----
City Line	-----
Reservation Line	-----
Property Line	-----
Property Line Symbol	POP
Exist. Iron Pin	○
Property Corner	+
Property Monument	⊕
Property Number	⊕
Parcel Number	⊕
Fence Line	-----X-----
Existing Wetland Boundaries	-----WW & ISBW-----
High Quality Wetland Boundary	-----HO WLB-----
Medium Quality Wetland Boundaries	-----MO WLB-----
Low Quality Wetland Boundaries	-----LO WLB-----
Proposed Wetland Boundaries	-----WLB-----
Existing Endangered Animal Boundaries	-----EAB-----
Existing Endangered Plant Boundaries	-----EPB-----

BUILDINGS & OTHER CULTURE

Buildings	-----
Foundations	-----
Area Outline	-----
Gate	-----
Gas Pump Vent or U/G Tank Cap	-----
Church	-----
School	-----
Park	-----
Cemetery	-----
Dam	-----
Sign	-----
Well	-----
Small Mine	-----
Swimming Pool	-----

TOPOGRAPHY

Loose Surface	-----
Hard Surface	-----
Change in Road Surface	-----
Curb	-----
Right of Way Symbol	R/W
Guard Post	⊕ GP
Paved Walk	-----
Bridge	-----
Box Culvert or Tunnel	-----
Ferry	-----
Culvert	-----
Footbridge	-----
Trail, Footpath	-----
Light House	-----

VEGETATION


Single Tree	-----
Single Shrub	-----
Hedge	-----
Woods Line	-----
Orchard	-----
Vineyard	-----

RAILROADS

Standard Gauge	-----
RR Signal Milepost	-----
Switch	-----

2/26/03

TYPICAL RIFFLE AND POOL FOR REACH 1 AND 2

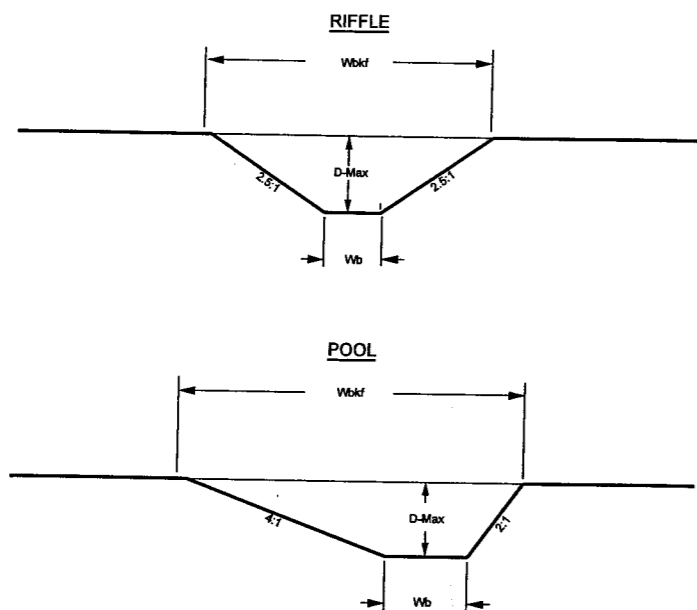

REACH 1		REACH 2		
RIFFLE	POOL	RIFFLE	POOL	
7.3'	8.9'	9.2'	11.9'	WIDTH OF BANKFULL (Wbkf)
0.6'	0.7'	0.7'	0.9'	AVERAGE DEPTH
0.9'	1.3'	0.9'	1.5'	MAXIMUM DEPTH (D-max)
12.0	12.2	14.0	13.1	WIDTH TO DEPTH RATIO (bkf WD)
4.5ft ²	6.5ft ²	6.0ft ²	10.8ft ²	BANKFULL AREA (Abkf)
3.0'	1.1'	4.9'	3.5'	BOTTOM WIDTH (Wb)

PROJECT REFERENCE NO. 170 SHEET NO. 2


PROJECT ENGINEER

APPROVED BY: *[Signature]*

DATE: 5-24-08

BUCK ENGINEERING


8000 Regency Parkway Suite 200
Cary, North Carolina 27511
Phone: 919-463-5488
Fax: 919-463-5490

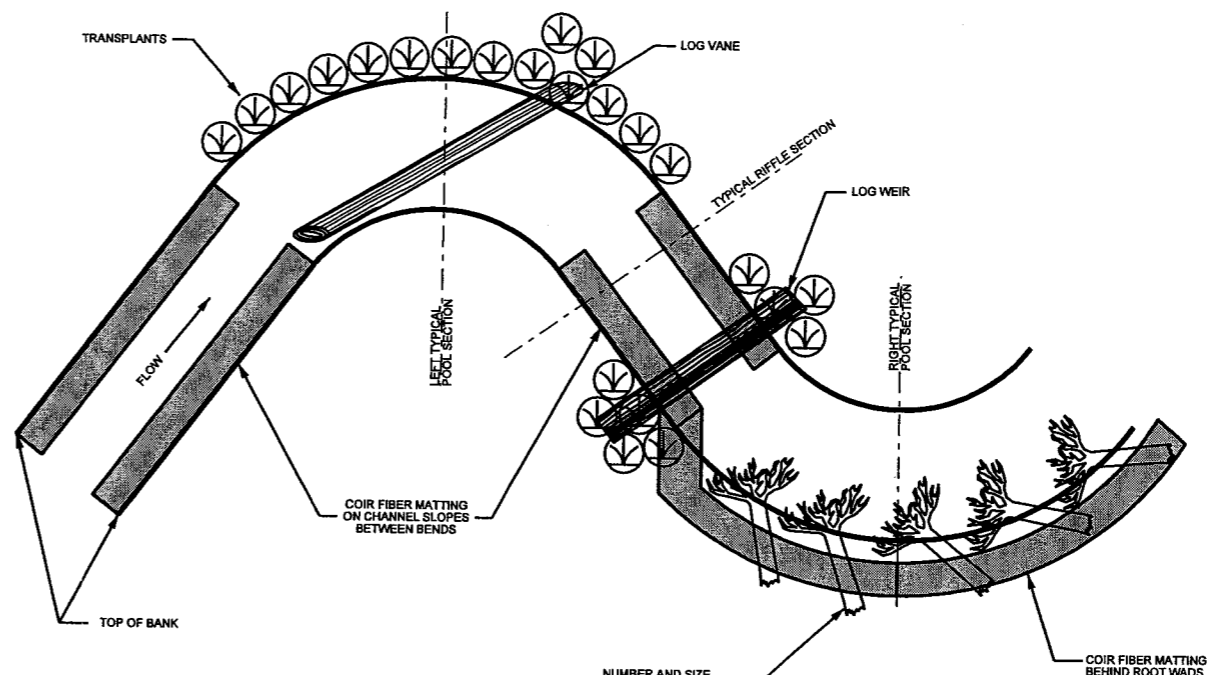


GENERALLY LOG WEIRS, ROOT WADS, LOG VANES, MATTING AND TRANSPLANTS WILL BE INSTALLED IN THE LOCATIONS AND SEQUENCE AS SHOWN. ADDITIONAL STRUCTURES OR CHANGES TO STRUCTURE LOCATIONS MAY BE MADE BY THE ENGINEER DURING CONSTRUCTION.

NUMBER AND SIZE OF ROOT WADS TO BE DETERMINED BY THE ENGINEER

ROOT WADS WITHOUT TRANSPLANTS
NTS

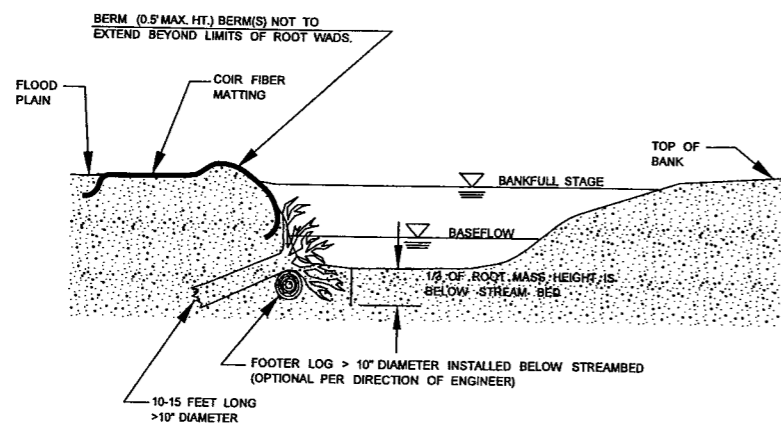


CROSS SECTION VIEW

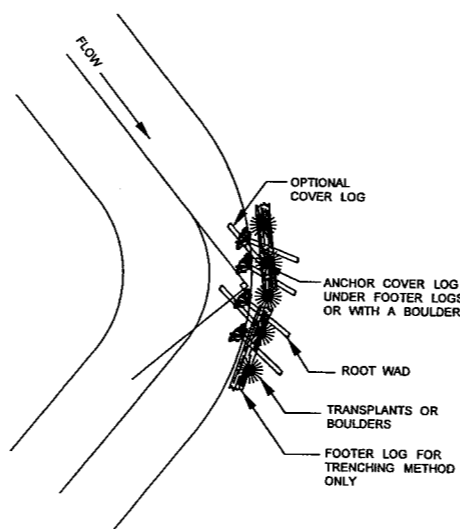

PLAN VIEW

ROOT WADS WITH TRANSPLANTS
NTS

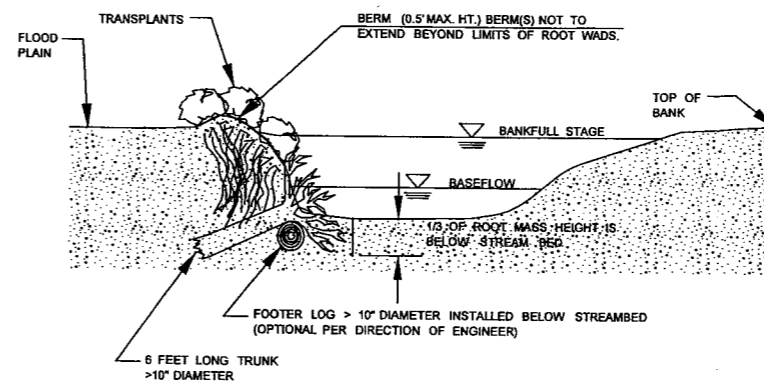



CROSS SECTION VIEW

NOTES:
TRENCHING METHOD:
IF THE ROOT WAD CANNOT BE DRIVEN INTO THE BANK OR THE BANK NEEDS TO BE RECONSTRUCTED, THE TRENCHING METHOD SHOULD BE USED. THIS METHOD REQUIRES THAT A TRENCH BE EXCAVATED FOR THE LOG PORTION OF THE ROOT WAD. IN THIS CASE A FOOTER LOG SHOULD BE INSTALLED UNDERNEATH THE ROOT WAD IN A TRENCH EXCAVATED PARALLEL TO THE BANK AND WELL BELOW THE STREAMBED, ONE-THIRD OF THE ROOT WAD SHOULD REMAIN BELOW NORMAL BASE FLOW CONDITIONS.

NOTES:
DRIVE POINT METHOD:
SHARPEN THE END OF THE LOG WITH A CHAINSAW BEFORE "DRIVING" IT INTO THE BANK. ORIENT ROOT WADS UPSTREAM SO THAT THE STREAM FLOW MEETS THE ROOT WAD AT A 90-DEGREE ANGLE. DEFLECTING THE WATER AWAY FROM THE BANK A TRANSPLANT OR BOULDER SHOULD BE PLACED ON THE DOWNSTREAM SIDE OF THE ROOT WAD IF A BACK EDDY IS FORMED BY THE ROOT WAD. THE BOULDER SHALL BE APPROXIMATELY 4' X 3' X 2'.

5/18/2005
P:\170R\Design\Plans\170R_EBX_dte_02.dgn

CONSTRUCTED RIFFLE

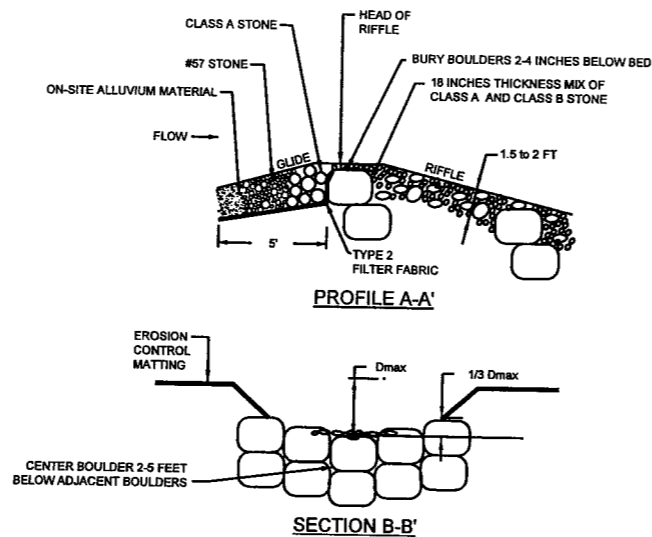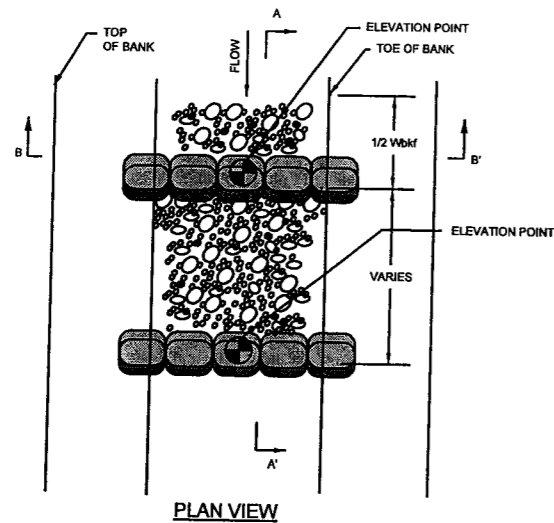



NOTES:

- BOULDERS MUST BE AT LEAST 3' x 3' x 2'.
- INSTALL FILTER FABRIC FOR DRAINAGE BEGINNING AT THE MIDDLE OF THE HEADER ROCKS AND EXTEND DOWNWARD TO THE DEPTH OF THE BOTTOM FOOTER ROCK, AND THEN UPSTREAM TO A MINIMUM OF FIVE FEET.
- DIG A TRENCH BELOW THE BED FOR FOOTER ROCKS AND PLACE FILL ON UPSTREAM SIDE OF VANE ARM, BETWEEN THE ARM AND STREAMBED.
- START AT BANK AND PLACE FOOTER ROCKS FIRST AND THEN HEADER (TOP) ROCK.
- CONTINUE WITH STRUCTURE, FOLLOWING ANGLE AND SLOPE SPECIFICATIONS.
- USE CLASS A STONE TO FILL GAPS ON UPSTREAM SIDE OF BOULDERS AND #57 STONE TO FILL GAPS ON UPSTREAM SIDE OF CLASS A STONE.
- AFTER ALL STONE HAS BEEN PLACED, FILL IN THE UPSTREAM SIDE OF THE STRUCTURE WITH ON-SITE ALLUVIUM TO THE ELEVATION OF THE TOP OF THE HEADER ROCK.

GREGORY SITE		
	REACH 1	REACH 2
WbKf (ft)	7.3	10.3
Dmax (ft)	0.9	1.0

CONSTRUCTED RIFFLE #	HEAD OF RIFFLE	ELEVATION	TAIL OF RIFFLE	ELEVATION
1	11+03.42	112.06	11+14.86	111.71
2	11+08.34	111.03	12+14.59	110.76
3	12+06.44	109.80	13+30.09	109.45
4	14+37.85	108.44	14+54.13	108.04
5	14+03.10	107.85	15+09.42	107.50
6	15+45.46	107.34	15+02.72	106.82
7	16+11.00	106.81	16+27.39	106.54
8	17+39.84	106.49	17+56.36	106.30



LOG VANE

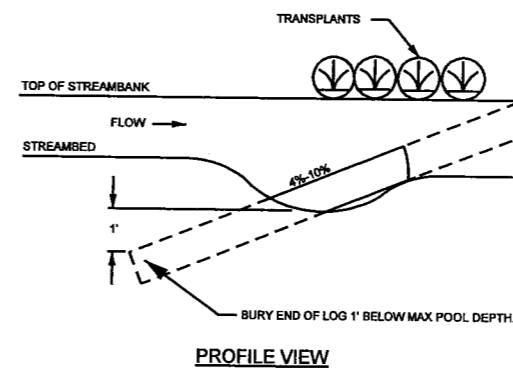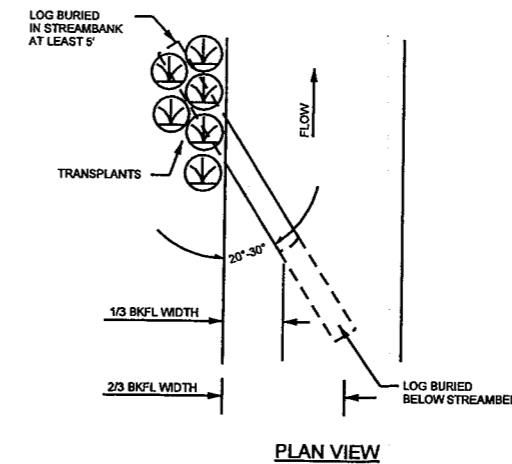

NOTES:


- LOGS SHOULD BE AT LEAST 12" INCHES IN DIAMETER, RELATIVELY STRAIGHT, HARDWOOD, AND RECENTLY HARVESTED.
- SOIL SHOULD BE COMPACTED WELL AROUND BURIED PORTIONS OF LOG.
- TRANSPLANTS ARE PLACED ALONG THE TOP OF THE BANK OVER THE BURIED LOG VANE TO PROTECT AGAINST EROSION DURING HIGH FLOWS.

LOG WEIR

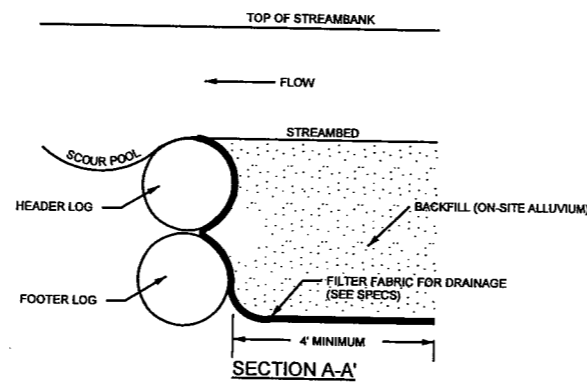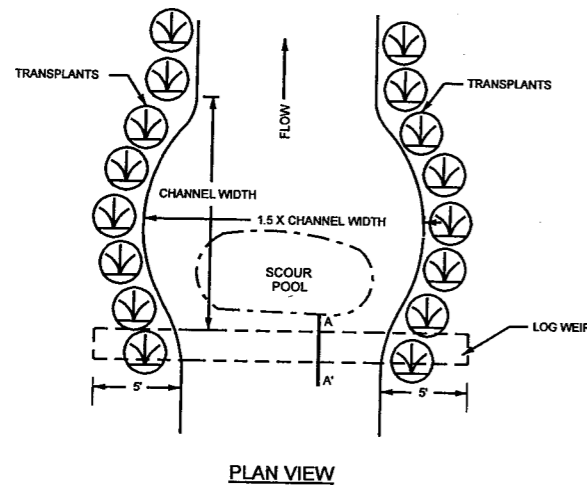


NOTES:

- LOGS SHOULD BE AT LEAST 10 INCHES IN DIAMETER, RELATIVELY STRAIGHT, HARDWOOD, AND RECENTLY HARVESTED.
- LOGS >20 INCHES IN DIAMETER MAY BE USED ALONE WITHOUT AN ADDITIONAL LOG. FILTER FABRIC SHOULD STILL BE USED TO SEAL AROUND LOG.
- TOP OF HEADER LOG SHOULD BE SET AT SAME ELEVATION AS THE STREAMBED.
- USE FILTER FABRIC FOR DRAINAGE TO SEAL GAPS BETWEEN LOGS.
- PLACE TRANSPLANTS FROM TOE OF STREAMBANK TO TOP OF STREAMBANK.

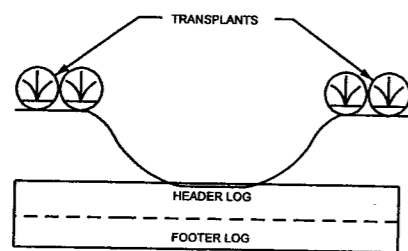

CROSS SECTION VIEW


TRANSPLANTED VEGETATION

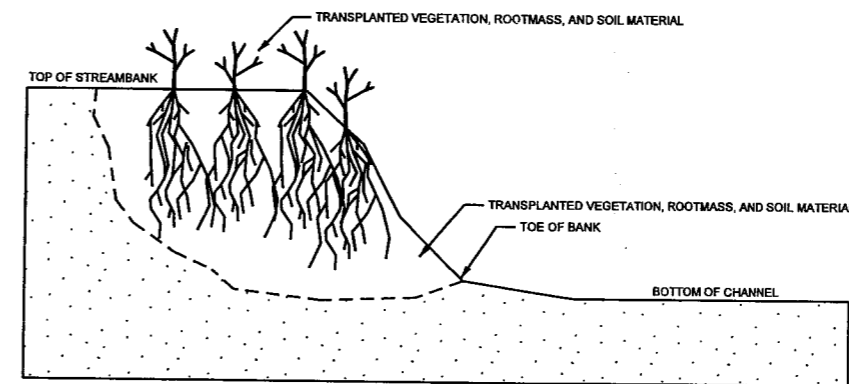

CROSS SECTION VIEW

NOTES:

- EXCAVATE A HOLE IN THE BANK TO BE STABILIZED THAT WILL ACCOMMODATE THE SIZE OF TRANSPLANT TO BE PLACED. BEGIN EXCAVATION AT THE TOE OF THE BANK.
- EXCAVATE TRANSPLANT USING A FRONT END LOADER. EXCAVATE THE ENTIRE ROOT MASS AND AS MUCH ADDITIONAL SOIL MATERIAL AS POSSIBLE. IF ENTIRE ROOT MASS CAN NOT BE EXCAVATED IN ONE BUCKET LOAD, THE TRANSPLANT IS TOO LARGE AND ANOTHER SHOULD BE SELECTED.
- PLACE TRANSPLANT IN THE BANK TO BE STABILIZED SO THAT VEGETATION IS ORIENTATED VERTICALLY.
- FILL IN ANY HOLES AROUND THE TRANSPLANT AND COMPACT.
- ANY LOOSE SOIL LEFT IN THE STREAM SHOULD BE REMOVED.
- PLACE MULTIPLE TRANSPLANTS CLOSE TOGETHER SUCH THAT THEY TOUCH.

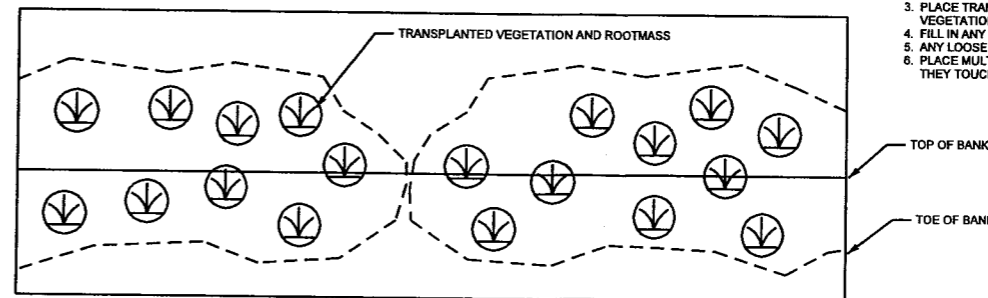


PLAN VIEW

PROJECT REFERENCE NO. 170	SHEET NO. 2-A
PROJECT ENGINEER	
APPROVED BY: <i>[Signature]</i>	
DATE: 5-24-05	
BUCK ENGINEERING 8000 Regency Parkway Suite 200 Cary, North Carolina 27511 Phone: 919-463-5488 Fax: 919-463-5490	


2/26/03

PLANTING SPECIFICATIONS

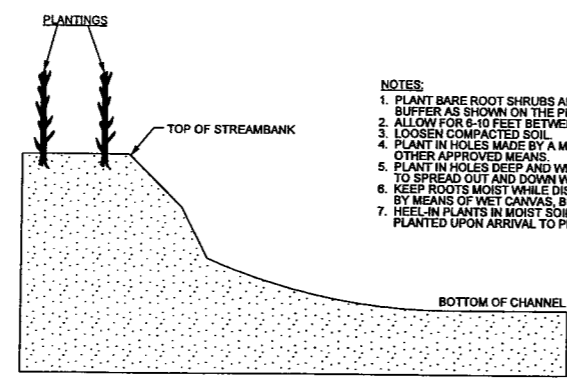

CROSS SECTION VIEW OF BARE ROOT PLANTING


- NOTES:**
1. PLANT BARE ROOT SHRUBS AND TREES TO THE WIDTH OF THE BUFFER AS SHOWN ON THE PLANS.
 2. ALLOW FOR 6-10 FEET BETWEEN PLANTINGS, DEPENDING ON SIZE.
 3. LOOSEN COMPACTED SOIL.
 4. PLANT IN HOLES MADE BY A MATTOCK, DIBBLE, PLANTING BAR, OR OTHER APPROVED MEANS.
 5. PLANT IN HOLES DEEP AND WIDE ENOUGH TO ALLOW THE ROOTS TO SPREAD OUT AND DOWN WITHOUT J-ROOTING.
 6. KEEP ROOTS MOIST WHILE DISTRIBUTING OR WAITING TO PLANT BY MEANS OF WET CANVAS, BURLAP, OR STRAW.
 7. HEEL-IN PLANTS IN MOIST SOIL OR SAWDUST IF NOT PROMPTLY PLANTED UPON ARRIVAL TO PROJECT SITE.

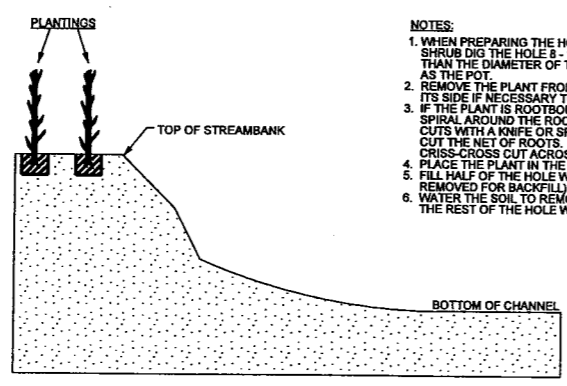

CROSS SECTION VIEW OF CONTAINER PLANTING

- NOTES:**
1. WHEN PREPARING THE HOLE FOR A POTTED PLANT OR SHRUB DIG THE HOLE 8 - 12 INCHES LARGER THAN THE DIAMETER OF THE POT AND THE SAME DEPTH AS THE POT.
 2. REMOVE THE PLANT FROM THE POT. LAY THE PLANT ON ITS SIDE IF NECESSARY TO REMOVE THE POT.
 3. IF THE PLANT IS ROOTBOUND (ROOTS GROWING IN A SPIRAL AROUND THE ROOT BALL), MAKE VERTICAL CUTS WITH A KNIFE OR SPADE JUST DEEP ENOUGH TO CUT THE NET OF ROOTS. ALSO MAKE A CRISS-CROSS CUT ACROSS THE BOTTOM OF THE BALL.
 4. PLACE THE PLANT IN THE HOLE.
 5. FILL HALF OF THE HOLE WITH SOIL (SAME SOIL REMOVED FOR BACKFILL).
 6. WATER THE SOIL TO REMOVE AIR POCKETS AND FILL THE REST OF THE HOLE WITH THE REMAINING SOIL.

CATTLE PATH

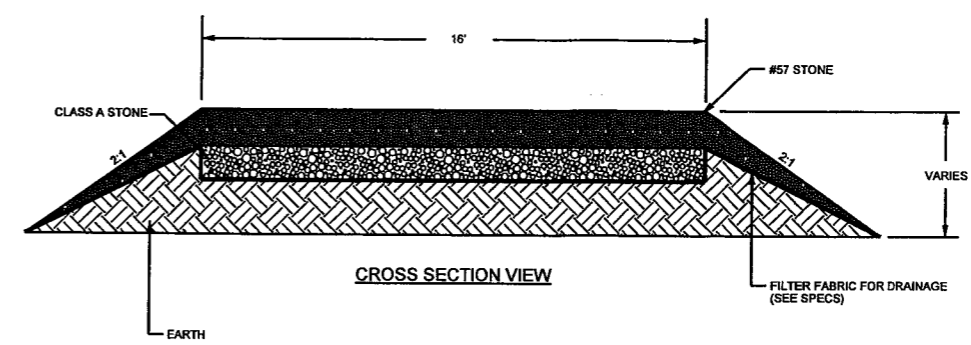


CROSS SECTION VIEW


- NOTES:**
1. PLACE 6 INCHES OF #57 STONE ON TOP OF 6 INCHES OF CLASS A STONE THEN SLOPE BANKS AT A 2:1 SLOPE.

PROJECT REFERENCE NO. 170	SHEET NO. 2-B
PROJECT ENGINEER	
APPROVED BY:	
DATE: 5-24-05	
<small>8000 Regency Parkway Suite 200 Cary, North Carolina 27511 Phone: 919-463-5488 Fax: 919-463-5490</small>	


LIVE STAKING SPECIFICATION

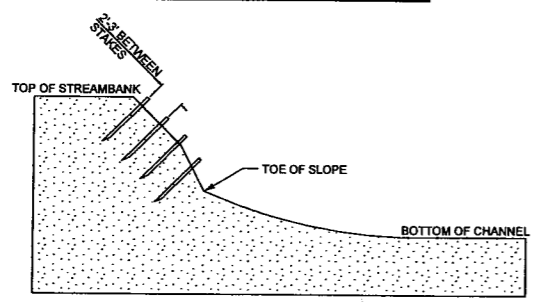

CROSS SECTION VIEW

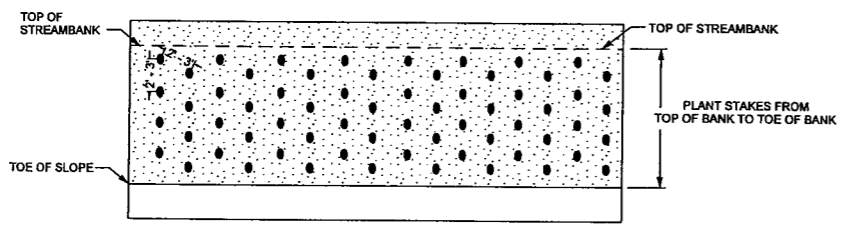


PLAN VIEW

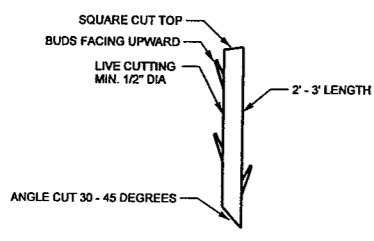


LIVE STAKE DETAIL

- NOTES:**
1. STAKES SHOULD BE CUT AND INSTALLED ON THE SAME DAY.
 2. DO NOT INSTALL STAKES THAT HAVE BEEN SPLIT.
 3. STAKES MUST BE INSTALLED WITH BUDS POINTING UPWARDS.
 4. STAKES SHOULD BE INSTALLED PERPENDICULAR TO BANK.
 5. STAKES SHOULD BE 1/2 TO 2 INCHES IN DIAMETER AND 2 TO 3 FT LONG.
 6. STAKES SHOULD BE INSTALLED LEAVING 1/5 OF STAKE ABOVE GROUND.

CHANNEL BLOCK

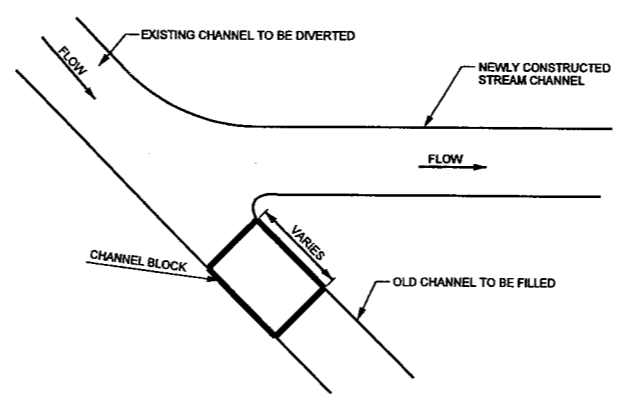


PLAN VIEW

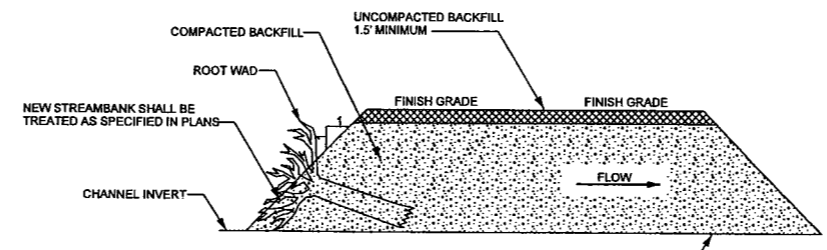


PROFILE VIEW

PERMANENT STREAM CROSSING

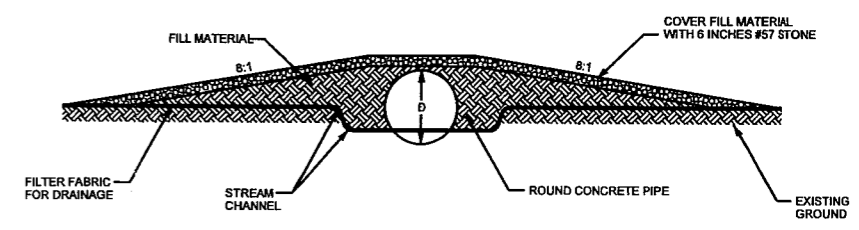

CROSS SECTION VIEW

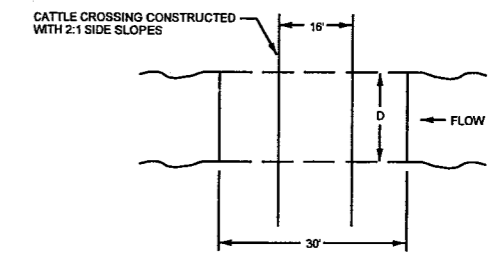


PLAN VIEW

5/18/2005 Design\Plans\0170R_EBX_dta_2b.dgn

PROJECT ENGINEER
APPROVED BY: *[Signature]*
DATE: 5-24-05



BUCK ENGINEERING
8000 Regency Parkway Suite 200
Cary, North Carolina 27511
Phone: 919-483-5488 Fax: 919-483-5490



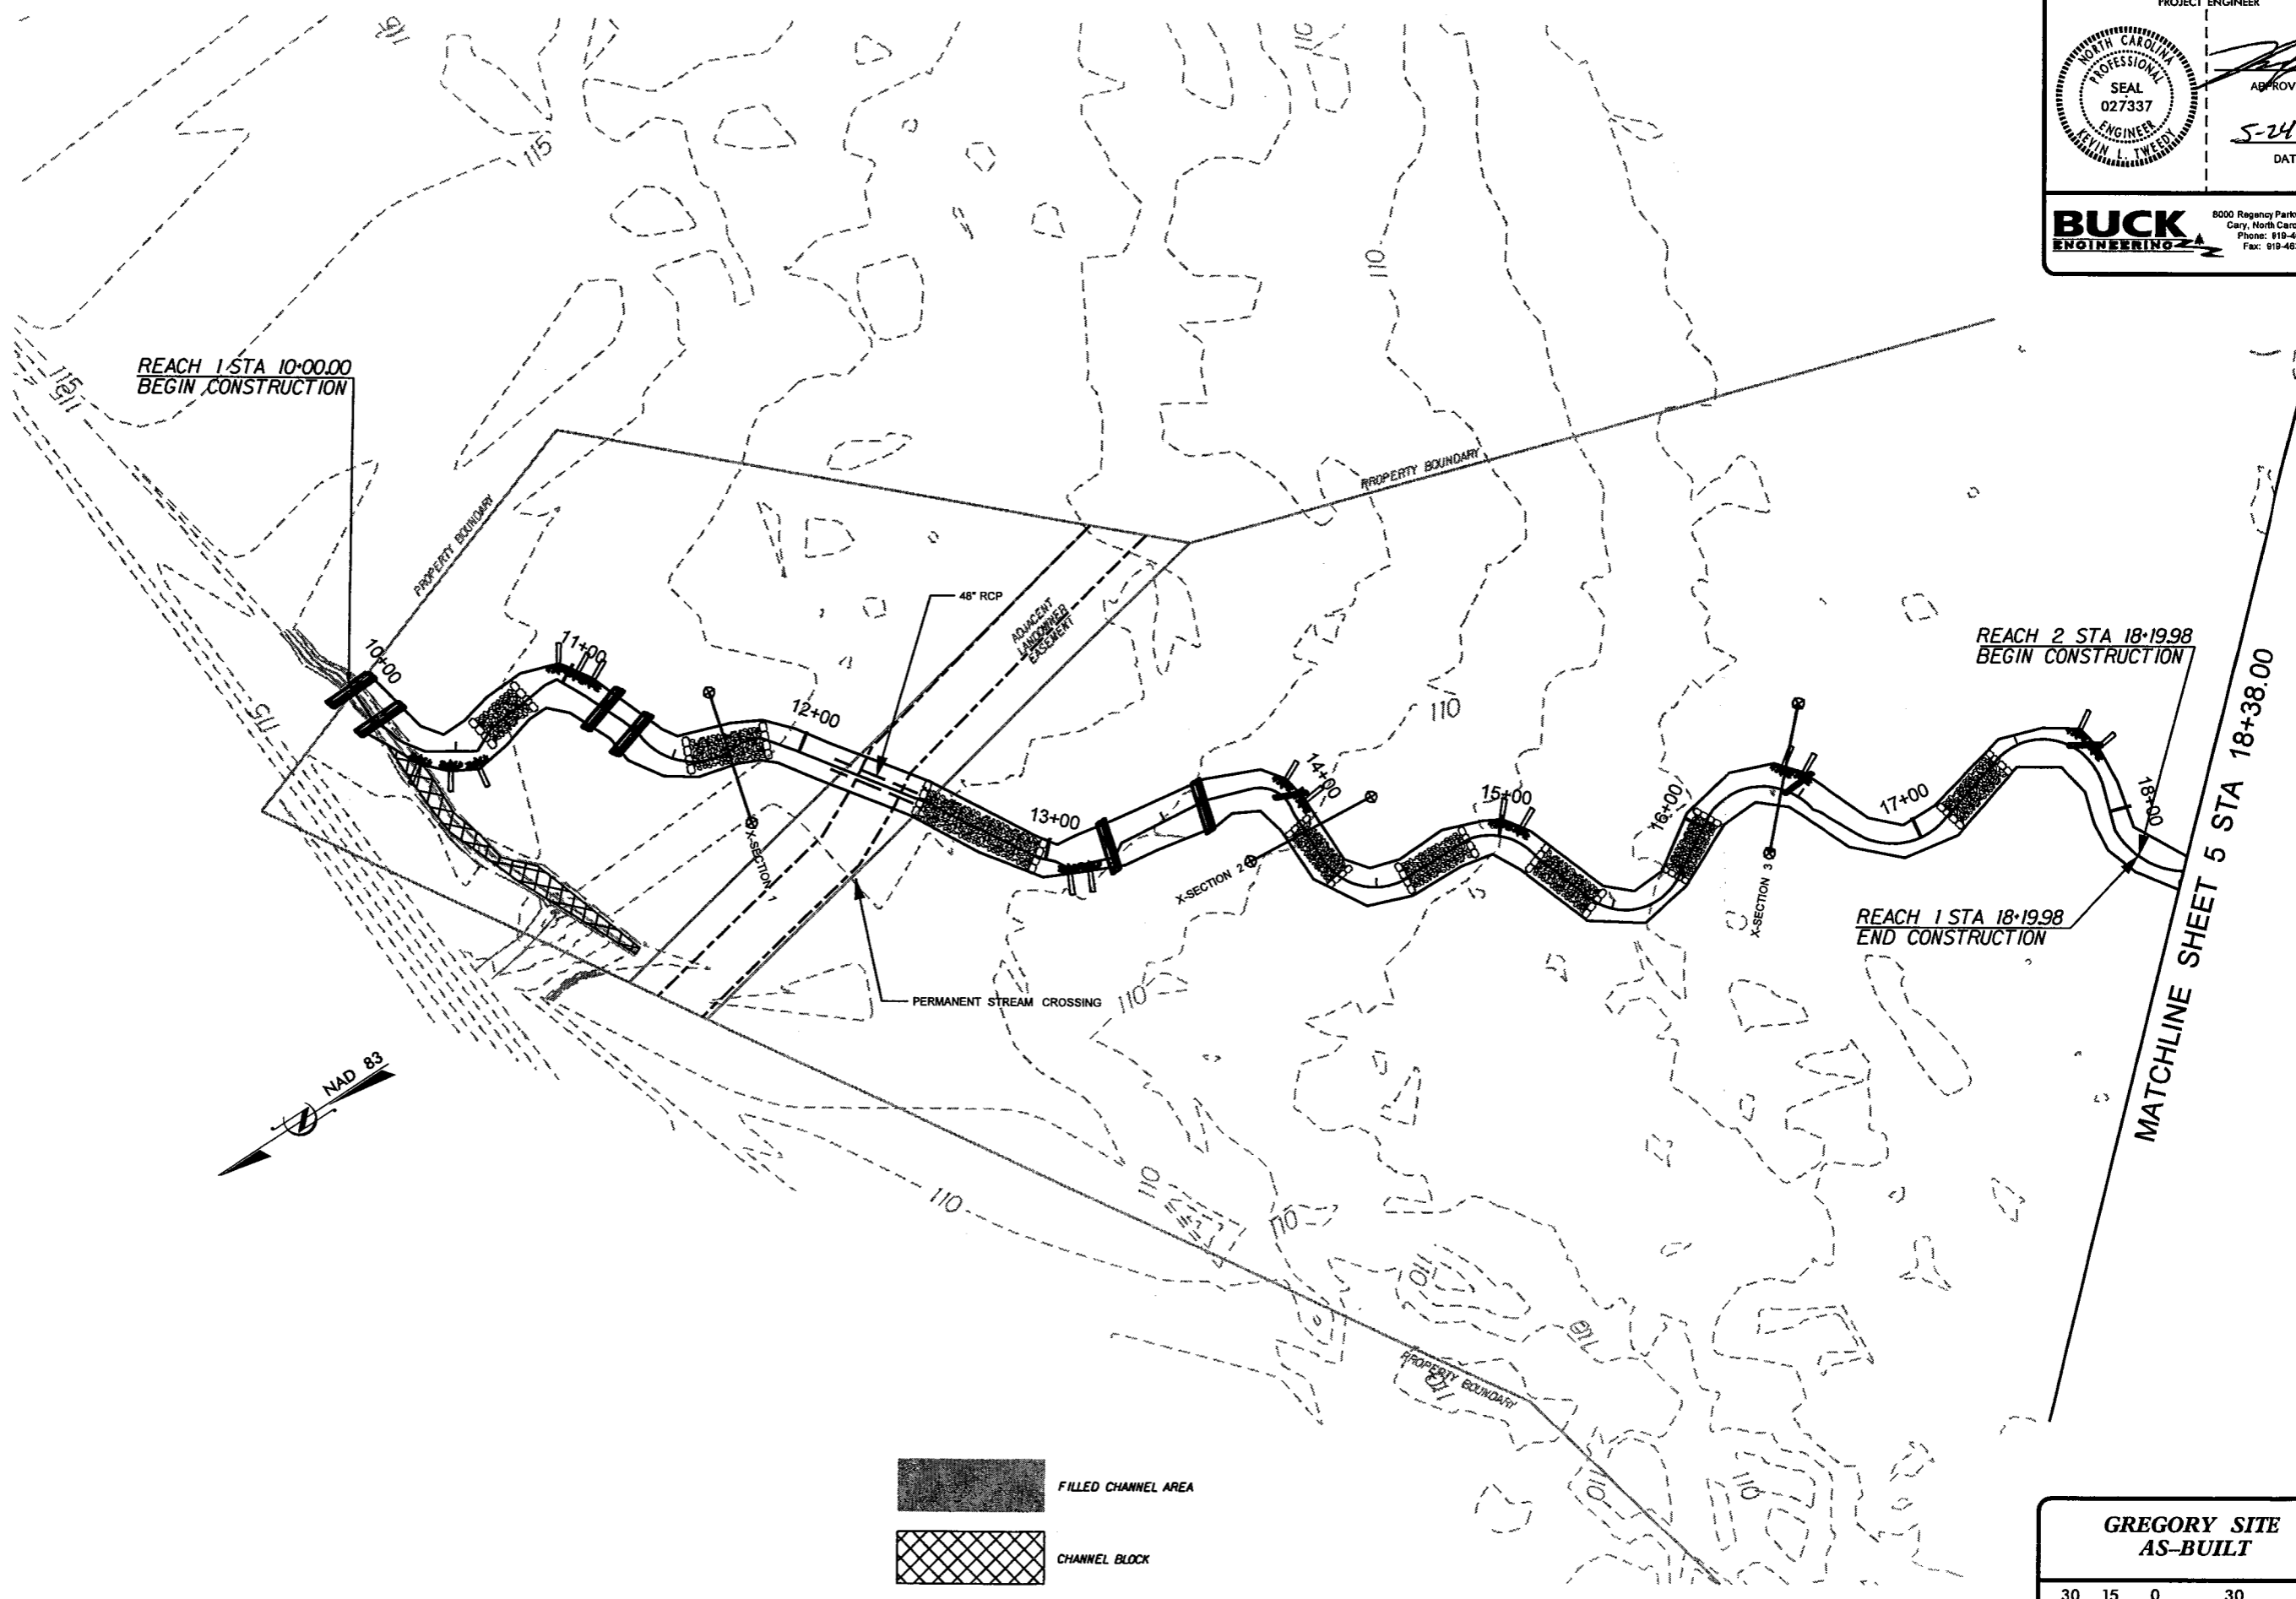


REACH 1 STA 10+00.00
BEGIN CONSTRUCTION

REACH 2 STA 18+19.98
BEGIN CONSTRUCTION



REACH 1 STA 18+19.98
END CONSTRUCTION

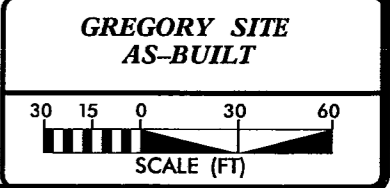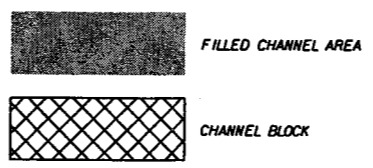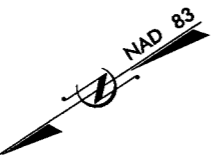
MATCHLINE SHEET 5 STA 18+38.00





**GREGORY SITE
AS-BUILT**


2/26/03

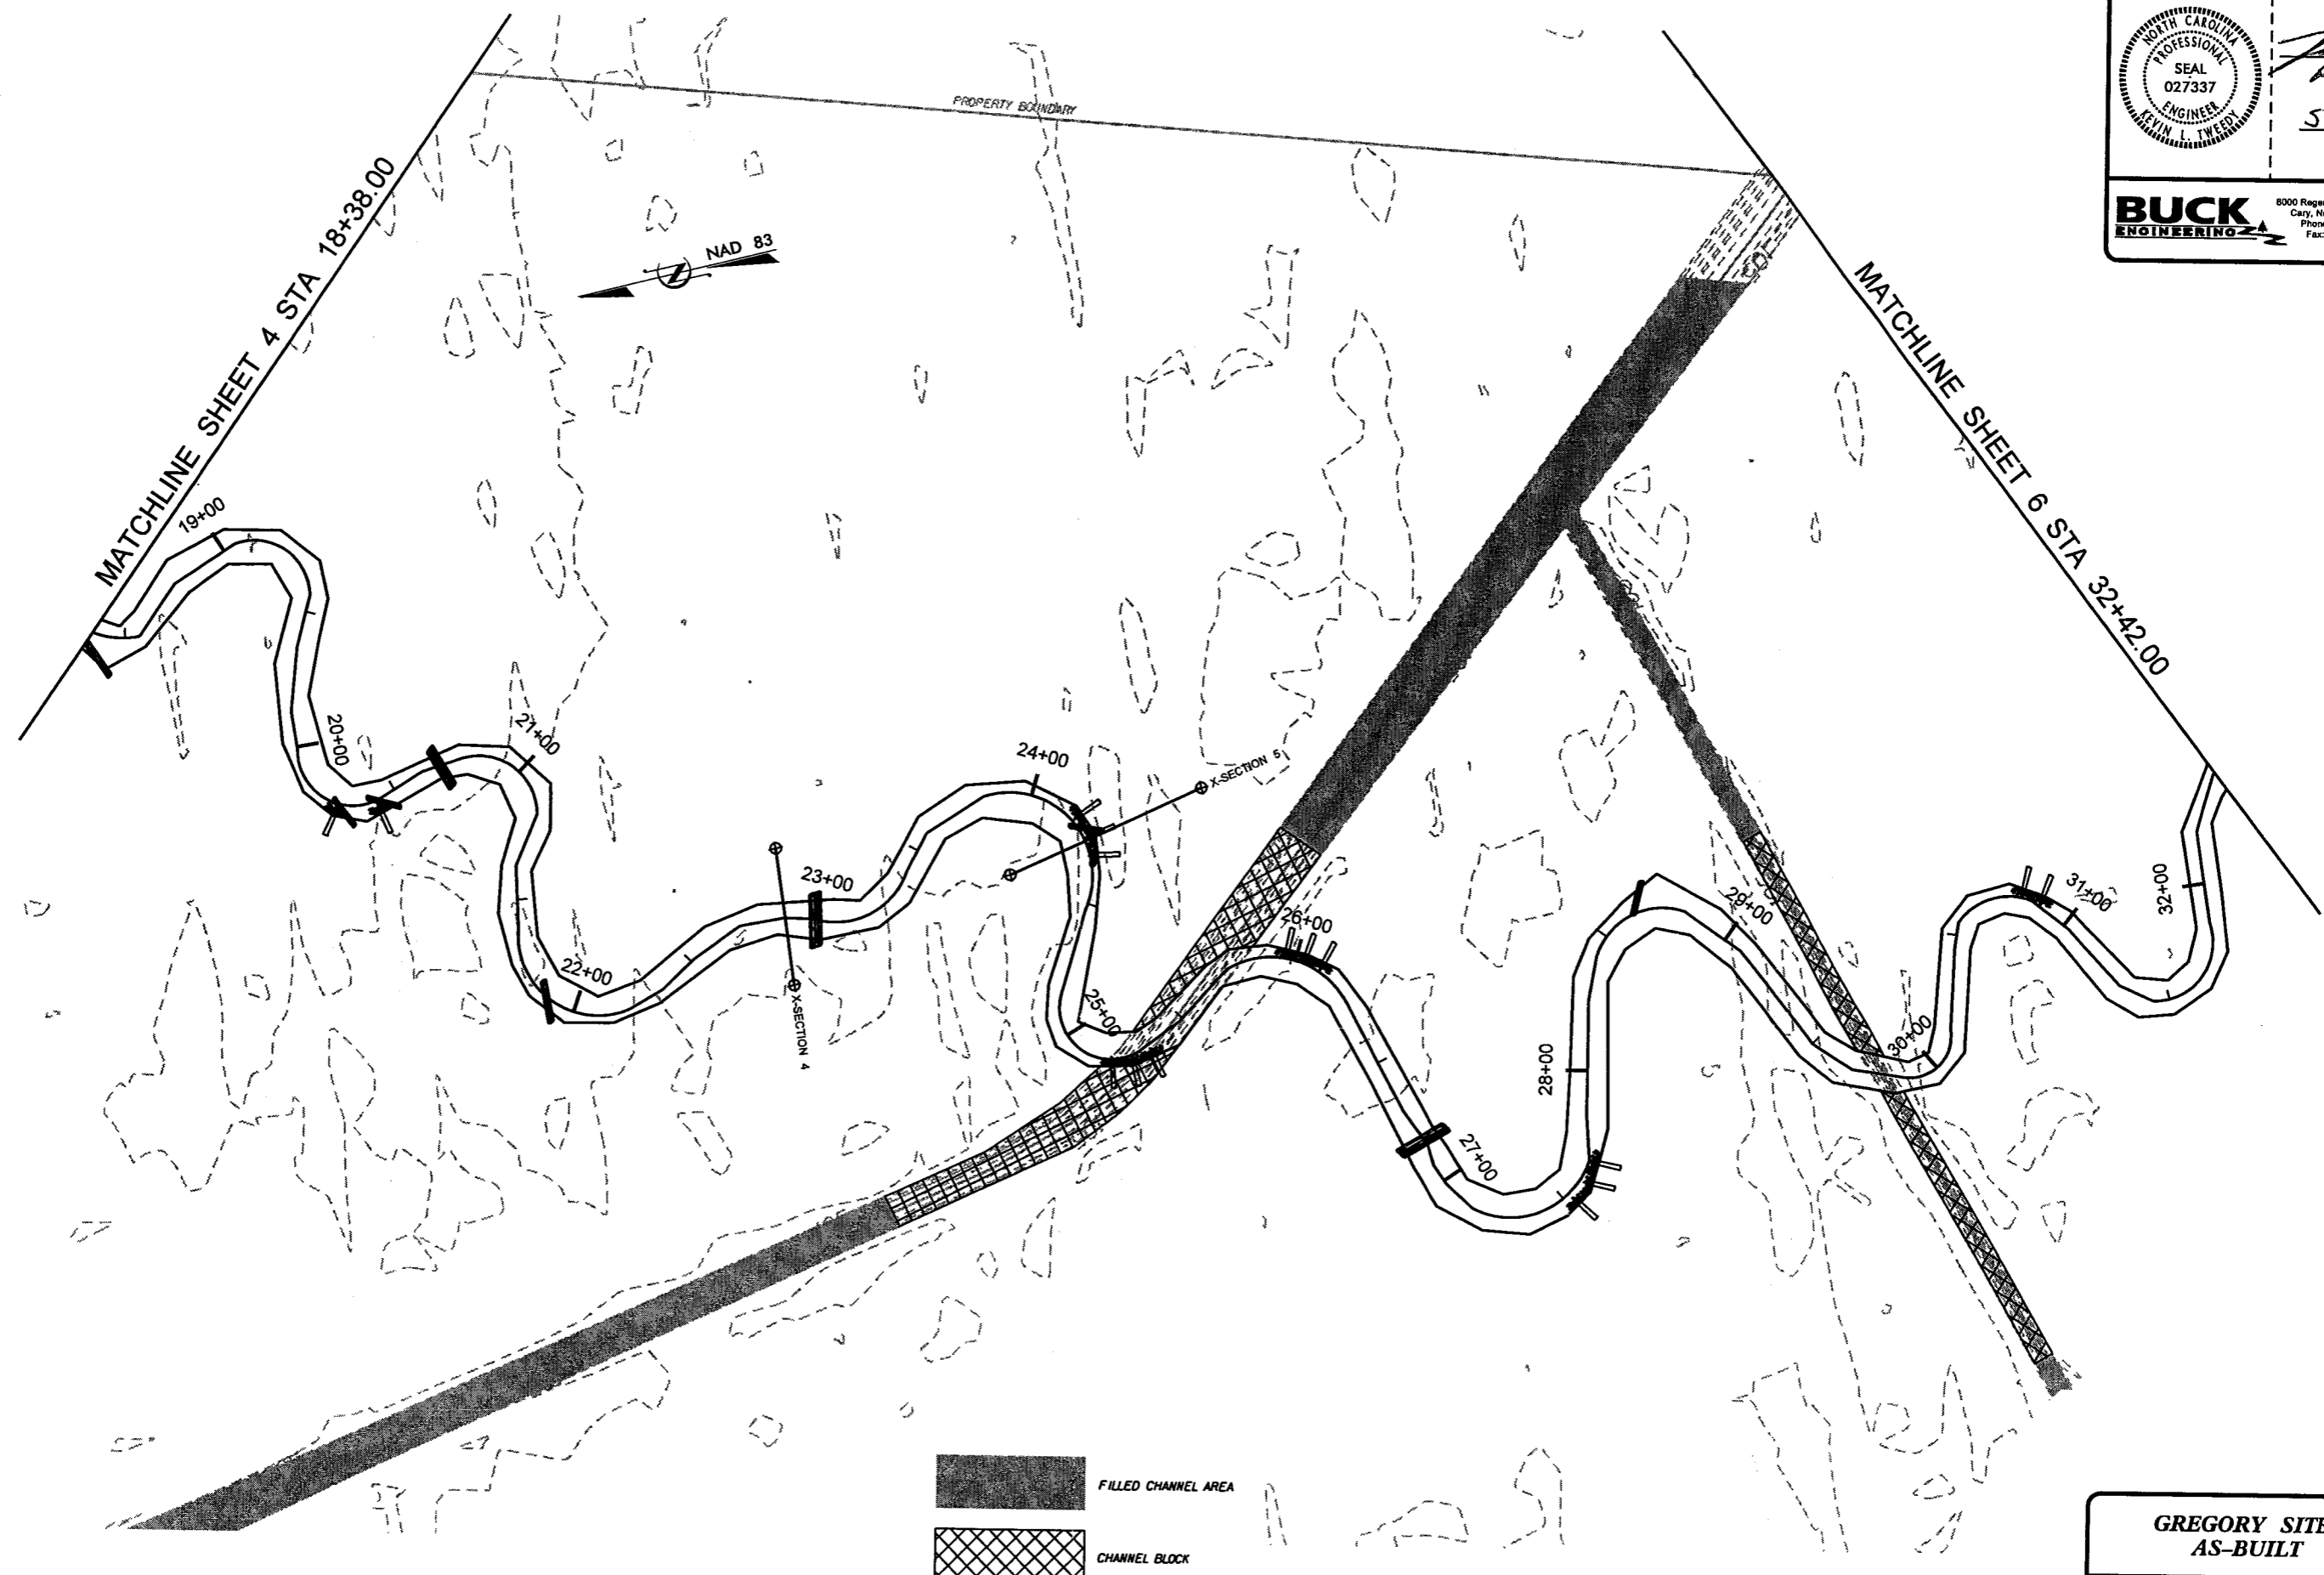PROJECT REFERENCE NO. 170	SHEET NO. 5
PROJECT ENGINEER	
	
APPROVED BY: 	
DATE: 5-24-05	
BUCK ENGINEERING <small>8000 Regency Parkway Suite 200 Cary, North Carolina 27511 Phone: 919-463-5488 Fax: 919-463-5490</small>	



	FILLED CHANNEL AREA
	CHANNEL BLOCK



**GREGORY SITE
AS-BUILT**



SCALE (FT)

5/19/2005 10:17:08 AM Design\Plans\0170R_EBX_psh_AB_05.dgn

PROJECT REFERENCE NO. 170	SHEET NO. 6
PROJECT ENGINEER	
	APPROVED BY: <i>[Signature]</i>
	DATE: 5-24-05
BUCK ENGINEERING 8000 Regency Parkway Suite 200 Cary, North Carolina 27511 Phone: 919-483-5488 Fax: 919-483-5489	

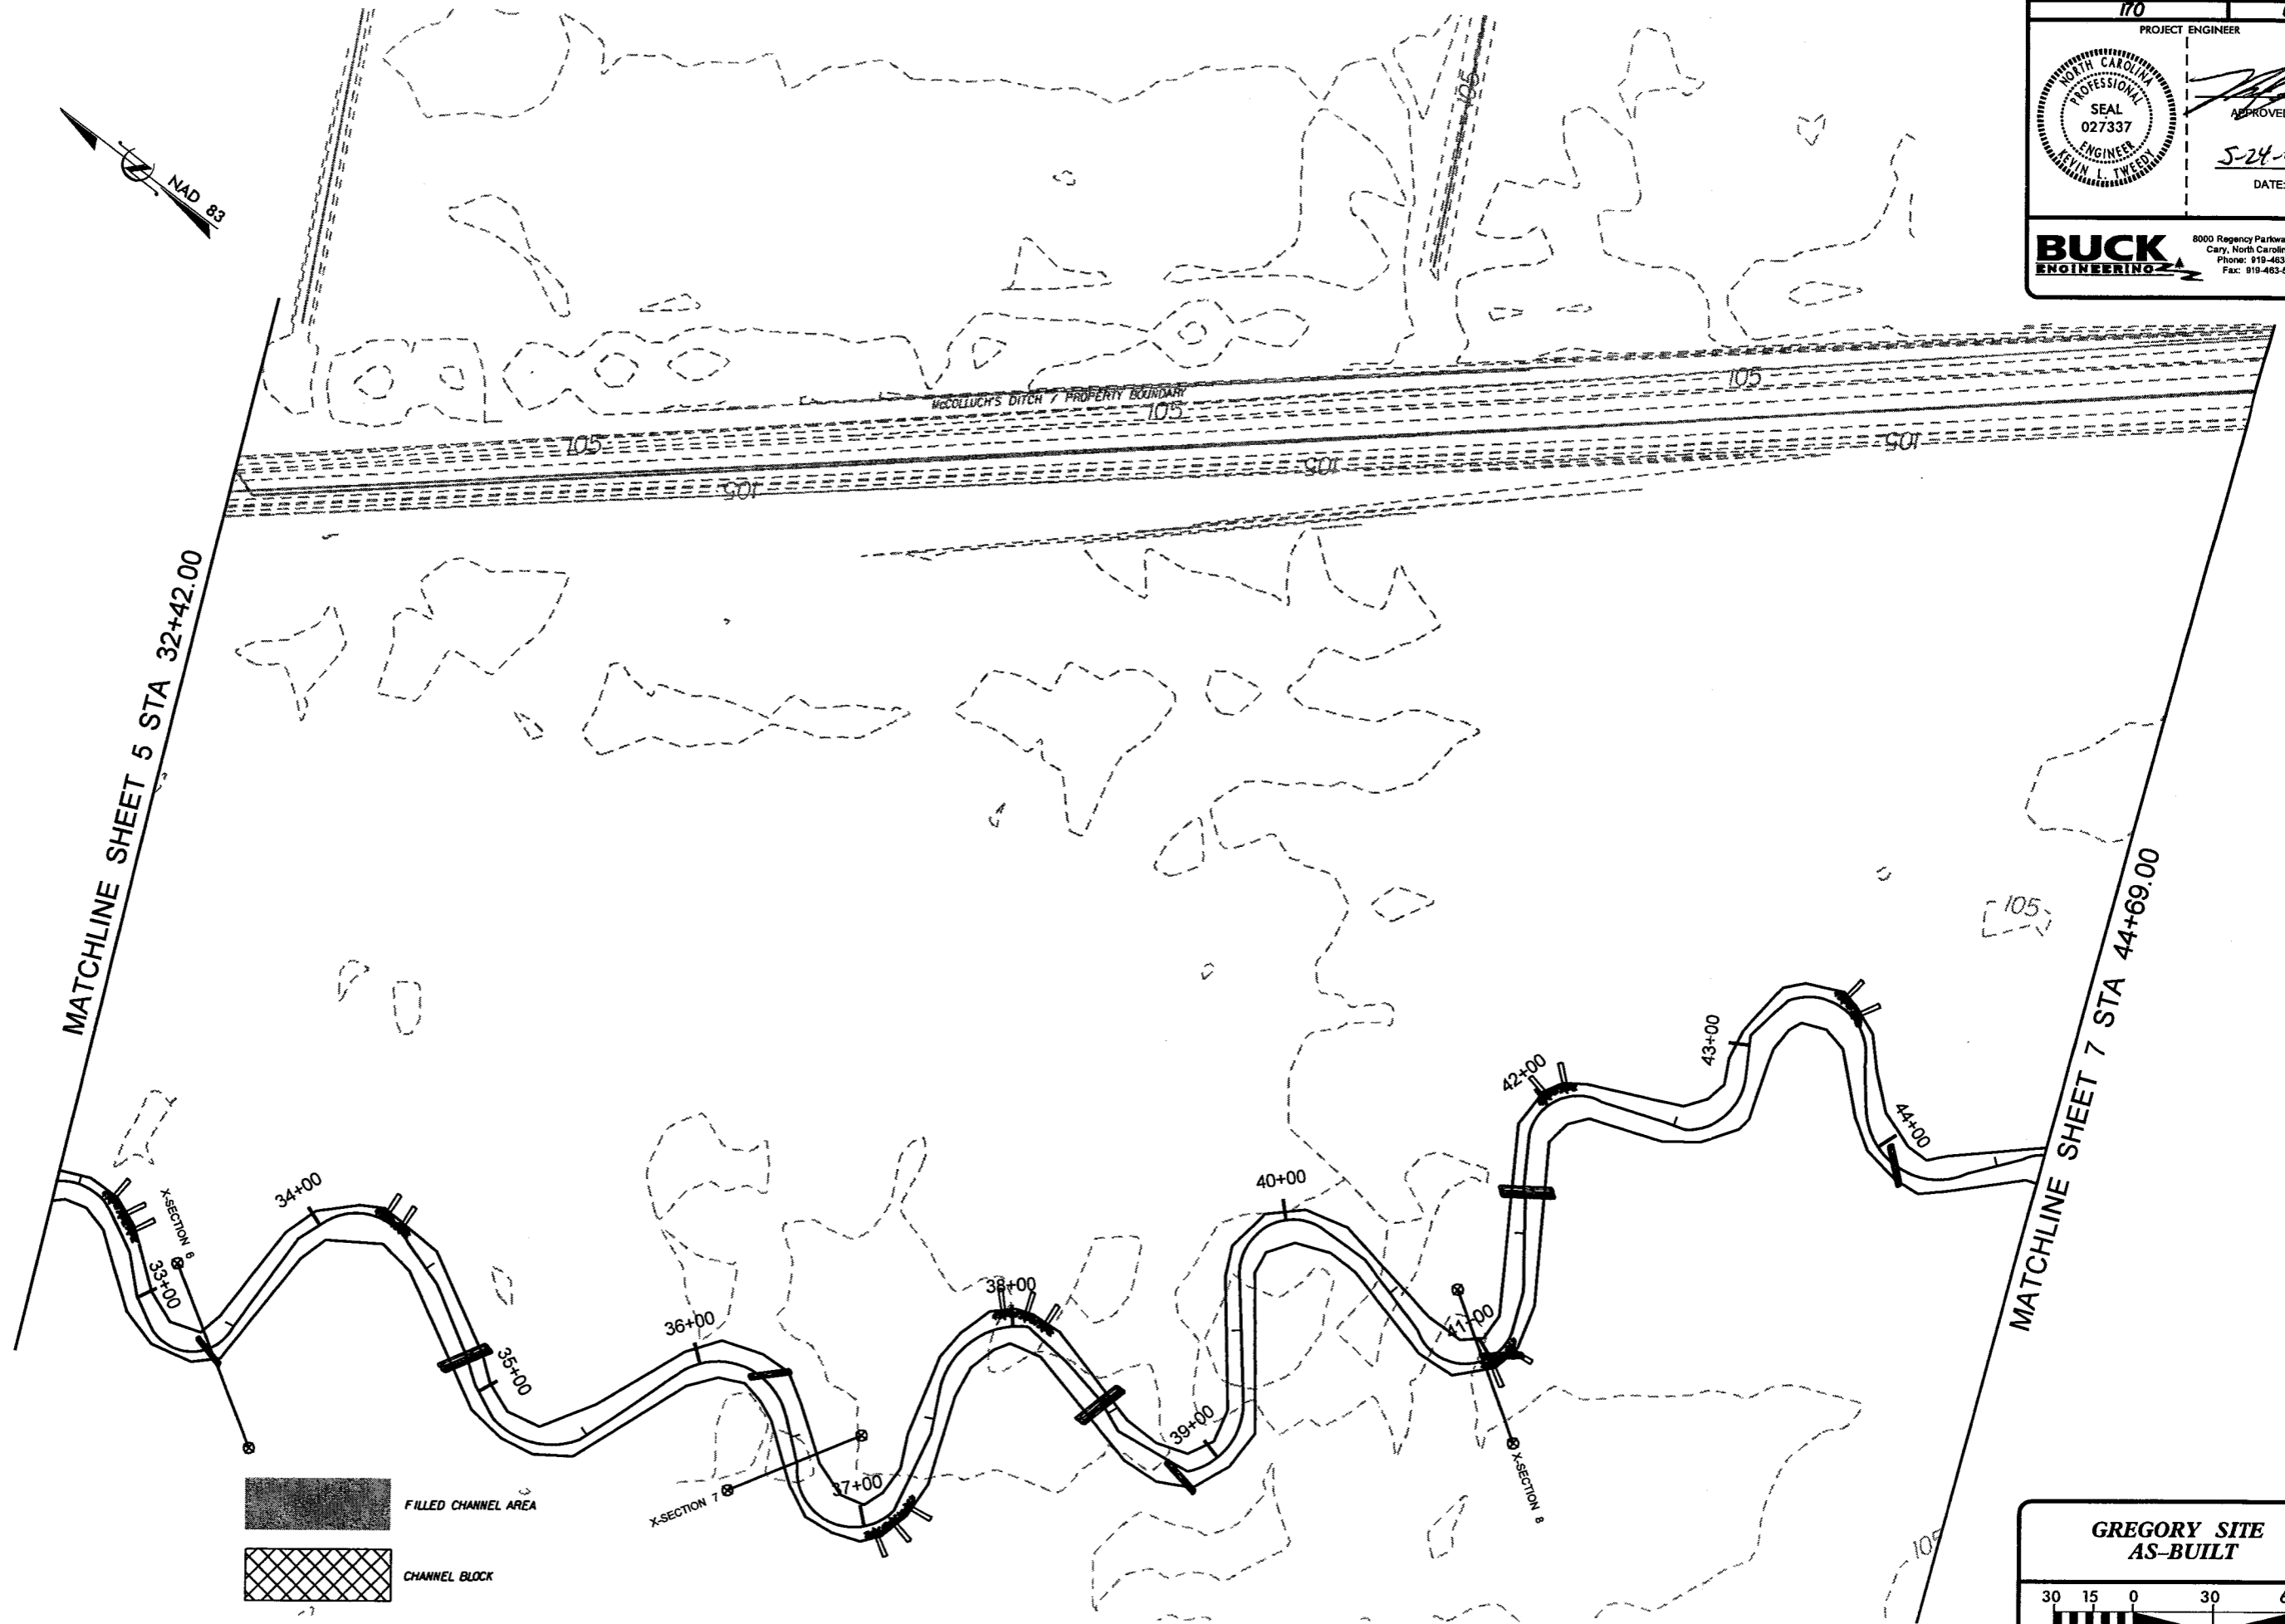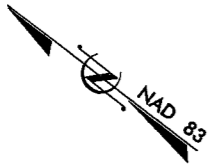




	FILLED CHANNEL AREA
	CHANNEL BLOCK

**GREGORY SITE
AS-BUILT**

SCALE (FT)



5:\17285\Design\Plans\0170R-EBX-psh_AB_06.dgn
 2/26/03

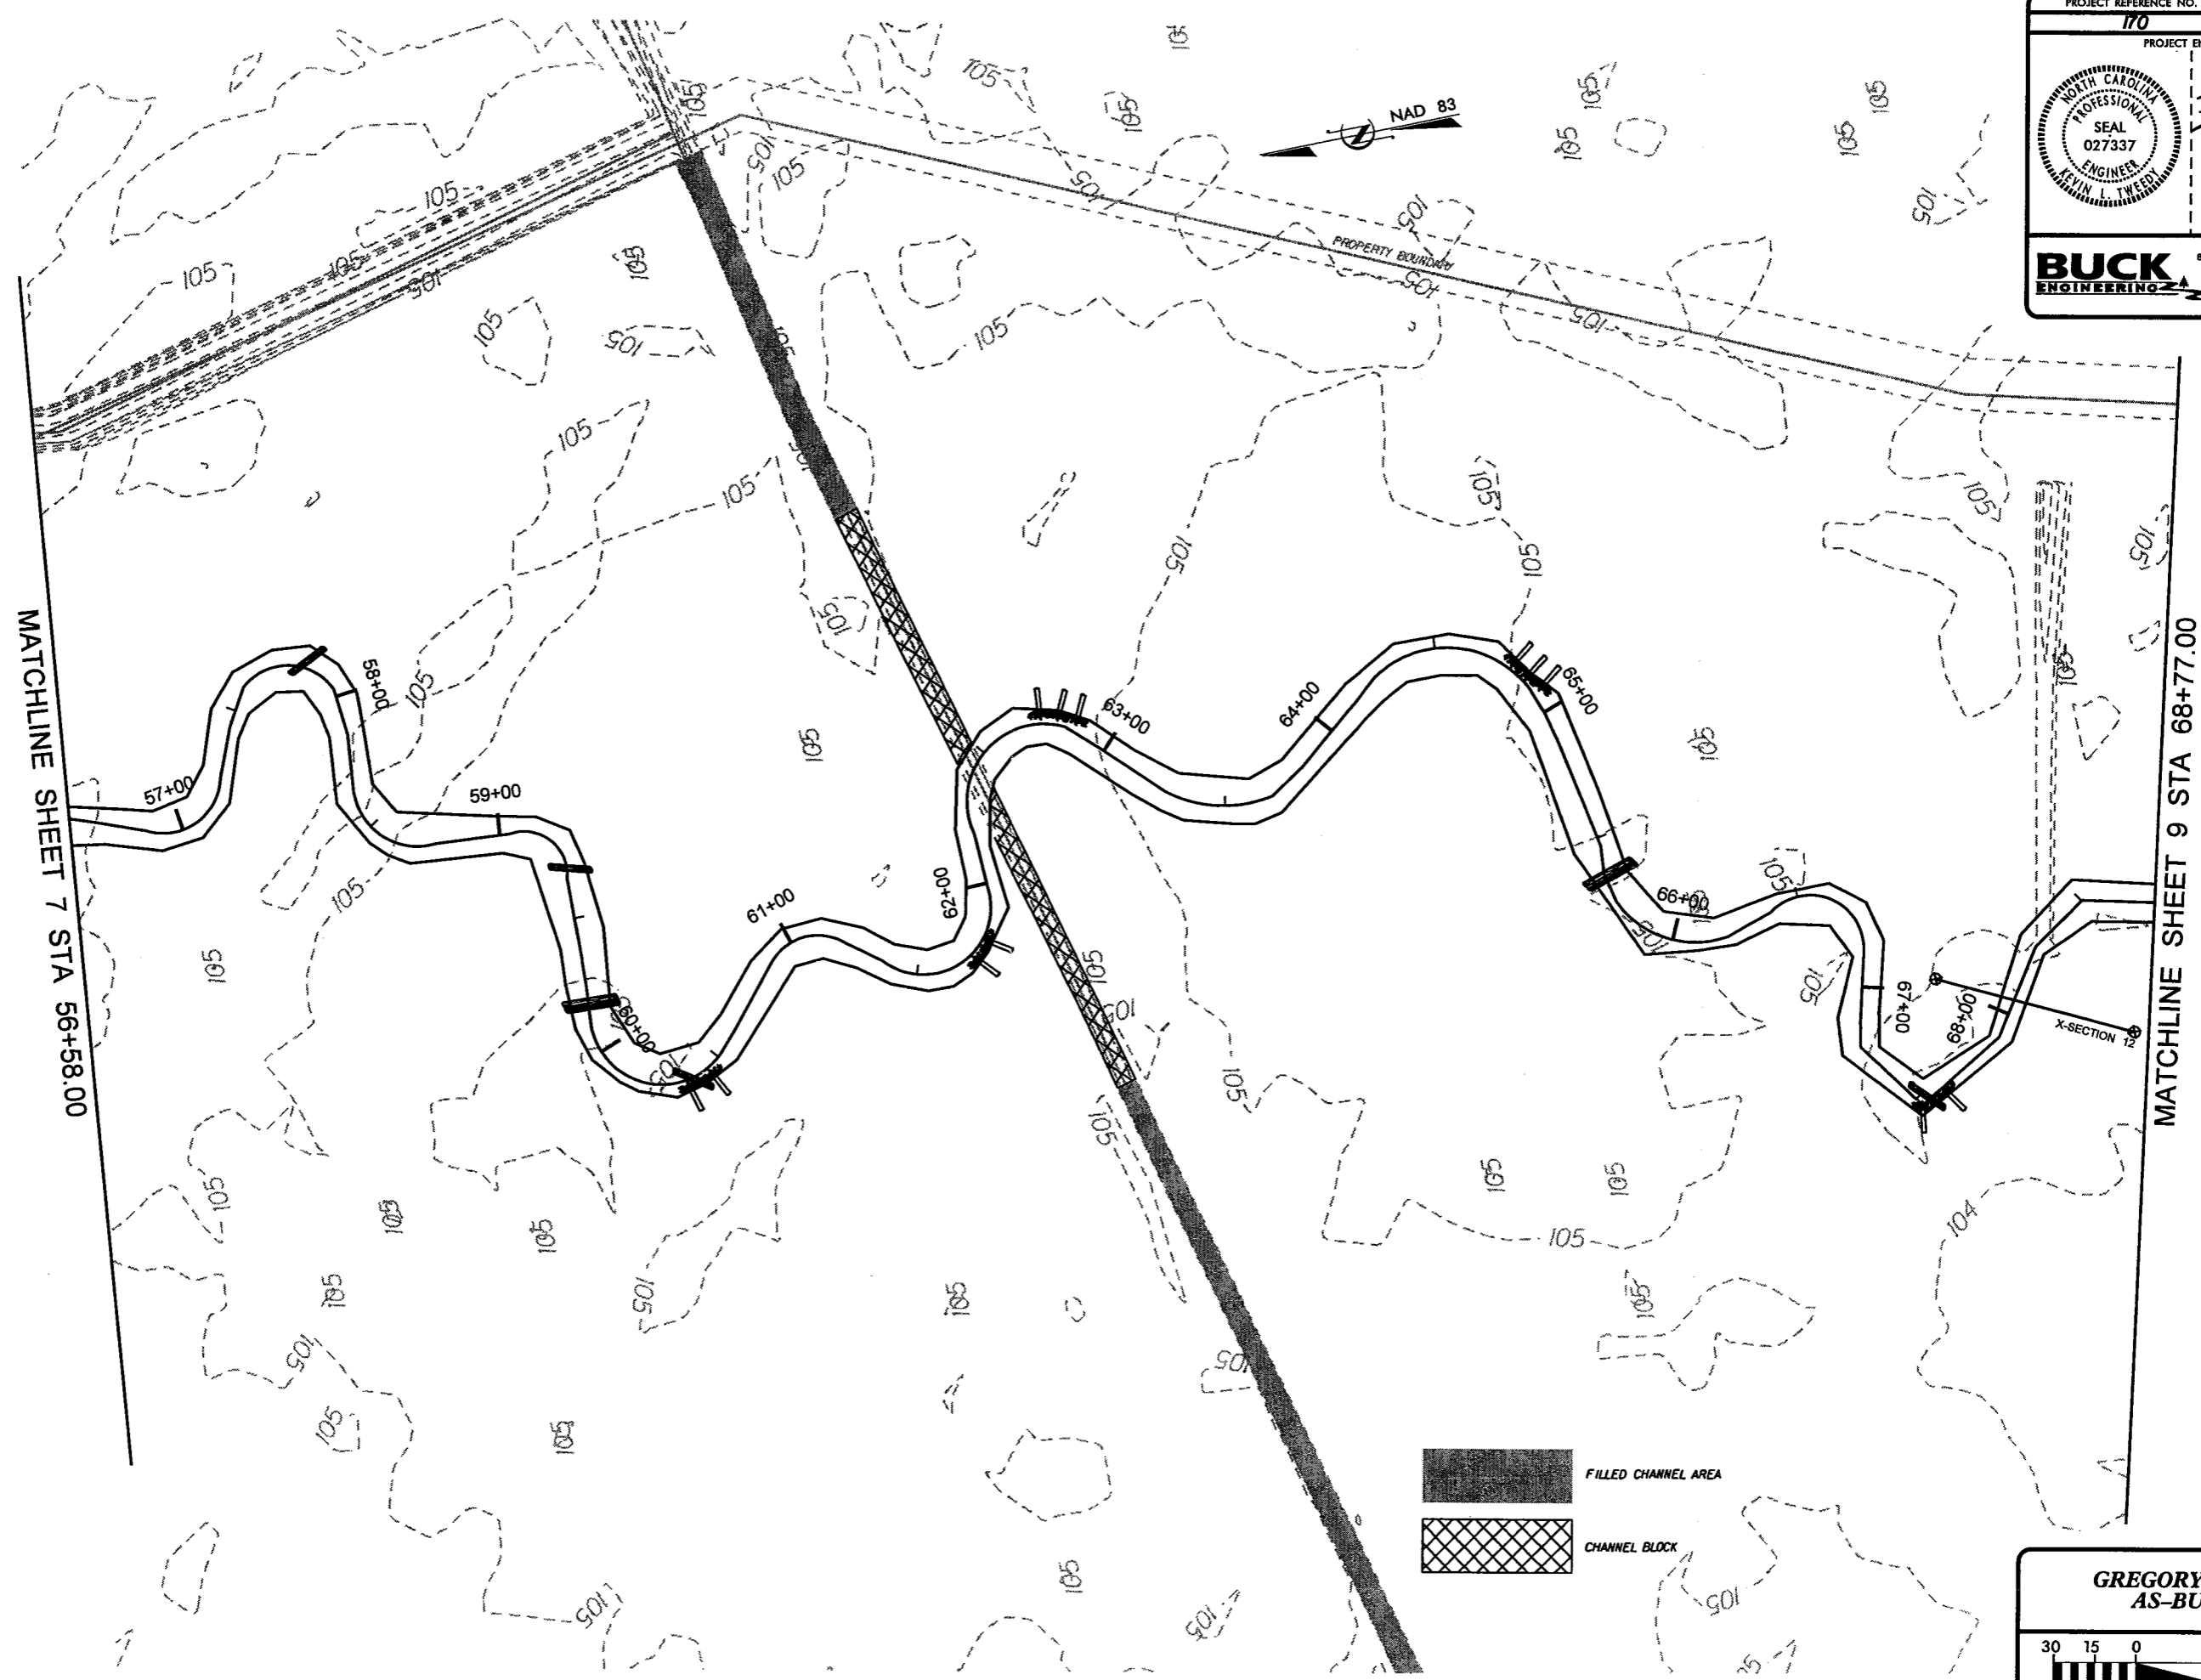PROJECT REFERENCE NO. 170	SHEET NO. 8
PROJECT ENGINEER	
	
APPROVED BY: 	
DATE: 5-24-05	
BUCK ENGINEERING <small>8000 Regency Parkway Suite 200 Cary, North Carolina 27511 Phone: 919-463-5488 Fax: 919-463-5490</small>	




MATCHLINE SHEET 7 STA 56+58.00

MATCHLINE SHEET 9 STA 68+77.00

	FILLED CHANNEL AREA
	CHANNEL BLOCK


**GREGORY SITE
AS-BUILT**

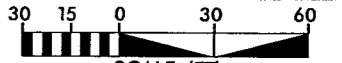


SCALE (FT)

S:\19\2885
 P:\170R\Design\Plans\0170R_EBX_psh_AB_08.dgn



2/26/03

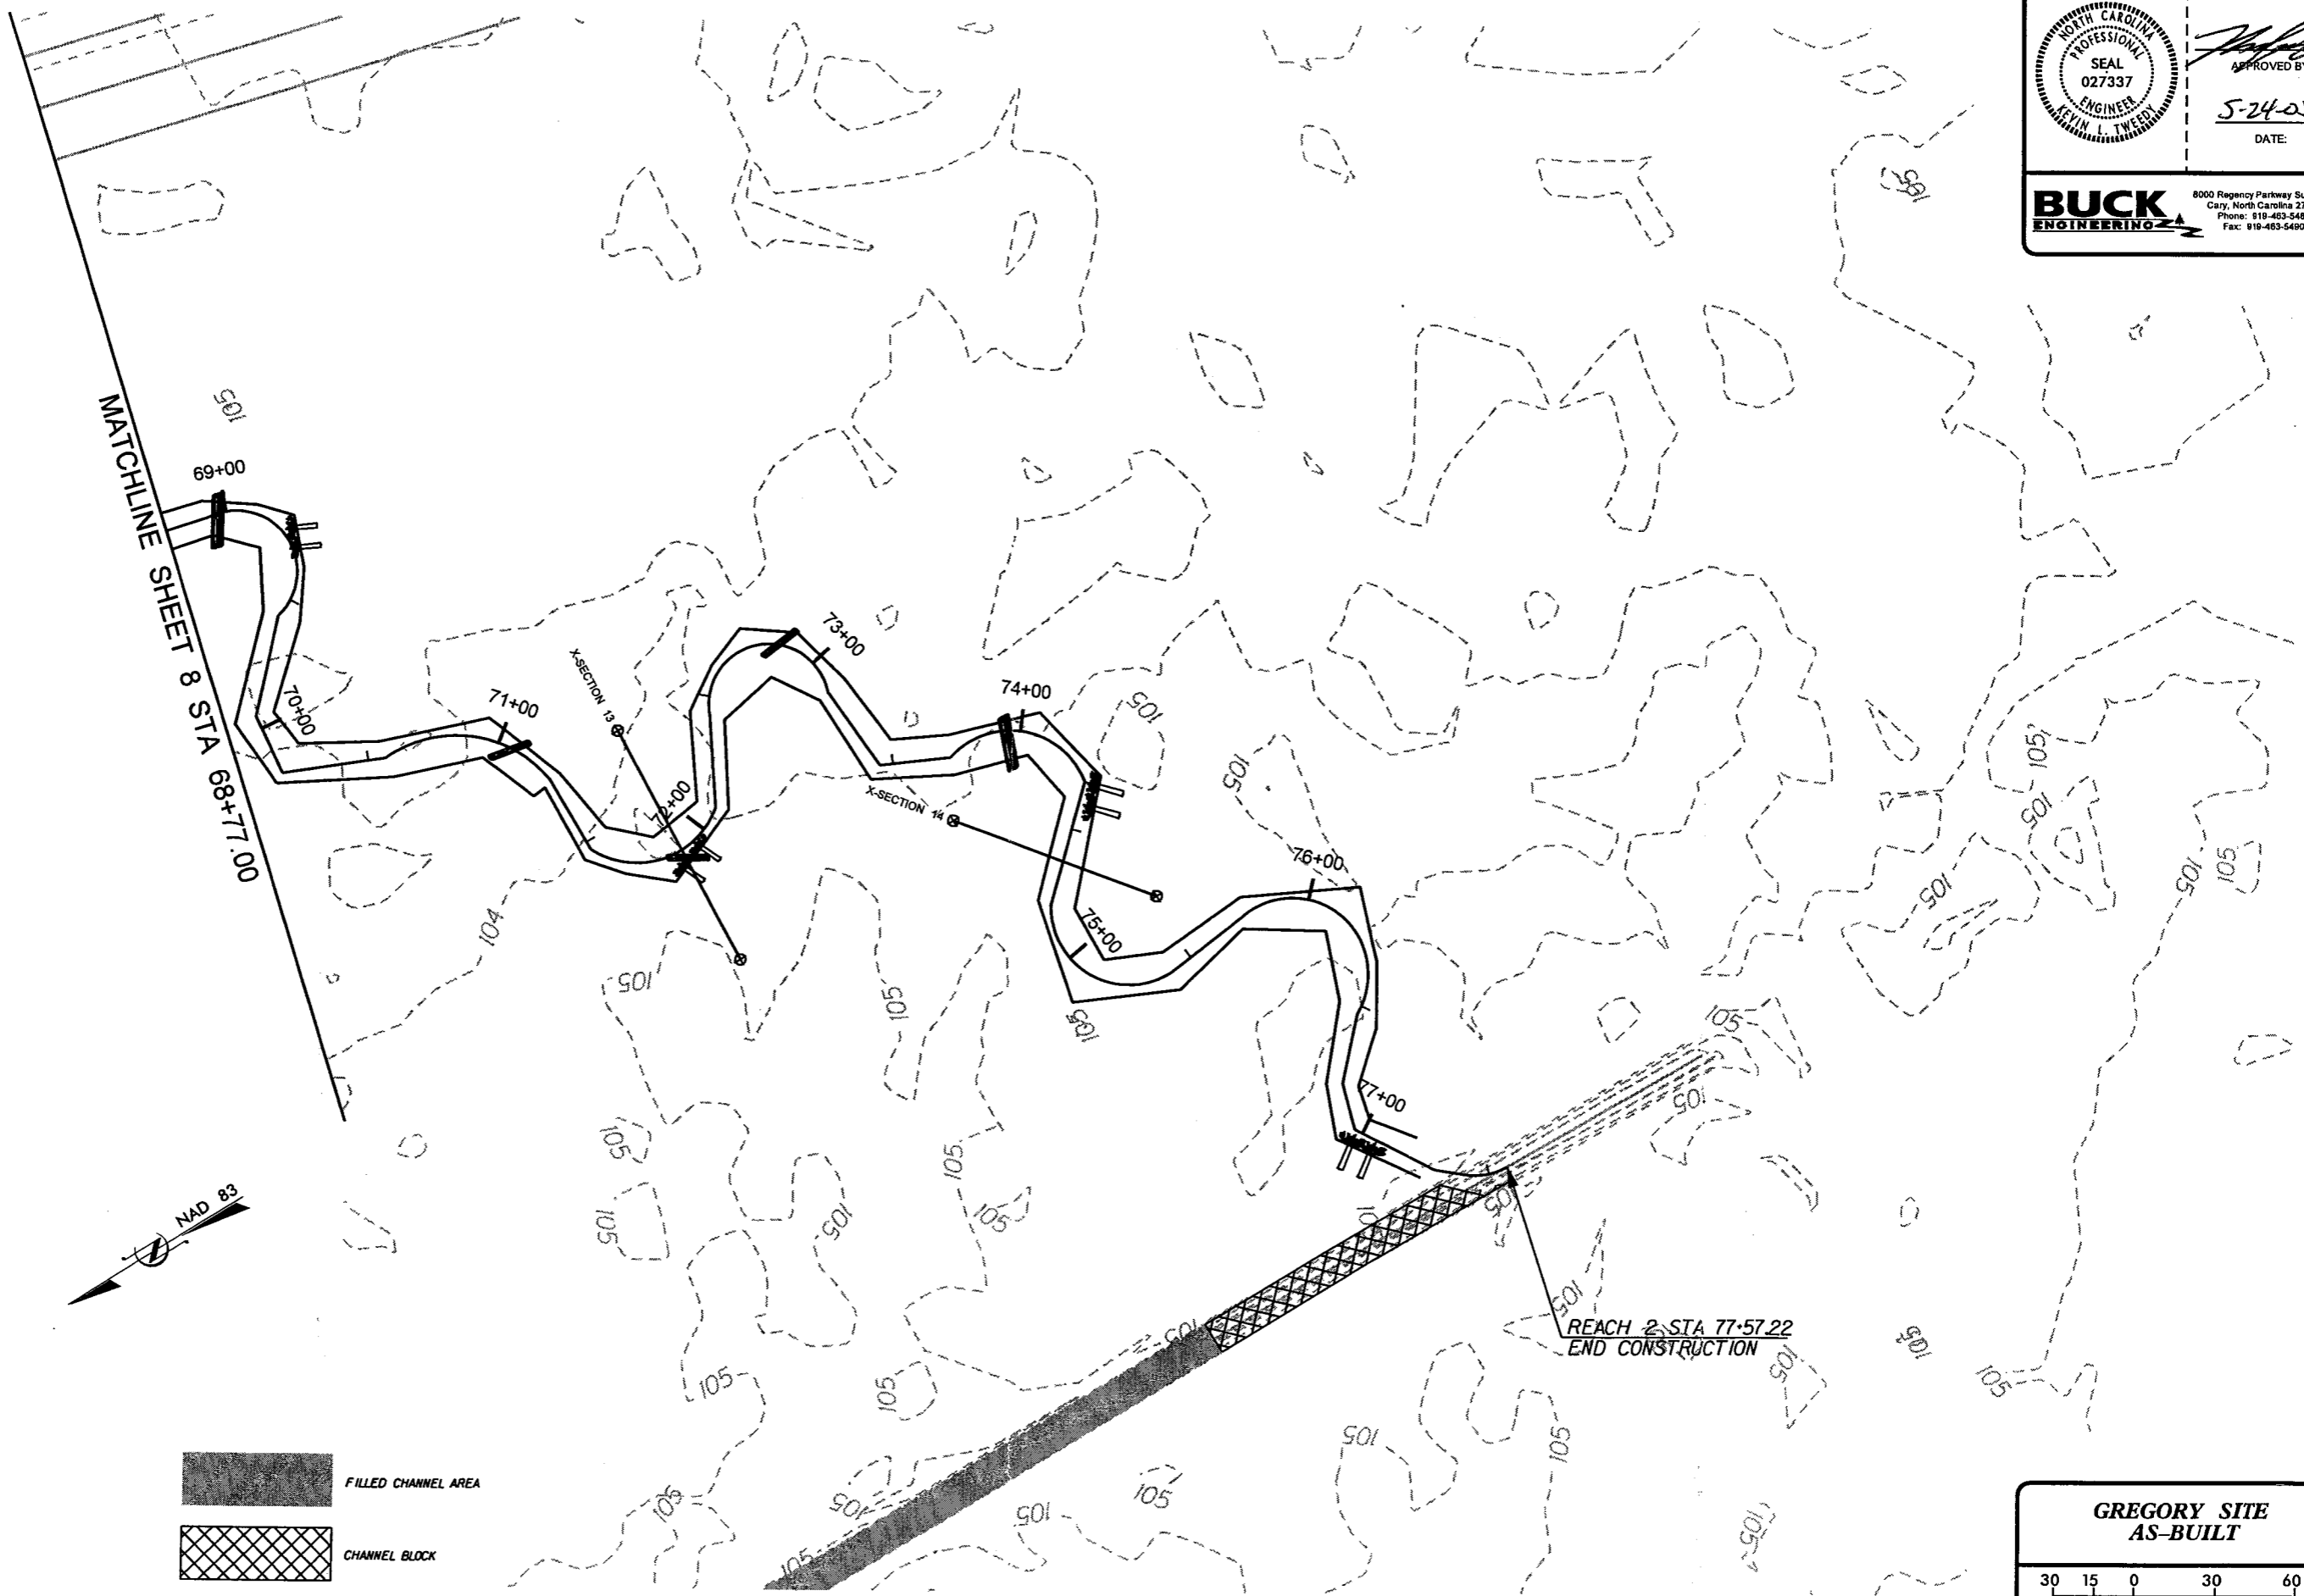PROJECT REFERENCE NO. 170	SHEET NO. 9
PROJECT ENGINEER	
	
APPROVED BY: <i>[Signature]</i>	
DATE: 5-24-05	
BUCK ENGINEERING <small>8000 Regency Parkway Suite 200 Cary, North Carolina 27511 Phone: 919-483-5488 Fax: 919-483-5490</small>	




MATCHLINE SHEET 8 STA 68+77.00



	FILLED CHANNEL AREA
	CHANNEL BLOCK

REACH 2 STA 77.57.22
END CONSTRUCTION

**GREGORY SITE
AS-BUILT**





SCALE (FT)




5/19/2005 Design\Plans\0170R.EBX_psh_AB_05.dgn

2/26/03


2/26/03

PROJECT REFERENCE NO. 170	SHEET NO. 10
PROJECT ENGINEER	
	
APPROVED BY: <i>[Signature]</i>	
DATE: 5-24-05	
	
<small>8000 Regency Parkway Suite 200 Cary, North Carolina 27511 Phone: 919-463-5488 Fax: 919-463-5490</small>	



-  AS-BUILT WETLAND AREA
-  CHANNEL BLOCK
-  FILLED CHANNEL AREA

**GREGORY SITE
AS-BUILT PLANS**



SCALE (FT)


MATCHLINE SHEET 11

NOTE:
AS-BUILT CONTOURS ARE ACCURATE
TO WITHIN +/- .5 INCHES

E:\2005\design\plans\0170R_EBX_psh_AB_10.dgn

2/26/03

PROJECT REFERENCE NO. 170	SHEET NO. 11
PROJECT ENGINEER	
	APPROVED BY: <i>[Signature]</i>
	DATE: 5-24-05
<small>8000 Regency Parkway Suite 200 Cary, North Carolina 27511 Phone: 919-483-5488 Fax: 919-483-5490</small>	

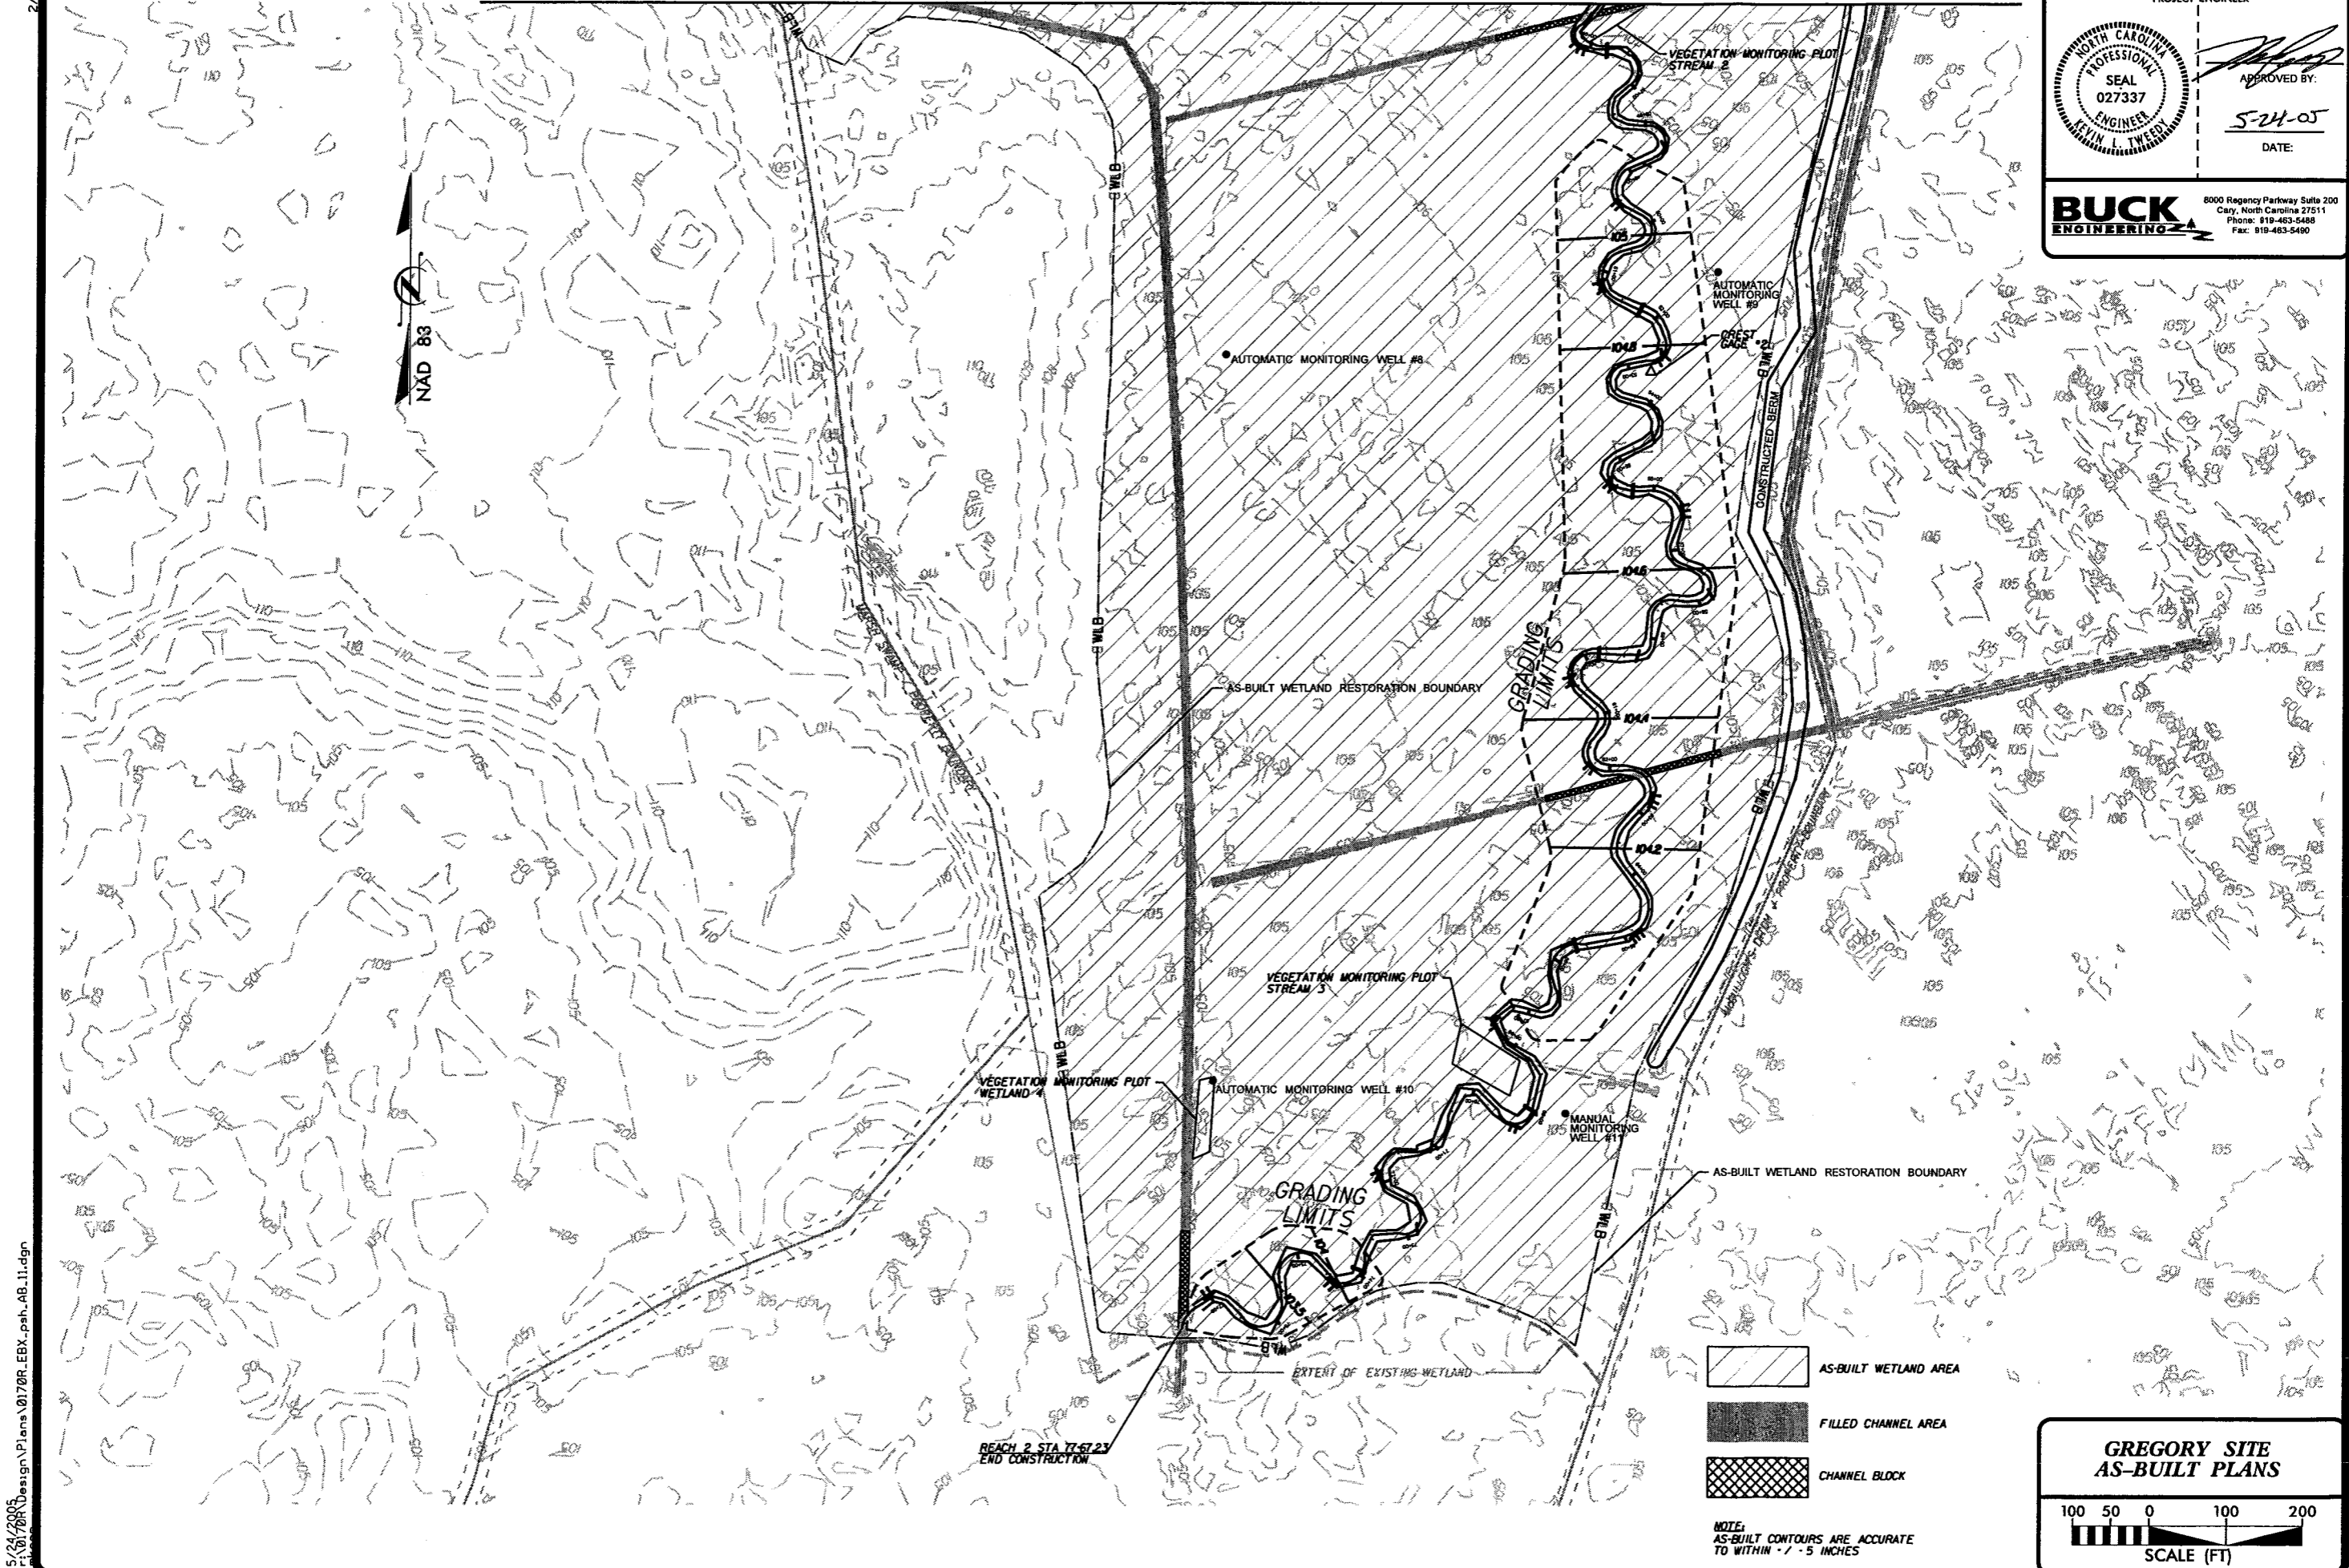

S:\24\2005\170\20R\Design\Plans\0170R_EBX.psh_AB_11.dgn