


AS-BUILT MITIGATION REPORT GROVE CREEK

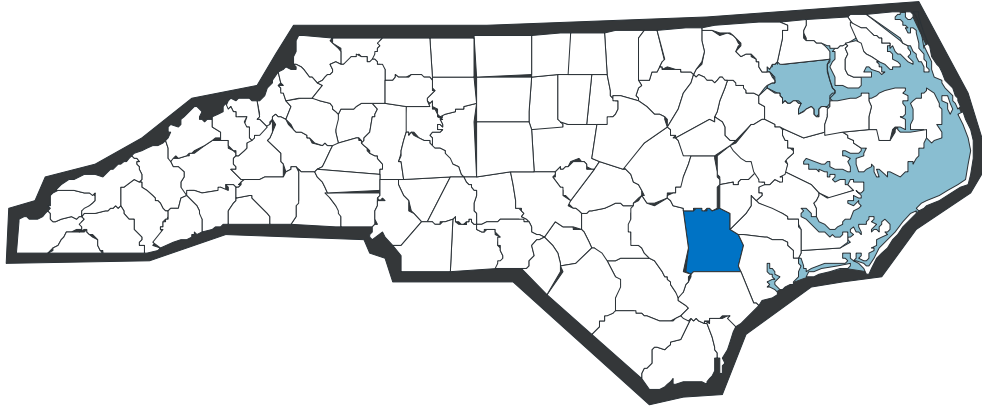

**GROVE CREEK MITIGATION SITE
DUPLIN COUNTY, NORTH CAROLINA
TIP No. R-2204 WM
NCDOT Project No. 8.1241801
(EEP Project Number .00038)**


Submitted to:
North Carolina Department of Environment and Natural Resources
Ecosystem Enhancement Program
Raleigh, North Carolina

Prepared by:
Axiom Environmental, Inc.
2126 Rowland Pond Drive
Willow Spring, North Carolina 27592

Design Firm:
Office of Natural Environment & Roadside Environmental Unit
North Carolina Department of Transportation
Raleigh, North Carolina

April 2007

AS-BUILT MITIGATION REPORT GROVE CREEK

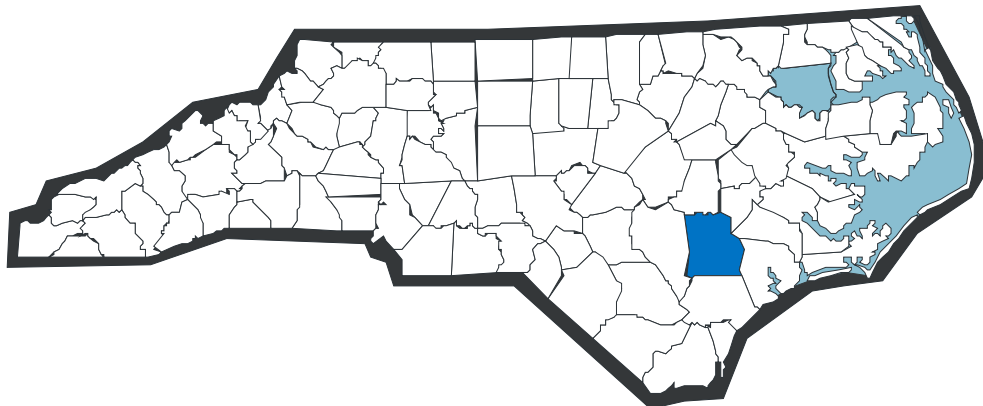

**GROVE CREEK MITIGATION SITE
DUPLIN COUNTY, NORTH CAROLINA
TIP No. R-2204 WM
NCDOT Project No. 8.1241801
(EEP Project Number .00038)**



Axiom Environmental, Inc.



Submitted to:
North Carolina Department of Environment and Natural Resources
Ecosystem Enhancement Program
Raleigh, North Carolina

Prepared by:
Axiom Environmental, Inc.
2126 Rowland Pond Drive
Willow Spring, North Carolina 27592

Design Firm:
Office of Natural Environment & Roadside Environmental Unit
North Carolina Department of Transportation
Raleigh, North Carolina

April 2007

EXECUTIVE SUMMARY

The Grove Creek Wetland Mitigation Site (Site) is located within the United States Geological Survey (USGS) Hydrologic Unit 03030007 (North Carolina Division of Water Quality [NCDWQ] subbasin 03-06-22) of the Cape Fear River Basin. The Site includes an approximately 549-acre tract, located 5 miles east of Kenansville in central Duplin County.

Prior to implementation of wetland restoration activities, the Site was characterized by active agricultural fields, mixed hardwood forests, and a large Bottomland Hardwood/Cypress-Gum Swamp wetland system located adjacent to the Northeast Cape Fear River.

Primary mitigation activities included

- restoration of 3.0 acres of previously ditched and filled riverine wetlands,
- creation of 9.2 acres of riverine wetlands within existing upland agricultural fields,
- hydrological enhancement of 18.4 acres of previously ditched riverine wetlands,
- preservation of the 375.9 acres of existing Coastal Plain Bottomland Hardwoods/Cypress-Gum Swamp Forest wetlands,
- restoration of 7.3 acres of a previously drained nonriverine wetland area,
- hydrological enhancement of 1.9 acres of previously drained nonriverine wetlands,
- and creation of 1.4 acres of nonriverine wetlands within existing upland agricultural fields.

Wetland restoration and creation at the Site entailed 1) ditch cleaning prior to backfill, 2) impervious ditch plug construction, 3) ditch/canal backfilling, and 4) removal of fill material from wetlands.

According to the January 2004 Mitigation Plan, the primary goals of the project include 1) maximizing the area returned to historic wetland function; 2) expand, enhance, and preserve 549 acres of the Northeast Cape Fear River riparian ecosystem; 3) protect the Site with a conservation easement in perpetuity; 4) provide valuable habitat to a diverse assemblage of flora and fauna; 5) serve as a wildlife corridor along the Northeast Cape Fear river; and 6) provide numerous wetland values including water storage, pollutant removal, aquatic/wildlife habitat, recreation, and education.

Table of Contents

EXECUTIVE SUMMARY i
1.0 PROJECT BACKGROUND..... 1
2.0 MITIGATION PLAN 1
 2.1 Hydrologic Success Criteria 5
 2.2 Hydrologic Monitoring 5
 2.3 Vegetation Success Criteria..... 5
 2.4 Vegetation Monitoring..... 5
3.0 MAINTENANCE AND CONTINGENCY PLAN..... 5
4.0. REFERENCES 6

List of Figures

Figure 1. Site Location 2
Figure 2. As-built Mitigation Plan..... 3
Figure 3. Monitoring Plan..... 4

1.0 PROJECT BACKGROUND

The Grove Creek Wetland Mitigation Site (Site) is located within the United States Geological Survey (USGS) Hydrologic Unit 03030007 (North Carolina Division of Water Quality [NCDWQ] subbasin 03-06-22) of the Cape Fear River Basin. The Site includes an approximately 549-acre tract, located 5 miles east of Kenansville in central Duplin County (Figure 1).

Directions to the Site:

From Raleigh take Interstate 40 East to Exit 373

- Travel east on Highway 24 through Kenansville
- Travel approximately 6 miles further east on Highway 24 (if you reach the Cape Fear River, you have gone too far) to a left onto Dobson Chapel Road.
- Road surface becomes gravel and intersects another gravel road in about 0.3 mile. The Site is straight ahead.

Prior to implementation of wetland restoration activities, the Site was characterized by active agricultural fields, mixed hardwood forests, and a large Bottomland Hardwood/Cypress-Gum Swamp wetland system located adjacent to the Northeast Cape Fear River.

Primary mitigation activities are outlined in Figure 2 and included

- restoration of 3.0 acres of previously ditched and filled riverine wetlands,
- creation of 9.2 acres of riverine wetlands within existing upland agricultural fields,
- hydrological enhancement of 18.4 acres of previously ditched riverine wetlands,
- preservation of the 375.9 acres of existing Coastal Plain Bottomland Hardwoods/Cypress-Gum Swamp Forest wetlands,
- restoration of 7.3 acres of a previously drained nonriverine wetland area,
- hydrological enhancement of 1.9 acres of previously drained nonriverine wetlands,
- and creation of 1.4 acres of nonriverine wetlands within existing upland agricultural fields.


Wetland restoration and creation at the Site entailed 1) ditch cleaning prior to backfill, 2) impervious ditch plug construction, 3) ditch/canal backfilling, and 4) removal of fill material from wetlands.

According to the January 2004 Mitigation Plan, the primary goals of the project include 1) maximizing the area returned to historic wetland function; 2) expand, enhance, and preserve 549 acres of the Northeast Cape Fear River riparian ecosystem; 3) protect the Site with a conservation easement in perpetuity; 4) provide valuable habitat to a diverse assemblage of flora and fauna; 5) serve as a wildlife corridor along the Northeast Cape Fear river; and 6) provide numerous wetland values including water storage, pollutant removal, aquatic/wildlife habitat, recreation, and education.

In order to demonstrate successful mitigation, hydrologic and vegetative monitoring must be conducted for five years or until success criteria are achieved. Success criteria are based on federal guidelines for wetland mitigation. These guidelines stipulate criteria for both hydrologic conditions and vegetation survival. The following report details the results of hydrologic and vegetative monitoring for the 2006 (year 1) growing season at the Grove Creek Mitigation Site.


2.0 MITIGATION PLAN

Vegetation and hydrology will be monitored at the Site for five years or until success criteria have been achieved. The mitigation plan is outline in Figure 3.

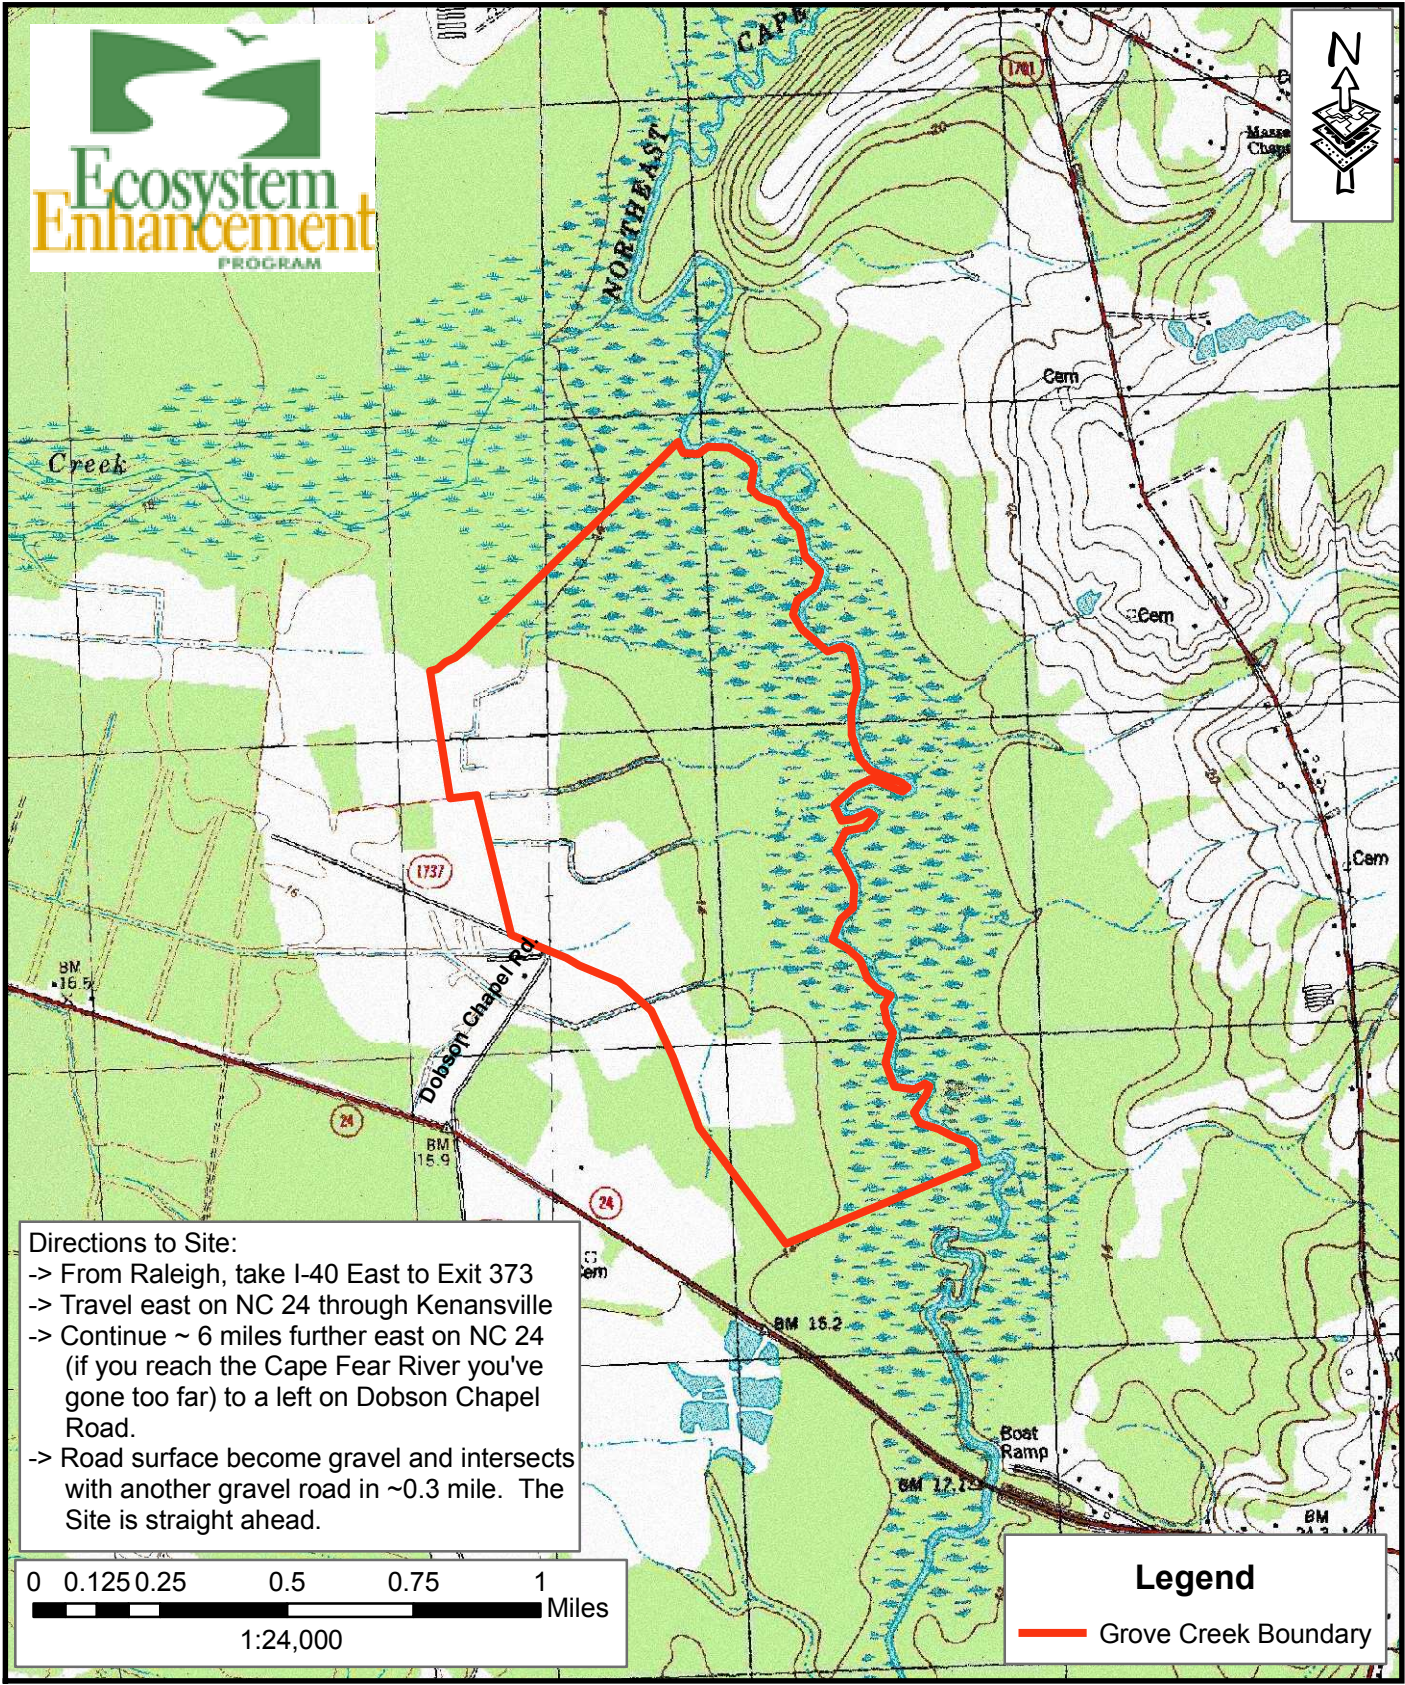

Directions to Site:

- > From Raleigh, take I-40 East to Exit 373
- > Travel east on NC 24 through Kenansville
- > Continue ~ 6 miles further east on NC 24 (if you reach the Cape Fear River you've gone too far) to a left on Dobson Chapel Road.
- > Road surface become gravel and intersects with another gravel road in ~0.3 mile. The Site is straight ahead.

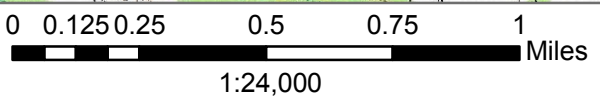

Legend

— Grove Creek Boundary




Axiom Environmental, Inc
 2126 Rowland Pond Drive
 Willow Spring, NC 27592
 (919) 215-1693
 (919) 341-3839 fax

SITE LOCATION
GROVE CREEK WETLAND RESTORATION SITE
 EEP Project Number .00038
 As-built Mitigation Report
 Duplin County, North Carolina

CLF
Date: April 2007
Project: 06-021

FIGURE
1

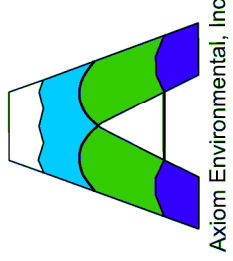

Axiom Environmental, Inc.




NOTES/REVISIONS

Project:
**Grove Creek
 Restoration Site**
 Project No. .00038
 Year 1 (2006) Monitoring Report
 Duplin County
 North Carolina

Title:
**As-Built
 Wetland Restoration
 Plan**

Scale: **1" = 655'**
 Date: **MAR 2007**
 Project No.: **06-021**

FIGURE NO.
2

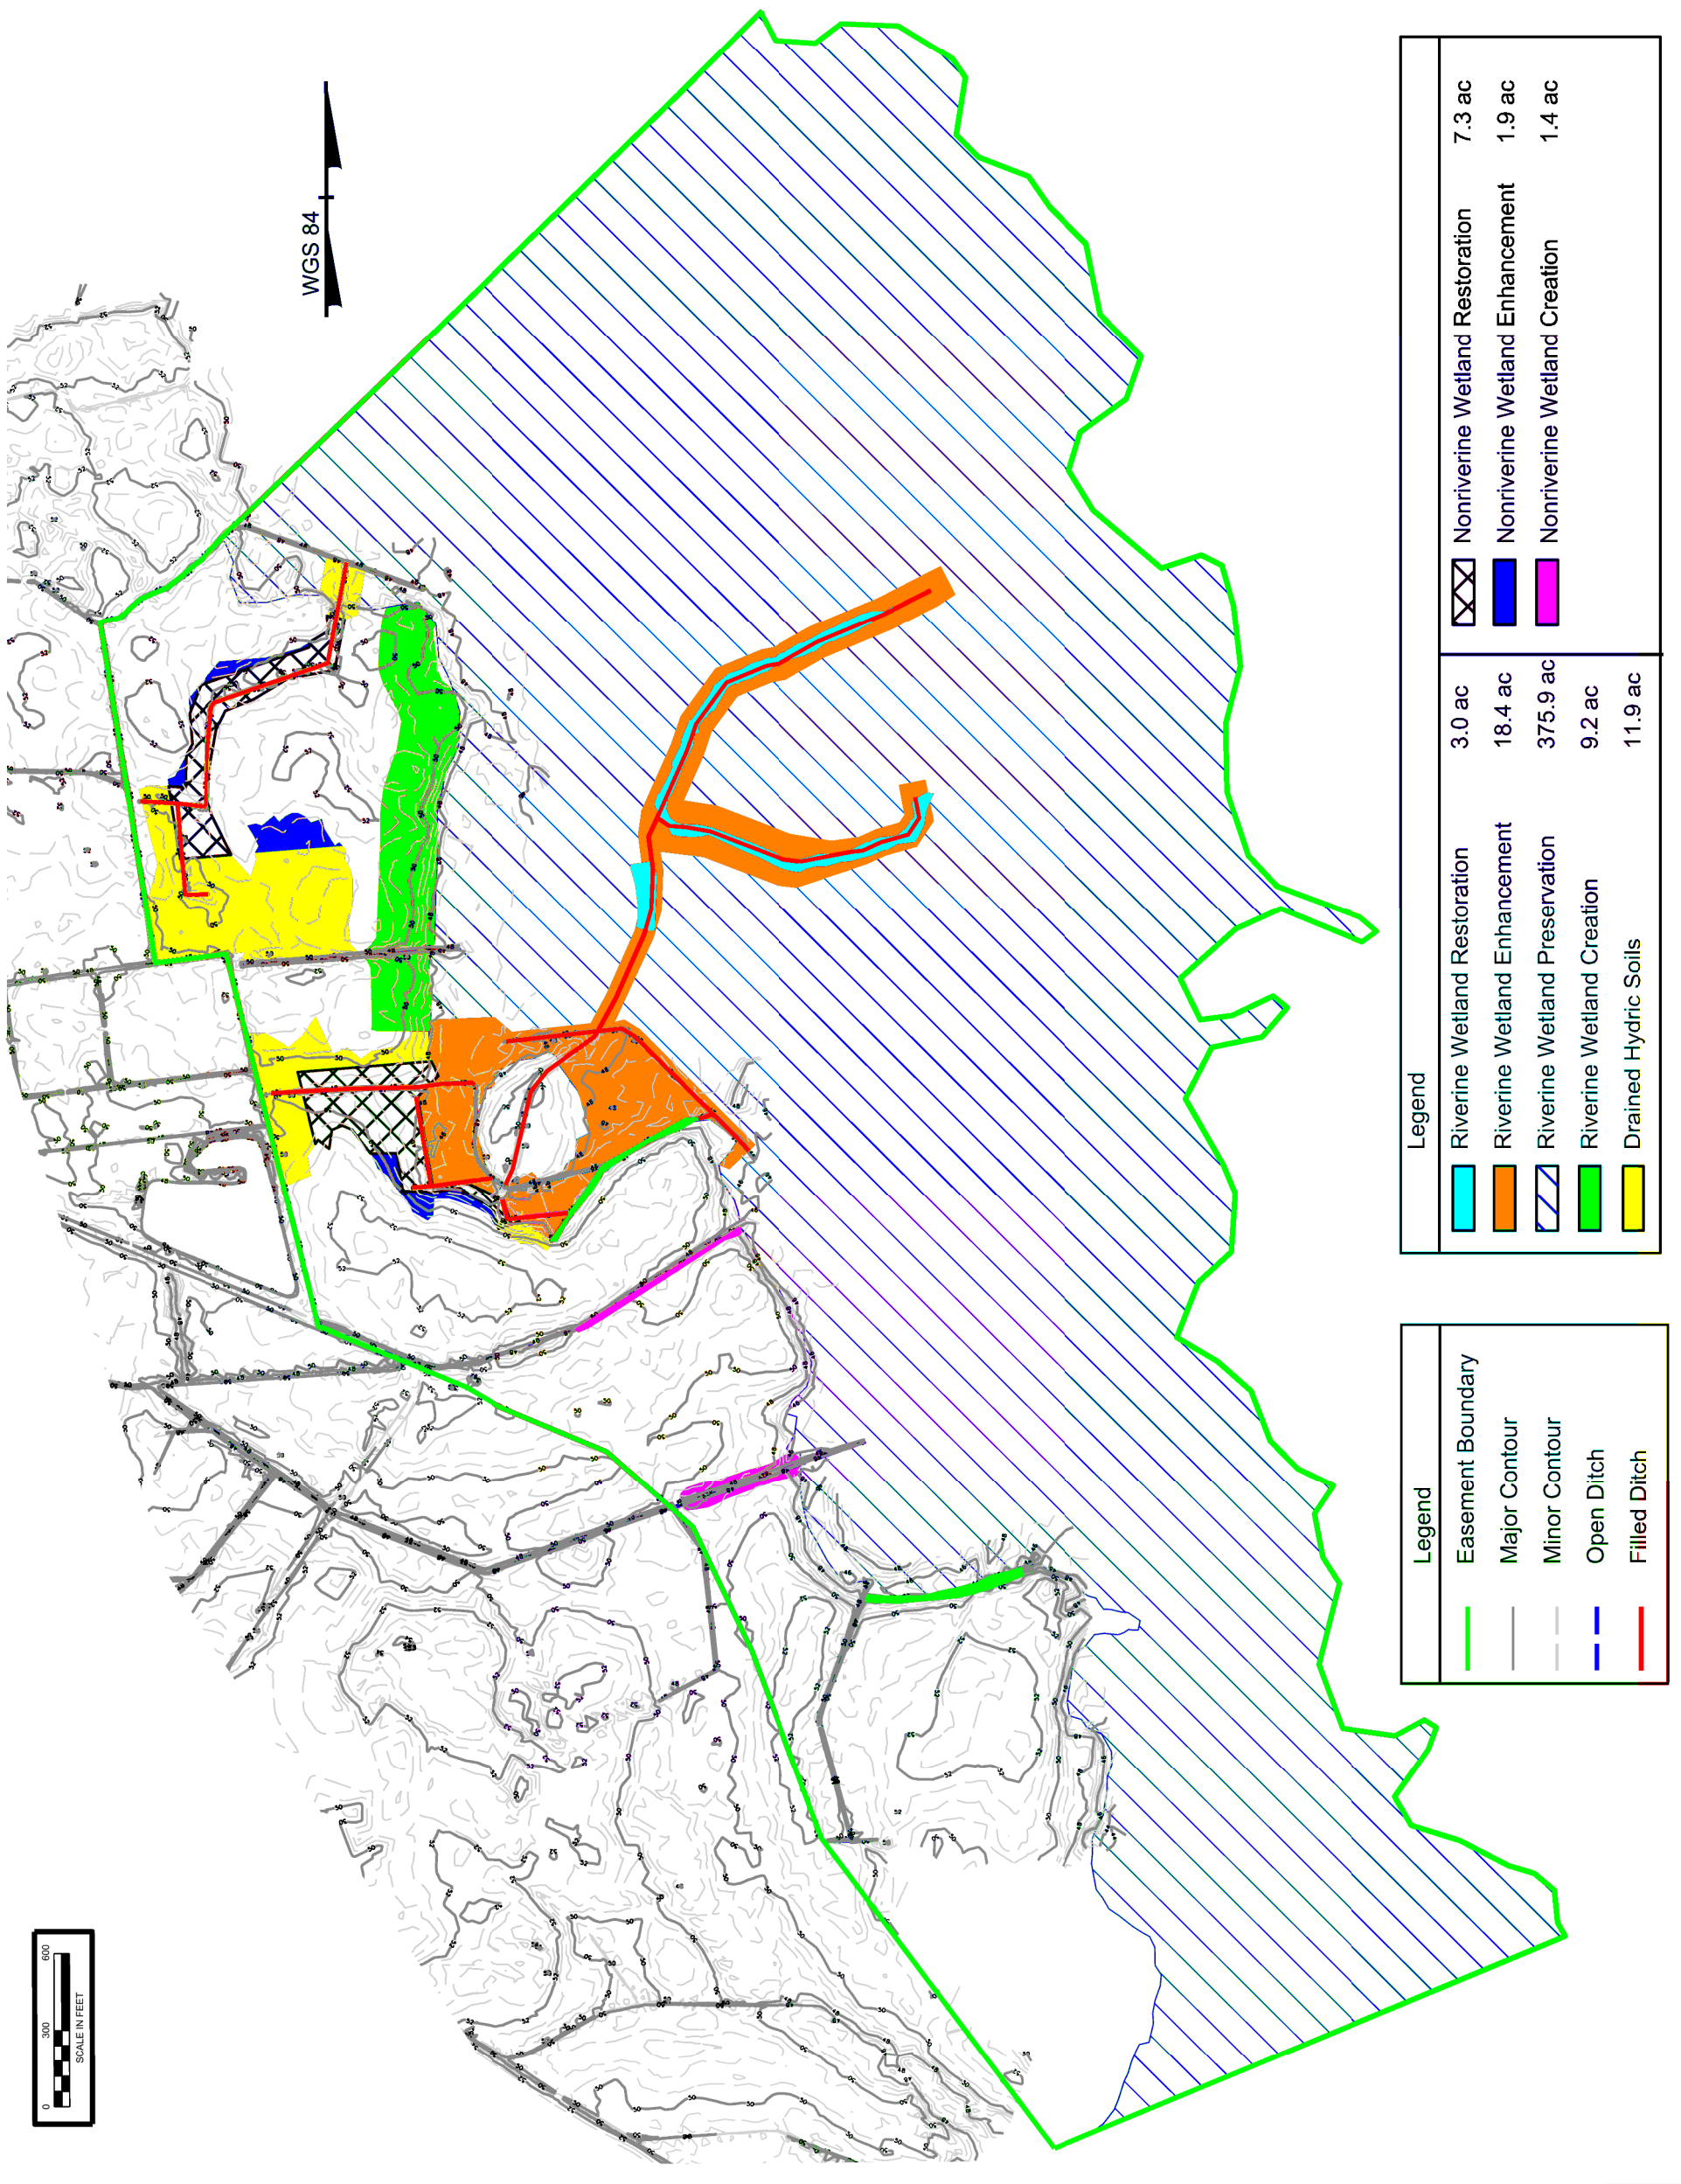


Legend	
	Easement Boundary
	Major Contour
	Minor Contour
	Open Ditch
	Filled Ditch

Legend			
	Riverine Wetland Restoration	3.0 ac	7.3 ac
	Riverine Wetland Enhancement	18.4 ac	1.9 ac
	Riverine Wetland Preservation	375.9 ac	1.4 ac
	Riverine Wetland Creation	9.2 ac	
	Drained Hydric Soils	11.9 ac	
	Nonriverine Wetland Restoration		
	Nonriverine Wetland Enhancement		
	Nonriverine Wetland Creation		



	Latitude	Longitude
Gauge		
GW2	34.96003	77.87585
GW3	34.95841	77.87735
GW4	34.95515	77.87559
GW5	34.95442	77.87496
GW8	34.95394	77.87337
GW9	34.95453	77.87221
GW11	34.95719	77.87174
SG3	34.95615	77.87488
SG4	34.95742	77.87483
SG5	34.95841	77.87467
SG6	34.95975	77.8746
Rain Gauge	34.95221	77.87422
Vegetation Plot		
1	34.95402	77.87417
2	34.95506	77.87554
3	34.95728	77.87754
4	34.96018	77.87636
5	34.95017	77.87484
6	34.95405	77.87608
7	34.9572	77.875

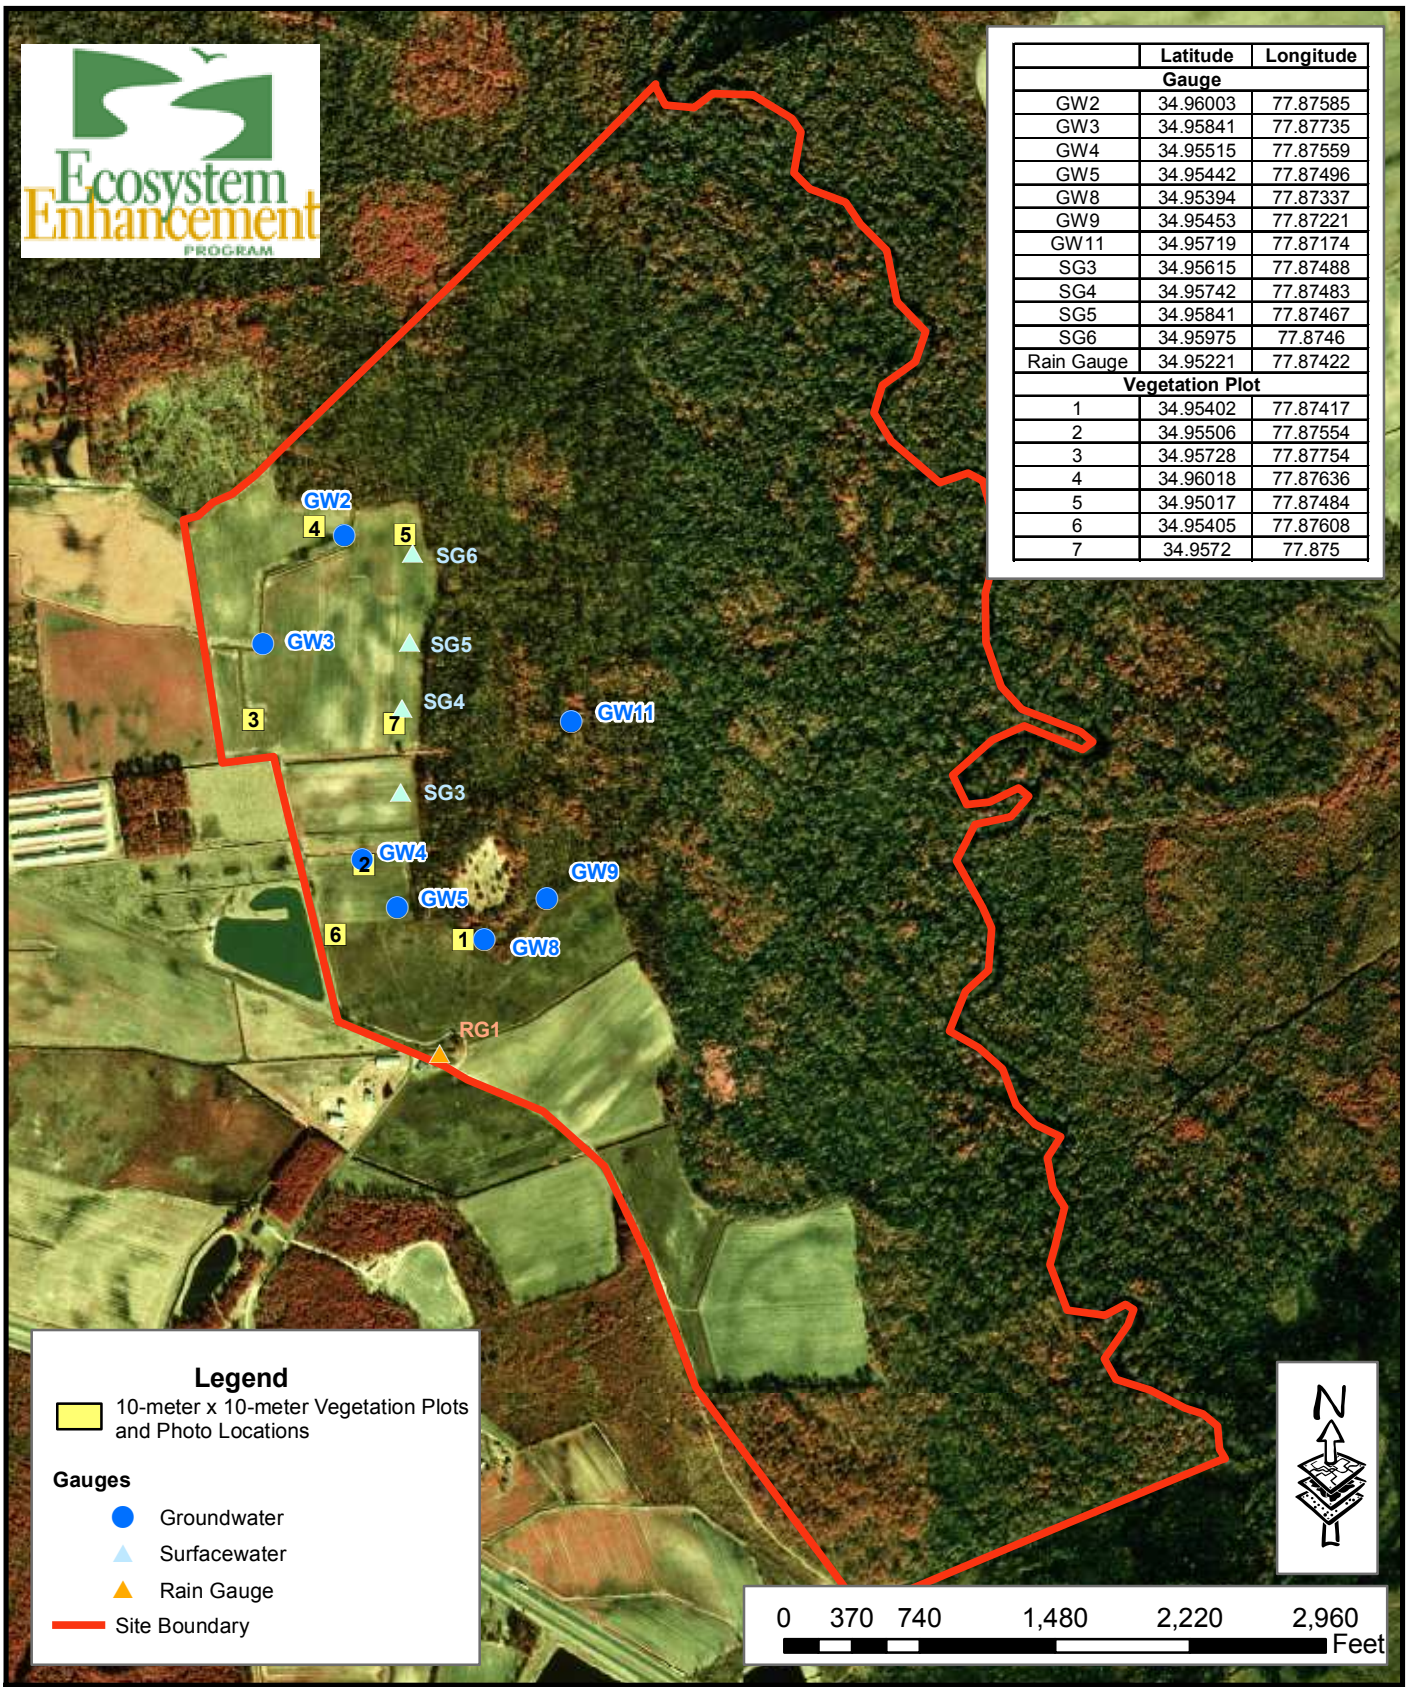


Legend

- 10-meter x 10-meter Vegetation Plots and Photo Locations

Gauges

- Groundwater
- Surfacewater
- Rain Gauge
- Site Boundary

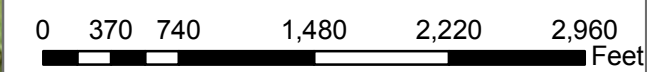


Axiom Environmental, Inc
 2126 Rowland Pond Drive
 Willow Spring, NC 27592
 (919) 215-1693
 (919) 341-3839 fax

Axiom Environmental, Inc.

MONITORING PLAN
GROVE CREEK WETLAND RESTORATION SITE
 EEP Project Number .00038
 As-built Mitigation Plan
 Duplin County, North Carolina

CLF
Date: Mar 2007
Project: 06-021

FIGURE
3

2.1 Hydrologic Success Criteria

Success criteria for wetland hydrology at Grove Creek require inundation or saturation within 12 inches of the ground surface for a consecutive period of 12.5 percent of the growing season. The soil survey for Duplin County does not contain growing season data; therefore, due to its close proximity the Sampson County soil survey was used. The estimate growing season begins March 18 and ends November 4 (239 days). In order to attain hydrologic success, saturation within 12 inches of the ground surface is required for at least 30 consecutive days (12.5 percent of the growing season).

2.2 Hydrologic Monitoring

Seven groundwater monitoring gauges, four surfacewater monitoring gauges, and one rain gauge will be maintained and monitored throughout the growing season for each monitoring year.

2.3 Vegetation Success Criteria

Wetland vegetation success criteria at Grove Creek will require an average across the Site of 320 stems per acre of approved target species surviving for the first three years of monitoring, 290 stems per acre in year four, and 260 stems per acre in year five. Target species include but are not limited to planted species and species listed within appropriate Schafale and Weakley (1980) communities.

According to the 2004 *Groove Creek Mitigation Plan*, seedlings were to be planted at a minimum density of 680 stems per acre and included:

1. water oak (*Quercus nigra*)
2. willow oak (*Quercus phellos*)
3. laurel oak (*Quercus laurifolia*)
4. swamp chestnut oak (*Quercus michauxii*)
5. green ash (*Fraxinus pennsylvanica*)
6. river birch (*Betula nigra*)
7. bald cypress (*Taxodium distichum* var. *distichum*)
8. water tupelo (*Nyssa biflora*)

2.4 Vegetation Monitoring

Seven 10-meter by 10-meter vegetation monitoring plots will be sampled each year using the EEP/CVS methods for vegetation sampling (Lee et al. 2006). In addition, photographs will be taken at each of the plots to provide a visual record of vegetation development over the monitoring period.

3.0 MAINTENANCE AND CONTINGENCY PLAN

In the event that vegetation and/or hydrology success criteria are not fulfilled, appropriate contingency measures will be implemented in coordination with the resource agencies. Examples of such actions include replanting and extension of the monitoring period if community mitigation types do not fulfill the minimum species density requirements. Additionally, invasive species concerns will be addressed if the need arises. Hydrologic contingency will require consultation with hydrologists and the resource agencies in the event that predicted hydrology is not achieved during the monitoring period; recommendations for altering hydrology will then be implemented and monitored until success criteria are achieved.

4.0. REFERENCES

Lee, M.T., R.K. Peet, S.D. Roberts, and T.R. Wentworth. 2006. CVS-EEP Protocol for Recording Vegetation. Version 4.0. North Carolina Department of Environment and Natural Resources, Ecosystem Enhancement Program. Raleigh, North Carolina.

North Carolina Department of Transportation (NCDOT). 2004. Grove Creek Mitigation Plan, Duplin County, North Carolina, TIP No. R-2204 WM. Office of Natural Environment & Roadside Environmental Unit.

Schafale, M.P. and A.S. Weakley. 1990. Classification of the Natural Communities of North Carolina: Third Approximation. North Carolina Natural Heritage Program, Division of Parks and Recreation, North Carolina Department of Environment, Health, and Natural Resources. Raleigh, North Carolina.

United States. Department of Agriculture (USDA). 1985. Soil Survey of Sampson County, North Carolina. United States Department of Agriculture.


STATE OF NORTH CAROLINA
DIVISION OF HIGHWAYS

DUPLIN COUNTY

LOCATION: EAST OF KENANSVILLE, EAST OF SR 1737

TYPE OF WORK: WETLAND RESTORATION, GRADING, AND DRAINAGE


STATE	STATE PROJECT REFERENCE NO.	SHEET NO.	TOTAL SHEETS
N.C.	R-2204WM	1	
STATE PROJ. NO.	F.A. PROJ. NO.	DESCRIPTION	
8.1241801	STP-III(4)	P.E.	
8.1241801	STP-III(4)	R/W	
NOT AVAILABLE	NOT AVAILABLE	CONST.	

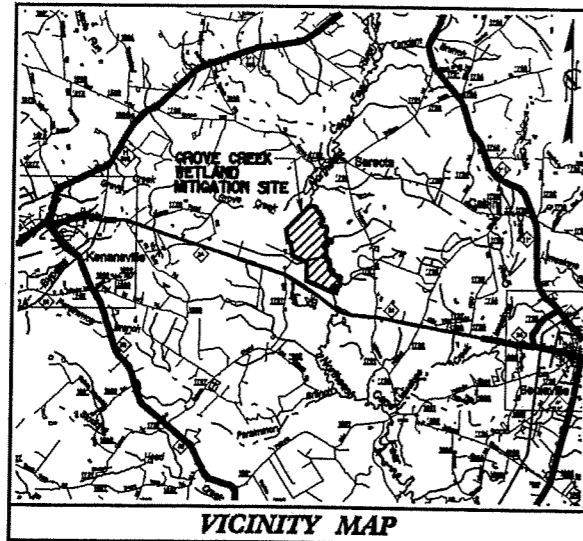

VICINITY MAP


INDEX OF SHEETS

SHEET NO.	SHEET
1	TITLE SHEET
1A	CONVENTIONAL SYMBOLS
2	TYPICAL SECTIONS AND DETAILS
3	SUMMARY OF QUANTITIES
4-6	PLAN SHEETS
7	PLANTING PLAN SHEET
X-1 THRU X-19	CROSS SECTION

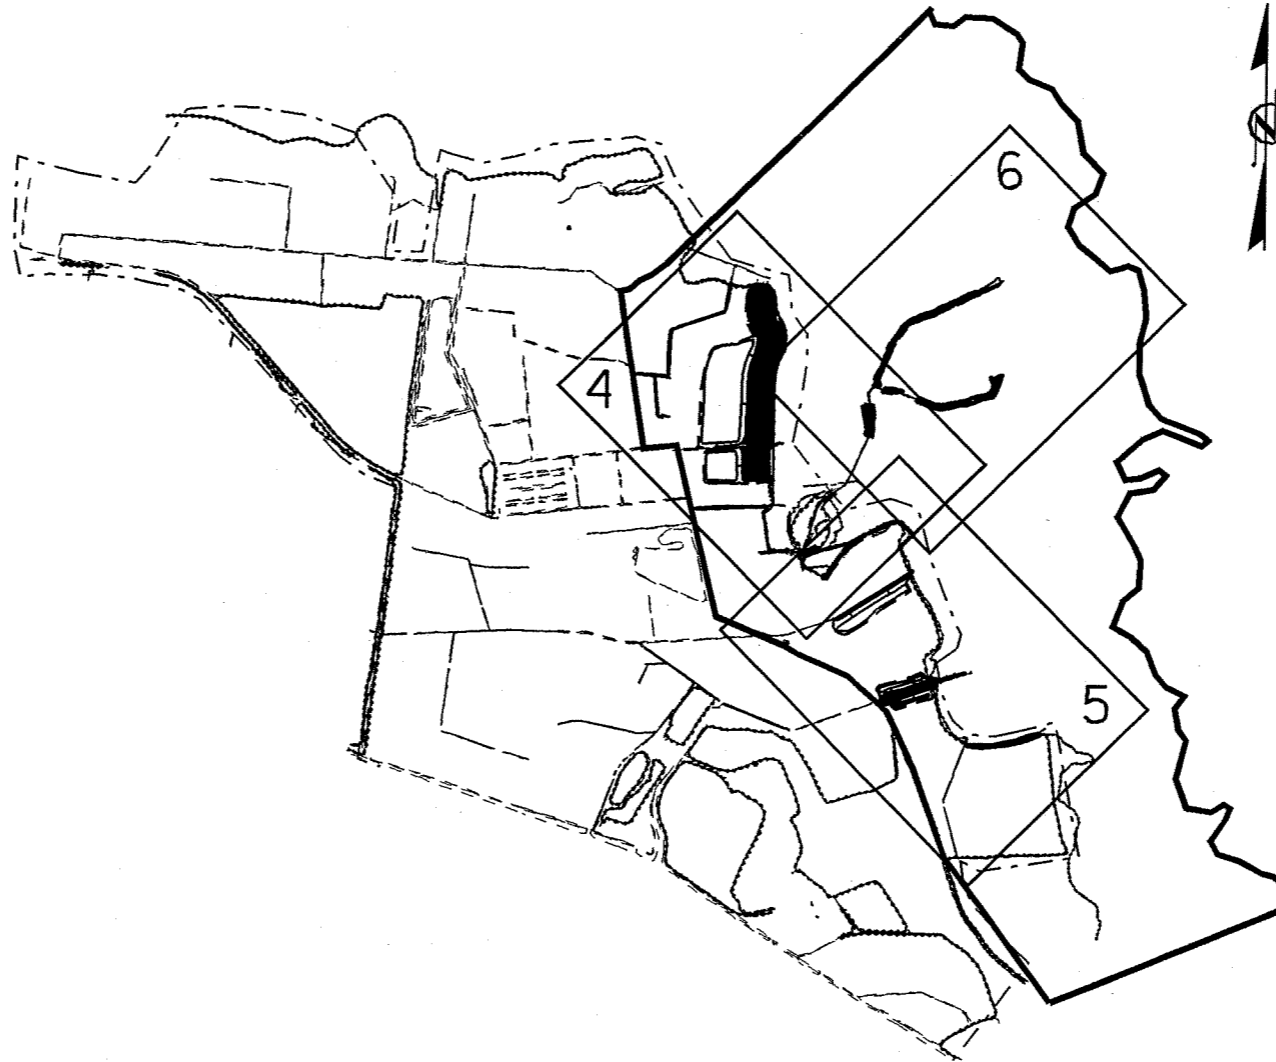

NCDOT CONTACT: JAMIE LANCASTER & PHILLIP TODD

GRAPHIC SCALES

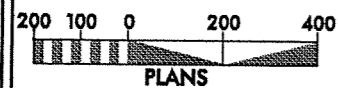

DESIGN DATA

PROJECT LENGTH

Prepared for the North Carolina Department of Transportation
in the Office of:
HSMM
1305 NAVAHO DR., SUITE 303
RALEIGH, NC 27609
(919) 878-5250

2002 STANDARD SPECIFICATIONS

RIGHT OF WAY DATE:

LETTING DATE:

S.G. GINN, P.E.
PROJECT ENGINEER

PROJECT DESIGN ENGINEER

PROJECT ENGINEER

SIGNATURE

P.E.

DIVISION OF HIGHWAYS
STATE OF NORTH CAROLINA

STATE DESIGN ENGINEER
DEPARTMENT OF TRANSPORTATION
FEDERAL HIGHWAY ADMINISTRATION

APPROVED
DIVISION ADMINISTRATOR


DATE

PROJECT: 8.1241801


R-2204WM

6/2/99


PROJECT REFERENCE NO. <i>R-2204WM</i>	SHEET NO. <i>2</i>
ROADWAY DESIGN ENGINEER	PAVEMENT DESIGN ENGINEER
H S M M ARCHITECTS - ENGINEERS - PLANNERS 1005 HAYWARD DR. SUITE 303 RALEIGH, NC 27609	

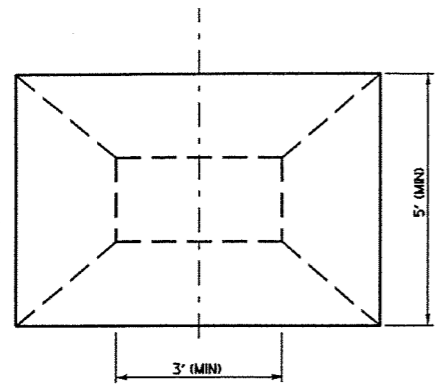


IMPERVIOUS BLOCK - PLAN
NOT TO SCALE

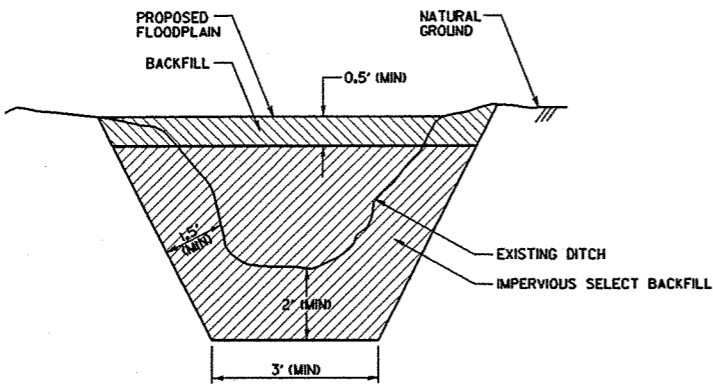


IMPERVIOUS BLOCK - SECTION
NOT TO SCALE

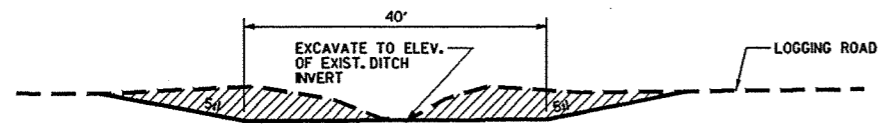


CONVEYANCE CHANNEL - SECTION
NOT TO SCALE

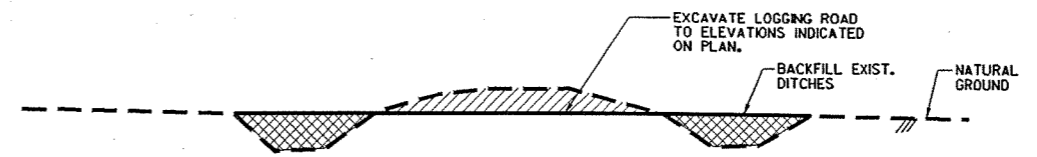


LOGGING ROAD - SECTION
NOT TO SCALE

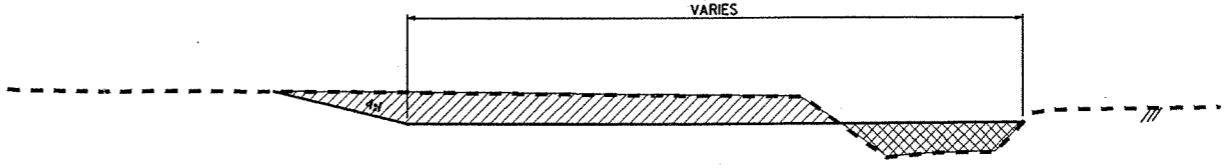

DITCH 22 - SECTION
NOT TO SCALE

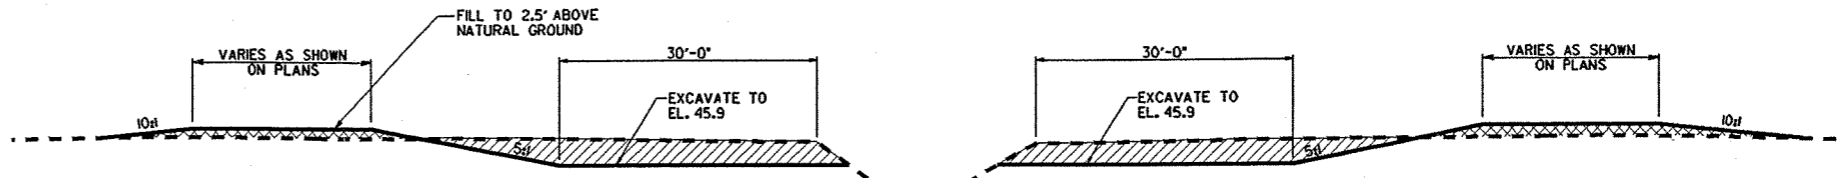

DITCH 12 - SECTION
NOT TO SCALE

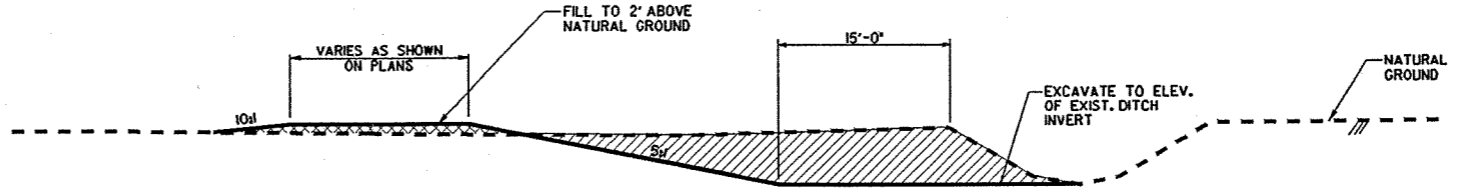


DITCH II - SECTION
NOT TO SCALE



DITCH 8 - SECTION
NOT TO SCALE




TYPICAL DITCH - SECTION
DITCHES 1, 2, 3, 5, 7, 16, AND 17
NOT TO SCALE

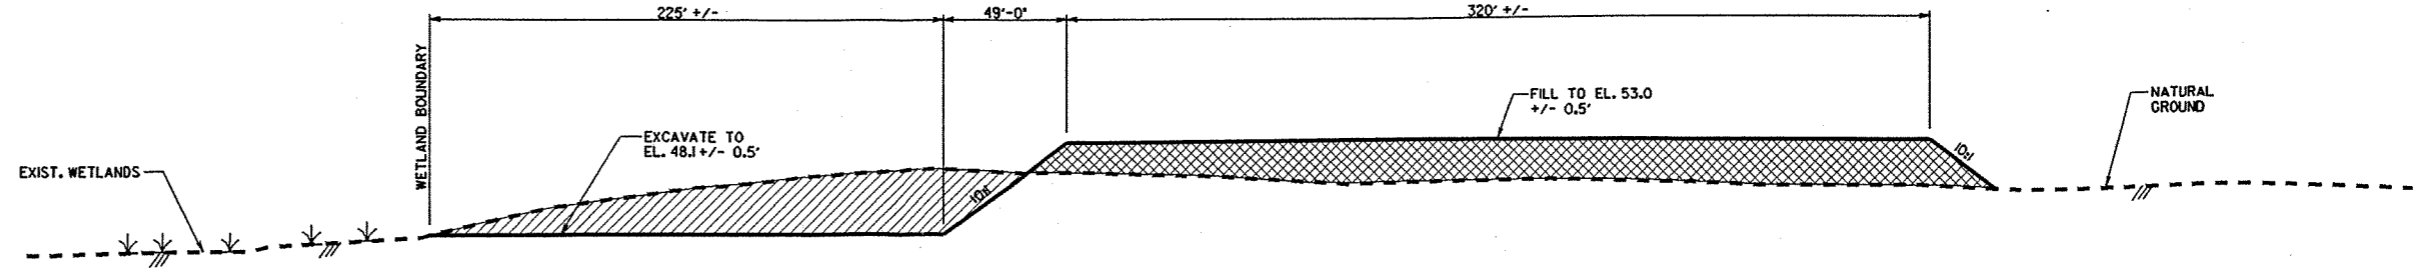

AREA B - SECTION
NOT TO SCALE

6/2/99
#2578
#2579
#2580
#2581
#2582
#2583
#2584
#2585
#2586
#2587
#2588
#2589
#2590
#2591
#2592
#2593
#2594
#2595
#2596
#2597
#2598
#2599
#2600

8/17/79
FILES
SCANS
DATES
STICKS
SUSERS

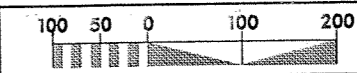


PROJECT REFERENCE NO. R-2204WM	SHEET NO. 4
RW SHEET NO.	
ROADWAY DESIGN ENGINEER	HYDRAULICS ENGINEER
H S M M ARCHITECTS - ENGINEERS - PLANNERS 1305 NAVAHO DR. SUITE 303 RALEIGH, NC 27609	

MATCHLINE SHEET 5

MATCHLINE SHEET 6

MATCHLINE SHEET 6

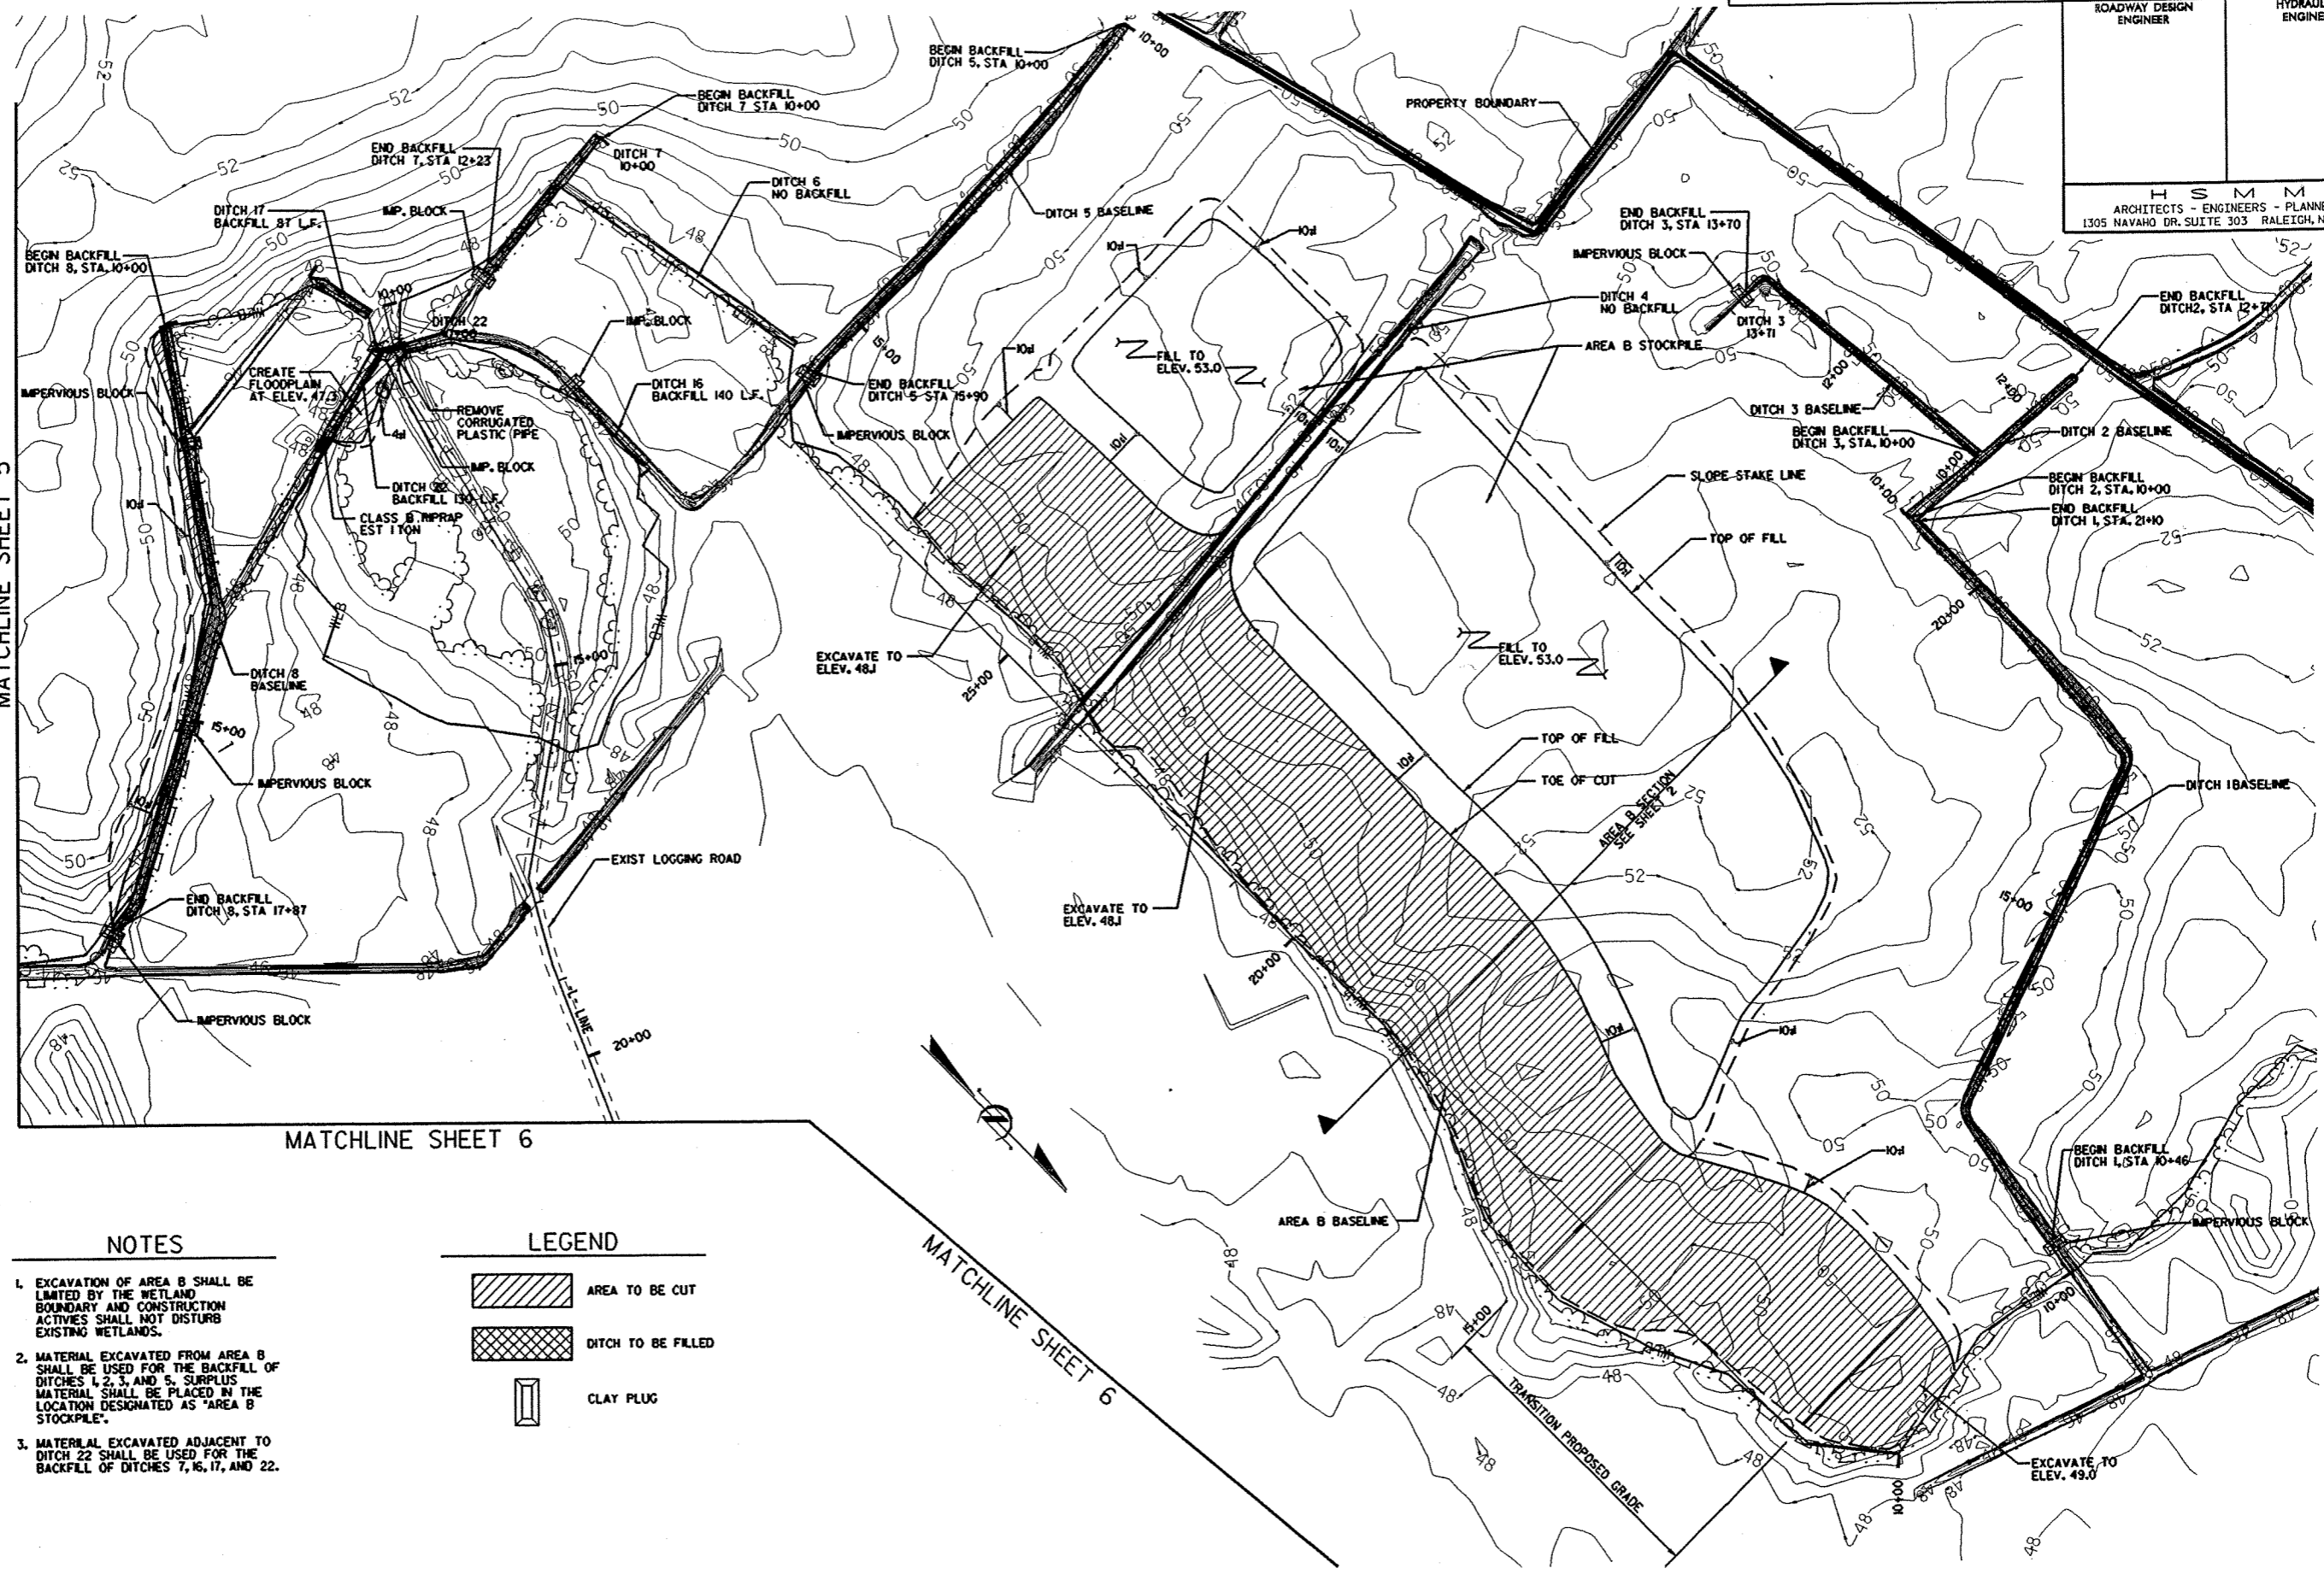


NOTES


1. EXCAVATION OF AREA B SHALL BE LIMITED BY THE WETLAND BOUNDARY AND CONSTRUCTION ACTIVITIES SHALL NOT DISTURB EXISTING WETLANDS.
2. MATERIAL EXCAVATED FROM AREA B SHALL BE USED FOR THE BACKFILL OF DITCHES 1, 2, 3, AND 5. SURPLUS MATERIAL SHALL BE PLACED IN THE LOCATION DESIGNATED AS "AREA B STOCKPILE".
3. MATERIAL EXCAVATED ADJACENT TO DITCH 22 SHALL BE USED FOR THE BACKFILL OF DITCHES 7, 16, 17, AND 22.

LEGEND

- AREA TO BE CUT
- DITCH TO BE FILLED
- CLAY PLUG

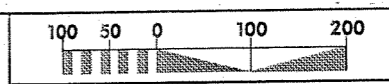

PROJECT REFERENCE NO. <i>R-2204WM</i>	SHEET NO. 5
1/4" SHEET NO.	
ROADWAY DESIGN ENGINEER	HYDRAULICS ENGINEER
H S M M ARCHITECTS - ENGINEERS - PLANNERS 1305 NAVAHO DR. SUITE 303 RALEIGH, NC 27609	

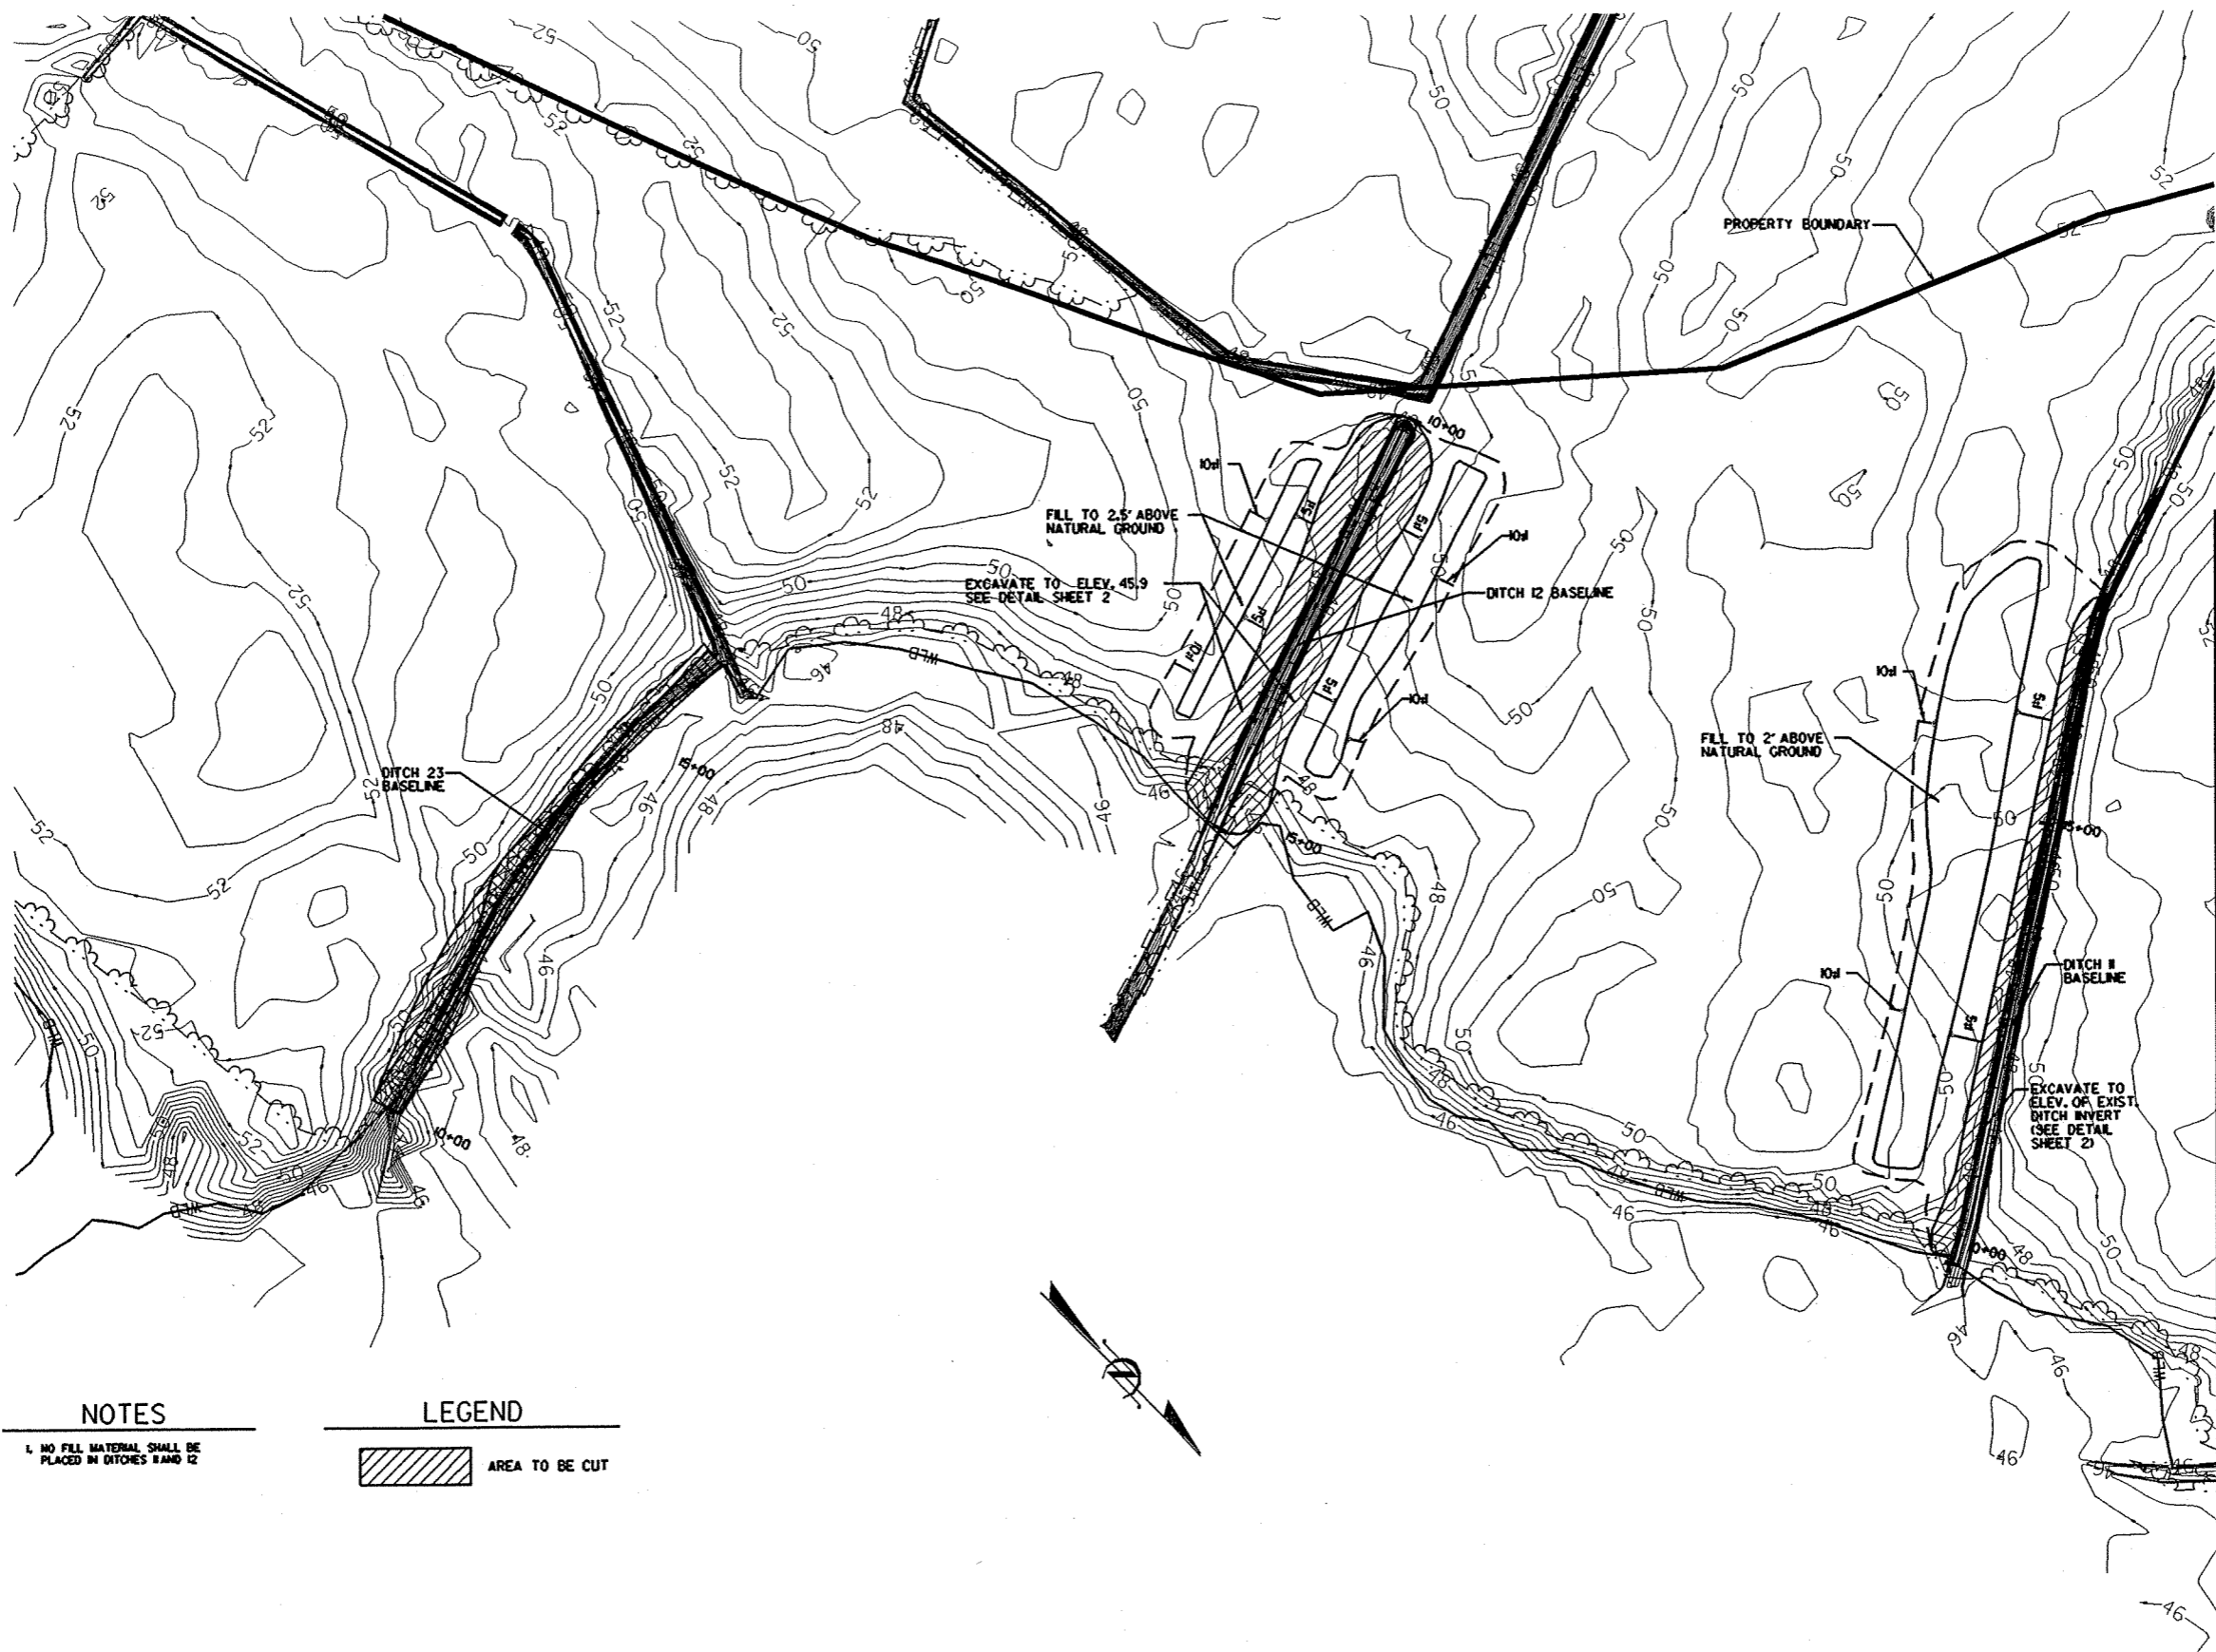


MATCHLINE SHEET 4

NOTES

1. NO FILL MATERIAL SHALL BE PLACED IN DITCHES 12 AND 12


LEGEND

AREA TO BE CUT


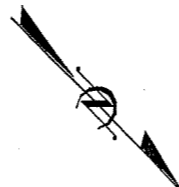


8/17/8
 567178
 \$125
 \$20000
 \$0175
 \$1000
 \$15000

8/17/98

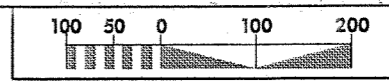


PROJECT REFERENCE NO. <i>R-2204WM</i>	SHEET NO. 6
R/W SHEET NO.	
ROADWAY DESIGN ENGINEER	HYDRAULICS ENGINEER
H S M M ARCHITECTS - ENGINEERS - PLANNERS 1305 NAVAHO DR. SUITE 303 RALEIGH, NC 27609	

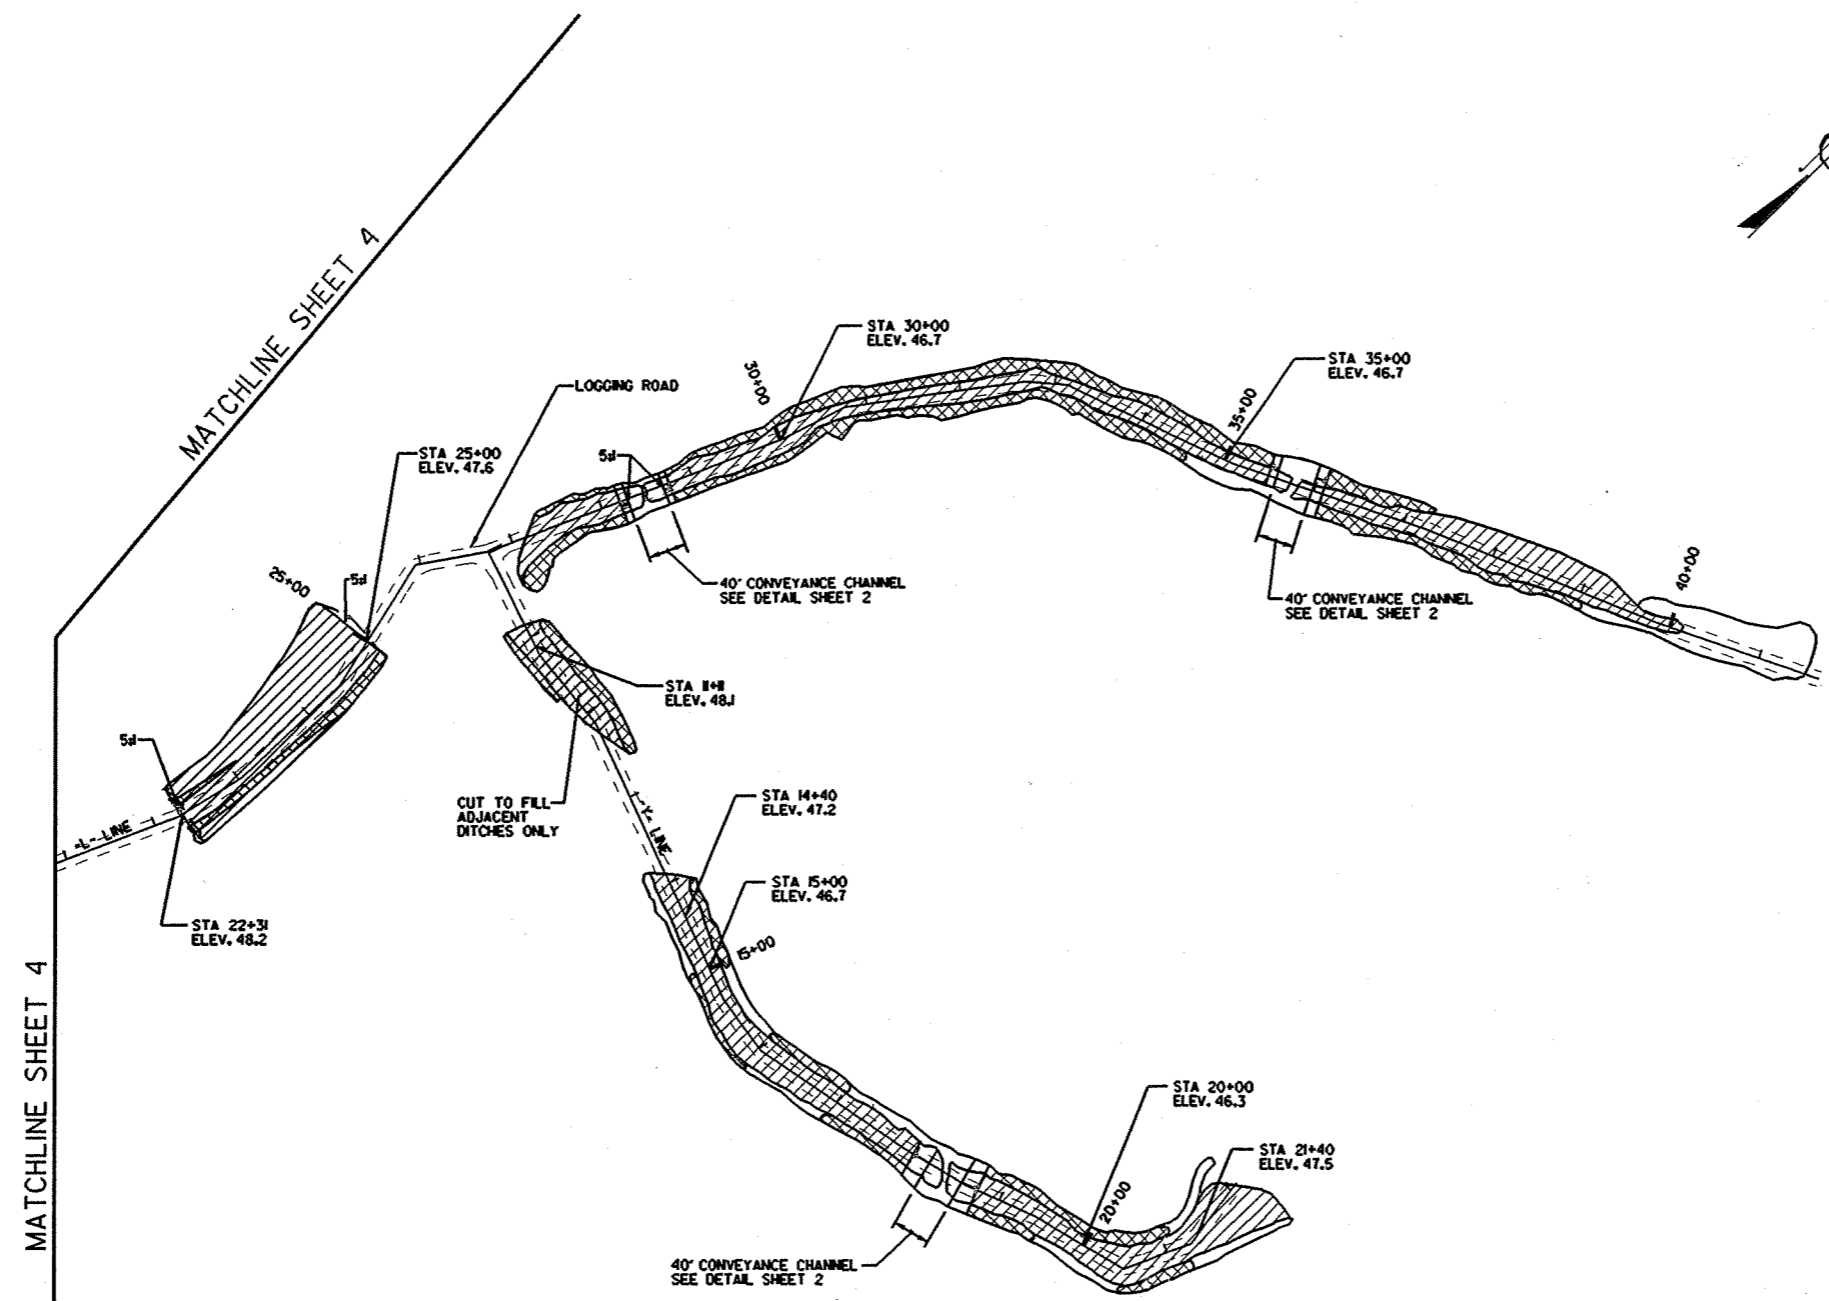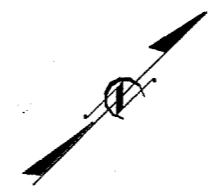

MATCHLINE SHEET 4


MATCHLINE SHEET 4

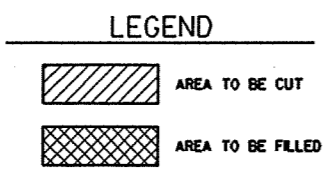

PROPERTY BOUNDARY

\$FILED
 \$COMANS
 \$DATES
 \$TIME\$
 \$USER\$
 \$PR\$

5/17/8

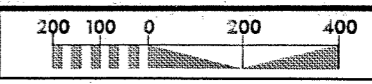

PROJECT REFERENCE NO. <i>R-2204MM</i>	SHEET NO. <i>7</i>
RW SHEET NO.	
ROADWAY DESIGN ENGINEER	HYDRAULICS ENGINEER
H S M M ARCHITECTS - ENGINEERS - PLANNERS 1305 NAVAHO DR. SUITE 303 RALEIGH, NC 27609	




REFORESTATION PLAN

GROVE CREEK MITIGATION SITE

NOTE: REFORESTATION PLAN IS NOT CONSIDERED TO BE PART OF THIS CONTRACT AND SHALL BE ACCOMPLISHED BY OTHERS.


FILES
SCOMAS
RDATES
STINES
RUSERS
SRS

8/17/99

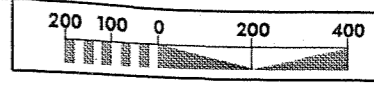

PROJECT REFERENCE NO. R-220-AM		SHEET NO. 7A	
RW SHEET NO.			
ROADWAY DESIGN ENGINEER		HYDRAULICS ENGINEER	
H S M M ARCHITECTS - ENGINEERS - PLANNERS 1305 NAVAHO DR., SUITE 303 RALEIGH, NC 27609			

MONITORING GAUGE AND VEGETATION PLOT LOCATIONS

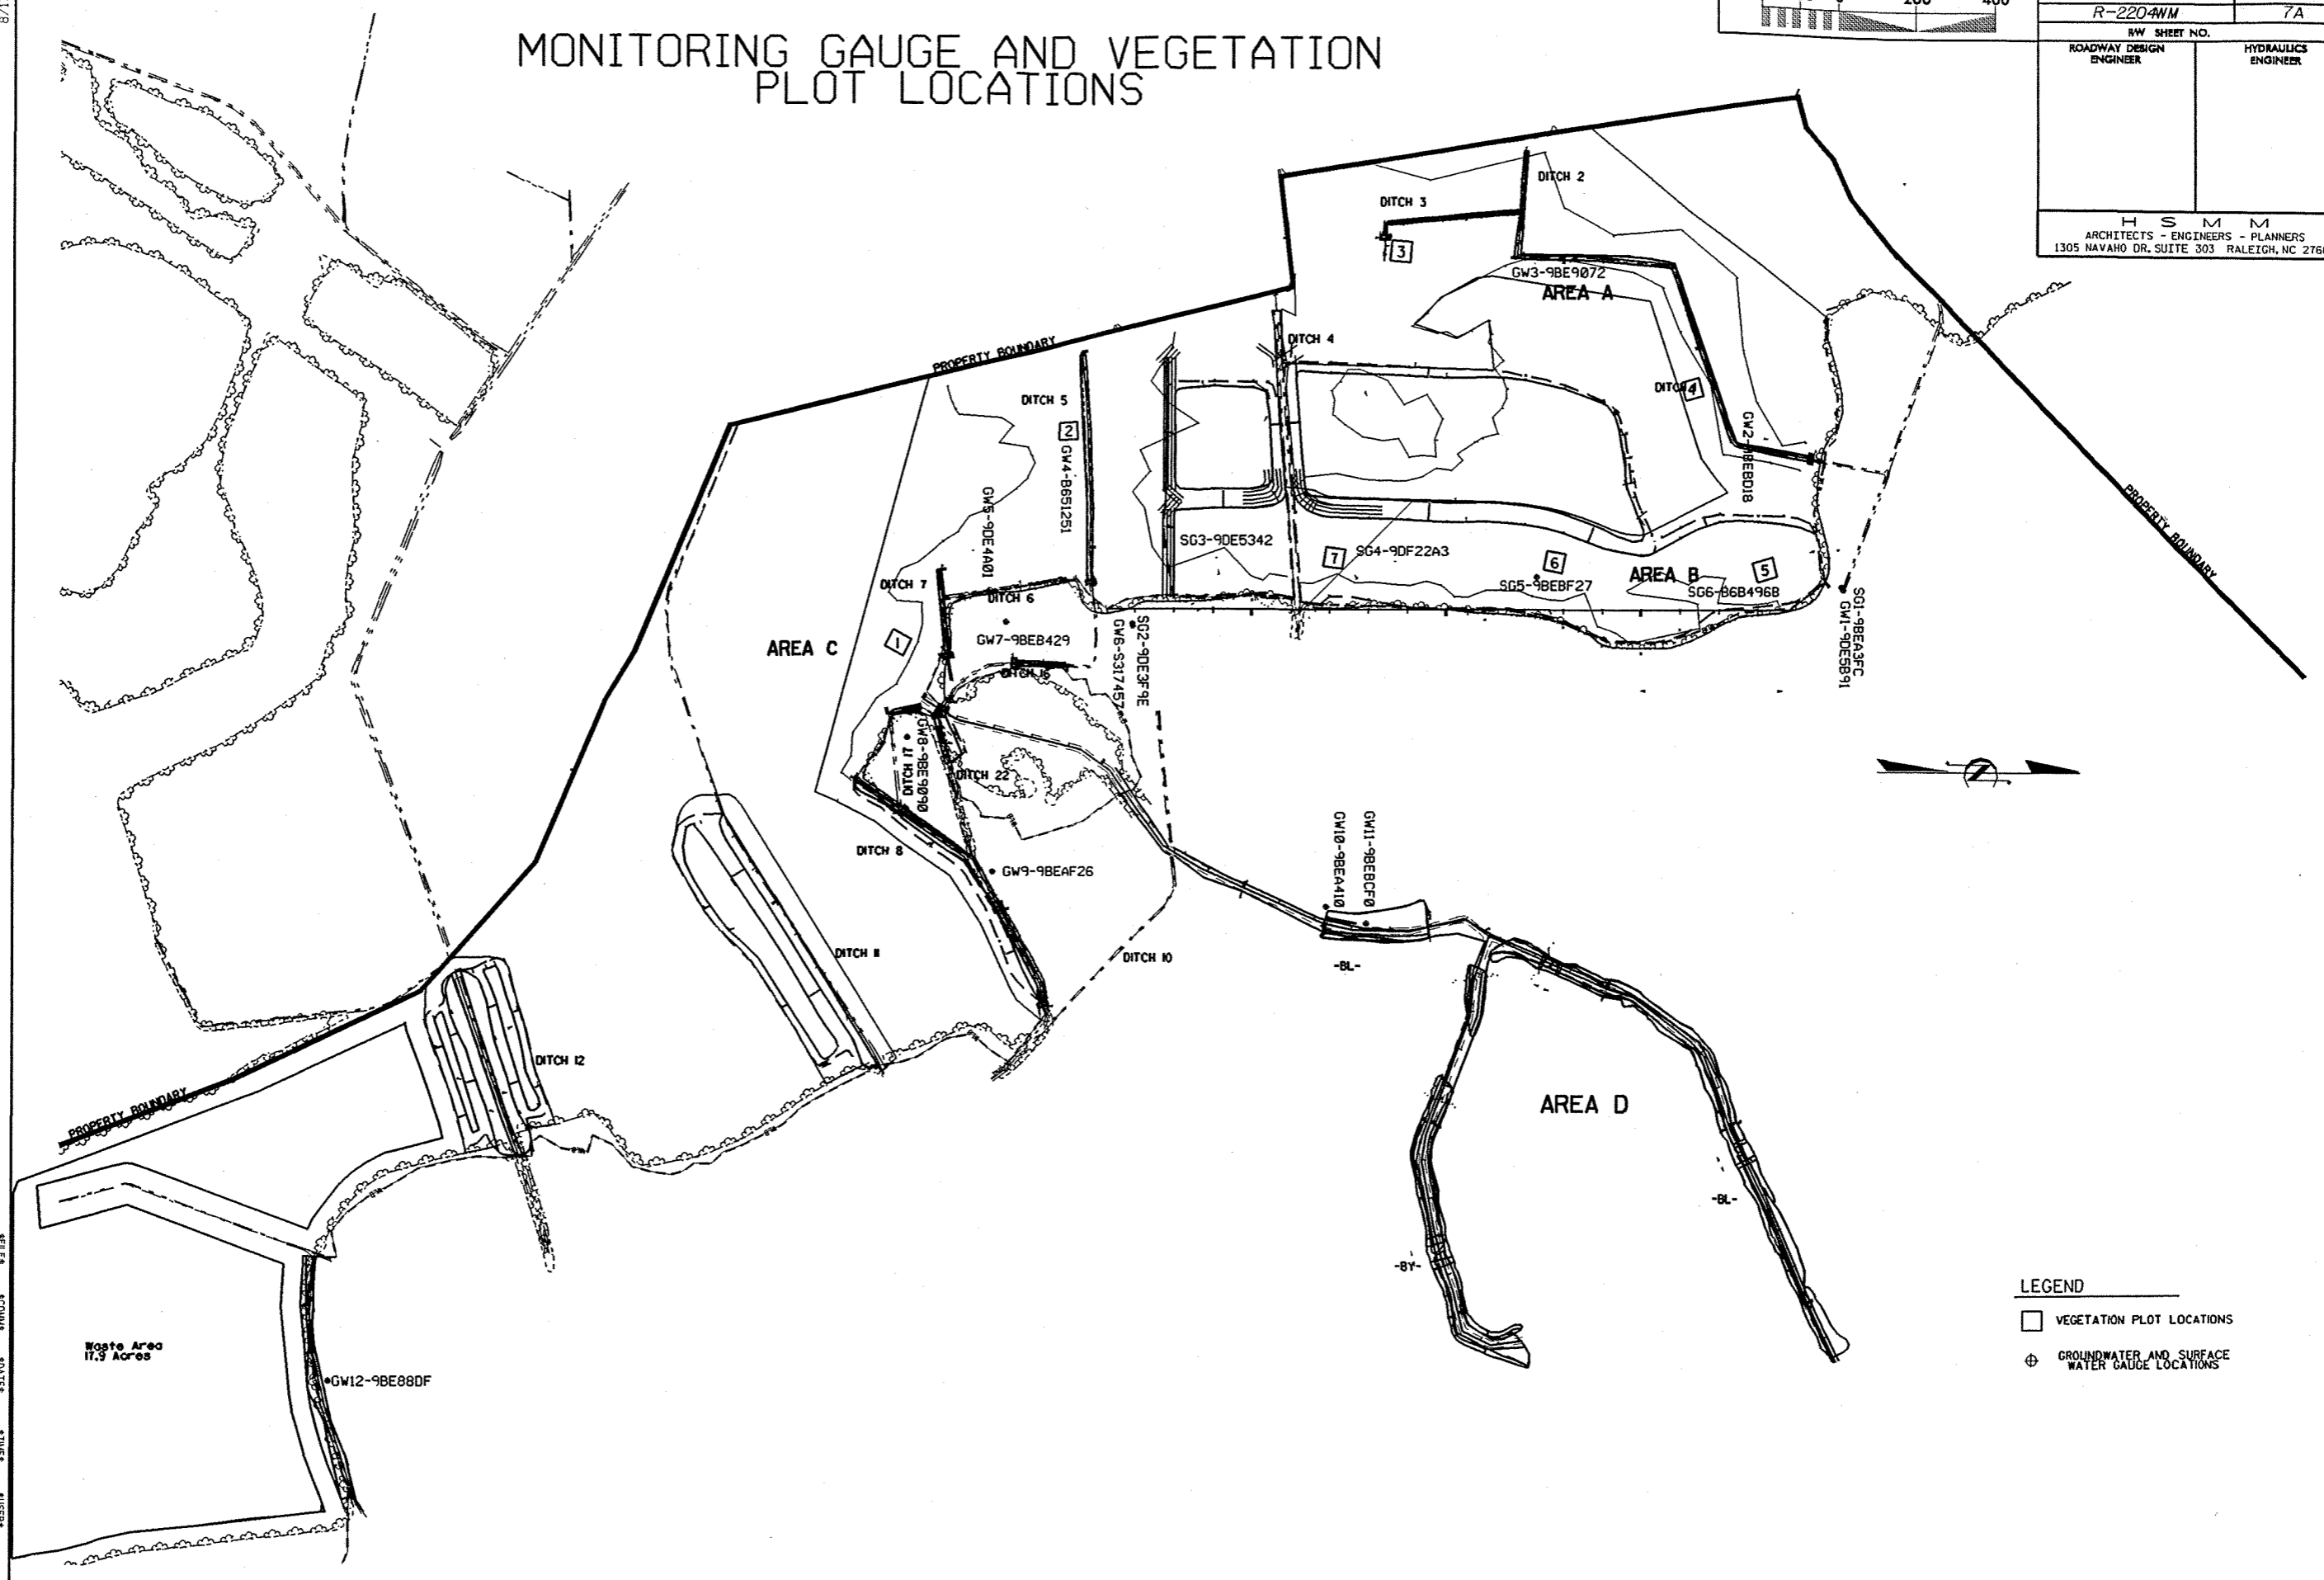

LEGEND

	VEGETATION PLOT LOCATIONS
⊕	GROUNDWATER AND SURFACE WATER GAUGE LOCATIONS

\$FILES \$COMMS \$DATES \$TIMES \$USERS \$RIS


PLANTING DETAILS

SEEDLING / LINER BAREROOT PLANTING DETAIL


HEALING IN

1. Locate a healing-in site in a shady, well protected area.


2. Excavate a flat bottom trench 12" deep and provide drainage.

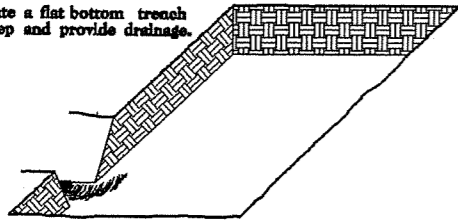


3. Backfill the trench with 2" well rotted sawdust. Place a 2" layer of well rotted sawdust at a sloping angle at one end of the trench.

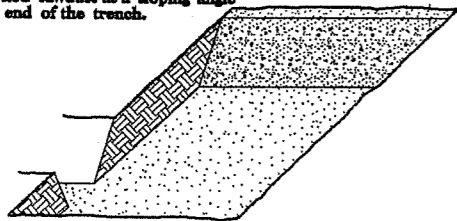

4. Place a single layer of plants against the sloping end so that the root collar is at ground level.

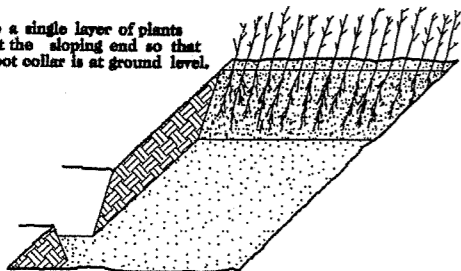


5. Place a 2" layer of well rotted sawdust over the roots maintaining a sloping angle.

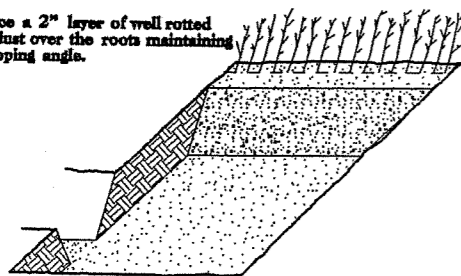


6. Repeat layers of plants and sawdust as necessary and water thoroughly.


DIBBLE PLANTING METHOD USING THE KBC PLANTING BAR

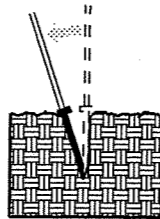


1. Insert planting bar as shown and pull handle toward planter.

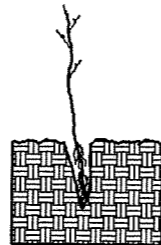


2. Remove planting bar and place seedling at correct depth.

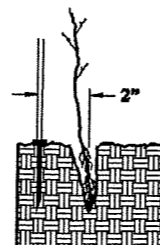


3. Insert planting bar 2" toward planter from seedling.

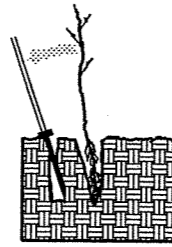

4. Pull handle of bar toward planter, firming soil at bottom.

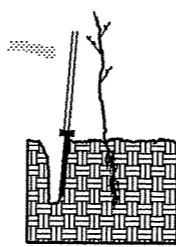

5. Push handle forward firming soil at top.

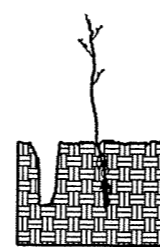

6. Leave compaction hole open. Water thoroughly.

PLANTING NOTES:

PLANTING BAG
During planting, seedlings shall be kept in a moist canvas bag or similar container to prevent the root systems from drying.



KBC PLANTING BAR
Planting bar shall have a blade with a triangular cross section, and shall be 12" long, 4" wide and 1" thick at center.



ROOT PRUNING
All seedlings shall be root pruned, if necessary, so that no roots extend more than 10 inches (10") below the root collar.

GROVE CREEK WETLAND PLANTING

STATE	STATE PROJECT REFERENCE NO.	CHART NO.	TOTAL SHEETS
N.C.	R-2204WM	RF-1	
STATE SYMBOL	F.A. SYMBOL	DESCRIPTION	

WETLAND TREE REFORESTATION

MIXTURE, TYPE, SIZE, AND FURNISH SHALL CONFORM TO THE FOLLOWING:

FRAXINUS PENNSYLVANICA
TAXODIUM DISTICHUM
BETULA NIGRA
QUERCUS MICHAUXII
QUERCUS LAURIFOLIA
NYSSA AQUATICA
LIRIODENDRON TULIPIFERA

GREEN ASH
BALDCYPRESS
RIVER BIRCH
SWAMP CHESTNUT OAK
LAUREL OAK
WATER TUPELO
TULIP POPLAR

BAREROOT SEEDLING
BAREROOT SEEDLING
TREE REFORESTATION SHALL BE PLANTED 6' TO 10' ON CENTER, RANDOM SPACING, AVERAGING 8' ON CENTER, APPROXIMATELY 680 PLANTS PER ACRE.

WETLAND REFORESTATION DETAIL SHEET

N.C.D.O.T. - ROADSIDE ENVIRONMENTAL UNIT