


STATE	STATE PROJECT REFERENCE NO.	SHEET NO.	TOTAL SHEETS
N.C.	000532601	1	9

STATE OF NORTH CAROLINA  
WETLANDS RESTORATION PROGRAM


# GUILFORD COUNTY

LOCATION: **HILLSDALE PARK**  
**SOUTH BUFFALO CREEK**  
**GREENSBORO, NORTH CAROLINA**

TYPE OF WORK: **AS-BUILT PLANS**

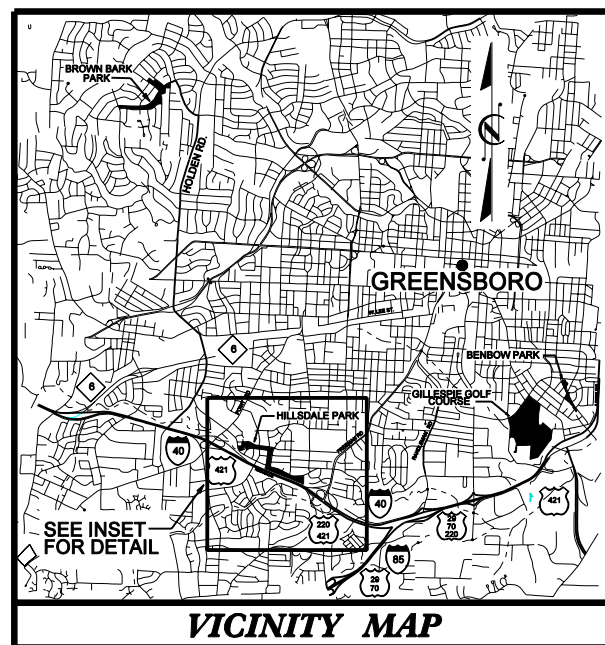


VICINITY MAP

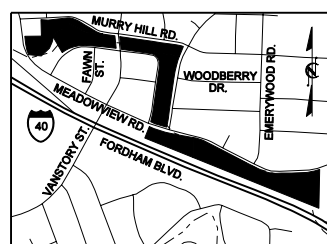

INSET

INDEX OF SHEETS:


- 1 TITLE SHEET
- 1-A SYMBOLOGY - BUCKENGINEERING
- 1-B SYMBOLOGY - NCDOT
- 2 TO 2-A TYPICAL POOL AND RIFFLE CROSS SECTIONS, STRUCTURE DETAILS, SPECIAL DETAILS
- 4-7 PLAN VIEW OF AS-BUILT DESIGN

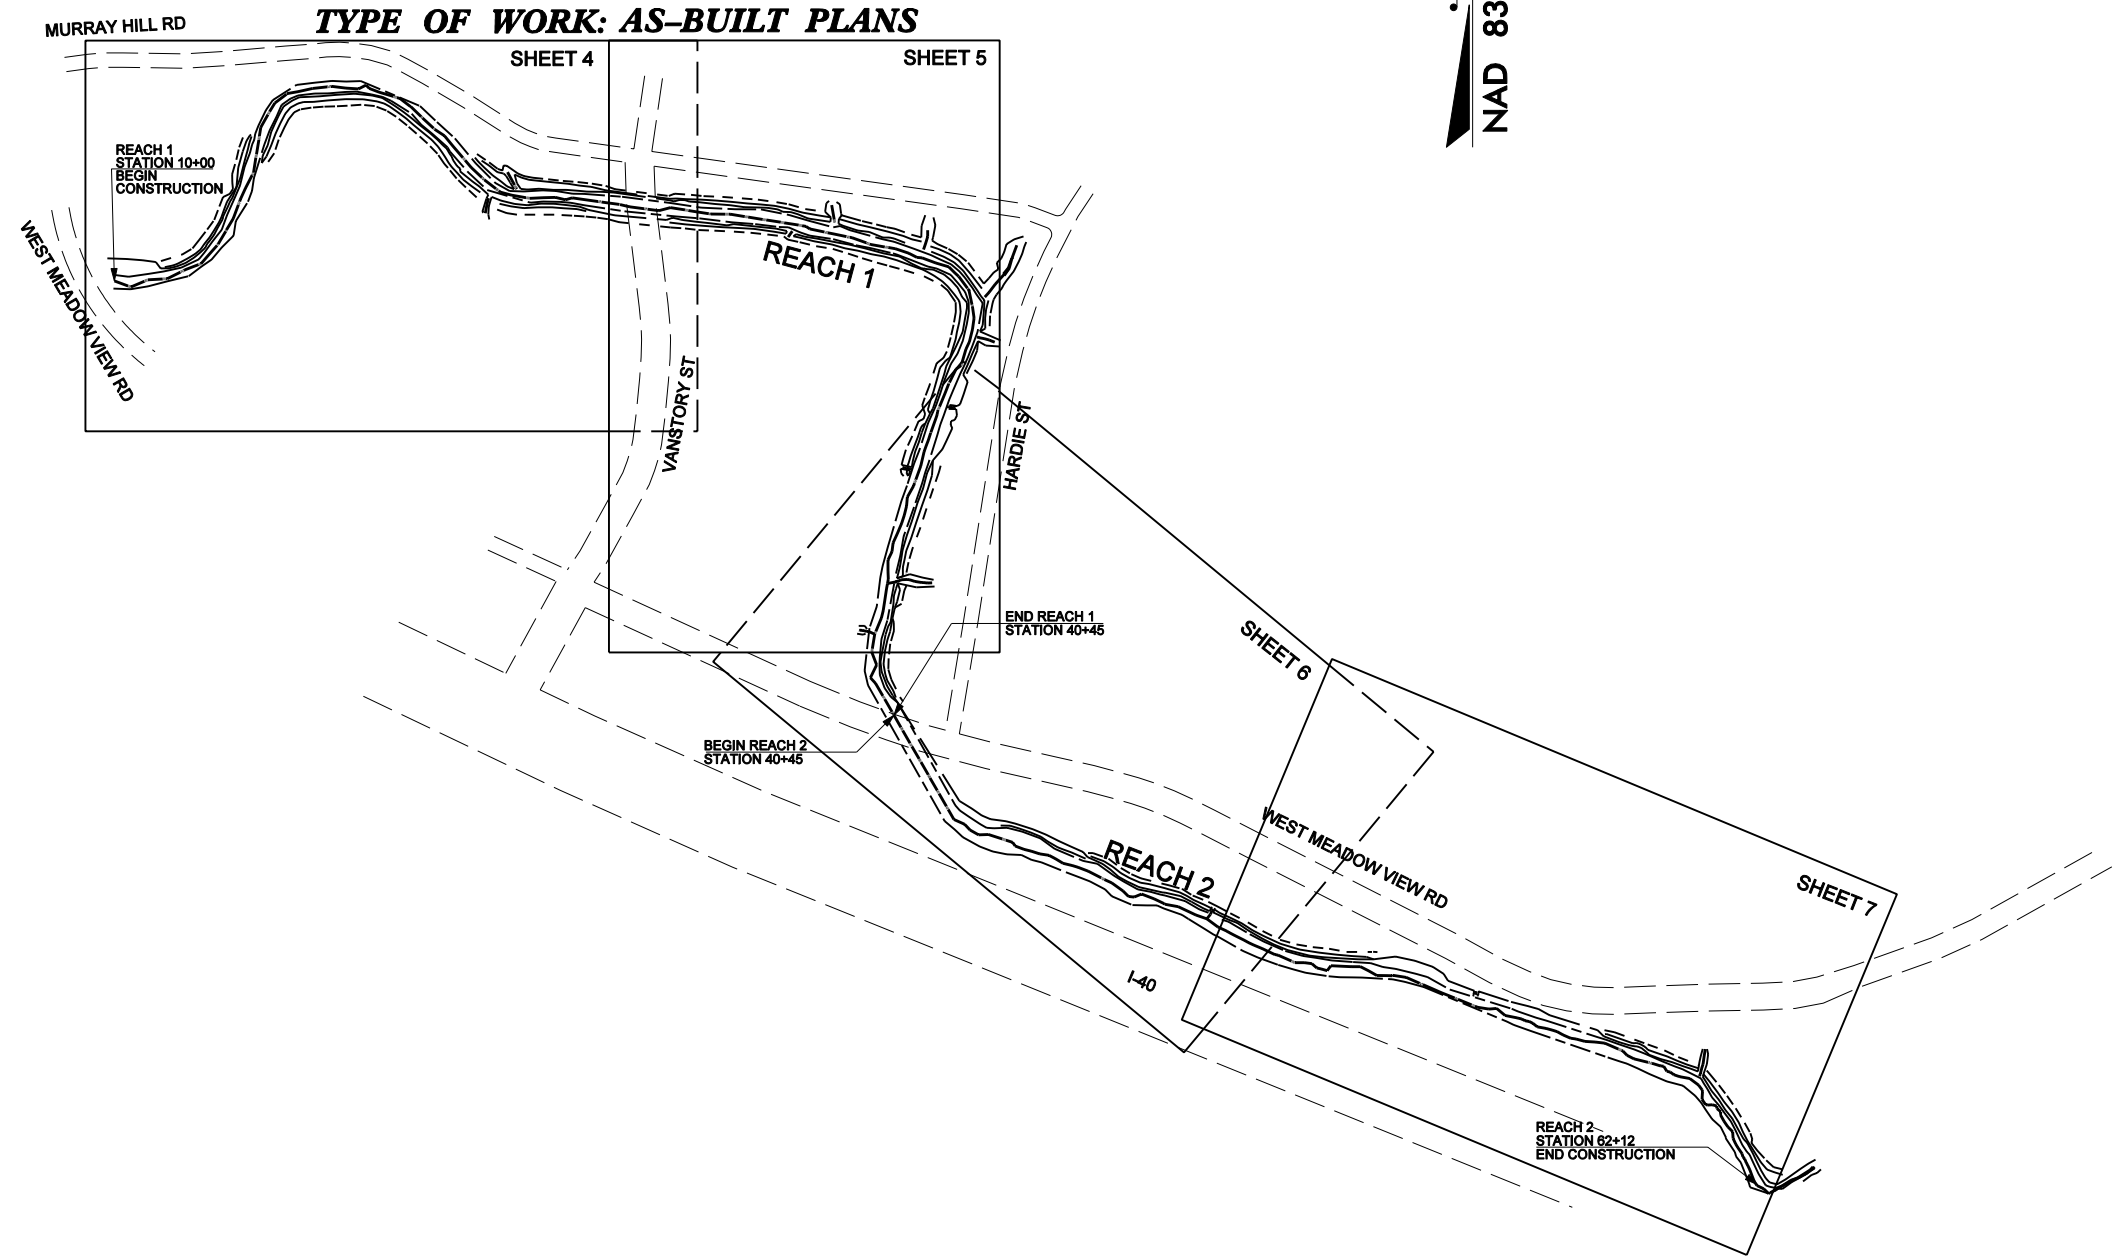

063

PROJECT: 000532601

GRAPHIC SCALES

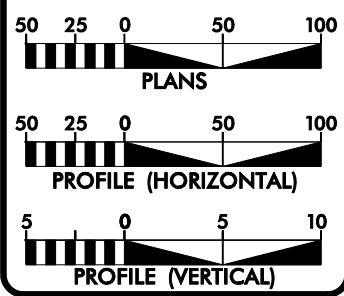

	DESIGN DATA	
	REACH 1	REACH 2
DESIGN STREAM TYPE(FT)	E4	B4c
DESIGN REACH LENGTH(FT)	3037	2265
BANKFULL XSEC AREA(FT <sup>2</sup> )	103-113	166
BANKFULL WIDTH(FT)	36-44	66
BANKFULL DEPTH(FT)	2.6-2.9	2.5
W/D RATIO(FT)	12-17	26.4

PROJECT LENGTH	
EXISTING STREAM LENGTH	= 5434 FEET
PROPOSED DESIGN STREAM LENGTH	= 5434 FEET
<b>CONTACT:</b>	
	<b>JEFF JUREK</b> WRP PROJECT MANAGER

Prepared In the Office of:

**BUCK ENGINEERING**  
8000 REGENCY PARKWAY  
SUITE 200  
CARY, NC 27511  
919-463-5488

LETTING DATE:

**WILL HARMAN, PG**  
PROJECT MANAGER

**ANDREW BICK, PE**  
PROJECT ENGINEER

PROJECT ENGINEER

THIS DOCUMENT ORIGINALLY ISSUED AND SEALED BY:


WILLIAM KENT  
L-3708  
DECEMBER 20, 2005

THIS MEDIA SHALL NOT BE CONSIDERED A CERTIFIED DOCUMENT

SIGNATURE: \_\_\_\_\_ P.E.

# STREAM CONVENTIONAL SYMBOLS

- |                                                                                                                                             |                                                                                                                            |
|---------------------------------------------------------------------------------------------------------------------------------------------|----------------------------------------------------------------------------------------------------------------------------|
| <p>— — — — TOP OF BANK (EXISTING)</p> <p>— — — — THALWEG (EXISTING)</p> <p>— — — — MINOR CONTOUR LINE</p> <p>— — — — MAJOR CONTOUR LINE</p> | <p>———— CENTERLINE /THALWEG (PROPOSED)</p> <p>—⊙— CONSERVATION EASEMENT</p> <p>—▲— SAFETY FENCE</p> <p>—SF— SILT FENCE</p> |
|---------------------------------------------------------------------------------------------------------------------------------------------|----------------------------------------------------------------------------------------------------------------------------|

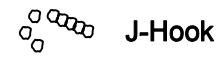


J-Hook




Double Wing Deflector



Silt Check

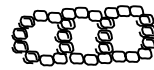


Step Pool

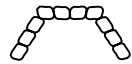

Cross Vane



Root Wad

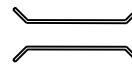

Temporary Ford Stream Crossing

PROJECT REFERENCE NO.	SHEET NO.
<b>000532601</b>	<b>1-A</b>
PROJECT ENGINEER	
THIS DOCUMENT ORIGINALLY ISSUED AND SEALED BY:	
WILLIAM KENT L-3708 DECEMBER 20, 2005	
THIS MEDIA SHALL NOT BE CONSIDERED A CERTIFIED DOCUMENT	



REVISIONS

STATE OF NORTH CAROLINA  
DIVISION OF HIGHWAYS

\*S.U.E = SUBSURFACE UTILITY ENGINEER

# CONVENTIONAL SYMBOLS

## ROADS & RELATED ITEMS

Edge of Pavement	----
Curb	----
Prop. Slope Stakes Cut	---C---
Prop. Slope Stakes Fill	---F---
Prop. Woven Wire Fence	○-----○
Prop. Chain Link Fence	□-----□
Prop. Barbed Wire Fence	◇-----◇
Prop. Wheelchair Ramp	WCR
Curb Cut for Future Wheelchair Ramp	CCFR
Exist. Guardrail	-----
Prop. Guardrail	-----
Equality Symbol	⊕
Pavement Removal	XXXXXX

## RIGHT OF WAY

Baseline Control Point	◆
Existing Right of Way Marker	△
Exist. Right of Way Line w/Marker	-----△-----
Prop. Right of Way Line with Proposed	-----▲-----
R/W Marker (Iron Pin & Cap)	▲
Prop. Right of Way Line with Proposed	-----▲-----
(Concrete or Granite) R/W Marker	⊙
Exist. Control of Access Line	⊙
Prop. Control of Access Line	⊙
Exist. Easement Line	-----E-----
Prop. Temp. Construction Easement Line	-----E-----
Prop. Temp. Drainage Easement Line	-----TDE-----
Prop. Perm. Drainage Easement Line	-----PDE-----

## HYDROLOGY

Stream or Body of Water	-----
River Basin Buffer	-----RBB-----
Flow Arrow	→
Disappearing Stream	-----
Spring	○
Swamp Marsh	-----
Shoreline	-----
Falls, Rapids	-----
Prop Lateral, Tail, Head Ditches	-----

## STRUCTURES

MAJOR	
Bridge, Tunnel, or Box Culvert	-----CONC-----
Bridge Wing Wall, Head Wall and End Wall	-----CONC WW-----

## MINOR

Head & End Wall	-----CONC HW-----
Pipe Culvert	=====
Footbridge	----->-----<-----
Drainage Boxes	□ CB
Paved Ditch Gutter	-----

## UTILITIES

Exist. Pole	•
Exist. Power Pole	⊙
Prop. Power Pole	⊙
Exist. Telephone Pole	⊙
Prop. Telephone Pole	⊙
Exist. Joint Use Pole	⊙
Prop. Joint Use Pole	⊙
Telephone Pedestal	⊕
UG Telephone Cable Hand Hold	⊕
Cable TV Pedestal	⊕
UG TV Cable Hand Hold	⊕
UG Power Cable Hand Hold	⊕
Hydrant	⊕
Satellite Dish	⊕
Exist. Water Valve	⊕
Sewer Clean Out	⊕
Power Manhole	⊕
Telephone Booth	⊕
Cellular Telephone Tower	⊕
Water Manhole	⊕
Light Pole	⊕
H-Frame Pole	⊕
Power Line Tower	⊕
Pole with Base	⊕
Gas Valve	⊕
Gas Meter	⊕
Telephone Manhole	⊕
Power Transformer	⊕
Sanitary Sewer Manhole	⊕
Storm Sewer Manhole	⊕
Tank; Water, Gas, Oil	⊕
Water Tank With Legs	⊕
Traffic Signal Junction Box	⊕
Fiber Optic Splice Box	⊕
Television or Radio Tower	⊕
Utility Power Line Connects to Traffic Signal Lines Cut Into the Pavement	-----TS-----

Recorded Water Line	-----
Designated Water Line (S.U.E.*)	-----
Sanitary Sewer	-----SS-----
Recorded Sanitary Sewer Force Main	-----FSS-----
Designated Sanitary Sewer Force Main(S.U.E.*)	-----FSS-----
Recorded Gas Line	-----G-----
Designated Gas Line (S.U.E.*)	-----G-----
Storm Sewer	-----S-----
Recorded Power Line	-----P-----
Designated Power Line (S.U.E.*)	-----P-----
Recorded Telephone Cable	-----T-----
Designated Telephone Cable (S.U.E.*)	-----T-----
Recorded U/G Telephone Conduit	-----TC-----
Designated U/G Telephone Conduit (S.U.E.*)	-----TC-----
Unknown Utility (S.U.E.*)	-----TUTL-----
Recorded Television Cable	-----TV-----
Designated Television Cable (S.U.E.*)	-----TV-----
Recorded Fiber Optics Cable	-----FO-----
Designated Fiber Optics Cable (S.U.E.*)	-----FO-----
Exist. Water Meter	⊕
UG Test Hole (S.U.E.*)	⊕
Abandoned According to U/G Record	ATTUR
End of Information	E.O.I.

## BOUNDARIES & PROPERTIES

State Line	-----
County Line	-----
Township Line	-----
City Line	-----
Reservation Line	-----
Property Line	-----
Property Line Symbol	PL
Exist. Iron Pin	⊕
Property Corner	⊕
Property Monument	⊕
Property Number	123
Parcel Number	6
Fence Line	-----X X X-----
Existing Wetland Boundaries	-----WW & ISBW-----
High Quality Wetland Boundary	-----WLB-----
Medium Quality Wetland Boundaries	-----HO WLB-----
Low Quality Wetland Boundaries	-----MO WLB-----
Proposed Wetland Boundaries	-----LO WLB-----
Existing Endangered Animal Boundaries	-----EAB-----
Existing Endangered Plant Boundaries	-----EPB-----

## BUILDINGS & OTHER CULTURE

Buildings	-----
Foundations	-----
Area Outline	-----
Gate	-----
Gas Pump Vent or UG Tank Cap	-----
Church	-----
School	-----
Park	-----
Cemetery	-----
Dam	-----
Sign	-----
Well	-----
Small Mine	-----
Swimming Pool	-----

## TOPOGRAPHY

Loose Surface	-----
Hard Surface	-----
Change in Road Surface	-----
Curb	-----
Right of Way Symbol	R/W
Guard Post	⊕ GP
Paved Walk	-----
Bridge	-----
Box Culvert or Tunnel	-----
Ferry	-----
Culvert	-----
Footbridge	-----
Trail, Footpath	-----
Light House	-----

## VEGETATION


Single Tree	-----
Single Shrub	-----
Hedge	-----
Woods Line	-----
Orchard	-----
Vineyard	-----

## RAILROADS

Standard Gauge	-----
RR Signal Milepost	-----
Switch	-----

TYPICAL RIFFLE, POOL AND BANKFULL BENCH FOR HILLSDALE PARK



PROJECT REFERENCE NO. 000532601	SHEET NO. 2
PROJECT ENGINEER	
THIS DOCUMENT ORIGINALLY ISSUED AND SEALED BY:  WILLIAM KENT L-3708 DECEMBER 20, 2005	
THIS MEDIA SHALL NOT BE CONSIDERED A CERTIFIED DOCUMENT	
<b>BUCK</b> ENGINEERING	8000 REGENCY PARKWAY SUITE 200 CARY, NC 27511 919-463-5488

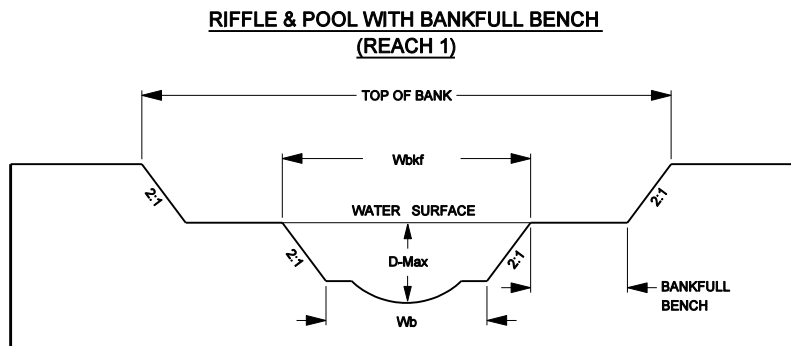

	REACH 1 & 2	
	RIFFLE	POOL
WIDTH OF BANKFULL (Wbkf) - FT	40	40
AVERAGE DEPTH - FT	4	4
MAXIMUM DEPTH (D-max) - FT	4	6
WIDTH TO DEPTH RATIO (bkfl W/D) - FT	10	10
BANKFULL AREA (Abkf) - FT <sup>2</sup>	160	160
BOTTOM WIDTH (Wb) - FT	20.8	16
BENCH WIDTH - FT	8-12	8-12

- NOTES:**
1. BANKFULL BENCH WIDTH WILL VARY.
  2. BANKFULL BENCH WILL NOT ALWAYS BE ON BOTH SIDES. (SEE PLANS)
  3. THE SHAPE OF THE POOL X-SECTION WILL BE SIMILAR TO THE RIFFLE X-SECTION IN THAT THE THALWEG WILL BE COINCIDENT WITH THE CENTER LINE.

EROSION CONTROL MATTING

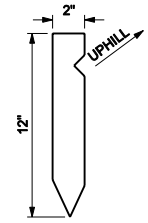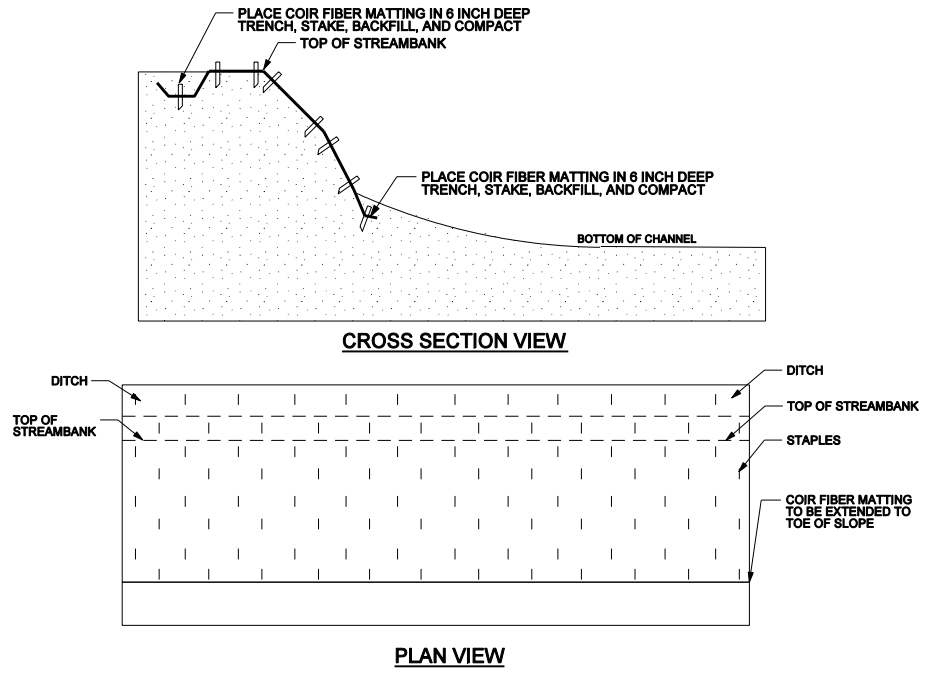

- NOTES:**
1. BANKS SHOULD BE SEEDED PRIOR TO PLACEMENT OF MATTING.
  2. PLACE COIR FIBER MATTING ACCORDING TO MANUFACTURER RECOMMENDATIONS.
  3. MATTING STAKES SHOULD BE PLACED IN A DIAMOND SHAPE PATTERN.

REVISIONS

PROJECT ENGINEER


THIS DOCUMENT  
ORIGINALLY ISSUED AND  
SEALED BY:

WILLIAM KENT  
L-3708  
DECEMBER 20, 2005


THIS MEDIA SHALL NOT BE CONSIDERED  
A CERTIFIED DOCUMENT

**BUCK**  
ENGINEERING  
8000 REGENCY PARKWAY  
SUITE 200  
CARY, NC 27511  
919-483-6488


**ROCK CROSS VANE**

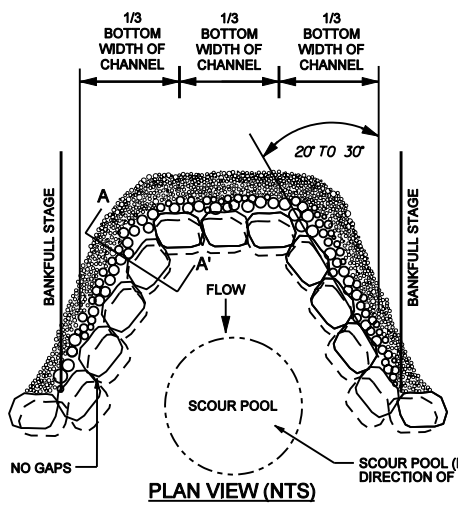

PLAN VIEW (NTS)

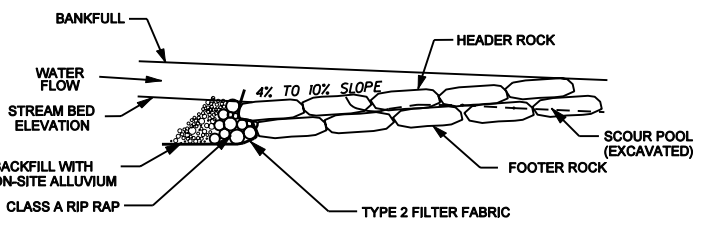


PROFILE VIEW (NTS)

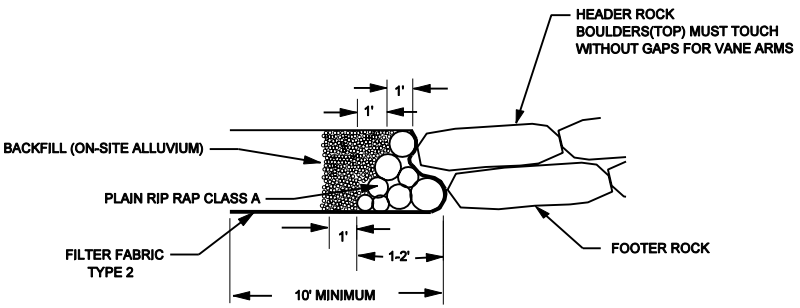


SECTION A-A' (NTS)


**"J" HOOK VANE**

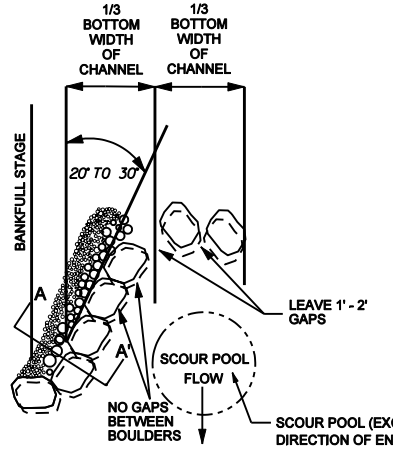

PLAN VIEW (NTS)

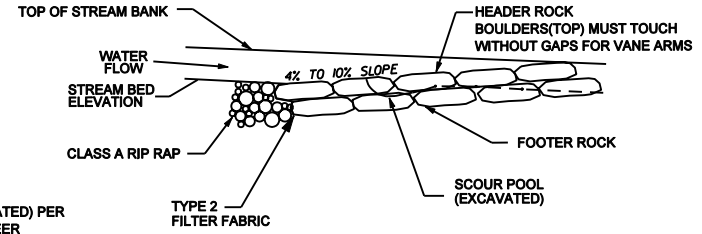

PROFILE VIEW (NTS)

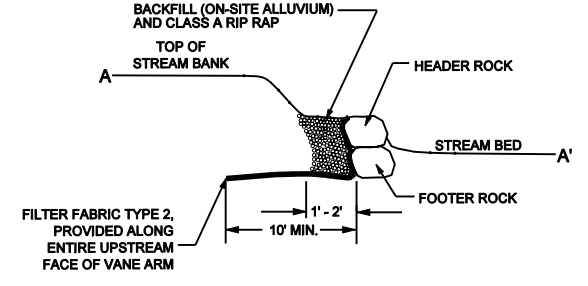


SECTION A-A' (NTS)


**NOTES FOR ALL VANE STRUCTURES:**

- BOULDERS MUST BE AT LEAST 4' x 3' x 2'.
- INSTALL FILTER FABRIC BEGINNING AT THE MIDDLE OF THE HEADER ROCKS ON THE UPSTREAM SIDE AND EXTEND DOWNWARD TO THE DEPTH OF THE BOTTOM FOOTER ROCK, AND THEN UPSTREAM TO A MINIMUM OF TEN FEET.
- DIG A TRENCH BELOW THE BED FOR FOOTER ROCKS AND PLACE FILL ON UPSTREAM SIDE OF VANE ARM, BETWEEN THE ARM AND STREAM BANK.
- START AT BANKFULL AND PLACE FOOTER ROCKS FIRST AND THEN HEADER ROCKS.
- CONTINUE WITH STRUCTURE, FOLLOWING ANGLE AND SLOPE SPECIFICATIONS.
- AN EXTRA BOULDER CAN BE PLACED IN SCOUR POOL FOR HABITAT IMPROVEMENT.
- USE CLASS A RIP RAP TO FILL GAPS ON UPSTREAM SIDE OF BOULDERS.
- AFTER ALL STONE HAS BEEN PLACED, FILL IN THE UPSTREAM SIDE OF THE STRUCTURE WITH SOIL TO THE ELEVATION OF THE TOP OF THE HEADER ROCKS.

**DOUBLE WING DEFLECTOR**

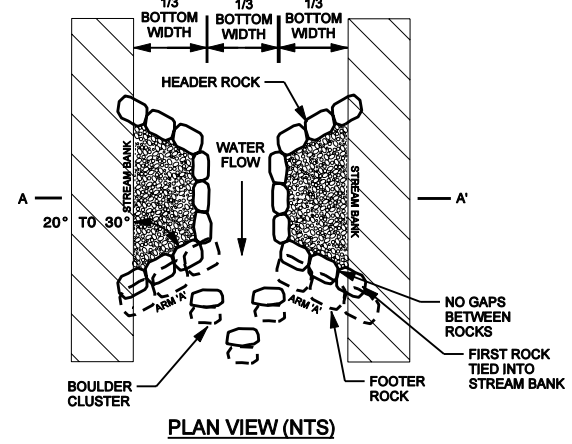

PLAN VIEW (NTS)

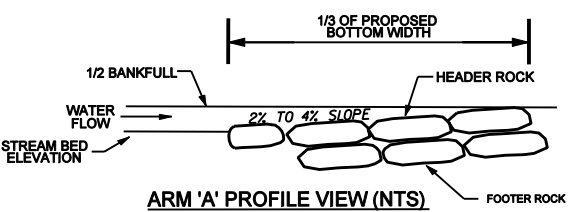

ARM 'A' PROFILE VIEW (NTS)


NOTE: NO SLOPE FOR ARMS B & C

- NOTE:
- BOULDERS MUST BE AT LEAST 4' x 3' x 2'.
  - 6' x 4' x 3' BOULDERS ARE PREFERRED.



SECTION A-A' CROSS SECTION (NTS)

**ROOT WADS**

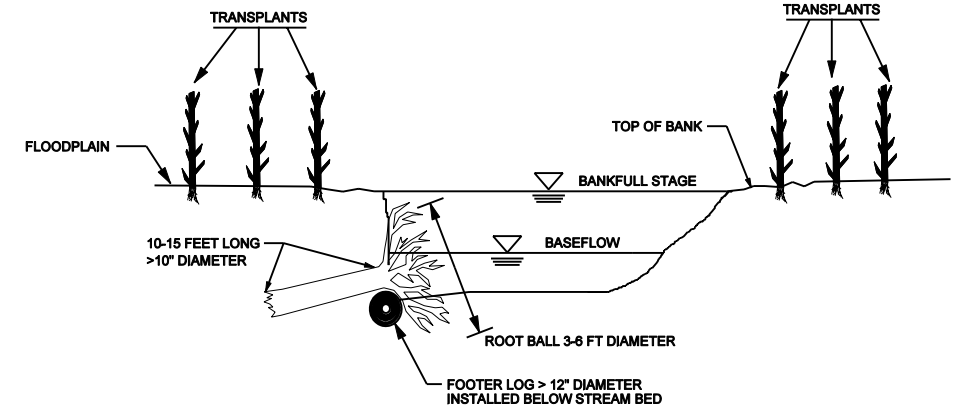

CROSS SECTION (NTS)


**NOTES:**

**DRIVE POINT METHOD:**

SHARPEN THE END OF THE LOG WITH A CHAINSAW BEFORE "DRIVING" IT INTO THE BANK. ORIENT ROOT WADS UPSTREAM SO THAT THE STREAM FLOW MEETS THE ROOT WAD AT A 90-DEGREE ANGLE, DEFLECTING THE WATER AWAY FROM THE BANK. A TRANSPLANT OR BOULDER SHOULD BE PLACED ON THE DOWNSTREAM SIDE OF THE ROOT WAD IF A BACK EDDY IS FORMED BY THE ROOT WAD. THE BOULDER SHALL BE APPROXIMATELY 4' x 3' x 2'.


**TRENCHING METHOD:**

IF THE ROOT WAD CANNOT BE DRIVEN INTO THE BANK OR THE BANK NEEDS TO BE RECONSTRUCTED, THE TRENCHING METHOD SHOULD BE USED. THIS METHOD REQUIRES THAT A TRENCH BE EXCAVATED FOR THE LOG PORTION OF THE ROOT WAD. IN THIS CASE, A FOOTER LOG SHOULD BE INSTALLED UNDERNEATH THE ROOT WAD IN A TRENCH EXCAVATED PARALLEL TO THE BANK AND WELL BELOW THE STREAMBED. ONE-THIRD OF THE ROOT WAD SHOULD REMAIN BELOW NORMAL BASE FLOW CONDITIONS.

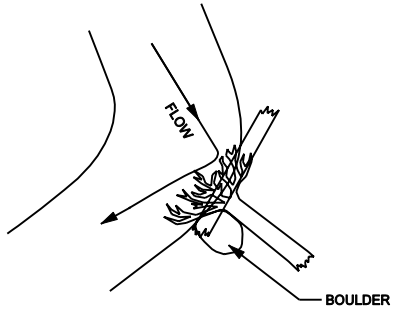


PLAN (NTS)


**STEP POOL**

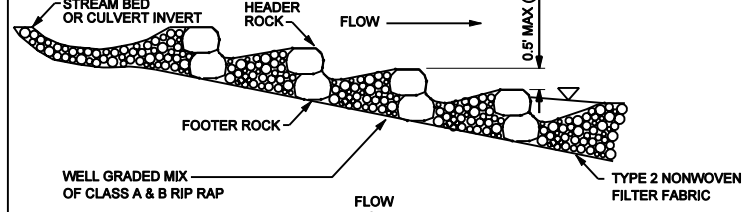

PLAN VIEW (NTS)

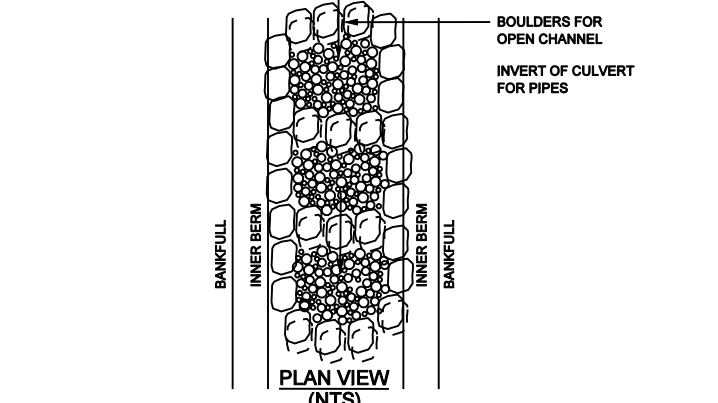

CROSS SECTION (NTS)

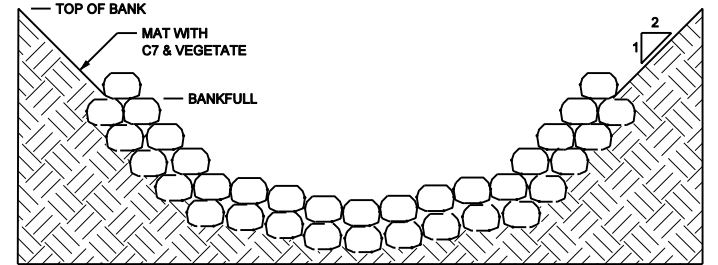

CROSS SECTION (NTS)

REVISIONS

PROJECT ENGINEER

THIS DOCUMENT  
ORIGINALLY ISSUED AND  
SEALED BY:  
WILLIAM KENT  
L-3708  
DECEMBER 20, 2005  
THIS MEDIA SHALL NOT BE CONSIDERED  
A CERTIFIED DOCUMENT



FULL SIZE SCALE: 1" = 50'  
HALF SIZE SCALE: 1" = 100'

NAD 83

REVISIONS

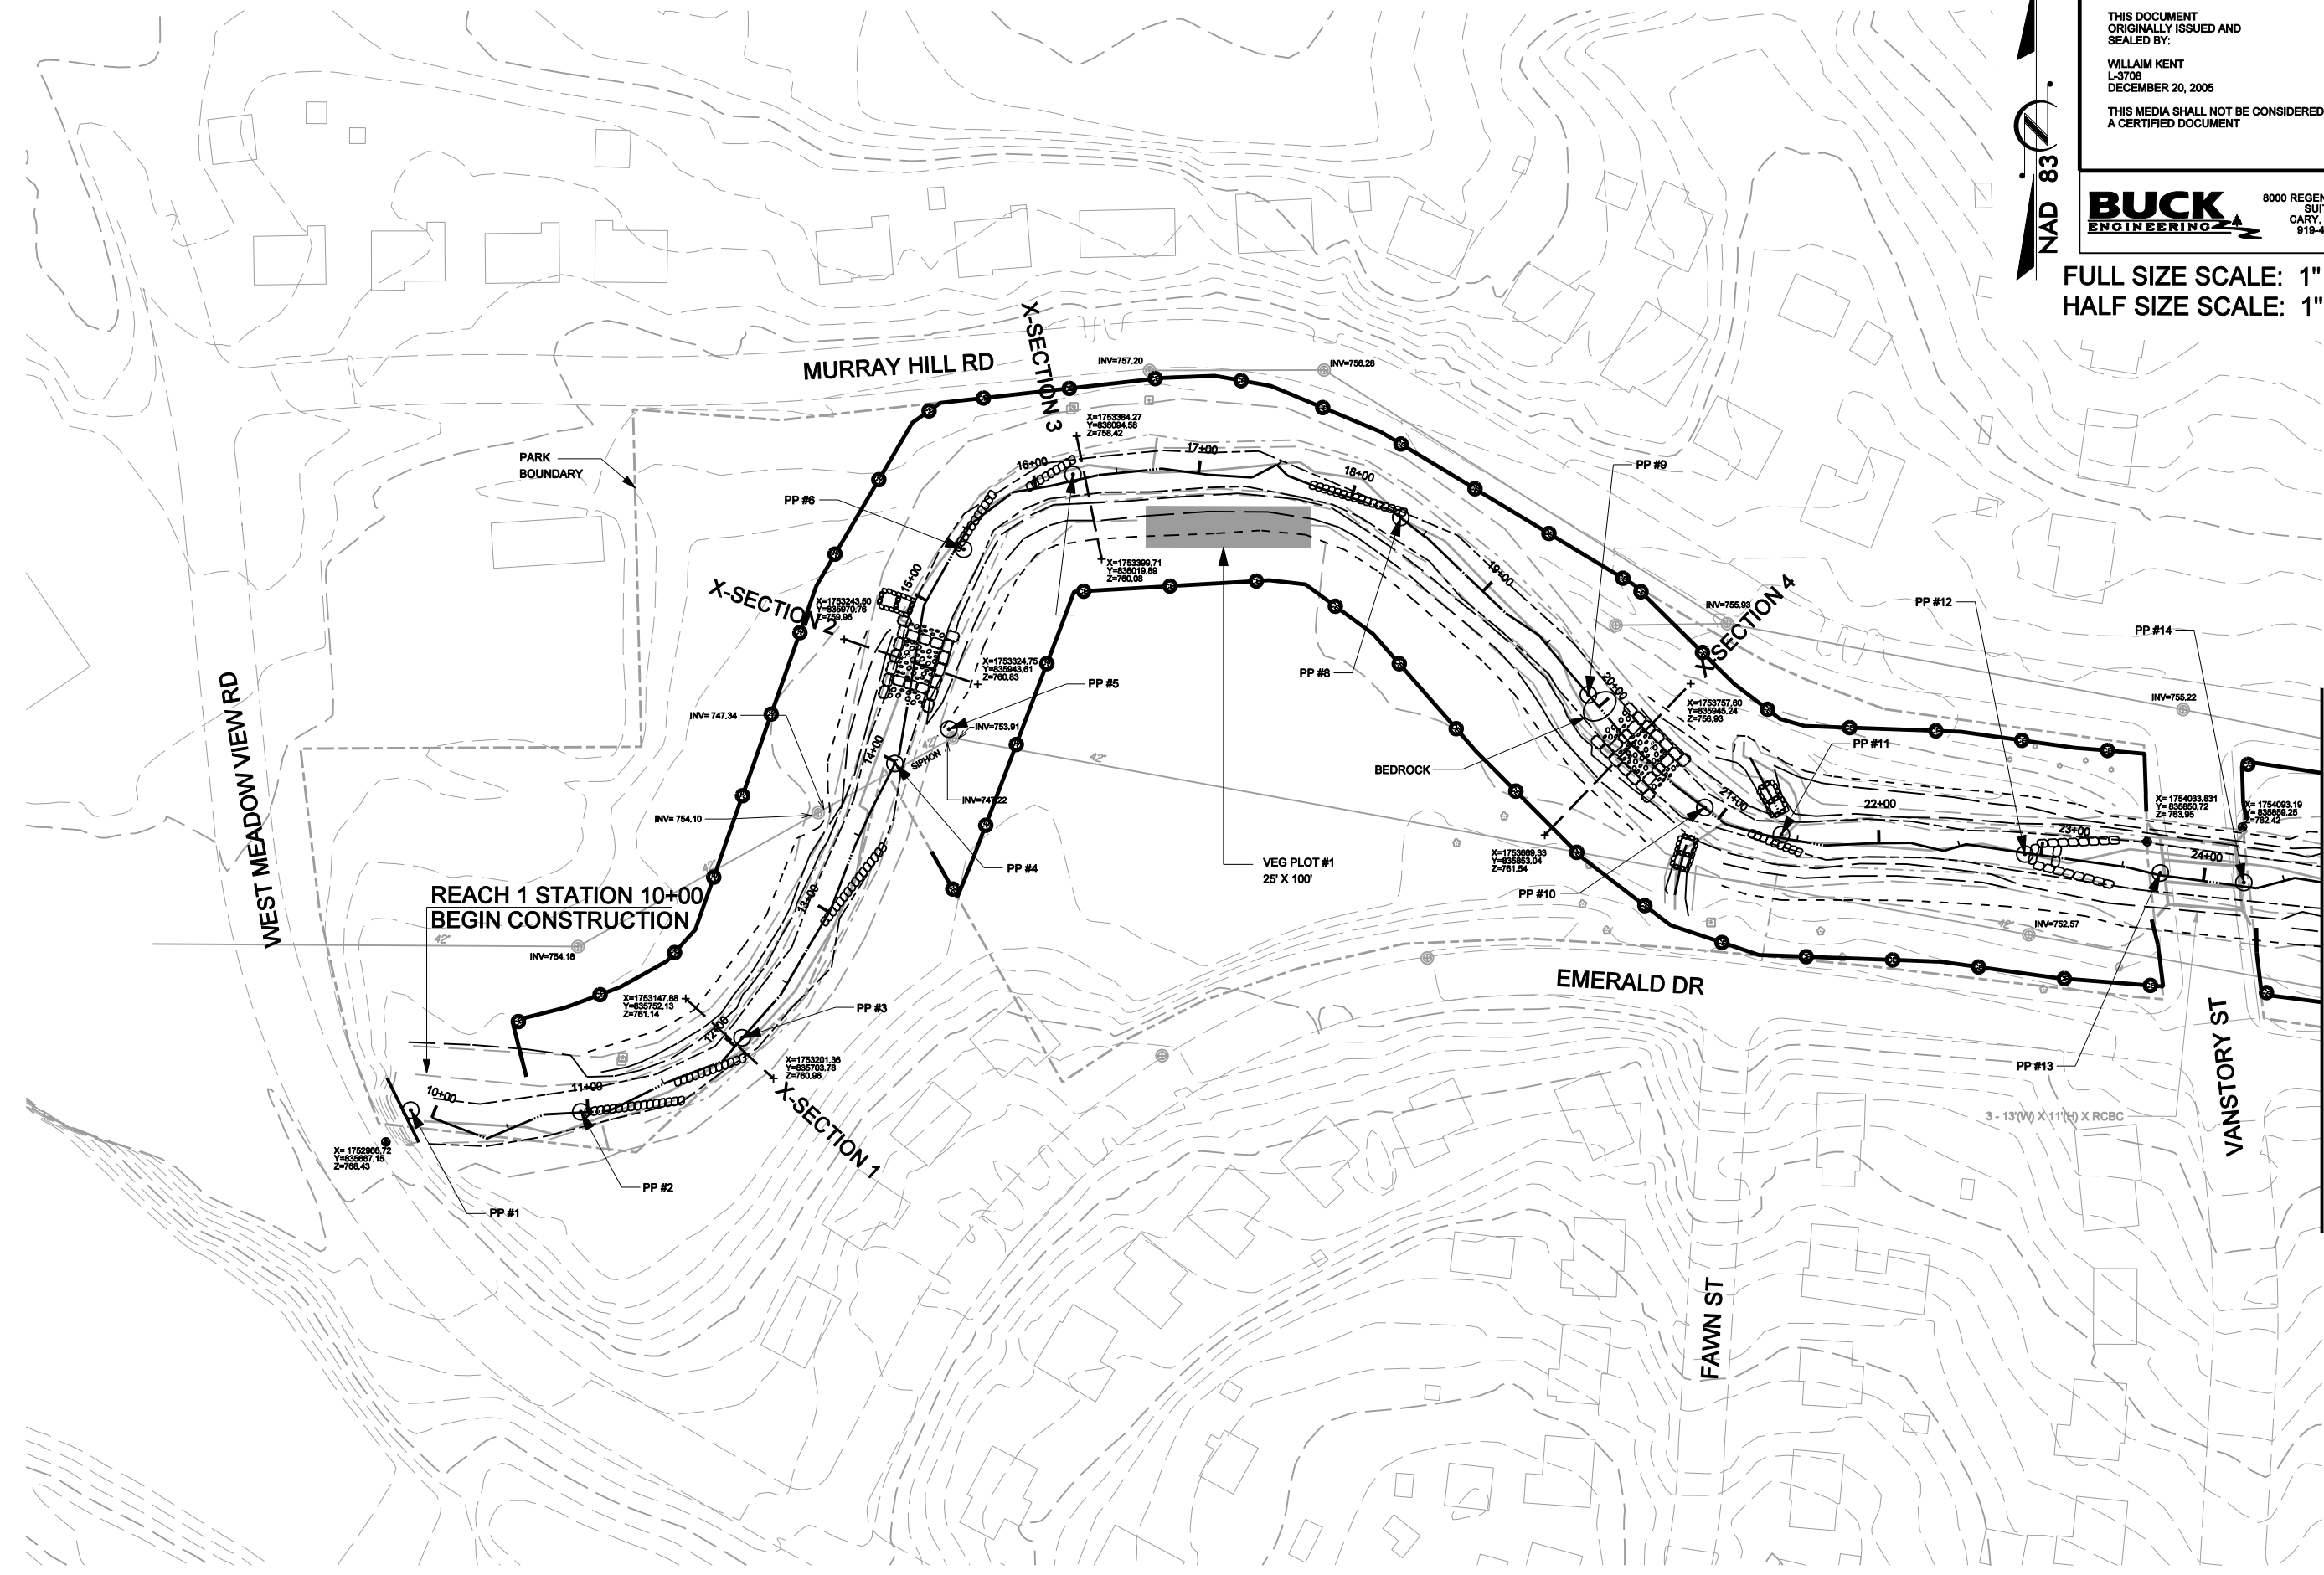


PHOTO POINT - ⊙ PP#

MATCH LINE STA 24+75 SHT 5




THIS DOCUMENT  
ORIGINALLY ISSUED AND  
SEALED BY:  
WILLIAM KENT  
L-3708  
DECEMBER 20, 2005  
THIS MEDIA SHALL NOT BE CONSIDERED  
A CERTIFIED DOCUMENT

**BUCK**  
ENGINEERING

8000 REGENCY PARKWAY  
SUITE 200  
CARY, NC 27511  
919-483-5488

FULL SIZE SCALE: 1" = 50'  
HALF SIZE SCALE: 1" = 100'

REVISIONS

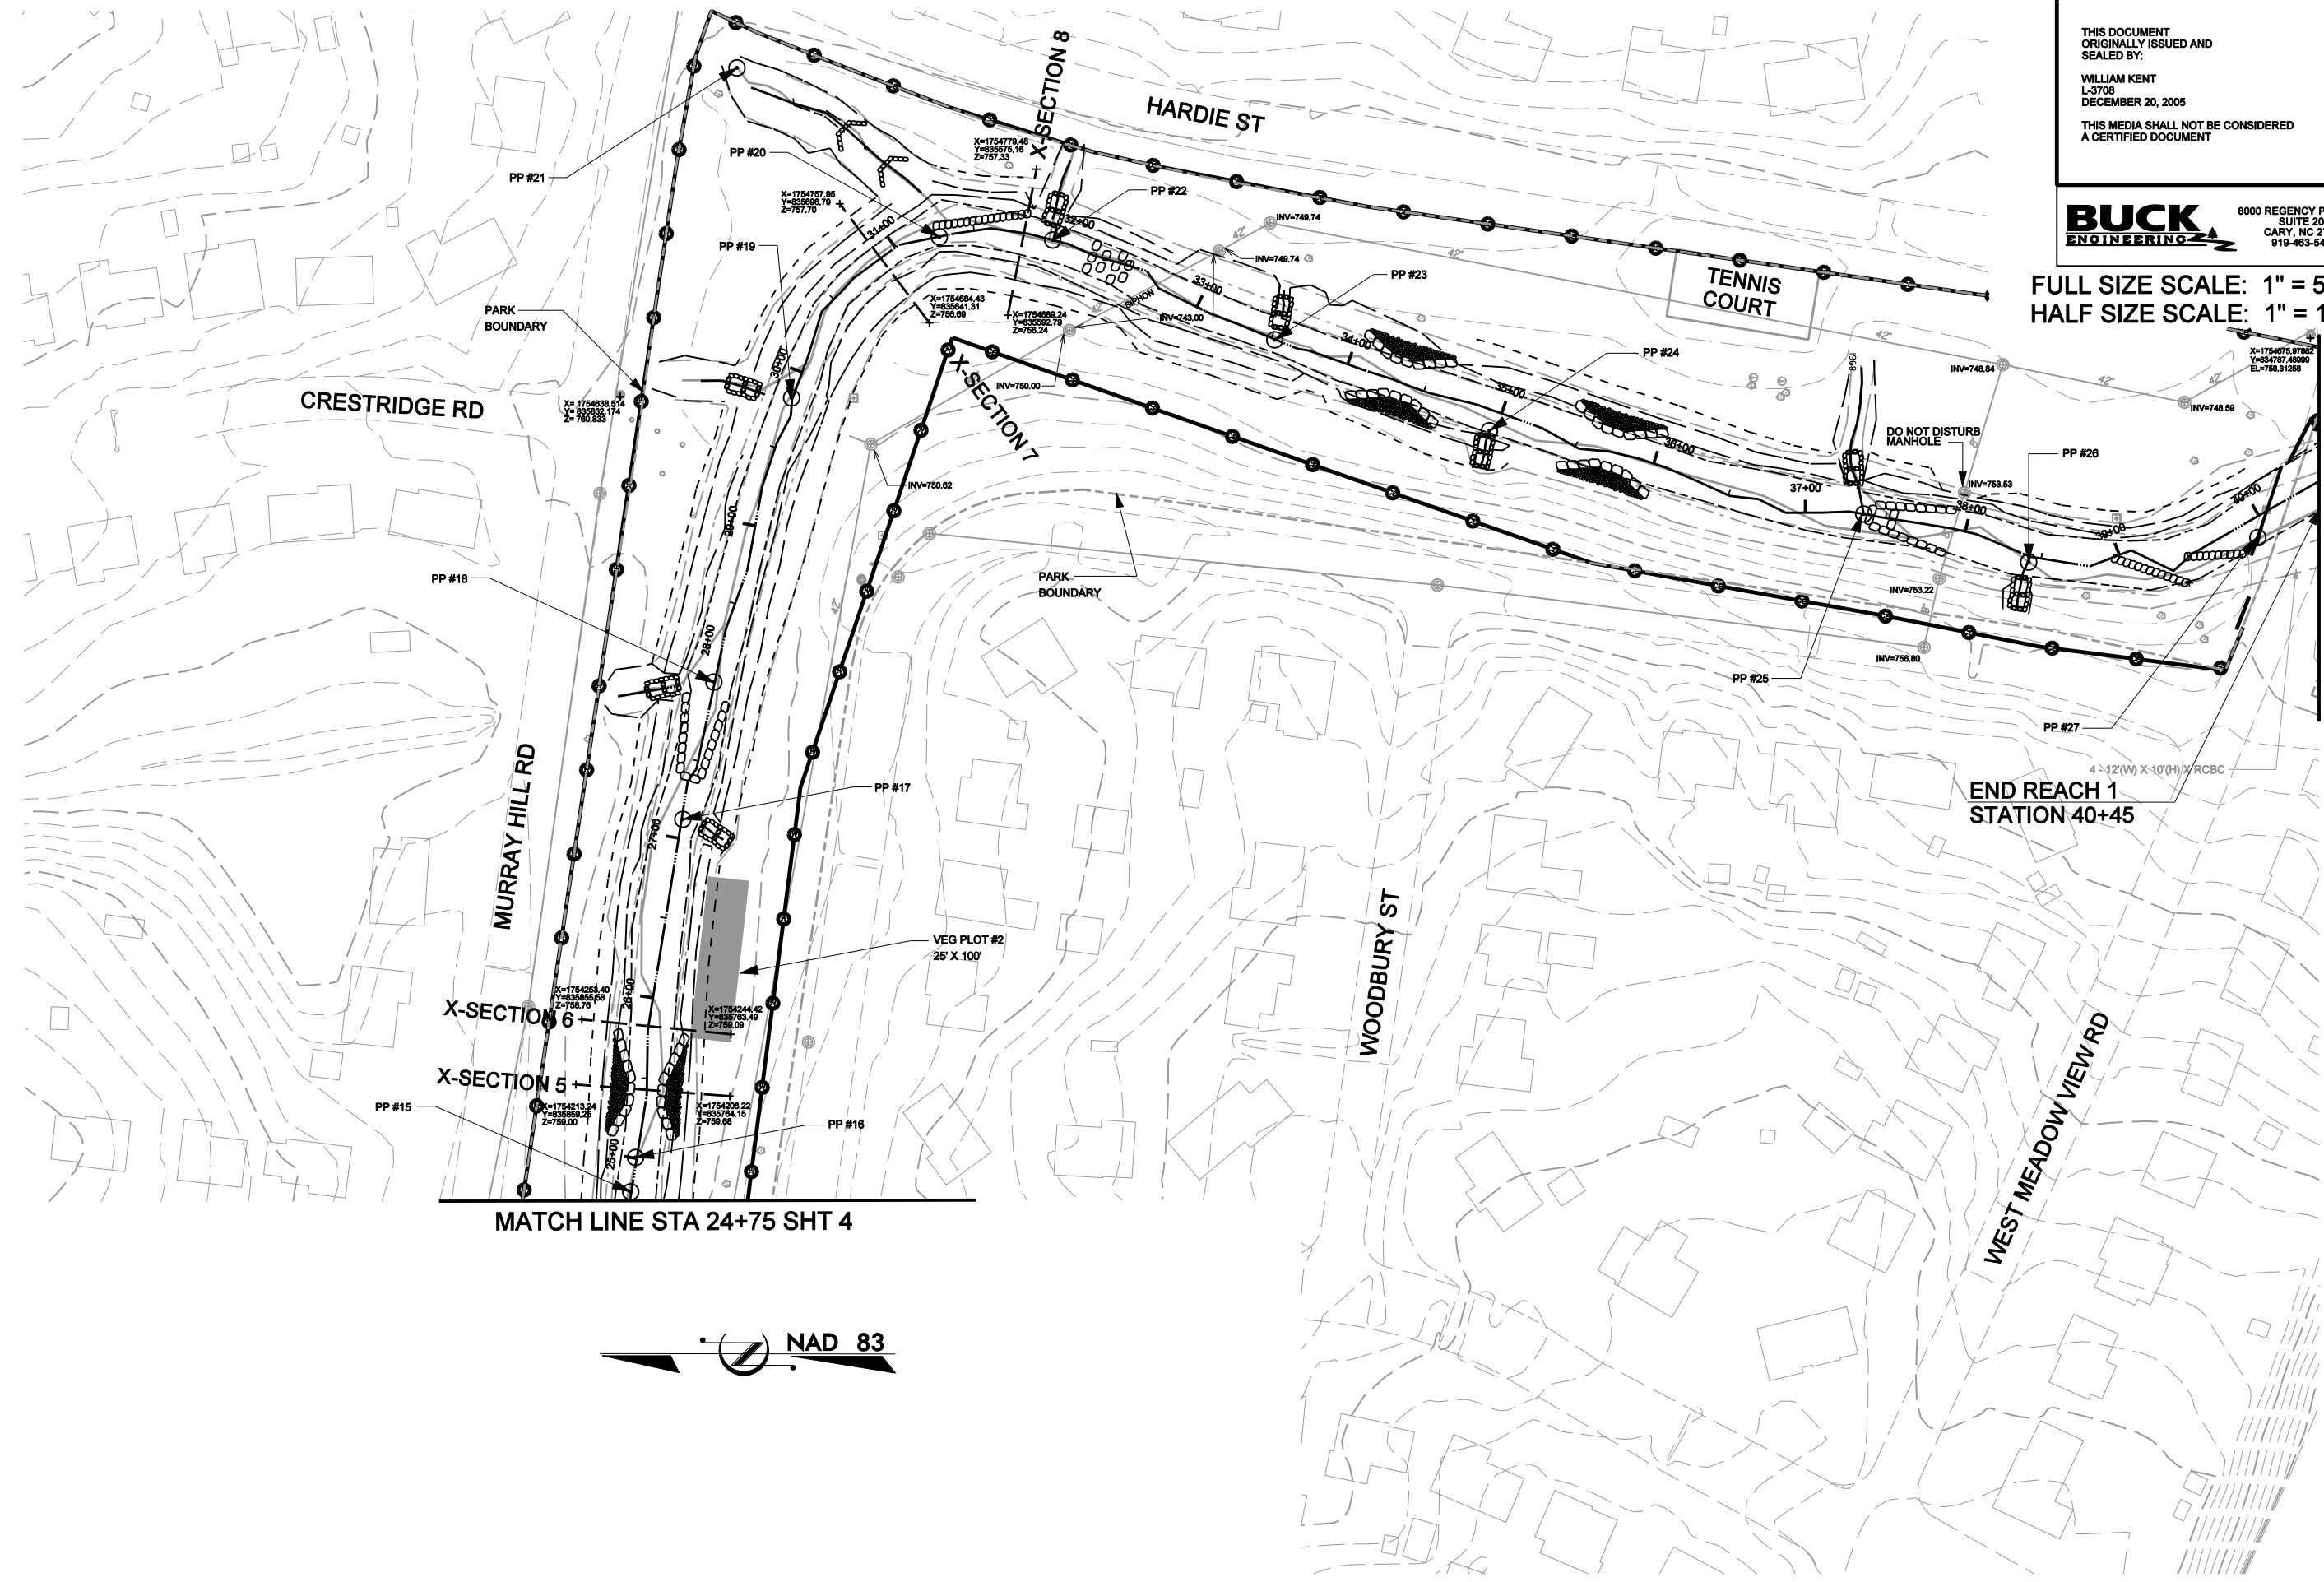

MATCH LINE STA 40+45 SHT 6

END REACH 1  
STATION 40+45

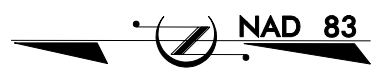


PHOTO POINT - ⊙ PP#

PROJECT ENGINEER


THIS DOCUMENT  
ORIGINALLY ISSUED AND  
SEALED BY:

KEVIN L. TWEEDY  
027337  
JULY 28, 2005


THIS MEDIA SHALL NOT BE CONSIDERED  
A CERTIFIED DOCUMENT

**BUCK**  
ENGINEERING  
8000 REGENCY PARKWAY  
SUITE 200  
CARY, NC 27511  
919-463-6488

FULL SIZE SCALE: 1" = 50'  
HALF SIZE SCALE: 1" = 100'

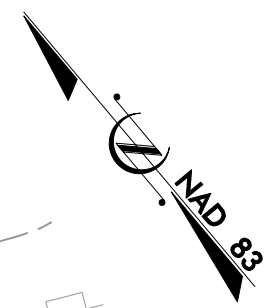

REVISIONS

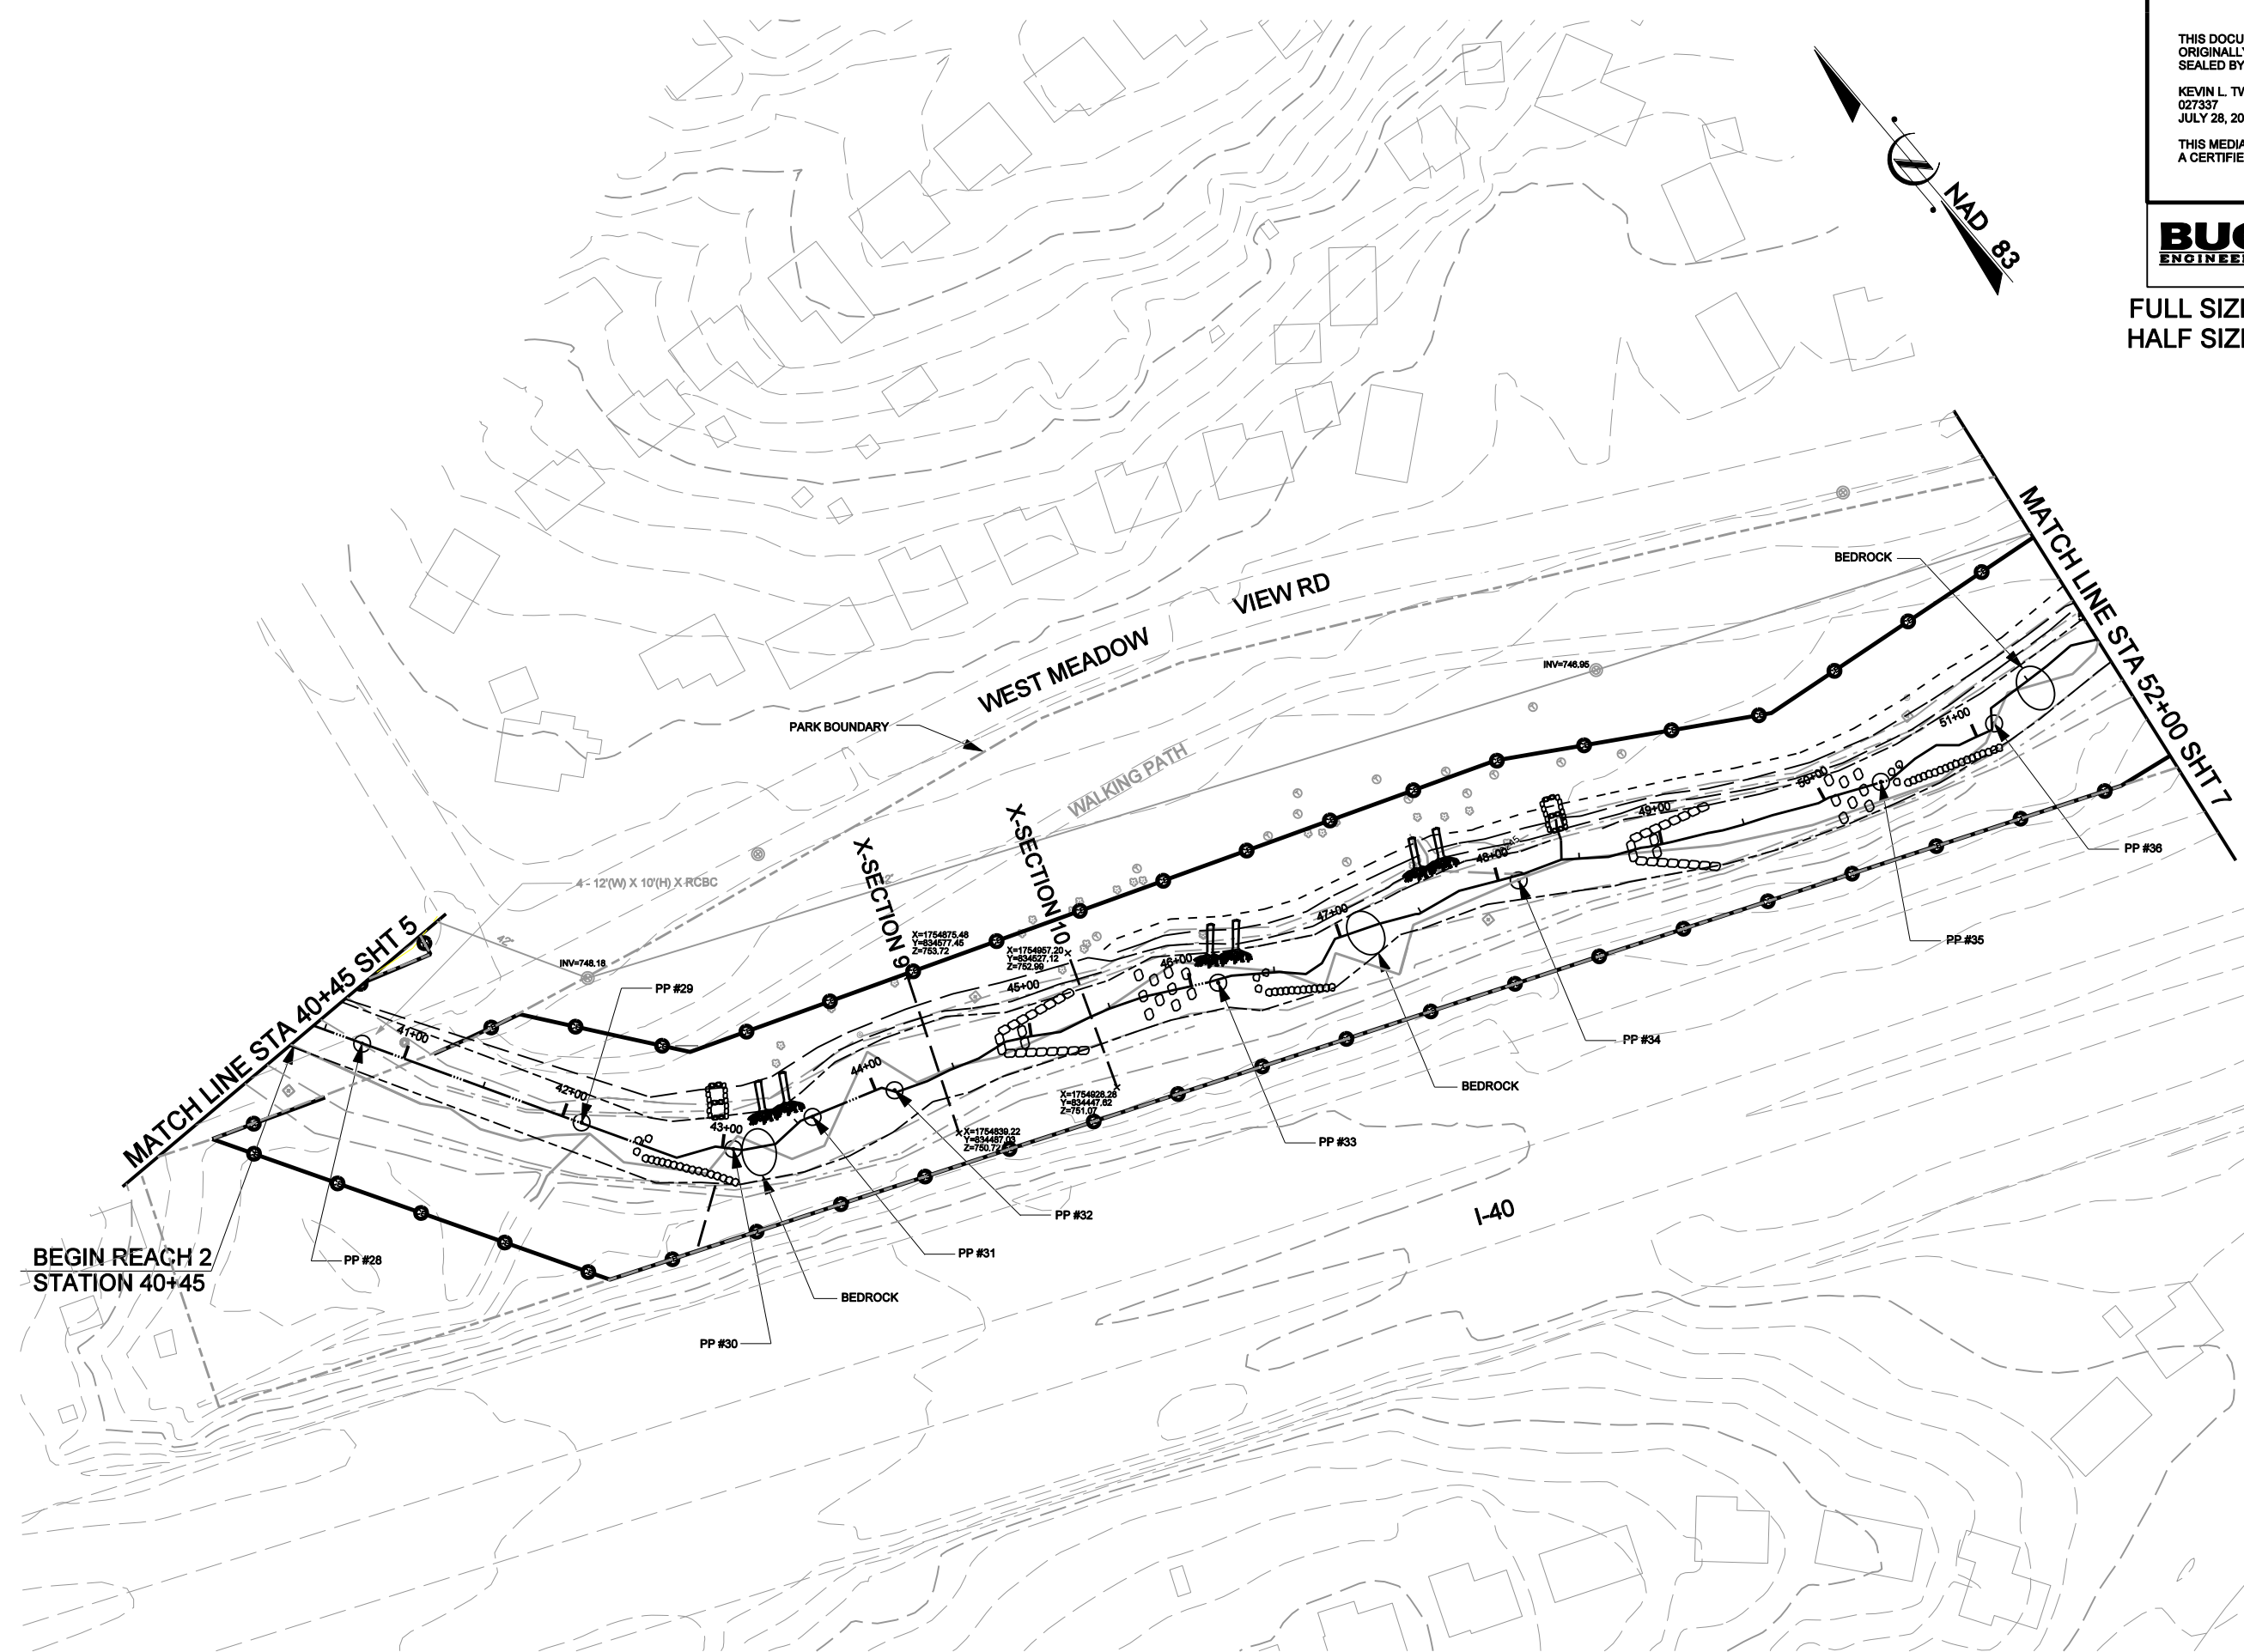

BEGIN REACH 2  
STATION 40+45

PHOTO POINT - ○ PP #




THIS DOCUMENT  
ORIGINALLY ISSUED AND  
SEALED BY:  
WILLIAM KENT  
L-3708  
DECEMBER 20, 2005  
THIS MEDIA SHALL NOT BE CONSIDERED  
A CERTIFIED DOCUMENT



FULL SIZE SCALE: 1" = 50'  
HALF SIZE SCALE: 1" = 100'

REVISIONS

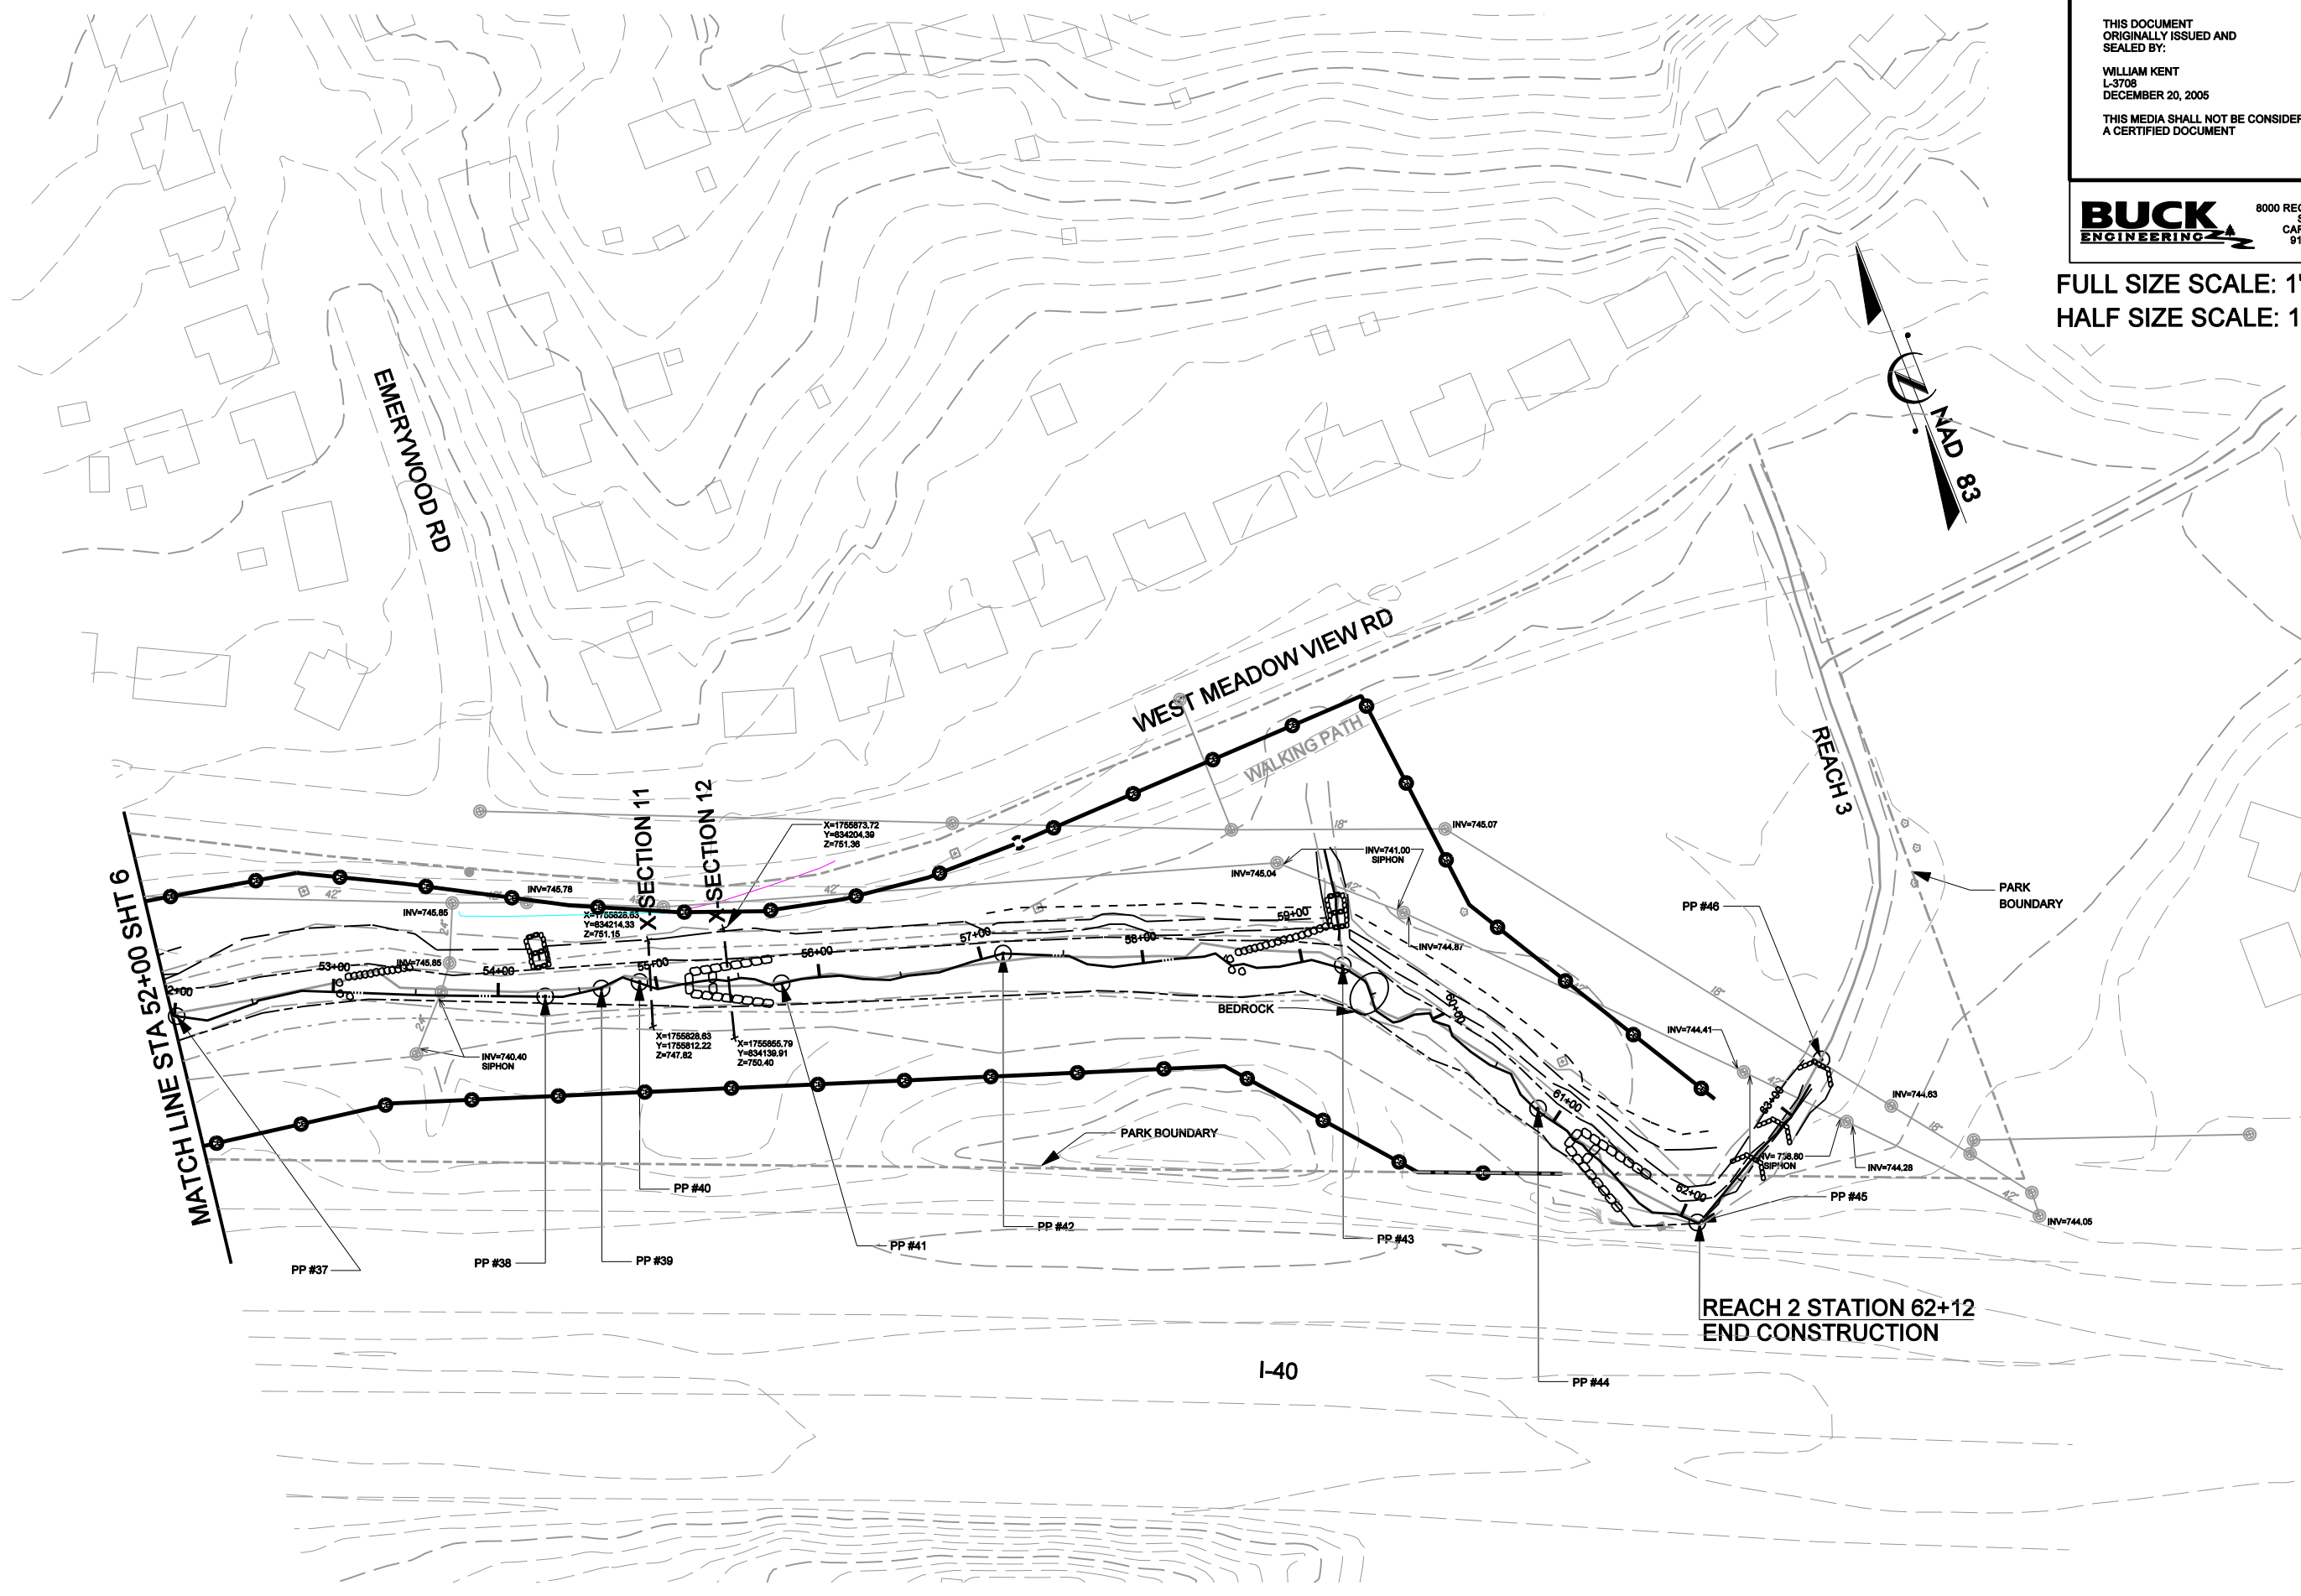

MATCH LINE STA 52+00 SHT 6

SECTION 11

SECTION 12

REACH 2 STATION 62+12  
END CONSTRUCTION

PHOTO POINT - ⊙ PP#