

Year 1 Monitoring Report FINAL

Hudson Property

DMS Project ID #: 95361

DMS Contract #: 004638

USACE Action ID# SAW-2012-01394

Beaufort County, North Carolina



Submitted: January 2017

Submitted to/Prepared for:

NC Department of Environment and Natural Resources

Division of Mitigation Services

1652 Mail Service Center

Raleigh, NC 27699-1652



Prepared by:

ALBEMARLE RESTORATIONS, LLC

P.O. Box 176

Fairfield, NC 27826

Tel (252) 333-0249 Fax (252) 926-9983

Table of Contents

1.0 Project Summary.....	1
2.0 Project Goals and Objectives	1
3.0 Project Success Criteria	1
3.1 Stream Restoration Performance Standards.....	1
3.2 Stream Channel Restoration Stability Performance Standards.....	2
3.3 Planted Vegetation Performance Standards.....	2
4.0 Site Conditions and Description	2
5.0 Mitigation Components	2
6.0 Design Approach	3
7.0 Construction and Planting Timeline	3
8.0 Plan Deviations	3
9.0 Project Performance	3
10.0 Methods and References.....	3
Figure 1 – Vicinity Map.....	4
Appendix A – Background Tables.....	5
Table 1. Project Components and Mitigation Credits.....	6
Table 2. Project Activity and Reporting History	7
Table 3. Project Contacts	7
Table 4. Project Information and Attributes	8
Appendix B – CCPV and Photos	9
Current Condition Plan View.....	10
Table 5. Visual Stream Morphology Stability Assessment (Reach 1-4) 16	
Table 6. Vegetation Condition Assessment Table.....	20
Site Photos	21
Appendix C – Vegetation Plot Data.....	25
Table 7: Vegetation Plot Counts and Densities	26
Appendix D – Stream Measurement and Geomorphology Data	27
Cross Sections with Annual Overlays (XS 1-11)	
Table 8: Bank Pin Data	39
Table 10a. Baseline Stream Data Summary (Reach 1-4).....	40
Table 11a. Monitoring Data – Dimensional Morphology Summary	44
Table 11b. Monitoring Data – Stream Reach Data Summary (Reach 1-4)	
.....	45
Appendix E – Hydrologic Data.....	49
Table 9: Verification of Bankfull Events	50
Table 12: Verification of Baseflow	50
Figure 2: Monthly Rainfall Data with Percentiles.....	51
Figures 3-12: Stream Surface Water Hydrology (Well 1-10)	52

1.0 PROJECT SUMMARY

The mitigation area is 13.49 acres located within a larger 106-acre property owned by Charles Hudson. It is located in Beaufort County, NC and the Tar-Pamlico River Basin. Mitigation components include five stream reaches totalling 2,891 linear feet contained within a Conservation Easement. Construction was completed in 2015 and planting completed in 2016. The first of seven monitoring years was initiated in 2016.

2.0 PROJECT GOALS AND OBJECTIVES

The project goals of the Hudson property per the approved mitigation plan are as follows:

- Improve and sustain hydrologic connectivity/interaction and storm flow/flood attenuation.
- Reduce nutrient and sediment stressors to the reach and receiving watershed.
- Provide uplift in water quality functions.
- Improve aquatic and terrestrial habitats (complexity, quality).
- Improve and maintain riparian buffer habitat.

The project goals will be addressed through the following project objectives:

- Implement a sustainable, reference-based, rehabilitation of the reach dimension, pattern, and profile to provide needed capacity and competency.
- Support the removal of barriers to anadromous fish movement and to help improve nursery and spawning habitats.
- Strategically install stream structures and plantings designed to maintain vertical and lateral stability and improve habitat diversity/complexity.
- Provide a sustainable and functional bankfull floodplain feature.
- Enhance and maintain hydrologic connection between stream and adjacent floodplain/riparian corridors.
- Utilize the additional width of the swamp runs to provide natural filters for sediment and nutrients and diffuse flow from upstream runoff.
- Install, augment, and maintain appropriate riparian buffer with sufficient density and robustness to support native forest succession.
- Water quality enhancement through riparian forest planting and woody material installation, and increased floodplain interaction/overbank flooding.
- Restore the existing ditched streams to single and multi-thread headwater systems with forested riparian buffers.
- Provide ecologically sound construction techniques that will require minimal grading and disturbance.

3.0 PROJECT SUCCESS CRITERIA

3.1 Stream Restoration Performance Standards

Single Thread Channels (Reaches 1 - 4) and Swamp Run (Reach 5)

Groundwater monitoring wells are installed in and near the thalweg of all five reaches. The wells are equipped with continuous-reading gauges capable of documenting sustained flow. Per the approved Mitigation Plan, each reach must exhibit water flow for at least 30 consecutive days during years with normal rainfall (demonstrating at least intermittent stream status). All restored channels shall receive sufficient flow through the monitoring period to maintain an Ordinary High Water Mark (OHWM). Field indicators

of flow events include a natural line impressed on the bank; shelving; changes in soil characteristics; destruction of terrestrial vegetation; presence of litter and debris; wracking; vegetation matted down, bent or absent; sediment sorting; leaf litter disturbed or washed away; scour; deposition; bed and bank formation; water staining; or change in plant community. In addition, two overbank flows shall be documented for each reach during the monitoring period using continuously monitored pressure transducers and crest gauges. All collected data and field indicators of water flow shall be documented in each monitoring report. Seven flow monitoring stations are located on Reaches 1 – 4, three are located in Reach 5.

3.2 Stream Channel Restoration Stability Performance Standards

Headwater System (Reach 5)

All stream areas shall remain stable with no areas of excessive erosion such as evidence of bank sloughing or actively eroding banks due to the exceedance in critical bank height and lack of deep rooted stream bank vegetation.

Single Thread Channels (Reaches 1 - 4)

1. Bank Height Ratio (BHR) shall not exceed 1.2 within restored reaches of the stream channel.
2. Entrenchment Ratio (ER) shall be no less than 2.2 within restored reaches of the stream channel.
3. The stream project shall remain stable and all other performance standards shall be met through two separate bankfull events, occurring in separate years, during the 7-year post construction monitoring period.
4. Three bank pin arrays and 11 cross sections are located on Reaches 1 - 4

3.3 Planted Vegetation Performance Standards

1. At least 320 three year-old planted stems/acre must be present after year three. At year five, density must be no less than 260 five year-old planted stems/acre. At year 7, density must be no less than 210 seven year-old planted stems/acre.
2. If this performance standard is met by year 5 and stem density is trending toward success (i.e., no less than 260 five year-old stems/acre) monitoring of vegetation on the site may be terminated provided written approval is provided by the USACE in consultation with the North Carolina Interagency Review Team (NCIRT).
3. Thirteen vegetation plot samples are located within the project area.

4.0 SITE CONDITIONS AND DESCRIPTION

The Hudson property is 13.49 acres located in Beaufort County, NC and the Tar-Pamlico River Basin. The majority of the site is used for crop production, primarily corn, soybeans and wheat. As a result of the lowering of local water tables and in some cases the complete elimination of ground and surface water interaction, the degradation of water quality and downstream anadromous fish spawning and nursery habitat has occurred. Hydric soils are present on site, meaning that the pre-existing site conditions were appropriate for raising the water table and re-establishing normal base flow conditions (See Figure 1 -Vicinity Map).

5.0 MITIGATION COMPONENTS

Mitigation components are limited to five reaches: Reach 1: 833 lf; Reach 2: 532 lf; Reach 3: 445 lf; Reach 4: 437 lf; Reach 5: 644 lf, for a total restored stream footage of 2,891 linear feet (Table 1).

6.0 DESIGN APPROACH

A natural design approach was used to restore the natural sinuosity and flow of the headwater streams which existed prior to channelization. Grading was done to decrease sediment load and erosion rate while allowing for floodplain connectivity and storage for overland flow. Banks were graded down to distribute flow velocity and the banks and riparian buffers were planted to stabilize the channel and create habitat. A combination of Priority 1 and Priority II restoration types were used. Where the proposed channels tie into the existing, non-restored channels, Priority II restoration was used.

7.0 CONSTRUCTION AND PLANTING TIMELINE

Construction commenced in December 2014 with the installation of recommended erosion control practices and was completed in May 2015. Planting was officially concluded in early January 2016. (Table 2 – Project History Table)

8.0 PLAN DEVIATIONS

There were no significant deviations between construction plans and the As-built conditions.

9.0 PROJECT PERFORMANCE

The Hudson stream restoration project is currently meeting functional goals and objectives. Annual monitoring took place in September and revealed the presence of bankfull events, floodplain connectivity, and lateral and vertical stability. In-stream structures were observed to be functioning as intended with minimal scouring of the channel's banks or bed. The entire length of the project is currently exhibiting fully vegetated banks with both herbaceous and woody plants. Overall, woody plantings within the riparian buffer are meeting project with goals with some dieback of planted stems and introduction of other woody vegetation in 11 out of 13 vegetation monitoring plots. Stream gauges indicated base flow and bankfull events at 10 out of 10 locations. Bank pin arrays have shown minimal erosion in 3 out of 3 locations. Stream cross sections are meeting objectives in 10 out of 10 locations. At this point in time, no corrective measures are necessary and monitoring will continue as scheduled.

10.0 METHODS AND REFERENCES

Monitoring methodology did not differ from the approved Mitigation Plan. Cross-section dimensions were collected using standard survey methods. Bank Pin arrays were measured for exposure in the bank and stream. Vegetation assessment was done according to the level 2 protocol specified by the Carolina Vegetation Survey. Hydrology monitoring wells were installed per ERDC TN-WRAP-00-02 "Installing Monitoring Wells/Piezometers in Wetlands" dated 2000. Groundwater levels were recorded using the U20-001-01 water level data loggers manufactured by Onset Computer. The loggers were installed in the wells per the manufacturer's instructions.

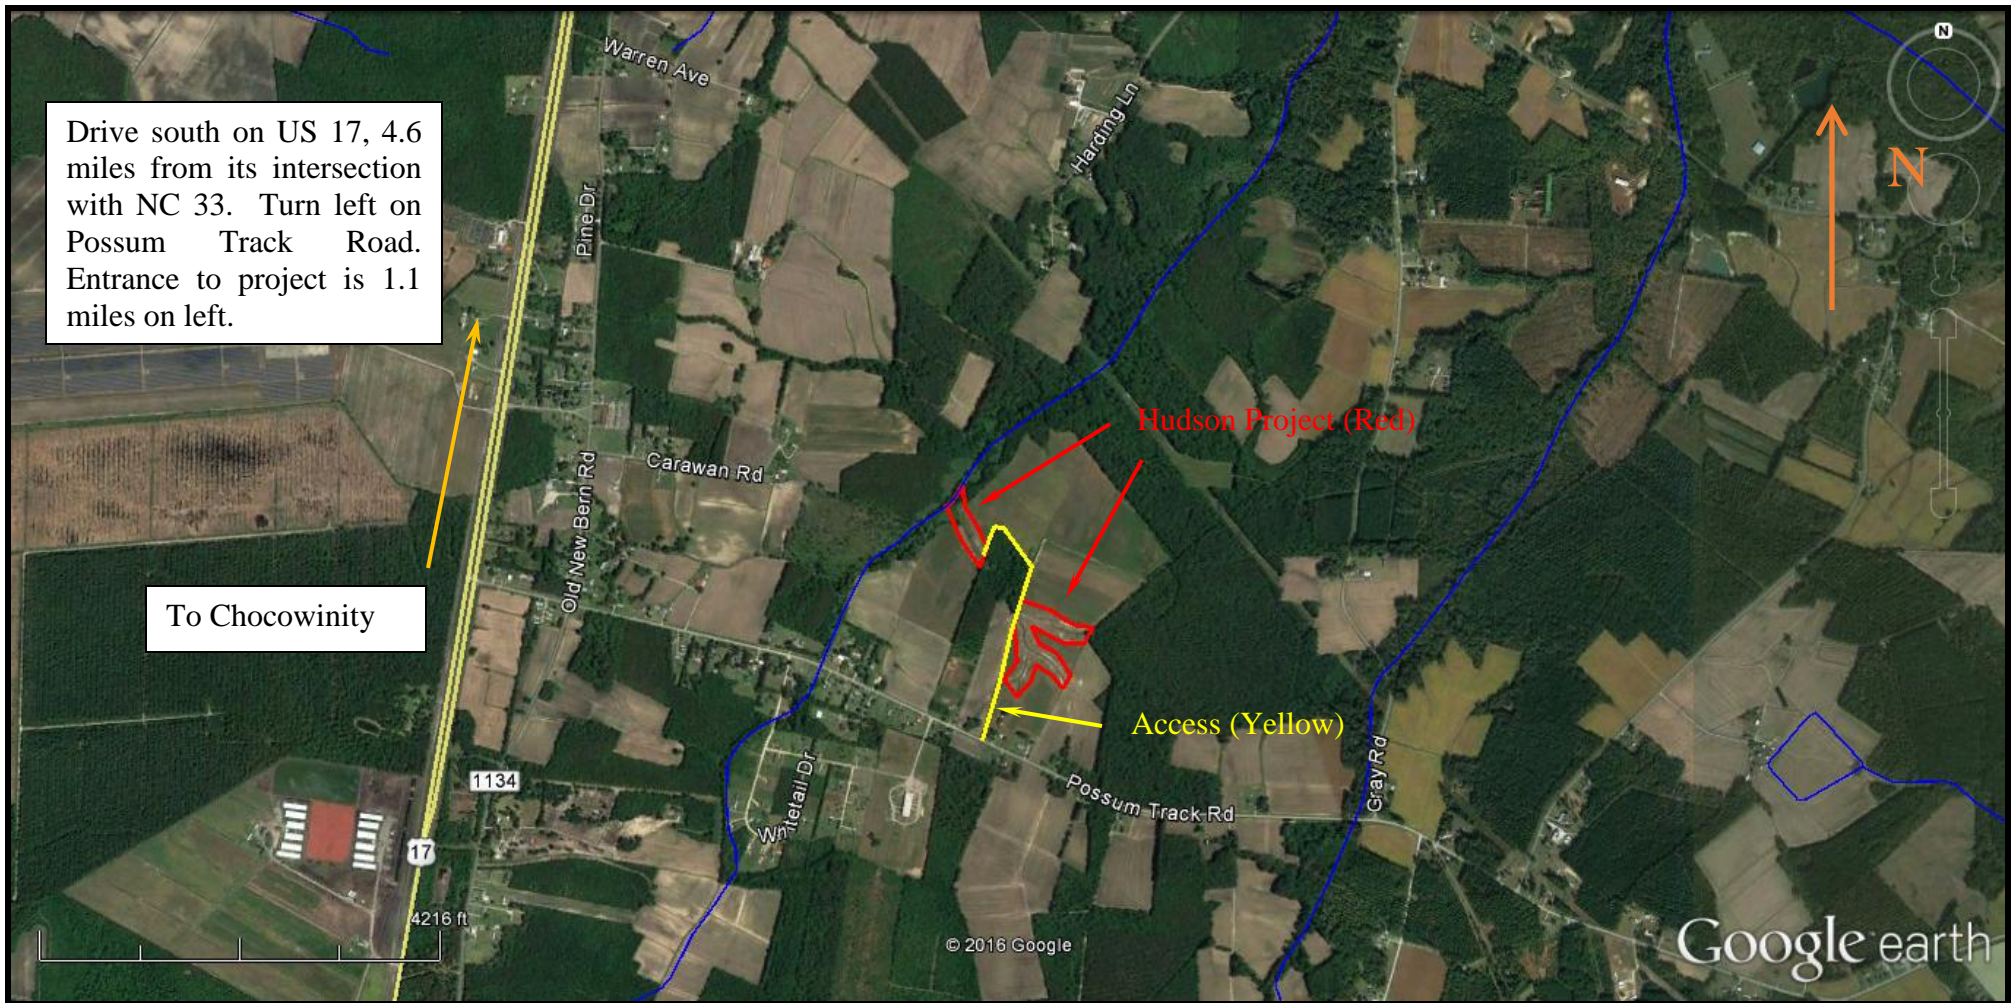


Figure 1 - Vicinity Map
Hudson Stream Mitigation Project
DMS Project #95361
Beaufort County, NC

APPENDIX A: PROJECT BACKGROUND TABLES

Table 1. Project Components and Mitigation Credits

Table 2. Project Activity and Reporting History

Table 3. Project Contacts

Table 4. Project Information and Attributes

Table 1: Project Components and Mitigation Credits Hudson Property, Beaufort County EEP Project Number: 95361									
Mitigation Credits									
	Stream		Riparian wetland		Non-riparian wetland		Buffer	Nitrogen Nutrient Offset	Phosphorous Nutrient Offset
Type	R	RE	R	RE	R	RE			
Totals	2,891								
Project Components									
Project Component or Reach ID	Stationing/Location		Existing Footage/Acreage		Approach (PI, PII etc.)		Restoration or Restoration Equivalent	Restoration Footage or Acreage	Mitigation Ratio
Reach 1			766 LF		PI			833 LF	1:1
Reach 2			516 LF		PI/PII			532 LF	1:1
Reach 3			611 LF		PI/PII			445 LF	1:1
Reach 4			503 LF		PI/PII			437 LF	1:1
Reach 5			689 LF		PI			644 LF	1:1
Total			3,085 LF					2,891 LF	
Component Summation									
Restoration Level	Stream (linear feet)		Riparian Wetland (acres)		Non-riparian Wetland (acres)		Buffer (square feet)	Upland (acres)	
			Riverine	Non-riverine					
Restoration	2,891 LF								
Enhancement									
Enhancement I									
Enhancement II									
Creation									
Preservation									
BMP Elements									
Element	Location				Purpose/Function		Notes		
FB	Adjacent to stream				Buffer		100 feet on either side of stream centerline		

Table 2: Project Activity and Reporting History Hudson Property- EEP Project Number 95361		
Activity, Deliverable, or Milestone	Data Collection Complete	Actual Completion or Delivery
Project Institution	N/A	June 2012
Mitigation Plan	July 2014	Oct 2014
Permits Issued	March 2013	May 2014
Final Design Construction	March 2013	May 2014
Construction	N/A	May 2015
Containerized, Bare Root, and B&B Planting	N/A	January 2016
Baseline Monitoring Document (Year 0 - Baseline)	January 2016	August 2016
Year 1 Monitoring	September 2016	Final: January 2017
Year 2 Monitoring		
Year 3 Monitoring		
Year 4 Monitoring		
Year 5 Monitoring		
Year 6 Monitoring		
Year 7 Monitoring		

Table 3: Project Contacts Hudson Property- EEP Project Number: 95361	
Primary Project Design POC	Ecotone, Inc. Scott McGill (410) 420-2600 P.O. Box 5, Jarrettsville, MD 21084
Construction Contractor POC	Riverside Excavation, Inc. Car Baynor (252) 943-8633
Survey Contractor POC	True Line Surveying Curk Lane (919) 359-0427
Planting and Seeding Contractor POC	Carolina Silvics, Inc. Mary Margaret McKinney (252) 482-8491 908 Indian Trail Road, Edenton, NC 27932
Seed Mix Sources	Ernst Conservation Seeds, LLP, Meadville, PA
Nursery Stock Suppliers	Carolina Silvics, Inc.
Monitoring Performers Stream and Vegetation POC	Ecotone, Inc. Scott McGill (410) 420-2600 P.O. Box 5, Jarrettsville, MD 21084

Table 4: Project information					
Hudson Property- EEP Project Number: 95361					
Project name		HUDSON PROPERTY			
County		BEAUFORT			
Project Area (ac)		13.4 AC			
Project Coordinates (Lat and Long)		77° 06" 13.62' W / 35° 26" 53.20' N			
4.1 Project Watershed Summary Information					
Physiographic province		INNER COASTAL PLAIN			
River basin		TAR-PAMLICO RIVER BASIN			
USGS Hydrologic Unit 8-digit	03020104	USGS Hydrologic Unit 14-digit	03020104010010		
DWQ Sub-basin		CHOCOWINITY CREEK – HORSE BRANCH			
Project Drainage Area (acres)		190.86			
Project Drainage Area Percentage of Impervious Area		1.2 % (2.24 acres)			
CGIA Land Use Classification		2.01.01.07 Annual Row Crop Rotation			
4.2 Reach Summary Information					
Parameters	Reach 1	Reach 2	Reach 3	Reach 4	Reach 5
Length of reach (linear feet)	766	516	611	503	689
Valley classification	VIII	VIII	VIII	VIII	VIII
Drainage area (acres)	40.51	74.63	35.21	150.35	190.86
NCDWR stream identification score	20.75	20.75	20.75	20.75	28
NCDWR Water Quality Classification	C;NSW	C;NSW	C;NSW	C;NSW	C;NSW
Morphological Description (stream type)	G5-G6	G5-G6	G5-G6	G5-G6	G5-G6
Evolutionary trend	Early (CEM)	Early (CEM)	Early (CEM)	Early (CEM)	Early (CEM)
Underlying mapped soils	GoA & CrB	CrB & Ly	CrB & Ly	CrB	CrB & Me
Drainage class	MW	MW & SP	MW & SP	MW	MW & P
Soil Hydric status	Non-Hydric	Non-Hydric	Non-Hydric	Non-Hydric	Hydric
Slope (ft/ft)	0.009	0.006	0.008	0.004	0.003
FEMA classification	N/A	N/A	N/A	N/A	AE/X
Native vegetation community	Pasture/Crop	Pasture/Crop	Pasture/Crop	Pasture/Crop	Pasture/Crop
Percent composition of exotic invasive vegetation	N/A	N/A	N/A	N/A	N/A
4.3 Regulatory Considerations					
Regulation	Applicable?	Resolved?	Supporting Documents		
Waters of the United States – Section 404	YES	YES	Supporting Documents		
Waters of the United States – Section 401	YES	YES	SAW-2012-01394		
Endangered Species Act	NO	YES	NA		
Historic Preservation Act	NO	YES	NA		
Coastal Zone Management Act (CZMA)/ Coastal Area Management Act (CAMA)	NO	YES	NA		
FEMA Floodplain Compliance	NO	YES	NA		
Essential Fisheries Habitat	NO	YES	NA		


APPENDIX B: VISUAL ASSESSMENT DATA

Current Condition Plan View

Table 5. Visual Stream Morphology Stability Assessment (Reach 1-4)

Table 6. Vegetation Condition Assessment Table

Site Photos

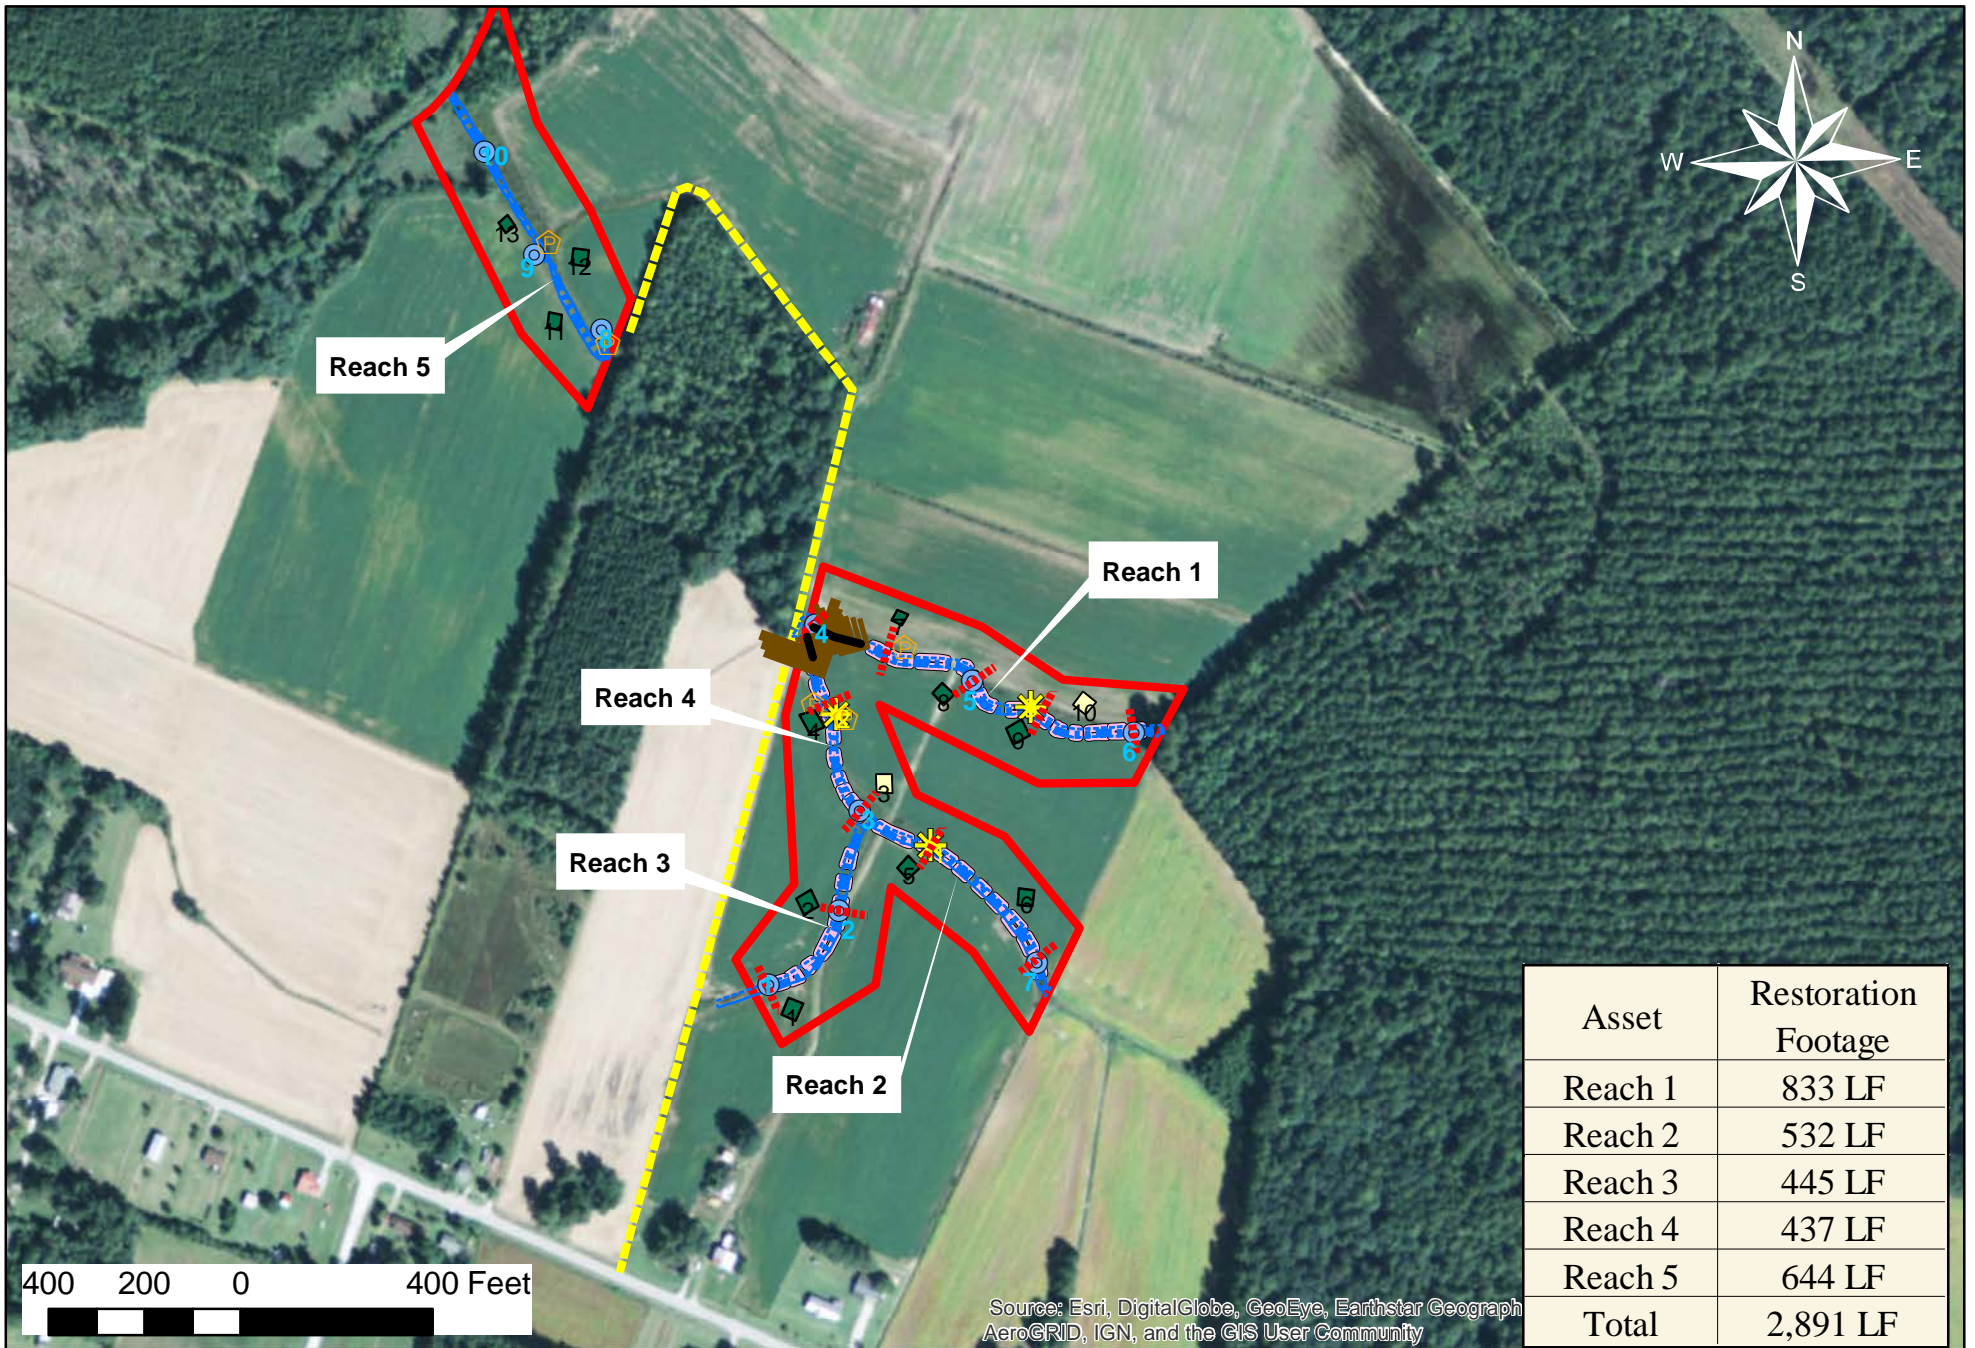

Asset	Restoration Footage
Reach 1	833 LF
Reach 2	532 LF
Reach 3	445 LF
Reach 4	437 LF
Reach 5	644 LF
Total	2,891 LF


Albemarle Restorations, LLC

Wetland Restoration
Stream Restoration
Wildlife Habitat

Hudson Stream Restoration Project
Current Condition Plan View

Project # 95361
Jan. 11, 2017

- Cross Sections
- Log Drops
- Flow Station
- Bank Pin Array
- Photo Point
- Top of Bank
- Access Road
- Stream Centerline
- Woody Riffles
- Easement Boundary
- Stable In-Stream Structure
- Veg Plot Condition Criteria Met
- Veg Plot Condition Criteria Unmet
- Stream Gauges Hydrology Met

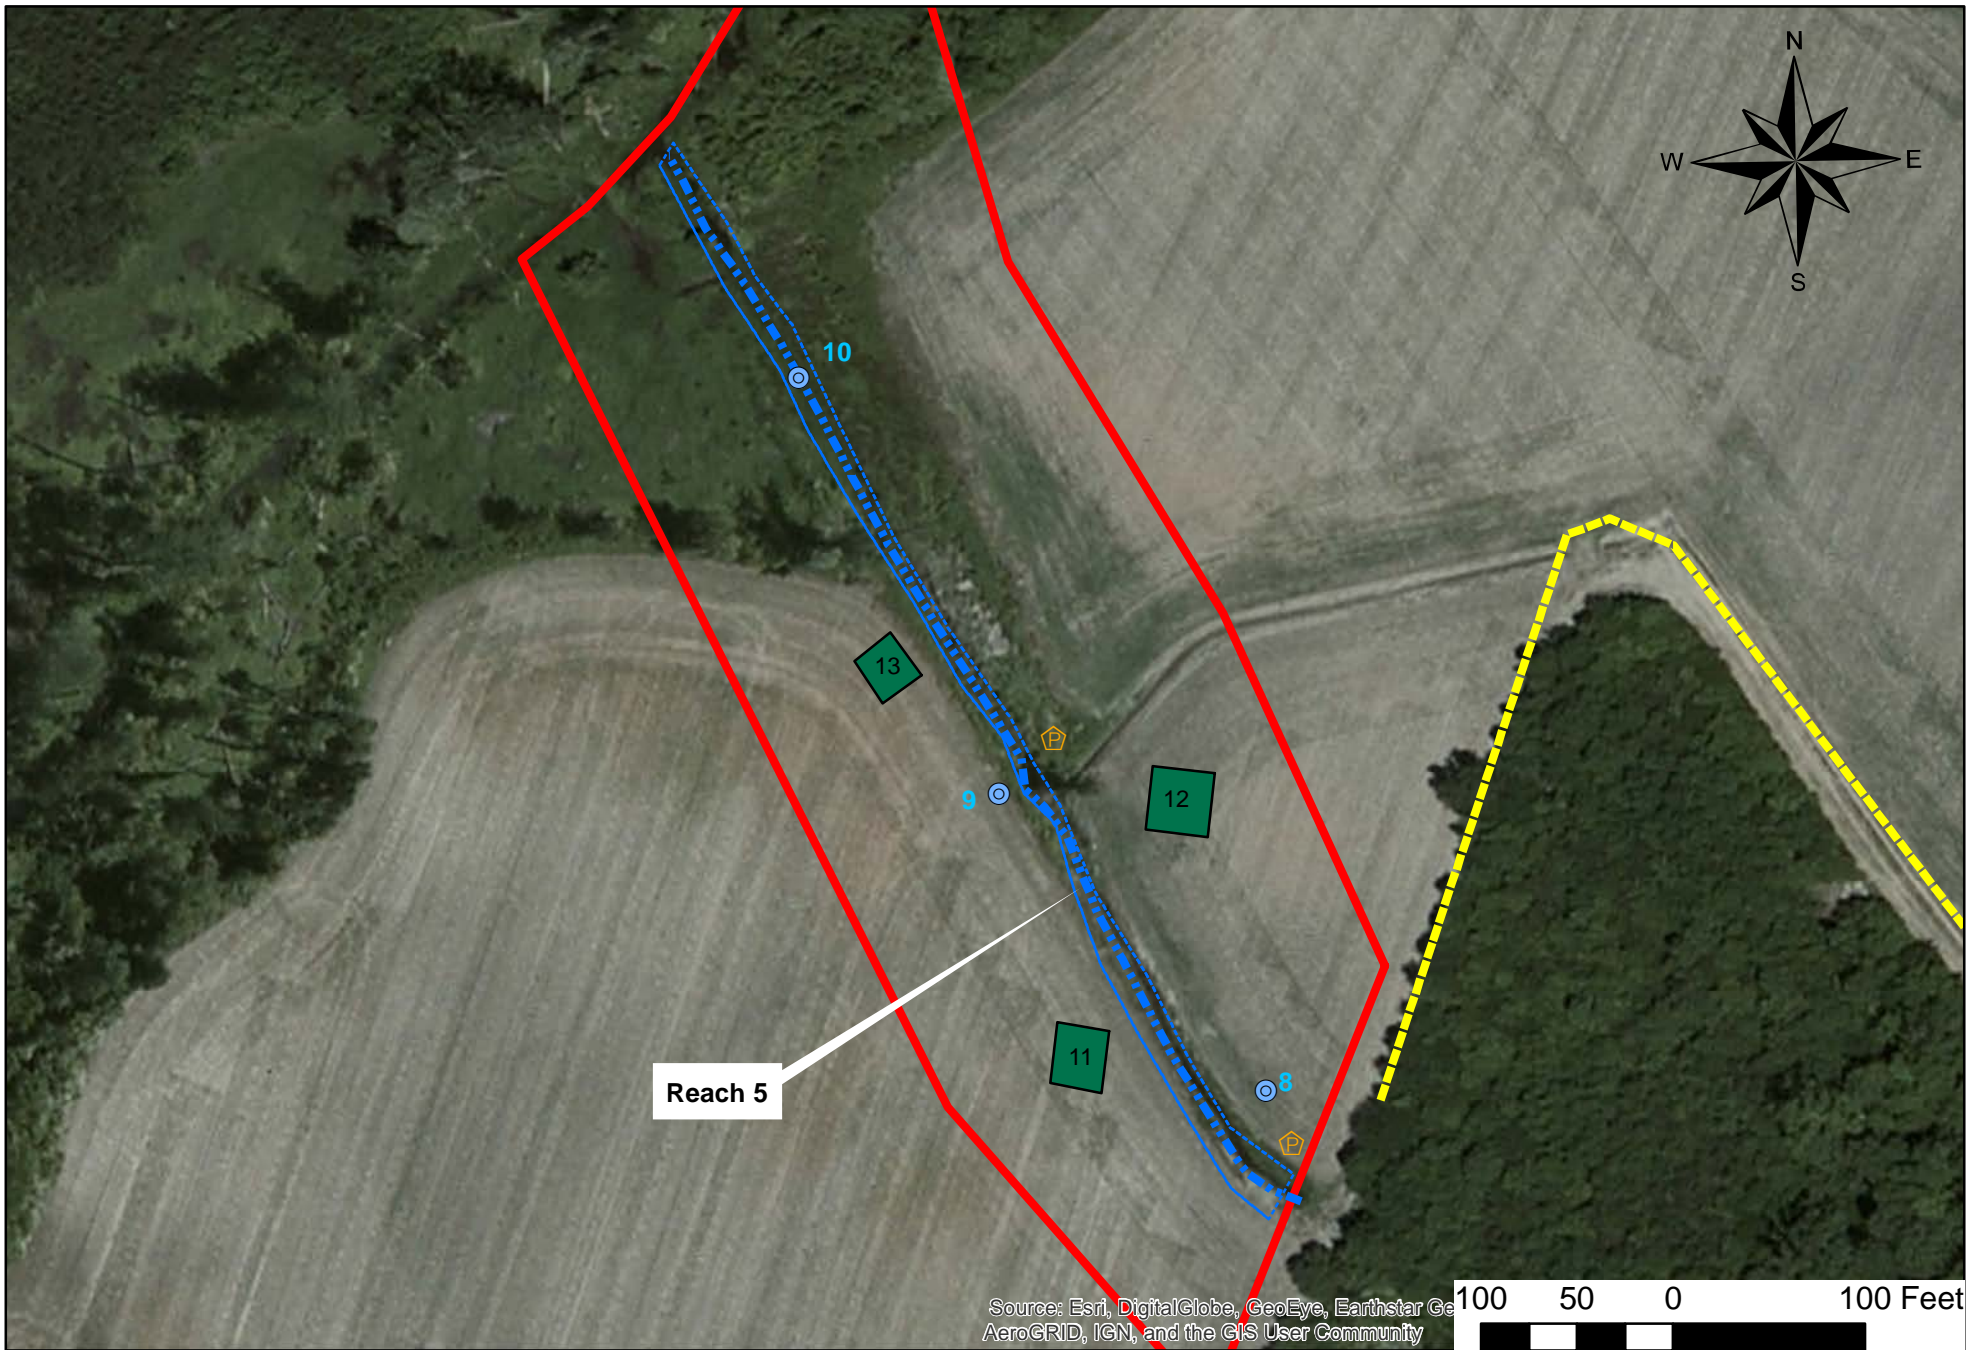


Albemarle Restorations, LLC

Wetland Restoration
Stream Restoration
Wildlife Habitat

Hudson Stream Restoration Project
Current Condition Plan View

Project # 95361
Jan. 11, 2017

Flow Station	Easement Boundary
Photo Point	
Top of Bank	
Access Road	
Stream Centerline	
Veg Plot Condition	
Criteria Met	Stream Gauges
Criteria Unmet	Hydrology Met

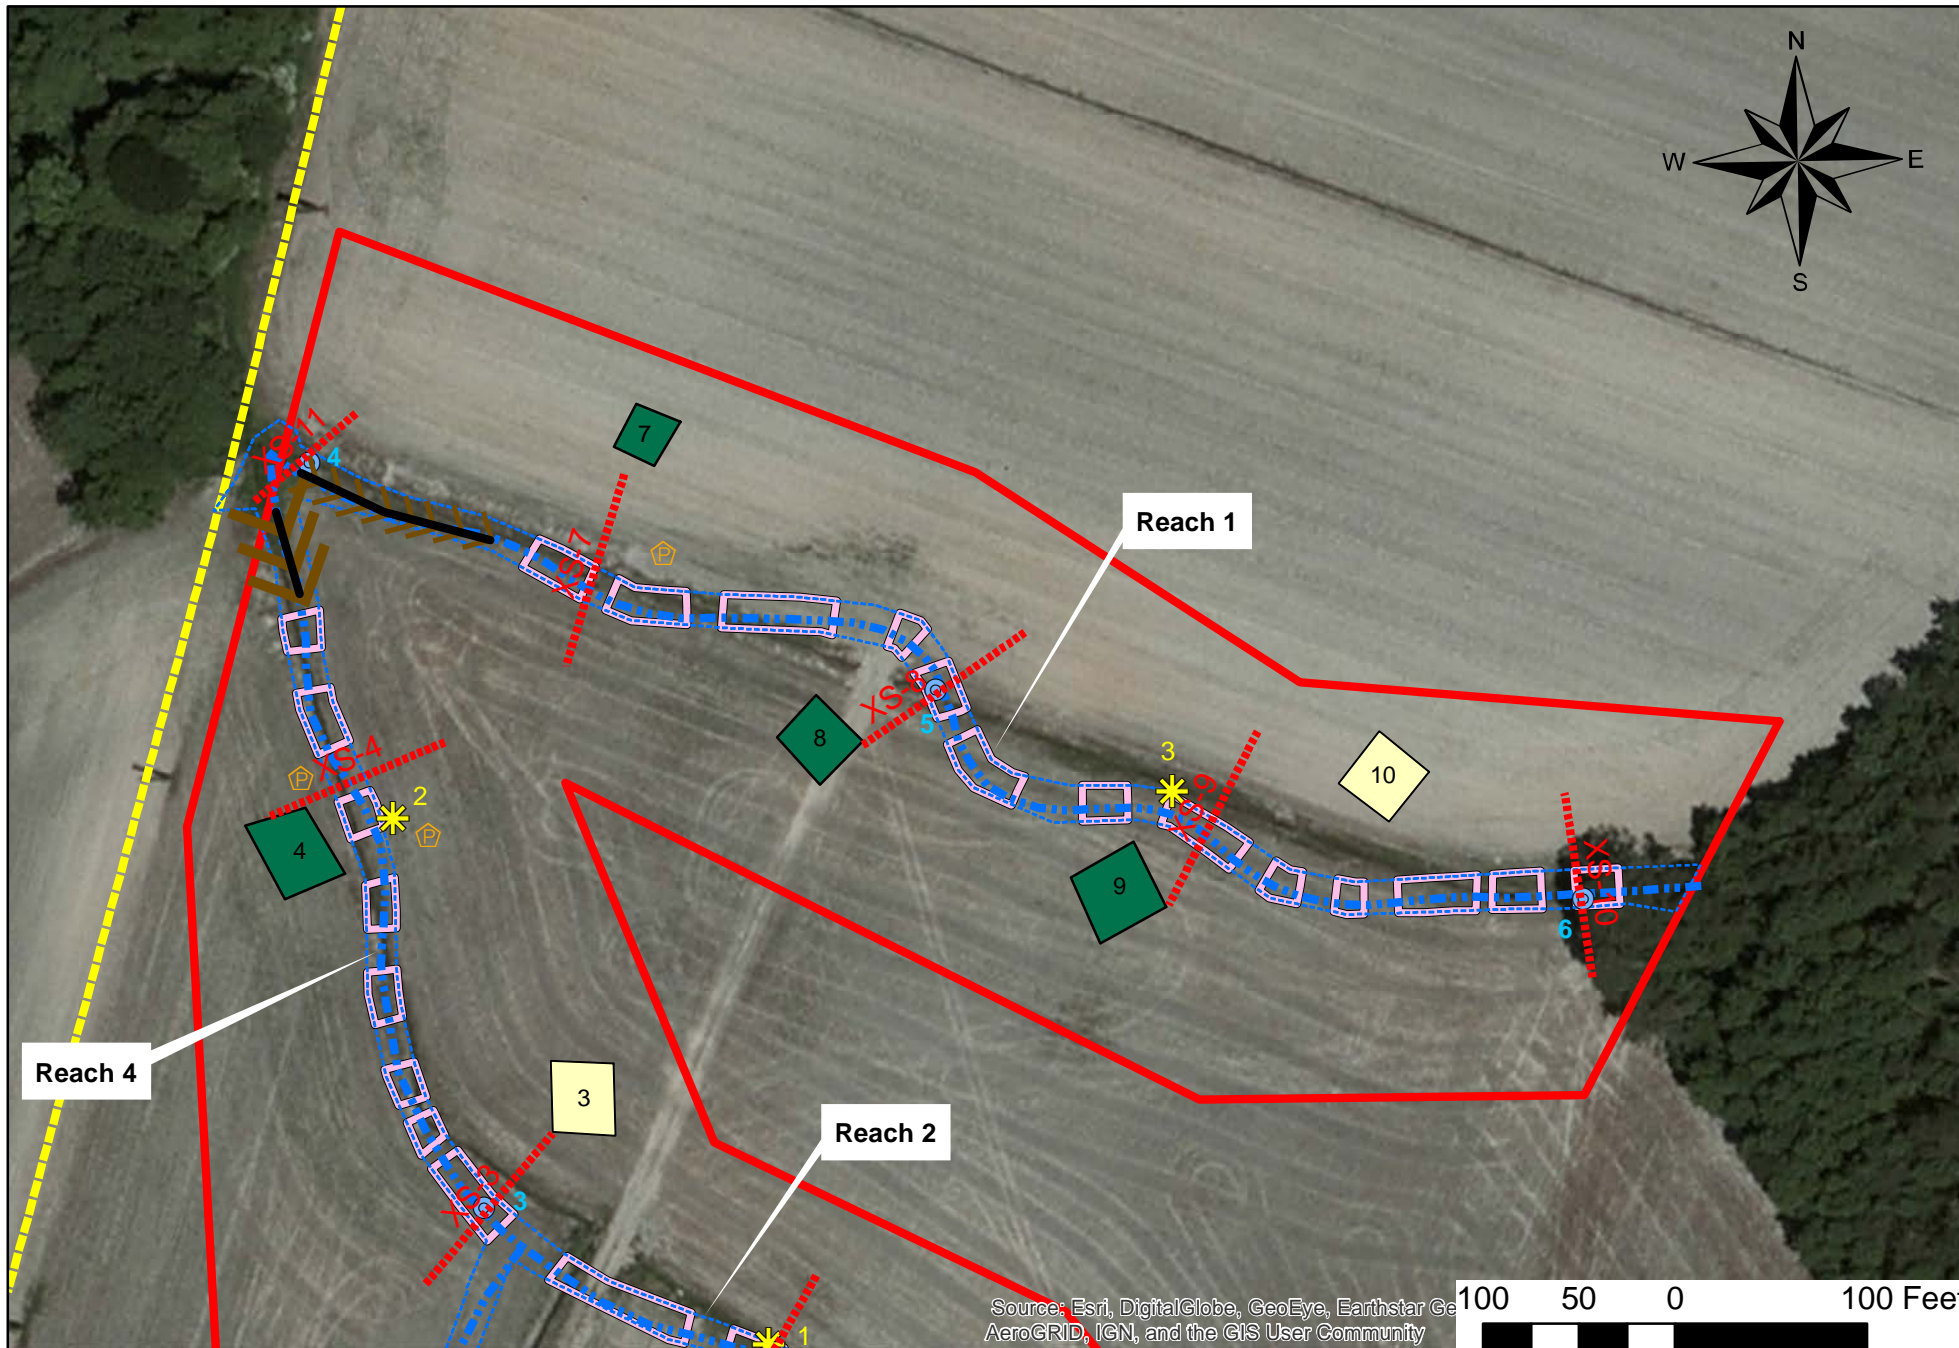

Source: Esri, DigitalGlobe, GeoEye, Earthstar Geographics, CNR AeroGRID, IGN, and the GIS User Community


Albemarle Restorations, LLC

Wetland Restoration
Stream Restoration
Wildlife Habitat

Hudson Stream Restoration Project Current Condition Plan View

Project # 95361
Jan. 11, 2017

- | | | |
|----------------|-------------------|----------------------------|
| Cross Sections | Bank Pin Array | Woody Riffles |
| Log Drops | Photo Point | Easement Boundary |
| Flow Station | Top of Bank | Stable In-Stream Structure |
| Access Road | Stream Centerline | Veg Plot Condition |
| | | Criteria Met |
| | | Criteria Unmet |
| | | Stream Gauges |
| | | Hydrology Met |

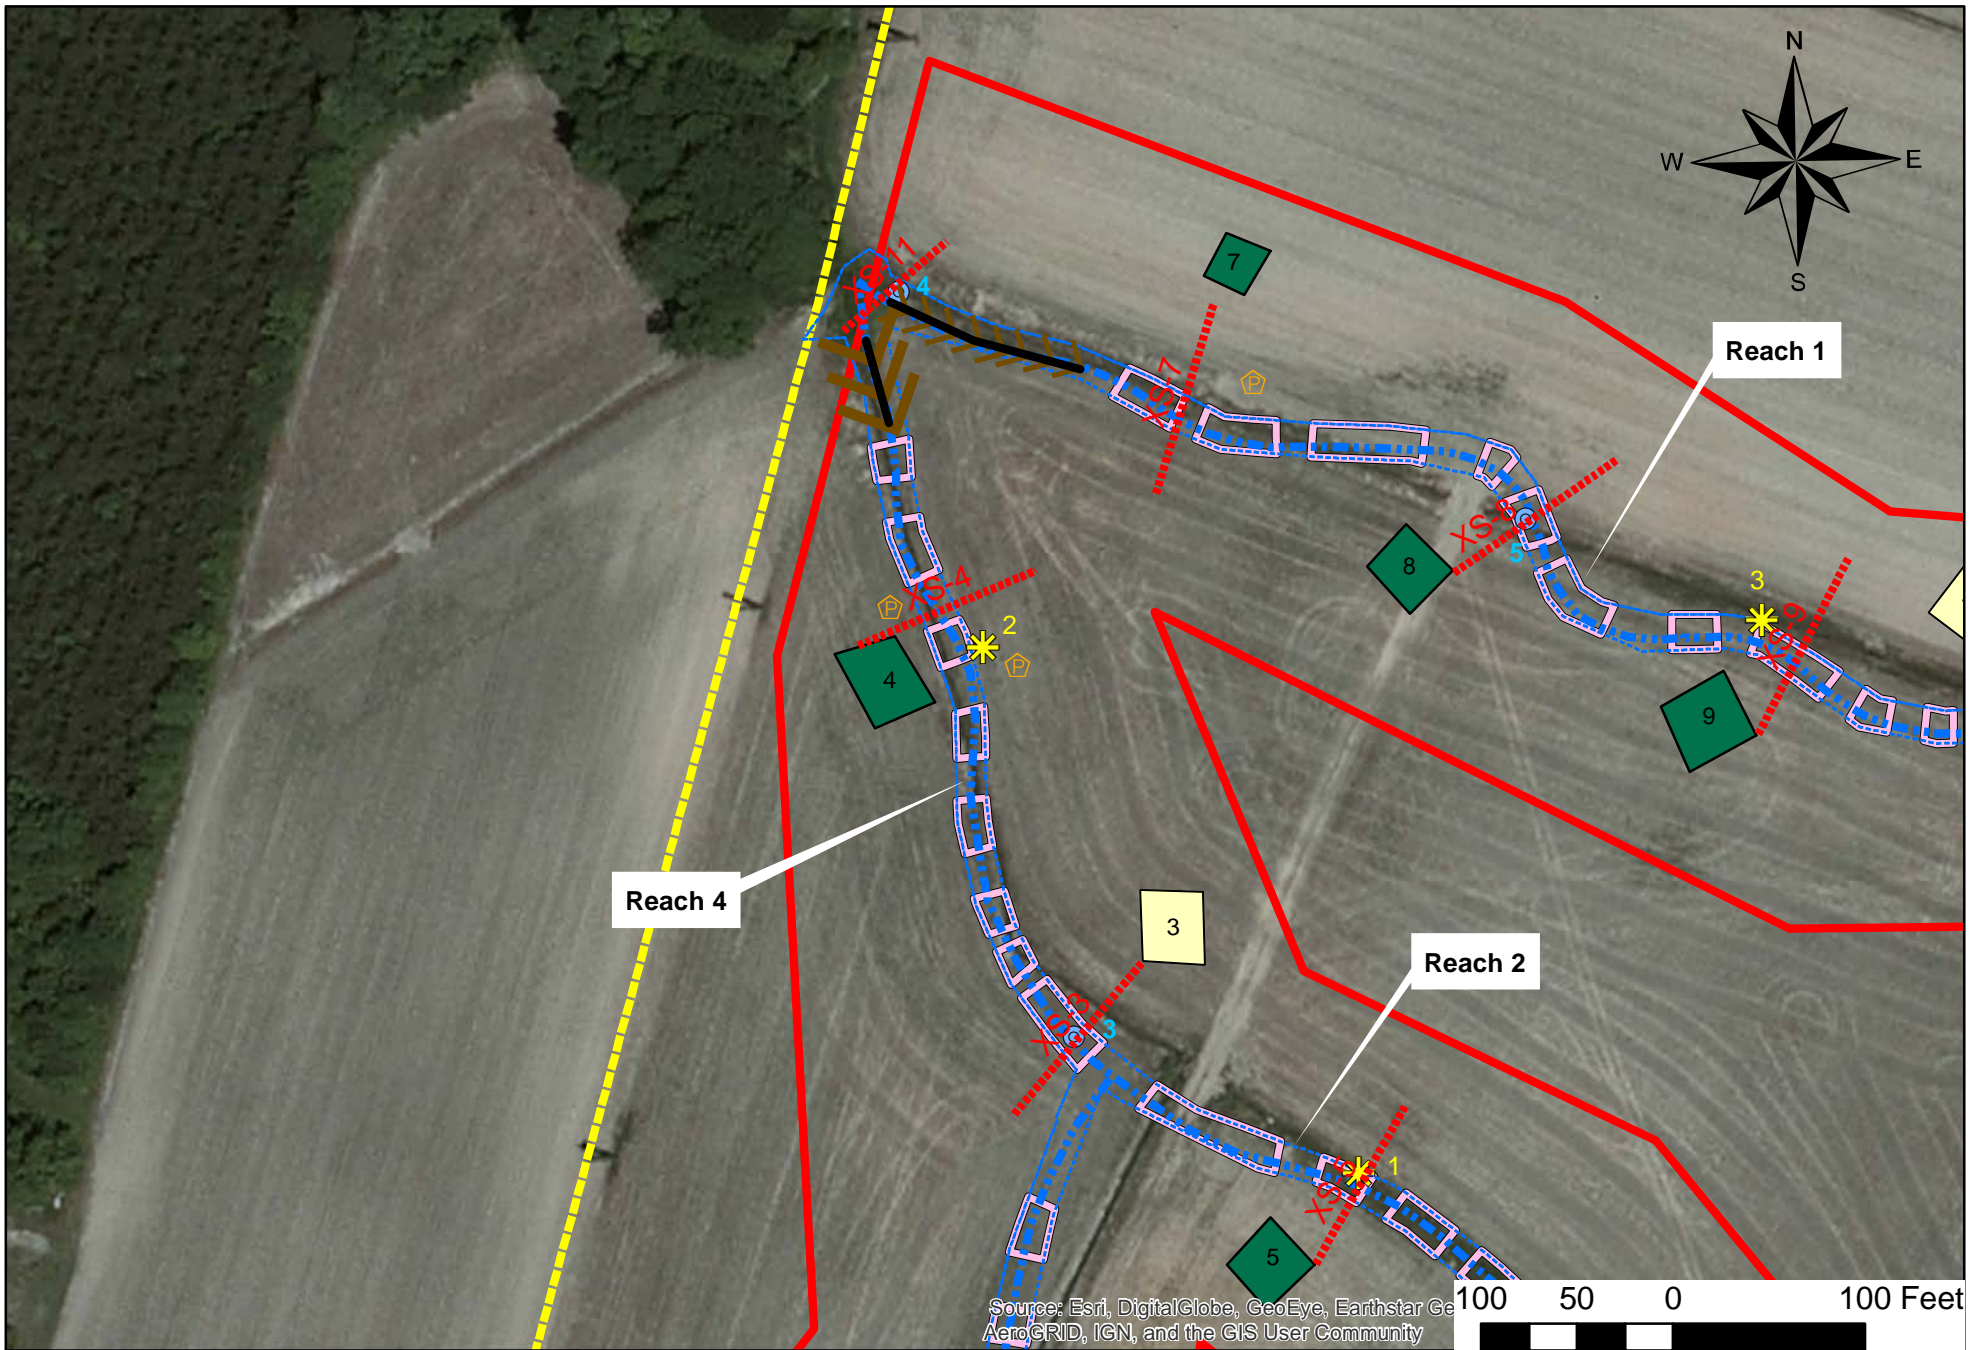


Albemarle Restorations, LLC

Wetland Restoration
Stream Restoration
Wildlife Habitat

Hudson Stream Restoration Project
Current Condition Plan View

Project # 95361
Jan. 11, 2017

Cross Sections	Bank Pin Array	Woody Riffles
Log Drops	Photo Point	Easement Boundary
Flow Station	Top of Bank	Stable In-Stream Structure
Access Road	Stream Centerline	Veg Plot Condition
		Criteria Met
		Criteria Unmet
		Stream Gauges
		Hydrology Met

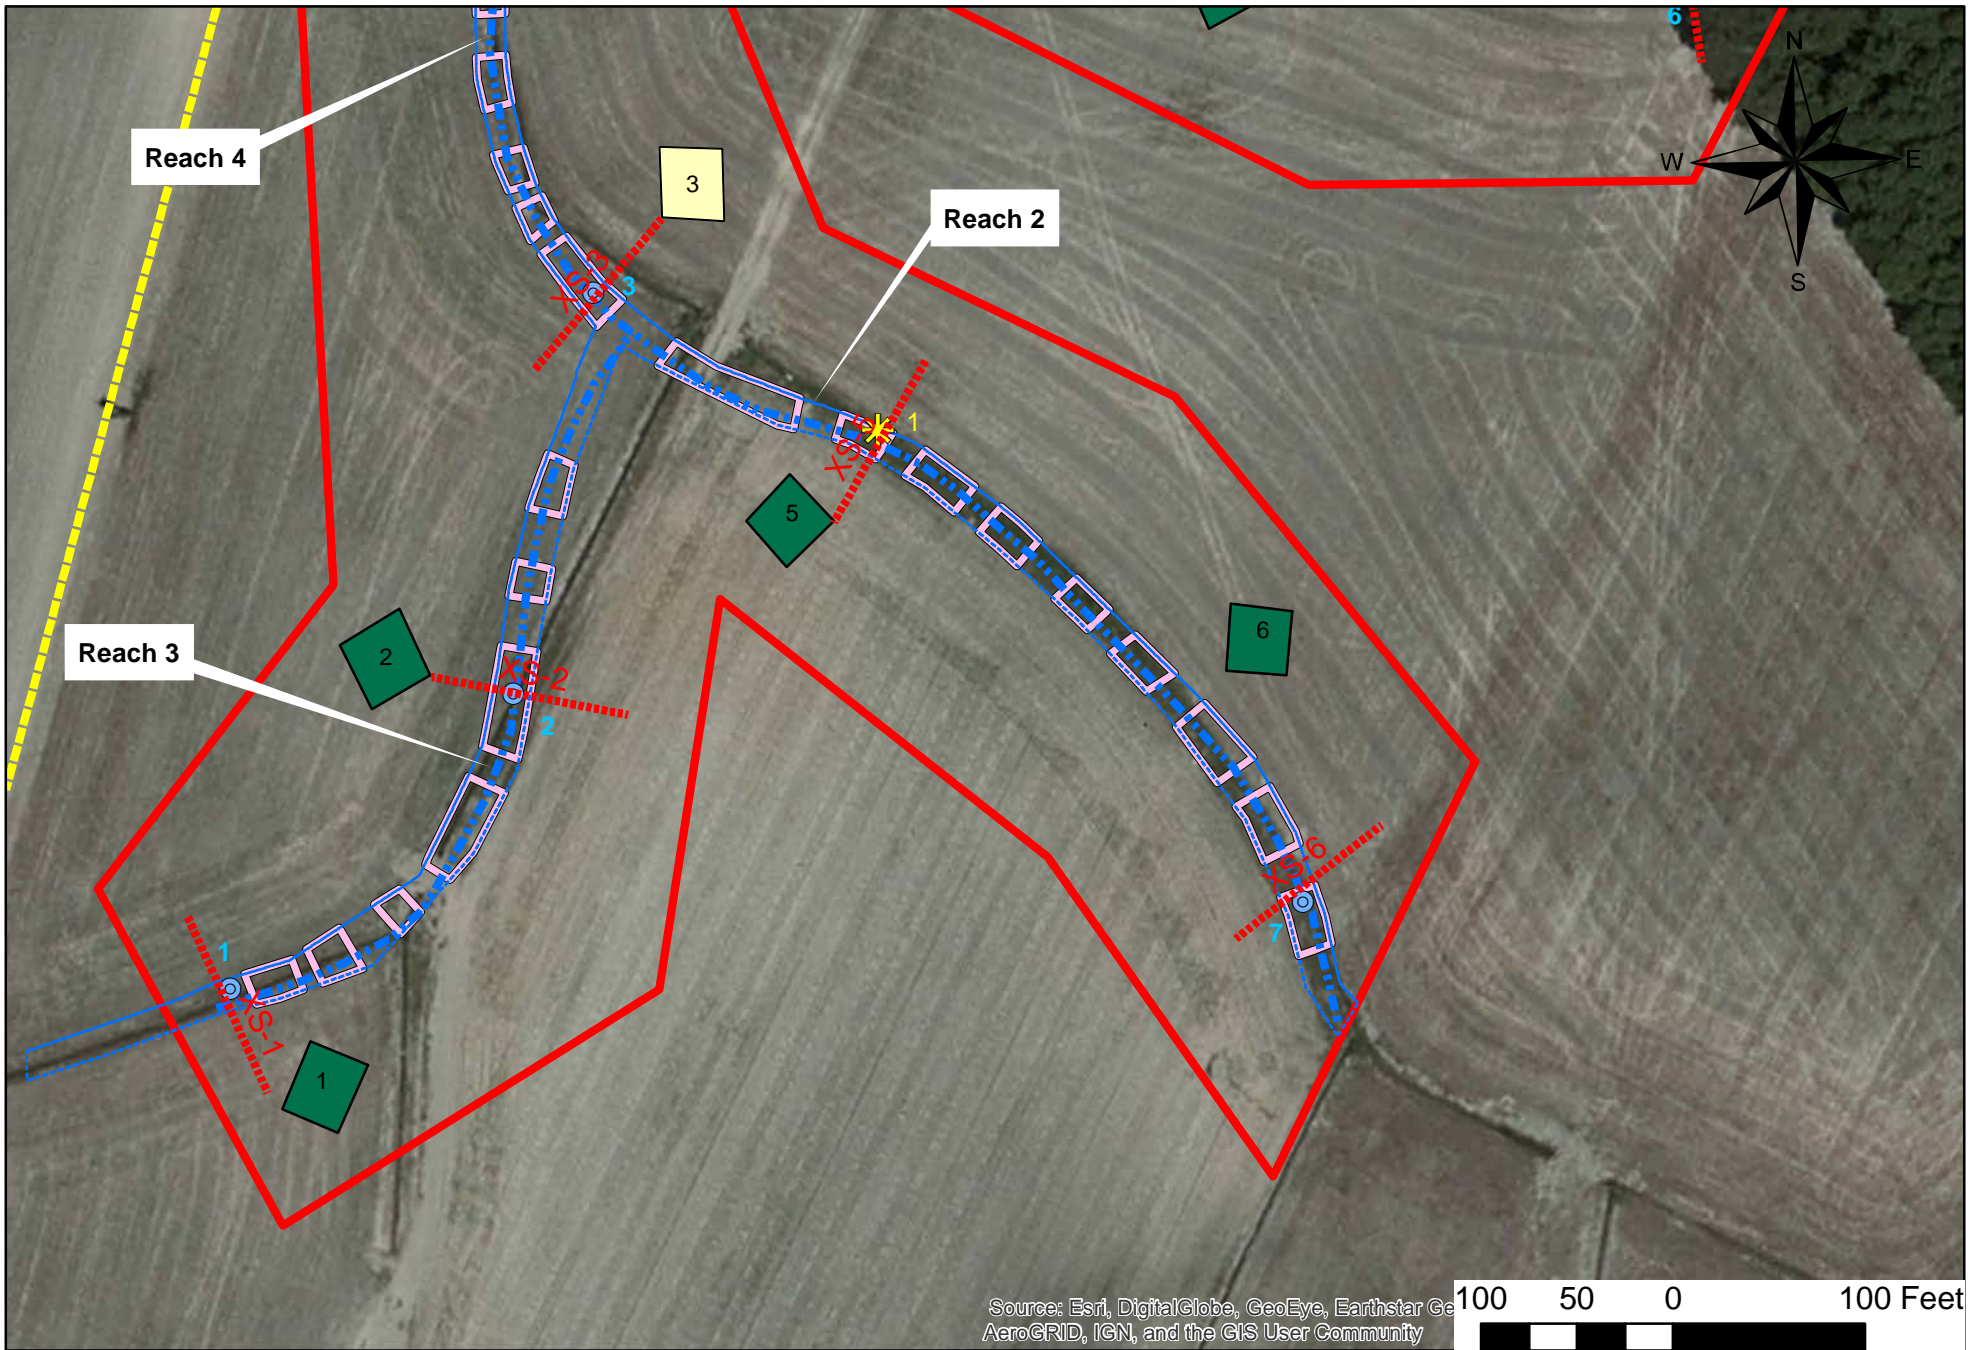


Albemarle Restorations, LLC

Wetland Restoration
Stream Restoration
Wildlife Habitat

Hudson Stream Restoration Project Current Condition Plan View

Project # 95361
Jan. 11, 2017

- | | | | |
|----------------------|-----------------------|---------------------------|----------------------|
| ----- Cross Sections | --- Stream Centerline | | |
| ⊙ Flow Station | --- Woody Riffles | | |
| ✱ Bank Pin Array | --- Easement Boundary | | |
| --- Top of Bank | | Veg Plot Condition | Stream Gauges |
| --- Access Road | | ■ Criteria Met | ⊙ Hydrology Met |
| | | ■ Criteria Unmet | |

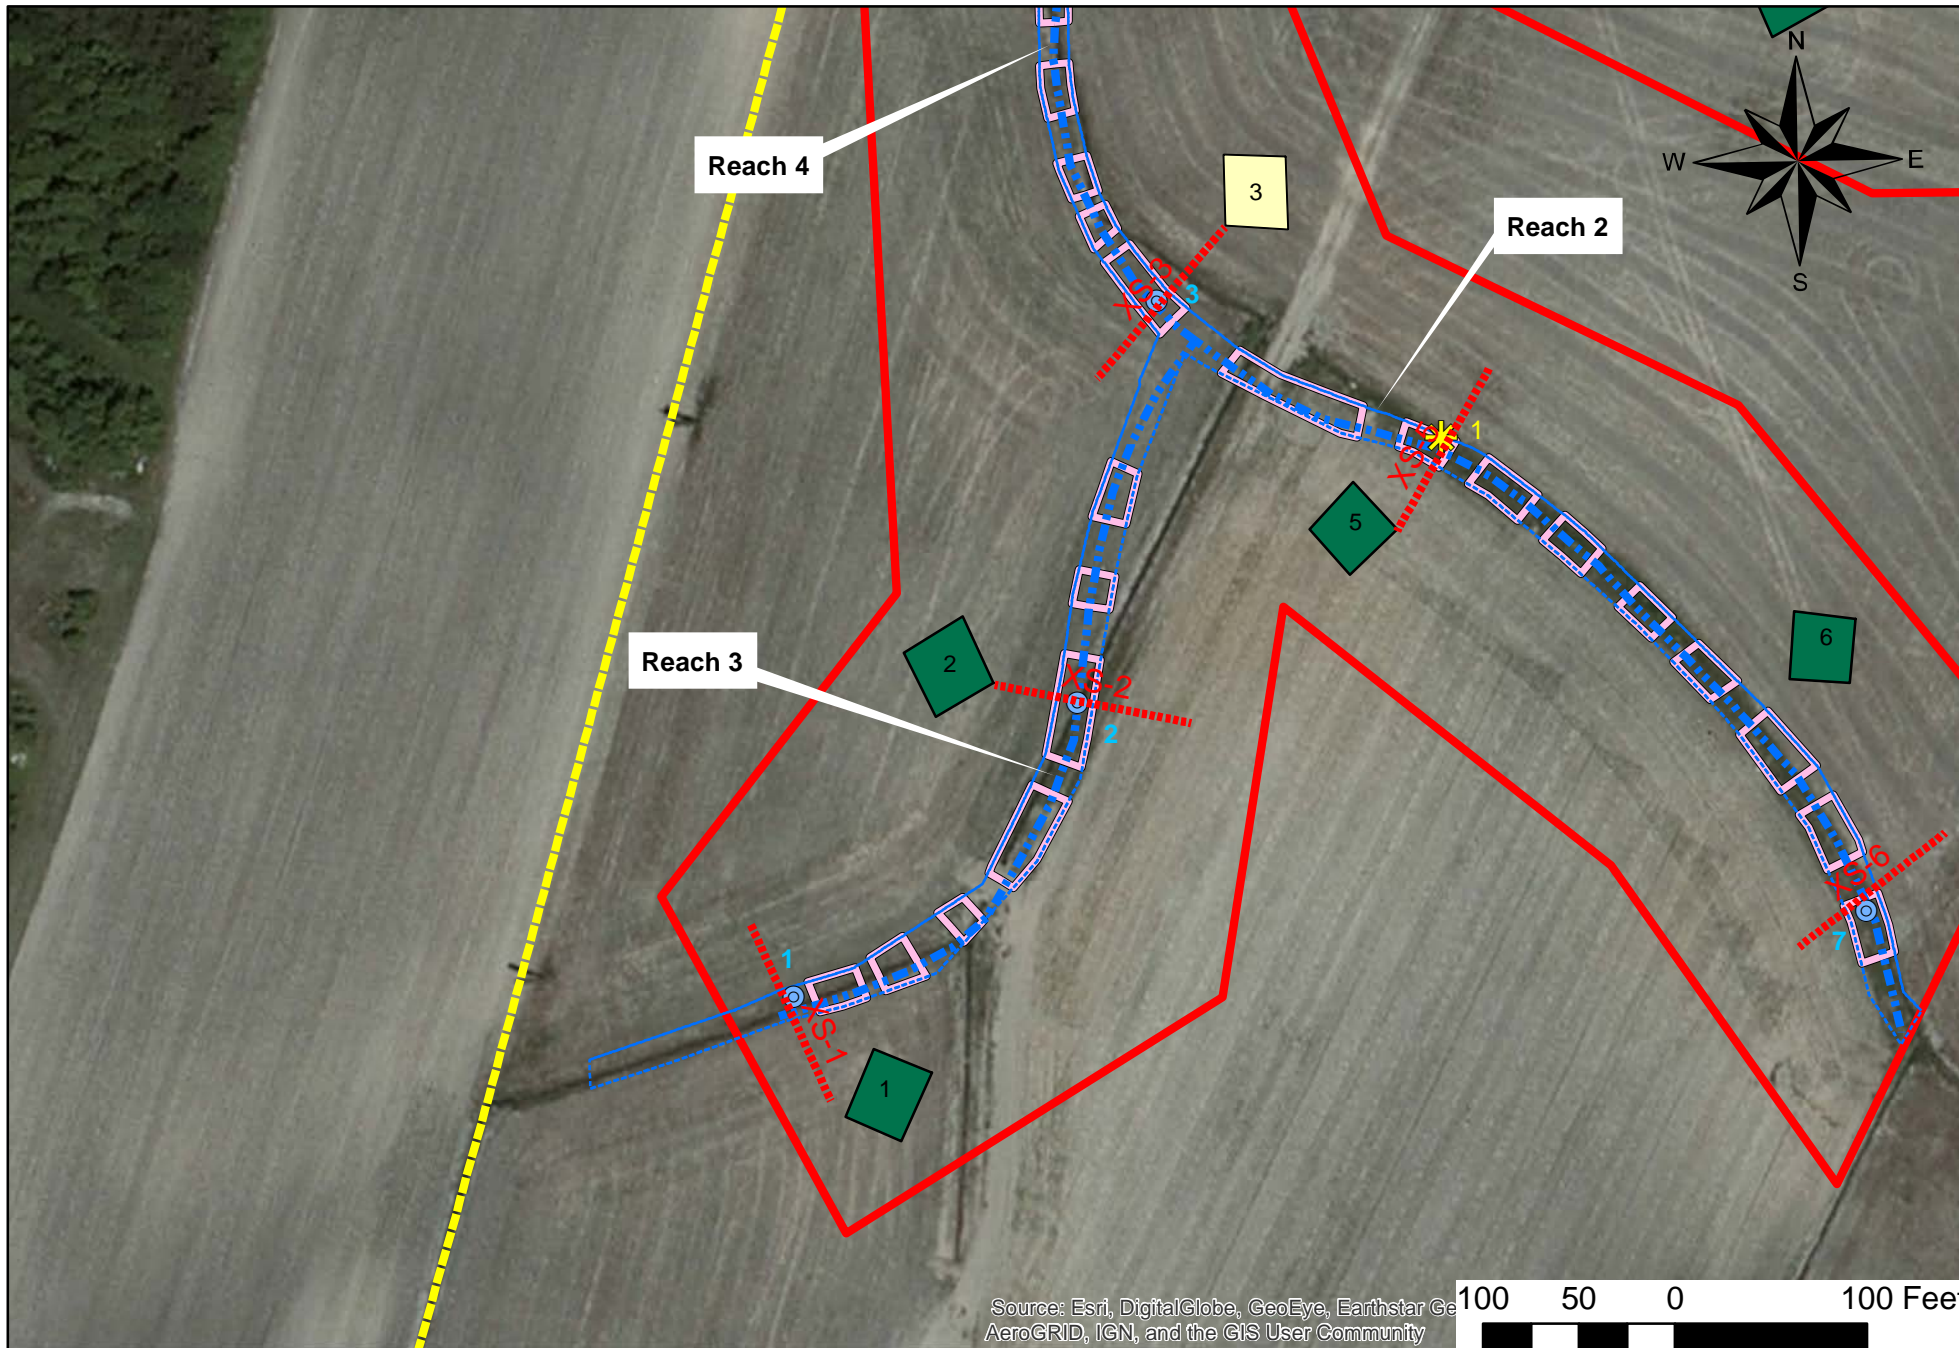

Albemarle Restorations, LLC

Wetland Restoration
Stream Restoration
Wildlife Habitat

Hudson Stream Restoration Project Current Condition Plan View

Project # 95361
Jan. 11, 2017

- | | | | |
|----------------------|-----------------------|---------------------------|----------------------|
| Cross Sections | --- Stream Centerline | | |
| ⊙ Flow Station | --- Woody Riffles | | |
| ★ Bank Pin Array | --- Easement Boundary | | |
| --- Top of Bank | | Veg Plot Condition | Stream Gauges |
| --- Access Road | | ■ Criteria Met | ⊙ Hydrology Met |
| | | ■ Criteria Unmet | |

Table 5		Visual Stream Morphology Stability Assessment									
Reach ID		Reach 1									
Assessed Length		766									
Major Channel Category	Channel Sub-Category	Metric	Number Stable, Performing as Intended	Total Number in As-built	Number of Unstable Segments	Amount of Unstable Footage	% Stable, Performing as Intended	Number with Stabilizing Woody Vegetation	Footage with Stabilizing Woody Vegetation	Adjusted % for Stabilizing Woody Vegetation	
1. Bed	1. Vertical Stability (Riffle and Run units)	1. <u>Aggradation</u> - Bar formation/growth sufficient to significantly deflect flow laterally (not to include point bars)			0	0	100%				
		2. <u>Degradation</u> - Evidence of downcutting			0	0	100%				
	2. Riffle Condition	1. <u>Texture/Substrate</u> - Riffle maintains coarser substrate	13	13			100%				
		3. Meander Pool Condition	1. <u>Depth</u> Sufficient (Max Pool Depth : Mean Bankfull Depth \geq 1.6)	5	5						100%
		2. <u>Length</u> appropriate (>30% of centerline distance between tail of upstream riffle and head of downstream riffle)	5	5			100%				
	4. Thalweg Position	1. Thalweg centering at upstream of meander bend (Run)	NA*	NA*			NA*				
2. Thalweg centering at downstream of meander (Glide)		NA*	NA*			NA*					
Totals											
2. Bank	1. Scoured/Eroding	Bank lacking vegetative cover resulting simply from poor growth and/or scour and erosion			0	0	100%	0	0	100%	
	2. Undercut	Banks undercut/overhanging to the extent that mass wasting appears likely. Does NOT include undercuts that are modest, appear sustainable and are providing habitat.			0	0	100%	0	0	100%	
	3. Mass Wasting	Bank slumping, calving, or collapse			0	0	100%	0	0	100%	
Totals											
3. Engineered Structures	1. Overall Integrity	Structures physically intact with no dislodged boulders or logs.	8	8			100%				
	2. Grade Control	Grade control structures exhibiting maintenance of grade across the sill.	8	8			100%				
	2a. Piping	Structures lacking any substantial flow underneath sills or arms.	8	8			100%				
	3. Bank Protection	Bank erosion within the structures extent of influence does <u>not</u> exceed 15%. (See guidance for this table in EEP monitoring guidance document)	8	8			100%				
	4. Habitat	Pool forming structures maintaining ~ Max Pool Depth : Mean Bankfull Depth ratio \geq 1.6 Rootwads/logs providing some cover at base-flow.	8	8			100%				

* Stream's narrow width, layout, and heavily vegetated banks make this attribute not applicable.

Table 5		Visual Stream Morphology Stability Assessment									
Reach ID		Reach 2									
Assessed Length		516									
Major Channel Category	Channel Sub-Category	Metric	Number Stable, Performing as Intended	Total Number in As-built	Number of Unstable Segments	Amount of Unstable Footage	% Stable, Performing as Intended	Number with Stabilizing Woody Vegetation	Footage with Stabilizing Woody Vegetation	Adjusted % for Stabilizing Woody Vegetation	
1. Bed	1. Vertical Stability (Riffle and Run units)	1. <u>Aggradation</u> - Bar formation/growth sufficient to significantly deflect flow laterally (not to include point bars)			0	0	100%				
		2. <u>Degradation</u> - Evidence of downcutting			0	0	100%				
	2. Riffle Condition	1. <u>Texture/Substrate</u> - Riffle maintains coarser substrate	9	9			100%				
		3. Meander Pool Condition	1. <u>Depth</u> Sufficient (Max Pool Depth : Mean Bankfull Depth \geq 1.6)	3	3						100%
			2. <u>Length</u> appropriate (>30% of centerline distance between tail of upstream riffle and head of downstream riffle)	3	3						100%
	4. Thalweg Position	1. Thalweg centering at upstream of meander bend (Run)	NA*	NA*			NA*				
2. Thalweg centering at downstream of meander (Glide)		NA*	NA*			NA*					
Totals					0	0	100%	0	0	100%	
2. Bank	1. Scoured/Eroding	Bank lacking vegetative cover resulting simply from poor growth and/or scour and erosion			0	0	100%	0	0	100%	
	2. Undercut	Banks undercut/overhanging to the extent that mass wasting appears likely. Does NOT include undercuts that are modest, appear sustainable and are providing habitat.			0	0	100%	0	0	100%	
	3. Mass Wasting	Bank slumping, calving, or collapse			0	0	100%	0	0	100%	
3. Engineered Structures	1. Overall Integrity	Structures physically intact with no dislodged boulders or logs.	0	0			NA				
	2. Grade Control	Grade control structures exhibiting maintenance of grade across the sill.	0	0			NA				
	2a. Piping	Structures lacking any substantial flow underneath sills or arms.	0	0			NA				
	3. Bank Protection	Bank erosion within the structures extent of influence does <u>not</u> exceed 15%. (See guidance for this table in EEP monitoring guidance document)	0	0			NA				
	4. Habitat	Pool forming structures maintaining ~ Max Pool Depth : Mean Bankfull Depth ratio \geq 1.6 Rootwads/logs providing some cover at base-flow.	0	0			NA				

* Stream's narrow width, layout, and heavily vegetated banks make this attribute not applicable.

Table 5		Visual Stream Morphology Stability Assessment								
Reach ID		Reach 3								
Assessed Length		611								
Major Channel Category	Channel Sub-Category	Metric	Number Stable, Performing as Intended	Total Number in As-built	Number of Unstable Segments	Amount of Unstable Footage	% Stable, Performing as Intended	Number with Stabilizing Woody Vegetation	Footage with Stabilizing Woody Vegetation	Adjusted % for Stabilizing Woody Vegetation
1. Bed	1. Vertical Stability (Rifle and Run units)	1. <u>Aggradation</u> - Bar formation/growth sufficient to significantly deflect flow laterally (not to include point bars)			0	0	100%			
		2. <u>Degradation</u> - Evidence of downcutting			0	0	100%			
	2. Rifle Condition	1. <u>Texture/Substrate</u> - Rifle maintains coarser substrate	7	7			100%			
		3. Meander Pool Condition	1. <u>Depth</u> Sufficient (Max Pool Depth : Mean Bankfull Depth \geq 1.6)	3	3					
		2. <u>Length</u> appropriate (>30% of centerline distance between tail of upstream riffle and head of downstream riffle)	3	3			100%			
	4. Thalweg Position	1. Thalweg centering at upstream of meander bend (Run)	NA*	NA*			NA*			
2. Thalweg centering at downstream of meander (Glide)		NA*	NA*			NA*				
Totals										
2. Bank	1. Scoured/Eroding	Bank lacking vegetative cover resulting simply from poor growth and/or scour and erosion			0	0	100%	0	0	100%
	2. Undercut	Banks undercut/overhanging to the extent that mass wasting appears likely. Does NOT include undercuts that are modest, appear sustainable and are providing habitat.			0	0	100%	0	0	100%
	3. Mass Wasting	Bank slumping, calving, or collapse			0	0	100%	0	0	100%
Totals										
3. Engineered Structures	1. Overall Integrity	Structures physically intact with no dislodged boulders or logs.	0	0			NA			
	2. Grade Control	Grade control structures exhibiting maintenance of grade across the sill.	0	0			NA			
	2a. Piping	Structures lacking any substantial flow underneath sills or arms.	0	0			NA			
	3. Bank Protection	Bank erosion within the structures extent of influence does <u>not</u> exceed 15%. (See guidance for this table in EEP monitoring guidance document)	0	0			NA			
	4. Habitat	Pool forming structures maintaining ~ Max Pool Depth : Mean Bankfull Depth ratio \geq 1.6 Rootwads/logs providing some cover at base-flow.	0	0			NA			

* Stream's narrow width, layout, and heavily vegetated banks make this attribute not applicable.

Table 5		Visual Stream Morphology Stability Assessment									
Reach ID		Reach 4									
Assessed Length		503									
Major Channel Category	Channel Sub-Category	Metric	Number Stable, Performing as Intended	Total Number in As-built	Number of Unstable Segments	Amount of Unstable Footage	% Stable, Performing as Intended	Number with Stabilizing Woody Vegetation	Footage with Stabilizing Woody Vegetation	Adjusted % for Stabilizing Woody Vegetation	
1. Bed	1. Vertical Stability (Riffle and Run units)	1. <u>Aggradation</u> - Bar formation/growth sufficient to significantly deflect flow laterally (not to include point bars)			0	0	100%				
		2. <u>Degradation</u> - Evidence of downcutting			0	0	100%				
	2. Riffle Condition	1. <u>Texture/Substrate</u> - Riffle maintains coarser substrate	8	8			NA				
		3. Meander Pool Condition	1. <u>Depth</u> Sufficient (Max Pool Depth : Mean Bankfull Depth \geq 1.6)	3	3						NA
			2. <u>Length</u> appropriate (>30% of centerline distance between tail of upstream riffle and head of downstream riffle)	3	3						NA
	4. Thalweg Position	1. Thalweg centering at upstream of meander bend (Run)	NA*	NA*			NA				
2. Thalweg centering at downstream of meander (Glide)		NA*	NA*			NA					
Totals					0	0	100%	0	0	100%	
2. Bank	1. Scoured/Eroding	Bank lacking vegetative cover resulting simply from poor growth and/or scour and erosion			0	0	100%	0	0	100%	
	2. Undercut	Banks undercut/overhanging to the extent that mass wasting appears likely. Does <u>NOT</u> include undercuts that are modest, appear sustainable and are providing habitat.			0	0	100%	0	0	100%	
	3. Mass Wasting	Bank slumping, calving, or collapse			0	0	100%	0	0	100%	
3. Engineered Structures	1. Overall Integrity	Structures physically intact with no dislodged boulders or logs.	3	3			NA				
	2. Grade Control	Grade control structures exhibiting maintenance of grade across the sill.	3	3			NA				
	2a. Piping	Structures lacking any substantial flow underneath sills or arms.	3	3			NA				
	3. Bank Protection	Bank erosion within the structures extent of influence does <u>not</u> exceed 15%. (See guidance for this table in EEP monitoring guidance document)	3	3			NA				
	4. Habitat	Pool forming structures maintaining ~ Max Pool Depth : Mean Bankfull Depth ratio \geq 1.6 Rootwads/logs providing some cover at base-flow.	3	3			NA				

* Stream's narrow width, layout, and heavily vegetated banks make this attribute not applicable.

Table 6		Vegetation Condition Assessment								
Planted Acreage		12.42								
Vegetation Category	Definitions	Mapping Threshold	CCPV Depiction	Number of Polygons	Combined Acreage	% of Planted Acreage				
1. Bare Areas	Very limited cover of both woody and herbaceous material.	0.1 acres	Pattern and Color	0	0	0.0%				
2. Low Stem Density Areas	Woody stem densities clearly below target levels based on MY 3, 4 or 5 stem count criteria	0.1 acres	Pattern and Color	0	0	0.0%				
				Total:	0	0	0.0%			
3. Areas of Poor Growth Rates or Vigor	Areas with woody stems of a size class that are obviously small given the monitoring year	0.25 acres	Pattern and Color	0	0	0.0%				
				Cumulative Total:	0	0	0.0%			
Easement Acreage		13.5								
Vegetation Category	Definitions	Mapping Threshold	CCPV Depiction	Number of Polygons	Combined Acreage	% of Planted Acreage				
4. Invasive Areas of Concern	Areas or points (if too small to render as polygons at map scale)	1000 sf	Pattern and Color	0	0	0.0%				
5. Easement Encroachment Areas	Areas or points (if too small to render as polygons at map scale)	none	Pattern and Color	0	0	0.0%				

No areas of concern are noted with the exception of plots 3 and 10. Plot 3 had seven planted stems (283 stems per acre) and plot 10 had five planted stems (202 stems per acre) at the end of the first growing season. Due to thick herbaceous vegetation stems may be found during next survey in 2017. According to definition above, the plots are not yet considered a problem area.



Photo 1: Highly vegetated restoration area along Reach 4 - View North



Photo 2: View Upstream on Reach 5



Photo 3: Bank Pin Array 2 – minimal exposure



Photo 4: Debris deposited above bankfull - Reach 5



Photo 5: Wrack lines above bankfull – Reach 1



Photos 6: Veg Plot 6 and floodprone area – Reach 2

APPENDIX C: VEGETATION PLOT DATA

Table 7: Vegetation Plot Counts and Densities

Table 7: Vegetation Plot Counts and Densities

EEP Project Code 0004638. Project Name: Hudson			Current Plot Data (MY1 2016)														
Scientific Name	Common Name	Species Type	0004638-01-0001			0004638-01-0002			0004638-01-0003			0004638-01-0004			0004638-01-0005		
			PnoLS	P-all	T	PnoLS	P-all	T	PnoLS	P-all	T	PnoLS	P-all	T	PnoLS	P-all	T
Liriodendron tulipifera	tuliptree	Tree	3	3	3				1	1	1	1	1	1	1	1	1
Platanus occidentalis	American sycamore	Tree	3	3	3	4	4	4	4	4	4	3	3	3	2	2	2
Quercus alba	white oak	Tree	1	1	1	3	3	3				2	2	2			
Quercus bicolor	swamp white oak	Tree	3	3	3	2	2	2							1	1	1
Quercus michauxii	swamp chestnut oak	Tree															
Quercus nigra	water oak	Tree	1	1	1										2	2	2
Quercus phellos	willow oak	Tree	2	2	2	1	1	1	2	2	2	4	4	4	4	4	4
Stem count			13	13	13	10	10	10	7	7	7	10	10	10	10	10	10
size (ares)			1			1			1			1			1		
size (ACRES)			0.02			0.02			0.02			0.02			0.02		
Species count			6	6	6	4	4	4	3	3	3	4	4	4	5	5	5
Stems per ACRE			526	526	526	405	405	405	283	283	283	405	405	405	405	405	405
EEP Project Code 0004638. Project Name: Hudson			Current Plot Data (MY1 2016)														
Scientific Name	Common Name	Species Type	0004638-01-0006			0004638-01-0007			0004638-01-0008			0004638-01-0009			0004638-01-0010		
			PnoLS	P-all	T	PnoLS	P-all	T	PnoLS	P-all	T	PnoLS	P-all	T	PnoLS	P-all	T
Liriodendron tulipifera	tuliptree	Tree	1	1	1										4	4	4
Platanus occidentalis	American sycamore	Tree	2	2	2	6	6	6	5	5	5	2	2	2			
Quercus alba	white oak	Tree															
Quercus bicolor	swamp white oak	Tree				4	4	4				1	1	1			
Quercus michauxii	swamp chestnut oak	Tree							1	1	1						
Quercus nigra	water oak	Tree										4	4	4			
Quercus phellos	willow oak	Tree	4	4	5	1	1	1	2	2	2	2	2	2	1	1	1
Stem count			7	7	8	11	11	11	8	8	8	9	9	9	5	5	5
size (ares)			1			1			1			1			1		
size (ACRES)			0.02			0.02			0.02			0.02			0.02		
Species count			3	3	3	3	3	3	3	3	3	4	4	4	2	2	2
Stems per ACRE			283	283	324	445	445	445	324	324	324	364	364	364	202	202	202

Table 7: Vegetation Plot Counts and Densities (Continued)

EEP Project Code 0004638. Project Name: Hudson			Current Plot Data (MY1 2016)									Annual Means					
Scientific Name	Common Name	Species Type	0004638-01-0011			0004638-01-0012			0004638-01-0013			MY0 (2016)			MY1 (2016)		
			PnoLS	P-all	T	PnoLS	P-all	T	PnoLS	P-all	T	PnoLS	P-all	T	PnoLS	P-all	T
<i>Liriodendron tulipifera</i>	tuliptree	Tree				1	1	1				31	31	31	12	12	12
<i>Platanus occidentalis</i>	American sycamore	Tree	8	8	11	1	1	1	4	4	4	54	54	54	44	44	47
<i>Quercus alba</i>	white oak	Tree				1	1	1	5	5	5	16	16	16	12	12	12
<i>Quercus bicolor</i>	swamp white oak	Tree	2	2	2	6	6	6				19	19	19	19	19	19
<i>Quercus michauxii</i>	swamp chestnut oak	Tree	1	1	1	2	2	2	4	4	4	13	13	13	8	8	8
<i>Quercus nigra</i>	water oak	Tree	3	3	3	1	1	1				18	18	18	11	11	11
<i>Quercus phellos</i>	willow oak	Tree				1	1	1				33	33	33	24	24	25
Stem count			14	14	17	13	13	13	13	13	13	184	184	184	130	130	134
size (ares)			1			1			1			13			13		
size (ACRES)			0.02			0.02			0.02			0.32			0.32		
Species count			4	4	4	7	7	7	3	3	3	7	7	7	7	7	7
Stems per ACRE			567	567	688	526	526	526	526	526	526	573	573	573	405	405	417

Color for Density
Exceeds requirements by 10%
Exceeds requirements, but by less than 10%
Fails to meet requirements, by less than 10%
Fails to meet requirements by more than 10%

APPENDIX D: STREAM MEASUREMENT AND GEOMORPHOLOGY DATA

Cross Sections with Annual Overlays (XS 1-11)

Table 8: Bank Pin Data


Table 10a. Baseline Stream Data Summary (Reach 1-4)

Table 11a. Monitoring Data – Dimensional Morphology Summary

Table 11b. Monitoring Data – Stream Reach Data Summary (Reach 1-4)

Monitoring XS 1 (Pool) - REACH 3 STA 0+09

STATION	ELEVATION
0+00	42.91
0+25	40.19
0+40	38.14
0+46.5	37.53
0+48	37.52
0+50	37.34
0+52	37.05
0+54	37.34
0+60	37.85
0+75	38.89
1+00	40.68

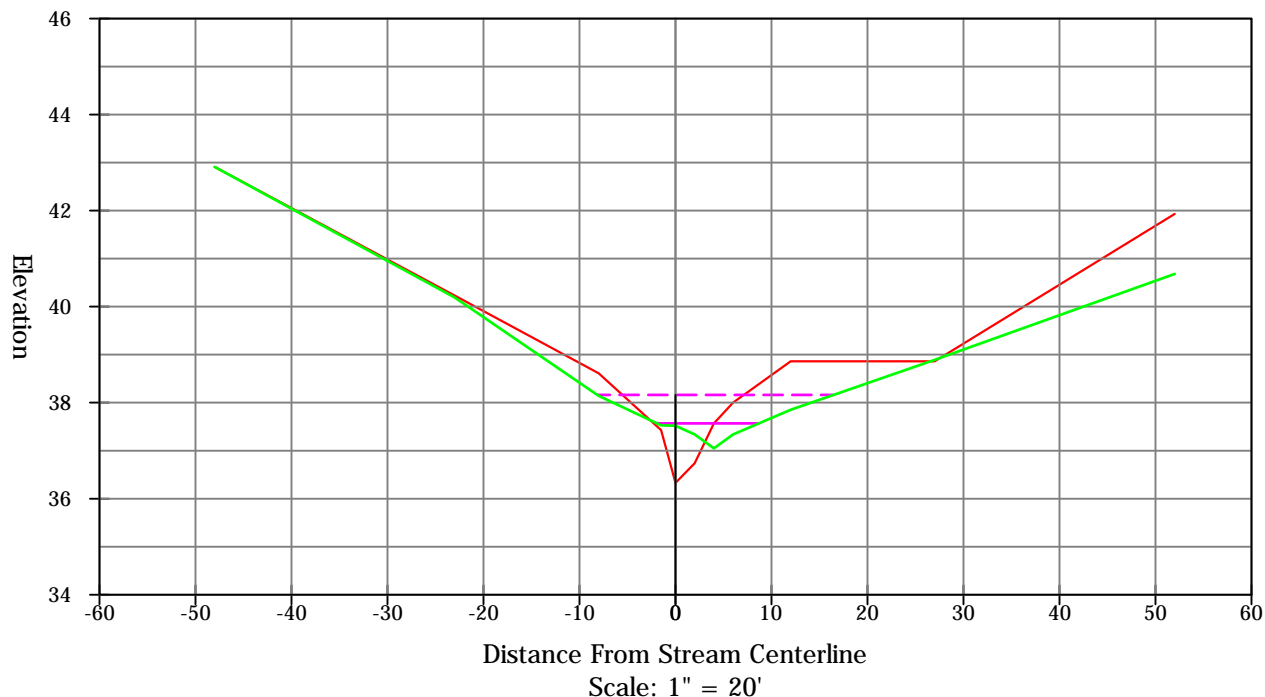

STREAM TYPE: C5/6 Vertical Exaggeration: 5x

LEGEND

- AS-BUILT GRADE
- YEAR 1 MONITORING GRADE
- BANKFULL ELEVATION
- - - FLOODPRONE ELEVATION

SUMMARY DATA (FT)	
BANKFULL ELEVATION:	37.57
BANKFULL CROSS SECTIONAL AREA:	2.17
BANKFULL WIDTH:	10.63
FLOOD PRONE AREA ELEVATION:	38.16
FLOOD PRONE WIDTH:	24.55
MAX DEPTH AT BANKFULL:	0.52
MEAN DEPTH AT BANKFULL:	0.20
W/D RATIO:	NA
ENTRENCHMENT RATIO:	NA
BANK HEIGHT RATIO:	1



HUDSON STREAM RESTORATION PROJECT


YEAR 1 MONITORING XS 1
PROJECT # 95361
BEAUFORT COUNTY, NORTH CAROLINA

SHEET:

1 of 11

STATION	ELEVATION
0+00	40
0+25	37.65
0+39	36.72
0+42	36.24
0+44	35.96
0+44.5	35.94
0+46	35.67
0+48	35.44
0+50	35.69
0+52	35.72
0+55	36.35
0+59	37.76
0+75	38.09
1+00	40.04

Monitoring XS 2 (Riffle) - REACH 3 STA 2+41

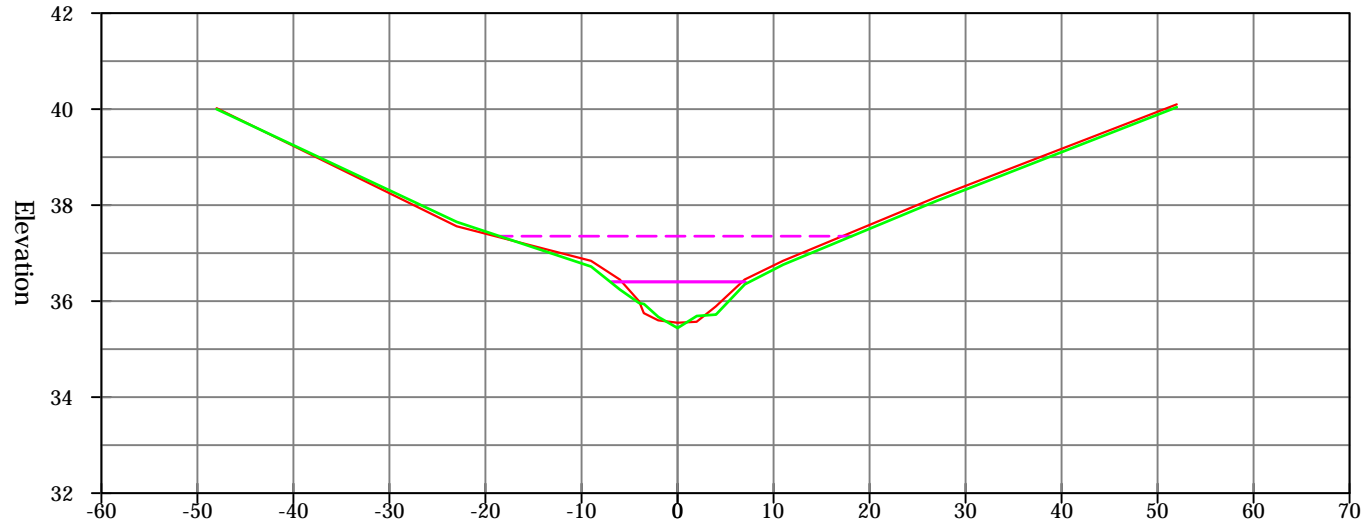

Distance From Stream Centerline

Scale: 1" = 20'

Vertical Exaggeration: 5x

LEGEND

- AS-BUILT GRADE
- YEAR 1 MONITORING GRADE
- BANKFULL ELEVATION
- - - FLOODPRONE ELEVATION

STREAM TYPE	C5/6
-------------	------

SUMMARY DATA (FT)	
BANKFULL ELEVATION:	36.40
BANKFULL CROSS SECTIONAL AREA:	16.24
BANKFULL WIDTH:	14.44
FLOOD PRONE AREA ELEVATION:	37.35
FLOOD PRONE WIDTH:	36.68
MAX DEPTH AT BANKFULL:	0.96
MEAN DEPTH AT BANKFULL:	0.48
W/D RATIO:	69.34
ENTRENCHMENT RATIO:	2.53
BANK HEIGHT RATIO:	1



HUDSON STREAM RESTORATION PROJECT

YEAR 1 MONITORING XS 2

PROJECT # 95361

BEAUFORT COUNTY, NORTH CAROLINA




SHEET:

2 of 11

STATION	ELEVATION
0+00	37.28
0+20	35.96
0+44	34.61
0+46	34.45
0+47	34.25
0+48	34.26
0+50	32.88
0+52	34.27
0+54	34.55
0+70	35.75
1+00	38.01

Monitoring XS 3 (Riffle) - REACH 4 STA 0+24

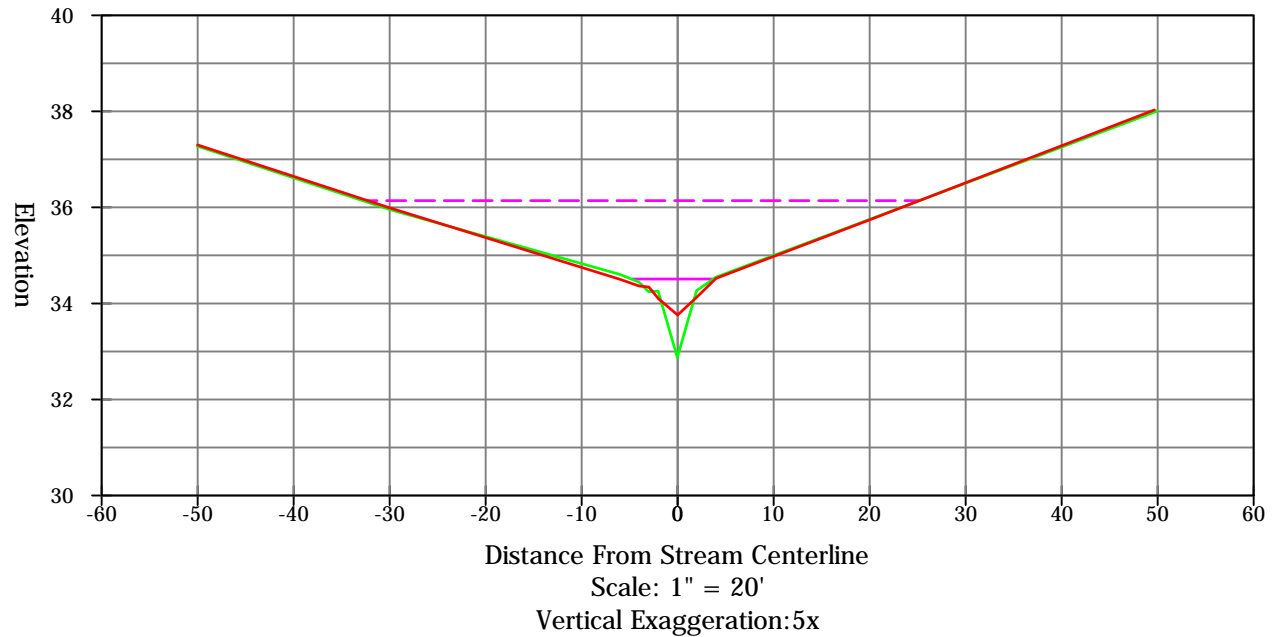

LEGEND

- AS-BUILT GRADE
- YEAR 1 MONITORING GRADE
- BANKFULL ELEVATION
- - - FLOODPRONE ELEVATION

STREAM TYPE	C5/6
-------------	------

SUMMARY DATA (FT)	
BANKFULL ELEVATION:	34.50
BANKFULL CROSS SECTIONAL AREA:	4.31
BANKFULL WIDTH:	8.27
FLOOD PRONE AREA ELEVATION:	36.14
FLOOD PRONE WIDTH:	57.96
MAX DEPTH AT BANKFULL:	1.62
MEAN DEPTH AT BANKFULL:	0.52
W/D RATIO:	15.86
ENTRENCHMENT RATIO:	7.01
BANK HEIGHT RATIO:	1



HUDSON STREAM RESTORATION PROJECT


YEAR 1 MONITORING XS 3
PROJECT # 95361
BEAUFORT COUNTY, NORTH CAROLINA

SHEET:

3 of 11

STATION	ELEVATION
0+00	35.73
0+20	34.16
0+25	34.67
0+27	34.67
0+29	33.64
0+30	33.23
0+32	33.25
0+33	32.92
0+35	33.42
0+37	33.74
0+40	33.85
0+60	34.81
0+84	36.83

Monitoring XS 4 (Pool) - REACH 4 STA 2+69

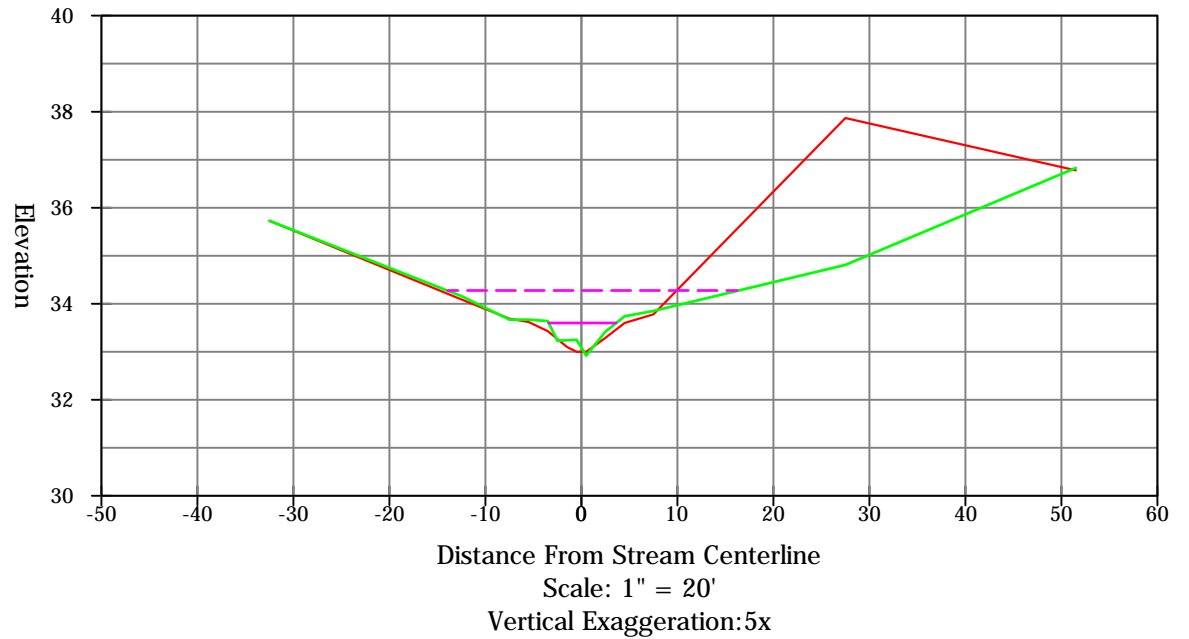

LEGEND

- AS-BUILT GRADE
- YEAR 1 MONITORING GRADE
- BANKFULL ELEVATION
- - - FLOODPRONE ELEVATION

STREAM TYPE	C5/6
-------------	------

SUMMARY DATA (FT)	
BANKFULL ELEVATION:	33.60
BANKFULL CROSS SECTIONAL AREA:	2.36
BANKFULL WIDTH:	7.03
FLOOD PRONE AREA ELEVATION:	34.28
FLOOD PRONE WIDTH:	30.15
MAX DEPTH AT BANKFULL:	0.68
MEAN DEPTH AT BANKFULL:	0.34
W/D RATIO:	NA
ENTRENCHMENT RATIO:	NA
BANK HEIGHT RATIO:	1



HUDSON STREAM RESTORATION PROJECT


YEAR 1 MONITORING XS 4
PROJECT # 95361
BEAUFORT COUNTY, NORTH CAROLINA

SHEET:

4 of 11

STATION	ELEVATION
0+00	38.98
0+25	37.66
0+50	35.42
0+53	34.91
0+55	34.77
0+57	35.45
0+70	36.44
0+75	36.82
1+00	38.85

Monitoring XS 5 (Pool) - REACH 2 STA 3+95

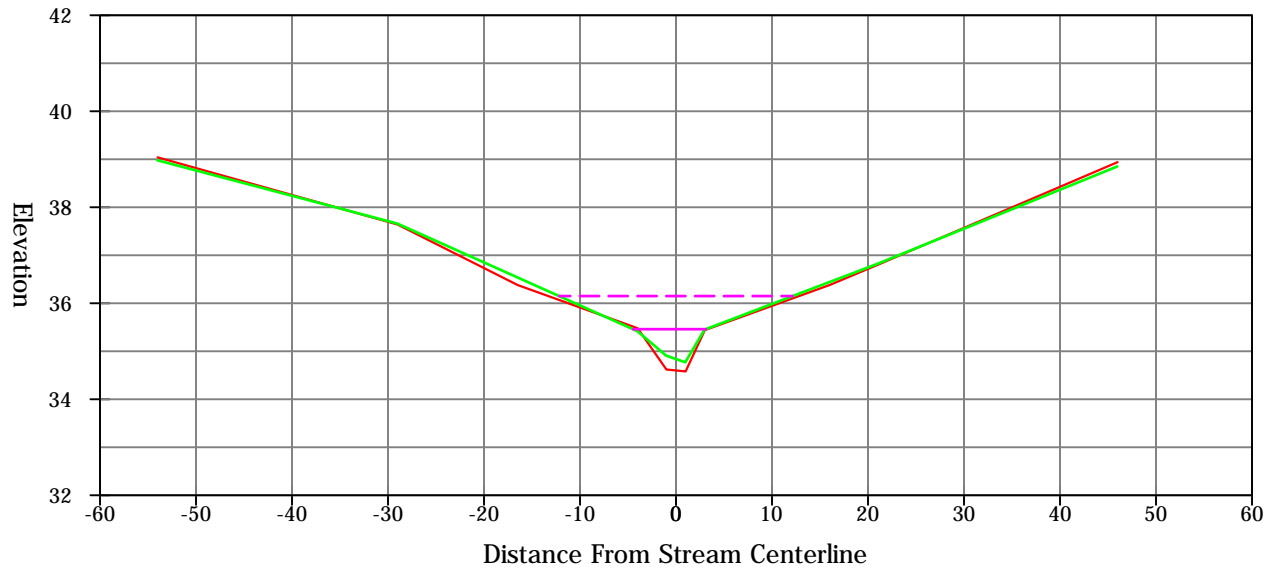

Distance From Stream Centerline

Scale: 1" = 20'

Vertical Exaggeration: 5x

LEGEND

- AS-BUILT GRADE
- YEAR 1 MONITORING GRADE
- BANKFULL ELEVATION
- - - FLOODPRONE ELEVATION

STREAM TYPE	C5/6
-------------	------

SUMMARY DATA (FT)	
BANKFULL ELEVATION:	35.46
BANKFULL CROSS SECTIONAL AREA:	2.83
BANKFULL WIDTH:	7.58
FLOOD PRONE AREA ELEVATION:	36.15
FLOOD PRONE WIDTH:	24.33
MAX DEPTH AT BANKFULL:	0.69
MEAN DEPTH AT BANKFULL:	0.37
W/D RATIO:	NA
ENTRENCHMENT RATIO:	NA
BANK HEIGHT RATIO:	1



HUDSON STREAM RESTORATION PROJECT

YEAR 1 MONITORING XS 5

PROJECT # 95361

BEAUFORT COUNTY, NORTH CAROLINA




SHEET:

5 of 11

STATION	ELEVATION
0+00	40.88
0+25	38.67
0+46	36.75
0+47	36.92
0+48	36.57
0+50	36.7
0+52	36.65
0+54	36.7
0+56	36.67
0+58	36.63
0+75	37.8
1+00	40.15

Monitoring XS 6 (Riffle) - REACH 2 STA 0+68

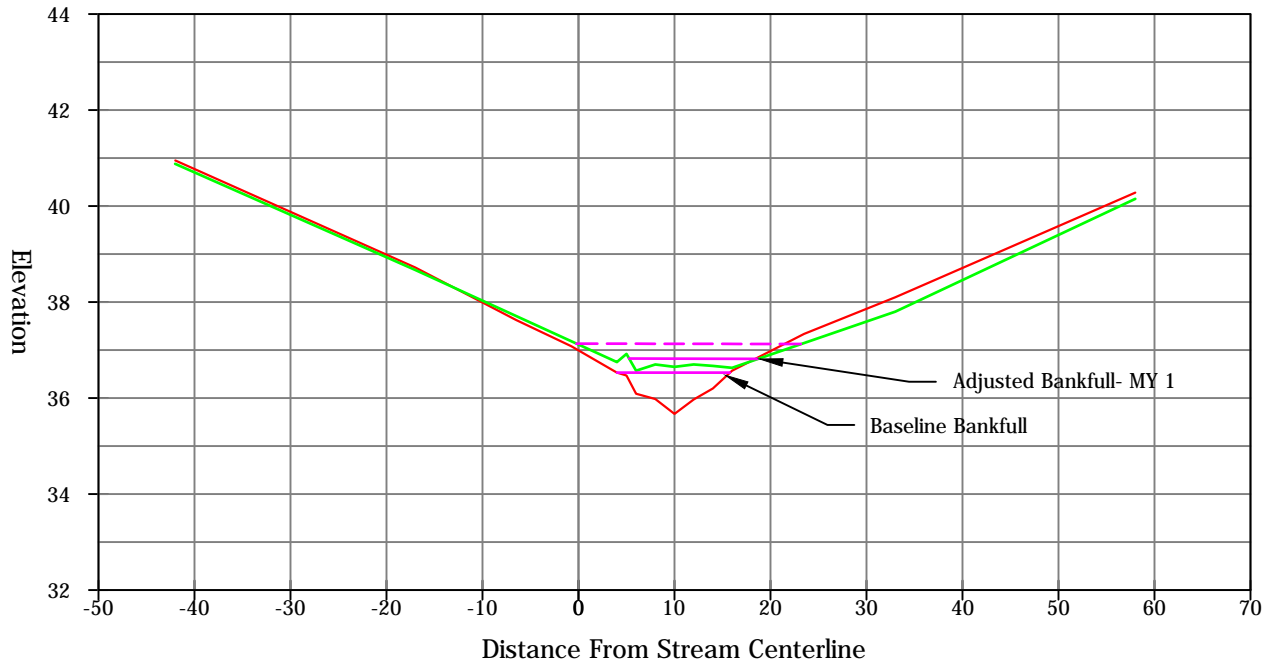

STREAM TYPE	C5/6
-------------	------

Scale: 1" = 20'
Vertical Exaggeration: 5x

LEGEND

- AS-BUILT GRADE
- YEAR 1 MONITORING GRADE
- BANKFULL ELEVATION
- - - FLOODPRONE ELEVATION

SUMMARY DATA (FT)	
BANKFULL ELEVATION:	36.78
BANKFULL CROSS SECTIONAL AREA:	1.39
BANKFULL WIDTH:	12.51
FLOOD PRONE AREA ELEVATION:	37.13
FLOOD PRONE WIDTH:	25.00
MAX DEPTH AT BANKFULL:	0.21
MEAN DEPTH AT BANKFULL:	0.11
W/D RATIO:	112.26
ENTRENCHMENT RATIO:	2.00
BANK HEIGHT RATIO:	1



HUDSON STREAM RESTORATION PROJECT

YEAR 1 MONITORING XS 6
PROJECT # 95361
BEAUFORT COUNTY, NORTH CAROLINA



2120 High Point Road • Forest Hill, Maryland 21050
(410) 420 2600 • Fax (410) 420 6983 • www.ecotoneinc.com

SHEET:

6 of 11

PROJECT NO: 1269


DATE: 11/7/2016

DRAWN BY: CSM

CHECKED BY: MVB

STATION	ELEVATION
0+00	38.31
0+25	37.32
0+28	37.17
0+42	36.75
0+44	36.7
0+45	36.53
0+46	36.38
0+48	35.87
0+50	36.12
0+52	36.66
0+70	36.68
0+97	37.13
1+00	37.27

Monitoring XS 7 (Pool) - REACH 1 STA 6+47

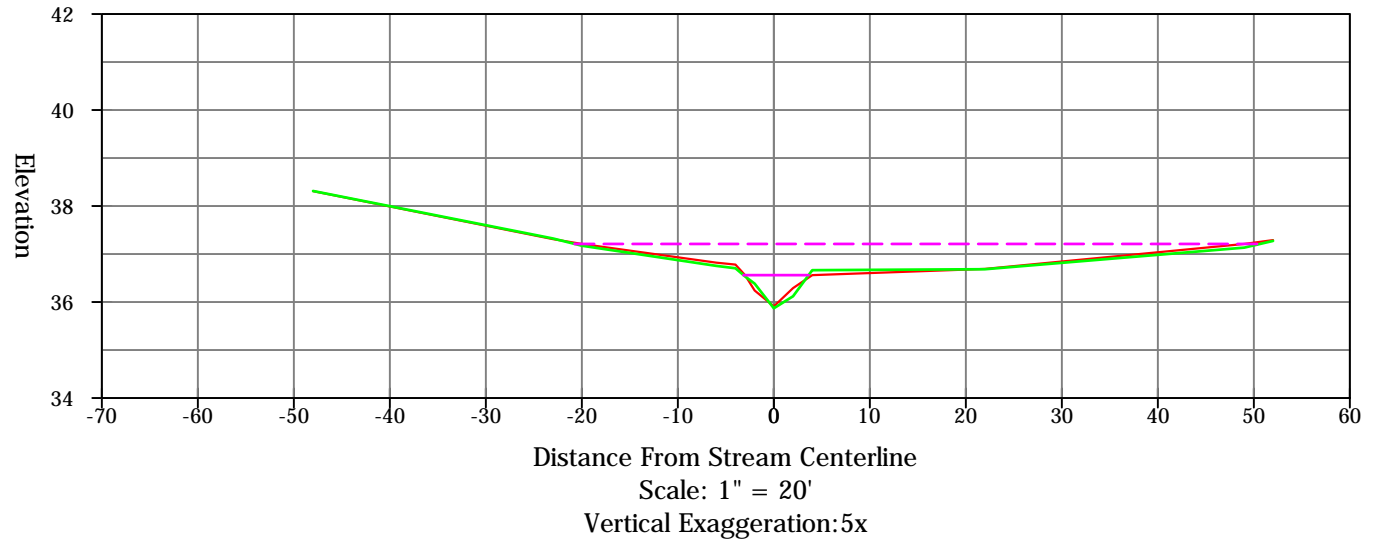

LEGEND

- AS-BUILT GRADE
- YEAR 1 MONITORING GRADE
- BANKFULL ELEVATION
- - - FLOODPRONE ELEVATION

STREAM TYPE	C5/6
-------------	------

SUMMARY DATA (FT)	
BANKFULL ELEVATION:	36.56
BANKFULL CROSS SECTIONAL AREA:	2.47
BANKFULL WIDTH:	6.81
FLOOD PRONE AREA ELEVATION:	37.21
FLOOD PRONE WIDTH:	71.00
MAX DEPTH AT BANKFULL:	0.69
MEAN DEPTH AT BANKFULL:	0.36
W/D RATIO:	NA
ENTRENCHMENT RATIO:	NA
BANK HEIGHT RATIO:	1



HUDSON STREAM RESTORATION PROJECT

YEAR 1 MONITORING XS 7

PROJECT # 95361

BEAUFORT COUNTY, NORTH CAROLINA

SHEET:

7 of 11



2120 High Point Road • Forest Hill, Maryland 21050
(410) 420 2600 • Fax (410) 420 6983 • www.ecotoneinc.com

PROJECT NO: 1269


DATE: 11/7/2016

DRAWN BY: CSM

CHECKED BY: MVB

STATION	ELEVATION
0+00	38.41
0+25	38.12
0+40	38.05
0+46	37.77
0+47	37.71
0+48	37.58
0+50	37.45
0+52	37.74
0+54	37.41
0+56	37.5
0+58	37.68
0+60	37.81
0+75	38.31
1+00	38.53

Monitoring XS 8 (Riffle) - REACH 1 STA 4+43

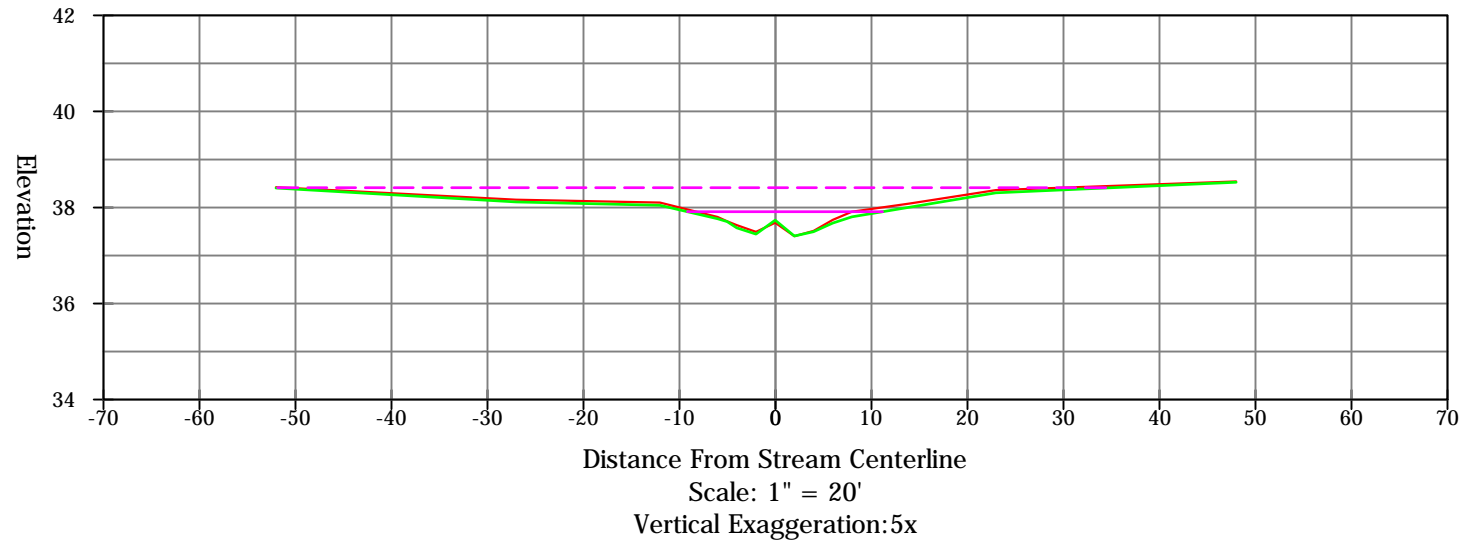

LEGEND

- AS-BUILT GRADE
- YEAR 1 MONITORING GRADE
- BANKFULL ELEVATION
- - - FLOODPRONE ELEVATION

STREAM TYPE	C5/6
-------------	------

SUMMARY DATA (FT)	
BANKFULL ELEVATION:	37.91
BANKFULL CROSS SECTIONAL AREA:	4.77
BANKFULL WIDTH:	20.00
FLOOD PRONE AREA ELEVATION:	38.41
FLOOD PRONE WIDTH:	86.26
MAX DEPTH AT BANKFULL:	0.50
MEAN DEPTH AT BANKFULL:	0.24
W/D RATIO:	83.95
ENTRENCHMENT RATIO:	4.31
BANK HEIGHT RATIO:	1



HUDSON STREAM RESTORATION PROJECT

YEAR 1 MONITORING XS 8
PROJECT # 95361
BEAUFORT COUNTY, NORTH CAROLINA

SHEET:

8 of 11



2120 High Point Road • Forest Hill, Maryland 21050
(410) 420 2600 • Fax (410) 420 6983 • www.ecotoneinc.com

PROJECT NO: 1269


DATE: 11/7/2016

DRAWN BY: CSM

CHECKED BY: MVB

STATION	ELEVATION
0+00	39.94
0+25	39.81
0+35	39.56
0+40	39.32
0+46	38.94
0+48	38.63
0+49	38.32
0+50	38.59
0+52	38.85
0+54	39.03
0+70	39.55
1+00	39.92

Monitoring XS 9 (Pool) - REACH 1 STA 2+73

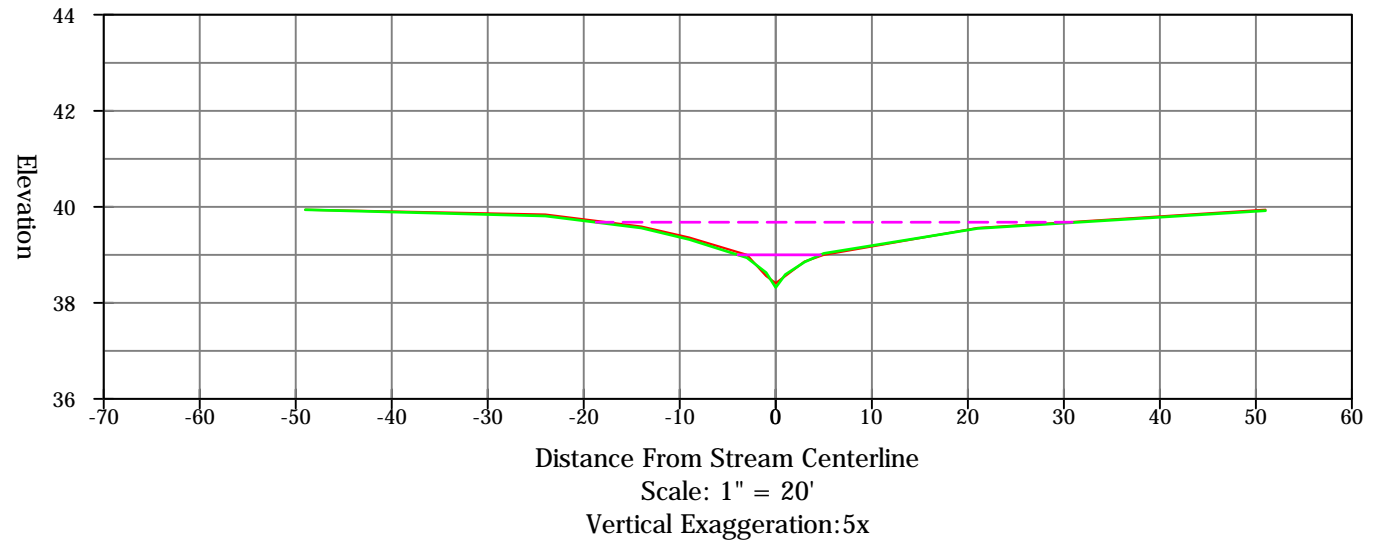

LEGEND

- AS-BUILT GRADE
- YEAR 1 MONITORING GRADE
- BANKFULL ELEVATION
- - - FLOODPRONE ELEVATION

STREAM TYPE	C5/6
-------------	------

SUMMARY DATA (FT)	
BANKFULL ELEVATION:	39.00
BANKFULL CROSS SECTIONAL AREA:	2.21
BANKFULL WIDTH:	8.61
FLOOD PRONE AREA ELEVATION:	39.68
FLOOD PRONE WIDTH:	49.57
MAX DEPTH AT BANKFULL:	0.68
MEAN DEPTH AT BANKFULL:	0.26
W/D RATIO:	NA
ENTRENCHMENT RATIO:	NA
BANK HEIGHT RATIO:	1



HUDSON STREAM RESTORATION PROJECT


YEAR 1 MONITORING XS 9
PROJECT # 95361
BEAUFORT COUNTY, NORTH CAROLINA

SHEET:

9 of 11

STATION	ELEVATION
0+00	39.94
0+20	39.81
0+34	39.56
0+42	39.32
0+44	38.94
0+46	38.63
0+48	38.32
0+50	38.59
0+52	38.85
0+54	39.03
0+75	39.55
1+00	39.92

Monitoring XS 10 (Riffle) - REACH 1 STA 0+64

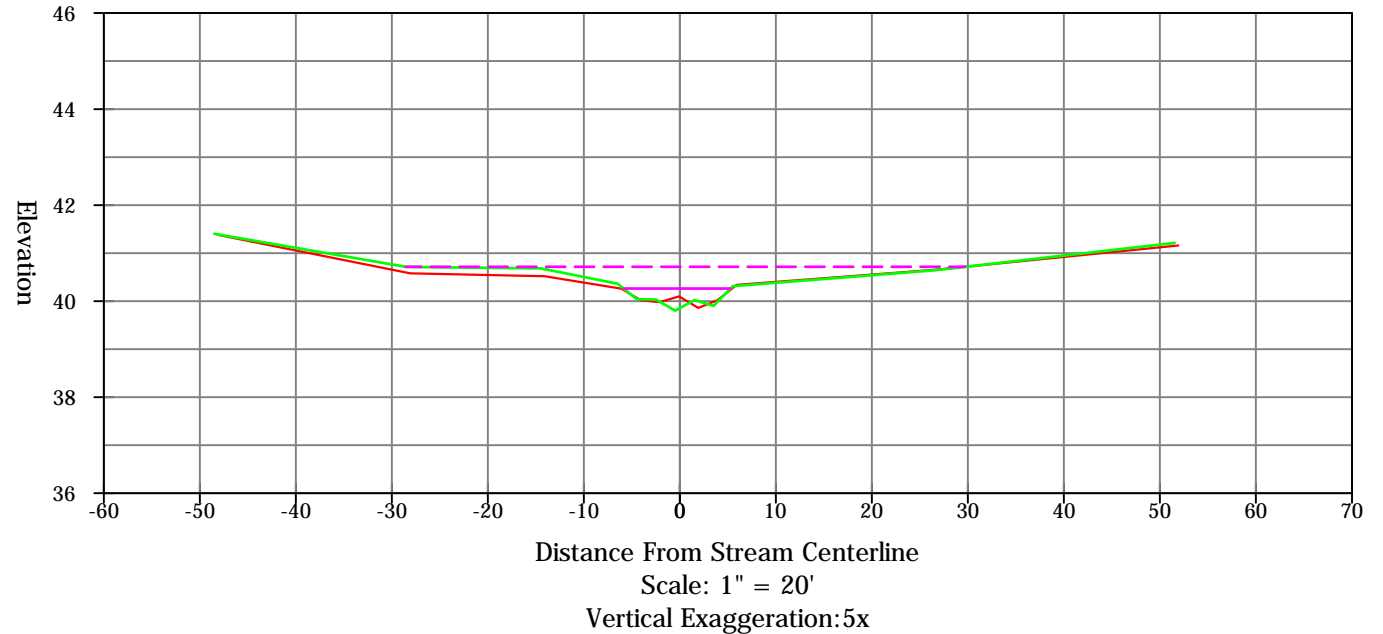

LEGEND

- AS-BUILT GRADE
- YEAR 1 MONITORING GRADE
- BANKFULL ELEVATION
- - - FLOODPRONE ELEVATION

STREAM TYPE	C5/6
-------------	------

SUMMARY DATA (FT)	
BANKFULL ELEVATION:	40.26
BANKFULL CROSS SECTIONAL AREA:	3.25
BANKFULL WIDTH:	11.46
FLOOD PRONE AREA ELEVATION:	40.72
FLOOD PRONE WIDTH:	58.28
MAX DEPTH AT BANKFULL:	0.49
MEAN DEPTH AT BANKFULL:	0.28
W/D RATIO:	40.49
ENTRENCHMENT RATIO:	5.08
BANK HEIGHT RATIO:	1



HUDSON STREAM RESTORATION PROJECT

YEAR 1 MONITORING XS 10
PROJECT # 95361
BEAUFORT COUNTY, NORTH CAROLINA

SHEET:

10 of 11



2120 High Point Road • Forest Hill, Maryland 21050
(410) 420 2600 • Fax (410) 420 6983 • www.ecotoneinc.com

PROJECT NO: 1269

DATE: 11/7/2016

DRAWN BY: CSM


CHECKED BY: MVB

STATION	ELEVATION
0+00	36.82
0+08	35.07
0+10.5	34.68
0+14	33.88
0+16	33.21
0+18	32.55
0+20	32.7
0+22	32.85
0+24	32.7
0+26	32.7
0+28	32.68
0+30	32.68
0+32	32.61
0+34	32.63
0+36	32.61
0+38	32.62
0+40	32.57
0+42	31.91
0+44	33.19
0+46	33.36
0+60	34.03
0+75	35.66

LEGEND

- AS-BUILT GRADE
- YEAR 1 MONITORING GRADE
- BANKFULL ELEVATION
- - - FLOODPRONE ELEVATION

Monitoring XS 11 REACH 1 STA 8+14 & Reach 4 (Station 4+28)

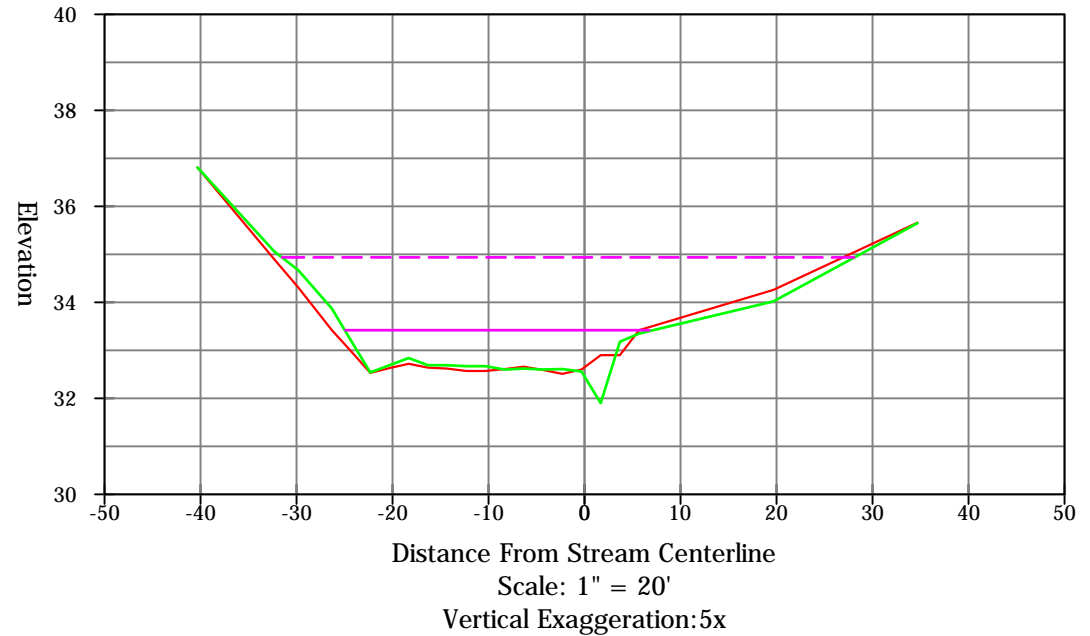

STREAM TYPE	C5/6
-------------	------

SUMMARY DATA (FT)	
BANKFULL ELEVATION:	33.42
BANKFULL CROSS SECTIONAL AREA:	22.13
BANKFULL WIDTH:	31.88
FLOOD PRONE AREA ELEVATION:	34.94
FLOOD PRONE WIDTH:	59.59
MAX DEPTH AT BANKFULL:	1.51
MEAN DEPTH AT BANKFULL:	0.69
W/D RATIO:	NA
ENTRENCHMENT RATIO:	NA
BANK HEIGHT RATIO:	1



HUDSON STREAM RESTORATION PROJECT

YEAR 1 MONITORING XS 11

PROJECT # 95361

BEAUFORT COUNTY, NORTH CAROLINA

SHEET:

11 of 11

Table 8: Monitoring Year 1 - Bank Pin Data

Pins arrays consist of three pins located in the middle of stream banks along meander bends

Bank Pin Array #1 @ XS 5 - Reach 2 – Station 2+69	
Pin	Exposure
Upstream Pin	Minimal exposure (<1/4 inch)
Middle Pin	Minor aggradation
Downstream Pin	Minor aggradation

Bank Pin Array #2 @ XS 4 - Reach 2 – Station 3+95	
Pin	Exposure
Upstream Pin	Could not find- minor aggradation
Middle Pin	Minor aggradation
Downstream Pin	Minimal exposure (<1/4 inch)

Bank Pin Array #1 @ XS 9 - Reach 1 – Station 2+73	
Pin	Exposure
Upstream Pin	Minimal exposure (<1/2 inch)
Middle Pin	Minimal exposure (<1/4 inch)
Downstream Pin	Minimal exposure (<1/4 inch)

Table 10a. Baseline Stream Data Summary
 Project Name/Number (Hudson/ DMS:95361) - Segment/Reach: Reach 1

Parameter	Gauge ²	Regional Curve			Pre-Existing Condition						Reference Reach(es) Data						Design			Monitoring Baseline					
		LL	UL	Eq.	Min	Mean	Med	Max	SD ⁵	n	Min	Mean	Med	Max	SD ⁵	n	Min	Med	Max	Min	Mean	Med	Max	SD ⁵	n
Dimension and Substrate - Riffle Only																									
Bankfull Width (ft)					3.36		3.83	6.02			19.74		21.97	24.2				9.02		11.5			16.2		2
Floodprone Width (ft)					6.47		6.91	10.5			44		64.5	85			18.06	26.74	34.89	57			83.33		2
Bankfull Mean Depth (ft)					0.45		0.52	0.6			0.7		0.75	0.82				0.42		0.22			0.26		2
¹ Bankfull Max Depth (ft)					0.56		0.87	1.07			0.85		1.02	1.18			0.44	0.53	0.61	0.4			0.51		2
Bankfull Cross Sectional Area (ft ²)					1.99		2	2.68			16.09		16.49	16.89				3.8		2.58			4.26		2
Width/Depth Ratio					5.64		7.37	13.52			24.22		29.27	34.67				21.4		52.27			62.31		2
Entrenchment Ratio					1.74		1.8	1.93			2		2.94	3.87			2	2.94	3.87	4.96			5.14		2
¹ Bank Height Ratio																			1			1		2	
Profile																									
Riffle Length (ft)					N/A*						12		46.5	81			4.93	19.09	33.25						
Riffle Slope (ft/ft)					N/A*						0.004		0.011	0.017			0.006	0.016	0.025						
Pool Length (ft)					N/A*						21		30.5	40			4.72	8.41	14.98						
Pool Max depth (ft)					N/A*						1.4		1.65	1.9			0.72	0.93	1.15						
Pool Spacing (ft)					N/A*						40		59	78			16.42	26.95	35.63						
Pattern																									
Channel Beltwidth (ft)					N/A*						27		49	76			11.08	20.11	31.19						
Radius of Curvature (ft)					N/A*						90		92	95			36.94	37.76	38.99						
Rc:Bankfull width (ft/ft)					N/A*												4.10	4.19	4.32						
Meander Wavelength (ft)					N/A*						12.43		15.07	18.25			112.1	135.9	164.6						
Meander Width Ratio					N/A*												1.23	2.23	3.46						
Transport parameters																									
Reach Shear Stress (competency) lb/ft ²								0.26										0.18							
Max part size (mm) mobilized at bankfull																									
Stream Power (transport capacity) W/m ²								0.56										0.14							
Additional Reach Parameters																									
Rosgen Classification								G5-G6					C5-C6				C5-C6		C5-C6					C5/6	
Bankfull Velocity (fps)																									
Bankfull Discharge (cfs)								5.6																	
Valley length (ft)								840					264												
Channel Thalweg length (ft)								846					264					833						850	
Sinuosity (ft)								1.01					1					1.04						1.04	
Water Surface Slope (Channel) (ft/ft)								0.007					0.004					0.007							
BF slope (ft/ft)																								0.006	
³ Bankfull Floodplain Area (acres)																									
⁴ % of Reach with Eroding Banks																									
Channel Stability or Habitat Metric																									
Biological or Other																									

Table 10a. Baseline Stream Data Summary
 Project Name/Number (Hudson/ DMS:95361) - Segment/Reach: Reach 2

Parameter	Gauge ²	Regional Curve			Pre-Existing Condition						Reference Reach(es) Data						Design			Monitoring Baseline					
		LL	UL	Eq.	Min	Mean	Med	Max	SD ⁵	n	Min	Mean	Med	Max	SD ⁵	n	Min	Med	Max	Min	Mean	Med	Max	SD ⁵	n
Dimension and Substrate - Riffle Only																									
Bankfull Width (ft)					5.97		6.87	7.2			19.74		21.97	24.2				14.83					11.78		1
Floodprone Width (ft)					10.03		12.03	13.47			44		64.5	85			29.71	43.55	57.39				28.2		1
Bankfull Mean Depth (ft)					0.91		0.92	0.94			0.7		0.75	0.82				0.67					0.45		1
¹ Bankfull Max Depth (ft)					1.38		1.42	1.54			0.85		1.02	1.18			0.7	0.84	0.98				0.86		1
Bankfull Cross Sectional Area (ft ²)					5.59		6.32	6.58			16.09		16.49	16.89				10					5.28		1
Width/Depth Ratio					6.38		7.47	7.88			24.22		29.27	34.67				22					26.18		1
Entrenchment Ratio					1.67		1.68	1.96			2		2.94	3.87				2.94					2.39		1
¹ Bank Height Ratio																						1		1	
Profile																									
Riffle Length (ft)					N/A*						12		46.5	81			8.1	31.39	54.68						
Riffle Slope (ft/ft)					N/A*						0.004		0.011	0.017			0.003	0.008	0.012						
Pool Length (ft)					N/A*						21		30.5	40			14.18	20.59	27						
Pool Max depth (ft)					N/A*						1.4		1.65	1.9			1.16	1.48	1.84						
Pool Spacing (ft)					N/A*						40		59	78			27	44.33	58.61						
Pattern																									
Channel Beltwidth (ft)					N/A*						27		49	76			18.23	33.08	51.31						
Radius of Curvature (ft)					N/A*						90		92	95			60.76	62.11	64.14						
Rc:Bankfull width (ft/ft)					N/A*												4.10	4.19	4.32						
Meander Wavelength (ft)					N/A*						12.43		15.07	18.25			184.3	223.5	270.7						
Meander Width Ratio					N/A*												1.23	2.23	3.46						
Transport parameters																									
Reach Shear Stress (competency) lb/ft ²							0.42											0.11							
Max part size (mm) mobilized at bankfull																									
Stream Power (transport capacity) W/m ²							1.25											0.18							
Additional Reach Parameters																									
Rosgen Classification							G5-G6						C5-C6				C5-C6							C 5/6	
Bankfull Velocity (fps)																									
Bankfull Discharge (cfs)							17.2																		
Valley length (ft)							486						264												
Channel Thalweg length (ft)							516						264					532						541	
Sinuosity (ft)							1.06						1					1.05						1.05	
Water Surface Slope (Channel) (ft/ft)							0.003						0.004					0.003							
BF slope (ft/ft)																								0.0035	
³ Bankfull Floodplain Area (acres)																									
⁴ % of Reach with Eroding Banks																									
Channel Stability or Habitat Metric																									
Biological or Other																									

Table 10a. Baseline Stream Data Summary
 Project Name/Number (Hudson/ DMS:95361) - Segment/Reach: Reach 3

Parameter	Gauge ²	Regional Curve			Pre-Existing Condition						Reference Reach(es) Data						Design			Monitoring Baseline							
		LL	UL	Eq.	Min	Mean	Med	Max	SD ⁵	n	Min	Mean	Med	Max	SD ⁵	n	Min	Med	Max	Min	Mean	Med	Max	SD ⁵	n		
Dimension and Substrate - Riffle Only																											
Bankfull Width (ft)					3.55		4.03	5.05			19.74		21.97	24.2				10						12.5		1	
Floodprone Width (ft)					5.97		6.44	9.13			44		64.5	85			20.03	29.36	38.69					32.9		1	
Bankfull Mean Depth (ft)					0.55		0.79	0.84			0.7		0.75	0.82				0.5					0.57		1		
¹ Bankfull Max Depth (ft)					0.88		1.15	1.44			0.85		1.02	1.18			0.52	0.63	0.72				0.85		1		
Bankfull Cross Sectional Area (ft ²)					1.94		3.17	4.26			16.09		16.49	16.89			5						7.07		1		
Width/Depth Ratio					5.12		5.99	6.5			24.22		29.27	34.67			20						21.95		1		
Entrenchment Ratio					1.6		1.68	1.8			2		2.94	3.87			2	2.94	3.87				2.63		1		
¹ Bank Height Ratio																							1		1		
Profile																											
Riffle Length (ft)					N/A*						12		46.5	81			5.46	21.17	36.87								
Riffle Slope (ft/ft)					N/A*						0.004		0.011	0.017			0.005	0.014	0.021								
Pool Length (ft)					N/A*						21		30.5	40			9.56	13.88	18.21								
Pool Max depth (ft)					N/A*						1.4		1.65	1.9			0.86	1.1	1.36								
Pool Spacing (ft)					N/A*						40		59	78			18.21	29.89	39.51								
Pattern																											
Channel Beltwidth (ft)					N/A*						27		49	76			12.29	22.3	24.59								
Radius of Curvature (ft)					N/A*						90		92	95			40.96	41.88	43.24								
Rc:Bankfull width (ft/ft)					N/A*												4.10	4.19	4.32								
Meander Wavelength (ft)					N/A*						12.43		15.07	18.25			124.3	150.7	182.5								
Meander Width Ratio					N/A*												1.23	2.23	3.46								
Transport parameters																											
Reach Shear Stress (competency) lb/ft ²								0.37										0.14									
Max part size (mm) mobilized at bankfull																											
Stream Power (transport capacity) W/m ²								1.02										0.18									
Additional Reach Parameters																											
Rosgen Classification								G5-G6						C5-C6				C5-C6								C 5/6	
Bankfull Velocity (fps)																											
Bankfull Discharge (cfs)								8																			
Valley length (ft)								442						264													
Channel Thalweg length (ft)								460						264				445								446	
Sinuosity (ft)								1.04						1				1.01								1.08	
Water Surface Slope (Channel) (ft/ft)								0.007						0.004				0.007									
BF slope (ft/ft)																										0.005	
³ Bankfull Floodplain Area (acres)																											
⁴ % of Reach with Eroding Banks																											
Channel Stability or Habitat Metric																											
Biological or Other																											

Table 10a. Baseline Stream Data Summary
 Project Name/Number (Hudson/ DMS:95361) - Segment/Reach: Reach 4

Parameter	Gauge ²	Regional Curve			Pre-Existing Condition						Reference Reach(es) Data						Design			Monitoring Baseline								
		LL	UL	Eq.	Min	Mean	Med	Max	SD ⁵	n	Min	Mean	Med	Max	SD ⁵	n	Min	Med	Max	Min	Mean	Med	Max	SD ⁵	n			
Dimension and Substrate - Riffle Only																												
Bankfull Width (ft)					7.34		7.48	8.84			19.74		21.97	24.2					21.82						9.9		1	
Floodprone Width (ft)					12.21		13.83	16.28			44		64.5	85			43.69	64.05	84.41						31.36		1	
Bankfull Mean Depth (ft)					0.97		1	1.05			0.7		0.75	0.82					0.78						0.32		1	
¹ Bankfull Max Depth (ft)					1.47		1.51	1.82			0.85		1.02	1.18			0.81	0.98	1.13						0.74		1	
Bankfull Cross Sectional Area (ft ²)					7.49		7.69	8.58			16.09		16.49	16.89					17						3.17		1	
Width/Depth Ratio					7.01		7.47	9.11			24.22		29.27	34.67					28						30.9		1	
Entrenchment Ratio					1.63		1.84	1.88			2		2.94	3.87			2	2.94	3.87						3.17		1	
¹ Bank Height Ratio																									1		1	
Profile																												
Riffle Length (ft)							N/A*				12		46.5	81			11.92	46.18	80.44									
Riffle Slope (ft/ft)							N/A*				0.004		0.011	0.017			0.006	0.016	0.025									
Pool Length (ft)							N/A*				21		30.5	40			20.85	30.29	39.72									
Pool Max depth (ft)							N/A*				1.4		1.65	1.9			1.34	1.71	2.12									
Pool Spacing (ft)							N/A*				40		59	78			39.72	65.21	86.21									
Pattern																												
Channel Beltwidth (ft)							N/A*				27		49	76			26.8	48.66	75.47									
Radius of Curvature (ft)							N/A*				90		92	95			89.37	91.36	94.34									
Rc:Bankfull width (ft/ft)							N/A*										4.096	4.188	4.324									
Meander Wavelength (ft)							N/A*				12.43		15.07	18.25			271.1	328.7	398.2									
Meander Width Ratio							N/A*										1.23	2.23	3.46									
Transport parameters																												
Reach Shear Stress (competency) lb/ft ²								0.48											0.16									
Max part size (mm) mobilized at bankfull																												
Stream Power (transport capacity) W/m ²								1.01											0.22									
Additional Reach Parameters																												
Rosgen Classification								G5-G6						C5-C6					C5-C6									C 5/6
Bankfull Velocity (fps)																												
Bankfull Discharge (cfs)								26.2																				
Valley length (ft)								434						264														
Channel Thalweg length (ft)								503						264					437									447
Sinuosity (ft)								1.16						1					1.01									1.01
Water Surface Slope (Channel) (ft/ft)								0.003						0.004					0.003									
BF slope (ft/ft)																												0.0035
³ Bankfull Floodplain Area (acres)																												
⁴ % of Reach with Eroding Banks																												
Channel Stability or Habitat Metric																												
Biological or Other																												

Table 11a. Monitoring Data - Dimensional Morphology Summary (Dimensional Parameters – Cross Sections)

Project Name/Number (Hudson/ DMS:95361) Segment/Reach: Reach 1-4 (2200 feet)

	Cross Section 1 (Pool - Reach 3)							Cross Section 2 (Riffle - Reach 3)							Cross Section 3 (Riffle - Reach 4)							Cross Section 4 (Pool - Reach 4)							Cross Section 5 (Pool - Reach 2)						
Based on fixed baseline bankfull elevation ¹	Base	MY1	MY2	MY3	MY4	MY5	MY+	Base	MY1	MY2	MY3	MY4	MY5	MY+	Base	MY1	MY2	MY3	MY4	MY5	MY+	Base	MY1	MY2	MY3	MY4	MY5	MY+	Base	MY1	MY2	MY3	MY4	MY5	MY+
Record elevation (datum) used	37.57	37.57						36.40	36.40						34.50	34.50						33.60	33.60						35.46	35.46					
Bankfull Width (ft)	6.30	10.63						12.50	14.44					9.90	8.27					9.79	7.03					7.55	7.58								
Floodprone Width (ft)	21.50	24.55						32.90	36.68					31.36	57.96					23.40	30.15					32.50	24.33								
Bankfull Mean Depth (ft)	0.64	0.20						0.57	0.48					0.32	0.52					0.33	0.34					0.53	0.37								
Bankfull Max Depth (ft)	1.24	0.52						0.85	0.96					0.74	1.62					0.60	0.68					0.90	0.69								
Bankfull Cross Sectional Area (ft ²)	4.00	2.17						7.07	16.24					3.17	4.31					3.19	2.36					4.00	2.83								
Bankfull Width/Depth Ratio	N/A	N/A						21.95	69.34					30.90	15.86					N/A	N/A					N/A	N/A								
Bankfull Entrenchment Ratio	N/A	N/A						2.63	2.53					3.17	7.01					N/A	N/A					N/A	N/A								
Bankfull Bank Height Ratio	1.00	1.00						1.00	1.00					1.00	1.00					1.00	1.00					1.00	1.00								
Cross Sectional Area between end pins (ft ²)																																			
d50 (mm)																																			
	Cross Section 6 (Riffle - Reach 2)							Cross Section 7 (Pool - Reach 1)							Cross Section 8 (Riffle - Reach 1)							Cross Section 9 (Pool - Reach 1)							Cross Section 10 (Riffle - Reach 1)						
Based on fixed baseline bankfull elevation ¹	Base	MY1 ²	MY2	MY3	MY4	MY5	MY+	Base	MY1	MY2	MY3	MY4	MY5	MY+	Base	MY1	MY2	MY3	MY4	MY5	MY+	Base	MY1	MY2	MY3	MY4	MY5	MY+	Base	MY1	MY2	MY3	MY4	MY5	MY+
Record elevation (datum) used	36.53	36.78						36.56	36.56					37.91	37.91					39.00	39.00					40.26	40.26								
Bankfull Width (ft)	11.78	12.51						7.00	6.81					16.20	20.00				8.00	8.61					11.50	11.46									
Floodprone Width (ft)	28.20	25.00						69.00	71.00					83.33	86.26				37.37	49.57					57.00	58.28									
Bankfull Mean Depth (ft)	0.45	0.11						0.33	0.36					0.26	0.24				0.27	0.26					0.22	0.28									
Bankfull Max Depth (ft)	0.86	0.21						0.65	0.69					0.51	0.50				0.59	0.68					0.40	0.49									
Bankfull Cross Sectional Area (ft ²)	5.28	1.39						2.37	2.47					4.26	4.77				2.19	2.21					2.58	3.25									
Bankfull Width/Depth Ratio	26.18	112.26						N/A	N/A					62.31	83.95				N/A	N/A					52.27	40.49									
Bankfull Entrenchment Ratio	2.39	2.00						N/A	N/A					5.14	4.31				N/A	N/A					4.96	5.08									
Bankfull Bank Height Ratio	1.00	1.00						1.00	1.00					1.00	1.00				1.00	1.00					1.00	1.00									
Cross Sectional Area between end pins (ft ²)																																			
d50 (mm)																																			
	Cross Section 11 (Confluence - Reach 1)																																		
Based on fixed baseline bankfull elevation ¹	Base	MY1	MY2	MY3	MY4	MY5	MY+																												
Record elevation (datum) used	33.42	33.42																																	
Bankfull Width (ft)	32.00	31.88																																	
Floodprone Width (ft)	50.34	59.59																																	
Bankfull Mean Depth (ft)	0.70	0.69																																	
Bankfull Max Depth (ft)	0.91	1.51																																	
Bankfull Cross Sectional Area (ft ²)	22.54	22.13																																	
Bankfull Width/Depth Ratio	N/A	N/A																																	
Bankfull Entrenchment Ratio	N/A	N/A																																	
Bankfull Bank Height Ratio	1.00	1.00																																	
Cross Sectional Area between end pins (ft ²)																																			
d50 (mm)																																			

1 = Widths and depths for annual measurements will be based on the baseline bankfull datum regardless of dimensional/depositional development. Input the elevation used as the datum, which should be consistent and based on the baseline datum established. If the performer has inherited the project and cannot acquire the datum used for prior years this must be discussed with EEP. If this cannot be resolved in time for a given years report submission a footnote in this should be included that states: "It is uncertain if the monitoring datum has been consistent over the monitoring history, which may influence calculated values. Additional data from a prior performer is being acquired to provide confirmation. Values will be recalculated in a future submission based on a consistent datum if determined to be necessary."

2 = Bankfull for XS 6 recalculated 2016.

Exhibit Table 11b. Monitoring Data - Stream Reach Data Summary																																				
Project Name/Number (Hudson/DMS:95361) Segment/Reach: Reach 2																																				
Parameter	Baseline					MY-1					MY-2					MY-3					MY-4					MY-5										
	Min	Mean	Med	Max	SD ⁴	n	Min	Mean	Med	Max	SD ⁴	n	Min	Mean	Med	Max	SD ⁴	n	Min	Mean	Med	Max	SD ⁴	n	Min	Mean	Med	Max	SD ⁴	n	Min	Mean	Med	Max	SD ⁴	n
Dimension and Substrate - Riffle only																																				
Bankfull Width (ft)			11.8			1			12.5			1																								
Floodprone Width (ft)			28.2			1			25			1																								
Bankfull Mean Depth (ft)			0.45			1			0.11			1																								
¹ Bankfull Max Depth (ft)			0.86			1			0.21			1																								
Bankfull Cross Sectional Area (ft ²)			5.28			1			1.39			1																								
Width/Depth Ratio			26.2			1			112			1																								
Entrenchment Ratio			2.39			1			2			1																								
¹ Bank Height Ratio			1			1			1			1																								
Profile																																				
Riffle Length (ft)																																				
Riffle Slope (ft/ft)																																				
Pool Length (ft)																																				
Pool Max depth (ft)																																				
Pool Spacing (ft)																																				
Pattern																																				
Channel Beltwidth (ft)									71																											
Radius of Curvature (ft)																																				
Rc:Bankfull width (ft/ft)																																				
Meander Wavelength (ft)																																				
Meander Width Ratio																																				
Additional Reach Parameters																																				
Rosgen Classification									C 5/5																											
Channel Thalweg length (ft)									541																											
Sinuosity (ft)									1.05																											
Water Surface Slope (Channel) (ft/ft)																																				
BF slope (ft/ft)									0.0035																											
2 = Bankfull for XS 6 recalculated																																				
³ Rp% / Ru% / P% / G% / S%																																				
³ SC% / Sa% / G% / C% / B% / Be%																																				
³ d16 / d35 / d50 / d84 / d95 /																																				
² % of Reach with Eroding Banks																																				
Channel Stability or Habitat Metric																																				
Biological or Other																																				

Shaded cells indicate that these will typically not be filled in.

1 = The distributions for these parameters can include information from both the cross-section measurements and the longitudinal profile.

2 = Proportion of reach exhibiting banks that are eroding based on the visual survey from visual assessment table

3 = Riffle, Run, Pool, Glide, Step; Silt/Clay, Sand, Gravel, Cobble, Boulder, Bedrock; dip = max pave, disp = max subpave

4. = Of value/needed only if the n exceeds 3

Exhibit Table 11b. Monitoring Data - Stream Reach Data Summary
Project Name/Number (Hudson/ DMS:95361) Segment/Reach: Reach 3

Parameter	Baseline						MY-1						MY-2						MY-3						MY-4						MY-5					
	Mn	Mean	Med	Max	SD ⁴	n	Mn	Mean	Med	Max	SD ⁴	n	Mn	Mean	Med	Max	SD ⁴	n	Mn	Mean	Med	Max	SD ⁴	n	Mn	Mean	Med	Max	SD ⁴	n	Mn	Mean	Med	Max	SD ⁴	n
Dimension and Substrate - Riffle only																																				
Bankfull Width (ft)			12.50			1				14.44		1																								
Floodprone Width (ft)			32.90			1				36.68		1																								
Bankfull Mean Depth (ft)			0.57			1				0.48		1																								
¹ Bankfull Max Depth (ft)			0.85			1				0.96		1																								
Bankfull Cross Sectional Area (ft ²)			7.07			1				16.24		1																								
Width/Depth Ratio			21.95			1				69.34		1																								
Entrenchment Ratio			2.63			1				2.53		1																								
¹ Bank Height Ratio			1.00			1				1.00		1																								
Profile																																				
Riffle Length (ft)																																				
Riffle Slope (ft/ft)																																				
Pool Length (ft)																																				
Pool Max depth (ft)																																				
Pool Spacing (ft)																																				
Pattern																																				
Channel Beltwidth (ft)																																				
Radius of Curvature (ft)																																				
Rc:Bankfull width (ft/ft)																																				
Meander Wavelength (ft)																																				
Meander Width Ratio																																				
Additional Reach Parameters																																				
Rosgen Classification			C 5/6							C 5/6																										
Channel Thalweg length (ft)			446							446																										
Sinuosity (ft)			1.08							1.08																										
Water Surface Slope (Channel) (ft/ft)																																				
BF slope (ft/ft)			0.005							0.005																										
2 = Bankfull for XS 6 recalculated																																				
³ Rr% / Ru% / P% / G% / S%																																				
³ SC% / Sa% / G% / C% / B% / Be%																																				
³ d16 / d35 / d50 / d84 / d95 /																																				
² % of Reach with Eroding Banks																																				
Channel Stability or Habitat Metric																																				
Biological or Other																																				

Pattern data will not typically be collected unless visual data, dimensional data or profile data indicate significant shifts from baseline

Shaded cells indicate that these will typically not be filled in.
1 = The distributions for these parameters can include information from both the cross-section measurements and the longitudinal profile.
2 = Proportion of reach exhibiting banks that are eroding based on the visual survey from visual assessment table
3 = Riffle, Run, Pool, Glide, Step; Silt/Clay, Sand, Gravel, Cobble, Boulder, Bedrock; dip = max pave, disp = max subpave
4 = Of value/needed only if the n exceeds 3

Exhibit Table 11b. Monitoring Data - Stream Reach Data Summary
Project Name/Number (Hudson/ DMS:95361) Segment/Reach: Reach 4

Parameter	Baseline		MY-1				MY-2				MY-3				MY-4				MY-5																						
	Mn	Mean	Med	Max	SD ¹	n	Min	Mean	Med	Max	SD ¹	n	Min	Mean	Med	Max	SD ¹	n	Min	Mean	Med	Max	SD ¹	n	Min	Mean	Med	Max	SD ¹	n											
Dimension and Substrate - Riffle only																																									
Bankfull Width (ft)			9.90			1				8.27			1																												
Floodprone Width (ft)			31.36			1				57.96			1																												
Bankfull Mean Depth (ft)			0.32			1				0.52			1																												
¹ Bankfull Max Depth (ft)			0.74			1				1.62			1																												
Bankfull Cross Sectional Area (ft ²)			3.17			1				4.31			1																												
Width/Depth Ratio			30.90			1				15.86			1																												
Entrenchment Ratio			3.17			1				7.01			1																												
¹ Bank Height Ratio			1.00			1				1.00			1																												
Profile																																									
Riffle Length (ft)																																									
Riffle Slope (ft/ft)																																									
Pool Length (ft)																																									
Pool Max depth (ft)																																									
Pool Spacing (ft)																																									
Pattern																																									
Channel Beltwidth (ft)																																									
Radius of Curvature (ft)																																									
Rc:Bankfull width (ft/ft)																																									
Meander Wavelength (ft)																																									
Meander Width Ratio																																									
Additional Reach Parameters																																									
Rosgen Classification			C 5/6							C 5/6																															
Channel Thalweg length (ft)			447							447																															
Sinuosity (ft)			1.01							1.01																															
Water Surface Slope (Channel) (ft/ft)																																									
BF slope (ft/ft)			0.0035							0.0035																															
2 = Bankfull for XS 6 recalculated																																									
³ R% / Ru% / P% / G% / S%																																									
³ SC% / Sa% / G% / C% / B% / Be%																																									
³ d16 / d35 / d50 / d84 / d95 /																																									
² % of Reach with Eroding Banks																																									
Channel Stability or Habitat Metric																																									
Biological or Other																																									

Pattern data will not typically be collected unless visual data, dimensional data or profile data indicate significant shifts from baseline

Shaded cells indicate that these will typically not be filled in.
 1 = The distributions for these parameters can include information from both the cross-section measurements and the longitudinal profile.
 2 = Proportion of reach exhibiting banks that are eroding based on the visual survey from visual assessment table
 3 = Riffle, Run, Pool, Glide, Step; Silt/Clay, Sand, Gravel, Cobble, Boulder, Bedrock; dip = max pave, disp = max subpave
 4. = Of value/needed only if the n exceeds 3

APPENDIX E: HYDROLOGIC DATA

Table 9: Verification of Bankfull Events

Table 12: Verification of Baseflow


Figure 2: Monthly Rainfall Data with Percentiles

Figures 3-12: Stream Surface Water Hydrology (Well 1-10)

Date of Observation	Date of Occurance	Method	Greater than Obkf Stage?	Notes
9/29/16	2/7-2/13/16, 3/7-3/9/16	On-Site data logger	Y	Reach 1 (Well 5, 6)
9/29/16	1/29-2/1/16, 2/2-2/8/16	On-Site data logger	Y	Reach 2 (Well 7)
9/29/16	2/5-6/16, 2/18/16, 5/29/16, 6/7/16	On-Site data logger	Y	Reach 3 (Well 1, 2)
9/29/16	2/4/16, 2/18/16, 5/3/16, 6/7/16	On-Site data logger	Y	Reach 4 (Well 3)
9/29/16	2/4/16, 2/18/16, 5/3/16, 6/7/16	On-Site data logger	Y	Reach 1& 4 Confluence (Well 4)
9/29/16	2/4/16, 7/13/16	On-Site data logger	Y	Reach 5 (Well 8, 9, 10)
9/29/16	Unknown	Photographed on site	Y	Debris/ Wrack lines on Reach 5
9/30/16	Unknown	Photographed on site	Y	Wrack lines on Reach 1
9/29/16	Unknown	Photographed on site	Y	Flow Lines along Reach 2 - Vegetation bent

Well (Reach)	Dates of Occurrence	30 Consecutive Days Minimum Flow Requirement Met?	Notes
1 (Reach 3)	1/29/16 - 4/2/16	Y	
2 (Reach 3)	1/29/16 – 4/27/16	Y	
3 (Reach 4)	12/30/15 – 8/11/16	Y	
4 (Confluence R1&4)	1/29/16 – 5/27/16	Y	
5 (Reach 1)	1/29/16 - 4/19/16	Y	
6 (Reach 1)	2/16/16 - 3/14/16	N	Head of Reach 1
7 (Reach 2)	1/29/16 - 3/14/16	Y	
8 (Reach 5)	12/30/15 – 6/15/16	Y	
9 (Reach 5)	12/30/15 – 8/11/16	Y	
10 (Reach 5)	12/30/15 – 8/11/16	Y	

Figure 2: Monthly Rainfall Data

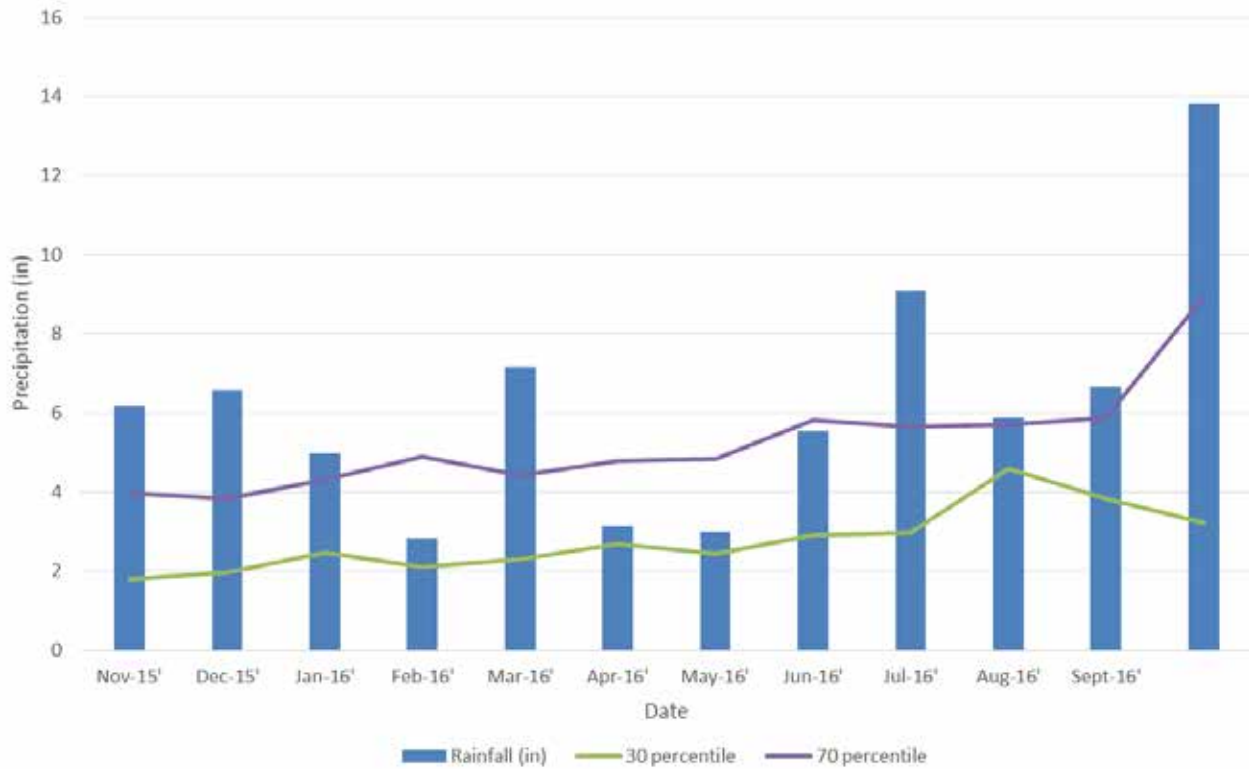

Rainfall Data collected from Washington WWTP in Beaufort County, NC. Data obtained from USDA-NRCS Agricultural Applied Climate Information System. Percentiles calculated from 2016-1997 data.

Figure 3

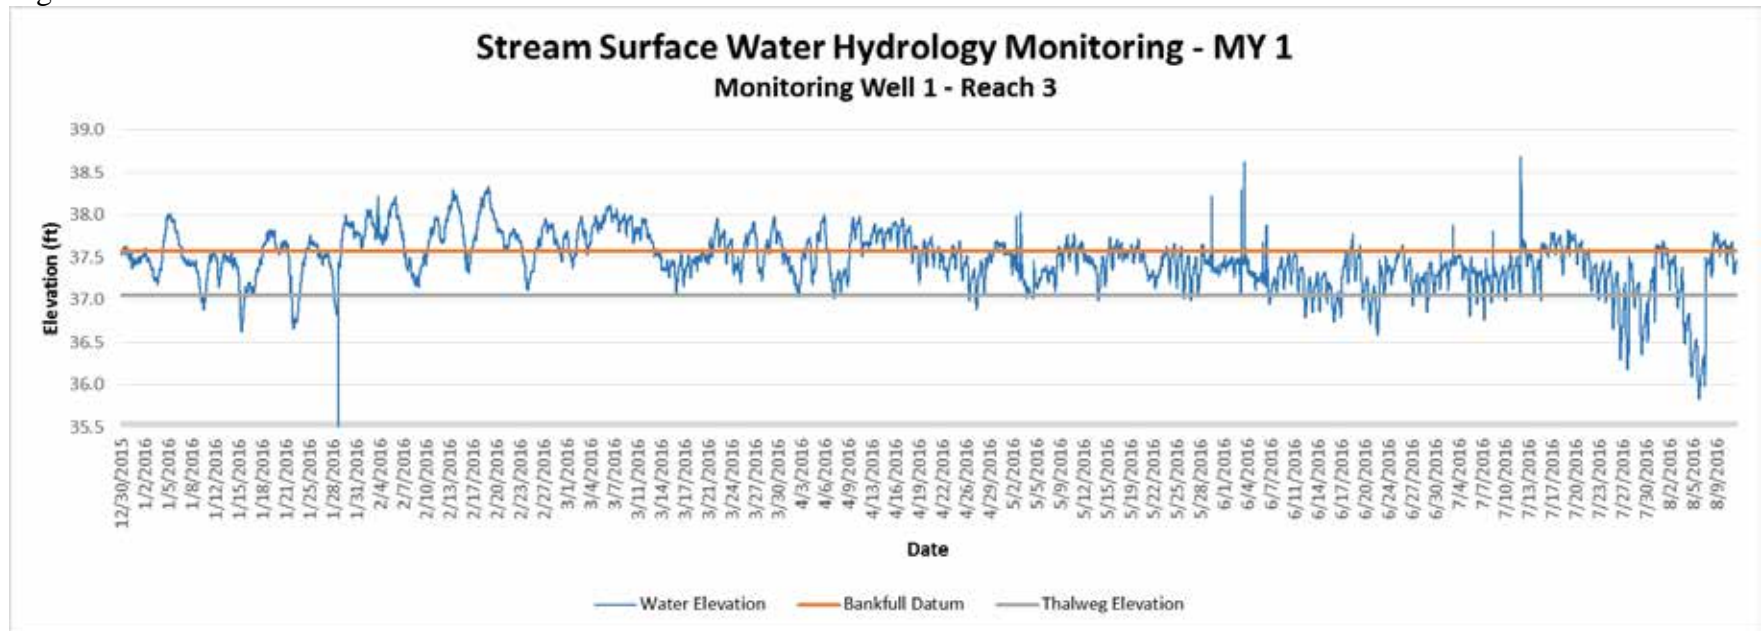


Figure 4

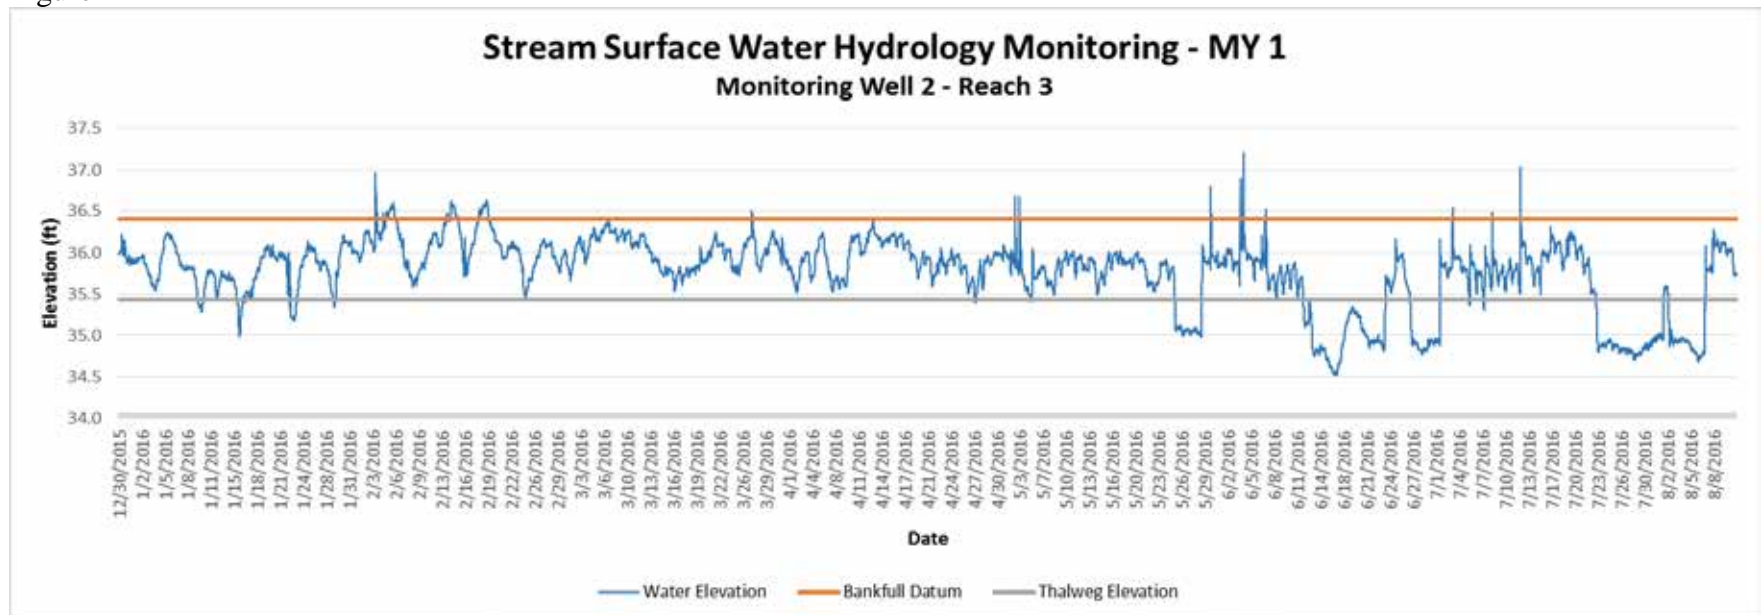


Figure 5

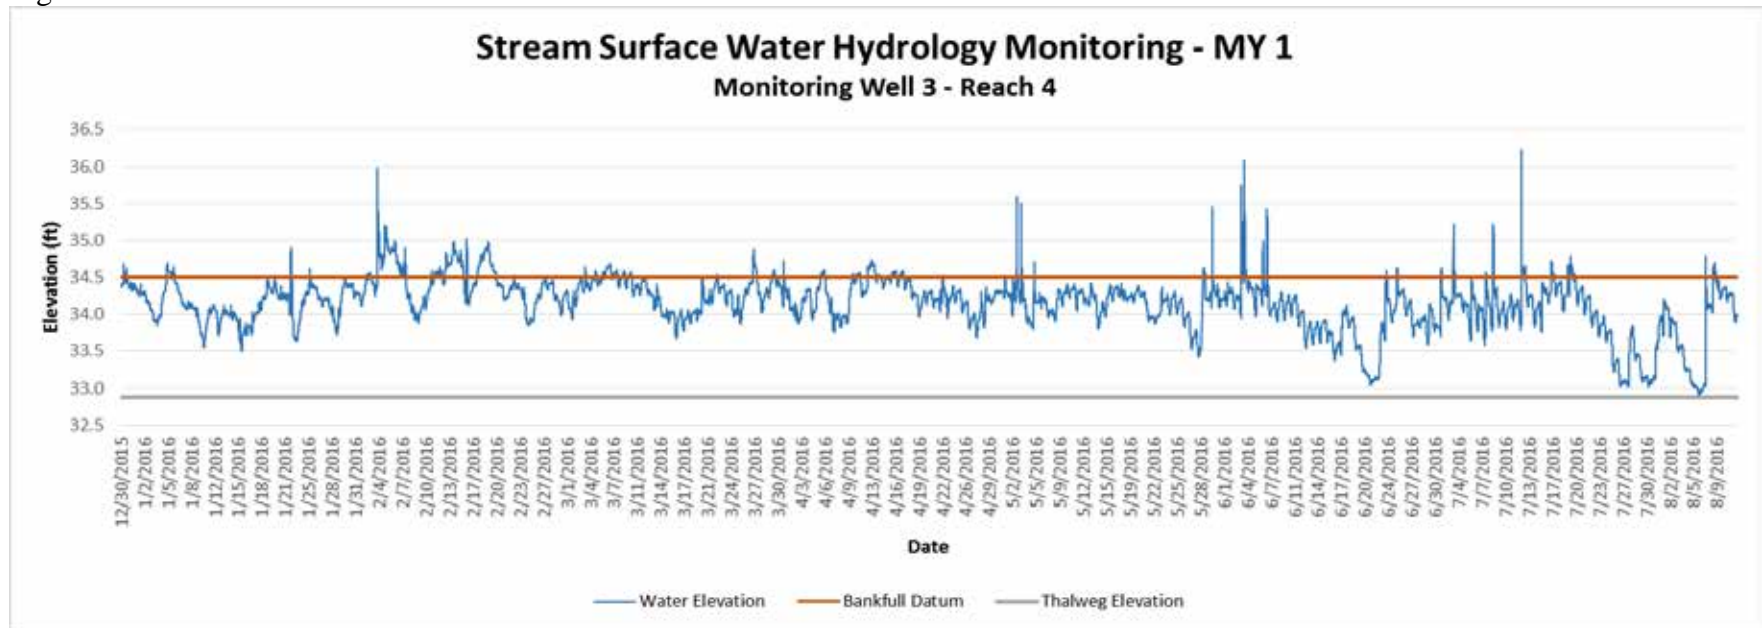


Figure 6

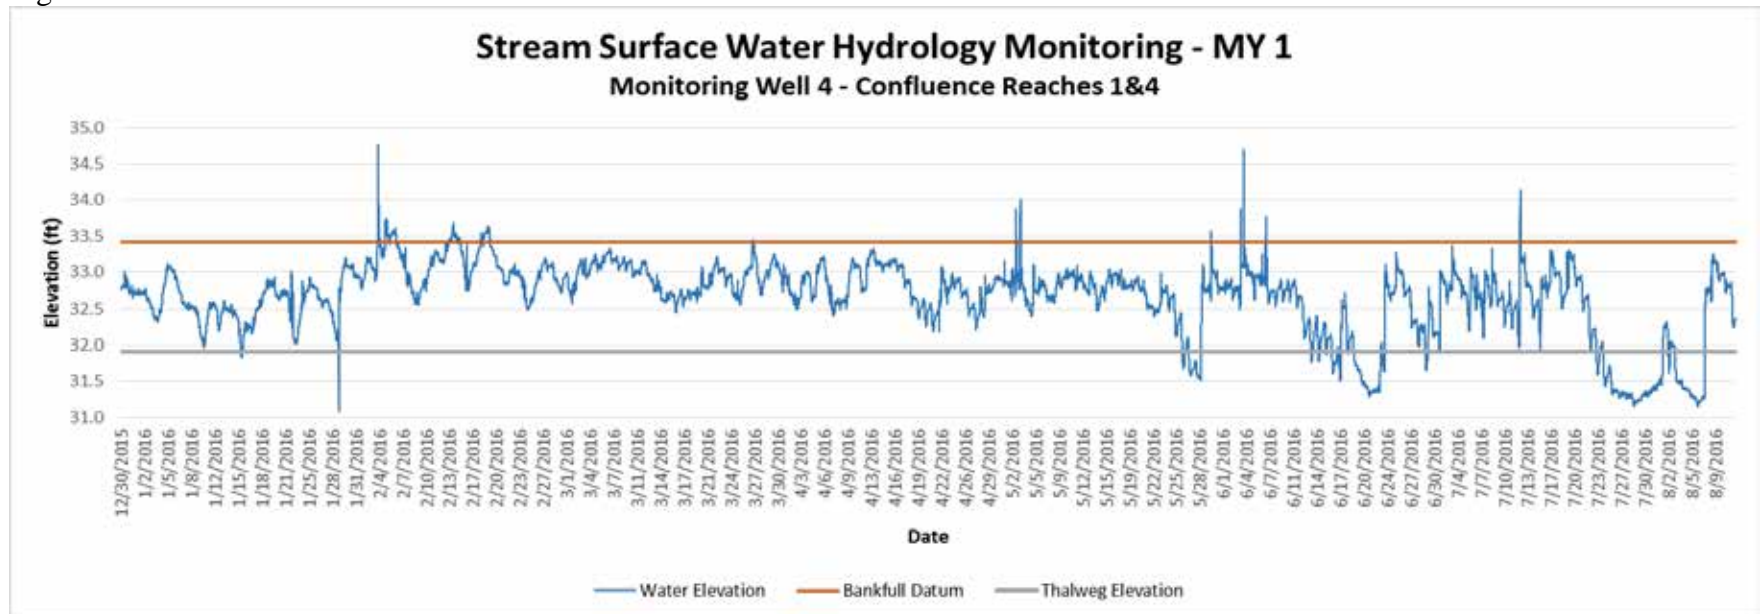


Figure 7

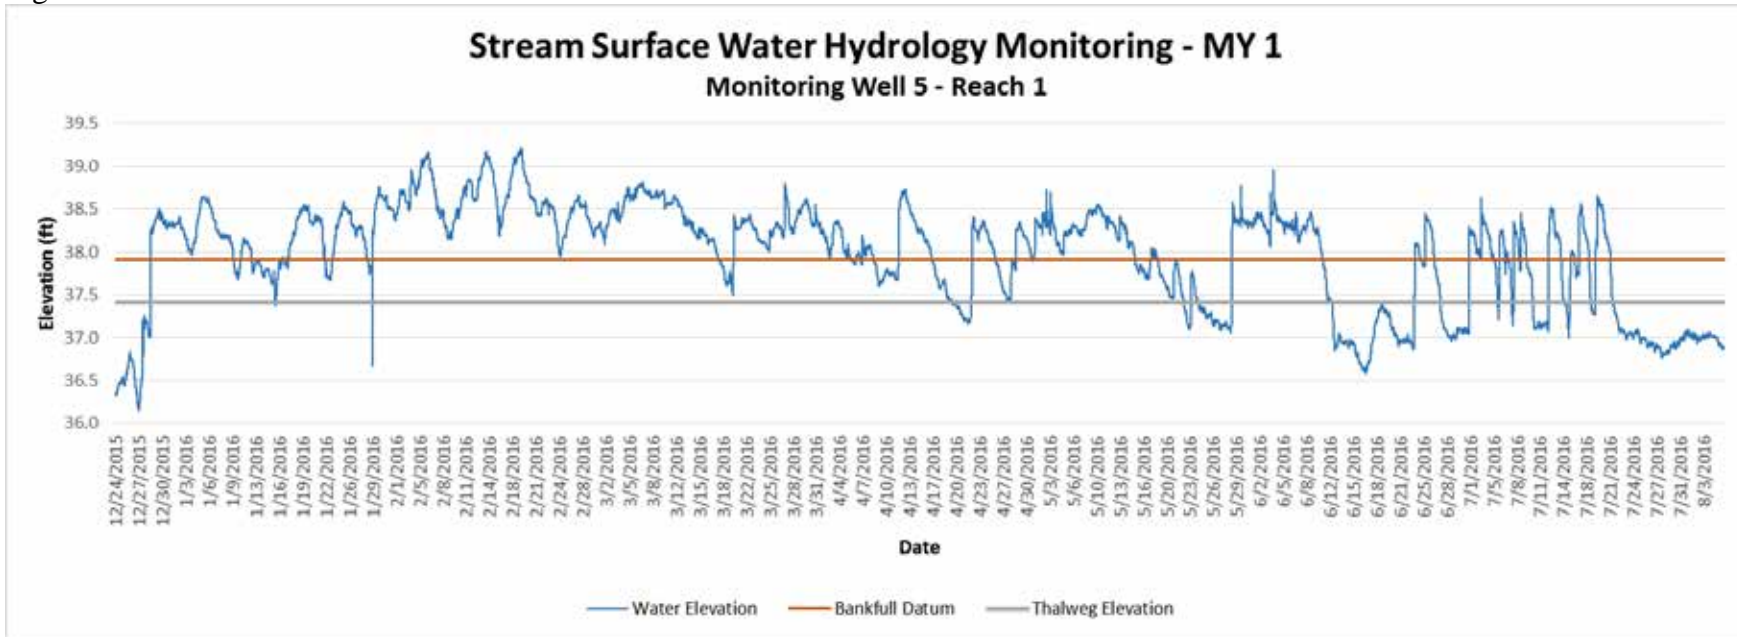


Figure 8

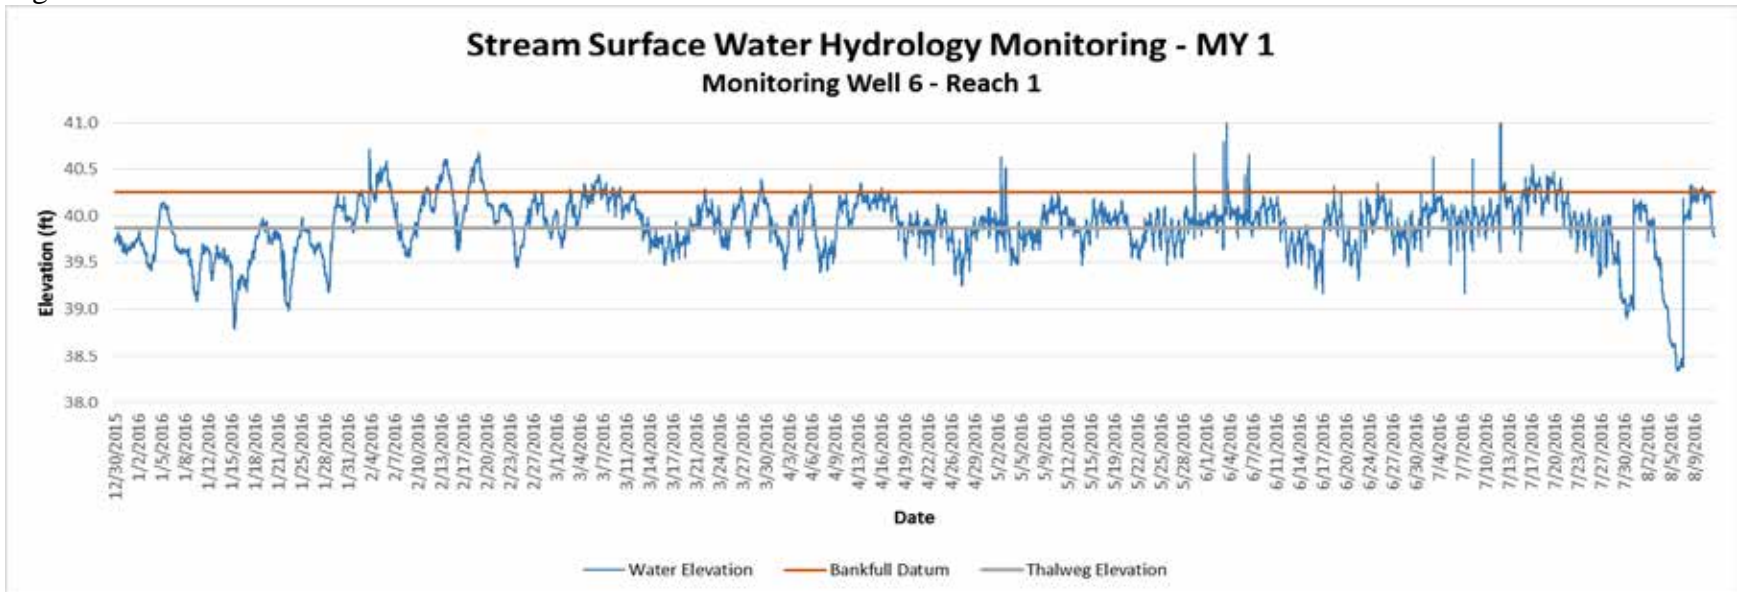


Figure 9

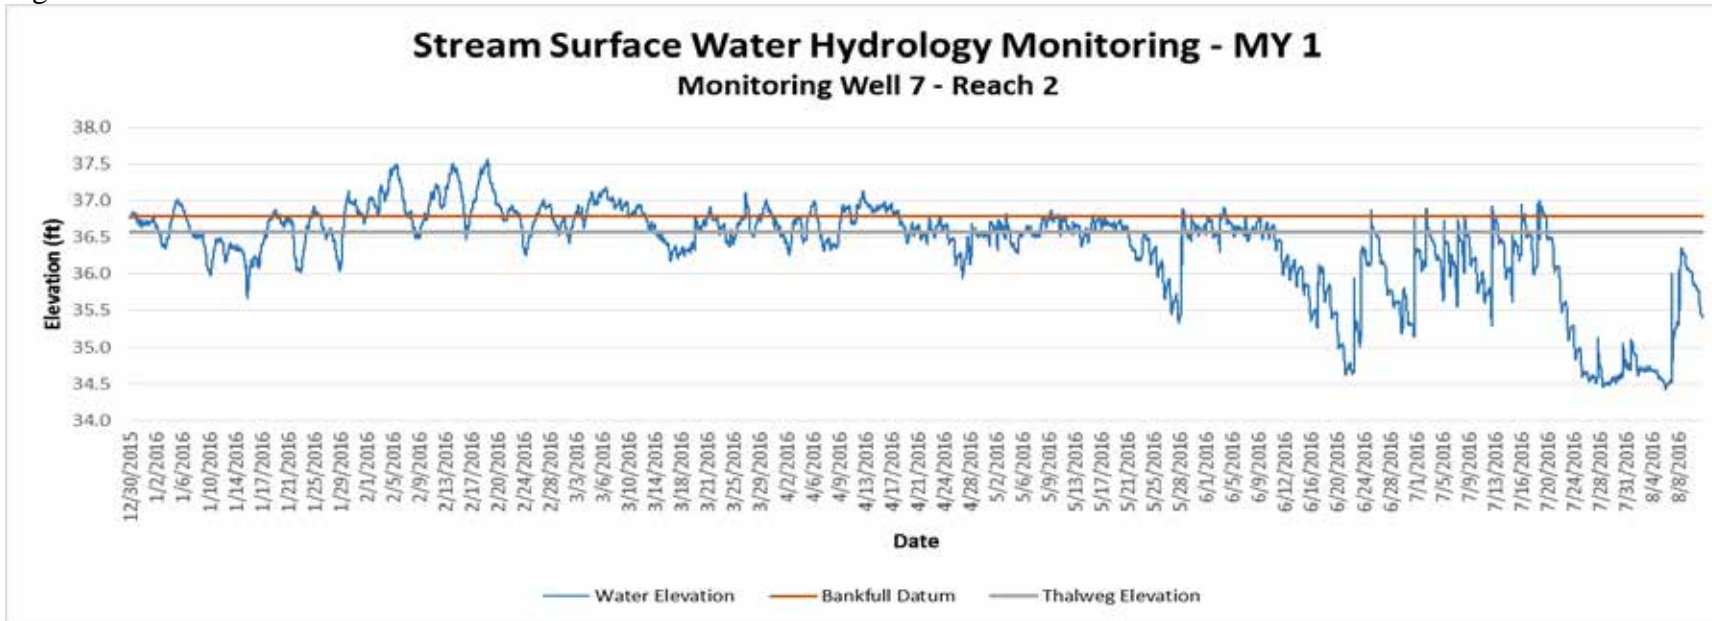


Figure 10

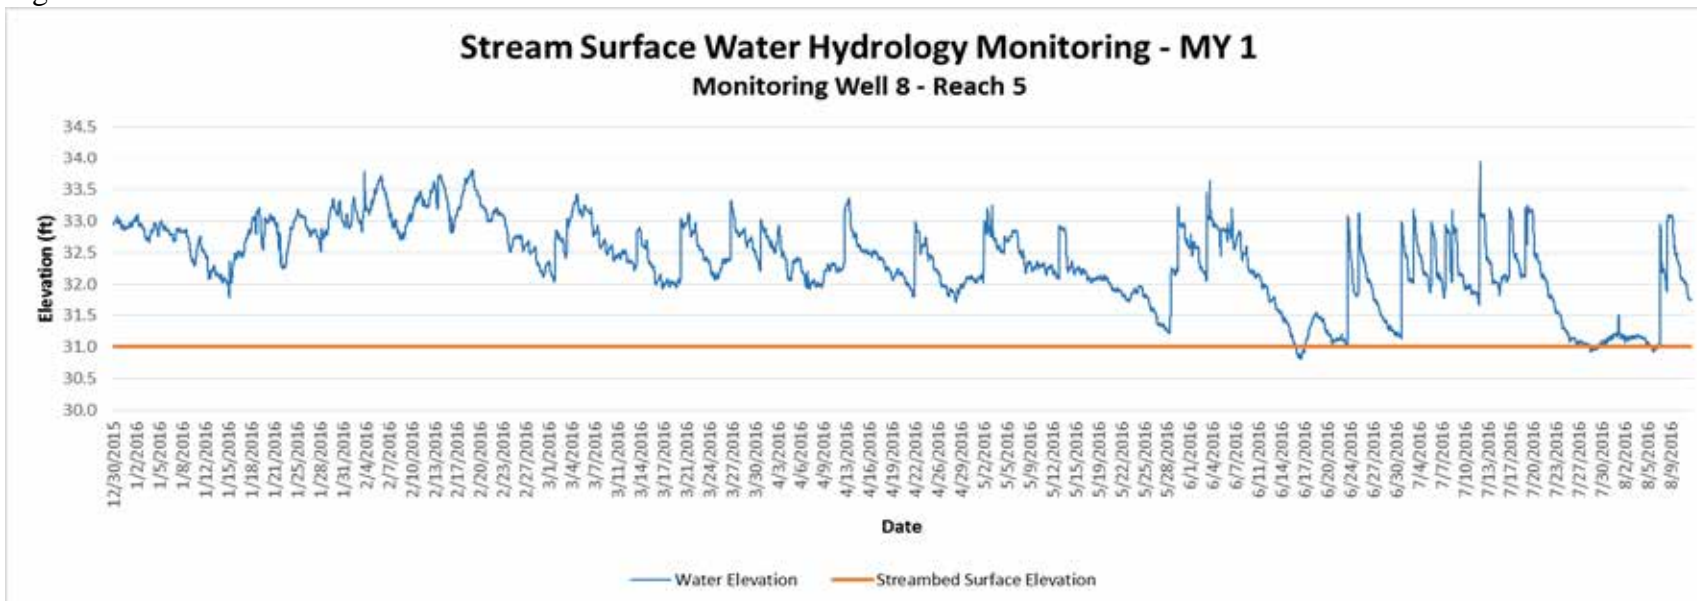


Figure 11

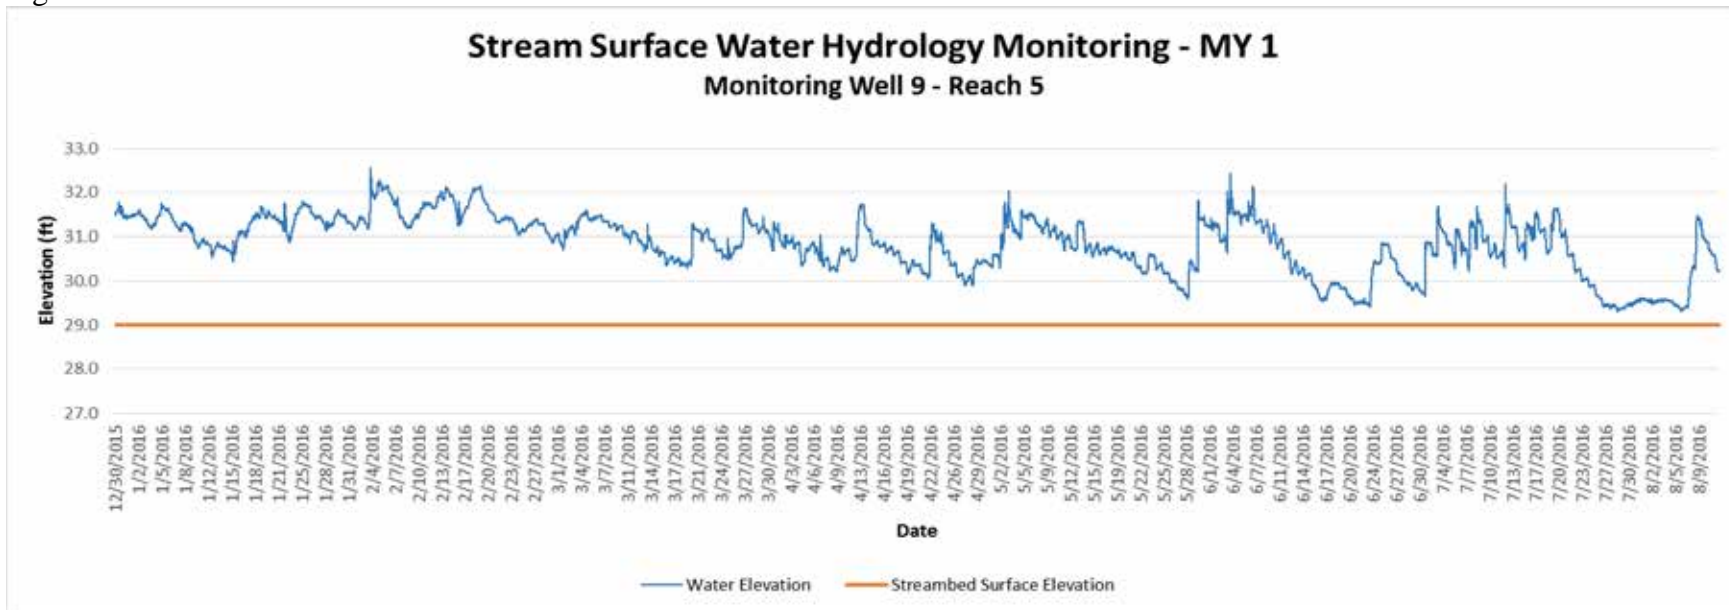


Figure 12

