

# OVERHILLS STREAM AND WETLAND RESTORATION MONITORING REPORT (YEAR 1 OF 5)

Harnett County, North Carolina  
NCEEP Project Number 199



Prepared for:  
North Carolina Ecosystem Enhancement Program  
1652 Mail Service Center  
Raleigh, NC 27699-1652



Status of Plan: Final  
Submission Date: March 2008

Monitoring Firm:



**Stantec**

Stantec Consulting Services Inc  
801 Jones Franklin Road, Suite 300  
Raleigh, NC 27606

## **EXECUTIVE SUMMARY**

### **Project Background**

The North Carolina Ecosystems Enhancement Program (EEP) restored 4,482 linear feet of Jumping Run Creek and 70 acres of adjacent riverine wetlands located on the Fort Bragg Overhills tract, north of Spring Lake, in Harnett County, North Carolina. Construction of the project began on July 12, 2004 and the restoration was completed on May 30, 2006. The following report provides the monitoring information for year one (1) of the stream and wetland restoration project. The project consists of a portion of Jumping Run Creek and the adjacent riverine wetland. The site is located on the Fort Bragg Military Reservation in Harnett County, North Carolina and can be accessed from Nursery Road between NC 87 and Overhills Road. Project goals and objectives for the Overhills stream restoration project included restoration of stream dimension, pattern, and profile; restoration of riverine wetland hydrology and vegetation; improvement of water quality; and protection of future water quality. Jumping Run Creek had been significantly altered from its natural path prior to the restoration efforts. The channel was relocated from its natural path to the far edge of its floodplain. The purpose of this type of relocation was typically to improve drainage of the surrounding area and create a large field for agricultural purposes. The adjacent riverine wetlands were also significantly altered due to the stream relocation. In addition a ditch that was created on the eastern edge of the property. Undeveloped forested land is located to the east and west of the project site. An agriculture field is located to the north and Nursery Road serves as the southern boundary. The Jumping Run Creek watershed is comprised of a mixture of undeveloped forested land, wetlands, suburban residential areas, commercial areas, and a large golf course community. The watershed has a drainage area of 15.9 square miles. The topography of the watershed is typical sandhills type topography which is rolling in nature.

### **Vegetation Assessment**

The Carolina Vegetation Survey (CVS) methodology was utilized to sample vegetation in October of 2007. Ten 100m<sup>2</sup> plots have been established throughout the project. In each plot, two plot corners have been permanently located with conduit or rebar. As per the mitigation plan, the vegetative success criteria are based on the US Army Corps of Engineers Stream Mitigation Guidelines (USACE, 2003). The final vegetative success criteria will be the survival of 260 5-year old planted trees per acre at the end of the year 5 monitoring period. An interim measure of vegetation planting success will be the survival of at least 320 3-year old planted trees per acre at the end of year 3 of the monitoring period. Six of the plots have over 320 stems per acre while four of the plots have less than 320 stems per acre. In addition to the four failing vegetation plot sites, several vegetation problem areas (VPA) exist on site. In VPA 1 and 2, standing water had been present for a substantial length of time, causing the majority of the planted vegetation to die. VPA 3 is overrun with invasive species, primarily *Lespedeza*. *Lespedeza* is a major problem on this project site, as it is also invading most high areas.

### **Stream Assessment**

The region has been in an extreme drought for much of 2007. No evidence of bankfull flows were observed onsite and flows were not measured with peak stage recorders. In order to verify bankfull events, a crest gauge should be installed onsite.

A major stream problem area is located from station 33+00 to 44+00 (1100 linear feet) where the stream has experienced serious failure. At Station 33+00 a head cut has developed and produced massive erosion around the bend at this location. Downstream from this head cut, most of the in-stream structures have failed. Erosion around the structures has forced the banks to migrate in as much as seven feet, making this section of stream extremely unstable. Mid-channel bar formation is also occurring along the reach. Other major issues include the presence of a beaver dam near Station 6+30. The dam is causing a hydraulic jump, producing scour downstream. Minor erosion problem areas were found from station 0+00 to station 32+00 of the restoration reach. Erosion causes were attributed to root wad failure in some cases, and shear stress in others. The placement and/or installation of some root wads has caused scouring along with bank erosion and migration from eddies that form around and behind the root wad structures.

Given the extent of the deterioration of this 1100 linear foot portion of the restoration reach, it will not be possible to repair the stream around the failed structures, or to rebuild or replace structures without addressing the characteristics of the stream. The stream has migrated vertically and is actively migrating horizontally. There are too many failed structures, and the potential for future bank erosion and additional horizontal migration is too great for a simple repair. The stream channel in this location has eroded below a clay layer into a highly erosive sandy soil layer which will continue to create stability problems. The channel should be realigned with the appropriate pattern, dimension, and structures that will adequately transition from the higher elevation of the restoration to the receiving stream which is at a lower elevation. There is room on the right side of the existing alignment to be able to develop a new pattern that will provide the correct channel dimensions, grade control structures, and step pools needed to dissipate energy through this section of the reach. This action will stop the head cut from continuing upstream causing further damage to the restored channel. The majority of the materials needed for construction could be salvaged from the impaired reach.

### **Wetland Assessment**

Fifteen groundwater monitoring wells are currently active on the project site. Nine of the wells met the criteria of wetland attainment during the growing season of 2007, but six did not. Well JR-5 had a maximum of 24 consecutive days (10%) where the ground was saturated within 12 inches of the surface. Wells JR-10 and JR-11 had a maximum of 7 days (3%), JR-12 a maximum of 6 (3%), JR-13 21 days (9%), and JR-14 a maximum of 12 days (5%). No conclusions regarding the success or failure of wetland areas in the project area can be made at this time due to a short period of reference well data. A reference well was installed in early October, 2007, for a reference well record of just over a month at the time of this report. Given that precipitation was below the 30% percentile for the area during most of the growing season, the failure of some gauges to indicate hydrologic success is not cause for significant concern.



## Table of Contents

Executive Summary.....	i
1.0 Project Background.....	1
1.1 Project objectives .....	1
1.2 Project structure .....	1
1.3 Location and Setting .....	2
1.4 Project History and Background.....	5
1.5 Monitoring Plan View.....	7
2.0 Project Condition and Monitoring Results.....	17
2.1 Vegetation Assessment .....	17
2.1.1 Vegetation Problem Areas .....	17
2.1.2 Vegetation Problem Area Plan View .....	17
2.2 Stream Assessment .....	17
2.2.1 Hydrology .....	17
2.2.2 Bank Stability.....	18
2.2.3 Stream Problem Areas .....	18
2.2.4 Stream Problem Area Plan View .....	19
2.2.5 Stability Assessment .....	19
2.2.6 Quantitative Measures Summary .....	20
2.3 Stream wetland Assessment.....	23
2.3.1 Wetland Criteria Attainment.....	23
2.3.2 Problem Areas Plan View .....	24
3.0 References.....	25
Appendix A. Vegetation Raw Data	
Appendix B. Geomorphologic Raw Data	
Appendix C. Wetland Data	
Appendix D. Integrated Problem Area Plan Views	



## **1.0 Project Background**

---

The project consists of a portion of Jumping Run Creek and the adjacent riverine wetland. The site is located on the Fort Bragg Military Reservation in Harnett County, North Carolina.

### **1.1 PROJECT OBJECTIVES**

Project goals and objectives for the Overhills stream and wetland restoration project included:

- restore stream dimension, pattern and profile
- restore riverine wetland hydrology and vegetation
- improve water quality
- protect future water quality

### **1.2 PROJECT STRUCTURE**

The project consists of a portion of Jumping Run Creek and the adjacent riverine wetland. The site is located on the Fort Bragg Military Reservation in Harnett County, North Carolina.

Jumping Run Creek has been significantly altered from its natural path prior to the restoration efforts. The channel was relocated from its natural path to the far edge of its floodplain. The purpose of this type of relocation was typically to improve drainage of the surrounding area and create a large field for agricultural purposes. The existing channel was dug approximately 5-8 feet deep and about 15 feet wide at the stream bed to 20+ feet wide at the top of bank. The stream classification system for the existing reach of this project was a G4/G5c. The adjacent riverine wetlands were also significantly altered due to the stream relocation as well as a ditch that was created on the eastern edge of the property.

Priority 1 stream restoration was carried out on the entire reach resulting in restored C type channel. The pattern, dimension, and profile were restored throughout the project site by relocating the entire reach of stream. Log structures and root wads were installed to provide grade control, extra bank protection, and encourage development of bedform features. In wetland restoration areas, a mixture of grading to create microtopography, channel plugs, and berms were used manipulate and enhance the hydrology of the site. Two vegetative communities or zones were planted in the project area. One was the bottomland hardwood forest planted through the riverine wetland and the second was the stream corridor.

**Exhibit Table I. Project Restoration Components  
Overhills/Jumping Run Creek Restoration Project - EEP Project No. 199**

	<b>Existing Feet/Acres</b>	<b>Type</b>	<b>Approach</b>	<b>Footage or Acreage</b>	<b>Mitigation Ratio</b>	<b>Mitigation Units</b>	<b>Stationing</b>	<b>Comment</b>
Stream	3064	R	P1	4482	1.0	4482	10+00.0 to 55+00.0	includes log structures and root wads
Riparian Wetlands	NA	R	-	70.0	1.0	70.0		floodplain of restored stream

R = Restoration  
P1 = Priority 1  
P = Preservation

### 1.3 LOCATION AND SETTING

The restoration site is located on the Fort Bragg Military Reservation in Harnett County, North Carolina can be accessed from Nursery Road between NC 87 and Overhills Road (Figure 1).

Undeveloped forested land is located to the east and west of the project site. An agriculture field is located to the north and Nursery Road serves as the southern boundary. The Jumping Run Creek watershed is comprised of a mixture of undeveloped forested land, wetlands, suburban residential areas, commercial areas, and a large golf course community. The watershed has a drainage area of 15.9 square miles. The topography of the watershed is typical sandhills type topography which is rolling in nature.

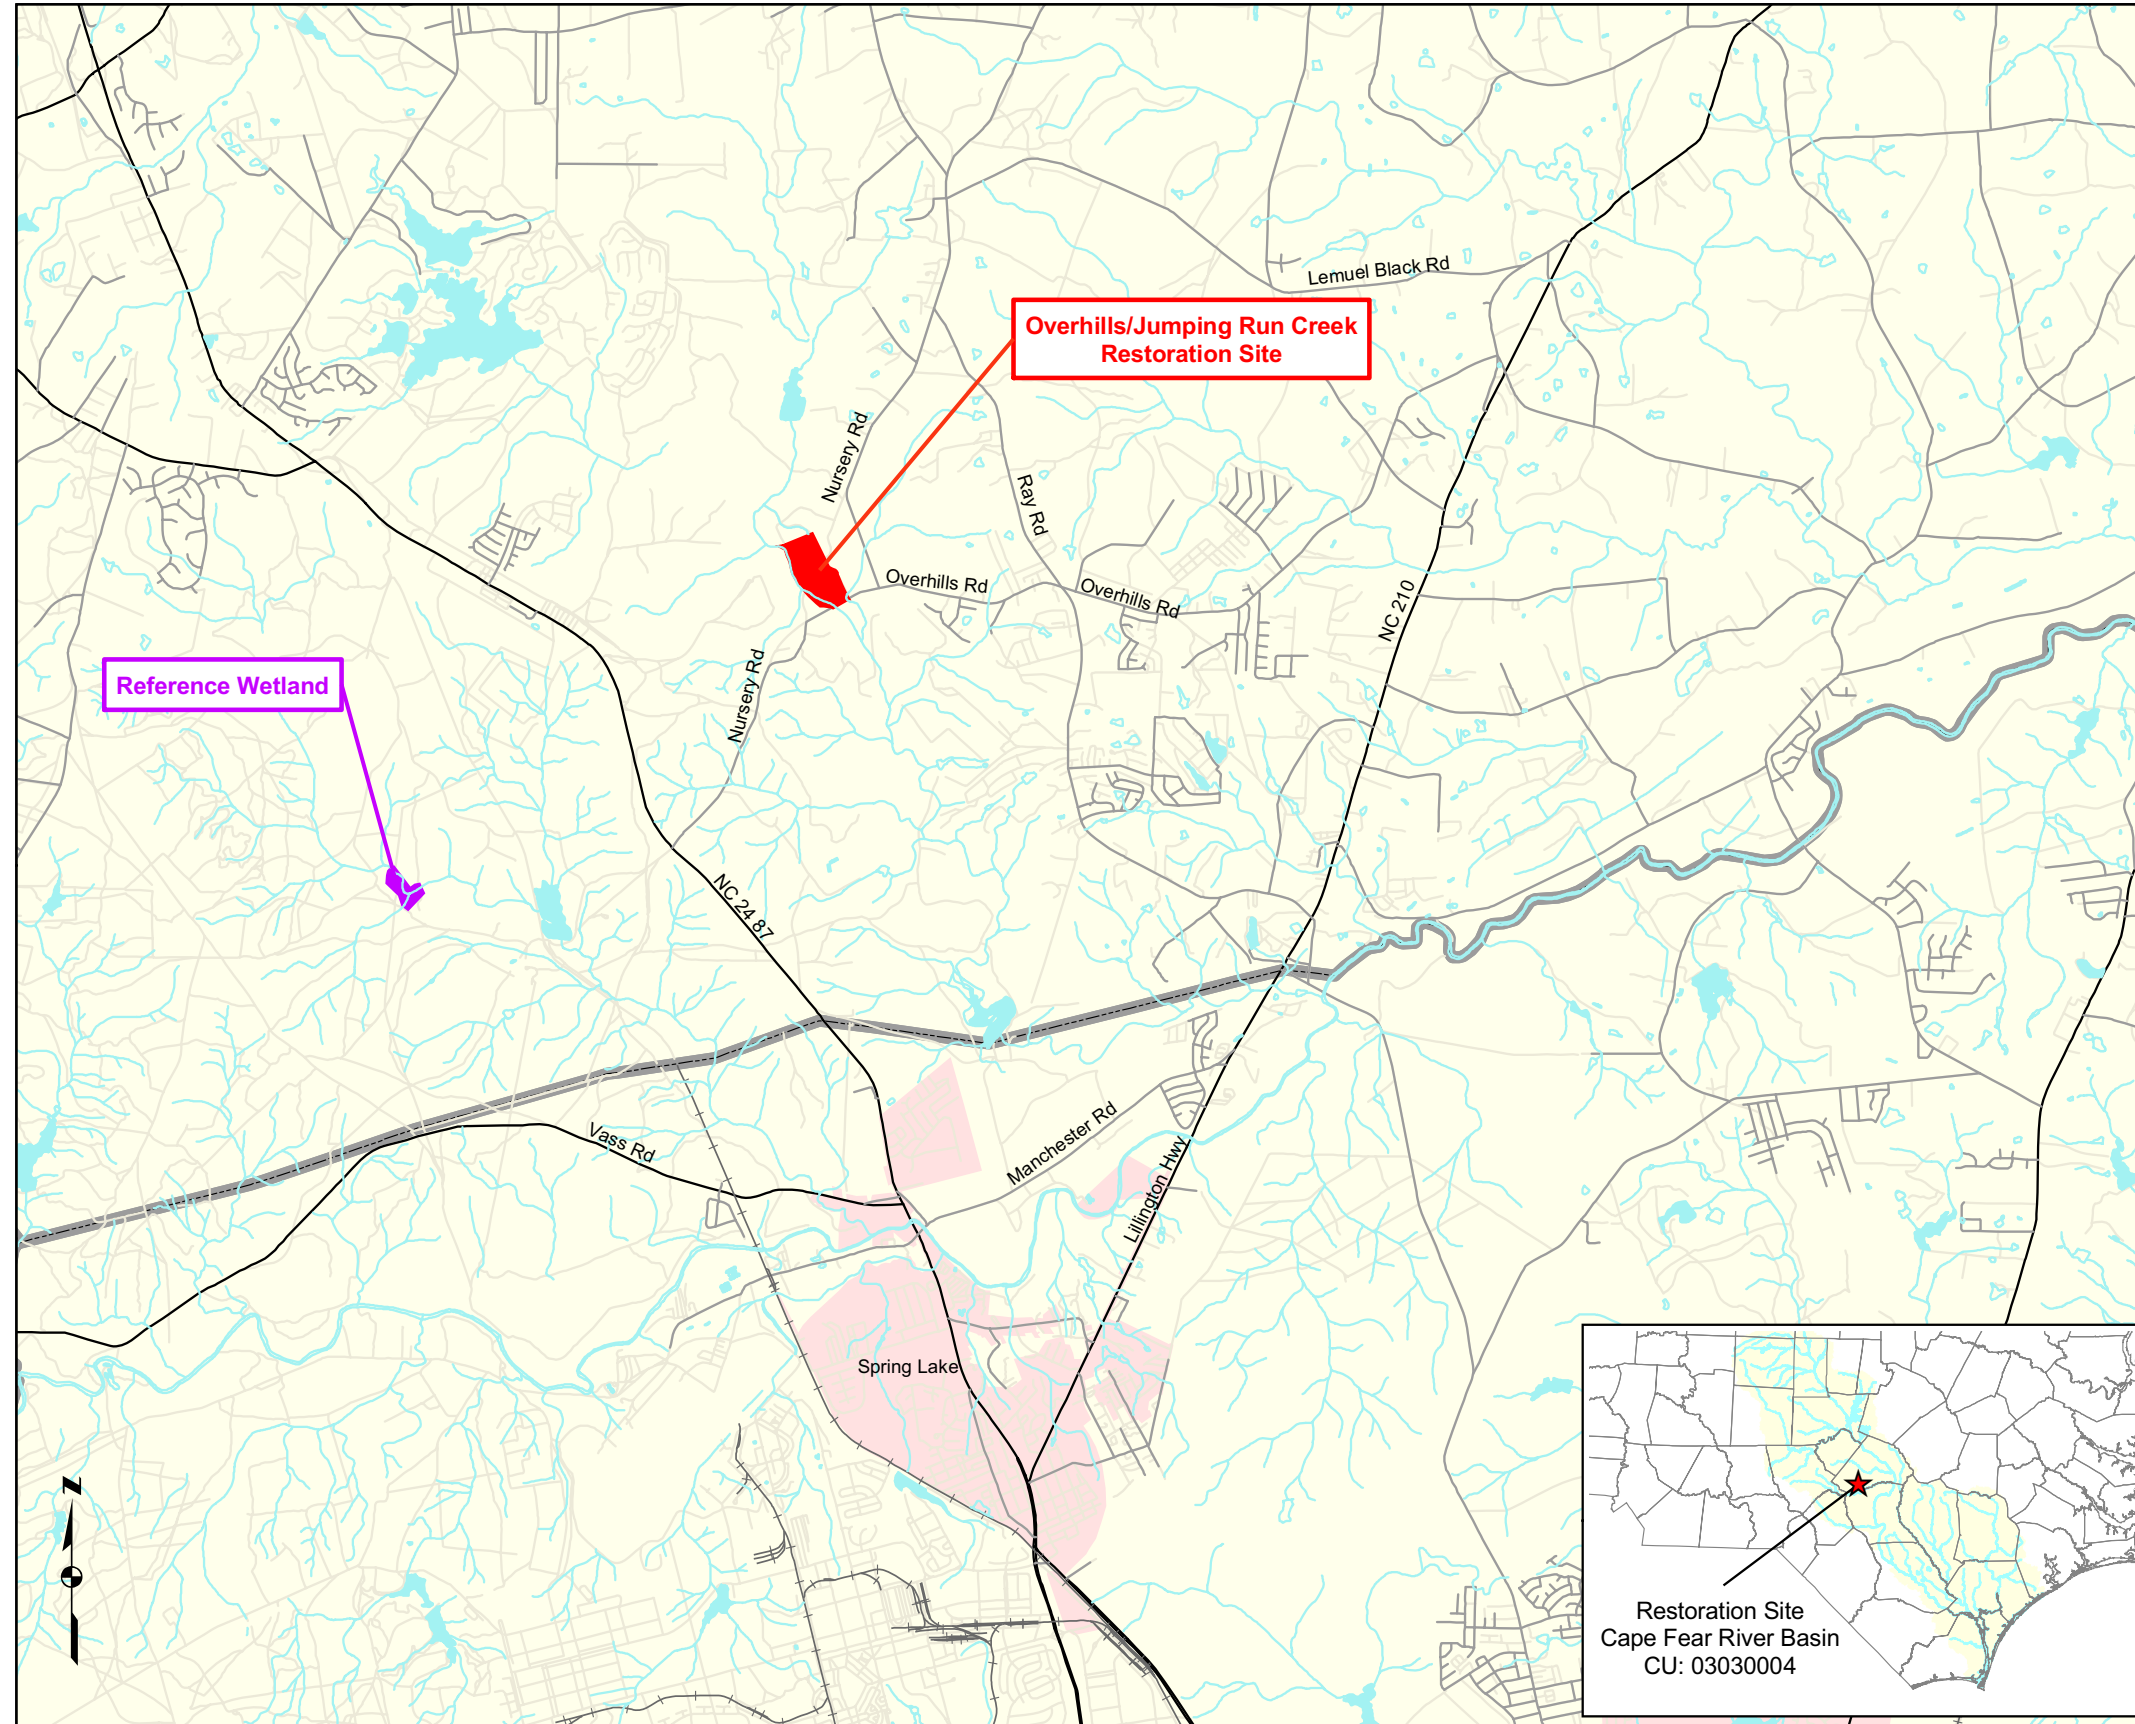


Figure 1. Location Map

Overhills/Jumping Run Creek Stream and Wetland Restoration Project  
 EEP #: 0199  
 Harnett County, North Carolina


Mitigation Plan  
 November 2007



- 1:24000 Hydrography
- NCDOT Primary Roads
- NCDOT Secondary Roads
- Railroads
- Overhills/Jumping Run Creek  
35.258N, 79.000W
- Reference Wetland  
35.227N, 79.050W



Directions to Overhills/Jumping Run Creek Restoration Site: From Raleigh, take US401 South following signs through Fuquay-Varina and into downtown Lillington. Turn right onto NC 27 and follow for about 9 miles, then turn left onto Nursery Rd. After 6.5 miles, Nursery Rd will come to a T, turn right to stay on Nursery Rd. The restoration site is half a mile from the T on the right hand side. To get to the reference site from the restoration site: Continue travelling east on Nursery Rd for 2 miles, then turn left onto NC24/NC87 for 3 miles. Turn right onto Vass Rd/NC 690. Continue for 3.5 miles, then turn right at sign that states "NO POVs" (this is part of Fort Bragg, need permission to enter). Follow the dirt road straight, at least 1.7 miles (do not turn or veer). The reference well is in the woods, about 100 feet from the end of the road.

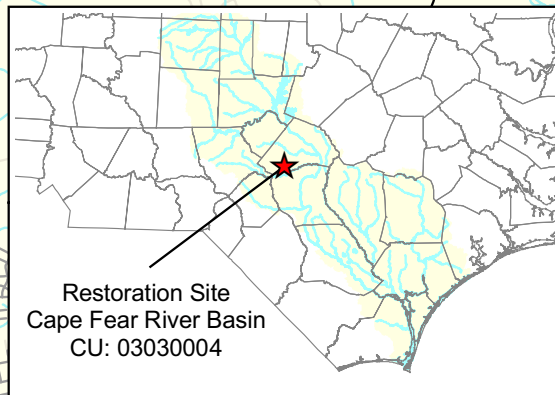



## 1.4 PROJECT HISTORY AND BACKGROUND

<b>Exhibit Table II. Project Activity and Reporting History Overhills/Jumping Run Creek Restoration Project - EEP Project No. 199</b>		
<b>Activity or Report</b>	<b>Data Collection Complete</b>	<b>Actual Completion or Delivery</b>
Restoration Plan	NA	March 2003
Final Design - 90%	NA	Dec 2003
Construction (2004-2006)	NA	June 2006
Temporary S&E mix applied to entire project area	NA	2004
Permanent seed mix applied to entire project area	NA	Nov 2004
Bare root, containers, and live stakes for majority of site	NA	Dec 2004
Water released into new channel	NA	Oct 2005
Permanent seed mix applied to entire project area	NA	Nov 2005
Bare root, containers, and live stakes for remainder of site	NA	Dec 2005
Mitigation Plan (Year 0 Monitoring - baseline)	July 2007	Nov 2007
Year 1 Monitoring	Nov 2007	Nov 2007
Year 2 Monitoring	NA	NA
Year 3 Monitoring	NA	NA
Year 4 Monitoring	NA	NA
Year 5 Monitoring	NA	NA

NA = Not Applicable

<b>Exhibit Table III. Project Component Table</b> <b>Overhills/Jumping Run Creek Restoration Project - EEP Project No. 199</b>	
<b>Designer</b>	BLUE: Land Water Infrastructure 1271 Old US Highway #1 South Southern Pines, NC 28387 Phone: 910-692-6461
<b>Construction Contractor</b>	Vaughn Contracting, Inc P.O. Box 796 Wadesboro, NC 28170 Phone: 704-694-6450
Surveying Subcontractor	Barbara H. Mulkey Engineers, Inc 7516 E. Independence Blvd, Suite 100 Charlotte, NC 28227 Phone: 704-537-7300
Site Preparation Subcontractor	Herndon, Inc P.O. Box 36 Lugoff, SC 29078 Phone: 803-513-8002
Erosion Control Subcontractor	Carolina Environmental Contractors, Inc P.O. Box 1905 Monut Airy, NC 27030 Phone: 336-320-3849
<b>Vegetation Planting Contractor</b> & Nursery Stock Supplier for lifestakes and potted plants	North State Environmental, Inc 2889 Lowery Street Winston-Salem, NC 27101 Phone: 339-725-2010
Nursery Stock Supplier for bare roots	International Paper
Seed Mix Sources	NA
<b>Monitoring Performers</b>	Stantec Consulting Services, Inc 801 Jones Franklin Rd, Ste 300 Raleigh, NC 27606
Stream Monitoring POC Vegetation Monitoring POC Wetland Monitoring POC	David Bidelspach 919-851-6866 Amber Coleman 919-851-6866 Amber Coleman 919-851-6866



<b>Exhibit Table IV. Project Background Table</b>	
<b>Overhills/Jumping Run Creek Restoration Project - EEP Project No. 199</b>	
Project County	Harnett County
Drainage Area	15.9 square miles
Drainage impervious cover estimate (%)	5%
Stream Order	3rd
Physiographic Region	Sandhills
Ecoregion	Sandhills
Rosgen Classification of As-built	C5
Cowardin Classification	Palustrine
Dominant soil types	Roanoke
	Bibb
	Wehadkee
	Augusta
Reference site ID	Gum Swamp
USGS HUC for Project	03030004
USGS HUC for Reference	03030004
NCDWQ Subbasin for Project	03-16-14
NCDWQ Subbasin for Reference	03-16-13
NCDWQ Classification for Project	C
NCDWQ Classification for Reference	C
Any portion of any project segment 303d listed?	No
Any portion of any project segment upstream of a 303d listed segment?	No
Reasons for 303d listing or stressor	
Percent of project easement fenced	0%

## 1.5 MONITORING PLAN VIEW

See Monitoring Plan View Sheets on the following pages.

This page intentionally blank




# OVERHILLS

(Nursery Road)

Jumping Run Creek / McLeod's Creek

Stream and Wetland Restoration Project


Garnett County, North Carolina

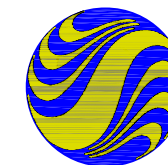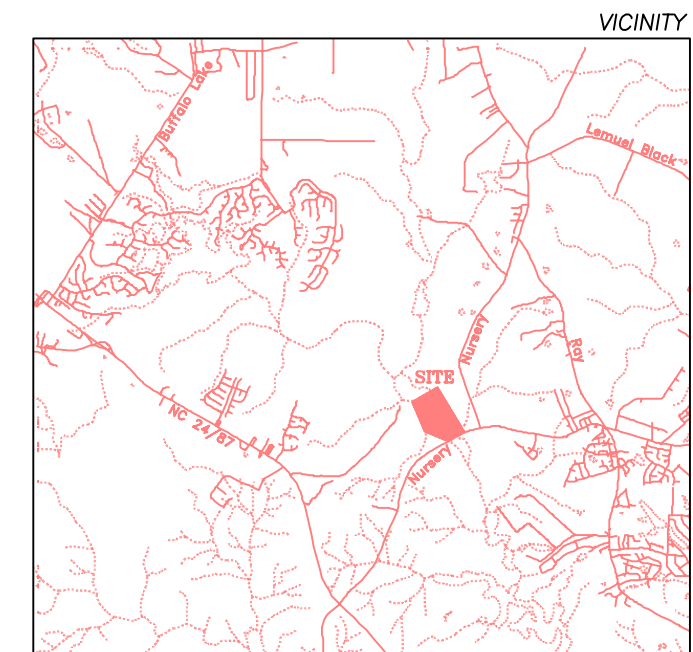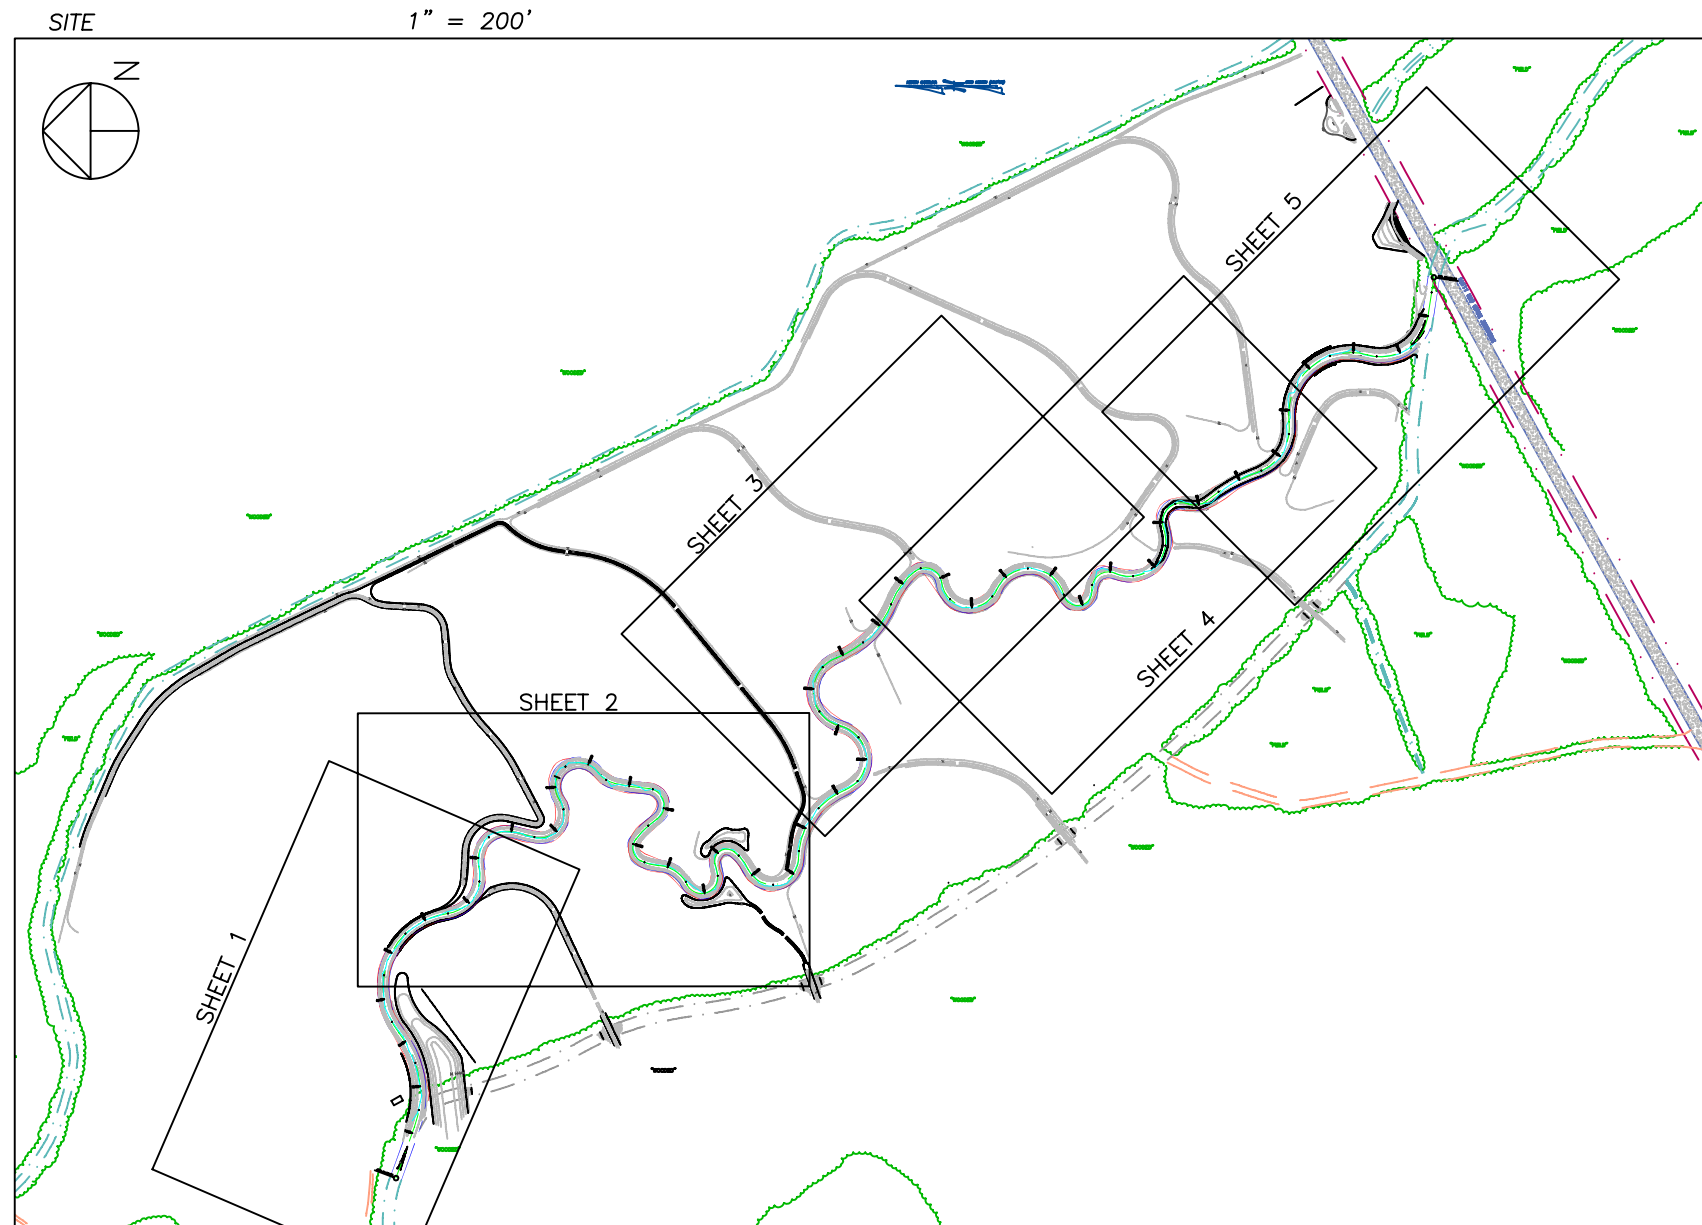

Stantec Consulting Services Inc.  
Suite 300, 801 Jones Franklin Rd  
Raleigh, NC 27606  
Tel. 919.851.6866  
Fax. 919.851.7024  
www.stantec.com

AS-BUILT PROJECT ENGINEER SIGNATURE

ORIGINAL STREAM RESTORATION DESIGN BY:  
BLUE: LAND, WATER, INFRASTRUCTURE, PA

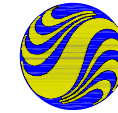


Stantec Consulting Services Inc.  
 Suite 300, 801 Jones Franklin Rd  
 Raleigh, NC 27606  
 Tel. 919.851.6866  
 Fax. 919.851.7024  
 www.stantec.com

PROJECT NO.	SHEET NO.
SCO#070695701	01
AS-BUILT PROJECT ENGINEER	

LEGEND			
	DESIGN THALWEG		DESIGN LOG CROSS VANE
	AS-BUILT BANKFULL		DESIGN ROOT WAD
	DESIGN BANKFULL		VEG PLOT PINS
	MONITORING LONGITUDINAL PROFILE		VEG PLOTS
	DESIGN GRADE		CROSS-SECTIONS
			PHOTO POINTS




CROSS SECTION PIN LOCATIONS			VEG PLOT PIN COORDINATES		
PIN	LAT	LONG	PIN	LAT	LONG
XS1PL	35.26109096	-79.00252352	VP1	35.26080136	-79.00066535
XS1PR	35.26124247	-79.00249424	VP1	35.26092137	-79.00083395
XS2PL	35.26081361	-79.00061178	VP7	35.26053462	-79.00144889
XS2PR	35.26072332	-79.00069698	VP7	35.26064411	-79.00136751

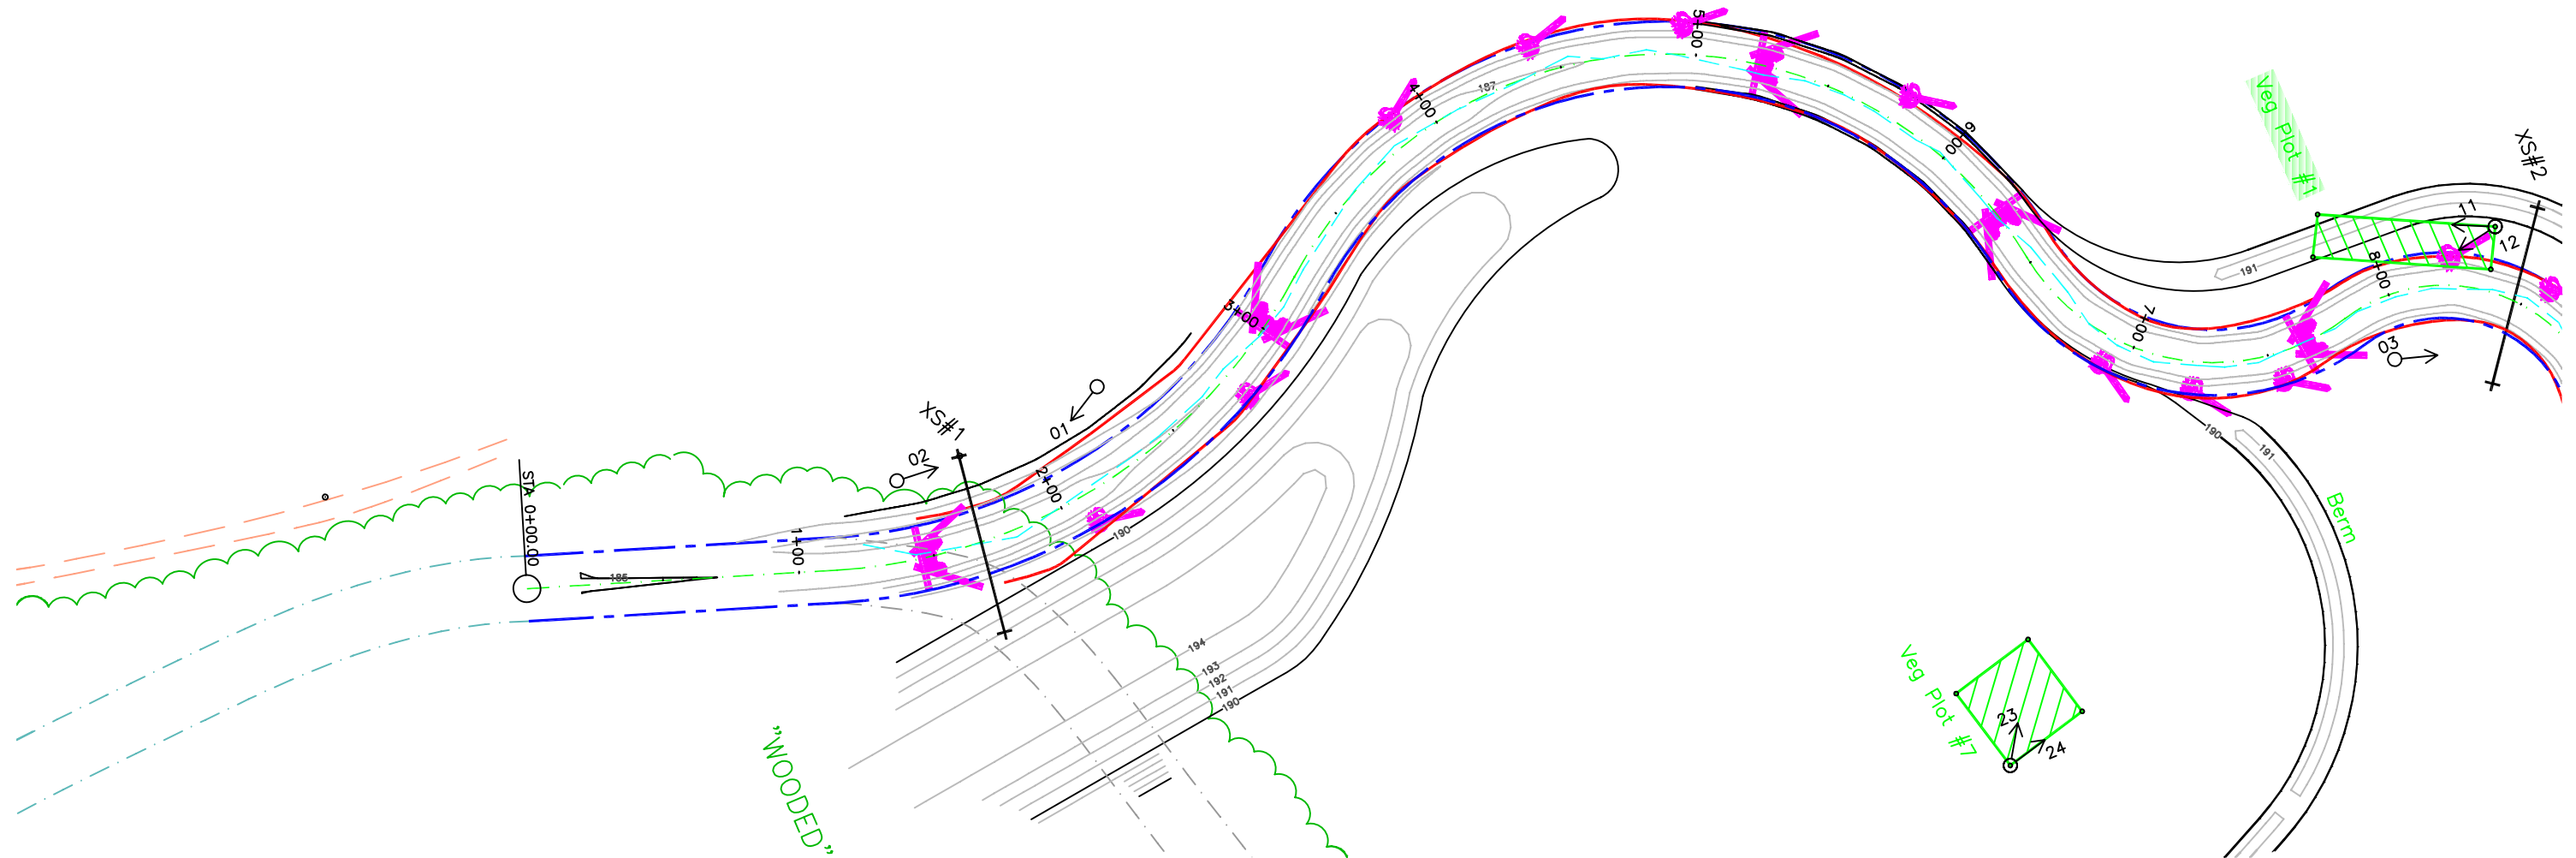



Stantec Consulting Services Inc.  
 Suite 300, 801 Jones Franklin Rd  
 Raleigh, NC 27606  
 Tel. 919.851.6866  
 Fax. 919.851.7024  
 www.stantec.com

PROJECT NO.	SHEET NO.
SCO#070695701	02
AS-BUILT PROJECT ENGINEER	

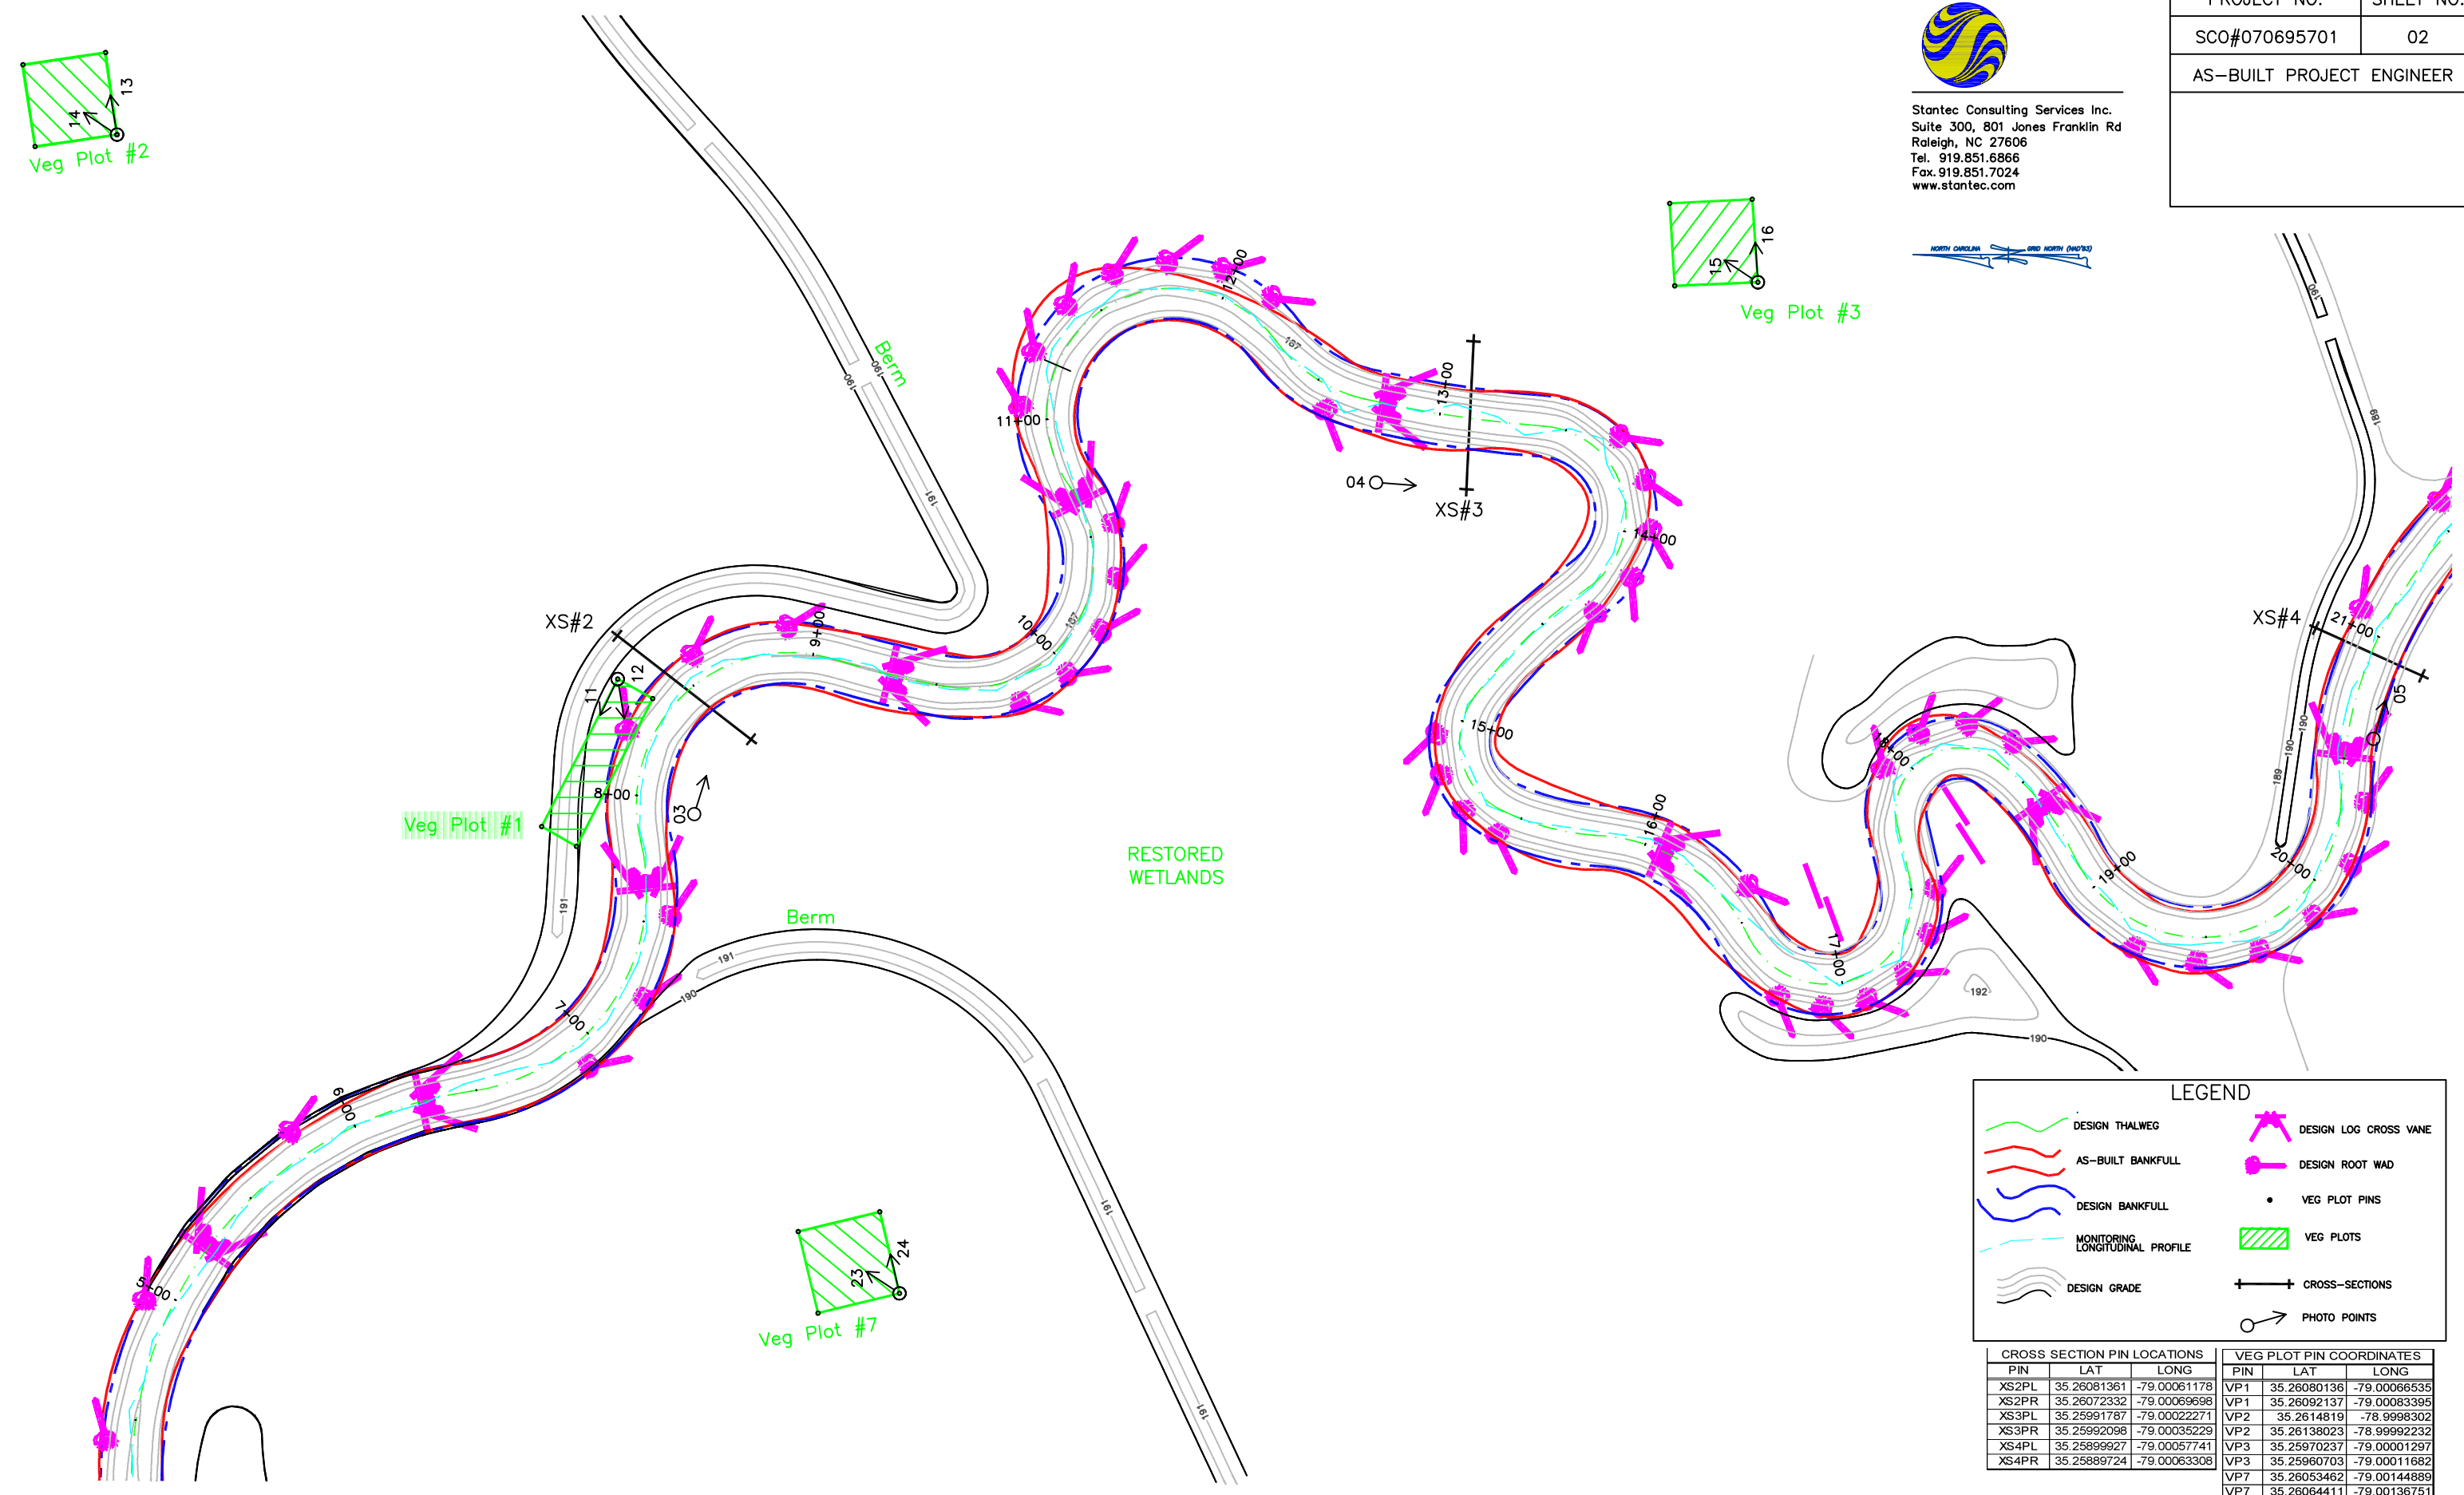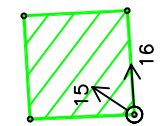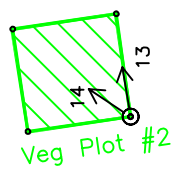

**LEGEND**




	DESIGN THALWEG		DESIGN LOG CROSS VANE
	AS-BUILT BANKFULL		DESIGN ROOT WAD
	DESIGN BANKFULL		VEG PLOT PINS
	MONITORING LONGITUDINAL PROFILE		VEG PLOTS
	DESIGN GRADE		CROSS-SECTIONS
			PHOTO POINTS

CROSS SECTION PIN LOCATIONS			VEG PLOT PIN COORDINATES		
PIN	LAT	LONG	PIN	LAT	LONG
XS2PL	35.26081361	-79.00061178	VP1	35.26080136	-79.00066535
XS2PR	35.26072332	-79.00069698	VP1	35.26092137	-79.00083395
XS3PL	35.25991787	-79.00022271	VP2	35.2614819	-78.9998302
XS3PR	35.25992098	-79.00035229	VP2	35.26138023	-78.99992232
XS4PL	35.25899927	-79.00057741	VP3	35.25970237	-79.00001297
XS4PR	35.25889724	-79.00063308	VP3	35.25960703	-79.00011682
			VP7	35.26053462	-79.00144889
			VP7	35.26064411	-79.00136751

PROJECT NO.	SHEET NO.
SCO#070695701	03
AS-BUILT PROJECT ENGINEER	



Stantec Consulting Services Inc.  
 Suite 300, 801 Jones Franklin Rd  
 Raleigh, NC 27606  
 Tel. 919.851.6866  
 Fax. 919.851.7024  
 www.stantec.com

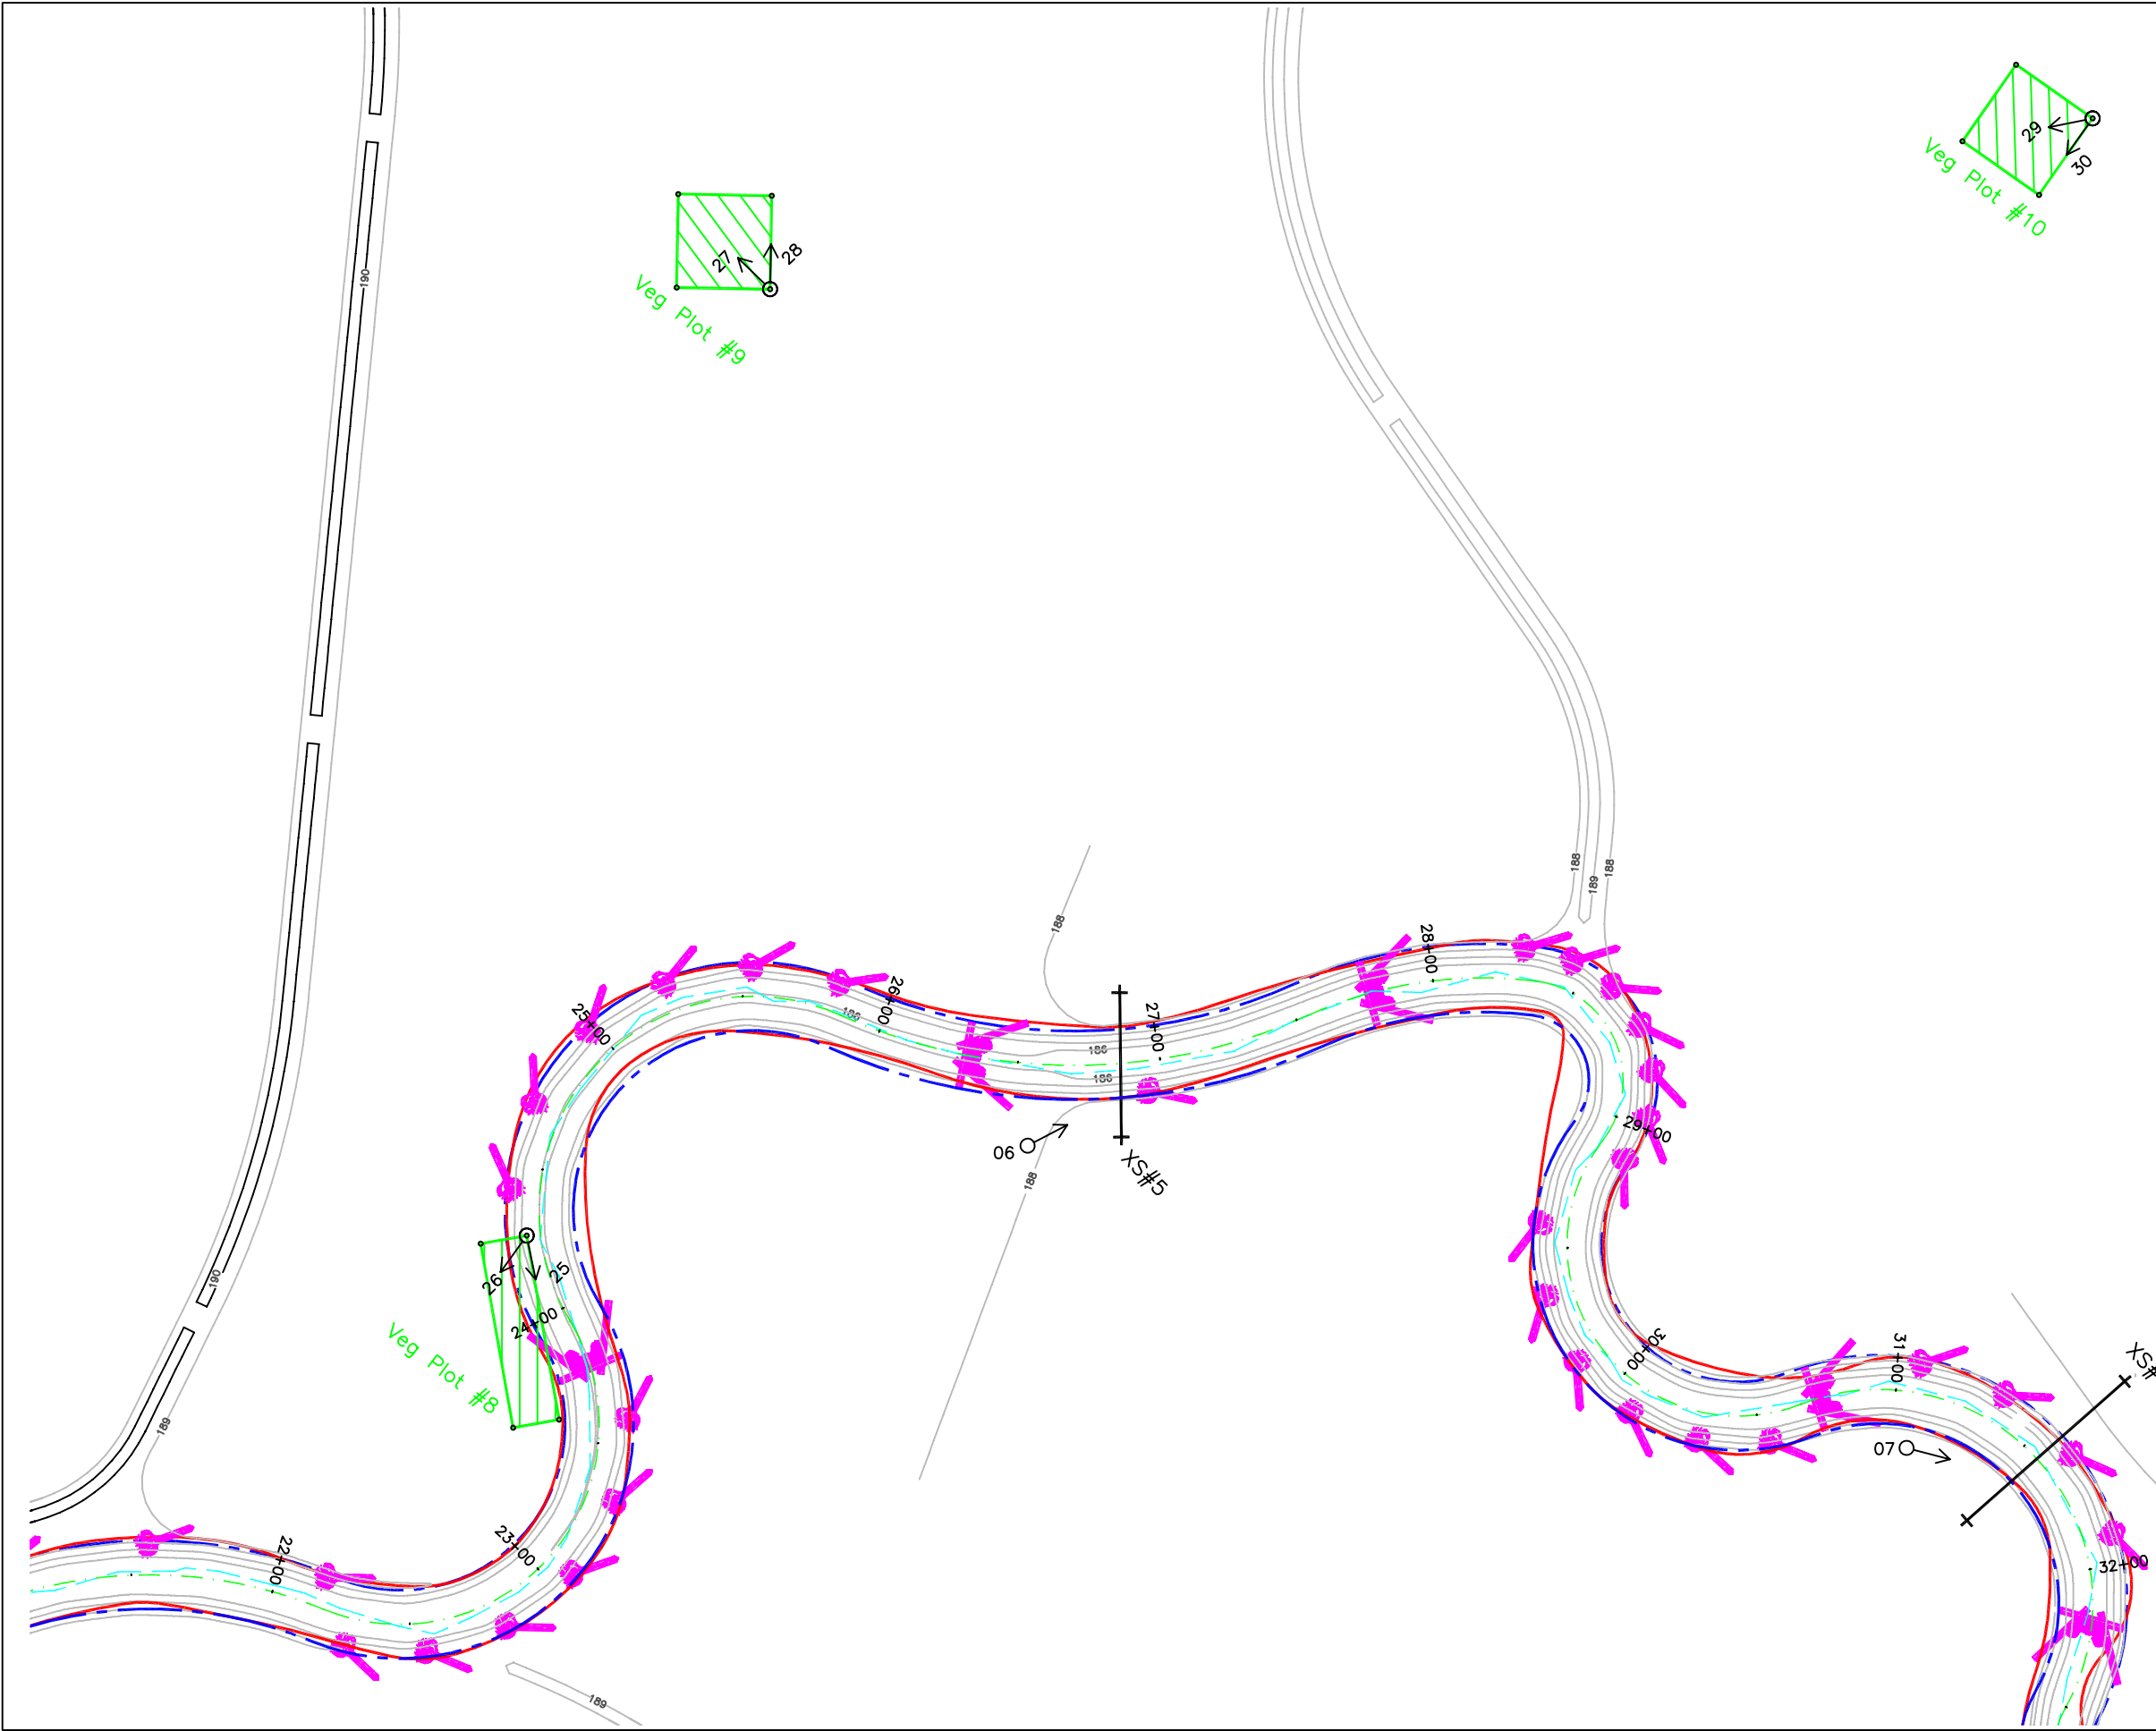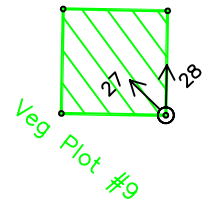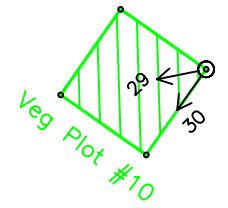

**LEGEND**

	DESIGN THALWEG		DESIGN LOG CROSS VANE
	AS-BUILT BANKFULL		DESIGN ROOT WAD
	DESIGN BANKFULL		VEG PLOT PINS
	MONITORING LONGITUDINAL PROFILE		VEG PLOTS
	DESIGN GRADE		CROSS-SECTIONS
			PHOTO POINTS

**CROSS SECTION PIN LOCATIONS**


PIN	LAT	LONG
XS5PL	35.25857955	-78.99914964
XS5PR	35.25849085	-78.99925158
XS6PL	35.25763716	-78.99869711
XS6PR	35.25764396	-78.99883106

**VEG PLOT PIN COORDINATES**





PIN	LAT	LONG
VP8	35.25882237	-78.99983412
VP8	35.25870055	-79.00000515
VP9	35.25930164	-78.99884514
VP9	35.25942907	-78.99884242
VP10	35.25851643	-78.99760386
VP10	35.25858954	-78.99773114



PROJECT NO.	SHEET NO.
SCO#070695701	04
AS-BUILT PROJECT ENGINEER	

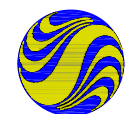

Stantec Consulting Services Inc.  
 Suite 300, 801 Jones Franklin Rd  
 Raleigh, NC 27606  
 Tel. 919.851.6866  
 Fax. 919.851.7024  
 www.stantec.com

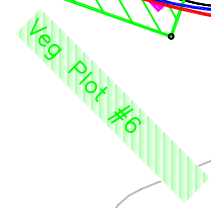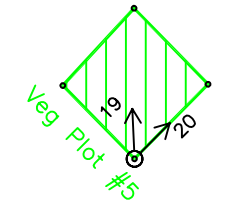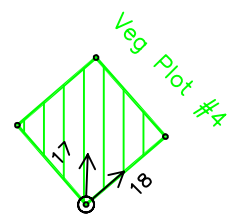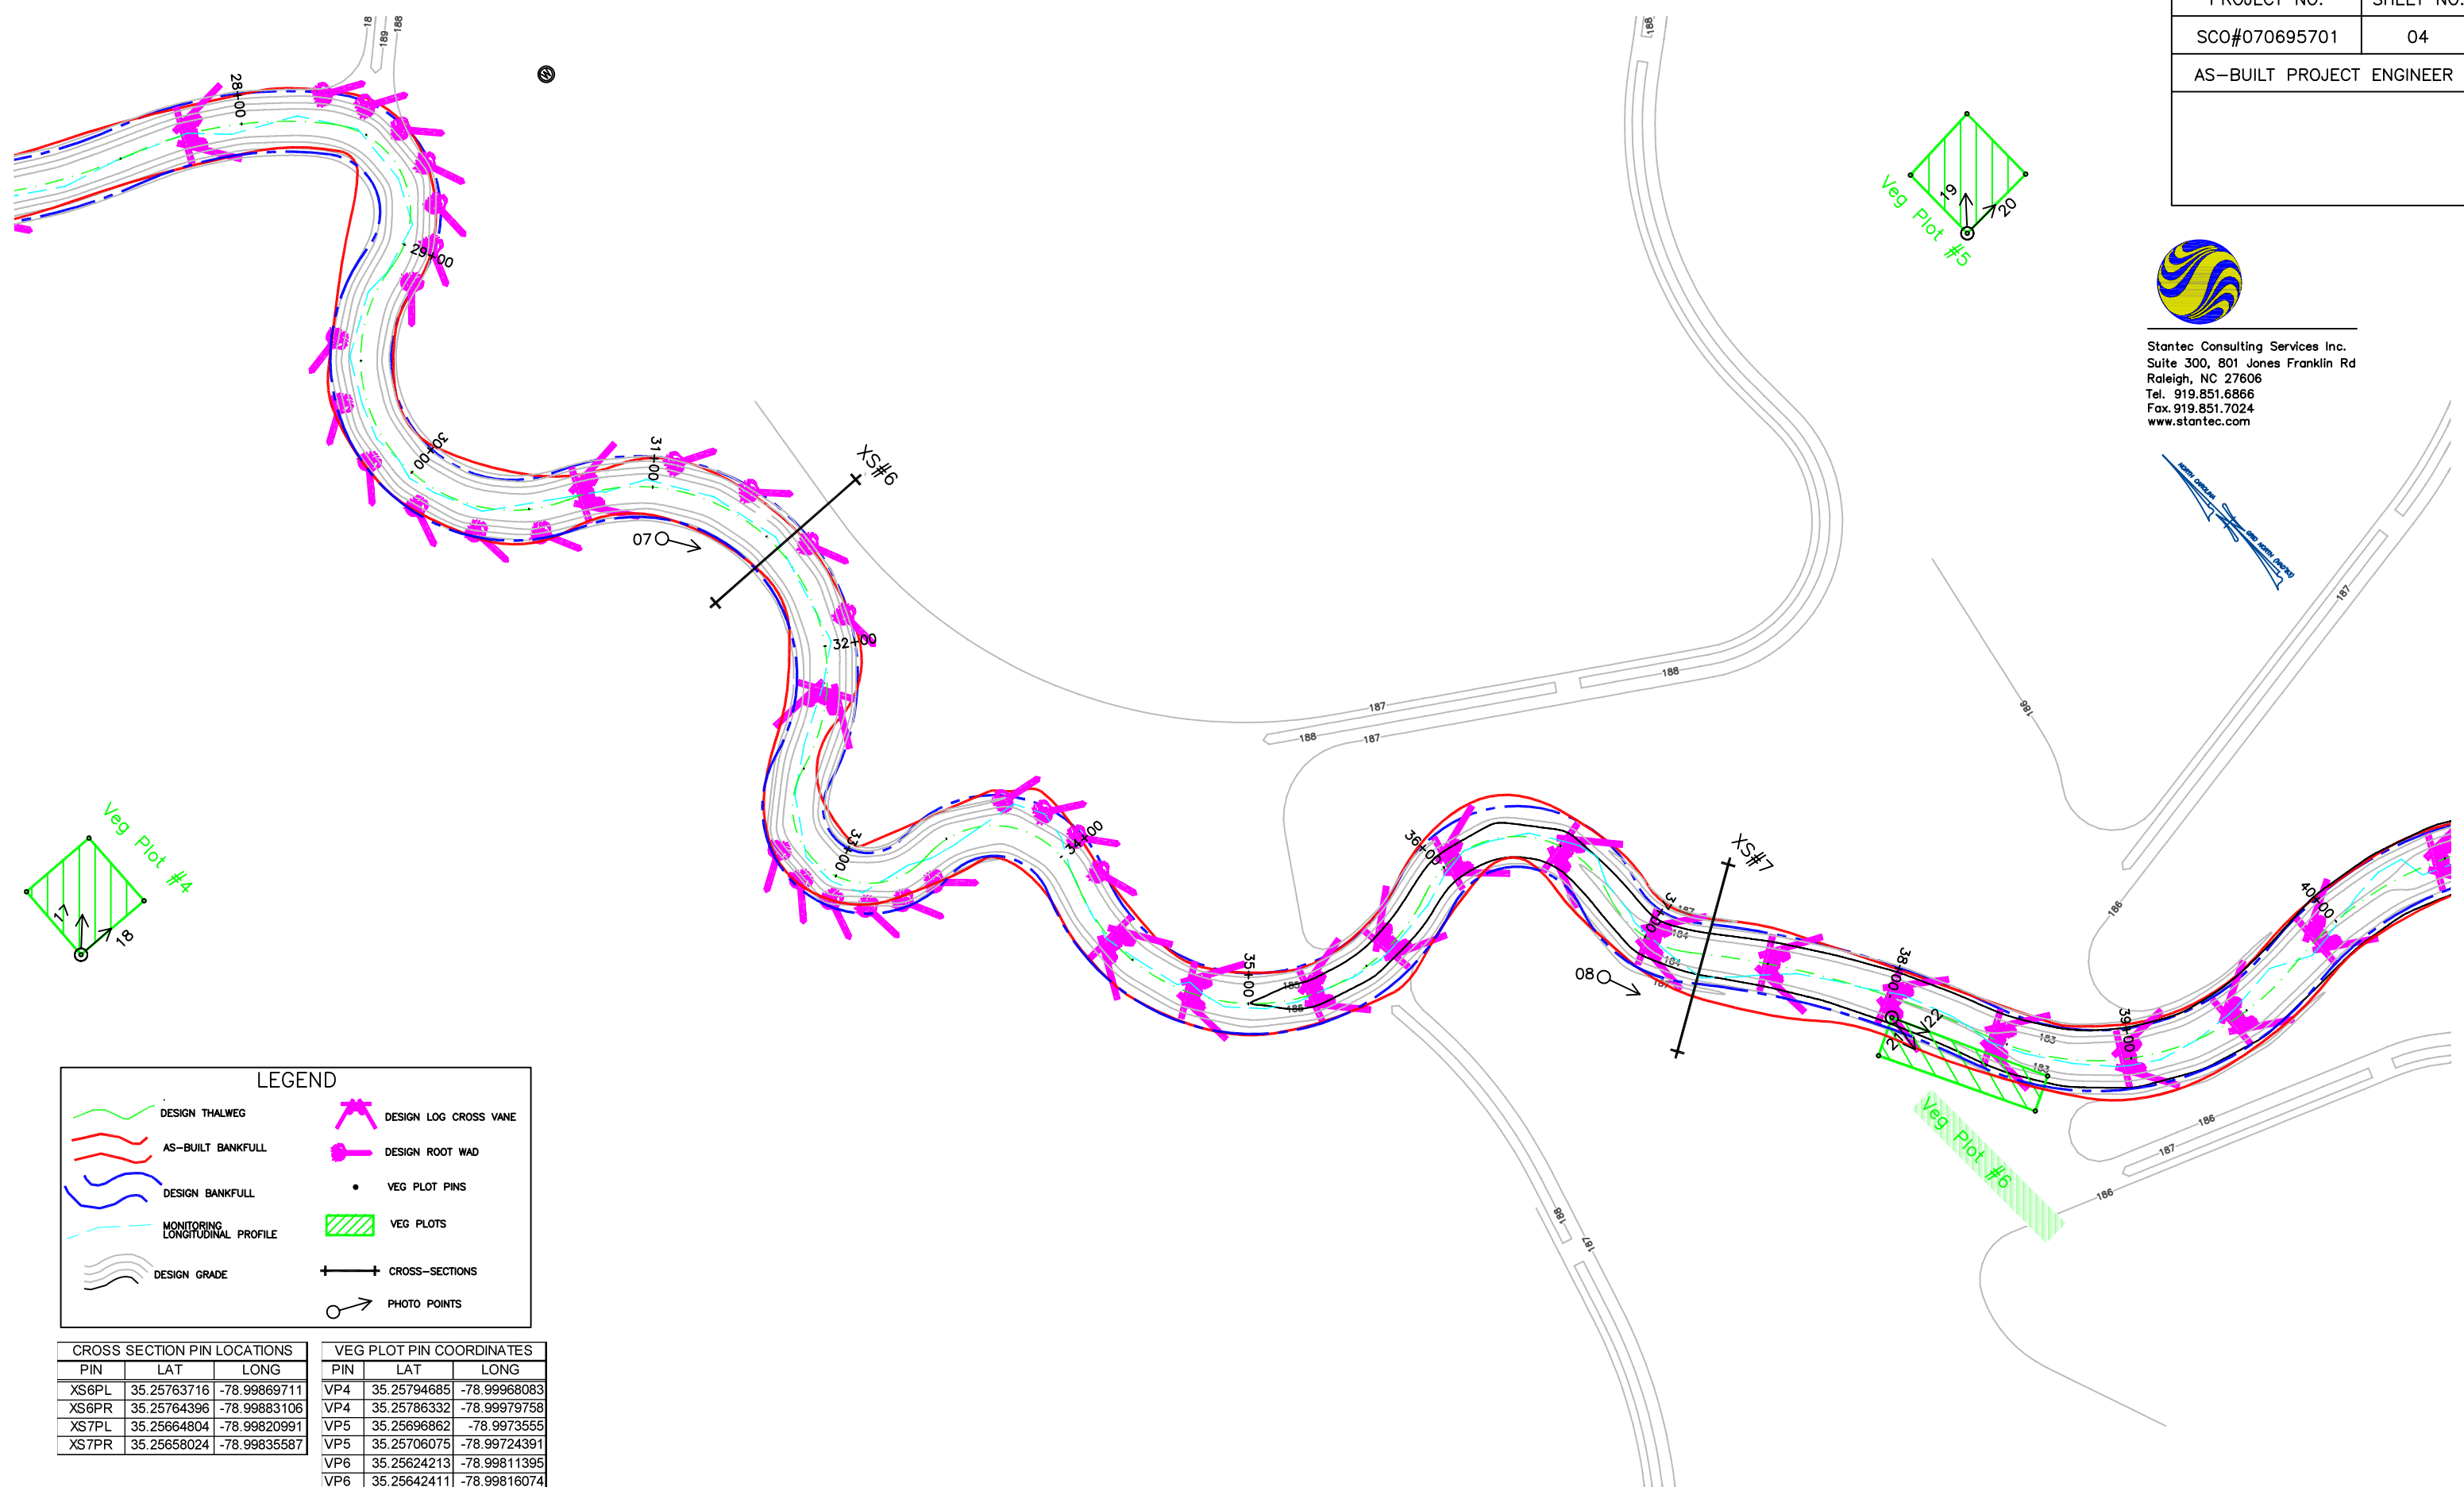


**LEGEND**

- DESIGN THALWEG
- AS-BUILT BANKFULL
- DESIGN BANKFULL
- MONITORING LONGITUDINAL PROFILE
- DESIGN GRADE
- DESIGN LOG CROSS VANE
- DESIGN ROOT WAD
- VEG PLOT PINS
- VEG PLOTS
- CROSS-SECTIONS
- PHOTO POINTS


CROSS SECTION PIN LOCATIONS		
PIN	LAT	LONG
XS6PL	35.25763716	-78.99869711
XS6PR	35.25764396	-78.99883106
XS7PL	35.25664804	-78.99820991
XS7PR	35.25658024	-78.99835587

VEG PLOT PIN COORDINATES		
PIN	LAT	LONG
VP4	35.25794685	-78.99968083
VP4	35.25786332	-78.99979758
VP5	35.25696862	-78.99735555
VP5	35.25706075	-78.99724391
VP6	35.25624213	-78.99811395
VP6	35.25642411	-78.99816074

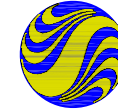

Stantec Consulting Services Inc.  
 Suite 300, 801 Jones Franklin Rd  
 Raleigh, NC 27606  
 Tel. 919.851.6866  
 Fax. 919.851.7024  
 www.stantec.com

PROJECT NO.	SHEET NO.
SCO#070695701	05
AS-BUILT PROJECT ENGINEER	

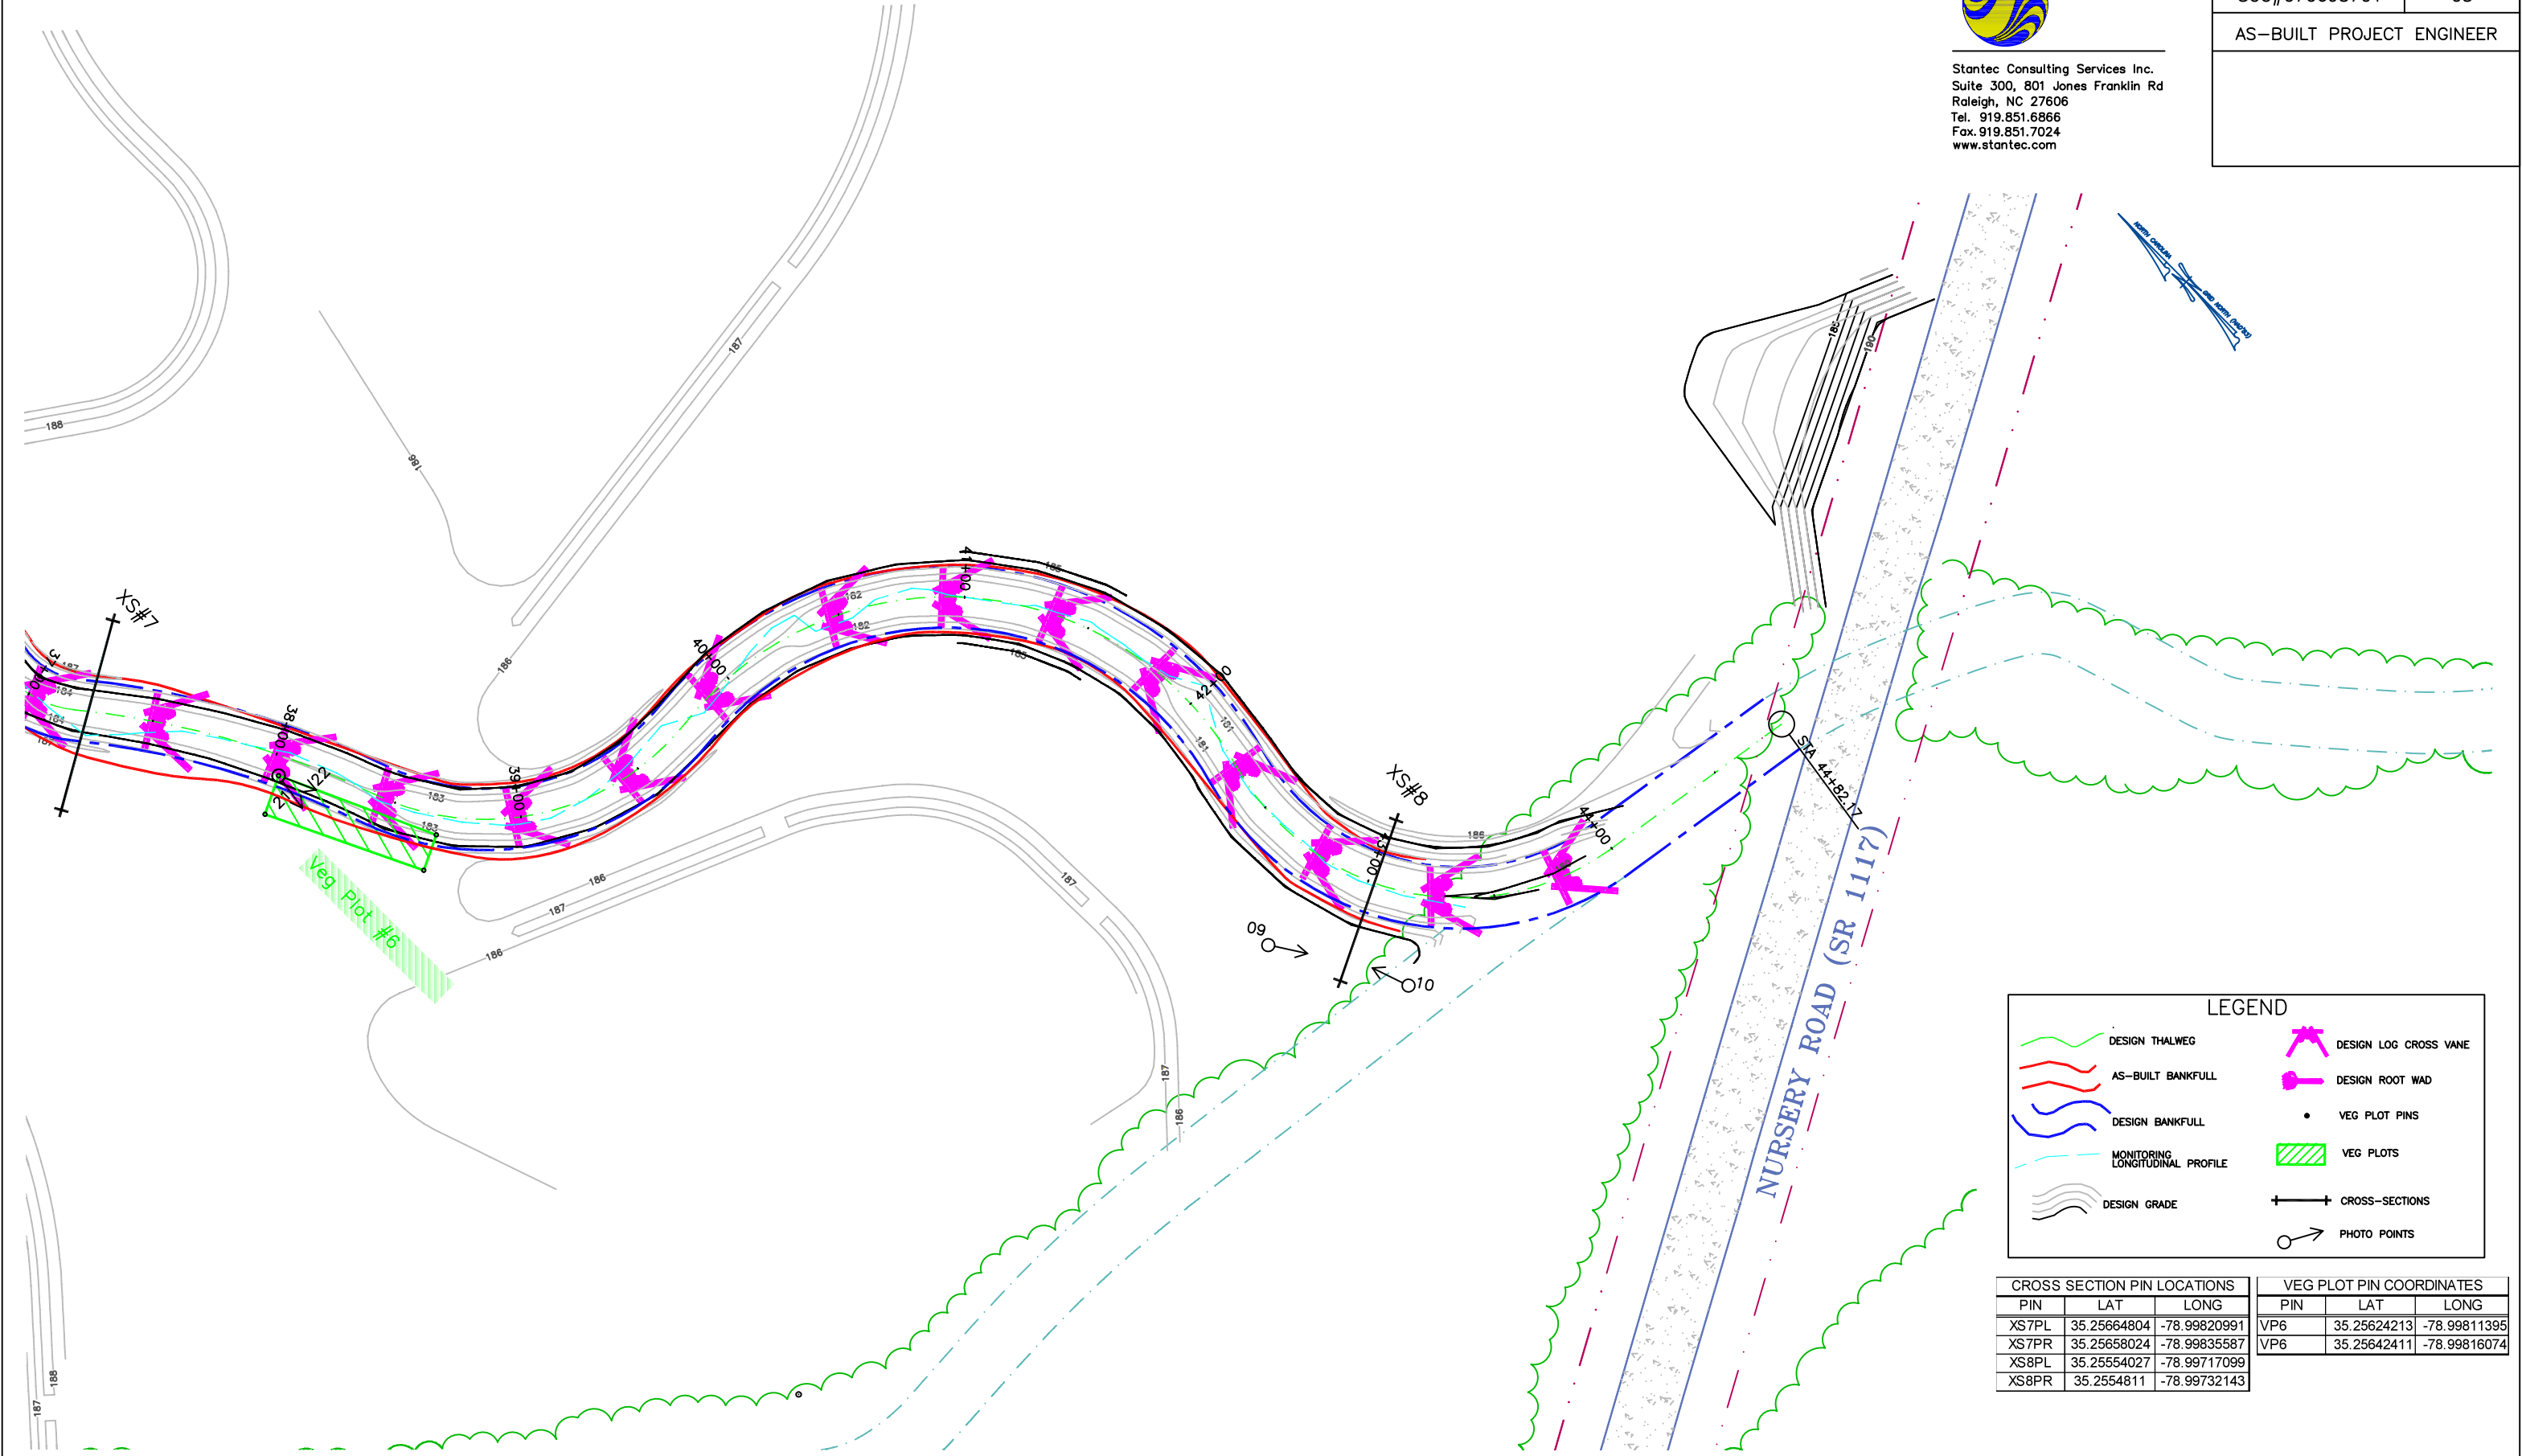

**LEGEND**

	DESIGN THALWEG		DESIGN LOG CROSS VANE
	AS-BUILT BANKFULL		DESIGN ROOT WAD
	DESIGN BANKFULL		VEG PLOT PINS
	MONITORING LONGITUDINAL PROFILE		VEG PLOTS
	DESIGN GRADE		CROSS-SECTIONS
			PHOTO POINTS

**CROSS SECTION PIN LOCATIONS**












PIN	LAT	LONG
XS7PL	35.25664804	-78.99820991
XS7PR	35.25658024	-78.99835587
XS8PL	35.25554027	-78.99717099
XS8PR	35.2554811	-78.99732143


**VEG PLOT PIN COORDINATES**

PIN	LAT	LONG
VP6	35.25624213	-78.99811395
VP6	35.25642411	-78.99816074



LEGEND


-  DESIGN THALWEG
-  AS-BUILT BANKFULL
-  DESIGN BANKFULL
-  MONITORING LONGITUDINAL PROFILE
-  DESIGN GRADE
-  DESIGN LOG CROSS VANE
-  DESIGN ROOT WAD
-  VEG PLOT PINS
-  VEG PLOTS
-  CROSS-SECTIONS
-  MONITORING WELLS

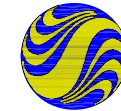

Stantec Consulting Services Inc.  
 Suite 300, 801 Jones Franklin Rd  
 Raleigh, NC 27606  
 Tel. 919.851.6866  
 Fax. 919.851.7024  
 www.stantec.com

PROJECT NO.	SHEET NO.
SCO#070695701	06
AS-BUILT PROJECT ENGINEER	

MONITORING WELL LOCATIONS		
NAME	LAT	LONG
JR1	35.25633325	-78.99619887
JR2	35.25704509	-78.99613104
JR3	35.25664382	-78.99728101
JR4	35.25619691	-78.99852738
JR5	35.25784127	-78.99692474
JR6	35.25862538	-78.99752997
JR7	35.25818234	-78.99853736
JR8	35.25781716	-78.99941543
JR9	35.25748554	-79.00022606
JR10	35.26158413	-78.99927614
JR11	35.26140403	-78.99991026
JR12	35.26115267	-79.00070518
JR13	35.26069372	-79.00165278
JR14	35.26164227	-79.00115399
JR15	35.2615367	-79.00177709
RG1	35.26235615	-79.00249699

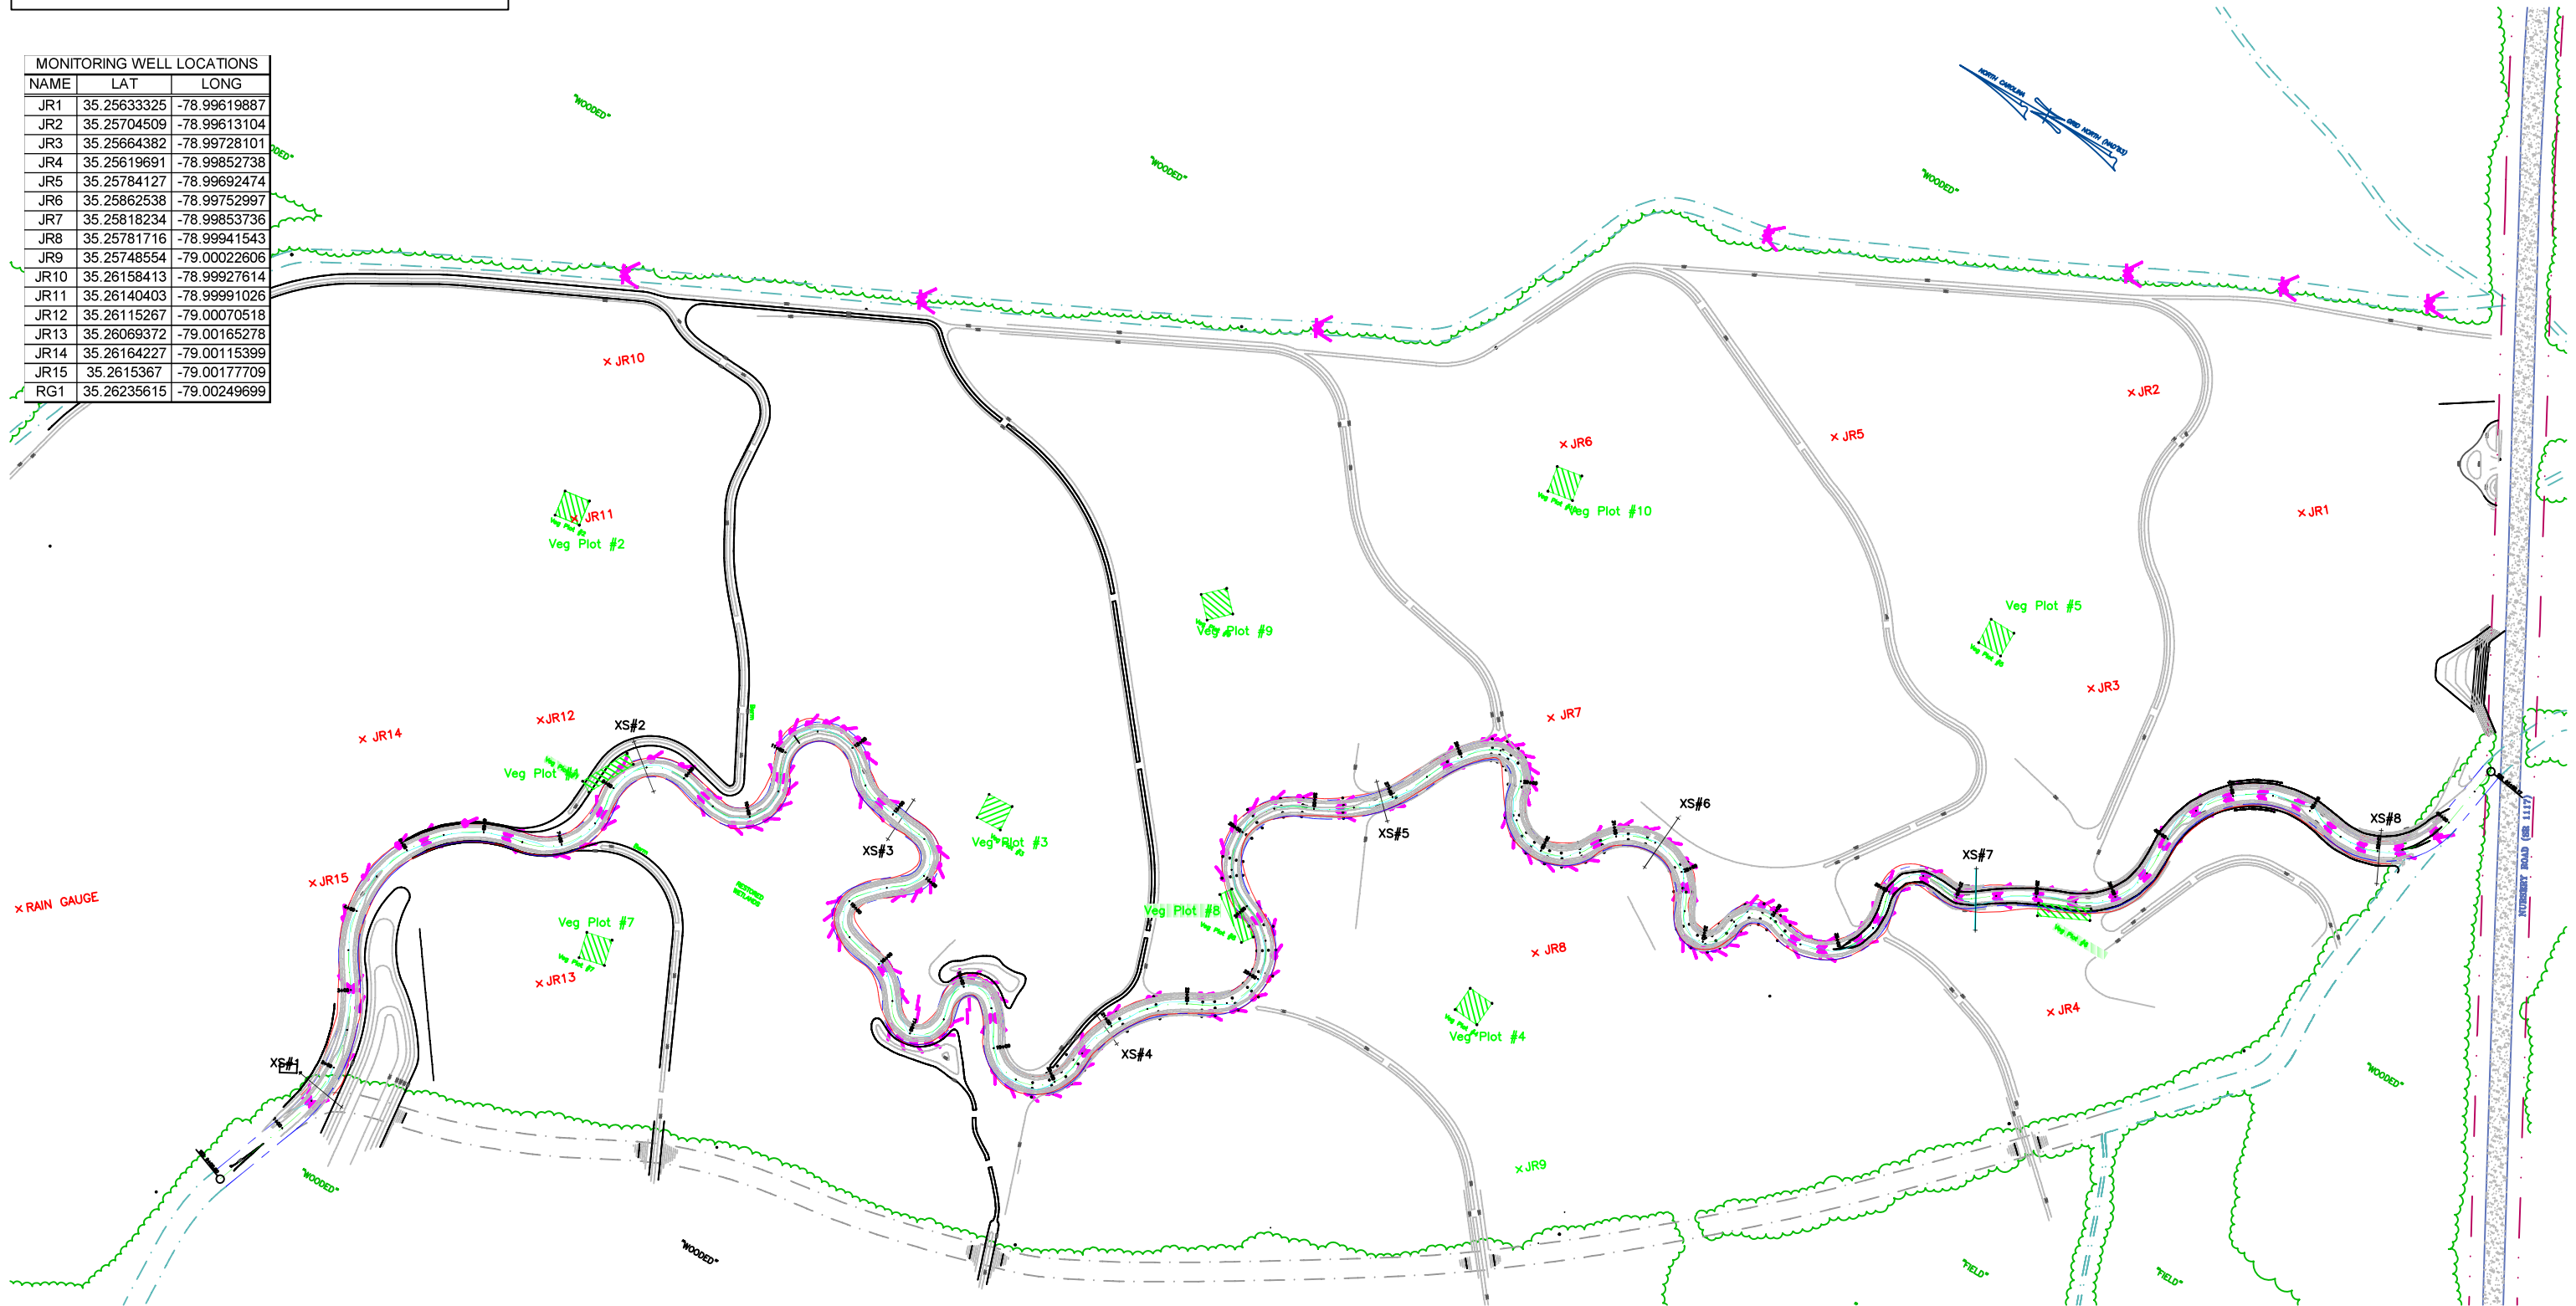



## **2.0 Project Condition and Monitoring Results**

---

### **2.1 VEGETATION ASSESSMENT**

The Carolina Vegetation Survey (CVS) methodology was utilized to sample vegetation in October of 2007. Ten 100m<sup>2</sup> plots have been established throughout the project. In each plot, two plot corners have been permanently located with conduit or rebar.

As per the mitigation plan, the vegetative success criteria are based on the US Army Corps of Engineers Stream Mitigation Guidelines (USACE, 2003). The final vegetative success criteria will be the survival of 260 5-year old planted trees per acre at the end of the year 5 monitoring period. An interim measure of vegetation planting success will be the survival of at least 320 3-year old planted trees per acre at the end of year 3 of the monitoring period.

The Year 1 stem counts within each of the vegetative monitoring plots are included in Exhibit Tables A1 through A5 in Appendix A. Six of the plots have over 320 stems per acre while four of the plots have less than 320 stems per acre.

#### **2.1.1 Vegetation Problem Areas**

In addition to the four failing vegetation plot sites, several vegetation problem areas exist on site. These sites are referred to as VPA 1, 2, & 3 on the Integrated Problem Area Plan View located in Appendix D. In VPA 1 and 2, standing water had been present for a substantial length of time, causing the majority of the planted vegetation to die (Photos 1 & 2 in Appendix A2). VPA 3 is currently overrun with invasive species, primarily *Lespedeza* (Photo 3). *Lespedeza* is a major problem on this project site, as it is also invading berms and most high areas (Photo 4).

#### **2.1.2 Vegetation Problem Area Plan View**

Vegetative problem areas are shown on the Current Condition Plan View in Appendix D.

### **2.2 STREAM ASSESSMENT**

#### **2.2.1 Hydrology**

The region has been in an extreme drought for much of 2007. No evidence of bankfull flows were observed onsite and flows were not measured with peak stage recorders. In order to verify bankfull events, a crest gauge should be installed onsite.

<b>Exhibit Table V. Verification of Bankfull Events</b>			
<b>Overhills/Jumping Run Creek Restoration Project - EEP Project No. 199</b>			
<b>Date of Data Collection</b>	<b>Date of Occurrence</b>	<b>Method</b>	<b>Photo</b>
2007	None	NA	NA

**2.2.2 Bank Stability**

As directed by EEP, bank stability will not formally be measured for this project.

**2.2.3 Stream Problem Areas**

A major stream problem area is located from station 33+00 to 44+00 (1100 linear feet) where the stream has experienced serious failure. At Station 33+00 a head cut has developed and produced massive erosion around the bend at this location (see SPA Photos 1 & 2 in Appendix B3 and Appendix D Integrated Problem Areas Plan View). Downstream from this head cut, most of the in-stream structures have failed (SPA Photos 3 & 4). Erosion around the structures has forced the banks to migrate as much as seven feet, making this section of stream extremely unstable. Mid-channel bar formation is also occurring along the reach (SPA Photo 5). The headcut and downstream problems are apparent in the longitudinal profile of the channel. The survey data suggest that this section of the stream may not have been transitioned to the existing stream properly. The designed pattern and structures were not appropriate for a channel with this gradient. The log cross-vane structures on this reach do not match the goals of the design. Instead of notching the log arms that connect to the vane, the log arms were simply “buted” up against one another (SPA Photo 3). There was also a lack of geotextile fabric in the installation and the angle of the structure was not optimal to reduce near bank shear stress and bank scour. Other major issues include the presence of a beaver dam near Station 6+30 (Photo 6). The dam is causing a hydraulic jump, producing scour downstream.

With the extent of the existing deterioration of this 1100 linear foot portion of the restoration reach, it will not be possible to repair the stream around the failed structures, or to rebuild or replace structures without addressing the characteristics of the stream. The stream has migrated vertically and is actively migrating horizontally. There are too many failed structures and the potential for future bank erosion and additional horizontal migration is too great for a simple repair. The stream channel in this location has eroded below a clay layer into a highly erosive sandy soil layer which will continue to create stability problems. The channel should be realigned with the appropriate pattern, dimension, and structures that will adequately transition from the higher elevation of the restoration to the receiving stream which is at a lower elevation. There is room on the right side of the existing alignment to be able to develop a new pattern that will provide the correct channel dimensions, grade control structures, and step pools needed to dissipate energy though this section of the reach. This action will stop the head cut from continuing upstream causing further damage to the restored channel. The majority of the materials needed for construction could be salvaged from the impaired reach.

Minor erosion problem areas were found from station 0+00 to station 32+00 of the restoration reach (Photo 7). Erosion causes were attributed to failure at the root wad in some cases and shear stress in others. Shear stress is caused by high velocity flows towards the outside of the meander. The placement and/or installation of some root wads has caused scouring, along with bank erosion and migration from

eddies that form around and behind the root wad structures (SPA Photo 8). The problem areas here can be fixed with simple hand grading of the banks and live stake planting around the toe of the structures. This will help stabilize the banks and limit the amount of erosion and degradation currently occurring. The hand grading should bring the banks back to a reasonable slope to the top of the banks or the berms on either side. These areas should be addressed to prevent additional erosion and migration from occurring. See Exhibit Table B1 and representative photos in Appendix B as well as the map in Appendix D for more information.

**2.2.4 Stream Problem Area Plan View**

Stream problem areas are shown on the Current Condition Plan View in Appendix D.

**2.2.5 Stability Assessment**

<b>Exhibit Table VI. Categorical Stream Feature Visual Stability Assessment Overhills/Jumping Run Creek - EEP Project No. 199</b>						
<b>Feature</b>	<b>Initial</b>	<b>MY-01</b>	<b>MY-02</b>	<b>MY-03</b>	<b>MY-04</b>	<b>MY-05</b>
A. Riffles	76%	76%				
B. Pools	70%	70%				
C. Thalweg	77%	77%				
D. Meanders	91%	91%				
E. Bed General	75%	75%				
F. Bank Condition	74%	73%				
G. Vanes / J Hooks, etc.	36%	34%				
H. Wads and Boulders	65%	63%				

2.2.6 Quantitative Measures Summary

Exhibit Table VII. Baseline Morphology and Hydraulics Summary  
Overhills/Jumping Run Creek Restoration Project - EEP Project No. 199

Parameter	USGS Gage Data			Regional Curve Interval			Pre-Existing Condition			Project Stream Reference			Design			Baseline		
	Min	Max	Med	Min	Max	Med	Min	Max	Med	Min	Max	Med	Min	Max	Med	Min	Max	Med
BF Width (ft)							11.7	15.9	14.5	10.8	20.4	14.4	21.0	25.0	22.5	18.5	23.2	20.1
Flood Prone Width (ft)							-	-	16.5	-	-	200.0	-	-	200	-	-	-
BF Cross Sectional Area (SF)							54.6	77.5	56.7	13.5	22.1	21.0	35.0	46	41	23.0	49.0	36.0
BF Mean Depth (ft)							2.4	2.5	2.50	1.0	2.7	2.7	2.5	2.5	2.5	1.2	2.7	1.7
BF Max Depth (ft)							2.4	2.5	2.5	1.8	4.2	3.2	2.5	2.5	2.5	2.4	4.8	2.9
Width/Depth Ratio							4.9	6.4	5.8	4.1	8	5.4	8.4	10	9	7.8	15.5	11.7
Entrenchment Ratio							-	-	1.2	-	-	13.9	-	-	8.9	-	-	-
Bank Height Ratio							2.5	0.8	2.4	0.6	1.5	1.2	1.0	2.4	1.2	-	-	-
Wetted Perimeter (ft)							-	-	-	-	-	-	-	-	-	-	-	-
Hydraulic Radius (ft)							-	-	-	-	-	-	-	-	-	-	-	-
<b>Pattern</b>																		
Channel Beltwidth (ft)							-	-	600	45	110	77	80	200	110	48	149	100
Radius of Curvature (ft)							-	235	235	12	30	23.4	30	175	80	30	167	68.0
Meander Wavelength (ft)							315	660	500	125	175	150	125	250	200	10	276	220
Meander Width ratio							21.8	45.6	3.5	8.7	12.2	10.4	5.6	11.1	8.9	6.40	13.00	10.10
<b>Profile</b>																		
Riffle Length							-	-	-	-	-	-	-	-	-	12	183	72
Riffle Slope							-	-	-	-	-	-	-	-	-	0.0500	0.1100	0.0810
Pool Length							-	-	-	-	-	-	-	-	-	8	116	151
Pool Spacing							-	-	-	-	-	-	-	-	-	39	231.00	121
<b>Substrate</b>																		
d50 (mm)							0.5	9	0.5	0.58	0.65	0.62	0.5	9	0.5	0.09	0.27	0.21
d84 (mm)							2.6	30	2.6	1.7	1.7	1.7	2.6	30	2.6	0.36	0.44	0.4
<b>Additional Reach Parameters</b>																		
Valley Length (ft)							-	-	2808	-	-	230	-	-	2444	-	-	2444
Channel Length (ft)							-	-	3064	-	-	330	-	-	4400	-	-	4400
Sinuosity							-	-	1.1	-	2.3	1.4	-	2.1	1.6	-	-	1.8
Water Surface Slope							-	-	-	-	-	-	-	-	7E-04	-	-	0.0011
BF Slope							-	-	-	-	-	-	-	-	-	-	-	0.0015
Rosgen Classification							G5c	G4	G5c	E5	C5	E5	E	C	E	-	-	C5
*Habitat Index																		
*Macrobenthos																		

\*Inclusion will be project specific and determined primarily by As-built monitoring plan/success criteria

**Exhibit Table VIII. Morphology and Hydraulic Monitoring Summary  
Overhills/Jumping Run Creek Restoration Project - EEP Project No. 199  
Overhills**

Parameter	Cross Section 1			Cross Section 2			Cross Section 3			Cross Section 4			Cross Section 5			Cross Section 6			Cross Section 7			Cross Section 8		
	Sta 1+64 Pool			Sta 8+47 Pool			Sta 13+12 Riffle			Sta 20+93 Riffle			Sta 26+86 Pool			Sta 31+56 Riffle			Sta 37+24 Pool			Sta 43+82 Pool		
Dimension	MY0	MY1		MY0	MY1		MY0	MY1		MY0	MY1		MY0	MY1		MY0	MY1		MY0	MY1		MY0	MY1	
BF Width (ft)	26.87	24.66		22.27	22.29		18.15	17.86		23.19	22.25		24.16	24.5		19.06	19.24		16.54	16.68		27.1	27.7	
Floodprone Width (ft) (approx)	>100	>100		>100	>100		>100	>100		>100	>100		>100	>100		>100	>100		>100	>100		>100	>100	
BF Cross Sectional Area (ft <sup>2</sup> )	71.89	67.45		44.82	51.12		31.03	31.52		49.19	59.6		37.7	40.91		23.43	25.35		35.21	39.41		106.1	111	
BF Mean Depth (ft)	2.74	2.68		2.01	2.29		1.71	1.76		2.12	2.68		1.56	1.67		1.23	1.32		2.13	2.36		3.92	4	
BF Max Depth (ft)	4.5	4.66		4.8	4.90		2.6	2.6		4.3	5.9		2.4	2.6		1.9	2.2		3.5	3.7		7.4	7.1	
Width/Depth Ratio	9.0	10.0		11.1	9.7		10.6	10.1		10.9	8.3		15.5	14.7		15.5	14.6		7.8	7.1		6.9	6.9	
Entrenchment Ratio	>3.72	>4.1		>4.49	>4.48		>5.51	>5.6		>4.32	>4.49		>4.14	>4.08		>5.25	>5.20		>6.05	>6.0		>3.69	>3.61	
Wetted Perimeter (ft)																								
Hydraulic radius (ft)																								
<b>Substrate</b>																								
d50 (mm)							0.27	0.10		0.093	0.081					0.27	0.15							
d84 (mm)							0.41	0.27		0.36	0.28					0.44	0.35							
<b>Parameter</b>	<b>MY-00 (2007)</b>			<b>MY-01 (2007)</b>			<b>MY-02 (2008)</b>			<b>MY-03 (2009)</b>			<b>MY-04 (2010)</b>			<b>MY-05 (2011)</b>								
<b>Pattern</b>	Min	Max	Med	Min	Max	Med	Min	Max	Med	Min	Max	Med	Min	Max	Med	Min	Max	Med						
Channel Beltwidth (ft)	48	149	100	42	146	94																		
Radius of Curvature (ft)	30	167	68.0	35	158	74																		
Meander Wavelength (ft)	130	26	220	125	276	205																		
Meander Width Ratio	6.40	13.70	10.10	6.30	14.00	10.10																		
<b>Profile</b>																								
Riffle Length (ft)	20	122	72	20	100	60																		
Riffle Slope (ft)	0.0011	0.1630	0.0815	0.0016	0.1404	0.0710																		
Pool Length (ft)	8	116	51.0	14	37	84																		
Pool Spacing (ft)	39	231	121	39	319	111																		
<b>Additional Reach Parameters</b>																								
Valley Length (ft)	2605			2605																				
Channel Length (ft)	4400			4400																				
Sinosity	1.68			2																				
Water Surface Slope (ft/ft)	0.0016			0.0015																				
BF Slope (ft/ft)	0.0012			0.0011																				
Rosgen Classification	C			C																				
*Habitat Index																								
*Macrobenthos																								

This page intentionally left blank



## **2.3 WETLAND ASSESSMENT**

### **2.3.1 Wetland Criteria Attainment**

A site is considered to meet the requirements for wetland hydrology if the groundwater saturation is within 12 inches of the ground surface consecutively for 12.5% of the growing season. Fifteen groundwater monitoring wells are currently active on the project site. Nine of the wells met the criteria during the growing season of 2007, but six did not. The growing season in this area is from March 18<sup>th</sup> to November 8<sup>th</sup> for a total of 234 days (NRCS 2002). Well JR-5 had a maximum of 24 consecutive days (10%) where the ground was saturated within 12 inches of the surface. Wells JR-10 and JR-11 had a maximum of 7 days (3%), JR-12 a maximum of 6 (3%), JR-13 21 days (9%), and JR-14 a maximum of 12 days (5%) (Appendix C1).

No conclusions regarding the success or failure of wetland areas in the project area can be made at this time due to a short period of reference well data. A reference well was installed in the vicinity of the site on October 2, 2007, and data was collected from this date until downloading on November 9<sup>th</sup> (Figure 1). The groundwater level at this site remained below the required saturation depth of 12 inches until October 27<sup>th</sup>. However, with just over a month of data at the reference well, no comparisons between the wells in the project area and the reference well can be made. Given that precipitation was below the 30% percentile for the area during most of the growing season, the failure of some gauges to indicate hydrologic success is not cause for significant concern.

**Exhibit Table IX. Wetland Criteria Attainment  
Overhills/Jumping Run Creek Restoration Project / EEP Project No. 199**

<b>Tract</b>	<b>Well ID</b>	<b>Well Hydrology Threshold Met?</b>	<b>Tract Mean</b>	<b>Vegetation Plot ID</b>	<b>Vegetation Density Met (320 stems/acre)</b>	<b>Tract Mean</b>
Site	1	Y	60%	VP1	Y (405)	60%  (453 stems/acre)
	2	Y		VP2	N (162)	
	3	Y		VP3	N (243)	
	4	Y		VP4	Y (324)	
	5	N		VP5	N (121)	
	6	Y		VP6	Y (1335)	
	7	Y		VP7	Y (445)	
	8	Y		VP8	Y (769)	
	9	Y		VP9	N (283)	
	10	N		VP10	Y (445)	
	11	N				
	12	N				
	13	N				
	14	N				
	15	Y				
Reference	Ref Site 1	n/a*				

\*Reference well was installed near the end of the growing season

### 2.3.2 Current Condition Plan View

The plan view for the wetland problem areas is located in the Current Condition Plan View in Appendix D.

### 3.0 References

---

Harrelson, C.C., C.L. Rawlins and J.P. Potyondy. 1994. Stream Channel Reference Sites: An Illustrated Guide to Field Technique. United States Department of Agriculture, Fort Collins, CO.

Lee, Michael T., R. K. Peet, S. D. Roberts, and T. R. Wentworth. 2006. CVS-EEP Protocol for Recording Vegetation, Version 4.0 (<http://cvs.bio.unc.edu/methods.htm>).

NCEEP. 2006. Content, Format and Data Requirements for EEP Monitoring Reports. North Carolina Department of Environment and Natural Resources, Ecosystem Enhancement Program. Raleigh, NC. Version 1.2 November 16, 2006.

Rosgen, D. 1996. Applied River Morphology. Wildland Hydrology, Pagosa Springs, CO.

USACE. 2003. Stream Mitigation Guidelines. United States Army Corps of Engineers, Wilmington Regulatory District; North Carolina Division of Water Quality; United States Environmental Protection Agency, Region IV; Natural Resources Conservation Service; and North Carolina Wildlife Resources Commission. April 2003.

Weakley, Alan S. 2007. Flora of the Carolinas, Virginia, Georgia, and surrounding areas. University of North Carolina Herbarium. Chapel Hill, NC. Working draft of January 11, 2007.

**Click on the Desired Link Below**

**Appendix A  
(Veg. Data & Photos)**

**Appendix B  
(Stream Photos)**

**Appendix C  
(Hydro Data)**

**Appendix D  
(Plan View)**

**APPENDIX A – VEGETATION RAW DATA & PHOTOS**

## Appendix A. Vegetation Raw Data

### A.1 VEGETATION DATA TABLES

<b>EXHIBIT TABLE A1. VEGETATION METADATA</b>	
<b>Report Prepared By</b>	Amber Coleman
<b>Date Prepared</b>	11/25/2007 17:43
<b>database name</b>	Stantec-Overhills_MillBranch-2007-A-v220-yr0-yr1.mdb
<b>database location</b>	U:\171300168
<b>computer name</b>	COLEMANA
<b>DESCRIPTION OF WORKSHEETS IN THIS DOCUMENT</b>	
<b>Metadata</b>	This worksheet, which is a summary of the project and the project data.
<b>Proj, planted</b>	Each project is listed with its PLANTED stems, for each year. This excludes live stakes and lists stems per acre.
<b>Proj, total stems</b>	Each project is listed with its TOTAL stems, for each year. This includes live stakes, all planted stems, and all natural/volunteer stems. Listed in stems per acre.
<b>Plots</b>	List of plots surveyed.
<b>Vigor</b>	Frequency distribution of vigor classes.
<b>Vigor by Spp</b>	Frequency distribution of vigor classes listed by species.
<b>Damage</b>	List of most frequent damage classes with number of occurrences and percent of total stems impacted by each.
<b>Damage by Spp</b>	Damage values tallied by type for each species.
<b>Damage by Plot</b>	Damage values tallied by type for each plot.
<b>Planted Stems by Plot and Spp</b>	Count of planted living stems of each species for each plot; dead and missing stems are excluded.
<b>PROJECT SUMMARY</b>	
<b>Project Code</b>	199
<b>project Name</b>	Overhills Stream and Wetland Restoration
<b>Description</b>	Stream and Wetland Restoration
<b>River Basin</b>	
<b>length(ft)</b>	
<b>stream-to-edge width (ft)</b>	
<b>area (sq m)</b>	
<b>Required Plots (calculated)</b>	
<b>Sampled Plots</b>	10

**EXHIBIT TABLE A2. VEGETATION VIGOR BY SPECIES**

	<b>Species</b>	<b>4</b>	<b>3</b>	<b>2</b>	<b>1</b>	<b>0</b>	<b>Missing</b>
	<i>Cephalanthus occidentalis</i>	3	5	3			
	<i>Cornus amomum</i>		6	6	1		
	<i>Cyrilla racemiflora</i>	1					
	<i>Fraxinus pennsylvanica</i>	7					
	<i>Nyssa biflora</i>	7	16				
	<i>Quercus nigra</i>		1				
	<i>Quercus phellos</i>	4					
	<i>Salix nigra</i>	4	2				
	<i>Sambucus canadensis</i>	1	5	2	4		
	<i>Sambucus nigra</i>		1				
	<i>Taxodium distichum</i>	26	1				
	<i>Morella cerifera</i>	1	1				
	<i>Magnolia grandiflora</i>	2				1	
	<i>Unknown</i>	1	2				
<b>TOT:</b>	<b>14</b>	<b>57</b>	<b>40</b>	<b>11</b>	<b>6</b>		

**EXHIBIT TABLE A3. VEGETATION DAMAGE BY SPECIES**

	<b>Species</b>	<b>All Damage Categories (no damage)</b>	<b>Drought</b>	<b>Other/Unknown Animal</b>	<b>Unknown</b>
	<i>Cephalanthus occidentalis</i>	11	8	3	
	<i>Cornus amomum</i>	13	6	3	2
	<i>Cyrilla racemiflora</i>	1	1		
	<i>Fraxinus pennsylvanica</i>	7	7		
	<i>Magnolia grandiflora</i>	3	2		1
	<i>Morella cerifera</i>	2	2		
	<i>Nyssa biflora</i>	23	23		
	<i>Quercus nigra</i>	1	1		
	<i>Quercus phellos</i>	4	4		
	<i>Salix nigra</i>	6	6		
	<i>Sambucus canadensis</i>	12	7	5	
	<i>Sambucus nigra</i>	1	1		
	<i>Taxodium distichum</i>	27	27		
	<i>Unknown</i>	3	3		
<b>TOT:</b>	<b>14</b>	<b>114</b>	<b>98</b>	<b>11</b>	<b>2</b>
				<b>2</b>	<b>3</b>

**EXHIBIT TABLE A4. VEGETATION DAMAGE BY PLOT**

plot	All Damage Categories				
	(no damage)	Drought	Other/Unknown Animal	Unknown	
Overhills-01-0001-year:1	10	9			1
Overhills-01-0002-year:1	4	4			
Overhills-01-0003-year:1	7	7			
Overhills-01-0004-year:1	8	8			
Overhills-01-0005-year:1	3	3			
Overhills-01-0006-year:1	34	22	10	1	1
Overhills-01-0007-year:1	11	11			
Overhills-01-0008-year:1	19	16	1	1	1
Overhills-01-0009-year:1	7	7			
Overhills-01-0010-year:1	11	11			
<b>TOT: 10</b>	<b>114</b>	<b>98</b>	<b>11</b>	<b>2</b>	<b>3</b>

**EXHIBIT TABLE A5-A. STEM COUNT BY PLOT AND SPECIES - Year 1**

Species	Total Planted Stems			plot Overhills-01-0001-year:1													
	# plots	avg# stems															
<i>Cephalanthus occidentalis</i>	11	2	5.5	4										7			
<i>Cornus amomum</i>	12	3	4	1										6		5	
<i>Cyrilla racemiflora</i>	1	1	1	1													
<i>Fraxinus pennsylvanica</i>	7	4	1.75			2	3							1		1	
<i>Magnolia grandiflora</i>	2	1	2											2			
<i>Morella cerifera</i>	2	2	1											1		1	
<i>Nyssa biflora</i>	23	9	2.56	1		3	3	1	1	4	4	1	5				
<i>Quercus nigra</i>	1	1	1													1	
<i>Quercus phellos</i>	4	2	2	1										3			
<i>Salix nigra</i>	6	3	2	2										2		2	
<i>Sambucus canadensis</i>	8	2	4											6		2	
<i>Sambucus nigra</i>	1	1	1													1	
<i>Taxodium distichum</i>	27	9	3		4	2	2	2	1	4	2	4	6				
Unknown	3	2	1.5											2		1	
<b>TOT: 14</b>	<b>108</b>	<b>14</b>		<b>10</b>	<b>4</b>	<b>7</b>	<b>8</b>	<b>3</b>	<b>29</b>	<b>11</b>	<b>18</b>	<b>7</b>	<b>11</b>				
<b>Total Planted Stems/Acre</b>				<b>405</b>	<b>162</b>	<b>283</b>	<b>324</b>	<b>121</b>	<b>1174</b>	<b>445</b>	<b>728</b>	<b>283</b>	<b>445</b>				



**EXHIBIT TABLE A5-B. STEM COUNT BY PLOT AND SPECIES - Year 0**

Species	Total Stems	# plots	avg# stems	Plot Overhills-01-0001	Plot Overhills-01-0002	Plot Overhills-01-0003	Plot Overhills-01-0004	Plot Overhills-01-0005	Plot Overhills-01-0006	Plot Overhills-01-0007	Plot Overhills-01-0008	Plot Overhills-01-0009	Plot Overhills-01-0010
Cephalanthus occidentalis	11	2	5.5	4				7					
Cornus amomum	13	3	4.33	1				7	5				
Cyrilla racemiflora	1	1	1	1									
Fraxinus pennsylvanica	7	4	1.75		2	3			1		1		
Magnolia grandiflora	3	2	1.5					2	1				
Morella cerifera	2	2	1					1	1				
Nyssa biflora	21	8	2.62	1	2	3	1		4	4	1	5	
Quercus nigra	1	1	1						1				
Quercus phellos	4	2	2	1				3					
Salix nigra	7	3	2.33	2				2	3				
Sambucus canadensis	12	2	6					10	2				
Taxodium distichum	27	9	3	4	2	2	2	1	4	2	4	6	
Unknown	3	2	1.5						2		1		
<b>TOT: 13</b>	<b>112</b>	<b>13</b>		<b>10</b>	<b>4</b>	<b>6</b>	<b>8</b>	<b>3</b>	<b>33</b>	<b>11</b>	<b>19</b>	<b>7</b>	<b>11</b>
<b>Total Planted Stems/Acre</b>				<b>405</b>	<b>162</b>	<b>243</b>	<b>324</b>	<b>121</b>	<b>1335</b>	<b>445</b>	<b>769</b>	<b>283</b>	<b>445</b>

**EXHIBIT TABLE A6. VEGETATION PROBLEM AREAS**

Feature/Issue	Station # / Range	Probable Cause	Photo #
death of trees and plants	VPA1 & VPA2	previous flooding	1 & 2
invasive/exotic species	VPA3	Invasion of <i>Lespedeza</i>	3 & 4

\*The location of vegetation problem areas is show in the integrated problem area plan view map in Appendix D

## A.2 VEGETATION PROBLEM AREA PHOTOS



Photo 1. Flooding in VPA-1 facing northeast. Ponding caused vegetation failure. (6/13/07)



Photo 2. Dried pond in VPA1 facing southwest. Note absence of woody vegetation. (10/2/07)





Photo 3. Invasive species, *Lespedeza*, in VPA3 (8/23/07)



Photo 4. Invasive species, *Lespedeza*, on berms and high areas throughout the project area (10/2/07)

### A.3 VEGETATION MONITORING PLOT PHOTOS



Photo Station 11. Veg Plot 1 – looking north (10/2/07)



Photo Station 12. Veg Plot 1 – looking northeast (10/2/07)





Photo Station 13. Veg Plot 2 – looking northeast (10/2/07)



Photo Station 14. Veg Plot 2 – looking north (10/2/07)



Photo Station 15. Veg Plot 3 – looking northeast (10/2/07)



Photo Station 16. Veg Plot 3 – looking north (10/2/07)





Photo Station 17. Veg Plot 4 – looking northeast (10/2/07)



Photo Station 18. Veg Plot 4 – looking east (10/2/07)





Photo Station 19. Veg Plot 5 – looking northeast (10/2/07)



Photo Station 20. Veg Plot 5 – looking east (10/2/07)





Photo Station 21. Veg Plot 6 – looking south (10/2/07)



Photo Station 22. Veg Plot 6 – looking southwest (10/2/07)





Photo Station 23. Veg Plot 7 – looking north (10/2/07)



Photo Station 24. Veg Plot 7 – looking northeast (10/2/07)



Photo Station 25. Veg Plot 8 – looking southwest (10/2/07)



Photo Station 26. Veg Plot 8 – looking west (10/2/07)





Photo Station 27. Veg Plot 9 – looking north (10/2/07)



Photo Station 28. Veg Plot 9 – looking northeast (10/2/07)



Photo Station 29. Veg Plot 10 – looking northwest (10/2/07)



Photo Station 30. Veg Plot 10 – looking west (10/2/07)

## **APPENDIX B – GEOMORPHOLOGIC RAW DATA**

## Appendix B. Geomorphologic Raw Data

---

### B.1 CURRENT CONDITION PLAN VIEW (STREAM)

Please see the Integrated Current Condition Plan View in Appendix D for stream problem areas.

### B.2 STREAM PROBLEM AREAS TABLE

Exhibit Table B1. Stream Problem Areas					
Overhills/Jumping run Creek Restoration Project - EEP No. 199					
MAJOR PROBLEM AREAS					
Feature/Issue	Stream Reach	Station # / Range	Probable Cause	ID	Photo #
Headcut	Restored reach	33+00	In-stream structural failure	SPA 1	1 & 2
Bank Erosion/Migration	Restored reach	33+00 to 44+00	Headcut formation, in-stream structural failure	SPA 1	3 & 4
Mid-channel Bar Formation	Restored reach	33+00 to 44+00	In-stream structural failure	SPA 1	5
Hydraulic Jump/Scour	Restored reach	6+30	Beaver dam	SPA 9	6
MINOR PROBLEM AREAS					
Bank Erosion	Restored reach	0+00 to 32+00	Excess near bank shear stress	SPA 3 & 8	7
Bank Erosion	Restored reach	0+00 to 32+00	Root wad failure	SPA 2 & 4-7	8



### B.3 REPRESENTATIVE STREAM PROBLEM AREAS PHOTOS



Photo 1. Looking downstream at the start of the head cut at Station 33+00 (7/4/07)



Photo 2. Looking upstream at the location of the head cut at Station 33+00 (7/4/07)





Photo 3. Failed log cross-vane structure downstream of the headcut. The logs were not notched together, allowing the arms to separate from the cross log. (7/4/07)



Photo 4. Typical example of a structure that has been washed away and resultant bank erosion (7/4/07)



Photo 5. Mid-channel bars forming in the failed restoration channel (7/4/07)



Photo 6. Beaver dam located at Station 6+30 (11/9/07)





Photo 7. Bank erosion developing around the meander bends at various locations of the project (7/4/07)



Photo 8. Example of eddies that have caused scouring and erosion around the toes and banks of the root wad structures (7/4/07)

#### B.4 STREAM PHOTO STATION PHOTOS



Photo Station 1. Beginning of Reach – looking upstream (7/4/07)  
(Note: Locations of stations are shown on the monitoring plan view)



Photo Station 2. Cross section 1 – looking downstream (11/9/07)





Photo Station 3. Cross section 2 – looking downstream (11/9/07)



Photo Station 4. Cross section 3 – looking downstream (11/9/07)



Photo Station 5. Cross section 4 – looking downstream (11/9/07)



Photo Station 6. Cross section 5 – looking downstream (7/4/07)



Photo Station 7. Cross section 6 – looking downstream (11/9/07)



Photo Station 8. Cross section 7 – looking downstream (11/9/07)





Photo Station 9. Cross section 8 – looking downstream (11/9/07)



Photo Station 10. End of Project – looking upstream (7/4/07)



## B.5 QUALITATIVE VISUAL STABILITY ASSESSMENT

Exhibit Table B.2. Visual Morphological Stability Assessment Overhills/Jumping Run Creek - EEP Project No. 199						
Feature Category	Metric (per As-built and reference baselines)	(# Stable) Number Performing as Intended	Total Number per As-built	Total Number/Feet in Unstable State	% Perform in Stable Condition	Feature Perform. Mean or Total
A. Riffles	1. Present?	14	21		67%	
	2. Armor stable (eg no displacement?)	N/A	N/A			
	3. Facet grade appears stable?	16	21		76%	
	4. Minimal evidence of embedding/fining?	N/A	N/A			
	5. Length appropriate?	18	21		86%	76%
B. Pools	1. Present? (e.g. not subject to severe aggrad. or migrat.?)	18	22		82%	
	2. Sufficiently deep (Max Pool D:Mean Bkf > 1.6?)	16	22		73%	
	3. Length appropriate?	12	22		55%	70%
C. Thalweg	1. Upstream of meander bend (run/inflection) centering?	16	22		73%	
	2. Downstream of meander (glide/inflection) centering?	18	22		82%	77%
D. Meanders	1. Outer bend in state of limited/controlled erosion?	24	32		75%	
	2. Of those eroding, # w/concomitant point bar formation?	3	3		100%	
	3. Apparent Rc within spec?	32	32		100%	
	4. Sufficient floodplain access and relief?	28	32		88%	91%
E. Bed General	1. General channel bed aggradation areas (bar formation)		4400	400	91%	
	2. Channel bed degradation - areas of increasing down-cutting or head-cutting?		4400	1100	75%	75%
F. Bank	1. Actively eroding, wasting, or slumping bank?		4400	1200	73%	73%
G. Vanes	1. Free of back or arm scour?	16	37		43%	
	2. Height appropriate?	12	37		32%	
	3. Angle and geometry appear appropriate?	10	37		27%	
	4. Free of piping or other structural failures?	12	37		32%	34%
H. Wads/Boulders	1. Free of scour?	12	19		63%	
	2. Footing stable?	N/A	N/A			63%


## **B.6 CROSS SECTION PLOTS**

See following page for cross section plots.

Project Name		Overhills		Feature		Rifle		Date		AS Built - 7/4/2007, Year 1 - 11/09/2007							
Cross Section		Cross Section 1						Crew		AS Built - Bidelspach, Jean, Geenen, Year 1 - Geenen, Ballestero							
Year 5 - 2011 2011 Survey			Year 4 - 2010 2010 Survey			Year 3 - 2009 2009 Survey			Year 2 - 2008 2008 Survey			Year 1 - 2007 2007 Survey			Baseline Survey		
Station	Elevation	Notes	Station	Elevation	Notes	Station	Elevation	Notes	Station	Elevation	Notes	Station	Elevation	Notes	Station	Elevation	Notes
									2.65	189.93	Left Pin	4.52	189.79	Left Pin			
									10.17	190.1					10.13	189.86	
									13.35	190.47					17.52	190.13	
									13.42	190.73					22.45	190.45	
									16.72	190.34					24.83	190.36	LBK
									22.13	190.63					26.52	189.62	
									25.3	190.45	LBK			27.86	189.2		
									27.61	189.17				29.2	188.45		
									28.71	188.24				29.55	187.98		
									30.15	187.37				31.02	187.2		
									32.17	186.32				32.34	186.45		
									35.43	185.87				34.32	185.91		
									37.8	186.21				36.69	185.7		
									40.81	186.56				38.09	186.11		
									42.86	187.36				40.41	186.17		
									44.47	187.99				40.54	186.18		
									46.74	189.12				43.99	187.02		
									50.28	190.43	RBK			44.12	187.46		
									54.26	190.41				45.25	187.93		
									58.46	190.71	Right Pin			46.24	188.41		
									61.65	190.21				47.76	189.19		
														49.99	190.07		
														52.1	190.43	RBK	
														54.6	190.2		
														58.49	190.32	Right Pin	
														64.25	190.03		
														68.06	190.73		
														70.27	192.07		
														73.77	192.89		




Photo of Cross-Section 2 - Looking Downstream @ STA 1+64							
	Year 5 - 2011	Year 4 - 2010	Year 3 - 2009	Year 2 - 2008	Year 1 - 2007	Baseline	Bench
Area						67.45	71.89
Width						24.66	26.87
Mean Depth						2.74	2.68
Max Depth						4.49	4.66
W/D						9.02	10.04

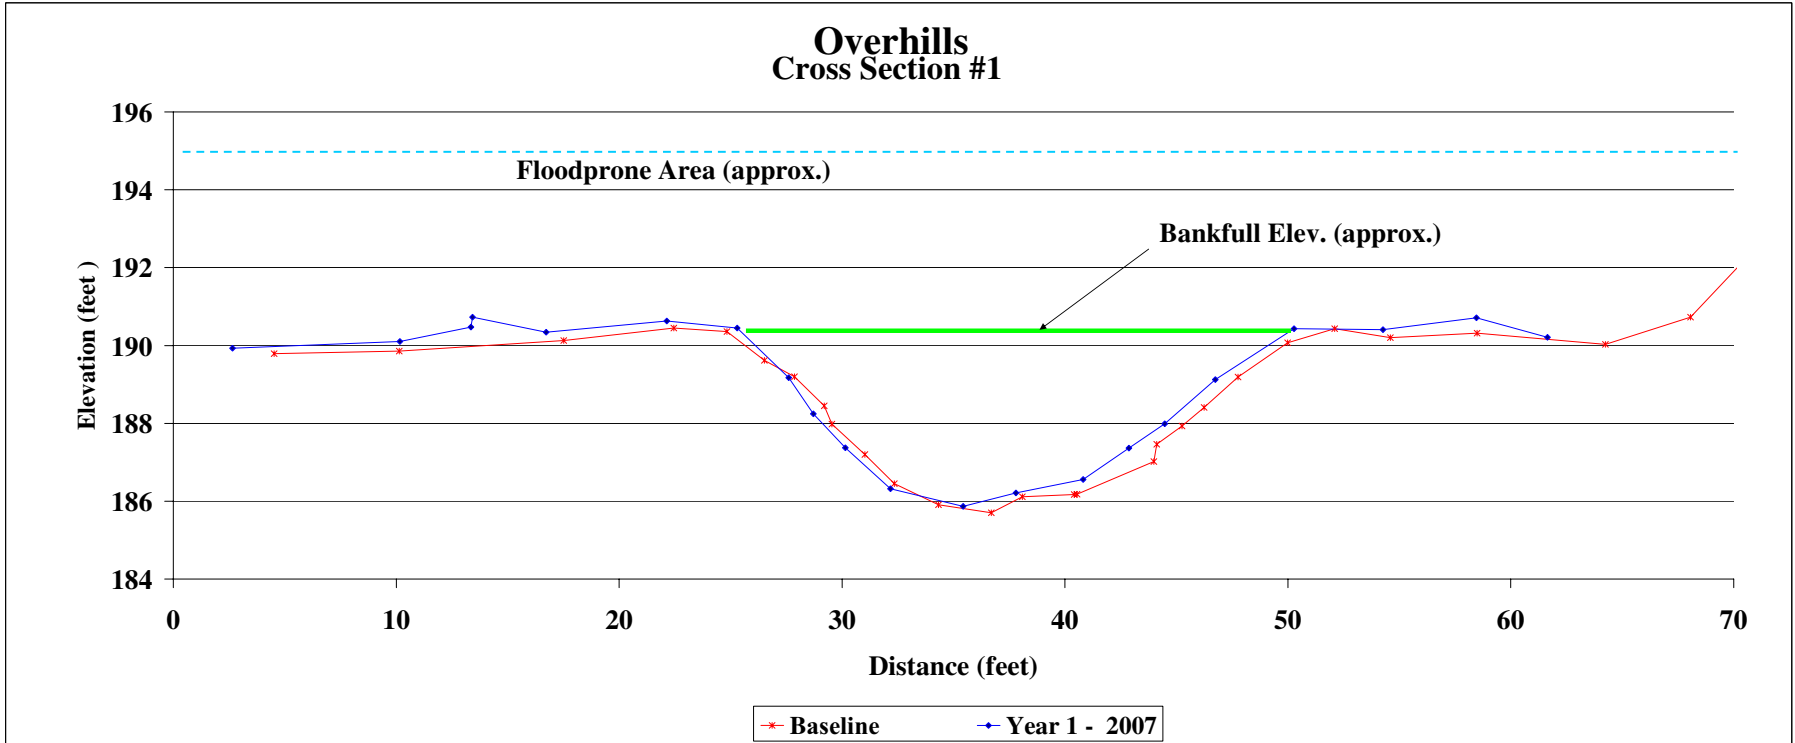

Project Name		Overhills		Feature		Pool		Date		As Built - 7/4/2007, Year 1 - 11/09/2007							
Cross Section		Cross Section 2						AS Built - Bialepach, Jean, Geenen, Year 1 - Geenen, Ballestero									
Year 5 - 2011 2011 Survey			Year 4 - 2010 2010 Survey			Year 3 - 2009 2009 Survey			Year 2 - 2008 2008 Survey			Year 1 - 2007 2007 Survey			Baseline Survey		
Station	Elevation	Notes	Station	Elevation	Notes	Station	Elevation	Notes	Station	Elevation	Notes	Station	Elevation	Notes	Station	Elevation	Notes
									3.3	190.38		4.56	190.23				
									8.33	189.53		6.9	189.82				
									12.7	189.11		13.65	189.51	Left Pin			
									12.8	189.54	Left Pin	16.04	189.01				
									17.6	189.03		22.49	189.55	LBK			
									22.12	189.57	LBK	24.16	189.47				
									24.71	189.27		25.49	188.99				
									26	188.58		26.1	188.61				
									27.56	187.82		26.85	188.28				
									29.26	186.52		28.44	187.47				
									31.67	184.65		29.87	186.93				
									32.55	184.84		30.45	185.55				
									33.78	184.97		31.66	184.76				
									35.78	185.83		34.28	185.57				
									37.72	186.94		34.93	186				
									39.57	187.34		36.53	186.94				
									40.23	187.92		38.16	187.5				
									40.72	187.88		39.43	187.8				
									45.38	189.82	RBK	40.48	188.05				
									50.51	189.52		41.2	188.42				
									54.36	189.84	Right Pin	42.91	188.86				
									59.59	189.33		43.74	189.32				
												46.29	189.89	RBK			
												48.93	189.71				
												51.53	189.34				
												54.39	189.81	Right Pin			
												57.19	189.28				
												62.87	189.3				




Photo of Cross-Section 2 - Looking Downstream @ STA 8+47							
	Year 5 - 2011	Year 4 - 2010	Year 3 - 2009	Year 2 - 2008	Year 1 - 2007	Baseline	Bench
Area					51.12	44.82	
Width					22.29	22.27	
Mean Depth					2.29	2.01	
Max Depth					4.90	4.79	
W/D					9.72	11.07	

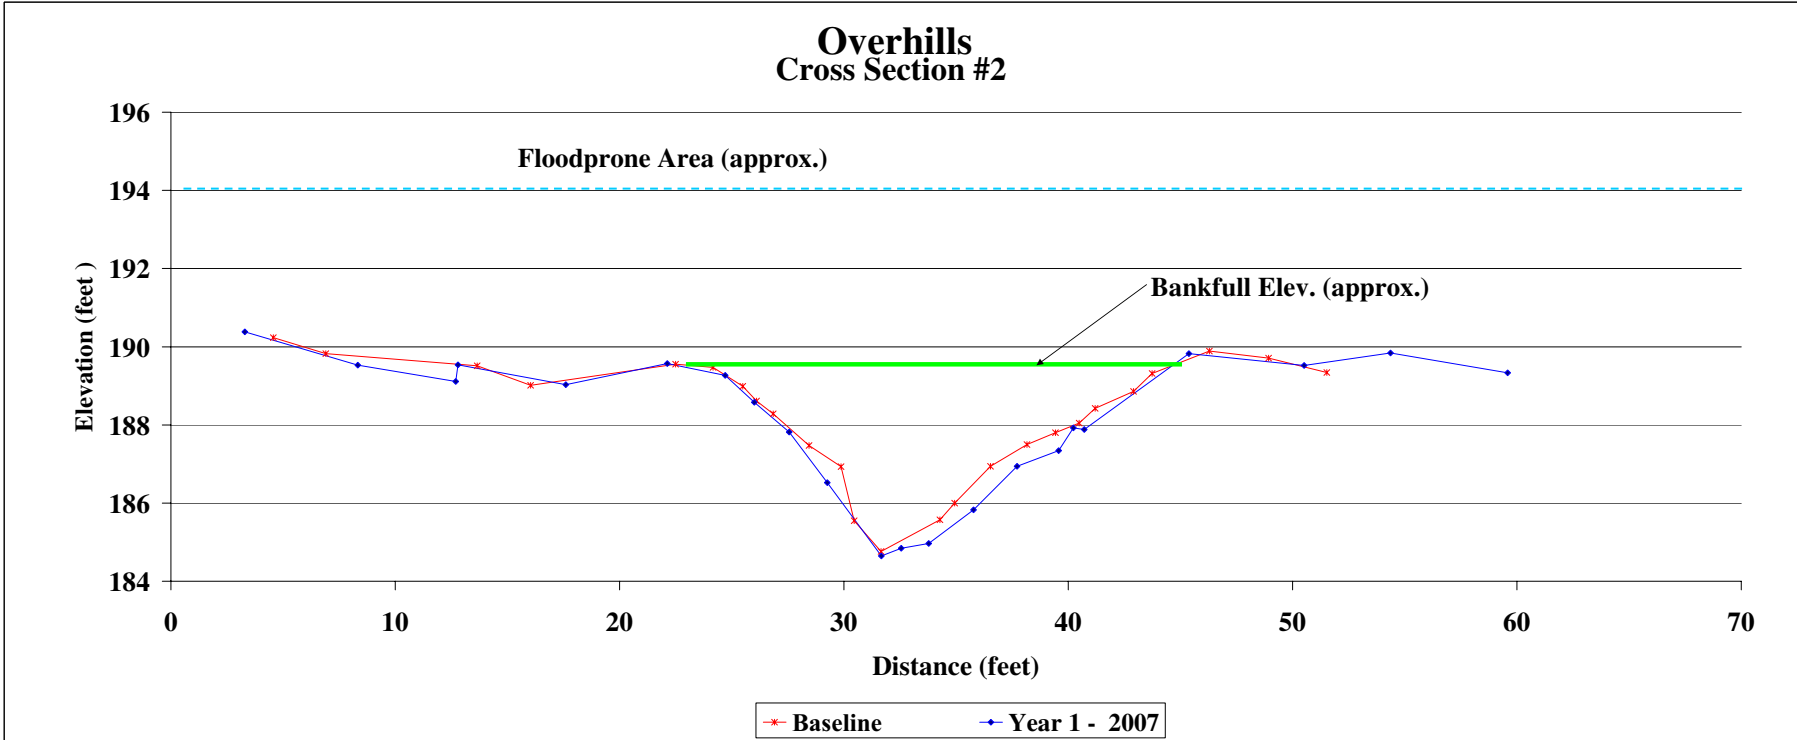

Project Name		Overhills		Feature		Rifle		Date		As Built - 7/4/2007, Year 1 - 11/09/2007							
Cross Section		Cross Section 3						Crew		AS Built - Bidelspach, Jean, Geenen, Year 1 - Geenen, Ballesterio							
Year 5 - 2011 2011 Survey			Year 4 - 2010 2010 Survey			Year 3 - 2009 2009 Survey			Year 2 - 2008 2008 Survey			Year 1 - 2007 2007 Survey			Baseline Survey		
Station	Elevation	Notes	Station	Elevation	Notes	Station	Elevation	Notes	Station	Elevation	Notes	Station	Elevation	Notes	Station	Elevation	Notes
							4.06	188.79		4.48	188.83						
							8.41	189.3		8.32	189.36			Left Pin			
							9.18	188.93		15.78	189.1						
							13.52	189.01		19.61	189.1						
							18	189.33		20.74	188.61			LBK			
							19.99	189.07		22.18	188.16						
							22.85	187.84		23.54	187.47						
							23.82	187.37		24.3	186.9						
							25.46	186.71		26.31	186.64						
							27.49	186.63		28.49	186.68						
							29.75	186.44		29.75	186.54						
							32.85	186.55		32.01	186.44						
							34.65	187.25		33.82	187.12						
							38.11	188.95		35.19	187.71						
							40.08	189.58		36.54	188.3						
							41.78	189.15		37.91	189.04			RBK			
							46.9	188.95		39.63	189.57						
							47.1	189.33		41.31	189.19			Right Pin			
							53.96	188.9		43.25	189.07						
										46.88	189.32			Right Pin			
										56.34	188.86						




Photo of Cross-Section 3 - Looking Downstream @ STA 13+12							
	Year 5 - 2011	Year 4 - 2010	Year 3 - 2009	Year 2 - 2008	Year 1 - 2007	Baseline	Bench
Area					31.52	31.03	
Width					17.86	18.15	
Mean Depth					1.76	1.71	
Max Depth					2.60	2.60	
W/D					10.13	10.62	

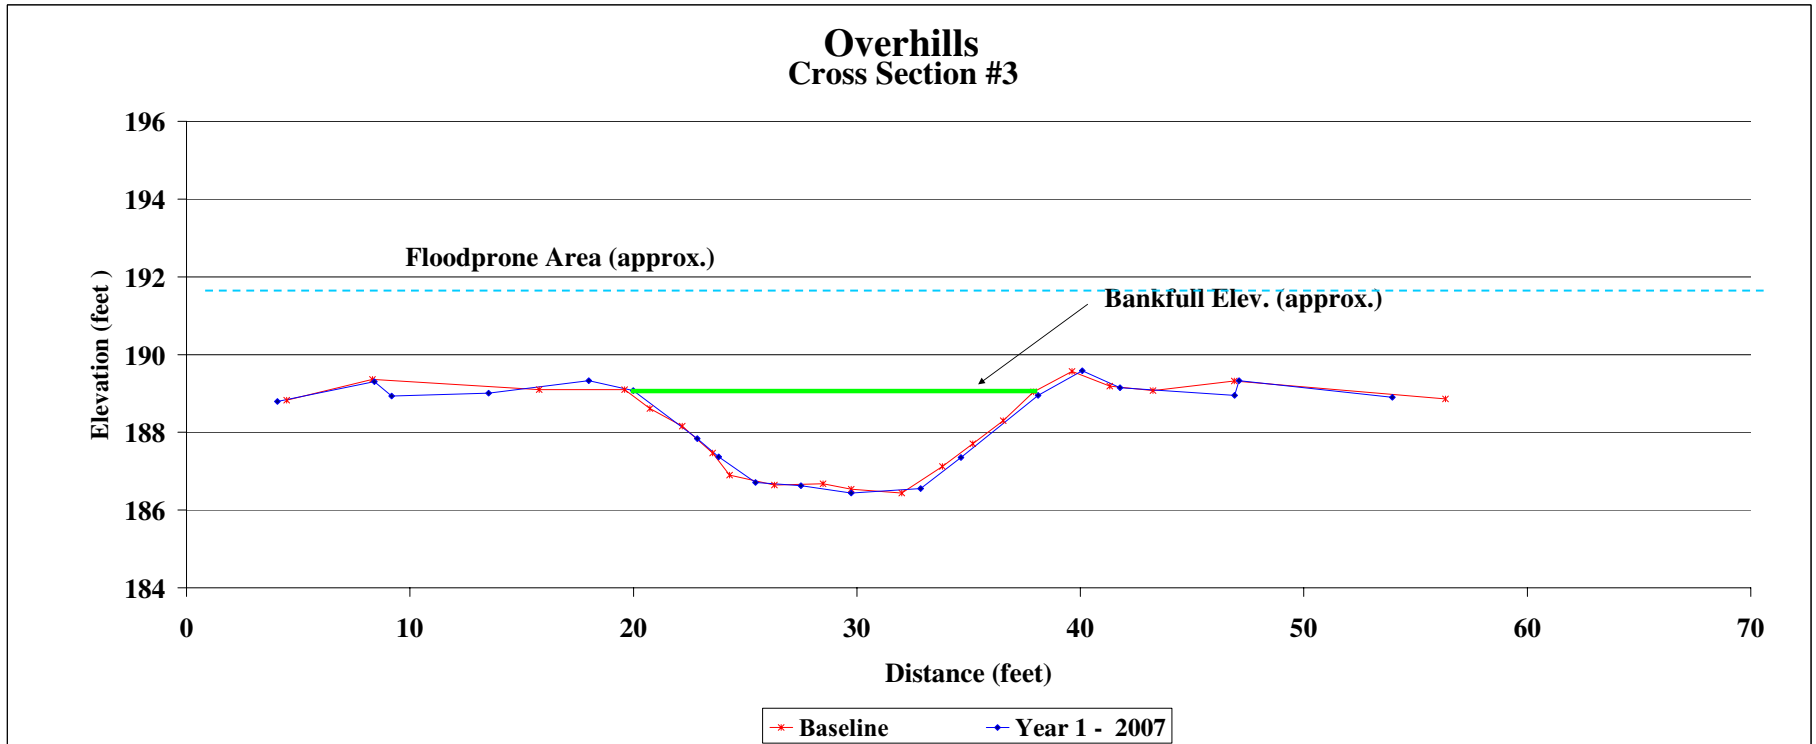

Project Name		Overhills		Feature		Pool		Date		As Built - 7/4/2007, Year 1 - 11/09/2007							
Cross Section		Cross Section 4						AS Built - Bialepach, Jean, Geenen, Year 1 - Geenen, Ballestero									
Year 5 - 2011 2011 Survey			Year 4 - 2010 2010 Survey			Year 3 - 2009 2009 Survey			Year 2 - 2008 2008 Survey			Year 1 - 2007 2007 Survey			Baseline Survey		
Station	Elevation	Notes	Station	Elevation	Notes	Station	Elevation	Notes	Station	Elevation	Notes	Station	Elevation	Notes	Station	Elevation	Notes
									2.24	189.15	Left Pin	2.04	189.13	Left Pin			
									2.87	188.66		2.74	188.58				
									7.53	188.67		7.31	188.61				
									10.56	188.99	LBK	9.06	188.89				
									13.14	188.94		12.06	188.99	LBK			
									17.08	187.18		16.45	187.43				
									19.34	186.74		18.45	186.88				
									19.81	185.16		20.09	186.27				
									21.82	184.21		22.22	185.12				
									22.82	183.09		25.87	184.66				
									23.69	183.01		28.01	185.47				
									25.3	183.27		28.79	186.87				
									26.72	184.1		30.5	187.29				
									27.42	184.09		32.24	188.05				
									27.96	184.89		35.46	188.92	RBK			
									28.95	185.94		39.85	188.47				
									32.83	188.22		43.15	188.9	Right Pin			
									35.51	188.89	RBK						
									41.76	188.31							
									42.92	188.89	Right Pin						




Photo of Cross-Section 4 - Looking Upstream @ STA 20+93							
	Year 5 - 2011	Year 4 - 2010	Year 3 - 2009	Year 2 - 2008	Year 1 - 2007	Baseline	Bench
Area					59.60	49.19	
Width					22.25	23.19	
Mean Depth					2.68	2.12	
Max Depth					5.91	4.26	
W/D					8.31	10.93	

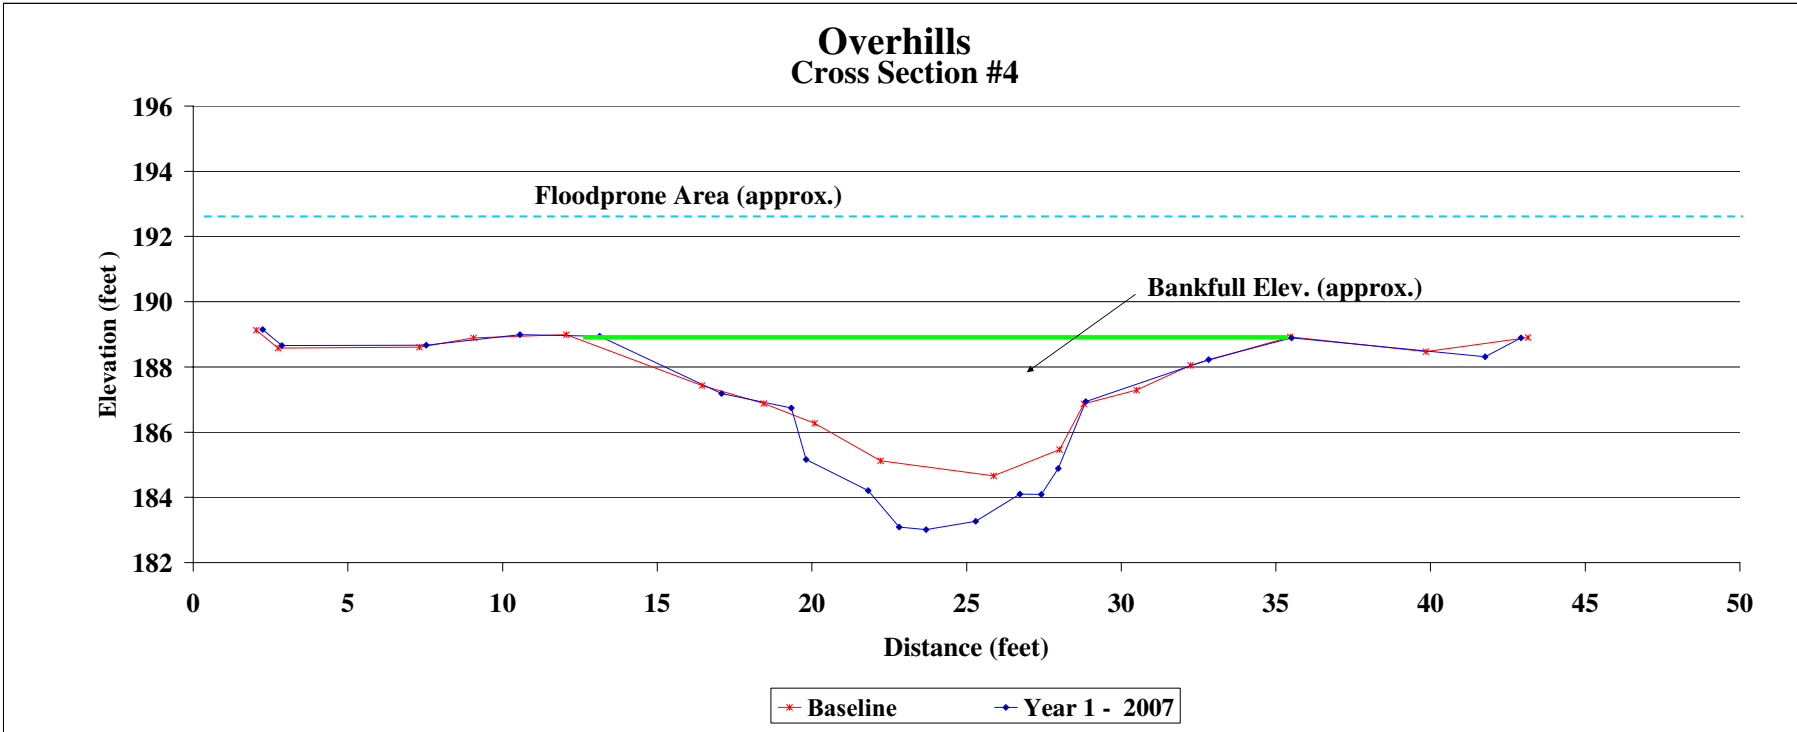

Project Name	Overhills	Feature	Riffle	Date	As Built -7/4/2007, Year 1 - 11/09/2007				
Cross Section	Cross Section 5			Crew	AS Built - Bidelspach, Jean, Geenen, Year 1 - Geenen, Ballestero				
Year 5 - 2011 2011 Survey	Year 4 - 2010 2010 Survey	Year 3 - 2009 2009 Survey	Year 2 - 2008 2008 Survey	Year 1 - 2007 2007 Survey	Baseline Survey				
Station	Elevation	Notes	Station	Elevation	Notes	Station	Elevation	Notes	
				1.97	187		3.05	187.3	Left Pin
				3.09	187.26	Left Pin	3.21	187.27	
				6.14	187.01		5.01	186.96	
				11.52	188.03	LBK	11.66	188.08	LBK
				14.4	187.54		14.84	187.43	
				17.16	186.66		16.8	186.56	
				19.42	186.15		20.84	185.74	
				20.32	185.91		28.91	185.57	
				22.12	185.62		32.28	186.73	
				23.61	185.58		36.26	187.99	RBK
				25.53	185.5		40.89	187.36	
				27.2	185.44		43.43	187.09	
				29.26	185.48		46.4	187.11	Right Pin
				31.34	185.47		47.3	187.8	
				32.57	186.42				
				35.43	187.61				
				39.09	187.87	RBK			
				43.07	186.93				
				46.38	187.14	Right Pin			
				47.57	187.74				
				47.83	187.74				
				48.91	186.99				




Photo of Cross-Section 2 - Looking Downstream @ STA 26+86							
	Year 5 - 2011	Year 4 - 2010	Year 3 - 2009	Year 2 - 2008	Year 1 - 2007	Baseline	Bench
Area					40.91	37.70	
Width					24.50	24.16	
Mean Depth					1.67	1.56	
Max Depth					2.55	2.42	
W/D					14.68	15.48	

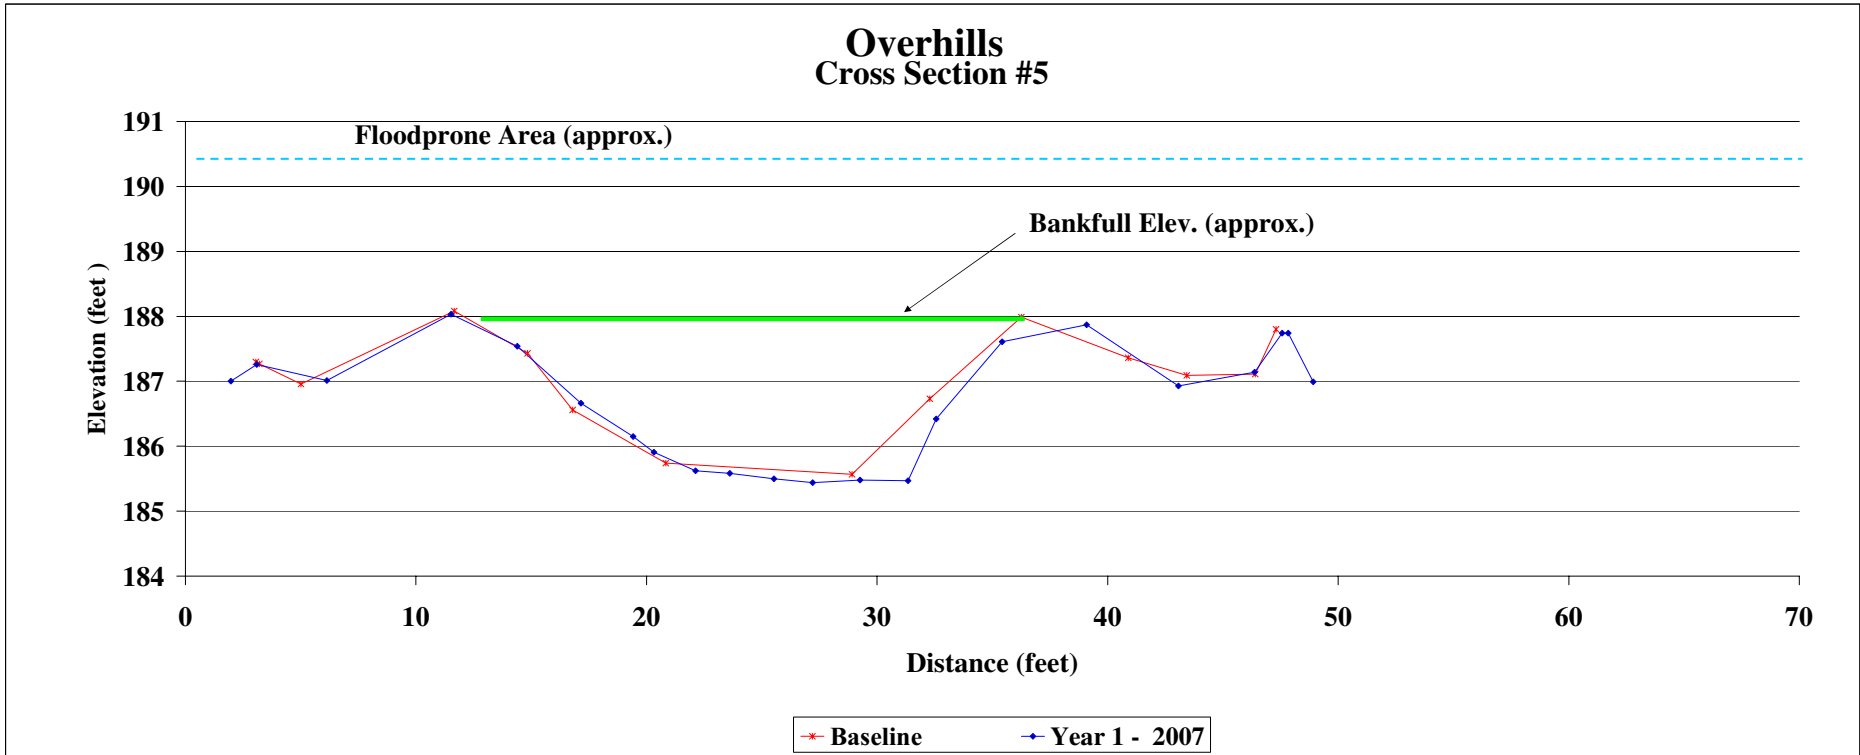

Project Name			Overhills			Feature			Pool			Date			As Built -7/4/2007, Year 1 - 11/09/2007		
Cross Section			Cross Section 6									Crew			AS Built - Bidelspach, Jean, Geenen, Year 1 - Geenen, Ballestero		
Year 5 - 2011 2011 Survey			Year 4 - 2010 2010 Survey			Year 3 - 2009 2009 Survey			Year 2 - 2008 2008 Survey			Year 1 - 2007 2007 Survey			Baseline Survey		
Station	Elevation	Notes	Station	Elevation	Notes	Station	Elevation	Notes	Station	Elevation	Notes	Station	Elevation	Notes	Station	Elevation	Notes
									15.39	186.16		6.32	186.34				
									20.95	186.77	Left Pin	14.35	186.41				
									22.67	186.49		20.81	186.85	Left Pin			
									26.84	186.81		26.11	186.7				
									29	187.06		29.39	187.26				
									31.73	187.31	LBK	32.45	187.28	LBK			
									33.93	186.72		33.59	187.02				
									34.87	186.42		35.23	186.42				
									35.74	185.77		36.01	185.93				
									37.91	185.46		39.3	185.34				
									39.01	185.06		42.44	185.54				
									39.91	185.64		45.4	185.91				
									40.69	185.72		46.64	185.79				
									42.18	185.35		48.59	186.21				
									43.56	185.97		49.86	186.77				
									44.34	185.54		51.69	187.32	RBK			
									45.33	185.55		53.89	187.8				
									45.95	186		56.5	187.47				
									46.84	185.71		58.64	186.97				
									48.16	186.01		60.87	187.14	Right Pin			
									51.75	187.16	RBK	72.27	186.14				
									54.56	187.78							
									57.01	187.12							
									59.8	186.66							
									61.01	187.04	Right Pin						
									62.77	186.33							



Photo of Cross-Section 6 - Looking Downstream @ STA 31+56							
	Year 5 - 2011	Year 4 - 2010	Year 3 - 2009	Year 2 - 2008	Year 1 - 2007	Baseline	Bench
Area					25.35	23.43	
Width					19.24	19.06	
Mean Depth					1.32	1.23	
Max Depth					2.21	1.94	
W/D					14.59	15.51	

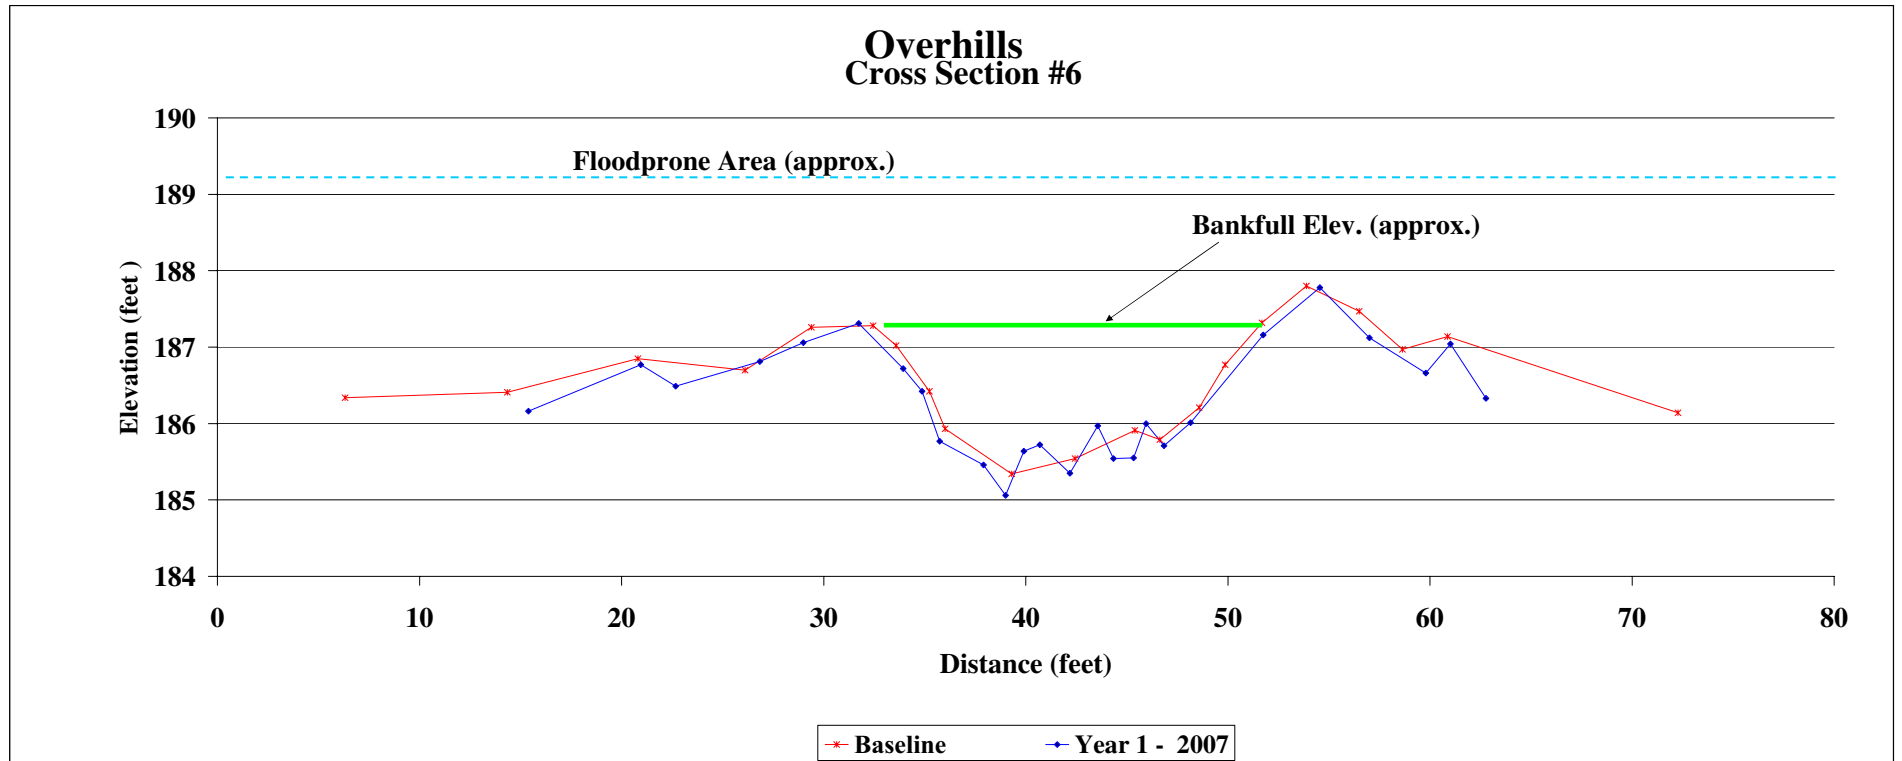




Project Name		Overhills		Feature		Rifle		Date		As Built -7/4/2007, Year 1 - 11/09/2007							
Cross Section		Cross Section 7						Crew		AS Built - Bidelspach, Jean, Geenen, Year 1 - Geenen, Ballestero							
Year 5 - 2011 2011 Survey			Year 4 - 2010 2010 Survey			Year 3 - 2009 2009 Survey			Year 2 - 2008 2008 Survey			Year 1 - 2007 2007 Survey			Baseline Survey		
Station	Elevation	Notes	Station	Elevation	Notes	Station	Elevation	Notes	Station	Elevation	Notes	Station	Elevation	Notes	Station	Elevation	Notes
												4.74	186.69		4.15	186.87	
												12.19	186.6		9.61	186.87	
												13.71	186.99	Left Pin	13.66	187.15	Left Pin
												21.01	186.69		15.81	186.72	
												24.31	186.86		20.13	186.73	
												30.38	184.52	LBK	24.47	186.97	
												35.69	184.22		30.71	184.7	
												38.52	183.06		34.39	184.84	LBK
												39.99	182.3		36.75	184.26	
												41.24	181.68		38.32	183.21	
												43.5	181.17		40.06	182.77	
												46.61	181.18		41.51	182.4	
												48.2	181.55		43.08	181.71	
												48.67	182.32		45.41	181.32	
												50	184.15		47.24	181.31	
												52.21	185.51	RBK	49.08	182.1	
												54.14	185.86		49.97	184.05	
												56.73	186.64		51.07	184.92	RBK
												61.3	186.44		53.14	185.58	
												63.79	186.97	Right Pin	56.23	186.41	
												69.14	186.4		60.6	186.59	
															63.81	187.1	Right Pin
															66.24	186.52	
															71.92	186.6	



Photo of Cross-Section 7 - Looking Downstream @ STA 37+24

	Year 5 - 2011	Year 4 - 2010	Year 3 - 2009	Year 2 - 2008	Year 1 - 2007	Baseline	Bench
Area					39.41	35.21	
Width					16.68	16.54	
Mean Depth					2.36	2.13	
Max Depth					3.67	3.53	
W/D					7.06	7.77	

## Overhills Cross Section #7

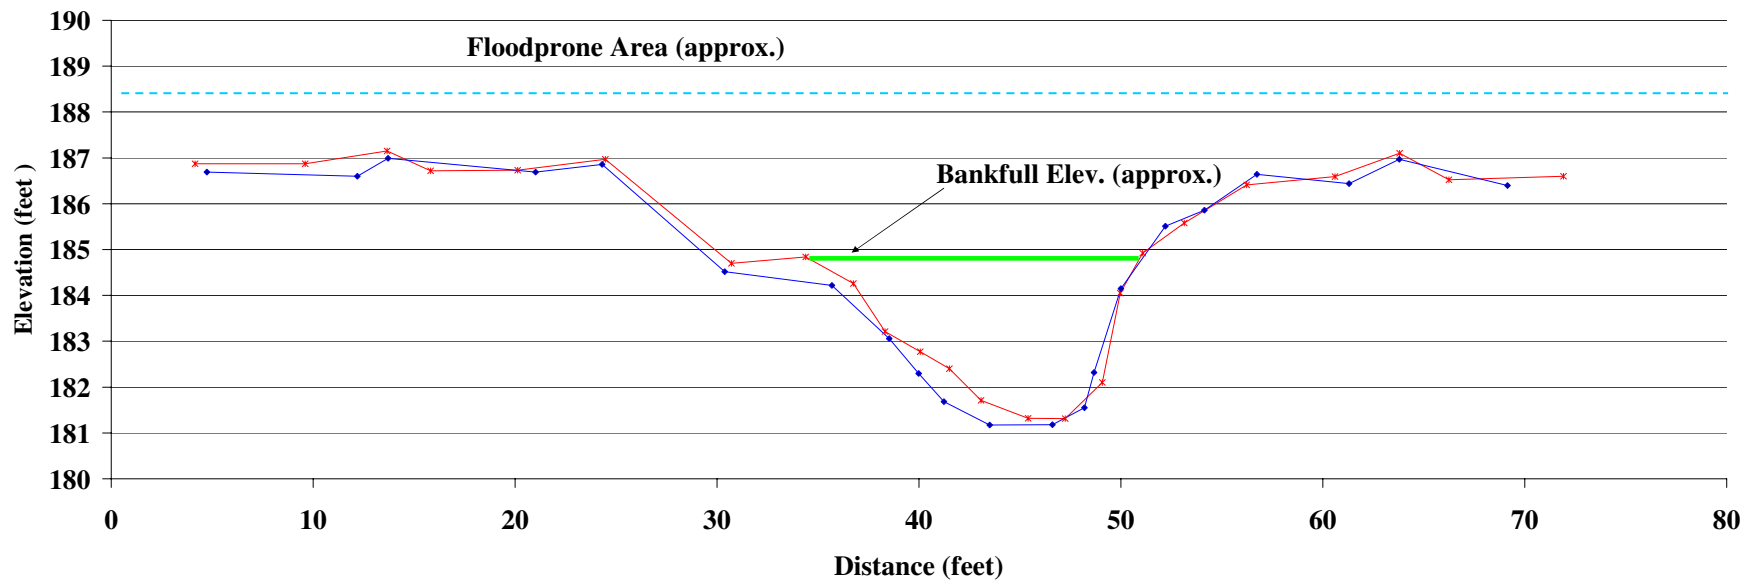


x Baseline     
 + Year 1 - 2007


Project Name		Overhills		Feature		Pool		Date		As Built - 7/4/2007, Year 1 - 11/09/2007							
Cross Section		Cross Section 8						Crew		AS Built - Bidelspach, Jean, Geenen, Year 1 - Geenen, Ballestero							
Year 5 - 2011 2011 Survey			Year 4 - 2010 2010 Survey			Year 3 - 2009 2009 Survey			Year 2 - 2008 2008 Survey			Year 1 - 2007 2007 Survey			AS-BUILT 2006 AS-BUILT Survey		
Station	Elevation	Notes	Station	Elevation	Notes	Station	Elevation	Notes	Station	Elevation	Notes	Station	Elevation	Notes	Station	Elevation	Notes
									13.4	185.53		3.83	185.78				
									22.11	185.5		24.28	185.45				
									25.75	185.77	Left Pin	25.7	185.93	Left Pin			
									29.88	185.43		31.91	185.43				
									32.68	185.44		34.62	185.98				
									37.04	185.88	LBK	37.77	186.2	LBK			
									38.3	185.65		41.17	184.6				
									41.67	184.04		44.37	182.74				
									43.77	182.64		46.27	181.63				
									46.24	181.29		46.85	180.88				
									46.38	179.99		47.86	179.7				
									48.16	179.17		49.44	178.94				
									48.17	179.1		51.31	178.81				
									49.67	179.2		53.14	179.2				
									51.99	179.1		54.48	179.72	RBK			
									54.04	179.44		56.58	180.29				
									56.36	180.22	RBK	57.59	180.59				
									57.57	180.65		58.19	182.71				
									58.63	182.81		60.26	183.96				
									63.42	185.79		62.63	185.33				
									65.87	186.27		65.42	186.4				
									68.7	185.65		67.81	185.93				
									73.19	185.15		71.84	185.25				
									75.56	185.81	Right Pin	75.73	185.85	Right Pin			
									76.68	185.21		81.92	185.58				
												89.04	186.33				




Photo of Cross-Section 8 - Looking Downstream @ STA 43+02							
	Year 5 - 2011	Year 4 - 2010	Year 3 - 2009	Year 2 - 2008	Year 1 - 2007	AS-BUILT 2006	Bench
Area					110.97	106.10	
Width					27.72	27.10	
Mean Depth					4.00	3.92	
Max Depth					7.09	7.38	
W/D					6.92	6.92	

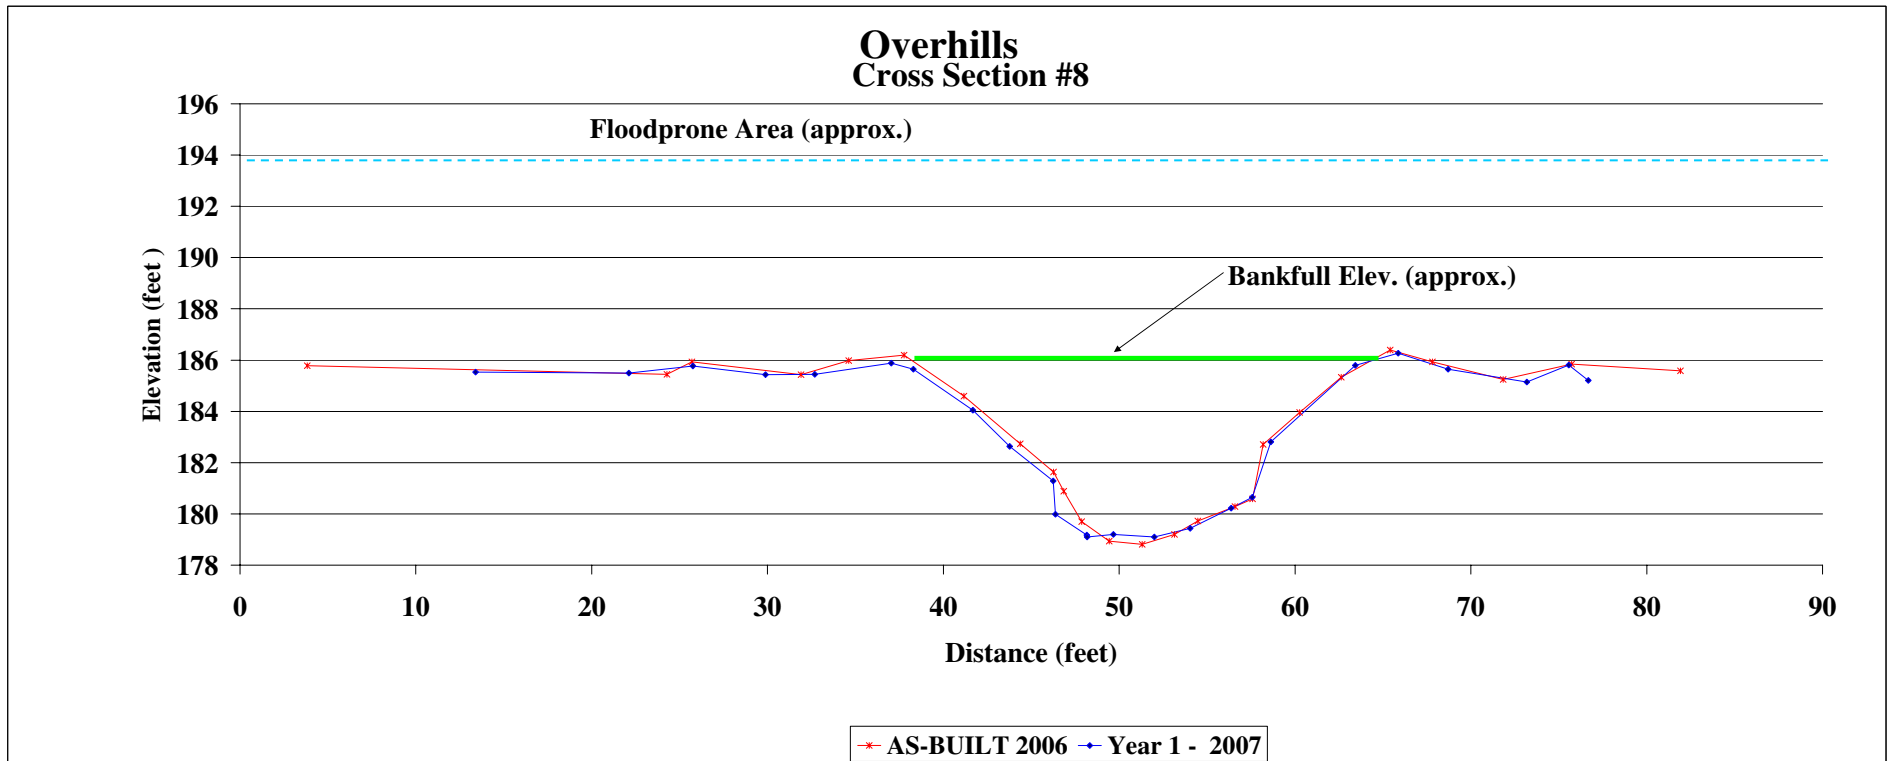



## B.7 LONGITUDINAL PLOTS

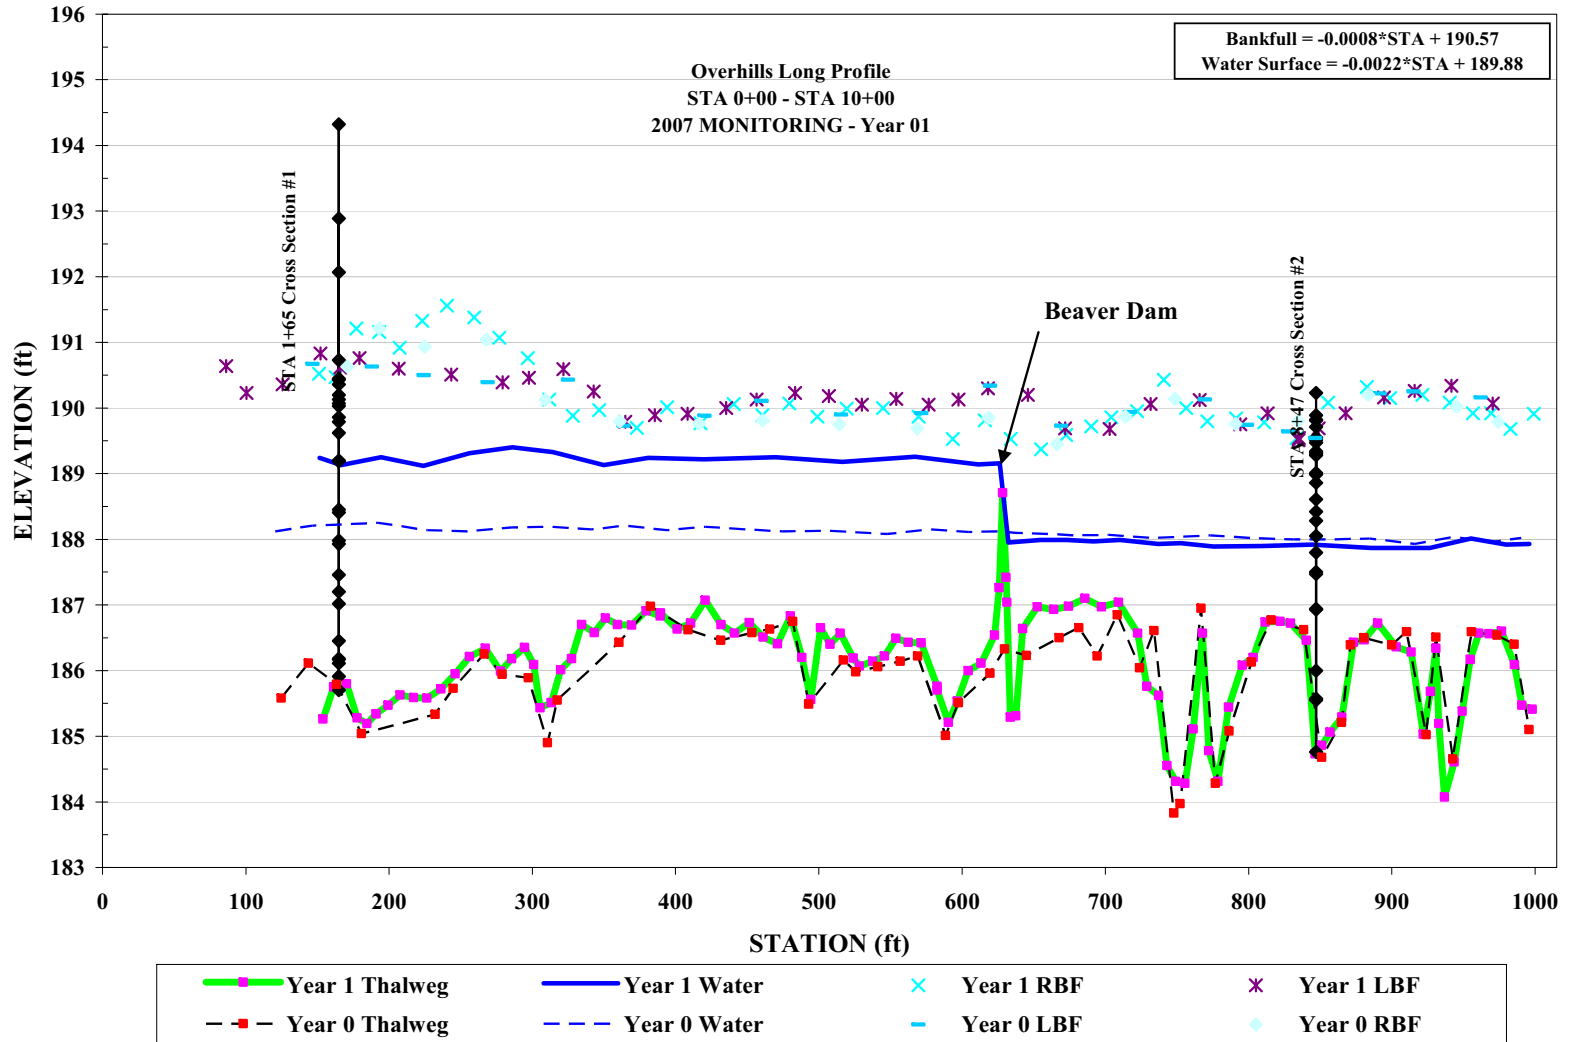

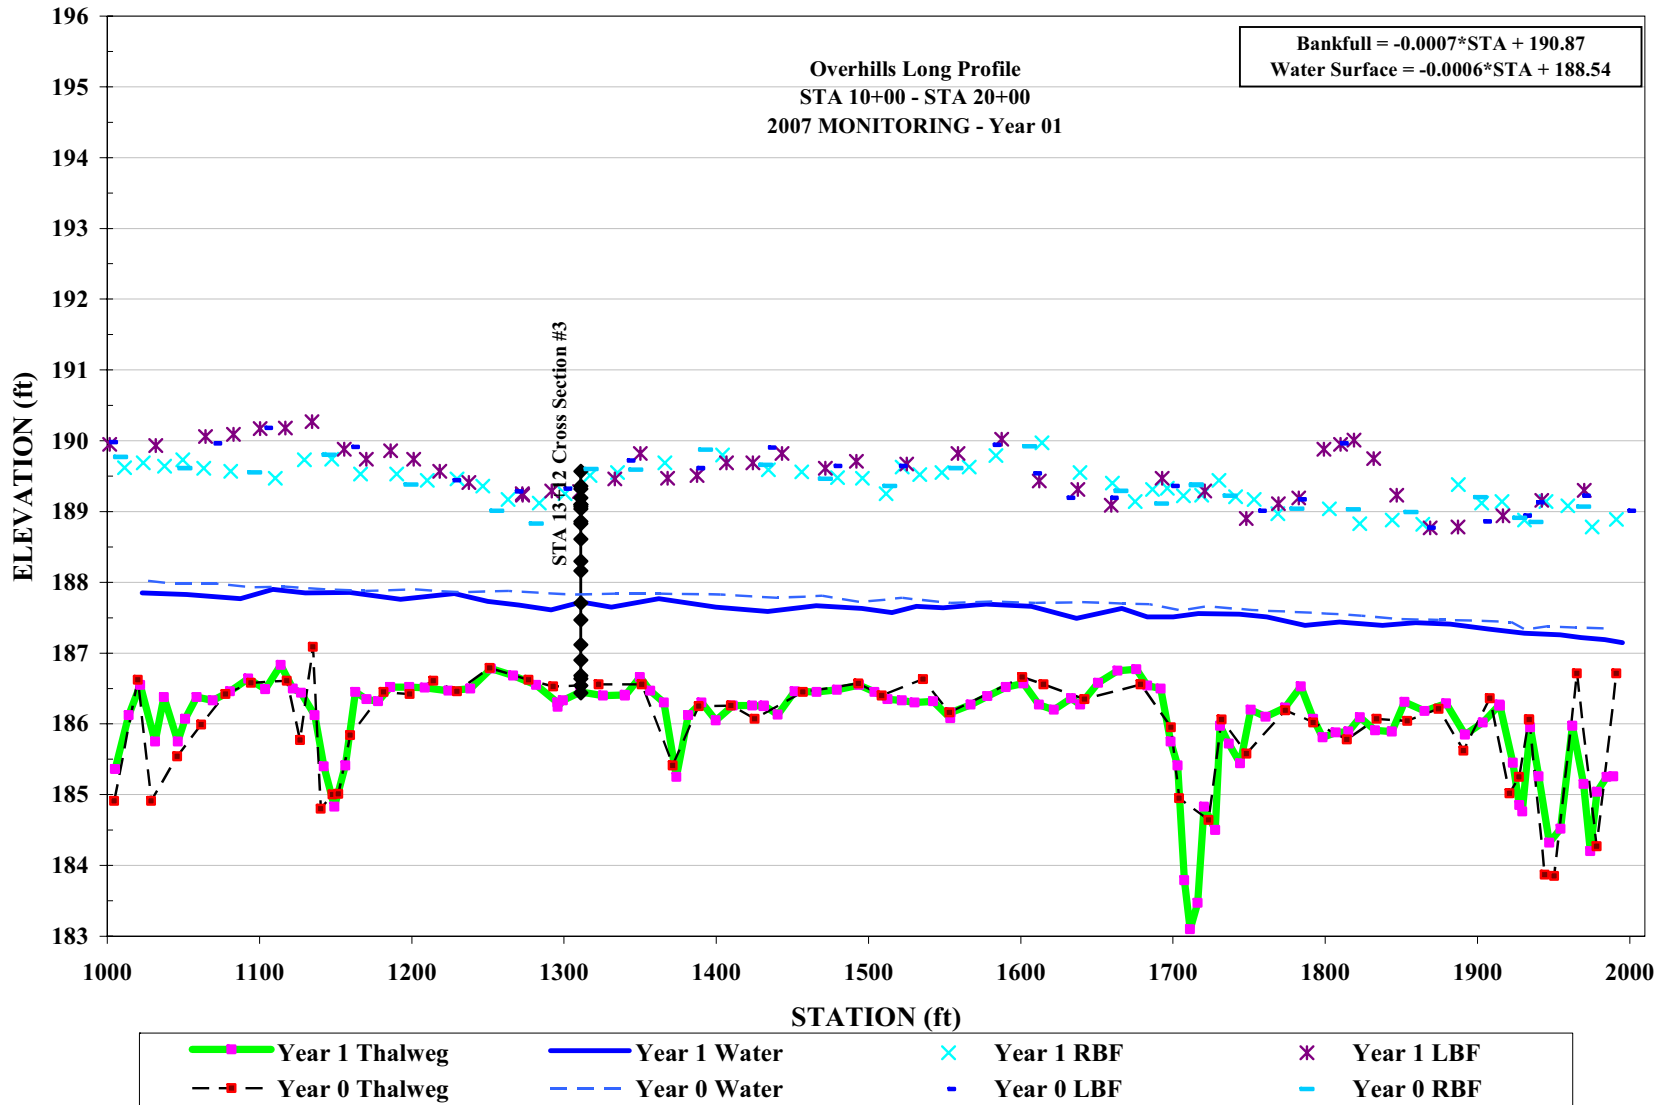




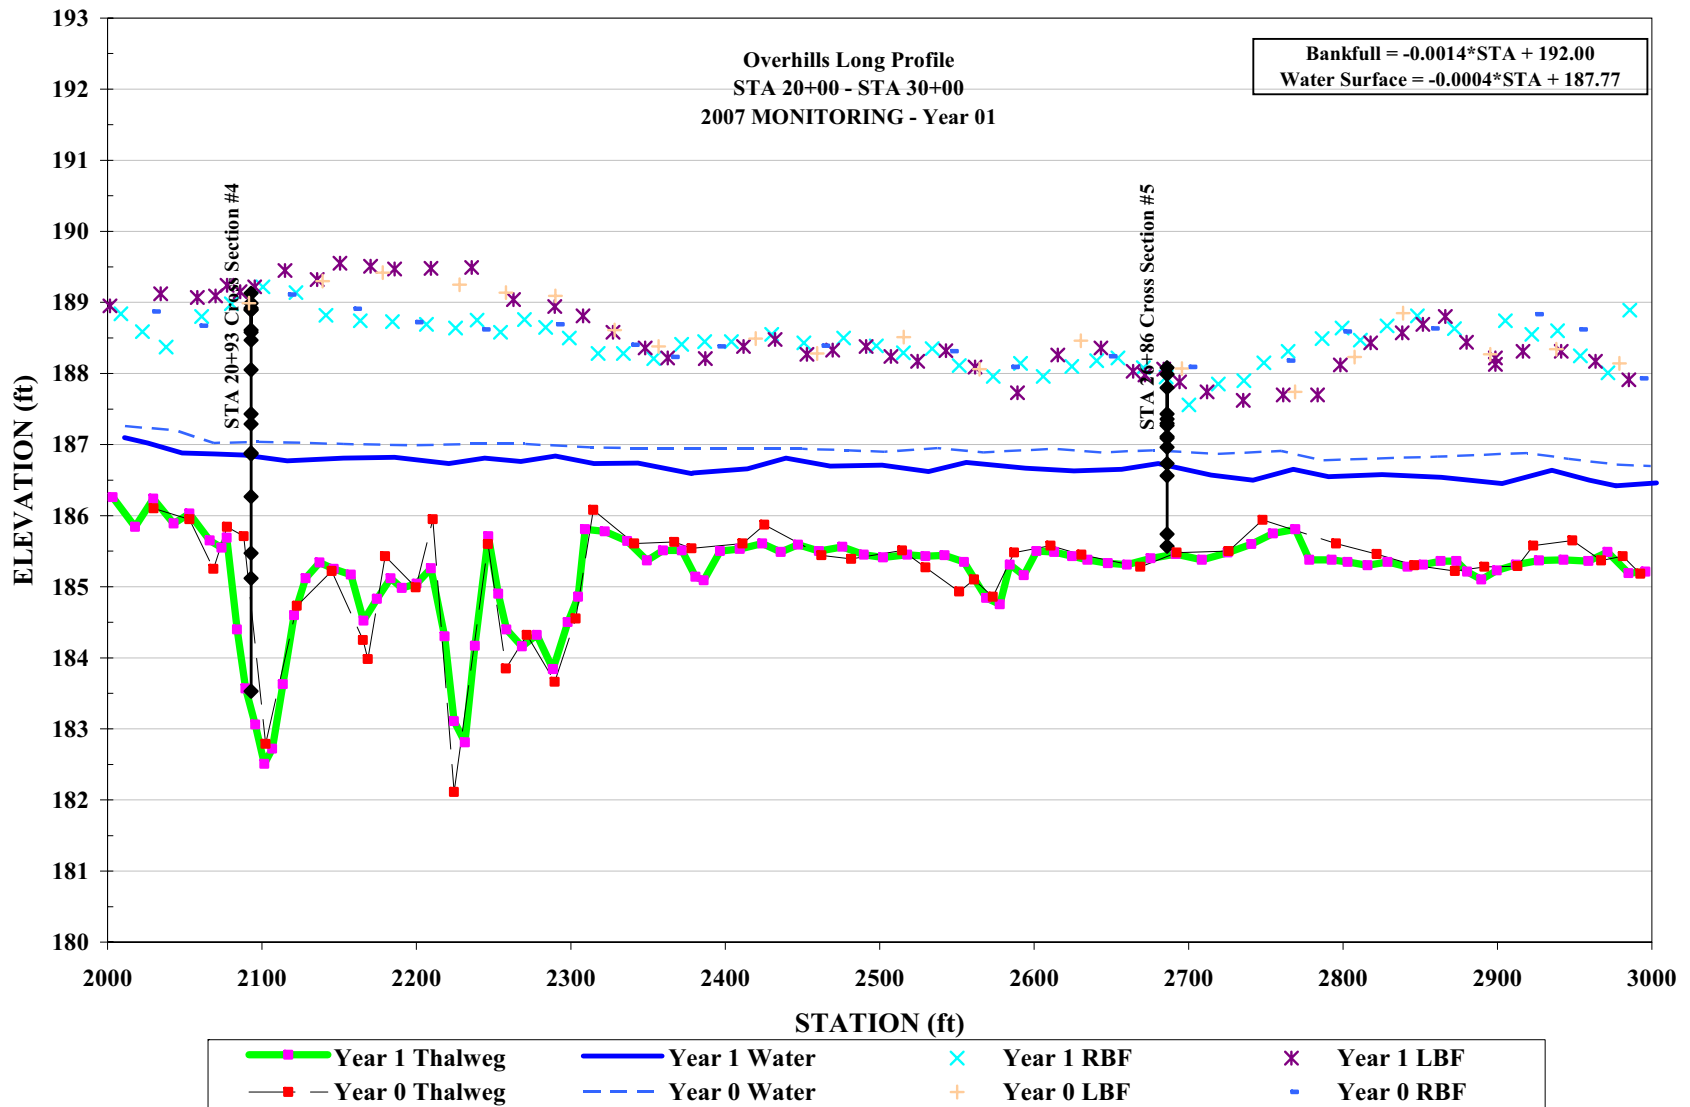

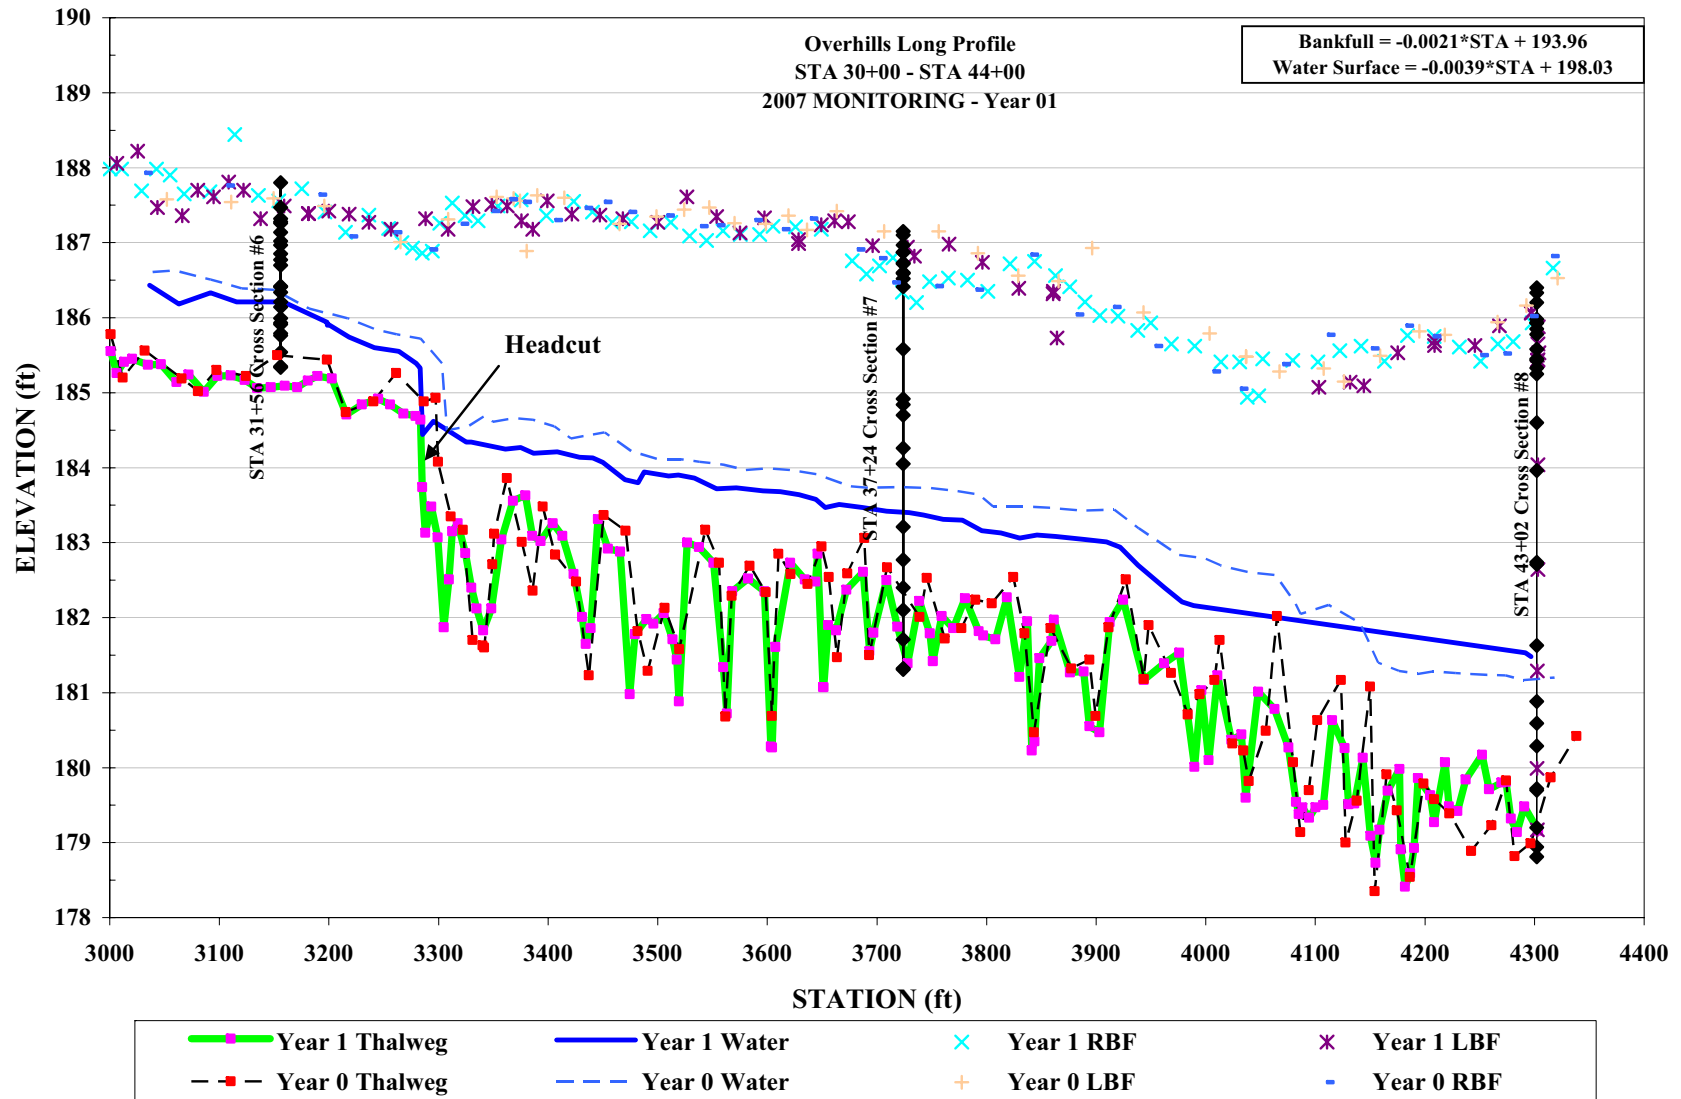


## B.8 PEBBLE COUNT DISTRIBUTION

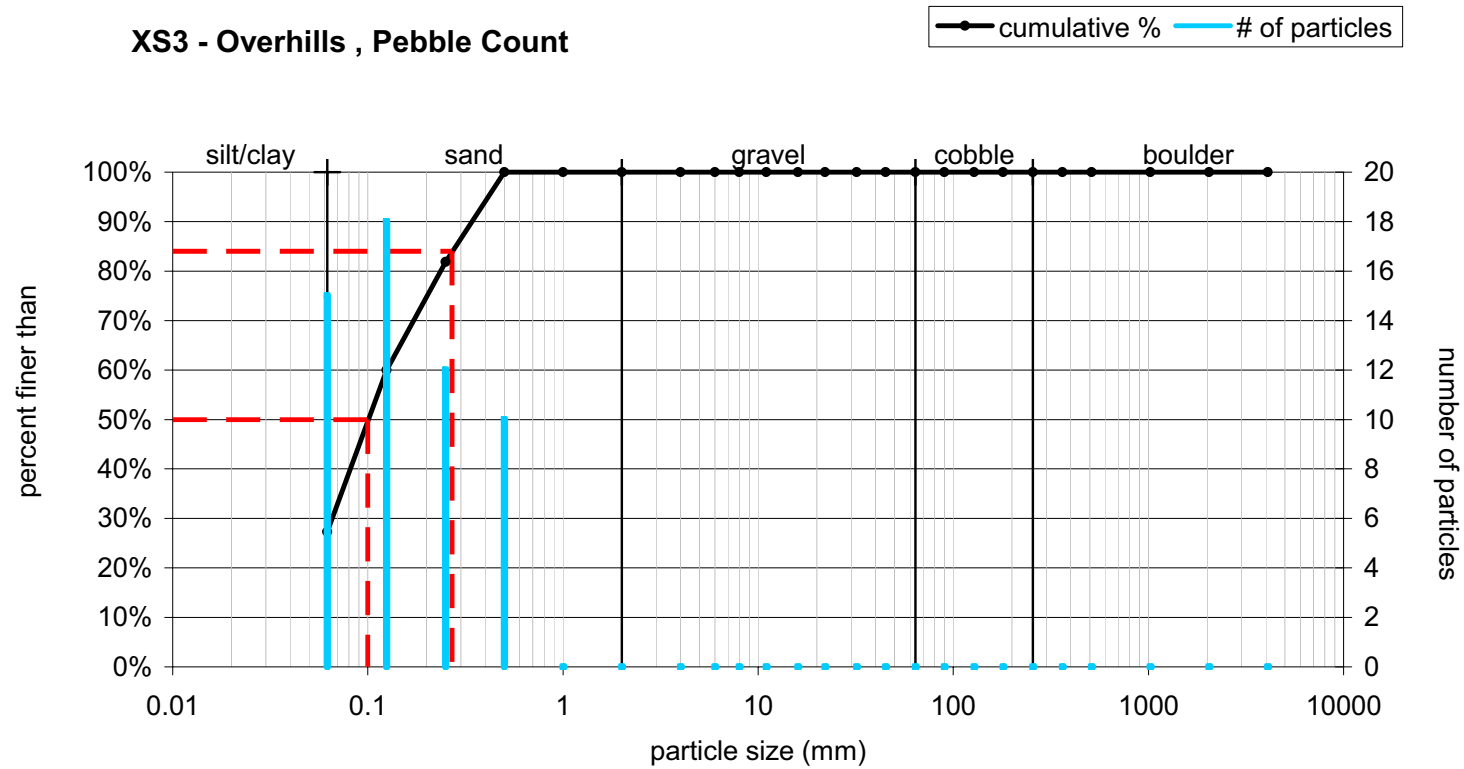

Size (mm)		Size Distribution		Type	
D16	0.062	mean	0.1	silt/clay	27%
D35	0.073	dispersion	2.2	sand	73%
D50	0.1	skewness	0.14	gravel	0%
D65	0.15			cobble	0%
D84	0.27			boulder	0%
D95	0.41				


### XS4 - Overhills , Pebble Count

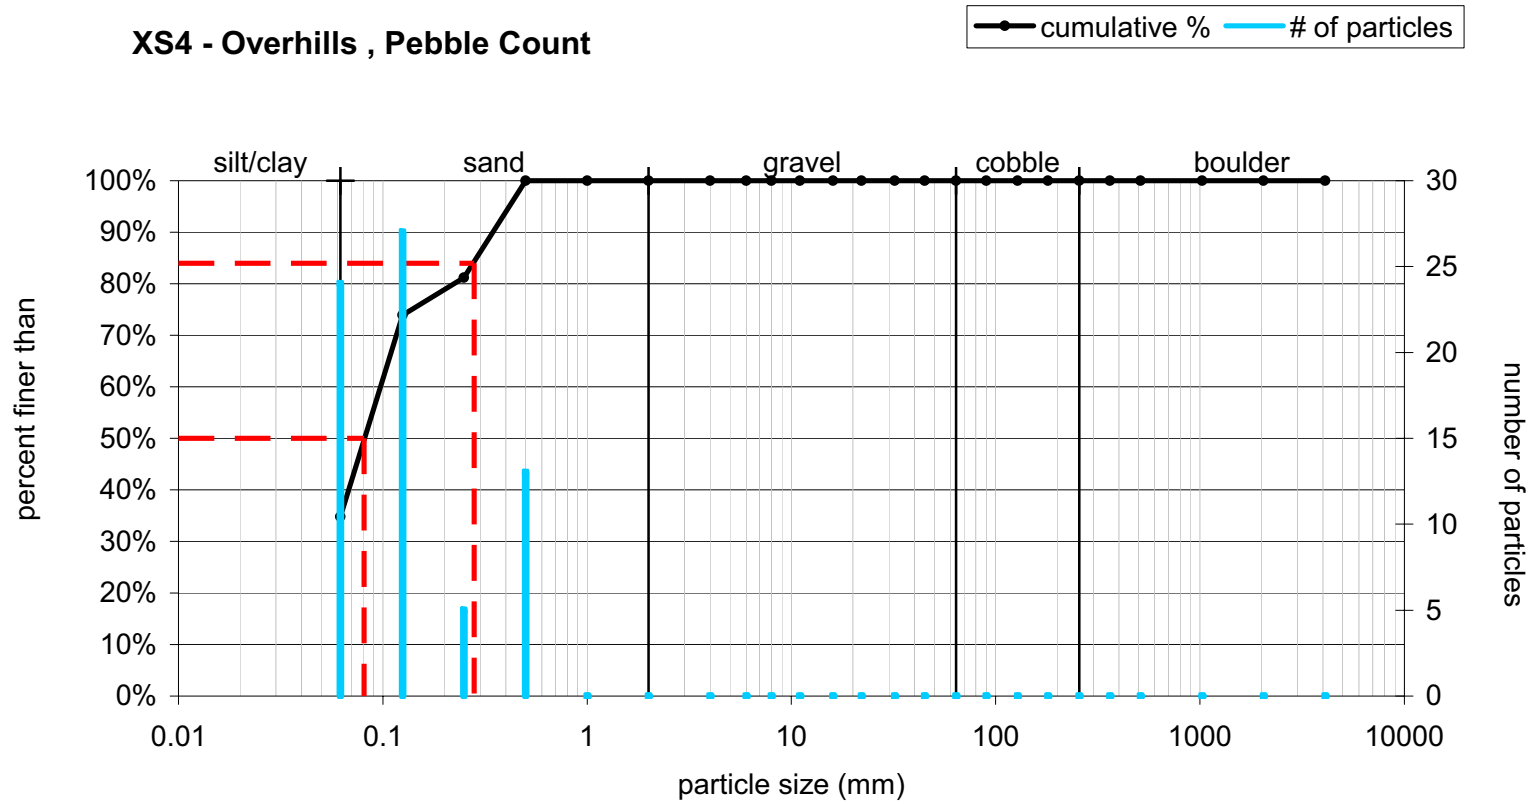

Size (mm)		Size Distribution		Type	
D16	0.062	mean	0.1	silt/clay	35%
D35	0.062	dispersion	2.4	sand	65%
D50	0.081	skewness	0.26	gravel	0%
D65	0.11			cobble	0%
D84	0.28			boulder	0%
D95	0.42				



### XS6 - Overhills , Pebble Count

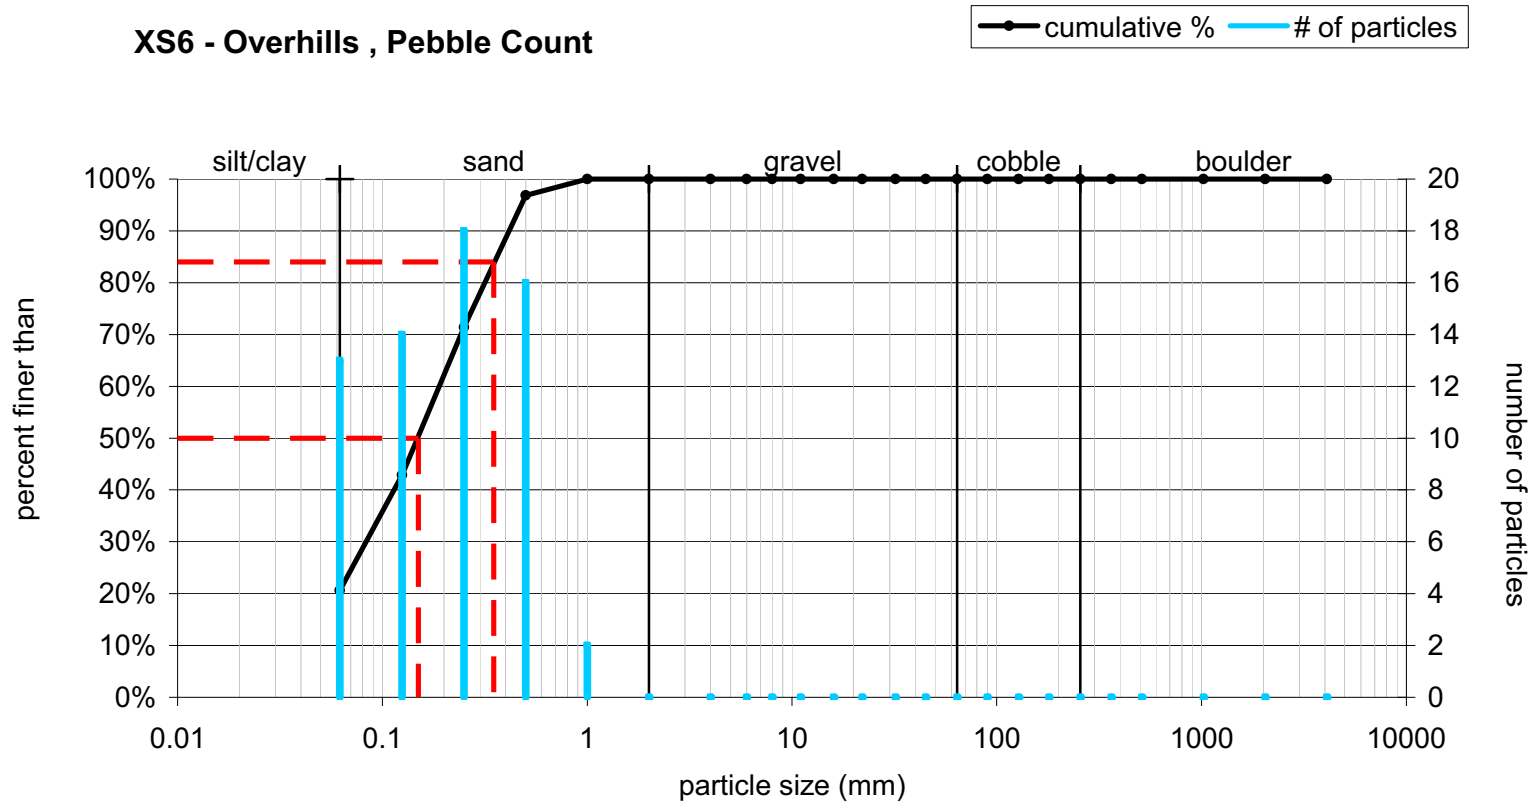


Size (mm)		Size Distribution		Type	
D16	0.062	mean	0.1	silt/clay	21%
D35	0.098	dispersion	2.4	sand	79%
D50	0.15	skewness	-0.01	gravel	0%
D65	0.21			cobble	0%
D84	0.35			boulder	0%
D95	0.48				


## **APPENDIX C – WETLAND RAW DATA**

# Appendix C. Wetland Raw Data

## C.1 GAUGE DATA

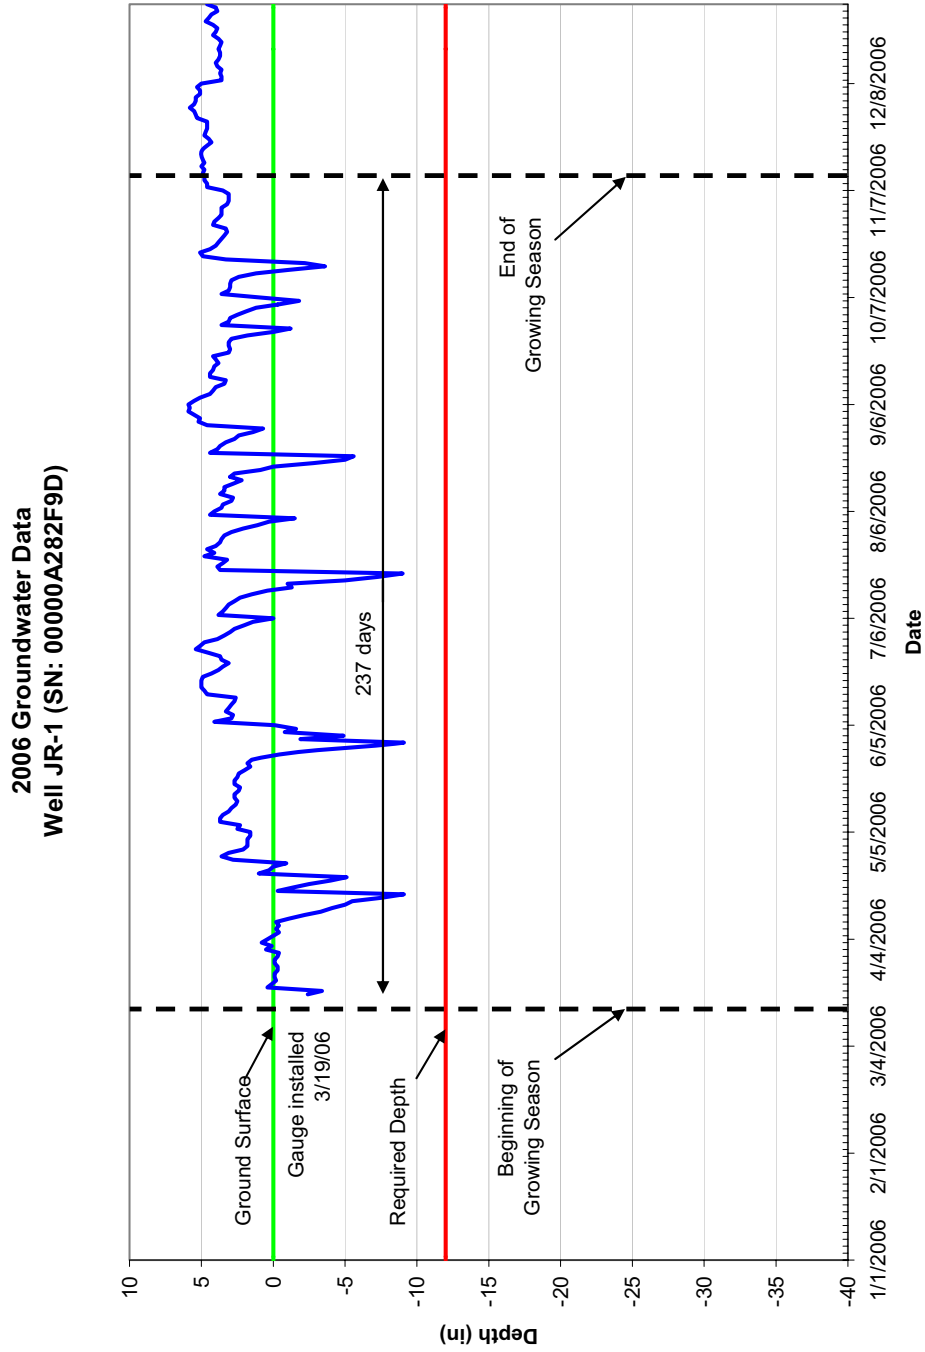


2007 Groundwater Data  
Well JR-1 (SN: 00000A282F9D)

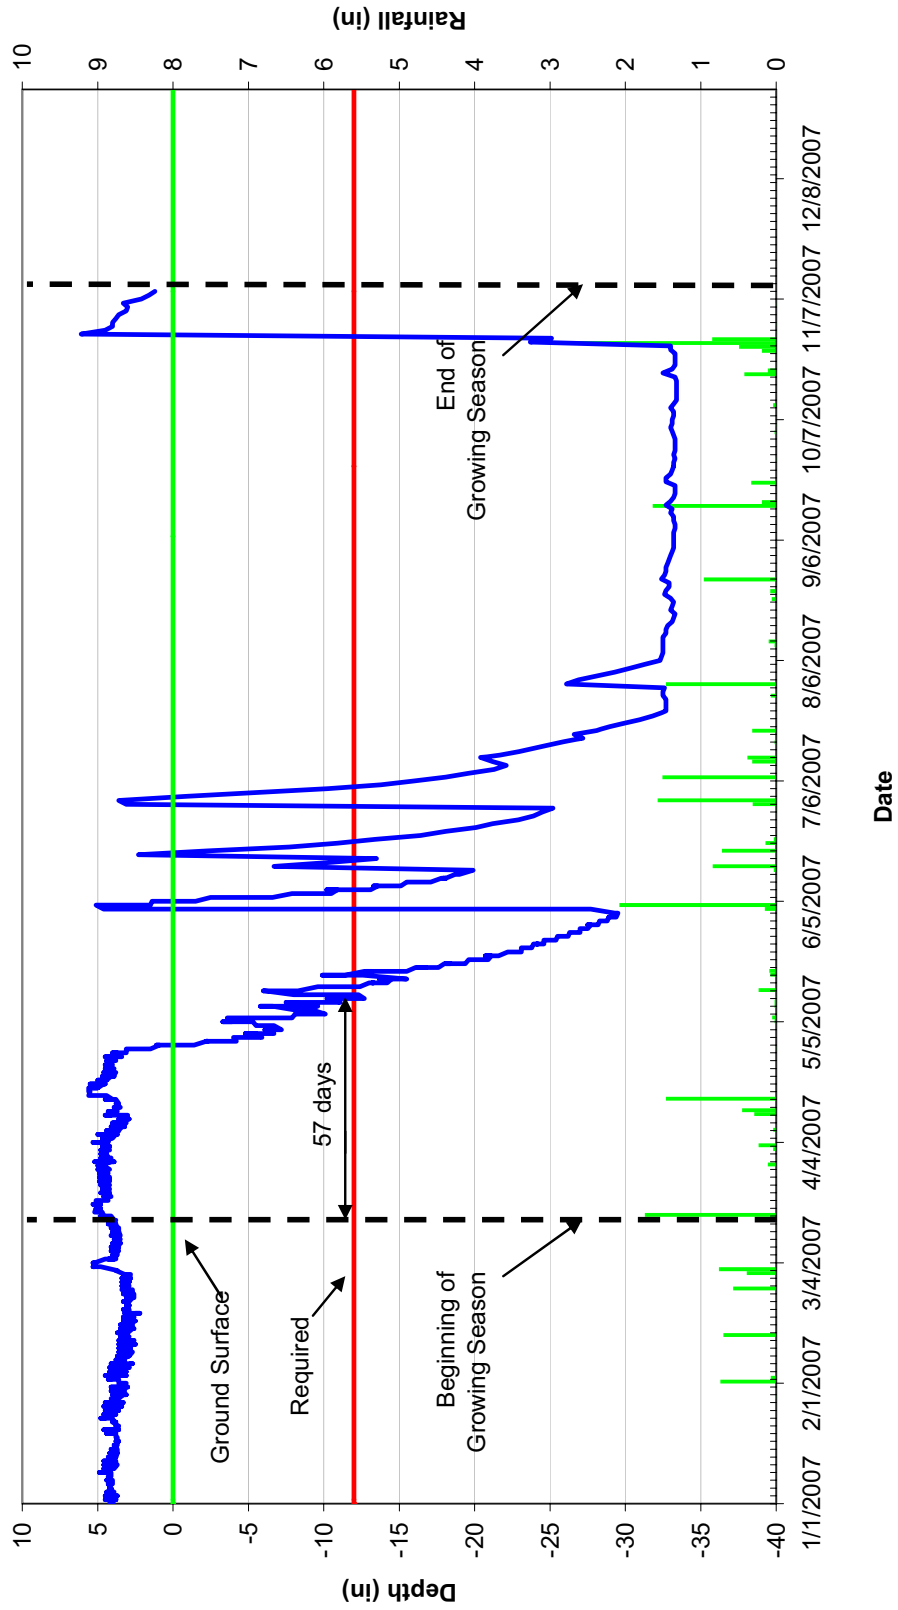





**2006 Groundwater Data  
Well JR-2 (SN: 00000B6517D5)**

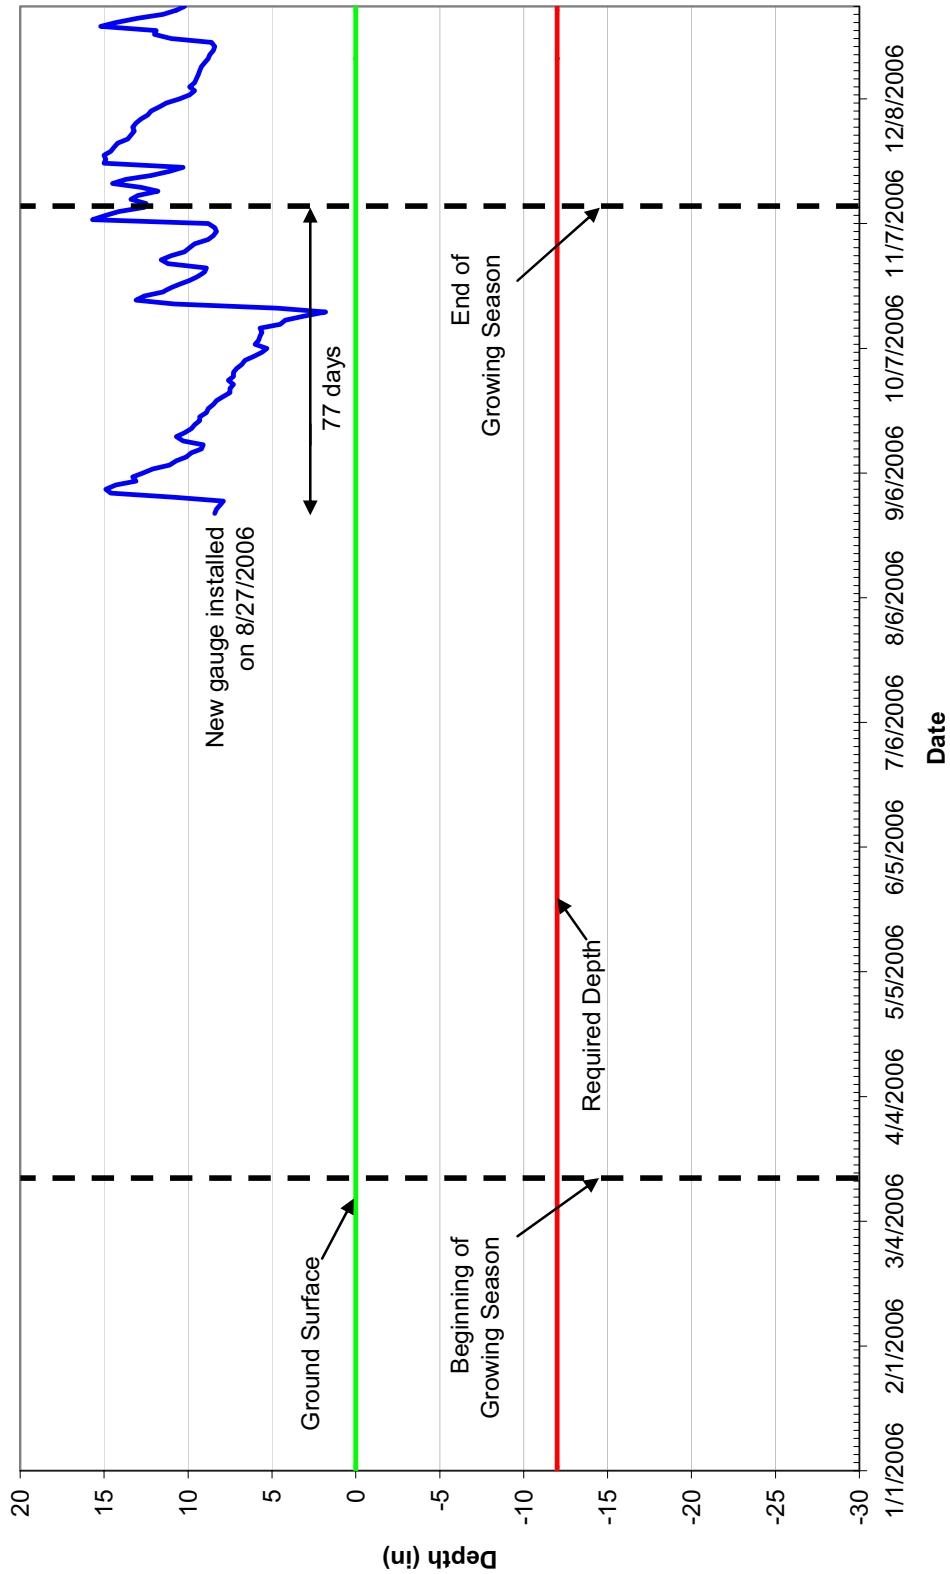


2007 Groundwater Data  
Well JR-2 (SN: 00000B6517D5)

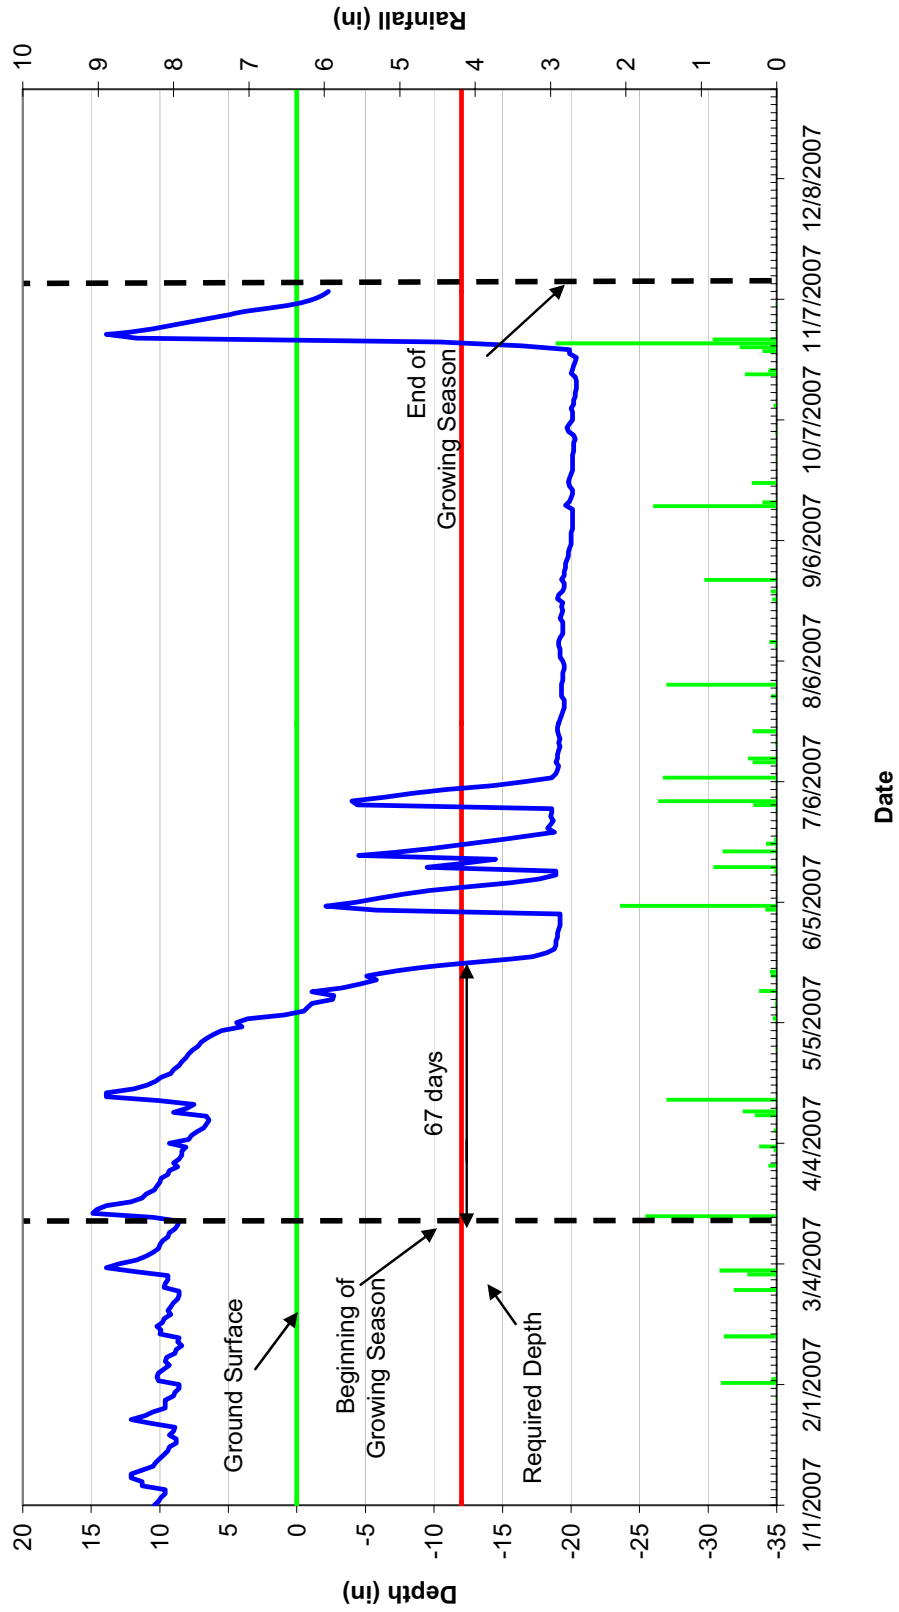


2006 Groundwater Data  
Well JR-3 (SN: 00000A287272)

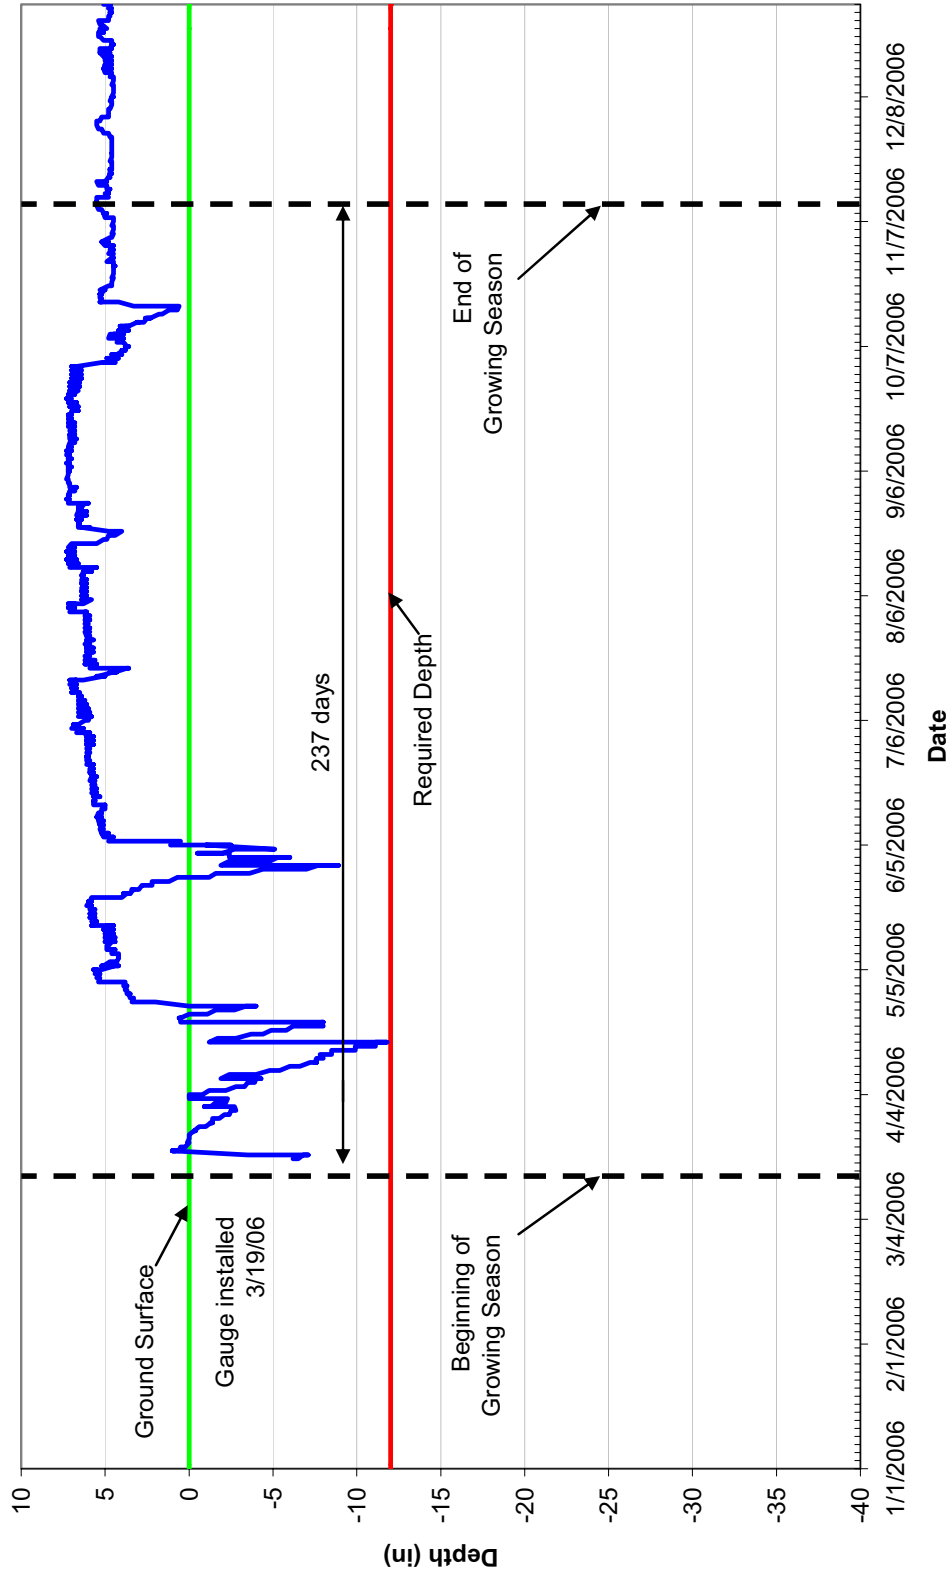

2007 Groundwater Data  
Well JR-3 (SN: 00000A287272)

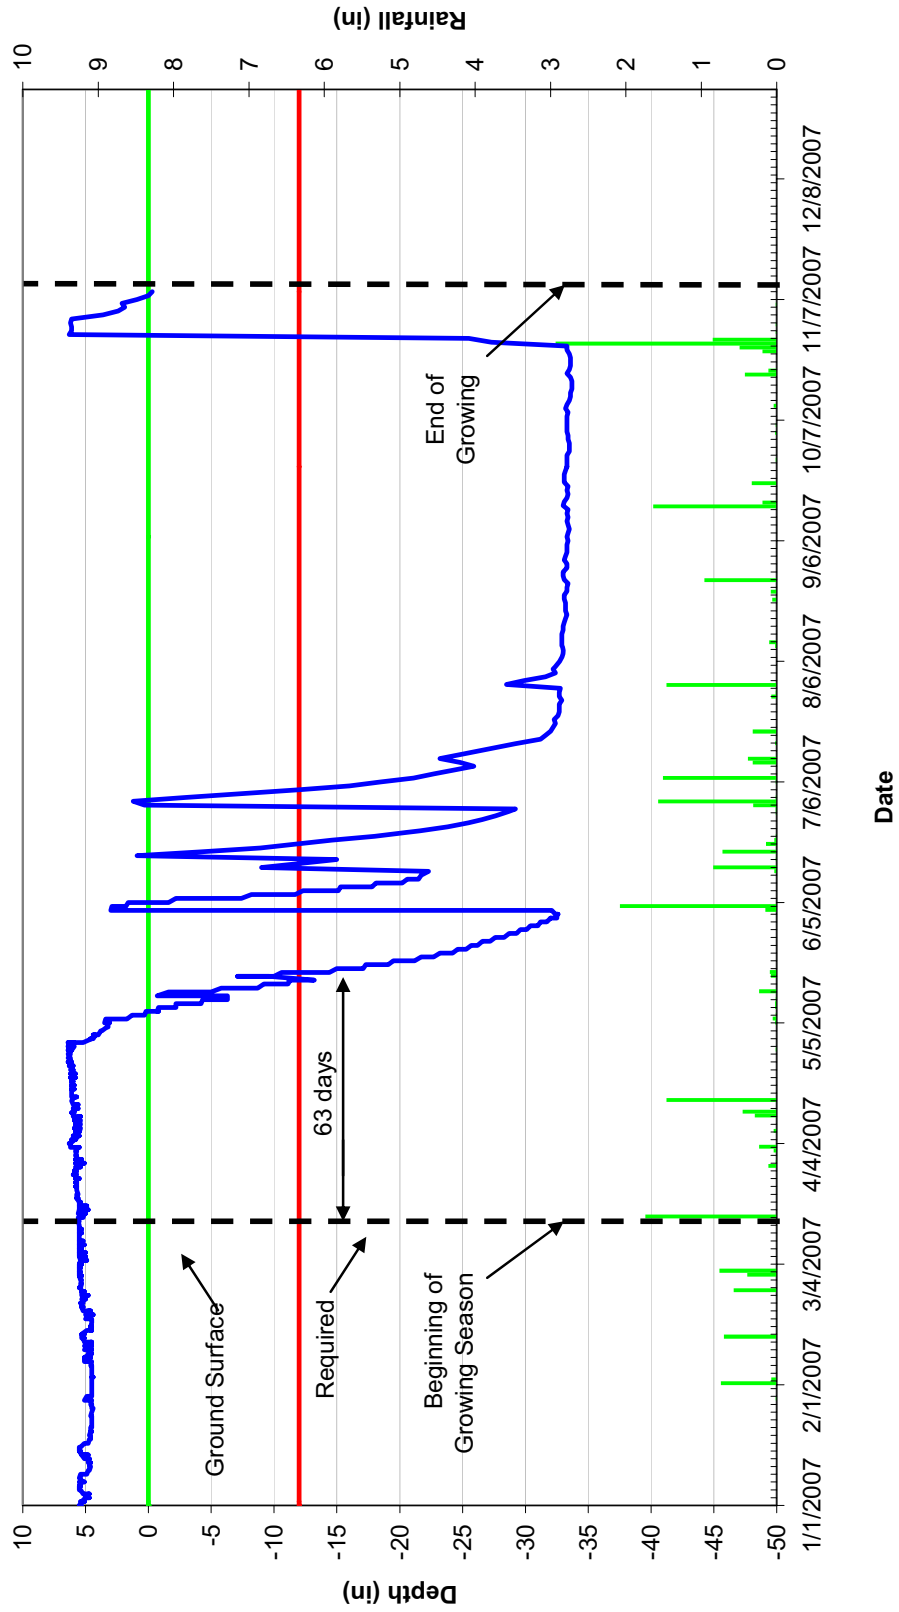


2006 Groundwater Data  
Well JR-4 (SN: 00000A28813D)

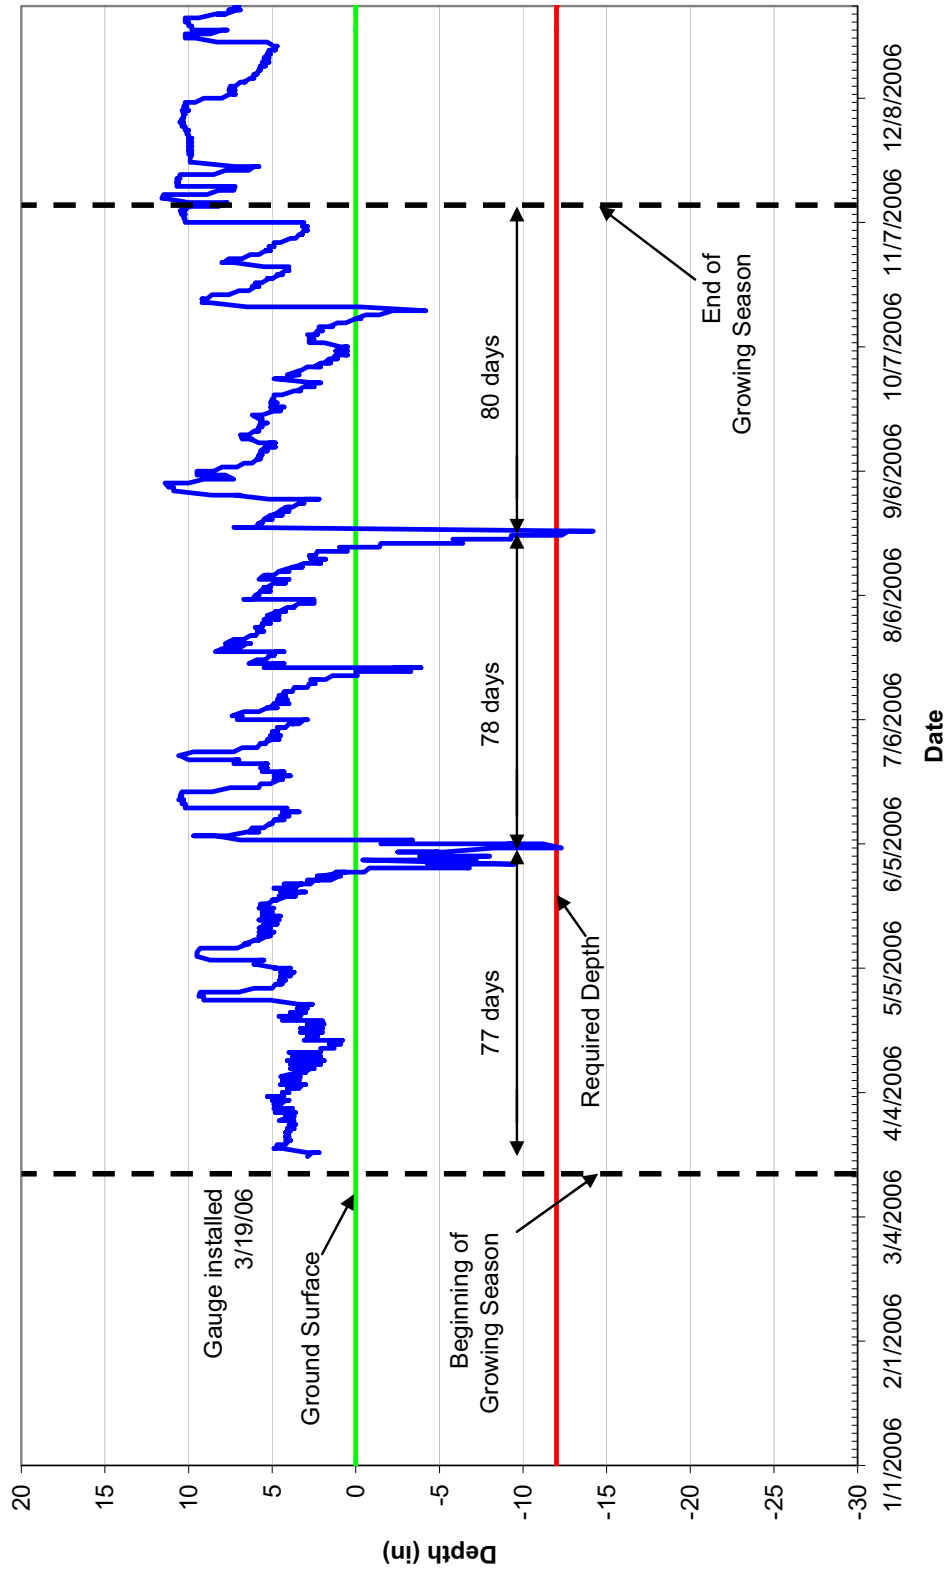





**2007 Groundwater Data  
Well JR-4 (SN: 00000A28813D)**

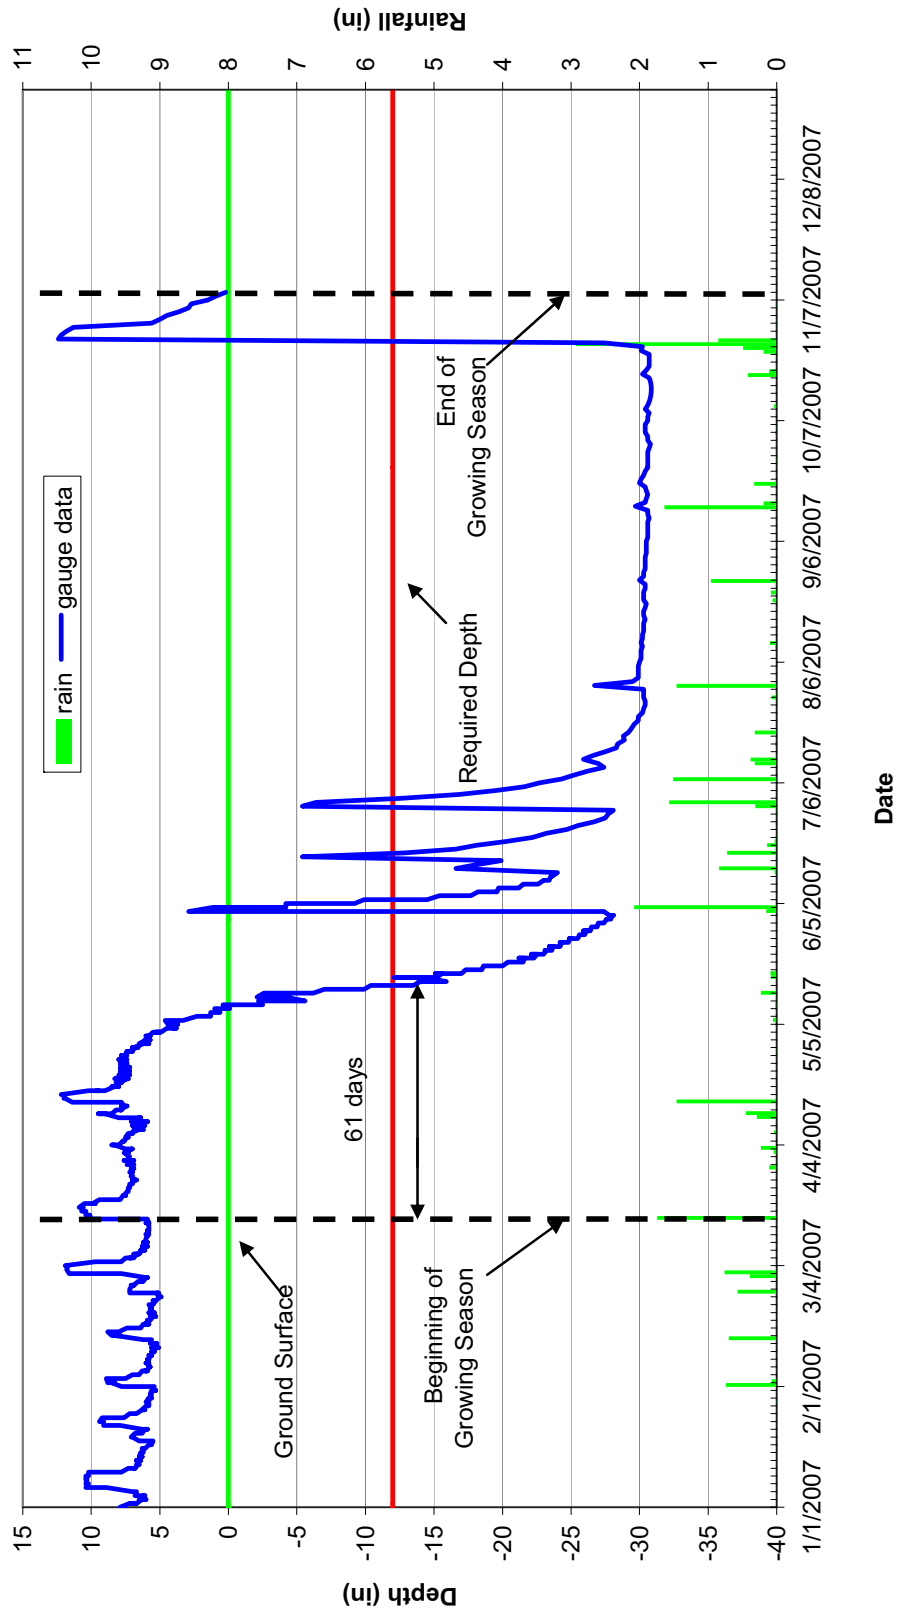


2006 Groundwater Data  
Well JR-5 (SN: 00000A278DE1)

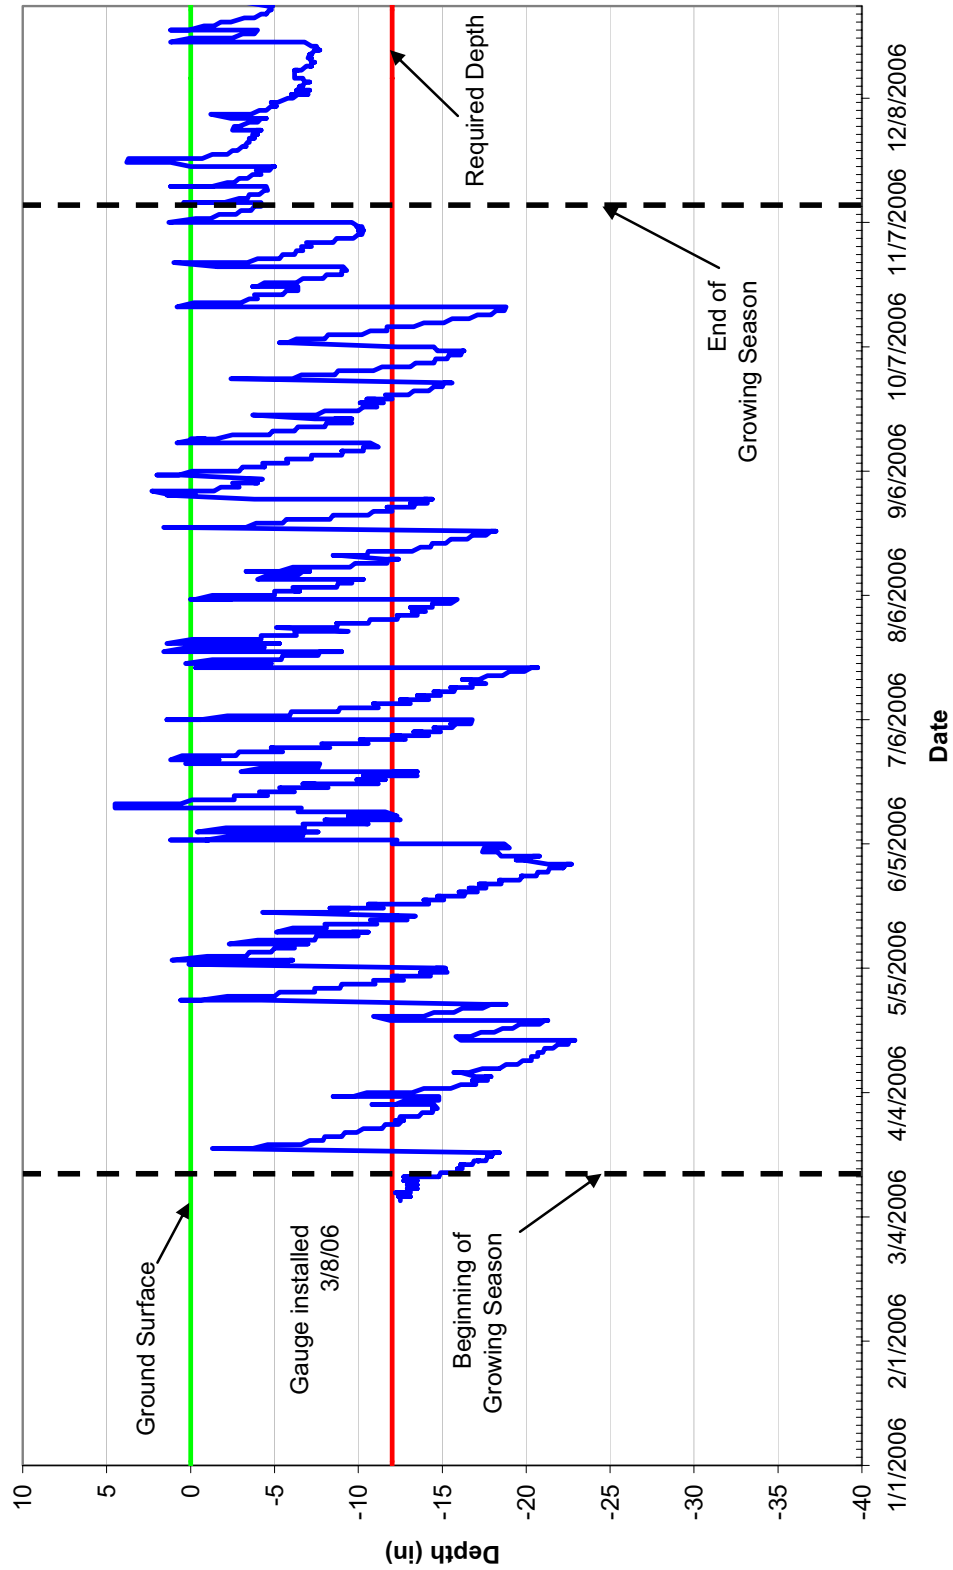


2007 Groundwater Data  
Well JR-5 (SN: 00000A278DE1)

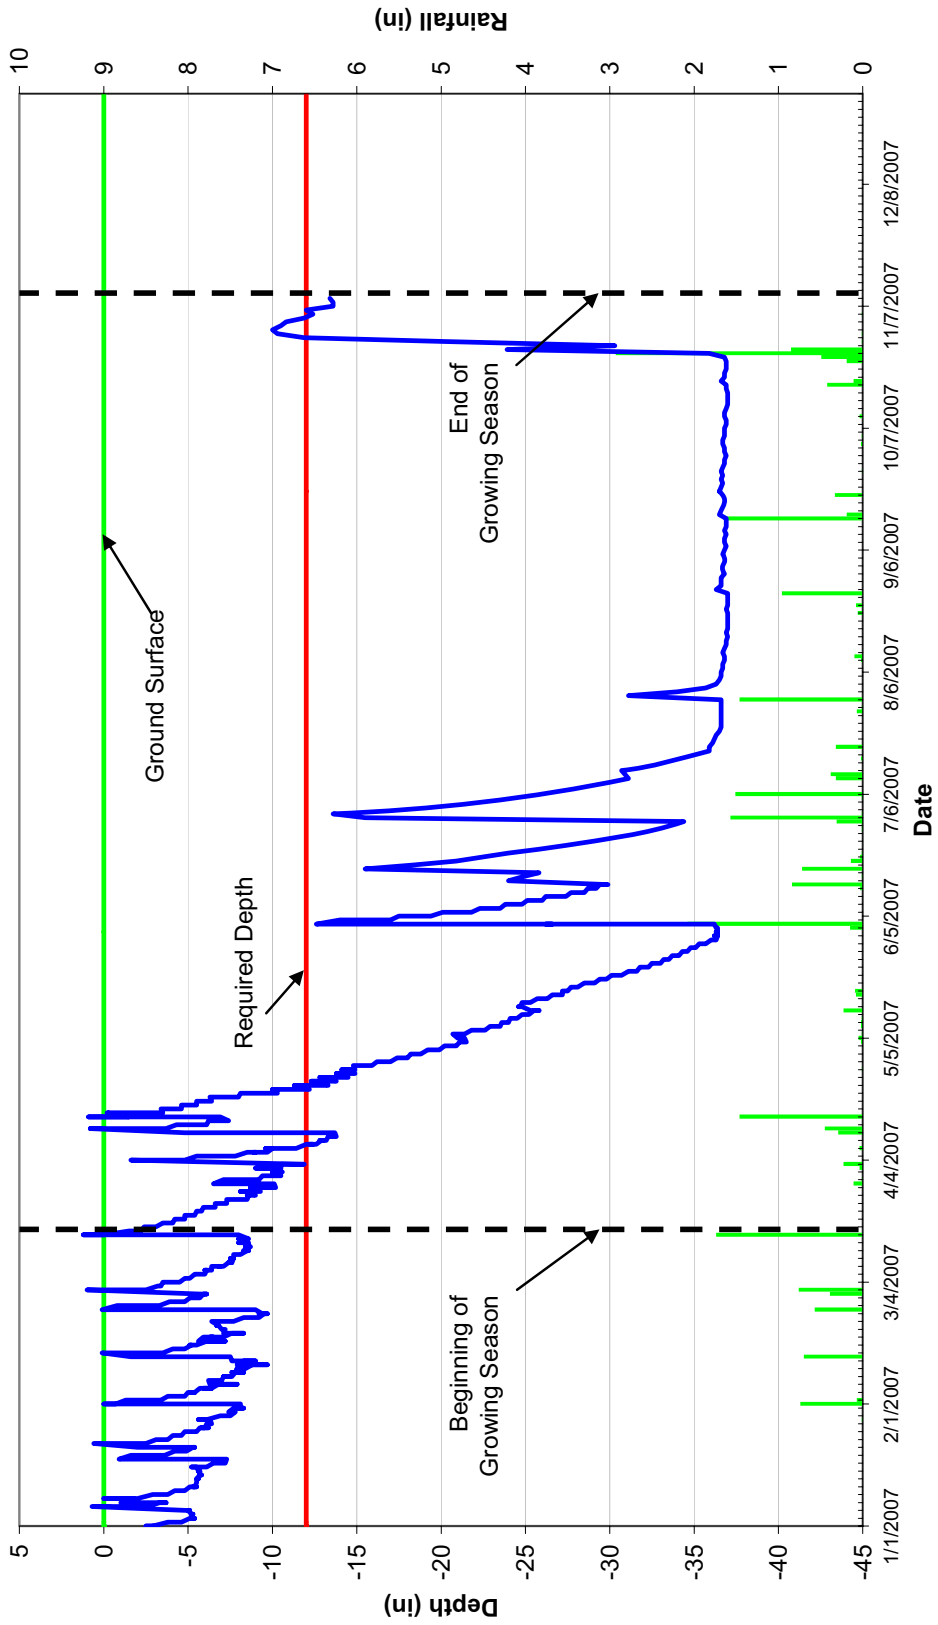

2006 Groundwater Data  
Well JR-6 (SN: 00000A28A0D9)

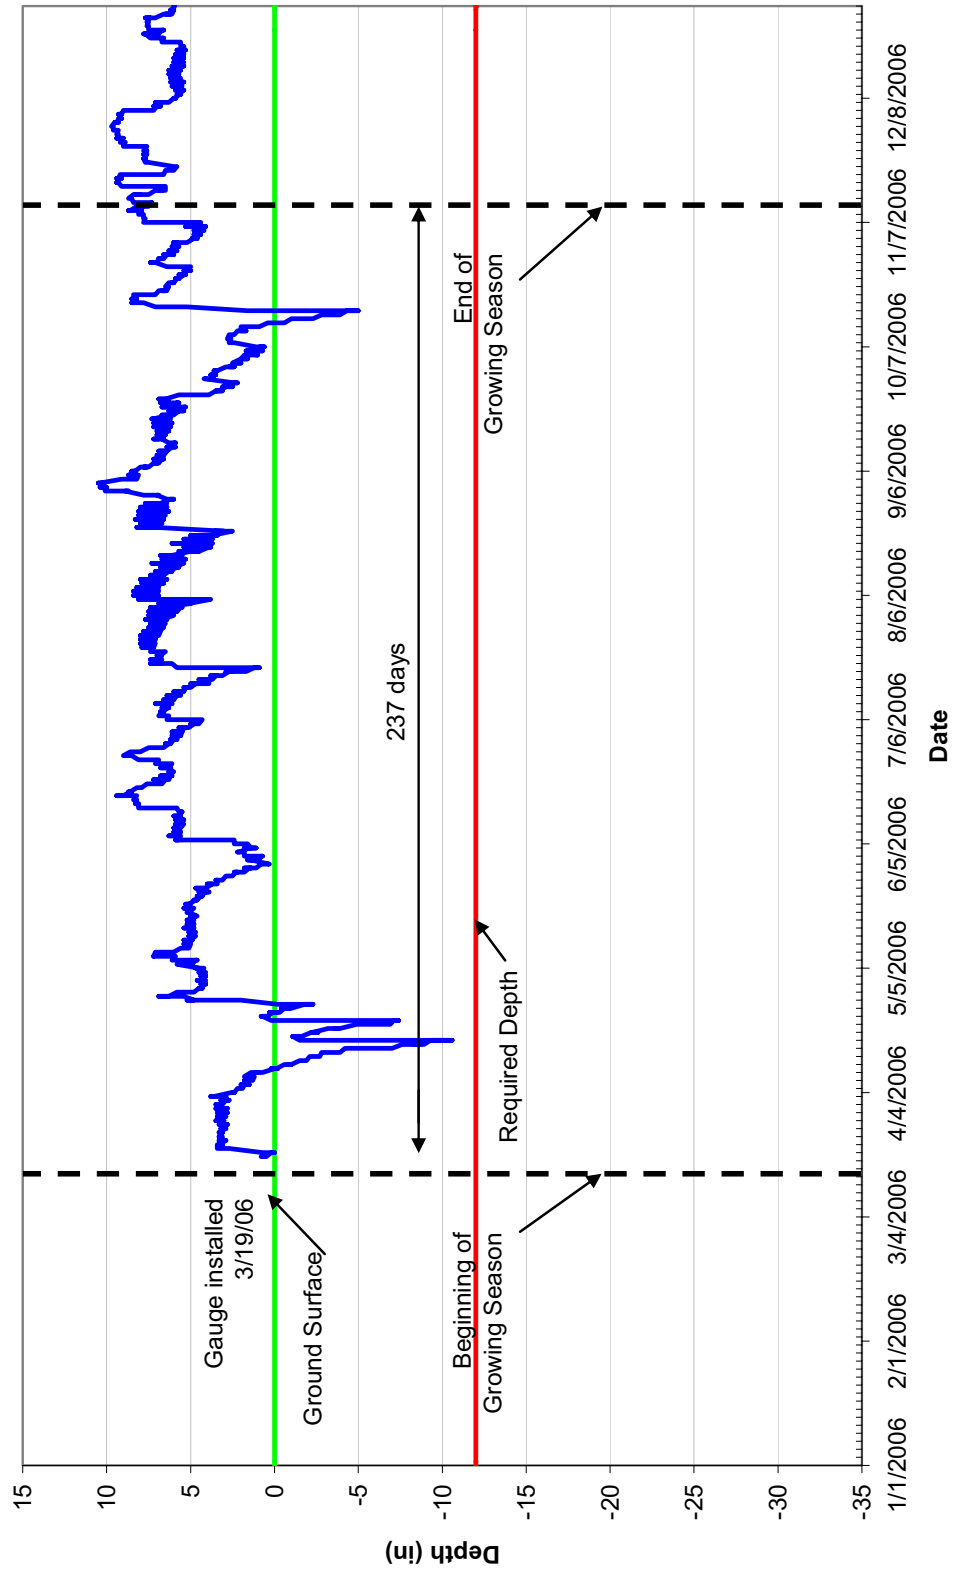


2007 Groundwater Data  
Well JR-6 (SN: 00000A28A0D9)

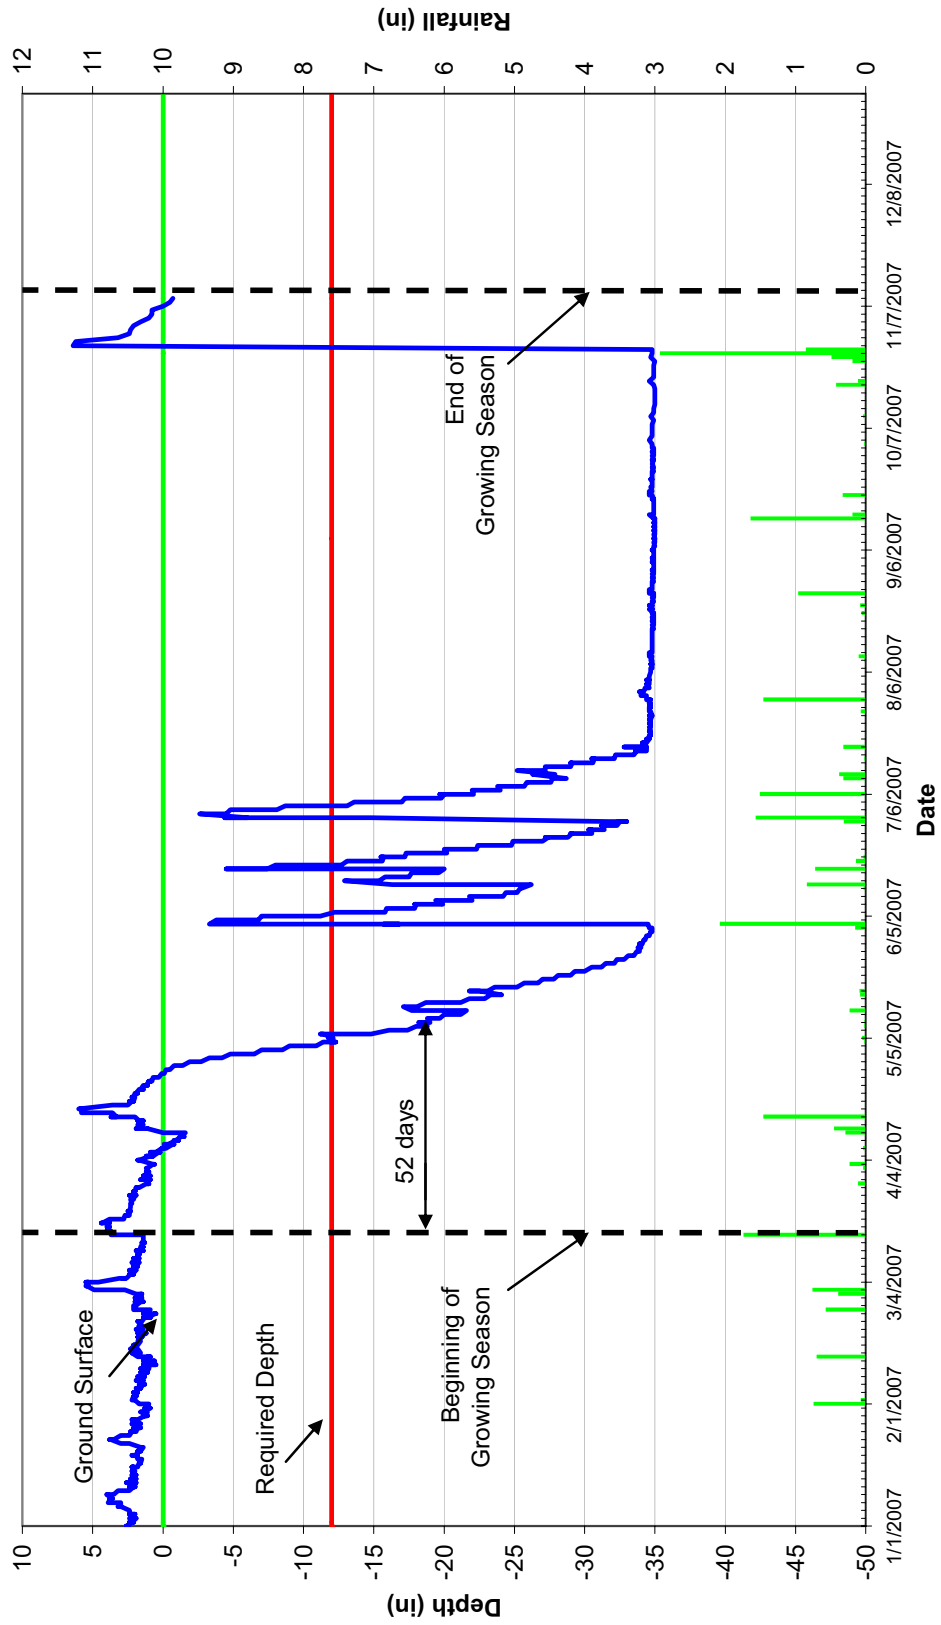





2006 Groundwater Data  
Well JR-7 (SN: 00000AB36E51)

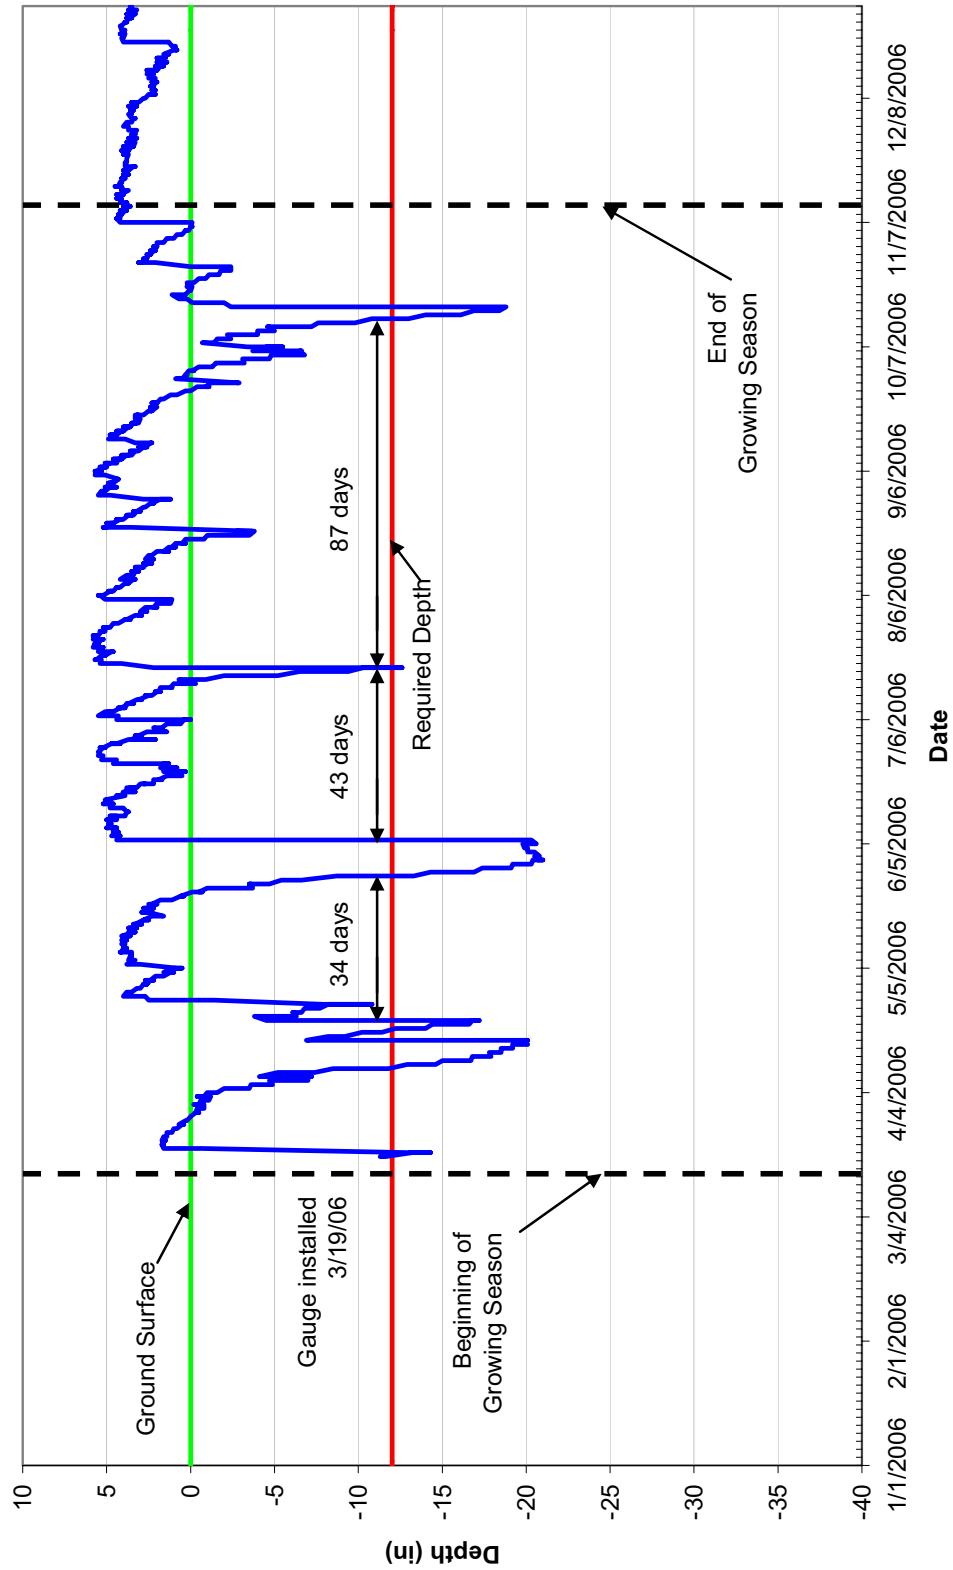


2007 Groundwater Data  
Well JR-7 (SN: 00000AB36E51)

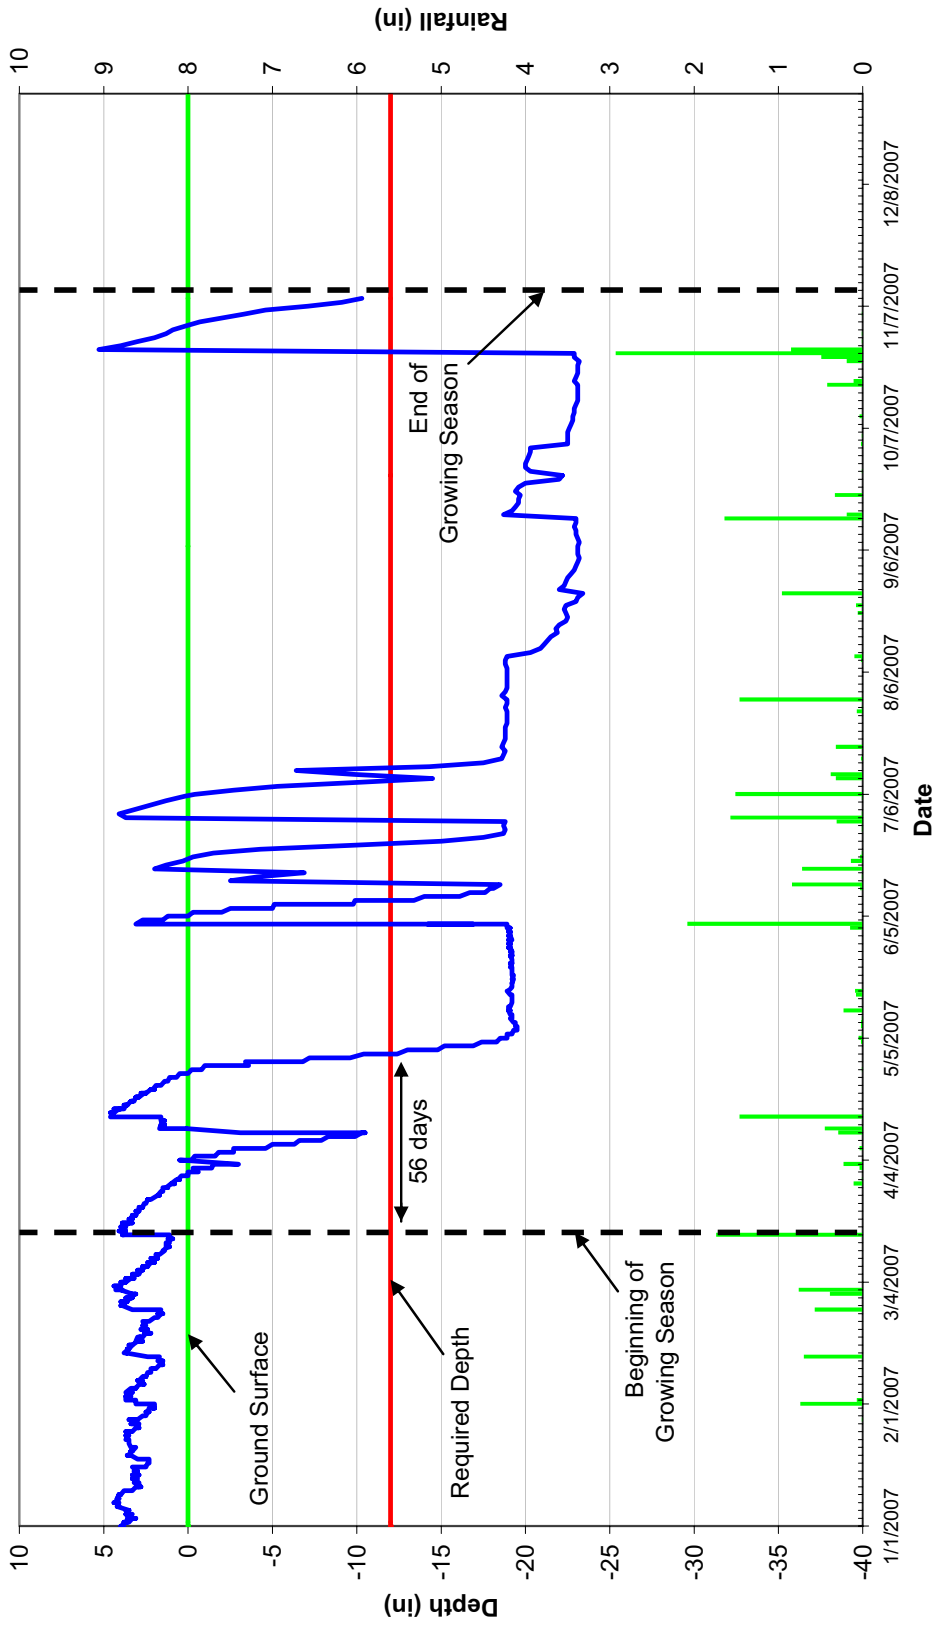


2006 Groundwater Data  
Well JR-8 (SN: 00000AB372F9)

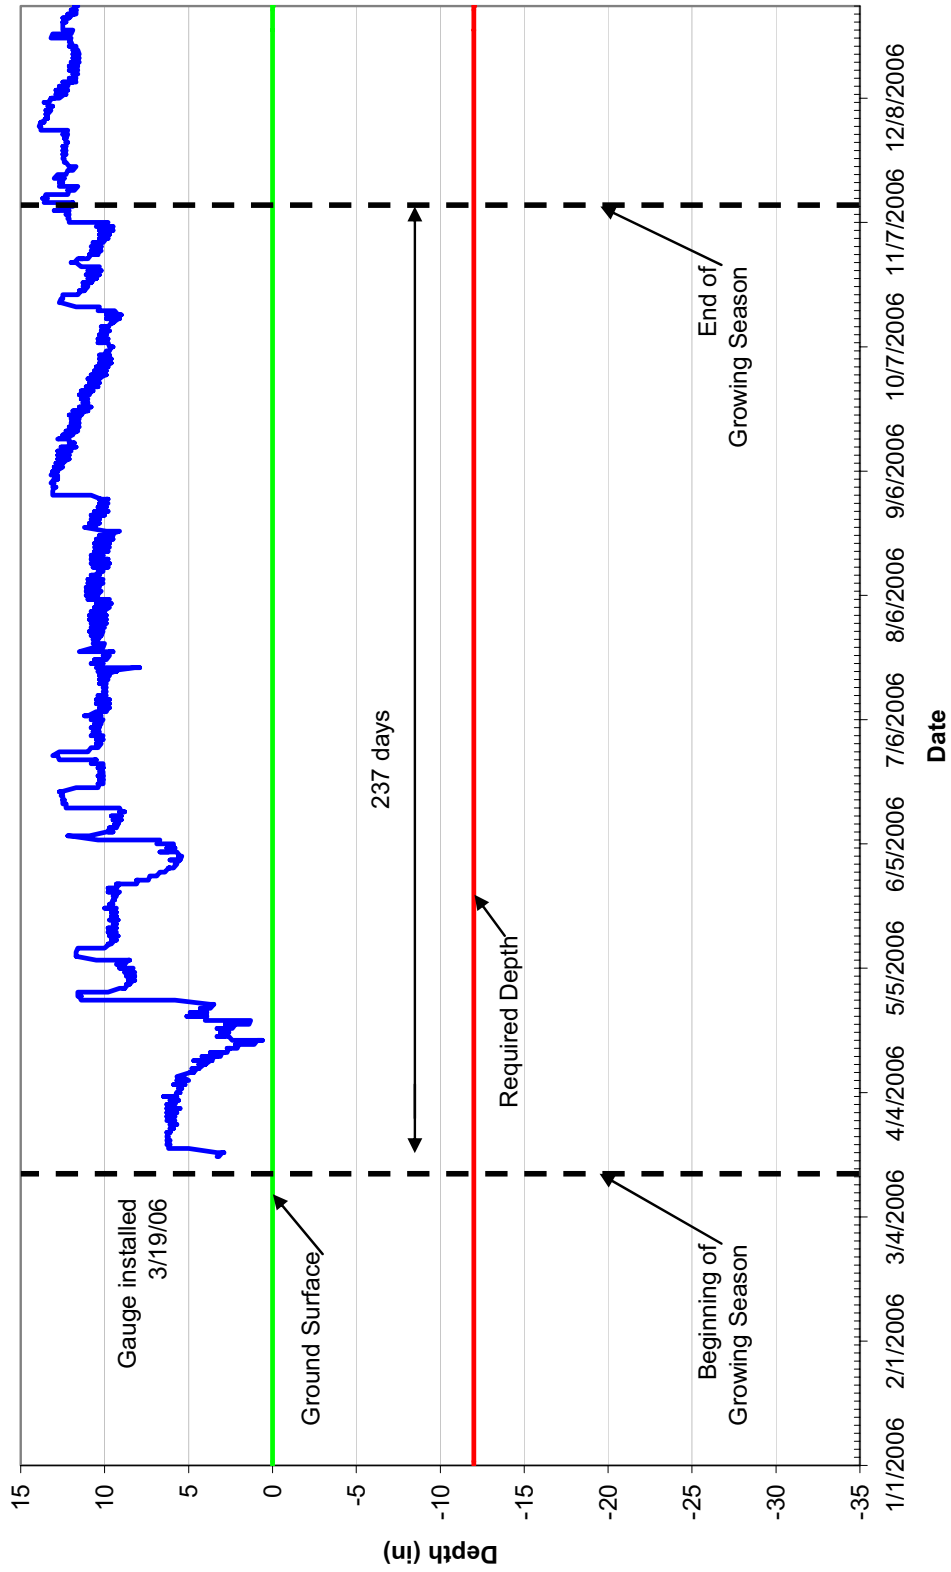

2007 Groundwater Data  
Well JR-8 (SN: 00000AB372F9)

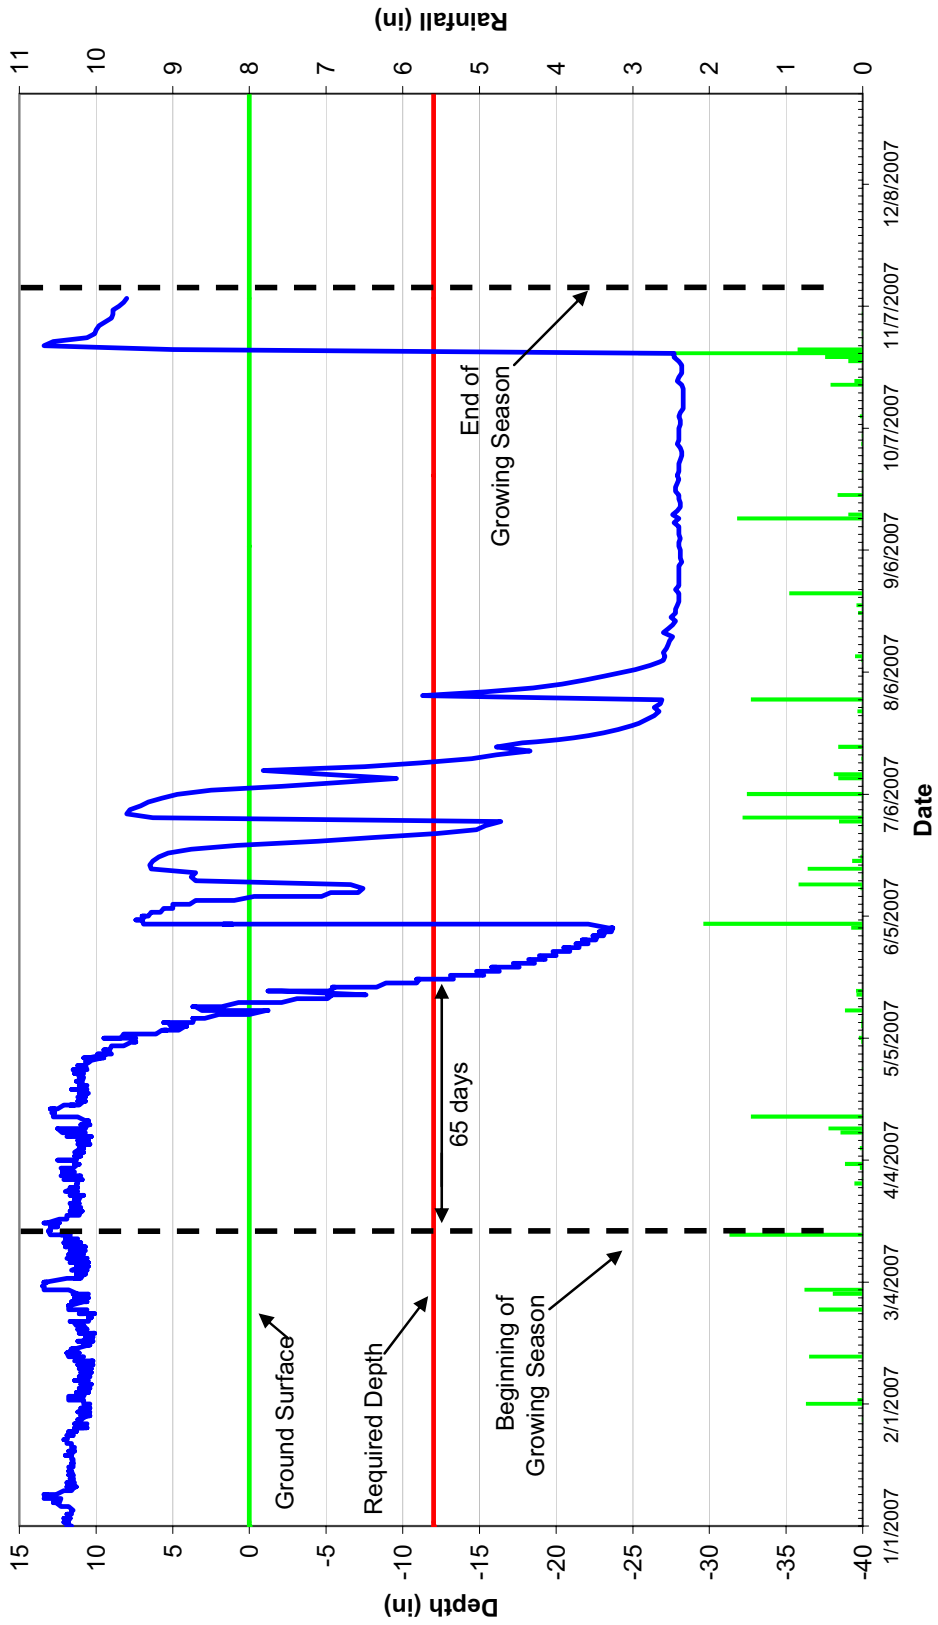


2006 Groundwater Data  
Well JR-9 (SN: 00000AB35FB9)

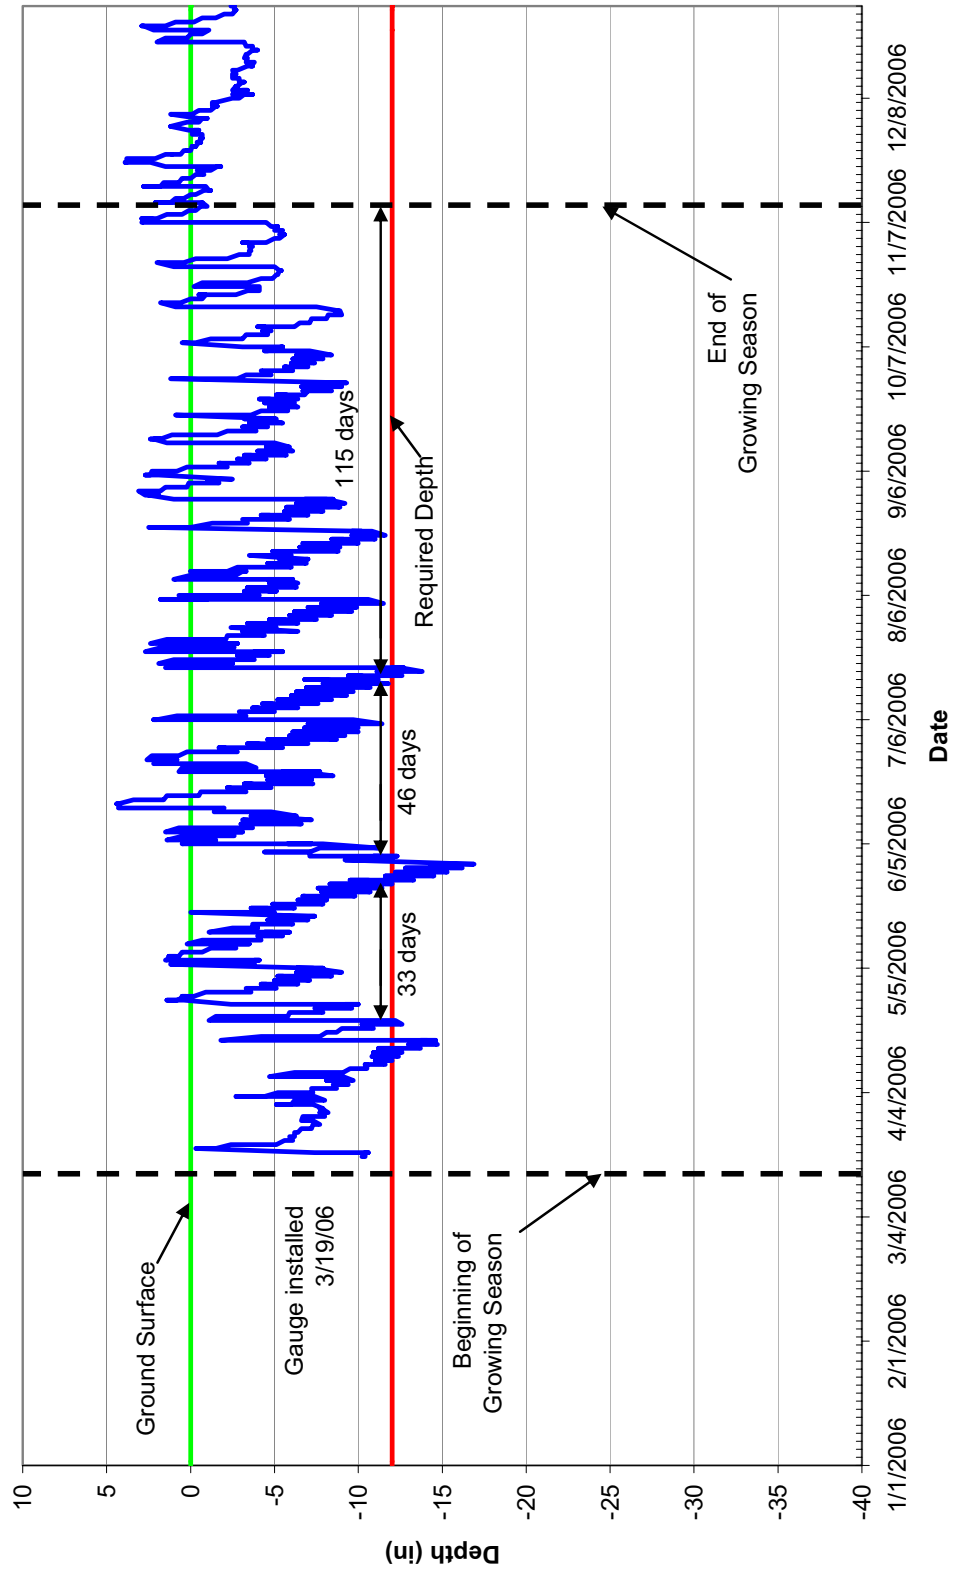





2007 Groundwater Data  
Well JR-9 (SN: 00000AB35FB9)

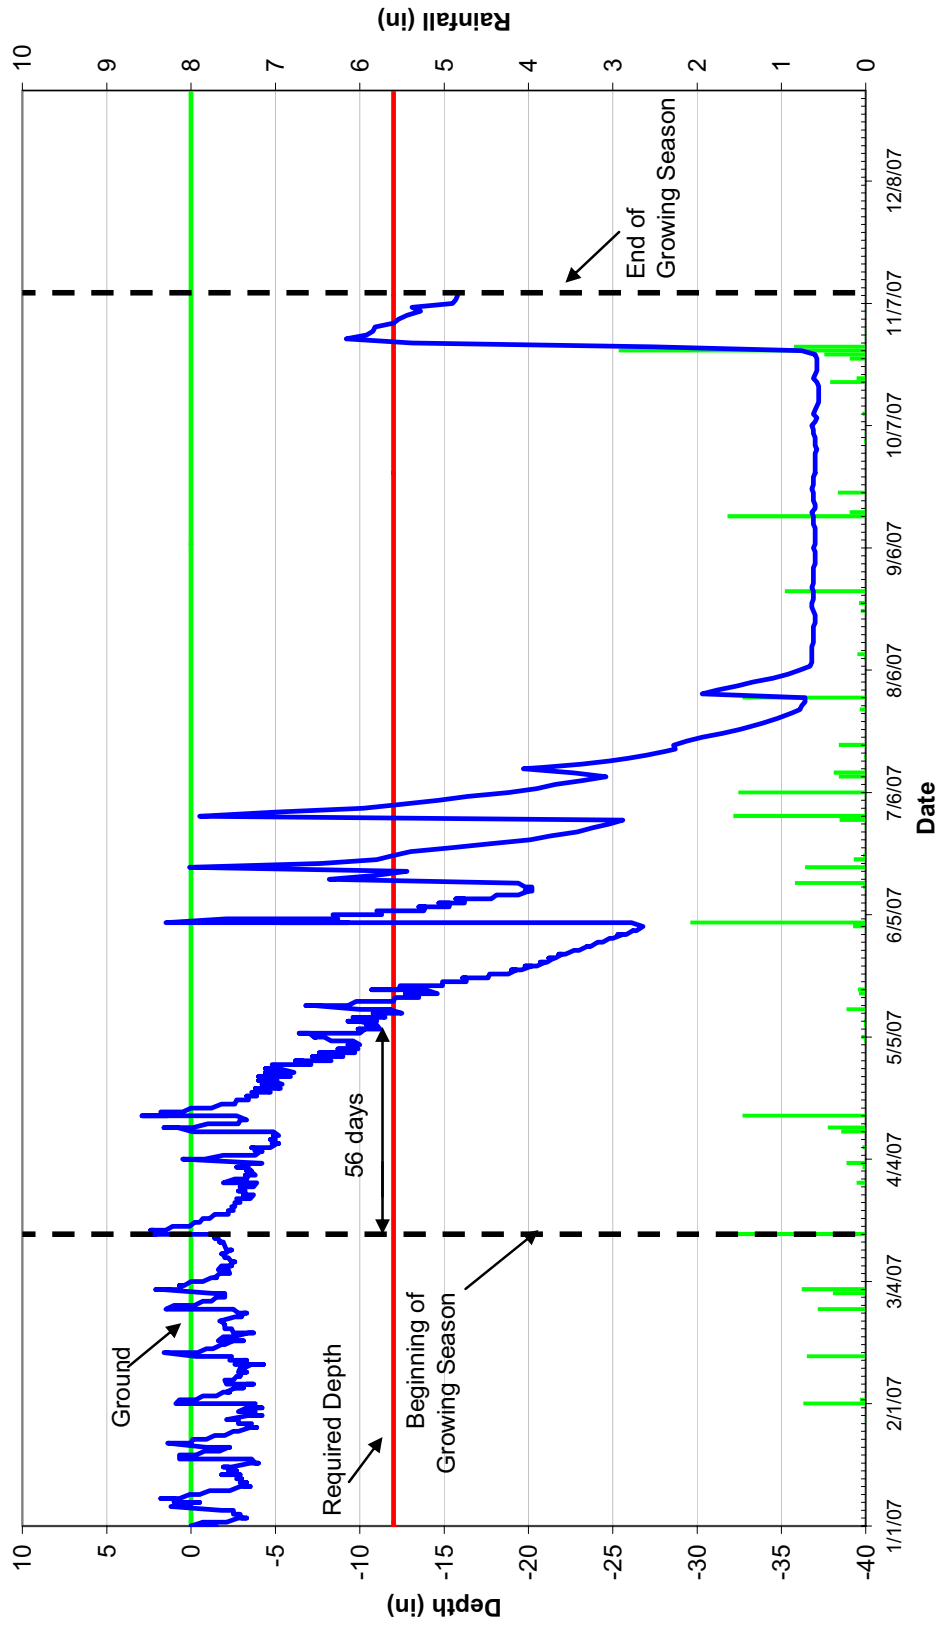


2006 Groundwater Data  
Well JR-10 (SN: 00000A287F34)

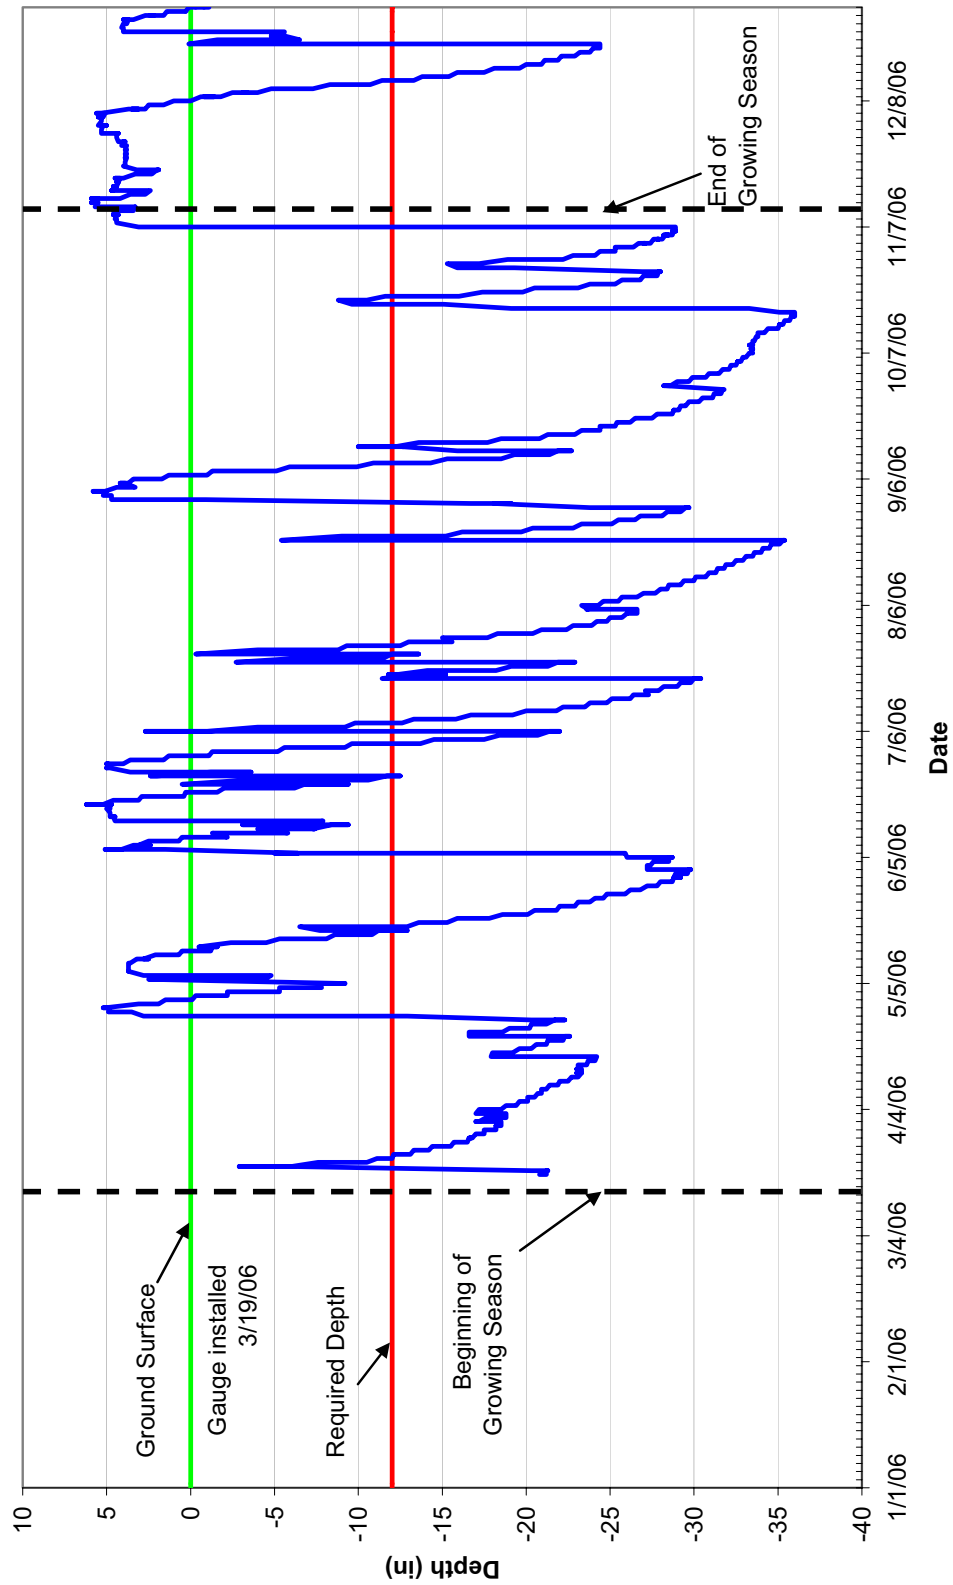


2007 Groundwater Data  
Well JR-10 (SN: 00000A287F34)

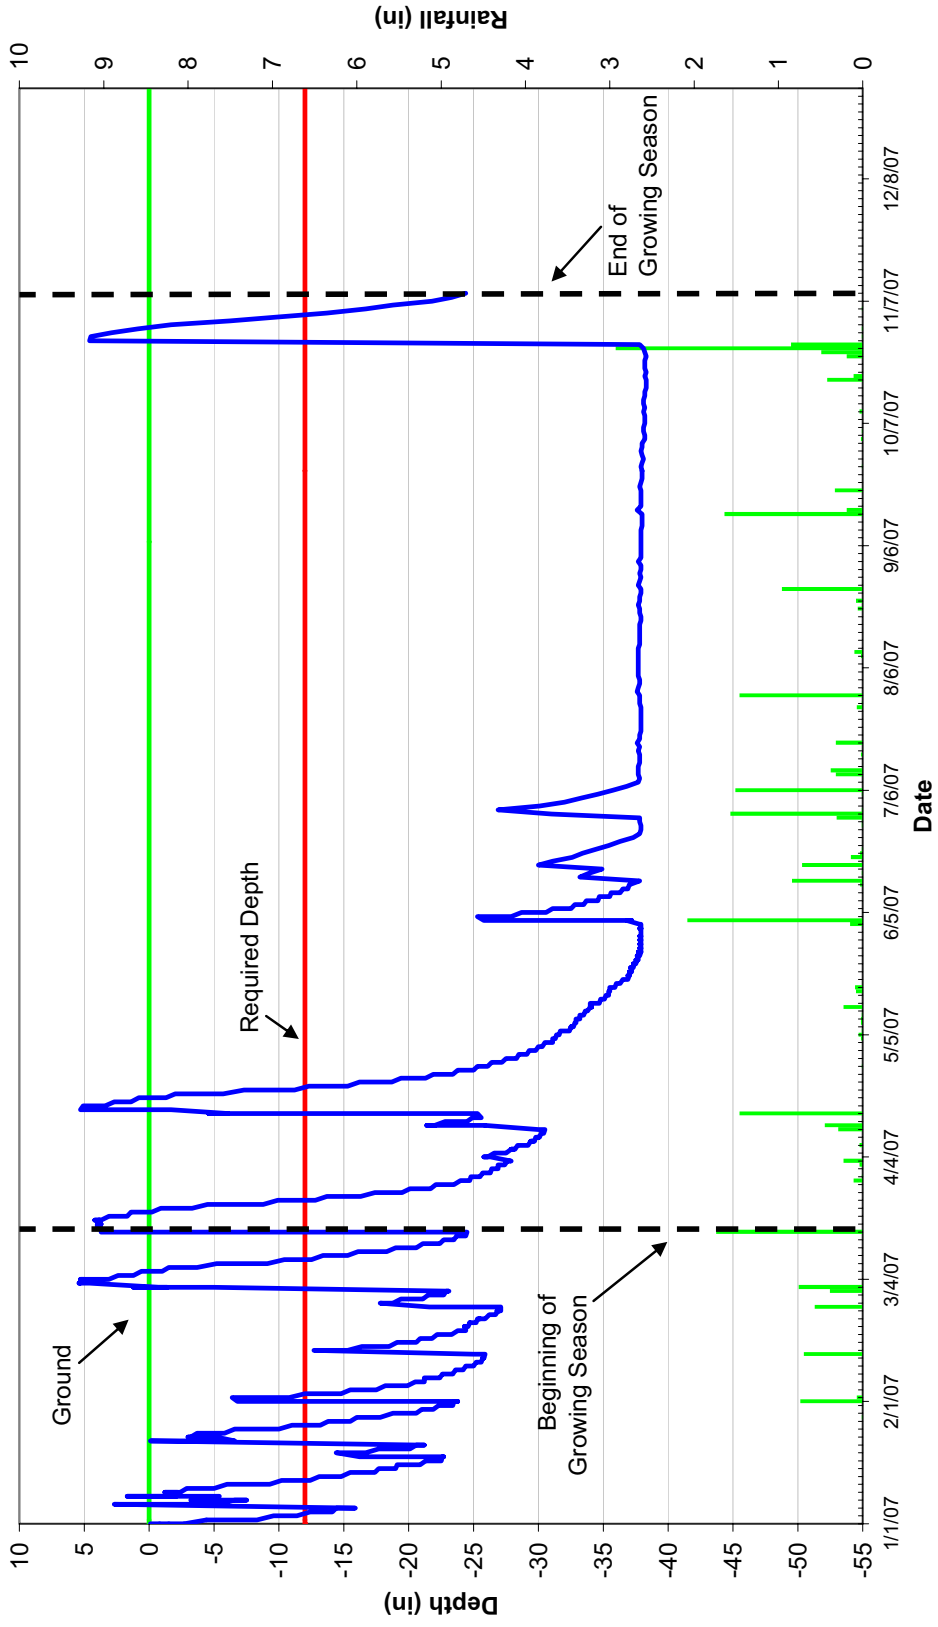


2006 Groundwater Data  
Well JR-11 (SN: 00000A289B07)

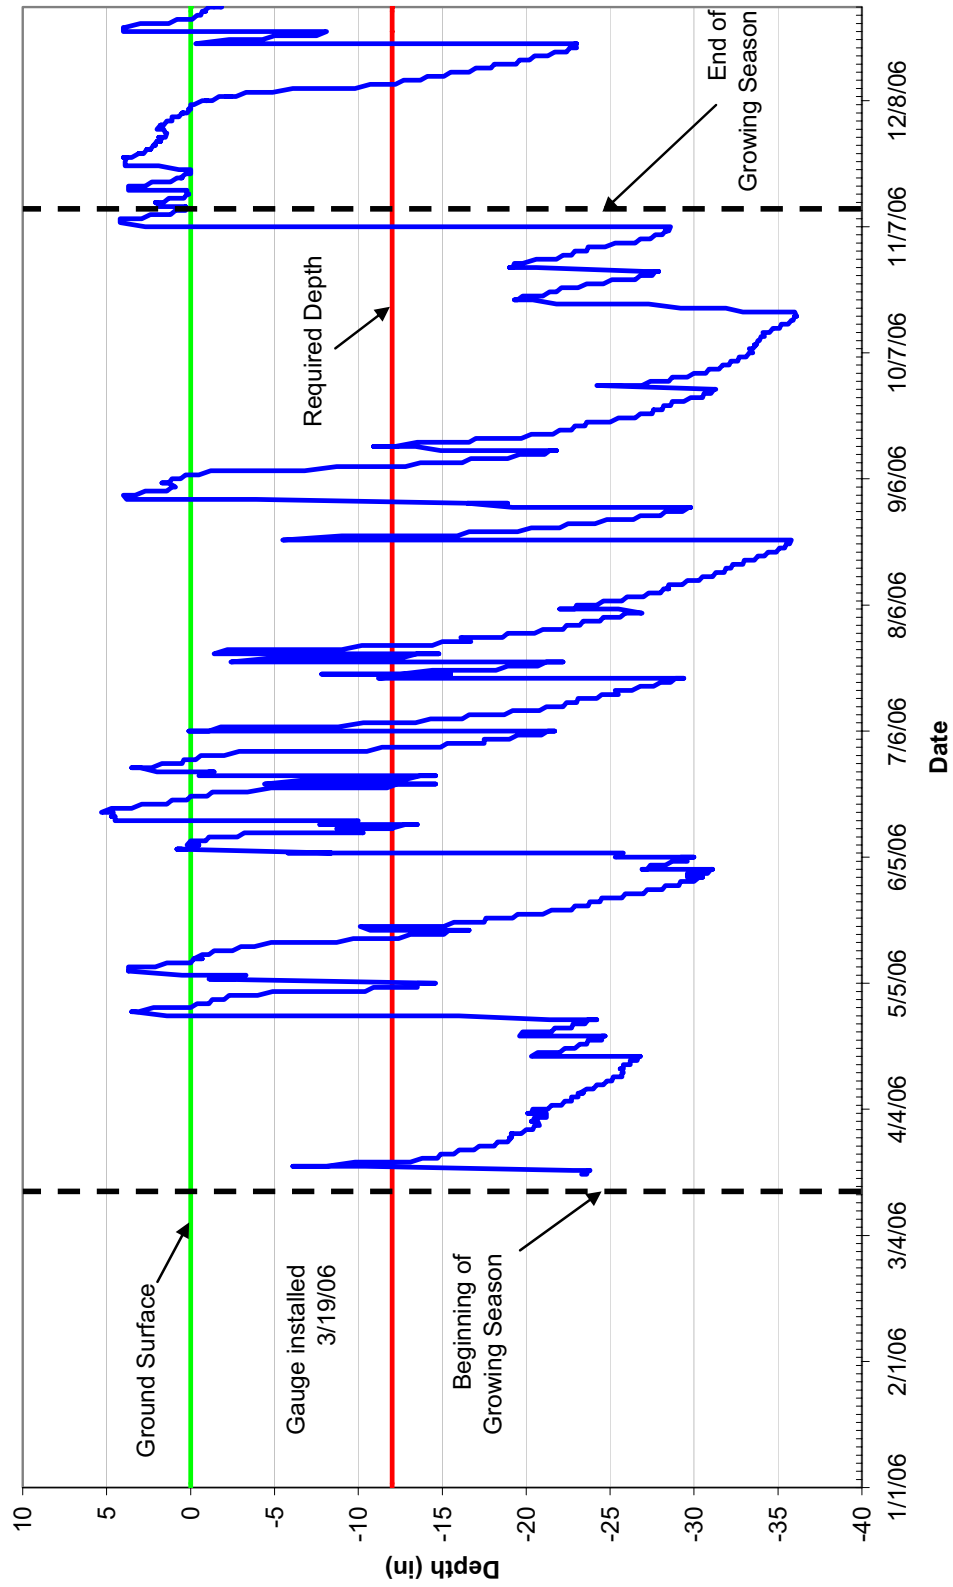

2007 Groundwater Data  
Well JR-11 (SN: 00000A289B07)

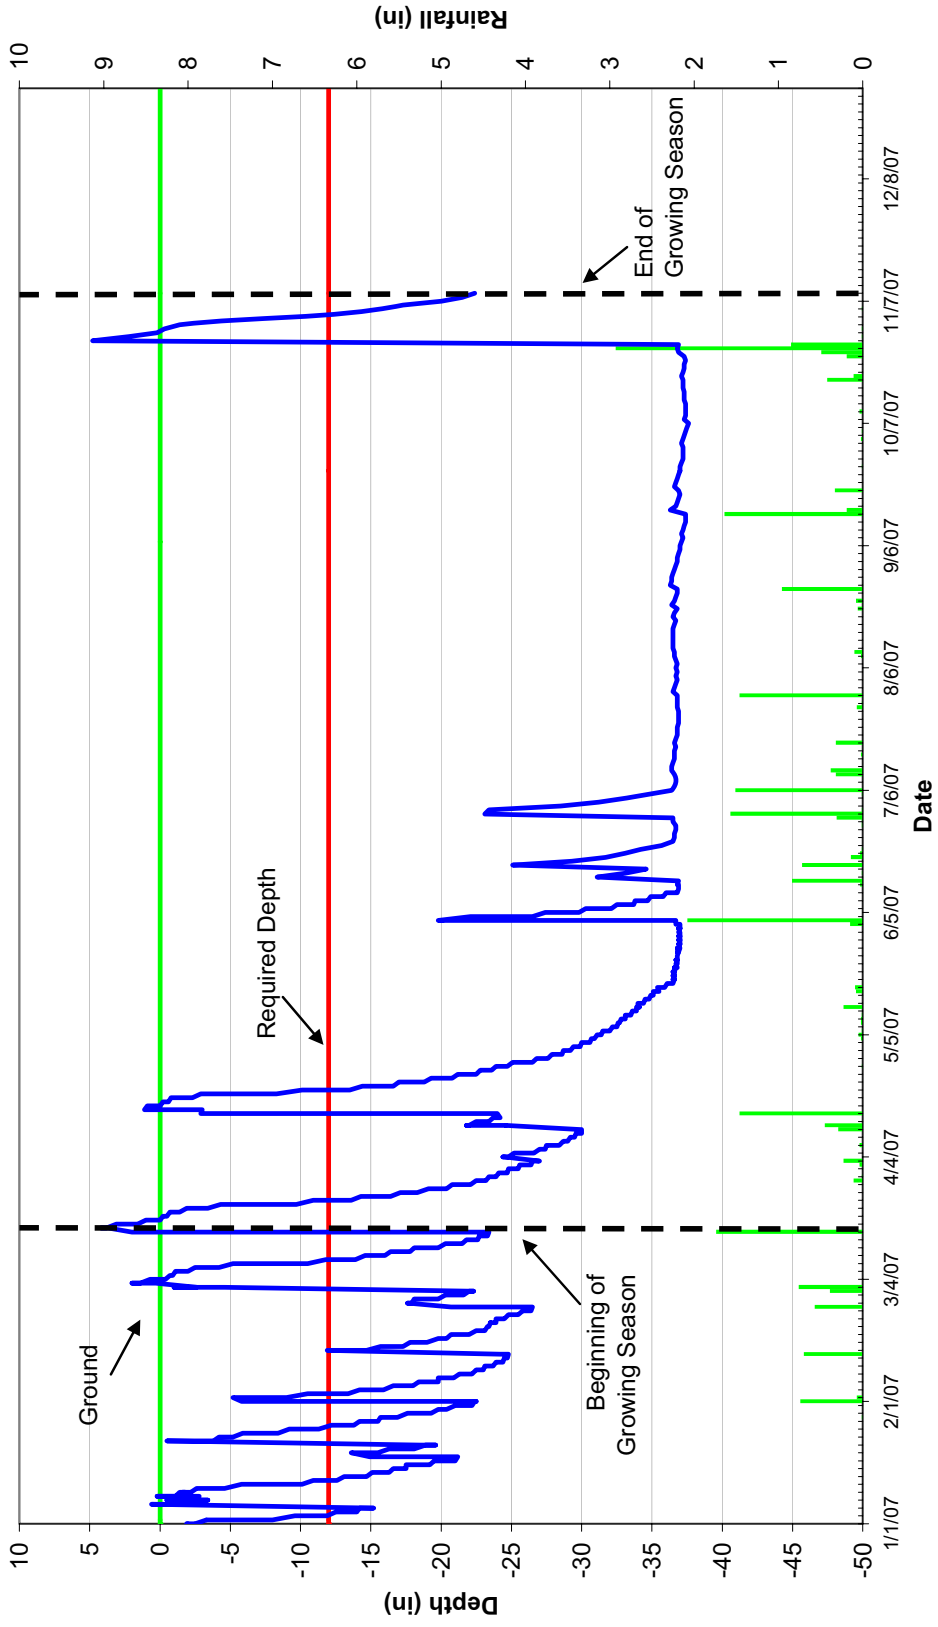


2006 Groundwater Data  
Well JR-12 (SN: 00000AB3660B)

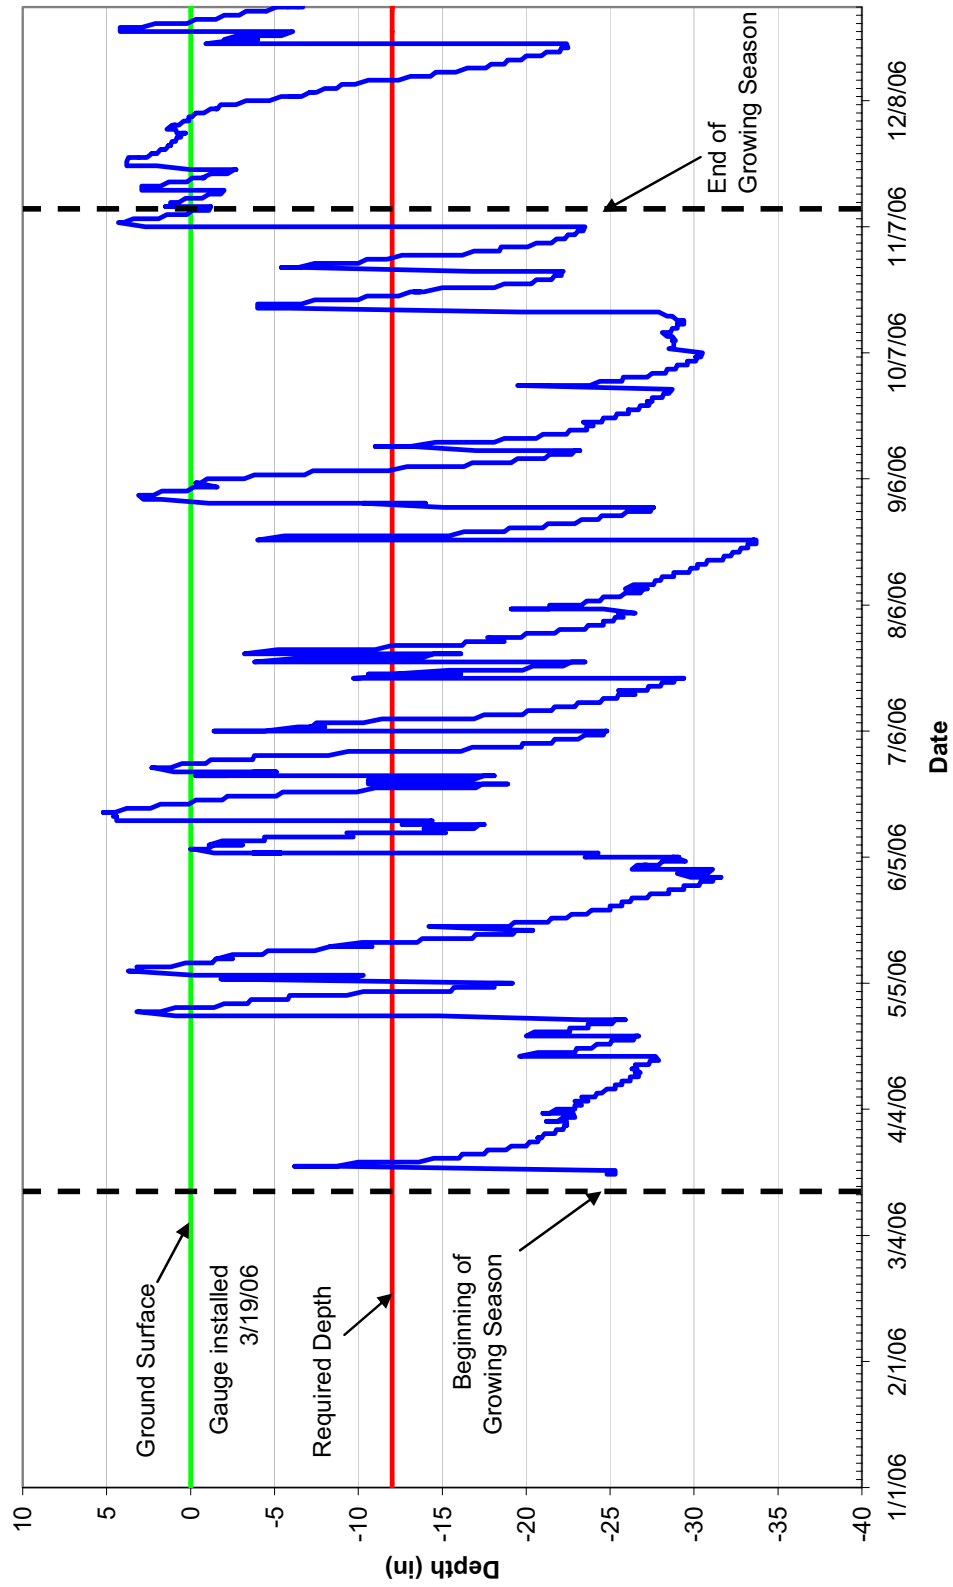





2007 Groundwater Data  
Well JR-12 (SN: 00000AB3660B)

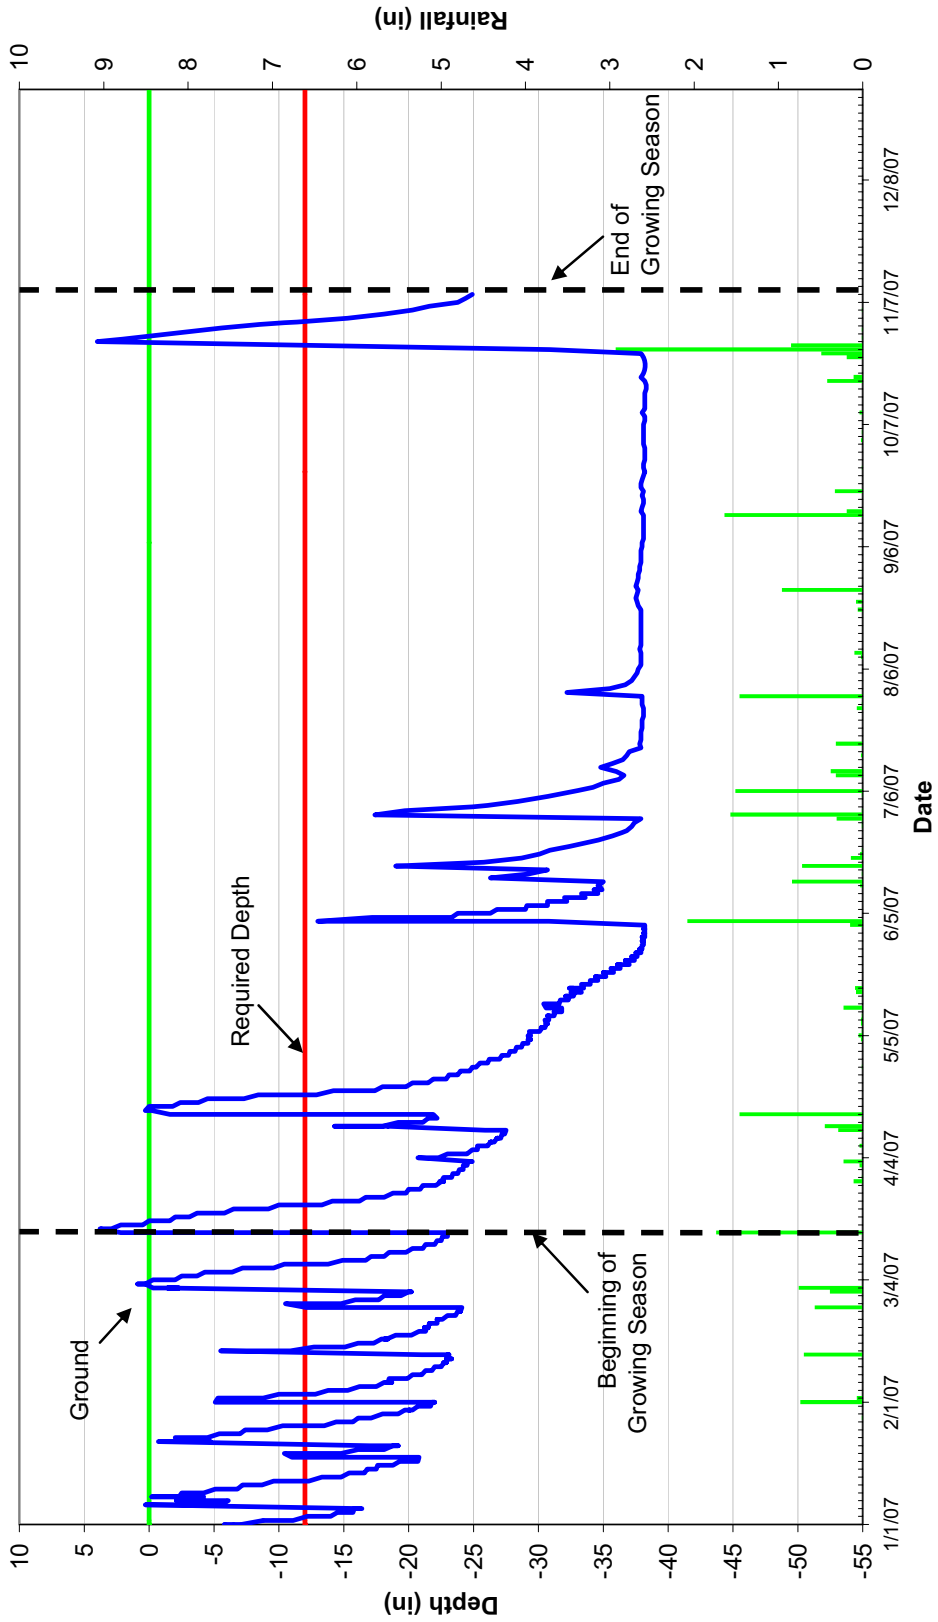


2006 Groundwater Data  
Well JR-13 (SN: 00000A28BC50)

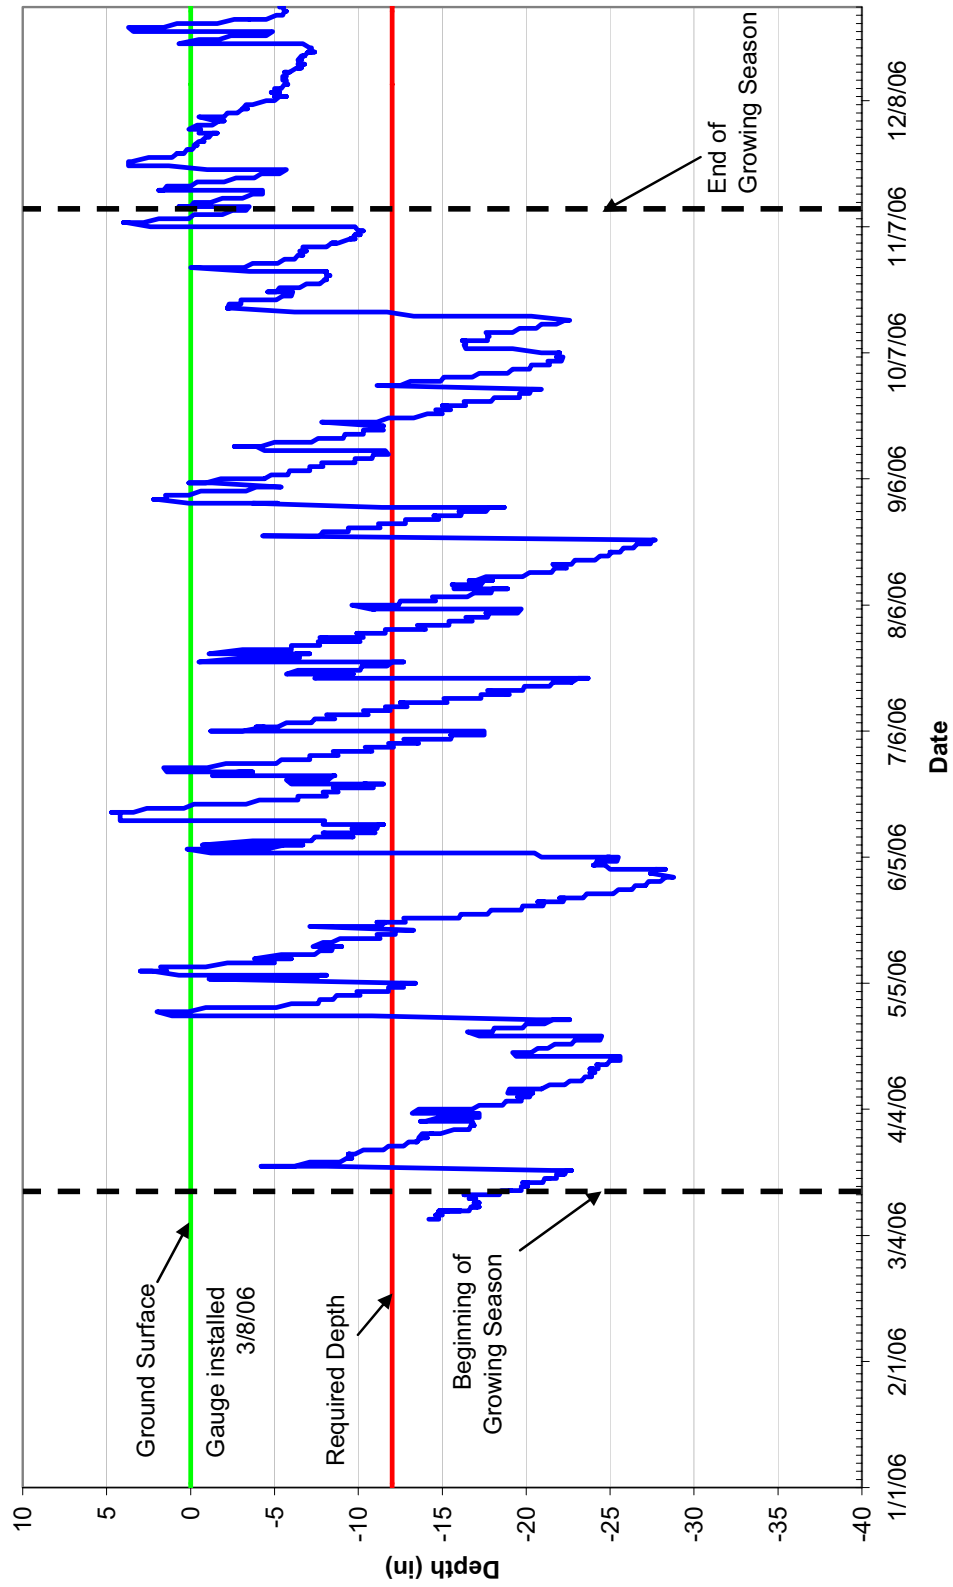


2007 Groundwater Data  
Well JR-13 (SN: 00000A28BC50)

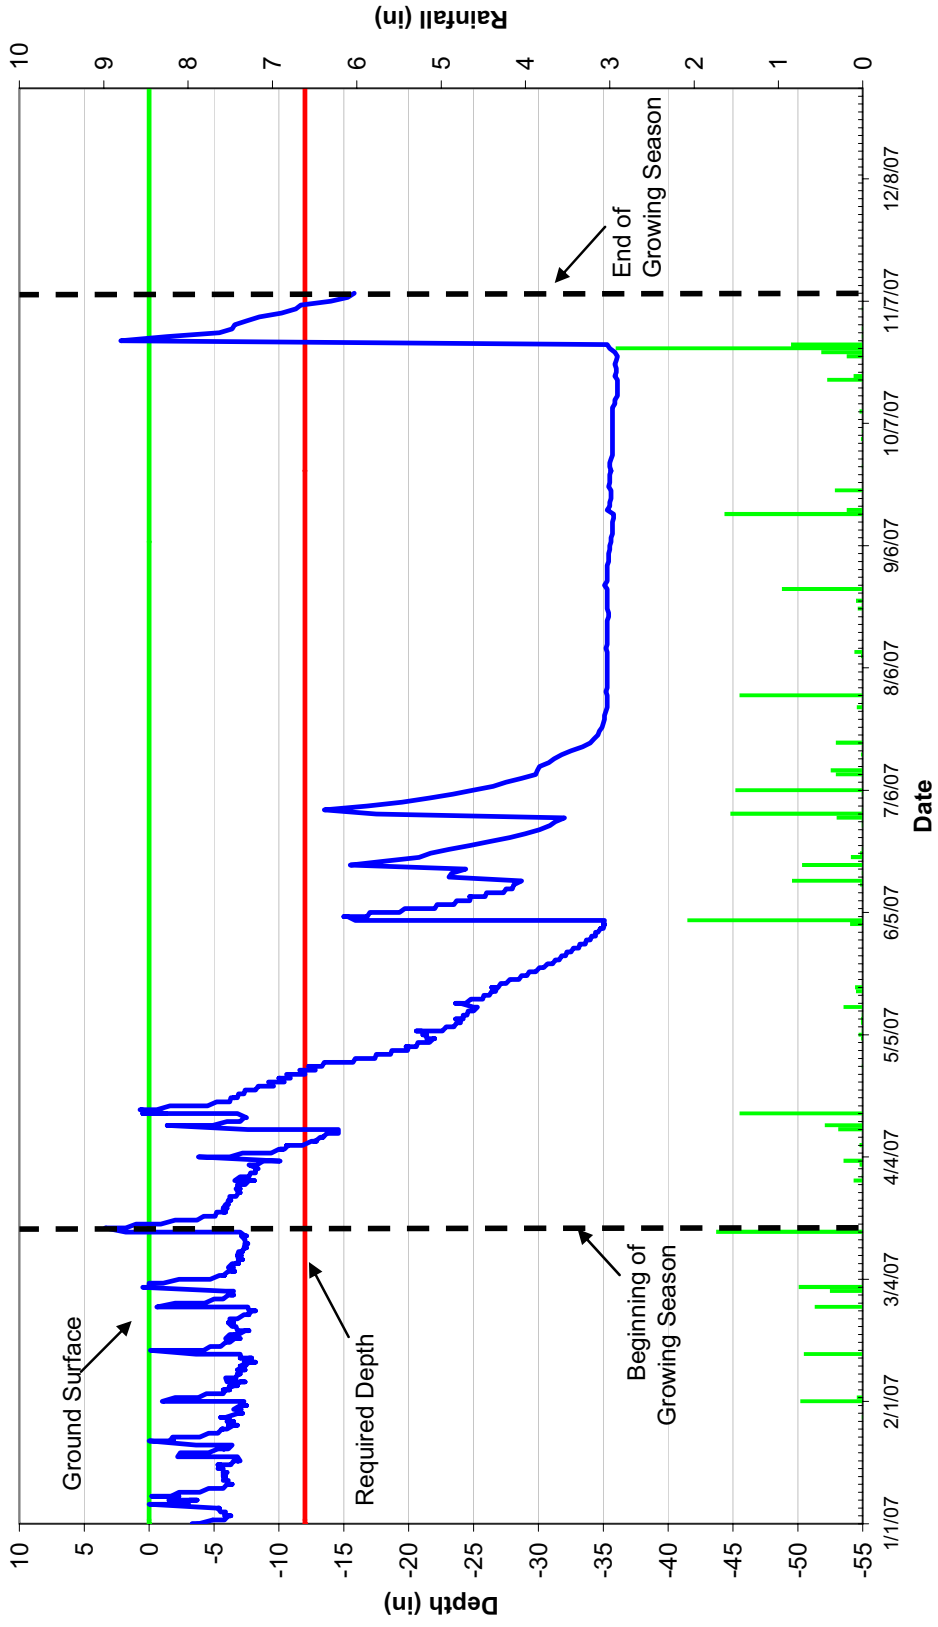


2006 Groundwater Data  
Well JR-14 (SN: 00000A285751)

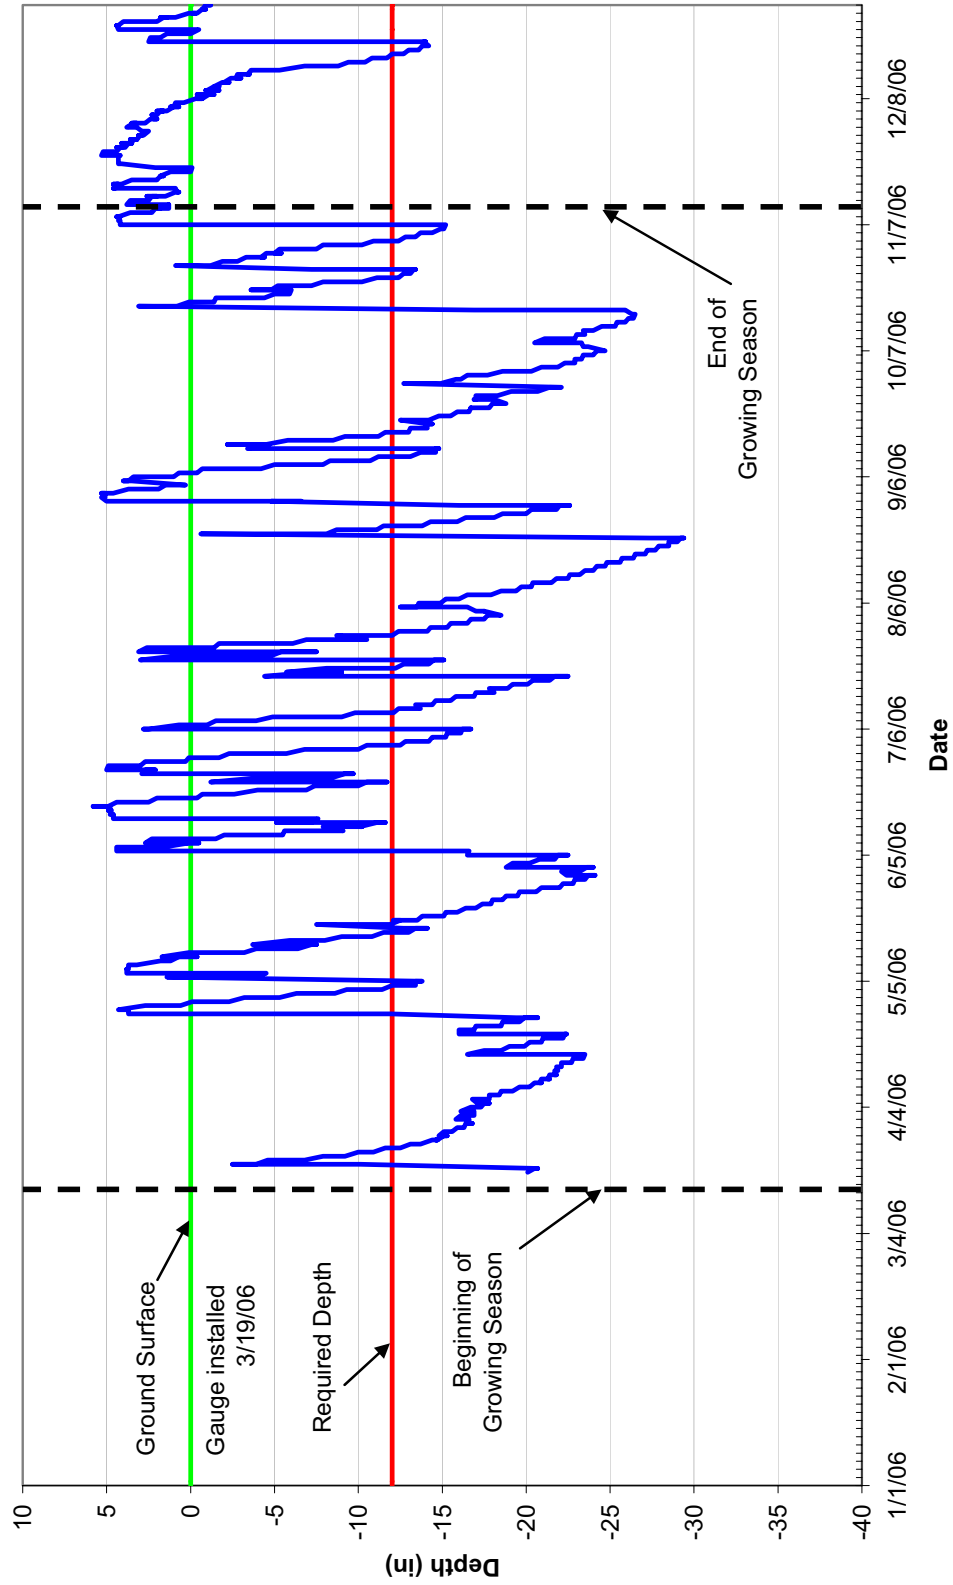

2007 Groundwater Data  
Well JR-14 (SN: 00000A285751)

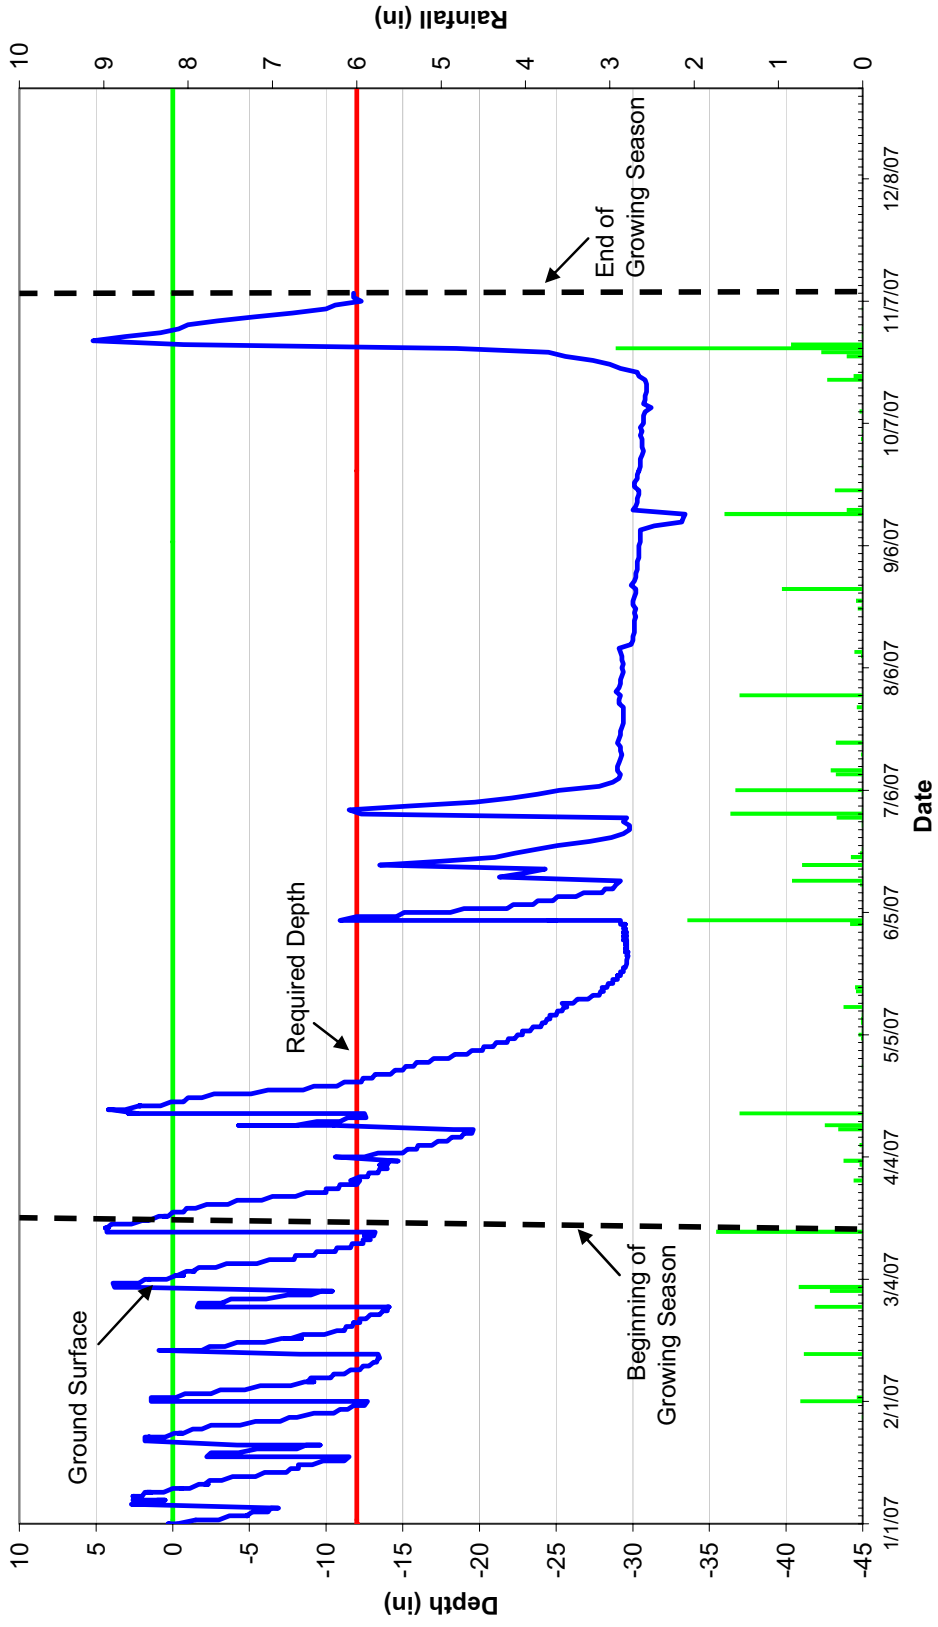


2006 Groundwater Data  
Well JR-15 (SN: 00000A288465)

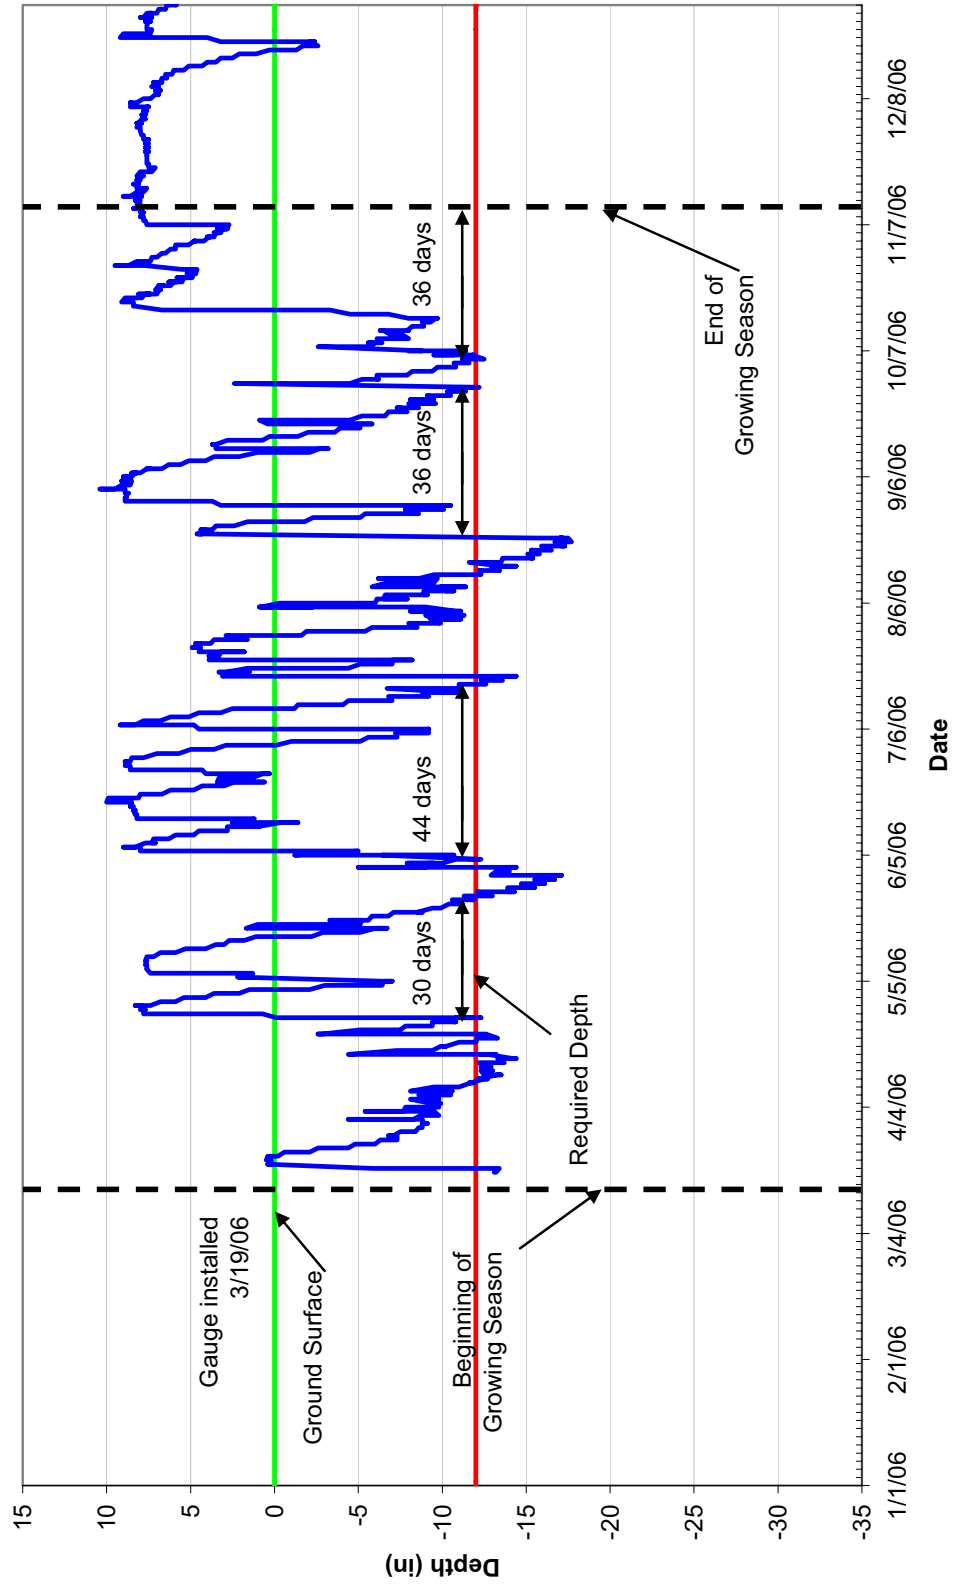





2007 Groundwater Data  
Well JR-15 (SN: 00000A288465)

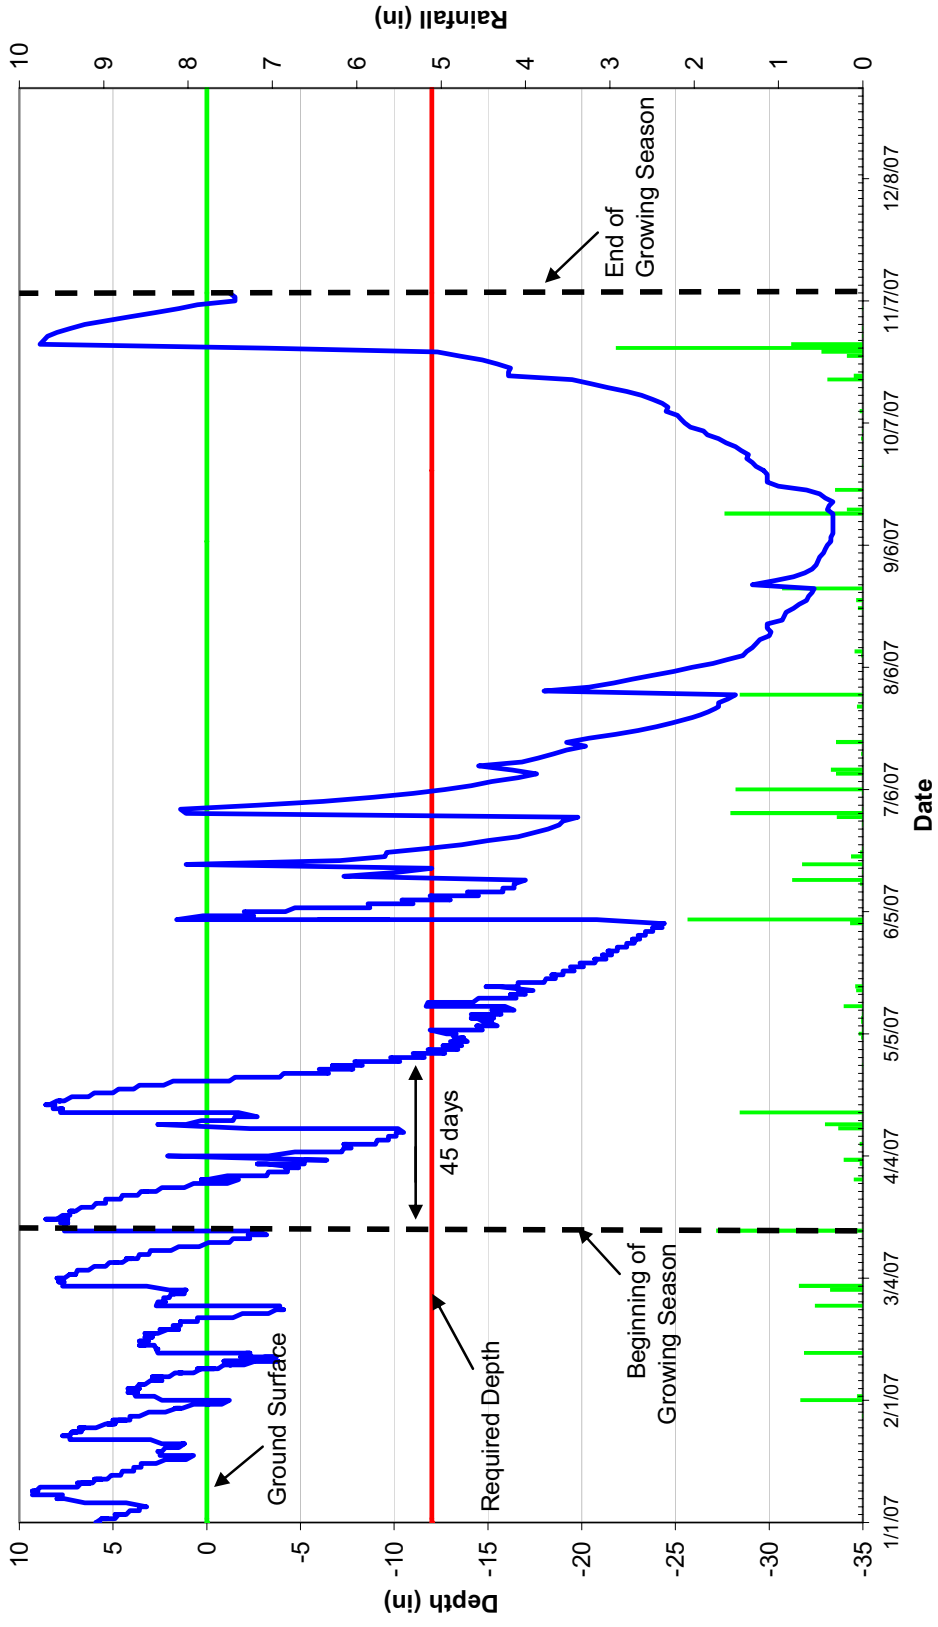

2007 Groundwater Data  
Reference Well 1 (SN: 00000EBD001B)

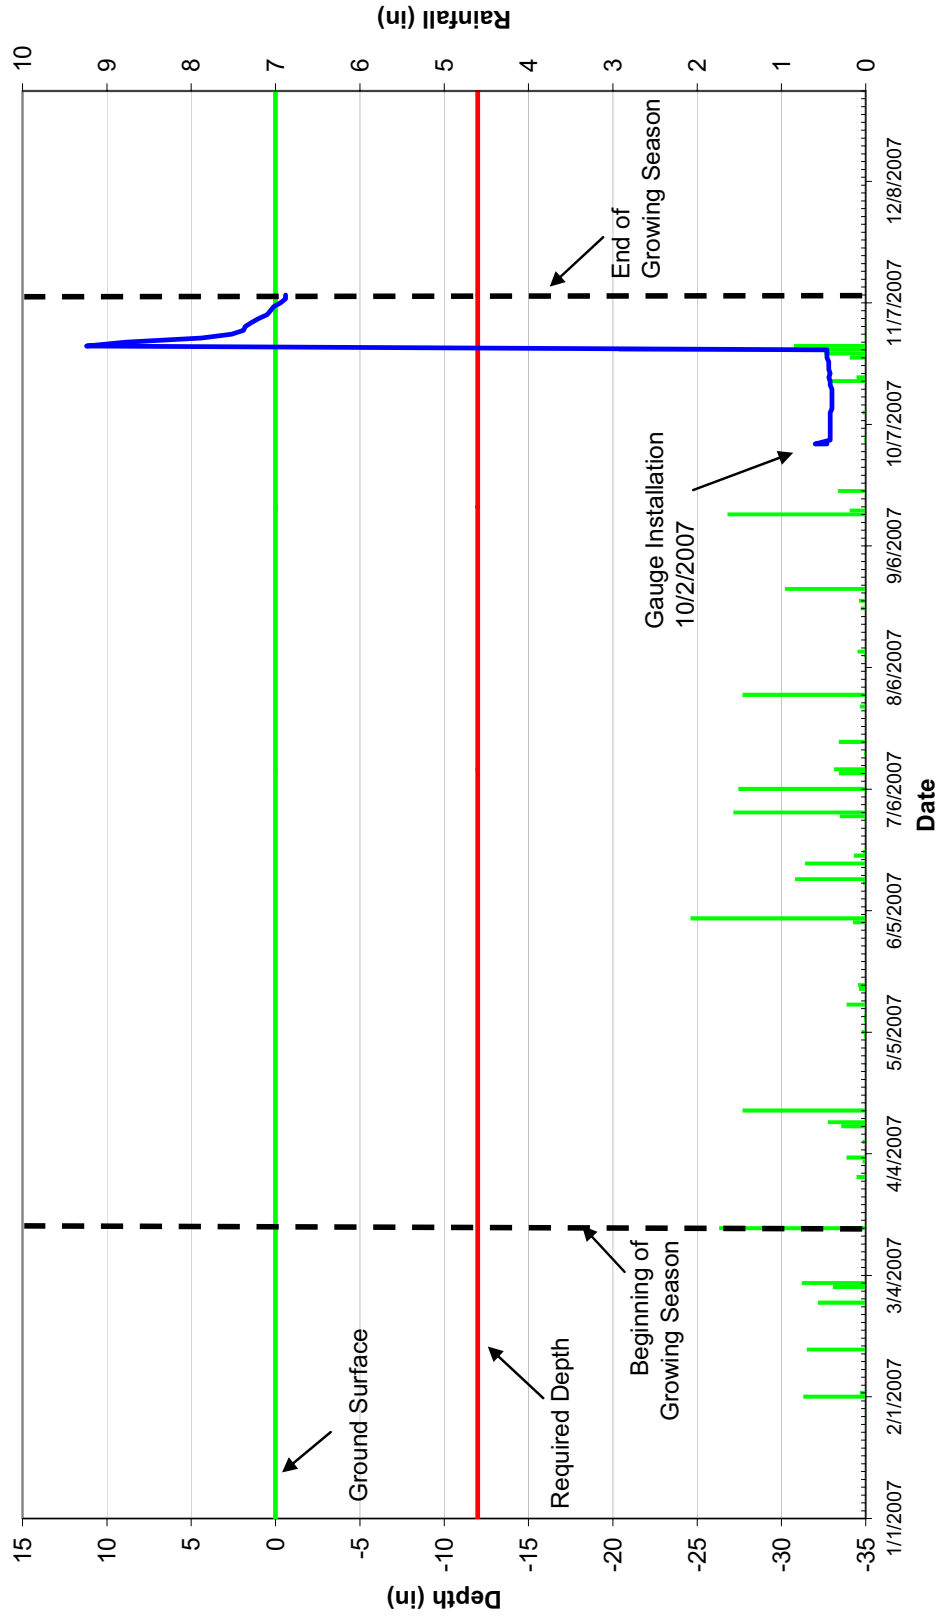

**Overhills 30-70 Percentile Graph  
Harnett, Co.**

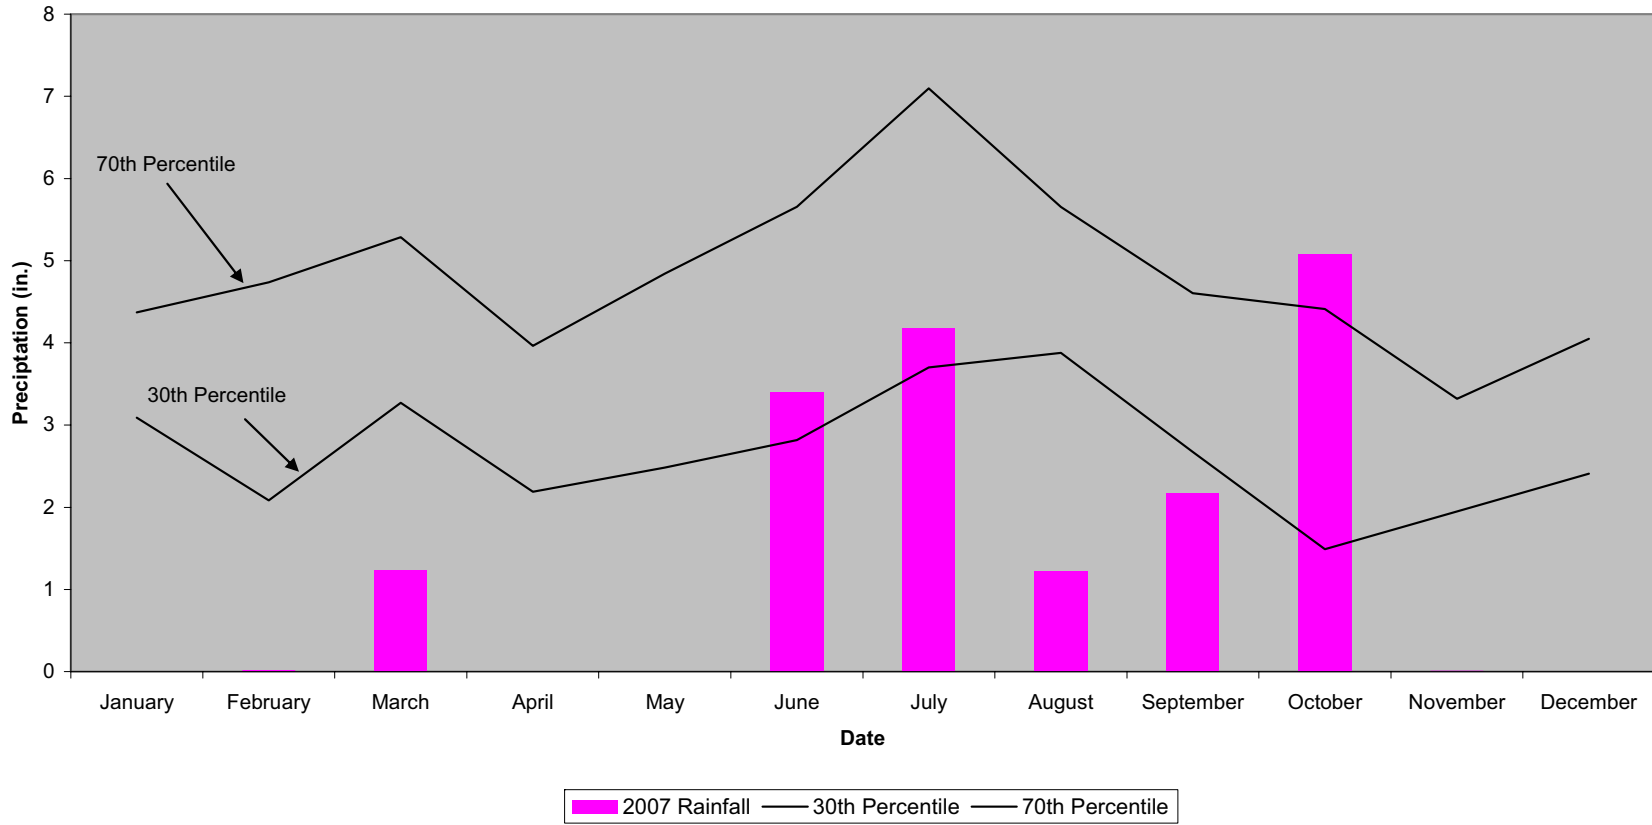

**APPENDIX D – CURRENT CONDITION PLAN VIEW**

## **Appendix D. Current Condition Plan View**

---

See following page for Current Condition Plan View Map.






\\171300168\200\_Overhills-JumpingRun\site\_data\cad\Overhills\_ProblemAreas\_Final.dwg, 3/10/2008 3:09:01 PM

### LEGEND

- ▲ Wells not meeting hydrologic success criteria
- ▲ Wells meeting hydrologic success criteria
- 2 Rootwad Failure
- 3 Bank Erosion
- Reach Failure (SPA1)
- Vegetation Problem Area (VPA1,2,3)
- Vegetation Plots w/ >320 stems/ac
- Vegetation Plots w/ <320 stems/ac
- Beaver Dam SPA 9

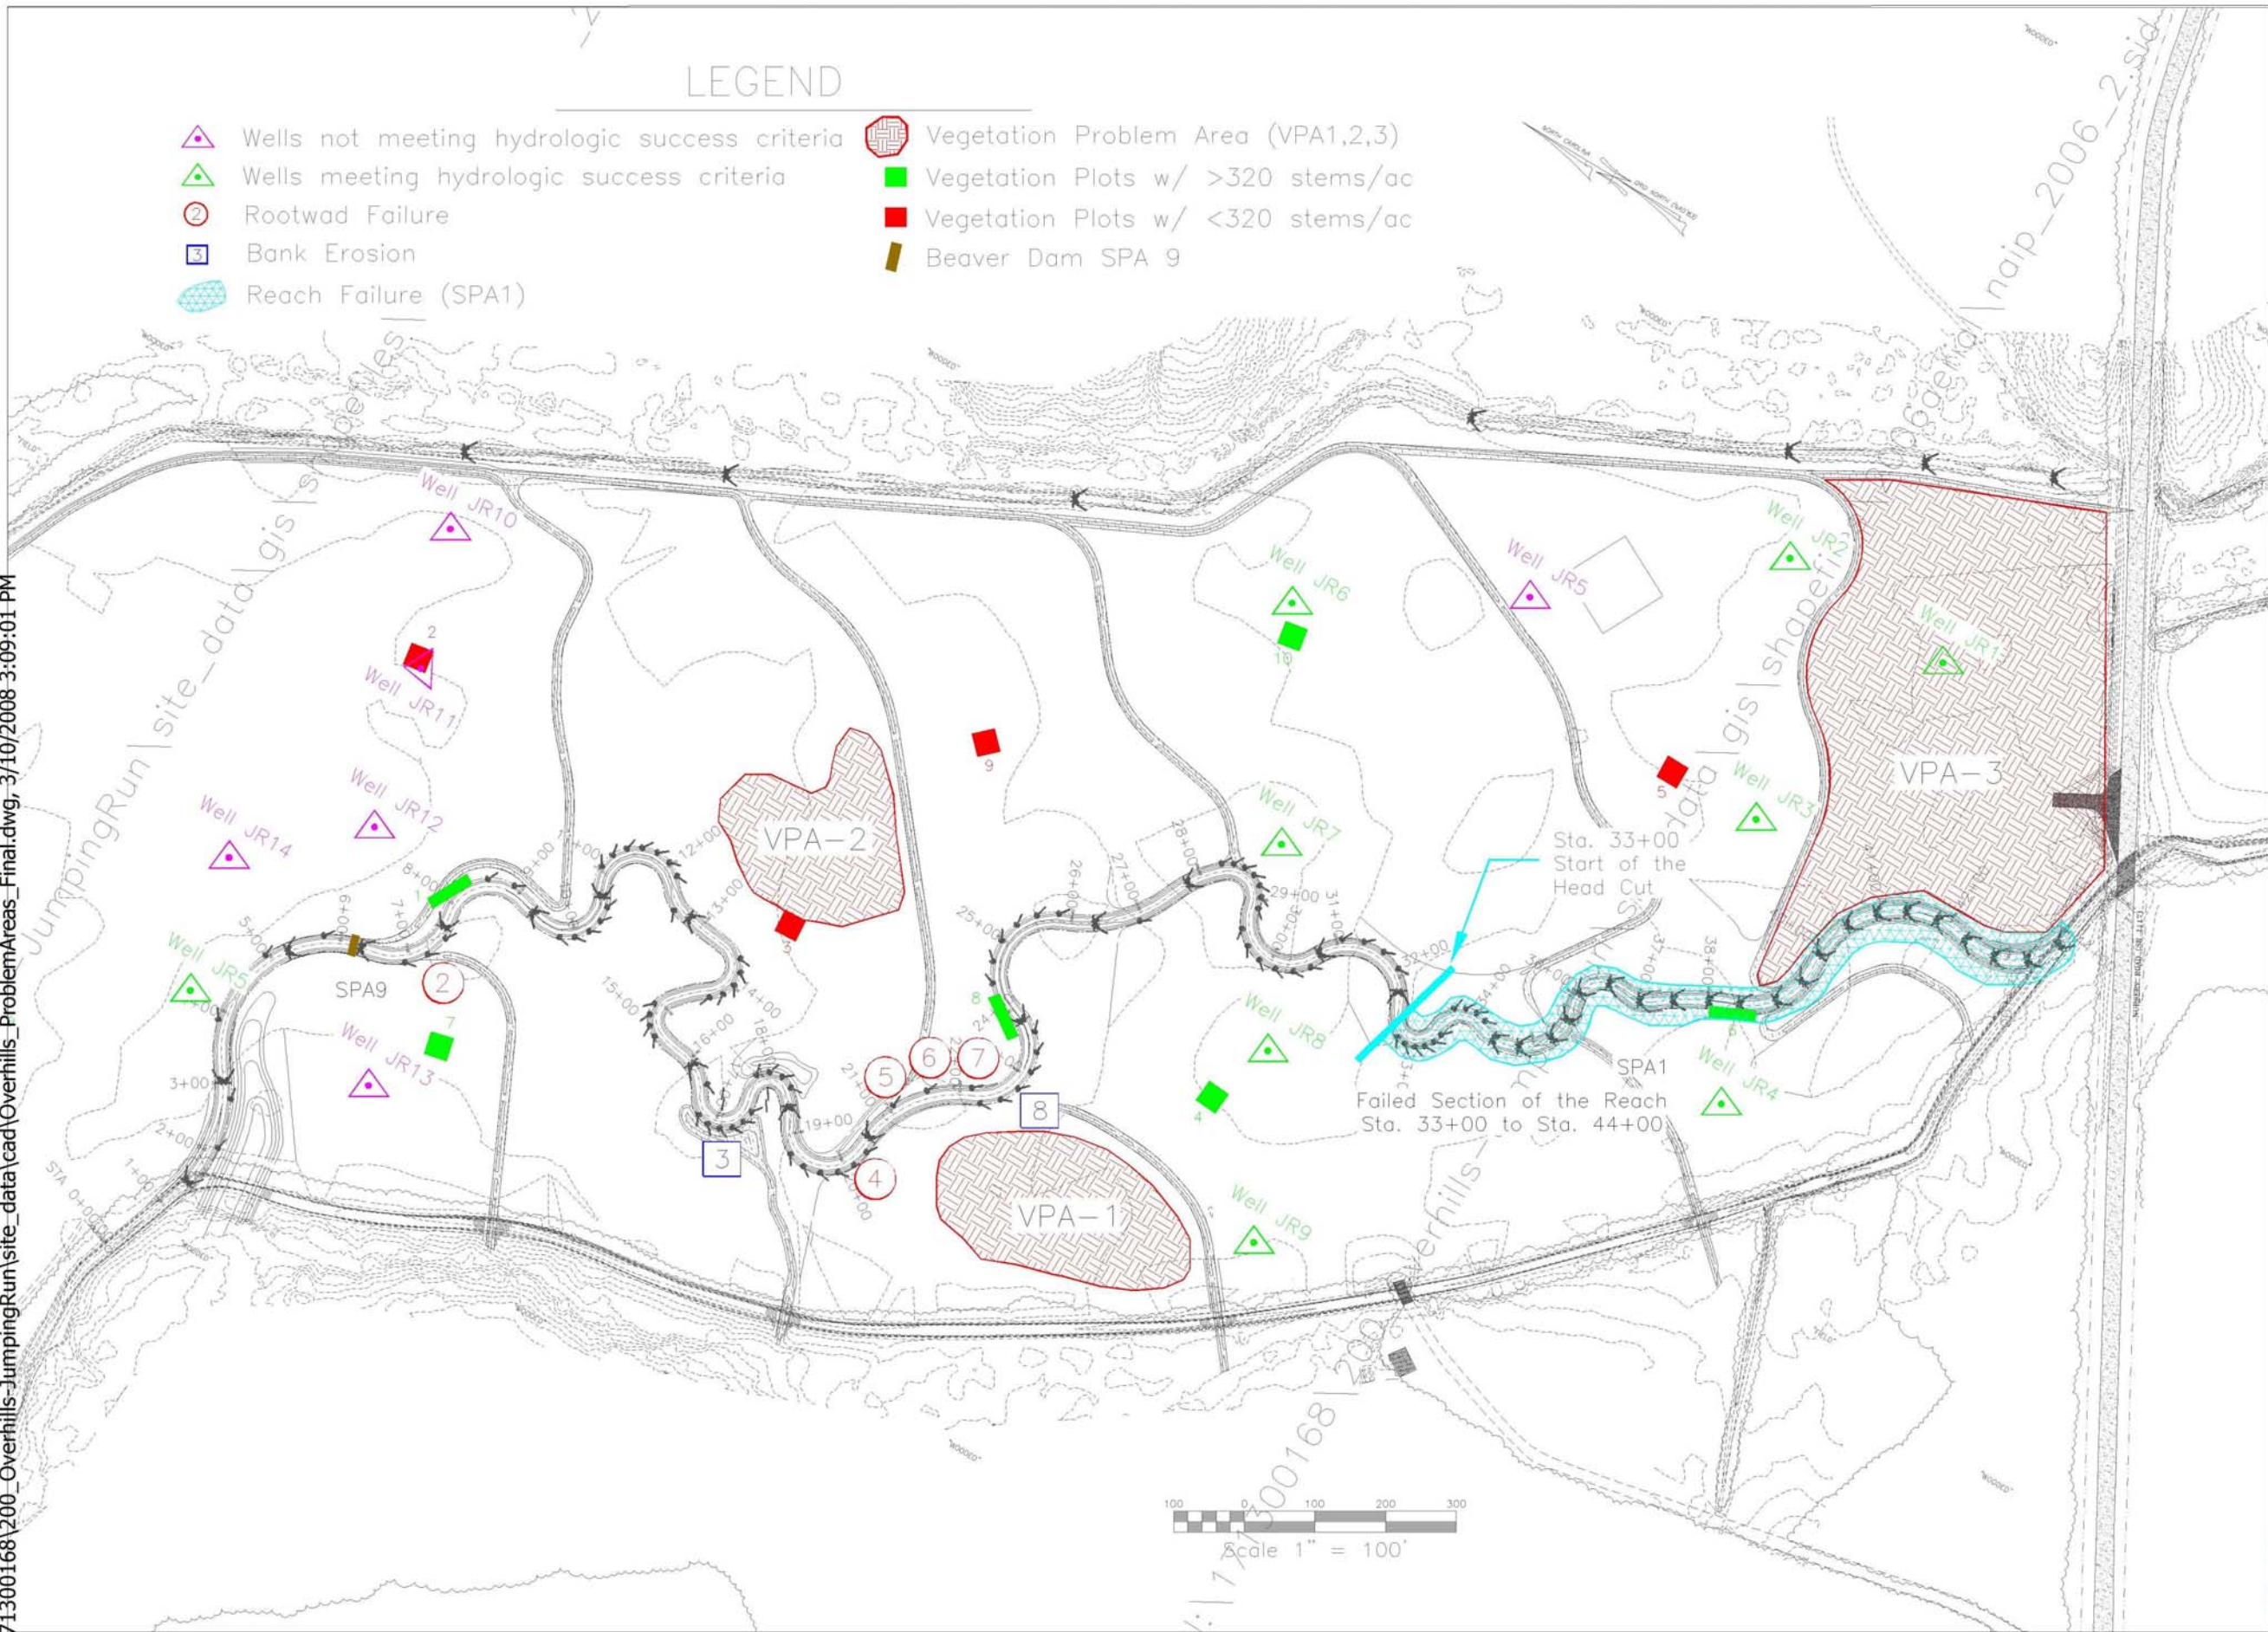

NO	REVISIONS	DRN	CHK	DATE
1	DRAFT REVISION 2 DESIGN			07/10/06



OVERHILLS  
STREAM RESTORATION MONITORING  
ASSESSMENT  
APPENDIX D  
CURRENT CONDITIONS PLAN VIEW

DATE	8/07/2007
PROJECT NO.	
FILENAME	.DWG
SHEET NO.	
DRAWING NO.	

\*\*\* RECORD DOCUMENT \*\*\*  
 NCDOA File: 01-05249-01A  
 NCEEP Project: JR/CF/01  
 \*\*\* RECORD DOCUMENT \*\*\*