


R-2231WM


PROJECT: 6.589013T

See Sheet 1-A For Index of Sheets

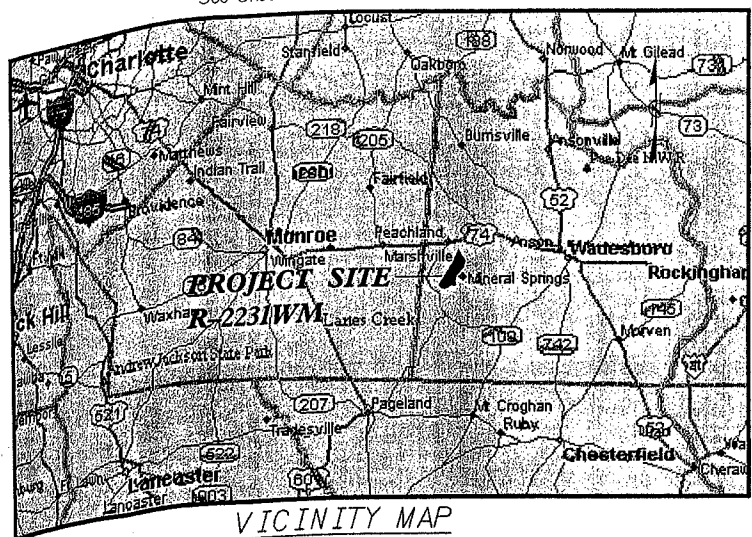

FROM PEACHLAND, NORTH CAROLINA GO APPROXIMATELY 1.5 MILES SOUTH ON MINERAL SPRINGS CHURCH ROAD TO LOWER WHITE STORE ROAD. GO WEST ON LOWER WHITE STORE ROAD APPROXIMATELY 2.6 MILES TO THE LEFT TURN ONTO THE SITE ENTRANCE/ACCESS ROAD


= As Built

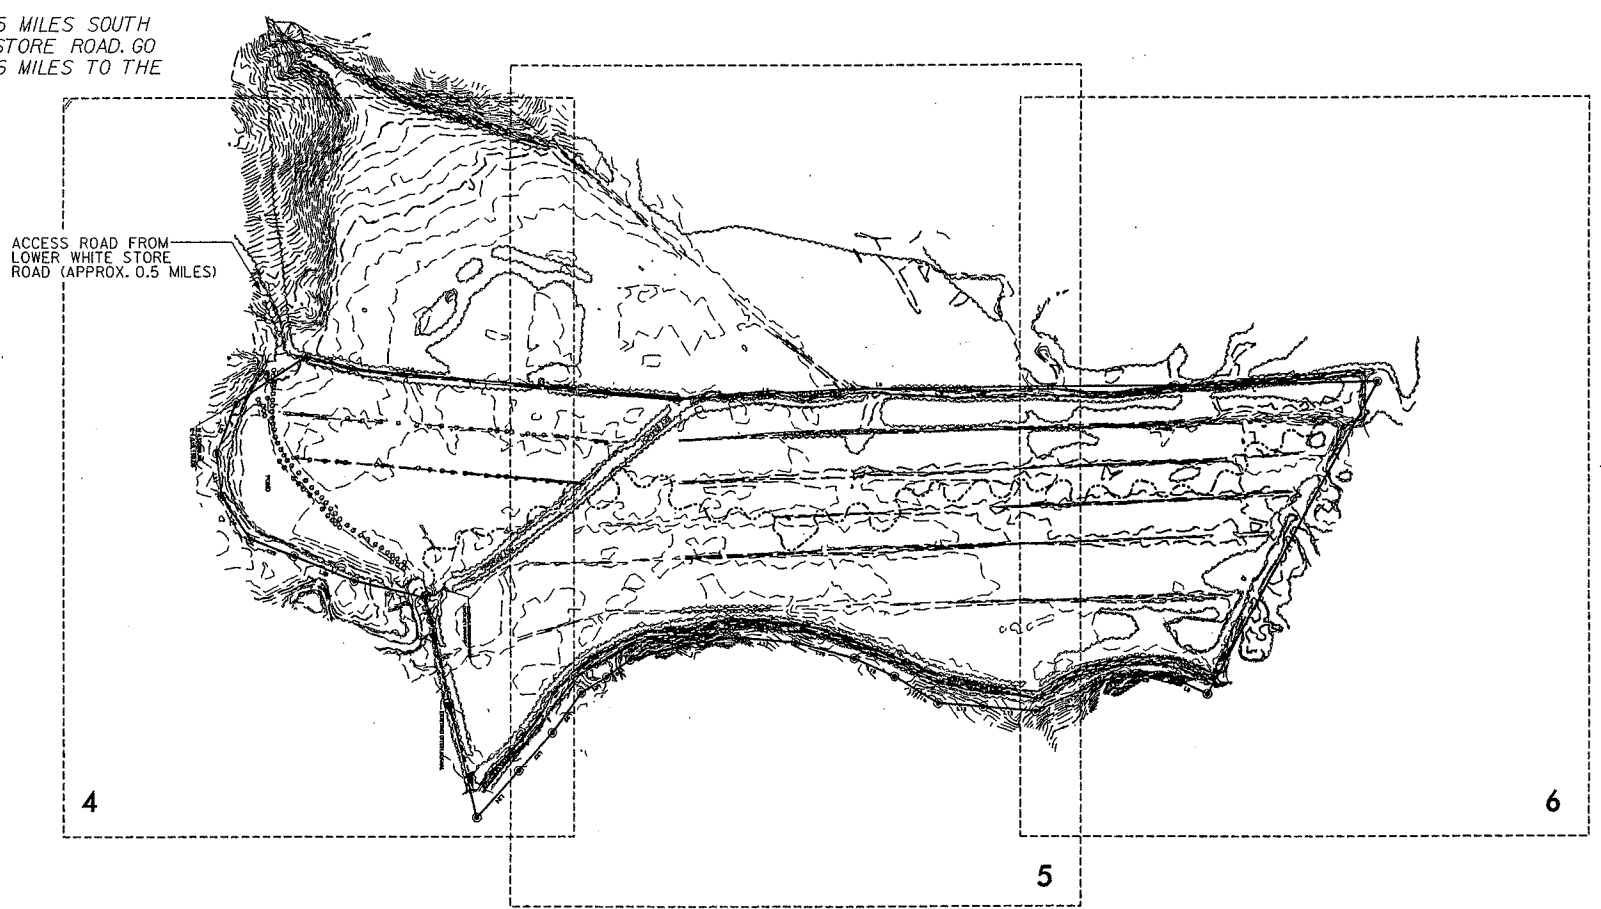

STATE OF NORTH CAROLINA  
DIVISION OF HIGHWAYS  
**ANSON COUNTY**

**LOCATION: KEY BRANCH MITIGATION SITE, LOCATED BETWEEN LOWER WHITE STORE ROAD (SR 1252) AND MINERAL SPRINGS CHURCH ROAD (SR 1240) ON THE BROWN CREEK FLOODPLAIN IN ANSON COUNTY, NORTH CAROLINA**  
**TYPE OF WORK: GRADING, CLEARING AND GRUBBING, MOWING, RIPPING, DISCING, DRAINAGE, AND STREAM RESTORATION**

STATE	STATE PROJECT REFERENCE NO.	SHEET NO.	TOTAL SHEETS
N.C.	R - 2231WM	1	34
STATE PROJ. NO.	P.A. PROJ. NO.	DESCRIPTION	
6.589013T		P.E. & CONST.	

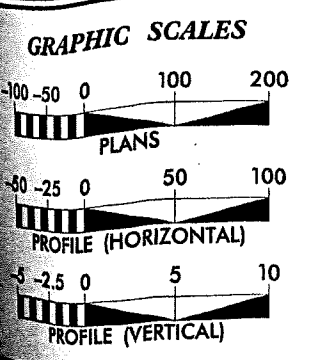

**PROJECT LENGTH**

TOTAL WETLAND MITIGATION = 118 ACRES

LENGTH OF STREAM RESTORATION = 6,183 FEET

Prepared in the Office of:

**KCI Associates of North Carolina, P.A.**  
SUITE 200 LANDMARK CENTER I, 4601 SIX FORKS RD., RALEIGH NC  
ENGINEERS • PLANNERS • ECOLOGISTS

For the:  
**DIVISION OF HIGHWAYS**  
2002 STANDARD SPECIFICATIONS

RIGHT OF WAY DATE: \_\_\_\_\_

LETTING DATE: \_\_\_\_\_

DESIGN ENGINEER

SIGNATURE: *James Waldo Blake* 7-16-02 P.E.

WETLAND SCIENTIST


SIGNATURE: \_\_\_\_\_

DIVISION OF HIGHWAYS  
STATE OF NORTH CAROLINA

STATE DESIGN ENGINEER P.E.

DEPARTMENT OF TRANSPORTATION  
FEDERAL HIGHWAY ADMINISTRATION

APPROVED DIVISION ADMINISTRATOR DATE

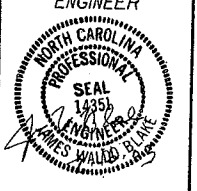PROJECT REFERENCE NO.	SHEET NO.
R-2231/WM	1-A
RWY SHEET NO.	
ENGINEER	SCIENTIST
	

INDEX OF SHEETS:

1	TITLE SHEET
1-A	INDEX OF SHEETS
1-B	STANDARD SYMBOLOGY SHEET
2	DETAILS: SEDIMENT AND EROSION CONTROL
2-A	DETAILS: IN-STREAM STRUCTURES
2-B	DETAILS: ROOT WADS
2-C	TYPICAL CROSS SECTIONS
3	SUMMARY SHEET
4	EXISTING CONDITIONS
5	EXISTING CONDITIONS
6	EXISTING CONDITIONS
7	LIMITS OF OPERATION
8	LIMITS OF OPERATION
9	LIMITS OF OPERATION
10	GRADING PLAN
11	GRADING PLAN
12	GRADING PLAN
13	STRUCTURES PLAN
14	STRUCTURES PLAN
15	STRUCTURES PLAN
16	STREAM GEOMETRY
17	STREAM GEOMETRY
18	STREAM GEOMETRY
19	STREAM GEOMETRY DATA
20	STREAM GEOMETRY DATA
21	STREAM GEOMETRY DATA
22	STREAM GEOMETRY DATA
23	STREAM PROFILE
24	STREAM PROFILE
25	STREAM PROFILE, CRITICAL ELEVATIONS DATA
EC-1	SEDIMENT AND EROSION CONTROL
EC-2	SEDIMENT AND EROSION CONTROL
EC-3	SEDIMENT AND EROSION CONTROL
EC-4	SEDIMENT AND EROSION CONTROL

ROADWAY STANDARD DRAWINGS:  
(REV. JAN. 15, 2002)

THE FOLLOWING ROADWAY STANDARDS AS APPEAR IN "ROADWAY STANDARD DRAWINGS" - HIGHWAY DESIGN BRANCH - N.C. DEPARTMENT OF TRANSPORTATION - RALEIGH, N.C., DATED JANUARY 15, 2002 AND THE LATEST REVISION THERETO ARE APPLICABLE TO THIS PROJECT AND BY REFERENCE HEREBY ARE CONSIDERED A PART OF THESE PLANS:

STD. NO.	TITLE
866.02	WOVEN WIRE FENCE WITH WOOD POSTS
866.04	BARBED WIRE FENCE WITH WOOD POSTS (ALTERNATE CATTLE GATE)
1605.01	TEMPORARY SILT FENCE
1636.01	ROCK SILT SCREEN
1633.01	TEMPORARY ROCK SILT CHECK TYPE A

GENERAL NOTES:

PROJECT SURVEY DATA HAS BEEN DEVELOPED AND PROVIDED IN PART BY NCDOT AND IN PART BY KCI.

PROPERTY BOUNDARY AND PROJECT/CONSERVATION EASEMENT BOUNDARY DATA HAS BEEN SUPPLIED BY NCDOT.

BEARINGS AND DISTANCES:

ALL DISTANCES AND COORDINATES SHOWN ARE HORIZONTAL (GROUND) VALUES.  
ALL INFORMATION IS BASED ON THE FOLLOWING CONTROL DATA, AS PUBLISHED BY NCDOT:  
"KB-1": N=435,839.42, E=1,616,856.12, ELEV.=373.37 FT.  
"KB-2": N=436,416.45, E=1,618,106.49, ELEV.=360.20 FT.  
(ALL BEARINGS ARE NAD '83 GRID BEARINGS.)

SUBSURFACE PLANS:

NO SUBSURFACE PLANS ARE AVAILABLE ON THIS PROJECT. THE CONTRACTOR SHOULD MAKE HIS OWN INVESTIGATION AS TO THE SUBSURFACE CONDITIONS.

UTILITIES:


UTILITY LOCATIONS NOTED ON THE PLANS, IF ANY, ARE FOR INFORMATIONAL PURPOSES ONLY. IT SHALL BE THE CONTRACTOR'S RESPONSIBILITY TO LOCATE AND VERIFY ANY EXISTING UTILITIES. THE CONTRACTOR SHOULD CONTACT THE NORTH CAROLINA ONE-CALL CENTER (1-800-632-4949) A MINIMUM OF 48 HOURS IN ADVANCE OF OCCUPYING THE PROJECT SITE.

GRADING:

ALL INFLECTION POINTS BETWEEN SLOPE ANGLES SHALL BE SLIGHTLY ROUNDED IN ORDER TO PROVIDE FOR SMOOTH TRANSITIONS AND A MORE NATURAL APPEARANCE.

INDEX SHEET

# CONVENTIONAL SYMBOLS

PROJECT REFERENCE NO. R-2231WM	SHEET NO. I-B
RW SHEET NO.	
ENGINEER	SCIENTIST
	

## ROADS & RELATED ITEMS

Edge of Pavement	-----
Curb	-----
Prop. Slope Stakes Cut	----- C
Prop. Slope Stakes Fill	----- F
Prop. Woven Wire Fence	-----
Prop. Chain Link Fence	-----
Prop. Barbed Wire Fence	-----
Prop. Wheelchair Ramp	----- WCR
Exist. Guardrail	-----
Prop. Guardrail	-----
Equality Symbol	-----
Pavement Removal	-----

## RIGHT OF WAY

Baseline Control Point	-----
Existing Right of Way Marker	-----
Exist. Right of Way Line w/Marker	-----
Prop. Right of Way Line with Proposed RW Marker (Iron Pin & Cap)	-----
Prop. Right of Way Line with Proposed (Concrete or Granite) RW Marker	-----
Exist. Control of Access Line	-----
Prop. Control of Access Line	-----
Exist. Easement Line	----- E
Prop. Temp. Construction Easement Line	----- E
Prop. Temp. Drainage Easement Line	----- TDE
Prop. Perm. Drainage Easement Line	----- PDE

## HYDROLOGY

Stream or Body of Water	-----
Flow Arrow	-----
Disappearing Stream	-----
Spring	-----
Swamp Marsh	-----
Shoreline	-----
Falls, Rapids	-----
Prop Lateral, Tail, Head Ditches	-----

## STRUCTURES

MAJOR	
Bridge, Tunnel, or Box Culvert	----- CONC
Bridge Wing Wall, Head Wall and End Wall	----- CONC WW

MINOR	
Head & End Wall	----- CONC HW
Pipe Culvert	-----
Footbridge	-----
Drainage Boxes	-----
Paved Ditch Gutter	----- CB

## UTILITIES

Exist. Pole	-----
Exist. Power Pole	-----
Prop. Power Pole	-----
Exist. Telephone Pole	-----
Prop. Telephone Pole	-----
Exist. Joint Use Pole	-----
Prop. Joint Use Pole	-----
Telephone Pedestal	-----
Cable TV Pedestal	-----
Hydrant	-----
Satellite Dish	-----
Exist. Water Valve	-----
Sewer Clean Out	-----
Power Manhole	-----
Telephone Booth	-----
Water Manhole	-----
Light Pole	-----
H-Frame Pole	-----
Power Line Tower	-----
Pole with Base	-----
Gas Valve	-----
Gas Meter	-----
Telephone Manhole	-----
Power Transformer	-----
Sanitary Sewer Manhole	-----
Storm Sewer Manhole	-----
Tank; Water, Gas, Oil	-----
Water Tank With Legs	-----
Traffic Signal Junction Box	-----
Fiber Optic Splice Box	-----
Television or Radio Tower	-----
Utility Power Line Connects to Traffic Signal Lines Cut Into the Pavement	----- TS

Water Line	----- W
Sanitary Sewer	----- SS
Sanitary Sewer Force Main	----- FSS
Gas Line	----- G
Storm Sewer	----- S
Power Line	----- P
Telephone Cable	----- T
UG Telephone Conduit	----- TC
Unknown Utility	----- ?UTL
Television Cable	----- TV
Fiber Optics Cable	----- FO
Exist. Water Meter	-----
Drawn According to U/G Records	----- DATUR
Abandoned According to U/G Records	----- AATUR
End Of Information	----- E.O.I.

## BOUNDARIES & PROPERTIES

State Line	-----
County Line	-----
Township Line	-----
City Line	-----
Reservation Line	-----
Property Line	-----
Property Line Symbol	----- PL
Exist. Iron Pin	----- EIP
Property Corner	-----
Property Monument	----- ECM
Property Number	----- 123
Parcel Number	----- 6
Fence Line	----- WW & ISBW
Existing Wetland Boundaries	----- WLB
Proposed Wetland Boundaries	----- WLB
Existing Endangered Animal Boundaries	----- EAB
Existing Endangered Plant Boundaries	----- EPB

## BUILDINGS & OTHER CULTURE

Buildings	-----
Foundations	-----
Area Outline	-----
Gate	-----

Gas Pump Vent or U/G Tank Cap	-----
Church	-----
School	-----
Park	-----
Cemetery	-----
Dam	-----
Sign	-----
Well	-----
Small Mine	-----
Swimming Pool	-----

## TOPOGRAPHY







Loose Surface	-----
Hard Surface	-----
Change in Road Surface	-----
Curb	-----
Right of Way Symbol	----- R/W
Guard Post	----- GP
Paved Walk	-----
Bridge	-----
Box Culvert or Tunnel	-----
Ferry	-----
Culvert	-----
Footbridge	-----
Trail, Footpath	-----
Light House	-----





## VEGETATION

Single Tree	-----
Single Shrub	-----
Hedge	-----
Woods Line	-----
Orchard	-----
Vineyard	----- VINEYARD


## RAILROADS

Standard Gauge	-----
RR Signal Milepost	-----
Switch	-----

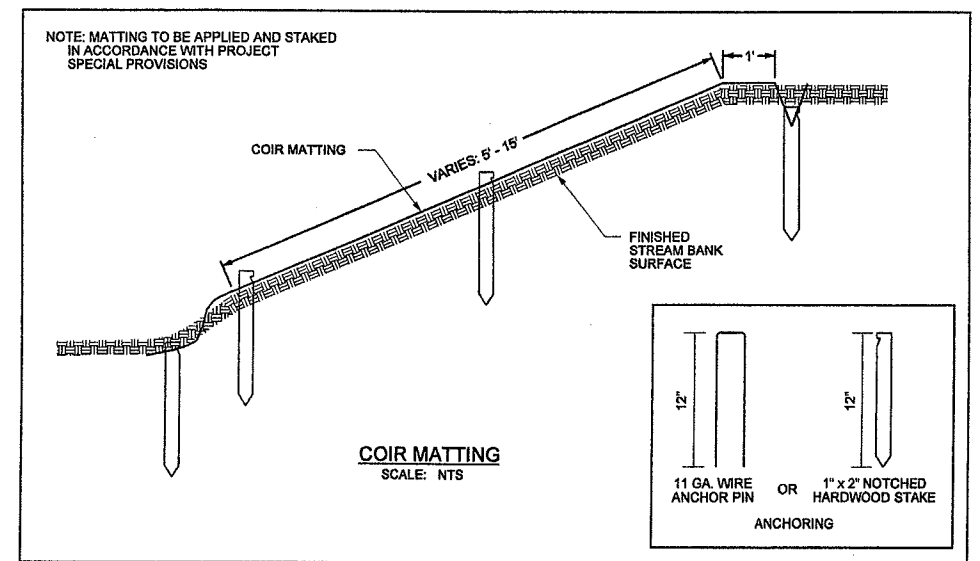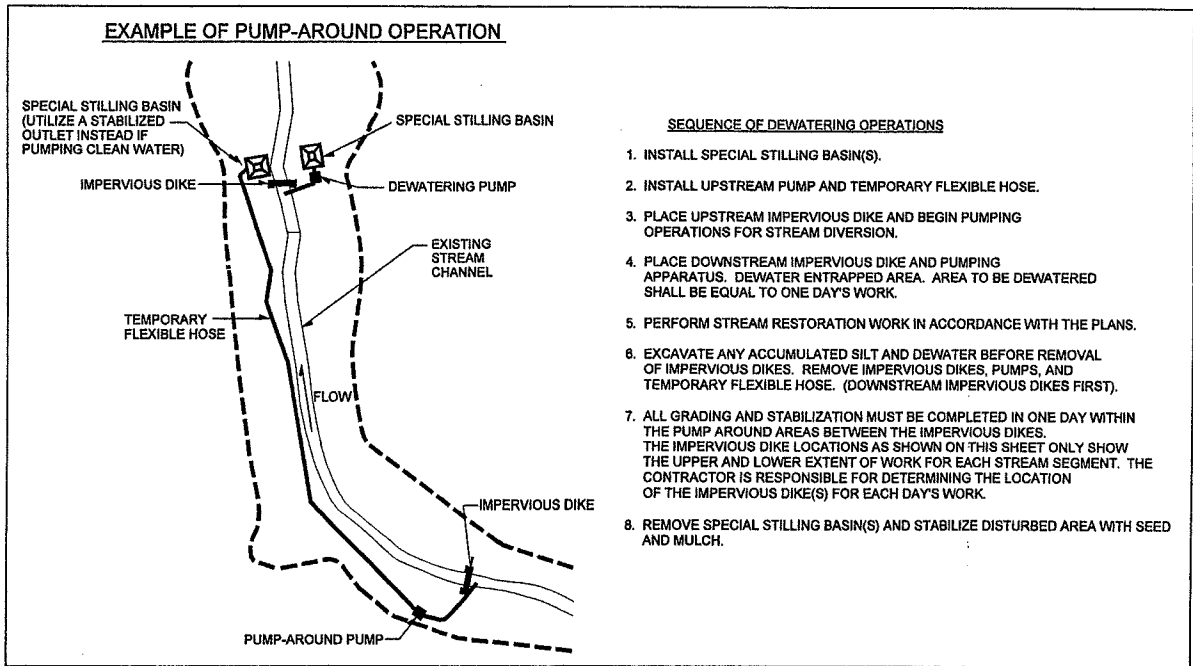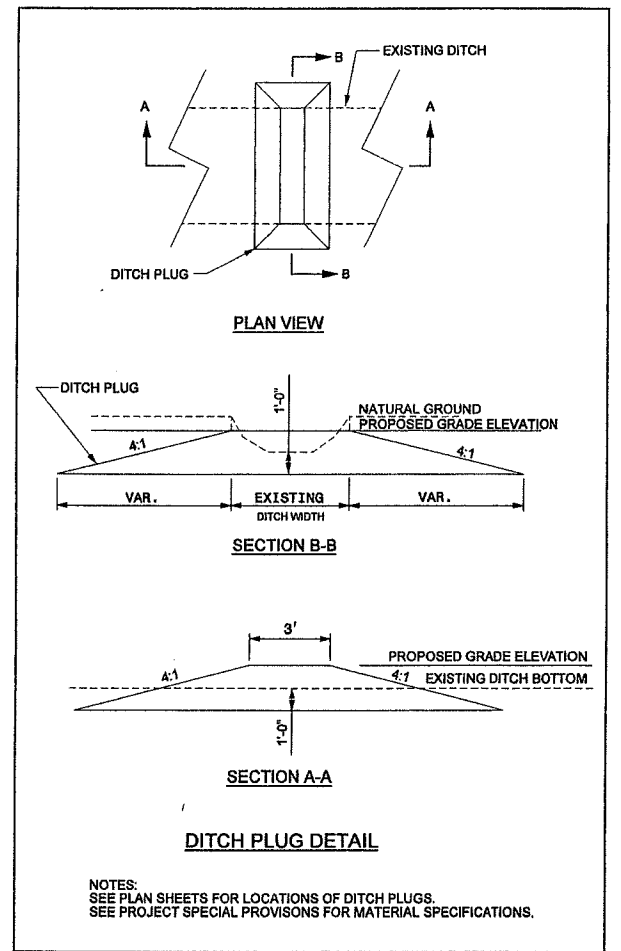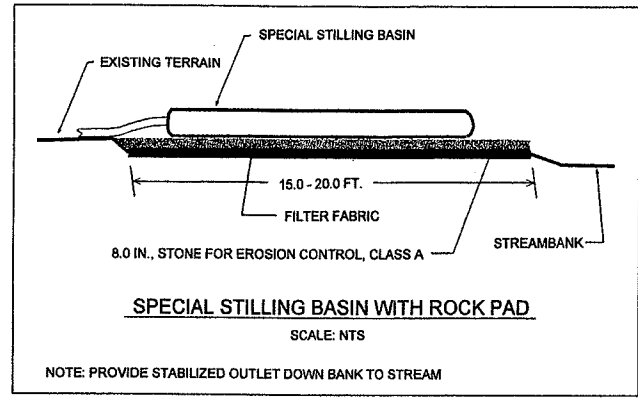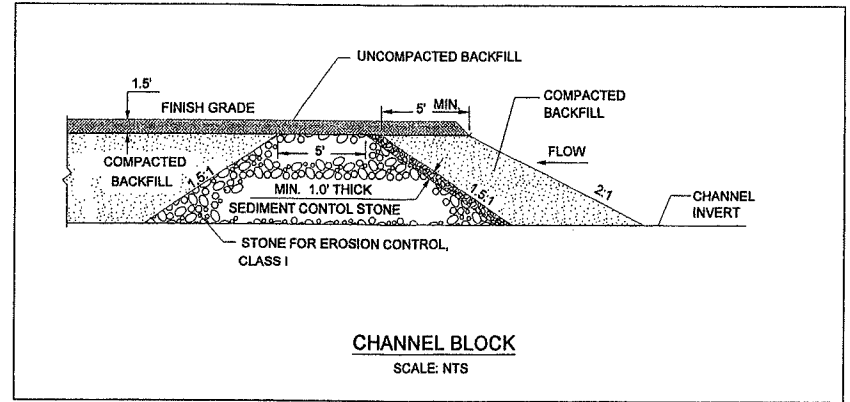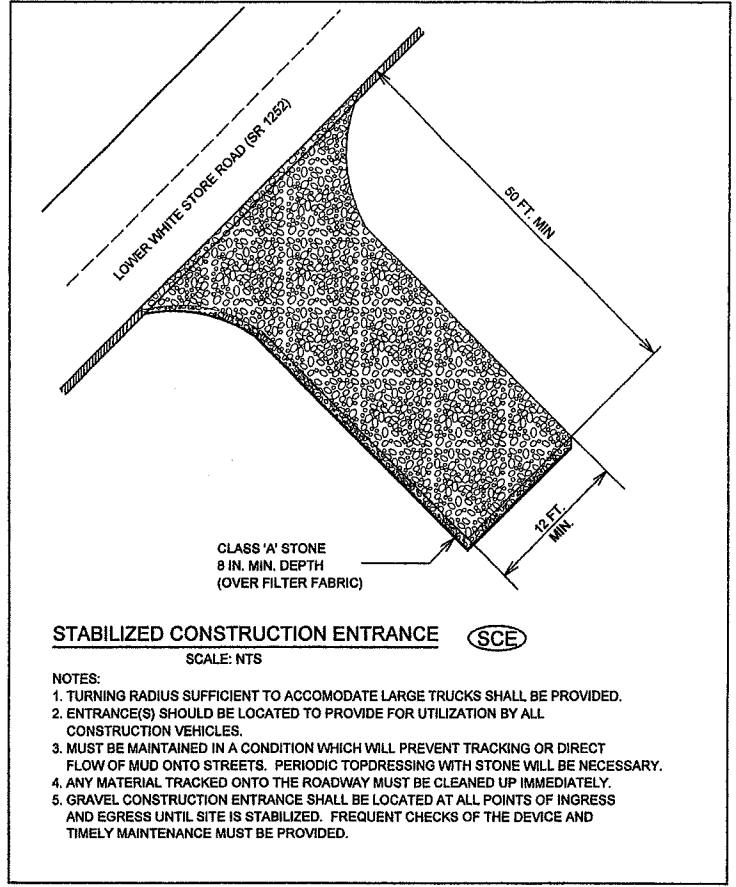

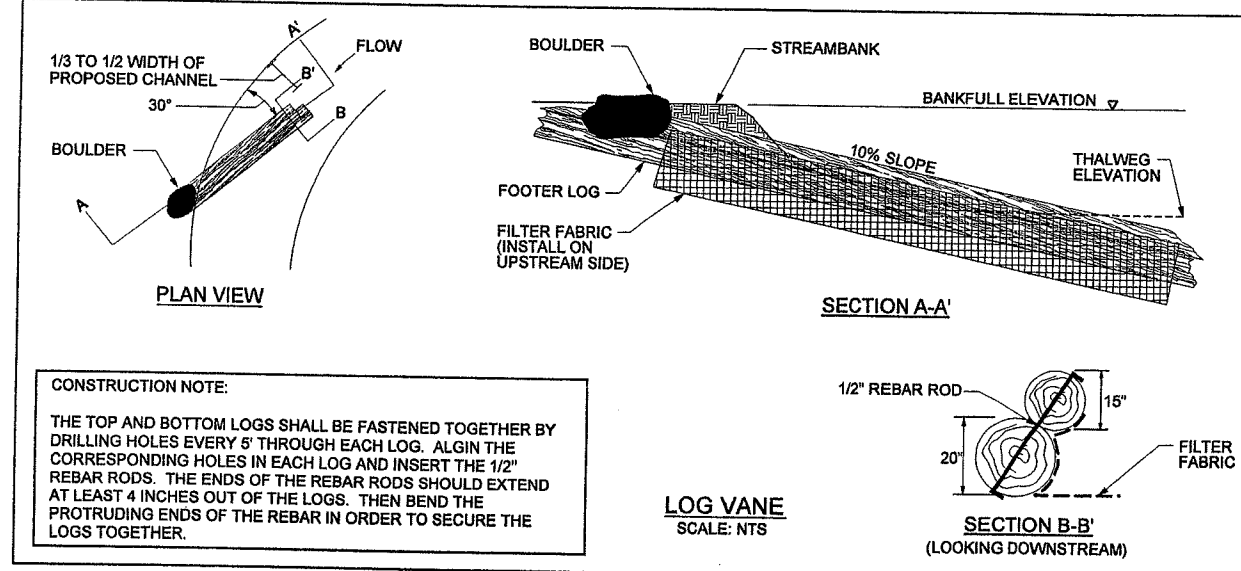
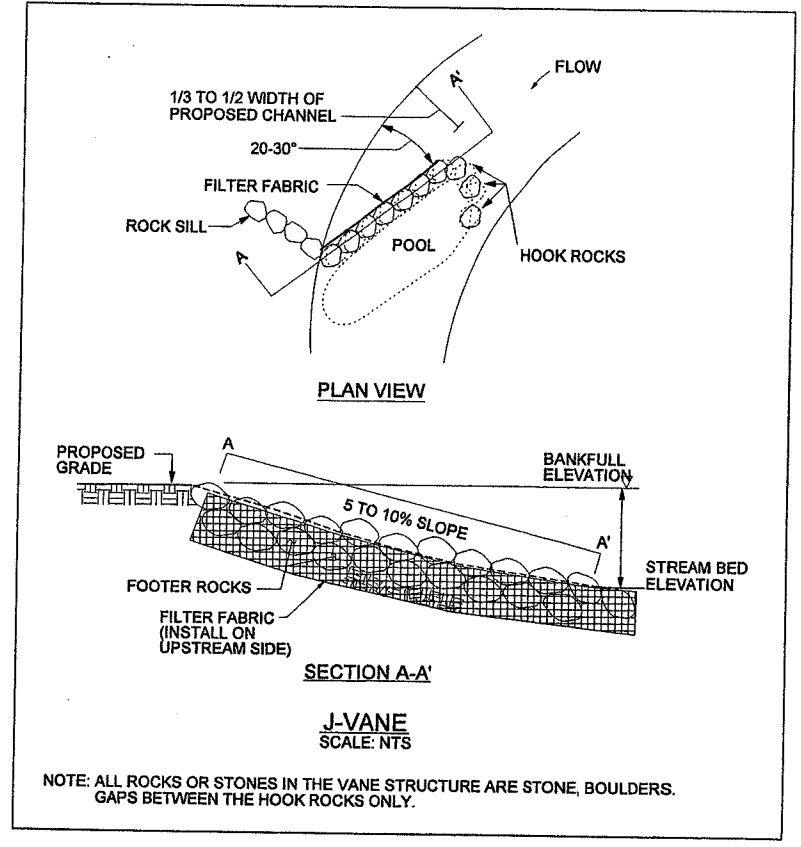
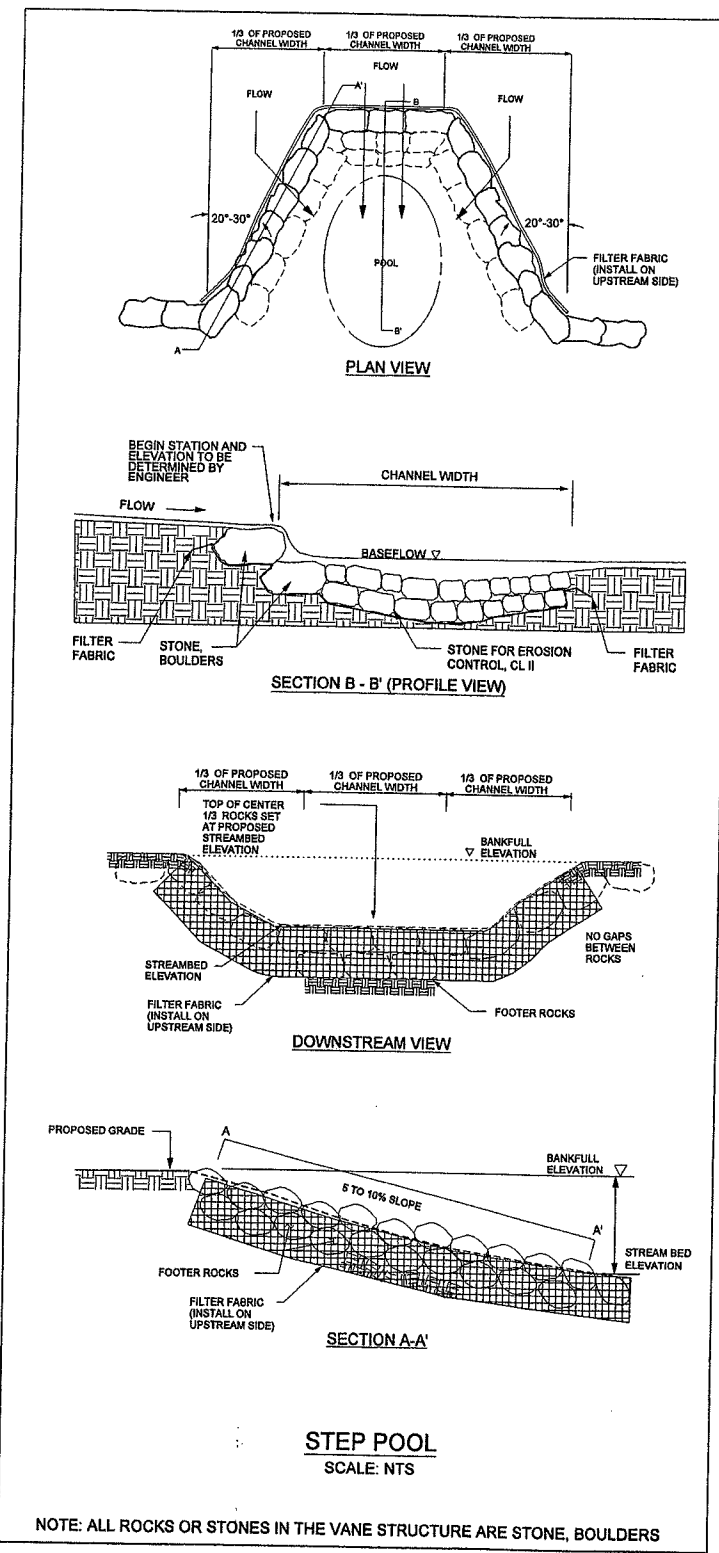
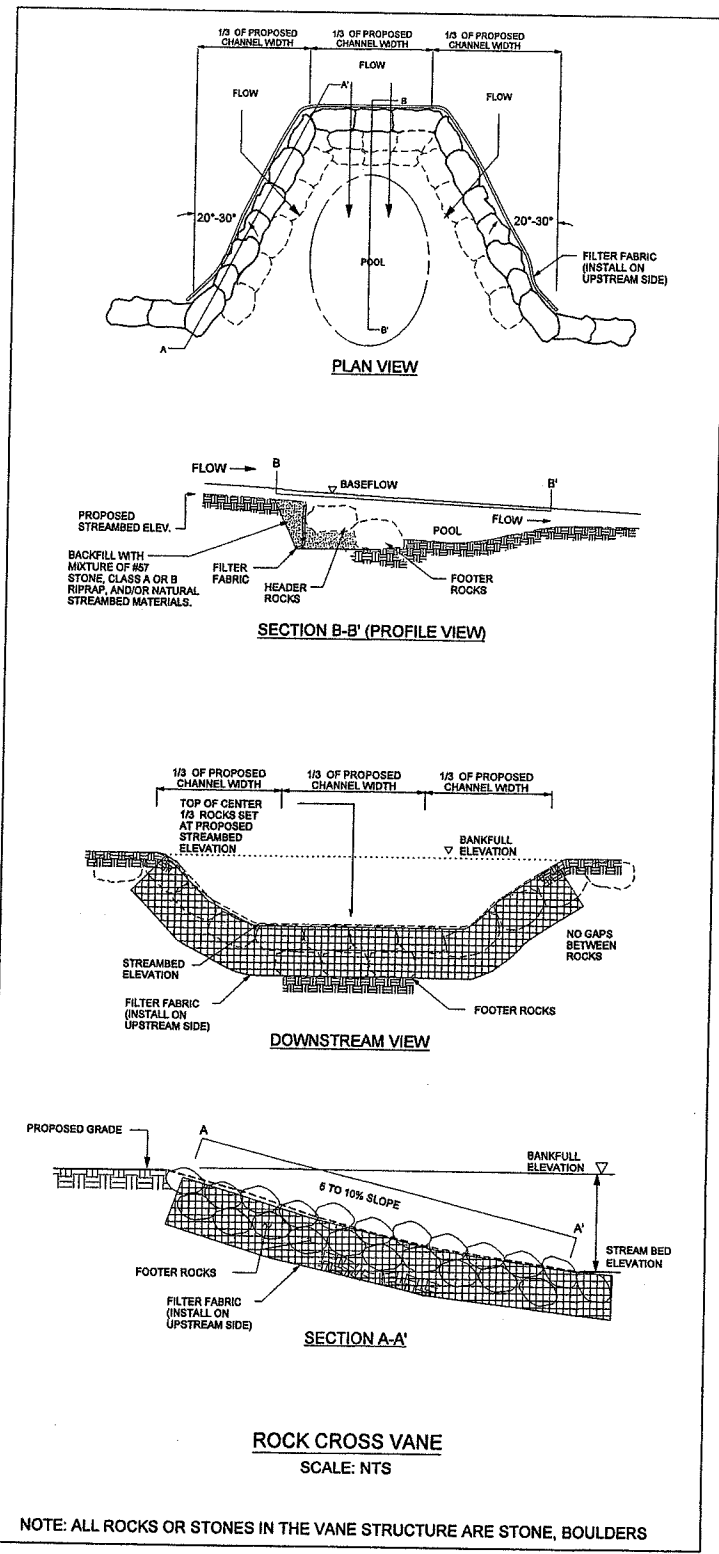


PROJECT REFERENCE NO. R-2231WM	SHEET NO. 2-B
RW SHEET NO.	
ENGINEER	SCIENTIST

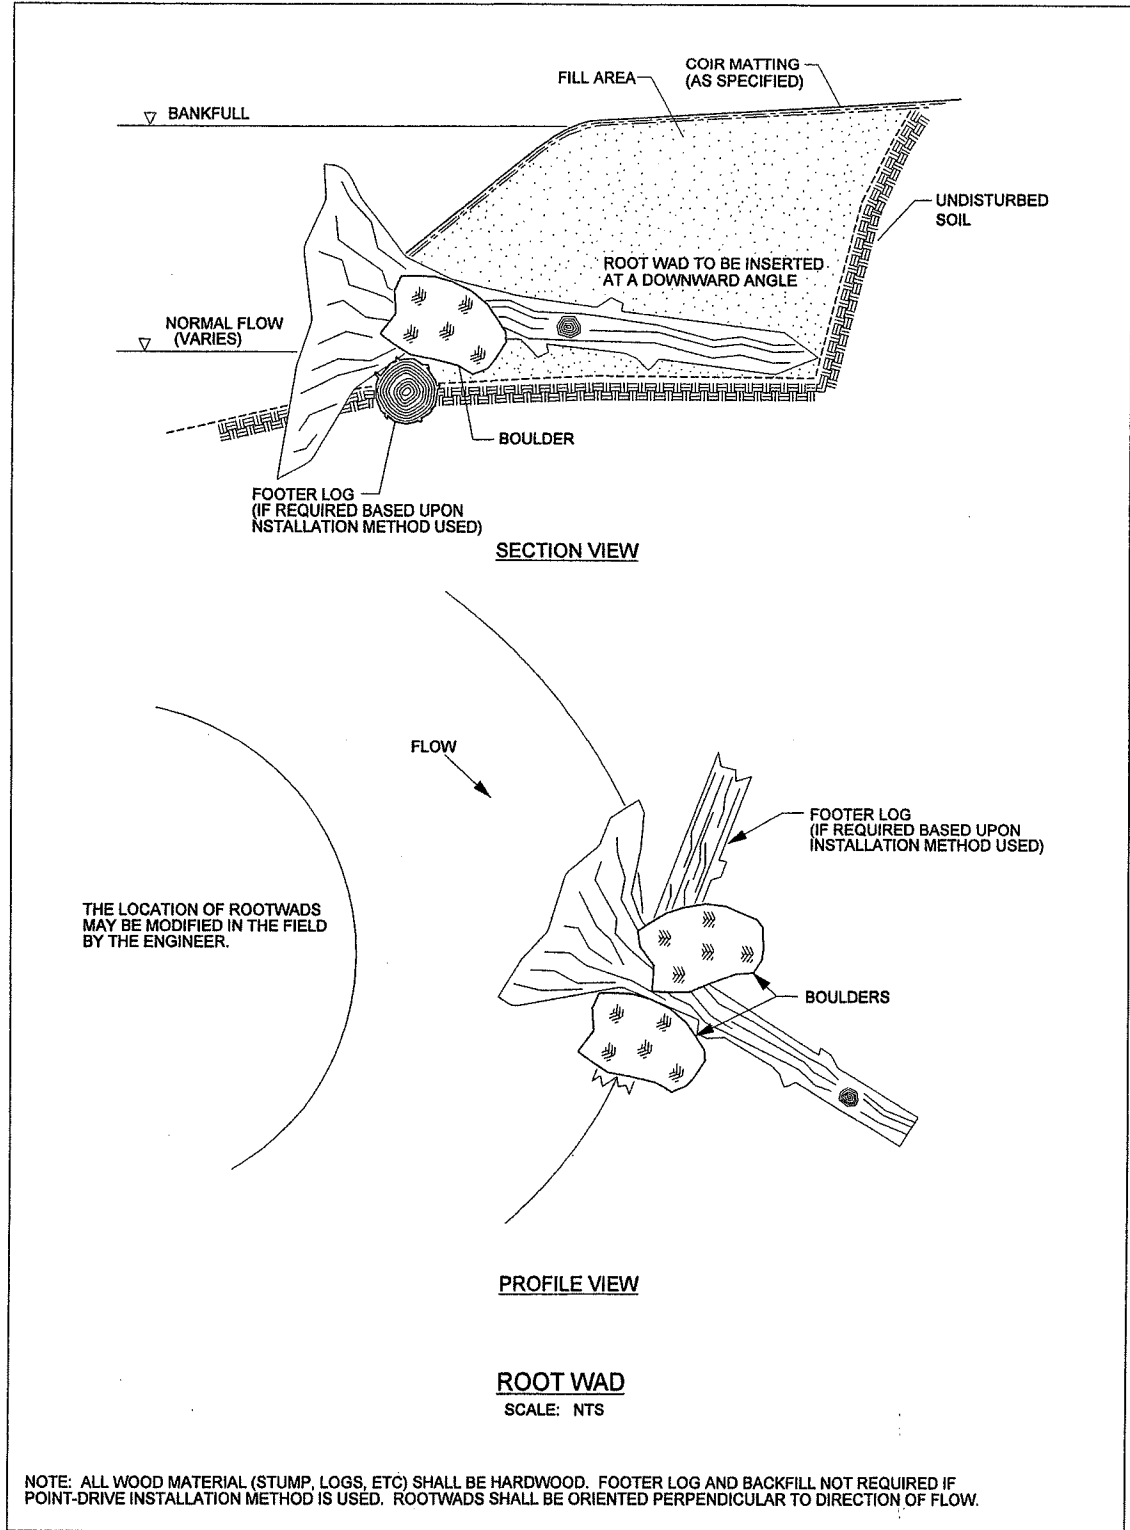

DETAILS - ROOT WAD

# TYPICAL CHANNEL CROSS SECTIONS

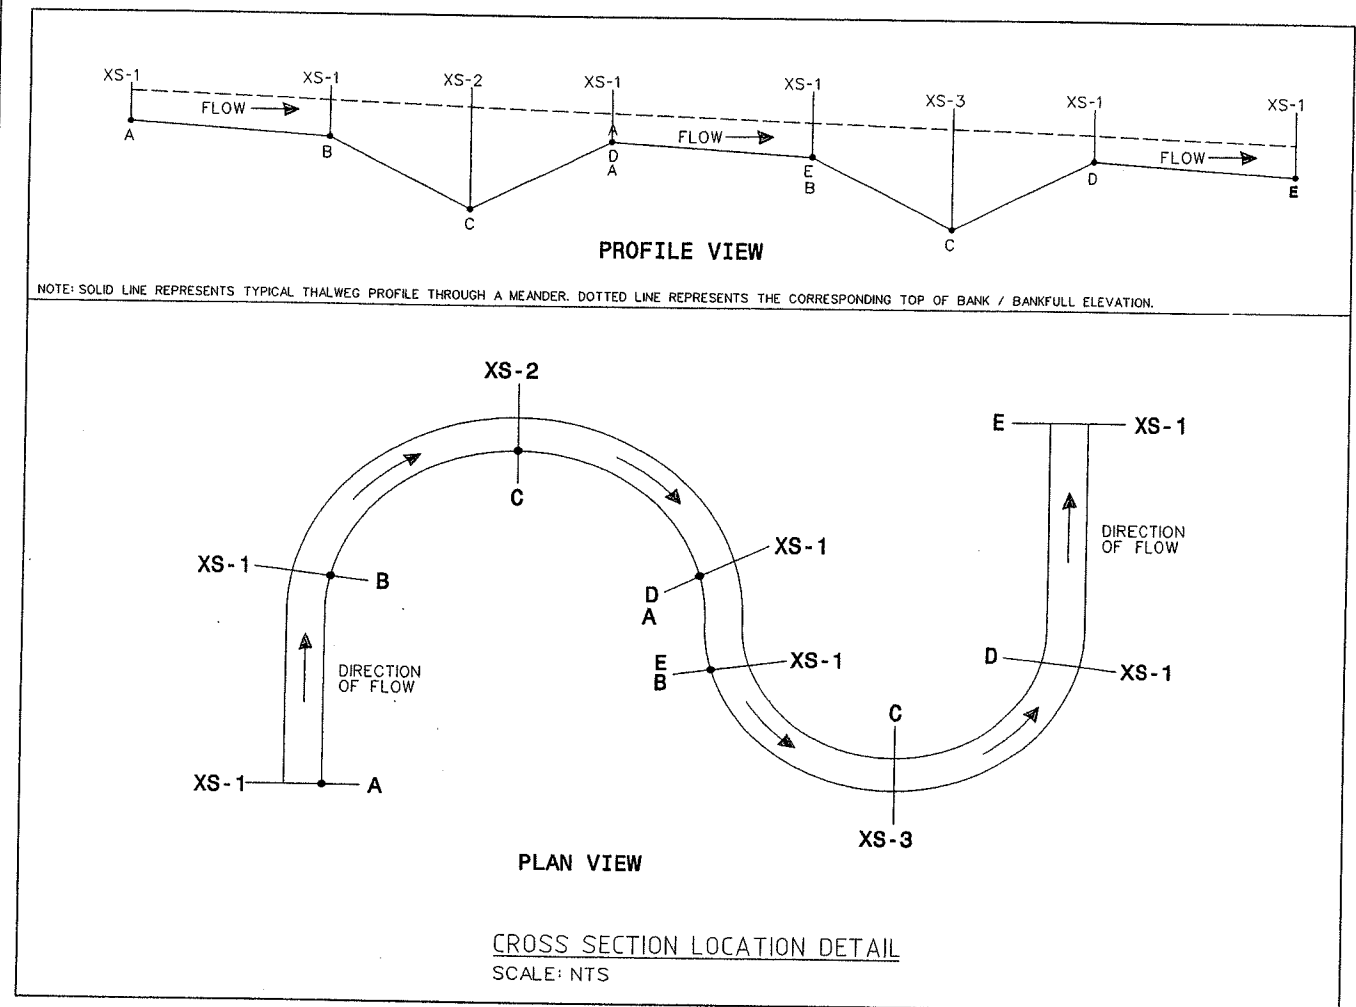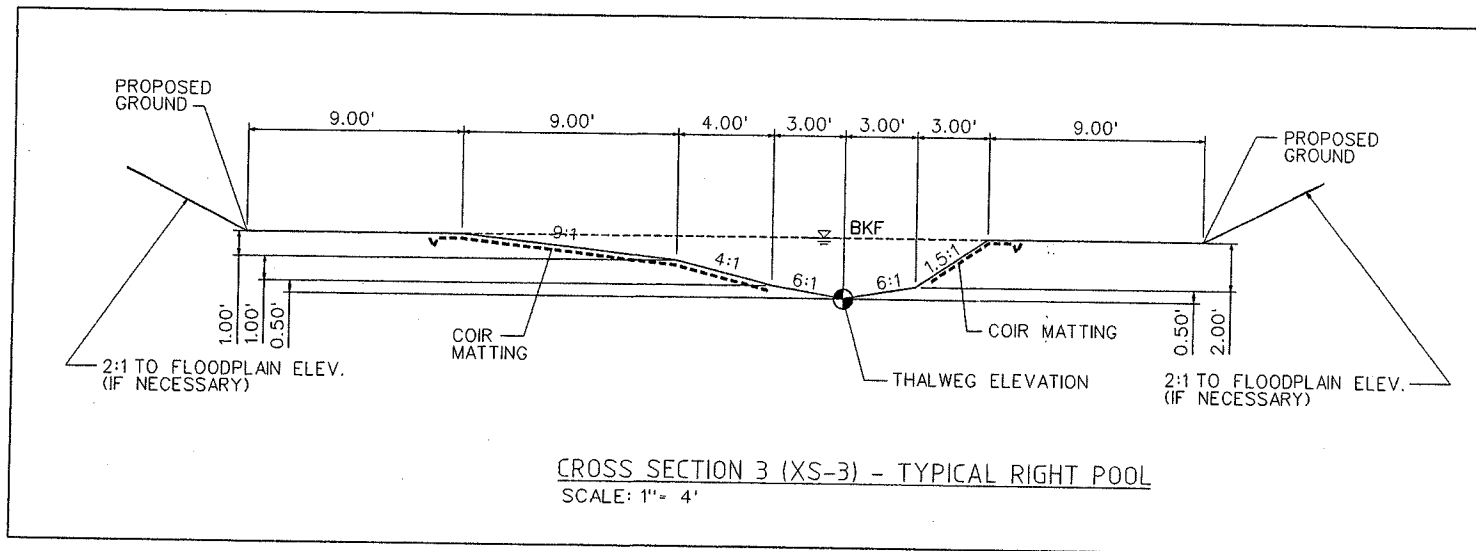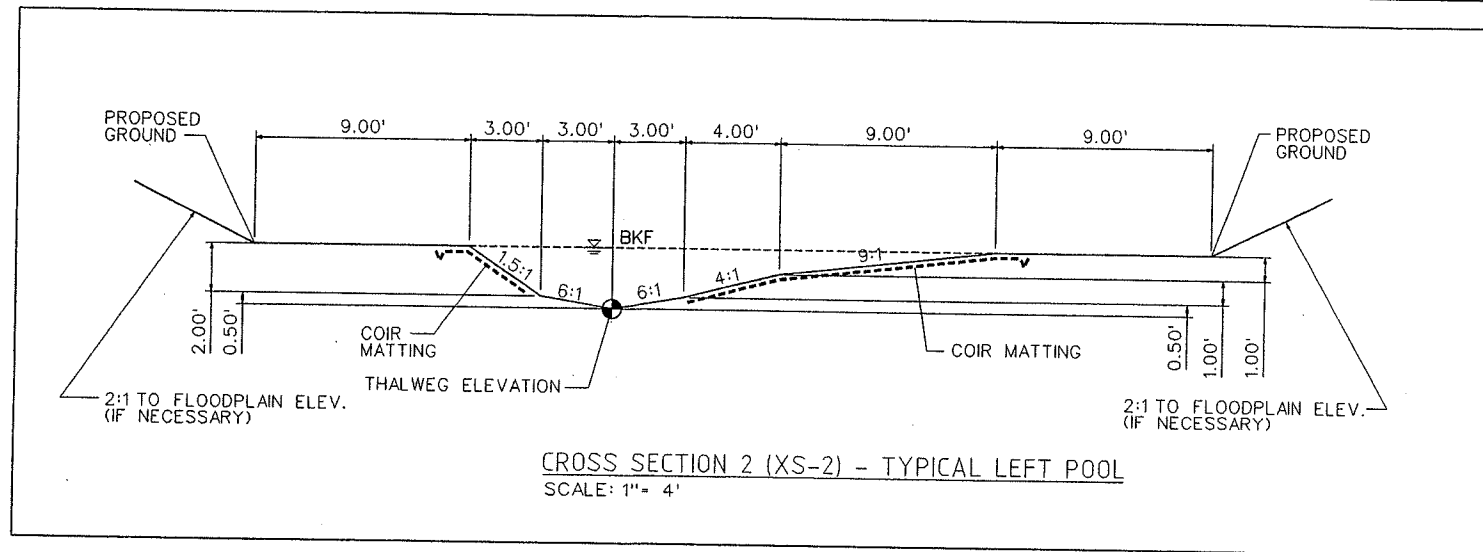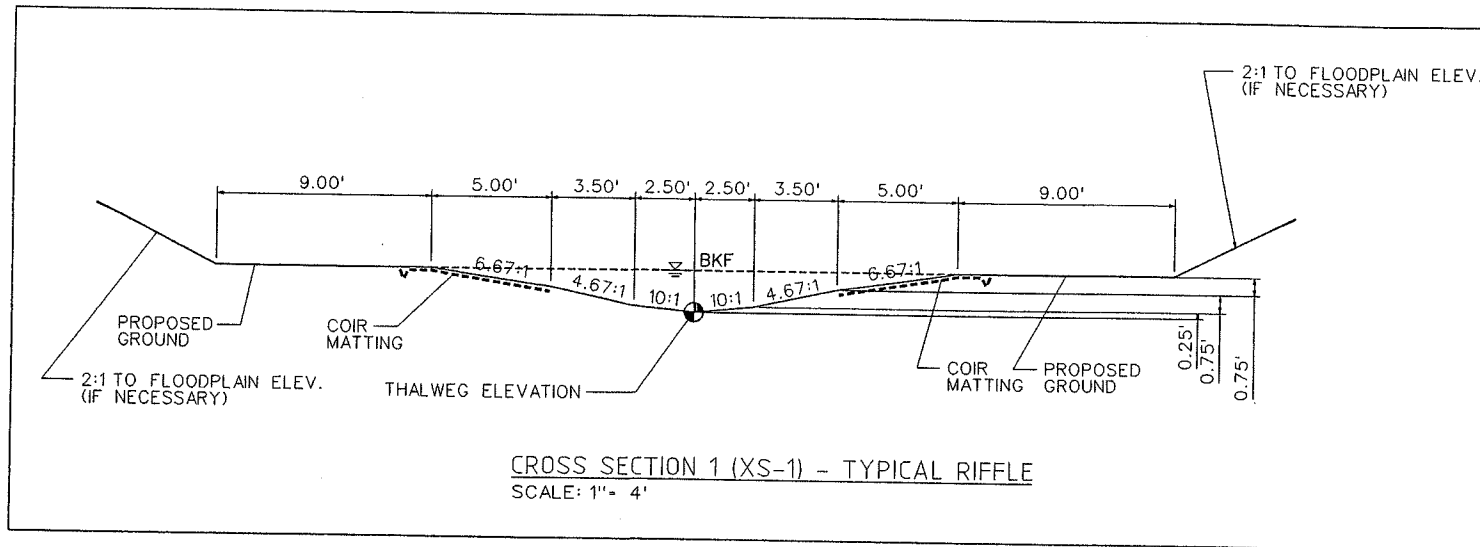

DETAILS - TYPICAL CROSS SECTIONS

PROJECT REFERENCE NO. R-2231WM	SHEET NO. 3
RAW SHEET NO.	
ENGINEER	SCIENTIST

DIVISION OF HIGHWAYS  
STATE OF NORTH CAROLINA

**SUMMARY OF QUANTITIES**

SECT.	QUANTITY	UNIT	ITEM DESCRIPTION
800	1	LS	MOBILIZATION
SP	1	LS	CONSTRUCTION SURVEY
1605	5,400	LF	TEMPORARY SILT FENCE
SP	1,100	LF	1/4 INCH HARDWARE CLOTH
SP	300	SY	EROSION CONTROL MATTING FOR LEVEE BREAK
SP	89	AC	MOWING
SP	1	LS	GRADING
SP	5	AC	SUPPLEMENTAL CLEARING AND GRUBBING
SP	6	EA	SPECIAL STILLING BASIN
SP	510	CY	IMPERVIOUS SELECT MATERIAL
SP	80	AC	RIPPING
SP	80	AC	DISCING
1056	1,500	SY	FILTER FABRIC FOR DRAINAGE
SP	88	AC	SEEDING AND MULCHING
545	400	TON	INCIDENTAL STONE BASE
1610	200	TON	SEDIMENT CONTROL STONE
1610	25	TON	STONE FOR EROSION CONTROL, CLASS A
1610	100	TON	STONE FOR EROSION CONTROL, CLASS B
1610	350	TON	STONE FOR EROSION CONTROL, CLASS 1
SP	225	TON	STONE, CLASS 2
SP	650	TON	STONE, BOULDER
SP	32	EA	ROOT WADS
SP	12	EA	LOG VANES
SP	14,000	SY	COIR MATTING
SP	12,145	LF	WOVEN WIRE FENCE, 47" FAB
SP	1,012	EA	5" TIMBER POSTS, 8' LONG
SP	2	EA	SINGLE GATES, 52" HIGH, 14' WIDE, 14' OPENING
SP	61	EA	SIGN ERECTION, TYPE F
SP	488	LF	SUPPORTS, 3-LB STEEL U-CHANNEL


**SUMMARY OF EARTHWORK**

IN CUBIC YARDS


SITE EXCAVATION =	17496 CY
STREAM EXCAVATION =	5287 CY
EXCAVATION TOTAL =	22783 CY
SITE EMBANKMENT =	22736 CY
NET WASTE =	0 CY
NET BORROW =	27 CY

SUMMARY SHEET



PROJECT REFERENCE NO. R-2231WM	SHEET NO. 4
RW SHEET NO.	
ENGINEER	SCIENTIST
	

MATCHLINE SEE SHEET 5

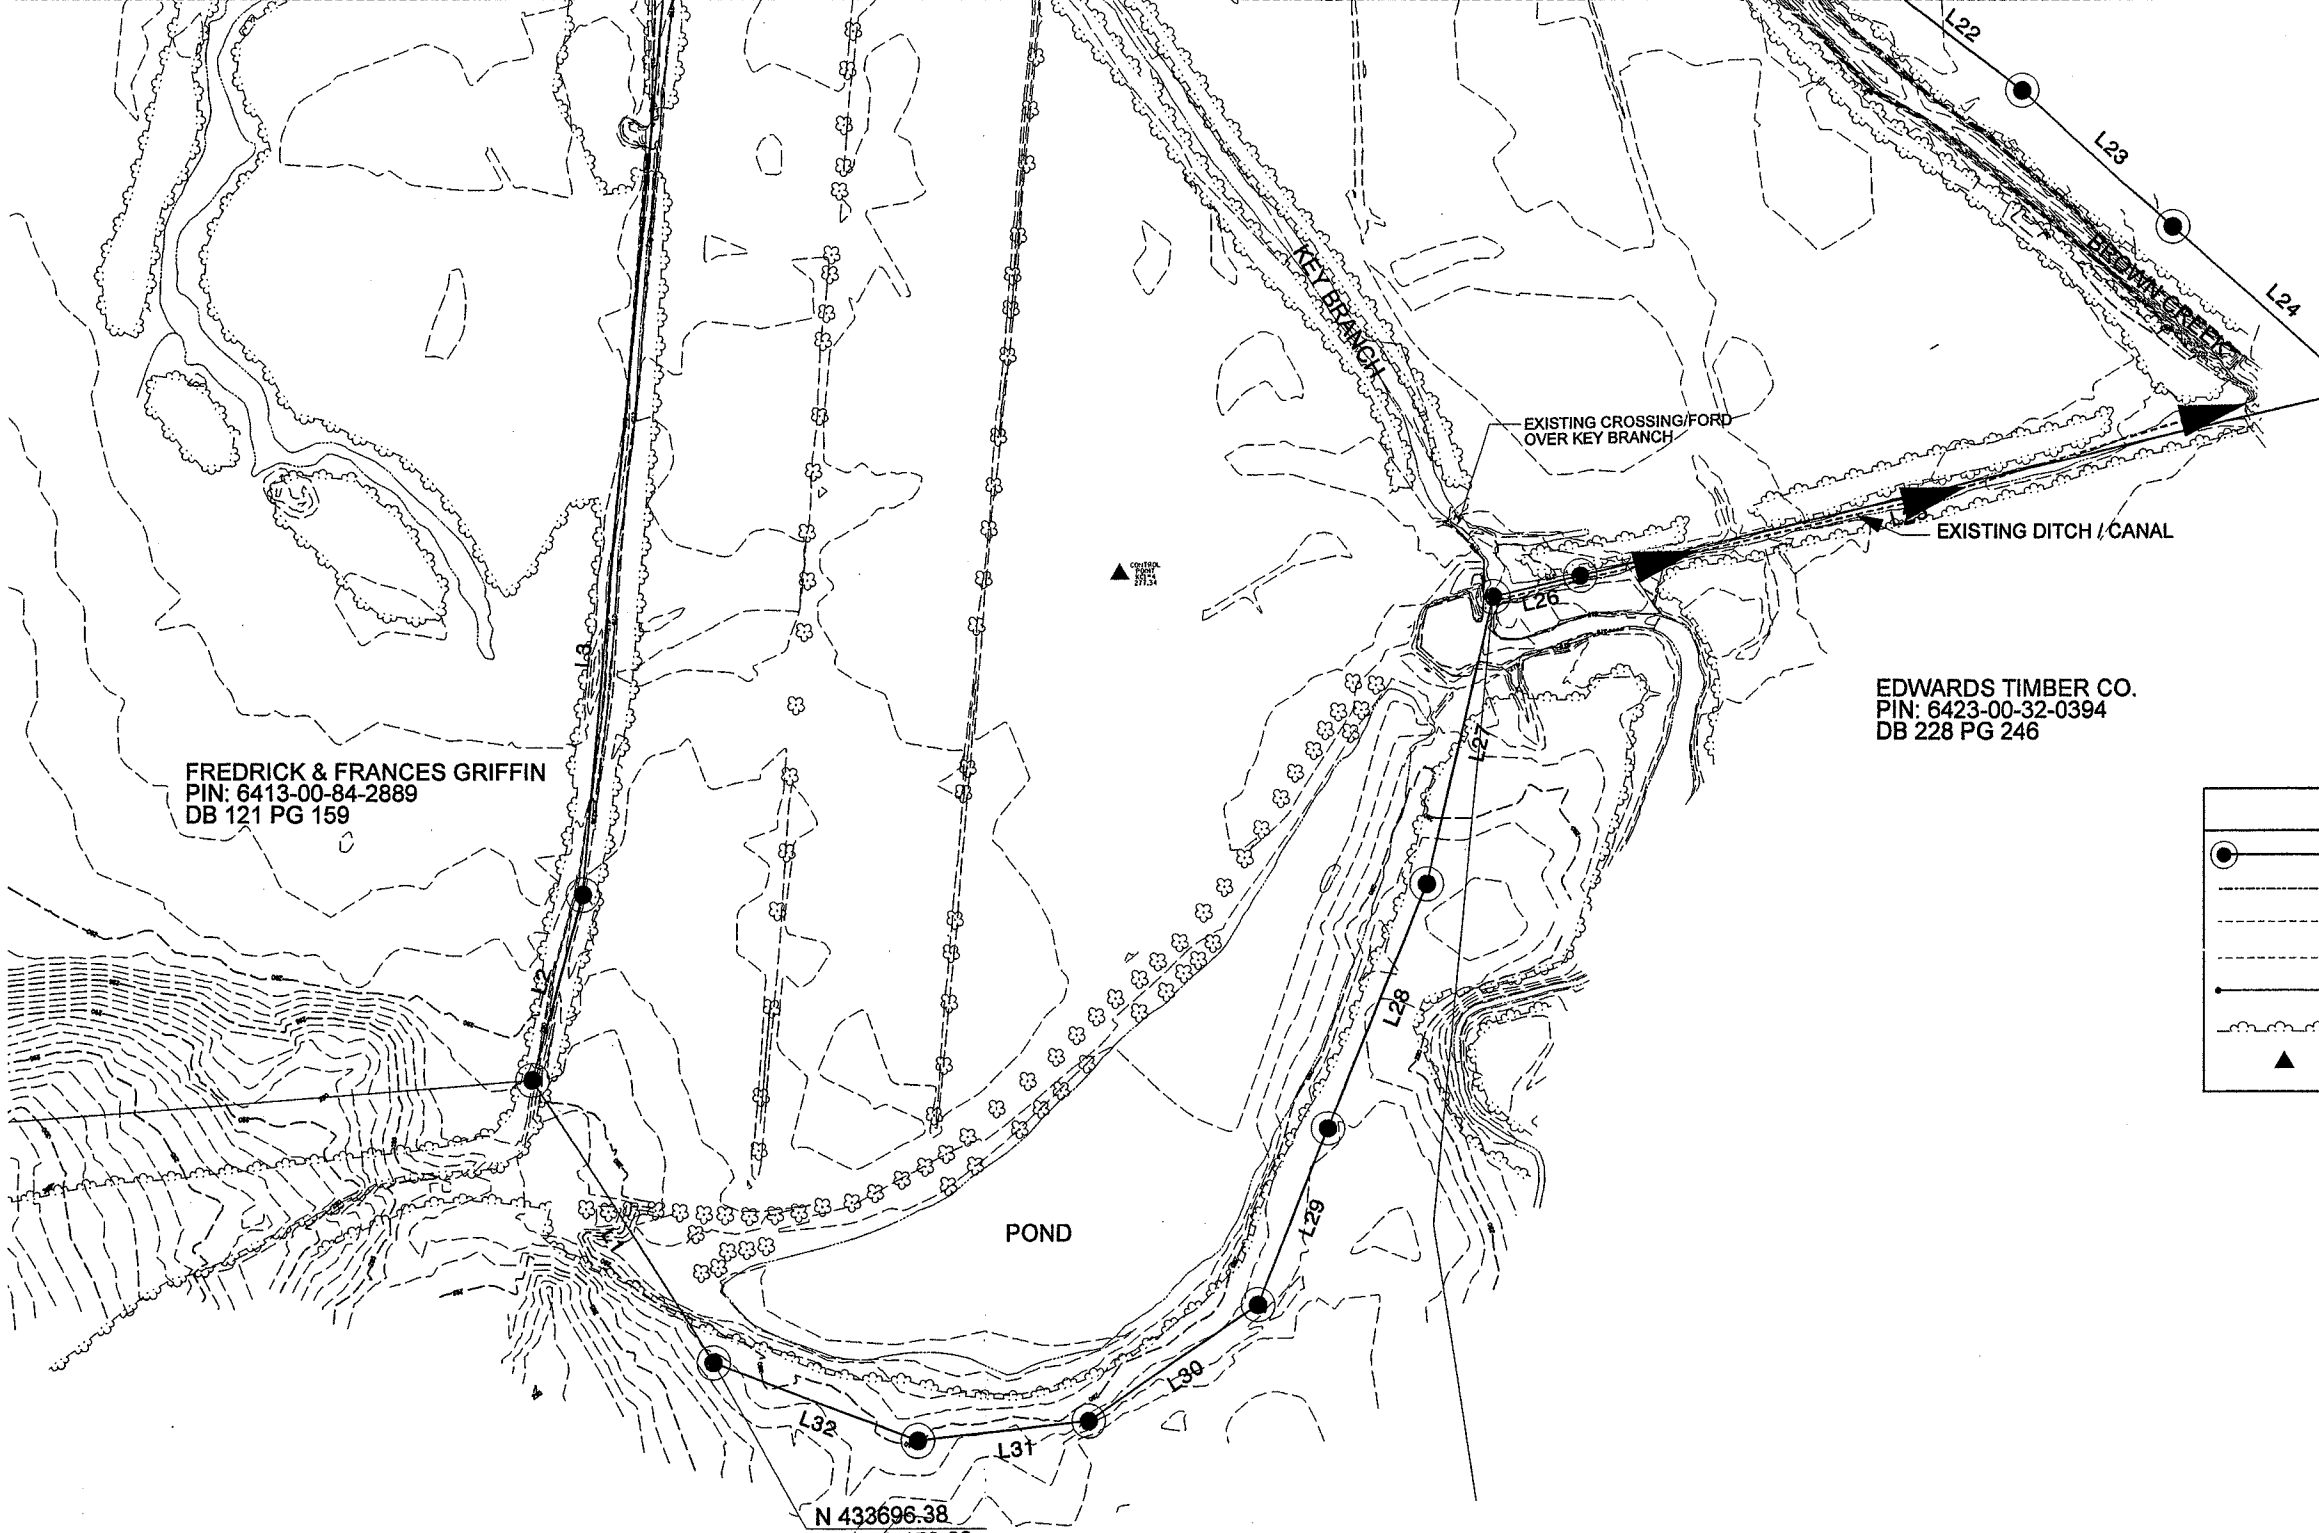


FREDRICK & FRANCES GRIFFIN  
PIN: 6413-00-84-2889  
DB 121 PG 159

EDWARDS TIMBER CO.  
PIN: 6423-00-32-0394  
DB 228 PG 246

GENERAL PLAN LEGEND	
	SITE BOUNDARY/ CONSERVATION EASEMENT
	PROPOSED STREAM CHANNEL PLANFORM
	EXISTING MAJOR CONTOUR LINES
	EXISTING MINOR CONTOUR LINES
	PROPOSED 1' CONTOUR LINES
	TREE LINE
	SURVEY CONTROL POINT

N 433696.38  
E-1,619,159.08

EXISTING CONDITIONS

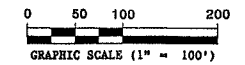


EXISTING CONDITIONS 1

**KCI Associates**  
of North Carolina, P.A.  
LANDMARK CENTER II, SUITE 220  
4601 SIX FORKS ROAD, RALEIGH, NC 27609-5210  
•ENGINEERS • SURVEYORS • SCIENTISTS

MATCHLINE SEE SHEET 6

MATCHLINE SEE SHEET 6

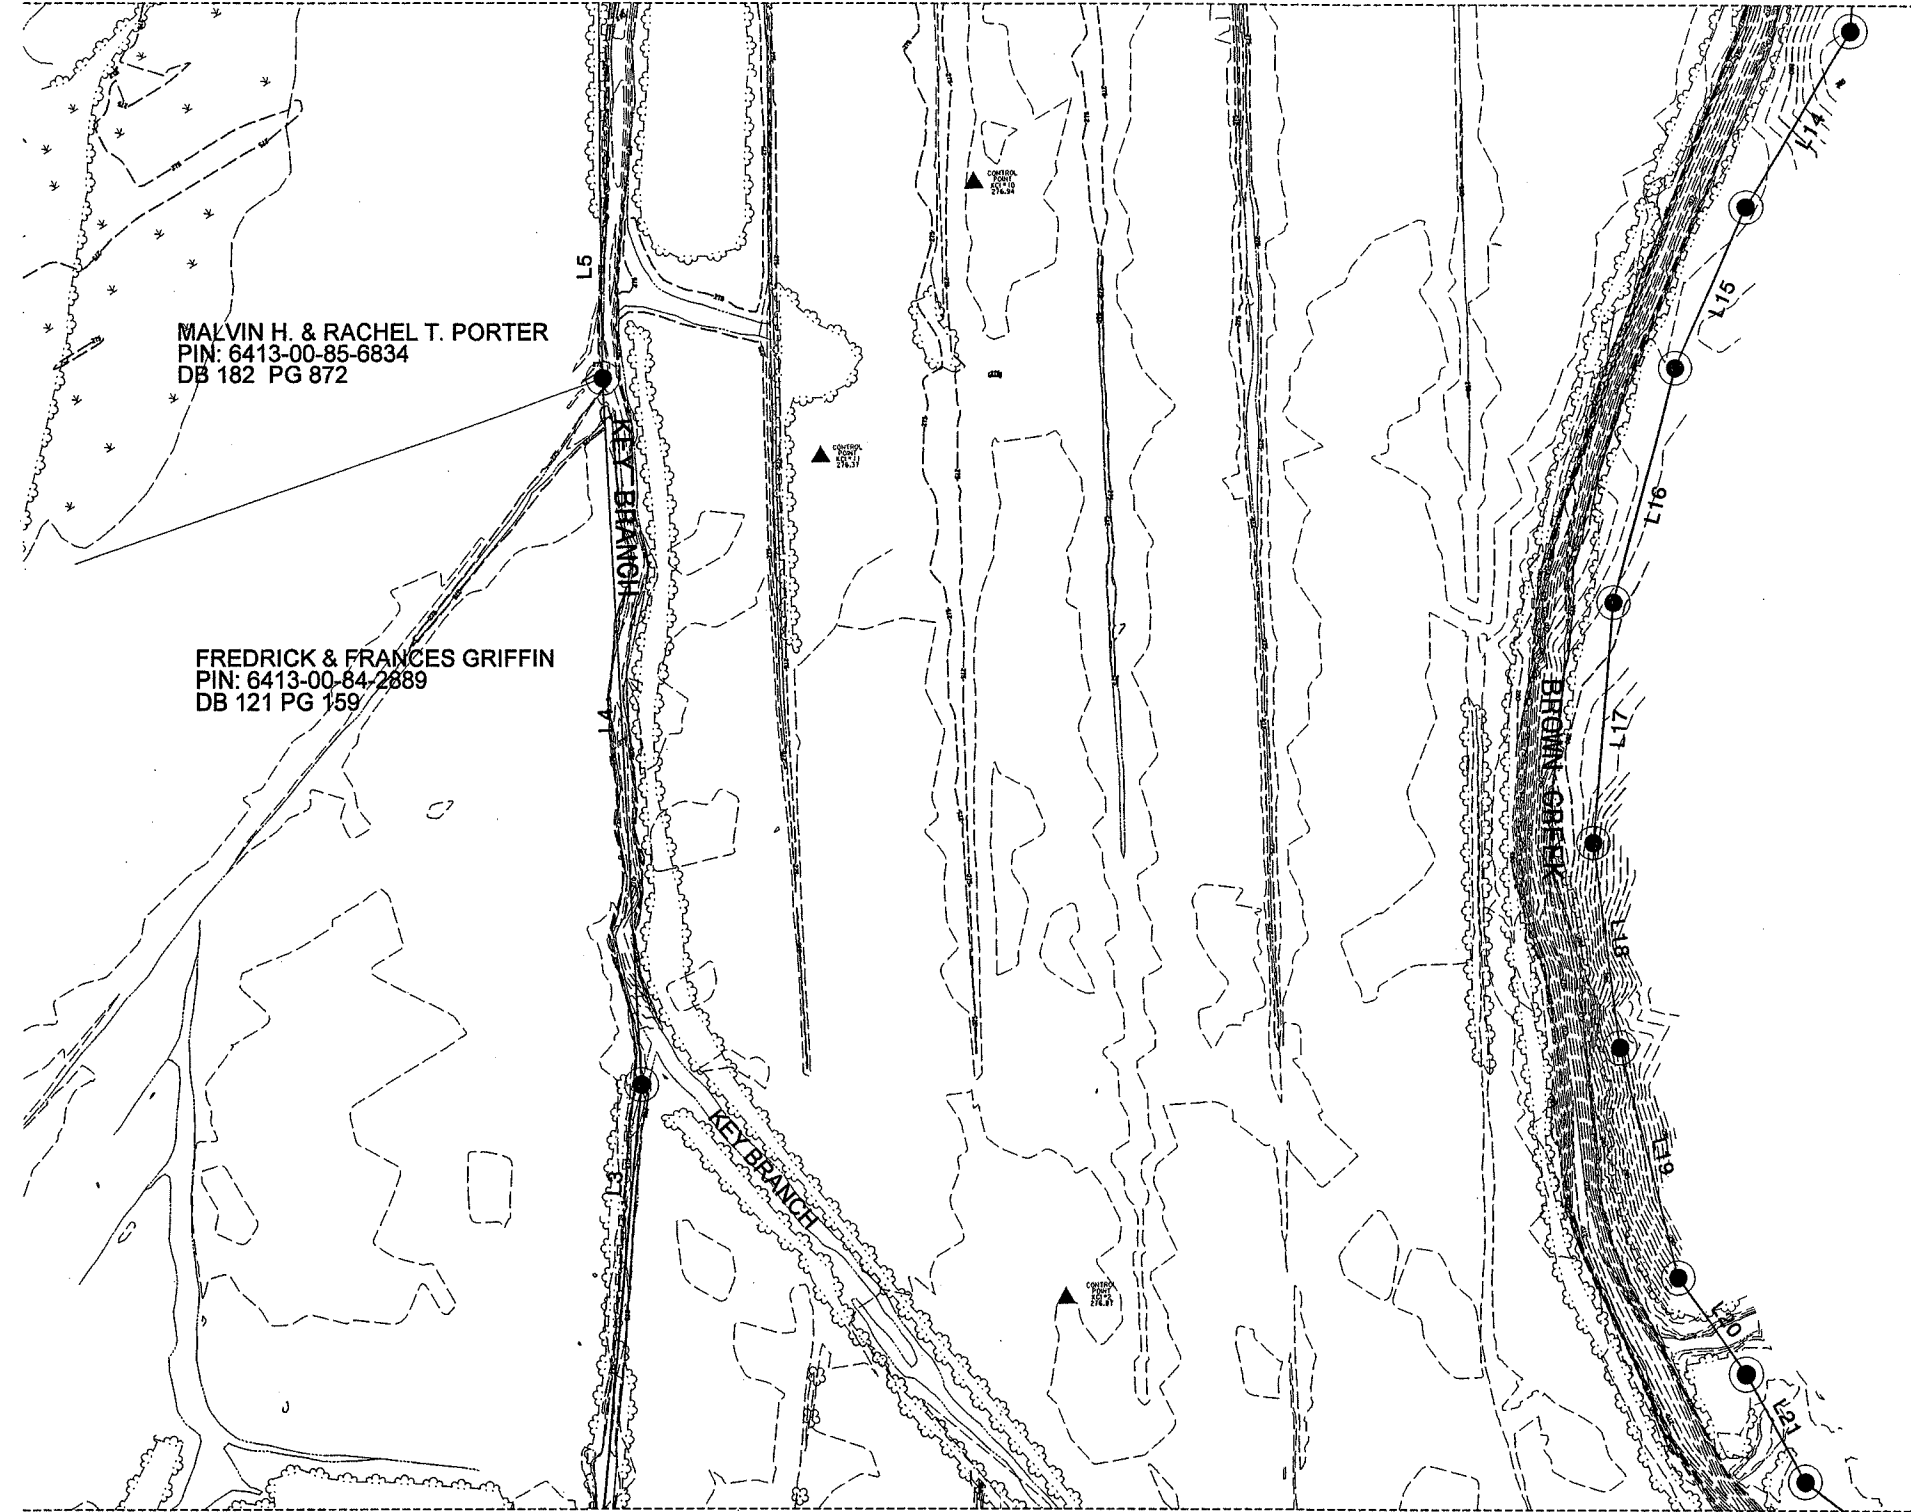

MALVIN H. & RACHEL T. PORTER  
PIN: 6413-00-85-6834  
DB 182 PG 872

FREDRICK & FRANCES GRIFFIN  
PIN: 6413-00-84-2889  
DB 121 PG 159




GENERAL PLAN LEGEND	
	SITE BOUNDARY/ CONSERVATION EASEMENT
	PROPOSED STREAM CHANNEL PLANFORM
	EXISTING MAJOR CONTOUR LINES
	EXISTING MINOR CONTOUR LINES
	PROPOSED 1' CONTOUR LINES
	TREE LINE
	SURVEY CONTROL POINT

MATCHLINE SEE SHEET 4


MATCHLINE SEE SHEET 4

**EXISTING CONDITIONS**

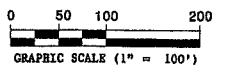

**EXISTING CONDITIONS 2**

**KCI Associates  
of North Carolina, P.A.**  
LANDMARK CENTER II, SUITE 220  
4601 SIX FORKS ROAD, RALEIGH, NC 27609-5210  
•ENGINEERS • SURVEYORS • SCIENTISTS

PROJECT REFERENCE NO. R-2231 WM	SHEET NO. 6
RAW SHEET NO.	
ENGINEER	SCIENTIST
	


 
 
 
 


MARGARET B. DELLINGER  
PIN: 6423-00-36-2407  
WB 88 PG E-25


SUSTAINABLE FORESTS LLC  
PIN: 6413-00-98-9674  
DB 487 PG 262

RICHARD M. & KIMBERLY H. PORTER  
PIN: 6413-00-86-7461  
DB 297 PG 369

MALVIN H. & RACHEL T. PORTER  
PIN: 6413-00-85-6834  
DB 182 PG 872




GENERAL PLAN LEGEND	
	SITE BOUNDARY/ CONSERVATION EASEMENT
	PROPOSED STREAM CHANNEL PLANFORM
	EXISTING MAJOR CONTOUR LINES
	EXISTING MINOR CONTOUR LINES
	PROPOSED 1' CONTOUR LINES
	TREE LINE
	SURVEY CONTROL POINT

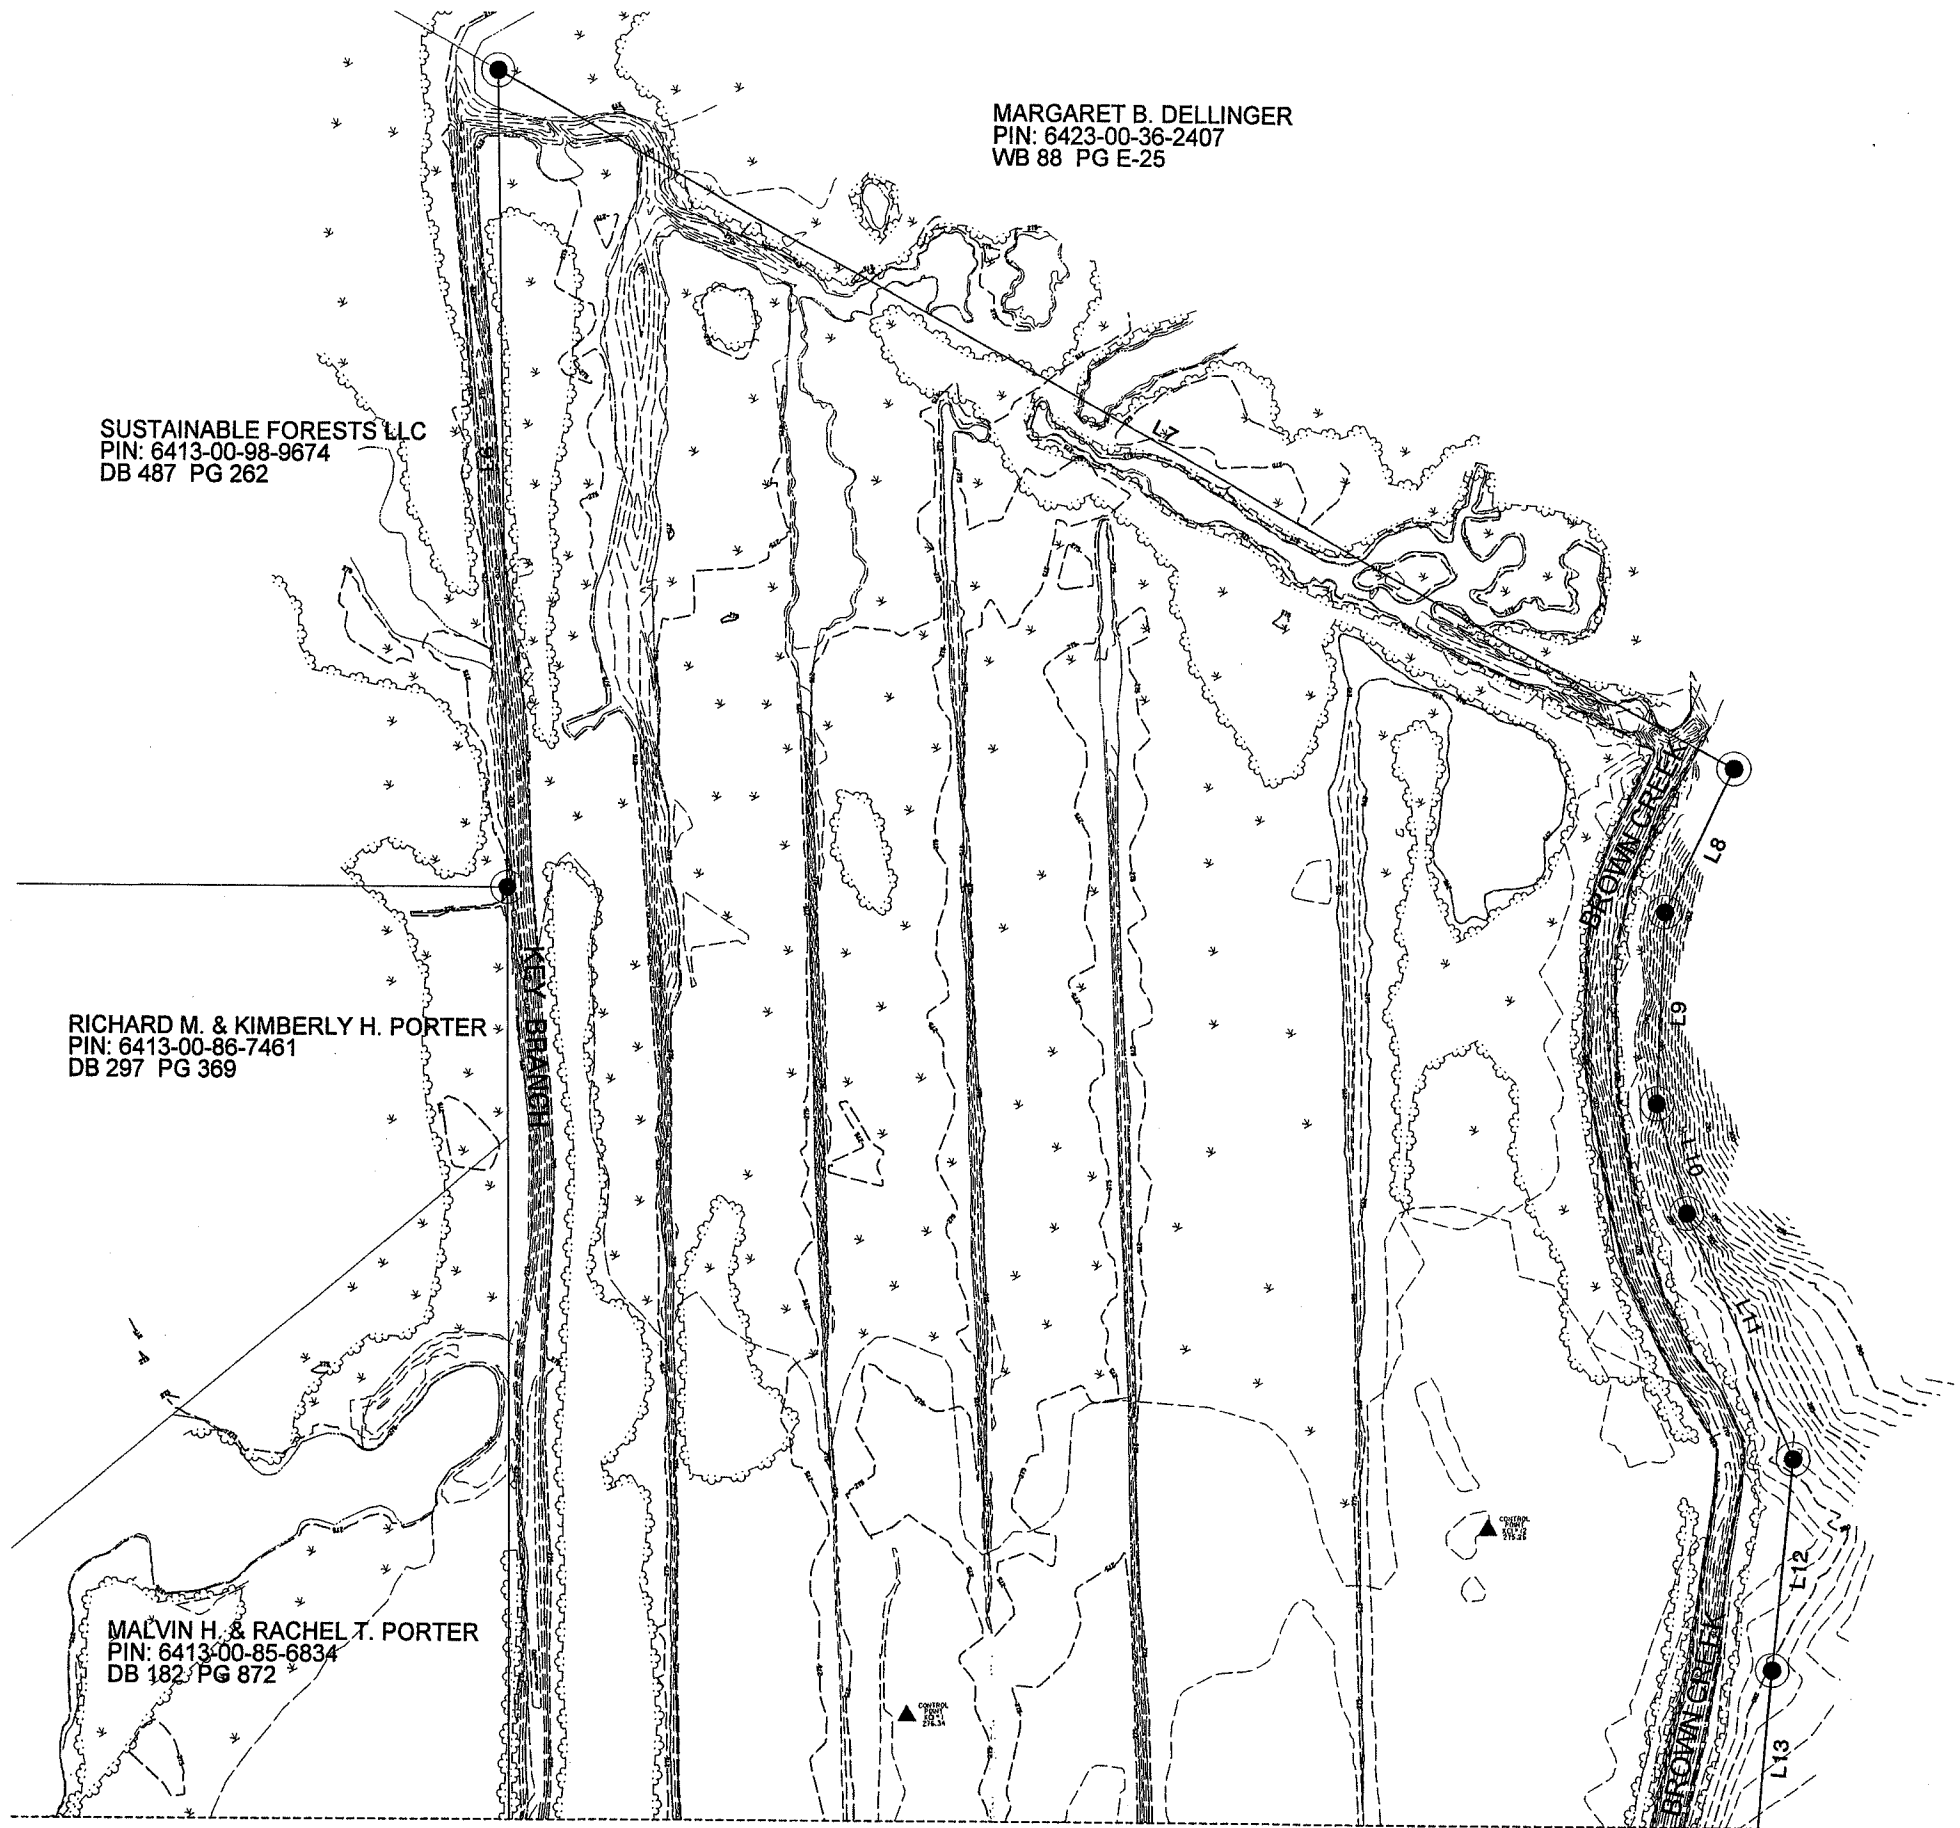

MATCHLINE SEE SHEET 5

MATCHLINE SEE SHEET 5

EXISTING CONDITIONS

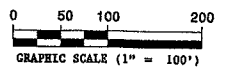


EXISTING CONDITIONS 3

**KCI Associates**  
of North Carolina, P.A.  
LANDMARK CENTER II, SUITE 220  
4601 SIX FORKS ROAD, RALEIGH, NC 27609-5210  
• ENGINEERS • SURVEYORS • SCIENTISTS




LINE	BEARING	LENGTH
L33	N 2° 24' 18.99" W	281.784
L34	N 40° 54' 02.59" E	244.223
L35	N 39° 14' 41.77" E	239.411
L36	N 34° 20' 30.12" E	1,106.496
L37	N 28° 27' 13.71" E	157.246
L38	S 84° 27' 40.26" E	55.497
L39	N 19° 34' 24.58" E	165.856
L40	N 34° 50' 39.69" E	256.285
L41	N 22° 47' 39.41" E	222.074
L42	N 58° 33' 27.37" W	27.259
L43	N 30° 41' 51.83" E	58.706
L44	S 59° 15' 27.21" E	142.159
L45	N 29° 51' 53.21" E	622.279
L46	S 59° 22' 16.58" E	164.881
L47	N 28° 38' 09.12" E	707.729
L48	N 59° 13' 03.48" W	197.659
L49	N 21° 06' 33.34" E	152.859
L50	N 30° 45' 35.90" E	371.033
L51	N 48° 42' 13.83" E	157.955
L52	S 30° 55' 08.44" E	43.490
L53	S 9° 05' 39.43" W	36.479
L54	S 30° 16' 16.23" E	129.731
L55	S 2° 17' 10.32" W	292.069
L56	S 59° 14' 22.86" E	215.587
L57	S 30° 45' 36.46" W	72.737
L58	N 59° 13' 21.00" W	166.394
L59	S 26° 52' 14.70" W	611.349
L60	S 59° 17' 34.20" E	527.183
L61	S 12° 45' 12.95" W	209.037
L62	S 22° 11' 17.96" E	150.910
L63	S 21° 06' 10.84" W	47.239
L64	S 39° 42' 13.74" W	280.655
L65	S 10° 12' 50.86" W	107.905
L66	S 47° 02' 04.54" W	107.905
L67	N 86° 29' 16.10" W	49.640
L68	S 56° 31' 01.74" W	41.816
L69	S 3° 49' 58.71" W	44.426
L70	S 52° 28' 42.05" W	212.208
L71	N 40° 03' 05.00" W	15.805
L72	S 49° 13' 17.72" W	133.510
L73	S 43° 50' 17.23" W	100.679
L74	S 48° 49' 36.42" E	16.166
L75	S 32° 34' 14.26" W	74.488
L76	S 41° 06' 14.88" W	119.188
L77	N 56° 02' 51.40" W	16.249
L78	S 30° 26' 11.20" W	114.940
L79	S 25° 12' 52.44" W	120.898
L80	S 38° 43' 42.53" E	39.845
L81	S 23° 30' 18.29" W	95.084
L82	S 80° 52' 52.22" W	41.018
L83	S 21° 37' 19.81" W	114.255
L84	S 14° 36' 13.39" W	69.973
L85	S 1° 48' 41.18" E	64.500
L86	S 7° 17' 26.01" W	125.484
L87	S 41° 56' 09.14" E	56.762
L88	S 13° 20' 48.67" E	109.760
L89	S 30° 45' 35.89" W	46.754
L90	S 21° 55' 05.60" E	296.253
L91	S 15° 11' 44.29" E	108.350
L92	N 86° 46' 05.76" E	36.007
L93	S 21° 20' 15.15" E	155.898
L94	N 72° 35' 10.28" W	749.402
L26	N 72° 35' 10.19" W	94.119
L95	S 43° 45' 21.75" W	87.436
L96	S 49° 54' 12.69" W	329.607
L97	S 57° 20' 33.92" W	187.394
L98	S 52° 09' 32.22" W	137.854
L99	S 76° 24' 47.70" W	58.991
L100	S 85° 37' 14.94" W	107.539
L101	N 79° 16' 39.11" W	90.981
L102	N 61° 09' 00.76" W	58.443
L103	N 48° 39' 59.17" W	88.469
L104	N 55° 23' 14.34" W	67.650
L105	N 39° 57' 29.48" W	98.323
L106	N 72° 51' 55.23" W	40.486

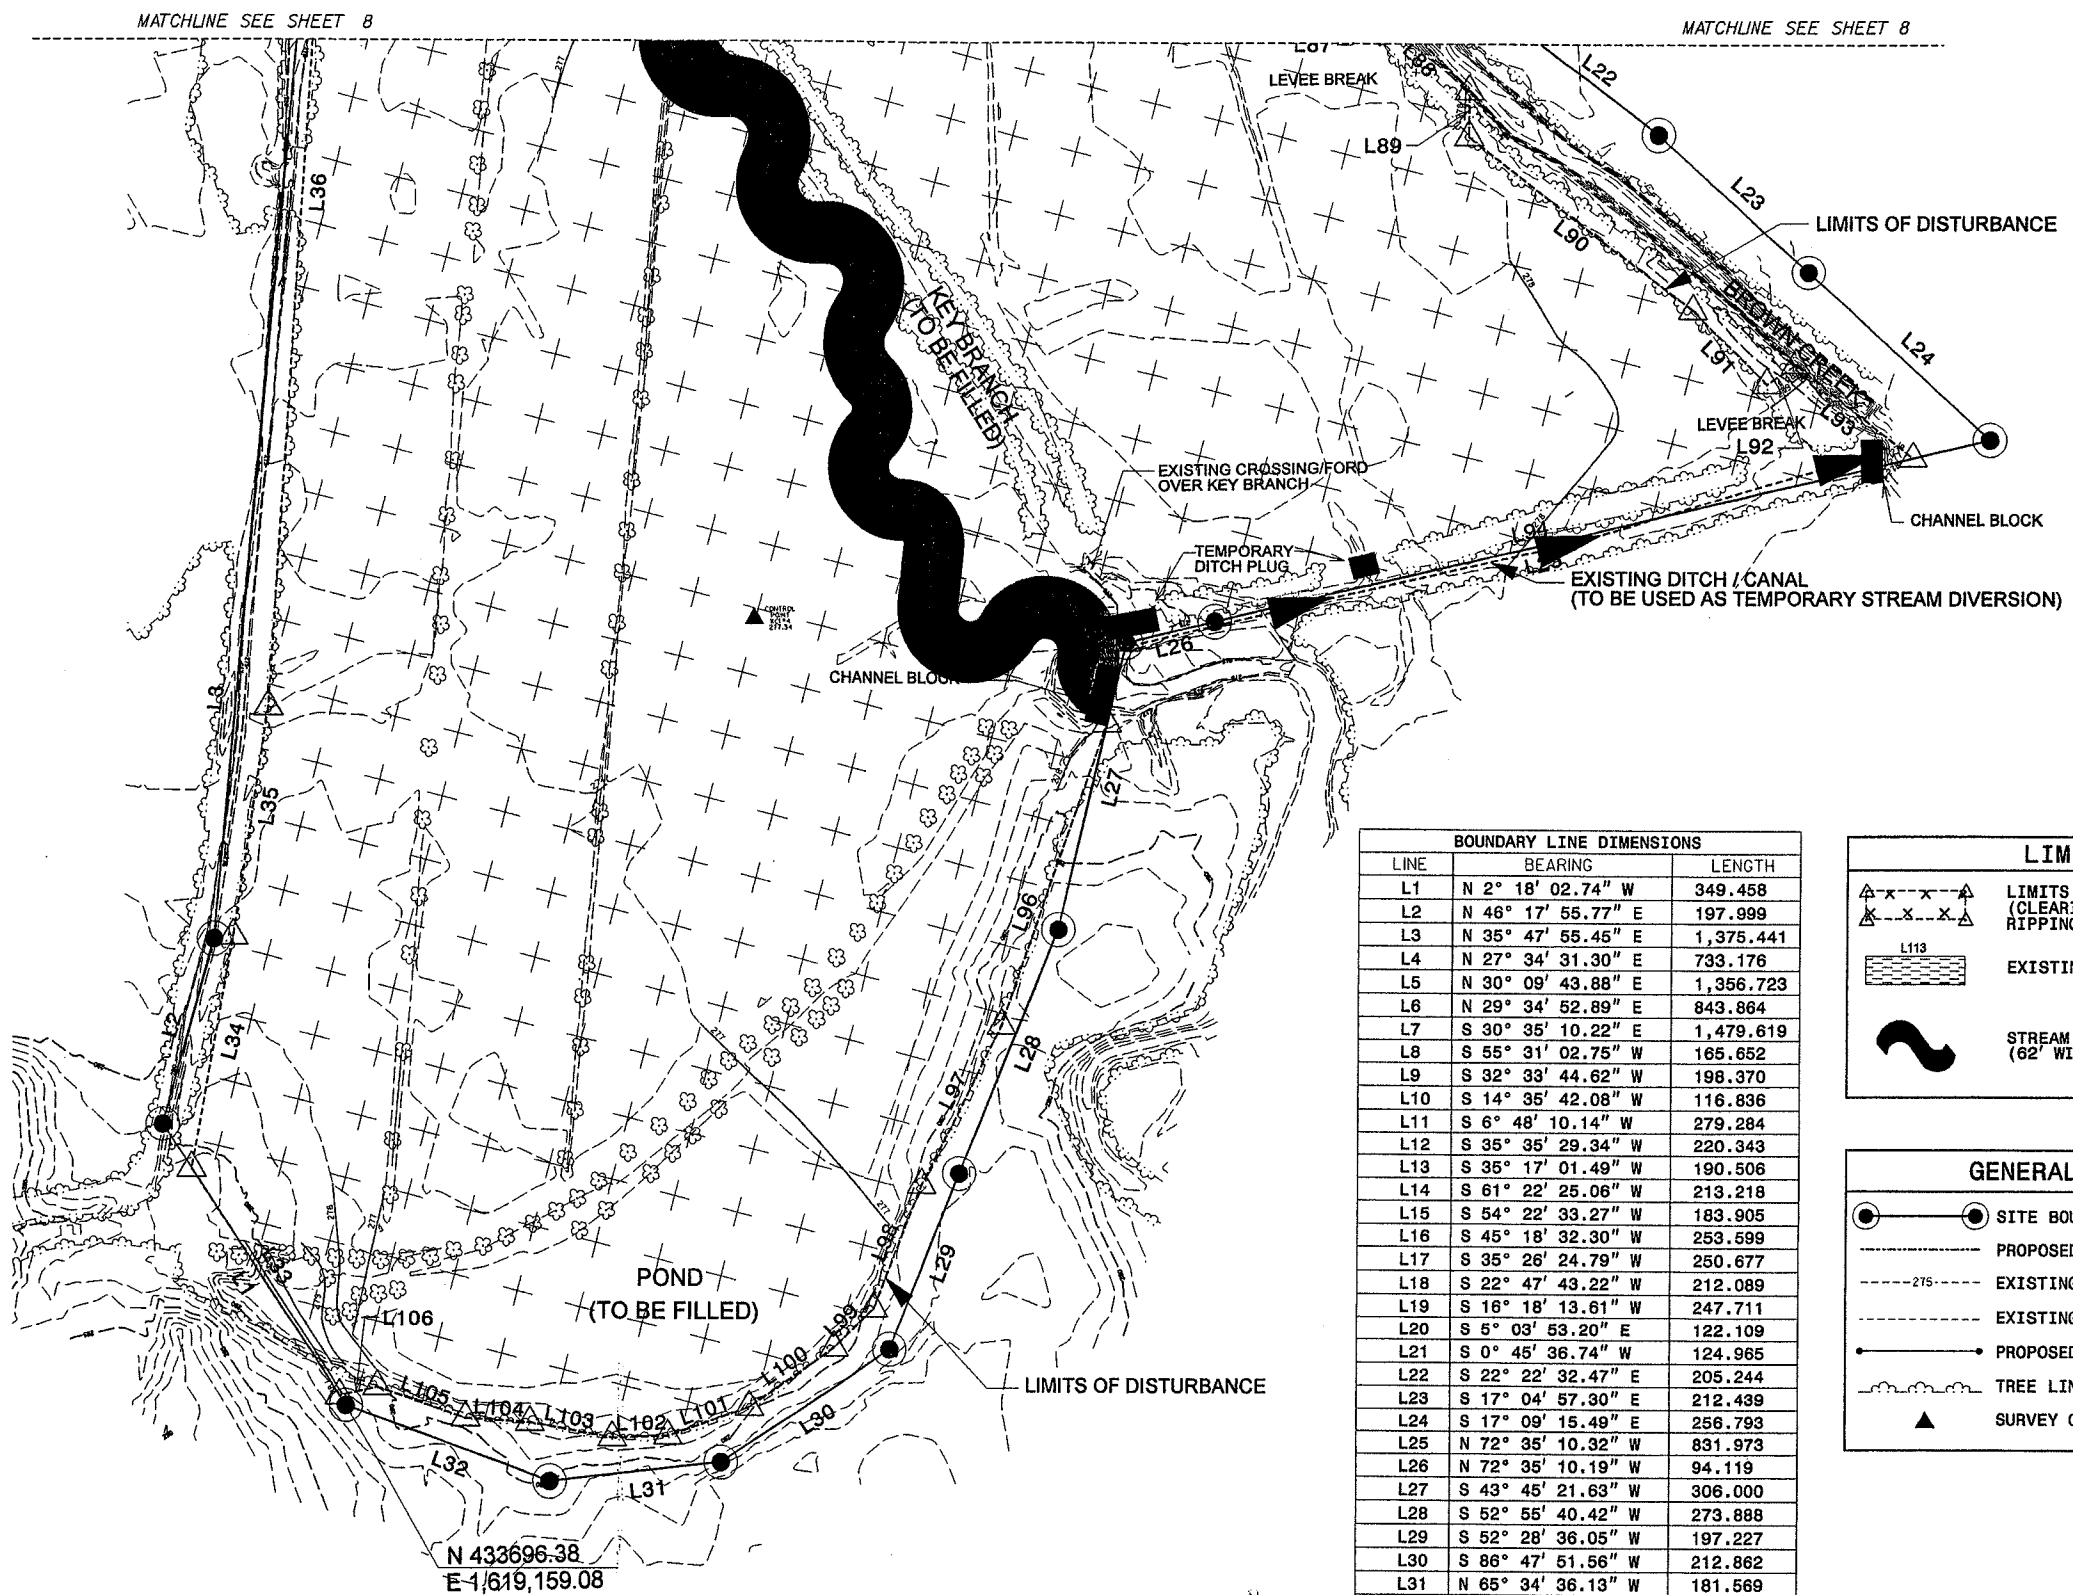


LINE	BEARING	LENGTH
L1	N 2° 18' 02.74" W	349.458
L2	N 46° 17' 55.77" E	197.999
L3	N 35° 47' 55.45" E	1,375.441
L4	N 27° 34' 31.30" E	733.176
L5	N 30° 09' 43.88" E	1,356.723
L6	N 29° 34' 52.89" E	843.864
L7	S 30° 35' 10.22" E	1,479.619
L8	S 55° 31' 02.75" W	165.652
L9	S 32° 33' 44.62" W	198.370
L10	S 14° 35' 42.08" W	116.836
L11	S 6° 48' 10.14" W	279.284
L12	S 35° 35' 29.34" W	220.343
L13	S 35° 17' 01.49" W	190.506
L14	S 61° 22' 25.06" W	213.218
L15	S 54° 22' 33.27" W	183.905
L16	S 45° 18' 32.30" W	253.599
L17	S 35° 26' 24.79" W	250.677
L18	S 22° 47' 43.22" W	212.089
L19	S 16° 18' 13.61" W	247.711
L20	S 5° 03' 53.20" E	122.109
L21	S 0° 45' 36.74" W	124.965
L22	S 22° 22' 32.47" E	205.244
L23	S 17° 04' 57.30" E	212.439
L24	S 17° 09' 15.49" E	256.793
L25	N 72° 35' 10.32" W	831.973
L26	N 72° 35' 10.19" W	94.119
L27	S 43° 45' 21.63" W	306.000
L28	S 52° 55' 40.42" W	273.888
L29	S 52° 28' 36.05" W	197.227
L30	S 86° 47' 51.56" W	212.862
L31	N 65° 34' 36.13" W	181.569
L32	N 38° 58' 07.00" W	228.048

LIMITS LEGEND	
	LIMITS OF DISTURBANCE (CLEARING AND GRUBBING, MOWING, RIPPING, DISCING, AND GRADING)
	EXISTING WETLAND - SENSITIVE AREA
	STREAM NON-RIP AREA (62' WIDE, CENTERED ALONG STREAM)

GENERAL PLAN LEGEND	
	SITE BOUNDARY/ CONSERVATION EASEMENT
	PROPOSED STREAM CHANNEL PLANFORM
	EXISTING MAJOR CONTOUR LINES
	EXISTING MINOR CONTOUR LINES
	PROPOSED 1' CONTOUR LINES
	TREE LINE
	SURVEY CONTROL POINT

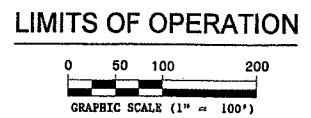

LIMITS OF OPERATION 1

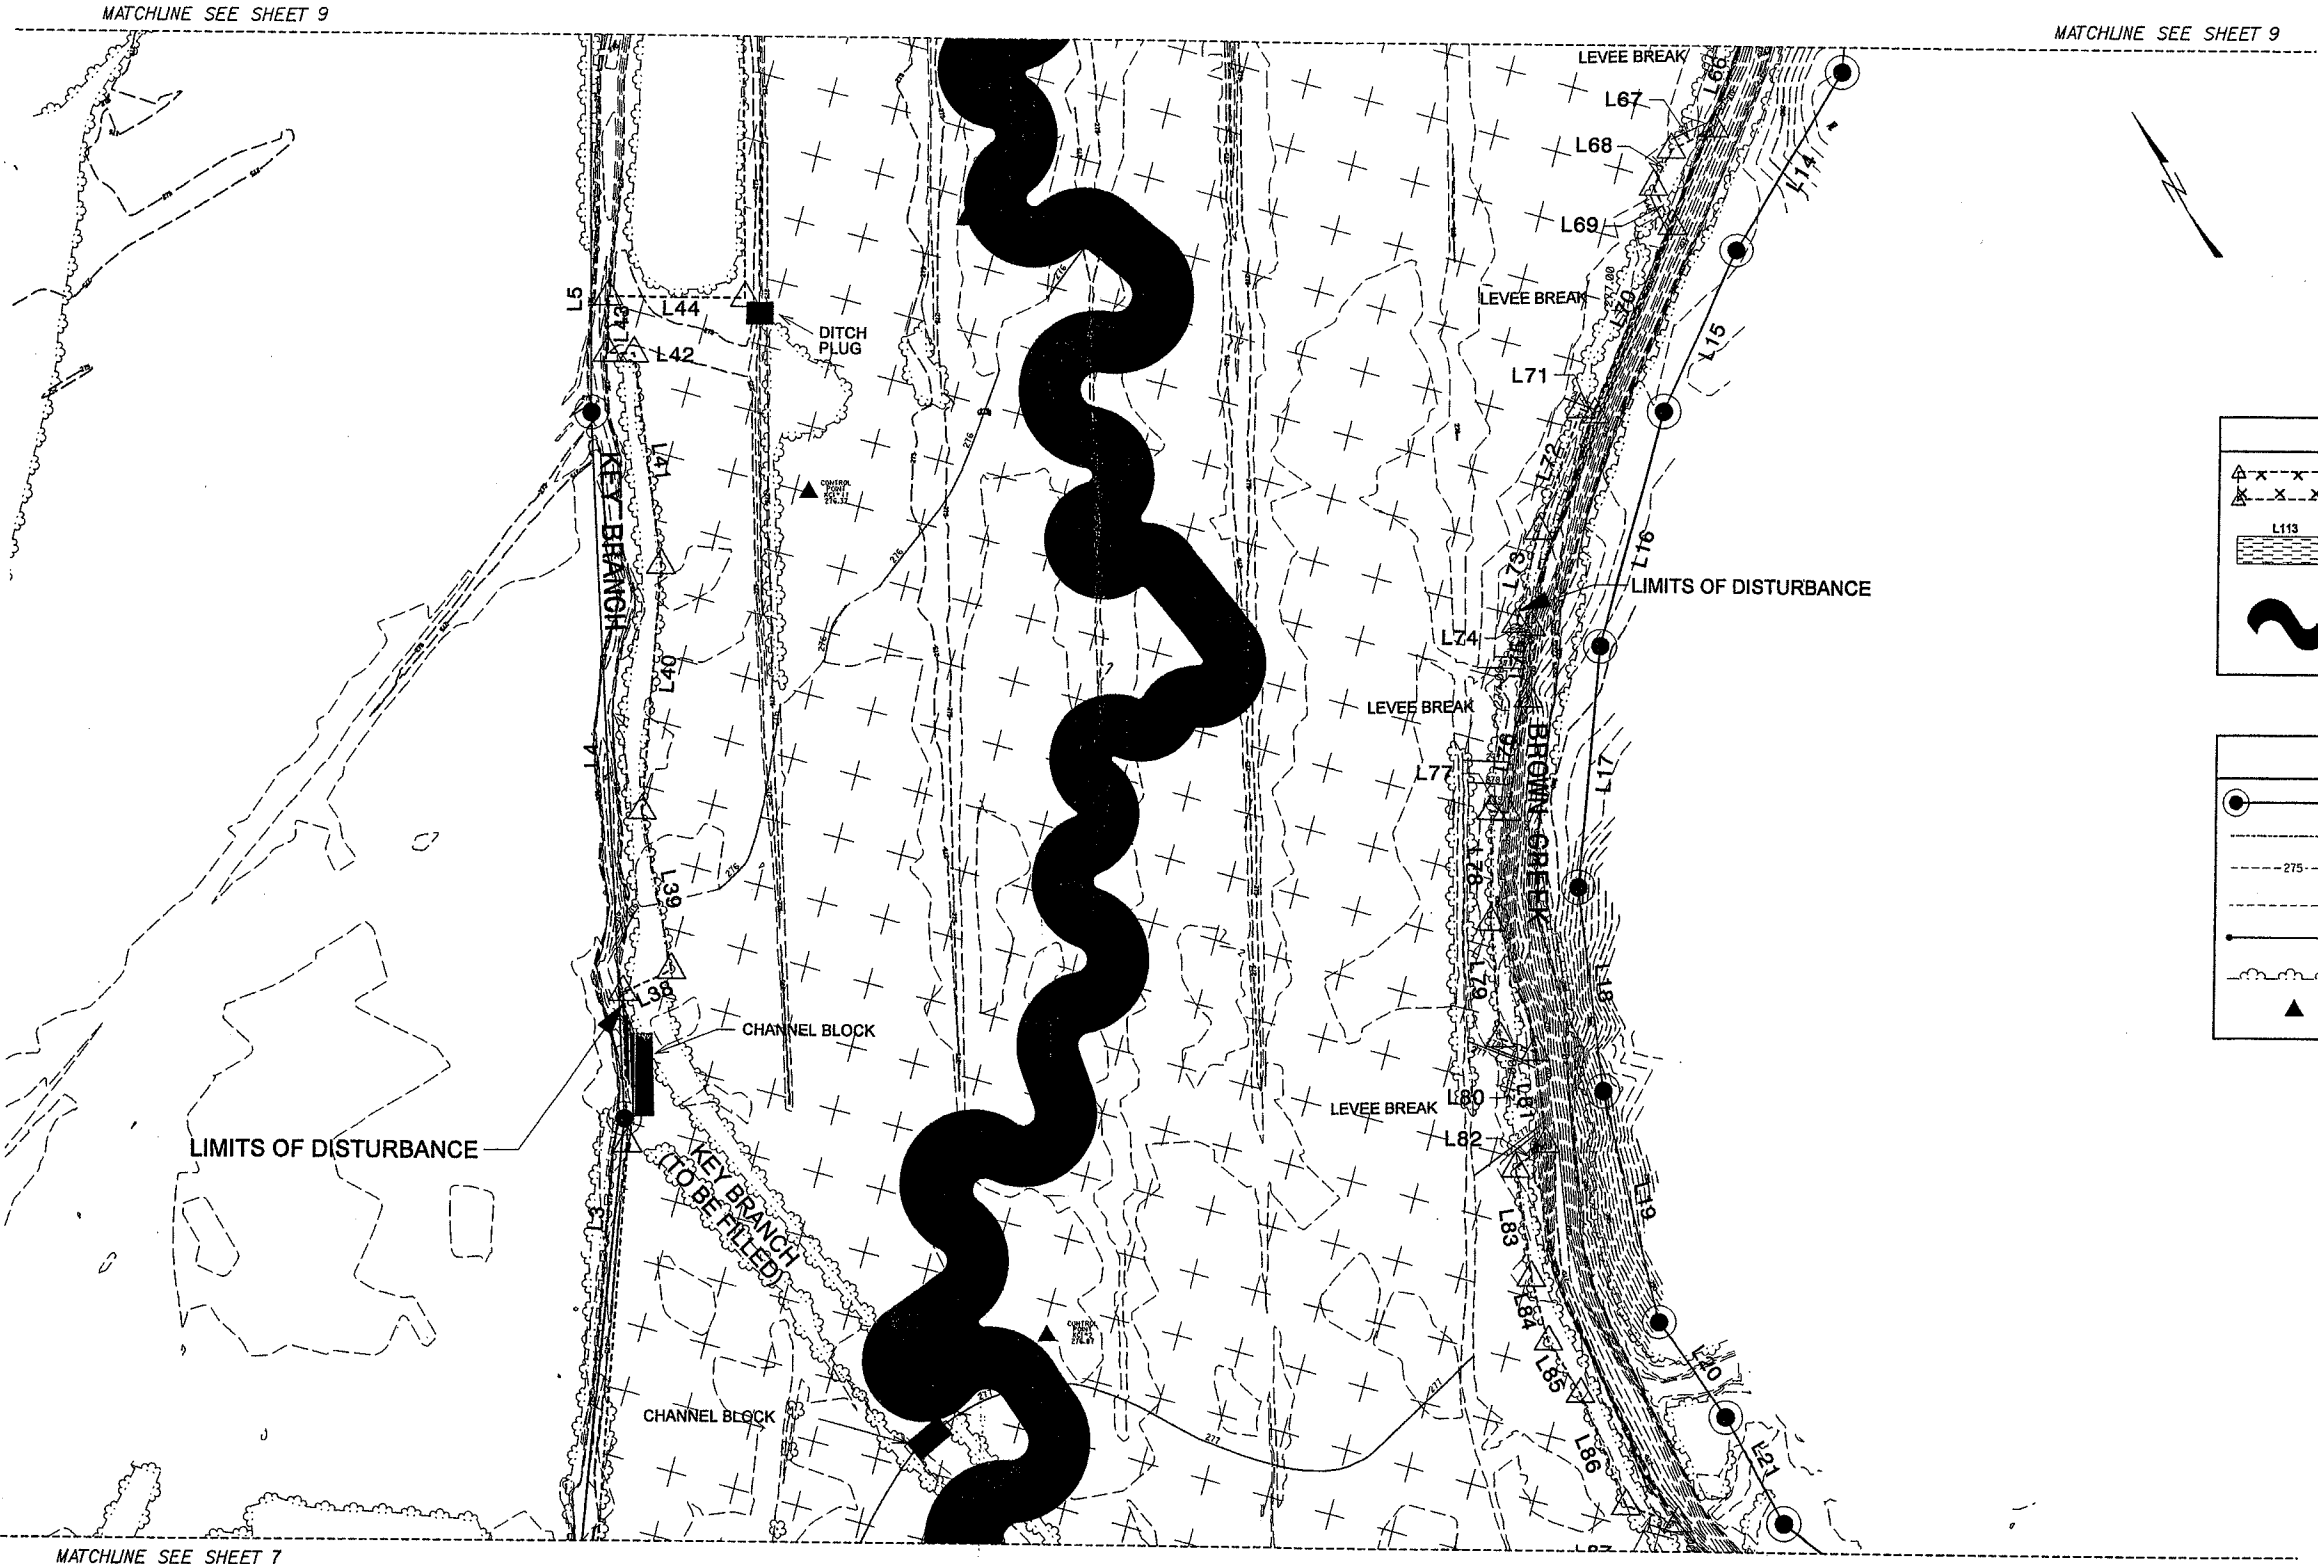

**LIMITS LEGEND**

- LIMITS OF DISTURBANCE (CLEARING AND GRUBBING, MOWING, RIPPING, DISCING, AND GRADING)
- EXISTING WETLAND - SENSITIVE AREA
- STREAM NON-RIP AREA (62' WIDE, CENTERED ALONG STREAM)

**GENERAL PLAN LEGEND**

- SITE BOUNDARY/ CONSERVATION EASEMENT
- PROPOSED STREAM CHANNEL PLANFORM
- EXISTING MAJOR CONTOUR LINES
- EXISTING MINOR CONTOUR LINES
- PROPOSED 1' CONTOUR LINES
- TREE LINE
- SURVEY CONTROL POINT


MATCHLINE SEE SHEET 9

MATCHLINE SEE SHEET 9

MATCHLINE SEE SHEET 7

MATCHLINE SEE SHEET 7

**LIMITS OF OPERATION**

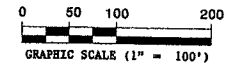


**LIMITS OF OPERATION**

**KCI Associates of North Carolina, P.A.**  
 LANDMARK CENTER II, SUITE 220  
 4601 SIX FORKS ROAD, RALEIGH, NC 27609-5210  
 ENGINEERS • SURVEYORS • SCIENTISTS

LINE	BEARING	LENGTH
L107	N 58° 48' 49.34" W	117.170
L108	N 29° 30' 43.60" E	87.049
L109	N 8° 02' 30.87" W	53.148
L110	S 89° 13' 17.42" W	56.230
L111	S 37° 14' 24.71" W	99.673
L112	N 59° 14' 24.10" W	76.052
L113	N 27° 27' 51.27" E	667.461
L114	S 30° 35' 10.10" E	502.204
L8	S 55° 31' 02.75" W	165.652
L9	S 32° 33' 44.62" W	198.370
L10	S 14° 35' 42.08" W	116.836
L11	S 6° 48' 10.14" W	279.284

Due to existing conditions  
C/A FENCE WAS eliminated in this area.

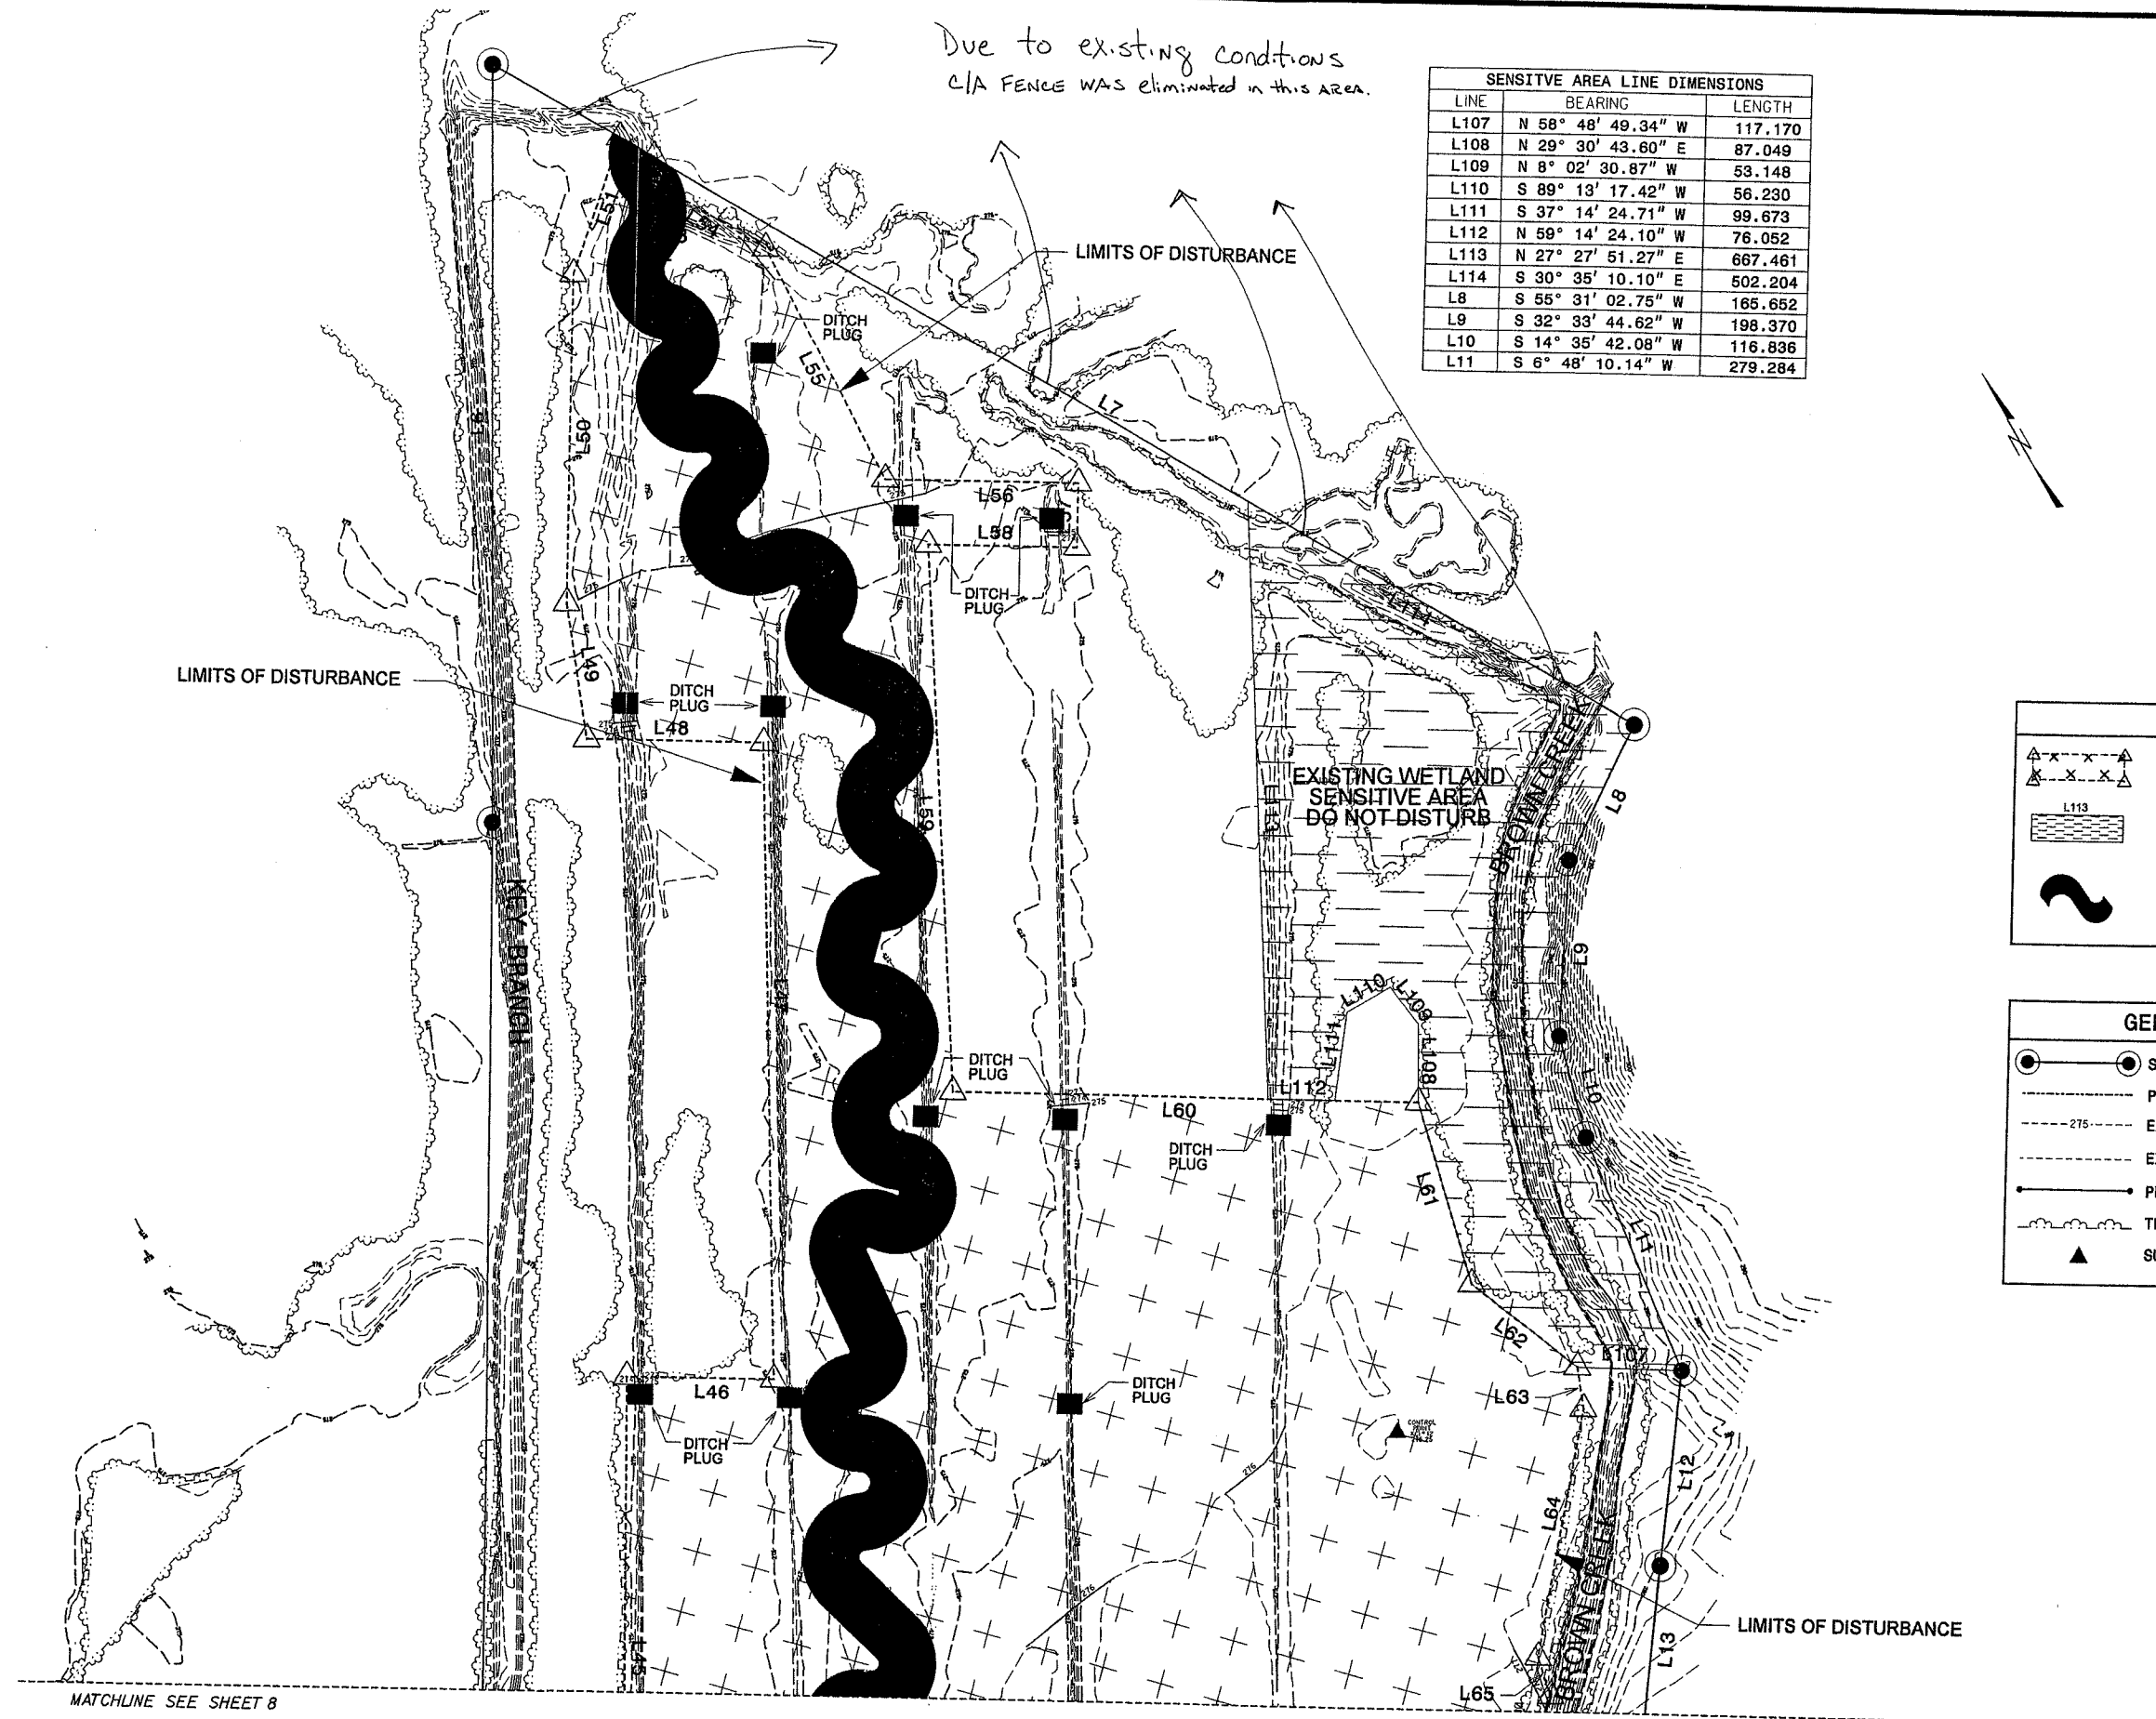

**LIMITS LEGEND**

- △ x x x △ LIMITS OF DISTURBANCE (CLEARING AND GRUBBING, MOWING, RIPPING, DISCING, AND GRADING)
- L113 [Hatched Box] EXISTING WETLAND - SENSITIVE AREA
- [Wavy Line] STREAM NON-RIP AREA (62' WIDE, CENTERED ALONG STREAM)


**GENERAL PLAN LEGEND**

- SITE BOUNDARY/ CONSERVATION EASEMENT
- PROPOSED STREAM CHANNEL PLANFORM
- 275- EXISTING MAJOR CONTOUR LINES
- - - EXISTING MINOR CONTOUR LINES
- PROPOSED 1' CONTOUR LINES
- ~ TREE LINE
- ▲ SURVEY CONTROL POINT

MATCHLINE SEE SHEET 8


MATCHLINE SEE SHEET 8

**LIMITS OF OPERATION**

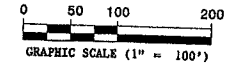

**LIMITS OF OPERATION 3**

**KCI Associates of North Carolina, P.A.**  
 LANDMARK CENTER II, SUITE 220  
 4601 SIX FORKS ROAD, RALEIGH, NC 27609-5210  
 ENGINEERS • SURVEYORS • SCIENTISTS

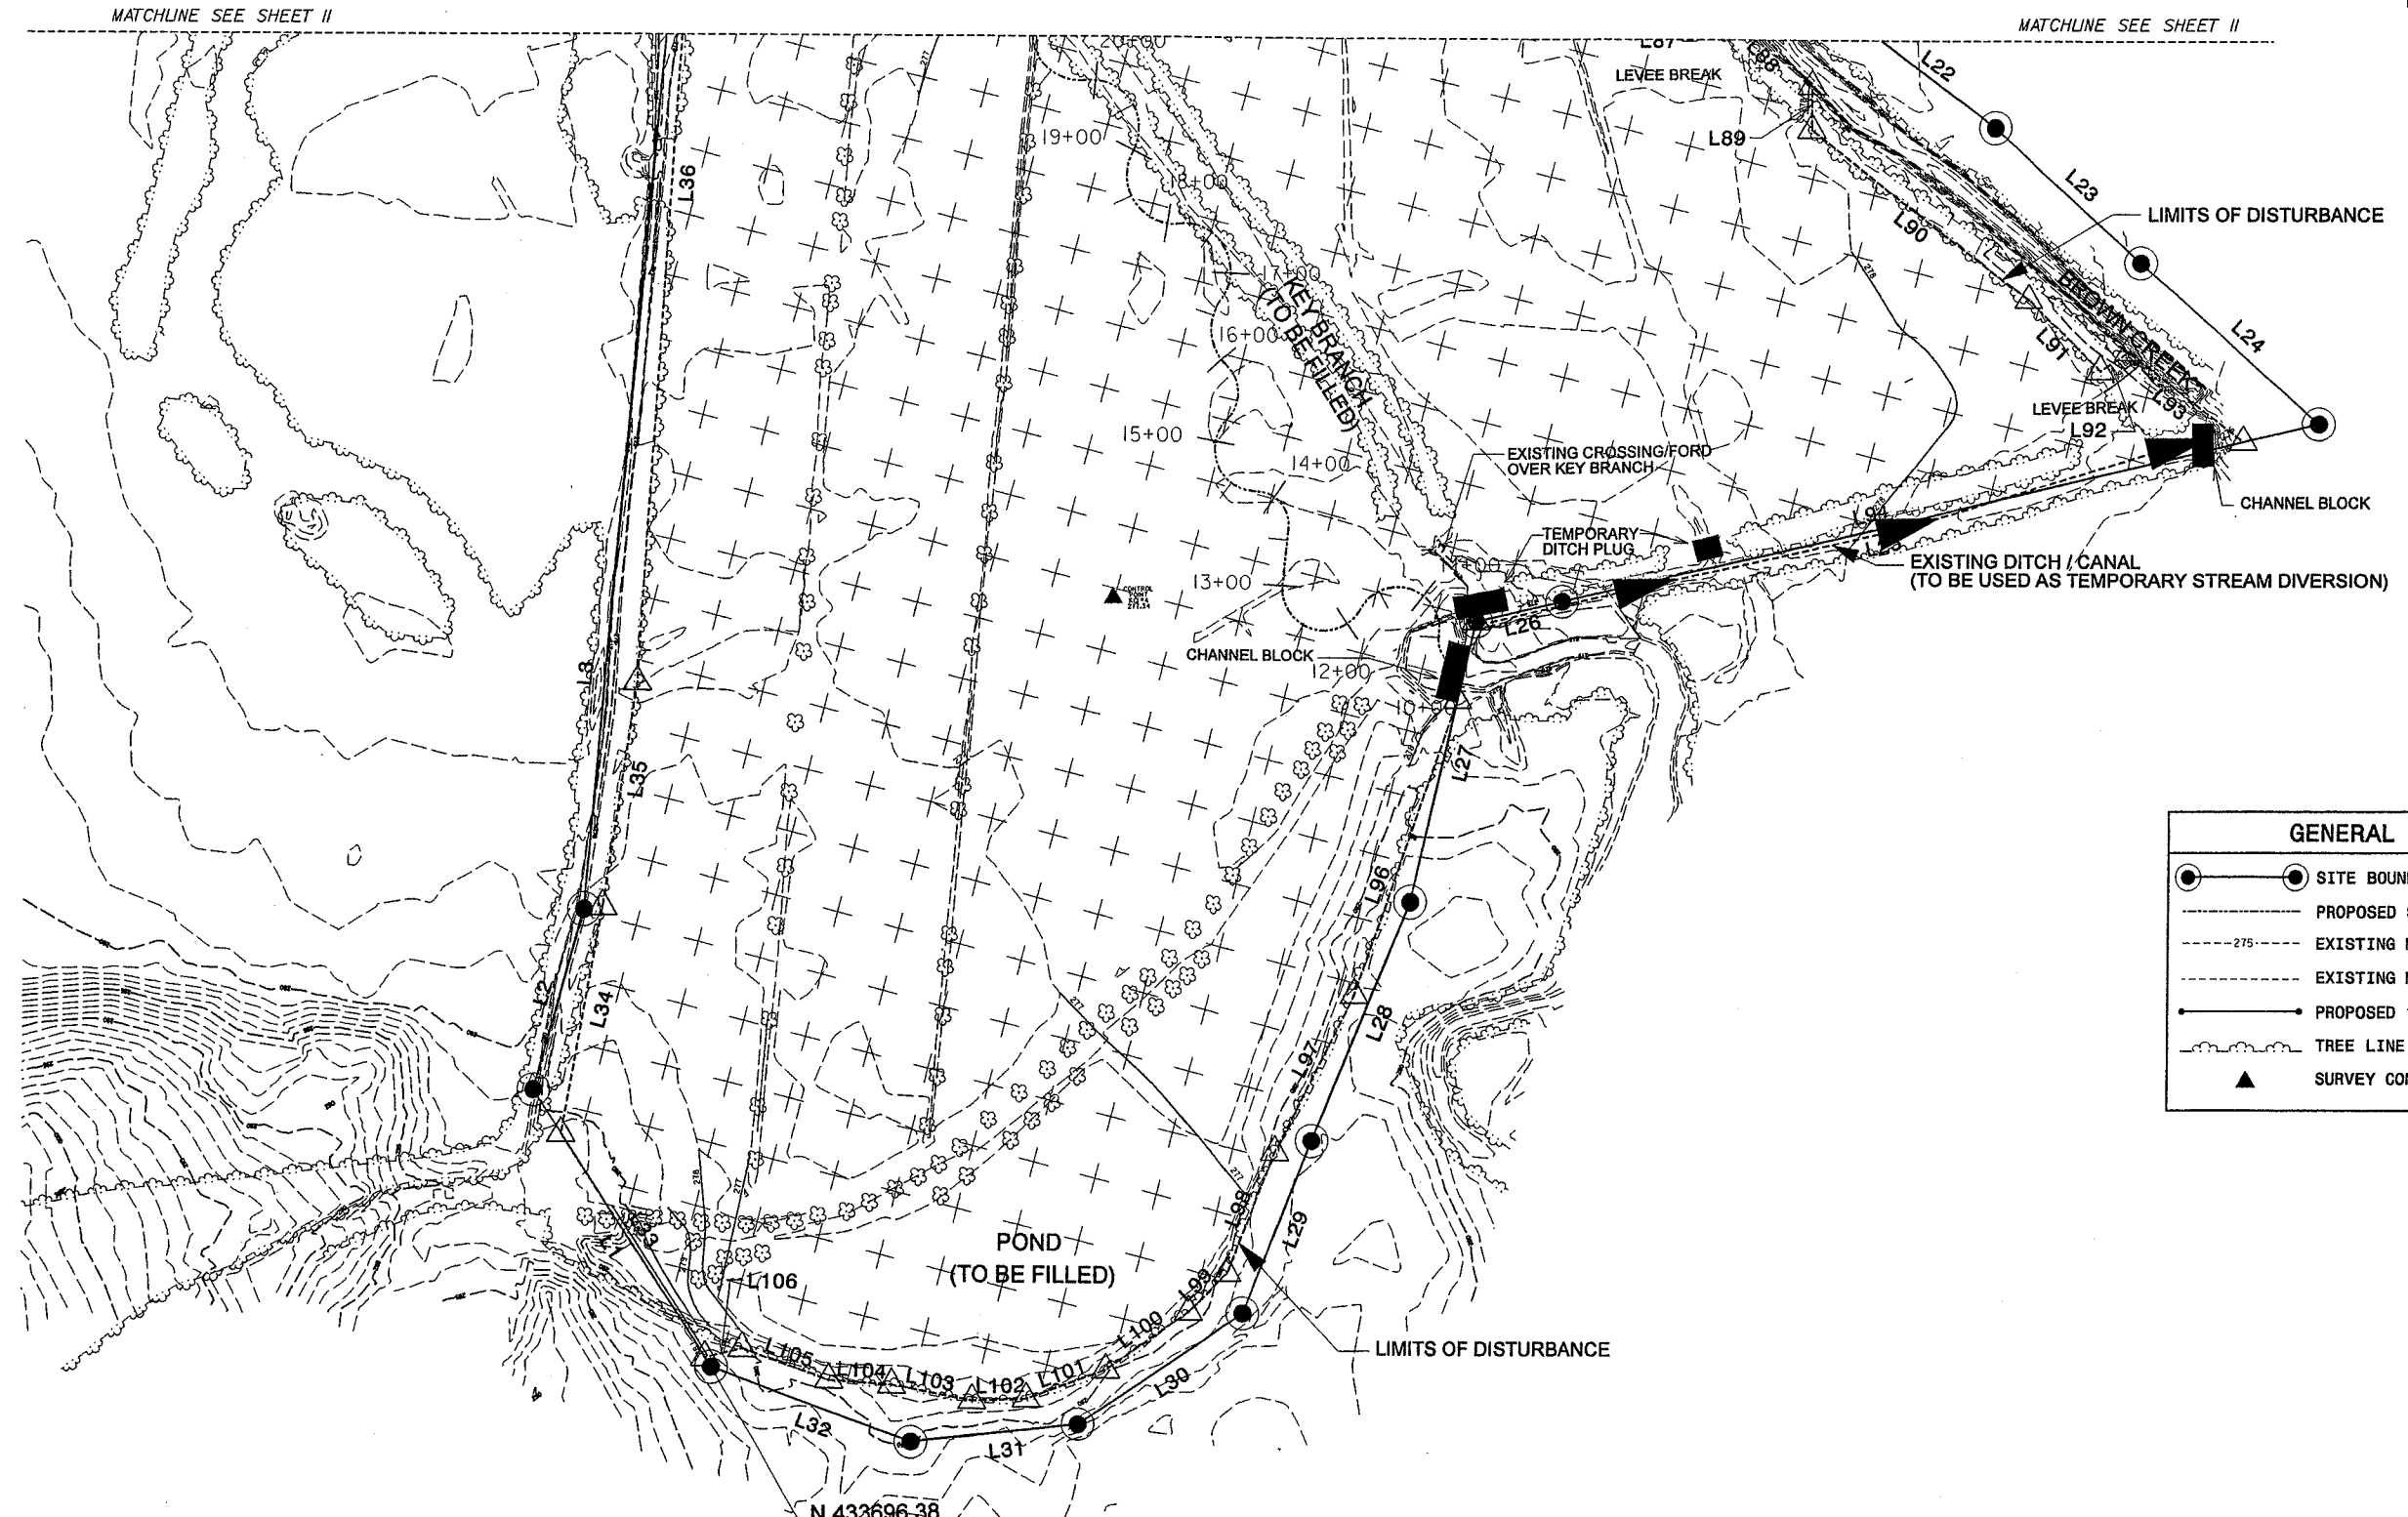

**GENERAL PLAN LEGEND**

- SITE BOUNDARY/ CONSERVATION EASEMENT
- PROPOSED STREAM CHANNEL PLANFORM
- EXISTING MAJOR CONTOUR LINES
- EXISTING MINOR CONTOUR LINES
- PROPOSED 1' CONTOUR LINES
- TREE LINE
- SURVEY CONTROL POINT

N 433696.38  
E 4,619,159.08



**GRADING PLAN**

GRAPHIC SCALE (1" = 100')


GRADING PLAN 1

**KCI Associates  
of North Carolina, P.A.**  
LANDMARK CENTER II, SUITE 220  
4601 SIX FORKS ROAD, RALEIGH, NC 27609-5210  
•ENGINEERS • SURVEYORS • SCIENTISTS

PROJECT REFERENCE NO. R-2231 WM	SHEET NO. II
RAW SHEET NO.	
ENGINEER	SCIENTIST

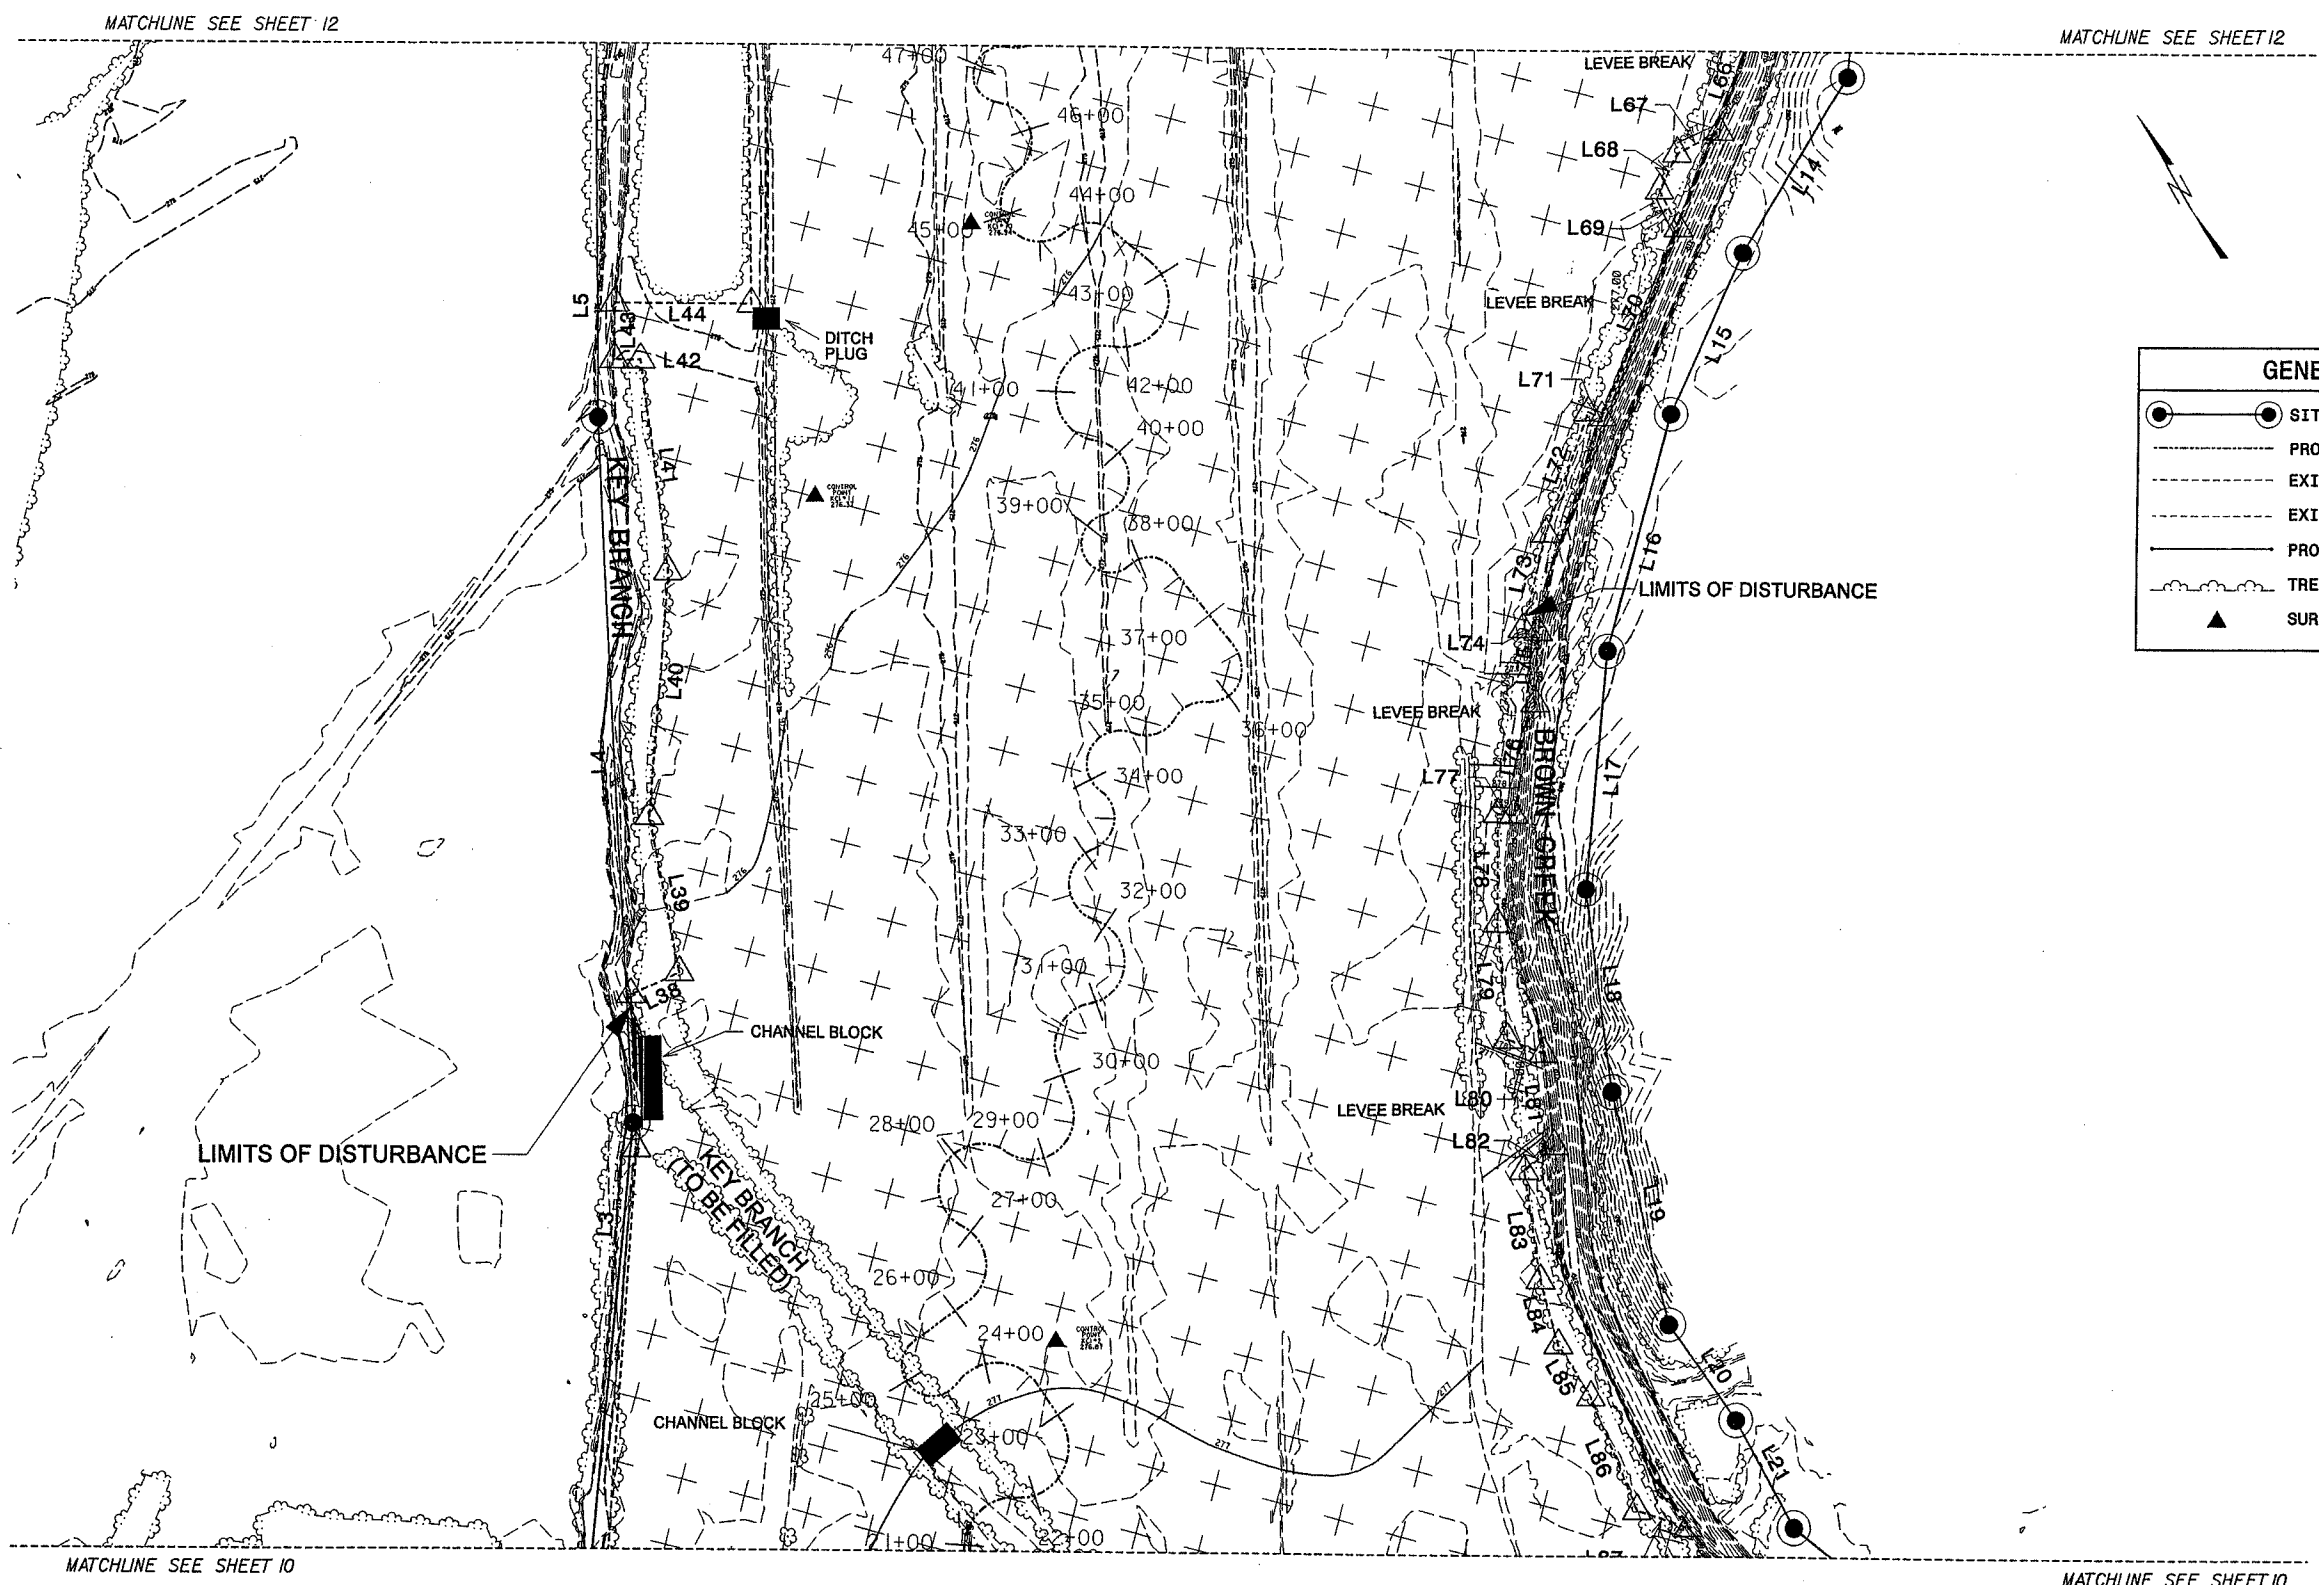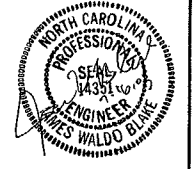

GENERAL PLAN LEGEND	
	SITE BOUNDARY/ CONSERVATION EASEMENT
	PROPOSED STREAM CHANNEL PLANFORM
	EXISTING MAJOR CONTOUR LINES
	EXISTING MINOR CONTOUR LINES
	PROPOSED 1' CONTOUR LINES
	TREE LINE
	SURVEY CONTROL POINT

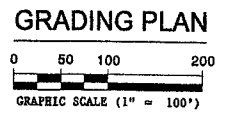


**KCI Associates of North Carolina, P.A.**  
 LANDMARK CENTER II, SUITE 220  
 4601 SIX FORKS ROAD, RALEIGH, NC 27609-5210  
 ENGINEERS • SURVEYORS • SCIENTISTS

GRADING PLAN 2




Due to existing conditions  
CA FENCE WAS eliminated in this area.

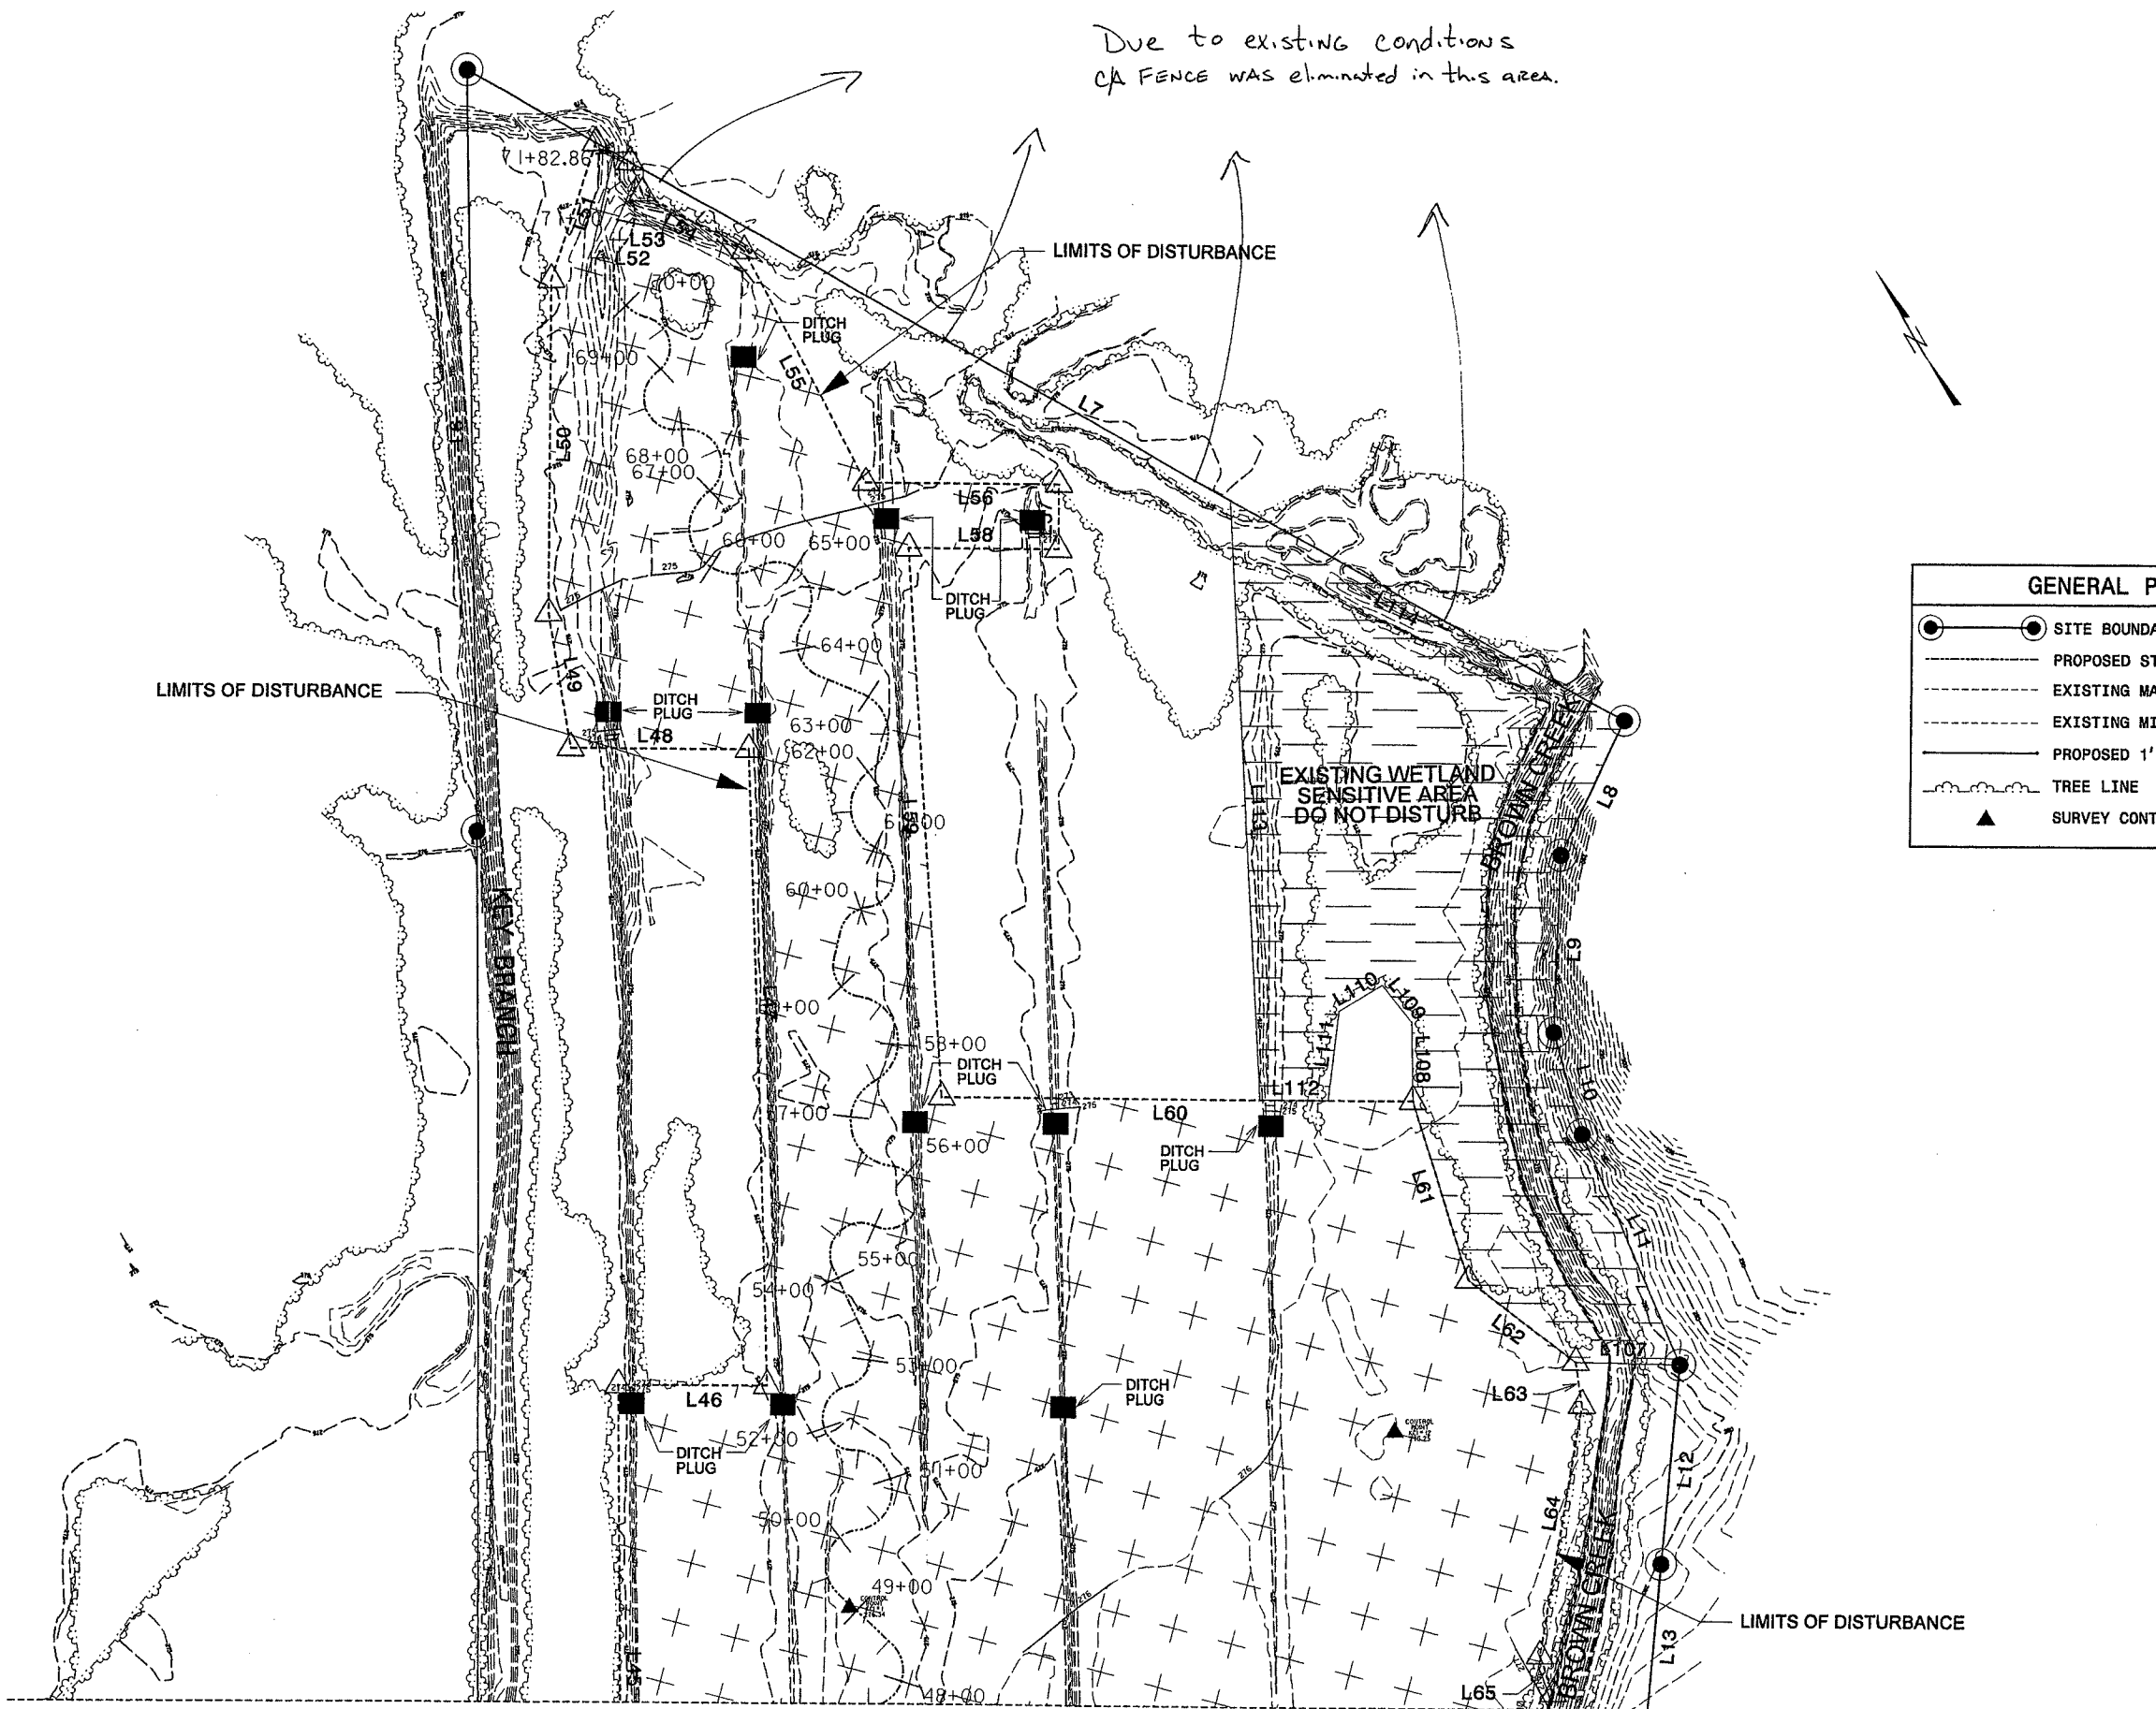

GENERAL PLAN LEGEND	
	SITE BOUNDARY/ CONSERVATION EASEMENT
	PROPOSED STREAM CHANNEL PLANFORM
	EXISTING MAJOR CONTOUR LINES
	EXISTING MINOR CONTOUR LINES
	PROPOSED 1' CONTOUR LINES
	TREE LINE
	SURVEY CONTROL POINT

GRADING PLAN

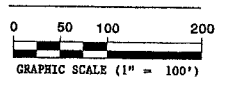


MATCHLINE SEE SHEET II

MATCHLINE SEE SHEET II

GRADING PLAN 3



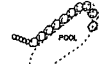


MATCHLINE SEE SHEET 14

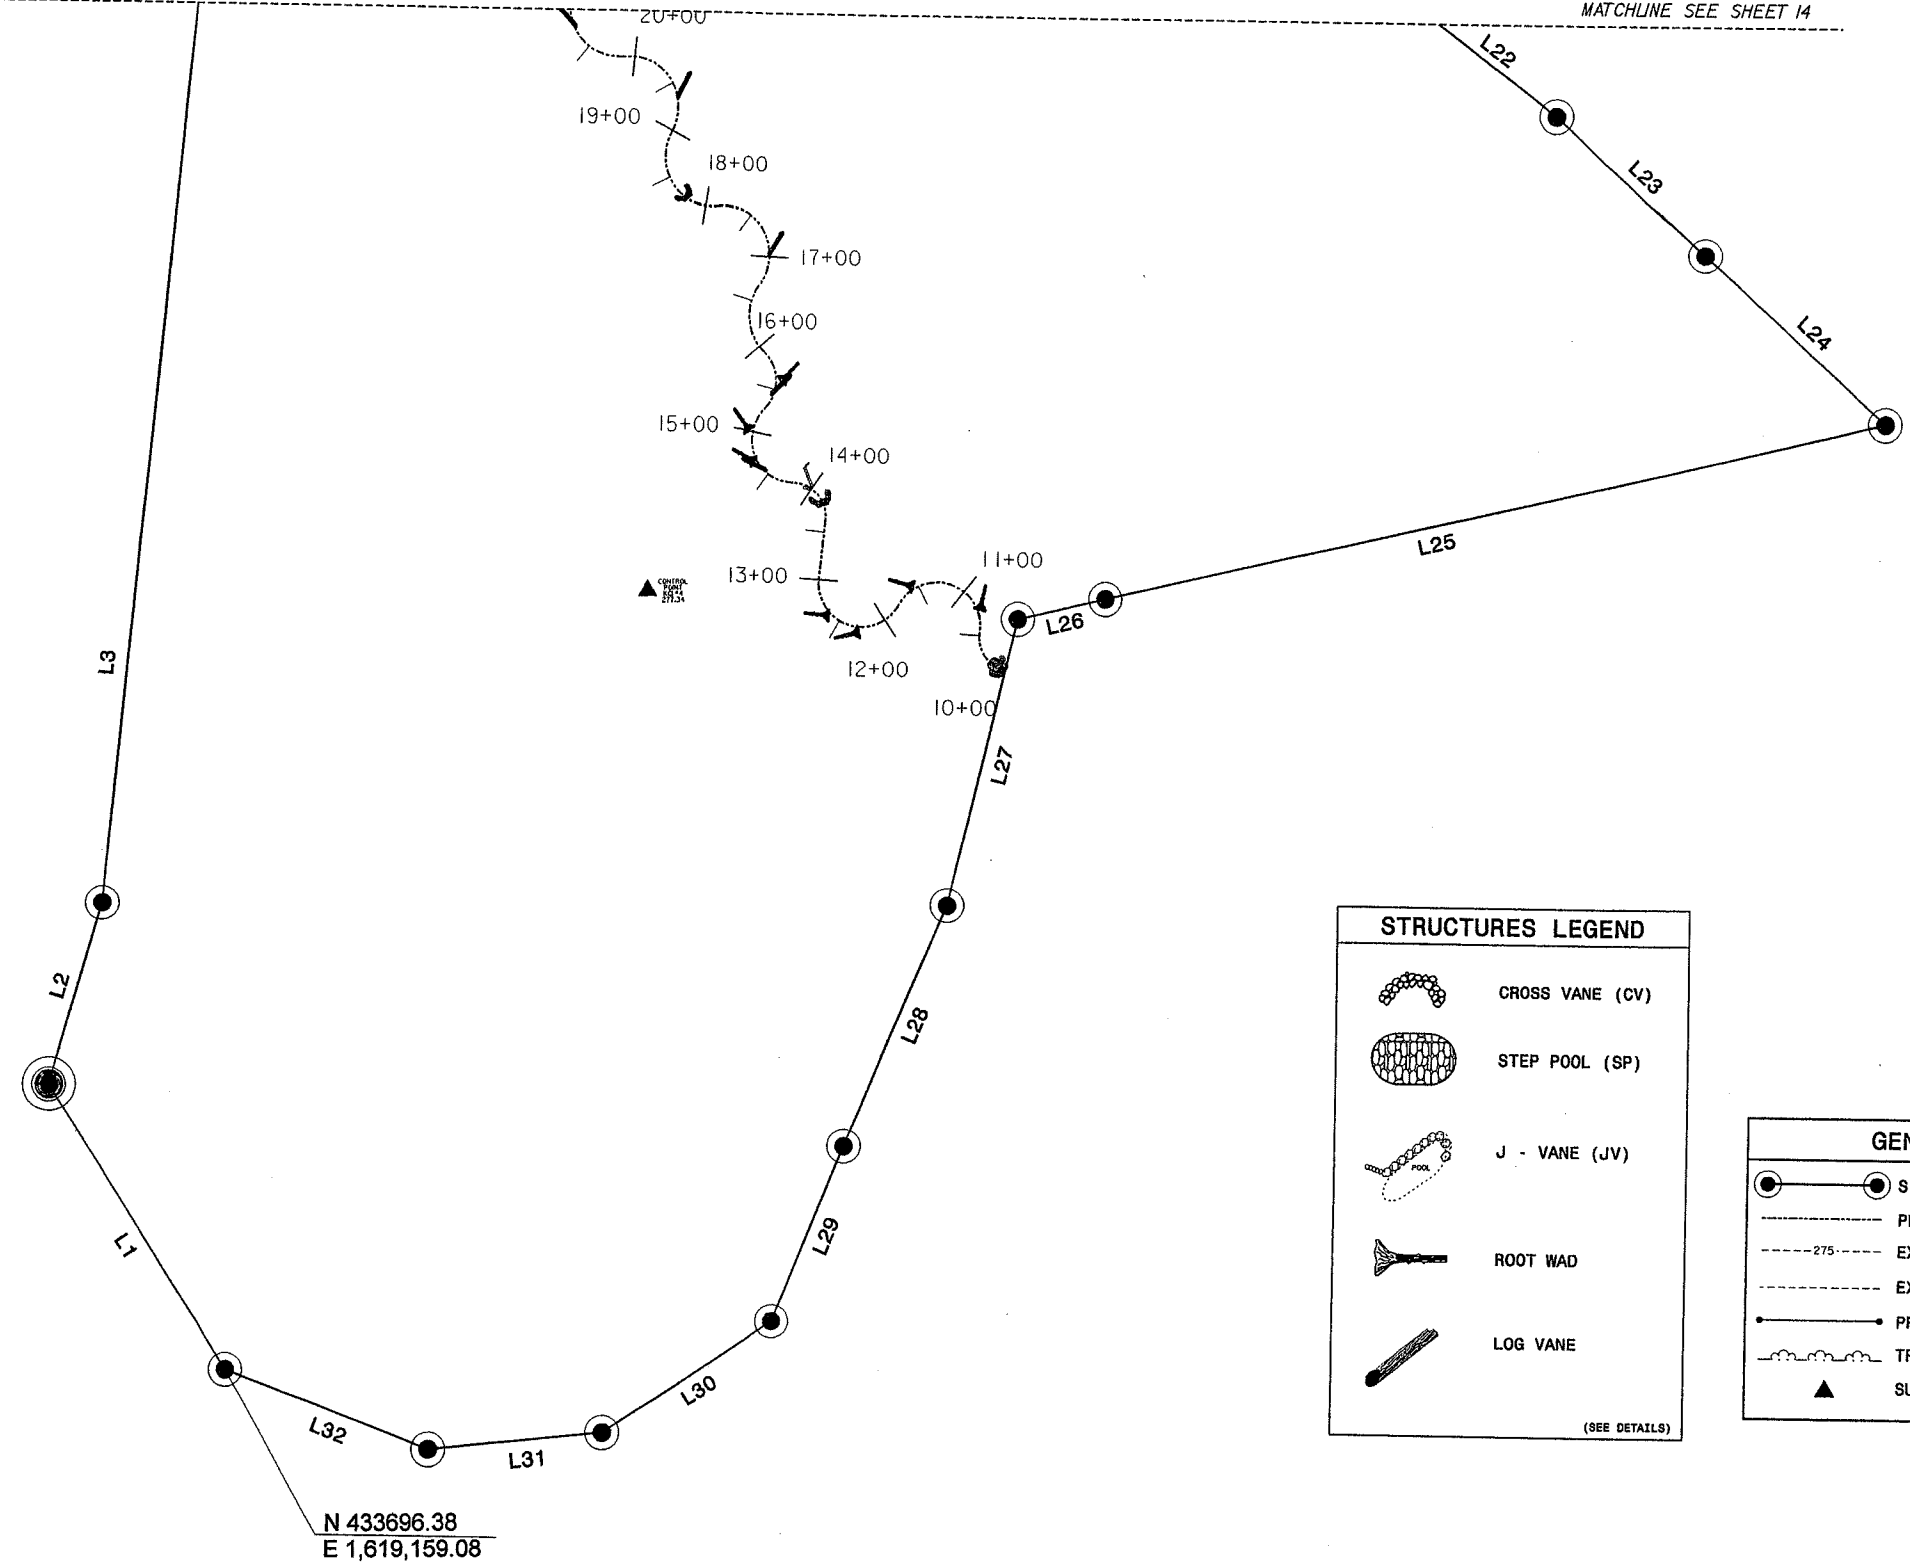MATCHLINE SEE SHEET 14




 


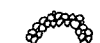


N 433696.38  
E 1,619,159.08

**STRUCTURES LEGEND**

 
	CROSS VANE (CV)
	STEP POOL (SP)
	J - VANE (JV)
	ROOT WAD
	LOG VANE

(SEE DETAILS)

**GENERAL PLAN LEGEND**

	SITE BOUNDARY/ CONSERVATION EASEMENT
	PROPOSED STREAM CHANNEL PLANFORM
	EXISTING MAJOR CONTOUR LINES
	EXISTING MINOR CONTOUR LINES
	PROPOSED 1' CONTOUR LINES
	TREE LINE
	SURVEY CONTROL POINT


**STRUCTURES PLAN**

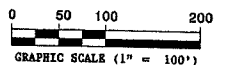

STRUCTURES 1



MATCHLINE SEE SHEET 15

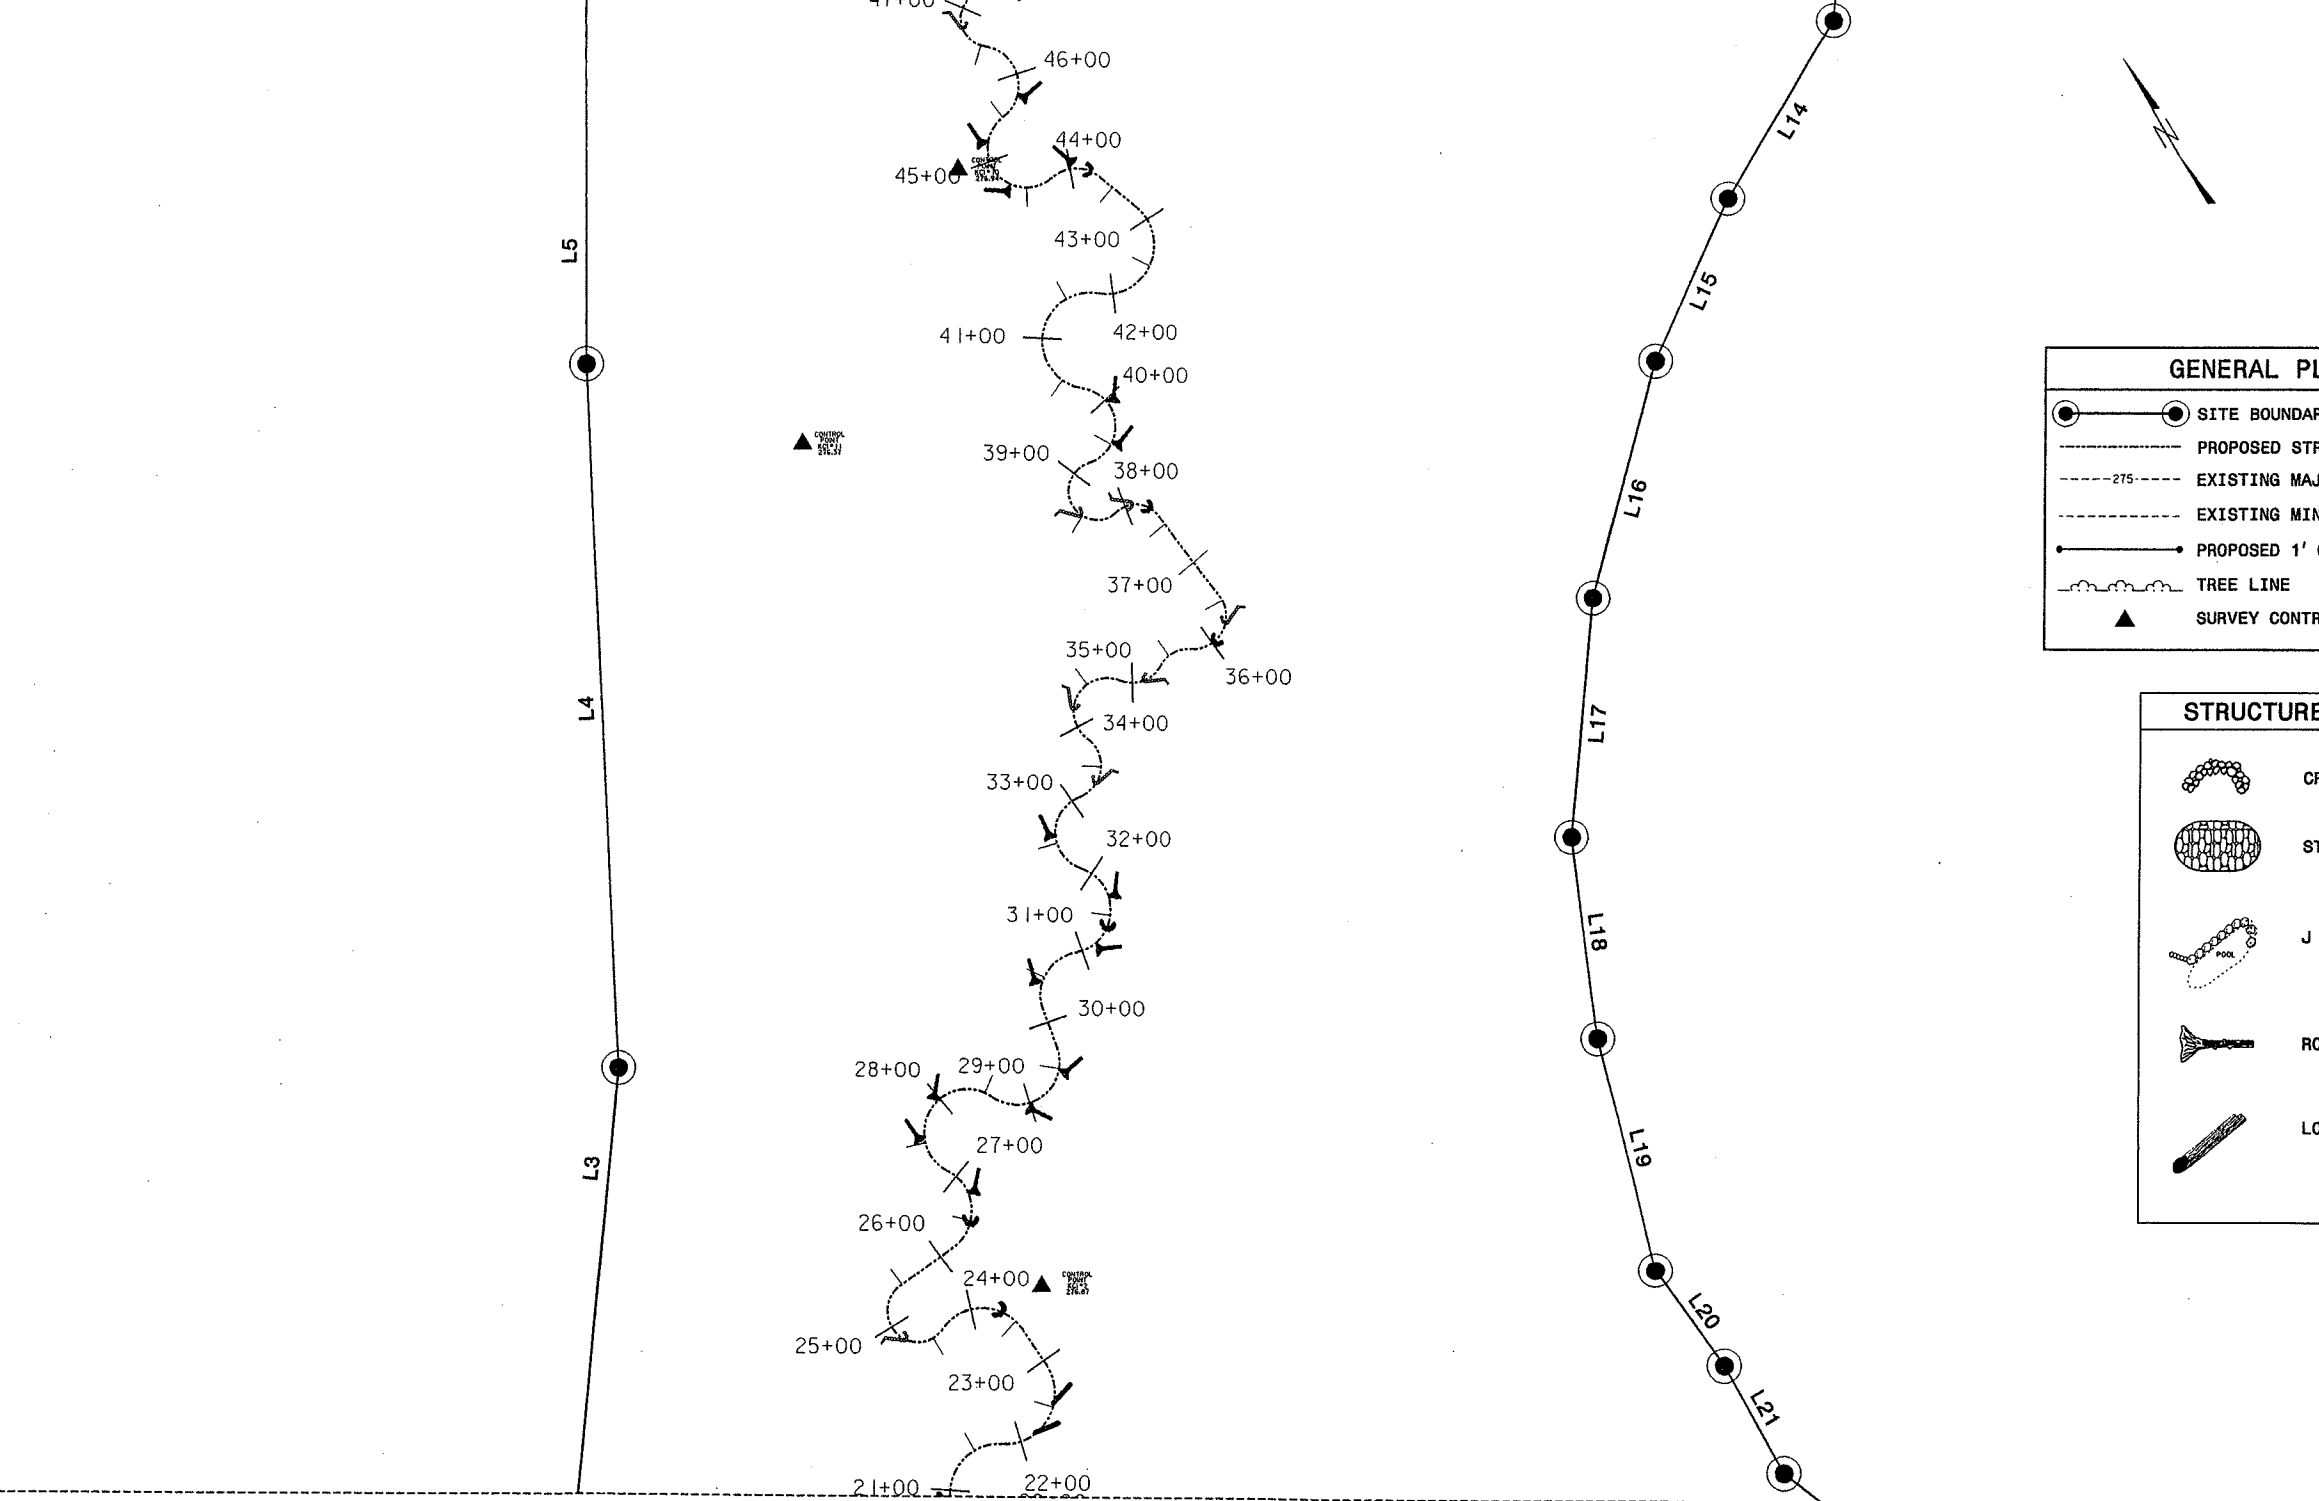

**GENERAL PLAN LEGEND**


- SITE BOUNDARY/ CONSERVATION EASEMENT
- PROPOSED STREAM CHANNEL PLANFORM
- EXISTING MAJOR CONTOUR LINES
- EXISTING MINOR CONTOUR LINES
- PROPOSED 1' CONTOUR LINES
- TREE LINE
- SURVEY CONTROL POINT

**STRUCTURES LEGEND**

- CROSS VANE (CV)
- STEP POOL (SP)
- J - VANE (JV)
- ROOT WAD
- LOG VANE

(SEE DETAILS)

**STRUCTURES PLAN**

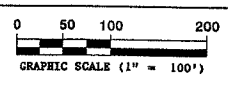


MATCHLINE SEE SHEET 13

STRUCTURES 2

MATCHLINE SEE SHEET 17


MATCHLINE SEE SHEET 17

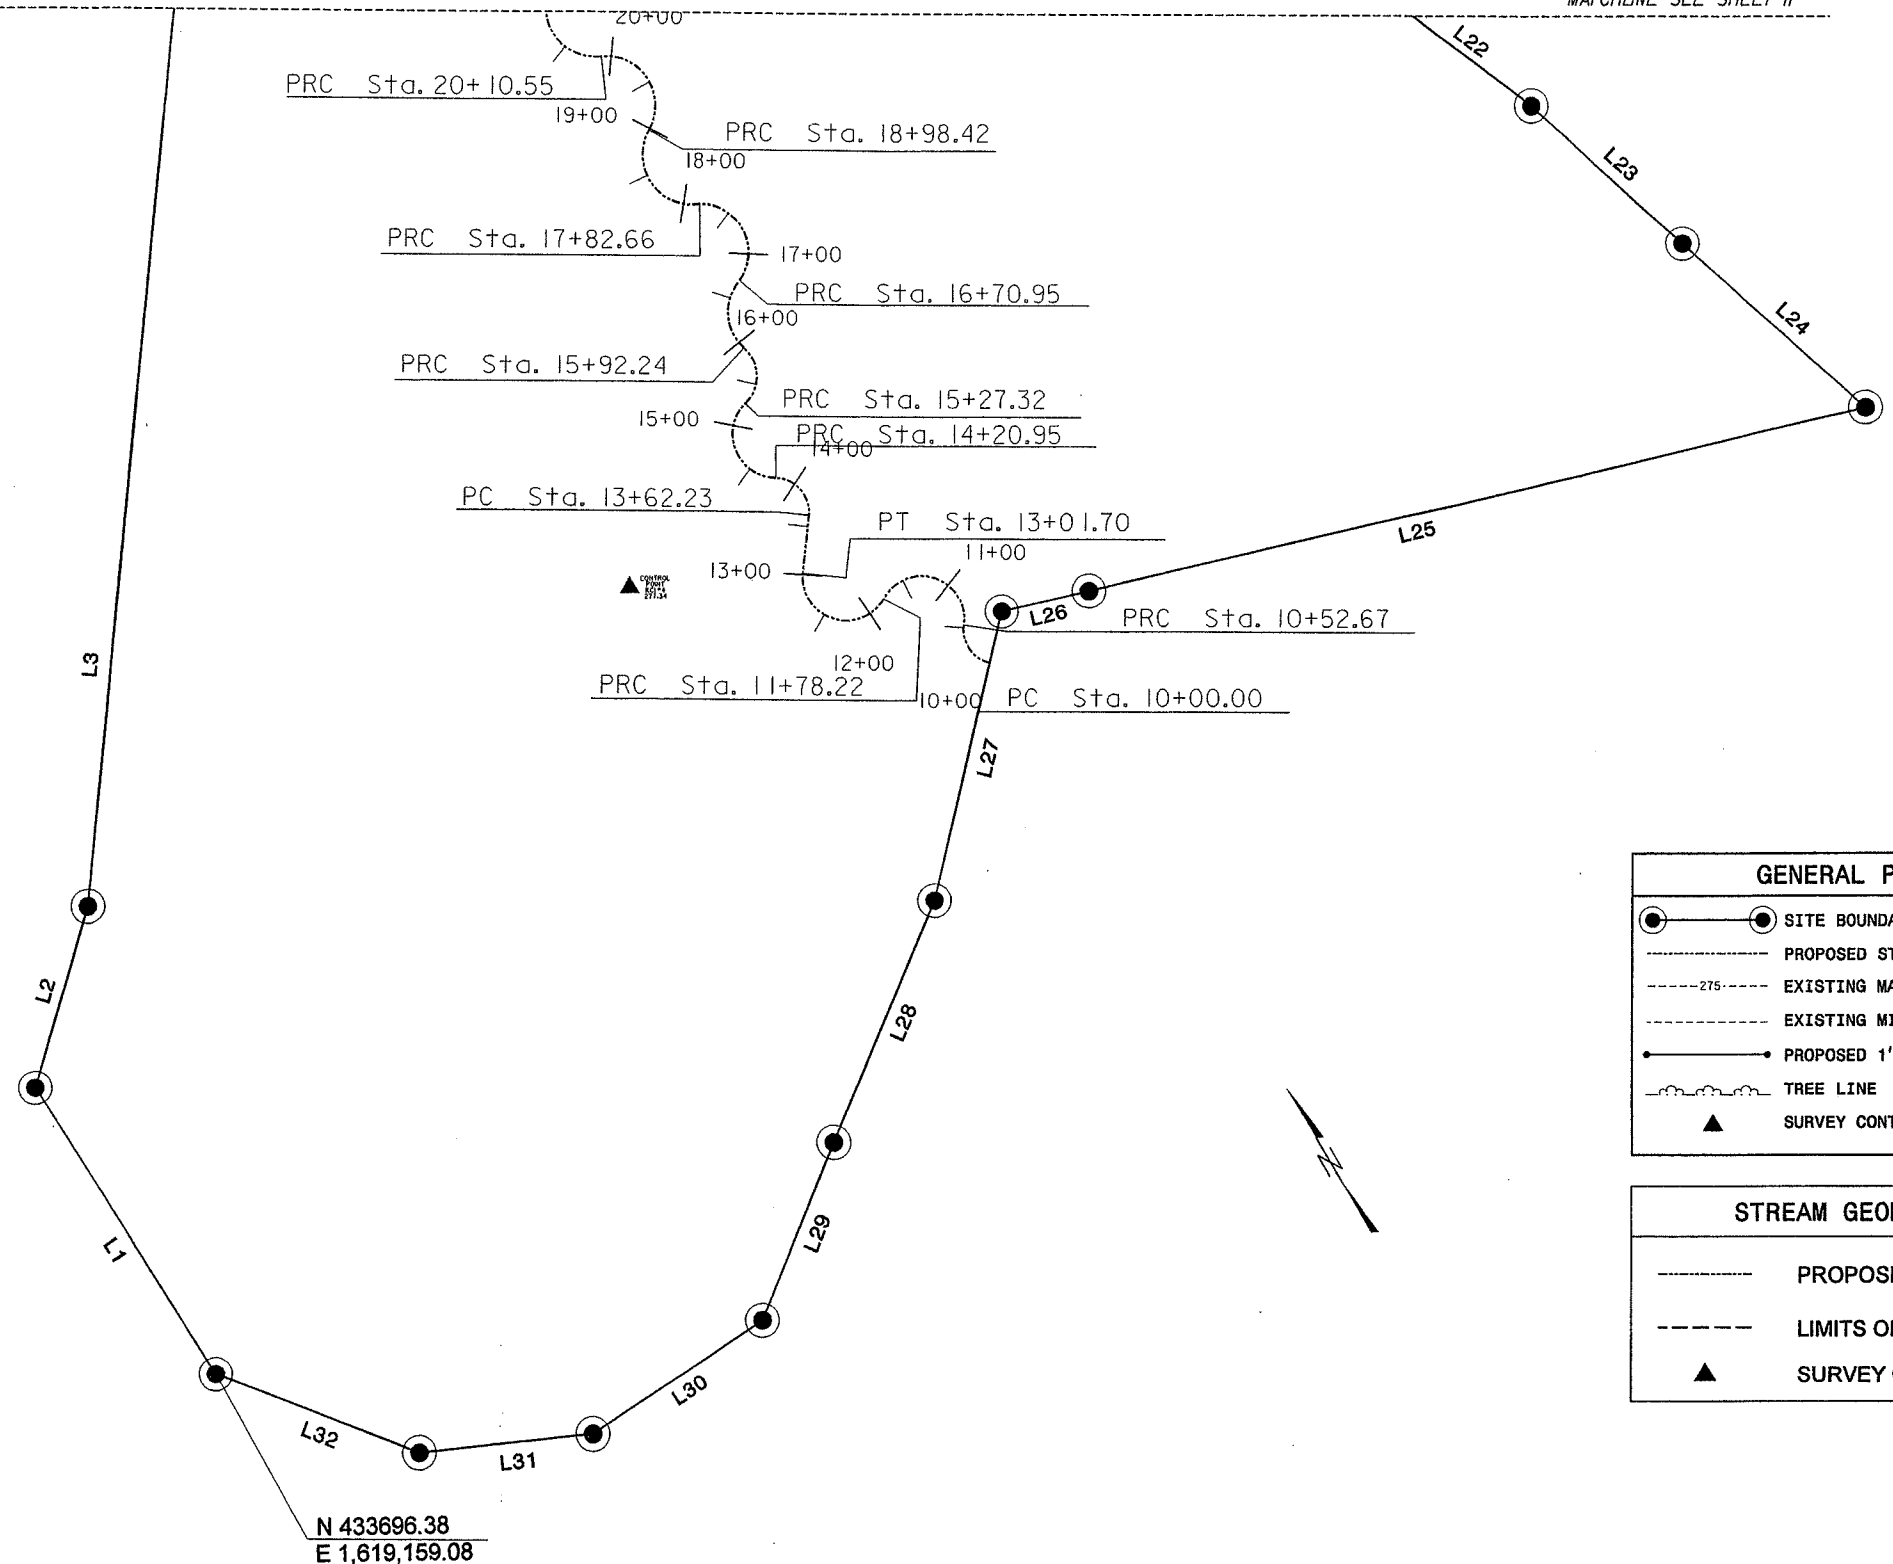

PRC Sta. 20+10.55  
19+00  
PRC Sta. 18+98.42  
18+00  
PRC Sta. 17+82.66  
17+00  
PRC Sta. 16+70.95  
16+00  
PRC Sta. 15+92.24  
15+00  
PRC Sta. 15+27.32  
14+00  
PRC Sta. 14+20.95  
14+00  
PC Sta. 13+62.23  
13+00  
PT Sta. 13+01.70  
11+00  
PRC Sta. 10+52.67  
12+00  
PRC Sta. 11+78.22  
10+00  
PC Sta. 10+00.00

N 433696.38  
E 1,619,159.08



**STREAM GEOMETRY**

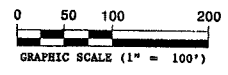

GENERAL PLAN LEGEND	
	SITE BOUNDARY/ CONSERVATION EASEMENT
	PROPOSED STREAM CHANNEL PLANFORM
	EXISTING MAJOR CONTOUR LINES
	EXISTING MINOR CONTOUR LINES
	PROPOSED 1' CONTOUR LINES
	TREE LINE
	SURVEY CONTROL POINT

STREAM GEOMETRY LEGEND	
	PROPOSED STREAM ALIGNMENT
	LIMITS OF DISTURBANCE
	SURVEY CONTROL POINT

STREAM GEOMETRY 1

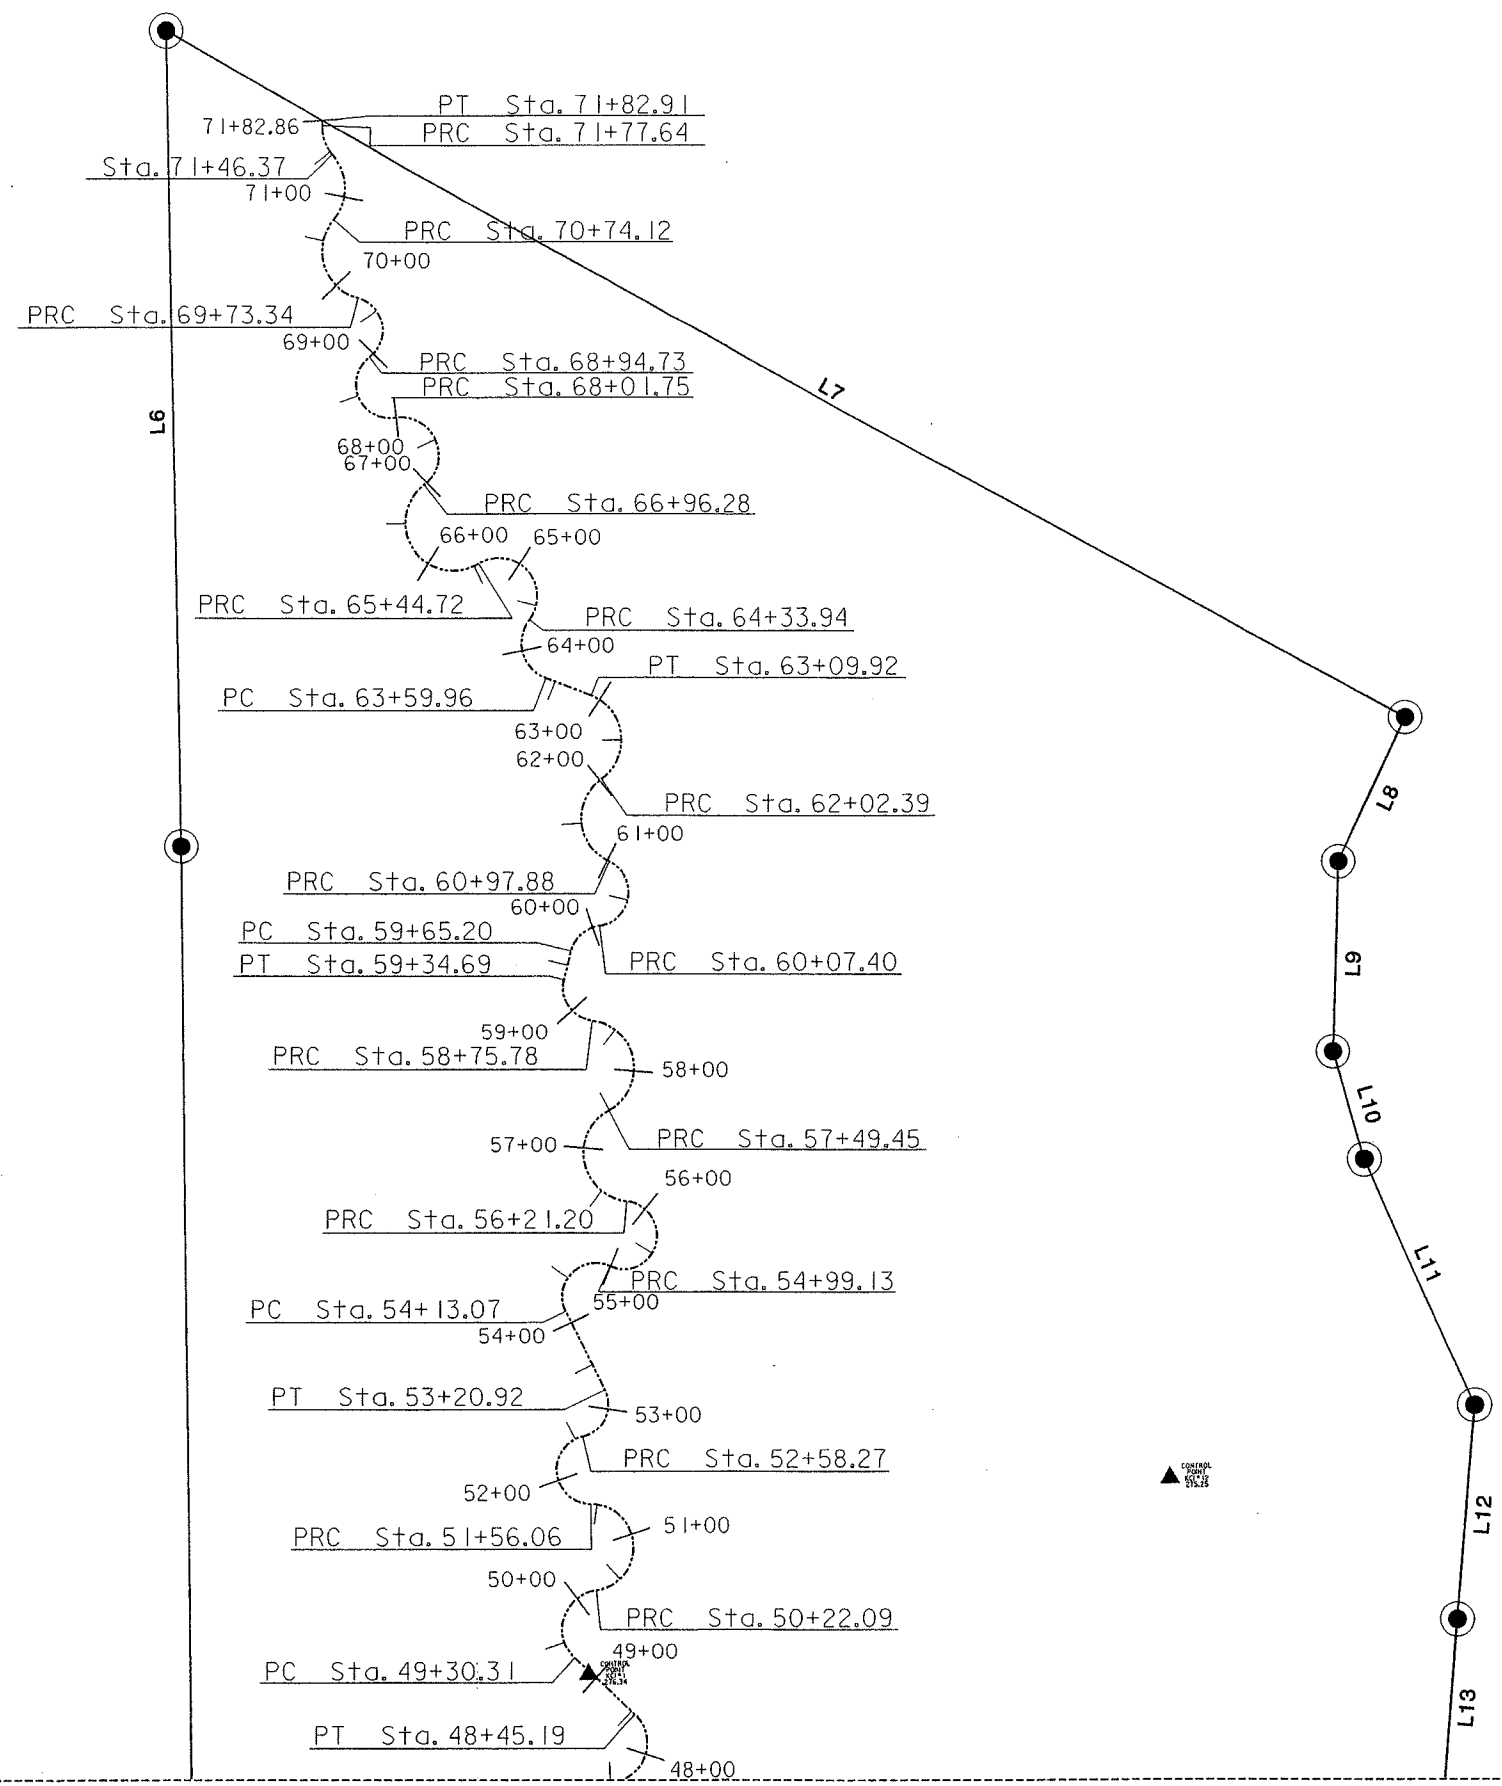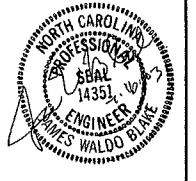


GENERAL PLAN LEGEND	
	SITE BOUNDARY/ CONSERVATION EASEMENT
	PROPOSED STREAM CHANNEL PLANFORM
	EXISTING MAJOR CONTOUR LINES
	EXISTING MINOR CONTOUR LINES
	PROPOSED 1' CONTOUR LINES
	TREE LINE
	SURVEY CONTROL POINT

STREAM GEOMETRY LEGEND	
	PROPOSED STREAM ALIGNMENT
	LIMITS OF DISTURBANCE
	SURVEY CONTROL POINT

MATCHLINE SEE SHEET 17


**STREAM GEOMETRY**

MATCHLINE SEE SHEET 17

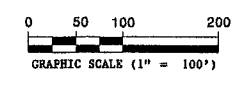

STREAM GEOMETRY 3

**KCI Associates**  
of North Carolina, P.A.  
LANDMARK CENTER II, SUITE 220  
4601 SIX FORKS ROAD, RALEIGH, NC 27609-5210  
• ENGINEERS • SURVEYORS • SCIENTISTS

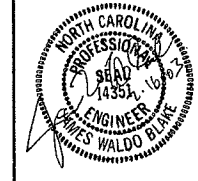

**Curve Data**  
\*-----\*

Curve STREAM-1 P.I. Station = 10+32.76 N Delta = 86° 12' 57.61" (RT) Degree = 163° 42' 08.02" Tangent = 32.7616 Length = 52.6664 Radius = 35.0000 External = 12.9408 Long Chord = 47.8363 Mid. Ord. = 9.4477 P.C. Station = 10+00.00 N P.T. Station = 10+52.67 N C.C. = Back = N 47° 14' 02.39" W Ahead = N 38° 58' 55.23" E Chord Bear = N 4° 07' 33.58" W	433,944.3579 E	1,620,204.5419
--	----------------	----------------

**Curve Data**  
\*-----\*

Curve STREAM-7 P.I. Station = 16+41.76 N Delta = 88° 05' 10.42" (RT) Degree = 111° 54' 20.93" Tangent = 49.5178 Length = 78.7146 Radius = 51.2000 External = 20.0282 Long Chord = 71.1884 Mid. Ord. = 14.3966 P.C. Station = 15+92.24 N P.T. Station = 16+70.95 N C.C. = Back = N 17° 21' 07.60" W Ahead = N 70° 44' 02.82" E Chord Bear = N 26° 41' 27.61" E	434,382.2134 E	1,620,157.9494
--	----------------	----------------

**Curve Data**  
\*-----\*

Curve STREAM-2 P.I. Station = 13+06.11 N Delta = 159° 51' 48.09" (LT) Degree = 127° 19' 26.24" Tangent = 253.4401 Length = 125.5564 Radius = 45.0000 External = 212.4042 Long Chord = 88.6140 Mid. Ord. = 37.1330 P.C. Station = 10+52.67 N P.T. Station = 11+78.22 N C.C. = Back = N 38° 58' 55.23" E Ahead = S 59° 07' 07.14" W Chord Bear = N 40° 56' 58.82" W	434,166.8349 E	1,620,384.5846
--	----------------	----------------

**Curve Data**  
\*-----\*

Curve STREAM-8 P.I. Station = 17+69.33 N Delta = 125° 00' 41.09" (LT) Degree = 111° 54' 20.97" Tangent = 98.3782 Length = 111.7113 Radius = 51.2000 External = 59.7041 Long Chord = 90.8346 Mid. Ord. = 27.5630 P.C. Station = 16+70.95 N P.T. Station = 17+82.66 N C.C. = Back = N 65° 00' 41.08" E Ahead = N 60° 00' 00.01" W Chord Bear = N 2° 30' 20.53" E	434,440.1105 E	1,620,293.8633
---	----------------	----------------

**Curve Data**  
\*-----\*

Curve STREAM-13 P.I. Station = 24+11.21 N Delta = 109° 32' 55.06" (LT) Degree = 111° 54' 20.95" Tangent = 72.5116 Length = 97.8936 Radius = 51.2000 External = 37.5658 Long Chord = 83.6492 Mid. Ord. = 21.6679 P.C. Station = 23+38.70 N P.T. Station = 24+36.59 N C.C. = Back = N 4° 28' 31.39" W Ahead = S 65° 58' 33.55" W Chord Bear = N 59° 14' 58.92" W	434,923.1231 E	1,620,315.7411
---	----------------	----------------

**Curve Data**  
\*-----\*

Curve STREAM-3 P.I. Station = 14+01.54 N Delta = 157° 12' 51.45" (RT) Degree = 127° 19' 26.24" Tangent = 223.3189 Length = 123.4758 Radius = 45.0000 External = 182.8076 Long Chord = 88.2266 Mid. Ord. = 36.1109 P.C. Station = 11+78.22 N P.T. Station = 13+01.70 N C.C. = Back = S 59° 07' 07.14" W Ahead = N 36° 19' 58.58" E Chord Bear = N 42° 16' 27.14" W	433,922.1327 E	1,619,975.4148
--	----------------	----------------

**Curve Data**  
\*-----\*

Curve STREAM-9 P.I. Station = 18+91.32 N Delta = 129° 32' 28.15" (RT) Degree = 111° 54' 20.92" Tangent = 108.6607 Length = 115.7591 Radius = 51.2000 External = 68.9190 Long Chord = 92.6319 Mid. Ord. = 29.3763 P.C. Station = 17+82.66 N P.T. Station = 18+98.42 N C.C. = Back = N 69° 59' 18.91" W Ahead = N 59° 33' 09.24" E Chord Bear = N 5° 13' 04.84" W	434,526.4841 E	1,620,106.5650
--	----------------	----------------

**Curve Data**  
\*-----\*

Curve STREAM-14 P.I. Station = 26+36.70 N Delta = 198° 10' 14.36" (RT) Degree = 179° 02' 57.52" Tangent = 200.1108 Length = 110.6794 Radius = 32.0000 External = 234.6532 Long Chord = 63.1971 Mid. Ord. = 37.0530 P.C. Station = 24+36.59 N P.T. Station = 25+47.27 N C.C. = Back = S 65° 58' 33.55" W Ahead = N 84° 08' 47.91" E Chord Bear = N 14° 56' 19.27" W	434,975.0712 E	1,620,432.2870
---	----------------	----------------

Course from PT STREAM-3 to PC STREAM-4 N 36° 19' 58.58" E Dist 60.5307

Course from PT STREAM-14 to PC STREAM-15 N 84° 08' 47.91" E Dist 70.5751

**Curve Data**  
\*-----\*

Curve STREAM-4 P.I. Station = 14+01.19 N Delta = 96° 08' 05.77" (LT) Degree = 163° 42' 08.02" Tangent = 38.9636 Length = 58.7255 Radius = 35.0000 External = 17.3752 Long Chord = 52.0753 Mid. Ord. = 11.6111 P.C. Station = 13+62.23 N P.T. Station = 14+20.95 N C.C. = Back = N 36° 19' 58.58" E Ahead = N 59° 48' 07.19" W Chord Bear = N 11° 44' 04.30" W	434,182.1871 E	1,620,166.6740
--	----------------	----------------

**Curve Data**  
\*-----\*

Curve STREAM-10 P.I. Station = 19+97.78 N Delta = 125° 28' 23.51" (LT) Degree = 111° 54' 20.99" Tangent = 99.3538 Length = 112.1239 Radius = 51.2000 External = 60.5704 Long Chord = 91.0244 Mid. Ord. = 27.7462 P.C. Station = 18+98.42 N P.T. Station = 20+10.55 N C.C. = Back = N 59° 33' 09.24" E Ahead = N 65° 55' 14.27" W Chord Bear = N 3° 11' 02.51" W	434,631.8950 E	1,620,285.8932
--	----------------	----------------

Course from PT STREAM-14 to PC STREAM-15 N 84° 08' 47.91" E Dist 70.5751

**Curve Data**  
\*-----\*

Curve STREAM-5 P.I. Station = 15+30.77 N Delta = 135° 25' 58.01" (RT) Degree = 127° 19' 26.24" Tangent = 109.8108 Length = 106.3687 Radius = 45.0000 External = 73.6736 Long Chord = 83.2786 Mid. Ord. = 27.9364 P.C. Station = 14+20.95 N P.T. Station = 15+27.32 N C.C. = Back = N 59° 48' 07.19" W Ahead = N 75° 37' 50.82" E Chord Bear = N 7° 54' 51.82" E	434,257.0191 E	1,620,038.0894
--	----------------	----------------

**Curve Data**  
\*-----\*

Curve STREAM-11 P.I. Station = 25+85.23 N Delta = 190° 10' 56.64" (RT) Degree = 111° 54' 20.95" Tangent = 574.6817 Length = 169.9486 Radius = 51.2000 External = 628.1579 Long Chord = 101.9960 Mid. Ord. = 55.7436 P.C. Station = 20+10.55 N P.T. Station = 21+80.50 N C.C. = Back = N 65° 55' 14.27" W Ahead = S 55° 44' 17.63" E Chord Bear = N 29° 10' 14.05" E	434,437.9604 E	1,620,719.8585
--	----------------	----------------

**Curve Data**  
\*-----\*

Curve STREAM-15 P.I. Station = 26+92.10 N Delta = 117° 34' 00.19" (LT) Degree = 127° 19' 26.24" Tangent = 74.2552 Length = 92.3367 Radius = 45.0000 External = 41.8264 Long Chord = 76.9692 Mid. Ord. = 21.6776 P.C. Station = 26+17.85 N P.T. Station = 27+10.18 N C.C. = Back = N 84° 08' 47.91" E Ahead = N 33° 25' 12.28" W Chord Bear = N 25° 21' 47.81" E	434,969.4336 E	1,620,377.2947
--	----------------	----------------

**Curve Data**  
\*-----\*

Curve STREAM-6 P.I. Station = 15+69.46 N Delta = 92° 58' 58.42" (LT) Degree = 143° 14' 22.02" Tangent = 42.1386 Length = 64.9143 Radius = 40.0000 External = 18.1004 Long Chord = 58.0217 Mid. Ord. = 12.4615 P.C. Station = 15+27.32 N P.T. Station = 15+92.24 N C.C. = Back = N 75° 37' 50.82" E Ahead = N 17° 21' 07.60" W Chord Bear = N 29° 08' 21.61" E	434,294.7283 E	1,620,185.2853
--	----------------	----------------

**Curve Data**  
\*-----\*

Curve STREAM-12 P.I. Station = 22+87.21 N Delta = 128° 44' 13.76" (LT) Degree = 111° 54' 20.95" Tangent = 106.7124 Length = 115.0406 Radius = 51.2000 External = 67.1595 Long Chord = 92.3234 Mid. Ord. = 29.0519 P.C. Station = 21+80.50 N P.T. Station = 22+95.54 N C.C. = Back = S 55° 44' 17.63" E Ahead = N 4° 28' 31.39" W Chord Bear = N 59° 53' 35.49" E	434,701.4152 E	1,620,333.0940
---	----------------	----------------

**Curve Data**  
\*-----\*

Curve STREAM-16 P.I. Station = 32+86.30 N Delta = 188° 55' 56.80" (RT) Degree = 127° 19' 26.24" Tangent = 576.1213 Length = 148.3872 Radius = 45.0000 External = 622.8760 Long Chord = 89.7267 Mid. Ord. = 48.5042 P.C. Station = 27+10.18 N P.T. Station = 28+58.57 N C.C. = Back = N 33° 25' 12.28" W Ahead = S 24° 29' 15.48" E Chord Bear = N 61° 02' 46.12" E	434,550.5486 E	1,620,653.7091
---	----------------	----------------

Course from PT STREAM-12 to PC STREAM-13 N 4° 28' 31.39" E Dist 43.1619

Course from PT STREAM-12 to PC STREAM-13 N 4° 28' 31.39" E Dist 43.1619

STREAM GEOMETRY DATA 1







**Curve Data**

Curve STREAM-33  
P.I. Station = 46+48.35 N  
Delta = 135° 28' 47.20" (LT)  
Degree = 143° 14' 22.01"  
Tangent = 97.7238  
Length = 94.5827  
Radius = 40.0000  
External = 65.5933  
Long Chord = 74.0379  
Mid. Ord. = 24.8475  
P.C. Station = 45+50.63 N  
P.T. Station = 46+45.21 N  
C.C. = N  
Back = N 83° 33' 31.87" E  
Ahead = N 51° 55' 15.33" W  
Chord Bear = N 15° 49' 08.27" E

**Curve Data**

Curve STREAM-39  
P.I. Station = 53+01.92 N  
Delta = 102° 33' 10.93" (LT)  
Degree = 163° 41' 49.24"  
Tangent = 43.6519  
Length = 62.6481  
Radius = 35.0011  
External = 20.9503  
Long Chord = 54.6139  
Mid. Ord. = 13.1057  
P.C. Station = 52+58.27 N  
P.T. Station = 53+20.92 N  
C.C. = N  
Back = S 72° 40' 58.77" E  
Ahead = N 4° 45' 50.31" E  
Chord Bear = N 56° 02' 25.77" E

**Curve Data**

Curve STREAM-34  
P.I. Station = 55+91.89 N  
Delta = 183° 37' 48.53" (RT)  
Degree = 190° 59' 09.35"  
Tangent = 946.6823  
Length = 96.1485  
Radius = 30.0000  
External = 977.1575  
Long Chord = 59.9699  
Mid. Ord. = 30.9502  
P.C. Station = 46+45.21 N  
P.T. Station = 47+41.36 N  
C.C. = N  
Back = N 51° 55' 15.33" W  
Ahead = S 48° 17' 26.80" W  
Chord Bear = N 39° 53' 38.94" E

Course from PT STREAM-39 to PC STREAM-40 N 4° 45' 50.31" E Dist 92.1506

**Curve Data**

Curve STREAM-40  
P.I. Station = 55+11.59 N  
Delta = 140° 53' 07.33" (RT)  
Degree = 163° 42' 08.02"  
Tangent = 98.5236  
Length = 86.0620  
Radius = 35.0000  
External = 69.5557  
Long Chord = 65.9615  
Mid. Ord. = 23.2838  
P.C. Station = 54+13.07 N  
P.T. Station = 54+99.13 N  
C.C. = N  
Back = N 4° 45' 50.31" E  
Ahead = S 34° 21' 02.36" E  
Chord Bear = N 75° 12' 23.97" E

**Curve Data**

Curve STREAM-45  
P.I. Station = 59+89.289 N  
Delta = 69° 04' 38.39" (RT)  
Degree = 163° 42' 08.02"  
Tangent = 24.090  
Length = 42.197  
Radius = 35.000  
External = 7.489  
Long Chord = 39.687  
Mid. Ord. = 6.169  
P.C. Station = 59+65.199 N  
P.T. Station = 60+07.396 N  
C.C. = N  
Back = N 44° 29' 33.56" E  
Ahead = S 66° 25' 48.06" E  
Chord Bear = N 79° 01' 52.75" E

**Curve Data**

Curve STREAM-35  
P.I. Station = 48+84.30 N  
Delta = 148° 43' 56.48" (LT)  
Degree = 143° 14' 26.09"  
Tangent = 142.9370  
Length = 103.8340  
Radius = 39.9997  
External = 108.4286  
Long Chord = 77.0397  
Mid. Ord. = 29.2202  
P.C. Station = 47+41.36 N  
P.T. Station = 48+45.19 N  
C.C. = N  
Back = S 48° 17' 26.80" E  
Ahead = N 17° 01' 23.28" W  
Chord Bear = N 57° 20' 34.96" E

**Curve Data**

Curve STREAM-41  
P.I. Station = 56+99.39 N  
Delta = 199° 49' 36.87" (LT)  
Degree = 163° 42' 08.02"  
Tangent = 200.2633  
Length = 122.0873  
Radius = 35.0000  
External = 238.2988  
Long Chord = 68.9548  
Mid. Ord. = 41.0256  
P.C. Station = 54+99.13 N  
P.T. Station = 56+21.20 N  
C.C. = N  
Back = S 34° 21' 02.36" E  
Ahead = N 54° 10' 39.24" W  
Chord Bear = N 45° 44' 09.20" E

**Curve Data**

Curve STREAM-46  
P.I. Station = 61+29.962 N  
Delta = 148° 07' 31.97" (LT)  
Degree = 163° 42' 08.02"  
Tangent = 122.566  
Length = 90.485  
Radius = 35.000  
External = 92.466  
Long Chord = 67.309  
Mid. Ord. = 25.390  
P.C. Station = 60+07.396 N  
P.T. Station = 60+97.881 N  
C.C. = N  
Back = S 66° 25' 48.06" E  
Ahead = N 34° 33' 20.02" W  
Chord Bear = N 39° 30' 25.96" E

Course from PT STREAM-35 to PC STREAM-36 N 17° 01' 23.28" W Dist 85.1167

**Curve Data**

Curve STREAM-36  
P.I. Station = 50+19.04 N  
Delta = 131° 28' 12.90" (RT)  
Degree = 143° 14' 22.02"  
Tangent = 88.7352  
Length = 91.7835  
Radius = 40.0000  
External = 57.3341  
Long Chord = 72.9324  
Mid. Ord. = 23.5618  
P.C. Station = 49+30.31 N  
P.T. Station = 50+22.09 N  
C.C. = N  
Back = N 17° 01' 23.28" W  
Ahead = S 65° 33' 10.36" E  
Chord Bear = N 48° 42' 43.17" E

**Curve Data**

Curve STREAM-42  
P.I. Station = 57+89.85 N  
Delta = 146° 58' 22.98" (RT)  
Degree = 114° 35' 29.62"  
Tangent = 168.6515  
Length = 128.2582  
Radius = 50.0000  
External = 125.9072  
Long Chord = 95.8753  
Mid. Ord. = 35.7880  
P.C. Station = 56+21.20 N  
P.T. Station = 57+49.45 N  
C.C. = N  
Back = N 54° 10' 39.24" W  
Ahead = S 87° 12' 16.26" E  
Chord Bear = N 19° 18' 32.25" E

**Curve Data**

Curve STREAM-47  
P.I. Station = 61+84.056 N  
Delta = 119° 45' 14.74" (RT)  
Degree = 114° 35' 29.61"  
Tangent = 86.175  
Length = 104.505  
Radius = 50.000  
External = 49.630  
Long Chord = 86.495  
Mid. Ord. = 24.907  
P.C. Station = 60+97.881 N  
P.T. Station = 62+02.386 N  
C.C. = N  
Back = N 34° 33' 20.02" W  
Ahead = N 85° 11' 54.72" E  
Chord Bear = N 25° 19' 17.35" E

**Curve Data**

Curve STREAM-37  
P.I. Station = 59+29.55 N  
Delta = 174° 26' 53.26" (LT)  
Degree = 130° 13' 03.65"  
Tangent = 907.4567  
Length = 133.9665  
Radius = 44.0000  
External = 864.5228  
Long Chord = 87.8967  
Mid. Ord. = 41.8691  
P.C. Station = 50+22.09 N  
P.T. Station = 51+56.06 N  
C.C. = N  
Back = S 65° 33' 10.38" E  
Ahead = N 60° 00' 03.65" W  
Chord Bear = N 27° 13' 22.99" E

**Curve Data**

Curve STREAM-43  
P.I. Station = 59+06.86 N  
Delta = 144° 45' 21.05" (LT)  
Degree = 114° 35' 29.62"  
Tangent = 157.4085  
Length = 126.3233  
Radius = 50.0000  
External = 115.1598  
Long Chord = 95.3074  
Mid. Ord. = 34.8631  
P.C. Station = 57+49.45 N  
P.T. Station = 58+75.78 N  
C.C. = N  
Back = S 87° 12' 16.26" E  
Ahead = N 51° 57' 37.31" W  
Chord Bear = N 20° 25' 03.22" E

**Curve Data**

Curve STREAM-48  
P.I. Station = 62+94.902 N  
Delta = 123° 13' 20.27" (LT)  
Degree = 114° 35' 29.61"  
Tangent = 92.516  
Length = 107.532  
Radius = 50.000  
External = 55.163  
Long Chord = 87.974  
Mid. Ord. = 26.227  
P.C. Station = 62+02.386 N  
P.T. Station = 63+09.918 N  
C.C. = N  
Back = N 85° 11' 54.72" E  
Ahead = N 38° 01' 25.56" W  
Chord Bear = N 23° 35' 14.58" E

**Curve Data**

Curve STREAM-38  
P.I. Station = 54+71.02 N  
Delta = 167° 19' 04.88" (RT)  
Degree = 163° 42' 10.82"  
Tangent = 314.9587  
Length = 102.2083  
Radius = 34.9998  
External = 281.8975  
Long Chord = 69.5714  
Mid. Ord. = 31.1343  
P.C. Station = 51+56.06 N  
P.T. Station = 52+58.27 N  
C.C. = N  
Back = N 60° 00' 03.65" W  
Ahead = S 72° 40' 58.77" E  
Chord Bear = N 23° 39' 28.79" E

**Curve Data**

Curve STREAM-44  
P.I. Station = 59+14.96 N  
Delta = 96° 27' 10.86" (RT)  
Degree = 163° 42' 30.02"  
Tangent = 39.1804  
Length = 58.9176  
Radius = 34.9987  
External = 17.5371  
Long Chord = 52.2030  
Mid. Ord. = 11.6830  
P.C. Station = 58+75.78 N  
P.T. Station = 59+34.69 N  
C.C. = N  
Back = N 51° 57' 37.31" W  
Ahead = N 44° 29' 33.56" E  
Chord Bear = N 3° 44' 01.87" W

Course from PT STREAM-48 to PC STREAM-49 N 38° 01' 25.56" W Dist 50.041

Course from PT STREAM-44 to PC STREAM-45 N 44° 29' 33.56" E Dist 30.5050

STREAM GEOMETRY DATA 3



**Curve Data**  
 \*-----\*

Curve STREAM-49  
 P.I. Station = 64+13.01 N 437,119.3431 E 1,621,497.9397  
 Delta = 105° 58' 14.05" (RT)  
 Degree = 143° 14' 22.02"  
 Tangent = 53.0534  
 Length = 73.9814  
 Radius = 40.0000  
 External = 26.4430  
 Long Chord = 63.8785  
 Mid. Ord. = 15.9192  
 P.C. Station = 63+59.96 N 437,077.5499 E 1,621,530.6200  
 P.T. Station = 64+33.94 N 437,139.2629 E 1,621,547.1115  
 C.C. = N 437,102.1895 E 1,621,562.1302  
 Back = N 38° 01' 25.56" W  
 Ahead = N 67° 56' 48.50" E  
 Chord Bear = N 14° 57' 41.47" E

**Curve Data**  
 \*-----\*

Curve STREAM-55  
 P.I. Station = 70+52.57 N 437,575.8805 E 1,621,509.8819  
 Delta = 115° 29' 46.15" (RT)  
 Degree = 114° 35' 36.28"  
 Tangent = 79.2380  
 Length = 100.7878  
 Radius = 49.9992  
 External = 43.6949  
 Long Chord = 84.5696  
 Mid. Ord. = 23.3175  
 P.C. Station = 69+73.34 N 437,519.4476 E 1,621,565.5055  
 P.T. Station = 70+74.12 N 437,601.7956 E 1,621,584.7623  
 C.C. = N 437,554.5461 E 1,621,601.1147  
 Back = N 44° 35' 10.44" W  
 Ahead = N 70° 54' 35.72" E  
 Chord Bear = N 13° 09' 42.64" E

**Curve Data**  
 \*-----\*

Curve STREAM-50  
 P.I. Station = 66+46.51 N 437,219.0742 E 1,621,744.1247  
 Delta = 158° 41' 08.56" (LT)  
 Degree = 143° 14' 22.02"  
 Tangent = 212.5654  
 Length = 110.7835  
 Radius = 40.0000  
 External = 176.2962  
 Long Chord = 78.6201  
 Mid. Ord. = 32.6027  
 P.C. Station = 64+33.94 N 437,139.2629 E 1,621,547.1115  
 P.T. Station = 65+44.72 N 437,216.3330 E 1,621,531.5770  
 C.C. = N 437,176.3363 E 1,621,532.0928  
 Back = N 67° 56' 48.50" E  
 Ahead = S 89° 15' 39.94" W  
 Chord Bear = N 11° 23' 45.78" W

**Curve Data**  
 \*-----\*

Curve STREAM-56  
 P.I. Station = 71+18.19 N 437,616.2087 E 1,621,626.4080  
 Delta = 82° 47' 00.16" (LT)  
 Degree = 114° 35' 17.62"  
 Tangent = 44.0693  
 Length = 72.2442  
 Radius = 50.0015  
 External = 16.6488  
 Long Chord = 66.1222  
 Mid. Ord. = 12.4900  
 P.C. Station = 70+74.12 N 437,601.7956 E 1,621,584.7623  
 P.T. Station = 71+46.37 N 437,659.3351 E 1,621,617.3407  
 C.C. = N 437,649.0473 E 1,621,668.4091  
 Back = N 70° 54' 35.72" E  
 Ahead = N 11° 52' 24.44" W  
 Chord Bear = N 29° 31' 05.64" E

**Curve Data**  
 \*-----\*

Curve STREAM-51  
 P.I. Station = 74+49.05 N 437,204.6709 E 1,620,627.3293  
 Delta = 173° 40' 14.47" (RT)  
 Degree = 114° 35' 30.20"  
 Tangent = 904.3228  
 Length = 151.5561  
 Radius = 49.9999  
 External = 855.7041  
 Long Chord = 99.8474  
 Mid. Ord. = 47.2397  
 P.C. Station = 65+44.72 N 437,216.3330 E 1,621,531.5770  
 P.T. Station = 66+96.28 N 437,315.9487 E 1,621,524.7796  
 C.C. = N 437,266.3288 E 1,621,530.9322  
 Back = S 89° 15' 39.94" W  
 Ahead = N 82° 55' 54.41" E  
 Chord Bear = N 3° 54' 12.82" W

**Curve Data**  
 \*-----\*

Curve STREAM-57  
 P.I. Station = 71+62.85 N 437,675.4661 E 1,621,613.9492  
 Delta = 44° 47' 43.40" (RT)  
 Degree = 143° 15' 02.07"  
 Tangent = 16.4836  
 Length = 31.2707  
 Radius = 39.9969  
 External = 3.2635  
 Long Chord = 30.4803  
 Mid. Ord. = 3.0173  
 P.C. Station = 71+46.37 N 437,659.3351 E 1,621,617.3407  
 P.T. Station = 71+77.64 N 437,689.3026 E 1,621,622.9080  
 C.C. = N 437,667.5645 E 1,621,656.4819  
 Back = N 11° 52' 24.44" W  
 Ahead = N 32° 55' 18.96" E  
 Chord Bear = N 10° 31' 27.26" E

**Curve Data**  
 \*-----\*

Curve STREAM-52  
 P.I. Station = 68+51.32 N 437,335.0268 E 1,621,678.6438  
 Delta = 151° 04' 00.41" (LT)  
 Degree = 143° 14' 17.75"  
 Tangent = 155.0425  
 Length = 105.4854  
 Radius = 40.0003  
 External = 120.1190  
 Long Chord = 77.4641  
 Mid. Ord. = 30.0076  
 P.C. Station = 66+96.28 N 437,315.9487 E 1,621,524.7796  
 P.T. Station = 68+01.75 N 437,392.7679 E 1,621,534.7545  
 C.C. = N 437,355.6450 E 1,621,519.8575  
 Back = N 82° 55' 54.41" E  
 Ahead = N 68° 08' 05.99" W  
 Chord Bear = N 7° 23' 54.21" E

**Curve Data**  
 \*-----\*



Curve STREAM-58  
 P.I. Station = 71+80.28 N 437,691.5166 E 1,621,624.3414  
 Delta = 7° 32' 28.48" (LT)  
 Degree = 143° 10' 11.66"  
 Tangent = 2.6375  
 Length = 5.2673  
 Radius = 40.0194  
 External = 0.0868  
 Long Chord = 5.2635  
 Mid. Ord. = 0.0866  
 P.C. Station = 71+77.64 N 437,689.3026 E 1,621,622.9080  
 P.T. Station = 71+82.91 N 437,693.8995 E 1,621,625.4719  
 C.C. = N 437,711.0530 E 1,621,589.3152  
 Back = N 32° 55' 18.96" E  
 Ahead = N 25° 22' 50.49" E  
 Chord Bear = N 29° 09' 04.72" E

**Curve Data**  
 \*-----\*


Curve STREAM-53  
 P.I. Station = 69+43.29 N 437,445.4825 E 1,621,403.3910  
 Delta = 152° 13' 20.60" (RT)  
 Degree = 163° 42' 13.35"  
 Tangent = 141.5457  
 Length = 92.9865  
 Radius = 34.9997  
 External = 110.8090  
 Long Chord = 67.9528  
 Mid. Ord. = 26.5984  
 P.C. Station = 68+01.75 N 437,392.7679 E 1,621,534.7545  
 P.T. Station = 68+94.73 N 437,460.0833 E 1,621,544.1838  
 C.C. = N 437,425.2498 E 1,621,547.7891  
 Back = N 68° 08' 05.99" W  
 Ahead = N 84° 05' 14.61" E  
 Chord Bear = N 7° 58' 34.31" E

**Curve Data**  
 \*-----\*



Curve STREAM-54  
 P.I. Station = 69+67.58 N 437,467.5673 E 1,621,616.6419  
 Delta = 128° 40' 25.04" (LT)  
 Degree = 163° 41' 57.66"  
 Tangent = 72.8456  
 Length = 78.6036  
 Radius = 35.0006  
 External = 45.8173  
 Long Chord = 63.0960  
 Mid. Ord. = 19.8425  
 P.C. Station = 68+94.73 N 437,460.0833 E 1,621,544.1838  
 P.T. Station = 69+73.34 N 437,519.4476 E 1,621,565.5055  
 C.C. = N 437,494.8778 E 1,621,540.5783  
 Back = N 84° 05' 14.61" E  
 Ahead = N 44° 35' 10.44" W  
 Chord Bear = N 19° 45' 02.09" E

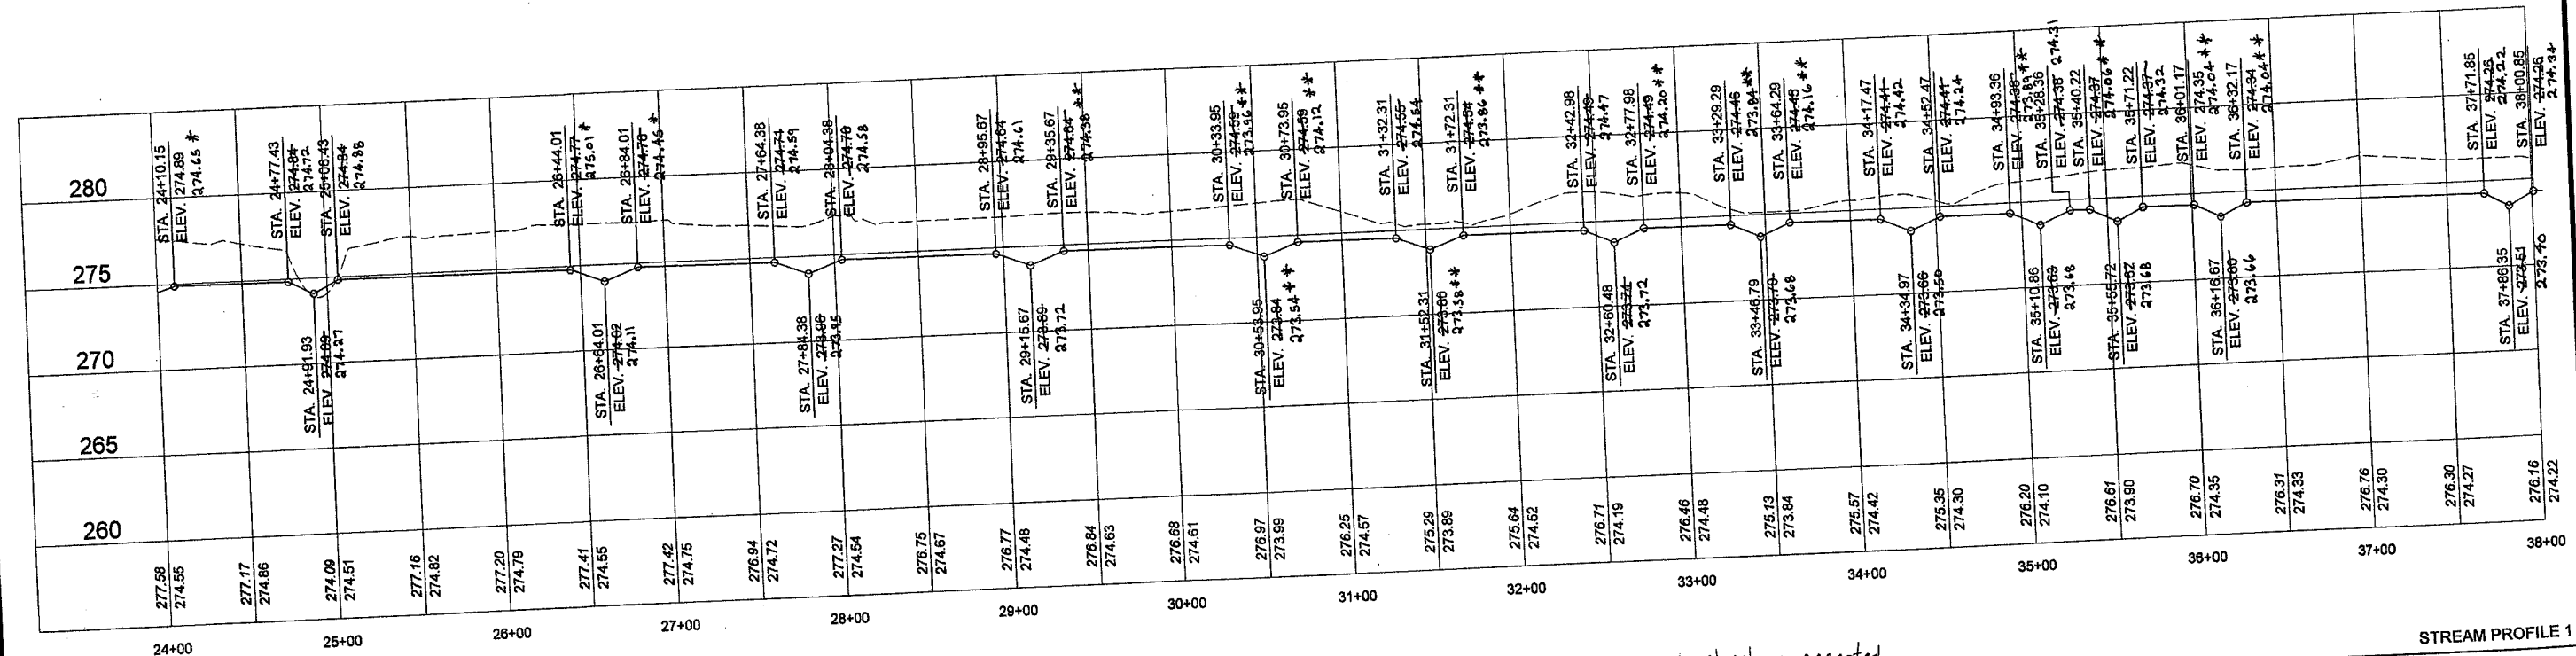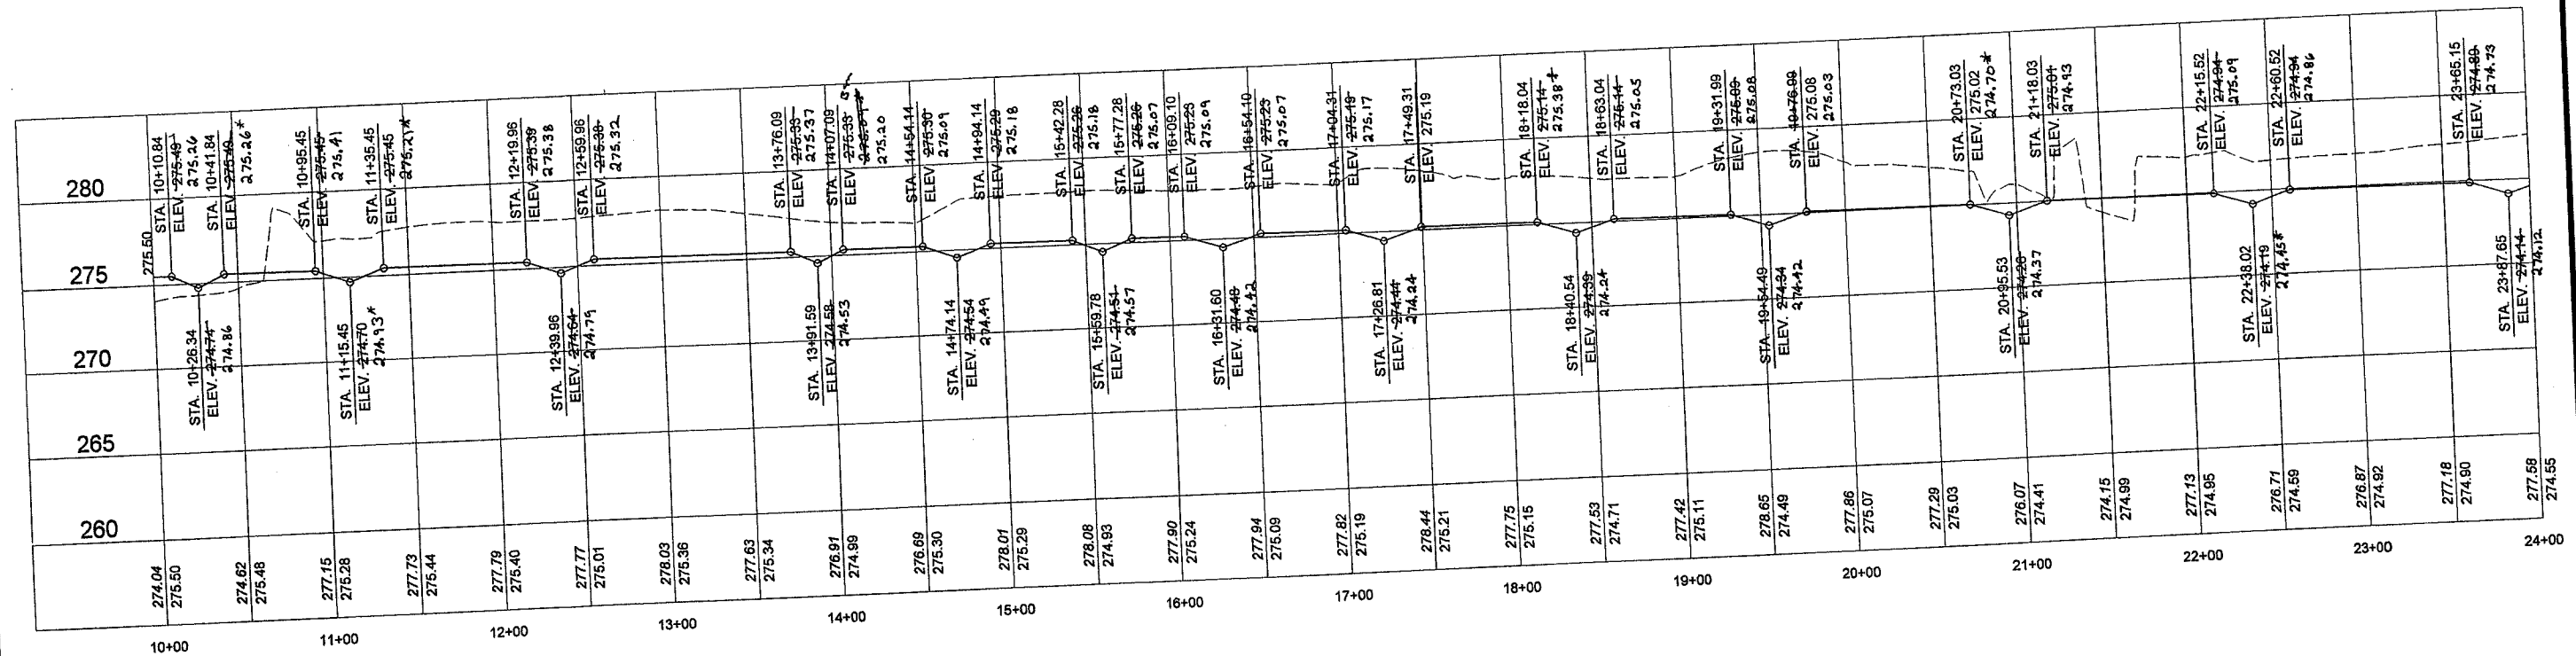

\* elevation accepted  
 \*\* Due to water flowing back into channel, accurate grades could not be attained.

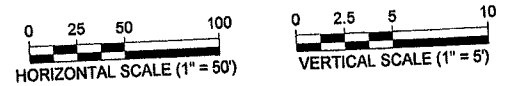


STREAM PROFILE 1

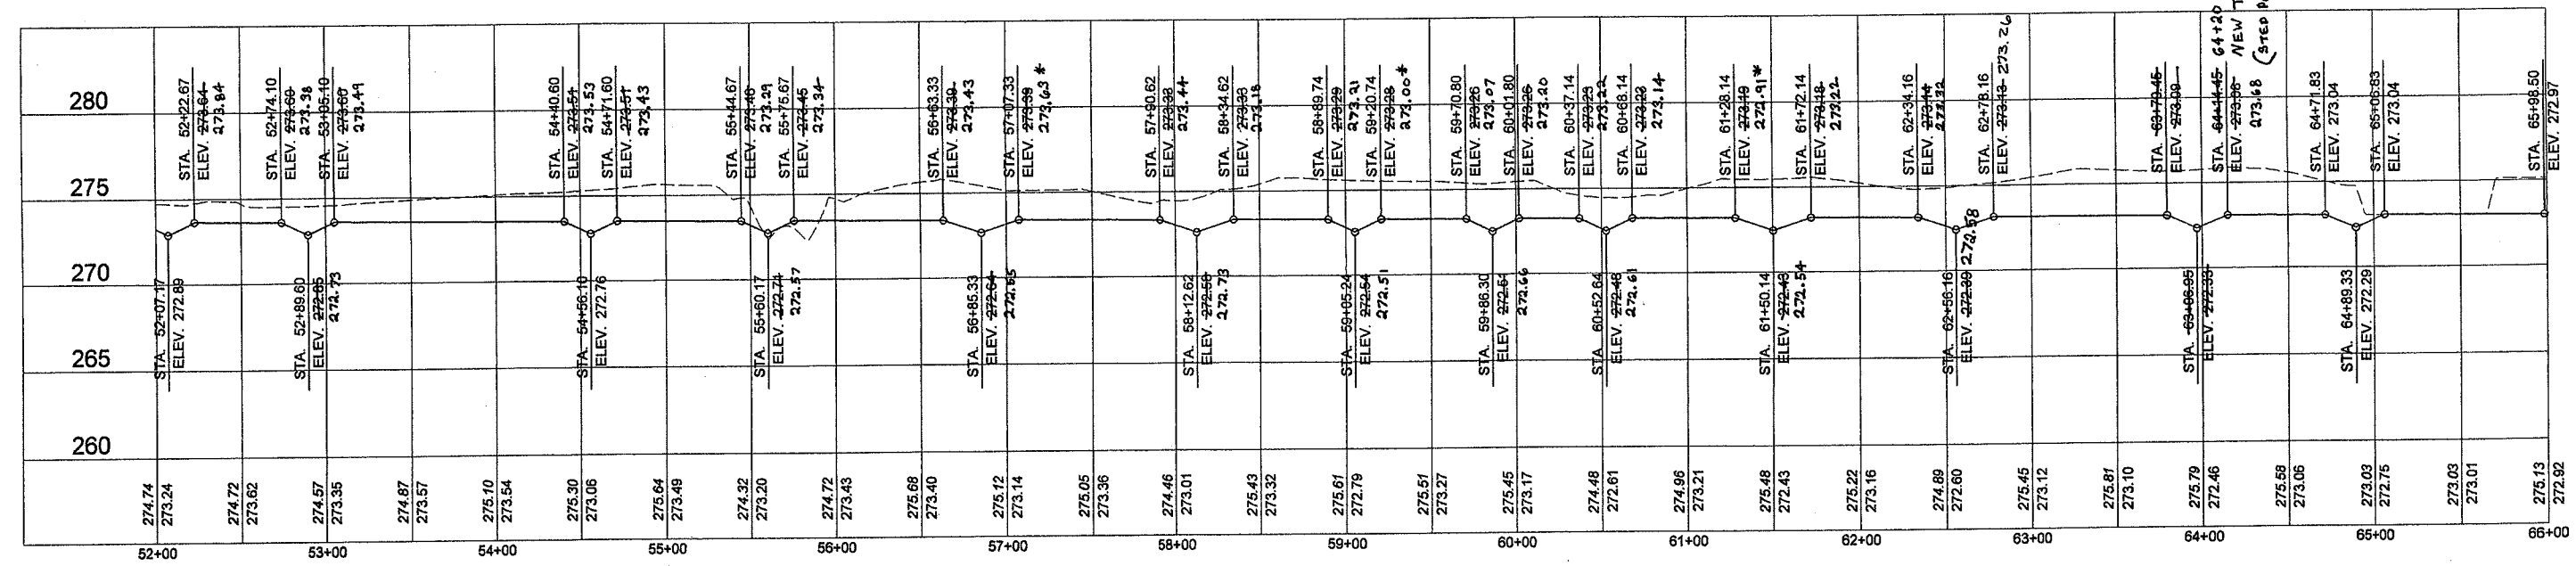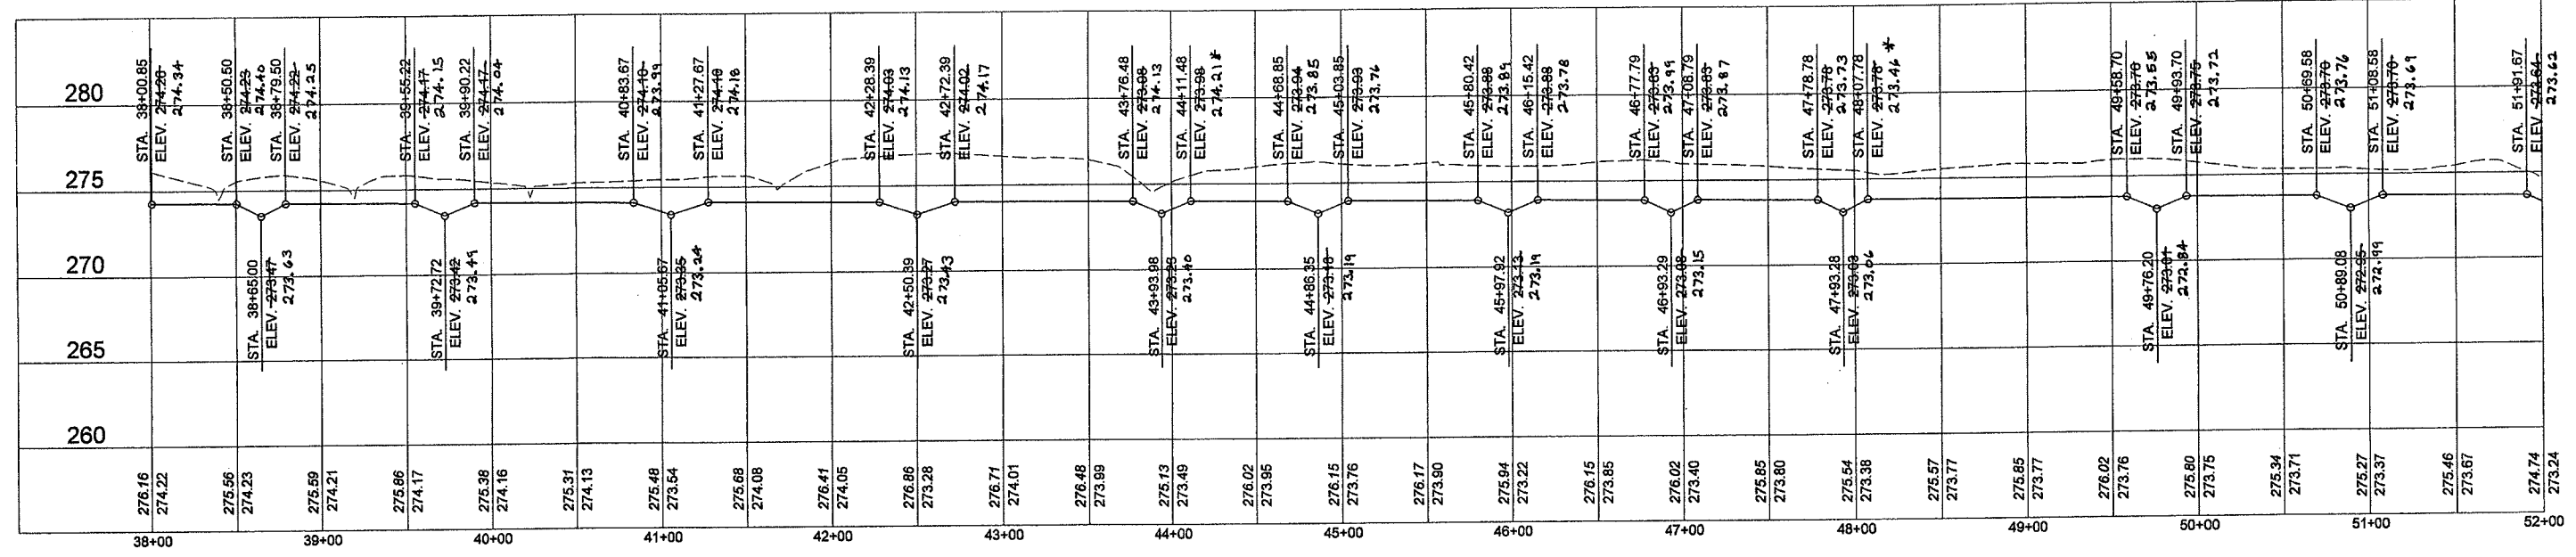


Due to water backing up, project ended at ≈ 64+20

NEW TIE IN (STEP POOL)

\* elevation accepted

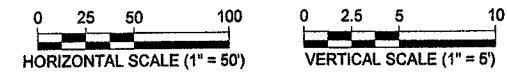

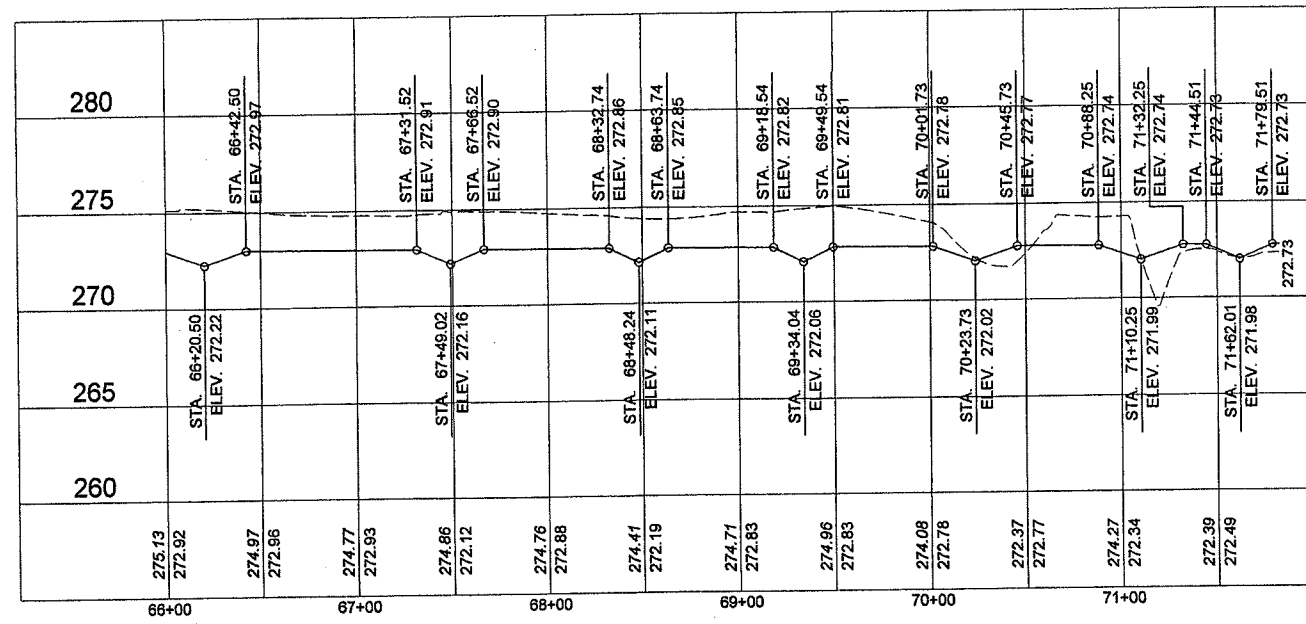


STATION	ELEVATION	DESCRIPTION
3346.79	273.70	MAX POOL
3364.29	274.48	HEAD OF RIFFLE
3417.47	274.41	HEAD OF POOL, J-VANE X
3434.97	273.66	MAX POOL
3452.47	274.41	HEAD OF RIFFLE
3493.36	274.38	HEAD OF POOL
3510.86	273.63	MAX POOL
3528.36	274.38	HEAD OF RIFFLE
3540.22	274.37	HEAD OF POOL
3555.72	273.62	MAX POOL
3571.22	274.37	HEAD OF RIFFLE
3601.17	274.35	HEAD OF POOL, CROSS VANE X
3616.67	273.60	MAX POOL
3632.17	274.34	HEAD OF RIFFLE
3771.85	274.26	HEAD OF POOL, CROSS VANE X
3786.35	273.61	MAX POOL
3800.85	274.26	HEAD OF RIFFLE
3850.50	274.23	HEAD OF POOL, J-VANE X
3865.00	273.47	MAX POOL
3879.50	274.22	HEAD OF RIFFLE
3955.22	274.17	HEAD OF POOL
3972.72	273.42	MAX POOL
3990.22	274.17	HEAD OF RIFFLE
4083.67	274.10	HEAD OF POOL
4105.67	273.35	MAX POOL
4127.67	274.10	HEAD OF RIFFLE
4228.39	274.03	HEAD OF POOL
4250.39	273.27	MAX POOL
4272.39	274.02	HEAD OF RIFFLE
4376.48	273.98	HEAD OF POOL, CROSS VANE X
4393.98	273.23	MAX POOL
4411.48	273.98	HEAD OF RIFFLE
4468.85	273.94	HEAD OF POOL
4486.35	273.48	MAX POOL
4503.85	273.93	HEAD OF RIFFLE
4580.42	273.88	HEAD OF POOL
4597.92	273.13	MAX POOL
4615.42	273.98	HEAD OF RIFFLE
4677.79	273.83	HEAD OF POOL, J-VANE X
4693.29	273.98	MAX POOL
4708.79	273.83	HEAD OF RIFFLE
4778.78	273.78	HEAD OF POOL
4793.28	273.93	MAX POOL
4807.78	273.78	HEAD OF RIFFLE
4958.70	273.76	HEAD OF POOL, CROSS VANE X
4976.20	273.91	MAX POOL
4993.70	273.75	HEAD OF RIFFLE
5069.58	273.70	HEAD OF POOL
5089.08	272.95	MAX POOL
5108.58	273.70	HEAD OF RIFFLE
5191.67	273.64	HEAD OF POOL, J-VANE X
5207.17	272.89	MAX POOL
5222.67	273.64	HEAD OF RIFFLE
5274.10	273.60	HEAD OF POOL, J-VANE X
5289.60	272.85	MAX POOL
5305.10	273.60	HEAD OF RIFFLE
5440.60	273.51	HEAD OF POOL, CROSS VANE X
5456.10	272.76	MAX POOL
5471.60	273.51	HEAD OF RIFFLE
5544.67	273.46	HEAD OF POOL, J-VANE X
5560.17	272.71	MAX POOL
5575.67	273.45	HEAD OF RIFFLE

STATION	ELEVATION	DESCRIPTION
5663.33	273.99	HEAD OF POOL
5685.33	272.64	MAX POOL
5707.33	273.39	HEAD OF RIFFLE
5790.62	273.33	HEAD OF POOL
5812.62	272.58	MAX POOL
5834.62	273.33	HEAD OF RIFFLE
5889.74	273.29	HEAD OF POOL, J-VANE X
5905.24	272.54	MAX POOL
5920.74	273.28	HEAD OF RIFFLE
5970.80	273.26	HEAD OF POOL, CROSS VANE X
5986.30	272.51	MAX POOL
6001.80	273.26	HEAD OF RIFFLE
6037.14	273.23	HEAD OF POOL, LOG-VANE X
6052.64	272.48	MAX POOL
6068.14	273.23	HEAD OF RIFFLE
6128.14	273.19	HEAD OF POOL, LOG VANE X
6150.14	272.43	MAX POOL
6172.14	273.18	HEAD OF RIFFLE
6234.16	273.14	HEAD OF POOL, LOG VANE X
6256.16	272.39	MAX POOL
6278.16	273.13	HEAD OF RIFFLE
6379.45	273.08	HEAD OF POOL, CROSS VANE X
6396.95	272.33	MAX POOL
6414.45	273.08	HEAD OF RIFFLE, STEP POOL
6471.83	273.04	HEAD OF POOL, LOG VANE
6489.33	272.29	MAX POOL
6506.83	273.04	HEAD OF RIFFLE
6598.50	272.97	HEAD OF POOL
6620.50	272.22	MAX POOL
6642.50	272.97	HEAD OF RIFFLE
6731.52	272.91	HEAD OF POOL, LOG VANE
6749.02	272.16	MAX POOL
6766.52	272.90	HEAD OF RIFFLE
6832.74	272.86	HEAD OF POOL, J-VANE
6848.24	272.11	MAX POOL
6863.74	272.85	HEAD OF RIFFLE
6918.54	272.82	HEAD OF POOL, J-VANE
6934.04	272.06	MAX POOL
6949.54	272.81	HEAD OF RIFFLE
7001.73	272.78	HEAD OF POOL
7023.73	272.02	MAX POOL
7045.73	272.77	HEAD OF RIFFLE
7088.25	272.74	HEAD OF POOL
7110.25	271.99	MAX POOL
7132.25	272.74	HEAD OF RIFFLE
7144.51	272.73	HEAD OF POOL, CROSS VANE
7162.01	271.98	MAX POOL
7179.51	272.73	HEAD OF RIFFLE
7182.91	272.73	END PROJECT

STATION	ELEVATION	DESCRIPTION
1000.00	275.50	BEGIN PROJECT, CROSS VANE
1010.84	275.49	HEAD OF POOL
1026.34	274.74	MAX POOL
1041.84	275.49	HEAD OF RIFFLE
1095.45	275.45	HEAD OF POOL
1115.45	274.70	MAX POOL
1135.45	275.45	HEAD OF RIFFLE
1219.96	275.39	HEAD OF POOL
1239.96	274.64	MAX POOL
1259.96	275.38	HEAD OF RIFFLE
1376.09	275.33	HEAD OF POOL, CROSS VANE X
1391.59	274.58	MAX POOL
1407.09	275.33	HEAD OF RIFFLE
1454.14	275.30	HEAD OF POOL, LOG VANE X
1474.14	274.54	MAX POOL
1494.14	275.29	HEAD OF RIFFLE
1542.28	275.26	HEAD OF POOL, LOG VANE X
1559.78	274.51	MAX POOL
1577.28	275.26	HEAD OF RIFFLE
1609.10	275.23	HEAD OF POOL
1631.60	274.48	MAX POOL
1654.10	275.23	HEAD OF RIFFLE
1704.31	275.18	HEAD OF POOL, LOG VANE X
1726.81	274.44	MAX POOL
1749.31	275.19	HEAD OF RIFFLE
1818.04	275.14	HEAD OF POOL, CROSS VANE X
1840.54	274.89	MAX POOL
1863.04	275.14	HEAD OF RIFFLE
1931.99	275.09	HEAD OF POOL, LOG VANE X
1954.49	274.34	MAX POOL
1976.99	275.08	HEAD OF RIFFLE

STATION	ELEVATION	DESCRIPTION
2073.03	275.02	HEAD OF POOL, LOG VANE X
2095.53	274.26	MAX POOL
2118.03	275.01	HEAD OF RIFFLE
2215.52	274.94	HEAD OF POOL, LOG VANE X
2238.02	274.19	MAX POOL
2260.52	274.94	HEAD OF RIFFLE
2385.15	274.89	HEAD OF POOL, CROSS VANE X
2387.65	274.14	MAX POOL
2410.15	274.89	HEAD OF RIFFLE
2477.43	274.84	HEAD OF POOL, J-VANE X
2491.93	274.89	MAX POOL
2506.43	274.84	HEAD OF RIFFLE
2644.01	274.77	HEAD OF POOL, CROSS VANE X
2664.01	274.02	MAX POOL
2684.01	274.76	HEAD OF RIFFLE
2764.38	274.71	HEAD OF POOL
2784.38	273.96	MAX POOL
2804.38	274.70	HEAD OF RIFFLE
2895.67	274.64	HEAD OF POOL
2915.67	273.89	MAX POOL
2935.67	274.64	HEAD OF RIFFLE
3033.95	274.59	HEAD OF POOL
3053.95	273.84	MAX POOL
3073.95	274.59	HEAD OF RIFFLE
3132.31	274.55	HEAD OF POOL, CROSS VANE X
3152.31	273.80	MAX POOL
3172.31	274.64	HEAD OF RIFFLE
3242.98	274.49	HEAD OF POOL
3260.48	273.74	MAX POOL
3277.98	274.49	HEAD OF RIFFLE
3329.29	274.48	HEAD OF POOL, J-VANE X

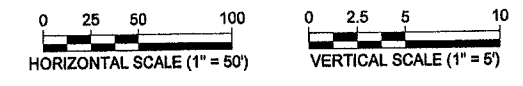


PROJECT: 6.589013T R-2231WM

STATE	STATE PROJECT REFERENCE NO.	SHEET NO.	TOTAL SHEETS
N.C.	R - 2231WM	EC-1	4
STATE PROJ. NO.	P.A. PROJ. NO.	DESCRIPTION	
6.589013T		P.E. & CONST.	

# STATE OF NORTH CAROLINA DIVISION OF HIGHWAYS

## PLAN FOR PROPOSED HIGHWAY EROSION CONTROL


# ANSON COUNTY

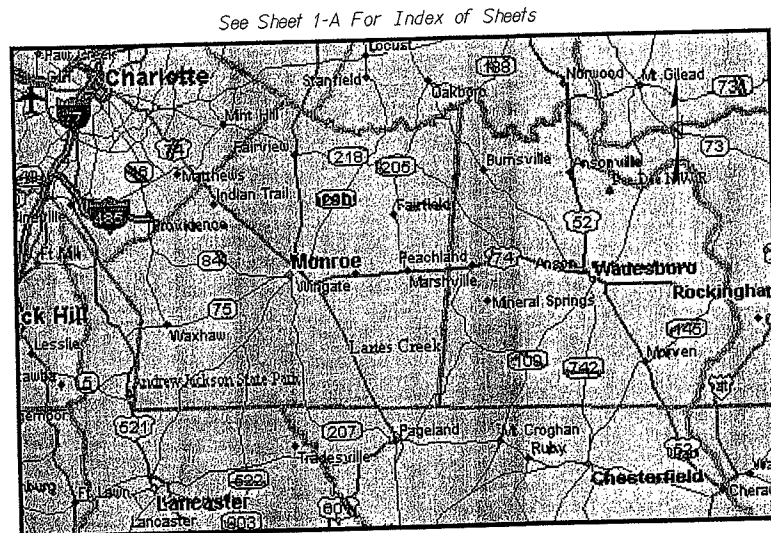

VICINITY MAP  
NOT TO SCALE

FROM PEACHLAND, NORTH CAROLINA GO APPROXIMATELY 1.5 MILES SOUTH ON MINERAL SPRINGS CHURCH ROAD TO LOWER WHITE STORE ROAD. GO WEST ON LOWER WHITE STORE ROAD APPROXIMATELY 2.6 MILES TO THE LEFT TURN ONTO THE SITE ENTRANCE/ACCESS ROAD

**LOCATION: KEY BRANCH MITIGATION SITE, LOCATED BETWEEN LOWER WHITE STORE ROAD (SR 1252) AND MINERAL SPRINGS CHURCH ROAD (SR 1240) ON THE BROWN CREEK FLOODPLAIN IN ANSON COUNTY, NORTH CAROLINA**

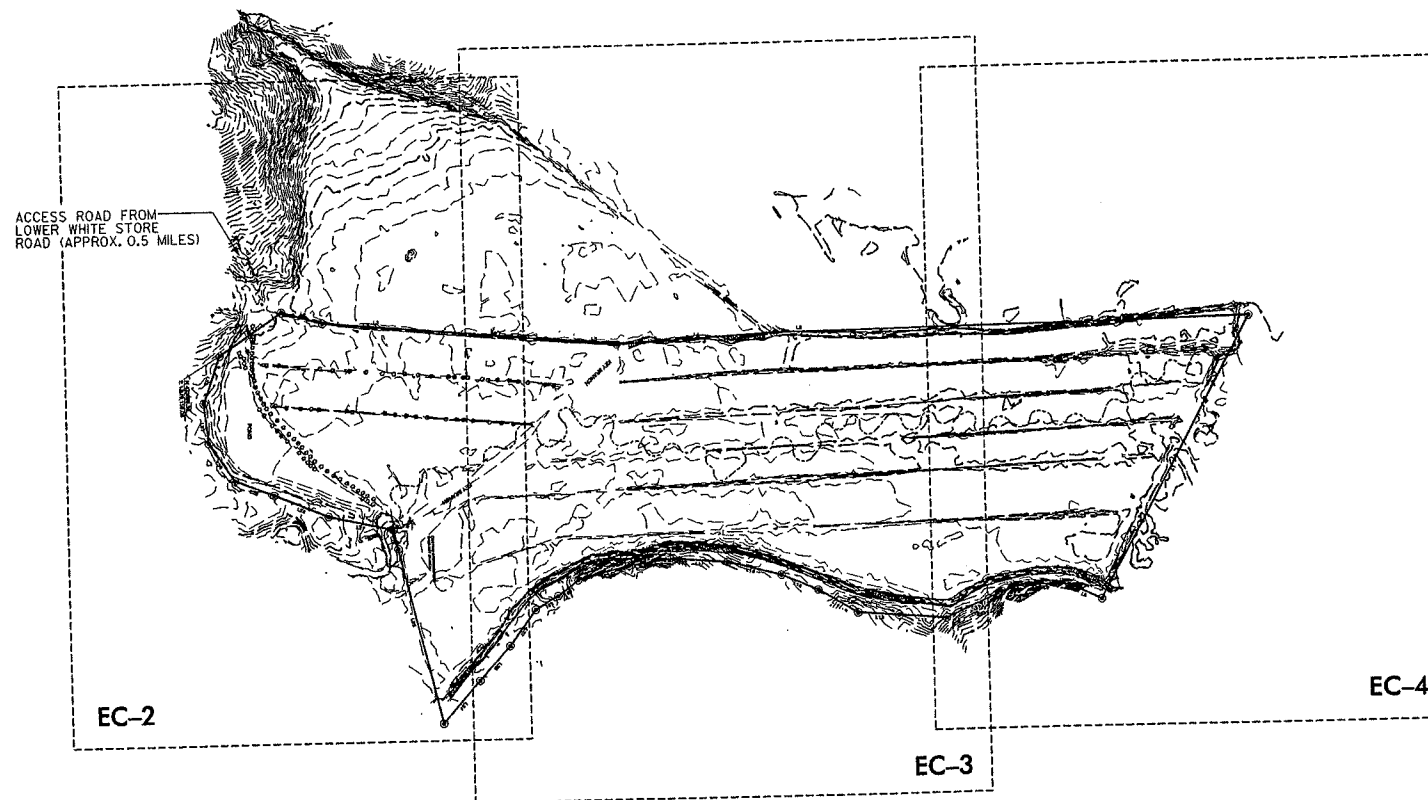


### EROSION AND SEDIMENT CONTROL MEASURES

Std. #	Description	Symbol
	Reforestation	
1630.05	Temporary Silt Ditch	
1630.05	Temporary Diversion	
1605.01	Temporary Silt Fence	
1606.01	Special Sediment Control Fence	
1622.01	Temporary Berms and Slope Drains	
1630.01	Riser Basin	
1630.02	Silt Basin Type B	
1635.01	Temporary Rock Silt Check Type-A	
1635.02	Temporary Rock Silt Check Type-B	
1634.01	Temporary Rock Sediment Dam Type-A	
1634.02	Temporary Rock Sediment Dam Type-B	
1635.01	Rock Pipe Inlet Sediment Trap Type-A	
1635.02	Rock Pipe Inlet Sediment Trap Type-B	
1636.01	Rock Silt Screen	
1630.04	Stilling Basin	
	Rock Inlet Sediment Trap:	
1632.01	Type A	OR
1632.02	Type B	OR
1632.03	Type C	OR

**ENVIRONMENTALLY SENSITIVE AREA(S) EXIST ON THIS PROJECT**  
Refer To E. C. Special Provisions for Special Considerations.

#### GRAPHIC SCALES

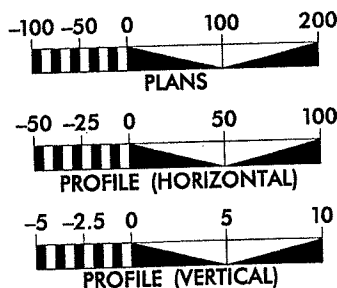

#### Roadway Standard Drawings

The following roadway English Standards as appear in "Roadway Standard Drawings"- Roadway Design Unit - N. C. Department of Transportation - Raleigh, N. C., dated January 20, 2002 and the latest revision thereto are applicable to this project and by reference hereby are considered a part of these plans.

1605.01 Temporary Silt Fence	1632.01 Rock Inlet Sediment Trap Type A
1606.01 Special Sediment Control Fence	1632.03 Rock Inlet Sediment Trap Type C
1622.01 Temporary Berms and Slope Drains	1633.01 Temporary Rock Silt Check Type A
1630.01 Riser Basin	1633.02 Temporary Rock Silt Check Type B
1630.02 Silt Basin Type B	1634.01 Temporary Rock Sediment Dam Type A
1630.03 Temporary Silt Ditch	1634.02 Temporary Rock Sediment Dam Type B
1630.04 Stilling Basin	1635.01 Rock Pipe Inlet Sediment Trap Type A
1630.05 Temporary Diversion	1636.01 Rock Silt Screen

Prepared in the Office of:

**KCI Associates of North Carolina, P.A.**  
SUITE 200 LANDMARK CENTER 1, 4601 SIX FORKS RD., RALEIGH NC  
ENGINEERS • PLANNERS • ECOLOGISTS

for the:  
**DIVISION OF HIGHWAYS**  
2002 STANDARD SPECIFICATIONS

RIGHT OF WAY DATE:

LETTING DATE:

DESIGN ENGINEER

SIGNATURE: *James Waldo Dine* 7.16.05 P.E.

WETLAND SCIENTIST


DIVISION OF HIGHWAYS  
STATE OF NORTH CAROLINA

STATE DESIGN ENGINEER


DEPARTMENT OF TRANSPORTATION  
FEDERAL HIGHWAY ADMINISTRATION

APPROVED  
DIVISION ADMINISTRATOR

DATE

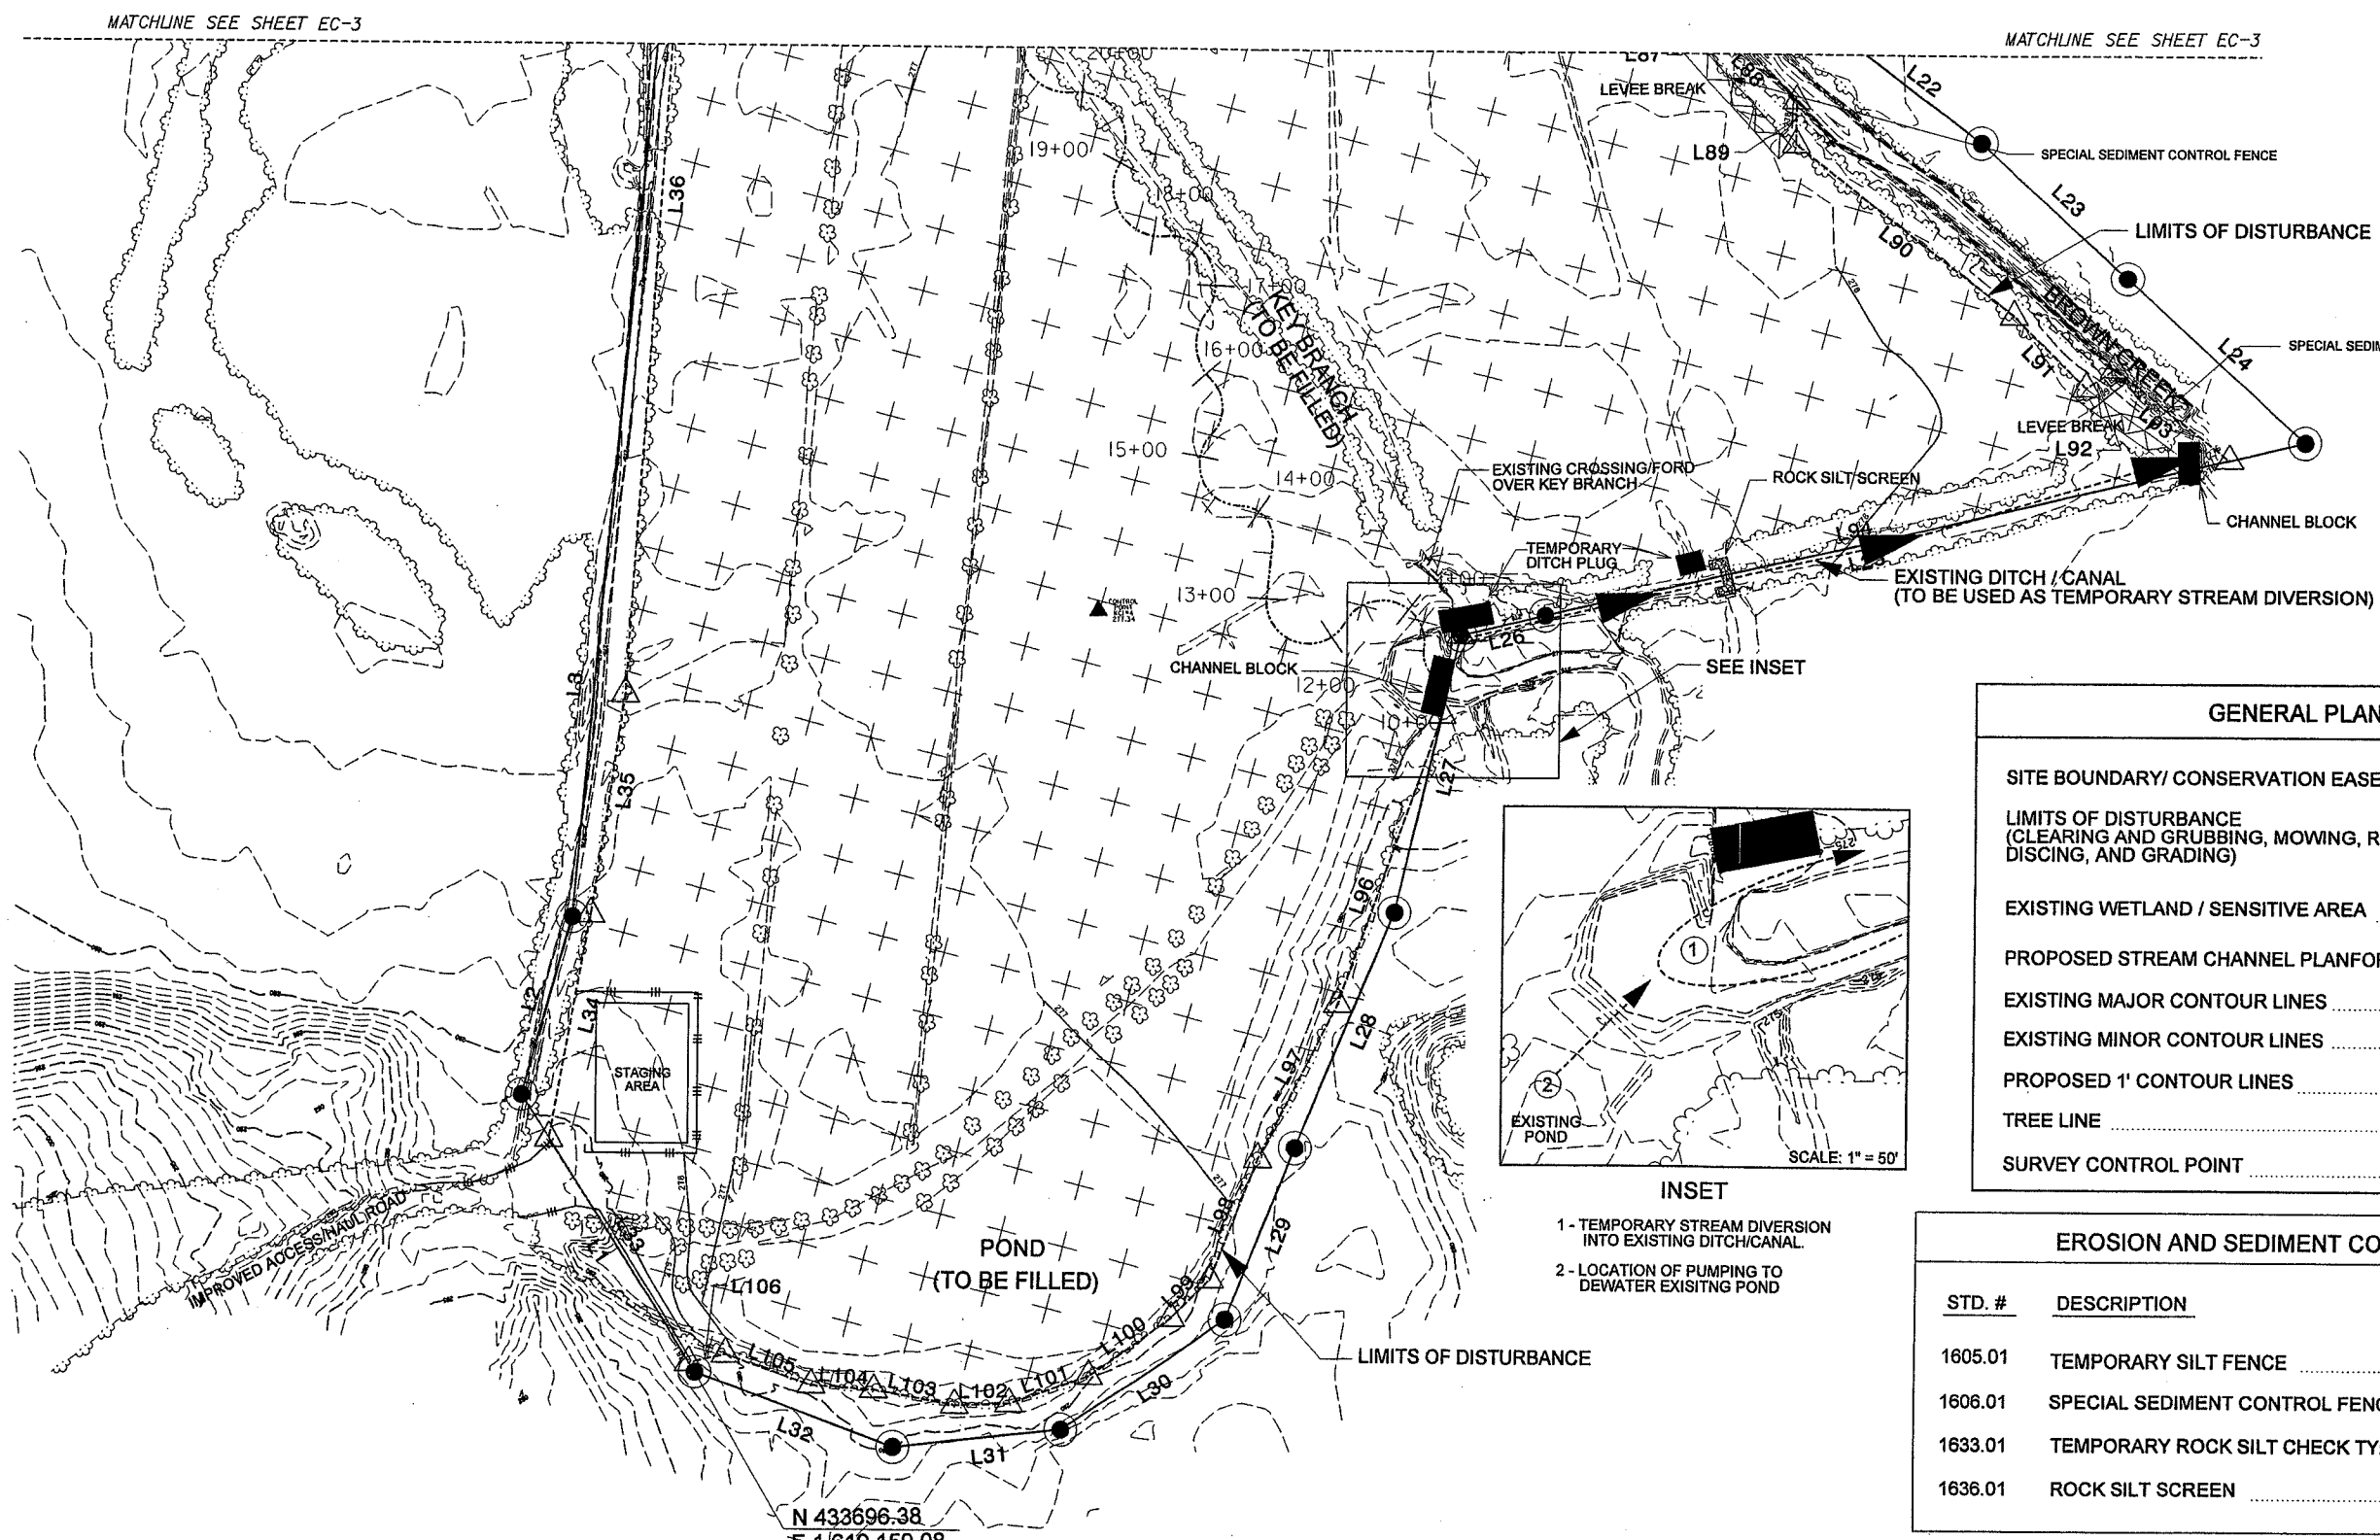


GENERAL PLAN LEGEND	
SITE BOUNDARY/ CONSERVATION EASEMENT	
LIMITS OF DISTURBANCE (CLEARING AND GRUBBING, MOWING, RIPPING, DISCING, AND GRADING)	
EXISTING WETLAND / SENSITIVE AREA	
PROPOSED STREAM CHANNEL PLANFORM	
EXISTING MAJOR CONTOUR LINES	
EXISTING MINOR CONTOUR LINES	
PROPOSED 1' CONTOUR LINES	
TREE LINE	
SURVEY CONTROL POINT	

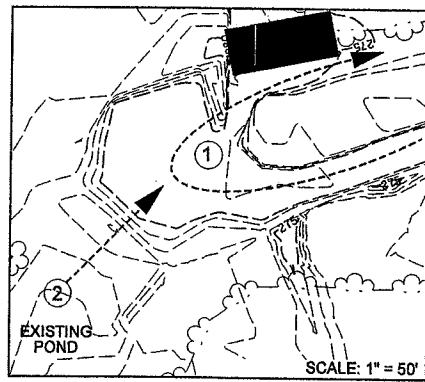


- INSET**
- 1- TEMPORARY STREAM DIVERSION INTO EXISTING DITCH/CANAL.
  - 2- LOCATION OF PUMPING TO DEWATER EXISTING POND

EROSION AND SEDIMENT CONTROL MEASURES		
STD. #	DESCRIPTION	SYMBOL
1605.01	TEMPORARY SILT FENCE	
1606.01	SPECIAL SEDIMENT CONTROL FENCE	
1633.01	TEMPORARY ROCK SILT CHECK TYPE-A	
1636.01	ROCK SILT SCREEN	

**SEDIMENT AND EROSION CONTROL**

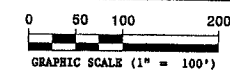



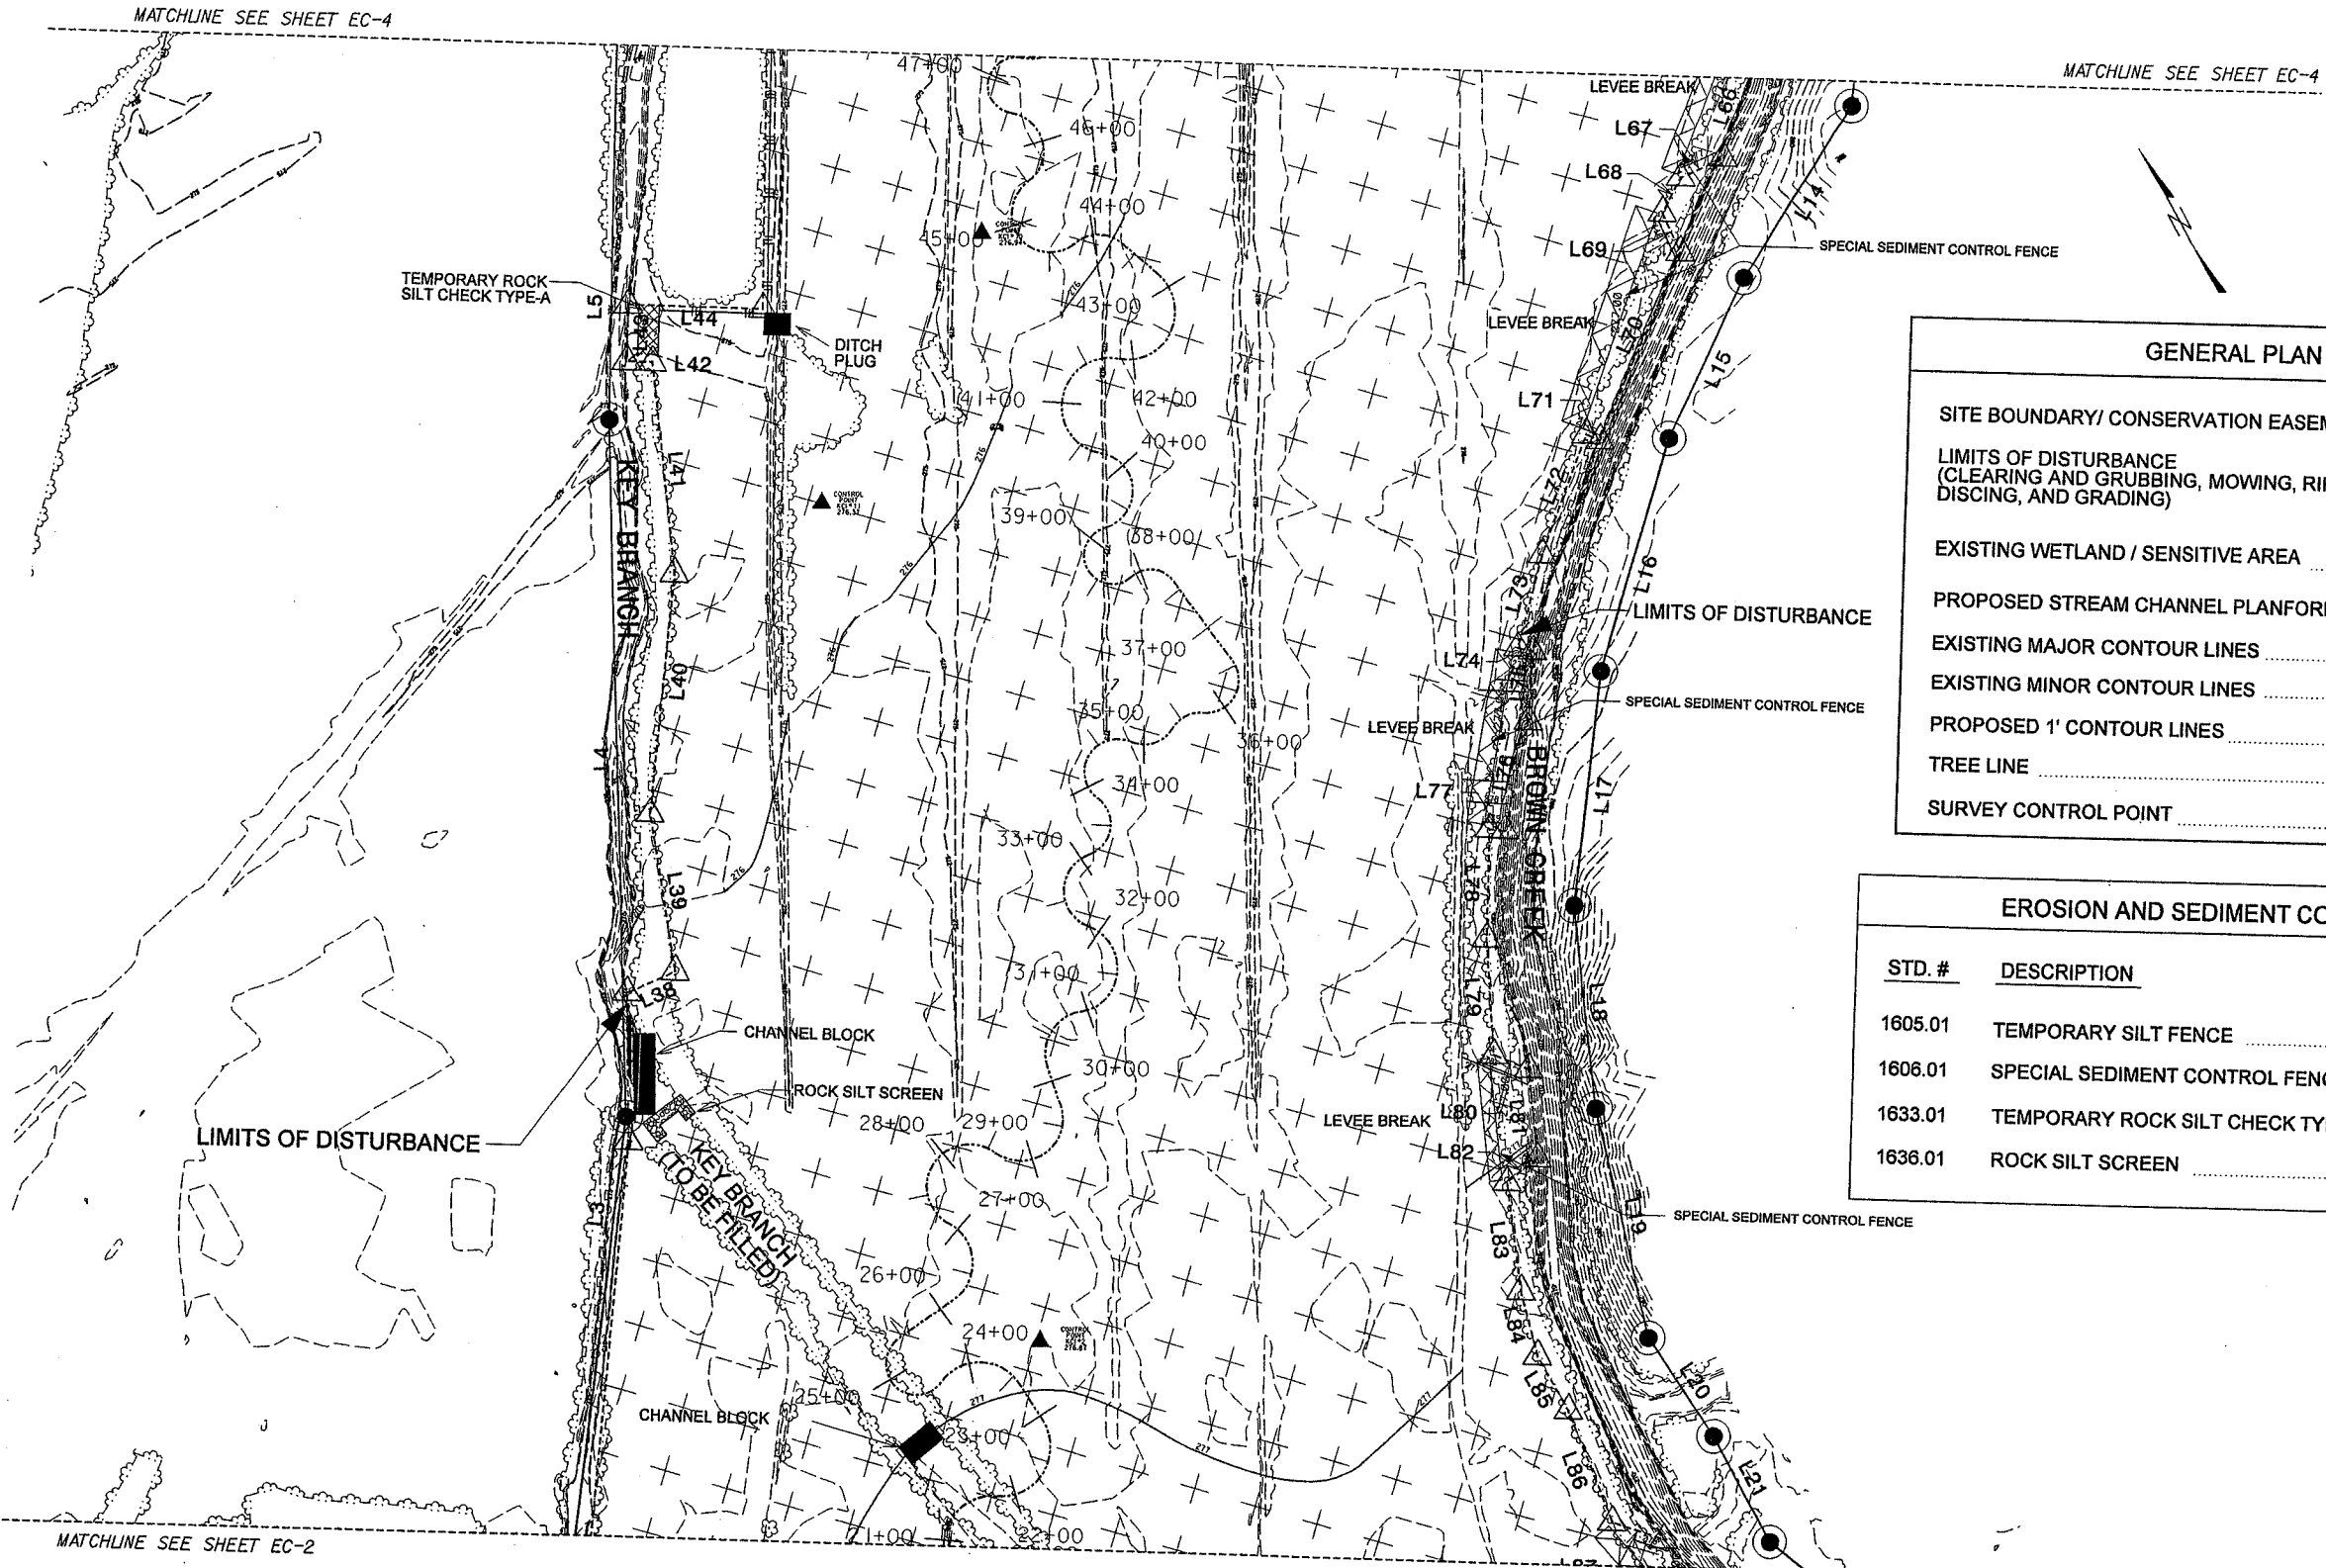


### GENERAL PLAN LEGEND


SITE BOUNDARY/ CONSERVATION EASEMENT	
LIMITS OF DISTURBANCE (CLEARING AND GRUBBING, MOWING, RIPPING, DISCING, AND GRADING)	
EXISTING WETLAND / SENSITIVE AREA	
PROPOSED STREAM CHANNEL PLANFORM	
EXISTING MAJOR CONTOUR LINES	
EXISTING MINOR CONTOUR LINES	
PROPOSED 1' CONTOUR LINES	
TREE LINE	
SURVEY CONTROL POINT	

### EROSION AND SEDIMENT CONTROL MEASURES

STD. #	DESCRIPTION	SYMBOL
1605.01	TEMPORARY SILT FENCE	
1606.01	SPECIAL SEDIMENT CONTROL FENCE	
1633.01	TEMPORARY ROCK SILT CHECK TYPE-A	
1636.01	ROCK SILT SCREEN	

### SEDIMENT AND EROSION CONTROL

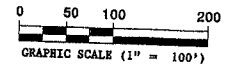

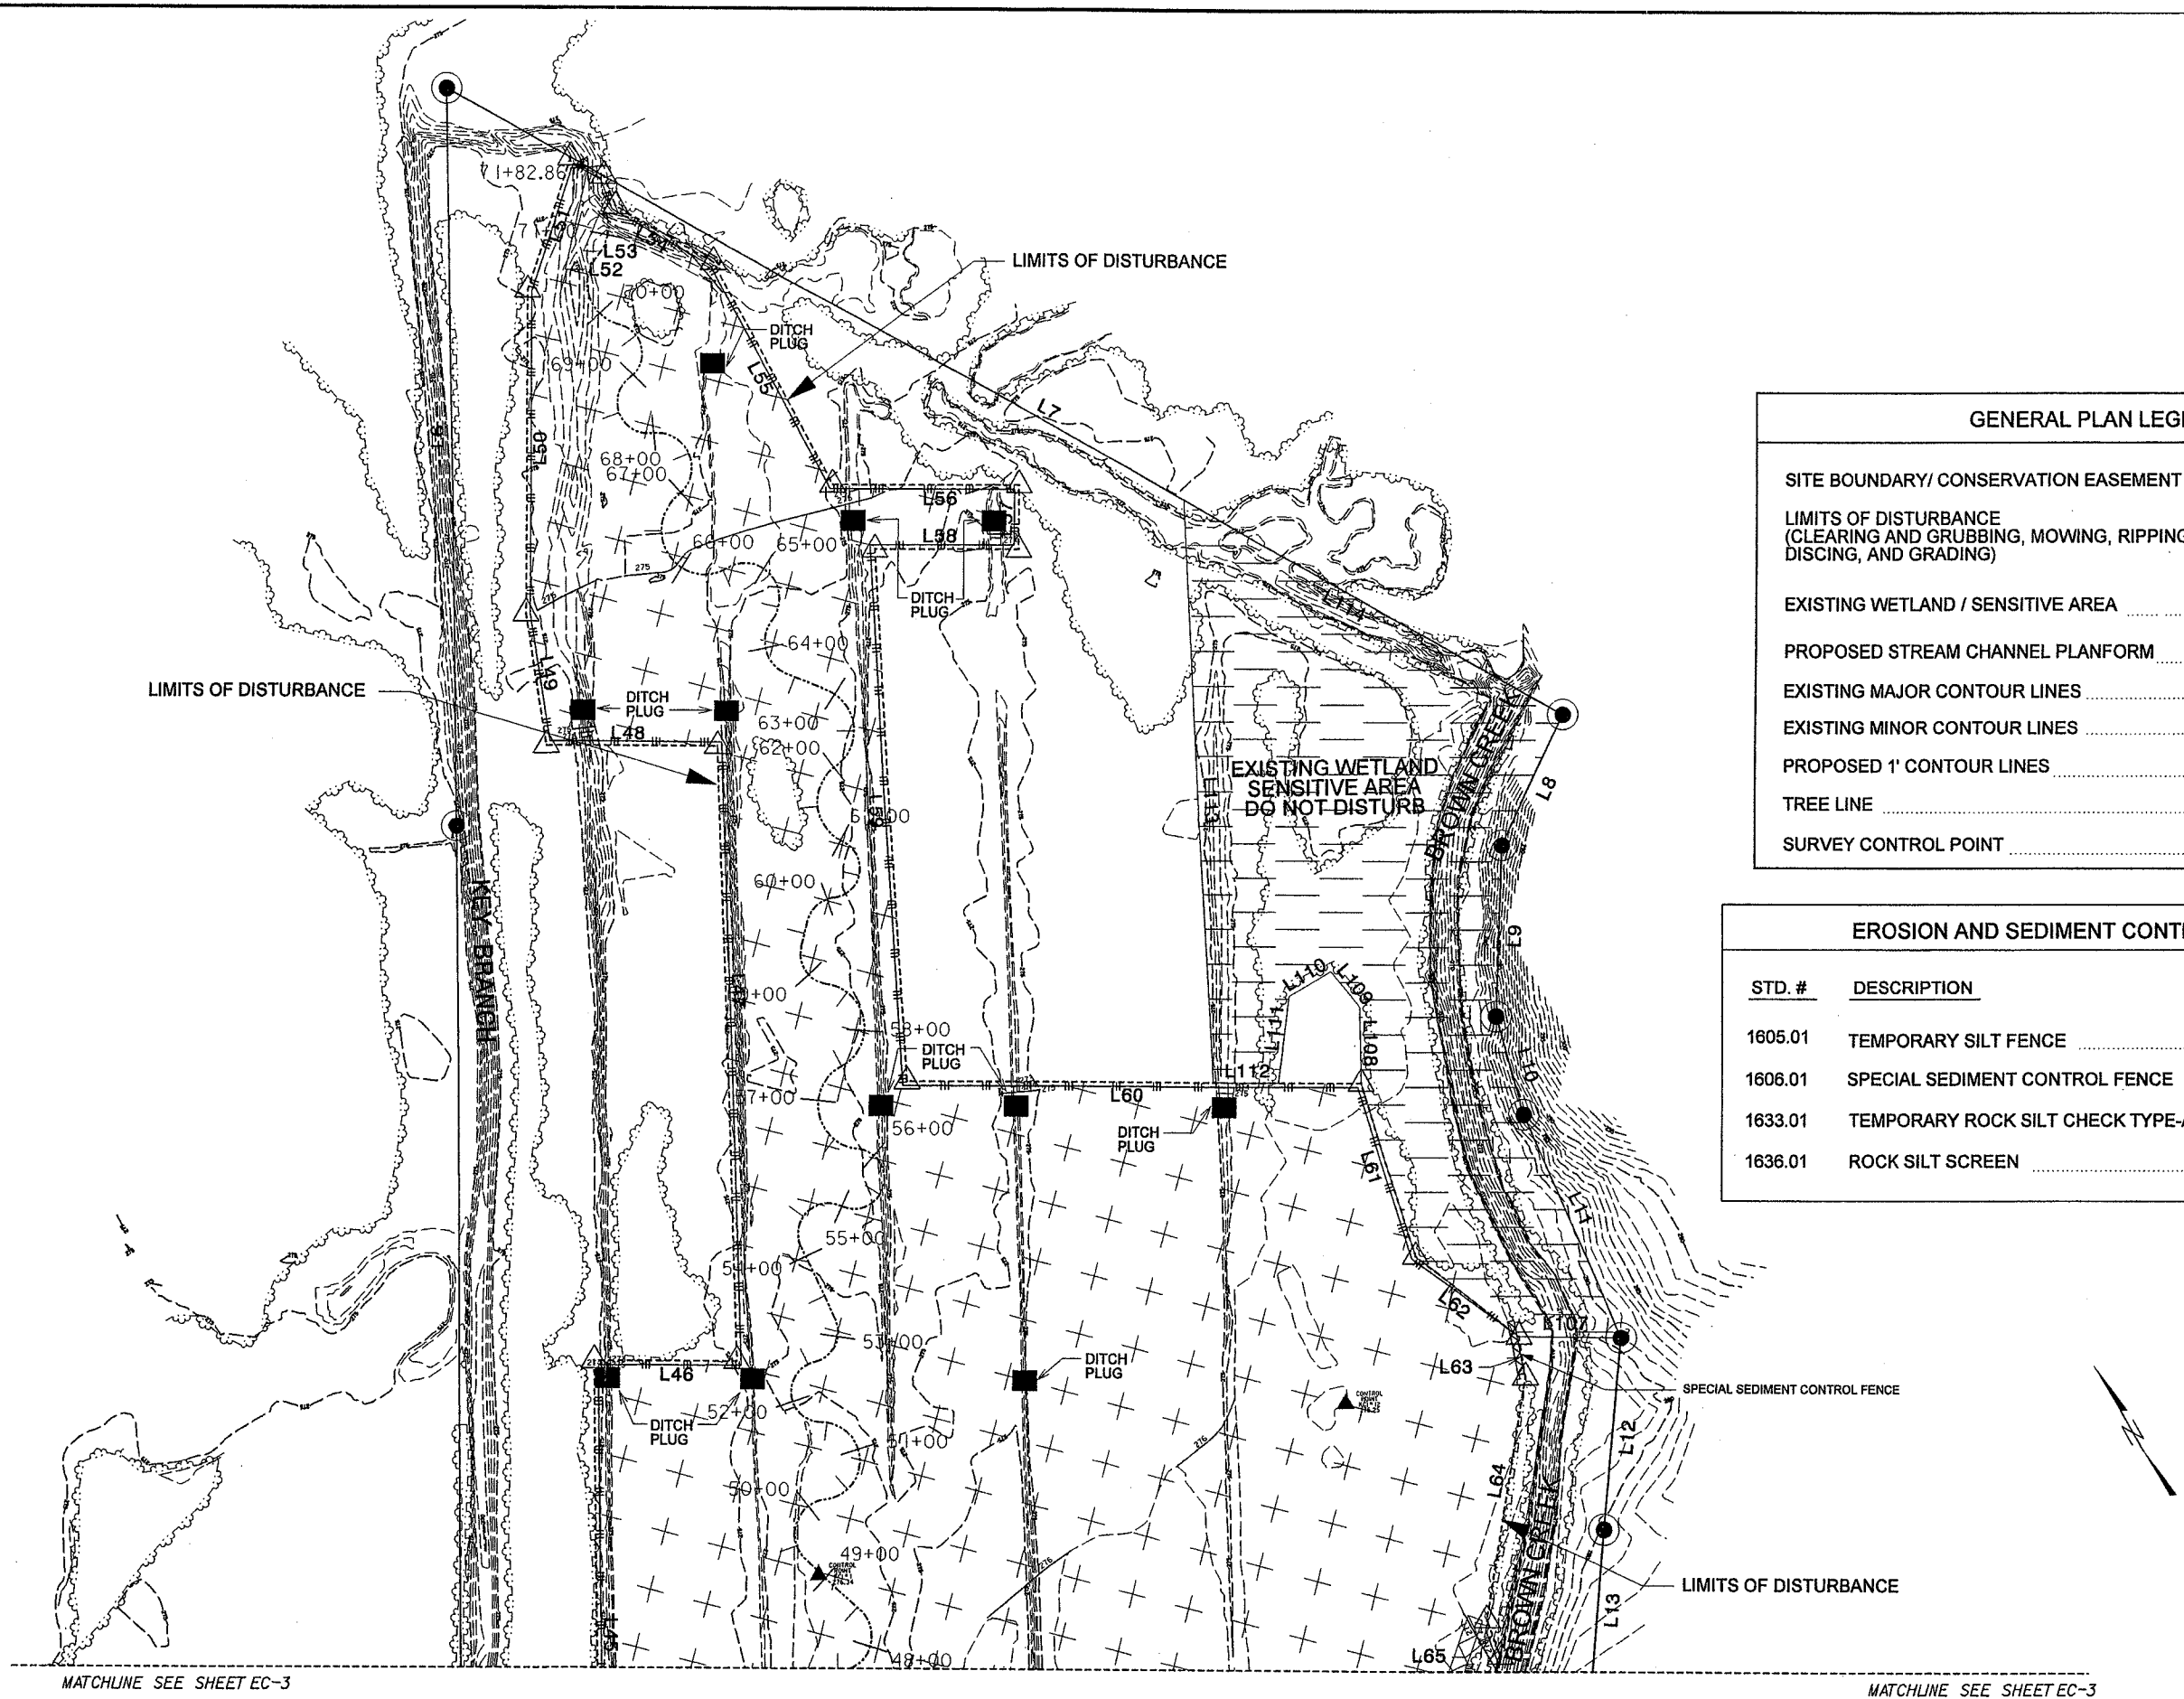


GENERAL PLAN LEGEND	
SITE BOUNDARY/ CONSERVATION EASEMENT	
LIMITS OF DISTURBANCE (CLEARING AND GRUBBING, MOWING, RIPPING, DISCING, AND GRADING)	
EXISTING WETLAND / SENSITIVE AREA	
PROPOSED STREAM CHANNEL PLANFORM	
EXISTING MAJOR CONTOUR LINES	
EXISTING MINOR CONTOUR LINES	
PROPOSED 1' CONTOUR LINES	
TREE LINE	
SURVEY CONTROL POINT	

EROSION AND SEDIMENT CONTROL MEASURES		
STD. #	DESCRIPTION	SYMBOL
1605.01	TEMPORARY SILT FENCE	
1606.01	SPECIAL SEDIMENT CONTROL FENCE	
1633.01	TEMPORARY ROCK SILT CHECK TYPE-A	
1636.01	ROCK SILT SCREEN	

MATCHLINE SEE SHEET EC-3

MATCHLINE SEE SHEET EC-3

**SEDIMENT AND EROSION CONTROL**

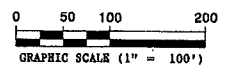

SEDIMENT & EROSION CONTROL


# PLANTING DETAILS

## SEEDLING / LINER BARERoot PLANTING DETAIL


### HEALING IN

1. Locate a healing-in site in a shady, well protected area.


2. Excavate a flat bottom trench 12" deep and provide drainage.

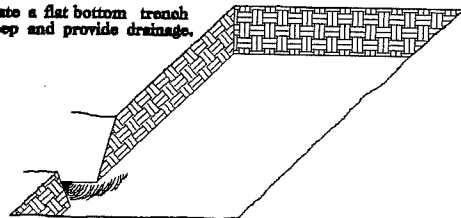


3. Backfill the trench with 2" well rotted sawdust. Place a 2" layer of well rotted sawdust at a sloping angle at one end of the trench.

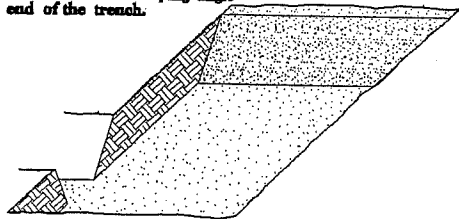

4. Place a single layer of plants against the sloping end so that the root collar is at ground level.

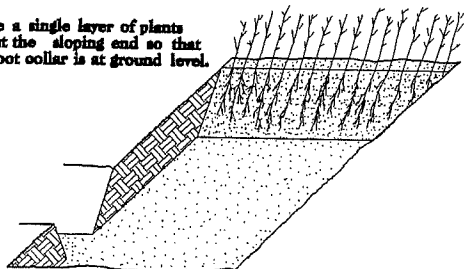


5. Place a 2" layer of well rotted sawdust over the roots maintaining a sloping angle.

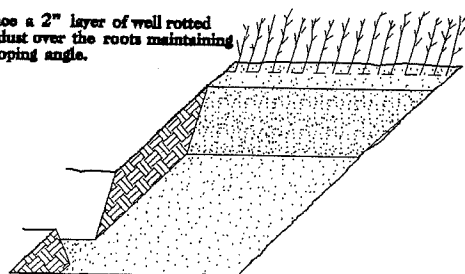


6. Repeat layers of plants and sawdust as necessary and water thoroughly.


### DIBBLE PLANTING METHOD USING THE KBC PLANTING BAR

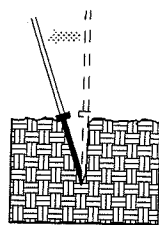


1. Insert planting bar as shown and pull handle toward planter.

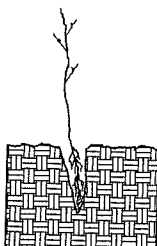


2. Remove planting bar and place seedling at correct depth.

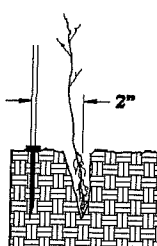


3. Insert planting bar 2" toward planter from seedling.

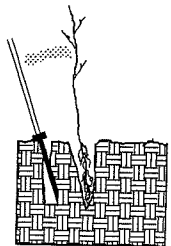

4. Pull handle of bar toward planter, firming soil at bottom.

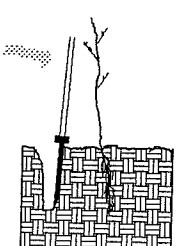

5. Push handle forward firming soil at top.

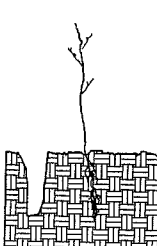

6. Leave compaction hole open. Water thoroughly.

### PLANTING NOTES:

**PLANTING BAG**  
During planting, seedlings shall be kept in a moist canvas bag or similar container to prevent the root systems from drying.



**KBC PLANTING BAR**  
Planting bar shall have a blade with a triangular cross section, and shall be 12" long, 4" wide and 1" thick at center.



**ROOT PRUNING**  
All seedlings shall be root pruned, if necessary, so that no roots extend more than 10 inches (10") below the root collar.

# KEY BRANCH WETLAND PLANTING

STATE	STATE PROJECT REFERENCE NO.	SHEET NO.	TOTAL SHEETS
N.C.	R-2231WM	RF-1	
STATE PROJ. NO.	F.A. PROJ. NO.	DESCRIPTION	

### WETLAND TREE REFORESTATION

MIXTURE, TYPE, SIZE, AND FURNISH SHALL CONFORM TO THE FOLLOWING:

FRAXINUS PENNSYLVANICA  
QUERCUS LYRATA  
BETULA NIGRA  
QUERCUS MICHAUXII  
QUERCUS NIGRA  
QUERCUS PHELLOS

GREEN ASH  
OVERCUP OAK  
RIVER BIRCH  
SWAMP CHESTNUT OAK  
WATER OAK  
WILLOW OAK

BARERoot SEEDLING  
BARERoot SEEDLING  
TREE REFORESTATION SHALL BE PLANTED 6' TO 10' ON CENTER, RANDOM SPACING, AVERAGING 8' ON CENTER, APPROXIMATELY 680 PLANTS PER ACRE.

SEE PLAN SHEETS FOR AREAS TO BE PLANTED



## WETLAND REFORESTATION DETAIL SHEET

N.C.D.O.T. - ROADSIDE ENVIRONMENTAL UNIT


STATE	STATE PROJECT REFERENCE NO.	SHEET NO.	TOTAL SHEETS
N.C.	R-2231WM	RF-2	
STATE FUNDING	F.A.FUNDING	DESCRIPTION	

# PLANTING DETAILS

## LIVE STAKES PLANTING DETAIL

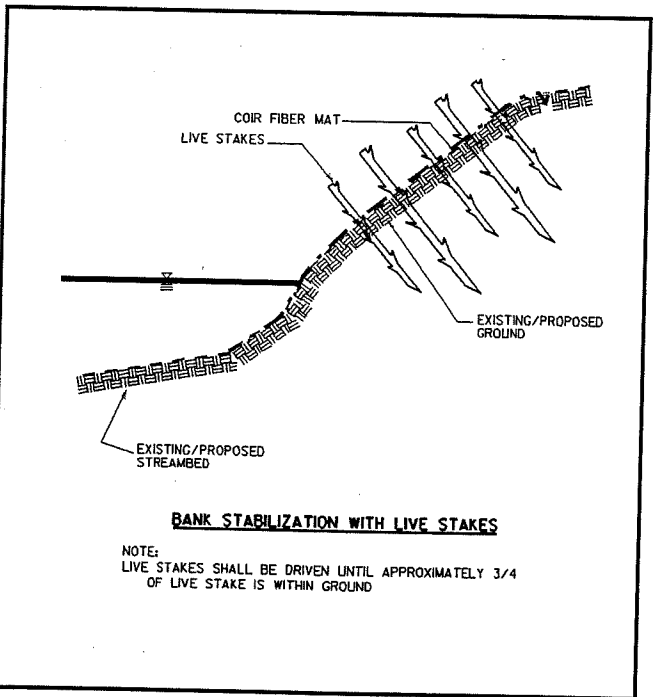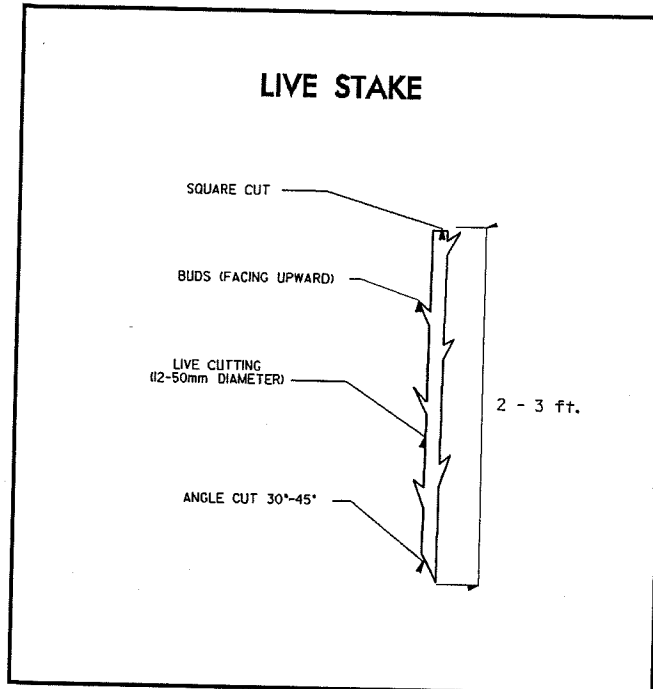

## BAREROOT PLANTING DETAIL DIBBLE PLANTING METHOD USING THE KBC PLANTING BAR

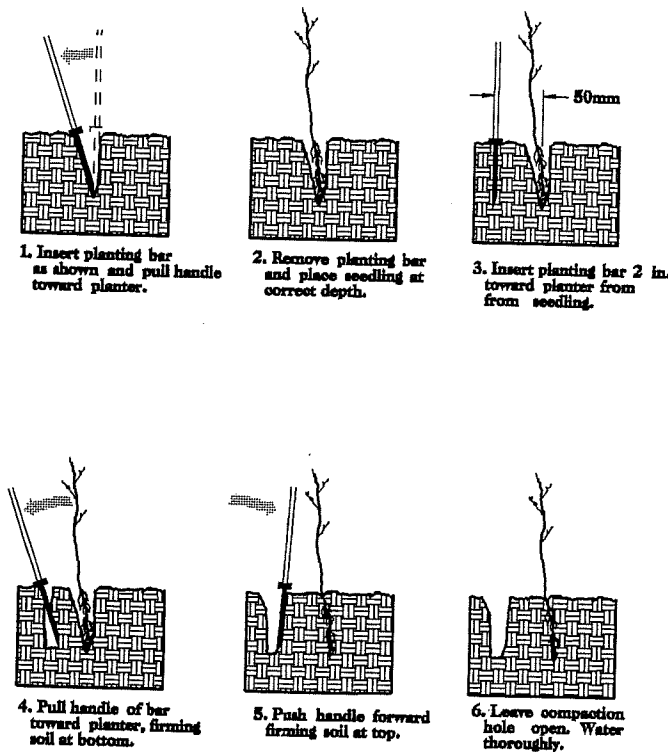

### PLANTING NOTES:

**PLANTING BAG**  
During planting, seedlings shall be kept in a moist canvas bag or similar container to prevent the root systems from drying.




**KBC PLANTING BAR**  
Planting bar shall have a blade with a triangular cross section, and shall be 12 in. long, 4 in. wide and 1 in. thick at center.



**ROOT PRUNING**  
All seedlings shall be root pruned, if necessary, so that no roots extend more than 10 in. below the root collar.

TYPE 1 STREAMBANK REFORESTATION SHALL BE PLANTED 3 ft. TO 5 ft. ON CENTER, RANDOM SPACING, AVERAGING 4 ft. ON CENTER, APPROXIMATELY 2723 PLANTS PER ACRE.

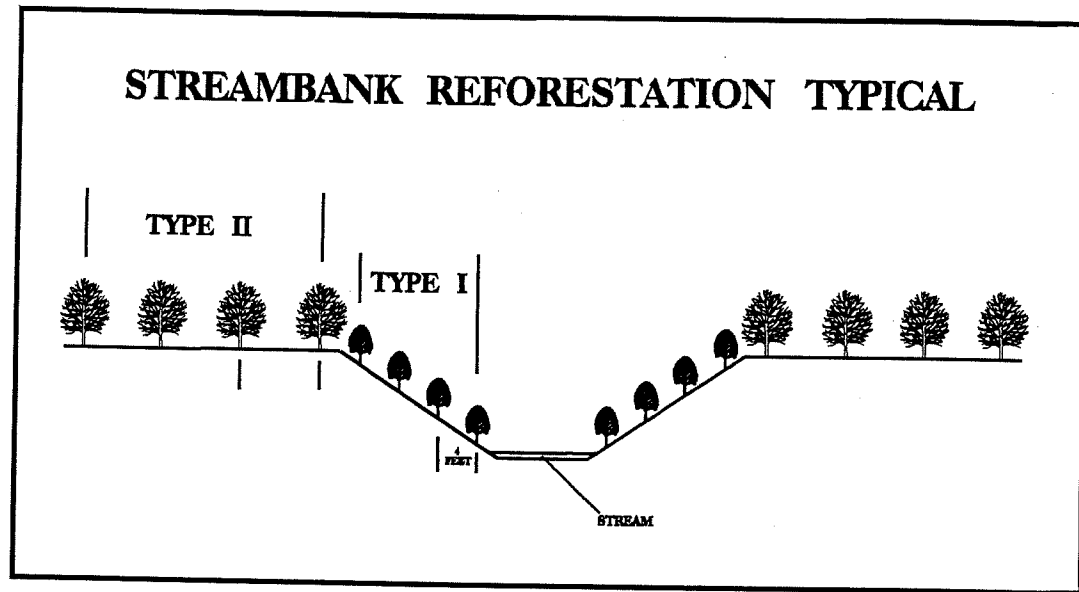

### STREAMBANK REFORESTATION

MIXTURE, TYPE, SIZE, AND FURNISH SHALL CONFORM TO THE FOLLOWING:


TYPE 1		
50% SALIX NIGRA	BLACK WILLOW	24 in. to 36 in. LIVE STAKES
50% CORNUS AMOMUM	SILKY DOGWOOD	24 in. to 36 in. LIVE STAKES

SEE PLAN SHEETS FOR AREAS TO BE PLANTED

**STREAMBANK REFORESTATION  
DETAIL SHEET**  
N.C.D.O.T. - ROADSIDE ENVIRONMENTAL UNIT

PROJECT REFERENCE NO.	SHEET NO.
R-2231 WM	
R/W SHEET NO.	
ENGINEER	SCIENTIST

# KEY BRANCH PLANTING PLAN

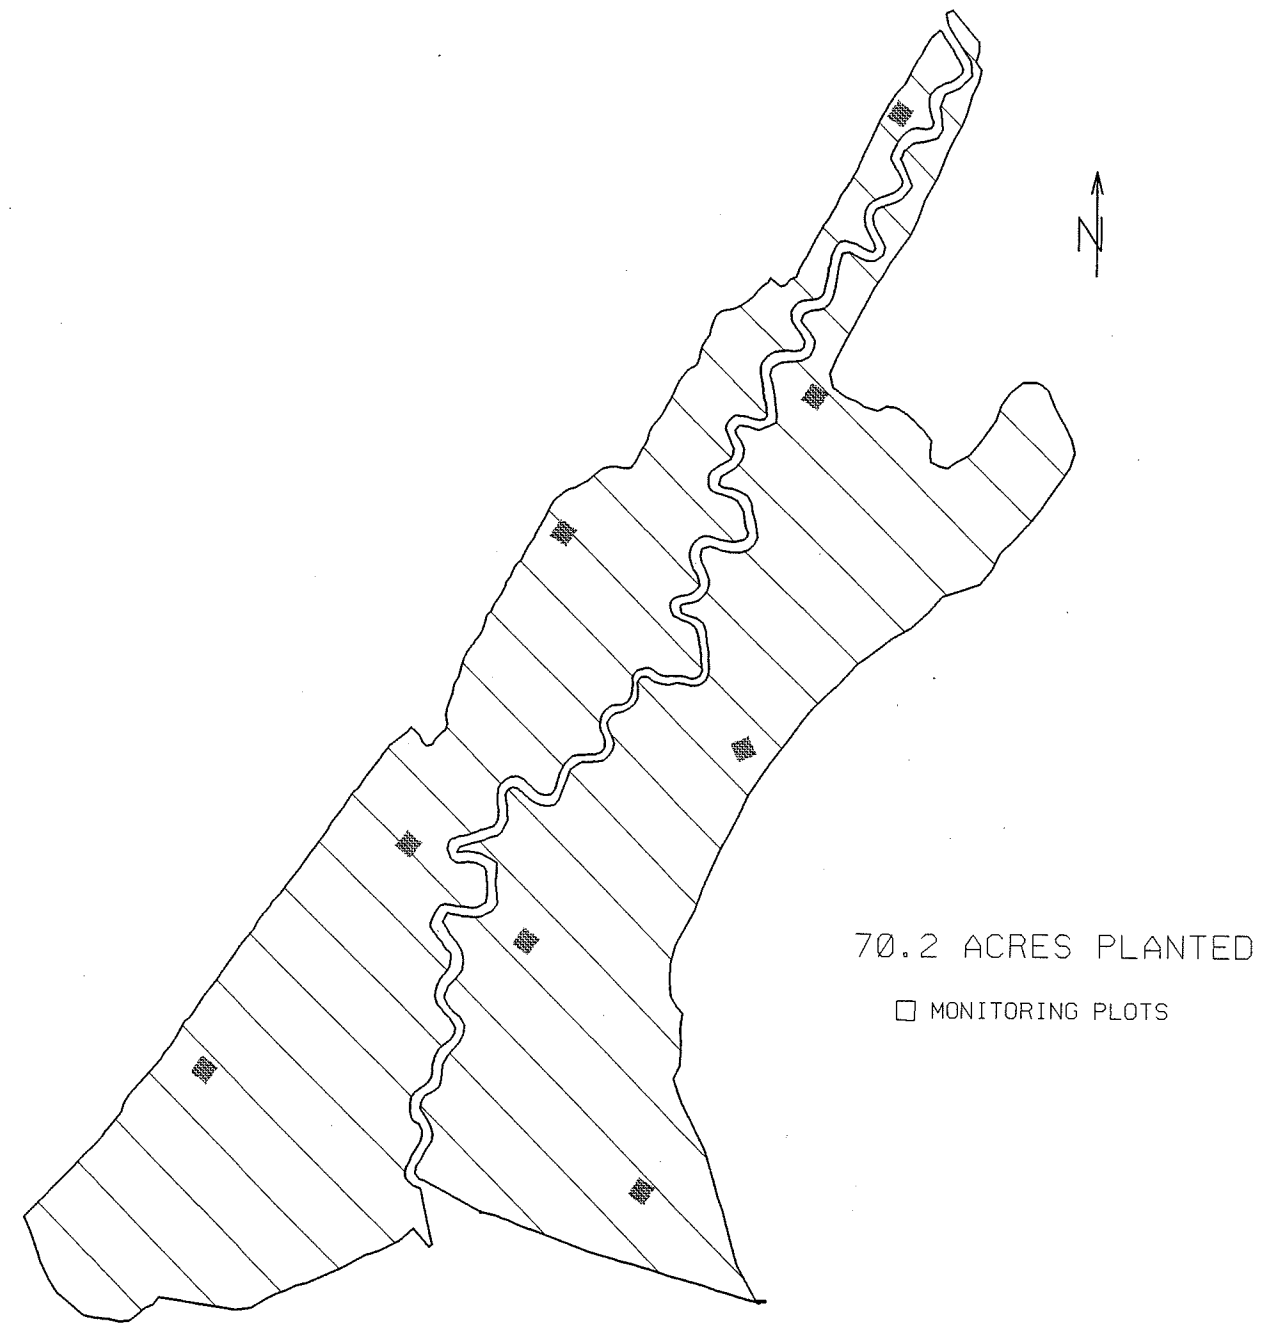

# MONITORING GAUGE & VEGETATION PLOT MAP

PROJECT REFERENCE NO. R-2231WM	SHEET NO.
R/W SHEET NO.	
ENGINEER	SCIENTIST

