

# Little White Oak Creek Stream Restoration

Polk County, North Carolina

Broad River Basin  
Cataloging Unit 03050105

CONTRACT # D06027-B



Prepared For:



Ecosystem Enhancement Program  
Department of Environment and Natural Resources  
1652 Mail Service Center  
Raleigh, NC 27699-1652

## MITIGATION REPORT

August 2008



Owner



NCDENR  
Ecosystem Enhancement Program  
Department of Environment and Natural Resources  
1652 Mail Service Center  
Raleigh, NC 27699-1652

EEP Project Manager: Guy Pearce  
Phone: (919) 715-1656

---

Design and Monitoring Firm



Mulkey Engineers and Consultants  
6750 Tryon Road  
Cary, North Carolina 27518  
Phone: (919) 851-1912  
Fax: (919) 851-1918

Project Manager: Wendee B. Smith  
Phone: (919) 858-1833

Project Engineer: Scott Hunt  
Phone: (919) 858-1825





### Table of Contents

**Executive Summary** ..... i

**1.0 Introduction** ..... **1**

1.1 Project Goals and Objectives ..... 1

1.2 Project Location ..... 1

1.3 Project Description and Watershed Characterization ..... 1

**2.0 Post Construction Site Conditions**..... **2**

2.1 Methods ..... 2

2.2 Streams ..... 3

2.3 Oxbow Wetlands ..... 4

2.4 Planted Vegetation ..... 4

**3.0 Monitoring Plan** ..... **4**

3.1 Dimension ..... 5

3.2 Pattern ..... 5

3.3 Profile ..... 5

3.4 Hydrology ..... 6

3.5 Vegetation ..... 6

3.6 Photo Documentation ..... 7

3.7 Bed Material ..... 7

3.8 BEHI and NBS Assessments ..... 7

3.9 Reporting ..... 8

**4.0 Maintenance and Contingency Plan** ..... **8**

**5.0 References** ..... **9**

### Figures

- Figure 1. Location Map
- Figure 2. Project Map

### Tables

- Table 1. Stream Restoration Summary
- Table 2. Designed Vegetative Communities
- Table 3. Vegetation Sampling Plot Information

### Appendices

- Appendix A. As-Built Plan Drawings
- Appendix B. Cross Sections
- Appendix C. Cross Section Photographs (Year 0, 2008)
- Appendix D. Crest Gauge Photographs (Year 0, 2008)
- Appendix E. Vegetation Plot Photographs (Year 0, 2008)
- Appendix F. Reference Photo Points (Year 0, 2008)
- Appendix G. Pebble Count Data (Year 0, 2008)

## **EXECUTIVE SUMMARY**

The Little White Oak Creek Stream Restoration Site (LWOC) is located in Polk County approximately 2.5 miles east/southeast from the Community of Mill Springs along NC Highway 9 South, and approximately 0.5 mile northwest from the intersection of NC Highway 9 South and US Highway 74. LWOC is located 0.6 mile north of Exit 167 at the intersection of NC Highway 9 and US 74, approximately 78 miles from Charlotte and 47 miles from Asheville. LWOC is situated in the Broad River Basin 8-digit cataloging unit of 03050105 and the 14-digit cataloging unit 03050105030010. Mulkey, Inc. (Mulkey) acquired an easement covering 55.3 acres, which will encompass the streams and associated buffers at LWOC (Figure 1).

LWOC is comprised of three main reaches (R1, R2 Upper and R2 Lower) and four tributaries (R1A, R2A, R2B and R2D). Prior to construction, these seven reaches were identified and proposed for restoration due to their distinct stream characteristics and drainage areas. The overall drainage area for LWOC is 7,124 acres (11.1 square miles). These seven existing reaches totaled approximately 15,487 linear feet (Table 1 and Figure 2).

The existing conditions at LWOC were a result of cattle use for the past 50 years. There are approximately 200 cattle and horses currently utilizing the pastures. These livestock have never been fenced from any of the stream channels within LWOC. This continual livestock access to the streams has resulted in substantial erosion along the stream banks, incision of the channels, channel widening in some areas, and heavy siltation throughout LWOC, as well as reduced water quality due to large quantities of fecal matter into the stream system. Through information from the property owner, we know that many of the streams at the LWOC, particularly the smaller tributaries, were historically maintained through channelization, dredging, and clearing of the riparian buffer.

Restoration of the stream channels was accomplished by using Natural Stream Channel design methods developed by Rosgen (1996). The proposed Rosgen channel type for two of the tributaries (R2A and R2B) was a C4 channel. These tributaries were implemented using Priority Level I and II methodologies. The proposed stream classification for the majority of the reaches (R1, R1A, R2 Upper, and R2 Lower) was a C5 channel. A combination of Priority Level I and II methods were used to construct these reaches. The remaining reach (R2D) was proposed to be a C6 channel using the same methods previously mentioned.

To restore the riparian and upland buffer communities along LWOC, a variety of plants that naturally occur in this physiographic province and within a specific hydrologic setting will be used. These plants will comprise a target community which will emulate the Piedmont/Low Mountain Alluvial Forest described by Shafale and Weakley (1990).

A total of 18,290 linear feet of stream channel was restored at LWOC within the 55.3 acre conservation easement (Table 1). Stream restoration activities were accomplished by using Priority Level I and II methodologies as defined by Rosgen (1998).

The restoration of the stream channels and their adjacent buffers combined with the establishment of a fenced conservation easement has provided multiple ecological improvements to LWOC. The primary ecological benefits of these restoration activities include improved water quality, soil stabilization, improved aquatic and terrestrial habitat, and natural flooding capabilities.

Success criteria for stream mitigation sites are based on guidelines established by the USACE, US Environmental Protection Agency (USEPA), NC Wildlife Resources Commission (NCWRC) and the NCDWQ (USACE *et al.*, 2003). These guidelines establish criteria for both hydrologic conditions and vegetation survival. LWOC will follow the success criteria set forth by these agencies.

Yearly monitoring reports will serve as the method for determining success at LWOC. Monitoring will be performed until success criteria are met up to a period of five years. Monitoring is proposed for hydrologic stream stability and vegetation. The monitoring plan will be designed in accordance with Stream Mitigation Guidelines (USACE *et al.*, 2003) and as specified by the EEP's monitoring report requirements (EEP, 2005a). Results will be documented on an annual basis, with the associated reports submitted to EEP as evidence that goals are being achieved. In the event that goals are not being met, Mulkey will coordinate with EEP to develop a plan for ameliorating the areas of concern.



## **1.0 Introduction**

LWOC lies within two parcels that have historically been used for pasture and forest land. Cattle and other land uses over the past 50 years have resulted in substantial degradation to the streams and riparian buffers. In addition, large quantities of fecal matter and several dead cattle were observed in the stream channels during the initial site visits. As a result of these land and water quality issues, Mulkey submitted LWOC for the Full Delivery RFP 16-D06027 to provide 18,200 Stream Mitigation Units (SMUs). Mulkey was awarded the stream restoration contract and began work on the project on May 16, 2007.

### **1.1 Project Goals and Objectives**

The primary goals of LWOC were to improve water quality, to reduce bank erosion, to reestablish a floodplain along each of the stream reaches, and to improve the aquatic and terrestrial wildlife habitat.

These goals will be met through the following objectives:

- By using natural channel design to restore stable pattern, dimension, and profile for 18,290 linear feet of stream channel
- By establishing a conservation easement, which will protect the streams from cattle intrusion and future development activities
- By establishing a floodplain or reconnecting the stream back to its historic floodplain, or a combination of both, for each project stream reach
- By creating or restoring floodplain features such as vernal pools, off channel ponds, or riparian wetlands
- By increasing the amount of aquatic habitat through the addition of rock and wood structures
- By reestablishing native plant communities throughout the conservation easement, whereby reintroducing shading, cover areas, and travel corridors.

### **1.2 Project Location**

LWOC is located in Polk County approximately 2.5 miles east/southeast from the Community of Mill Springs along NC Highway 9 South, and approximately 0.5 mile northwest from the intersection of NC Highway 9 South and US Highway 74 (Figure 1). LWOC is situated in the Broad River Basin 8-digit cataloging unit of 03050105 and the 14-digit cataloging unit 03050105030010. Mulkey has acquired an easement covering 55.3 acres, which will encompass the streams and associated buffers at the Site (Figure 2).

### **1.3 Project Description and Watershed Characterization**

The two main streams at LWOC are third order streams, Little White Oak Creek at the north end of the Site and South Branch Little White Oak Creek at the south end. These two streams converge at the center of LWOC as Little White Oak Creek to form a fourth order

stream. LWOC also includes one second order unnamed tributary and five first order unnamed tributaries.

The headwaters of the Little White Oak Creek are located southeast of Lake Adger and north and east of Little White Oak Mountain then flow in an easterly direction through the project site. The drainage area of Little White Oak Creek as it enters the project area is approximately 3,400 acres (5.3 square miles). The headwaters of the South Branch Little White Oak Creek are located north and east of Fox Mountain and flow east to its confluence with Little White Oak Creek. The drainage area of the South Branch of the Little White Oak Creek as it enters the project area is approximately 2,560 acres (4.0 square miles). The overall drainage area of the project is 7,124 acres (11.1 square miles).

It is estimated that 78% of the land cover within the watershed is forest or wetland. Although urbanization is dramatically increasing in the area, it is estimated there is currently 2% of urbanized (impervious) area in the watershed. The remaining land cover is pasture and cultivated cropland. Due to the increase in development in the adjacent properties surrounding LWOC, the property currently encompassing the conservation easement will likely be developed in the next decade.

## **2.0 Post Construction Site Conditions**

### **2.1 Methods**

Mulkey utilized natural channel design methods to restore approximately 18,290 linear feet of stream channel (Rosgen, 1998). Restoration of the stream channels was accomplished by using Natural Stream Channel design methods developed by Rosgen (1996). The proposed stream classification for the majority of the reaches (R1, R1A, R2 Upper, and R2 Lower) was a C5 channel. A combination of Priority Level I and II methods were used to construct these reaches. The proposed Rosgen channel type for two of the tributaries (R2A and R2B) was a C4 channel. These tributaries were also implemented using Priority Level I and II methodologies. The remaining reach (R2D) was proposed to be a C6 channel using the same methods previously mentioned.

During construction, modifications are always made to the plans due to various constraints including bedrock, vegetation, soil, etc. The restoration of the reaches proposed installing 191 rock structures (cross vane, j-hook, and rock vanes), 32 constructed riffles, and numerous rootwads throughout the site.

Post construction surveys depicted in Appendix A (Sheets 20 – 33), illustrate the changes to the proposed design. Field changes at the site were typically minor, with most of the changes involving the adjustment of benches and grading to protect vegetation at the site. Bedrock was encountered in several locations and structures were modified or moved to account for its occurrence.

Mulkey conducted monitoring baseline surveys along the entire length of each of the restored project stream reaches using total station survey equipment. These surveys were

conducted to establish or to document baseline conditions for the newly restored stream channels for future monitoring activities. As an industry standard, such surveys are also used for other purposes such as comparing how a proposed design was actually constructed versus what was proposed, including the length of stream actually constructed versus what length of stream was proposed by the design.

Streams are typically measured along their thalweg by surveying the representative points creating the known, repeating sequence of stream features (i.e., head of riffle, head of run, head of pool, max pool, and the head of glide) along with other supplemental points to adequately describe the stream's horizontal geometry (i.e., points on tangents and points on curves) or other site specific stream features. Once these points are surveyed, they are then typically "connected" via straight line segments when the survey is processed to create the drawing describing the alignment of the surveyed stream. Because a representative number of points connected by straight line segments are used to describe a stream alignment that is actually a smooth, continuous curve, accepted total station survey practices can only approximate, albeit closely, the actual length of a stream. The more feet of stream that are measured using this process, the greater the magnitude or difference between the actual stream footage and the measured stream footage, with the measured stream footage being shorter than the actual stream footage. As described above, because of the magnitude of this project, the footage of restored stream measured during the monitoring baseline survey was less than the footage of stream actually restored. To clearly demonstrate that at least 18,200 linear feet of stream were restored within the project easement boundaries, Mulkey conducted supplemental measurements of the project stream reaches using additional, more accurate techniques. These techniques included connecting the surveyed thalweg points in Microstation using smooth curves instead of straight line segments as well as diligently field-measuring the thalweg of the restored stream alignments with a cloth tape. This additional exercise was conducted solely to demonstrate that at least 18,200 linear feet of stream were restored at the Little White Oak Creek Stream Restoration Site. The results of these measurements of restored channel are shown in Table 1. As noted above, the alignments created using the results of the monitoring baseline surveys will be used to establish baseline stationing for as-built and monitoring documentation and activities.

Major grading and channel construction was completed during the last week of November 2007. As-Built Surveys were conducted immediately following the installation of plant material. The following sections describe the conditions of LWOC following construction and follow the guidelines for Mitigation Reports (NCEEP, 2005).

## **2.2 Streams**

The stream reaches at LWOC were surveyed utilizing aerial photography and total station survey equipment and by following the protocols set forth by the 2003 USACE Stream Mitigation guidelines. Stream data included in this report shall serve as the basis for future monitoring reports.

Longitudinal profiles were surveyed along the entire length of all restored reaches. Longitudinal profiles were surveyed by identifying each stream feature (riffle, run, pool, or



glide) and surveying specific points at each feature. These specific locations included top of bank, bankfull, water's edge or surface, and thalweg). A summary of the restored stream channel lengths and their proposed Stream Mitigation Units (SMUs) are outlined in Table 1. A complete set of As-Built Drawings including a plan view, longitudinal profiles for restored channels, and a proposed versus as-built plan view can be found in Appendix A.

### **2.3 Oxbow Wetlands**

Oxbow wetlands were created throughout LWOC where conditions permitted their installation. Most of the oxbow wetlands were created by modifying sections of abandoned channel that were left unfilled. Where feasible, mature vegetation was saved around the oxbow wetland areas to provide shading, seed source, as well as woody detritus input. The oxbow wetlands will provide additional floodplain habitat diversity as well as providing some additional flood storage. It is anticipated that the oxbow wetlands will also trap sediment, woody debris and seeds during flood flows, thereby providing additional habitat benefits. During wet seasons, some of the oxbow wetlands are expected to catch and hold runoff as well as ground water, thus providing a greater diversity of aquatic habitat at the site. These oxbow wetlands are shown on the As-Built Drawings in Appendix A.

Additionally, a treated waste water pipe emanating from the Polk County School property along NC 9 now deposits into an oxbow wetland prior to entering Little White Oak Creek. This reconfiguration of the outfall pipe area provides retention time for the effluent, increased nutrient uptake, and overall water quality improvement.

### **2.4 Planted Vegetation**

All plant material was installed during the months of November and December 2007. A list of vegetation planted within each planting zone can be found in Table 2. Specific vegetation plot information including plot size, species, and species counts can be found in Table 3. A total of 24 vegetation plots were installed in December 2007 to provide long-term monitoring of the plant material. In addition to planted vegetation, great efforts were made during construction to save mature riparian vegetation along the restored and abandoned stream channels.

### **3.0 Monitoring Plan**

Stream channel monitoring will determine the degree of success a mitigation project has achieved in meeting the objectives of providing proper channel function and improved aquatic habitat. Stream monitoring will be performed each year for a 5-year monitoring period. The following sections describe the methods, frequencies, and success criteria for preparing a monitoring report for LWOC. Monitoring guidelines described in this section follow the outline described in the "Content, Format, and Data Requirements for EEP Monitoring Reports, Version 1.1" dated September 16, 2005. Success criteria for stream mitigation sites are based on guidelines established by the USACE, US Environmental Protection Agency (USEPA), NC Wildlife Resources Commission (NCWRC) and the NCDWQ (USACE *et. al*, 2003). These guidelines establish criteria for both hydrologic

conditions and vegetation survival. LWOC site conditions will be monitored during the latter part of the growing season months (August, September, and October) over the 5-year monitoring period. This monitoring period will allow compliance with the RFP#16-D0627 requirements.

### **3.1 Dimension**

A total of 13 permanent cross sections were established across LWOC to establish baseline data for future monitoring reports. Cross section information and photos for the 13 permanent cross sections can be found in Appendix B and C respectively. The number of cross sections was determined using the sampling rates outlined by the USACE et al. (2003).

These cross sections will be surveyed each year of the 5-year monitoring period. Specific stations for each permanent cross section have been established during the As-Built Surveys and should be recreated during the monitoring years. Cross section stationing always begins on the left side of the channel while facing downstream and continues across to the right side. The left side and right sides of the stream channel are marked with a polyvinyl chloride (PVC) pipes with a rebar pin inside the PVC. An aluminum tag identifies the cross section number on the left side of the channel.

Dimension measurements should remain consistent from year to year and should fall within the proposed design parameter outlined in the restoration plan. It is expected that minor adjustments in dimension will occur such as the development of point bars and the subsequent deepening of pool. As vegetation becomes established and the stream banks are stabilized, it is anticipated that the width depth ratios will decrease and that the entrenchment ratios will likely increase slightly, both within the normal ranges for C and E stream channel types.

### **3.2 Pattern**

Pattern for the constructed channels will be measured using Microstation after completing the yearly monitoring surveys. Three specific measurements will be made for each reach including Radius of Curvature, Meander Wavelength, and Belt Width. These measurements will be made along the specified sampling areas for monitoring which correspond directly to the longitudinal profiles for each reach.

Pattern measurements should remain consistent from year to year and fall within the proposed design parameters outlined in the restoration plan. As vegetation becomes established and the stream banks are stabilized, it is anticipated that the sinuosity of the streams will adjust, likely becoming more sinuous with time.

### **3.3 Profile**

As a part of the As-built Surveys, longitudinal profiles were conducted for the entire lengths of the restored channels (Appendix A). Longitudinal profiles were surveyed by identifying each stream feature (riffle, run, pool, or glide) and surveying specific points at each feature.

These specific locations included top of bank, bankfull, water's edge or surface, and thalweg). The monitoring lengths of each reach were determined using the sampling rates outlined by the USACE et al. (2003). A total of 5,893 linear feet (32%) of all restored stream channels will be surveyed during the monitoring period.

Following the sampling rates discussed above, longitudinal profiles should be conducted for monitoring as shown below:

R1 – 1,974 Linear Feet Total (Stations 14+00-R1- through 33+74-R1-)  
R1A – 500 Linear Feet Total (Stations 0+00-R1A- through 5+00-R1A-)  
R2 – 2,047 Linear Feet Total (Stations 25+13-R2- through 45+60-R2-)  
R2A – 326 Linear Feet Total (Stations 0+00-R2A- through 3+26-R2A-)  
R2B – 551 Linear Feet Total (Stations 9+35-R2B- through 14+86-R2B-)  
R2D – 495 Linear Feet Total (Stations 2+84-R2D- through 7+79-R2D-)

Longitudinal profiles should remain relatively consistent (stable) from year to year. Profiles should not show aggrading or degrading conditions during the 5-year monitoring period, however, minor profile adjustments such as deepening of pools is expected. Channels should be indicative of the proposed Rosgen channel type (Rosgen 1994, 1996).

### **3.4 Hydrology**

Hydrology will be assessed throughout the 5-year monitoring period to determine the occurrence of bankfull events at LWOC. A minimum of two bankfull events must be documented within the 5-year monitoring period and these must occur during separate monitoring years. Crest gauges will be used to determine the occurrence of these bankfull events. To further document these events, a rain gauge with a datalogger will be installed at the LWOC, so as to obtain on-site precipitation records.

Eight crest gauges were installed across LWOC, with one at each reach and one at the confluence of R1 and R2. Photos of the crest gauges can be found in Appendix D. These gauges will be checked during each visit to LWOC for the entire 5-year monitoring period.

### **3.5 Vegetation**

Planted vegetation will be evaluated using stem counts and vegetation plots. Mulkey installed 24 vegetation plots were installed throughout LWOC to assess the survival of planted vegetation (Appendix E). Plots were installed randomly throughout the site and have a total area of approximately 100 square meters. An iron pipe was installed at each plot corner and a polyvinyl chloride (PVC) pipe was installed at the corner specified for photo documentation. A label specifying the plot number is attached to each PVC pipe corner. During the establishment of these plots, stems were identified, counted, and flagged on lateral branches. Specific information regarding each vegetation plot can be found in Table 3.



Vegetation success at LWOC will be measured by survivability over a five year monitoring period. Survivability will be based on achieving at least 320 stems per acre after three years and 260 stems per acre after five years. Stem counts will be conducted on annual basis to calculate survivability.

If during any given year, the planted species are not anticipated to meet final criteria established for vegetation; supplemental plantings will be considered. In the event that this occurs, a remedial planting plan will be developed that will achieve the survivability goals established for Years 3 and 5.

### **3.6 Photo Documentation**

Photo documentation is essential to monitoring the success of a restoration site because it provides a visual assessment of the stream and vegetative conditions. A total of 11 permanent reference photo points were installed at the site using rebar and PVC. Photos from these permanent locations can be found Appendix F. In the event that circumstances require, additional photo points may be added during the first year of monitoring to adequately depict the site conditions.

### **3.7 Bed Material**

Bed material will be assessed using the Modified Wolman pebble counts. These pebble counts will be conducted each year of the 5-year monitoring period during the specified monitoring time frame. Large reaches including R1 and R2 will be sampled at each permanent cross section location from bankfull to bankfull. These larger reaches should be sampled at a rate of 25 counts per cross section (Example – R1 has 4 cross sections which will equal 100 counts for the entire reach). The smaller tributary reaches including R1A, R2A, R2B, and R2D should be sampled at a rate of 50 counts per reach. Sampling on the smaller tributaries should be completed from bankfull to bankfull on 3 riffle and 2 pool features with 10 counts being collected at each feature specified. Data collected for each reach is presented in Appendix G.

Success criteria for the bed material will be determined at the end of the 5-year monitoring period when data can be reviewed and compared to the proposed channel material type. Fluctuations in bed material will likely occur during the early years following construction and several years may be needed to observe a consistent bed material. Bed materials should ultimately reflect the proposed design conditions for each reach at LWOC.

### **3.8 BEHI and NBS Assessments**

Assessments of BEHI and NBS are currently recommended during monitoring years 3 & 5 following construction. Collection and presentation of the BEHI and NBS information should follow the format outlined by EEP's monitoring report guidelines (NCEEP, 2005a). Data collected during these years will be compared with pre-construction conditions to determine the change in bank erosion hazard indices and sediment export quantities for each reach assessed.

### **3.9 Reporting**

The monitoring reports will follow the methods outlined by the latest version of the EEP Guidance document guidance for monitoring report content, format, and data requirements. Monitoring reports will be submitted to the EEP's designated project representative for coordination with the appropriate regulatory agencies on an annual basis. It is understood that the EEP will coordinate any necessary monitoring report submittals with the regulatory agencies. If monitoring reports indicate any deficiencies in achieving the success criteria on schedule, a remedial action plan will be included in the annual monitoring reports.

### **4.0 Maintenance and Contingency Plan**

Mulkey will reassess the condition of the stream channels, structures, vegetation, and overall bank stability during the next five years of monitoring (2008 - 2012). In the event, there is significant problem or concern at the site, a meeting with EEP will be scheduled to discuss the problem. Mulkey will develop a remediation plan and schedule for addressing the particular problem and submit this to EEP for review and comment. Upon approval, Mulkey will initiate the remediation plan through the appropriate means.

## **5.0 References**

NCEEP. 2005. Mitigation Report DRAFT outline. September 20, 2005. NCDENR, NCEEP. 4 pp.

NCEEP. 2005a. Content, Format, and Data Requirements for EEP Monitoring Reports. Version 1.1, September 16, 2005. NCDENR, NCEEP. 17 pp.

Rosgen, D.L. 1998. The Reference Reach – A Blueprint for Natural Channel Design. From Proceedings of the Wetlands and Restoration Conference, March 1998, Denver CO. Wildland Hydrology, Pagosa Springs, CO.

Rosgen, D.L. 1996. Applied River Morphology. Wildland Hydrology, Pagosa Springs, Colorado.

Rosgen, D.L. 1994. A Classification of Natural Rivers. *Catena*, 22:169-199.

Schafale, M.P. and A.S. Weakley. 1990. Classification of the Natural Communities of North Carolina, Third Approximation. North Carolina Natural Heritage Program, Division of Parks and Recreation, N.C. Department of Environment, Health and Natural Resources.

USACE, USEPA, NCWRC, and NCDWQ. 2003. Stream Mitigation Guidelines. April 2003.



# **APPENDIX A**



SCO ID NO. D06027-B

# POLK COUNTY

## LITTLE WHITE OAK CREEK STREAM RESTORATION SITE

LOCATION: NORTHEAST OF THE INTERSECTION OF NC 9 AND US 74 (EXIT 167)

# AS-BUILT DRAWINGS

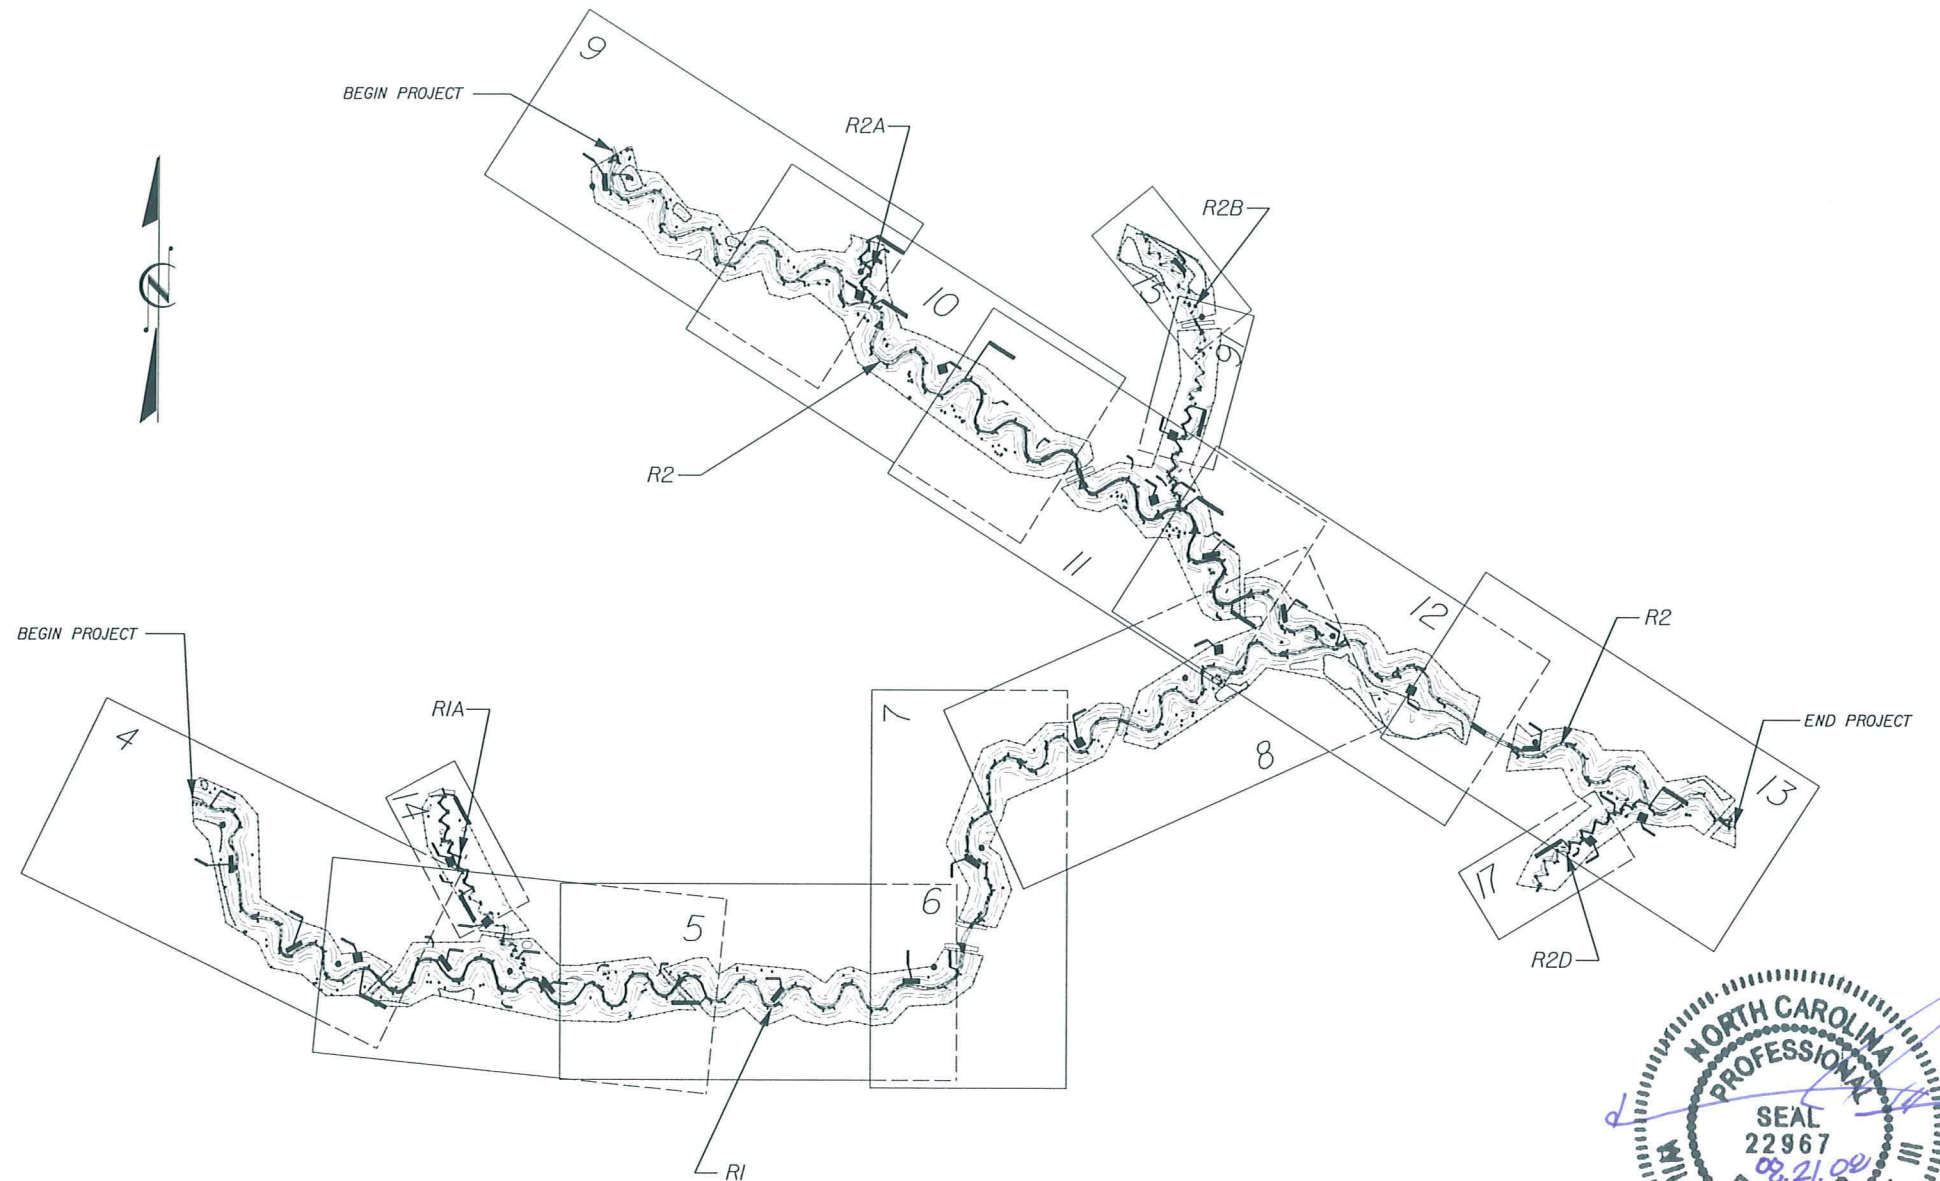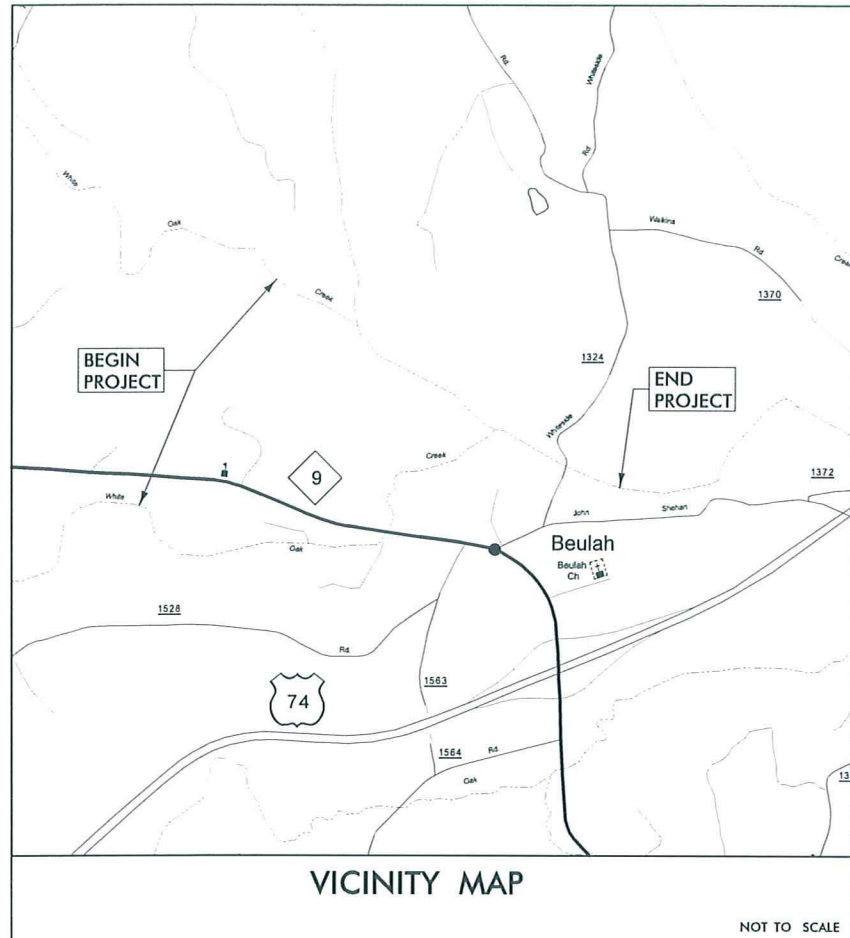

INDEX OF SHEETS	
SHEET NUMBER	SHEET
1	TITLE SHEET
2	LEGEND
3	PROJECT OVERVIEW
4 - 33	AS-BUILT DRAWINGS




NOT TO SCALE

REVISIONS			SCALE AS SHOWN		PLANS PREPARED BY:		PROJECT ENGINEER					
DATE	BY	DESCRIPTION	DATE:	3/14/08	<p>PO Box 33127 RALEIGH, N.C. 27636 (919) 851-1912 (919) 851-1918 (FAX) WWW.MULKEYINC.COM</p>		<p>MULKEY PROJECT MANAGER WENDEE B. SMITH</p> <p>MULKEY SENIOR ENGINEER WILLIAM SCOTT HUNT, III, PE</p> <p>MULKEY SENIOR SCIENTIST THOMAS BARRETT, RF</p>					
3/14/08	JTL	AS-BUILT DRAWINGS	DESIGNED:	WSH					<p><b>TITLE SHEET</b></p>		<p>1 SHEET OF 33</p>	
6/19/08	EMP	CHANGED MONITORING LIMITS	DRAWN:	JTL								
			CHECKED:	WSH								
			APPROVED:	WSH								
			MULKEY PROJECT NUMBER		2006237.00							



**NOTE: NOT TO SCALE**  
**Not all symbols used in plans**

# LEGEND

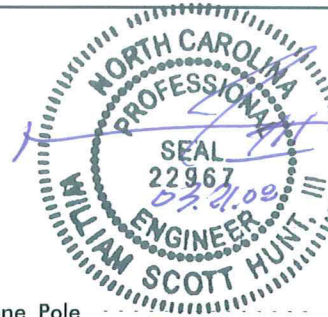

REVISIONS		
DATE	BY	DESCRIPTION
3/24/08	JTL	AS-BUILT DRAWINGS

PROJECT REFERENCE NO. SHEET NO.  
 LITTLE WHITE OAK CREEK 2

**LEGEND**

**MULKEY**  
 ENGINEERS & CONSULTANTS

PO Box 33127  
 RALEIGH, N.C. 27636  
 (919) 851-1912  
 (919) 851-1918 (FAX)  
 WWW.MULKEYINC.COM

**BOUNDARIES AND PROPERTY:**

State Line	-----
County Line	-----
Township Line	-----
City Line	-----
Reservation Line	-----
Property Line	-----
Existing Iron Pin	○
Property Corner	⊗
Property Monument	□
Existing Fence	-----
Temporary Fence	-----
Proposed Woven Wire Fence	-----
Proposed Chain Link Fence	-----
Proposed Barbed Wire Fence	-----
Tree Protection Fence	-----
Wetland Boundary	-----
Proposed Oxbow Wetland Boundary	-----
Conservation Easement	-----
Construction Limits	-----
Limits Of Disturbance	-----
Proposed Gate	⊗
Bench Mark	■
Control Point	⊗

**BUILDINGS AND OTHER CULTURE:**

Sign	○
Foundation	▭
Area Outline	▭
Building	▭
School	▭
Church	▭

**HYDROLOGY:**

Hydro, Pool or Reservoir	▭
River Basin Buffer	-----
Flow Arrow	←
Disappearing Stream	-----
Spring	○
Thalweg	-----
Top Of Bank	-----
Swamp Marsh	-----
Proposed Lateral, Tail, Head Ditch	-----
Bedrock	○

**RAILROADS:**

Standard Gauge	-----
RR Signal Milepost	○
Switch	□
RR Abandoned	-----

**ROADS AND RELATED FEATURES:**

Existing Edge of Pavement	-----
Existing Curb	-----
Existing Soil Road	-----
Existing Metal Guardrail	-----
Existing Cable Guiderail	-----

**VEGETATION:**

Single Tree	○
Single Shrub	○
Hedge	-----
Woods Line	-----
Orchard	-----
Vineyard	-----

**EXISTING STRUCTURES:**

<b>MAJOR:</b>	
Bridge, Tunnel or Box Culvert	▭
Bridge Wing Wall, Head Wall and End Wall	▭
<b>MINOR:</b>	
Head and End Wall	▭
Pipe Culvert	-----
Footbridge	-----
Drainage Box: Catch Basin, DI or JB	□
Paved Ditch Gutter	-----
Storm Sewer Manhole	○
Storm Sewer	-----

**UTILITIES:**

<b>POWER:</b>	
Existing Power Pole	●
Existing Joint Use Pole	●
Power Manhole	○
Power Line Tower	⊗
Power Transformer	⊗
U/G Power Cable Hand Hole	□
H-Frame Pole	●
Recorded U/G Power Line	-----
<b>GAS:</b>	
Gas Meter	○
Recorded U/G Gas Line	-----
Above Ground Gas Line	-----

**TELEPHONE:**

Existing Telephone Pole	●
Telephone Manhole	○
Telephone Booth	□
Telephone Pedestal	□
Telephone Cell Tower	⊗
U/G Telephone Cable Hand Hole	□
Recorded U/G Telephone Cable	-----
Recorded U/G Telephone Conduit	-----
Recorded U/G Fiber Optics Cable	-----
<b>WATER:</b>	
Water Manhole	○
Water Valve	⊗
Water Hydrant	⊗
Recorded U/G Water Line	-----
Above Ground Water Line	-----

**TV:**

TV Satellite Dish	⊗
TV Pedestal	□
TV Tower	⊗
U/G TV Cable Hand Hole	□
Recorded U/G TV Cable	-----
Recorded U/G Fiber Optic Cable	-----

**MISCELLANEOUS:**

Utility Pole	●
Utility Pole with Base	□
Utility Located Object	○
Utility Traffic Signal Box	□
Utility Unknown U/G Line	-----
U/G Tank; Water, Gas, Oil	▭
A/G Tank; Water, Gas, Oil	▭
Abandoned According to Utility Records	AATUR
End of Information	E.O.I.

**SANITARY SEWER:**

Sanitary Sewer Manhole	○
Sanitary Sewer Cleanout	⊕
U/G Sanitary Sewer Line	-----
Above Ground Sanitary Sewer	-----
Recorded SS Forced Main Line	-----

**PROPOSED STREAM WORK:**


<b>STREAM STRUCTURES:</b>	
Rock Crossvane	-----
Rock Vane	-----
J Hook Rock Vane	-----
Flood Plane Interceptor	-----
Constructed Riffle	-----
Root Wad	-----
Structure Number	○
Constructed Flood Plane Interceptor	-----

**STREAM FEATURES:**

Constructed Bankfull/Top Of Bank	-----
Old Top Of Bank	-----
Constructed Thalweg	-----
Proposed Thalweg	-----
Waters Edge	-----
Old Waters Edge	-----
Vernal Pool	▭
Surface Water	-----
Staging Area	-----
Impervious Dike	-----
Permanent Improved Gravel Road	-----
Temporary Gravel Road	-----
Stone Outlet Sediment Trap	-----
Impervious Stream Channel Plug	-----
Fill Existing Stream Channel	-----
Vegetation Plot	-----
<b>MISCELLANEOUS:</b>	
Photo Point	○
Cross Section	-----
Crest Gauge	-----




**Legend**

-  Easement
-  Restored Streams

PROJECT ENGINEER	PROJECT REFERENCE NO.	SHEET NO.
	LITTLE WHITE OAK CREEK	3
	AS-BUILT DRAWING	

**MULKEY**  
ENGINEERS & ARCHITECTS  
200 BUCKLE UP  
RALEIGH, N.C. 27604  
(919) 881-0112  
(919) 881-0114 (FAX)  
WWW.MULKEYINC.COM

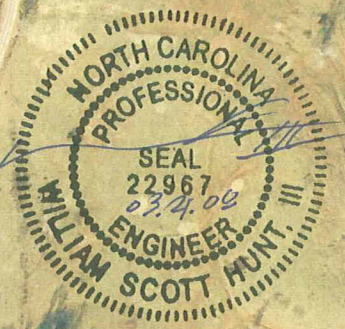



1:2,400  
1 inch equals 200 feet




REVISIONS		
DATE	BY	DESCRIPTION
3/14/08	JTL	AS-BUILT DRAWINGS
8/19/08	EMP	CHANGED MONITORING LIMITS

PROJECT ENGINEER

PROJECT REFERENCE NO.	SHEET NO.
LITTLE WHITE OAK CREEK	4
<b>AS-BUILT DRAWING</b>	
<b>MULKEY</b> ENGINEERS & CONSULTANTS	
PO Box 33127 RALEIGH, N.C. 27636 (919) 851-1912 (919) 851-1918 (FAX) WWW.MULKEYINC.COM	

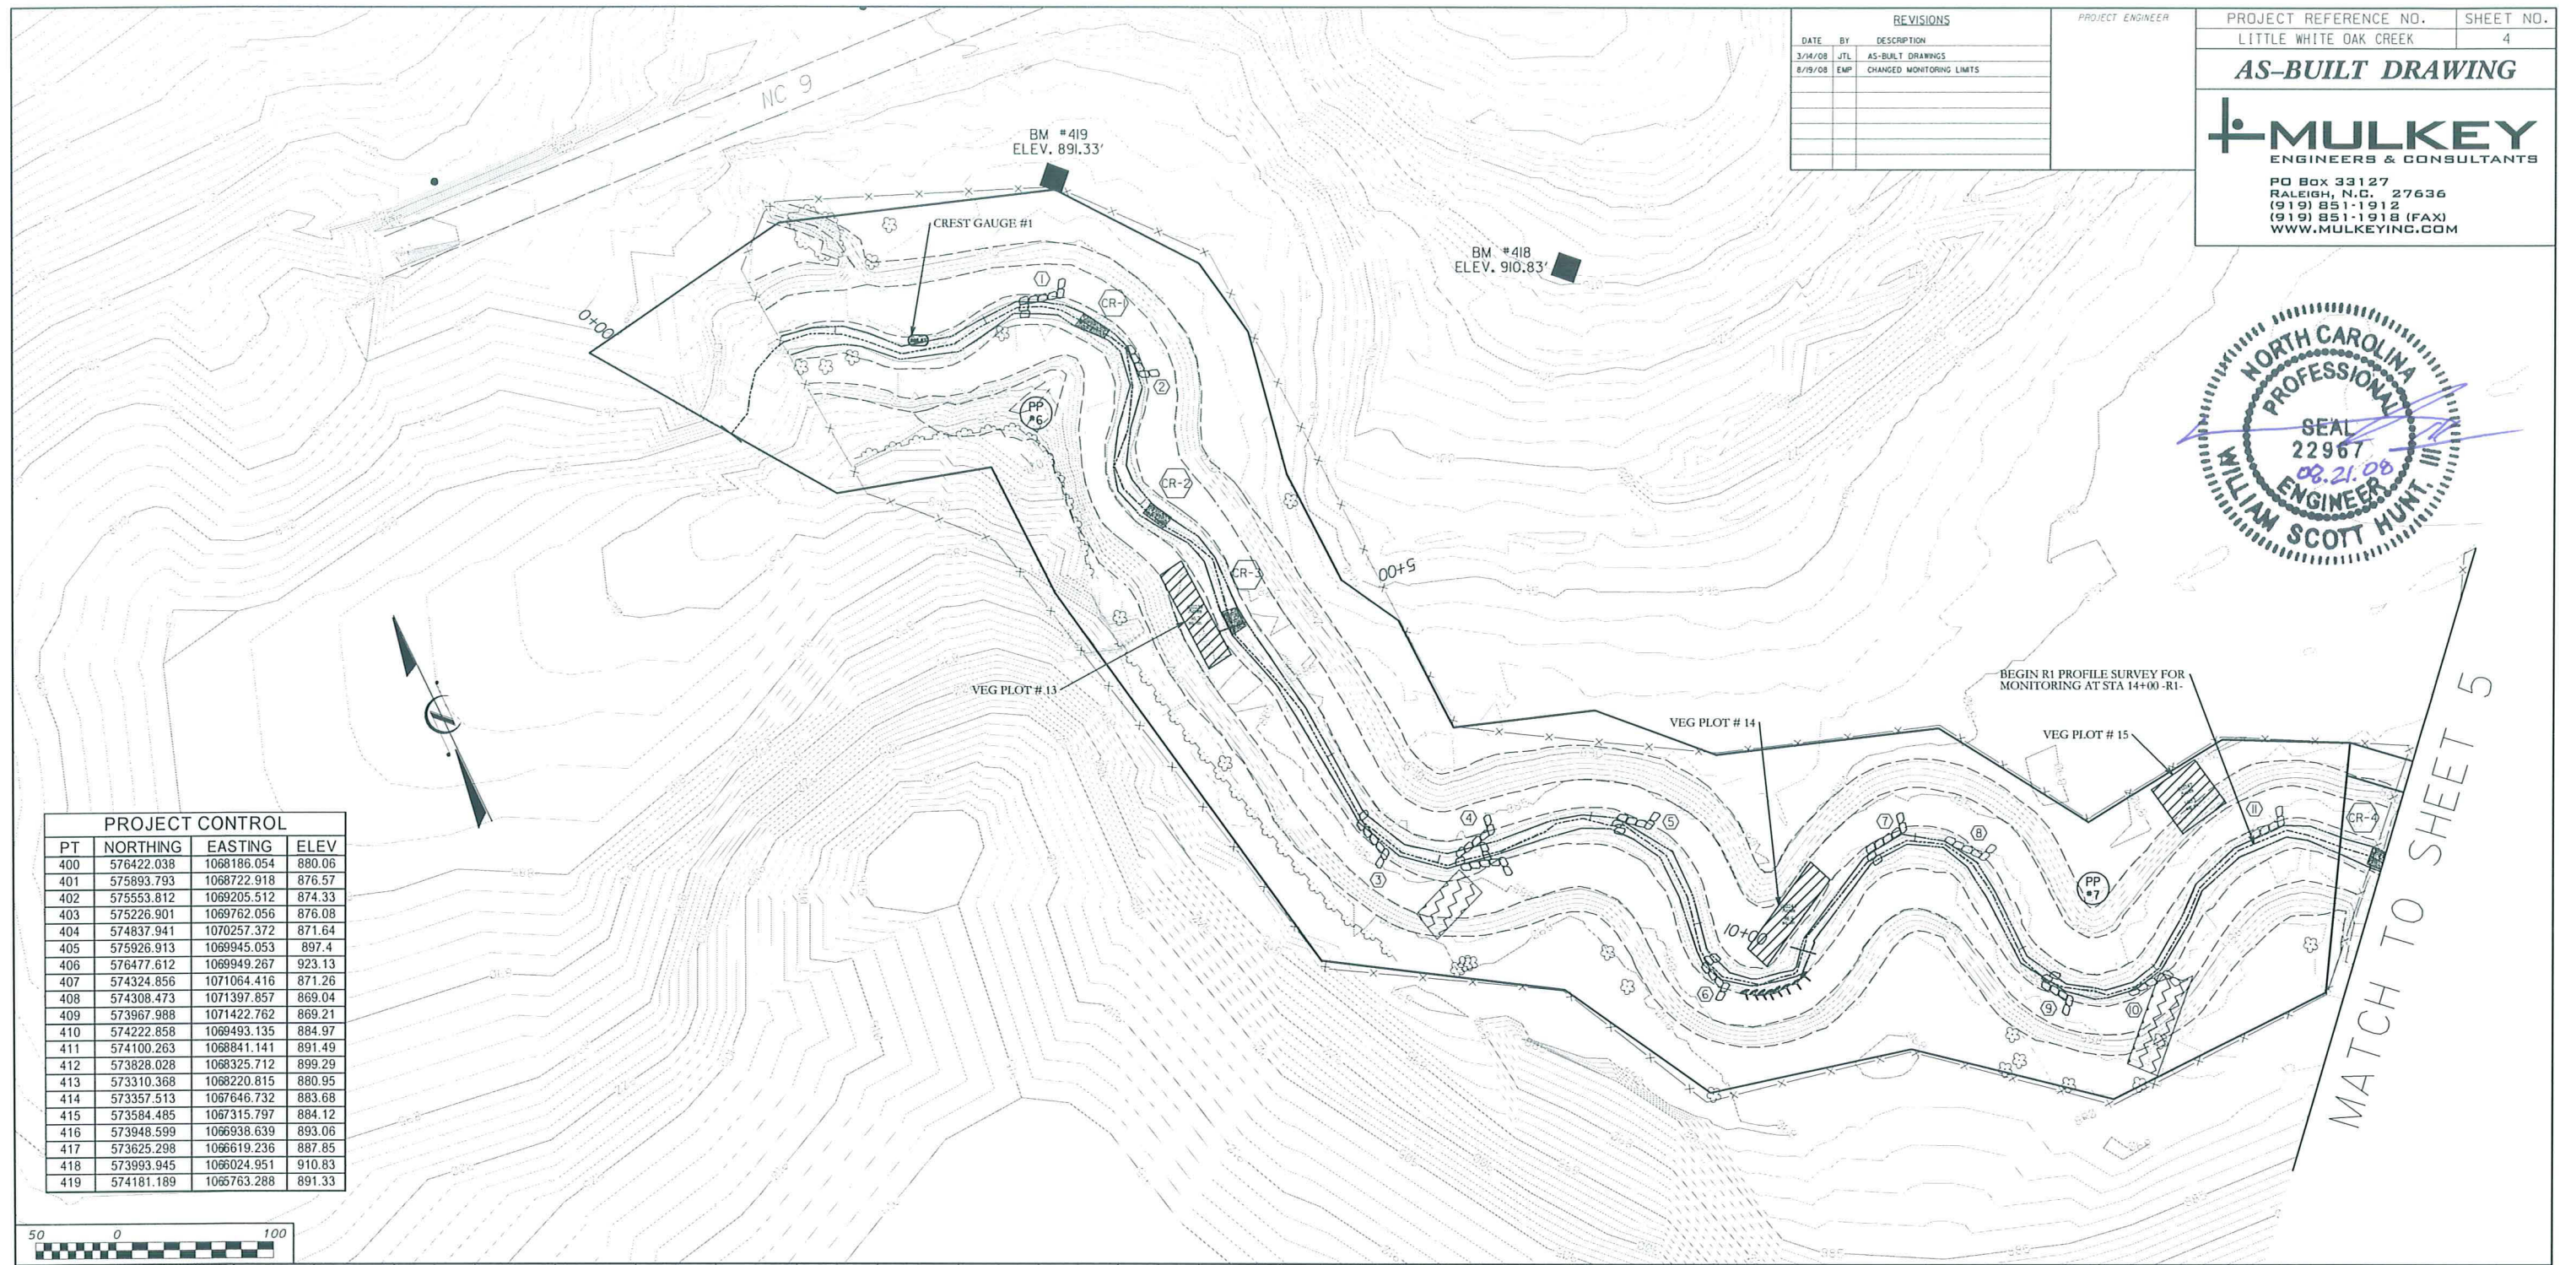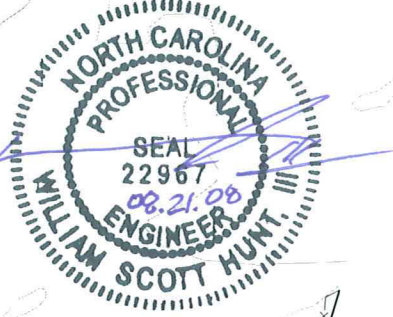

PROJECT CONTROL			
PT	NORTHING	EASTING	ELEV
400	576422.038	1068186.054	880.06
401	575893.793	1068722.918	876.57
402	575553.812	1069205.512	874.33
403	575226.901	1069762.056	876.08
404	574837.941	1070257.372	871.64
405	575926.913	1069945.053	897.4
406	576477.612	1069949.267	923.13
407	574324.856	1071064.416	871.26
408	574308.473	1071397.857	869.04
409	573967.988	1071422.762	869.21
410	574222.858	1069493.135	884.97
411	574100.263	1068841.141	891.49
412	573828.028	1068325.712	899.29
413	573310.368	1068220.815	880.95
414	573357.513	1067646.732	883.68
415	573584.485	1067315.797	884.12
416	573948.599	1066938.639	893.06
417	573625.298	1066619.236	887.85
418	573993.945	1066024.951	910.83
419	574181.189	1065763.288	891.33

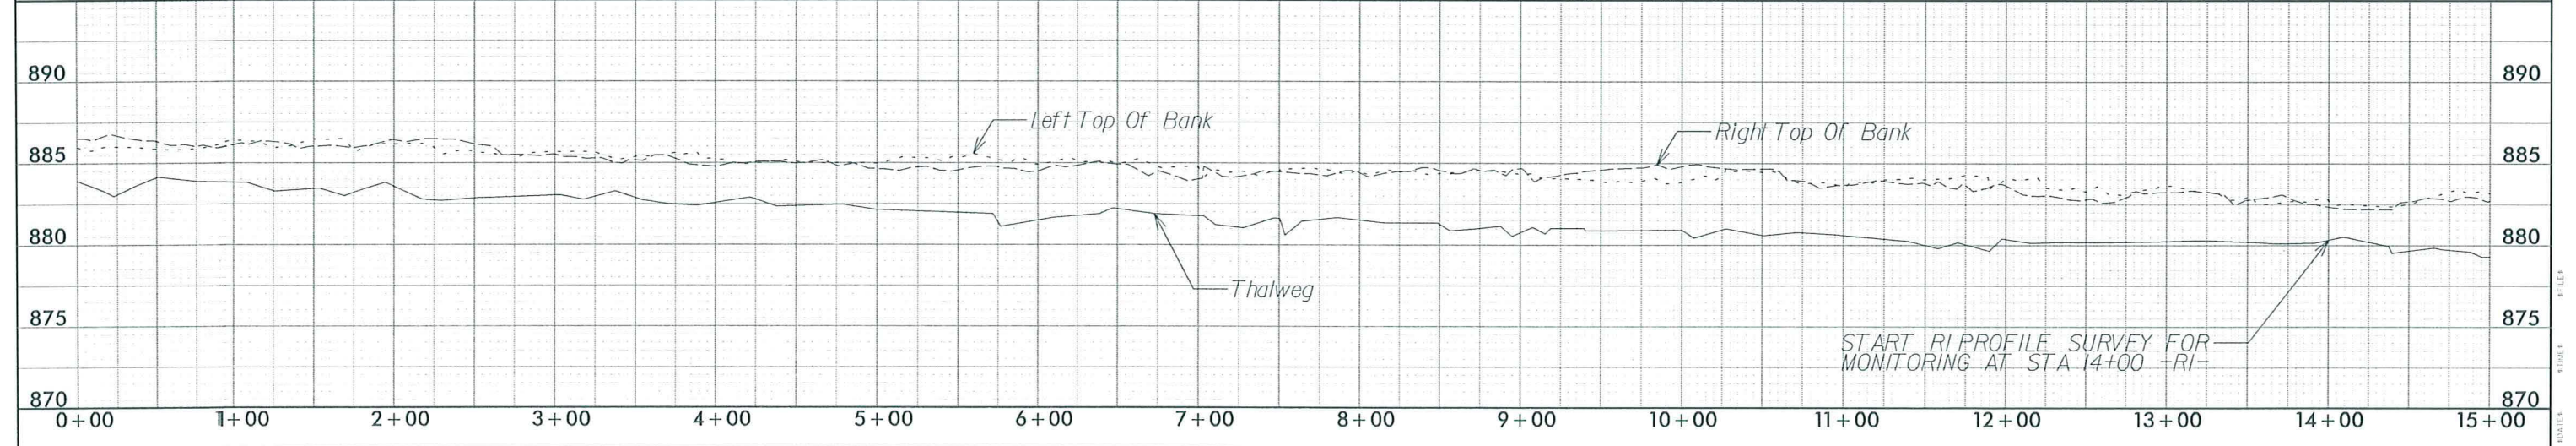


MATCH TO SHEET 5





REVISIONS		
DATE	BY	DESCRIPTION
3/14/08	JTL	AS-BUILT DRAWINGS
8/18/08	EMP	CHANGED MONITORING LIMITS

PROJECT ENGINEER

PROJECT REFERENCE NO. SHEET NO.  
 LITTLE WHITE OAK CREEK 5  
**AS-BUILT DRAWING**  
  
 MULKEY  
 ENGINEERS & CONSULTANTS  
 PO Box 33127  
 RALEIGH, N.C. 27636  
 (919) 851-1912  
 (919) 851-1918 (FAX)  
 WWW.MULKEYINC.COM

PROJECT CONTROL			
PT	NORTHING	EASTING	ELEV
400	576422.038	1068186.054	880.06
401	575893.793	1068722.918	876.57
402	575553.812	1069205.512	874.33
403	575226.901	1069762.056	876.08
404	574837.941	1070257.372	871.64
405	575926.913	1069945.053	897.4
406	576477.612	1069949.267	923.13
407	574324.856	1071064.416	871.26
408	574308.473	1071397.857	869.04
409	573967.988	1071422.762	869.21
410	574222.858	1069493.135	884.97
411	574100.263	1068841.141	891.49
412	573828.028	1068325.712	899.29
413	573310.368	1068220.815	880.95
414	573357.513	1067646.732	883.68
415	573584.485	1067315.797	884.12
416	573948.599	1066938.639	893.06
417	573625.298	1066619.236	887.85
418	573993.945	1066024.951	910.83
419	574181.189	1065763.288	891.33

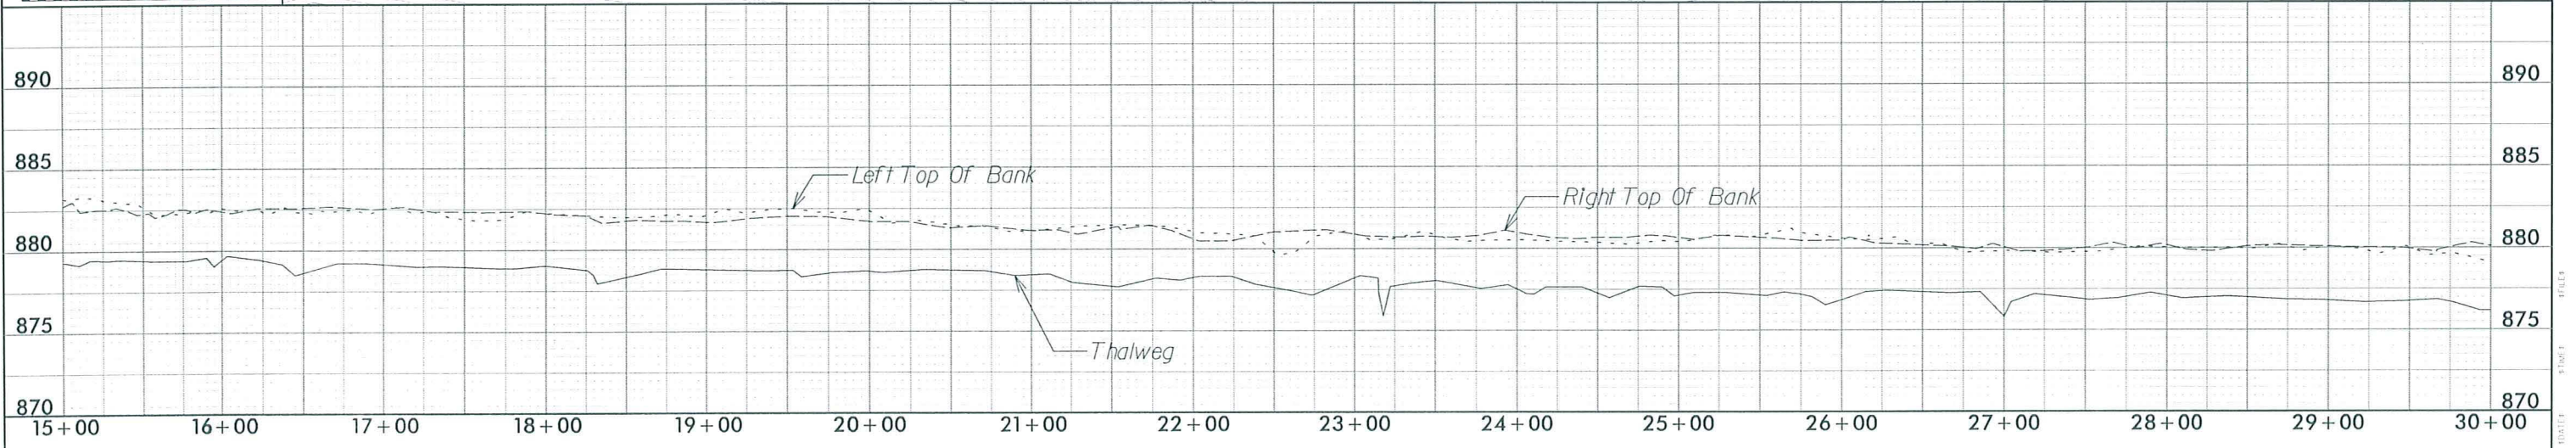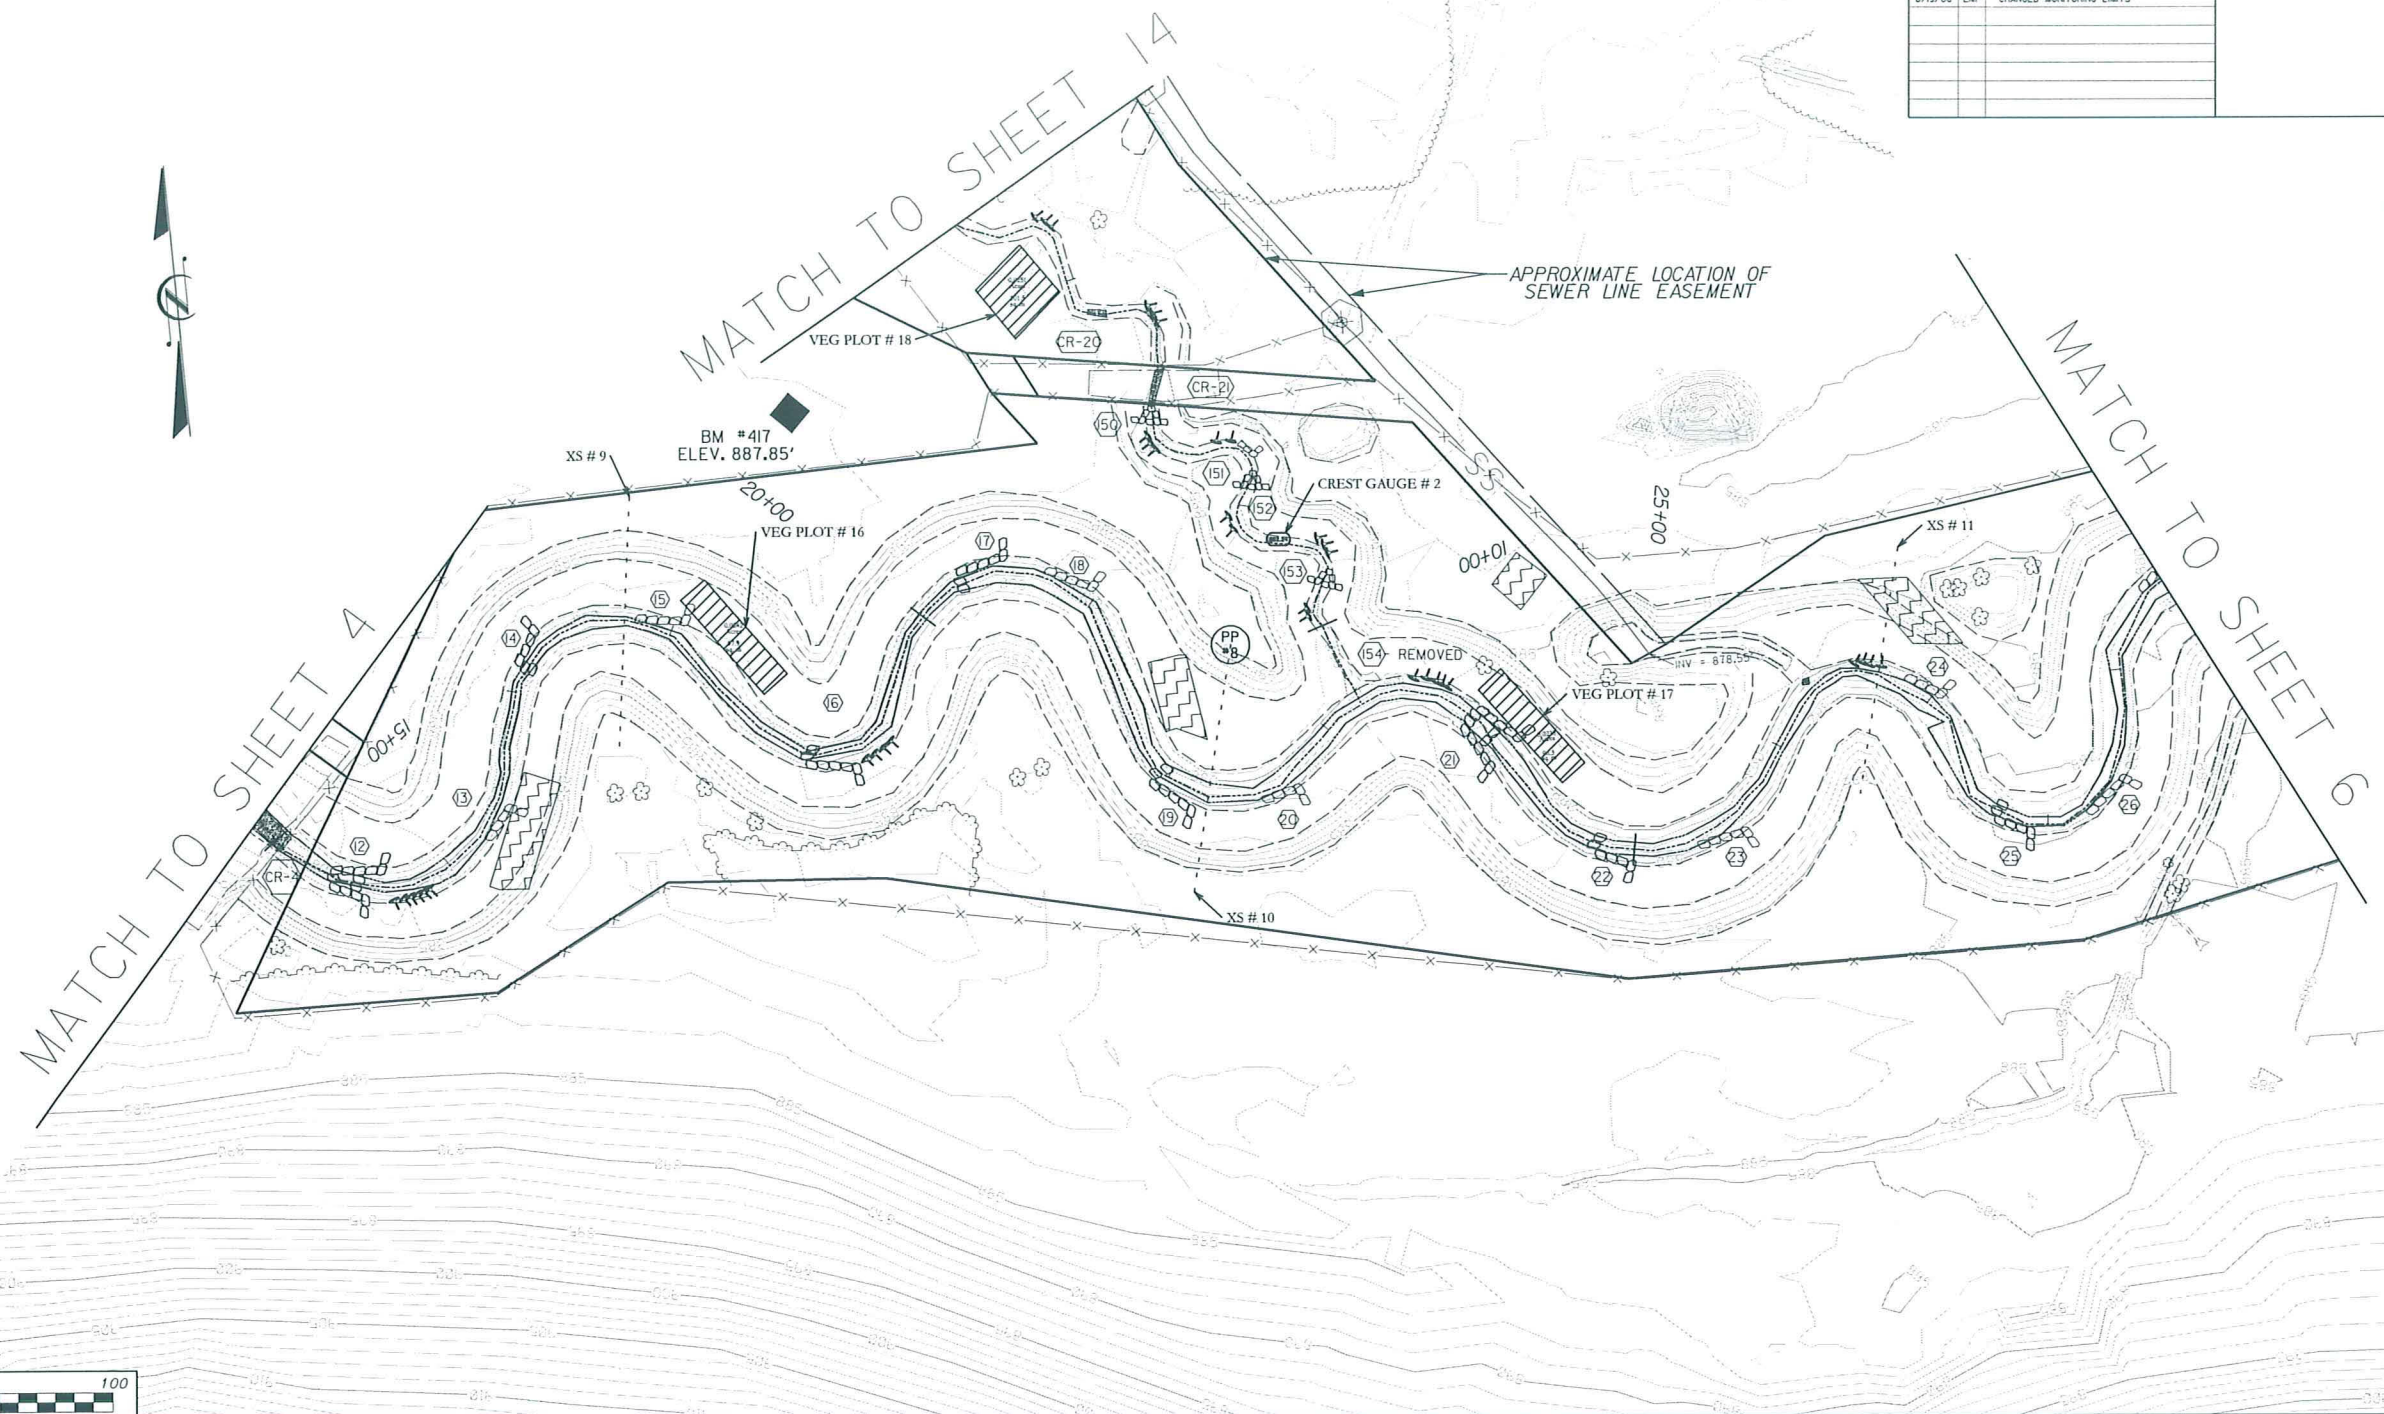



REVISIONS	
DATE	DESCRIPTION
3/14/08	JTL AS-BUILT DRAWINGS
8/19/08	EMP CHANGED MONITORING LIMITS

PROJECT ENGINEER

PROJECT REFERENCE NO. SHEET NO.  
LITTLE WHITE OAK CREEK 6



**AS-BUILT DRAWING**

**MULKEY**  
ENGINEERS & CONSULTANTS

PO Box 33127  
RALEIGH, N.C. 27636  
(919) 851-1912  
(919) 851-1918 (FAX)  
WWW.MULKEYINC.COM



PROJECT CONTROL			
PT	NORTHING	EASTING	ELEV.
400	576422.038	1068186.054	880.06
401	575893.793	1068722.918	876.57
402	575553.812	1069205.512	874.33
403	575226.901	1069762.056	876.08
404	574837.941	1070257.372	871.64
405	575926.913	1069945.053	897.4
406	576477.612	1069949.267	923.13
407	574324.856	1071064.416	871.26
408	574308.473	1071397.857	869.04
409	573967.988	1071422.762	869.21
410	574222.858	1069493.135	884.97
411	574100.263	1068841.141	891.49
412	573828.028	1068325.712	899.29
413	573310.368	1068220.815	880.95
414	573357.513	1067646.732	883.68
415	573584.485	1067315.797	884.12
416	573948.599	1066938.639	893.06
417	573625.298	1066619.236	887.85
418	573993.945	1066024.951	910.83
419	574181.189	1065763.288	891.33

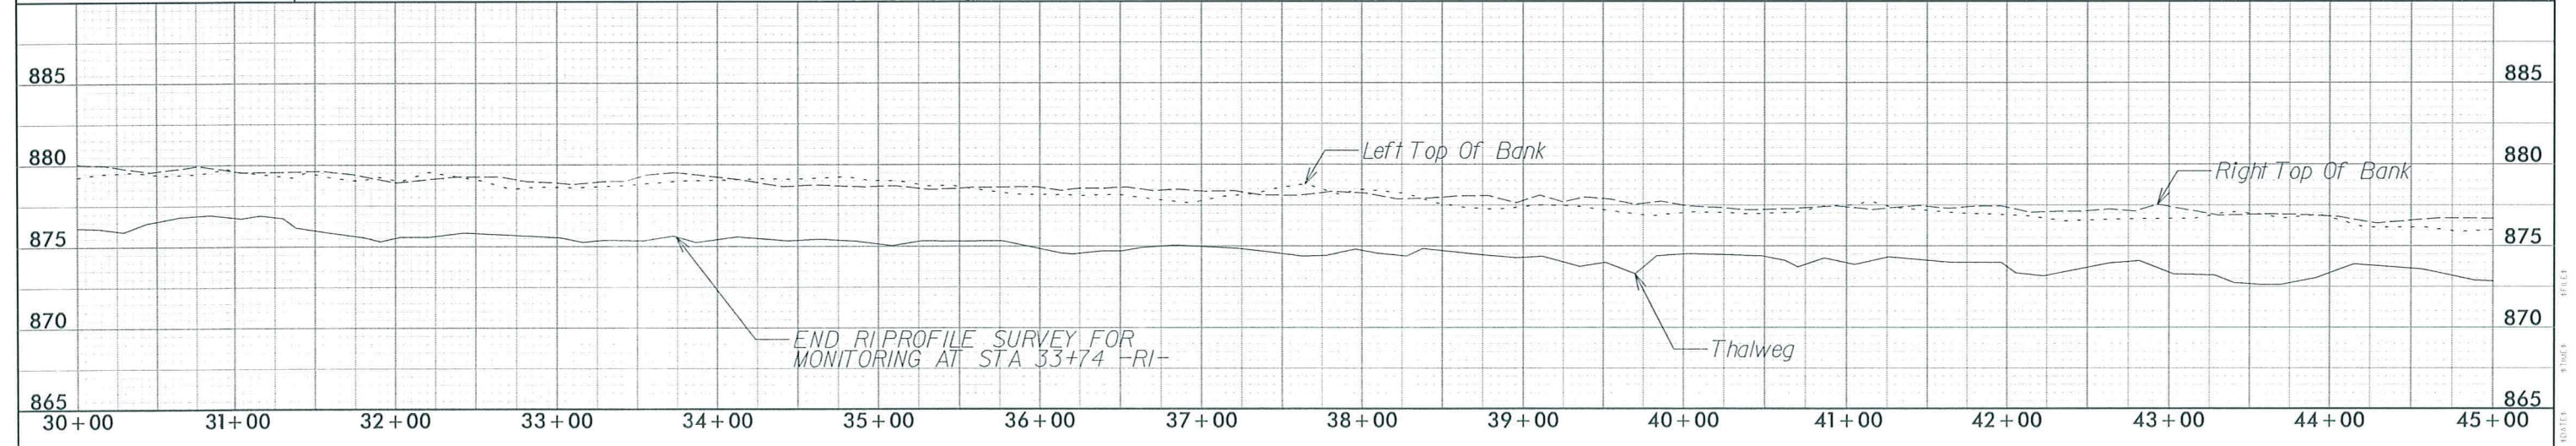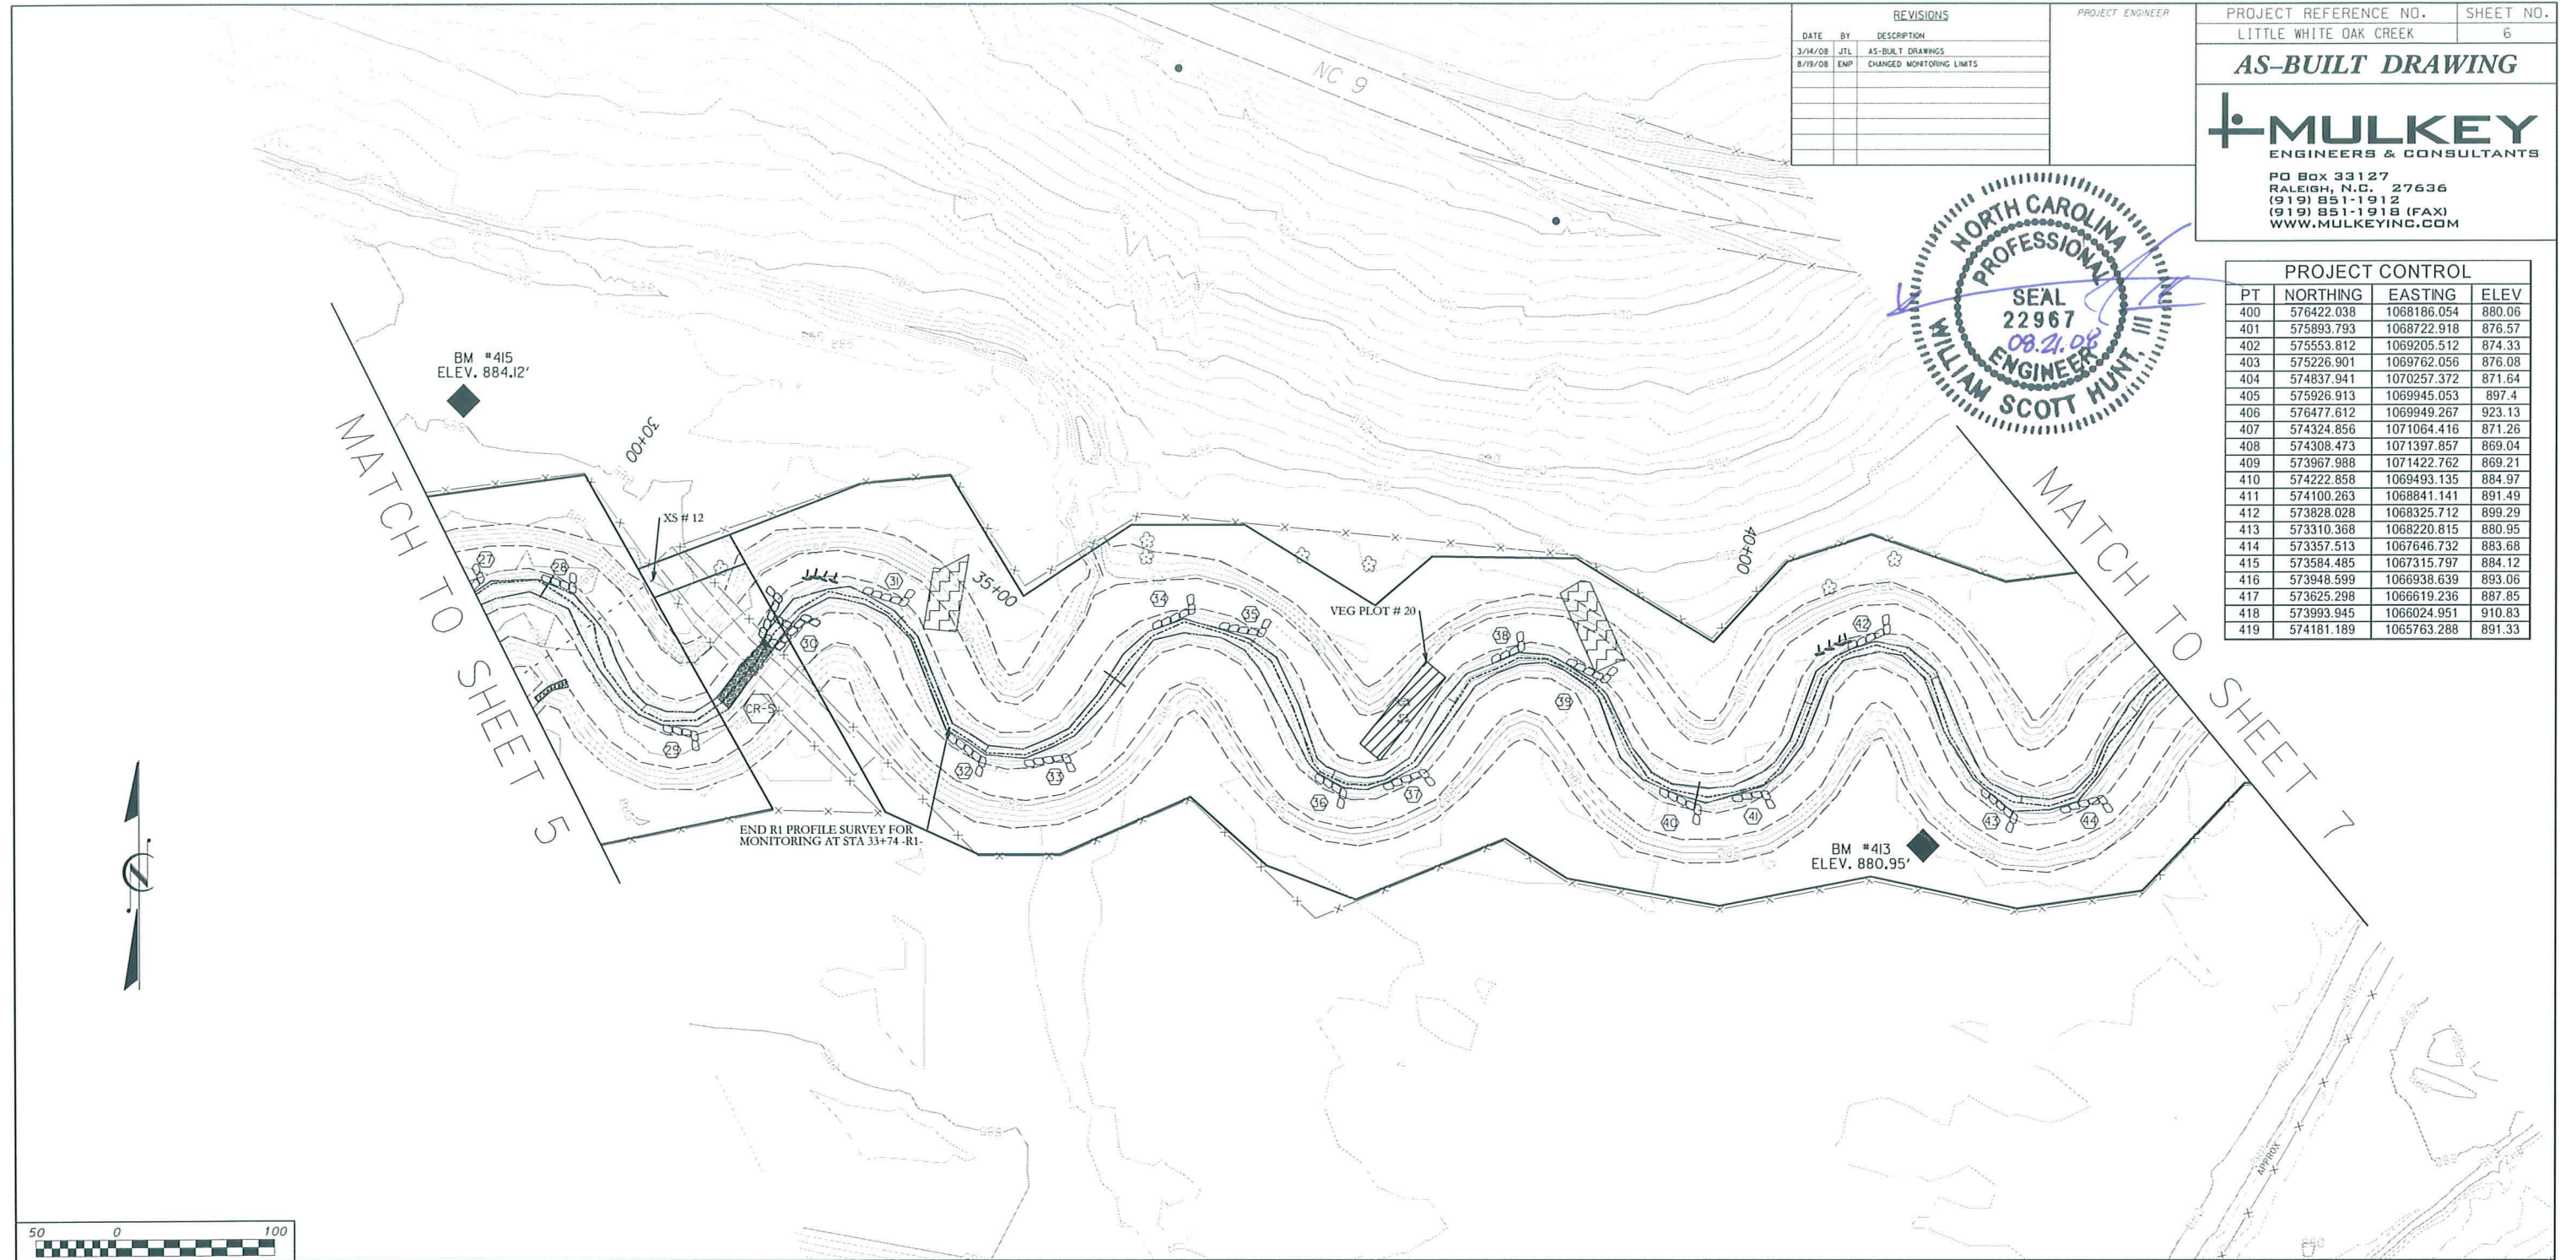



REVISIONS			
DATE	BY	DESCRIPTION	
3/14/08	JTL	AS-BUILT DRAWINGS	


PROJECT ENGINEER

PROJECT REFERENCE NO. LITTLE WHITE OAK CREEK SHEET NO. 7



**AS-BUILT DRAWING**

**MULKEY**  
ENGINEERS & CONSULTANTS

PO Box 33127  
RALEIGH, N.C. 27636  
(919) 851-1912  
(919) 851-1918 (FAX)  
WWW.MULKEYINC.COM

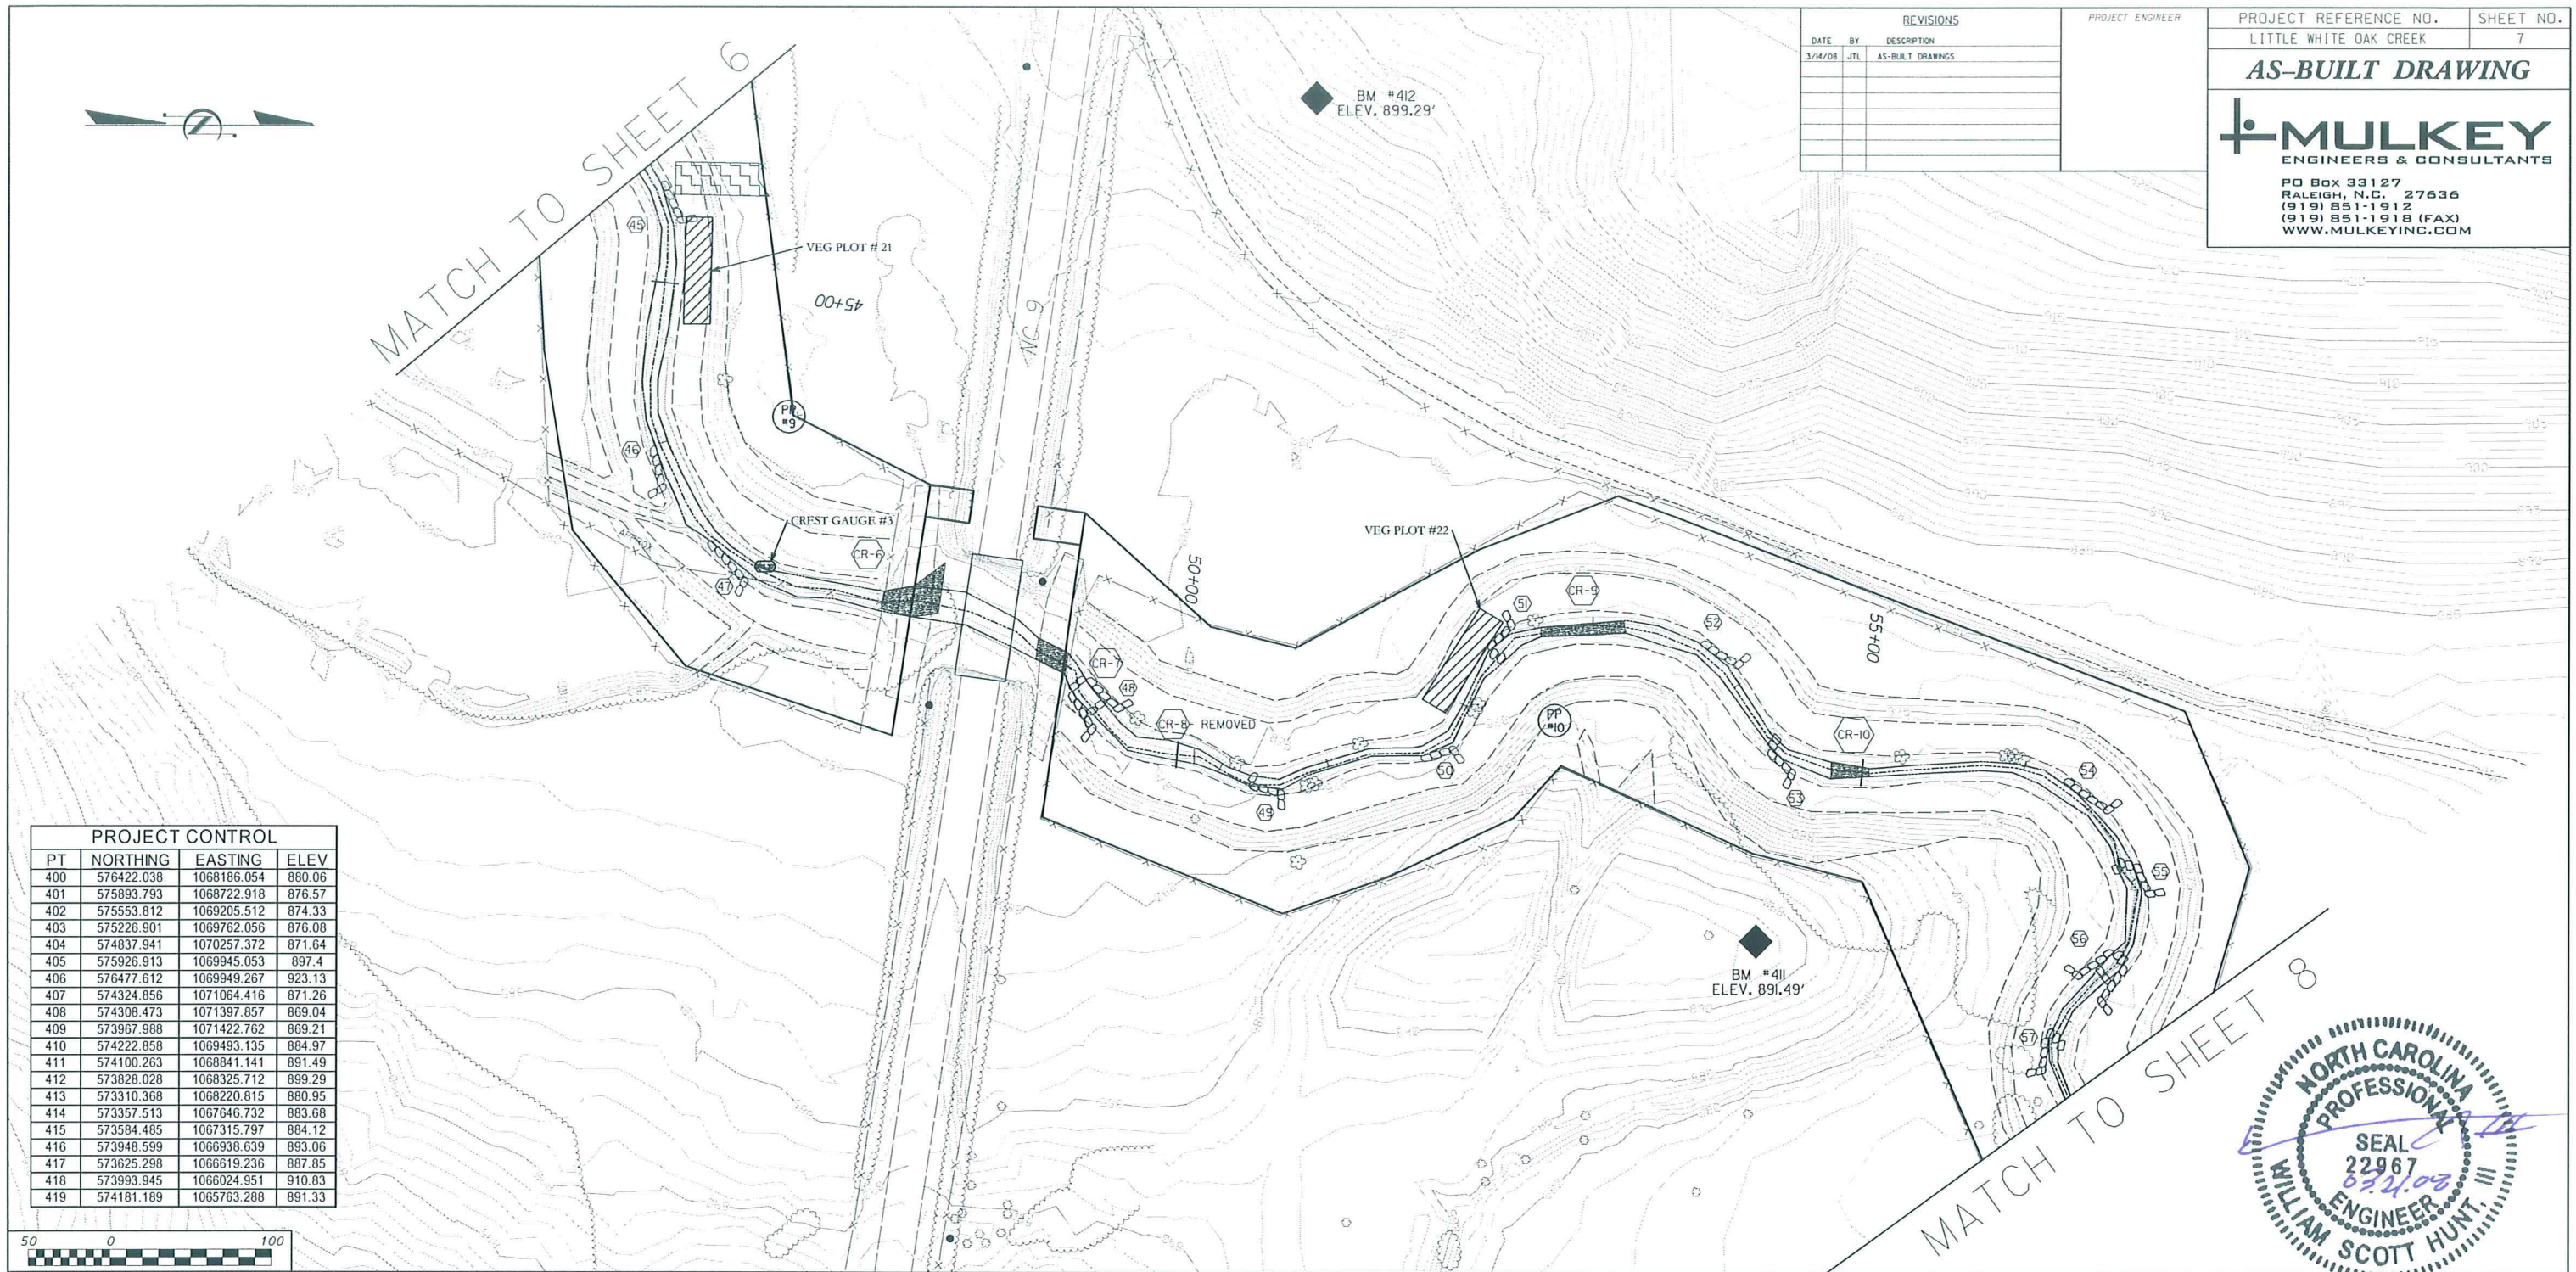

PROJECT CONTROL			
PT	NORTHING	EASTING	ELEV
400	576422.038	1068186.054	880.06
401	575893.793	1068722.918	876.57
402	575553.812	1069205.512	874.33
403	575226.901	1069762.056	876.08
404	574837.941	1070257.372	871.64
405	575926.913	1069945.053	897.4
406	576477.612	1069949.267	923.13
407	574324.856	1071064.416	871.26
408	574308.473	1071397.857	869.04
409	573967.988	1071422.762	869.21
410	574222.858	1069493.135	884.97
411	574100.263	1068841.141	891.49
412	573828.028	1068325.712	899.29
413	573310.368	1068220.815	880.95
414	573357.513	1067646.732	883.68
415	573584.485	1067315.797	884.12
416	573948.599	1066938.639	893.06
417	573625.298	1066619.236	887.85
418	573993.945	1066024.951	910.83
419	574181.189	1065763.288	891.33

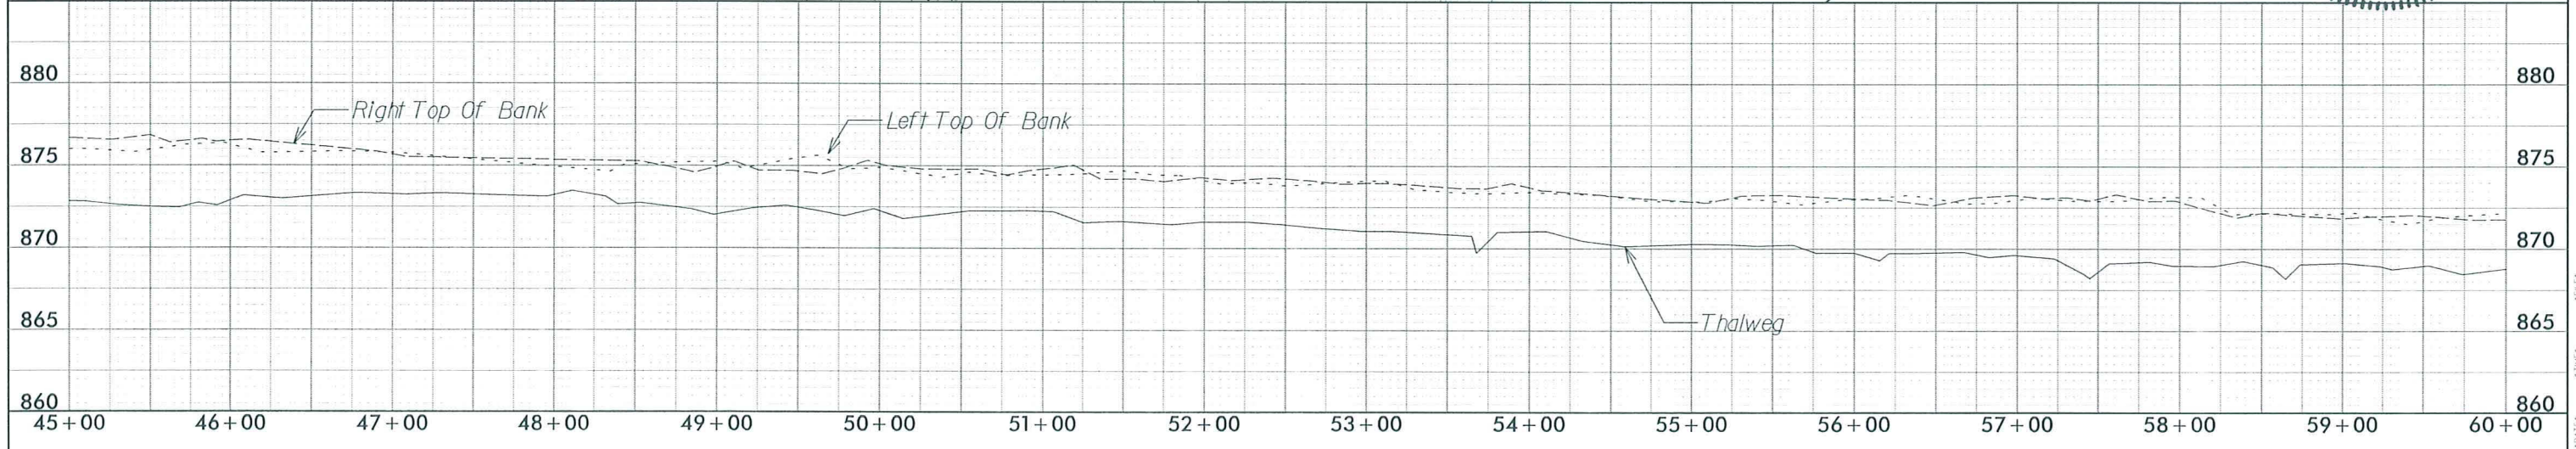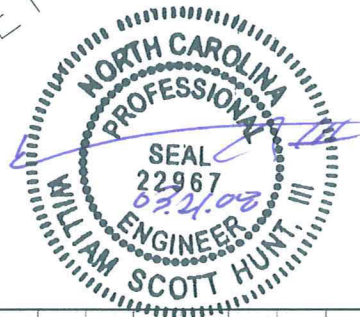



REVISIONS		
DATE	BY	DESCRIPTION
3/14/08	JTL	AS-BUILT DRAWINGS

PROJECT ENGINEER

PROJECT REFERENCE NO. SHEET NO.  
LITTLE WHITE OAK CREEK 8


**AS-BUILT DRAWING**




PO Box 33127  
RALEIGH, N.C. 27636  
(919) 851-1912  
(919) 851-1918 (FAX)  
WWW.MULKEYINC.COM

MATCH TO SHEET 7

MATCH TO SHEET 12

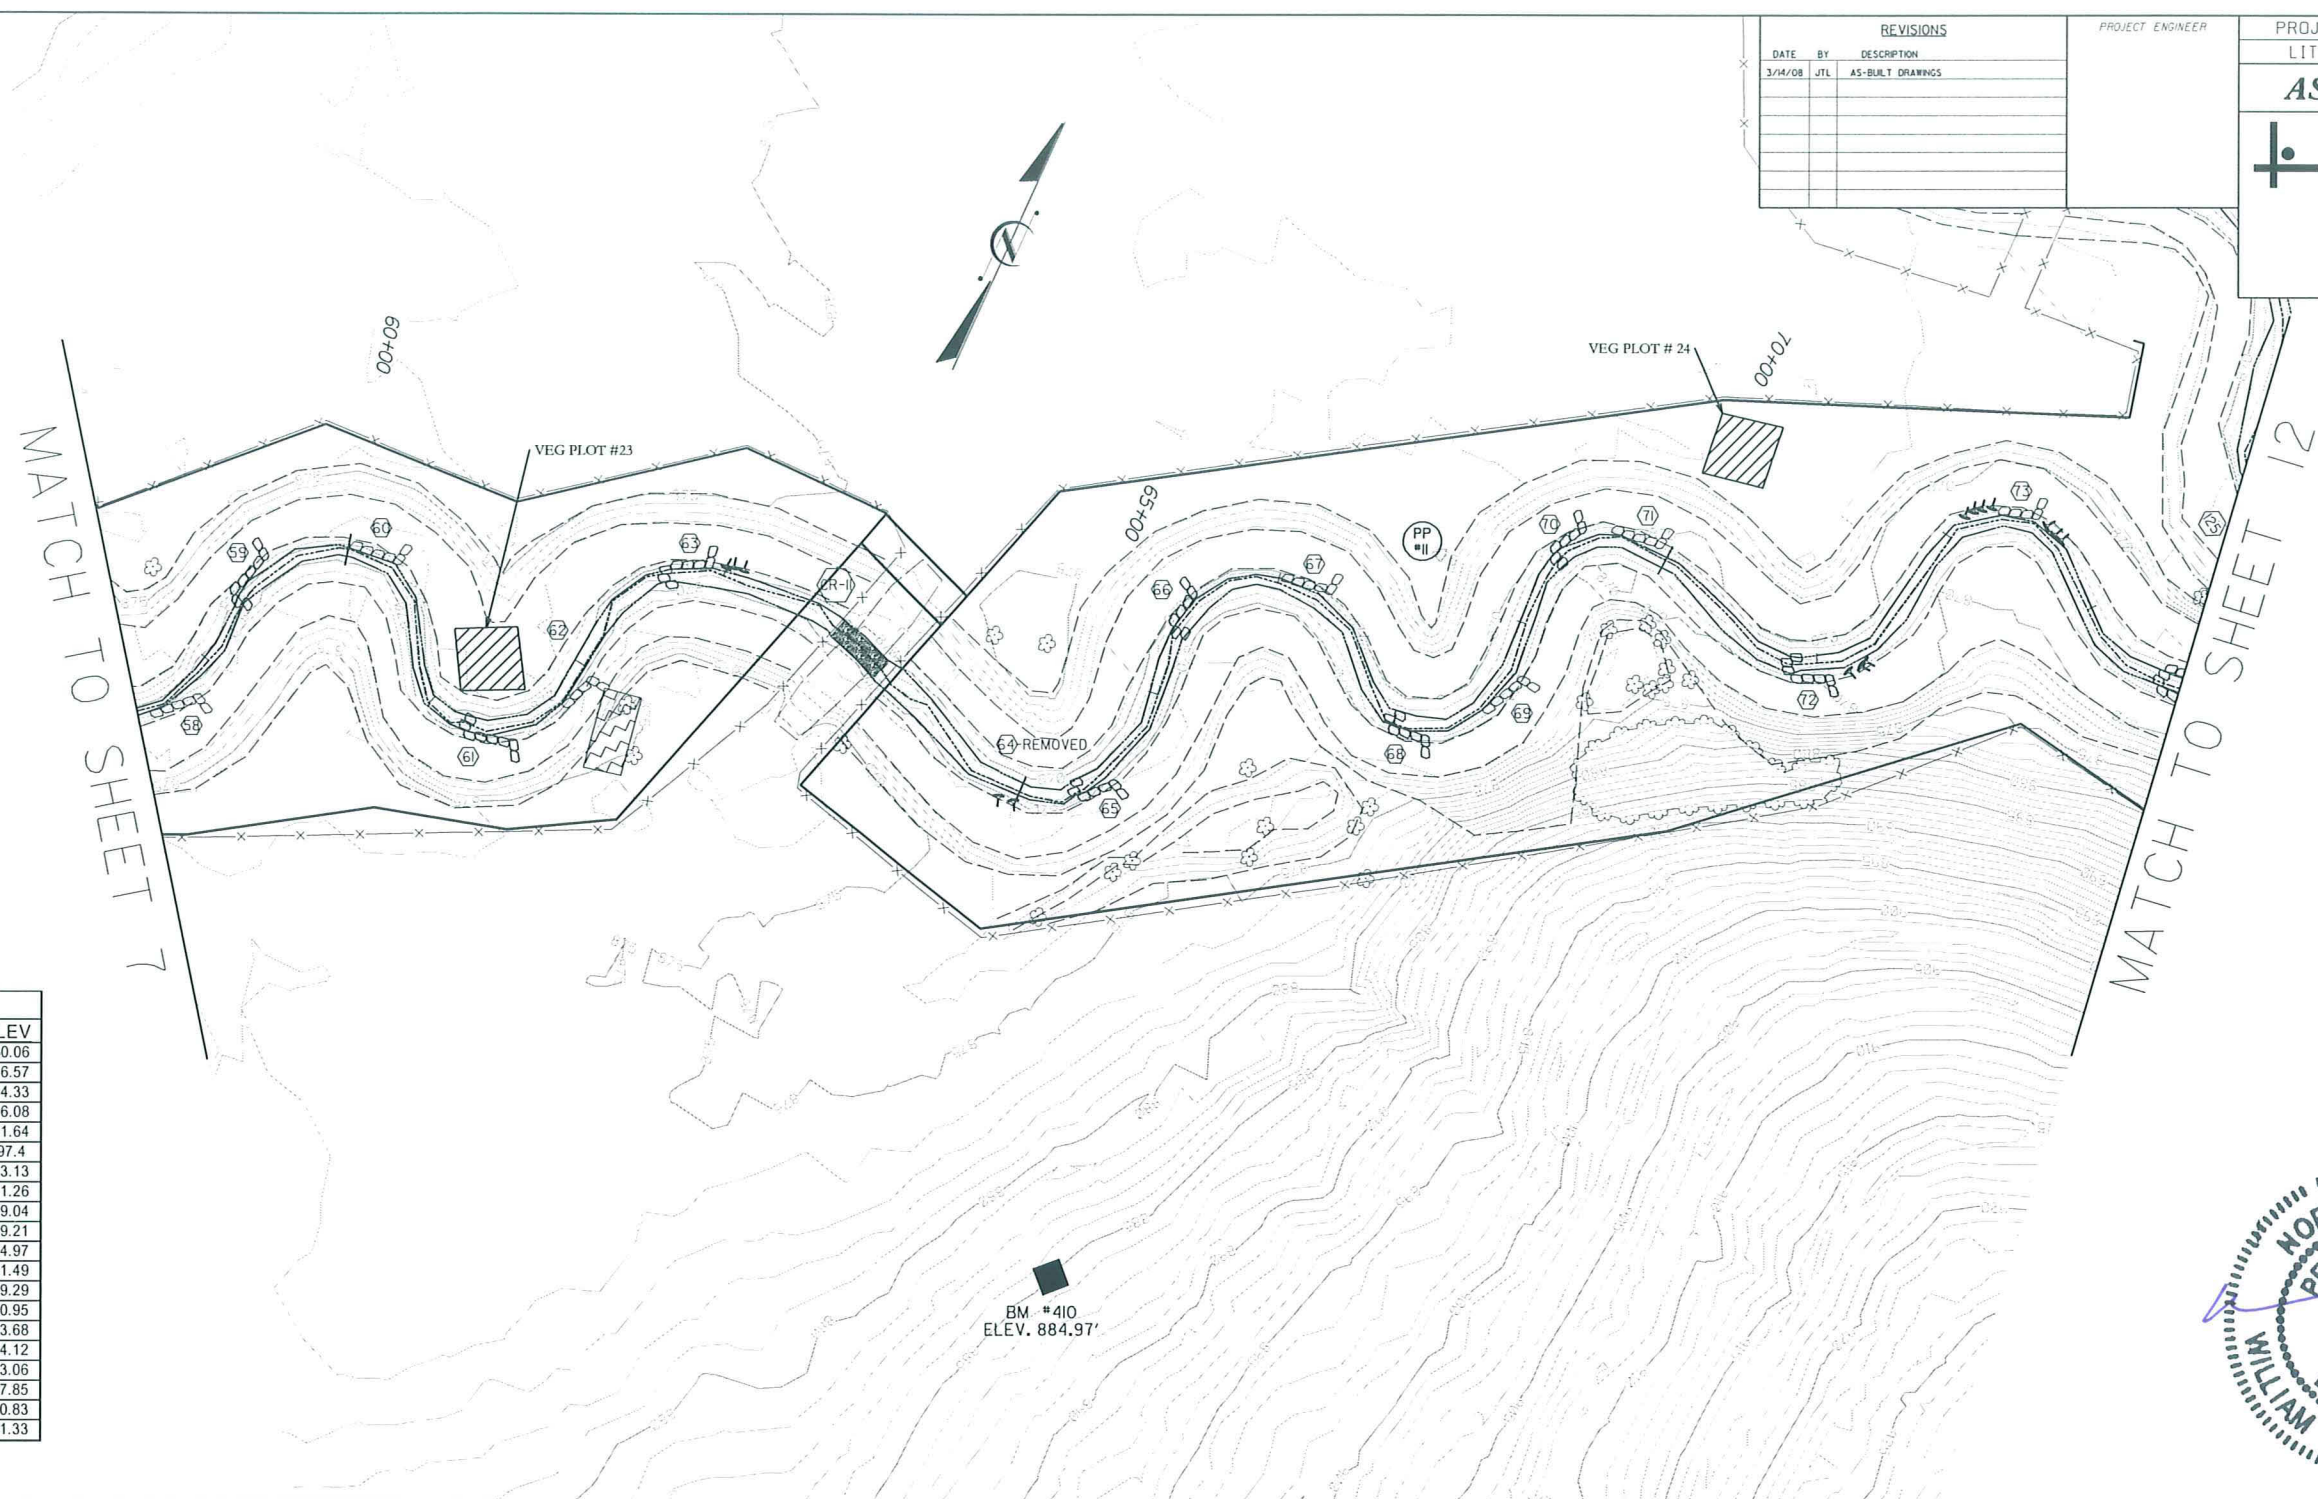


PROJECT CONTROL			
PT	NORTHING	EASTING	ELEV
400	576422.038	1068186.054	880.06
401	575893.793	1068722.918	876.57
402	575553.812	1069205.512	874.33
403	575226.901	1069762.056	876.08
404	574837.941	1070257.372	871.64
405	575926.913	1069945.053	897.4
406	576477.612	1069949.267	923.13
407	574324.856	1071064.416	871.26
408	574308.473	1071397.857	869.04
409	573967.988	1071422.762	869.21
410	574222.858	1069493.135	884.97
411	574100.263	1068841.141	891.49
412	573828.028	1068325.712	899.29
413	573310.368	1068220.815	880.95
414	573357.513	1067646.732	883.68
415	573584.485	1067315.797	884.12
416	573948.599	1066938.639	893.06
417	573625.298	1066619.236	887.85
418	573993.945	1066024.951	910.83
419	574181.189	1065763.288	891.33


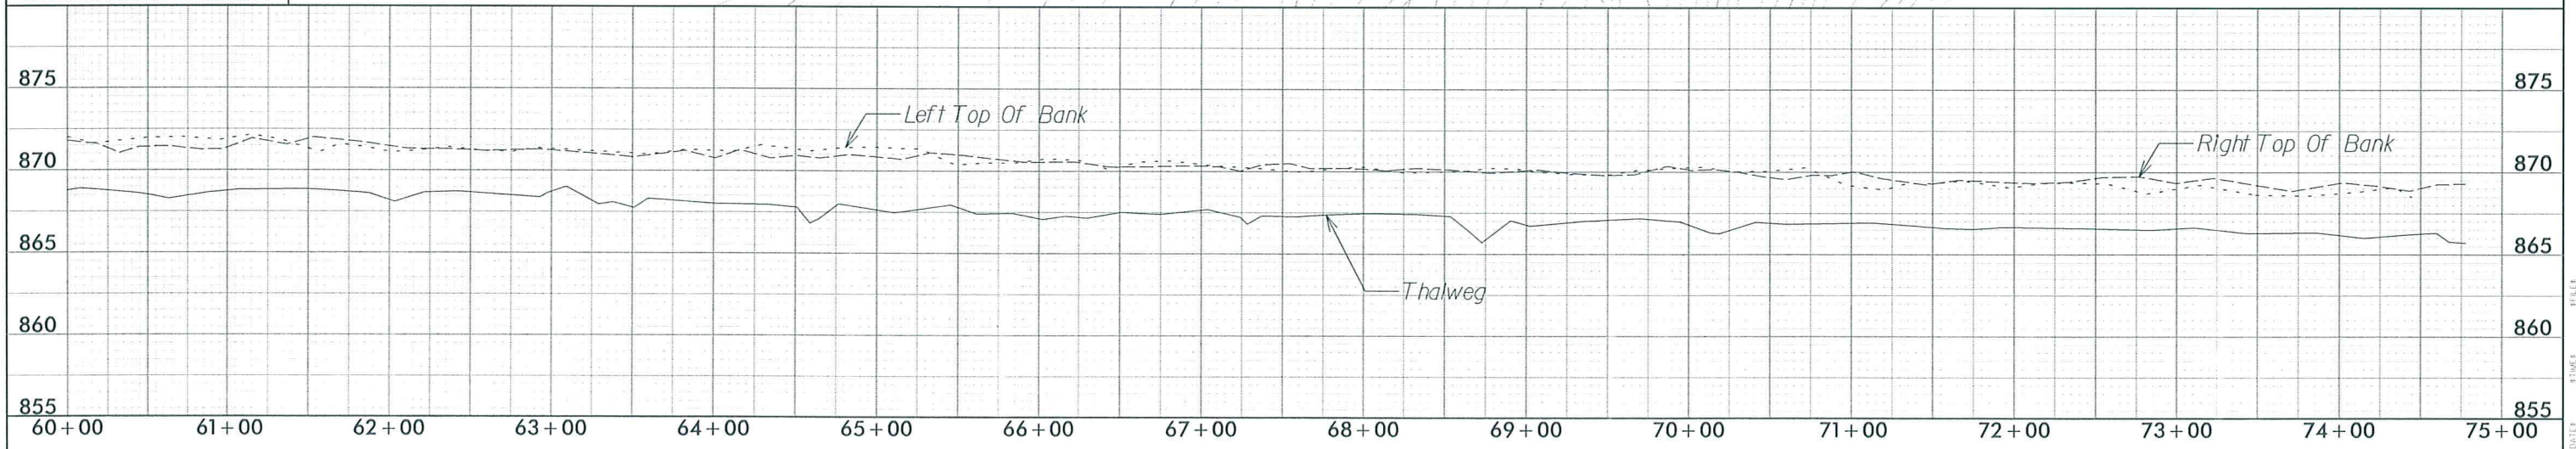




REVISIONS		
DATE	BY	DESCRIPTION
3/14/08	JTL	AS-BUILT DRAWINGS


PROJECT ENGINEER

PROJECT REFERENCE NO. SHEET NO.  
 LITTLE WHITE OAK CREEK 9  
**AS-BUILT DRAWING**  
  
 PO Box 33127  
 RALEIGH, N.C. 27636  
 (919) 851-1912  
 (919) 851-1918 (FAX)  
 WWW.MULKEYINC.COM

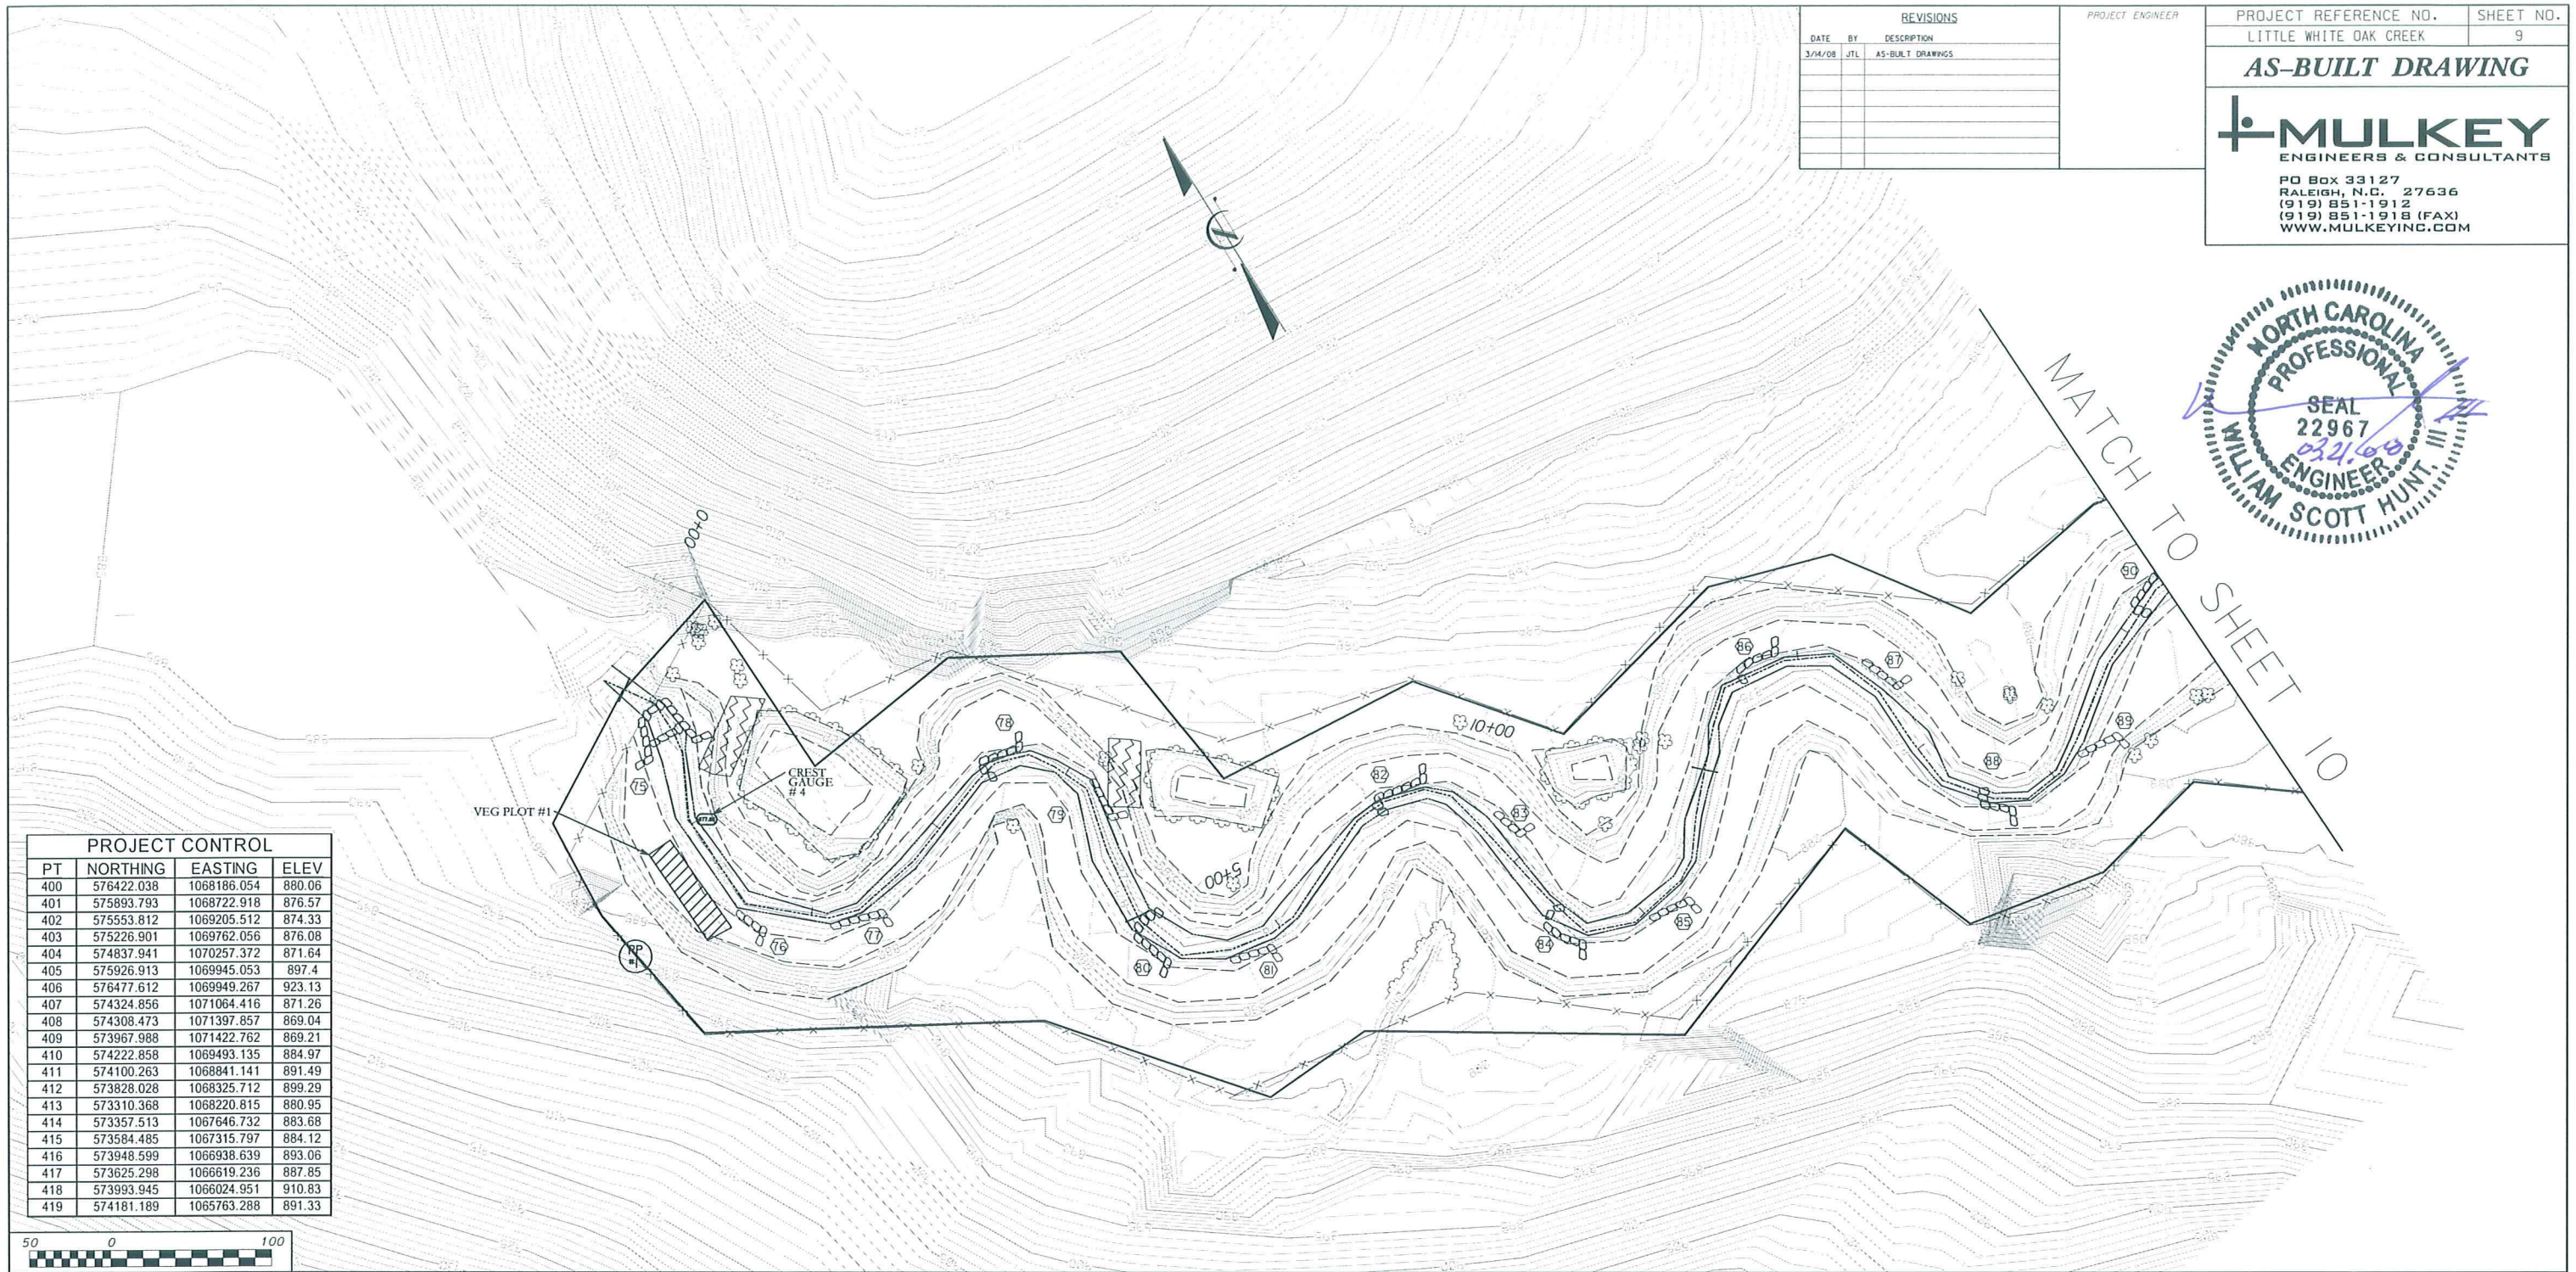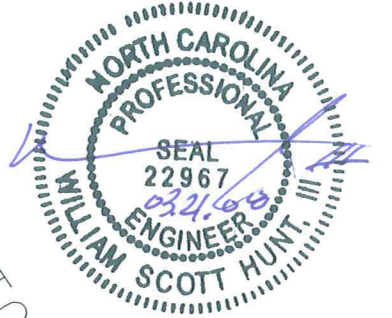

**PROJECT CONTROL**

PT	NORTHING	EASTING	ELEV
400	576422.038	1068186.054	880.06
401	575893.793	1068722.918	876.57
402	575553.812	1069205.512	874.33
403	575226.901	1069762.056	876.08
404	574837.941	1070257.372	871.64
405	575926.913	1069945.053	897.4
406	576477.612	1069949.267	923.13
407	574324.856	1071064.416	871.26
408	574308.473	1071397.857	869.04
409	573967.988	1071422.762	869.21
410	574222.858	1069493.135	884.97
411	574100.263	1068841.141	891.49
412	573828.028	1068325.712	899.29
413	573310.368	1068220.815	880.95
414	573357.513	1067646.732	883.68
415	573584.485	1067315.797	884.12
416	573948.599	1066938.639	893.06
417	573625.298	1066619.236	887.85
418	573993.945	1066024.951	910.83
419	574181.189	1065763.288	891.33

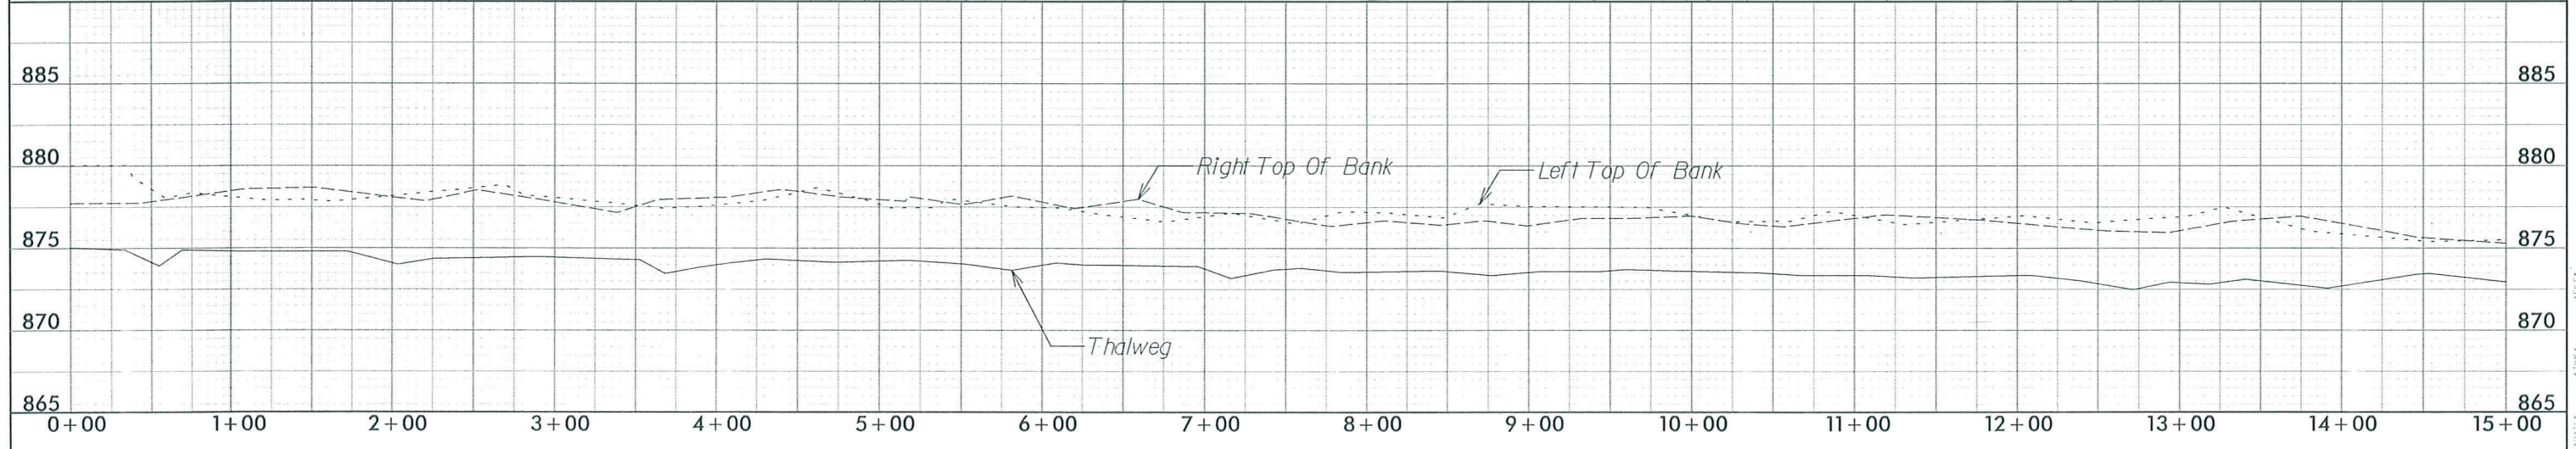




REVISIONS		
DATE	BY	DESCRIPTION
3/14/08	JTL	AS-BUILT DRAWINGS
8/19/08	EMP	CHANGED MONITORING LIMITS

PROJECT ENGINEER


PROJECT REFERENCE NO. SHEET NO.  
 LITTLE WHITE OAK CREEK 10  
**AS-BUILT DRAWING**  
  
 PO Box 33127  
 RALEIGH, N.C. 27636  
 (919) 851-1912  
 (919) 851-1918 (FAX)  
 WWW.MULKEYINC.COM

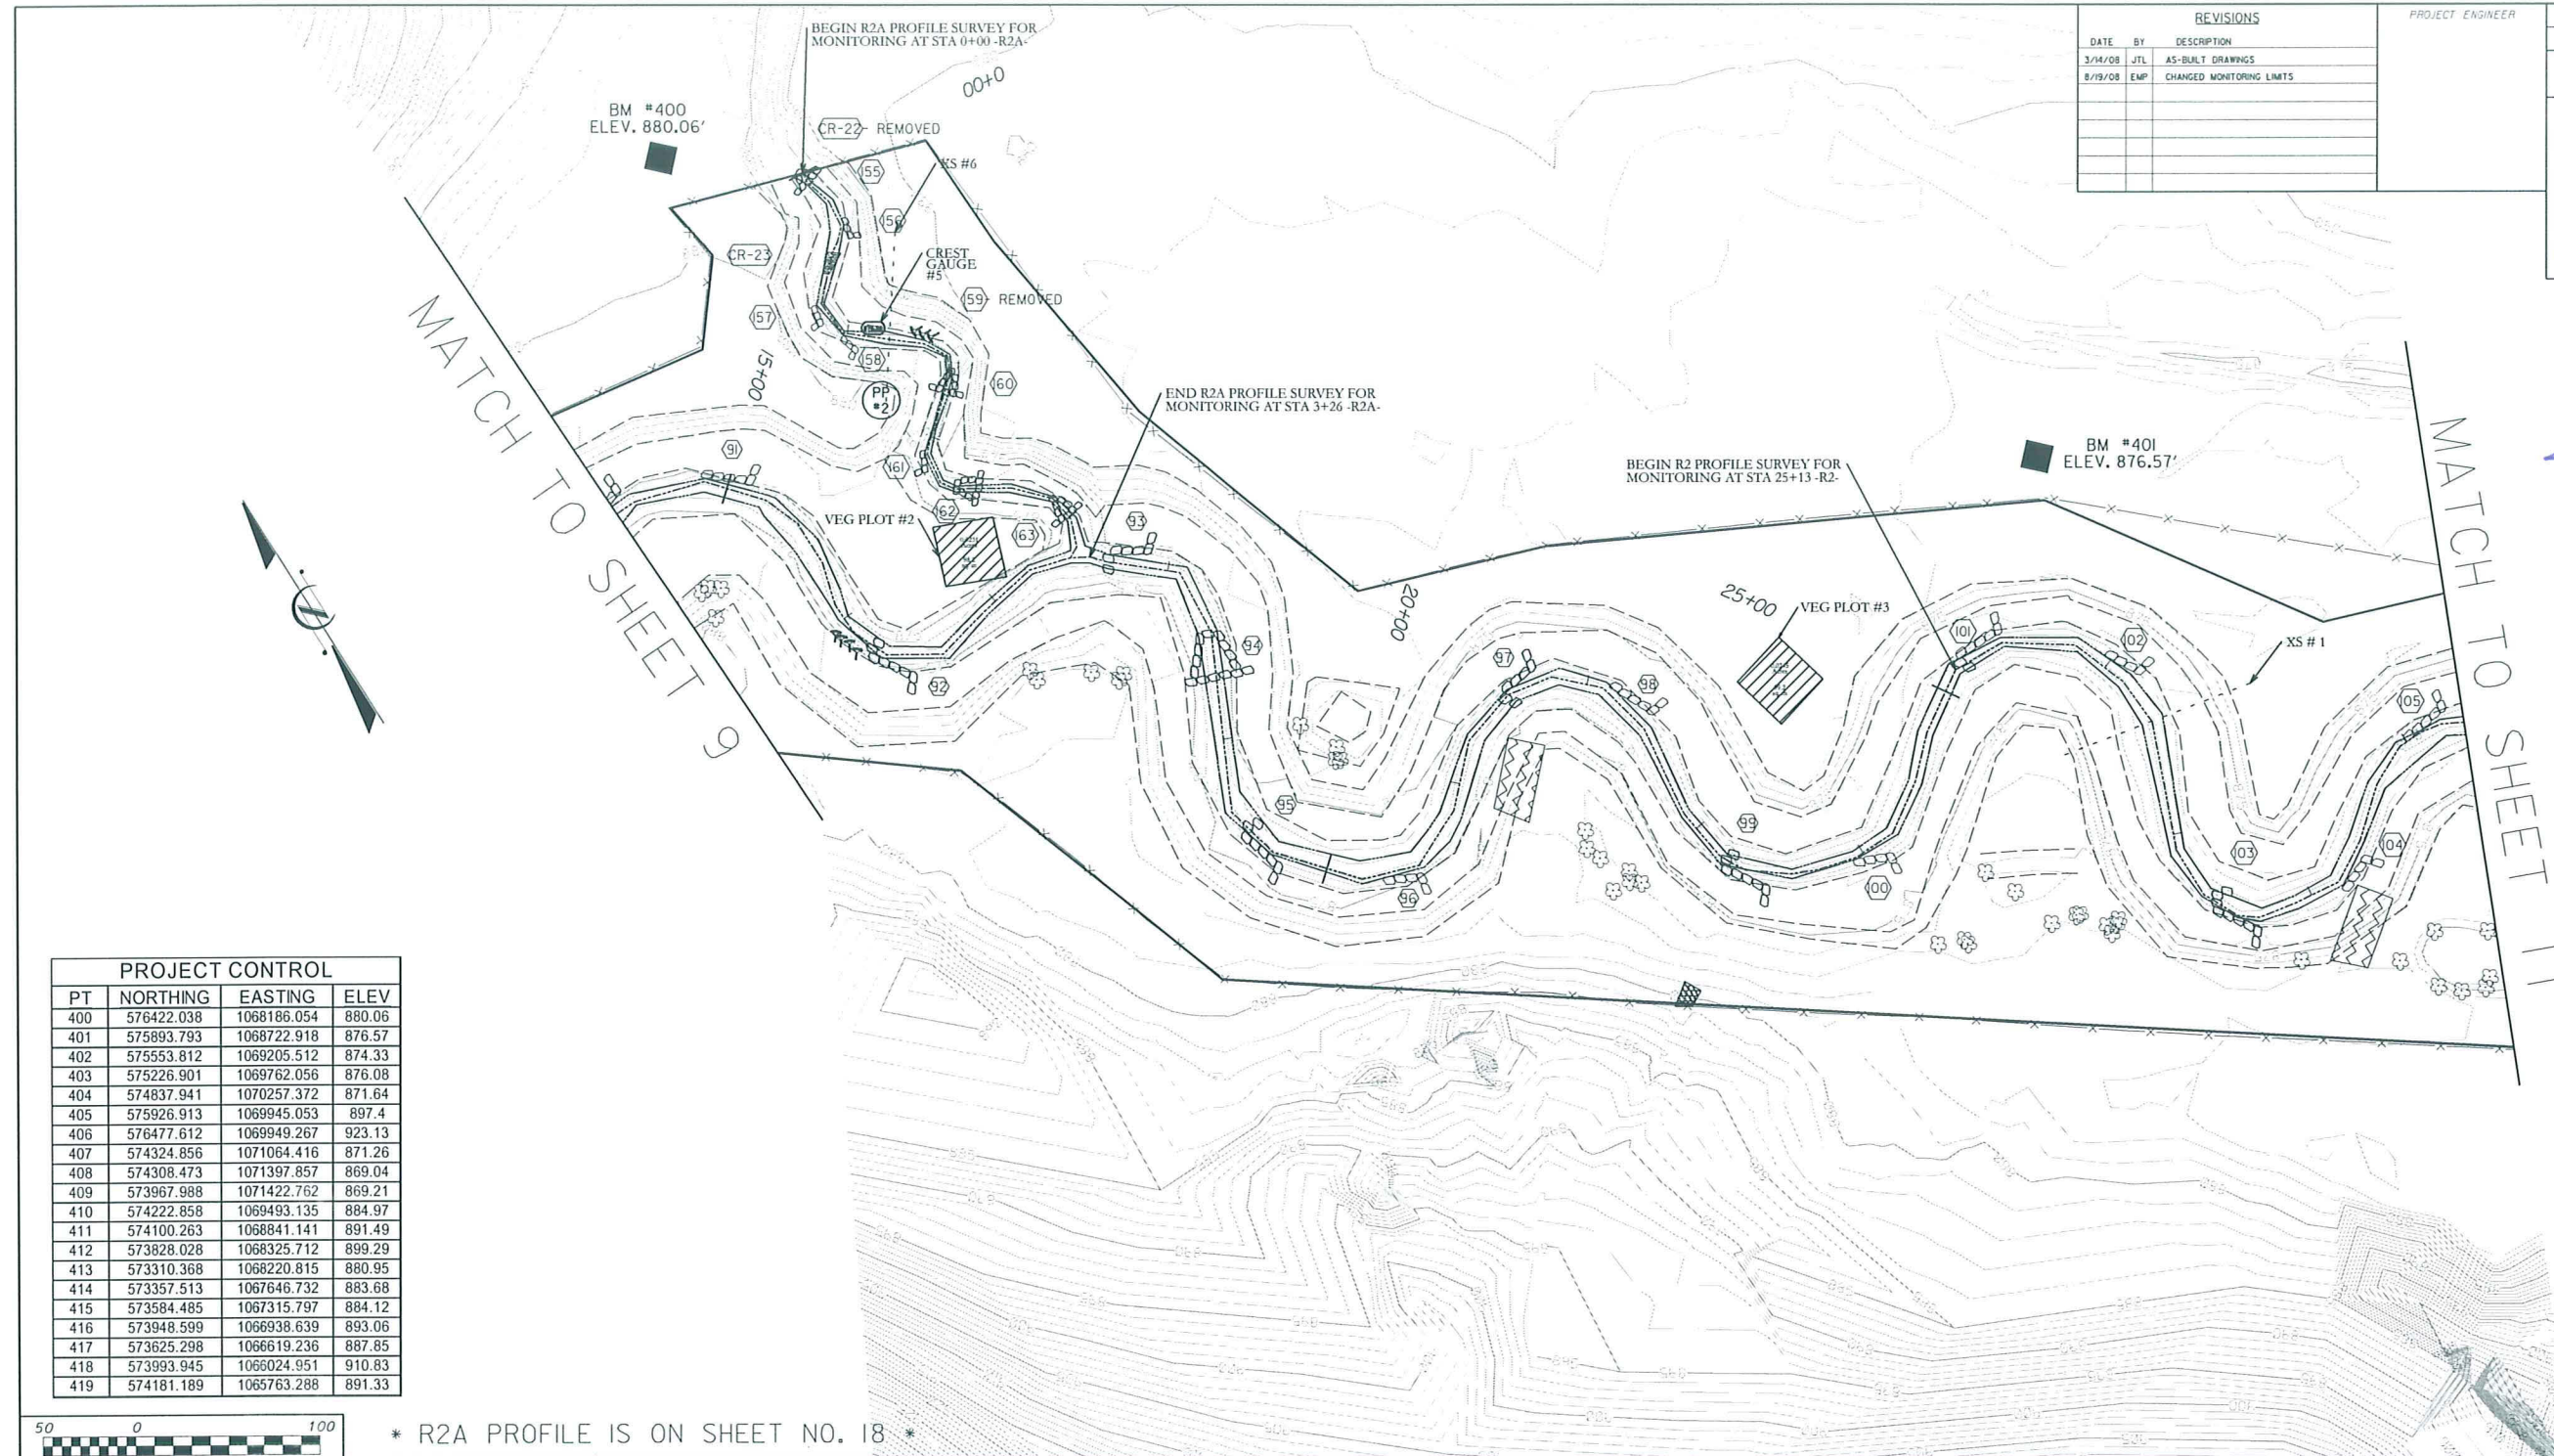

PROJECT CONTROL			
PT	NORTHING	EASTING	ELEV
400	576422.038	1068186.054	880.06
401	575893.793	1068722.918	876.57
402	575553.812	1069205.512	874.33
403	575226.901	1069762.056	876.08
404	574837.941	1070257.372	871.64
405	575926.913	1069945.053	897.4
406	576477.612	1069949.267	923.13
407	574324.856	1071064.416	871.26
408	574308.473	1071397.857	869.04
409	573967.988	1071422.762	869.21
410	574222.858	1069493.135	884.97
411	574100.263	1068841.141	891.49
412	573828.028	1068325.712	899.29
413	573310.368	1068220.815	880.95
414	573357.513	1067646.732	883.68
415	573584.485	1067315.797	884.12
416	573948.599	1066938.639	893.06
417	573625.298	1066619.236	887.85
418	573993.945	1066024.951	910.83
419	574181.189	1065763.288	891.33



\* R2A PROFILE IS ON SHEET NO. 18 \*

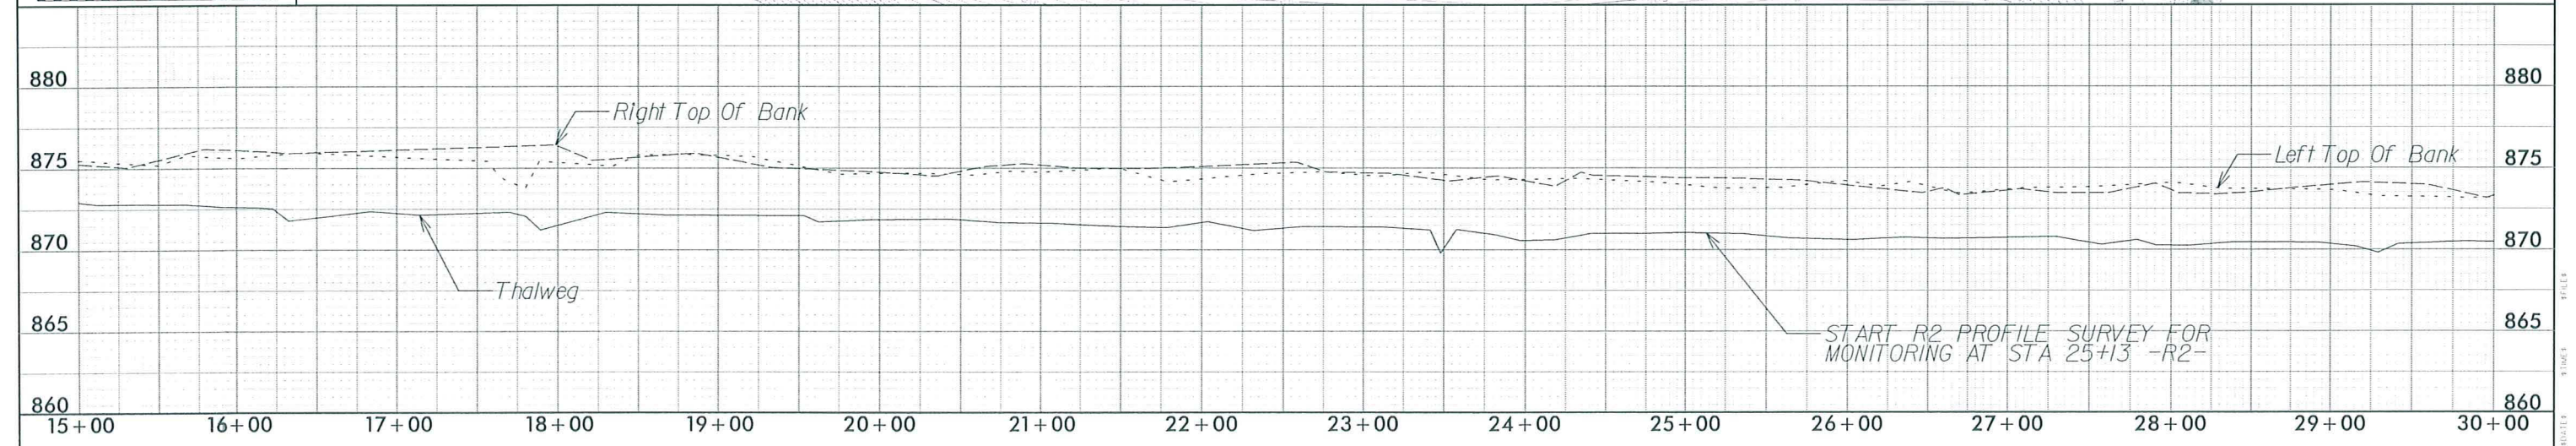



REVISIONS		
DATE	BY	DESCRIPTION
3/14/08	JTL	AS-BUILT DRAWINGS
8/19/08	EMP	CHANGED MONITORING LIMITS


PROJECT ENGINEER

PROJECT REFERENCE NO. SHEET NO.  
 LITTLE WHITE OAK CREEK 11  
**AS-BUILT DRAWING**  
**MULKEY**  
 ENGINEERS & CONSULTANTS  
 PO Box 33127  
 RALEIGH, N.C. 27636  
 (919) 851-1912  
 (919) 851-1918 (FAX)  
 WWW.MULKEYINC.COM


MATCH TO SHEET 16

MATCH TO SHEET 10

MATCH TO SHEET 12

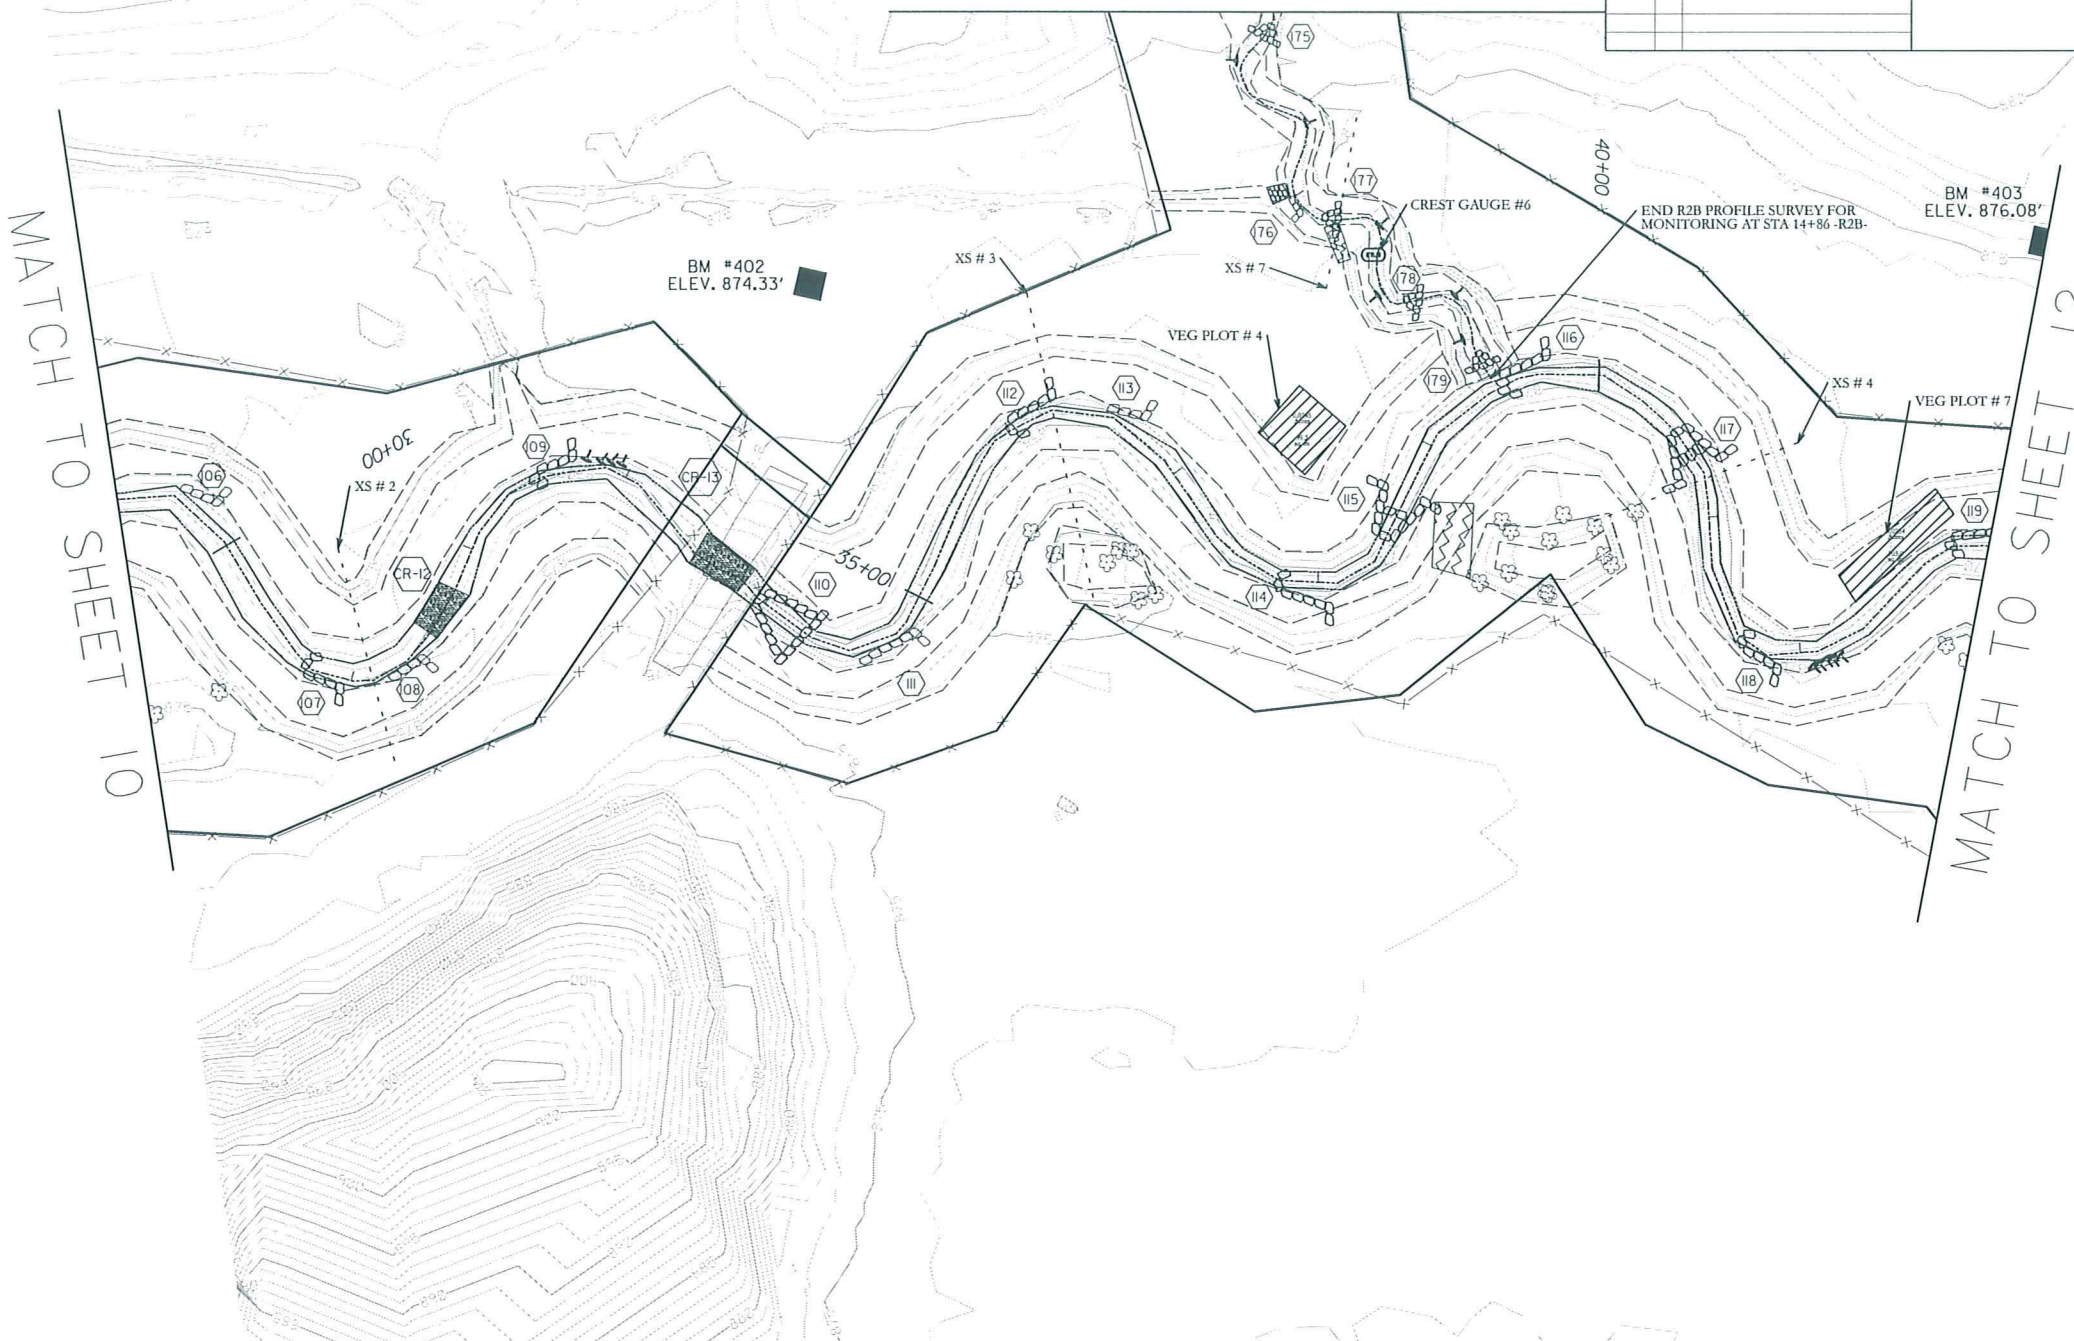

PROJECT CONTROL			
PT	NORTHING	EASTING	ELEV
400	576422.038	1068186.054	880.06
401	575893.793	1068722.918	876.57
402	575553.812	1069205.512	874.33
403	575226.901	1069762.056	876.08
404	574837.941	1070257.372	871.64
405	575926.913	1069945.053	897.4
406	576477.612	1069949.267	923.13
407	574324.856	1071064.416	871.26
408	574308.473	1071397.857	869.04
409	573967.988	1071422.762	869.21
410	574222.858	1069493.135	884.97
411	574100.263	1068841.141	891.49
412	573828.028	1068325.712	899.29
413	573310.368	1068220.815	880.95
414	573357.513	1067646.732	883.68
415	573584.485	1067315.797	884.12
416	573948.599	1066938.639	893.06
417	573625.298	1066619.236	887.85
418	573993.945	1066024.951	910.83
419	574181.189	1065763.288	891.33

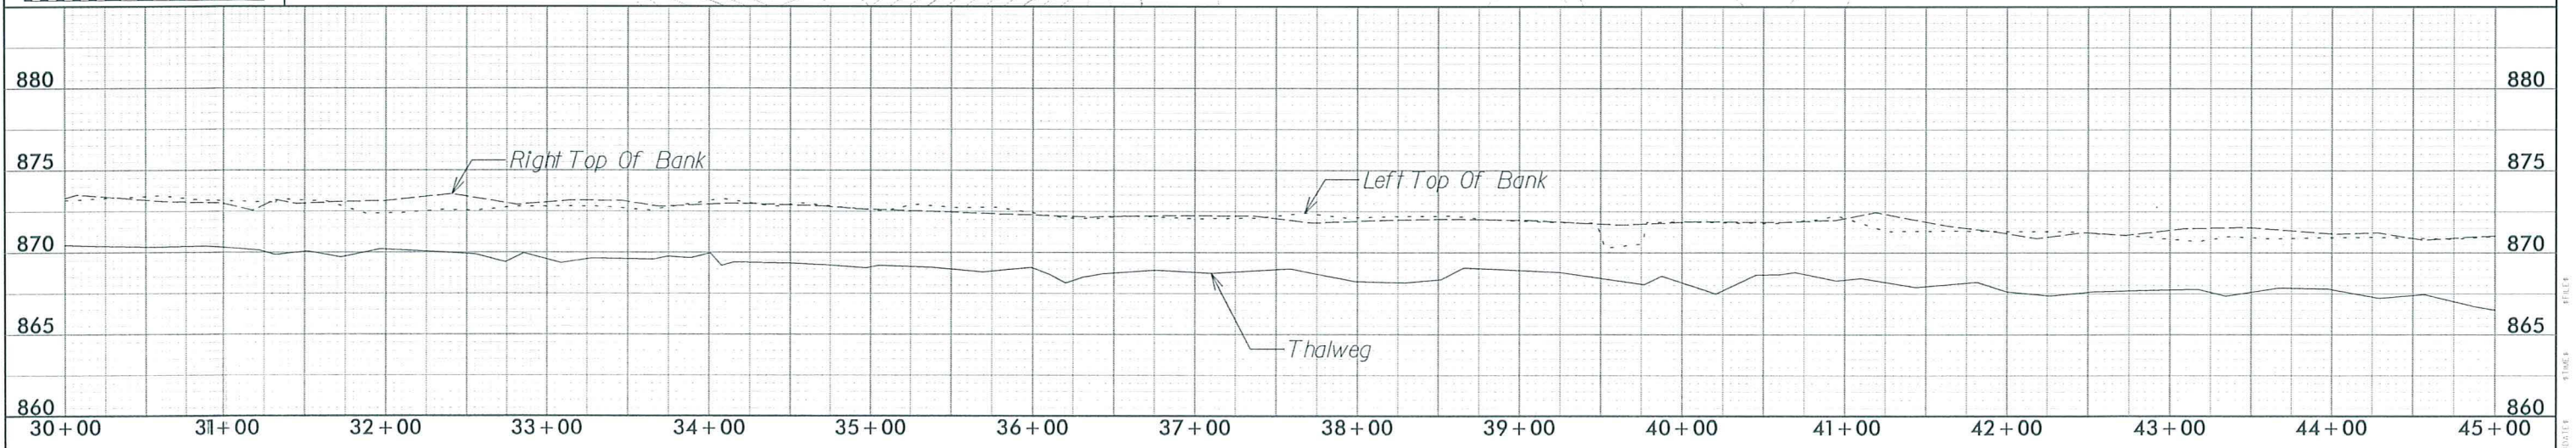




DATE PLOTTED: 08/21/08



REVISIONS		
DATE	BY	DESCRIPTION
3/14/08	JTL	AS-BUILT DRAWINGS
8/19/08	EMP	CHANGED MONITORING LIMITS

PROJECT REFERENCE NO. SHEET NO.  
 LITTLE WHITE OAK CREEK 12  
**AS-BUILT DRAWING**  
  
 PO Box 33127  
 RALEIGH, N.C. 27636  
 (919) 851-1912  
 (919) 851-1918 (FAX)  
 WWW.MULKEYINC.COM

PROJECT CONTROL			
PT	NORTHING	EASTING	ELEV
400	576422.038	1068186.054	880.06
401	575893.793	1068722.918	876.57
402	575553.812	1069205.512	874.33
403	575226.901	1069762.056	876.08
404	574837.941	1070257.372	871.64
405	575926.913	1069945.053	897.4
406	576477.612	1069949.267	923.13
407	574324.856	1071064.416	871.26
408	574308.473	1071397.857	869.04
409	573967.988	1071422.762	869.21
410	574222.858	1069493.135	884.97
411	574100.263	1068841.141	891.49
412	573828.028	1068325.712	899.29
413	573310.368	1068220.815	880.95
414	573357.513	1067646.732	883.68
415	573584.485	1067315.797	884.12
416	573948.599	1066938.639	893.06
417	573625.298	1066619.236	887.85
418	573993.945	1066024.951	910.83
419	574181.189	1065763.288	891.33

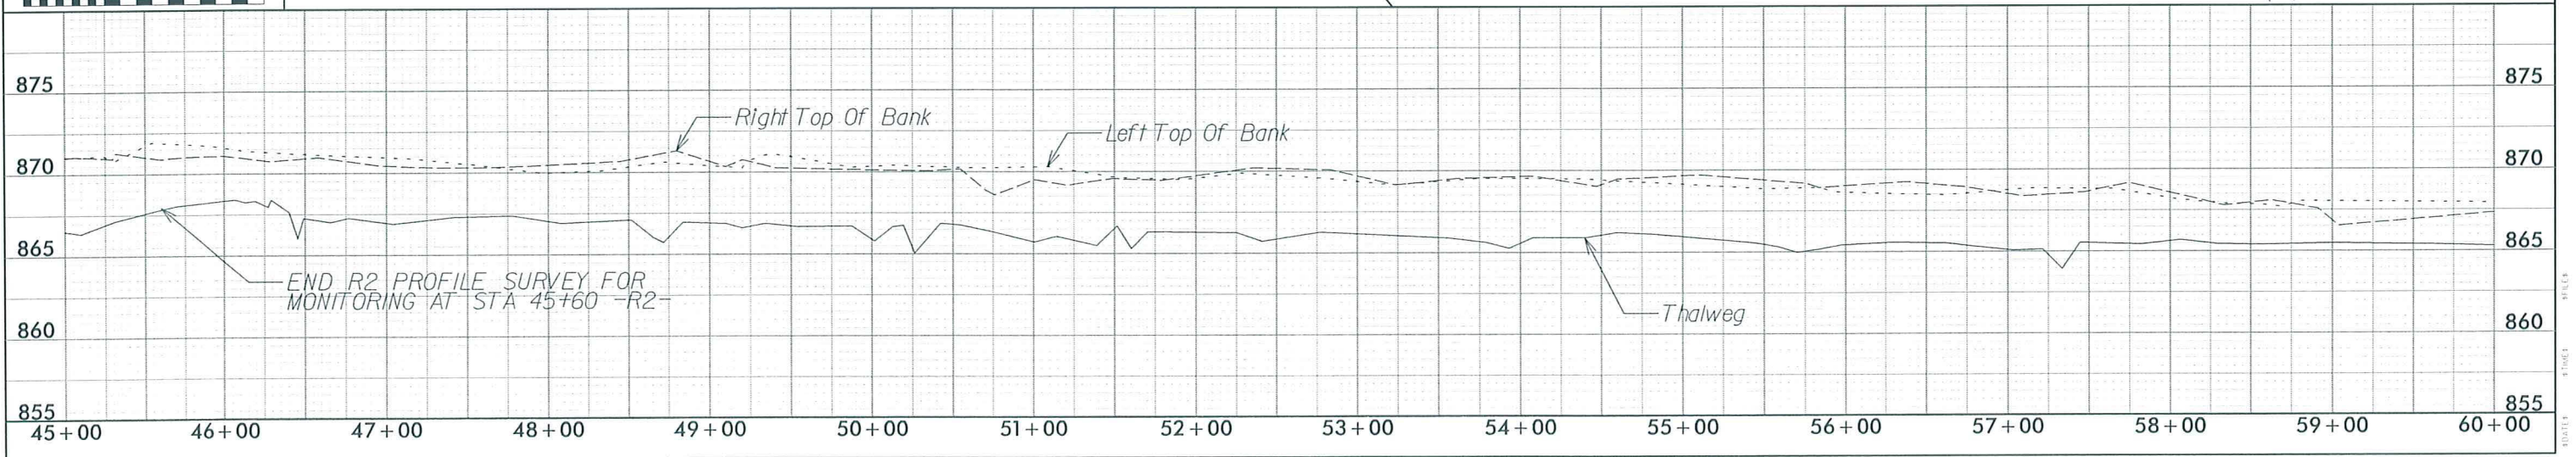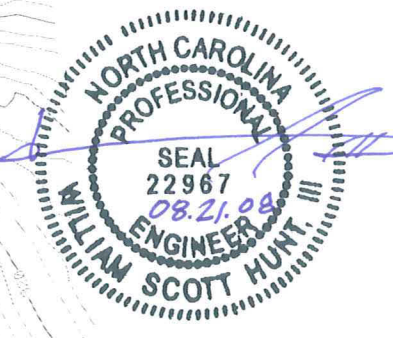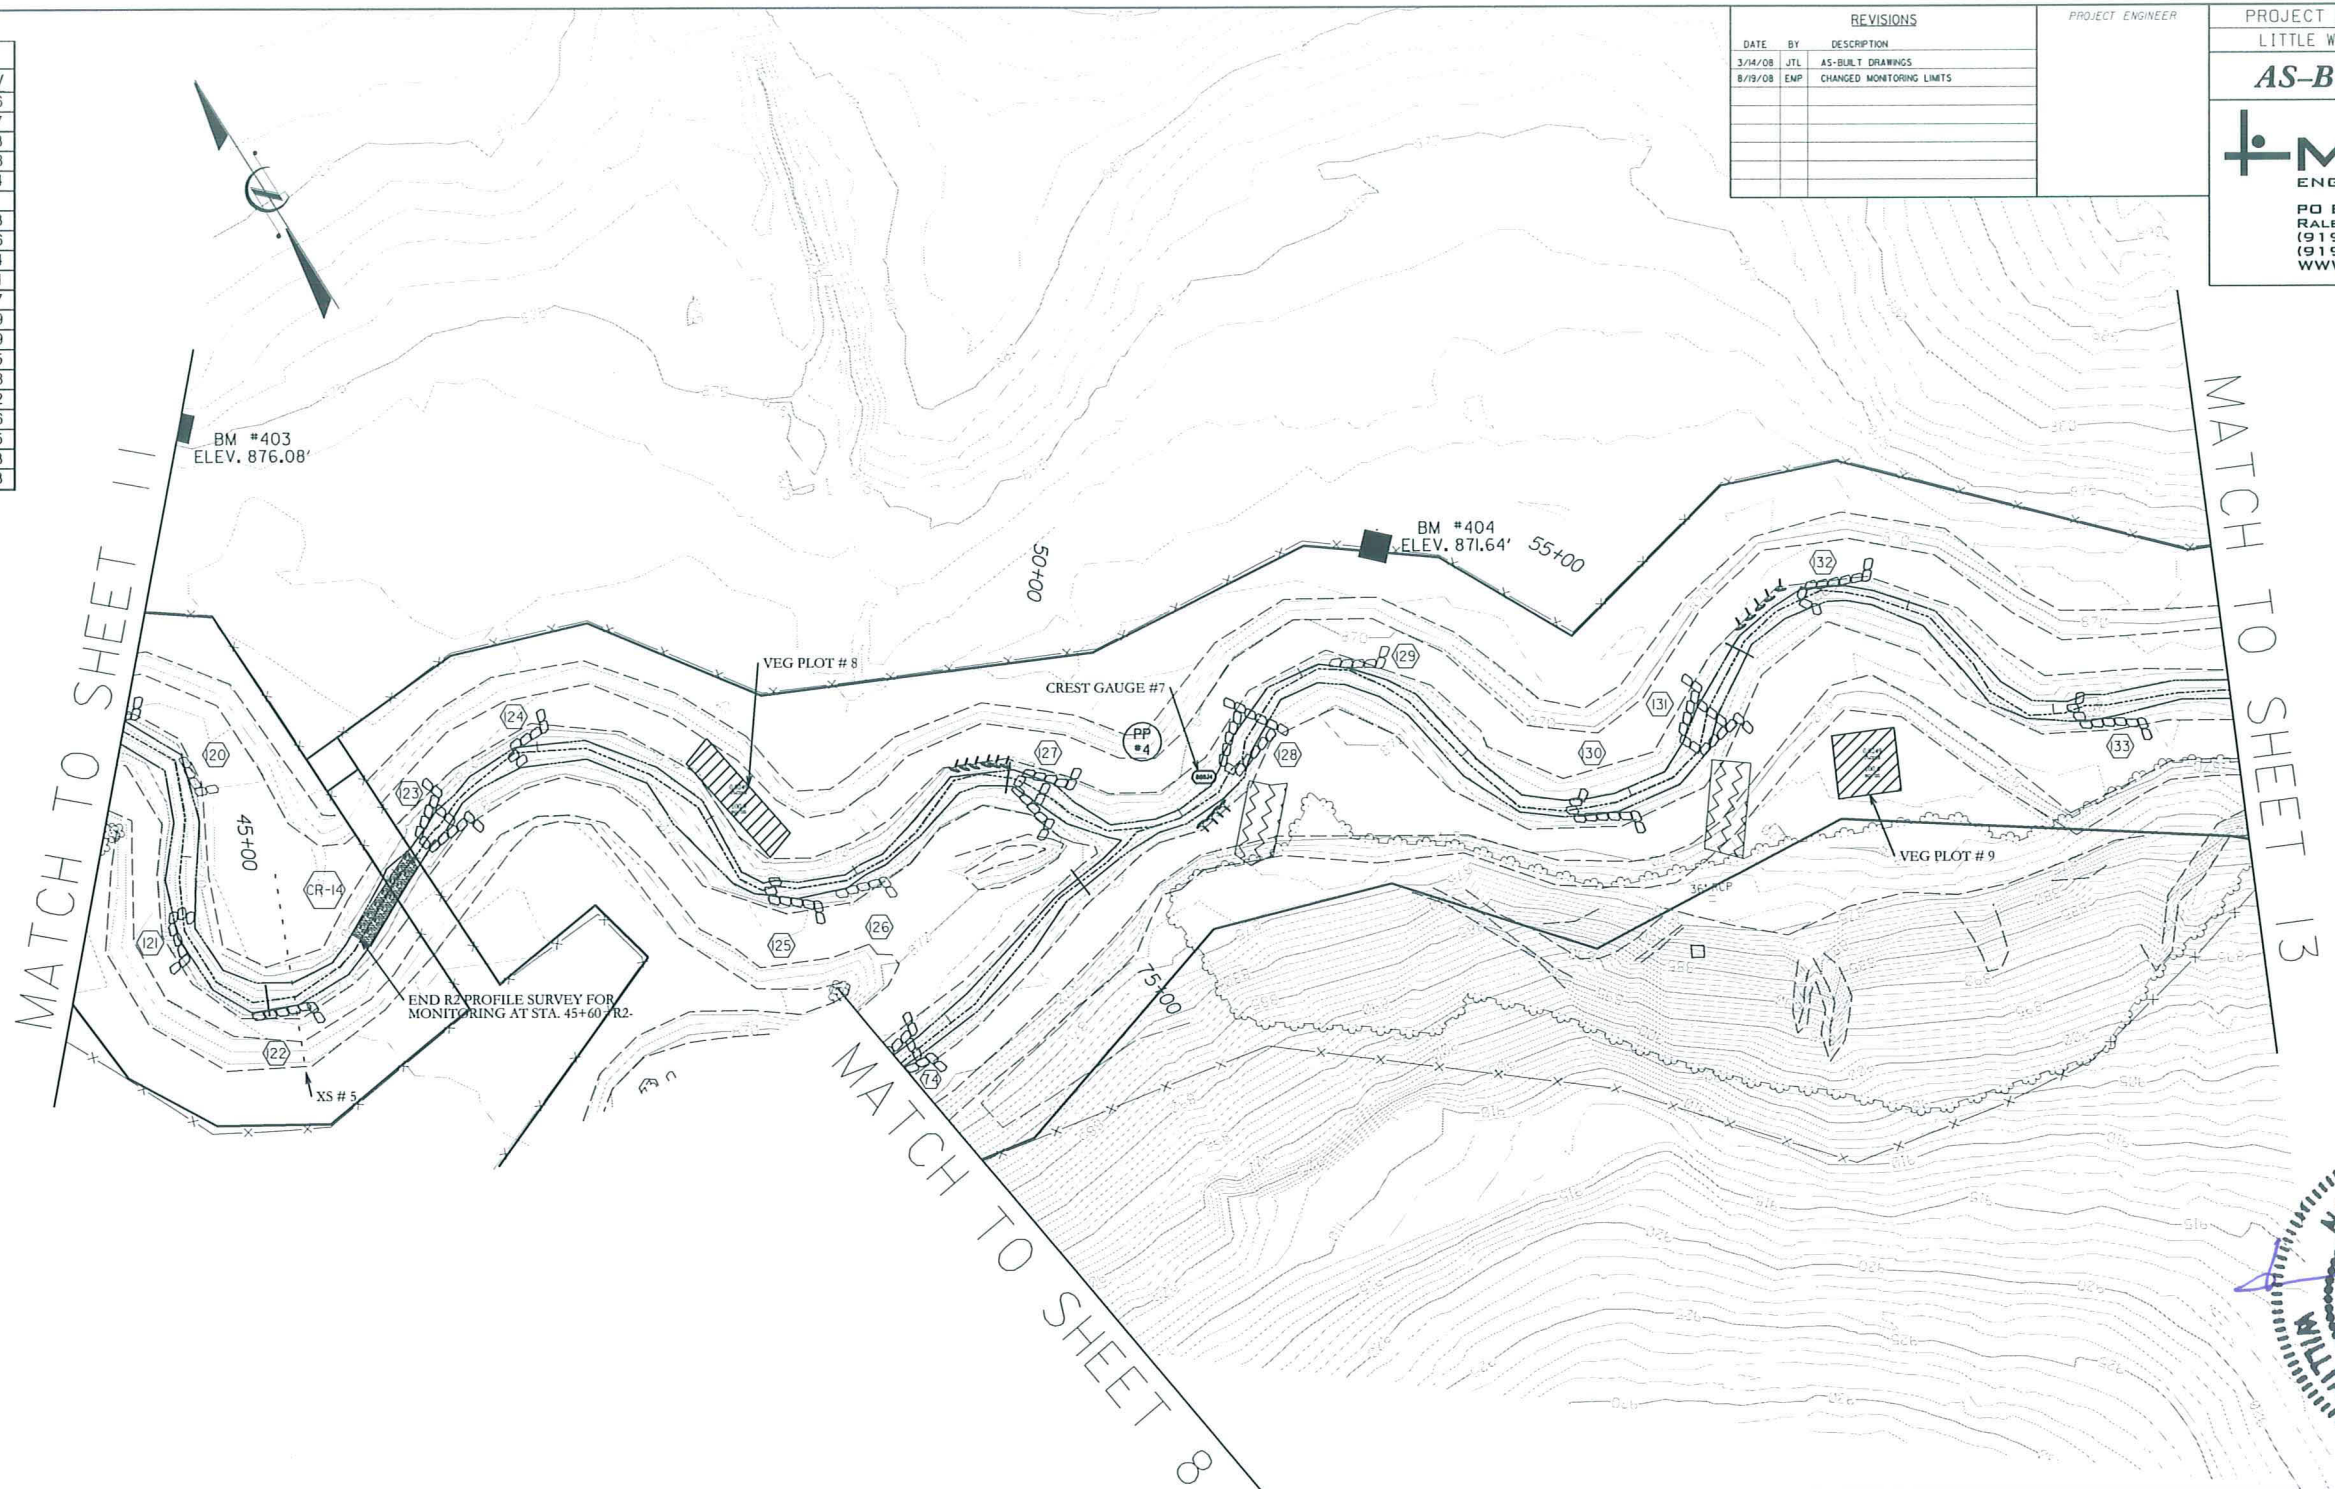



PT	NORTHING	EASTING	ELEV
400	576422.038	1068186.054	880.06
401	575893.793	1068722.918	876.57
402	575553.812	1069205.512	874.33
403	575226.901	1069762.056	876.08
404	574837.941	1070257.372	871.64
405	575926.913	1069945.053	897.4
406	576477.612	1069949.267	923.13
407	574324.856	1071084.416	871.26
408	574308.473	1071397.857	869.04
409	573967.988	1071422.762	869.21
410	574222.858	1069493.135	884.97
411	574100.263	1068841.141	891.49
412	573828.028	1068325.712	899.29
413	573310.368	1068220.815	880.95
414	573357.513	1067646.732	883.68
415	573584.485	1067315.797	884.12
416	573948.599	1066938.639	893.06
417	573625.298	1066619.236	887.85
418	573993.945	1066024.951	910.83
419	574181.189	1065763.288	891.33

REVISIONS		
DATE	BY	DESCRIPTION
3/24/08	JTL	AS-BUILT DRAWINGS
8/29/08	EMP	CHANGED MONITORING LIMITS



PROJECT ENGINEER

PROJECT REFERENCE NO. LITTLE WHITE OAK CREEK SHEET NO. 13

**AS-BUILT DRAWING**

**MULKEY**  
ENGINEERS & CONSULTANTS

PO Box 33127  
RALEIGH, N.C. 27636  
(919) 851-1912  
(919) 851-1918 (FAX)  
WWW.MULKEYINC.COM

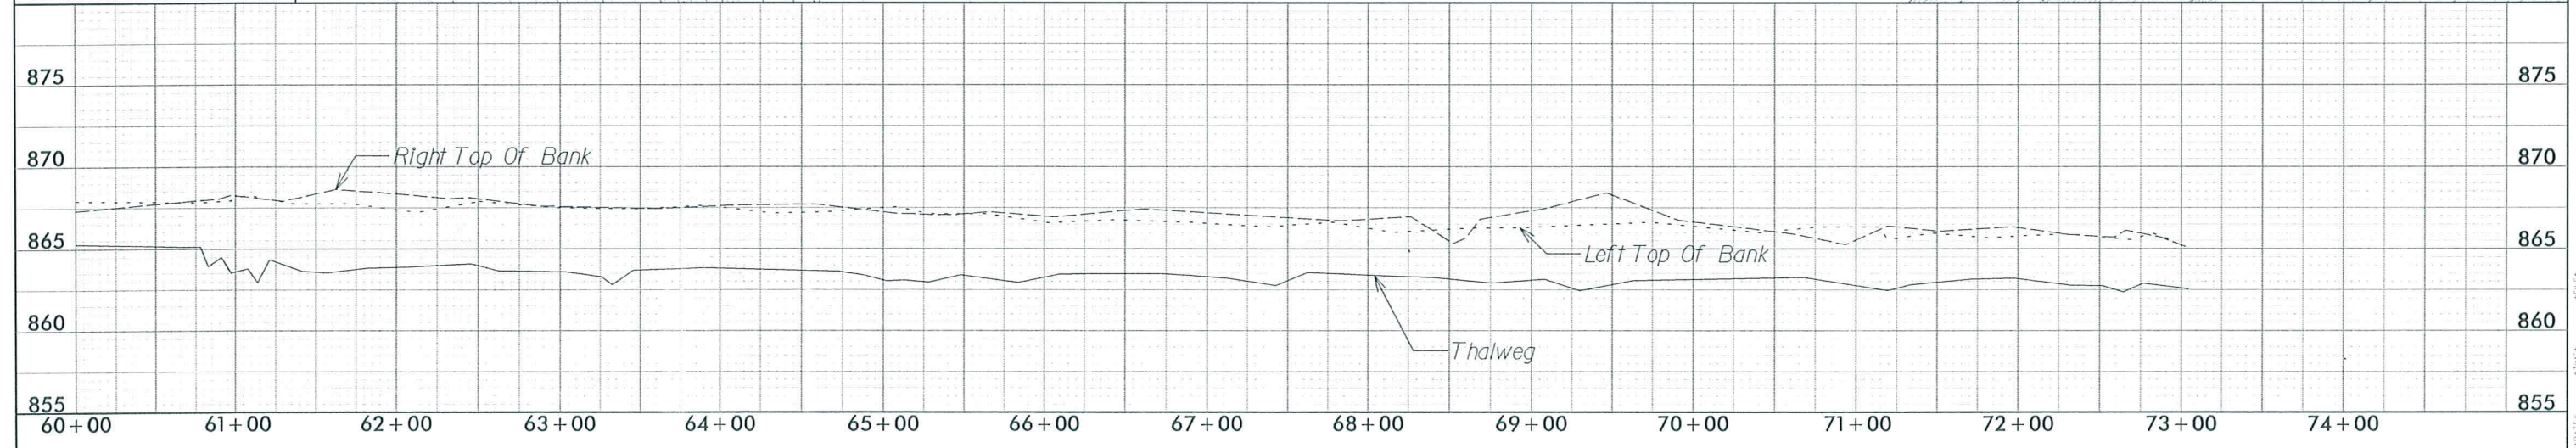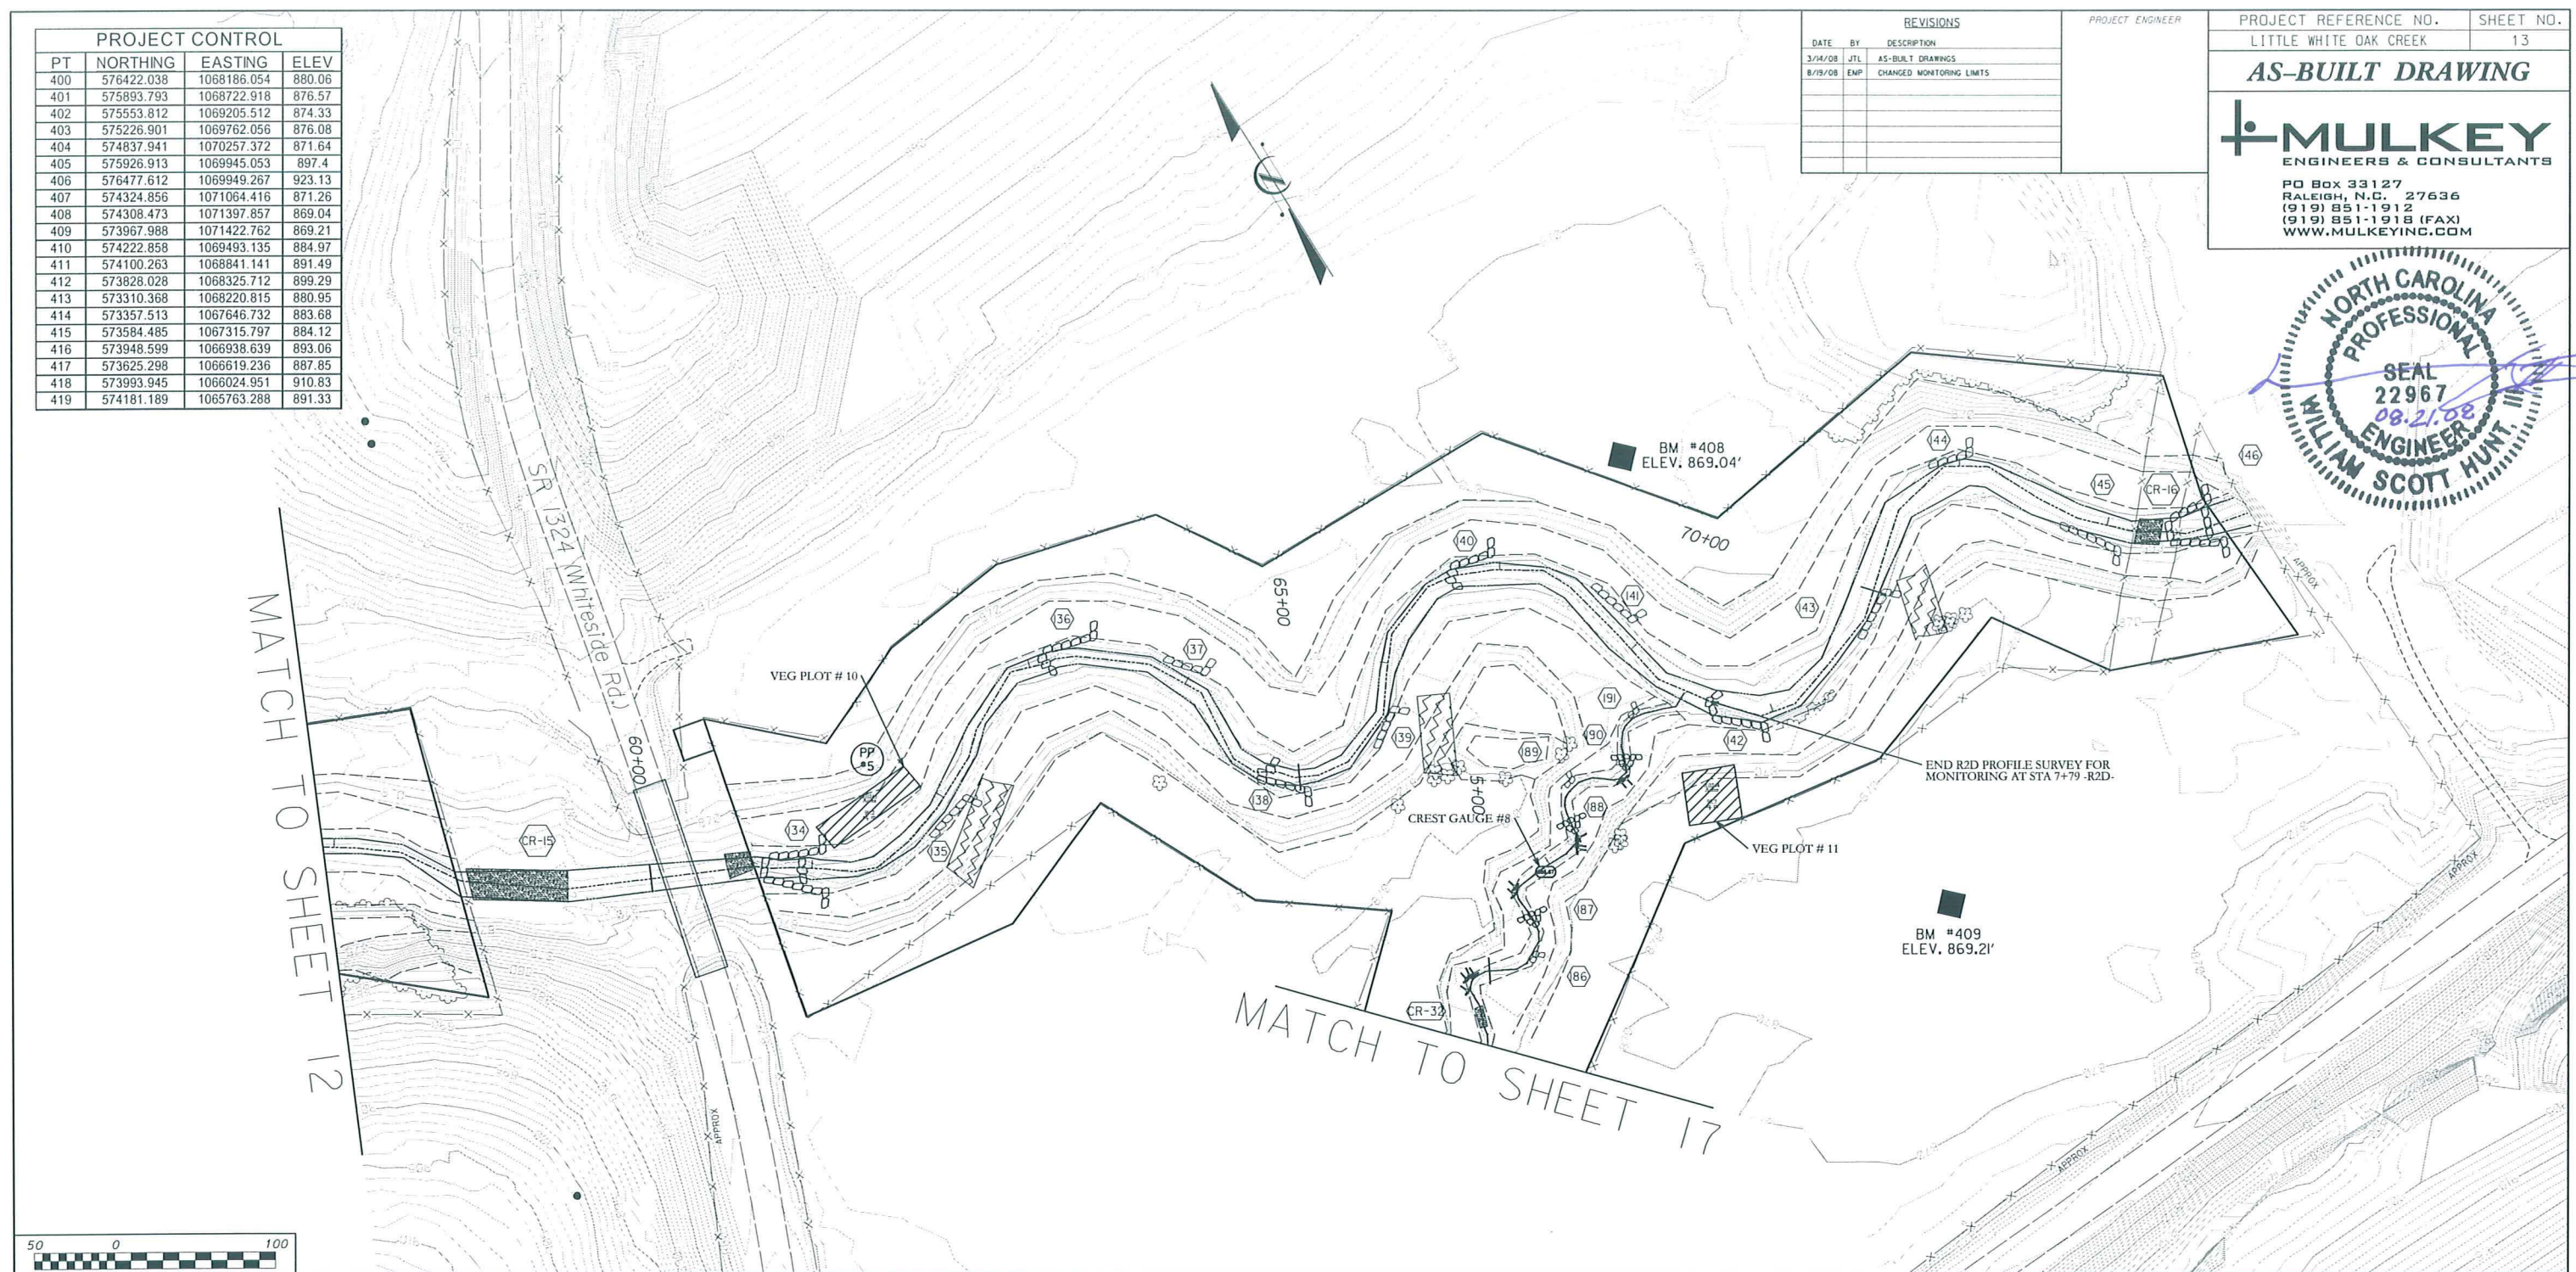



REVISIONS		
DATE	BY	DESCRIPTION
3/14/08	JTL	AS-BUILT DRAWINGS
8/19/08	EMP	CHANGED MONITORING LIMITS


PROJECT ENGINEER

PROJECT REFERENCE NO. LITTLE WHITE OAK CREEK SHEET NO. 14

**AS-BUILT DRAWING**

**MULKEY**  
ENGINEERS & CONSULTANTS

PO Box 33127  
RALEIGH, N.C. 27636  
(919) 851-1912  
(919) 851-1918 (FAX)  
WWW.MULKEYINC.COM

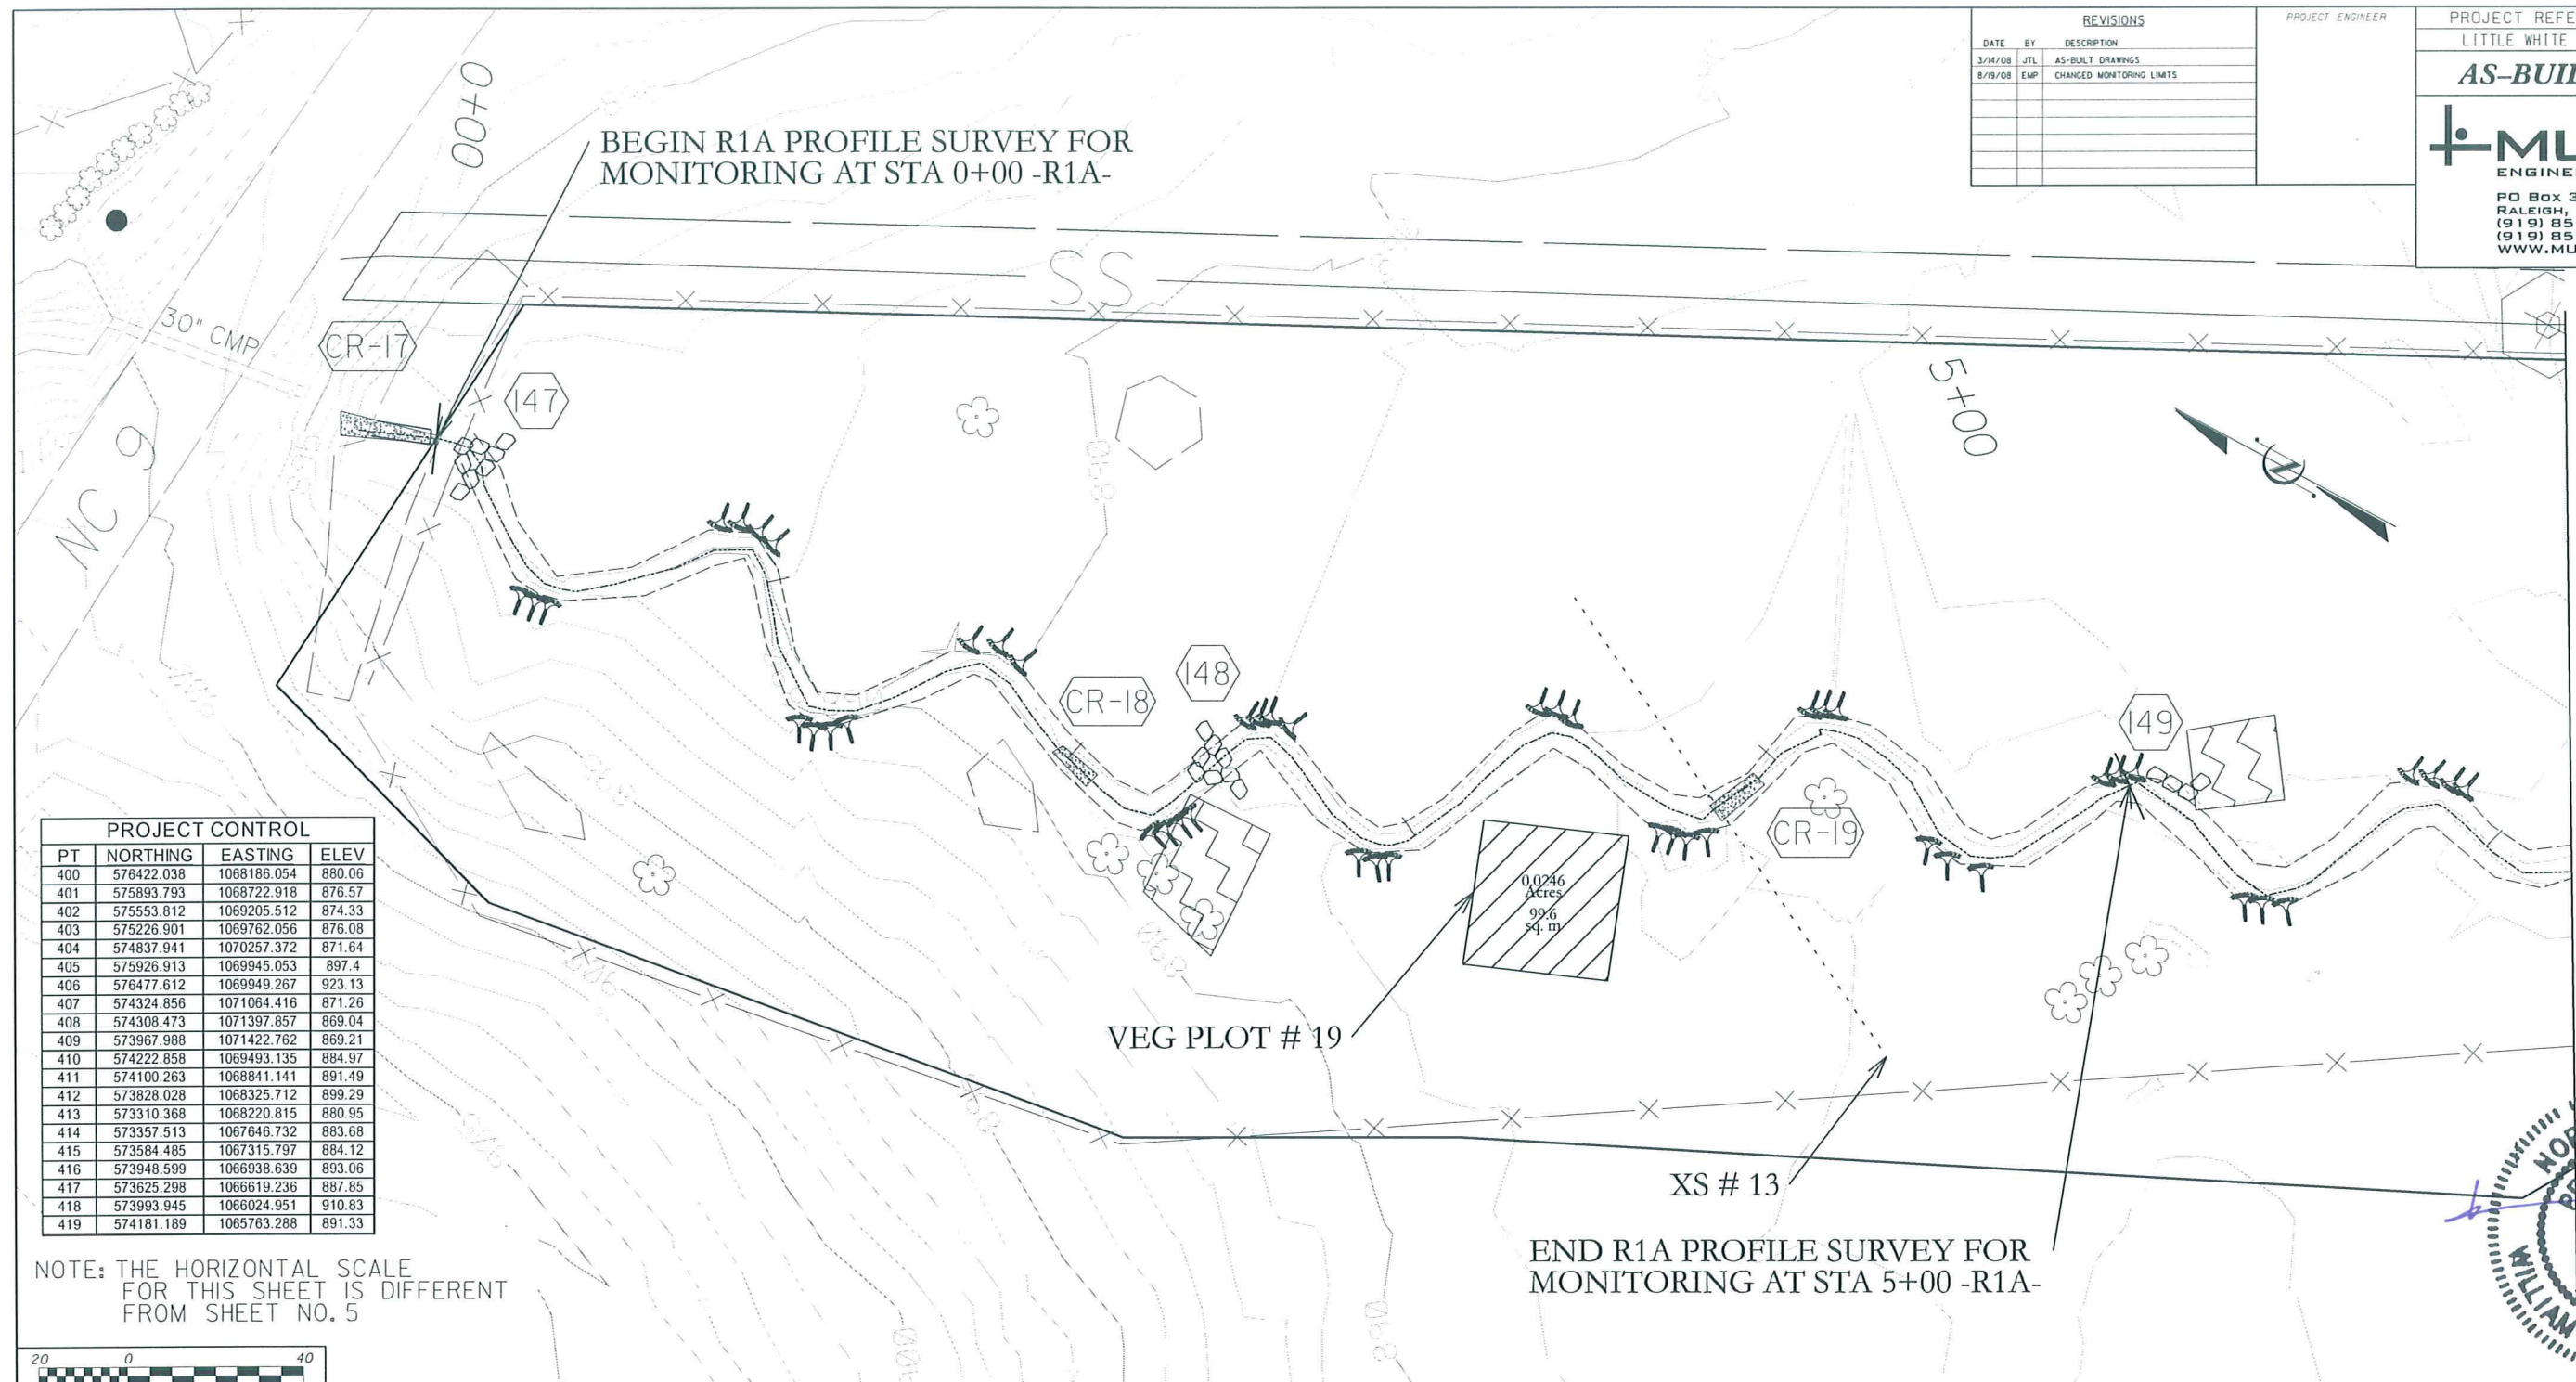

PROJECT CONTROL			
PT	NORTHING	EASTING	ELEV
400	576422.038	1068186.054	880.06
401	575893.793	1068722.918	876.57
402	575553.812	1069205.512	874.33
403	575226.901	1069762.056	876.08
404	574837.941	1070257.372	871.64
405	575926.913	1069945.053	897.4
406	576477.612	1069949.267	923.13
407	574324.856	1071064.416	871.26
408	574308.473	1071397.857	869.04
409	573967.988	1071422.762	869.21
410	574222.858	1069493.135	884.97
411	574100.263	1068841.141	891.49
412	573828.028	1068325.712	899.29
413	573310.368	1068220.815	880.95
414	573357.513	1067646.732	883.68
415	573584.485	1067315.797	884.12
416	573948.599	1066938.639	893.06
417	573625.298	1066619.236	887.85
418	573993.945	1066024.951	910.83
419	574181.189	1065763.288	891.33

NOTE: THE HORIZONTAL SCALE FOR THIS SHEET IS DIFFERENT FROM SHEET NO. 5



MATCH TO SHEET 5

SEE SHEET NO. 18 FOR -R1A- PROFILE



REVISIONS		
DATE	BY	DESCRIPTION
3/14/08	JTL	AS-BUILT DRAWINGS
8/19/08	EMP	CHANGED MONITORING LIMITS

PROJECT ENGINEER

PROJECT REFERENCE NO.	SHEET NO.
LITTLE WHITE OAK CREEK	15

**AS-BUILT DRAWING**

**MULKEY**  
ENGINEERS & CONSULTANTS

PO Box 33127  
RALEIGH, N.C. 27636  
(919) 851-1912  
(919) 851-1918 (FAX)  
WWW.MULKEYINC.COM



APPROXIMATE LOCATION  
OF GAS LINE EASEMENT

00+0

VEG PLOT # 6

0.0242  
Acres  
98.0  
sq. m

CR-24

164

165

CR-25

166

167

CR-26

RP  
#3

MATCH TO SHEET 16

NOTE: THE HORIZONTAL SCALE  
FOR THIS SHEET IS DIFFERENT  
FROM SHEET NO. 11



PROJECT CONTROL			
PT	NORTHING	EASTING	ELEV
400	576422.038	1068186.054	880.06
401	575893.793	1068722.918	876.57
402	575553.812	1069205.512	874.33
403	575226.901	1069762.056	876.08
404	574837.941	1070257.372	871.64
405	575926.913	1069945.053	897.4
406	576477.612	1069949.267	923.13
407	574324.856	1071064.416	871.26
408	574308.473	1071397.857	869.04
409	573967.988	1071422.762	869.21
410	574222.858	1069493.135	884.97
411	574100.263	1068841.141	891.49
412	573828.028	1068325.712	899.29
413	573310.368	1068220.815	880.95
414	573357.513	1067646.732	883.68
415	573584.485	1067315.797	884.12
416	573948.599	1066938.639	893.06
417	573625.298	1066619.236	887.85
418	573993.945	1066024.951	910.83
419	574181.189	1065763.288	891.33

SEE SHEET NO. 19 FOR -R2B- PROFILE




PROJECT CONTROL			
PT	NORTHING	EASTING	ELEV
400	576422.038	1068186.054	880.06
401	575893.793	1068722.918	876.57
402	575553.812	1069205.512	874.33
403	575226.901	1069762.056	876.08
404	574837.941	1070257.372	871.64
405	575926.913	1069945.053	897.4
406	576477.612	1069949.267	923.13
407	574324.856	1071064.416	871.26
408	574308.473	1071397.857	869.04
409	573967.988	1071422.762	869.21
410	574222.858	1069493.135	884.97
411	574100.263	1068841.141	891.49
412	573828.028	1068325.712	899.29
413	573310.368	1068220.815	880.95
414	573357.513	1067646.732	883.68
415	573584.485	1067315.797	884.12
416	573948.599	1066938.639	893.06
417	573625.298	1066619.236	887.85
418	573993.945	1066024.951	910.83
419	574181.189	1065763.288	891.33

REVISIONS		
DATE	BY	DESCRIPTION
3/14/08	JTL	AS-BUILT DRAWINGS
8/19/08	EMP	CHANGED MONITORING LIMITS

PROJECT ENGINEER

PROJECT REFERENCE NO. SHEET NO.  
 LITTLE WHITE OAK CREEK 16  
**AS-BUILT DRAWING**  
**MULKEY**  
 ENGINEERS & CONSULTANTS  
 PO Box 33127  
 RALEIGH, N.C. 27636  
 (919) 851-1912  
 (919) 851-1918 (FAX)  
 WWW.MULKEYINC.COM

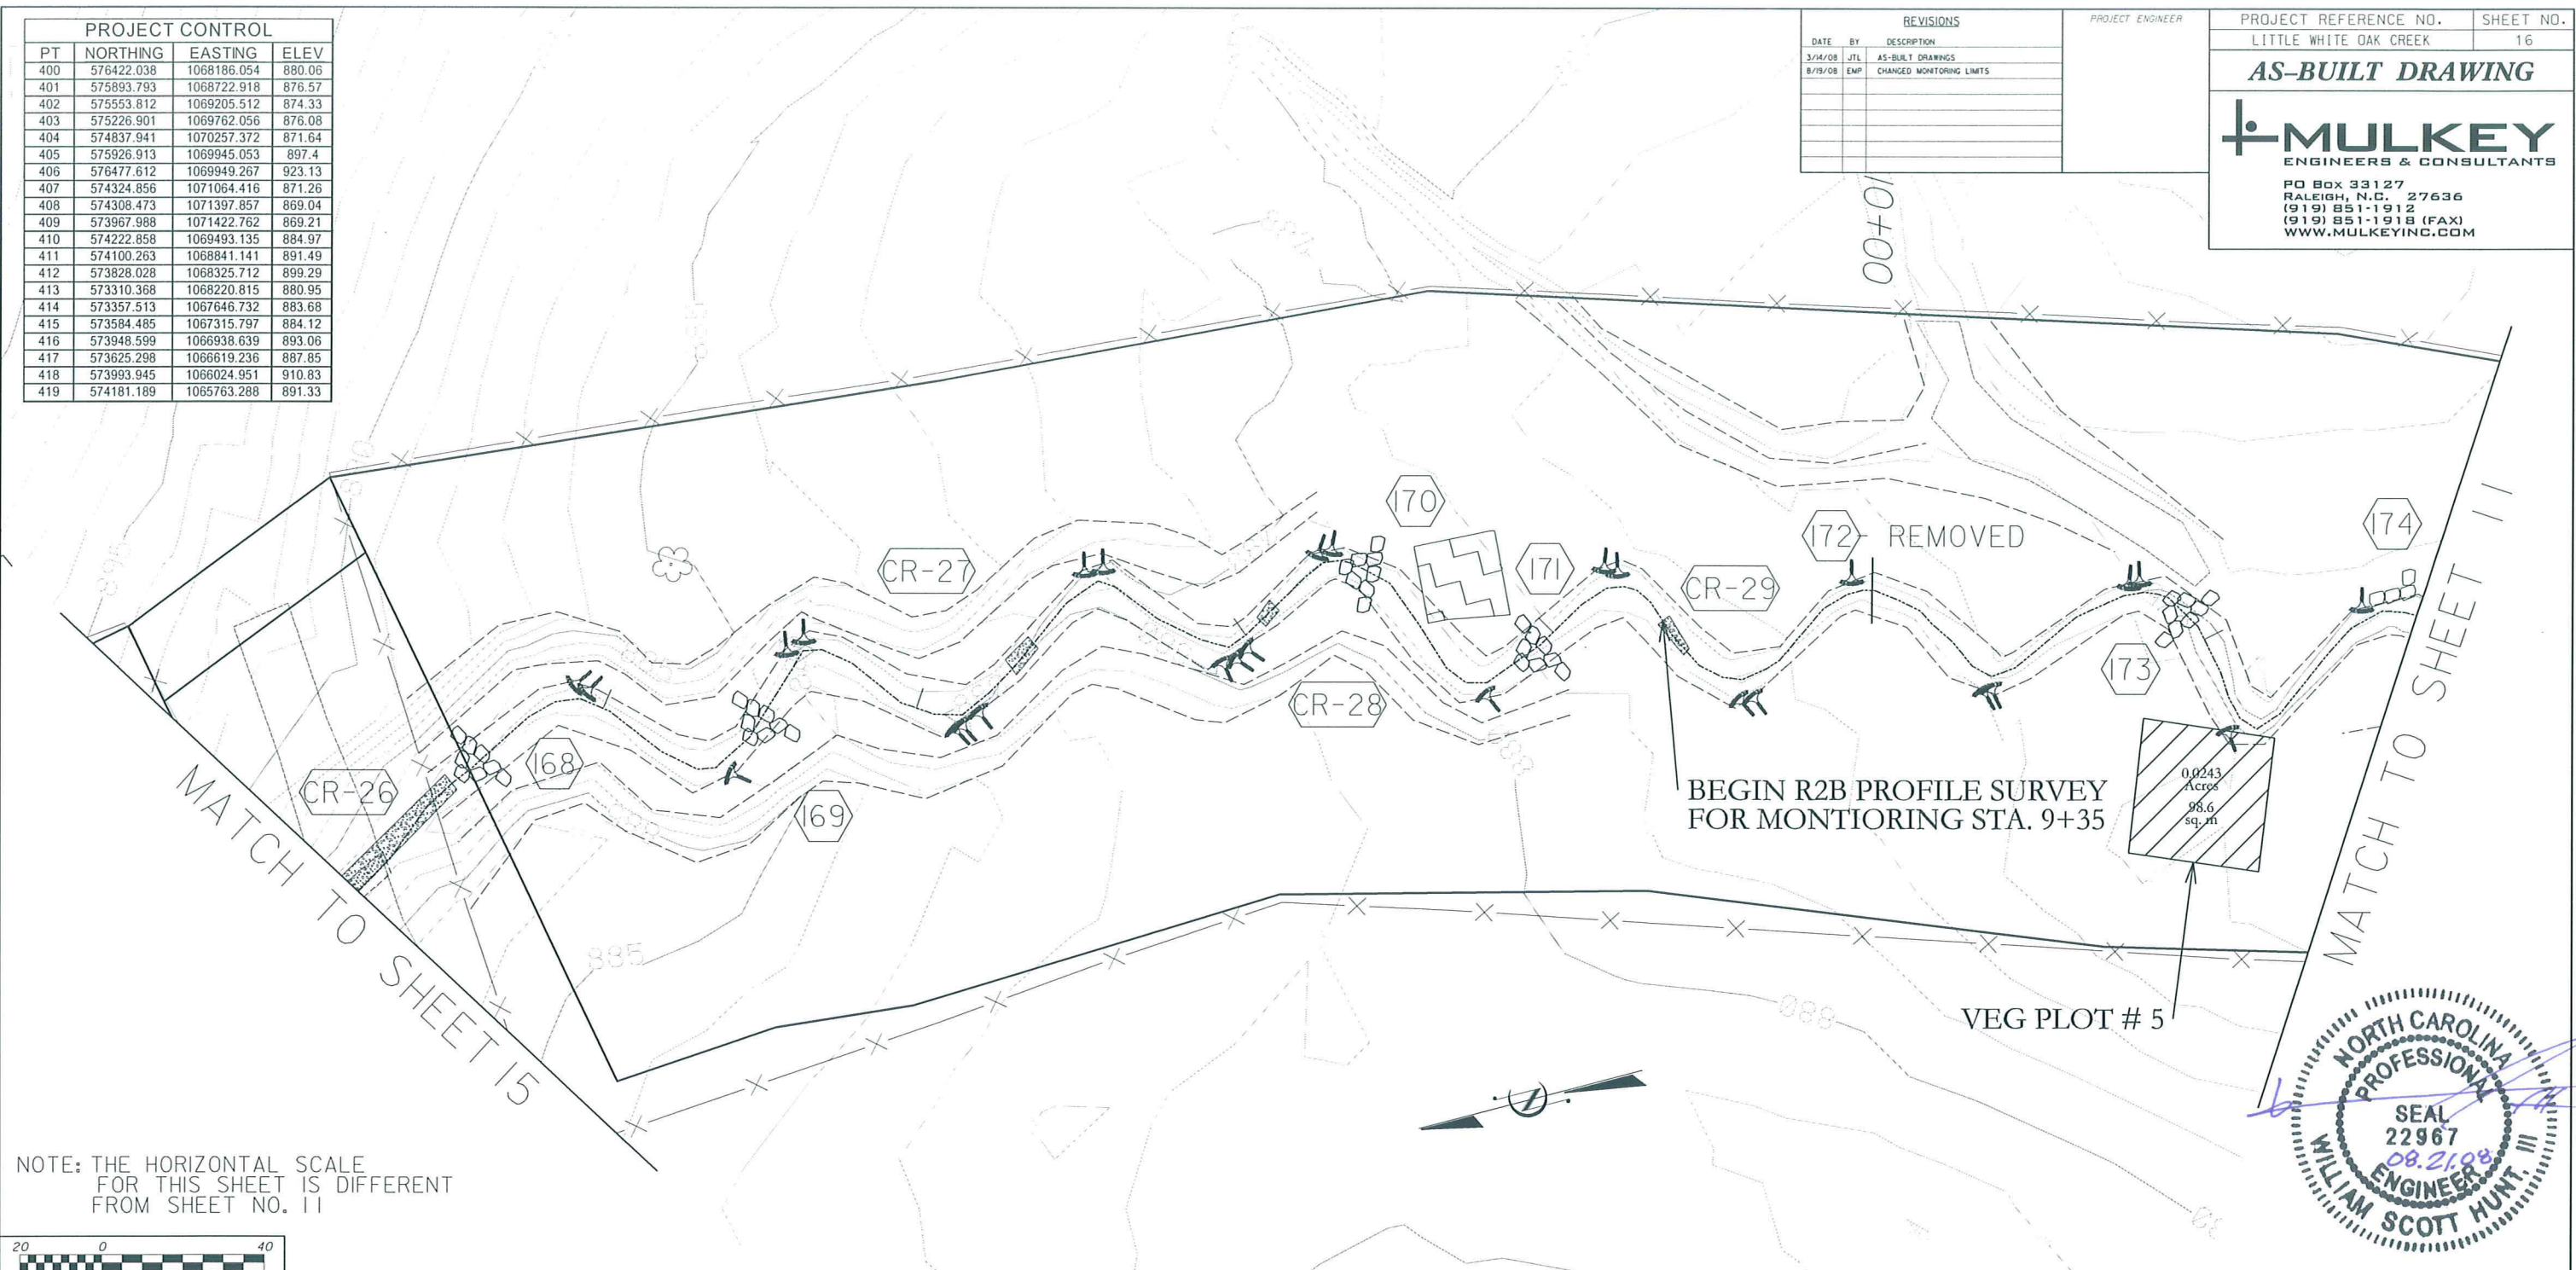

NOTE: THE HORIZONTAL SCALE FOR THIS SHEET IS DIFFERENT FROM SHEET NO. 11



SEE SHEET NO. 19 FOR -R2B- PROFILE




PROJECT CONTROL			
PT	NORTHING	EASTING	ELEV
400	576422.038	1068186.054	880.06
401	575893.793	1068722.918	876.57
402	575553.812	1069205.512	874.33
403	575226.901	1069762.056	876.08
404	574837.941	1070257.372	871.64
405	575926.913	1069945.053	897.4
406	576477.612	1069949.267	923.13
407	574324.856	1071064.416	871.26
408	574308.473	1071397.857	869.04
409	573967.988	1071422.762	869.21
410	574222.858	1069493.135	884.97
411	574100.263	1068841.141	891.49
412	573828.028	1068325.712	899.29
413	573310.368	1068220.815	880.95
414	573357.513	1067646.732	883.68
415	573584.485	1067315.797	884.12
416	573948.599	1066938.639	893.06
417	573625.298	1066619.236	887.85
418	573993.945	1066024.951	910.83
419	574181.189	1065763.288	891.33

REVISIONS		
DATE	BY	DESCRIPTION
3/14/08	JTL	AS-BUILT DRAWINGS
8/19/08	EMP	CHANGED MONITORING LIMITS

PROJECT ENGINEER

PROJECT REFERENCE NO. LITTLE WHITE OAK CREEK	SHEET NO. 17
<b>AS-BUILT DRAWING</b>	
<b>MULKEY</b> ENGINEERS & CONSULTANTS	
PO Box 33127 RALEIGH, N.C. 27636 (919) 851-1912 (919) 851-1918 (FAX) WWW.MULKEYINC.COM	

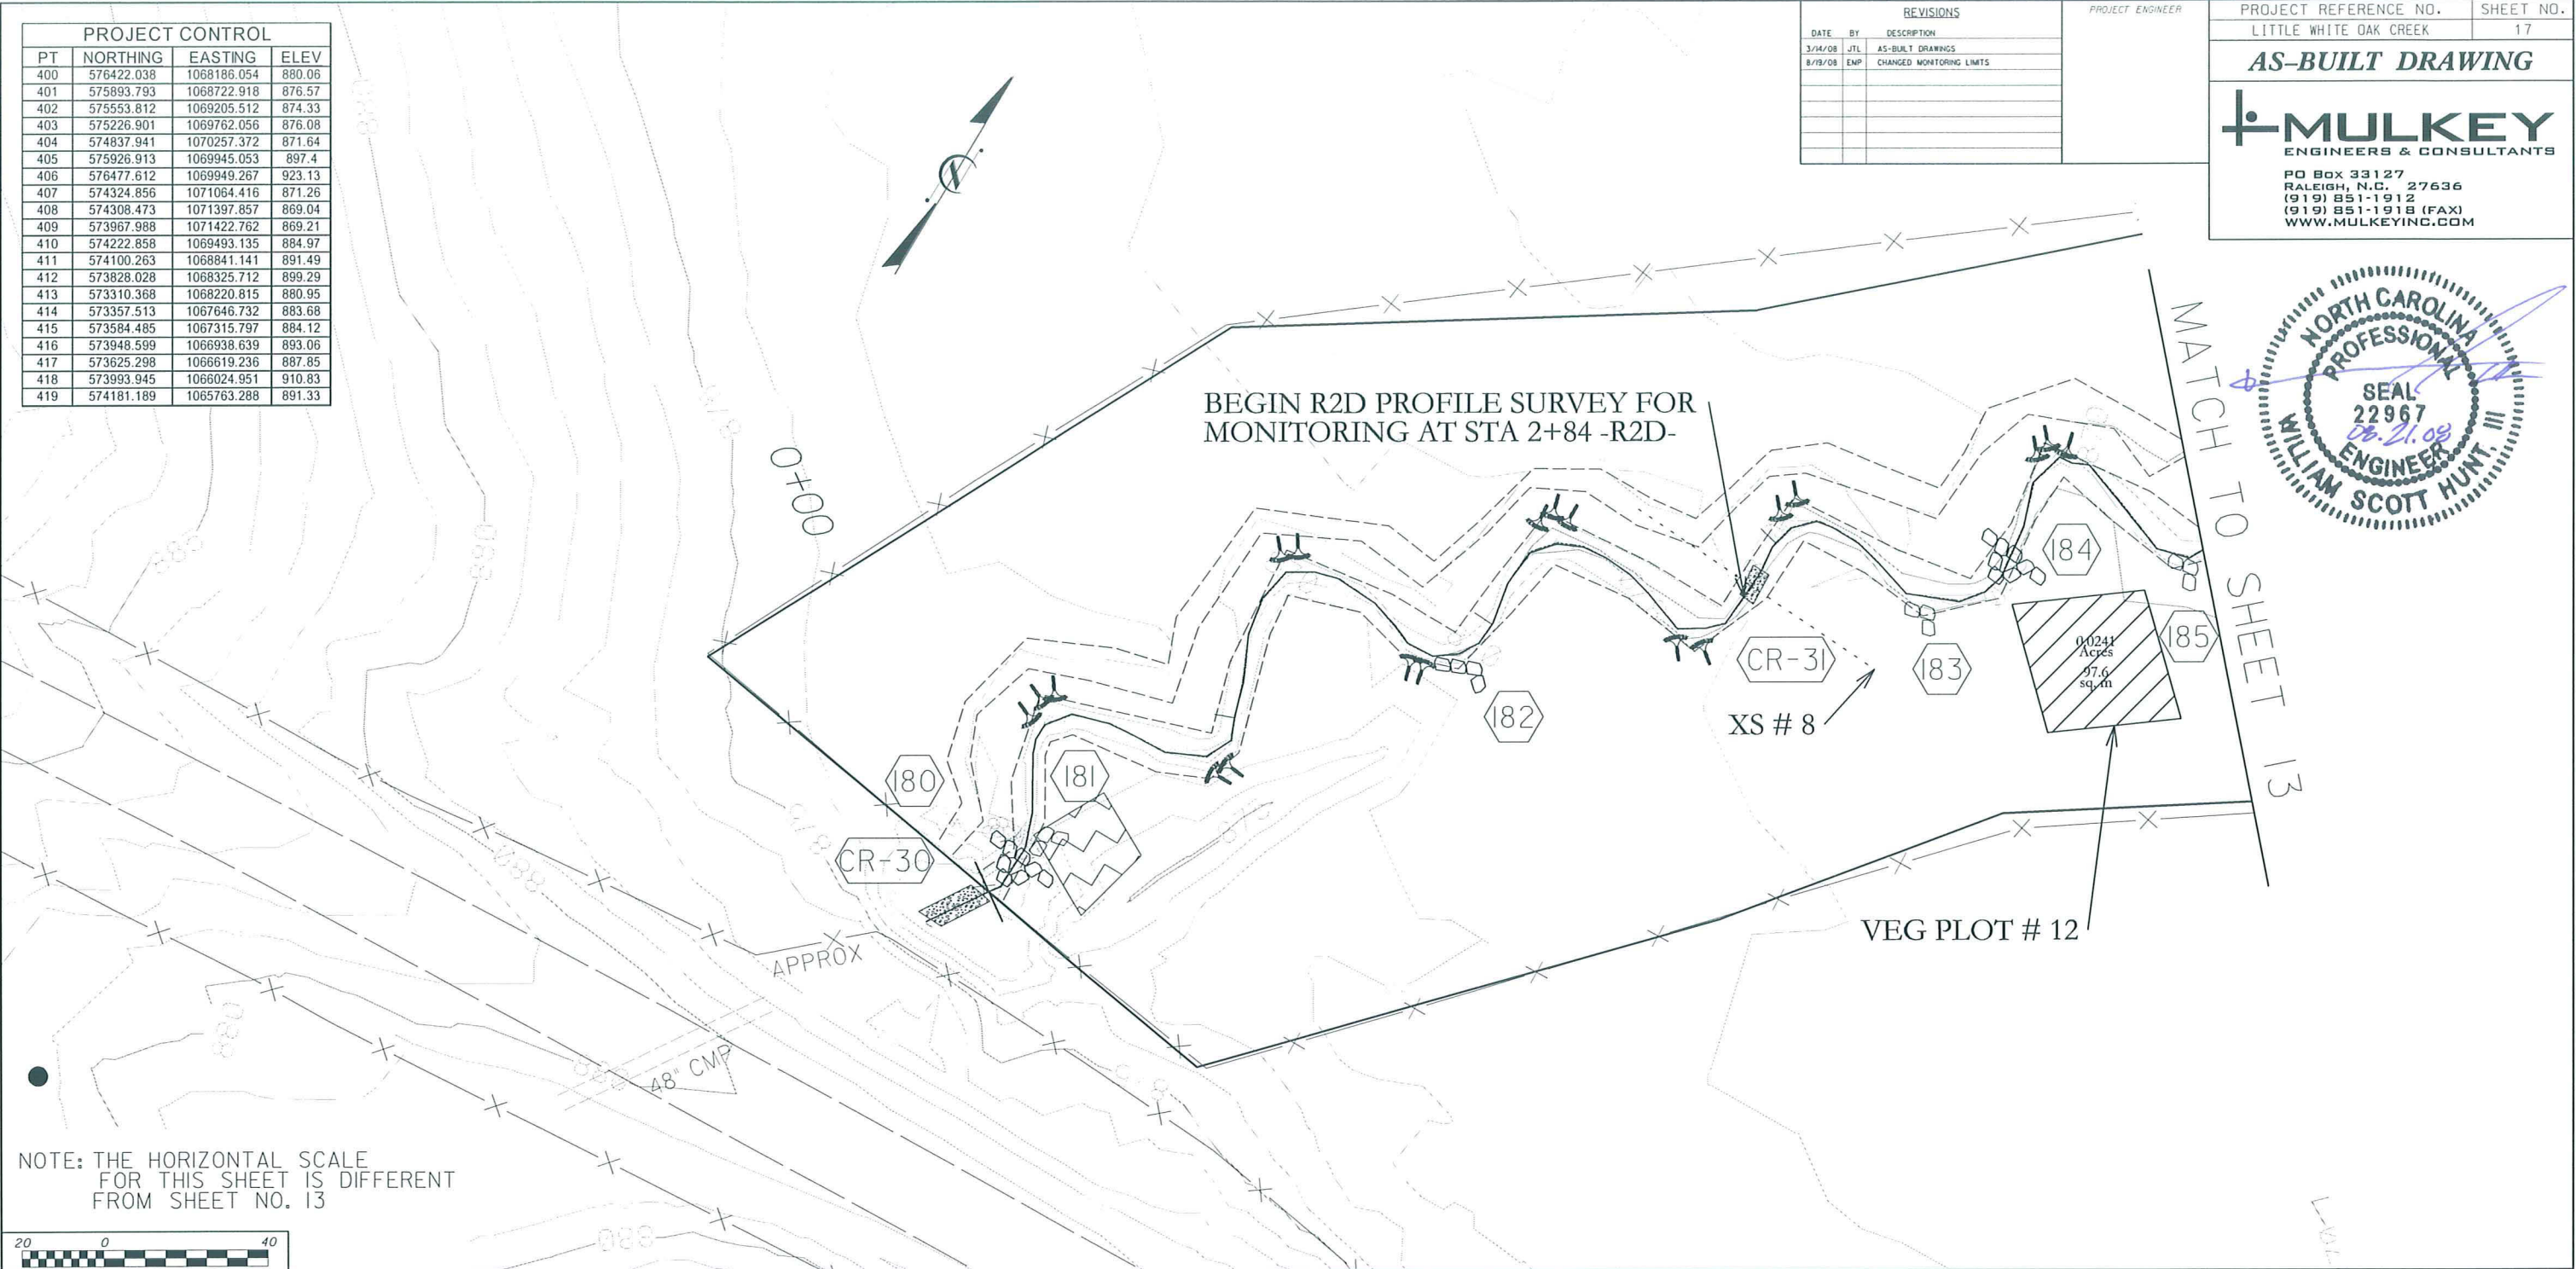

NOTE: THE HORIZONTAL SCALE FOR THIS SHEET IS DIFFERENT FROM SHEET NO. 13







SEE SHEET NO. 19 FOR -R2D- PROFILE




# PROPOSED PROFILES





REVISIONS			PROJECT ENGINEER	PROJECT REFERENCE NO.	SHEET NO.
DATE	BY	DESCRIPTION		LITTLE WHITE OAK CREEK	18
3/14/08	JTL	AS-BUILT DRAWING			
8/19/08	EMP	CHANGED MONITORING LIMITS			

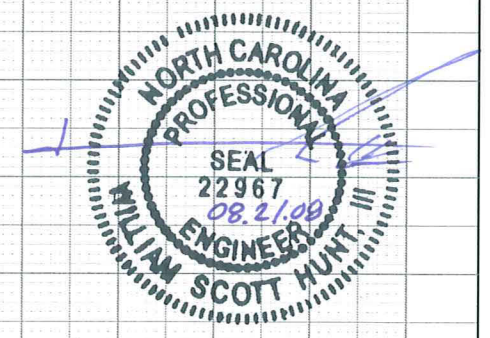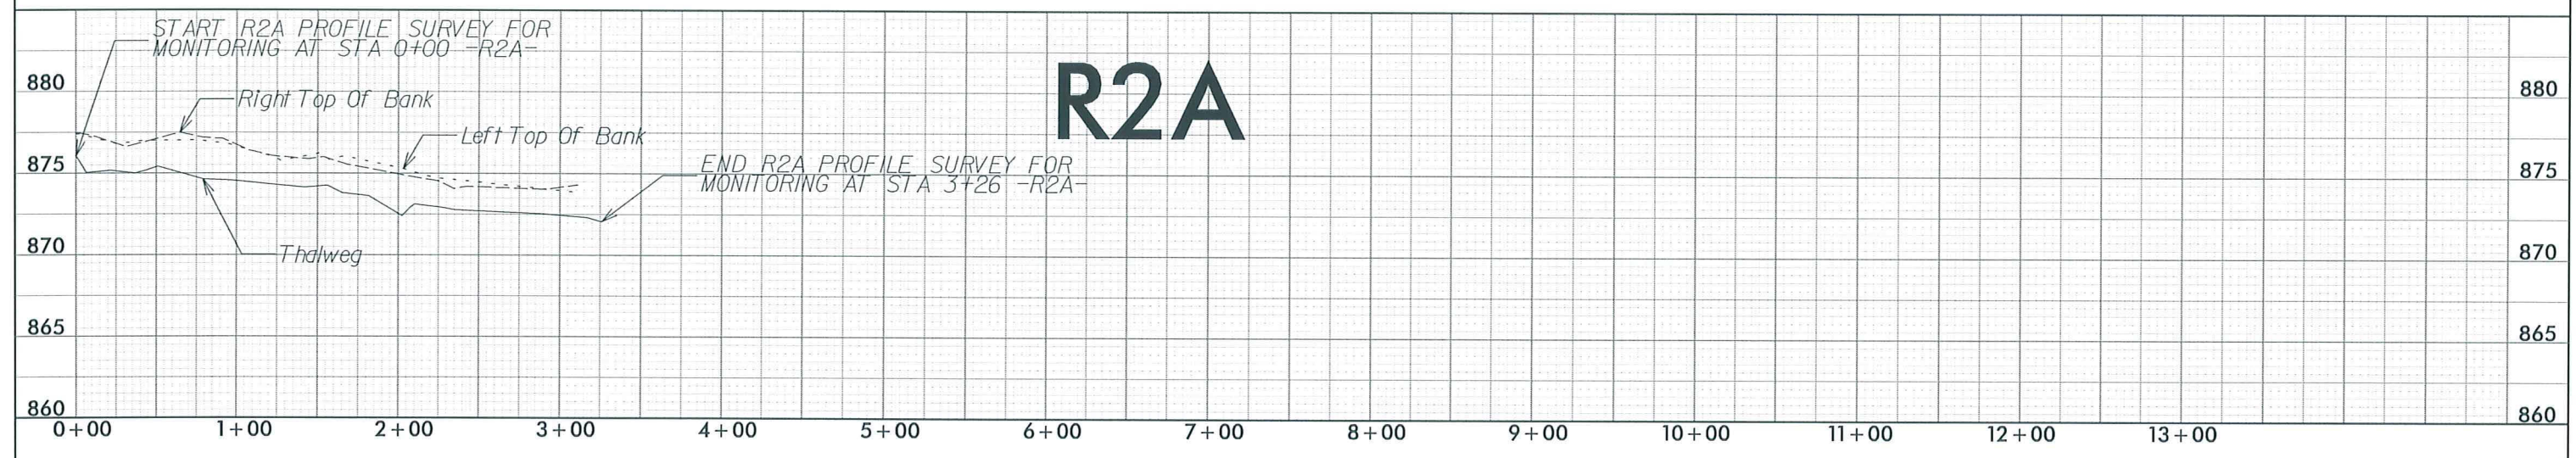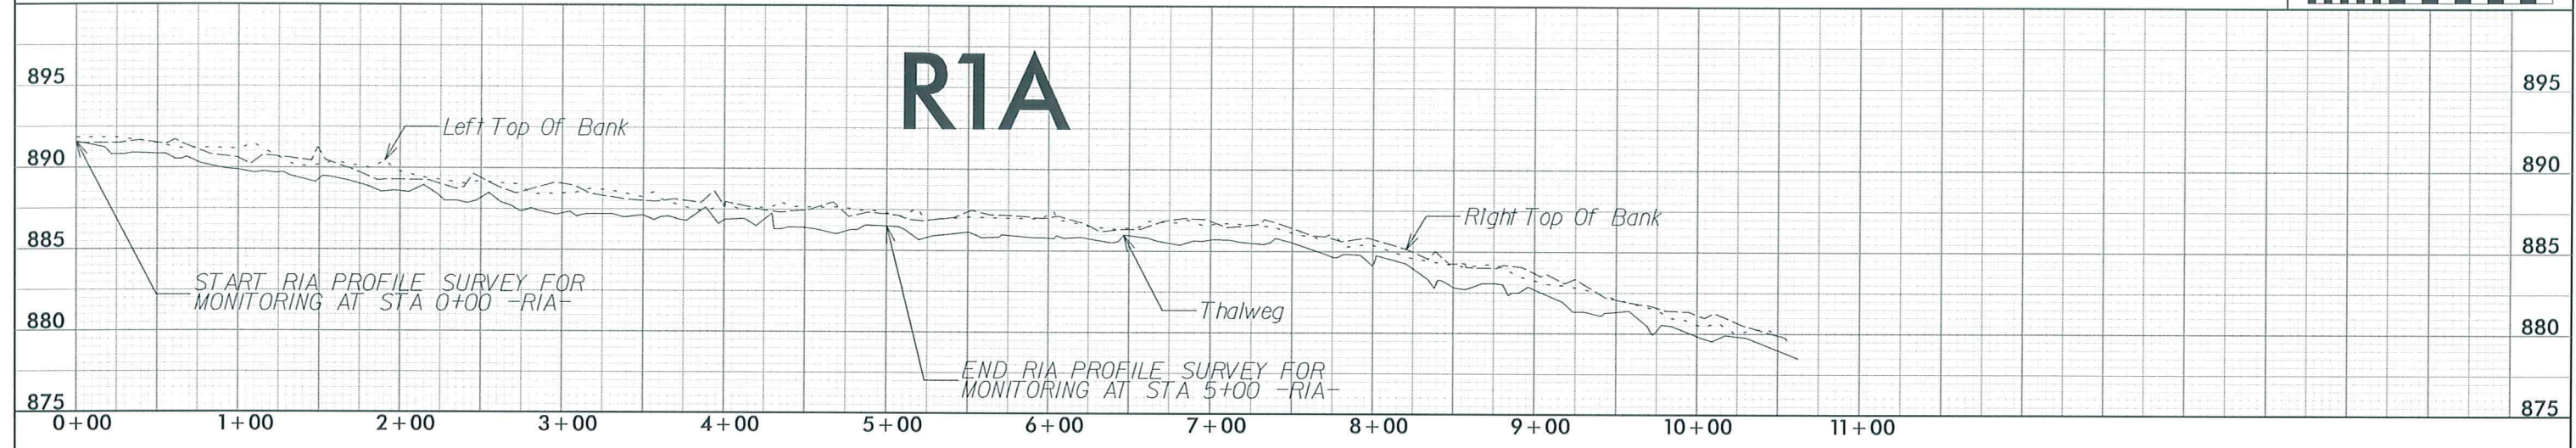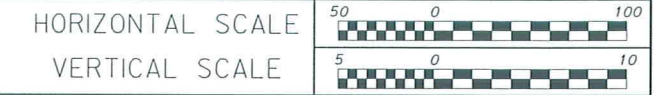



# PROPOSED PROFILES

REVISIONS			PROJECT ENGINEER	PROJECT REFERENCE NO.	SHEET NO.
DATE	BY	DESCRIPTION		LITTLE WHITE OAK CREEK	19
3/14/08	JTL	AS-BUILT DRAWING		<b>AS-BUILT DRAWING</b>	
8/19/08	EMP	CHANGED MONITORING LIMITS			
					

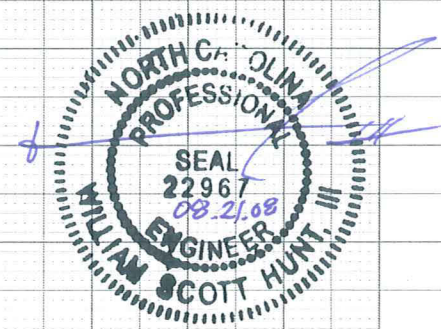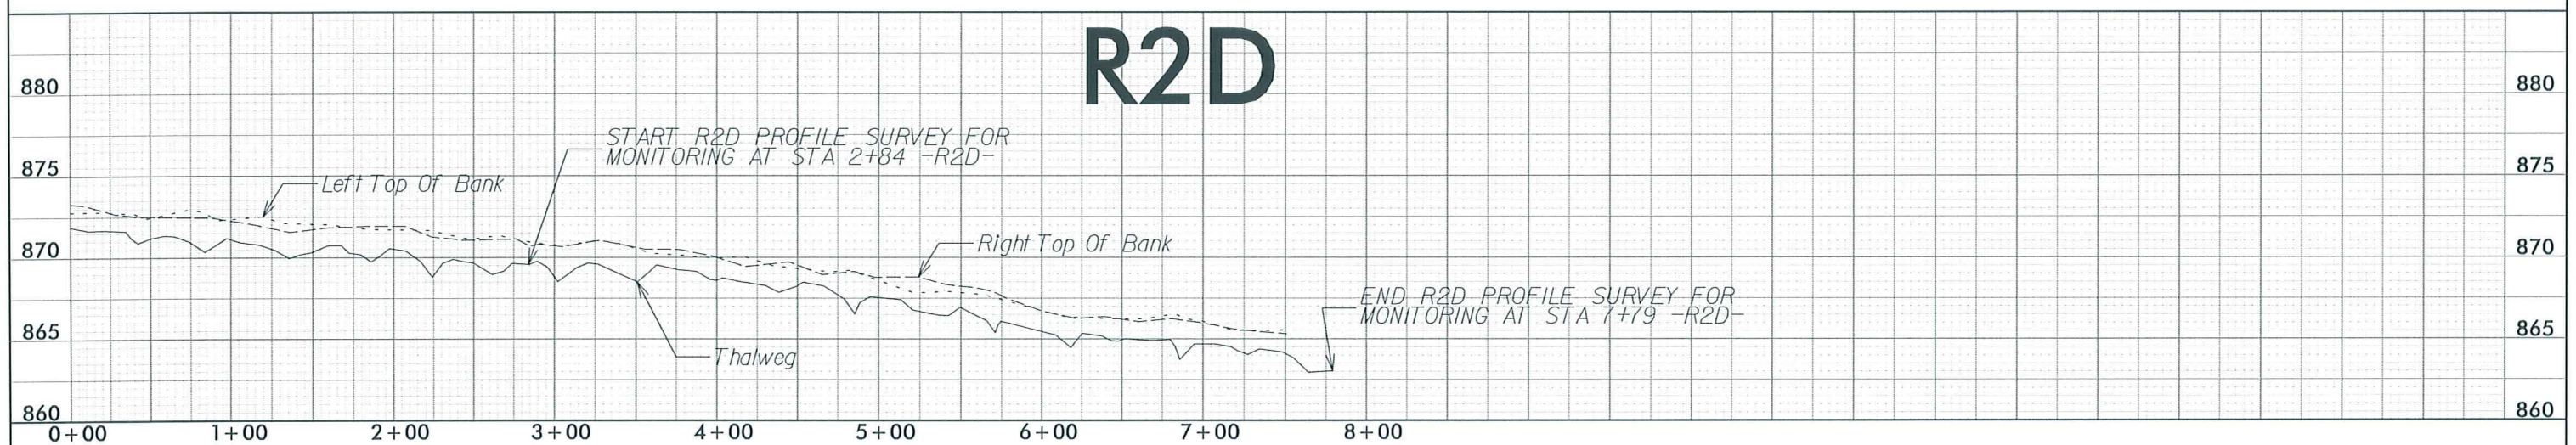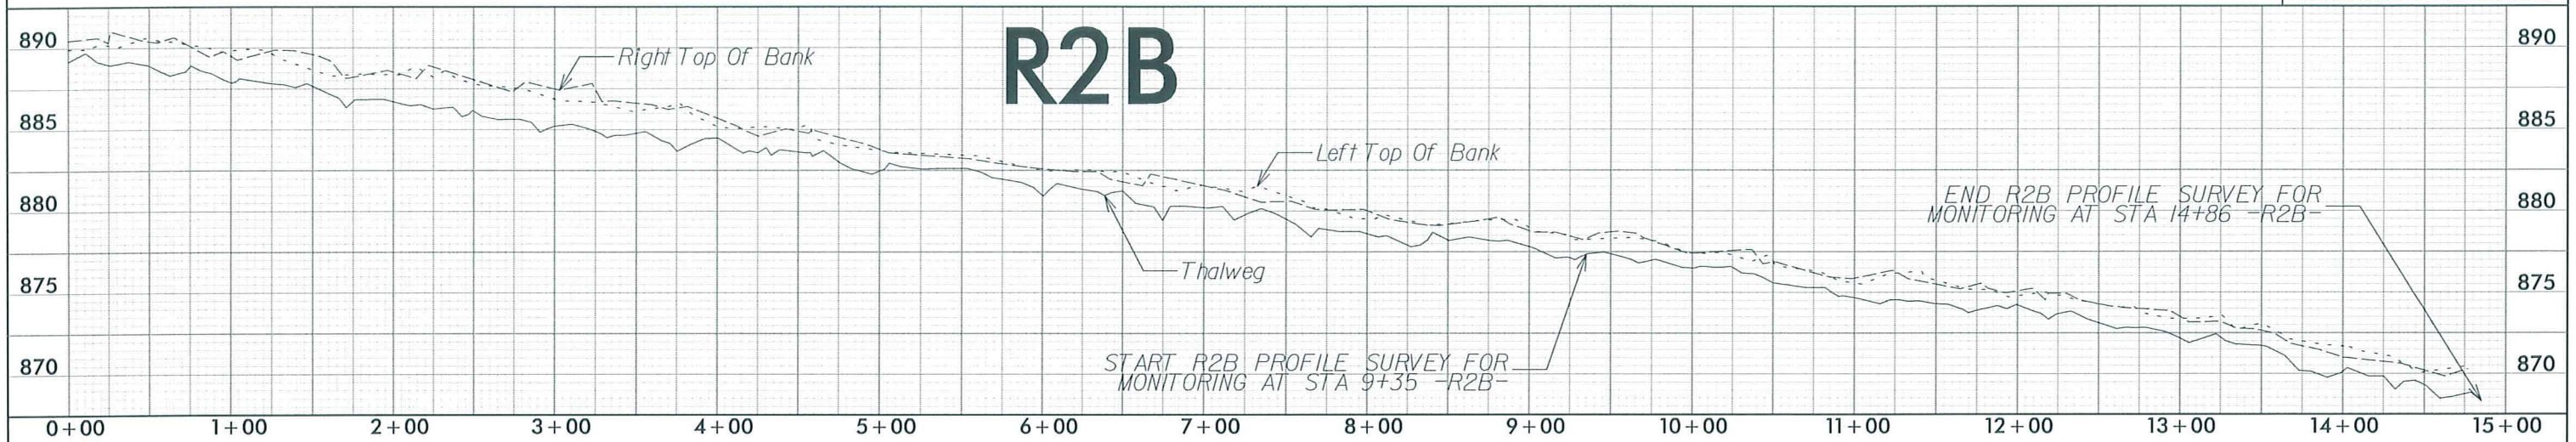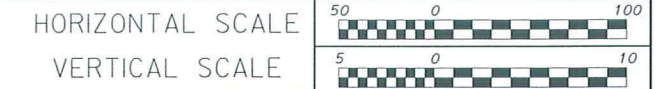



REVISIONS		
DATE	BY	DESCRIPTION
3/24/08	JTL	AS-BUILT DRAWINGS
8/29/08	EMP	CHANGED MONITORING LIMITS


PROJECT ENGINEER

PROJECT REFERENCE NO.	SHEET NO.
LITTLE WHITE OAK CREEK	20

**AS-BUILT DRAWING**


**MULKEY**  
ENGINEERS & CONSULTANTS

PO Box 33127  
RALEIGH, N.C. 27636  
(919) 851-1912  
(919) 851-1918 (FAX)  
WWW.MULKEYINC.COM

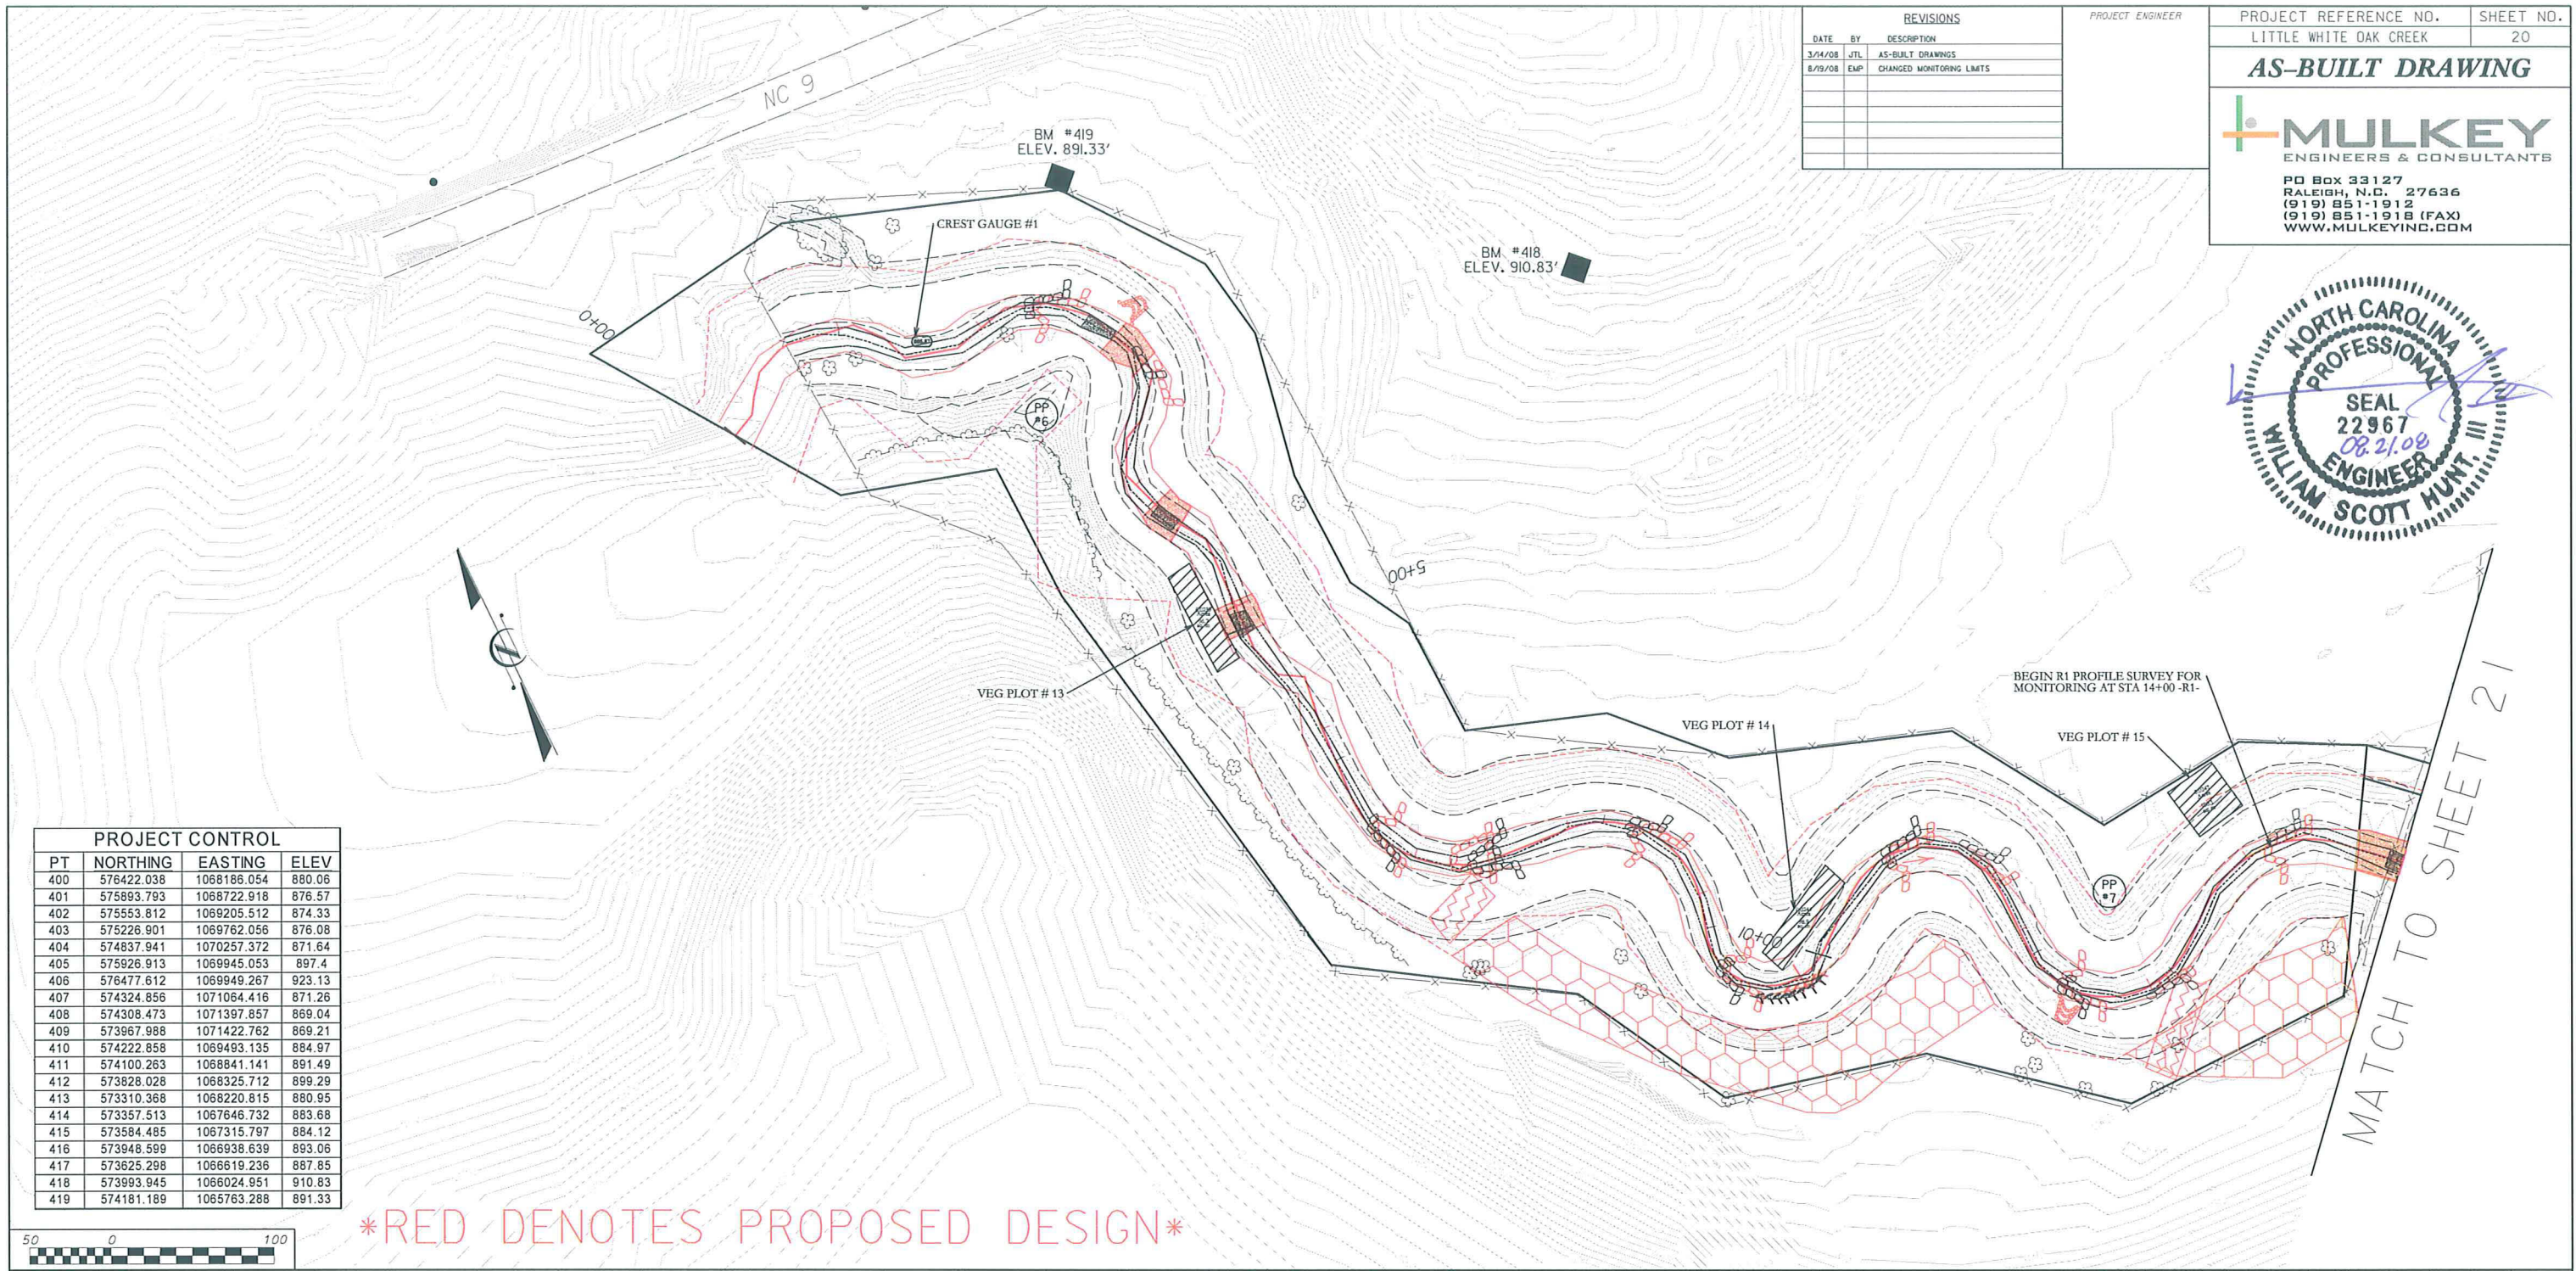

PROJECT CONTROL			
PT	NORTHING	EASTING	ELEV
400	576422.038	1068186.054	880.06
401	575893.793	1068722.918	876.57
402	575553.812	1069205.512	874.33
403	575226.901	1069762.056	876.08
404	574837.941	1070257.372	871.64
405	575926.913	1069945.053	897.4
406	576477.612	1069949.267	923.13
407	574324.856	1071064.416	871.26
408	574308.473	1071397.857	869.04
409	573967.988	1071422.762	869.21
410	574222.858	1069493.135	884.97
411	574100.263	1068841.141	891.49
412	573828.028	1068325.712	899.29
413	573310.368	1068220.815	880.95
414	573357.513	1067646.732	883.68
415	573584.485	1067315.797	884.12
416	573948.599	1066938.639	893.06
417	573625.298	1066619.236	887.85
418	573993.945	1066024.951	910.83
419	574181.189	1065763.288	891.33

\*RED DENOTES PROPOSED DESIGN\*

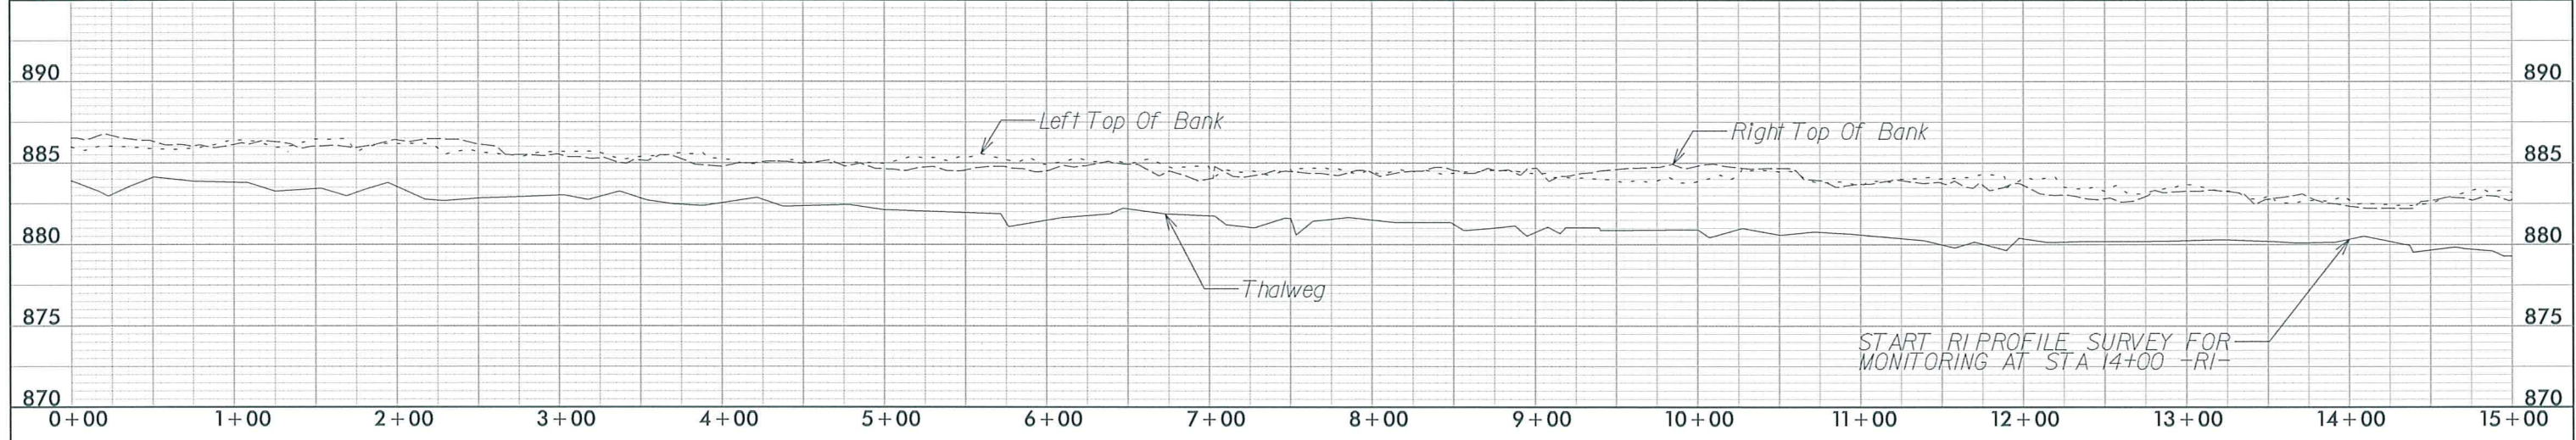


MATCH TO SHEET 21





\*RED DENOTES PROPOSED DESIGN\*

REVISIONS		
DATE	BY	DESCRIPTION
3/14/08	JTL	AS-BUILT DRAWINGS
8/19/08	EMP	CHANGED MONITORING LIMITS

PROJECT ENGINEER

PROJECT REFERENCE NO.	SHEET NO.
LITTLE WHITE OAK CREEK	21
<b>AS-BUILT DRAWING</b>	
	
PO Box 33127 RALEIGH, N.C. 27636 (919) 851-1912 (919) 851-1918 (FAX) WWW.MULKEYINC.COM	

PROJECT CONTROL			
PT	NORTHING	EASTING	ELEV
400	576422.038	1068186.054	880.06
401	575893.793	1068722.918	876.57
402	575553.812	1069205.512	874.33
403	575226.901	1069762.056	876.08
404	574837.941	1070257.372	871.64
405	575926.913	1069945.053	897.4
406	576477.612	1069949.267	923.13
407	574324.856	1071064.416	871.26
408	574308.473	1071397.857	869.04
409	573967.988	1071422.762	869.21
410	574222.858	1069493.135	884.97
411	574100.263	1068841.141	891.49
412	573828.028	1068325.712	899.29
413	573310.368	1068220.815	880.95
414	573357.513	1067646.732	863.88
415	573584.485	1067315.797	884.12
416	573948.599	1066938.639	893.06
417	573625.298	1066619.236	887.85
418	573993.945	1066024.951	910.83
419	574181.189	1065763.288	891.33

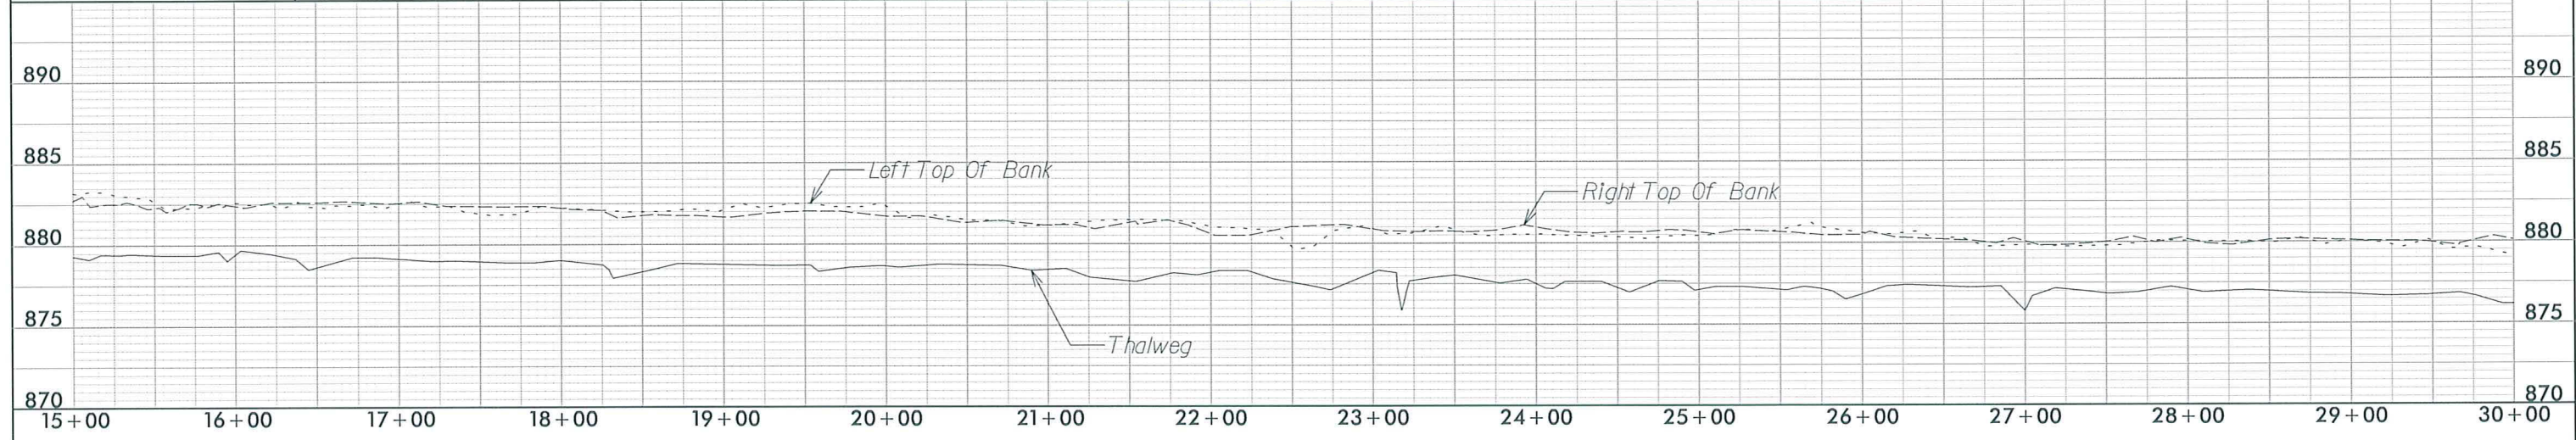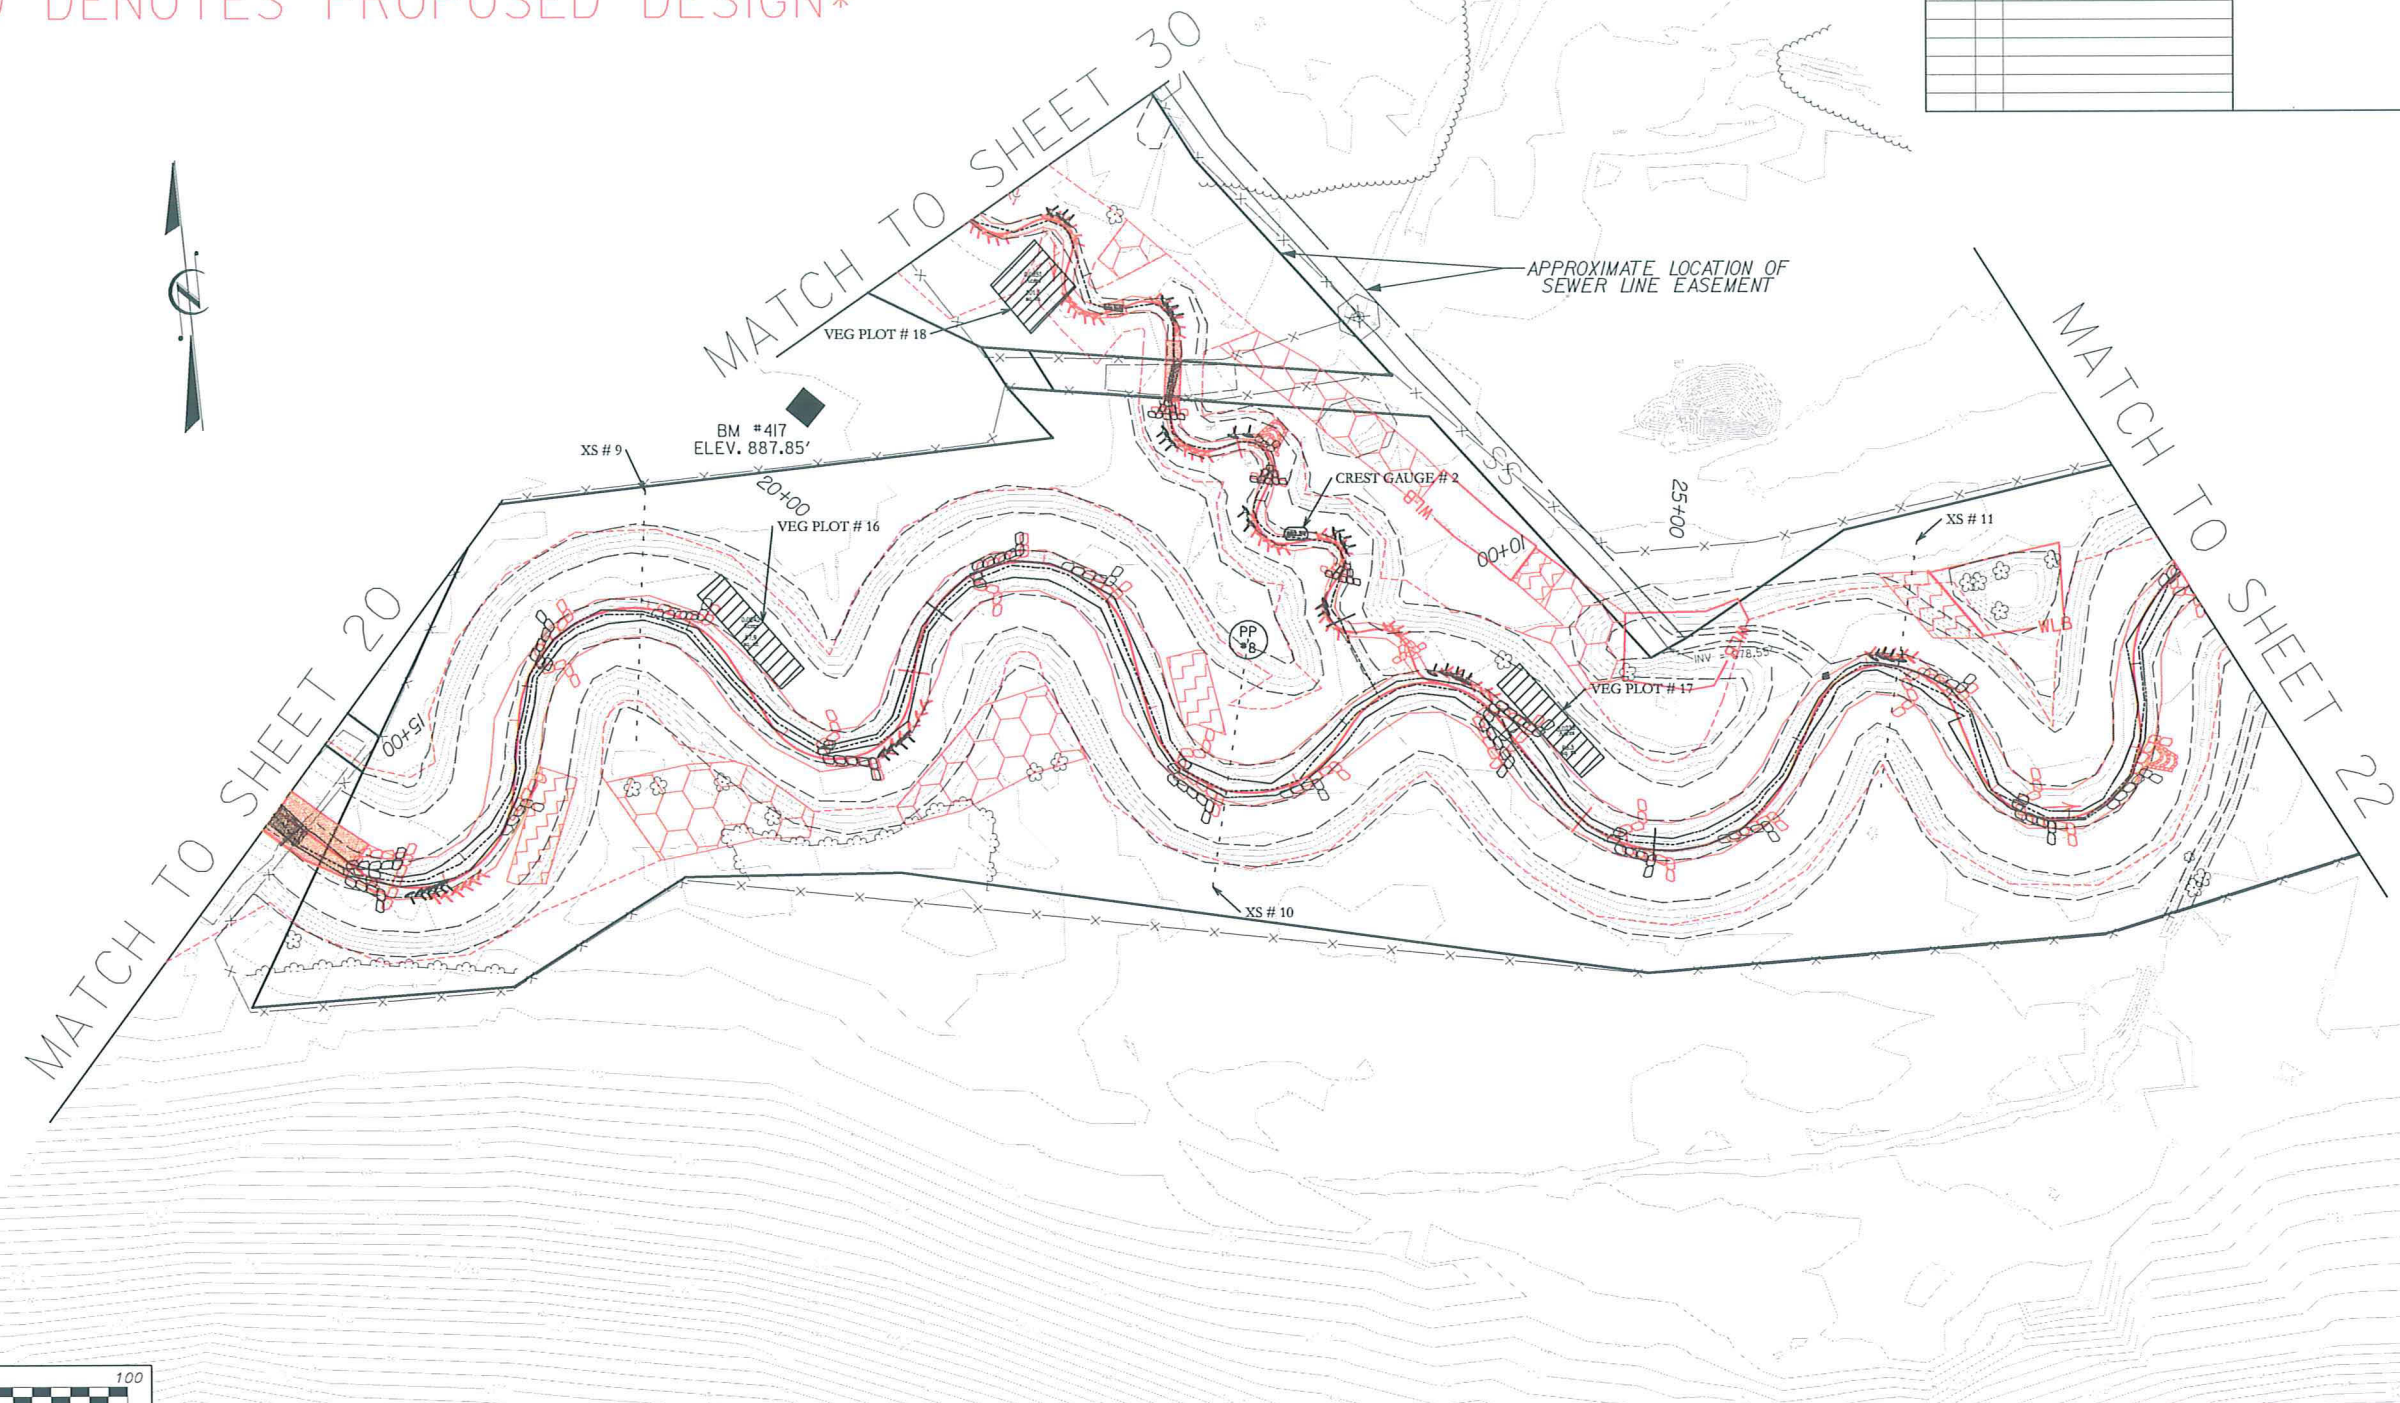



REVISIONS		
DATE	BY	DESCRIPTION
3/14/08	JTL	AS-BUILT DRAWINGS
8/19/08	EMP	CHANGED MONITORING LIMITS

PROJECT ENGINEER


PROJECT REFERENCE NO. LITTLE WHITE OAK CREEK SHEET NO. 22

**AS-BUILT DRAWING**


**MULKEY**  
ENGINEERS & CONSULTANTS

PO Box 33127  
RALEIGH, N.C. 27636  
(919) 851-1912  
(919) 851-1918 (FAX)  
WWW.MULKEYINC.COM

PROJECT CONTROL			
PT	NORTHING	EASTING	ELEV
400	576422.038	1068188.054	880.06
401	575893.793	1068722.918	876.57
402	575553.812	1069205.512	874.33
403	575226.901	1069762.056	876.08
404	574837.941	1070257.372	871.64
405	575926.913	1069945.053	897.4
406	576477.612	1069949.267	923.13
407	574324.856	1071064.416	871.26
408	574308.473	1071397.857	869.04
409	573967.988	1071422.762	869.21
410	574222.858	1069493.135	884.97
411	574100.263	1068841.141	891.49
412	573828.028	1068325.712	899.29
413	573310.368	1068220.815	880.95
414	573357.513	1067646.732	883.68
415	573584.485	1067315.797	884.12
416	573948.599	1066938.639	893.06
417	573625.298	1066619.236	887.85
418	573993.945	1066024.951	910.83
419	574181.189	1065763.288	891.33

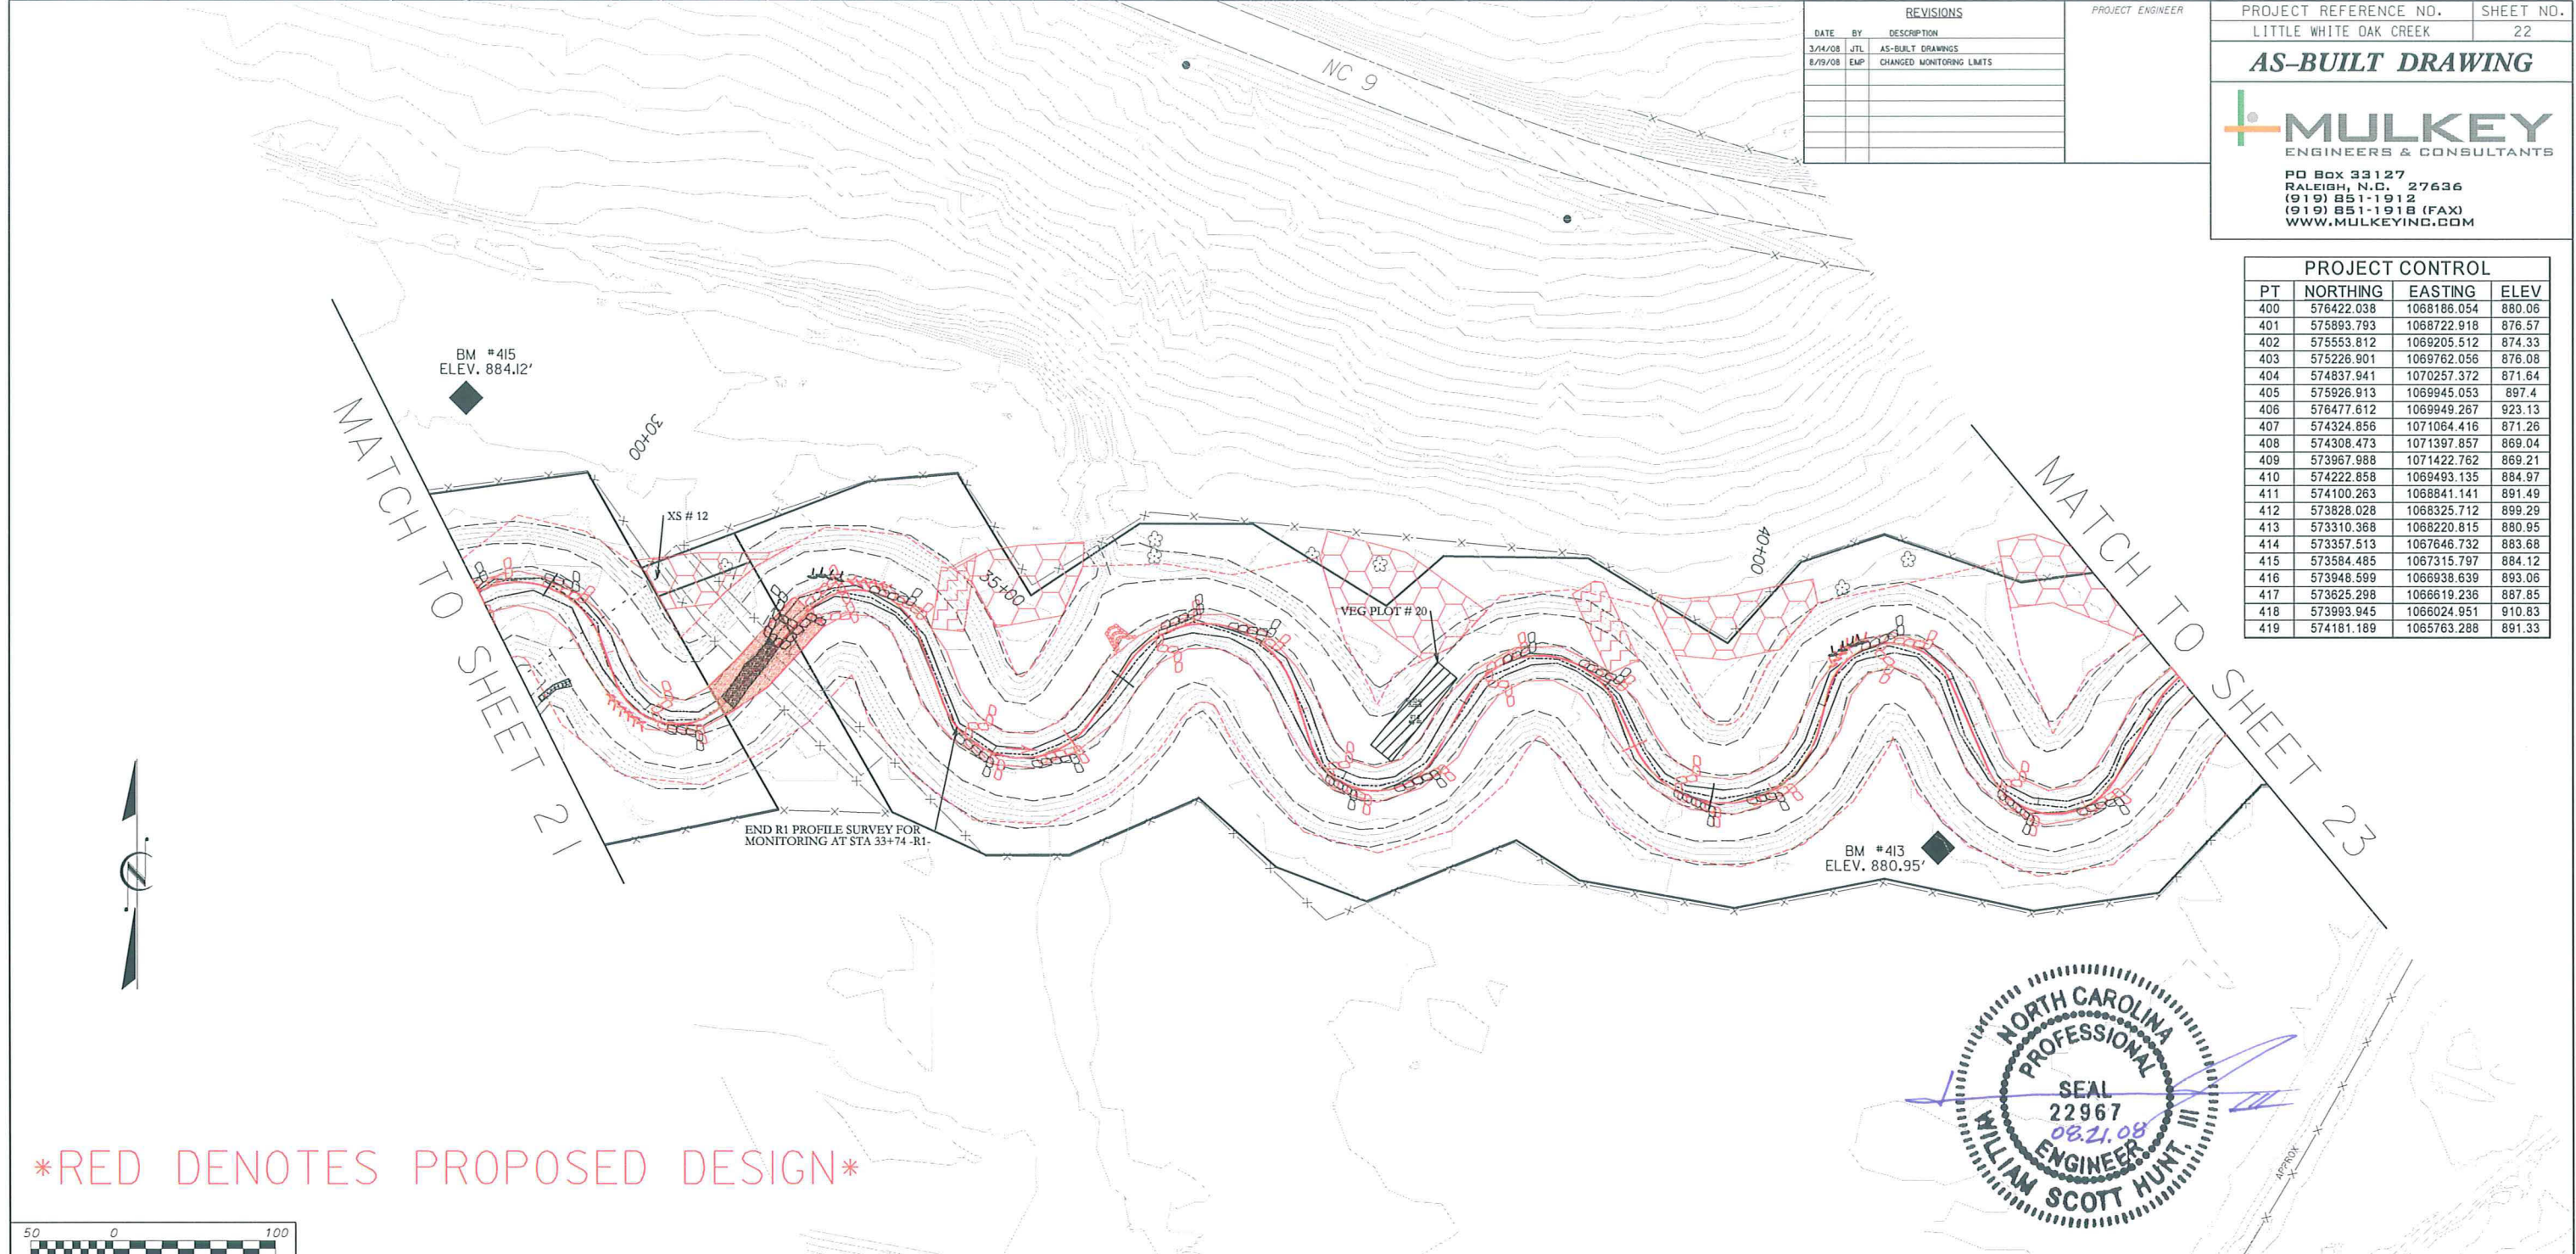

\*RED DENOTES PROPOSED DESIGN\*

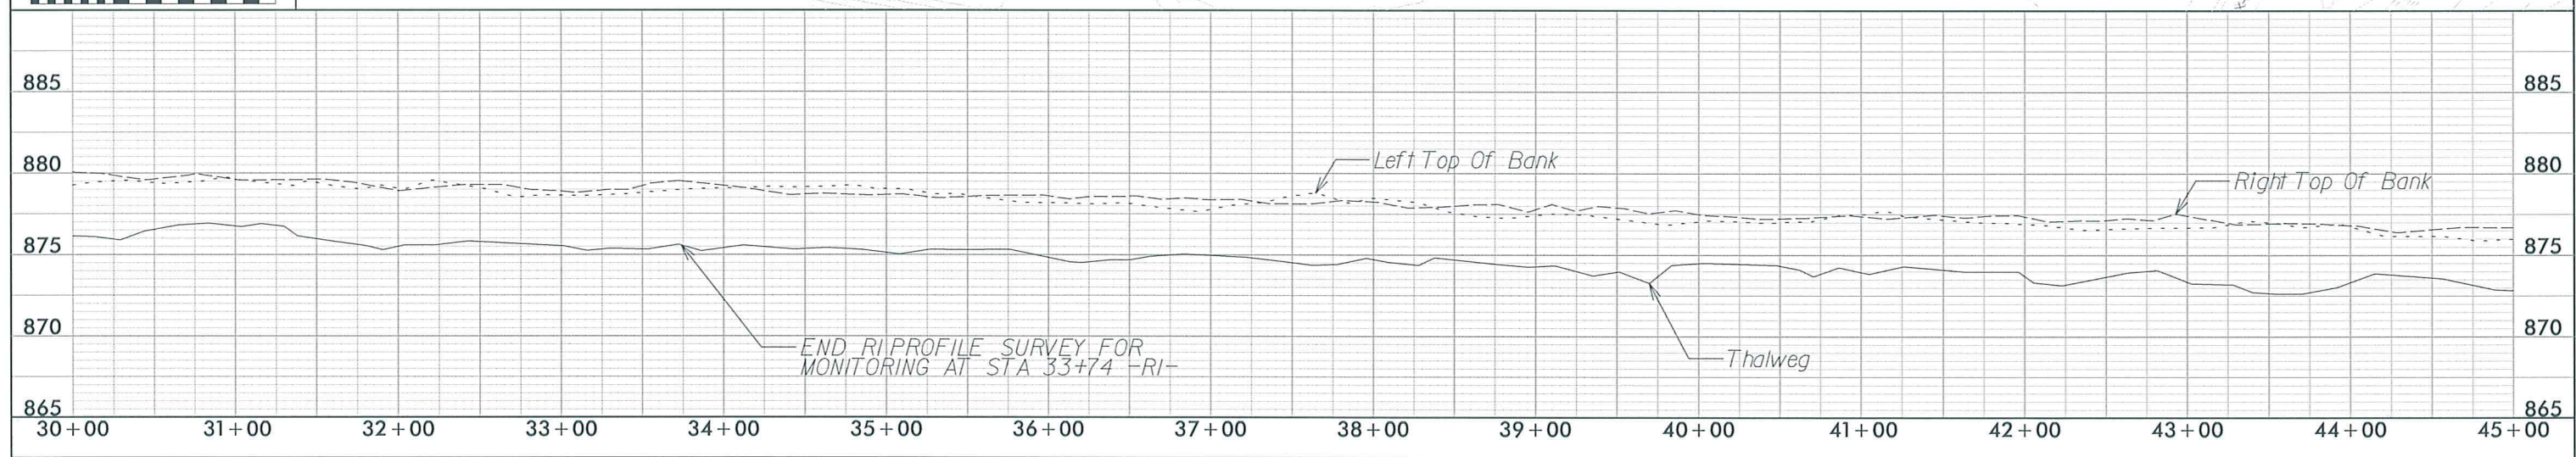



REVISIONS		
DATE	BY	DESCRIPTION
3/14/08	JTL	AS-BUILT DRAWINGS

PROJECT ENGINEER

PROJECT REFERENCE NO.	SHEET NO.
LITTLE WHITE OAK CREEK	23

**AS-BUILT DRAWING**

**MULKEY**  
ENGINEERS & CONSULTANTS


PO Box 33127  
RALEIGH, N.C. 27636  
(919) 851-1912  
(919) 851-1918 (FAX)  
WWW.MULKEYINC.COM



MATCH TO SHEET 22

\*RED DENOTES PROPOSED DESIGN\*

PROJECT CONTROL			
PT	NORTHING	EASTING	ELEV
400	576422.038	1068186.054	880.06
401	575893.793	1068722.918	876.57
402	575553.812	1069205.512	874.33
403	575226.901	1069762.056	876.08
404	574837.941	1070257.372	871.64
405	575926.913	1069945.053	897.4
406	576477.612	1069949.267	923.13
407	574324.856	1071064.416	871.26
408	574308.473	1071397.857	869.04
409	573967.988	1071422.762	869.21
410	574222.858	1069493.135	884.97
411	574100.263	1068841.141	891.49
412	573828.028	1068325.712	899.29
413	573310.368	1068220.815	880.95
414	573357.513	1067646.732	883.68
415	573584.485	1067315.797	884.12
416	573948.599	1066938.639	893.06
417	573625.298	1066619.236	887.85
418	573993.945	1066024.951	910.83
419	574181.189	1065763.288	891.33

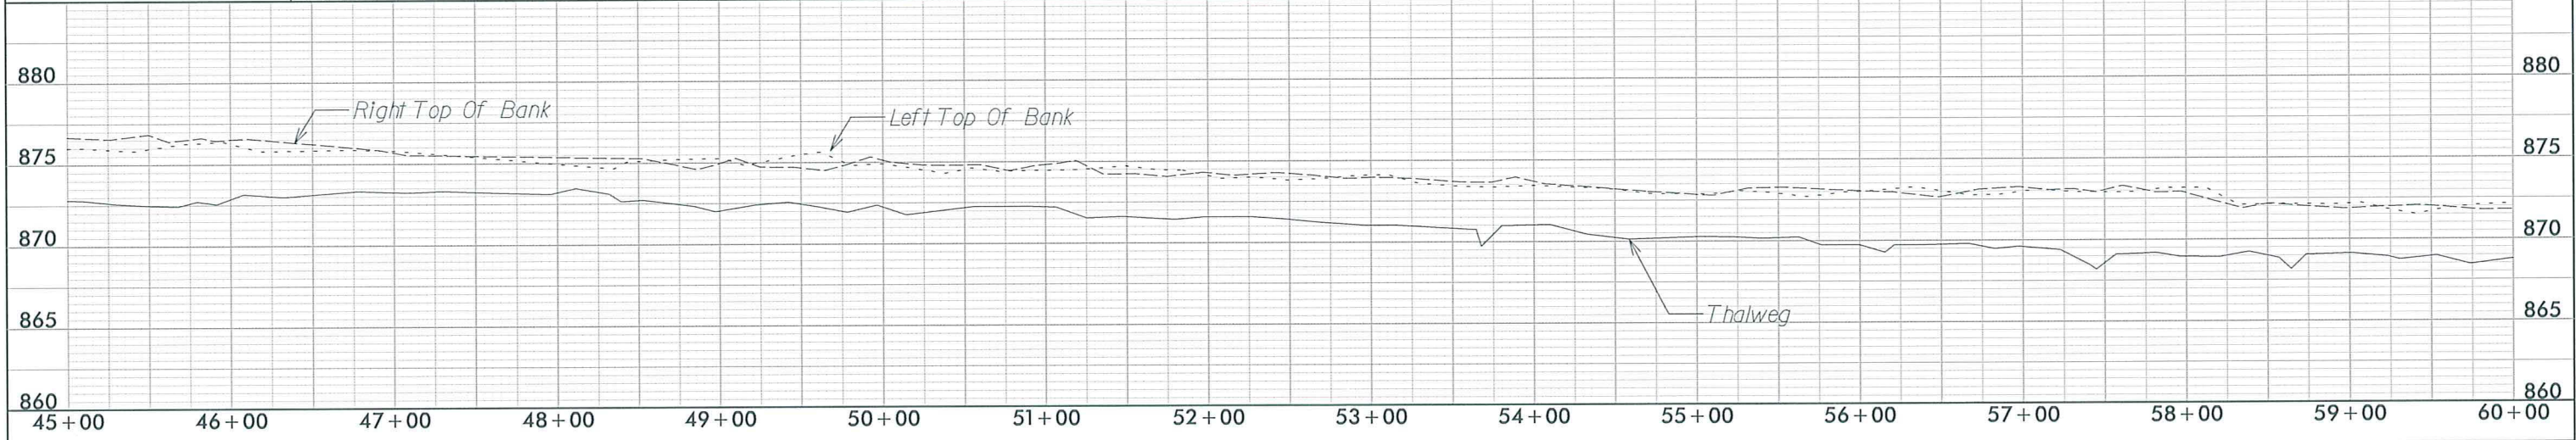

MATCH TO SHEET 24

BM #412  
ELEV. 899.29'

BM #411  
ELEV. 891.49'

VEG PLOT #21

VEG PLOT #22

CREST GAUGE #3

NC 9

50+00

55+00

880

880

875

875

870

870

865

865

860

860

45+00 46+00 47+00 48+00 49+00 50+00 51+00 52+00 53+00 54+00 55+00 56+00 57+00 58+00 59+00 60+00



REVISIONS		
DATE	BY	DESCRIPTION
3/14/08	JTL	AS-BUILT DRAWINGS

PROJECT ENGINEER

PROJECT REFERENCE NO.	SHEET NO.
LITTLE WHITE OAK CREEK	24

**AS-BUILT DRAWING**

PO Box 33127  
 RALEIGH, N.C. 27636  
 (919) 851-1912  
 (919) 851-1918 (FAX)  
 WWW.MULKEYINC.COM



MATCH TO SHEET 23

MATCH TO SHEET 28

PROJECT CONTROL			
PT	NORTHING	EASTING	ELEV
400	576422.038	1068186.054	880.06
401	575893.793	1068722.918	876.57
402	575553.812	1069205.512	874.33
403	575226.901	1069762.056	876.08
404	574837.941	1070257.372	871.64
405	575926.913	1069945.053	897.4
406	576477.612	1069949.267	923.13
407	574324.856	1071064.416	871.26
408	574308.473	1071397.857	869.04
409	573967.988	1071422.762	869.21
410	574222.858	1069493.135	884.97
411	574100.263	1068841.141	891.49
412	573828.028	1068325.712	899.29
413	573310.368	1068220.815	880.95
414	573357.513	1067646.732	883.68
415	573584.485	1067315.797	884.12
416	573948.599	1066938.639	893.06
417	573625.298	1066619.236	887.85
418	573993.945	1066024.951	910.83
419	574181.189	1065763.288	891.33

BM #410  
 ELEV. 884.97'

\*RED DENOTES PROPOSED DESIGN\*

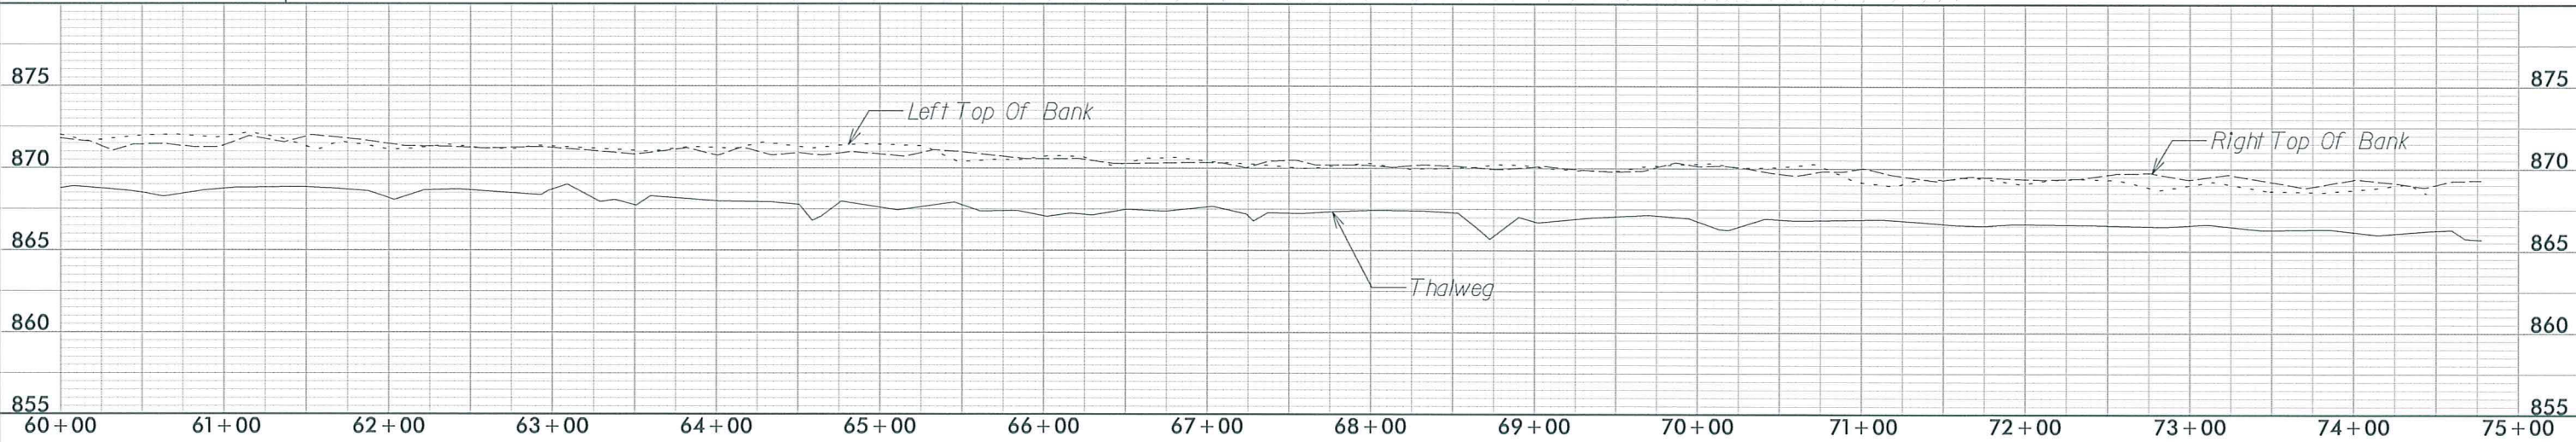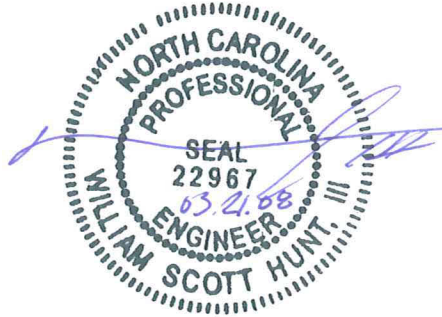



REVISIONS		
DATE	BY	DESCRIPTION
3/14/08	JTL	AS-BUILT DRAWINGS


PROJECT ENGINEER

PROJECT REFERENCE NO. SHEET NO.  
LITTLE WHITE OAK CREEK 25

**AS-BUILT DRAWING**


**MULKEY**  
ENGINEERS & CONSULTANTS

PO Box 33127  
RALEIGH, N.C. 27636  
(919) 851-1912  
(919) 851-1918 (FAX)  
WWW.MULKEYINC.COM

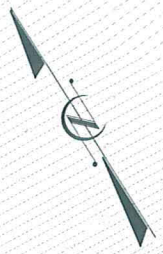


MATCH TO SHEET 26

PROJECT CONTROL			
PT	NORTHING	EASTING	ELEV
400	576422.038	1068186.054	880.06
401	575893.793	1068722.918	876.57
402	575553.812	1069205.512	874.33
403	575226.901	1069762.056	876.08
404	574837.941	1070257.372	871.64
405	575926.913	1069945.053	897.4
406	576477.612	1069949.267	923.13
407	574324.856	1071064.416	871.26
408	574308.473	1071397.857	869.04
409	573967.988	1071422.762	869.21
410	574222.858	1069493.135	884.97
411	574100.263	1068841.141	891.49
412	573828.028	1068325.712	899.29
413	573310.368	1068220.815	880.95
414	573357.513	1067646.732	883.68
415	573584.485	1067315.797	884.12
416	573948.599	1066938.639	893.06
417	573625.298	1066619.236	887.85
418	573993.945	1066024.951	910.83
419	574181.189	1065763.288	891.33

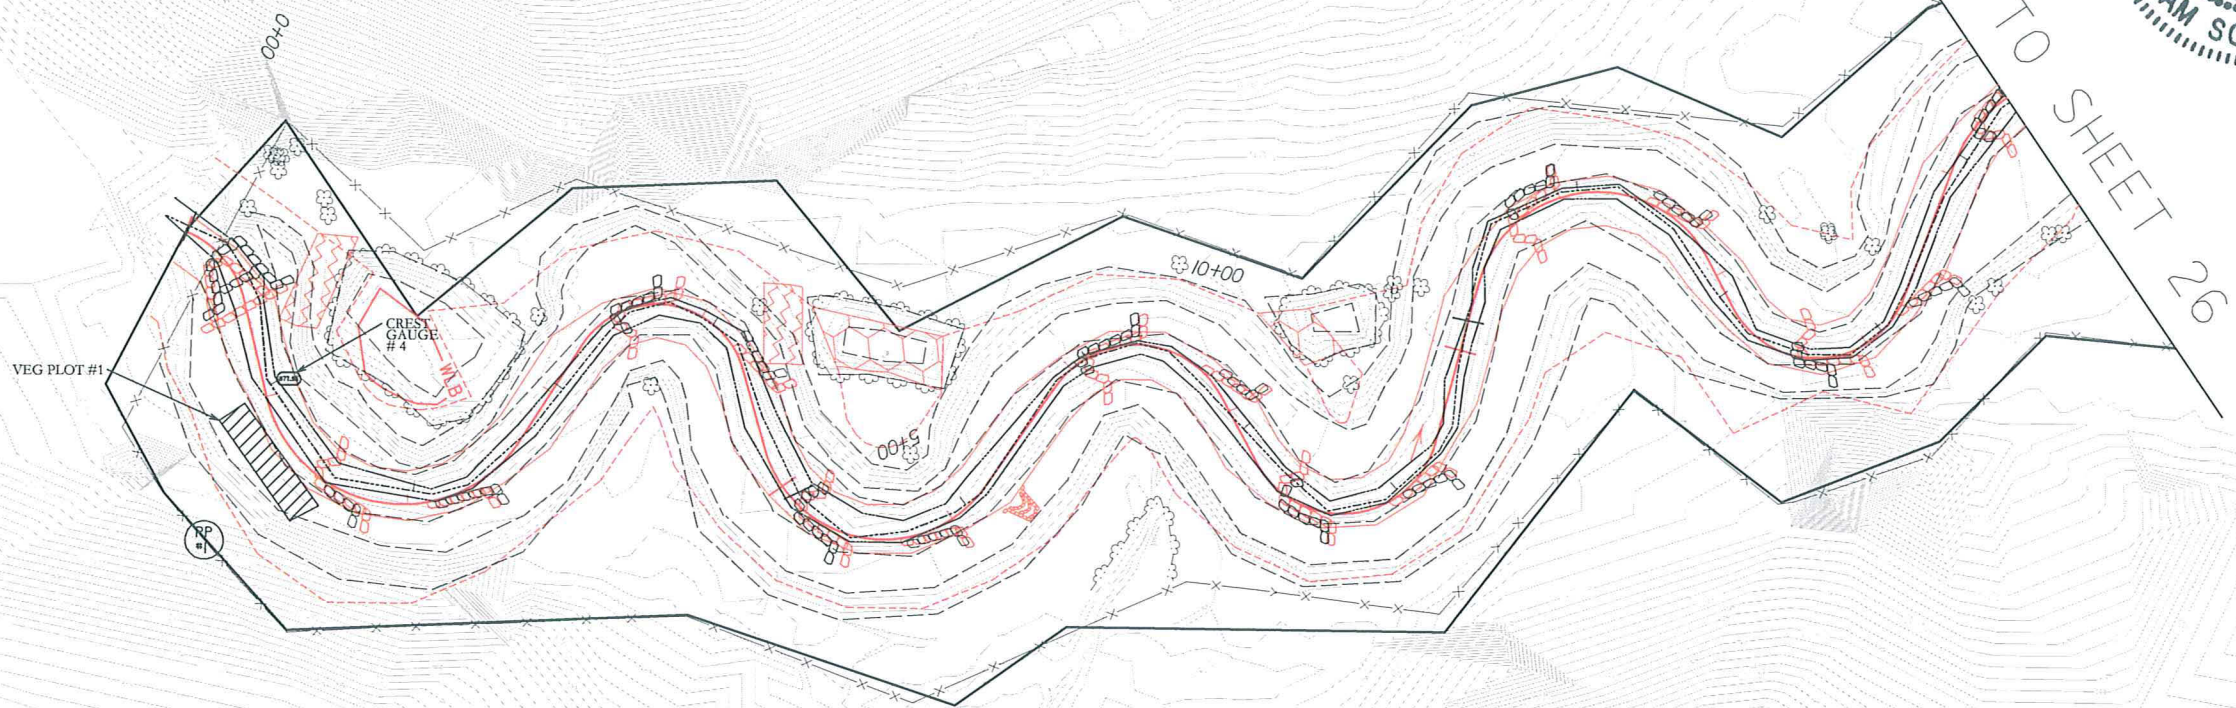


\*RED DENOTES PROPOSED DESIGN\*

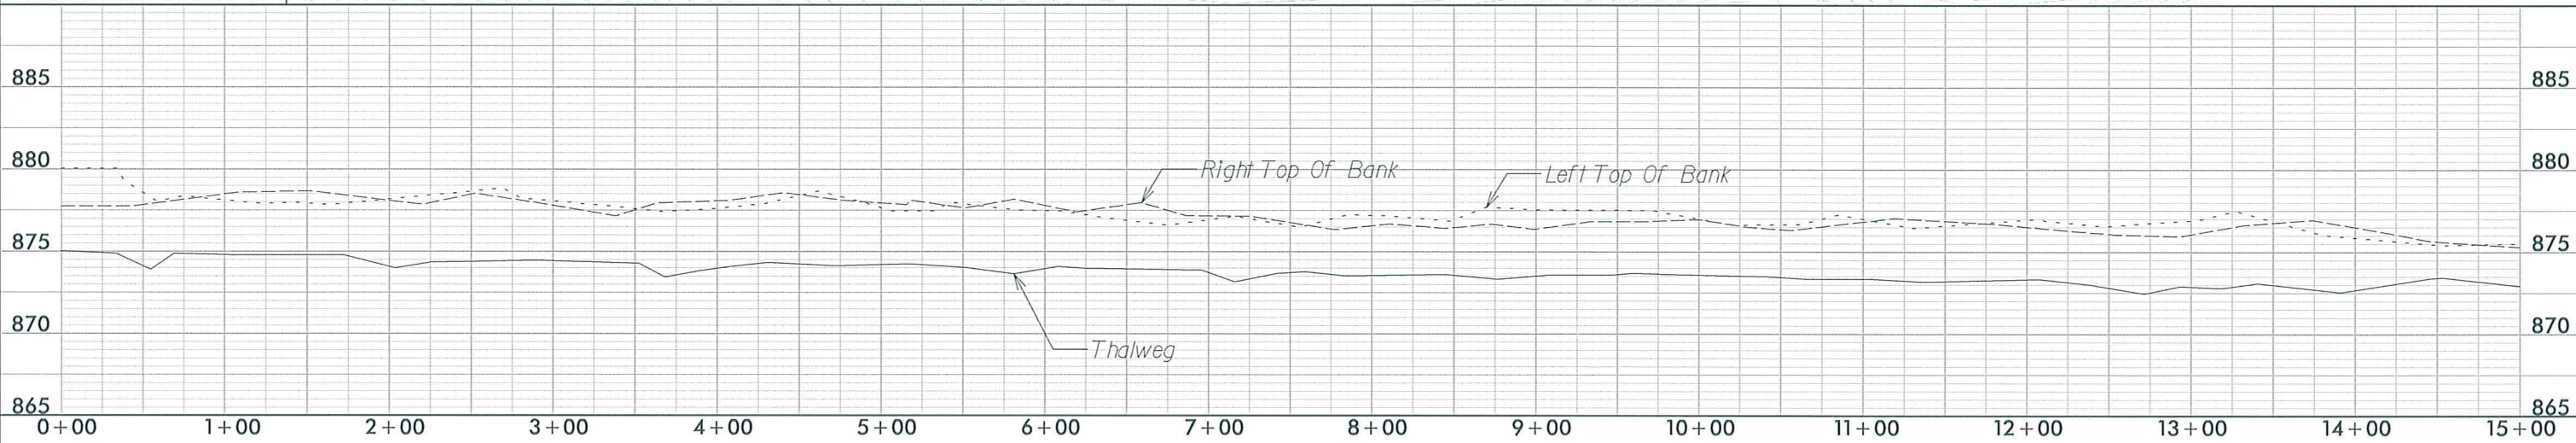




REVISIONS		
DATE	BY	DESCRIPTION
3/4/08	JTL	AS-BUILT DRAWINGS
8/19/08	EMP	CHANGED MONITORING LIMITS


PROJECT ENGINEER

PROJECT REFERENCE NO.	SHEET NO.
LITTLE WHITE OAK CREEK	26
<b>AS-BUILT DRAWING</b>	
	
PO Box 33127 RALEIGH, N.C. 27636 (919) 851-1912 (919) 851-1918 (FAX) WWW.MULKEYINC.COM	

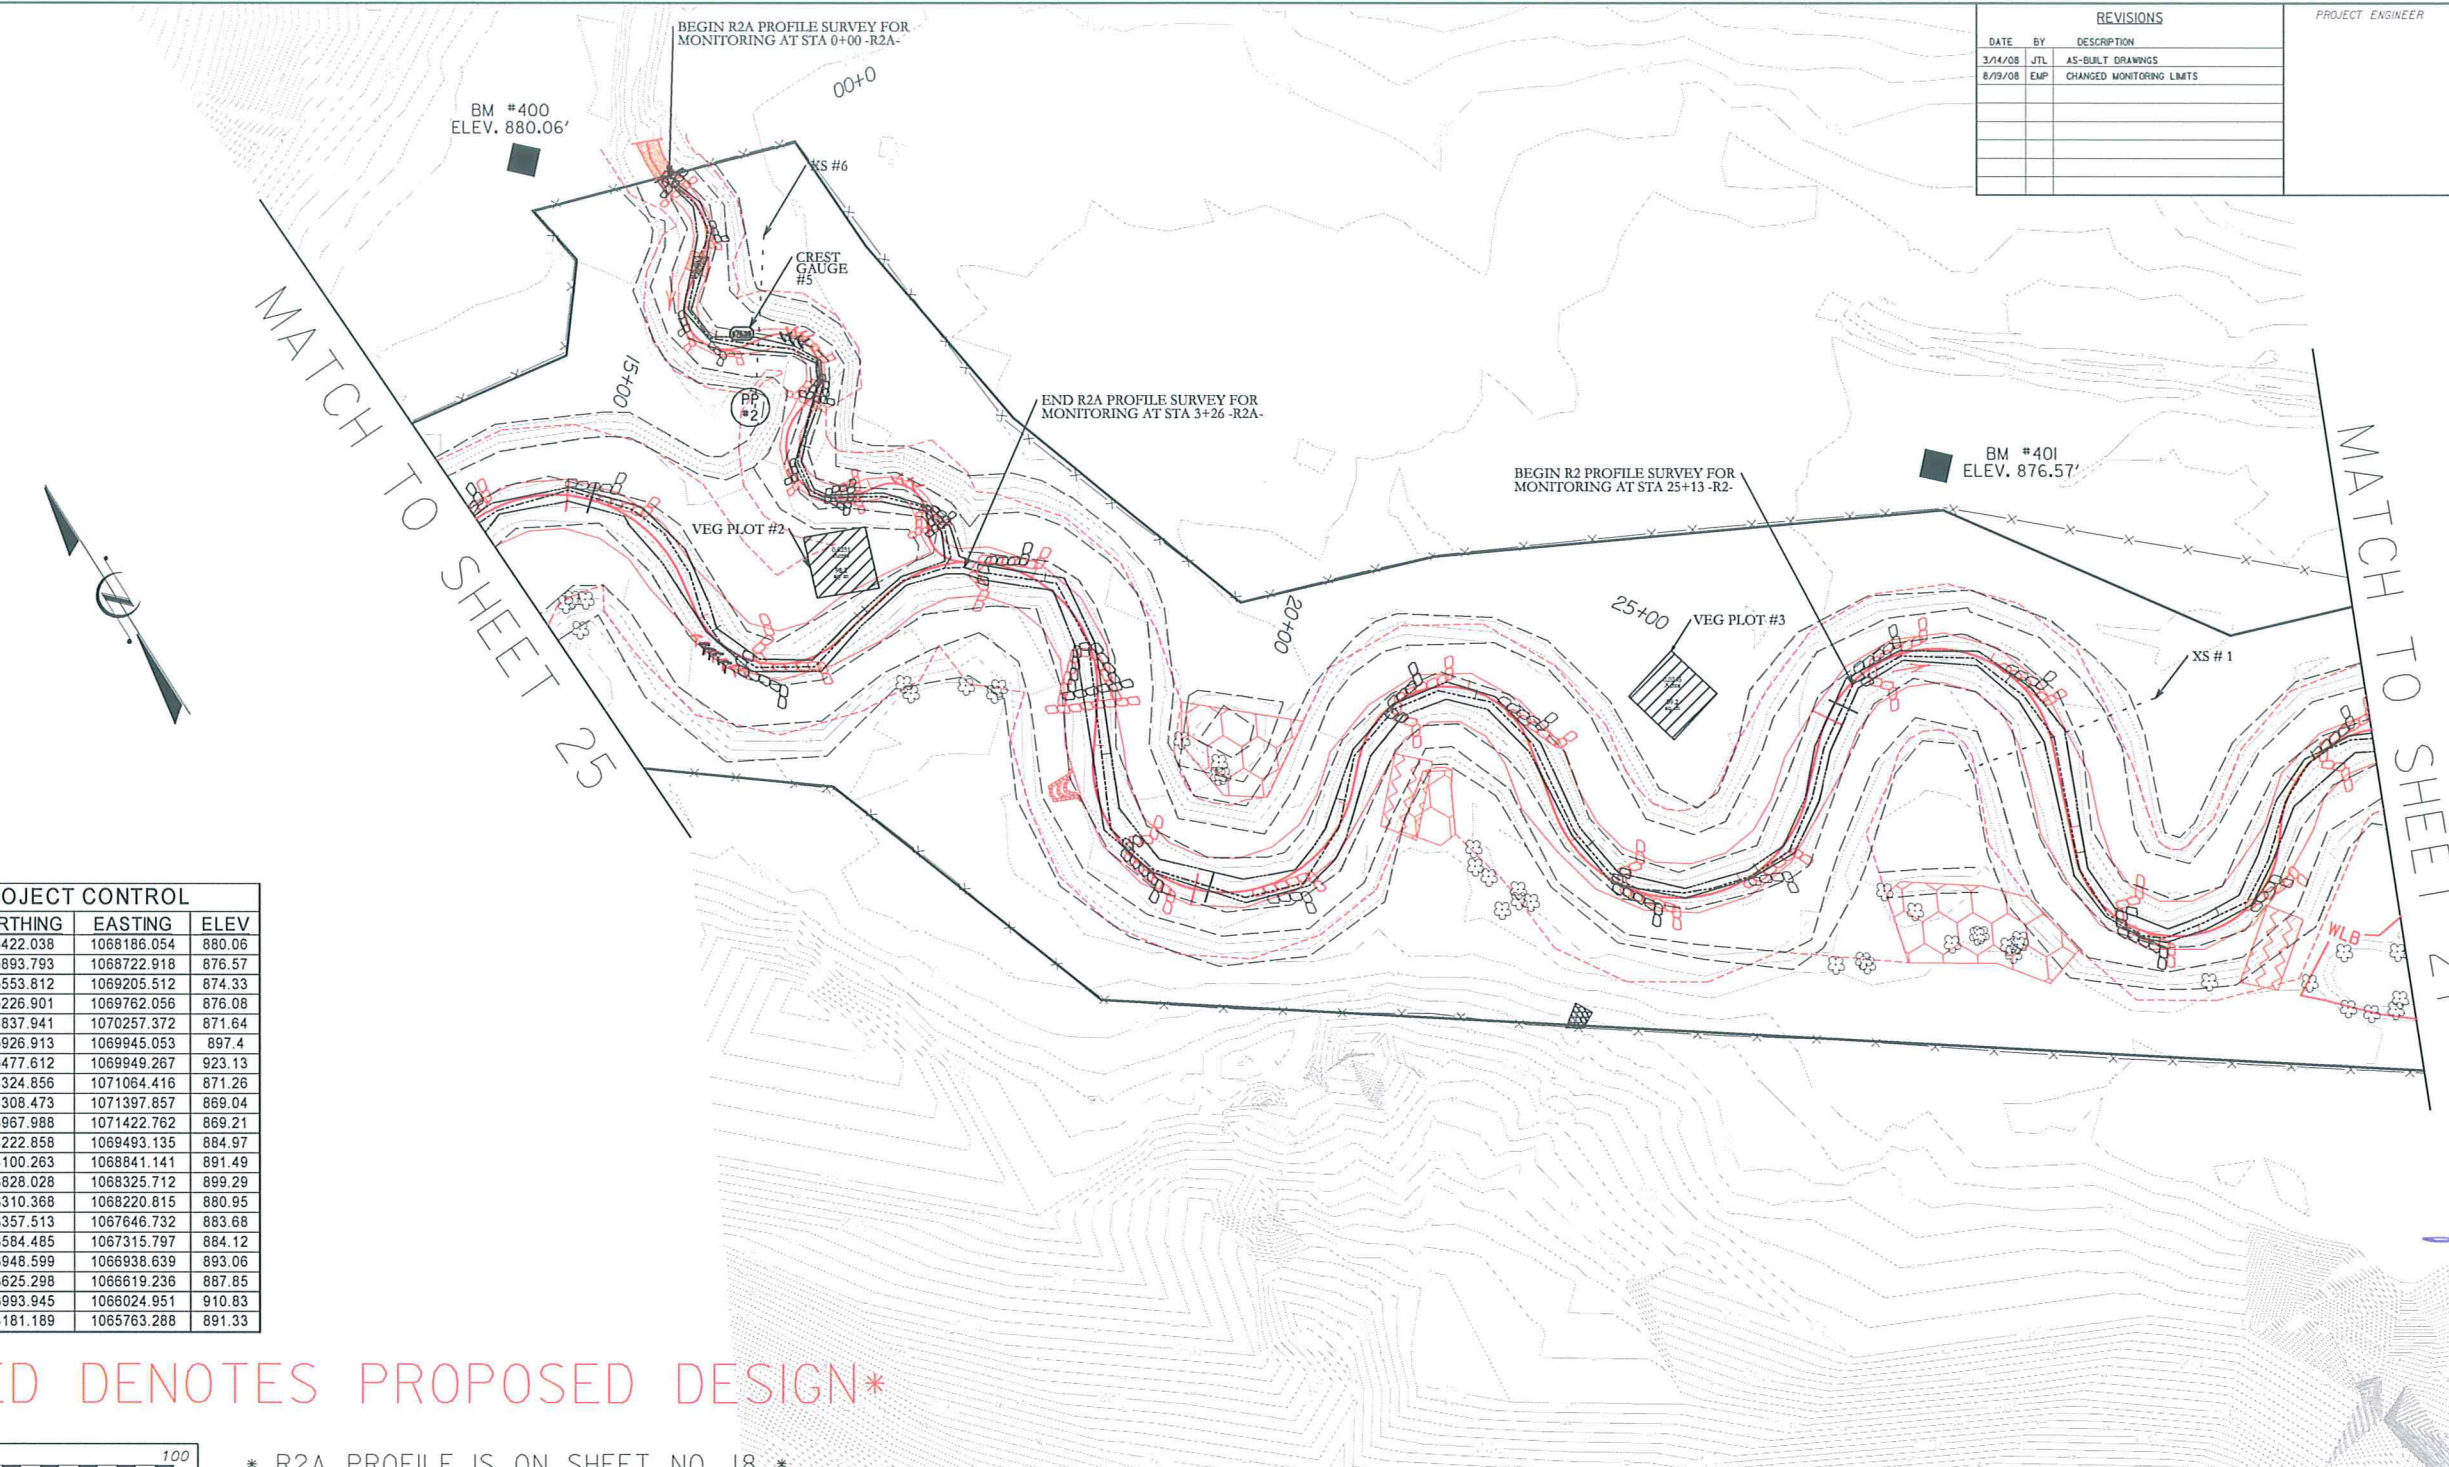


PROJECT CONTROL			
PT	NORTHING	EASTING	ELEV
400	576422.038	1068186.054	880.06
401	575893.793	1068722.918	876.57
402	575553.812	1069205.512	874.33
403	575226.901	1069762.056	876.08
404	574837.941	1070257.372	871.64
405	575926.913	1069945.053	897.4
406	576477.612	1069949.267	923.13
407	574324.856	1071064.416	871.26
408	574308.473	1071397.857	869.04
409	573967.988	1071422.762	869.21
410	574222.858	1069493.135	884.97
411	574100.263	1068841.141	891.49
412	573828.028	1068325.712	899.29
413	573310.368	1068220.815	880.95
414	573357.513	1067646.732	883.68
415	573584.485	1067315.797	884.12
416	573948.599	1066938.639	893.06
417	573625.298	1066619.236	887.85
418	573993.945	1066024.951	910.83
419	574181.189	1065763.288	891.33

**\*RED DENOTES PROPOSED DESIGN\***

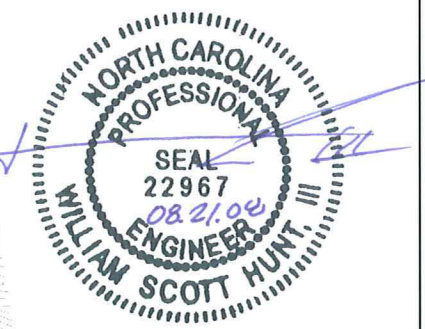

\* R2A PROFILE IS ON SHEET NO. 18 \*

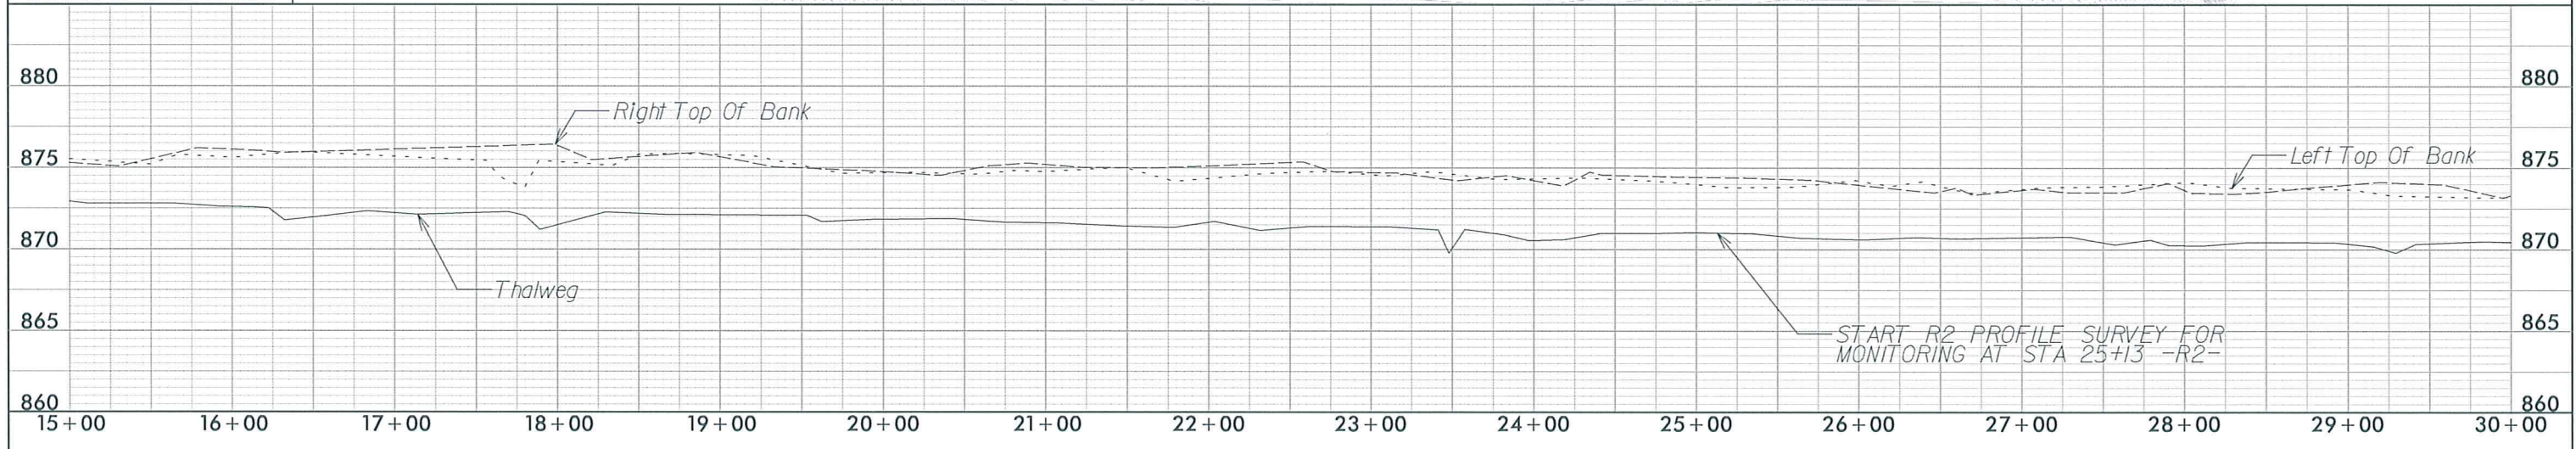



REVISIONS		
DATE	BY	DESCRIPTION
3/14/08	JTL	AS-BUILT DRAWINGS
8/19/08	EMP	CHANGED MONITORING LIMITS

PROJECT ENGINEER

PROJECT REFERENCE NO. SHEET NO.  
LITTLE WHITE OAK CREEK 27

**AS-BUILT DRAWING**





MULKEY  
ENGINEERS & CONSULTANTS

PO Box 33127  
RALEIGH, N.C. 27636  
(919) 851-1912  
(919) 851-1918 (FAX)  
WWW.MULKEYINC.COM

MATCH TO SHEET 32

MATCH TO SHEET 26


MATCH TO SHEET 28

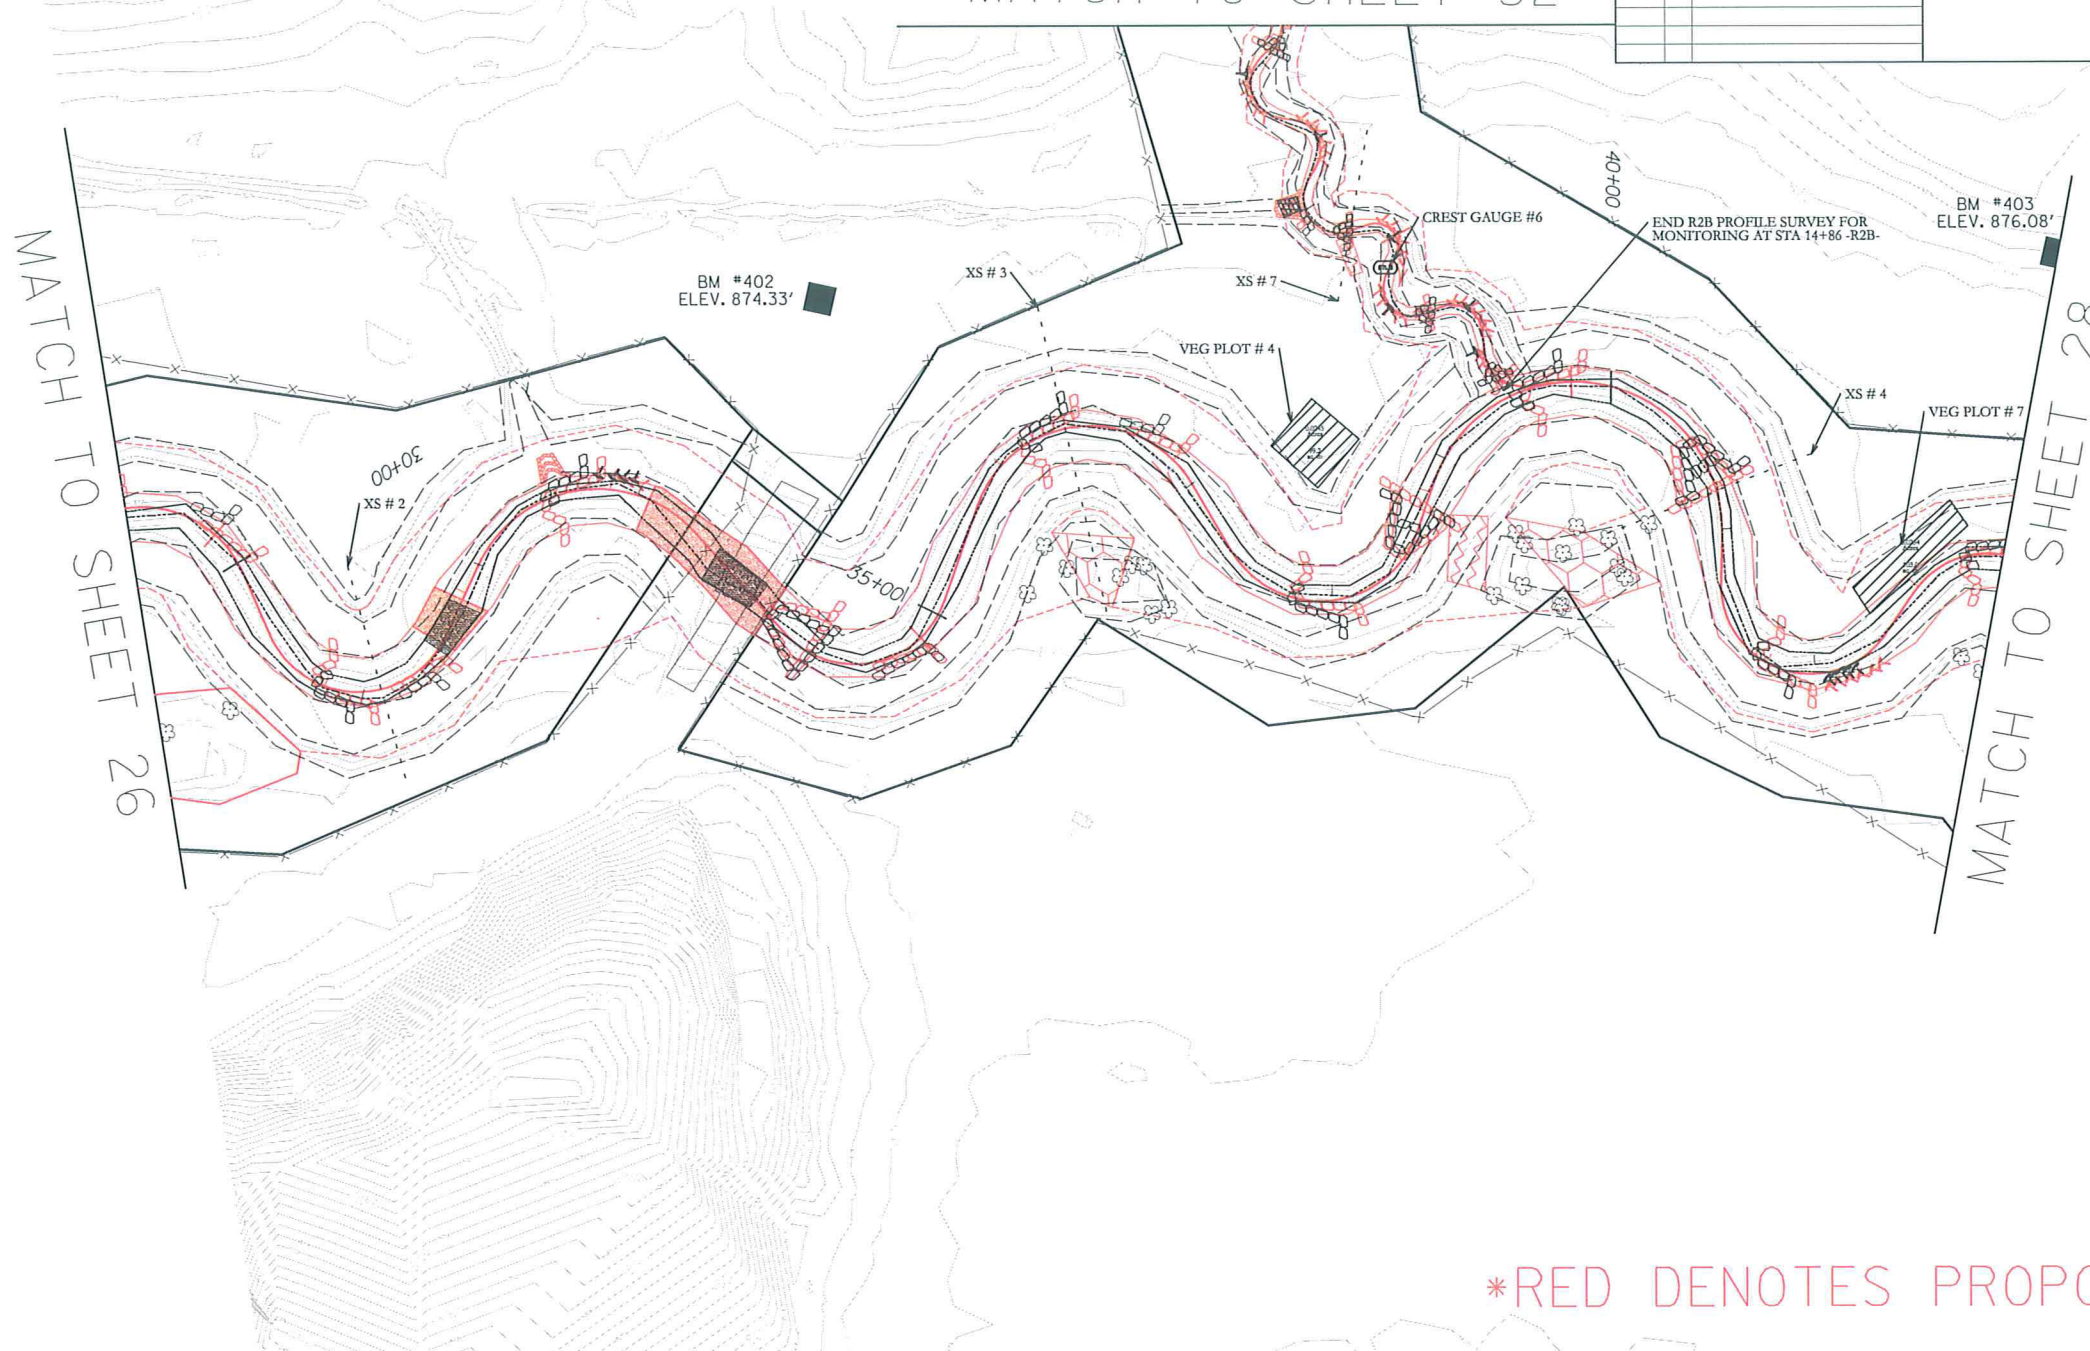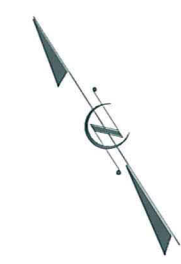

PROJECT CONTROL			
PT	NORTHING	EASTING	ELEV
400	576422.038	1068186.054	880.06
401	575893.793	1068722.918	876.57
402	575553.812	1069205.512	874.33
403	575226.901	1069762.056	876.08
404	574837.941	1070257.372	871.64
405	575926.913	1069945.053	897.4
406	576477.612	1069949.267	923.13
407	574324.856	1071064.416	871.26
408	574308.473	1071397.857	869.04
409	573967.988	1071422.762	869.21
410	574222.858	1069493.135	884.97
411	574100.263	1068841.141	891.49
412	573828.028	1068325.712	899.29
413	573310.368	1068220.815	880.95
414	573357.513	1067646.732	883.68
415	573584.485	1067315.797	884.12
416	573948.599	1066938.639	893.06
417	573625.298	1066619.236	887.85
418	573993.945	1066024.951	910.83
419	574181.189	1065763.288	891.33



\*RED DENOTES PROPOSED DESIGN\*

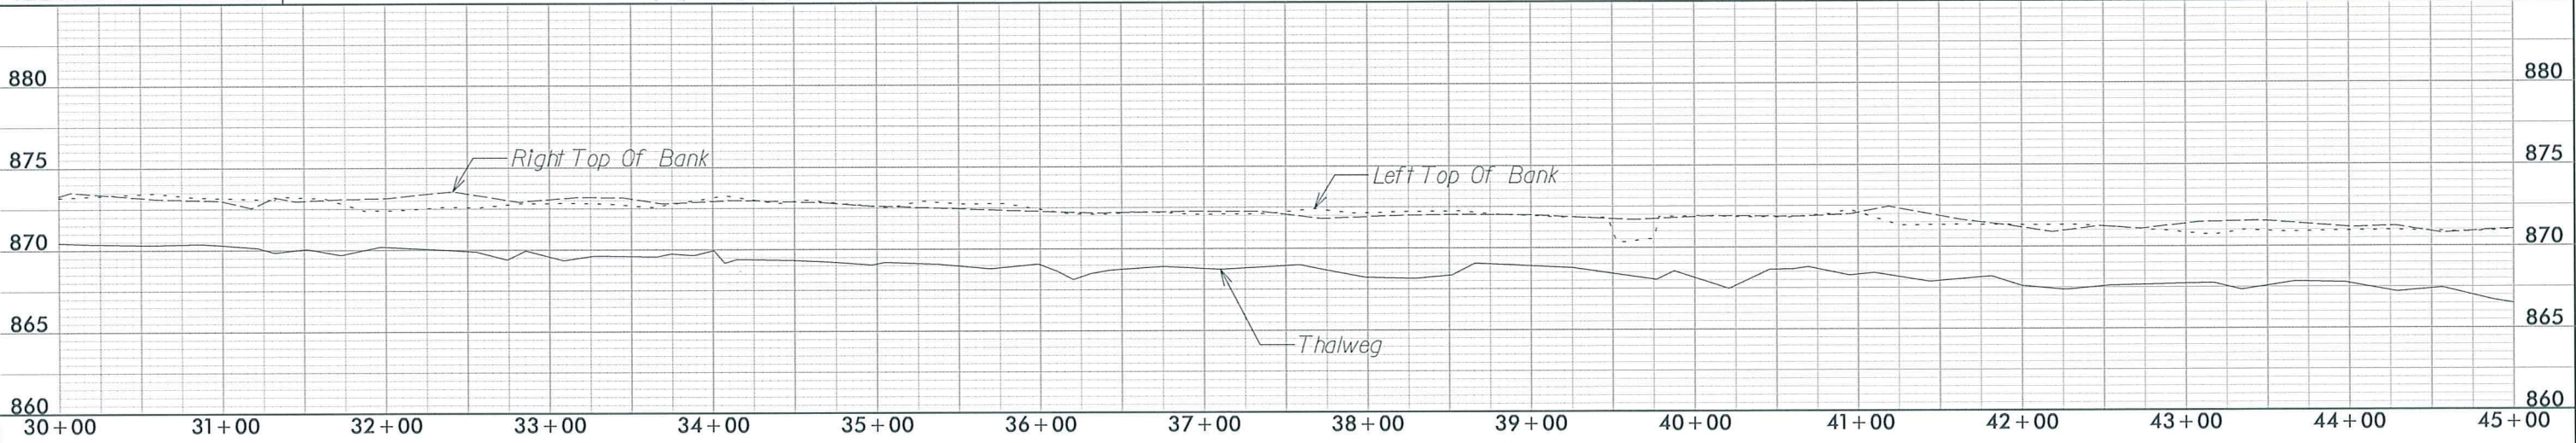



PROJECT CONTROL			
PT	NORTHING	EASTING	ELEV
400	576422.038	1068186.054	880.06
401	575893.793	1068722.918	876.57
402	575553.812	1069205.512	874.33
403	575226.901	1069762.056	876.08
404	574837.941	1070257.372	871.64
405	575926.913	1069945.053	897.4
406	576477.612	1069949.267	923.13
407	574324.856	1071064.416	871.26
408	574308.473	1071397.857	869.04
409	573967.988	1071422.762	869.21
410	574222.858	1069493.135	884.97
411	574100.263	1068841.141	891.49
412	573828.028	1068325.712	899.29
413	573310.368	1068220.815	880.95
414	573357.513	1067646.732	883.68
415	573584.485	1067315.797	884.12
416	573948.599	1066938.639	893.06
417	573625.298	1066619.236	887.85
418	573993.945	1066024.951	910.83
419	574181.189	1065763.288	891.33



REVISIONS		
DATE	BY	DESCRIPTION
3/14/08	JTL	AS-BUILT DRAWINGS
8/19/08	EMP	CHANGED MONITORING LIMITS

PROJECT ENGINEER


PROJECT REFERENCE NO.	SHEET NO.
LITTLE WHITE OAK CREEK	28

**AS-BUILT DRAWING**

PO Box 33127  
RALEIGH, N.C. 27636  
(919) 851-1912  
(919) 851-1918 (FAX)  
WWW.MULKEYINC.COM

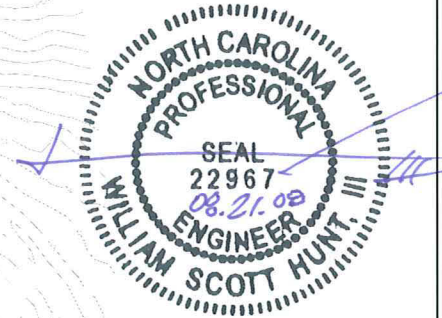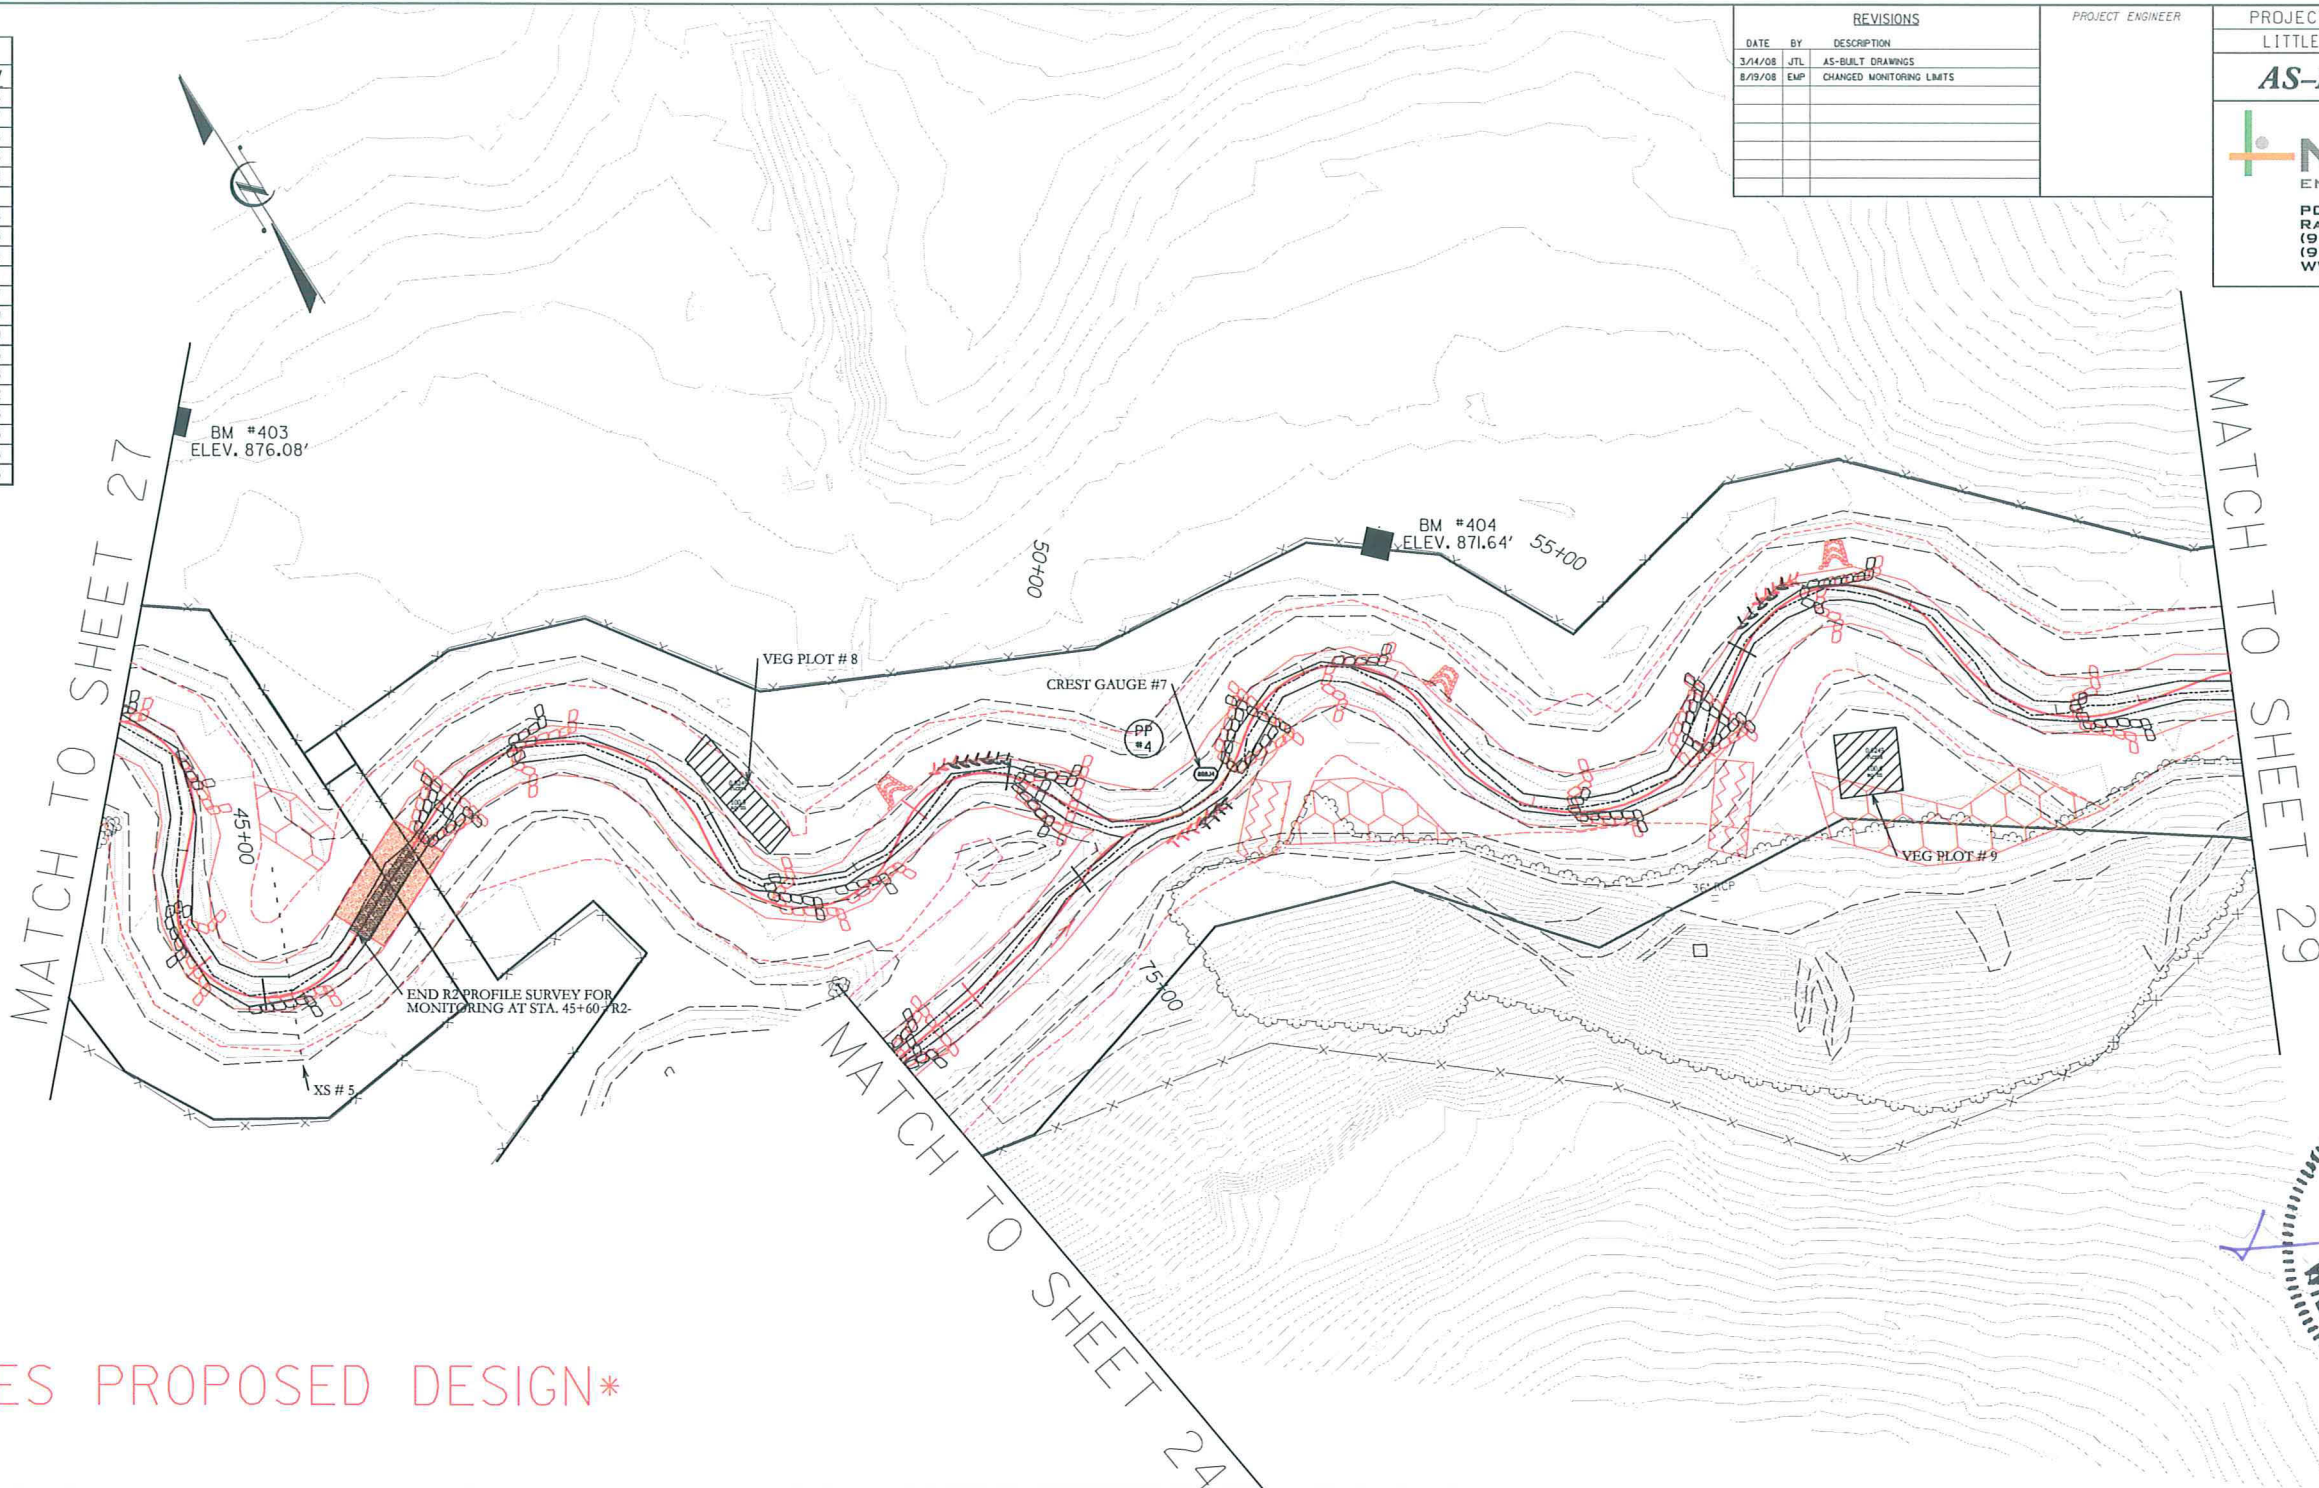

\*RED DENOTES PROPOSED DESIGN\*

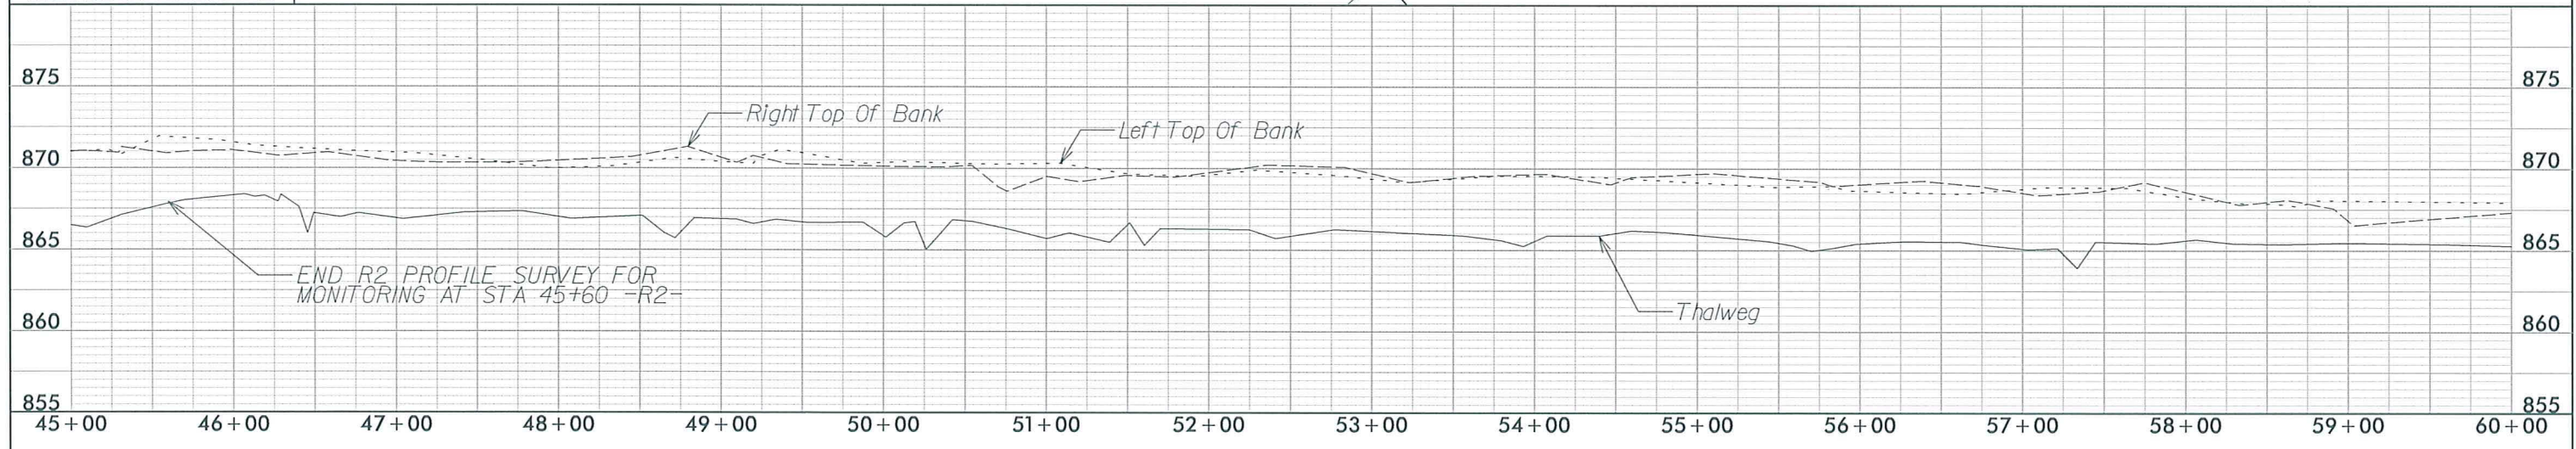



PROJECT CONTROL			
PT	NORTHING	EASTING	ELEV
400	576422.038	1068186.054	880.06
401	575893.793	1068722.918	876.57
402	575553.812	1069205.512	874.33
403	575226.901	1069762.056	876.08
404	574837.941	1070257.372	871.64
405	575926.913	1069945.053	897.4
406	576477.612	1069949.267	923.13
407	574324.856	1071064.416	871.26
408	574308.473	1071397.857	869.04
409	573967.988	1071422.762	869.21
410	574222.858	1069493.135	884.97
411	574100.263	1068841.141	891.49
412	573828.028	1068325.712	899.29
413	573310.368	1068220.815	880.95
414	573357.513	1067646.732	883.68
415	573584.485	1067315.797	884.12
416	573948.599	1066938.639	893.06
417	573625.298	1066619.236	887.85
418	573993.945	1066024.951	910.83
419	574181.189	1065763.288	891.33

REVISIONS		
DATE	BY	DESCRIPTION
3/14/08	JTL	AS-BUILT DRAWINGS
8/19/08	EMP	CHANGED MONITORING LIMITS


PROJECT ENGINEER

PROJECT REFERENCE NO. SHEET NO.  
LITTLE WHITE OAK CREEK 29

**AS-BUILT DRAWING**

**MULKEY**  
ENGINEERS & CONSULTANTS


PO Box 33127  
RALEIGH, N.C. 27636  
(919) 851-1912  
(919) 851-1918 (FAX)  
WWW.MULKEYINC.COM

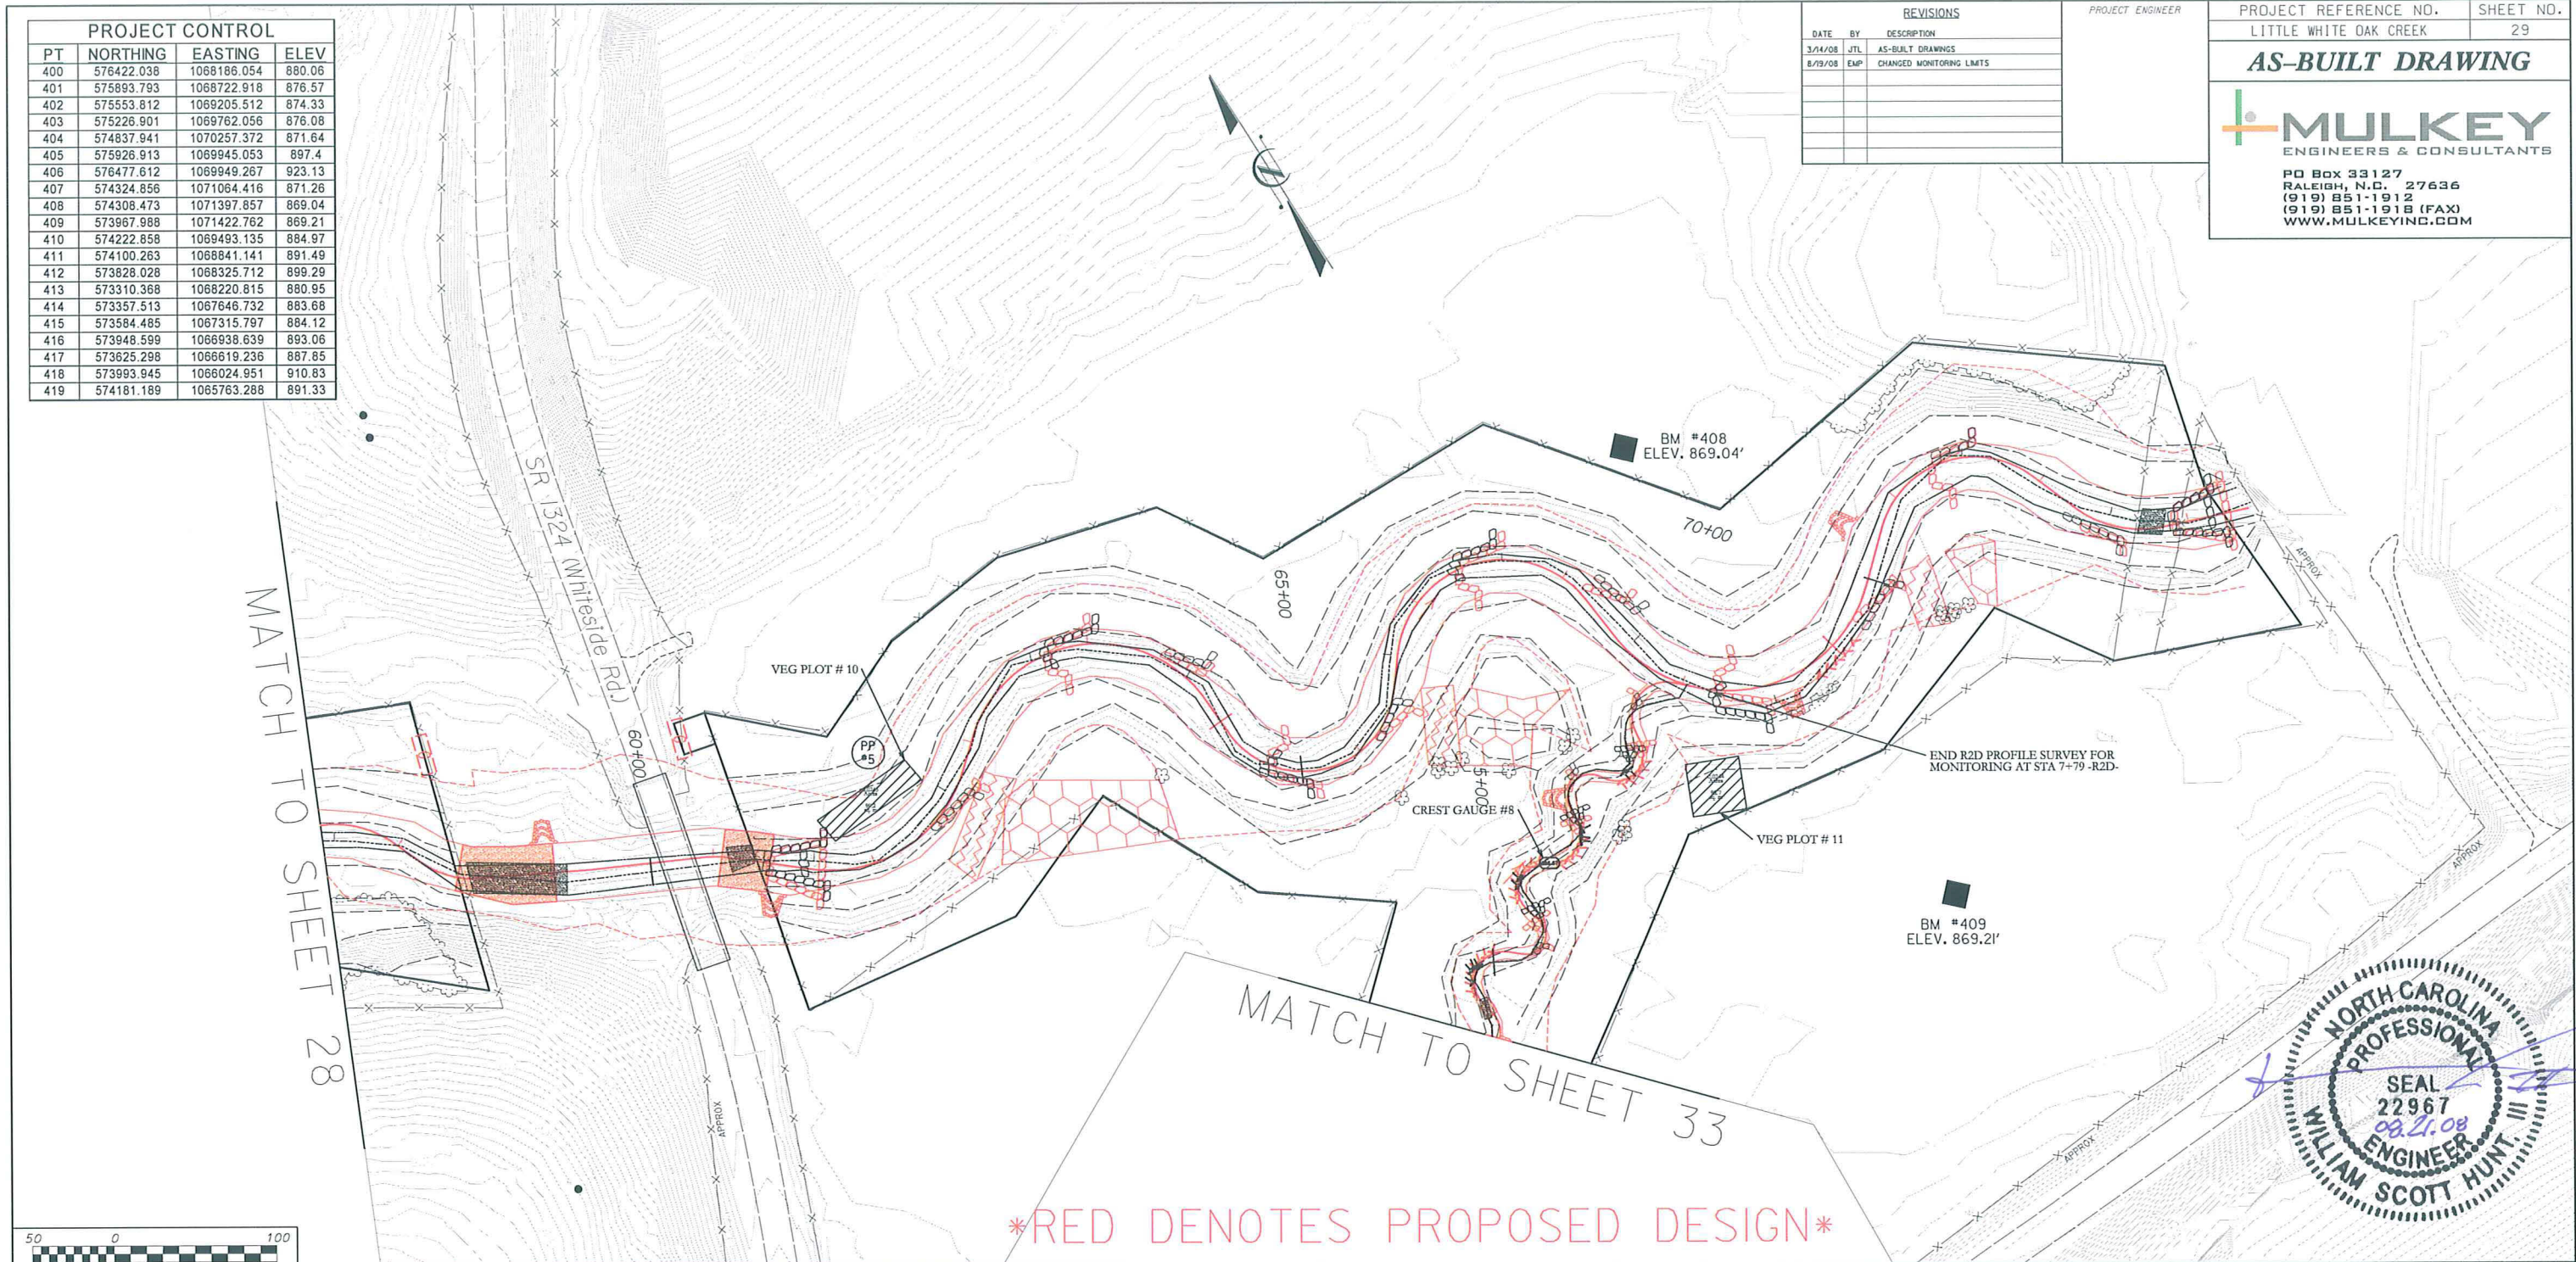

MATCH TO SHEET 28

MATCH TO SHEET 33

\*RED DENOTES PROPOSED DESIGN\*

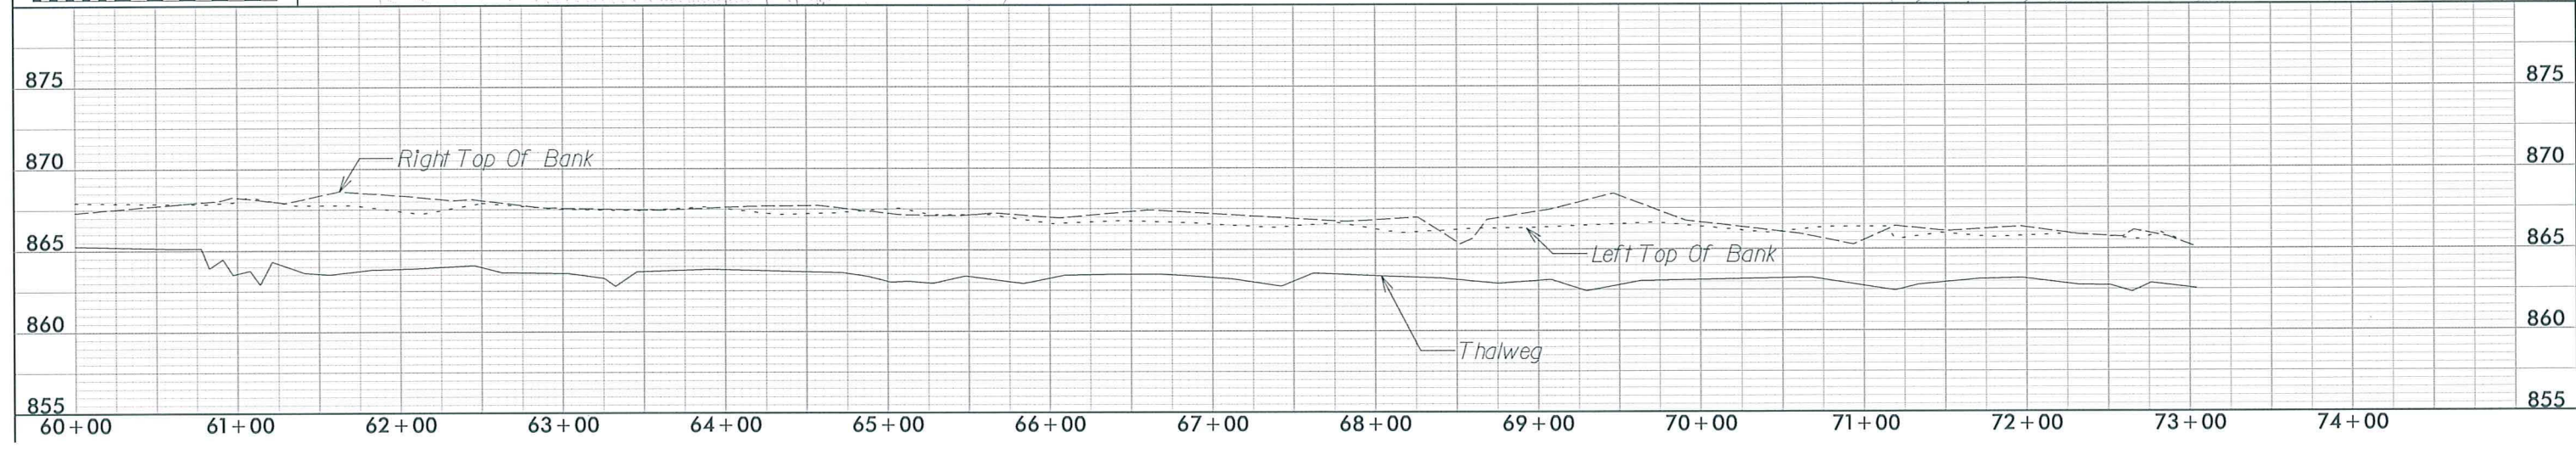

DATE PLOTTED



REVISIONS		
DATE	BY	DESCRIPTION
3/14/08	JTL	AS-BUILT DRAWINGS
8/19/08	EMP	CHANGED MONITORING LIMITS


PROJECT ENGINEER

PROJECT REFERENCE NO. LITTLE WHITE OAK CREEK SHEET NO. 30

**AS-BUILT DRAWING**

**MULKEY**  
ENGINEERS & CONSULTANTS

PO Box 33127  
RALEIGH, N.C. 27636  
(919) 851-1912  
(919) 851-1918 (FAX)  
WWW.MULKEYINC.COM

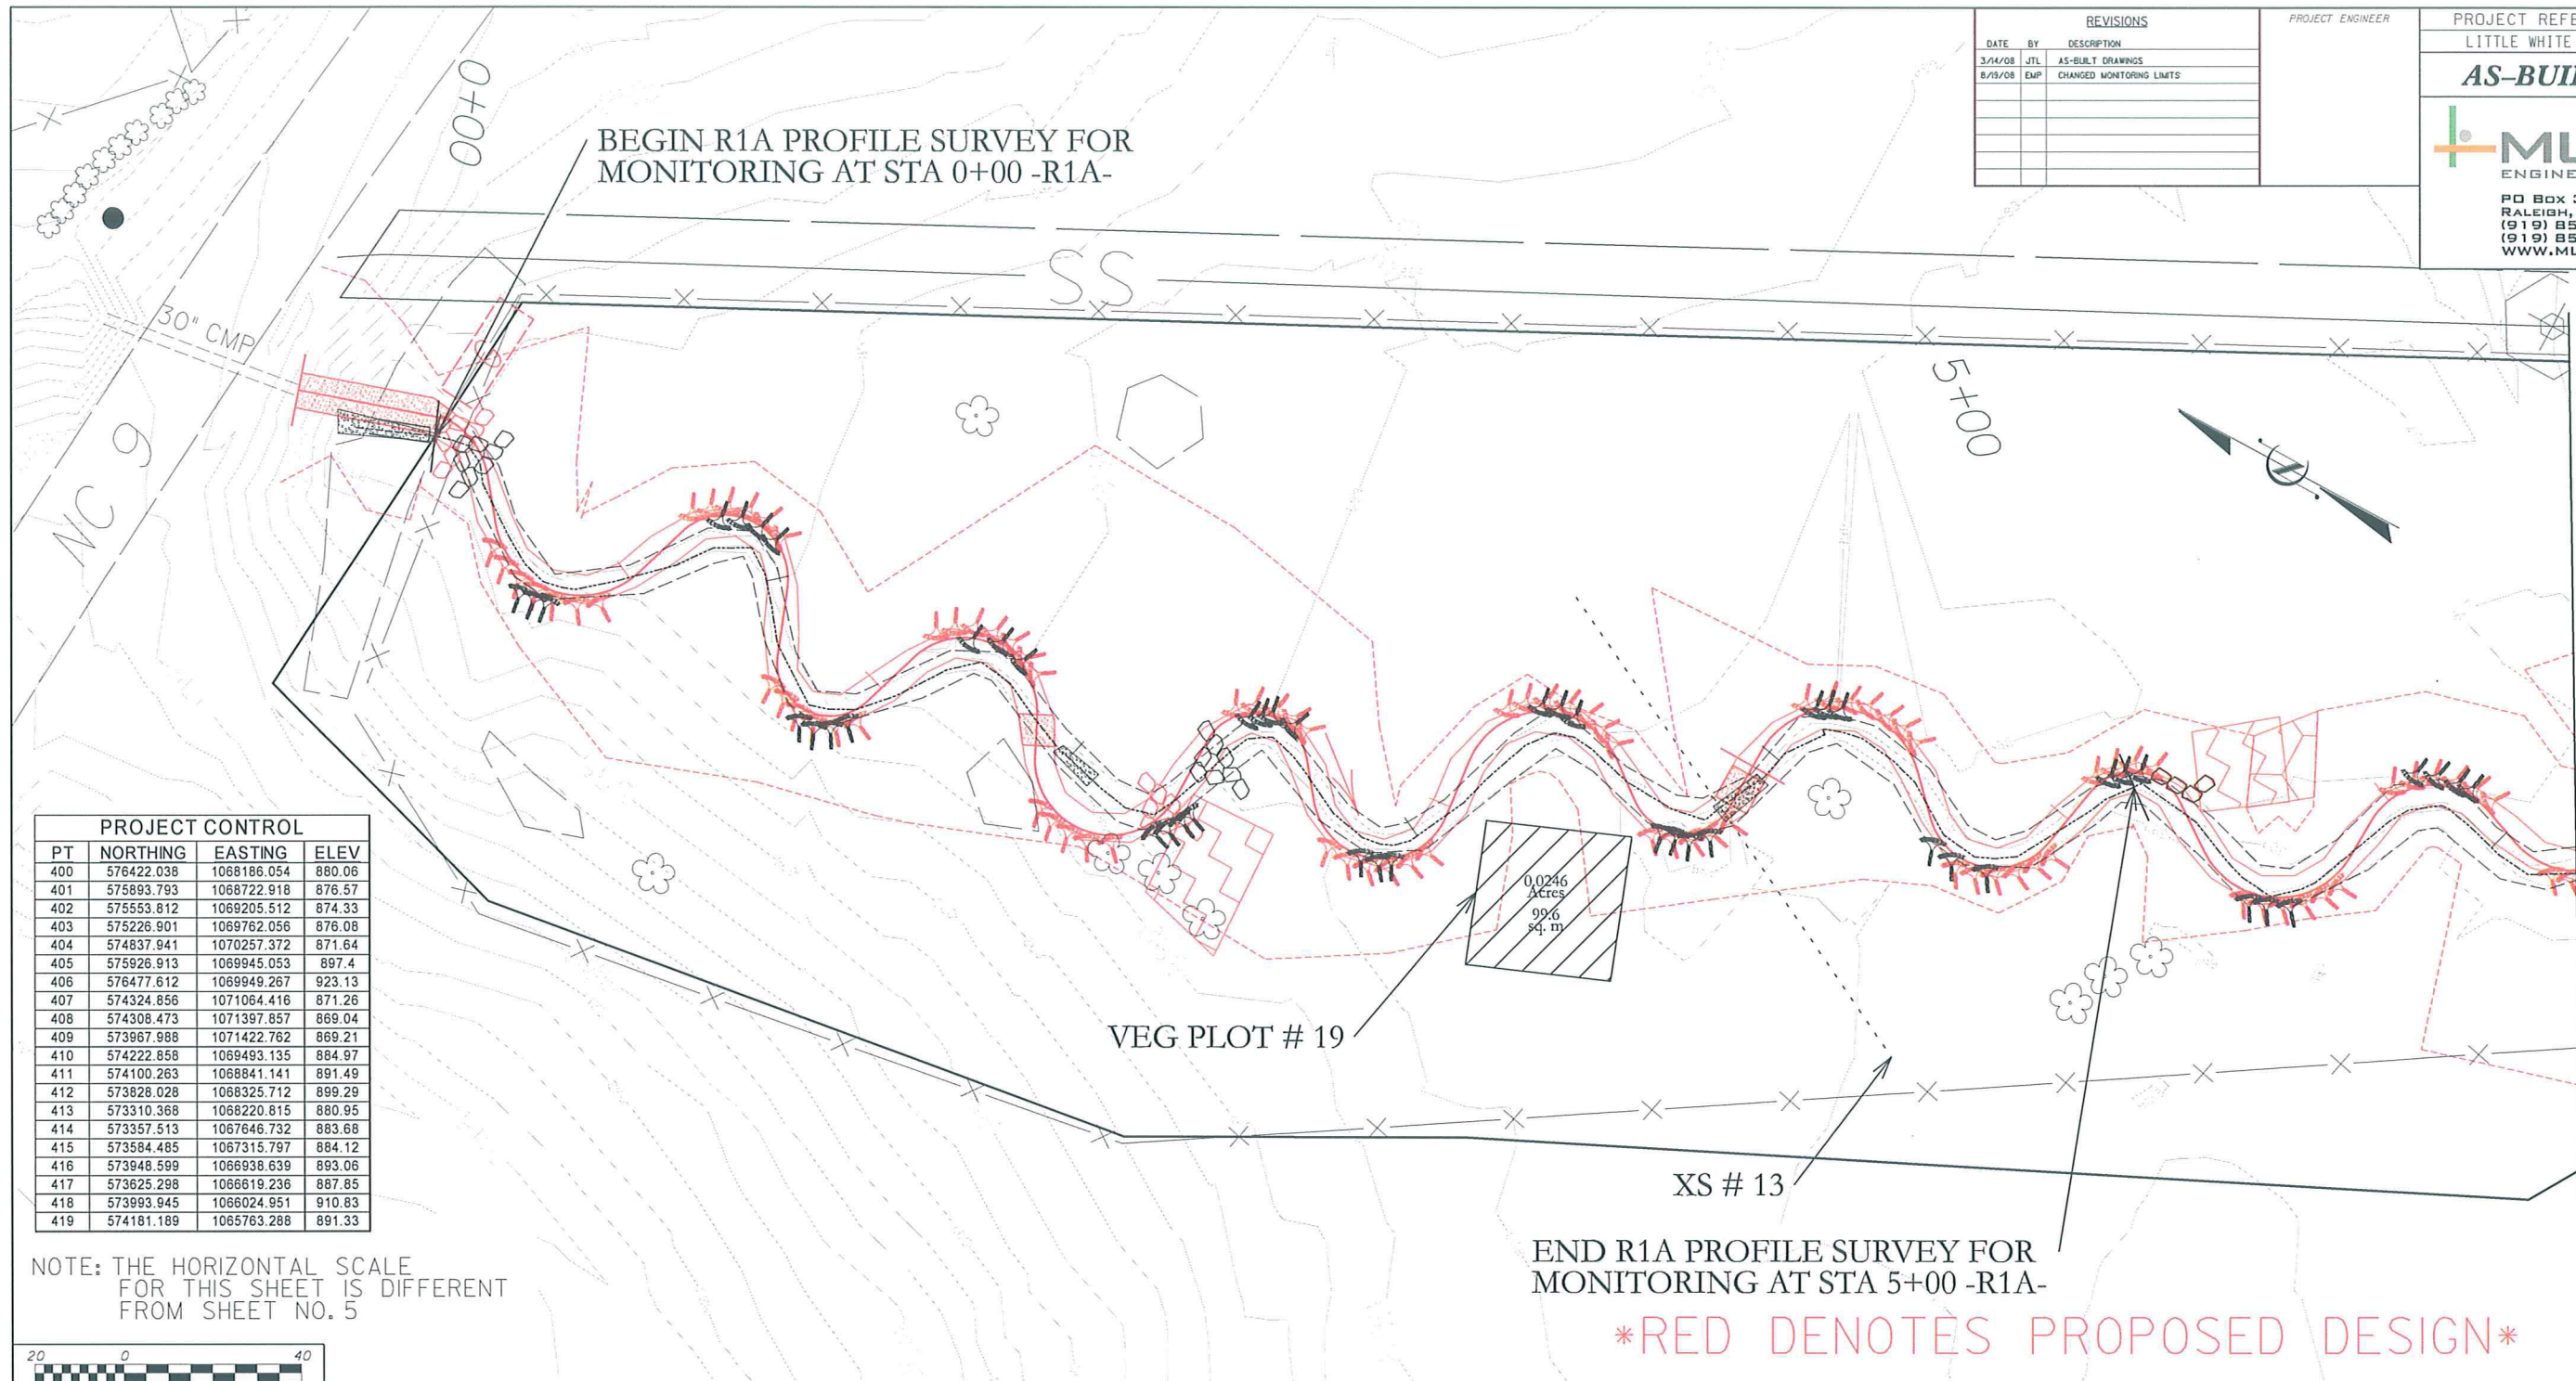

**PROJECT CONTROL**

PT	NORTHING	EASTING	ELEV
400	576422.038	1068186.054	880.06
401	575893.793	1068722.918	876.57
402	575553.812	1069205.512	874.33
403	575228.901	1069762.056	876.08
404	574837.941	1070257.372	871.64
405	575926.913	1069945.053	897.4
406	576477.612	1069949.267	923.13
407	574324.856	1071064.416	871.26
408	574308.473	1071397.857	869.04
409	573967.988	1071422.762	869.21
410	574222.858	1069493.135	884.97
411	574100.263	1068841.141	891.49
412	573826.028	1068325.712	899.29
413	573310.368	1068220.815	880.95
414	573357.513	1067646.732	883.68
415	573584.485	1067315.797	884.12
416	573948.599	1066938.639	893.06
417	573625.298	1066619.236	887.85
418	573993.945	1066024.951	910.83
419	574181.189	1065763.288	891.33

NOTE: THE HORIZONTAL SCALE FOR THIS SHEET IS DIFFERENT FROM SHEET NO. 5



MATCH TO SHEET 21

\*RED DENOTES PROPOSED DESIGN\*

SEE SHEET NO. 18 FOR -R1A- PROFILE





REVISIONS		
DATE	BY	DESCRIPTION
3/14/08	JTL	AS-BUILT DRAWINGS
8/19/08	EMP	CHANGED MONITORING LIMITS

PROJECT ENGINEER

PROJECT REFERENCE NO. SHEET NO.  
LITTLE WHITE OAK CREEK 31

**AS-BUILT DRAWING**



**MULKEY**  
ENGINEERS & CONSULTANTS

PO Box 33127  
RALEIGH, N.C. 27636  
(919) 851-1912  
(919) 851-1918 (FAX)  
WWW.MULKEYINC.COM

APPROXIMATE LOCATION OF GAS LINE EASEMENT

00+0

VEG PLOT # 6

0.0242 Acres  
98.0 sq.m

MATCH TO SHEET 32



PROJECT CONTROL

PT	NORTHING	EASTING	ELEV
400	576422.038	1068186.054	880.06
401	575893.793	1068722.918	876.57
402	575553.812	1069205.512	874.33
403	575226.901	1069762.056	876.08
404	574837.941	1070257.372	871.64
405	575926.913	1069945.053	897.4
406	576477.612	1069949.267	923.13
407	574324.856	1071064.416	871.26
408	574308.473	1071397.857	869.04
409	573967.988	1071422.762	869.21
410	574222.858	1069493.135	884.97
411	574100.283	1068841.141	891.49
412	573828.028	1068325.712	899.29
413	573310.368	1068220.815	880.95
414	573357.513	1067646.732	883.68
415	573584.485	1067315.797	884.12
416	573948.599	1066938.639	893.06
417	573825.298	1066619.236	887.85
418	573993.945	1066024.951	910.83
419	574181.189	1065763.288	891.33

NOTE: THE HORIZONTAL SCALE FOR THIS SHEET IS DIFFERENT FROM SHEET NO. 11



\*RED DENOTES PROPOSED DESIGN\*

SEE SHEET NO. 19 FOR -R2B- PROFILE



REVISIONS		
DATE	BY	DESCRIPTION
3/14/08	JTL	AS-BUILT DRAWINGS
8/19/08	EMP	CHANGED MONITORING LIMITS

PROJECT ENGINEER


PROJECT REFERENCE NO. SHEET NO.  
LITTLE WHITE OAK CREEK 32

**AS-BUILT DRAWING**

**MULKEY**  
ENGINEERS & CONSULTANTS

PO Box 33127  
RALEIGH, N.C. 27636  
(919) 851-1912  
(919) 851-1918 (FAX)  
WWW.MULKEYINC.COM

PROJECT CONTROL			
PT	NORTHING	EASTING	ELEV
400	576422.038	1068186.054	880.06
401	575893.793	1068722.918	876.57
402	575553.812	1069205.512	874.33
403	575226.901	1069762.056	876.08
404	574837.941	1070257.372	871.64
405	575926.913	1069945.053	897.4
406	576477.612	1069949.267	923.13
407	574324.856	1071064.416	871.26
408	574308.473	1071397.857	869.04
409	573967.988	1071422.762	869.21
410	574222.858	1069493.135	884.97
411	574100.263	1068841.141	891.49
412	573828.028	1068325.712	899.29
413	573310.368	1068220.815	880.95
414	573357.513	1067646.732	883.68
415	573584.485	1067315.797	884.12
416	573948.599	1066938.839	893.06
417	573625.298	1066619.236	887.85
418	573993.945	1066024.951	910.83
419	574181.189	1065763.288	891.33

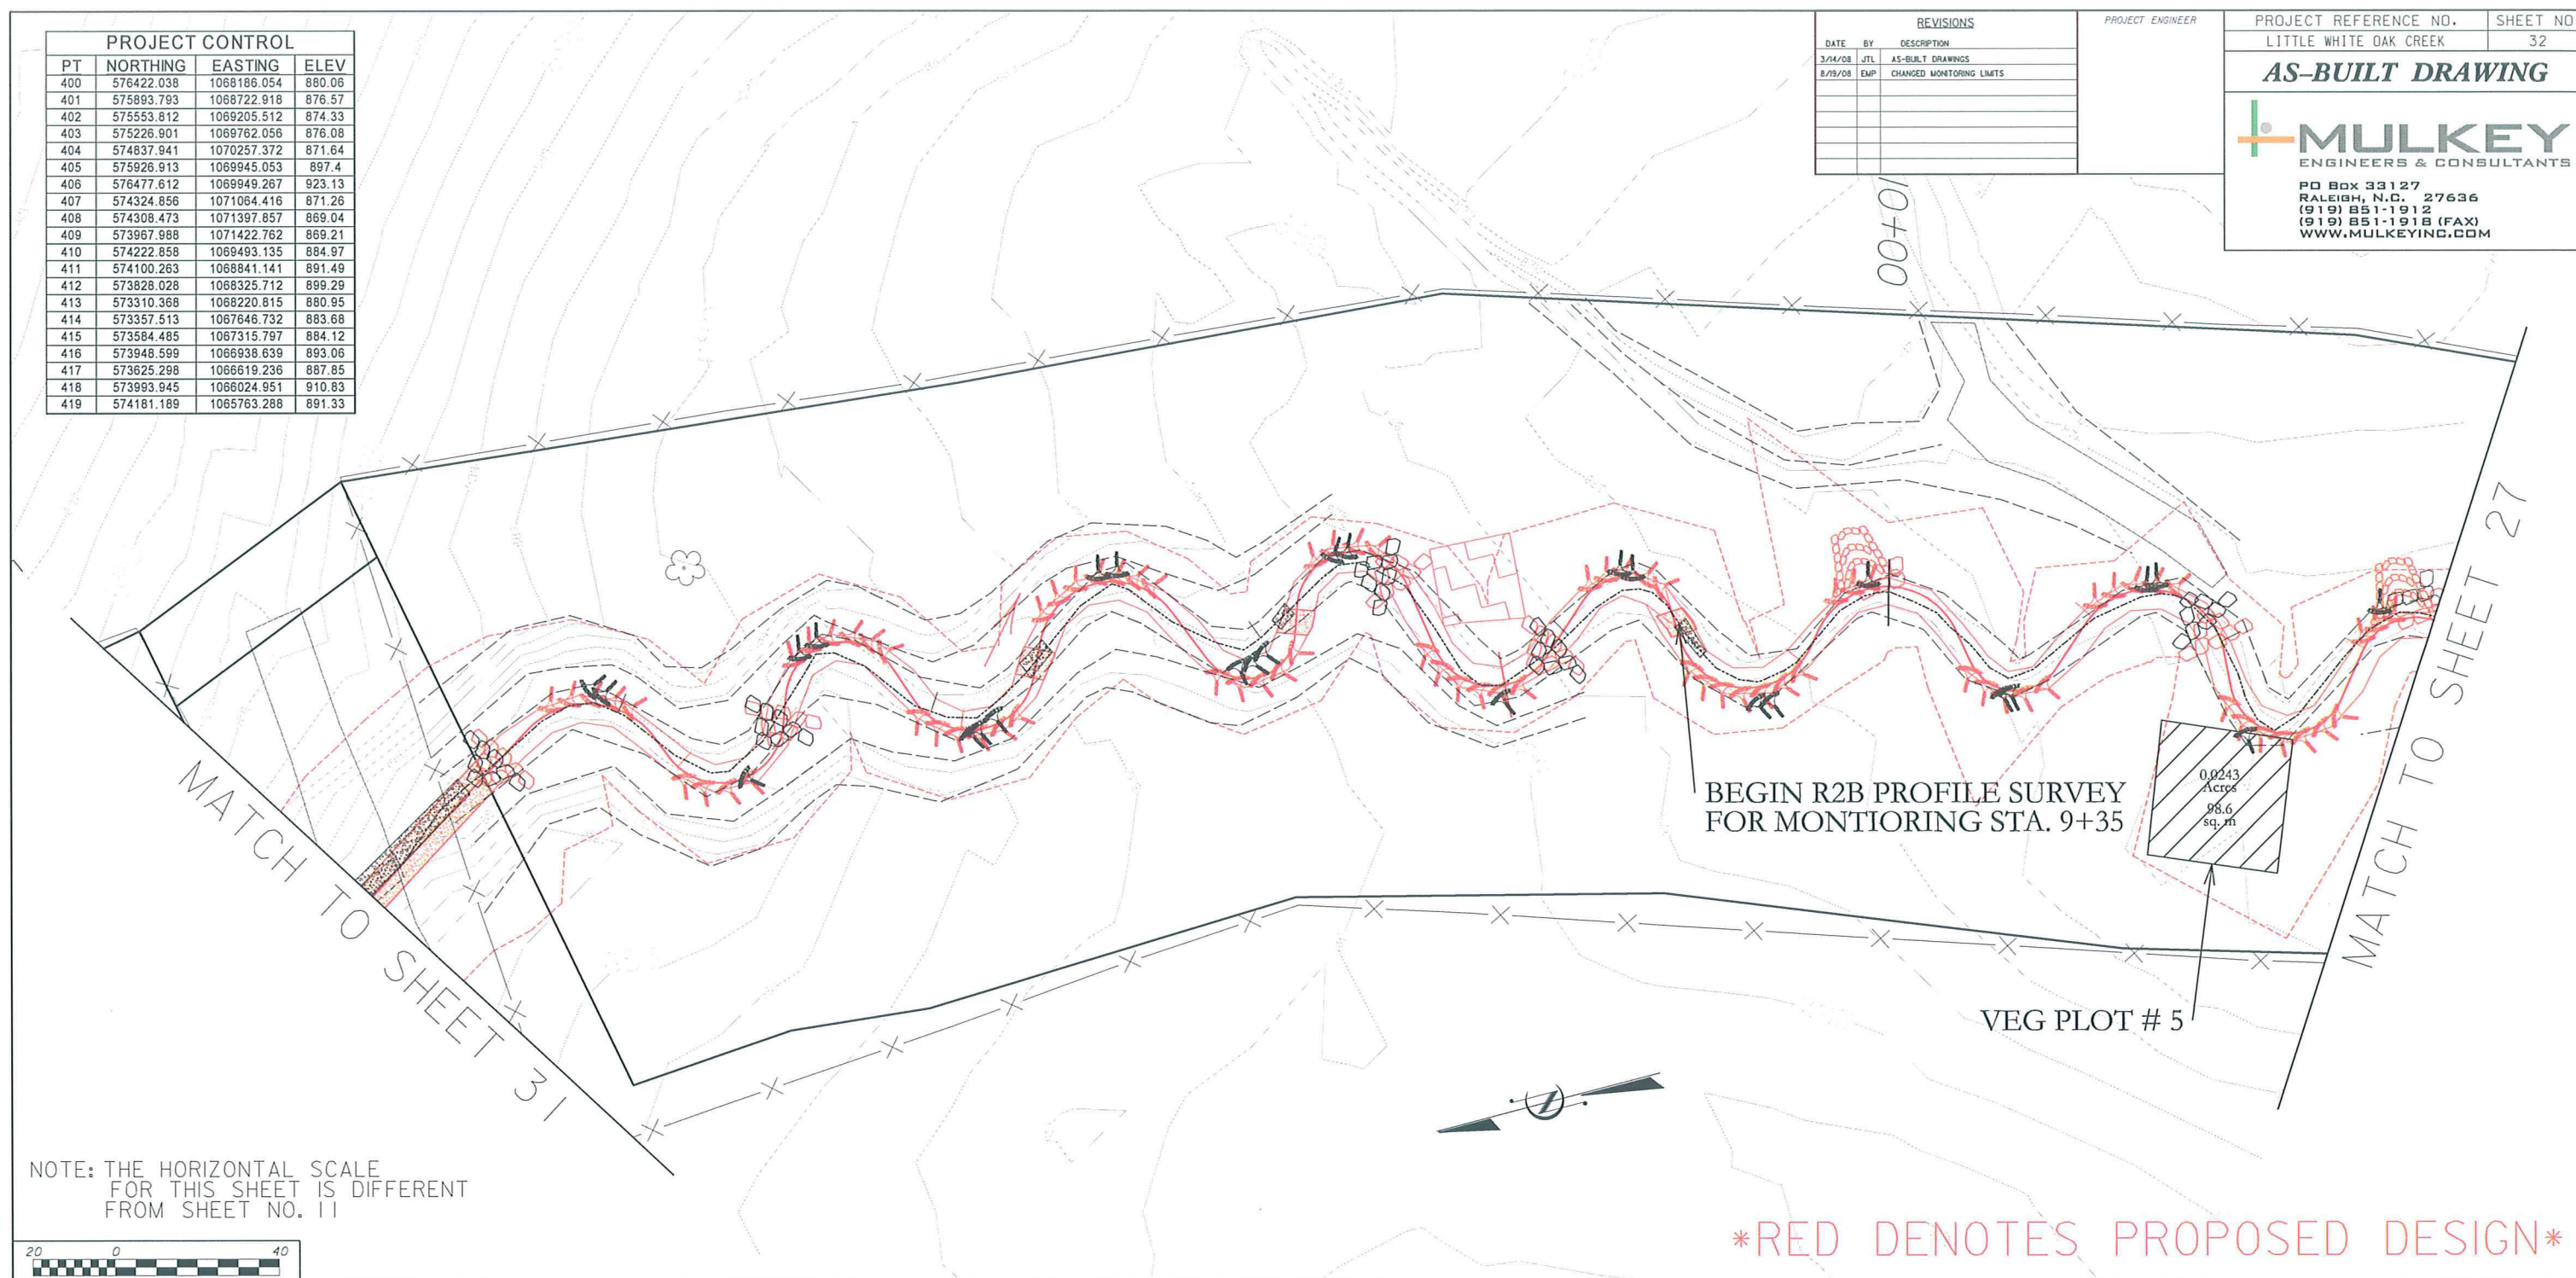

NOTE: THE HORIZONTAL SCALE FOR THIS SHEET IS DIFFERENT FROM SHEET NO. 11



SEE SHEET NO. 19 FOR -R2B- PROFILE





PROJECT CONTROL			
PT	NORTHING	EASTING	ELEV
400	576422.038	1068186.054	880.06
401	575893.793	1068722.918	876.57
402	575553.812	1069205.512	874.33
403	575226.901	1069762.056	878.08
404	574837.941	1070257.372	871.64
405	575926.913	1069945.053	897.4
406	576477.612	1069949.267	923.13
407	574324.856	1071064.416	871.26
408	574308.473	1071397.857	869.04
409	573967.988	1071422.762	869.21
410	574222.858	1069493.135	884.97
411	574100.263	1068841.141	891.49
412	573828.028	1068325.712	899.29
413	573310.368	1068220.815	880.95
414	573357.513	1067646.732	883.68
415	573584.465	1067315.797	884.12
416	573948.599	1066938.639	893.06
417	573625.298	1066619.236	887.85
418	573993.945	1066024.951	910.83
419	574181.189	1065763.288	891.33

REVISIONS		
DATE	BY	DESCRIPTION
3/14/08	JTL	AS-BUILT DRAWINGS
8/19/08	EMP	CHANGED MONITORING LIMITS


PROJECT ENGINEER

PROJECT REFERENCE NO. LITTLE WHITE OAK CREEK SHEET NO. 33

**AS-BUILT DRAWING**

**MULKEY**  
ENGINEERS & CONSULTANTS

PO Box 33127  
RALEIGH, N.C. 27636  
(919) 851-1912  
(919) 851-1918 (FAX)  
WWW.MULKEYINC.COM

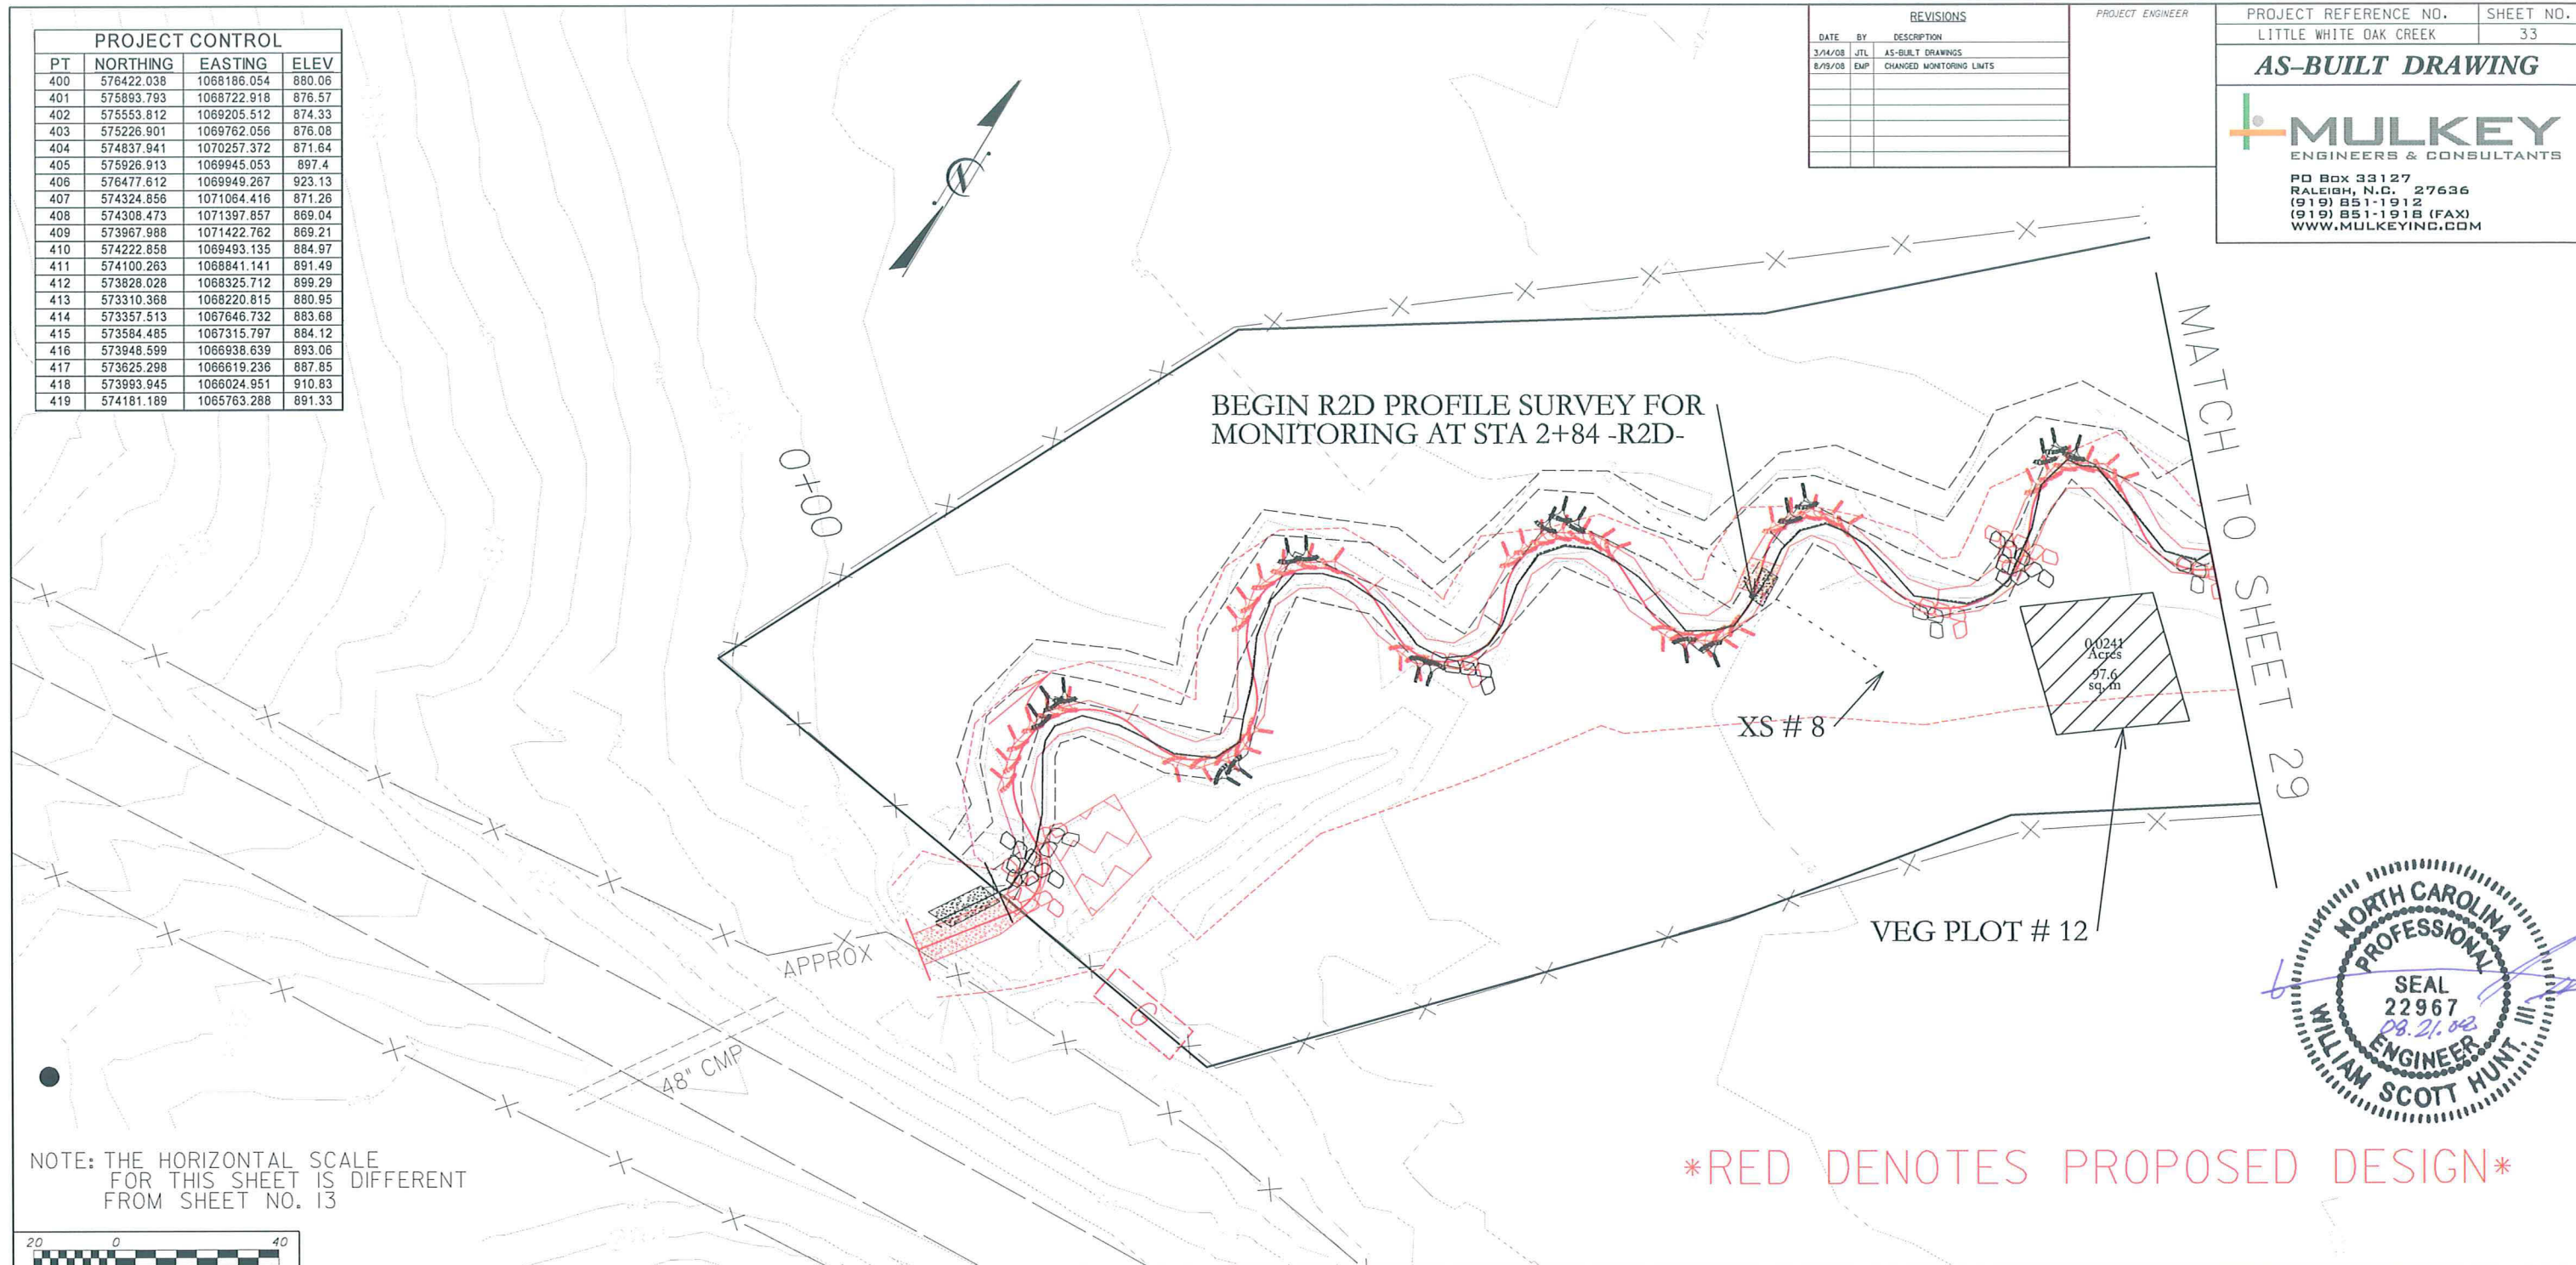

NOTE: THE HORIZONTAL SCALE FOR THIS SHEET IS DIFFERENT FROM SHEET NO. 13




SEE SHEET NO. 19 FOR -R2D- PROFILE



## **APPENDIX B**



# Cross Section 1 - Rifle (R2)

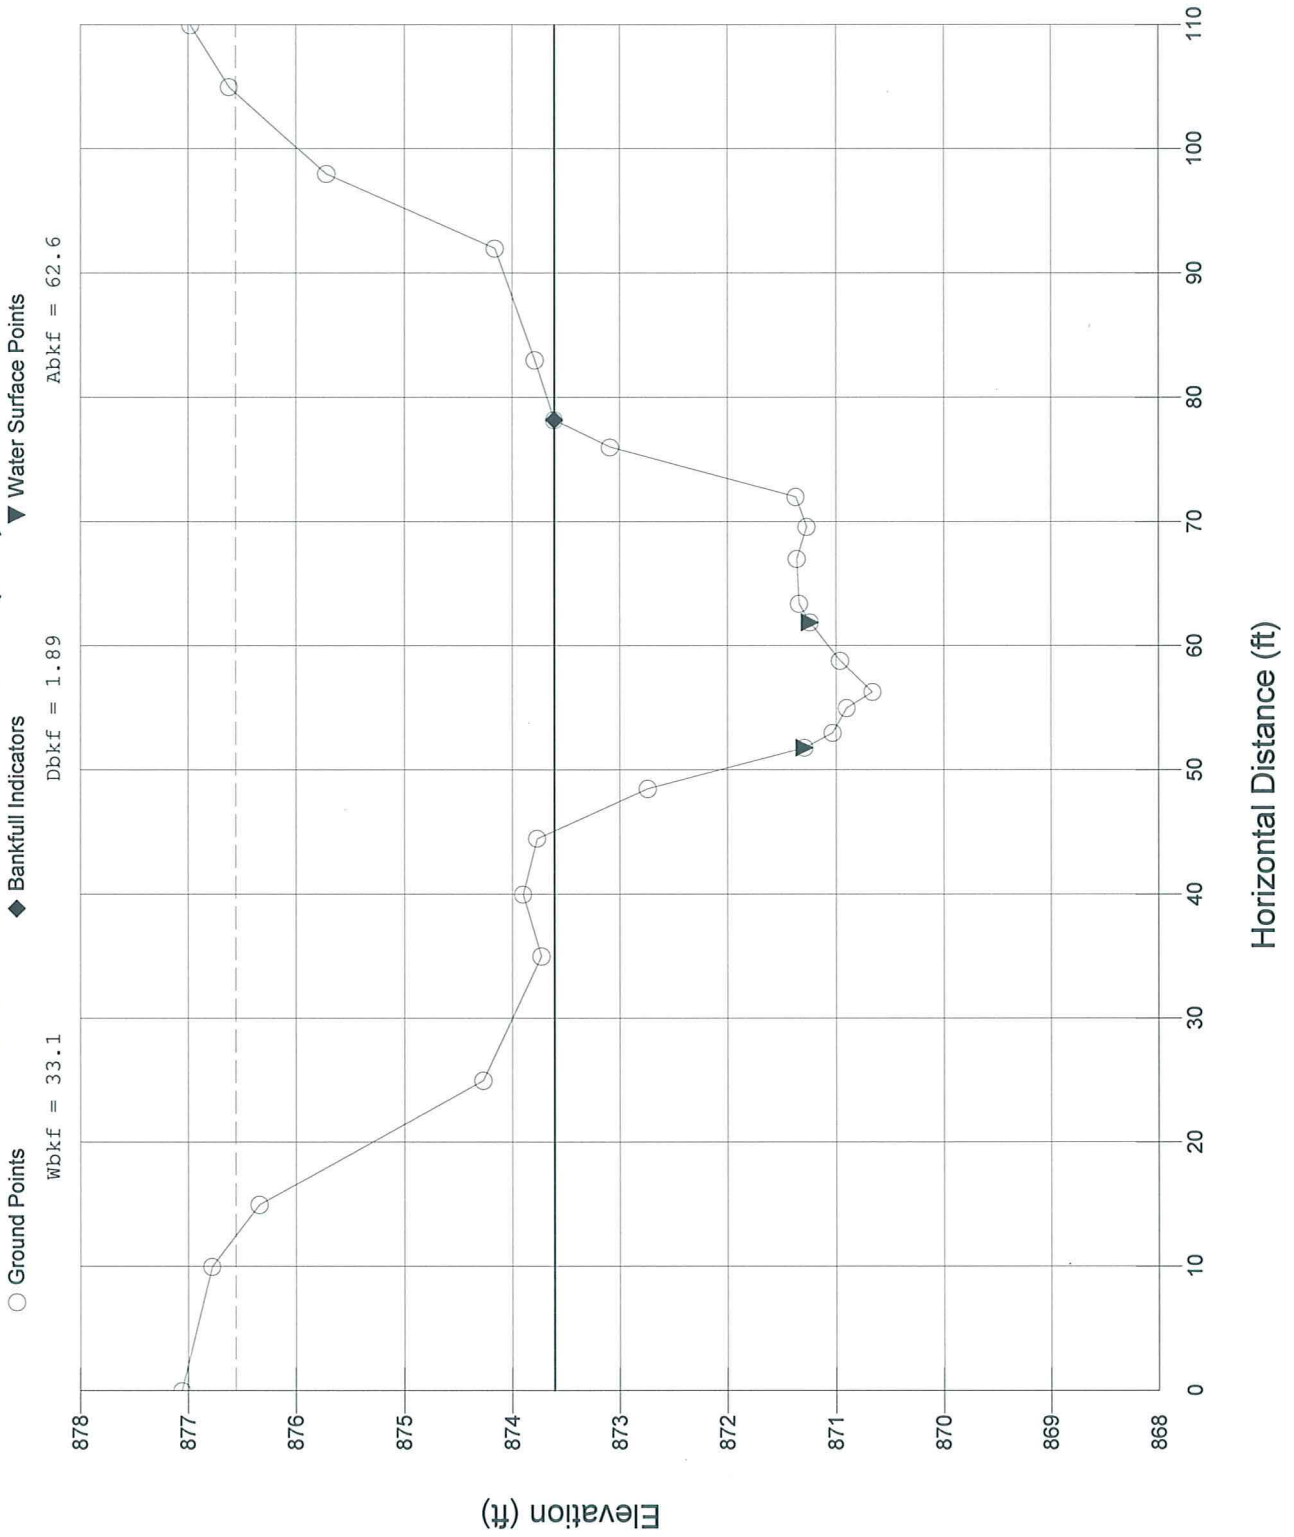



RIVERMORPH CROSS SECTION SUMMARY

River Name: Little white oak creek  
 Reach Name: R2  
 Cross Section Name: XS1 Riffle  
 Survey Date: 03/14/2008

Cross Section Data Entry

BM Elevation: 0 ft  
 Backsight Rod Reading: 0 ft

TAPE	FS	ELEV	NOTE
0	0	877.06	GS
10	0	876.78	GS
15	0	876.34	GS
25	0	874.27	GS
35	0	873.73	GS
40	0	873.9	GS
44.5	0	873.77	LB
48.5	0	872.74	GS
51.8	0	871.29	LEW
53	0	871.03	SB
55	0	870.9	SB
56.3	0	870.66	TW
58.8	0	870.96	SB
61.9	0	871.24	REW
63.4	0	871.34	GS
67	0	871.36	GS
69.6	0	871.27	GS
72	0	871.37	GS
76	0	873.09	GS
78.2	0	873.61	BKF
83	0	873.79	GS
92	0	874.16	GS
98	0	875.72	GS
105	0	876.62	GS
110	0	876.98	GS

Cross Sectional Geometry

	Channel	Left	Right
Floodprone Elevation (ft)	876.56	876.56	876.56
Bankfull Elevation (ft)	873.61	873.61	873.61
Floodprone width (ft)	92.03	-----	-----
Bankfull width (ft)	33.08	16.54	16.54
Entrenchment Ratio	2.78	-----	-----
Mean Depth (ft)	1.89	1.99	1.8
Maximum Depth (ft)	2.95	2.95	2.39
Width/Depth Ratio	17.5	8.31	9.19
Bankfull Area (sq ft)	62.59	32.85	29.74
Wetted Perimeter (ft)	34	19.43	19.35
Hydraulic Radius (ft)	1.84	1.69	1.54
Begin BKF Station	45.12	45.12	61.66
End BKF Station	78.2	61.66	78.2



# Entrainment Calculations


---

Entrainment Formula: Rosgen Modified Shields Curve

	Channel	Left Side	Right Side
Slope	0	0	0
Shear Stress (lb/sq ft)			
Movable Particle (mm)			



# Cross Section 2 - Pool (R2)

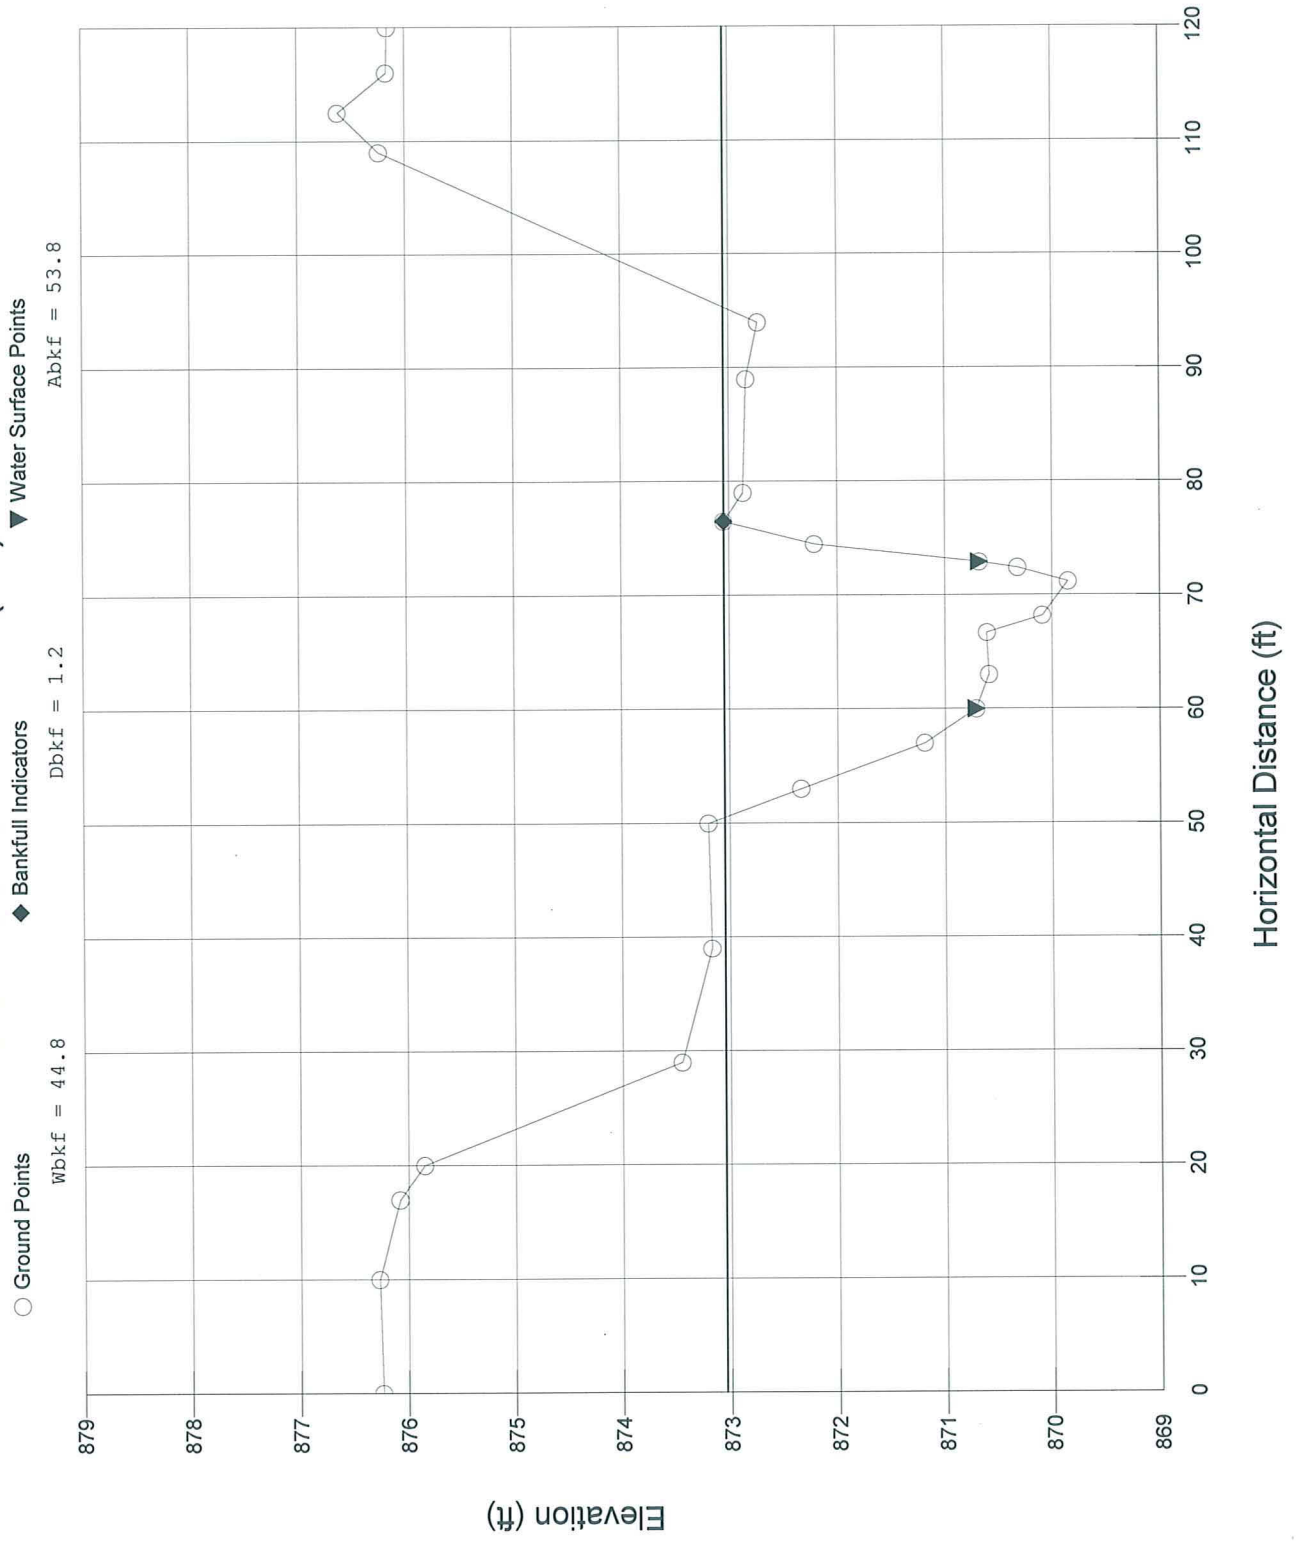



RIVERMORPH CROSS SECTION SUMMARY

River Name: Little white oak Creek  
 Reach Name: R2  
 Cross Section Name: XS2 Pool  
 Survey Date: 03/14/2008

Cross Section Data Entry

BM Elevation: 0 ft  
 Backsight Rod Reading: 0 ft

TAPE	FS	ELEV	NOTE
0	0	876.24	GS
10	0	876.27	GS
17	0	876.08	GS
20	0	875.85	GS
29	0	873.45	GS
39	0	873.17	GS
50	0	873.2	LB
53	0	872.34	GS
57	0	871.19	GS
60	0	870.71	LEW
63	0	870.59	SB
66.7	0	870.61	SB
68.2	0	870.09	SB
71.2	0	869.85	TW
72.4	0	870.32	SB
72.9	0	870.68	REW
74.5	0	872.21	GS
76.5	0	873.05	BKF
79	0	872.87	GS
89	0	872.84	GS
94	0	872.73	GS
109	0	876.24	GS
112.5	0	876.62	GS
116	0	876.17	GS
120	0	876.16	GS

Cross Sectional Geometry

	Channel	Left	Right
Floodprone Elevation (ft)	876.25	876.25	876.25
Bankfull Elevation (ft)	873.05	873.05	873.05
Floodprone width (ft)	106.31	-----	-----
Bankfull width (ft)	44.84	22.43	22.42
Entrenchment Ratio	2.37	-----	-----
Mean Depth (ft)	1.2	2.09	0.31
Maximum Depth (ft)	3.2	3.2	2.32
Width/Depth Ratio	37.37	10.73	72.32
Bankfull Area (sq ft)	53.83	46.82	7.01
wetted Perimeter (ft)	46.28	25.37	25.55
Hydraulic Radius (ft)	1.16	1.85	0.27
Begin BKF Station	50.52	50.52	72.95
End BKF Station	95.37	72.95	95.37



# Entrainment Calculations


---

Entrainment Formula: Rosgen Modified Shields Curve

	Channel	Left Side	Right Side
Slope	0	0	0
Shear Stress (lb/sq ft)			
Movable Particle (mm)			



# Cross Section 3 - Pool (R2)

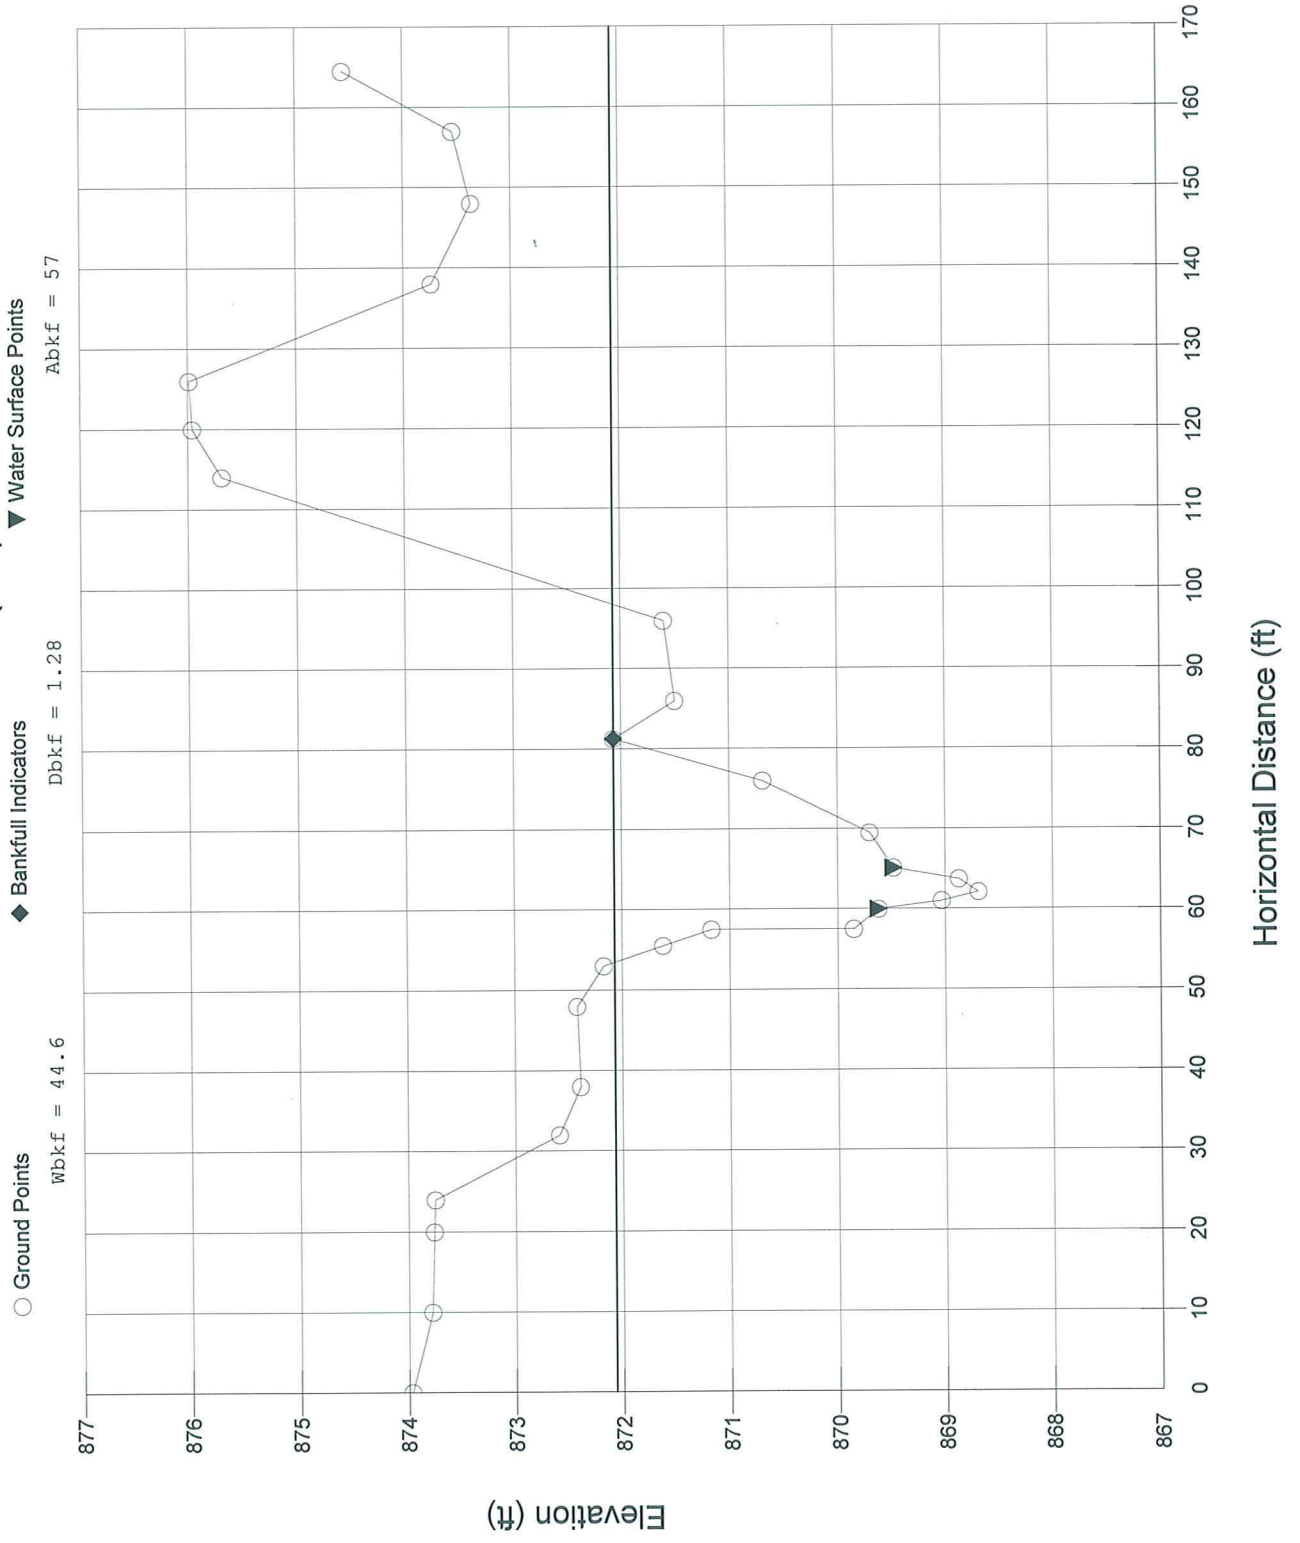

○ Ground Points  
Wbkf = 44.6

◆ Bankfull Indicators  
Dbkf = 1.28

▼ Water Surface Points  
Abkf = 57



RIVERMORPH CROSS SECTION SUMMARY

River Name: Little white Oak Creek  
 Reach Name: R2  
 Cross Section Name: XS3 Pool  
 Survey Date: 03/14/2008

Cross Section Data Entry

BM Elevation: 0 ft  
 Backsight Rod Reading: 0 ft

TAPE	FS	ELEV	NOTE
0	0	873.97	GS
10	0	873.78	GS
20	0	873.76	GS
24	0	873.75	GS
32	0	872.59	GS
38	0	872.39	GS
48	0	872.42	GS
53	0	872.17	LB
55.5	0	871.62	GS
57.5	0	871.17	GS
57.5	0	869.85	GS
60	0	869.62	LEW
61	0	869.03	SB
62.1	0	868.69	TW
63.7	0	868.87	SB
65.1	0	869.48	REW
69.5	0	869.7	GS
76	0	870.69	GS
81.3	0	872.07	BKF
86	0	871.5	GS
96	0	871.6	GS
114	0	875.69	GS
120	0	875.96	GS
126	0	875.99	GS
138	0	873.74	GS
148	0	873.37	GS
157	0	873.54	GS
164.5	0	874.56	GS

Cross Sectional Geometry

	Channel	Left	Right
Floodprone Elevation (ft)	875.45	875.45	875.45
Bankfull Elevation (ft)	872.07	872.07	872.07
Floodprone width (ft)	148.56	-----	-----
Bankfull width (ft)	44.61	22.31	22.31
Entrenchment Ratio	3.33	-----	-----
Mean Depth (ft)	1.28	2.06	0.49
Maximum Depth (ft)	3.38	3.38	1.42
Width/Depth Ratio	34.85	10.83	45.53
Bankfull Area (sq ft)	57.02	46	11.02
Wetted Perimeter (ft)	46.74	25.58	23.99
Hydraulic Radius (ft)	1.22	1.8	0.46
Begin BKF Station	53.45	53.45	75.76



End BKF Station

98.07

75.76

98.07


-----  
Entrainment Calculations  
-----

Entrainment Formula: Rosgen Modified Shields Curve

	Channel	Left Side	Right Side
Slope	0	0	0
Shear Stress (lb/sq ft)			
Movable Particle (mm)			



# Cross Section 4 - Rifle (R2)

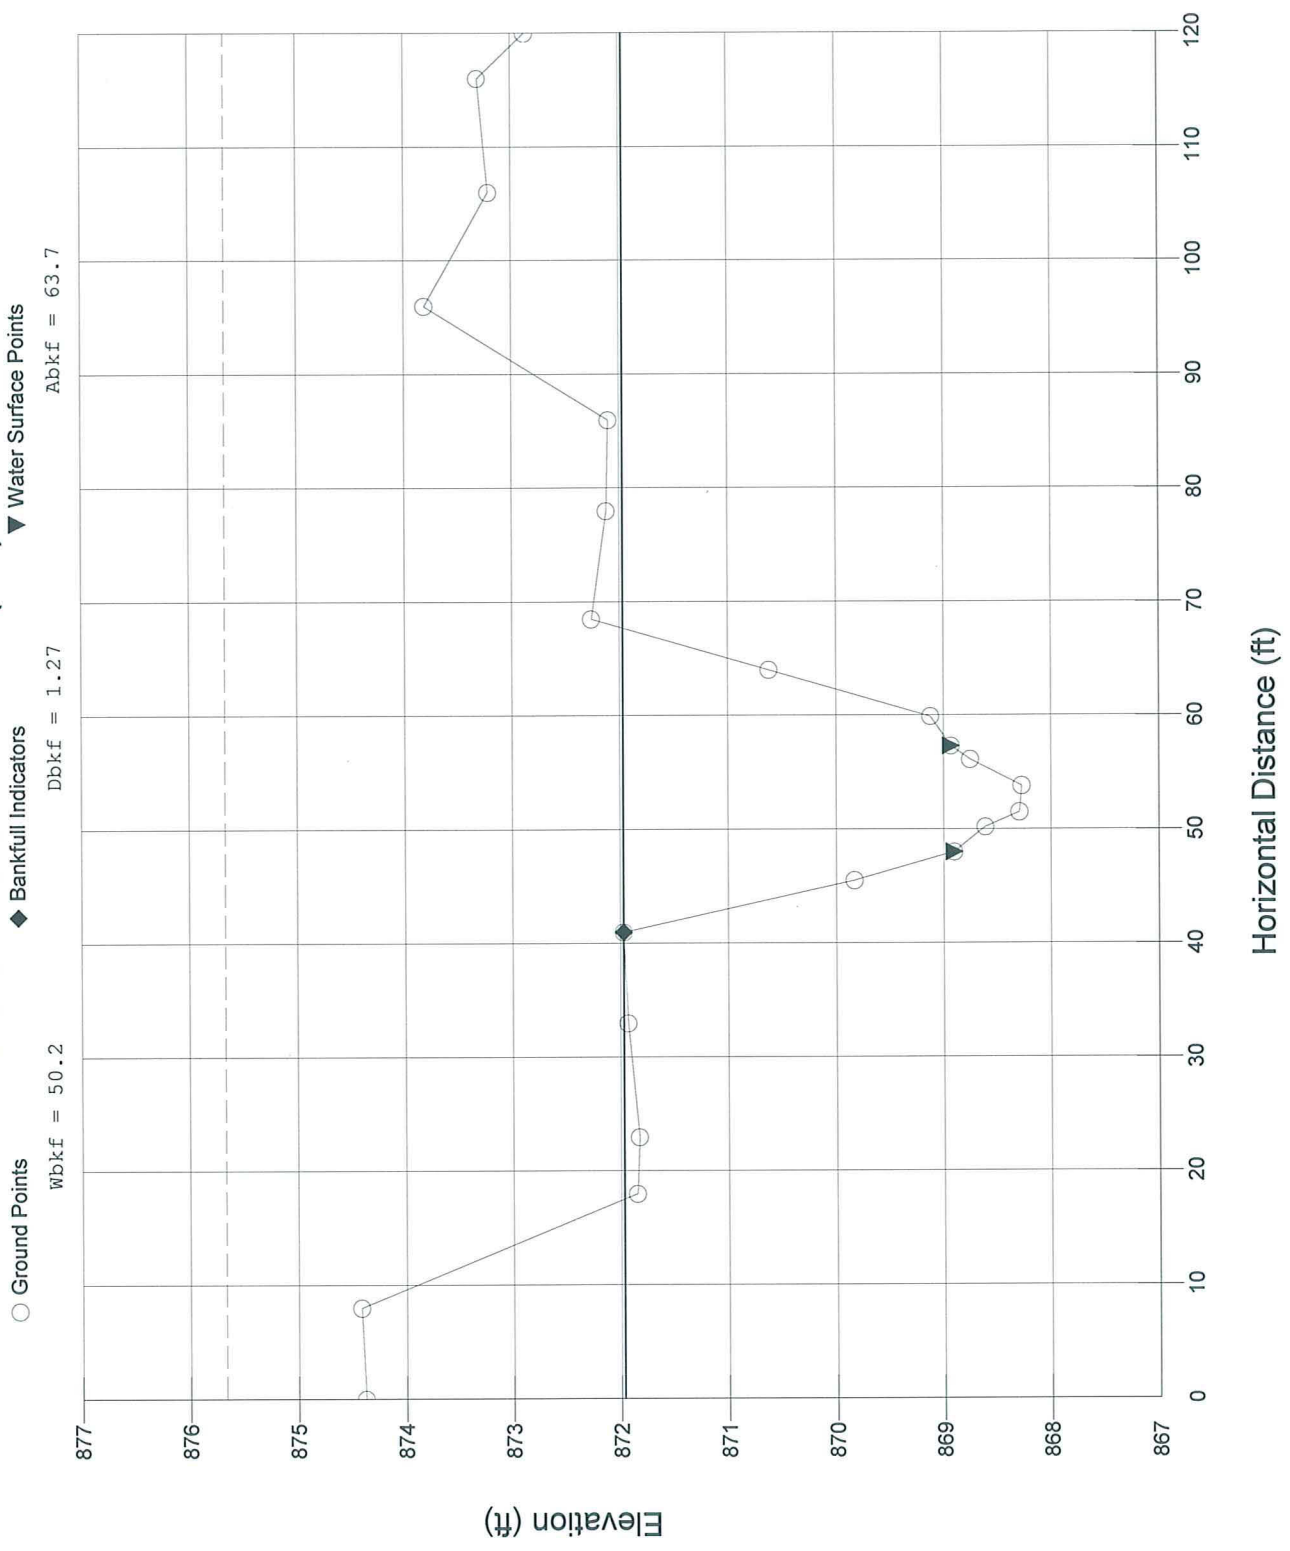



RIVERMORPH CROSS SECTION SUMMARY

River Name: Little white Oak Creek  
 Reach Name: R2  
 Cross Section Name: XS4 Riffle  
 Survey Date: 03/14/2008

Cross Section Data Entry

BM Elevation: 0 ft  
 Backsight Rod Reading: 0 ft

TAPE	FS	ELEV	NOTE
0	0	874.38	GS
8	0	874.42	GS
18	0	871.85	GS
23	0	871.83	GS
33	0	871.93	GS
41	0	871.97	BKF
45.5	0	869.83	GS
48	0	868.9	LEW
50.2	0	868.61	SB
51.5	0	868.29	TW
53.8	0	868.27	SB
56.1	0	868.75	SB
57.3	0	868.93	REW
59.9	0	869.12	GS
64	0	870.62	GS
68.5	0	872.26	RB
78	0	872.12	GS
86	0	872.1	GS
96	0	873.81	GS
106	0	873.21	GS
116	0	873.31	GS
120	0	872.87	GS

Cross Sectional Geometry

	Channel	Left	Right
Floodprone Elevation (ft)	875.67	875.67	875.67
Bankfull Elevation (ft)	871.97	871.97	871.97
Floodprone width (ft)	120	-----	-----
Bankfull width (ft)	50.17	25.09	25.08
Entrenchment Ratio	2.39	-----	-----
Mean Depth (ft)	1.27	0.09	2.45
Maximum Depth (ft)	3.7	0.77	3.7
Width/Depth Ratio	39.5	278.78	10.24
Bankfull Area (sq ft)	63.68	2.36	61.32
Wetted Perimeter (ft)	51.47	26.05	26.96
Hydraulic Radius (ft)	1.24	0.09	2.27
Begin BKF Station	17.53	17.53	42.62
End BKF Station	67.7	42.62	67.7

Entrainment Calculations




Entrainment Formula: Rosgen Modified Shields Curve

	Channel	Left Side	Right Side
Slope	0	0	0
Shear Stress (lb/sq ft)			
Movable Particle (mm)			



# Cross Section 5 - Pool (R2)

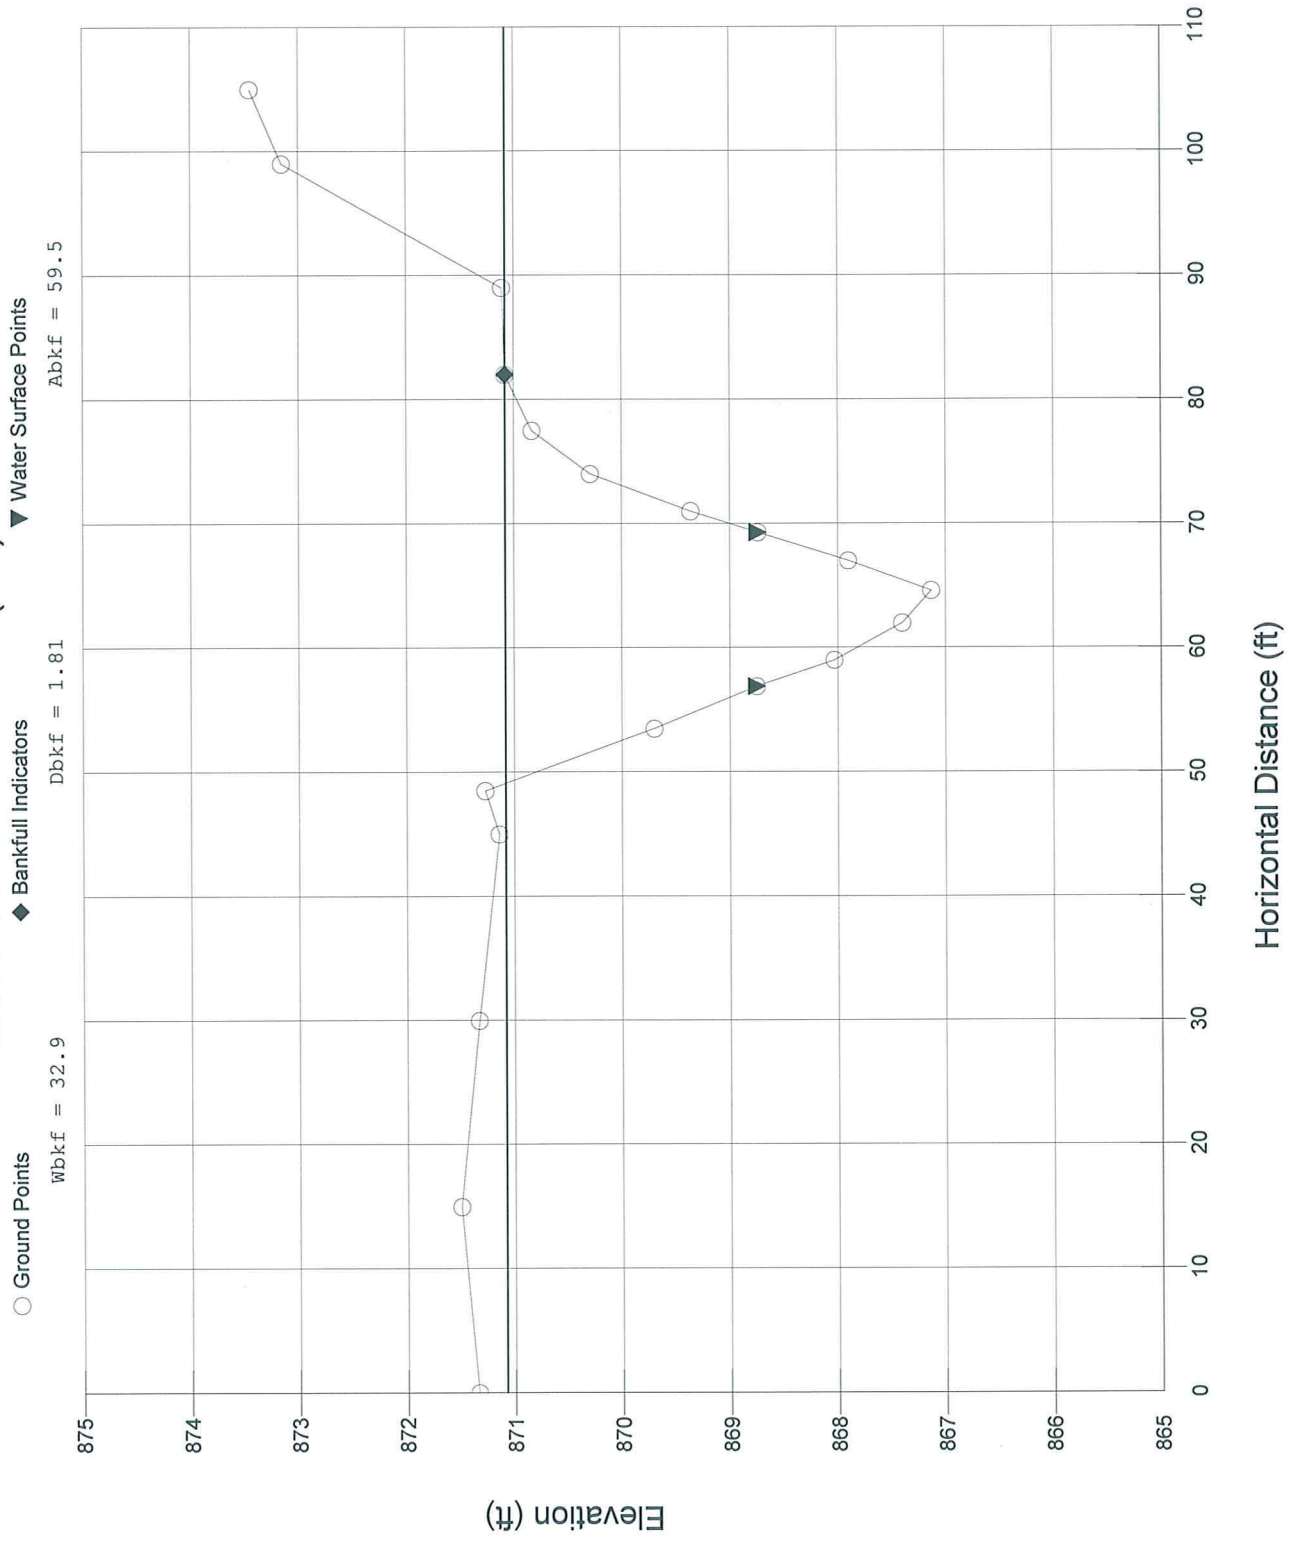



RIVERMORPH CROSS SECTION SUMMARY

River Name: Little white Oak Creek  
 Reach Name: R2  
 Cross Section Name: XS5 Pool  
 Survey Date: 03/14/2008

Cross Section Data Entry

BM Elevation: 0 ft  
 Backsight Rod Reading: 0 ft

TAPE	FS	ELEV	NOTE
0	0	871.34	GS
15	0	871.5	GS
30	0	871.33	GS
45	0	871.14	GS
48.5	0	871.27	LB
53.5	0	869.7	GS
56.9	0	868.75	LEW
59	0	868.03	SB
62	0	867.4	SB
64.6	0	867.13	TW
67	0	867.9	SB
69.3	0	868.74	REW
71	0	869.36	GS
74	0	870.29	GS
77.5	0	870.83	RB
82	0	871.08	BKF
89	0	871.11	GS
99	0	873.15	GS
105	0	873.45	GS

Cross Sectional Geometry

	Channel	Left	Right
Floodprone Elevation (ft)	875.03	875.03	875.03
Bankfull Elevation (ft)	871.08	871.08	871.08
Floodprone width (ft)	105	-----	-----
Bankfull width (ft)	32.89	16.44	16.45
Entrenchment Ratio	3.19	-----	-----
Mean Depth (ft)	1.81	2.35	1.27
Maximum Depth (ft)	3.95	3.95	3.65
width/Depth Ratio	18.17	7	12.95
Bankfull Area (sq ft)	59.5	38.61	20.89
wetted Perimeter (ft)	34	20.68	20.62
Hydraulic Radius (ft)	1.75	1.87	1.01
Begin BKF Station	49.11	49.11	65.55
End BKF Station	82	65.55	82

Entrainment Calculations

Entrainment Formula: Rosgen Modified Shields Curve

channel left side right side



Slope  
Shear Stress (lb/sq ft)  
Movable Particle (mm)


0

0

0



# Cross Section 6 - Riffle (R2A)

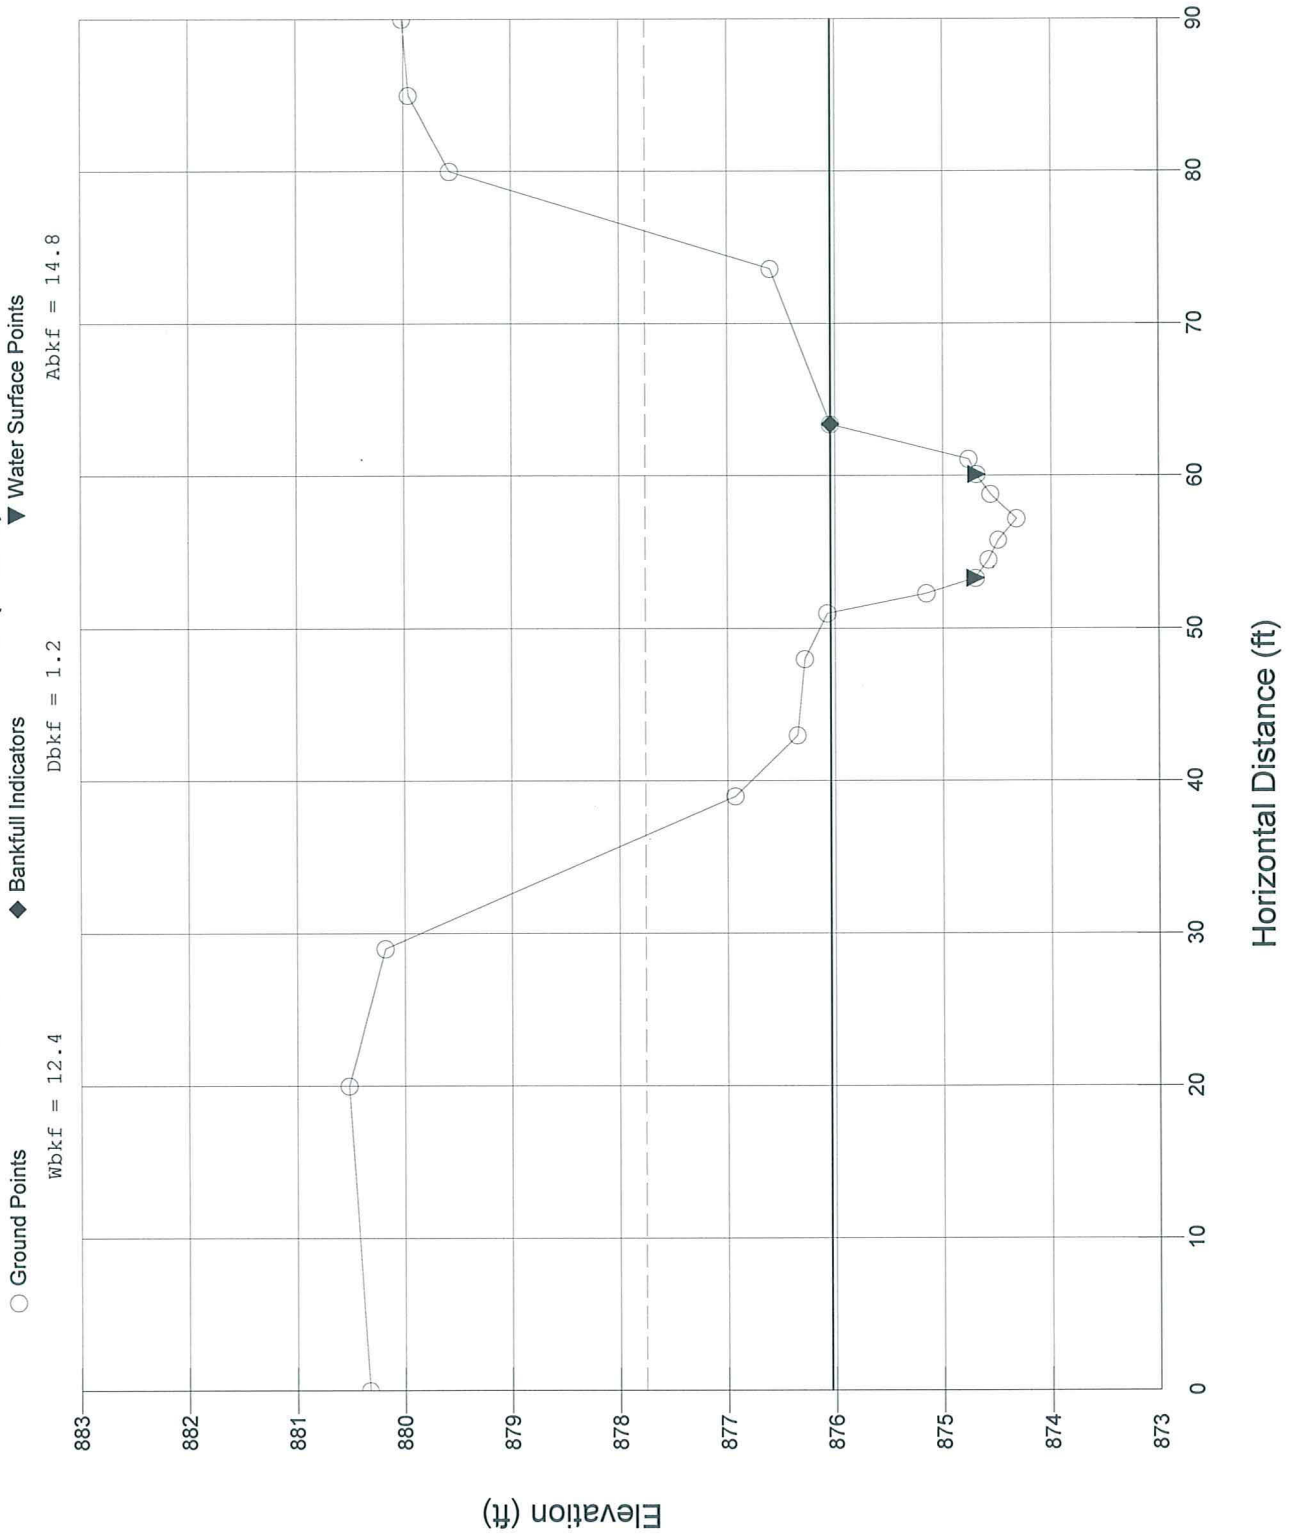



RIVERMORPH CROSS SECTION SUMMARY

River Name: Little White Oak Creek  
 Reach Name: R2A  
 Cross Section Name: XS6 Riffle  
 Survey Date: 03/14/2008

Cross Section Data Entry

BM Elevation: 0 ft  
 Backsight Rod Reading: 0 ft

TAPE	FS	ELEV	NOTE
0	0	880.33	GS
20	0	880.52	GS
29	0	880.18	GS
39	0	876.93	GS
43	0	876.35	GS
48	0	876.28	GS
51	0	876.07	LB
52.3	0	875.15	GS
53.3	0	874.7	LEW
54.5	0	874.58	SB
55.8	0	874.49	SB
57.2	0	874.32	TW
58.8	0	874.56	SB
60.1	0	874.69	REW
61.1	0	874.76	GS
63.4	0	876.04	BKF
73.6	0	876.6	GS
80	0	879.57	GS
85	0	879.95	GS
90	0	880.01	GS

Cross Sectional Geometry

	Channel	Left	Right
Floodprone Elevation (ft)	877.76	877.76	877.76
Bankfull Elevation (ft)	876.04	876.04	876.04
Floodprone width (ft)	39.65	-----	-----
Bankfull width (ft)	12.36	6.18	6.18
Entrenchment Ratio	3.21	-----	-----
Mean Depth (ft)	1.2	1.24	1.16
Maximum Depth (ft)	1.72	1.72	1.72
Width/Depth Ratio	10.3	4.98	5.33
Bankfull Area (sq ft)	14.79	7.63	7.15
Wetted Perimeter (ft)	13.12	8.29	8.26
Hydraulic Radius (ft)	1.13	0.92	0.87
Begin BKF Station	51.04	51.04	57.22
End BKF Station	63.4	57.22	63.4

Entrainment Calculations

Entrainment Formula: Rosgen Modified Shields Curve



Slope  
Shear Stress (lb/sq ft)  
Movable Particle (mm)


Channel  
0

Left Side  
0

Right Side  
0



# Cross Section 7 - Rifle (R2B)

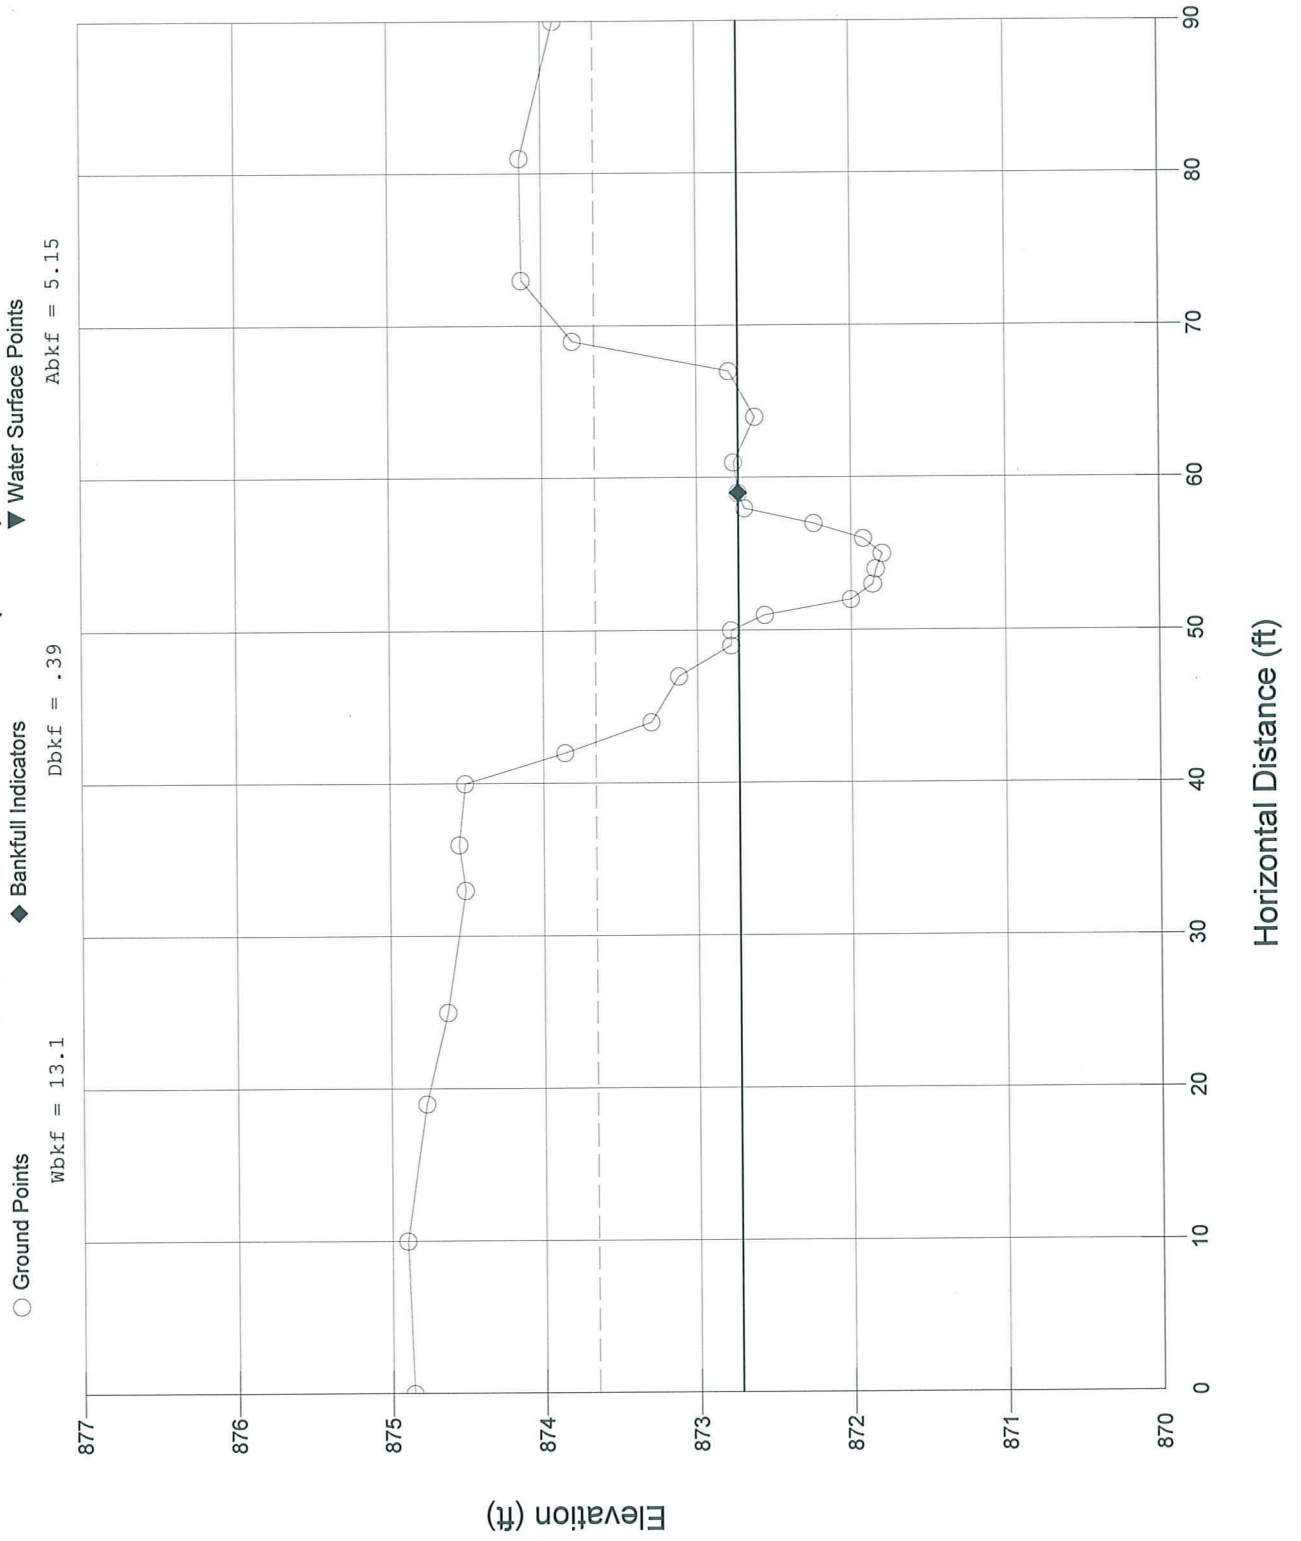



RIVERMORPH CROSS SECTION SUMMARY

River Name: Little white oak creek  
 Reach Name: R2B  
 Cross Section Name: XS7 Riffle  
 Survey Date: 03/14/2008

Cross Section Data Entry

BM Elevation: 0 ft  
 Backsight Rod Reading: 0 ft

TAPE	FS	ELEV	NOTE
0	0	874.86	GS
10	0	874.9	GS
19	0	874.77	GS
25	0	874.63	GS
33	0	874.51	GS
36	0	874.55	GS
40	0	874.51	GS
42	0	873.86	GS
44	0	873.3	GS
47	0	873.12	GS
49	0	872.78	GS
50	0	872.78	LB
51	0	872.56	GS
52	0	872	GS
53	0	871.86	GS
54	0	871.84	TW
55	0	871.8	GS
56	0	871.92	GS
57	0	872.24	GS
58	0	872.69	RB
59	0	872.73	BKF
61	0	872.76	GS
64	0	872.62	GS
67	0	872.79	GS
69	0	873.8	GS
73	0	874.13	GS
81	0	874.14	GS
90	0	873.92	GS

Cross Sectional Geometry

	Channel	Left	Right
Floodprone Elevation (ft)	873.66	873.66	873.66
Bankfull Elevation (ft)	872.73	872.73	872.73
Floodprone width (ft)	26.01	-----	-----
Bankfull width (ft)	13.07	6.53	9.18
Entrenchment Ratio	1.99	-----	-----
Mean Depth (ft)	0.39	0.69	0.1
Maximum Depth (ft)	0.93	0.93	0.57
Width/Depth Ratio	33.51	9.46	91.8
Bankfull Area (sq ft)	5.15	4.5	0.65
Wetted Perimeter (ft)	13.41	7.32	7.22
Hydraulic Radius (ft)	0.38	0.61	0.09
Begin BKF Station	50 23	50 23	56 76



End BKF Station

65.94

56.76

65.94

---

Entrainment Calculations


---

Entrainment Formula: Rosgen Modified Shields Curve

	Channel	Left Side	Right Side
Slope	0	0	0
Shear Stress (lb/sq ft)			
Movable Particle (mm)			



# Cross Section 8 - Riffle (R2D)

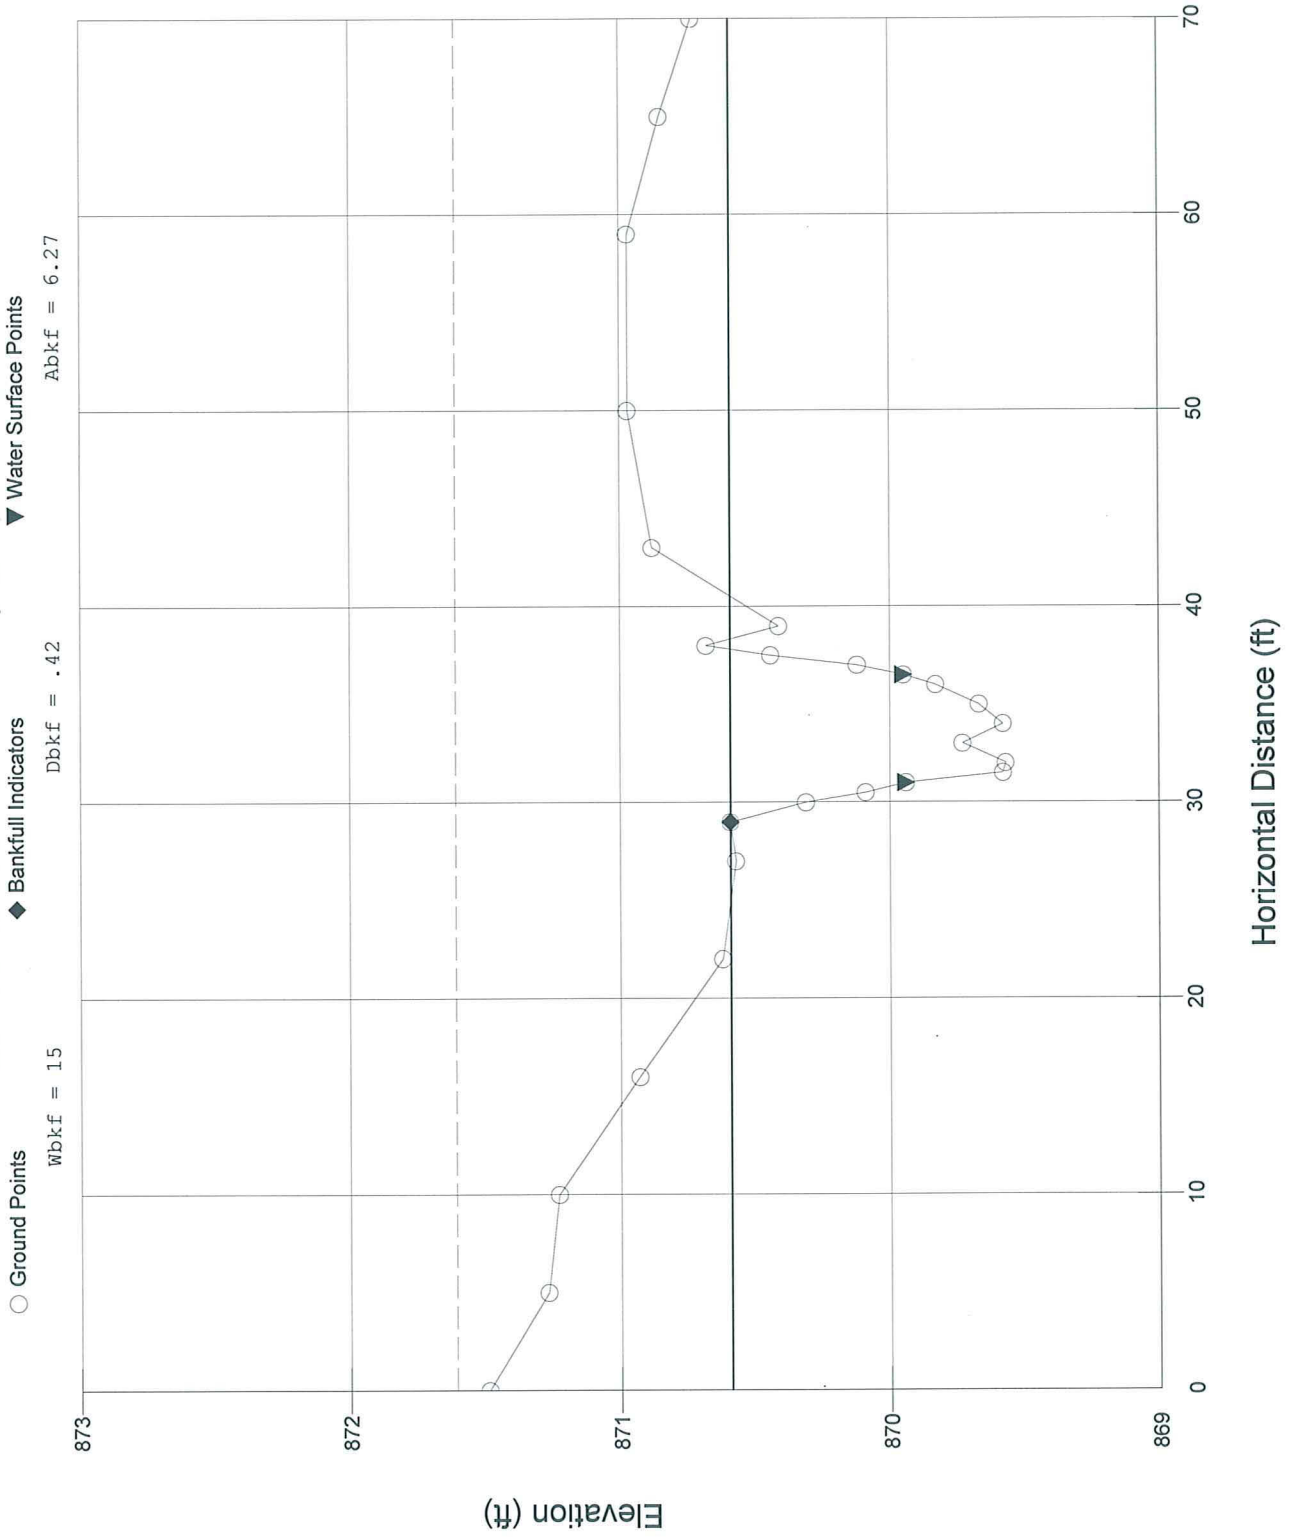



RIVERMORPH CROSS SECTION SUMMARY

River Name: Little white Oak Creek  
 Reach Name: R2  
 Cross Section Name: XS8 Pool  
 Survey Date: 03/14/2008

Cross Section Data Entry

BM Elevation: 0 ft  
 Backsight Rod Reading: 0 ft

TAPE	FS	ELEV	NOTE
0	0	871.34	GS
15	0	871.5	GS
30	0	871.33	GS
45	0	871.14	GS
48.5	0	871.27	LB
53.5	0	869.7	GS
56.9	0	868.75	LEW
59	0	868.03	SB
62	0	867.4	SB
64.6	0	867.13	TW
67	0	867.9	SB
69.3	0	868.74	REW
71	0	869.36	GS
74	0	870.29	GS
77.5	0	870.83	RB
82	0	871.08	BKF
89	0	871.11	GS
99	0	873.15	GS
105	0	873.45	GS

Cross Sectional Geometry

	Channel	Left	Right
Floodprone Elevation (ft)	875.03	875.03	875.03
Bankfull Elevation (ft)	871.08	871.08	871.08
Floodprone width (ft)	105	-----	-----
Bankfull width (ft)	32.89	16.44	16.45
Entrenchment Ratio	3.19	-----	-----
Mean Depth (ft)	1.81	2.35	1.27
Maximum Depth (ft)	3.95	3.95	3.65
Width/Depth Ratio	18.17	7	12.95
Bankfull Area (sq ft)	59.5	38.61	20.89
Wetted Perimeter (ft)	34	20.68	20.62
Hydraulic Radius (ft)	1.75	1.87	1.01
Begin BKF Station	49.11	49.11	65.55
End BKF Station	82	65.55	82

Entrainment Calculations

Entrainment Formula: Rosgen Modified Shields Curve

Channel Left Side Right Side



Slope  
Shear Stress (lb/sq ft)  
Movable Particle (mm)


0

0

0



# Cross Section 9 - Pool (R1)

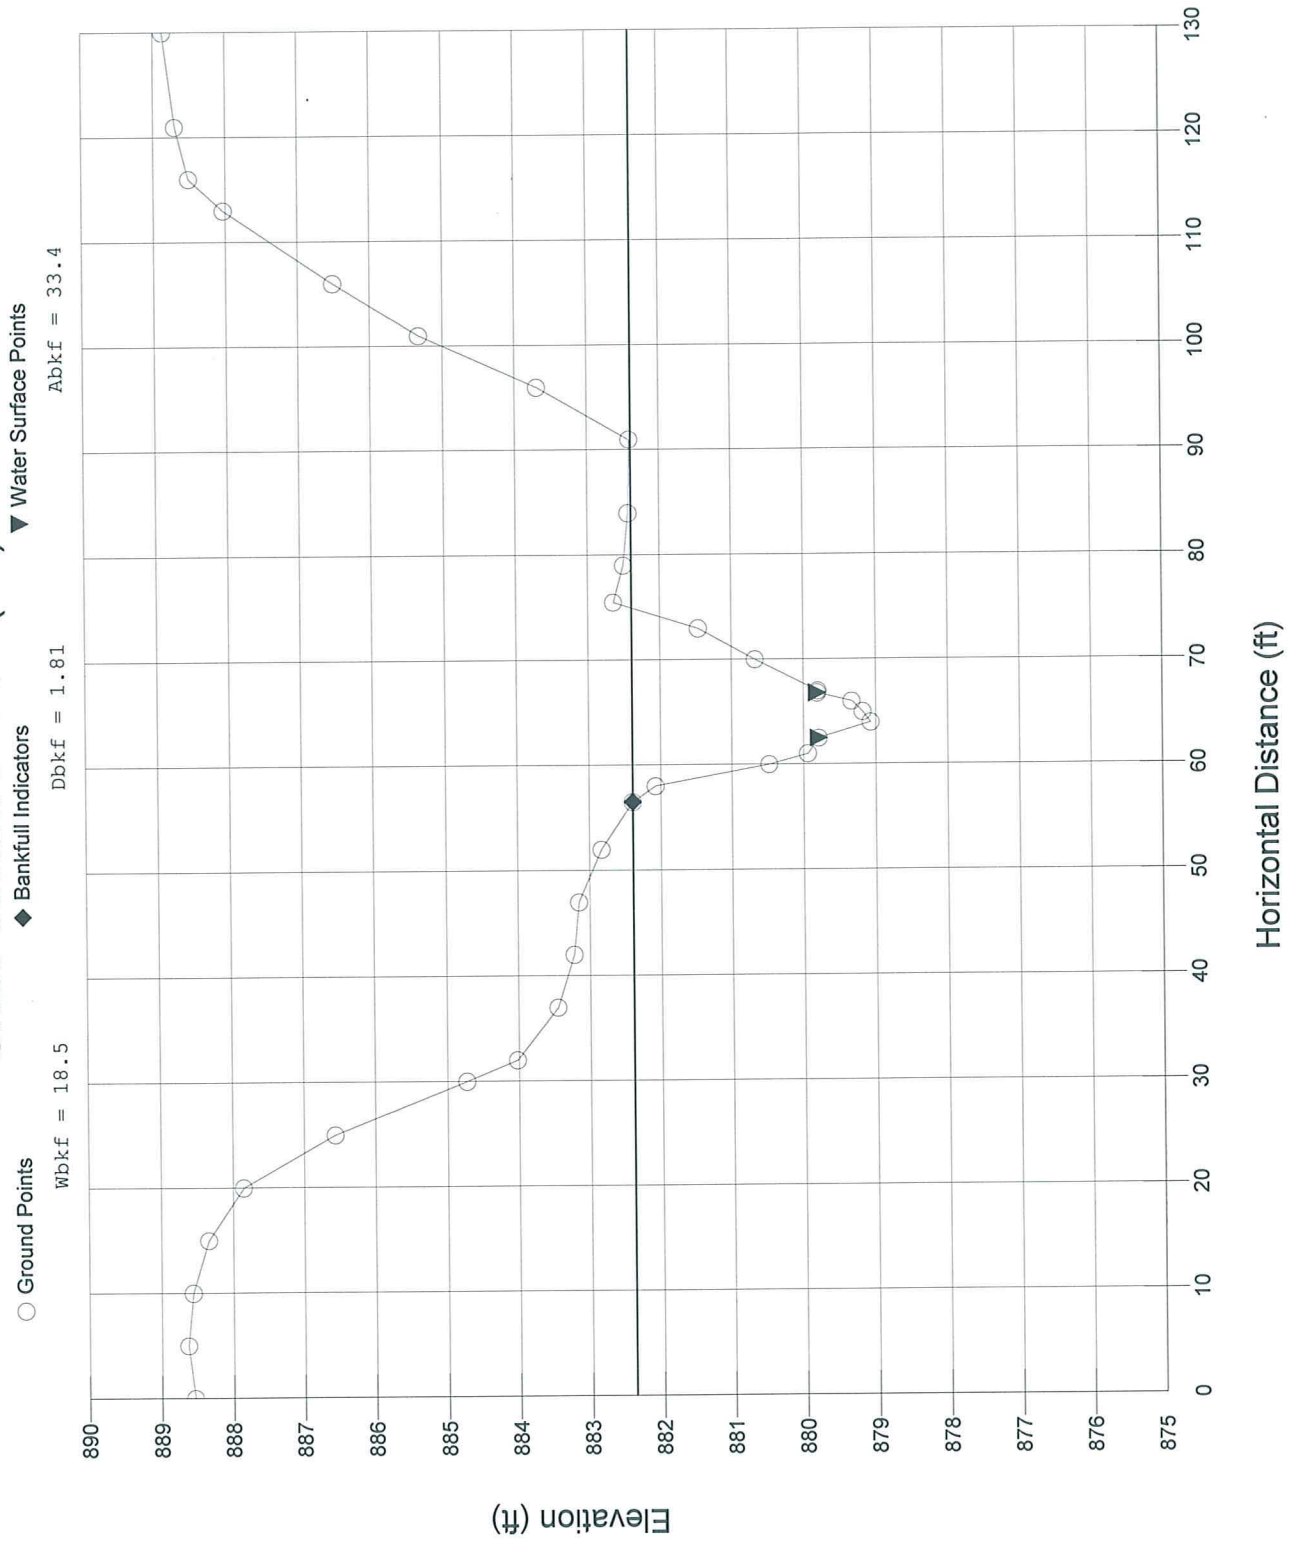



RIVERMORPH CROSS SECTION SUMMARY

River Name: Little white Oak Creek  
 Reach Name: R1  
 Cross Section Name: XS9 - Pool  
 Survey Date: 03/14/2008

Cross Section Data Entry

BM Elevation: 0 ft  
 Backsight Rod Reading: 0 ft

TAPE	FS	ELEV	NOTE
0	0	888.54	GS
5	0	888.63	GS
10	0	888.56	GS
15	0	888.34	GS
20	0	887.85	GS
25	0	886.56	GS
30	0	884.73	GS
32	0	884.02	GS
37	0	883.45	GS
42	0	883.22	GS
47	0	883.15	GS
52	0	882.83	GS
56.5	0	882.39	BKF
58	0	882.07	GS
60	0	880.48	GS
61	0	879.94	GS
62.5	0	879.79	LEW
64	0	879.07	TW
65	0	879.18	SB
66	0	879.33	SB
66.8	0	879.81	REW
67	0	879.8	GS
70	0	880.67	GS
73	0	881.46	GS
75.5	0	882.64	RB
79	0	882.5	GS
84	0	882.43	GS
91	0	882.41	GS
96	0	883.69	GS
101	0	885.33	GS
106	0	886.51	GS
113	0	888.03	GS
116	0	888.51	GS
121	0	888.7	GS
130	0	888.87	GS

Cross Sectional Geometry

	Channel	Left	Right
Floodprone Elevation (ft)	885.71	885.71	885.71
Bankfull Elevation (ft)	882.39	882.39	882.39
Floodprone width (ft)	75.29	-----	-----
Bankfull width (ft)	18.47	9.32	9.15
Entrenchment Ratio	4.08	-----	-----



Mean Depth (ft)	1.81	2.01	1.6
Maximum Depth (ft)	3.32	3.32	3.09
Width/Depth Ratio	10.2	4.64	5.72
Bankfull Area (sq ft)	33.41	18.72	14.68
Wetted Perimeter (ft)	19.95	13.32	12.81
Hydraulic Radius (ft)	1.67	1.41	1.15
Begin BKF Station	56.5	56.5	65.82
End BKF Station	74.97	65.82	74.97


-----  
 Entrainment Calculations  
 -----

Entrainment Formula: Rosgen Modified Shields Curve

	Channel	Left side	Right side
Slope	0	0	0
Shear Stress (lb/sq ft)			
Movable Particle (mm)			



# Cross Section 10 - Pool (R1)

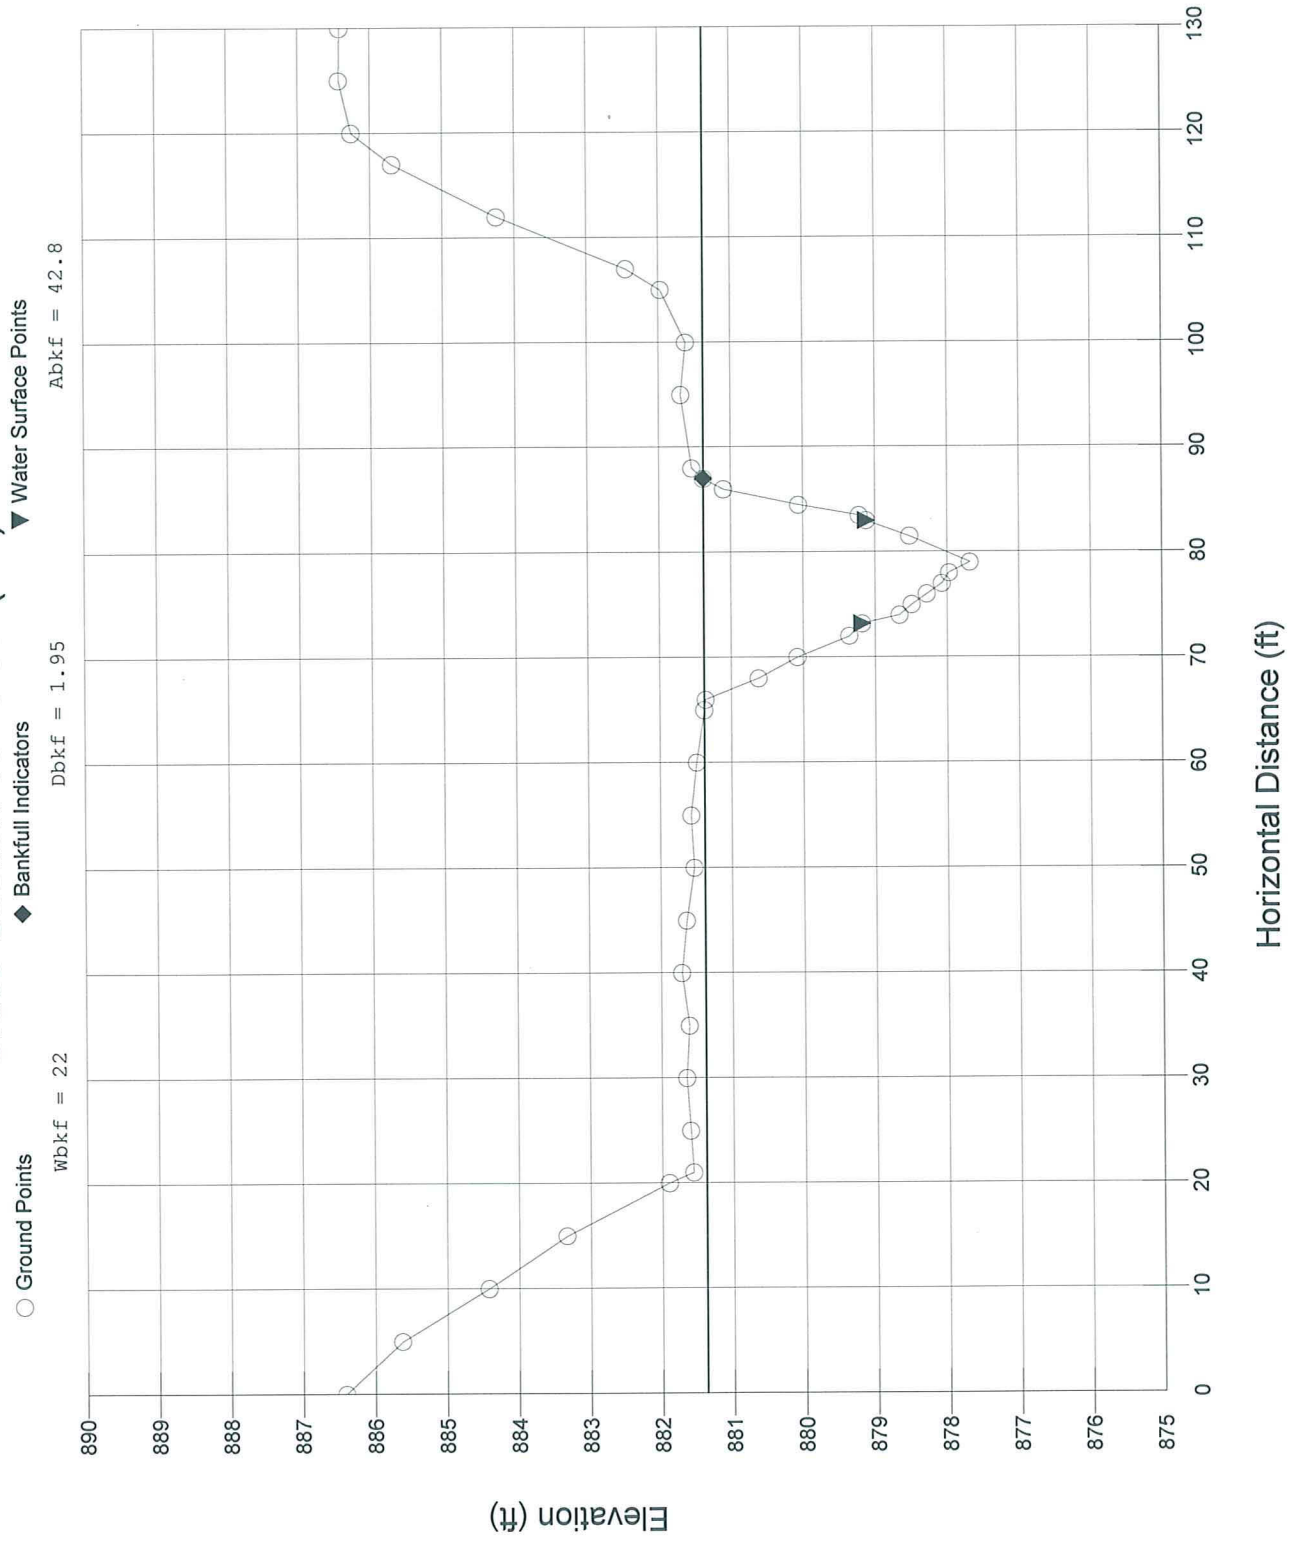

RIVERMORPH CROSS SECTION SUMMARY

River Name: Little white Oak Creek  
 Reach Name: R1  
 Cross Section Name: XS10 - Pool  
 Survey Date: 03/14/2008

Cross Section Data Entry

BM Elevation: 0 ft  
 Backsight Rod Reading: 0 ft

TAPE	FS	ELEV	NOTE
0	0	886.41	GS
5	0	885.63	GS
10	0	884.42	GS
15	0	883.33	GS
20	0	881.9	GS
21	0	881.56	GS
25	0	881.6	GS
30	0	881.65	GS
35	0	881.61	GS
40	0	881.71	GS
45	0	881.64	GS
50	0	881.53	GS
55	0	881.57	GS
60	0	881.49	GS
65	0	881.38	GS
66	0	881.36	LB
68	0	880.62	GS
70	0	880.08	GS
72	0	879.36	GS
73.2	0	879.18	LEW
74	0	878.66	SB
75	0	878.49	SB
76	0	878.28	SB
77	0	878.07	SB
78	0	877.97	SB
79	0	877.68	TW
81.5	0	878.52	SB
83	0	879.12	REW
83.5	0	879.22	GS
84.5	0	880.06	GS
86	0	881.1	GS
87	0	881.38	BKF
88	0	881.54	GS
95	0	881.69	GS
100	0	881.62	GS
105	0	881.97	GS
107	0	882.45	GS
112	0	884.25	GS
117	0	885.7	GS
120	0	886.26	GS
125	0	886.43	GS
130	0	886.42	GS

Cross Sectional Geometry




	Channel	Left	Right
Floodprone Elevation (ft)	885.08	885.08	885.08
Bankfull Elevation (ft)	881.38	881.38	881.38
Floodprone width (ft)	107.59	-----	-----
Bankfull width (ft)	22	10.82	11.18
Entrenchment Ratio	4.89	-----	-----
Mean Depth (ft)	1.95	1.47	2.41
Maximum Depth (ft)	3.7	3.06	3.7
Width/Depth Ratio	11.28	7.36	4.64
Bankfull Area (sq ft)	42.81	15.92	26.9
wetted Perimeter (ft)	23.53	14.41	15.25
Hydraulic Radius (ft)	1.82	1.1	1.76
Begin BKF Station	65	65	75.82
End BKF Station	87	75.82	87

-----  
 Entainment Calculations  
 -----

Entrainment Formula: Rosgen Modified Shields Curve

	Channel	Left side	Right side
Slope	0	0	0
Shear Stress (lb/sq ft)			
Movable Particle (mm)			

# Cross Section 11 - Pool (R1)

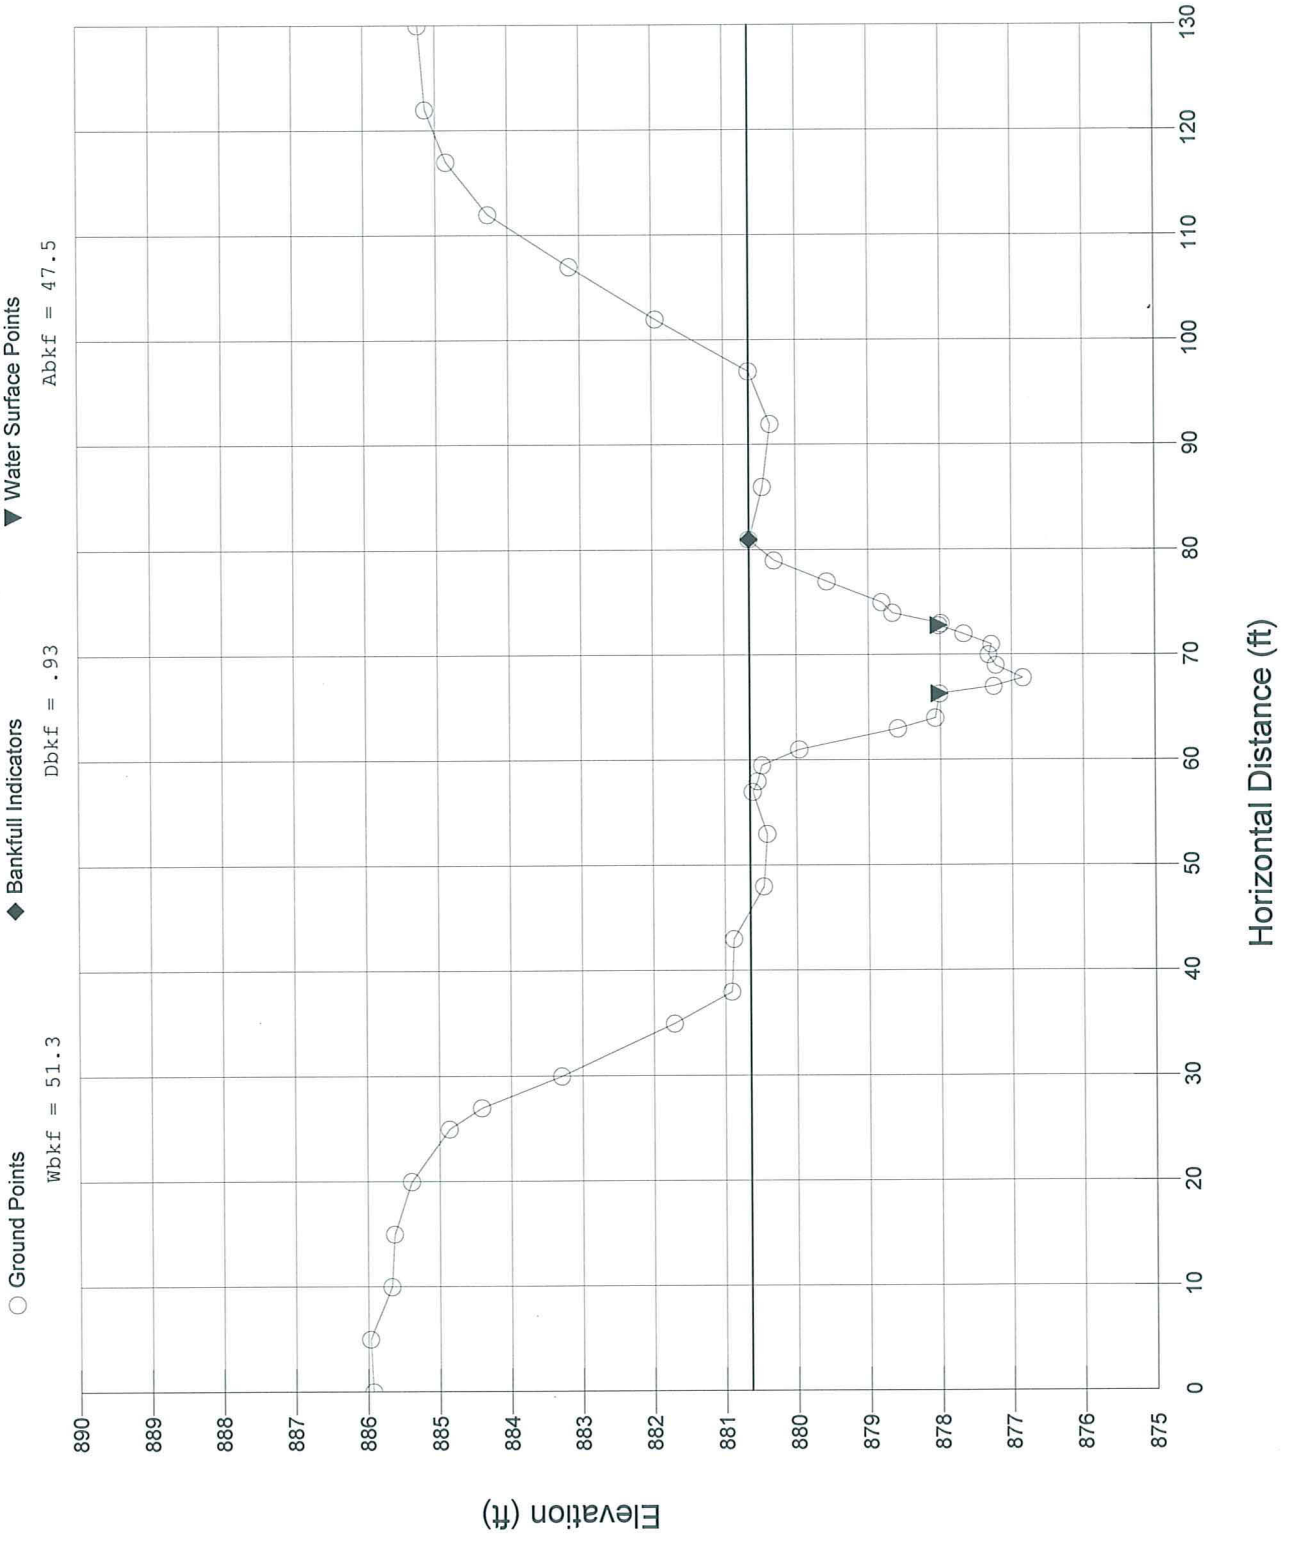



RIVERMORPH CROSS SECTION SUMMARY

River Name: Little white Oak Creek  
 Reach Name: R1  
 Cross Section Name: XS11 - Pool  
 Survey Date: 03/14/2008

Cross Section Data Entry

BM Elevation: 0 ft  
 Backsight Rod Reading: 0 ft

TAPE	FS	ELEV	NOTE
0	0	885.93	GS
5	0	885.97	GS
10	0	885.67	GS
15	0	885.63	GS
20	0	885.39	GS
25	0	884.86	GS
27	0	884.41	GS
30	0	883.29	GS
35	0	881.71	GS
38	0	880.91	GS
43	0	880.88	GS
48	0	880.46	GS
53	0	880.41	GS
57	0	880.61	GS
58	0	880.54	GS
59.5	0	880.48	LB
61	0	879.96	GS
63	0	878.59	GS
64	0	878.07	GS
66.3	0	878.01	LEW
67	0	877.25	SB
67.8	0	876.84	TW
69	0	877.22	SB
70	0	877.32	SB
71	0	877.28	SB
72	0	877.67	SB
72.8	0	878.02	REW
73	0	877.99	GS
74	0	878.66	GS
75	0	878.81	GS
77	0	879.57	GS
79	0	880.3	GS
81	0	880.65	BKF
86	0	880.46	GS
92	0	880.35	GS
97	0	880.65	GS
102	0	881.94	GS
107	0	883.14	GS
112	0	884.27	GS
117	0	884.85	GS
122	0	885.14	GS
130	0	885.24	GS

Cross Sectional Geometry

	Channel	Left	Right
Floodprone Elevation (ft)	884.46	884.46	884.46
Bankfull Elevation (ft)	880.65	880.65	880.65
Floodprone width (ft)	86.86	-----	-----
Bankfull width (ft)	51.26	25.48	25.78
Entrenchment Ratio	1.69	-----	-----
Mean Depth (ft)	0.93	1.2	0.65
Maximum Depth (ft)	3.81	3.81	3.28
Width/Depth Ratio	55.12	21.23	39.66
Bankfull Area (sq ft)	47.51	30.66	16.85
Wetted Perimeter (ft)	53.09	29.94	29.72
Hydraulic Radius (ft)	0.89	1.02	0.57
Begin BKF Station	45.74	45.74	71.22
End BKF Station	97	71.22	97


-----  
 Entainment Calculations  
 -----

Entainment Formula: Rosgen Modified Shields Curve

	Channel	Left side	Right side
Slope	0	0	0
Shear Stress (lb/sq ft)			
Movable Particle (mm)			



# Cross Section 12 - Rifle (R1)

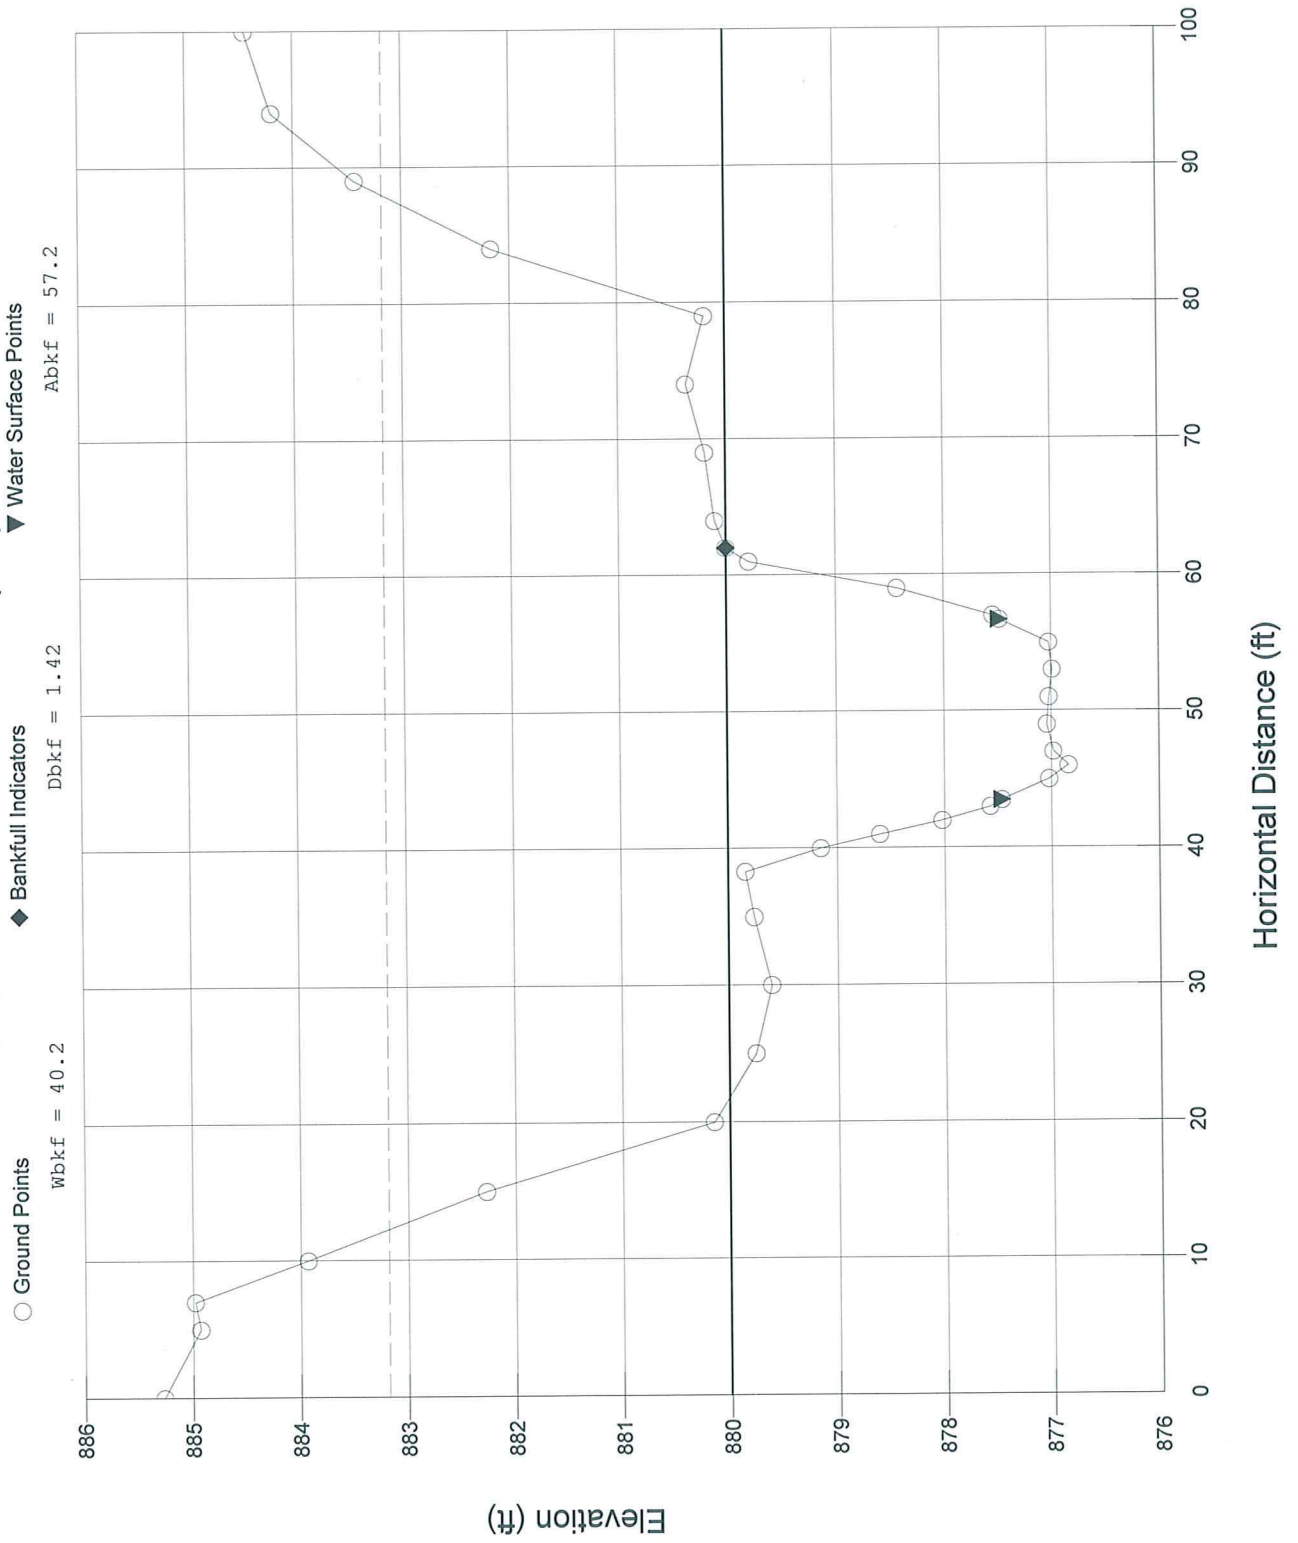

RIVERMORPH CROSS SECTION SUMMARY

River Name: Little white Oak Creek  
 Reach Name: R1  
 Cross Section Name: XS12 - Riffle  
 Survey Date: 03/14/2008

Cross Section Data Entry

BM Elevation: 0 ft  
 Backsight Rod Reading: 0 ft

TAPE	FS	ELEV	NOTE
0	0	885.27	GS
5	0	884.93	GS
7	0	884.98	GS
10	0	883.93	GS
15	0	882.27	GS
20	0	880.15	GS
25	0	879.76	GS
30	0	879.61	GS
35	0	879.77	GS
38.3	0	879.85	LB
40	0	879.15	GS
41	0	878.6	GS
42	0	878.02	GS
43	0	877.57	GS
43.5	0	877.46	LEW
45	0	877.02	SB
46	0	876.84	TW
47	0	876.98	SB
49	0	877.04	SB
51	0	877.02	SB
53	0	876.99	SB
55	0	877.02	SB
56.7	0	877.48	REW
57	0	877.54	GS
59	0	878.43	GS
61	0	879.8	GS
62	0	880.01	BKF
64	0	880.11	GS
69	0	880.2	GS
74	0	880.37	GS
79	0	880.2	GS
84	0	882.17	GS
89	0	883.43	GS
94	0	884.2	GS
100	0	884.45	GS

Cross Sectional Geometry

	Channel	Left	Right
Floodprone Elevation (ft)	883.18	883.18	883.18
Bankfull Elevation (ft)	880.01	880.01	880.01
Floodprone width (ft)	75.75	-----	-----
Bankfull width (ft)	40.21	19.81	20.4
Entrenchment Ratio	1.88	-----	-----




Mean Depth (ft)	1.42	0.37	2.45
Maximum Depth (ft)	3.17	1.76	3.17
Width/Depth Ratio	28.32	53.54	8.33
Bankfull Area (sq ft)	57.15	7.24	49.91
Wetted Perimeter (ft)	41.56	21.95	23.12
Hydraulic Radius (ft)	1.38	0.33	2.16
Begin BKF Station	21.79	21.79	41.6
End BKF Station	62	41.6	62

-----  
 Entrainment Calculations  
 -----

Entrainment Formula: Rosgen Modified Shields Curve

	Channel	Left side	Right side
Slope	0	0	0
Shear Stress (lb/sq ft)			
Movable Particle (mm)			

# Cross Section 13 - Pool (R1A)

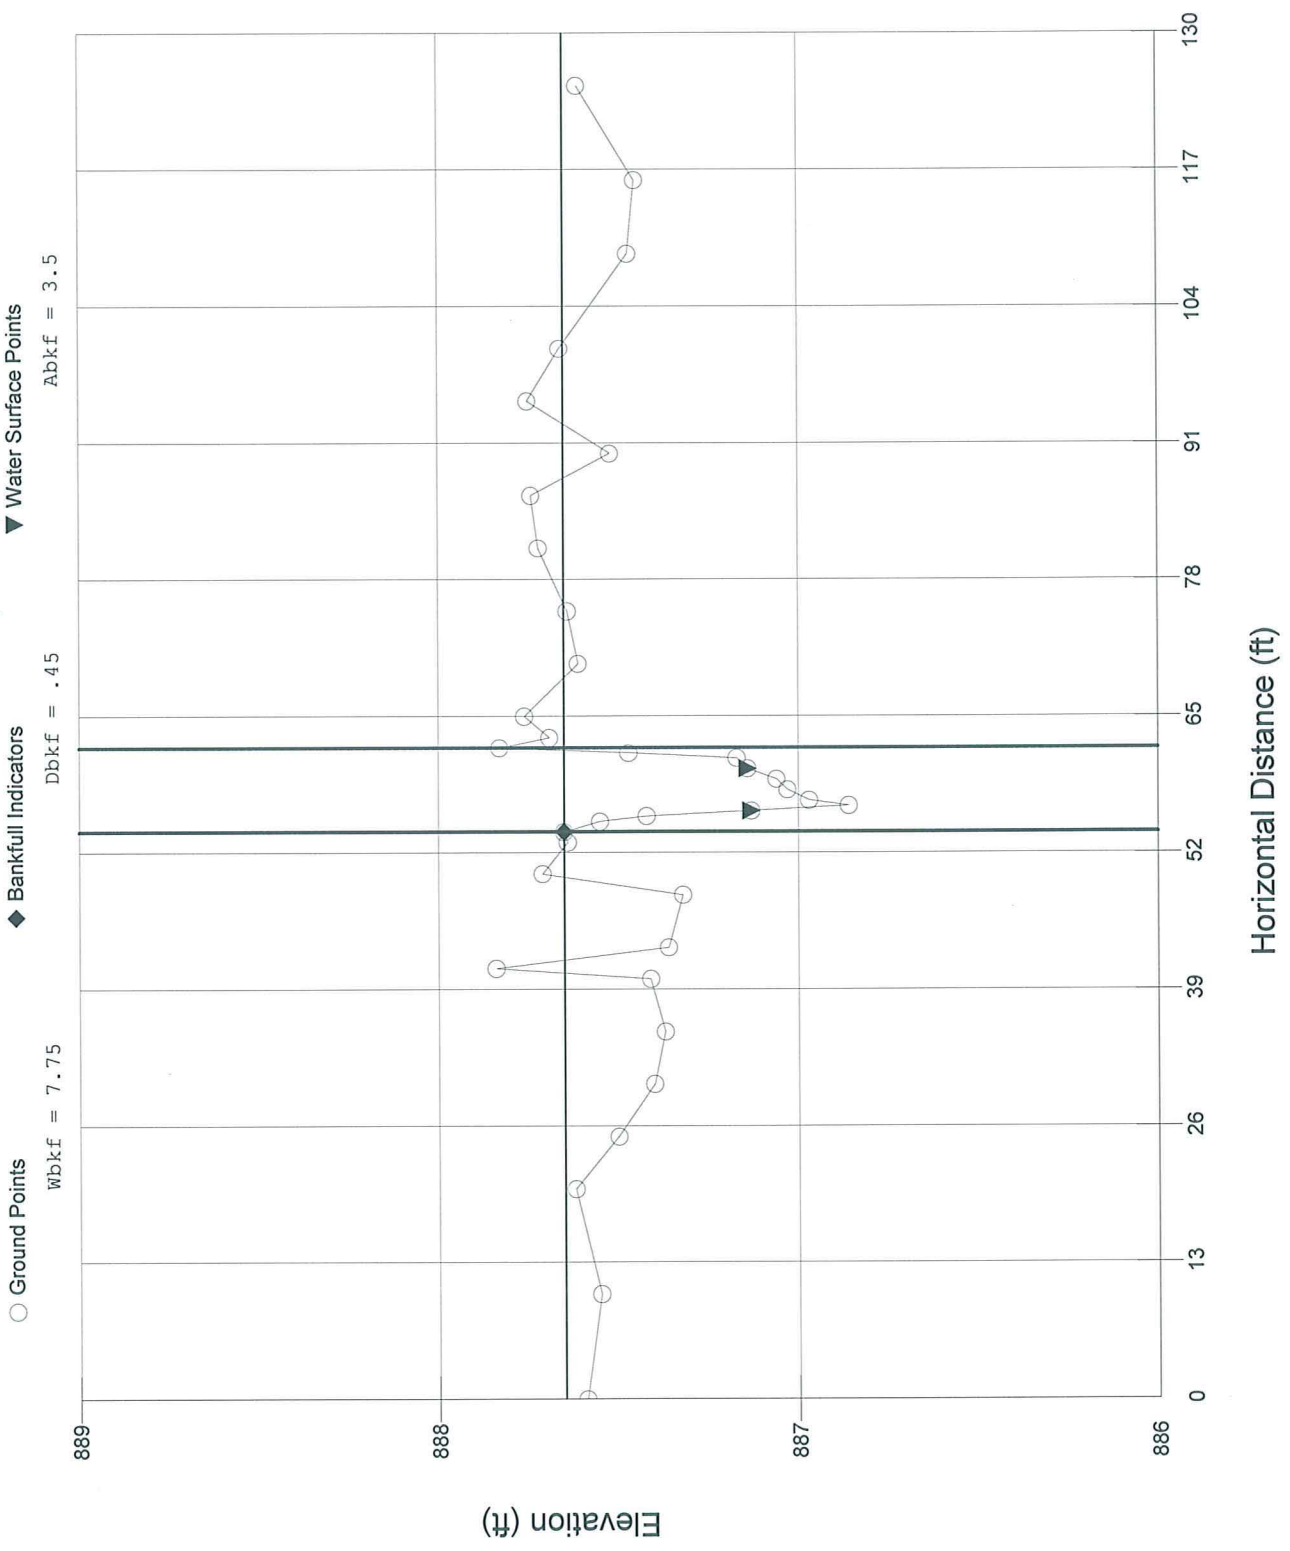



RIVERMORPH CROSS SECTION SUMMARY

River Name: Little White Oak Creek  
 Reach Name: R1A  
 Cross Section Name: XS13 - Pool  
 Survey Date: 03/14/2008

Cross Section Data Entry

BM Elevation: 0 ft  
 Backsight Rod Reading: 0 ft

TAPE	FS	ELEV	NOTE
0	0	887.59	GS
10	0	887.55	GS
20	0	887.62	GS
25	0	887.5	GS
30	0	887.4	GS
35	0	887.37	GS
40	0	887.41	GS
41	0	887.84	GS
43	0	887.36	GS
48	0	887.32	GS
50	0	887.71	GS
53	0	887.64	LB
54	0	887.65	BKF
55	0	887.55	GS
55.5	0	887.42	GS
56	0	887.13	LEW
56.5	0	886.86	SB
57	0	886.97	TW
58	0	887.03	SB
59	0	887.06	SB
60	0	887.14	REW
61	0	887.17	GS
61.5	0	887.47	GS
62	0	887.83	RB
62.963	0	887.69	GS
65	0	887.76	GS
70	0	887.61	GS
75	0	887.64	GS
81	0	887.72	GS
86	0	887.74	GS
90	0	887.52	GS
95	0	887.75	GS
100	0	887.66	GS
109	0	887.47	GS
116	0	887.45	GS
125	0	887.61	GS

Cross Sectional Geometry

	Channel	Left	Right
Floodprone Elevation (ft)	888.44	888.44	888.44
Bankfull Elevation (ft)	887.65	887.65	887.65
Floodprone width (ft)	125	-----	-----
Bankfull width (ft)	04 11	47 06	77 04

Entrenchment Ratio	1.32	-----	-----
Mean Depth (ft)	0.16	0.15	0.16
Maximum Depth (ft)	0.79	0.32	0.79
Width/Depth Ratio	590.25	313.73	487.13
Bankfull Area (sq ft)	14.78	7.01	7.77
Wetted Perimeter (ft)	94.99	46.3	49.34
Hydraulic Radius (ft)	0.16	0.15	0.16
Begin BKF Station	0	0	47.06
End BKF Station	125	47.06	125


-----  
 Entrainment Calculations  
 -----

Entrainment Formula: Rosgen Modified Shields Curve

	Channel	Left side	Right side
Slope	0	0	0
Shear Stress (lb/sq ft)			
Movable Particle (mm)			



## **APPENDIX C**

<b>Client Name:</b> EEP		<b>Project Name:</b> Little White Oak Creek Stream Restoration	<b>Appendix C:</b> Cross Section Photographs
<b>Photo No.</b> 1	<b>Date:</b> 1/30/08		
<b>Perspective:</b> Looking left to right			
<b>Description:</b> Cross Section 1 on Reach R2.			

<b>Photo No.</b> 2	<b>Date:</b> 1/30/08		
<b>Perspective:</b> Looking left to right			
<b>Description:</b> Cross Section 2 on Reach R2.			



<b>Client Name:</b> EEP		<b>Project Name:</b> Little White Oak Creek Stream Restoration	<b>Appendix C:</b> Cross Section Photographs
<b>Photo No.</b> 3	<b>Date:</b> 1/30/08		
<b>Perspective:</b> Looking left to right			
<b>Description:</b> Cross Section 3 on Reach R2.			

01/30/2008

<b>Photo No.</b> 4	<b>Date:</b> 1/31/08		
<b>Perspective:</b> Looking left to right			
<b>Description:</b> Cross Section 4 on Reach R2.			

01/31/2008



<b>Client Name:</b> EEP	<b>Project Name:</b> Little White Oak Creek Stream Restoration	<b>Appendix C:</b> Cross Section Photographs
----------------------------	---	---

<b>Photo No.</b> 5	<b>Date:</b> 1/31/08
-----------------------	-------------------------

**Perspective:**  
Looking left to right

**Description:**  
Cross Section 5 on Reach R2.



<b>Photo No.</b> 6	<b>Date:</b> 2/13/08
-----------------------	-------------------------

**Perspective:**  
Looking left to right

**Description:**  
Cross Section 6 on Reach R2A.





<b>Client Name:</b> EEP	<b>Project Name:</b> Little White Oak Creek Stream Restoration	<b>Appendix C:</b> Cross Section Photographs
----------------------------	---	---

<b>Photo No.</b> 7	<b>Date:</b> 1/30/08
-----------------------	-------------------------

**Perspective:**  
Looking left to right

**Description:**  
Cross Section 7 on Reach R2B.



<b>Photo No.</b> 8	<b>Date:</b> 1/31/08
-----------------------	-------------------------

**Perspective:**  
Looking left to right

**Description:**  
Cross Section 8 on Reach R2D.





<b>Client Name:</b> EEP	<b>Project Name:</b> Little White Oak Creek Stream Restoration	<b>Appendix C:</b> Cross Section Photographs
----------------------------	---	---


<b>Photo No.</b> 9	<b>Date:</b> 1/31/08
<b>Perspective:</b> Looking left to right	
<b>Description:</b> Cross Section 9 on Reach R1.	



<b>Photo No.</b> 10	<b>Date:</b> 1/31/08
<b>Perspective:</b> Looking left to right	
<b>Description:</b> Cross Section 10 on Reach R1.	






<b>Client Name:</b> EEP		<b>Project Name:</b> Little White Oak Creek Stream Restoration	<b>Appendix C:</b> Cross Section Photographs
<b>Photo No.</b> 11	<b>Date:</b> 1/31/08		
<b>Perspective:</b> Looking left to right			
<b>Description:</b> Cross Section 11 on Reach R1.			

<b>Photo No.</b> 12	<b>Date:</b> 2/28/08		
<b>Perspective:</b> Looking left to right			
<b>Description:</b> Cross Section 12 on Reach R1.			




<b>Client Name:</b> EEP		<b>Project Name:</b> Little White Oak Creek Stream Restoration	<b>Appendix C:</b> Cross Section Photographs
<b>Photo No.</b> 13	<b>Date:</b> 1/13/08		
<b>Perspective:</b> Looking left to right			
<b>Description:</b> Cross Section 13 on Reach R1A.			



## **APPENDIX D**

# **APPENDIX E**



<b>Client Name:</b> EEP		<b>Project Name:</b> Little White Oak Creek Stream Restoration	<b>Appendix E:</b> Vegetation Plot Photographs
<b>Photo No.</b> 1	<b>Date:</b> 1/30/08		
<b>Perspective:</b> Facing downstream, right to left diagonal view across plot.			
<b>Description:</b> Veg Plot 1 on Reach R2 Upper.			

<b>Photo No.</b> 2	<b>Date:</b> 1/30/08		
<b>Perspective:</b> Facing downstream, right to left diagonal view across plot.			
<b>Description:</b> Veg Plot 2 on Reach R2 Upper/R2A.			

<b>Client Name:</b> EEP		<b>Project Name:</b> Little White Oak Creek Stream Restoration	<b>Appendix E:</b> Vegetation Plot Photographs
<b>Photo No.</b> 3	<b>Date:</b> 1/30/08		
<b>Perspective:</b> Facing downstream, right to left diagonal view across plot.			
<b>Description:</b> Veg Plot 3 on Reach R2 Upper.			

<b>Photo No.</b> 4	<b>Date:</b> 1/30/08		
<b>Perspective:</b> Facing downstream, right to left diagonal view across plot.			
<b>Description:</b> Veg Plot 4 on Reach R2 Upper.			



<b>Client Name:</b> EEP		<b>Project Name:</b> Little White Oak Creek Stream Restoration	<b>Appendix E:</b> Vegetation Plot Photographs
<b>Photo No.</b> 5	<b>Date:</b> 1/30/08		
<b>Perspective:</b> Facing downstream, right to left diagonal view across plot.			
<b>Description:</b> Veg Plot 5 on Reach R2B.			

<b>Photo No.</b> 6	<b>Date:</b> 1/31/08		
<b>Perspective:</b> Facing downstream, right to left diagonal view across plot.			
<b>Description:</b> Veg Plot 6 on Reach R2B.			

<b>Client Name:</b> EEP	<b>Project Name:</b> Little White Oak Creek Stream Restoration	<b>Appendix E:</b> Vegetation Plot Photographs
----------------------------	---	---

<b>Photo No.</b> 7	<b>Date:</b> 1/31/08
-----------------------	-------------------------

**Perspective:**  
Facing downstream, right to left diagonal view across plot.

**Description:**  
Veg Plot 7 on Reach R2 Upper.




<b>Photo No.</b> 8	<b>Date:</b> 1/31/08
-----------------------	-------------------------

**Perspective:**  
Facing downstream, right to left diagonal view across plot.

**Description:**  
Veg Plot 8 on Reach R2 Upper.






<b>Client Name:</b> EEP		<b>Project Name:</b> Little White Oak Creek Stream Restoration	<b>Appendix E:</b> Vegetation Plot Photographs
<b>Photo No.</b> 9	<b>Date:</b> 1/31/08		
<b>Perspective:</b> Facing downstream, right to left diagonal view across plot.			
<b>Description:</b> Veg Plot 9 on Reach R2 Upper.			


<b>Photo No.</b> 10	<b>Date:</b> 1/31/08		
<b>Perspective:</b> Facing downstream, right to left diagonal view across plot.			
<b>Description:</b> Veg Plot 10 on Reach R2 Lower.			



<b>Client Name:</b> EEP		<b>Project Name:</b> Little White Oak Creek Stream Restoration	<b>Appendix E:</b> Vegetation Plot Photographs
<b>Photo No.</b> 11	<b>Date:</b> 1/31/08		
<b>Perspective:</b> Facing downstream, right to left diagonal view across plot.			
<b>Description:</b> Veg Plot 11 on Reach R2 Lower.			


<b>Photo No.</b> 12	<b>Date:</b> 1/31/08		
<b>Perspective:</b> Facing downstream, right to left diagonal view across plot.			
<b>Description:</b> Veg Plot 12 on Reach R2D.			



<b>Client Name:</b> EEP		<b>Project Name:</b> Little White Oak Creek Stream Restoration	<b>Appendix E:</b> Vegetation Plot Photographs
<b>Photo No.</b> 13	<b>Date:</b> 1/31/08		
<b>Perspective:</b> Facing downstream, right to left diagonal view across plot.			
<b>Description:</b> Veg Plot 13 on Reach R1.			


<b>Photo No.</b> 14	<b>Date:</b> 1/31/08		
<b>Perspective:</b> Facing downstream, right to left diagonal view across plot.			
<b>Description:</b> Veg Plot 14 on Reach R1.			



<b>Client Name:</b> EEP		<b>Project Name:</b> Little White Oak Creek Stream Restoration	<b>Appendix E:</b> Vegetation Plot Photographs
<b>Photo No.</b> 15	<b>Date:</b> 1/31/08		
<b>Perspective:</b> Facing downstream, right to left diagonal view across plot.			
<b>Description:</b> Veg Plot 15 on Reach R1.			

<b>Photo No.</b> 16	<b>Date:</b> 1/31/08	
<b>Perspective:</b> Facing downstream, right to left diagonal view across plot.		
<b>Description:</b> Veg Plot 16 on Reach R1.		



<b>Client Name:</b> EEP		<b>Project Name:</b> Little White Oak Creek Stream Restoration	<b>Appendix E:</b> Vegetation Plot Photographs
<b>Photo No.</b> 17	<b>Date:</b> 1/31/08		
<b>Perspective:</b> Facing downstream, right to left diagonal view across plot.			
<b>Description:</b> Veg Plot 17 on Reach R1.			


<b>Photo No.</b> 18	<b>Date:</b> 1/31/08		
<b>Perspective:</b> Facing downstream, right to left diagonal view across plot.			
<b>Description:</b> Veg Plot 18 on Reach R1A.			



<b>Client Name:</b> EEP		<b>Project Name:</b> Little White Oak Creek Stream Restoration	<b>Appendix E:</b> Vegetation Plot Photographs
<b>Photo No.</b> 19	<b>Date:</b> 1/31/08		
<b>Perspective:</b> Facing downstream, right to left diagonal view across plot.			
<b>Description:</b> Veg Plot 19 on Reach R1A.			


<b>Photo No.</b> 20	<b>Date:</b> 2/28/08	
<b>Perspective:</b> Facing downstream, right to left diagonal view across plot.		
<b>Description:</b> Veg Plot 20 on Reach R1.		



<b>Client Name:</b> EEP		<b>Project Name:</b> Little White Oak Creek Stream Restoration	<b>Appendix E:</b> Vegetation Plot Photographs
<b>Photo No.</b> 21	<b>Date:</b> 2/28/08		
<b>Perspective:</b> Facing downstream, right to left diagonal view across plot.			
<b>Description:</b> Veg Plot 21 on Reach R1.			

<b>Photo No.</b> 22	<b>Date:</b> 2/28/08		
<b>Perspective:</b> Facing downstream, right to left diagonal view across plot.			
<b>Description:</b> Veg Plot 22 on Reach R1 below bridge.			




<b>Client Name:</b> EEP		<b>Project Name:</b> Little White Oak Creek Stream Restoration	<b>Appendix E:</b> Vegetation Plot Photographs
<b>Photo No.</b> 23	<b>Date:</b> 2/28/08		
<b>Perspective:</b> Facing downstream, right to left diagonal view across plot.			
<b>Description:</b> Veg Plot 23 on Reach R1.			

<b>Photo No.</b> 24	<b>Date:</b> 2/28/08		
<b>Perspective:</b> Facing downstream, right to left diagonal view across plot.			
<b>Description:</b> Veg Plot 24 on Reach R1.			



# **APPENDIX F**

<b>Client Name:</b> EEP		<b>Project Name:</b> Little White Oak Creek Stream Restoration	<b>Appendix F:</b> Reference Photo Points
<b>Photo No.</b> 1	<b>Date:</b> 1/30/08		
<b>Perspective:</b> Facing downstream			
<b>Description:</b> Photo Point 1 located on Reach R2 Upper.			

<b>Photo No.</b> 2	<b>Date:</b> 1/30/08		
<b>Perspective:</b> Facing upstream			
<b>Description:</b> Photo Point 2 view upstream on Reach R2 Upper.			



<b>Client Name:</b> EEP	<b>Project Name:</b> Little White Oak Creek Stream Restoration	<b>Appendix F:</b> Reference Photo Points
----------------------------	---	--

<b>Photo No.</b> 3	<b>Date:</b> 1/30/08
-----------------------	-------------------------

**Perspective:**  
Facing downstream

**Description:**  
Photo Point 2 view downstream on Reach R2A.



<b>Photo No.</b> 4	<b>Date:</b> 1/30/08
-----------------------	-------------------------

**Perspective:**  
Facing upstream

**Description:**  
Photo Point 2 view upstream on Reach R2A.



<b>Client Name:</b> EEP	<b>Project Name:</b> Little White Oak Creek Stream Restoration	<b>Appendix F:</b> Reference Photo Points
----------------------------	---	--

<b>Photo No.</b> 5	<b>Date:</b> 1/31/08
-----------------------	-------------------------

**Perspective:**  
Facing downstream

**Description:**  
Photo Point 3 view downstream on Reach R2B.



<b>Photo No.</b> 6	<b>Date:</b> 1/31/08
-----------------------	-------------------------

**Perspective:**  
Looking left to right

**Description:**  
Photo Point 3 view upstream on Reach R2B.





<b>Client Name:</b> EEP	<b>Project Name:</b> Little White Oak Creek Stream Restoration	<b>Appendix F:</b> Reference Photo Points
----------------------------	---	--

<b>Photo No.</b> 7	<b>Date:</b> 1/31/08
-----------------------	-------------------------

**Perspective:**  
Facing downstream

**Description:**  
Photo Point 4 view downstream on Reach R2 Upper.



<b>Photo No.</b> 8	<b>Date:</b> 1/31/08
-----------------------	-------------------------

**Perspective:**  
Facing upstream

**Description:**  
Photo Point 4 view upstream on Reach R2 Upper.



<b>Client Name:</b> EEP	<b>Project Name:</b> Little White Oak Creek Stream Restoration	<b>Appendix F:</b> Reference Photo Points
----------------------------	---	--

<b>Photo No.</b> 9	<b>Date:</b> 1/31/08
-----------------------	-------------------------

**Perspective:**  
Facing upstream

**Description:**  
Photo Point 4 view upstream on Reach R1.



<b>Photo No.</b> 10	<b>Date:</b> 1/31/08
------------------------	-------------------------

**Perspective:**  
Facing downstream

**Description:**  
Photo Point 5 view downstream on Reach R2 Lower.






<b>Client Name:</b> EEP		<b>Project Name:</b> Little White Oak Creek Stream Restoration	<b>Appendix F:</b> Reference Photo Points
<b>Photo No.</b> 11	<b>Date:</b> 1/31/08		
<b>Perspective:</b> Facing upstream			
<b>Description:</b> Photo Point 5 view upstream on Reach R2 Lower.			

<b>Photo No.</b> 12	<b>Date:</b> 1/31/08		
<b>Perspective:</b> Facing downstream			
<b>Description:</b> Photo Point 6 view downstream on Reach R1.			



<b>Client Name:</b> EEP		<b>Project Name:</b> Little White Oak Creek Stream Restoration	<b>Appendix F:</b> Reference Photo Points
<b>Photo No.</b> 13	<b>Date:</b> 1/31/08		
<b>Perspective:</b> Facing upstream			
<b>Description:</b> Photo Point 6 view upstream on Reach R1.			

<b>Photo No.</b> 14	<b>Date:</b> 1/31/08		
<b>Perspective:</b> Facing downstream			
<b>Description:</b> Photo Point 7 view downstream on Reach R1.			



<b>Client Name:</b> EEP	<b>Project Name:</b> Little White Oak Creek Stream Restoration	<b>Appendix F:</b> Reference Photo Points
----------------------------	---	--

<b>Photo No.</b> 15	<b>Date:</b> 1/31/08
------------------------	-------------------------

**Perspective:**  
Facing upstream

**Description:**  
Photo Point 7 view upstream on Reach R1.




<b>Photo No.</b> 16	<b>Date:</b> 1/31/08
------------------------	-------------------------

**Perspective:**  
Facing downstream

**Description:**  
Photo Point 8 view downstream on Reach R1.



<b>Client Name:</b> EEP		<b>Project Name:</b> Little White Oak Creek Stream Restoration	<b>Appendix F:</b> Reference Photo Points
<b>Photo No.</b> 17	<b>Date:</b> 1/31/08		
<b>Perspective:</b> Facing upstream			
<b>Description:</b> Photo Point 8 view upstream on Reach R1.			

<b>Photo No.</b> 18	<b>Date:</b> 1/31/08	
<b>Perspective:</b> Facing upstream		
<b>Description:</b> Photo Point 8 view upstream on Reach R1A.		



<b>Client Name:</b> EEP	<b>Project Name:</b> Little White Oak Creek Stream Restoration	<b>Appendix F:</b> Reference Photo Points
----------------------------	---	--

<b>Photo No.</b> 19	<b>Date:</b> 2/28/08
------------------------	-------------------------

**Perspective:**  
Facing downstream

**Description:**  
Photo Point 9 view downstream on Reach R1.




<b>Photo No.</b> 20	<b>Date:</b> 2/28/08
------------------------	-------------------------

**Perspective:**  
Facing across


**Description:**  
Photo Point 9 view across Reach R1.



<b>Client Name:</b> EEP		<b>Project Name:</b> Little White Oak Creek Stream Restoration	<b>Appendix F:</b> Reference Photo Points
<b>Photo No.</b> 21	<b>Date:</b> 2/28/08		
<b>Perspective:</b> Facing upstream			
<b>Description:</b> Photo Point 9 view upstream on Reach R1.			


<b>Photo No.</b> 22	<b>Date:</b> 2/28/08	
<b>Perspective:</b> Facing downstream		
<b>Description:</b> Photo Point 10 view downstream on Reach R1.		



<b>Client Name:</b> EEP		<b>Project Name:</b> Little White Oak Creek Stream Restoration	<b>Appendix F:</b> Reference Photo Points
<b>Photo No.</b> 23	<b>Date:</b> 2/28/08		
<b>Perspective:</b> Facing across			
<b>Description:</b> Photo Point 10 view across Reach R1.			


<b>Photo No.</b> 24	<b>Date:</b> 2/28/08	
<b>Perspective:</b> Facing upstream		
<b>Description:</b> Photo Point 10 view upstream on Reach R1.		



<b>Client Name:</b> EEP		<b>Project Name:</b> Little White Oak Creek Stream Restoration	<b>Appendix F:</b> Reference Photo Points
<b>Photo No.</b> 25	<b>Date:</b> 2/28/08		
<b>Perspective:</b> Facing downstream			
<b>Description:</b> Photo Point 11 view downstream on Reach R1.			

<b>Photo No.</b> 26	<b>Date:</b> 2/28/08	
<b>Perspective:</b> Facing across		
<b>Description:</b> Photo Point 11 view across Reach R1.		




<b>Client Name:</b> EEP		<b>Project Name:</b> Little White Oak Creek Stream Restoration	<b>Appendix F:</b> Reference Photo Points
<b>Photo No.</b> 27	<b>Date:</b> 2/28/08		
<b>Perspective:</b> Facing upstream			
<b>Description:</b> Photo Point 11 view upstream on Reach R1.			

## **APPENDIX G**



R1 Reachwide Pebble Count

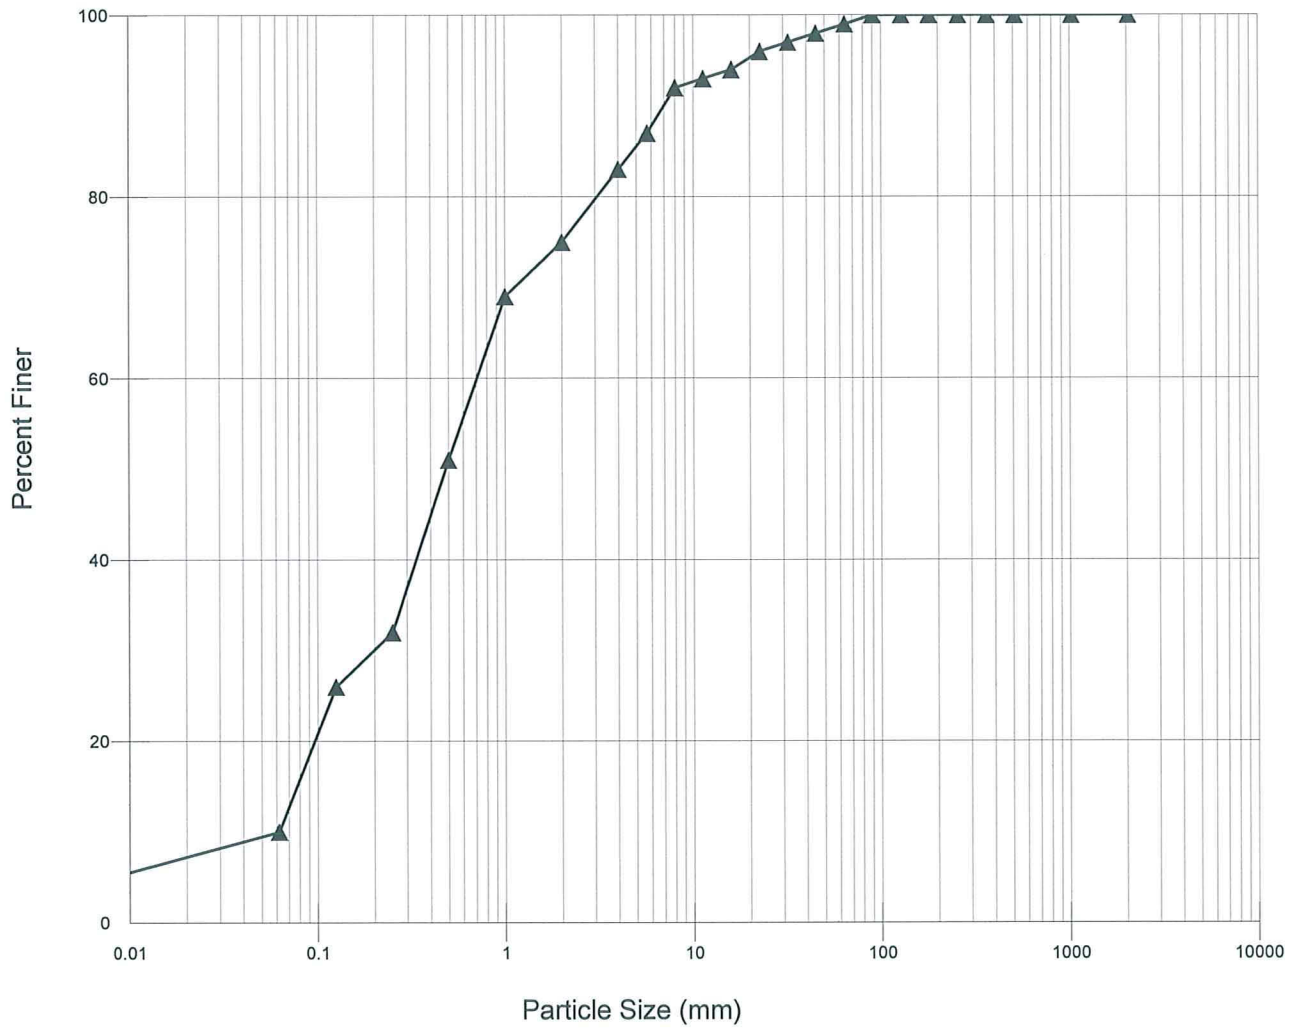

RIVERMORPH PARTICLE SUMMARY


River Name: Little White Oak Creek  
 Reach Name: R1  
 Sample Name: R1 Reachwide Pebble Count  
 Survey Date: 03/04/2008

Size (mm)	TOT #	ITEM %	CUM %
0 - 0.062	10	10.00	10.00
0.062 - 0.125	16	16.00	26.00
0.125 - 0.25	6	6.00	32.00
0.25 - 0.50	19	19.00	51.00
0.50 - 1.0	18	18.00	69.00
1.0 - 2.0	6	6.00	75.00
2.0 - 4.0	8	8.00	83.00
4.0 - 5.7	4	4.00	87.00
5.7 - 8.0	5	5.00	92.00
8.0 - 11.3	1	1.00	93.00
11.3 - 16.0	1	1.00	94.00
16.0 - 22.6	2	2.00	96.00
22.6 - 32.0	1	1.00	97.00
32 - 45	1	1.00	98.00
45 - 64	1	1.00	99.00
64 - 90	1	1.00	100.00
90 - 128	0	0.00	100.00
128 - 180	0	0.00	100.00
180 - 256	0	0.00	100.00
256 - 362	0	0.00	100.00
362 - 512	0	0.00	100.00
512 - 1024	0	0.00	100.00
1024 - 2048	0	0.00	100.00
Bedrock	0	0.00	100.00
D16 (mm)	0.09		
D35 (mm)	0.29		
D50 (mm)	0.49		
D84 (mm)	4.42		
D95 (mm)	19.3		
D100 (mm)	90		
Silt/Clay (%)	10		
Sand (%)	65		
Gravel (%)	24		
Cobble (%)	1		
Boulder (%)	0		
Bedrock (%)	0		

Total Particles = 100.



### Reachwide Pebble Count (R1A)

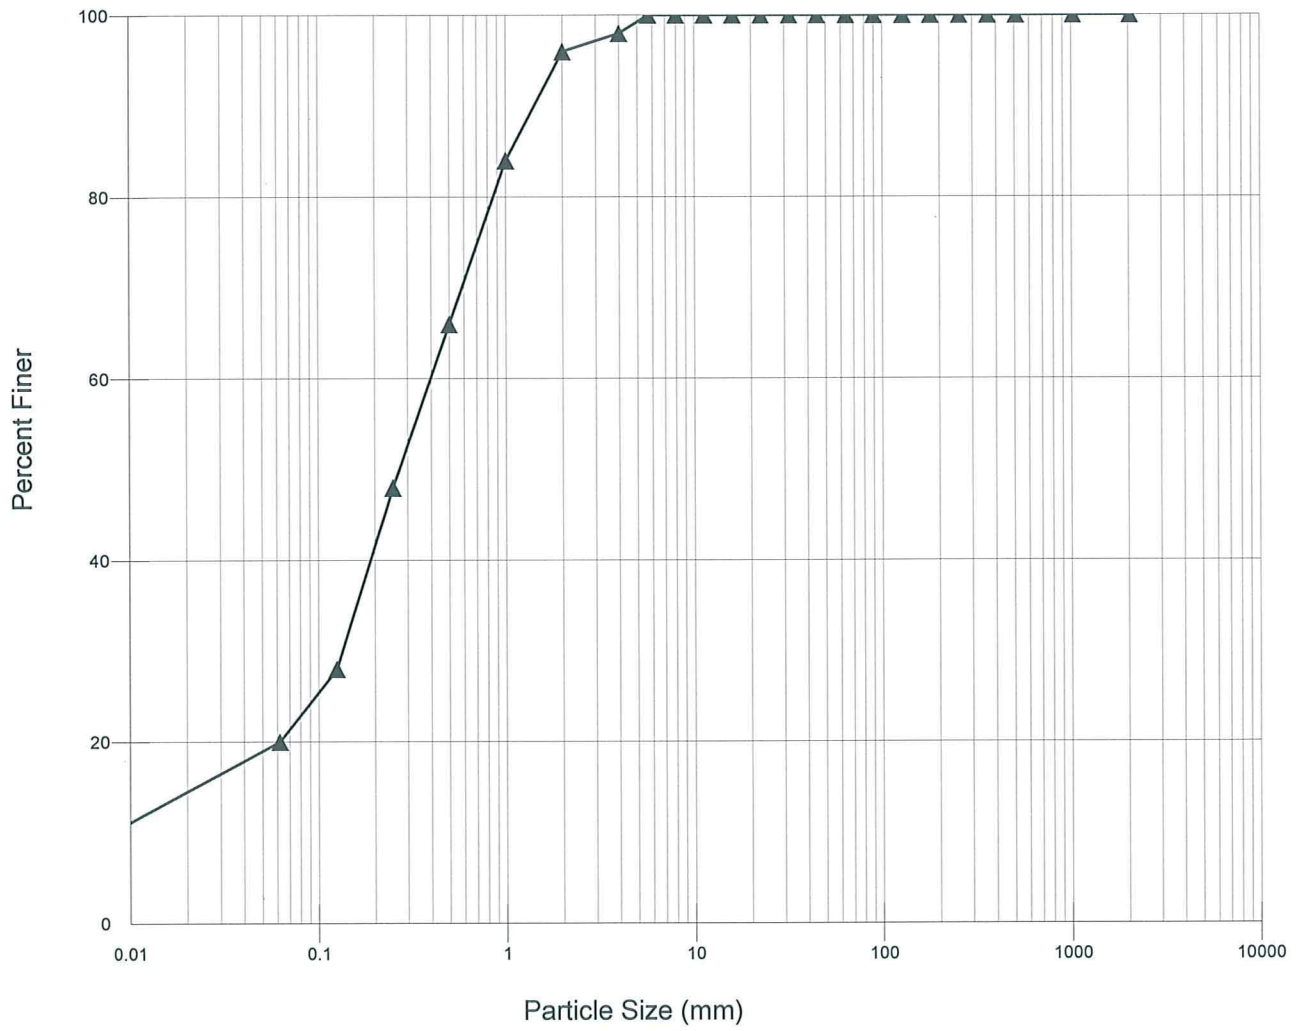

RIVERMORPH PARTICLE SUMMARY


-----  
 River Name: Little white Oak Creek  
 Reach Name: R1A  
 Sample Name: R1A Reachwide Pebble Count  
 Survey Date: 03/04/2008  
 -----

Size (mm)	TOT #	ITEM %	CUM %
0 - 0.062	10	20.00	20.00
0.062 - 0.125	4	8.00	28.00
0.125 - 0.25	10	20.00	48.00
0.25 - 0.50	9	18.00	66.00
0.50 - 1.0	9	18.00	84.00
1.0 - 2.0	6	12.00	96.00
2.0 - 4.0	1	2.00	98.00
4.0 - 5.7	1	2.00	100.00
5.7 - 8.0	0	0.00	100.00
8.0 - 11.3	0	0.00	100.00
11.3 - 16.0	0	0.00	100.00
16.0 - 22.6	0	0.00	100.00
22.6 - 32.0	0	0.00	100.00
32 - 45	0	0.00	100.00
45 - 64	0	0.00	100.00
64 - 90	0	0.00	100.00
90 - 128	0	0.00	100.00
128 - 180	0	0.00	100.00
180 - 256	0	0.00	100.00
256 - 362	0	0.00	100.00
362 - 512	0	0.00	100.00
512 - 1024	0	0.00	100.00
1024 - 2048	0	0.00	100.00
Bedrock	0	0.00	100.00
D16 (mm)	0.05		
D35 (mm)	0.17		
D50 (mm)	0.28		
D84 (mm)	1		
D95 (mm)	1.92		
D100 (mm)	5.7		
Silt/Clay (%)	20		
Sand (%)	76		
Gravel (%)	4		
Cobble (%)	0		
Boulder (%)	0		
Bedrock (%)	0		

Total Particles = 50 (need at least 60).



R2 Reachwide Pebble Count

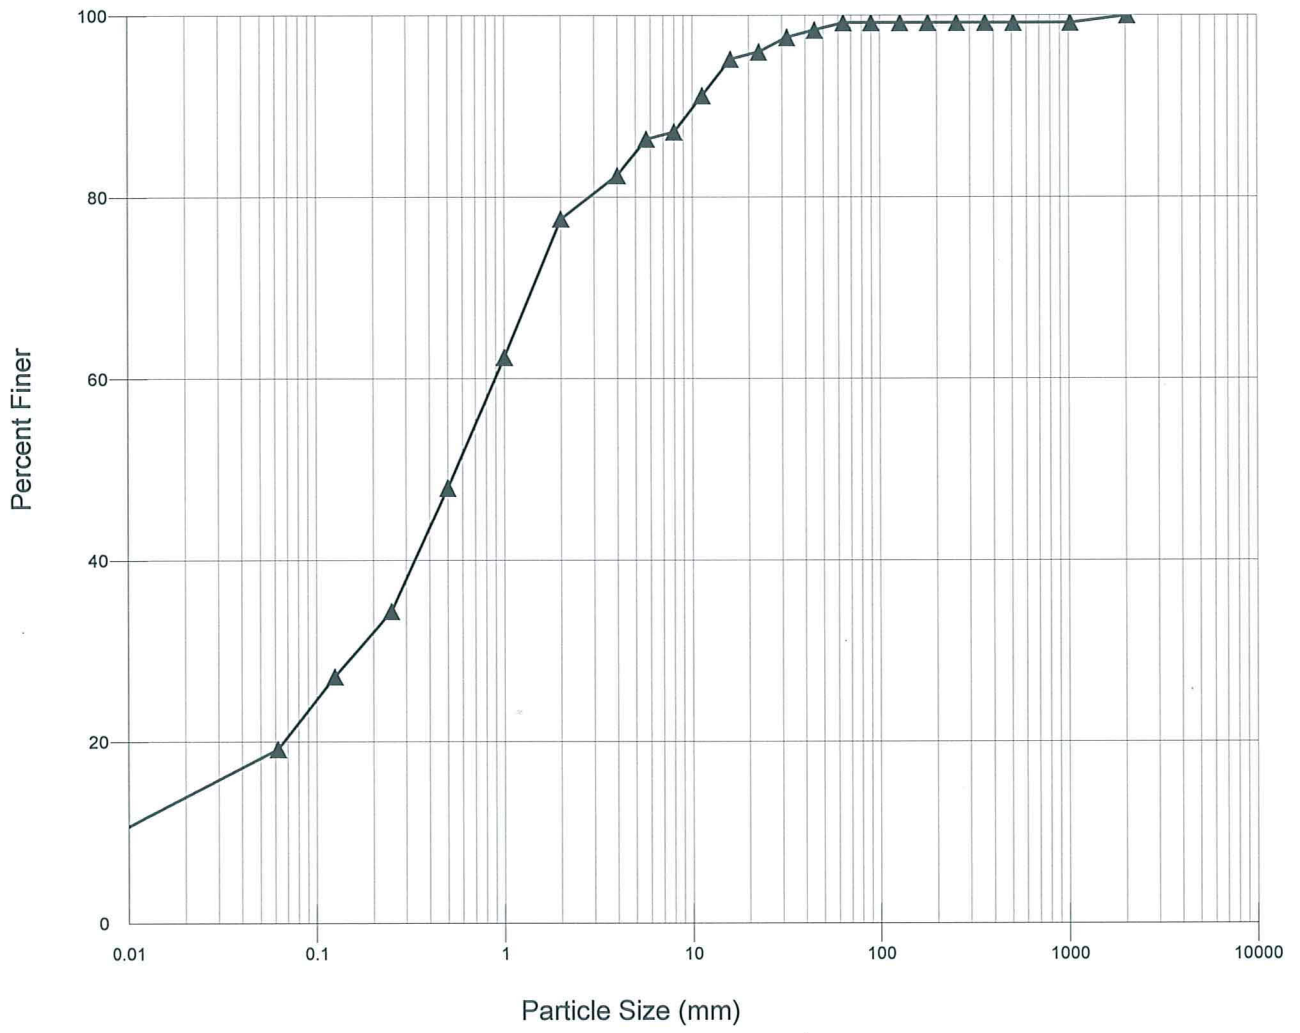

RIVERMORPH PARTICLE SUMMARY


-----  
 River Name: Little white Oak Creek  
 Reach Name: R2  
 Sample Name: R2 Reachwide Pebble Count  
 Survey Date: 08/20/2008  
 -----

Size (mm)	TOT #	ITEM %	CUM %
0 - 0.062	24	19.20	19.20
0.062 - 0.125	10	8.00	27.20
0.125 - 0.25	9	7.20	34.40
0.25 - 0.50	17	13.60	48.00
0.50 - 1.0	18	14.40	62.40
1.0 - 2.0	19	15.20	77.60
2.0 - 4.0	6	4.80	82.40
4.0 - 5.7	5	4.00	86.40
5.7 - 8.0	1	0.80	87.20
8.0 - 11.3	5	4.00	91.20
11.3 - 16.0	5	4.00	95.20
16.0 - 22.6	1	0.80	96.00
22.6 - 32.0	2	1.60	97.60
32 - 45	1	0.80	98.40
45 - 64	1	0.80	99.20
64 - 90	0	0.00	99.20
90 - 128	0	0.00	99.20
128 - 180	0	0.00	99.20
180 - 256	0	0.00	99.20
256 - 362	0	0.00	99.20
362 - 512	0	0.00	99.20
512 - 1024	0	0.00	99.20
1024 - 2048	1	0.80	100.00
Bedrock	0	0.00	100.00
D16 (mm)	0.05		
D35 (mm)	0.26		
D50 (mm)	0.57		
D84 (mm)	4.68		
D95 (mm)	15.77		
D100 (mm)	2047.87		
Silt/Clay (%)	19.2		
Sand (%)	58.4		
Gravel (%)	21.6		
Cobble (%)	0		
Boulder (%)	0.8		
Bedrock (%)	0		

Total Particles = 125.



### Reachwide Pebble Count (R2A)

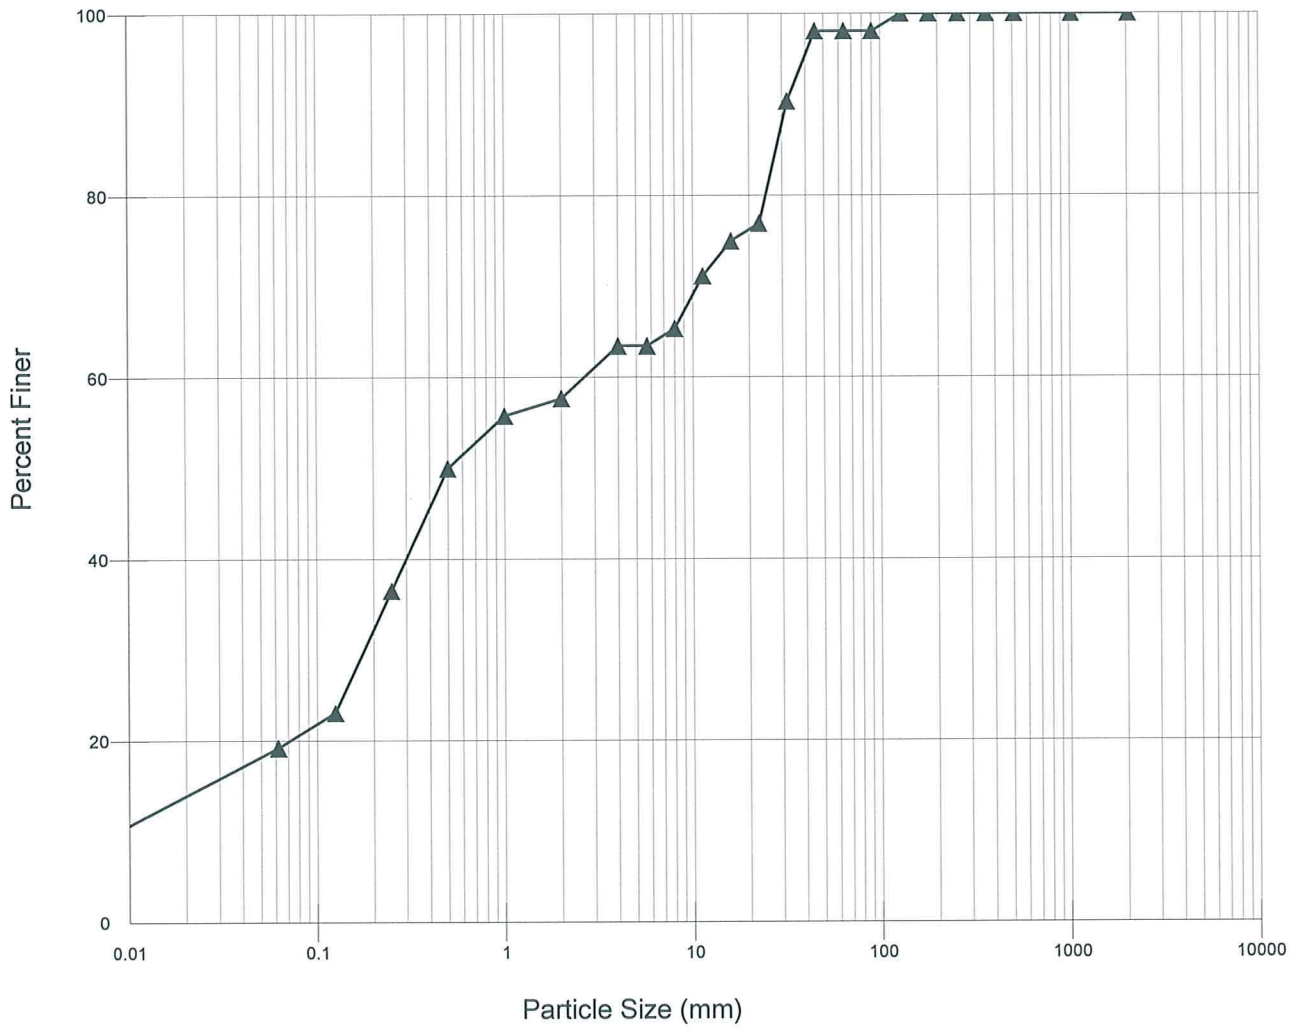

RIVERMORPH PARTICLE SUMMARY


River Name: Little white oak Creek  
 Reach Name: R2A  
 Sample Name: R2A Reachwide Pebble Count  
 Survey Date: 03/04/2008

Size (mm)	TOT #	ITEM %	CUM %
0 - 0.062	10	19.23	19.23
0.062 - 0.125	2	3.85	23.08
0.125 - 0.25	7	13.46	36.54
0.25 - 0.50	7	13.46	50.00
0.50 - 1.0	3	5.77	55.77
1.0 - 2.0	1	1.92	57.69
2.0 - 4.0	3	5.77	63.46
4.0 - 5.7	0	0.00	63.46
5.7 - 8.0	1	1.92	65.38
8.0 - 11.3	3	5.77	71.15
11.3 - 16.0	2	3.85	75.00
16.0 - 22.6	1	1.92	76.92
22.6 - 32.0	7	13.46	90.38
32 - 45	4	7.69	98.08
45 - 64	0	0.00	98.08
64 - 90	0	0.00	98.08
90 - 128	1	1.92	100.00
128 - 180	0	0.00	100.00
180 - 256	0	0.00	100.00
256 - 362	0	0.00	100.00
362 - 512	0	0.00	100.00
512 - 1024	0	0.00	100.00
1024 - 2048	0	0.00	100.00
Bedrock	0	0.00	100.00
D16 (mm)	0.05		
D35 (mm)	0.24		
D50 (mm)	0.5		
D84 (mm)	27.54		
D95 (mm)	39.8		
D100 (mm)	128		
silt/clay (%)	19.23		
sand (%)	38.46		
Gravel (%)	40.39		
Cobble (%)	1.92		
Boulder (%)	0		
Bedrock (%)	0		

Total Particles = 52 (need at least 60).



### Reachwide Pebble Count (R2B)

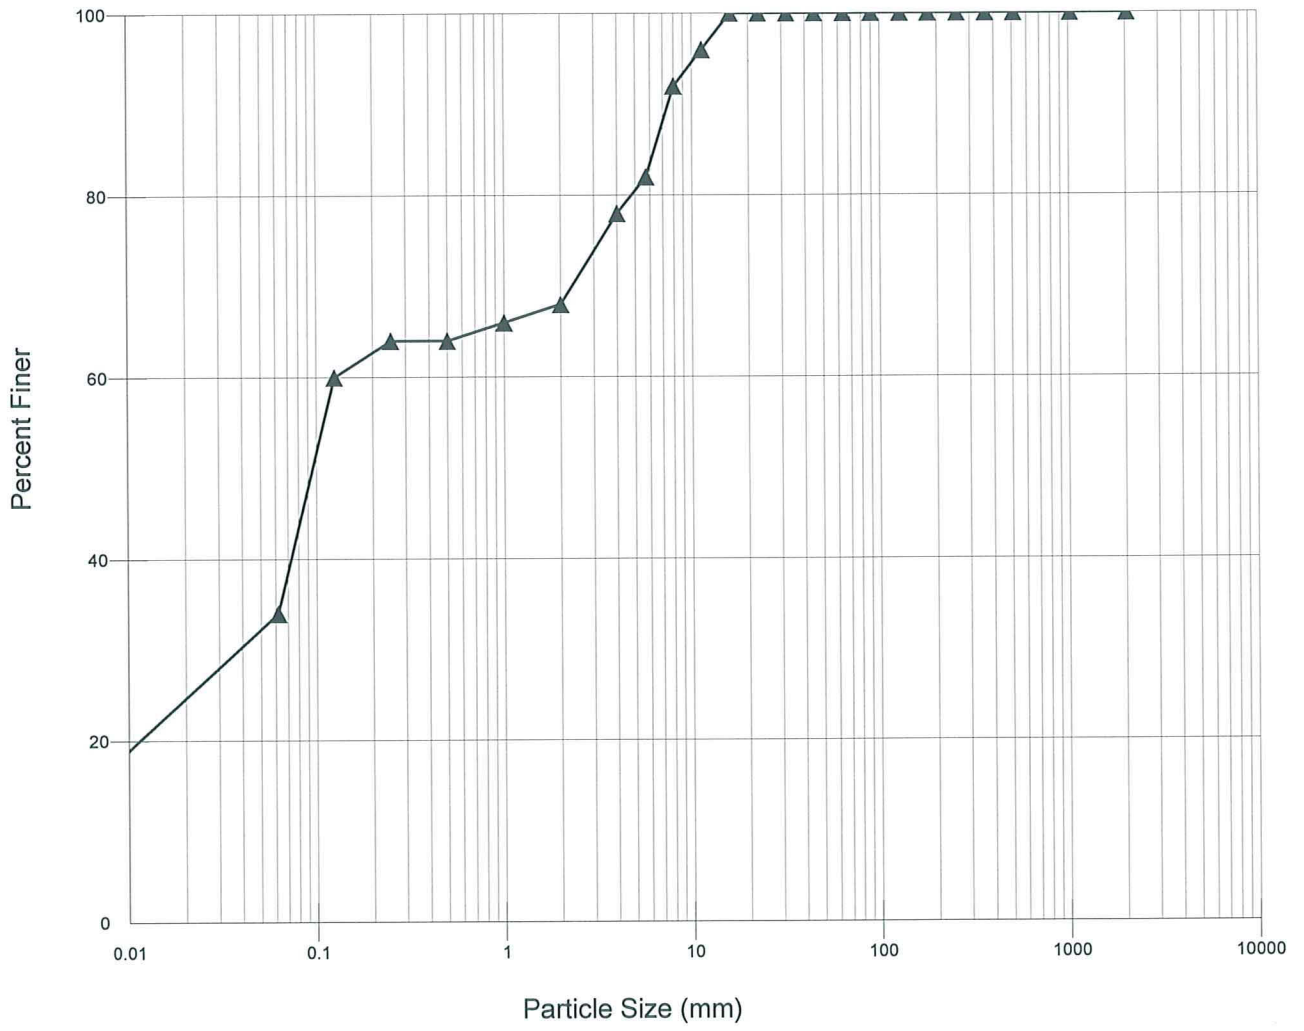

RIVERMORPH PARTICLE SUMMARY

-----  
 River Name: Little white oak creek  
 Reach Name: R2B  
 Sample Name: R2B Reachwide Pebble Count  
 Survey Date: 03/04/2008  
 -----


Size (mm)	TOT #	ITEM %	CUM %
0 - 0.062	17	34.00	34.00
0.062 - 0.125	13	26.00	60.00
0.125 - 0.25	2	4.00	64.00
0.25 - 0.50	0	0.00	64.00
0.50 - 1.0	1	2.00	66.00
1.0 - 2.0	1	2.00	68.00
2.0 - 4.0	5	10.00	78.00
4.0 - 5.7	2	4.00	82.00
5.7 - 8.0	5	10.00	92.00
8.0 - 11.3	2	4.00	96.00
11.3 - 16.0	2	4.00	100.00
16.0 - 22.6	0	0.00	100.00
22.6 - 32.0	0	0.00	100.00
32 - 45	0	0.00	100.00
45 - 64	0	0.00	100.00
64 - 90	0	0.00	100.00
90 - 128	0	0.00	100.00
128 - 180	0	0.00	100.00
180 - 256	0	0.00	100.00
256 - 362	0	0.00	100.00
362 - 512	0	0.00	100.00
512 - 1024	0	0.00	100.00
1024 - 2048	0	0.00	100.00
Bedrock	0	0.00	100.00

D16 (mm)	0.03
D35 (mm)	0.06
D50 (mm)	0.1
D84 (mm)	6.16
D95 (mm)	10.48
D100 (mm)	16
silt/Clay (%)	34
sand (%)	34
Gravel (%)	32
Cobble (%)	0
Boulder (%)	0
Bedrock (%)	0

Total Particles = 50 (need at least 60).



### Reachwide Pebble Count (R2D)

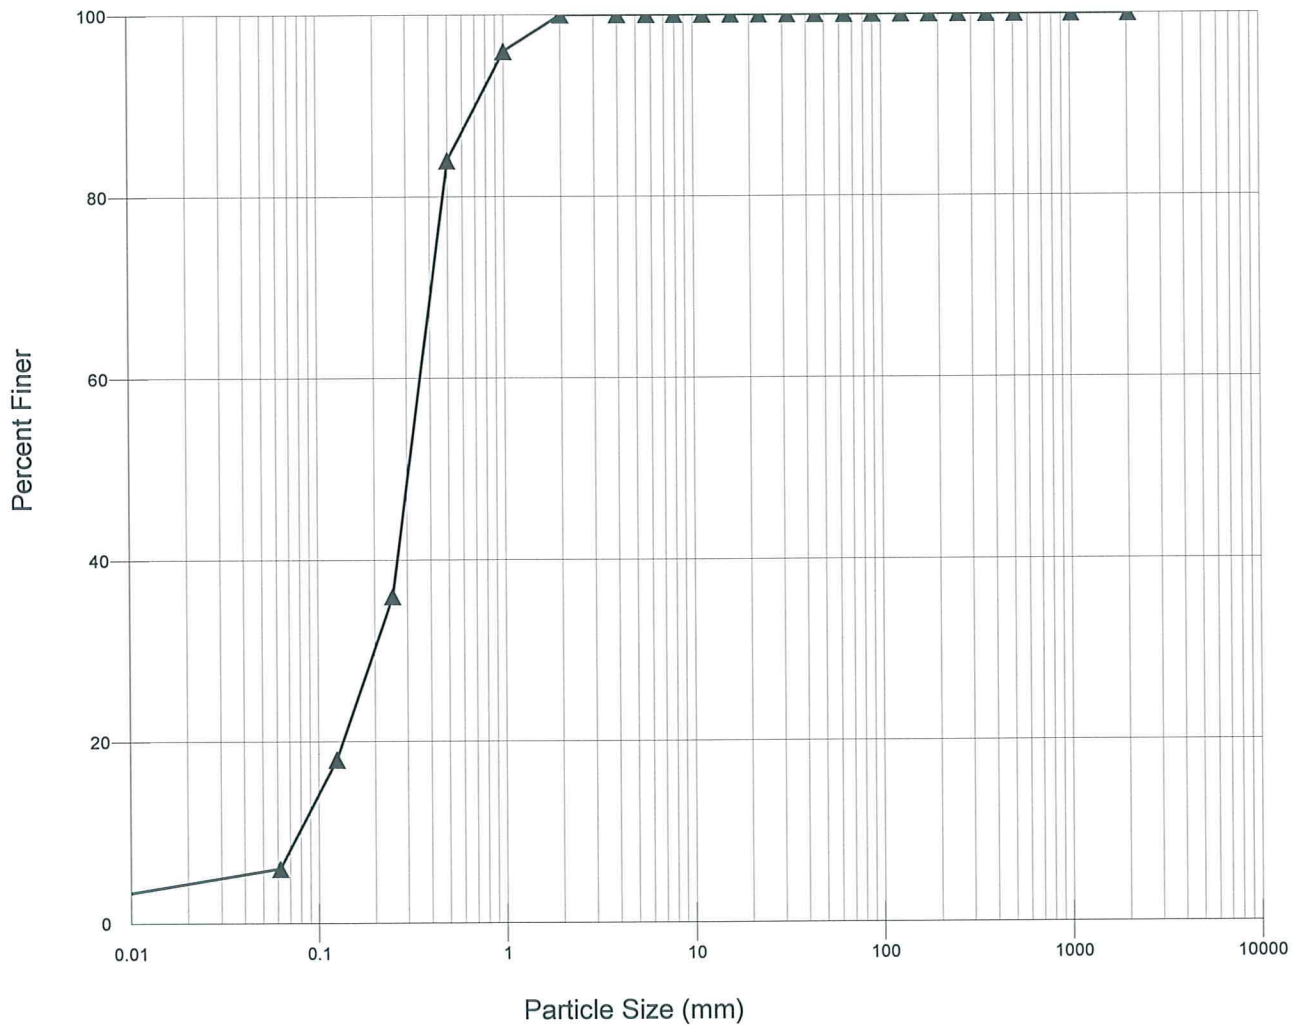

RIVERMORPH PARTICLE SUMMARY


River Name: Little white oak Creek  
 Reach Name: R2D  
 Sample Name: R2D Reachwide Pebble Count  
 Survey Date: 03/04/2008

Size (mm)	TOT #	ITEM %	CUM %
0 - 0.062	3	6.00	6.00
0.062 - 0.125	6	12.00	18.00
0.125 - 0.25	9	18.00	36.00
0.25 - 0.50	24	48.00	84.00
0.50 - 1.0	6	12.00	96.00
1.0 - 2.0	2	4.00	100.00
2.0 - 4.0	0	0.00	100.00
4.0 - 5.7	0	0.00	100.00
5.7 - 8.0	0	0.00	100.00
8.0 - 11.3	0	0.00	100.00
11.3 - 16.0	0	0.00	100.00
16.0 - 22.6	0	0.00	100.00
22.6 - 32.0	0	0.00	100.00
32 - 45	0	0.00	100.00
45 - 64	0	0.00	100.00
64 - 90	0	0.00	100.00
90 - 128	0	0.00	100.00
128 - 180	0	0.00	100.00
180 - 256	0	0.00	100.00
256 - 362	0	0.00	100.00
362 - 512	0	0.00	100.00
512 - 1024	0	0.00	100.00
1024 - 2048	0	0.00	100.00
Bedrock	0	0.00	100.00
D16 (mm)	0.11		
D35 (mm)	0.24		
D50 (mm)	0.32		
D84 (mm)	0.5		
D95 (mm)	0.96		
D100 (mm)	2		
silt/clay (%)	6		
sand (%)	94		
Gravel (%)	0		
Cobble (%)	0		
Boulder (%)	0		
Bedrock (%)	0		

Total Particles = 50 (need at least 60).




# **FIGURES**

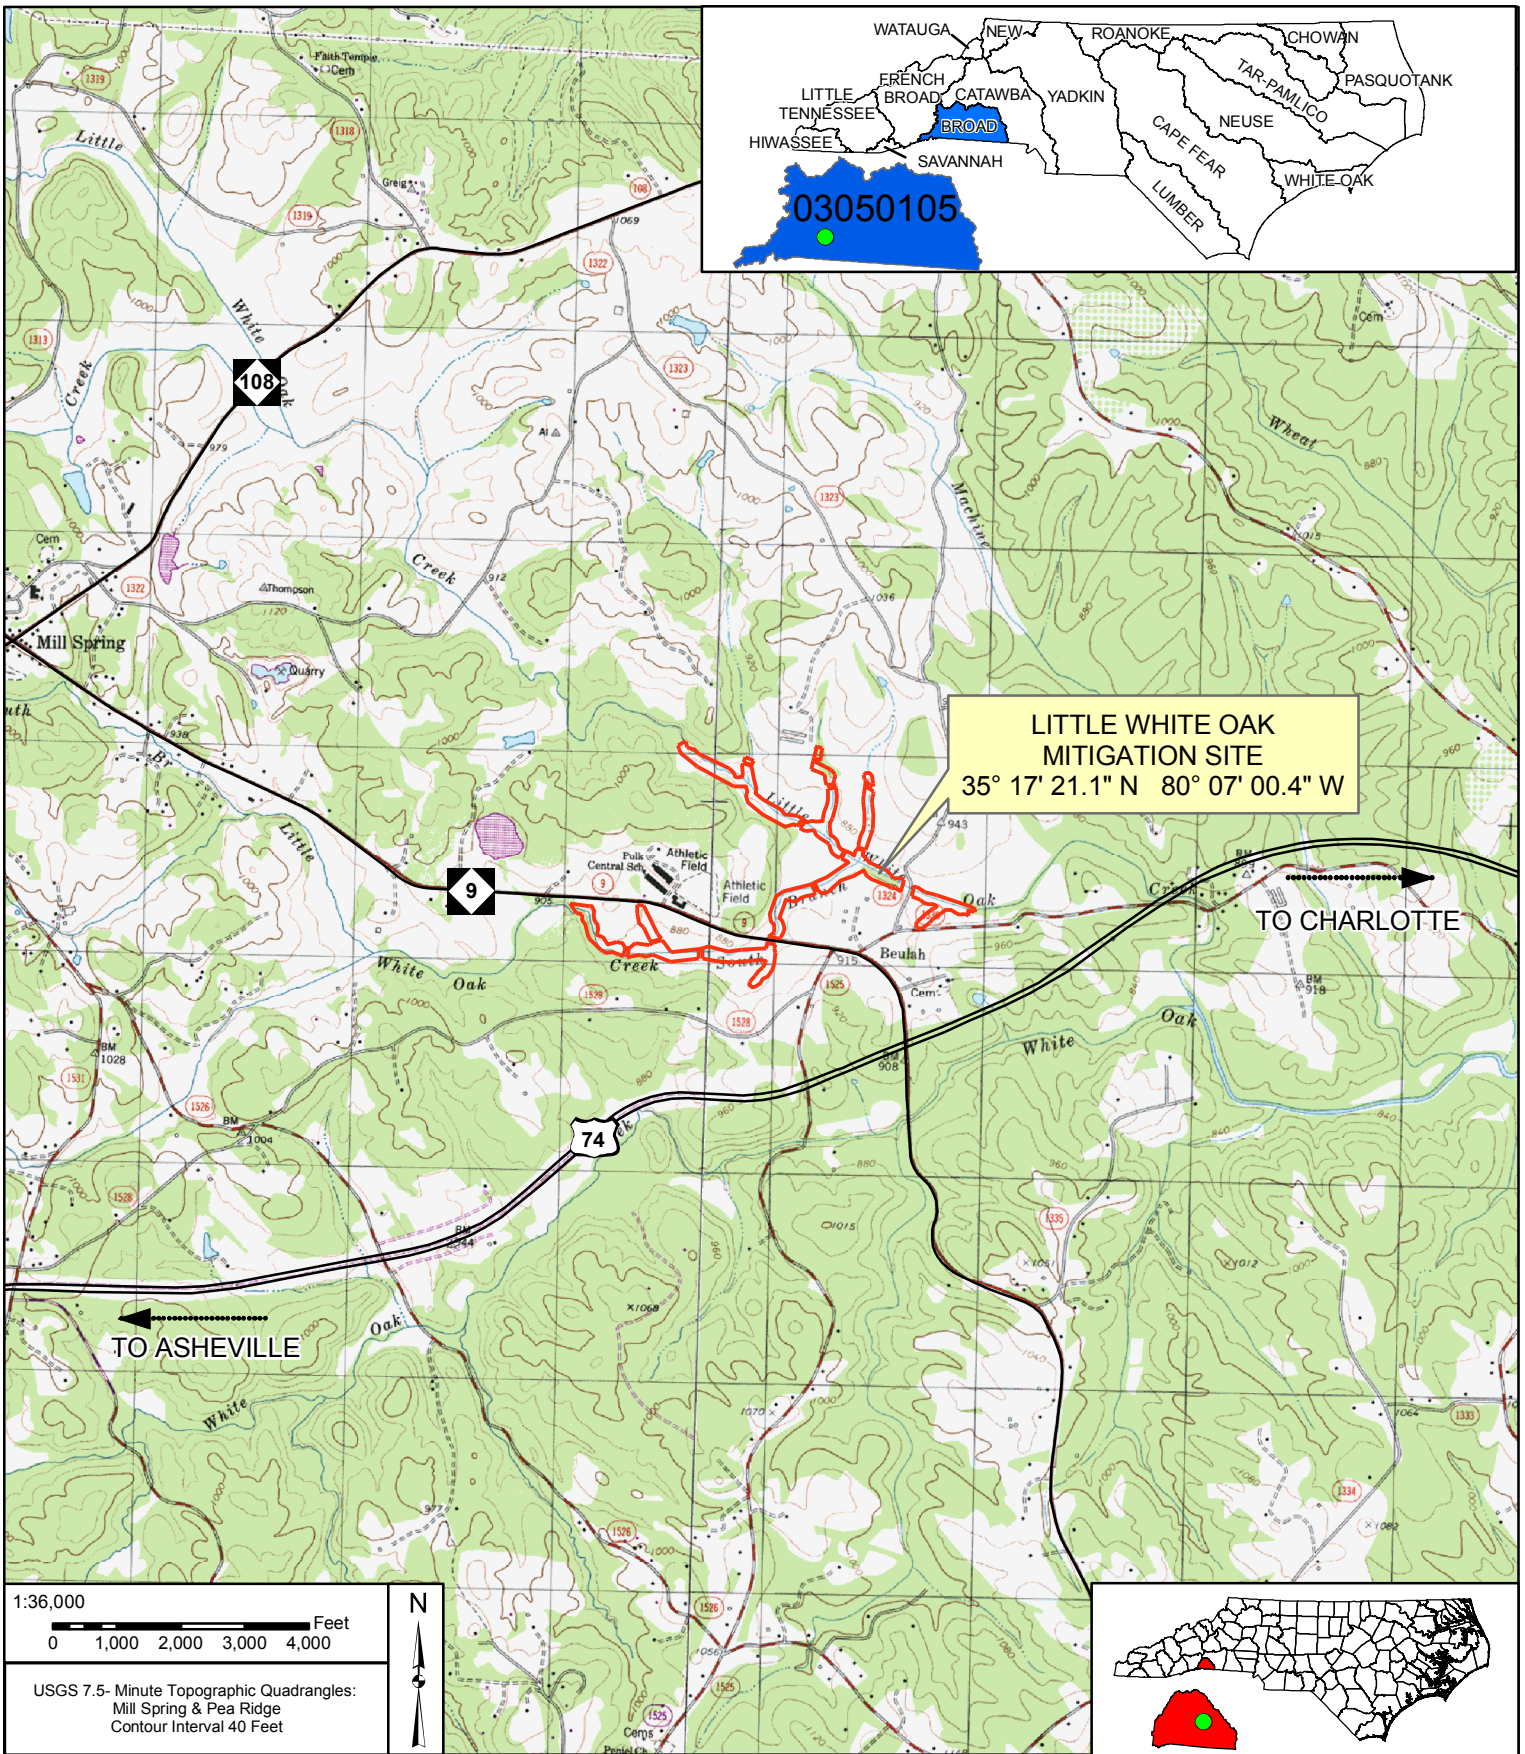

1:36,000  
 0 1,000 2,000 3,000 4,000 Feet



USGS 7.5- Minute Topographic Quadrangles:  
 Mill Spring & Pea Ridge  
 Contour Interval 40 Feet

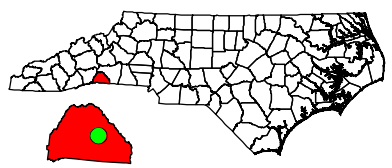

# LOCATION MAP

## LITTLE WHITE OAK STREAM RESTORATION

POLK COUNTY, NORTH CAROLINA

March 20, 2008


Figure

1




PROJECT NO. D06027-B



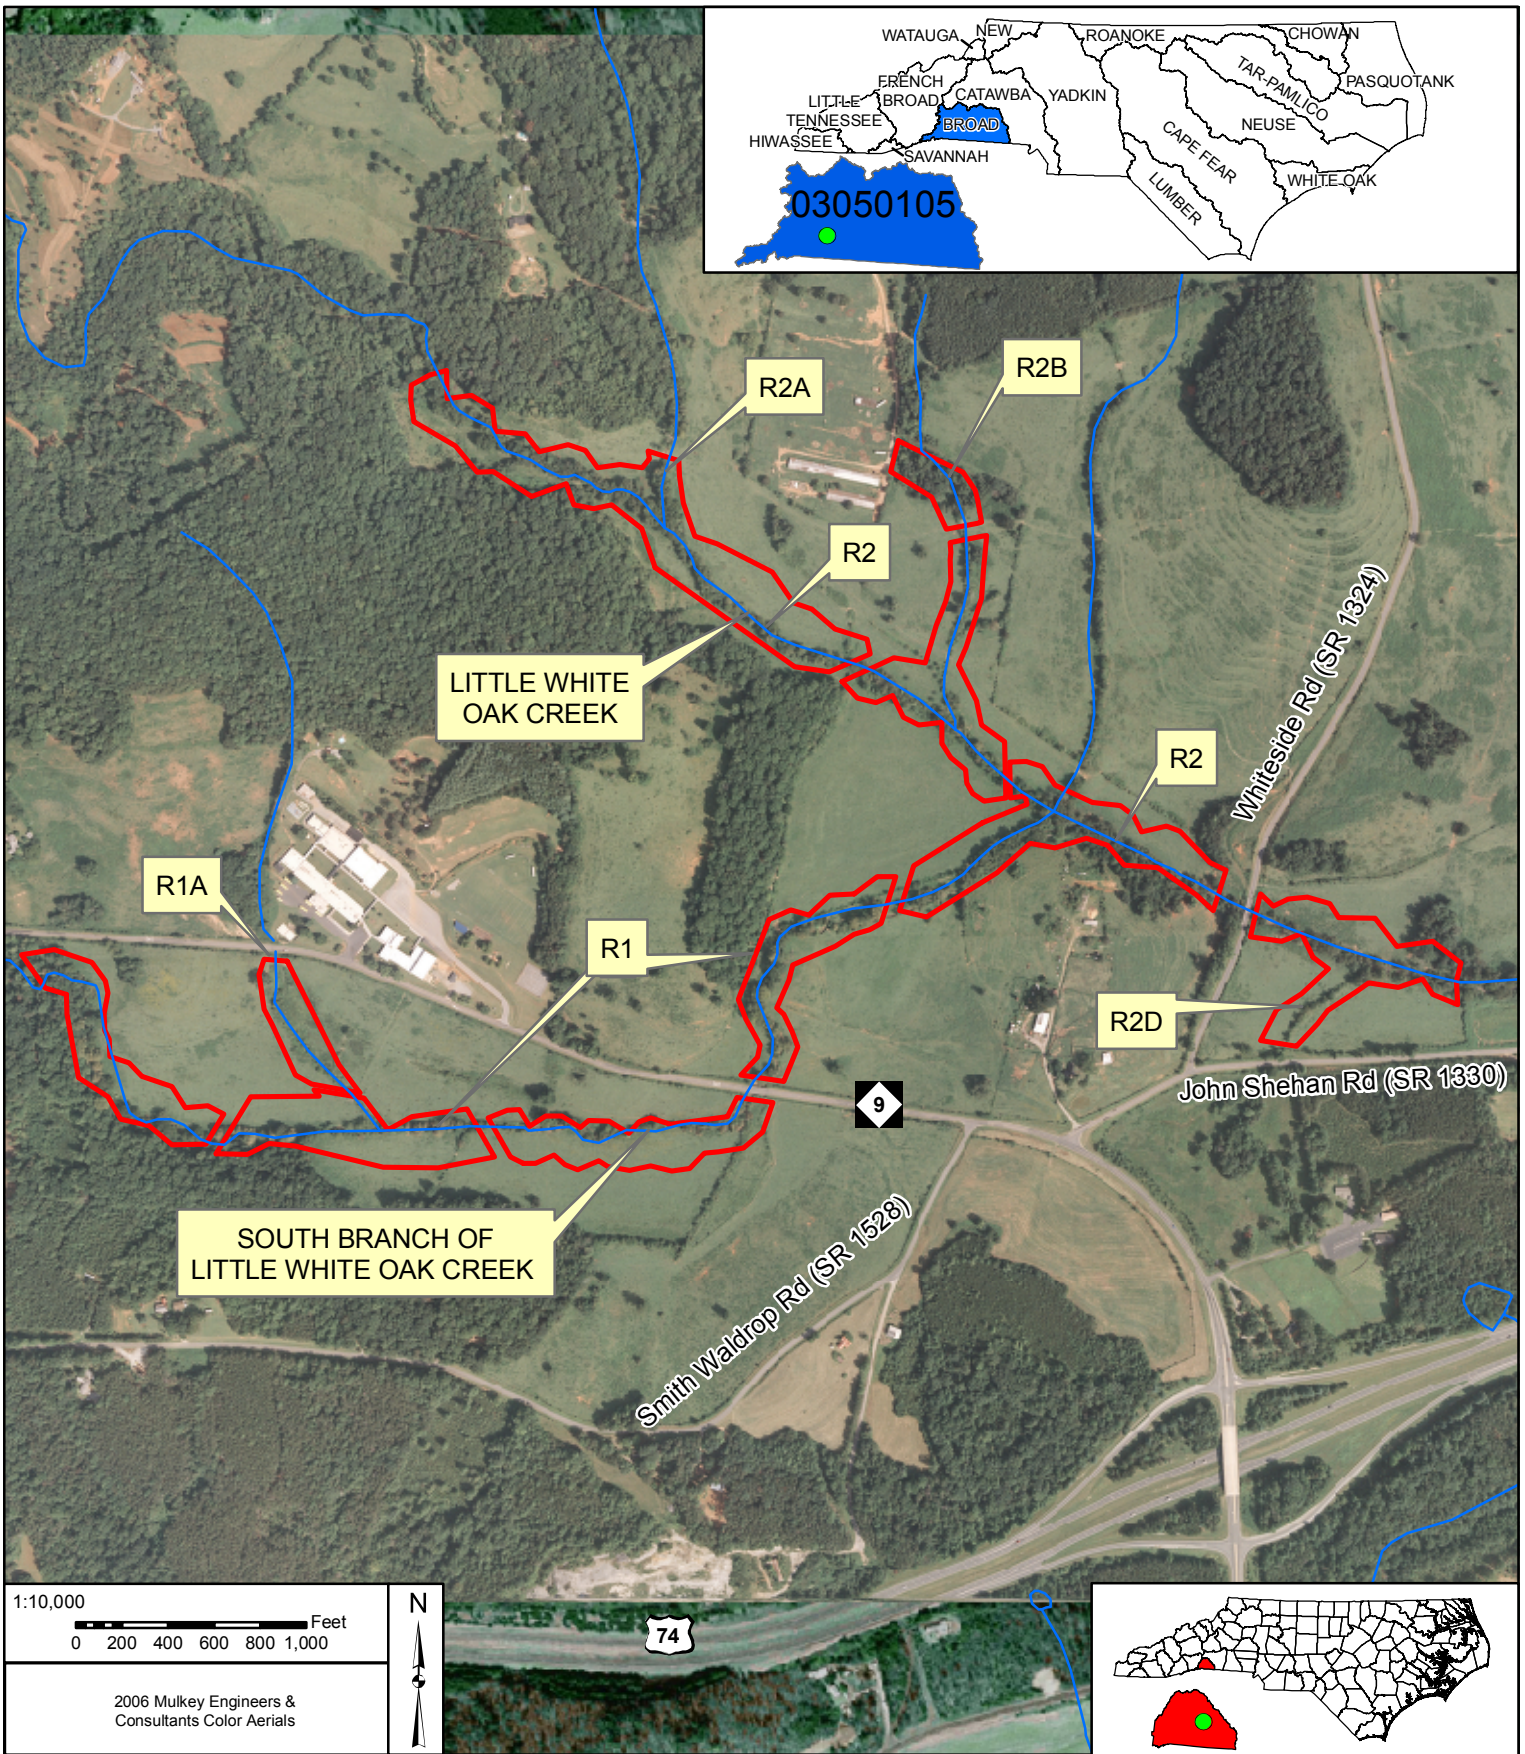

  
  
 PROJECT NO. D06027-B

**PROJECT MAP**  
**LITTLE WHITE OAK STREAM RESTORATION**  
 POLK COUNTY, NORTH CAROLINA  
 March 20, 2008

**Figure**  
**2**

# **TABLES**



### Table 1. Stream Restoration Summary

Project Number D06027-B (Little White Oak Creek Stream Restoration)

Stream Channel Summary					
Stream Reach ID	Approach	Mitigation Type	Original Channel Length (lf)	Restored Channel Length (lf)	Stream Mitigation Units (SMU)
R1	P2	R	6,530	7,543	7,543
R1A	P1/P2	R	906	1,040	1,040
R2 (Upper and Lower)	P2	R	5,978	7,107	7,107
R2A	P2	R	287	336	336
R2B	P1/P2	R	1,237	1,474	1,474
R2D	P1/P2	R	549	790	790
		Totals	15,487	18,290	18,290

**Table 2. Designed Vegetative Communities**

**Project Number D06027-B (Little White Oak Creek Stream Restoration)**

Planting Zone	Acres	Zone Description	Recommended Plant Species	
			Scientific Name	Common Name
1	5.26	Stream Banks	<i>Alnus serrulata</i>	Tag alder
			<i>Cornus amomum</i>	Silky dogwood
			<i>Salix nigra</i>	Black willow
			<i>Sambucus canadensis</i>	Elderberry
2	14.30	Riparian Buffer	<i>Betula nigra</i>	River birch
			<i>Cephalanthus occidentalis</i>	Buttonbush
			<i>Cornus amomum</i>	Silky dogwood
			<i>Corylus americana</i>	American hazelnut
			<i>Fraxinus americana</i>	White ash
			<i>Fraxinus pennsylvanica</i>	Green ash
			<i>Plantanus occidentalis</i>	Sycamore
			<i>Quercus michauxii</i>	Swamp chestnut oak
			<i>Quercus nigra</i>	Water oak
			<i>Quercus phellos</i>	Willow oak
			<i>Sambucus canadensis</i>	Elderberry
<i>Ulmus americana</i>	American elm			
3	0.35	Wetland Pockets/Oxbows	<i>Alnus serrulata</i>	Tag alder
			<i>Betula nigra</i>	River birch
			<i>Cephalanthus occidentalis</i>	Buttonbush
			<i>Cornus amomum</i>	Silky dogwood
			<i>Sambucus canadensis</i>	Elderberry
4	32.50	Upland Buffer	<i>Cornus florida</i>	Flowering dogwood
			<i>Diospyros virginiana</i>	Persimmon
			<i>Juglans nigra</i>	Black walnut
			<i>Pinus echinata</i>	Shortleaf pine
			<i>Pinus strobus</i>	Eastern white pine
			<i>Pinus virginiana</i>	Virginia Pine
			<i>Prunus serotina</i>	Black cherry
			<i>Quercus alba</i>	White oak
<i>Quercus falcata</i>	Southern red oak			



**Table 3. Vegetation Sampling Plot Information.**

Vegetation Plot	Zone Description	Actual Plot Size, sq. meters (sq. feet)	Identified Species
			Common Name
1	Riparian	97.7 (1,051.6)	River birch (1) Swamp chestnut oak (6) Water oak (14) <u>Willow oak (3)</u> <b>Total - 24</b>
2	Riparian	98.2 (1,057.0)	River birch (9) Silky dogwood (2) Swamp chestnut oak (2) <u>Water oak (6)</u> <b>Total - 19</b>
3	Upland	99.2 (1,067.8)	Black cherry (1) Black walnut (3) Persimmon (1) Shortleaf pine (3) Southern red oak (1) Virginia pine (2) White pine (2) <u>White oak (5)</u> <b>Total - 18</b>
4	Upland	99.2 (1,067.8)	Shortleaf pine (6) Southern red oak (5) White pine (1) <u>White oak (4)</u> <b>Total - 16</b>
5	Upland	98.6 (1,061.3)	Black cherry (2) Shortleaf pine (7) Southern red oak (2) Virginia pine (2) Water oak (2) <u>White oak (3)</u> <b>Total - 18</b>
6	Riparian	98.0 (1,054.9)	American hazelnut (1) River birch (4) Water oak (12) <u>Willow oak (6)</u> <b>Total - 23</b>

(<sup>1</sup>) Denotes the number of species found within a particular vegetation plot (bareroot or live stake)

<sup>A</sup> Species designated for live staking at 1,742 stakes/acre, which is a 5' x 5' spacing.

**Note:** All bareroot species were planted at 680 stems/acre, which is an 8' x 8' spacing.

**Table 3 contd. Vegetation Sampling Plot Information.**

Vegetation Plot	Zone Description	Actual Plot Size, sq. meters (sq. feet)	Identified Species
			Common Name
7	Riparian	103.0 (1,108.7)	Black willow <sup>A</sup> (1) River birch (8) Silky dogwood (4) Silky dogwood <sup>A</sup> (4) <u>Sycamore (2)</u> <b>Total - 19</b>
8	Riparian	100.9 (1,086.1)	American elm (1) American hazelnut (3) Green ash (4) River birch (5) Silky dogwood (1) Swamp chestnut oak (2) <u>Sycamore (2)</u> <b>Total - 18</b>
9	Upland	100.6 (1,082.8)	Shortleaf pine (3) White pine (4) Virginia pine (3) White oak (2) <u>Southern red oak (5)</u> Total - 17
10	Riparian/Upland	99.2 (1,067.8)	American elm (3) American hazelnut (2) Green ash (2) River birch (1) Silky dogwood (1) Southern red oak (1) Swamp chestnut oak (2) <u>Sycamore (5)</u> <b>Total - 17</b>
11	Upland	98.7 (1,062.4)	Persimmon (4) Black walnut (1) Shortleaf pine (2) White pine (1) Virginia pine (1) Black cherry (1) White oak (1) <u>Southern red oak (5)</u> <b>Total - 16</b>

(<sup>^</sup>) Denotes the number of species found within a particular vegetation plot (bareroot or live stake)

<sup>A</sup> Species designated for live staking at 1,742 stakes/acre, which is a 5' x 5' spacing.

**Note:** All bareroot species were planted at 680 stems/acre, which is an 8' x 8' spacing.



**Table 3 contd. Vegetation Sampling Plot Information.**

Vegetation Plot	Zone Description	Actual Plot Size, sq. meters (sq. feet)	Identified Species
			Common Name
12	Riparian/Upland	97.6 (1,050.6)	Persimmon (2) River birch (1) Shortleaf pine (3) Silky dogwood (1) Southern red oak (1) Swamp chestnut oak (1) Sycamore (7) <u>White oak (1)</u> <b>Total - 17</b>
13	Riparian	96.7 (1,040.9)	Elderberry (2) Green ash (7) <u>Swamp chestnut oak (10)</u> <b>Total - 18</b>
14	Riparian	98.9 (1,064.6)	American elm (2) American hazelnut (4) Green ash (2) River birch (1) Silky dogwood (2) <u>Swamp chestnut oak (4)</u> <b>Total - 15</b>
15	Upland	100.1 (1077.5)	Flowering dogwood (1) Persimmon (1) Shortleaf pine (2) White pine (5) Virginia pine (1) Black cherry (1) White oak (1) <u>Southern red oak (9)</u> <b>Total - 21</b>
16	Riparian	97.9 (1,053.8)	American elm (4) Buttonbush (5) Green ash (3) Swamp chestnut oak (4) <u>Sycamore (5)</u> <b>Total - 21</b>
17	Upland	96.3 (1036.6)	Persimmon (2) Shortleaf pine (1) White pine (1) Virginia pine (3) White oak (9) <u>Southern red oak (3)</u> <b>Total - 19</b>

( ) Denotes the number of species found within a particular vegetation plot (bareroot or live stake)

<sup>A</sup> Species designated for live staking at 1,742 stakes/acre, which is a 5' x 5' spacing.

**Note:** All bareroot species were planted at 680 stems/acre, which is an 8' x 8' spacing.

**Table 3 contd. Vegetation Sampling Plot Information.**

Vegetation Plot	Zone Description	Actual Plot Size, sq. meters (sq. feet)	Identified Species
			Common Name
18	Riparian	101.5 (1,092.5)	American elm (2) Buttonbush (1) Green ash (3) River birch (3) Swamp chestnut oak (1) <u>Sycamore (3)</u> <b>Total - 13</b>
19	Riparian	99.6 (1,072.1)	American elm (9) American hazelnut (1) Buttonbush (1) Green ash (3) Swamp chestnut oak (3) <u>Sycamore (4)</u> <b>Total - 21</b>
20	Riparian	97.2 (1,046.3)	Green ash (2) River birch (2) Swamp chestnut oak (3) <u>Sycamore (15)</u> <b>Total - 23</b>
21	Upland	98.6 (1,061.3)	Flowering dogwood (1) Black walnut (1) White pine (2) Black cherry (1) White oak (4) <u>Southern red oak (7)</u> <b>Total - 16</b>
22	Riparian	101.1 (1,088.2)	American elm (3) American hazelnut (5) Green ash (9) <u>Swamp chestnut oak (6)</u> <b>Total - 23</b>
23	Riparian	99.3 (1,068.9)	American elm (2) American hazelnut (1) Buttonbush (2) Green ash (2) River birch (6) Swamp chestnut oak (3) <u>Sycamore (2)</u> <b>Total - 18</b>

( ) Denotes the number of species found within a vegetation plot (bareroot or live stake)

<sup>A</sup> Species designated for live staking at 1,742 stakes/acre, which is a 5' x 5' spacing.

**Note:** All bareroot species were planted at 680 stems/acre, which is an 8' x 8' spacing.



**Table 3 contd. Vegetation Sampling Plot Information.**

24	Upland	99.2 (1,067.8)	Persimmon (9) Black walnut (2) Shortleaf pine (1) White pine (4) White oak (5) <u>Southern red oak (2)</u> <b>Total - 23</b>
----	--------	----------------	--

<sup>( )</sup> Denotes the number of species found within a vegetation plot (bareroot or live stake)

<sup>A</sup> Species designated for live staking at 1,742 stakes/acre, which is a 5' x 5' spacing.

**Note:** All bareroot species were planted at 680 stems/acre, which is an 8' x 8' spacing.