

**Newtown Stream and Wetland
Restoration Project
Union County, North Carolina
RFP 16-001117, SCO ID# 002025**



**Baseline Monitoring Document and As-Built Baseline Report
Final**

Data Collected: April 2011
Submitted: June 13, 2011



Prepared for:
North Carolina Department of Environment and Natural Resources
Ecosystem Enhancement Program
Parker Lincoln Building
2728 Capital Boulevard, Suite 1H-103
Raleigh, NC 27606

Submitted by:



Environmental Banc & Exchange
909 Capability Drive, Suite 3100
Raleigh, NC 27606

Phone Number: (919) 829-9909

Fax Number: (919) 829-9913

Project Manager: Norton Webster, PWS

Prepared by:



Ward Consulting Engineers, P.C.
8368 Six Forks Road, Suite 104
Raleigh, NC 27615

Phone Number: (919) 870-0526

Fax Number: (919) 870-5359

Project Manager: Becky Ward, PE

TABLE OF CONTENTS

1.0 Executive Summary/Project Abstract	1
2.0 Success Criteria.....	3
3.0 Monitoring Plan Guidelines.....	4
4.0 Documenting the As-Built Conditions (Baseline)	6
5.0 Report and Data Submission Format	7
6.0 References.....	7

APPENDICES

Appendix A. General Tables and Figures	8
Figure 1. Vicinity Map	9
Figure 2. Asset Map	10
Table 1a. Project Components.....	11
Table 1b. Component Summations	11
Table 2. Project Activity and Reporting History	12
Table 3. Project Contacts Table.....	13
Table 4. Project Attribute Table	14
Appendix B. Morphological Summary Data and Plots.....	15
Table 10a. Baseline Stream Data Summary	15
Table 10b. Baseline Stream Data Summary	18
Table 11a. Monitoring Data-Dimensional Morphology Summary	20
Table 11b. Monitoring Data-Stream Reach Data Summary.....	22
Longitudinal Profile - Underwood Creek.....	24
Longitudinal Profile - UT to Underwood Creek	25
Cross Sections - Underwood Creek.....	26
Cross Sections - UT to Underwood Creek	29
Appendix C. Vegetation Data	36
Veg Plot Photos. Vegetation Plot photos	37
Table 7. Planted and Total Stem Counts	44
CVS Tables. CVS Output Tables	45
Appendix D. Groundwater Gauge Charts	50
Appendix E. Record Drawings	56

1.0 EXECUTIVE SUMMARY/PROJECT ABSTRACT

The Newtown Stream and Wetland Restoration Site is located within the sub-basin 03-08-38 of the Catawba River Basin in Union County, North Carolina and contains Underwood Creek and one Unnamed Tributary (UT) to Underwood Creek. The restoration lengths of Underwood Creek (Main Channel) and UT to Underwood Creek (Tributary) are 1273 and 4075 feet, respectively, for a total project length of 5348 feet (Figure 1). The project included restoration of 3.38 acres of riparian wetland and wetland preservation of 0.15 acres. The project site is owned by one property owner Mr. Frank W. Howey, Jr. The project is located within the HUC 03050103030020 (Lower Catawba Basin) of the South Atlantic-Gulf Region; however it is not located within a North Carolina Department of Water Quality (NCDWQ) Ecosystem Enhancement Program (EEP) Local Watershed Plan area. NCDWQ classifies Underwood Creek (DWQ Stream Index Number 11-138-2-3-1) as class C. The 1.5 square mile watershed contributing drainage to the stream restoration segment is located in a rural setting. The land adjacent to the project streams is primarily used for agricultural practices and single family development. The floodplain is more confined in the upper reach of the project and opens up to a broad width for the majority of the project length. Vegetation typical of a Piedmont Alluvial Forest was planted throughout the conservation easement.

Project Goals Achieved:

- Improve water quality with the construction of stable stream banks and the establishment of a vegetated buffer
- Improve the stream function and habitat with the connection of the channelized and incised stream back to its floodplain
- Improve wetland hydrology with the functional uplift of the proposed channel
- Restore long-term stability with the restoration of channel pattern, profile and dimension
- Improve in-stream habitat with the installation of root wads, constructed riffles, log vanes and rock cross vanes to enhance pool depths

Project Objectives Achieved:

- The restoration of 4690 linear feet of Priority I, 558 feet of Priority II and 100 feet of Enhancement II in order to raise the stream elevation, reconnect the floodplain, restore pattern, and re-establish channel dimension on Underwood Creek and UT to Underwood Creek
- Restoration of 3.38 acres of wetlands through the functional uplift of the stream to improve wetland hydrology and the removal of depositional sediment from the wetland surface due to agricultural field soil wash
- Preserve an existing 0.15-acre jurisdictional wetland
- Establish a minimum 50 feet riparian buffer along the entire stream length

Construction, as-built survey and plantings were completed in April 2011. In April 2011, 13 vegetation plots were established and baseline vegetation data was collected, excluding natural stems, in accordance with Level I of the EEP/CVS protocol Version 4.2. Data collected for these plots are in Appendix C. The success criterion for planted

woody species is 320 stems/acre after MY-03. A mortality rate of ten percent will be allowed after MY-04 (288 stems/acre), with another ten percent allowed after MY-05 (260 stems/acre). Invasive exotic vegetation was present prior to restoration. Currently there are no invasive exotics within the conservation easement.

1.1 Restoration Type and Approach

The project site is immediately surrounded by land used primarily for farming. The streams were incised, with unstable banks and little buffer vegetation was present prior to the beginning of the project. The streams were restored and enhanced using a combination of Rosgen Priority 1 and 2 Restoration techniques. The wetland restoration portion of this project involved removing depositional sediment that had eroded and imported from the adjacent farmland. The riparian buffer and wetlands were planted with native vegetation. The mitigation work at the project site has resulted in the restoration of 5248 linear feet of stream, the enhancement (Level II) of 100 linear feet of stream, the restoration of 3.38 acres of riparian wetlands, and the preservation of 0.15 acres of riparian wetlands. The project component breakdown can be found in Table 1a and overall project component summations can be found in Table 1b.

1.2 Project History, Contacts and Attribute Data

Stream construction began in November 2010 and concluded in April 2011. Live stakes and bare root planting of the site occurred in April 2011. Baseline stream data collection coincided with the designer verification survey and was an ongoing process that took place throughout construction and concluded in April 2011. Vegetation monitoring baseline data was established and collected in April 2011. Significant milestone dates for the project can be found in Table 2. The project designer, construction contractor and all other consultants, contractors and suppliers contact information can be found in Table 3. The drainage area for Underwood Creek is approximately 0.72 square miles at the downstream limit, where Underwood Creek crosses Newtown Road. The Unnamed Tributary to Underwood Creek has an approximate drainage area of 0.74 square miles. The combined watershed, 1.46 square miles, consists of 21% forested land, 66% cleared land for agricultural use (row crops), and 14% remaining land in single family residential use with 1 acre lots. All project attributes can be found in Table 4.

1.3 Modifications to the Restoration Plan and Construction Plan Summary

The following is a summary of changes implemented during construction that differ from the Construction Drawings. Several structures were not installed during construction as field conditions did not warrant their installation. Several rock structures were changed to log structures to better utilize onsite woody vegetation.

Underwood Creek:

- No clay plugs were installed throughout the entire length of the stream. Deemed unnecessary and no suitable impervious material was found onsite,
- Rock cross vane at station 5+50 installed as a single wing rock vane
- Log vanes were installed in place of single wing rock vanes at stations: 6+60, 10+20 and 11+59

- Log vane arms used on A-Vane structures from station 18+61 through 19+06

UT to Underwood Creek:

- No clay plugs were installed throughout the entire length of the stream. Deemed unnecessary and no suitable impervious material was found onsite
- Floodplain sill at station 9+90 not installed
- Single wing rock vane at station 10+60 not installed
- Earthen berms with openings added to the south floodplain debris toe between approximate stations 11+00 – 20+00
- Earthen berm added to floodplain at approximate stations 23+50 – 25+00 to preserve the existing wetland
- Log vanes were installed in place of single wing rock vanes at stations 34+65, 36+32, 37+89 and 39+33
- Constructed riffles not installed at stations 35+61 and 39+85
- Rock toe stabilization not installed at station 42+00
- Log vane arms used on A-Vane structures from station 42+70 through 43+00

2.0 SUCCESS CRITERIA

2.1 Morphologic Parameters and Channel Stability

2.1.1 Dimension

The dimension parameters of the restored channel should remain stable throughout the monitoring period. Cross sectional overlays should show modest changes from year to year. The channel should not show a trend towards widening or increases in cross sectional area. Riffle depths should maintain a low bank height ratio (<1.2).

2.1.2 Pattern and Profile

Annual overlays of the longitudinal profile should not indicate significant aggradation or degradation over any substantial continuous lengths of channel. The bedform should develop or be maintained during the monitoring period and be consistent with the reference and design reaches. Variation within bedform parameters is acceptable as long as they are within design distributions. Pattern parameters should show little change over the monitoring period.

2.1.3 Substrate

The substrate should maintain or progress towards the design distribution. Particle size distribution within riffles should coarsen throughout the monitoring period.

2.1.4 Sediment Transport

The success of parameters described above should be demonstrated by the lack on any significant aggradation or deposition within the channel. Point bar and inner berms should not encroach excessively into the channel. Mid-channel bars should not be present.

2.2 Vegetation

Vegetation success is based on the criteria established in the USACE Stream Mitigation Guidelines (2003). The success criteria of the planted woody species will be the survival of 320 stems/acre after monitoring year three (MY3). A mortality rate of ten percent will be allowed after MY4 (288 stems/acre), with another ten percent mortality rate allowed after MY5 (260 stems/acre). Invasive exotic species were observed before construction. Additional treatments will be conducted where deemed necessary if regeneration of these invasive exotic species is observed.

2.3 Hydrology

2.3.1 Streams

Two bankfull storm events must be recorded during the standard 5-year monitoring period. For the monitoring to be completed, these events must occur in separate monitoring years.

2.3.2 Wetlands

In February of 2010, seven (7) groundwater gauges were installed to collect pre-construction groundwater data. An additional groundwater gauge will be installed in June 2011. An additional groundwater gauge (Gauge 8) will be installed in June 2011. No data for gauge 8 will be included in this report. Gauges were installed according to the specifications of Technical Note HY-1A-3.1 (USACE 1993). Six gauges were installed within areas containing hydric soils and one (Gauge 4) was installed within the wetland preservation area. Pre-construction data for Gauges 3 and 7 was corrupt therefore it is not included. Post construction, groundwater levels should be within 12 inches of the surface for at least 6.3% of the growing season to meet wetland hydrology success criteria. Union County has a growing season of 221 days (March 28-November 3), based upon Union County Soil Survey. Therefore groundwater levels must be within 12 inches of the soil surface for a minimum of 14 consecutive days within the growing season to meet wetland hydrology success criteria. Gauges 2 and 5 displayed wetland hydrology while Gauges 1, 4 and 6 did not meet the wetland hydrology success criteria. Gauge 2 hydrology was affected by the adjacent downstream farmer damming the stream and Gauge 5 hydrology was affected by beaver activity, which were subsequently removed.

3.0 MONITORING PLAN GUIDELINES

Monitoring protocol will follow that outlined within the EEP Monitoring Report guidelines and detailed in the U.S. Army Corps of Engineers (USACE) Stream Mitigation Guidelines for Monitoring Level I. Monitoring shall occur annually for a minimum of five years and consist of the collection and analysis of stream stability and riparian/stream bank vegetation survivability data to support the evaluation of the project in meeting established restoration objectives. Monitoring shall include measurements of stream dimension, profile, pattern, bed materials, photo documentation, vegetation survivability sampling, and stream bankfull return interval.

3.1 Hydrology

3.1.1 Wetland

Currently there are seven Remote Data Systems (RDS) groundwater gauges (1-8) within wetlands in the conservation easement. Gauge 4 is located within an onsite reference wetland. The gauges record groundwater levels every twelve hours and will be checked and downloaded on a monthly basis. One RDS rain bucket gauge and one manual funnel rain gauge were installed adjacent to UT to Underwood Creek collects precipitation data to correlate groundwater level fluctuations and site specific data.

3.1.2 Stream

A crest gage shall be installed on the site to document bankfull events. The gage shall be checked, documented, and reset during each site visit by the monitoring performer.

3.2 Stream Channel Stability and Geomorphology

This project consisted of two restoration reaches: Underwood Creek (Main Channel) and UT to Underwood Creek (Tributary). Ten permanent cross sections were established on the site as detailed below:

Underwood Creek: Station 5+00 – 18+91

- Cross Section 1: Station 9+54 – Riffle
- Cross Section 2: Station 13+36 – Riffle
- Cross Section 3: Station 17+12 – Riffle

UT to Underwood Creek: Station 5+82 – 36+78

- Cross Section 1: Station 6+40 – Riffle
- Cross Section 2: Station 14+45 – Riffle
- Cross Section 3: Station 20+04 – Riffle
- Cross Section 4: Station 26+68 – Riffle
- Cross Section 5: Station 31+26 – Riffle
- Cross Section 6: Station 35+35 – Riffle
- Cross Section 7: Station 39+90 – Riffle

Cross sections were established only on riffle sections. Pool data is neglected from the Dimension portion of Table 11b and does not provide adequate data to forecast function and stability in the stream performance. More riffle cross sections were established to provide additional data for better statistical evaluation.

3.2.1 Dimension

The permanent cross sections shall be surveyed annually during the monitoring period. These sections should be overlaid to allow for comparison. Dimension parameters shall be calculated from the surveyed cross sections and compared to previous monitoring periods. The dimension data is detailed by section in Table 11a. and summarized in the Table 11b.

3.2.2 Profile and Pattern

The entire project length of Underwood Creek and a 3000 LF length of UT to Underwood Creek were surveyed for this baseline monitoring plan. The MY-00 profile data for each reach is summarized in Table 11b. For subsequent monitoring years, these reaches shall be surveyed and the profiles overlaid for comparison. Pattern data shall be extracted and compared during the monitoring period.

3.2.3 Visual Assessment

An annual visual assessment shall be conducted during each monitoring year per NCEEP morphometric monitoring guidelines.

3.2.4 Bank Stability Assessment

Bank stability assessment (BEHI and NBS) shall be assessed during monitoring year 5.

3.2.5 Vegetation

Thirteen (13) vegetation plots were installed along Underwood Creek and UT to Underwood Creek. Vegetation data collection for the baseline monitoring report follows the CVS-EEP Protocol for Recording Vegetation Version 4.2 (Lee et al. 2008). The baseline vegetation monitoring was conducted according to the Level I: Inventory of Planted Stems. Level I will also be used for MY-01 data collection. However, from MY-02 and through the remainder of the monitoring period, vegetation monitoring data collection will follow Level II of the CVS-EEP protocol which includes planted and natural stems. Plant identification will be verified according to Alan Weakley's, *Flora of the Carolinas, Virginia, Georgia, and Surrounding Areas* (Weakley 2010).

3.2.6 Digital Photos

Photo points were established at the start/end of the project, at each vegetation monitoring plot, and at each cross section. For each subsequent monitoring period, photos shall be taken at the same location and, preferably, within the same two-month window between monitoring periods. The cross section photos can be found on their corresponding cross section sheets located in Appendix B. The vegetation monitoring plot photo log is located in Appendix C.

3.3 Maintenance and Contingency Plans

If deemed necessary, recommendations for increased monitoring, maintenance, or repair shall be made in the annual monitoring reports. Problem areas shall be located on the monitoring report plan view and tabulated noting the severity and possible causes.

4.0 DOCUMENTING THE AS-BUILT CONDITION (BASELINE)

4.1 As-Built/Record Drawings

The project as-built survey was conducted in April 2011 upon completion of construction in two parts. The entire project length of Underwood Creek (Main Channel) and the portion downstream of the tributary crossing at station 36+84 is

FEMA regulated. Therefore, the as-built survey of these portions was conducted by a Registered Land Surveyor. UT to Underwood Creek (Tributary) survey from the beginning of the project to the stream crossing at station 36+84) was conducted by the staff of the Designer/Monitoring Performer. A compilation of these two maps are used to complete the Record Drawings. The Record Drawings (including red-line markups) were completed on May 13, 2011. Baseline vegetative data was collected in April 2011.

4.2 Installation and Marking of Monitoring Features

Monitoring features installation and the baseline monitoring data collection occurred in April 2011. Cross Section pins are 5/8" rebar and are located with 8' gardening stakes with pink flagging. Vegetation monitoring plots were established as 10mX10m squares with each corner marked with 3' long 1/2" in diameter PVC pipes and orange pin flags. One corner of each vegetation plot is marked with a 10' PVC pipe. Plants within the plot were marked with pink flagging. Groundwater monitoring gauges are marked with pink flagging and 48" green T posts.

5.0 REPORT AND DATA SUBMISSION FORMAT

Refer to the NCEEP Monitoring Report guidelines for report and data submission requirements, formats and procedures.


6.0 REFERENCES

Lee, Michael T. Peet, Robert K. Roberts, Steven D., Wentworth, Thomas R. (2008). *CVS-EEP Protocol for Recording Vegetation Version 4.2*.

Weakley, Alan (2010). *Flora of the Carolinas, Virginia, Georgia, and Surrounding Areas*. <http://www.herbarium.unc.edu/flora.htm>.

Appendix A. General Tables and Figures

The subject project site is an environmental restoration site of the NCDENR Ecosystem Enhancement Program (EEP) and is encompassed by a recorded conservation easement, but is bordered by land under private ownership. Accessing the site may require traversing areas near or along the easement boundary and therefore access by the general public is not permitted. Access by authorized personnel of state and federal agencies or their designees/contractors involved in the development, oversight and stewardship of the restoration site is permitted within the terms and timeframes of their defined roles. Any intended site visitation or activity by any person outside of these previously sanctioned roles and activities requires prior coordination with EEP.

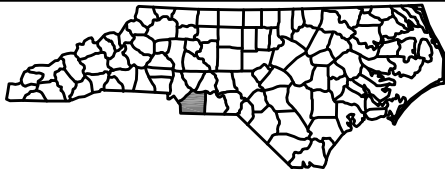

North Carolina - Ecosystem Enhancement Program
 Newtown Stream and Wetland Restoration Site
 Union County, North Carolina


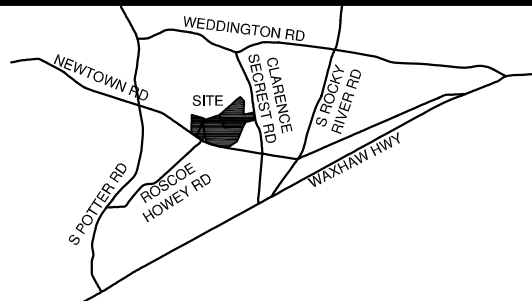


FIGURE 1 NEWTOWN STREAM AND WETLAND RESTORATION AERIAL VICINITY MAP

DATE: APRIL 29, 2011

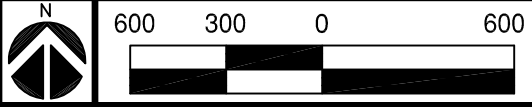

WARD CONSULTING ENGINEERS, PC

8368 Six Forks Rd. Suite 104 (919) 870-0526
 Raleigh, NC 27615-5088 FAX (919) 870-5359

Table 1a. Project Components

Table 1. Project Components Newtown Stream and Wetland Restoration									
Project Component or Reach ID	Existing Feet/Acres	Restoration Level	Approach	Footage or Acreage	Stationing	Mitigation Ratio	Mitigation Units	BMP Elements ¹	Comment
Underwood Creek	520	R	P2	558	5+00 - 10+58	1:1	558		
Underwood Creek	625	R	P1	715	11+16 - 19+06	1:1	715		58 LF easement exclusion for Stream Crossing
UT to Underwood Creek	3923	R	P1	3975	2+00 - 43+07	1:1	3975		125 LF easement exclusion for two (2) Stream Crossings
UT to Underwood Creek	100	E2		100	1+00 - 2+00	2.5:1	40		
Wetland	3.38	R	-	3.38		1:1	3.38		
Wetland	0.15	P	-	0.15		5:1	0.03		

1 = BR = Bioretention Cell; SF = Sand Filter; SW = Stormwater Wetland; WDP = Wet Detention Pond; DDP = Dry Detention Pond; FS = Filter Strip; Grassed Swale = S; LS = Level Spreader; NI = Natural Infiltration Area, O = Other; CF = Cattle Fencing; WS = Watering System; CH = Livestock Housing

Table 1b. Component Summations

Table 1b. Component Summations Newtown Stream and Wetland Restoration							
Restoration Level	Stream (lf)	Riparian Wetland (Ac)		Non-Ripar (Ac)	Upland (Ac)	Buffer (Ac)	BMP
		Riverine	Non-Riverine				
Restoration	5248	3.38					
Enhancement							
Enhancement I							
Enhancement II	100						
Creation							
Preservation		0.15					
HQ Preservation							
Totals (Feet/Acres)	5248	3.53		0	0		
MU Totals	5288	3.41					
	Non-Applicable						

Table 2. Project Activity and Reporting History

**Table 2. Project Activity and Reporting History
Newtown Stream and Wetland Restoration**

Activity or Deliverable	Data Collection Complete	Completion or Delivery
Restoration Plan	June 2010	June 2010
Final Design – Construction Plans	July 2010	July 2010
Construction	-	April 2011
Bare root and livestake planting	-	April 2011
Mitigation Plan / As-built (Year 0 Monitoring – baseline)	April 2011	May 2011
Year 1 Monitoring		
Year 2 Monitoring		
Year 3 Monitoring		
Year 4 Monitoring		
Year 5 Monitoring		

Bolded items are examples of those items that are not standard, but may come up and should be included. Non-bolded items represent events that are standard components over the course of a typical project.

Table 3. Project Contacts Table

Table 3. Project Contacts Table Newtown Stream and Wetland Restoration	
Designer Primary project design POC	Ward Consulting Engineers, P.C. 8368 Six Forks Rd, Suite 104 Raleigh, NC 27615 Becky Ward 919-870-0526
Construction Contractor Construction contractor POC	RFG Construction 1907 Cambridge Dr Kinston, NC 28504 Robert Grady 252-559-6954
Survey Contractor Survey contractor POC	R.B. Pharr & Associates 420 Hawthorne Ln Charlotte, NC 28204 Justin Cloninger 704-376-2186
Planting Contractor Planting contractor POC	New Forest Services P.O. Box 255 Manistee, MI 49660 Brian Jarvinen 910-512-6754
Seeding Contractor Contractor point of contact	RFG Construction 1907 Cambridge Dr Kinston, NC 28504 Robert Grady 252-559-6954
Seed Mix Sources	Evergreen Seed - Fuquay Varina, NC 919-567-1333
Nursery Stock Suppliers	Arbor Gen - Blenheim, SC - South Carolina SuperTree Nursery 800-222-1290
Monitoring Performers	Ward Consulting Engineers, P.C. 8368 Six Forks Rd, Suite 104 Raleigh, NC 27615
Stream Monitoring POC	Zack Pitts 919-870-0526
Vegetation Monitoring POC	Chris Sheats - The Catena Group - 919-732-1300
Wetland Monitoring POC	Chris Sheats - The Catena Group - 919-732-1300

Table 4. Project Attribute Table

Table 4. Project Attribute Table Newtown Stream and Wetland Restoration		
Project County	Union	
Physiographic Region	Piedmont	
Ecoregion	Carolina Slate Belt	
Project River Basin	Catawba River Basin	
USGS HUC for Project (14 digit)	3050103030020	
NCDWQ Sub-basin for Project	03-08-38	
Within extent of EEP Watershed Plan?	No	
WRC Hab Class (Warm, Cool, Cold)	-	
% of project easement fenced or demarcated	100%	
Beaver activity observed during design phase?	No	
Restoration Component Attribute Table		
	Underwood Creek	UT to Underwood Creek
Drainage area	0.72 sq mi	0.74 sq mi
Stream order	-	-
Restored length (feet)	1273	3975
Perennial or Intermittent	Perennial	Perennial
Watershed type (Rural, Urban, Developing etc.)	Rural	Rural
Watershed LULC Distribution (e.g.)		
Residential		14%
Ag-Row Crop		66%
Ag-Livestock		-
Forested		20%
Etc.		-
Watershed impervious cover (%)		-
NCDWQ AU/Index number	11-138-2-3-1	N/A
NCDWQ classification	C	N/A
303d listed?	N	N
Upstream of a 303d listed segment?	N	N
Reasons for 303d listing or stressor	N/A	N/A
Total acreage of easement		16.43 Ac
Total vegetated acreage within the easement	0.17 Ac	0.53 Ac
Total planted acreage as part of the restoration		15.73 Ac
Rosgen classification of pre-existing	incised C4/E4	incised C4/E4 w/sections of G4
Rosgen classification of As-built	C4	C4
Valley type		
Valley slope	0.64%	0.63%
Valley side slope range (e.g. 2-3.%)	-	-
Valley toe slope range (e.g. 2-3.%)	-	-
Cowardin classification	-	-
Trout waters designation	N	N
Species of concern, endangered etc.? (Y/N)	N	N
Dominant soil series and characteristics		
Series	Chewacla	Chewacla
Depth	-	-
Clay%	-	-
K	-	-
T	-	-

Use N/A for items that may not apply. Use “-“ for items that are unavailable and “U” for items that are unknown

Appendix B. Morphological Summary Data and Plots

Table 10a. Baseline Stream Data Summary
 Newtown Stream and Wetland Restoration - Underwood Creek - 1273 feet

Parameter	Gauge ²		Regional Curve		Pre-Existing Condition					Reference Reach(es) Data					Design					Monitoring Baseline							
	LL	UL	Eq.	Min	Mean	Med	Max	SD ⁵	n	Min	Mean	Med	Max	SD ⁵	n	Min	Med	Max	SD ⁵	n	Min	Mean	Med	Max	SD ⁵	n	
Dimension and Substrate - Rifle Only																											
Bankfull Width (ft)				8.3	11.72	16.3	107			10	12.2	14.3	14.3			16	15.27	15.88	16.69	16.69	15.27	15.88	15.67	16.69	16.69	0.734	3
Floodprone Width (ft)				12	58											130	140	250	225	225	130	158.3	140	225	59.65	3	
Bankfull Mean Depth (ft)				0.93	1.16	1.29				0.92	1.12	1.34			1.06	1.028	1.049	1.035	1.084	1.028	1.049	1.035	1.084	1.031	0.031	3	
¹ Bankfull Max Depth (ft)				1.02	1.58	2.05									1.6	1.66	1.717	1.74	1.75	1.66	1.717	1.74	1.75	1.75	0.049	3	
Bankfull Cross Sectional Area (ft ²)				10.5	13.3	19.6				12.2	13	13.4			17	15.81	16.67	16.11	18.1	15.81	16.67	16.11	18.1	1.246	3		
Width/Depth Ratio				6.5	10.42	16.8				7.7	11.3	15.6			15	14.76	15.13	15.24	15.4	14.76	15.13	15.24	15.4	0.334	3		
Entrenchment Ratio				1.47	4.65	7.71				2.9	6.5	8.6			8	7.203	9.872	8.936	13.48	7.203	9.872	8.936	13.48	3.241	3		
¹ Bank Height Ratio				1.61	1.83	2.28				0.9	1	1.2			1	1	1	1	1	1	1	1	1	1	0	3	
Profile																											
Rifle Length (ft)				6.33	37.84	106.9				4.03	14.18	23.61			10	21.7	58	7.36	20.81	20.51	20.81	20.51	31.54	5.577	22		
Rifle Slope (ft/ft)				0.0001	0.054	0.238				0	0.02	0.082			0.007	0.013	0.017	0.003	0.013	0.013	0.013	0.013	0.029	0.005	22		
Pool Length (ft)				19.07	55.73	119.9				18.51	32.11	58.03			19	35.96	54	17.45	34.81	34.92	34.81	34.92	52.82	7.611	24		
Pool Max depth (ft)				2	2.31	3.1				1.7	2.47	3.1			2.4	3.5	4.5	2.76	3.402	3.43	3.402	3.43	4.04	0.374	24		
Pool Spacing (ft)				34	91	245				29	48	84			37	63	110	31.47	55.97	54.57	54.57	78.46	10.48	22			
Pattern																											
Channel Beltwidth (ft)				35	47.8	56				25	40	65			34	53	86	34									
Radius of Curvature (ft)				7	47	173				20	31	122			26	41	59	26									
Rc:Bankfull width (ft/ft)				0.06	0.04	0.148				0.016	0.026	0.037			0.016	0.026	0.037	0.016									
Meander Wavelength (ft)				55	113.6	245				62	85.5	245			82	112	130	82									
Meander Width Ratio				1.84	2.52	2.95				2.1	3.3	5.4			2.1	3.3	5.4	2.1									
Transport parameters																											
Reach Shear Stress (competency) lb/ft ²						0.45																					
Max part size (mm) mobilized at bankfull																											
Stream Power (transport capacity) W/m ²																											
Additional Reach Parameters																											
Rosgen Classification						incised C4/E4						E4/C4															
Bankfull Velocity (fps)						4.05																					
Bankfull Discharge (cfs)						55																					
Valley length (ft)						1110						542															
Channel Thalweg length (ft)						1149						650															
Sinuosity (ft)						1.04						1.2															
Water Surface Slope (Channel) (ft/ft)						0.006						0.0065															
BF slope (ft/ft)						0.0071						0.0114															
³ Bankfull Floodplain Area (acres)																											
⁴ % of Reach with Eroding Banks																											
Channel Stability or Habitat Metric																											
Biological or Other																											

Shaded cells indicate that these will typically not be filled in.

1 = The distributions for these parameters can include information from both the cross-section surveys and the longitudinal profile. 2 = For projects with a proximal USGS gauge in-line with the project reach (added bankfull verification - rare).

3. Utilizing survey data produce an estimate of the bankfull Floodplain area in acres, which should be the area from the top of bank to the toe of the terrace rise/slope.

4 = Proportion of reach exhibiting banks that are eroding based on the visual survey for comparison to monitoring data. 5. Of value/needed only if the n exceeds 3.

**Table 10b. Baseline Stream Data Summary (Substrate, Bed, Bank, and Hydrologic Containment Parameter Distributions)
Newtown Stream and Wetland Restoration - UT to Underwood Creek: 3000 feet**

Parameter	Pre-Existing Condition						Reference Reach(es) Data						
¹ Ri% / Ru% / P% / G% / S%	39%	2%	53%	4%			28%	4%	60%	8%			
¹ SC% / Sa% / G% / C% / B% / Be%	0%	2%	92.81%	4.72%	0.47%	0%	0.9%	3%	81.6%	14.0%	0%	0.5%	
¹ d16 / d35 / d50 / d84 / d95 / d1 ^p / d1 ^{SP} (mm)	12.70	19.80	24.50	43.05	60.50		11.59	20.73	29.25	60.76	82.68		
² Entrenchment Class <1.5 / 1.5-1.99 / 2.0-4.9 / 5.0-9.9 / >10													
³ Incision Class <1.2 / 1.2-1.49 / 1.5-1.99 / >2.0													
Parameter	Design						As-built/Baseline						
¹ Ri% / Ru% / P% / G% / S%	34%		64%			1%	34%		64%			1%	
¹ SC% / Sa% / G% / C% / B% / Be%													
¹ d16 / d35 / d50 / d84 / d95 / d1 ^p / d1 ^{SP} (mm)													
² Entrenchment Class <1.5 / 1.5-1.99 / 2.0-4.9 / 5.0-9.9 / >10													
³ Incision Class <1.2 / 1.2-1.49 / 1.5-1.99 / >2.0													

Shaded cells indicate that these will typically not be filled in.

1 = Riffle, Run, Pool, Glide, Step; Silt/Clay, Sand, Gravel, Cobble, Boulder, Bedrock; dip = max pave, disp = max subpave

2 = Entrenchment Class - Assign/bin the reach footage into the classes indicated and provide the percentage of the total reach footage in each class in the table. This will result from the measured cross-sections as well as visual estimates

3 = Assign/bin the reach footage into the classes indicated and provide the percentage of the total reach footage in each class in the table. This will result from the measured cross-sections as well as the longitudinal profile

Footnotes 2.3 - These classes are loosely built around the Rosgen classification and hazard ranking breaks, but were adjusted slightly to make for easier assignment to somewhat coarser bins based on visual estimates in the field such that measurement of every segment for ER would not be necessary. The intent here is to provide the reader/consumer of design and monitoring information with a good general sense of the extent of hydrologic containment in the pre-existing and the rehabilitated states as well as comparisons to the reference distributions. ER and BHR have been addressed in prior submissions as a subsample (cross-sections as part of the design survey), however, these subsamples have often focused entirely on facilitating design without providing a thorough pre-construction distribution of these parameters, leaving the reader/consumer with a sample that is weighted heavily on the stable sections of the reach. This means that the distributions for these parameters should include data from both the cross-section surveys and the longitudinal profile and in the case of ER, visual estimates. For example, the typical longitudinal profile permits sampling of the BHR at riffles beyond those subject to cross-sections and therefore can be readily

Table 11a. Monitoring Data - Dimensional Morphology Summary (Dimensional Parameters – Cross Sections)

Newtown Stream and Wetland Restoration - Underwood Creek: 1273 feet

	Cross Section 1 (Riffle)					Cross Section 2 (Riffle)					Cross Section 3 (Riffle)										
	Base	MY1	MY2	MY3	MY4	MY5	MY+	Base	MY1	MY2	MY3	MY4	MY5	MY+	Base	MY1	MY2	MY3	MY4	MY5	MY+
Based on fixed baseline bankfull elevation¹	594.36							592.56							590.75						
Record elevation (datum) used																					
Bankfull Width (ft)	15.67							16.69							15.27						
Floodprone Width (ft)	140							225							110						
Bankfull Mean Depth (ft)	1.03							1.08							1.03						
Bankfull Max Depth (ft)	1.74							1.75							1.66						
Bankfull Cross Sectional Area (ft ²)	16.11							18.10							15.81						
Bankfull Width/Depth Ratio	15.24							15.40							14.76						
Bankfull Entrenchment Ratio	8.94							13.48							7.20						
Bankfull Bank Height Ratio	1.00							1.00							1.00						
Based on current/developing bankfull feature²																					
Record elevation (datum) used																					
Bankfull Width (ft)																					
Floodprone Width (ft)																					
Bankfull Mean Depth (ft)																					
Bankfull Max Depth (ft)																					
Bankfull Cross Sectional Area (ft ²)																					
Bankfull Width/Depth Ratio																					
Bankfull Entrenchment Ratio																					
Bankfull Bank Height Ratio																					
Cross Sectional Area between end pins (ft ²)																					
d50 (mm)																					

These cells may or may not require population in any given year. See footnote 2 below

1 = Widths and depths for monitoring resurvey will be based on the baseline bankfull datum regardless of dimensional/depositional development. Input the elevation used as the datum, which should be consistent and based on the baseline datum established. If the performer has inherited the project and cannot acquire the datum used for prior years this must be discussed with EEP. If this cannot be resolved in time for a given years report submission a footnote in this should be included that states: "It is uncertain if the monitoring datum has been consistent over the monitoring history, which may influence calculated values. Additional data from a prior performer is being acquired to provide confirmation. Values will be recalculated in a future submission based on a consistent datum if determined to be necessary."

2 = Based on the elevation of any dominant depositional feature that develops and is observed at the time of survey. If the baseline datum remains the only significant depositional feature then these two sets of dimensional parameters will be equal, however, if another depositional feature of significance develops above or below the baseline bankfull datum then this should be tracked and quantified in these cells.


Exhibit Table 11b. Monitoring Data - Stream Reach Data Summary
 Newtown Stream and Wetland Restoration - Underwood Creek: 1273 feet

Parameter	Baseline										MY-1					MY-2					MY-3					MY-4					MY-5					
	Min	Mean	Med	Max	SD ¹	n	Min	Mean	Med	Max	SD ¹	n	Min	Mean	Med	Max	SD ¹	n	Min	Mean	Med	Max	SD ¹	n	Min	Mean	Med	Max	SD ¹	n	Min	Mean	Med	Max	SD ¹	n
Dimension and Substrate - Riffs only																																				
Bankfull Width (ft)	15.27	15.88	15.67	16.69	0.734	3																														
Floodprone Width (ft)	110	159.3	140	225	59.65	3																														
Bankfull Mean Depth (ft)	1.028	1.049	1.035	1.084	0.031	3																														
Bankfull Max Depth (ft)	1.66	1.717	1.74	1.75	0.049	3																														
Bankfull Cross Sectional Area (ft ²)	15.81	16.67	16.11	18.1	1.246	3																														
Width/Depth Ratio	14.76	15.13	15.24	15.4	0.334	3																														
Entranchment Ratio	7.203	9.872	8.936	13.48	3.241	3																														
'Bank Height Ratio	1	1	1	1	0	3																														
Profile																																				
Rifle Length (ft)	7.36	20.81	20.51	31.54	5.577	22																														
Rifle Slope (ft/ft)	0.003	0.013	0.013	0.029	0.005	22																														
Pool Length (ft)	17.45	34.81	34.92	52.82	7.611	24																														
Pool Max depth (ft)	2.76	3.402	3.43	4.04	0.374	24																														
Pool Spacing (ft)	31.47	55.97	54.57	78.46	10.48	22																														
Pattern																																				
Channel Beltwidth (ft)	34	53	86																																	
Radius of Curvature (ft)	26	41	59																																	
Rc:Bankfull width (ft/ft)	0.016	0.026	0.037																																	
Meander Wavelength (ft)	82	112	130																																	
Meander Width Ratio	2.1	3.3	5.4																																	
Additional Reach Parameters																																				
Rosgen Classification																																				
Channel Thalweg length (ft)																																				
Sinuosity (ft)																																				
Water Surface Slope (Channel) (ft/ft)																																				
BF slope (ft/ft)																																				
² Ri% / Ru% / P% / G% / S%																																				
³ SC% / Sa% / G% / C% / B% / Be%																																				
⁴ d16 / d85 / d50 / d84 / d85																																				
% of Reach with Eroding Banks																																				
Channel Stability or Habitat Metric																																				
Biological or Other																																				

Pattern data will not typically be collected unless visual data, dimensional data or profile data indicate significant shifts from baseline

Shaded cells indicate that these will typically not be filled in.
 1 = The distributions for these parameters can include information from both the cross-section surveys and the longitudinal profile.
 2 = Riparian vegetation metrics that are eroding based on the visual survey from visual assessment table.
 3 = Riparian Channel Stability Metric: Sand, Silt/Clay, Gravel, Cobble, Boulder, Bedrock, dp = max pave; dsp = max subpave
 4 = Of values needed only if the n exceeds 3

Underwood Creek (Newtown)
Longitudinal Profile
Main: Station 5+00 - 19+00

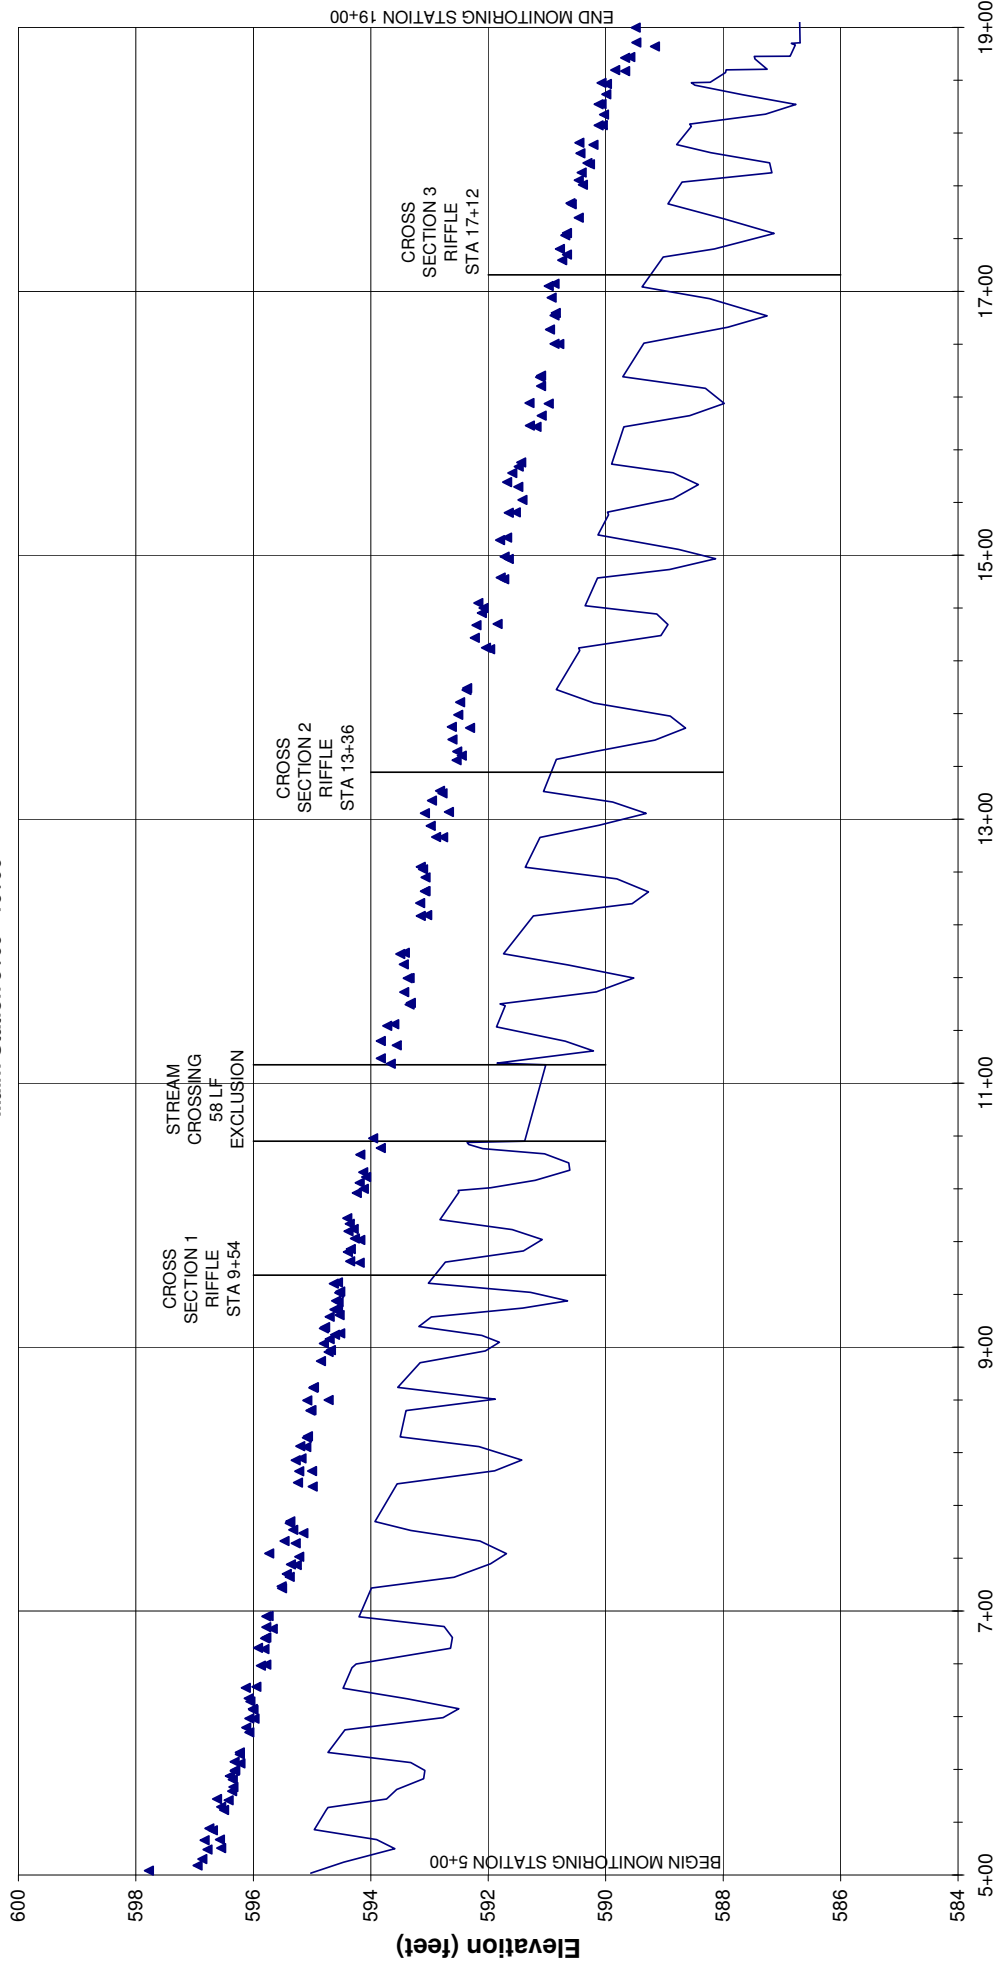

Station (feet)


— TW MY-00 ▲ BKF MY-00

Elevation (feet)

BEGIN MONITORING STATION 5+00

END MONITORING STATION 19+00

UT to Underwood Creek (Newtown)
 Longitudinal Profile
 Tributary: Station 5+82 - 36+78

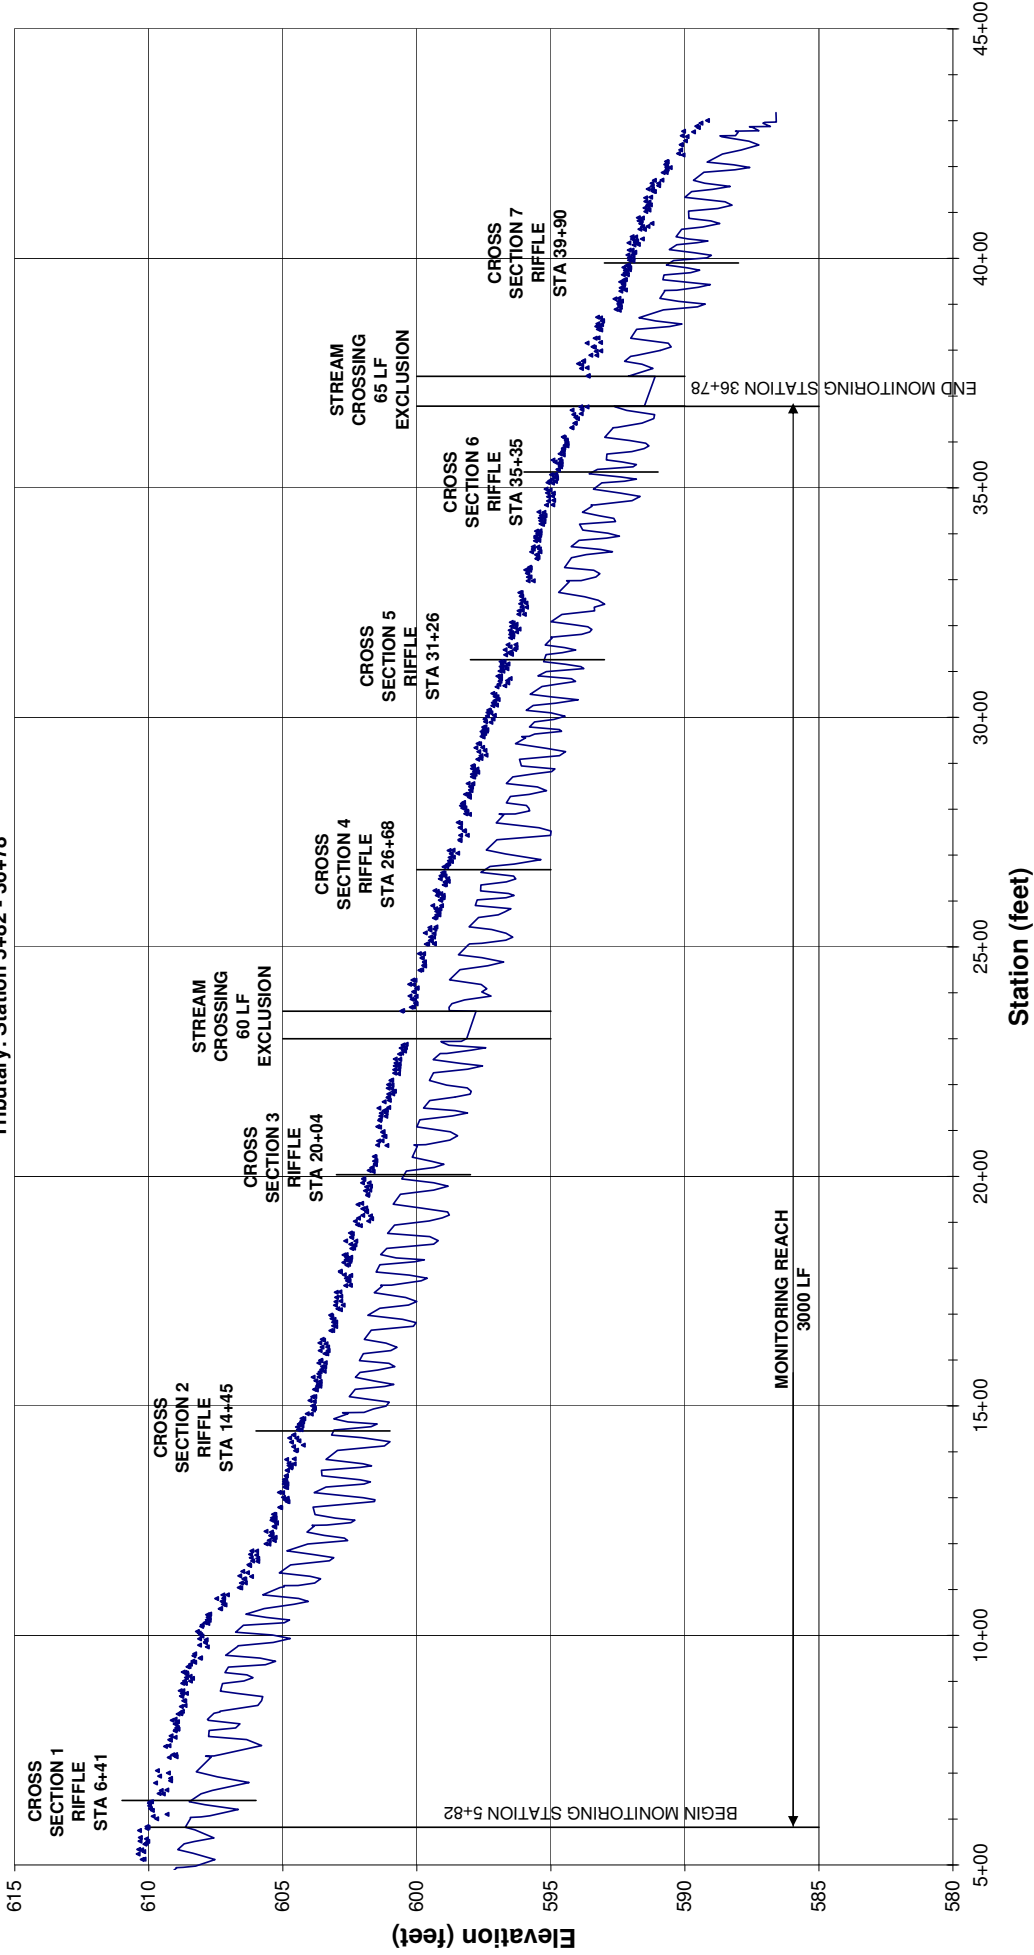

— TW MY-00 · BKF MY-00


Project: Underwood Creek		Summary (bankfull)	
Cross Section: Cross Section 1	MY0		
Feature: R/Rifle	A (BKF)	16.1	
Station: 9+54.47	W (BKF)	15.7	
Date: 4/22/11	Max d	1.7	
Crew: ZAP	Mean d	1.0	
	W/D	15.2	

Station	Elevation	Notes
0.00	594.84	LPIN
0.01	594.63	
4.29	594.61	
9.27	594.58	
13.01	594.50	BKF L
15.20	594.36	
16.21	594.12	
17.17	593.87	
18.21	593.78	
19.94	593.30	
21.10	592.79	TOE L
21.89	592.64	
23.14	592.65	
24.17	592.73	TW
24.80	592.62	
25.43	592.81	
26.36	592.74	
26.87	592.75	TOE R
27.98	593.54	
28.77	593.60	
29.79	593.97	
30.48	594.24	
31.61	594.59	BKF R
33.90	594.68	
36.18	594.57	
39.99	594.55	
42.80	594.38	
45.62	594.49	
50.18	594.82	
50.19	595.08	RPIN



Photo of XS-1, looking in the downstream direction

Underwood Creek Cross Section 1

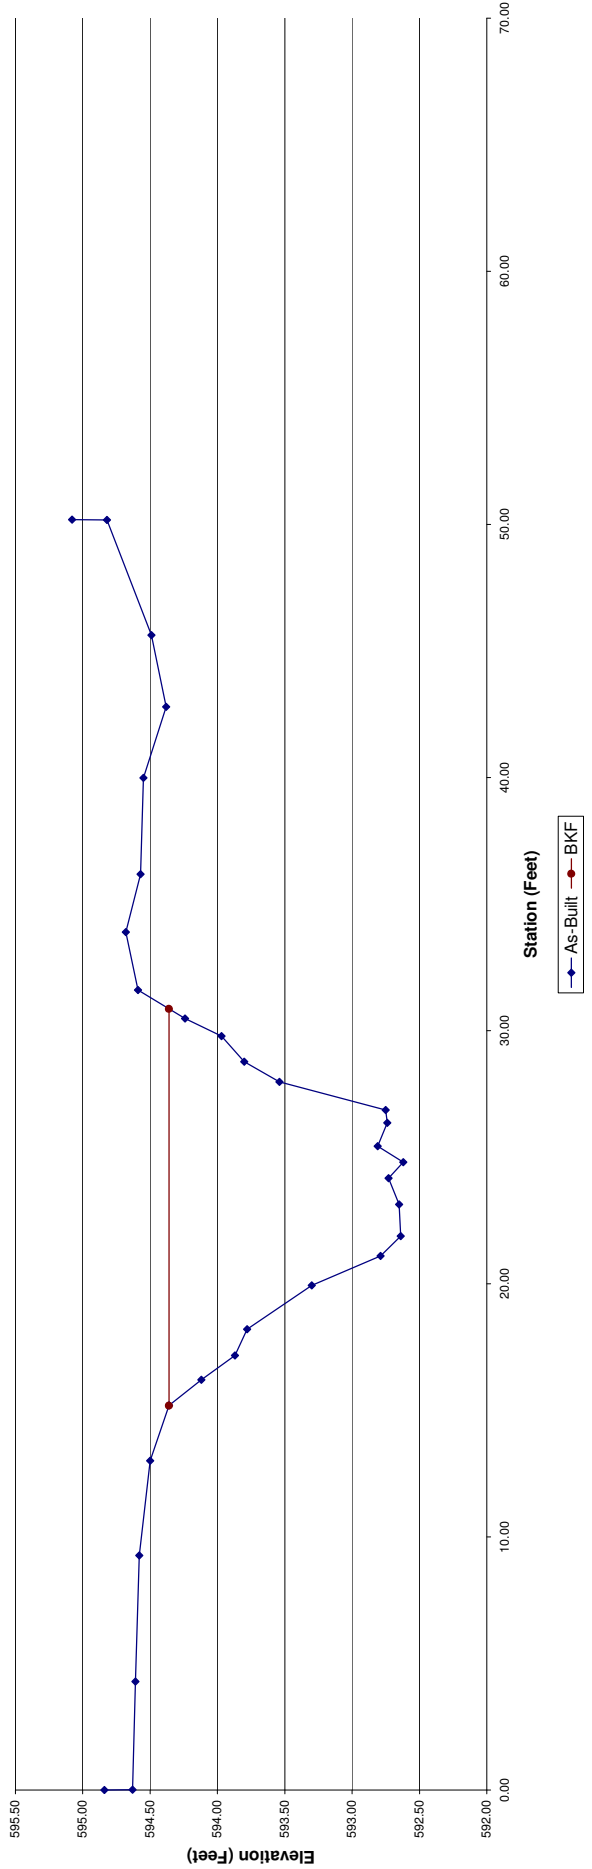


Project: Underwood Creek		Summary (bankfull)	
Cross Section: Cross Section 2	MY0		
Feature: Riffe	A (BKF)	18.1	
Station: 13+35.70	W (BKF)	16.7	
Date: 4/22/11	Max d	1.8	
Crew: ZAP	Mean d	1.1	
	W/D	15.4	

Station	Elevation	Notes
0.00	592.82	LPIN
0.01	592.63	
4.04	592.74	
8.34	592.67	
11.02	592.59	BKF L
13.25	592.56	
14.11	592.29	
15.01	591.97	
15.85	591.92	
16.62	591.68	
18.56	590.87	TOE L
19.72	590.81	
20.50	590.81	TW
21.49	590.89	
22.58	590.84	
23.35	590.82	
24.28	590.91	TOE R
25.09	591.29	
27.02	591.91	
28.05	591.94	
29.00	592.34	
30.33	592.65	BKF R
31.93	592.74	
35.28	593.06	
39.83	593.11	
43.88	593.18	
43.89	593.30	RPIN



Photo of XS-2, looking in the downstream direction

Underwood Creek Cross Section 2

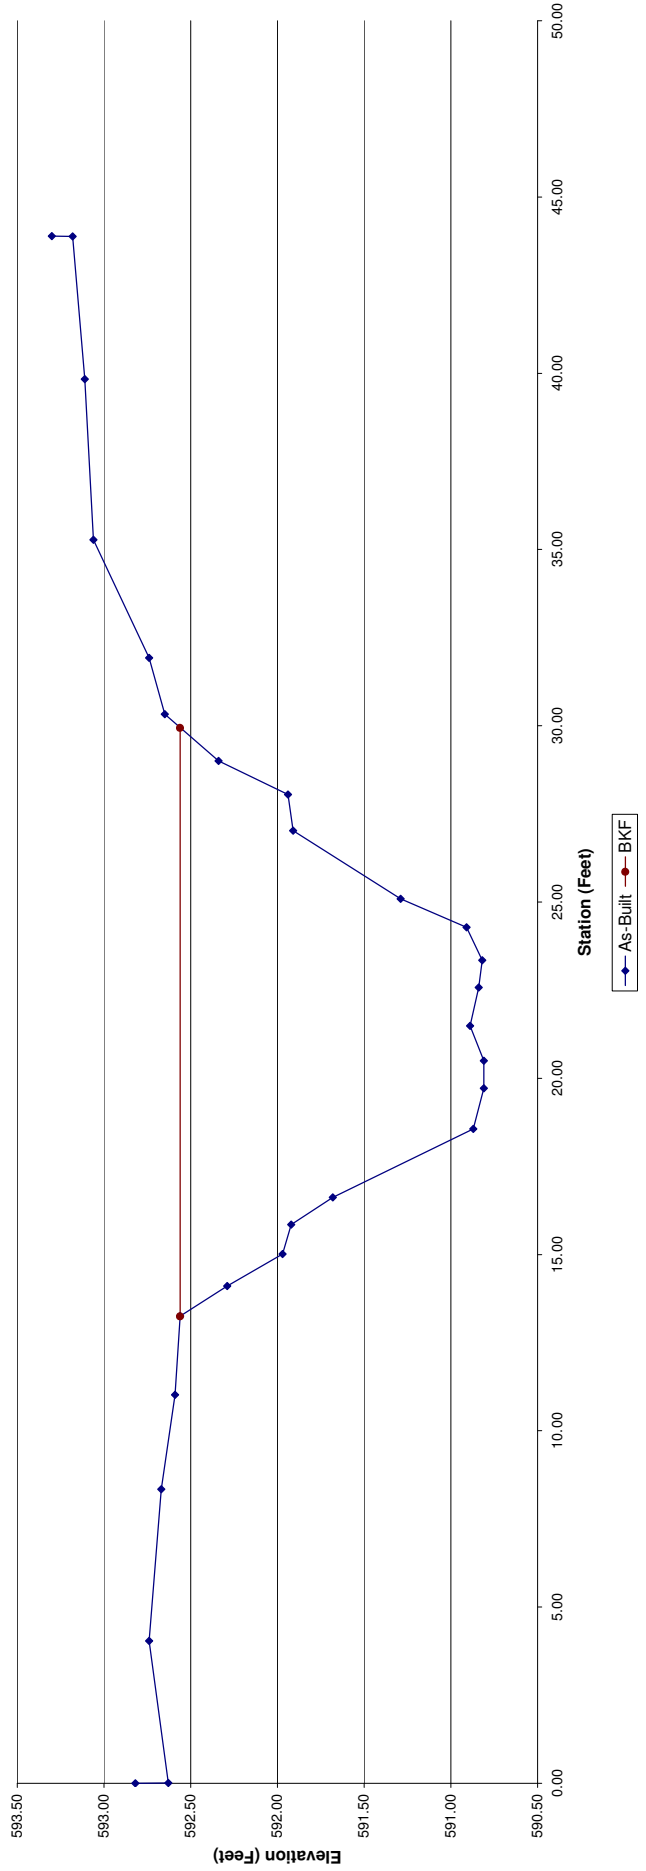


Project: Underwood Creek		Summary (bankfull)	
Cross Section: Cross Section 3		MY0	
Feature: Riffe		15.8	
Station: 17+12.49		15.3	
Date: 4/22/11		1.7	
Crew: ZAP		1.0	
		14.8	

Station	Elevation	Notes
0.00	591.00	LPIN
0.01	590.82	
3.42	590.87	
7.15	590.76	
11.17	590.76	BKF L
13.49	590.75	
14.38	590.42	
15.73	590.06	
16.68	589.94	
17.23	589.65	
18.76	589.16	TOE L
19.65	589.14	
20.43	589.25	
20.92	589.13	
21.39	589.09	TW
22.89	589.19	
24.28	589.25	TOE R
25.22	589.70	
26.25	590.07	
26.86	590.19	
27.87	590.55	
29.03	590.81	BKF R
31.53	590.93	
34.50	590.84	
38.05	591.16	
41.52	591.17	
43.70	591.25	
43.71	591.55	RPIN



Photo of XS-3 looking in the downstream direction

Underwood Creek Cross Section 3

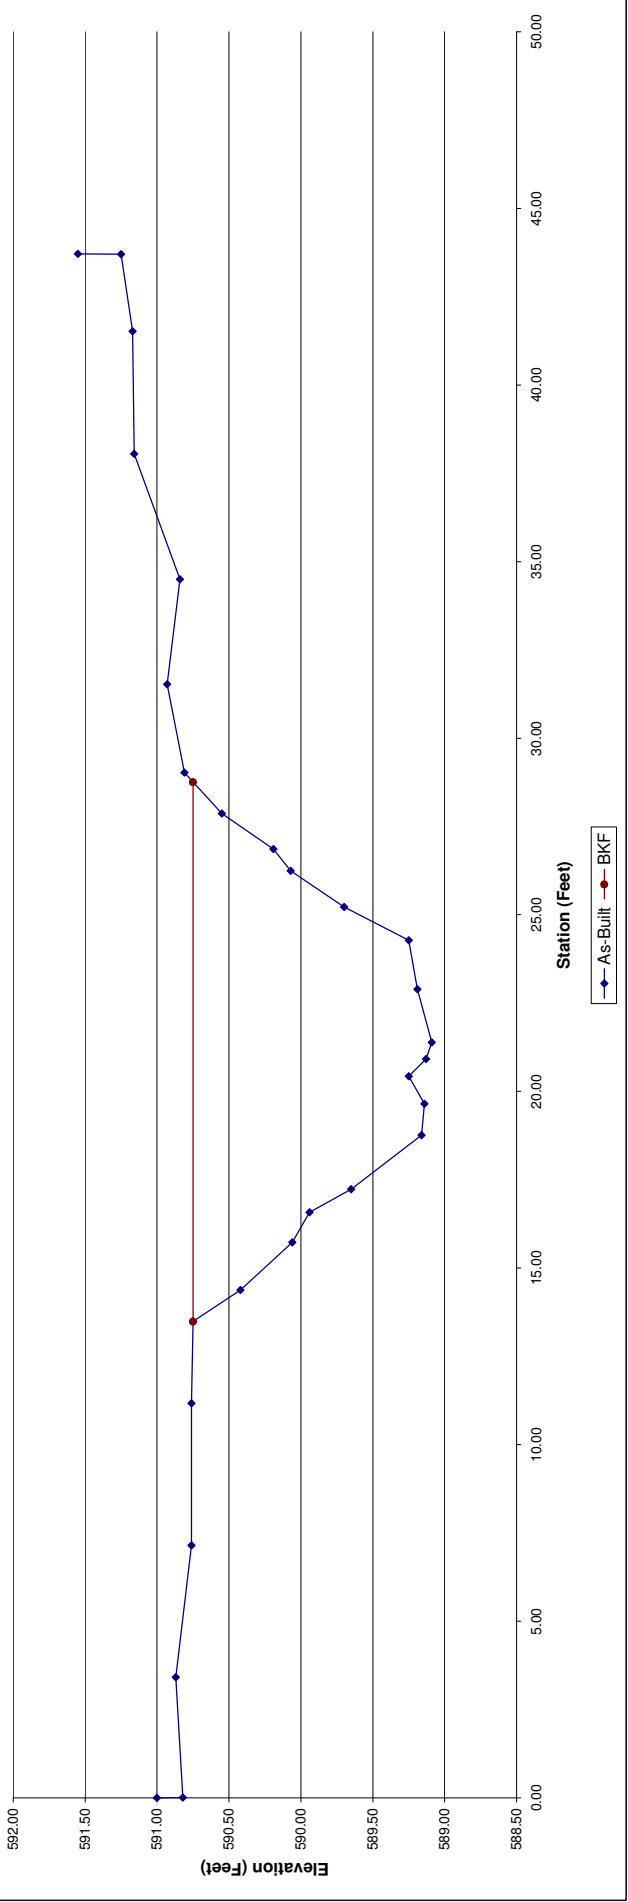


Project: UT to Underwood Creek		Summary (bankfull)	
Cross Section: Cross Section 1	MY0		
Feature: Riffe	13.1		
Station: 6+40.50	12.3		
Date: 4/22/11	Max d	2.0	
Crew: ZAP	Mean d	1.1	
	W/D	1.1.6	



Photo of XS-1, looking in the downstream direction

Station	Elevation	Notes
0.00	610.36	LPIN
0.01	610.16	
2.48	609.97	
6.28	609.88	
10.49	610.00	
14.36	610.04	
18.19	609.89	
20.42	609.86	BKF L
21.34	609.52	
22.06	609.32	
22.82	609.14	
23.59	609.03	
24.39	608.70	
24.81	608.42	TOE L
25.25	608.35	
25.59	607.98	
26.36	607.91	TW
27.30	607.88	
28.35	608.45	
29.33	608.42	
29.95	608.64	TOE R
30.62	609.04	
31.79	609.42	
32.56	609.80	
33.38	610.07	BKF R
35.33	609.97	
37.99	609.90	
41.46	609.89	
43.74	610.14	
47.41	609.86	
50.12	610.21	
53.50	610.88	
56.38	610.94	
59.39	611.08	
59.40	611.20	RPIN

UT to Underwood Creek Cross Section 1

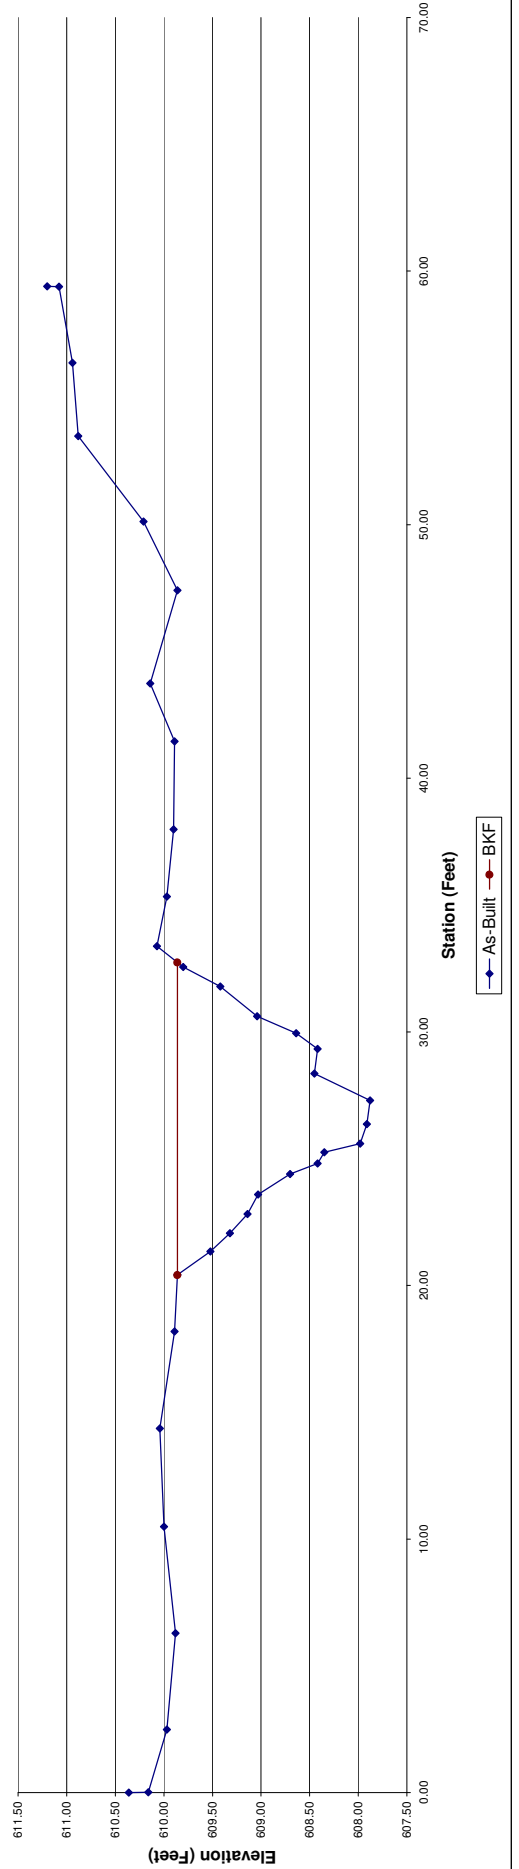


Project:	UT to Underwood Creek			
Cross Section:	Cross Section 2			
Feature:	Riffle			
Station:	14+45.49			
Date:	4/22/11			
Crew:	ZAP			
	Summary (bankfull)			
A (BKF)	MY0			
W (BKF)	13.4			
Max d	16.5			
Mean d	1.7			
W/D	0.8			
	20.4			

Station	Elevation	Notes
0.00	604.39	LPIN
0.01	604.26	
2.13	604.32	
6.38	604.27	
10.78	604.22	
14.17	604.38	
16.41	604.15	
19.49	604.31	
21.94	604.39	
24.06	604.46	
26.07	604.51	BKF L
26.70	604.43	
27.72	604.12	
28.56	603.72	
29.42	603.54	
30.07	603.36	
30.53	602.97	TOE L
31.04	602.79	
31.51	602.89	
32.26	602.86	TW
33.00	602.96	
33.70	603.06	
34.47	602.97	TOE R
35.66	603.12	
36.57	603.59	
37.18	603.76	
37.68	603.87	
38.50	604.27	
39.63	604.48	BKF R
40.84	604.41	
43.11	604.54	
46.87	604.49	
50.62	604.59	
53.56	604.60	
56.79	604.43	
61.38	604.74	
64.10	604.80	
65.88	604.87	
65.89	605.07	RPIN



Photo of XS-2, looking in the downstream direction

UT to Underwood Creek Cross Section 2

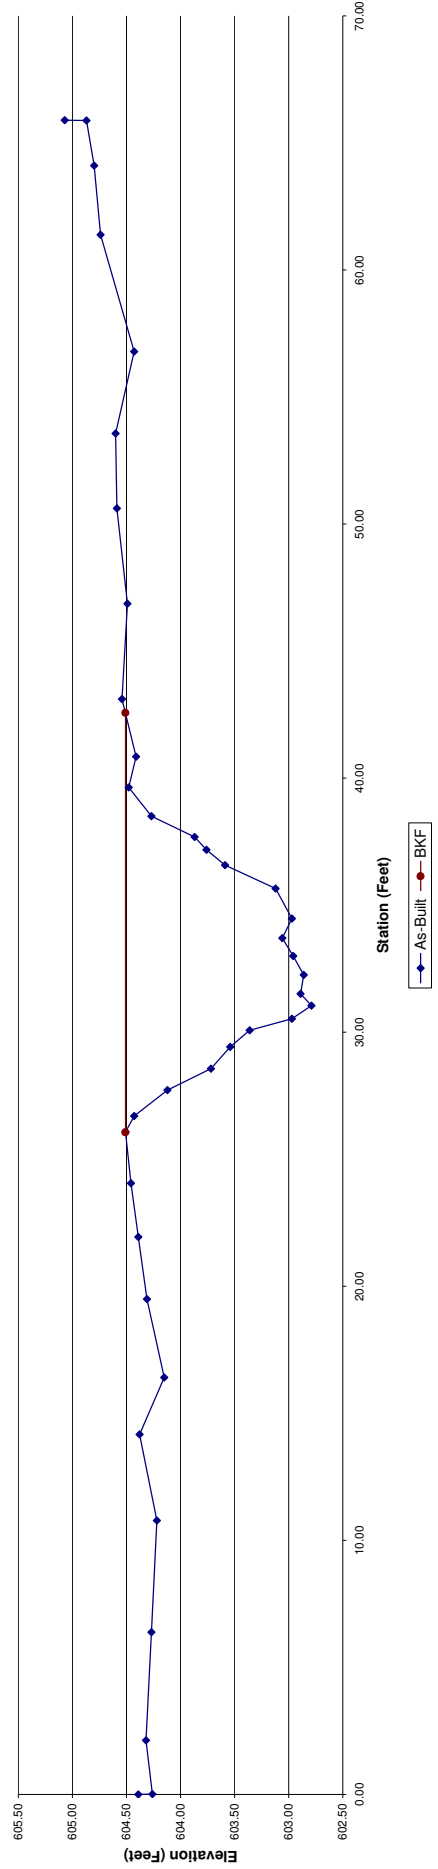


Project:	UT to Underwood Creek				
Cross Section:	Cross Section 3				
Feature:	Rifle				
Station:	20+03.76				
Date:	4/22/11				
Crew:	ZAP				
	Summary (bankfull)				
	MY0				
A (BKF)	13.6				
W (BKF)	14.0				
Max d	1.6				
Mean d	1.0				
W/D	14.4				



Photo of XS-3 looking in the downstream direction

Station	Elevation	Notes
0.00	602.04	LPIN
0.01	601.90	
3.76	601.85	
7.03	601.91	
9.84	602.05	
12.83	601.80	
16.24	601.76	
19.36	601.88	
21.99	601.96	
23.08	601.91	BKF L
24.00	601.63	
24.95	601.26	
25.91	601.08	
26.83	600.79	
27.43	600.43	TOE L
28.02	600.41	
28.88	600.45	
29.99	600.40	
30.80	600.33	TW
31.59	600.50	
32.75	600.56	TOE R
34.04	601.07	
34.27	601.09	
35.37	601.33	
36.49	601.77	
37.60	602.04	BKFR
39.63	602.06	
43.50	601.91	
47.20	602.18	
49.43	602.21	
54.28	602.08	
59.47	602.06	
62.81	601.90	
64.53	602.10	
64.54	602.18	RPIN

UT to Underwood Creek Cross Section 3

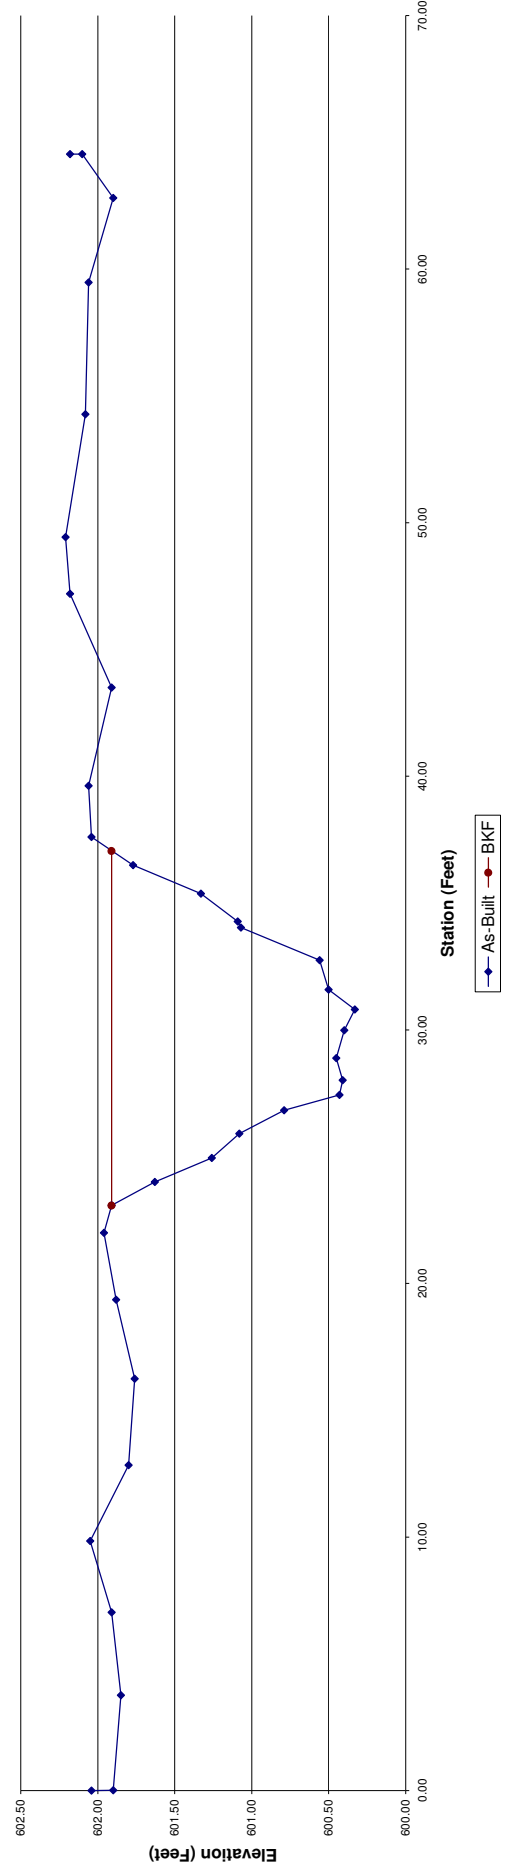

Project:	UT to Underwood Creek										
Cross Section:	Cross Section 4										
Feature:	Rifle										
Station:	26+68.31										
Date:	4/22/11										
Crew:	ZAP										
	Summary (bankfull)										
	MY0	MY1	MY2	MY3	MY4	MY5					
A (BKF)	12.9										
W (BKF)	13.4										
Max d	1.5										
Mean d	1.0										
W/D	13.9										


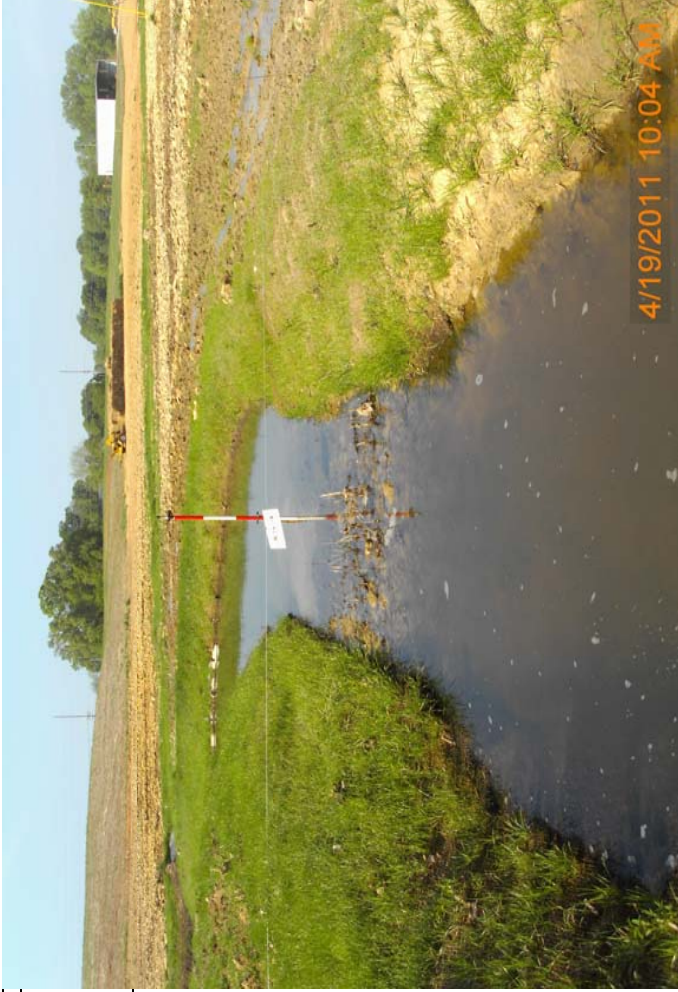


Photo of XS-4, looking in the downstream direction

Station	Elevation	Notes
0.00	599.34	LPIN
0.01	599.19	
1.91	599.33	
3.64	599.10	
6.29	599.07	
9.53	599.07	
12.65	599.00	
15.43	598.95	
18.68	598.94	
20.80	598.96	
22.62	599.01	BKF L
23.56	598.60	
24.24	598.22	
25.35	598.10	
26.18	597.86	
27.34	597.51	TOE L
28.46	597.43	
29.36	597.40	
30.01	597.51	
30.73	597.36	TW
31.61	597.38	
32.18	597.53	TOE R
33.00	597.91	
33.71	598.09	
34.41	598.27	
35.47	598.65	
36.38	598.86	BKF R
38.52	598.80	
41.13	598.96	
43.78	598.88	
46.56	598.63	
50.05	598.86	
51.84	599.07	
54.06	599.11	
55.13	599.42	
55.14	599.66	RPIN

UT to Underwood Creek Cross Section 4

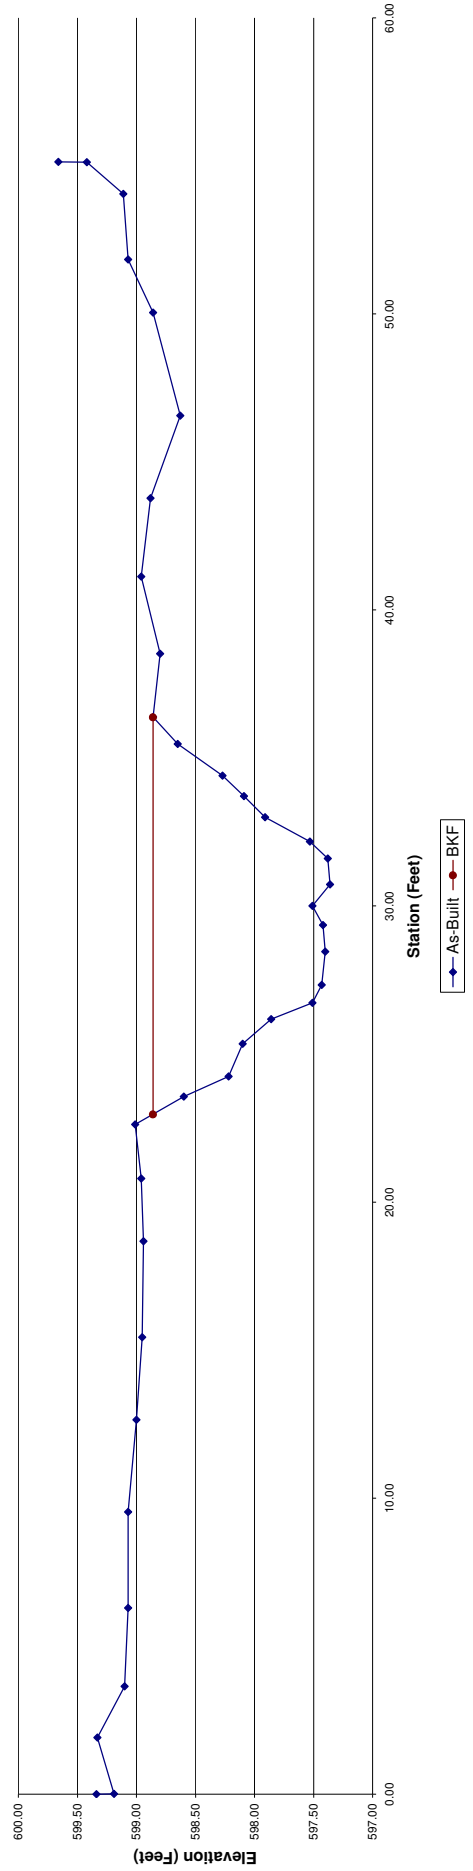


Project:	UT to Underwood Creek				
Cross Section:	Cross Section 5				
Feature:	Rifle				
Station:	31+25.66				
Date:	4/22/11				
Crew:	ZAP				
	Summary (bankfull)				
	MY0				
A (BKF)	11.6				
W (BKF)	12.7				
Max d	1.6				
Mean d	0.9				
W/D	13.9				

Station	Elevation	Notes
0.00	597.59	LPIN
0.01	597.21	
2.24	597.21	
5.17	597.02	
7.12	596.76	
7.76	597.17	
10.04	596.62	
12.46	596.74	
15.65	596.78	
18.38	596.88	
20.76	596.80	BKF L
22.48	596.36	
24.00	595.84	
24.80	595.63	
25.41	595.16	TOE L
25.82	595.06	TW
26.19	595.24	
26.73	595.25	
27.31	595.33	
28.06	595.36	
29.06	595.27	
29.86	595.27	
30.51	595.40	TOE R
31.27	595.87	
31.83	596.08	
32.56	596.24	
33.12	596.46	
33.98	596.67	BKF R
35.42	596.67	
37.44	596.73	
39.55	596.62	
42.32	596.65	
45.33	596.60	
48.12	596.83	
50.51	596.70	
53.00	596.62	
55.88	596.83	
58.69	596.92	
58.70	597.14	RPIN



Photo of XS-5, looking in the downstream direction

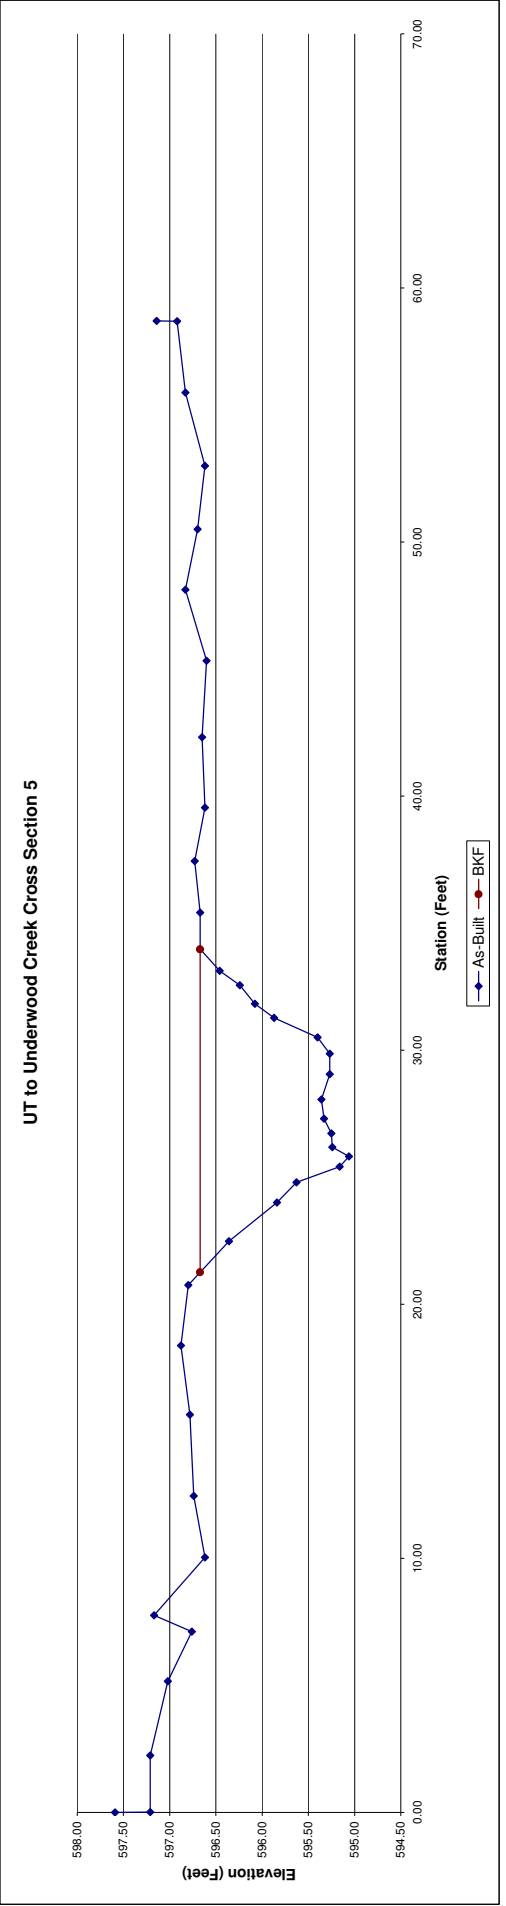


Project:	UT to Underwood Creek				
Cross Section:	Cross Section 6				
Feature:	Rifle				
Station:	35+34.55				
Date:	4/22/11				
Crew:	ZAP				
	Summary (bankfull)				
	MY0				
A (BKF)	12.8				
W (BKF)	13.6				
Max d	1.5				
Mean d	0.9				
W/D	14.5				



Photo of XS-6, looking in the downstream direction

Station	Elevation	Notes
0.00	594.99	LPIN
0.01	594.86	
2.08	594.78	
4.66	594.70	
7.34	594.73	
9.67	594.79	
13.36	594.76	
15.87	594.76	
17.51	594.85	BKF L
18.49	594.64	
19.57	594.20	
20.43	594.10	
21.80	593.55	TOE L
22.73	593.43	
23.64	593.47	
24.42	593.47	TW
25.40	593.47	
26.25	593.50	
27.45	593.39	TOE R
27.72	593.76	
28.89	594.09	
29.93	594.32	
31.18	594.87	BKF R
33.96	594.79	
36.54	594.71	
39.97	594.71	
44.21	594.81	
46.97	594.85	
51.14	595.00	
54.31	595.02	
57.33	595.31	
60.20	595.24	
60.21	595.31	RPIN

UT to Underwood Creek Cross Section 6

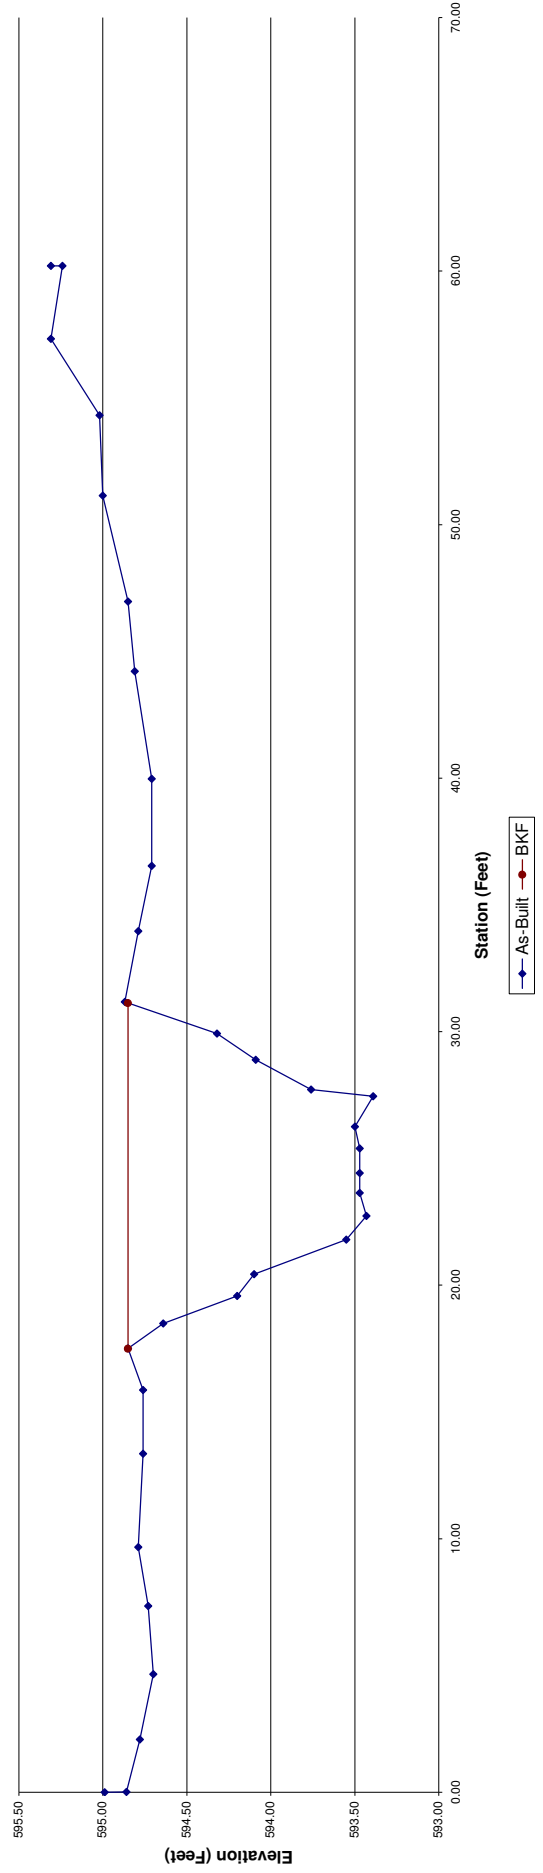


Project:	UT to Underwood Creek	Summary (bankfull)			
Cross Section:	Cross Section 7	MY0			
Feature:	Rifle	15.2			
Station:	39+30.06	15.3			
Date:	4/22/11	1.6			
Crew:	ZAP	1.0			
		15.3			

Station	Elevation	Notes
0.00	592.28	LPIN
0.01	592.07	
2.48	592.11	
5.11	592.10	
8.04	592.01	
12.48	591.96	BKF L
15.52	592.00	
16.48	591.72	
17.58	591.30	
18.47	591.22	
19.44	590.90	
19.93	590.69	
20.28	590.42	TOE L
21.01	590.46	
22.16	590.46	TW
23.50	590.42	
24.59	590.44	
25.55	590.39	TOE R
26.31	590.85	
27.53	591.25	
28.74	591.34	
29.94	591.80	
30.91	592.03	BKF R
32.47	592.00	
35.62	592.03	
38.35	592.00	
41.08	592.05	
42.92	592.08	
42.93	592.26	RPIN




Photo of XS-7, looking in the downstream direction

UT to Underwood Creek Cross Section 7

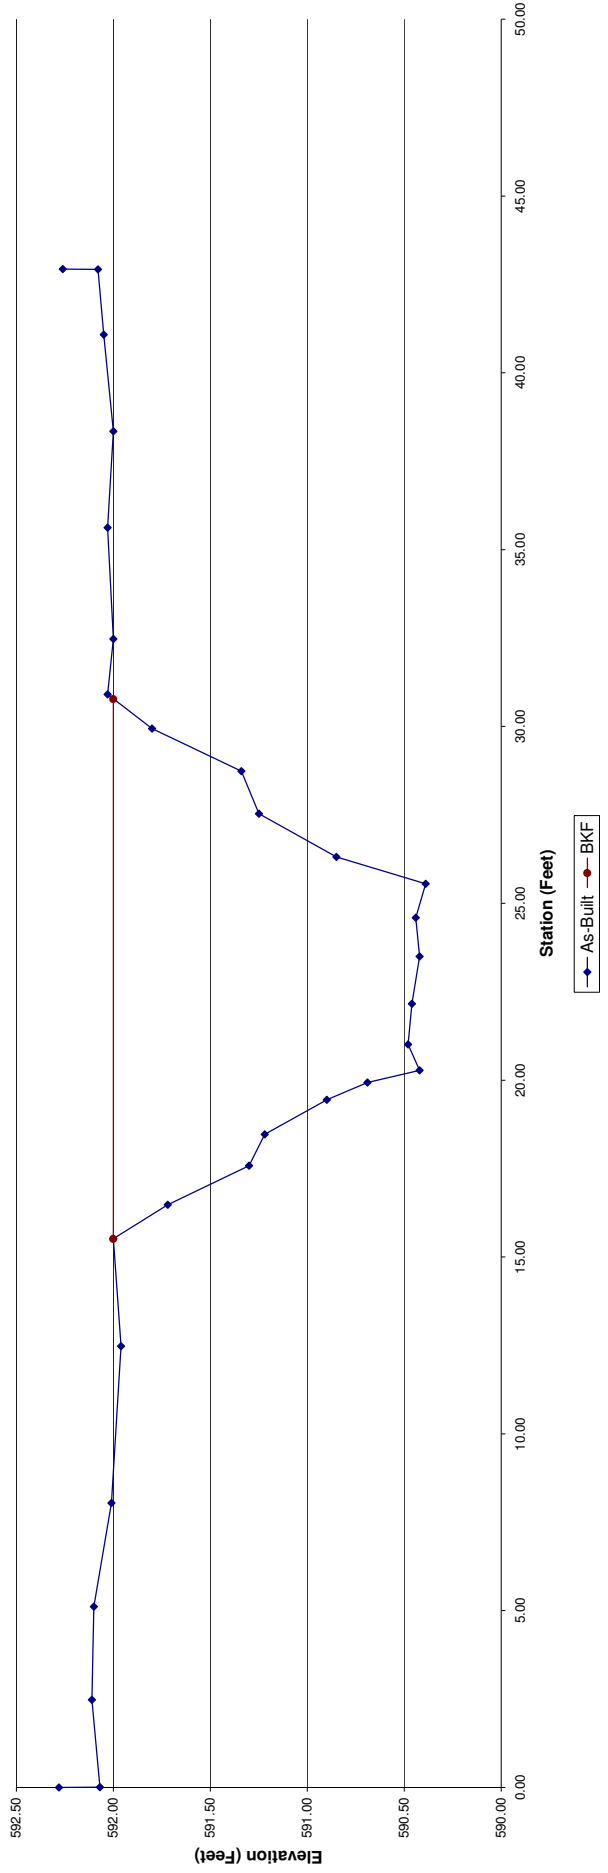

Appendix C. Vegetation Data

Vegetation Plot Photos

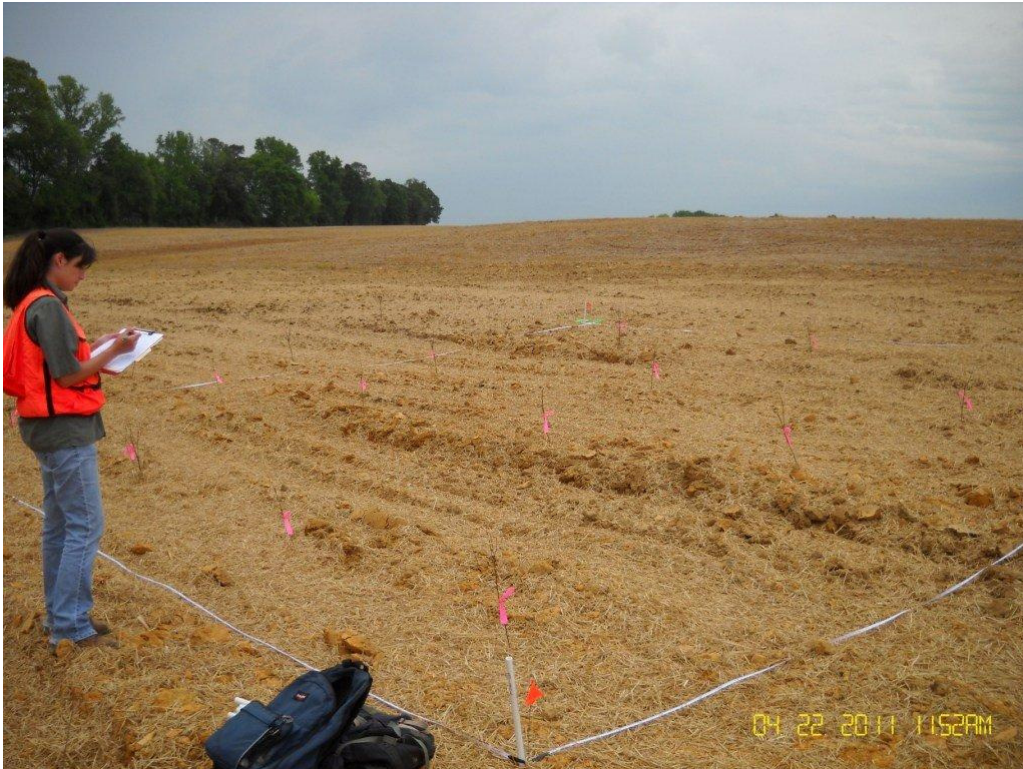


Veg Plot 1



Veg Plot 2



Veg Plot 3

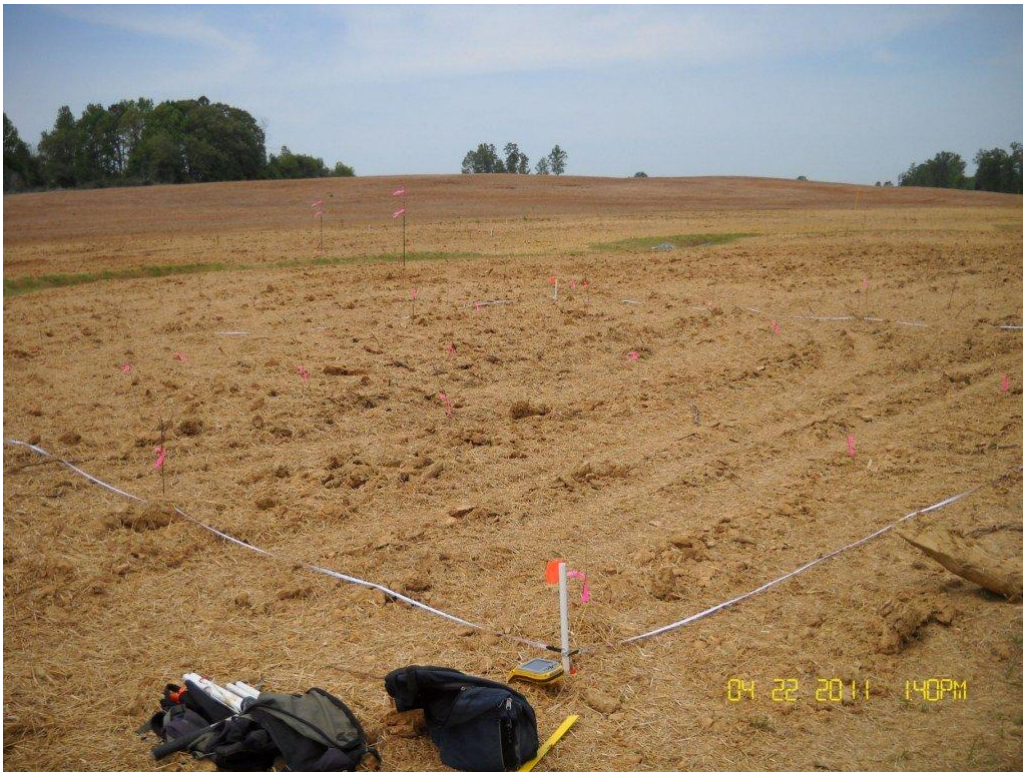

Veg Plot 4



Veg Plot 5



Veg Plot 6



Veg Plot 7



Veg Plot 8



Veg Plot 9



Veg Plot 10



Veg Plot 11



Veg Plot 12



Veg Plot 13

Table 7. Planted and Total Stem Counts (Species by Plot with Annual Means)

EPP Project Code 4143. Project Name: Newtown Stream and Wetland Restoration

Scientific Name	Common Name	Species Type	Current Plot Data (MYO 2011)												Annual Means				
			4143-01-0001		4143-01-0002		4143-01-0003		4143-01-0004		4143-01-0005		4143-01-0006		4143-01-0007				
			P-noLS	T	P-noLS	T	P-noLS	T	P-noLS	T	P-noLS	T	P-noLS	T	P-noLS	T			
<i>Asimina triloba</i>	pawpaw	Shrub Tree			1	1													
<i>Betula nigra</i>	river birch	Tree	7	7	3	3	6	6							1	1	1	1	6
<i>Carpinus caroliniana</i>	American hornbeam	Shrub Tree							2	2									
<i>Carpinus caroliniana</i> var. <i>caroliniana</i>	Coastal American Hornbeam	Shrub Tree							3	3									1
<i>Carya</i>	hickory	Tree																	1
<i>Celtis laevigata</i>	sugarberry	Shrub Tree																	1
<i>Cornus amomum</i>	silky dogwood	Shrub													1	1			1
<i>Diospyros virginiana</i>	common persimmon	Tree	3	3	2	2	2	2											
<i>Fraxinus pennsylvanica</i>	green ash	Tree			5	5	2	2							5	5	3	3	3
<i>Platanus occidentalis</i>	American sycamore	Tree																	
<i>Platanus occidentalis</i> var. <i>occidentalis</i>	Sycamore, Plane-tree	Tree	3	3	10	10	6	6	16	16									1
<i>Quercus</i>	oak	Shrub Tree	1	1					6	6	5	5	2	2					1
<i>Quercus michauxii</i>	swamp chestnut oak	Tree													1	1			1
Unknown		unknown																	
Stem count size (ares)			14	14	21	21	20	20	19	19	21	21	21	21	13	13	13	13	13
size (ACRES)			0.02	0.02	0.02	0.02	0.02	0.02	0.02	0.02	0.02	0.02	0.02	0.02	0.02	0.02	0.02	0.02	0.02
Species count			4	4	5	5	4	4	5	5	2	2	2	2	6	6	6	6	6
Stems per ACRE			566.6	566.6	849.8	849.8	809.4	809.4	768.9	768.9	849.8	849.8	849.8	849.8	526.1	526.1	526.1	526.1	526.1

Scientific Name	Common Name	Species Type	Current Plot Data (MYO 2011)												Annual Means				
			4143-01-0008		4143-01-0009		4143-01-0010		4143-01-0011		4143-01-0012		4143-01-0013		MYO (2011)				
			P-noLS	T	P-noLS	T	P-noLS	T	P-noLS	T	P-noLS	T	P-noLS	T	P-noLS	T			
<i>Asimina triloba</i>	pawpaw	Shrub Tree	8	8															16
<i>Betula nigra</i>	river birch	Tree																	24
<i>Carpinus caroliniana</i>	American hornbeam	Shrub Tree																	2
<i>Carpinus caroliniana</i> var. <i>caroliniana</i>	Coastal American Hornbeam	Shrub Tree																	6
<i>Carya</i>	hickory	Tree																	2
<i>Celtis laevigata</i>	sugarberry	Shrub Tree																	2
<i>Cornus amomum</i>	silky dogwood	Shrub																	5
<i>Diospyros virginiana</i>	common persimmon	Tree			1	1	4	4	2	2	2	2	1	1	1	1	1	1	3
<i>Fraxinus pennsylvanica</i>	green ash	Tree			3	3	2	2	1	1	2	2	2	2	7	7	26	26	26
<i>Platanus occidentalis</i>	American sycamore	Tree	1	1															20
<i>Platanus occidentalis</i> var. <i>occidentalis</i>	Sycamore, Plane-tree	Tree	2	2	2	2	2	2											7
<i>Quercus</i>	oak	Shrub Tree	2	2	8	8	6	6	6	6	7	7	7	7	3	3	65	65	65
<i>Quercus michauxii</i>	swamp chestnut oak	Tree																	1
Unknown		unknown	1	1															1
Stem count size (ares)			14	14	14	14	15	15	15	15	15	15	14	14	15	15	208	208	208
size (ACRES)			0.02	0.02	0.02	0.02	0.02	0.02	0.02	0.02	0.02	0.02	0.02	0.02	0.02	0.02	0.32	0.32	0.32
Species count			5	5	4	4	4	4	6	6	5	5	5	5	6	6	14	14	14
Stems per ACRE			566.6	566.6	566.6	566.6	566.6	566.6	607	607	607	607	566.6	566.6	607	607	647.5	647.5	647.5

Color for Density

- Exceeds requirements by 10%
- Exceeds requirements, but by less than 10%
- Falls to meet requirements, by less than 10%
- Falls to meet requirements by more than 10%

MYO (2011) values: 16, 24, 2, 6, 2, 2, 7, 26, 20, 7, 21, 15, 6, 6, 6, 6, 14, 14, 14

CVS Metadata

Report Prepared By Chris Sheats
Date Prepared 5/11/2011 17:19

database name TheCatenaGroup-2011-A-Newtownbaseline.mdb
database location C:\Users\csheats\Desktop
computer name CHRIS-PC
file size 37355520

DESCRIPTION OF WORKSHEETS IN THIS DOCUMENT-----

- **Metadata** Description of database file, the report worksheets, and a summary of project(s) and project data.
- **Proj, planted** Each project is listed with its PLANTED stems per acre, for each year. This excludes live stakes.
- **Proj, total stems** Each project is listed with its TOTAL stems per acre, for each year. This includes live stakes, all planted stems, and all natural/volunteer stems.
- **Plots** List of plots surveyed with location and summary data (live stems, dead stems, missing, etc.).
- **Vigor** Frequency distribution of vigor classes for stems for all plots.
- **Vigor by Spp** Frequency distribution of vigor classes listed by species.
- **Damage** List of most frequent damage classes with number of occurrences and percent of total stems impacted by each.
- **Damage by Spp** Damage values tallied by type for each species.
- **Damage by Plot** Damage values tallied by type for each plot.
- **Planted Stems by Plot and Spp** A matrix of the count of PLANTED living stems of each species for each plot; dead and missing stems are excluded.

PROJECT SUMMARY-----

Project Code 4143
project Name Newtown Stream and Wetland Restoration
Description Underwood Creek Stream Restoration in Union County
southwest of Monroe, NC.
River Basin Catawba
length(ft) 5317
stream-to-edge width (ft) 50
area (sq m) 49391.55
Required Plots (calculated) 13
Sampled Plots 13

CVS Proj, planted

Living planted stems, excluding live stakes, per acre: Negative (red) numbers indicate the project failed to reach requirements in a particular year.

Project Code	Project Name	River Basin	Year 0 (baseline)
4143	Newtown Stream and Wetland Restoration	Catawba	647.50

CVS Proj, total stems

Total stems, including planted stems of all kinds (including live stakes) and natural/volunteer stems:

Project Code	Project Name	River Basin	Year 0 (baseline)
4143	Newtown Stream and Wetland Restoration	Catawba	647.4970288

CVS Vigor

vigor	Count	Percent
3	208	100

CVS Vigor by Spp

Species	CommonName	4	3	2	1	0	Missing	Unk.
Asimina triloba	pawpaw		16					
Betula nigra	river birch		24					
Carpinus caroliniana var. caroliniana	Coastal American Hornbeam		6					
Celtis laevigata	sugarberry		5					
Cornus amomum	silky dogwood		3					
Diospyros virginiana	common persimmon		26					
Fraxinus pennsylvanica	green ash		20					
Platanus occidentalis var. occidentalis	Sycamore, Plane-tree		21					
Quercus michauxii	swamp chestnut oak		1					
Carpinus caroliniana	American hornbeam		2					
Quercus	oak		65					
Carya	hickory		2					
Platanus occidentalis	American sycamore		7					
Unknown			10					
TOT:	14	13	208					

CVS Damage

Damage	Count	Percent Of Stems
(no damage)	208	100

CVS Damage by Spp

	Species	CommonName	Count of Damage Categories	(other damage)
	Asimina triloba	pawpaw	0	16
	Betula nigra	river birch	0	24
	Carpinus caroliniana	American hornbeam	0	2
	Carpinus caroliniana var. caroliniana	Coastal American Hornbeam	0	6
	Carya	hickory	0	2
	Celtis laevigata	sugarberry	0	5
	Cornus amomum	silky dogwood	0	3
	Diospyros virginiana	common persimmon	0	26
	Fraxinus pennsylvanica	green ash	0	20
	Platanus occidentalis	American sycamore	0	7
	Platanus occidentalis var. occidentalis	Sycamore, Plane-tree	0	21
	Quercus	oak	0	65
	Quercus michauxii	swamp chestnut oak	0	1
	Unknown		0	10
TOT:	14	13	0	208

CVS Damage by Plot

	plot	Count of Damage Categories	(other damage)
	4143-01-0001	0	14
	4143-01-0002	0	21
	4143-01-0003	0	20
	4143-01-0004	0	19
	4143-01-0005	0	21
	4143-01-0006	0	13
	4143-01-0007	0	13
	4143-01-0008	0	14
	4143-01-0009	0	14
	4143-01-0010	0	15
	4143-01-0011	0	15
	4143-01-0012	0	14
	4143-01-0013	0	15
TOT:	13	0	208

CVS Planted Stems by Plot and Spp

	Comment	Species	CommonName	Total Planted Stems	# plots	avg# stems	plot 4143-01-0001	plot 4143-01-0002	plot 4143-01-0003	plot 4143-01-0004	plot 4143-01-0005
		Asimina triloba	pawpaw	16	4	4		1			
		Betula nigra	river birch	24	7	3.43	7	3	6		
		Carpinus caroliniana	American hornbeam	2	1	2				2	
		Carpinus caroliniana var. caroliniana	Coastal American Hornbeam	6	4	1.5					3
		Carya	hickory	2	1	2					
		Celtis laevigata	sugarberry	5	4	1.25					
		Cornus amomum	silky dogwood	3	2	1.5					
		Diospyros virginiana	common persimmon	26	8	3.25	3	2		6	
		Fraxinus pennsylvanica	green ash	20	8	2.5			2		
		Platanus occidentalis	American sycamore	7	2	3.5		5		2	
		Platanus occidentalis var. occidentalis	Sycamore, Plane-tree	21	4	5.25					16
		Quercus	oak	65	13	5	3	10	6	6	5
		Quercus michauxii	swamp chestnut oak	1	1	1	1				
		Unknown		10	4	2.5			6		
TOT:	0	14	13	208	14		14	21	20	19	21


CVS Plots

plot	Plot Level	Year	Latitude/ Northing	Longitude/ Easting	Zone	Datum	Date Sampled	Planted Living Stems	Planted Living Stems EXCLUDING Live Stakes	Dead/Missing Stems	Natural (Volunteer) Stems	Total Living Stems	Total Living Stems EXCLUDING Live Stakes
4143-01-0001	1	0	34.9716	-80.6453	17	NAD83/WGSS84	4/21/2011	14	14	0	0	14	14
4143-01-0010	1	0	34.9710	-80.6399	17	NAD83/WGSS84	4/21/2011	15	15	0	0	15	15
4143-01-0011	1	0	34.9714	-80.6392	17	NAD83/WGSS84	4/21/2011	15	15	0	0	15	15
4143-01-0012	1	0	34.9713	-80.6384	17	NAD83/WGSS84	4/21/2011	14	14	0	0	14	14
4143-01-0013	1	0	34.9715	-80.6375	17	NAD83/WGSS84	4/21/2011	15	15	0	0	15	15
4143-01-0002	1	0	34.9710	-80.6461	17	NAD83/WGSS84	4/21/2011	21	21	0	0	21	21
4143-01-0003	1	0	34.9702	-80.6464	17	NAD83/WGSS84	4/21/2011	20	20	0	0	20	20
4143-01-0004	1	0	34.9696	-80.6463	17	NAD83/WGSS84	4/21/2011	19	19	0	0	19	19
4143-01-0005	1	0	34.9702	-80.6455	17	NAD83/WGSS84	4/21/2011	21	21	0	0	21	21
4143-01-0006	1	0	34.9704	-80.6439	17	NAD83/WGSS84	4/21/2011	13	13	0	0	13	13
4143-01-0007	1	0	34.9703	-80.6429	17	NAD83/WGSS84	4/21/2011	13	13	0	0	13	13
4143-01-0008	1	0	34.9705	-80.6421	17	NAD83/WGSS84	4/21/2011	14	14	0	0	14	14
4143-01-0009	1	0	34.9708	-80.6406	17	NAD83/WGSS84	4/21/2011	14	14	0	0	14	14


plot	Plot Level	Year	Latitude/ Northing	Longitude/ Easting	Zone	Datum	Date Sampled	Planted Living Stems per ACRE	Planted Living Stems EXCLUDING Live Stakes PER ACRE	Natural (Volunteer) Stems PER ACRE	Total Living Stems PER ACRE	Total Living Stems EXCLUDING Live Stakes PER ACRE	# species
4143-01-0001	1	0	34.9716	-80.6453	17	NAD83/WGSS84	4/21/2011	566.5599002	566.5599002	0	566.5599002	566.5599002	4
4143-01-0010	1	0	34.9710	-80.6399	17	NAD83/WGSS84	4/21/2011	607.0284645	607.0284645	0	607.0284645	607.0284645	5
4143-01-0011	1	0	34.9714	-80.6392	17	NAD83/WGSS84	4/21/2011	607.0284645	607.0284645	0	607.0284645	607.0284645	6
4143-01-0012	1	0	34.9713	-80.6384	17	NAD83/WGSS84	4/21/2011	566.5599002	566.5599002	0	566.5599002	566.5599002	5
4143-01-0013	1	0	34.9715	-80.6375	17	NAD83/WGSS84	4/21/2011	607.0284645	607.0284645	0	607.0284645	607.0284645	6
4143-01-0002	1	0	34.9710	-80.6461	17	NAD83/WGSS84	4/21/2011	849.8398503	849.8398503	0	849.8398503	849.8398503	5
4143-01-0003	1	0	34.9702	-80.6464	17	NAD83/WGSS84	4/21/2011	809.371286	809.371286	0	809.371286	809.371286	4
4143-01-0004	1	0	34.9696	-80.6463	17	NAD83/WGSS84	4/21/2011	768.9027217	768.9027217	0	768.9027217	768.9027217	5
4143-01-0005	1	0	34.9702	-80.6455	17	NAD83/WGSS84	4/21/2011	849.8398503	849.8398503	0	849.8398503	849.8398503	2
4143-01-0006	1	0	34.9704	-80.6439	17	NAD83/WGSS84	4/21/2011	526.0913359	526.0913359	0	526.0913359	526.0913359	6
4143-01-0007	1	0	34.9703	-80.6429	17	NAD83/WGSS84	4/21/2011	526.0913359	526.0913359	0	526.0913359	526.0913359	6
4143-01-0008	1	0	34.9705	-80.6421	17	NAD83/WGSS84	4/21/2011	566.5599002	566.5599002	0	566.5599002	566.5599002	5
4143-01-0009	1	0	34.9708	-80.6406	17	NAD83/WGSS84	4/21/2011	566.5599002	566.5599002	0	566.5599002	566.5599002	4

Appendix D. Goundwater Gauge Charts


Newtown Gauge 1

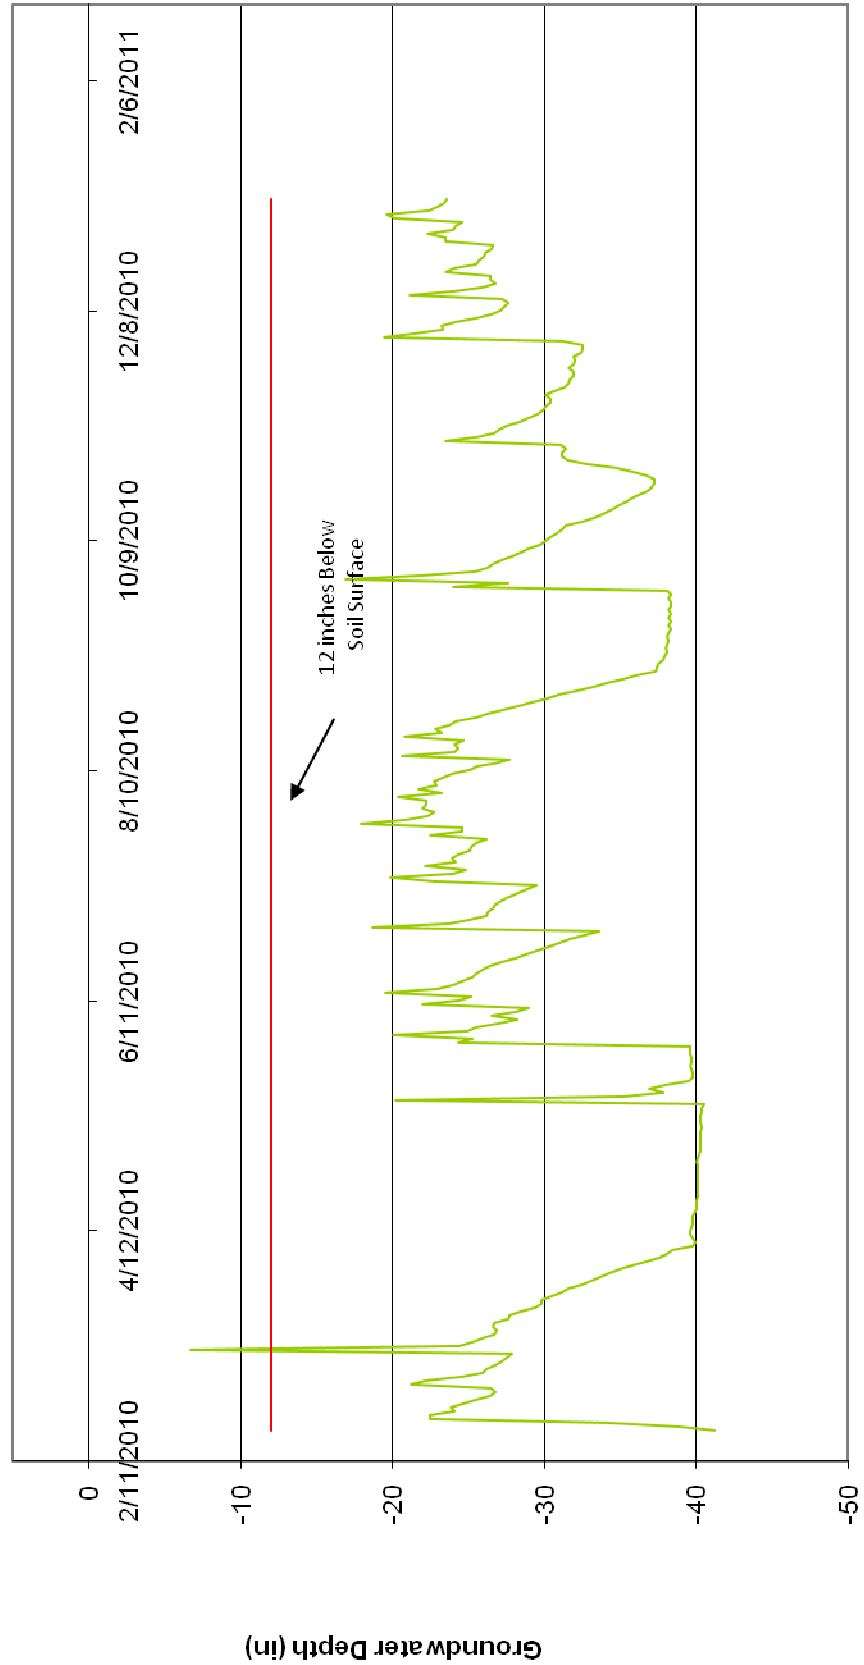


Newtown Gauge 2

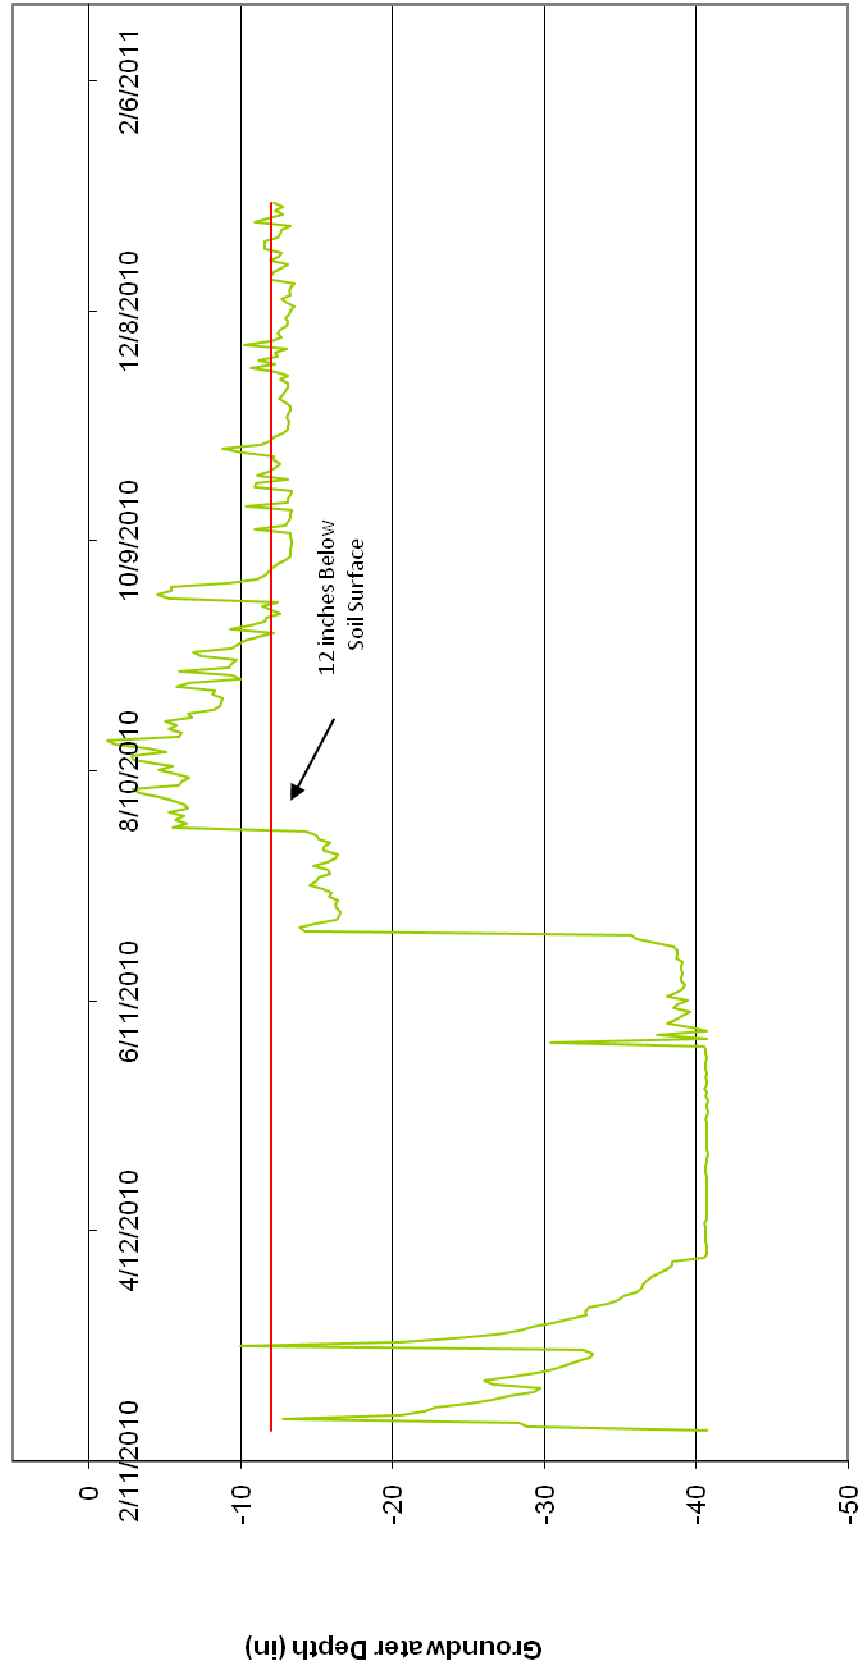


Newtown Gauge 4

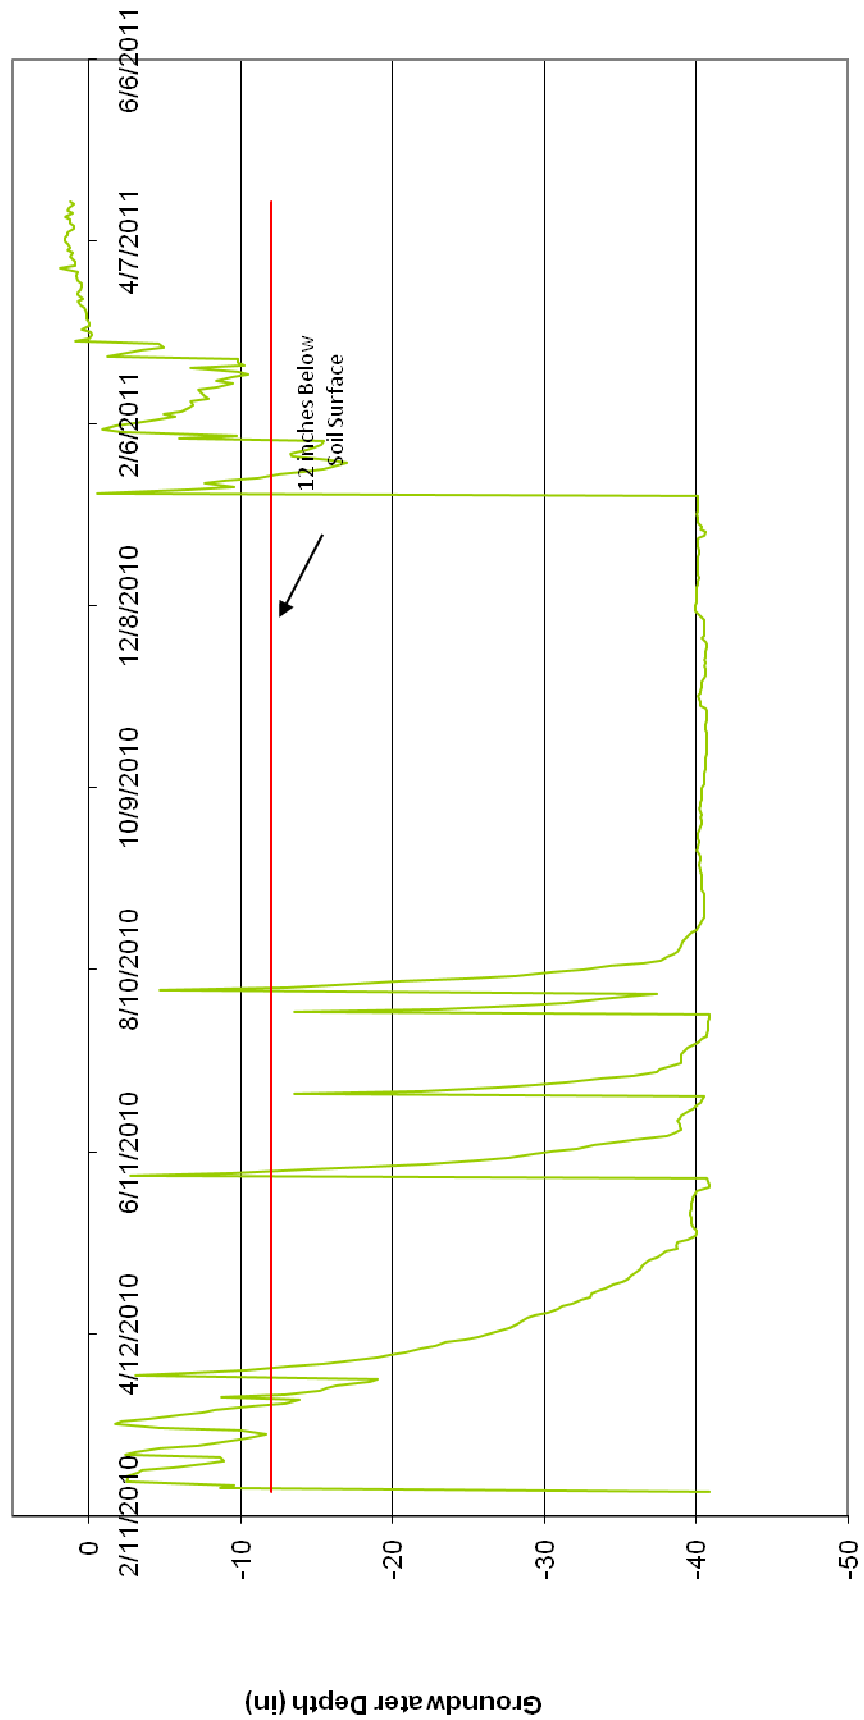

Newtown Gauge 5

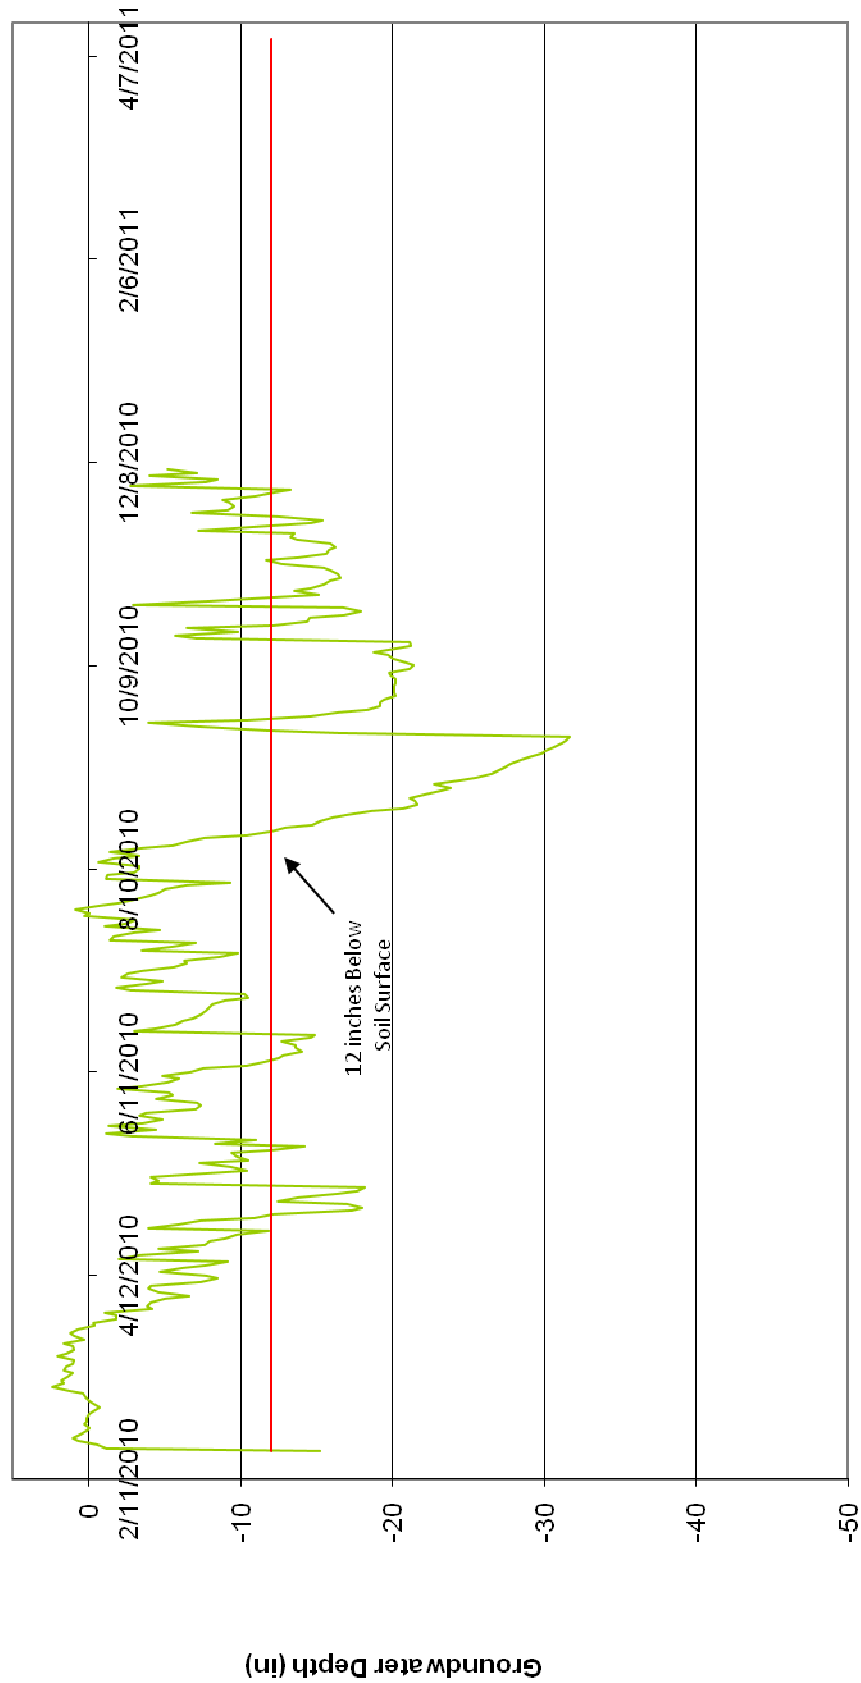




Newtown Gauge 6

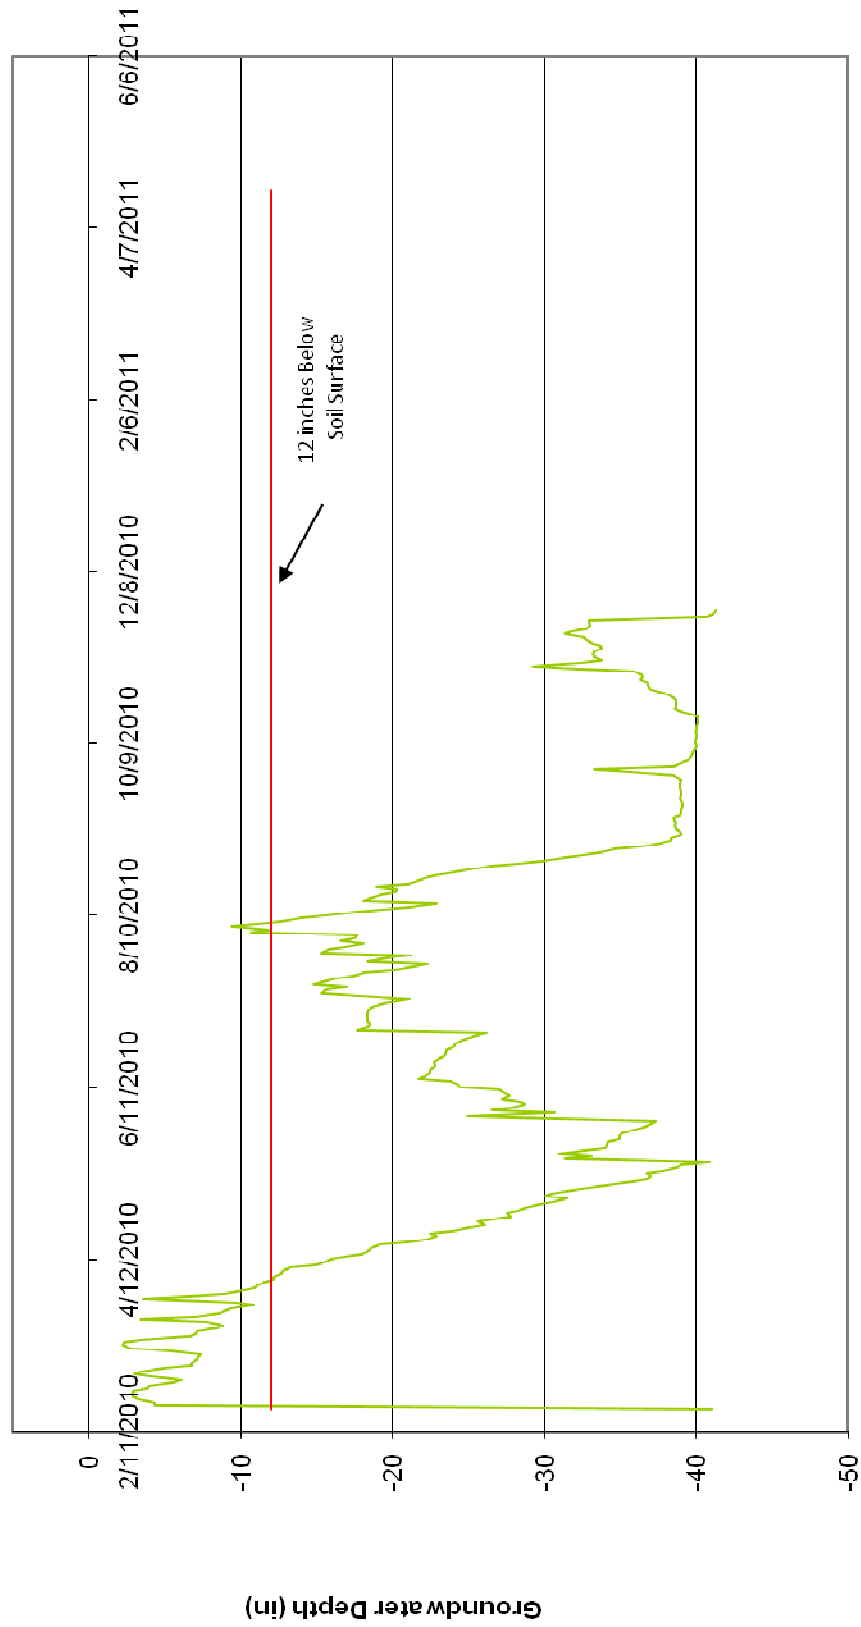

Appendix E. Record Drawings

RECORD DRAWINGS FOR NEWTOWN STREAM AND WETLAND RESTORATION PROJECT

UNION COUNTY, NORTH CAROLINA
STATE CONTRACT NO:002025
RFP 16-001117

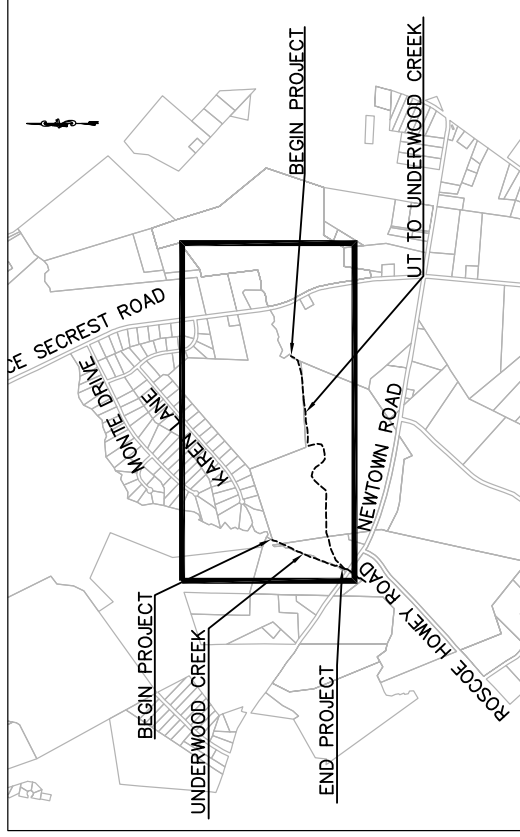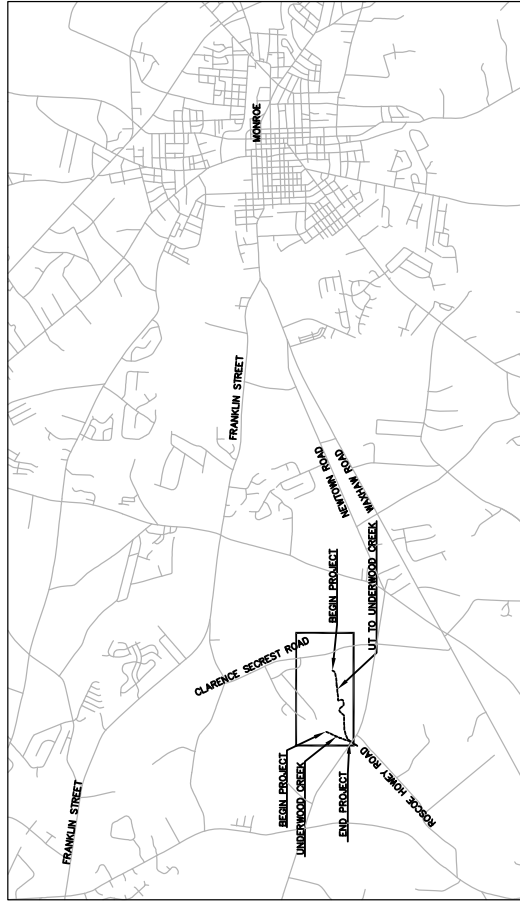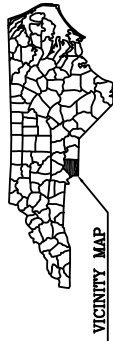

INDEX OF SHEETS

SHEET NO.	DESCRIPTION
T1	TITLE SHEET
L1	LEGENDS SYMBOLS AND SHEET KEY
TCS1	TYPICAL CONSTRUCTED CROSS SECTIONS
PLN1-PLN2	STREAM PLAN UNDERWOOD CREEK
PLN3-PLN6	STREAM PLAN UT TO UNDERWOOD CREEK
PRO1	PROFILE UNDERWOOD CREEK
PRO2-PRO3	PROFILES UT TO UNDERWOOD CREEK
PRO4	PROFILE TABLES
VP1	PLANT QUANTITIES
VP2	PLANTING PLAN LEGENDS AND KEY
VP3-VP8	PLANTING PLAN
ABF1-ABF5	UNDERWOOD CREEK FEMA AS-BUILT SURVEY AND CROSS SECTIONS


SURVEY DATA PROVIDED BY: R.B. Pharr & Associates
420 Hawthorne Lane
Charlotte NC 28204
PHONE: 704-376-2186
FAX: 704-333-8724

NATURAL SYSTEMS INVESTIGATION:

The Catena Group Inc.
410-B Millstone Drive
Hillsborough, NC 27278
PH: 919-732-1300
FAX: 919-732-1303

NCEEP CONTACT: GUY PEARCE (919) 715-1656
WARD CONSULTING ENGINEERS CONTACT: BECKY WARD, PE (919) 870-0526
ENVIRONMENTAL BANC AND EXCHANGE CONTACT: NORTON WEBSTER (919) 829-9909


Ward Consulting Engineers, P.C.
FIRM LICENSE NO. C-619
8368 Six Forks Rd., Suite 104
Raleigh, NC 27615-5083 FAX (919) 870-5359
Environmental Banc & Exchange
909 Capabilities Drive, Suite 3100
Raleigh NC 27606 Phone: (919) 829-9909
Fax: (919) 229-9913

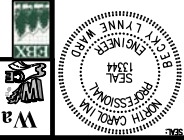

NEWTOWN
TITLE SHEET
UNION COUNTY, NORTH CAROLINA

DATE: 8-27-2011
REVISIONS:
PROJECT NAME: Underwood Creek
DWG. NAME: Construction Cover Sheet
SCALE: NTS
RECORD DRAWINGS
SHEET NO. T1


- NOTES:
1. AS BUILT SURVEY PROVIDED ON UNDERWOOD CREEK BY R.B. PHARR & ASSOCIATES, P.A. DATED APRIL 28, 2011. SEE PLAN VIEW FOR LIMITS OF SURVEY. VERTICAL DATUM = NAVD 88. HORIZONTAL DATUM = NC GRID NAD 83.
 2. CONSTRUCTION VERIFICATION SURVEY PROVIDED ON UT TO UNDERWOOD CREEK BY WARD CONSULTING ENGINEERS, P.C. CONSTRUCTION BENCHMARK DATA SET BY R.B. PHARR & ASSOCIATES, P.A. UTILIZED FOR DATA COLLECTION. SEE PLAN VIEW FOR LIMITS OF SURVEY.
 3. JURISDICTIONAL WETLANDS AND WETLAND RESTORATION DELINEATION BY THE CATENA GROUP, HILLSBOROUGH, NC DATED MAY 12, 2010.

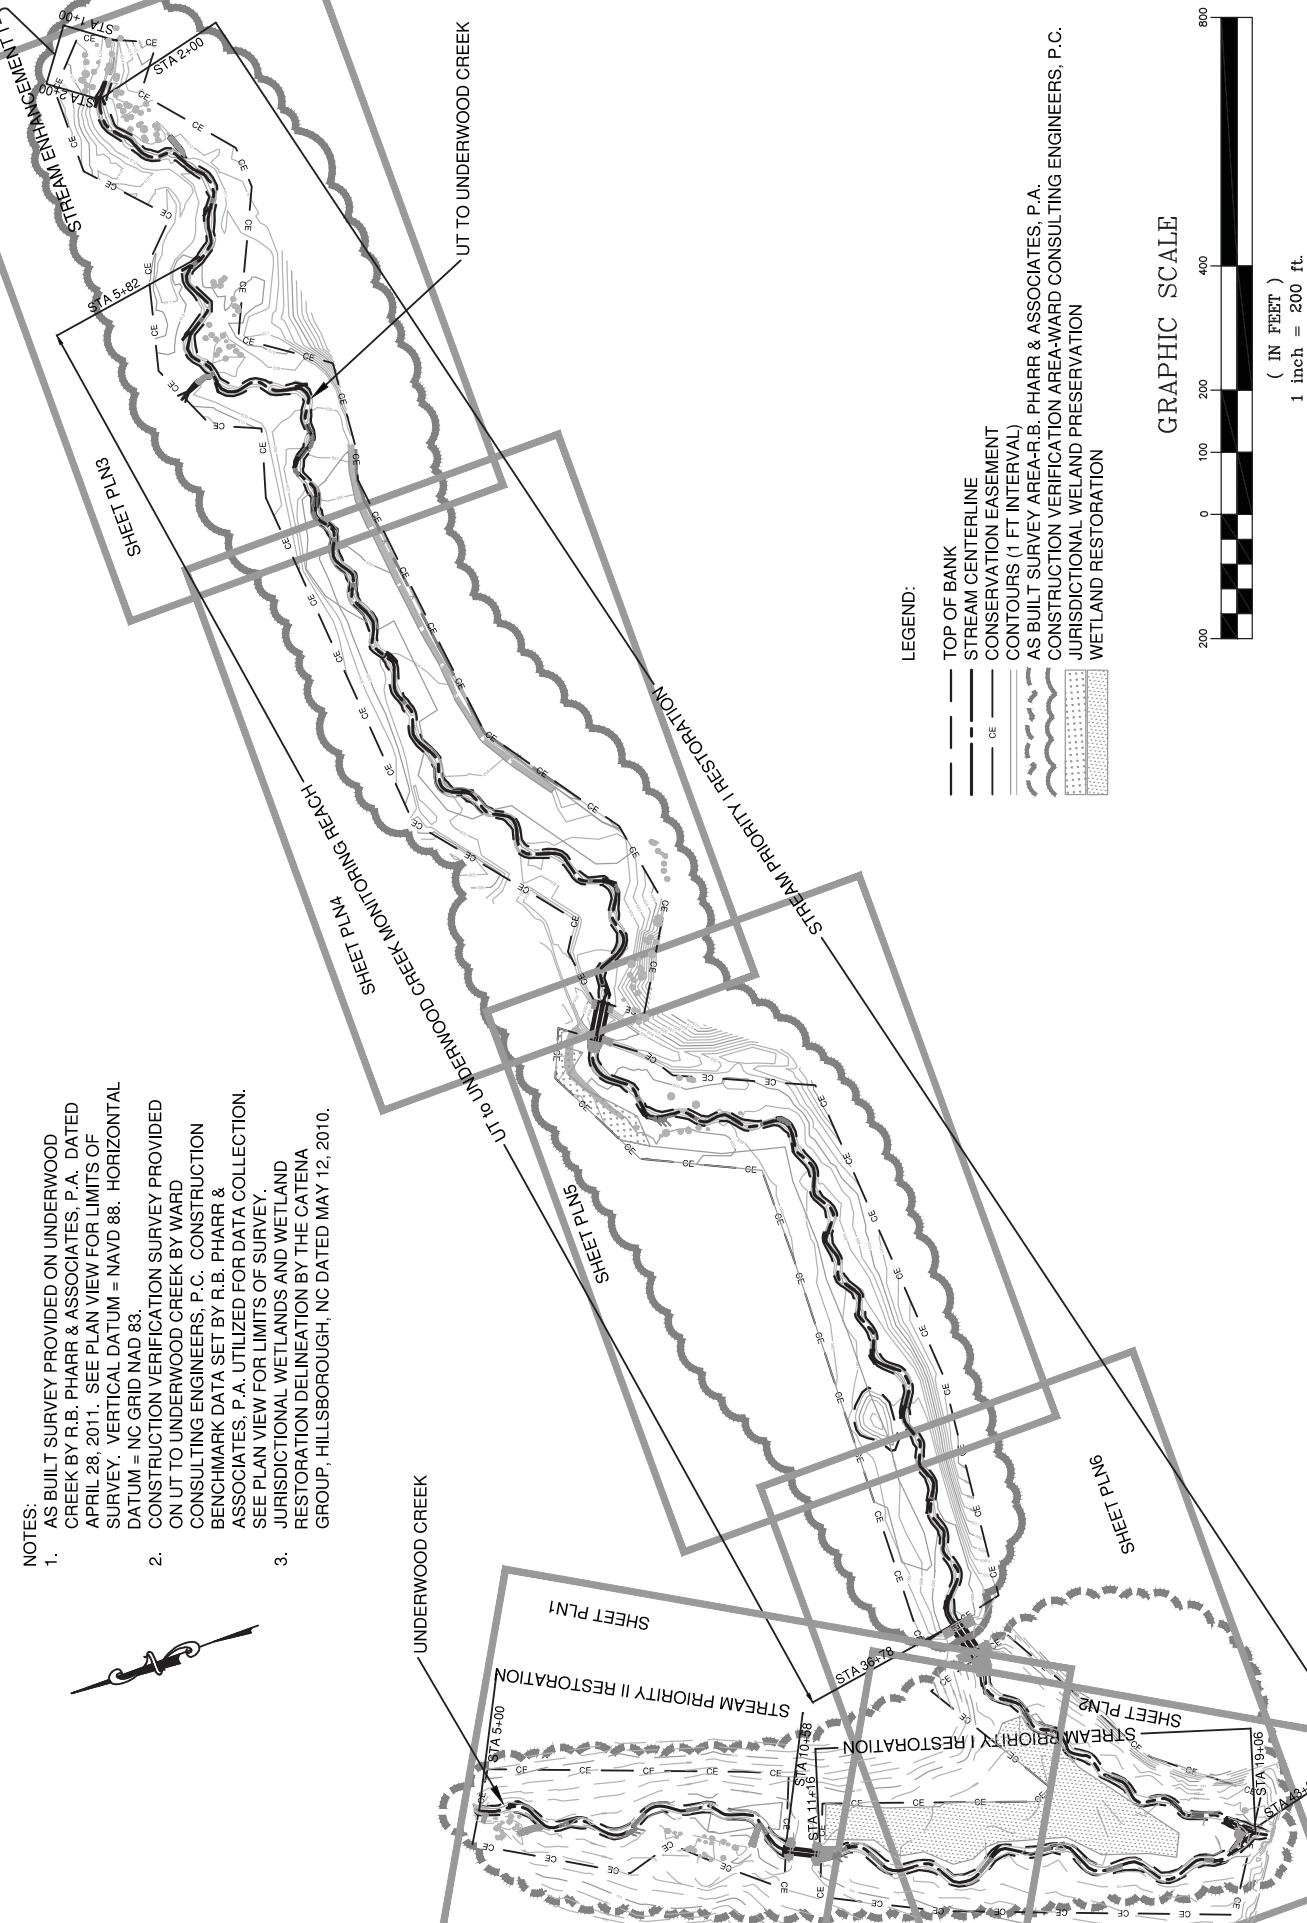


LEGEND:

- TOP OF BANK
- STREAM CENTERLINE
- CE CONSERVATION EASEMENT
- CONTOURS (1 FT INTERVAL)
- AS BUILT SURVEY AREA-R.B. PHARR & ASSOCIATES, P.A.
- CONSTRUCTION VERIFICATION AREA-WARD CONSULTING ENGINEERS, P.C.
- JURISDICTIONAL WETLAND PRESERVATION
- WETLAND RESTORATION

GRAPHIC SCALE

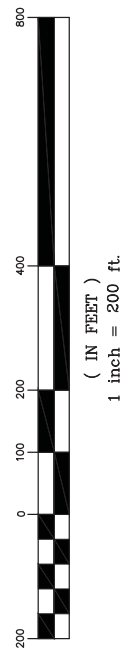


Ward Consulting Engineers, P.C.
 FIRM LICENSE NO. C-2619
 8368 Six Forks Rd. Suite 104
 Raleigh, NC 27615-5083
 (919) 870-0526
 FAX (919) 870-5359

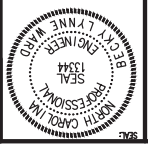


NEWTOWN
 LEGENDS, SYMBOLS AND
 SHEET KEY
 UNION COUNTY, NORTH CAROLINA

DATE: 6-27-2011
 REVISIONS:
 PROJECT NAME:
 EIR: NEWTOWN
 DWS NAME:
 SHEET:
 SCALE: 1" = 200'
 RECORD DRAWINGS
 SHEET NO.


- NOTES:**
- POOLS TO BE EXCAVATED BY CONTRACTOR ONE FOOT DEEPER TO ALLOW FOR SEDIMENTATION.
 - CONTRACTOR TO PROVIDE A SMOOTH TRANSITION BETWEEN THE RIFFLE AND POOL SECTIONS SHOWN BELOW.
 - CENTER LINE THALWEG. SEE STAKING PLAN SHEETS (SP) FOR VERTICAL ELEVATIONS AND HORIZONTAL LAYOUTS.
 - OF STREAM FOR HORIZONTAL LAYOUT AND OF THALWEG ARE AT DIFFERENT LOCATIONS IN POOL SECTIONS.
 - USE 700 GRAM COIR FIBER MATTING BLANKET WESTERN EXCELSIOR CORPORATION COIR MAT 700 OR APPROVED EQUAL.

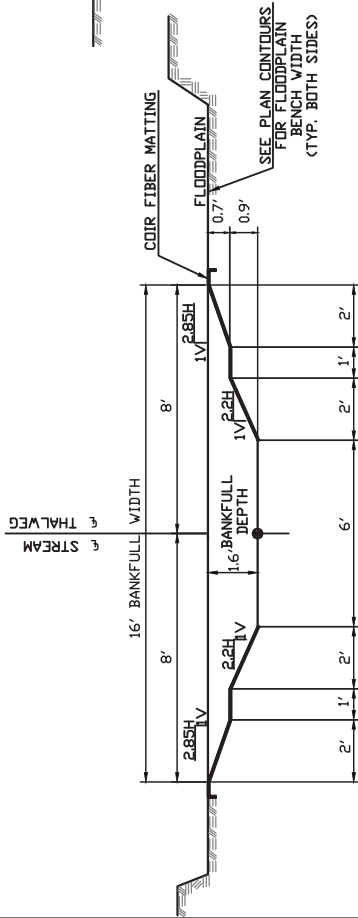


1 PROPOSED RIFFLE SECTION (UNDERWOOD CREEK)
 (PRIORITY TWO RESTORATION)
 SCALE: NOT TO SCALE

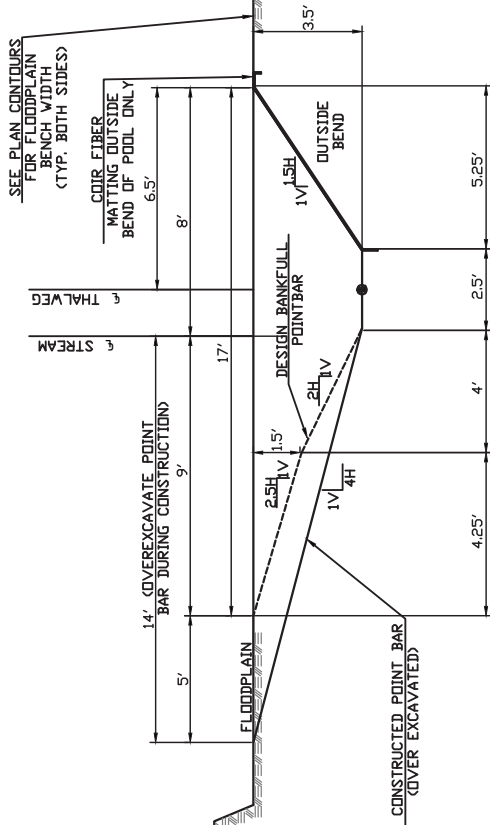

2 PROPOSED POOL SECTION (UNDERWOOD CREEK)
 (PRIORITY TWO RESTORATION)
 SCALE: NOT TO SCALE

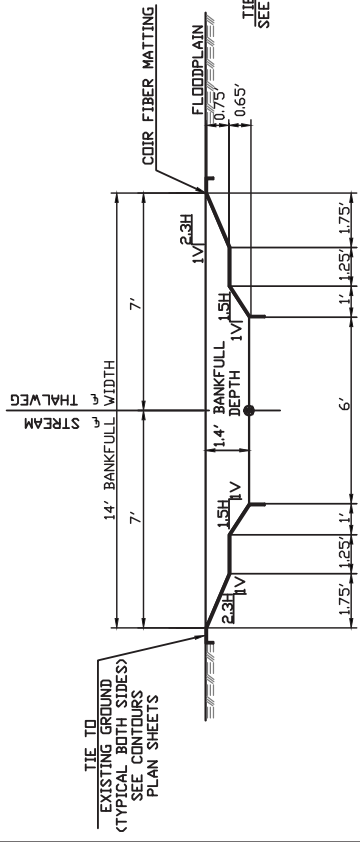

3 PROPOSED RIFFLE SECTION (UT-UNDERWOOD CREEK)
 (PRIORITY ONE RESTORATION)
 SCALE: NOT TO SCALE

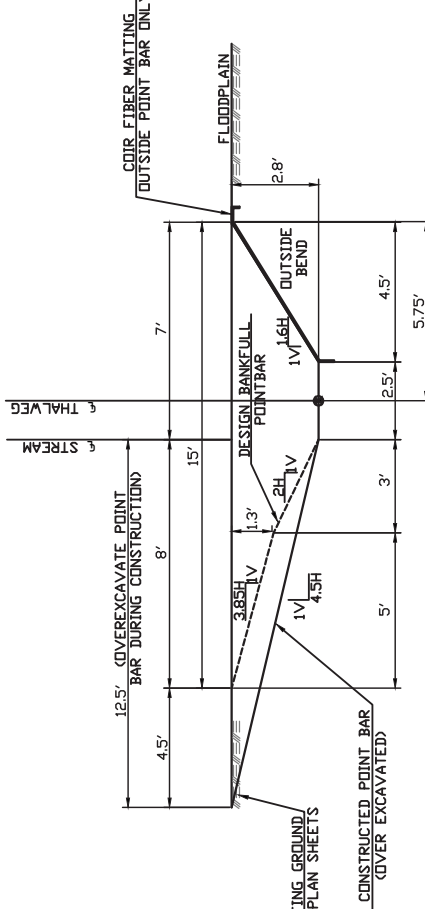

4 PROPOSED POOL SECTION (UT-UNDERWOOD CREEK)
 (PRIORITY ONE RESTORATION)
 SCALE: NOT TO SCALE


Ward Consulting Engineers, P.C.
 Environmental, Planning & Exchange
 909 Copability Drive, Suite 3100
 Raleigh, NC 27606
 Phone: (919) 829-9909
 Fax: (919) 229-9913
 FIRM LICENSE NO. C-2619
 Raleigh, NC 27615-5083
 Phone: (919) 870-5359
 Fax: (919) 870-5359




NEWTOWN
TYPICAL CROSS SECTIONS WITH LEGENDS
 UNION COUNTY, NORTH CAROLINA

DATE:	9-27-2011
REVISIONS:	
PROJECT NO.:	11-000000
PROJECT NAME:	Newtown Creek
DWG. NAME:	Typical Cross Sections
SCALE:	
BY:	
CHECKED:	
RECORDED:	
DRAWING NO.:	

TCSI

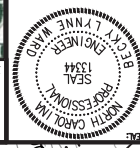

DATE	5-27-2011
REVISIONS	
PROJECT NAME	EMA NEWTOWN
DWG NAME	EMA NEWTOWN
AS-BUILT	
SCALE	1" = 60'
RECORD DRAWINGS	
SHEET NO.	

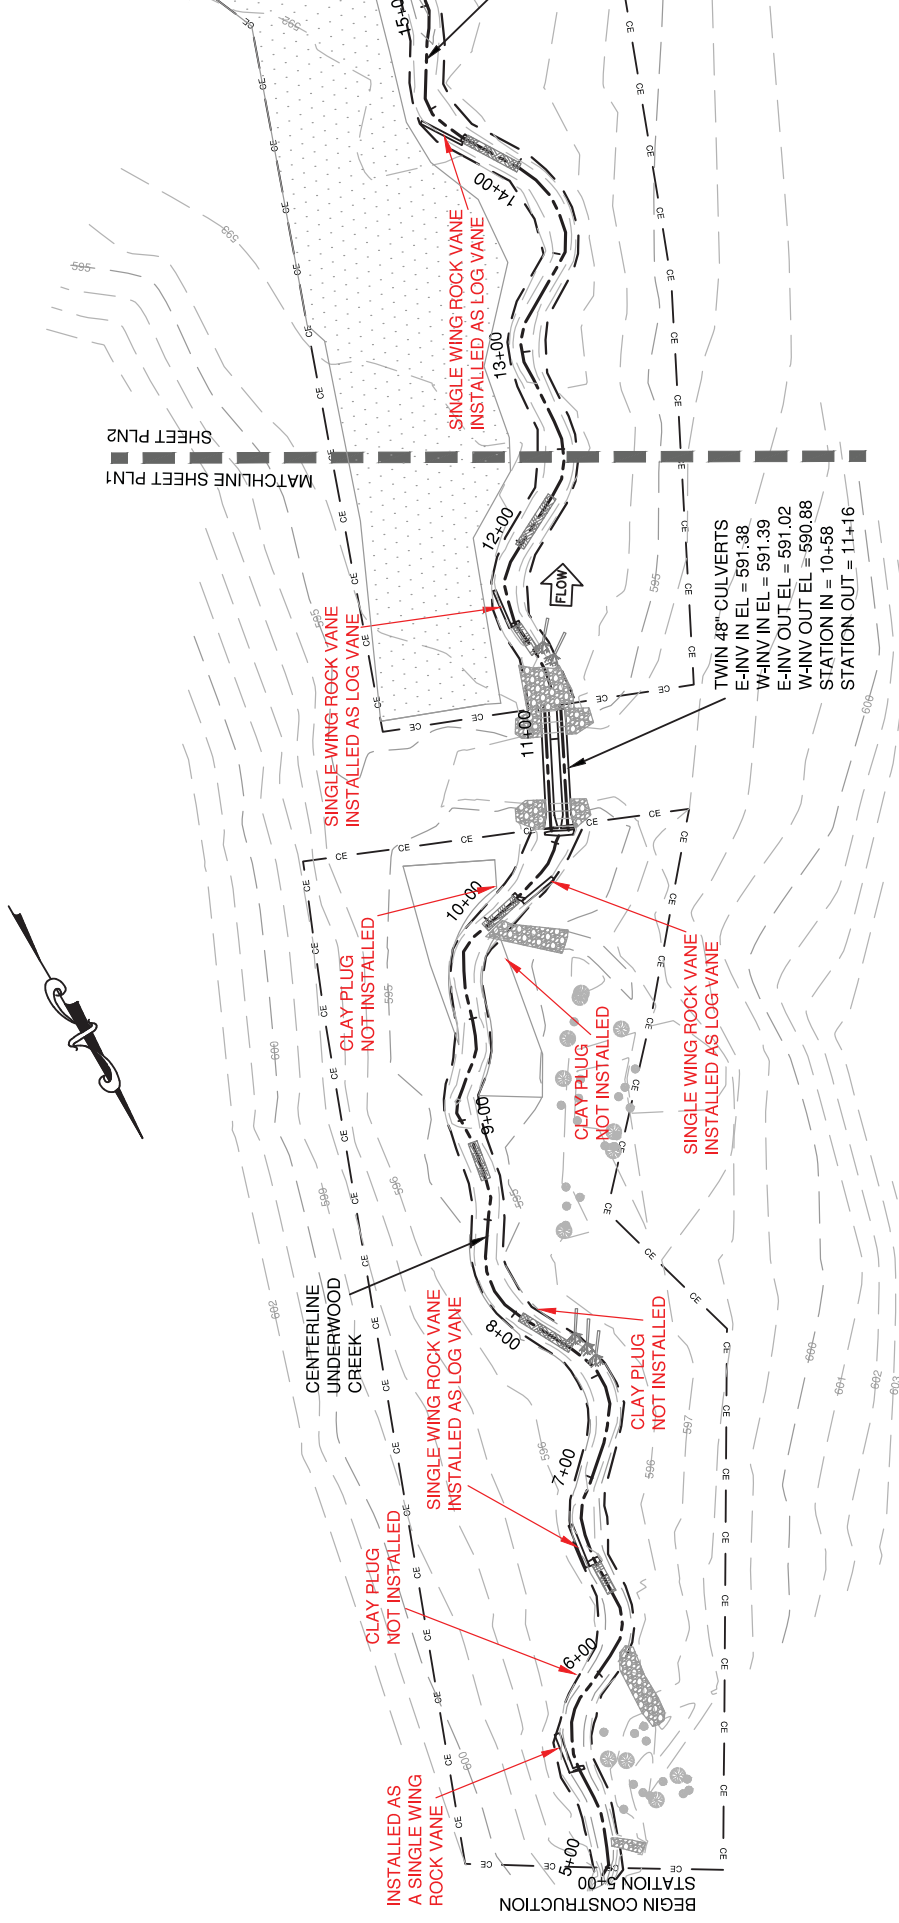

LEGEND:

- AS-BUILT CONTOURS RBPA (1 FT INTERVALS)
- AS-BUILT TOP OF BANK
- AS-BUILT THALWEG
- DESIGN CENTERLINE STATIONING
- CONSERVATION EASEMENT
- WETLAND RESTORATION
- WETLAND PRESERVATION
- AS-BUILT STRUCTURE
- AS-BUILT GRADE TRANSITION STRUCTURE
- ROOT WADS
- ROCK TOE
- BRUSH TOE
- EARTHEN BERM
- BRUSH WETLAND EDGE
- RIP RAP PROTECTION

NOTE: AS-BUILT SURVEY DATA THIS SHEET PROVIDED BY R.B. PHARR & ASSOCIATES, P.A.

GRAPHIC SCALE



MATCHLINE SHEET PLAN1
 SHEET PLAN2



Ward Consulting Engineers, P.C.
 FIRM LICENSE NO. 2619
 8368 Six Forks Rd, Suite 104
 Raleigh, NC 27615-5083
 (919) 870-5262
 FAX (919) 870-5359


Environmental Banc & Exchange
 909 Capability Drive, Suite 3100
 Raleigh NC 27606
 Phone: (919) 829-9909
 Fax: (919) 229-9913



NEWTOWN
UNDERWOOD CREEK
UNION COUNTY, NORTH CAROLINA

DATE: 6-27-2011
 REVISIONS:
 PROJECT NAME:
 EBM: NEWTOWN
 DWS NAME:
 AS-BUILT:
 SCALE: 1" = 60'
 RECORD DRAWINGS
 SHEET NO.

PLN2

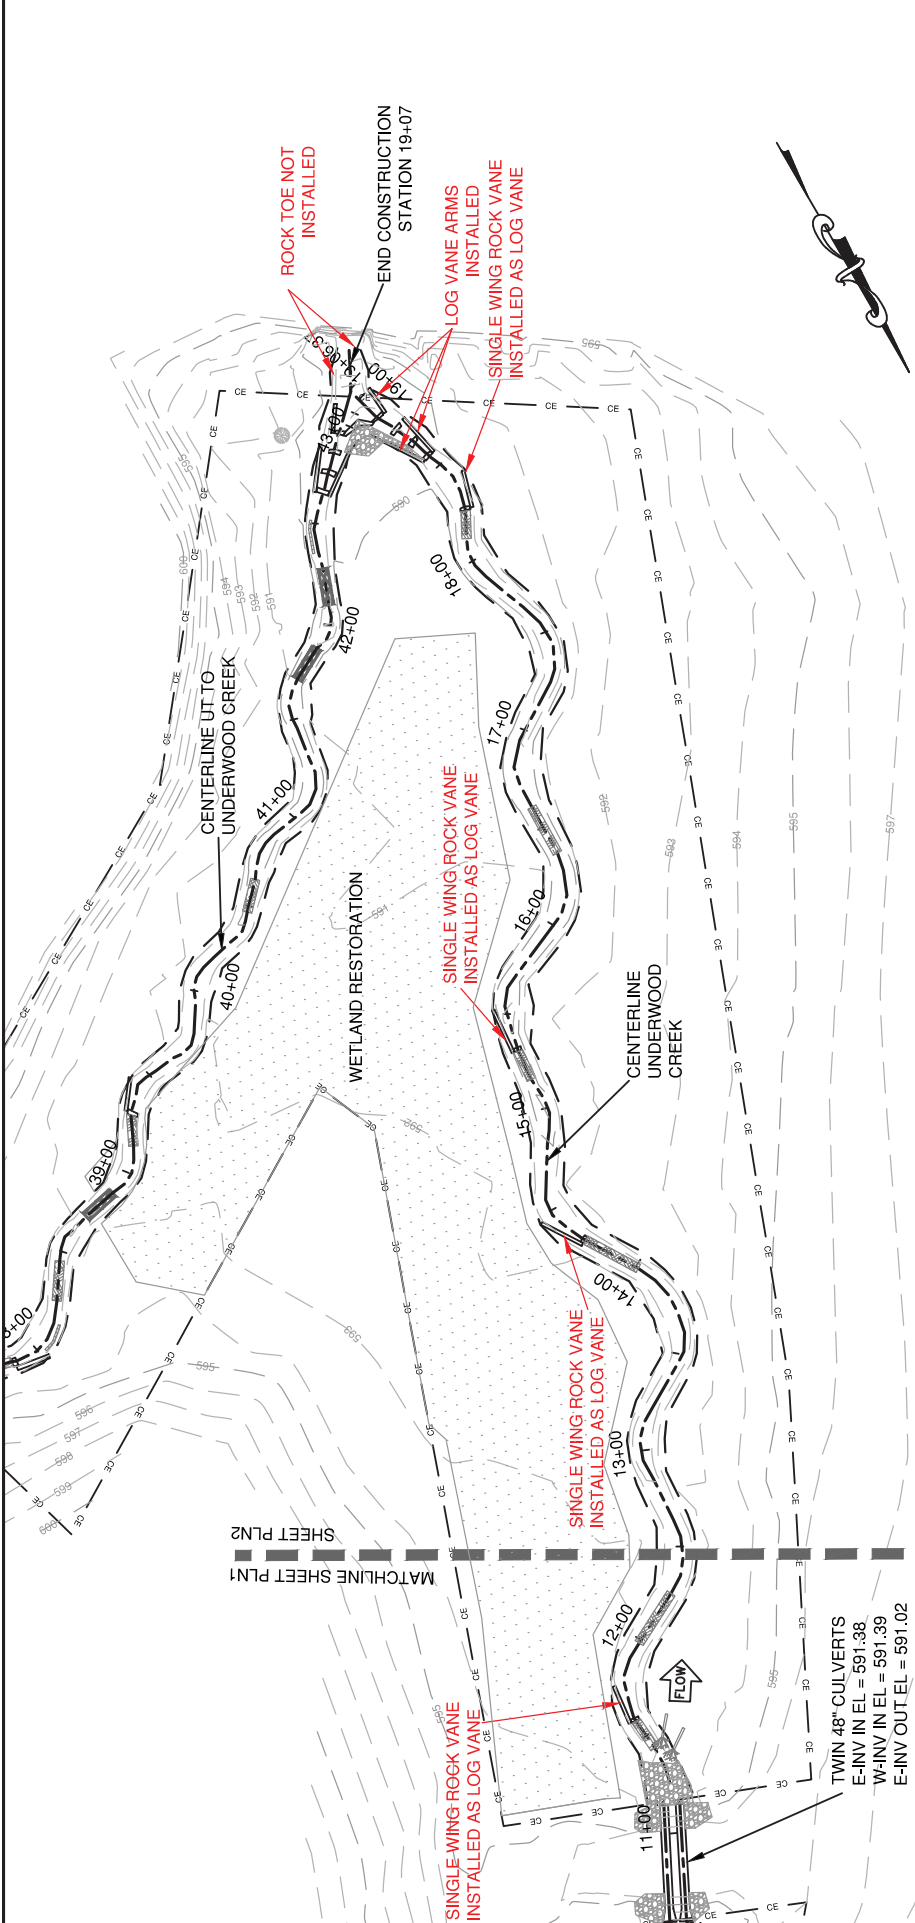

- LEGEND:**
- AS-BUILT CONTOURS RBPA (1 FT INTERVALS)
 - AS-BUILT TOP OF BANK
 - AS-BUILT THALWEG
 - DESIGN CENTERLINE STATIONING
 - CONSERVATION EASEMENT
 - WETLAND RESTORATION
 - WETLAND PRESERVATION
 - AS-BUILT STRUCTURE
 - AS-BUILT CONSTRUCTED RIFFLE
 - AS-BUILT GRADE TRANSITION STRUCTURE
 - ROOT WADS
 - ROCK TOE
 - BRUSH TOE
 - EARTHEN BERM
 - BRUSH WETLAND EDGE
 - RIP RAP PROTECTION

NOTE: ASBUILT SURVEY DATA THIS SHEET
 PROVIDED BY R.B. PHARR & ASSOCIATES, P.A.

GRAPHIC SCALE




(IN FEET)
 1 inch = 60 ft.

MATCHLINE SHEET PLN1
 SHEET PLN2

TWIN 48" CULVERTS
 E-INV IN EL = 591.38
 W-INV IN EL = 591.39
 E-INV OUT EL = 591.02
 W-INV OUT EL = 590.88
 STATION IN = 10+56
 STATION OUT = 11+16




DATE:	6-27-2011
REVISIONS:	
PROJECT NAME:	EBK NEWTOWN
DRAWN NAME:	
CHECKED NAME:	
SCALE:	1" = 60'
RECORD DRAWINGS	
SHEET NO.	

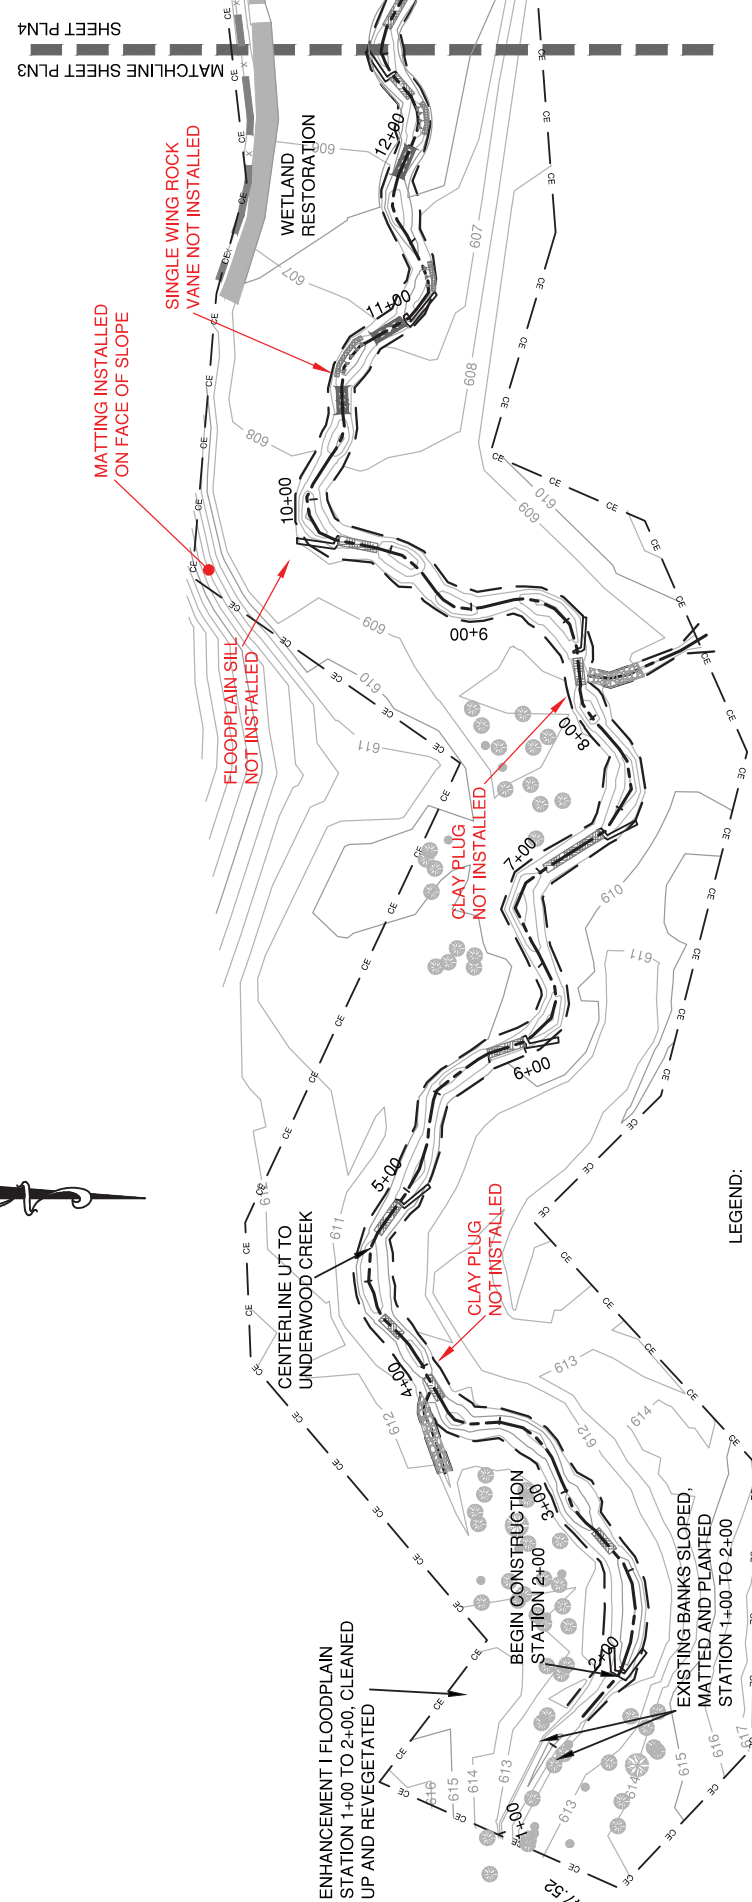

LEGEND:

- AS-BUILT CONTOURS WCE (1 FT INTERVALS)
- AS-BUILT TOP OF BANK
- AS-BUILT THALWEG
- DESIGN CENTERLINE STATIONING
- CONSERVATION EASEMENT
- WETLAND RESTORATION
- WETLAND PRESERVATION
- AS-BUILT STRUCTURE
- AS-BUILT CONSTRUCTED RIFFLE
- AS-BUILT GRADE TRANSITION STRUCTURE
- ROOT WADS
- ROCK TOE
- BRUSH TOE
- EARTHEN BERM
- BRUSH WETLAND EDGE
- RIP RAP PROTECTION

NOTE: AS-BUILT CONSTRUCTION VERIFICATION SURVEY DATA THIS SHEET PROVIDED BY WARD CONSULTING ENGINEERS, P.C.

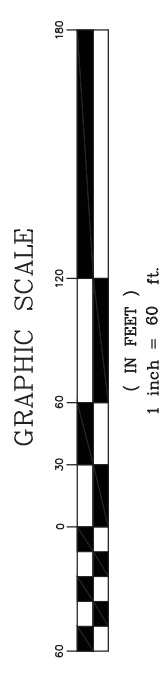

MATCHLINE SHEET PLN3
 SHEET PLN4

ENHANCEMENT I FLOODPLAIN STATION 1+00 TO 2+00. CLEANED UP AND REVEGETATED

BEGIN CONSTRUCTION STATION 2+00

EXISTING BANKS SLOPED, MATTED AND PLANTED STATION 1+00 TO 2+00

CENTERLINE UT TO UNDERWOOD CREEK

WETLAND RESTORATION

Ward Consulting Engineers, P.C.
 8368 Six Forks Rd, Suite 104
 Raleigh, NC 27615-5083
 FIRM LICENSE NO. C-2619
 (919) 870-5262
 Fax: (919) 229-9913




NEWTOWN
UT to UNDERWOOD CREEK
UNION COUNTY, NORTH CAROLINA

DATE:	6-27-2011
REVISIONS:	
PROJECT NAME:	EBK NEWTOWN
DRAWN BY:	
CHECKED BY:	
SCALE:	1" = 60'
RECORD DRAWINGS:	
SHEET NO.:	

PLN4

MATCHLINE SHEET PLN4
 SHEET PLN5

MATCHLINE SHEET PLN5
 SHEET PLN4

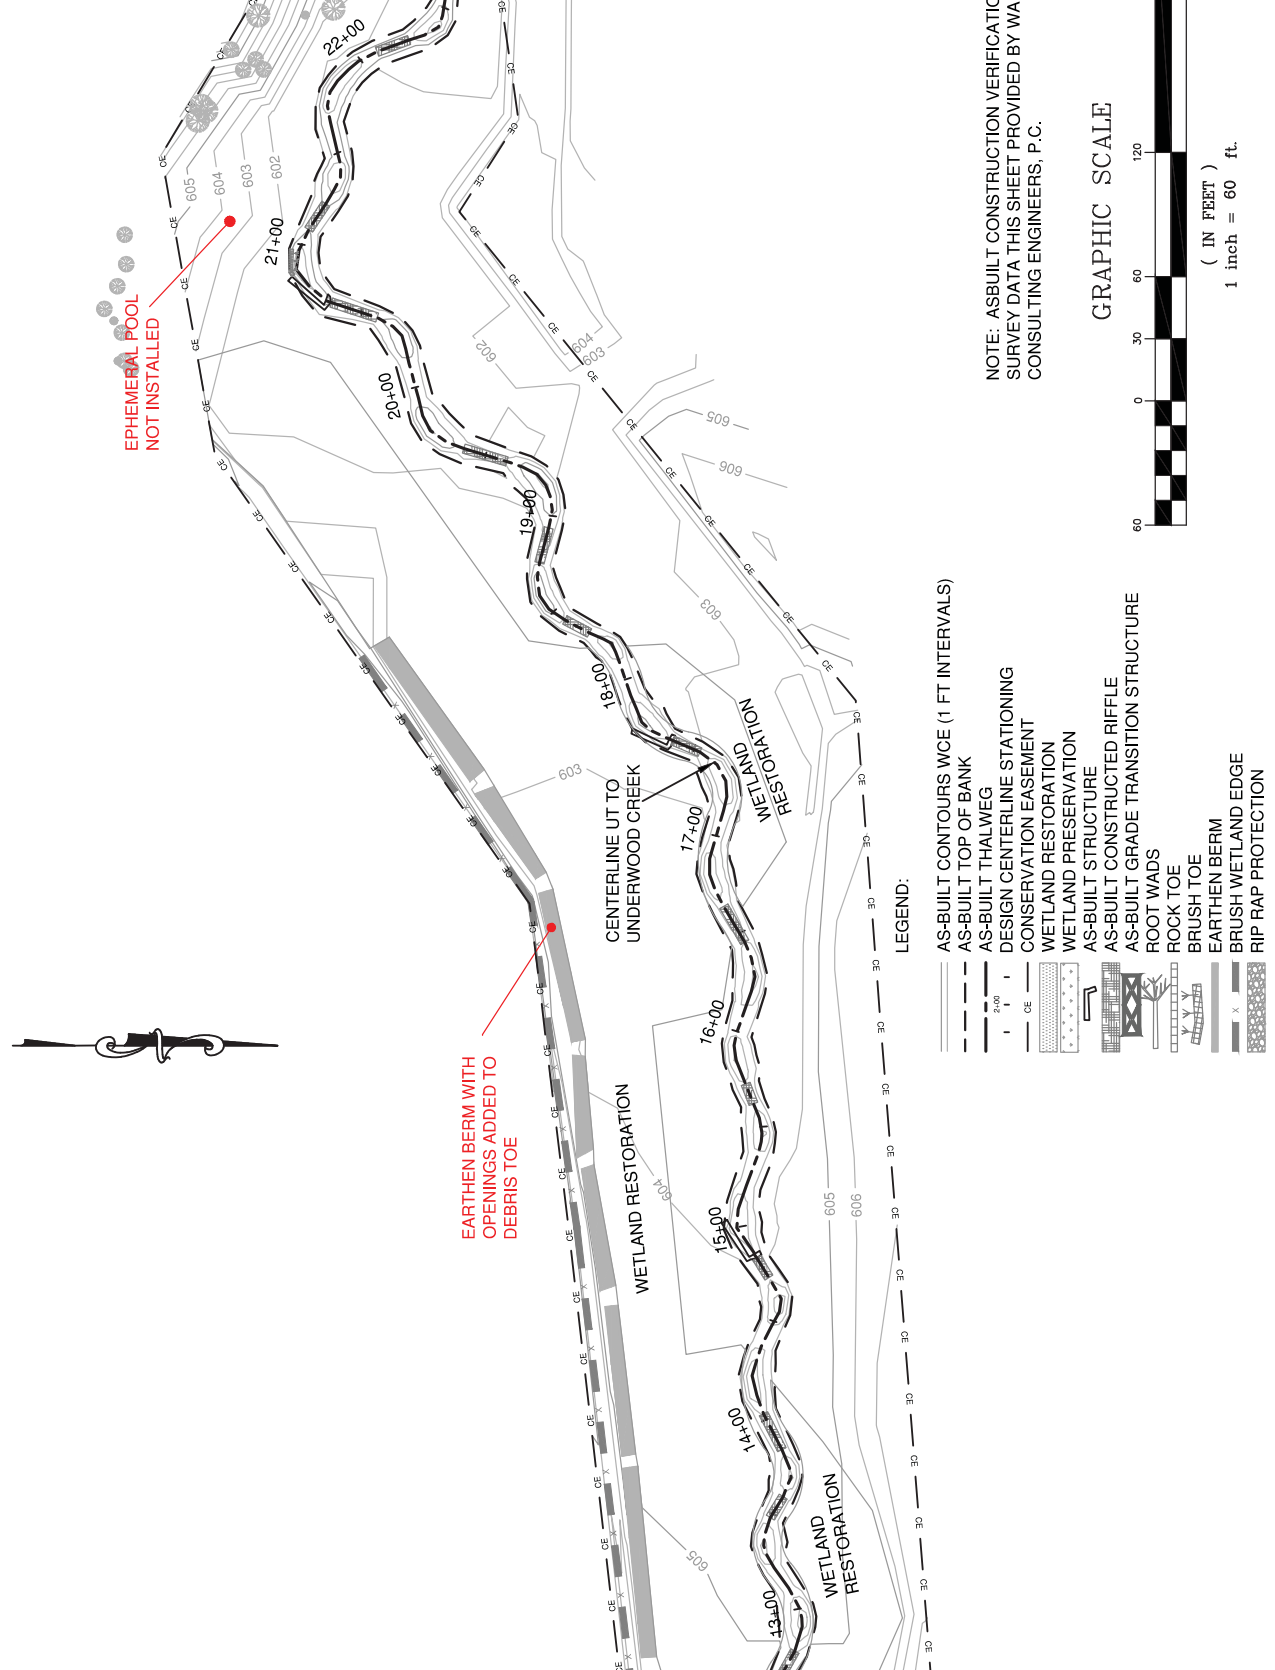

**EPHEMERAL POOL
 NOT INSTALLED**

**EARTHEN BERM WITH
 OPENINGS ADDED TO
 DEBRIS TOE**

LEGEND:

- AS-BUILT CONTOURS WCE (1 FT INTERVALS)
- AS-BUILT TOP OF BANK
- AS-BUILT THALWEG
- DESIGN CENTERLINE STATIONING
- CONSERVATION EASEMENT
- WETLAND RESTORATION
- WETLAND PRESERVATION
- AS-BUILT STRUCTURE
- AS-BUILT CONSTRUCTED RIFFLE
- AS-BUILT GRADE TRANSITION STRUCTURE
- ROOT WADS
- ROCK TOE
- BRUSH TOE
- EARTHEN BERM
- BRUSH WETLAND EDGE
- RIP RAP PROTECTION

**NOTE: AS-BUILT CONSTRUCTION VERIFICATION
 SURVEY DATA THIS SHEET PROVIDED BY WARD
 CONSULTING ENGINEERS, P.C.**


GRAPHIC SCALE




(IN FEET)
 1 inch = 60 ft.



DATE:	5-27-2011
REVISIONS:	
PROJECT NAME:	EBK NEWTOWN
DRAWN BY:	
CHECKED BY:	
SCALE:	1" = 60'
RECORD DRAWINGS	
SHEET NO.	

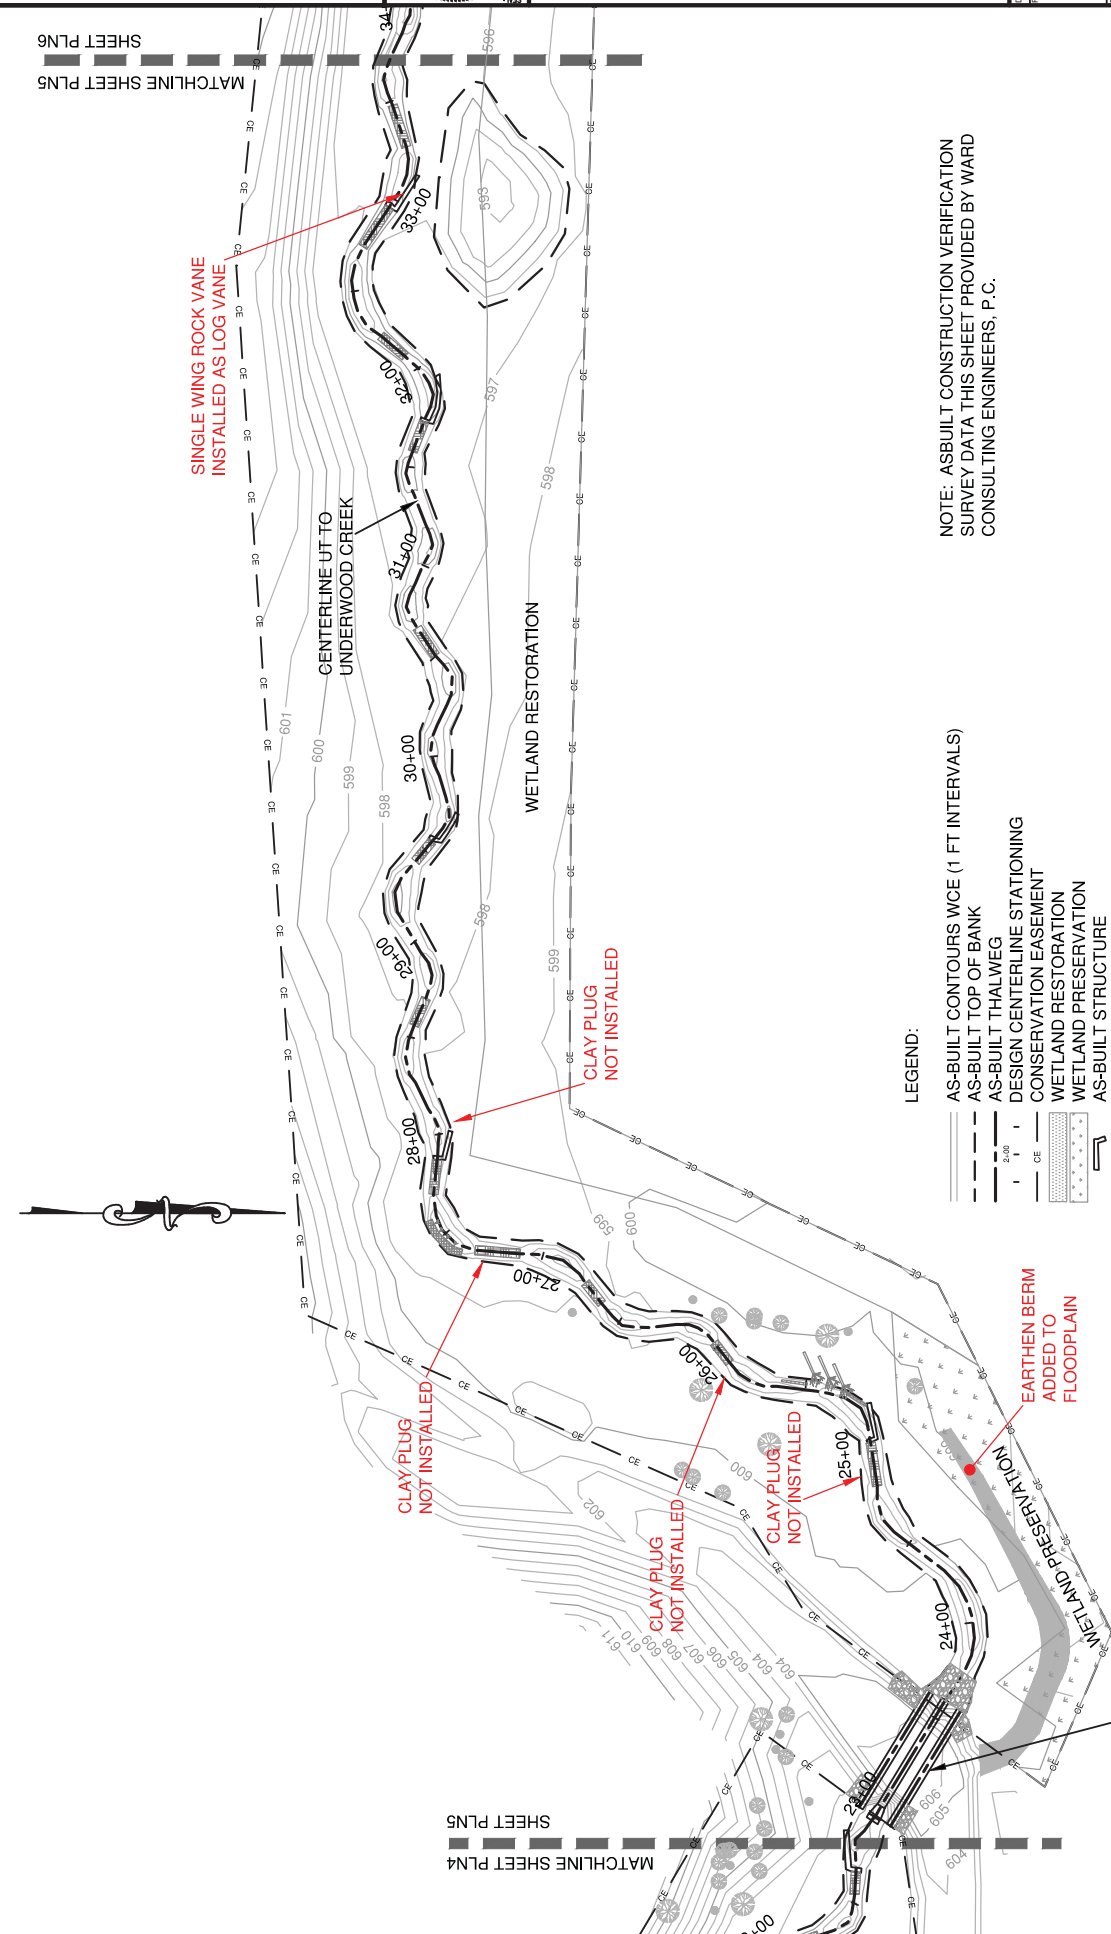

NOTE: AS-BUILT CONSTRUCTION VERIFICATION SURVEY DATA THIS SHEET PROVIDED BY WARD CONSULTING ENGINEERS, P.C.

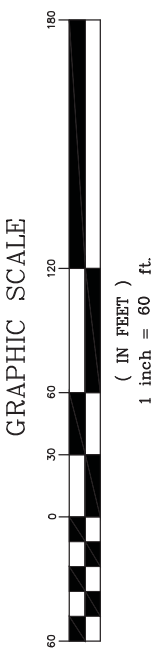

- LEGEND:
- AS-BUILT CONTOURS WCE (1 FT INTERVALS)
 - AS-BUILT TOP OF BANK
 - AS-BUILT THALWEG
 - DESIGN CENTERLINE STATIONING
 - CONSERVATION EASEMENT
 - WETLAND RESTORATION
 - WETLAND PRESERVATION
 - AS-BUILT STRUCTURE
 - AS-BUILT GRADE TRANSITION STRUCTURE
 - ROOT WADS
 - BRUSH TOE
 - EARTHEN BERM
 - BRUSH WETLAND EDGE
 - RIP RAP PROTECTION

- CHANNEL 48" RCP STATION IN = 22+95, 64 LF
- FLOODPLAIN S-36" RCP STATION IN = 22+95, 64 LF
- FLOODPLAIN N-36" RCP STATION IN = 22+95, 64 LF
- 48" INV IN = 598.34
- N-36" INV IN = 600.55
- S-36" INV IN = 600.55
- 48" INV OUT = 597.79
- N-36" INV OUT = 600.00
- S-36" INV OUT = 600.00

MATCHLINE SHEET PLN4

MATCHLINE SHEET PLN6




NEWTOWN
AS-BUILT PROFILE
UNDERWOOD CREEK
UNION COUNTY, NORTH CAROLINA

DATE	5-27-2011
REVISIONS	
PROJECT NAME	ERN, NEWTOWN
DWG NAME	ASBUILT PROFILES
SCALE	L = 100
RECORD DRAWINGS	
SHEET NO.	

PROJ

AS-BUILT UNDERWOOD CREEK (NEWTOWN)
LONGITUDINAL PROFILE
MAIN CHANNEL

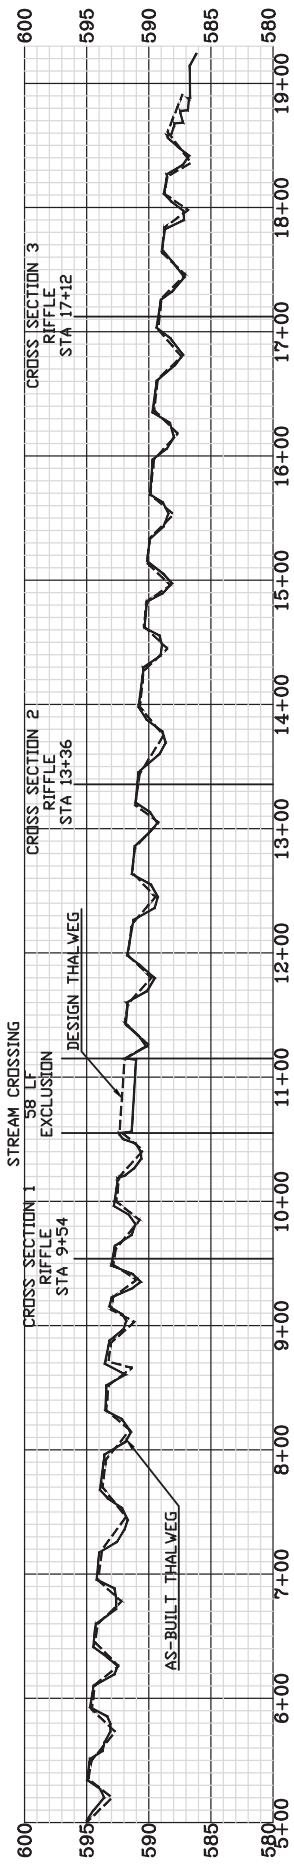

SCALE:
 HORIZONTAL - 1" = 100'
 VERTICAL - 1" = 10'


LEGEND
 _____ AS-BUILT TW
 - - - - - DESIGN TW

GRAPHIC SCALE




(IN FEET)
 1 inch = 100 ft.

AS-BUILT UT TO UNDERWOOD CREEK (NEWTOWN)
LONGITUDINAL PROFILE
TRIBUTARY CHANNEL

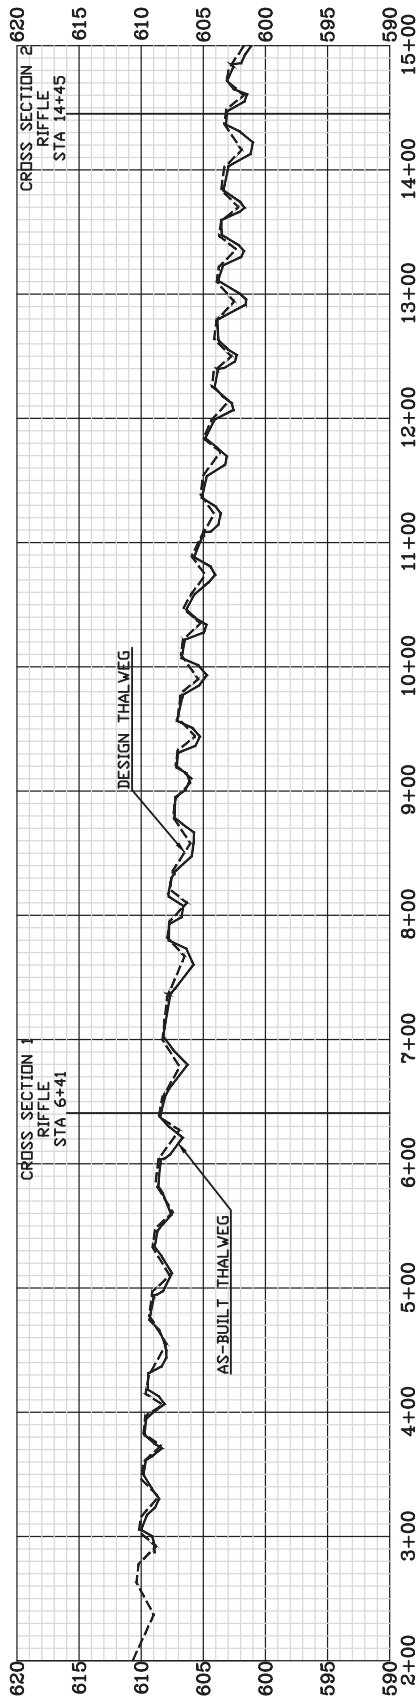

SCALE:
HORIZONTAL - 1" = 100'
VERTICAL - 1" = 10'

LEGEND
—— AS-BUILT TW
----- DESIGN TW

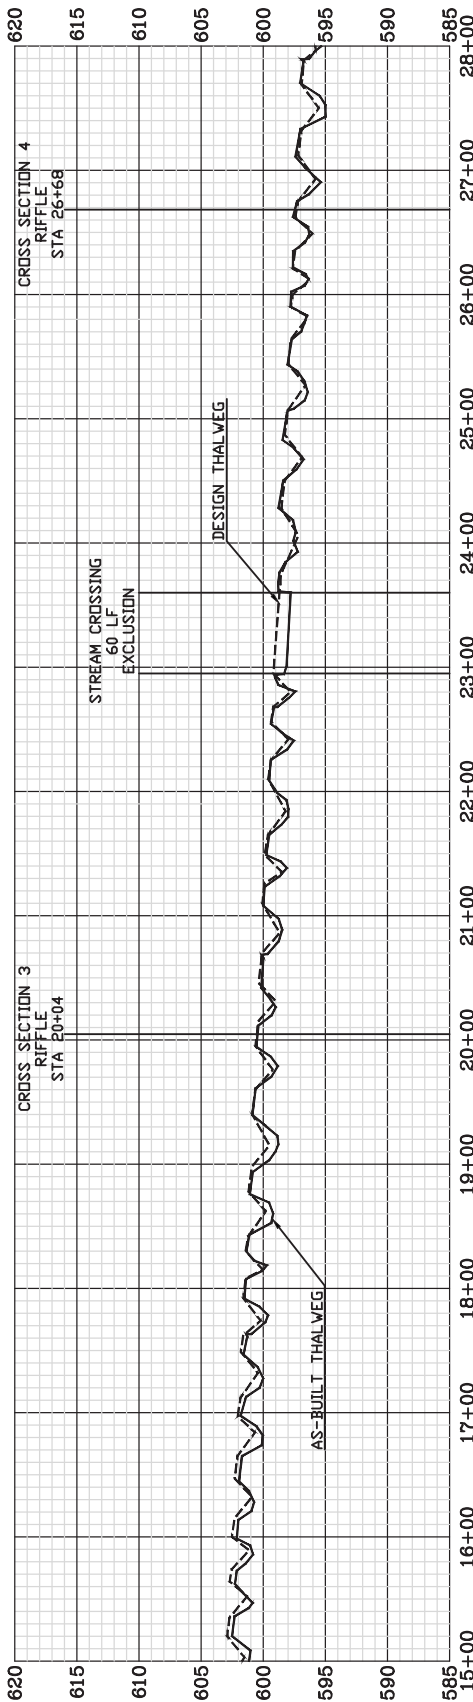

SCALE:
HORIZONTAL - 1" = 100'
VERTICAL - 1" = 10'

GRAPHIC SCALE



(IN FEET)
1 inch = 100 ft.


Ward Consulting Engineers, P.C.
FIRM LICENSE NO. C-2619
8368 Six Forks Rd, Suite 104 (919) 870-0526
Raleigh, NC 27615-5883 FAX (919) 870-3359
909 Capabilities Drive, Suite 310
Environmental Banc & Exchange
Raleigh NC 27606 Phone (919) 829-9909
Fax (919) 229-9913



NEWTOWN
AS-BUILT PROFILES
UT TO UNDERWOOD CREEK
UNION COUNTY, NORTH CAROLINA


DATE	5-27-2011
REVISIONS	
PROJECT NAME	ER. NEWTOWN
DWG NAME	ASBUILT PROFILES
SCALE	L = 100
RECORD DRAWINGS	
SHEET NO.	

AS-BUILT UT TO UNDERWOOD CREEK (NEWTOWN)
LONGITUDINAL PROFILE
TRIBUTARY CHANNEL

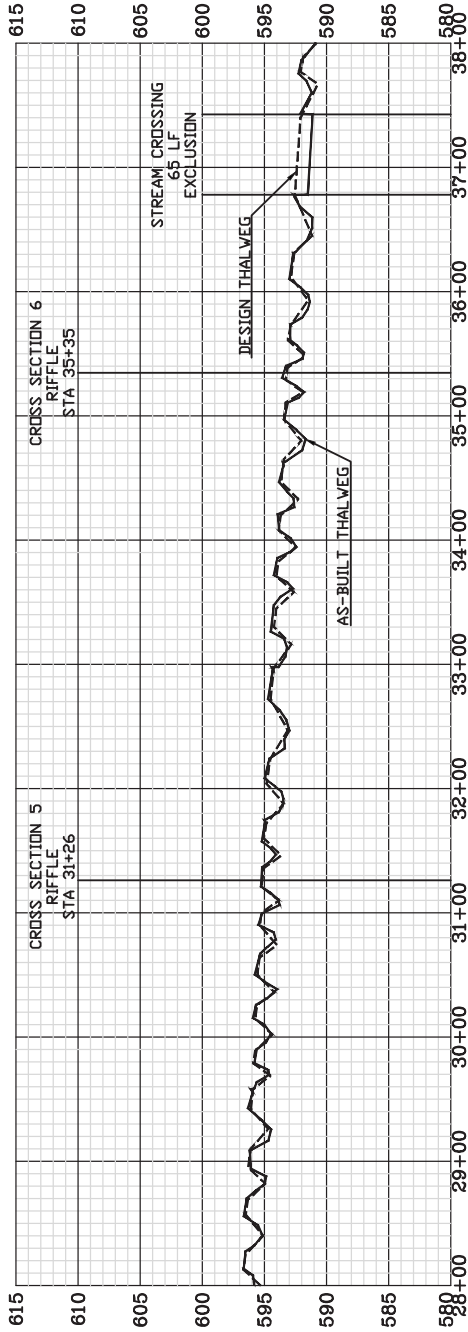

SCALE:
HORIZONTAL - 1" = 100'
VERTICAL - 1" = 10'

LEGEND
—— AS-BUILT TW
----- DESIGN TW

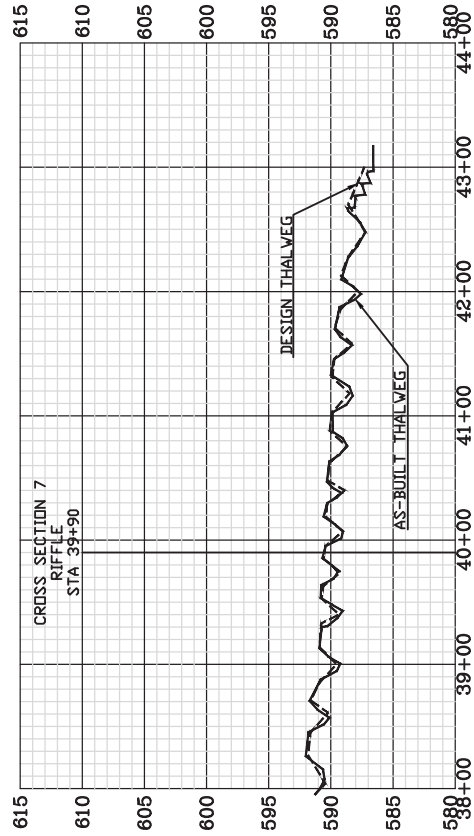

SCALE:
HORIZONTAL - 1" = 100'
VERTICAL - 1" = 10'

GRAPHIC SCALE



(IN FEET)
1 inch = 100 ft.

Ward Consulting Engineers, P.C.
FIRM LICENSE NO. C-6619
8368 Six Forks Rd, Suite 104 (919) 870-0526
Raleigh, NC 27615-5883 FAX (919) 870-5359
Environmental Bond & Exchange
909 Capabilities Drive, Suite 210
Raleigh, NC 27606 Phone: (919) 829-9909
Fax: (919) 229-9913



NEWTOWN
AS-BUILT PROFILES
UT TO UNDERWOOD CREEK
UNION COUNTY, NORTH CAROLINA

DATE	5-27-2011
REVISIONS	
PROJECT NAME	ERN. NEWTOWN
DWG NAME	ASBUILT PROFILES
SCALE	1" = 100'
RECORD DRAWINGS	
SHEET NO.	




GENERAL NOTES:

- TEMPORARY PLANTING WILL OCCUR IMMEDIATELY AFTER CONSTRUCTION TO STABILIZE AREAS OF BARE SOIL. PERMANENT PLANTING AND SEEDINGS SHALL BEGIN IN SEASON OPTIMALLY BETWEEN NOVEMBER 15 AND APRIL 15.
- PRIOR TO PERMANENT PLANTINGS AND SEEDINGS, THE SITE SOILS SHALL BE PREPARED FOR PLANTING WHERE NEEDED. THE SOILS SHOULD BE PLOWED AND RIPPED TO THE WORKING DEPTH TO ELIMINATE CHLORINE AND OTHER CONTAMINANTS FROM TARGET AREAS. TARGET AREAS SHOULD BE MANAGED WITH STORED SITE TOPSOIL TO FACILITATE VIGOROUS PLANT GROWTH.
- EXOTIC AND INVASIVE PLANTS SHALL BE TREATED AND REMOVED.
- SUMMARY OF PLANT QUANTITIES CHART SIZE REFERS TO THE SIZE OF THE PLANTS AT INSTALLATION.
- THE SPACING OF THE PLANTS SHALL BE 3' ON CENTER FOR SMALL PLANTS. PLANTS TO BE PLANTED IN STREAM BUFFER AREAS SHALL BE SPACED AT 10' ON CENTER. SPACING SHALL BE 10 FEET LONG ROWS WITH 10 FOOT ROW SPACING. FOR TREES AND SHRUBS PLANTING DENSITY IS TO BE 640 PLANTS/ACRE.
- PLANTS WILL BE KEPT SHADED AND WELL WATERED TO MAINTAIN HEALTHY, VIGOROUS CONDITION PRIOR TO PLANTING.
- PERMANENT SEED MIX REQUIRES ADVANCE PRE-ORDER AND SHIPMENT.
- ALL PLANT MATERIAL SHALL CONFORM TO OR EXCEED THE AMERICAN NATIONAL STANDARD FOR PLANT MATERIAL (EDITION) AS PUBLISHED BY THE AMERICAN ASSOCIATION OF NURSERYMEN.
- THE SITE SHALL BE PLANTED BY THE ZONES DEPICTED IN THE PLANTING PLAN SHEETS WITH SPECIES LISTED IN THE PLANTING TABLES.
- PLANTING ZONE DESCRIPTIONS:
 - ZONE 1 - STREAM BANK
 - THE STREAM BANK ZONE INCLUDES THE STREAM CHANNEL FROM THE BANKFULL ELEVATION TO THE BANKFULL ELEVATION.
 - ZONE 2 - STREAM BUFFER
 - THE STREAM BUFFER INCLUDES THE AREA FROM THE BANKFULL ELEVATION TO THE CONSERVATION EASEMENT LIMIT.
 - ZONE 3 - WETLAND
 - THE WETLAND ZONES INCLUDE POCKETS OF RESTORED WETLAND AREAS WITHIN ZONE 2.

Plant Table

	Zone 1 (Stream banks)	Zone 2 (Buffer)	Zone 3 (Wetland)
Bare Roots			
Willow Oak (<i>Quercus phellos</i>)	1500	500	500
Swamp Chestnut Oak (<i>Quercus michauxii</i>)	2000	500	500
Hackberry (<i>Celtis laevigata</i>)	500	500	500
Paw Paw (<i>Asimina triloba</i>)	500	500	500
American Sycamore (<i>Platanus occidentalis</i>)	1300	300	300
Green Ash (<i>Fraxinus pennsylvanica</i>)	1500	300	300
American Hornbeam/Lironwood (<i>Carpinus caroliniana</i>)	500	200	200
Silky Dogwood (<i>Cornus amomum</i>)	500	300	300
Bulldozer (<i>Cephalanthus occidentalis</i>)	500	300	300
Persimmon (<i>Diospyros virginiana</i>)	300	300	300
River Birch (<i>Betula nigra</i>)	0	8600	2600
Live Stakes			
Silky Dogwood (<i>Cornus amomum</i>)	2000		
Black Willow (<i>Salix nigra</i>)	3700		
Bare Root Total =	0	8600	2600

Species	Common Name	Percent
Creeping bentgrass	Creeping bentgrass	33
Fox sedge	Fox sedge	20
Virginia wild rye	Virginia wild rye	25
Sheepshead	Sheepshead	5
Blue flag	Blue flag	4
Showy tick trefoil	Showy tick trefoil	4
Black-eyed susan	Black-eyed susan	4
Blue vervain	Blue vervain	4
Total	Total	100
3.38 Total Acres		
20 lbs./acre		
67.6 Total lbs.		

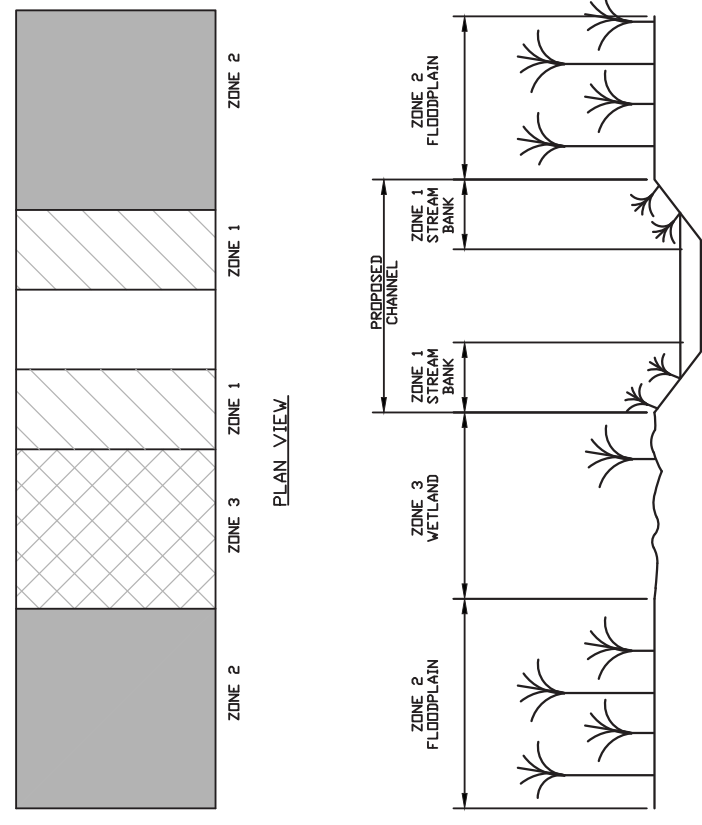

PLANTING ZONE PROFILE SCHEMATIC
 NOT TO SCALE

Stream Buffer and Stream Banks Planting Zones-Permanent Seed Mix

Scientific Name	Common Name	Percent
<i>Elymus virginicus</i>	Virginia wild rye	20
<i>Panicum virgatum</i>	Switchgrass	20
<i>Agrostis stolonifera</i>	Creeping bentgrass	15
<i>Coreopsis</i>	Coreopsis	10
<i>Panicum clandestinum</i>	Deer tongue	10
<i>Andropogon gerardi</i>	Big bluestem	5
<i>Juncus effusus</i>	Soft rush	5
<i>Polygonum pensylvanicum</i>	Penn. Smartweed	5
<i>Schizanthus scapularium</i>	Little bluestem	5
<i>Sorghastrum nutans</i>	Indian grass	5
13.86 Total Acres		
20 lbs./acre		
277.2 Total lbs.		

Recommended application rate: 20 lbs. per acre


Common Name	Percent
Creeping bentgrass	33
Fox sedge	20
Virginia wild rye	25
Sheepshead	5
Blue flag	4
Showy tick trefoil	4
Black-eyed susan	4
Blue vervain	4
Total	100
3.38 Total Acres	
20 lbs./acre	
67.6 Total lbs.	

Ward Consulting Engineers, P.C.
 FIRM LICENSE NO. C-2619
 8368 Six Forks Rd., Suite 104
 Raleigh, NC 27615-5083 FAX (919) 870-5359
 Environmental Banc & Exchange
 909 Copability Drive, Suite 3100
 Raleigh NC 27606 Phone (919) 829-9909
 Fax: (919) 229-9913




NEWTOWN PLANTING PLAN
 STATION 5+00 TO 14+00
 UNDERWOOD CREEK
 UNION COUNTY, NORTH CAROLINA

DATE:	5-27-2011
REVISIONS:	
PROJECT NAME:	Underwood Creek
DWG. NAME:	Planting Plan
SCALE:	1"=40'
RECORD DRAWING:	
SHEET NO.:	VP3

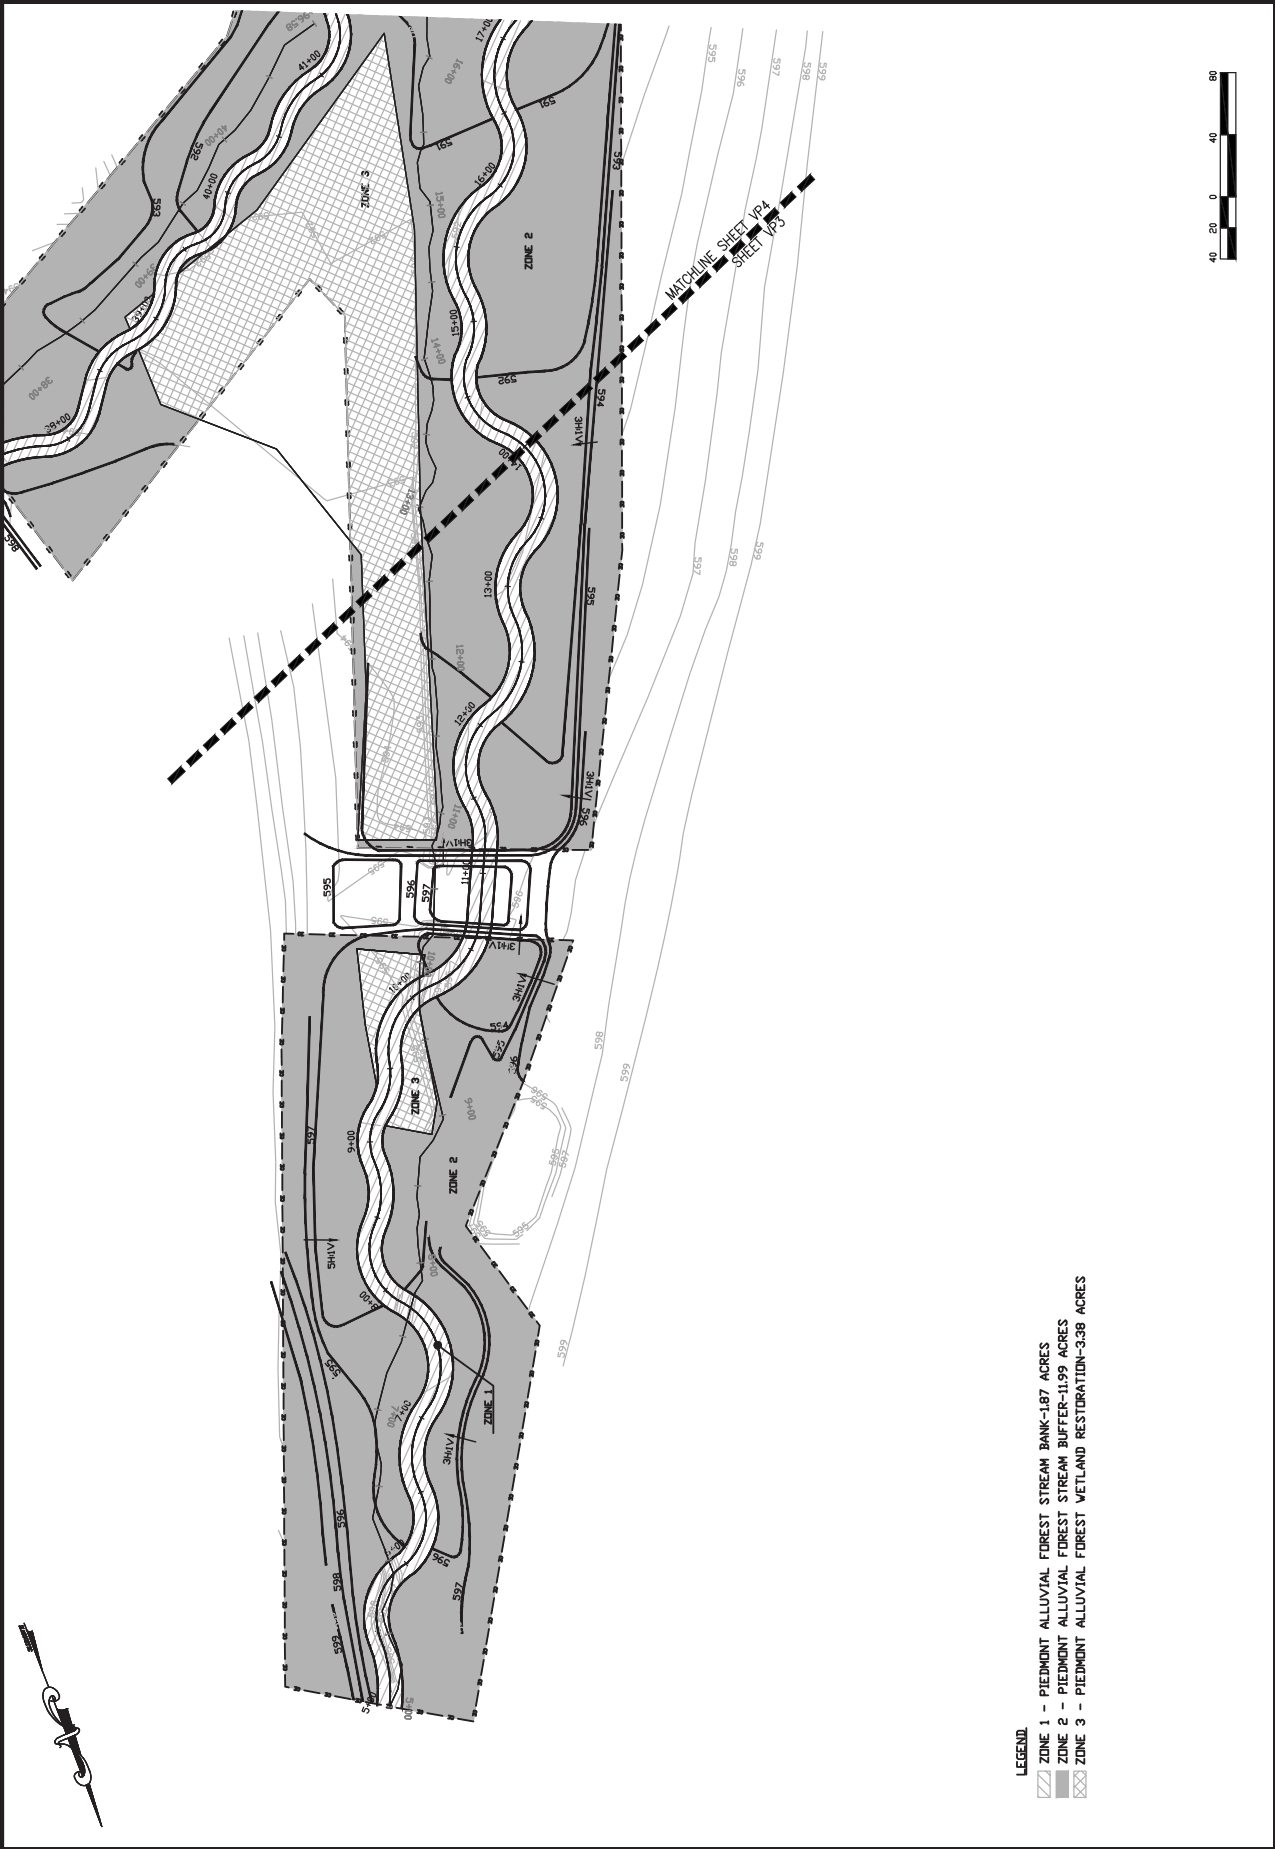

- LEGEND:**
- ▨ ZONE 1 - PIEDMONT ALLUVIAL FOREST STREAM BANK-1.87 ACRES
 - ▩ ZONE 2 - PIEDMONT ALLUVIAL FOREST STREAM BUFFER-11.99 ACRES
 - ▧ ZONE 3 - PIEDMONT ALLUVIAL FOREST WETLAND RESTORATION-3.38 ACRES

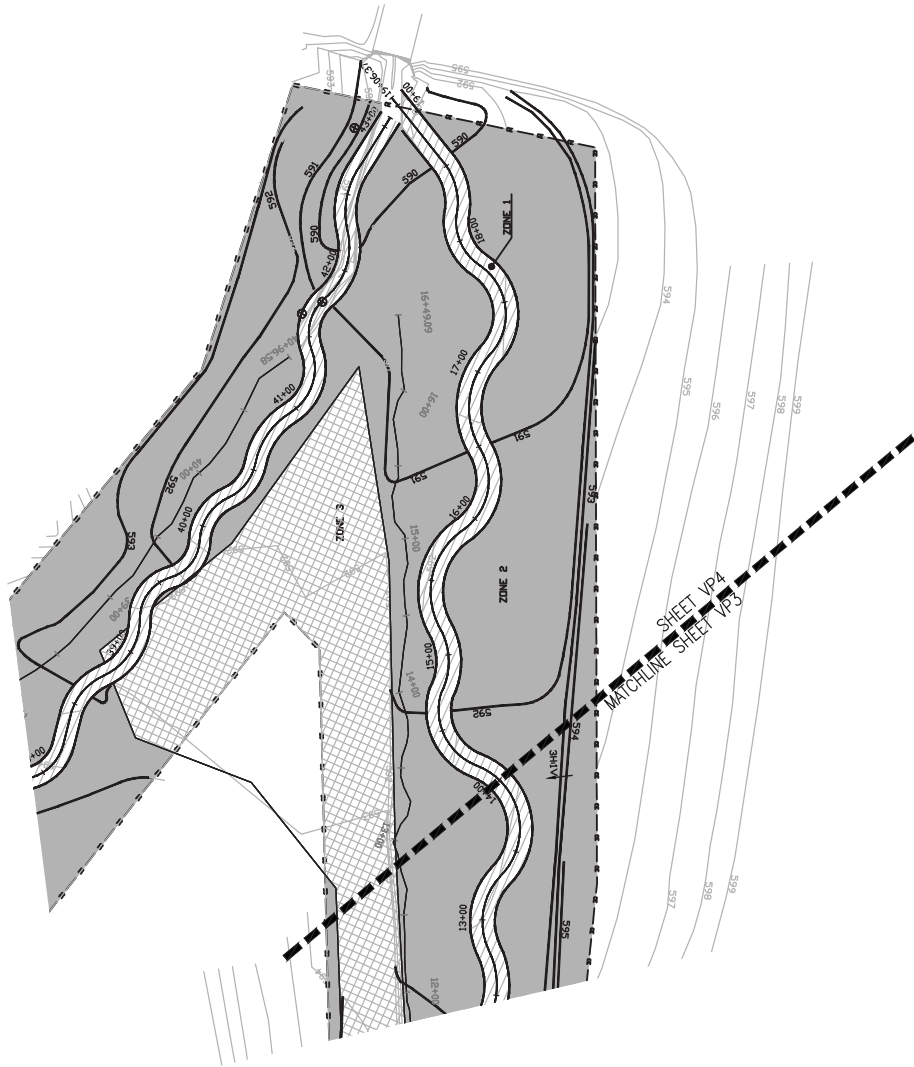

- LEGEND**
- ZONE 1 - PIEDMONT ALLUVIAL FOREST STREAM BANK
 - ZONE 2 - PIEDMONT ALLUVIAL FOREST STREAM BUFFER
 - ZONE 3 - PIEDMONT ALLUVIAL FOREST WETLAND RESTORATION



Ward Consulting Engineers, P.C.
 FIRM LICENSE NO. C-2619
 8368 Six Forks Rd., Suite 104 Raleigh, NC 27615-5083
 Environmental Banc & Exchange
 909 Capability Drive, Suite 3100 Raleigh NC 27606
 Phone: (919) 829-9909
 Fax: (919) 229-9913



NEWTOWN PLANTING PLAN
STATION 14+00 TO 19+06.37
UNDERWOOD CREEK
UNION COUNTY, NORTH CAROLINA


DATE:	5-27-2011
REVISIONS:	
PROJECT NAME:	Underwood Creek
DWG. NAME:	Planting Plan
SCALE:	1"=40'
RECORD DRAWINGS	
SHEET NO.	VP4

Ward Consulting Engineers, P.C.
 FIRM LICENSE NO. C-2619
 8368 Six Forks Rd., Suite 104 Raleigh, NC 27615-5083
 Environmental Banc & Exchange
 909 Copability Drive, Suite 3100 Raleigh NC 27606
 Phone: (919) 829-9909 Fax: (919) 229-9913



NEWTOWN PLANTING PLAN
 STATION 0+00 TO 12+00
 UT TO UNDERWOOD CREEK
 UNION COUNTY, NORTH CAROLINA

DATE:	5-27-2011
REVISIONS:	
PROJECT NAME:	Underwood Creek
DWG. NAME:	Planting Plan
SCALE:	1"=40'
RECORD DRAWINGS	
SHEET NO.	VPS

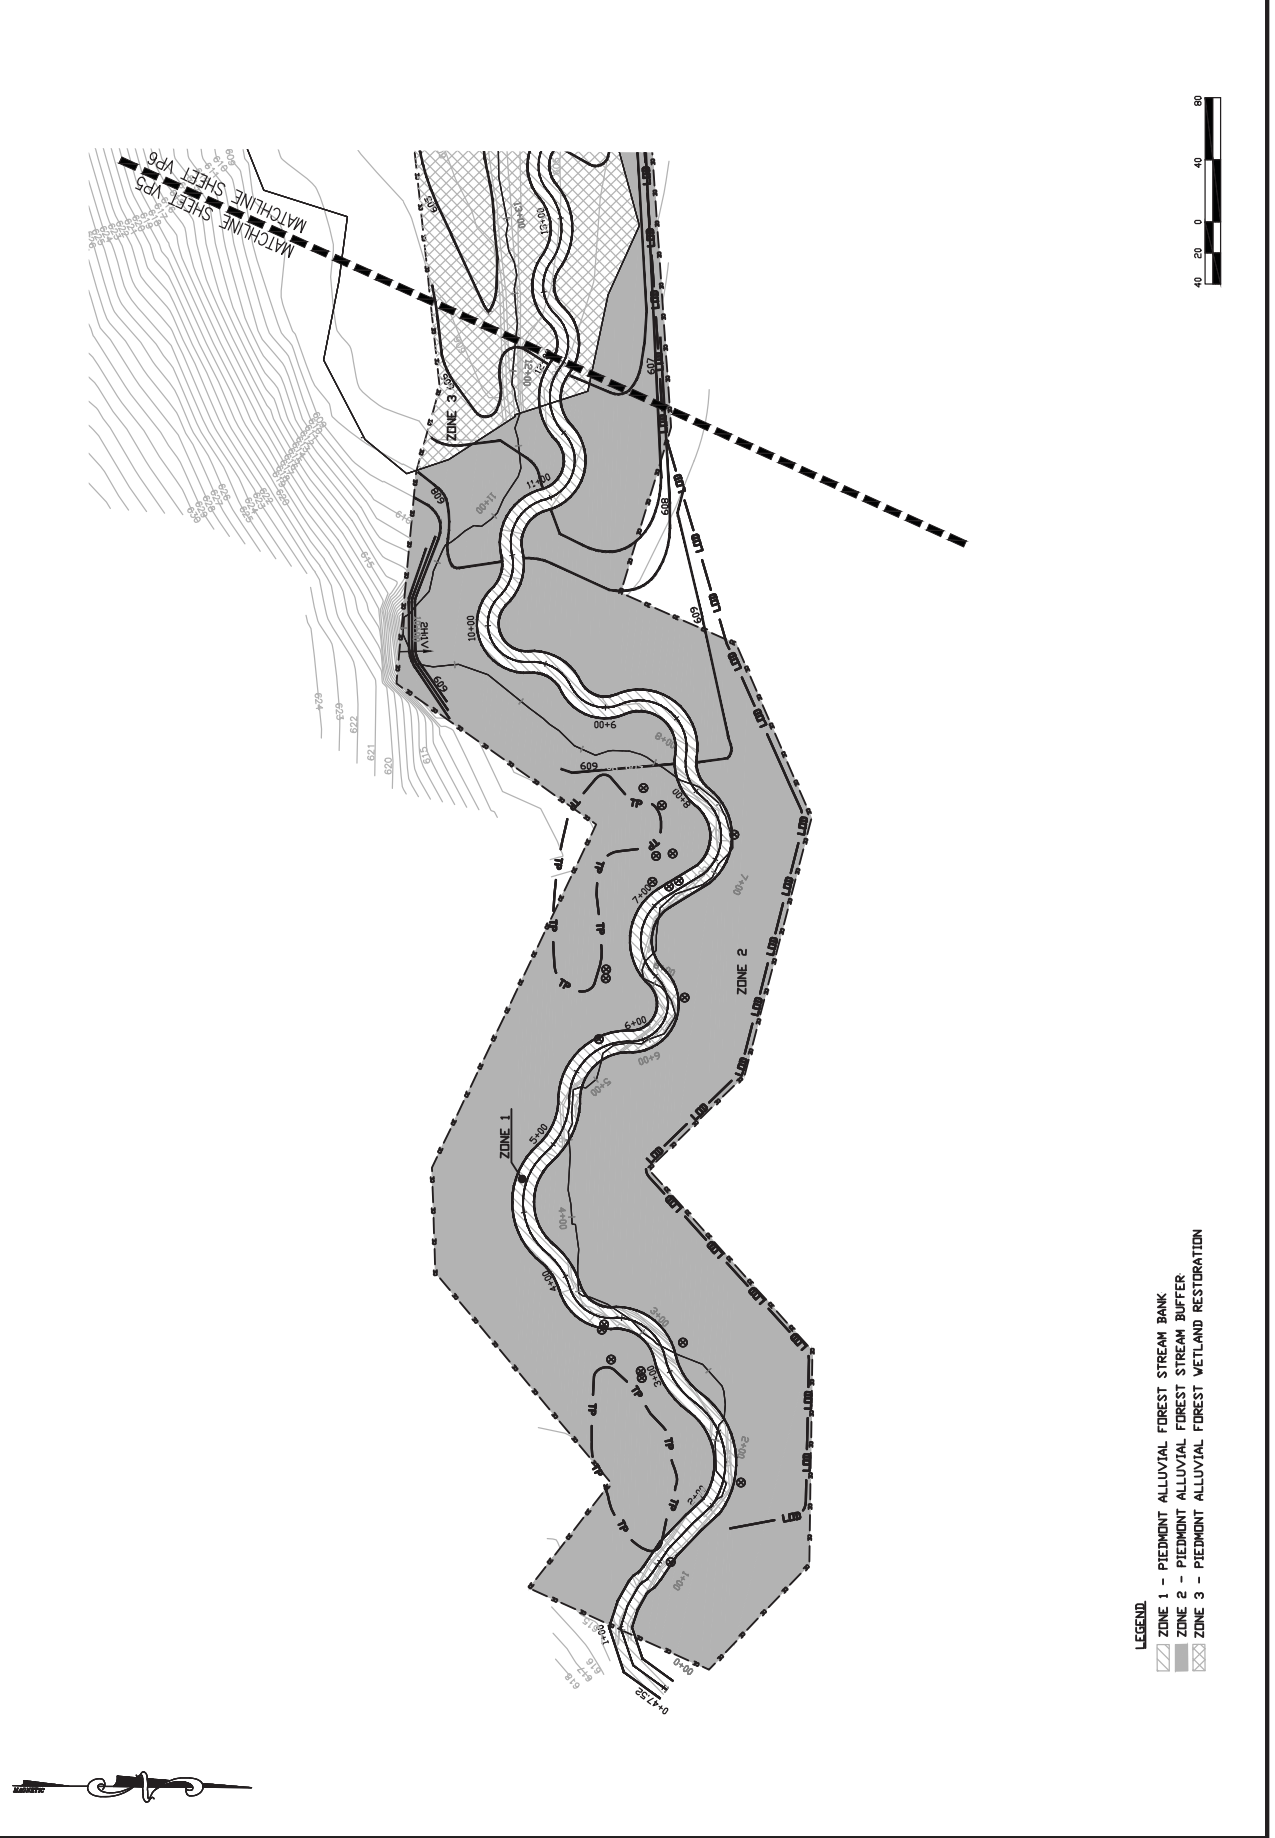

- LEGEND:**
- ▨ ZONE 1 - PIEDMONT ALLUVIAL FOREST STREAM BANK
 - ▩ ZONE 2 - PIEDMONT ALLUVIAL FOREST STREAM BUFFER
 - ▧ ZONE 3 - PIEDMONT ALLUVIAL FOREST WETLAND RESTORATION




Ward Consulting Engineers, P.C.
 FIRM LICENSE NO. C-2619
 8368 Six Forks Rd., Suite 104
 Raleigh, NC 27615-5083
 FAX (919) 870-5359
 Environmental Banc & Exchange
 909 Capabilities Drive, Suite 3100
 Raleigh, NC 27606
 Phone: (919) 829-9909
 Fax: (919) 229-9913



NEWTOWN PLANTING PLAN
STATION 12+00 TO 24+00
UT TO UNDERWOOD CREEK
UNION COUNTY, NORTH CAROLINA

DATE:	5-27-2011
REVISIONS:	
PROJECT NAME:	Marion Creek
DWG. NAME:	Planting Plan
SCALE:	1"=40'
RECORD DRAWINGS	
SHEET NO.	VP6

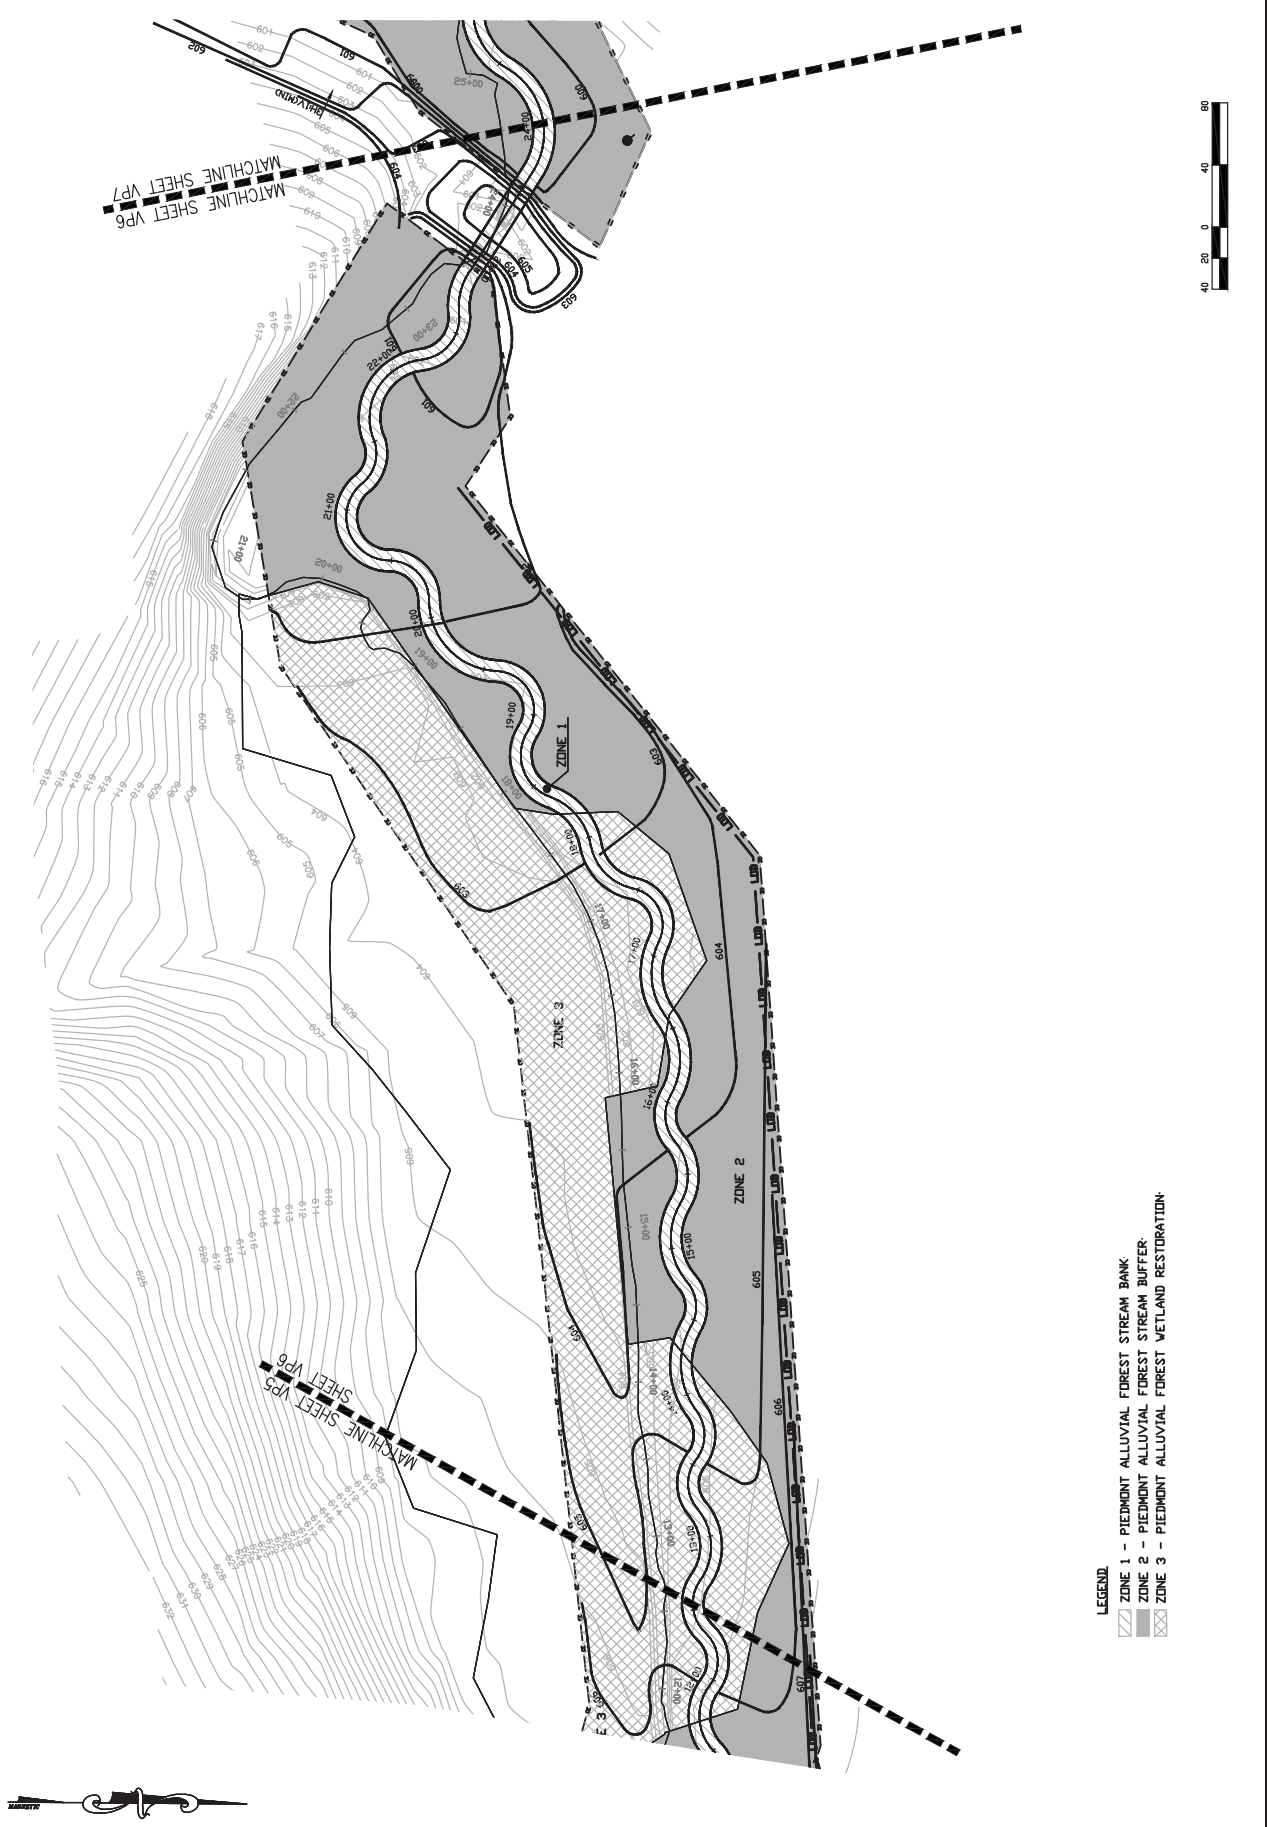


- LEGEND**
- ▨ ZONE 1 - PIEDMONT ALLUVIAL FOREST STREAM BANK
 - ▩ ZONE 2 - PIEDMONT ALLUVIAL FOREST STREAM BUFFER
 - ▧ ZONE 3 - PIEDMONT ALLUVIAL FOREST WETLAND RESTORATION

Ward Consulting Engineers, P.C.
 FIRM LICENSE NO. C-2619
 8368 Six Forks Rd., Suite 104 Raleigh, NC 27615-5083 FAX (919) 870-5359
 Environmental Banc & Exchange
 909 Copability Drive, Suite 3100 Raleigh NC 27606 Phone (919) 829-9909 Fax: (919) 229-9913



NEWTOWN PLANTING PLAN
 STATION 24+00 TO 36+00
 UT TO UNDERWOOD CREEK
 UNION COUNTY, NORTH CAROLINA

DATE: 5-27-2011
 REVISIONS:
 PROJECT NAME: Newtown Creek
 Dwg Name: Planting Plan
 SCALE: 1"=40'
 RECORD DRAWINGS
 SHEET NO. VP7

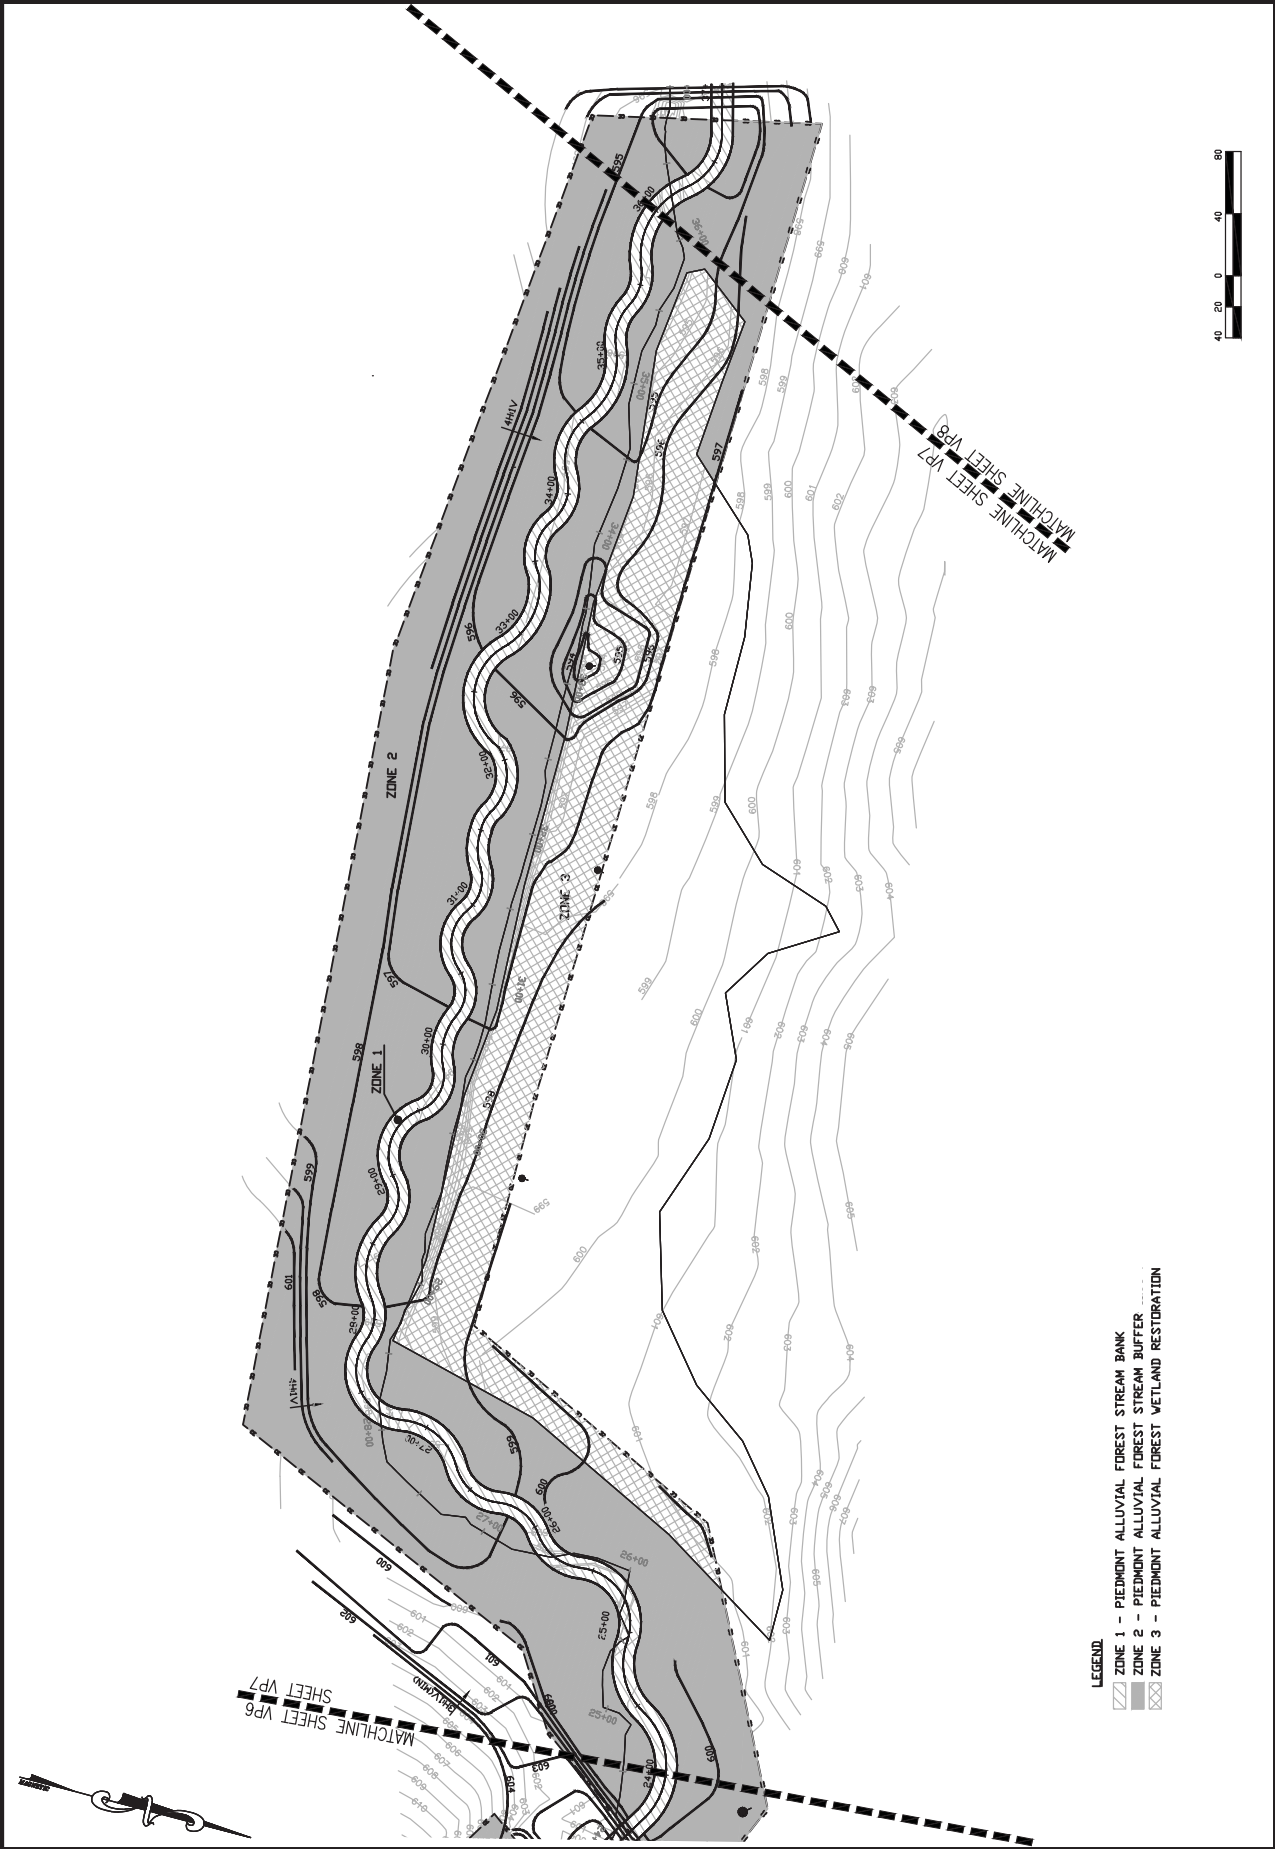


- LEGEND:
- ▨ ZONE 1 - PIEDMONT ALLUVIAL FOREST STREAM BANK
 - ▩ ZONE 2 - PIEDMONT ALLUVIAL FOREST STREAM BUFFER
 - ▧ ZONE 3 - PIEDMONT ALLUVIAL FOREST WETLAND RESTORATION

Ward Consulting Engineers, P.C.
 FIRM LICENSE NO. C-2619
 8368 Six Forks Rd., Suite 104
 Raleigh, NC 27615-5083 FAX (919) 870-5326
 Environmental Banc & Exchange
 909 Capability Drive, Suite 3100
 Raleigh NC 27606 Phone (919) 829-9909
 Fax: (919) 229-9913




NEWTOWN PLANTING PLAN
 STATION 36+00 TO 43+06
 UT TO UNDERWOOD CREEK
 UNION COUNTY, NORTH CAROLINA


DATE:	5-27-2011
REVISIONS:	
PROJECT NAME:	Marathon Creek
DWG. NAME:	Planting Plan
SCALE:	1"=40'
RECORD DRAWINGS	
SHEET NO.	VP8

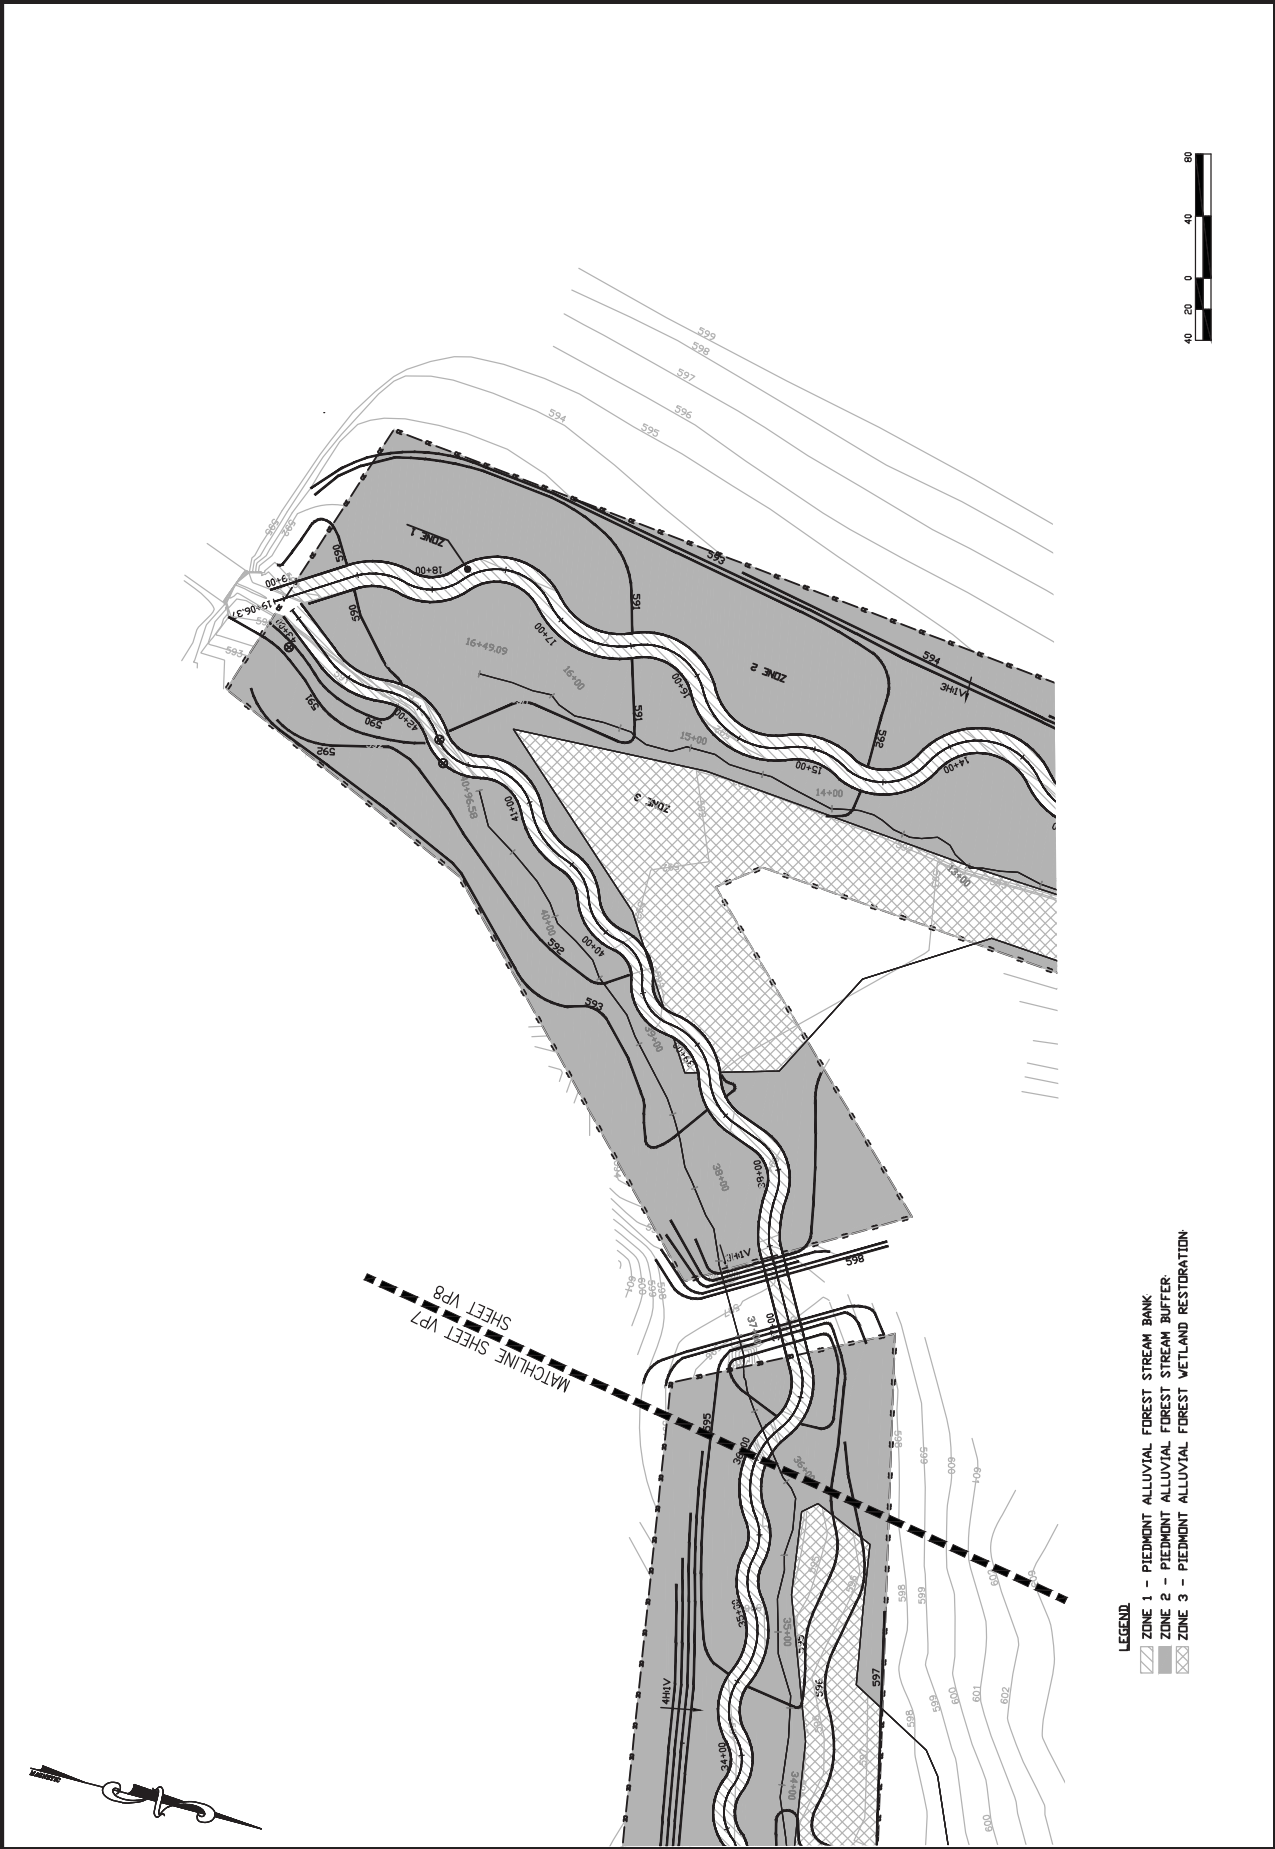


- LEGEND**
- ▨ ZONE 1 - PIEDMONT ALLUVIAL FOREST STREAM BANK
 - ▩ ZONE 2 - PIEDMONT ALLUVIAL FOREST STREAM BUFFER
 - ▧ ZONE 3 - PIEDMONT ALLUVIAL FOREST WETLAND RESTORATION

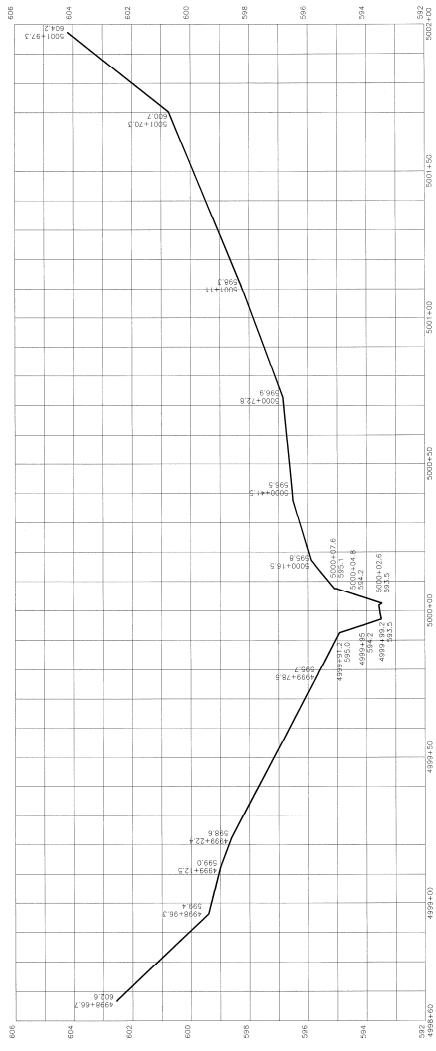

CROSS SECTION
12695 (POST PROJECT)

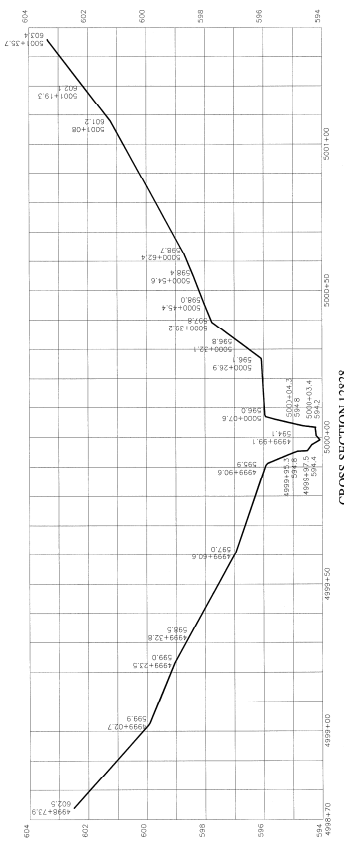

CROSS SECTION 12828

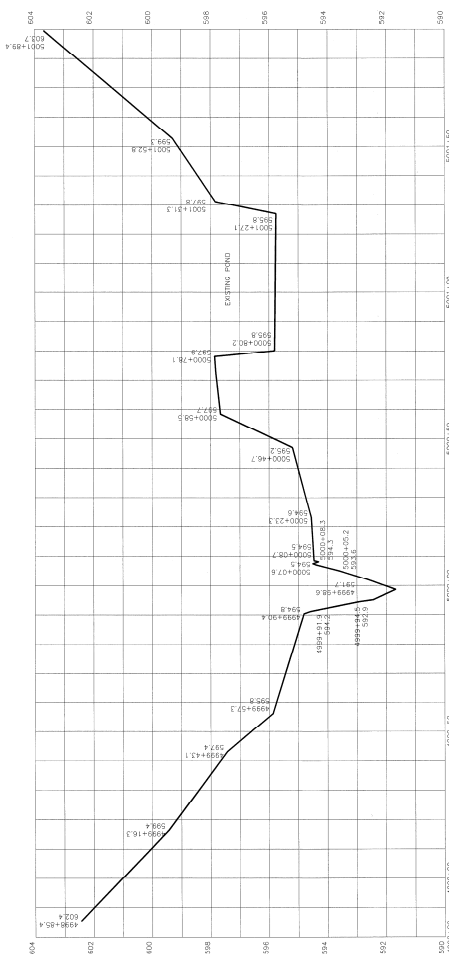

CROSS SECTION 12584

REVISIONS

DATE: 04/28/2011
SCALE: 1" = 20'



NOTES:
1. SEE SHEET 1 OF 5 FOR ALL NOTES AND PLAN VIEW OF UNIMPROVED DATA.

SHEET 2 OF 5
NOT BE REPRODUCED
WITHOUT ALL 5 SHEETS

ENVIRONMENTAL BANK & EXCHANGE
RE: UNIMPROVED DATA
NEWTON ROAD
UNION COUNTY, NORTH CAROLINA
DEED PARCEL # 09408004 AND 09408005
TAX PARCEL # 09408004 AND 09408005
R.B. PHARR & ASSOCIATES, P.A.
SURVEYING AND MAPPING
1000 W. MARKET STREET
APRILE, NC 28111
JOB NO. 77111

DATE: APRIL 28, 2011
JOB NO. 77111

SCALE: 1" = 20'

REVISIONS

DATE: APRIL 28, 2011
JOB NO. 77111



SCALE: 1" = 20'

REVISIONS

DATE: APRIL 28, 2011
JOB NO. 77111

SCALE: 1" = 20'

REVISIONS

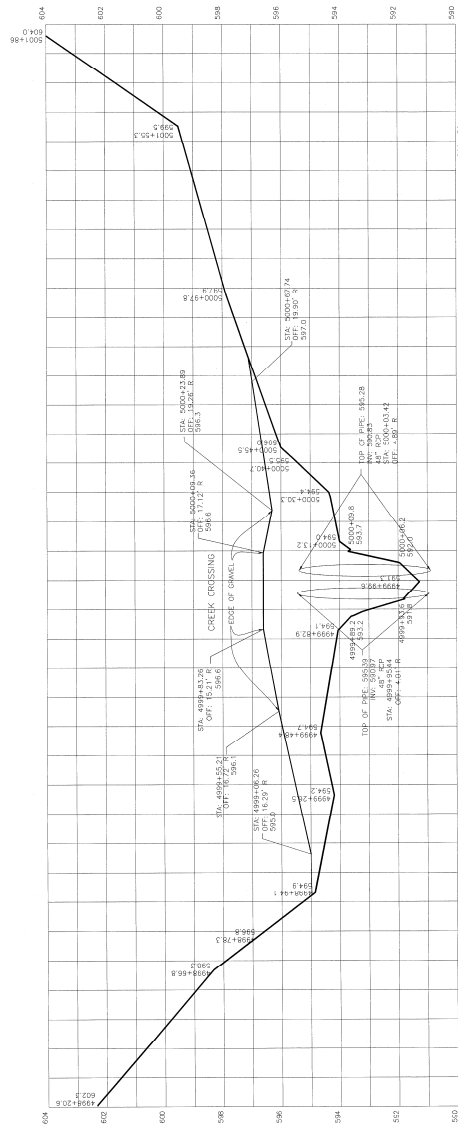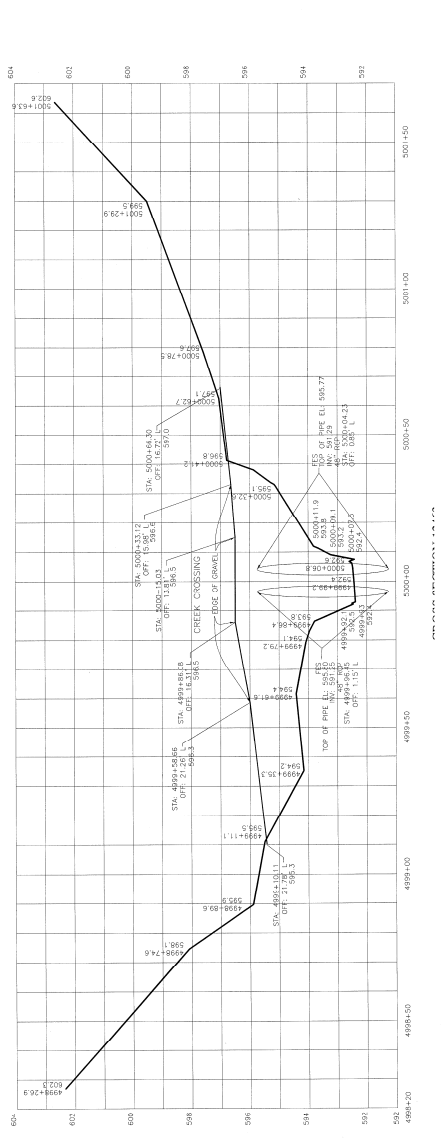

CROSS SECTION 12406

REVISIONS	
TR	CW


SURVEY PREPARED FOR:
ENVIRONMENTAL BANK & EXCHANGE
 1000 WEST 10TH STREET
 KEATOWN ROAD #3001
 UNDER COUNTY NORTH CAROLINA
 TAX PARCEL # 0940804 AND 0940800

SCALE: HORIZONTAL: AS SHOWN
 VERTICAL: AS SHOWN
 DATE: COMPLETE: 04/28/2011
 FILE NO.: W-38468
 APRIL 28, 2011
 JOB NO.: 77111


SHEET 3 OF 5
 NOT TO SCALE
 WITHOUT ALL 5 SHEETS



NOTES:
 1. SEE SHEET 1 OF 5 FOR ALL NOTES AND PLAN VIEW OF THIS WORK.

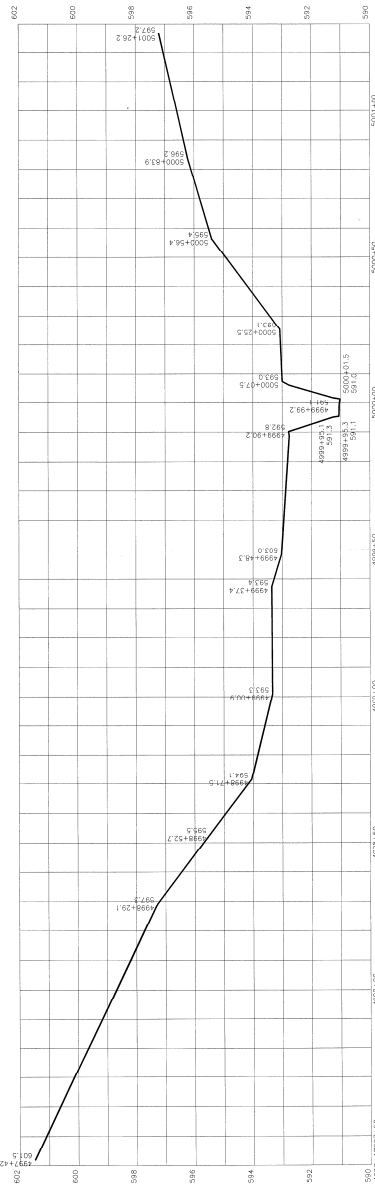

CROSS SECTION 12253

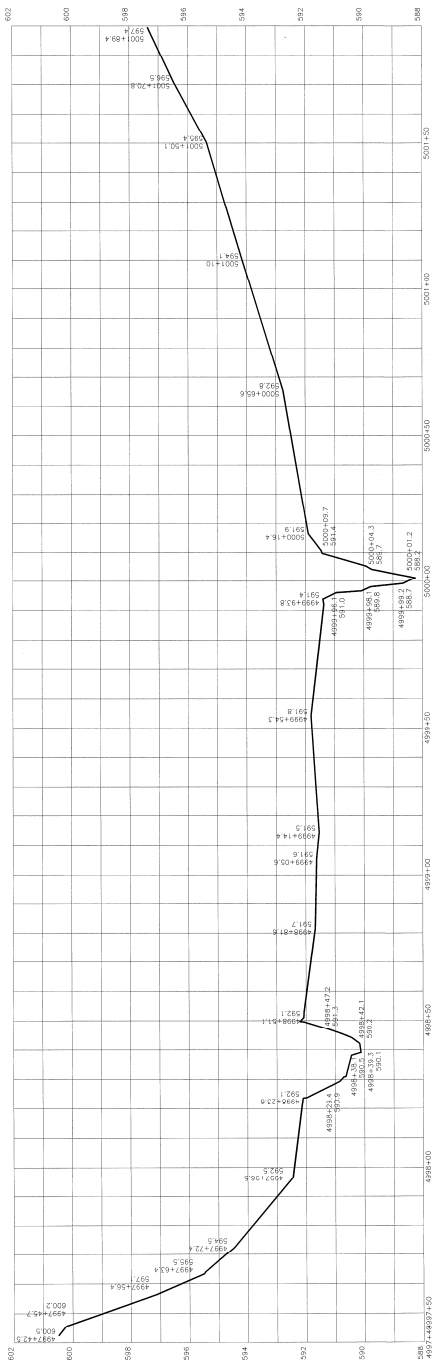

CROSS SECTION 12022

REVISIONS



NO.	DATE	BY	DESCRIPTION
1			



NOTES:
 1. SEE SHEET 7 OF 7 FOR ALL NOTES AND NOTES TO BE OBSERVED ON THIS DRAWING.

SURVEY PREPARED FOR:
ENVIRONMENTAL BANK & EXCHANGE
 ONE UNIVERSITY CENTER
 NEWTOWN ROAD, SUITE 100
 UNION COUNTY, NORTH CAROLINA 28788
 DEED TAX PARCEL F: 09409004 AND 09409005
 TAX PARCEL F: 09409004 AND 09409005

R.B. PHARR & ASSOCIATES, P.A.
 SURVEYING & MAPPING
 425 LAWRENCE STREET, SUITE 100
 CHARLOTTE, NC 28202
 TEL: 704.333.3338
 FAX: 704.333.3339
 APRIL 29, 2011 | JOB NO. 77112022

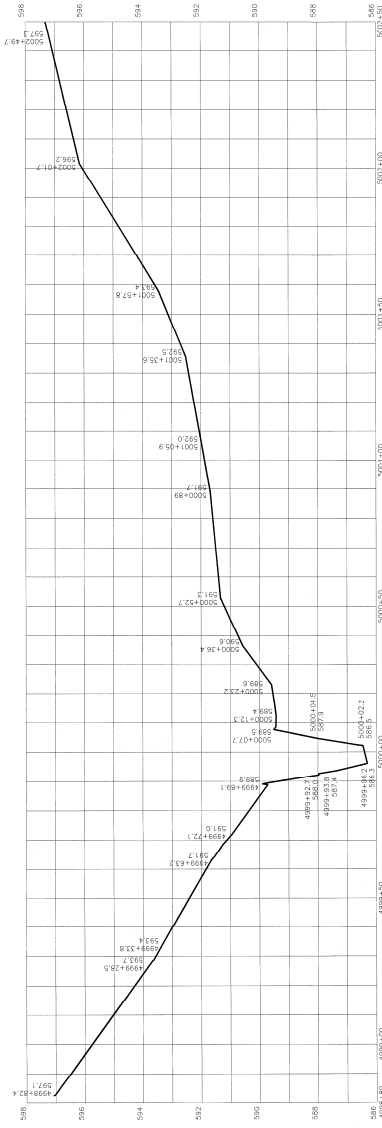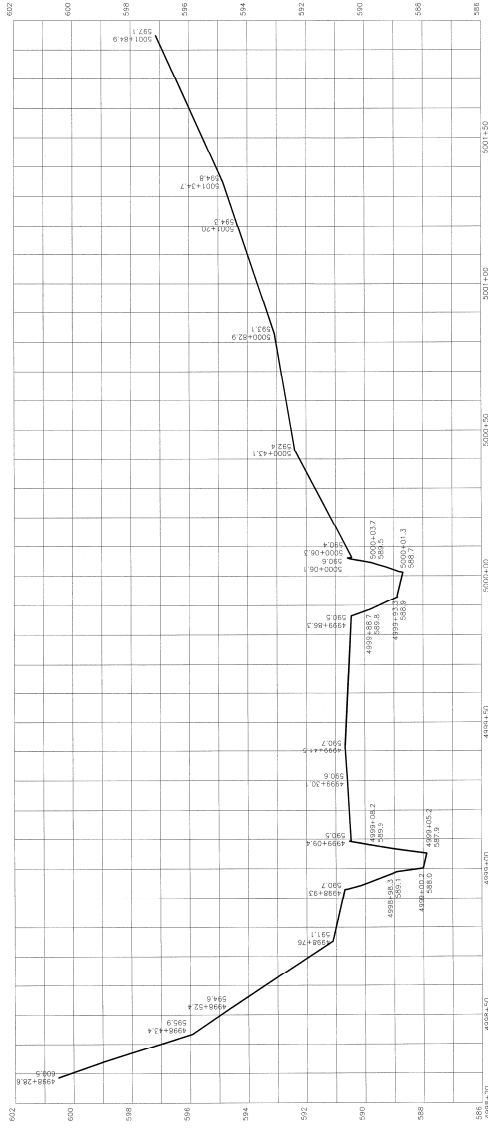

NOTES:
 1. REFER TO ALL NOTES AND PLANS OF CROSSINGS ON SHEET 11895.
 2. SHEETS 11895 & 11896 NOT COMPLETE SURVEY WITHOUT ALL 5 SHEETS.



REVISIONS:

NO.	DATE	BY	DESCRIPTION
1	APR 28, 2011	RBP	ISSUE FOR PERMITTING
2	APR 28, 2011	RBP	ISSUE FOR PERMITTING

DATE: APR 28, 2011
 SCALE: 1" = 20'
 FILE NO. W-3848E

SURVEY PREPARED FOR:
ENVIRONMENTAL BANC & EXCHANGE
 1000 NEWTOWN ROAD
 NEWTOWN ROAD
 DEED REFERENCE: 18-1811 AND 2001-692
 TAX PARCEL # 09408004 AND 09408005

R.B. PHARR & ASSOCIATES, P.A.
 300 W. MARKET STREET, SUITE 200
 WILMINGTON, NC 28401