


- EXISTING TOPOGRAPHY (KCI TECHNOLOGIES, JAMES M. GELLENTHIN L-3860)
- DESIGN (URS CORPORATION, KATHLEEM M. MCKEITHAN NC-28432)
- AS-BUILT SURVEY (LEVEL CROSS SURVEYING, SHERI WILLARD L-3385)
- CONSERVATION EASEMENT (LANDMARK SURVEYING, INC., DOUGLAS R. YARBROUGH L-3395)
- AS-BUILT ADDITIONAL NOTES (URS CORPORATION, KATHLEEM M. MCKEITHAN NC- 28432)

BEGIN CONSTRUCTION
REACH A STA.10+00

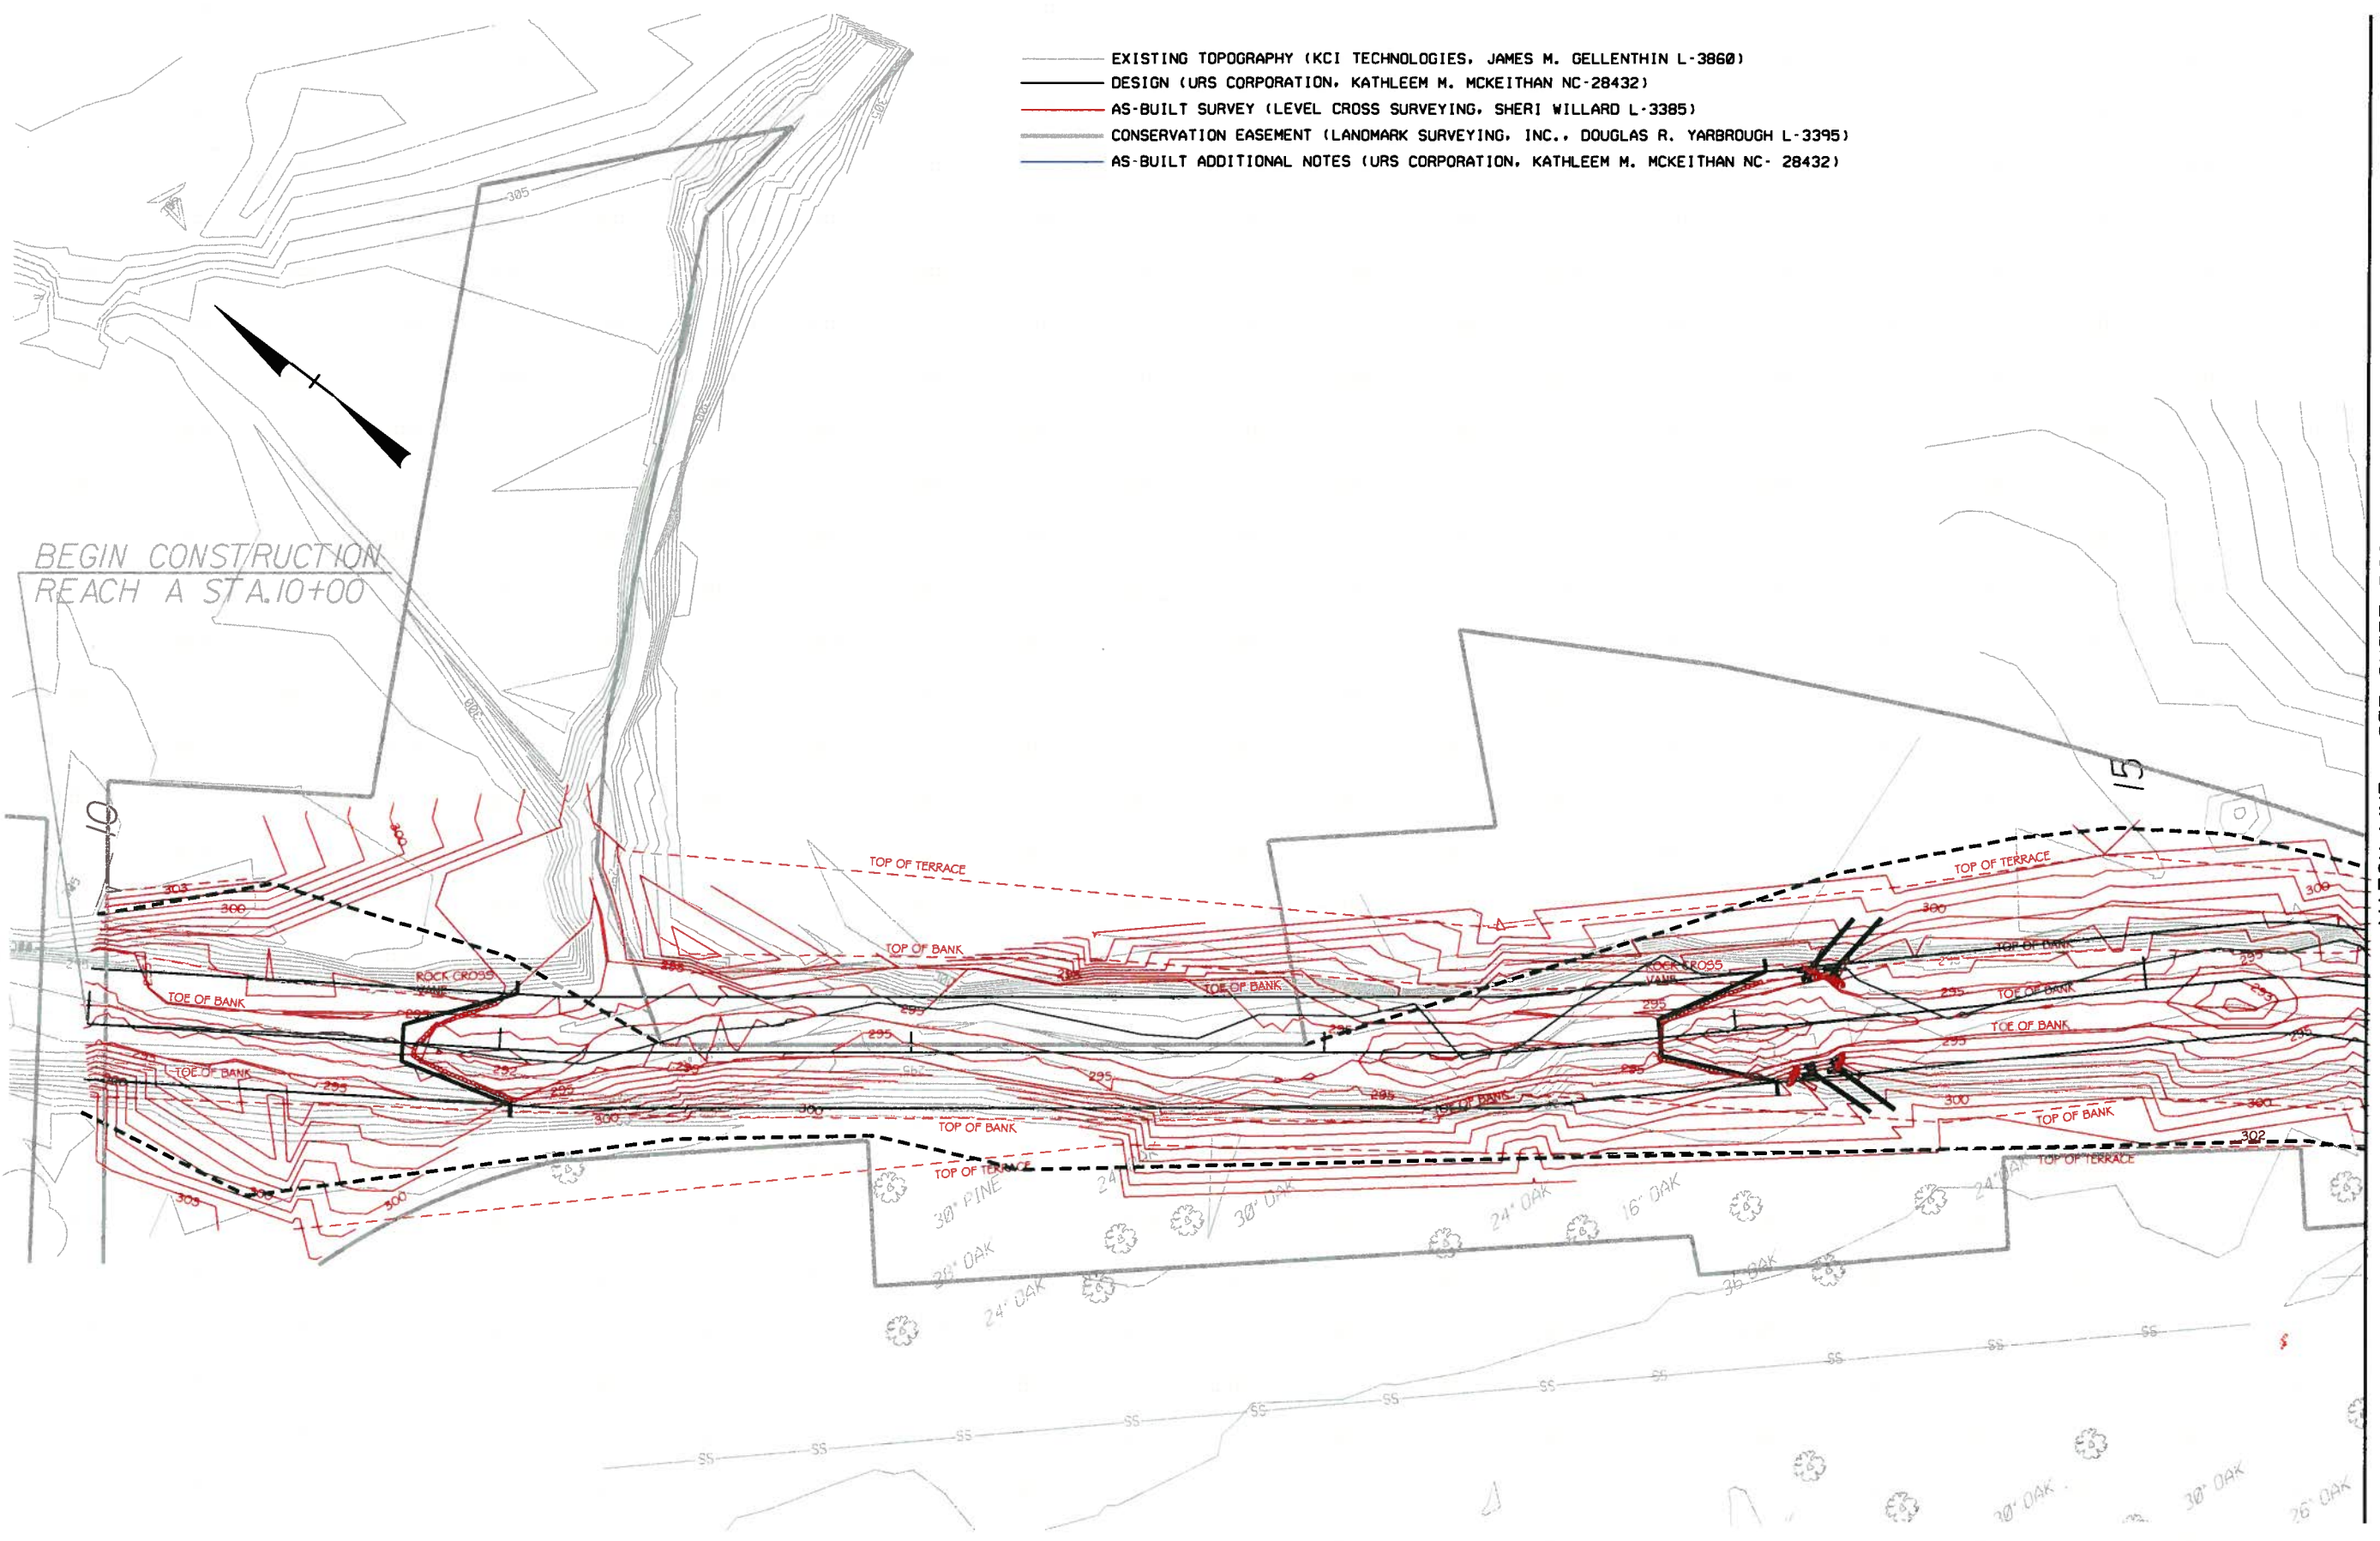

REACH A

NOTE: CHANNEL'S LEFT BANK SHALL REMAIN IN IT'S EXISTING CONDITION FROM STA. 11+40 TO 12+90. DO NOT DISTURB BOST PROPERTY.



RECORD DRAWING

MATCH LINE - SEE SHEET PS2

REVISIONS	
NO.	DATE

Prepared by

 1600 Perimeter Park Drive, Suite 400
 Morrisville, North Carolina 27560
 Phone (919)461-1100 Fax (919)461-1415
 NC Lic.# C-2243

PROJECT: ELLERBE CREEK
(NORTHGATE PARK)
STREAM RESTORATION
PROJECT

TITLE:
AS-BUILT PLAN SHEET

CLIENT: NORTH CAROLINA
ECOSYSTEM
ENHANCEMENT PROGRAM



SEAL




DATE: DEC 2009
 TECHNICIAN: EHJ
 CHECKED BY: KMM
 PROJ. NO.
 SCO 04064250IA

PSI

MATCH LINE - SEE SHEET PSI

MATCH LINE - SEE SHEET PS3

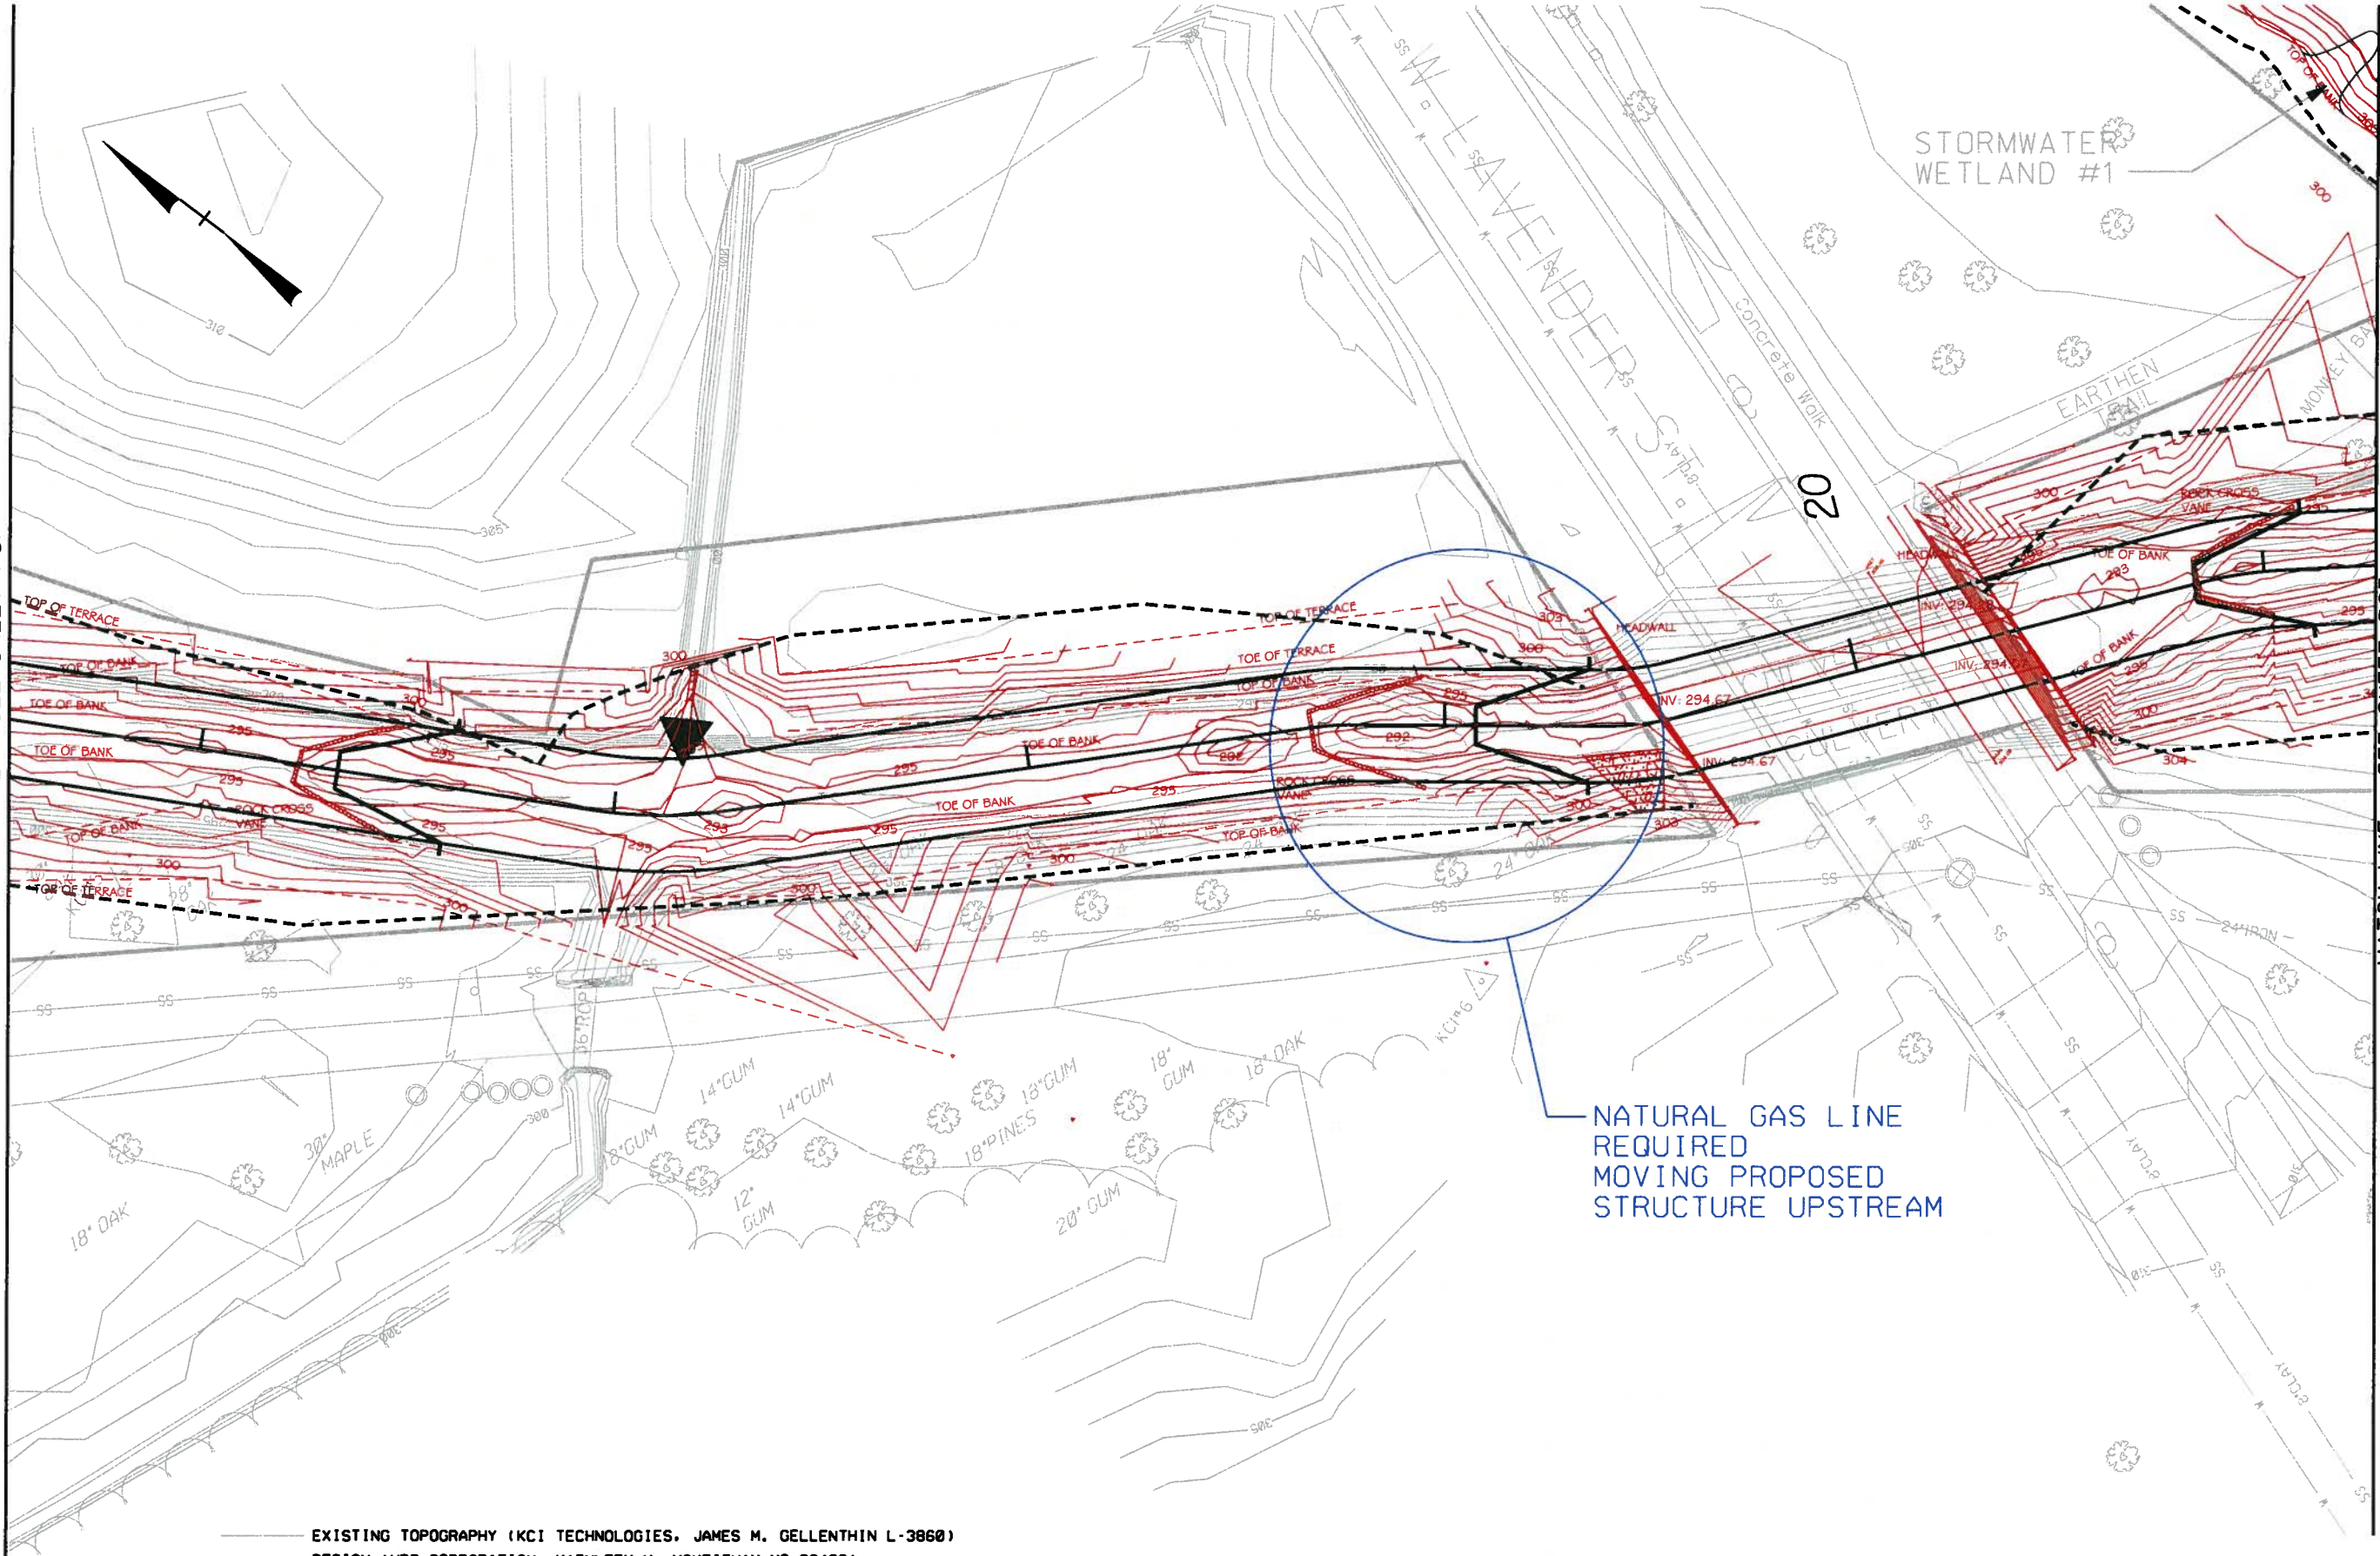

- EXISTING TOPOGRAPHY (KCI TECHNOLOGIES, JAMES M. GELLENTHIN L-3860)
- DESIGN (URS CORPORATION, KATHLEEM M. MCKEITHAN NC-28432)
- AS-BUILT SURVEY (LEVEL CROSS SURVEYING, SHERI WILLARD L-3385)
- CONSERVATION EASEMENT (LANDMARK SURVEYING, INC., DOUGLAS R. YARBROUGH L-3395)
- AS-BUILT ADDITIONAL NOTES (URS CORPORATION, KATHLEEM M. MCKEITHAN NC- 28432)



RECORD DRAWING

REVISIONS


NO.	DATE

Prepared by
URS
 1600 Perimeter Park Drive, Suite 400
 Morrisville, North Carolina 27560
 Phone (919)461-1100 Fax (919)461-1415
 NC Lic# C-2243

PROJECT: ELLERBE CREEK
 (NORTHGATE PARK)
 STREAM RESTORATION
 PROJECT
 TITLE:
 AS-BUILT PLAN SHEET



DATE: DEC 2009
 TECHNICIAN: EHJ
 CHECKED BY: KMM
 PROJ. NO.
 SCO 04064250IA

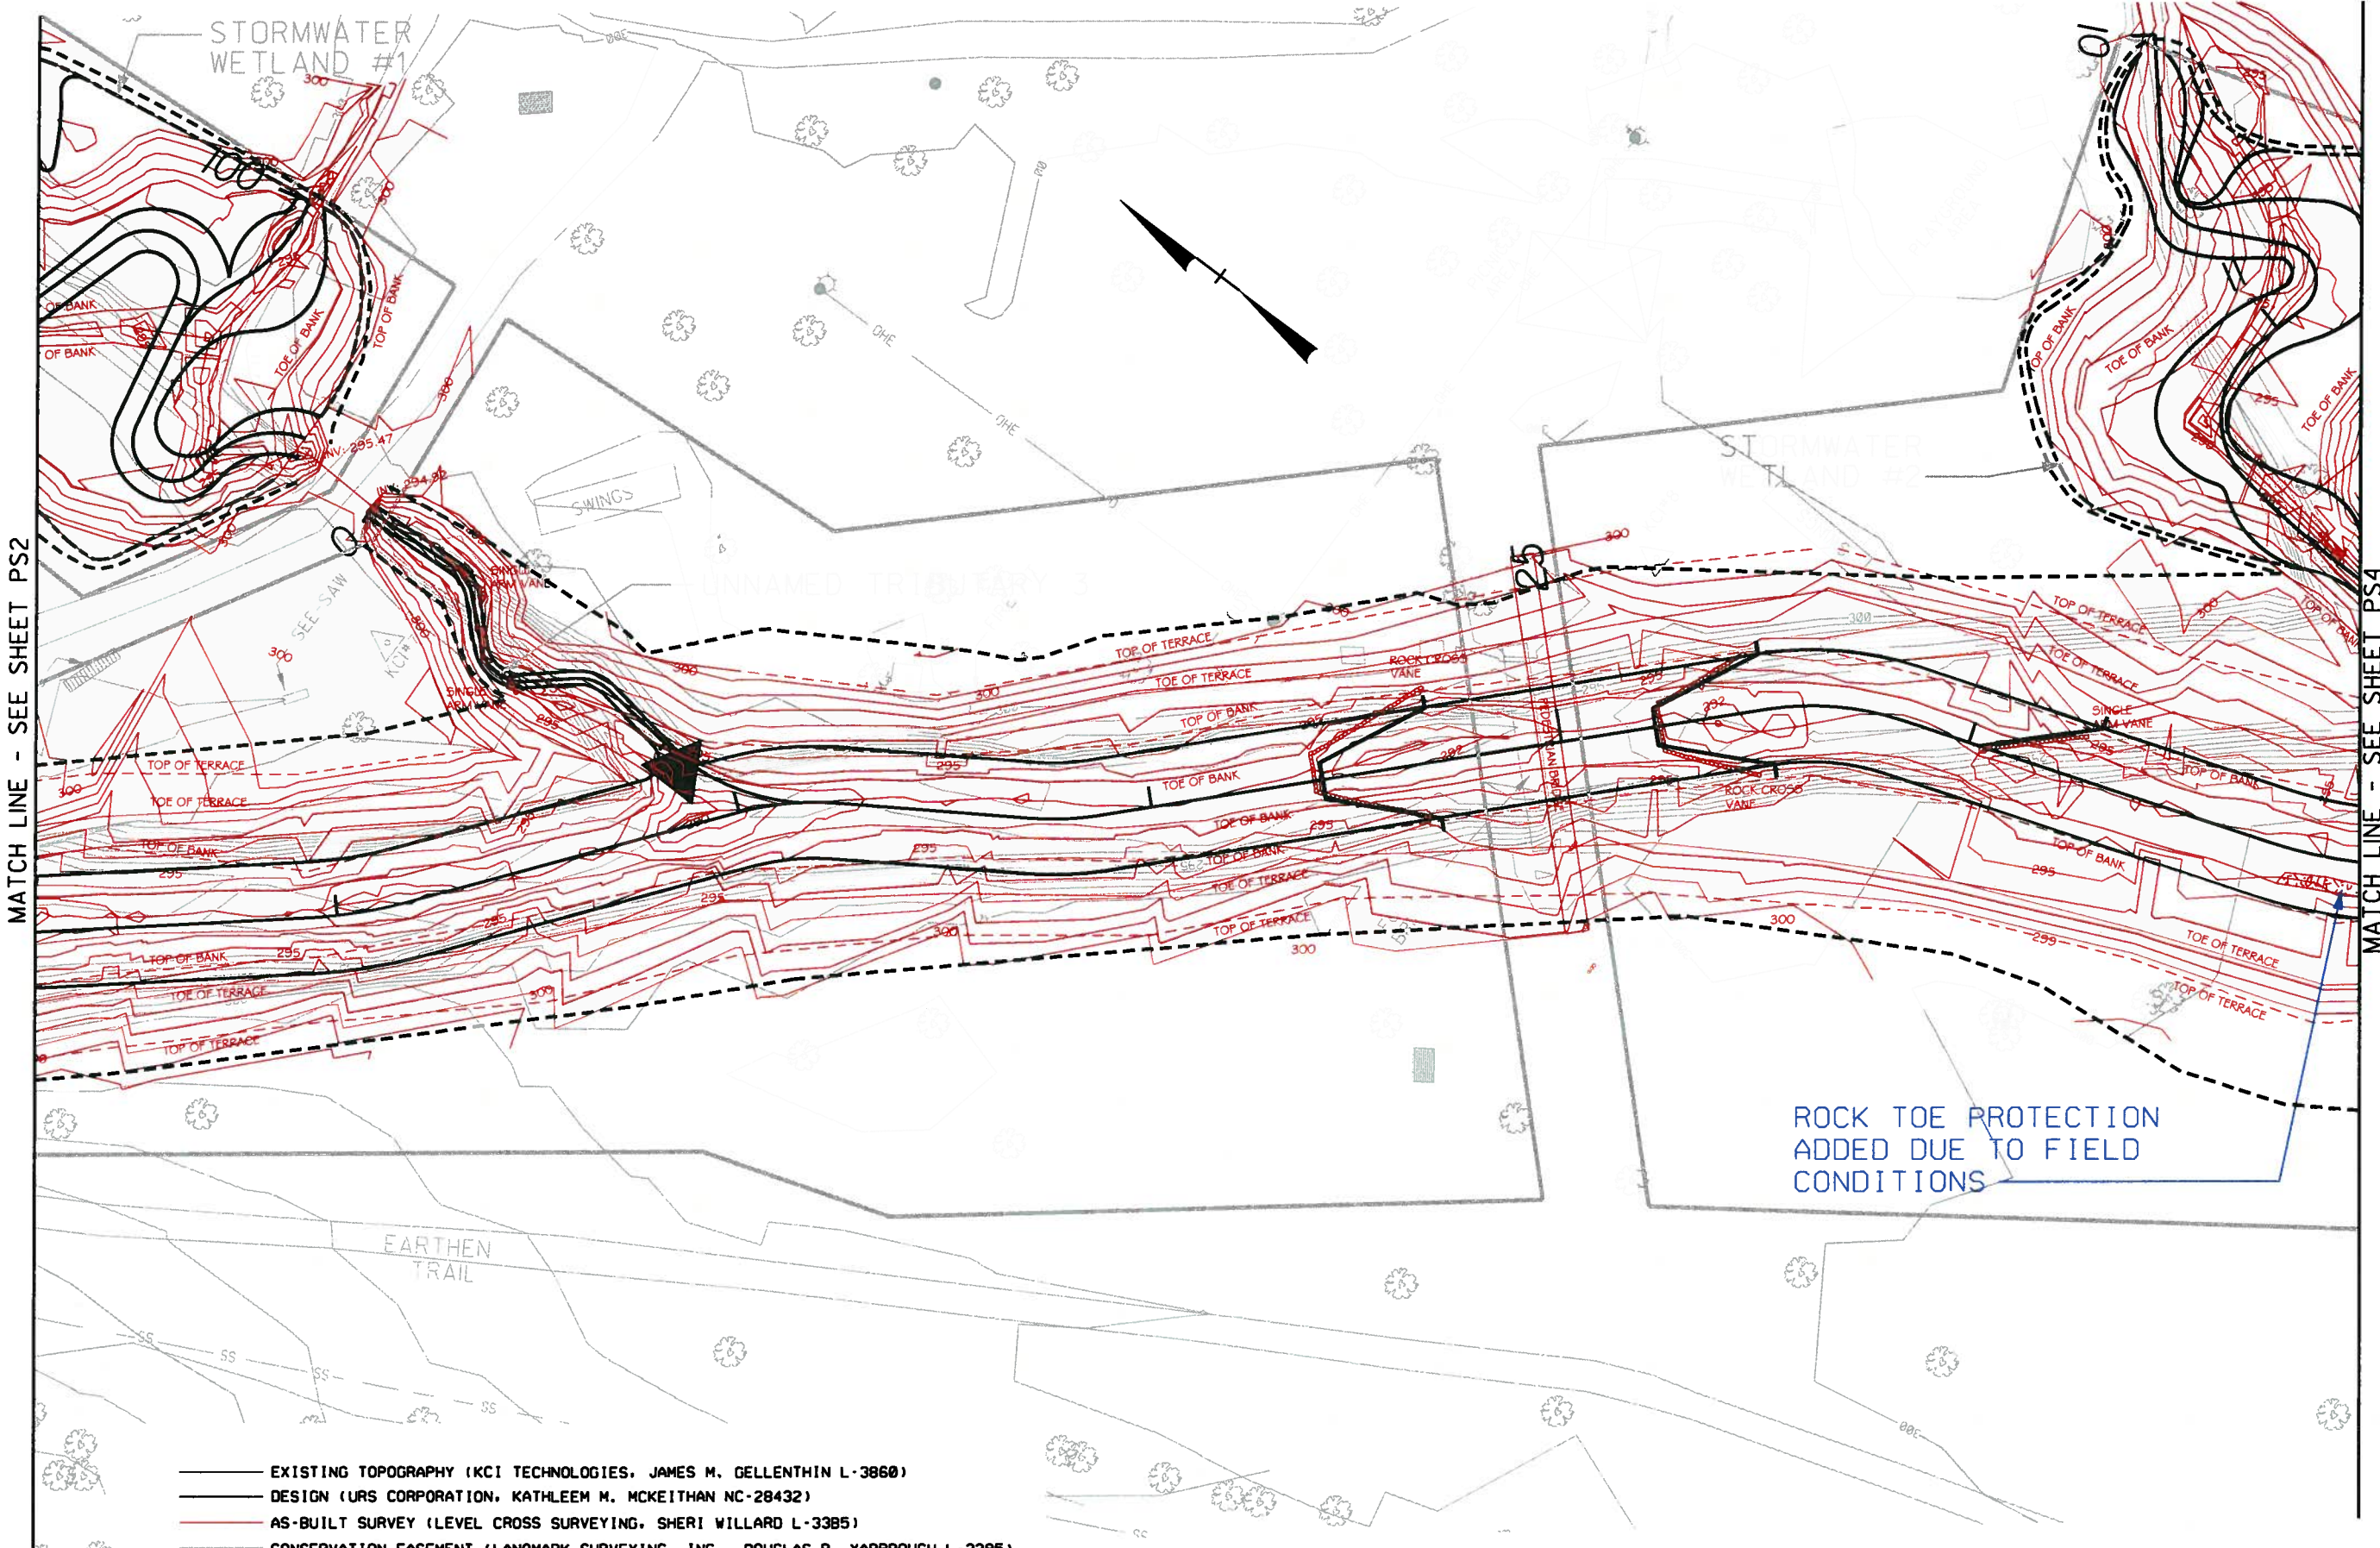

MATCH LINE - SEE SHEET PS2

MATCH LINE - SEE SHEET PS4

- EXISTING TOPOGRAPHY (KCI TECHNOLOGIES, JAMES M. GELLENTHIN L-3860)
- DESIGN (URS CORPORATION, KATHLEEM M. MCKEITHAN NC-28432)
- AS-BUILT SURVEY (LEVEL CROSS SURVEYING, SHERI WILLARD L-3385)
- CONSERVATION EASEMENT (LANOMARK SURVEYING, INC., DOUGLAS R. YARBROUGH L-3395)
- AS-BUILT ADDITIONAL NOTES (URS CORPORATION, KATHLEEM M. MCKEITHAN NC-28432)

REACH A



RECORD DRAWING

REVISIONS

NO.	DATE

Prepared by
URS
 1600 Perimeter Park Drive, Suite 400
 Morrisville, North Carolina 27560
 Phone (919)461-1100 Fax (919)461-1415
 NC Lic.# C-2243


PROJECT: ELLERBE CREEK
 (NORTHGATE PARK)
 STREAM RESTORATION
 PROJECT
 TITLE:
 AS-BUILT PLAN SHEETS

CLIENT: NORTH CAROLINA
 ECOSYSTEM
 ENHANCEMENT PROGRAM




DATE: DEC 2009
 TECHNICIAN: EHJ
 CHECKED BY: KMM
 PROJ. NO.
 SCO 04064250IA

MATCH LINE - SEE SHEET PS3

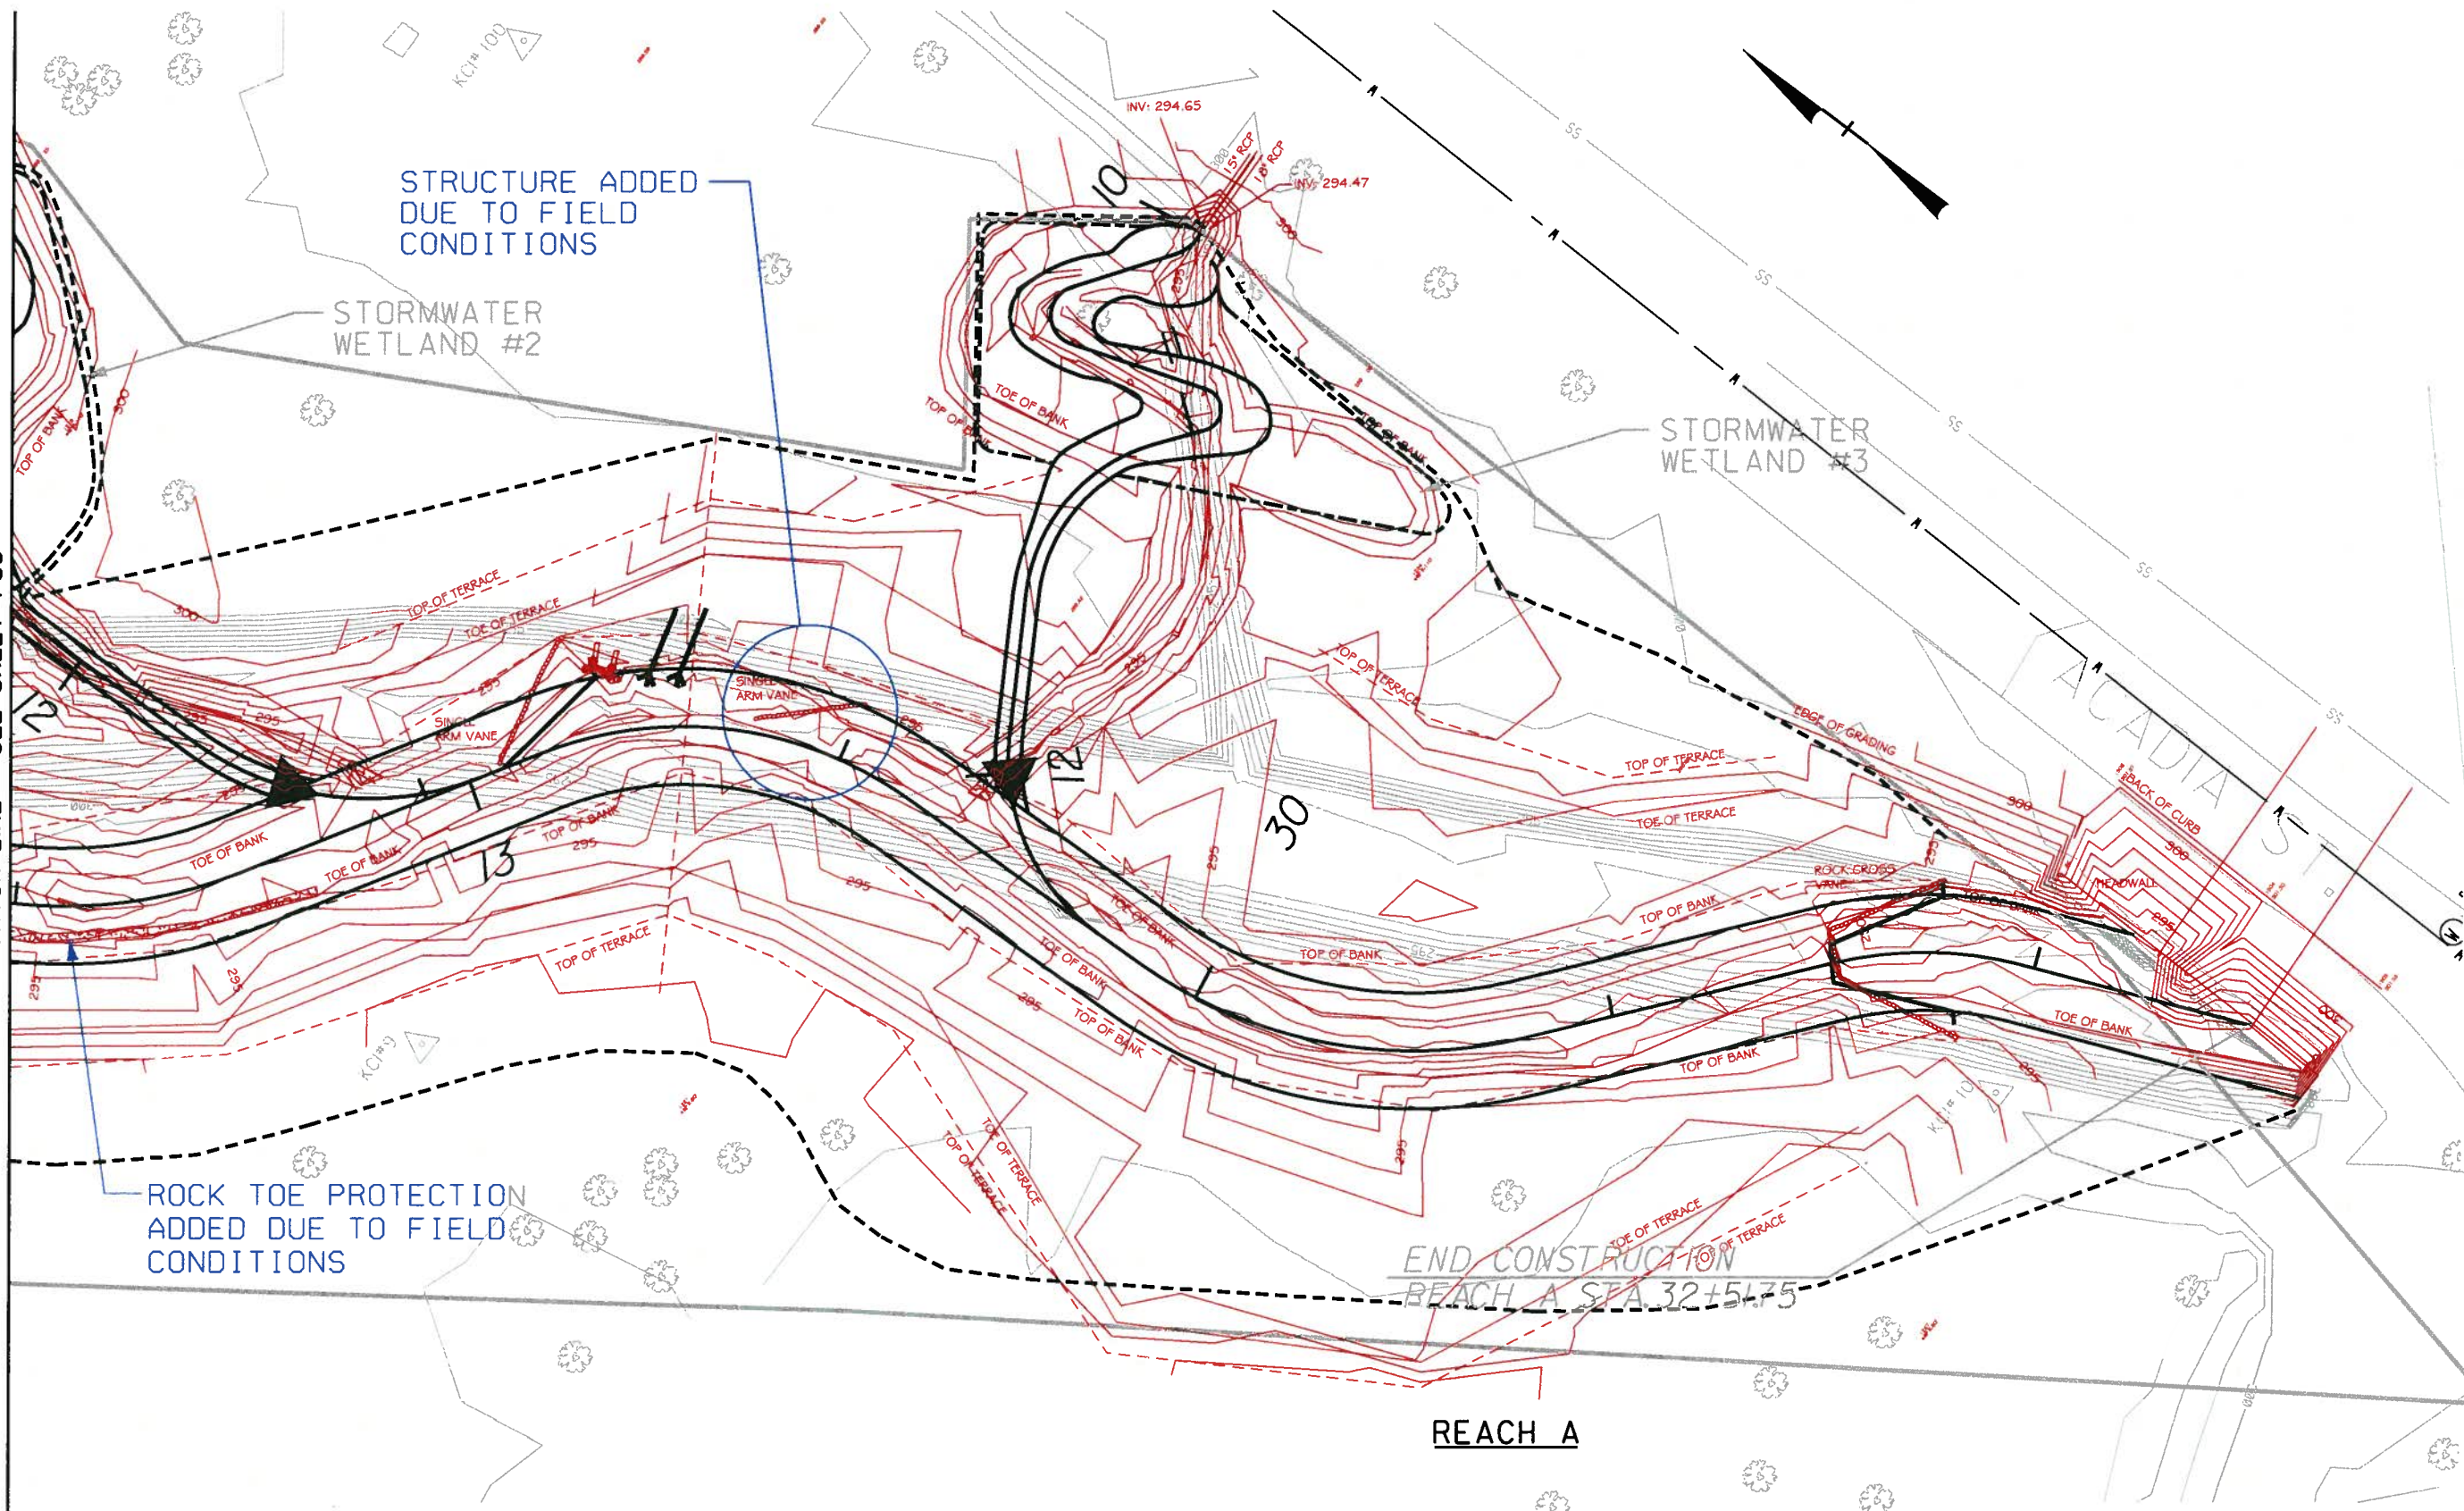

- EXISTING TOPOGRAPHY (KCI TECHNOLOGIES, JAMES M. GELLENTHIN L-3860)
- DESIGN (URS CORPORATION, KATHLEEM M. MCKEITHAN NC-28432)
- AS-BUILT SURVEY (LEVEL CROSS SURVEYING, SHERI WILLARO L-3385)
- CONSERVATION EASEMENT (LANOMARK SURVEYING, INC., DOUGLAS R. YARBROUGH L-3395)
- AS-BUILT ADDITIONAL NOTES (URS CORPORATION, KATHLEEM M. MCKEITHAN NC- 28432)




RECORD DRAWING

REVISIONS	
NO.	DATE


Prepared by
URS
 1600 Perimeter Park Drive, Suite 400
 Morrisville, North Carolina 27560
 Phone (919)461-1100 Fax (919)461-1415
 NC Lic.# C-2243

PROJECT: ELLERBE CREEK
 (NORTHGATE PARK)
 STREAM RESTORATION
 PROJECT
 TITLE:
 AS-BUILT PLAN SHEET

CLIENT:
 NORTH CAROLINA
 ECOSYSTEM
 ENHANCEMENT PROGRAM

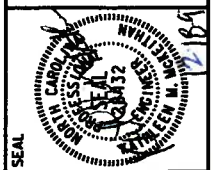

DATE: DEC 2009
 TECHNICIAN: EHJ
 CHECKED BY: KMM
 PROJ. NO.
 SCO 040642501A

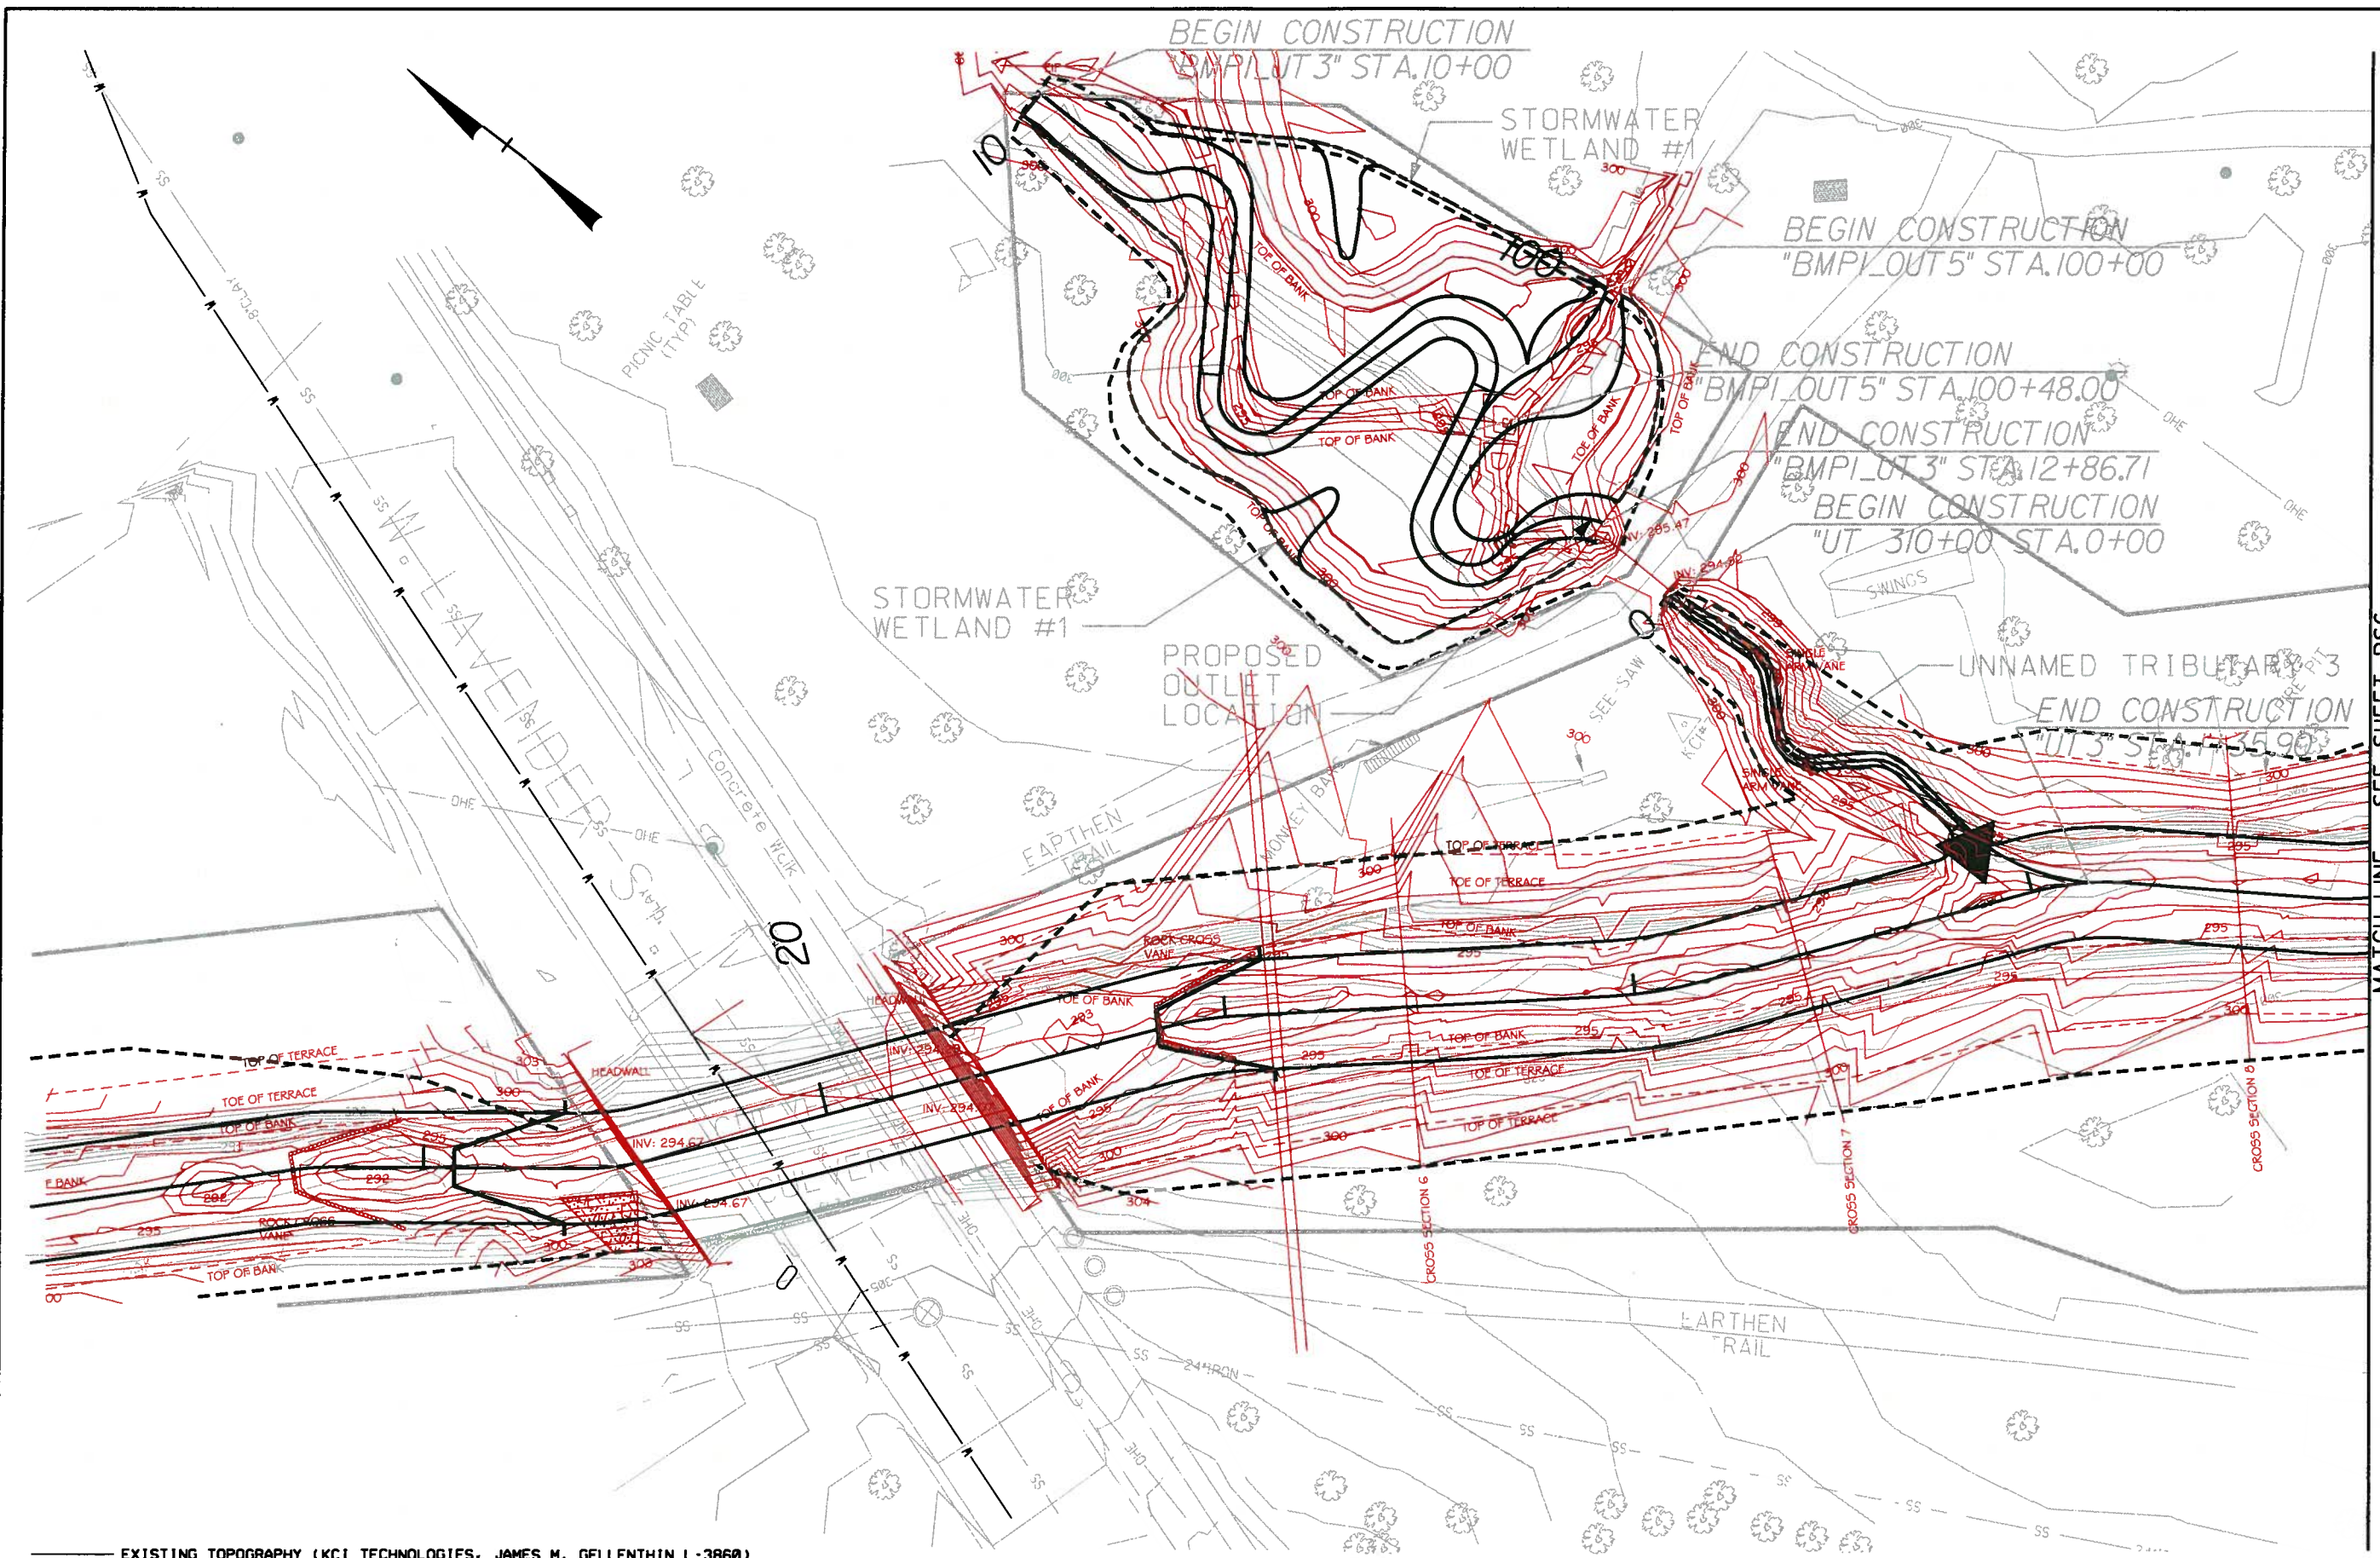

- EXISTING TOPOGRAPHY (KCI TECHNOLOGIES, JAMES M. GELLENTHIN L-3860)
- DESIGN (URS CORPORATION, KATHLEEM M. MCKEITHAN NC-28432)
- AS-BUILT SURVEY (LEVEL CROSS SURVEYING, SHERI WILLARD L-3385)
- CONSERVATION EASEMENT (LANDMARK SURVEYING, INC., DOUGLAS R. YARBROUGH L-3395)
- AS-BUILT ADDITIONAL NOTES (URS CORPORATION, KATHLEEM M. MCKEITHAN NC-28432)




RECORD DRAWING

MATCH LINE - SEE SHEET PS6

REVISIONS	
NO.	DATE
Prepared by 	
1600 Perimeter Park Drive, Suite 400 Morrisville, North Carolina 27560 Phone (919)461-1100 Fax (919)461-1415 NC Lic.# C-2243	
PROJECT: ELLERBE CREEK (NORTHGATE PARK) STREAM RESTORATION PROJECT	TITLE: AS-BUILT PLAN SHEET BMP
CLIENT: NORTH CAROLINA ECOSYSTEM ENHANCEMENT PROGRAM 	
SEAL 	
DATE: DEC 2009 TECHNICIAN: EBJ CHECKED BY: KMM PROJ. NO. SCO 04064250IA	
PS5	

MATCH LINE - SEE SHEET PS5

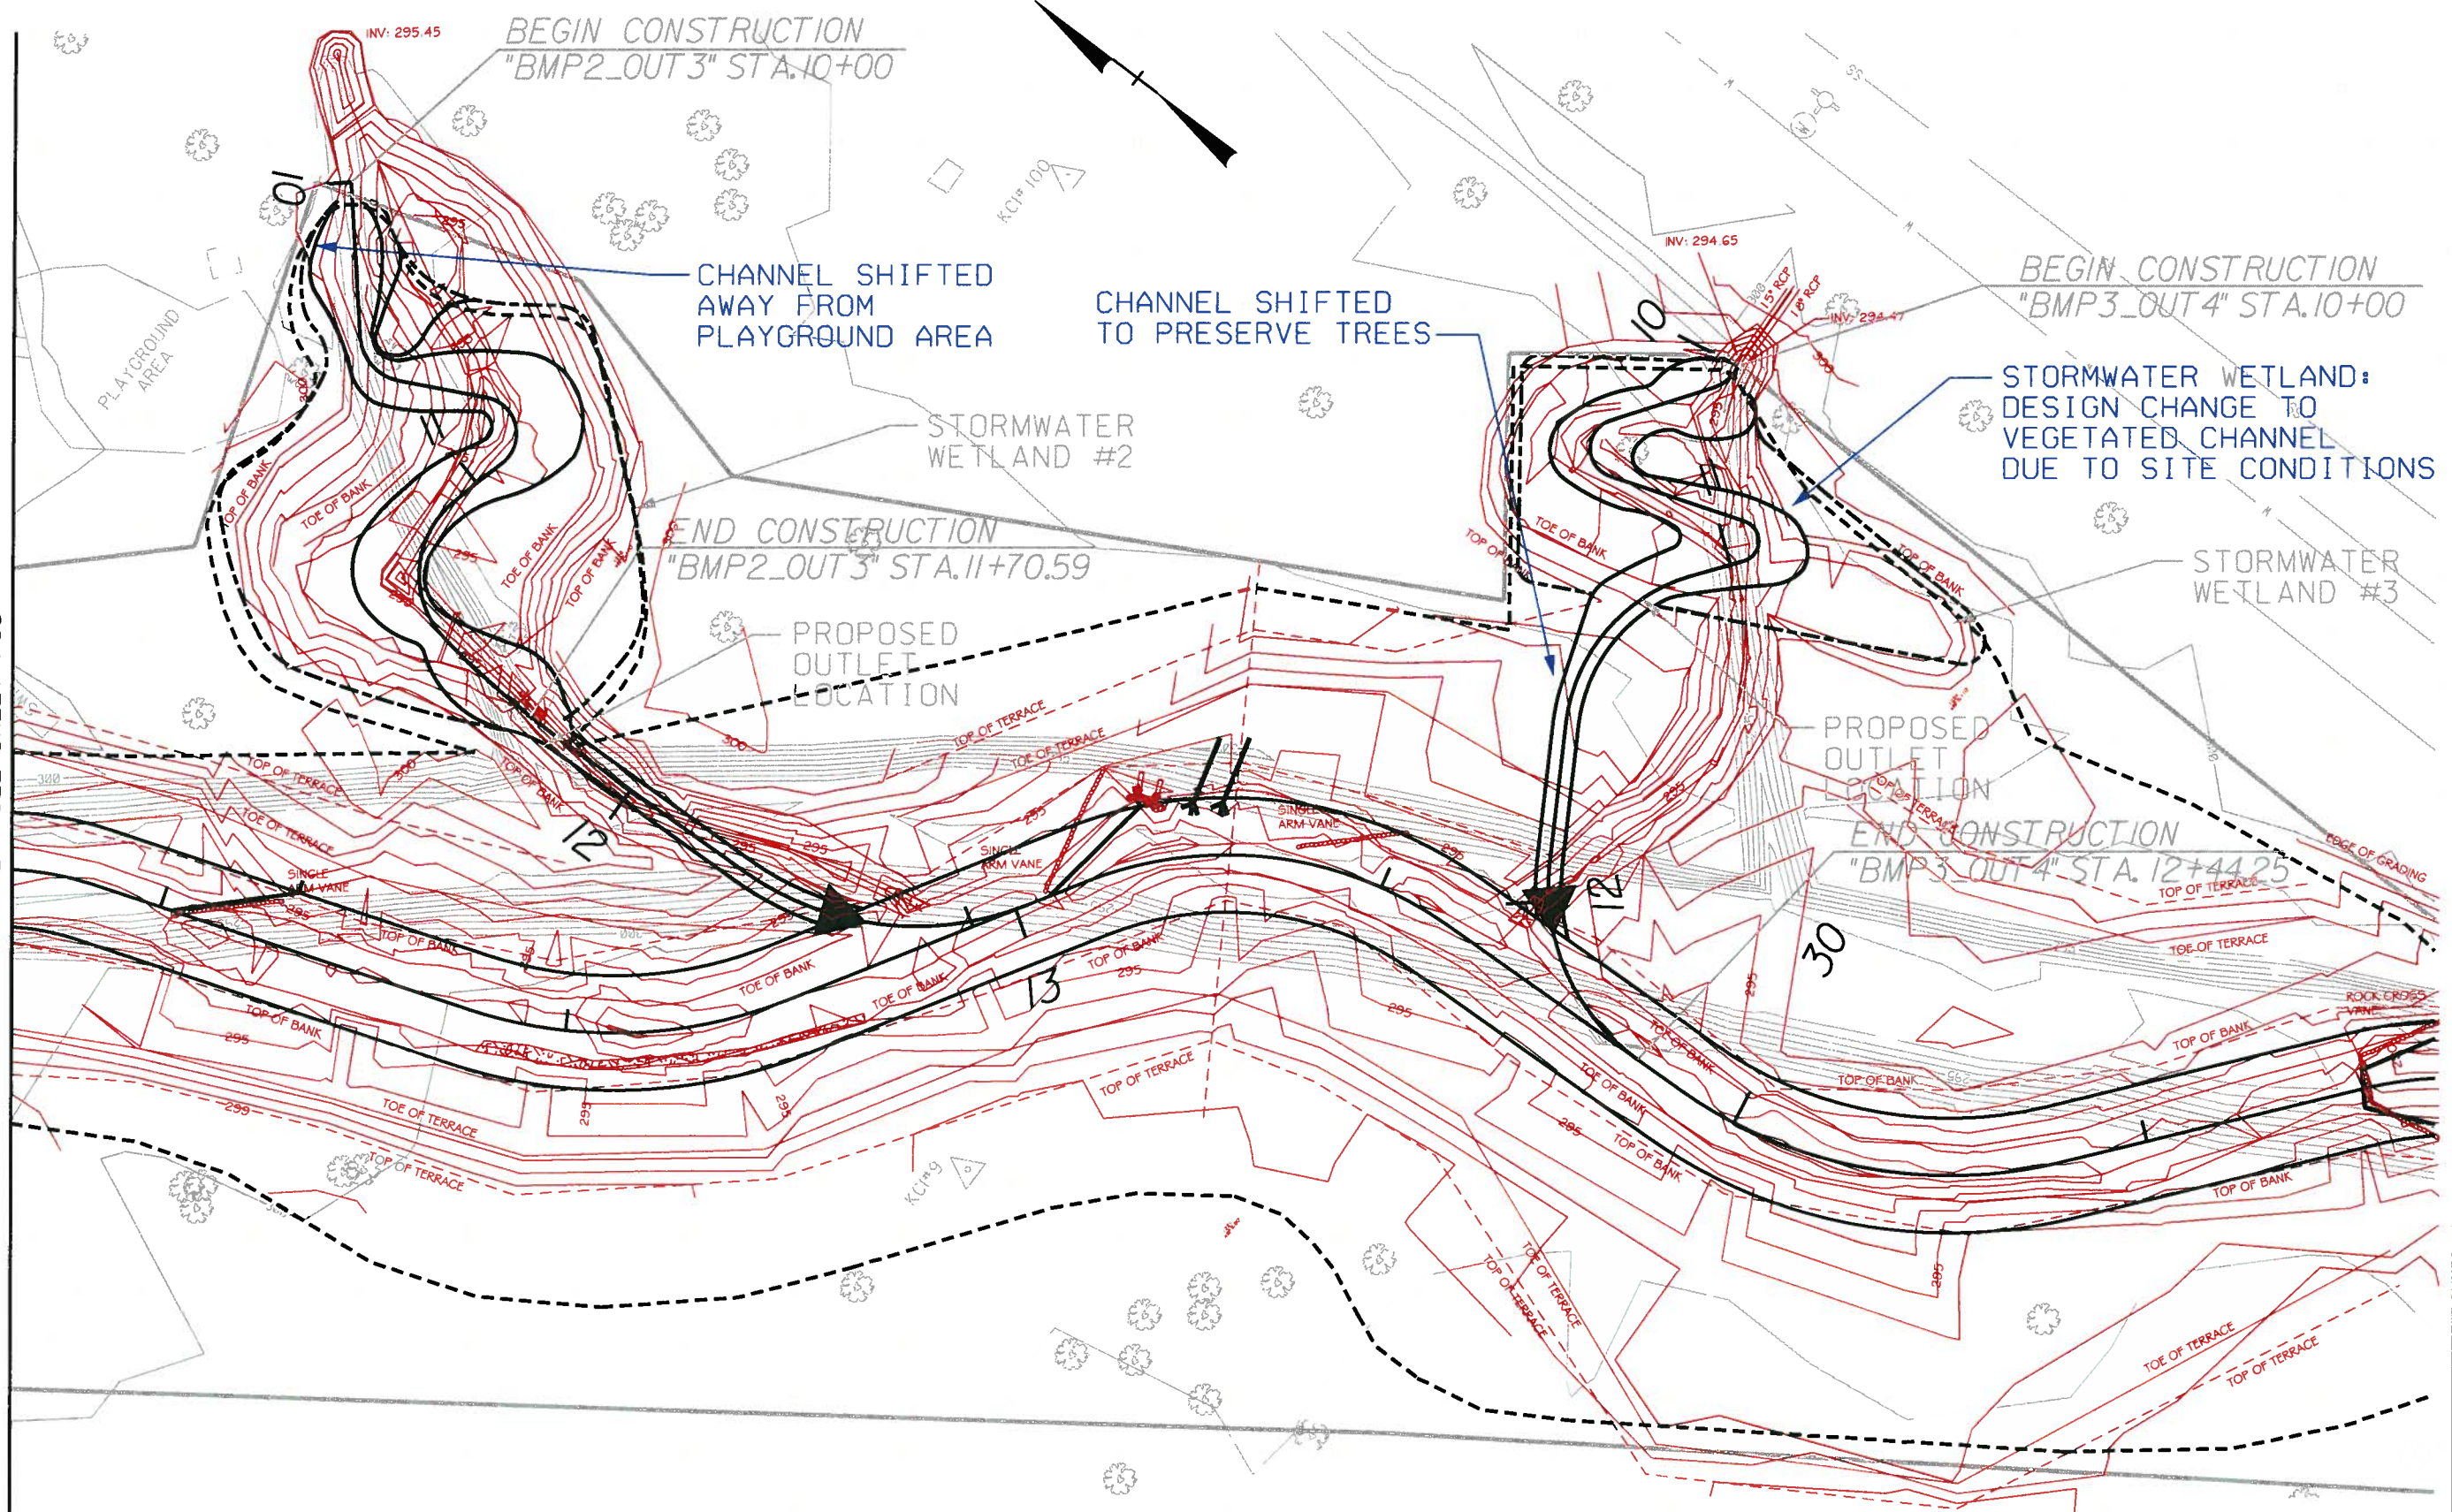

- EXISTING TOPOGRAPHY (KCI TECHNOLOGIES, JAMES M. GELLENTHIN L-3860)
- DESIGN (URS CORPORATION, KATHLEEM M. MCKEITHAN NC-28432)
- AS-BUILT SURVEY (LEVEL CROSS SURVEYING, SHERI WILLARD L-3385)
- CONSERVATION EASEMENT (LANDMARK SURVEYING, INC., DOUGLAS R. YARBROUGH L-3395)
- AS-BUILT ADDITIONAL NOTES (URS CORPORATION, KATHLEEM M. MCKEITHAN NC- 28432)



RECORD DRAWING

REVISIONS	
NO.	DATE

Prepared by
URS
 1600 Perimeter Park Drive, Suite 400
 Morrisville, North Carolina 27560
 Phone (919)461-1100 Fax (919)461-1415
 NC Lic.# C-2243

PROJECT: ELLERBE CREEK (NORTHGATE PARK) STREAM RESTORATION PROJECT
 TITLE: AS-BUILT PLAN SHEET BMP

CLIENT: NORTH CAROLINA ECOSYSTEM ENHANCEMENT PROGRAM



DATE: DEC 2009
 TECHNICIAN: EHJ
 CHECKED BY: KMM
 PROJ. NO. SCO 04064250IA

PS6