
MYO FINAL MONITORING REPORT

Odell's House Mitigation Project

Johnston County

Neuse River Basin

CU 03020201

DMS Project # 100041

DMS Contract # 7420

Contracted RFP # 16-007279

USACE Action ID Number: SAW-2018-00431

DWR Project # 2018-0200

Calendar Year of Data Collection: 2021



Prepared for:

**North Carolina Department of Environmental Quality
Division of Mitigation Services**

1652 Mail Service Center
Raleigh, NC 27699-1652





July 16, 2021

NC Department of Environmental Quality

Division of Mitigation Services

Attn: Lindsay Crocker, Project Manager

217 W. Jones Street, Suite 3000

Raleigh, NC 27609

RE: WLS Responses to NCDEQ DMS Review Comments for Task 6 Submittal, Draft Baseline Monitoring Report for the Odell's House Mitigation Project, DMS Full-Delivery Project ID #100041, Contract #7420, Neuse River Basin, Cataloging Unit 03020201, Johnston County, NC

Dear Ms. Crocker:

Water & Land Solutions, LLC (WLS) is pleased to present the Final Baseline Monitoring Report (including record drawings) for the Odell's House Mitigation Project to the North Carolina Department of Environmental Quality (NCDEQ) Division of Mitigation Services (DMS). Per the DMS review comments, WLS has updated the Final As-Built Baseline Monitoring Report and associated deliverables accordingly. We are providing the electronic deliverables via cloud link. The electronic deliverables are organized under the following folder structure as required under the digital submission requirements:

1. Report PDF
2. Support Files
 - 1_ Tables
 - 2_CCPV
 - 3_Veg
 - 4_Geomorph
 - 5_Hydro
 - 6_Photos

We are providing our written responses to DMS' review comments on the Draft As-Built Baseline Report below. Each of the DMS review comments is copied below in **bold** text, followed by the appropriate response from WLS in regular text:

General:

- **Page 1, indicates linear feet of construction and wetland. Clarify that this is the design, not as-built footage.** Response: Language was added to indicate that these numbers are based on design.
- **The stream geomorphology tables show that the bankfull discharge from pre to design to post remained constant. Explain how this occurred or correct calculations.** Response: The discharge numbers in the table are correct for pre, design, and MY0 for all reaches. The bankfull discharge estimate is held constant throughout and what varies is the cross-sectional area and velocity. As cross-sectional area increases, the velocity decreases and vice versus. The bankfull discharge is chosen and held at a constant and the designed cross-sectional area is based on that

number. For 'C' stream types, the design channels acceptable velocity ranges are between 3-5 ft/s and for 'B' stream types it is between 4-6 ft/s.

- **The stream geomorphology tables do not appear to be populated correctly. The 'n' columns are showing many more cross-sections than were taken. Please explain or revise, contact DMS for verbal explanation. This may also apply to recently reviewed Buffalo Creek Tributaries.** Response: The definition of the 'n' columns was misunderstood and has been corrected accordingly.
- **The Mitigation Plan indicates that macrobenthic invertebrate monitoring will occur to show pre- and post-response. Please provide this data and show monitoring on location on the CCPV in the baseline report.** Response: Data from the invertebrate monitoring occurred pre-construction and is included in App F. Data is not tied to a performance standard and repeat sampling will occur in MY3. The location of sampling is shown on the CCPV.
- **Describe if there was any temporary or permanent cover planted in the vegetation section of the baseline report.** Response: Temporary and permanent seeding occurred during construction and followed the mitigation plan. The report has been updated to include the temporary/permanent seeding.
- **It was noted in the field that given the dense vegetative conditions, it was very difficult to discern any flow paths for R1 and R5 (headwater valley through the ponds). It was also noted that much of the accumulated/legacy sediment was left along pond bottoms, creating some very mushy areas for ponded water. DMS thinks that the headwater stream areas through the ponds may be at-risk for credit and advises WLS to consider that as the project moves forward.** Response: This concern was addressed in the mitigation plan Section 6.7.1 site construction methods and in more detail within Section 6.7.3 and the USACE IRT mitigation plan response. WLS followed the construction approach described in the mitigation plan, however during construction the contractor did not remove excess legacy sediments greater than 12" across the entire pond bottom areas. Extreme wetness and saturated soil conditions during the winter months prevented the contractor from removing all legacy sediments throughout R1 and R5. The contractor incorporated suitable fill material and woody debris to construct the headwater pilot channels across the low point of valley (pond bottom) as shown on the mitigation plan design, as-built drawings, and orthophotos. The mushy areas were graded as floodplain depressions and are expected to fill in with vegetation during the monitoring period. WLS observed surface flow after construction prior to vegetation establishment. We understand the recent herbaceous vegetation growth makes it difficult to observe surface flow and will monitor surface flow per the mitigation plan Section 8.2.3. Any subterranean flow will be documented to determine if a corrective action is required during the monitoring period.
- **The "fencing encroachment" area shown on the CCPV appeared to be a slight variation in the fence install that was corrected and fence moved. If that is the case, it is ok to leave this off the CCPV since it was quickly corrected following construction and did not result in any vegetation damage. This comment also applies to the visual assessment table.** Response: The encroachment area has been removed from the CCPV, report, and table.
- **Please label the wetland areas on the detailed pages of the CCPV (1a and 1b).** Response: The wetland areas have been labeled on Figures 1a and 1b.
- **Provide elevation of wetland gages in a table format or on drawings if possible/available.** Response: The elevation of wetland gauges was not surveyed during as-built.

- **Include any pictures and/or drone videos to assist IRT in visualizing.** Response: Drone videos and photos are included in the Photos folder of E-Data.

Riparian Buffer MY0:

- **Confirm that the headwater mitigation credit requires 7 years of monitoring per alternative mitigation.** Response: Headwater mitigation credit requires 7 years of monitoring.
- **Replace Table 1 with the current DWR/DMS credit table (available at DWR or DMS website for templates). Confirm that shapefiles are attributed (labeled) to match these tables and that the physical area calculations reflect the table.** Response: Table 1 has been updated to the current format and the attribute tables match the data in Table 1.
- **Confirm that the new as-built top of bank was used to calculate as-built buffer conditions and that the table was updated to reflect surveyed as-built conditions.** Response: The new top of bank was used to calculate the as-built buffer conditions and the table has been updated appropriately.

Electronic Comments:

- **Please include the zero credit spatial features that connect creditable features if possible (e.g. easement breaks).** Response: The zero credit features are included in the e-data.
- **The following stream segments, excluding the headwater restoration segments, have lengths that do not match the asset table – presented below as feature length vs. asset table length. Please review and address these differences.**
 - **R4: 199 ft. vs. 192 ft.**
 - **R6: 422 ft. vs. 438 ft.**
 - **R7 (Upper): 673 ft. vs. 659 ft.**

Response: The stream lengths in the asset table now match the attribute table. The differences noted by DMS were a result of transferring from CAD into GIS.

- **Please include spatial features characterizing the Pre-Existing Channel.** Response: The pre-existing channel is included in the e-data.

Please contact me if you have any questions or comments.

Sincerely,

Water & Land Solutions, LLC



Catherine Manner
Water & Land Solutions, LLC
7721 Six Forks Road, Suite 130

Raleigh, NC 27615

Office Phone: (919) 614-5111

Mobile Phone: (571) 643-3165

Email: catherine@waterlandsolutions.com

Table of Contents

| | | |
|-------|--|----|
| 1 | Project Summary..... | 1 |
| 1.1 | Project Location and Description..... | 1 |
| 1.2 | Project Quantities and Credits..... | 1 |
| 1.3 | Current Condition Plan View..... | 3 |
| 2 | Goals, Performance Criteria, and Functional Improvements | 4 |
| 2.1 | Project Goals and Objectives | 4 |
| 2.2 | Project Success Criteria..... | 5 |
| 2.2.1 | Streams | 5 |
| 2.2.2 | Wetlands | 7 |
| 2.2.3 | Vegetation..... | 8 |
| 2.2.4 | Visual Assessment..... | 8 |
| 3 | Project Attributes..... | 8 |
| 3.1 | Design Approach | 8 |
| 3.1.1 | Stream..... | 8 |
| 3.1.2 | Wetland..... | 10 |
| 3.2 | Project Attributes..... | 11 |
| 4 | Monitoring Year 0 Assessment and Results..... | 13 |
| 4.1 | As-built Survey | 13 |
| 4.2 | As-Built Plans/ Record Drawings..... | 13 |
| 4.3 | As-Built/ Baseline Assessment | 13 |
| 4.4 | Morphological Assessment | 13 |
| 4.5 | Stream Hydrology | 14 |
| 4.5.1 | Stream Flow | 14 |
| 4.5.2 | Headwater Stream Channel Formation | 14 |
| 4.5.3 | Wetlands | 14 |
| 4.5.4 | Vegetation..... | 14 |

LIST OF APPENDICES

Appendix A - Visual Assessment Data

Visual Stream Morphology Stability Assessment Table
Vegetation Condition Assessment Table
Cross-Section Photos
Stream Photo Points (Culverts Crossings, EII Reaches)

Appendix B - Vegetation Plot Data

Final Plant List
Redline Plant List
Vegetation Performance Standards and Summary Table
Vegetation Plot Counts and Densities Table
Vegetation Plot Photos
Vegetation Plot Maps

Appendix C - Stream Morphology Data

Cross-Sections with Annual Overlays
Baseline Longitudinal Profile
Baseline Stream Data Summary Tables
Cross-Section Morphology Data

Appendix D - Hydrologic Data

Flow Gauge and Crest Gauge Installation Diagrams
Surface Flow and Wetland Gauge Photos

Appendix E - Project Timeline and Contact Info

Appendix F – Other Data

1 Project Summary

1.1 Project Location and Description

The Odell's House Mitigation Project ("Project") is a North Carolina Department of Environmental Quality (NCDEQ), Division of Mitigation Services (DMS) full-delivery stream and wetland mitigation project contracted with Water & Land Solutions, LLC (WLS) in response to RFP 16-007279. The Project provides stream and wetland mitigation credits in the Neuse River Basin (Cataloging Unit 03020201). The project site is in Johnston County, North Carolina, between the Town of Wendell and the Community of Archer Lodge. The Project is in the Lower Buffalo Creek Priority Sub-watershed 030202011504, study area for the Neuse 01 Regional Watershed Plan Phase II, Final Report (RWP), and in the Targeted Local Watershed 03020201180050, of the Neuse River Basin.

The Project involved the restoration, enhancement, preservation and permanent protection of eight stream reaches (R1, R2, R3, R4, R5, R6, R7 upper, and R7 lower), 6 wetland areas (W1, W2, W3, W4, W5, and W6), and their riparian buffers, totaling approximately 4,313 linear feet of designed streams, and 453,057.200 square feet of riparian buffers. Stream restoration is within the conservation easement and the existing powerline right-of-way. The Project also includes riparian wetland restoration (re-establishment and rehabilitation), enhancement and the preservation of 3.890 acres (based on design). The Project will provide significant ecological improvements and functional uplift through stream and wetland restoration and will decrease nutrient and sediment loads within the watershed. The mitigation plan provides a detailed project summary and Table 1 provides a summary of project assets. Figure 1a-c illustrates the project mitigation components.

Prior to construction, landowners historically manipulated streams and ditched riparian wetland systems to provide areas for crop production and cattle grazing. Cattle had complete access to streams and wetlands except for R7 and W5/W6, resulting in eroded banks, habitat destruction, and poor water quality. Two man-made ponds existed where reaches R1 and R5 are now located.

1.2 Project Quantities and Credits

The Project mitigation components include a combination of Stream Restoration, Enhancement, and Preservation activities, as well as Riparian Wetland Restoration (Re-establishment & Rehabilitation) Enhancement, and Preservation, as summarized in the Table 1 below.



Table 1. Odell's House (ID-100041) Project Mitigation Quantities and Credits

| Project Segment | Original Mitigation Plan Ft/Ac | As-Built Ft/Ac | Original Mitigation Category | Original Restoration Level | Original Mitigation Ratio (X:1) | Credits | Comments |
|-----------------|--------------------------------|----------------|------------------------------|----------------------------|---------------------------------|------------------|--|
| Stream | | | | | | | |
| R1 | 437 | 533 | Warm | R | 1.00000 | 437.000 | Full Channel Restoration, Planted Buffer, Exclusion of Livestock, Permanent Conservation Easement |
| R2 | 526 | 518 | Warm | EII | 2.50000 | 210.400 | Livestock Exclusion, Invasive Control, Supplemental Planting, Habitat Structures, Permanent Conservation Easement |
| R3 | 1,091 | 1,103 | Warm | R | 1.00000 | 1,091.000 | Full Channel Restoration, Planted Buffer, Exclusion of Livestock, Permanent Conservation Easement |
| R4 | 190 | 199 | Warm | EII | 3.00000 | 63.333 | Livestock Exclusion, Invasive Control, Supplemental Planting, Habitat Structures, Permanent Conservation Easement |
| R5 | 340 | 392 | Warm | R | 1.00000 | 340.000 | Full Channel Restoration, Planted Buffer, Exclusion of Livestock, Permanent Conservation Easement |
| R6 | 432 | 422 | Warm | R | 1.00000 | 432.000 | Full Channel Restoration, Planted Buffer, Exclusion of Livestock, Permanent Conservation Easement |
| R7 (upper) | 625 | 674 | Warm | EI | 1.50000 | 416.667 | Dimension, Pattern and Profile modified, Livestock Exclusion, Supplemental Planting, Permanent Conservation Easement |
| R7 (lower) | 412 | 461 | Warm | P | 10.00000 | 41.200 | Permanent Conservation Easement |
| | | | | | Total: | 3,031.600 | |
| Wetland | | | | | | | |
| W1 | 0.476 | 0.477 | R | REE | 1.00000 | 0.476 | Livestock Exclusion, Pond drainage, Limited soil manipulation, and Planting |
| W2 | 0.416 | 0.413 | R | REE | 1.00000 | 0.416 | Livestock Exclusion, Pond drainage, Limited soil manipulation, and Planting |
| W3 | 0.666 | 0.645 | R | RH | 1.50000 | 0.444 | Limited soil manipulation and Planting |
| W4 | 0.234 | 0.227 | R | REE | 1.00000 | 0.234 | Limited soil manipulation, Restored groundwater hydrology and Planting |
| W5 | 1.654 | 1.636 | R | E | 2.50000 | 0.662 | Restored hydrology and Planting |
| W6 | 0.444 | 0.440 | R | P | 10.00000 | 0.044 | Permanent Conservation Easement |
| | | | | | Total: | 2.276 | |

| Project Credits | | | | | | |
|------------------------|------------------|------|------|--------------|---------|---------|
| Restoration Level | Stream | | | Riparian | Non-Rip | Coastal |
| | Warm | Cool | Cold | Wetland | Wetland | Marsh |
| Restoration | 2,300.000 | | | | | |
| Re-establishment | | | | 1.126 | | |
| Rehabilitation | | | | 0.444 | | |
| Enhancement | | | | 0.662 | | |
| Enhancement I | 416.667 | | | | | |
| Enhancement II | 273.733 | | | | | |
| Creation | | | | | | |
| Preservation | 41.200 | | | 0.044 | | |
| Totals | 3,031.600 | | | 2.276 | | |

| | |
|-----------------------------|------------------|
| Total Stream Credit | 3,031.600 |
| Total Wetland Credit | 2.276 |







1.3 Current Condition Plan View

The following pages present the Current Condition Plan View (CCPV).





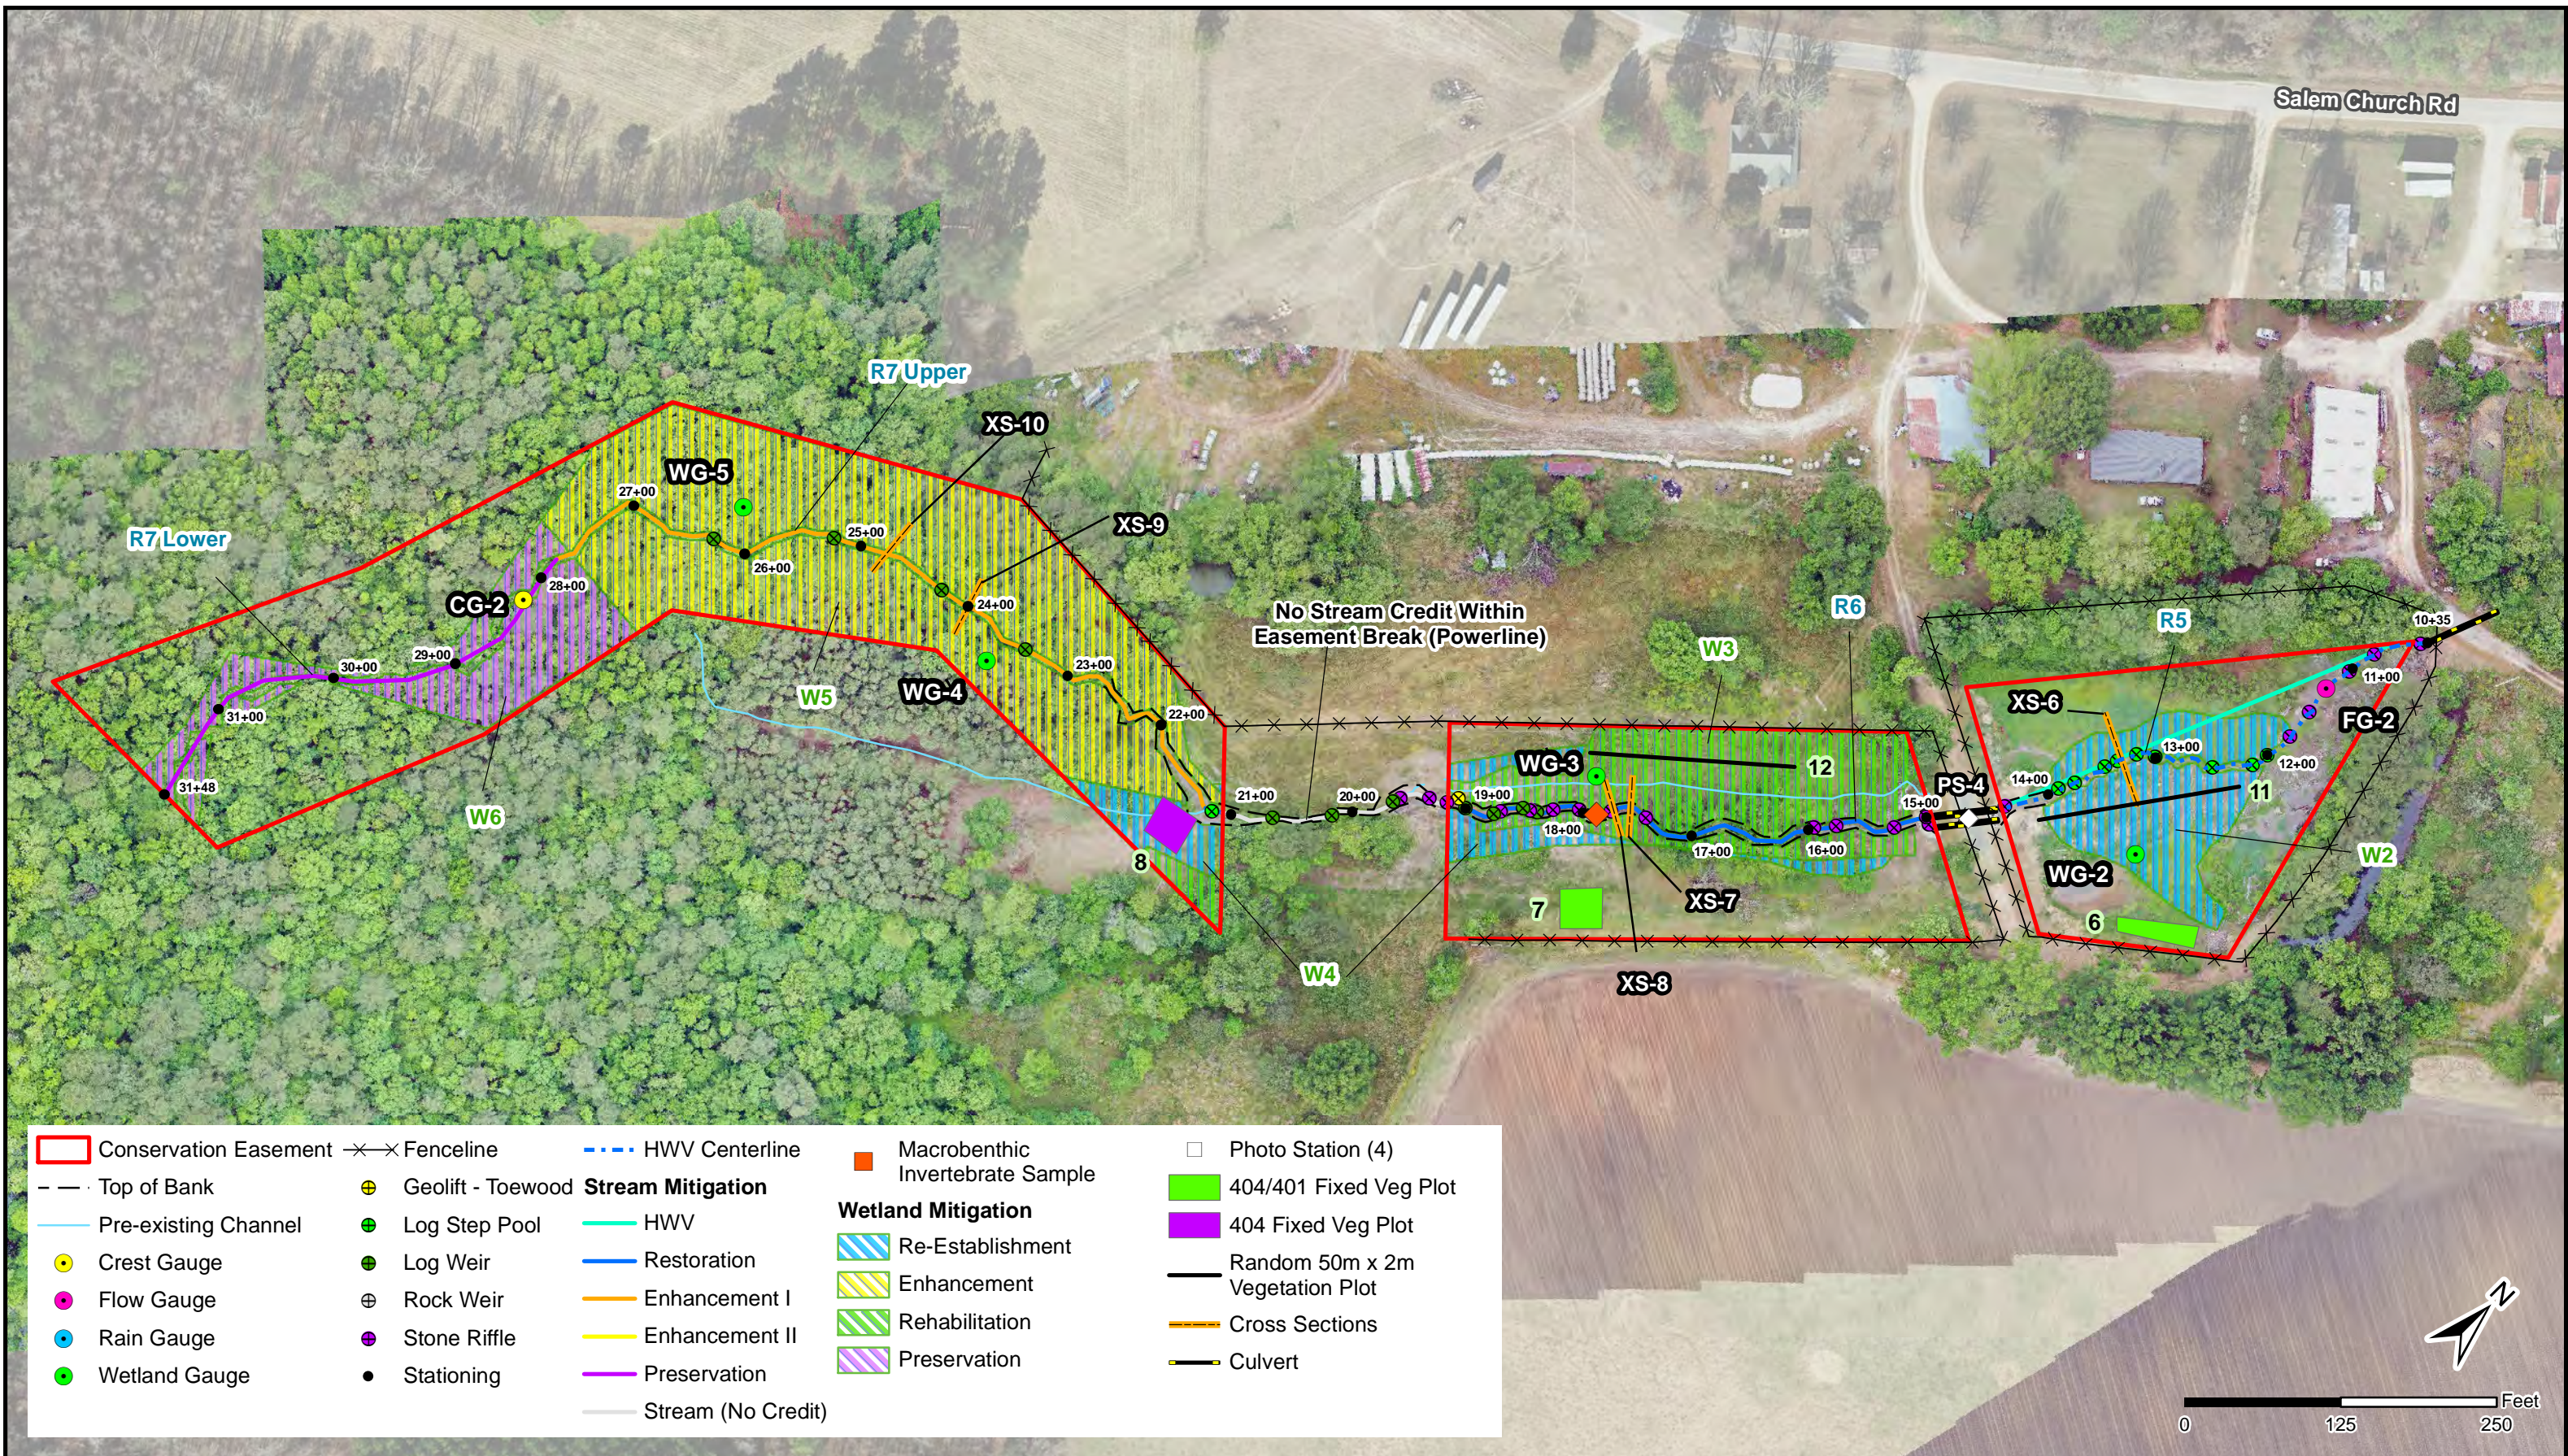

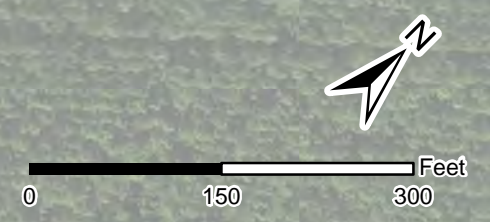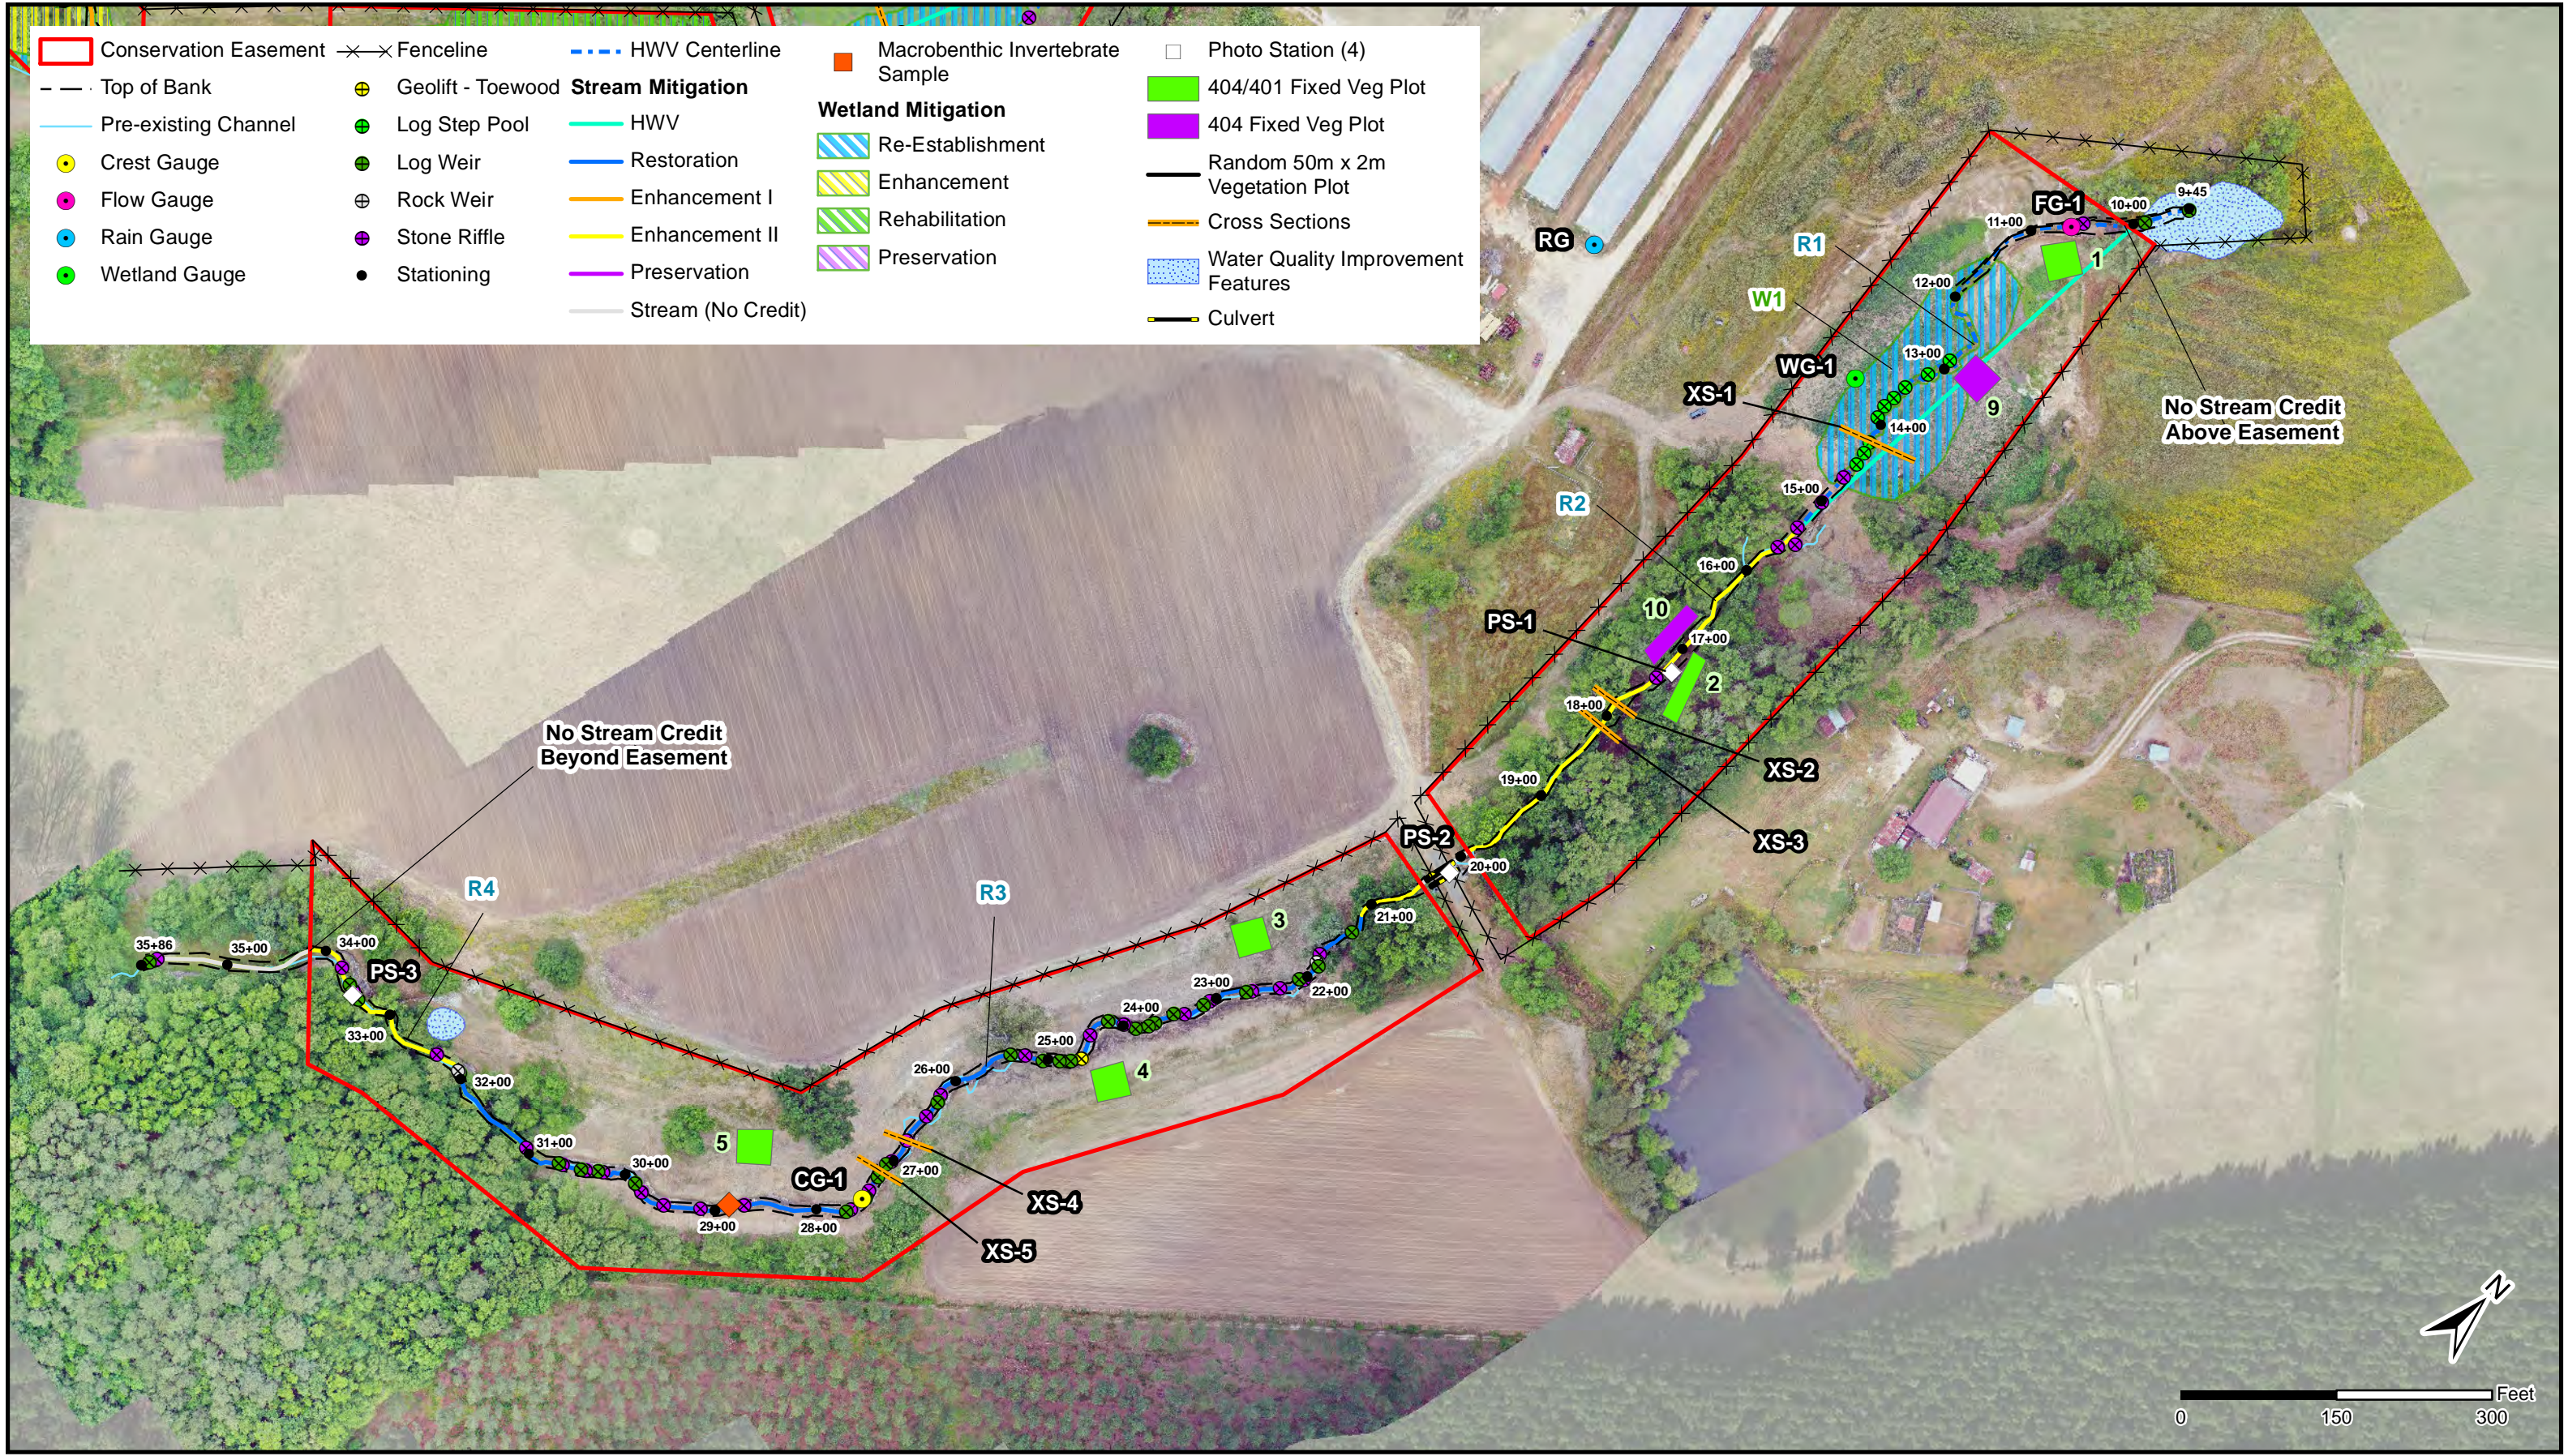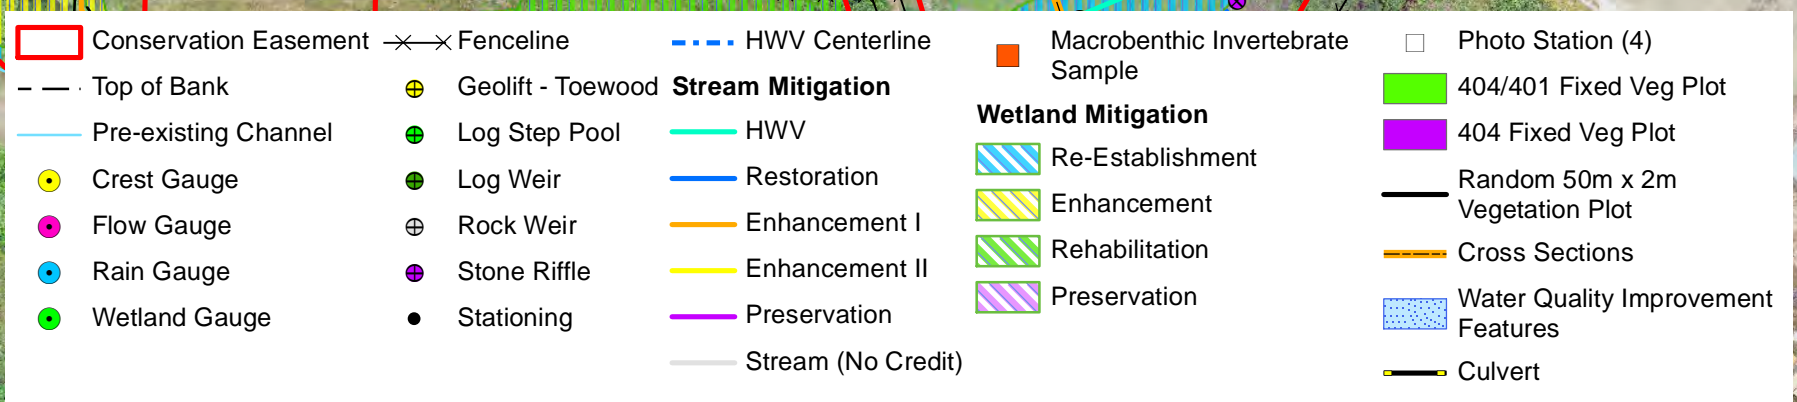

Odells House Mitigation Project
Johnston County, North Carolina

USACE Action ID Number:
SAW-2018-00431
June 2021
MY0

USACE
Current Conditions Plan View
Monitoring Year 0

NAD 1983 2011 State Plane
North Carolina FIPS 3200 FT US

FIGURE
1C

2 Goals, Performance Criteria, and Functional Improvements

2.1 Project Goals and Objectives

The Project will meet the goals and objectives described in the Odell's House Final Approved Mitigation Plan and address the general restoration goals and opportunities outlined in the DMS Neuse River Basin Watershed Restoration Priorities (RBRP). More specifically, three out of the four functional goals and objectives outlined in the Wake-Johnston Collaborative Local Watershed Plan (LWP) as well as the Neuse 01 RWP will be met by:

- Reducing sediment and nutrient inputs to the Buffalo Creek Watershed.
- Restoring, preserving and protecting wetlands, streams, riparian buffers and aquatic habitat.
- Implementing agricultural BMPs and stream restoration in rural catchments together as “project clusters”.

To accomplish these project-specific goals, the following objectives will be measured to document overall project success:

- Restore stream and floodplain interaction and geomorphically stable conditions by reconnecting historic flow paths and promoting more natural flood processes;
- Improve and protect water quality by reducing streambank erosion, nutrient and sediment inputs;
- Restore and protect riparian buffer functions and habitat connectivity in perpetuity by recording a permanent conservation easement;
- Incorporate water quality improvement features to reduce nonpoint source inputs to receiving waters



| Table 2: Summary: Goals, Performance and Results | | | | | |
|---|---|--|---|---|-------------------------------|
| Goal | Objective/Treatment | Likely Functional Uplift | Performance Criteria | Measurement | Cumulative Monitoring Results |
| Improve Stream Base Flow Duration | Improve and/or remove existing stream crossings and restore a more natural flow regime and aquatic passage. | Create a more natural and higher functioning headwater flow regime and provide aquatic passage; re-establish appropriate wetland hydroperiods and provide hydrologic storage | Maintain seasonal flow on intermittent stream for a minimum of 30 consecutive days during normal annual rainfall | 2 Flow gauges (R1 & R5) | Data in MY1 |
| Reconnect channels with floodplains and riparian wetlands to allow a natural flooding regime. | Design BHRs to not exceed 1.2 and increase ERs no less than 2.2 for Rosgen 'C' and 'E' stream types and 1.4 for 'B' stream types. | Provide temporary water storage and reduce erosive forces (shear stress) in channel during larger flow events. | Minimum of four bankfull events in separate years. Wetland hydrology for 8% of growing season. | 2 Crest Gauges/pressure transducers (R3 & R7 Lower) and 5 wetland groundwater gauges (W1, W2, W3, & W5) | Data in MY1 |
| Improve stability of stream channels | Construct stream channels that will maintain stable cross-sections, patterns, and profiles over time. | Reduction in sediment inputs from bank erosion, reduction of shear stress, and improved overall hydraulic function. | Bank height ratios remain below 1.2 over the monitoring period. Visual assessments showing progression towards stability. | 10 Cross section surveys | all cross sections BHR<1.2 |
| Establish Riparian Buffer Vegetation | Plant native species vegetation a minimum 50' wide from the top of the streambanks with a composition/density comparable to downstream reference condition. | Increase woody and herbaceous vegetation will provide channel stability and reduce streambank erosion, runoff rates and exotic species vegetation. | Within planted portions of the site, a minimum of 320 stems per acre must be present at year three; a minimum of 260 stems per acre must be present at year five and average height of seven feet; and a minimum of 210 stems per acre and average ten foot tree heights must be present at year seven. | Tree data for 12 Veg Plots (species & height), visual assessment | 12/12 veg plots met - 2021 |

2.2 Project Success Criteria

The success criteria for the Project will follow the approved performance standards and monitoring protocols from the final approved mitigation plan; which was developed in compliance with the USACE October 2016 Guidance, USACE Stream Mitigation Guidelines (April 2003 and October 2005), and 2008 Compensatory Mitigation Final Rule. Cross-section and vegetation plot data will be collected in Years 0, 1, 2, 3, 5, and 7. Stream hydrology data and visual monitoring will be reported annually. Specific success criteria components and evaluation methods are described below.

2.2.1 Streams

Stream Hydrology: Four separate bankfull or over bank events must be documented within the seven-year monitoring period and the stream hydrology monitoring will continue until four bankfull events have been documented in separate years. Stream hydrology monitoring will be accomplished with pressure transducers installed in pools and correlating sensor depth to top of bank elevation (see appendix D for installation diagrams). Recorded water depth above the top of bank elevation will document a bankfull event. The devices will record water depth hourly and will be inspected quarterly. In addition to the pressure transducers, traditional cork gauges will be installed at bankfull elevation and will be used to document bankfull events with photographs.



Stream Profiles, Vertical Stability, and Floodplain Access: Stream profiles, as a measure of vertical stability and floodplain access will be evaluated by looking at Bank Height Ratios (BHR). In addition, observed bedforms should be consistent with those observed for channels of the design stream type(s). The BHR shall not exceed 1.2 along the restored Project stream reaches. This standard only applies to restored reaches of the channel where BHRs were corrected through design and construction. Vertical stability will be evaluated with visual assessment, cross-sections and, if directed by the IRT, longitudinal profile.

Stream Horizontal Stability: Cross-sections will be used to evaluate horizontal stream stability on restored streams. There should be little change expected in as-built restoration cross-sections. If measurable changes do occur, they should be evaluated to determine if the changes represent a movement toward a more unstable condition (e.g., downcutting, erosion) or a movement towards increased stability (e.g., settling, vegetation establishment, deposition along the streambanks, decrease in width/depth ratio). Cross-sections shall be classified using the Rosgen Stream Classification method and all monitored cross-sections should fall within the quantitative parameters defined for channels of the design stream type.

Stream cross-section monitoring will be conducted using a Topcon RL-H5 Laser Level. Three-dimensional coordinates associated with cross-section data will be collected in the field (NAD83 State Plane feet FIPS 3200). Morphological data will be collected at ten cross-sections. Survey data will be imported into Microsoft Excel® and the DMS Shiny App for data processing and analysis.

Reference photo transects will be taken at each permanent cross-section. Lateral photos should not indicate excessive erosion or continuing degradation of the streambanks. Photographs will be taken of both streambanks at each cross-section. A survey tape stretched between the permanent cross-section monuments/pins will be centered in each of the streambank photographs. The water elevation will be shown in the lower edge of the frame, and as much of the streambank as possible will be included in each photo. Photographers will attempt to consistently maintain the same area in each photo over time.

Jurisdictional Stream Flow: Monitoring of stream flow will be conducted to demonstrate that the restored stream systems classified as intermittent exhibit surface flow for a minimum of 30 consecutive days throughout some portion of the year during a year with normal rainfall conditions. Stream flow monitoring will be accomplished with pressure transducers installed in pools and correlating sensor depth to the downstream top of riffle elevation (see appendix D for installation diagrams). If the pool water depth is at or above the top of riffle elevation, then the channel will be assumed to have surface flow. The devices will record water elevation twice per day and will be inspected quarterly to document surface hydrology and provide a basis for evaluating flow response to rainfall events.

The stage recorders include an automatic pressure transducer (HOBO Water Level (13 ft) Logger) set in PVC piping in the channel. The elevation of the bed and top of bank at each stage recorder location will be recorded to be able to document presence of water in the channel and out of bank events. Visual observations (i.e. wrack or debris lines) and traditional cork crest gauges will also be used to document out of bank events.

Channel Formation: During monitoring years 1 through 4, the preponderance of evidence must demonstrate a concentration of flow indicative of headwater stream channel formation within the



topographic low-point of the valley or crenulation as documented by the following indicators for reaches R1 and R5:

- Scour (indicating sediment transport by flowing water)
- Sediment deposition (accumulations of sediment and/or formation of ripples)
- Sediment sorting (sediment sorting indicated by grain-size distribution with the primary path of flow)
- Multiple observed flow events (must be documented by gauge data and/or photographs)
- Destruction of terrestrial vegetation
- Presence of litter and debris
- Wracking (deposits of drift material indicating surface water flow)
- Vegetation matted down, bent, or absent (herbaceous or otherwise)
- Leaf litter disturbed or washed away

During monitoring years 5 through 7, the stream must successfully meet the requirements above and the preponderance of evidence must demonstrate the development of stream bed and banks as documented by the following indicators:

- Bed and banks (may include the formation of stream bed and banks, development of channel pattern such as meander bends and/or braiding at natural topographic breaks, woody debris, or plant root systems)
- Natural line impressed on the bank (visible high-water mark)
- Shelving (shelving of sediment depositions indicating transport)
- Water staining (staining of rooted vegetation)
- Change in plant community (transition to species adapted for flow or inundation for a long duration, including hydrophytes)
- Changes in character of soil (texture and/or chroma changes when compared to the soils abutting the primary path of flow)

2.2.2 Wetlands

Wetland Hydrology: The performance standard for wetland hydrology will be 12 percent based on the suggested wetland saturation thresholds for soils taxonomic subgroups. The proposed success criteria for wetland hydrology will be when the soils are saturated within 12 inches of the soil surface for 12 percent (27 days) of the 227-day growing season (March 21st through November 3rd) based on WETS data table for Johnston County, NC. The saturated conditions should occur during a period when antecedent precipitation has been normal or drier than normal for a minimum frequency of 5 years in 10 (USACE, 2005 and 2010b). Precipitation data will be obtained from an on-site rain gauge and the Clayton (CLAY) Research Weather Station, approximately 9 miles southeast of the Project site. If a normal year of precipitation does not occur during the first seven years of monitoring, WLS will continue to monitor the Project hydrology until the Project site has been saturated for the appropriate hydroperiod. If rainfall amounts for any given year during the monitoring period are abnormally low, reference wetland



hydrology data will be compared to determine if there is a correlation with the weather conditions and site variability.

2.2.3 Vegetation

Vegetation monitoring will occur in the fall each required monitoring year, prior to leaf drop. Plots will be monitored in years 1, 2, 3, 5, and 7. Vegetative success for the Project during the intermediate monitoring years will be based the survival of at least 320, three-year-old planted trees per acre at the end of Year 3 of the monitoring period; and at least 260, five-year-old, planted trees per acre that must average seven feet in height at the end of Year 5 of the monitoring period. The final vegetative restoration success criteria will be achieving a density of no less than 210, seven-year-old planted stems per acre that must average ten feet in height in Year 7 of monitoring.

Vegetation success will be monitored at a total of nine permanent vegetation plots (10m x 10m) and 3 random vegetation transects (50m x 2m and 20m x 5m). Vegetation plot monitoring follows the CVS-EEP Level 2 Protocol for Recording Vegetation, version 4.2 (Lee et al. 2008) and includes analysis of species composition and density of planted species. Data will be processed using the DMS Shiny App. In the field, the four corners of each plot will be permanently marked with PVC at the origin and rebar at the other corners. Tree species and height will be recorded for each planted stem and photos of each plot are to be taken from the origin each monitoring year.

2.2.4 Visual Assessment

WLS will conduct visual assessments in support of mitigation performance monitoring. Visual assessments of all stream reaches will be conducted twice per monitoring year with at least five months in between each site visit for each of the seven years of monitoring. Photographs will be used to visually document system performance and any areas of concern related to streambank and bed stability, condition of in-stream structures, channel migration, active headcuts, live stake mortality, invasive plant species or animal browsing, easement boundary encroachments, cattle exclusion fence damage, and general streambed conditions.

3 Project Attributes

3.1 Design Approach

3.1.1 Stream

The Project stream design approach included a combination of Stream Restoration, Enhancement, and Preservation activities. Priority Level I restoration approaches were incorporated with the design of both single-thread meandering channels and headwater stream valleys. All non-vegetated areas within the conservation easement were planted with native species vegetation and any areas of invasive species were removed and/or treated.

Restoration: R1, R3, R5, and R6

- **R1** – R1 begins near the top of what was previously a farm pond. The outlet pipe and earthen dam was removed, and the pond was drained to reconnect the new stream channel with its geomorphic floodplain. The reach was restored as a Rosgen ‘DA’ stream type. This approach



allowed the restoration of a stable headwater channel with appropriate bedform diversity, as well as improved ecological function through increased aquatic and terrestrial habitats. The valley bottom within the old pond bed was graded to restore the natural microtopographic variability that is common within headwater stream and wetland systems. A small pilot channel was graded to allow the natural flow path to maintain a defined channel form as vegetation becomes established. One agricultural BMP was installed above R1 to capture, attenuate, and treat concentrated flow that would otherwise enter the riparian buffer as untreated water. The BMP was constructed outside of the conservation easement and was fenced to restrict cattle access.

- **R3** – R3 begins at a culvert crossing downstream of R2. Work along R3 involved a Priority Level I Restoration. A majority of the channel was restored in its natural valley location with minor adjustments to channel planform. The reach was restored as a Rosgen ‘B4’ stream type. This approach allowed the restoration of a stable channel form with appropriate bedform diversity, as well as improved ecological function through increased aquatic and terrestrial habitats. A dilapidated CMP pipe was replaced and a bankfull culvert was added to improve flood flows and aquatic life passage. A fence was constructed outside of the conservation easement to restrict cattle access.
- **R5** – Similar to R1, R5 begins near the top of what was previously a farm pond. An existing pipe was removed and replaced near station 10+00 to redirect flows within the natural valley. In addition, the existing pond drainage pipe was removed at the permanent easement crossing and the embankment was lowered. A new culvert and bankfull pipe was installed near station 14+50 to improve flood flows and aquatic life passage. The reach was restored as a Rosgen ‘DA’ stream type. This approach allows restoration of a stable headwater channel with appropriate bedform diversity, as well as improved ecological function through increased aquatic and terrestrial habitats. The valley bottom within the old pond bed was graded to restore the natural microtopographic variability that is common within headwater systems. Similar to R1, a small pilot channel was graded to allow the natural flow path to maintain a defined channel form as vegetation becomes established. A fence was constructed outside of the conservation easement to restrict cattle access.
- **R6** – R6 begins at the culvert outlet below R5 and the previously existing pond dam. Work along R6 involved a Priority Level I Restoration. The remnant channel was back filled, and a majority of this reach was constructed offline in the low part of the valley. The reach was restored as a Rosgen ‘B4c’ stream type. This approach allows restoration of a stable channel form with appropriate bedform diversity, as well as improved ecological function through increased aquatic and terrestrial habitats. A fence was constructed outside of the conservation easement to restrict cattle access.

Enhancement Level II: R2 and R4

- **R2** – R2 begins at the terminus of R1. An Enhancement Level II approach was utilized along the entire reach. Construction activities consisted of strategic mechanized removal of invasive species



vegetation (i.e. golden bamboo), grading existing or disturbed stream banks back to a stable dimension, installing erosion control matting, and supplemental riparian buffer planting and live stakes. The reach is classified as a Rosgen 'C5' stream type. A fence was constructed outside of the conservation easement to restrict cattle access.

- **R4** – R4 begins at the terminus of R3. An Enhancement Level II approach was utilized along this reach. Construction activities consisted of strategic mechanized removal of invasive species, in-stream structure installation to stabilize an existing headcut and bank erosion, grading the stream banks back to the existing stable dimension, installing erosion control matting, and supplemental riparian buffer planting and live stakes. The reach in this section is classified as a Rosgen 'E5' stream type. A fence was constructed outside of the conservation easement to restrict cattle access.

Enhancement Level I: R7 upper

- **R7 upper** - The upper section of R7 begins at the terminus of R6. The reach was constructed as a Rosgen 'DA' stream type. The remnant straightened channel and small pond were backfilled and a pilot channel was relocated within the natural valley. This work allows diffuse flows across the R7 floodplain and extensive wetting of the adjacent wetlands. Small in-stream structures in the form of log weirs were installed to increase bedform diversity. The low flows through R7 upper now follow historic flow patterns and spread out through channel depressions, restoring a more natural stream hydrology function.

Preservation: R7 lower

- **R7 lower** - The downstream section of R7 is currently classified as a Rosgen 'E5' stream type. The Preservation approach extends the wildlife corridor from the Buffalo Creek floodplain boundary throughout a majority of the riparian valley, while providing a natural hydrologic connection and critical habitat linkage within the catchment area.

3.1.2 Wetland

Riparian Wetland Re-establishment: W1, W2, and W4

Areas of hydric soils were documented along portions of the project floodplains areas. These hydric soil areas and pond impoundments were restored to higher functioning riparian wetlands as a direct result of implementing Priority Level I stream restoration, pond removal, limited soil manipulation and removal of soils (less than 1-foot depth) and planting native vegetation. The restored groundwater hydrology will allow the wetland areas to regain their natural or historic functions.

Riparian Wetland Rehabilitation: W3

Areas of significantly degraded riparian wetlands (poorly functioning) were also documented along portions of the project floodplains areas. These poorly functioning wetland areas were restored as a direct result of implementing a Priority Level I stream restoration, removal of livestock, limited soil manipulation



and removal (less than 1-foot depth) and planting native vegetation. The groundwater hydrology will be restored and allow the wetland areas to regain their natural or historic functions.

Riparian Wetland Enhancement: W5

As described above, the restoration activities provide significant functional uplift across the project area. The activities also improve and enhance the hyporheic zone interaction and hydrology to existing wetland areas. Wetland enhancement areas were planted with native wet tolerant species. The restoration of the stream channels will also improve areas of adjacent wetlands through higher water table conditions (elevated stream profile) and a more frequent over-bank flooding regime.

Riparian Wetland Preservation: W6

Areas of highly functioning riparian wetlands were also documented along lower portions of R7 floodplain. These wetland areas benefited from upstream functional uplift as a direct result of implementing a Priority Level I restoration, removal of livestock and planting native vegetation. The groundwater hydrology will be improved upstream which allow these wetland areas to maintain their natural or historic functions.

3.2 Project Attributes

See Table 3 below for Project Attributes.



| Table 3. Project Attribute Table | | | | | | | | |
|--|---|---------------------|------------------------------------|------------------------------------|--|------------------------------|--------------|--------------|
| Project Name | Odell's House Mitigation Project | | | | | | | |
| County | Johnston | | | | | | | |
| Project Area (acres) | 15.092 | | | | | | | |
| Project Coordinates (latitude and longitude decimal degrees) | 35.71589, -78.35345 | | | | | | | |
| Project Watershed Summary Information | | | | | | | | |
| Physiographic Province | Piedmont | | | | | | | |
| River Basin | Neuse | | | | | | | |
| USGS Hydrologic Unit 8-digit | 3020201 | | | | | | | |
| DWR Sub-basin | 03-04-06 | | | | | | | |
| Project Drainage Area (acres) | 41.8 (R7 lower) and 95.4 (R4) | | | | | | | |
| Project Drainage Area Percentage of Impervious Area | <1% | | | | | | | |
| Land Use Classification | 2.01.03, 2.01.01, 3.02 (69% cultivated crops/hay, 2% grass/herbaceous, 25% mixed forest, 4% pond) | | | | | | | |
| Reach Summary Information | | | | | | | | |
| Parameters | R1 | R2 | R3 | R4 | R5 | R6 | R7 (upper) | R7 (lower) |
| Pre-project length (feet) | N/A (pond) | 632 | 1169 | 392 | N/A (pond) | 610 | 468 | 412 |
| Post-project (feet) | 533 | 518 | 1103 | 199 | 392 | 422 | 674 | 461 |
| Valley confinement (Confined, moderately confined, unconfined) | N/A | moderately confined | moderately confined | unconfined | N/A | unconfined | unconfined | unconfined |
| Drainage area (acres) | 42.9 | 64 | 83.2 | 95.4 | 19.4 | 30.7 | 39.7 | 41.8 |
| Perennial, Intermittent, Ephemeral | N/A | Perennial | Intermittent | Intermittent | N/A | Intermittent | Intermittent | Intermittent |
| NCDWR Water Quality Classification | C, NSW | C, NSW | C, NSW | C, NSW | C, NSW | C, NSW | C, NSW | C, NSW |
| Dominant Stream Classification (existing) | N/A (pond) | C5 | G5 | E5 | N/A (pond) | E5 | G5 | E5/DA |
| Dominant Stream Classification (proposed) | DA/E5 | C5 | B5 | E5 | DA/E5 | B5c | B5c | E5 |
| Dominant Evolutionary class (Simon) if applicable | N/A | IV/V | III | IV/V | N/A | III | I | I |
| Wetland Summary Information | | | | | | | | |
| Parameters | W1 | W2 | W3 | W4 | W5 | W6 | | |
| Pre-project (acres) | 0.476 | 0.416 | 0.666 | 0.234 | 1.654 | 0.444 | | |
| Post-project (acres) | 0.476 | 0.416 | 0.666 | 0.234 | 1.654 | 0.444 | | |
| Wetland Type (non-riparian, riparian) | Riparian Riverine | Riparian Riverine | Riparian Riverine | Riparian Riverine | Riparian Riverine | Riparian Riverine | | |
| Mapped Soil Series | Water, Cowarts loamy sand | Water | Leaf silt loam, Cowarts loamy sand | Leaf silt loam, Cowarts loamy sand | Leaf silt loam, Bonneau sand, Wedowee sandy loam | Bonneau sand, Leaf silt loam | | |
| Soil Hydric Status | N/A, non hydric | N/A | Hydric, non hydric | Hydric, non hydric | Hydric, non hydric | non-hydric, Hydric | | |
| Regulatory Considerations | | | | | | | | |
| Parameters | Applicable? | | Resolved? | | Supporting Docs? | | | |
| Water of the United States - Section 404 | Yes | | Yes | | PCN/404 permit | | | |
| Water of the United States - Section 401 | Yes | | Yes | | PCN/401 permit | | | |
| Endangered Species Act | Yes | | Yes | | Categorical Exclusion | | | |
| Historic Preservation Act | Yes | | Yes | | Categorical Exclusion | | | |
| Coastal Zone Management Act (CZMA or CAMA) | No | | N/A | | N/A | | | |
| Essential Fisheries Habitat | No | | N/A | | N/A | | | |



4 Monitoring Year 0 Assessment and Results

4.1 As-built Survey

An as-built survey conducted under the responsible charge of a North Carolina Professional Land Surveyor (Marshall Wight, PLS with WithersRavenel), was utilized to document the as-built or baseline condition of the Project post-construction. The Project construction and planting were completed in March and April 2021 and as-built survey was completed in May 2021. Cattle were removed from the site prior to construction and permanent fencing was completed in April 2021. Baseline monitoring activities occurred in March - May 2021.

4.2 As-Built Plans/ Record Drawings

The results of the as-built survey establish and document post-construction or baseline conditions and will be used for comparing annual post-construction monitoring data. The as-built plans or record drawings were developed utilizing the final construction plans as the “background”, and then overlaying the as-built survey information on the plan and profile sheets. Any significant adjustments or deviations made to the final construction plans during construction are shown as redline mark-ups or callouts on the as-built survey plan sheets. The as-built plans/record drawings were submitted separately.

4.3 As-Built/ Baseline Assessment

No significant deviations were documented between the final construction plans and the as-built condition that may affect channel performance, channel lengths, or changes in vegetation species planted. Along R1, the channel alignment was adjusted from approximate design station 11+62 to 12+37 due to poor/wet soil conditions in the remnant pond bottom. Upper R6 was also slightly adjusted from approximate station 16+00 to 17+37 to protect existing vegetation and prevent root damage within the dripline. Lastly, upper R7 was realigned from approximate station 12+17 to 14+59 to more closely follow the existing flow paths and floodplain contours. The in-stream structure installation generally followed the proposed design in these locations and additional woody material was installed along R1 and R5 respectively. Lastly, six log riffles were replaced with three log weirs and woody debris along upper R7 to increase bedform diversity and minimize disturbance to existing wetland vegetation. No major issues or mitigating factors were observed immediately after construction which require consideration or remedial action.

4.4 Morphological Assessment

Morphological data for the as-built profile was collected in March 2021. Refer to Appendices A and C for summary data tables, morphological plots, and stream photographs.

4.4.1.1 *Stream Horizontal Pattern & Longitudinal Profile*

The MY0 stream channel pattern and longitudinal profiles closely match the design parameters. The MY0 plan form geometry or pattern fell within acceptable ranges of the design parameters for all restored reaches. These minor channel adjustments in riffle slopes, pool depths and pattern do not present a stability concern or indicate a need for remedial action and will be assessed visually during the annual assessments.



4.4.1.2 Stream Horizontal Dimension

The MYO channel dimensions generally match the design parameters and are within acceptable and stable ranges of tolerance. It is expected that over time that some pools may accumulate fine sediment and organic matter, however, this is not an indicator of channel instability. Maximum riffle depths are also expected to fluctuate slightly throughout the monitoring period as the channels adjust to the new flow regime and catchment conditions.

4.5 Stream Hydrology

4.5.1 Stream Flow

Two pressure transducers (flow gauges) were installed in March 2021 on reaches R1 and R5 to document baseflow conditions. The flow gauge locations are within the upper one-third of the project reaches as shown on the CCPV and data will be included in the Monitoring Year 1 Report.

4.5.1.1 Bankfull Events

Two crest gauges were installed in March 2021 to document bankfull events. WLS installed a conventional cork crest gauge, along with a pressure transducer to validate flood status on R3 and R7 lower. Stream hydrology data will be included in the Monitoring Year 1 Report in this section and in the appendices. Recorder locations are shown on the CCPV.

4.5.2 Headwater Stream Channel Formation

During monitoring years 1 through 4, the preponderance of evidence must demonstrate a concentration of flow indicative of channel formation within the topographic low-point of the valley or crenulation as documented by the indicators listed in section 2.2.1. This evidence will be addressed in the Monitoring Year 1 Report.

4.5.3 Wetlands

Five groundwater wells were installed in March 2021 to monitor wetland hydrology. Groundwater well locations are shown on the CCPV and the data will be included in subsequent monitoring reports.

4.5.4 Vegetation

Monitoring of the nine permanent vegetation plots and three random plots/transects was completed during the first week of May 2021. Vegetation data and photos can be found in Appendix B. The MYO average planted density is 748 stems per acre, which exceeds the interim measure of vegetative success of at least 320 planted stems per acre at the end of the third monitoring year. Each plot also met the interim measure requirement with 607 – 1,214 stems per acre. Volunteer species were not noted at baseline monitoring but are expected to establish in upcoming years.

Visual assessment of vegetation outside of the monitoring plots indicates that the herbaceous vegetation is becoming well established throughout the project. Temporary and permanent seeding of the project was completed during and following construction activities per the mitigation plan.

A large population of golden bamboo (*Phyllostachys aurea*) existed along the left floodplain of R2 prior to construction. Construction activities included bamboo removal in this area by ripping the roots/rhizomes,



cut stump herbicide treatments, and foliar spray of small shoots. Herbicide treatments used 50 percent glyphosate for cut/stump and three percent for foliar spray. This area will continue to be monitored closely and any treatments will be documented in future monitoring reports.



Appendix A:

Visual Assessment Data

Visual Stream Morphology Stability Assessment Table

Vegetation Condition Assessment Table

Photos: Cross-Section Photos

Photos: Stream Photo Points (Culvert Crossings and EII Reaches)

Table 4: Visual Stream Stability Assessment

| | |
|-------------------------------|--|
| Reach | R1, R2, R3, R4, R5, R6, R7 (upper and lower) |
| Assessed Stream Length | 4,302 |
| Assessed Bank Length | 5,384 |

| Major Channel Category | | Metric | Number Stable, Performing as Intended | Total Number in As-built | Amount of Unstable Footage | % Stable, Performing as Intended |
|------------------------|--------------------------------|---|---------------------------------------|--------------------------|----------------------------|----------------------------------|
| Bank | Surface Scour/Bare Bank | Bank lacking vegetative cover resulting simply from poor growth and/or surface scour | | | 0 | 100% |
| | Toe Erosion | Bank toe eroding to the extent that bank failure appears likely. Does <u>NOT</u> include undercuts that are modest, appear sustainable and are providing habitat. | | | 0 | 100% |
| | Bank Failure | Fluvial and geotechnical - rotational, slumping, calving, or collapse | | | 0 | 100% |
| Totals | | | | | 0 | 100% |
| Structure | Grade Control | Grade control structures exhibiting maintenance of grade across the sill. | 116 | 116 | | 100% |
| | Bank Protection | Bank erosion within the structures extent of influence does <u>not</u> exceed 15%. (See guidance for this table in DMS monitoring guidance document) | 34 | 34 | | 100% |

Visual Vegetation Assessment

Planted acreage 11.17

| Vegetation Category | Definitions | Mapping Threshold | Combined Acreage | % of Planted Acreage |
|----------------------------|---|-------------------|------------------|----------------------|
| Bare Areas | Very limited cover of both woody and herbaceous material. | 0.10 acres | 0.00 | 0.0% |
| Low Stem Density Areas | Woody stem densities clearly below target levels based on current MY stem count criteria. | 0.10acres | 0.00 | 0.0% |
| Total | | | 0.00 | 0.0% |
| Areas of Poor Growth Rates | Planted areas where average height is not meeting current MY Performance Standard. | 0.10 acres | 0.00 | 0.0% |
| Cumulative Total | | | 0.00 | 0.0% |

Easement Acreage 15.1

| Vegetation Category | Definitions | Mapping Threshold | Combined Acreage | % of Easement Acreage |
|-----------------------------|---|-------------------|------------------|-----------------------|
| Invasive Areas of Concern | Invasives may occur outside of planted areas and within the easement and will therefore be calculated against the total easement acreage- Include species with the potential to directly outcompete native, young, woody stems in the short-term or community structure for existing communities. Species included in summation above should be identified in report summary. | 0.10 acres | 0.00 | 0.0% |
| Easement Encroachment Areas | Encroachment may be point, line, or polygon. Encroachment to be mapped consists of any violation of restrictions specified in the conservation easement. Common encroachments are mowing, cattle access, vehicular access. Encroachment has no threshold value as will need to be addressed regardless of impact area. | none | 0.00 | |



5/6/21, 9:51 AM
Johnston

R1, XS-1, Upstream (MY-00)



5/6/21, 9:53 AM
Johnston

R1, XS-1, Left Bank (MY-00)



5/6/21, 9:51 AM
Johnston

R1, XS-1, Downstream (MY-00)



5/6/21, 9:50 AM
Johnston

R1, XS-1, Right Bank (MY-00)



3/2/21, 10:30 AM
Johnston

R2, XS-2, Upstream (MY-00)



3/2/21, 10:30 AM
Johnston

R2, XS-2, Left Bank (MY-00)



3/2/21, 10:30 AM
Johnston

R2, XS-2, Downstream (MY-00)



3/2/21, 10:30 AM
Johnston

R2, XS-2, Right Bank (MY-00)



3/2/21, 10:52 AM
Johnston

R2, XS-3, Upstream (MY-00)



3/2/21, 10:52 AM
Johnston

R2, XS-3, Left Bank (MY-00)



3/2/21, 10:52 AM
Johnston

R2, XS-3, Downstream (MY-00)



3/2/21, 10:52 AM
Johnston

R2, XS-3, Right Bank (MY-00)



3/2/21, 9:17 AM
Johnston

R3, XS-4, Upstream (MY-00)



3/2/21, 9:18 AM
Johnston

R3, XS-4, Left Bank (MY-00)



3/2/21, 9:17 AM
Johnston

R3, XS-4, Downstream (MY-00)



3/2/21, 9:17 AM
Johnston

R3, XS-4, Right Bank (MY-00)



3/2/21, 9:43 AM
Johnston

R3, XS-5, Upstream (MY-00)



3/2/21, 9:41 AM
Johnston

R3, XS-5, Left Bank (MY-00)



3/2/21, 9:42 AM
Johnston

R3, XS-5, Downstream (MY-00)



3/2/21, 9:42 AM
Johnston

R3, XS-5, Right Bank (MY-00)



5/6/21, 10:29 AM
Johnston

R5, XS-6, Upstream (MY-00)



5/6/21, 10:24 AM
Johnston

R5, XS-6, Left Bank (MY-00)



5/6/21, 10:27 AM
Johnston

R5, XS-6, Downstream (MY-00)



5/6/21, 10:29 AM
Johnston

R5, XS-6, Right Bank (MY-00)



R6, XS-7, Upstream (MY-00)



R6, XS-7, Left Bank (MY-00)



R6, XS-7, Downstream (MY-00)



R6, XS-7, Right Bank (MY-00)



3/2/21, 1:02 PM
Johnston

R6, XS-8, Upstream (MY-00)



3/2/21, 1:02 PM
Johnston

R6, XS-8, Left Bank (MY-00)



3/2/21, 1:02 PM
Johnston

R6, XS-8, Downstream (MY-00)



3/2/21, 1:02 PM
Johnston

R6, XS-8, Right Bank (MY-00)



3/2/21, 2:00 PM
Johnston

R7 upper, XS-9, Upstream (MY-00)



3/2/21, 2:01 PM
Johnston

R7 upper, XS-9, Left Bank (MY-00)



3/2/21, 2:01 PM
Johnston

R7 upper, XS-9, Downstream (MY-00)



3/2/21, 2:01 PM
Johnston

R7 upper, XS-9, Right Bank (MY-00)



3/2/21, 1:49 PM
Johnston

R7 upper, XS-10, Upstream (MY-00)



3/2/21, 1:49 PM
Johnston

R7 upper, XS-10, Left Bank (MY-00)



3/2/21, 1:49 PM
Johnston

R7 upper, XS-10, Downstream (MY-00)



3/2/21, 1:50 PM
Johnston

R7 upper, XS-10, Right Bank (MY-00)



PS-1 – R2, EII, Upstream (MY-00)



PS-1 – R2, EII, Downstream (MY-00)



PS-2 – R2 Culvert Crossing, Upstream (MY-00)



PS-2 – R2 Culvert Crossing, Downstream (MY-00)



3/2/21, 10:03 AM
Johnston

PS-3 – R4, EII, Upstream (MY-00)



3/2/21, 10:04 AM
Johnston

PS-3 – R4, EII, Downstream (MY-00)



5/4/21, 11:53 AM
Johnston

PS-4 – R5 Culvert Crossing, Upstream (MY-00)



5/4/21, 11:55 AM
Johnston

PS-4 – R5 Culvert Crossing, Downstream (MY-00)

Appendix B:

Vegetation Plot Data

Redline Plant List
Vegetation Performance Standards Summary Table
Vegetation Plot Counts and Densities Table
Photos: Vegetation Plot Photos
Veg Plot Maps

**Odell's House Mitigation Project
Red-line Planting List**

| Species | Common Name | Stems | % Planted | Mitigation Plan % |
|--------------------------------|--------------------|--------------|-------------|-------------------|
| <i>Fraxinus pennsylvanica</i> | Green Ash | 228 | 3.00% | 3% |
| <i>Betula nigra</i> | River birch | 608 | 8.00% | 12% |
| <i>Quercus michauxii</i> | Swamp chestnut oak | 608 | 8.00% | 10% |
| <i>Quercus pagoda</i> | Cherrybark oak | 532 | 7.00% | 10% |
| <i>Platanus occidentalis</i> | American sycamore | 684 | 9.00% | 12% |
| <i>Quercus nigra</i> | Water Oak | 532 | 7.00% | 10% |
| <i>Liriodendron tulipifera</i> | Tulip Poplar | 684 | 9.00% | 12% |
| <i>Quercus phellos</i> | Willow Oak | 532 | 7.00% | 10% |
| <i>Diospyros virginiana</i> | Persimmon | 456 | 6.00% | 4% |
| <i>Carpinus caroliniana</i> | Ironwood | 456 | 6.00% | 3% |
| <i>Hamamelis virginiana</i> | Witch Hazel | 456 | 6.00% | 3% |
| <i>Asimina triloba</i> | Pawpaw | 456 | 6.00% | 4% |
| <i>Lindera benzoin</i> | Spicebush | 456 | 6.00% | 4% |
| <i>Alnus serulatta</i> | Tag Alder | 456 | 6.00% | 0% |
| <i>Corylus americana</i> | Hazelnut | 456 | 6.00% | 3% |
| Total | | 7,600 | 100% | |

* changes from mitigation plan in red

*Tag Alder was not planted within potential Nutrient Buffer Areas

| Vegetation Performance Standards Summary Table (Data Collected: 5/6/2021) | | | | | | | | | | | | |
|---|--------------------|--------------|-----------|-------------|--------------------|--------------|-----------|-------------|--------------------|--------------|-----------|-------------|
| | Veg Plot 1 F | | | | Veg Plot 2 F | | | | Veg Plot 3 F | | | |
| | Stems/Ac. | Av. Ht. (ft) | # Species | % Invasives | Stems/Ac. | Av. Ht. (ft) | # Species | % Invasives | Stems/Ac. | Av. Ht. (ft) | # Species | % Invasives |
| Monitoring Year 7 | | | | | | | | | | | | |
| Monitoring Year 5 | | | | | | | | | | | | |
| Monitoring Year 3 | | | | | | | | | | | | |
| Monitoring Year 2 | | | | | | | | | | | | |
| Monitoring Year 1 | | | | | | | | | | | | |
| Monitoring Year 0 | 688 | 2 | 9 | 0 | 648 | 2 | 9 | 0 | 607 | 2 | 8 | 0 |
| | Veg Plot 4 F | | | | Veg Plot 5 F | | | | Veg Plot 6 F | | | |
| | Stems/Ac. | Av. Ht. (ft) | # Species | % Invasives | Stems/Ac. | Av. Ht. (ft) | # Species | % Invasives | Stems/Ac. | Av. Ht. (ft) | # Species | % Invasives |
| Monitoring Year 7 | | | | | | | | | | | | |
| Monitoring Year 5 | | | | | | | | | | | | |
| Monitoring Year 3 | | | | | | | | | | | | |
| Monitoring Year 2 | | | | | | | | | | | | |
| Monitoring Year 1 | | | | | | | | | | | | |
| Monitoring Year 0 | 769 | 2 | 9 | 0 | 607 | 2 | 8 | 0 | 1214 | 2 | 9 | 0 |
| | Veg Plot 7 F | | | | Veg Plot 8 F | | | | Veg Plot 9 F | | | |
| | Stems/Ac. | Av. Ht. (ft) | # Species | % Invasives | Stems/Ac. | Av. Ht. (ft) | # Species | % Invasives | Stems/Ac. | Av. Ht. (ft) | # Species | % Invasives |
| Monitoring Year 7 | | | | | | | | | | | | |
| Monitoring Year 5 | | | | | | | | | | | | |
| Monitoring Year 3 | | | | | | | | | | | | |
| Monitoring Year 2 | | | | | | | | | | | | |
| Monitoring Year 1 | | | | | | | | | | | | |
| Monitoring Year 0 | 850 | 2 | 8 | 0 | 769 | 2 | 6 | 0 | 688 | 2 | 8 | 0 |
| | Veg Plot Group 1 R | | | | Veg Plot Group 2 R | | | | Veg Plot Group 3 R | | | |
| | Stems/Ac. | Av. Ht. (ft) | # Species | % Invasives | Stems/Ac. | Av. Ht. (ft) | # Species | % Invasives | Stems/Ac. | Av. Ht. (ft) | # Species | % Invasives |
| Monitoring Year 7 | | | | | | | | | | | | |
| Monitoring Year 5 | | | | | | | | | | | | |
| Monitoring Year 3 | | | | | | | | | | | | |
| Monitoring Year 2 | | | | | | | | | | | | |
| Monitoring Year 1 | | | | | | | | | | | | |
| Monitoring Year 0 | 648 | 2 | 7 | 0 | 688 | 2 | 11 | 0 | 810 | 2 | 11 | 0 |

*Each monitoring year represents a different plot for the random vegetation plot "groups". Random plots are denoted with an R, and fixed plots with an F.

Odell's House Stem Counts and Densities Table

| | |
|----------------------------------|------------|
| Planted Acreage | 11.17 |
| Date of Initial Plant | 2021-03-03 |
| Date(s) of Supplemental Plant(s) | #N/A |
| Date(s) Mowing | #N/A |
| Date of Current Survey | 2021-03-23 |
| Plot size (ACRES) | 0.0247 |

| | Scientific Name | Common Name | Tree/Shrub | Indicator Status | Veg Plot 1 F | | Veg Plot 2 F | | Veg Plot 3 F | | Veg Plot 4 F | | Veg Plot 5 F | | Veg Plot 6 F | | Veg Plot 7 F | | Veg Plot 8 F | | Veg Plot 9 F | | Veg Plot 10 R | Veg Plot 11 R | Veg Plot 12 R |
|--|----------------------------------|---------------------|------------|------------------|--------------|-------|--------------|-------|--------------|-------|--------------|-------|--------------|-------|--------------|-------|--------------|-------|--------------|-------|--------------|-------|---------------|---------------|---------------|
| | | | | | Planted | Total | Planted | Total | Planted | Total | Planted | Total | Planted | Total | Planted | Total | Planted | Total | Planted | Total | Planted | Total | Total | Total | Total |
| Species Included in Approved Mitigation Plan | <i>Asimina triloba</i> | pawpaw | Tree | FAC | | | 1 | 1 | 1 | 1 | 2 | 2 | 1 | 1 | | | | | | | | | | | 1 |
| | <i>Betula nigra</i> | river birch | Tree | FACW | 1 | 1 | 2 | 2 | 1 | 1 | 1 | 1 | | | 8 | 8 | 2 | 2 | 1 | 1 | 1 | 1 | | 1 | 2 |
| | <i>Carpinus caroliniana</i> | American hornbeam | Tree | FAC | 2 | 2 | | | | | 3 | 3 | | | | | 1 | 1 | 3 | 3 | 1 | 1 | | 2 | |
| | <i>Corylus americana</i> | American hazelnut | Shrub | FACU | | | 1 | 1 | | | | | | | 1 | 1 | 1 | 1 | | | | | | 2 | |
| | <i>Diospyros virginiana</i> | common persimmon | Tree | FAC | | | | | | | | | 1 | 1 | 1 | 1 | | | 1 | 1 | | | 2 | 1 | 2 |
| | <i>Fraxinus pennsylvanica</i> | green ash | Tree | FACW | 1 | 1 | | | | | | | | | 4 | 4 | | | 6 | 6 | 2 | 2 | | 2 | 1 |
| | <i>Hamamelis virginiana</i> | American witchhazel | Tree | FACU | 1 | 1 | 2 | 2 | 1 | 1 | 1 | 1 | | | | | | | 1 | 1 | | | | | 1 |
| | <i>Lindera benzoin</i> | northern spicebush | Tree | FACW | | | 1 | 1 | | | | | 1 | 1 | | | 1 | 1 | | | | | | | 1 |
| | <i>Liriodendron tulipifera</i> | tuliptree | Tree | FACU | 4 | 4 | 2 | 2 | 4 | 4 | 4 | 4 | 7 | 7 | | | 5 | 5 | | | 2 | 2 | 6 | | 4 |
| | <i>Platanus occidentalis</i> | American sycamore | Tree | FACW | 4 | 4 | 2 | 2 | 4 | 4 | 3 | 3 | 2 | 2 | 5 | 5 | 6 | 6 | 7 | 7 | 1 | 1 | 1 | 2 | 5 |
| | <i>Quercus michauxii</i> | swamp chestnut oak | Tree | FACW | 2 | 2 | 2 | 2 | | | | | 1 | 1 | 3 | 3 | | | | | | | 1 | 1 | 2 |
| | <i>Quercus nigra</i> | water oak | Tree | FAC | 1 | 1 | | | 1 | 1 | 1 | 1 | 1 | 1 | 3 | 3 | | | | | 2 | 2 | 2 | 2 | |
| | <i>Quercus pagoda</i> | cherrybark oak | Tree | FACW | | | 3 | 3 | 1 | 1 | 2 | 2 | | | 2 | 2 | 1 | 1 | | | 3 | 3 | 2 | 3 | |
| <i>Quercus phellos</i> | willow oak | Tree | FACW | 1 | 1 | | | 2 | 2 | 2 | 2 | 1 | 1 | 3 | 3 | 4 | 4 | | | 5 | 5 | 2 | 1 | 1 | |
| Sum | Performance Standard | | | | 17 | 17 | 16 | 16 | 15 | 15 | 19 | 19 | 15 | 15 | 30 | 30 | 21 | 21 | 19 | 19 | 17 | 17 | 16 | 17 | 20 |
| Post Mitigation Plan Species | <i>Alnus serrulata</i> | hazel alder | Tree | FACW | | | | | | | | | | | | | | | | | | | | 1 | 1 |
| Sum | Proposed Standard | | | | 17 | 17 | 16 | 16 | 15 | 15 | 19 | 19 | 15 | 15 | 30 | 30 | 21 | 21 | 19 | 19 | 17 | 17 | 16 | 18 | 21 |
| Mitigation Plan Performance Standard | Current Year Stem Count | | | | 17 | | 16 | | 15 | | 19 | | 15 | | 30 | | 21 | | 19 | | 17 | 16 | 17 | 20 | |
| | Stems/Acre | | | | 688 | | 648 | | 607 | | 769 | | 607 | | 1214 | | 850 | | 769 | | 688 | 648 | 688 | 810 | |
| | Species Count | | | | 9 | | 9 | | 8 | | 9 | | 8 | | 9 | | 8 | | 6 | | 8 | 7 | 10 | 10 | |
| | Dominant Species Composition (%) | | | | 24 | | 19 | | 27 | | 21 | | 47 | | 27 | | 29 | | 37 | | 29 | 38 | 17 | 24 | |
| | Average Plot Height | | | | 2 | | 2 | | 2 | | 2 | | 2 | | 2 | | 2 | | 2 | | 2 | 2 | 2 | 2 | |
| % Invasives | | | | 0 | | 0 | | 0 | | 0 | | 0 | | 0 | | 0 | | 0 | | 0 | 0 | 0 | 0 | | |
| Post Mitigation Plan Performance Standard | Current Year Stem Count | | | | 17 | | 16 | | 15 | | 19 | | 15 | | 30 | | 21 | | 19 | | 17 | 16 | 18 | 21 | |
| | Stems/Acre | | | | 688 | | 648 | | 607 | | 769 | | 607 | | 1214 | | 850 | | 769 | | 688 | 648 | 729 | 850 | |
| | Species Count | | | | 9 | | 9 | | 8 | | 9 | | 8 | | 9 | | 8 | | 6 | | 8 | 7 | 11 | 11 | |
| | Dominant Species Composition (%) | | | | 24 | | 19 | | 27 | | 21 | | 47 | | 27 | | 29 | | 37 | | 29 | 38 | 17 | 24 | |
| | Average Plot Height | | | | 2 | | 2 | | 2 | | 2 | | 2 | | 2 | | 2 | | 2 | | 2 | 2 | 2 | 2 | |
| % Invasives | | | | 0 | | 0 | | 0 | | 0 | | 0 | | 0 | | 0 | | 0 | | 0 | 0 | 0 | 0 | | |

1). Bolded species are proposed for the current monitoring year, italicized species are not approved, and a regular font indicates that the species has been approved.
 2). The "Species Included in Approved Mitigation Plan" section contains only those species that were included in the original approved mitigation plan. The "Post Mitigation Plan Species" section includes species that are being proposed through a mitigation plan addendum for the current monitoring year (bolded) , species that have been approved in prior monitoring years through a mitigation plan addendum (regular font), and species that are not approved (italicized).
 3). The "Mitigation Plan Performance Standard" section is derived only from stems included in the original mitigation plan, whereas the "Post Mitigation Plan Performance Standard" includes data from mitigation plan approved, post mitigation plan approved, and proposed stems.



3/23/21, 11:45 AM
Johnston

Fixed Veg Plot 1 (MY-00)



3/23/21, 2:18 PM
Johnston

Fixed Veg Plot 3 (MY-00)



3/23/21, 1:12 PM
Johnston

Fixed Veg Plot 2 (MY-00)



3/23/21, 2:41 PM
Johnston

Fixed Veg Plot 4 (MY-00)



Fixed Veg Plot 5 (MY-00)



Fixed Veg Plot 7 (MY-00)



Fixed Veg Plot 6 (MY-00)



Fixed Veg Plot 8 (MY-00)



Fixed Veg Plot 9 (MY-00)



Random Veg Plot 10 (MY-00)



Random Veg Plot 11 (View Northeast) (MY-00)




Random Veg Plot 11 (View Southwest) (MY-00)




Random Veg Plot 12 (View Southwest) (MY-00)




Random Veg Plot 12 (View Northeast) (MY-00)

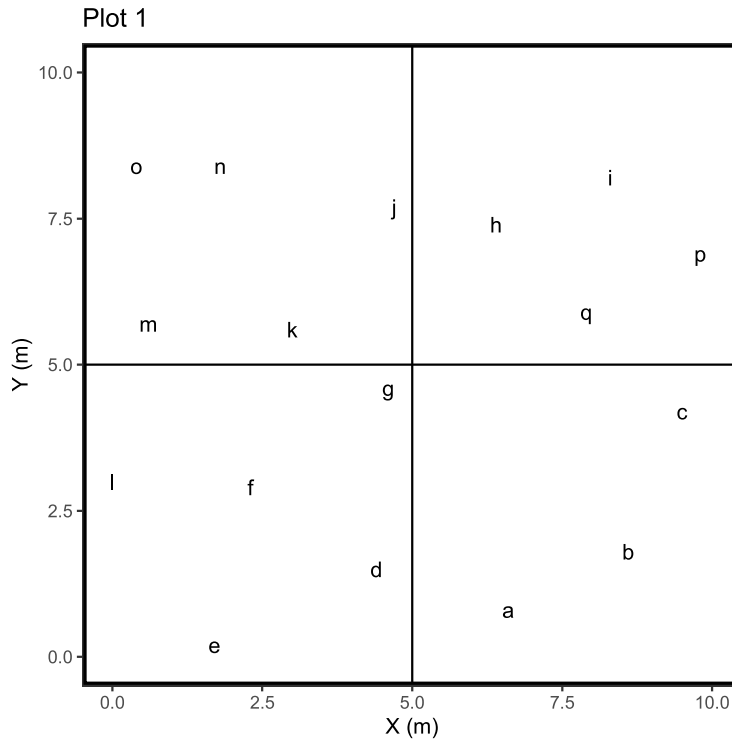


| Plot ID | Scientific Name | Common Name | Map ID |
|---------|--------------------------------|---------------------|--------|
| 1 | <i>Liriodendron tulipifera</i> | tuliptree | a |
| 1 | <i>Platanus occidentalis</i> | American sycamore | b |
| 1 | <i>Liriodendron tulipifera</i> | tuliptree | c |
| 1 | <i>Platanus occidentalis</i> | American sycamore | d |
| 1 | <i>Quercus nigra</i> | water oak | e |
| 1 | <i>Quercus phellos</i> | willow oak | f |
| 1 | <i>Liriodendron tulipifera</i> | tuliptree | g |
| 1 | <i>Betula nigra</i> | river birch | h |
| 1 | <i>Carpinus caroliniana</i> | American hornbeam | i |
| 1 | <i>Hamamelis virginiana</i> | American witchhazel | j |
| 1 | <i>Fraxinus pennsylvanica</i> | green ash | k |
| 1 | <i>Quercus michauxii</i> | swamp chestnut oak | l |
| 1 | <i>Quercus michauxii</i> | swamp chestnut oak | m |
| 1 | <i>Platanus occidentalis</i> | American sycamore | n |
| 1 | <i>Platanus occidentalis</i> | American sycamore | o |
| 1 | <i>Liriodendron tulipifera</i> | tuliptree | p |
| 1 | <i>Carpinus caroliniana</i> | American hornbeam | q |

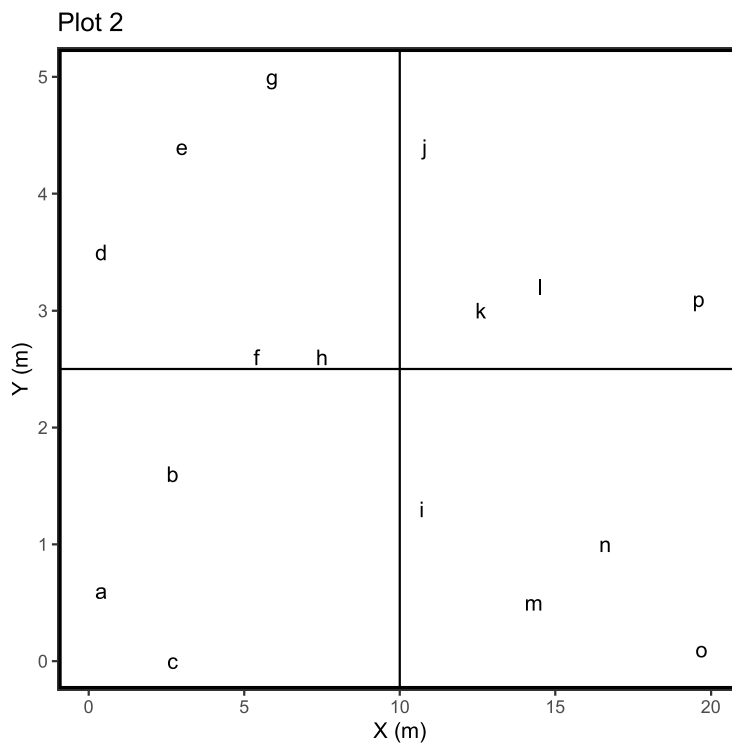

| Plot ID | Scientific Name | Common Name | Map ID |
|---------|--------------------------------|---------------------|--------|
| 2 | <i>Quercus pagoda</i> | cherrybark oak | a |
| 2 | <i>Quercus pagoda</i> | cherrybark oak | b |
| 2 | <i>Hamamelis virginiana</i> | American witchhazel | c |
| 2 | <i>Betula nigra</i> | river birch | d |
| 2 | <i>Quercus pagoda</i> | cherrybark oak | e |
| 2 | <i>Betula nigra</i> | river birch | f |
| 2 | <i>Asimina triloba</i> | pawpaw | g |
| 2 | <i>Corylus americana</i> | American hazelnut | h |
| 2 | <i>Platanus occidentalis</i> | American sycamore | i |
| 2 | <i>Liriodendron tulipifera</i> | tuliptree | j |
| 2 | <i>Liriodendron tulipifera</i> | tuliptree | k |
| 2 | <i>Quercus michauxii</i> | swamp chestnut oak | l |
| 2 | <i>Hamamelis virginiana</i> | American witchhazel | m |
| 2 | <i>Quercus michauxii</i> | swamp chestnut oak | n |
| 2 | <i>Platanus occidentalis</i> | American sycamore | o |
| 2 | <i>Lindera benzoin</i> | northern spicebush | p |

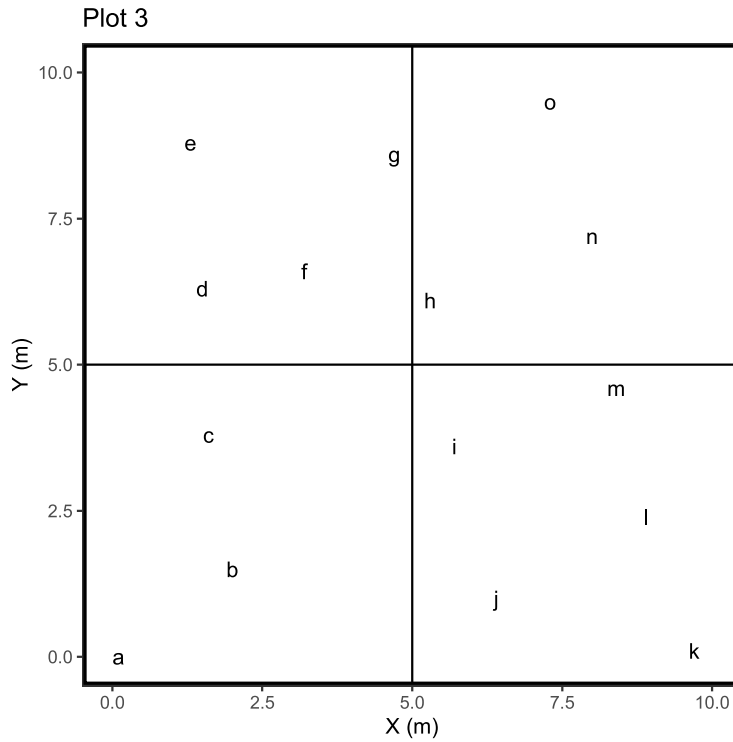


| Plot ID | Scientific Name | Common Name | Map ID |
|---------|--------------------------------|---------------------|--------|
| 3 | <i>Platanus occidentalis</i> | American sycamore | a |
| 3 | <i>Hamamelis virginiana</i> | American witchhazel | b |
| 3 | <i>Quercus phellos</i> | willow oak | c |
| 3 | <i>Platanus occidentalis</i> | American sycamore | d |
| 3 | <i>Asimina triloba</i> | pawpaw | e |
| 3 | <i>Platanus occidentalis</i> | American sycamore | f |
| 3 | <i>Liriodendron tulipifera</i> | tuliptree | g |
| 3 | <i>Quercus pagoda</i> | cherrybark oak | h |
| 3 | <i>Liriodendron tulipifera</i> | tuliptree | i |
| 3 | <i>Liriodendron tulipifera</i> | tuliptree | j |
| 3 | <i>Quercus phellos</i> | willow oak | k |
| 3 | <i>Platanus occidentalis</i> | American sycamore | l |
| 3 | <i>Liriodendron tulipifera</i> | tuliptree | m |
| 3 | <i>Betula nigra</i> | river birch | n |
| 3 | <i>Quercus nigra</i> | water oak | o |

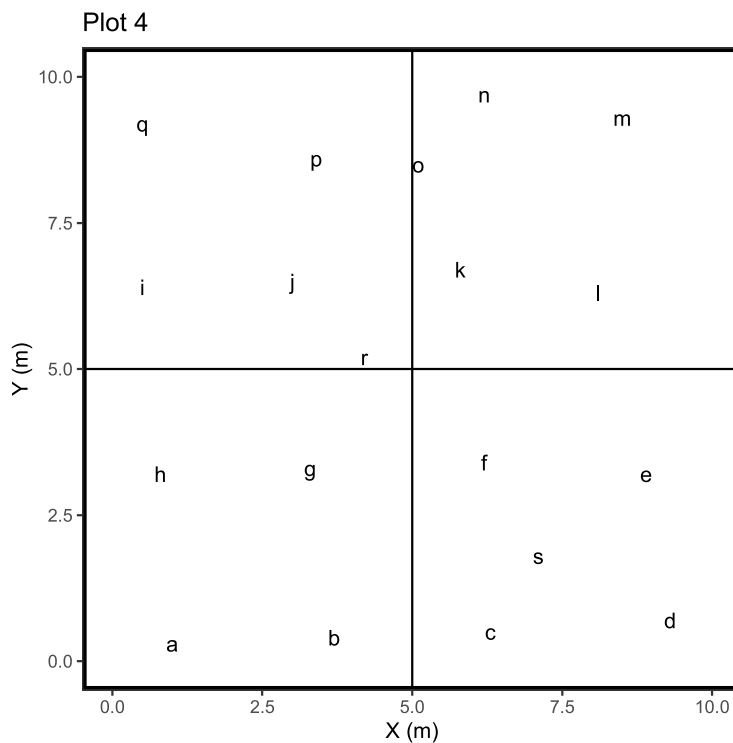


| Plot ID | Scientific Name | Common Name | Map ID |
|---------|--------------------------------|---------------------|--------|
| 4 | <i>Quercus phellos</i> | willow oak | a |
| 4 | <i>Liriodendron tulipifera</i> | tuliptree | b |
| 4 | <i>Carpinus caroliniana</i> | American hornbeam | c |
| 4 | <i>Quercus pagoda</i> | cherrybark oak | d |
| 4 | <i>Quercus pagoda</i> | cherrybark oak | e |
| 4 | <i>Platanus occidentalis</i> | American sycamore | f |
| 4 | <i>Carpinus caroliniana</i> | American hornbeam | g |
| 4 | <i>Liriodendron tulipifera</i> | tuliptree | h |
| 4 | <i>Asimina triloba</i> | pawpaw | i |
| 4 | <i>Asimina triloba</i> | pawpaw | j |
| 4 | <i>Quercus phellos</i> | willow oak | k |
| 4 | <i>Platanus occidentalis</i> | American sycamore | l |
| 4 | <i>Liriodendron tulipifera</i> | tuliptree | m |
| 4 | <i>Liriodendron tulipifera</i> | tuliptree | n |
| 4 | <i>Betula nigra</i> | river birch | o |
| 4 | <i>Carpinus caroliniana</i> | American hornbeam | p |
| 4 | <i>Quercus nigra</i> | water oak | q |
| 4 | <i>Platanus occidentalis</i> | American sycamore | r |
| 4 | <i>Hamamelis virginiana</i> | American witchhazel | s |

Plot 5

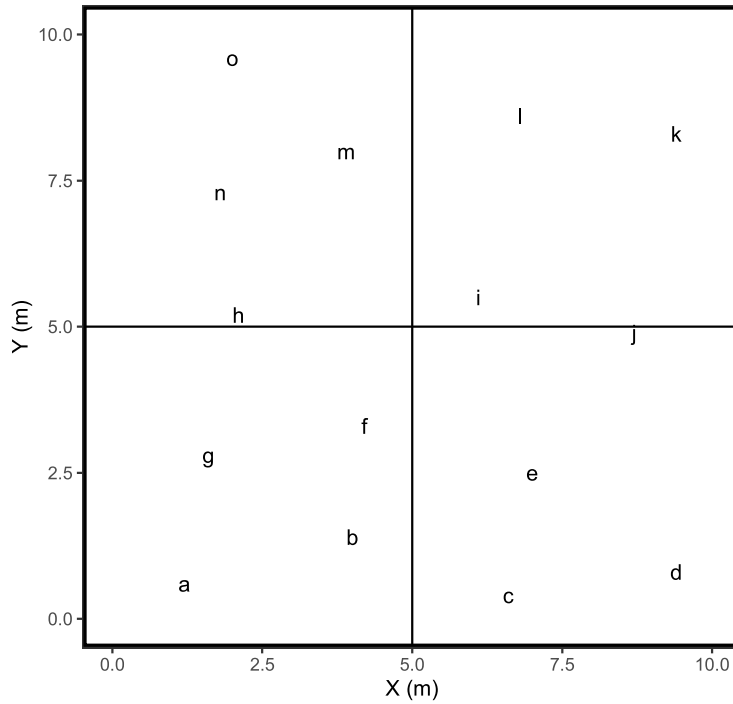


| Plot ID | Scientific Name | Common Name | Map ID |
|---------|-------------------------|--------------------|--------|
| 5 | Diospyros virginiana | common persimmon | a |
| 5 | Liriodendron tulipifera | tuliptree | b |
| 5 | Quercus michauxii | swamp chestnut oak | c |
| 5 | Platanus occidentalis | American sycamore | d |
| 5 | Liriodendron tulipifera | tuliptree | e |
| 5 | Quercus phellos | willow oak | f |
| 5 | Lindera benzoin | northern spicebush | g |
| 5 | Asimina triloba | pawpaw | h |
| 5 | Liriodendron tulipifera | tuliptree | i |
| 5 | Quercus nigra | water oak | j |
| 5 | Platanus occidentalis | American sycamore | k |
| 5 | Liriodendron tulipifera | tuliptree | l |
| 5 | Liriodendron tulipifera | tuliptree | m |
| 5 | Liriodendron tulipifera | tuliptree | n |
| 5 | Liriodendron tulipifera | tuliptree | o |


Plot 6

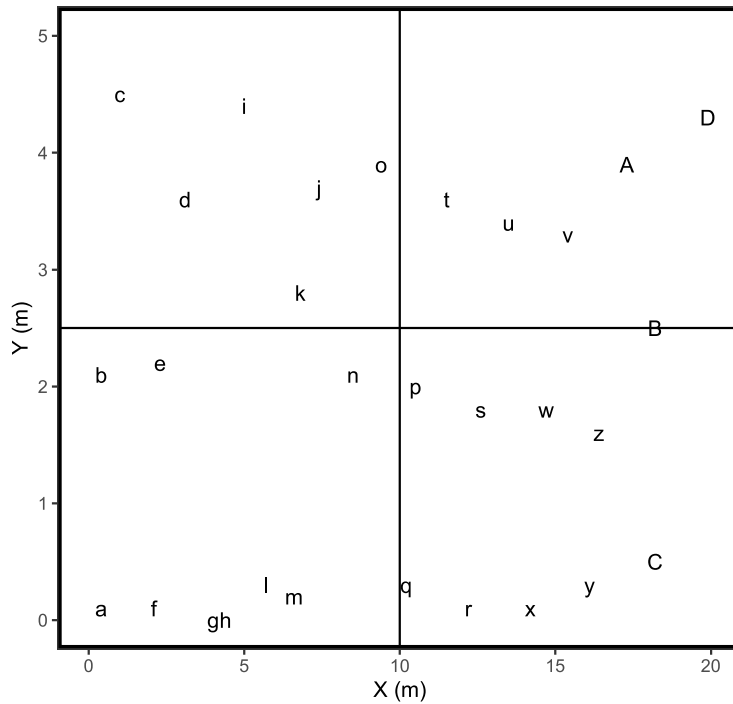


| Plot ID | Scientific Name | Common Name | Map ID |
|---------|------------------------|--------------------|--------|
| 6 | Diospyros virginiana | common persimmon | a |
| 6 | Quercus phellos | willow oak | b |
| 6 | Quercus phellos | willow oak | c |
| 6 | Fraxinus pennsylvanica | green ash | d |
| 6 | Quercus pagoda | cherrybark oak | e |
| 6 | Platanus occidentalis | American sycamore | f |
| 6 | Fraxinus pennsylvanica | green ash | g |
| 6 | Corylus americana | American hazelnut | h |
| 6 | Quercus phellos | willow oak | i |
| 6 | Quercus nigra | water oak | j |
| 6 | Quercus nigra | water oak | k |
| 6 | Betula nigra | river birch | l |
| 6 | Platanus occidentalis | American sycamore | m |
| 6 | Quercus pagoda | cherrybark oak | n |
| 6 | Platanus occidentalis | American sycamore | o |
| 6 | Betula nigra | river birch | p |
| 6 | Betula nigra | river birch | q |
| 6 | Quercus michauxii | swamp chestnut oak | r |
| 6 | Betula nigra | river birch | s |
| 6 | Platanus occidentalis | American sycamore | t |
| 6 | Platanus occidentalis | American sycamore | u |
| 6 | Quercus nigra | water oak | v |
| 6 | Betula nigra | river birch | w |
| 6 | Betula nigra | river birch | x |
| 6 | Fraxinus pennsylvanica | green ash | y |
| 6 | Betula nigra | river birch | z |
| 6 | Quercus michauxii | swamp chestnut oak | A |
| 6 | Betula nigra | river birch | B |
| 6 | Fraxinus pennsylvanica | green ash | C |
| 6 | Quercus michauxii | swamp chestnut oak | D |

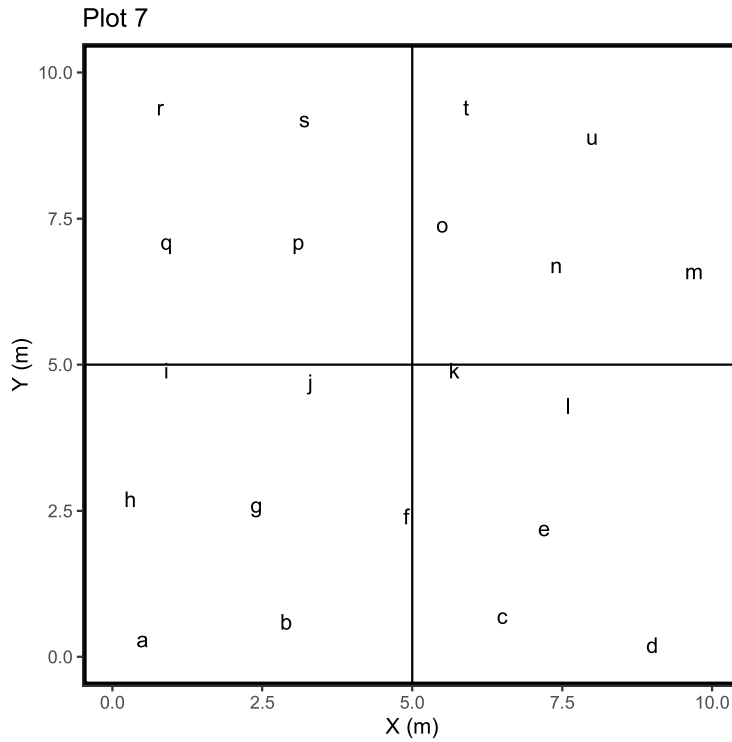

| Plot ID | Scientific Name | Common Name | Map ID |
|---------|--------------------------------|--------------------|--------|
| 7 | <i>Carpinus caroliniana</i> | American hornbeam | a |
| 7 | <i>Platanus occidentalis</i> | American sycamore | b |
| 7 | <i>Platanus occidentalis</i> | American sycamore | c |
| 7 | <i>Betula nigra</i> | river birch | d |
| 7 | <i>Quercus phellos</i> | willow oak | e |
| 7 | <i>Betula nigra</i> | river birch | f |
| 7 | <i>Corylus americana</i> | American hazelnut | g |
| 7 | <i>Platanus occidentalis</i> | American sycamore | h |
| 7 | <i>Lindera benzoin</i> | northern spicebush | i |
| 7 | <i>Liriodendron tulipifera</i> | tuliptree | j |
| 7 | <i>Platanus occidentalis</i> | American sycamore | k |
| 7 | <i>Platanus occidentalis</i> | American sycamore | l |
| 7 | <i>Quercus phellos</i> | willow oak | m |
| 7 | <i>Quercus phellos</i> | willow oak | n |
| 7 | <i>Platanus occidentalis</i> | American sycamore | o |
| 7 | <i>Liriodendron tulipifera</i> | tuliptree | p |
| 7 | <i>Quercus pagoda</i> | cherrybark oak | q |
| 7 | <i>Quercus phellos</i> | willow oak | r |
| 7 | <i>Liriodendron tulipifera</i> | tuliptree | s |
| 7 | <i>Liriodendron tulipifera</i> | tuliptree | t |
| 7 | <i>Liriodendron tulipifera</i> | tuliptree | u |

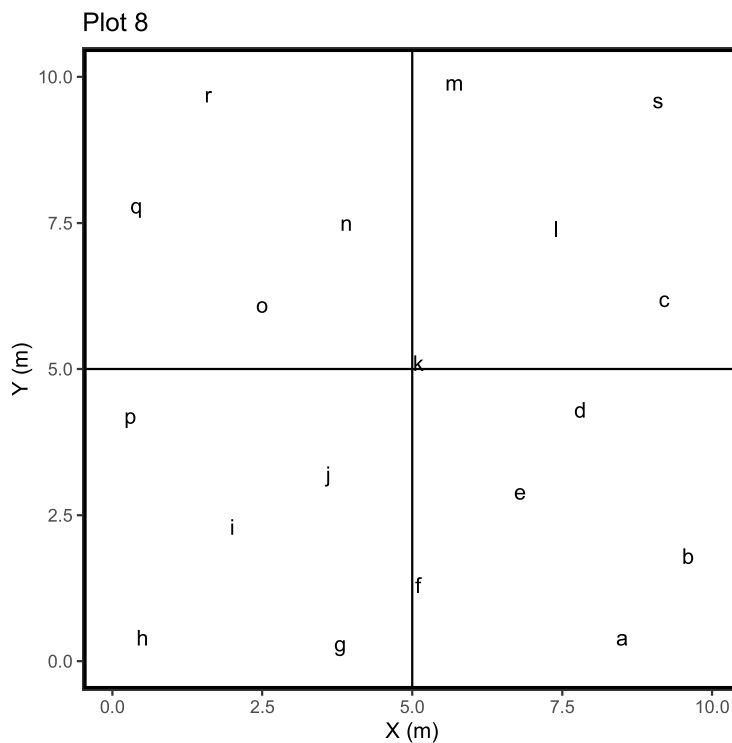

| Plot ID | Scientific Name | Common Name | Map ID |
|---------|-------------------------------|---------------------|--------|
| 8 | <i>Fraxinus pennsylvanica</i> | green ash | a |
| 8 | <i>Diospyros virginiana</i> | common persimmon | b |
| 8 | <i>Carpinus caroliniana</i> | American hornbeam | c |
| 8 | <i>Fraxinus pennsylvanica</i> | green ash | d |
| 8 | <i>Fraxinus pennsylvanica</i> | green ash | e |
| 8 | <i>Platanus occidentalis</i> | American sycamore | f |
| 8 | <i>Platanus occidentalis</i> | American sycamore | g |
| 8 | <i>Fraxinus pennsylvanica</i> | green ash | h |
| 8 | <i>Platanus occidentalis</i> | American sycamore | i |
| 8 | <i>Platanus occidentalis</i> | American sycamore | j |
| 8 | <i>Carpinus caroliniana</i> | American hornbeam | k |
| 8 | <i>Betula nigra</i> | river birch | l |
| 8 | <i>Carpinus caroliniana</i> | American hornbeam | m |
| 8 | <i>Fraxinus pennsylvanica</i> | green ash | n |
| 8 | <i>Platanus occidentalis</i> | American sycamore | o |
| 8 | <i>Platanus occidentalis</i> | American sycamore | p |
| 8 | <i>Platanus occidentalis</i> | American sycamore | q |
| 8 | <i>Fraxinus pennsylvanica</i> | green ash | r |
| 8 | <i>Hamamelis virginiana</i> | American witchhazel | s |

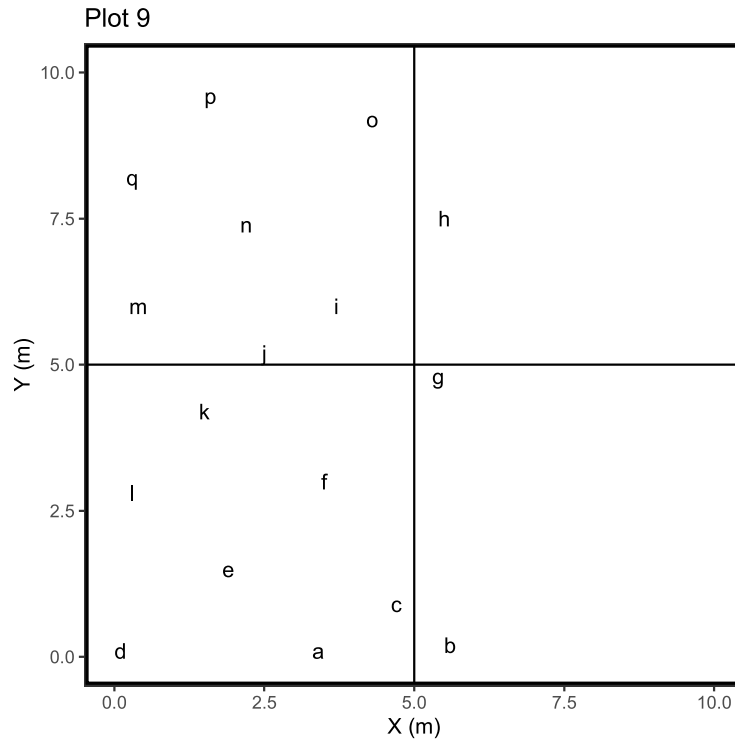


| Plot ID | Scientific Name | Common Name | Map ID |
|---------|-------------------------|-------------------|--------|
| 9 | Liriodendron tulipifera | tuliptree | a |
| 9 | Liriodendron tulipifera | tuliptree | b |
| 9 | Quercus nigra | water oak | c |
| 9 | Quercus nigra | water oak | d |
| 9 | Quercus phellos | willow oak | e |
| 9 | Quercus phellos | willow oak | f |
| 9 | Quercus phellos | willow oak | g |
| 9 | Fraxinus pennsylvanica | green ash | h |
| 9 | Fraxinus pennsylvanica | green ash | i |
| 9 | Carpinus caroliniana | American hornbeam | j |
| 9 | Platanus occidentalis | American sycamore | k |
| 9 | Quercus pagoda | cherrybark oak | l |
| 9 | Quercus pagoda | cherrybark oak | m |
| 9 | Quercus phellos | willow oak | n |
| 9 | Quercus phellos | willow oak | o |
| 9 | Quercus pagoda | cherrybark oak | p |
| 9 | Betula nigra | river birch | q |

Appendix C:

Stream Geomorphology Data

Cross-Sections with Annual Overlays
Baseline Longitudinal Profile
Baseline Stream Data Summary Tables
Cross-Section Morphology Data


Cross-Section 1 (R1 - Headwater) MY0

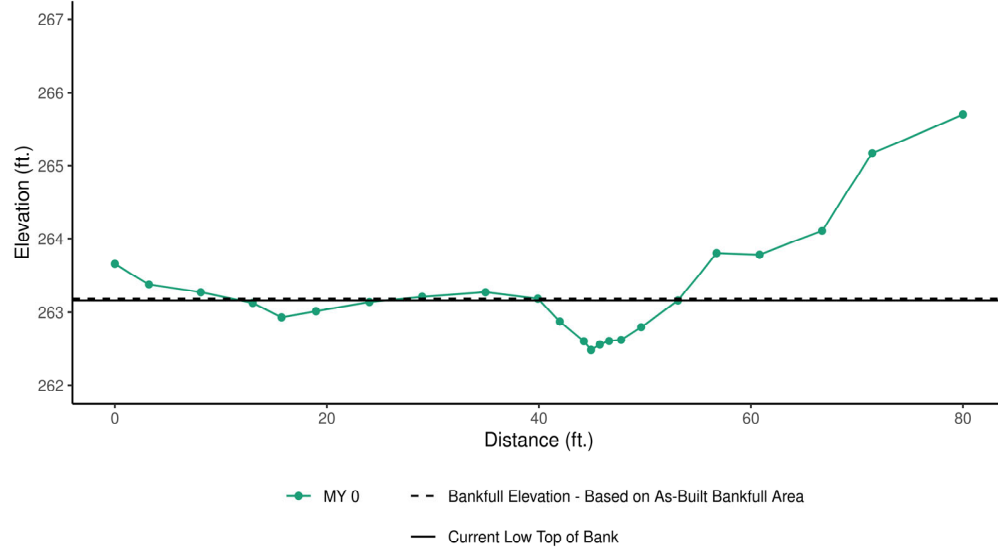

| Distance | Elevation | Features |
|------------|-----------|----------|
| 0 | 263.66 | TLP |
| 3.21762102 | 263.377 | |
| 8.1012209 | 263.268 | |
| 13.0068711 | 263.123 | |
| 15.7230882 | 262.931 | |
| 18.9721333 | 263.013 | |
| 24.0131884 | 263.136 | |
| 28.9898673 | 263.206 | |
| 34.9634537 | 263.268 | |
| 39.8961583 | 263.181 | TLB, BKF |
| 41.9740322 | 262.875 | |
| 44.2414602 | 262.6 | LEW |
| 44.9172464 | 262.483 | THW |
| 45.7456592 | 262.555 | |
| 46.6212066 | 262.603 | REW |
| 47.7577308 | 262.618 | |
| 49.6458951 | 262.797 | |
| 53.1173216 | 263.157 | TRB |
| 56.7610276 | 263.804 | |
| 60.8177063 | 263.782 | |
| 66.7124862 | 264.11 | |
| 71.4457487 | 265.174 | |
| 80 | 265.698 | TRP |

| | MY0 | MY1 | MY2 | MY3 | MY4 | MY5 | MY6 | MY7 |
|--|--------|-----|-----|-----|-----|-----|-----|-----|
| Bankfull Elevation - Based on As-Built Bankfull Area | 263.18 | | | | | | | |
| Bank Height Ratio - Based on As-Built Bankfull Area | 0.96 | | | | | | | |
| Thalweg Elevation | 262.48 | | | | | | | |
| LTOB Elevation | 263.16 | | | | | | | |
| LTOB Max Depth | 0.674 | | | | | | | |
| LTOB Cross Sectional Area | 4.77 | | | | | | | |


Cross-Section 2 (R2 - Pool) MY0

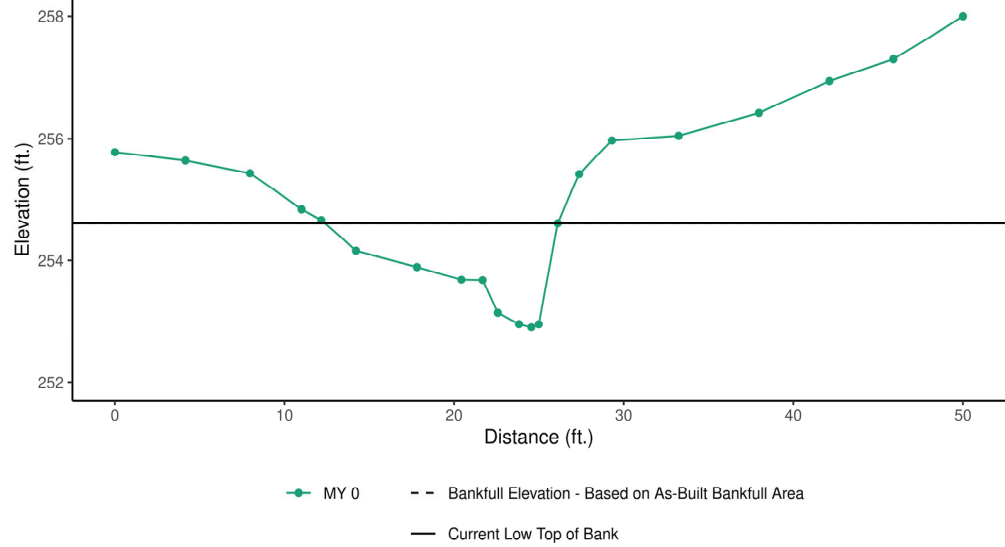

| Distance | Elevation | Features |
|------------|-----------|----------|
| 0 | 255.772 | TLP |
| 4.16149649 | 255.637 | |
| 7.96496585 | 255.428 | |
| 11.007553 | 254.835 | |
| 12.1749619 | 254.66 | TLB |
| 14.2163795 | 254.155 | |
| 17.8122883 | 253.891 | |
| 20.4328914 | 253.682 | |
| 21.6817288 | 253.675 | |
| 22.5765706 | 253.143 | LEW |
| 23.8282721 | 252.957 | |
| 24.5543602 | 252.906 | THW |
| 24.9935798 | 252.955 | REW |
| 26.1109158 | 254.61 | TRB, BKF |
| 27.3725572 | 255.414 | |
| 29.3058486 | 255.971 | |
| 33.2406827 | 256.048 | |
| 37.9718276 | 256.416 | |
| 42.1271405 | 256.945 | |
| 45.8967429 | 257.296 | |
| 50 | 258 | TRP |

| | MY0 | MY1 | MY2 | MY3 | MY4 | MY5 | MY6 | MY7 |
|--|--------|-----|-----|-----|-----|-----|-----|-----|
| Bankfull Elevation - Based on As-Built Bankfull Area | 254.61 | | | | | | | |
| Bank Height Ratio - Based on As-Built Bankfull Area | 1.00 | | | | | | | |
| Thalweg Elevation | 252.91 | | | | | | | |
| LTOB Elevation | 254.61 | | | | | | | |
| LTOB Max Depth | 1.704 | | | | | | | |
| LTOB Cross Sectional Area | 11.76 | | | | | | | |


Cross-Section 3 (R2 - Riffle) MY0

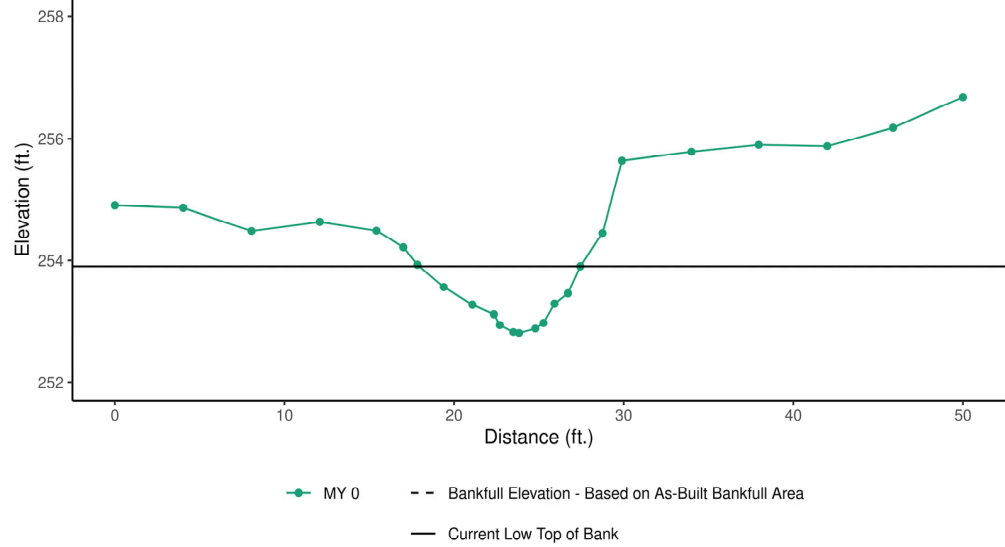

| Distance | Elevation | Features |
|------------|-----------|----------|
| 0 | 254.901 | TLP |
| 4.03151312 | 254.86 | |
| 8.05891389 | 254.479 | |
| 12.0820873 | 254.633 | |
| 15.4218492 | 254.484 | |
| 17.0051659 | 254.212 | |
| 17.8380307 | 253.93 | TLB |
| 19.388986 | 253.558 | |
| 21.0775378 | 253.272 | |
| 22.3455016 | 253.118 | |
| 22.6948921 | 252.943 | LEW |
| 23.4904365 | 252.825 | |
| 23.8309149 | 252.809 | THW |
| 24.7871188 | 252.885 | |
| 25.2678376 | 252.977 | REW |
| 25.918131 | 253.288 | |
| 26.71262 | 253.456 | |
| 27.4435581 | 253.904 | TRB, BKF |
| 28.7524682 | 254.444 | |
| 29.8957815 | 255.632 | |
| 33.9938929 | 255.781 | |
| 37.9593341 | 255.899 | |
| 42.0014874 | 255.877 | |
| 45.8818011 | 256.178 | |
| 50 | 256.675 | TRP |

| | MY0 | MY1 | MY2 | MY3 | MY4 | MY5 | MY6 | MY7 |
|--|--------|-----|-----|-----|-----|-----|-----|-----|
| Bankfull Elevation - Based on As-Built Bankfull Area | 253.90 | | | | | | | |
| Bank Height Ratio - Based on As-Built Bankfull Area | 1.00 | | | | | | | |
| Thalweg Elevation | 252.81 | | | | | | | |
| LTOB Elevation | 253.90 | | | | | | | |
| LTOB Max Depth | 1.095 | | | | | | | |
| LTOB Cross Sectional Area | 6.03 | | | | | | | |


Cross-Section 4 (R3 - Riffle) MY0

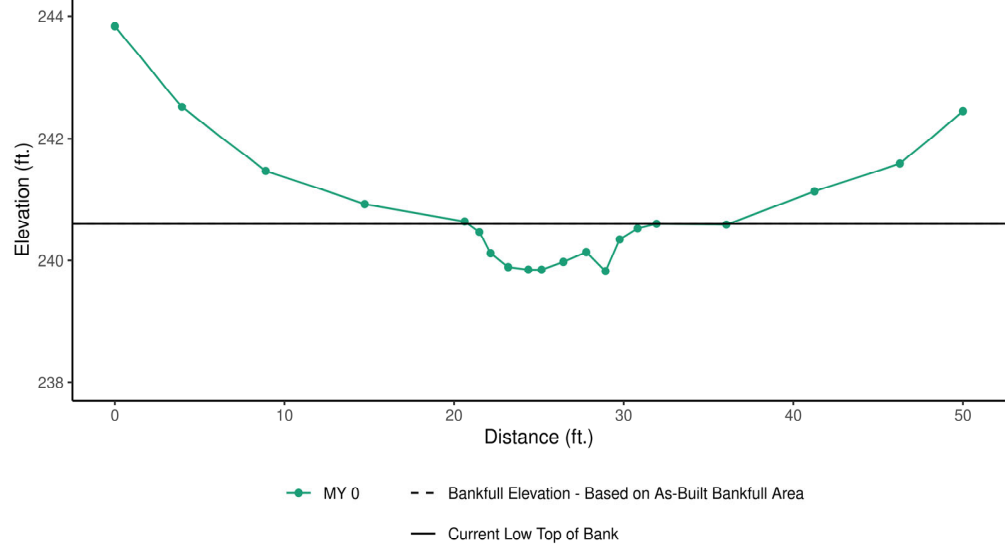

| Distance | Elevation | Features |
|------------|-----------|----------|
| 0 | 243.839 | TLP |
| 3.95452715 | 242.514 | |
| 8.89212427 | 241.467 | |
| 14.7295684 | 240.919 | |
| 20.623485 | 240.639 | TLB |
| 21.486855 | 240.462 | |
| 22.149498 | 240.115 | LEW |
| 23.1882395 | 239.892 | |
| 24.3784161 | 239.85 | |
| 25.1576374 | 239.849 | THW |
| 26.4426693 | 239.976 | |
| 27.7896542 | 240.132 | |
| 28.9273996 | 239.826 | |
| 29.7624802 | 240.338 | REW |
| 30.819244 | 240.523 | |
| 31.9363554 | 240.601 | TRB, BKF |
| 36.0512331 | 240.588 | |
| 41.2482107 | 241.125 | |
| 46.281841 | 241.588 | |
| 50 | 242.442 | TRP |

| | MY0 | MY1 | MY2 | MY3 | MY4 | MY5 | MY6 | MY7 |
|--|--------|-----|-----|-----|-----|-----|-----|-----|
| Bankfull Elevation - Based on As-Built Bankfull Area | 240.60 | | | | | | | |
| Bank Height Ratio - Based on As-Built Bankfull Area | 1.00 | | | | | | | |
| Thalweg Elevation | 239.85 | | | | | | | |
| LTOB Elevation | 240.60 | | | | | | | |
| LTOB Max Depth | 0.752 | | | | | | | |
| LTOB Cross Sectional Area | 4.90 | | | | | | | |


Cross-Section 5 (R3 - Pool) MY0

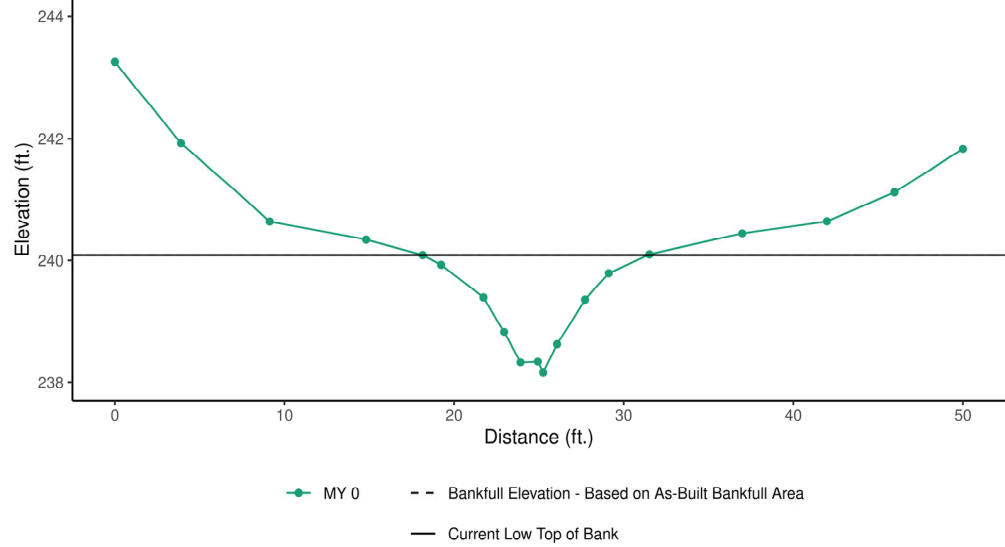

| Distance | Elevation | Features |
|------------|-----------|----------|
| 0 | 243.251 | TLP |
| 3.90129889 | 241.924 | |
| 9.12909289 | 240.639 | |
| 14.8138033 | 240.335 | |
| 18.1463366 | 240.085 | TLB, BKF |
| 19.233291 | 239.928 | |
| 21.7313279 | 239.389 | LEW |
| 22.9514465 | 238.825 | |
| 23.9180688 | 238.323 | |
| 24.9357467 | 238.336 | THW |
| 25.2514991 | 238.159 | |
| 26.0717019 | 238.622 | |
| 27.7204923 | 239.353 | REW |
| 29.1177418 | 239.79 | |
| 31.5173604 | 240.097 | TRB |
| 36.9876084 | 240.438 | |
| 41.9813675 | 240.642 | |
| 45.9617756 | 241.11 | |
| 50 | 241.829 | TRP |

| | MY0 | MY1 | MY2 | MY3 | MY4 | MY5 | MY6 | MY7 |
|--|--------|-----|-----|-----|-----|-----|-----|-----|
| Bankfull Elevation - Based on As-Built Bankfull Area | 240.09 | | | | | | | |
| Bank Height Ratio - Based on As-Built Bankfull Area | 1.00 | | | | | | | |
| Thalweg Elevation | 238.34 | | | | | | | |
| LTOB Elevation | 240.09 | | | | | | | |
| LTOB Max Depth | 1.749 | | | | | | | |
| LTOB Cross Sectional Area | 10.02 | | | | | | | |


Cross-Section 6 (R5 - Headwater) MY0

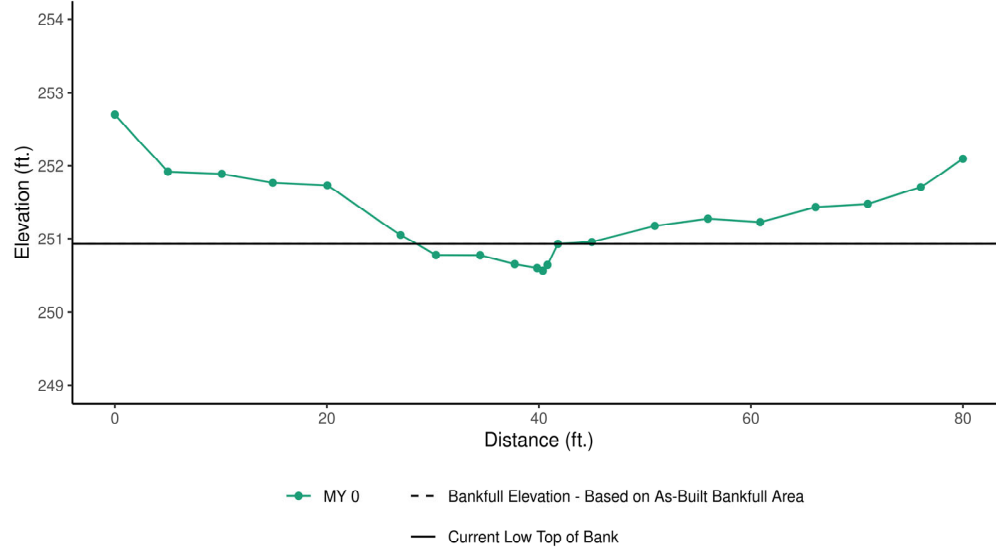

| Distance | Elevation | Features |
|------------|-----------|----------|
| 0 | 252.697 | TLP |
| 5.00446241 | 251.92 | |
| 10.0878593 | 251.89 | |
| 14.8985366 | 251.766 | |
| 20.044288 | 251.729 | |
| 26.9519767 | 251.052 | TLB |
| 30.2900103 | 250.778 | |
| 34.4575034 | 250.776 | |
| 37.717808 | 250.657 | |
| 39.8296093 | 250.605 | |
| 40.3774576 | 250.569 | THW |
| 40.8095245 | 250.647 | REW |
| 41.7972294 | 250.928 | TRB, BKF |
| 44.9950278 | 250.954 | |
| 50.9320066 | 251.18 | |
| 55.9426926 | 251.278 | |
| 60.8786019 | 251.231 | |
| 66.1009831 | 251.433 | |
| 71.0224593 | 251.475 | |
| 76.0234489 | 251.704 | |
| 80 | 252.094 | TRP |

| | MY0 | MY1 | MY2 | MY3 | MY4 | MY5 | MY6 | MY7 |
|--|--------|-----|-----|-----|-----|-----|-----|-----|
| Bankfull Elevation - Based on As-Built Bankfull Area | 250.93 | | | | | | | |
| Bank Height Ratio - Based on As-Built Bankfull Area | 1.00 | | | | | | | |
| Thalweg Elevation | 250.57 | | | | | | | |
| LTOB Elevation | 250.93 | | | | | | | |
| LTOB Max Depth | 0.359 | | | | | | | |
| LTOB Cross Sectional Area | 2.55 | | | | | | | |


Cross-Section 7 (R6 - Pool) MY0

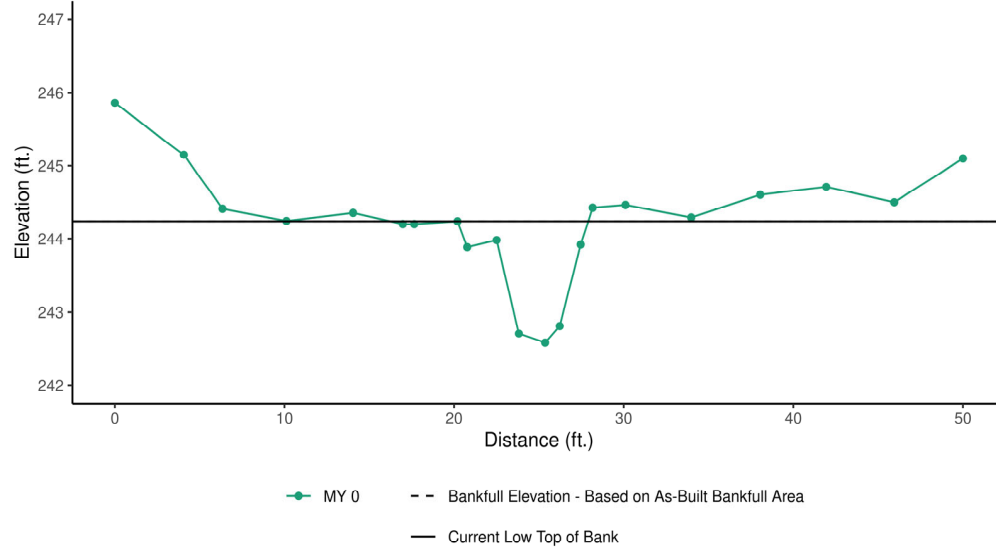

| Distance | Elevation | Features |
|------------|-----------|----------|
| 0 | 245.859 | TLP |
| 4.06531881 | 245.15 | |
| 6.34482159 | 244.411 | |
| 10.1161799 | 244.246 | |
| 14.0444837 | 244.356 | |
| 16.9767609 | 244.204 | |
| 17.6503834 | 244.204 | |
| 20.1993214 | 244.242 | TLB, BKF |
| 20.7724056 | 243.884 | |
| 22.5087482 | 243.98 | LEW |
| 23.8193192 | 242.707 | |
| 25.3651806 | 242.579 | THW |
| 26.2278646 | 242.812 | |
| 27.4620956 | 243.919 | REW |
| 28.1685243 | 244.425 | TRB |
| 30.1043234 | 244.462 | |
| 33.9797334 | 244.294 | |
| 38.0488834 | 244.6 | |
| 41.9404591 | 244.708 | |
| 45.9495869 | 244.498 | |
| 50 | 245.099 | TRP |

| | MY0 | MY1 | MY2 | MY3 | MY4 | MY5 | MY6 | MY7 |
|--|--------|-----|-----|-----|-----|-----|-----|-----|
| Bankfull Elevation - Based on As-Built Bankfull Area | 244.24 | | | | | | | |
| Bank Height Ratio - Based on As-Built Bankfull Area | 1.00 | | | | | | | |
| Thalweg Elevation | 242.58 | | | | | | | |
| LTOB Elevation | 244.24 | | | | | | | |
| LTOB Max Depth | 1.663 | | | | | | | |
| LTOB Cross Sectional Area | 6.78 | | | | | | | |

Cross-Section 8 (R6 - Riffle) MY0

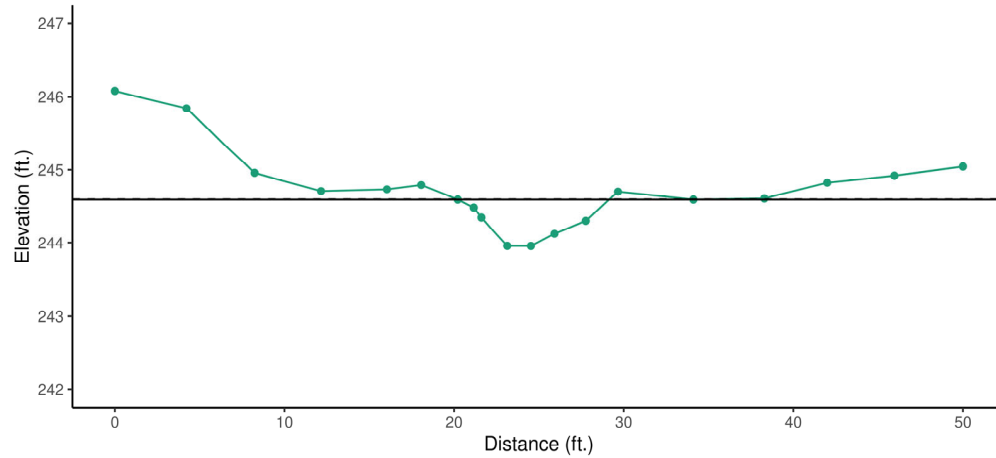


—●— MY 0 - - Bankfull Elevation - Based on As-Built Bankfull Area
— Current Low Top of Bank

| Distance | Elevation | Features |
|------------|-----------|----------|
| 0 | 246.08 | TLP |
| 4.22098531 | 245.838 | |
| 8.24019302 | 244.958 | |
| 12.1560777 | 244.704 | |
| 16.0390876 | 244.729 | |
| 18.0612763 | 244.791 | |
| 20.2145515 | 244.588 | TLB |
| 21.1587208 | 244.479 | |
| 21.609788 | 244.347 | LEW |
| 23.1343721 | 243.956 | THW |
| 24.5295715 | 243.955 | |
| 25.9175317 | 244.127 | |
| 27.7622968 | 244.302 | REW |
| 29.661418 | 244.696 | |
| 34.1093706 | 244.588 | TRB, BKF |
| 38.2920663 | 244.603 | |
| 41.9982984 | 244.823 | |
| 45.9587526 | 244.92 | |
| 50 | 245.044 | TRP |

| | MY0 | MY1 | MY2 | MY3 | MY4 | MY5 | MY6 | MY7 |
|--|--------|-----|-----|-----|-----|-----|-----|-----|
| Bankfull Elevation - Based on As-Built Bankfull Area | 244.59 | | | | | | | |
| Bank Height Ratio - Based on As-Built Bankfull Area | 1.00 | | | | | | | |
| Thalweg Elevation | 243.96 | | | | | | | |
| LTOB Elevation | 244.59 | | | | | | | |
| LTOB Max Depth | 0.632 | | | | | | | |
| LTOB Cross Sectional Area | 3.23 | | | | | | | |


Cross-Section 9 (R7 upper - Riffle) MY0

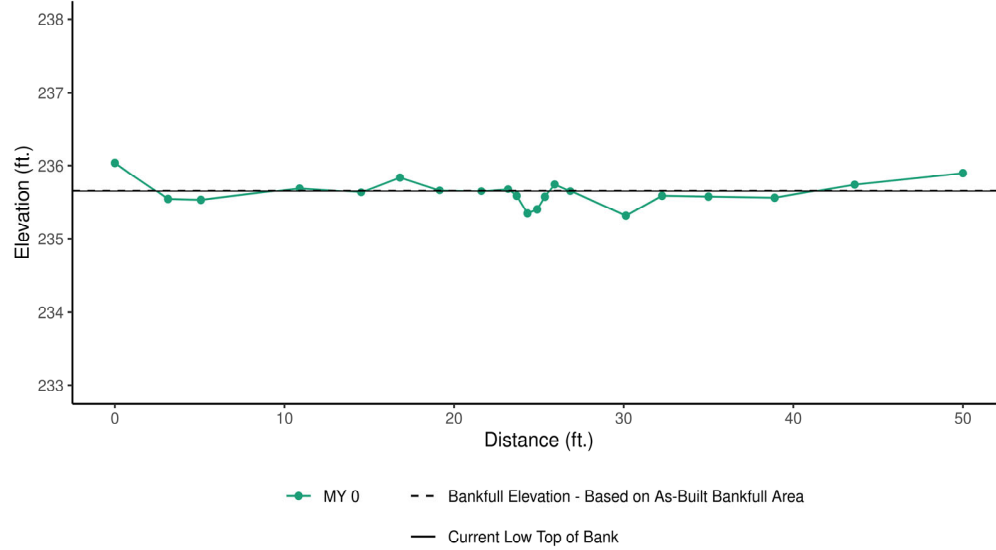

| Distance | Elevation | Features |
|------------|-----------|----------|
| 0 | 236.034 | TLP |
| 3.1349504 | 235.54 | |
| 5.07291258 | 235.528 | |
| 10.8944722 | 235.69 | |
| 14.5207868 | 235.633 | |
| 16.8093882 | 235.839 | |
| 19.1489961 | 235.66 | |
| 21.6081564 | 235.649 | |
| 23.1828047 | 235.677 | TLB |
| 23.69206 | 235.582 | LEW |
| 24.3258246 | 235.35 | THW |
| 24.8979 | 235.403 | |
| 25.3532398 | 235.569 | |
| 25.927702 | 235.745 | REW |
| 26.8508177 | 235.649 | TRB, BKF |
| 30.1282337 | 235.319 | |
| 32.2623764 | 235.582 | |
| 34.996658 | 235.571 | |
| 38.9002414 | 235.556 | |
| 43.6166778 | 235.742 | |
| 50 | 235.9 | TRP |

| | MY0 | MY1 | MY2 | MY3 | MY4 | MY5 | MY6 | MY7 |
|--|--------|-----|-----|-----|-----|-----|-----|-----|
| Bankfull Elevation - Based on As-Built Bankfull Area | 235.65 | | | | | | | |
| Bank Height Ratio - Based on As-Built Bankfull Area | 0.97 | | | | | | | |
| Thalweg Elevation | 235.35 | | | | | | | |
| LTOB Elevation | 235.65 | | | | | | | |
| LTOB Max Depth | 0.299 | | | | | | | |
| LTOB Cross Sectional Area | 0.39 | | | | | | | |


Cross-Section 10 (R7 upper - Pool) MY0

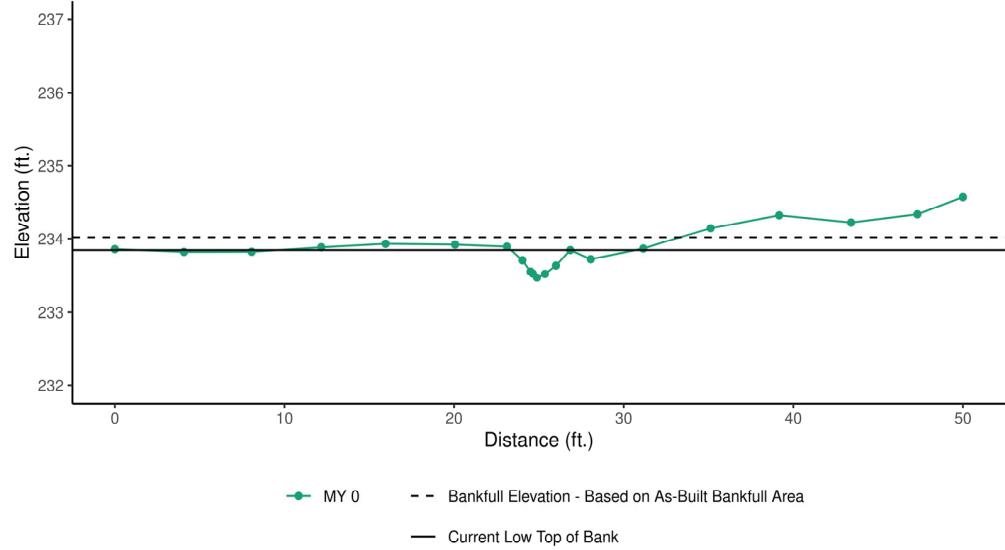


| Distance | Elevation | Features |
|------------|-----------|----------|
| 0 | 233.858 | TLP |
| 4.07528551 | 233.82 | |
| 8.0649266 | 233.822 | |
| 12.1713 | 233.883 | |
| 15.963298 | 233.93 | |
| 20.058336 | 233.919 | |
| 23.1165907 | 233.892 | TLB, BKF |
| 24.028201 | 233.708 | LEW |
| 24.5076751 | 233.555 | |
| 24.6497585 | 233.527 | |
| 24.8844045 | 233.474 | THW |
| 25.35148 | 233.524 | |
| 26.0052017 | 233.637 | REW |
| 26.8511769 | 233.845 | TRB |
| 28.0551381 | 233.722 | |
| 31.1541693 | 233.866 | |
| 35.1212256 | 234.147 | |
| 39.1651712 | 234.323 | |
| 43.4049889 | 234.226 | |
| 47.3148504 | 234.337 | |
| 50 | 234.566 | TRP |

| | MY0 | MY1 | MY2 | MY3 | MY4 | MY5 | MY6 | MY7 |
|--|--------|-----|-----|-----|-----|-----|-----|-----|
| Bankfull Elevation - Based on As-Built Bankfull Area | 233.89 | | | | | | | |
| Bank Height Ratio - Based on As-Built Bankfull Area | 0.68 | | | | | | | |
| Thalweg Elevation | 233.47 | | | | | | | |
| LTOB Elevation | 233.85 | | | | | | | |
| LTOB Max Depth | 0.371 | | | | | | | |
| LTOB Cross Sectional Area | 0.70 | | | | | | | |

Odell's House Mitigation Project
Longitudinal Profile - R1, R2, R3, R4
As-Built (MY0 2021)(Data Collected May 2021)

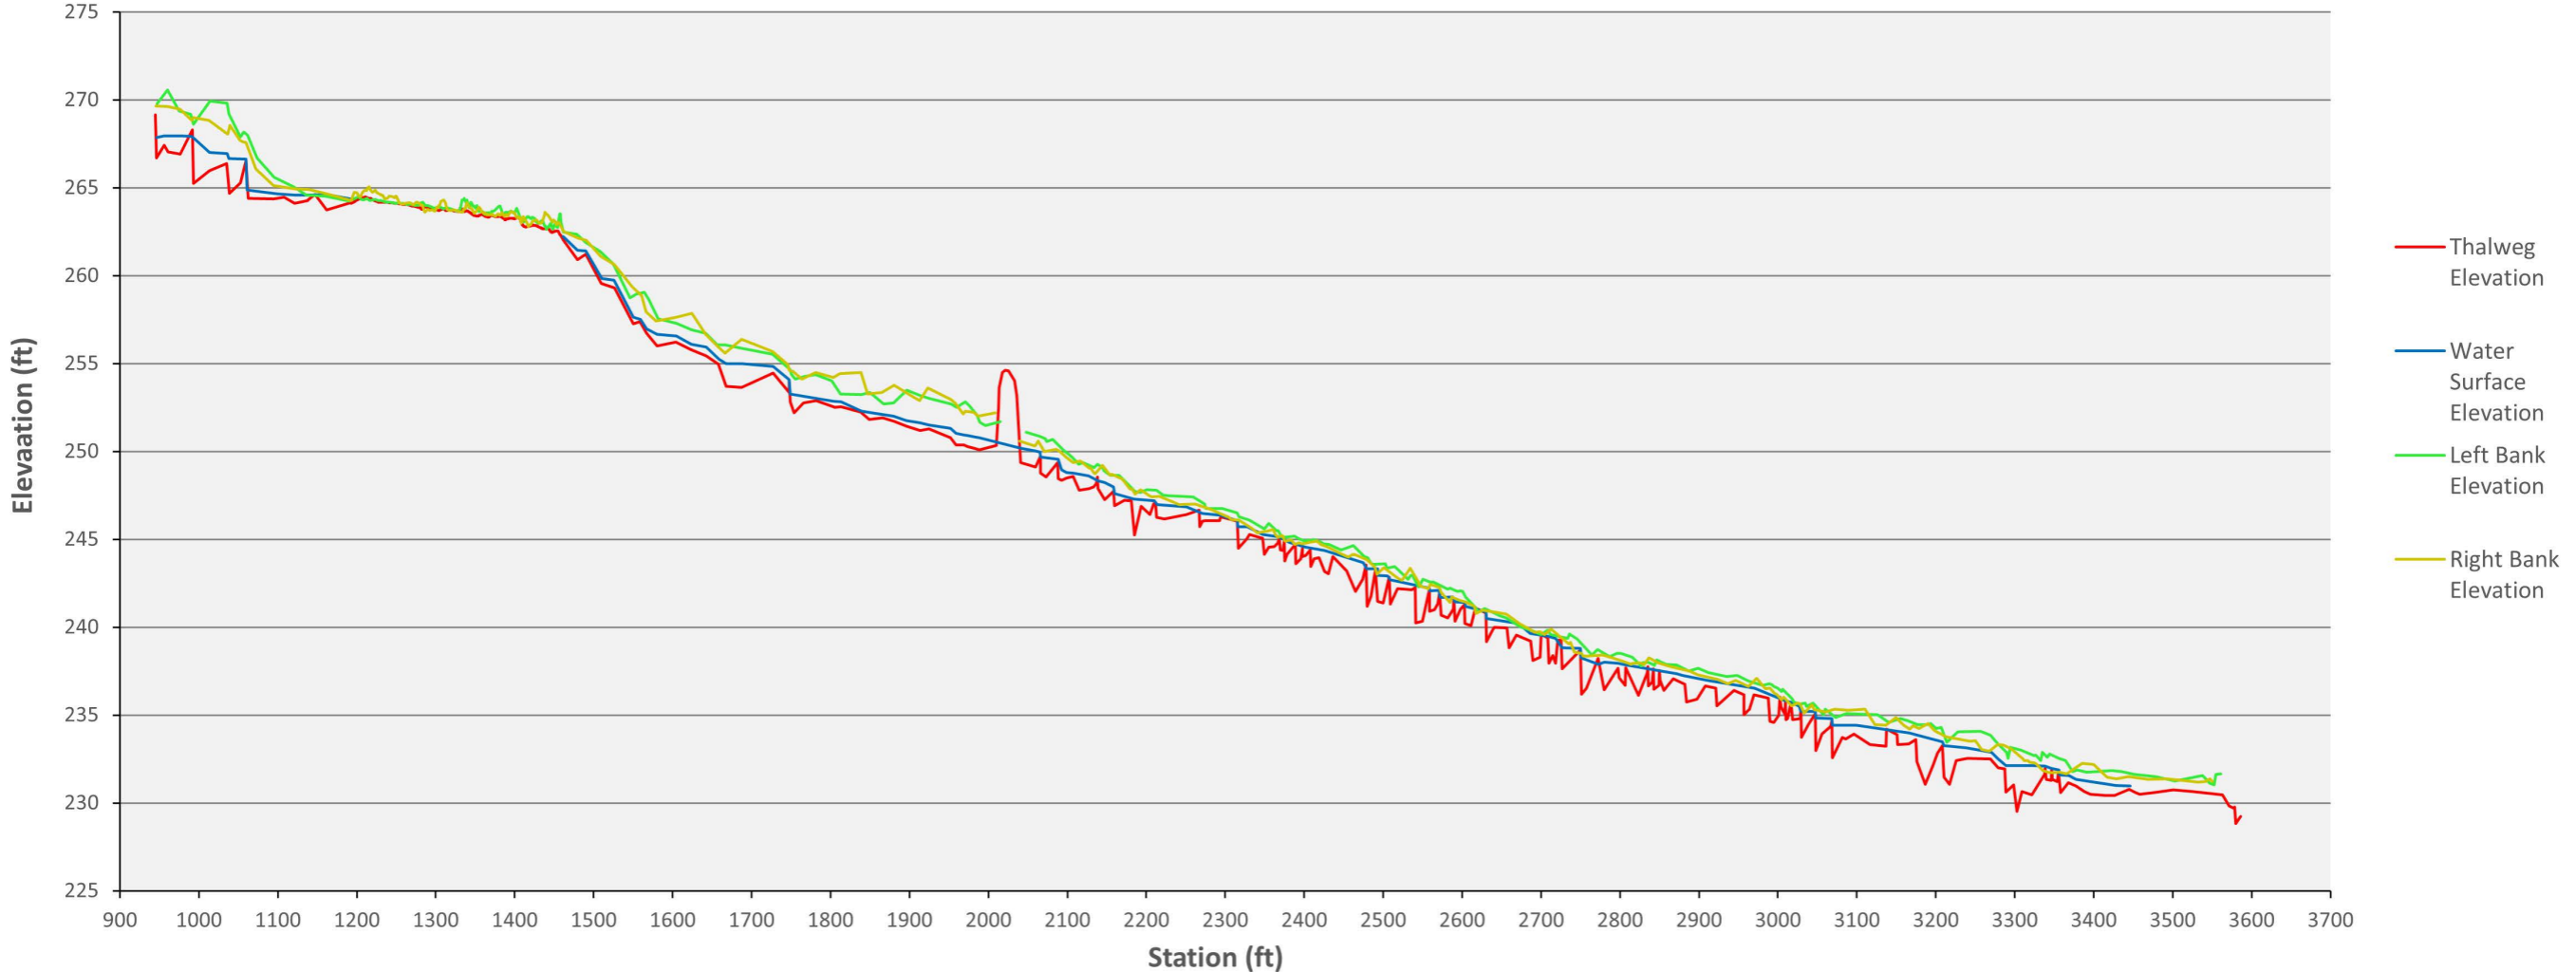

Odell's House Mitigation Project
Longitudinal Profile - R5, R6, R7
As-Built (MY0 2021)(Data Collected May 2021)

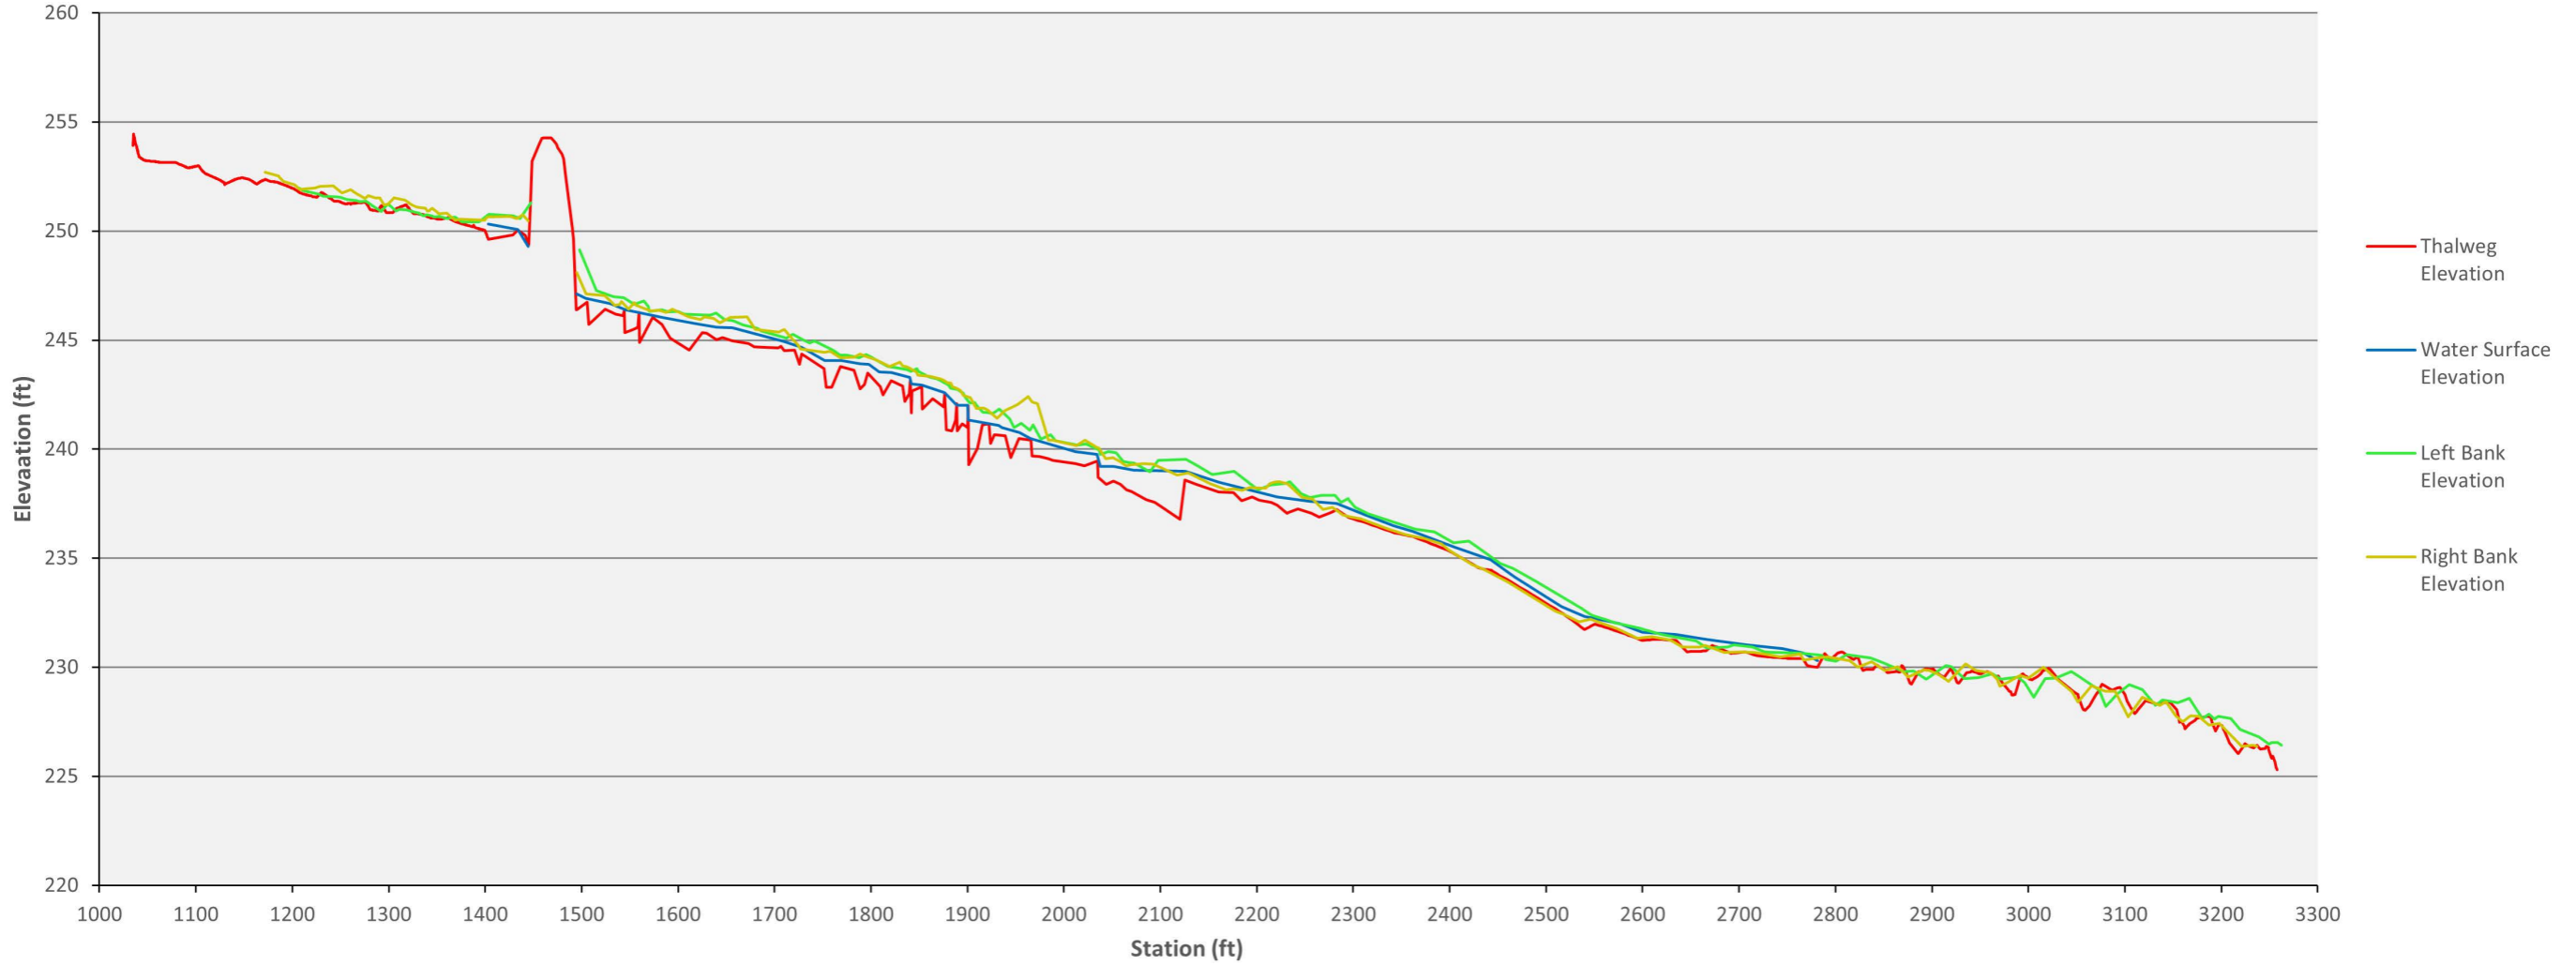

| Baseline Stream Data Summary Odell's House, R1 | | | | | | | | | | | | Odell's House, R2 | | | | | | | | | Odell's House, R3 | | | | | | | | | | |
|---|-------------------------------------|------|-----|-----|---|--------|-------|---|---------------------------|------|-----|-------------------------------------|------|-----|-----|-----|--------|------|---------------------------|------|-------------------|-------------------------------------|------|-----|-----|-----|--------|------|---------------------------|------|-----|
| Parameter | Pre-Existing Condition (applicable) | | | | | Design | | | Monitoring Baseline (MY0) | | | Pre-Existing Condition (applicable) | | | | | Design | | Monitoring Baseline (MY0) | | | Pre-Existing Condition (applicable) | | | | | Design | | Monitoring Baseline (MY0) | | |
| | Min | Mean | Med | Max | n | Min | Max | n | Min | Max | n | Min | Mean | Med | Max | n | Min | Max | Min | Max | n | Min | Mean | Med | Max | n | Min | Max | Min | Max | n |
| Riffle Only | | | | | | | | | | | | | | | | | | | | | | | | | | | | | | | |
| Bankfull Width (ft) | | N/A | | | 0 | | 6.0 | | | 13.2 | 1.0 | | 11.0 | | | 1.0 | | 8.0 | | 9.5 | 1.0 | | 5.7 | | | 1.0 | | 8.0 | | 11.1 | 1.0 |
| Floodprone Width (ft) | | N/A | | | 0 | 31.3 | 115.0 | | | 62.6 | 1.0 | | 27.0 | | | 1.0 | 25.0 | 50.0 | | 29.3 | 1.0 | | 11.5 | | | 1.0 | 25.0 | 30.0 | | 34.3 | 1.0 |
| Bankfull Mean Depth (ft) | | N/A | | | 0 | | 0.5 | | | 0.4 | 1.0 | | 0.3 | | | 1.0 | | 0.5 | | 0.6 | 1.0 | | 1.0 | | | 1.0 | | 0.6 | | 0.5 | 1.0 |
| Bankfull Max Depth (ft) | | N/A | | | 0 | | 0.7 | | | 0.7 | 1.0 | | 0.7 | | | 1.0 | | 0.7 | | 1.1 | 1.0 | | 1.4 | | | 1.0 | | 0.8 | | 0.8 | 1.0 |
| Bankfull Cross Sectional Area (ft²) | | N/A | | | 0 | | 3.2 | | | 5.1 | 1.0 | | 3.7 | | | 1.0 | | 4.2 | | 6.0 | 1.0 | | 5.6 | | | 1.0 | | 4.8 | | 5.4 | 1.0 |
| Width/Depth Ratio | | N/A | | | 0 | | 11.4 | | | 34.3 | 1.0 | | 33.0 | | | 1.0 | | 15.2 | | 15.0 | 1.0 | | 5.8 | | | 1.0 | | 13.3 | | 23.2 | 1.0 |
| Entrenchment Ratio | | N/A | | | 0 | 5.2 | 19.2 | | | 4.7 | 1.0 | | 2.5 | | | 1.0 | 3.1 | 6.3 | | 3.1 | 1.0 | | 2.0 | | | 1.0 | 3.1 | 3.8 | | 3.1 | 1.0 |
| Bank Height Ratio | | N/A | | | 0 | | 1.0 | | | 1.0 | 1.0 | | 1.0 | | | 1.0 | | 1.0 | | 1.0 | 1.0 | | 1.4 | | | 1.0 | | 1.0 | | 1.0 | 1.0 |
| Max part size (mm) mobilized at bankfull | N/A | | | | | 19.0 | | | 17.0 | | | 25.0 | | | | | 37.0 | | 42.0 | | | 46.0 | | | | | 35.0 | | 32.0 | | |
| Rosgen Classification | Pond | | | | | DA/E5 | | | DA | | | C5 | | | | | C5 | | C5 | | | G5 | | | | | B5 | | B5c | | |
| Bankfull Discharge (cfs) | 11.0 | | | | | 11.0 | | | 11.0 | | | 14.5 | | | | | 14.5 | | 14.5 | | | 20.0 | | | | | 20.0 | | 20.0 | | |
| Sinuosity (ft) | N/A | | | | | 1.08 | | | 1.16 | | | 1.07 | | | | | 1.07 | | 1.04 | | | 1.20 | | | | | 1.12 | | 1.10 | | |
| Water Surface Slope (Channel) (ft/ft) | N/A | | | | | 0.0089 | | | 0.0107 | | | 0.0168 | | | | | 0.0168 | | 0.0195 | | | 0.0133 | | | | | 0.0142 | | 0.0152 | | |
| Other | | | | | | | | | | | | | | | | | | | | | | | | | | | | | | | |

| Baseline Stream Data Summary Odell's House, R5 | | | | | | | | | | | | Odell's House, R6 | | | | | | | | | Odell's House, R7 upper | | | | | | | | | | |
|---|-------------------------------------|------|-----|-----|---|--------|-------|---|---------------------------|------|-----|-------------------------------------|------|-----|-----|-----|--------|------|---------------------------|------|-------------------------|-------------------------------------|------|-----|-----|-----|--------|-------|---------------------------|------|-----|
| Parameter | Pre-Existing Condition (applicable) | | | | | Design | | | Monitoring Baseline (MY0) | | | Pre-Existing Condition (applicable) | | | | | Design | | Monitoring Baseline (MY0) | | | Pre-Existing Condition (applicable) | | | | | Design | | Monitoring Baseline (MY0) | | |
| | Min | Mean | Med | Max | n | Min | Max | n | Min | Max | n | Min | Mean | Med | Max | n | Min | Max | Min | Max | n | Min | Mean | Med | Max | n | Min | Max | Min | Max | n |
| Riffle Only | | | | | | | | | | | | | | | | | | | | | | | | | | | | | | | |
| Bankfull Width (ft) | | N/A | | | 0 | | 5.5 | | | 13.4 | 1.0 | | 4.1 | | | 1.0 | | 6.0 | | 8.9 | 1.0 | | | | | 1.0 | | 6.0 | | 2.2 | 1.0 |
| Floodprone Width (ft) | | N/A | | | 0 | 49.0 | 103.0 | | | 38.1 | 1.0 | | 53.3 | | | 1.0 | 22.0 | 40.0 | | 44.0 | 1.0 | | | | | 1.0 | 126.0 | 145.0 | | 49.6 | 1.0 |
| Bankfull Mean Depth (ft) | | N/A | | | 0 | | 0.3 | | | 0.2 | 1.0 | | 0.6 | | | 1.0 | | 0.4 | | 0.4 | 1.0 | | | | | 1.0 | | 0.4 | | 0.2 | 1.0 |
| Bankfull Max Depth (ft) | | N/A | | | 0 | | 0.4 | | | 0.4 | 1.0 | | 1.1 | | | 1.0 | | 0.5 | | 0.6 | 1.0 | | | | | 1.0 | | 0.5 | | 0.3 | 1.0 |
| Bankfull Cross Sectional Area (ft²) | | N/A | | | 0 | | 1.8 | | | 2.6 | 1.0 | | 2.5 | | | 1.0 | | 2.4 | | 3.3 | 1.0 | | | | | 1.0 | | 2.4 | | 0.4 | 1.0 |
| Width/Depth Ratio | | N/A | | | 0 | | 16.8 | | | 68.9 | 1.0 | | 6.8 | | | 1.0 | | 15.2 | | 24.0 | 1.0 | | 4.2 | | | 1.0 | | 15.2 | | 14.0 | 1.0 |
| Entrenchment Ratio | | N/A | | | 0 | 8.9 | 18.7 | | | 2.8 | 1.0 | | 12.9 | | | 1.0 | 3.7 | 6.7 | | 4.9 | 1.0 | | 1.5 | | | 1.0 | 21.0 | 24.2 | | 22.2 | 1.0 |
| Bank Height Ratio | | N/A | | | 0 | | 1.0 | | | 1.0 | 1.0 | | 2.3 | | | 1.0 | | 1.0 | | 1.0 | 1.0 | | 1.3 | | | 1.0 | | 1.0 | | 1.0 | 1.0 |
| Max part size (mm) mobilized at bankfull | N/A | | | | | 10.0 | | | 7.0 | | | 32.0 | | | | | 22.0 | | 20.0 | | | G5 / Channelized | | | | | 20.0 | | 11.0 | | |
| Rosgen Classification | Pond | | | | | DA/E5 | | | DA | | | E5 | | | | | B5c | | B5c | | | G5 / Channelized | | | | | B5c | | B5c | | |
| Bankfull Discharge (cfs) | 10.0 | | | | | 10.0 | | | 10.0 | | | 10.0 | | | | | 10.0 | | 10.0 | | | 10.0 | | | | | 10.0 | | 10.0 | | |
| Sinuosity (ft) | N/A | | | | | 1.08 | | | 1.09 | | | 1.05 | | | | | 1.12 | | 1.09 | | | 1.03 | | | | | 1.07 | | 1.09 | | |
| Water Surface Slope (Channel) (ft/ft) | N/A | | | | | 0.0077 | | | 0.0083 | | | 0.0145 | | | | | 0.0135 | | 0.0129 | | | 0.0153 | | | | | 0.0123 | | 0.0131 | | |
| Other | | | | | | | | | | | | | | | | | | | | | | | | | | | | | | | |

Cross-Section Morphology Data
Odell's House Mitigation Project: DMS #100041 (Data Collected 3/24/2021)

| | Cross-Section 1 (Headwater - R1) | | | | | | | Cross-Section 2 (Pool - R2) | | | | | | | Cross-Section 3 (Riffle - R2) | | | | | | | Cross Section-4 (Riffle - R3) | | |---|
| | MY0 | MY1 | MY2 | MY3 | MY5 | MY7 | MY+ | MY0 | MY1 | MY2 | MY3 | MY5 | MY7 | MY+ | MY0 | MY1 | MY2 | MY3 | MY5 | MY7 | MY+ | MY0 | MY1 | MY2 | MY3 | MY5 | MY7 | MY+ | | | | | | | | | | | | | | |
| Bankfull Elevation (ft) - Based on AB-Bankfull ¹ Area | 263.18 | | | | | | | 254.61 | | | | | | | 253.90 | | | | | | | 240.60 | | | | | | | | | | | | | | | | | | | | |
| Bank Height Ratio_Based on AB Bankfull ¹ Area | 0.96 | | | | | | | 1.00 | | | | | | | 1.00 | | | | | | | 1.00 | | | | | | | | | | | | | | | | | | | | |
| Thalweg Elevation | 262.48 | | | | | | | 252.91 | | | | | | | 252.81 | | | | | | | 239.85 | | | | | | | | | | | | | | | | | | | | |
| LTOB ² Elevation | 263.16 | | | | | | | 254.61 | | | | | | | 253.90 | | | | | | | 240.60 | | | | | | | | | | | | | | | | | | | | |
| LTOB ² Max Depth (ft) | 0.67 | | | | | | | 1.70 | | | | | | | 1.10 | | | | | | | 0.75 | | | | | | | | | | | | | | | | | | | | |
| LTOB ² Cross Sectional Area (ft ²) | 4.77 | | | | | | | 11.76 | | | | | | | 6.03 | | | | | | | 4.90 | | | | | | | | | | | | | | | | | | | | |
| | Cross-Section 5 (Pool - R3) | | | | | | | Cross-Section 6 (Headwater - R5) | | | | | | | Cross-Section 7 (Pool - R6) | | | | | | | Cross-Section 8 (Riffle - R6) | | | | MY0 | MY1 | MY2 | MY3 | MY5 | MY7 | MY+ | MY0 | MY1 | MY2 | MY3 | MY5 | MY7 | MY+ | MY0 | MY1 | MY2 | MY3 | MY5 | MY7 | MY+ | MY0 | MY1 | MY2 | MY3 | MY5 | MY7 | MY+ | | | | | | | | | | | | | | |
| Bankfull Elevation (ft) - Based on AB-Bankfull ¹ Area | 240.09 | | | | | | | 250.93 | | | | | | | 244.24 | | | | | | | 244.59 | | | | | | | | | | | | | | | | | | | | |
| Bank Height Ratio_Based on AB Bankfull ¹ Area | 1.00 | | | | | | | 1.00 | | | | | | | 1.00 | | | | | | | 1.00 | | | | | | | | | | | | | | | | | | | | |
| Thalweg Elevation | 238.34 | | | | | | | 250.57 | | | | | | | 242.58 | | | | | | | 243.96 | | | | | | | | | | | | | | | | | | | | |
| LTOB ² Elevation | 240.09 | | | | | | | 250.93 | | | | | | | 244.24 | | | | | | | 244.59 | | | | | | | | | | | | | | | | | | | | |
| LTOB ² Max Depth (ft) | 1.75 | | | | | | | 0.36 | | | | | | | 1.66 | | | | | | | 0.63 | | | | | | | | | | | | | | | | | | | | |
| LTOB ² Cross Sectional Area (ft ²) | 10.02 | | | | | | | 2.55 | | | | | | | 6.78 | | | | | | | 3.23 | | | | | | | | | | | | | | | | | | | | |
| | Cross-Section 9 (Riffle - R7 upper) | | | | | | | Cross-Section 10 (Pool - R7 upper) | | | | | | | | | | | | | | | | | | | | | | | | | | | | | | | | | | |
| | MY0 | MY1 | MY2 | MY3 | MY5 | MY7 | MY+ | MY0 | MY1 | MY2 | MY3 | MY5 | MY7 | MY+ | | | | | | | | | | | | | | | | | | | | | | | | | | | | |
| Bankfull Elevation (ft) - Based on AB-Bankfull ¹ Area | 235.65 | | | | | | | 233.89 | | | | | | | | | | | | | | | | | | | | | | | | | | | | | | | | | | |
| Bank Height Ratio_Based on AB Bankfull ¹ Area | 0.97 | | | | | | | 0.68 | | | | | | | | | | | | | | | | | | | | | | | | | | | | | | | | | | |
| Thalweg Elevation | 235.35 | | | | | | | 233.47 | | | | | | | | | | | | | | | | | | | | | | | | | | | | | | | | | | |
| LTOB ² Elevation | 235.65 | | | | | | | 233.85 | | | | | | | | | | | | | | | | | | | | | | | | | | | | | | | | | | |
| LTOB ² Max Depth (ft) | 0.30 | | | | | | | 0.37 | | | | | | | | | | | | | | | | | | | | | | | | | | | | | | | | | | |
| LTOB ² Cross Sectional Area (ft ²) | 0.39 | | | | | | | 0.70 | | | | | | | | | | | | | | | | | | | | | | | | | | | | | | | | | | |

The above morphology parameters reflect the 2018 guidance that arose from the mitigation technical workgroup consisting of DMS, the IRT and industry mitigation providers/practitioners. The outcome resulted in the focus on three primary morphological parameters of interest for the purposes of tracking channel change moving forward. They are the bank height ratio using a constant As-built bankfull area and the cross-sectional area and max depth based on each years low top of bank. These are calculated as follows:


- Bank Height Ratio (BHR)** takes the As-built bankfull area as the basis for adjusting each subsequent years bankfull elevation. For example if the As-built bankfull area was 10 ft², then the MY1 bankfull elevation would be adjusted until the calculated bankfull area within the MY1 cross section survey = 10 ft². The BHR would then be calculated with the difference between the low top of bank (LTOB) elevation for MY1 and the thalweg elevation for MY1 in the numerator with the difference between the MY1 bankfull elevation and the MY1 thalweg elevation in the denominator. This same process is then carried out in each successive year.
- LTOB Area and Max depth** - These are based on the LTOB elevation for each years survey (The same elevation used for the LTOB in the BHR calculation). Area below the LTOB elevation will be used and tracked for each year as above. The difference between the LTOB elevation and the thalweg elevation (same as in the BHR calculation) will be recorded and tracked above as LTOB max depth.

Note: The smaller the channel the closer the survey measurements are to their limit of reliable detection, therefore inter-annual variation in morphological measurement (as a percentage) is by default magnified as channel size decreases. Some of the variability above is the result of this factor and some is due to the large amount of depositional sediments observed.

Appendix D:


Hydrologic Data

Flow Gauge and Crest Gauge Diagrams
Photos: Surface Flow and Wetland Gauges

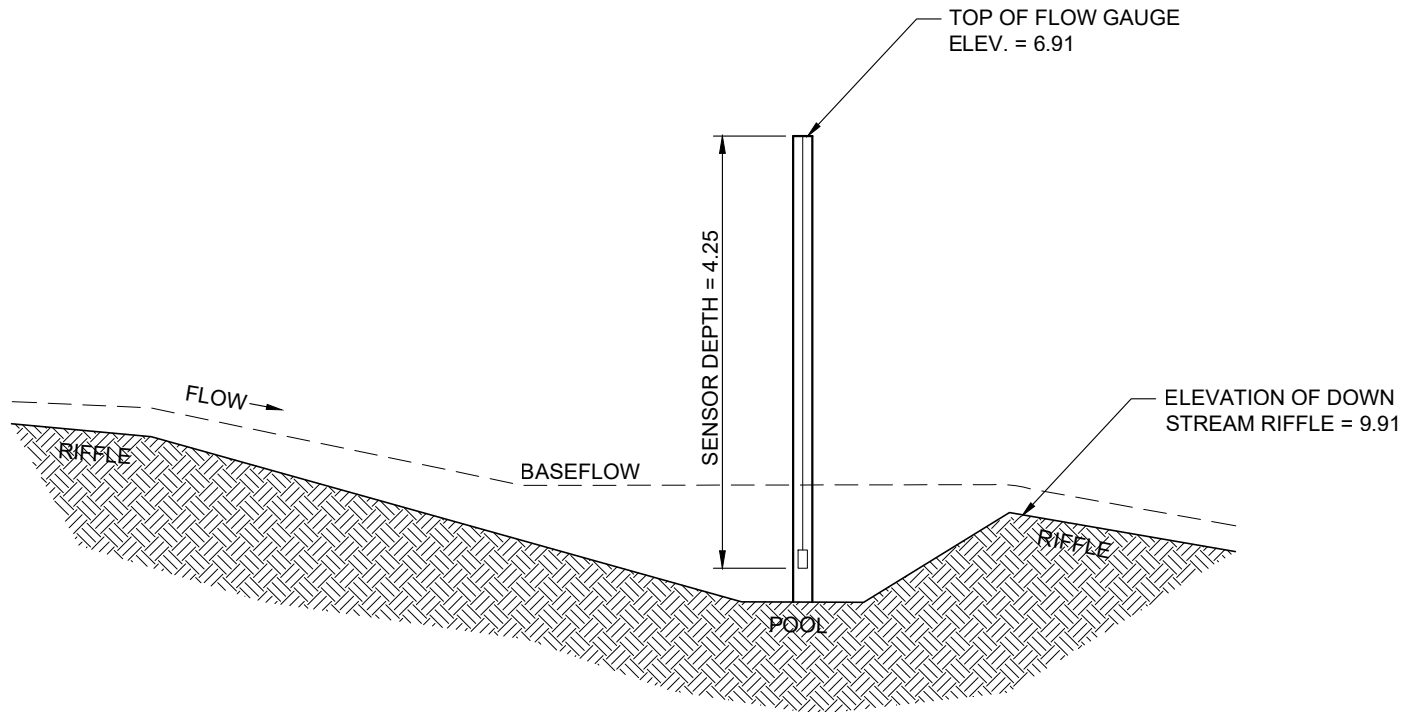

FLOW GAUGE #1 - R1

Flow Depth = (Sensor Depth + Top) - Elevation of Riffle
Flow Depth = (4.25 + 6.91) - 9.91
Flow Depth = 1.25 feet

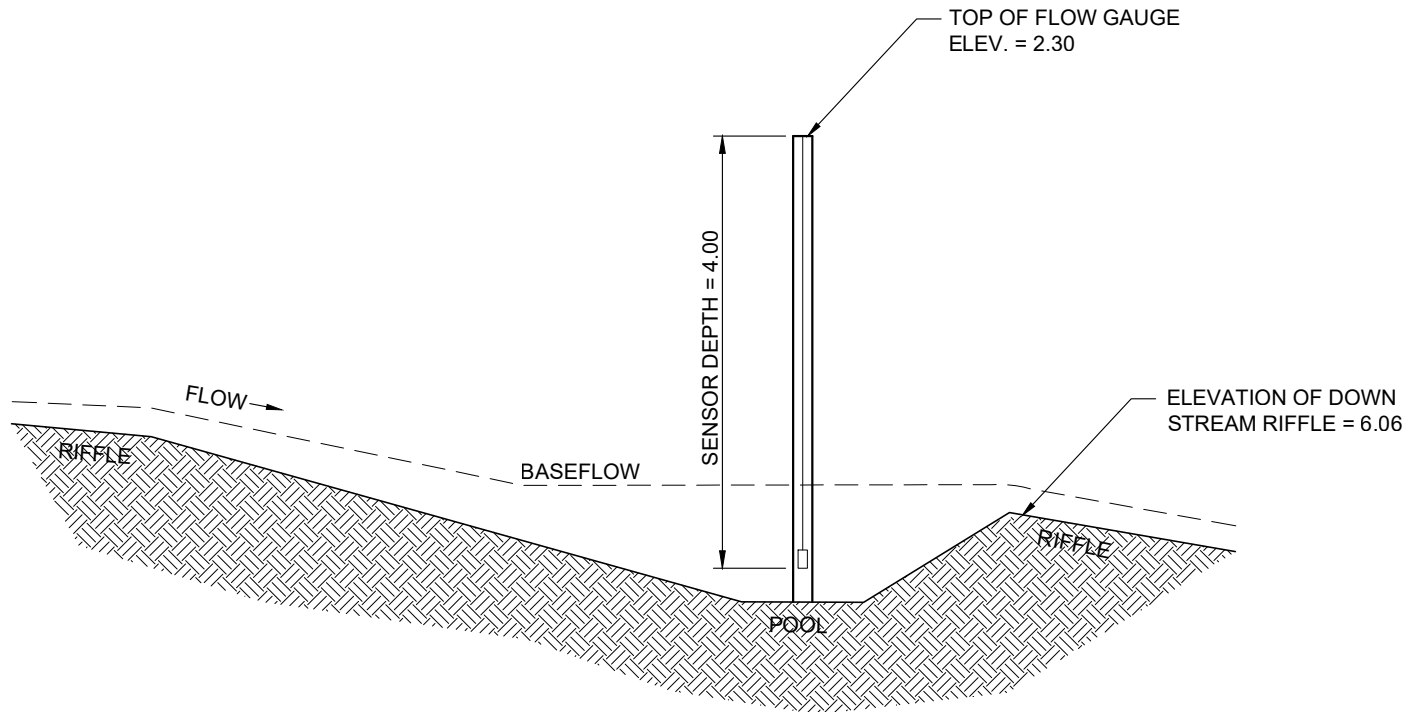


FLOW GAUGE #2 - R5

Flow Depth = (Sensor Depth + Top) - Elevation of Riffle

Flow Depth = (4.00 + 2.30) - 6.06

Flow Depth = 0.24 feet

CROSS SECTIONAL VIEW OF STREAM

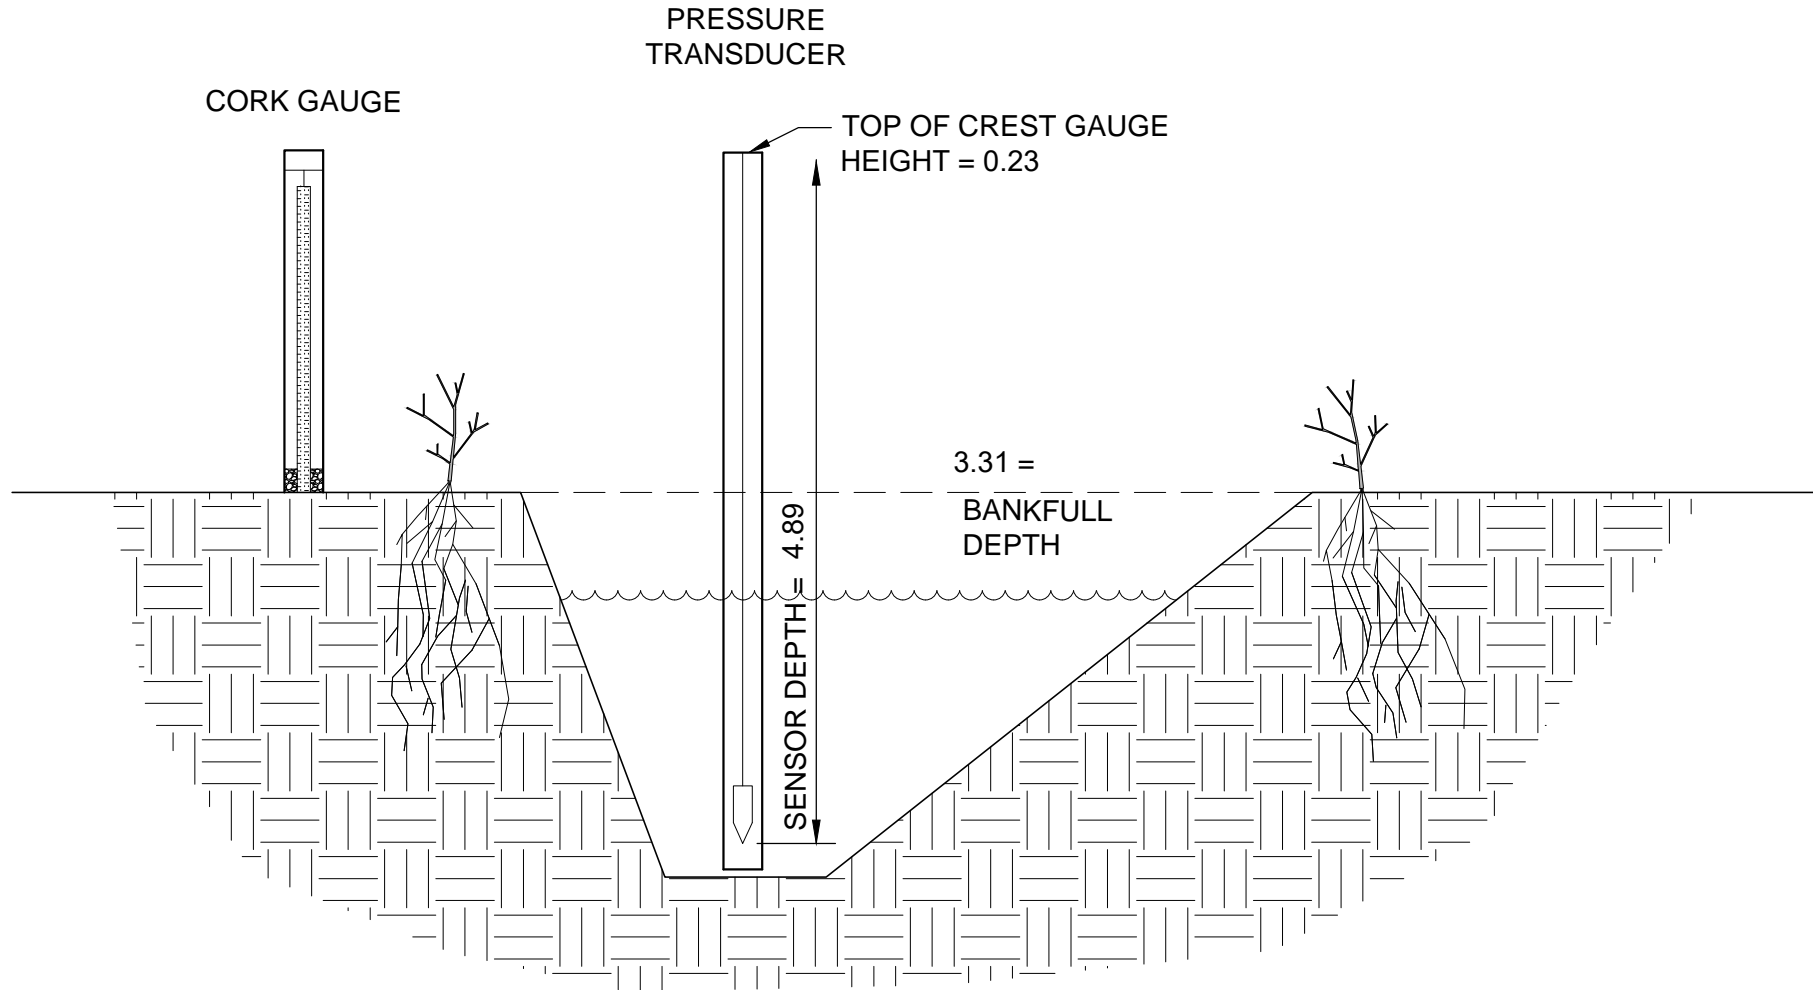


Crest Gauge CG-1 (R3)

Bankfull Event Depth (for transducer) = (Top of Gauge + Sensor Depth) - Bankfull Depth

Bankfull Event Depth = (0.23 + 4.89) - 3.31

Bankfull Event Depth = 1.81 feet

CROSS SECTIONAL VIEW OF STREAM

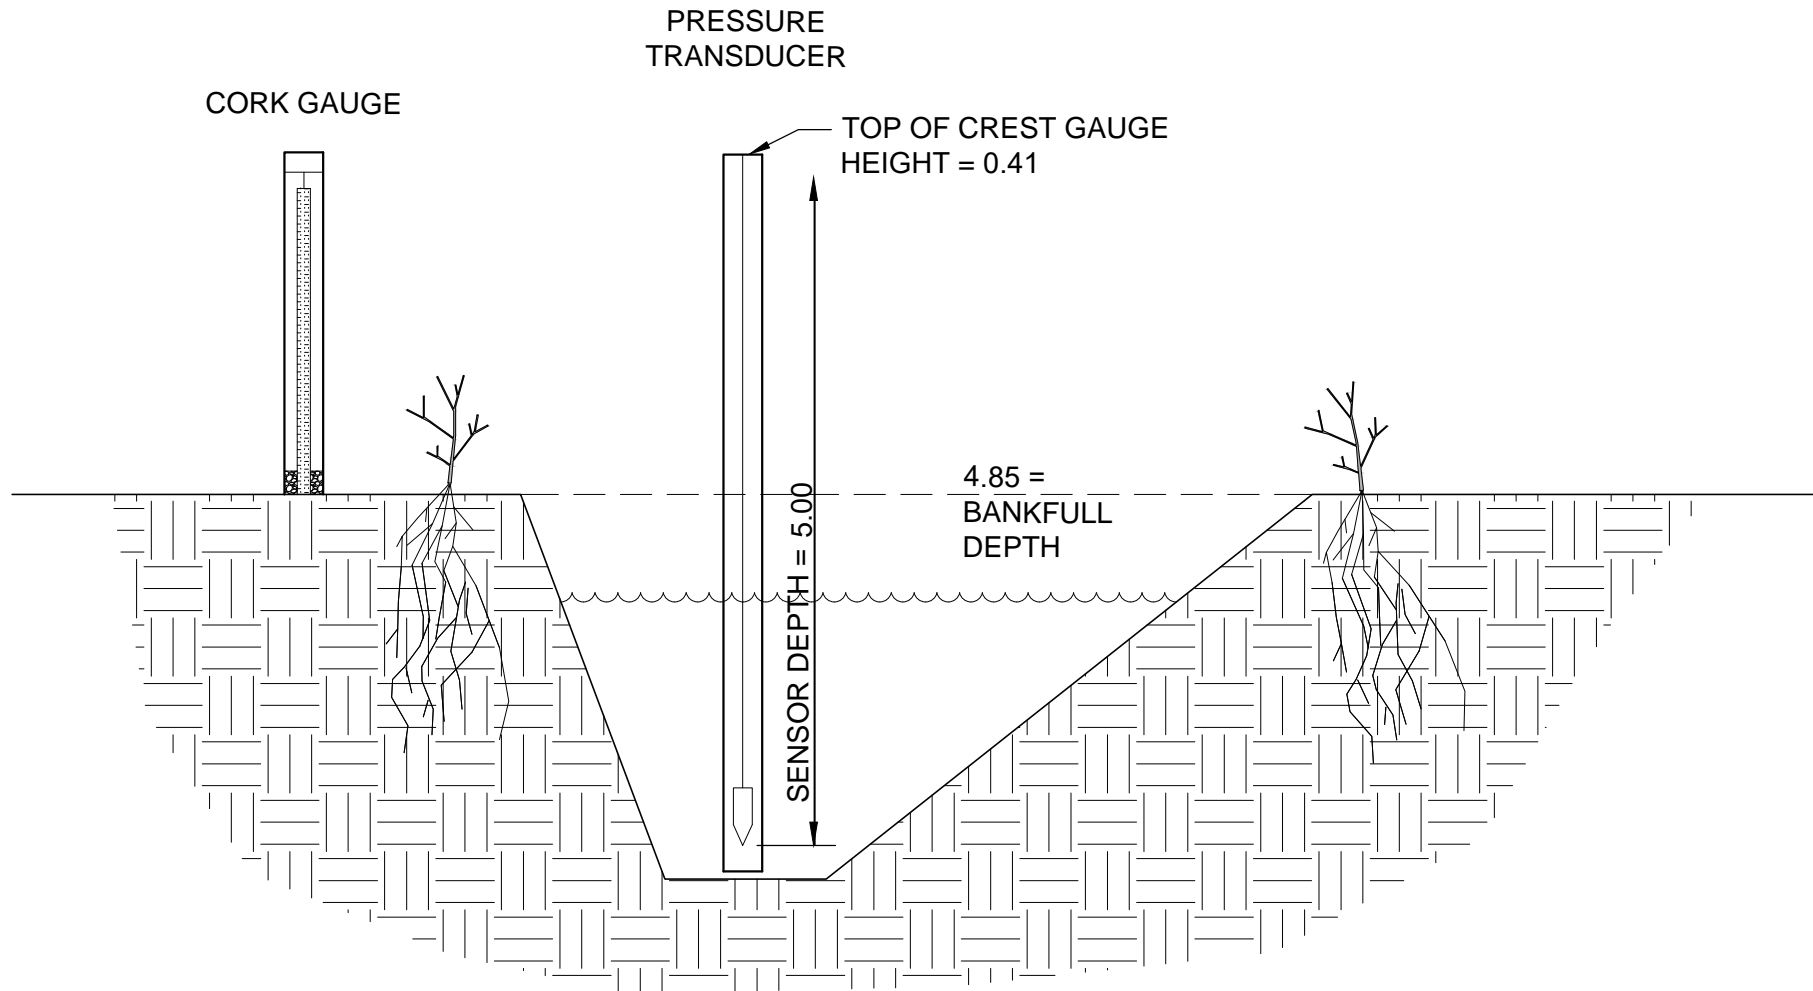

Crest Gauge CG-2 (R7 lower)

Bankfull Event Depth (for transducer) = (Top of Gauge + Sensor Depth) - Bankfull Depth

Bankfull Event Depth = (0.41 + 5.00) - 4.85

Bankfull Event Depth = 0.56 feet



3/2/21, 11:14 AM
Johnston

Flow Gauge (FG-1) – R1



3/2/21, 11:23 AM
Johnston

Flow Gauge (FG-2) – R5



3/1/21, 2:42 PM
Johnston

Crest Gauge (CG-1, Pressure Transducer) – R3



3/1/21, 2:42 PM
Johnston

Crest Gauge (CG-1, Cork) – R3



3/2/21, 2:40 PM
Johnston

Crest Gauge (CG-2, Pressure Transducer) – R7 lower



3/2/21, 2:40 PM
Johnston

Crest Gauge (CG-2, Cork) – R7 lower



3/3/21, 8:57 AM
Johnston

Wetland Gauge (WG-1) – W1



3/3/21, 8:36 AM
Johnston

Wetland Gauge (WG-2) – W2



3/3/21, 9:19 AM
Johnston

Wetland Gauge (WG-3) – W3



3/3/21, 9:39 AM
Johnston

Wetland Gauge (WG-4) – W5



3/3/21, 9:55 AM
Johnston

Wetland Gauge (WG-5) – W6

Appendix E:
Project Timeline and Contact
Info

| Project Timeline and Contacts Table | | |
|--|--------------------------|---|
| Activity or Deliverable | Data Collection Complete | Task Completion or Deliverable Submission |
| Project Instituted | N/A | 1/2/2018 |
| Mitigation Plan Approved | N/A | 8/26/2020 |
| Construction (Grading) Completed | N/A | 3/25/2021 |
| Planting Completed | N/A | 4/1/2021 |
| As-built Survey Completed | NA | 6/11/2021 |
| MY-0 Baseline Report | 5/6/2021 | 6/15/2021 |
| MY1+ Monitoring Reports | | |
| Remediation Items (e.g. beaver removal, supplements, repairs etc.) | | |
| Encroachment | | |
| | | |

| Project Name/Number | | |
|--|-------------------------|-----------|
| Provider | 7721 Six Forks Road | Suite 130 |
| Water & Land Solutions, LLC | Raleigh, NC 27615 | |
| Mitigation Provider POC: Emily Dunnigan | (269) 908-6306 | |
| Designer | 7721 Six Forks Road | Suite 130 |
| Water & Land Solutions, LLC | Raleigh, NC 27615 | |
| Primary project design POC: Chris Tomsic, WLS | (828) 492-3287 | |
| Construction Contractor | 2889 Lowery Street | |
| North State Environmental, Inc. | Winston-Salem, NC 27101 | |
| Primary contractor POC: Andrew Roten | (336) 406-9078 | |

Appendix F: Other Data

Macrobenthic Survey Data

Macrobenthic Sampling Data

| R3 - Odell's House Mitigation Site | | | |
|------------------------------------|-----|--|--|
| Monitoring Year | MY0 | | |
| Biotic Index Score | NA* | | |
| Water Quality Level | NA* | | |

**No benthics were collected during sampling*



View Upstream



View Downstream

Macrobenthic Sampling Data

| R7 - Odell's House Mitigation Site | | | |
|------------------------------------|-----|--|--|
| Monitoring Year | MY0 | | |
| Biotic Index Score | NA* | | |
| Water Quality Level | NA* | | |

**No benthics were collected during sampling*



View Upstream



View Downstream

DEPARTMENT OF ENVIRONMENTAL QUALITY - DIVISION OF MITIGATION SERVICES

ODELL'S HOUSE MITIGATION PROJECT

JOHNSTON COUNTY, NORTH CAROLINA

NCDEQ - DMS PROJECT ID # 100041

NCDEQ - DMS CONTRACT # 7420 UNDER RFP 16-007279

NEUSE RIVER BASIN (CU 03020201)

USACE ACTION ID # SAW-2018-00431

DWR ID # 2018-0200

TYPE OF WORK : STREAM, BUFFER AND WETLAND MITIGATION

PROJECT SUMMARY

| Project Reach Designation | Type of Mitigation | Creditable Units (LF) | Mitigation Ratio (X:1) | Stream Mitigation Credits (SMCs) | Project Wetland Area | Type of Mitigation | Proposed Wetland Area (AC) | Mitigation Ratio (X:1) | Riparian Wetland Mitigation Credits (WMCs) |
|---------------------------|-----------------------------|-----------------------|------------------------|----------------------------------|--|--------------------------|----------------------------|------------------------|--|
| R1 | Stream Restoration (P/HW) | 437 | 1 | 437.000 | W1 | Wetland Re-establishment | 0.476 | 1 | 0.476 |
| R2 | Stream Enhancement Level II | 526 | 2.5 | 210.400 | W2 | Wetland Re-establishment | 0.416 | 1 | 0.416 |
| R3 | Stream Restoration (PI) | 1,091 | 1 | 1,091.000 | W3 | Wetland Rehabilitation | 0.666 | 1.5 | 0.444 |
| R4 | Stream Enhancement Level II | 190 | 3 | 63.333 | W4 | Wetland Re-establishment | 0.234 | 1 | 0.234 |
| R5 | Stream Restoration (P/HW) | 340 | 1 | 340.000 | W5 | Wetland Enhancement | 1.654 | 2.5 | 0.662 |
| R6 | Stream Restoration (PI) | 432 | 1 | 432.000 | W6 | Wetland Preservation | 0.444 | 10 | 0.044 |
| R7 (upper) | Stream Enhancement Level I | 625 | 1.5 | 416.667 | Total | | 3.890 | | 2.276 |
| R7 (lower) | Stream Preservation | 412 | 10 | 41.200 | <i>Note 1: No mitigation credits were calculated outside the conservation easement boundaries.</i> | | | | |
| Total | | 4,053 | | 3,031.600 | <i>Note 2: R1 and R5 credits are calculated based on headwater valley length.</i> | | | | |

SHEET INDEX



| | |
|-------|------------------|
| 1 | COVER SHEET |
| 2 | LEGEND |
| 3-10 | PLAN AND PROFILE |
| 11-13 | MONITORING PLAN |

SURVEY CERTIFICATE
 I, MARSHALL G. WIGHT, CERTIFY THAT THIS PROJECT WAS COMPLETED UNDER MY DIRECT AND RESPONSIBLE CHARGE FROM AN ACTUAL SURVEY MADE UNDER MY SUPERVISION; THAT THIS GROUND SURVEY WAS PERFORMED AT THE 95 PERCENT CONFIDENCE LEVEL TO MEET FEDERAL GEOGRAPHIC DATA COMMITTEE STANDARDS; THAT THIS SURVEY WAS PERFORMED TO MEET THE REQUIREMENTS FOR A TOPOGRAPHIC/PLANIMETRIC SURVEY TO THE ACCURACY OF CLASS A AND VERTICAL ACCURACY WHEN APPLICABLE TO CLASS C STANDARD, AND THAT THE ORIGINAL DATA WAS OBTAINED ON MARCH 19TH 2021; THAT THE SURVEY WAS COMPLETED ON MAY 18TH, 2021; THAT CONTOURS SHOWN AS (BROKEN LINES) MAY NOT MEET THE STATED STANDARD; AND ALL COORDINATES ARE BASED ON NAD 83 (2011) AND ALL ELEVATIONS ARE BASED ON NAVD 88"

THIS DOCUMENT ORIGINALLY ISSUED AND SEALED BY MARSHALL G. WIGHT, L-5034, ON



DocuSigned by:
Marshall G. Wight
 62C73F441B864C1... 8/16/2021

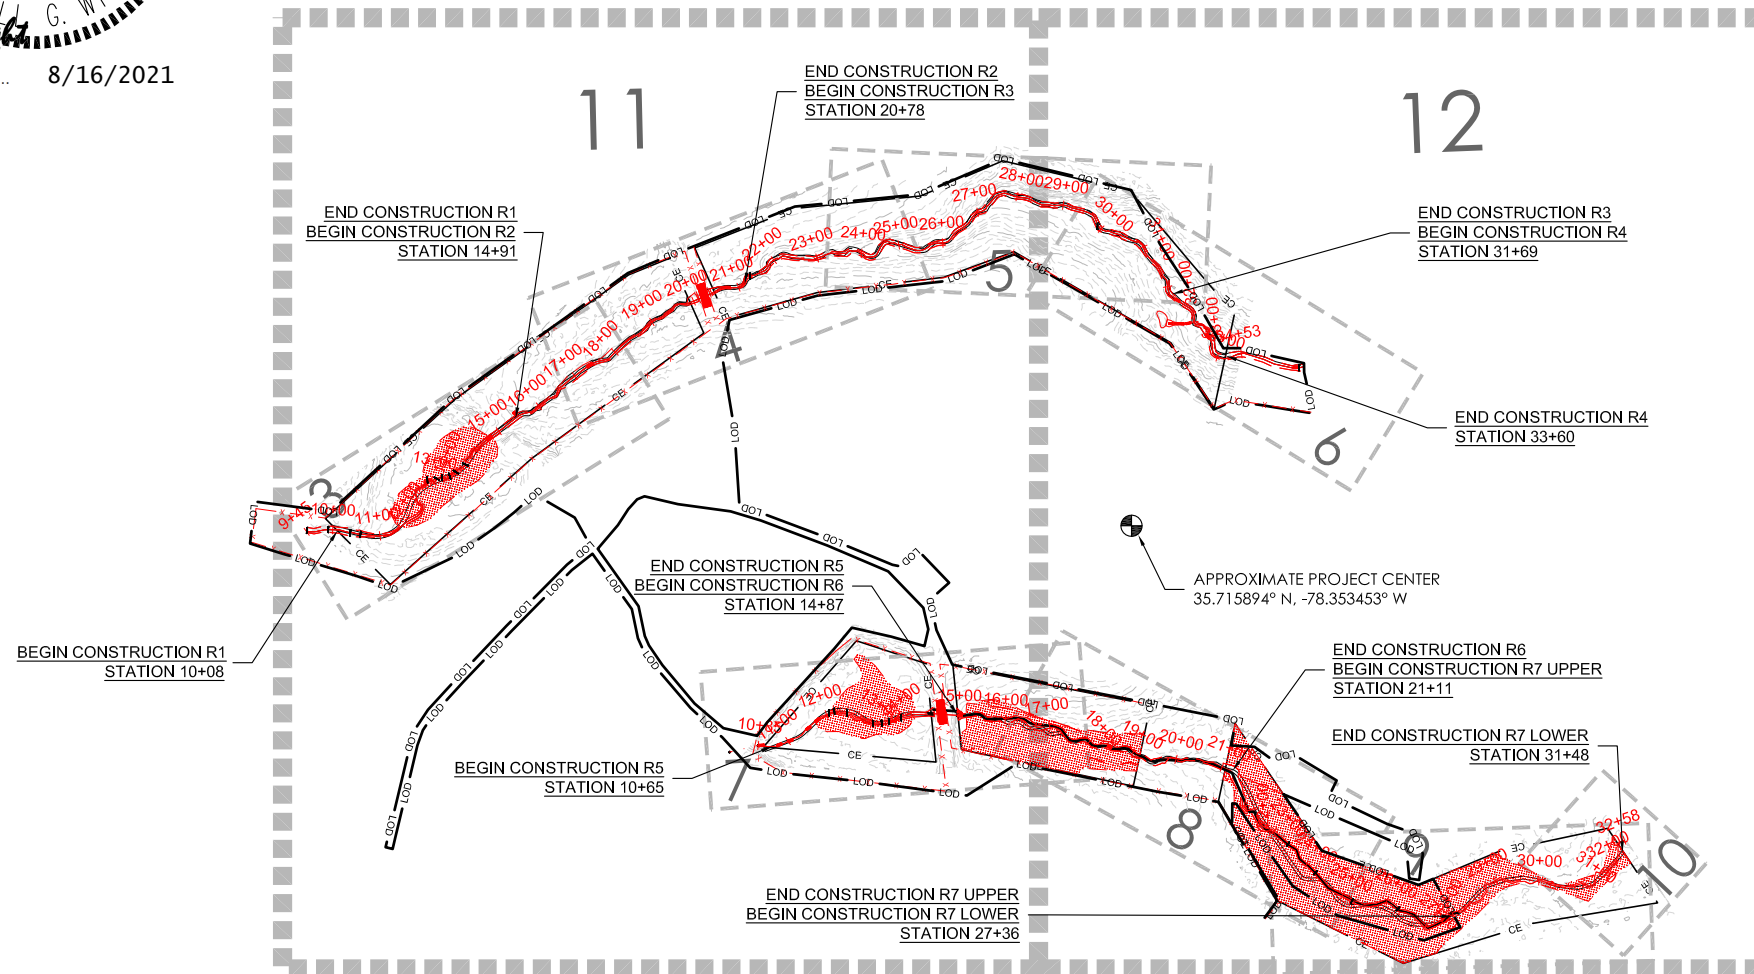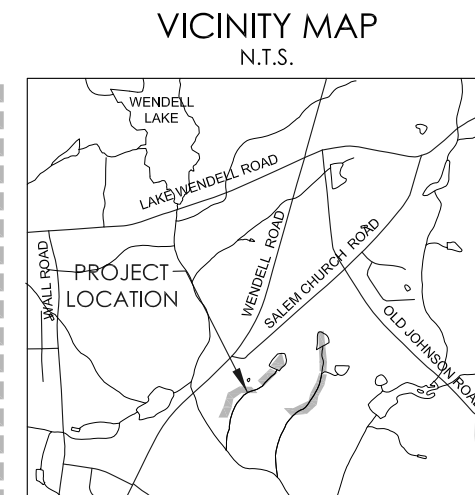

WATER & LAND SOLUTIONS
 7721 Six Forks Rd., Suite 130
 Raleigh, NC 27615
 (919)614-5111
 waterlandsolutions.com

PROJECT ENGINEER
 8/16/2021

 DocuSigned by:
Christopher A. Tomasi
 ENGINEERING SERVICES BY
 WLS ENGINEERING, PLLC
 6 DULA SPRINGS RD.
 WEAVERVILLE, NC 28787
 FIRM LICENSE NO. P-1480


REVISIONS

| | | |
|---|--------------------------|----------|
| A | DRAFT MIT PLAN | 2-24-20 |
| B | FINAL DRAFT MIT PLAN | 5-15-20 |
| C | FINAL MIT PLAN | 8-12-20 |
| D | FINAL MIT PLAN | 9-8-20 |
| E | IFC PLANS | 10-12-20 |
| F | AS-BUILT PLANS | 6-14-21 |
| G | AS-BUILT PLANS (REVISED) | 8-13-21 |

PROJECT NAME
ODELL'S HOUSE MITIGATION PROJECT
 JOHNSTON COUNTY, NC

DRAWING INFORMATION

| | |
|--------------|-------------------------------|
| PROJECT NO. | 18-003 |
| FILENAME | ASB_01_ODELLS_HOUSE_COVER.DWG |
| DESIGNED BY | CAT |
| DRAWN BY | AL |
| DATE | 8-13-21 |
| HORIZ. SCALE | 1" = 400' |
| VERT. SCALE | N/A |

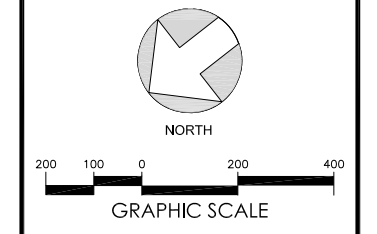

SHEET NAME
COVER SHEET

SHEET NUMBER
1

AS-BUILT



WATER & LAND SOLUTIONS


 
















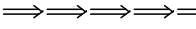


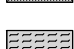
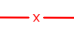
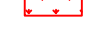

7721 Six Forks Rd., Suite 130
Raleigh, NC 27615
(919)614-5111
waterlandsolutions.com

PROJECT ENGINEER
8/16/2021

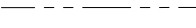

ENGINEERING SERVICES BY
WLS ENGINEERING, PLLC
6 DULA SPRINGS RD.
WEAVERVILLE, NC 28787
FIRM LICENSE NO. P-1480

LEGEND

-  ROOTWAD
-  LOG VANE
-  LOG WEIR
-  LOG STEP-POOL
-  CONSTRUCTED STONE RIFFLE
-  CONSTRUCTED LOG RIFFLE
-  GEOLIFT W/ TOEWOOD
-  RIP RAP
-  OUTLET CHANNEL
-  CONSERVATION EASEMENT BOUNDARY
-  EXISTING MAJOR CONTOUR
-  EXISTING MINOR CONTOUR
-  LIMITS OF DISTURBANCE
-  EXISTING WETLAND BOUNDARY
-  EXISTING WOODLINE
-  AS-BUILT TOP OF STREAM BANK
-  EXISTING PROPERTY BOUNDARY
-  EXISTING FENCE
-  AS-BUILT CENTERLINE (THALWEG)
-  EXISTING FARM PATH
-  EXISTING TREE
-  FLOODPLAIN DEPRESSION
-  WATER QUALITY TREATMENT FEATURE
-  AS-BUILT FIELD FENCE
-  AS-BUILT WETLAND BOUNDARY

| REVISIONS | | |
|-----------|--------------------------|----------|
| A | DRAFT MIT PLAN | 2-24-20 |
| B | FINAL DRAFT MIT PLAN | 5-15-20 |
| C | FINAL MIT PLAN | 8-12-20 |
| D | FINAL MIT PLAN | 9-8-20 |
| E | IFC PLANS | 10-12-20 |
| F | AS-BUILT PLANS | 6-14-21 |
| G | AS-BUILT PLANS (REVISED) | 8-13-21 |



PROJECT NAME
ODELL'S HOUSE MITIGATION PROJECT
JOHNSTON COUNTY, NC

| DRAWING INFORMATION | |
|---------------------|--------------------------------|
| PROJECT NO. | 18-003 |
| FILENAME | ASB_02_ODELLS HOUSE_LEGEND.DWG |
| DESIGNED BY | CAT |
| DRAWN BY | AL |
| DATE | 8-13-21 |
| HORIZ. SCALE | N/A |
| VERT. SCALE | N/A |


SHEET NAME
LEGEND

SHEET NUMBER
2

AS-BUILT

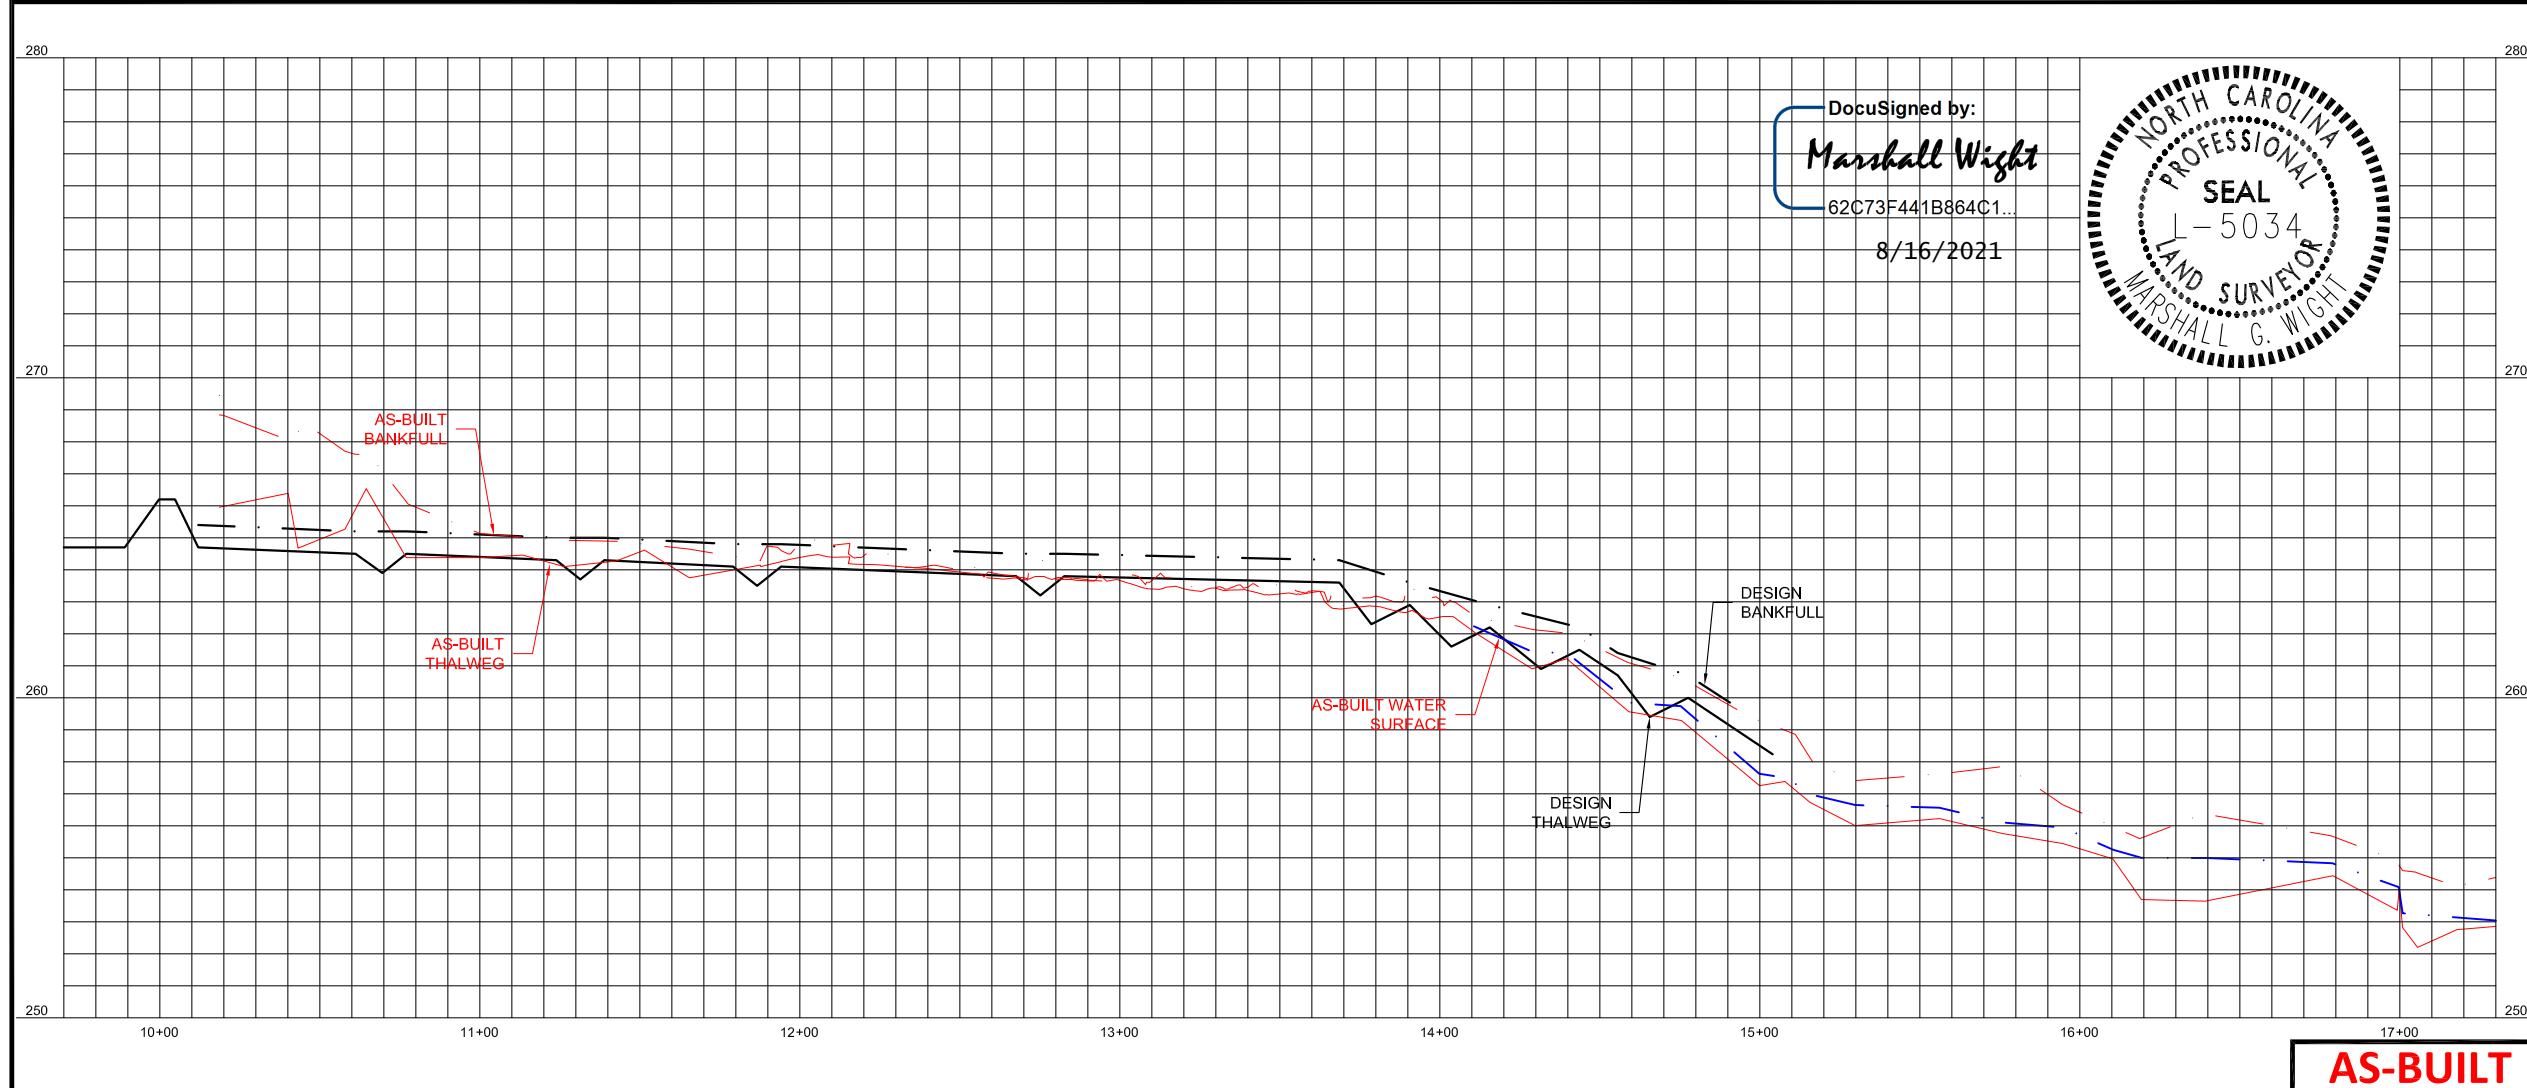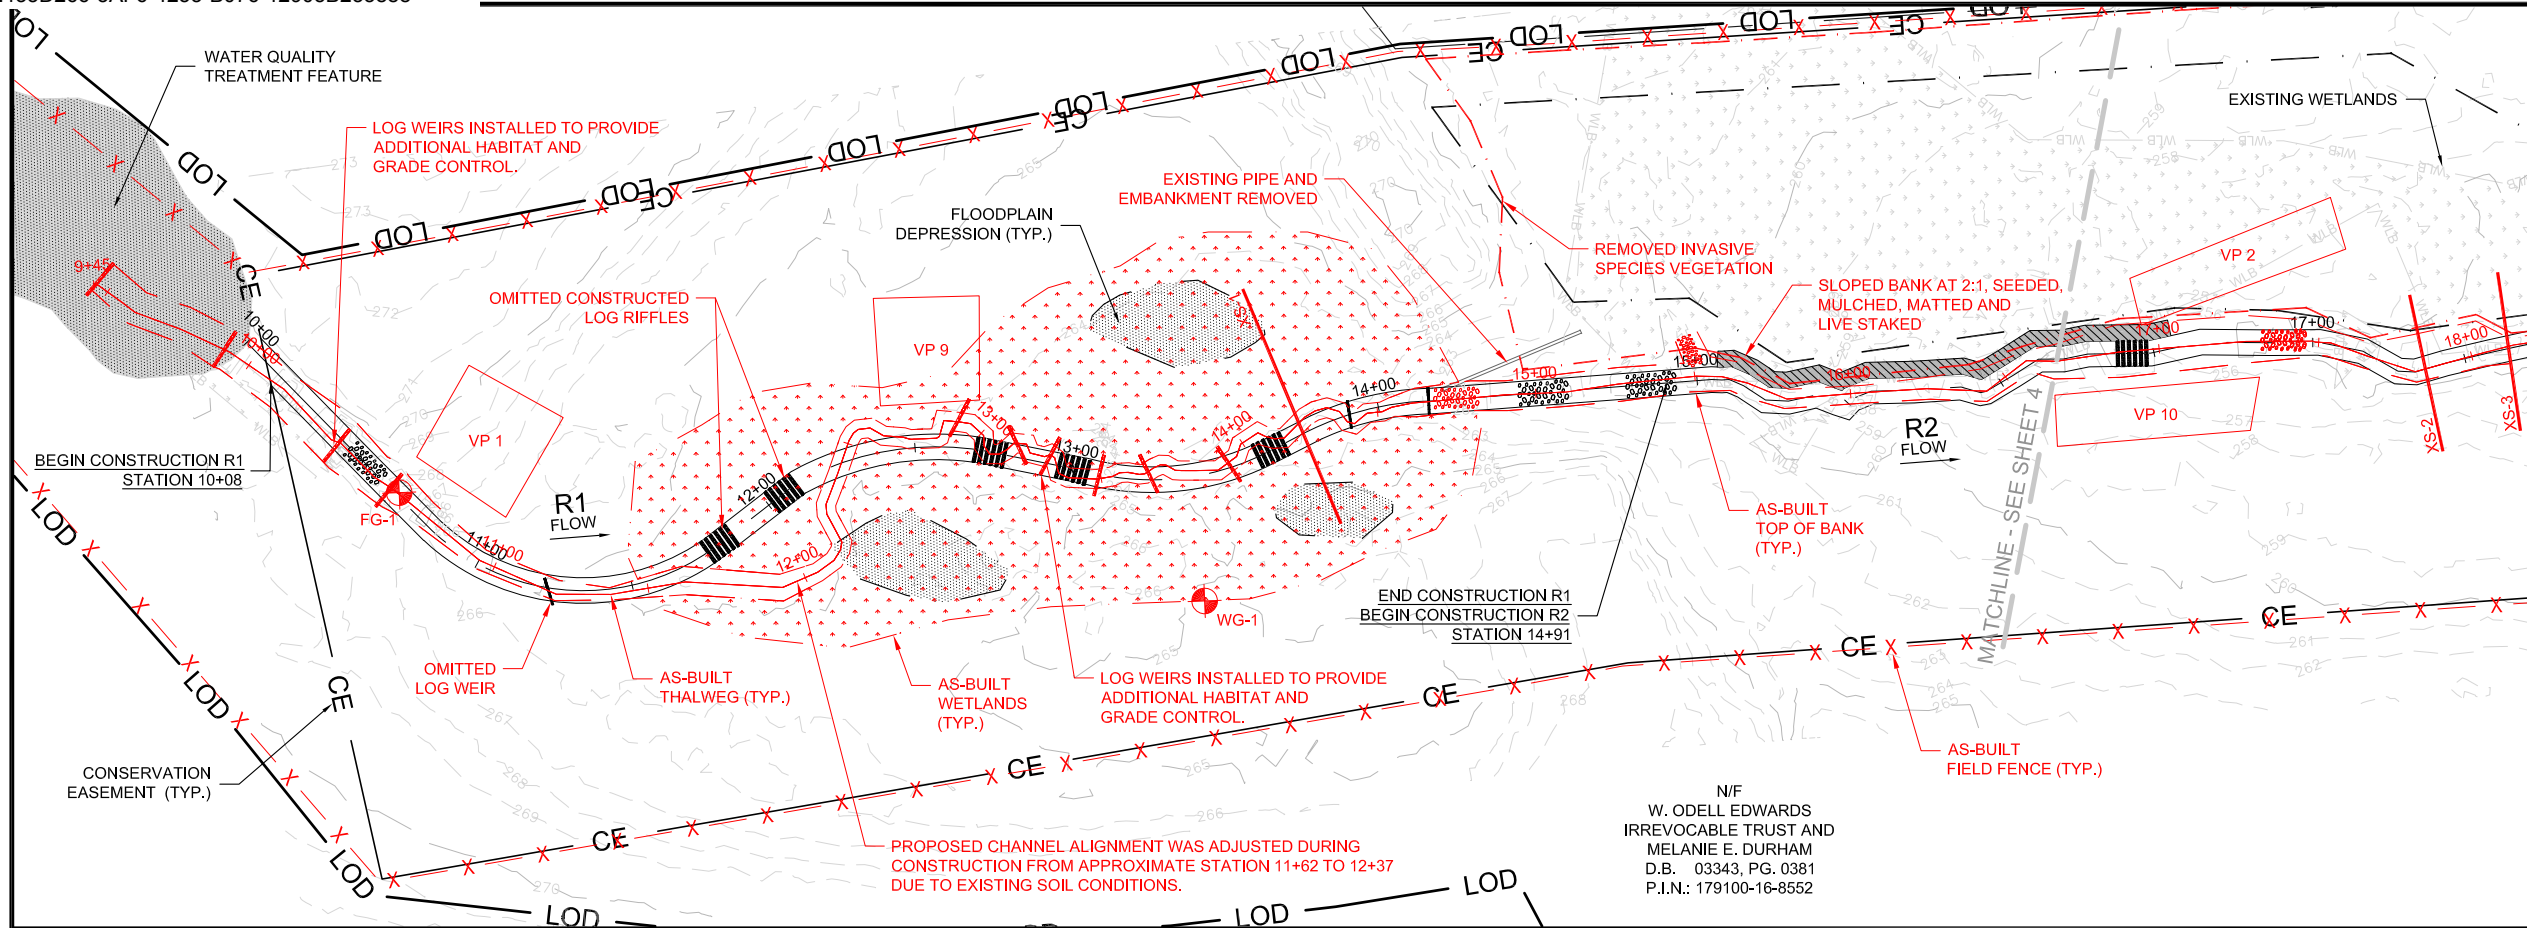

DocuSigned by:
Marshall Wight
62C73F441B864C1...
8/16/2021

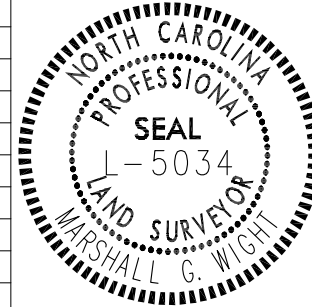

WATER & LAND SOLUTIONS
7721 Six Forks Rd., Suite 130
Raleigh, NC 27615
(919)614-5111
waterlandsolutions.com

PROJECT ENGINEER
8/16/2021

DocuSigned by:
Christopher A. Tomascik
36916

ENGINEERING SERVICES BY
WLS ENGINEERING, PLLC
6 DULA SPRINGS RD.
WEAVERVILLE, NC 28787
FIRM LICENSE NO. P-1480


REVISIONS

| REVISION | DESCRIPTION | DATE |
|----------|--------------------------|----------|
| A | DRAFT MIT PLAN | 2-24-20 |
| B | FINAL DRAFT MIT PLAN | 5-15-20 |
| C | FINAL MIT PLAN | 8-12-20 |
| D | FINAL MIT PLAN | 9-8-20 |
| E | IFC PLANS | 10-12-20 |
| F | AS-BUILT PLANS | 6-14-21 |
| G | AS-BUILT PLANS (REVISED) | 8-13-21 |

PROJECT NAME
ODELL'S HOUSE MITIGATION PROJECT
JOHNSTON COUNTY, NC

DRAWING INFORMATION



| | |
|--------------|--|
| PROJECT NO. | 18-003 |
| FILENAME | ASB_01_01_ODELL'S HOUSE PLAN AND PROFILE.DWG |
| DESIGNED BY | CAT |
| DRAWN BY | AL |
| DATE | 8-13-21 |
| HORIZ. SCALE | 1" = 60' |
| VERT. SCALE | 1" = 3' |

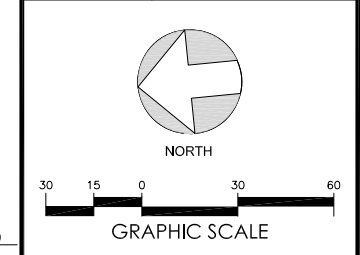

SHEET NAME
R1 & R2

PLAN AND PROFILE

SHEET NUMBER
3

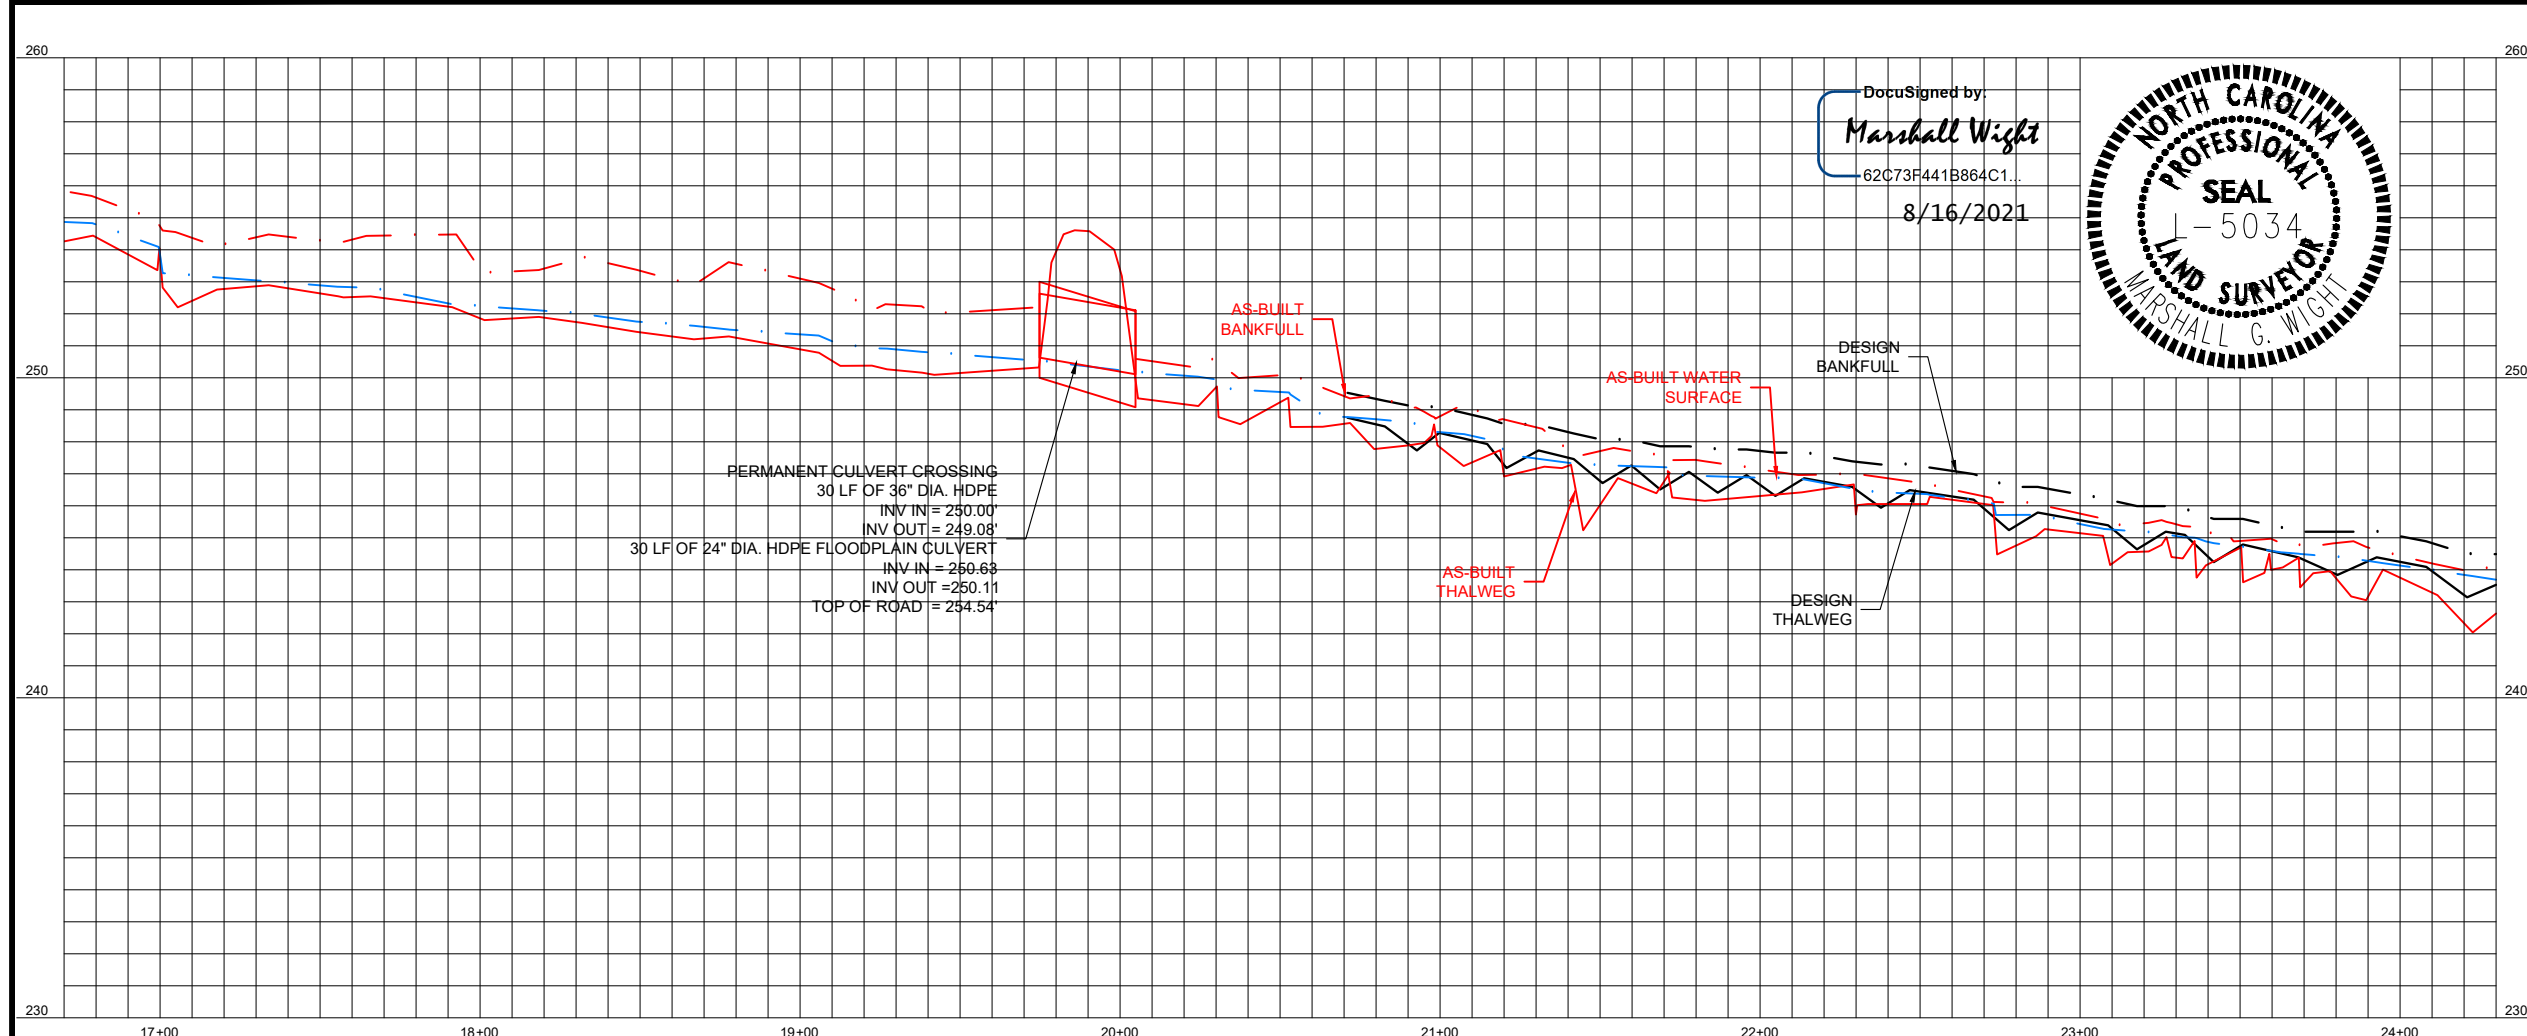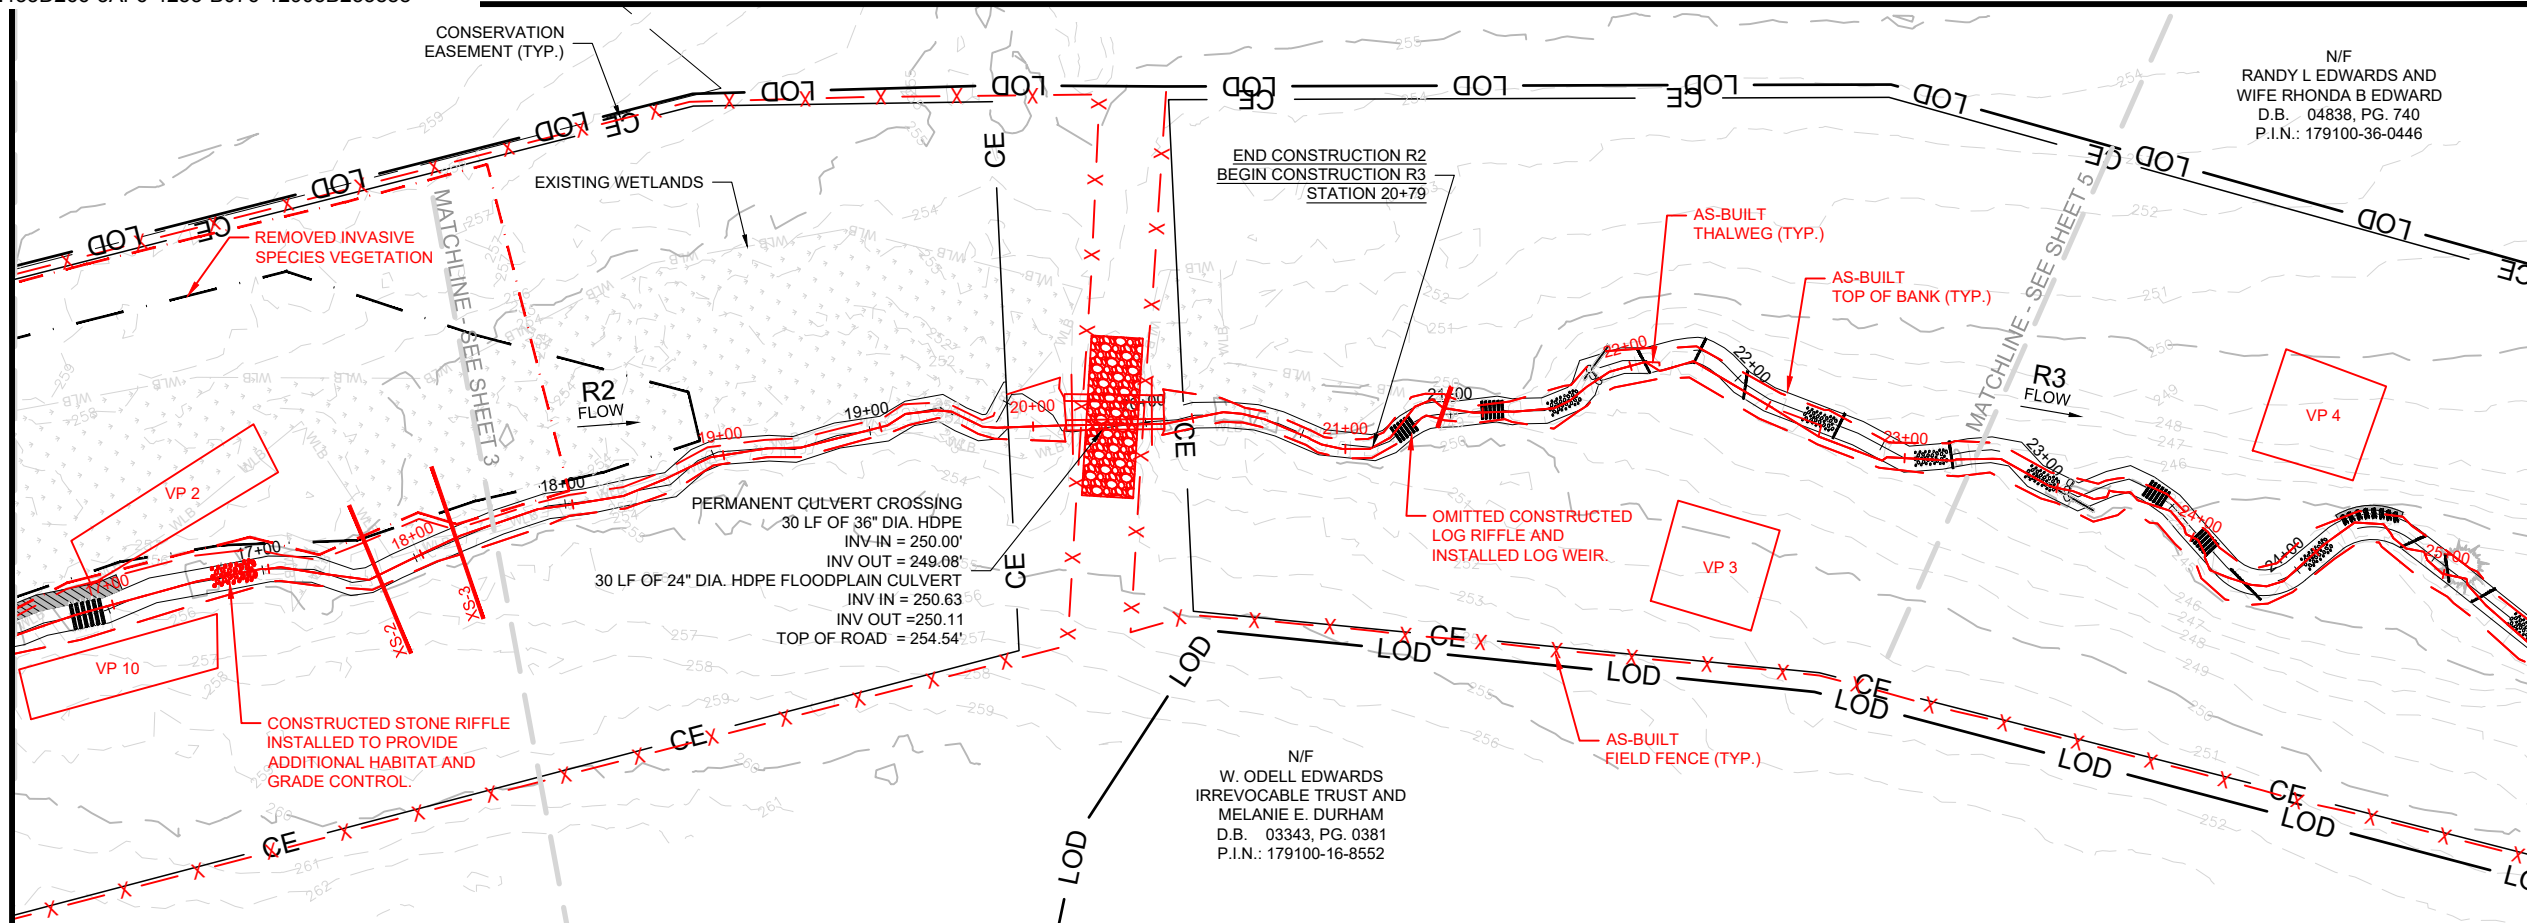

WATER & LAND SOLUTIONS

7721 Six Forks Rd., Suite 130
Raleigh, NC 27615
(919)614-5111
waterlandsolutions.com

PROJECT ENGINEER
8/16/2021

NORTH CAROLINA PROFESSIONAL SEAL
DocuSigned By:
36916
Christopher A. Tomasi
ENGINEER

ENGINEERING SERVICES BY
WLS ENGINEERING, PLLC
6 DULA SPRINGS RD.
WEAVERVILLE, NC 28787
FIRM LICENSE NO. P-1480

REVISIONS

| | | |
|---|--------------------------|----------|
| A | DRAFT MIT PLAN | 2-24-20 |
| B | FINAL DRAFT MIT PLAN | 5-15-20 |
| C | FINAL MIT PLAN | 8-12-20 |
| D | FINAL MIT PLAN | 9-8-20 |
| E | IFC PLANS | 10-12-20 |
| F | AS-BUILT PLANS | 6-14-21 |
| G | AS-BUILT PLANS (REVISED) | 8-13-21 |

PROJECT NAME

ODELL'S HOUSE MITIGATION PROJECT

JOHNSTON COUNTY, NC

DRAWING INFORMATION

| | |
|--------------|---|
| PROJECT NO. | 18-003 |
| FILENAME | ASR_03_10_ODELLS HOUSE_PLAN AND PROFILE.DWG |
| DESIGNED BY | CAT |
| DRAWN BY | AL |
| DATE | 8-13-21 |
| HORIZ. SCALE | 1" = 60' |
| VERT. SCALE | 1" = 3' |

NORTH CAROLINA PROFESSIONAL SEAL
-5034
LAND SURVEYOR
MARSHALL G. WIGHT

GRAPHIC SCALE: 0, 15, 30, 60

NORTH

SHEET NAME



R2 & R3

PLAN AND PROFILE


SHEET NUMBER

4

AS-BUILT

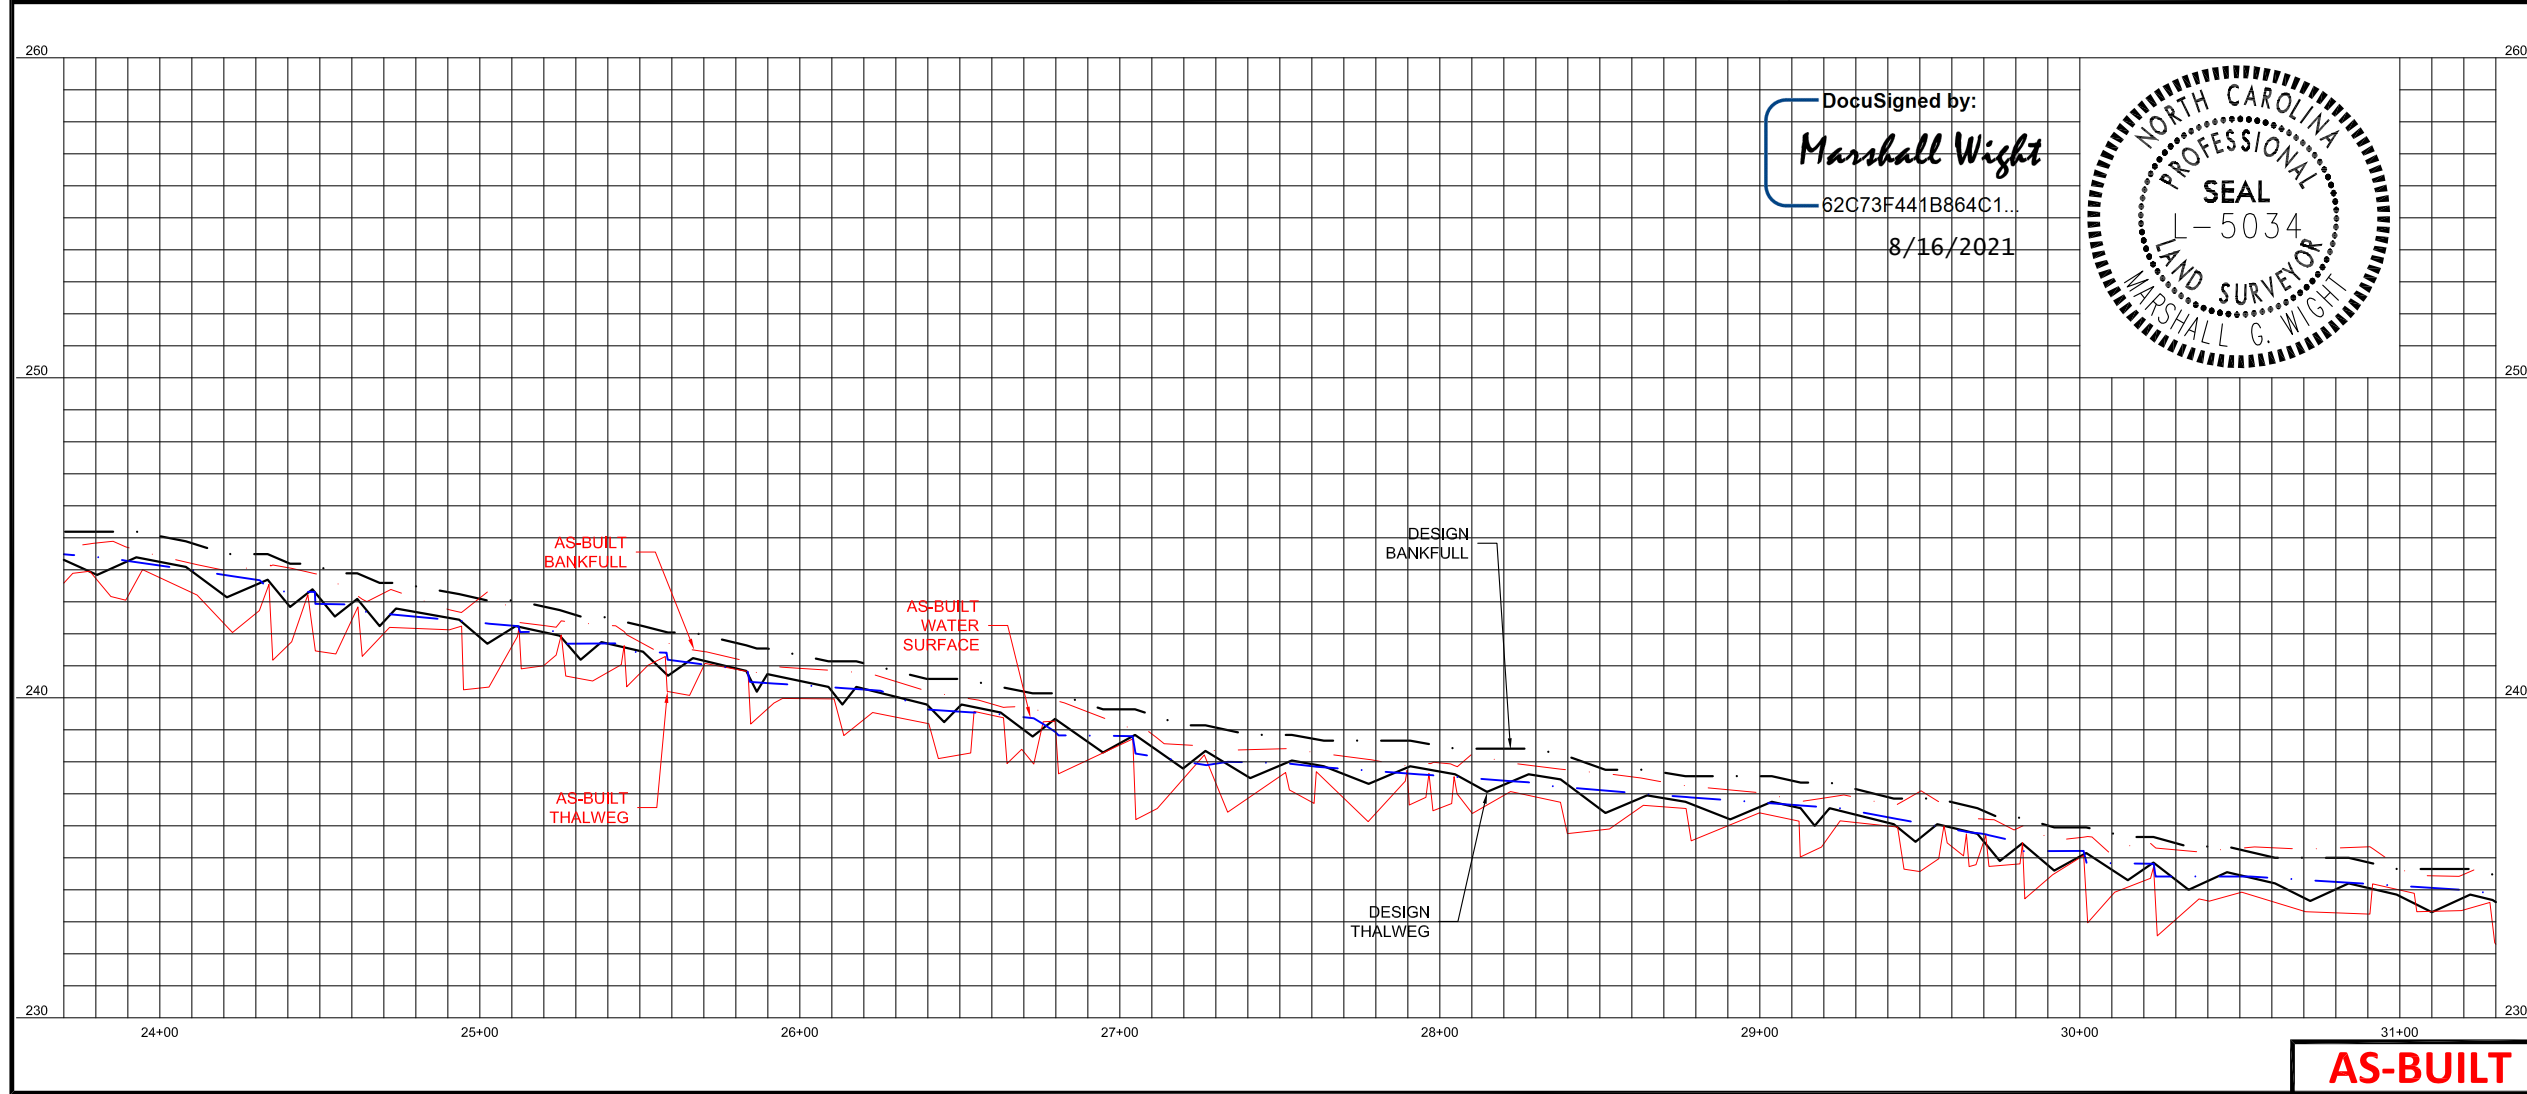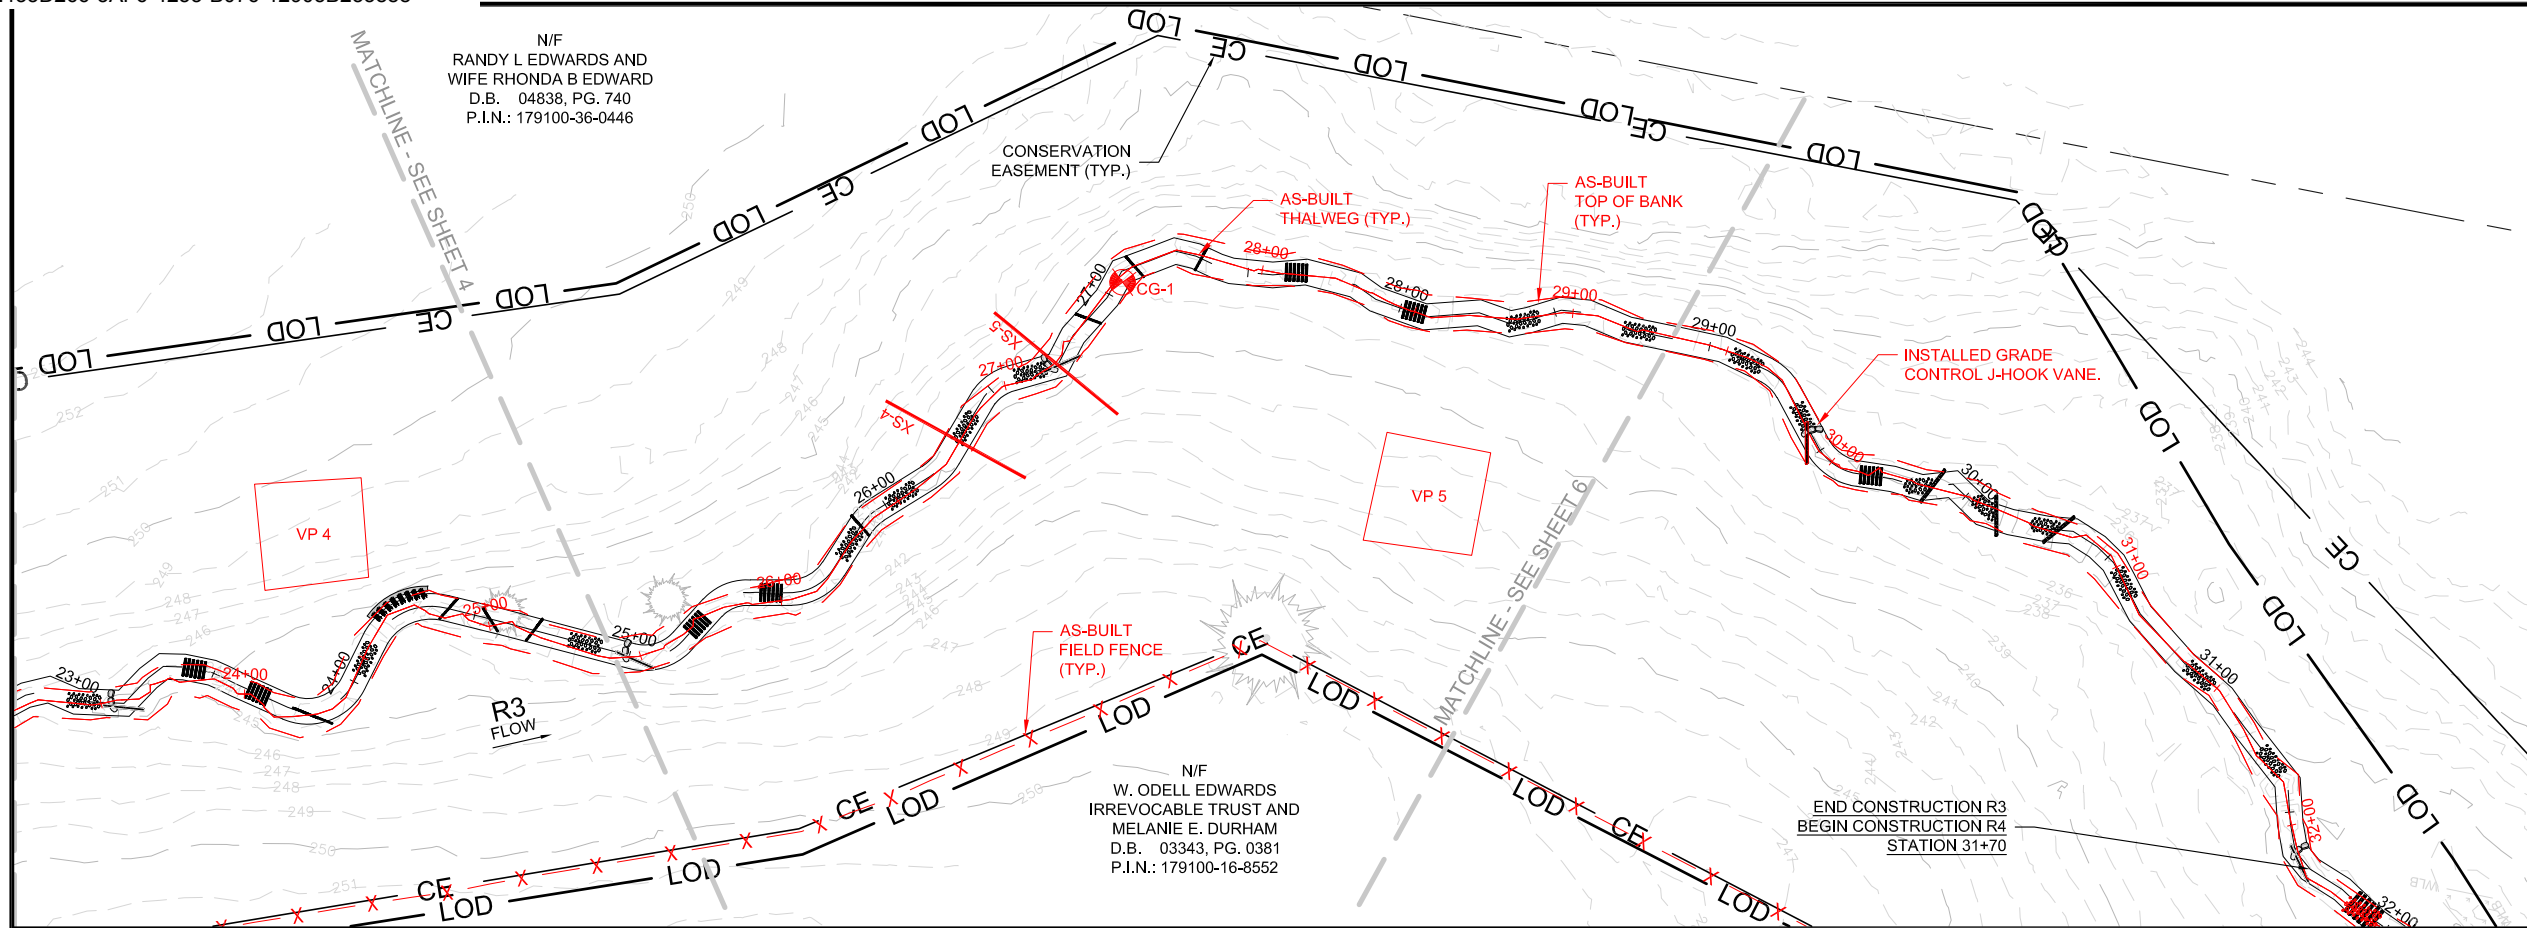

DocuSigned by:
Marshall Wight
 62C73F441B864C1...
 8/16/2021

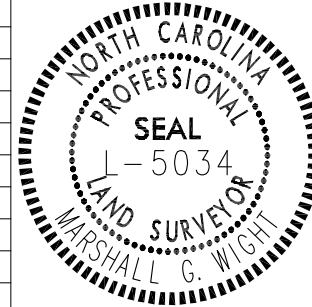

WATER & LAND SOLUTIONS
 7721 Six Forks Rd., Suite 130
 Raleigh, NC 27615
 (919)614-5111
 waterlandsolutions.com

PROJECT ENGINEER
 8/16/2021

DocuSigned by:
Christopher A. Tombs
 36916

ENGINEERING SERVICES BY
 WLS ENGINEERING, PLLC
 6 DULA SPRINGS RD.
 WEAVERVILLE, NC 28787
 FIRM LICENSE NO. P-1480


REVISIONS

| REVISION | DESCRIPTION | DATE |
|----------|--------------------------|----------|
| A | DRAFT MIT PLAN | 2-24-20 |
| B | FINAL DRAFT MIT PLAN | 5-15-20 |
| C | FINAL MIT PLAN | 8-12-20 |
| D | FINAL MIT PLAN | 9-8-20 |
| E | IFC PLANS | 10-12-20 |
| F | AS-BUILT PLANS | 6-14-21 |
| G | AS-BUILT PLANS (REVISED) | 8-13-21 |

PROJECT NAME
ODELL'S HOUSE MITIGATION PROJECT
 JOHNSTON COUNTY, NC

DRAWING INFORMATION


| | |
|--------------|--|
| PROJECT NO. | 18-003 |
| FILENAME | ASR_01_10_ODELL'S HOUSE_PLAN AND PROFILE.DWG |
| DESIGNED BY | CAT |
| DRAWN BY | AL |
| DATE | 8-13-21 |
| HORIZ. SCALE | 1" = 60' |
| VERT. SCALE | 1" = 3' |

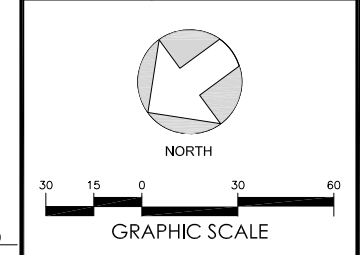

SHEET NAME
R3 & R4

PLAN AND PROFILE

SHEET NUMBER
5

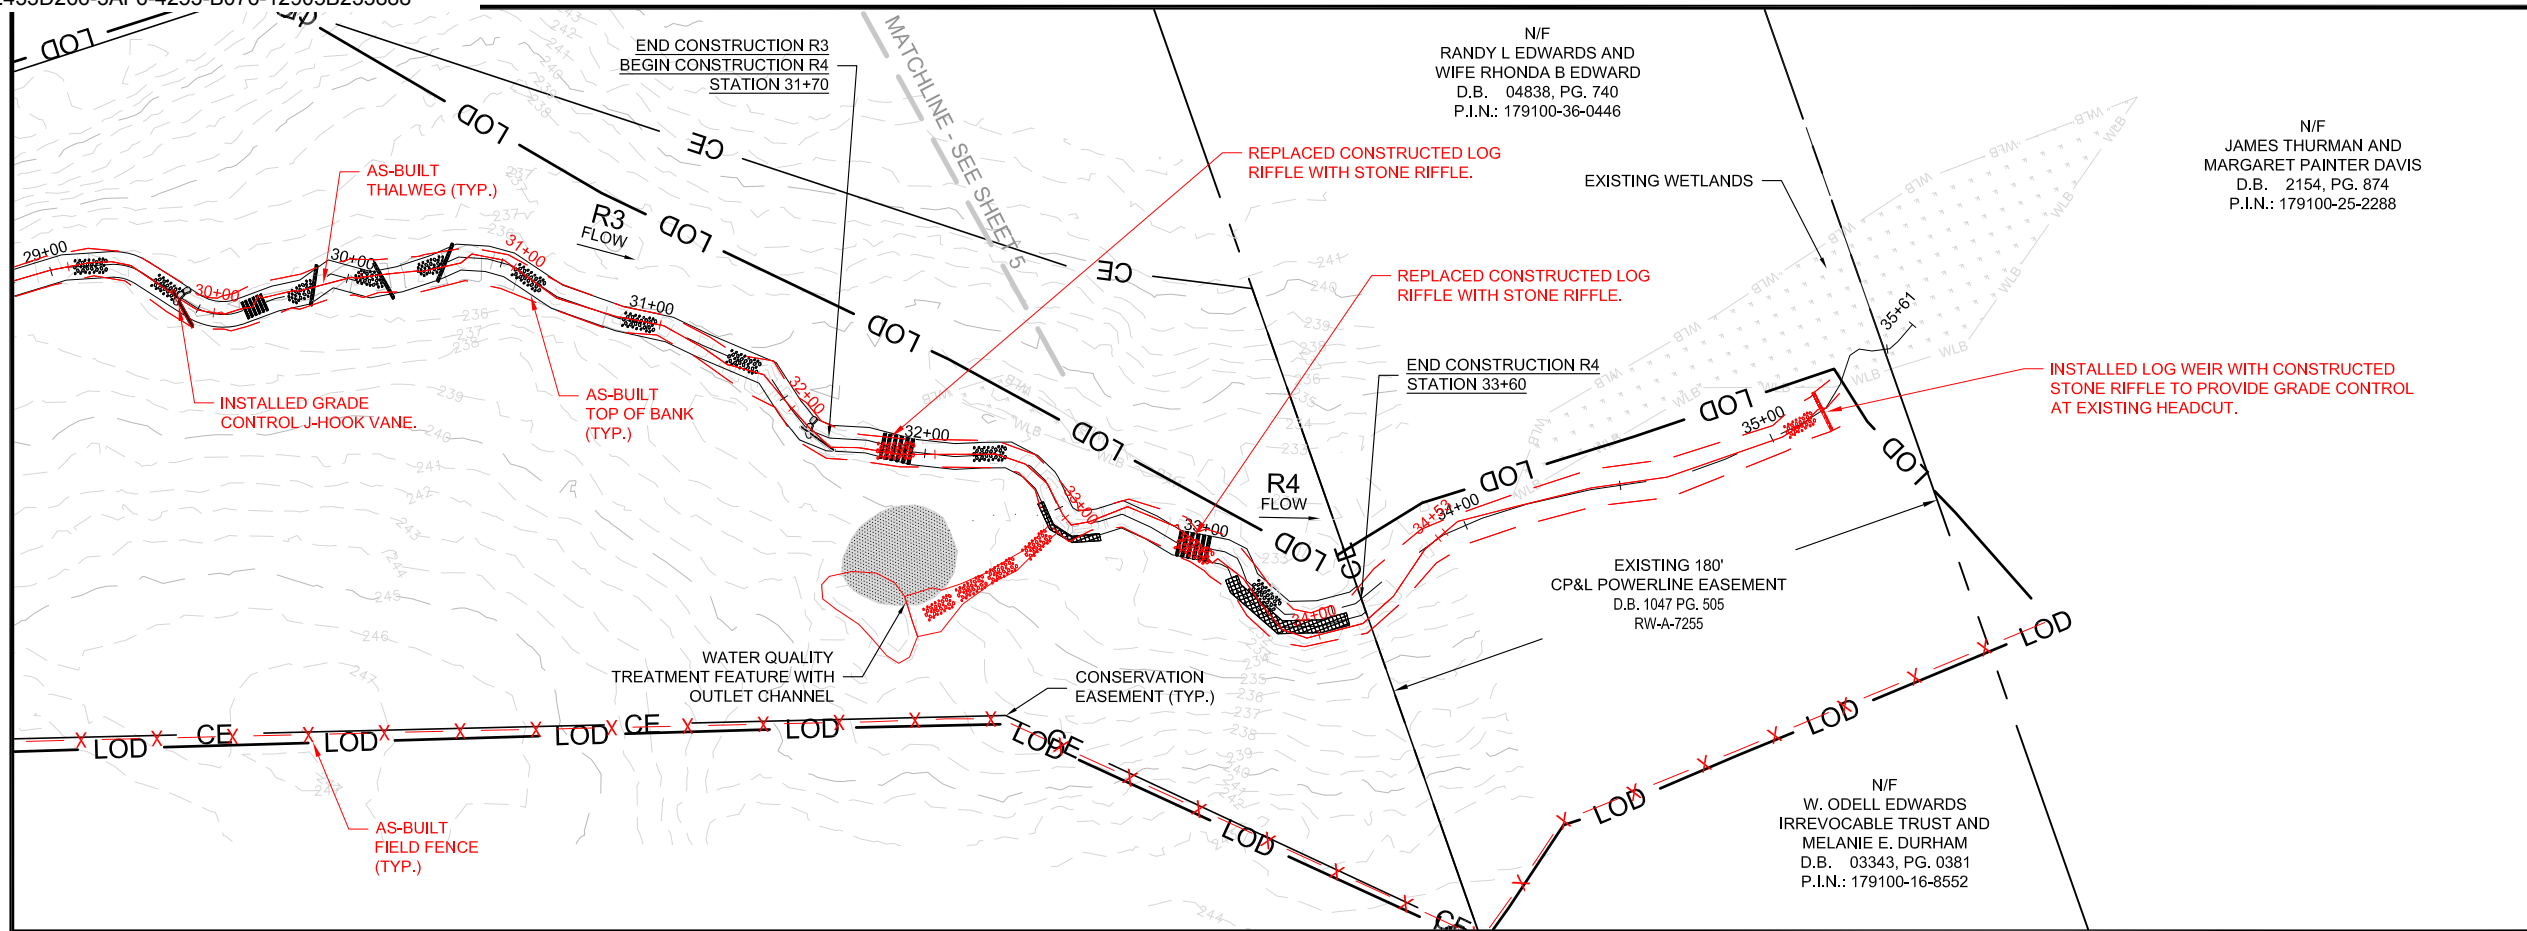

DocuSigned by:
Marshall Wight
 62C73F441B864C1
 8/16/2021



WATER & LAND SOLUTIONS
 7721 Six Forks Rd., Suite 130
 Raleigh, NC 27615
 (919)614-5111
 waterlandsolutions.com

PROJECT ENGINEER
 8/16/2021

DocuSigned by:
Christopher A. Tomascik
 36916

ENGINEERING SERVICES BY
 WLS ENGINEERING, PLLC
 6 DULA SPRINGS RD.
 WEAVERVILLE, NC 28787
 FIRM LICENSE NO. P-1480


REVISIONS

| REVISION | DESCRIPTION | DATE |
|----------|--------------------------|----------|
| A | DRAFT MIT PLAN | 2-24-20 |
| B | FINAL DRAFT MIT PLAN | 5-15-20 |
| C | FINAL MIT PLAN | 8-12-20 |
| D | FINAL MIT PLAN | 9-8-20 |
| E | IFC PLANS | 10-12-20 |
| F | AS-BUILT PLANS | 6-14-21 |
| G | AS-BUILT PLANS (REVISED) | 8-13-21 |

PROJECT NAME
ODELL'S HOUSE MITIGATION PROJECT
 JOHNSTON COUNTY, NC

DRAWING INFORMATION



| | |
|--------------|--|
| PROJECT NO. | 18-003 |
| FILENAME | ASR_01_10_ODELL'S HOUSE_PLAN AND PROFILE.DWG |
| DESIGNED BY | CAT |
| DRAWN BY | AL |
| DATE | 8-13-21 |
| HORIZ. SCALE | 1" = 60' |
| VERT. SCALE | 1" = 3' |

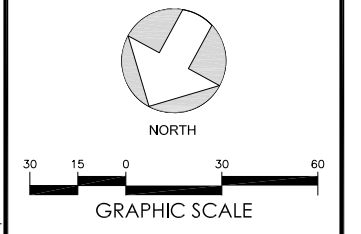

SHEET NAME
R3 & R4
PLAN AND PROFILE

SHEET NUMBER
6

AS-BUILT

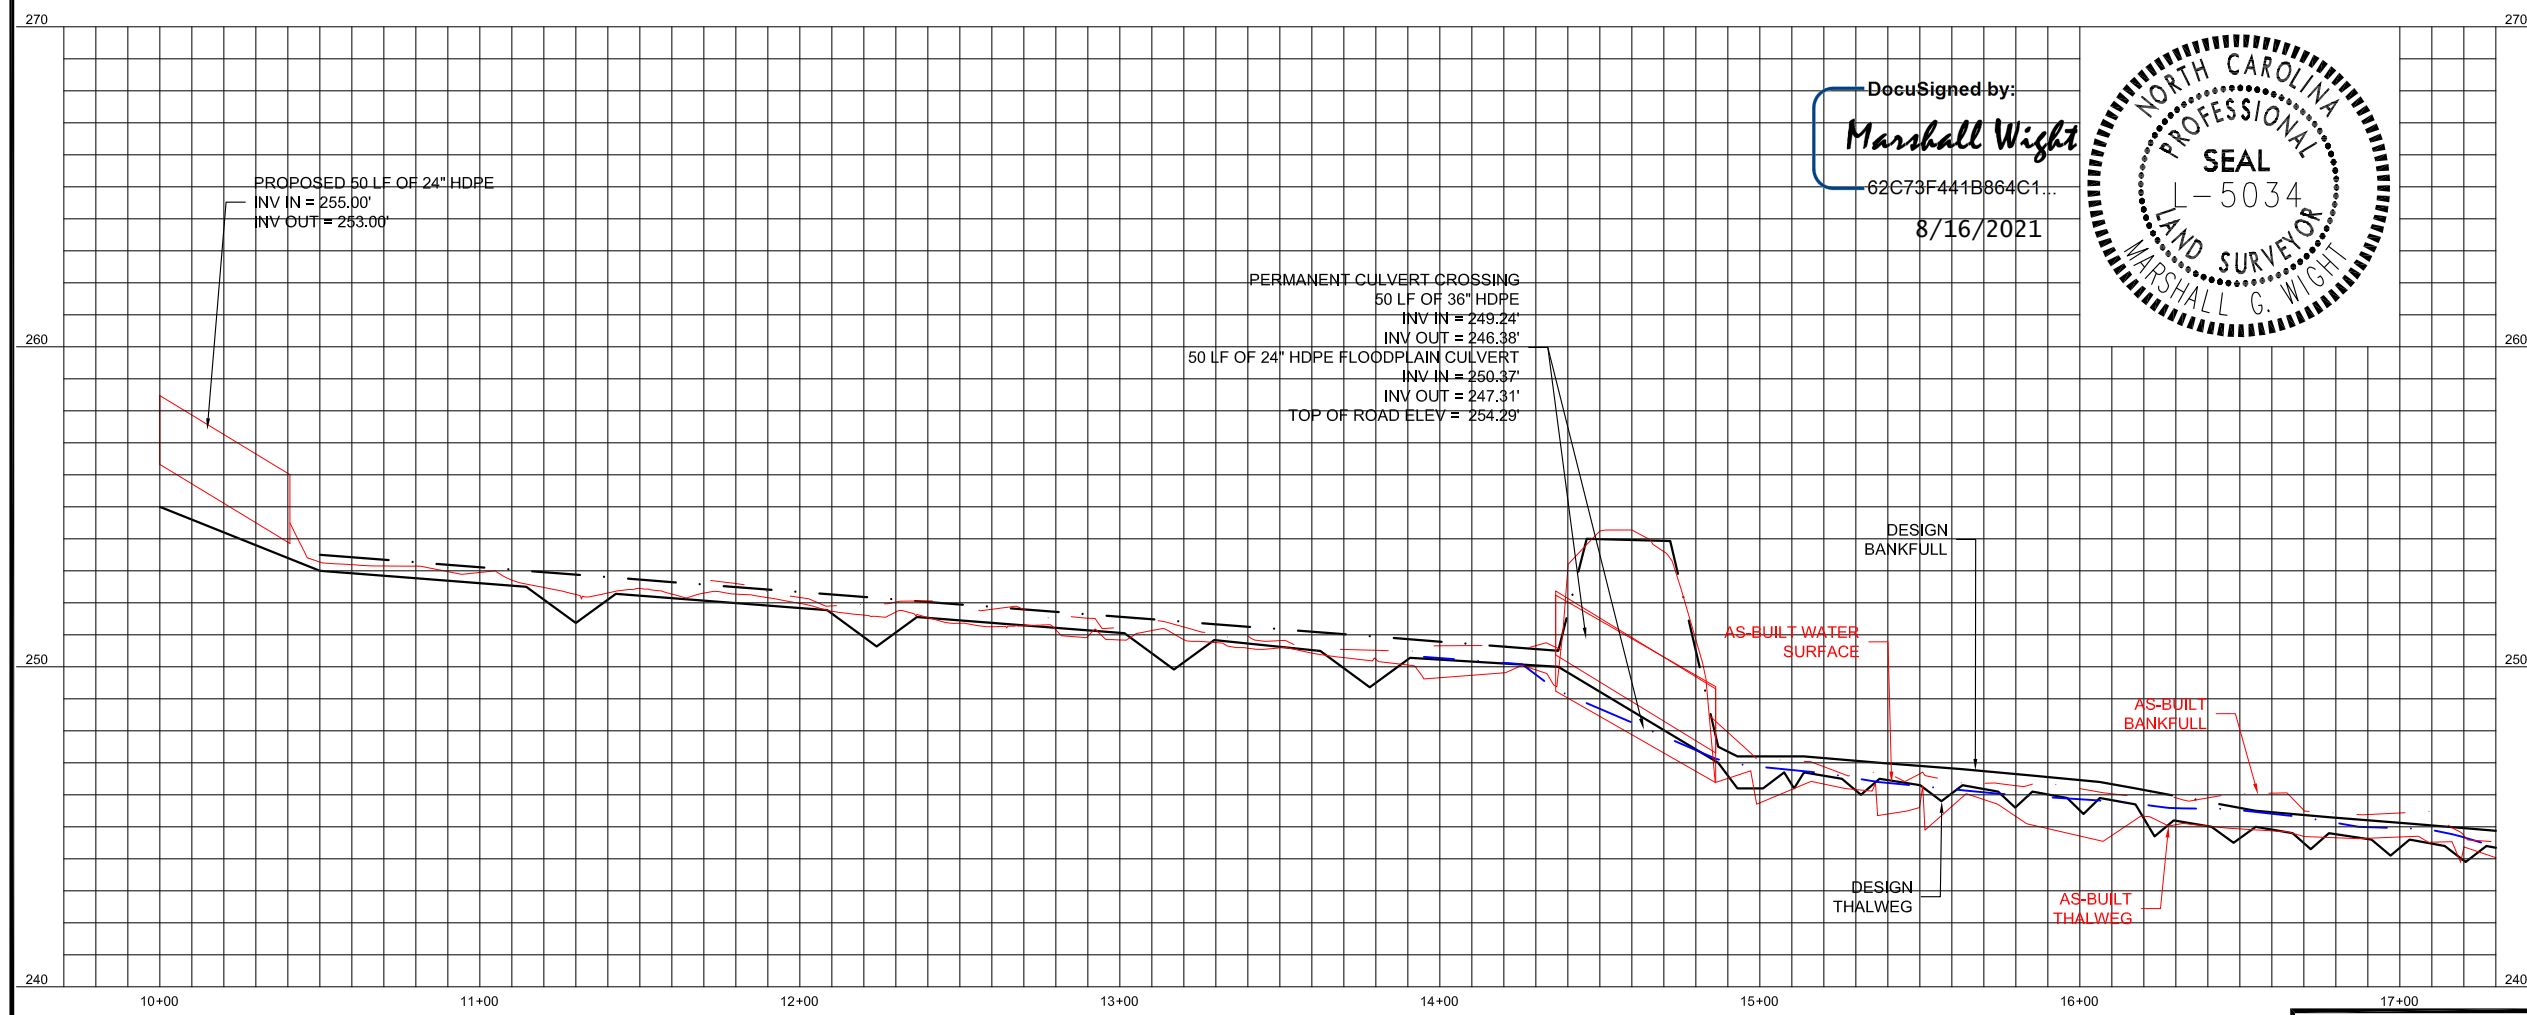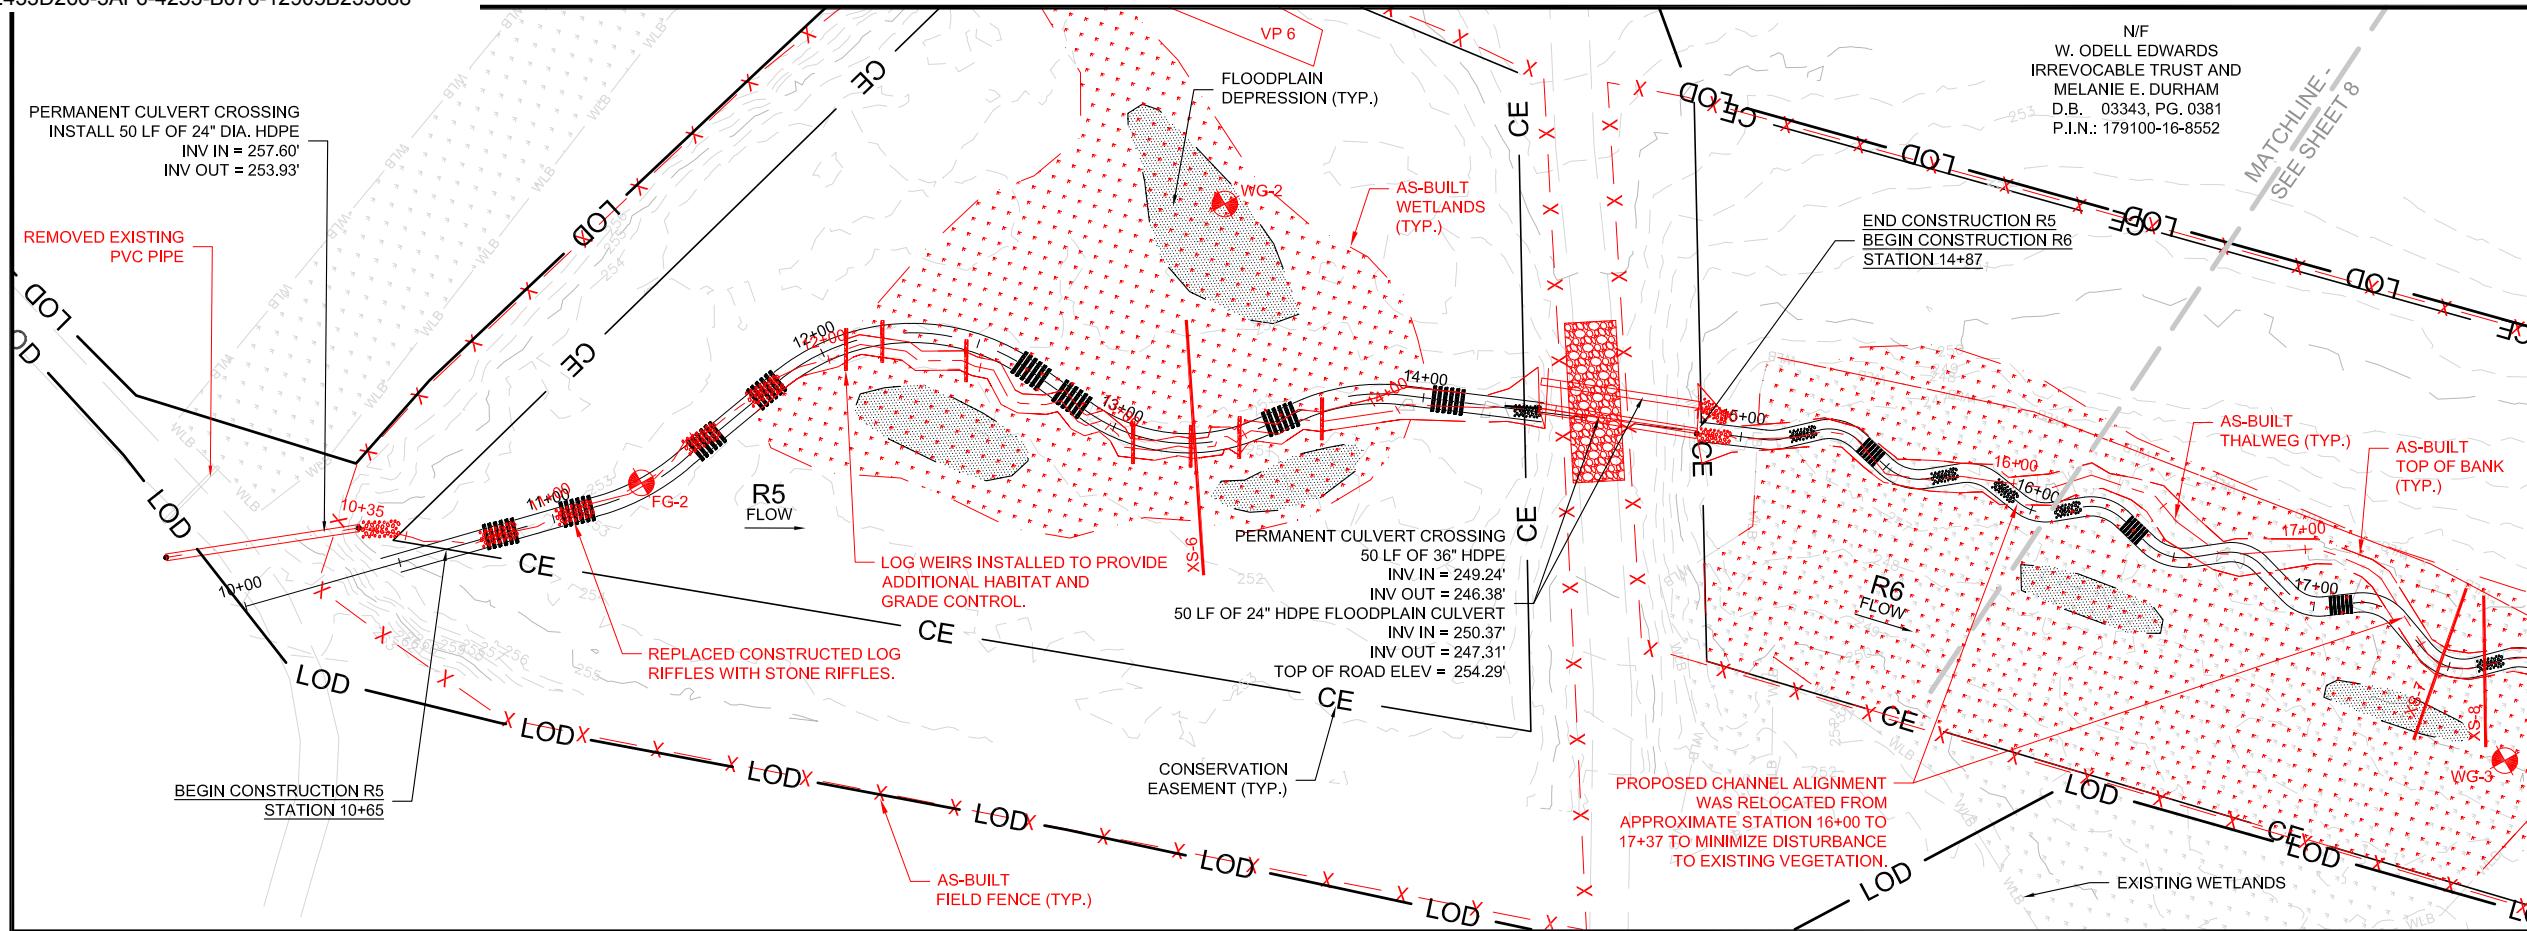

N/F
W. ODELL EDWARDS
IRREVOCABLE TRUST AND
MELANIE E. DURHAM
D.B. 03343, PG. 0381
P.I.N.: 179100-16-8552

WATER & LAND SOLUTIONS

7721 Six Forks Rd., Suite 130
Raleigh, NC 27615
(919)614-5111
waterlandsolutions.com

PROJECT ENGINEER
8/16/2021

NORTH CAROLINA PROFESSIONAL SEAL
DocuSigned by:
36916
CHRISTOPHER A. TOMS

ENGINEERING SERVICES BY
WLS ENGINEERING, PLLC
6 DULA SPRINGS RD.
WEAVERVILLE, NC 28787
FIRM LICENSE NO. P-1480

REVISIONS

| | | |
|---|--------------------------|----------|
| A | DRAFT MIT PLAN | 2-24-20 |
| B | FINAL DRAFT MIT PLAN | 5-15-20 |
| C | FINAL MIT PLAN | 8-12-20 |
| D | FINAL MIT PLAN | 9-8-20 |
| E | IFC PLANS | 10-12-20 |
| F | AS-BUILT PLANS | 6-14-21 |
| G | AS-BUILT PLANS (REVISED) | 8-13-21 |


PROJECT NAME

ODELL'S HOUSE MITIGATION PROJECT

JOHNSTON COUNTY, NC

DRAWING INFORMATION

| | |
|--------------|--|
| PROJECT NO. | 18-003 |
| FILENAME | ASB_01_01_ODELL'S HOUSE PLAN AND PROFILE.DWG |
| DESIGNED BY | CAT |
| DRAWN BY | AL |
| DATE | 8-13-21 |
| HORIZ. SCALE | 1" = 60' |
| VERT. SCALE | 1" = 3' |

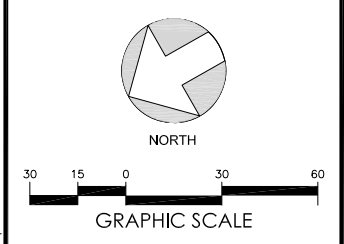



SHEET NAME

R5 & R6

PLAN AND PROFILE

SHEET NUMBER

7

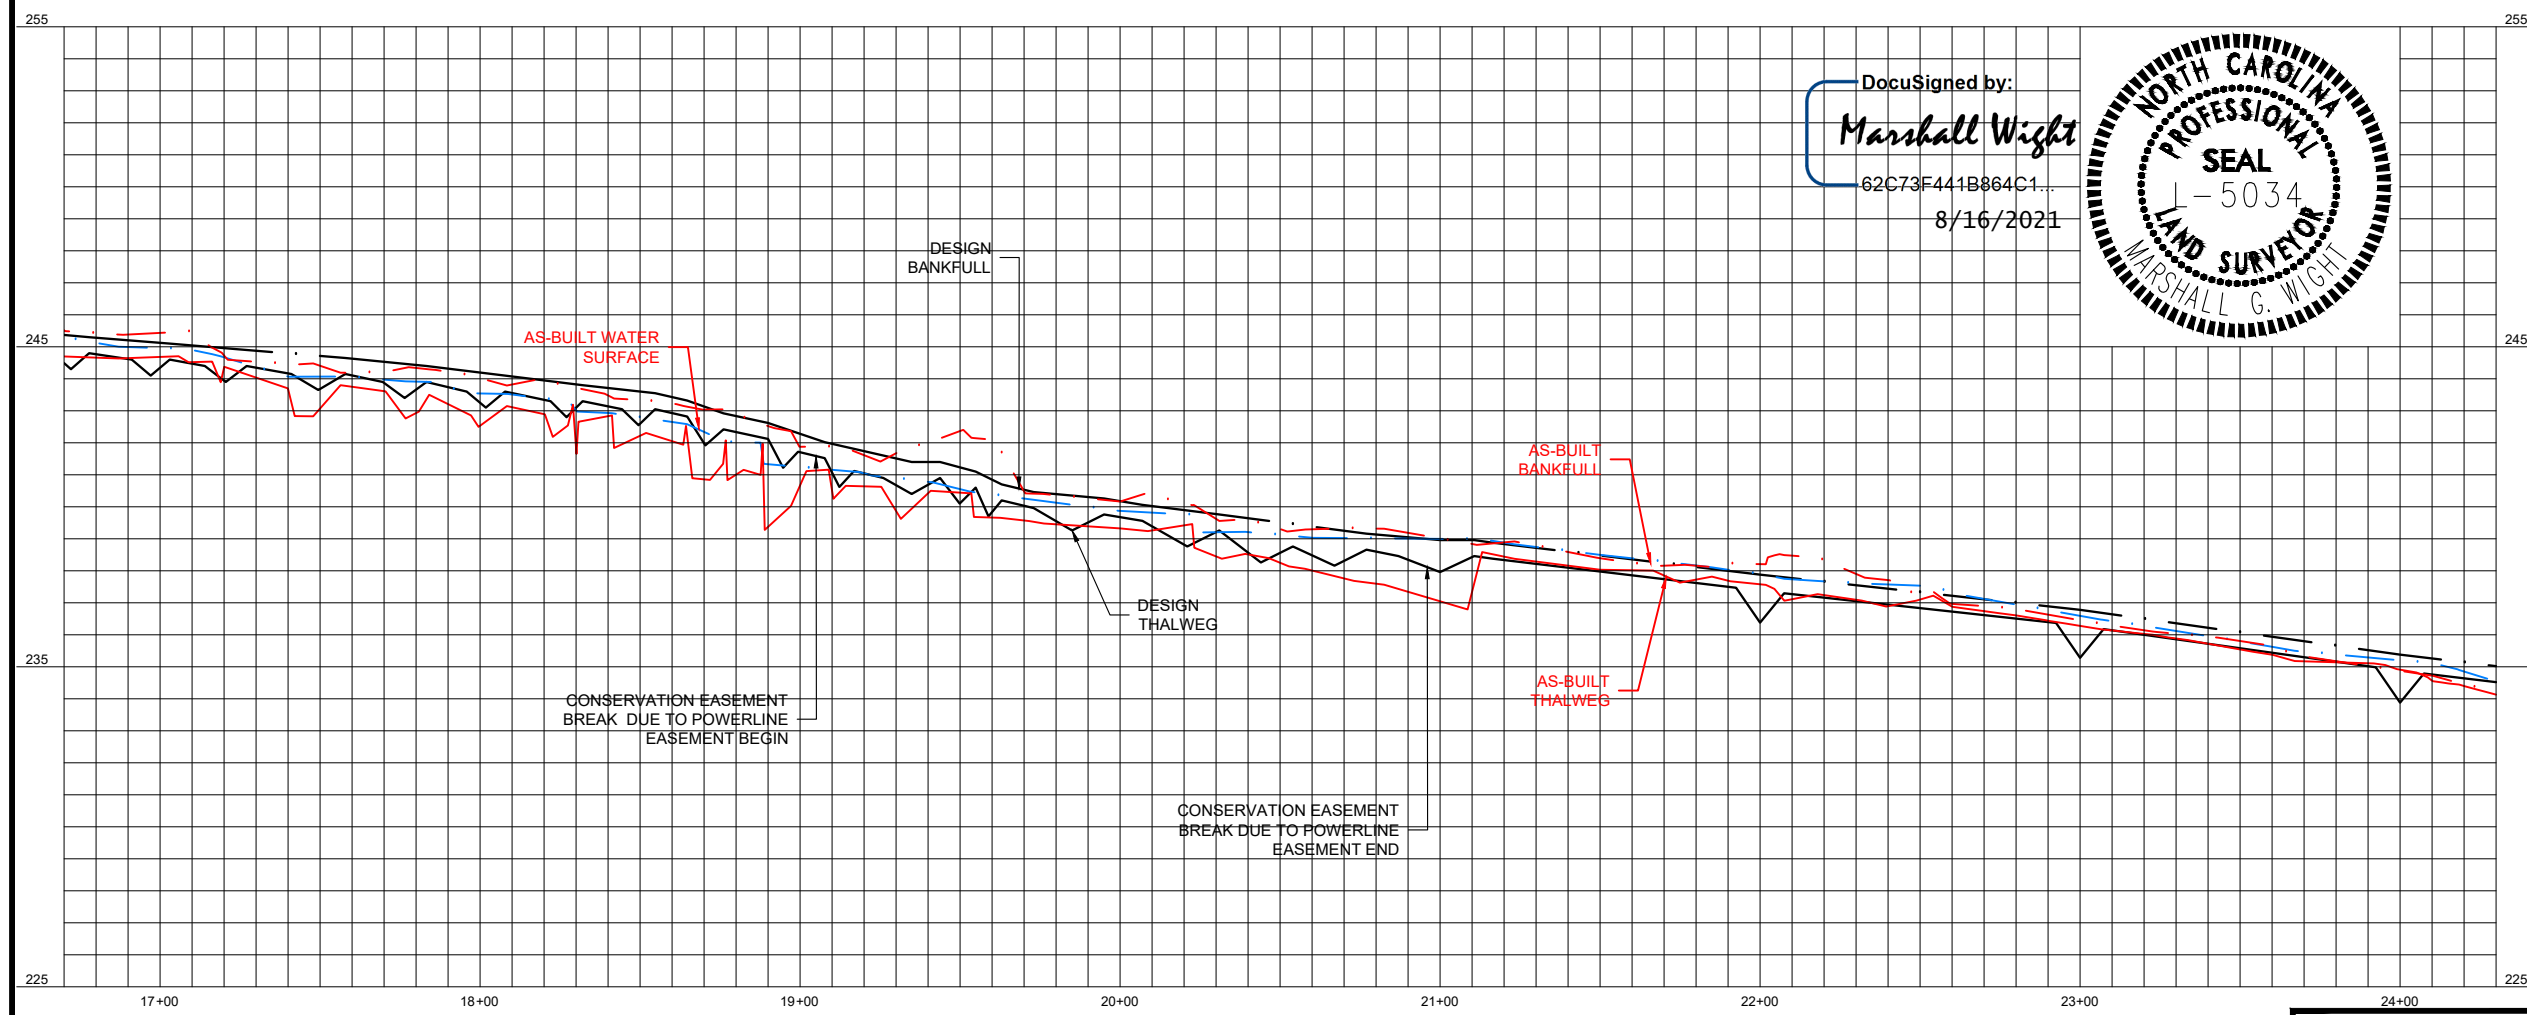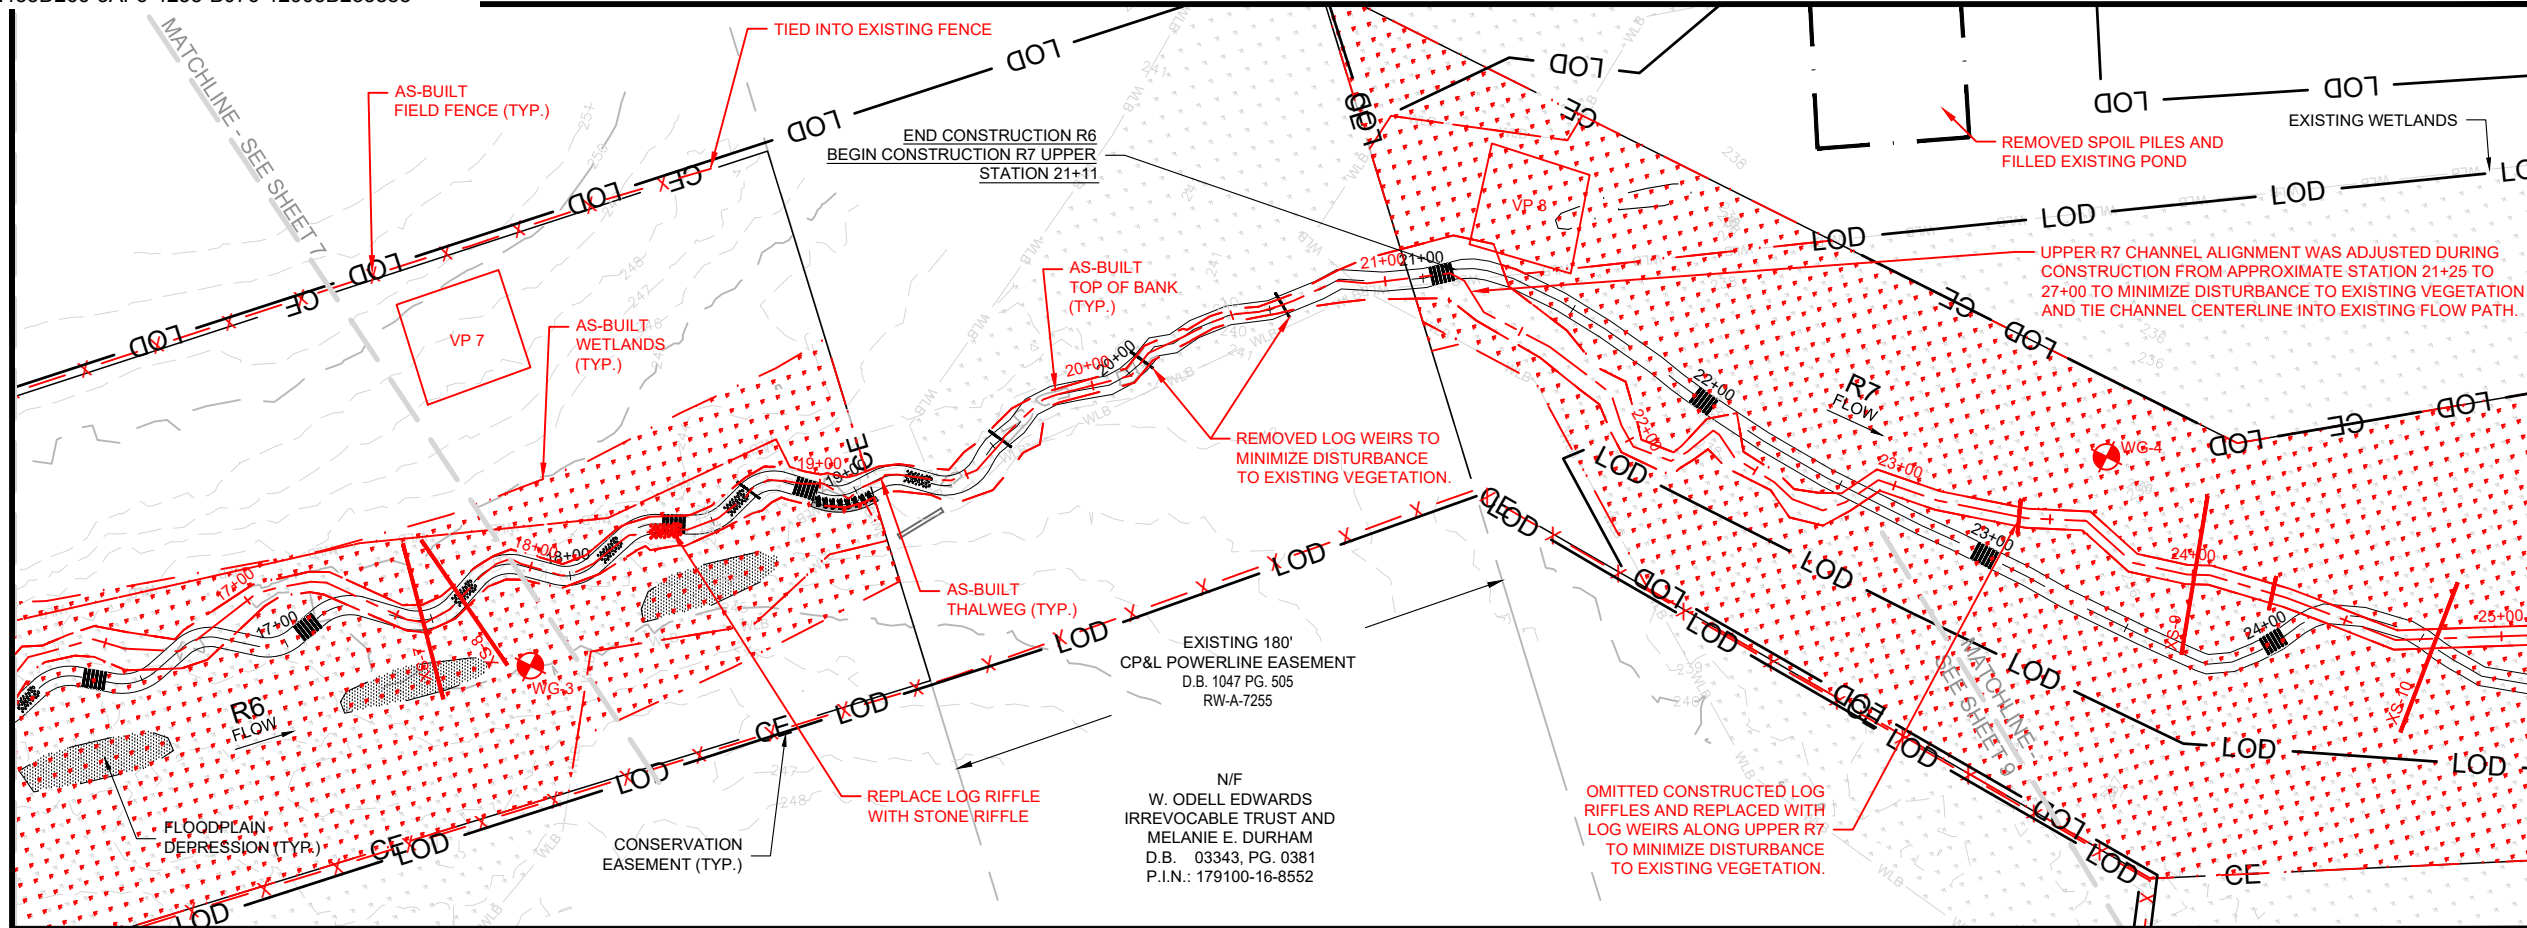

DocuSigned by:
Marshall Wight
 62C73F441B864C1...
 8/16/2021



WATER & LAND SOLUTIONS
 7721 Six Forks Rd., Suite 130
 Raleigh, NC 27615
 (919)614-5111
 waterlandsolutions.com

PROJECT ENGINEER
 8/16/2021

DocuSigned By:
36916
CHRISTOPHER A. TOMISE
 ENGINEER

ENGINEERING SERVICES BY
 WLS ENGINEERING, PLLC
 6 DULA SPRINGS RD.
 WEAVERVILLE, NC 28787
 FIRM LICENSE NO. P-1480


REVISIONS

| REVISION | DESCRIPTION | DATE |
|----------|--------------------------|----------|
| A | DRAFT MIT PLAN | 2-24-20 |
| B | FINAL DRAFT MIT PLAN | 5-15-20 |
| C | FINAL MIT PLAN | 8-12-20 |
| D | FINAL MIT PLAN | 9-8-20 |
| E | IFC PLANS | 10-12-20 |
| F | AS-BUILT PLANS | 6-14-21 |
| G | AS-BUILT PLANS (REVISED) | 8-13-21 |

PROJECT NAME
ODELL'S HOUSE MITIGATION PROJECT
 JOHNSTON COUNTY, NC

DRAWING INFORMATION


| | |
|--------------|---|
| PROJECT NO. | 18-003 |
| FILENAME | ASR_03_10_ODELLS HOUSE_PLAN AND PROFILE.DWG |
| DESIGNED BY | CAT |
| DRAWN BY | AL |
| DATE | 8-13-21 |
| HORIZ. SCALE | 1" = 60' |
| VERT. SCALE | 1" = 3' |

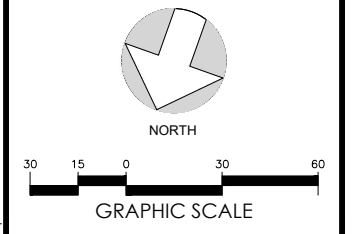

SHEET NAME
R6 & R7
PLAN AND PROFILE


SHEET NUMBER
8

AS-BUILT

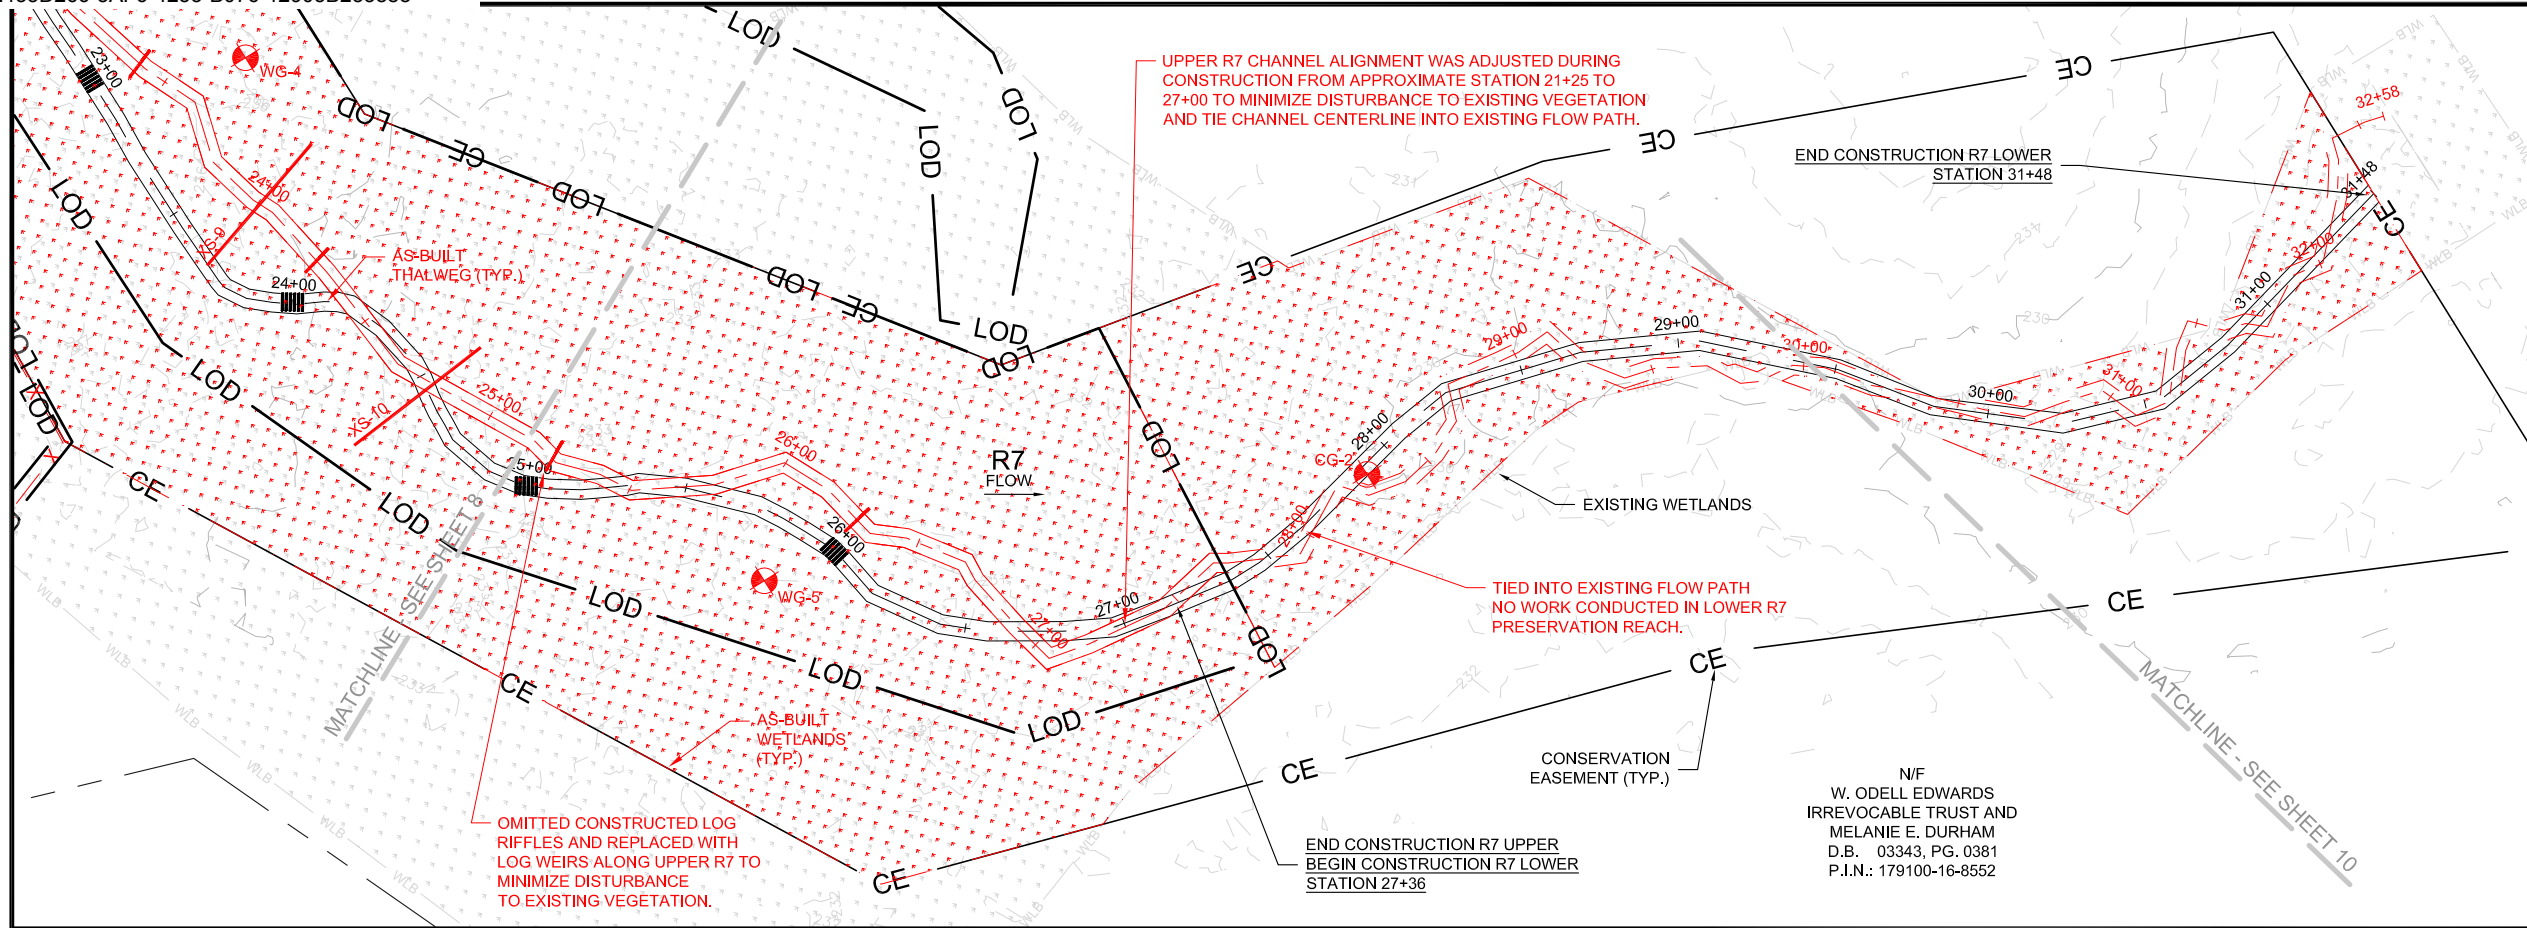

WATER & LAND SOLUTIONS
 7721 Six Forks Rd., Suite 130
 Raleigh, NC 27615
 (919)614-5111
 waterlandsolutions.com

PROJECT ENGINEER
8/16/2021

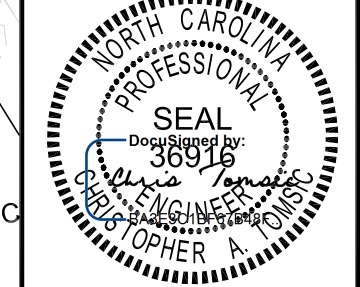

ENGINEERING SERVICES BY
 WLS ENGINEERING, PLLC
 6 DULA SPRINGS RD.
 WEAVERVILLE, NC 28787
 FIRM LICENSE NO. P-1480


REVISIONS

| REVISION | DESCRIPTION | DATE |
|----------|--------------------------|----------|
| A | DRAFT MIT PLAN | 2-24-20 |
| B | FINAL DRAFT MIT PLAN | 5-15-20 |
| C | FINAL MIT PLAN | 8-12-20 |
| D | FINAL MIT PLAN | 9-8-20 |
| E | IFC PLANS | 10-12-20 |
| F | AS-BUILT PLANS | 6-14-21 |
| G | AS-BUILT PLANS (REVISED) | 8-13-21 |

PROJECT NAME
ODELL'S HOUSE MITIGATION PROJECT
 JOHNSTON COUNTY, NC


DRAWING INFORMATION

| | |
|--------------|--|
| PROJECT NO. | 18-003 |
| FILENAME | ASR_01_10_ODELL'S HOUSE_PLAN AND PROFILE.DWG |
| DESIGNED BY | CAT |
| DRAWN BY | AL |
| DATE | 8-13-21 |
| HORIZ. SCALE | 1" = 60' |
| VERT. SCALE | 1" = 3' |


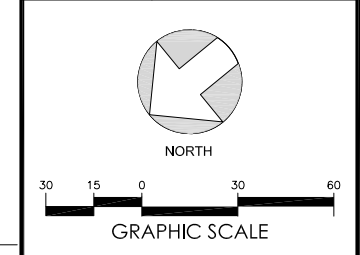


SHEET NAME
R7
PLAN AND PROFILE

SHEET NUMBER
9

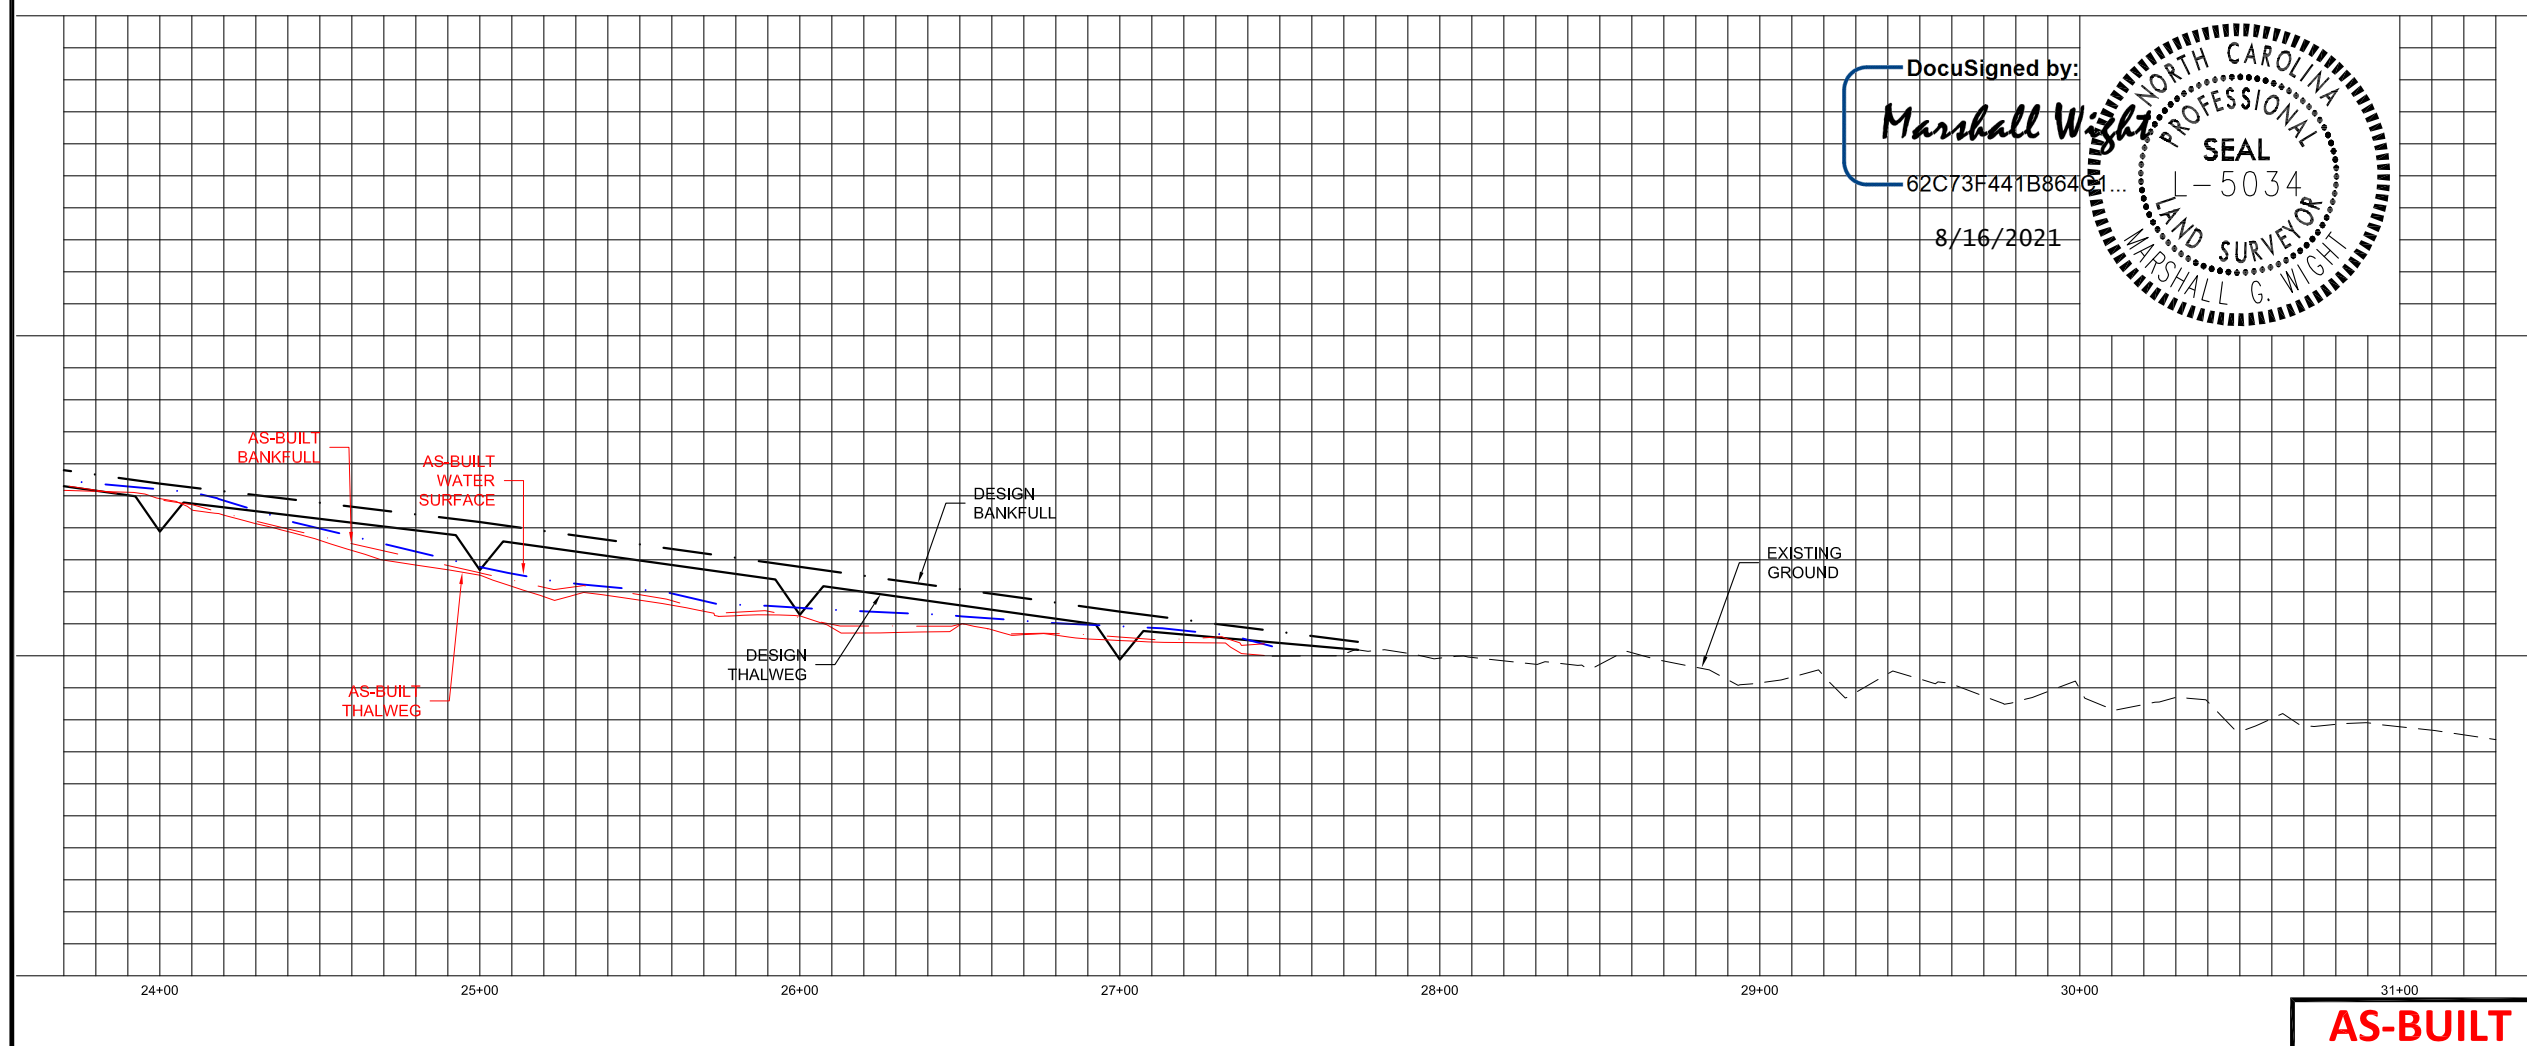

AS-BUILT

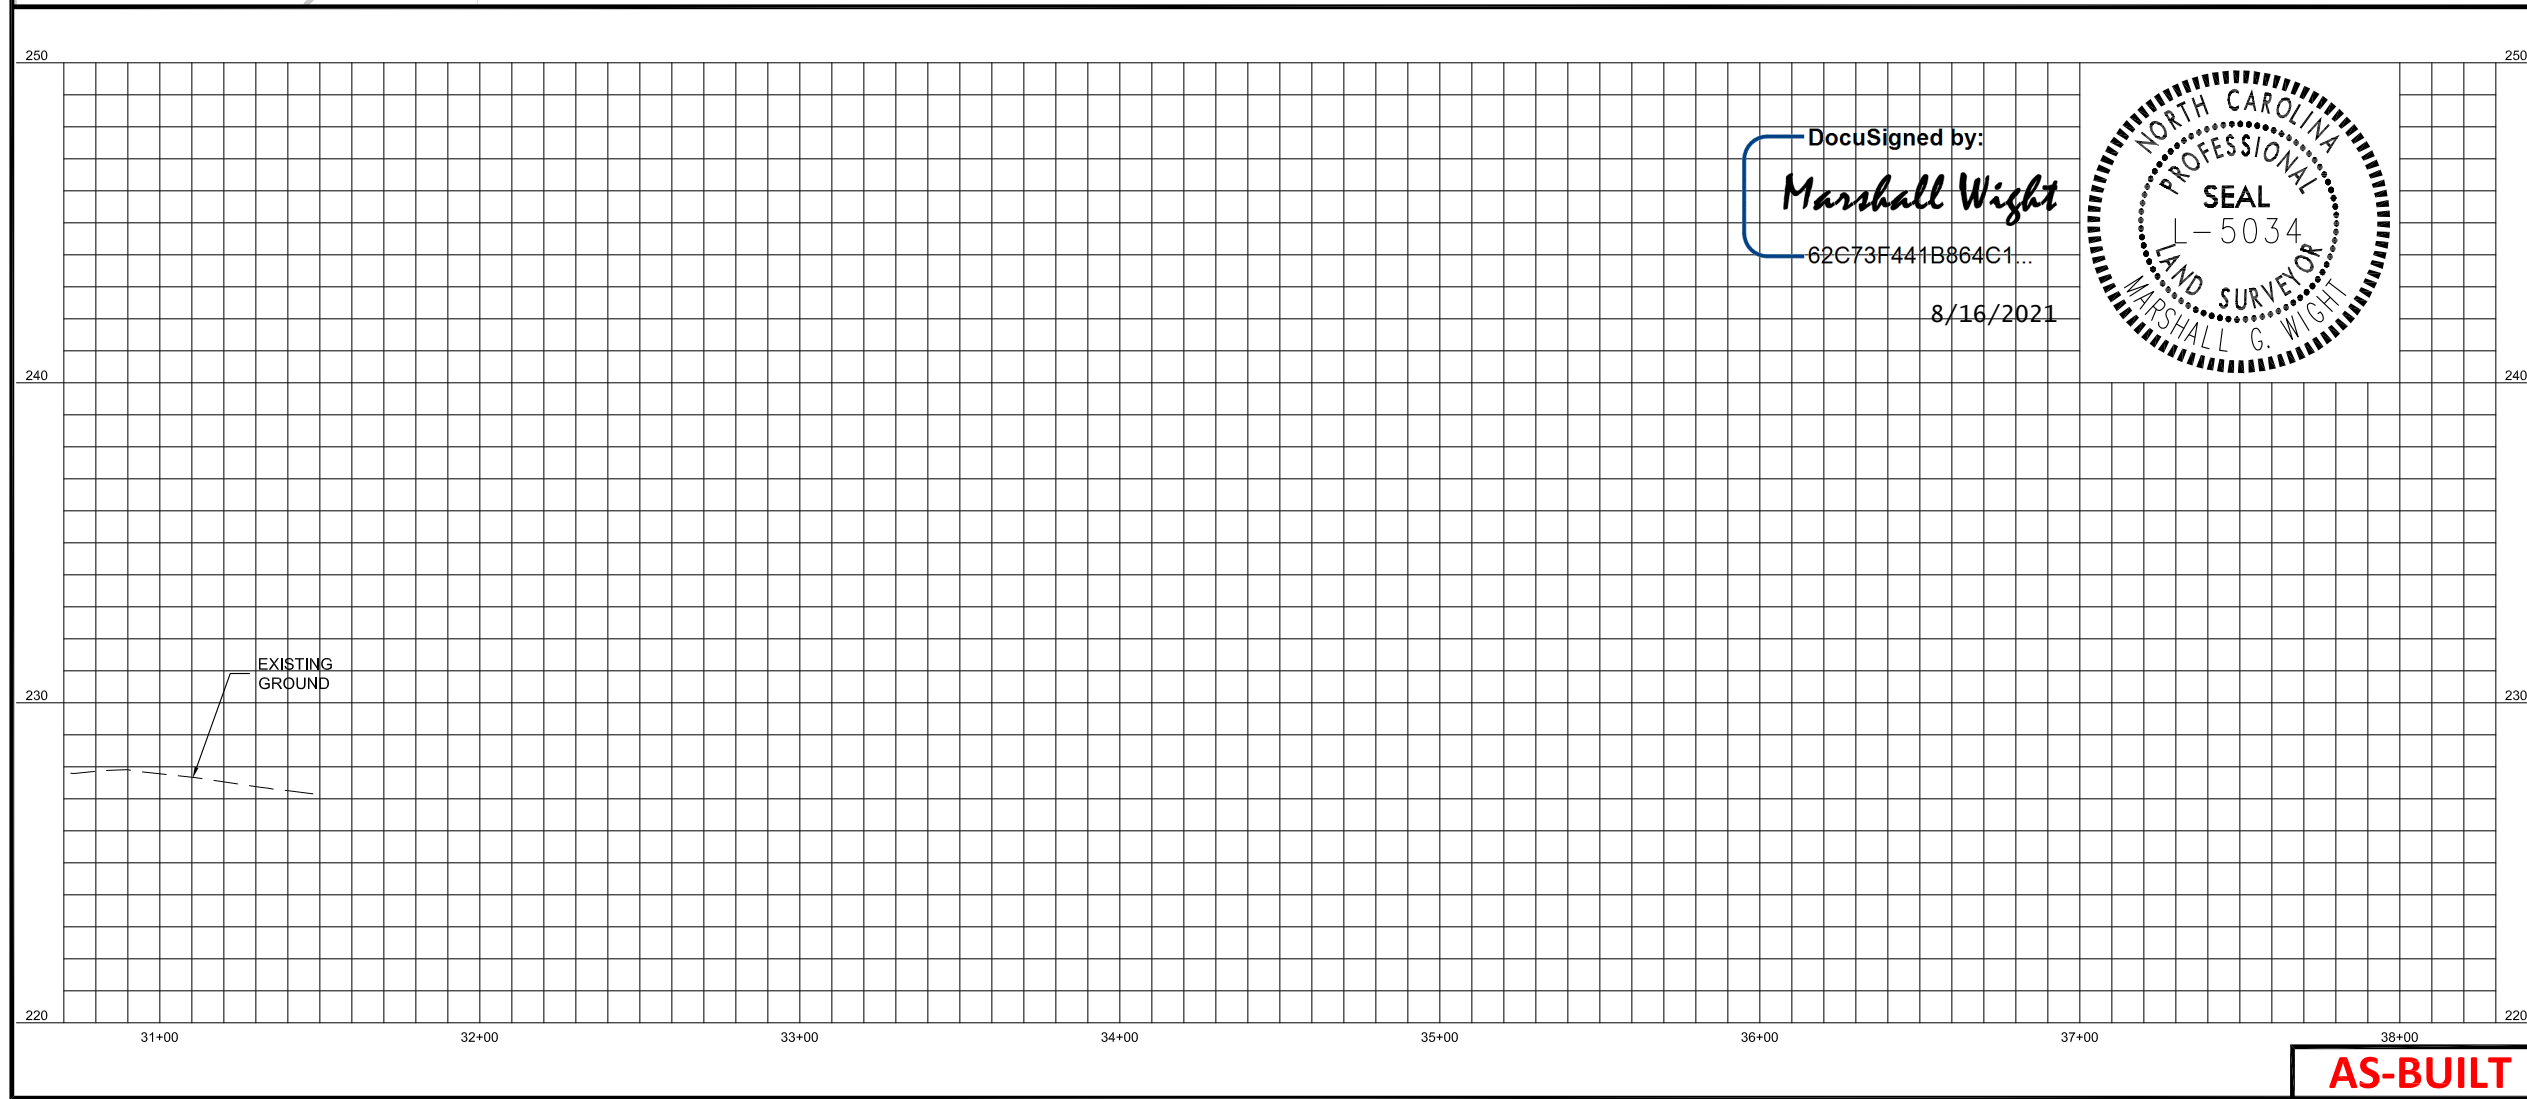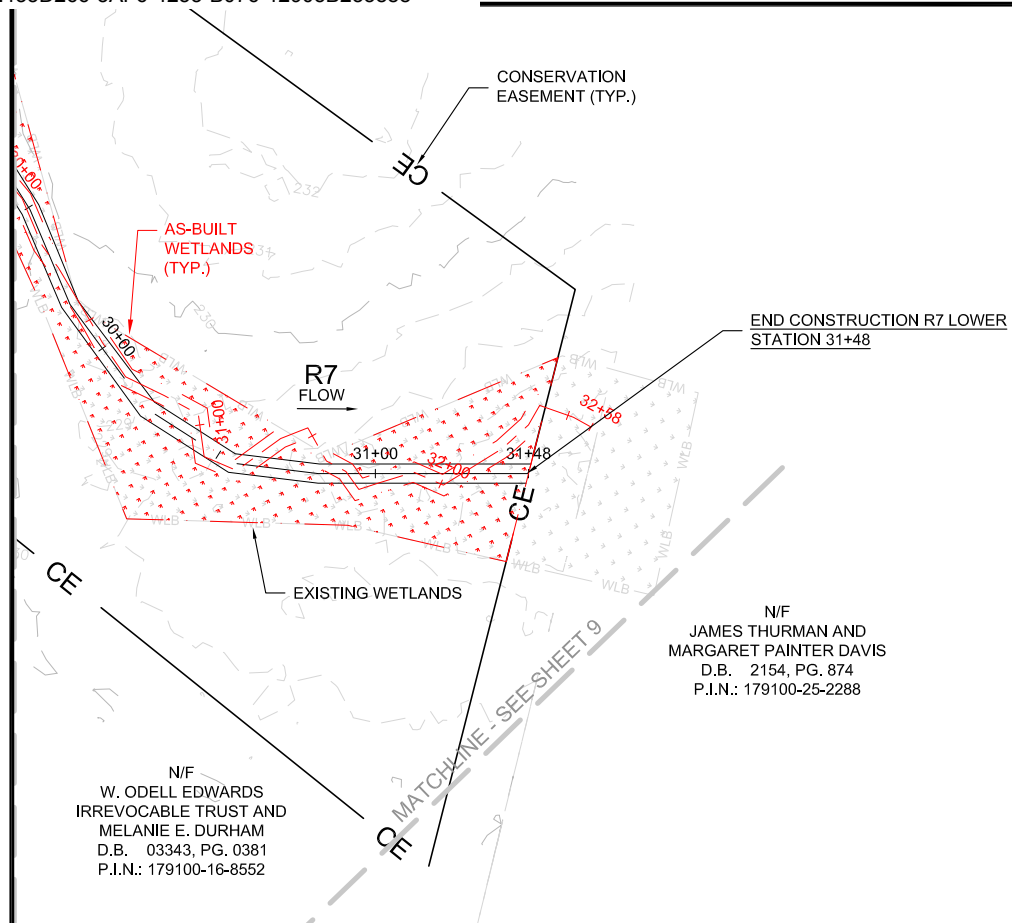

AS-BUILT

WATER & LAND SOLUTIONS
 7721 Six Forks Rd., Suite 130
 Raleigh, NC 27615
 (919)614-5111
 waterlandsolutions.com

PROJECT ENGINEER
 8/16/2021

ENGINEERING SERVICES BY
 WLS ENGINEERING, PLLC
 6 DULA SPRINGS RD.
 WEAVERVILLE, NC 28787
 FIRM LICENSE NO. P-1480


REVISIONS

| REVISION | DESCRIPTION | DATE |
|----------|--------------------------|----------|
| A | DRAFT MIT PLAN | 2-24-20 |
| B | FINAL DRAFT MIT PLAN | 5-15-20 |
| C | FINAL MIT PLAN | 8-12-20 |
| D | FINAL MIT PLAN | 9-8-20 |
| E | IFC PLANS | 10-12-20 |
| F | AS-BUILT PLANS | 6-14-21 |
| G | AS-BUILT PLANS (REVISED) | 8-13-21 |

PROJECT NAME
ODELL'S HOUSE MITIGATION PROJECT
 JOHNSTON COUNTY, NC

DRAWING INFORMATION

| | |
|--------------|--|
| PROJECT NO. | 18-003 |
| FILENAME | ASB_01_10_ODELL'S HOUSE_PLAN AND PROFILE.DWG |
| DESIGNED BY | CAT |
| DRAWN BY | AL |
| DATE | 8-13-21 |
| HORIZ. SCALE | 1" = 60' |
| VERT. SCALE | 1" = 3' |

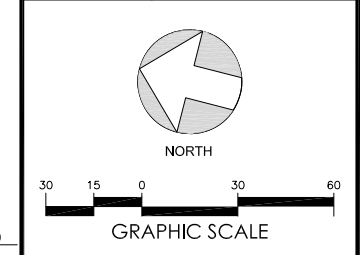


SHEET NAME
R7
PLAN AND PROFILE

SHEET NUMBER
10



7721 Six Forks Rd., Suite 130
Raleigh, NC 27615
(919)614-5111
waterlandsolutions.com

PROJECT ENGINEER
8/16/2021

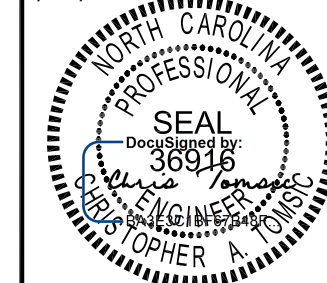


ENGINEERING SERVICES BY
WLS ENGINEERING, PLLC
6 DULA SPRINGS RD.
WEAVERVILLE, NC 28787
FIRM LICENSE NO. P-1480

| REVISIONS | | |
|-----------|--------------------------|----------|
| A | DRAFT MIT PLAN | 2-24-20 |
| B | FINAL DRAFT MIT PLAN | 5-15-20 |
| C | FINAL MIT PLAN | 8-12-20 |
| D | FINAL MIT PLAN | 9-8-20 |
| E | IFC PLANS | 10-12-20 |
| F | AS-BUILT PLANS | 6-14-21 |
| G | AS-BUILT PLANS (REVISED) | 8-13-21 |


PROJECT NAME
ODELL'S HOUSE MITIGATION PROJECT
JOHNSTON COUNTY, NC


| DRAWING INFORMATION | |
|---------------------|---|
| PROJECT NO. | 18-003 |
| FILENAME | ASB_11_12_ODELL'S HOUSE_MONITORING PLAN.DWG |
| DESIGNED BY | CAT |
| DRAWN BY | AL |
| DATE | 8-13-21 |
| HORIZ. SCALE | 1" = 150' |
| VERT. SCALE | N/A |

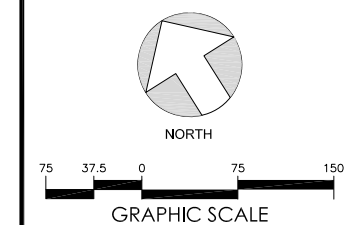

SHEET NAME
MONITORING PLAN

SHEET NUMBER
11

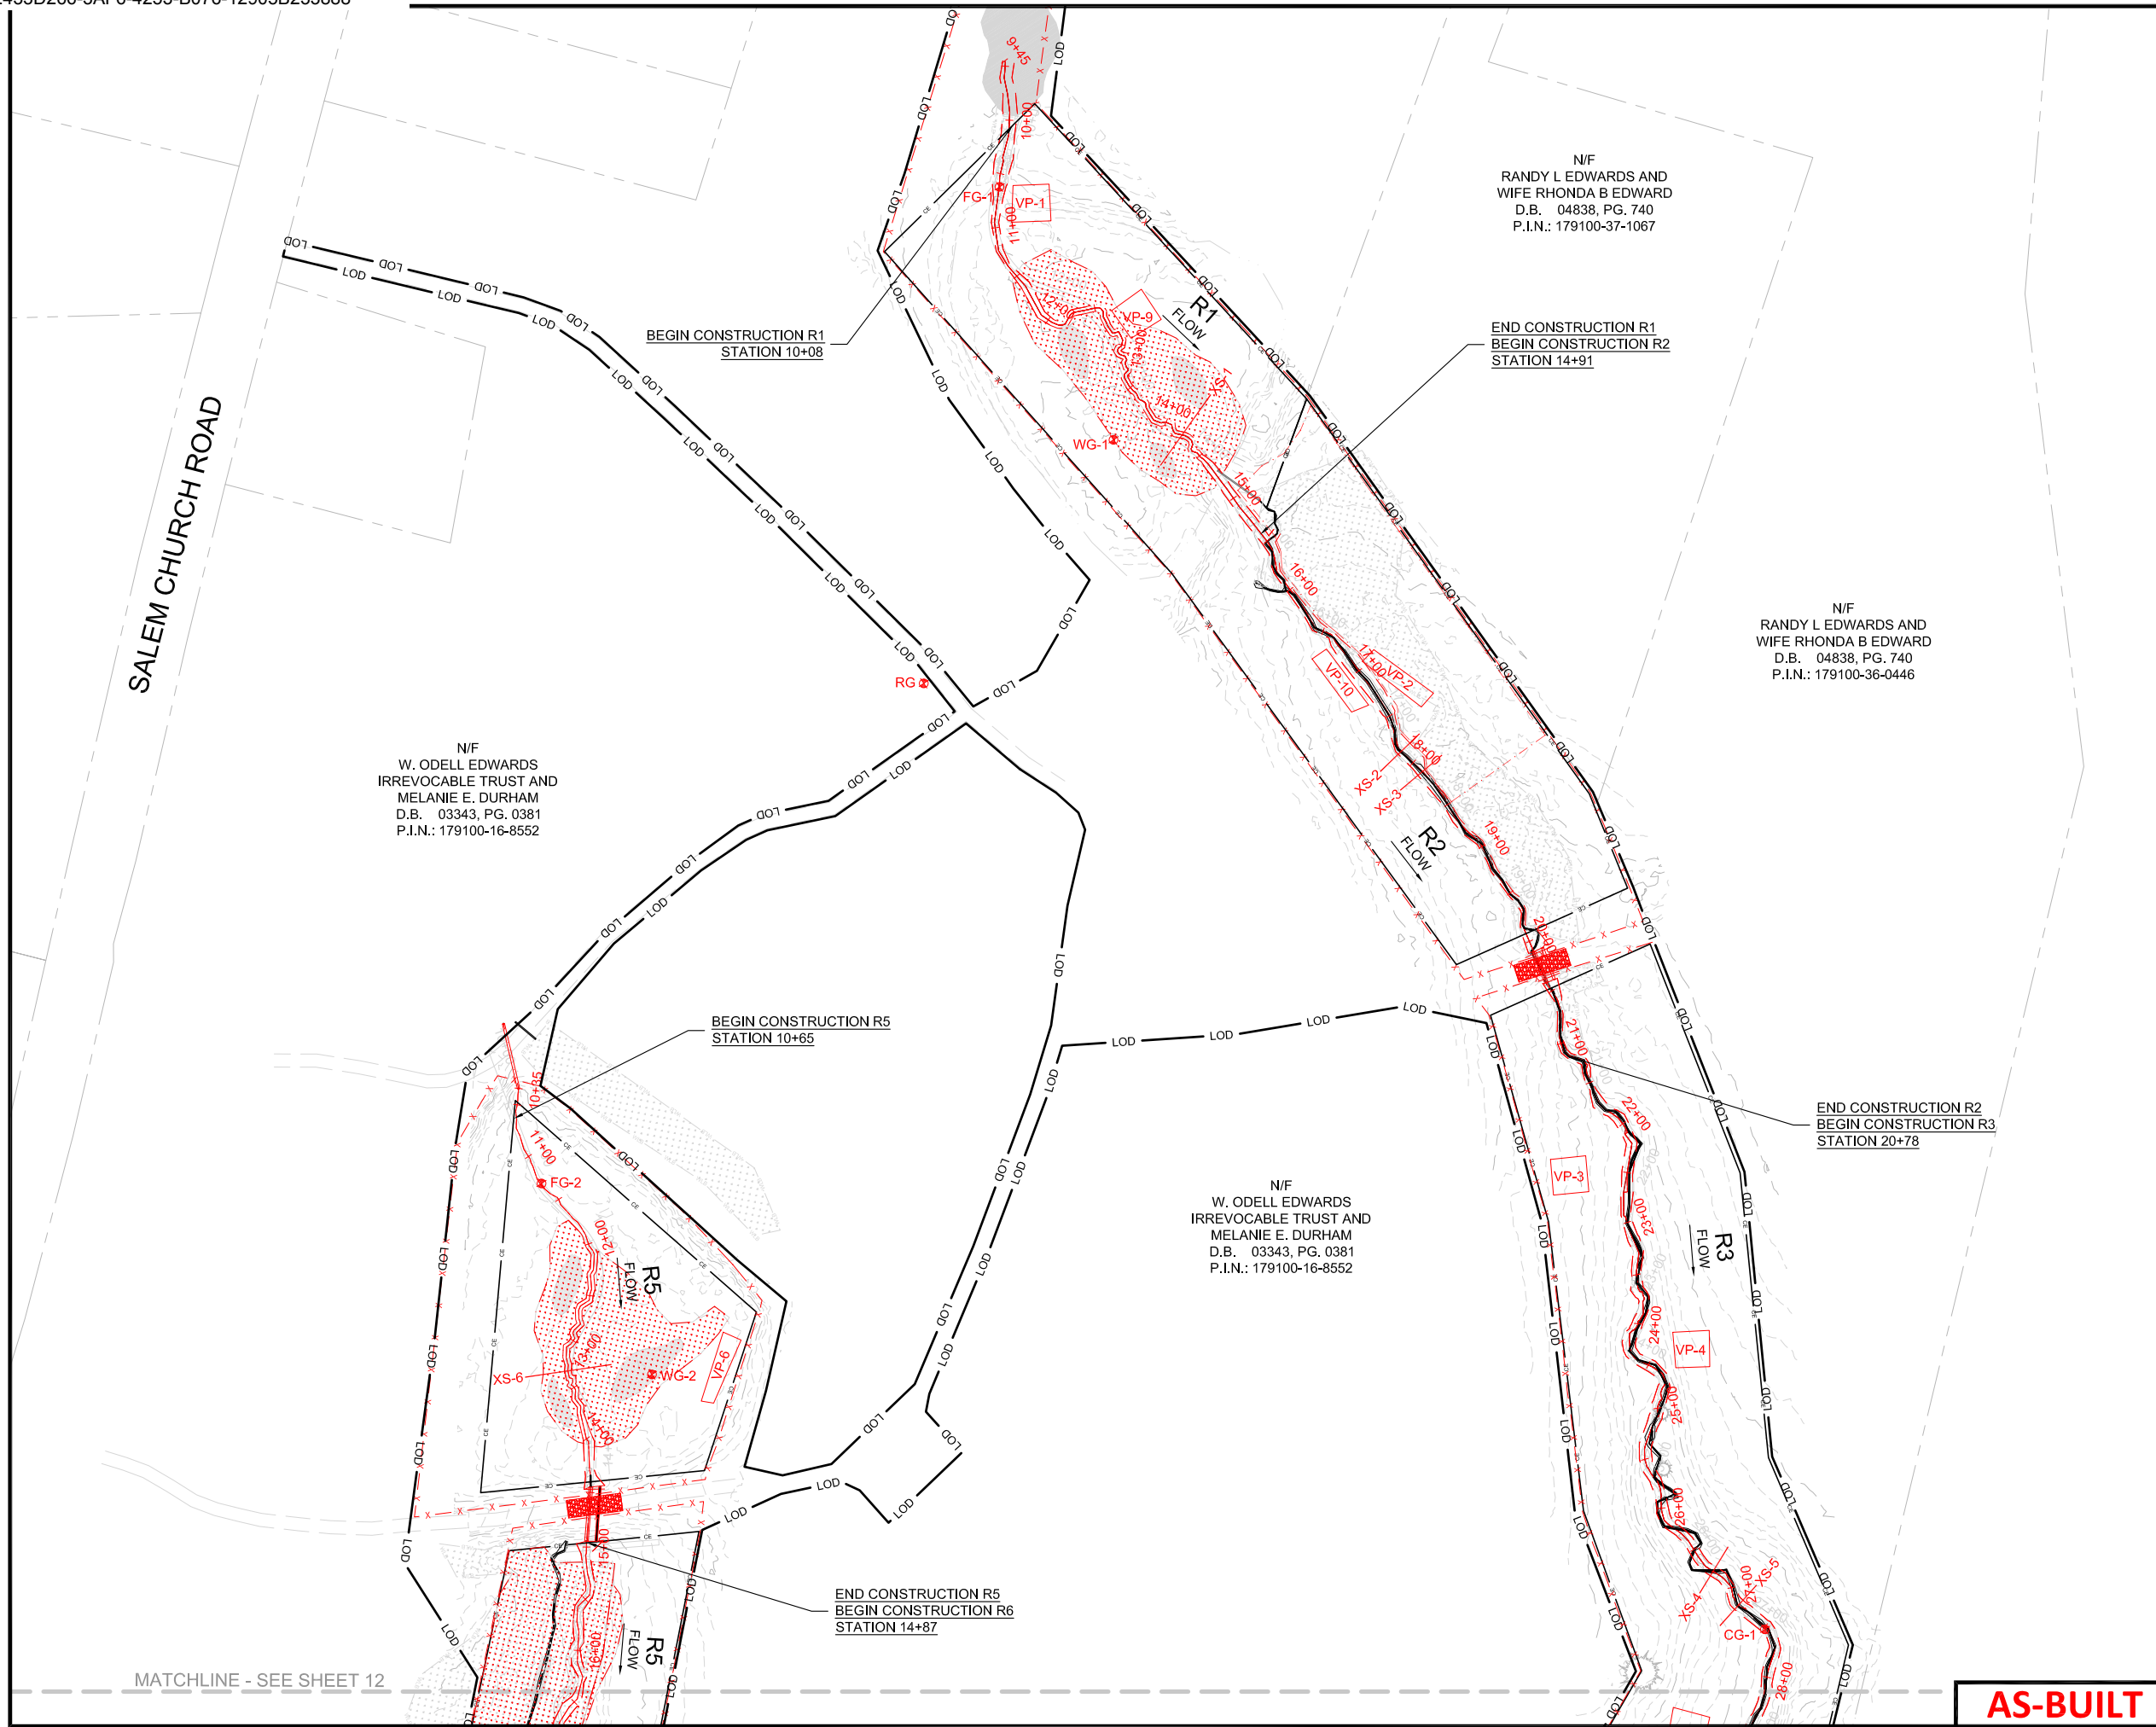

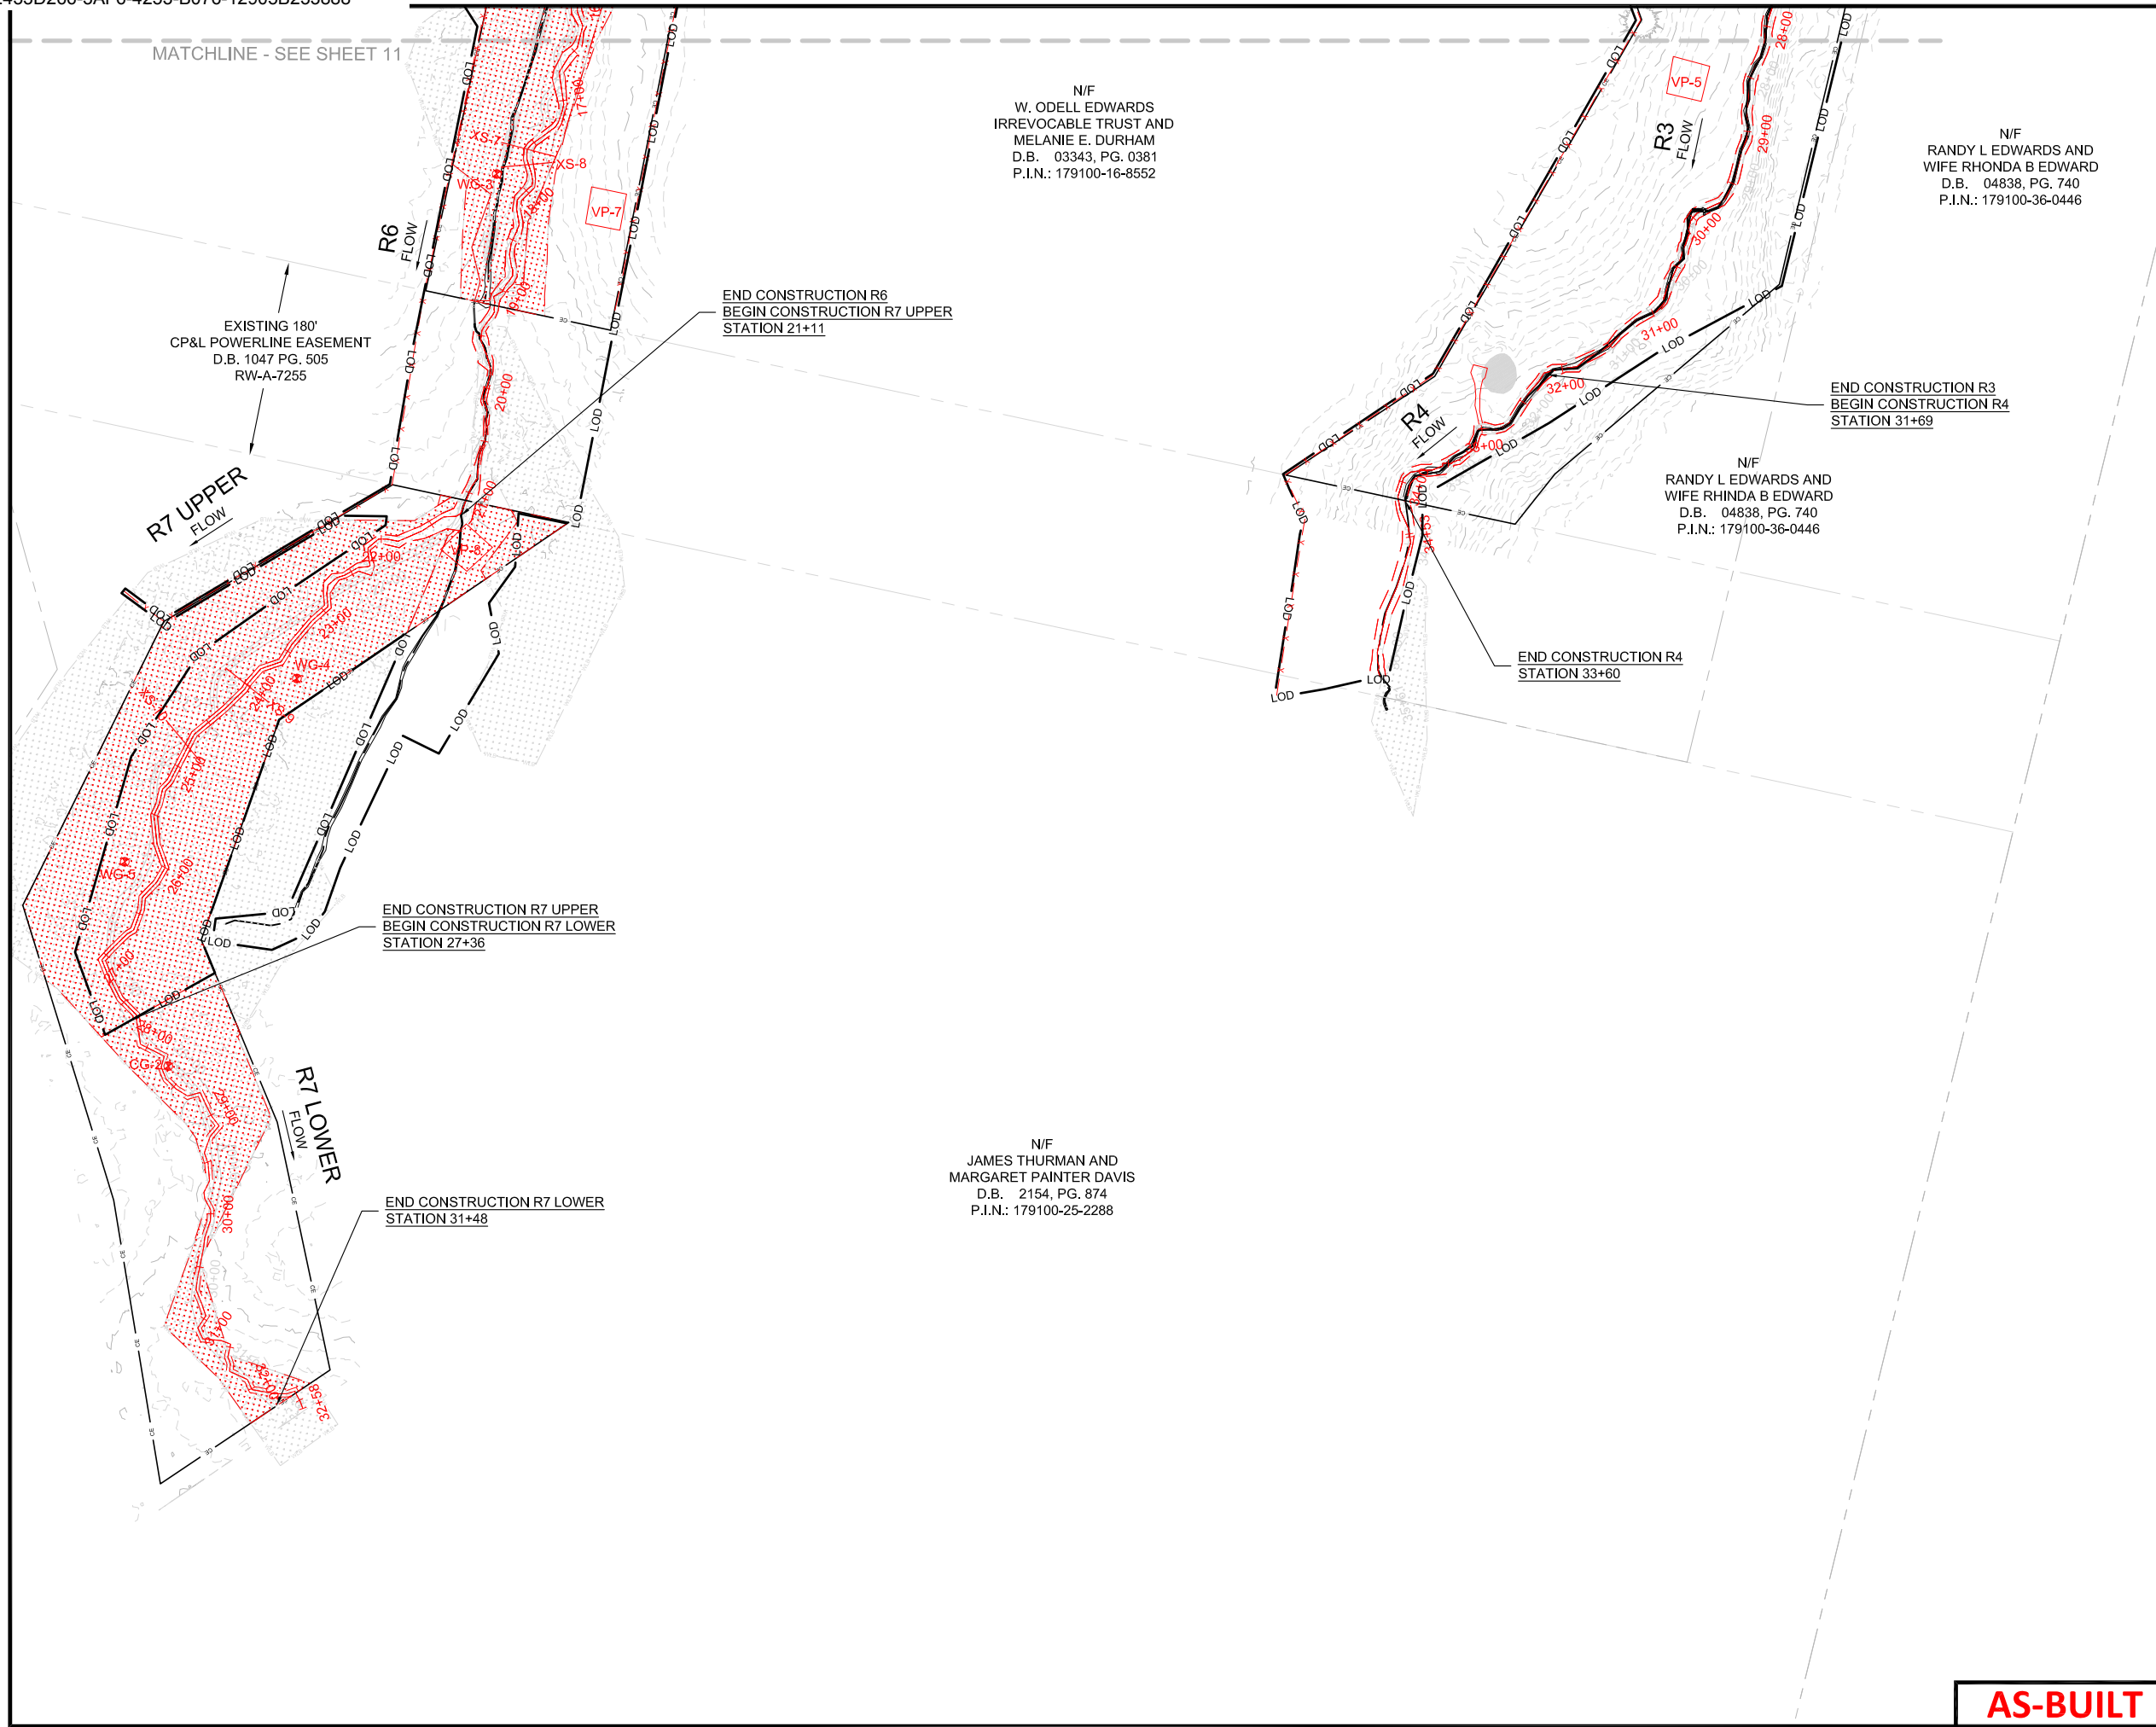

WATER & LAND SOLUTIONS
 7721 Six Forks Rd., Suite 130
 Raleigh, NC 27615
 (919)614-5111
 waterlandsolutions.com

PROJECT ENGINEER
 8/16/2021

NORTH CAROLINA PROFESSIONAL SEAL
 DocuSigned by:
 36916
 Christopher A. Tomasi
 ENGINEER
 BASED IN STATE OF NORTH CAROLINA

ENGINEERING SERVICES BY
 WLS ENGINEERING, PLLC
 6 DULA SPRINGS RD.
 WEAVERVILLE, NC 28787
 FIRM LICENSE NO. P-1480


REVISIONS

| | | |
|---|--------------------------|----------|
| A | DRAFT MIT PLAN | 2-24-20 |
| B | FINAL DRAFT MIT PLAN | 5-15-20 |
| C | FINAL MIT PLAN | 8-12-20 |
| D | FINAL MIT PLAN | 9-8-20 |
| E | IFC PLANS | 10-12-20 |
| F | AS-BUILT PLANS | 6-14-21 |
| G | AS-BUILT PLANS (REVISED) | 8-13-21 |

PROJECT NAME
ODELL'S HOUSE MITIGATION PROJECT
 JOHNSTON COUNTY, NC

DRAWING INFORMATION

| | |
|--------------|---|
| PROJECT NO. | 18-003 |
| FILENAME | ASB_11_12_ODELL'S HOUSE_MONITORING PLAN.DWG |
| DESIGNED BY | CAT |
| DRAWN BY | AL |
| DATE | 8-13-21 |
| HORIZ. SCALE | 1" = 150' |
| VERT. SCALE | N/A |

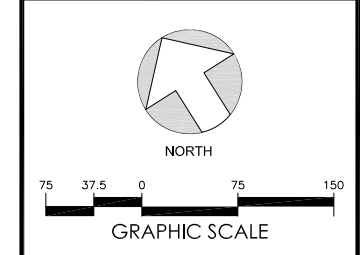

SHEET NAME
MONITORING PLAN

SHEET NUMBER
12

AS-BUILT

Table 1. Odell's House Mitigation Site, DWR #2018-0200v1, Project Credits

| Neuse 03020201 - Outside Falls Lake | | | | Project Area | | | | | | | | | | | | |
|-------------------------------------|----------|---|-------------------|--|---------------------------|-----------------|-------------------------------|---|----------------------------|---------------|--------------------------|---------------------------------|-------------------------|---------------------------------|------------------------------------|------------------------------------|
| 19.16394 | | | | N Credit Conversion Ratio (ft ² /pound) | | | | | | | | | | | | |
| N/A | | | | P Credit Conversion Ratio (ft ² /pound) | | | | | | | | | | | | |
| Credit Type | Location | Subject? (enter NO if ephemeral or ditch ¹) | Feature Type | Mitigation Activity | Min-Max Buffer Width (ft) | Feature Name | Total Area (ft ²) | Total (Creditable) Area of Buffer Mitigation (ft ²) | Initial Credit Ratio (x:1) | % Full Credit | Final Credit Ratio (x:1) | Convertible to Riparian Buffer? | Riparian Buffer Credits | Convertible to Nutrient Offset? | Delivered Nutrient Offset: N (lbs) | Delivered Nutrient Offset: P (lbs) |
| Buffer | Rural | Yes | Coastal Headwater | Restoration | 0-100 | R1 | 36,185 | 36,185 | 1 | 100% | 1.00000 | N/A | 36,185.000 | No | — | — |
| Buffer | Rural | Yes | I / P | Enhancement via Cattle Exclusion | 0-100 | R2 (right bank) | 36,352 | 36,352 | 2 | 100% | 2.00000 | N/A | 18,176.000 | No | — | — |
| Buffer | Rural | Yes | I / P | Enhancement | 0-100 | R2 (left bank) | 54,325 | 54,325 | 2 | 100% | 2.00000 | N/A | 27,162.500 | No | — | — |
| Buffer | Rural | Yes | I / P | Restoration | 0-100 | R3 | 126,221 | 126,221 | 1 | 100% | 1.00000 | N/A | 126,221.000 | Yes | 6,586.386 | — |
| Buffer | Rural | Yes | I / P | Enhancement via Cattle Exclusion | 0-100 | R4 (right bank) | 10,360 | 10,360 | 2 | 100% | 2.00000 | N/A | 5,180.000 | No | — | — |
| Buffer | Rural | Yes | Coastal Headwater | Restoration | 0-100 | R5 | 28,116 | 28,116 | 1 | 100% | 1.00000 | N/A | 28,116.000 | No | — | — |
| Buffer | Rural | Yes | Coastal Headwater | Restoration | 101-200 | R5 | 8,493 | 8,493 | 1 | 33% | 3.03030 | N/A | 2,802.693 | No | — | — |
| Buffer | Rural | Yes | I / P | Restoration | 0-100 | R6 | 31,084 | 31,084 | 1 | 100% | 1.00000 | N/A | 31,084.000 | Yes | 1,622.014 | — |
| Buffer | Rural | Yes | I / P | Restoration | 101-200 | R3 | 6,320 | 6,320 | 1 | 33% | 3.03030 | N/A | 2,085.602 | Yes | 329.779 | — |
| Buffer | Rural | Yes | Coastal Headwater | Restoration | 101-200 | R1 | 10,456 | 10,456 | 1 | 33% | 3.03030 | N/A | 3,450.483 | No | — | — |
| Buffer | Rural | Yes | I / P | Restoration | 101-200 | R7 upper | 1,922 | 1,922 | 1 | 33% | 3.03030 | N/A | 634.261 | Yes | 100.283 | — |
| | | | | | | | | | | | | | | | | |
| | | | | | | | | | | | | | | | | |
| | | | | | | | Totals: | 349,835 | 349,835 | | | | | | | |

| Enter Preservation Credits Below | | | | | | | Eligible for Preservation (ft ²): | | 116,612 | | | | | |
|--|----------|----------|--------------|---------------------|---------------------------|----------------|---|--|----------------------------|---------------|--------------------------|-------------------------|--|--|
| Credit Type | Location | Subject? | Feature Type | Mitigation Activity | Min-Max Buffer Width (ft) | Feature Name | Total Area (sf) | Total (Creditable) Area for Buffer Mitigation (ft ²) | Initial Credit Ratio (x:1) | % Full Credit | Final Credit Ratio (x:1) | Riparian Buffer Credits | | |
| Buffer | Rural | Yes | I / P | Preservation | 0-100 | R3 (left bank) | 60,900 | 60,900 | 10 | 100% | 10.00000 | 6,090.000 | | |
| | Rural | Yes | I / P | | 0-100 | R7 lower | 42,323 | 42,323 | 10 | 100% | 10.00000 | 4,232.300 | | |
| | | | | | | | | | | | | | | |
| | | | | | | | | | | | | | | |
| Preservation Area Subtotal (ft²): | | | | | | | | 103,222 | | | | | | |
| Preservation as % Total Area of Buffer Mitigation: | | | | | | | | 22.1% | | | | | | |
| Ephemeral Reaches as % Total Area of Buffer Mitigation: | | | | | | | | 0.0% | | | | | | |

| TOTAL AREA OF BUFFER MITIGATION (TABM) | | |
|--|-------------|-------------|
| Mitigation Totals | Square Feet | Credits |
| Restoration: | 248,798 | 230,579.039 |
| Enhancement: | 101,037 | 50,518.500 |
| Preservation: | 103,222 | 10,322.300 |
| Total Riparian Buffer: | 453,057 | 291,419.839 |

| TOTAL NUTRIENT OFFSET MITIGATION | | |
|----------------------------------|-------------|---------|
| Mitigation Totals | Square Feet | Credits |
| Nutrient | Nitrogen: | 0.000 |
| Offset: | Phosphorus: | 0.000 |

1. The Randleman Lake buffer rules allow some ditches to be classified as subject according to 15A NCAC 02B .0250 (5)(a).



- Conservation Easement
- Top of Bank
- Stream
- Headwater Valley
- Wetland
- Buffer Mitigation**
- Restoration 0-100ft
- Restoration 101-200ft
- Enhancement 0-100ft
- Enhancement (cattle exclusion) 0-100ft
- Preservation 0-100ft
- 404/401 Fixed Veg Plot
- Culvert

