

Jumping Run Creek at Payne Dairy Stream Restoration

2004 Annual Monitoring Report



Delivered to: NCDENR/Wetlands Restoration Program
1619 Mail Service Center
Raleigh, NC 27699-1619

Prepared by: Biological & Agricultural Engineering
Water Resources Research Institute
North Carolina State University
Campus Box 7625
Raleigh, NC 27695

February, 2005



NC STATE UNIVERSITY

2004 Jumping Run at Payne Dairy Monitoring Abstract

Jumping Run was restored through the North Carolina Wetlands Restoration Program (NCWRP). The goals and objectives of this project are as follows:

- 1.) Restore 5,177-linear feet of Jumping Run Creek through dimension, pattern and profile adjustments.
- 2.) Restore 470-linear feet of Jumping Run Creek through dimension and profile adjustments and cattle exclusion.
- 3.) Establish a riparian zone surrounding restored sections of Jumping Run Creek, an additional 1,350-linear feet of Jumping run, and 1,350-linear feet of a tributary.
- 4.) Improve the habitat within the channel and the riparian zone.

This is the 4th year of the 5-year monitoring plan for Jumping Run.

Table 1A. Background Information

Project Name	Jumping Run Creek
Designer's Name	Kimley-Horn and Associates, Inc. PO Box 33068, Raleigh, NC, 27636 (919) 677-2000
Contractor's Name	Shamrock, Inc
Project County	Alexander County
Directions to Project Site	From Statesville, follow Interstate I-64 west to Millersville road. Turn left (south) on Millersville road and follow to Henry Road. Turn right (west) on Henry Road until it dead ends with Paul Payne Store Road. Turn right on Paul Payne Store Road and follow to the top of the hill. At the top of the hill turn right onto a field road. The beginning of the project is located at the bottom of the hill. Please note that this is a private residence and permission is suggested prior to entering the site.
Drainage Area	1.2 sq. mi. (End of Area 3 - Upstream of SR-1614) 2.2 sq. mi. (End of Area 4 at the end of the project)
USGS Hydro Unit	3050101
NCDWQ Subbasin	05-07-04
Project Length	5,755 Linear feet (Restoration) 2,640 Linear feet (Preservation)
Restoration Approach	5,177-feet of dimension, pattern, and profile 470-feet of dimension and profile modifications 1,350-feet of cattle exclusion and riparian enhancement 1,400-feet of cattle exclusion and riparian enhancement (one side)
Date of Completion	2001
Monitoring Dates	June, 2001 (as-built); December, 2001; December, 2002; October, 2003, July 2004

Table 2A. Summary of Results

DIMENSION	Jumping Run Area #1				Jumping Run Area #2				Jumping Run Area #3				Jumping Run Area #4			
	Riffle		Pool		Riffle		Pool		Riffle		Pool		Riffle		Pool	
	As-built	2004	As-built	2004	As-built	2004	As-built	2004	As-built	2004	As-built	2004	As-built	2004	As-built	2004
Bankfull Cross-sectional Area	9.4	6.6	19.2	11.2	9.0	7.8	12.8	7.2	8.3	6.8	27.1	25.3	13.5	8.3	15.9	14.9
Bankfull Width	14.0	9.8	16.0	9.7	11.5	7.8	13.7	8.7	9.0	8.7	15.0	12.9	17.0	13.5	14.0	12.9
Bankfull Mean Depth	0.7	0.7	1.2	1.2	0.8	1.0	0.9	0.8	0.9	0.8	1.8	2.0	0.8	0.6	1.1	1.2
Bankfull Max Depth	1.6	1.5	2.3	2.0	1.4	2.0	1.5	1.6	1.3	1.3	3.6	3.0	1.2	1.1	2.0	2.1
Width/Depth Ratio	20.8	14.5			14.7	7.8			9.8	11.2			21.4	21.8		

PATTERN	Jumping Run As-built - 2000				Jumping Run 2003				Jumping Run 2004			
	Area 1	Area 2	Area 3	Area 4	Area 1	Area 2	Area 3	Area 4	Area 1	Area 2	Area 3	Area 4
	Meander Wave Length	130	100	120-165	140	115-123	49-95	145-149	30-52	108-126	49-108	124-148
Radius of Curvature	60	33	35-84	60+	27-39	22-30	34-58	30-51	30-44	14-43	30-42	26-69
Beltwidth	-	-	-	-	35-39	36-47	43-51	25-49	32-39	29-45	38-46	20-35

PROFILE*	Jumping Run 2003 - Area 1	Jumping Run 2004 - Area 1			Jumping Run 2003 - Area 2	Jumping Run 2004 - Area 2			Jumping Run 2003 - Area 3	Jumping Run 2004 - Area 3			Jumping Run 2003 - Area 4	Jumping Run 2004 - Area 4		
	Median	Min	Max	Median	Median	Min	Max	Median	Median	Min	Max	Median	Median	Min	Max	Median
	Riffle Length	20.9	31.4	68.9	49.7	11.8	No data reported (data collection error)			23.6	17.0	38.0	27.5	17.9	15.0	52.0
Riffle Slope	1.66%	0.47%	1.05%	0.60%	1.39%				1.86%	1.40%	3.29%	2.05%	1.52%	0.23%	1.62%	1.00%
Pool Length	16.9	25.0	36.0	30.5	30.0				29.5	24.0	59.0	38.0	35.0	28.0	83.0	53.0
Pool to Pool Spacing	44.0	39.5	94.5	87.5	43.3				89.2	42.5	87.0	59.0	89.5	48.0	115.5	70.5

*Data for previous monitoring periods were not reported

SUBSTRATE	Jumping Run Area #1				Jumping Run Area #2				Jumping Run Area #3				Jumping Run Area #4			
	Cross-section #1		Cross-section #2		Cross-section #1		Cross-section #2		Cross-section #1		Cross-section #2		Cross-section #1		Cross-section #2	
	Riffle	Pool	Riffle	Pool	Riffle	Pool	Riffle	Pool	Riffle	Pool	Riffle	Pool	Riffle	Pool	Riffle	Pool
d50	0.27	0.16	0.08	0.23	7.41	0.11	0.09	0.26	12.65	0.09	0.38	0.16	9.65	3.37	0.14	0.16
d84	8.09	1.07	0.14	0.44	14.03	0.7	0.15	13.65	44.9	15.91	8.87	1.95	27.3	15.43	0.56	1.29

VEGETATION	Jumping Run Area 1 - 2003		Jumping Run Area 1 - 2004		Jumping Run Area 2 - 2003		Jumping Run Area 2 - 2004		Jumping Run Area 3 - 2003		Jumping Run Area 3 - 2004		Jumping Run Area 4 - 2003		Jumping Run Area 4 - 2004	
	Quad #1		Quad #1		Quad #2		Quad #2		Quad #3		Quad #3		Quad #4		Quad #4	
	Observed	Planted	Observed	Planted	Observed	Planted	Observed	Planted	Observed	Planted	Observed	Planted	Observed	Planted	Observed	Planted
Tree Stratum (trees/acre)	480	360	160	80	1080	240	160	0	1040	840	120	120	520	520	640	280
Shrub Stratum (%cover)	25	-	20	-	2.5		11		10.5	-	1	-	12	-	3	-
Herb Stratum (%cover)	143	-	110	-	115		100		206.5	-	85	-	169	-	105	-

MACROINVERTEBRATES	Upstream Reference				Site 2 - within restoration				Site 3 - below restoration			
Year of Survey	2000	2002	2003	2004	2000	2002	2003	2004	2000	2002	2003	2004
Total Taxa Richness	43	37	44	41	38	12	20	27	31	28	44	44
EPT Taxa Richness	19	20	19	20	8	3	12	11	9	7	16	16
EPT Abundance	67	88	87	88	39	7	34	39	47	28	71	54
Dominants in Common Index (%)	-	-	-	-	25%	5%	28%	30%	19%	16%	50%	60%
# Keystone taxa	10	12	14	19	2	0	5	6	4	0	6	12





Results and Discussion

Overall, the Jumping Run Restoration Project is demonstrating excellent stability and performance. Dimension, pattern, profile, and channel materials are similar to as-built conditions and where deviations are occurring, the trend is in the positive, indicating a properly functioning system. A headcut previously noted was not evident in the field during the survey. Two cross vane structures show signs of stress and should be monitored closely in upcoming monitoring events. Reach 4 has areas that should continue to be monitored. These areas include some localized downcutting, localized bank migration and sediment laden water cutting through the buffer. Vegetation has established and is thriving in the restored conditions of the channel and riparian zone.

Benthic macroinvertebrate data have been collected from this project annually for three years following construction. Data from Jumping Run within the restored reach illustrate a rapid decline in biological integrity following construction. Many of the taxa collected during this investigation were very tolerant chironomidae. The number of taxa and the Dominant in Common analyses improved during surveys conducted in 2003 and 2004. These data mimic, to some degree, pre-construction conditions. Interestingly conditions continue to improve at Site 3 below the restoration reach. Both the number of keystone taxa and the Dominant in Common taxa increased at this site in 2004. This may be a response to the elimination of the cattle and the increased efficiency of the newly constructed riparian zone to assimilate nutrients.

The following areas of concern for 2004:

- **Piping through the structure (Issue Photo 1)**
 - A cross vane just upstream of section 2 should be monitored for changes. It is presently partially piping through the structure.
- **Downcutting in Reach 4 (See Area 4 profile graph)**
 - Two areas of bed downcutting had occurred since construction (between stations 0+40 and 0+70 and 3+50 and 4+00). These areas should be watched closely in upcoming monitoring events.
- **Right bank migration on pool cross-section in area 4 (See Area 4 Cross-section)**
 - The bank has migrated over the past two monitoring periods. This area should be watched closely to ensure bank stability in upcoming monitoring events.
- **Toe scour at riffle cross-section in area 4 (See Area 4 Cross-section)**
 - Scour along the right bank toe should be watched closely to ensure bank stability in upcoming monitoring events.
- **Sediment laden water cutting through buffer in Area 4 (Issue Photo 3)**
 - Concentrated sediment laden water cutting through the buffer. The path has formed into a small gully. The source of the water is the cow pasture adjacent to the project. The water is likely carrying significant amount of nutrients as well as sediment. This should be monitored to see if the problem continues. A level spreader may be necessary stop the short cutting of the buffer.
 - Station: End of Area 4.
- **Vegetation**
 - Plantings are currently below minimum requirements (120 stems/acre planted and 270 stems/acre total including volunteer species). Supplemental planting should be considered.

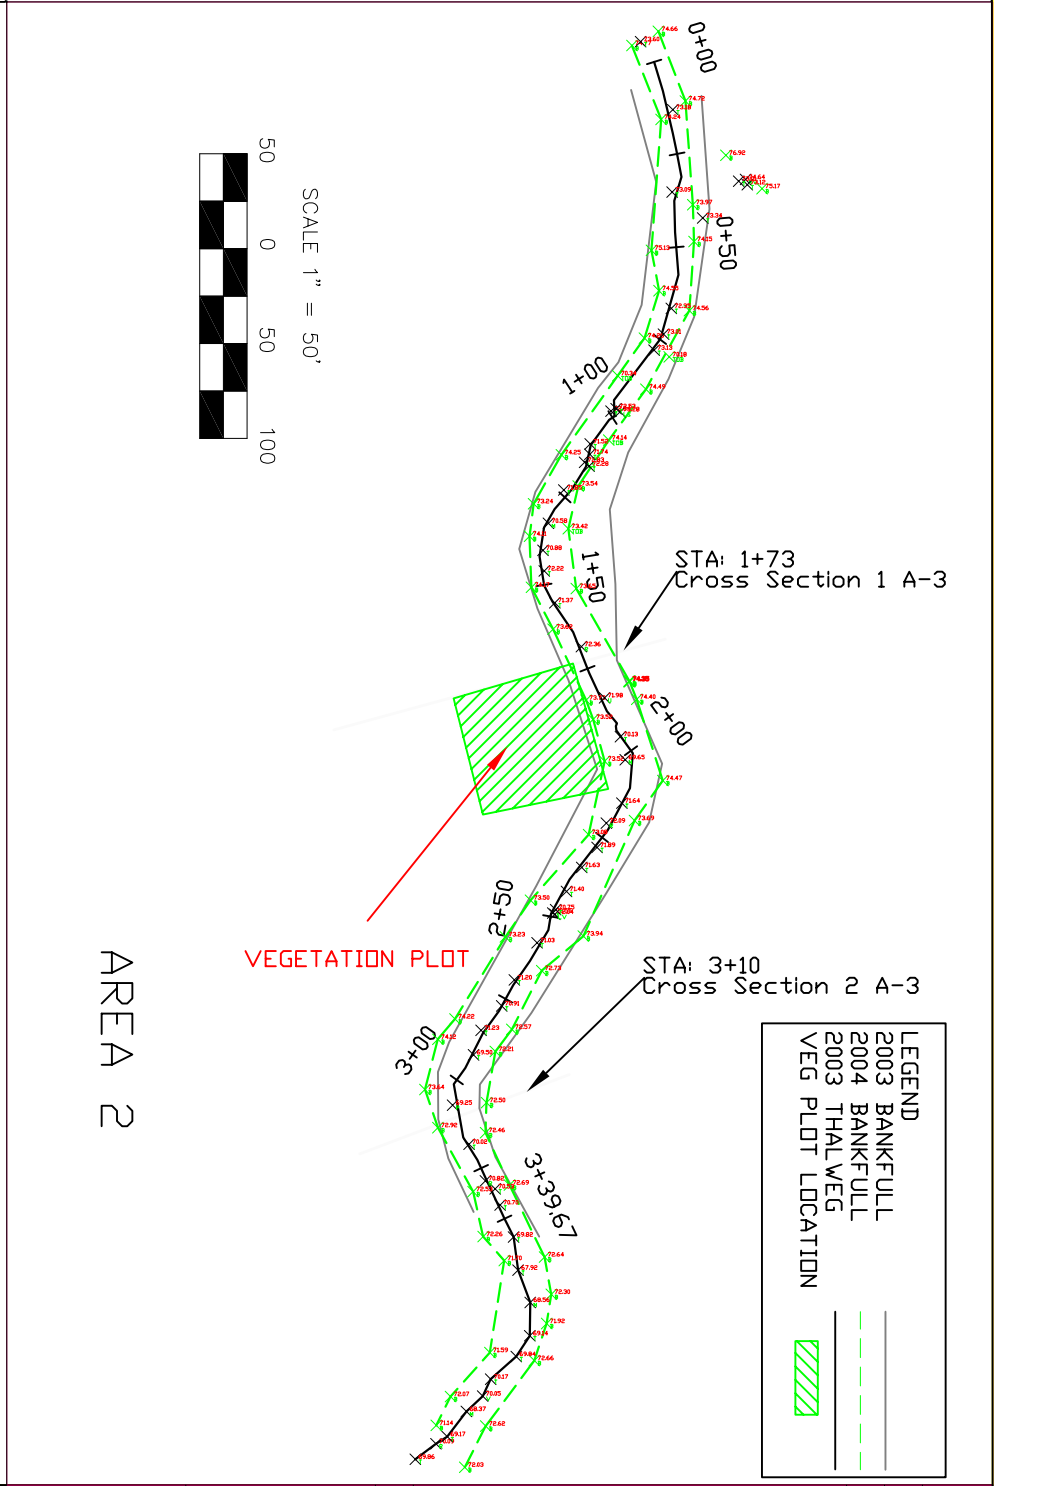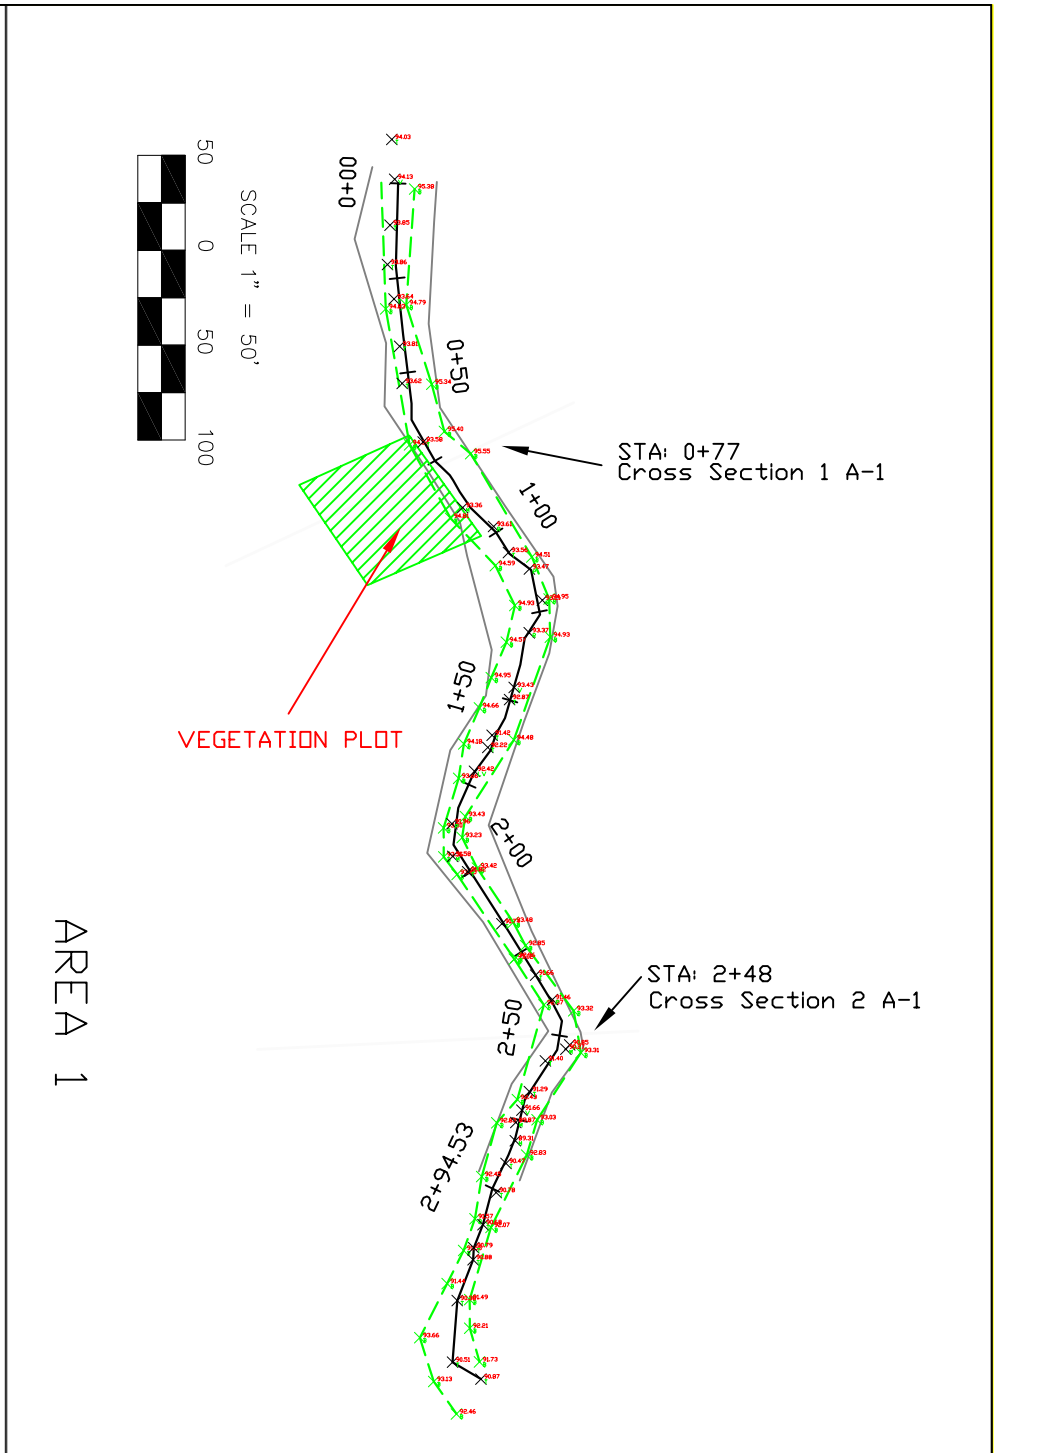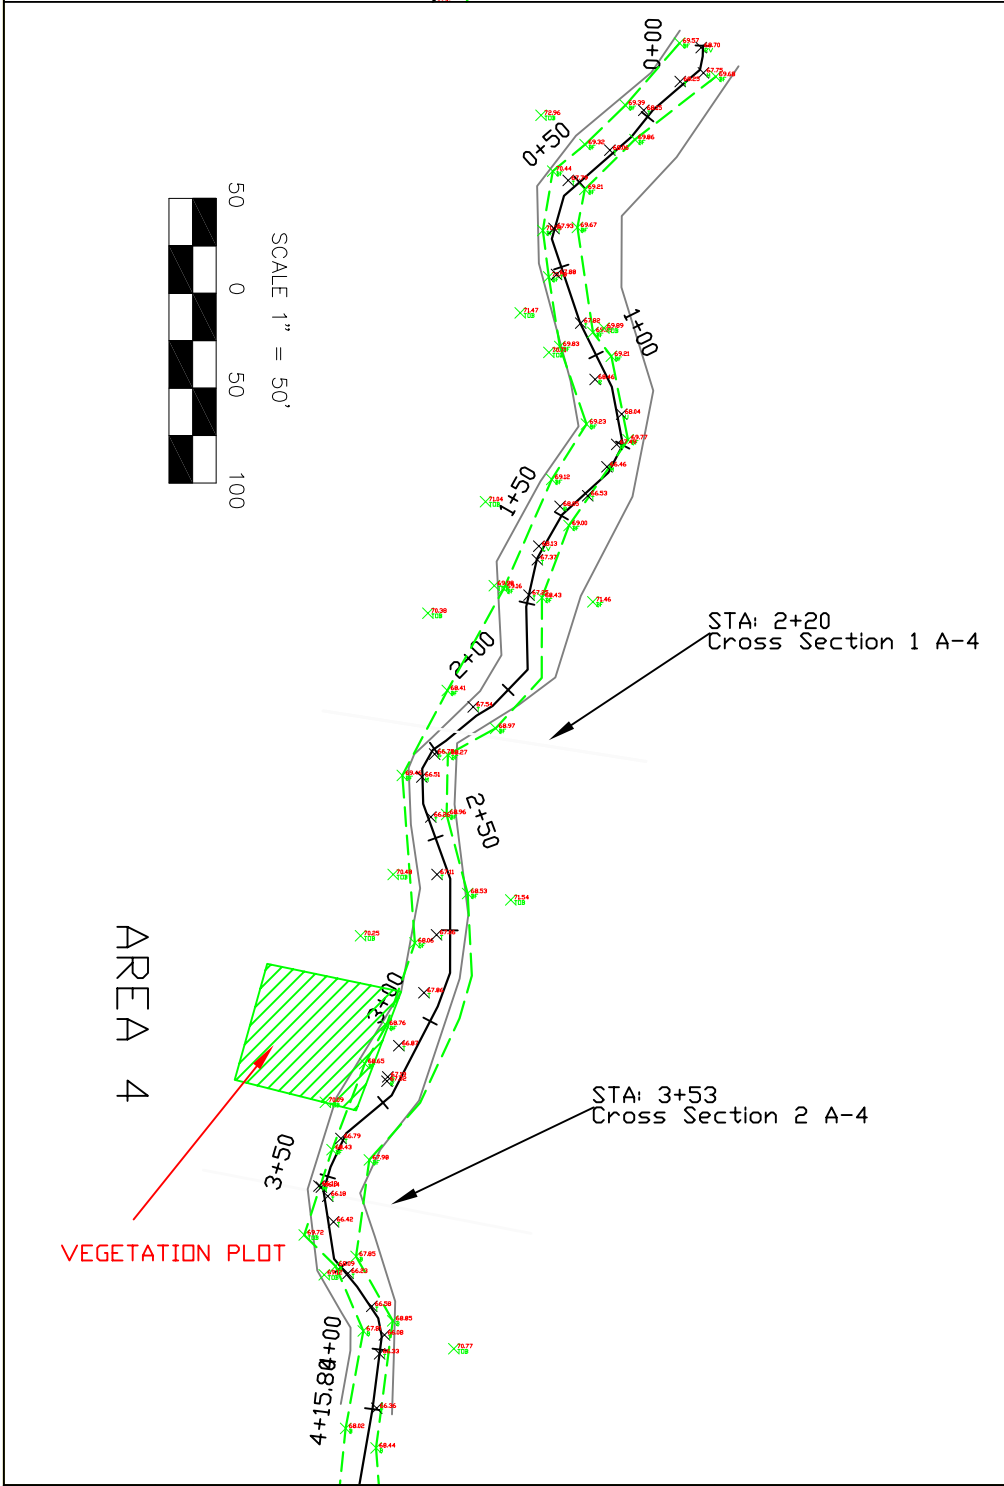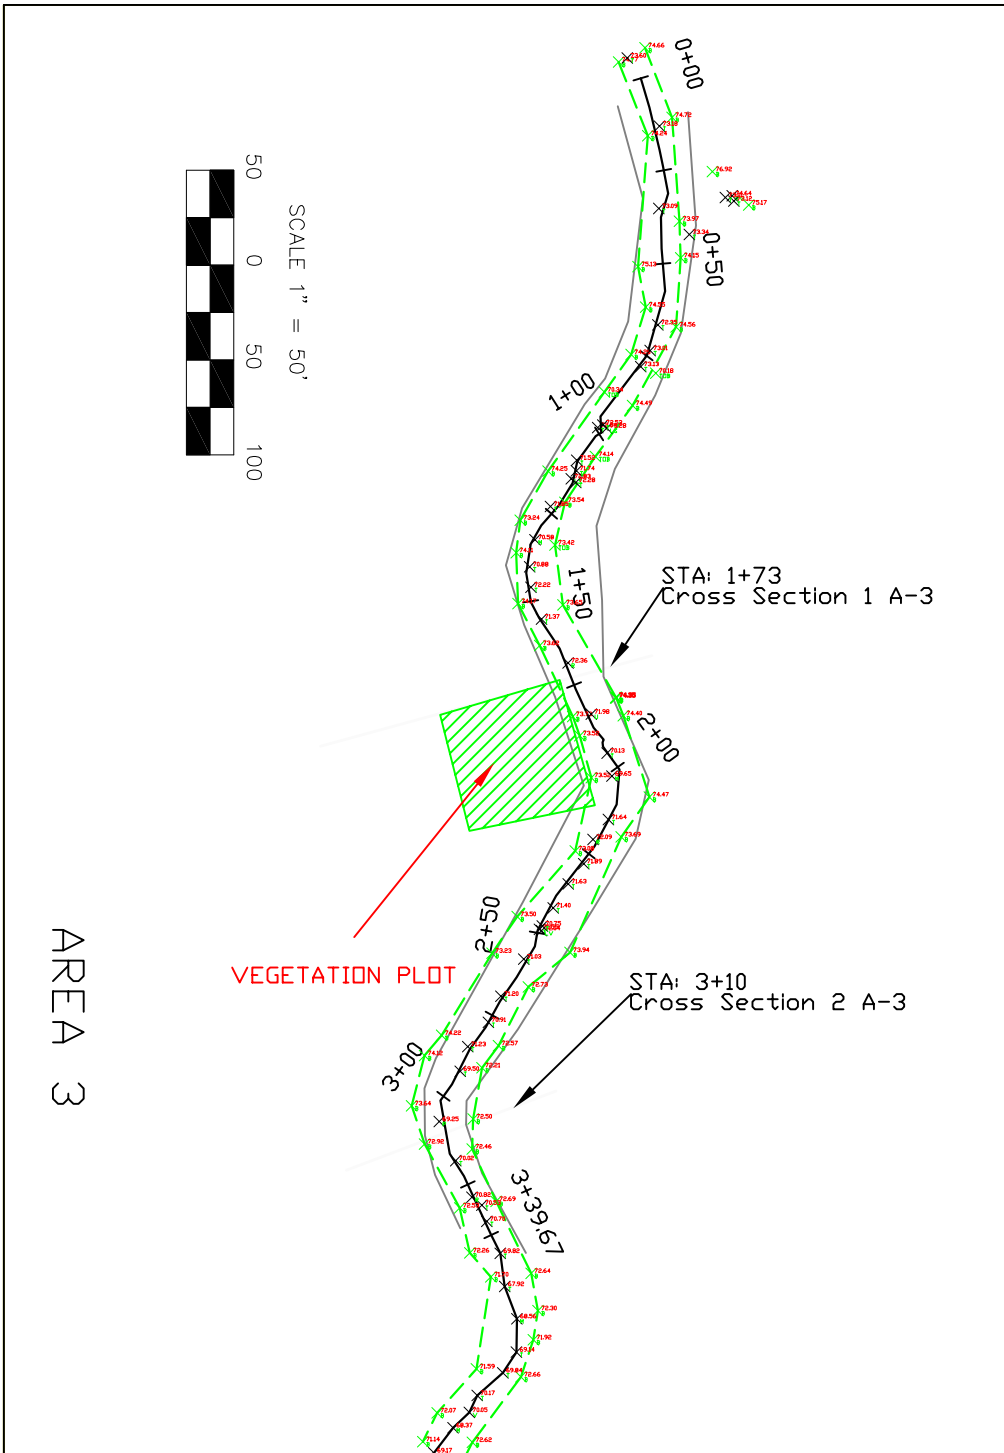

JUMPING RUN STREAM RESTORATION
ALEXANDER, N.C.
ECOSYSTEM ENHANCEMENT PROGRAM

FIGURE
2004 MONITORING PLAN VIEW

DATE: 3/01/2005
PROJECT NO.:
FILENAME: PAINE.DRAWING
SHEET NO.: C-1
DRAWING NO.:

NC STATE UNIVERSITY

BIOLOGICAL & AGRICULTURAL ENGINEERING
Weaver Labs Campus Box 7625
North Carolina State University
Raleigh, NC 27695

1	ISSUED TO EEP	DAB	DRC	3/01/05
NO	REVISIONS	DRN	CHK	DATE

Photos

The following are photographs of typical sections and areas of concern throughout the project.



Typical Pool



Typical Riffle



Issue Photo 1. Piping through structure
Station: Just upstream of Area 2.



Issue Photo 2. Slumped cross vane arm.
Located just upstream of Paul Payne Road
culvert. A cross vane 20 feet downstream
is holding grade.



Issue Photo 3. Concentrated sediment laden water
cutting through the buffer. Station: End of Area 4.

Table of Contents

2004 Jumping Run at Payne Dairy Monitoring Abstract	i
Tables and Figures	vi
1.0 BACKGROUND INFORMATION	1
1.1 Goals and Objective	1
1.2 Project Location.....	1
1.3 Project Description	1
2.0 YEAR 2004 RESULTS AND DISCUSSION	6
2.1 Vegetation.....	6
2.1.1 Results and Discussion.....	6
2.2 Morphology	7
2.2.1 Results and Discussion.....	7
2.3 Benthic Macroinvertebrates Results	15
2.4 Areas of Concern	16

Tables and Figures

Figure 1A. 2004 Payne Dairy Monitoring Plan View.....	iv
Figure 1. Project Location.....	2
Figure 2. Watershed Ortho-photo	3
Figure 3. Payne Dairy As-built Plan View	4
Figure 4. 2004 Payne Dairy Monitoring Plan View	5
Table 1. Summary of Results.....	10
Figure 5. Jumping Run Area 1 Profile	11
Figure 6. Jumping Run Area 2 Profile	12
Figure 7. Jumping Run Area 3 Profile	13
Figure 8. Jumping Run Area 4 Profile	14
Table 2. Benthic Summary Statistics from the stream restoration project at Payne Dairy.	15
Table 3. 2003 EPT Abundance Table	16

1.0 BACKGROUND INFORMATION

This project is located within the limits of the Payne Dairy Farm in Alexander County. Drainage area at the outlet is 2.2 sq. mi. at the end of Area 4 (at the end of the project) and 1.2 square miles at SR-1614. The project was completed in 2001 with an as-built survey completed in June of 2001. Additional background information for this report was not provided at the time of completion. Please refer to prior documentation for background information.

1.1 Goals and Objective

The goals and objectives of this project are as follows:


- 1.) Restore 5,177-linear feet of Jumping Run Creek through dimension, pattern and profile adjustments.
- 2.) Restore 470-linear feet of Jumping Run Creek through dimension and profile adjustments and cattle exclusion.
- 3.) Establish a riparian zone surrounding restored sections of Jumping Run Creek, an additional 1,350-linear feet of Jumping run, and 1,350-linear feet of a tributary.
- 4.) Improve the habitat within the channel and the riparian zone.

1.2 Project Location

This project is located southeast of Taylorsville in Alexander County. From Statesville, follow Interstate I-64 west to Millersville road. Turn left (south) on Millersville road and follow to Henry Road. Turn right (west) on Henry Road until it dead ends with Paul Payne Store Road. Turn right on Paul Payne Store Road and follow to the top of the hill. At the top of the hill turn right onto a field road. The beginning of the project is located at the bottom of the hill. Please note that this is a private residence and permission is suggested prior to entering the site.

1.3 Project Description

A previously impaired stream flowing through a cow pasture, Jumping Run Creek was restored using channel dimension, pattern, and profile modifications and the establishment of riparian zone adjacent to the creek. Channel profile is maintained through the use of log and rock cross vanes. Channel pattern is maintained through the use of root wads and vegetation along the channel banks. Easement boundaries are maintained with fencing.

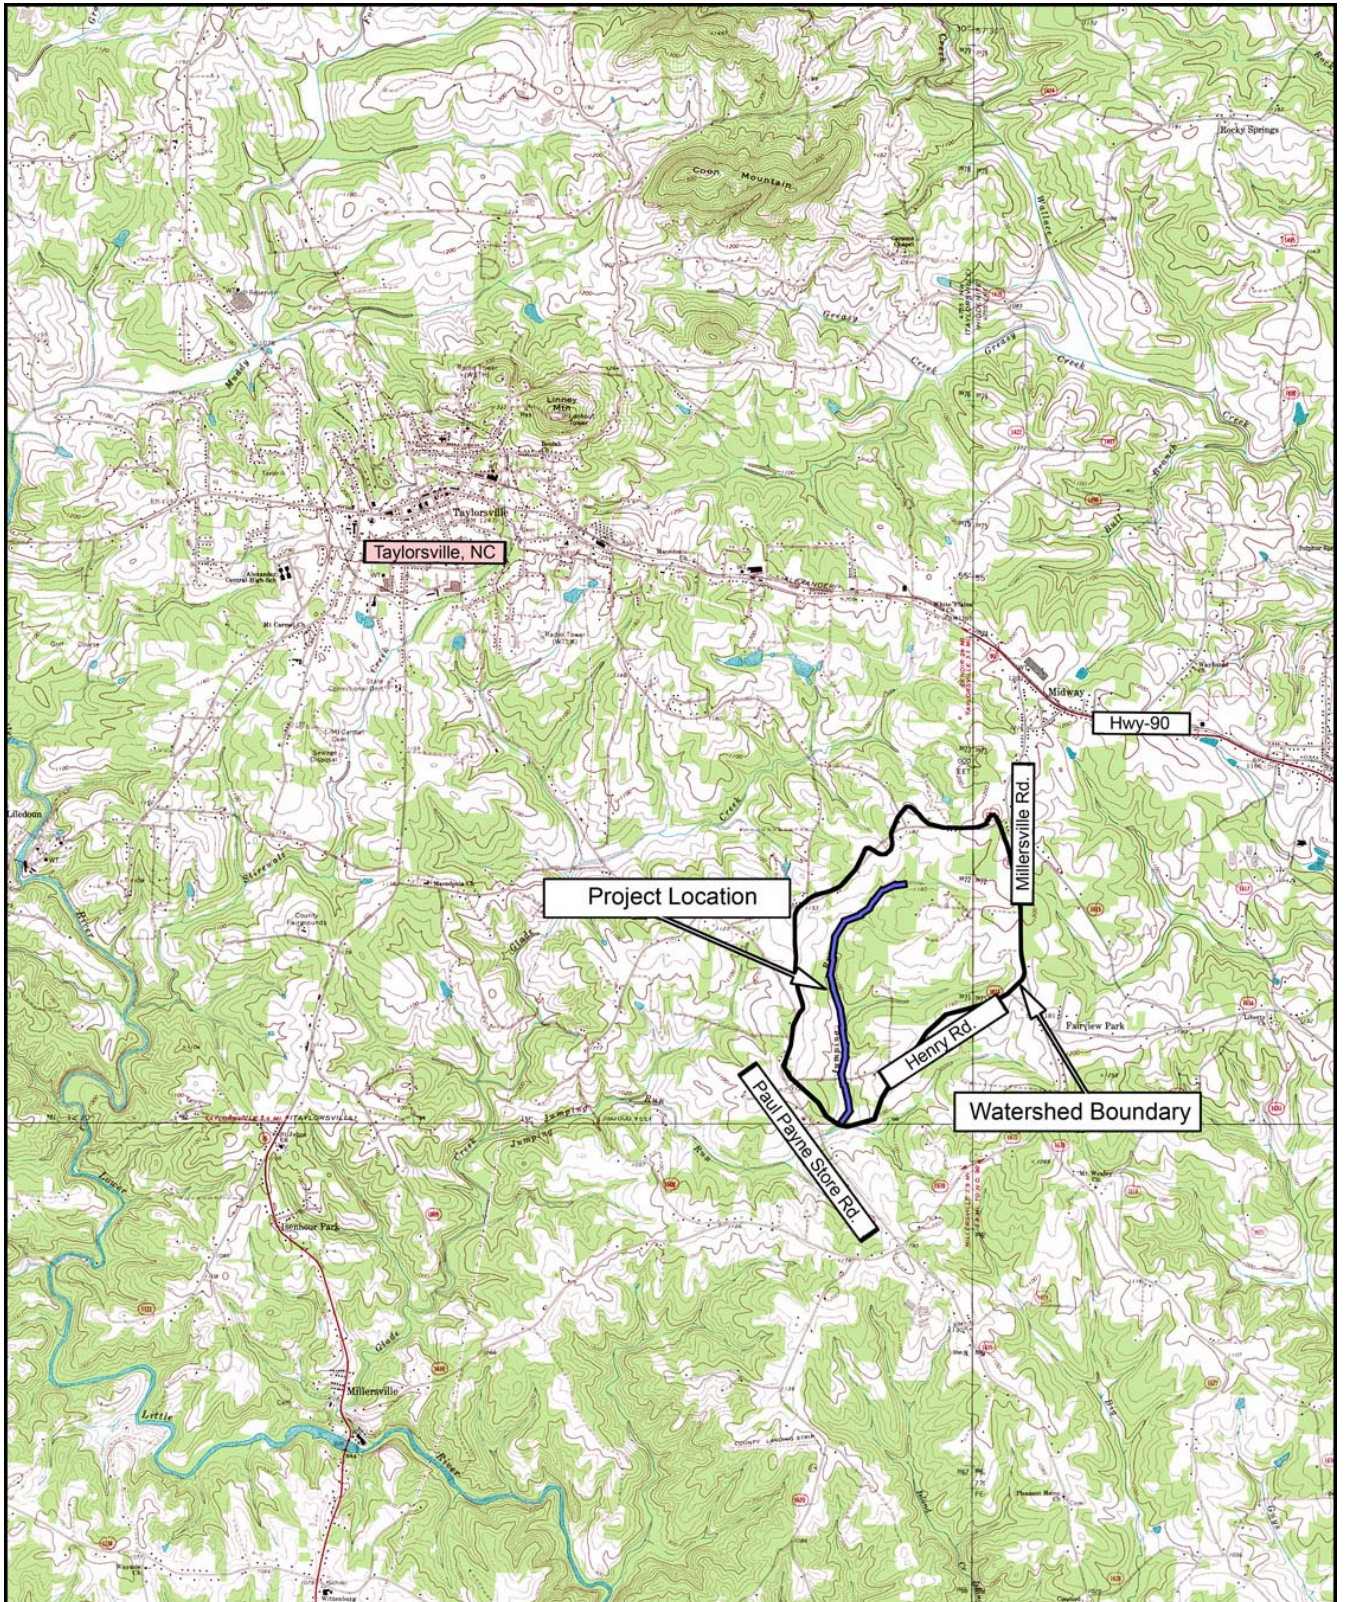


NC STATE UNIVERSITY

Department of Biological & Agricultural Engineering

Campus Box 7625
Raleigh, NC 27606

Project Location: Jumping Run
Axelander County, North Carolina


EEP Monitoring Report

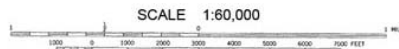


Dwn. By:	MVH
Ckd By:	DAB
Date:	March 2004

FIGURE


1

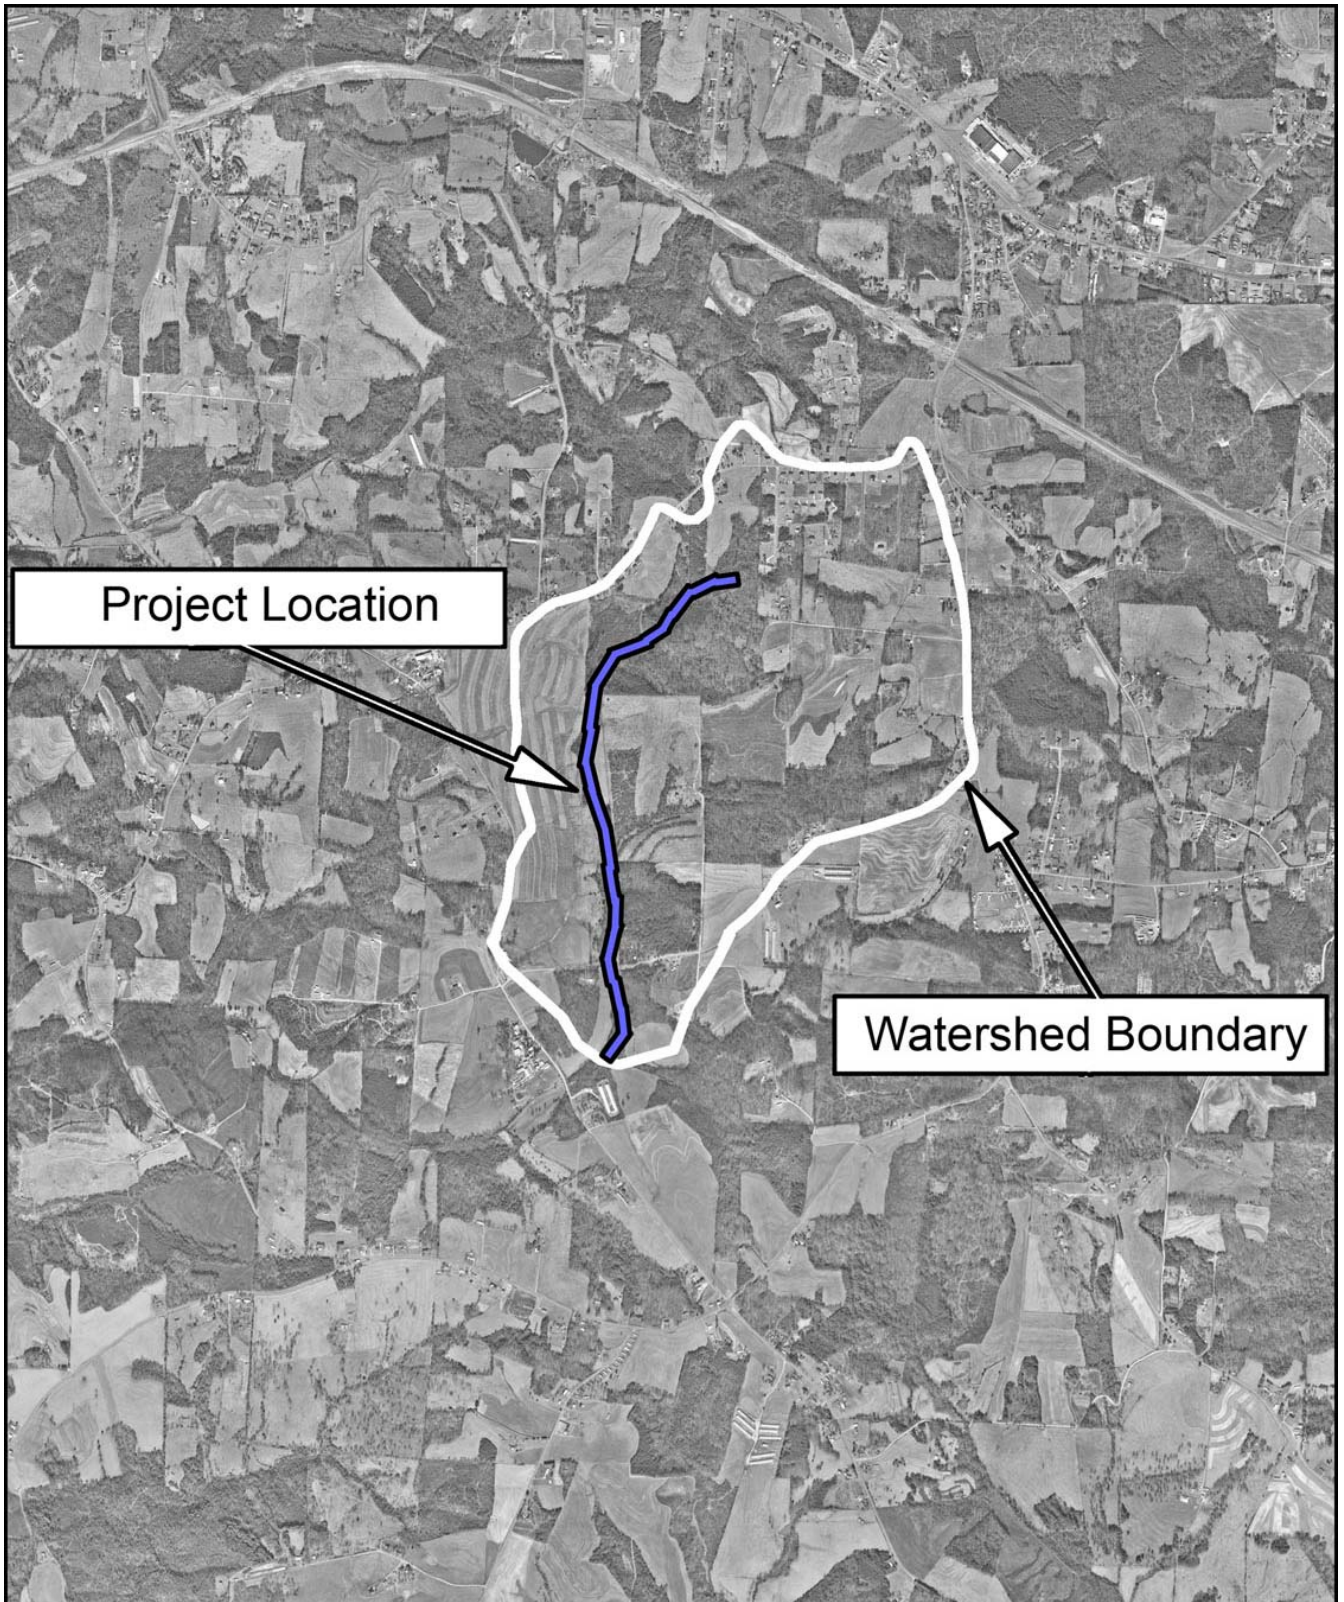


<p>NC STATE UNIVERSITY Department of Biological & Agricultural Engineering Campus Box 7625 Raleigh, NC 27606</p>	<p>Aerial Watershed Photo: Jumping Run Alexander County, North Carolina</p> <p>EEP Monitoring Report</p> <p>SCALE 1:30,000</p> <p>0 1000 2000 3000 4000 5000 FEET 1 MILE</p> <p>N</p>	<p>Dwn. By: MVH Ckd By: DAB Date: March 2004</p>	<p>FIGURE 2</p>
--	---	--	-----------------------------

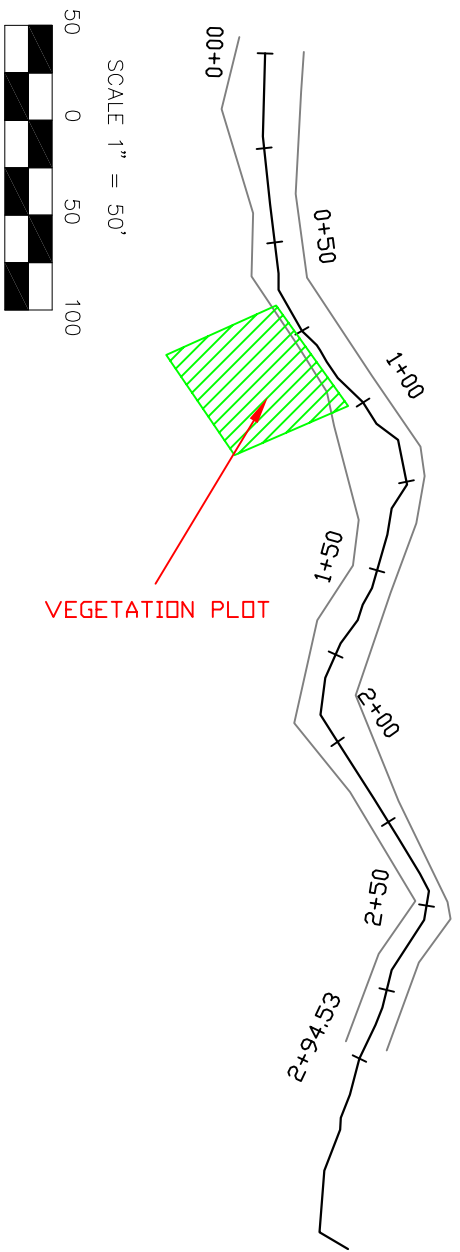

AREA 1

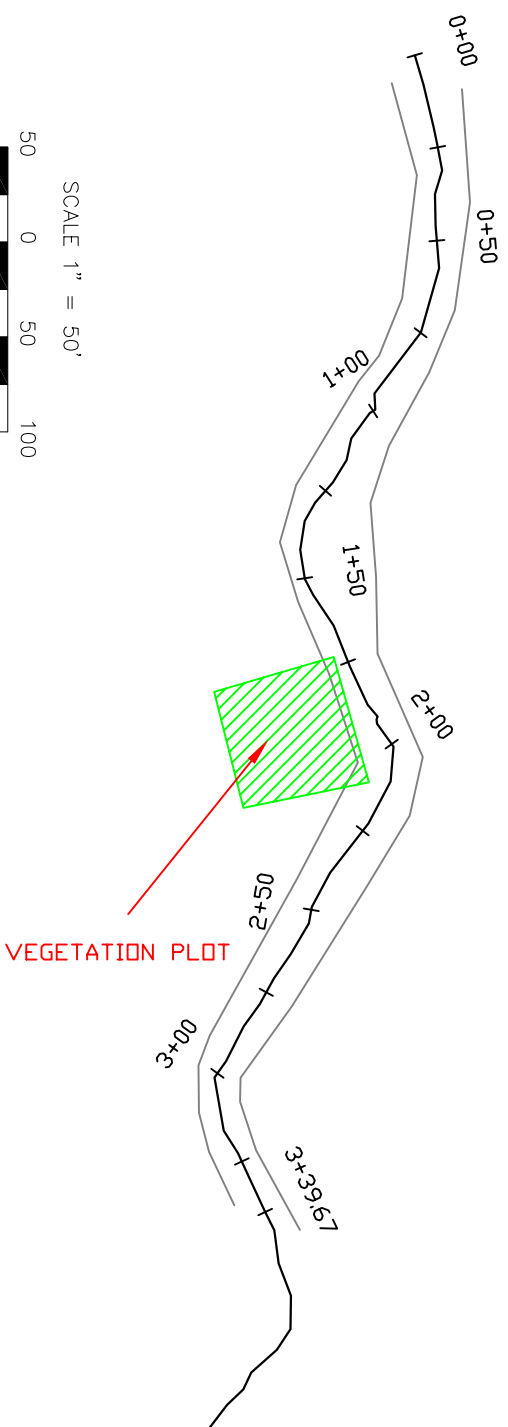


AREA 3

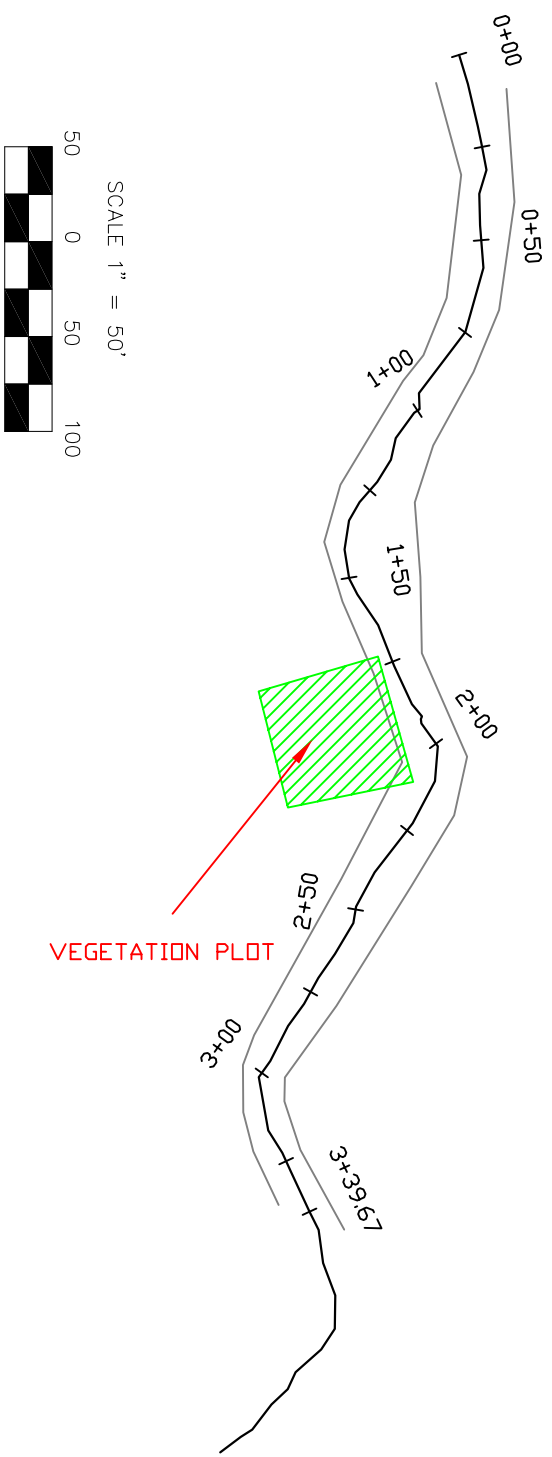

AREA 2

LEGEND	
2003 BANKFULL	---
2004 BANKFULL	---
2003 THALWEG	---
VEG PLOT LOCATION	

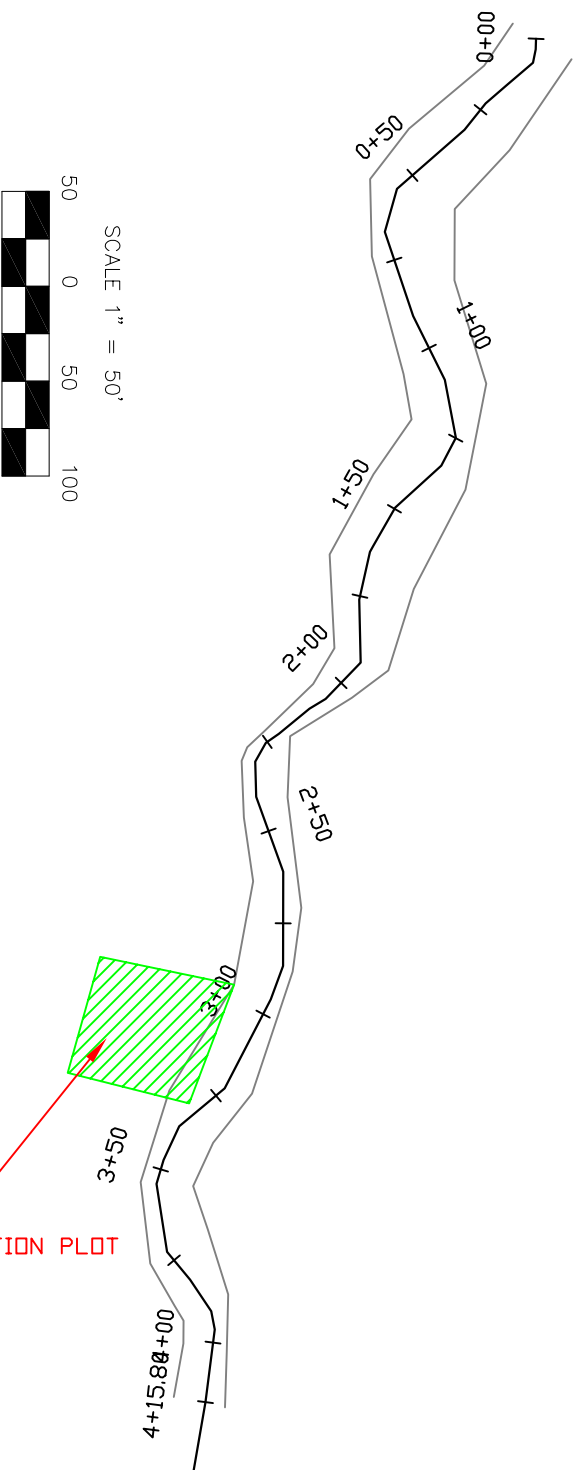

AREA 4

NO	REVISIONS	DRN	CHK	DATE
1	ISSUED TO EEP	DAB	DRC	3/01/05





NC STATE UNIVERSITY

BIOLOGICAL & AGRICULTURAL ENGINEERING
 Weaver Labs Campus Box 7625
 North Carolina State University
 Raleigh, NC 27695

JUMPING RUN STREAM RESTORATION
 ALEXANDER, N.C.
 ECOSYSTEM ENHANCEMENT PROGRAM

FIGURE
 AS-BUILT MONITORING PLAN VIEW

DATE	3/01/2005
PROJECT NO.	
FILENAME	PAVNE DARR.DWG
SHEET NO.	C - 1
DRAWING NO.	

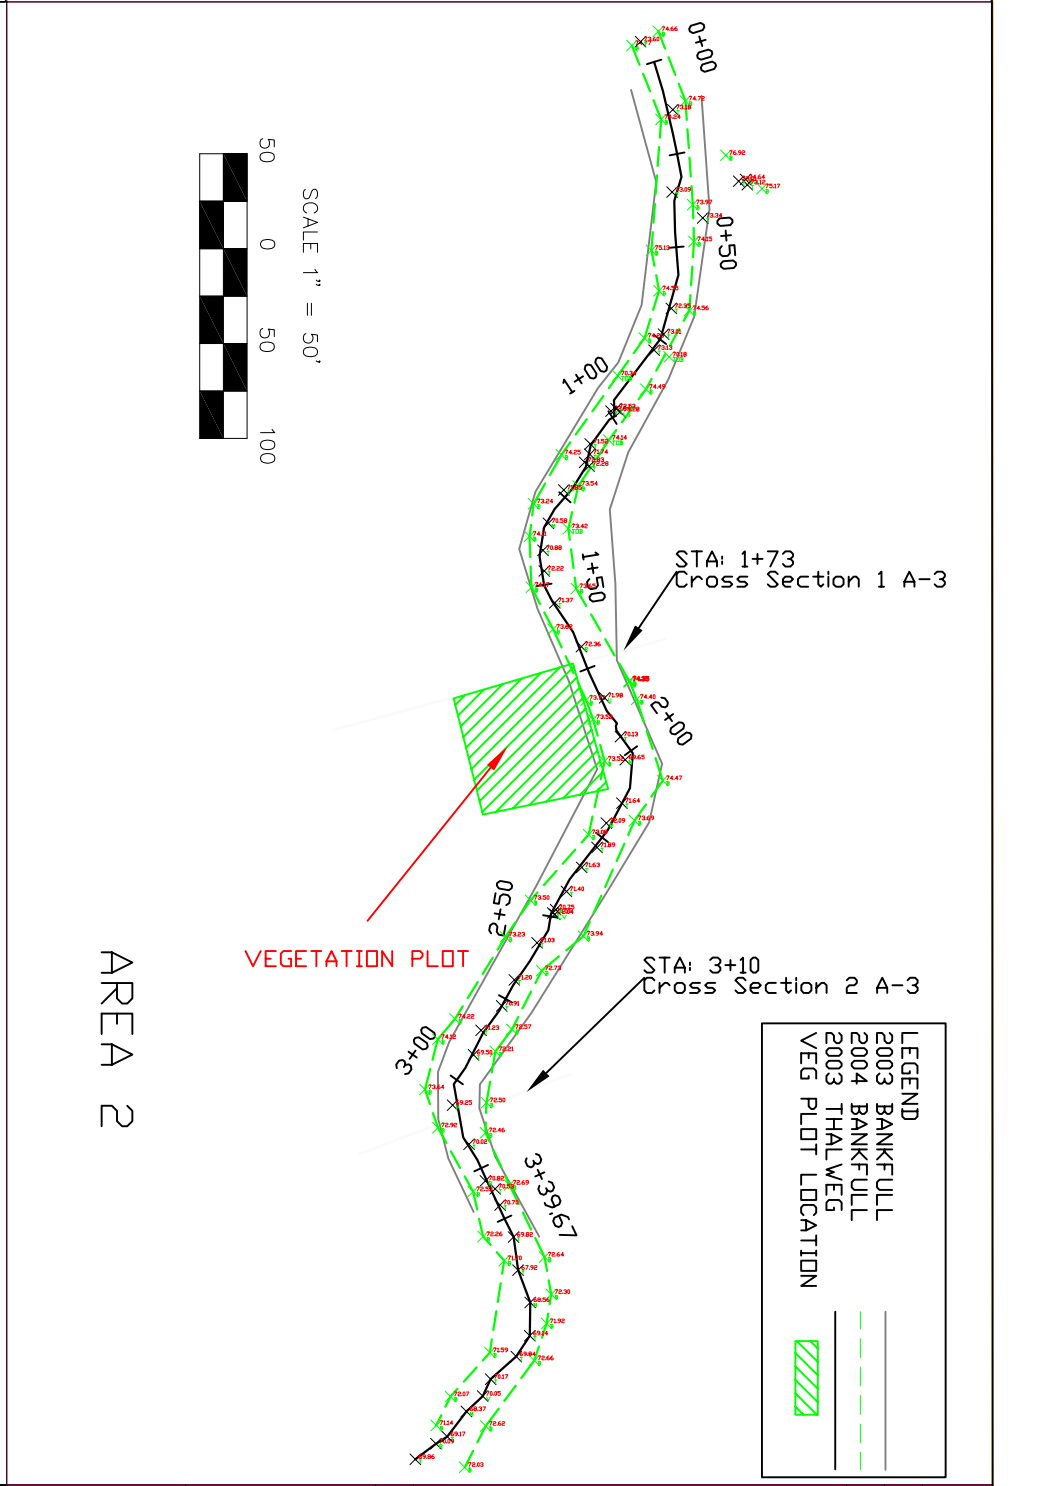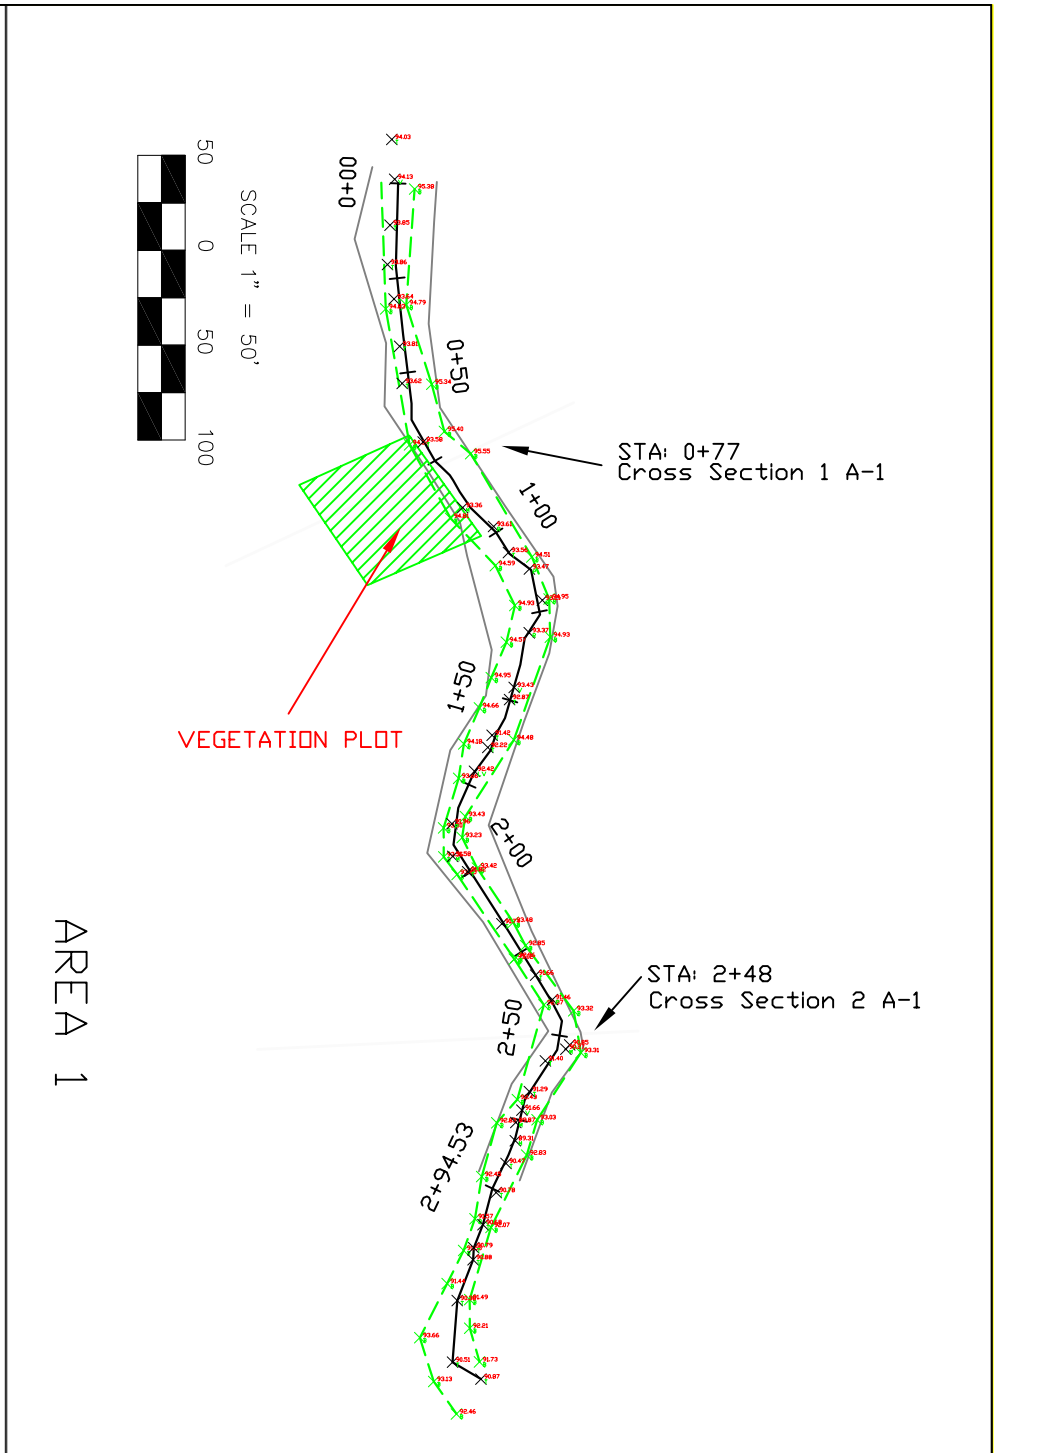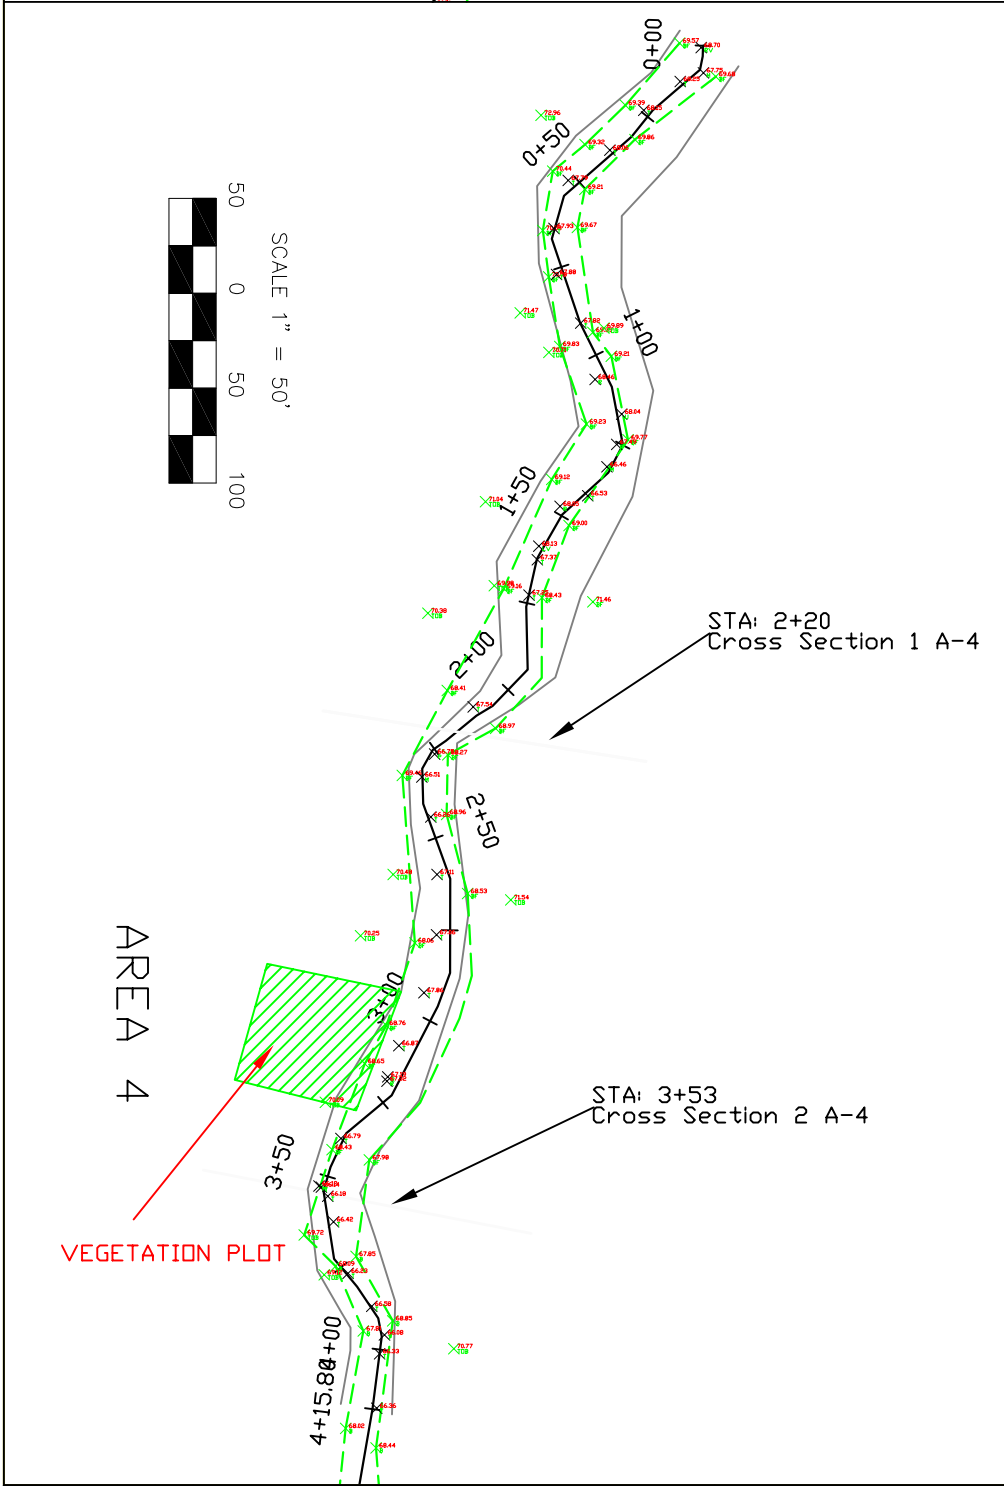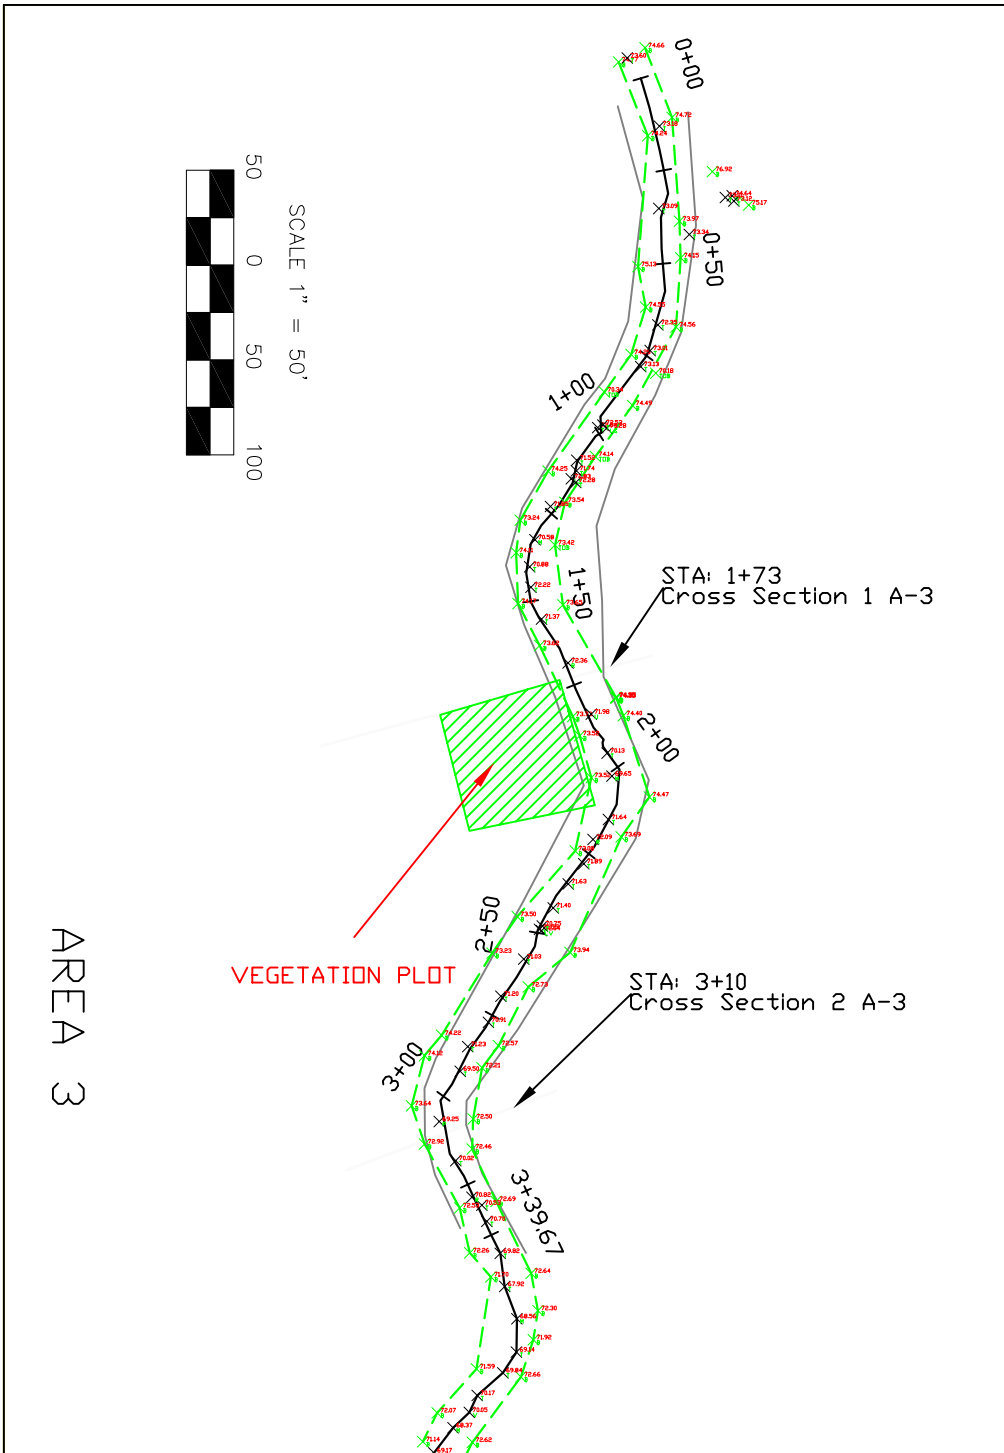

LEGEND	
2003 BANKFULL	---
2004 BANKFULL	---
2003 THALWEG	---
VEG PLOT LOCATION	

JUMPING RUN STREAM RESTORATION
ALEXANDER, N.C.
ECOSYSTEM ENHANCEMENT PROGRAM

FIGURE
2004 MONITORING PLAN VIEW

DATE: 3/01/2005
PROJECT NO.:
FILENAME: PAVNE.DRAWING
SHEET NO.: C-1
DRAWING NO.:

NC STATE UNIVERSITY

BIOLOGICAL & AGRICULTURAL ENGINEERING
Weaver Labs Campus Box 7625
North Carolina State University
Raleigh, NC 27695

NO	REVISIONS	DRN	CHK	DATE
1	ISSUED TO EEP	DAB	DRC	3/01/05

2.0 YEAR 2004 RESULTS AND DISCUSSION

Year 2004 monitoring results are shown for Jumping Run monitoring.

2.1 Vegetation

The following describes the results of 2004 vegetation monitoring conducted at the Jumping Run Restoration Site. Sampling and analysis methods used can be found in the appendix. Modifications to those methods are described below. Using the Draft Vegetation Monitoring Plan for NCWRP Riparian Buffer and Wetland Restoration Projects, 4 vegetation monitoring plots located within the riparian buffer of the Payne Dairy Stream Restoration project were resurveyed. Because of several flood events during the year, plots 1, 3, and 4 had to be realigned or moved due to washouts. No reference area was studied; therefore no comparisons could be made to reference conditions.

2.1.1 Results and Discussion

Vegetation within the riparian buffer of Jumping Run Creek is overall considered successful. The herbaceous layer is well established and diverse. *Panicum virgatum* (switchgrass), *Juncus* spp. (rushes) and *Carex* spp. (sedges) were most notably dominant throughout. Herbaceous vegetation can be considered extremely thick, perhaps to the detriment of naturally regenerating shrubs and trees. Streambanks and floodplain areas were well covered with herbaceous plants at time of surveying. Shrub species, particularly those sprouting from livestock stakes appeared to be performing well. In the majority of areas where livestock stakes were planted, they were alive and growing. *Salix nigra* (black willow) seems to be performing exceptionally well throughout the entire project area. There is also a large number of naturally regeneration shrub species throughout the project area where herbaceous vegetation is not dense. Several clumps of shrubs appear to be transplanted during construction. These continue to appear healthy and vigorous.

Extrapolation from the four plots resulted in an overall average of approximately 120 planted trees per acre for this restoration site. If natural regeneration is included with planted trees, the number is increased to an average of approximately 270 trees per acre. Both of these estimates are based on a diverse mix of species as well. Natural regeneration obviously plays an important role in the restoration of this site, although natural regeneration numbers were not as high as expected.

Microstegium vimineum was the only major invasive exotic plant located within these areas. *Festuca* sp. (Fescue) was prevalent in the adjacent fields surrounding the buffer; however, the native herbaceous vegetation seemed to be well established in the majority of the project site. Only a few areas contained the fescue. Chinese Privet (*Ligustrum sinense*) was also seen in limited locations throughout the site and should be monitored as well. Native herbaceous vegetation appears to be out competing the fescue and microstegium in most areas.

Recommendations include planting more trees to meet mitigation requirements and live stakes in areas where bare areas exist along the channel banks. The invasive vegetation

should also be monitored over time to determine if it will be a limiting factor in native plant growth in the future. No treatment is recommended at this time.

2.2 Morphology

Restored channel dimension, pattern, profile and substrate were examined during the 2004 monitoring. Methodology used for data collection can be found in the appendix. Deviations from those methods are detailed below. The entire data set can be found in the appendix.

2.2.1 Results and Discussion

Area 1

Channel profile along area 1 of Jumping Run remained similar to 2003 survey. The headcut previously discussed in prior reports appears to have stabilized. The upper end of the reach (station 0+0 to 1+50) has a decrease in bedform and has slightly aggraded. This area should be closely examined in upcoming monitoring events. Vegetation dominating the channel banks is maintaining stability through the reach.

Channel cross sections remain very stable. Cross-sectional area has decreased in both, the riffle and the pool. Decrease in area is likely due to dense vegetation lining the channel banks. Maximum depth is consistent to as-built conditions and the entire reach appears to be functioning properly.

Riffle channel materials, although finer than as-built conditions, are slightly coarser than 2003 conditions. Gravel appears more dominant throughout the reach. Pool channel materials are coarser than as-built conditions but have become finer for the past three years. The channel appears to be transporting the sediment load delivered to it by its watershed.

Channel pattern appears to have been maintained since construction. Dense vegetation has established along the channel banks. This vegetation is providing an excellent root mass to stabilize the banks. There are no areas of visible meander migrations throughout this reach.

Area 2

Channel profile along area 2 of Jumping Run has remained similar to as-built conditions. Riffles appear to be maintaining grade and pools are maintaining their max depth. No downcutting or headcuts are evident in this section. Profile survey results from this reach are unavailable due to unrecoverable data error. Cross-sections were resurveyed and verify channel grade has not changed since 2003 survey. Pools and riffles are in the appropriate locations in the plan form and do not appear to have changed much over the past year.

Channel cross sections remain very stable. Both sections had a reduction in cross-sectional area. The dense vegetation is capturing sediment washing through the reach, narrowing the channel throughout the reach. The pool is narrowing by building the point bar. The maximum depth is similar to 2003 conditions.

Riffle channel materials are finer than as-built conditions but the reduction in d50 is less than previous years. Coarse material in the form of coarse sand is dominating the channel bed. Pool channel materials are coarser than as-built conditions and are similar to 2002 conditions.

Channel pattern appears to have been maintained since construction. Dense vegetation has established along the channel banks. This vegetation is providing an excellent root mass to stabilize the banks. There are no areas of visible meander migrations throughout this reach.

Area 3

Channel profile along area 3 of Jumping Run has remained similar to as-built conditions. Riffles appear to be maintaining grade and pools are maintaining their max depth and location. No down-cutting or head cuts are evident in this section.

Channel cross sections remain very stable. As with the other study cross-sections, cross-sectional area continues to decrease. The ample floodplain area is being accessed frequently, allowing deposition occur along the channel banks. Maximum depth is consistent to as-built conditions and the entire reach appears to be functioning properly. Vegetation is stabilizing the banks in both sections.

Riffle channel materials at cross section #1 were similar to 2003 conditions and continue to be finer than as-built conditions. Sands dominate the bed but gravel remains present. Pool cross-section substrate was similar to 2003 conditions and remain finer than as-built conditions.

Channel pattern appears to have been maintained since construction. Plan from measurements are very similar to 2003 data. Dense vegetation has established along the channel banks. This vegetation is providing an excellent root mass to stabilize the banks. There are no areas of visible meander migrations throughout this reach.

Below area #3, a cross vane had previously been cut through and the left arm had slumped. Although water was still cutting around the structure to the left, vegetation has established and the near bank area is aggrading slightly. A structure 20 feet downstream is doing an excellent job of holding grade so there is little risk of head cutting. No degradation has occurred in this area over the past two years. This area will be monitored closely in future monitoring periods.

Area 4

Channel profile along area 4 of Jumping Run remained similar to as-built conditions. The pool at station 0+60 is now a run or flat riffle and a short section of downcutting has occurred between stations 3+50 and 4+00 but appears to be localized. Riffles throughout the middle part of the reach are being maintained. Profile appeared to be properly formed. Upcoming monitoring should examine this area closely to see if the downcutting expands. Pools are maintaining depth and location. Vegetation dominating the channel banks is helping to maintain bank stability.

Riffle cross-section area has remained similar to 2003 measurements. A small decrease in cross-sectional area has occurred as the left bank continues to aggrade. Toe scour along the right bank should be monitored in following years although the dense vegetation along the channel bank makes significant erosion unlikely. The pool cross-section slightly increased in area since 2003. This is due to some right bank migration. Right bank scour was noticed in 2003. The bank has migrated 0.7 feet over the past year. This appears to be relatively localized due to the dense vegetation lining the channel bank. Upcoming monitoring should examine this area closely to see if the migration continues. Overall, this reach remains very stable. Maximum depth is consistent to as-built conditions and the entire reach appears to be functioning properly.

Data collected on channel materials was unrecovered prior to preparing this report; therefore, visual assessment is used. Channel material appears similar to previous conditions. Coarse gravel dominates the riffle bed and pools remain sandy. Previous surveys have not indicated any potential problems with bed material condition and 2004 visual inspections were consistent with those observations.

Channel pattern appears to have been maintained since construction. Plan form measurements are very similar to 2003 data. Dense vegetation has established along the channel banks. This vegetation is providing an excellent root mass to stabilize the banks. There are no areas of visible meander migrations throughout this reach.

Table 1. Summary of Results

DIMENSION	Jumping Run Area #1				Jumping Run Area #2				Jumping Run Area #3				Jumping Run Area #4			
	Riffle		Pool		Riffle		Pool		Riffle		Pool		Riffle		Pool	
	As-built	2004	As-built	2004	As-built	2004	As-built	2004	As-built	2004	As-built	2004	As-built	2004	As-built	2004
Bankfull Cross-sectional Area	9.4	6.6	19.2	11.2	9.0	7.8	12.8	7.2	8.3	6.8	27.1	25.3	13.5	8.3	15.9	14.9
Bankfull Width	14.0	9.8	16.0	9.7	11.5	7.8	13.7	8.7	9.0	8.7	15.0	12.9	17.0	13.5	14.0	12.9
Bankfull Mean Depth	0.7	0.7	1.2	1.2	0.8	1.0	0.9	0.8	0.9	0.8	1.8	2.0	0.8	0.6	1.1	1.2
Bankfull Max Depth	1.6	1.5	2.3	2.0	1.4	2.0	1.5	1.6	1.3	1.3	3.6	3.0	1.2	1.1	2.0	2.1
Width/Depth Ratio	20.8	14.5			14.7	7.8			9.8	11.2			21.4	21.8		

PATTERN	Jumping Run As-built - 2000				Jumping Run 2003				Jumping Run 2004			
	Area 1	Area 2	Area 3	Area 4	Area 1	Area 2	Area 3	Area 4	Area 1	Area 2	Area 3	Area 4
Meander Wave Length	130	100	120-165	140	115-123	49-95	145-149	30-52	108-126	49-108	124-148	66-148
Radius of Curvature	60	33	35-84	60+	27-39	22-30	34-58	30-51	30-44	14-43	30-42	26-69
Beltwidth	-	-	-	-	35-39	36-47	43-51	25-49	32-39	29-45	38-46	20-35

PROFILE*	Jumping Run 2003 - Area 1		Jumping Run 2004 - Area 1		Jumping Run 2003 - Area 2		Jumping Run 2004 - Area 2		Jumping Run 2003 - Area 3		Jumping Run 2004 - Area 3		Jumping Run 2003 - Area 4		Jumping Run 2004 - Area 4		
	Median	Min	Max	Median	Median	Min	Max	Median	Median	Min	Max	Median	Median	Min	Max	Median	
Riffle Length	20.9	31.4	68.9	49.7	11.8	No data reported (data collection error)				23.6	17.0	38.0	27.5	17.9	15.0	52.0	34.0
Riffle Slope	1.66%	0.47%	1.05%	0.60%	1.39%	No data reported (data collection error)				1.86%	1.40%	3.29%	2.05%	1.52%	0.23%	1.62%	1.00%
Pool Length	16.9	25.0	36.0	30.5	30.0	No data reported (data collection error)				29.5	24.0	59.0	38.0	35.0	28.0	83.0	53.0
Pool to Pool Spacing	44.0	39.5	94.5	87.5	43.3	No data reported (data collection error)				89.2	42.5	87.0	59.0	89.5	48.0	115.5	70.5


*Data for previous monitoring periods were not reported

SUBSTRATE	Jumping Run Area #1				Jumping Run Area #2				Jumping Run Area #3				Jumping Run Area #4			
	Cross-section #1		Cross-section #2		Cross-section #1		Cross-section #2		Cross-section #1		Cross-section #2		Cross-section #1		Cross-section #2	
	Riffle		Pool		Riffle		Pool		Riffle		Pool		Riffle		Pool	
	As-built	2004	As-built	2004	As-built	2004	As-built	2004	As-built	2004	2001	2004	As-built	2003	As-built	2003
d50	0.27	0.16	0.08	0.23	7.41	0.11	0.09	0.26	12.65	0.09	0.38	0.16	9.65	3.37	0.14	0.16
d84	8.09	1.07	0.14	0.44	14.03	0.7	0.15	13.65	44.9	15.91	8.87	1.95	27.3	15.43	0.56	1.29

VEGETATION	Jumping Run Area 1 - 2003		Jumping Run Area 1 - 2004		Jumping Run Area 2 - 2003		Jumping Run Area 2 - 2004		Jumping Run Area 3 - 2003		Jumping Run Area 3 - 2004		Jumping Run Area 4 - 2003		Jumping Run Area 4 - 2004	
	Quad #1		Quad #1		Quad #2		Quad #2		Quad #3		Quad #3		Quad #4		Quad #4	
	Observed	Planted	Observed	Planted	Observed	Planted	Observed	Planted	Observed	Planted	Observed	Planted	Observed	Planted	Observed	Planted
Tree Stratum (trees/acre)	480	360	160	80	1080	240	160	0	1040	840	120	120	520	520	640	280
Shrub Stratum (%cover)	25	-	20	-	2.5	-	11	-	10.5	-	1	-	12	-	3	-
Herb Stratum (%cover)	143	-	110	-	115	-	100	-	206.5	-	85	-	169	-	105	-


MACROINVERTEBRATES	Upstream Reference				Site 2 - within restoration				Site 3 - below restoration			
Year of Survey	2000	2002	2003	2004	2000	2002	2003	2004	2000	2002	2003	2004
Total Taxa Richness	43	37	44	41	38	12	20	27	31	28	44	44
EPT Taxa Richness	19	20	19	20	8	3	12	11	9	7	16	16
EPT Abundance	67	88	87	88	39	7	34	39	47	28	71	54
Dominants in Common Index (%)	-	-	-	-	25%	5%	28%	30%	19%	16%	50%	60%
# Keystone taxa	10	12	14	19	2	0	5	6	4	0	6	12

**Jumping Run Creek
Longitudinal Profile
2004 - Area #1**

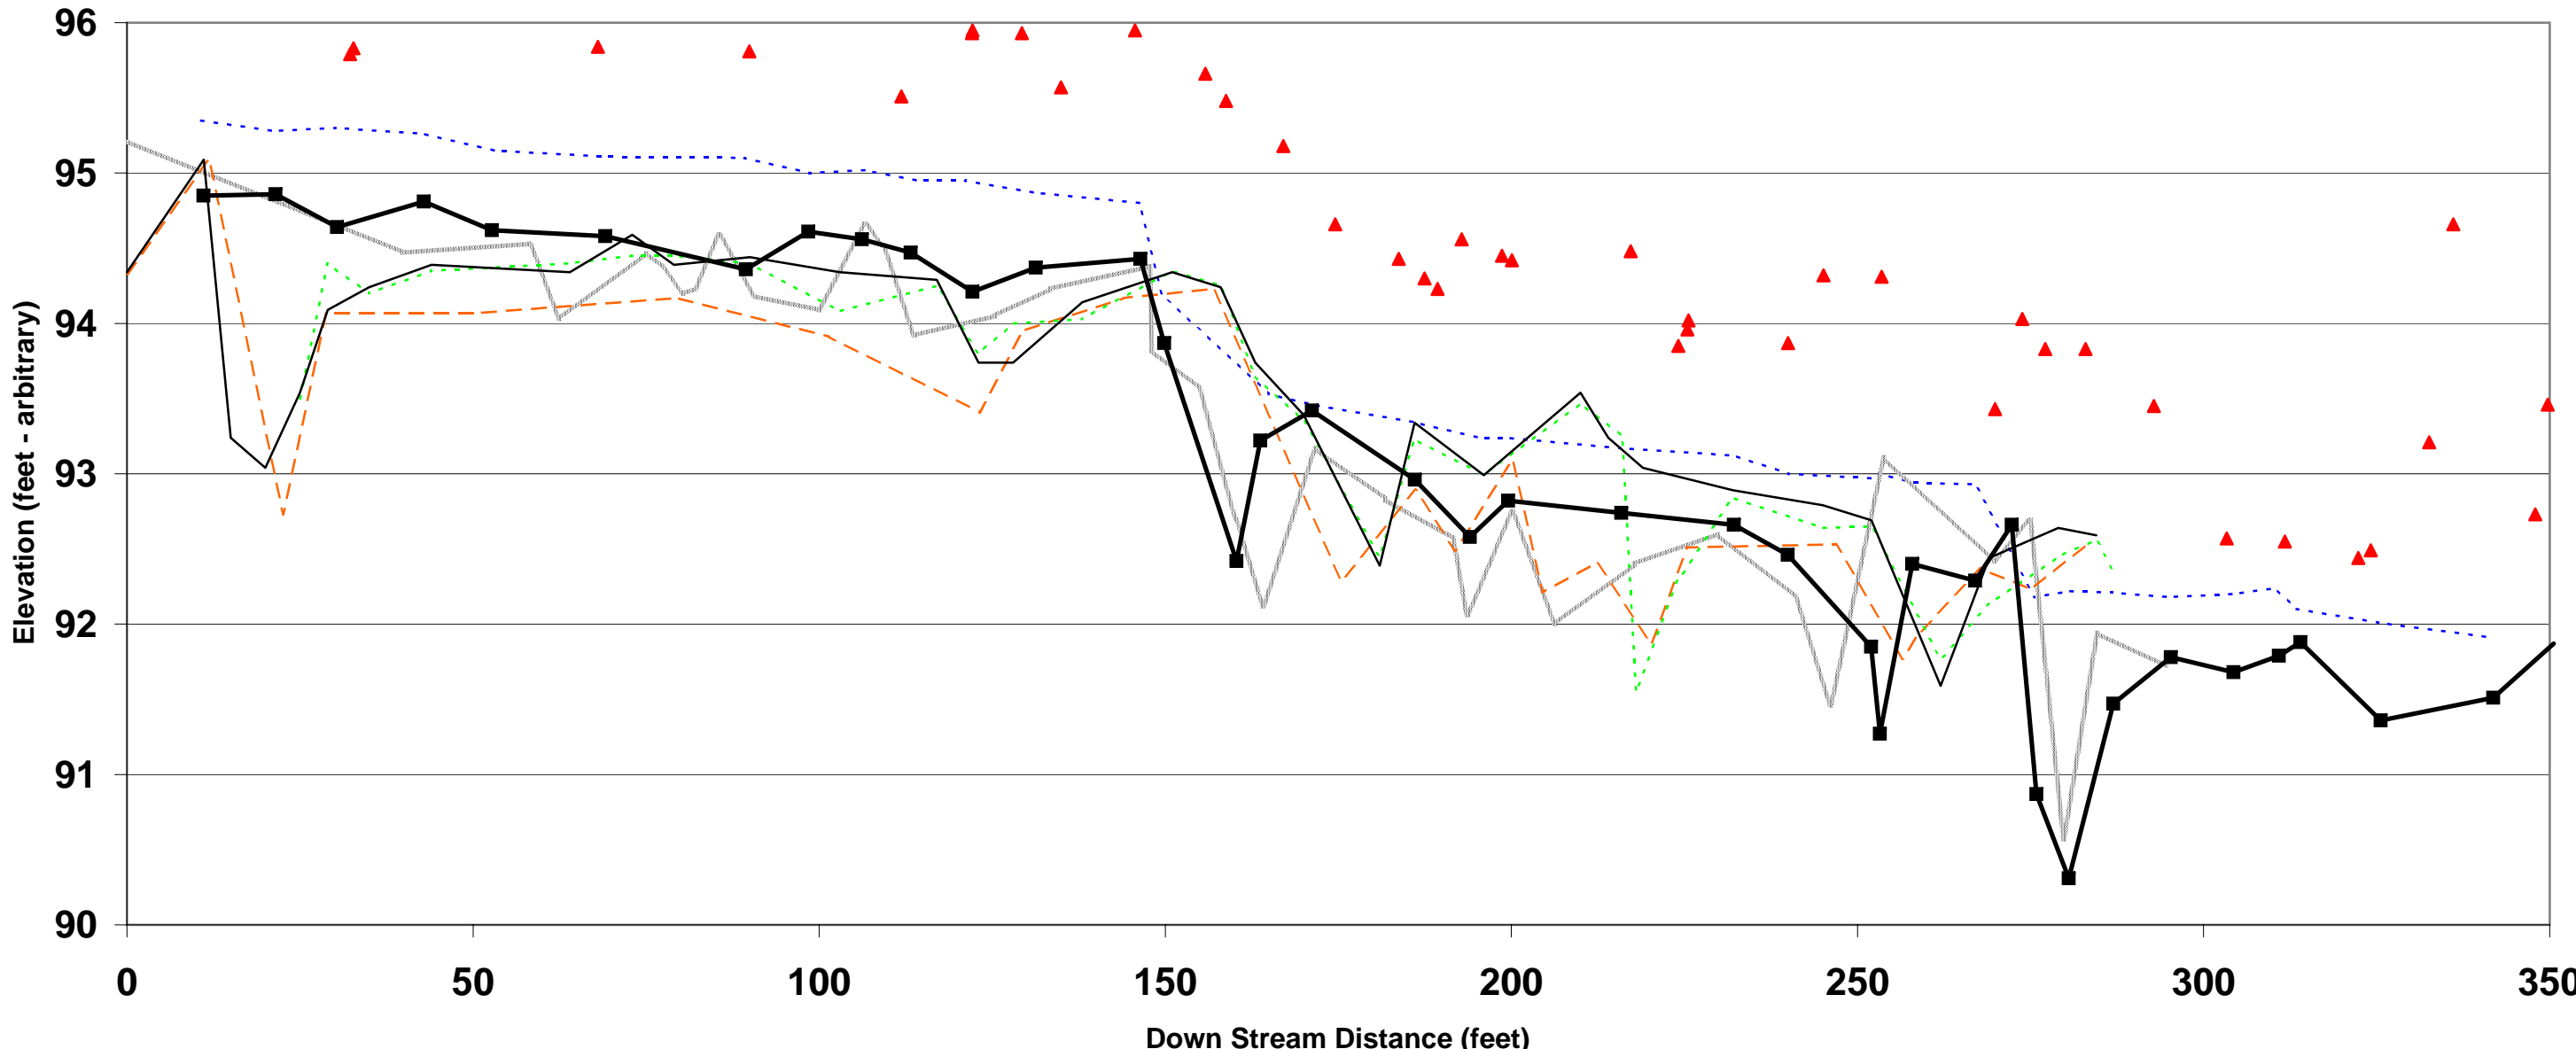


▲ Bankfull -.-.- Water Surface Long Pro 2003 -.-.- Long Pro 2002 -.-.- Long Pro 2001 — As-built 2000 —■— Long Pro 2004

**Jumping Run Creek
Longitudinal Profile
Area #2**

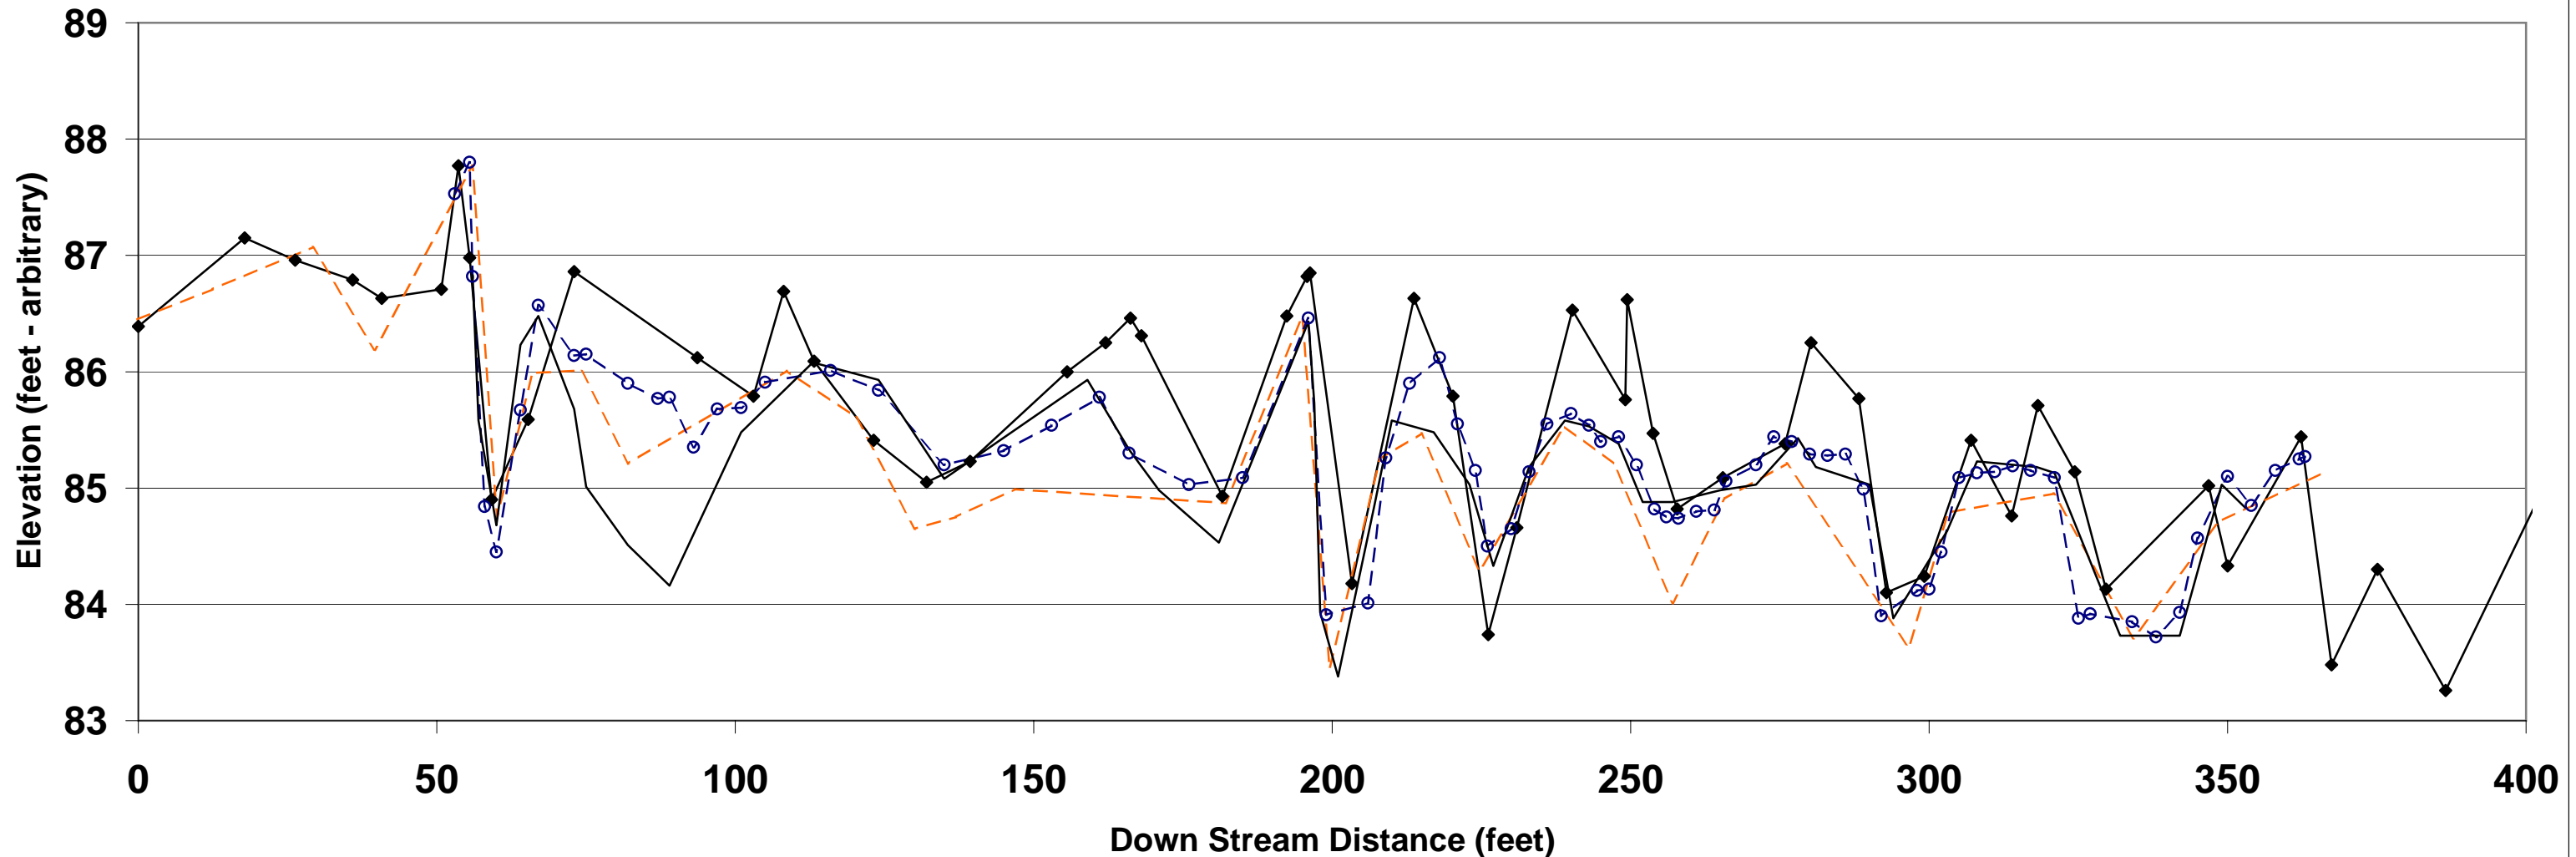


▲ Right Bankfull ◆ Long Pro 2003 - - - Long Pro 2002 - - - ○ Long Pro 2001 — As-built 2000

Jumping Run Creek
Longitudinal Profile
2004 - Area #3

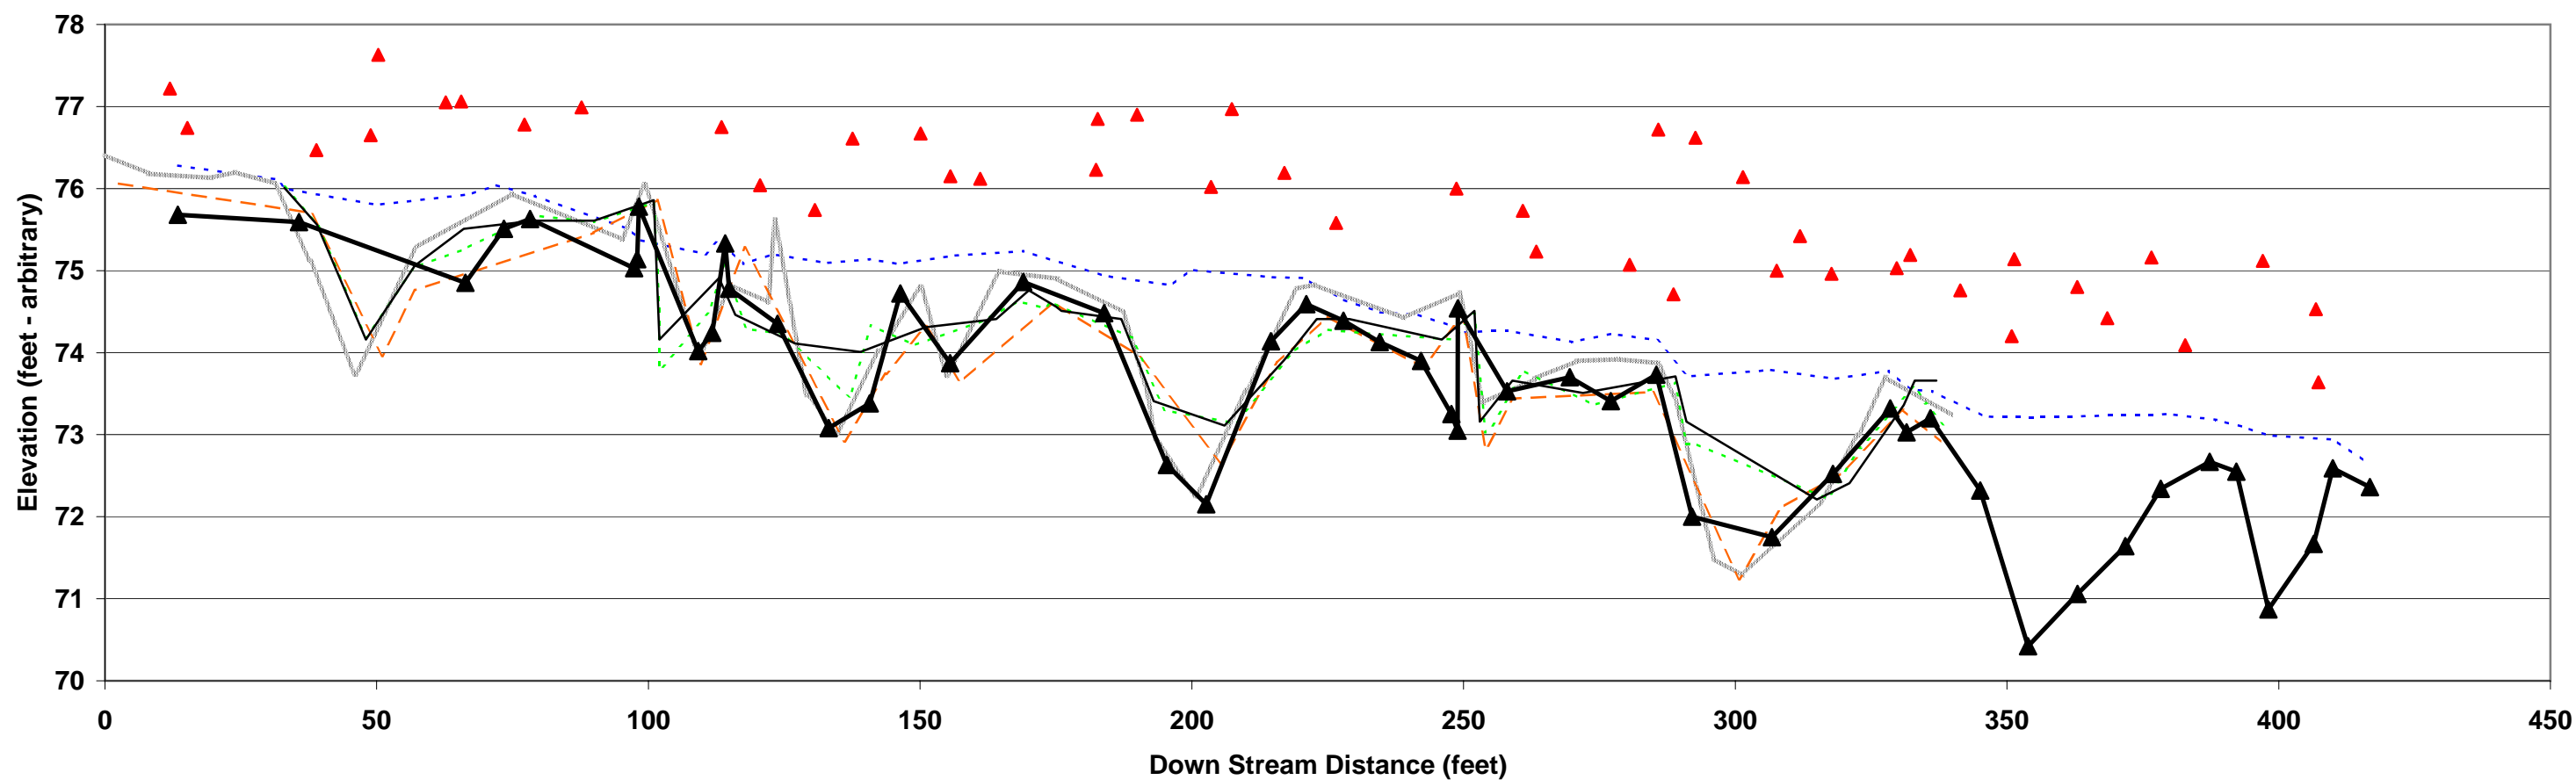

▲ Bankfull -.-.- Water Surface Long Pro 2003 -.-.- Long Pro 2002 -.-.- Long Pro 2001 — As-built 2000 —▲ Long Pro 2004

Jumping Run Creek
Longitudinal Profile
2004 - Area #4

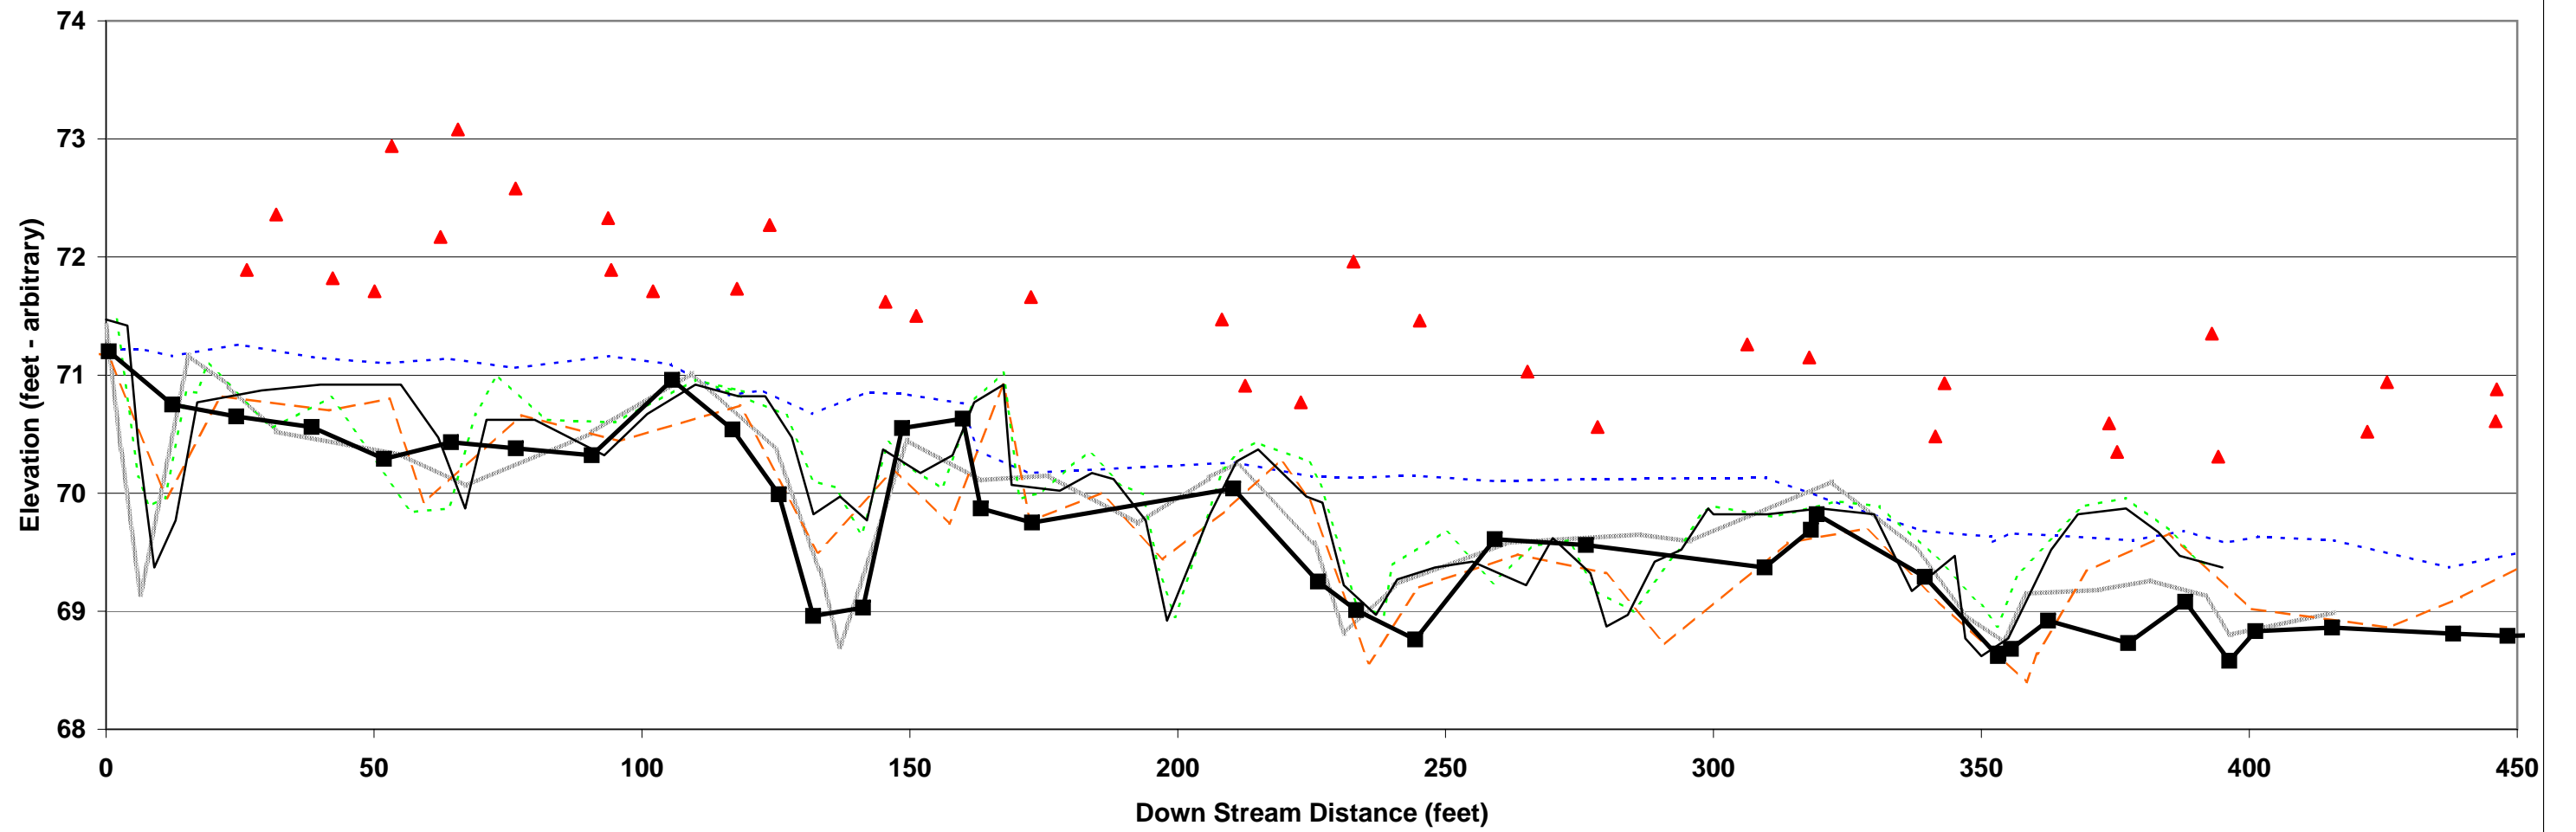

▲ Bankfull - - - - Water Surface Long Pro 2003 - - - - Long Pro 2002 - - - - Long Pro 2001 — As-built 2000 —■— Long Pro 2004

2.3 Benthic Macroinvertebrates Results

Benthic macroinvertebrates samples were collected from three locations in this project to assess the restoration of Jumping Run Creek. Qual-4 collections were used at all locations and the organic/inorganic fractions of the collections were kept separate during the 2004 investigation. Station 1 is located above the restoration project in a relatively stable reach of Jumping Run Creek (approximately 3-4 riffles above the fence that marks the property line), although there is some sedimentation and bank erosion at this location. The catchment above this location contains mostly pasture and has some stormwater from residential development. Station 2 is located approximately 50 meters above SR 1614 and is within the reach of Jumping Run Creek that was restored. The stream was very unstable at this point with cattle access prior to construction. Following restoration herbaceous vegetation dominated the riparian canopy. Sand and silt dominated the substrate at this location, bank erosion was severe and the canopy has been reduced or eliminated in some places. Also it appears that this reach of Jumping Run Creek has been channelized in the past. Station 3 is below a UT of Jumping Run Creek, which drains the farm property. Jumping Run Creek at this point appeared to be more stable and had a much wider riparian zone. Cattle had access to this reach prior to restoration and *Physella* (an air breathing snail) was very abundant at this location, suggesting accumulation of fine particulate organic material (FPOM) and occasional low DO values dominated the benthos prior to restoration. The data in table 4 summarize the data from these three locations during pre-construction (2000) and two post-construction surveys (2002 and 2003). Additional information will be collected from this project in October 2004.

Table 2. Benthic Summary Statistics from the stream restoration project at Payne Dairy.

Year of Survey	Upstream Reference				Site 2				Site 3			
	2000	2002	2003	2004	2000	2002	2003	2004	2000	2002	2003	2004
Total Taxa Richness	43	37	44	41	38	12	20	27	31	28	44	44
EPT Taxa Richness	19	20	19	20	8	3	12	11	9	7	16	16
EPT Abundance	67	88	87	88	39	7	34	39	47	28	71	54
Dominants in Common Index (%)	-	-	-	-	25%	5%	28%	30%	19%	16%	50%	60%
# Keystone taxa	10	12	14	19	2	0	5	6	4	0	6	12

Taxa richness and EPT abundance values from the upstream reference site indicate relatively stable conditions and a surprising number of intolerant (keystone) species. Many of these taxa were completely eliminated downstream of this location prior to construction and replaced by tolerant filter-feeding taxa, presumably responding to the input of fine particulate organic matter. Following construction, the number of taxa and EPT abundance values declined dramatically at site 2 (in bold). The Dominant in Common Index and the number of keystone species also declined at this site following restoration and this decline was also noted at site 3 near the lower end of the project. Interestingly the most dominant taxa at site 2 in 2002 following restoration were very tolerant chironomidae (*Cricotopus bicinctus*). The abundance of these taxa may be a response to the presence of coir-matting in this reach used for bank stabilization. Recovery from this initial impact to Jumping Run Creek appears to be occurring as taxa richness, EPT abundance have increased from data collected in 2002 and in 2003 and 2004 mimic, to some extent, pre-construction conditions. Interestingly conditions continued to improve at Site 3 below the restoration project, both the DIC and the number of keystone taxa increased at this location in 2004 (in bold). This may be a response to

the elimination of cattle and the efficiency of nutrient uptake of the new riparian zone at Site 2. This improvement was not noted within the restored reach where conditions were very similar to those in 2003.

Table 5 summarizes the number of animals collected from organic (leaf packs and sweeps) and inorganic (kicks and visuals) components of the collection. During this investigation, we noted that there was a great deal of organic material in the stream at site 2, primarily decomposing grasses that were planted near the stream to stabilize the new banks as well as coir-matting. However, this material didn't provide a productive habitat for organisms that would normally be found in the organic component of the collection. Note overall the decline in abundance values at this site compared to those found at the reference location and the numbers found in the organic fraction (in bold). The abundance values increased at site 3.

Table 3. 2003 EPT Abundance Table

Abundance values of Ephemeroptera, Plecoptera and Trichoptera collected from inorganic and organic components of samples during the 2003 investigation from Payne Dairy.

	Upstream Reference		Site 2		Site 3	
	inorganic	organic	inorganic	organic	inorganic	organic
Ephemeroptera	32	60	24	25	81	65
Plecoptera	20	20	0	3	8	10
Trichoptera	21	15	5	11	32	5
Subtotal	73	95	29	39	121	80
Total Abundance	168		68		201	

2.4 Areas of Concern

The following areas of concern for 2004 should be monitored closely and considered for repair as suggested:

- **Piping through the structure (Issue Photo 1)**
 - A cross vane just upstream of section 2 should be monitored for changes. It is presently partially piping through the structure.
- **Downcutting in Reach 4 (See Area 4 profile graph)**
 - Two areas of bed downcutting had occurred since construction (between stations 0+40 and 0+70 and 3+50 and 4+00). These areas should be watched closely in upcoming monitoring events.
- **Right bank migration on pool cross-section in area 4 (See Area 4 Cross-section)**
 - The bank has migrated over the past two monitoring periods. This area should be watched closely to ensure bank stability in upcoming monitoring events.
- **Toe scour at riffle cross-section in area 4 (See Area 4 Cross-section)**
 - Scour along the right bank toe should be watched closely to ensure bank stability in upcoming monitoring events.
- **Sediment laden water cutting through buffer in Area 4 (Issue Photo 3)**

- Concentrated sediment laden water cutting through the buffer. The path has formed into a small gully. The source of the water is the cow pasture adjacent to the project. The water is likely carrying significant amount of nutrients as well as sediment. This should be monitored to see if the problem continues. A level spreader may be necessary stop the short cutting of the buffer.
- Station: End of Area 4.
- **Vegetation**
 - Plantings are currently below minimum requirements (120 stems/acre planted and 270 stems/acre total including volunteer species). Supplemental planting should be considered.

The following areas of concern for 2003 and there current status:

- **Head cut area**
 - A previously noted headcut in Area 1 should be monitored in the future.
Status: Headcut was not noticeable in the field or on the survey.
- **Piping through the structure (Issue Photo 2)**
 - A cross vane just upstream of section 2 should be monitored for changes. It is presently partially piping through the structure.
Status: Structure was still piping but no further degradation was evident.
- **Cross vane wing slump**
 - `Cross vane below area 3 should be monitored for changes. Presently the arm has slumped
Status: Vane arm remains in slumped condition but vegetation has established along the bank and not further degradation has occurred.

2.5 Jumping Run Photo Document

2000 – As built – Year 0



2004 – Year 4

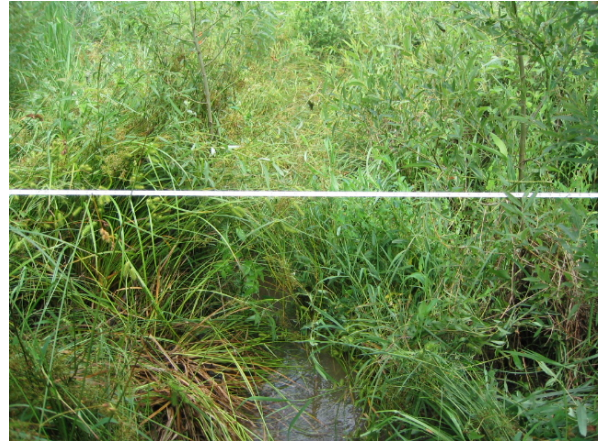


Photo Point 1: Standing at riffle cross-section looking downstream (begin project)



Photo Point 2: Standing at riffle cross-section looking upstream (begin project)



Photo Point 3: Standing at pool cross-section looking upstream

2000 – As built – Year 0



2003 – Year 3



Photo Point 4: Standing at pool cross-section looking downstream



Photo Point 15: Standing at riffle cross-section looking downstream



Photo Point 16: Standing at riffle cross-section looking upstream

2000 – As built – Year 0



2003 – Year 3



Photo Point 19: Standing at pool cross-section looking upstream



Photo Point 20: Standing at pool cross-section looking downstream



Photo Point 39: Standing at riffle cross-section looking upstream

2000 – As built – Year 0



2003 – Year 3



Photo Point 40: Standing at riffle cross-section looking downstream near Henry Road

2002 – Year 2



Photo Point 41: Standing at pool cross-section looking upstream

2002 – Year 2



Photo Point 42: Standing at pool cross-section looking downstream

2000 – As built – Year 0



2003 – Year 3



Photo Point 46: Standing at pool cross-section looking upstream



Photo Point 47: Standing at pool cross-section looking downstream



Photo Point 48: Standing at riffle cross-section looking upstream

2000 – As built – Year 0



2003 – Year 3



Photo Point 49: Standing at riffle cross-section looking downstream



Photo Point 50: Looking upstream towards Paul Payne Store Road

Appendices

- A. Methods
 - 1. Vegetation
 - 2. Morphology
- B. Vegetation data
 - 1. Listed by plot
 - 2. Species, number and age
 - 3. Analysis of planted vs. natural recruitment
- C. Morphology Data
 - 1. Cross-section data and plotted (DONE)
 - 2. Longitudinal data and plotted (DONE)
 - 3. Pebble count data and plotted (DONE)
 - 4. Pattern (DONE)

Project Name Jumping Run Area 1
Cross Section #1 (pins A-B)
Feature Riffle
Date 10/7/2003
Crew Shaffer, Bidelspach, Clinton

*2003 Elevation Adjusted +3.01

**2004 Elev. Adjusted up by 4.0 ft


2000 As-Built Survey			2001 Survey			2002 Survey			2003 Survey			2004 Survey		
Station	Elevation	Notes	Station	Elevation	Notes	Station	Elevation	Notes	Station	Elevation *	Notes	Station	Elev**	Notes
0.0	99.95	Grnd	0	99.95	Grnd	0.0	100.01	PIN-A	0.0	100.1	PIN-A	0.2	99.97	X1LP
2.0	99.90		2	99.9		1.1	99.77	G	0.6	99.87		4.5	99.59	X1
7.0	99.90		7	99.85		5.5	99.77	G	6.5	99.78		15.5	99.74	X1
12.0	99.60		12	99.4		13.0	99.43	G	13.5	99.34		23.5	99.58	X1
16.0	99.85		16	99.83		18.1	99.77	G	21.8	99.56		30.0	99.61	X1
18.0	99.92		18	99.9		24.3	99.55	G	27.7	99.49		30.8	99.57	X1B
25.0	99.65		25	99.65		28.9	99.49	G	31.4	99.58		31.7	99.57	X1
29.0	99.65		29	99.67		32.2	99.63	G	33.7	99.05	LBF (est)	33.3	98.96	X1
32.0	99.75		32	99.83		33.9	99.31	G	35.3	98.8		35.9	98.59	X1
33.0	99.63		33	99.55		35.1	98.99	LBF	36.8	98.6		37.3	98.09	X1
35.0	99.05	LBF (est)	35	99.03	LBF (est)	36.9	98.41	G	37.3	98.2		38.3	97.6	X1
37.0	98.55		37	98.5		38.5	98.11	LEOW	37.9	97.84		39.1	97.55	X1
38.0	98.25		38	98.35		38.8	97.49	CHN	38.7	97.47		39.7	97.69	X1
38.9	97.75		38.9	97.6		39.4	97.45	CHN	39.9	97.61		39.7	98.12	X1W
39.0	97.45		39	97.56		40.7	97.31	TW	40.2	98.03		40.9	98.65	X1
40.0	97.65		40	97.58		41.6	97.43	CHN	40.5	98.38		42.0	98.58	X1
41.0	97.75		41	97.57		42.8	97.77	CHN	40.9	98.51		43.2	98.9	X1
42.0	97.75		42	97.67		43.8	98.13	REOW	41.8	98.33		47.4	99.27	X1
42.5	97.90		42.5	98		45.4	98.55	G	42.4	98.31		53.2	99.52	X1
43.0	98.10		43	98.16		46.6	98.75	RBF	43.0	98.86		60.1	100.08	X1
44.0	98.45		44	98.51		48.5	99.19	G	43.7	98.93		68.9	100.21	X1
45.0	98.65		45	98.6	Est.	50.1	99.63	G	45.1	98.83		78.8	99.14	X1
46.0	98.80		46	98.67		53.4	99.89	G	48.0	99.36	RBF (est)	81.2	98.69	X1
47.0	98.95	RBF (est)	47	99.05	RBF (est)	58.1	100.01	G	54.1	99.75		86.1	98.3	X1
49.0	99.50		49	99.55		62.2	99.79	G	61.9	99.87		90.9	98.01	X1
51.0	99.75		51	99.75		66.6	99.51	G	67.9	100.16		96.2	98.25	X1
54.0	100.05		54	100		72.4	99.37	G	78.7	98.99		98.9	99.63	X1
57.0	100.10		57	100.1		77.3	99.19	G	82.1	98.45				
64.0	99.75		64	99.7		81.5	99.41	G	100.4	99.08	PIN-B1			
69.0	99.65		69	99.6		82.7	99.91	PIN-B						
76.0	99.40		74	99.5										
81.0	99.55		78	99.4										
82.3	99.85	Grnd	81	99.6										
82.3	99.93	Pin B?	82.3	99.85	Grnd									
100.00			82.3	99.91	Pin B?									



Photo of Area 1 Cross-Section #1 - Looking Downstream

	Bankfull Area				
	As-Built	2001	2002	2003	2004
Area	9.4	9.60	11.52	7.06	6.57
Width	14.0	12.0	13.3	11.8	9.8
Mean Depth	0.7	0.8	0.9	0.6	0.7
Max Depth	1.6	2.0	1.5	1.6	1.5
w/d ratio	20.8	15.0	15.4	19.9	14.5


Area 1 Cross-Section #1 - Riffle
Jumping Run Creek

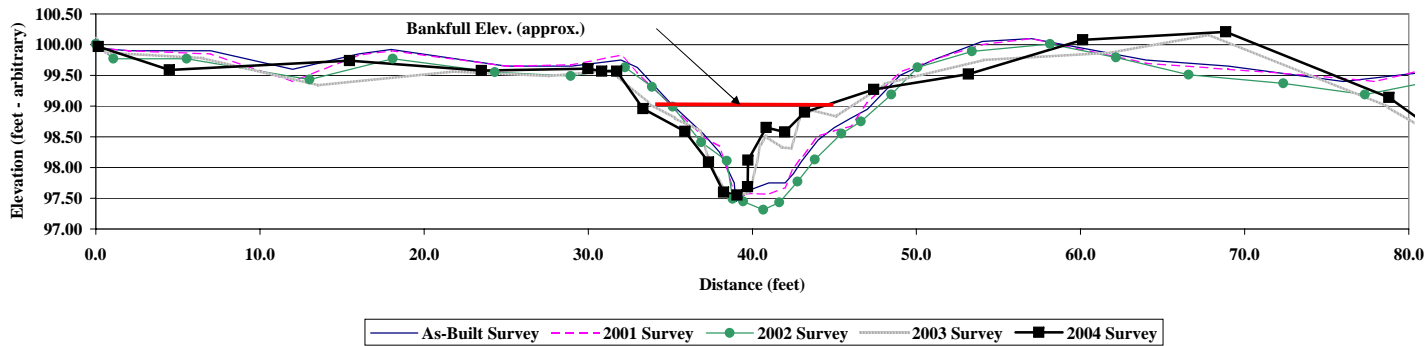

Project Name Payne Dairy - Jumping Run Creek
Cross Section #1 Section 1
Feature Riffle
Date 10/7/03
Crew Shaffer, Bidelspach, Clinton

Description	Material	2000 As-Built				2001				2002				2003				2004			
		Size (mm)	Riffle - Bed	%	Cum %	Riffle - Bed	%	Cum %	Riffle - Bed	%	Cum %	Riffle - Bed	%	Cum %	Riffle - Bed	%	Cum %	Riffle - Bed	%	Cum %	
Silt/Clay	silt/clay	0.061	10	20.0%	20.0%	1	2.0%	2.0%	10	20.0%	20.0%	0	12	12.0%	12.0%	0.0%	0.0%	1	2	6.0%	6.0%
Sand	very fine sand	0.062	6	12.0%	32.0%	3	6.0%	8.0%	13	26.0%	46.0%	0	34	34.0%	46.0%	0.0%	0.0%	3	8	22.0%	28.0%
	fine sand	0.125	5	10.0%	42.0%	10	20.0%	28.0%	8	16.0%	62.0%	8	4	12.0%	58.0%	16.0%	16.0%	16		32.0%	60.0%
	medium sand	0.25	9	18.0%	60.0%	3	6.0%	34.0%	7	14.0%	76.0%	12		12.0%	70.0%	24.0%	40.0%	6		12.0%	72.0%
	course sand	0.50	3	6.0%	66.0%	6	12.0%	46.0%	3	6.0%	82.0%	15		15.0%	85.0%	30.0%	70.0%	3		6.0%	78.0%
	very course sand	1.0		0.0%	66.0%		0.0%	46.0%	1	2.0%	84.0%	7		7.0%	92.0%	14.0%	84.0%	7		14.0%	92.0%
Gravel	very fine gravel	2.0	3	6.0%	72.0%	5	10.0%	56.0%	5	10.0%	94.0%	0		0.0%	92.0%	0.0%	84.0%	3		6.0%	98.0%
	fine gravel	4.0	1	2.0%	74.0%	2	4.0%	60.0%		0.0%	94.0%	1		1.0%	93.0%	2.0%	86.0%	0		0.0%	98.0%
	fine gravel	5.7	1	2.0%	76.0%	4	8.0%	68.0%	1	2.0%	96.0%	2		2.0%	95.0%	4.0%	90.0%	1		2.0%	100.0%
	medium gravel	8.0	9	18.0%	94.0%	7	14.0%	82.0%		0.0%	96.0%	3		3.0%	98.0%	6.0%	96.0%			0.0%	100.0%
	medium gravel	11.3		0.0%	94.0%	6	12.0%	94.0%	1	2.0%	98.0%	2		2.0%	100.0%	4.0%	100.0%			0.0%	100.0%
	course gravel	16.0	1	2.0%	96.0%	1	2.0%	96.0%		0.0%	98.0%			0.0%	100.0%	0.0%	100.0%			0.0%	100.0%
	course gravel	22.6	2	4.0%	100.0%		0.0%	96.0%		0.0%	98.0%			0.0%	100.0%	0.0%	100.0%			0.0%	100.0%
	very course gravel	32		0.0%	100.0%	1	2.0%	98.0%		0.0%	98.0%			0.0%	100.0%	0.0%	100.0%			0.0%	100.0%
	very course gravel	45		0.0%	100.0%	1	2.0%	100.0%	1	2.0%	100.0%			0.0%	100.0%	0.0%	100.0%			0.0%	100.0%
Cobble	small cobble	64		0.0%	100.0%		0.0%	100.0%		0.0%	100.0%			0.0%	100.0%	0.0%	100.0%			0.0%	100.0%
	medium cobble	90		0.0%	100.0%		0.0%	100.0%		0.0%	100.0%			0.0%	100.0%	0.0%	100.0%			0.0%	100.0%
	large cobble	128		0.0%	100.0%		0.0%	100.0%		0.0%	100.0%			0.0%	100.0%	0.0%	100.0%			0.0%	100.0%
	very large cobble	180		0.0%	100.0%		0.0%	100.0%		0.0%	100.0%			0.0%	100.0%	0.0%	100.0%			0.0%	100.0%
Boulder	small boulder	256		0.0%	100.0%		0.0%	100.0%		0.0%	100.0%			0.0%	100.0%	0.0%	100.0%			0.0%	100.0%
	small boulder	362		0.0%	100.0%		0.0%	100.0%		0.0%	100.0%			0.0%	100.0%	0.0%	100.0%			0.0%	100.0%
	medium boulder	512		0.0%	100.0%		0.0%	100.0%		0.0%	100.0%			0.0%	100.0%	0.0%	100.0%			0.0%	100.0%
	large boulder	1024		0.0%	100.0%		0.0%	100.0%		0.0%	100.0%			0.0%	100.0%	0.0%	100.0%			0.0%	100.0%
	very large boulder	2049		0.0%	100.0%		0.0%	100.0%		0.0%	100.0%			0.0%	100.0%	0.0%	100.0%			0.0%	100.0%
Bedrock	bedrock	40096	0	0.0%	100.0%	0	0.0%	100.0%	0	0.0%	100.0%			0.0%	100.0%	0.0%	100.0%			0.0%	100.0%
TOTAL / % of whole count			50	100.0%		50	100.0%		50	100.0%		50	100.0%		100.0%		100.0%	40	10	100.0%	

	d16	d35	d50	d84	d95
As-Built	0.00	0.12	0.27	8.09	16.48
2001	0.13	0.41	2.10	10.32	10.32
2002	0.00	0.08	0.12	1.50	1.50
2003	0.07	0.08	0.12	0.73	6.85
2004	0.08	0.11	0.16	1.07	2.25

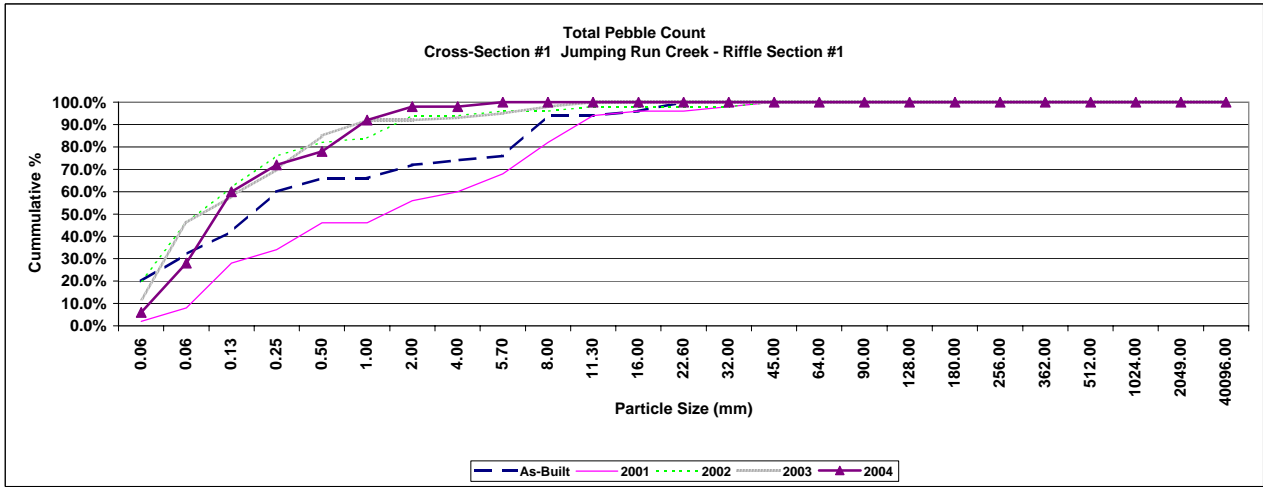

Project Name Jumping Run Area 1
Cross Section #2 (pins C-D)
Feature Pool
Date 10/7/2003
Crew Shaffer, Bidelspach, Clinton


*2003 Stationing adjusted -28 ft
 **2003 Elevations adjusted +5.73 ft
 ***2004 Elev adjusted +6.78 ft

2000 As-Built Survey			2001 2001 Survey			2002 2002 Survey			2003 2003 Survey			2004 2004 Survey		
Station	Elevation	Notes	Station	Elevation	Notes	Station	Elevation	Notes	Station*	Elevation**	Notes	Station	Elev***	Notes
0.0	100.00	PIN-C	0	99.78		0.0	99.87	PIN-C	-25.18	100.4		0	99.91	X2LP
2.0	99.74		2	99.76		0.7	99.61	G	-7.58	99.82		0.14	99.91	XSRP2
10.0	99.74		10	99.8		5.7	99.65	G	0.92	99.87		5.38	99.89	X2
13.0	99.79		13	99.84		9.9	99.57	G	6.38	99.87	Pin-C	10.61	100.05	X2
16.0	99.39		16	99.79		12.7	99.67	G	16	99.99		15.92	100.17	X2
17.0	99.69	LBF (est)	17	99.41	LBF (est)	15.5	99.67	G	17.52	99.84		17.89	98.64	X2W
18.0	98.59		18	98.94		16.5	99.43	LBF	18.5	99.19		19.46	97.74	X2W
18.5	97.59		18.5	97.85		17.5	99.01	G	18.72	99.17		21.14	97.78	X2
19.0	97.44		19	97.6		18.0	98.79	LEOW	19.33	98.68		22.38	98.18	X2
20.0	97.44		20	97.8		18.5	98.45	CHN	19.76	97.4		23.51	98.69	X2W
21.0	97.54		21	98.35		18.9	97.89	CHN	20.55	97.38		24.51	99.13	X2
22.0	97.59		22	98.2		19.8	97.81	CHN	22.22	97.47		25.58	99.84	X2
23.0	97.54		23	98.08		20.6	98.07	CHN	23.39	97.85		26.66	99.99	X2
24.0	97.94		24	98.07		21.7	98.41	CHN	24.45	98.52		29.83	99.74	X2
25.0	98.54		25	97.67		23.0	98.35	CHN	25.3	99.51		34.32	99.93	X2
26.0	98.79		26	97.84		24.2	98.21	CHN	26.27	99.64		39.02	100.03	X2
27.0	98.89		27	98.94		25.2	98.67	REOW	29.16	99.95		46.53	99.81	X2
28.0	98.99		28	99.06		27.3	98.81	G	31.47	99.63		50.97	100.19	X2
30.0	99.24		30	99.34		31.4	99.17	G	34.56	99.93		58.41	100.06	X2
32.0	99.44		32	99.41		34.8	99.77	RBF	43.65	99.68		64.78	99.66	X2
33.0	99.59	RBF (est)	33	99.59	RBF (est)	38.9	99.81	G	50.86	99.95		70.6	99.8	X2
37.0	100.09		37	100.1		42.9	99.65	G	55.29	99.81		74.82	99.59	X2
43.0	99.99		43	100		47.2	99.61	G	60.32	99.62		79.86	99.03	X2
47.0	100.04		47	100.04		50.2	99.85	G	66.91	99.44		82.81	98.57	X2
49.0	99.89		49	99.87		55.9	99.95	G	74.24	99.55		86.99	98.53	X2
57.0	100.09		57	100.15		59.3	99.79	G+VP	79.5	99.14		92.15	98.67	X2
60.0	99.84		60	99.87		61.7	99.49	G	82.59	98.81		93.81	98.95	X2
66.5	99.59		66.5	99.65		65.6	99.41	G	85.21	98.41		96.81	99.92	X2
72.0	99.49		72	99.5		74.2	99.41	G	91.91	98.43		97.62	100.25	X2
77.0	99.44		77	99.35		79.8	98.79	G	94.87	98.57		99.66	100.95	X2RP
80.0	98.89		84	98.64		82.3	98.53	G	98.32	100.27		99.79	100.74	X2
84.0	98.69		91	98.45		85.6	98.33	G	101.07	100.99	Pin-D	100.42	101.01	XSLP2
86.0	98.39		93	98.7		88.3	98.41	G	101.66	100.83				
88	98.59		95	99.31		93.3	98.41	G	104.6	102				
90	98.54		96	98.67		95.5	99.19	G	108.24	102.84				
93	98.54		99	100.48		96.9	99.85	G+VP	120.38	104.8				
95	99.14		100	100.78		98.9	100.29	G						
96	99.74		100	100.99	PIN-D?	100.1	100.99	PIN-D						
99	100.44													
100	100.69													
100	100.94	PIN-D												



Photo of Area 1 Cross-Section #2 - Looking Upstream


	Bankfull Area				
	As-Built	2001	2002	2003	2004
Area	19.2	17.88	17.25	11.72	11.17
Width	16.0	16.0	19.3	8.8	9.7
Mean Depth	1.2	1.1	0.9	1.3	1.2
Max Depth	2.3	2.1	1.9	2.3	2.0

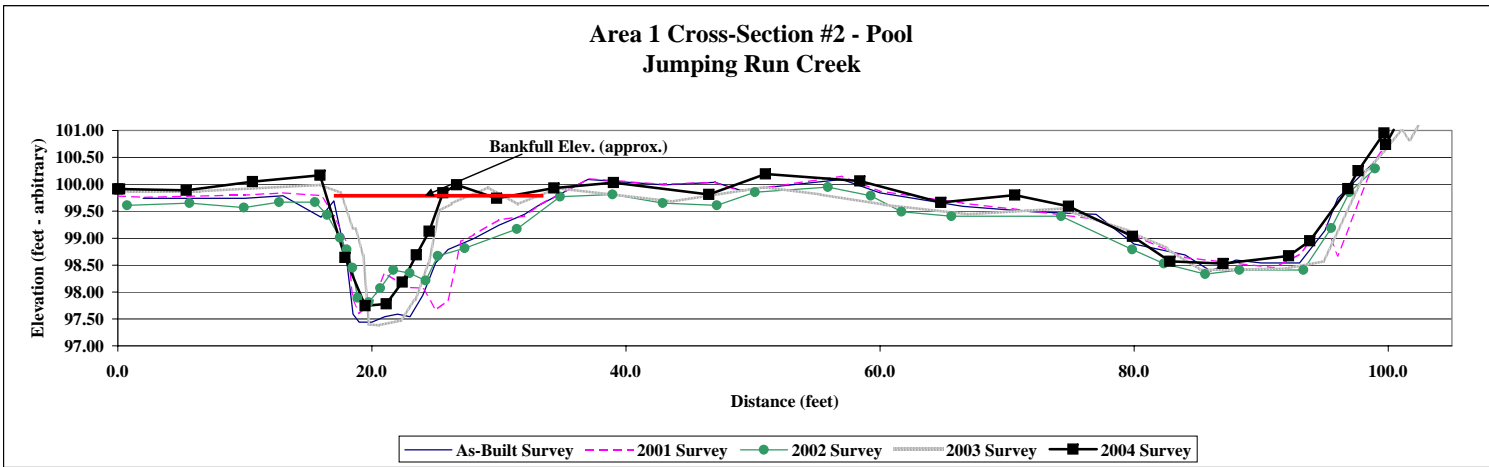

Project Name Payne Dairy - Jumping Run Creek
Cross Section #2 Section 1
Feature Pool
Date 10/7/03
Crew Shaffer, Bidelspach, Clinton

Description	Material	2000		As-Built		2001		2002		2003		2004									
		Size (mm)	Pool	%	Cum %	Riffle - Bed	%	Cum %	Riffle - Bed	%	Cum %	Riffle - Bed	Riffle - Bar	%	Cum %	Riffle - Bar	%	Cum %			
Silt/Clay	silt/clay	0.061	2	4.0%	4.0%	14	28.0%	28.0%	8	16.0%	16.0%	4	6	10.0%	10.0%	8.0%	8.0%	2	0	4.0%	4.0%
Sand	very fine sand	0.062	39	78.0%	82.0%	0	0.0%	28.0%	0	0.0%	16.0%	6	3	9.0%	19.0%	12.0%	20.0%	8	0	16.0%	20.0%
	fine sand	0.125	2	4.0%	86.0%	25	50.0%	78.0%	1	2.0%	18.0%	8	9	17.0%	36.0%	16.0%	36.0%	10	1	22.0%	42.0%
	medium sand	0.25	3	6.0%	92.0%	10	20.0%	98.0%	3	6.0%	24.0%	15	14	29.0%	65.0%	30.0%	66.0%	12	8	40.0%	82.0%
	course sand	0.50	4	8.0%	100.0%	1	2.0%	100.0%	5	10.0%	34.0%	9	8	17.0%	82.0%	18.0%	84.0%	5	1	12.0%	94.0%
	very course sand	1.0	0	0.0%	100.0%	0	0.0%	100.0%	8	16.0%	50.0%	15		15.0%	97.0%	30.0%	114.0%	2		4.0%	98.0%
Gravel	very fine gravel	2.0	0	0.0%	100.0%	0	0.0%	100.0%	7	14.0%	64.0%	1		1.0%	98.0%	2.0%	116.0%	0		0.0%	98.0%
	fine gravel	4.0	0	0.0%	100.0%	0	0.0%	100.0%	1	2.0%	66.0%	0		0.0%	98.0%	0.0%	116.0%	0		0.0%	98.0%
	fine gravel	5.7	0	0.0%	100.0%	0	0.0%	100.0%	5	10.0%	76.0%	1		1.0%	99.0%	2.0%	118.0%	0		0.0%	98.0%
	medium gravel	8.0	0	0.0%	100.0%	0	0.0%	100.0%	4	8.0%	84.0%	1		1.0%	100.0%	2.0%	120.0%	1		2.0%	100.0%
	medium gravel	11.3	0	0.0%	100.0%	0	0.0%	100.0%	8	16.0%	100.0%			0.0%	100.0%	0.0%	120.0%			0.0%	100.0%
	course gravel	16.0	0	0.0%	100.0%	0	0.0%	100.0%	0	0.0%	100.0%			0.0%	100.0%	0.0%	120.0%			0.0%	100.0%
	course gravel	22.6	0	0.0%	100.0%	0	0.0%	100.0%	0	0.0%	100.0%			0.0%	100.0%	0.0%	120.0%			0.0%	100.0%
	very course gravel	32	0	0.0%	100.0%	0	0.0%	100.0%	0	0.0%	100.0%			0.0%	100.0%	0.0%	120.0%			0.0%	100.0%
Cobble	very course gravel	45	0	0.0%	100.0%	0	0.0%	100.0%	0	0.0%	100.0%			0.0%	100.0%	0.0%	120.0%			0.0%	100.0%
	small cobble	64	0	0.0%	100.0%	0	0.0%	100.0%	0	0.0%	100.0%			0.0%	100.0%	0.0%	120.0%			0.0%	100.0%
	medium cobble	90	0	0.0%	100.0%	0	0.0%	100.0%	0	0.0%	100.0%			0.0%	100.0%	0.0%	120.0%			0.0%	100.0%
	large cobble	128	0	0.0%	100.0%	0	0.0%	100.0%	0	0.0%	100.0%			0.0%	100.0%	0.0%	120.0%			0.0%	100.0%
	very large cobble	180	0	0.0%	100.0%	0	0.0%	100.0%	0	0.0%	100.0%			0.0%	100.0%	0.0%	120.0%			0.0%	100.0%
Boulder	small boulder	256	0	0.0%	100.0%	0	0.0%	100.0%	0	0.0%	100.0%			0.0%	100.0%	0.0%	120.0%			0.0%	100.0%
	small boulder	362	0	0.0%	100.0%	0	0.0%	100.0%	0	0.0%	100.0%			0.0%	100.0%	0.0%	120.0%			0.0%	100.0%
	medium boulder	512	0	0.0%	100.0%	0	0.0%	100.0%	0	0.0%	100.0%			0.0%	100.0%	0.0%	120.0%			0.0%	100.0%
	large boulder	1024	0	0.0%	100.0%	0	0.0%	100.0%	0	0.0%	100.0%			0.0%	100.0%	0.0%	120.0%			0.0%	100.0%
	very large boulder	2049	0	0.0%	100.0%	0	0.0%	100.0%	0	0.0%	100.0%			0.0%	100.0%	0.0%	120.0%			0.0%	100.0%
Bedrock	bedrock	40096	0	0.0%	100.0%	0	0.0%	100.0%	0	0.0%	100.0%			0.0%	100.0%	0.0%	120.0%			0.0%	100.0%
TOTAL / % of whole count			50	100.0%		50	100.0%		50	100.0%		60	40	100.0%		120.0%		40	10	100.0%	

	d16	d35	d50	d84	d95
As-Built	0.07	0.07	0.08	0.14	0.52
2001	0.00	0.11	0.13	0.24	0.24
2002	0.16	0.80	1.50	9.65	9.65
2003	0.08	0.18	0.28	0.85	1.40
2004	0.09	0.16	0.23	0.44	0.94

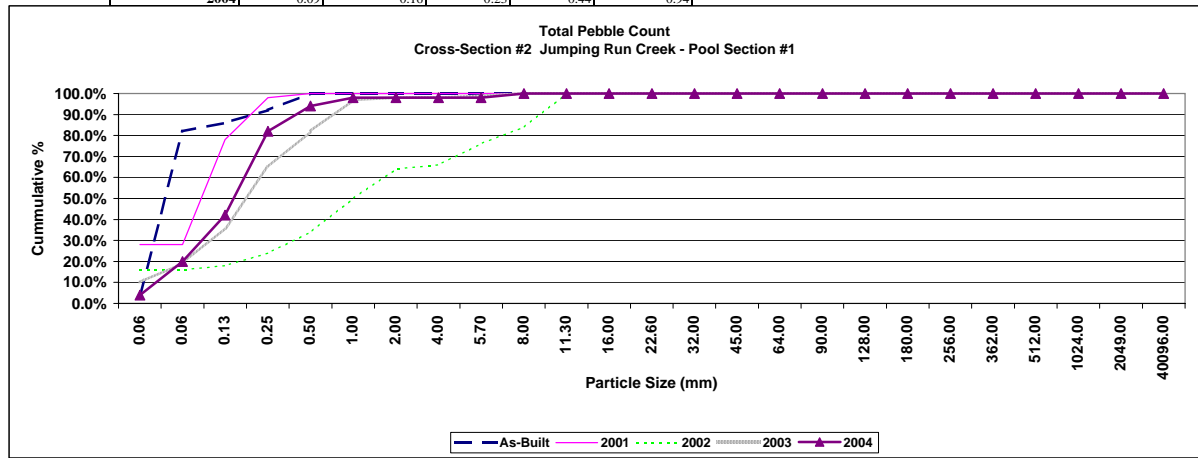

Project Name Jumping Run Area 2
Cross Section #1 (pins E-F)
Feature Riffle
Date 10/7/2003
Crew Shaffer, Bidelspach, Clinton


*2003 Elev adjusted +30.25 ft

2000 As-Built Survey			2001 2001 Survey			2002 2002 Survey			2003 2003 Survey			2004 2004 Survey		
Station	Elevation	Notes	Station	Elevation	Notes	Station	Elevation	Notes	Station	Elev*	Notes	Station	Elev	Notes
0.0	100.32	PIN-E?	0	99.8		0.0	99.96	PIN-E	0	99.84	Pin-E	1	99.84	XSLP
0.0	99.77		5	100.03		1.4	99.78	G	2.08	99.79		1	99.64	XS
5.0	99.97		10	100.12		9.2	99.9	G	6.12	99.88		5	99.89	XS
10.0	100.07		18	99.94		18.7	99.84	G	12.75	99.87		12.8	99.99	XS1
18.0	99.92		21	100.01		22.9	99.88	G	26.43	99.73		15.3	99.77	XS
21.0	100.02		24	99.95		26.9	99.26	G	30.11	98.94		20	99.94	XS1
24.0	99.97		26	99.58		31.7	98.28	LBF	32.3	98.15 LBF (est)		26	99.99	XS1W
26.0	99.67		28	99.03		33.8	97.56	G	34.87	97.7		30	99.69	XS1
28.0	99.07		30	98.77		35.0	97.22	LEOW	35.5	96.79		31.2	99.11	XS1
30.0	98.77		32	98.33		35.9	96.72	CHN	36.17	96.55		32.6	98.74	XS1
32.0	98.17	LBF (est)	33.5	97.84	LBF (est)	37.7	96.52	TW	37.72	96.86		33.6	98.12	BKF
33.5	97.72		34	97.78		38.8	96.8	CHN	40.03	96.88		34.8	97.95	XS1
34.0	97.72		35	97.46		40.6	97.16	REOW	41.16	97.39		35.6	96.62	XS1
35.0	97.42		35.2	97.11		41.8	97.52	RBF	41.2	97.49 RBF (est)		36.6	96.07	XS1W
35.5	96.92		35.5	96.88		43.6	98.72	G	44.7	99.04		38.4	96.27	XS1
36.0	96.82		36	96.82		45.2	99.22	G	47.64	99.48		39.1	96.52	XS1
37.0	96.67		37	96.71		48.6	99.52	G	53.39	99.79		39.5	96.94	XS1
38.0	96.77		38	96.73		54.4	99.6	G	60.2	100		39.7	97.61	XS1
39.0	96.92		39	96.9		61.1	100	G	65.16	100.17 Pin-F		40.6	97.61	XS1
40.5	97.17		40.5	97.16		64.4	100.06	G				41.1	98	BKF
41.0	97.32	RBF (est)	41	97.29		65.3	100.32	PIN-F				42.6	98.25	XS1
42.0	97.97		42	97.99	RBF (est)							43.9	98.74	XS1
43.0	98.72		43	98.66								45.7	99.2	XS1
45.0	99.37		45	99.35								47.0	99.3	XS1
48.0	99.67		48	99.69								50.5	99.68	XS1
54.0	99.82		54	99.8								58.6	99.55	XS
61.0	100.12		61	100.12								61.0	99.87	XS1
63.0	100.12		63	100.15								66.6	100.04	XS1
63.0	100.32	Pin--F?	63	100.32								66.7	100.14	XS1RP



Photo of Area 2 Cross-Section #1 - Looking Downstream


Bankfull Area					
	As-Built	2001	2002	2003	2004
Area	9.0	8.30	10.17	10.76	7.76
Width	11.5	9.5	11.9	12.8	7.8
Mean Depth	0.8	0.9	0.9	0.8	1.00
Max Depth	1.4	1.4	1.6	1.6	2.0
w/d Ratio	14.7	10.9	13.9	15.2	7.8

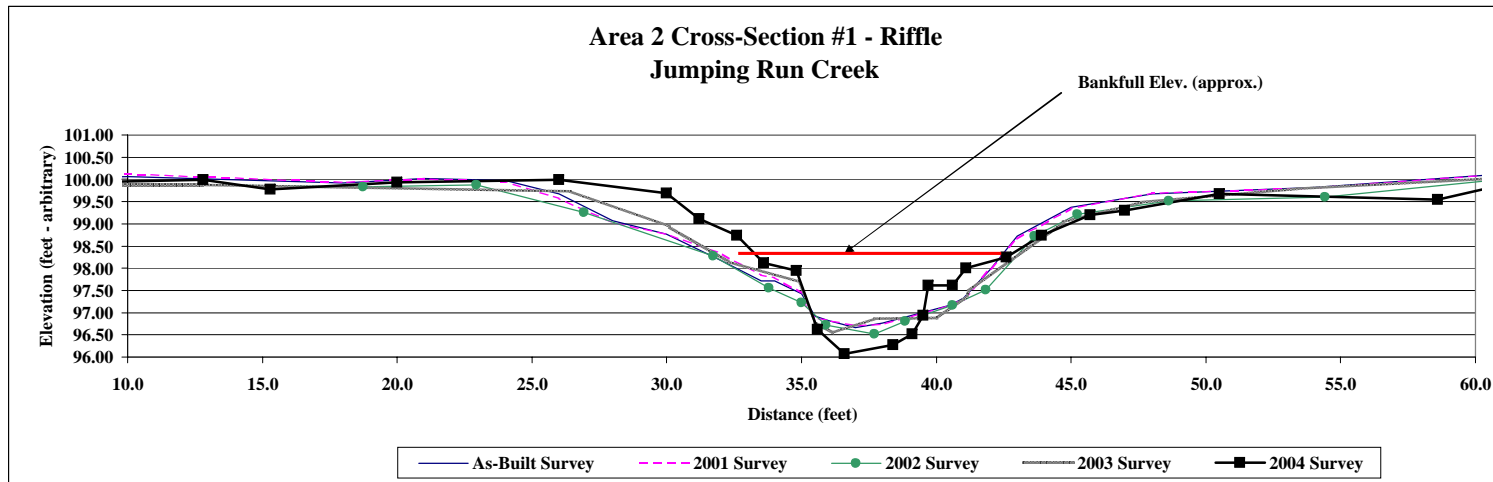

Project Name Payne Dairy - Jumping Run Creek
Cross Section #1 Section 2
Feature Rifle
Date 9/30/03
Crew Shaffer, Bidelspach, Clinton

Description	Material	2000			2001			2002			2003			2004						
		Size (mm)	Rifle - Bed	%	Cum %	Rifle - Bed	%	Cum %	Rifle - Bed	%	Cum %	Rifle - Bed	%	Cum %	Rifle - Bed	%	Cum %			
Silt/Clay	silt/clay	0.061	1	3.3%	3.3%	5	10.0%	10.0%	5	10.0%	10.0%	6	6.0%	6.0%	0.0%	0.0%	8	11	28.8%	28.8%
Sand	very fine sand	0.062	2	6.7%	10.0%		0.0%	10.0%	5	10.0%	20.0%	0	21.0%	27.0%	0.0%	0.0%	3	9	18.2%	47.0%
	fine sand	0.125	2	6.7%	16.7%	4	8.0%	18.0%	1	2.0%	22.0%	16	29.0%	56.0%	32.0%	32.0%	3	9	18.2%	65.2%
	medium sand	0.25	3	10.0%	26.7%	5	10.0%	28.0%	4	8.0%	30.0%	12	12.0%	68.0%	24.0%	56.0%	1	4	7.6%	72.7%
	course sand	0.50	2	6.7%	33.3%	13	26.0%	54.0%	3	6.0%	36.0%	11	11.0%	79.0%	22.0%	78.0%	8	9	25.8%	98.5%
	very course sand	1.0	2	6.7%	40.0%		0.0%	54.0%	8	16.0%	52.0%	2	2.0%	81.0%	4.0%	82.0%	1		1.5%	100.0%
Gravel	very fine gravel	2.0		0.0%	40.0%	1	2.0%	56.0%	8	16.0%	68.0%	4	4.0%	85.0%	8.0%	90.0%	0		0.0%	100.0%
	fine gravel	4.0	1	3.3%	43.3%		0.0%	56.0%	3	6.0%	74.0%	2	2.0%	87.0%	4.0%	94.0%	0		0.0%	100.0%
	fine gravel	5.7	1	3.3%	46.7%	1	2.0%	58.0%		0.0%	74.0%	4	4.0%	91.0%	8.0%	102.0%	0		0.0%	100.0%
	medium gravel	8.0	5	16.7%	63.3%	1	2.0%	60.0%		0.0%	74.0%	6	6.0%	97.0%	12.0%	114.0%	0		0.0%	100.0%
	medium gravel	11.3	6	20.0%	83.3%	4	8.0%	68.0%	4	8.0%	82.0%	2	2.0%	99.0%	4.0%	118.0%	0		0.0%	100.0%
	course gravel	16.0	3	10.0%	93.3%	5	10.0%	78.0%	3	6.0%	88.0%	1	1.0%	100.0%	2.0%	120.0%	0		0.0%	100.0%
	course gravel	22.6	1	3.3%	96.7%	6	12.0%	90.0%	1	2.0%	90.0%		0.0%	100.0%	0.0%	120.0%			0.0%	100.0%
	very course gravel	32	1	3.3%	100.0%	3	6.0%	96.0%	3	6.0%	96.0%		0.0%	100.0%	0.0%	120.0%			0.0%	100.0%
	very course gravel	45		0.0%	100.0%	2	4.0%	100.0%	1	2.0%	98.0%		0.0%	100.0%	0.0%	120.0%			0.0%	100.0%
Cobble	small cobble	64		0.0%	100.0%		0.0%	100.0%		0.0%	98.0%		0.0%	100.0%	0.0%	120.0%			0.0%	100.0%
	medium cobble	90		0.0%	100.0%		0.0%	100.0%	1	2.0%	100.0%		0.0%	100.0%	0.0%	120.0%			0.0%	100.0%
	large cobble	128		0.0%	100.0%		0.0%	100.0%		0.0%	100.0%		0.0%	100.0%	0.0%	120.0%			0.0%	100.0%
	very large cobble	180		0.0%	100.0%		0.0%	100.0%		0.0%	100.0%		0.0%	100.0%	0.0%	120.0%			0.0%	100.0%
	very large cobble	256		0.0%	100.0%		0.0%	100.0%		0.0%	100.0%		0.0%	100.0%	0.0%	120.0%			0.0%	100.0%
Boulder	small boulder	362		0.0%	100.0%		0.0%	100.0%		0.0%	100.0%		0.0%	100.0%	0.0%	120.0%			0.0%	100.0%
	medium boulder	512		0.0%	100.0%		0.0%	100.0%		0.0%	100.0%		0.0%	100.0%	0.0%	120.0%			0.0%	100.0%
	large boulder	1024		0.0%	100.0%		0.0%	100.0%		0.0%	100.0%		0.0%	100.0%	0.0%	120.0%			0.0%	100.0%
	very large boulder	2049		0.0%	100.0%		0.0%	100.0%		0.0%	100.0%		0.0%	100.0%	0.0%	120.0%			0.0%	100.0%
Bedrock	bedrock	40096	0	0.0%	100.0%	0	0.0%	100.0%	0	0.0%	100.0%		0.0%	100.0%	0.0%	120.0%			0.0%	100.0%
TOTAL / %of whole count			30	100.0%		50	100.0%		50	100.0%		60	100.0%	120.0%		24	42	100.0%		

	d16	d35	d50	d84	d95
As-Built	0.18	0.94	7.41	14.03	23.30
2001	0.16	0.48	0.69	23.30	23.30
2002	0.08	0.69	1.41	15.53	15.53
2003	0.08	0.12	0.17	2.63	8.72
2004	0.00	0.07	0.11	0.54	0.70

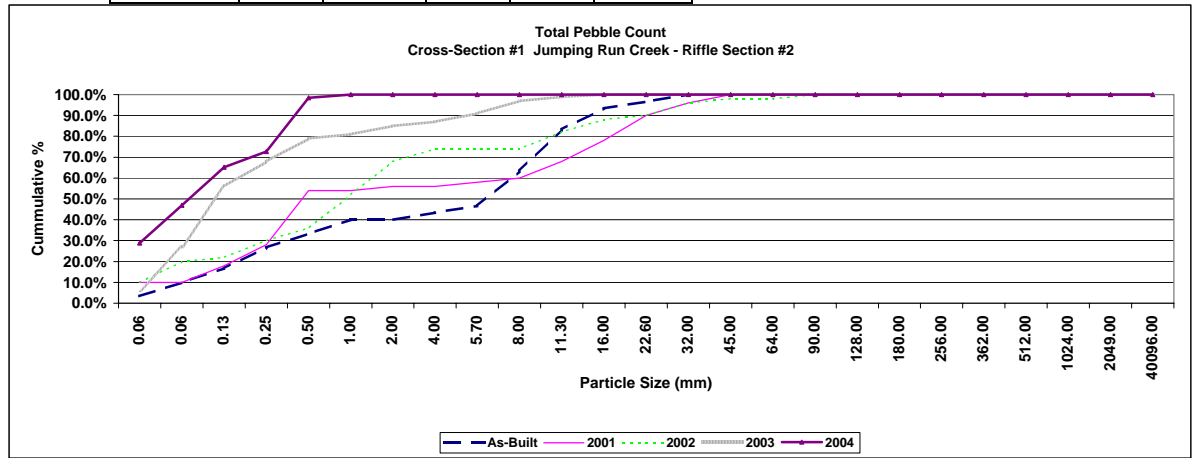

Project Name Jumping Run Area 2
Cross Section #2 (pins G-H)
Feature Pool
Date 10/7/2003
Crew Shaffer, Bidelspach, Clinton


*2003 Elevations adjusted +9.85 ft

2000 As-Built Survey			2001 2001 Survey			2002 2002 Survey			2003 2003 Survey			2004 2004 Survey		
Station	Elevation	Notes	Station	Elevation	Notes	Station	Elevation	Notes	Station	Elev*	Notes	Station	Elev	Notes
0.0	99.85		0	99.87		0.0	99.85	PIN-G	0	99.86	Pin G	64.7	100.2	
6.0	99.45		2	99.73		0.9	99.62	G	12.4	99.71		60.7	100.38	
10.0	99.50		10	99.53		6.6	99.3	G	18.4	99.55		56.2	99.94	
15.0	99.65		13	99.64		11.4	99.5	G	21.0	98.41		50.0	99.14	
17.0	99.70		16	99.7		17.9	99.48	G	22.2	97.08		46.9	98.44	
19.0	99.30		17	99.71		19.6	98.52	G	24.4	96.92	LBF (est)	44.2	98.05	
20.0	98.65		18	99.55		21.0	97.74	G	25.8	96.48		38.7	98.03	
21.3	96.70	LBF (est)	19	98.94		21.2	96.76	LBF	26.6	95.89		35.7	97.49	
21.5	96.50		20	98.53		22.5	96.24	CHN	30.5	95.27		34.4	97.32	BKF
22.0	96.30		21	96.51	LBF (est)	24.8	95.66	CHN	32.1	95.07		33.8	96.37	
23.0	96.15		22	96.4		26.2	95.38	CHN	32.9	95.08		33.7	95.13	
24.0	96.15		23	96.34		27.9	94.9	TW	33.7	95.21		31.7	95.12	
26.0	95.55		24	96.1		30.4	95.06	TW	34.5	96.9	RBF (est)	29.0	95.61	
27.0	95.40		25	95.87		32.9	95.7	CHN	34.7	97.38		27.1	96.09	
28.0	95.30		26	95.77		34.8	96.74	RBF	36.4	97.48		25.7	96.74	BKF
29.0	95.50		27	95.3		35.9	96.96	G	40.3	98.14		24.7	97.06	
30.0	95.40		28	95.39		39.8	97.4	G	45.0	98.13		23.5	97.48	
31.0	95.45		30	95.37		45.6	98.08	G	48.7	99.05		21.4	97.37	
32.0	95.70		32	95.75		49.1	99.06	G	54.3	99.81		20.4	98.52	
33.0	95.85		33	96.01		54.5	99.64	G	59.7	100.41	Pin H	19.4	99.2	
35.0	96.75	RBF (est)	35	96.78	RBF (est)	60.9	100.06	G	64.4	100.2		17.2	99.86	
37.5	97.25		37	97.27		69.3	99.92	G				14.7	99.74	
39.0	97.45		43	97.78		70.4	100.54	PIN-H				7.7	99.48	
40.0	97.30		47	98.65								4.7	99.64	
41.0	97.55		49	99.18								0	99.85	
42.0	97.50		57	99.88								0	99.84	
43.0	97.80		60	100.18										
45.0	98.15		66	100.17										
50.0	99.40		70	100.27										
52.0	99.60		70	100.5	Pin H?									
59.0	100.15													
62.0	100.25													
67.0	100.15													
70.5	100.25													
70.5	100.51	Pin H?												



Photo of Area 2 Cross-Section #2 - Looking Upstream

Bankfull Area					
	As-Built	2001	2002	2003	2004
Area	12.8	12.22	15.53	10.85	7.20
Width	13.7	14.0	13.6	12.3	8.7
Mean Depth	0.9	0.9	1.1	0.9	0.8
Max Depth	1.5	1.5	1.8	1.7	1.6

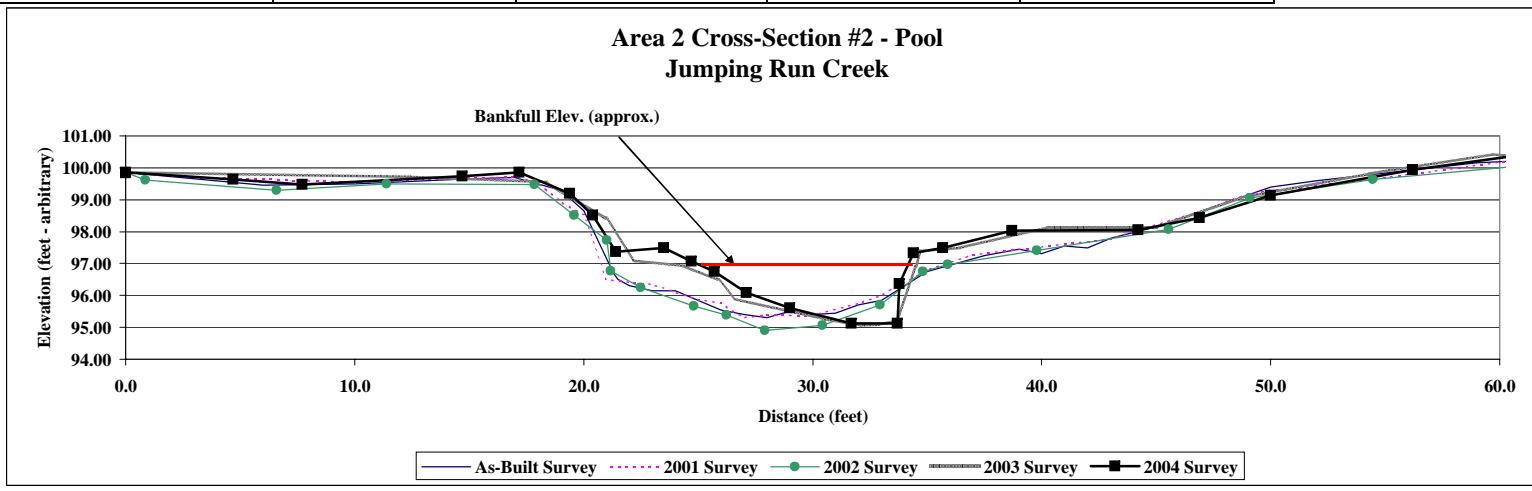


Project Name Payne Dairy - Jumping Run Creek
Cross Section #2 Section 2
Feature Pool
Date 9/30/03
Crew Shaffer, Bidelspach, Clinton

Cross Section #1

Description	Material	2000				2001				2002				2003				2004			
		Size (mm)	Rifle - Bed	%	Cum %	Rifle - Bed	%	Cum %	Rifle - Bed	%	Cum %	Rifle - Bed	Rifle - Bar	%	Cum %	%	Cum %	Rifle - Bed	Rifle - Bar	%	Cum %
Silt/Clay	silt/clay	0.061	6	20.0%	20.0%	4	8.0%	8.0%	6	12.0%	12.0%	0	10	10.0%	10.0%	0.0%	0.0%	0	12	24.0%	24.0%
Sand	very fine sand	0.062	10	33.3%	53.3%	0	0.0%	8.0%	8	16.0%	28.0%	3	12	15.0%	25.0%	6.0%	6.0%	0	5	10.0%	34.0%
	fine sand	0.125	8	26.7%	80.0%	24	48.0%	56.0%	11	22.0%	50.0%	10	8	18.0%	43.0%	20.0%	26.0%	0	4	8.0%	42.0%
	medium sand	0.25	5	16.7%	96.7%	22	44.0%	100.0%	5	10.0%	60.0%	19	0	19.0%	62.0%	38.0%	64.0%	1	10	22.0%	64.0%
	course sand	0.50	1	3.3%	100.0%	0	0.0%	100.0%	5	10.0%	70.0%	16	0	16.0%	78.0%	32.0%	96.0%	1	2	6.0%	70.0%
	very course sand	1.0	0	0.0%	100.0%	0	0.0%	100.0%	5	10.0%	80.0%	6	0	6.0%	84.0%	12.0%	108.0%	1	0	2.0%	72.0%
Gravel	very fine gravel	2.0	0	0.0%	100.0%	0	0.0%	100.0%	2	4.0%	84.0%	1	0	1.0%	85.0%	2.0%	110.0%	2	0	4.0%	76.0%
	fine gravel	4.0	0	0.0%	100.0%	0	0.0%	100.0%	0	0.0%	84.0%	0	0	0.0%	85.0%	0.0%	110.0%	1	0	2.0%	78.0%
	fine gravel	5.7	0	0.0%	100.0%	0	0.0%	100.0%	2	4.0%	88.0%	1	0	1.0%	86.0%	2.0%	112.0%	0	0	0.0%	78.0%
	medium gravel	8.0	0	0.0%	100.0%	0	0.0%	100.0%	2	4.0%	92.0%	2		2.0%	88.0%	4.0%	116.0%	1		2.0%	80.0%
	medium gravel	11.3	0	0.0%	100.0%	0	0.0%	100.0%	2	4.0%	96.0%	4		4.0%	92.0%	8.0%	124.0%	2		4.0%	84.0%
	course gravel	16.0	0	0.0%	100.0%	0	0.0%	100.0%	0	0.0%	96.0%	4		4.0%	96.0%	8.0%	132.0%	1		2.0%	86.0%
	course gravel	22.6	0	0.0%	100.0%	0	0.0%	100.0%	0	0.0%	96.0%	3		3.0%	99.0%	6.0%	138.0%	1		2.0%	88.0%
	very course gravel	32	0	0.0%	100.0%	0	0.0%	100.0%	0	0.0%	96.0%			0.0%	99.0%	0.0%	138.0%	0		0.0%	88.0%
	very course gravel	45	0	0.0%	100.0%	0	0.0%	100.0%	0	0.0%	96.0%			0.0%	99.0%	0.0%	138.0%	2		4.0%	92.0%
	very course gravel																				
Cobble	small cobble	64	0	0.0%	100.0%	0	0.0%	100.0%	1	2.0%	98.0%	1		1.0%	100.0%	2.0%	140.0%	2		4.0%	96.0%
	medium cobble	90	0	0.0%	100.0%	0	0.0%	100.0%	0	0.0%	98.0%			0.0%	100.0%	0.0%	140.0%	1		2.0%	98.0%
	large cobble	128	0	0.0%	100.0%	0	0.0%	100.0%	1	2.0%	100.0%			0.0%	100.0%	0.0%	140.0%	0		0.0%	98.0%
	very large cobble	180	0	0.0%	100.0%	0	0.0%	100.0%	0	0.0%	100.0%			0.0%	100.0%	0.0%	140.0%	1		2.0%	100.0%
Boulder	small boulder	256	0	0.0%	100.0%	0	0.0%	100.0%	0	0.0%	100.0%			0.0%	100.0%	0.0%	140.0%			0.0%	100.0%
	small boulder	362	0	0.0%	100.0%	0	0.0%	100.0%	0	0.0%	100.0%			0.0%	100.0%	0.0%	140.0%			0.0%	100.0%
	medium boulder	512	0	0.0%	100.0%	0	0.0%	100.0%	0	0.0%	100.0%			0.0%	100.0%	0.0%	140.0%			0.0%	100.0%
	large boulder	1024	0	0.0%	100.0%	0	0.0%	100.0%	0	0.0%	100.0%			0.0%	100.0%	0.0%	140.0%			0.0%	100.0%
Bedrock	very large boulder	2049	0	0.0%	100.0%	0	0.0%	100.0%	0	0.0%	100.0%			0.0%	100.0%	0.0%	140.0%			0.0%	100.0%
	bedrock	40096	0	0.0%	100.0%	0	0.0%	100.0%	0	0.0%	100.0%			0.0%	100.0%	0.0%	140.0%			0.0%	100.0%
TOTAL / %of whole count			30	100.0%		50	100.0%		50	100.0%		70	30	100.0%		140.0%		17	33	100.0%	

	d16	d35	d50	d84	d95
As-Built	0.00	0.08	0.09	0.23	0.36
2001	0.11	0.15	0.18	0.31	0.31
2002	0.07	0.12	0.19	7.85	7.85
2003	0.07	0.15	0.26	1.50	17.89
2004	0.00	0.11	0.26	13.65	71.37

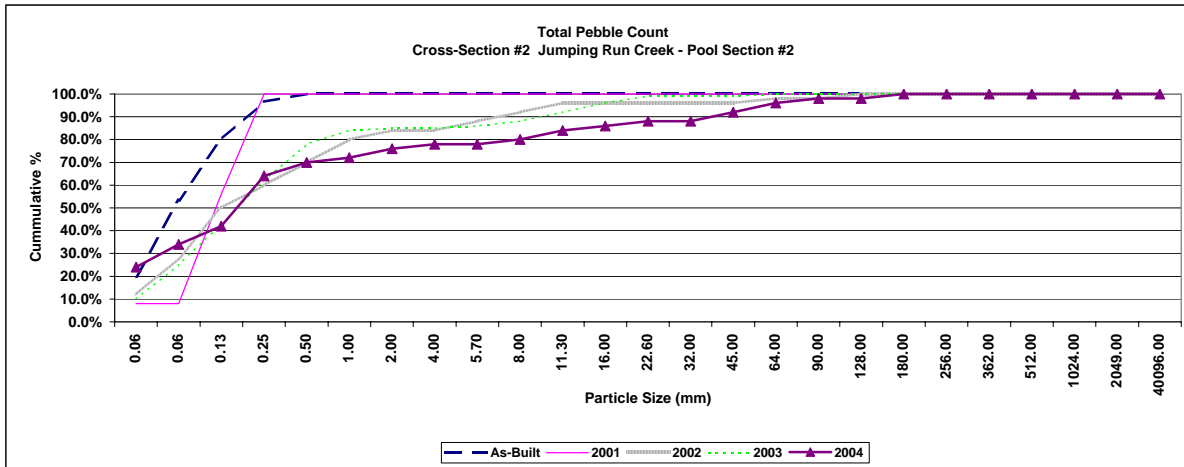

Project Name	Jumping Run Area 3
Cross Section	#1 (pins I-J)
Feature	Riffle
Date	10/7/2003
Crew	Shaffer, Bidelspach, Clinton

*2003 Survey Elev Adjusted +21.09 ft


**2004 Survey Elev Adjusted +23.7 ft

2000 As-Built Survey			2001 2001 Survey			2002 2002 Survey			2003 2003 Survey			2004 2004 Survey		
Station	Elevation	Notes	Station	Elevation	Notes	Station	Elevation	Notes	Station	Elev*	Notes	Station	Elev**	Notes
0.0	99.85		0.0	99.82		0.0	99.79	PIN-I	0.0	99.79	Pin - I	0.0	99.57	(X1)
3.0	99.65		2.0	99.7		1.3	99.59	G	2.7	99.46		0.3	99.69	(X1LP)
6.0	99.15		3.0	99.61		4.2	99.37	G	9.6	98.53		1.3	99.7	(X1LP)
8.0	99.10		6.0	99.11		6.3	98.91	G	13.9	98.03		5.4	99.2	(X1)
11.0	98.40		8.0	99.07		8.9	98.89	G	15.8	97.54	LBF (est)	9.3	98.82	(X1)
13.0	98.10		11.0	98.41		10.9	98.27	G	17.1	96.34		13.6	97.89	(X1)
15.0	97.75		13.0	98.11		15.2	97.57	G	19.4	96		16.7	97.53	BKF
16.0	97.55		15.0	97.72		16.9	97.29	LBF	20.9	96.09		19.0	96.43	(X1)
17.0	97.35	LBF (est)	16.0	97.59		17.4	96.81	G	21.9	96.05		19.9	96.21	(X1W)
18.0	96.25		17.0	97.35	LBF (est)	18.0	96.21	LEOW	22.6	96.36		21.2	96.02	(X1T)
19.0	96.15		18.0	96.78		19.9	95.87	CHN	23.6	96.18		21.7	96.35	(X1W)
20.0	96.10		19.0	96.2		21.0	95.91	TW	23.8	96.49		22.3	96.43	(X1W)
21.0	96.05		20.0	96.08		22.6	95.97	CHN	24.4	96.96		22.5	96.43	(X1)
22.0	96.05		21.0	95.88		23.5	96.27	REOW	25.5	97.54	RBF (est)	23.7	96.44	(X1)
23.0	96.15		22.0	96.04		24.5	96.75	G	27.7	98.01		25.5	97.57	BKF
24.0	96.55		23.0	96.16		25.8	97.41	RBF	31.5	98.42		29.0	98.23	(X1)
25.0	97.10		24.0	96.49		28.5	98.01	G	37.3	98.65		42.1	98.74	(X1)
26.0	97.55	RBF (est)	25.0	97.12		32.1	98.39	G	45.7	99.01		58.0	98.95	(X1)
27.0	97.75		26.0	97.55	RBF (est)	35.4	98.21	G	50.7	99.05		65.8	97.01	(X1)
29.0	98.05		27.0	97.68		40.5	98.45	G	59.4	98.82		66.3	96.9	(X1)
32.0	98.45		29.0	98.12		45.2	98.81	G	64.8	97.4		68.9	95.11	(X1)
35.0	98.40		32.0	98.43		51.8	98.85	G	66.9	96.19		74.8	94.46	(X1)
39.0	98.55		35.0	98.34		56.8	98.83	G	71.0	94.45		79.2	96.35	(X1)
46.0	98.90		39.0	98.53		59.5	98.61	G	74.1	94.57		81.1	98.65	(X1)
58.0	98.95		46.0	98.91		61.8	98.07	G	77.8	96		86.9	98.05	(X1)
62.0	98.15		58.0	98.93		63.8	97.39	G	80.9	98.8		90.6	97.87	(X1RP)
64.0	97.55		62.0	98.13		64.5	97.13	G+VP	89.8	97.84	Pin - J			
65.5	96.95		64.0	97.51		65.8	96.27	G						
67.0	95.70		65.5	96.92		67.4	95.59	G						
68.0	94.65		67.0	95.48		69.4	94.67	G						
69.0	94.70		68.0	94.88		70.9	94.63	G						
76.0	94.75		69.0	94.76		72.5	94.77	G						
77.0	95.00		76.0	94.76		75.2	94.55	G						
78	96.30		77.0	95.55		77.0	95.63	G						
78.5	96.95		78.0	96.27		78.5	96.21	G						
79.5	97.6		78.5	96.92		79.2	97.03	G+VP						
81	98.6		79.5	97.75		80.7	98.51	G						
84	98.35		81.0	98.62		83.9	98.25	G						
87	97.95		84.0	98.38		89.1	97.67	G						
90.3	97.7		87.0	97.93		90.2	97.85	PIN-J						
90.3	97.85	Pin J?	90.3	97.71										
			90.3	97.83	Pin J?									



Photo of Area 3 Cross-Section #1 - Looking Upstream


Bankfull Area					
	As-Built	2002	2003	2003	2004
Area	8.3	7.95	9.35	8.99	6.83
Width	9.0	9.0	10.6	9.7	8.7
Mean Depth	0.9	0.9	0.9	0.9	0.8
Max Depth	1.3	1.5	1.5	1.3	1.3
w/d ratio	9.8	10.2	12.0	10.4	11.2

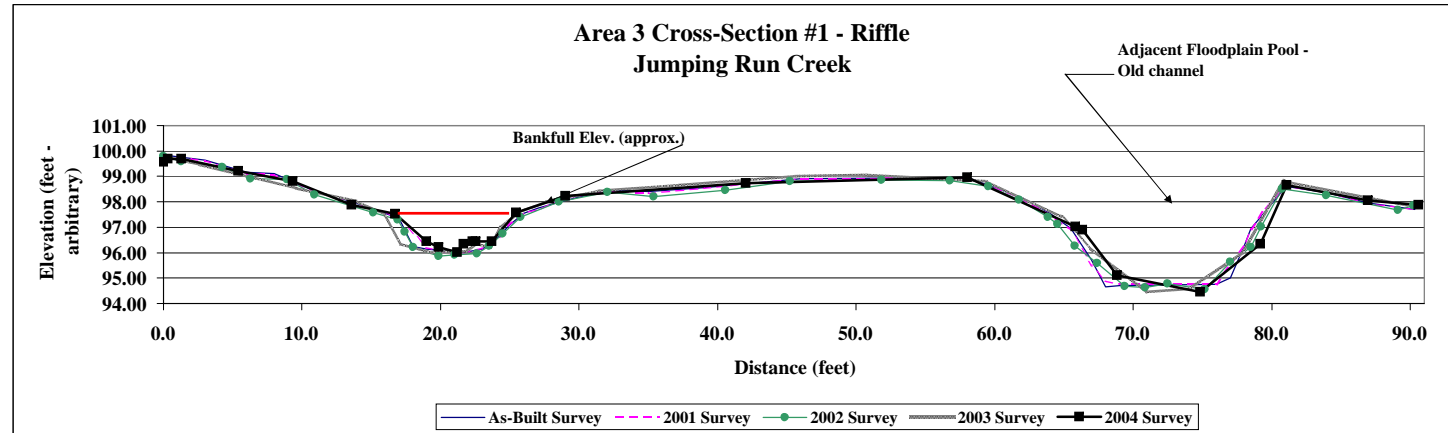

Project Name Payne Dairy - Jumping Run Creek
Cross Section #1 Section 3
Feature Riffle
Date 9/30/03
Crew Shaffer, Bidelspach, Clinton

Description	Material	2000 As-Built				2001				2002				2003				2004			
		Size (mm)	Riffle - Bed	%	Cum %	Riffle - Bed	%	Cum %	Riffle - Bed	%	Cum %	Riffle - Bed	%	Cum %	Riffle - Bed	%	Cum %	Riffle - Bed	%	Cum %	
Silt/Clay	silt/clay	0.061	9	18.0%	18.0%	6	12.0%	12.0%		0.0%	0.0%	2	5	7.0%	7.0%	4.0%	4.0%	1	9	20.0%	20.0%
Sand	very fine sand	0.062	2	4.0%	22.0%	1	2.0%	14.0%		0.0%	0.0%	1	14	15.0%	22.0%	2.0%	6.0%	5	10	30.0%	50.0%
	fine sand	0.125		0.0%	22.0%	1	2.0%	16.0%	3	6.0%	6.0%	10	10	20.0%	42.0%	20.0%	26.0%	1	0	2.0%	52.0%
	medium sand	0.25	2	4.0%	26.0%	1	2.0%	18.0%	5	10.0%	16.0%	8		8.0%	50.0%	16.0%	42.0%	2	0	4.0%	56.0%
	course sand	0.50	3	6.0%	32.0%	1	2.0%	20.0%	2	4.0%	20.0%	5		5.0%	55.0%	10.0%	52.0%	1	0	2.0%	58.0%
	very course sand	1.0		0.0%	32.0%		0.0%	20.0%		0.0%	20.0%	3		3.0%	58.0%	6.0%	58.0%	4	0	8.0%	66.0%
Gravel	very fine gravel	2.0	1	2.0%	34.0%	3	6.0%	26.0%	1	2.0%	22.0%	0		0.0%	58.0%	0.0%	58.0%	0	0	0.0%	66.0%
	fine gravel	4.0	1	2.0%	36.0%		0.0%	26.0%	1	2.0%	24.0%	0		0.0%	58.0%	0.0%	58.0%	0	0	0.0%	66.0%
	fine gravel	5.7		0.0%	36.0%		0.0%	26.0%		0.0%	24.0%	5		5.0%	63.0%	10.0%	68.0%	0	0	0.0%	66.0%
	medium gravel	8.0	4	8.0%	44.0%	2	4.0%	30.0%		0.0%	24.0%	5		5.0%	68.0%	10.0%	78.0%	2	0	4.0%	70.0%
	medium gravel	11.3	4	8.0%	52.0%	2	4.0%	34.0%	1	2.0%	26.0%	7		7.0%	75.0%	14.0%	92.0%	4	1	10.0%	80.0%
	course gravel	16.0	8	16.0%	68.0%	1	2.0%	36.0%	7	14.0%	40.0%	3		3.0%	78.0%	6.0%	98.0%	5		10.0%	90.0%
	course gravel	22.6	4	8.0%	76.0%	5	10.0%	46.0%	3	6.0%	46.0%	4		4.0%	82.0%	8.0%	106.0%	1		2.0%	92.0%
	very course gravel	32	2	4.0%	80.0%	7	14.0%	60.0%	7	14.0%	60.0%	3		3.0%	85.0%	6.0%	112.0%	1		2.0%	94.0%
	very course gravel	45	5	10.0%	90.0%	5	10.0%	70.0%	9	18.0%	78.0%	8		8.0%	93.0%	16.0%	128.0%	2		4.0%	98.0%
Cobble	small cobble	64	2	4.0%	94.0%	4	8.0%	78.0%	6	12.0%	90.0%	3		3.0%	96.0%	6.0%	134.0%	1		2.0%	100.0%
	medium cobble	90	3	6.0%	100.0%	1	2.0%	80.0%	4	8.0%	98.0%	2	1	3.0%	99.0%	4.0%	138.0%			0.0%	100.0%
	large cobble	128		0.0%	100.0%		0.0%	80.0%		0.0%	98.0%	1		1.0%	100.0%	2.0%	140.0%			0.0%	100.0%
	very large cobble	180		0.0%	100.0%		0.0%	80.0%	1	2.0%	100.0%			0.0%	100.0%	0.0%	140.0%			0.0%	100.0%
Boulder	small boulder	256		0.0%	100.0%		0.0%	80.0%		0.0%	100.0%			0.0%	100.0%	0.0%	140.0%			0.0%	100.0%
	small boulder	362		0.0%	100.0%		0.0%	80.0%		0.0%	100.0%			0.0%	100.0%	0.0%	140.0%			0.0%	100.0%
	medium boulder	512		0.0%	100.0%		0.0%	80.0%		0.0%	100.0%			0.0%	100.0%	0.0%	140.0%			0.0%	100.0%
	large boulder	1024		0.0%	100.0%		0.0%	80.0%		0.0%	100.0%			0.0%	100.0%	0.0%	140.0%			0.0%	100.0%
Bedrock	very large boulder	2049		0.0%	100.0%		0.0%	80.0%		0.0%	100.0%			0.0%	100.0%	0.0%	140.0%			0.0%	100.0%
	bedrock	40096	0	0.0%	100.0%	0	0.0%	80.0%	0	0.0%	100.0%			0.0%	100.0%	0.0%	140.0%			0.0%	100.0%
TOTAL / %of whole count			50	100.0%		40	80.0%		50	100.0%		70	30	100.0%		140.0%		30	20	100.0%	

	d16	d35	d50	d84	d95
As-Built	0.00	3.93	12.65	44.90	82.33
2001	0.19	16.48	30.50	0.00	0.00
2002	0.38	17.28	30.50	65.75	65.75
2003	0.08	0.15	0.38	34.77	69.50
2004	0.00	0.08	0.09	15.91	42.50

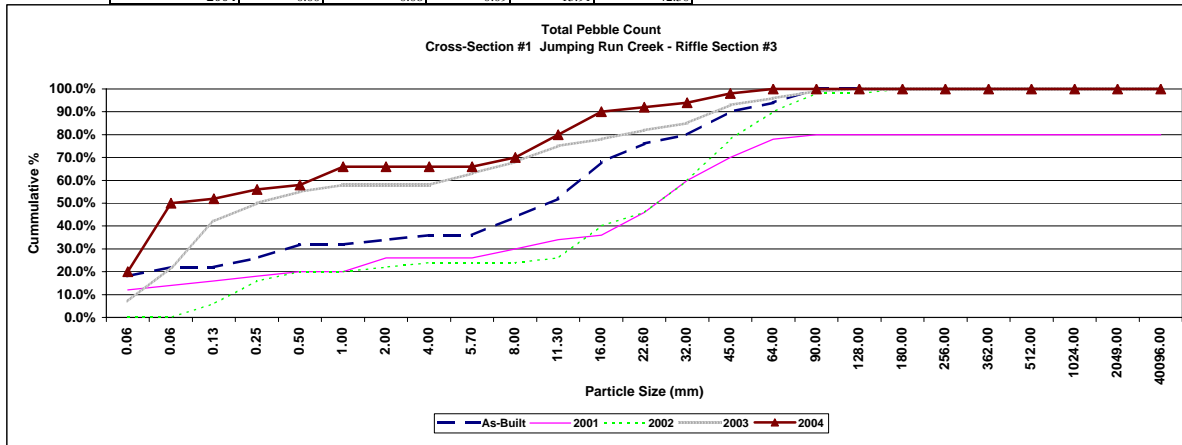

Project Name	Jumping Run Area 3
Cross Section	#2 (pins K-L)
Feature	Pool
Date	10/7/2003
Crew	Shaffer, Bidelspach, Clinton

*2003 Survey Elev Adjusted +21.88 ft


**2004 Survey Elev Adjusted +24.6 ft

2000 As-Built Survey			2001 2001 Survey			2002 2002 Survey			2003 2003 Survey			2004 2004 Survey		
Station	Elevation	Notes	Station	Elevation	Notes	Station	Elevation	Notes	Station	Elev*	Notes	Station	Elev**	Notes
0.0	99.75		0.0	99.75		0	Bad shot	Pin-K	0	99.75	Pin - K	0	99.73	(X2LP)
2.0	99.35		2.0	99.44		0.77	99.55	G	2.29	99.26		0.73	99.77	(X2LP)
5.0	98.40		5.0	98.46		2.03	99.35	G	7.06	97.87		1.42	99.29	(X2)
8.0	98.00		8.0	97.97		3.90	98.91	G	15.45	96.94	LBF(est)	24.00	97.21	(X2)
11.0	97.60		11.0	97.56		5.89	98.23	G	22.90	96.68		26.37	95.75	(X2W)
14.0	97.35		14.0	97.25		8.61	97.73	G	25.11	96.41		26.70	95.76	(X2)
16.0	97.15		16.0	97.09		12.78	97.17	G	25.31	96.10		29.17	94.46	(X2)
18.0	96.95		18.0	96.92		16.65	97.03	LBKF	25.91	95.08		33.44	94.01	(X2T)
20.0	97.00		20.0	97.01		19.66	96.87	G	28.19	94.87		34.89	94.01	(X2)
22.0	97.00	LBF (est)	22.0	97.01	LBF (est)	22.94	96.83	G	29.27	94.61		35.90	95.90	(X2W)
23.0	96.95		23.0	96.87		24.86	96.53	G	31.05	94.03		39.29	98.07	(X2)
24.0	96.70		24.0	96.63		25.27	96.25	LEOW	33.54	93.87		41.25	98.70	(X2)
25.0	96.15		25.0	96.11		26.03	95.79	CHN	34.79	94.17		49.10	98.54	(X2)
26.0	95.40		26.0	95.61		26.61	94.33	CHN	35.80	95.76		53.58	98.70	(X2)
28.0	94.70		28.0	94.94		27.59	93.91	CHN	35.90	96.10		58.03	98.70	(X2RP)
29.0	93.95		29.0	94.45		29.58	94.03	CHN	36.97	97.06	RBF(est)	59.06	98.64	(X2RP)
31.0	93.45		31.0	94.35		31.23	94.29	CHN	39.90	98.58				
32.5	93.60		32.5	94.1		32.73	94.37	CHN	45.10	98.54				
33.0	93.85		33.0	94.1		34.05	94.59	CHN	53.11	98.72				
34.0	94.30		34.0	94.43		35.20	95.03	CHN	58.34	98.62	Pin - L			
35.0	96.10		35.0	94.65		35.77	95.17	CHN						
38.0	97.65	RBF (est)	38.0	97.85	RBF (est)	36.31	95.35	CHN						
39.0	98.05		39.0	98.29		36.98	97.21	RBF						
40.0	98.70		40.0	98.71		38.65	97.63	G						
41.0	99.00		41.0	98.91		39.81	98.21	G						
50.0	99.10		50.0	99.03		40.91	98.77	G						
58.5	99.05		58.5	99.04		42.81	98.83	G						
58.5	99.25	Pin L?	58.5	99.21	Pin L?	47.99	98.69	G						
						52.62	98.85	G						
						58.27	98.81	G						
						58.87	98.87	Pin L						



Photo of Area 3 Cross-Section #2 - Looking Downstream


	As-Built	2001	2002	2003	2004
Area	27.1	25.97	29.27	28.98	25.32
Width	15.0	15.0	20.3	28.8	12.9
Mean Depth	1.8	1.7	1.4	1.0	2.0
Max Depth	3.6	2.9	3.1	3.1	3.0

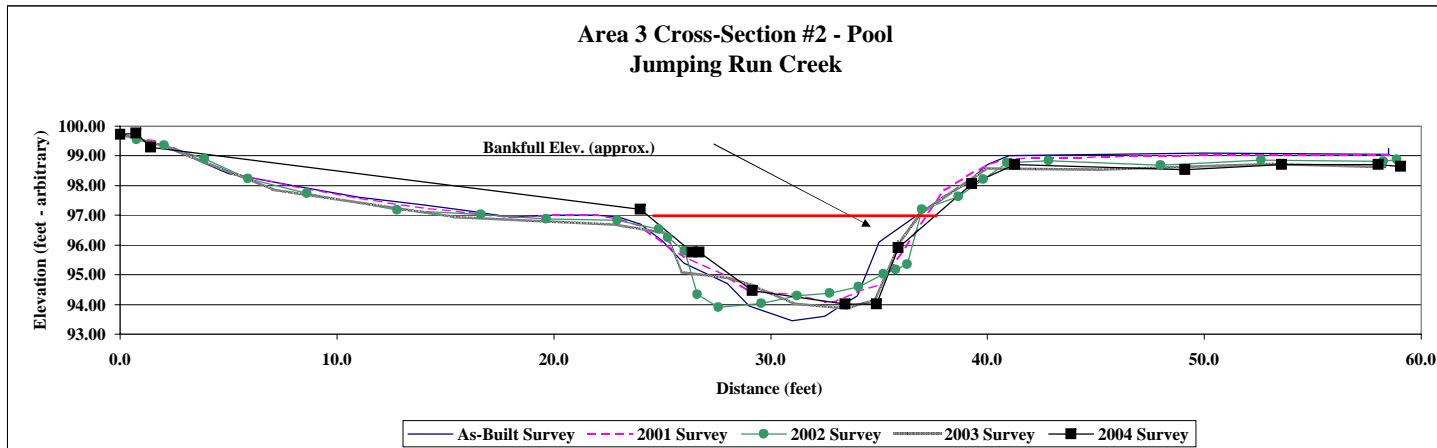

Project Name Payne Dairy - Jumping Run Creek
Cross Section #2 Section 3
Feature Pool
Date 9/30/03
Crew Shaffer, Bidelspach, Clinton

Description	Material	2000 As-Built				2001				2002				2003				2004			
		Size (mm)	Pool	%	Cum %	Pool	%	Cum %	Pool	%	Cum %	Pool - Bed	Pool - Banl	%	Cum %	%	Cum %	Pool - Bed	Pool - Banl	%	Cum %
Silt/Clay	silt/clay	0.061		0.0%	0.0%	3	7.5%	7.5%	1	2.0%	2.0%	6	14	20.0%	20.0%	12.0%	12.0%	8		20.0%	20.0%
Sand	very fine sand	0.062		0.0%	0.0%	5	12.5%	20.0%	0	0.0%	2.0%	2	12	14.0%	34.0%	4.0%	16.0%	7		17.5%	37.5%
	fine sand	0.125		0.0%	0.0%	10	25.0%	45.0%	2	4.0%	6.0%	22	13	35.0%	69.0%	44.0%	60.0%	7		17.5%	55.0%
	medium sand	0.25		0.0%	0.0%	2	5.0%	50.0%	6	12.0%	18.0%	9	1	10.0%	79.0%	18.0%	78.0%	7		17.5%	72.5%
	course sand	0.50		0.0%	0.0%	6	15.0%	65.0%	6	12.0%	30.0%	5		5.0%	84.0%	10.0%	88.0%	3		7.5%	80.0%
	very course sand	1.0		0.0%	0.0%	0	0.0%	65.0%	10	20.0%	50.0%	6		6.0%	90.0%	12.0%	100.0%	1		2.5%	82.5%
Gravel	very fine gravel	2.0		0.0%	0.0%	1	2.5%	67.5%	10	20.0%	70.0%	4		4.0%	94.0%	8.0%	108.0%	2		5.0%	87.5%
	fine gravel	4.0		0.0%	0.0%	2	5.0%	72.5%	2	4.0%	74.0%	2		2.0%	96.0%	4.0%	112.0%	1		2.5%	90.0%
	fine gravel	5.7		0.0%	0.0%	1	2.5%	75.0%	2	4.0%	78.0%	3		3.0%	99.0%	6.0%	118.0%	4		10.0%	100.0%
	medium gravel	8.0		0.0%	0.0%	5	12.5%	87.5%	4	8.0%	86.0%	0		0.0%	99.0%	0.0%	118.0%			0.0%	100.0%
	medium gravel	11.3		0.0%	0.0%	0	0.0%	87.5%	4	8.0%	94.0%	0		0.0%	99.0%	0.0%	118.0%			0.0%	100.0%
	course gravel	16.0		0.0%	0.0%	2	5.0%	92.5%	3	6.0%	100.0%			0.0%	99.0%	0.0%	118.0%			0.0%	100.0%
	course gravel	22.6		0.0%	0.0%	1	2.5%	95.0%	0	0.0%	100.0%			0.0%	99.0%	0.0%	118.0%			0.0%	100.0%
	very course gravel	32		0.0%	0.0%	0	0.0%	95.0%	0	0.0%	100.0%			0.0%	99.0%	0.0%	118.0%			0.0%	100.0%
	very course gravel	45		0.0%	0.0%	2	5.0%	100.0%	0	0.0%	100.0%			0.0%	99.0%	0.0%	118.0%			0.0%	100.0%
Cobble	small cobble	64		0.0%	0.0%	0	0.0%	100.0%	0	0.0%	100.0%			0.0%	99.0%	0.0%	118.0%			0.0%	100.0%
	medium cobble	90		0.0%	0.0%	0	0.0%	100.0%	0	0.0%	100.0%			0.0%	99.0%	0.0%	118.0%			0.0%	100.0%
	large cobble	128		0.0%	0.0%	0	0.0%	100.0%	0	0.0%	100.0%			0.0%	99.0%	0.0%	118.0%			0.0%	100.0%
	very large cobble	180		0.0%	0.0%	0	0.0%	100.0%	0	0.0%	100.0%	1		1.0%	100.0%	2.0%	120.0%			0.0%	100.0%
	very large cobble	256		0.0%	0.0%	0	0.0%	100.0%	0	0.0%	100.0%			0.0%	100.0%	0.0%	120.0%			0.0%	100.0%
Boulder	small boulder	362		0.0%	0.0%	0	0.0%	100.0%	0	0.0%	100.0%			0.0%	100.0%	0.0%	120.0%			0.0%	100.0%
	medium boulder	512		0.0%	0.0%	0	0.0%	100.0%	0	0.0%	100.0%			0.0%	100.0%	0.0%	120.0%			0.0%	100.0%
	large boulder	1024		0.0%	0.0%	0	0.0%	100.0%	0	0.0%	100.0%			0.0%	100.0%	0.0%	120.0%			0.0%	100.0%
	very large boulder	2049		0.0%	0.0%	0	0.0%	100.0%	0	0.0%	100.0%			0.0%	100.0%	0.0%	120.0%			0.0%	100.0%
	bedrock	40096	0.01	0.0%	0.0%	0	0.0%	100.0%	0	0.0%	100.0%			0.0%	100.0%	0.0%	120.0%			0.0%	100.0%
TOTAL / % of whole count			no data	0.0%		40	100.0%		50	100.0%		60	40	100.0%		120.0%		40	0	100.0%	

	d16	d35	d50	d84	d95
As-Built	0.00	0.00	0.00	0.00	0.00
2001	0.08	0.15	0.38	8.87	8.87
2002	0.34	0.94	1.50	8.95	8.95
2003	0.00	0.10	0.14	0.75	3.93
2004	0.00	0.09	0.16	1.95	5.85

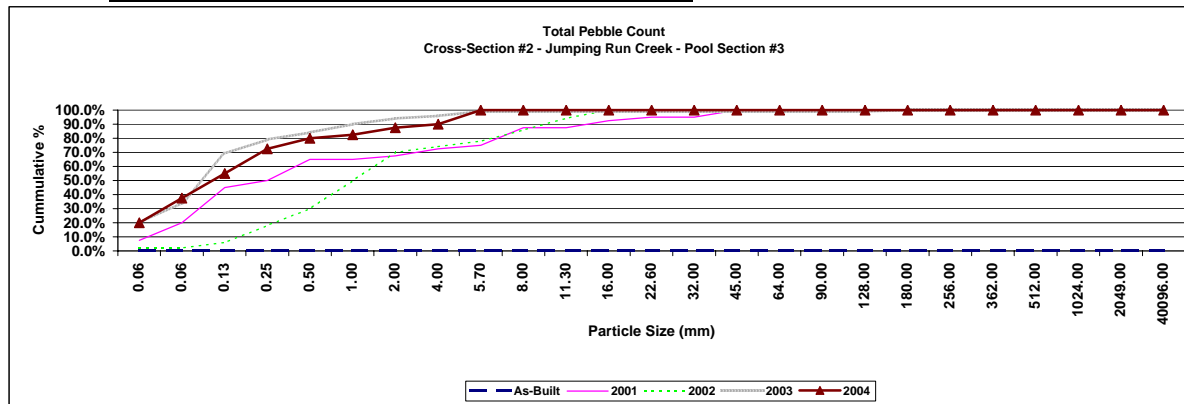

Project Name Jumping Run Area 4
Cross Section #1 (pins M-N)
Feature Riffle
Date 10/7/2003
Crew Shaffer, Bidelspach, Clinton

*2003 Survey Elevations Adjusted +26.28 ft

*2003 Survey Stations Adjusted -3.94 ft


***2004 elev adjusted up by +28.98ft

2000 As-Built Survey			2001 2001 Survey			2002 2002 Survey			2003 2003 Survey			2004 2004 Survey		
Station	Elevation	Notes	Station	Elevation	Notes	Station	Elevation	Notes	Station**	Elev*	Notes	Station	Elev***	Notes
0.0	100.00	Pin-M	0.0	99.79		0.0	100.01	PIN-M	0	100	PIN-M	0	100 (XSLP1)	
0.0	99.58		9.0	99.98		1.2	99.65	G	8.13	99.94		0	100 (XSLP1)	
6.0	99.80		13.0	100.11		8.4	99.81	G	20.74	100.63		1.95	100.06 (XSLP)	
16.0	100.50		19.0	100.51		15.8	100.25	G	31.69	100.64		32.62	100.61 (XS)	
20.0	100.55		24.0	101.05		21.6	100.55	G	37.2	98.41		44.71	97.79 BKF	
28.0	101.30		29.0	101.35		30.6	101.09	TOB	43.75	97.94		47.47	97.25 (XS)	
30.0	101.30		31.0	101.21		32.5	100.47	G	49.8	97.33 LBF (est)		50.35	97 (XS)	
32.0	100.95		33.0	100.53		34.5	99.55	G	51.06	96.66		51.67	96.45 (XS)	
33.0	100.60		35.0	99.61		36.8	98.63	G	51.39	96.3		53.97	96.5 (XS)	
35.0	99.65		37.0	98.73		38.7	98.05	G	51.41	96.46		55.28	96.57 (XS)	
37.0	98.75		38.0	98.17		41.2	97.31	LBF	52.7	96.1		57.29	96.4 (XS)	
38.0	98.40		39.0	98.11		42.7	97.03	G	54.12	96.14		57.34	96.4 (XS)	
39.0	98.00		41.0	97.56	LBF (est)	45.6	96.83	G	55.37	96.05		57.79	96.45 (XS)	
41.0	97.45	LBF (est)	42.0	97.27		48.1	96.71	LEOW	55.62	96.1		58.2	97.62 BKF	
42.0	96.90		44.0	97.07		48.9	96.33	CHN	56.06	96.1		58.53	97.59 (XS)	
45.0	96.65		45.0	96.81		50.5	96.31	CHN	56.43	96.2		59.02	97.97 (XS)	
47.0	96.65		47.0	96.89		51.6	96.11	TW	58.37	97.44	RBF (est)	64.64	98.95 (XS)	
48.0	96.55		48.0	96.73		53.3	96.23	CHN	60.31	98.09		72.98	100 (XS)	
49.0	96.50		49.0	96.6		54.6	96.55	REOW	64.2	98.67		79.85	100.4 (XS)	
51.0	96.35		51.0	96.39		55.3	96.97	G	68.23	99.38		85.46	100.79 (XSRP1)	
52.0	96.25		52.0	96.25		55.3	96.93	G	73.62	99.88	PIN N	85.46	100.79 (XSRP1)	
53.0	96.35		53.0	96.32		57.4	97.27	RBF	85.19	100.79		85.47	100.79 (X1RP)	
54.0	96.30		54.0	96.4		59.1	97.97	G				86.1	100.86 (XSRP)	
54.5	96.40		54.5	96.55		62.5	98.23	G						
55.0	96.65		55.0	96.71		65.6	98.81	G						
56.0	96.80		56.0	96.88		68.2	99.37	G						
57.0	97.10		57.0	97.16		71.1	99.67	G						
58.0	97.60	RBF (est)	58.0	97.58	RBF (est)	75.7	100.09	G						
60.0	98.20		59.0	97.96		79.7	100.13	G						
62.0	98.35		60.0	98.21		83.5	100.41	G						
65.0	98.95		62.0	98.39		85.0	100.79	PIN N						
67.0	99.35		65.0	98.91										
69.0	99.81		67.0	99.32										
70	99.95		69.0	99.96										
73	99.95		70.0	100.06										
77	100.4		73.0	100.01										
85	100.6		77.0	100.37										
85	100.79	Pin-N	85.0	100.61										
			85.0	100.8	Pin-N									



Photo of Area 4 Cross-Section #1 - Looking Downstream


	2000	2001	2002	2003	2004
Area	13.5	11.14	11.91	8.58	8.33
Width	17.0	17.0	18.0	8.6	13.5
Mean Depth	0.8	0.7	0.7	1.0	0.6
Max Depth	1.2	1.2	1.3	1.4	1.1
w/d Ratio	21.4	25.9	27.1	8.6	21.8

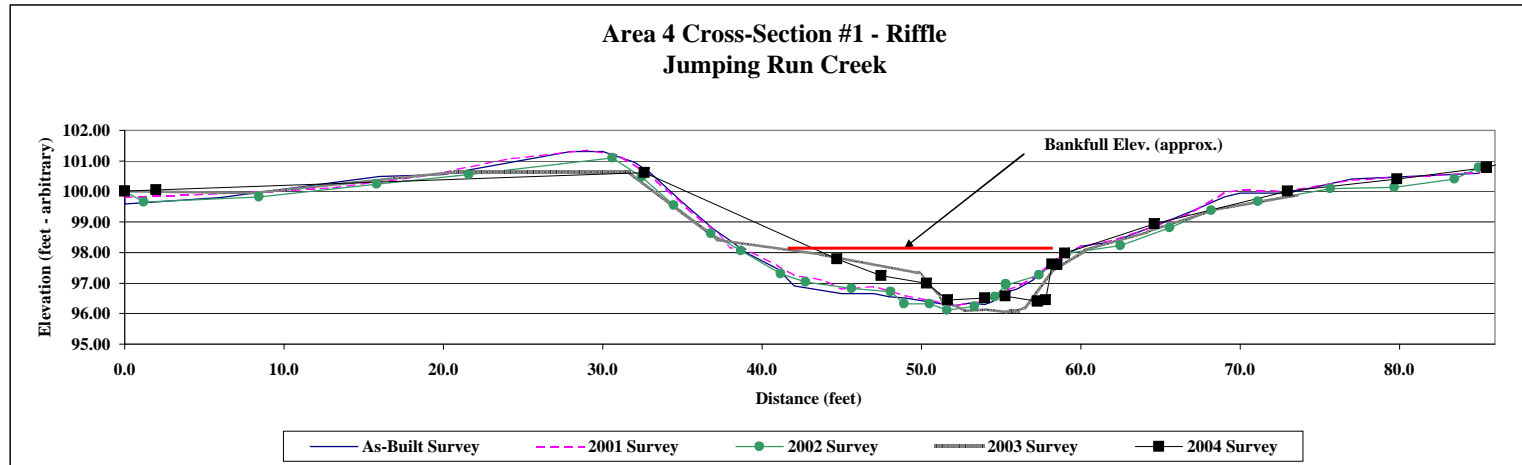

Project Name Payne Dairy - Jumping Run Creek
Cross Section #1 Section 3
Feature Riffle
Date 9/30/03
Crew Shaffer, Bidelspach, Clinton

Description	Material	2000				2001				2002				2003				2004			
		Size (mm)	Riffle	%	Cum %	Riffle	%	Cum %	Riffle	%	Cum %	Riffle - Bed	Riffle - Bar	%	Cum %	%	Cum %	Riffle - Bed	Riffle - Bar	%	Cum %
Silt/Clay	silt/clay	0.061	4	8.0%	8.0%	2	4.0%	4.0%		0.0%	0.0%	0	2	2.0%	2.0%	0.0%	0.0%	1		100.0%	100.0%
Sand	very fine sand	0.062	4	8.0%	16.0%	2	4.0%	8.0%	2	4.0%	4.0%	0	18	18.0%	20.0%	0.0%	0.0%			0.0%	100.0%
	fine sand	0.125		0.0%	16.0%	6	12.0%	20.0%	3	6.0%	10.0%	1	20	21.0%	41.0%	2.0%	2.0%			0.0%	100.0%
	medium sand	0.25	1	2.0%	18.0%	1	2.0%	22.0%	1	2.0%	12.0%	1		1.0%	42.0%	2.0%	4.0%			0.0%	100.0%
	course sand	0.50	1	2.0%	20.0%	4	8.0%	30.0%	3	6.0%	18.0%	1		1.0%	43.0%	2.0%	6.0%			0.0%	100.0%
	very course sand	1.0	2	4.0%	24.0%		0.0%	30.0%	4	8.0%	26.0%	2		2.0%	45.0%	4.0%	10.0%			0.0%	100.0%
Gravel	very fine gravel	2.0	2	4.0%	28.0%	2	4.0%	34.0%	2	4.0%	30.0%	4		4.0%	49.0%	8.0%	18.0%			0.0%	100.0%
	fine gravel	4.0		0.0%	28.0%	3	6.0%	40.0%	3	6.0%	36.0%	5		5.0%	54.0%	10.0%	28.0%			0.0%	100.0%
	fine gravel	5.7	5	10.0%	38.0%	1	2.0%	42.0%		0.0%	36.0%	6		6.0%	60.0%	12.0%	40.0%			0.0%	100.0%
	medium gravel	8.0	6	12.0%	50.0%	3	6.0%	48.0%	2	4.0%	40.0%	6		6.0%	66.0%	12.0%	52.0%			0.0%	100.0%
	medium gravel	11.3	6	12.0%	62.0%	5	10.0%	58.0%	4	8.0%	48.0%	12		12.0%	78.0%	24.0%	76.0%			0.0%	100.0%
	course gravel	16.0	5	10.0%	72.0%	5	10.0%	68.0%	2	4.0%	52.0%	19		19.0%	97.0%	38.0%	114.0%			0.0%	100.0%
	course gravel	22.6	6	12.0%	84.0%	7	14.0%	82.0%	7	14.0%	66.0%			0.0%	97.0%	0.0%	114.0%			0.0%	100.0%
	very course gravel	32	5	10.0%	94.0%	2	4.0%	86.0%	7	14.0%	80.0%			0.0%	97.0%	0.0%	114.0%			0.0%	100.0%
	very course gravel	45	1	2.0%	96.0%	7	14.0%	100.0%	6	12.0%	92.0%	2		2.0%	99.0%	4.0%	118.0%			0.0%	100.0%
Cobble	small cobble	64	1	2.0%	98.0%		0.0%	100.0%	4	8.0%	100.0%	1		1.0%	100.0%	2.0%	120.0%			0.0%	100.0%
	medium cobble	90	1	2.0%	100.0%		0.0%	100.0%		0.0%	100.0%			0.0%	100.0%	0.0%	120.0%			0.0%	100.0%
	large cobble	128		0.0%	100.0%		0.0%	100.0%		0.0%	100.0%			0.0%	100.0%	0.0%	120.0%			0.0%	100.0%
	very large cobble	180		0.0%	100.0%		0.0%	100.0%		0.0%	100.0%			0.0%	100.0%	0.0%	120.0%			0.0%	100.0%
Boulder	small boulder	256		0.0%	100.0%		0.0%	100.0%		0.0%	100.0%			0.0%	100.0%	0.0%	120.0%			0.0%	100.0%
	small boulder	362		0.0%	100.0%		0.0%	100.0%		0.0%	100.0%			0.0%	100.0%	0.0%	120.0%			0.0%	100.0%
	medium boulder	512		0.0%	100.0%		0.0%	100.0%		0.0%	100.0%			0.0%	100.0%	0.0%	120.0%			0.0%	100.0%
	large boulder	1024		0.0%	100.0%		0.0%	100.0%		0.0%	100.0%			0.0%	100.0%	0.0%	120.0%			0.0%	100.0%
	very large boulder	2049		0.0%	100.0%		0.0%	100.0%		0.0%	100.0%			0.0%	100.0%	0.0%	120.0%			0.0%	100.0%
Bedrock	bedrock	40096	0	0.0%	100.0%	0	0.0%	100.0%	0	0.0%	100.0%			0.0%	100.0%	0.0%	120.0%			0.0%	100.0%
TOTAL / %of whole count			50			50	100.0%		50	100.0%		60	40	100.0%		120.0%		1	0	100.0%	100.0%

	d16	d35	d50	d84	d95
As-Built	0.28	6.25	9.65	27.30	46.50
2001	0.16	3.31	10.45	32.90	32.90
2002	0.63	4.54	16.48	43.83	43.83
2003	0.09	0.16	3.37	15.43	18.71
2004	0.00	0.00	0.00	0.00	0.00

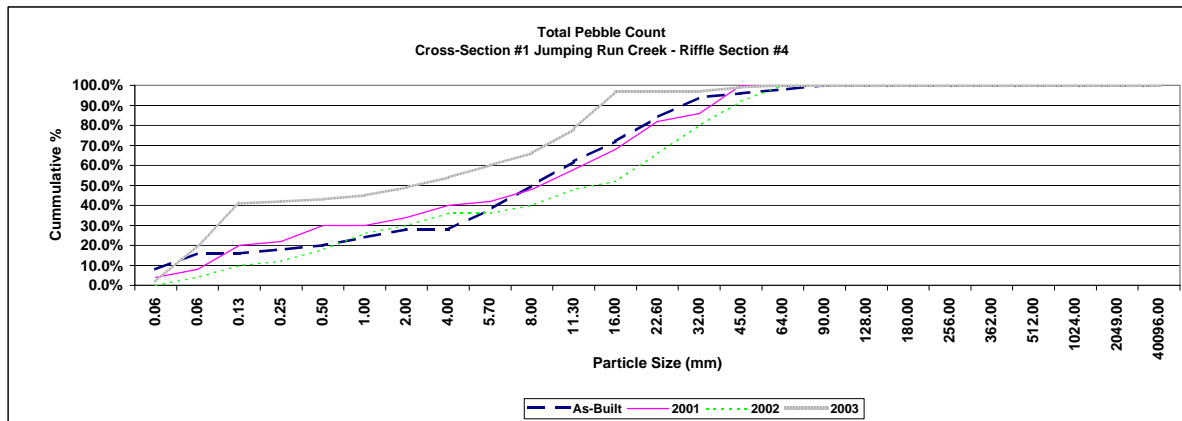

Project Name	Jumping Run Area 4
Cross Section	#2 (pins O-P)
Feature	Pool
Date	10/7/2003
Crew	Shaffer, Bidelspach, Clinton


*2003 Survey Elevations Adjusted +26.46 ft
 **2003 Survey Stations Adjusted -3.94 ft
 ***2004 elev adjusted up by +28.98ft

2000 As-Built Survey			2001 Survey			2002 Survey			2003 Survey			2004 Survey		
Station	Elevation	Notes	Station	Elevation	Notes	Station	Elevation	Notes	Station**	Elev*	Notes	Station	Elev***	Notes
0.0	100.00	Pin-O	2.0	99.79		0	100	PIN-O	-2	100	LP2	0	99.83	(X2LP)
0.0	99.70		12.0	99.95		1.07	99.50	G	1.74	99.99		0.2	99.82	(XSLP2)
2.0	99.80		15.0	100.03		8.24	99.70	G	14.23	99.84		0.72	99.84	(X2LP)
12.0	99.95		20.0	99.43		14.24	99.86	G	21.66	98.97		8.9	99.8	(X2)
15.0	100.05		24.0	98.79		19.19	99.42	G	27.77	98.36		18.41	99.49	(X2)
20.0	99.45		27.0	98.35		21.57	99.10	G	39.79	97.63		26.78	98.41	(X2)
24.0	98.85		30.0	98.1		23.81	98.60	G	44.21	97.77		33.57	98.28	(X2)
27.0	98.40		32.0	97.86		26.21	98.18	G	46.92	97.18	LBF (est)	39.64	97.93	(X2)
30.0	98.10		34.0	97.6		29.83	98.00	G	50.27	96.2		46.02	97.31	(X2)
32.0	97.85		36.0	97.42		32.58	97.60	G	51.99	96.03		46.39	97.54	(X2)
34.0	97.50		38.0	97.38		36.32	97.20	G	53.85	95.46		48.37	97.41	BKF
36.0	97.30		40.0	97.27		38.91	97.02	G	55.23	95.26		51.17	96.19	(X2)
38.0	97.35		43.0	97.22		42.03	97.00	G	57.91	95.44		51.41	96.15	(X2W)
40.0	97.30		44.0	97.13	LBF (est)	43.71	97.04	LBF	58	96.03		52.99	95.43	(X2)
43.0	97.20		45.0	97		46.78	96.86	G	58.58	99.09	RBF (est)	55.16	94.98	(X2T)
44.0	97.10	LBF (est)	46.0	96.81		49.61	96.52	LEOW	61.48	99.31		59.19	95.64	(X2W)
45.0	96.75		48.0	96.71		50.31	96.00	CHN	66.05	99.29		59.25	98.94	BKF
46.0	96.70		49.0	96.62		51.61	95.24	CHN	69.58	99.24		74.11	99.15	(X2)
48.0	96.40		50.0	95.62		52.54	95.10	CHN	75.04	99.27		87.15	99.69	(X2RP)
49.0	96.20		51.0	95.25		54.46	94.90	TW	80.66	99.74				
50.0	95.90		52.0	95.15		56.22	95.08	CHN	85.58	99.94	RP2			
51.0	95.55		53.0	95.1		57.85	95.40	CHN						
52.0	95.45		54.0	95.09		58.54	96.58	REOW						
53.0	95.25		55.0	95.24		59.49	97.40	G						
54.0	95.10		56.0	95.35		60.28	97.52	RBF						
55.0	95.25		57.0	95.85		61.78	98.60	G						
56.0	95.40		57.5	95.9		62.96	98.84	G						
57.0	95.85		57.8	96.6		66.34	99.20	G						
57.5	96.30		58.0	97.61	RBF (est)	69.96	99.08	G						
58.0	97.60	RBF (est)	59.0	98.2		75.60	98.96	G						
59.0	98.10		60.0	98.75		81.24	99.14	G						
60.0	98.60		61.0	98.97		85.3	99.30	G						
61.0	98.95		69.0	99.69		87.9	99.69	G						
69	99.45		88.0	99.63		88.7	99.92	PIN-P						
88	99.60		88.0	99.94	Pin-P									
88	99.93	Pin-P												



Photo of Area 4 Cross-Section #2 - Looking Downstream


Bankfull Area					
	As-Built	2001	2002	2003	2004
Area	15.9	15.98	17.57	13.11	14.94
Width	14.0	14.0	15.8	11.7	12.9
Mean Depth	1.1	1.1	1.1	1.1	1.2
Max Depth	2.0	2.0	2.2	1.8	2.1

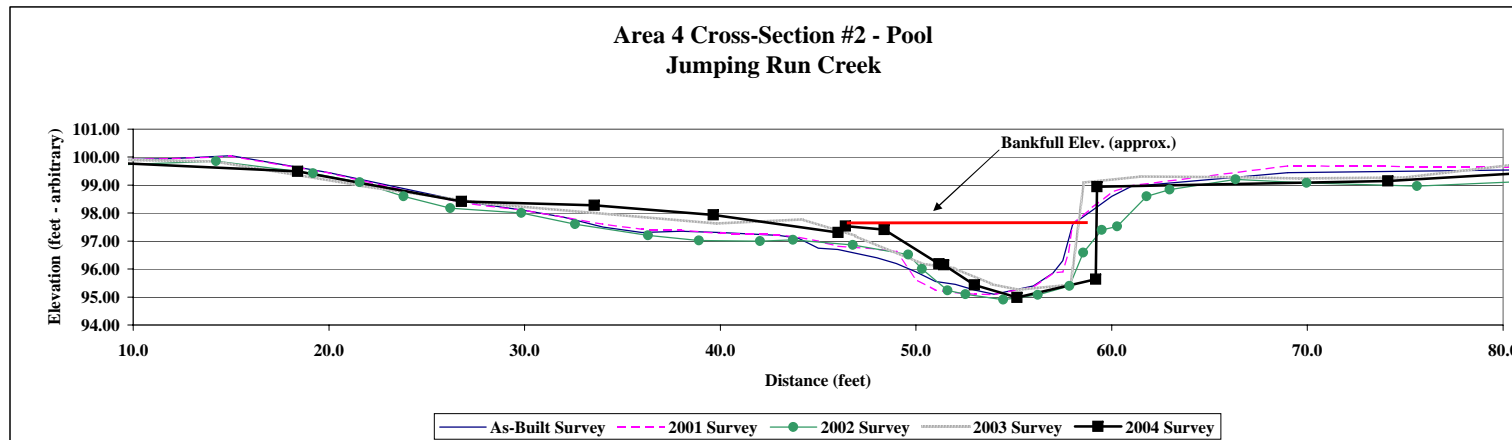

Project Name	Payne Dairy - Jumping Run Creek
Cross Section	#2 Section 4
Feature	Pool
Date	9/30/03
Crew	Shaffer, Bidelspach, Clinton

Description	Material	2000				2001				2002				2003				2004			
		Size (mm)	Pool	%	Cum %	Pool	%	Cum %	Pool	%	Cum %	Pool - Bed	Pool - Banl	%	Cum %	%	Cum %	Pool - Bed	Pool - Banl	%	Cum %
Silt/Clay	silt/clay	0.061	8	16.0%	16.0%	2	4.0%	4.0%	4	8.0%	8.0%	3	9	12.0%	12.0%	6.0%	6.0%	1		100.0%	100.0%
Sand	very fine sand	0.062	9	18.0%	34.0%	7	14.0%	18.0%	2	4.0%	12.0%	3	22	25.0%	37.0%	6.0%	12.0%			0.0%	100.0%
	fine sand	0.125	17	34.0%	68.0%	11	22.0%	40.0%	9	18.0%	30.0%	17	2	19.0%	56.0%	34.0%	46.0%			0.0%	100.0%
	medium sand	0.25	7	14.0%	82.0%	13	26.0%	66.0%	1	2.0%	32.0%	14		14.0%	70.0%	28.0%	74.0%			0.0%	100.0%
	course sand	0.50	2	4.0%	86.0%	4	8.0%	74.0%	5	10.0%	42.0%	9		9.0%	79.0%	18.0%	92.0%			0.0%	100.0%
	very course sand	1.0	0	0.0%	86.0%	1	2.0%	76.0%	3	6.0%	48.0%	7		7.0%	86.0%	14.0%	106.0%			0.0%	100.0%
G r a v e l	very fine gravel	2.0	0	0.0%	86.0%	1	2.0%	78.0%	2	4.0%	52.0%	2		2.0%	88.0%	4.0%	110.0%			0.0%	100.0%
	fine gravel	4.0	0	0.0%	86.0%	1	2.0%	80.0%	1	2.0%	54.0%	0		0.0%	88.0%	0.0%	110.0%			0.0%	100.0%
	fine gravel	5.7	0	0.0%	86.0%	1	2.0%	82.0%	5	10.0%	64.0%	2		2.0%	90.0%	4.0%	114.0%			0.0%	100.0%
	medium gravel	8.0	0	0.0%	86.0%	1	2.0%	84.0%	0	0.0%	64.0%	1		1.0%	91.0%	2.0%	116.0%			0.0%	100.0%
	medium gravel	11.3	2	4.0%	90.0%	-1	-2.0%	82.0%	6	12.0%	76.0%	1		1.0%	92.0%	2.0%	118.0%			0.0%	100.0%
	course gravel	16.0	1	2.0%	92.0%	1	2.0%	84.0%	5	10.0%	86.0%	1		1.0%	93.0%	2.0%	120.0%			0.0%	100.0%
	course gravel	22.6	0	0.0%	92.0%	2	4.0%	88.0%	0	0.0%	86.0%	6		6.0%	99.0%	12.0%	132.0%			0.0%	100.0%
	very course gravel	32	2	4.0%	96.0%	4	8.0%	96.0%	3	6.0%	92.0%			0.0%	99.0%	0.0%	132.0%			0.0%	100.0%
	very course gravel	45	1	2.0%	98.0%	2	4.0%	100.0%	2	4.0%	96.0%			0.0%	99.0%	0.0%	132.0%			0.0%	100.0%
Cobble	small cobble	64	1	2.0%	100.0%	0	0.0%	100.0%	1	2.0%	98.0%	1		1.0%	100.0%	2.0%	134.0%			0.0%	100.0%
	medium cobble	90	0	0.0%	100.0%	0	0.0%	100.0%	1	2.0%	100.0%			0.0%	100.0%	0.0%	134.0%			0.0%	100.0%
	large cobble	128	0	0.0%	100.0%	0	0.0%	100.0%	0	0.0%	100.0%			0.0%	100.0%	0.0%	134.0%			0.0%	100.0%
	very large cobble	180	0	0.0%	100.0%	0	0.0%	100.0%	0	0.0%	100.0%			0.0%	100.0%	0.0%	134.0%			0.0%	100.0%
Boulder	small boulder	256	0	0.0%	100.0%	0	0.0%	100.0%	0	0.0%	100.0%			0.0%	100.0%	0.0%	134.0%			0.0%	100.0%
	small boulder	362	0	0.0%	100.0%	0	0.0%	100.0%	0	0.0%	100.0%			0.0%	100.0%	0.0%	134.0%			0.0%	100.0%
	medium boulder	512	0	0.0%	100.0%	0	0.0%	100.0%	0	0.0%	100.0%			0.0%	100.0%	0.0%	134.0%			0.0%	100.0%
	large boulder	1024	0	0.0%	100.0%	0	0.0%	100.0%	0	0.0%	100.0%			0.0%	100.0%	0.0%	134.0%			0.0%	100.0%
	very large boulder	2049	0	0.0%	100.0%	0	0.0%	100.0%	0	0.0%	100.0%			0.0%	100.0%	0.0%	134.0%			0.0%	100.0%
Bedrock	bedrock	40096	0	0.0%	100.0%	0	0.0%	100.0%	0	0.0%	100.0%			0.0%	100.0%	0.0%	134.0%			0.0%	100.0%
TOTAL / %of whole count			50			50	100.0%		50	100.0%		67	33	100.0%		134.0%		1	0	100.0%	

	d16	d35	d50	d84	d95
As-Built	0.06	0.10	0.14	0.56	35.70
2001	0.09	0.17	0.26	28.95	28.95
2002	0.11	0.49	2.25	18.17	18.17
2003	0.07	0.09	0.16	1.29	21.97
2004	0.00	0.00	0.00	0.00	0.00

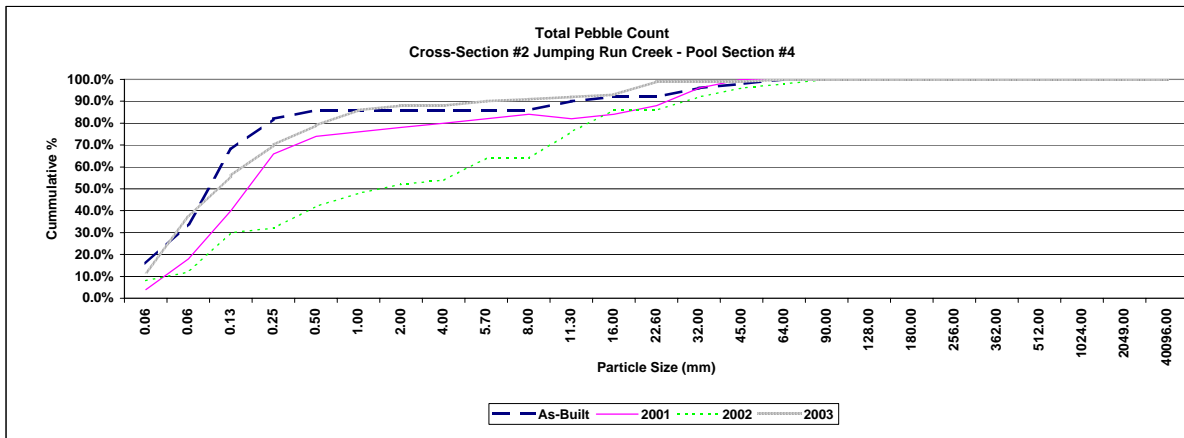

Project Name Jumping Run Area 1
Task Longitudinal Profile
Section Area #1
Date 10/7/03
Crew Shaffer, Bidelspach, Clinton

Symbol Key
T Thalweg
TR Head of Riffle
TP Head of Pool
TU Head of Run
TM Max Pool

2004 Survey* * 2004 elev adjusted up by 1.0 ft

TW Station	TW Elevation	WS Station	WS Elevation	BKF Station	BKF Elevation	Feature
11.05	94.85	10.72	95.35	1.36	96.38	TR
21.46	94.86	21.14	95.28	32.24	95.79	T
30.35	94.64	30.15	95.3	32.74	95.83	T
42.9	94.81	42.91	95.26	53.86	96.34	T
52.71	94.62	53.06	95.15	68.04	95.84	TP
69.12	94.58	68.92	95.11	69.51	96.4	T
89.43	94.36	89.24	95.1	89.92	95.81	TR
98.42	94.61	98.61	95	111.86	95.51	T
106.18	94.56	106.66	95.02	122.07	95.93	T
113.22	94.47	114.12	94.95	122.17	95.95	T
122.14	94.21	121.1	94.95	129.28	95.93	T
131.31	94.37	131.02	94.87	134.95	95.57	T
146.42	94.43	146.23	94.8	145.62	95.95	TP
149.83	93.87	149.46	94.2	155.8	95.66	T
160.3	92.42	164.97	93.53	158.76	95.48	T
163.72	93.22	171.18	93.46	167.07	95.18	T
171.17	93.42	186.34	93.34	174.56	94.66	TR
186.08	92.96	195.26	93.24	183.73	94.43	T
194.01	92.58	199.42	93.24	187.46	94.3	T
199.53	92.82	215.77	93.17	189.32	94.23	T
215.9	92.74	232.25	93.12	192.84	94.56	T
232.13	92.66	240.03	93	198.63	94.45	T
239.94	92.46	251.92	92.97	200.09	94.42	TP
251.96	91.85	253.08	93	217.23	94.48	T
253.24	91.27	258.21	92.94	224.1	93.85	T
257.91	92.4	266.96	92.93	225.44	93.96	T
267	92.29	275.59	92.18	225.6	94.02	T
272.31	92.66	280.63	92.22	239.95	93.87	T
275.84	90.87	286.75	92.21	245.11	94.32	TP
280.52	90.31	294.95	92.18	253.5	94.31	T
286.96	91.47	304.43	92.2	269.87	93.43	T
295.26	91.78	310.34	92.24	273.81	94.03	T
304.32	91.68	313.45	92.1	277.13	93.83	T
310.87	91.79	325.26	92.01	282.94	93.83	TR
314.01	91.88	341.74	91.91	292.83	93.45	T
325.58	91.36			303.34	92.57	T
341.86	91.51			311.74	92.55	T
350.56	91.87			322.36	92.44	
				324.16	92.49	
				332.57	93.21	
				336.09	94.66	
				347.93	92.73	
				349.71	93.46	

2003 Survey

TW Station	TW Elevation	WS Station	WS Elevation	LBKF Station	LBKF Elevation	RBKF Station	RBKF Elevation	Feature
0.16	95.21	0	95.46	9.89	97.25	14.94	97.6	T
39.84	94.47	21.67	95.45	37.83	96.74			TU
58.23	94.53	39.48	95.42	59.36	96.36	59	96.44	TP
62.53	94.03	58.18	95.35					TM
75.05	94.47	62.59	95.42					T
77.17	94.38	74.69	95.27					TU
80.43	94.2	76.17	95.37					T
82.06	94.23	76.77	95.34					T
85.53	94.59	80.48	95.35					T
90.72	94.18	81.26	95.36					T
99.89	94.09	85.62	95.28					T
106.61	94.66	90.01	95.28			101.11	95.94	T
109.26	94.52	99.69	95.26					TP
113.73	93.92	109.56	95.22	116.66	96.25			T
125.4	94.05	113.56	95.18					TM
133.38	94.23	125.74	95.09			137.63	95.97	TR
147.74	94.38	133.22	95.05					LV
148.08	93.82	140.21	94.89			150.52	95.7	T
154.87	93.57	147.71	94.4	154.74	95.42			TU
160.17	92.7	148.01	94.27					TP
164.16	92.12	155.12	93.84					TM
171.73	93.17	159.9	93.8			170.54	95.45	T
181.82	92.83	163.87	93.9	185.23	95.02			TR
191.54	92.57	171.95	93.9					TP
193.61	92.06	181.71	93.78					TM
200.17	92.75	191.78	93.57					TU
206.35	92	193.07	93.56					T
217.77	92.4	200.26	93.55	221.74	94.72	212.89	94.64	T
229.77	92.6	206.19	93.58					T
241.02	92.18	217.75	93.53					TP
246.1	91.46	229.93	93.55			249.4	94.09	TM
253.84	93.11	241.14	93.47	252.48	94.35			T
269.57	92.42	245.9	93.46	264	94.11			TR
274.94	92.69	253.65	93.46					V
279.78	90.57	269.22	93.26					TM
284.66	91.94	274.57	93.18	289.51	93.84			T
294.53	91.72	279.87	92.73			291.98	93.81	T
		284.38	92.78					

2002 Survey
Conducted by S&EC, PA, Inc

* Previous surveys elevations adjust 5.8

Original Station	Original TW Elevation	Adjusted Station	Adjusted TW Elevation
0	100.13	0	94.33
12	100.89	12	95.09
23	98.53	23	92.73
29	99.87	29	94.07
51	99.87	51	94.07
80	99.97	80	94.17
101	99.71	101	93.91
123	99.21	123	93.41
129	99.75	129	93.95
144	99.97	144	94.17
157	100.03	157	94.23
175	98.09	175	92.29
186	98.69	186	92.89
192	98.29	192	92.49
200	98.89	200	93.09
205	98.01	205	92.21
212	98.21	212	92.41
220	97.67	220	91.87
225	98.31	225	92.51
247	98.33	247	92.53
257	97.57	257	91.77
259	97.75	259	91.95
268	98.17	268	92.37
275	98.03	275	92.23
284	98.35	284	92.55

2001 Survey
Conducted by K-H & Assoc., Inc

Original Station	Original TW Elevation	Adjusted Station	Adjusted TW Elevation
0		0	
20		20	
25	99.3	25	93.5
29	100.2	29	94.4
35	100	35	94.2
44	100.15	44	94.35
64	100.2	64	94.4
73	100.25	73	94.45
79	100.25	79	94.45
90	100.2	90	94.4
103	99.88	103	94.08
117	100.05	117	94.25
123	99.6	123	93.8
128	99.8	128	94
138	99.83	138	94.03
151	100.15	151	94.35
158	100.05	158	94.25
163	99.45	163	93.65
170	99.15	170	93.35
181	98.25	181	92.45
186	99.03	186	93.23
196	98.79	196	92.99
210	99.27	210	93.47
216	99.05	216	93.25
218	97.35	218	91.55
224	98.09	224	92.29
232	98.64	232	92.84
245	98.44	245	92.64
252	98.45	252	92.65
262	97.57	262	91.77
269	97.93	269	92.13
279	98.25	279	92.45
284.5	98.36	284.5	92.56
287	98.15	287	92.35

Year 1 - Head cut observed at Station 218

2000 As-built
Conducted by K-H & Assoc., Inc

Longitudinal Profile - Jumping Run Area 1
Alexander County, NC

Station	TW	Notes	Adjusted Station	Adjusted Elevation
0	100.14		0	94.34
11.1	100.89	top of rock cross vane	11.1	95.09
15	99.04	pool	15	93.24
20	98.84		20	93.04
25	99.34		25	93.54
29	99.89	end pool/begin glide	29	94.09
35	100.04		35	94.24
44	100.19		44	94.39
64	100.14		64	94.34
73	100.39	top riffle/end glide	73	94.59
79	100.19	xsection riffle	79	94.39
90	100.24	end riffle	90	94.44
103	100.14		103	94.34
117	100.09	log vane	117	94.29
123	99.54	d/s log vane	123	93.74
128	99.54	center of pool	128	93.74
138	99.94	end pool	138	94.14
151	100.14	start riffle	151	94.34
158	100.04	center of notch in log	158	94.24
163	99.54		163	93.74
170	99.19		170	93.39
181	99.19		181	92.39
186	99.14		186	93.34
196	98.79	center of pool	196	92.99
210	99.34	end pool	210	93.54
214	99.04	begin riffle	214	93.24
219	98.84	center of riffle	219	93.04
232	98.69		232	92.89
245	98.59		245	92.79
252	98.49	end run/begin pool	252	92.69
262	97.39	center of pool	262	91.59
269	98.24		269	92.44
279	98.44		279	92.64
284.5	98.39	center of rock struc	284.5	92.59

Project Nam	Jumping Run
Task	Channel Pattern Measurements
Date	6/1/04
Crew	Shaffer, Bidelspach, Clinton

Area 1 2004		
Radius of Curvature	Meander Wavelength	Channel Beltwidth
44	108	32
34	119	33
30	126	39
30		
34		
30	108	32
44	126	39
34	119	33

Area 2 2004		
Radius of Curvature	Meander Wavelength	Channel Beltwidth
25	108	36
23	59	29
14	49	45
16	91	36
16	80	
15		
43		
29		
14	49	29
43	108	45
20	80	36

Area 3 2004		
Radius of Curvature	Meander Wavelength	Channel Beltwidth
42	124	38
38	148	46
30	146	44
38		
33		
30	124	38
42	148	46
38	146	44

Area 4 2004		
Radius of Curvature	Meander Wavelength	Channel Beltwidth
28	148	35
36	123	29
26	76	30
60	93	29
28	80	27
69	66	20
39		
31		
26	66	20
69	148	35
34	87	29

Area 1 2003		
Radius of Curvature	Meander Wavelength	Channel Beltwidth
27	115	36
34	123	38
36		40
39		
27	115	36
39	123	40
35	119	38

Area 2 2003		
Radius of Curvature	Meander Wavelength	Channel Beltwidth
22	50	36
22	61	38
24	75	38
25	95	39
26		40
27		47
28		
30		
30		
30		
22	50	36
30	95	47
27	68	39

Area 3 2003		
Radius of Curvature	Meander Wavelength	Channel Beltwidth
34	146	43
41	149	43
46		50
58		51
34	146	43
58	149	51
43	147	47

Area 4 2003		
Radius of Curvature	Meander Wavelength	Channel Beltwidth
30	69	25
35	71	28
36	80	31
39	93	34
45	106	49
47	120	
52		
30	69	25
52	120	49
39	86	31

min
max
median

min
max
median

Payne Dairy Stream Restoration
 Alexander County, NC

Quad 1

Tree Stratum

<u>Species</u>	<u>Height (cm)</u>	<u>Diameter (mm)</u>	<u>Radius (mm)</u>	<u>Σ X-sec. (mm²)</u>	<u>Rel. x-sec (%)</u>	<u>Density</u>	<u>Rel. Density (%)</u>	<u>Rank (Importance)</u>	<u>Average</u>
Liquidambar styraciflua	210	30		15					
Total	210	30		15	706.9	66.7	1	25	
Betula nigra	190	15		7.5					
Total				7.5	176.7	16.7	1	25	
Quercus phellos	180	12		6					
Total				6	113.1	10.7	1	25	
Acer rubrum	100	9		4.5					
Total				4.5	63.6	6.0	1	25	
Overall Total					1060.3	100.0	4	100	
Total Trees per acre							160		
Planted trees per acre							80		
Natural regen. trees per acre							80		

Shrub Stratum

<u>Species</u>	<u>Cover (%)</u>	<u>Rel. cover (%)</u>	<u>Density</u>	<u>Rel. Density (%)</u>	<u>Rank (Importance)</u>
Cornus amomum	15	75	7	63.6	
Salix nigra	3	15	3	27.3	
Sambucus canadensis	2	10	1	9.1	
Total	20	100	11	100	

Herb Stratum

<u>Species</u>	<u>Cover (%)</u>	<u>Rel. cover (%)</u>	<u>Rank (Importance)</u>
Fescue sp.	100	90.9	
Solidago sp.	10	9.1	
Total	110	100	

Payne Dairy Stream Restoration
Alexander County, NC

Quad 2

Tree Stratum

<u>Species</u>	<u>Height (cm)</u>	<u>Diameter (mm)</u>	<u>Radius (mm)</u>	<u>Σ X-sec. (mm²)</u>	<u>Rel. x-sec (%)</u>	<u>Density</u>	<u>Rel. Density (%)</u>	<u>Rank (Importance)</u>	<u>Average</u>
Acer rubrum	400	200	100	31415.9					
	500	250	125	49087.4					
Total			225	80503.3	97.0	2	50		
Liquidambar styraciflua	220	40	20	1256.6					
	105	12	20	1256.6					
Total			40	2513.3	3.0	2	50		
Overall Total				83016.6	100	4	100		
Total Trees per acre						160			
Planted trees per acre						0			
Natural regen. trees per acre						160			

Shrub Stratum

<u>Species</u>	<u>Cover (%)</u>	<u>Rel. cover (%)</u>	<u>Density</u>	<u>Rel. Density (%)</u>	<u>Rank (Importance)</u>
Alnus serrulata	1	9.1	1	2.0	
Salix nigra	10	90.9	13	92.9	
Total	11	100	14	94.9	

Herb Stratum

<u>Species</u>	<u>Cover (%)</u>	<u>Rel. cover (%)</u>	<u>Rank (Importance)</u>
Panicum virgatum	100	100	
Total	100	100	

Payne Dairy Stream Restoration
 Alexander County, NC

Quad 3

Tree Stratum

<u>Species</u>	<u>Height (cm)</u>	<u>Diameter (mm)</u>	<u>Radius (mm)</u>		<u>Σ X-sec. (mm²)</u>	<u>Rel. x-sec (%)</u>	<u>Density</u>	<u>Rel. Density (%)</u>	<u>Rank (Importance)</u>	<u>Average</u>
Quercus phellos	115	12		6	113.0973355					
	149	15		7.5	176.7145868					
Total				13.5	289.8119223	56.07902736	2	66.66666667		
Fraxinis americana	153	17		8.5	226.9800692					
Total				8.5	226.9800692	43.92097264	1	33.33333333		
Overall total					516.7919915	100	3	100		
Total Trees per acre							120			
Planted trees per acre							120			
Natural regen. trees per acre							0			

Shrub Stratum

<u>Species</u>	<u>Cover (%)</u>	<u>Rel. cover (%)</u>	<u>Density</u>	<u>Rel. Density (%)</u>	<u>Rank (Importance)</u>
Dispyros virginiana	1	100	1	100	
Total	1		1		

Herb Stratum

<u>Species</u>	<u>Cover (%)</u>	<u>Rel. cover (%)</u>	<u>Rank (Importance)</u>
Trifolium sp.	5	5.882352941	
Carex sp.	70	82.35294118	
Fescue sp.	10	11.76470588	
Total	85	100	

Payne Dairy Stream Restoration
Alexander County, NC

Quad 4

Tree Stratum

<u>Species</u>	<u>Height (cm)</u>	<u>Diameter (mm)</u>	<u>Radius (mm)</u>	<u>Σ X-sec. (mm²)</u>	<u>Rel. x-sec (%)</u>	<u>Density</u>	<u>Rel. Density (%)</u>	<u>Rank (Importance)</u>	<u>Average</u>
Platanus occidentalis	160	32	16	804.2					
	42	5	2.5	19.6					
	43	2	1	3.1					
	40	3	1.5	7.1					
	68	5	2.5	19.6					
	96	10	5	78.5					
Total				932.3	33.5	6	37.5	2	35.5
Quercus phellos	138	25	12.5	490.9					
	78	5	2.5	19.6					
	134	10	5	78.5					
	81	10	5	78.5					
	137	7	3.5	38.5					
	23	12	6	113.1					
	142	17	8.5	227.0					
	170	8	4	50.3					
	147.5	8	4	50.3					
Total				1146.7	41.2	9	56.25	1	48.7
Betula nigra	185.5	30	15	706.9					
Total				706.9	25.4	1	6.25	3	15.8
Overall total				2785.8	100.0	16	100		100
Total Trees per acre						640			
Planted trees per acre						280			
Natural regen. trees per acre						360			

Shrub Stratum

<u>Species</u>	<u>Cover (%)</u>	<u>Rel. cover (%)</u>	<u>Density</u>	<u>Rel. Density (%)</u>	<u>Rank (Importance)</u>
Sambucus canadensis	2	66.7	2	66.7	1
Diospyros virginiana	1	33.3	1	33.3	2
Total	3	100.0	3	100.0	

Herb Stratum

<u>Species</u>	<u>Cover (%)</u>	<u>Rel. cover (%)</u>	<u>Rank (Importance)</u>
Juncus effusus	5	4.8	3
Microstegium	10	9.5	2
Fescue sp.	90	85.7	1
Total	105	100.0	