


**RUSSELL GAP**  
**PROJECT: 157329**

**NORTH CAROLINA**  
**DIVISION OF MITIGATION SERVICES**

**ALEXANDER COUNTY**

**LOCATION: NEAR RUSSELL GAP ROAD AND MOUNT OLIVE CHURCH ROAD**  
**TYPE OF WORK: AS - BUILT PLAN**




STATE	BAKER PROJECT REFERENCE NO.	SHEET NO.	TOTAL SHEETS
NC	157329	1	43

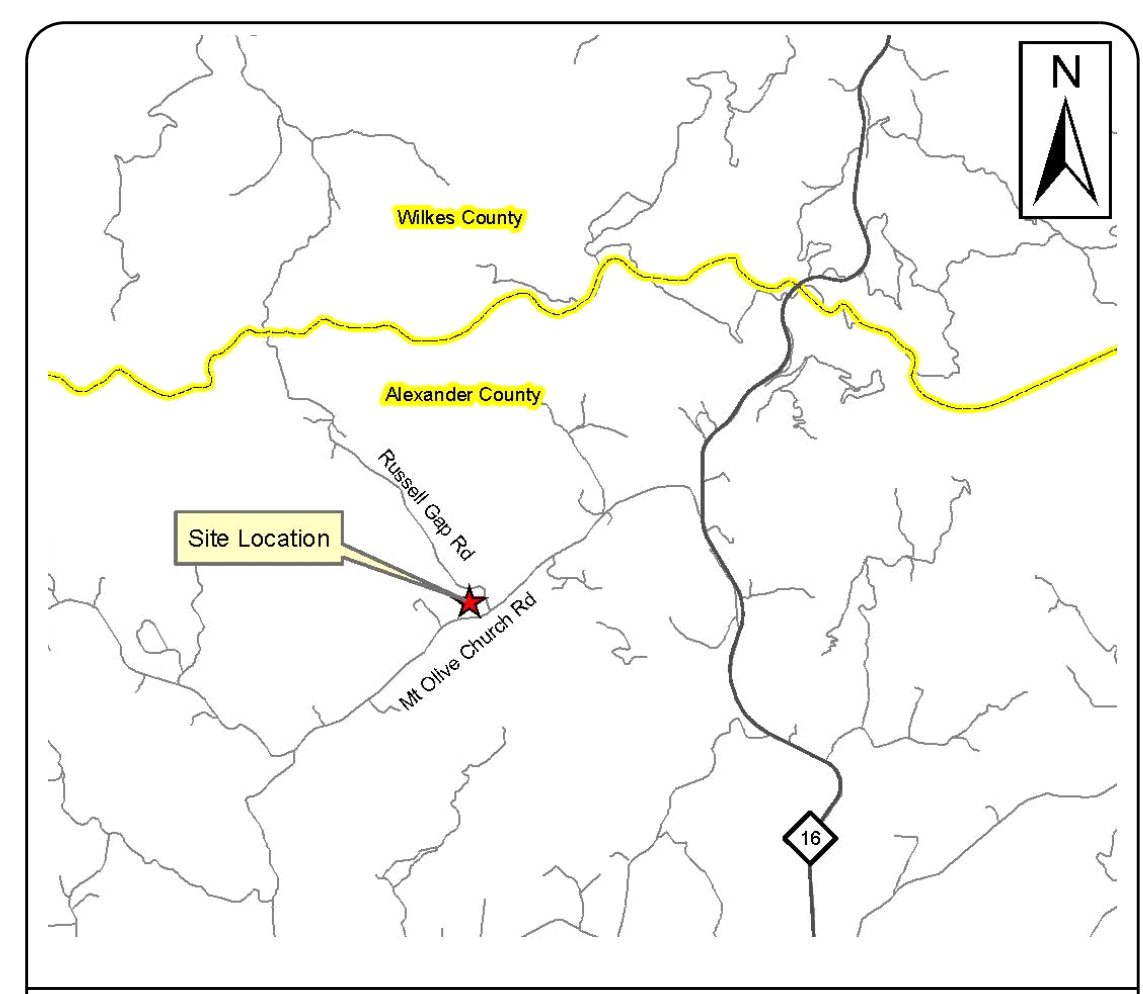

**VICINITY MAP**

**INDEX OF SHEETS**

- 1..... TITLE SHEET
- 1-A..... STREAM CONVENTIONAL SYMBOLS  
GENERAL NOTES  
STANDARD SPECIFICATIONS  
VEGETATION SELECTION
- 1-B..... NCDOT CONVENTIONAL SYMBOLS
- 2 - 2-E..... DETAILS
- 3 - 25..... PLAN VIEW
- 26 - 36..... PROFILES

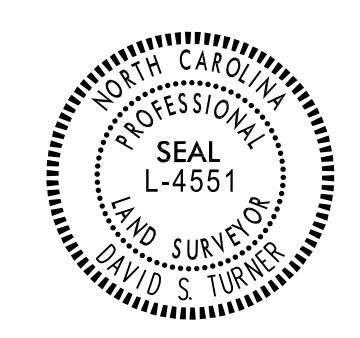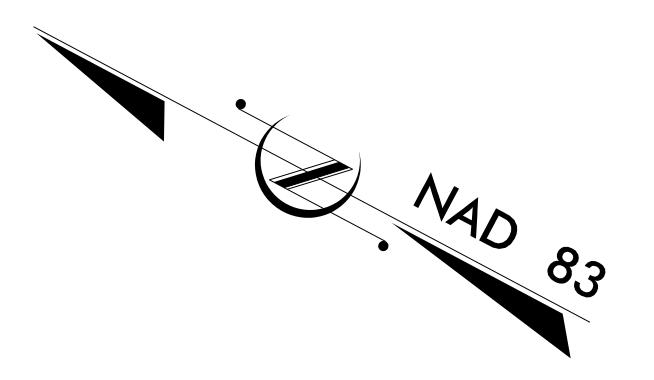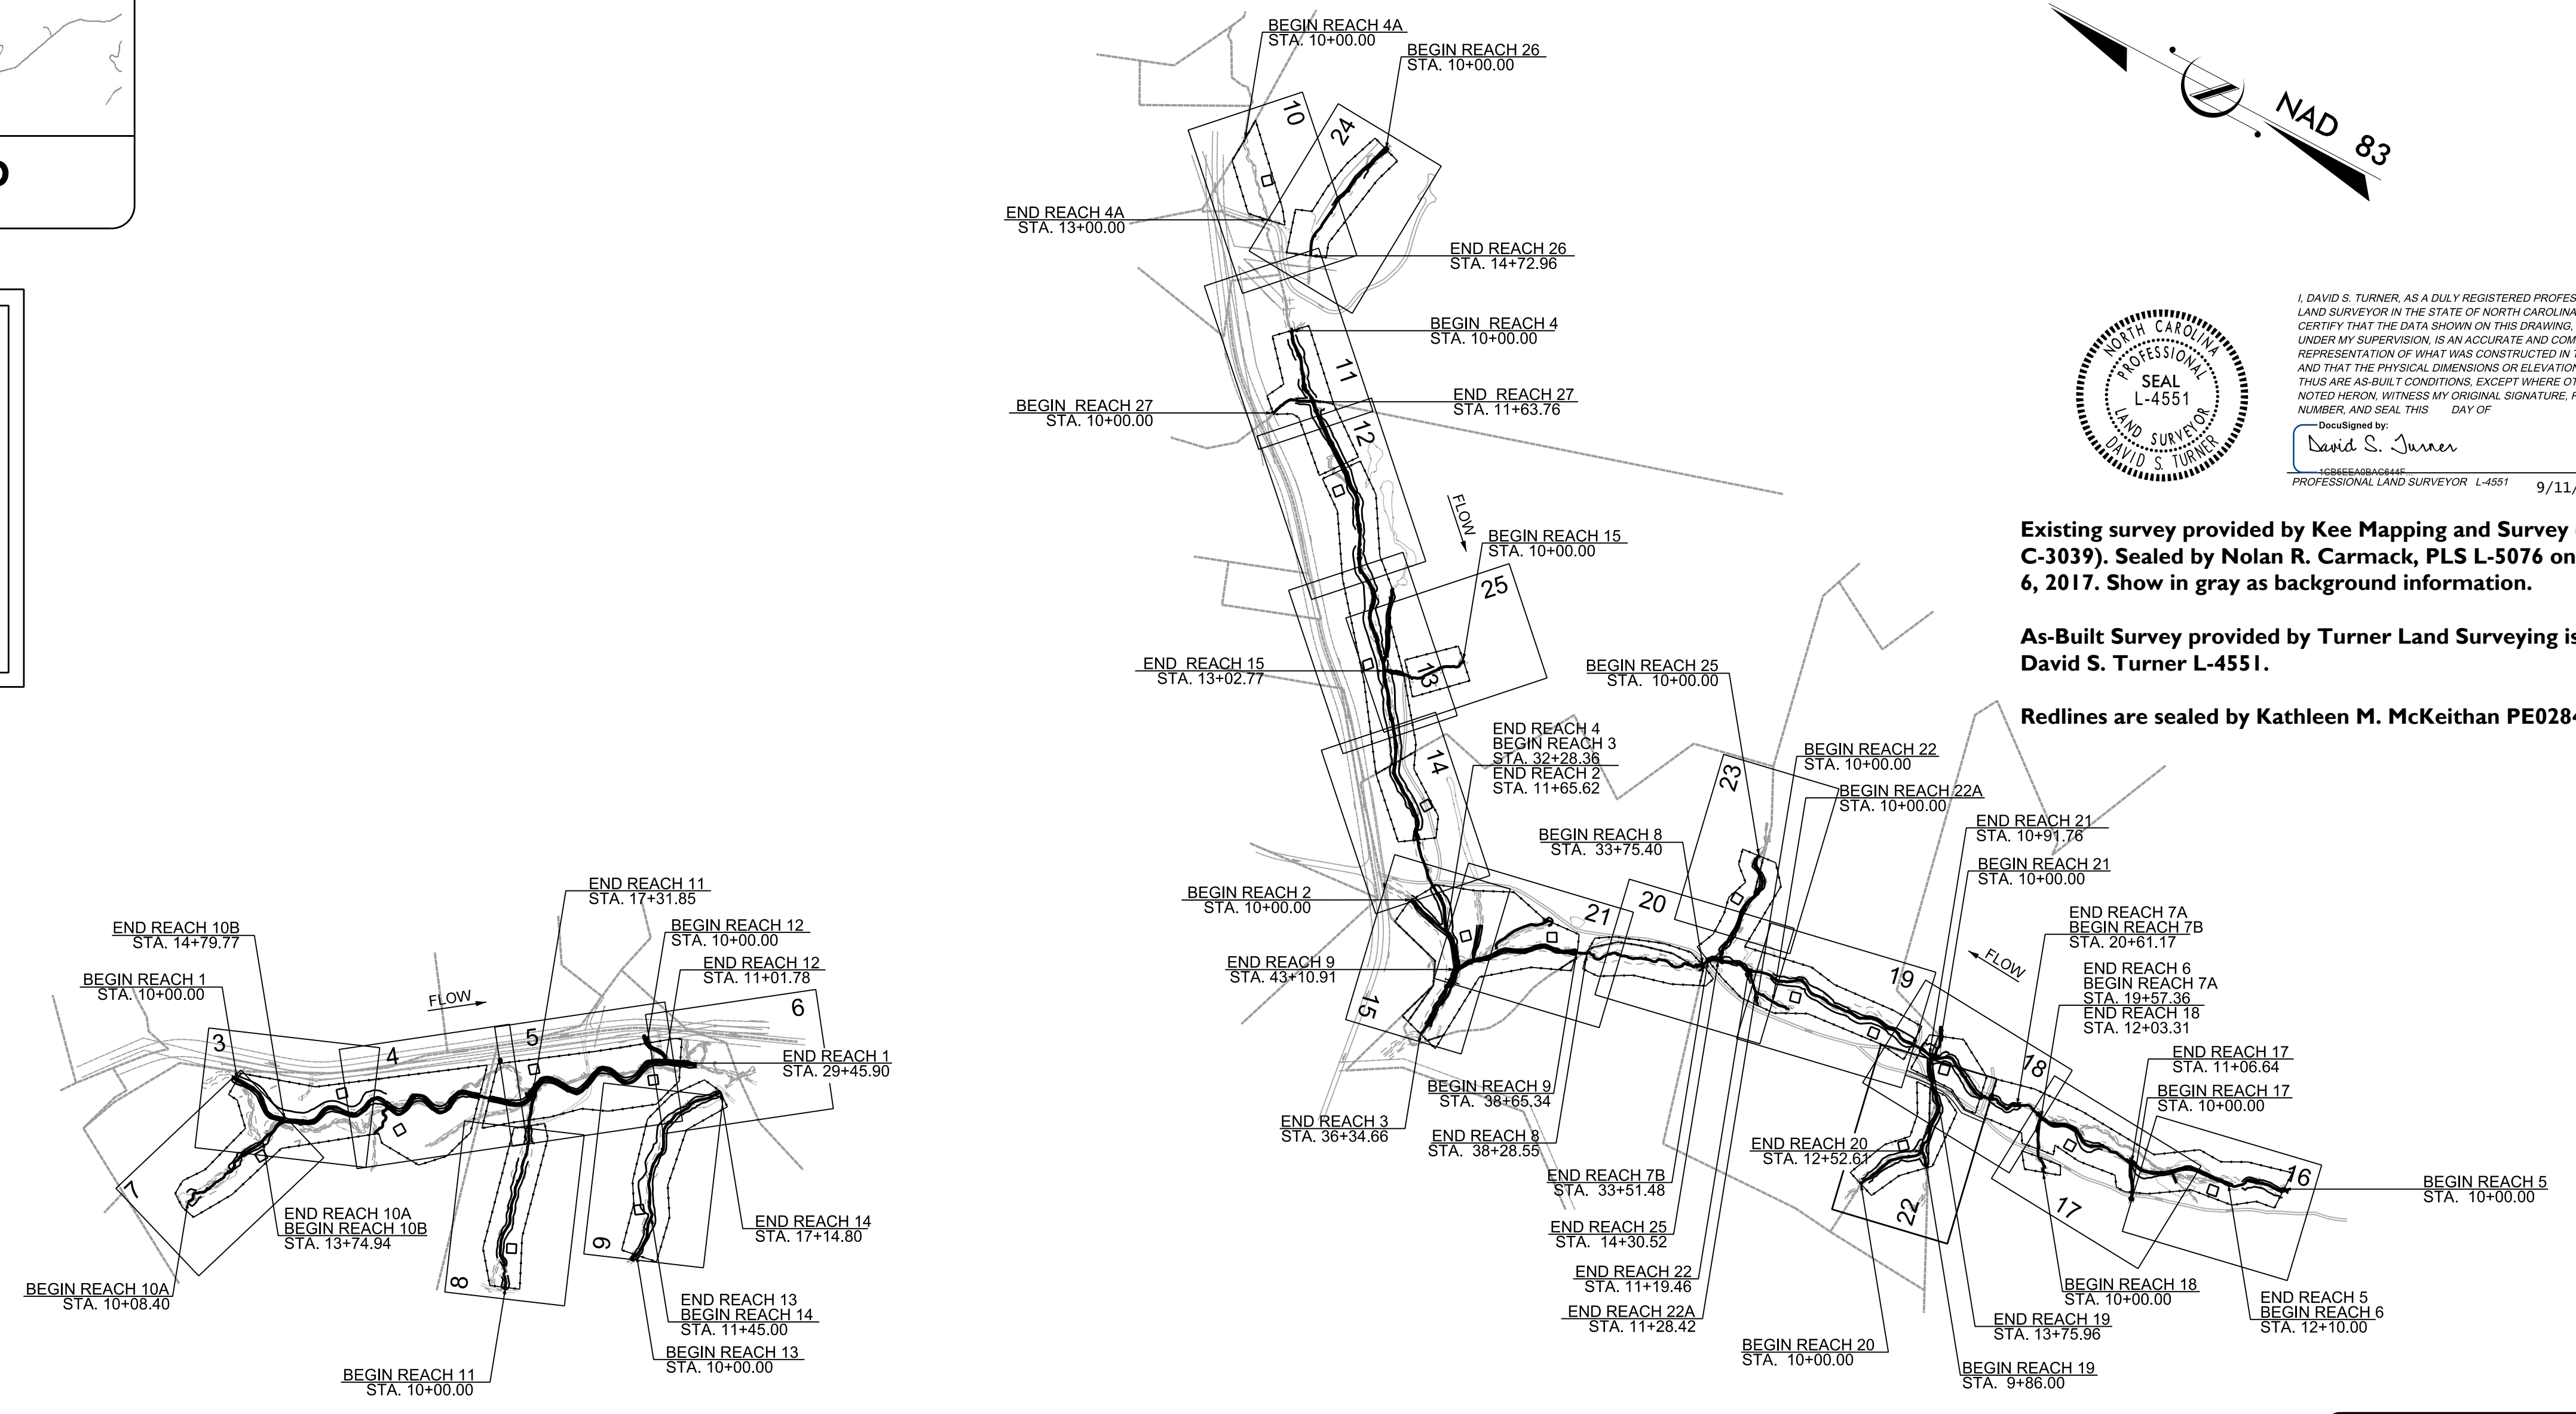

I, DAVID S. TURNER, AS A DULY REGISTERED PROFESSIONAL LAND SURVEYOR IN THE STATE OF NORTH CAROLINA, HEREBY CERTIFY THAT THE DATA SHOWN ON THIS DRAWING, WAS OBTAINED UNDER MY SUPERVISION, IS AN ACCURATE AND COMPLETE REPRESENTATION OF WHAT WAS CONSTRUCTED IN THE FIELD, AND THAT THE PHYSICAL DIMENSIONS OR ELEVATIONS SHOWN THUS ARE AS-BUILT CONDITIONS, EXCEPT WHERE OTHERWISE NOTED HERON. WITNESS MY ORIGINAL SIGNATURE, REGISTRATION NUMBER, AND SEAL, THIS DAY OF


DocuSigned by:  
**David S. Turner**  
PROFESSIONAL LAND SURVEYOR L-4551 9/11/2020

**Existing survey provided by Kee Mapping and Survey (License # C-3039). Sealed by Nolan R. Carmack, PLS L-5076 on November 6, 2017. Show in gray as background information.**

**As-Built Survey provided by Turner Land Surveying is sealed by David S. Turner L-4551.**

**Redlines are sealed by Kathleen M. McKeithan PE028432.**

NCDMS ID NO. 100003

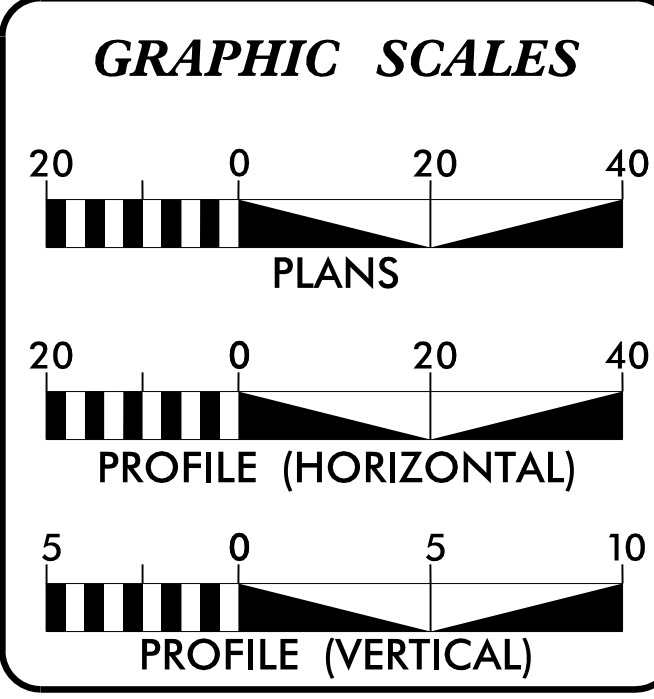

**MITIGATION SUMMARY**

STREAM CREDITS	9,166.949
WETLAND CREDITS	7.053

**PREPARED FOR THE OFFICE OF:**

NCDEQ  
DIVISION OF MITIGATION SERVICES  
1652 MAIL SERVICE CENTER  
RALEIGH, NC 27699-1652

**CONTACT:** MATTHEW REID  
PROJECT MANAGER

**Michael Baker**  
INTERNATIONAL

Michael Baker Engineering Inc.  
8000 Regency Parkway, Suite 600  
Cary, NORTH CAROLINA 27518  
Phone: 919.463.5488  
Fax: 919.463.5490  
License #: F-1084

SPRING 2018  
LETTING DATE:

KATHLEEN M. MCKEITHAN, PE  
PROJECT ENGINEER

**PROJECT ENGINEER**



DocuSigned by:  
**Kathleen Mckeithan**  
SIGNATURE: P.E.

9/11/2020



2/26/2013

## STREAM CONVENTIONAL SYMBOLS SUPERCEDES SHEET 1-B

ROCK J-HOOK ROCK VANE OUTLET PROTECTION ROCK CROSS VANE DOUBLE DROP ROCK CROSS VANE SINGLE WING DEFLECTOR DOUBLE WING DEFLECTOR TEMPORARY SILT CHECK ROOT WAD GRADE CONTROL LOG J-HOOK LOG VANE LOG WEIR LOG CROSS VANE LOG ROLLER GRADE CONTROL LOG JAM CONSTRUCTED RIFFLE BOULDER CLUSTER ROCK STEP POOL SAFETY FENCE TAPE FENCE	100 YEAR FLOOD PLAIN CONSERVATION EASEMENT EXISTING MAJOR CONTOUR EXISTING MINOR CONTOUR LIMITS OF DISTURBANCE PROPERTY LINE FOOT BRIDGE TEMPORARY STREAM CROSSING PERMANENT STREAM CROSSING TRANSPLANTED VEGETATION TREE REMOVAL TREE PROTECTION CHANNEL PLUG CHANNEL FILL SLOPE, SEED, MULCH, MAT, AND LIVE STAKE GEOLIFT WITH BRUSH TOE PROPOSED WETLAND RESTORATION PROPOSED WETLAND ENHANCEMENT JURISDICTIONAL WETLAND BOUNDARY V-NOTCH WEIR
---	--

\*\*NOTE: ALL ITEMS ABOVE MAY NOT BE USED ON THIS PROJECT

Shumard oak, *Quercus shumardii*, added to planting list. Not supplemental but additional planting.

## VEGETATION SELECTION

Riparian planting ( 25.23 ac. )			
Common Name	Scientific Name	Percent Planted by Species	Wetness Tolerance
<b>Trees (75%) Planted 9' X 9' Spacing – 538 Trees/ Acre</b>			
River Birch	<i>Betula nigra</i>	15%	FACW
Black Walnut	<i>Juglans nigra</i>	10%	FACU
Sycamore	<i>Platanus occidentalis</i>	20%	FACW
Tulip Poplar	<i>Liriodendron tulipifera</i>	20%	FACU
Green ash	<i>Fraxinus pennsylvanica</i>	5%	FACW
Willow oak	<i>Quercus phellos</i>	20%	FAC
Persimmon	<i>Diospyros virginiana</i>	10%	FAC
<b>Tree total</b>		<b>100%</b>	
<b>Shrubs (25%) Planted 16' X 16' Spacing - 164 Shrubs/ Acre</b>			
Tag Alder	<i>Alnus serrulata</i>	20%	OBL
Spicebush	<i>Lindera benzoin</i>	25%	FAC
Redbud	<i>Cercis canadensis</i>	20%	FACU
Elderberry	<i>Sambucus canadensis</i>	15%	FAC
Silky Dogwood	<i>Cornus amomum</i>	20%	FACW
<b>Shrub Total</b>		<b>100%</b>	

Upland planting ( 4.44 ac. )			
<b>Trees (75%) Planted 9' X 9' Spacing – 538 Trees/ Acre</b>			
Tulip Poplar	<i>Liriodendron tulipifera</i>	20%	FACU
Black Walnut	<i>Juglans nigra</i>	10%	FACU
Black Gum	<i>Nyssa sylvatica</i>	10%	FAC
Persimmon	<i>Diospyros virginiana</i>	10%	FAC
Southern red oak	<i>Quercus falcata</i>	15%	FACU
White oak	<i>Quercus alba</i>	15%	FACU
American Beech	<i>Fagus grandifolia</i>	10%	FACW
Red Maple	<i>Acer rubrum</i>	10%	FAC
<b>Total Trees</b>		<b>100%</b>	
<b>Shrubs (25%) Planted 16' X 16' Spacing - 164 Shrubs/ Acre</b>			
Spicebush	<i>Lindera benzoin</i>	15%	FAC
Redbud	<i>Cercis canadensis</i>	20%	FACU
Flowering Dogwood	<i>Cornus florida</i>	15%	FACU
Blackhaw Viburnum	<i>Viburnum prunifolium</i>	15%	FACU
Ironwood	<i>Carpinus caroliniana</i>	20%	FAC
Hazelnut	<i>Corylus americana</i>	15%	FACU
<b>Shrub total</b>		<b>100%</b>	

Streambank Live Stake Plantings			
Silky Willow	<i>Salix sericea</i>	25%	OBL
Elderberry	<i>Sambucus nigra canadensis</i>	25%	FAC
Buttonbush	<i>Cephalanthus occidentalis</i>	15%	OBL
Silky Dogwood	<i>Cornus amomum</i>	25%	FACW
Black Willow	<i>Salix nigra</i>	10%	OBL

Note: Final species selection may change due to refinement or availability at the time of planting. If species substitution is required, the planting contractor will submit a revised planting list to Baker for approval prior to the procurement of plant stock.

Permanent seed mixtures for the project site shall be planted throughout the floodplain and riparian buffer areas except the vernal pools. Permanent seed mixtures shall be applied with temporary seed, as defined in the construction specifications.				
Common Name	Scientific Name	Percent of Mixture	Seeding Density (lbs/acre)	Wetness Tolerance
Redtop	<i>Agrostis alba</i>	10%	1.5	FACW
Virginia Wildrye	<i>Elymus virginicus</i>	15%	2.25	FACW
Switchgrass	<i>Panicum virgatum</i>	15%	2.25	FAC
Eastern Gamma Grass	<i>Tripsacum dactyloides</i>	5%	0.75	FACW
Pennsylvania Smartweed	<i>Polygonum pennsylvanicum</i>	5%	0.75	FACW
Little Blue Stem	<i>Schizachyrium scoparium</i>	5%	0.75	FACU
Soft Rush	<i>Juncus effusus</i>	5%	0.75	FACW
Beggars Tick	<i>Bidens frondosa (or aristosa)</i>	5%	0.75	FACW
Lance-Leaved Tick Seed	<i>Coreopsis lanceolata</i>	10%	1.5	FACU
Tioga Deer Tongue	<i>Dichanthelium clandestinum</i>	15%	2.25	FAC
Big Blue Stem	<i>Andropogon gerardii</i>	5%	0.75	FAC
Indian Grass	<i>Sorghastrum nutans</i>	5%	0.75	FACU

## STANDARD SPECIFICATIONS

### NORTH CAROLINA EROSION AND SEDIMENT CONTROL PLANNING AND DESIGN MANUAL MARCH 2009 (REV 2013)

- 6.06 TEMPORARY GRAVEL CONSTRUCTION ENTRANCE
- 6.24 RIPARIAN AREA SEEDING
- 6.60 TEMPORARY SEDIMENT TRAP
- 6.62 TEMPORARY SILT FENCE
- 6.63 TEMPORARY ROCK DAM
- 6.70 TEMPORARY STREAM CROSSING

## GENERAL NOTES

1. THE CONTRACTOR IS REQUIRED TO INSTALL IN-STREAM STRUCTURES USING A TRACK HOE WITH A HYDRAULIC THUMB OF SUFFICIENT SIZE TO PLACE BOULDERS (3'x2'x2'), LOGS AND ROOTWADS.
2. WORK IS BEING PERFORMED AS AN ENVIRONMENTAL RESTORATION PLAN. THE CONTRACTOR SHOULD MAKE ALL REASONABLE EFFORTS TO REDUCE SEDIMENT LOSS AND MINIMIZE DISTURBANCE OF THE SITE WHILE PERFORMING THE CONSTRUCTION WORK.
3. CONSTRUCTION IS SCHEDULED FOR 2018.
4. CONTRACTOR SHOULD CALL NORTH CAROLINA "ONE-CALL" BEFORE EXCAVATION STARTS. (1-800-632-4949)
5. BOULDER SIZES FOR IN-STREAM STRUCTURES SHALL BE A MINIMUM OF 2'x2'x1' AND CAN BE CHANGED PER STRUCTURE OR THE DIRECTION OF THE ENGINEER.
6. ALL ON-SITE ALLUVIUM SHALL BE HARVESTED AND STOCKPILED PRIOR TO FILLING ABANDONED CHANNELS.
7. TOPSOIL SHALL BE EXCAVATED TO A DEPTH OF 8" AND STOCKPILED SEPARATELY FROM UNDERCUT SOIL. 6" OF TOPSOIL SHALL BE PLACED ON ALL BANKFULL BENCHES AND AS DIRECTED BY THE ENGINEER.
8. ALL DISTURBED EMBANKMENTS SHALL BE MATTED WITH COIR FIBER MATTING OR AS DIRECTED BY THE ENGINEER.
9. ALL STREAM BANKS SHALL BE LIVE STAKED.
10. UNLESS THE ALIGNMENT IS BEING ALTERED, THE EXISTING CHANNEL DIMENSIONS ARE TO REMAIN UNLESS OTHERWISE NOTED.
11. BANKFULL BENCHES SHALL BE A MINIMUM OF 6' IN WIDTH UNLESS OTHERWISE SHOWN ON THE PLANS.
12. CONTRACTOR WILL ENSURE THAT FENCING IS INSTALLED ON OR OUTSIDE THE CONSERVATION EASEMENT AS SHOWN ON THE PLANS BUT NO MORE THAN 1' OUTSIDE.
13. WHERE PROPOSED FENCE CROSSES EXISTING STREAMS, THE CONTRACTOR SHALL UTILIZE A SECTION OF BREAK AWAY FENCE, A FLOOD GATE, OR ELECTRIFIED CHAINS AS DIRECTED BY THE ENGINEER.

PROJECT REFERENCE NO. <b>157329</b>	SHEET NO. <b>1-A</b>
PROJECT ENGINEER	
	DocuSigned by: <b>Michael Baker International</b> APPROVED BY:  DATE: 9/11/2020
<b>Michael Baker International</b> Michael Baker Engineering Inc. 8000 Regency Parkway, Suite 500 Cary, NORTH CAROLINA 27518 Phone: 919.463.5488 Fax: 919.463.5490 License #: F-1084	
NCDMS ID NO. 100003	

R:\157329\157329\_Russell\_Cop\Design\AS-BUILD\PLANS\157329\_AB-PSH-01A.dgn

STATE OF NORTH CAROLINA  
DIVISION OF HIGHWAYS

# CONVENTIONAL SYMBOLS

\*S.U.E = SUBSURFACE UTILITY ENGINEER

### BOUNDARIES AND PROPERTY:

State Line	-----
County Line	-----
Township Line	-----
City Line	-----
Reservation Line	-----
Property Line	-----
Existing Iron Pin	○ EP
Property Corner	-----
Property Monument	□ ECM
Parcel/Sequence Number	②③
Existing Fence Line	-x-x-x-
Proposed Woven Wire Fence	○
Proposed Chain Link Fence	□
Proposed Barbed Wire Fence	◇
Existing Wetland Boundary	-WLB-
Proposed Wetland Boundary	-WLB-
Existing Endangered Animal Boundary	-EAB-
Existing Endangered Plant Boundary	-EPB-

### BUILDINGS AND OTHER CULTURE:

Gas Pump Vent or U/G Tank Cap	○
Sign	○ S
Well	○ W
Small Mine	⋈
Foundation	□
Area Outline	□
Cemetery	↑
Building	□
School	□
Church	□
Dam	□

### HYDROLOGY:

Stream or Body of Water	-----
Hydro, Pool or Reservoir	□
Jurisdictional Stream	-JS-
Buffer Zone 1	-BZ 1-
Buffer Zone 2	-BZ 2-
Flow Arrow	←
Disappearing Stream	-----
Spring	○
Wetland	▾
Proposed Lateral, Tail, Head Ditch	-----
False Sump	▽

### RAILROADS:

Standard Gauge	-----
RR Signal Milepost	○ MILEPOST 35
Switch	□ SWITCH
RR Abandoned	-----
RR Dismantled	-----

### RIGHT OF WAY:

Baseline Control Point	◆
Existing Right of Way Marker	△
Existing Right of Way Line	-----
Proposed Right of Way Line	-----
Proposed Right of Way Line with Iron Pin and Cap Marker	○ R W
Proposed Right of Way Line with Concrete or Granite Marker	△ R W
Existing Control of Access	○ C A
Proposed Control of Access	○ C A
Existing Easement Line	-E-
Proposed Temporary Construction Easement	-E-
Proposed Temporary Drainage Easement	-TDE-
Proposed Permanent Drainage Easement	-PDE-
Proposed Permanent Utility Easement	-PUE-
Proposed Temporary Utility Easement	-TUE-
Proposed Permanent Easement with Iron Pin and Cap Marker	◆

### ROADS AND RELATED FEATURES:

Existing Edge of Pavement	-----
Existing Curb	-----
Proposed Slope Stakes Cut	-C-
Proposed Slope Stakes Fill	-F-
Proposed Wheel Chair Ramp	WCR
Existing Metal Guardrail	-----
Proposed Guardrail	-----
Existing Cable Guiderail	-----
Proposed Cable Guiderail	-----
Equality Symbol	⊕
Pavement Removal	XXXX

### VEGETATION:

Single Tree	☼
Single Shrub	☼
Hedge	-----
Woods Line	-----
Orchard	☼ ☼ ☼ ☼
Vineyard	□ Vineyard

### EXISTING STRUCTURES:

MAJOR:	
Bridge, Tunnel or Box Culvert	CONC
Bridge Wing Wall, Head Wall and End Wall	CONC WW
MINOR:	
Head and End Wall	CONC HW
Pipe Culvert	-----
Footbridge	-----
Drainage Box: Catch Basin, DI or JB	□ CB
Paved Ditch Gutter	-----
Storm Sewer Manhole	○ S
Storm Sewer	-S-

### UTILITIES:

POWER:	
Existing Power Pole	●
Proposed Power Pole	○
Existing Joint Use Pole	●
Proposed Joint Use Pole	○
Power Manhole	○ P
Power Line Tower	□
Power Transformer	□
U/G Power Cable Hand Hole	□ H
H-Frame Pole	●
Recorded U/G Power Line	-P-
Designated U/G Power Line (S.U.E.*)	-P-

### TELEPHONE:

Existing Telephone Pole	●
Proposed Telephone Pole	○
Telephone Manhole	○ T
Telephone Booth	□
Telephone Pedestal	□
Telephone Cell Tower	☼
U/G Telephone Cable Hand Hole	□ H
Recorded U/G Telephone Cable	-T-
Designated U/G Telephone Cable (S.U.E.*)	-T-
Recorded U/G Telephone Conduit	-TC-
Designated U/G Telephone Conduit (S.U.E.*)	-TC-
Recorded U/G Fiber Optics Cable	-T FO-
Designated U/G Fiber Optics Cable (S.U.E.*)	-T FO-

### WATER:

Water Manhole	○ W
Water Meter	○
Water Valve	⊗
Water Hydrant	⊕
Recorded U/G Water Line	-W-
Designated U/G Water Line (S.U.E.*)	-W-
Above Ground Water Line	-A/G Water-

### TV:

TV Satellite Dish	☼
TV Pedestal	□
TV Tower	⊗
U/G TV Cable Hand Hole	□ H
Recorded U/G TV Cable	-TV-
Designated U/G TV Cable (S.U.E.*)	-TV-
Recorded U/G Fiber Optic Cable	-TV FO-
Designated U/G Fiber Optic Cable (S.U.E.*)	-TV FO-

### GAS:

Gas Valve	◇
Gas Meter	⊕
Recorded U/G Gas Line	-G-
Designated U/G Gas Line (S.U.E.*)	-G-
Above Ground Gas Line	-A/G Gas-

### SANITARY SEWER:


Sanitary Sewer Manhole	⊕
Sanitary Sewer Cleanout	⊕
U/G Sanitary Sewer Line	-SS-
Above Ground Sanitary Sewer	-A/G Sanitary Sewer-
Recorded SS Forced Main Line	-FSS-
Designated SS Forced Main Line (S.U.E.*)	-FSS-

### MISCELLANEOUS:


Utility Pole	●
Utility Pole with Base	□
Utility Located Object	○
Utility Traffic Signal Box	□
Utility Unknown U/G Line	-TUTL-
U/G Tank; Water, Gas, Oil	□
A/G Tank; Water, Gas, Oil	□
U/G Test Hole (S.U.E.*)	⊕
Abandoned According to Utility Records	AATUR
End of Information	E.O.I.




### TYPICAL RIFFLE, POOL, AND BANKFULL BENCH CROSS SECTIONS

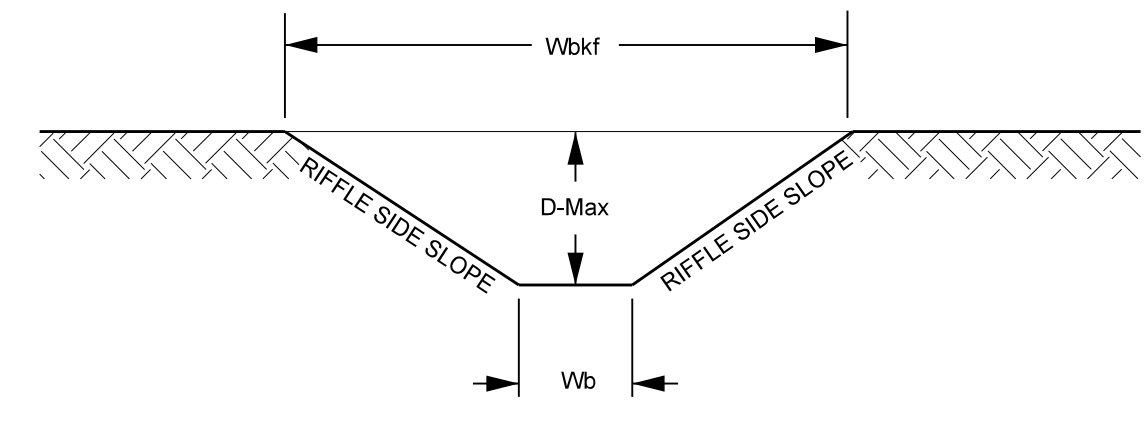


RIFFLE

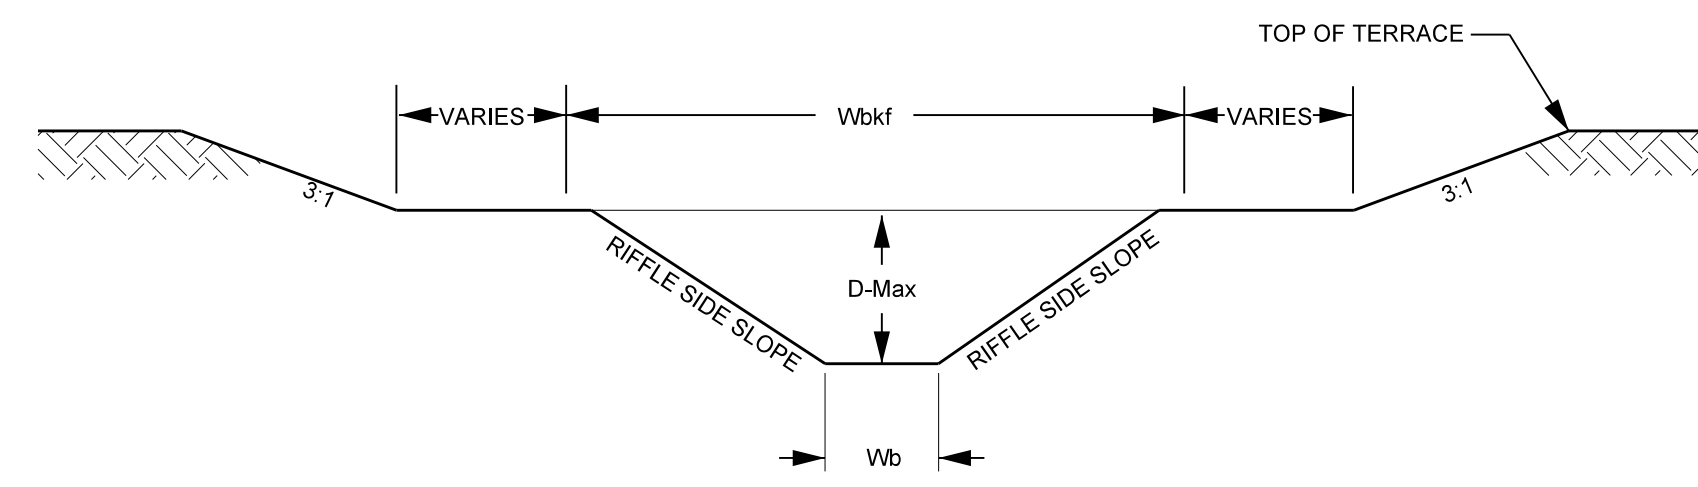

RIFFLE WITH BANKFULL BENCH

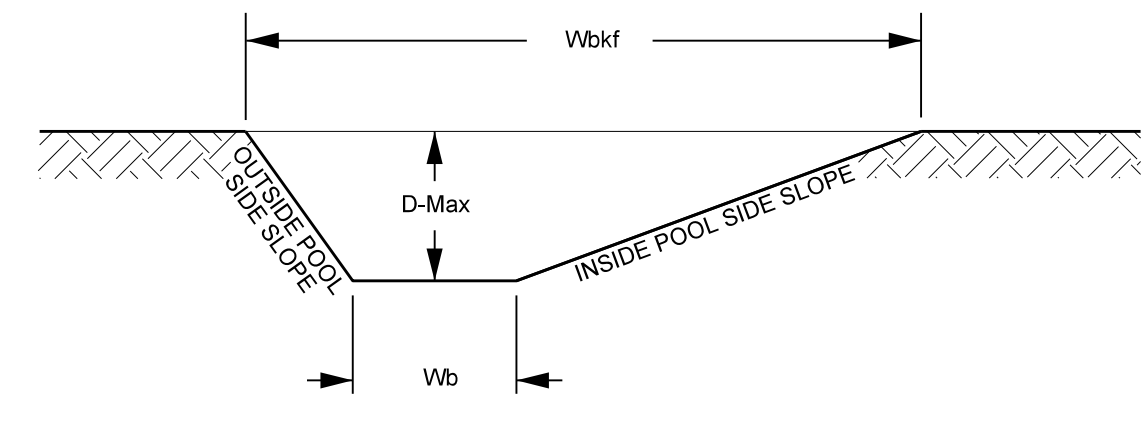

POOL

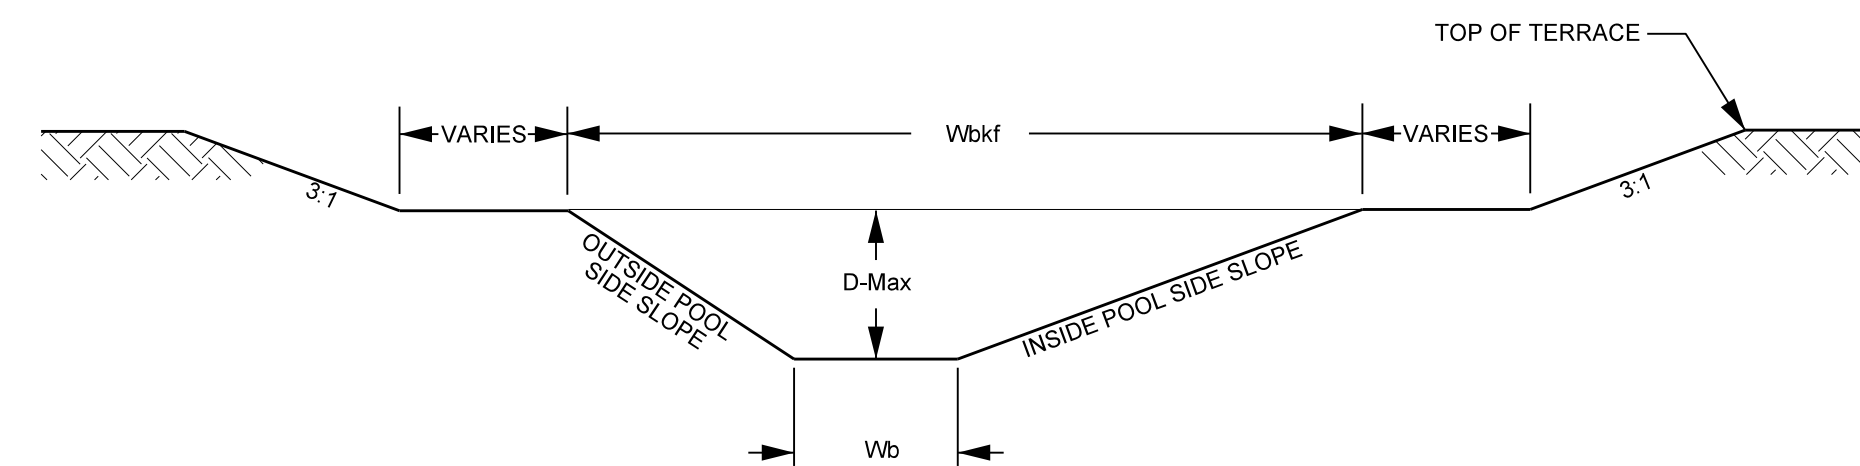

POOL WITH BANKFULL BENCH

**NOTES:**

- TERRACE SLOPES ON RESTORATION BENCHES (R1, R6, R9, R12, R14) SHALL BE 3:1. FILL OTHER TERRACE SLOPES SHALL BE 2.5:1.
- WHERE POSSIBLE, ON REACHES WITH WETLAND RESTORATION ADJACENT TO THE STREAM, THE BANKFULL ELEVATION SHALL BE CARRIED OUT TO THE PROPOSED WETLAND RESTORATION BOUNDARY. NO MORE THAN 6" OF CUT CAN BE EXCAVATED IN THE WETLAND RESTORATION AREAS IN CONJUNCTION WITH THESE EFFORTS.
- BANKFULL BENCHES SHALL BE A MINIMUM OF 6' IN WIDTH UNLESS OTHERWISE NOTED ON THE PLANS.

WIDTH OF BANKFULL (Wb<sub>kf</sub>)  
 MAXIMUM DEPTH (D<sub>max</sub>)  
 W/D (Wb<sub>kf</sub>/D<sub>max</sub>)  
 BANKFULL AREA (Ab<sub>kf</sub>)  
 BOTTOM WIDTH (W<sub>b</sub>)  
 RIFFLE SIDE SLOPE (X:1)  
 INSIDE POOL SIDE SLOPE  
 OUTSIDE POOL SIDE SLOPE

R1		R2		R3		R4		R5/R6/R7		R9		R10	
RIFFLE	POOL	RIFFLE	POOL	RIFFLE	POOL	RIFFLE	POOL	RIFFLE	POOL	RIFFLE	POOL	RIFFLE	POOL
16.9	25.0	18.0	25.0	23.7	35.0	16.9	21.0	10.2	13.0	12.7	17.0	4.9	6.0
1.6	3.5	1.7	3.5	2.5	4.0	1.6	3.0	1.1	1.8	1.2	2.5	0.5	1.0
13.0	12.3	13.0	12.3	12.0	13.3	13.0	12.3	13.0	12.4	13.5	12.2	12.3	9.0
22.0	50.8	25.0	50.8	47.0	92.0	22.0	36.0	8.0	13.9	12.0	23.8	2.0	4.0
10.5	4.0	11.2	4.0	13.7	11.0	10.2	3.0	4.9	2.2	6.5	2.0	2.8	2.0
2.0	N/A	2.0	N/A	2.0	N/A	2.0	N/A	2.5	N/A	2.5	N/A	2.0	N/A
N/A	4.0	N/A	3.0	N/A	4.0	N/A	4.0	N/A	3.0	N/A	3.0	N/A	2.0
2.0	N/A	3.0	N/A	2.0	N/A	2.0	N/A	3.0	N/A	3.0	N/A	2.0	N/A

WIDTH OF BANKFULL (Wb<sub>kf</sub>)  
 MAXIMUM DEPTH (D<sub>max</sub>)  
 W/D (Wb<sub>kf</sub>/D<sub>max</sub>)  
 BANKFULL AREA (Ab<sub>kf</sub>)  
 BOTTOM WIDTH (W<sub>b</sub>)  
 RIFFLE SIDE SLOPE (X:1)  
 INSIDE POOL SIDE SLOPE  
 OUTSIDE POOL SIDE SLOPE

R11		R12		R14 (Upper)		R14 (Lower)		R19		R20		R25	
RIFFLE	POOL	RIFFLE	POOL	RIFFLE	POOL	RIFFLE	POOL	RIFFLE	POOL	RIFFLE	POOL	RIFFLE	POOL
3.9	4.0	8.8	11.5	5.1	5.5	5.0	7.0	5.1	6.5	4.2	5.0	5.1	7.0
0.4	0.6	0.8	1.5	0.5	0.7	0.5	1.0	0.5	1.0	0.4	1.0	0.5	1.2
13.0	9.5	13.0	10.4	13.0	12.7	12.5	12.3	13.0	9.4	12.0	8.3	13.0	8.9
1.2	1.7	6.0	12.8	2.0	2.4	2.0	4.0	2.0	4.5	1.5	3.0	2.0	5.5
2.4	1.6	5.5	5.5	2.4	1.3	3.0	1.0	3.2	2.5	2.4	1.0	3.2	2.2
2.0	N/A	2.0	N/A	2.5	N/A	2.0	N/A	2.0	N/A	2.0	N/A	2.0	N/A
N/A	2.0	N/A	2.0	N/A	3.0	N/A	4.0	N/A	2.0	N/A	2.0	N/A	2.0
2.0	N/A	2.0	N/A	3.0	N/A	2.0	N/A	2.0	N/A	2.0	N/A	2.0	N/A


### TYPICAL STRUCTURE PLACEMENT

**STRUCTURE NOTES:**





- GENERALLY LOG AND ROCK J-HOOK VANES. ROOT WADS, LOG VANES AND COIR FIBER MATTING WILL BE INSTALLED IN THE LOCATION AND SEQUENCE AS SHOWN.
- ADDITIONAL STRUCTURES OR CHANGES TO STRUCTURE LOCATIONS MAY BE MADE BY THE DESIGN ENGINEER DURING CONSTRUCTION.

**NOTES:**

- COIR FIBER MATTING TO BE INSTALLED ON ALL RESTORED STREAMBANKS.
- IF ROOT WADS DO NOT COVER ENTIRE SLOPE ON OUTSIDE OF MEANDER BENDS, COIR FIBER MATTING IS NEEDED.

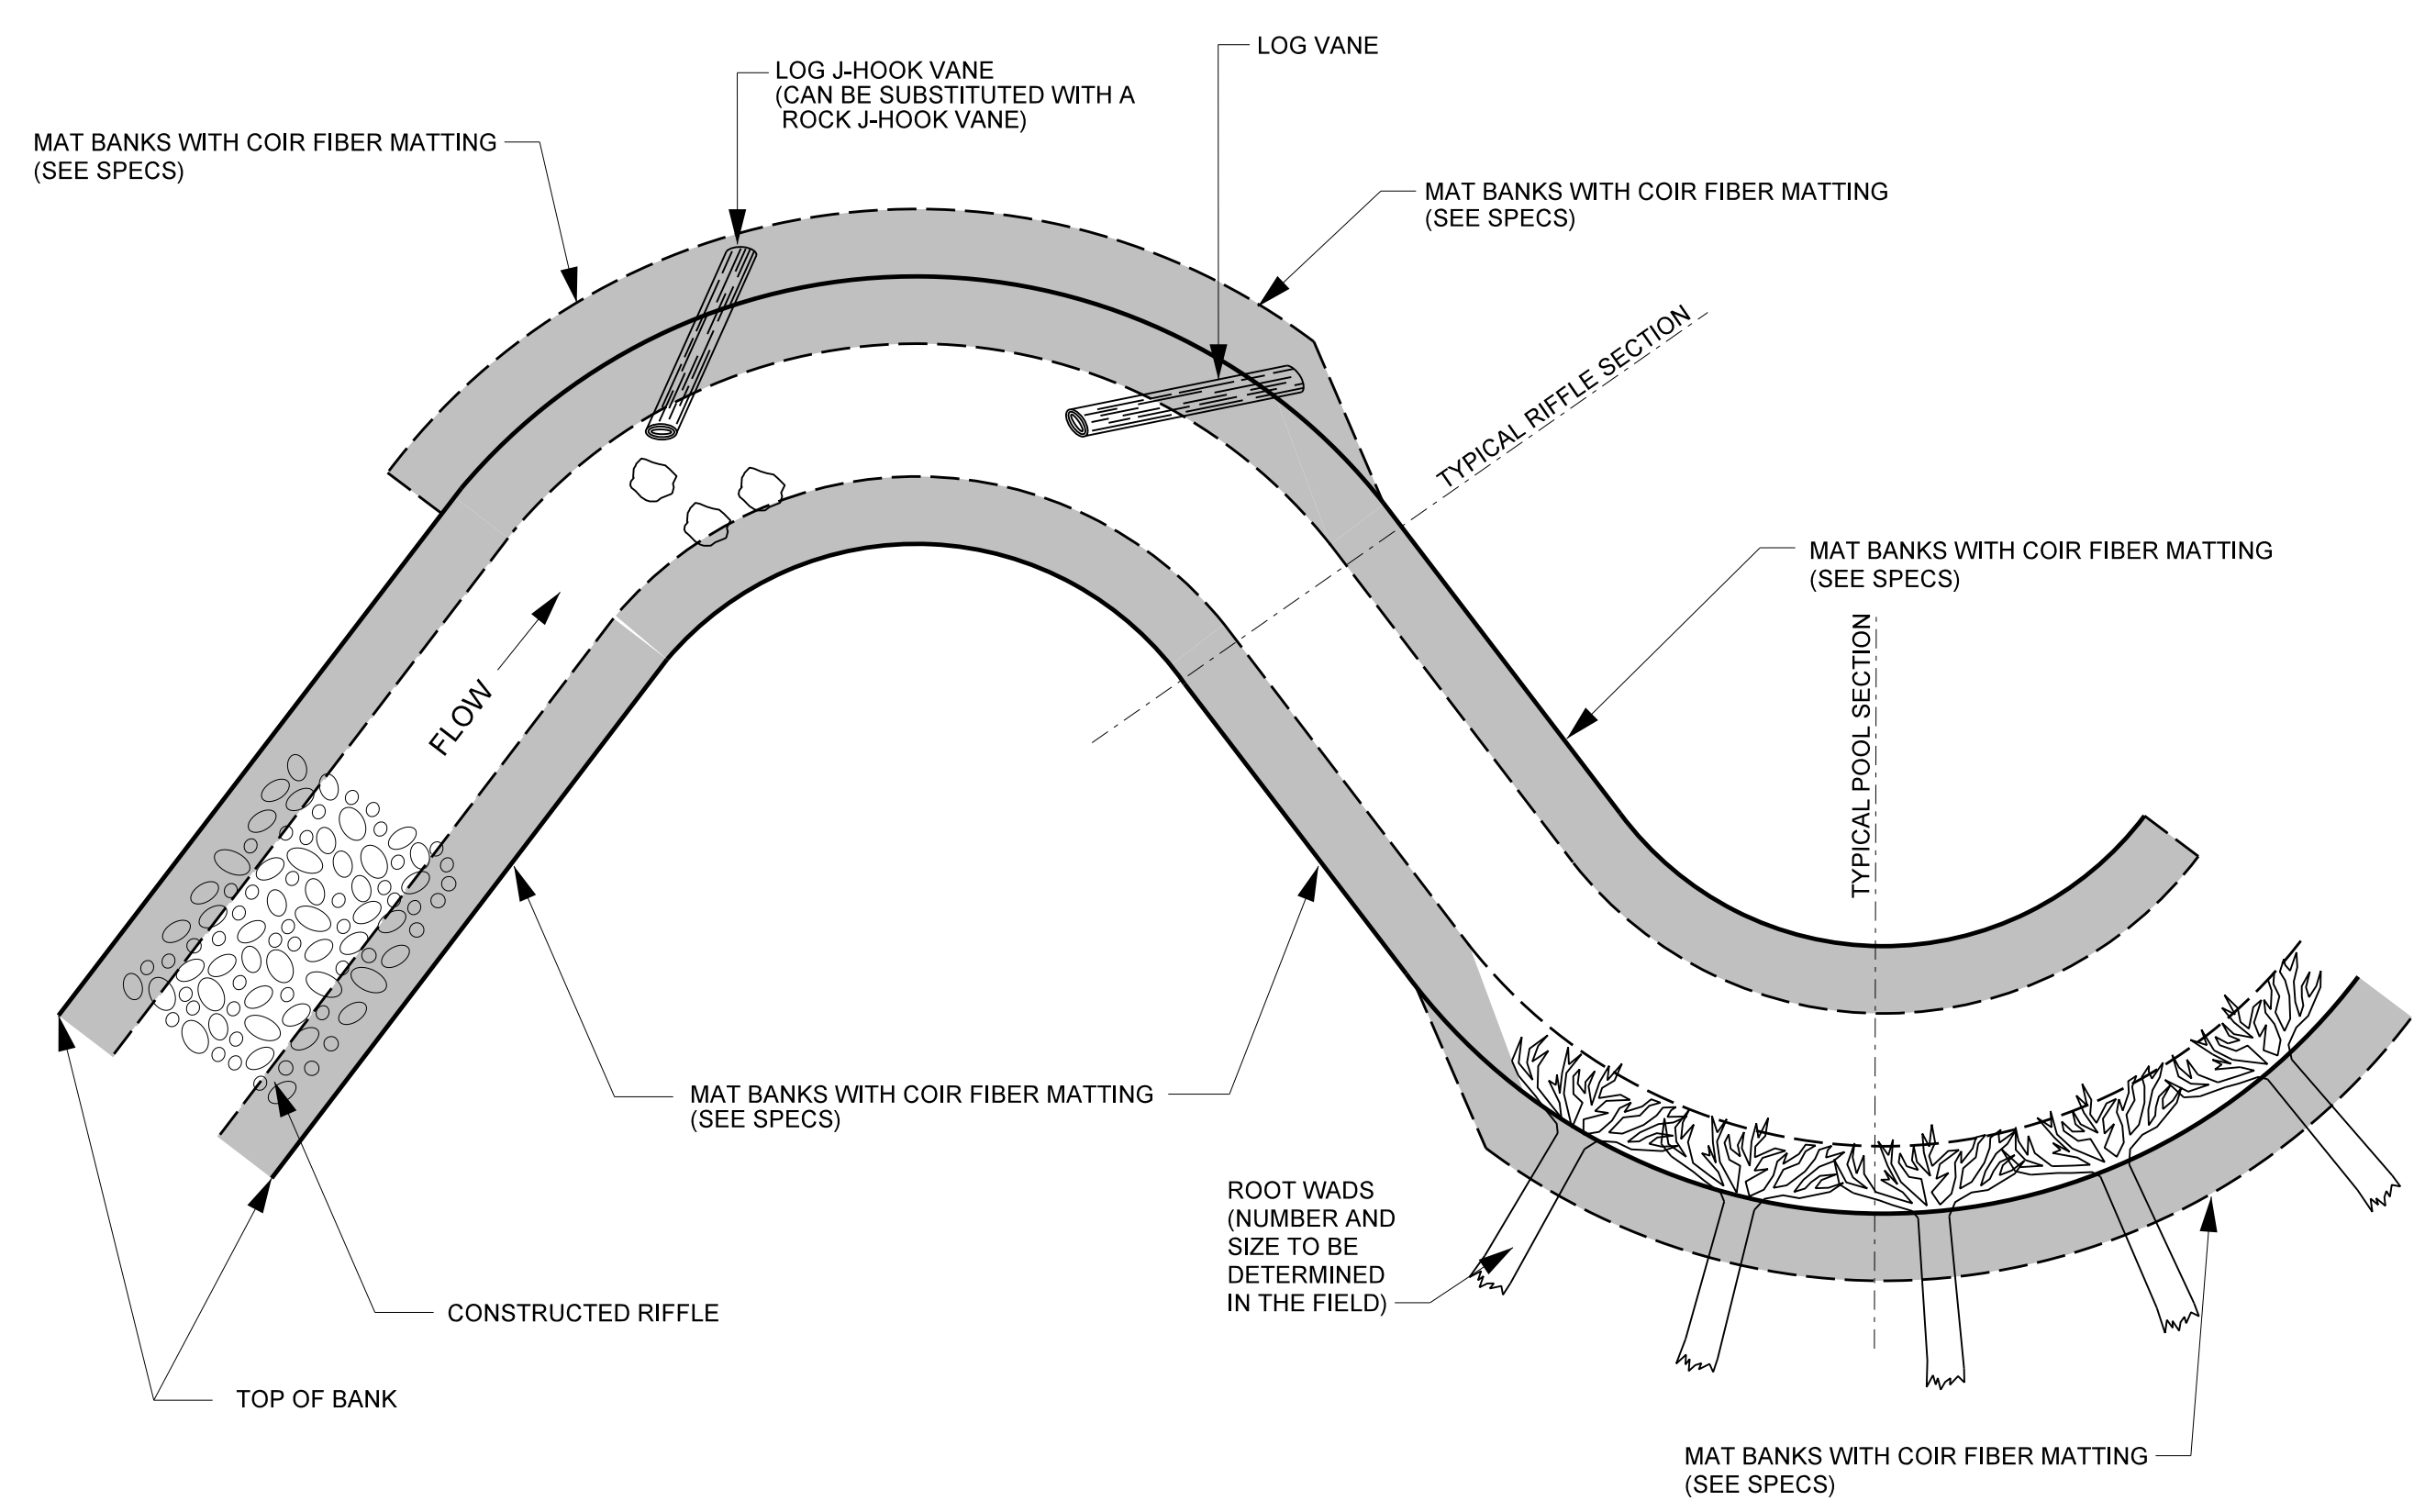

### ROCK CROSS VANE

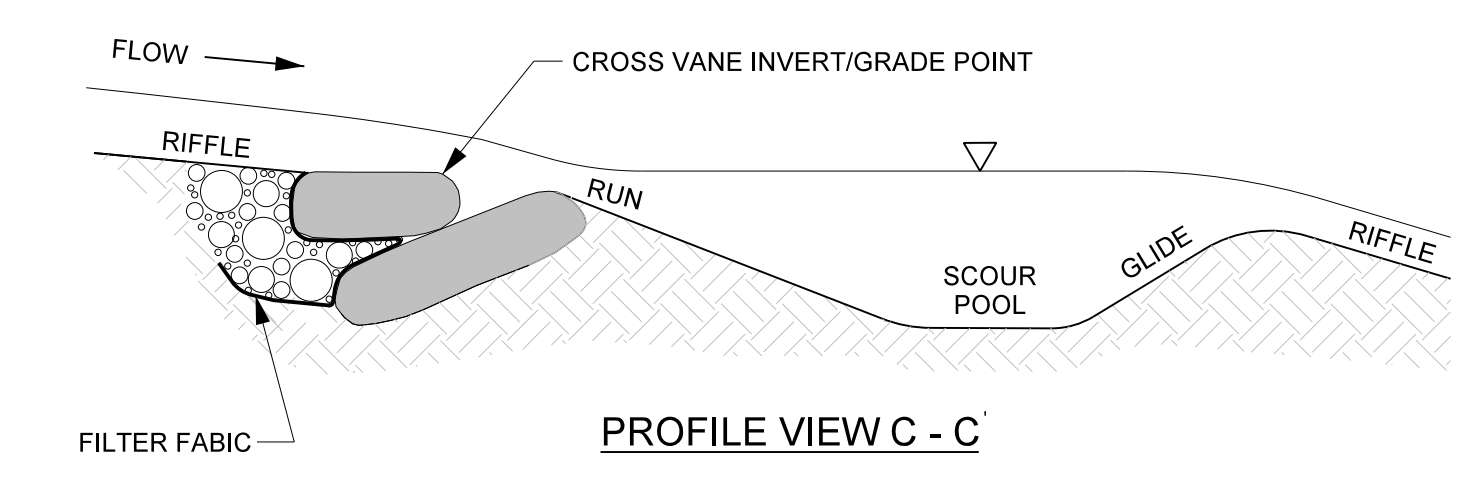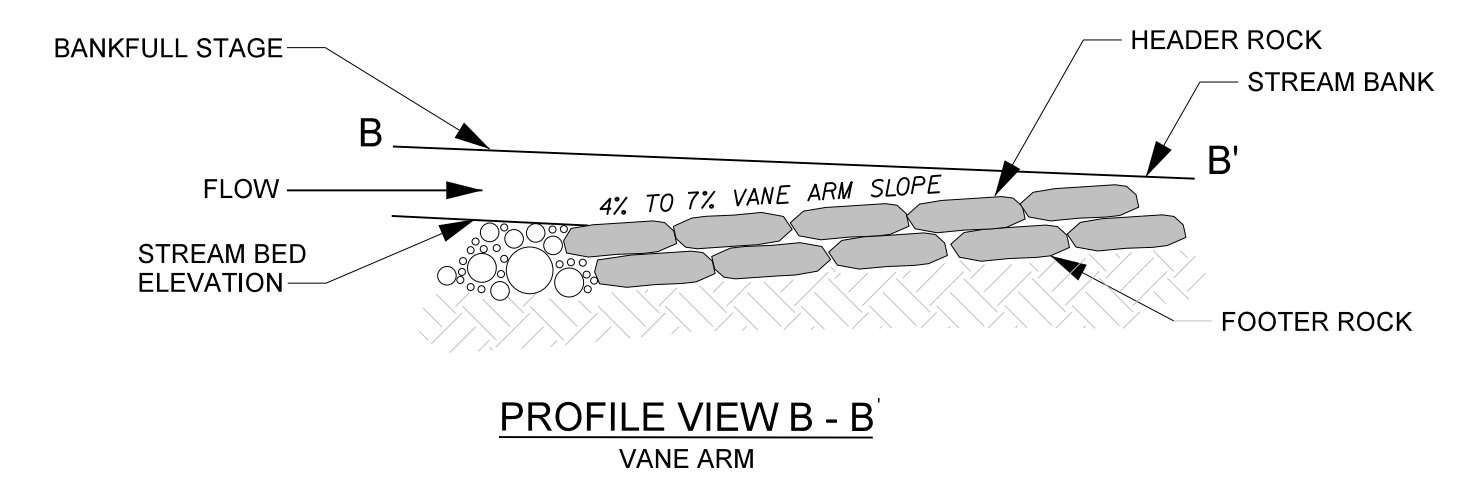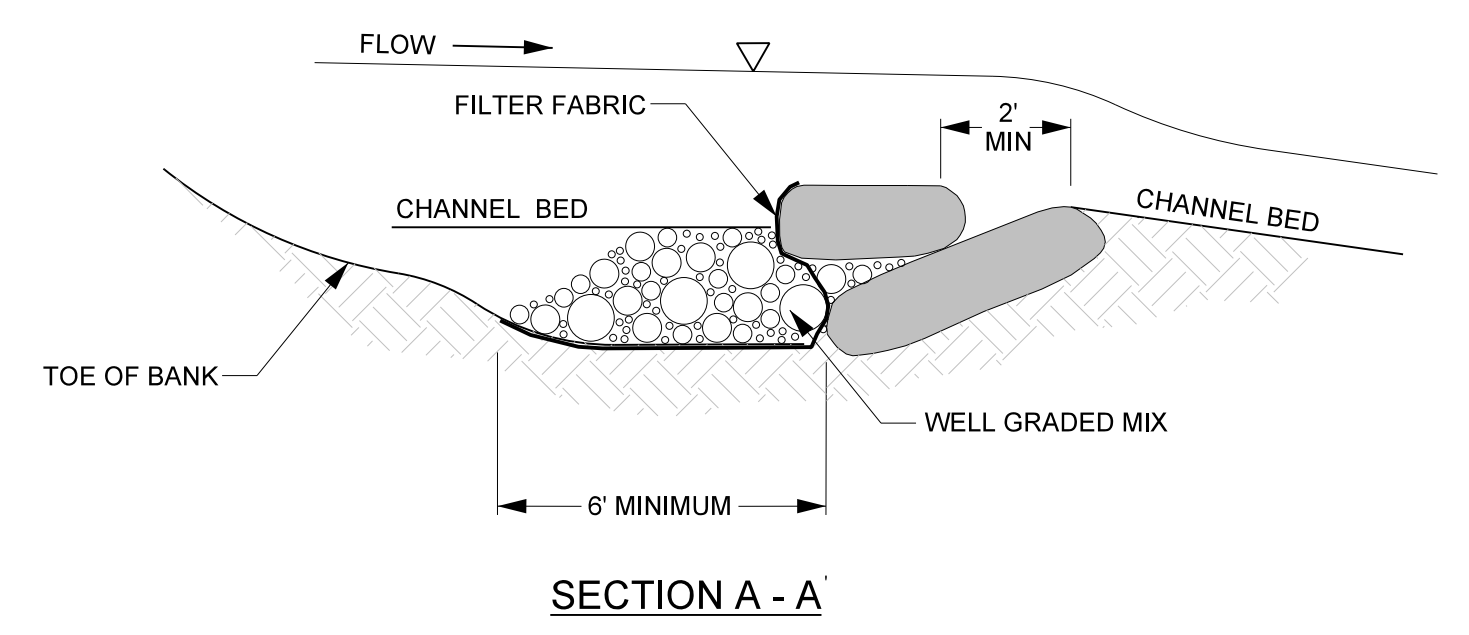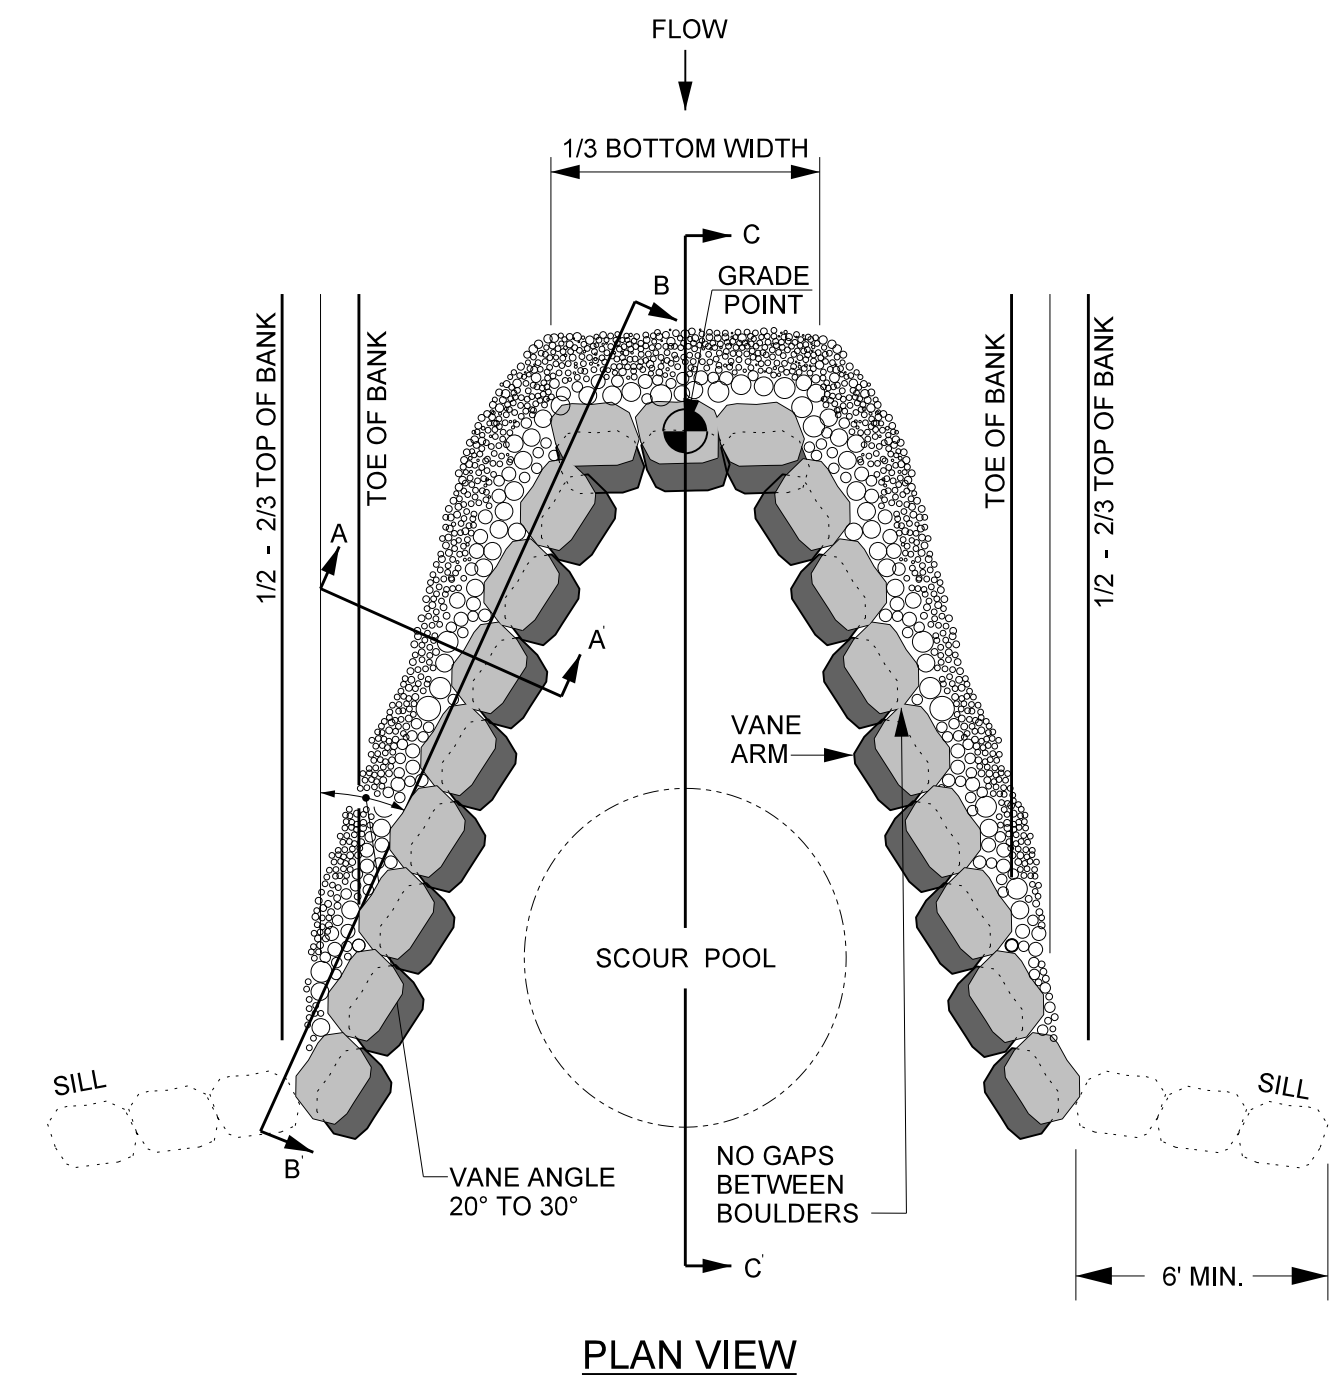


**NOTES FOR ALL VANE STRUCTURES:**

- INSTALL FILTER FABRIC FOR DRAINAGE BEGINNING AT THE MIDDLE OF THE HEADER ROCKS AND EXTEND DOWNWARD TO THE DEPTH OF THE BOTTOM FOOTER ROCK, AND THEN UPSTREAM TO A MINIMUM OF SIX FEET.
- DIG A TRENCH BELOW THE BED FOR FOOTER ROCKS AND PLACE FILL ON UPSTREAM SIDE OF VANE ARM, BETWEEN THE ARM AND STREAMBANK.
- CONSTRUCT ANGLE AND SLOPE SPECIFICATIONS AS SHOWN.
- BACKFILL VANE ARMS AND INVERT WITH A WELL GRADED MIX OF CLASS B, A, AND #57 STONE.
- ON-SITE ALLUVIUM SHALL BE INCORPORATED INTO THE STONE BACKFILL WHERE AVAILABLE.
- BOULDER SILL MUST BE A MINIMUM OF 6'.




2/26/20


### ROCK STEP-POOL CHANNEL

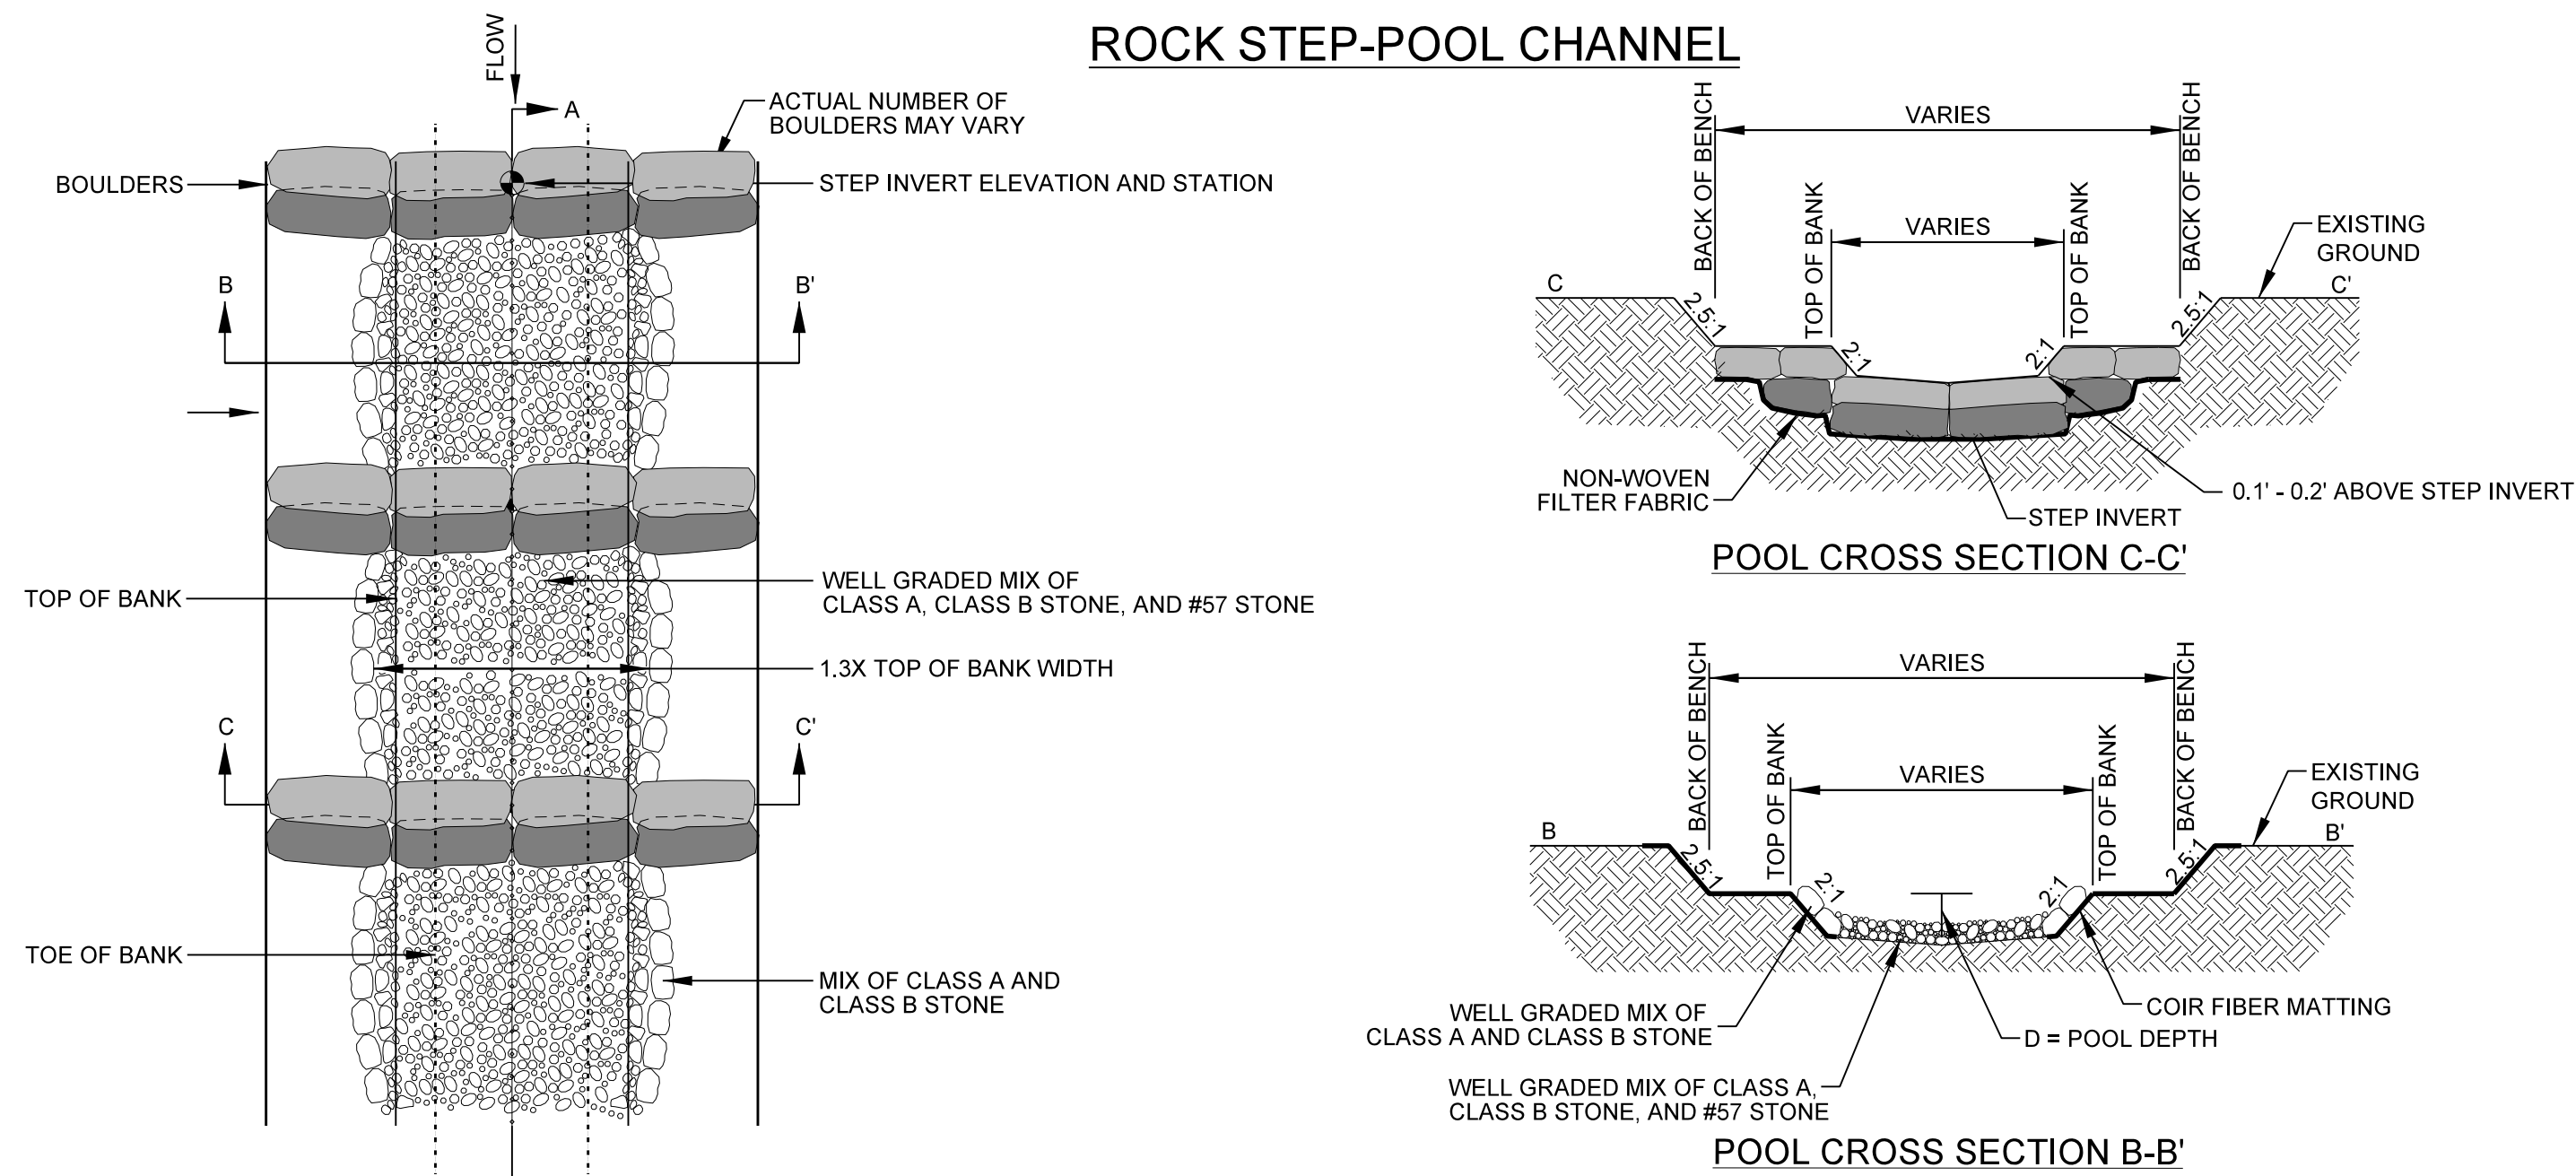

- NOTES:**
1. HEADER BOULDERS MUST BE 2' X 2' X 1' AND FOOTERS SHALL NOT EXCEED 3' X 2' X 1'.
  2. FOOTERS SHALL BE INSTALLED SUCH THAT 1/4 TO 1/3 OF THE LENGTH IS DOWNSTREAM OF THE HEADER.
  3. SOIL SHALL BE WELL COMPACTED AROUND BURIED PORTION OF FOOTERS WITH THE BUCKET OF EXCAVATOR.
  4. INSTALL NON-WOVEN FILTER FABRIC BELOW FOOTER BOULDERS.
  5. UNDERCUT POOL BED ELEVATION 8 INCHES TO ALLOW FOR LAYER OF STONE.
  6. INSTALL EROSION CONTROL MATTING ALONG COMPLETED BANKS SUCH THAT THE EROSION CONTROL MATTING AT THE TOE OF THE BANK EXTENDS DOWN TO THE UNDERCUT ELEVATION.
  7. INSTALL WELL GRADED MIX OF CLASS A AND CLASS B STONE ALONG SIDE SLOPES.
  8. FINAL CHANNEL BED SHAPE SHOULD BE ROUNDED, COMPACTED, AND CONCAVE, WITH THE ELEVATION OF THE BED APPROXIMATELY 0.5 FT DEEPER IN THE CENTER THAN AT THE EDGES.
  9. STEP HEIGHT (H) SHALL NOT EXCEED 1.0 FT.
  10. MINIMUM POOL DEPTH (D) SHALL BE NO LESS THAN 1.3 FT.
  11. AT LEAST 6" OF THE UPSTREAM FOOTER MUST BE BURIED BELOW THE DOWNSTREAM HEADER INVERT ELEVATIONS.
  12. ALL STRUCTURES MUST BE FOOTERED.

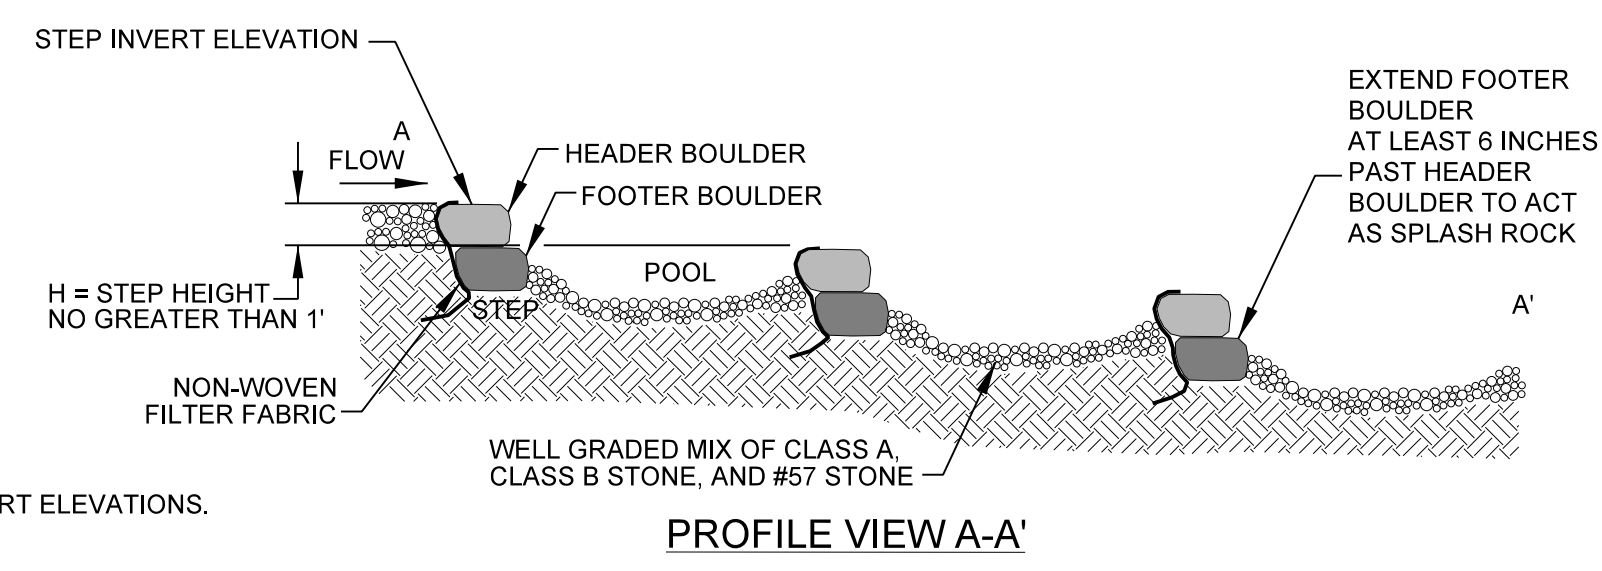


### ROCK VANE

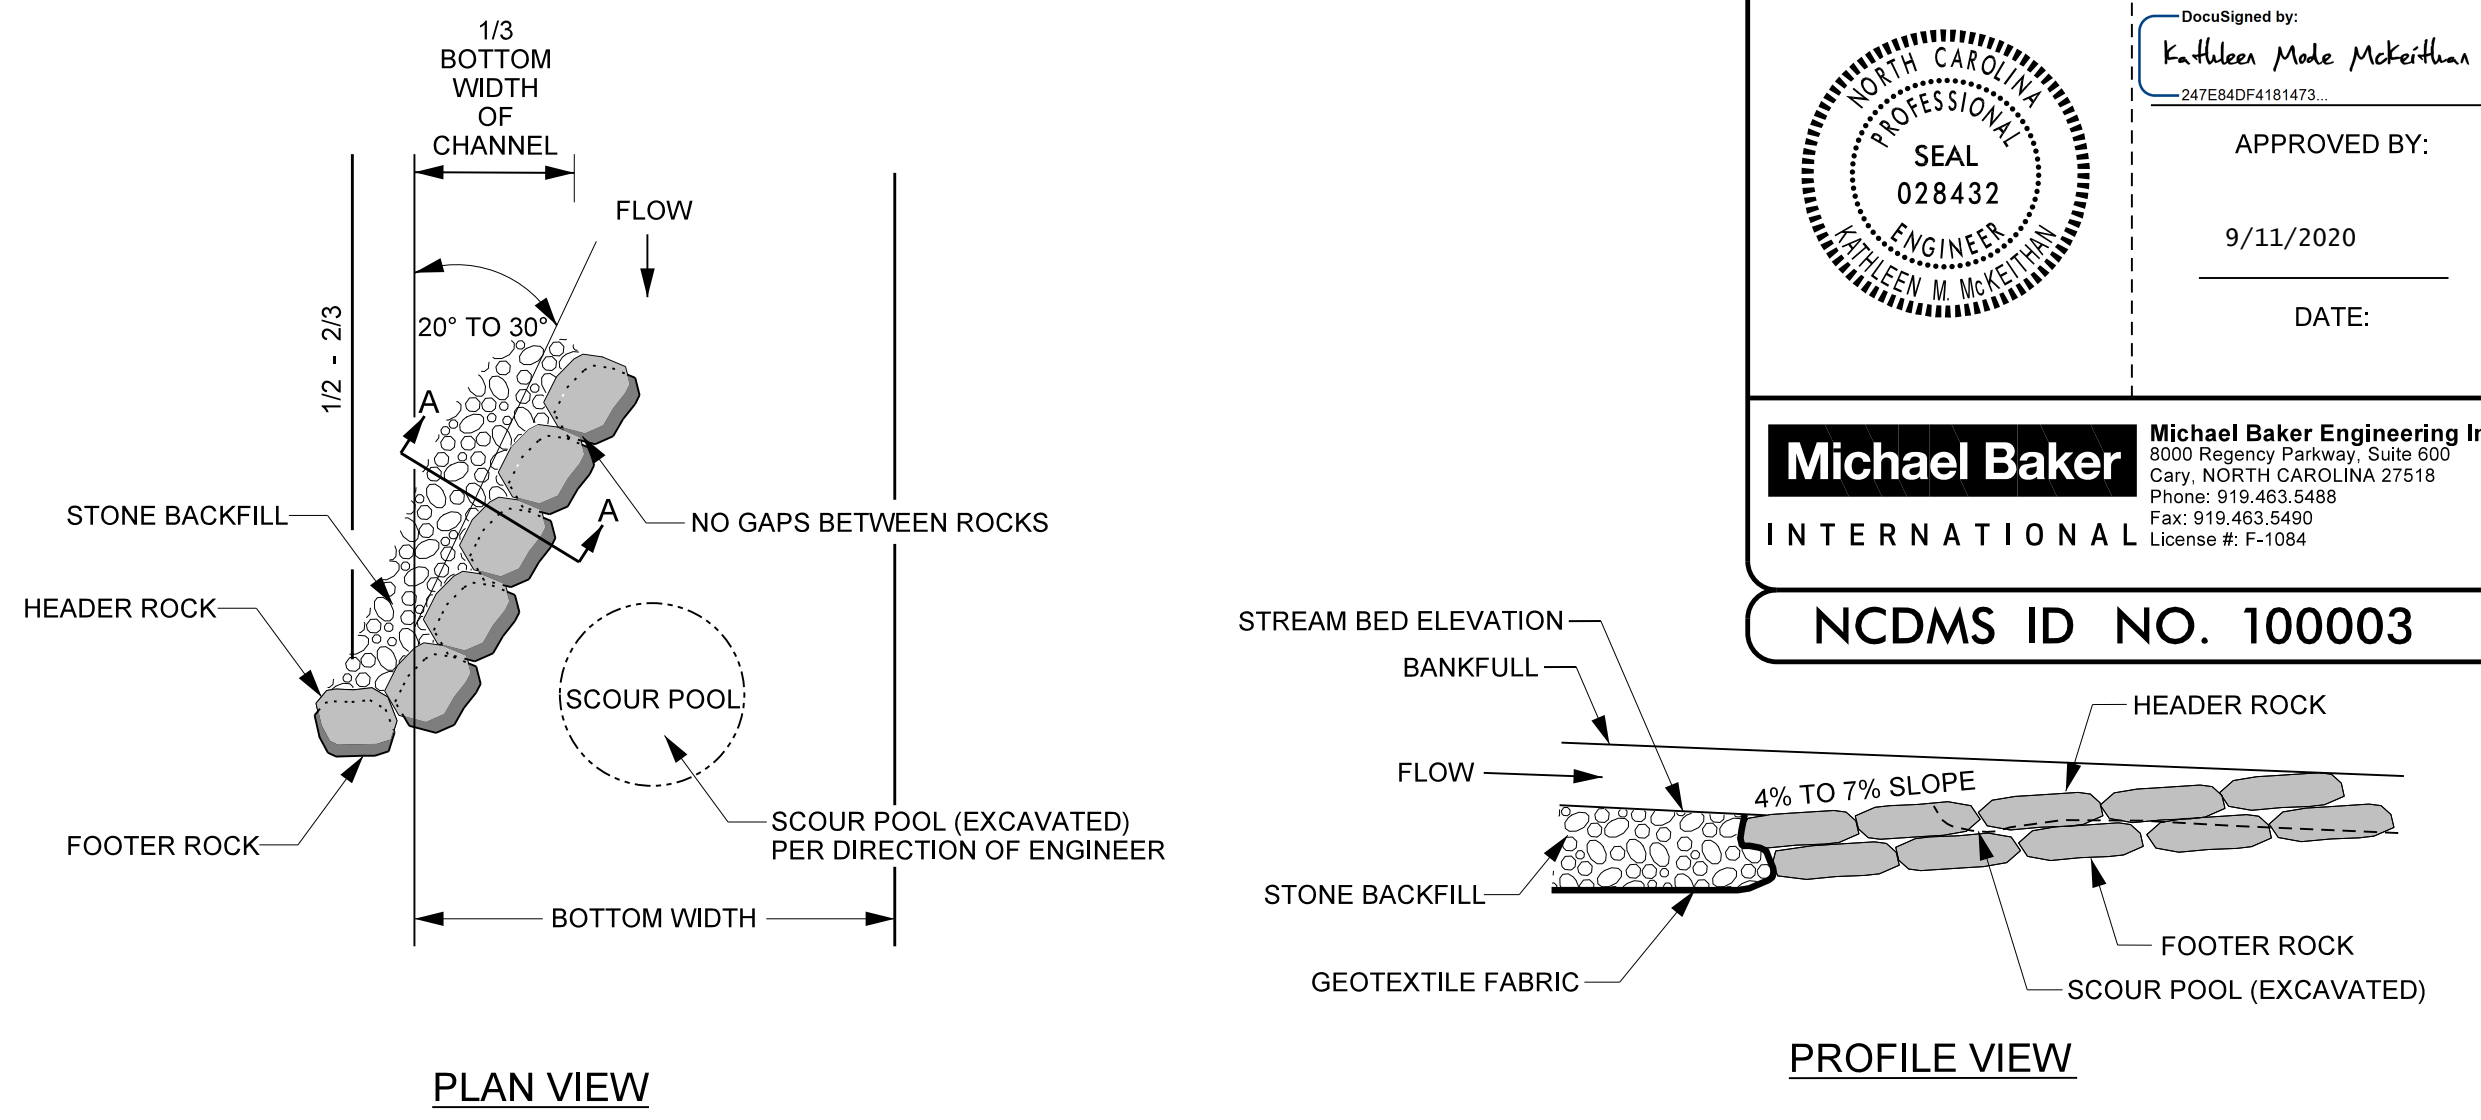

- NOTES FOR ALL VANE STRUCTURES:**
1. INSTALL GEOTEXTILE FABRIC BEGINNING AT THE TOP OF THE HEADER ROCKS AND EXTEND DOWNWARD TO THE DEPTH OF THE BOTTOM FOOTER ROCK, AND THEN UPSTREAM TO A MINIMUM OF TEN FEET.
  2. DIG A TRENCH BELOW THE BED FOR FOOTER ROCKS AND PLACE FILL ON UPSTREAM SIDE OF VANE ARM, BETWEEN THE ARM AND STREAMBANK.
  3. START AT BANK AND PLACE FOOTER ROCKS FIRST AND THEN HEADER (TOP) ROCK.
  4. CONTINUE WITH STRUCTURE, FOLLOWING ANGLE AND SLOPE SPECIFICATIONS.
  5. AN EXTRA ROCK CAN BE PLACED IN SCOUR POOL FOR HABITAT IMPROVEMENT.
  6. USE HAND PLACED STONE TO FILL GAPS ON UPSTREAM SIDE OF HEADER AND FOOTER ROCKS.
  7. AFTER ALL STONE BACKFILL HAS BEEN PLACED, FILL IN THE UPSTREAM SIDE OF THE STRUCTURE WITH WELL GRADED MIX OF CLASS B, CLASS A, & #57 STONE TO THE ELEVATION OF THE TOP OF THE HEADER ROCK. INCORPORATE ON-SITE ALLUVIUM WHERE AVAILABLE.
  8. START SLOPE AT 2/3 TO 3/4 TIMES THE BANKFULL STAGE.


PROJECT REFERENCE NO. <b>157329</b>	SHEET NO. <b>2A</b>
PROJECT ENGINEER <i>Kathleen M. Mckeithan</i>	
APPROVED BY:  9/11/2020	
DATE:	
<b>Michael Baker International</b>	
Michael Baker Engineering Inc. 8000 Regency Parkway, Suite 600 Cary, NORTH CAROLINA 27518 Phone: 919.463.5486 Fax: 919.463.5490 License #: F-1084	
<b>NC DMS ID NO. 100003</b>	

### GRADE CONTROL J-HOOK VANE

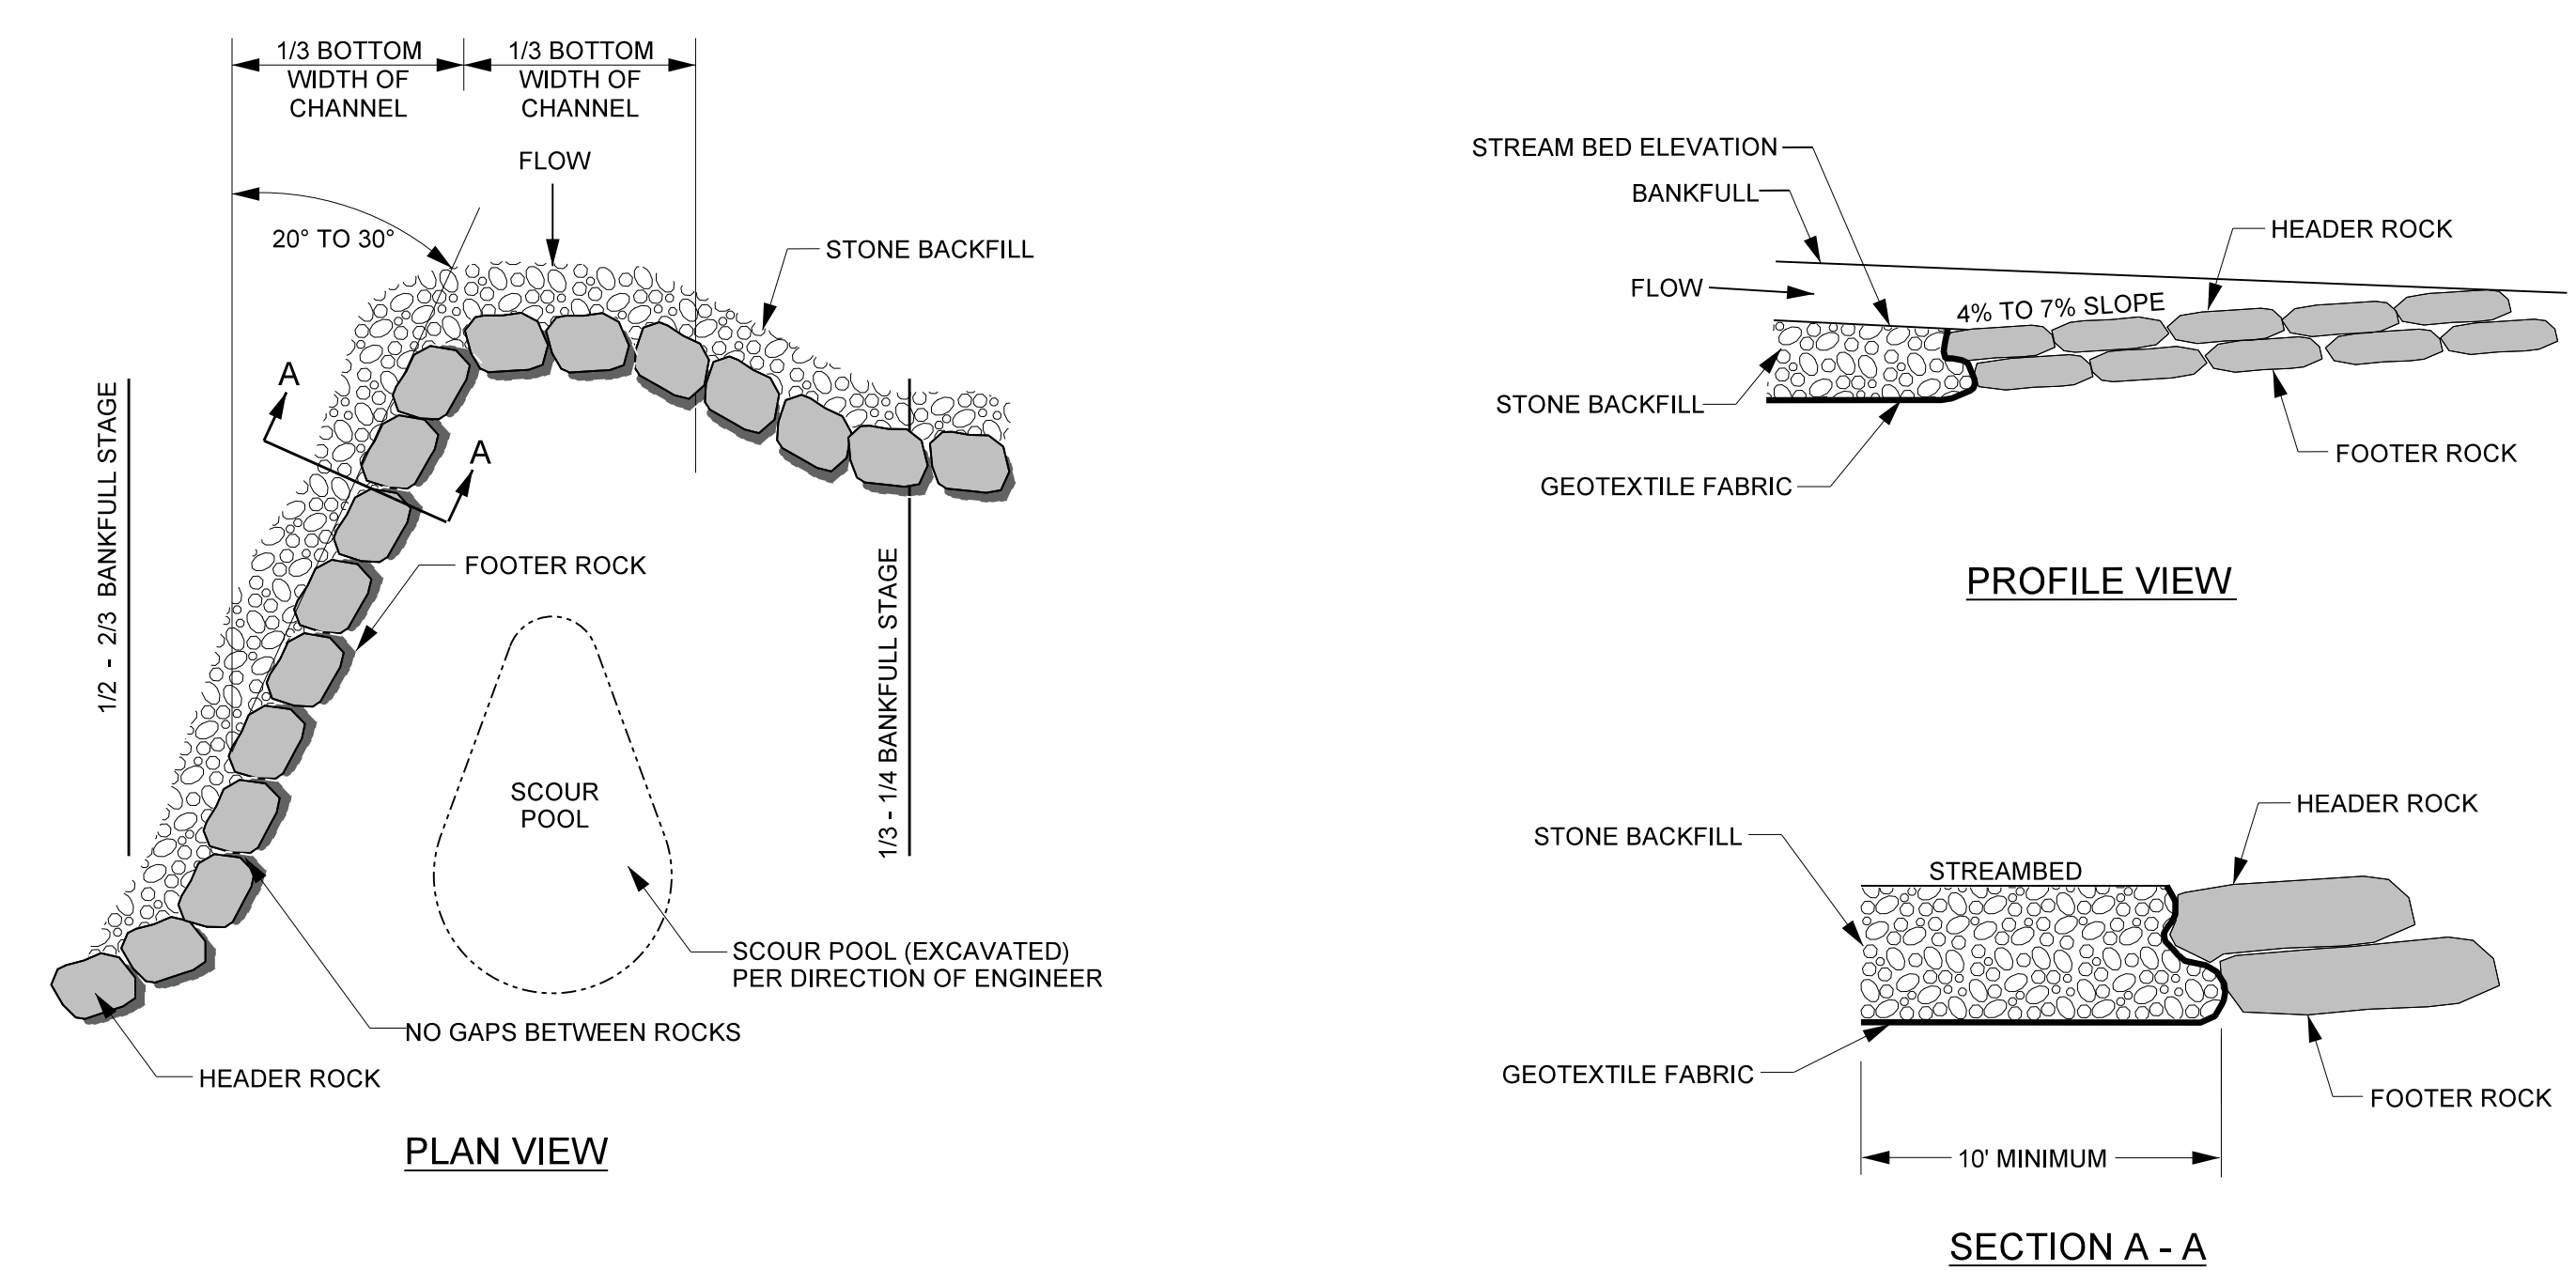

- NOTES FOR ALL VANE STRUCTURES:**
1. INSTALL FILTER FABRIC FOR DRAINAGE BEGINNING AT THE MIDDLE OF THE HEADER ROCKS AND EXTEND DOWNWARD TO THE DEPTH OF THE BOTTOM FOOTER ROCK, AND THEN UPSTREAM TO A MINIMUM OF SIX FEET.
  2. DIG A TRENCH BELOW THE BED FOR FOOTER ROCKS AND PLACE FILL ON UPSTREAM SIDE OF VANE ARM, BETWEEN THE ARM AND STREAMBANK.
  3. CONSTRUCT ANGLE AND SLOPE SPECIFICATIONS AS SHOWN.
  4. BACKFILL VANE ARMS AND INVERT WITH A WELL GRADED MIX OF CLASS B, A, AND #57 STONE.
  5. ON-SITE ALLUVIUM SHALL BE INCORPORATED INTO THE STONE BACKFILL WHERE AVAILABLE.
  6. BOULDER SILL MUST BE A MINIMUM OF 6'.

### CONSTRUCTED RIFFLE

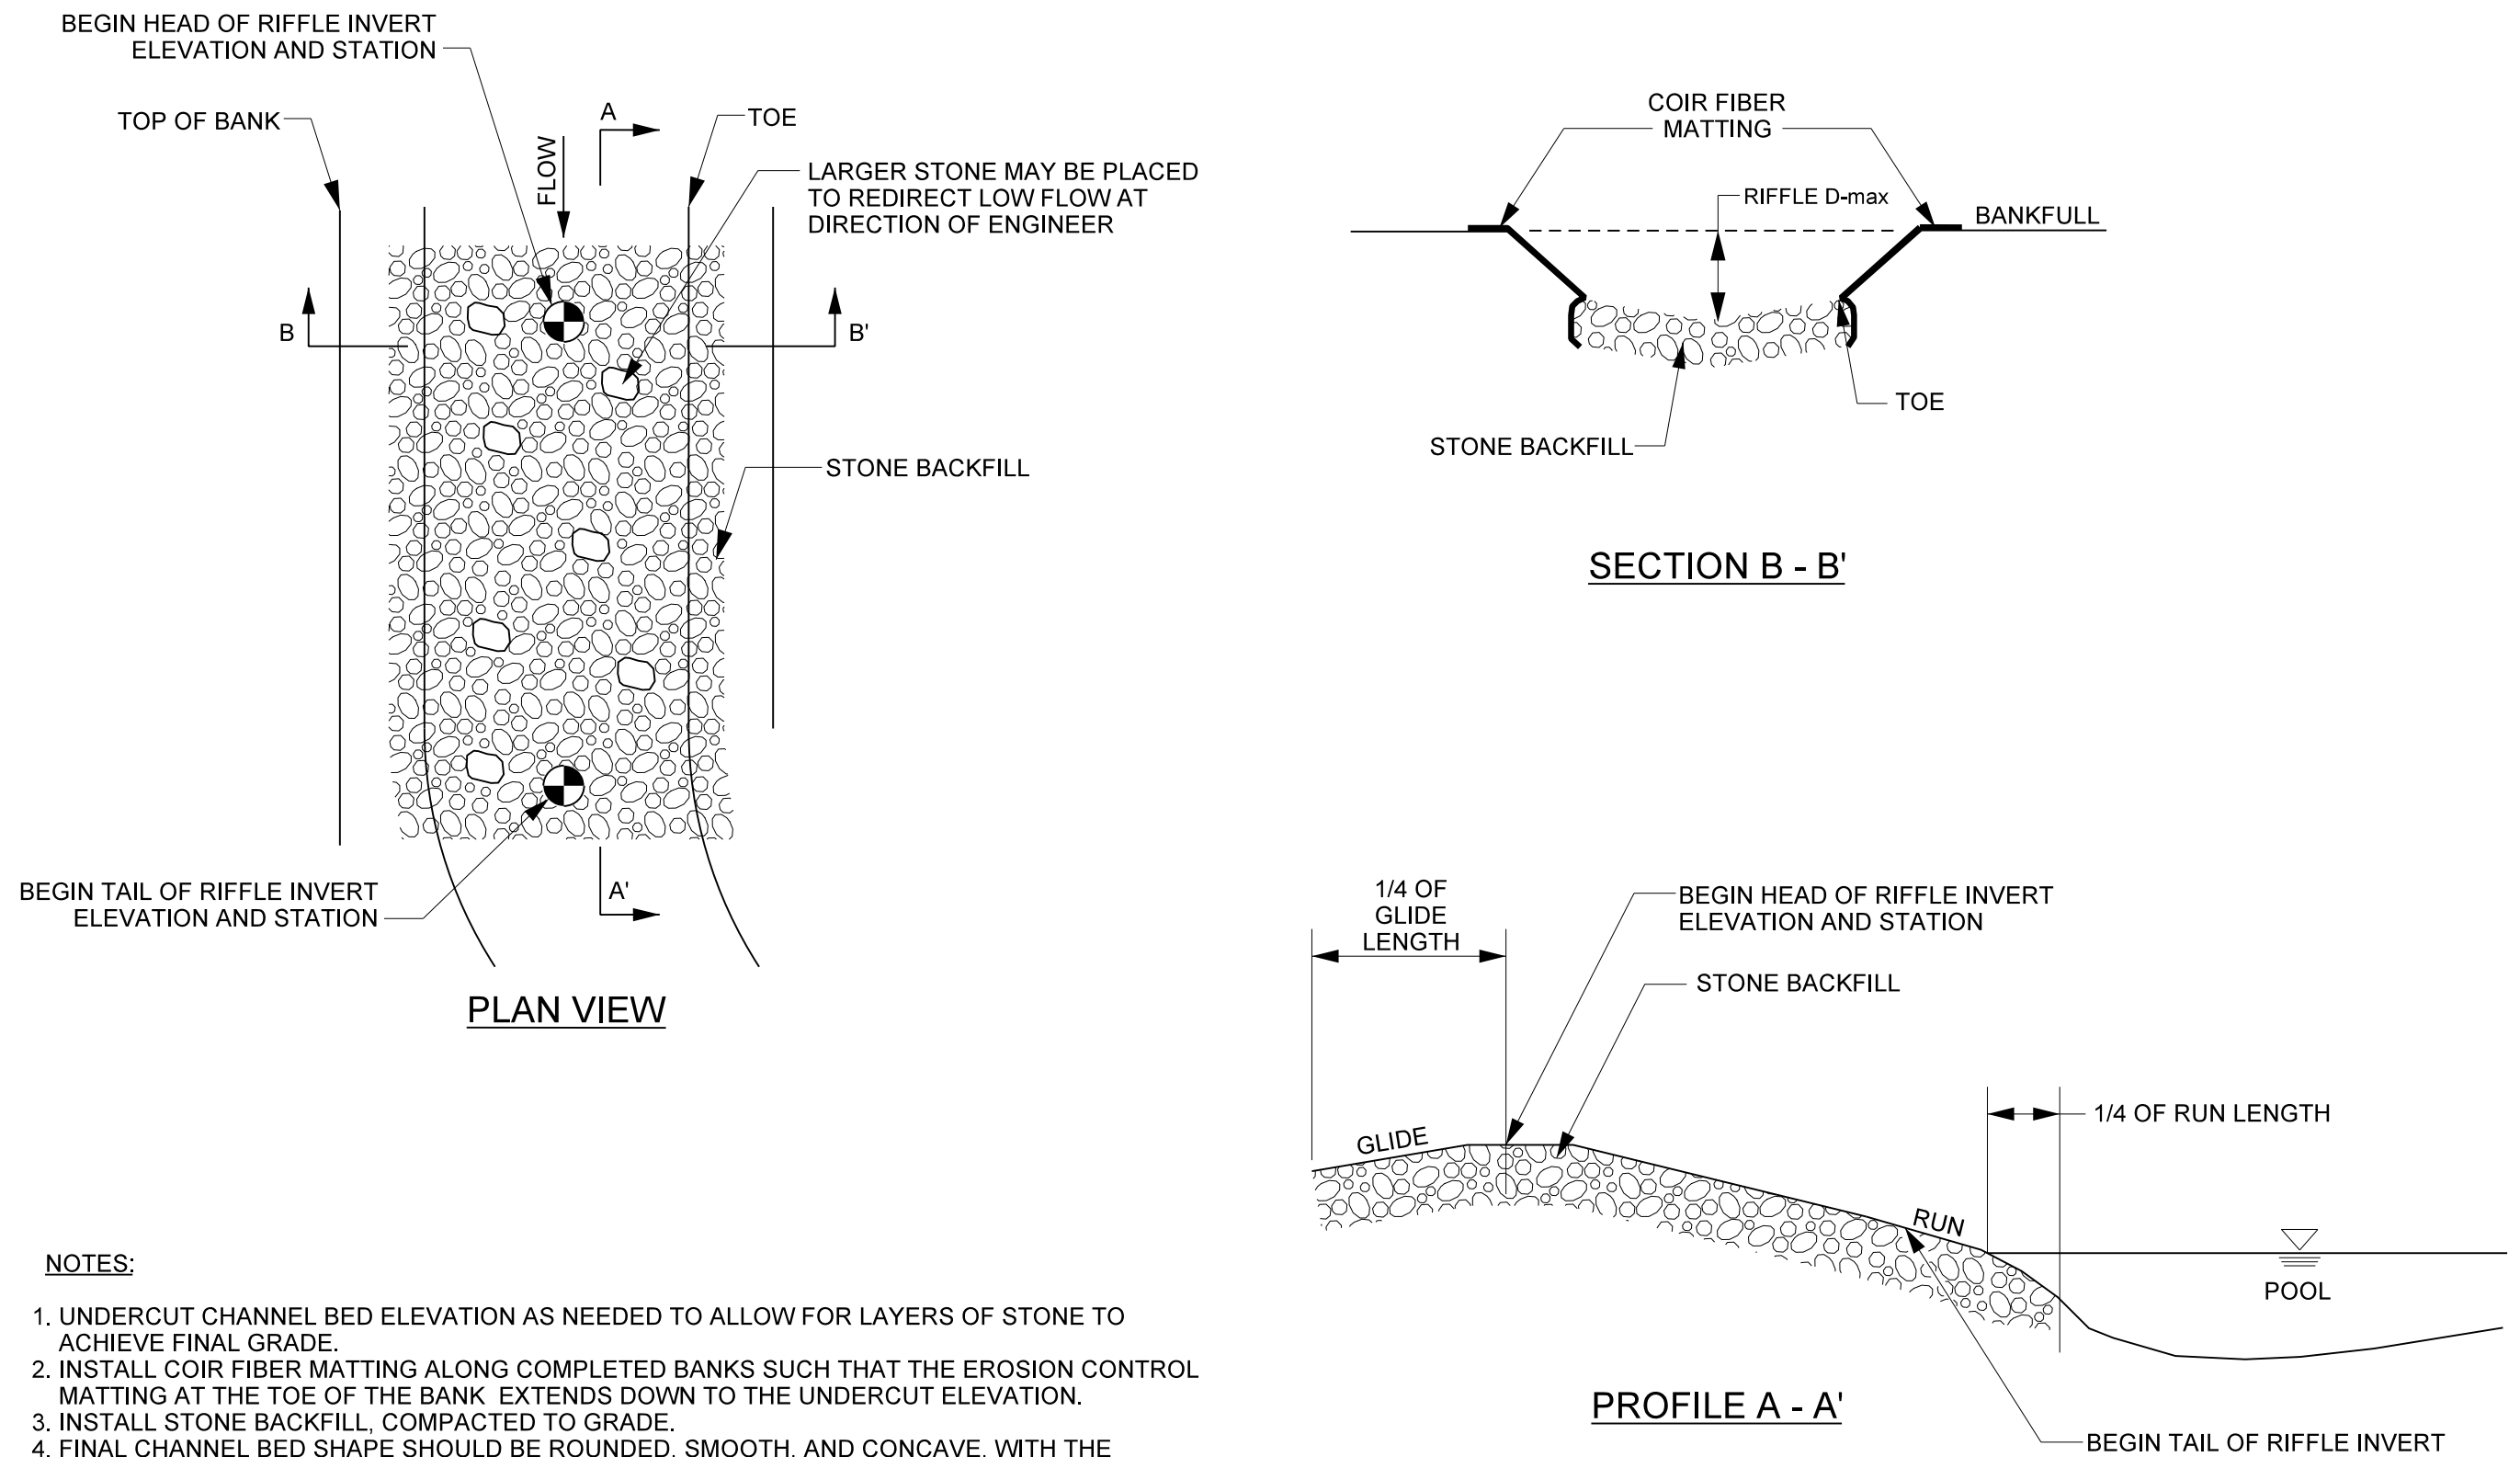


- NOTES:**
1. UNDERCUT CHANNEL BED ELEVATION AS NEEDED TO ALLOW FOR LAYERS OF STONE TO ACHIEVE FINAL GRADE.
  2. INSTALL COIR FIBER MATTING ALONG COMPLETED BANKS SUCH THAT THE EROSION CONTROL MATTING AT THE TOE OF THE BANK EXTENDS DOWN TO THE UNDERCUT ELEVATION.
  3. INSTALL STONE BACKFILL, COMPACTED TO GRADE.
  4. FINAL CHANNEL BED SHAPE SHOULD BE ROUNDED, SMOOTH, AND CONCAVE, WITH THE ELEVATION OF THE BED 0.2 FT DEEPER IN THE CENTER THAN AT THE EDGES.
  5. STONE BACKFILL SHALL CONSIST OF 10% CLASS I, 20% CLASS B, 40% CLASS A, AND 30% ON-SITE ALLUVIUM BY VOLUME. IF ALLUVIUM IS UNAVAILABLE, BACKFILL SHALL BE A WELL GRADED MIX OF 10% CLASS I, 20% CLASS B, 40% CLASS A, AND 30% #57 STONE.
  6. CONSTRUCTED RIFFLES SHALL BE 18" THICK ON REACHES R1, R4, & R9. ALL OTHER CONSTRUCTED RIFFLES SHALL BE 12" THICK.

R:\157329\157329.dgn




2/26/20

### LOG AND ROCK STEP / POOL

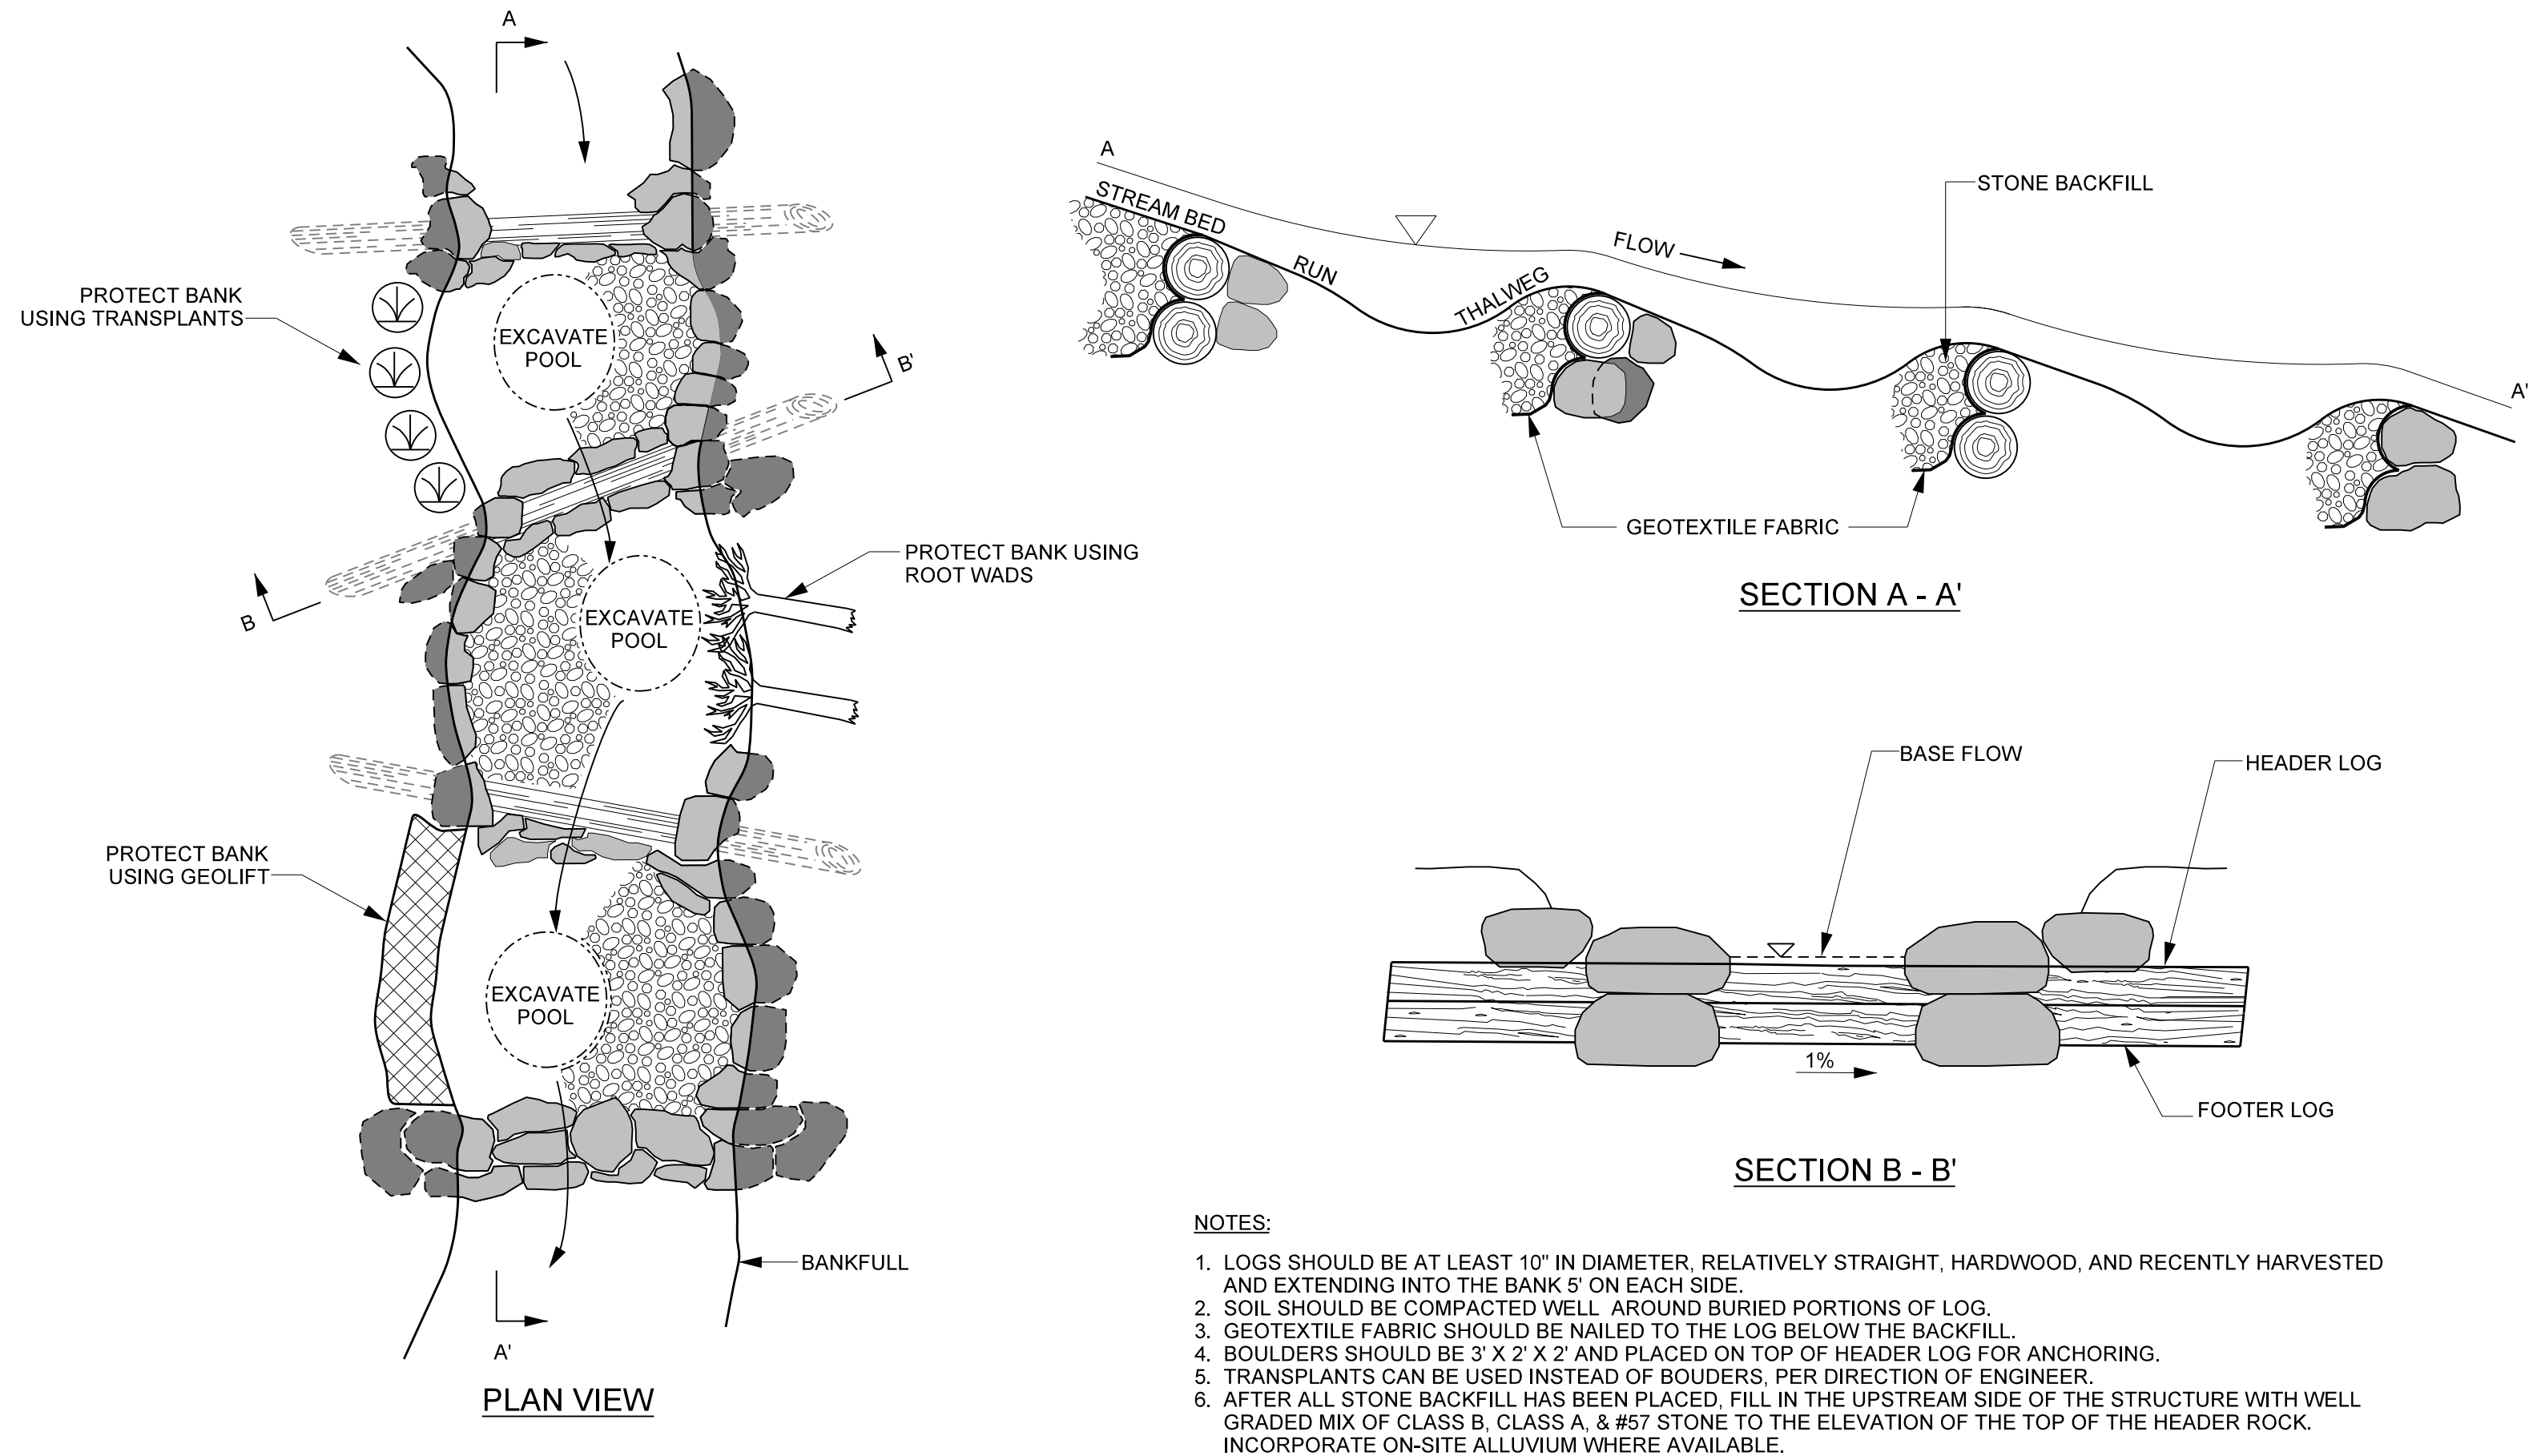

- NOTES:**
- LOGS SHOULD BE AT LEAST 10" IN DIAMETER, RELATIVELY STRAIGHT, HARDWOOD, AND RECENTLY HARVESTED AND EXTENDING INTO THE BANK 5' ON EACH SIDE.
  - SOIL SHOULD BE COMPACTED WELL AROUND BURIED PORTIONS OF LOG.
  - GEOTEXTILE FABRIC SHOULD BE NAILED TO THE LOG BELOW THE BACKFILL.
  - BOULDERS SHOULD BE 3' X 2' X 2' AND PLACED ON TOP OF HEADER LOG FOR ANCHORING.
  - TRANSPLANTS CAN BE USED INSTEAD OF BOULDERS, PER DIRECTION OF ENGINEER.
  - AFTER ALL STONE BACKFILL HAS BEEN PLACED, FILL IN THE UPSTREAM SIDE OF THE STRUCTURE WITH WELL GRADED MIX OF CLASS B, CLASS A, & #57 STONE TO THE ELEVATION OF THE TOP OF THE HEADER ROCK. INCORPORATE ON-SITE ALLUVIUM WHERE AVAILABLE.


### BOULDER STEP

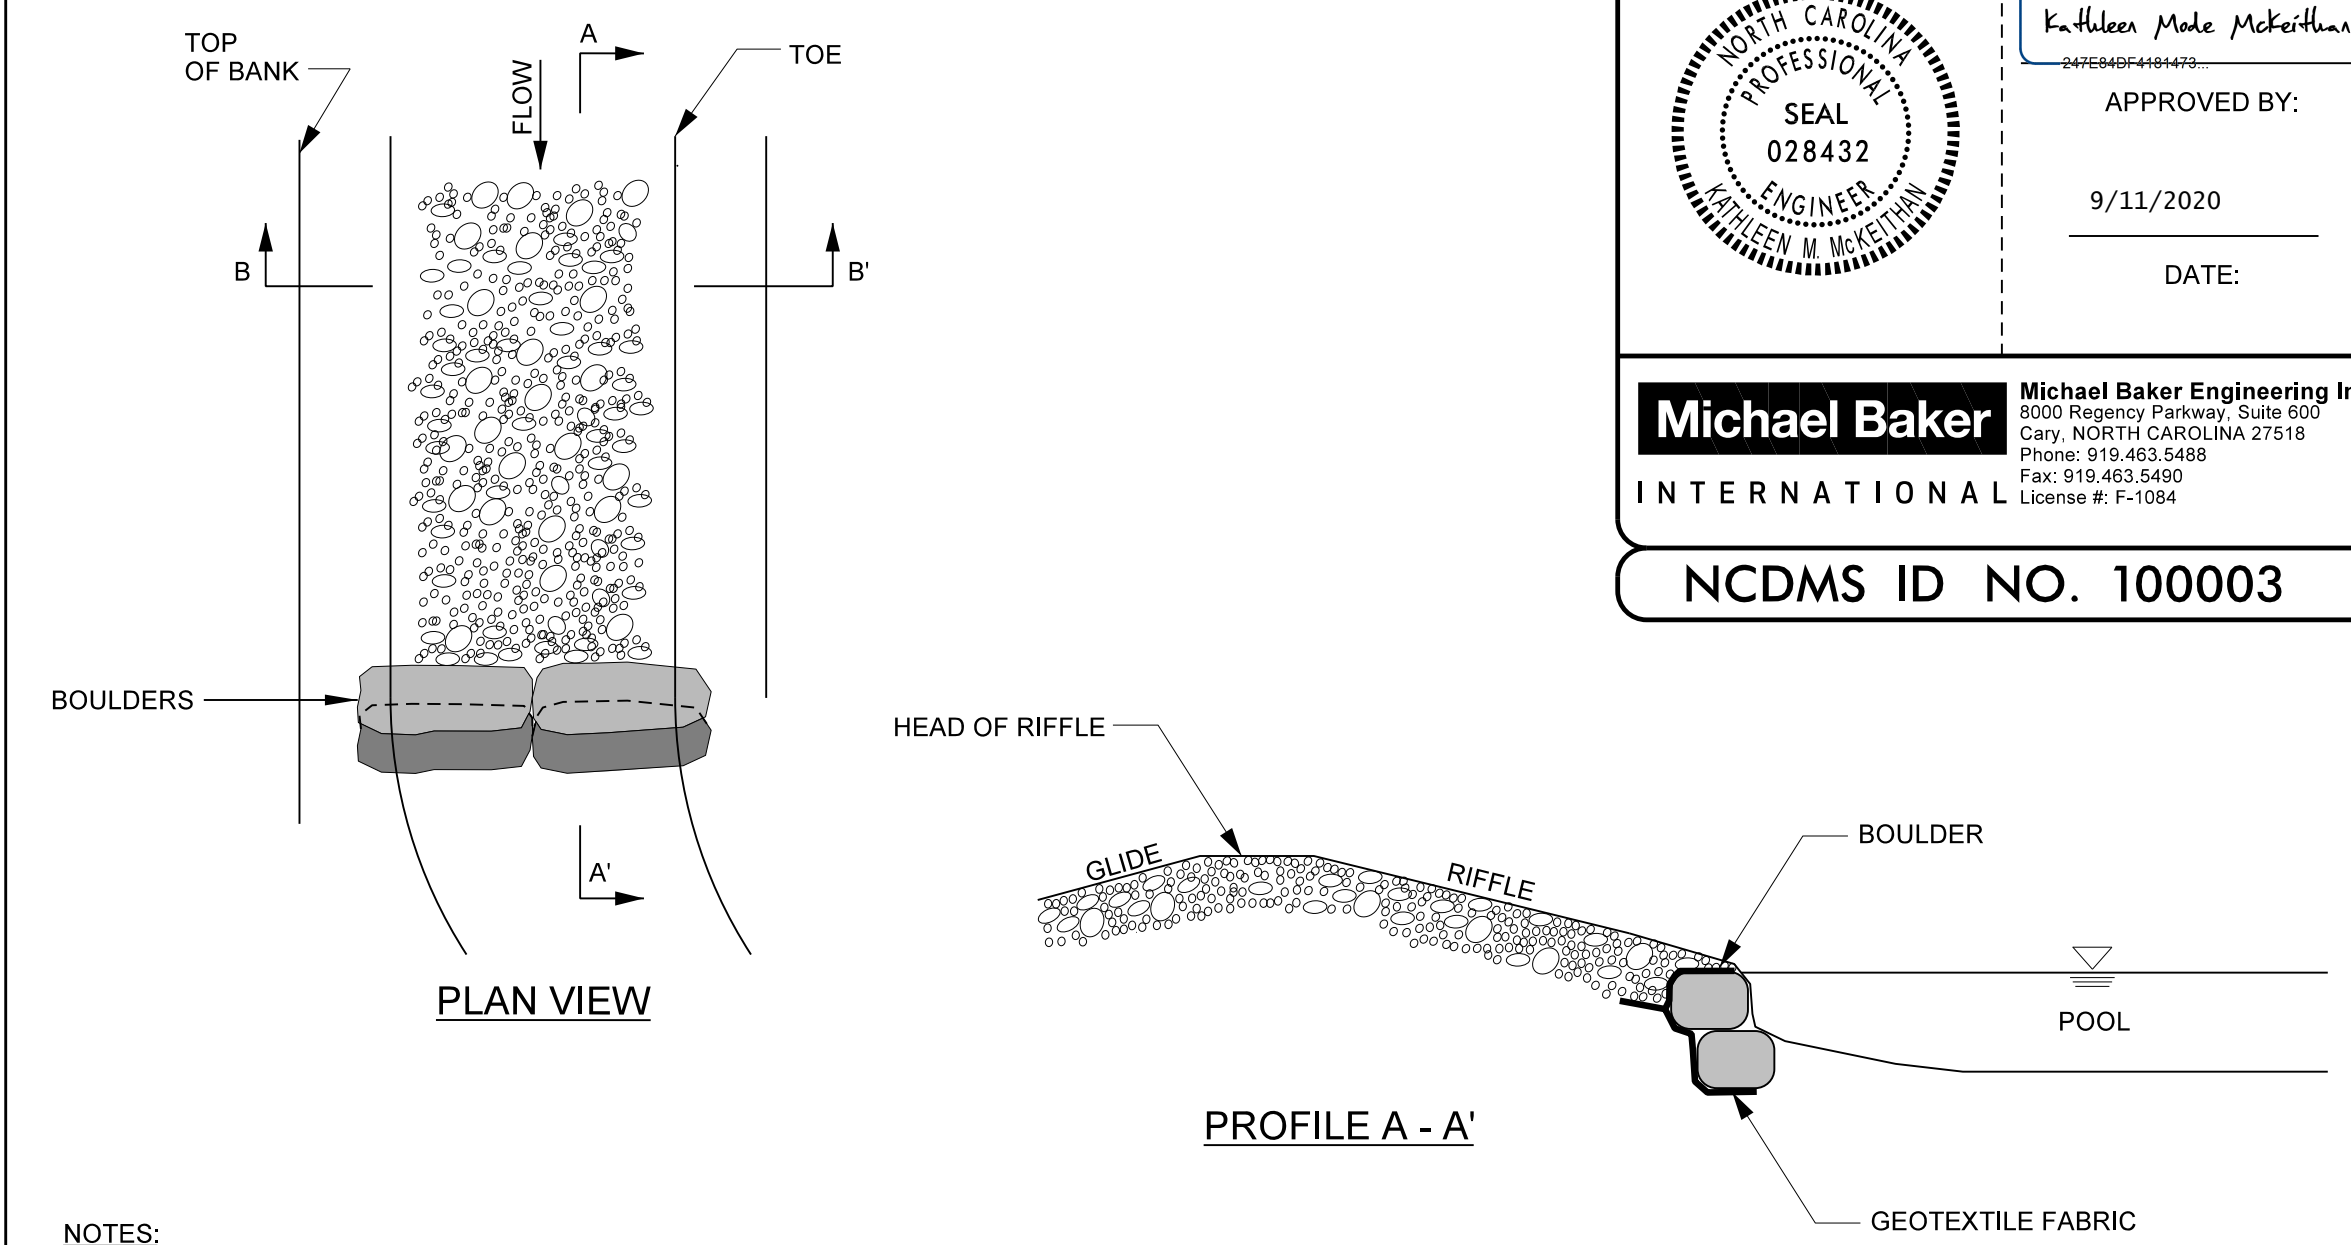

- NOTES:**
- HEADER BOULDERS MUST BE 3' X 2' X 2' AND FOOTERS SHALL NOT EXCEED 4' X 3' X 2'.
  - FOOTERS SHALL BE INSTALLED SUCH THAT 1/4 TO 1/3 OF THE LENGTH IS DOWNSTREAM OF THE HEADER.
  - SOIL SHALL BE WELL COMPACTED AROUND BURIED PORTION OF FOOTERS WITH THE BUCKET OF EXCAVATOR.
  - INSTALL NON-WOVEN FILTER FABRIC UNDERNEATH FOOTER BOULDERS.
  - UNDERCUT THE RIFFLE ELEVATION 16 INCHES TO ALLOW FOR A LAYER OF STONE.
  - INSTALL EROSION CONTROL MATTING ALONG COMPLETED BANKS SUCH THAT THE EROSION CONTROL MATTING AT THE TOE OF THE BANK EXTENDS DOWN TO THE UNDERCUT ELEVATION.
  - FILL TRENCH WITH GRADED MIX OF CLASS A, CLASS B, AND #57 STONE TO THE BED ELEVATION OF THE CHANNEL.
  - BOULDER STEPS MUST BE EXTENDED TO A MINIMUM OF 2' INTO THE BANK. USE SILL BOULDERS IF NECESSARY.
  - THALWEG AND STEP INVERT WILL BE CONCAVE AND SHAPED PER DIRECTION OF THE DESIGNER.


PROJECT REFERENCE NO. <b>157329</b>	SHEET NO. <b>2B</b>
PROJECT ENGINEER	
Designated by: <i>Kathleen M. McKeithan</i> APPROVED BY: _____ DATE: 9/11/2020	
<b>Michael Baker International</b> Michael Baker Engineering Inc. 8000 Regency Parkway, Suite 600 Cary, NORTH CAROLINA 27518 Phone: 919.463.5488 Fax: 919.463.5490 License #: F-1084	
<b>NC DMS ID NO. 100003</b>	

### GRADE CONTROL LOG J-HOOK VANE

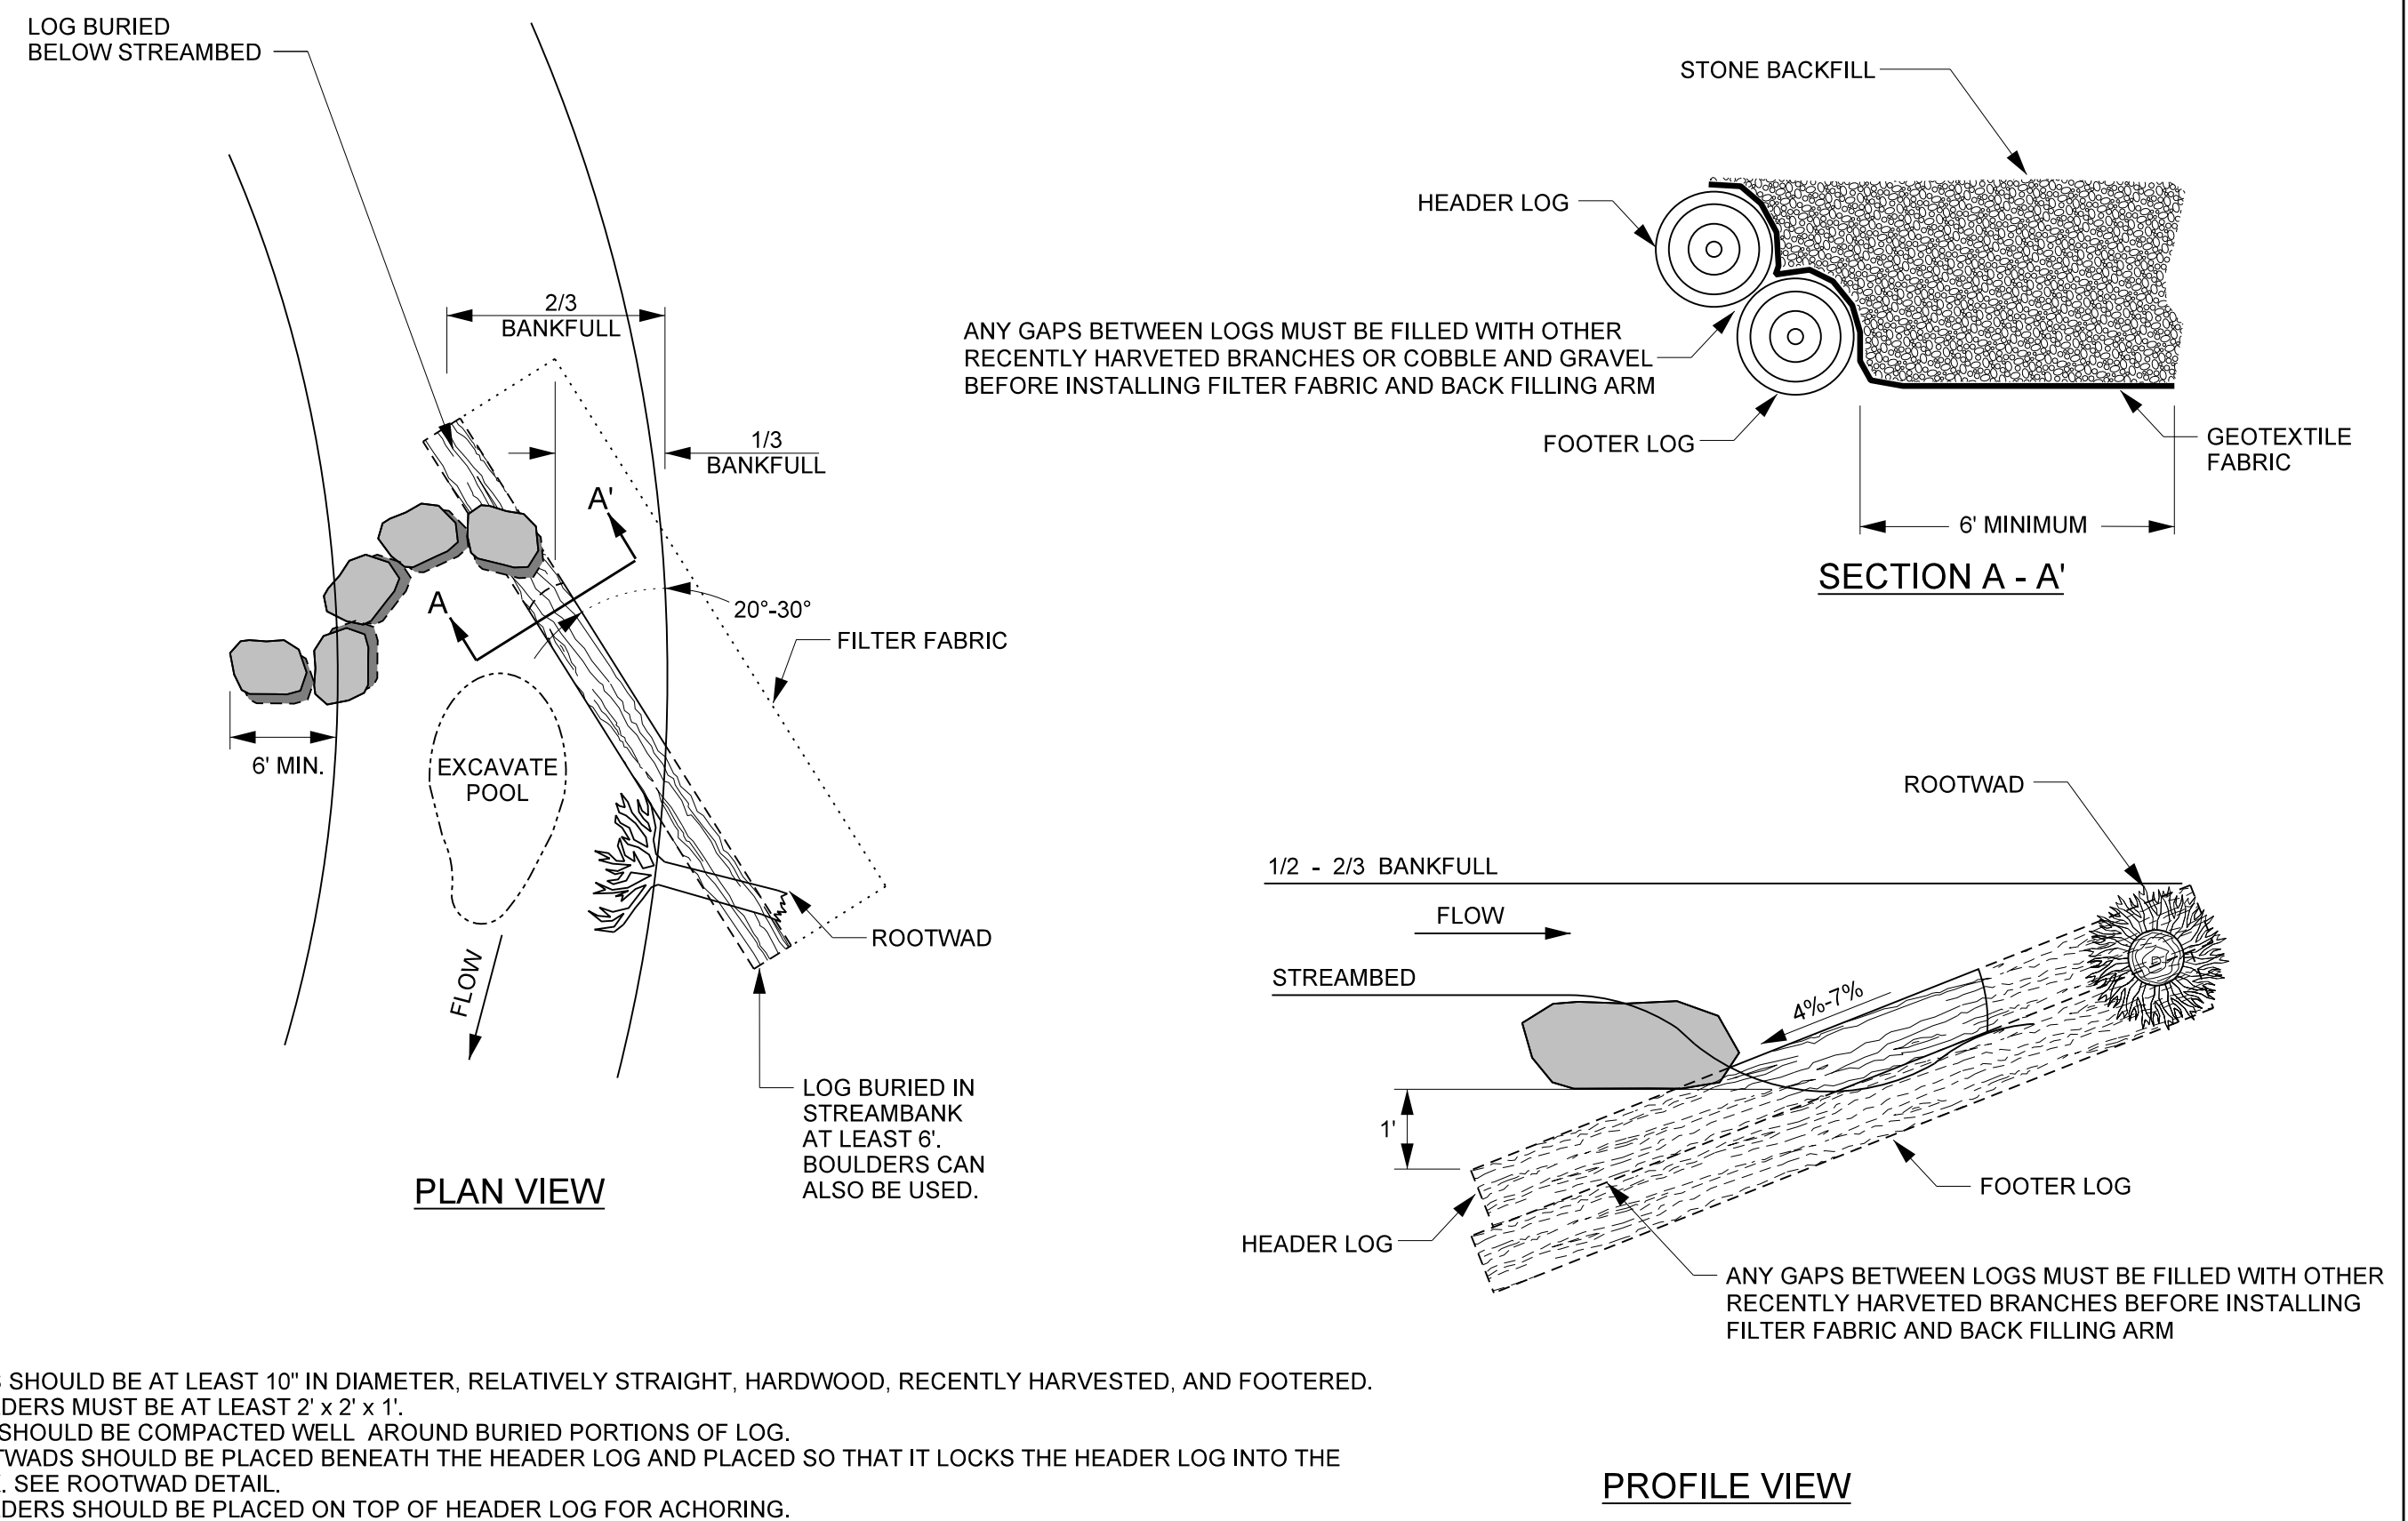

- NOTES:**
- LOGS SHOULD BE AT LEAST 10" IN DIAMETER, RELATIVELY STRAIGHT, HARDWOOD, RECENTLY HARVESTED, AND FOOTERED.
  - BOULDERS MUST BE AT LEAST 2' X 2' X 1'.
  - SOIL SHOULD BE COMPACTED WELL AROUND BURIED PORTIONS OF LOG.
  - ROOTWADS SHOULD BE PLACED BENEATH THE HEADER LOG AND PLACED SO THAT IT LOCKS THE HEADER LOG INTO THE BANK. SEE ROOTWAD DETAIL.
  - BOULDERS SHOULD BE PLACED ON TOP OF HEADER LOG FOR ANCHORING.
  - HEADER BOULDERS TO BE PLACED 0.5 TO 0.75 FEET APART.
  - FILTER FABRIC SHOULD BE NAILED TO THE LOG BELOW THE BACKFILL.
  - TRANSPLANTS OR BOULDERS CAN BE USED INSTEAD OF ROOTWADS, PER DIRECTION OF ENGINEER.
  - BOULDER SILL MUST BE A MINIMUM OF 5'.
  - AFTER ALL STONE BACKFILL HAS BEEN PLACED, FILL IN THE UPSTREAM SIDE OF THE STRUCTURE WITH WELL GRADED MIX OF CLASS B, CLASS A, & #57 STONE TO THE ELEVATION OF THE TOP OF THE HEADER ROCK. INCORPORATE ON-SITE ALLUVIUM WHERE AVAILABLE.

### LOG VANE

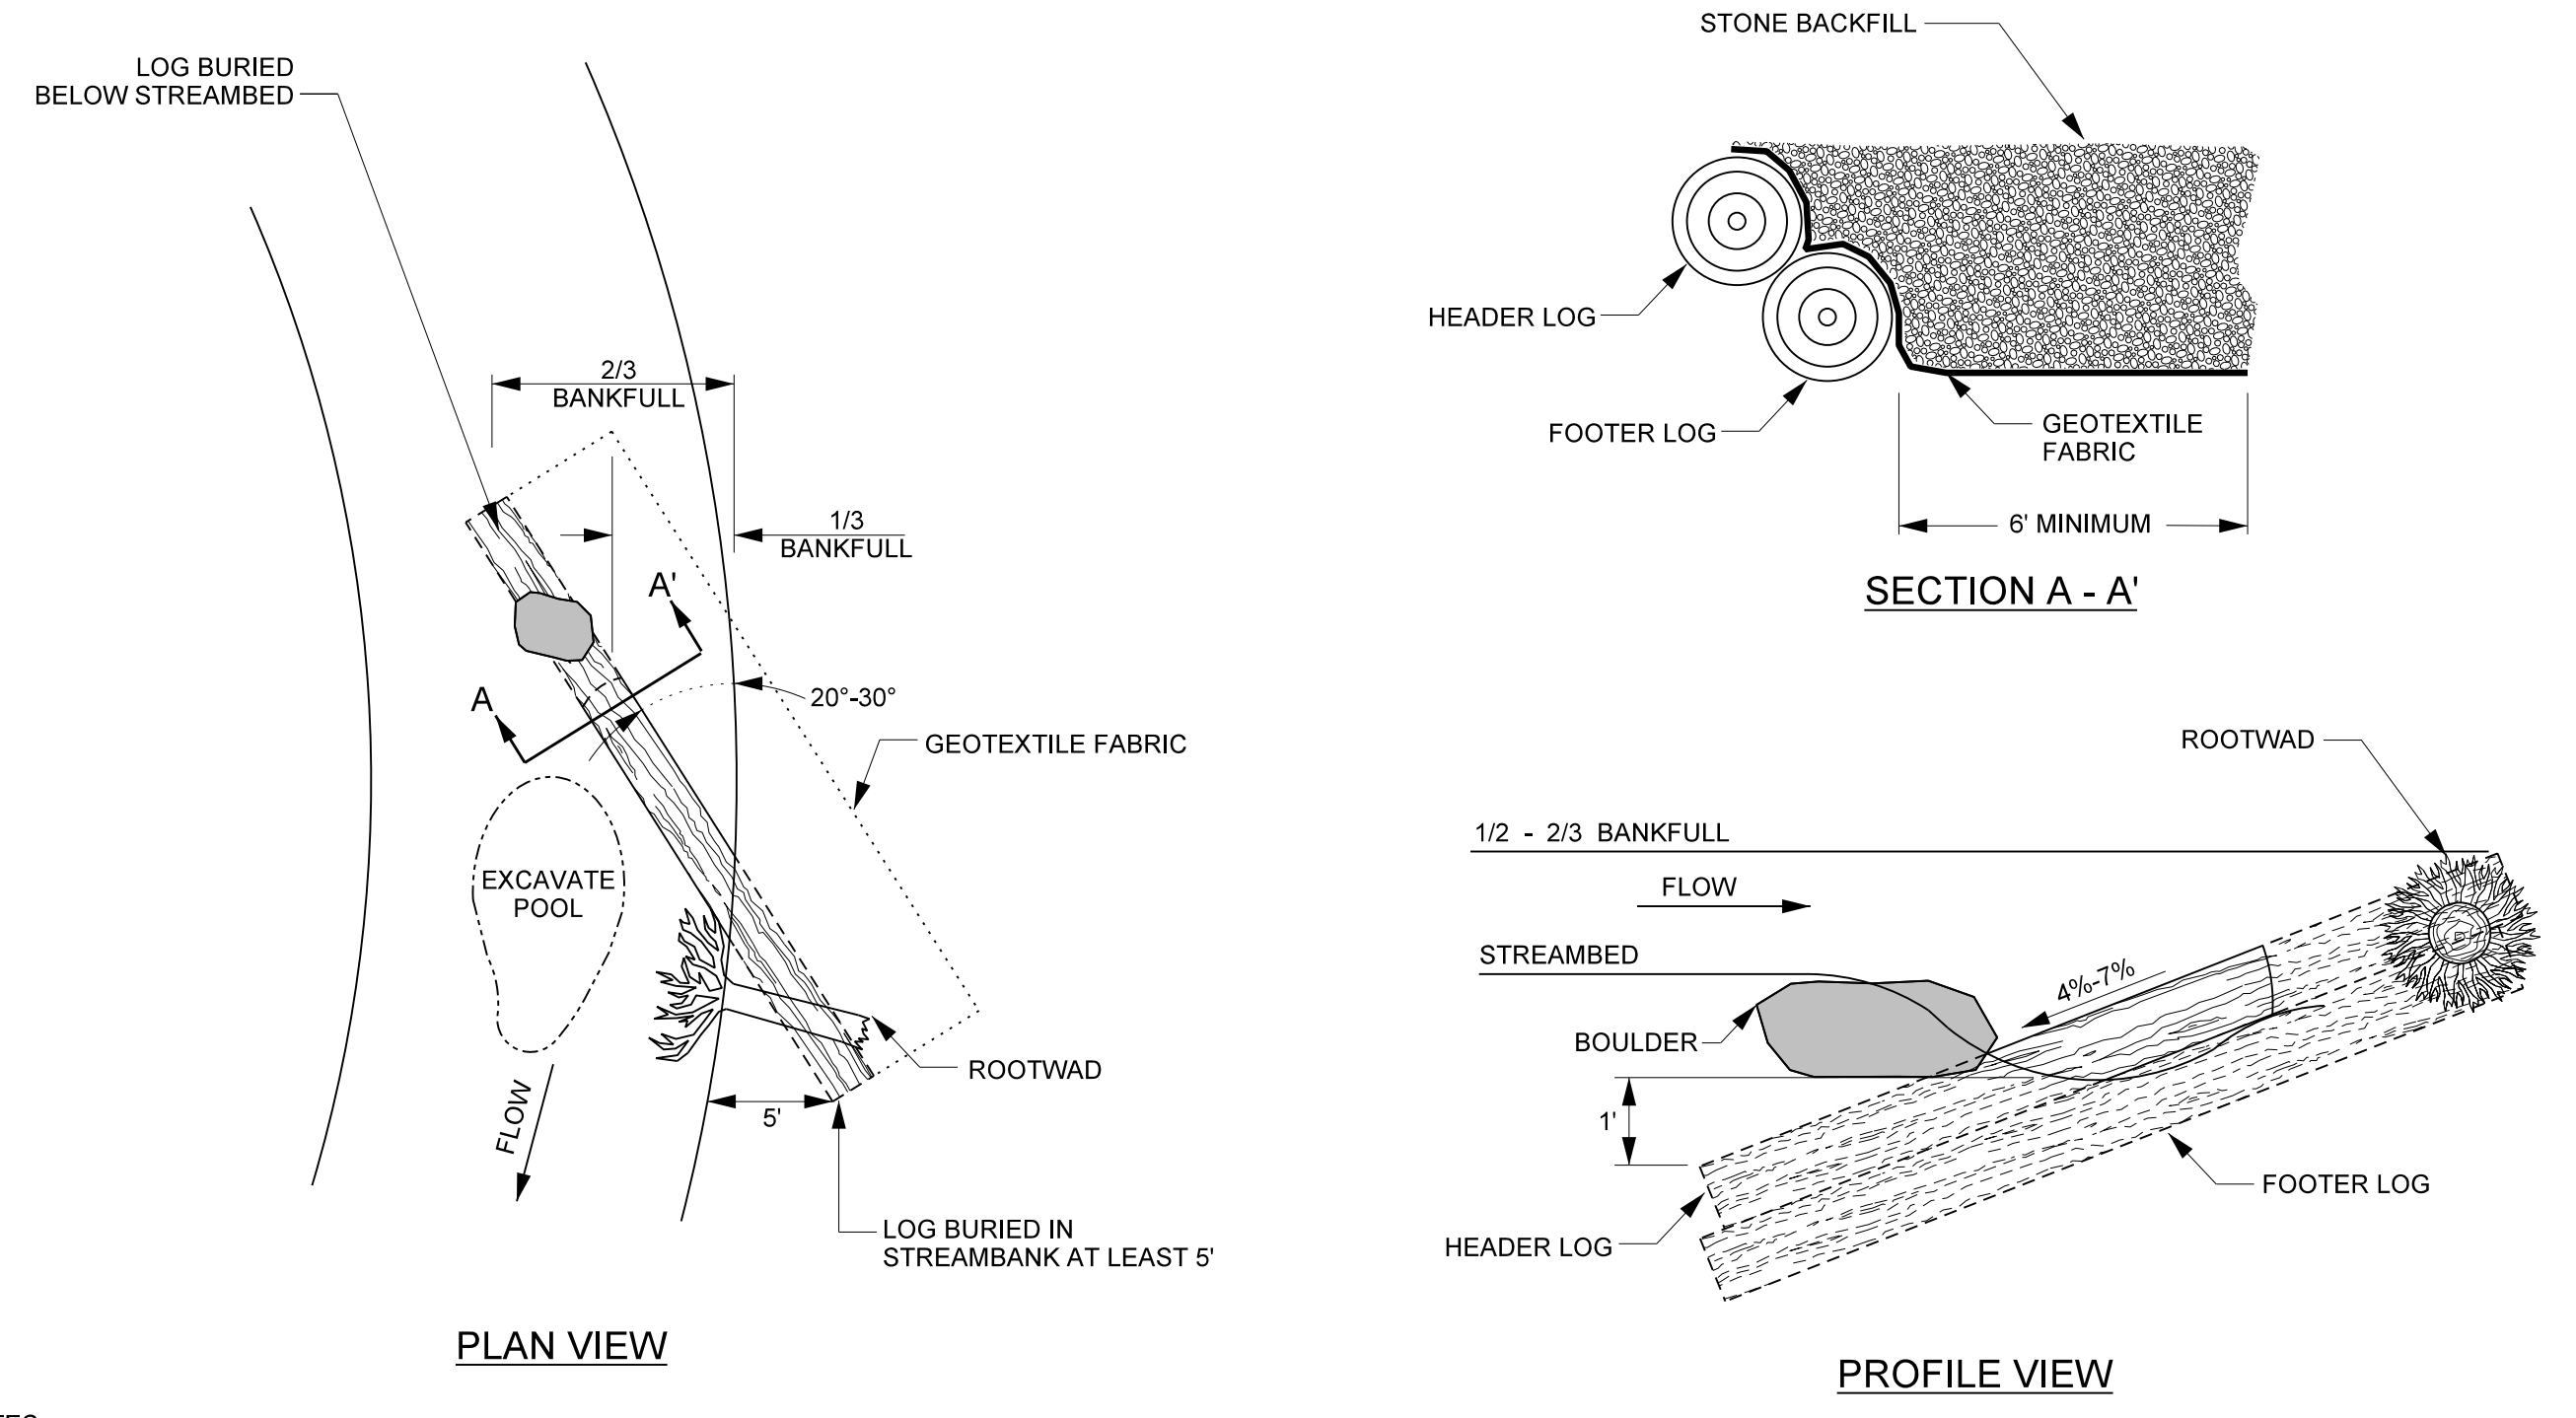


- NOTES:**
- LOGS SHOULD BE AT LEAST 10" IN DIAMETER, RELATIVELY STRAIGHT, HARDWOOD, AND RECENTLY HARVESTED.
  - BOULDERS MUST BE OF SUFFICIENT SIZE TO ANCHOR LOGS.
  - SOIL SHOULD BE COMPACTED WELL AROUND BURIED PORTIONS OF LOGS.
  - ROOTWADS SHOULD BE PLACED BENEATH THE HEADER LOG AND PLACED SO THAT IT LOCKS THE HEADER LOG INTO THE BANK. SEE ROOTWAD DETAIL.
  - BOULDER SHOULD BE PLACED ON TOP OF HEADER LOG FOR ANCHORING.
  - GEOTEXTILE FABRIC SHOULD BE NAILED TO THE LOG BELOW THE BACKFILL.
  - TRANSPLANTS CAN BE USED INSTEAD OF ROOTWADS, PER DIRECTION OF ENGINEER.
  - AFTER ALL STONE BACKFILL HAS BEEN PLACED, FILL IN THE UPSTREAM SIDE OF THE STRUCTURE WITH WELL GRADED MIX OF CLASS B, CLASS A, & #57 STONE TO THE ELEVATION OF THE TOP OF THE HEADER ROCK. INCORPORATE ON-SITE ALLUVIUM WHERE AVAILABLE.

R:\157329\_01\_Russell\_Cop\Design\AS-BUILD\PLANS\157329\_AB-PSH-02B.dgn  
 8/15/2020




2/26/20


### LIVE STAKING

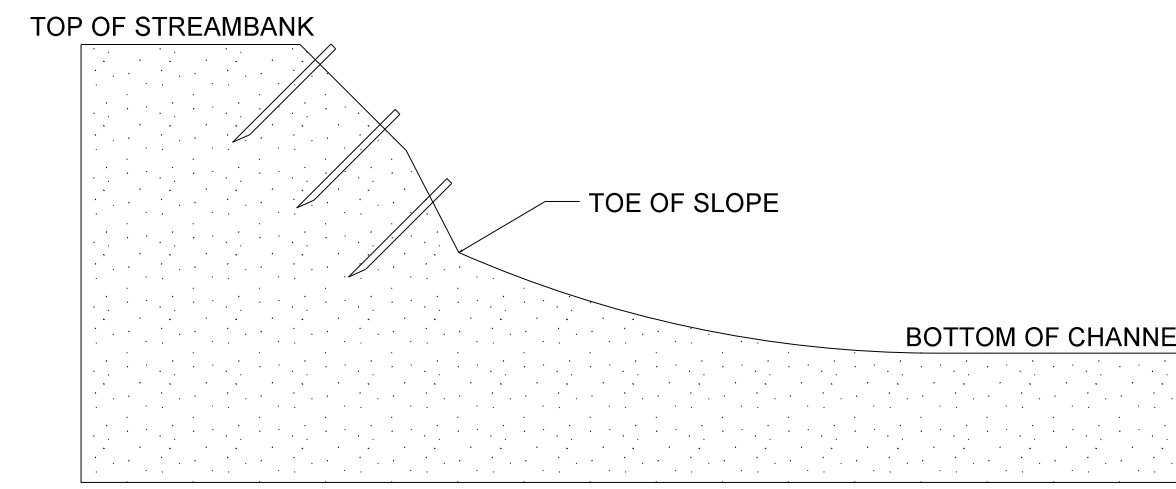


CROSS SECTION VIEW

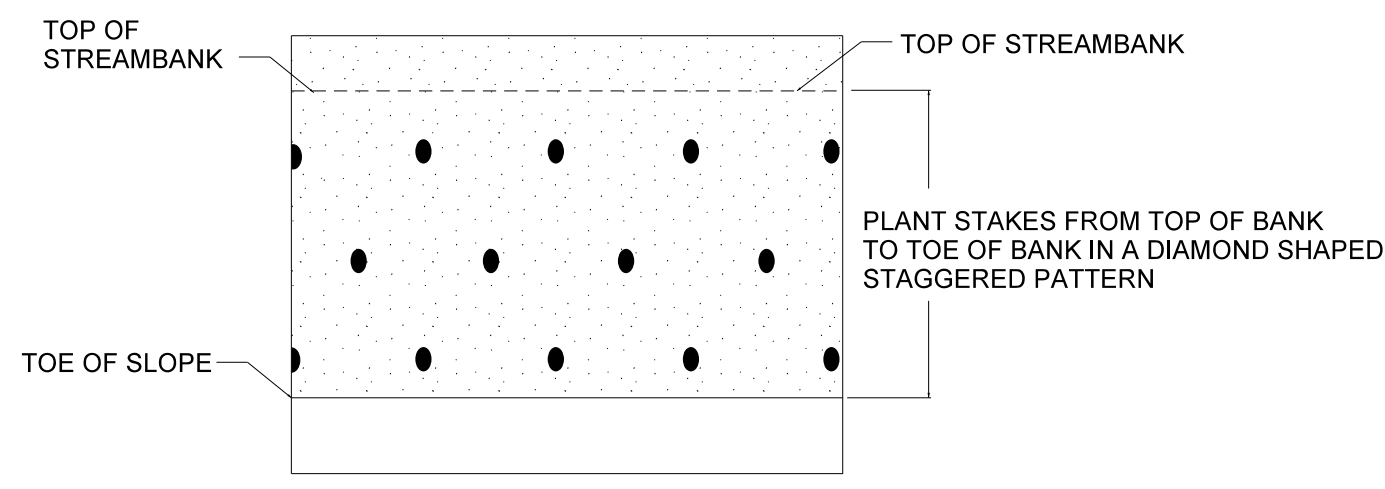

PLAN VIEW

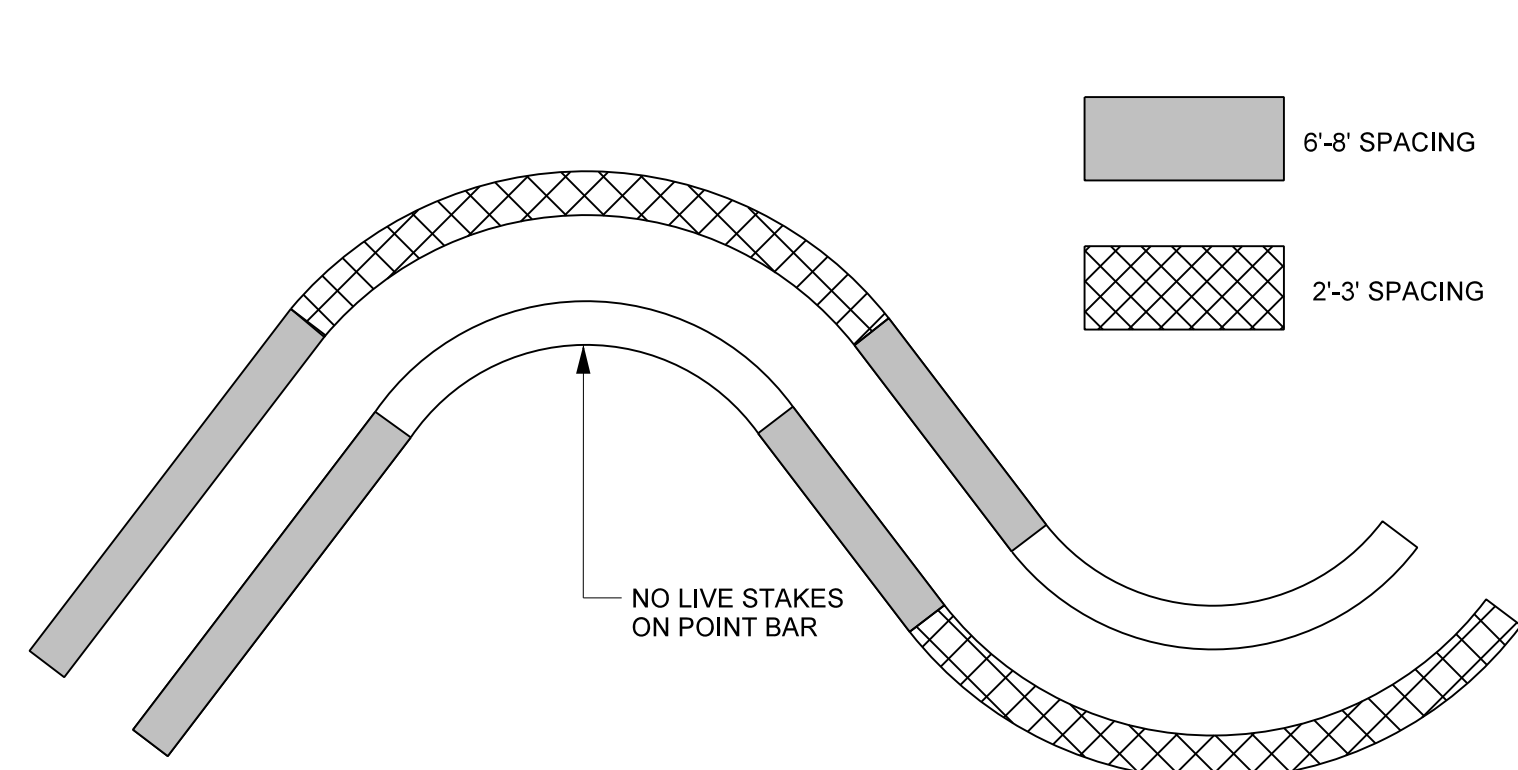

PLAN VIEW

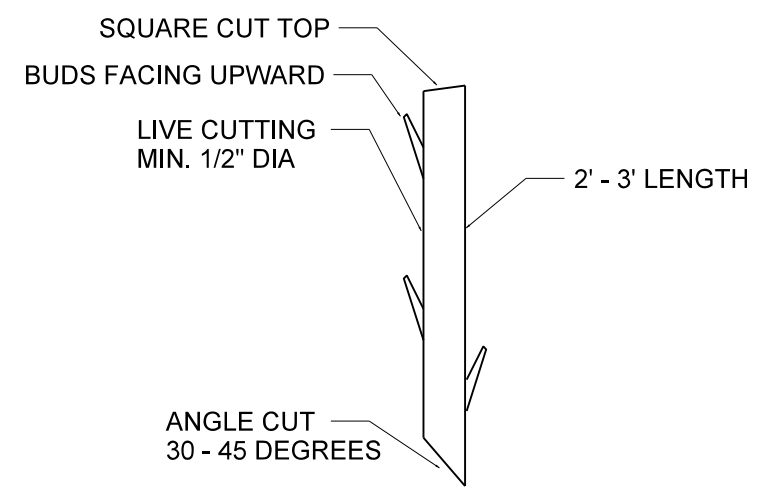


LIVE STAKE DETAIL


**NOTES:**

1. STAKES SHOULD BE CUT AND INSTALLED ON THE SAME DAY.
2. DO NOT INSTALL STAKES THAT HAVE BEEN SPLIT.
3. STAKES MUST BE INSTALLED WITH BUDS POINTING UPWARDS.
4. STAKES SHOULD BE INSTALLED PERPENDICULAR TO BANK.
5. STAKES SHOULD BE 1/2 TO 2 INCHES IN DIAMETER AND 2 TO 3 FT LONG.
6. STAKES SHOULD BE INSTALLED LEAVING 1/5 OF STAKE ABOVE GROUND.

### TRANSPLANTED VEGETATION

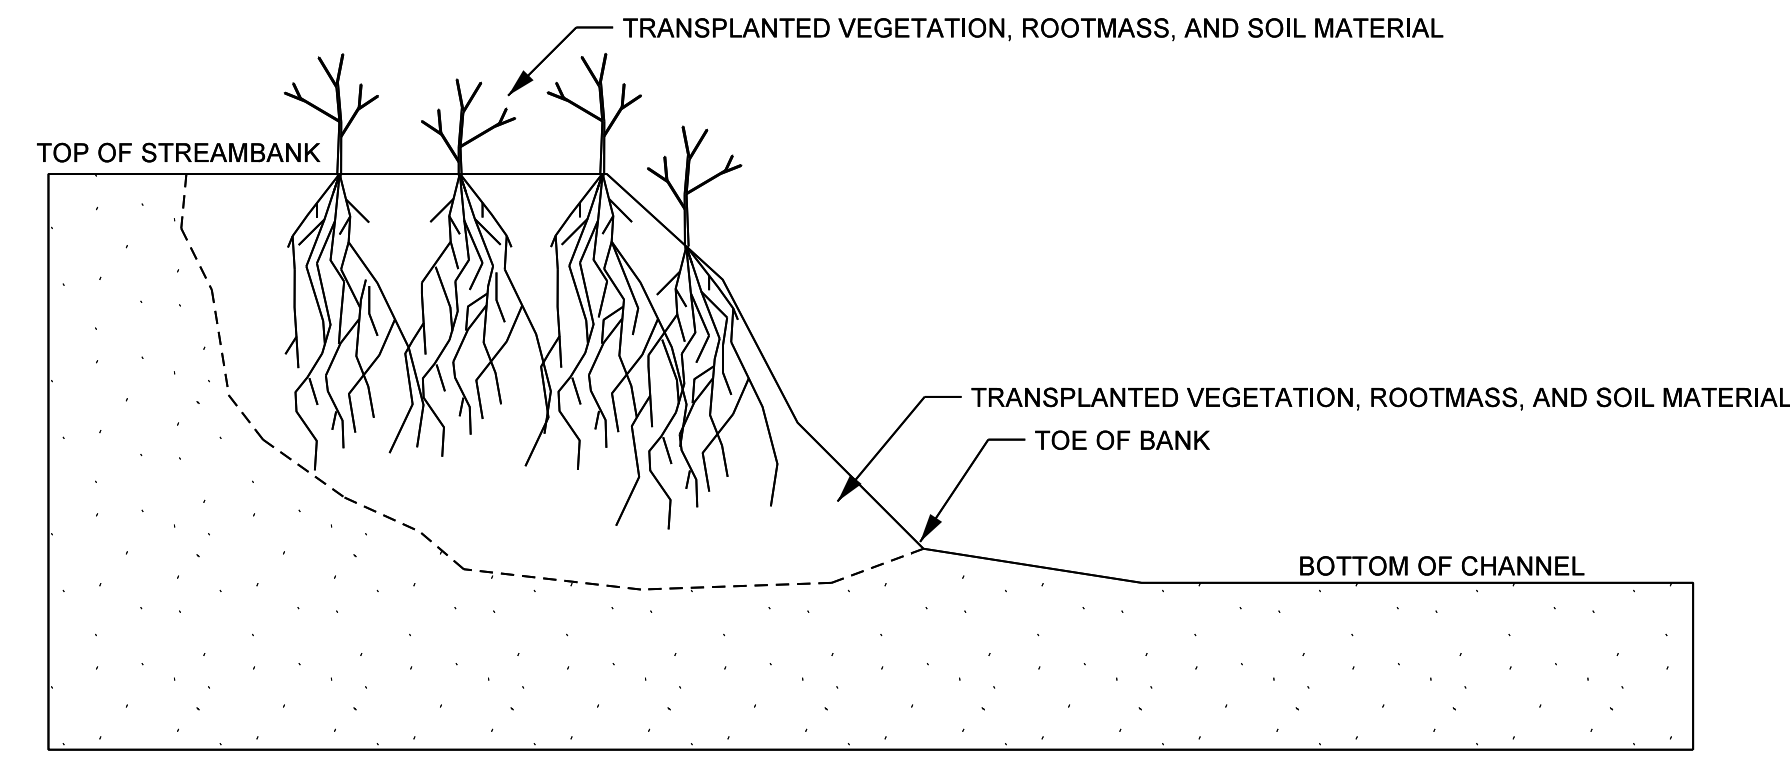

CROSS SECTION VIEW

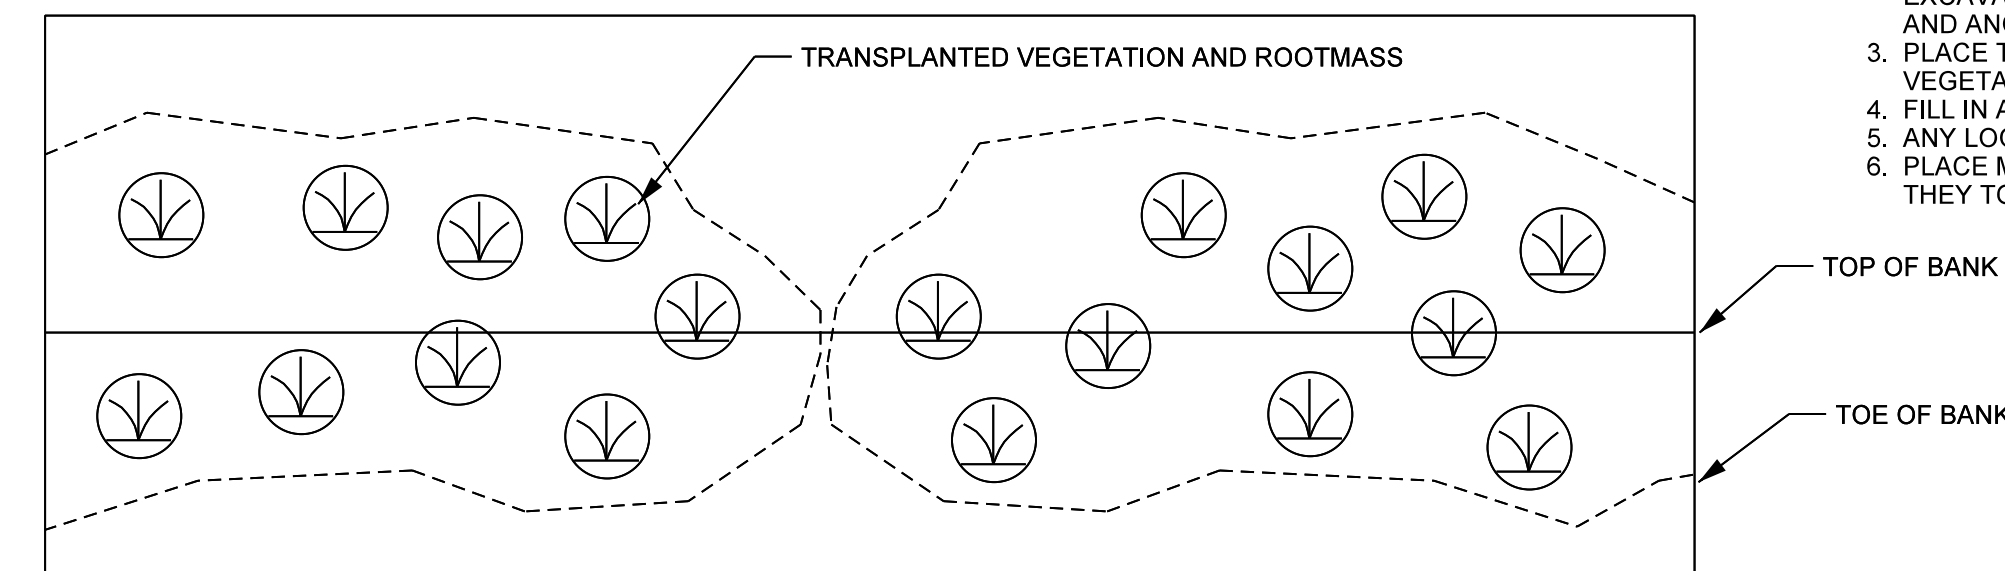


PLAN VIEW

**NOTES:**

1. EXCAVATE A HOLE IN THE BANK TO BE STABILIZED THAT WILL ACCOMMODATE THE SIZE OF TRANSPLANT TO BE PLACED. BEGIN EXCAVATION AT THE TOE OF THE BANK.
2. EXCAVATE TRANSPLANT USING A FRONT END LOADER. EXCAVATE THE ENTIRE ROOT MASS AND AS MUCH ADDITIONAL SOIL MATERIAL AS POSSIBLE. IF ENTIRE ROOT MASS CAN NOT BE EXCAVATED IN ONE BUCKET LOAD, THE TRANSPLANT IS TOO LARGE AND ANOTHER SHOULD BE SELECTED.
3. PLACE TRANSPLANT IN THE BANK TO BE STABILIZED SO THAT VEGETATION IS ORIENTATED VERTICALLY.
4. FILL IN ANY HOLES AROUND THE TRANSPLANT AND COMPACT.
5. ANY LOOSE SOIL LEFT IN THE STREAM SHOULD BE REMOVED.
6. PLACE MULTIPLE TRANSPLANTS CLOSE TOGETHER SUCH THAT THEY TOUCH.


### PLANTING SPECIFICATIONS

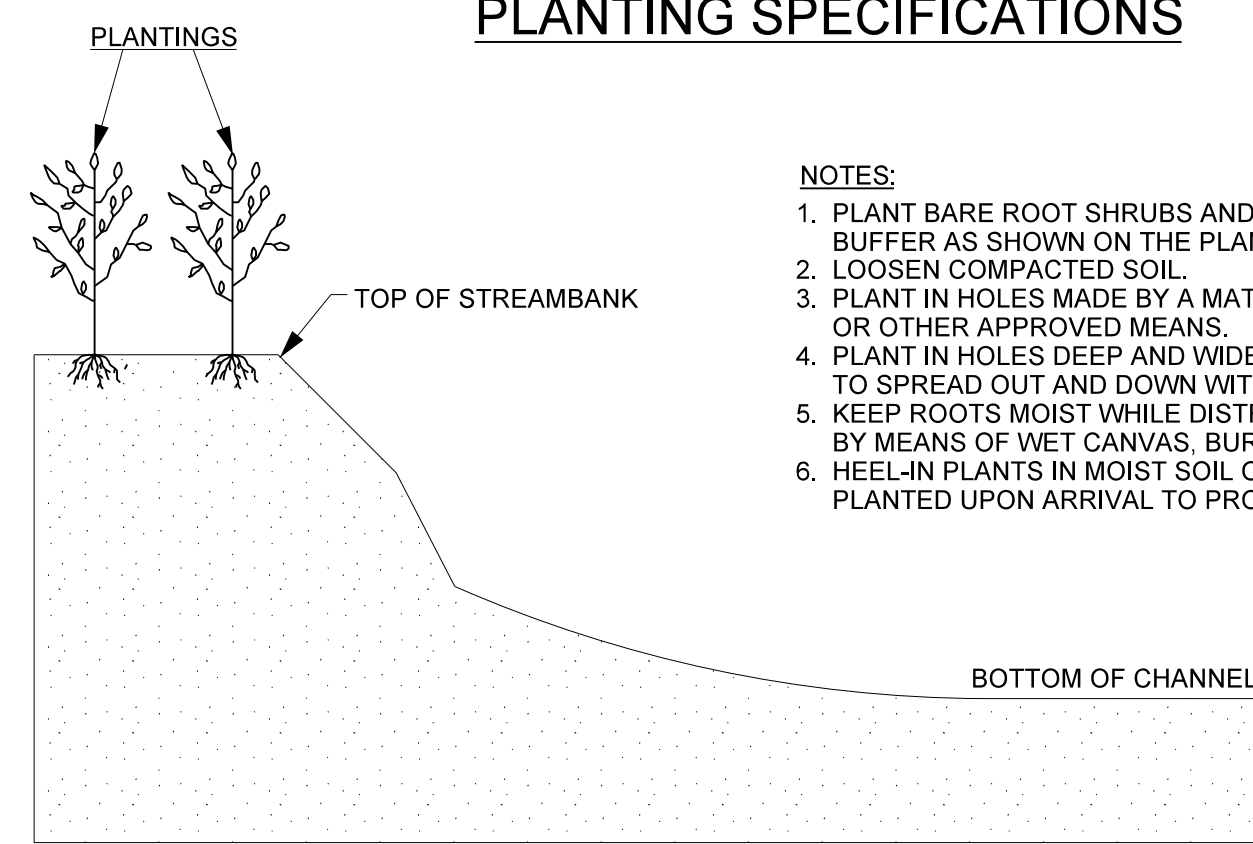

CROSS SECTION VIEW OF BARE ROOT PLANTING

**NOTES:**

1. PLANT BARE ROOT SHRUBS AND TREES TO THE WIDTH OF THE BUFFER AS SHOWN ON THE PLANS.
2. LOOSEN COMPACTED SOIL.
3. PLANT IN HOLES MADE BY A MATTOCK, DIBBLE, PLANTING BAR, OR OTHER APPROVED MEANS.
4. PLANT IN HOLES DEEP AND WIDE ENOUGH TO ALLOW THE ROOTS TO SPREAD OUT AND DOWN WITHOUT J-ROOTING.
5. KEEP ROOTS MOIST WHILE DISTRIBUTING OR WAITING TO PLANT BY MEANS OF WET CANVAS, BURLAP, OR STRAW.
6. HEEL-IN PLANTS IN MOIST SOIL OR SAWDUST IF NOT PROMPTLY PLANTED UPON ARRIVAL TO PROJECT SITE.

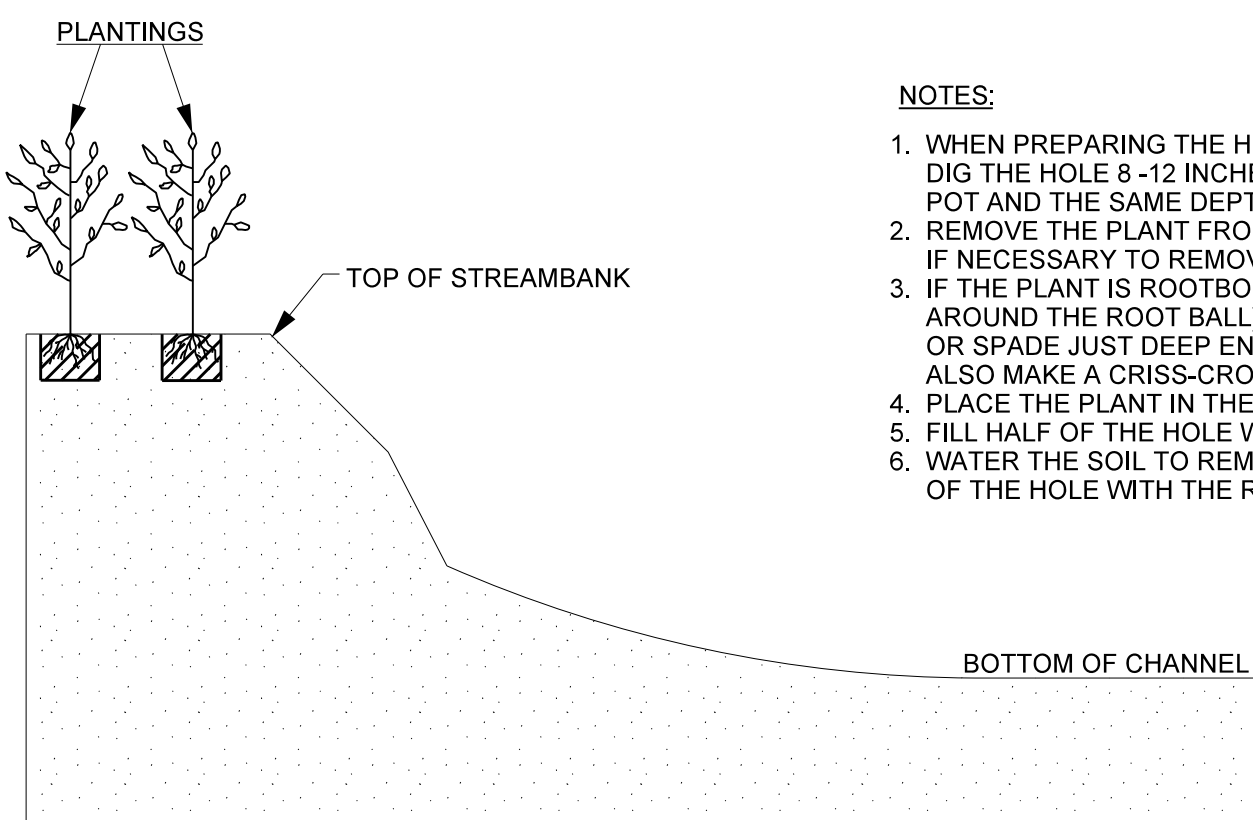

CROSS SECTION VIEW OF CONTAINER PLANTING


**NOTES:**

1. WHEN PREPARING THE HOLE FOR A POTTED PLANT OR SHRUB DIG THE HOLE 8-12 INCHES LARGER THAN THE DIAMETER OF THE POT AND THE SAME DEPTH AS THE POT.
2. REMOVE THE PLANT FROM THE POT. LAY THE PLANT ON ITS SIDE IF NECESSARY TO REMOVE THE POT.
3. IF THE PLANT IS ROOTBOUND (ROOTS GROWING IN A SPIRAL AROUND THE ROOT BALL), MAKE VERTICAL CUTS WITH A KNIFE OR SPADE JUST DEEP ENOUGH TO CUT THE NET OF ROOTS. ALSO MAKE A CRISS-CROSS CUT ACROSS THE BOTTOM OF THE BALL.
4. PLACE THE PLANT IN THE HOLE.
5. FILL HALF OF THE HOLE WITH SOIL (SAME SOIL REMOVED FOR BACKFILL).
6. WATER THE SOIL TO REMOVE AIR POCKETS AND FILL THE REST OF THE HOLE WITH THE REMAINING SOIL.

### GEOLEFT WITH BRUSH TOE

**NOTES:**

1. LIVE BRANCH CUTTINGS SHALL BE THE SAME SPECIES AS THE LIVE STAKES AND SHALL BE INSTALLED DURING VEGETATION DORMANCY.
2. LIVE BRANCH CUTTINGS SHALL BE INSTALLED AT A DENSITY OF 20-30 CUTTINGS PER LINEAR FOOT AND A MAXIMUM DIAMETER OF 2.5 INCHES.
3. NUMBER OF SOIL LIFTS MAY VARY. IN GENERAL LIFTS SHALL EXTEND TO THE TOP OF BANK OR BANKFULL STAGE.

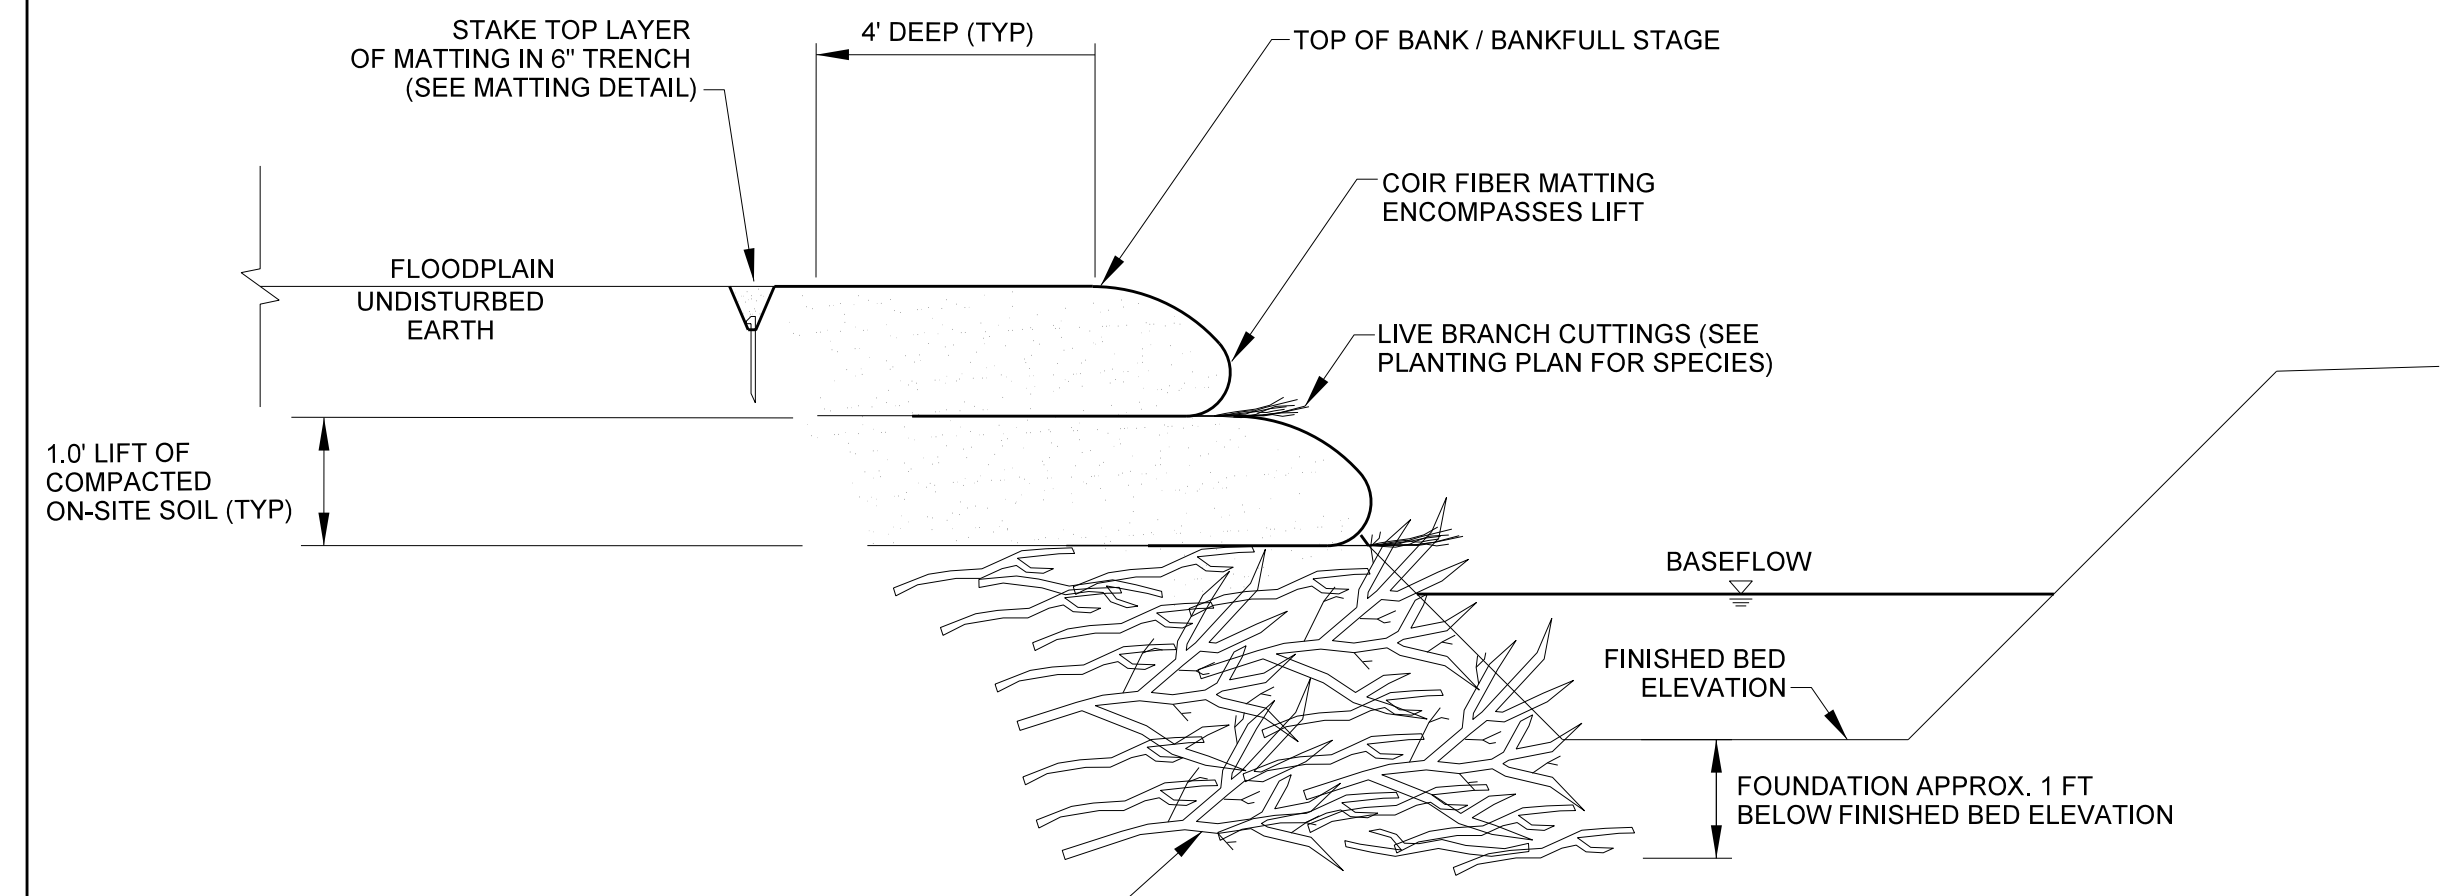

BRUSH CAN BE LIMBS, BRANCHES, ROOTS OR ANY OTHER WOODY VEGETATION APPROVED BY THE ENGINEER.

**NOTES:**

1. WHEN GEOLIFTS ARE BUILT ABOVE ROOTWAD CLUSTER, USE LARGE STONE BACKFILL BEHIND ROOT MASS TO BUILT FOUNDATION.
2. CLASS I STONE MAY BE USED AT THE DIRECTION OF THE ENGINEER TO BUILD THE FOUNDATION IN LIEU OF BRUSH MATERIAL.


PROJECT REFERENCE NO. <b>157329</b>	SHEET NO. <b>2C</b>
PROJECT ENGINEER	
DocuSigned by: <b>Kathleen M. McKeithan</b> 247E840E4181473	
APPROVED BY:	
9/11/2020	
DATE:	
<b>Michael Baker International</b> Michael Baker Engineering Inc. 8000 Regency Parkway, Suite 600 Cary, NORTH CAROLINA 27518 Phone: 919.463.5486 Fax: 919.463.5490 License #: F-1084	
<b>NCDMS ID NO. 100003</b>	

R:\157329\157329\_Russell\_Cop\Design\AS-BUILD\PLANS\157329\_AB-PSH-02C.dgn  
 8/28/2020 8:15:29 AM




2/26/20

### BARB WIRE FIELD FENCE

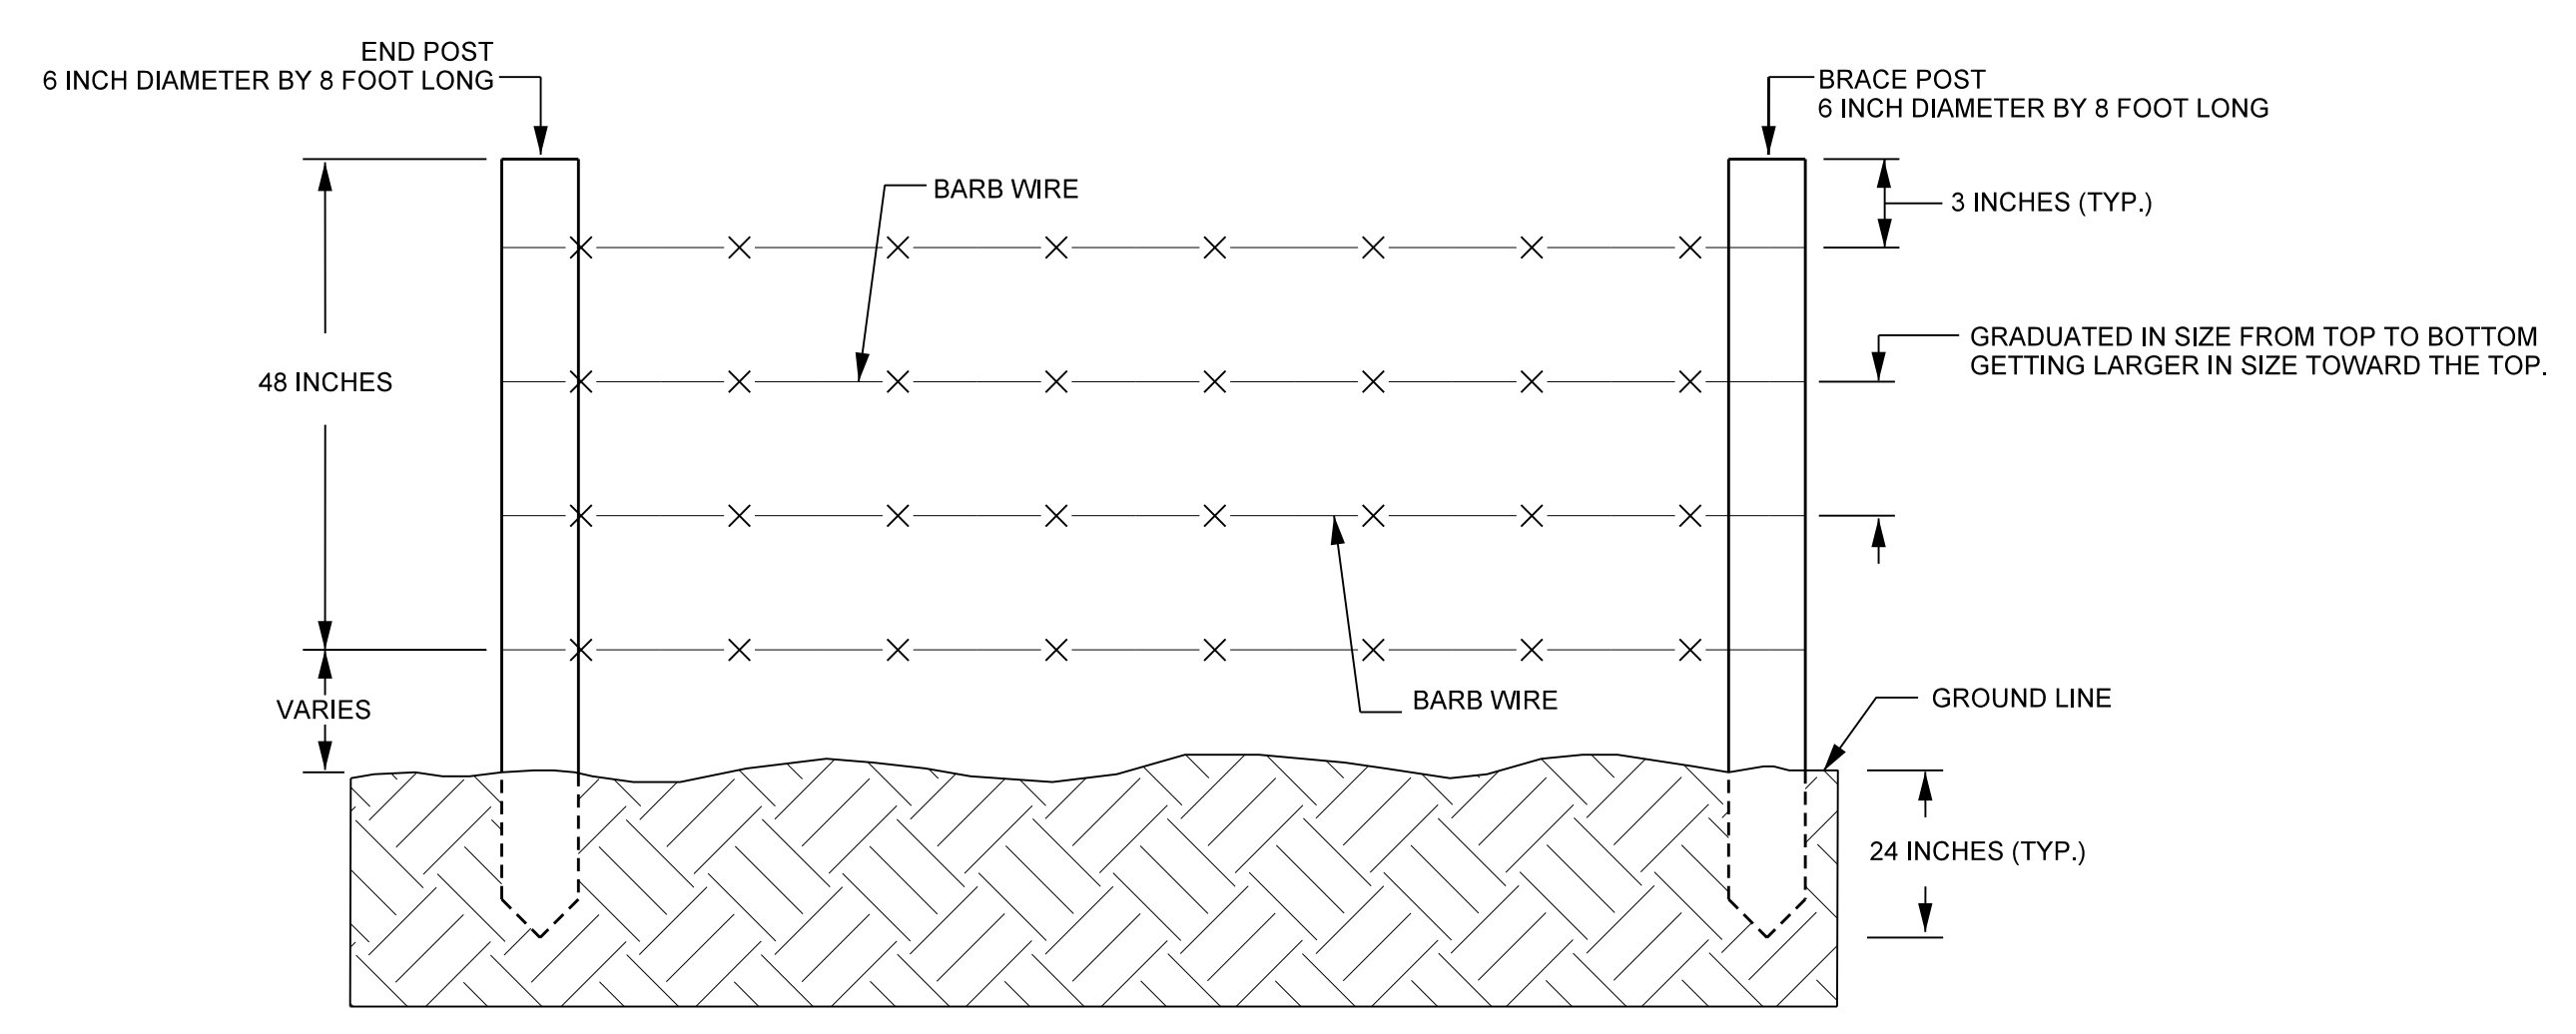


**NOTE:**  
1. END POSTS SHALL BE INSTALLED AT A SPACING OF 10-15 FEET.

### WOVEN WIRE FENCE

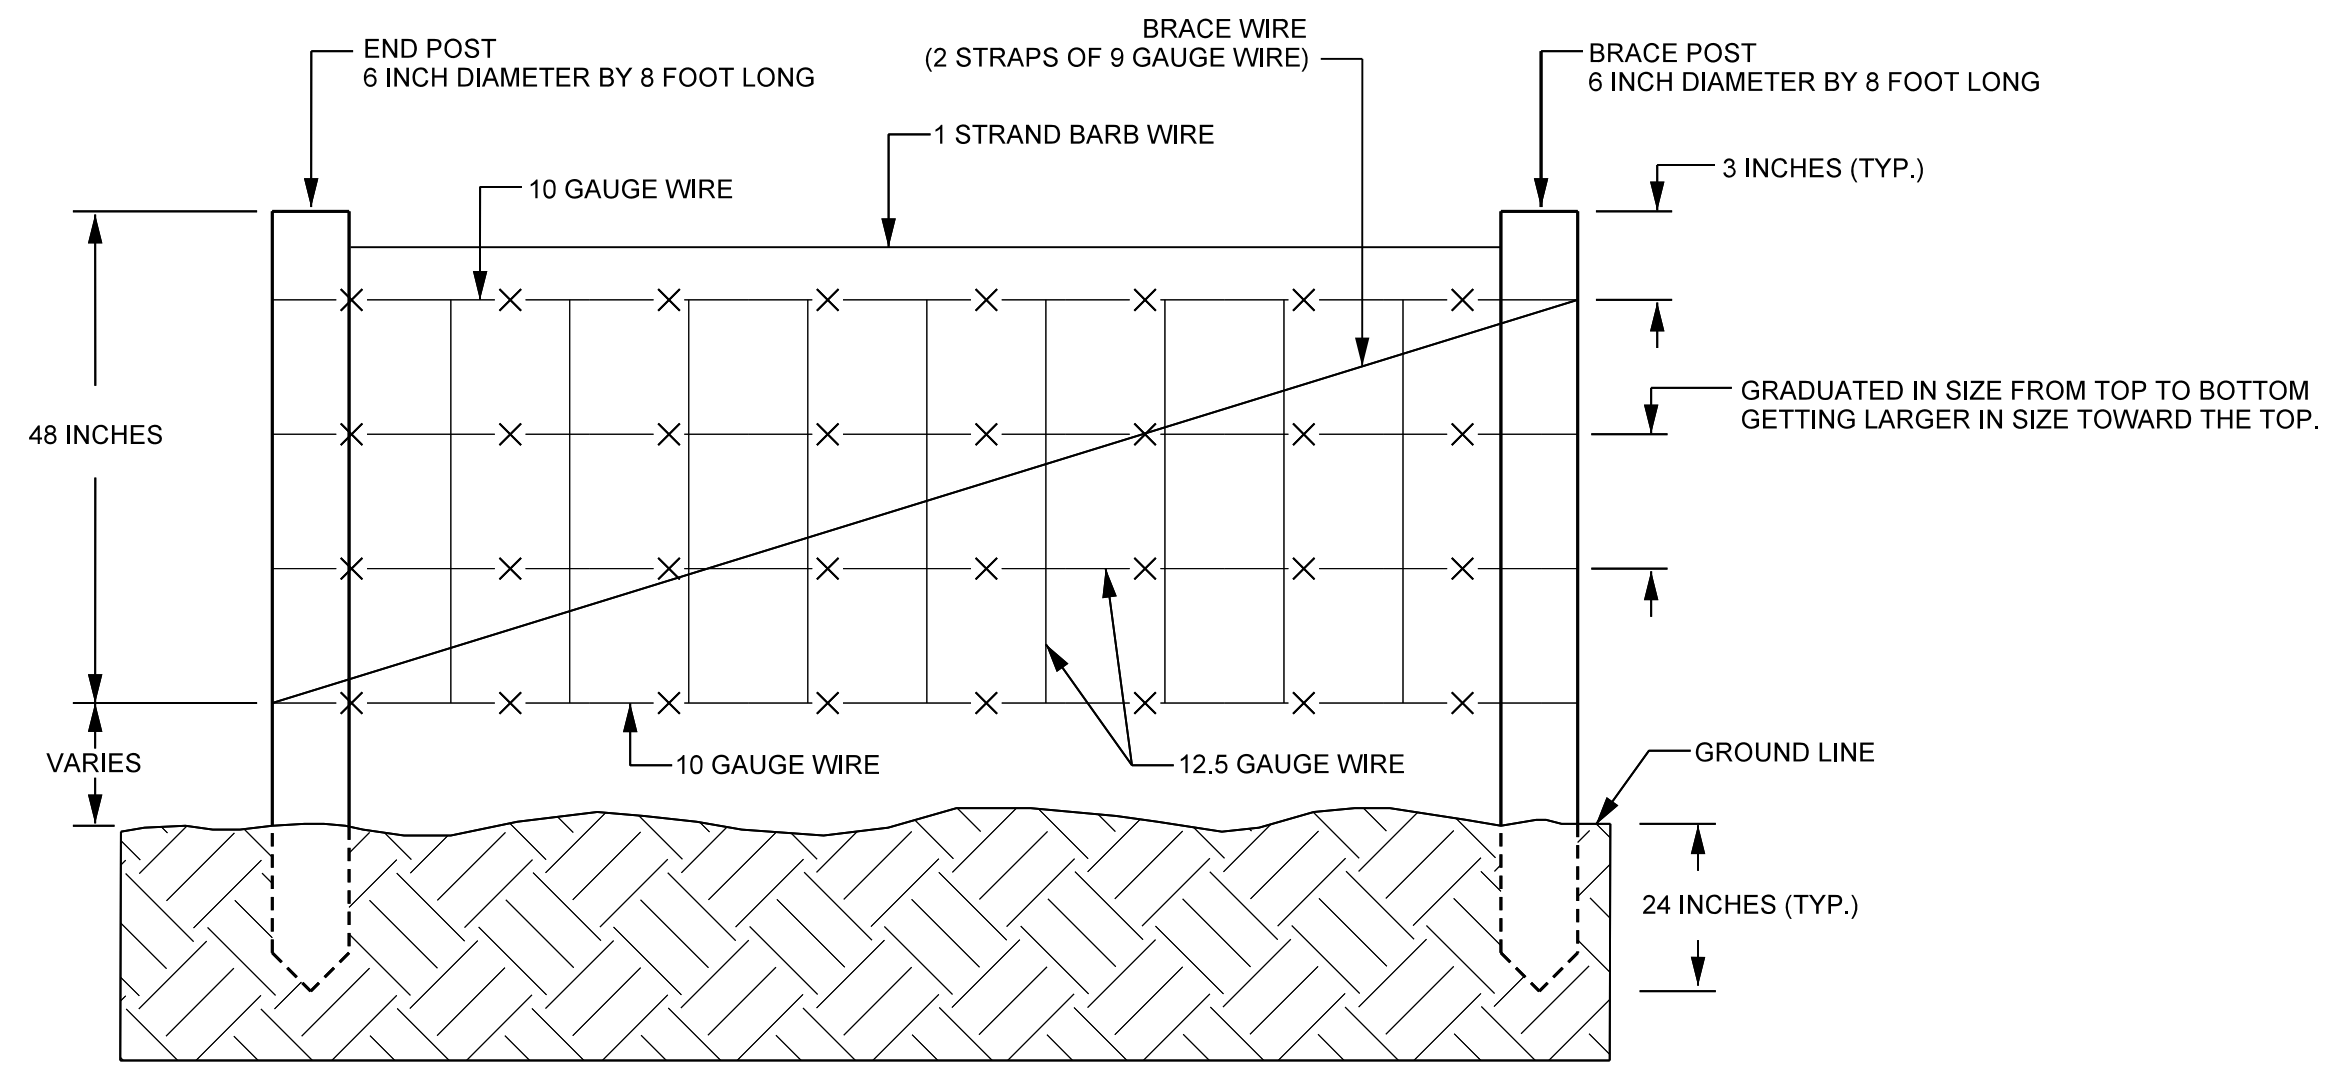


**NOTE:**  
1. END POSTS SHALL BE INSTALLED AT A SPACING OF 10-15 FEET.

### STEEL GATES

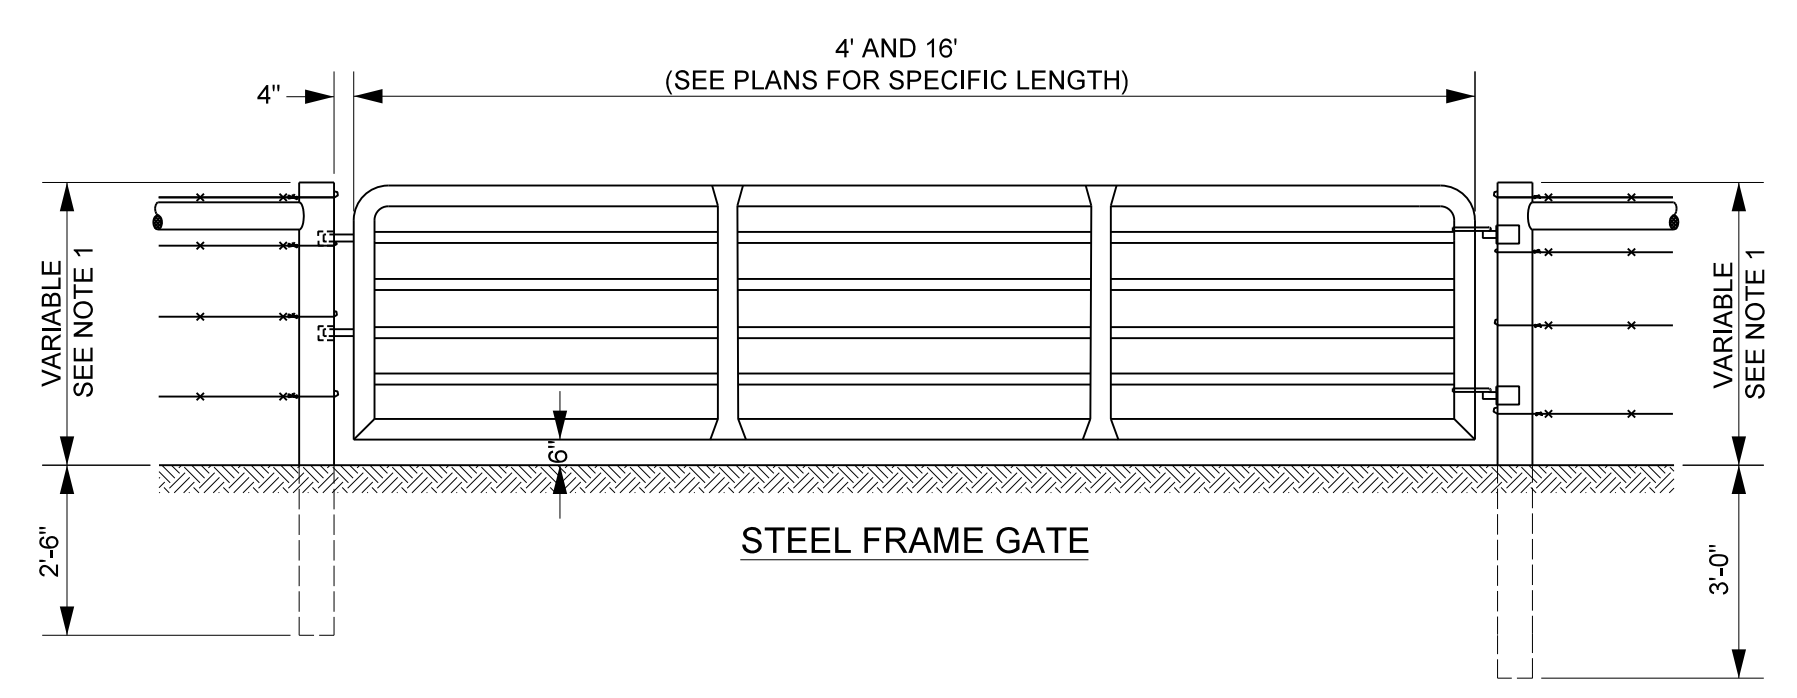


**NOTES:**  
1. POST HEIGHT DIMENSION SHALL BE THE SAME AS REQUIRED FOR THE ADJACENT FENCE.  
2. CONSTRUCT AN END OR STRESS PANEL, AS REQUIRED IN THE SPECIFICATION, ON EACH SIDE OF GATE.  
3. HINGES AND LOCKS SHALL BE INSTALLED AS SPECIFIED BY GATE MANUFACTURER.


### 4 STRAND - HIGH TENSILE FENCING

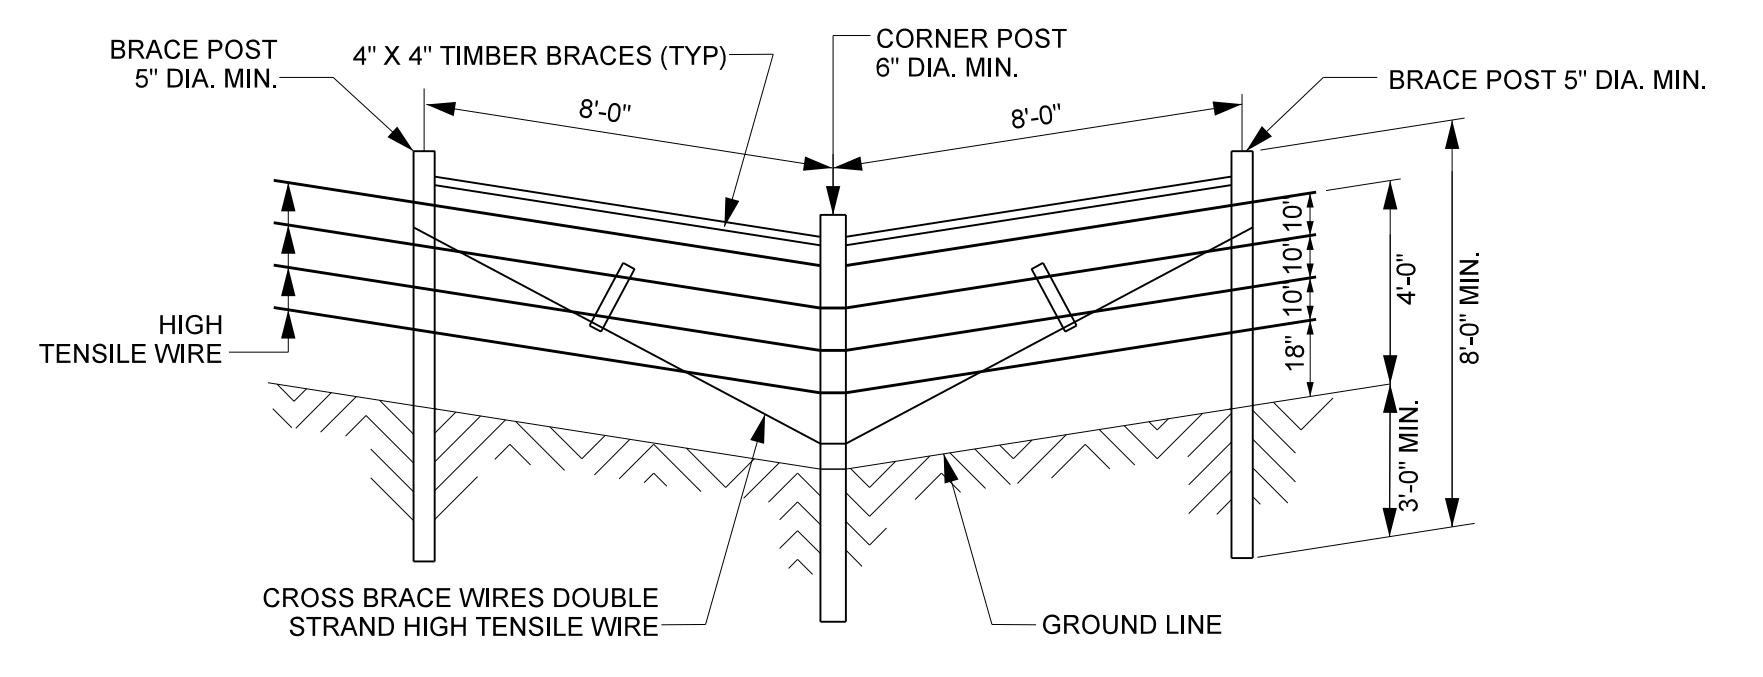


**CORNER AND VERTICAL CHANGE BRACING**  
INSTALL AT ALL POINTS WHERE FENCE ALIGNMENT CHANGES 15 DEGREES OR MORE

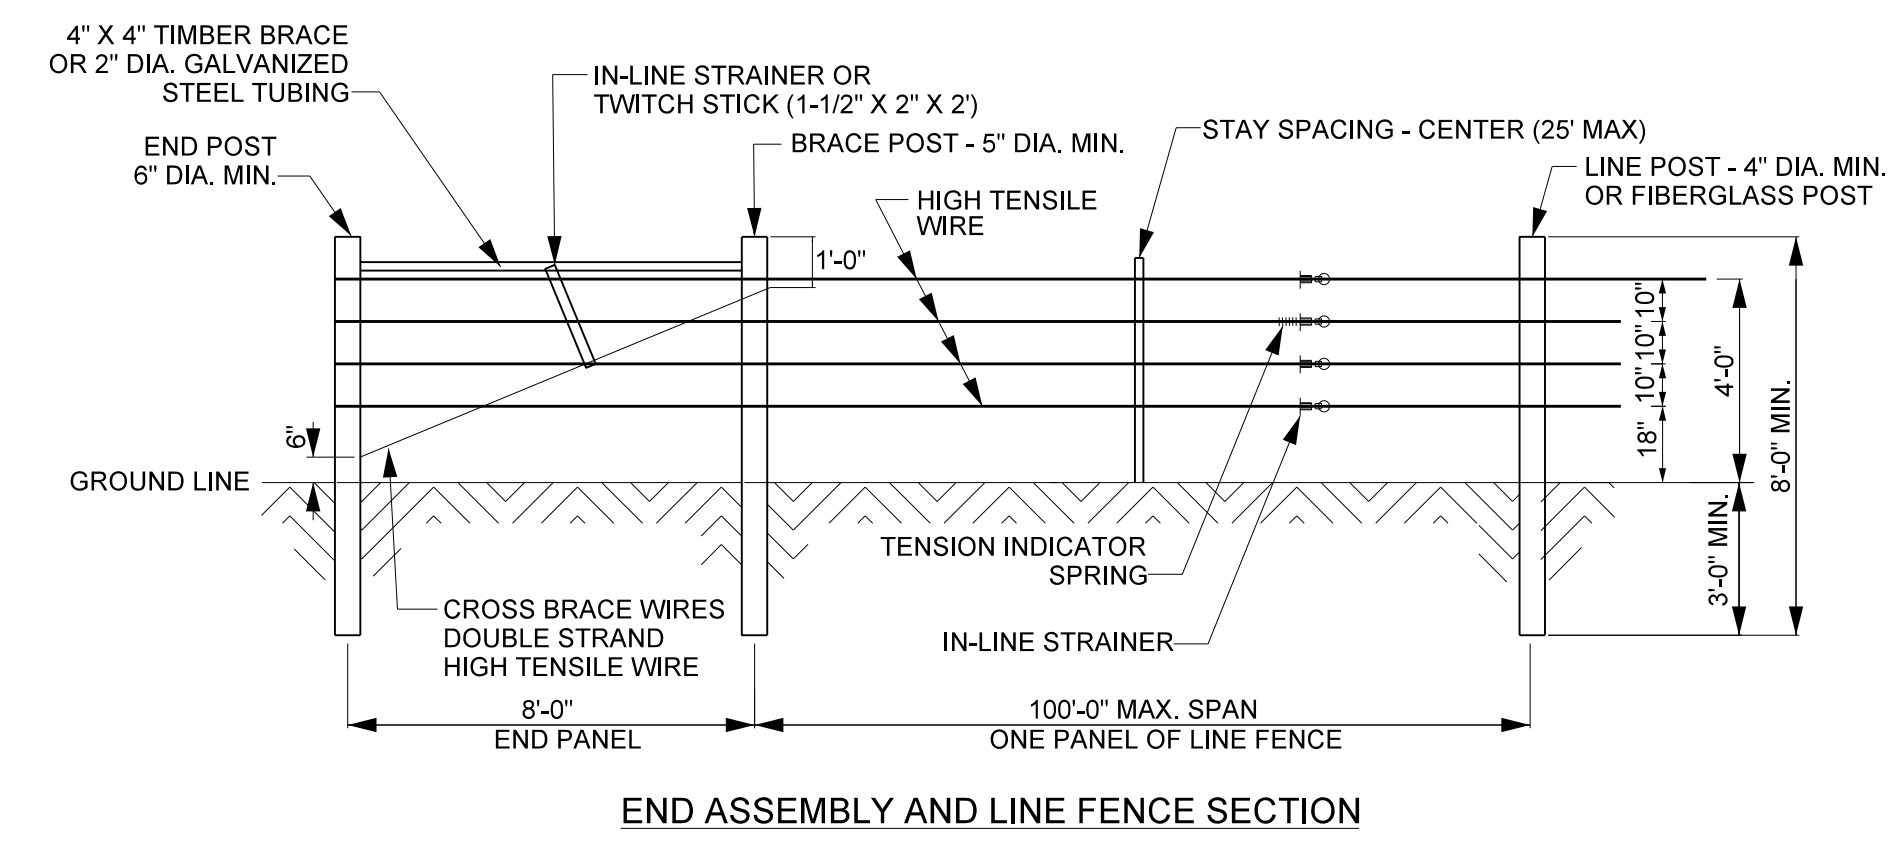

END ASSEMBLY AND LINE FENCE SECTION

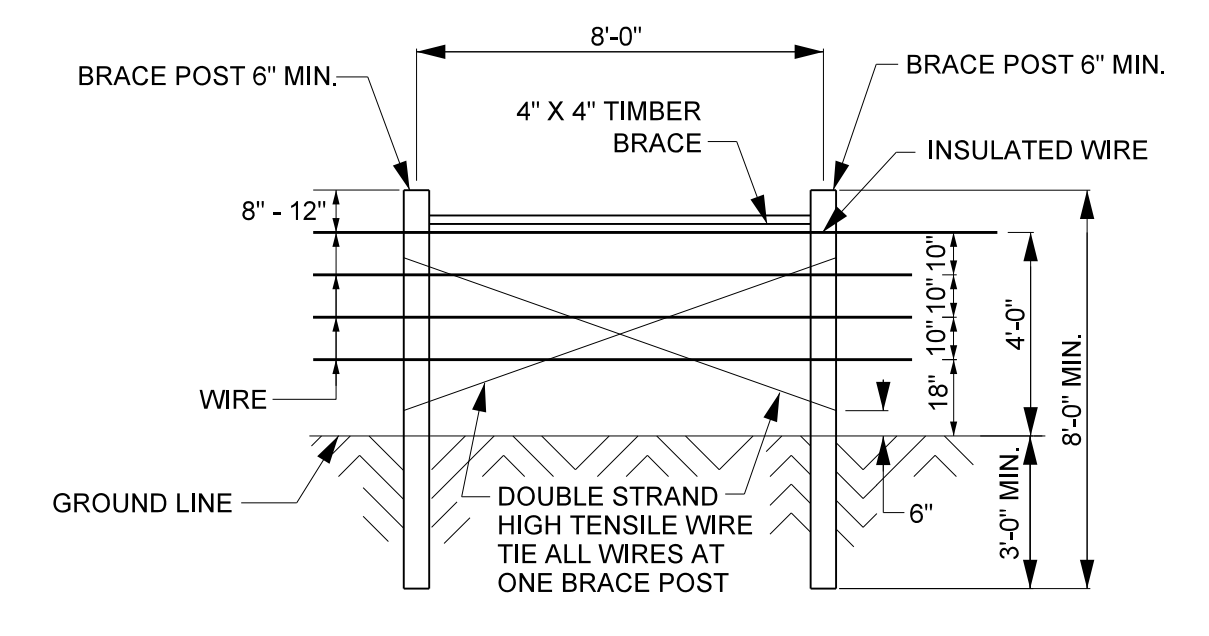

PULL POST ASSEMBLY

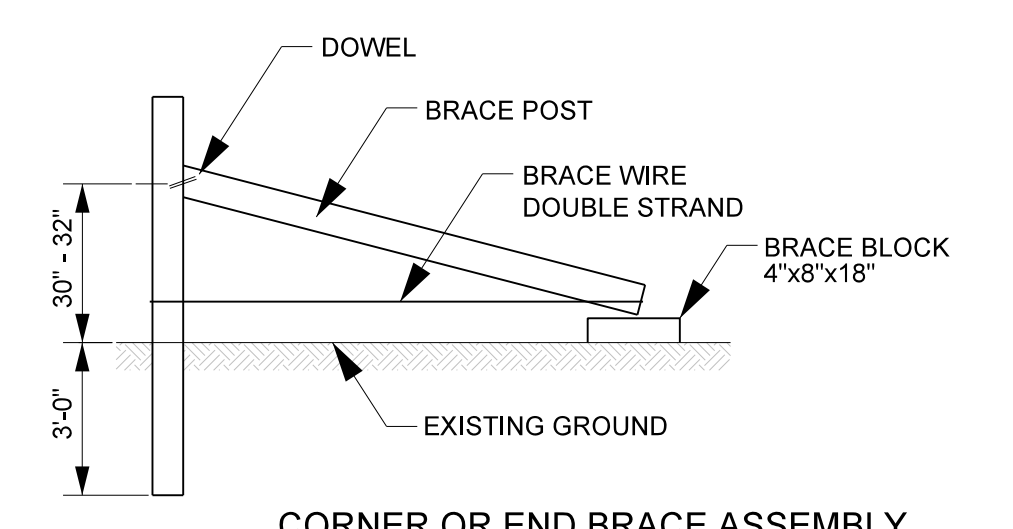

CORNER OR END BRACE ASSEMBLY

OPTIONAL FIGURE 4

PLACE IN FENCE LINE SO THAT MAXIMUM DISTANCE BETWEEN BRACED POSTS DOES NOT EXCEED 1320 FEET

- NOTES:**
- NOTCH POSTS 3/4" FOR 4" X 4" TIMBER BRACES.
  - DOWELS TO BE 1/2" DIA. X 5" PLAIN STEEL RODS. DRIVE DOWELS IN 7/16" DIA. HOLES, 2-1/2" INTO EACH POST AND TIMBER BRACE.
  - STAPLE CROSS-BRACE WIRES TO BRACE AND CORNER POSTS AT QUARTER POINTS OF THE POSTS.
  - HIGH TENSILE WIRE WILL BE NEW AND SMOOTH AND WILL MEET THE FOLLOWING  
1) TENSILE STRENGTH - 110,000 PSI 2) GALVANIZING - TYPE III 3) GAGE - 12-1/2.
  - ALL CORNER POSTS, BRACE POSTS, BRACES, AND STAY SPACERS, SHALL BE PRESSURE TREATED. PRESSURE TREATMENT SHALL CONFORM TO FEDERAL SPECIFICATION TT-W-571. (1-1/4" LONG FOR HARD WOODS).
  - AT CORNER POSTS, STAPLE EACH WIRE AT QUARTER POINTS OF POSTS. AT BRACE POSTS, DOUBLE STAPLE EACH WIRE. AT LINE POSTS, SECURE EACH WIRE WITH STANDARD CLAMPS.
  - FIBERGLASS MAY BE USED FOR LINE POSTS. THESE WILL CONSIST OF MARBLE, FIBERGLASS, AND POLYMER RESINS WHICH HAVE BEEN TREATED BY THERMOSETTING (HEAT TREATMENT). POSTS MUST BE DRIVEN IN THE SOIL AT LEAST 18 INCHES.
  - 2" DIAMETER PIPE DIAGONAL BRACE MAY BE USED IN PLACE OF HORIZONTAL TIMBER BRACE AND DIAGONAL WIRES.
  - MINIMUM NET RETENTION OF CHROMATED COPPER ARSENATE (CCA) FOR WOOD FENCE POSTS SHALL BE 0.40 POUNDS PER CUBIC FOOT.
  - A SINGLE 12 FOOT LONG, 6 INCH MINIMUM DIAMETER POST MAY BE SUBSTITUTED FOR END PANEL, CORNER AND VERTICAL CHANGE BRACING, AND PULL POST ASSEMBLY. THE 12 FOOT LONG POSTS SHALL EXTEND A MINIMUM OF 7.5 FEET INTO THE GROUND AND BE BACKFILLED WITH GRAVEL.
  - FOR FURTHER DETAILS ON APPROVED METHODS OF FENCE INSTALLATION, SEE NATURAL RESOURCE SERVICE'S CONSERVATION PRACTICE MATERIALS AND CONSTRUCTION SPECIFICATIONS FOR FENCING (CODE 382) BY NRCS NORTH CAROLINA (FEBRUARY 2008).


PROJECT REFERENCE NO. <b>157329</b>	SHEET NO. <b>2D</b>
PROJECT ENGINEER <b>Kathleen M. McKeithan</b>	
APPROVED BY:  9/11/2020	
DATE:	
<b>Michael Baker International</b> Michael Baker Engineering Inc. 8050 Regency Parkway, Suite 600 Cary, NORTH CAROLINA 27518 Phone: 919.463.5486 Fax: 919.463.5490 License #: F-1084	
<b>NC DMS ID NO. 100003</b>	

R:\157329\157329-1\_Russell\_Cap\Design\AS-BUILD\PLANS\157329\_AB-PSH-02D.dgn



2/26/20


### CHANNEL PLUG

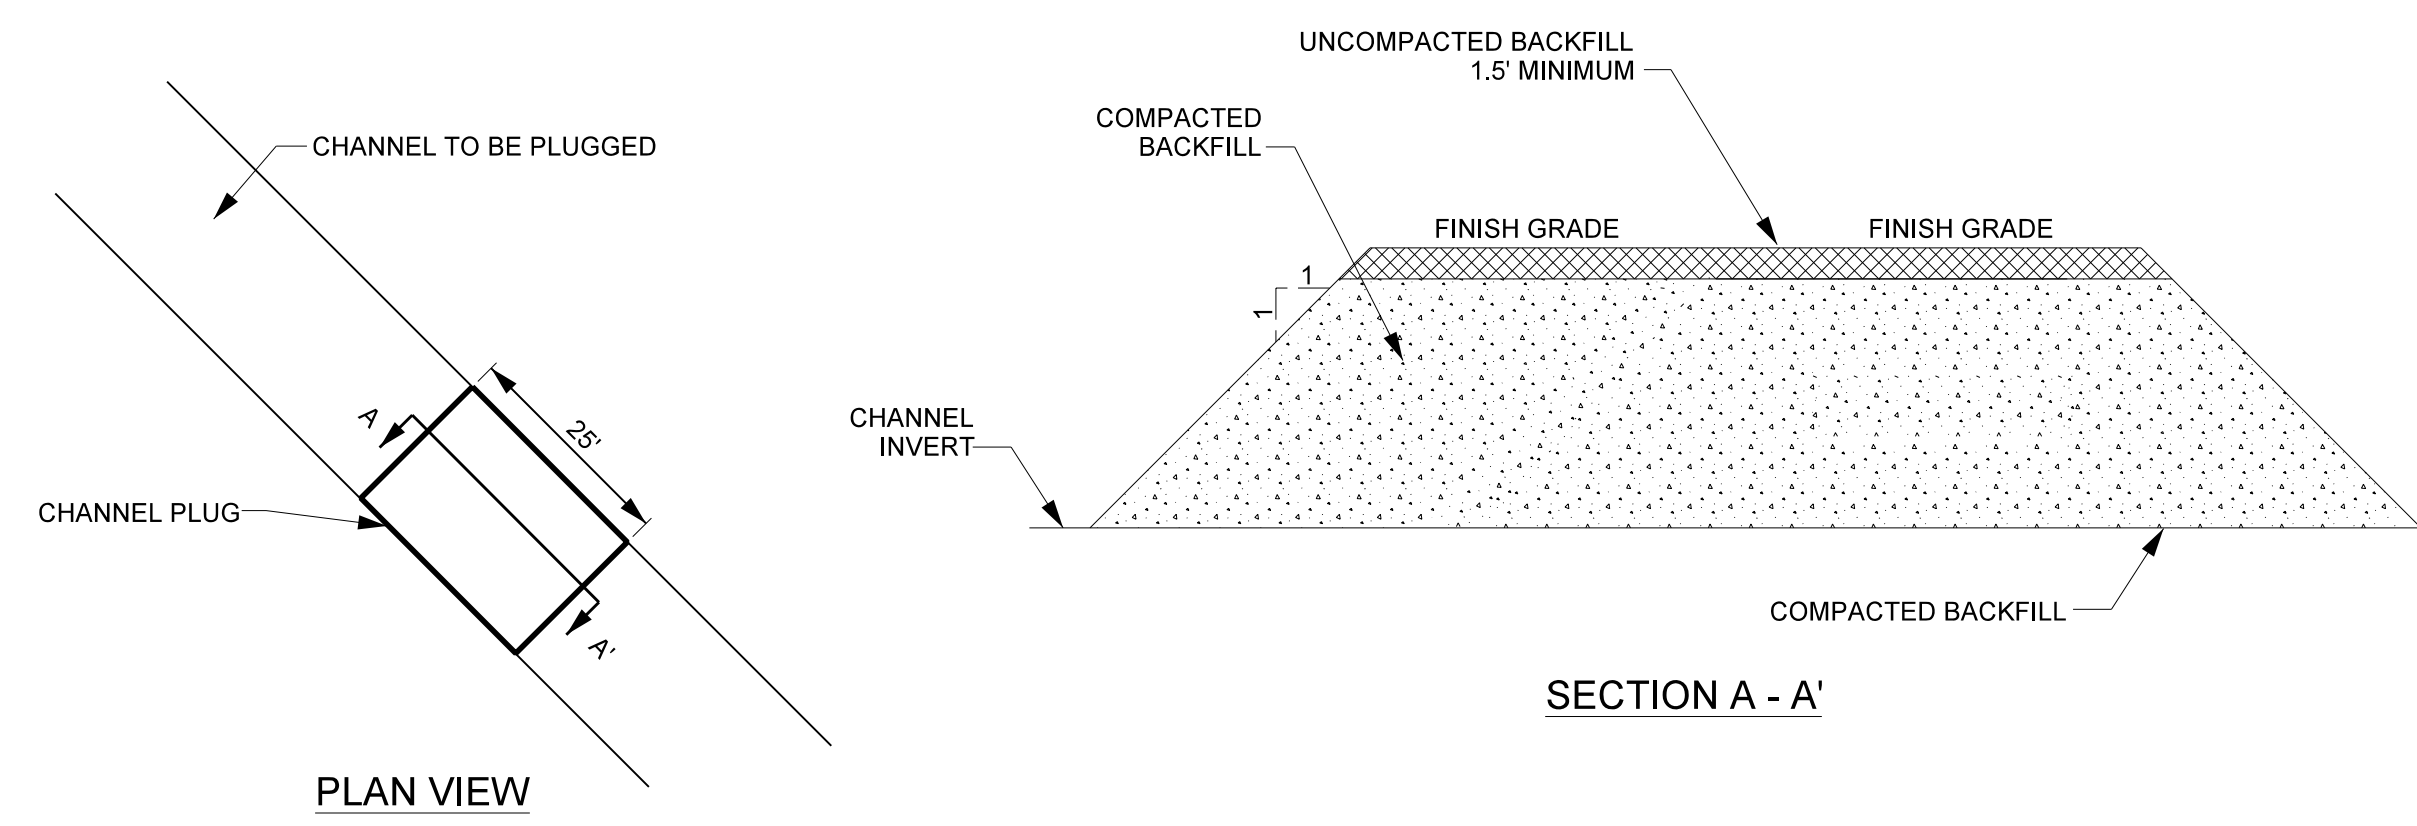

SECTION A - A'

**NOTE:**  
COMPACT BACKFILL USING ON-SITE HEAVY EQUIPMENT IN 10 INCH LIFTS.

### PERMANENT STREAM CROSSING

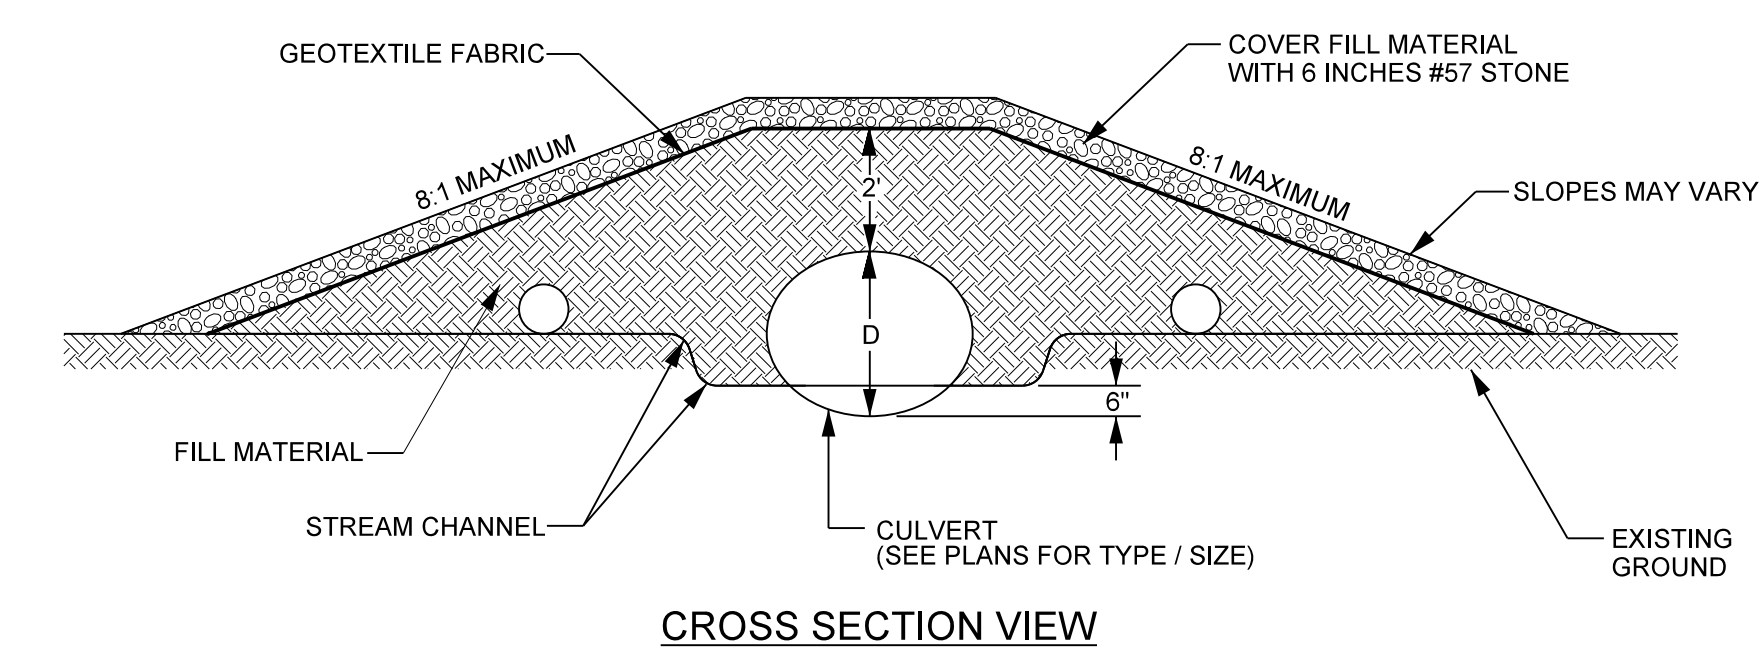

CROSS SECTION VIEW


- NOTES:**
1. SIZE DIMENSIONS SHOWN ON PLANS.
  2. APPLY SUFFICIENT FILL (18" MIN) OVER CULVERT TO PREVENT COLLAPSE.
  3. STABILIZE SIDE SLOPES WITH EROSION CONTROL MATTING AND FILL AROUND CULVERTS WITH CLASS II STONE.
  4. INSTALL HEADWALLS AND ENDWALLS AS SHOWN ON THE PLANS.

PROJECT REFERENCE NO. <b>157329</b>	SHEET NO. <b>2E</b>
PROJECT ENGINEER	
DocuSigned by: <b>Kathleen M. McKeithan</b>	
APPROVED BY:	
9/11/2020	
DATE:	
<b>Michael Baker International</b>	
<small>Michael Baker Engineering Inc. 8000 Regency Parkway, Suite 600 Cary, NORTH CAROLINA 27518 Phone: 919.463.5486 Fax: 919.463.5490 License #: F-1084</small>	
<b>NCDMS ID NO. 100003</b>	

8/15/2020 8:37:29 AM Russell, C. Design, VAS-BUILD PLANS\157329\_AB-PSH-02E.dgn



2/26/2023

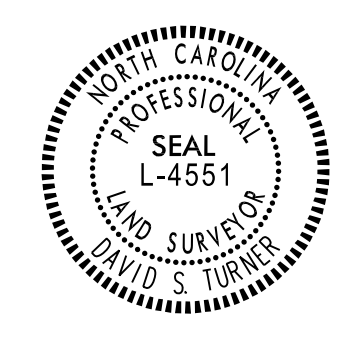



DocuSigned by:  
*David S. Turner*  
1C85EAD9AC6A6E

APPROVED BY:  
  
9/11/2020  
  
DATE:

**Michael Baker** International  
Michael Baker Engineering Inc.  
5000 Regency Parkway, Suite 500  
Cary, NORTH CAROLINA 27518  
Phone: 919.453.5488  
Fax: 919.453.5490  
License #: F-1084

NC DMS ID NO. 100003

- NOTES:
1. ANY HARDWOOD TREES REMOVED MUST BE INCORPORATED WITHIN THE STRUCTURES BEING INSTALLED.
  2. EXCAVATE STREAMBED MATERIAL BEFORE FILLING IN THE OLD CHANNEL AND USE STREAMBED MATERIAL WITHIN THE NEWLY CONSTRUCTED CHANNEL.
  3. CONTRACTOR CAN USE BRUSH MATERIAL TO INCORPORATE WITHIN THE CONSTRUCTED RIFFLES AND BRUSH TOES ALONG MEANDER BENDS.
  4. FENCING INSIDE EASEMENT WILL BE REMOVED AND HAULED OFF-SITE BY THE CONTRACTOR.
  5. ANY AREA THAT HAS BEEN GRADED MUST HAVE POSITIVE DRAINAGE, UNLESS OTHERWISE DIRECTED BY ENGINEER.
  6. AREAS OF BENCHING: CONTRACTOR WILL EXCAVATE THE TOPSOIL, STOCKPILE IT, AND THEN ADD THE TOPSOIL AS TOP LAYER OF BENCH TO A DEPTH OF AT LEAST 8 INCHES.
  7. CONTRACTOR WILL CONTROL ANY INVASIVE SPECIES WITHIN EASEMENT.
  8. LOCATIONS OF BOULDER STEPS AND GRADE CONTROL STRUCTURES ARE SUBJECT TO CHANGE BASED ON FIELD CONDITIONS AND BY THE DIRECTION OF THE ENGINEER.
  9. CONTRACTOR SHALL INCORPORATE SOIL WITHIN THE CONSTRUCTED RIFFLES ALONG ALL STEEP HEADWATER TRIBUTARIES TO REDUCE PERMEABILITY AND KEEP SURFACE FLOW.
  10. WHERE DESIGN PROFILE OF STEEP HEADWATER CHANNELS DIVIATES FROM THE EXISTING PROFILE, CONTRACTOR SHALL SLOPE STREAM BANKS AT 2:1 AS NECESSARY TO TIE TO EXISTING GROUND.

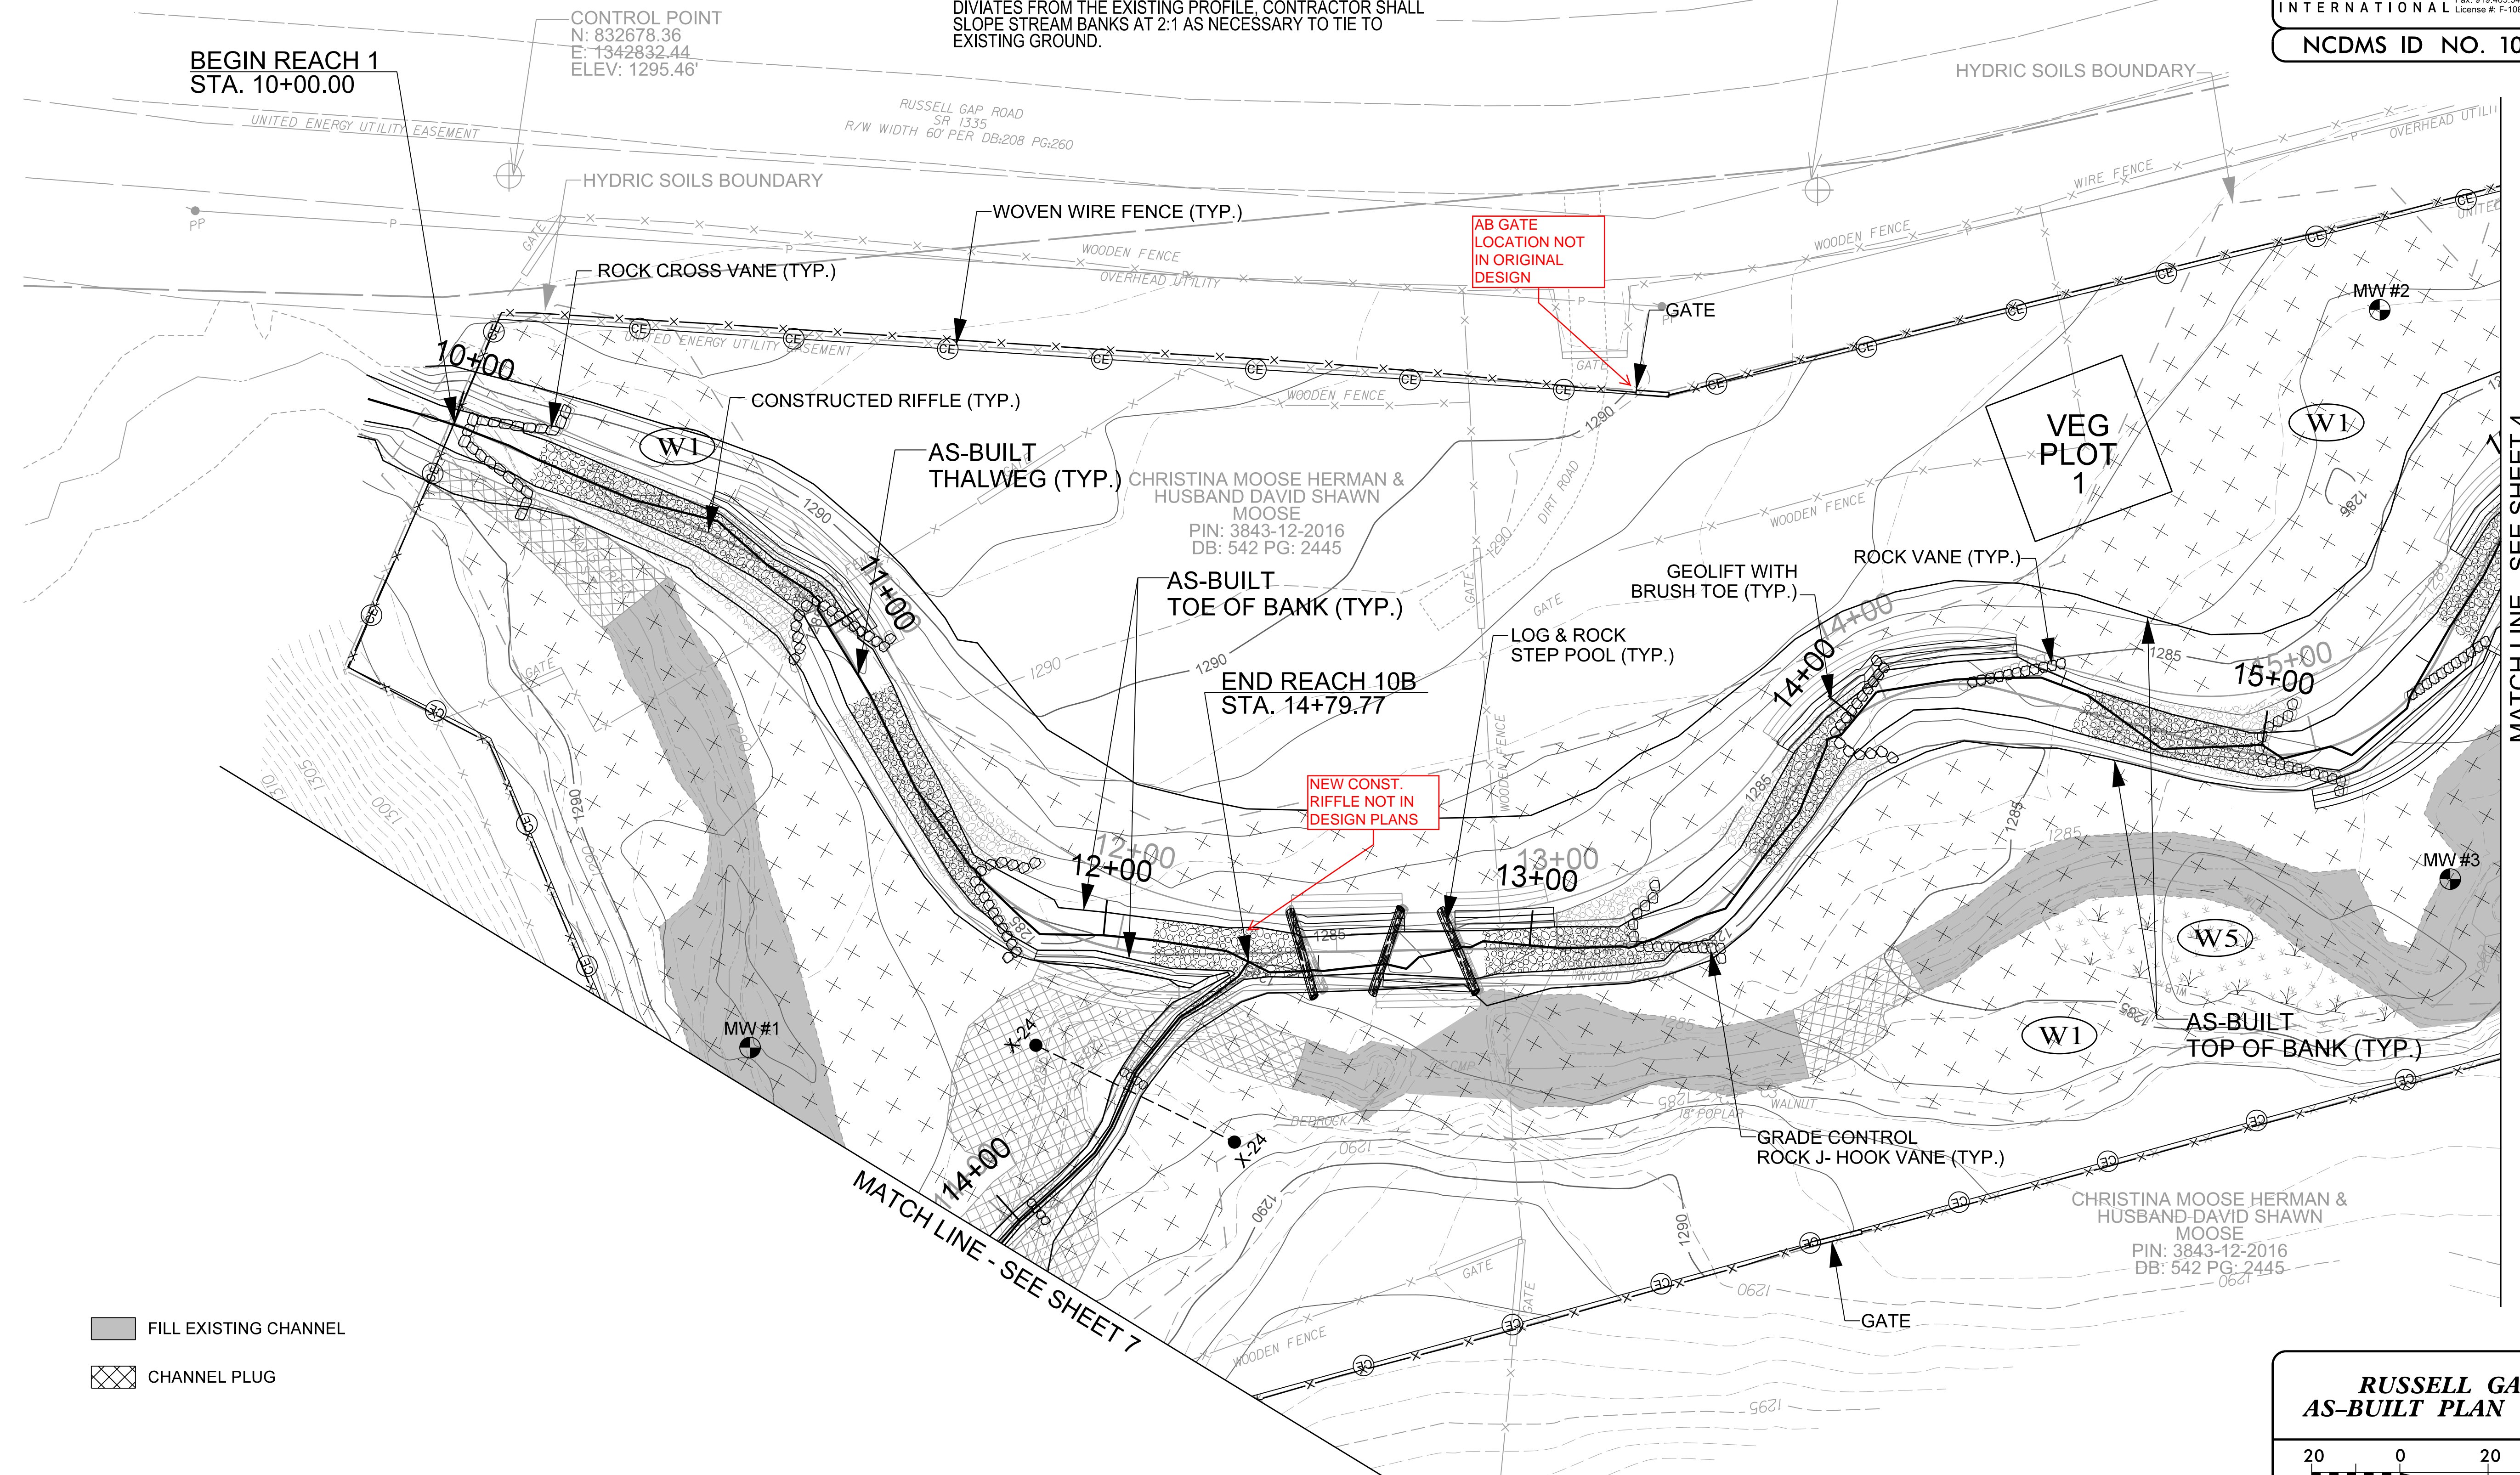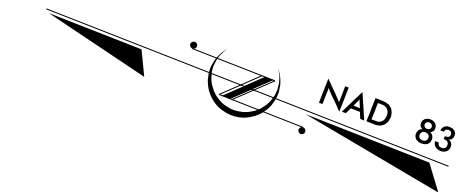

■ FILL EXISTING CHANNEL  
 ▨ CHANNEL PLUG

**RUSSELL GAP AS-BUILT PLAN VIEW**

SCALE (FT)


R:\157329\_Russell1\_Cap\Design\AS-BUILT\PLANS\157329\_AB-PSH-03.dgn  
 8/15/2020 8:15:29 AM




2/26/2023



1. ANY HARDWOOD TREES REMOVED MUST BE INCORPORATED WITHIN THE STRUCTURES BEING INSTALLED.
2. EXCAVATE STREAMBED MATERIAL BEFORE FILLING IN THE OLD CHANNEL AND USE STREAMBED MATERIAL WITHIN THE NEWLY CONSTRUCTED CHANNEL.
3. CONTRACTOR CAN USE BRUSH MATERIAL TO INCORPORATE WITHIN THE CONSTRUCTED RIFFLES AND BRUSH TOES ALONG MEANDER BENDS.
4. FENCING INSIDE EASEMENT WILL BE REMOVED AND HAULED OFF-SITE BY THE CONTRACTOR.
5. ANY AREA THAT HAS BEEN GRADED MUST HAVE POSITIVE DRAINAGE, UNLESS OTHERWISE DIRECTED BY ENGINEER.

- NOTES:
6. AREAS OF BENCHING: CONTRACTOR WILL EXCAVATE THE TOPSOIL, STOCKPILE IT, AND THEN ADD THE TOPSOIL AS TOP LAYER OF BENCH TO A DEPTH OF AT LEAST 8 INCHES.
  7. CONTRACTOR WILL CONTROL ANY INVASIVE SPECIES WITHIN EASEMENT.
  8. LOCATIONS OF BOULDER STEPS AND GRADE CONTROL STRUCTURES ARE SUBJECT TO CHANGE BASED ON FIELD CONDITIONS AND BY THE DIRECTION OF THE ENGINEER.
  9. CONTRACTOR SHALL INCORPORATE SOIL WITHIN THE CONSTRUCTED RIFFLES ALONG ALL STEEP HEADWATER TRIBUTARIES TO REDUCE PERMEABILITY AND KEEP SURFACE FLOW.
  10. WHERE DESIGN PROFILE OF STEEP HEADWATER CHANNELS DIVERGES FROM THE EXISTING PROFILE, CONTRACTOR SHALL SLOPE STREAM BANKS AT 2:1 AS NECESSARY TO TIE TO EXISTING GROUND.

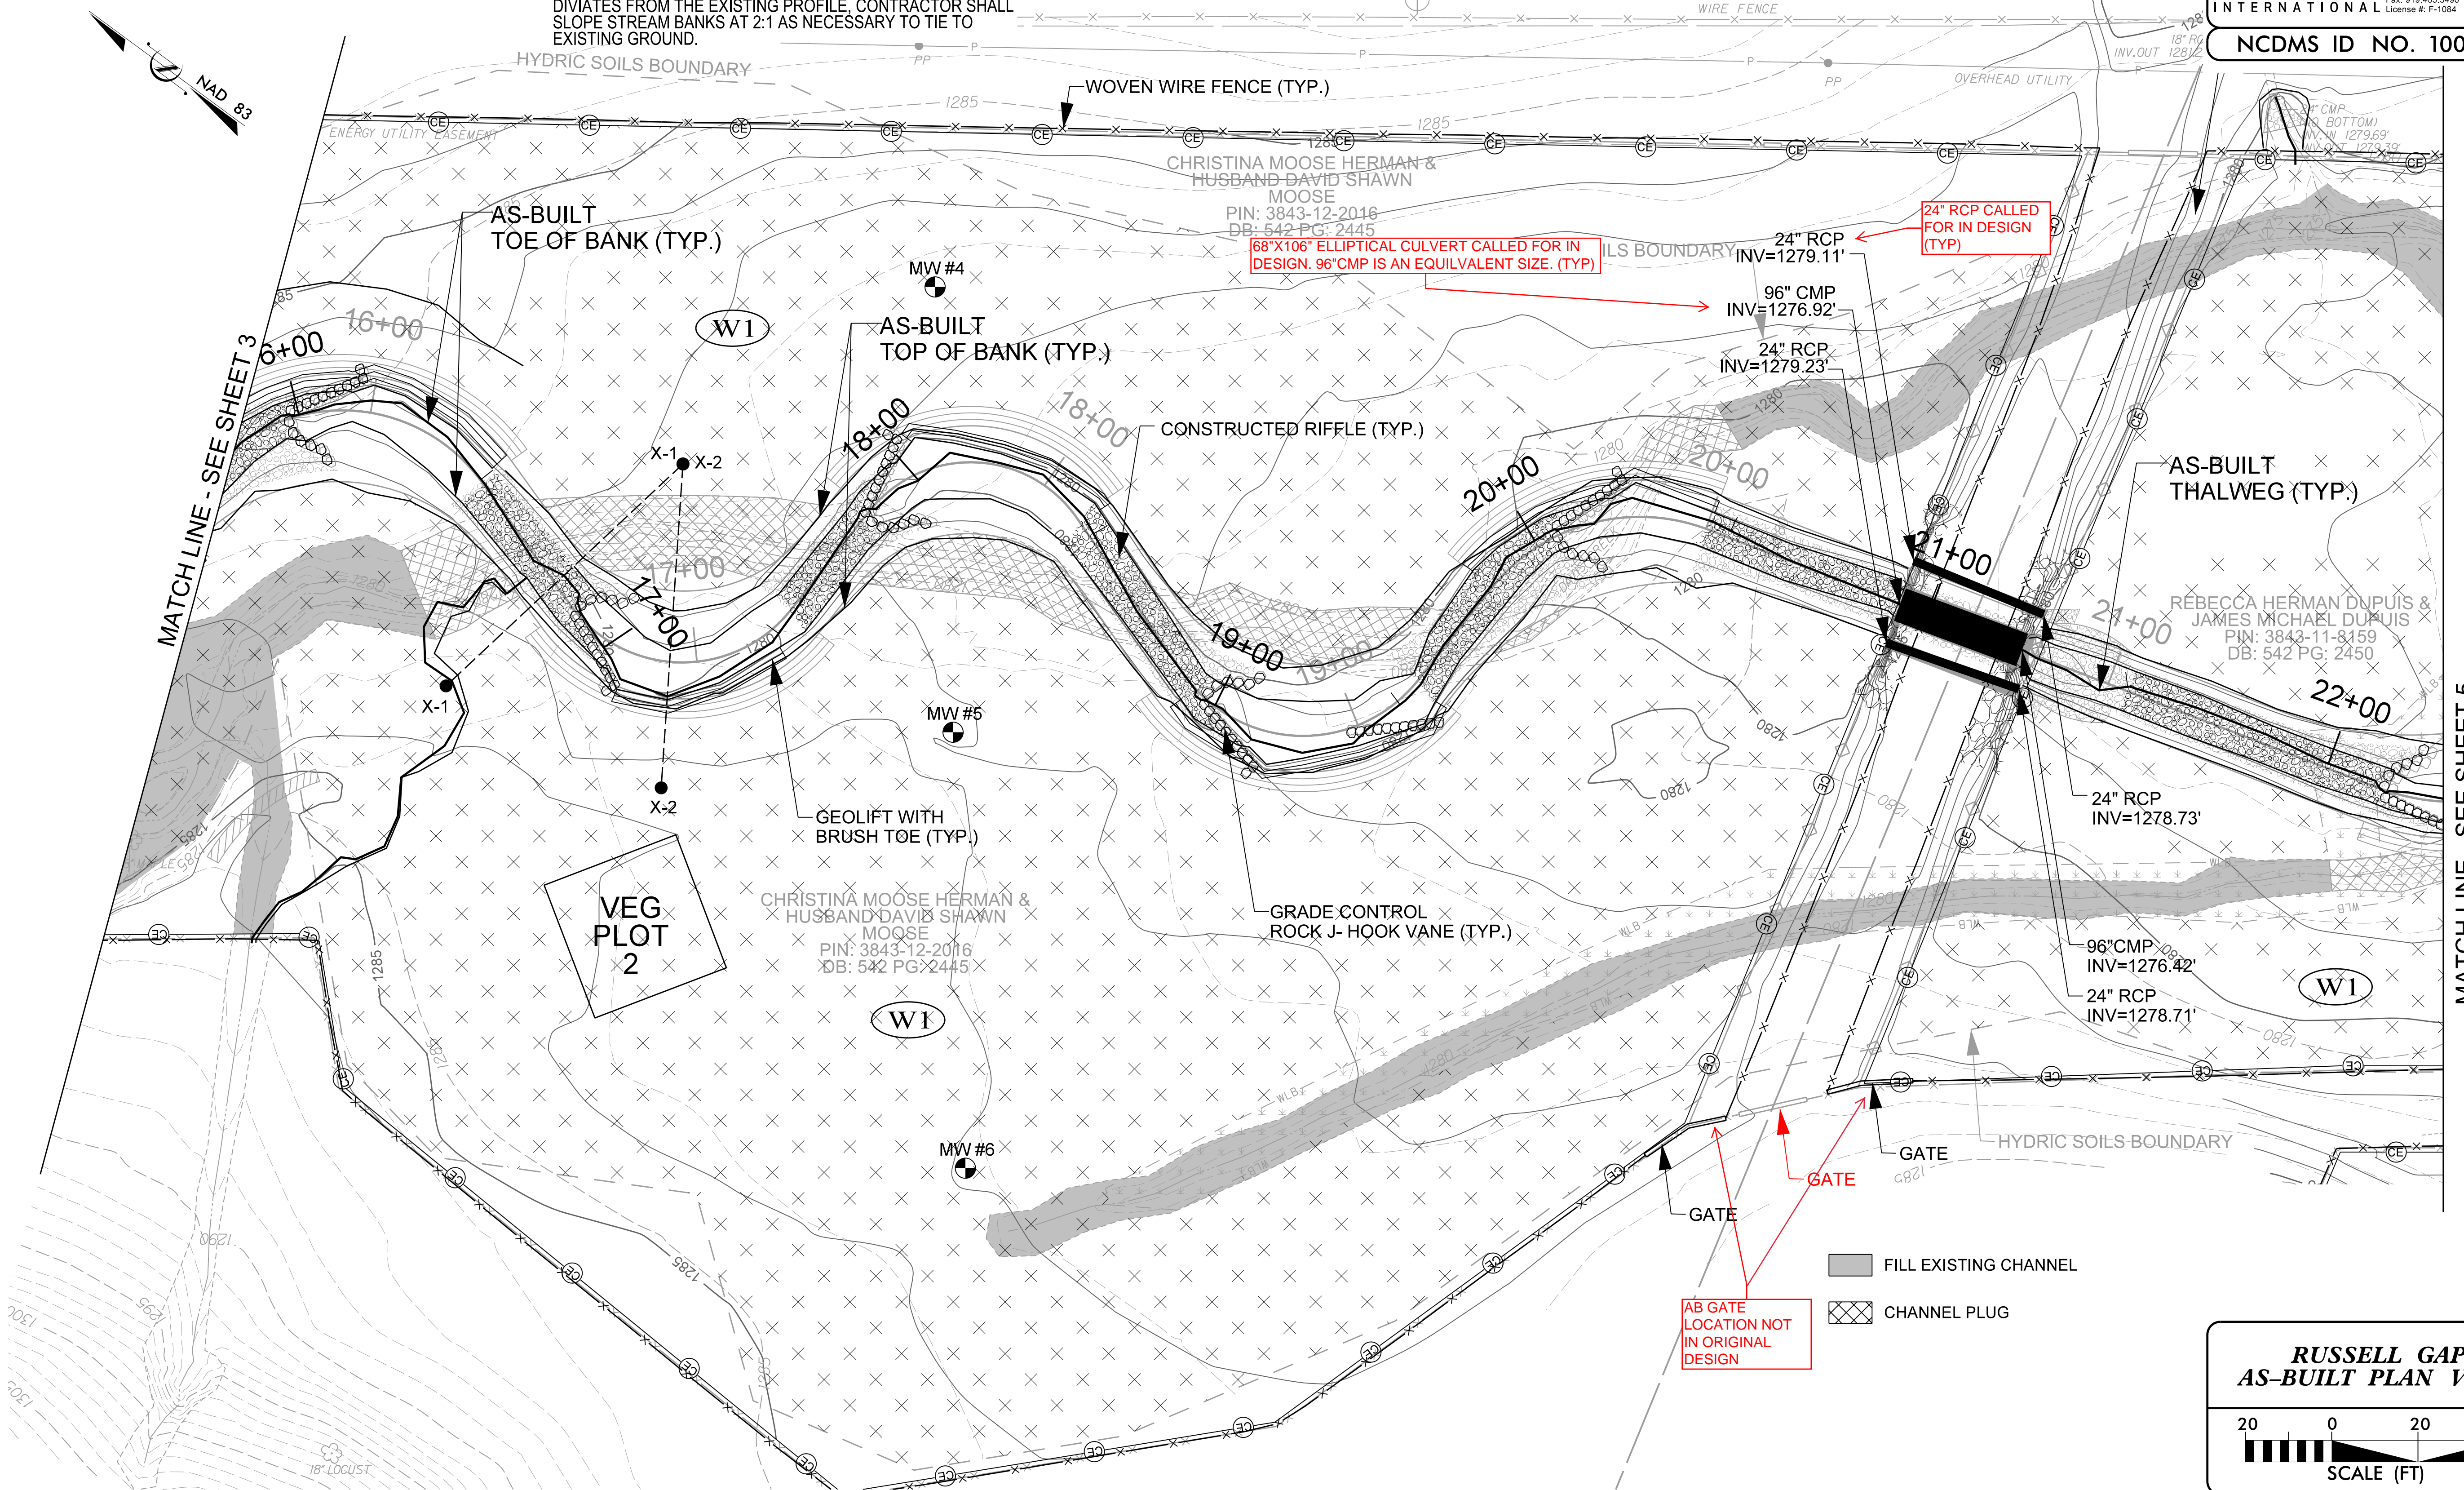
BAKER PROJECT REFERENCE NO. 157329	SHEET NO. 4
Documented by: <i>David S. Junner</i> APPROVED BY:  9/11/2020 DATE:	
	
<b>Michael Baker International</b>	
Michael Baker Engineering Inc. 5000 Regency Parkway, Suite 600 Cary, NORTH CAROLINA 27518 Phone: 919.453.5488 Fax: 919.453.5490 License #: F-1084	
<b>NC DMS ID NO. 100003</b>	



AB GATE LOCATION NOT IN ORIGINAL DESIGN

-  FILL EXISTING CHANNEL
-  CHANNEL PLUG

**RUSSELL GAP AS-BUILT PLAN VIEW**




SCALE (FT)

8/15/2020 - Russell1\_Cap\_Design\_VAS-BUILD\_PLANS\157329\_AB-PSH-04.dgn  
 2/26/2023

MATCH LINE - SEE SHEET 3



MATCH LINE - SEE SHEET 5




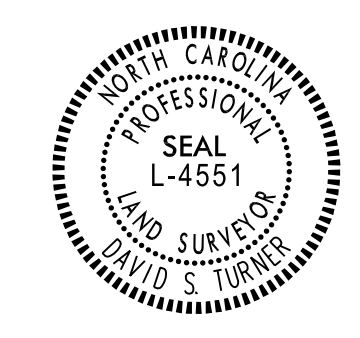


DocuSigned by:  
*David S. Turner*  
APPROVED BY:  
  
9/11/2020  
DATE:

**Michael Baker International**  
Michael Baker Engineering Inc.  
5030 Regency Parkway, Suite 600  
Cary, NORTH CAROLINA 27518  
Phone: 919.453.5488  
Fax: 919.453.5490  
License #: F-1084  
NCDMS ID NO. 100003

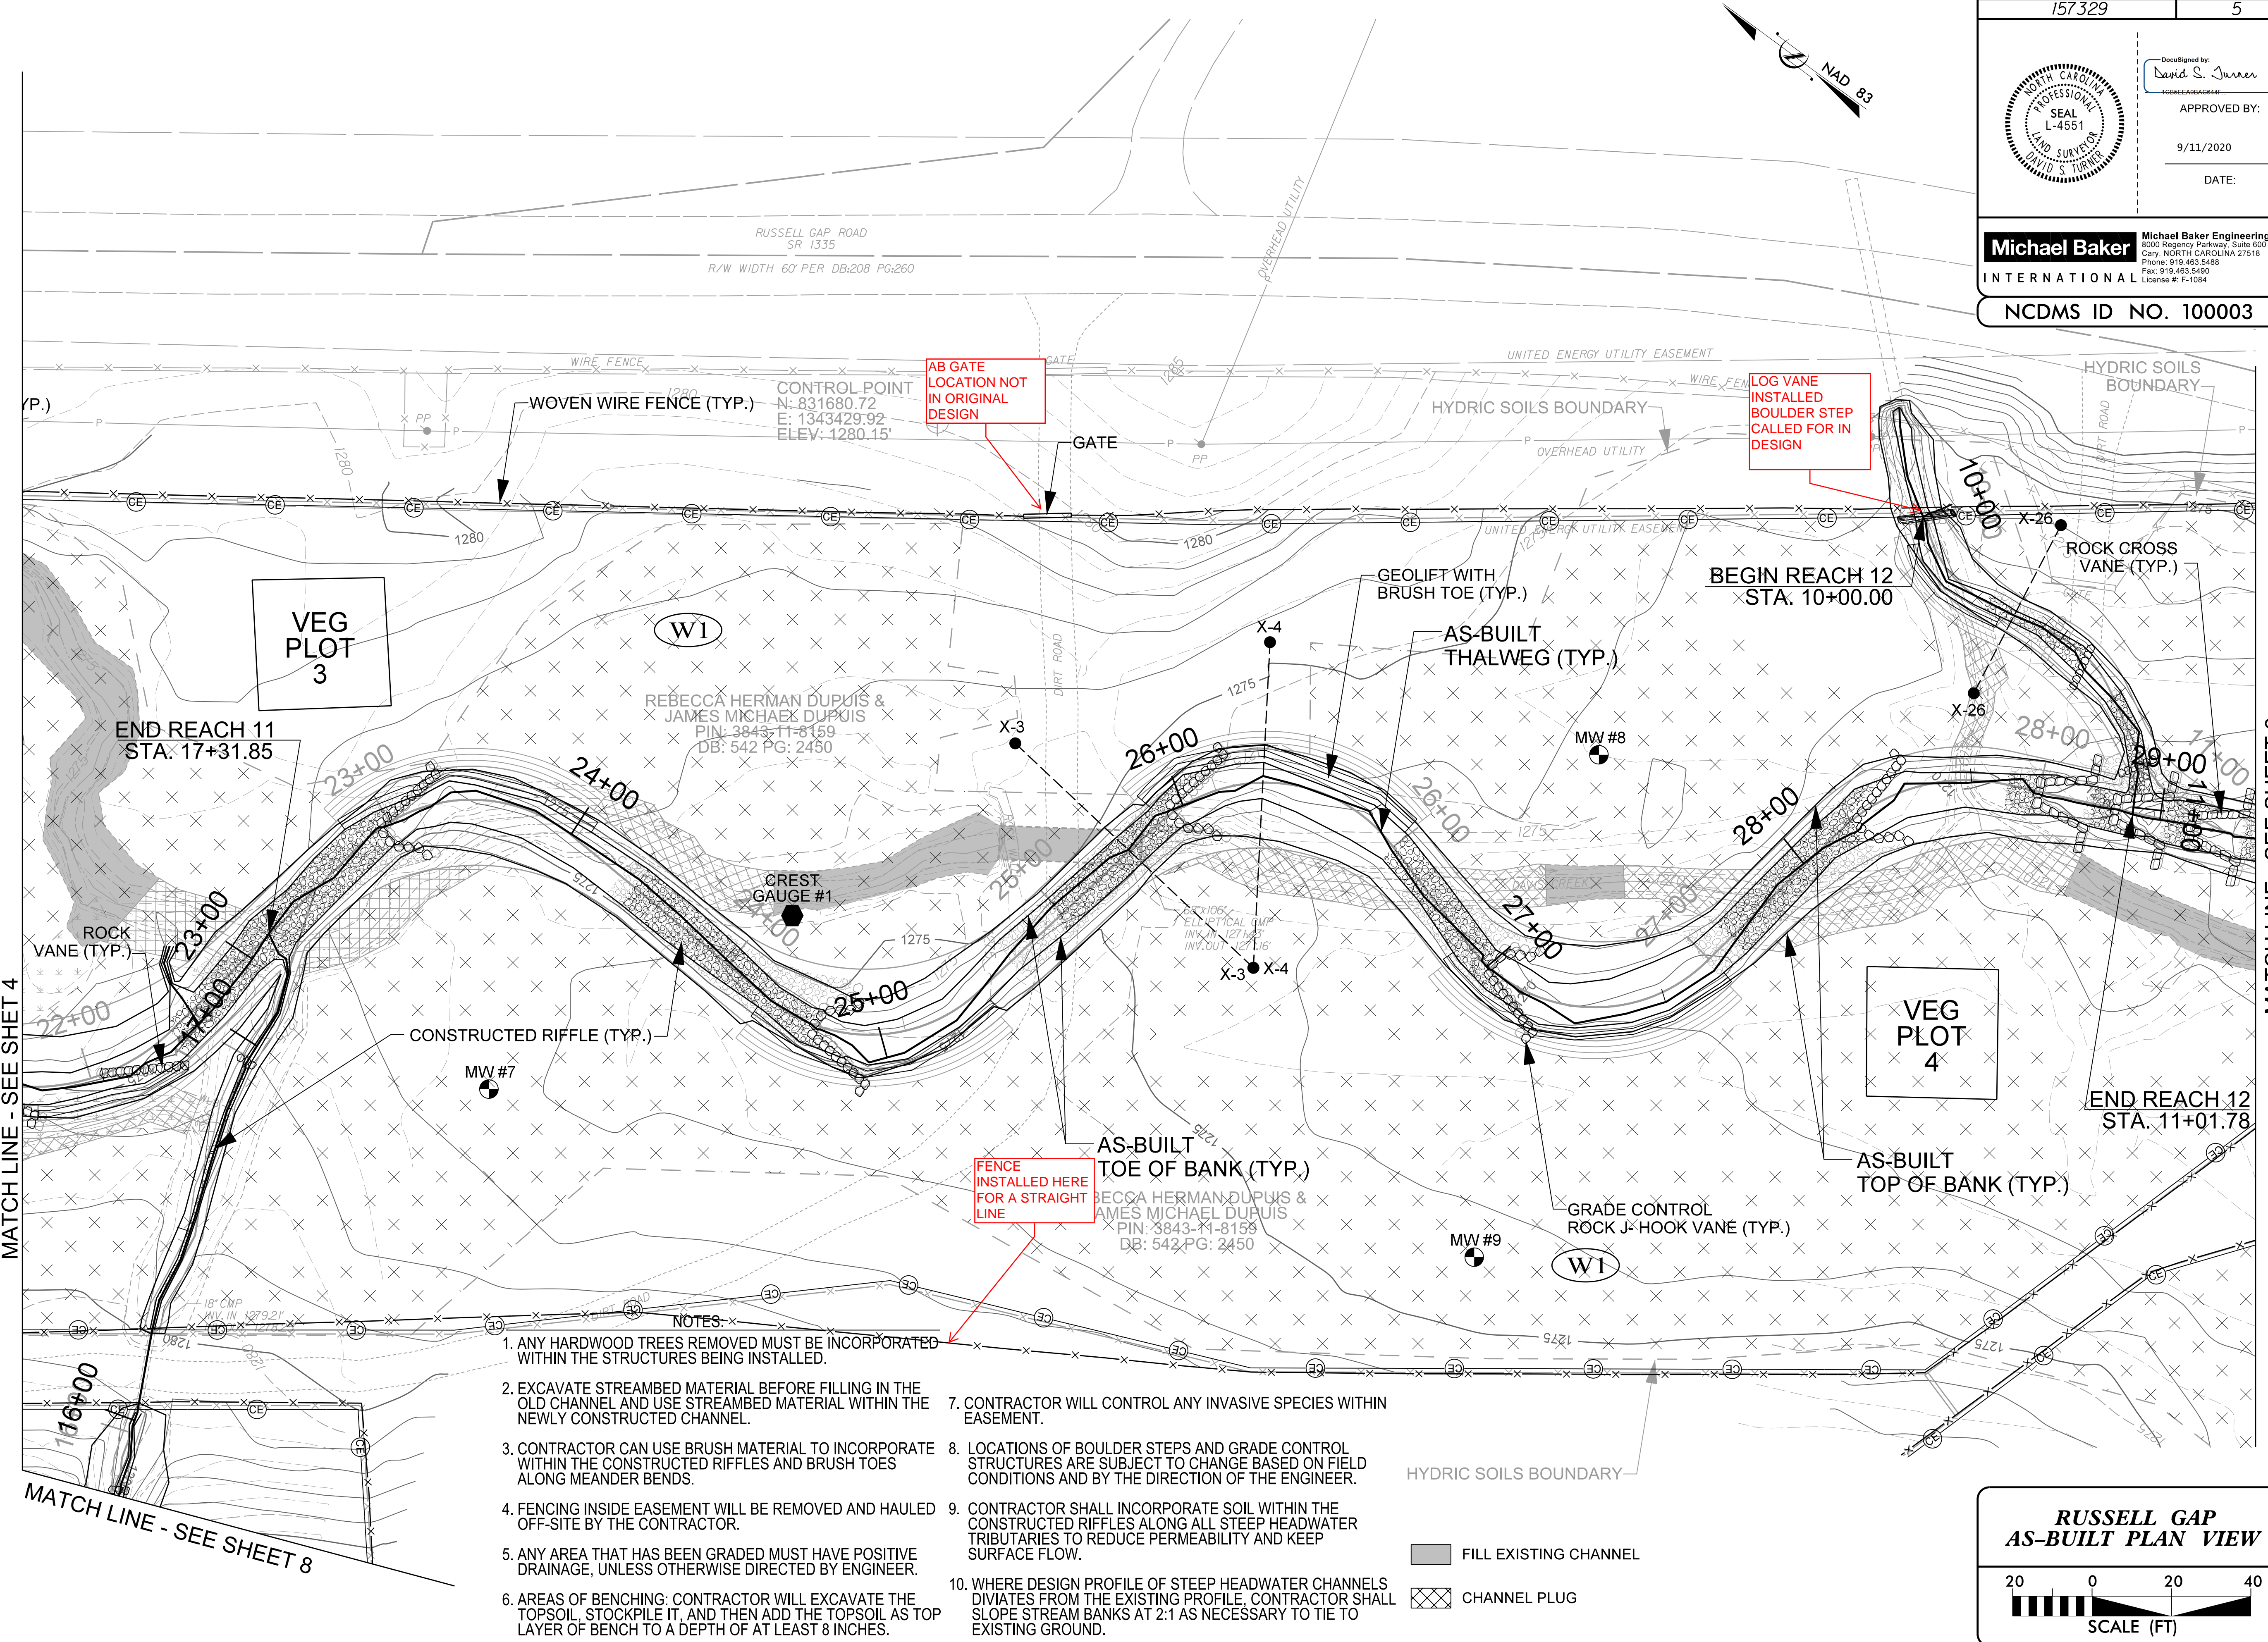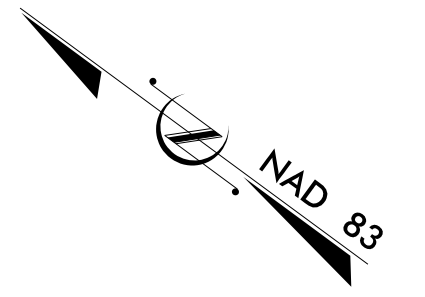

- NOTES**
1. ANY HARDWOOD TREES REMOVED MUST BE INCORPORATED WITHIN THE STRUCTURES BEING INSTALLED.
  2. EXCAVATE STREAMBED MATERIAL BEFORE FILLING IN THE OLD CHANNEL AND USE STREAMBED MATERIAL WITHIN THE NEWLY CONSTRUCTED CHANNEL.
  3. CONTRACTOR CAN USE BRUSH MATERIAL TO INCORPORATE WITHIN THE CONSTRUCTED RIFFLES AND BRUSH TOES ALONG MEANDER BENDS.
  4. FENCING INSIDE EASEMENT WILL BE REMOVED AND HAULED OFF-SITE BY THE CONTRACTOR.
  5. ANY AREA THAT HAS BEEN GRADED MUST HAVE POSITIVE DRAINAGE, UNLESS OTHERWISE DIRECTED BY ENGINEER.
  6. AREAS OF BENCHING: CONTRACTOR WILL EXCAVATE THE TOPSOIL, STOCKPILE IT, AND THEN ADD THE TOPSOIL AS TOP LAYER OF BENCH TO A DEPTH OF AT LEAST 8 INCHES.
  7. CONTRACTOR WILL CONTROL ANY INVASIVE SPECIES WITHIN EASEMENT.
  8. LOCATIONS OF BOULDER STEPS AND GRADE CONTROL STRUCTURES ARE SUBJECT TO CHANGE BASED ON FIELD CONDITIONS AND BY THE DIRECTION OF THE ENGINEER.
  9. CONTRACTOR SHALL INCORPORATE SOIL WITHIN THE CONSTRUCTED RIFFLES ALONG ALL STEEP HEADWATER TRIBUTARIES TO REDUCE PERMEABILITY AND KEEP SURFACE FLOW.
  10. WHERE DESIGN PROFILE OF STEEP HEADWATER CHANNELS DIVIATES FROM THE EXISTING PROFILE, CONTRACTOR SHALL SLOPE STREAM BANKS AT 2:1 AS NECESSARY TO TIE TO EXISTING GROUND.

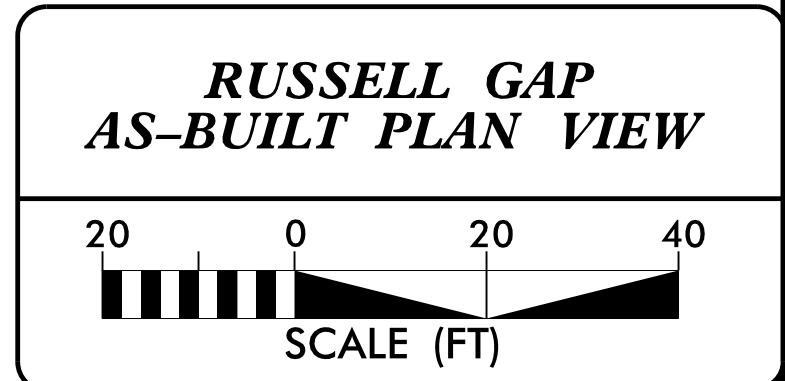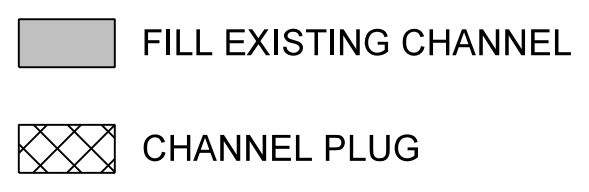

8/15/2020 - Russell1\_Cap\_Udesign\_VAS-BUILD\_PLANS\157329\_AB-PSH-05.dgn

MATCH LINE - SEE SHET 4

MATCH LINE - SEE SHEET 8

MATCH LINE - SEE SHEET 6





2/26/20



DocuSigned by:  
*David S. Turner*  
APPROVED BY:  
9/11/2020  
DATE:

**Michael Baker International** Michael Baker Engineering Inc.  
5030 Regency Parkway, Suite 600  
Cary, NORTH CAROLINA 27518  
Phone: 919.453.5488  
Fax: 919.453.5490  
License #: F-1084

**NCDMS ID NO. 100003**

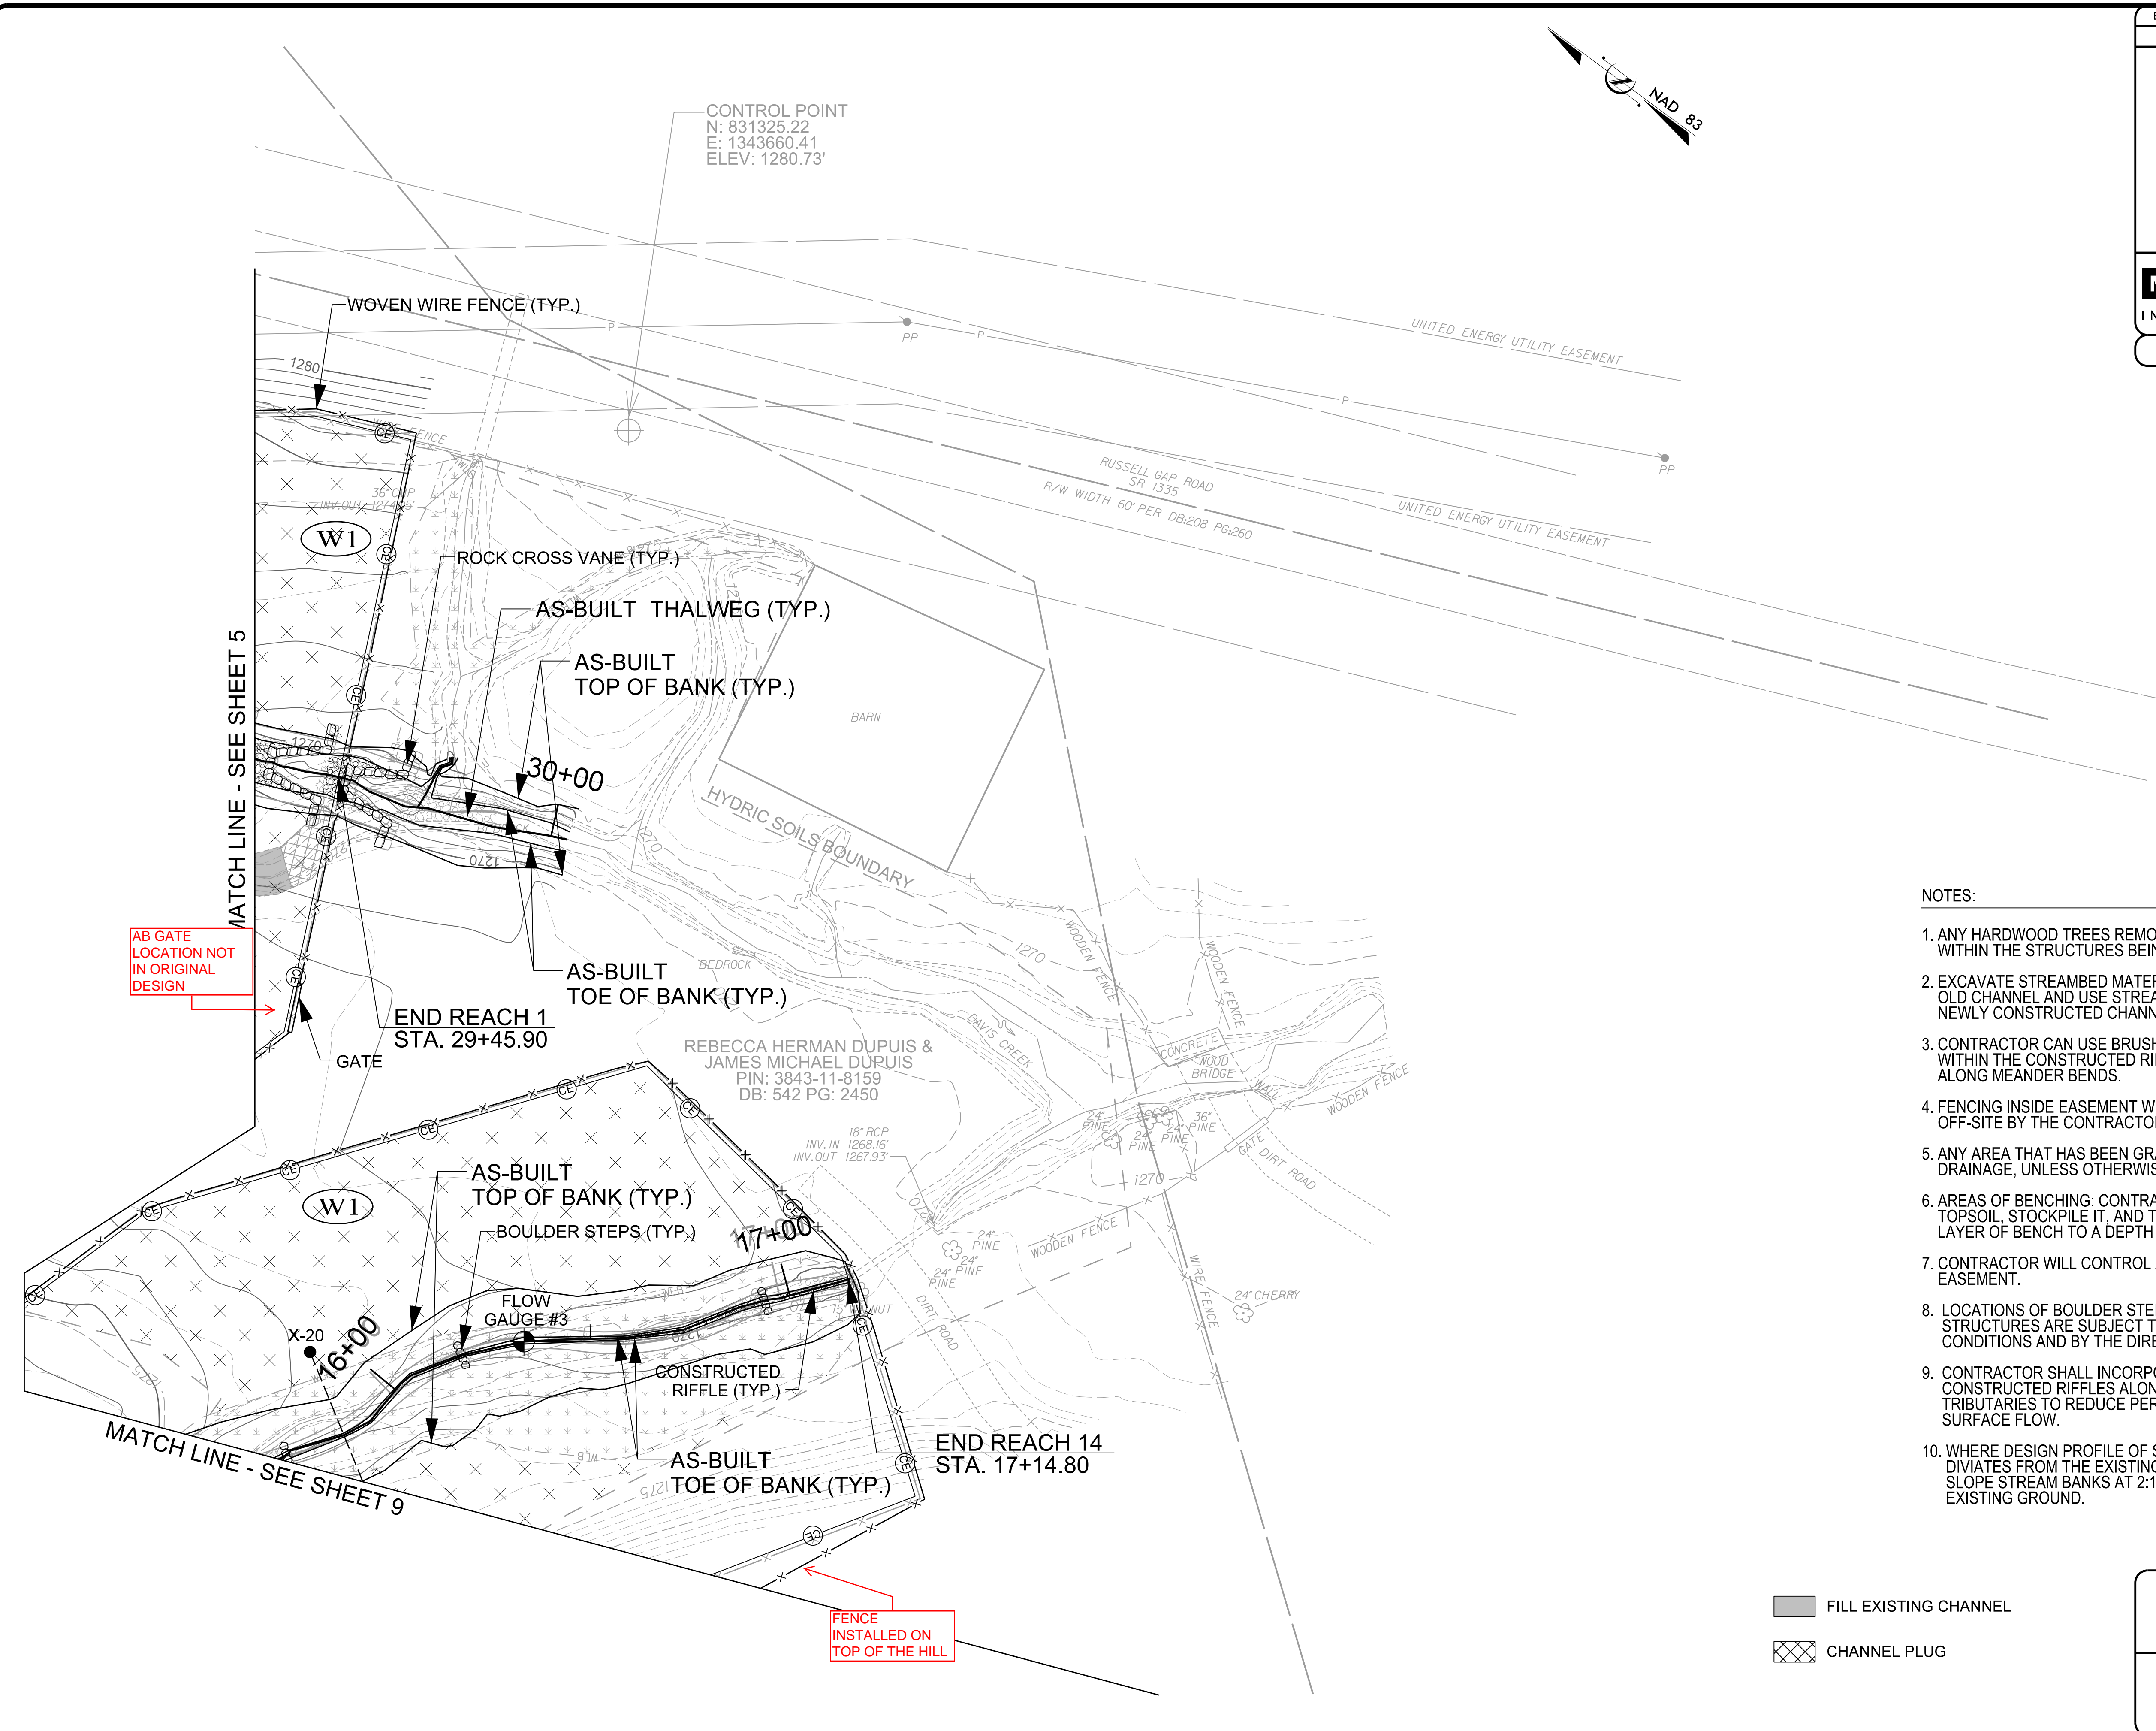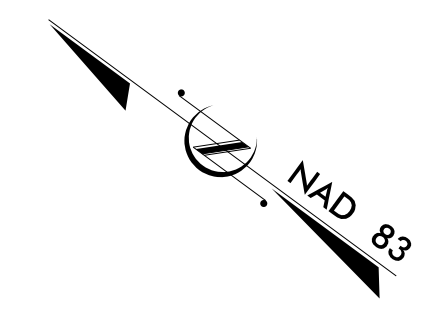


AB GATE LOCATION NOT IN ORIGINAL DESIGN

FENCE INSTALLED ON TOP OF THE HILL

**NOTES:**

1. ANY HARDWOOD TREES REMOVED MUST BE INCORPORATED WITHIN THE STRUCTURES BEING INSTALLED.
2. EXCAVATE STREAMBED MATERIAL BEFORE FILLING IN THE OLD CHANNEL AND USE STREAMBED MATERIAL WITHIN THE NEWLY CONSTRUCTED CHANNEL.
3. CONTRACTOR CAN USE BRUSH MATERIAL TO INCORPORATE WITHIN THE CONSTRUCTED RIFFLES AND BRUSH TOES ALONG MEANDER BENDS.
4. FENCING INSIDE EASEMENT WILL BE REMOVED AND HAULED OFF-SITE BY THE CONTRACTOR.
5. ANY AREA THAT HAS BEEN GRADED MUST HAVE POSITIVE DRAINAGE, UNLESS OTHERWISE DIRECTED BY ENGINEER.
6. AREAS OF BENCHING: CONTRACTOR WILL EXCAVATE THE TOPSOIL, STOCKPILE IT, AND THEN ADD THE TOPSOIL AS TOP LAYER OF BENCH TO A DEPTH OF AT LEAST 8 INCHES.
7. CONTRACTOR WILL CONTROL ANY INVASIVE SPECIES WITHIN EASEMENT.
8. LOCATIONS OF BOULDER STEPS AND GRADE CONTROL STRUCTURES ARE SUBJECT TO CHANGE BASED ON FIELD CONDITIONS AND BY THE DIRECTION OF THE ENGINEER.
9. CONTRACTOR SHALL INCORPORATE SOIL WITHIN THE CONSTRUCTED RIFFLES ALONG ALL STEEP HEADWATER TRIBUTARIES TO REDUCE PERMEABILITY AND KEEP SURFACE FLOW.
10. WHERE DESIGN PROFILE OF STEEP HEADWATER CHANNELS DIVIATES FROM THE EXISTING PROFILE, CONTRACTOR SHALL SLOPE STREAM BANKS AT 2:1 AS NECESSARY TO TIE TO EXISTING GROUND.

- FILL EXISTING CHANNEL
- CHANNEL PLUG

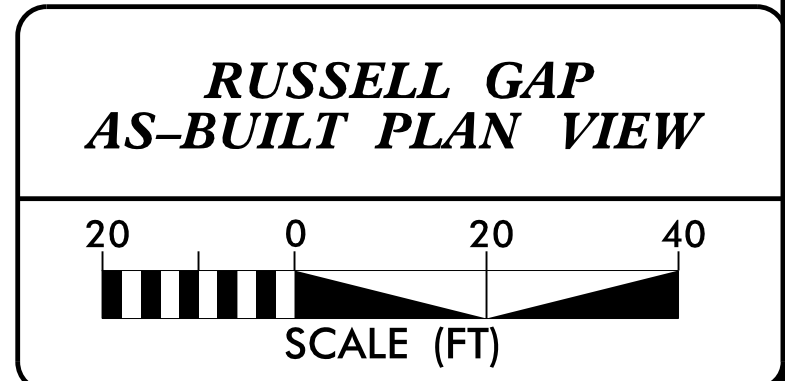


8/15/2020 - Russell1\_Cop - Design - AS-BUILT PLANS - 157329 - AB-PSH-06.dgn





BAKER PROJECT REFERENCE NO.	SHEET NO.
157329	7

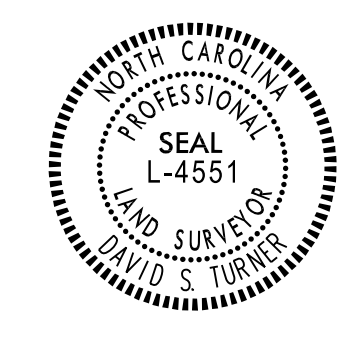

DocuSigned by:  
David S. Turner  
1C8BEE6BAC44E


APPROVED BY:

9/11/2020

DATE:


**Michael Baker International** Michael Baker Engineering Inc.  
5000 Regency Parkway, Suite 800  
Cary, NORTH CAROLINA 27518  
Phone: 919.453.5488  
Fax: 919.453.5490  
License #: F-1084

**NC DMS ID NO. 100003**

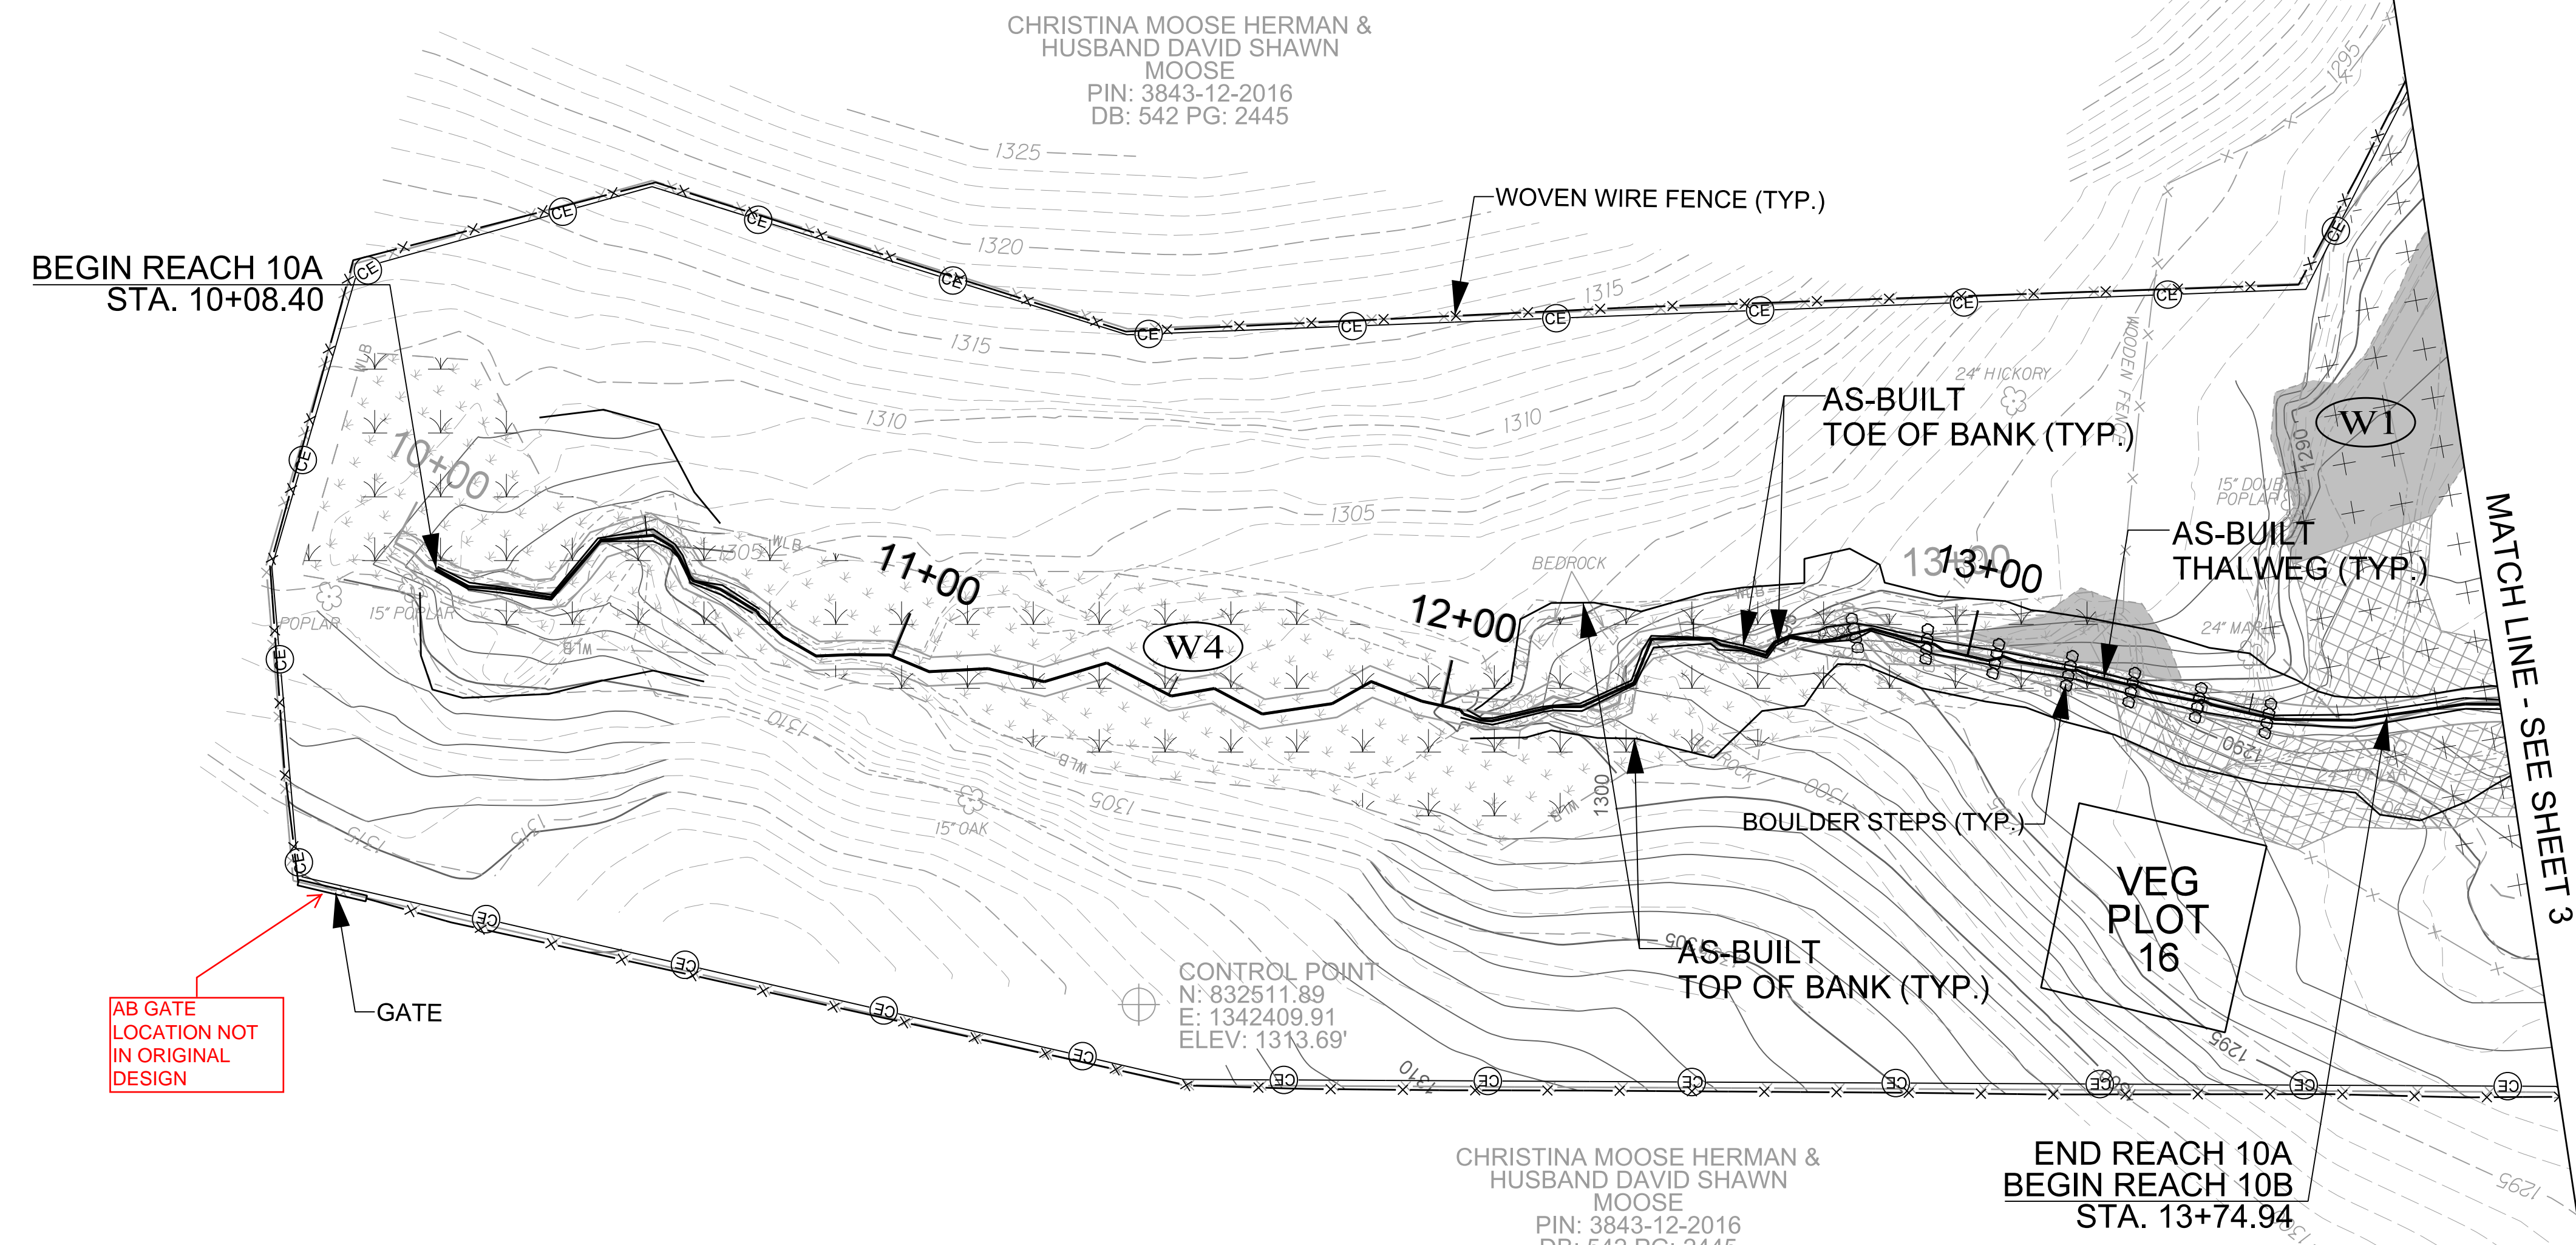


- NOTES:
1. ANY HARDWOOD TREES REMOVED MUST BE INCORPORATED WITHIN THE STRUCTURES BEING INSTALLED.
  2. EXCAVATE STREAMBED MATERIAL BEFORE FILLING IN THE OLD CHANNEL AND USE STREAMBED MATERIAL WITHIN THE NEWLY CONSTRUCTED CHANNEL.
  3. CONTRACTOR CAN USE BRUSH MATERIAL TO INCORPORATE WITHIN THE CONSTRUCTED RIFFLES AND BRUSH TOES ALONG MEANDER BENDS.
  4. FENCING INSIDE EASEMENT WILL BE REMOVED AND HAULED OFF-SITE BY THE CONTRACTOR.
  5. ANY AREA THAT HAS BEEN GRADED MUST HAVE POSITIVE DRAINAGE, UNLESS OTHERWISE DIRECTED BY ENGINEER.
  6. AREAS OF BENCHING: CONTRACTOR WILL EXCAVATE THE TOPSOIL, STOCKPILE IT, AND THEN ADD THE TOPSOIL AS TOP LAYER OF BENCH TO A DEPTH OF AT LEAST 8 INCHES.
  7. CONTRACTOR WILL CONTROL ANY INVASIVE SPECIES WITHIN EASEMENT.
  8. LOCATIONS OF BOULDER STEPS AND GRADE CONTROL STRUCTURES ARE SUBJECT TO CHANGE BASED ON FIELD CONDITIONS AND BY THE DIRECTION OF THE ENGINEER.
  9. CONTRACTOR SHALL INCORPORATE SOIL WITHIN THE CONSTRUCTED RIFFLES ALONG ALL STEEP HEADWATER TRIBUTARIES TO REDUCE PERMEABILITY AND KEEP SURFACE FLOW.
  10. WHERE DESIGN PROFILE OF STEEP HEADWATER CHANNELS DIVIATES FROM THE EXISTING PROFILE, CONTRACTOR SHALL SLOPE STREAM BANKS AT 2:1 AS NECESSARY TO TIE TO EXISTING GROUND.

- FILL EXISTING CHANNEL
- CHANNEL PLUG

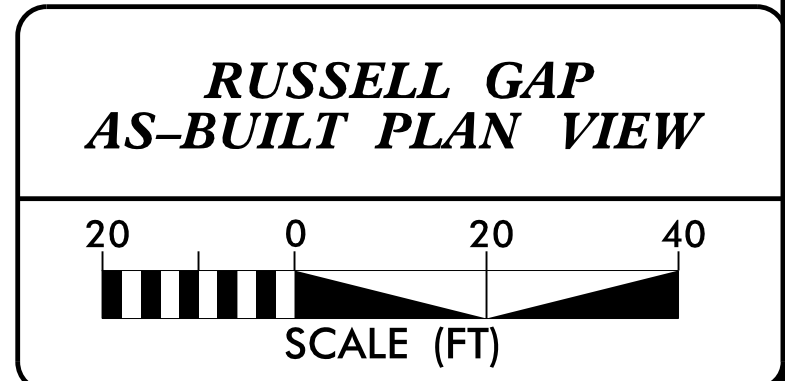



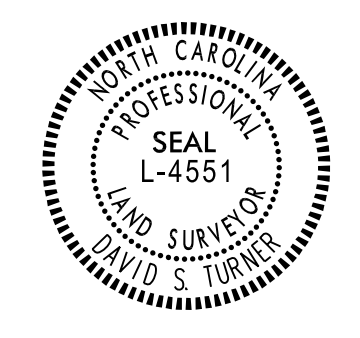

DocuSigned by:  
David S. Turner  
1CB8EEA8AC44F...


APPROVED BY:

9/11/2020


DATE:

**Michael Baker** INTERNATIONAL  
Michael Baker Engineering Inc.  
5030 Regency Parkway, Suite 800  
Cary, NORTH CAROLINA 27518  
Phone: 919.453.5488  
Fax: 919.453.5490  
License #: F-1084

NC DMS ID NO. 100003

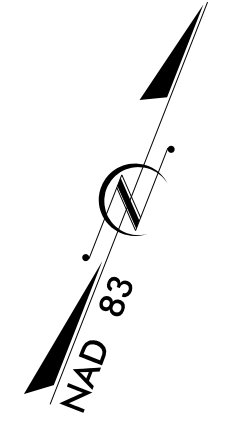

REBECCA HERMAN DUPUIS &  
JAMES MICHAEL DUPUIS  
PIN: 3843-11-8159  
DB: 542 PG: 2450

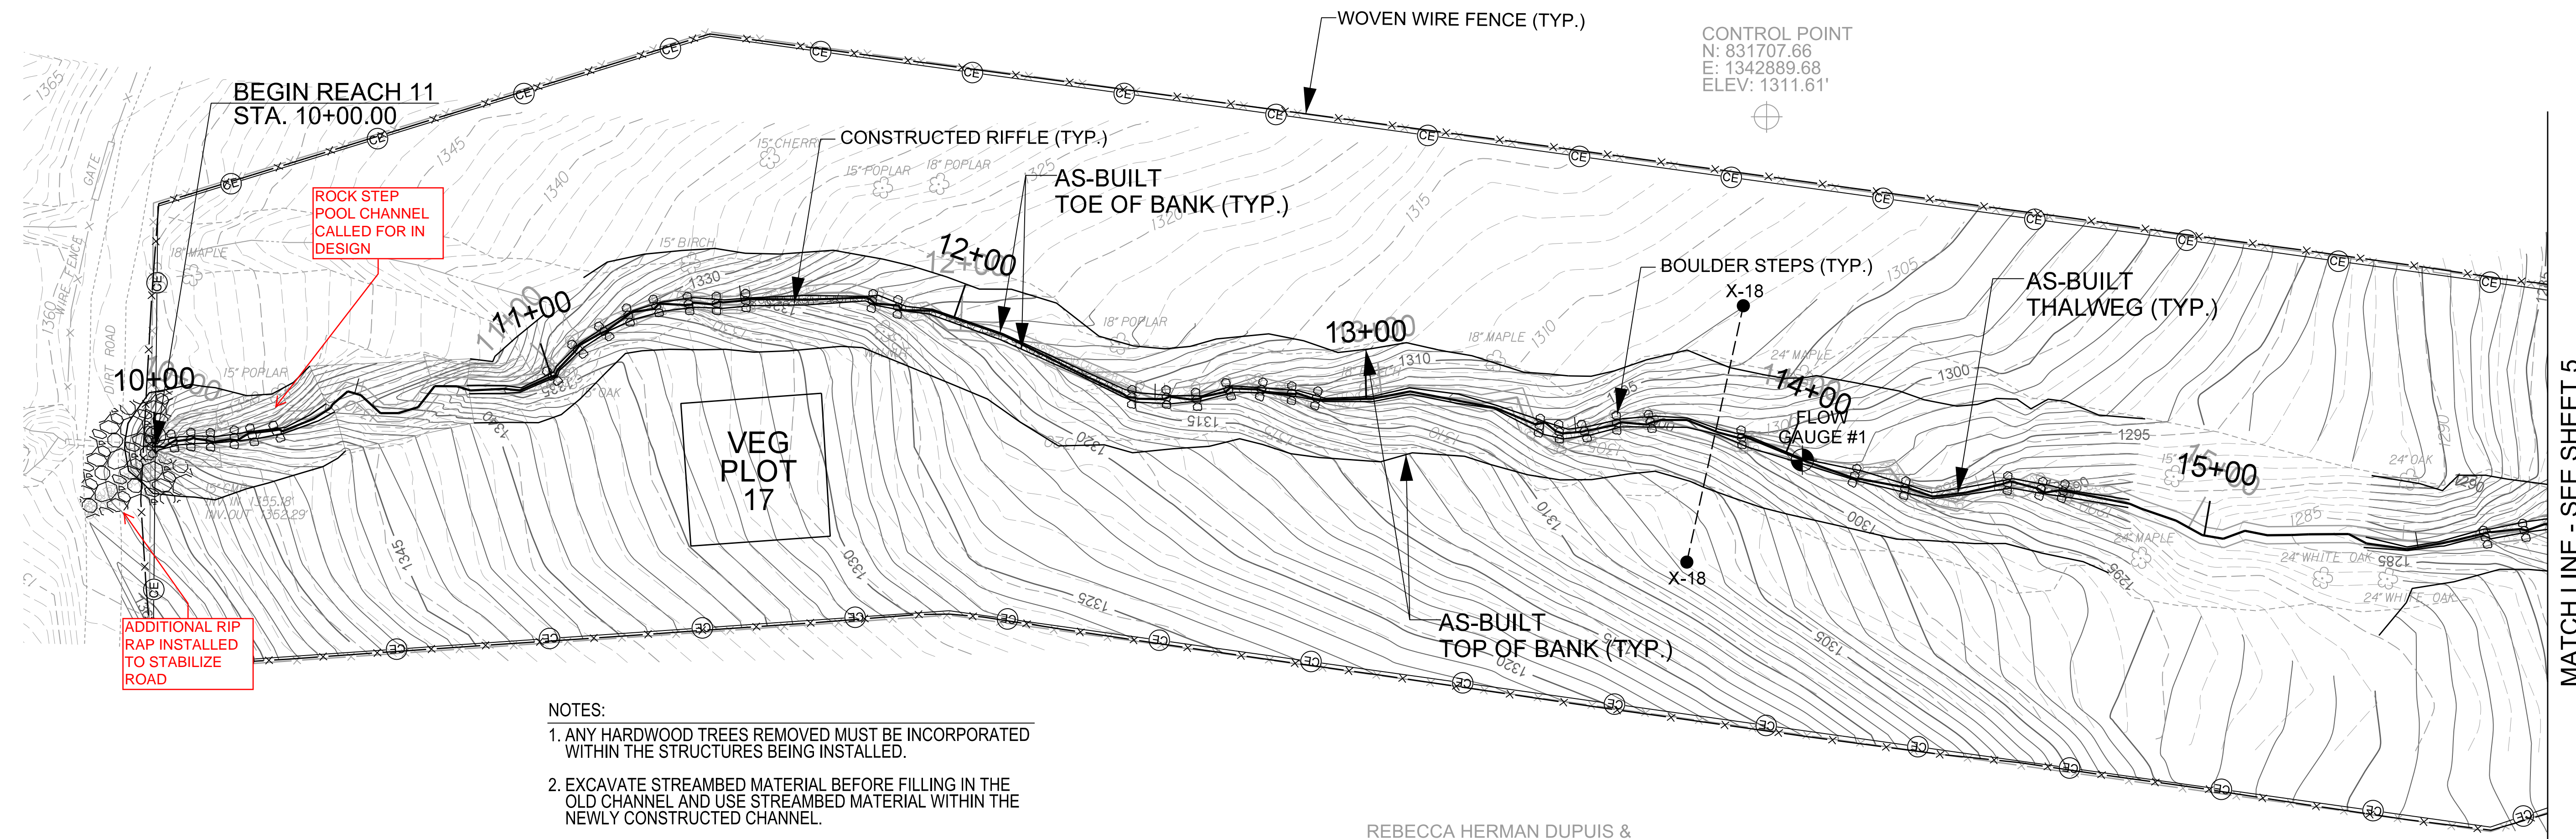


ROCK STEP  
POOL CHANNEL  
CALLED FOR IN  
DESIGN

ADDITIONAL RIP  
RAP INSTALLED  
TO STABILIZE  
ROAD


- NOTES:
1. ANY HARDWOOD TREES REMOVED MUST BE INCORPORATED WITHIN THE STRUCTURES BEING INSTALLED.
  2. EXCAVATE STREAMBED MATERIAL BEFORE FILLING IN THE OLD CHANNEL AND USE STREAMBED MATERIAL WITHIN THE NEWLY CONSTRUCTED CHANNEL.
  3. CONTRACTOR CAN USE BRUSH MATERIAL TO INCORPORATE WITHIN THE CONSTRUCTED RIFFLES AND BRUSH TOES ALONG MEANDER BENDS.
  4. FENCING INSIDE EASEMENT WILL BE REMOVED AND HAULED OFF-SITE BY THE CONTRACTOR.
  5. ANY AREA THAT HAS BEEN GRADED MUST HAVE POSITIVE DRAINAGE, UNLESS OTHERWISE DIRECTED BY ENGINEER.
  6. AREAS OF BENCHING: CONTRACTOR WILL EXCAVATE THE TOPSOIL, STOCKPILE IT, AND THEN ADD THE TOPSOIL AS TOP LAYER OF BENCH TO A DEPTH OF AT LEAST 8 INCHES.
  7. CONTRACTOR WILL CONTROL ANY INVASIVE SPECIES WITHIN EASEMENT.
  8. LOCATIONS OF BOULDER STEPS AND GRADE CONTROL STRUCTURES ARE SUBJECT TO CHANGE BASED ON FIELD CONDITIONS AND BY THE DIRECTION OF THE ENGINEER.
  9. CONTRACTOR SHALL INCORPORATE SOIL WITHIN THE CONSTRUCTED RIFFLES ALONG ALL STEEP HEADWATER TRIBUTARIES TO REDUCE PERMEABILITY AND KEEP SURFACE FLOW.
  10. WHERE DESIGN PROFILE OF STEEP HEADWATER CHANNELS DIVIATES FROM THE EXISTING PROFILE, CONTRACTOR SHALL SLOPE STREAM BANKS AT 2:1 AS NECESSARY TO TIE TO EXISTING GROUND.

REBECCA HERMAN DUPUIS &  
JAMES MICHAEL DUPUIS  
PIN: 3843-11-8159  
DB: 542 PG: 2450

■ FILL EXISTING CHANNEL  
▣ CHANNEL PLUG

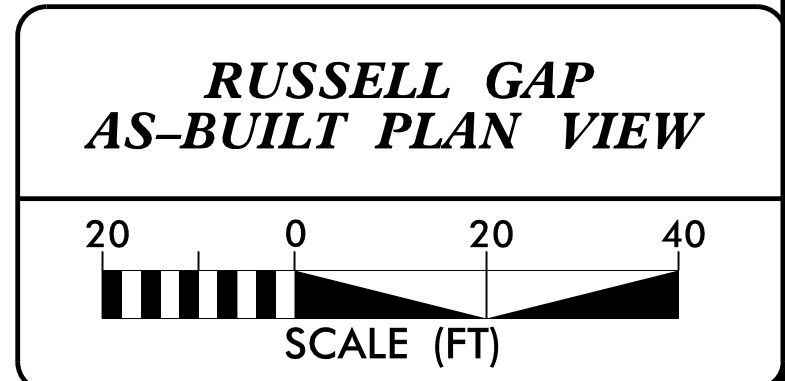




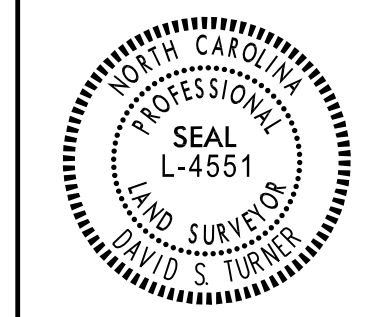

DocuSigned by:  
David S. Turner  
APPROVED BY:  
9/11/2020  
DATE:

**Michael Baker** International  
Michael Baker Engineering Inc.  
5020 Regency Parkway, Suite 600  
Cary, NORTH CAROLINA 27518  
Phone: 919.453.5488  
Fax: 919.453.5490  
License #: F-1084

NCDS ID NO. 100003

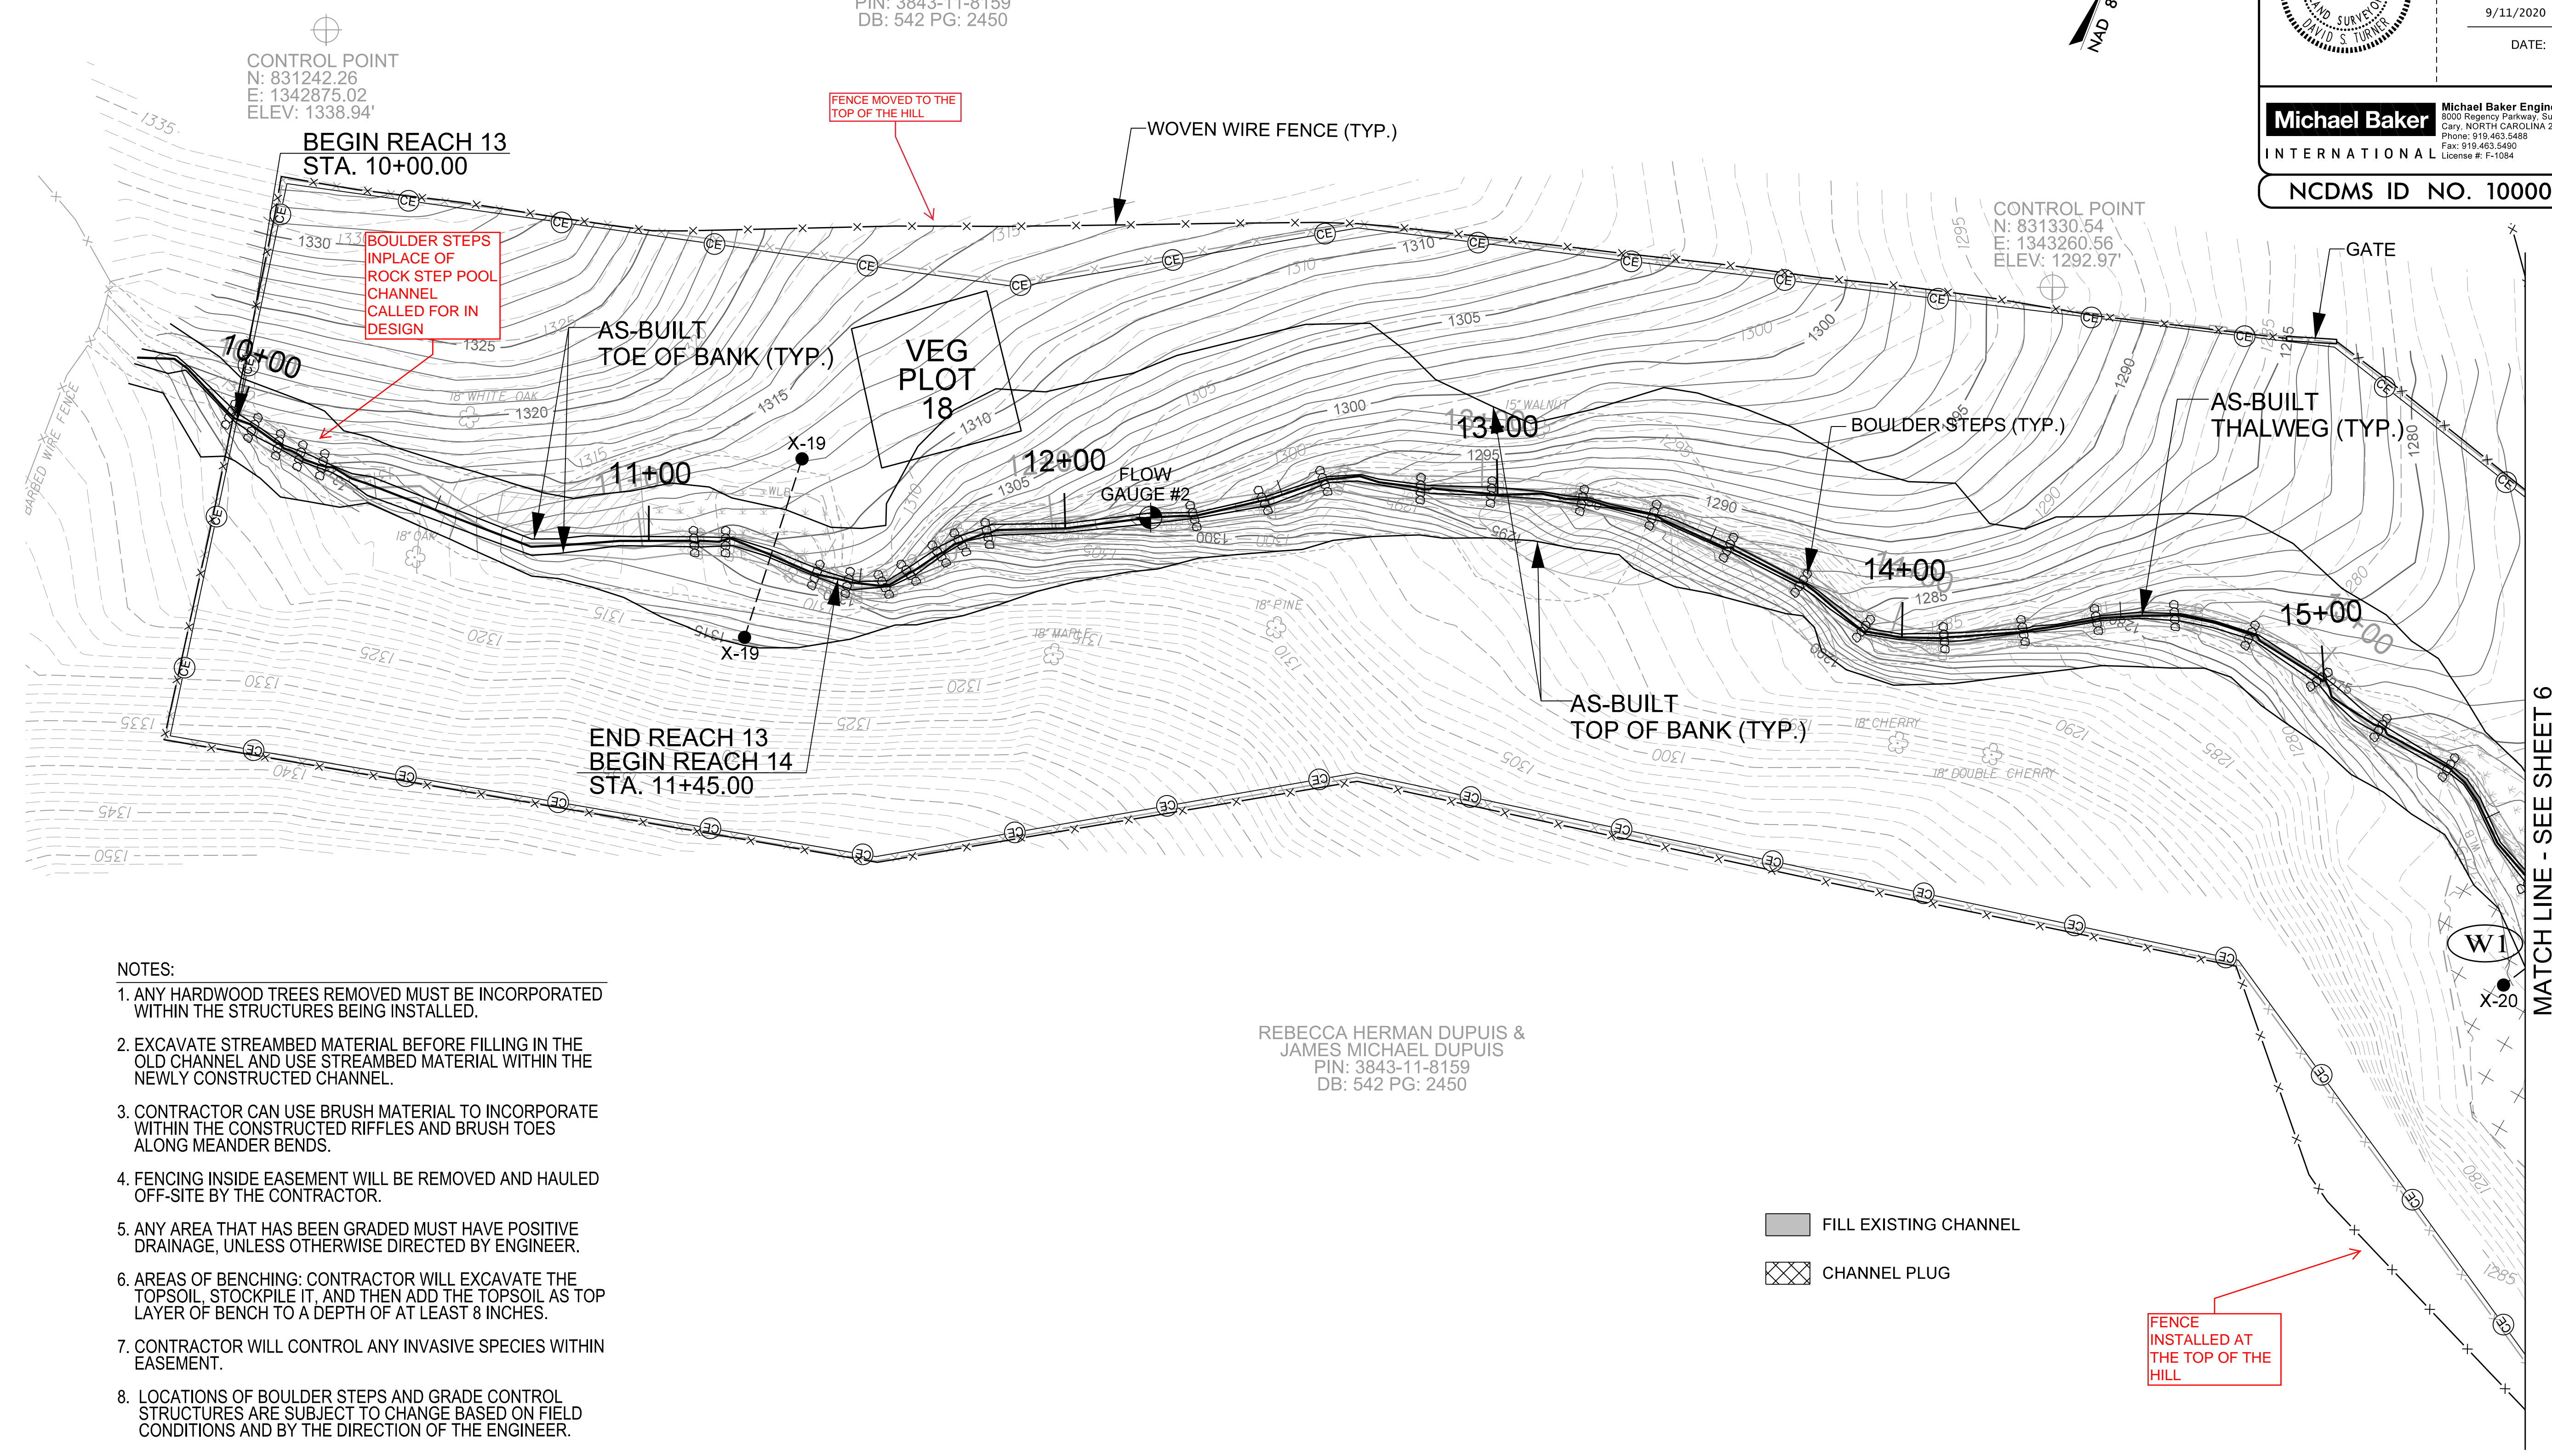

**NOTES:**

1. ANY HARDWOOD TREES REMOVED MUST BE INCORPORATED WITHIN THE STRUCTURES BEING INSTALLED.
2. EXCAVATE STREAMBED MATERIAL BEFORE FILLING IN THE OLD CHANNEL AND USE STREAMBED MATERIAL WITHIN THE NEWLY CONSTRUCTED CHANNEL.
3. CONTRACTOR CAN USE BRUSH MATERIAL TO INCORPORATE WITHIN THE CONSTRUCTED RIFFLES AND BRUSH TOES ALONG MEANDER BENDS.
4. FENCING INSIDE EASEMENT WILL BE REMOVED AND HAULED OFF-SITE BY THE CONTRACTOR.
5. ANY AREA THAT HAS BEEN GRADED MUST HAVE POSITIVE DRAINAGE, UNLESS OTHERWISE DIRECTED BY ENGINEER.
6. AREAS OF BENCHING: CONTRACTOR WILL EXCAVATE THE TOPSOIL, STOCKPILE IT, AND THEN ADD THE TOPSOIL AS TOP LAYER OF BENCH TO A DEPTH OF AT LEAST 8 INCHES.
7. CONTRACTOR WILL CONTROL ANY INVASIVE SPECIES WITHIN EASEMENT.
8. LOCATIONS OF BOULDER STEPS AND GRADE CONTROL STRUCTURES ARE SUBJECT TO CHANGE BASED ON FIELD CONDITIONS AND BY THE DIRECTION OF THE ENGINEER.
9. CONTRACTOR SHALL INCORPORATE SOIL WITHIN THE CONSTRUCTED RIFFLES ALONG ALL STEEP HEADWATER TRIBUTARIES TO REDUCE PERMEABILITY AND KEEP SURFACE FLOW.
10. WHERE DESIGN PROFILE OF STEEP HEADWATER CHANNELS DIVIATES FROM THE EXISTING PROFILE, CONTRACTOR SHALL SLOPE STREAM BANKS AT 2:1 AS NECESSARY TO TIE TO EXISTING GROUND.

REBECCA HERMAN DUPUIS &  
JAMES MICHAEL DUPUIS  
PIN: 3843-11-8159  
DB: 542 PG: 2450

- FILL EXISTING CHANNEL
- CHANNEL PLUG

FENCE  
INSTALLED AT  
THE TOP OF THE  
HILL

**RUSSELL GAP  
AS-BUILT PLAN VIEW**

SCALE (FT)

MATCH LINE - SEE SHEET 6



2/26/20

DocuSigned by:  
*David S. Janner*  
1CB8E8A8AC44F...



APPROVED BY:  
  
9/11/2020  
DATE:

**Michael Baker** International  
Michael Baker Engineering Inc.  
5000 Regency Parkway, Suite 500  
Cary, NORTH CAROLINA 27518  
Phone: 919.453.5488  
Fax: 919.453.5490  
License #: F-1084

NCDMS ID NO. 100003

NOTES:

1. ANY HARDWOOD TREES REMOVED MUST BE INCORPORATED WITHIN THE STRUCTURES BEING INSTALLED.
2. EXCAVATE STREAMBED MATERIAL BEFORE FILLING IN THE OLD CHANNEL AND USE STREAMBED MATERIAL WITHIN THE NEWLY CONSTRUCTED CHANNEL.
3. CONTRACTOR CAN USE BRUSH MATERIAL TO INCORPORATE WITHIN THE CONSTRUCTED RIFFLES AND BRUSH TOES ALONG MEANDER BENDS.
4. FENCING INSIDE EASEMENT WILL BE REMOVED AND HAULED OFF-SITE BY THE CONTRACTOR.
5. ANY AREA THAT HAS BEEN GRADED MUST HAVE POSITIVE DRAINAGE, UNLESS OTHERWISE DIRECTED BY ENGINEER.
6. AREAS OF BENCHING: CONTRACTOR WILL EXCAVATE THE TOPSOIL, STOCKPILE IT, AND THEN ADD THE TOPSOIL AS TOP LAYER OF BENCH TO A DEPTH OF AT LEAST 8 INCHES.
7. CONTRACTOR WILL CONTROL ANY INVASIVE SPECIES WITHIN EASEMENT.
8. LOCATIONS OF BOULDER STEPS AND GRADE CONTROL STRUCTURES ARE SUBJECT TO CHANGE BASED ON FIELD CONDITIONS AND BY THE DIRECTION OF THE ENGINEER.
9. CONTRACTOR SHALL INCORPORATE SOIL WITHIN THE CONSTRUCTED RIFFLES ALONG ALL STEEP HEADWATER TRIBUTARIES TO REDUCE PERMEABILITY AND KEEP SURFACE FLOW.
10. WHERE DESIGN PROFILE OF STEEP HEADWATER CHANNELS DIVIATES FROM THE EXISTING PROFILE, CONTRACTOR SHALL SLOPE STREAM BANKS AT 2:1 AS NECESSARY TO TIE TO EXISTING GROUND.

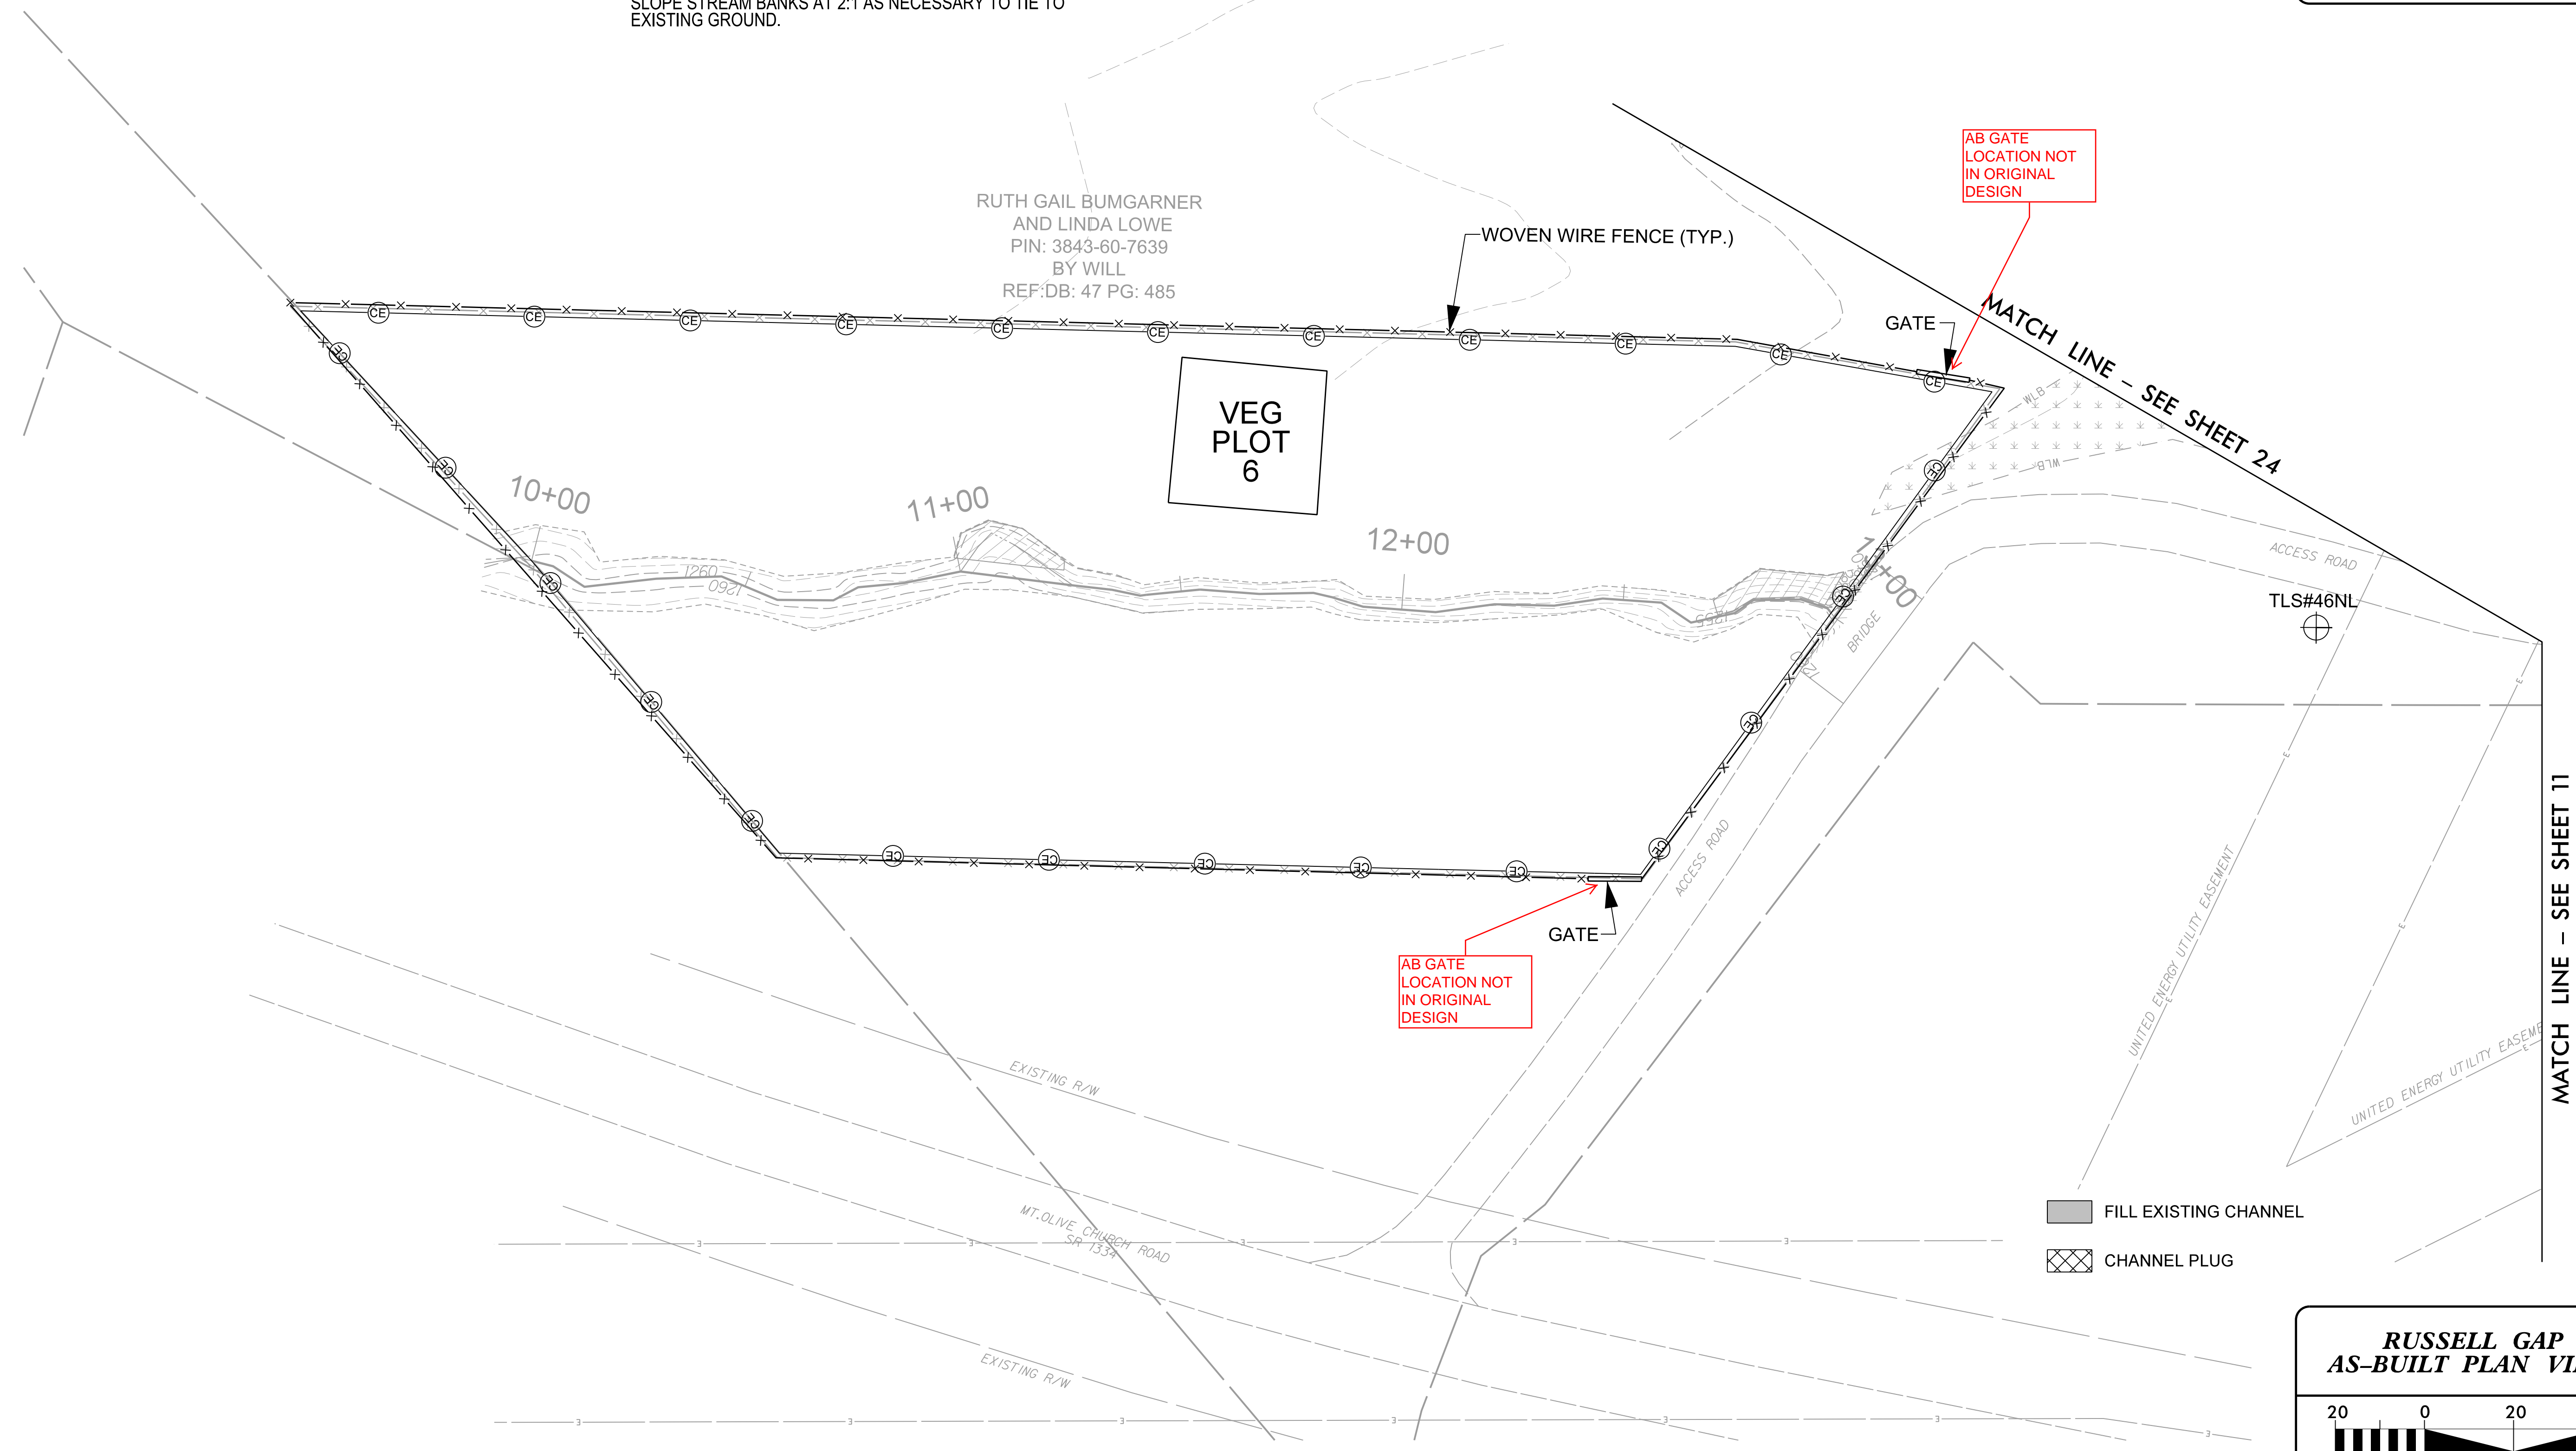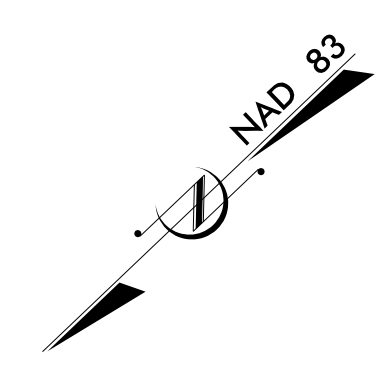


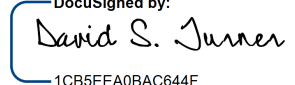
**RUSSELL GAP  
AS-BUILT PLAN VIEW**

SCALE (FT)


8/15/2020 - Russell - Cop - Design - AS-BUILT PLANS - 157329 - AB-PSH-10.dgn



2/26/03

BAKER PROJECT REFERENCE NO. 157329	SHEET NO. 11
	
DocuSigned by:  APPROVED BY: 9/11/2020 DATE:	
<b>Michael Baker</b> International <small>Michael Baker Engineering Inc.          800 Regency Parkway, Suite 600          Cary, NORTH CAROLINA 27518          Phone: 919-463-5488          Fax: 919-463-5490          License #: F-1084</small>	
<b>NCDMS ID NO. 100003</b>	

- NOTES:
1. ANY HARDWOOD TREES REMOVED MUST BE INCORPORATED WITHIN THE STRUCTURES BEING INSTALLED.
  2. EXCAVATE STREAMBED MATERIAL BEFORE FILLING IN THE OLD CHANNEL AND USE STREAMBED MATERIAL WITHIN THE NEWLY CONSTRUCTED CHANNEL.
  3. CONTRACTOR CAN USE BRUSH MATERIAL TO INCORPORATE WITHIN THE CONSTRUCTED RIFFLES AND BRUSH TOES ALONG MEANDER BENDS.
  4. FENCING INSIDE EASEMENT WILL BE REMOVED AND HAULED OFF-SITE BY THE CONTRACTOR.
  5. ANY AREA THAT HAS BEEN GRADED MUST HAVE POSITIVE DRAINAGE, UNLESS OTHERWISE DIRECTED BY ENGINEER.
  6. AREAS OF BENCHING: CONTRACTOR WILL EXCAVATE THE TOPSOIL, STOCKPILE IT, AND THEN ADD THE TOPSOIL AS TOP LAYER OF BENCH TO A DEPTH OF AT LEAST 8 INCHES.
  7. CONTRACTOR WILL CONTROL ANY INVASIVE SPECIES WITHIN EASEMENT.
  8. LOCATIONS OF BOULDER STEPS AND GRADE CONTROL STRUCTURES ARE SUBJECT TO CHANGE BASED ON FIELD CONDITIONS AND BY THE DIRECTION OF THE ENGINEER.
  9. CONTRACTOR SHALL INCORPORATE SOIL WITHIN THE CONSTRUCTED RIFFLES ALONG ALL STEEP HEADWATER TRIBUTARIES TO REDUCE PERMEABILITY AND KEEP SURFACE FLOW.
  10. WHERE DESIGN PROFILE OF STEEP HEADWATER CHANNELS DIVERGES FROM THE EXISTING PROFILE, CONTRACTOR SHALL SLOPE STREAM BANKS AT 2:1 AS NECESSARY TO TIE TO EXISTING GROUND.

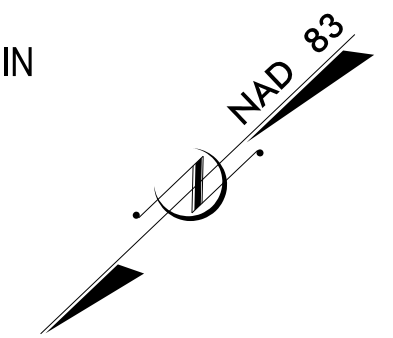



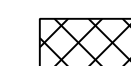
RUTH GAIL BUMGARDNER  
 AND LINDA LOWE  
 PIN: 3843-60-7639  
 BY WILL  
 REF:DB: 47 PG: 485

RUTH GAIL BUMGARDNER  
 AND LINDA LOWE  
 PIN: 3843-60-7639  
 BY WILL  
 REF:DB: 396 PG: 1279


CONTROL POINT  
 NCGS MONUMENT (504)  
 (UNPUBLISHED)  
 STATE PLANE COORDINATES  
 N: 830822.79  
 E: 1346664.50  
 ELEV: 1271.27'

CONTROL POINT  
 N: 830684.72  
 E: 1346562.31  
 ELEV: 1265.93'

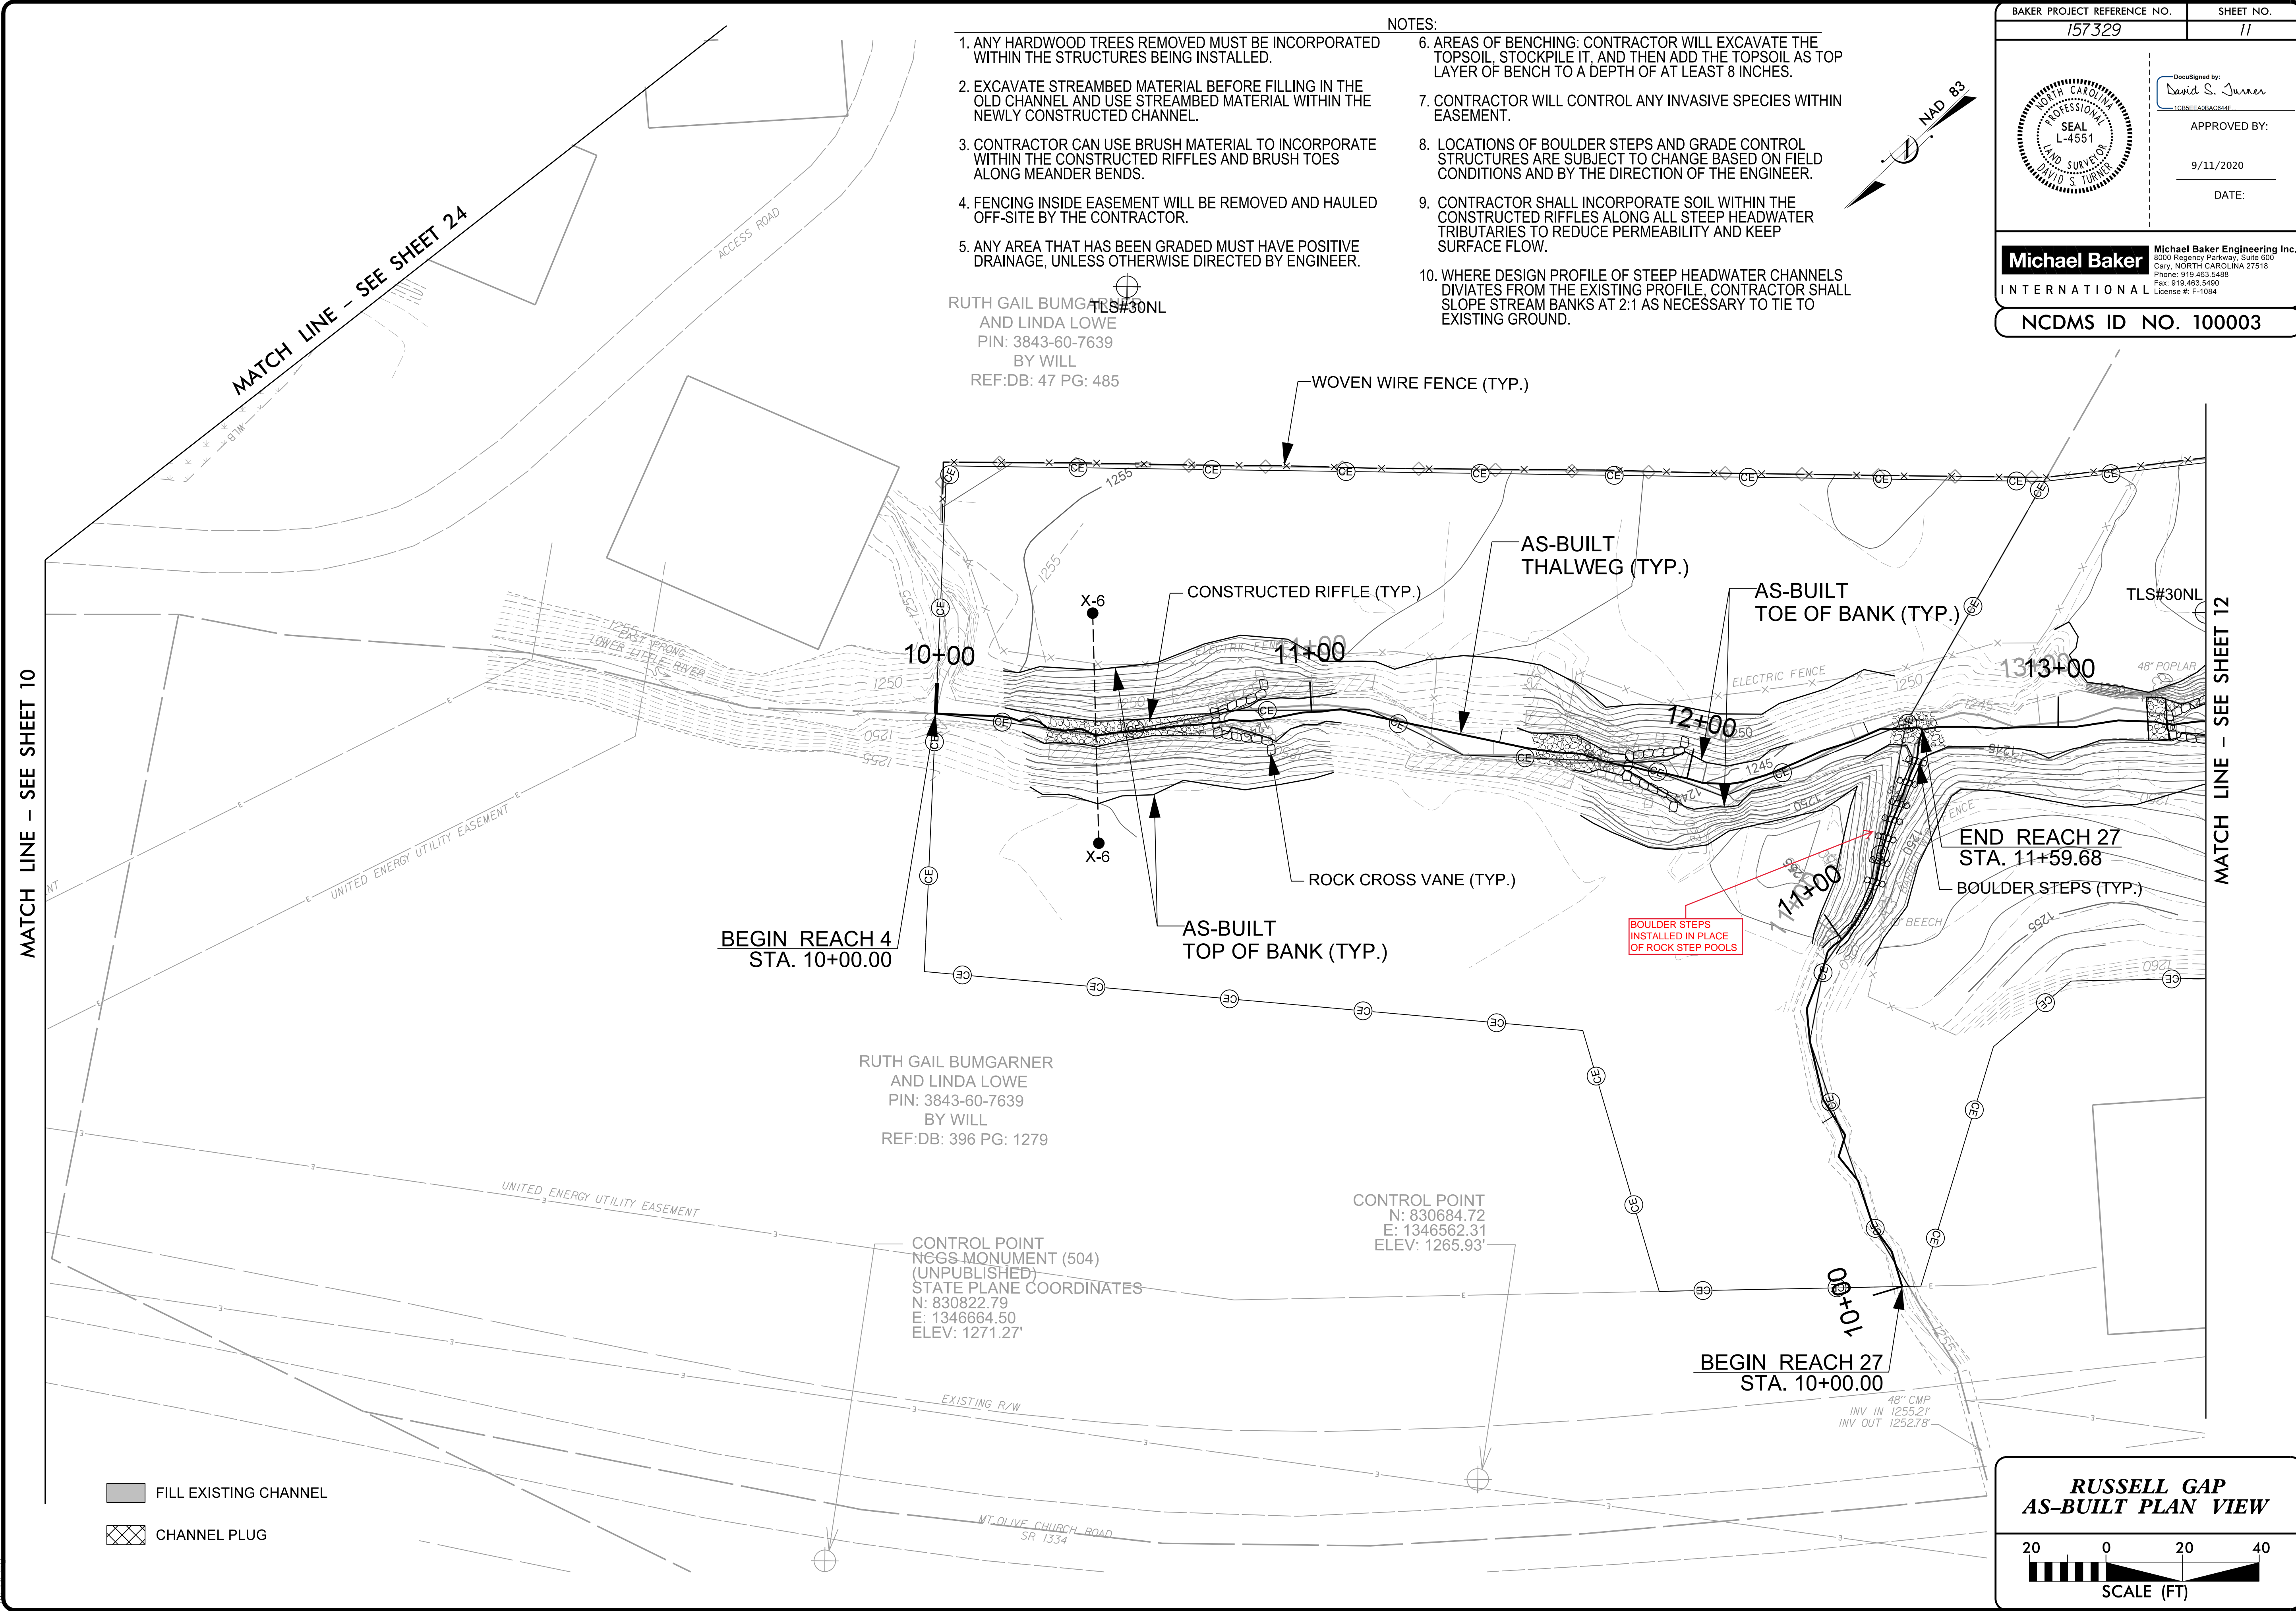

-  FILL EXISTING CHANNEL
-  CHANNEL PLUG


**RUSSELL GAP  
 AS-BUILT PLAN VIEW**



SCALE (FT)

9/3/2020  
 R:\157329\_Russell\_Gap\Design\AS-BUILT\PLANS\157329\_AB\_PSH-11.dgn  
 Michael Baker International



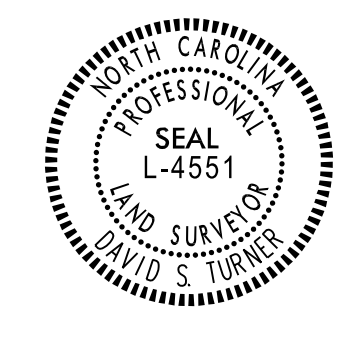

DocuSigned by:  
David S. Turner  
1C8E5EAD3AC244E


APPROVED BY:

9/11/2020

DATE:

**Michael Baker International** Michael Baker Engineering Inc.  
5000 Regency Parkway, Suite 600  
Cary, NORTH CAROLINA 27518  
Phone: 919.453.5488  
Fax: 919.453.5490  
License #: F-1084

**NC DMS ID NO. 100003**

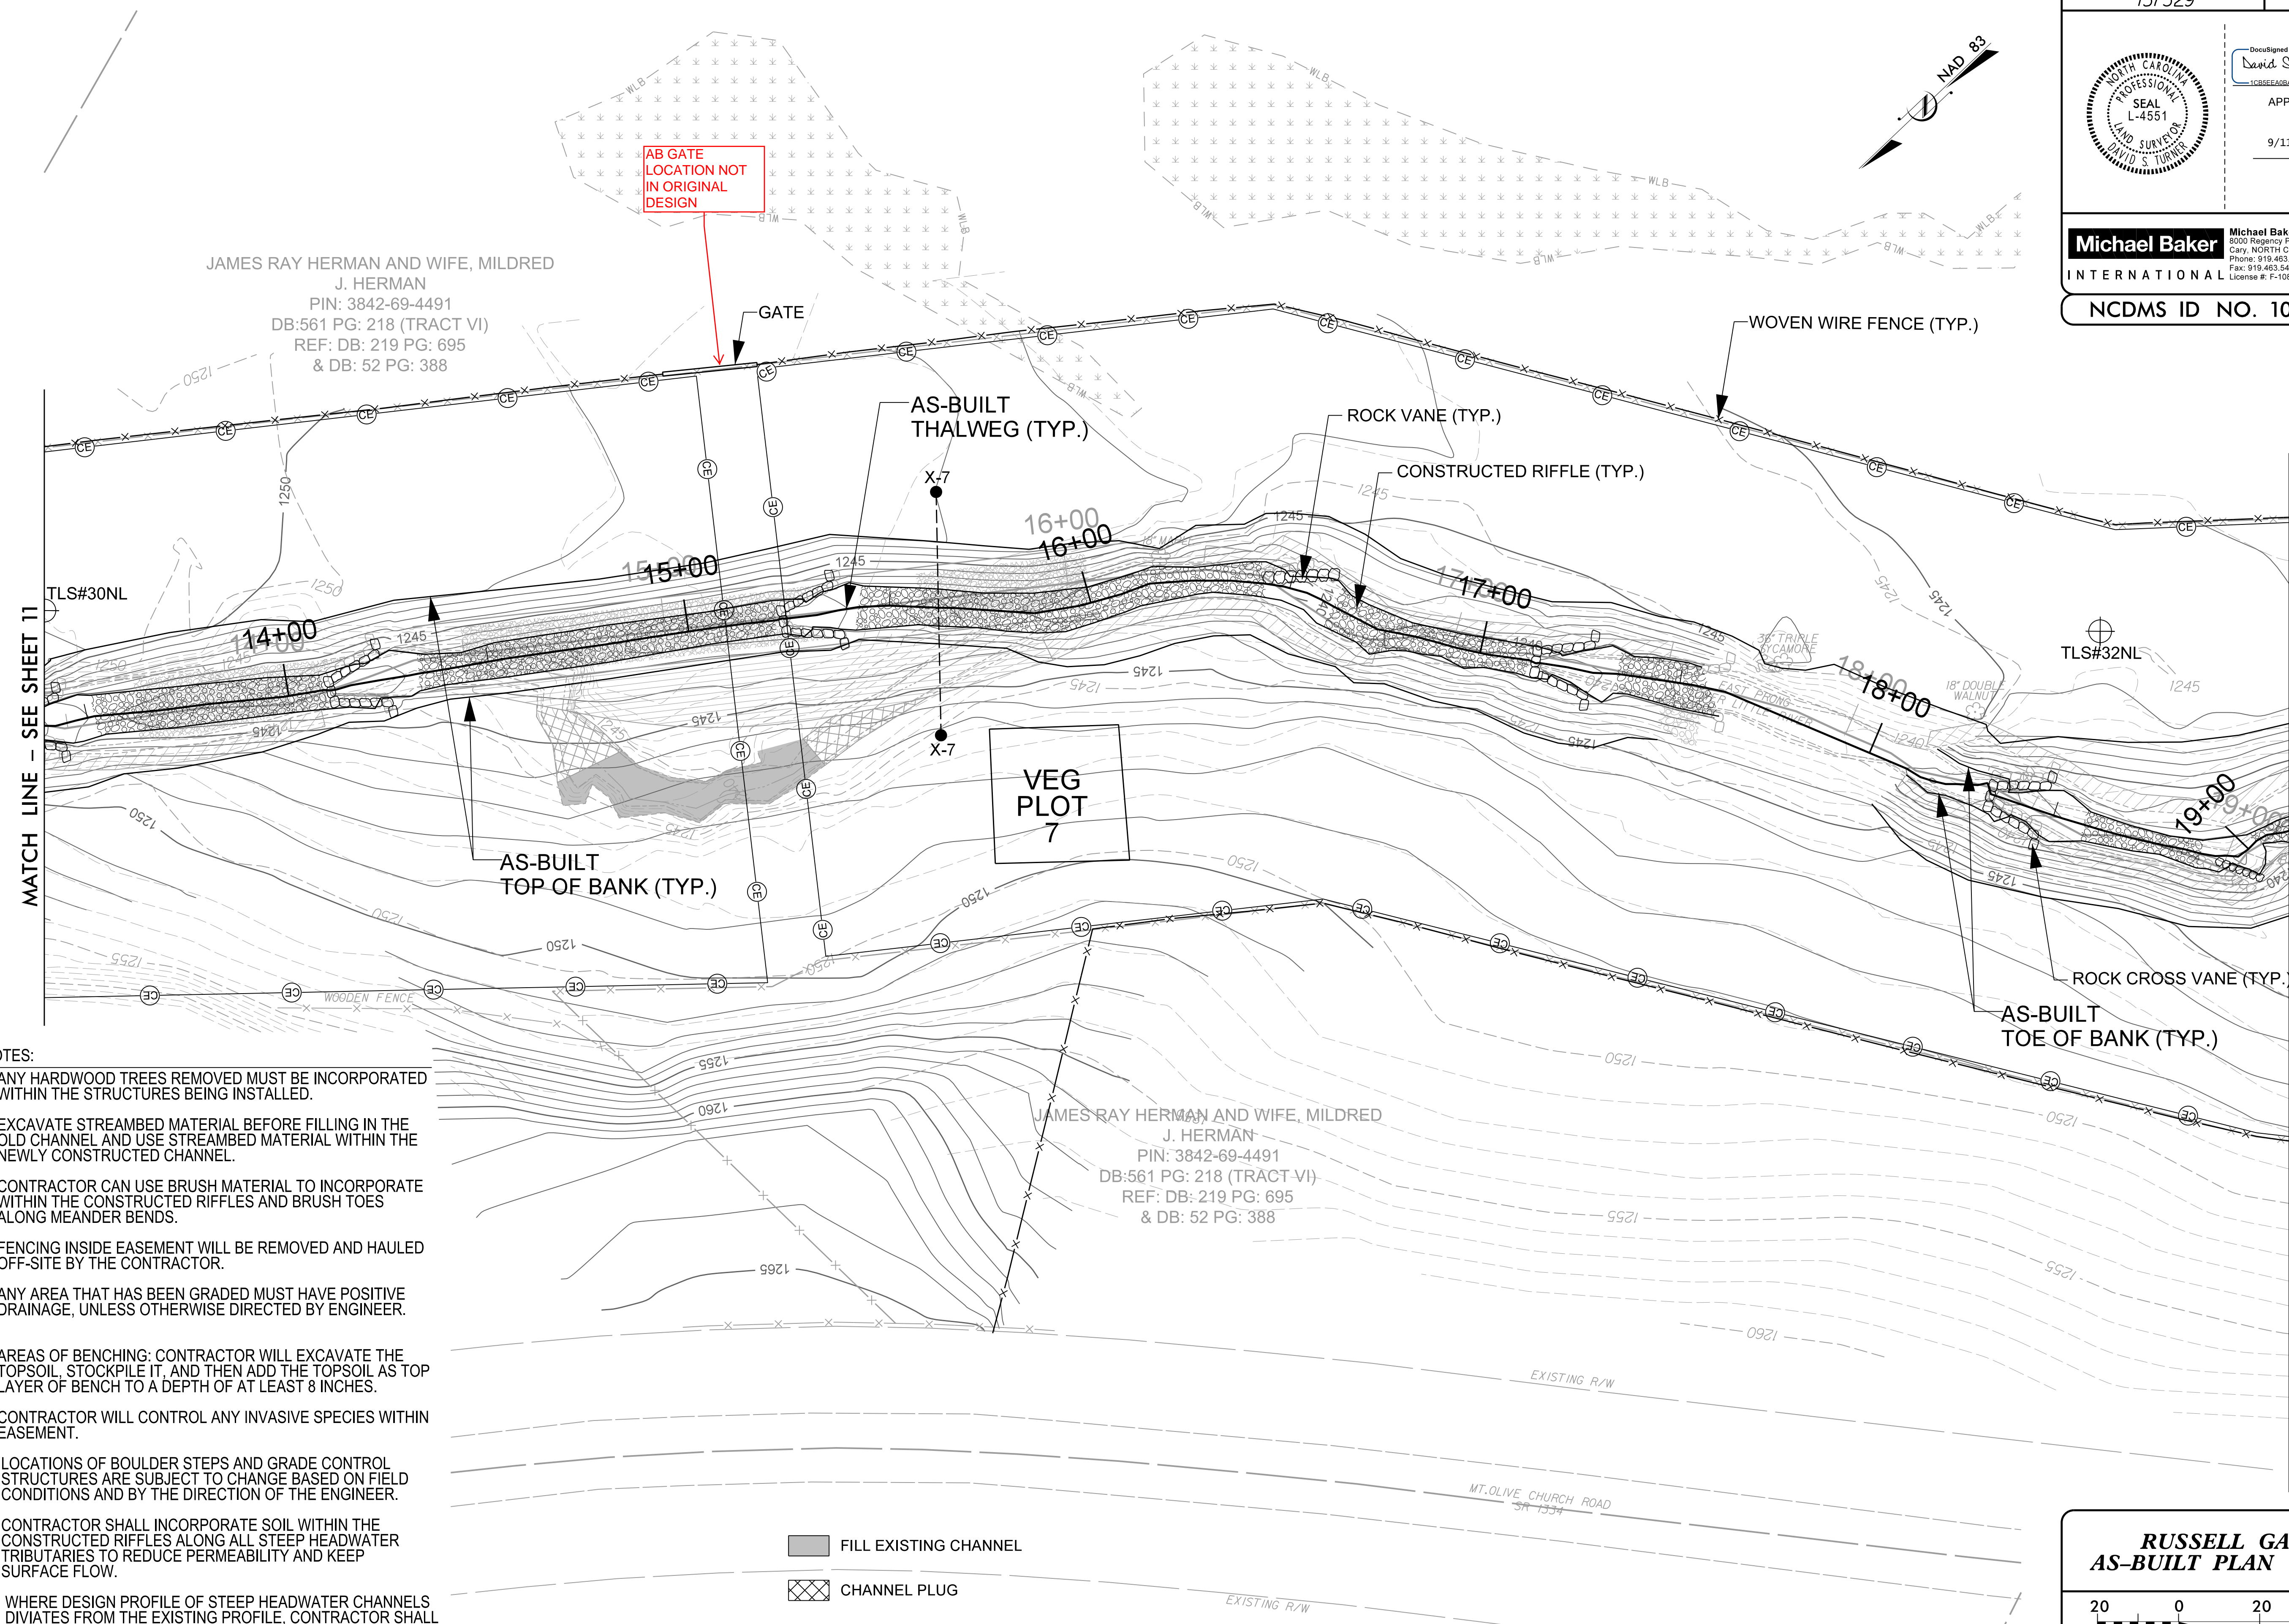

NOTES:

1. ANY HARDWOOD TREES REMOVED MUST BE INCORPORATED WITHIN THE STRUCTURES BEING INSTALLED.
2. EXCAVATE STREAMBED MATERIAL BEFORE FILLING IN THE OLD CHANNEL AND USE STREAMBED MATERIAL WITHIN THE NEWLY CONSTRUCTED CHANNEL.
3. CONTRACTOR CAN USE BRUSH MATERIAL TO INCORPORATE WITHIN THE CONSTRUCTED RIFFLES AND BRUSH TOES ALONG MEANDER BENDS.
4. FENCING INSIDE EASEMENT WILL BE REMOVED AND HAULED OFF-SITE BY THE CONTRACTOR.
5. ANY AREA THAT HAS BEEN GRADED MUST HAVE POSITIVE DRAINAGE, UNLESS OTHERWISE DIRECTED BY ENGINEER.
6. AREAS OF BENCHING: CONTRACTOR WILL EXCAVATE THE TOPSOIL, STOCKPILE IT, AND THEN ADD THE TOPSOIL AS TOP LAYER OF BENCH TO A DEPTH OF AT LEAST 8 INCHES.
7. CONTRACTOR WILL CONTROL ANY INVASIVE SPECIES WITHIN EASEMENT.
8. LOCATIONS OF BOULDER STEPS AND GRADE CONTROL STRUCTURES ARE SUBJECT TO CHANGE BASED ON FIELD CONDITIONS AND BY THE DIRECTION OF THE ENGINEER.
9. CONTRACTOR SHALL INCORPORATE SOIL WITHIN THE CONSTRUCTED RIFFLES ALONG ALL STEEP HEADWATER TRIBUTARIES TO REDUCE PERMEABILITY AND KEEP SURFACE FLOW.
10. WHERE DESIGN PROFILE OF STEEP HEADWATER CHANNELS DIVERGES FROM THE EXISTING PROFILE, CONTRACTOR SHALL SLOPE STREAM BANKS AT 2:1 AS NECESSARY TO TIE TO EXISTING GROUND.


- FILL EXISTING CHANNEL
- CHANNEL PLUG

**RUSSELL GAP  
AS-BUILT PLAN VIEW**

SCALE (FT)

8/15/2020 - Russell1\_Cop\Design\AS-BUILT\PLANS\157329\_AB-PSH-12.dgn  
 2/26/20



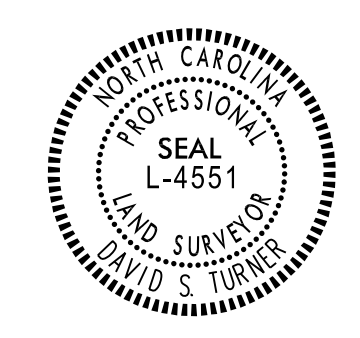


DocuSigned by:  
*David S. Turner*  
APPROVED BY:  
9/11/2020  
DATE:

**Michael Baker International**  
Michael Baker Engineering Inc.  
5030 Regency Parkway, Suite 600  
Cary, NORTH CAROLINA 27518  
Phone: 919.453.5488  
Fax: 919.453.5490  
License #: F-1084

**NC DMS ID NO. 100003**

NOTES:

1. ANY HARDWOOD TREES REMOVED MUST BE INCORPORATED WITHIN THE STRUCTURES BEING INSTALLED.
2. EXCAVATE STREAMBED MATERIAL BEFORE FILLING IN THE OLD CHANNEL AND USE STREAMBED MATERIAL WITHIN THE NEWLY CONSTRUCTED CHANNEL.
3. CONTRACTOR CAN USE BRUSH MATERIAL TO INCORPORATE WITHIN THE CONSTRUCTED RIFFLES AND BRUSH TOES ALONG MEANDER BENDS.
4. FENCING INSIDE EASEMENT WILL BE REMOVED AND HAULED OFF-SITE BY THE CONTRACTOR.
5. ANY AREA THAT HAS BEEN GRADED MUST HAVE POSITIVE DRAINAGE, UNLESS OTHERWISE DIRECTED BY ENGINEER.
6. AREAS OF BENCHING: CONTRACTOR WILL EXCAVATE THE TOPSOIL, STOCKPILE IT, AND THEN ADD THE TOPSOIL AS TOP LAYER OF BENCH TO A DEPTH OF AT LEAST 8 INCHES.
7. CONTRACTOR WILL CONTROL ANY INVASIVE SPECIES WITHIN EASEMENT.
8. LOCATIONS OF BOULDER STEPS AND GRADE CONTROL STRUCTURES ARE SUBJECT TO CHANGE BASED ON FIELD CONDITIONS AND BY THE DIRECTION OF THE ENGINEER.
9. CONTRACTOR SHALL INCORPORATE SOIL WITHIN THE CONSTRUCTED RIFFLES ALONG ALL STEEP HEADWATER TRIBUTARIES TO REDUCE PERMEABILITY AND KEEP SURFACE FLOW.
10. WHERE DESIGN PROFILE OF STEEP HEADWATER CHANNELS DIVIATES FROM THE EXISTING PROFILE, CONTRACTOR SHALL SLOPE STREAM BANKS AT 2:1 AS NECESSARY TO TIE TO EXISTING GROUND.

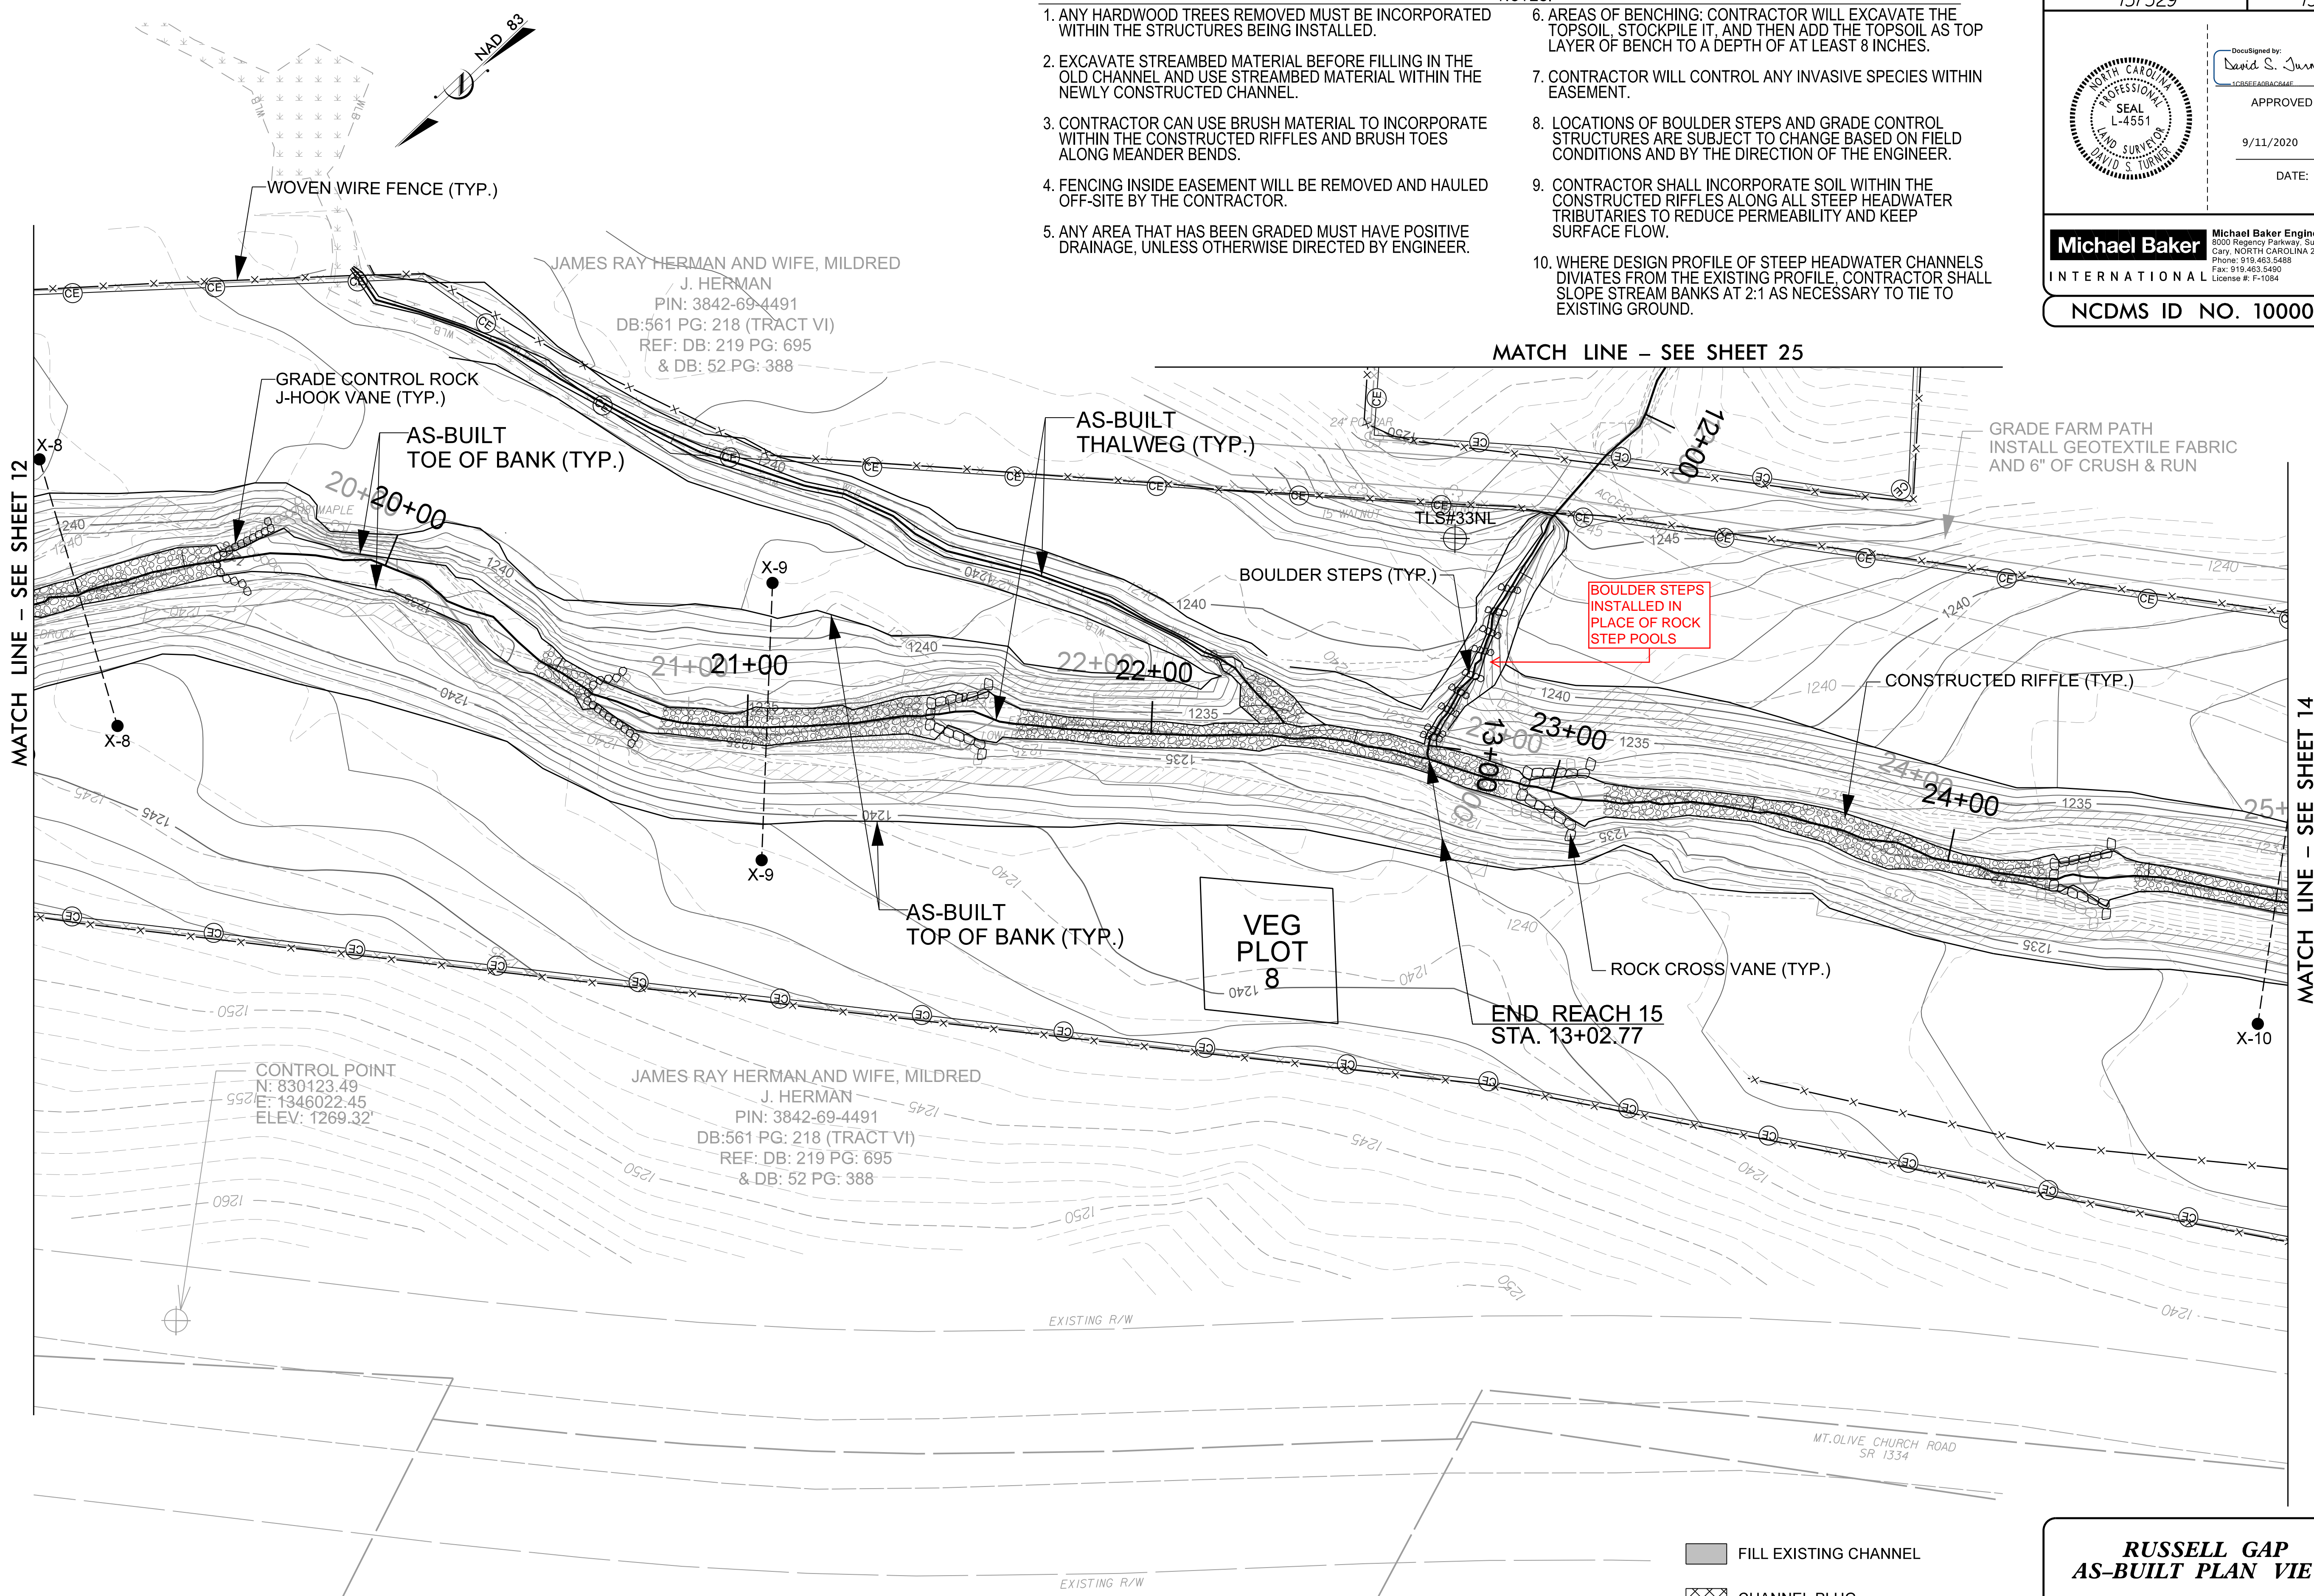

■ FILL EXISTING CHANNEL  
 ▨ CHANNEL PLUG

**RUSSELL GAP  
AS-BUILT PLAN VIEW**

SCALE (FT)




DocuSigned by:  
*David S. Junner*  
1CB5EEA0BAC844F

APPROVED BY:  
  
9/11/2020  
  
DATE:

**Michael Baker** International  
Michael Baker Engineering Inc.  
5000 Regency Parkway, Suite 500  
Cary, NORTH CAROLINA 27518  
Phone: 919.453.5488  
Fax: 919.453.5490  
License #: F-1084

NCDS ID NO. 100003

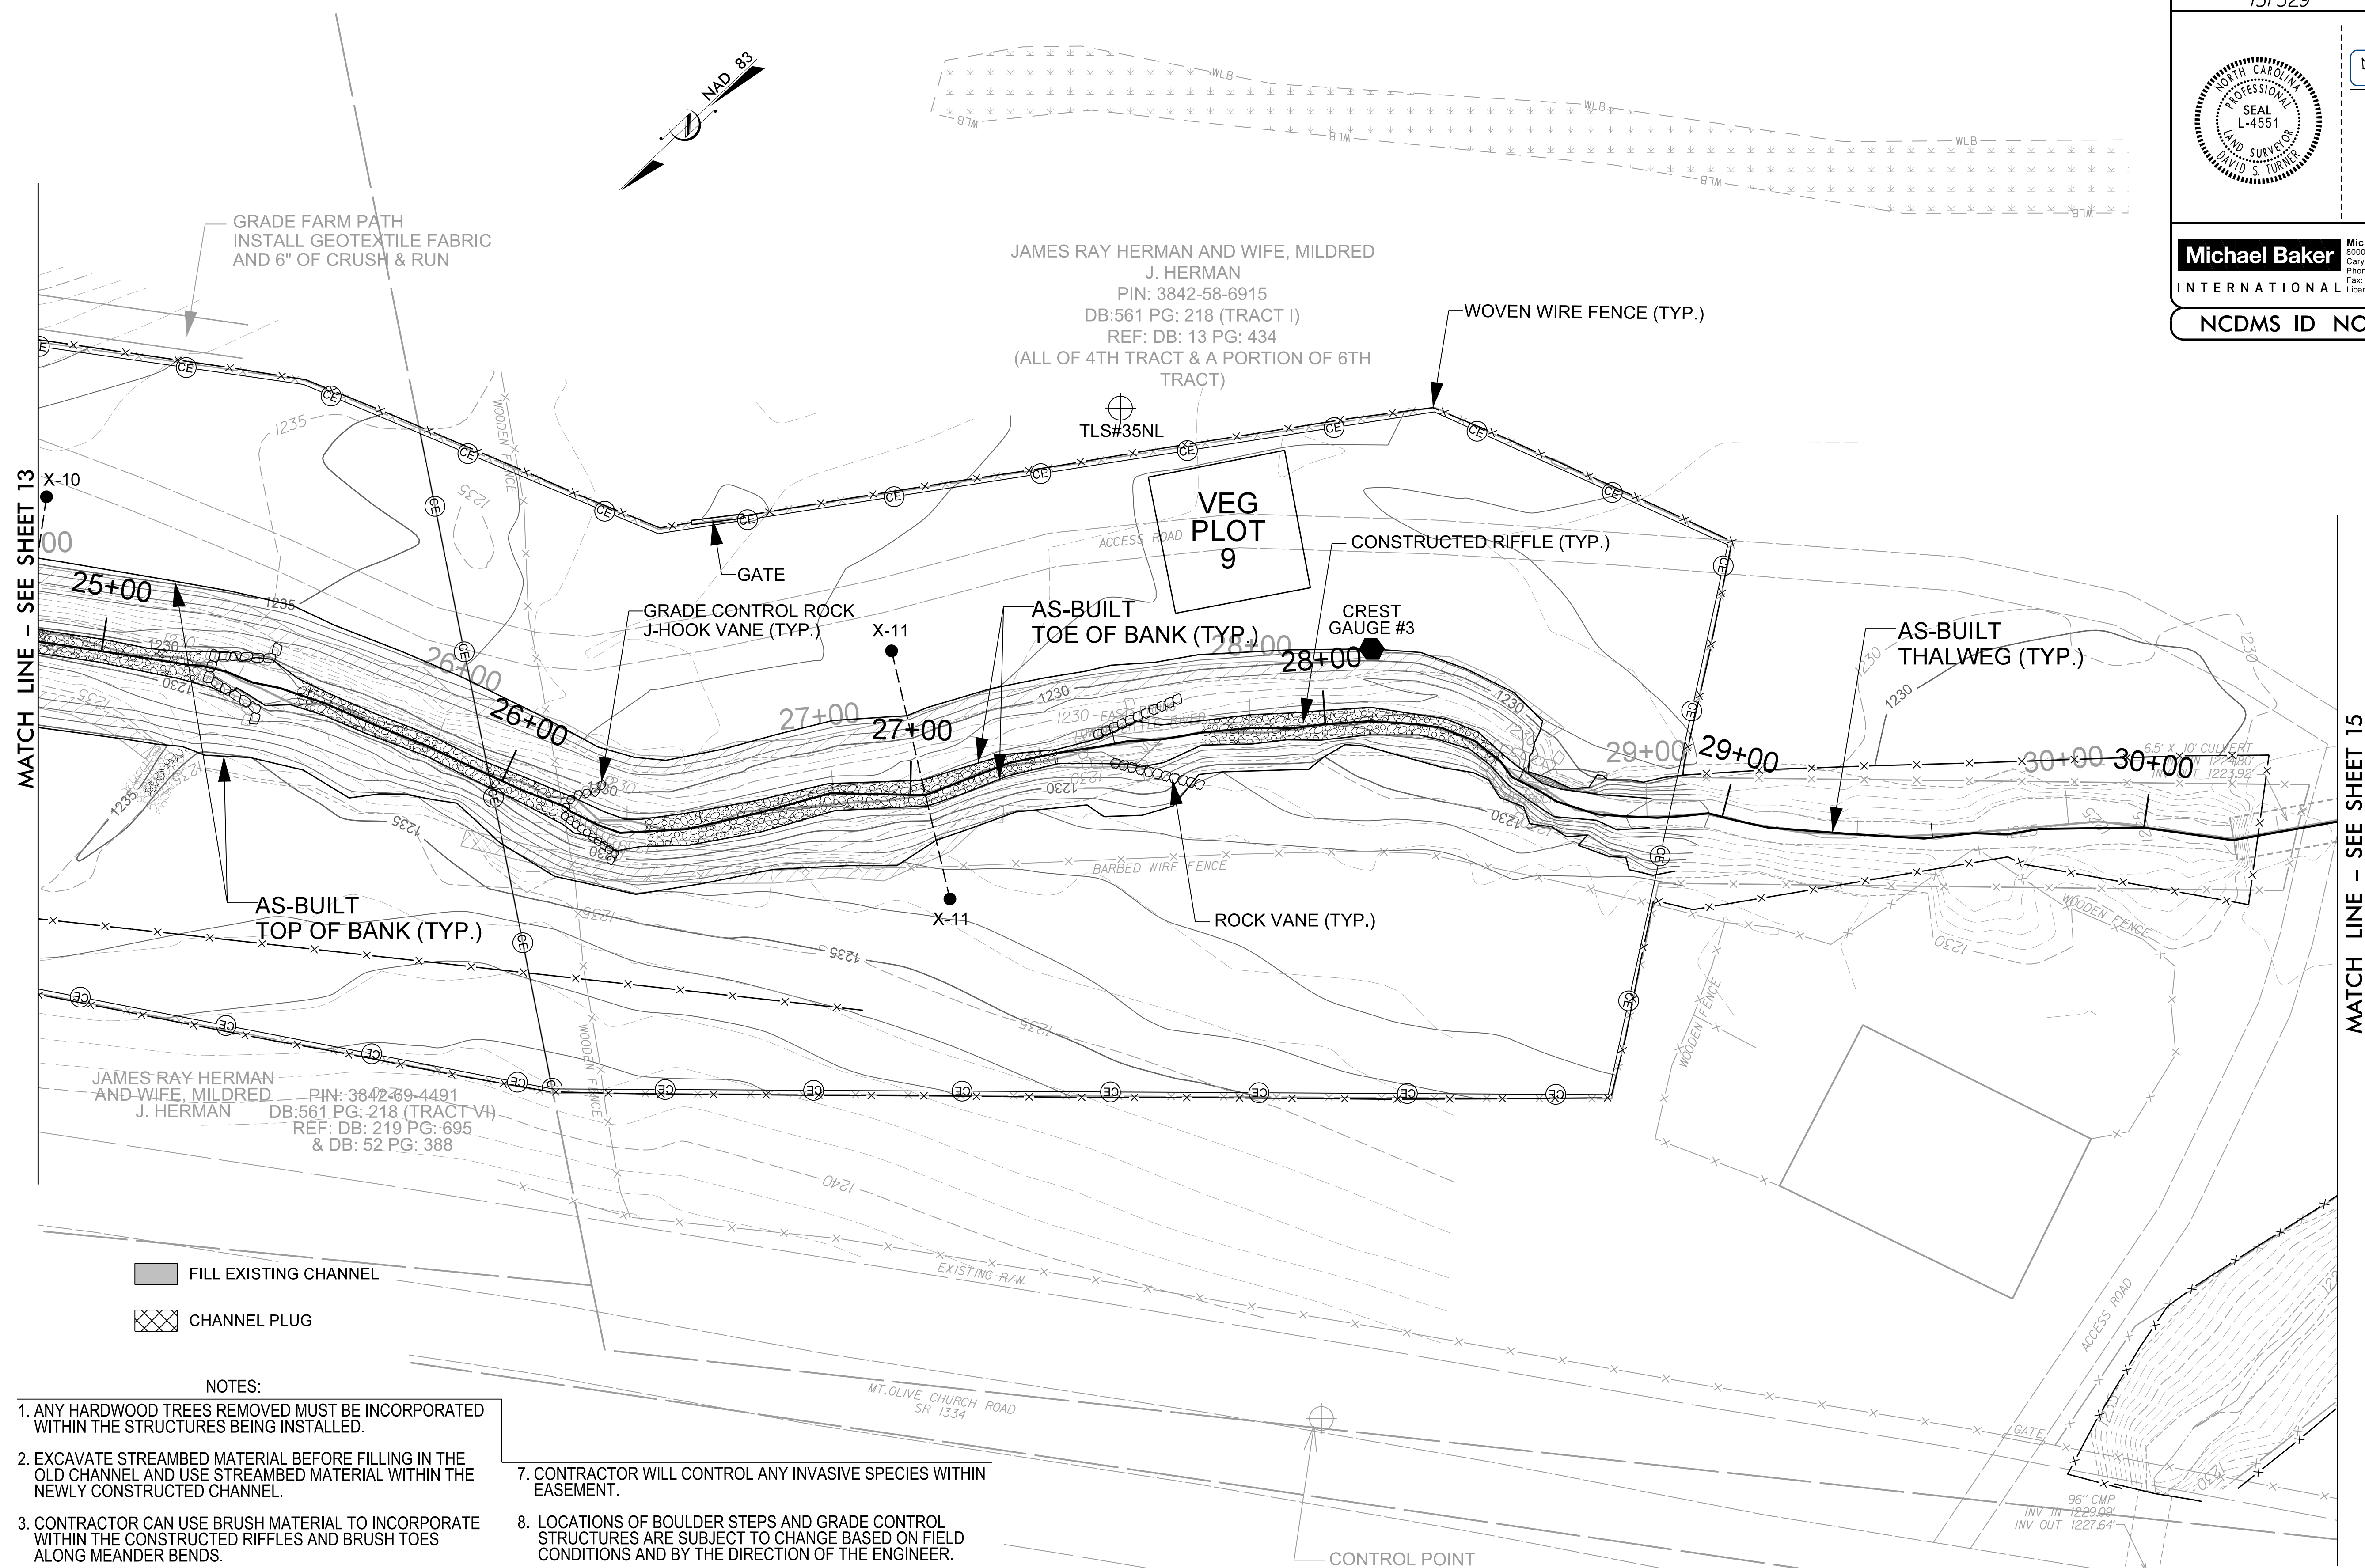

- FILL EXISTING CHANNEL
- CHANNEL PLUG

- NOTES:
- ANY HARDWOOD TREES REMOVED MUST BE INCORPORATED WITHIN THE STRUCTURES BEING INSTALLED.
  - EXCAVATE STREAMBED MATERIAL BEFORE FILLING IN THE OLD CHANNEL AND USE STREAMBED MATERIAL WITHIN THE NEWLY CONSTRUCTED CHANNEL.
  - CONTRACTOR CAN USE BRUSH MATERIAL TO INCORPORATE WITHIN THE CONSTRUCTED RIFFLES AND BRUSH TOES ALONG MEANDER BENDS.
  - FENCING INSIDE EASEMENT WILL BE REMOVED AND HAULED OFF-SITE BY THE CONTRACTOR.
  - ANY AREA THAT HAS BEEN GRADED MUST HAVE POSITIVE DRAINAGE, UNLESS OTHERWISE DIRECTED BY ENGINEER.
  - AREAS OF BENCHING: CONTRACTOR WILL EXCAVATE THE TOPSOIL, STOCKPILE IT, AND THEN ADD THE TOPSOIL AS TOP LAYER OF BENCH TO A DEPTH OF AT LEAST 8 INCHES.

- CONTRACTOR WILL CONTROL ANY INVASIVE SPECIES WITHIN EASEMENT.
- LOCATIONS OF BOULDER STEPS AND GRADE CONTROL STRUCTURES ARE SUBJECT TO CHANGE BASED ON FIELD CONDITIONS AND BY THE DIRECTION OF THE ENGINEER.
- CONTRACTOR SHALL INCORPORATE SOIL WITHIN THE CONSTRUCTED RIFFLES ALONG ALL STEEP HEADWATER TRIBUTARIES TO REDUCE PERMEABILITY AND KEEP SURFACE FLOW.
- WHERE DESIGN PROFILE OF STEEP HEADWATER CHANNELS DEVIATES FROM THE EXISTING PROFILE, CONTRACTOR SHALL SLOPE STREAM BANKS AT 2:1 AS NECESSARY TO TIE TO EXISTING GROUND.

CONTROL POINT  
NCGS MONUMENT (502)  
(UNPUBLISHED)  
STATE PLANE COORDINATES  
N: 829584.83  
E: 1345397.75  
ELEV: 1245.48'  
CF: .99990545


**RUSSELL GAP  
AS-BUILT PLAN VIEW**

SCALE (FT)

8/15/2020 - Russell - Cap - Design - AS-BUILT PLANS - 157329 - AB-PSH-14.dgn



2/26/20

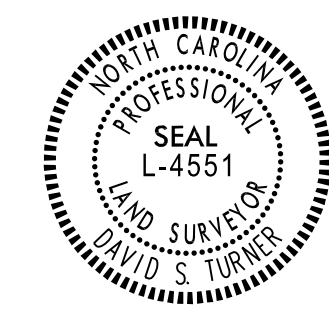

DocuSigned by:  
David S. Turner  
1C8BEEA0BAC84F

APPROVED BY:  
  
9/11/2020  
  
DATE:


**Michael Baker International** Michael Baker Engineering Inc.  
5030 Regency Parkway, Suite 600  
Cary, NORTH CAROLINA 27518  
Phone: 919.453.5488  
Fax: 919.453.5490  
License #: F-1084

**NC DMS ID NO. 100003**





JAMES RAY HERMAN AND WIFE, MILDRED J. HERMAN  
PIN: 3842-58-6915  
DB:561 PG: 218 (TRACT I)  
REF: DB: 13 PG: 434  
(ALL OF 4TH TRACT & A PORTION OF 6TH TRACT)

CONTROL POINT  
N: 828996.30  
E: 1344995.61  
ELEV: 1230.04'

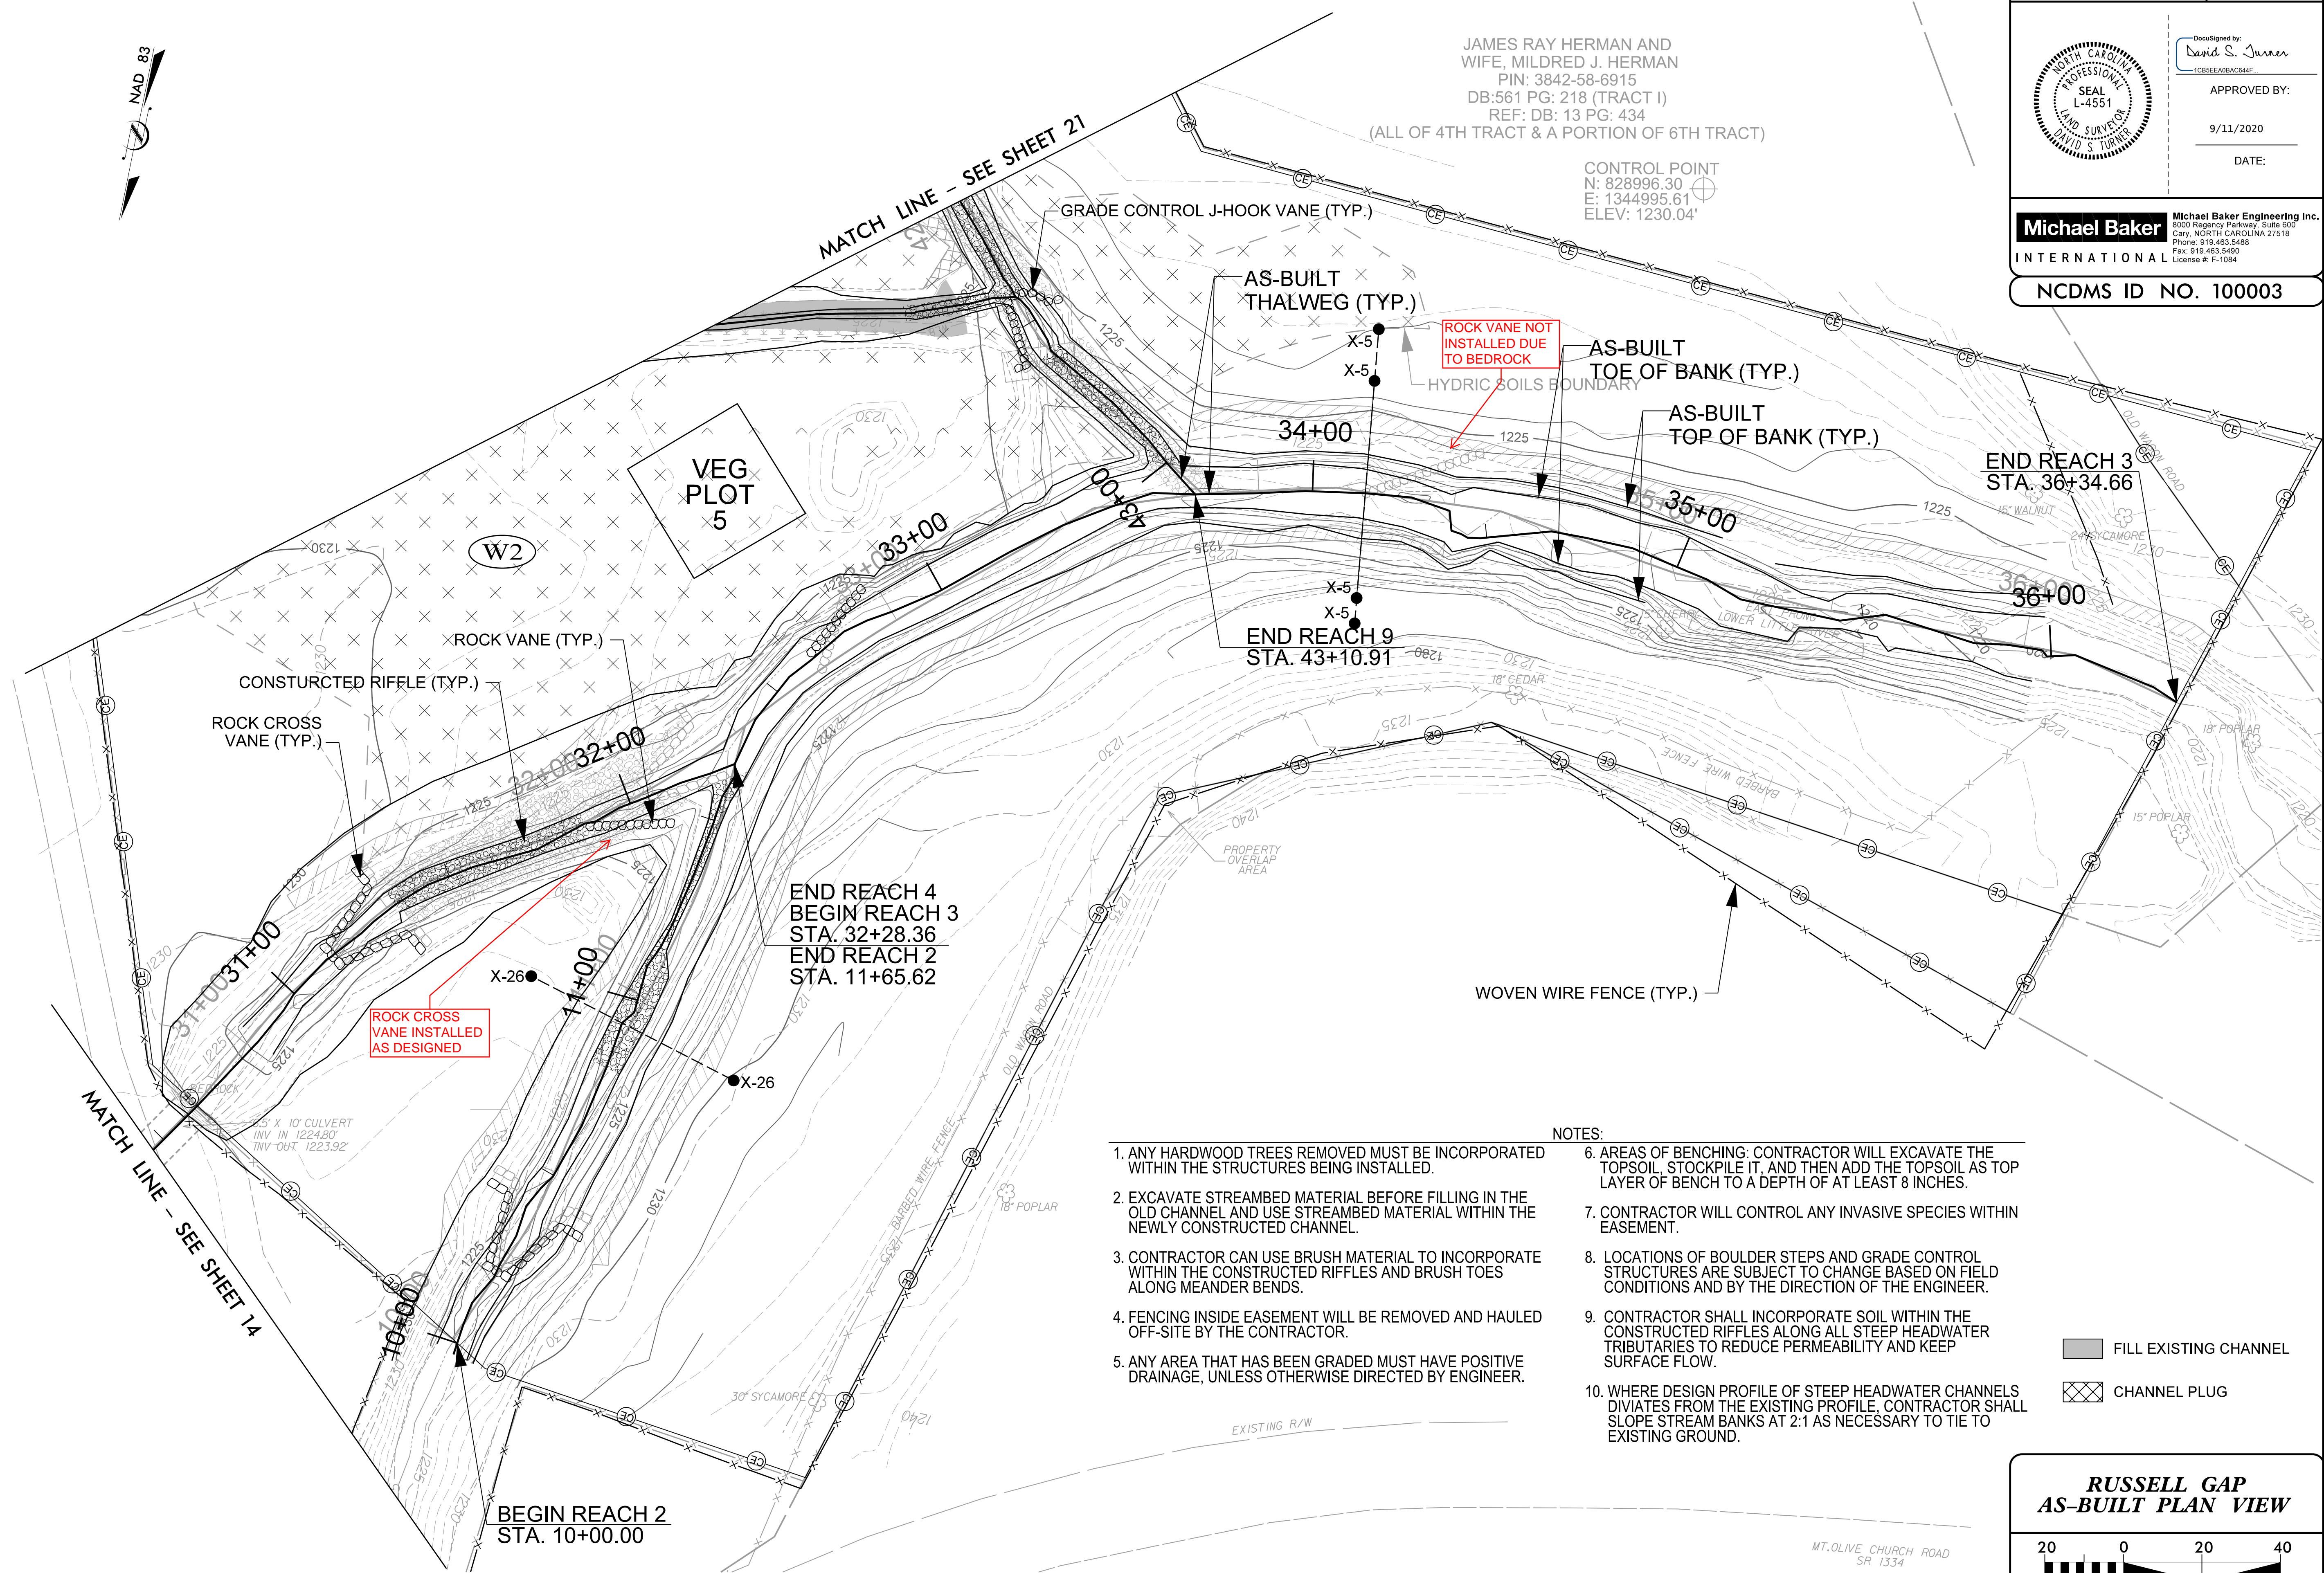


- NOTES:
1. ANY HARDWOOD TREES REMOVED MUST BE INCORPORATED WITHIN THE STRUCTURES BEING INSTALLED.
  2. EXCAVATE STREAMBED MATERIAL BEFORE FILLING IN THE OLD CHANNEL AND USE STREAMBED MATERIAL WITHIN THE NEWLY CONSTRUCTED CHANNEL.
  3. CONTRACTOR CAN USE BRUSH MATERIAL TO INCORPORATE WITHIN THE CONSTRUCTED RIFFLES AND BRUSH TOES ALONG MEANDER BENDS.
  4. FENCING INSIDE EASEMENT WILL BE REMOVED AND HAULED OFF-SITE BY THE CONTRACTOR.
  5. ANY AREA THAT HAS BEEN GRADED MUST HAVE POSITIVE DRAINAGE, UNLESS OTHERWISE DIRECTED BY ENGINEER.
  6. AREAS OF BENCHING: CONTRACTOR WILL EXCAVATE THE TOPSOIL, STOCKPILE IT, AND THEN ADD THE TOPSOIL AS TOP LAYER OF BENCH TO A DEPTH OF AT LEAST 8 INCHES.
  7. CONTRACTOR WILL CONTROL ANY INVASIVE SPECIES WITHIN EASEMENT.
  8. LOCATIONS OF BOULDER STEPS AND GRADE CONTROL STRUCTURES ARE SUBJECT TO CHANGE BASED ON FIELD CONDITIONS AND BY THE DIRECTION OF THE ENGINEER.
  9. CONTRACTOR SHALL INCORPORATE SOIL WITHIN THE CONSTRUCTED RIFFLES ALONG ALL STEEP HEADWATER TRIBUTARIES TO REDUCE PERMEABILITY AND KEEP SURFACE FLOW.
  10. WHERE DESIGN PROFILE OF STEEP HEADWATER CHANNELS DIVIATES FROM THE EXISTING PROFILE, CONTRACTOR SHALL SLOPE STREAM BANKS AT 2:1 AS NECESSARY TO TIE TO EXISTING GROUND.

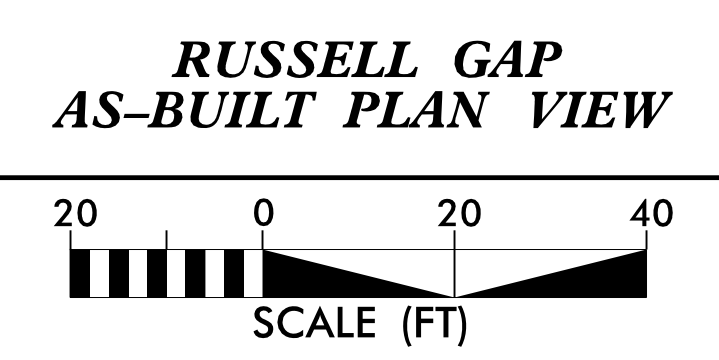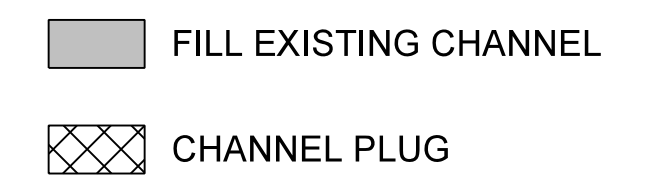

8/15/2020 - Russell - Cap Design - AS-BUILT PLANS - 157329 - AB-PSH-15.dgn  
 2/26/20




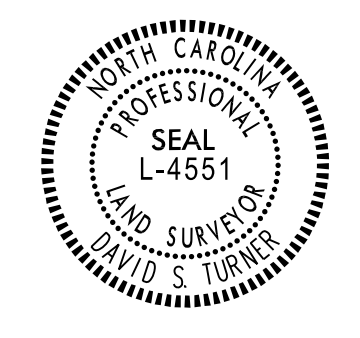

DocuSigned by:  
*David S. Turner*  
APPROVED BY:  
  
9/11/2020  
DATE:

**Michael Baker International** Michael Baker Engineering Inc.  
5000 Regency Parkway, Suite 600  
Cary, NORTH CAROLINA 27518  
Phone: 919.453.5488  
Fax: 919.453.5490  
License #: F-1084


**NCDMS ID NO. 100003**

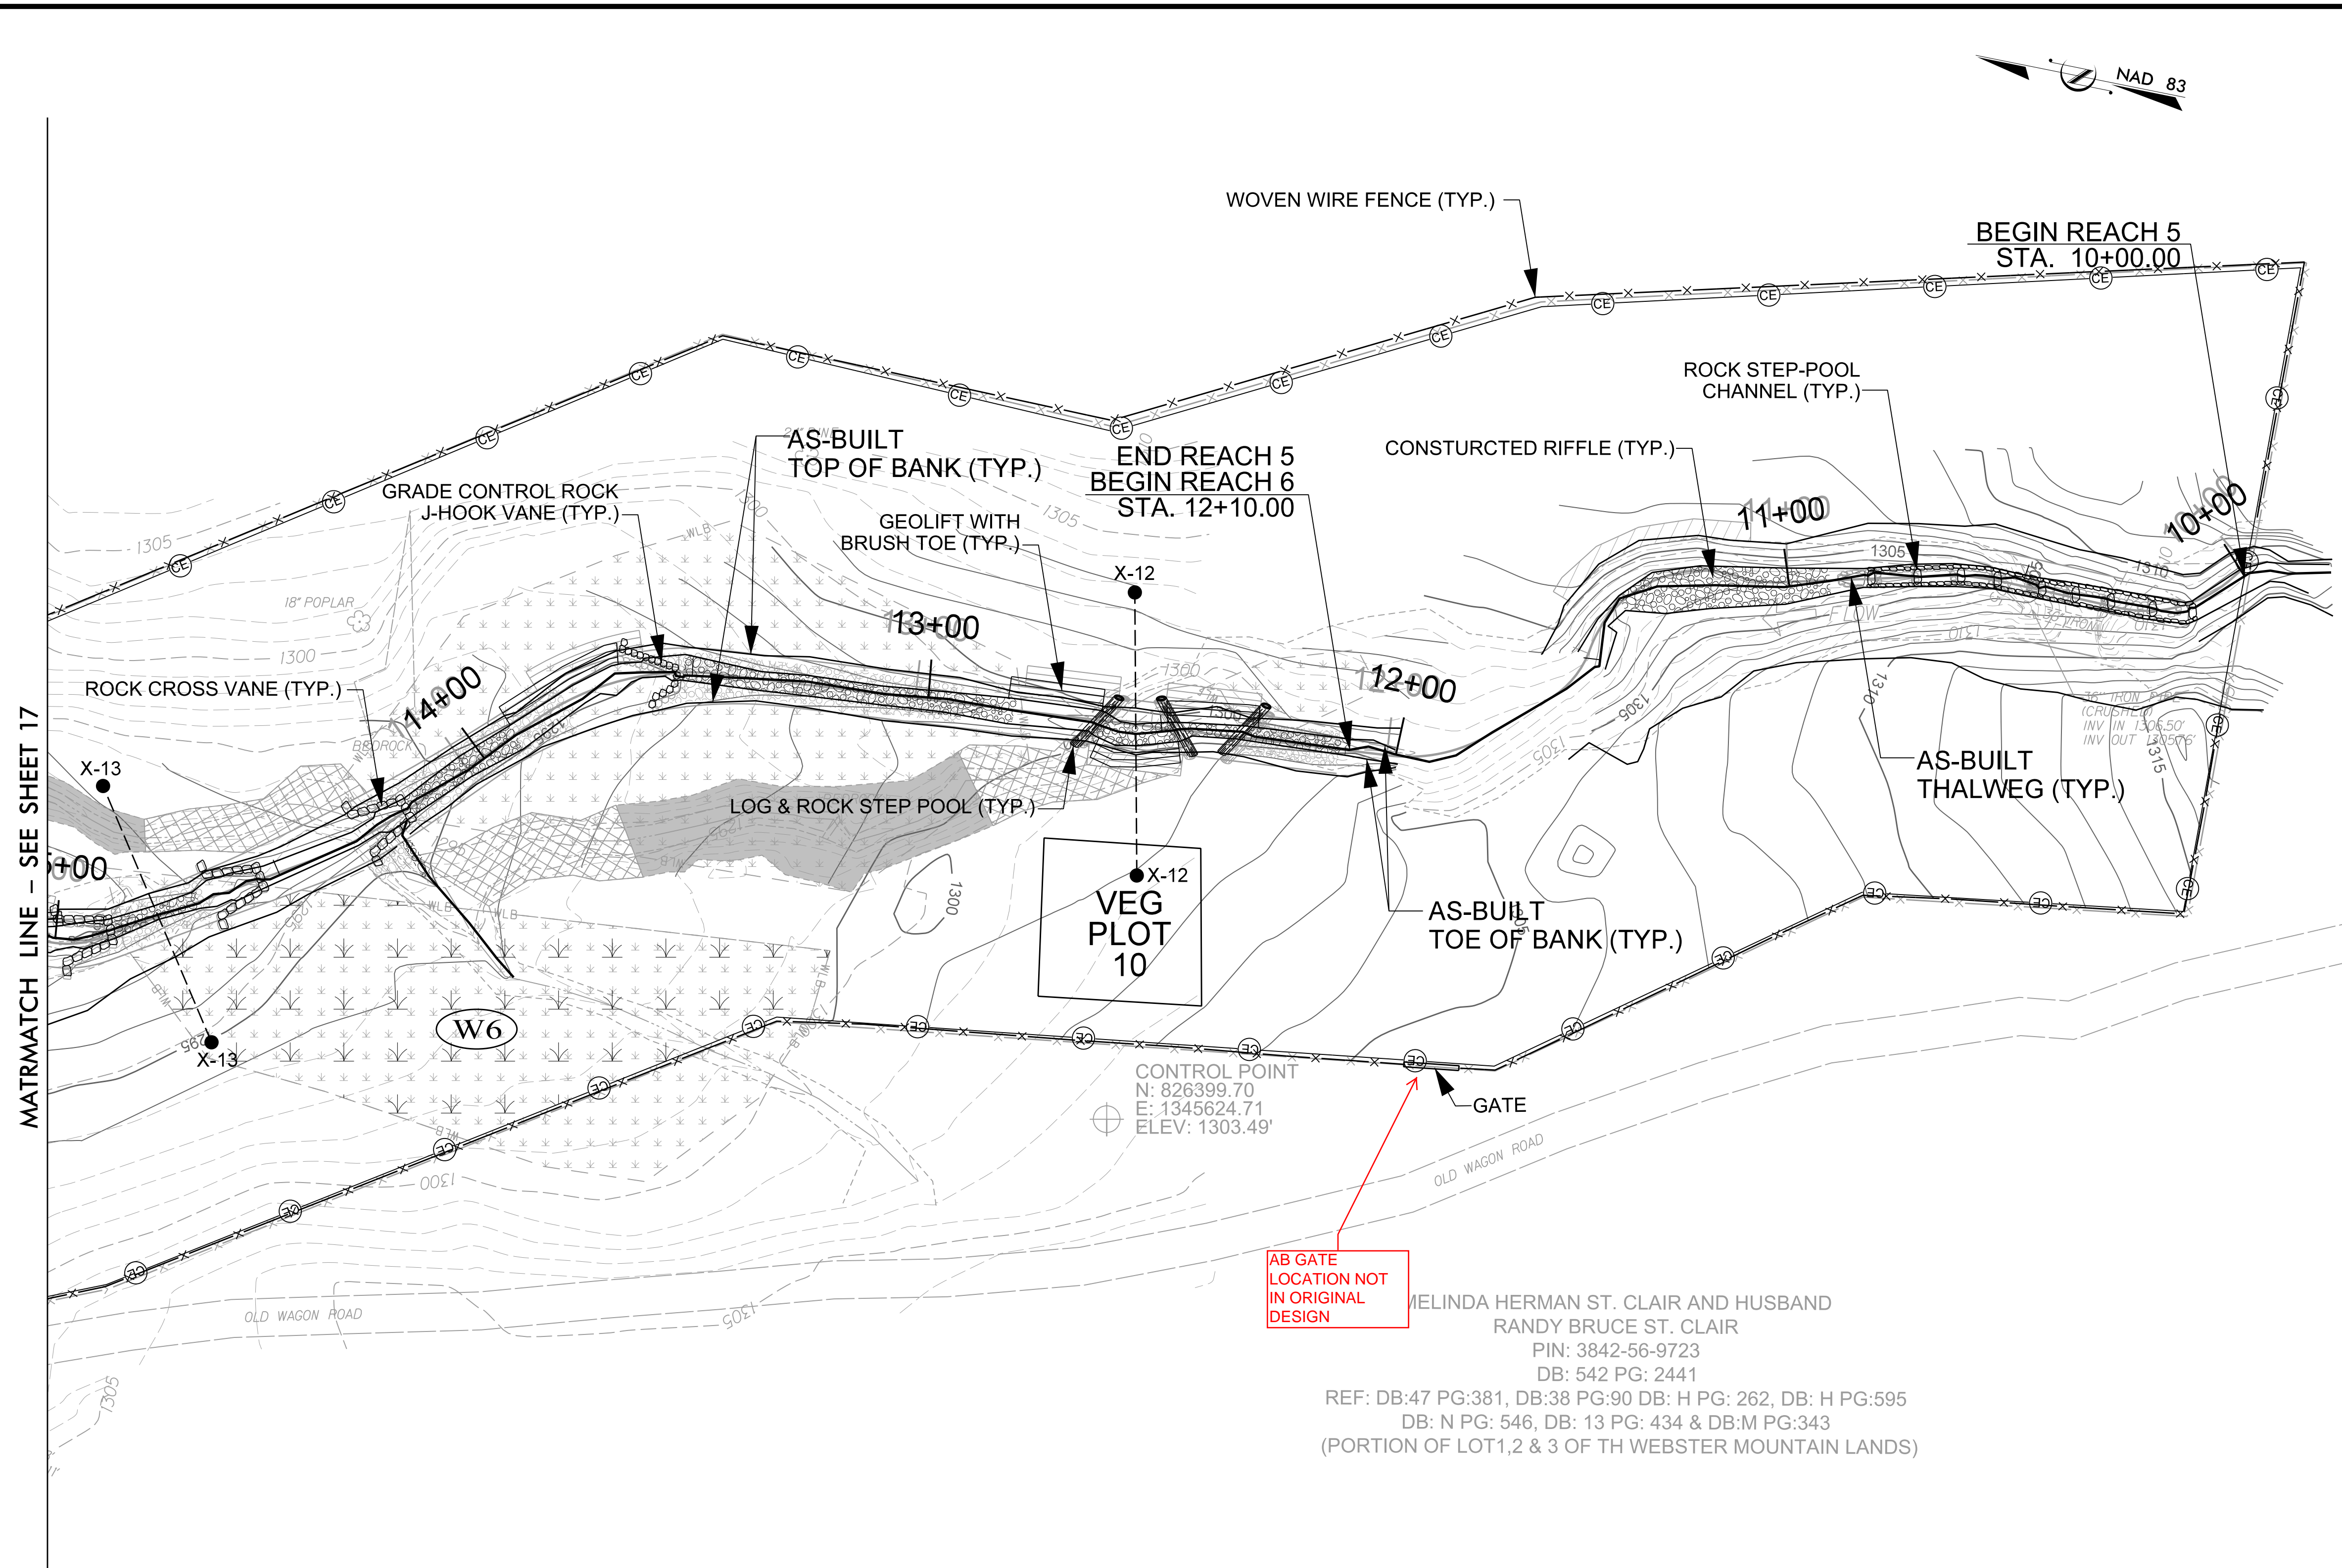

MATRMATCH LINE - SEE SHEET 17

- NOTES:
1. ANY HARDWOOD TREES REMOVED MUST BE INCORPORATED WITHIN THE STRUCTURES BEING INSTALLED.
  2. EXCAVATE STREAMBED MATERIAL BEFORE FILLING IN THE OLD CHANNEL AND USE STREAMBED MATERIAL WITHIN THE NEWLY CONSTRUCTED CHANNEL.
  3. CONTRACTOR CAN USE BRUSH MATERIAL TO INCORPORATE WITHIN THE CONSTRUCTED RIFFLES AND BRUSH TOES ALONG MEANDER BENDS.
  4. FENCING INSIDE EASEMENT WILL BE REMOVED AND HAULED OFF-SITE BY THE CONTRACTOR.
  5. ANY AREA THAT HAS BEEN GRADED MUST HAVE POSITIVE DRAINAGE, UNLESS OTHERWISE DIRECTED BY ENGINEER.
  6. AREAS OF BENCHING: CONTRACTOR WILL EXCAVATE THE TOPSOIL, STOCKPILE IT, AND THEN ADD THE TOPSOIL AS TOP LAYER OF BENCH TO A DEPTH OF AT LEAST 8 INCHES.
  7. CONTRACTOR WILL CONTROL ANY INVASIVE SPECIES WITHIN EASEMENT.
  8. LOCATIONS OF BOULDER STEPS AND GRADE CONTROL STRUCTURES ARE SUBJECT TO CHANGE BASED ON FIELD CONDITIONS AND BY THE DIRECTION OF THE ENGINEER.
  9. CONTRACTOR SHALL INCORPORATE SOIL WITHIN THE CONSTRUCTED RIFFLES ALONG ALL STEEP HEADWATER TRIBUTARIES TO REDUCE PERMEABILITY AND KEEP SURFACE FLOW.
  10. WHERE DESIGN PROFILE OF STEEP HEADWATER CHANNELS DIVIATES FROM THE EXISTING PROFILE, CONTRACTOR SHALL SLOPE STREAM BANKS AT 2:1 AS NECESSARY TO TIE TO EXISTING GROUND.

■ FILL EXISTING CHANNEL  
 ▨ CHANNEL PLUG

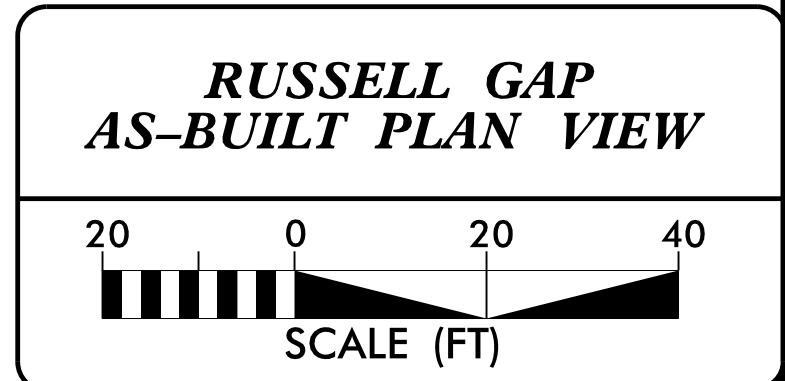




DocuSigned by:  
*David S. Turner*  
L-4551

APPROVED BY:  
  
9/11/2020  
DATE:


**Michael Baker International** Michael Baker Engineering Inc.  
5000 Regency Parkway, Suite 500  
Cary, NORTH CAROLINA 27518  
Phone: 919.453.5488  
Fax: 919.453.5490  
License #: F-1084

NCDS ID NO. 100003

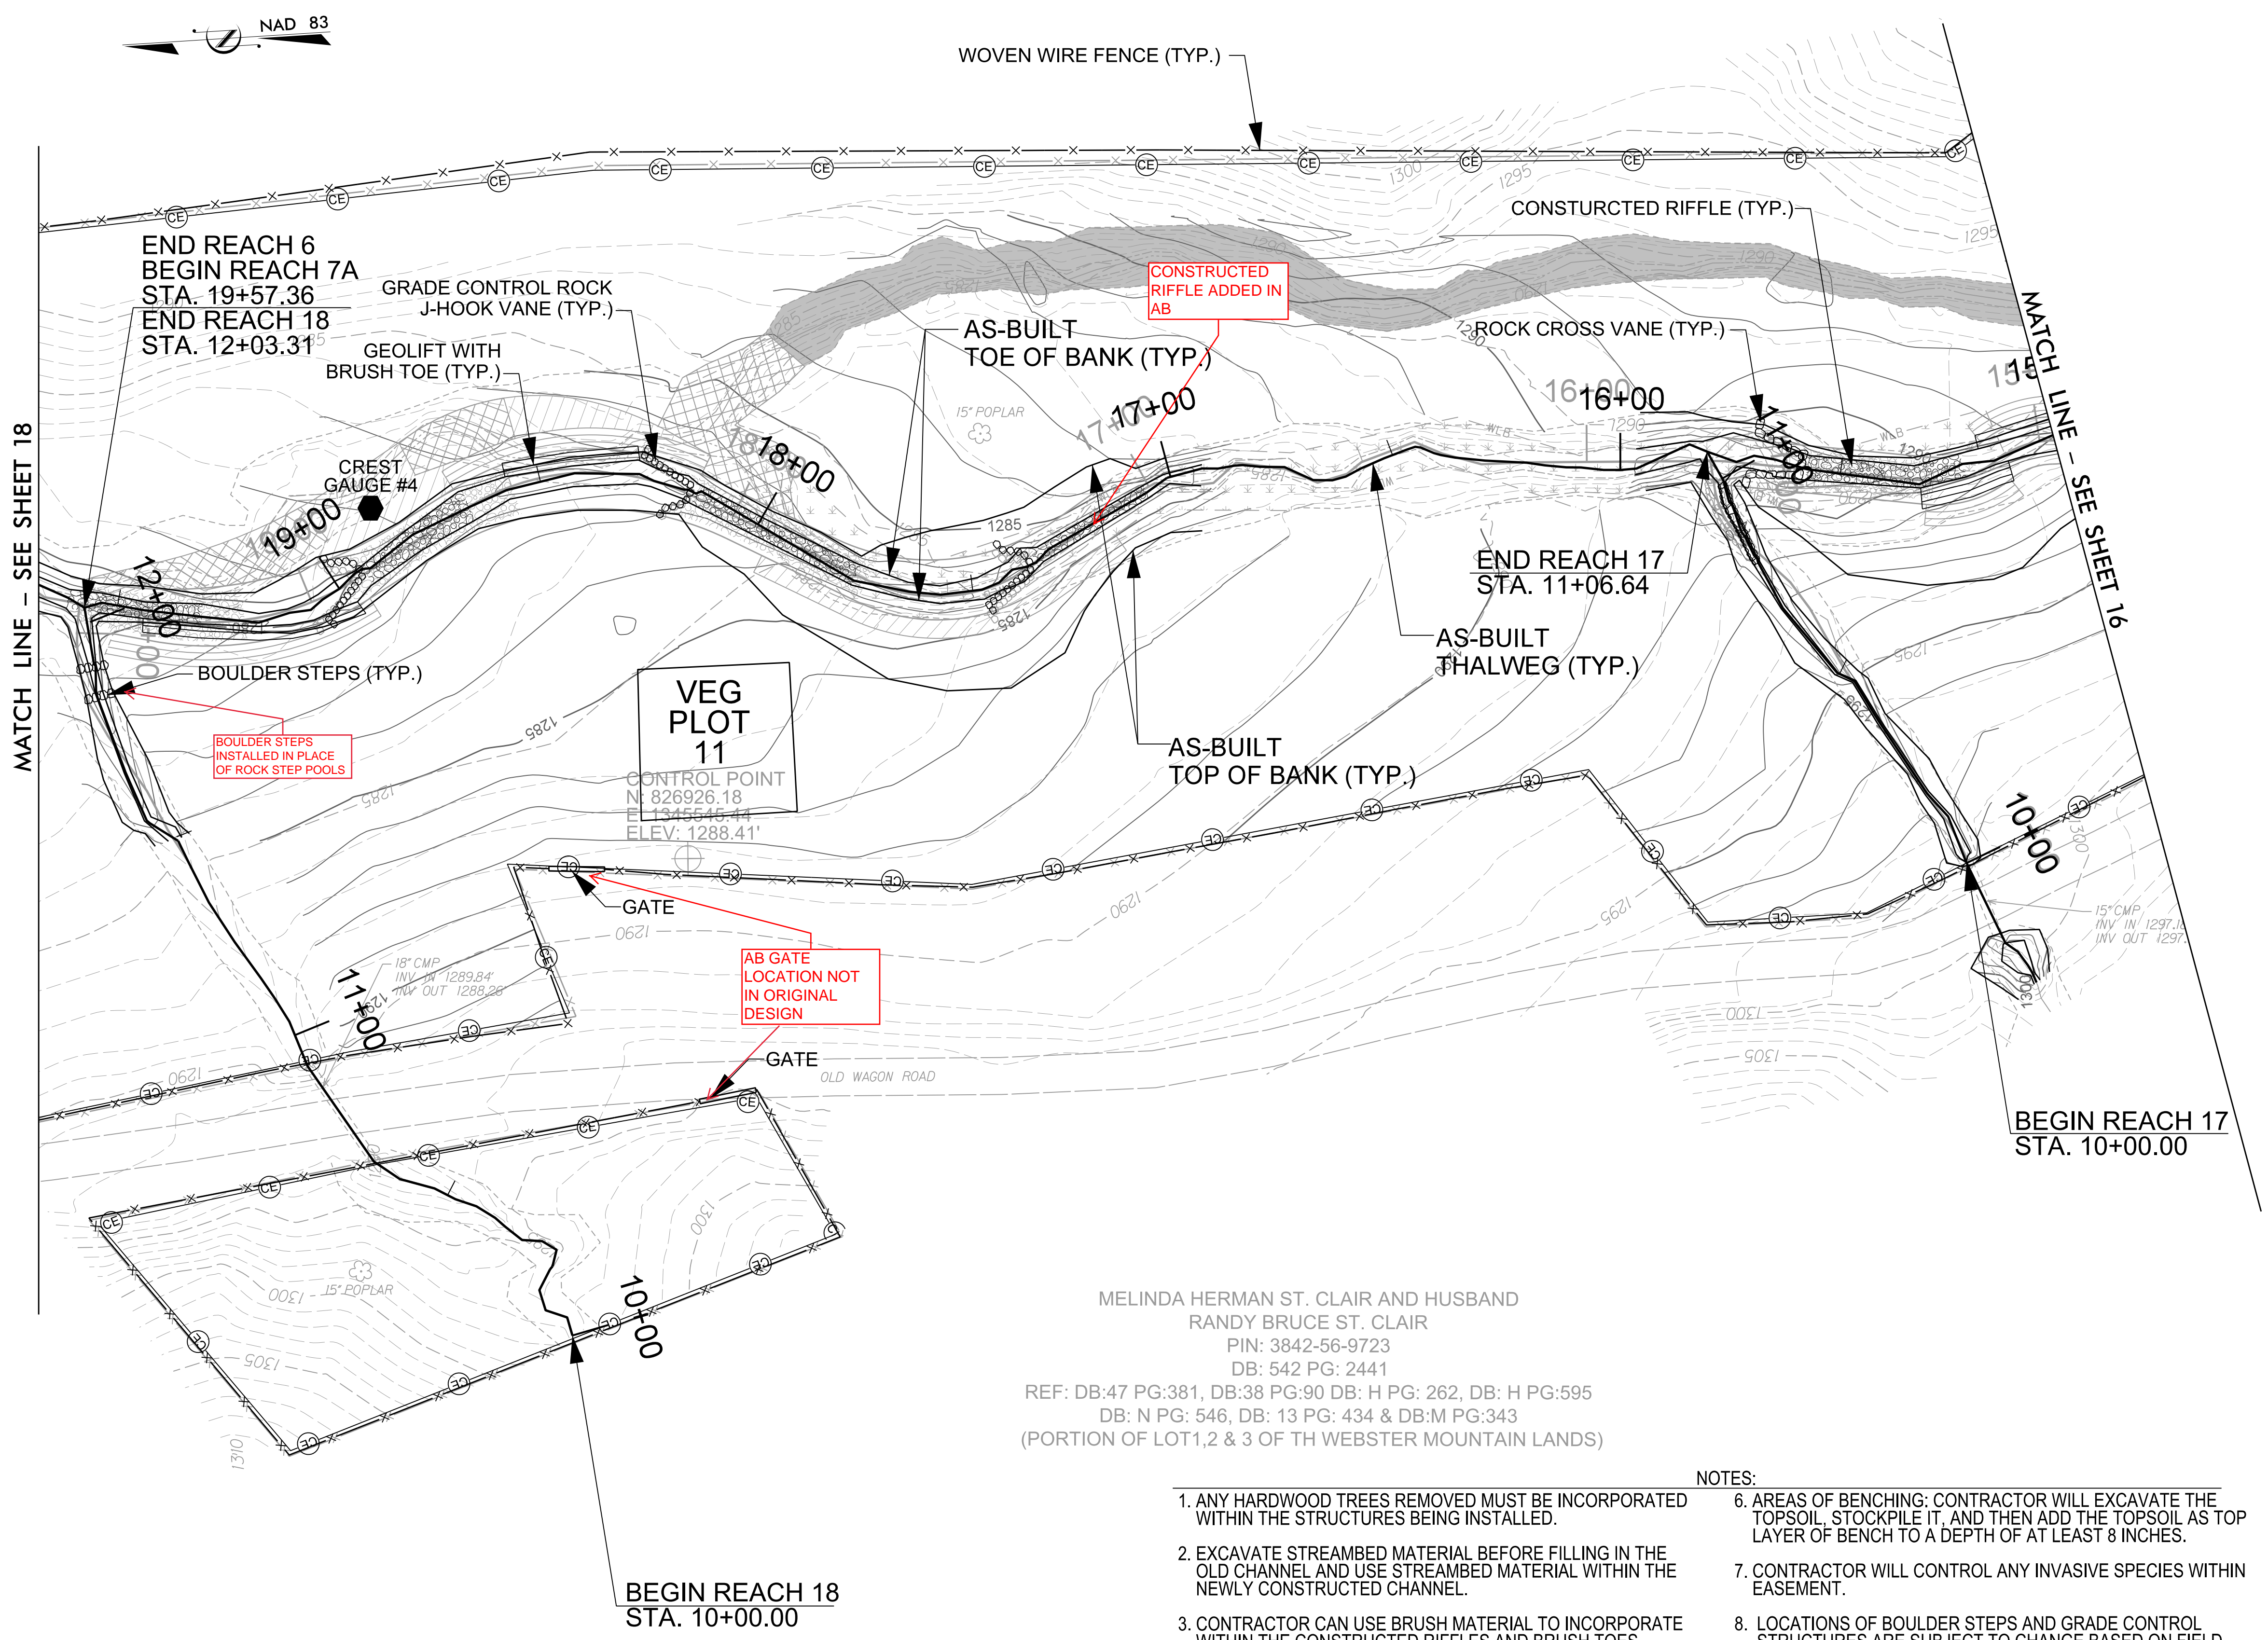

MELINDA HERMAN ST. CLAIR AND HUSBAND  
RANDY BRUCE ST. CLAIR  
PIN: 3842-56-9723  
DB: 542 PG: 2441  
REF: DB:47 PG:381, DB:38 PG:90 DB: H PG: 262, DB: H PG:595  
DB: N PG: 546, DB: 13 PG: 434 & DB:M PG:343  
(PORTION OF LOT 1,2 & 3 OF TH WEBSTER MOUNTAIN LANDS)

- NOTES:
1. ANY HARDWOOD TREES REMOVED MUST BE INCORPORATED WITHIN THE STRUCTURES BEING INSTALLED.
  2. EXCAVATE STREAMBED MATERIAL BEFORE FILLING IN THE OLD CHANNEL AND USE STREAMBED MATERIAL WITHIN THE NEWLY CONSTRUCTED CHANNEL.
  3. CONTRACTOR CAN USE BRUSH MATERIAL TO INCORPORATE WITHIN THE CONSTRUCTED RIFFLES AND BRUSH TOES ALONG MEANDER BENDS.
  4. FENCING INSIDE EASEMENT WILL BE REMOVED AND HAULED OFF-SITE BY THE CONTRACTOR.
  5. ANY AREA THAT HAS BEEN GRADED MUST HAVE POSITIVE DRAINAGE, UNLESS OTHERWISE DIRECTED BY ENGINEER.
  6. AREAS OF BENCHING: CONTRACTOR WILL EXCAVATE THE TOPSOIL, STOCKPILE IT, AND THEN ADD THE TOPSOIL AS TOP LAYER OF BENCH TO A DEPTH OF AT LEAST 8 INCHES.
  7. CONTRACTOR WILL CONTROL ANY INVASIVE SPECIES WITHIN EASEMENT.
  8. LOCATIONS OF BOULDER STEPS AND GRADE CONTROL STRUCTURES ARE SUBJECT TO CHANGE BASED ON FIELD CONDITIONS AND BY THE DIRECTION OF THE ENGINEER.
  9. CONTRACTOR SHALL INCORPORATE SOIL WITHIN THE CONSTRUCTED RIFFLES ALONG ALL STEEP HEADWATER TRIBUTARIES TO REDUCE PERMEABILITY AND KEEP SURFACE FLOW.
  10. WHERE DESIGN PROFILE OF STEEP HEADWATER CHANNELS DIVIATES FROM THE EXISTING PROFILE, CONTRACTOR SHALL SLOPE STREAM BANKS AT 2:1 AS NECESSARY TO TIE TO EXISTING GROUND.

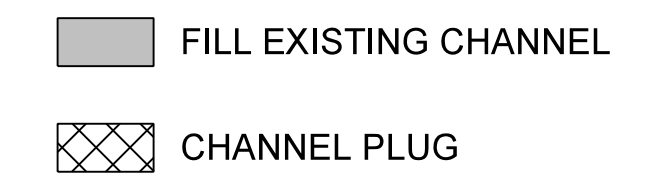

**RUSSELL GAP  
AS-BUILT PLAN VIEW**

SCALE (FT)







DocuSigned by:  
David S. Turner  
10B5EA2BAC04E

APPROVED BY:  
  
9/11/2020  
  
DATE:

**Michael Baker International** Michael Baker Engineering Inc.  
5000 Regency Parkway, Suite 800  
Cary, NORTH CAROLINA 27518  
Phone: 919.453.5488  
Fax: 919.453.5490  
License #: F-1084

NCDMS ID NO. 100003

- NOTES:
1. ANY HARDWOOD TREES REMOVED MUST BE INCORPORATED WITHIN THE STRUCTURES BEING INSTALLED.
  2. EXCAVATE STREAMBED MATERIAL BEFORE FILLING IN THE OLD CHANNEL AND USE STREAMBED MATERIAL WITHIN THE NEWLY CONSTRUCTED CHANNEL.
  3. CONTRACTOR CAN USE BRUSH MATERIAL TO INCORPORATE WITHIN THE CONSTRUCTED RIFFLES AND BRUSH TOES ALONG MEANDER BENDS.
  4. FENCING INSIDE EASEMENT WILL BE REMOVED AND HAULED OFF-SITE BY THE CONTRACTOR.
  5. ANY AREA THAT HAS BEEN GRADED MUST HAVE POSITIVE DRAINAGE, UNLESS OTHERWISE DIRECTED BY ENGINEER.
  6. AREAS OF BENCHING: CONTRACTOR WILL EXCAVATE THE TOPSOIL, STOCKPILE IT, AND THEN ADD THE TOPSOIL AS TOP LAYER OF BENCH TO A DEPTH OF AT LEAST 8 INCHES.
  7. CONTRACTOR WILL CONTROL ANY INVASIVE SPECIES WITHIN EASEMENT.
  8. LOCATIONS OF BOULDER STEPS AND GRADE CONTROL STRUCTURES ARE SUBJECT TO CHANGE BASED ON FIELD CONDITIONS AND BY THE DIRECTION OF THE ENGINEER.
  9. CONTRACTOR SHALL INCORPORATE SOIL WITHIN THE CONSTRUCTED RIFFLES ALONG ALL STEEP HEADWATER TRIBUTARIES TO REDUCE PERMEABILITY AND KEEP SURFACE FLOW.
  10. WHERE DESIGN PROFILE OF STEEP HEADWATER CHANNELS DIVIATES FROM THE EXISTING PROFILE, CONTRACTOR SHALL SLOPE STREAM BANKS AT 2:1 AS NECESSARY TO TIE TO EXISTING GROUND.

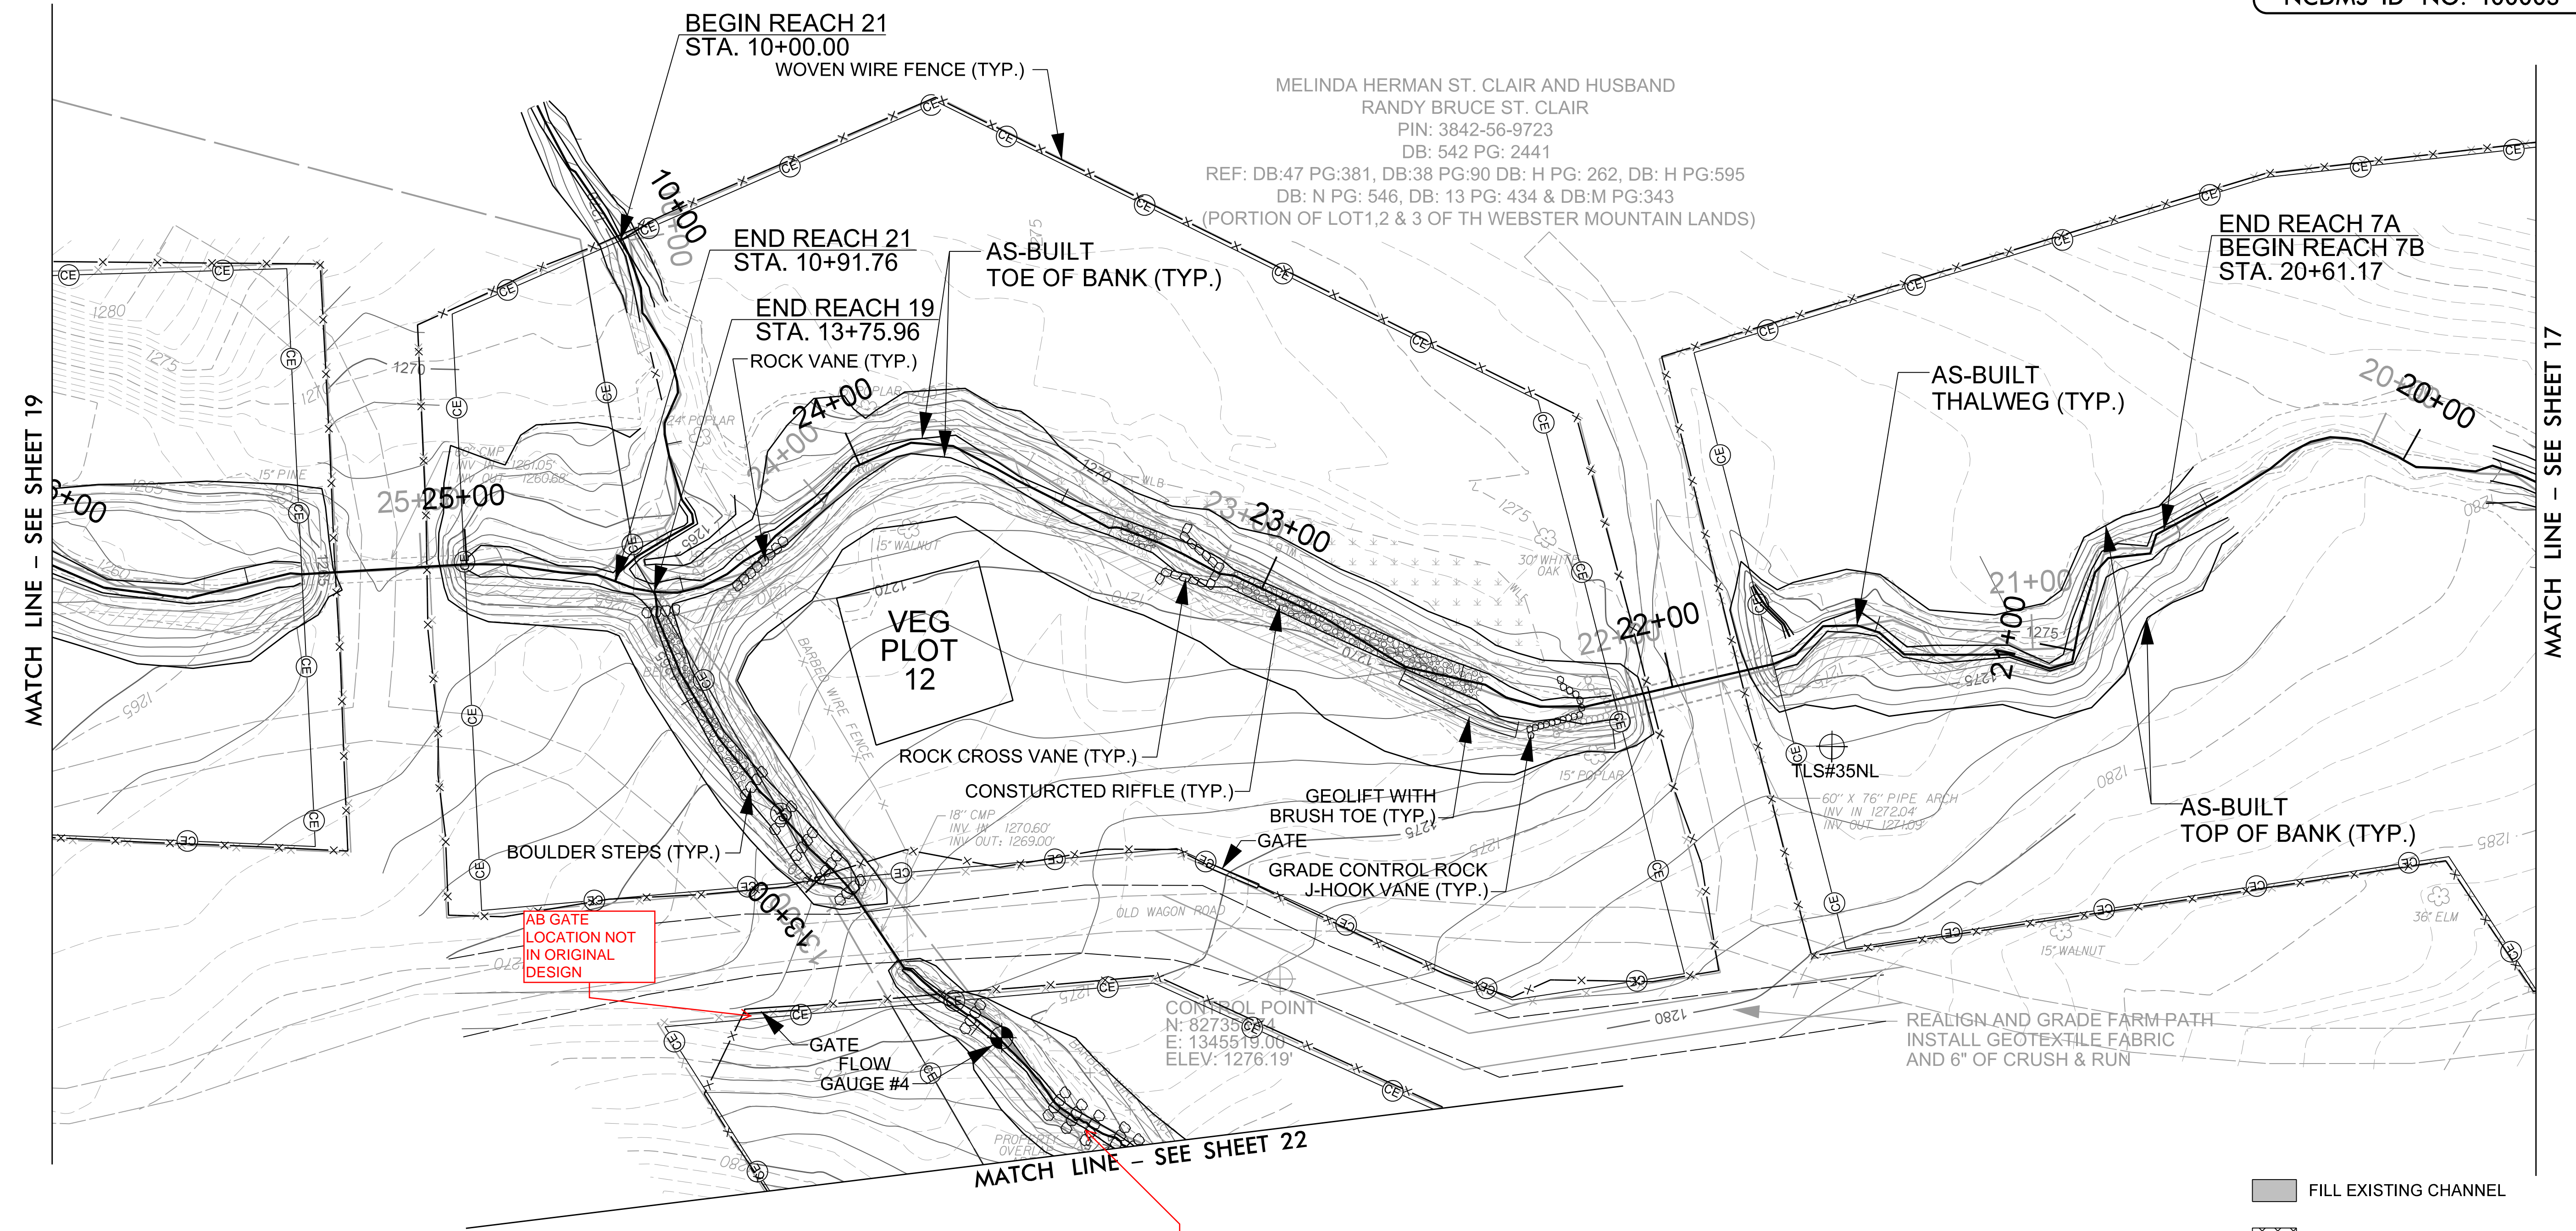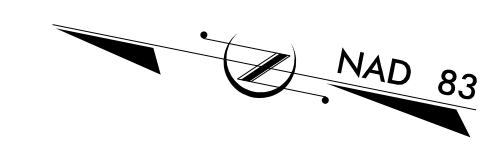

MATCH LINE - SEE SHEET 19

MATCH LINE - SEE SHEET 17

AB GATE LOCATION NOT IN ORIGINAL DESIGN


BOULDER STEPS INSTALLED IN PLACE OF STEP POOLS

- FILL EXISTING CHANNEL
- CHANNEL PLUG

**RUSSELL GAP AS-BUILT PLAN VIEW**

SCALE (FT)



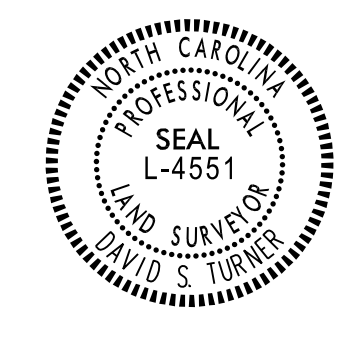

DocuSigned by:  
*David S. Turner*  
1C8EE6A8AC844F


APPROVED BY:

9/11/2020

DATE:

**Michael Baker International** Michael Baker Engineering Inc.  
5000 Regency Parkway, Suite 800  
Cary, NORTH CAROLINA 27518  
Phone: 919.453.5488  
Fax: 919.453.5490  
License #: F-1084

**NC DMS ID NO. 100003**

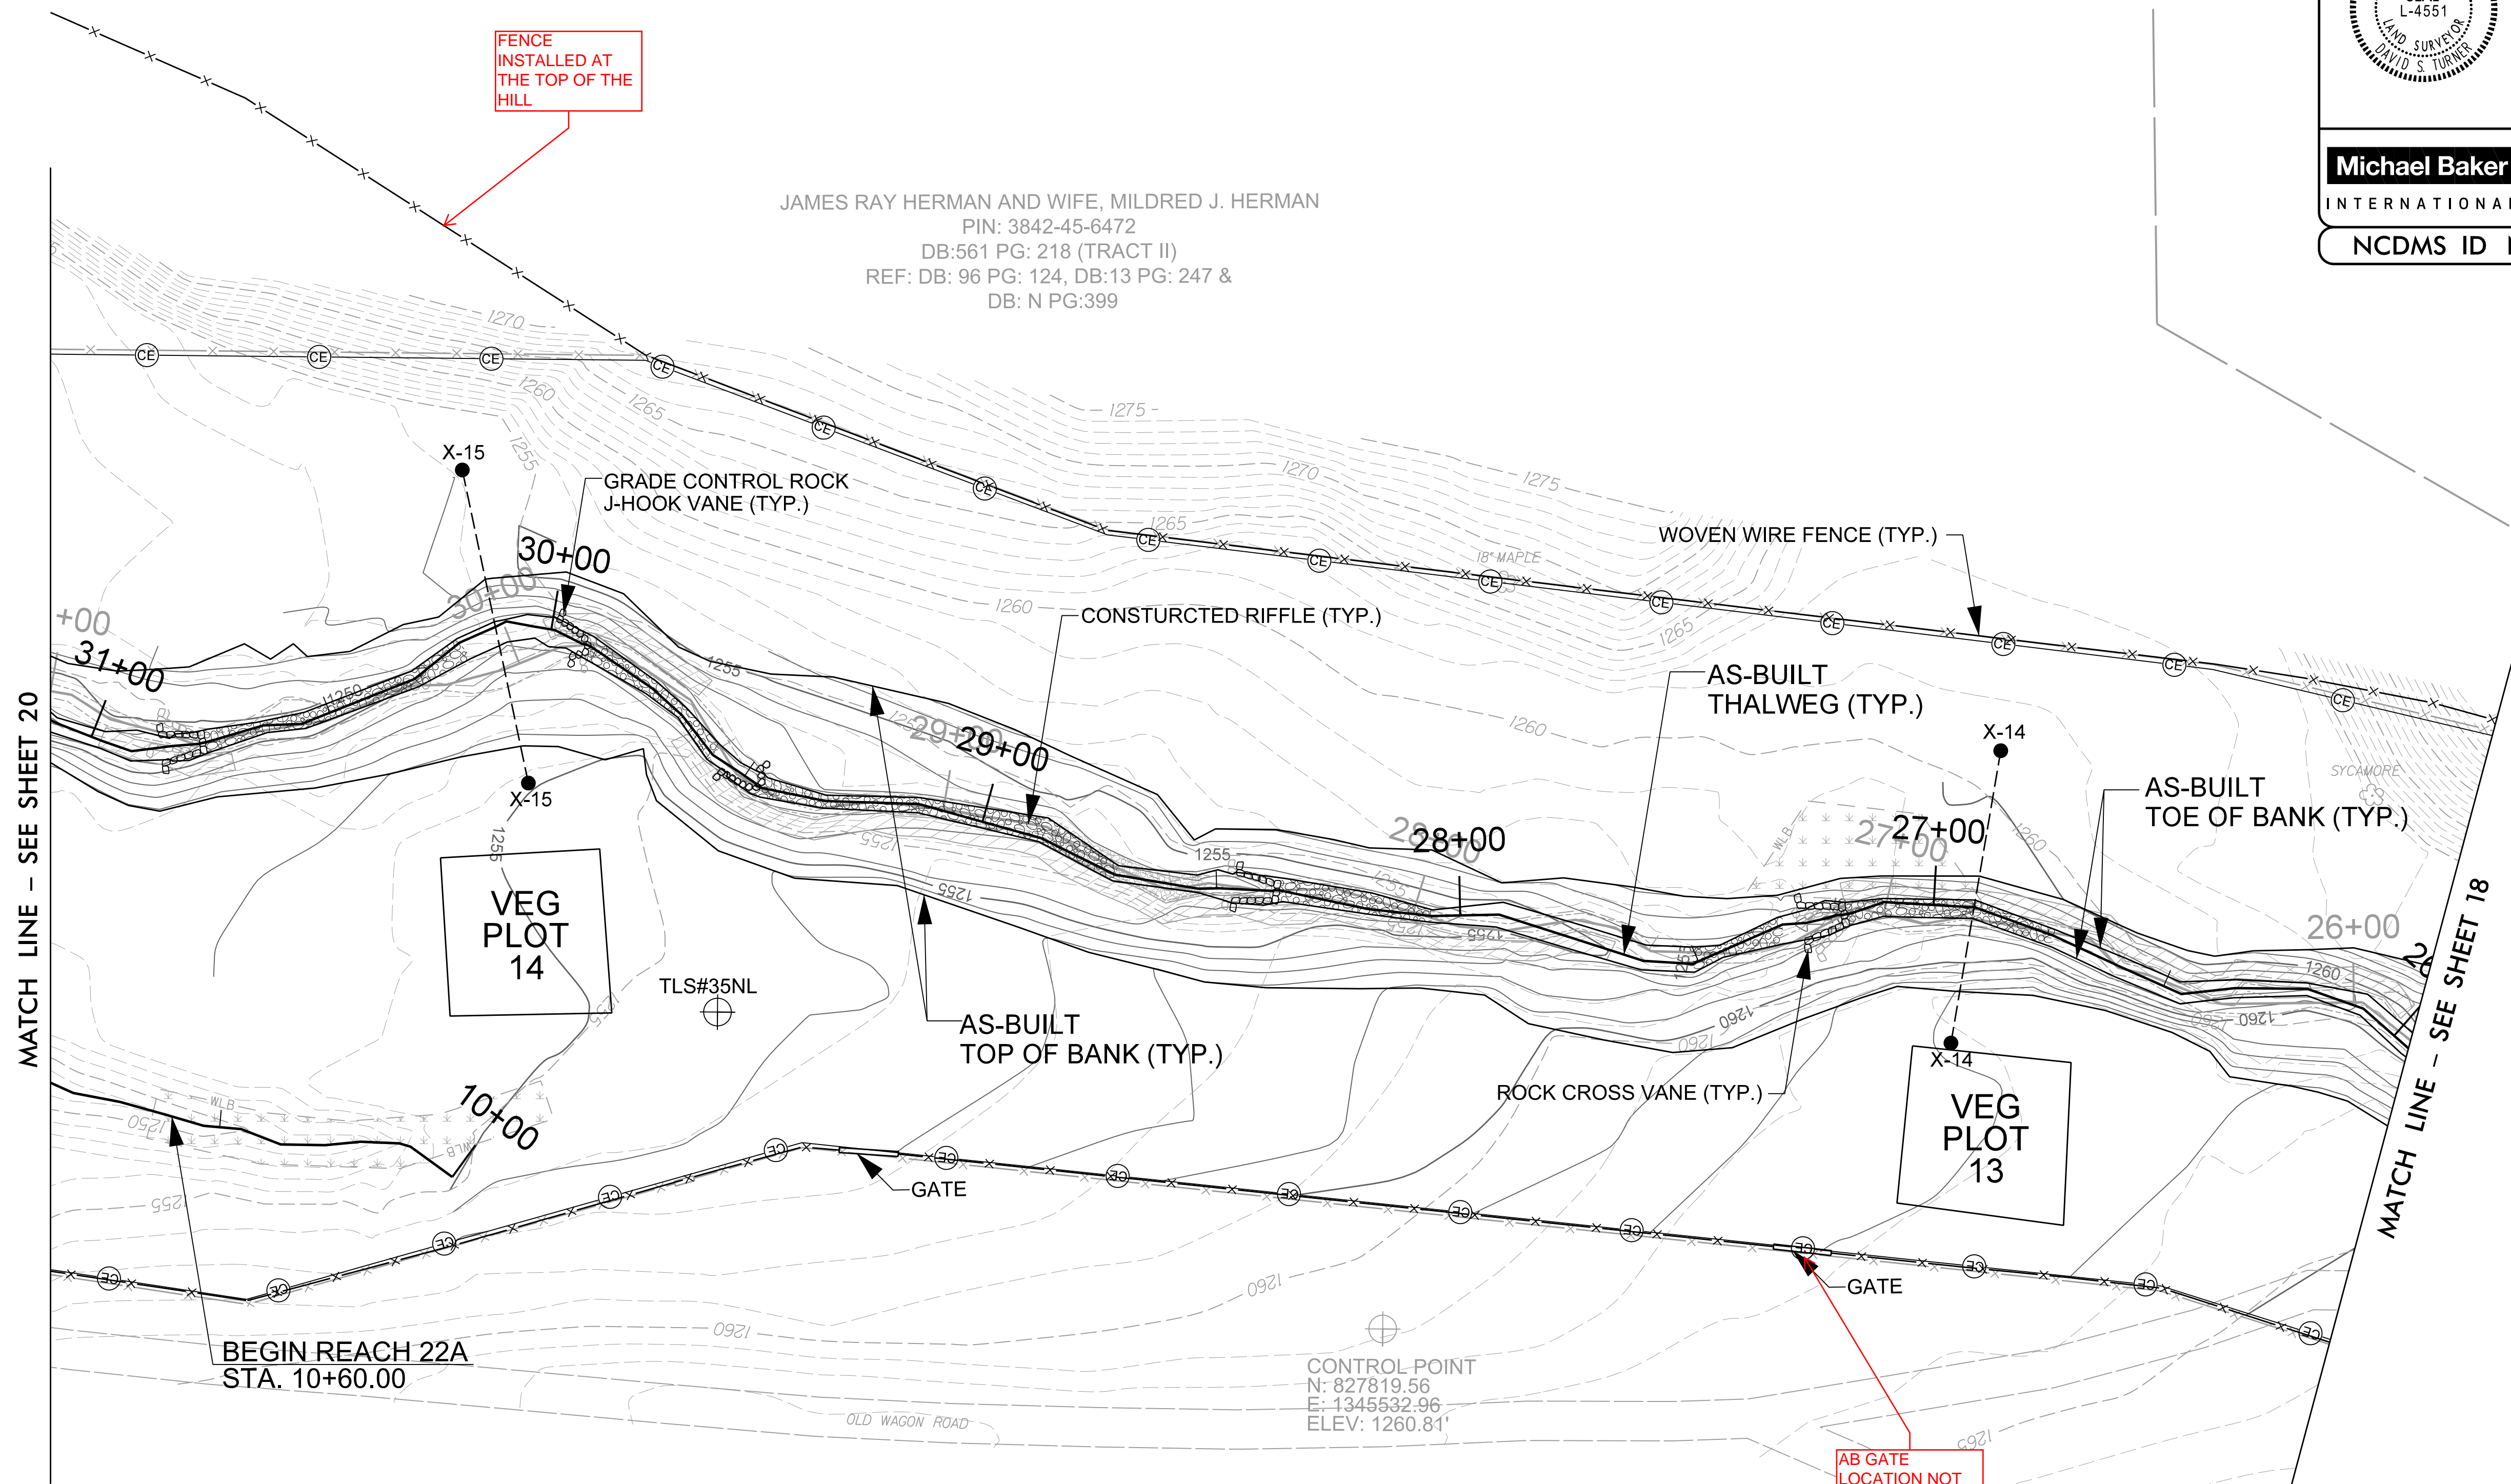


JAMES RAY HERMAN AND WIFE, MILDRED J. HERMAN  
PIN: 3842-45-6472  
DB:561 PG: 218 (TRACT II)  
REF: DB: 96 PG: 124, DB:13 PG: 247 &  
DB: N PG:399

JAMES RAY HERMAN AND WIFE, MILDRED J. HERMAN  
PIN: 3842-45-6472  
DB:561 PG: 218 (TRACT II)  
REF: DB: 96 PG: 124, DB:13 PG: 247 &  
DB: N PG:399

- NOTES:
1. ANY HARDWOOD TREES REMOVED MUST BE INCORPORATED WITHIN THE STRUCTURES BEING INSTALLED.
  2. EXCAVATE STREAMBED MATERIAL BEFORE FILLING IN THE OLD CHANNEL AND USE STREAMBED MATERIAL WITHIN THE NEWLY CONSTRUCTED CHANNEL.
  3. CONTRACTOR CAN USE BRUSH MATERIAL TO INCORPORATE WITHIN THE CONSTRUCTED RIFFLES AND BRUSH TOES ALONG MEANDER BENDS.
  4. FENCING INSIDE EASEMENT WILL BE REMOVED AND HAULED OFF-SITE BY THE CONTRACTOR.
  5. ANY AREA THAT HAS BEEN GRADED MUST HAVE POSITIVE DRAINAGE, UNLESS OTHERWISE DIRECTED BY ENGINEER.
  6. AREAS OF BENCHING: CONTRACTOR WILL EXCAVATE THE TOPSOIL, STOCKPILE IT, AND THEN ADD THE TOPSOIL AS TOP LAYER OF BENCH TO A DEPTH OF AT LEAST 8 INCHES.
  7. CONTRACTOR WILL CONTROL ANY INVASIVE SPECIES WITHIN EASEMENT.
  8. LOCATIONS OF BOULDER STEPS AND GRADE CONTROL STRUCTURES ARE SUBJECT TO CHANGE BASED ON FIELD CONDITIONS AND BY THE DIRECTION OF THE ENGINEER.
  9. CONTRACTOR SHALL INCORPORATE SOIL WITHIN THE CONSTRUCTED RIFFLES ALONG ALL STEEP HEADWATER TRIBUTARIES TO REDUCE PERMEABILITY AND KEEP SURFACE FLOW.
  10. WHERE DESIGN PROFILE OF STEEP HEADWATER CHANNELS DIVERGES FROM THE EXISTING PROFILE, CONTRACTOR SHALL SLOPE STREAM BANKS AT 2:1 AS NECESSARY TO TIE TO EXISTING GROUND.

- FILL EXISTING CHANNEL
- CHANNEL PLUG

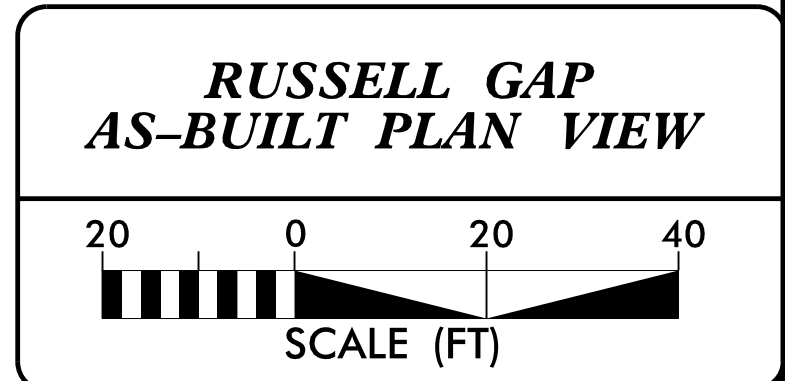





2/26/2023

- NOTES:
1. ANY HARDWOOD TREES REMOVED MUST BE INCORPORATED WITHIN THE STRUCTURES BEING INSTALLED.
  2. EXCAVATE STREAMBED MATERIAL BEFORE FILLING IN THE OLD CHANNEL AND USE STREAMBED MATERIAL WITHIN THE NEWLY CONSTRUCTED CHANNEL.
  3. CONTRACTOR CAN USE BRUSH MATERIAL TO INCORPORATE WITHIN THE CONSTRUCTED RIFFLES AND BRUSH TOES ALONG MEANDER BENDS.
  4. FENCING INSIDE EASEMENT WILL BE REMOVED AND HAULED OFF-SITE BY THE CONTRACTOR.
  5. ANY AREA THAT HAS BEEN GRADED MUST HAVE POSITIVE DRAINAGE, UNLESS OTHERWISE DIRECTED BY ENGINEER.

6. AREAS OF BENCHING: CONTRACTOR WILL EXCAVATE THE TOPSOIL, STOCKPILE IT, AND THEN ADD THE TOPSOIL AS TOP LAYER OF BENCH TO A DEPTH OF AT LEAST 8 INCHES.
7. CONTRACTOR WILL CONTROL ANY INVASIVE SPECIES WITHIN EASEMENT.
8. LOCATIONS OF BOULDER STEPS AND GRADE CONTROL STRUCTURES ARE SUBJECT TO CHANGE BASED ON FIELD CONDITIONS AND BY THE DIRECTION OF THE ENGINEER.
9. CONTRACTOR SHALL INCORPORATE SOIL WITHIN THE CONSTRUCTED RIFFLES ALONG ALL STEEP HEADWATER TRIBUTARIES TO REDUCE PERMEABILITY AND KEEP SURFACE FLOW.
10. WHERE DESIGN PROFILE OF STEEP HEADWATER CHANNELS DIVERGES FROM THE EXISTING PROFILE, CONTRACTOR SHALL SLOPE STREAM BANKS AT 2:1 AS NECESSARY TO TIE TO EXISTING GROUND.

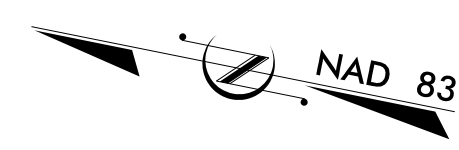

BAKER PROJECT REFERENCE NO. 157329	SHEET NO. 20
	APPROVED BY: David S. Turner
	DATE: 9/11/2020
	DATE:
<b>Michael Baker International</b> Michael Baker Engineering Inc. 5020 Regency Parkway, Suite 500 Cary, NORTH CAROLINA 27518 Phone: 919.453.5488 Fax: 919.453.5490 License #: F-1084	
NCDMS ID NO. 100003	

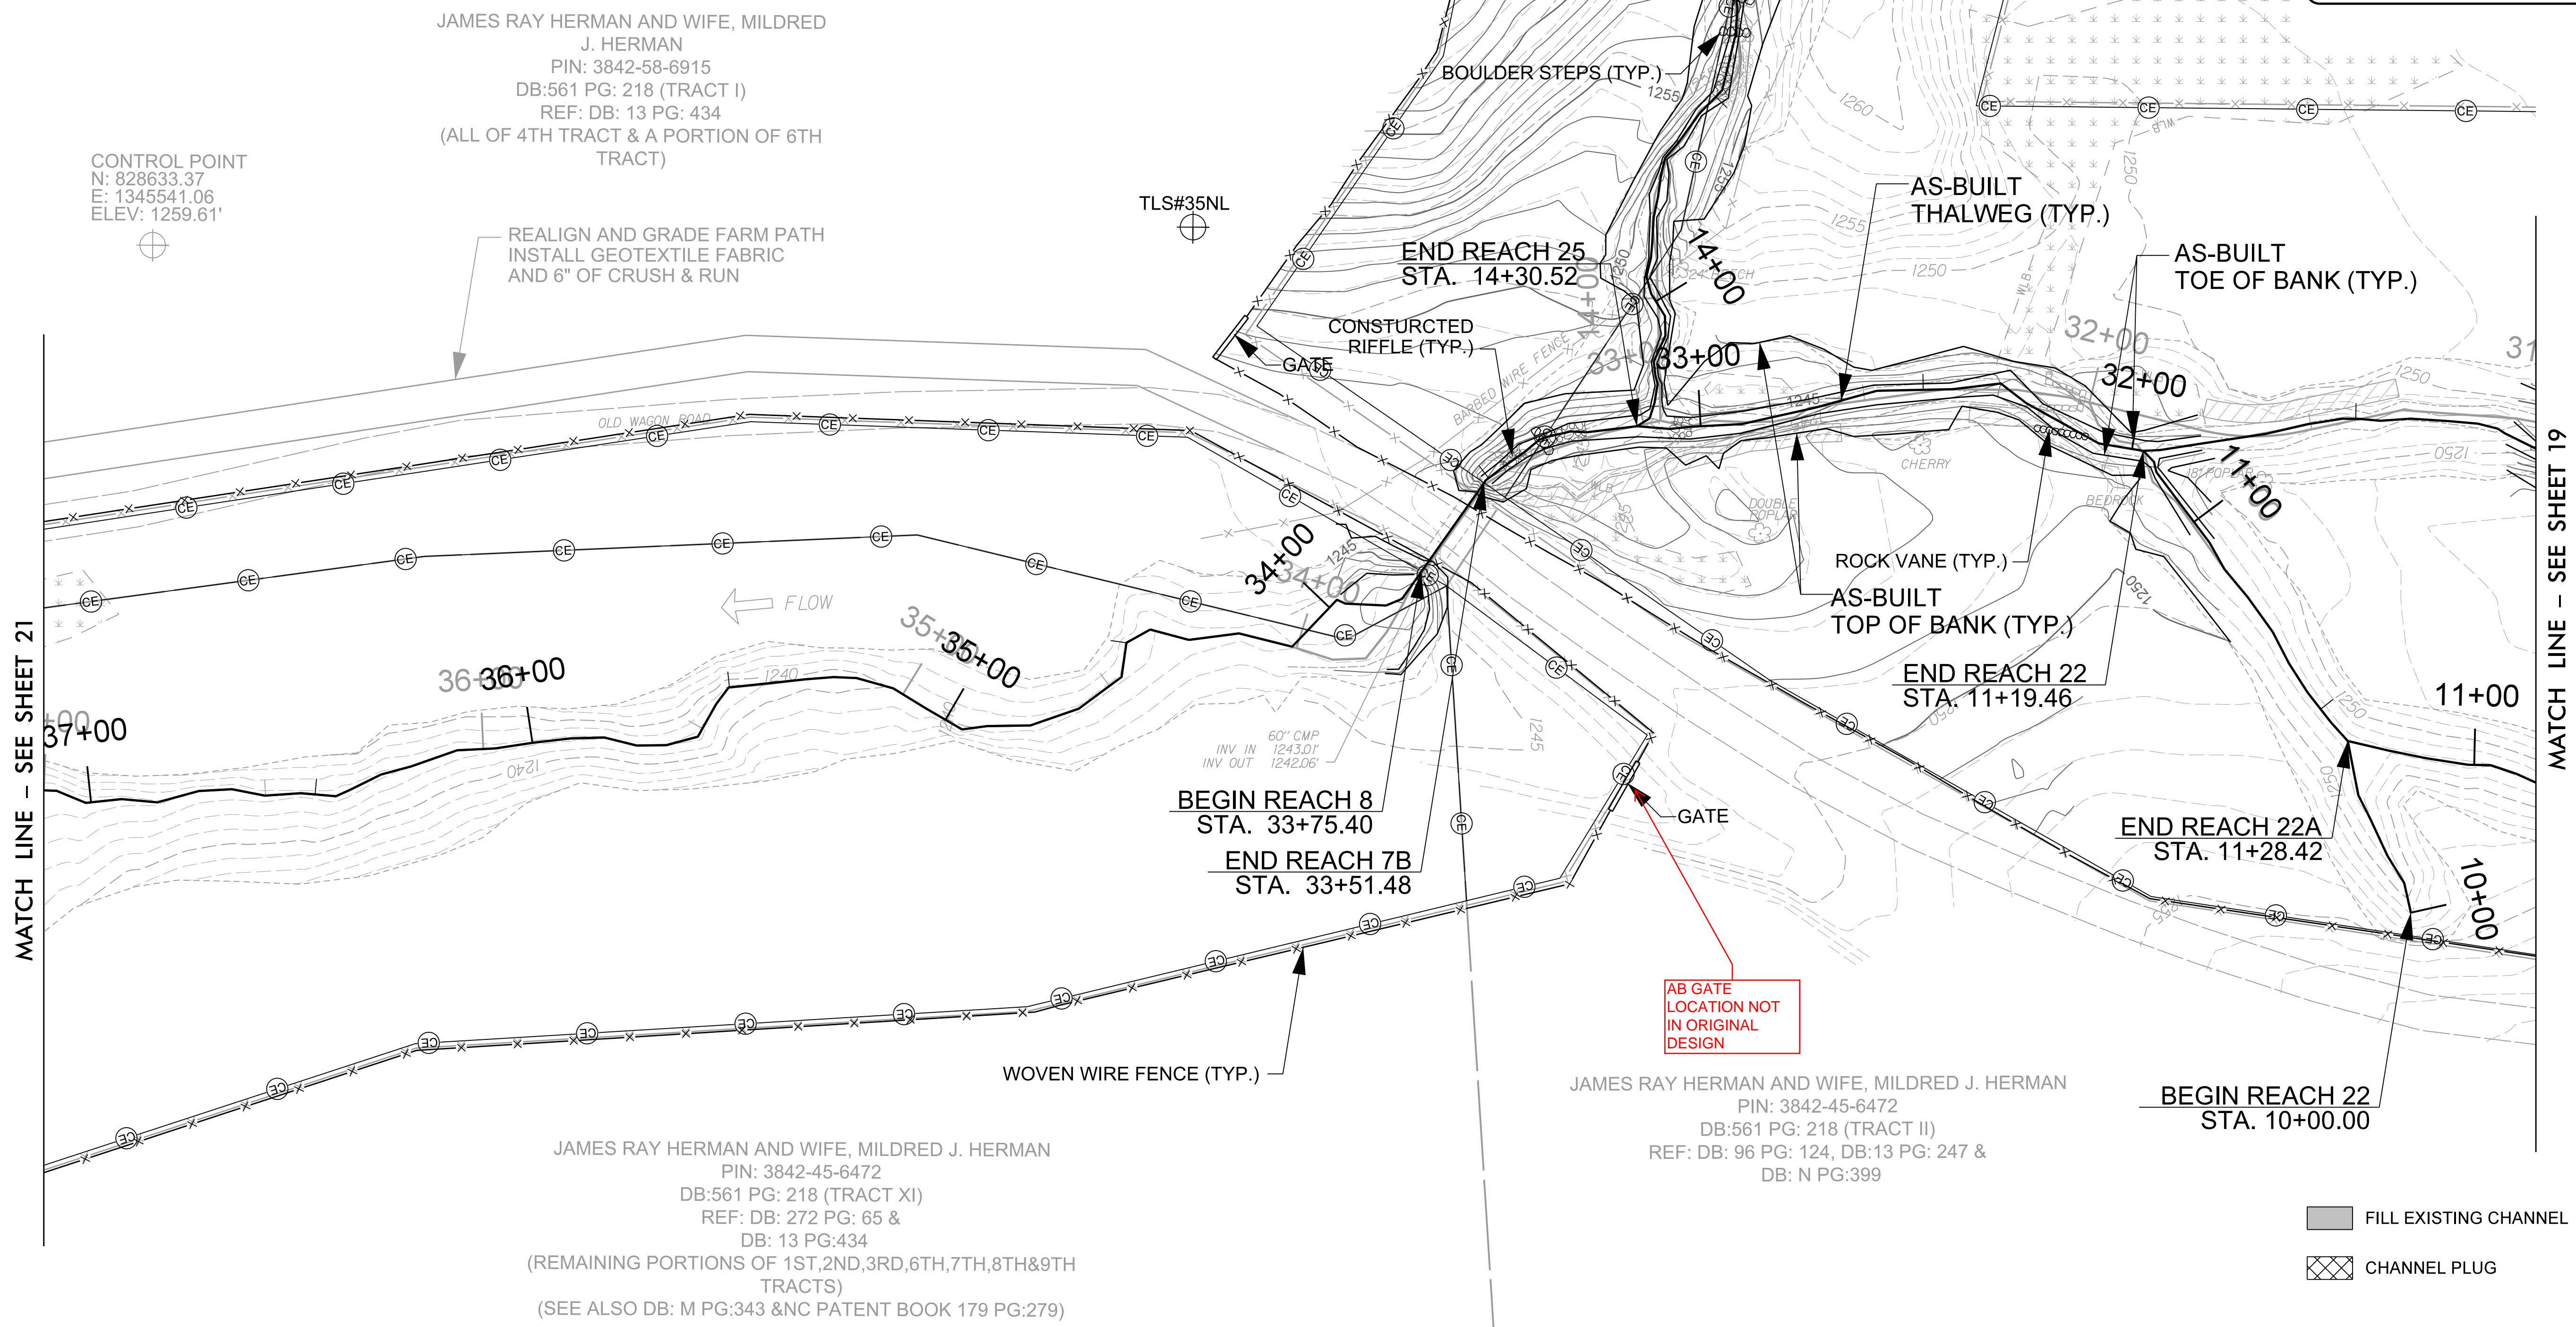

- FILL EXISTING CHANNEL
- CHANNEL PLUG

**RUSSELL GAP  
AS-BUILT PLAN VIEW**

SCALE (FT)

8/15/2020 8:15:22 AM Russell1\_Cop\Design\AS-BUILT\PLANS\157329\_AB-PSH-20.dgn



2/26/20


DocuSigned by:  
*David S. Turner*  
1CB8EE6BAC44E

APPROVED BY:  
  
9/11/2020  
DATE:

**Michael Baker** International  
Michael Baker Engineering Inc.  
5030 Regency Parkway, Suite 600  
Cary, NORTH CAROLINA 27518  
Phone: 919.453.5488  
Fax: 919.453.5490  
License #: F-1084


NC DMS ID NO. 100003

JAMES RAY HERMAN AND WIFE, MILDRED  
J. HERMAN  
PIN: 3842-58-6915  
DB:561 PG: 218 (TRACT I)  
REF: DB: 13 PG: 434  
(ALL OF 4TH TRACT & A PORTION OF 6TH TRACT)

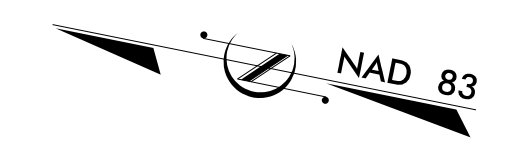

AB GATE  
LOCATION NOT  
IN ORIGINAL  
DESIGN


AB GATE  
LOCATION NOT  
IN ORIGINAL  
DESIGN

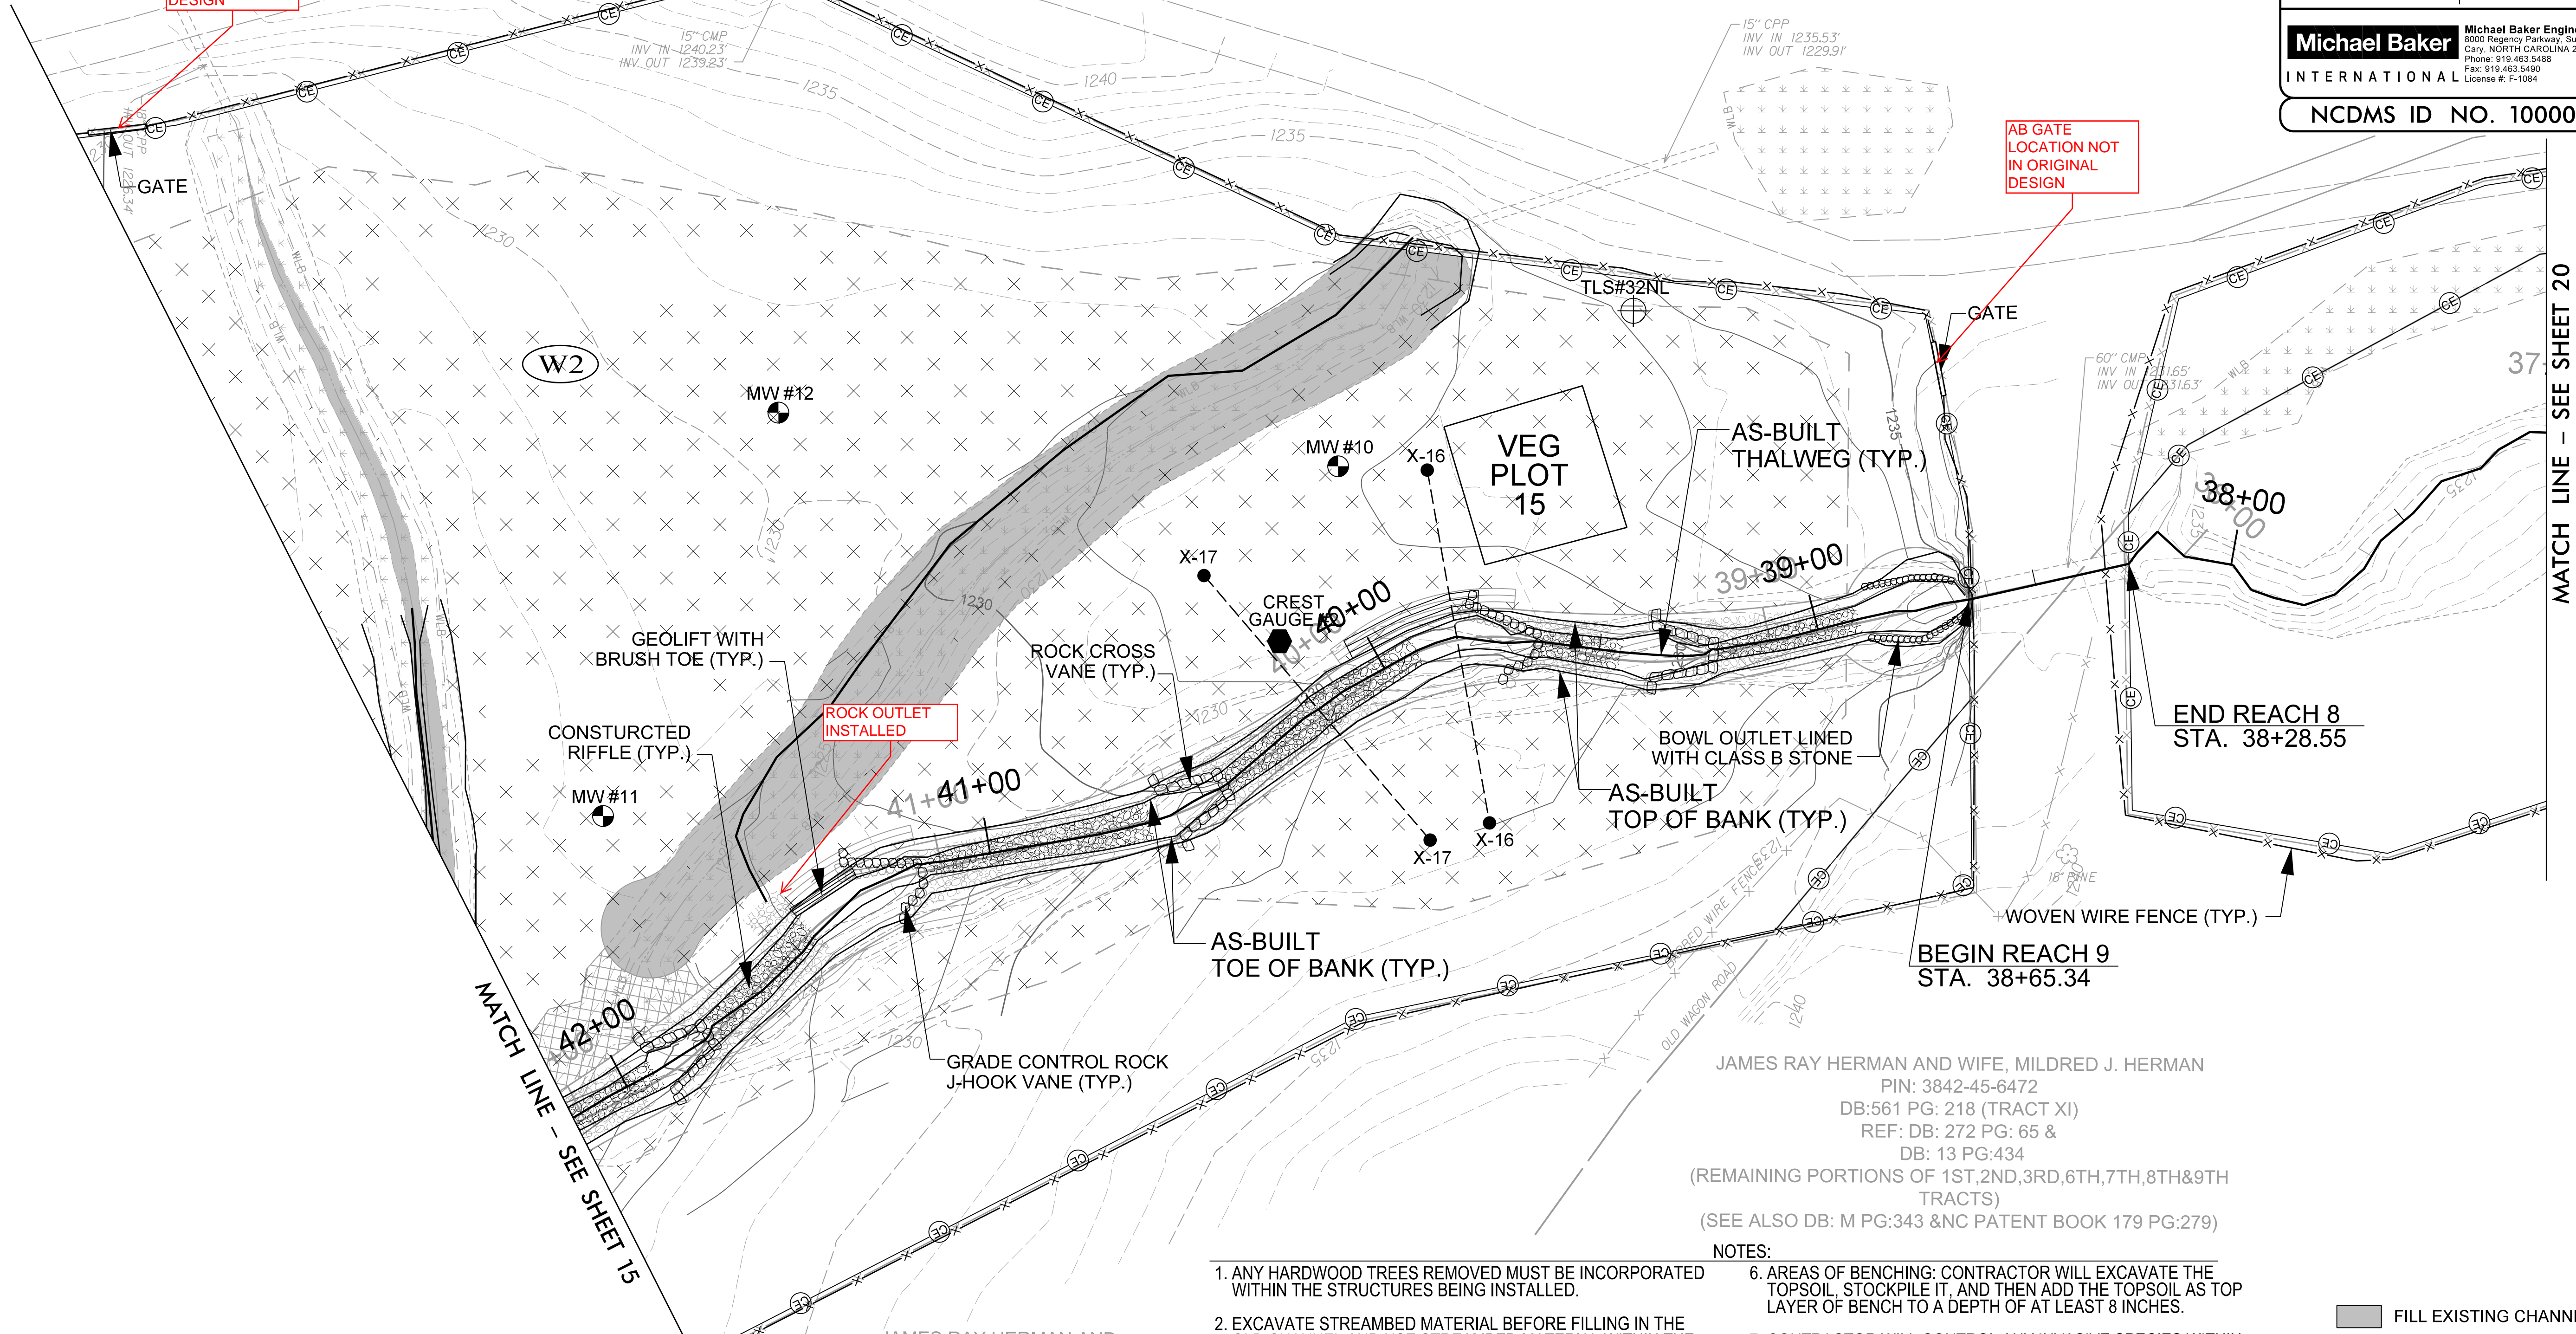

JAMES RAY HERMAN AND WIFE, MILDRED J. HERMAN  
PIN: 3842-45-6472  
DB:561 PG: 218 (TRACT XI)  
REF: DB: 272 PG: 65 &  
DB: 13 PG:434  
(REMAINING PORTIONS OF 1ST,2ND,3RD,6TH,7TH,8TH&9TH TRACTS)  
(SEE ALSO DB: M PG:343 & NC PATENT BOOK 179 PG:279)

NOTES:

1. ANY HARDWOOD TREES REMOVED MUST BE INCORPORATED WITHIN THE STRUCTURES BEING INSTALLED.
2. EXCAVATE STREAMBED MATERIAL BEFORE FILLING IN THE OLD CHANNEL AND USE STREAMBED MATERIAL WITHIN THE NEWLY CONSTRUCTED CHANNEL.
3. CONTRACTOR CAN USE BRUSH MATERIAL TO INCORPORATE WITHIN THE CONSTRUCTED RIFFLES AND BRUSH TOES ALONG MEANDER BENDS.
4. FENCING INSIDE EASEMENT WILL BE REMOVED AND HAULED OFF-SITE BY THE CONTRACTOR.
5. ANY AREA THAT HAS BEEN GRADED MUST HAVE POSITIVE DRAINAGE, UNLESS OTHERWISE DIRECTED BY ENGINEER.
6. AREAS OF BENCHING: CONTRACTOR WILL EXCAVATE THE TOPSOIL, STOCKPILE IT, AND THEN ADD THE TOPSOIL AS TOP LAYER OF BENCH TO A DEPTH OF AT LEAST 8 INCHES.
7. CONTRACTOR WILL CONTROL ANY INVASIVE SPECIES WITHIN EASEMENT.
8. LOCATIONS OF BOULDER STEPS AND GRADE CONTROL STRUCTURES ARE SUBJECT TO CHANGE BASED ON FIELD CONDITIONS AND BY THE DIRECTION OF THE ENGINEER.
9. CONTRACTOR SHALL INCORPORATE SOIL WITHIN THE CONSTRUCTED RIFFLES ALONG ALL STEEP HEADWATER TRIBUTARIES TO REDUCE PERMEABILITY AND KEEP SURFACE FLOW.
10. WHERE DESIGN PROFILE OF STEEP HEADWATER CHANNELS DIVIATES FROM THE EXISTING PROFILE, CONTRACTOR SHALL SLOPE STREAM BANKS AT 2:1 AS NECESSARY TO TIE TO EXISTING GROUND.

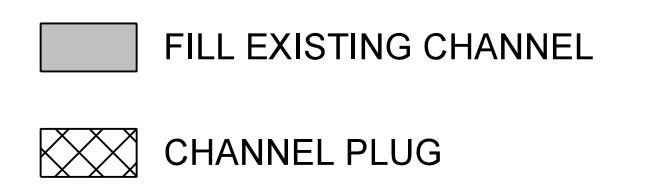

**RUSSELL GAP  
AS-BUILT PLAN VIEW**

SCALE (FT)

R:\157329\_Russell\_Cap\Design\AS-BUILT\PLANS\157329\_AB-PSH-21.dgn  
 8/15/2020 8:15 AM

MATCH LINE - SEE SHEET 15

MATCH LINE - SEE SHEET 20






DocuSigned by:  
David S. Turner  
1085E2A8264E

APPROVED BY:  
  
9/11/2020  
  
DATE:

**Michael Baker International** Michael Baker Engineering Inc.  
5000 Regency Parkway, Suite 600  
Cary, NORTH CAROLINA 27518  
Phone: 919.453.5488  
Fax: 919.453.5490  
License #: F-1084

**NC DMS ID NO. 100003**

- NOTES:
1. ANY HARDWOOD TREES REMOVED MUST BE INCORPORATED WITHIN THE STRUCTURES BEING INSTALLED.
  2. EXCAVATE STREAMBED MATERIAL BEFORE FILLING IN THE OLD CHANNEL AND USE STREAMBED MATERIAL WITHIN THE NEWLY CONSTRUCTED CHANNEL.
  3. CONTRACTOR CAN USE BRUSH MATERIAL TO INCORPORATE WITHIN THE CONSTRUCTED RIFFLES AND BRUSH TOES ALONG MEANDER BENDS.
  4. FENCING INSIDE EASEMENT WILL BE REMOVED AND HAULED OFF-SITE BY THE CONTRACTOR.
  5. ANY AREA THAT HAS BEEN GRADED MUST HAVE POSITIVE DRAINAGE, UNLESS OTHERWISE DIRECTED BY ENGINEER.
  6. AREAS OF BENCHING: CONTRACTOR WILL EXCAVATE THE TOPSOIL, STOCKPILE IT, AND THEN ADD THE TOPSOIL AS TOP LAYER OF BENCH TO A DEPTH OF AT LEAST 8 INCHES.
  7. CONTRACTOR WILL CONTROL ANY INVASIVE SPECIES WITHIN EASEMENT.
  8. LOCATIONS OF BOULDER STEPS AND GRADE CONTROL STRUCTURES ARE SUBJECT TO CHANGE BASED ON FIELD CONDITIONS AND BY THE DIRECTION OF THE ENGINEER.
  9. CONTRACTOR SHALL INCORPORATE SOIL WITHIN THE CONSTRUCTED RIFFLES ALONG ALL STEEP HEADWATER TRIBUTARIES TO REDUCE PERMEABILITY AND KEEP SURFACE FLOW.
  10. WHERE DESIGN PROFILE OF STEEP HEADWATER CHANNELS DIVERGES FROM THE EXISTING PROFILE, CONTRACTOR SHALL SLOPE STREAM BANKS AT 2:1 AS NECESSARY TO TIE TO EXISTING GROUND.

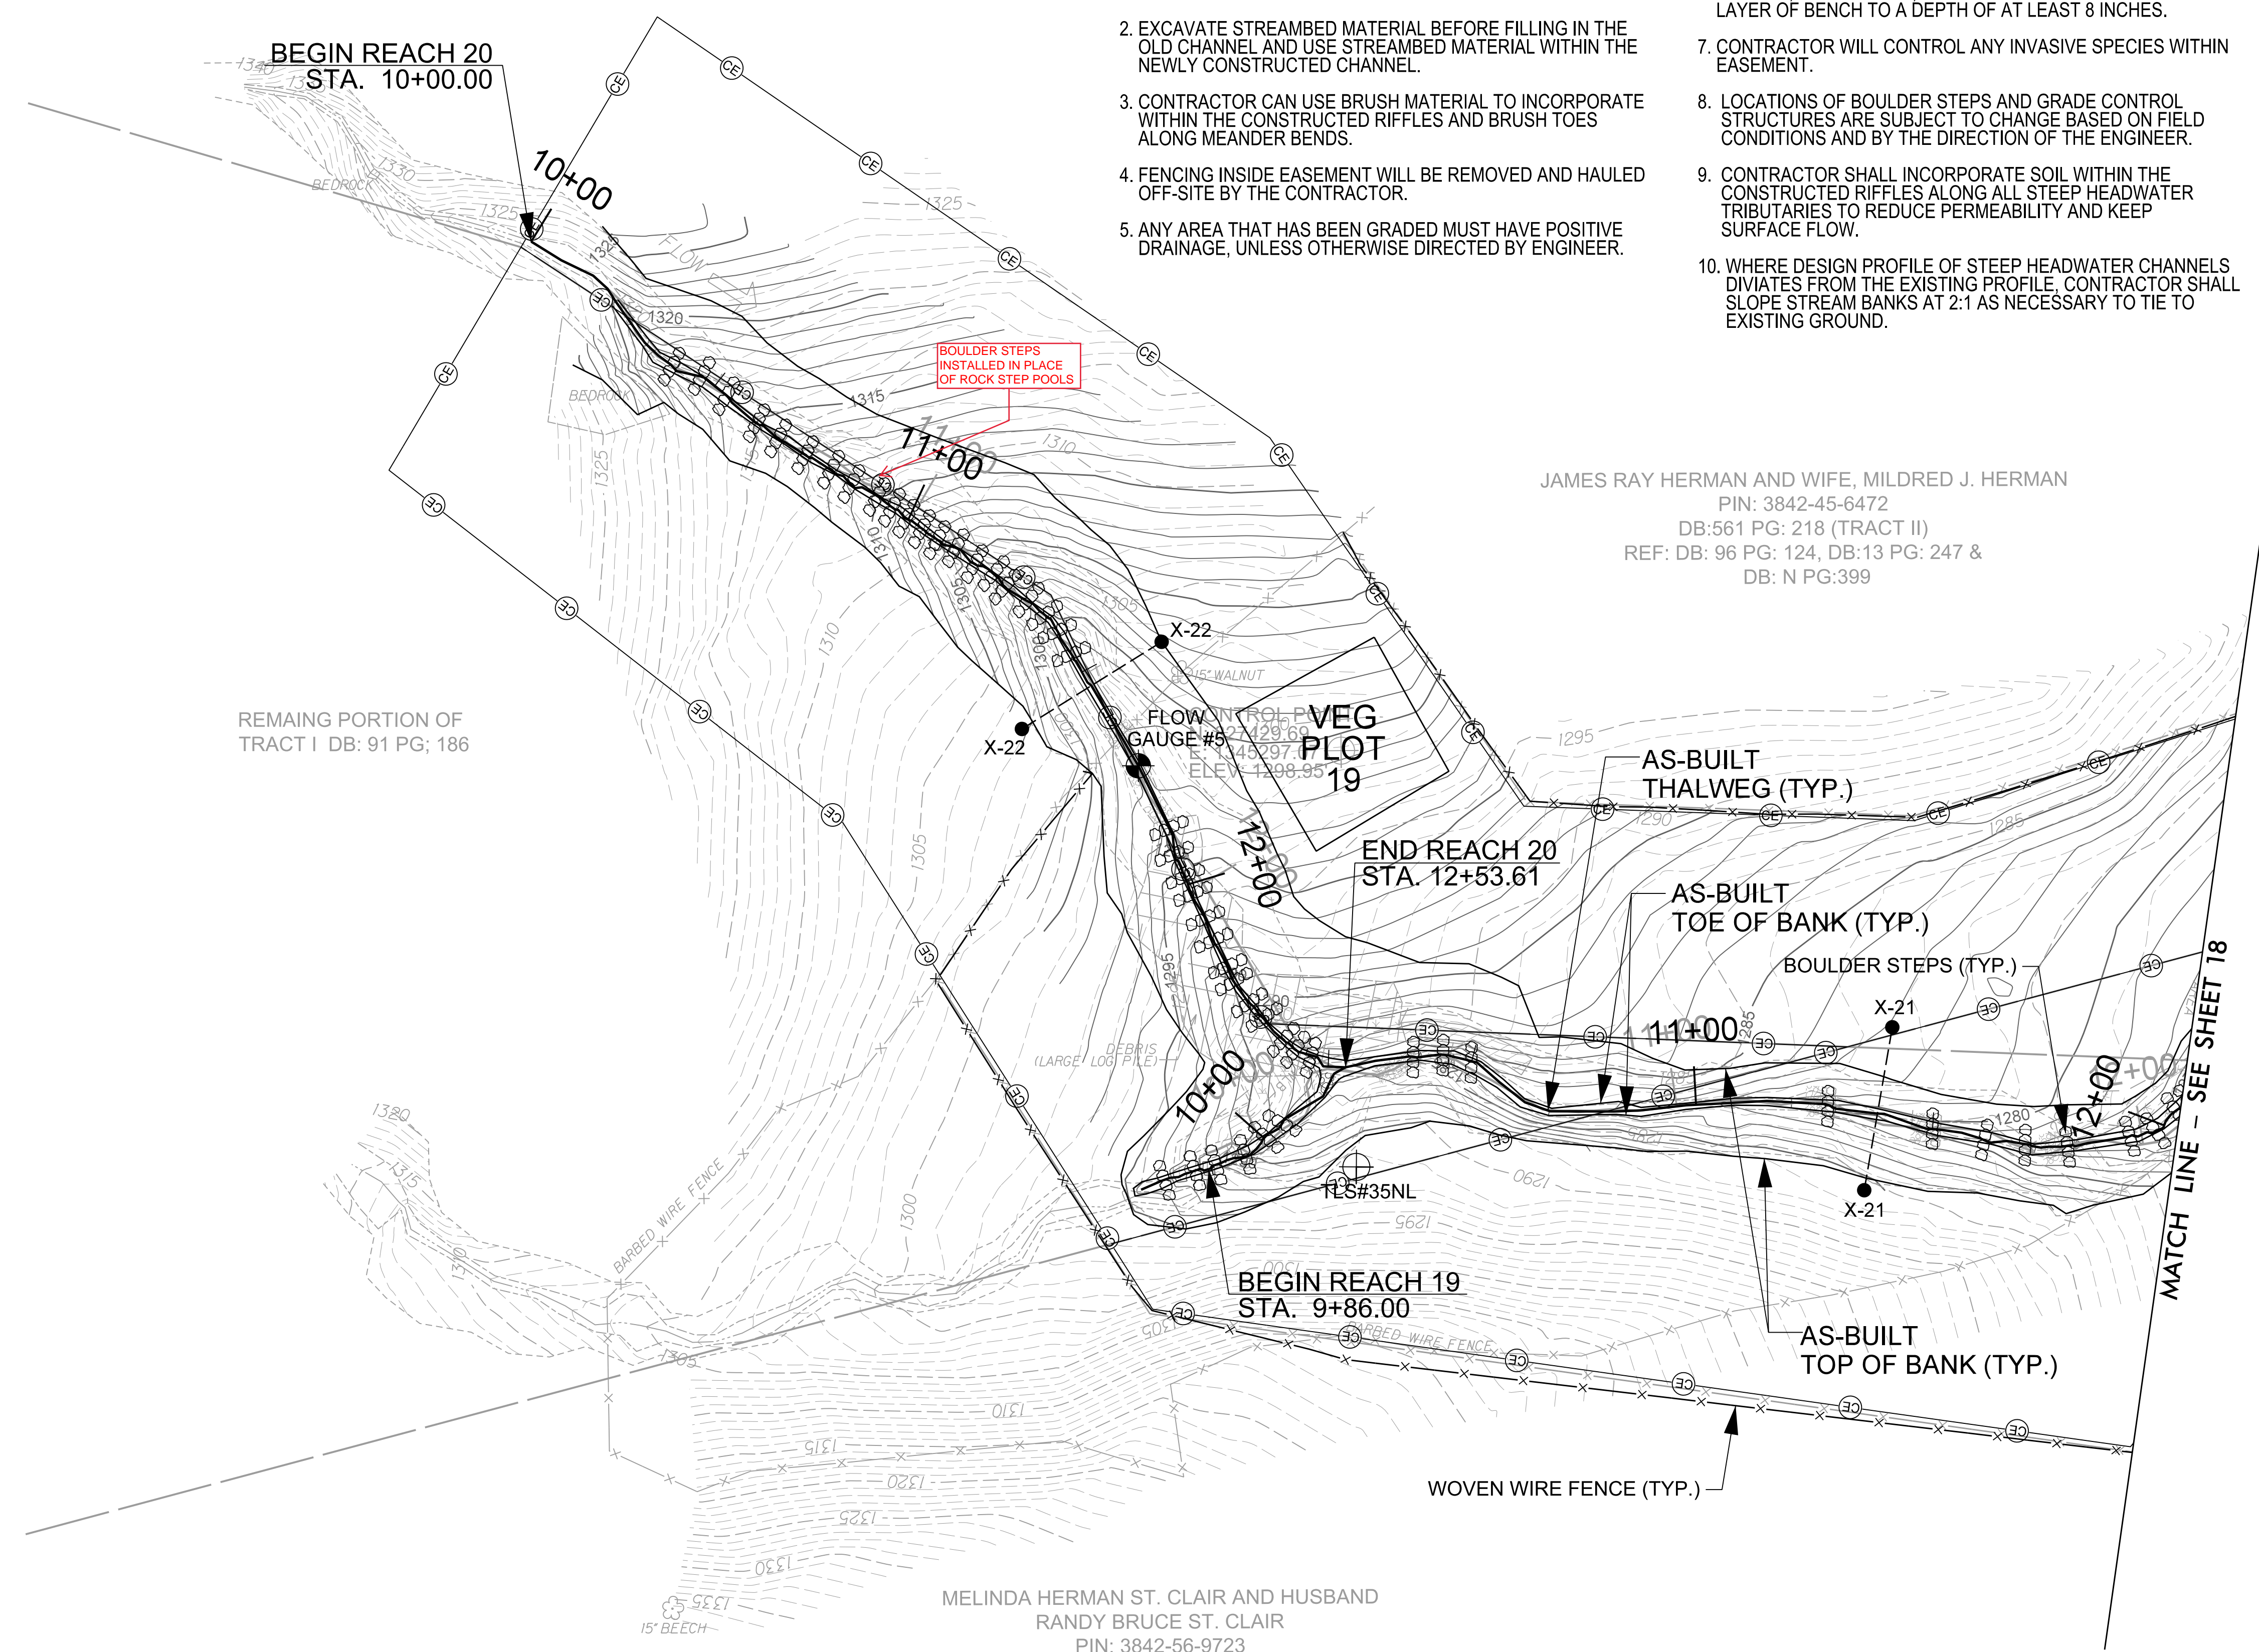


MELINDA HERMAN ST. CLAIR AND HUSBAND  
RANDY BRUCE ST. CLAIR  
PIN: 3842-56-9723  
DB: 542 PG: 2441  
REF: DB:47 PG:381, DB:38 PG:90 DB: H PG: 262, DB: H PG:595  
DB: N PG: 546, DB: 13 PG: 434 & DB:M PG:343  
(PORTION OF LOT1,2 & 3 OF TH WEBSTER MOUNTAIN LANDS)

JAMES RAY HERMAN AND WIFE, MILDRED J. HERMAN  
PIN: 3842-45-6472  
DB:561 PG: 218 (TRACT II)  
REF: DB: 96 PG: 124, DB:13 PG: 247 &  
DB: N PG:399


REMAINING PORTION OF  
TRACT I DB: 91 PG: 186

- FILL EXISTING CHANNEL
- CHANNEL PLUG

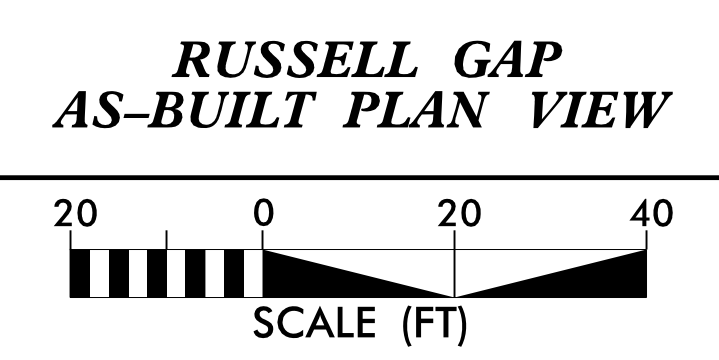



2/26/20

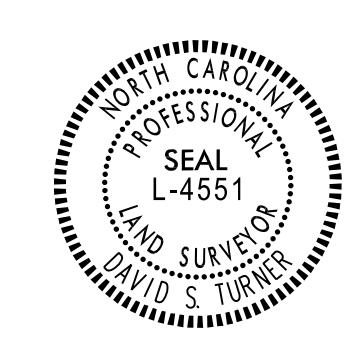

DocuSigned by:  
*David S. Turner*  
1C8FEFA0BAC84E

APPROVED BY:

9/11/2020

DATE:


**Michael Baker** International  
Michael Baker Engineering Inc.  
5000 Regency Parkway, Suite 800  
Cary, NORTH CAROLINA 27518  
Phone: 919.453.5488  
Fax: 919.453.5490  
License #: F-1084

NCDMS ID NO. 100003



JAMES RAY HERMAN AND WIFE, MILDRED J. HERMAN  
PIN: 3842-58-6915  
DB:561 PG: 218 (TRACT I)  
REF: DB: 13 PG: 434  
(ALL OF 4TH TRACT & A PORTION OF 6TH TRACT)


CONTROL POINT  
N: 828431.49  
E: 1345935.36  
ELEV: 1300.17'

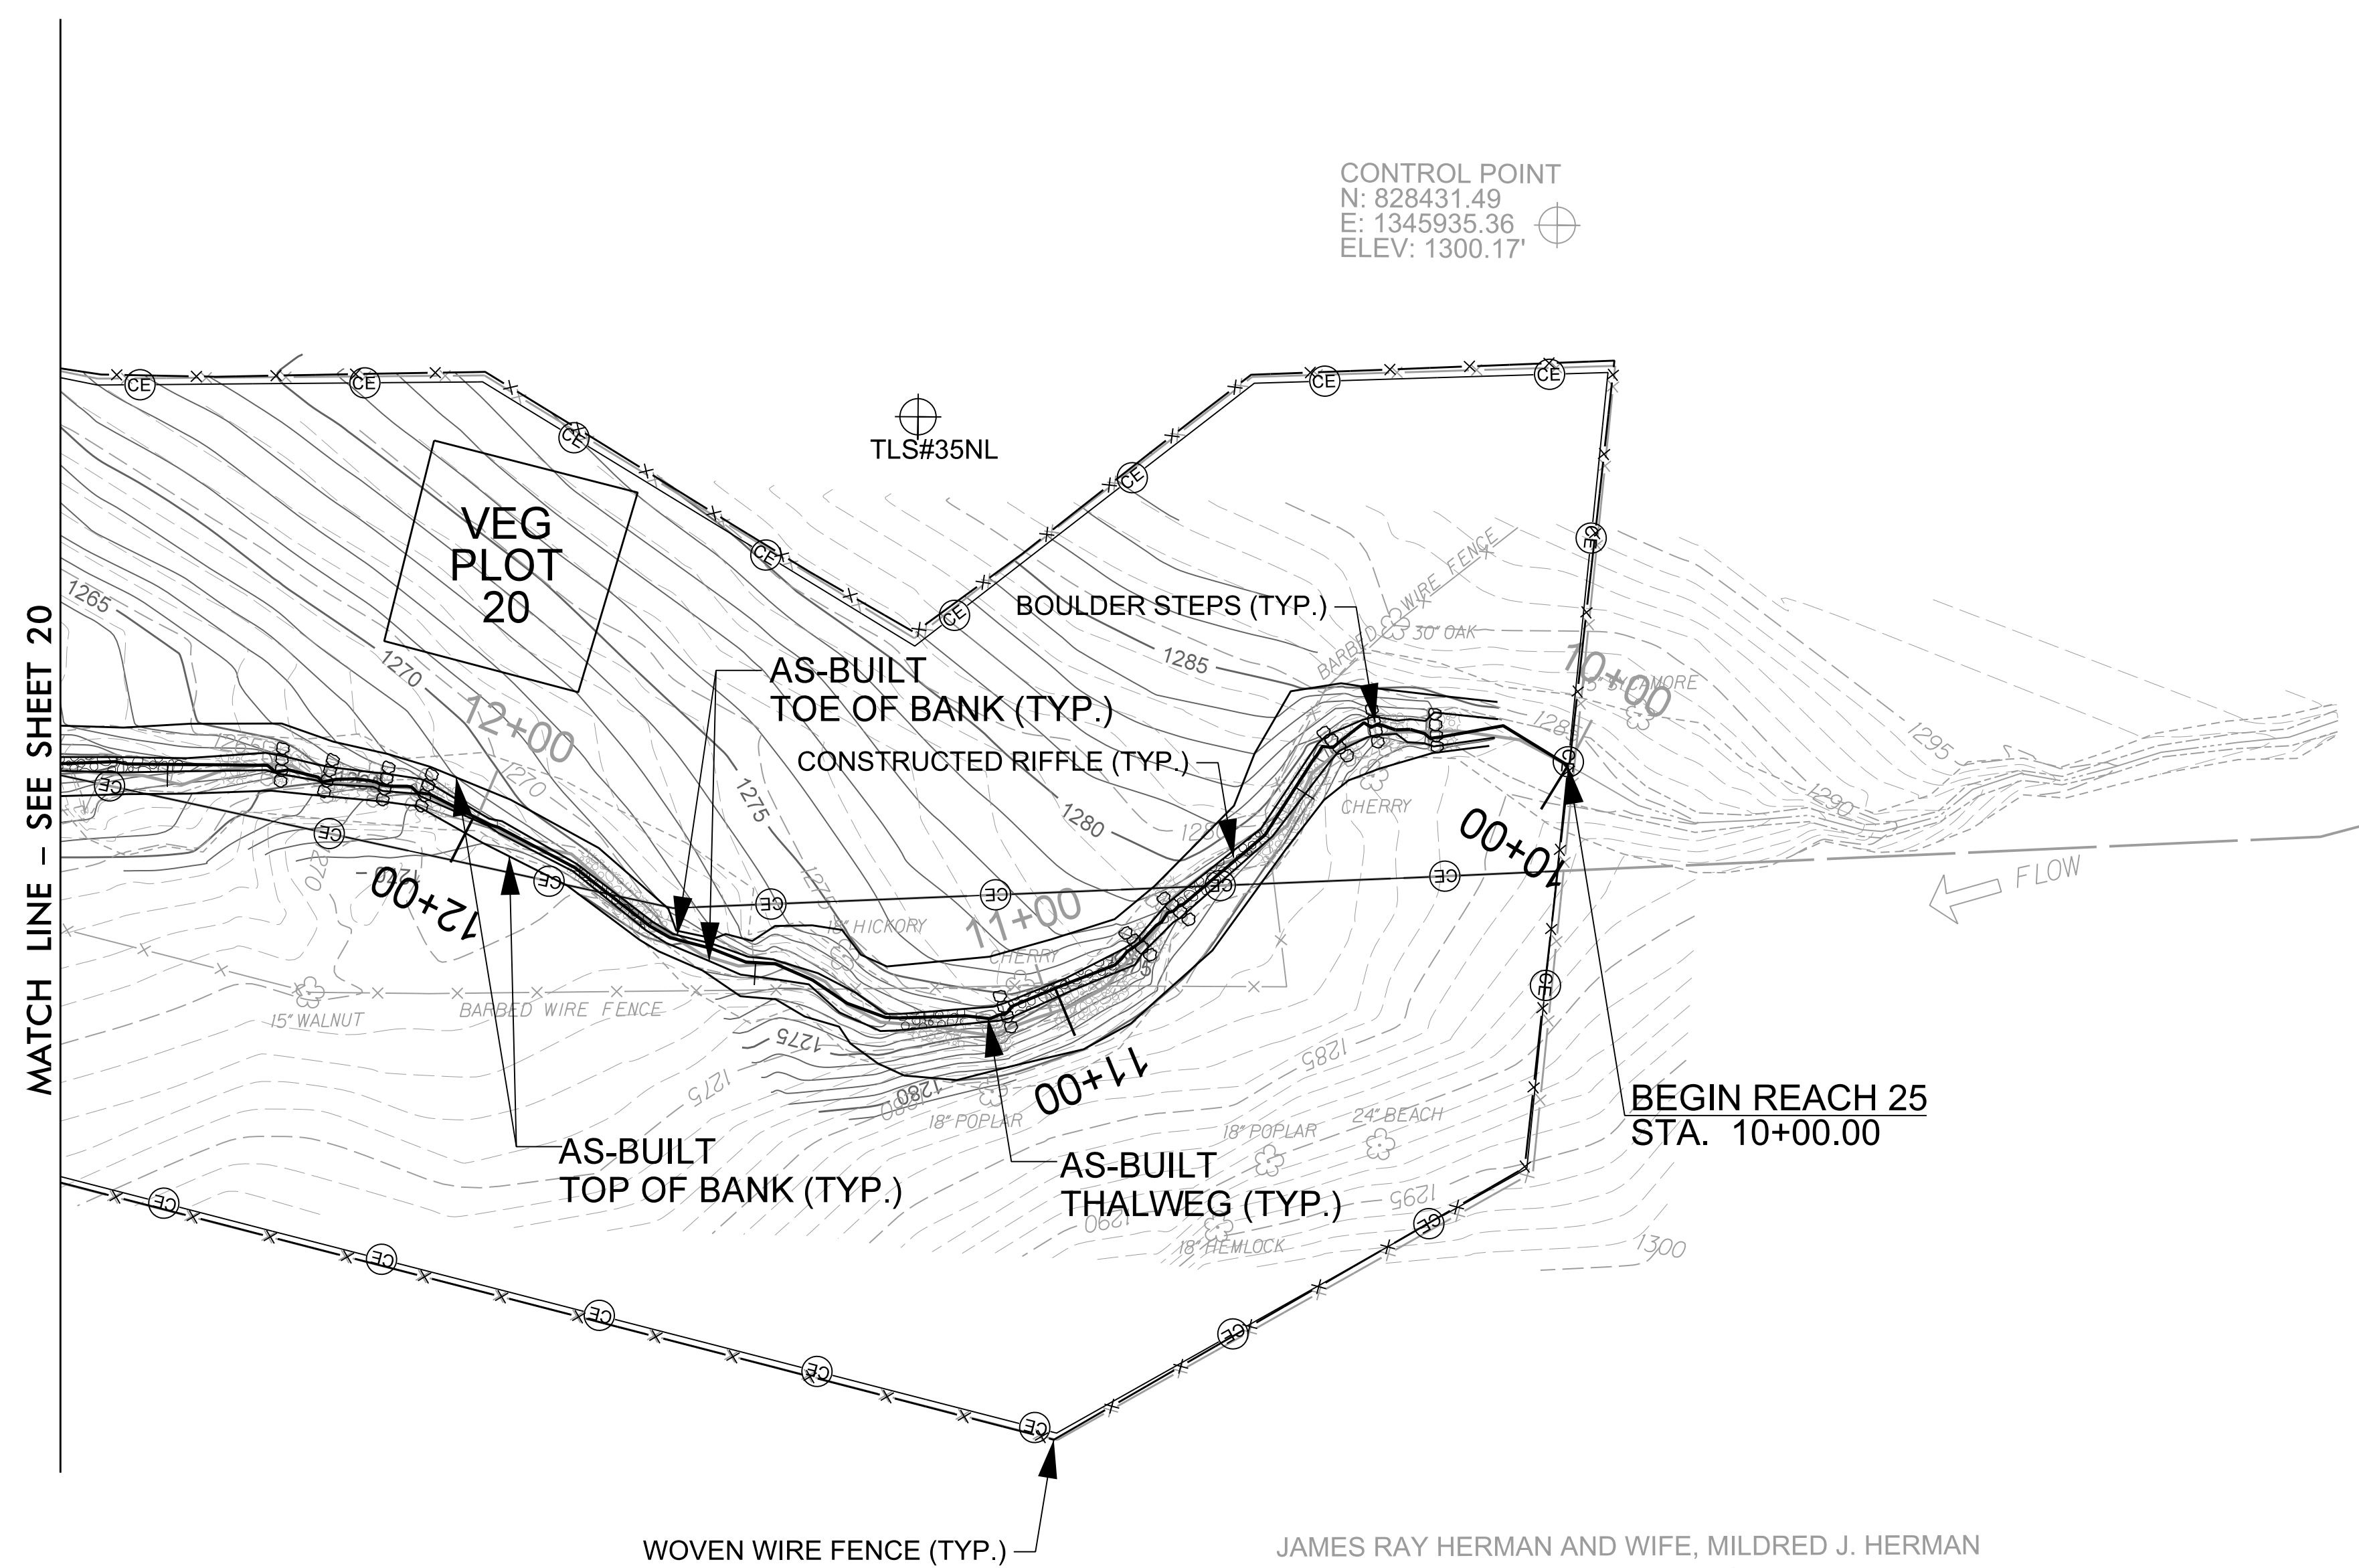

JAMES RAY HERMAN AND WIFE, MILDRED J. HERMAN  
PIN: 3842-45-6472  
DB:561 PG: 218 (TRACT II)  
REF: DB: 96 PG: 124, DB:13 PG: 247 &  
DB: N PG:399


- NOTES:
1. ANY HARDWOOD TREES REMOVED MUST BE INCORPORATED WITHIN THE STRUCTURES BEING INSTALLED.
  2. EXCAVATE STREAMBED MATERIAL BEFORE FILLING IN THE OLD CHANNEL AND USE STREAMBED MATERIAL WITHIN THE NEWLY CONSTRUCTED CHANNEL.
  3. CONTRACTOR CAN USE BRUSH MATERIAL TO INCORPORATE WITHIN THE CONSTRUCTED RIFFLES AND BRUSH TOES ALONG MEANDER BENDS.
  4. FENCING INSIDE EASEMENT WILL BE REMOVED AND HAULED OFF-SITE BY THE CONTRACTOR.
  5. ANY AREA THAT HAS BEEN GRADED MUST HAVE POSITIVE DRAINAGE, UNLESS OTHERWISE DIRECTED BY ENGINEER.
  6. AREAS OF BENCHING: CONTRACTOR WILL EXCAVATE THE TOPSOIL, STOCKPILE IT, AND THEN ADD THE TOPSOIL AS TOP LAYER OF BENCH TO A DEPTH OF AT LEAST 8 INCHES.
  7. CONTRACTOR WILL CONTROL ANY INVASIVE SPECIES WITHIN EASEMENT.
  8. LOCATIONS OF BOULDER STEPS AND GRADE CONTROL STRUCTURES ARE SUBJECT TO CHANGE BASED ON FIELD CONDITIONS AND BY THE DIRECTION OF THE ENGINEER.
  9. CONTRACTOR SHALL INCORPORATE SOIL WITHIN THE CONSTRUCTED RIFFLES ALONG ALL STEEP HEADWATER TRIBUTARIES TO REDUCE PERMEABILITY AND KEEP SURFACE FLOW.
  10. WHERE DESIGN PROFILE OF STEEP HEADWATER CHANNELS DIVIATES FROM THE EXISTING PROFILE, CONTRACTOR SHALL SLOPE STREAM BANKS AT 2:1 AS NECESSARY TO TIE TO EXISTING GROUND.

- FILL EXISTING CHANNEL
- CHANNEL PLUG


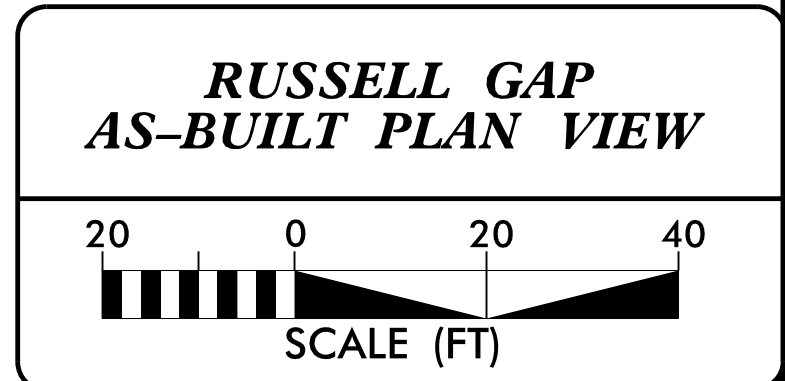


8/15/2020 - Russell - Cap - Design - AS-BUILT PLANS - 157329 - AB-PSH-23.dgn




BAKER PROJECT REFERENCE NO. 157329	SHEET NO. 24
	DocuSigned by: David S. Turner 1C85EAD8AC644F
	APPROVED BY:
	DATE: 9/11/2020
<b>Michael Baker International</b> Michael Baker Engineering Inc. <small>2500 Regency Parkway, Suite 500      Cary, NORTH CAROLINA 27518      Phone: 919.463.5488      Fax: 919.463.5490      License #: F-1084</small>	
NCDMS ID NO. 100003	

- NOTES:
1. ANY HARDWOOD TREES REMOVED MUST BE INCORPORATED WITHIN THE STRUCTURES BEING INSTALLED.
  2. EXCAVATE STREAMBED MATERIAL BEFORE FILLING IN THE OLD CHANNEL AND USE STREAMBED MATERIAL WITHIN THE NEWLY CONSTRUCTED CHANNEL.
  3. CONTRACTOR CAN USE BRUSH MATERIAL TO INCORPORATE WITHIN THE CONSTRUCTED RIFFLES AND BRUSH TOES ALONG MEANDER BENDS.
  4. FENCING INSIDE EASEMENT WILL BE REMOVED AND HAULED OFF-SITE BY THE CONTRACTOR.
  5. ANY AREA THAT HAS BEEN GRADED MUST HAVE POSITIVE DRAINAGE, UNLESS OTHERWISE DIRECTED BY ENGINEER.
  6. AREAS OF BENCHING: CONTRACTOR WILL EXCAVATE THE TOPSOIL, STOCKPILE IT, AND THEN ADD THE TOPSOIL AS TOP LAYER OF BENCH TO A DEPTH OF AT LEAST 8 INCHES.
  7. CONTRACTOR WILL CONTROL ANY INVASIVE SPECIES WITHIN EASEMENT.
  8. LOCATIONS OF BOULDER STEPS AND GRADE CONTROL STRUCTURES ARE SUBJECT TO CHANGE BASED ON FIELD CONDITIONS AND BY THE DIRECTION OF THE ENGINEER.
  9. CONTRACTOR SHALL INCORPORATE SOIL WITHIN THE CONSTRUCTED RIFFLES ALONG ALL STEEP HEADWATER TRIBUTARIES TO REDUCE PERMEABILITY AND KEEP SURFACE FLOW.
  10. WHERE DESIGN PROFILE OF STEEP HEADWATER CHANNELS DIVIATES FROM THE EXISTING PROFILE, CONTRACTOR SHALL SLOPE STREAM BANKS AT 2:1 AS NECESSARY TO TIE TO EXISTING GROUND.

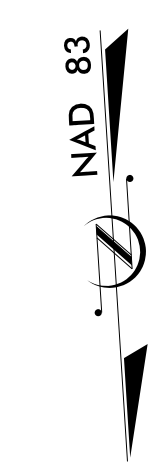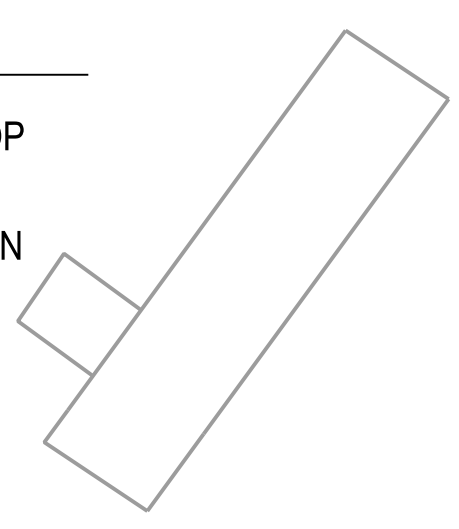


RUTH GAIL BUMGARNER  
AND LINDA LOWE  
PIN: 3843-60-7639  
BY WILL  
REF:DB: 47 PG: 485

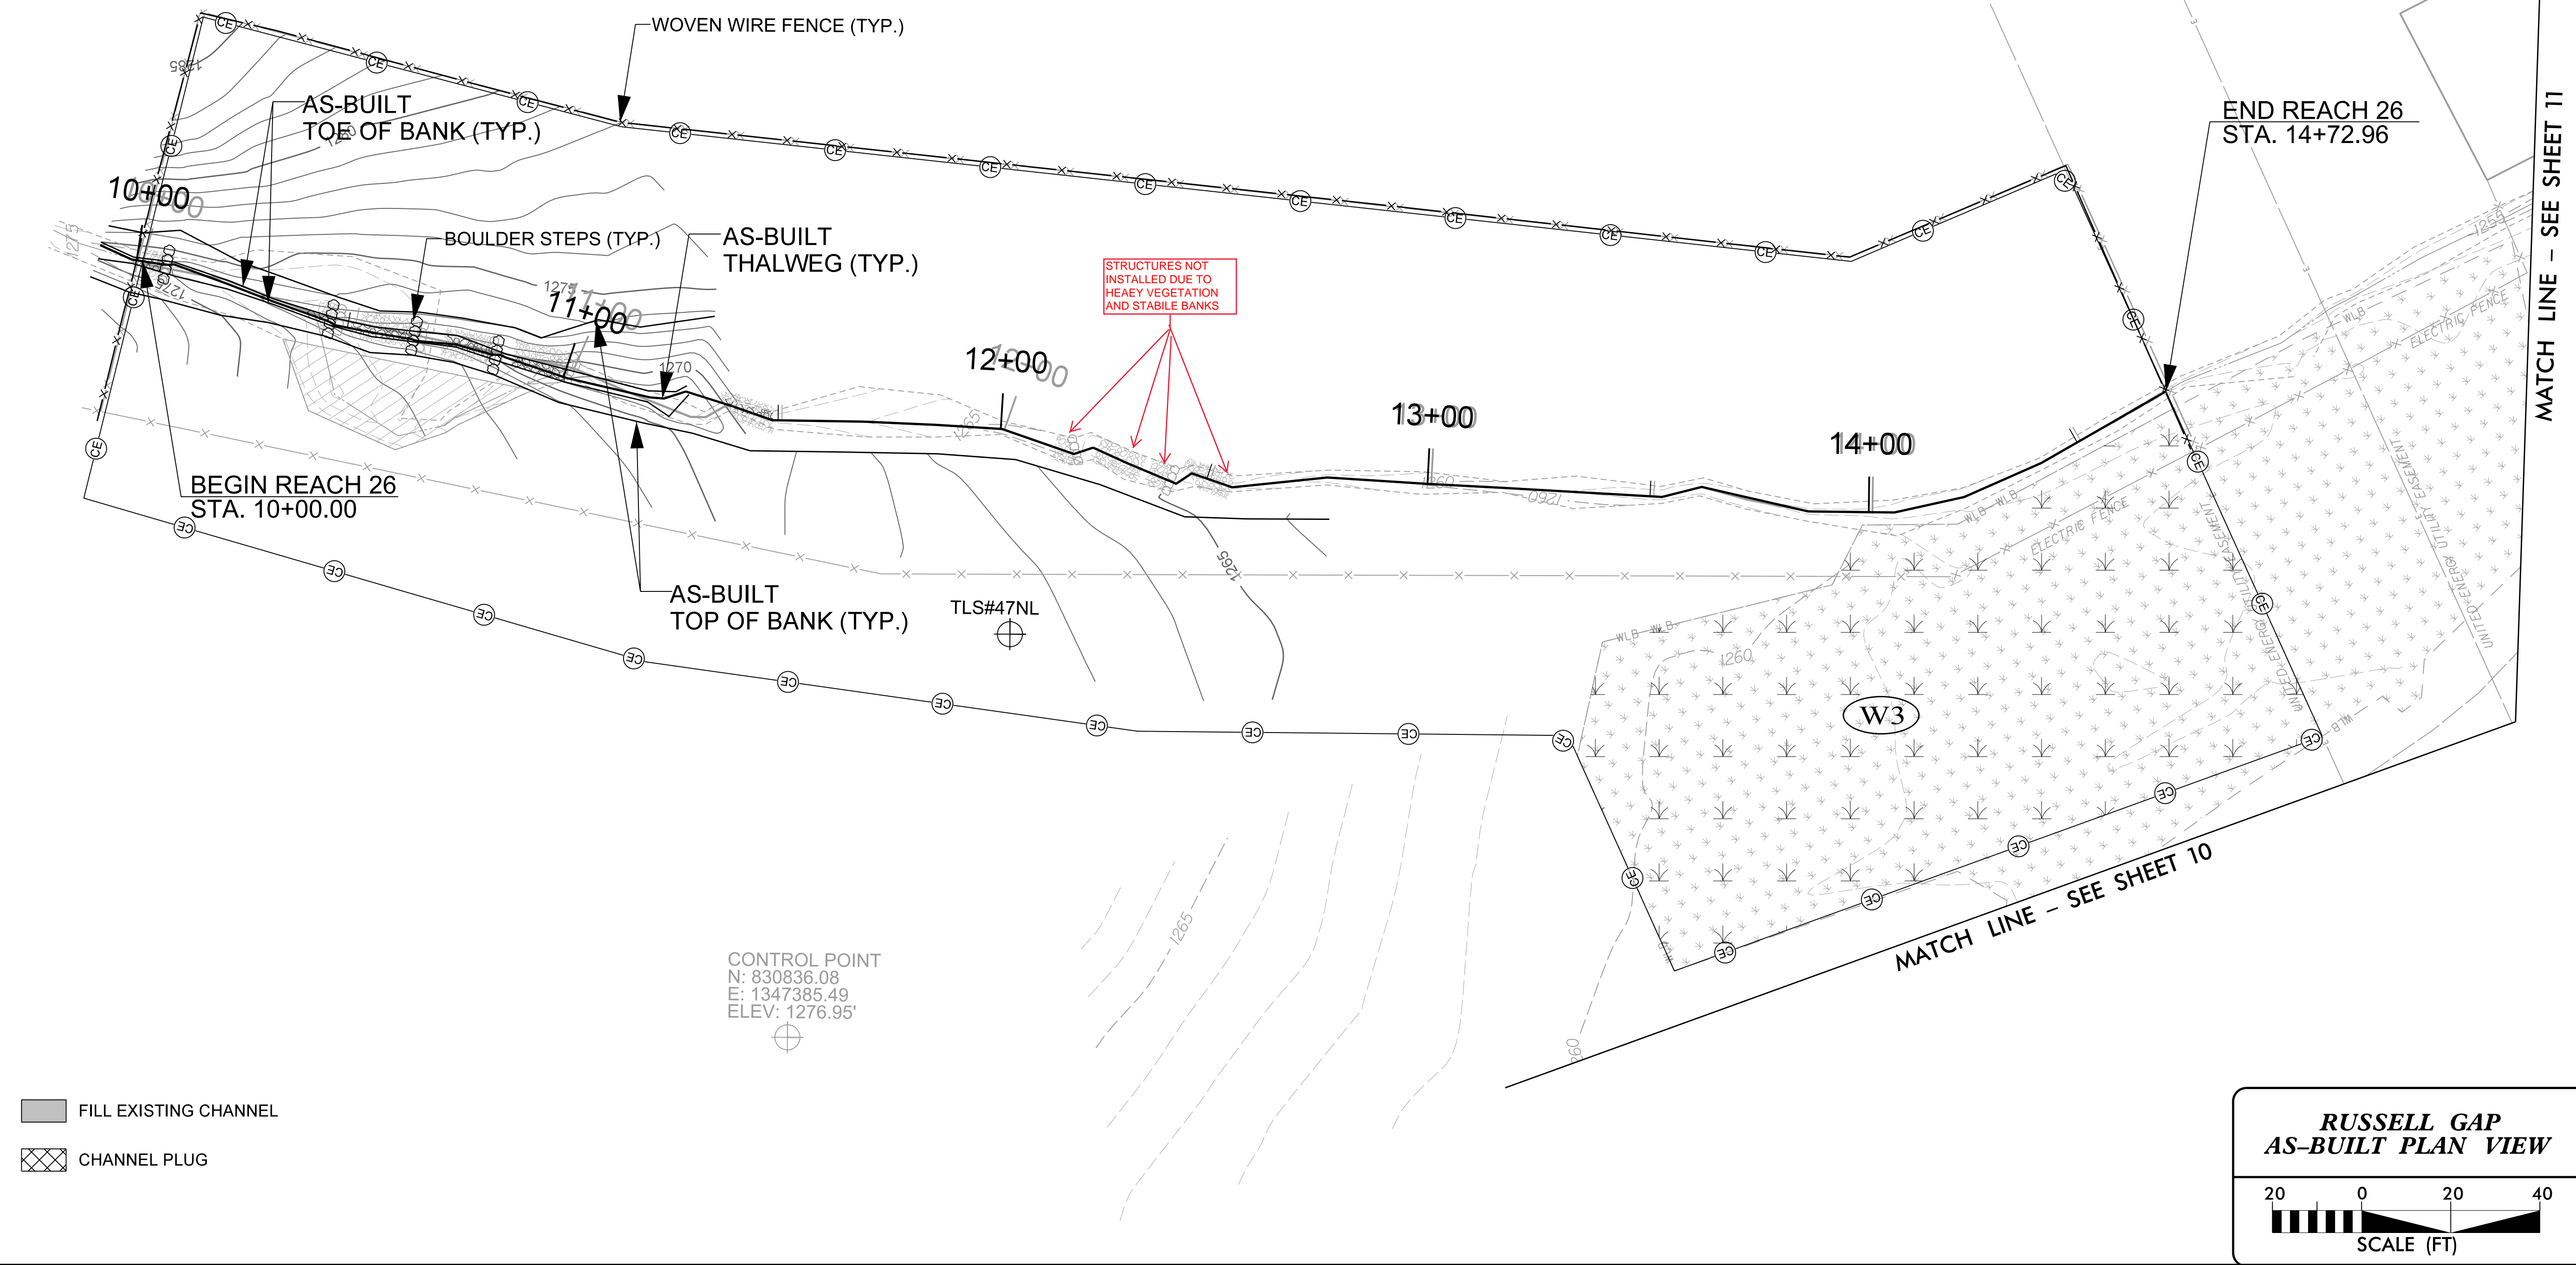



2/26/20

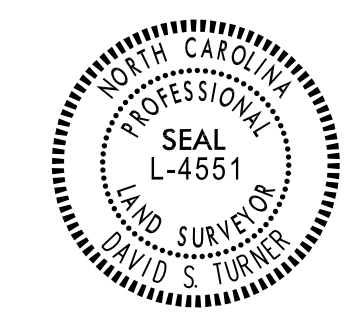

DocuSigned by:  
*David S. Turner*  
APPROVED BY:  
9/11/2020  
DATE:



**Michael Baker** International  
Michael Baker Engineering Inc.  
5000 Regency Parkway, Suite 500  
Cary, NORTH CAROLINA 27518  
Phone: 919.453.5488  
Fax: 919.453.5490  
License #: F-1084

**NCDMS ID NO. 100003**

**NOTES:**

1. ANY HARDWOOD TREES REMOVED MUST BE INCORPORATED WITHIN THE STRUCTURES BEING INSTALLED.
2. EXCAVATE STREAMBED MATERIAL BEFORE FILLING IN THE OLD CHANNEL AND USE STREAMBED MATERIAL WITHIN THE NEWLY CONSTRUCTED CHANNEL.
3. CONTRACTOR CAN USE BRUSH MATERIAL TO INCORPORATE WITHIN THE CONSTRUCTED RIFFLES AND BRUSH TOES ALONG MEANDER BENDS.
4. FENCING INSIDE EASEMENT WILL BE REMOVED AND HAULED OFF-SITE BY THE CONTRACTOR.
5. ANY AREA THAT HAS BEEN GRADED MUST HAVE POSITIVE DRAINAGE, UNLESS OTHERWISE DIRECTED BY ENGINEER.
6. AREAS OF BENCHING: CONTRACTOR WILL EXCAVATE THE TOPSOIL, STOCKPILE IT, AND THEN ADD THE TOPSOIL AS TOP LAYER OF BENCH TO A DEPTH OF AT LEAST 8 INCHES.
7. CONTRACTOR WILL CONTROL ANY INVASIVE SPECIES WITHIN EASEMENT.
8. LOCATIONS OF BOULDER STEPS AND GRADE CONTROL STRUCTURES ARE SUBJECT TO CHANGE BASED ON FIELD CONDITIONS AND BY THE DIRECTION OF THE ENGINEER.
9. CONTRACTOR SHALL INCORPORATE SOIL WITHIN THE CONSTRUCTED RIFFLES ALONG ALL STEEP HEADWATER TRIBUTARIES TO REDUCE PERMEABILITY AND KEEP SURFACE FLOW.
10. WHERE DESIGN PROFILE OF STEEP HEADWATER CHANNELS DIVIATES FROM THE EXISTING PROFILE, CONTRACTOR SHALL SLOPE STREAM BANKS AT 2:1 AS NECESSARY TO TIE TO EXISTING GROUND.

JAMES RAY HERMAN AND WIFE, MILDRED  
J. HERMAN  
PIN: 3842-69-4491  
DB:561 PG: 218 (TRACT VI)  
REF: DB: 219 PG: 695  
& DB: 52 PG: 388

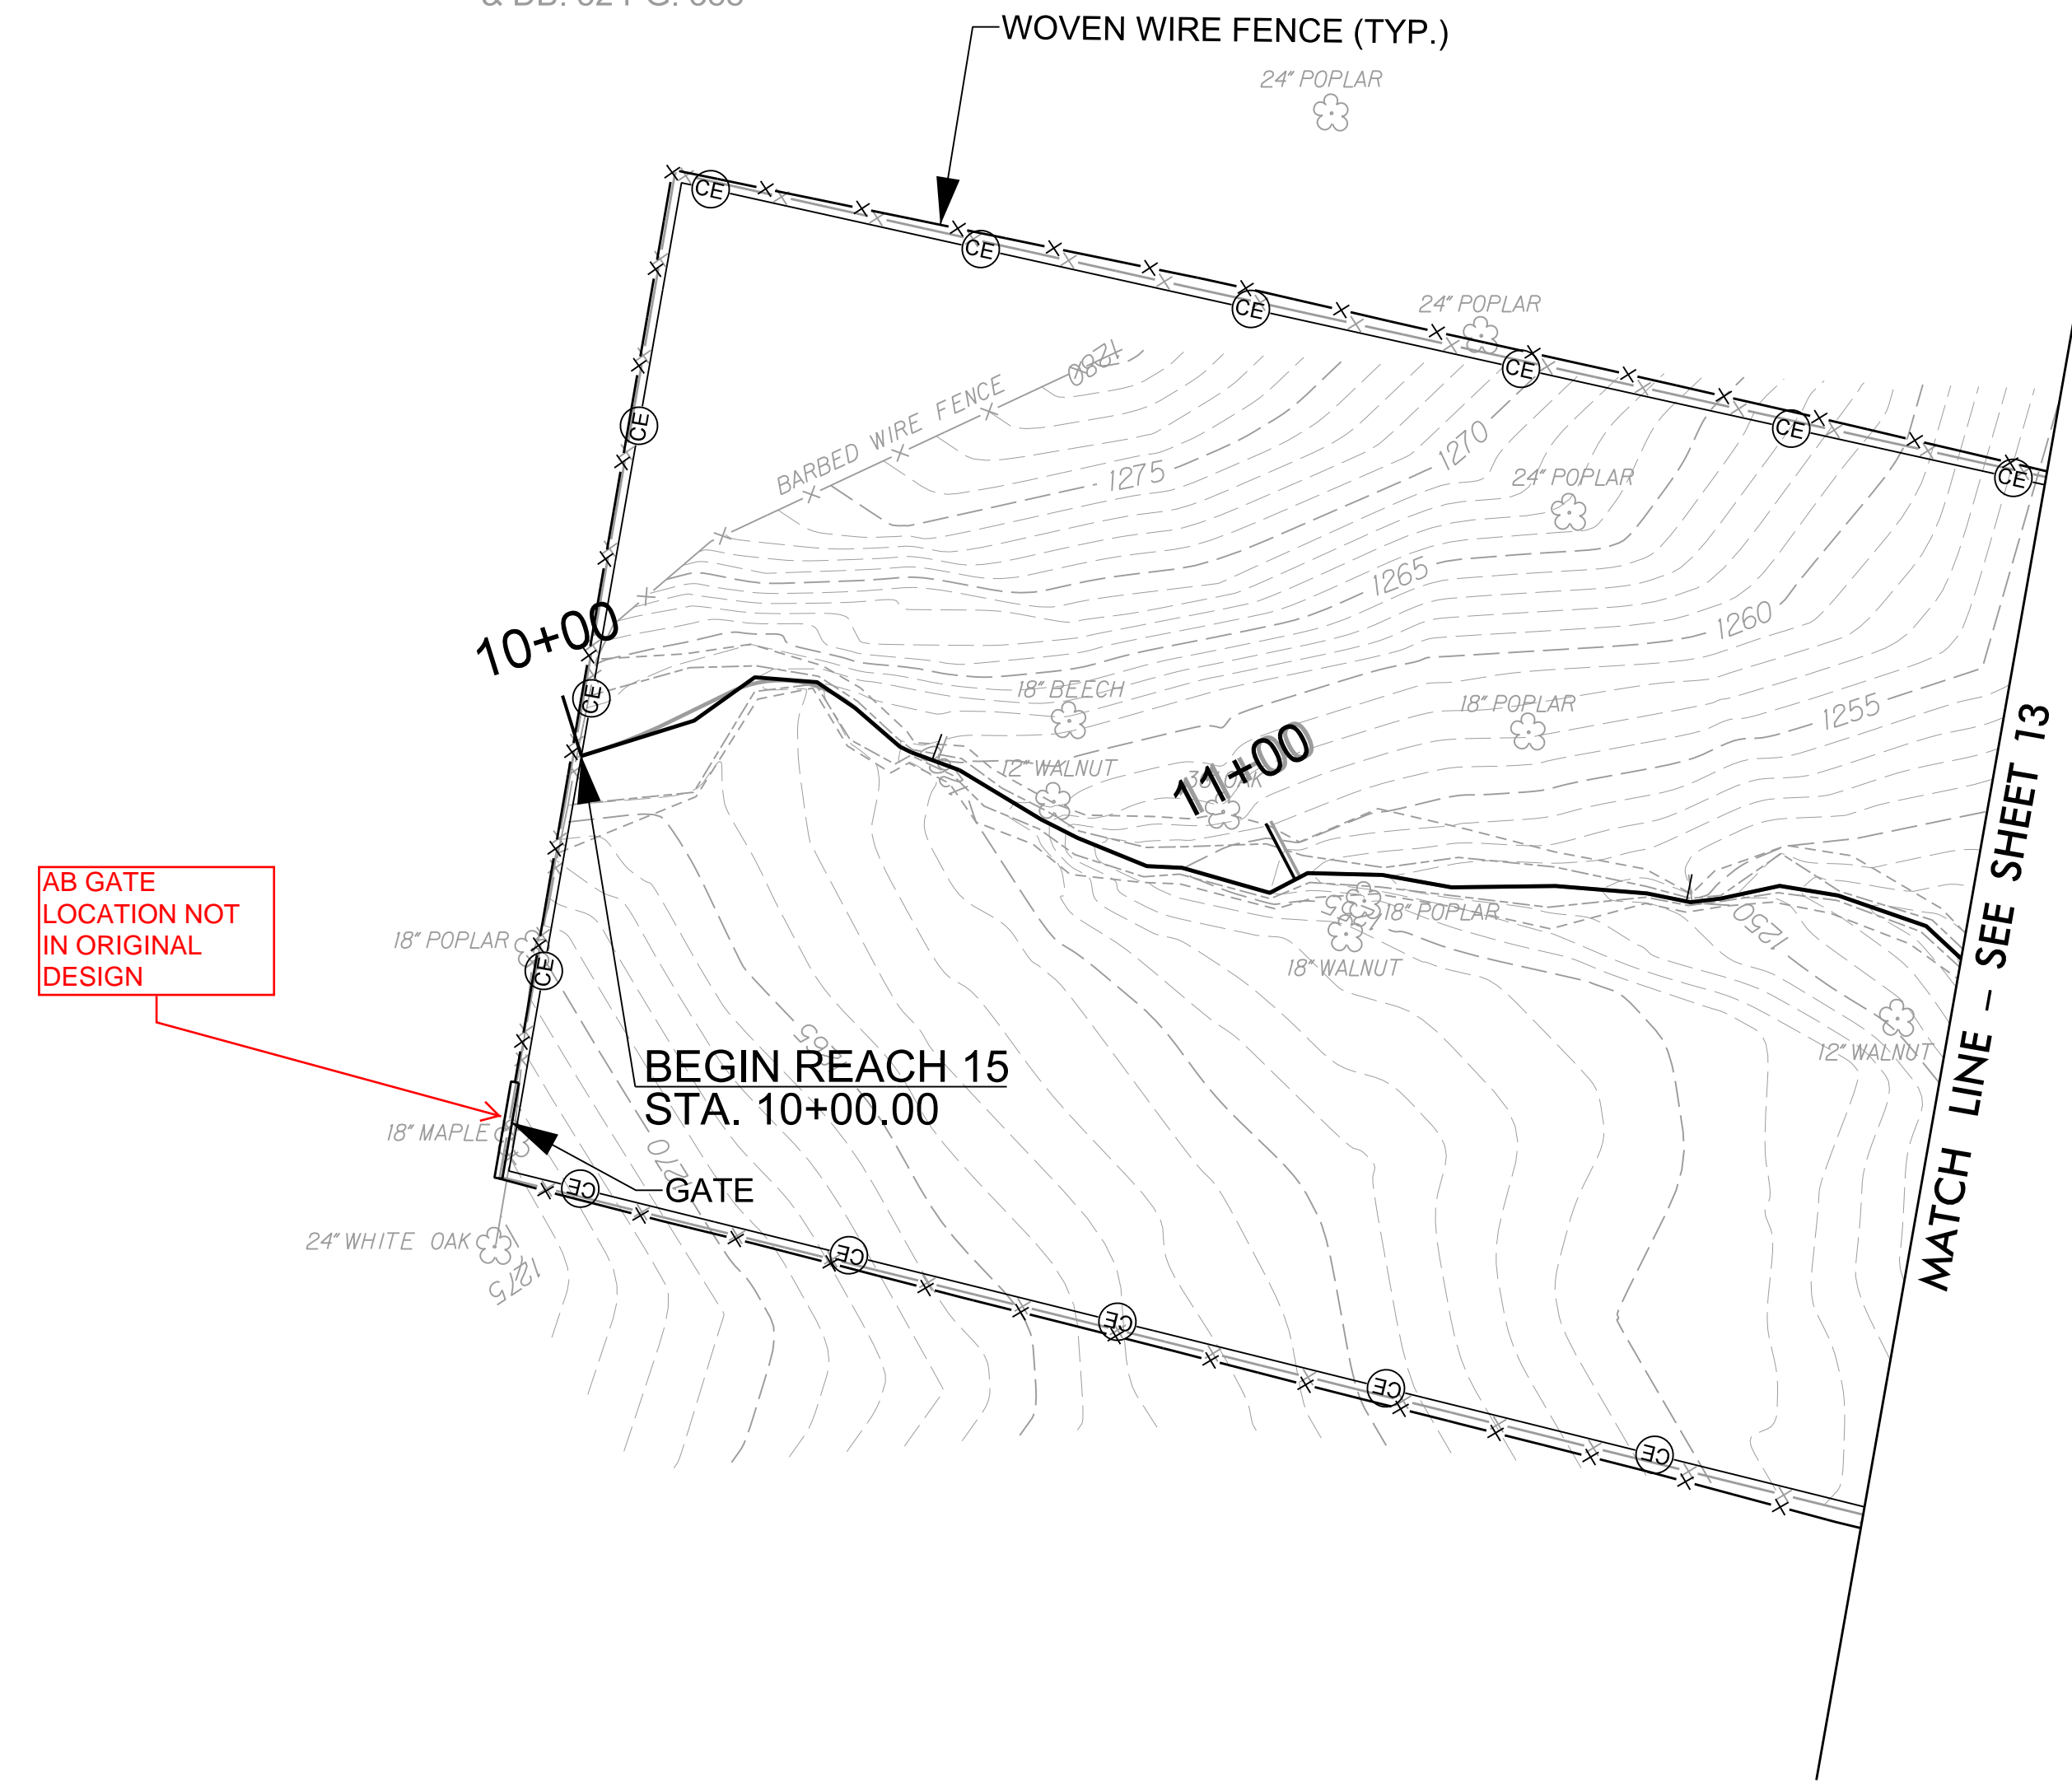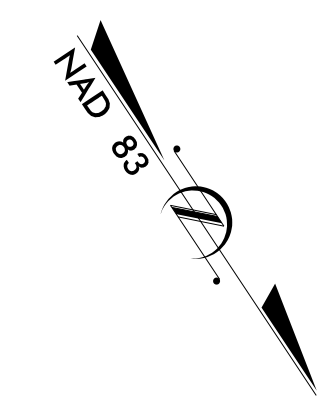

- FILL EXISTING CHANNEL
- CHANNEL PLUG

**RUSSELL GAP  
AS-BUILT PLAN VIEW**

SCALE (FT)

8/15/2020\_Russell11\_Cop\Design\AS-BUILT\PLANS\157329\_AB-PSH-25.dgn






DocuSigned by:  
*David S. Turner*  
1C85E6A8AC644E

APPROVED BY:  
\_\_\_\_\_  
9/11/2020

DATE:  
\_\_\_\_\_  
9/11/2020

**Michael Baker** International  
Michael Baker Engineering Inc.  
3000 Regency Parkway, Suite 500  
Cary, NORTH CAROLINA 27518  
Phone: 919.463.6488  
Fax: 919.463.6489  
License #: F-1084

NCDMS ID NO. 100003

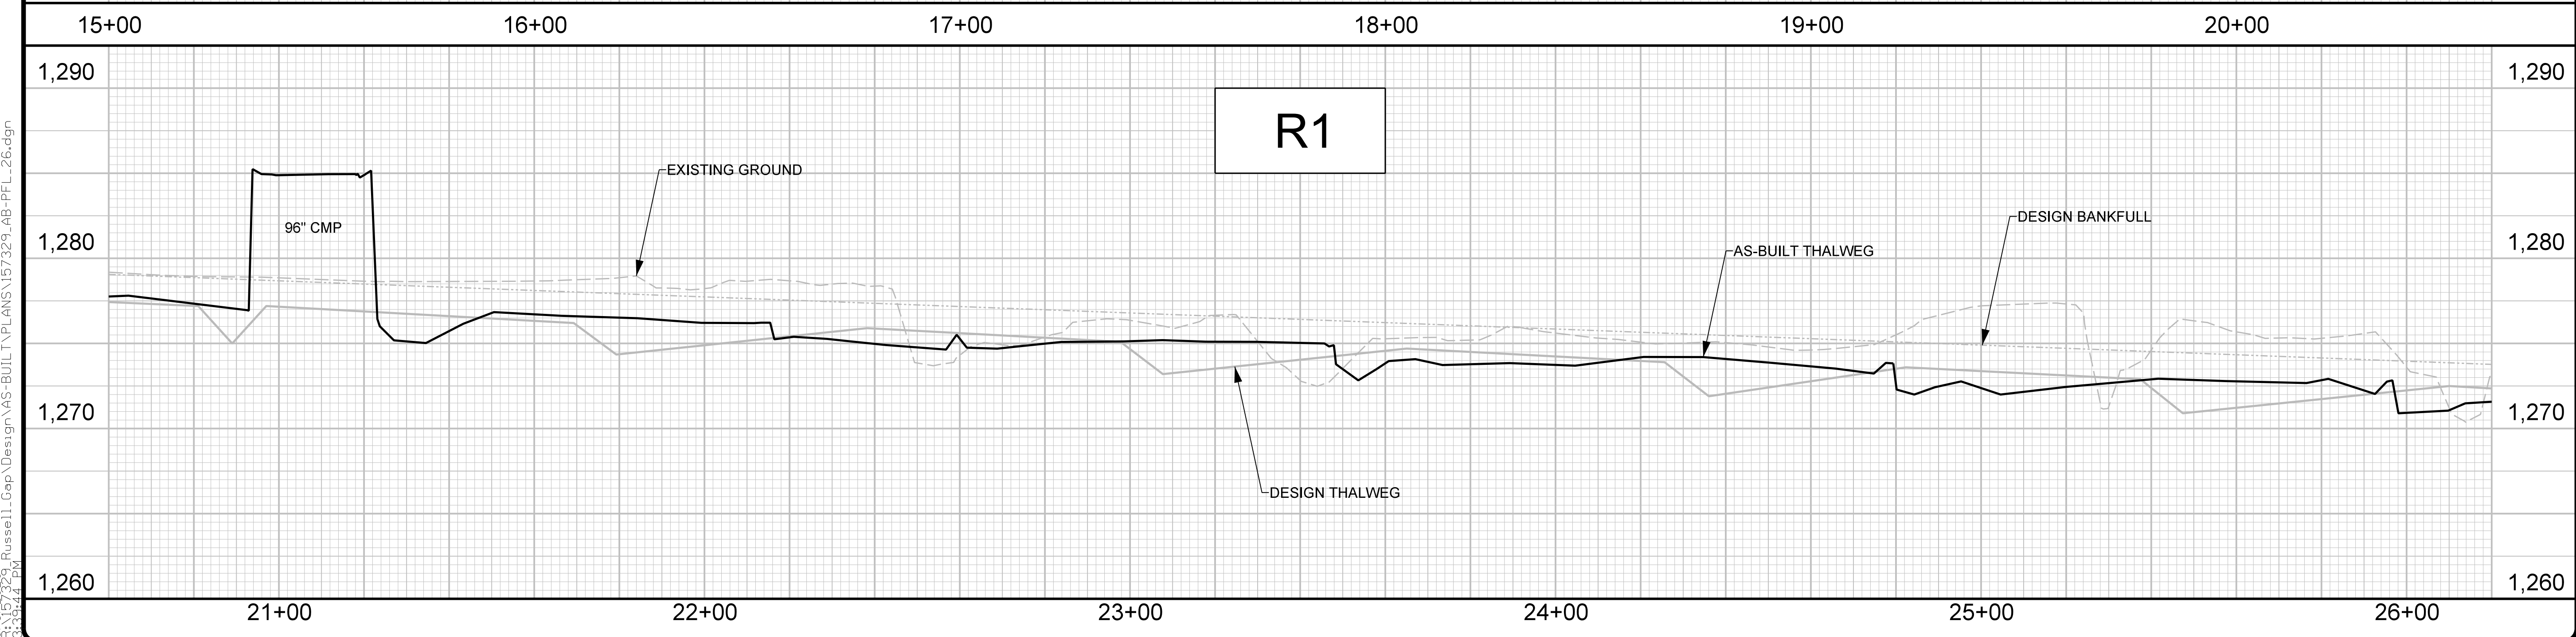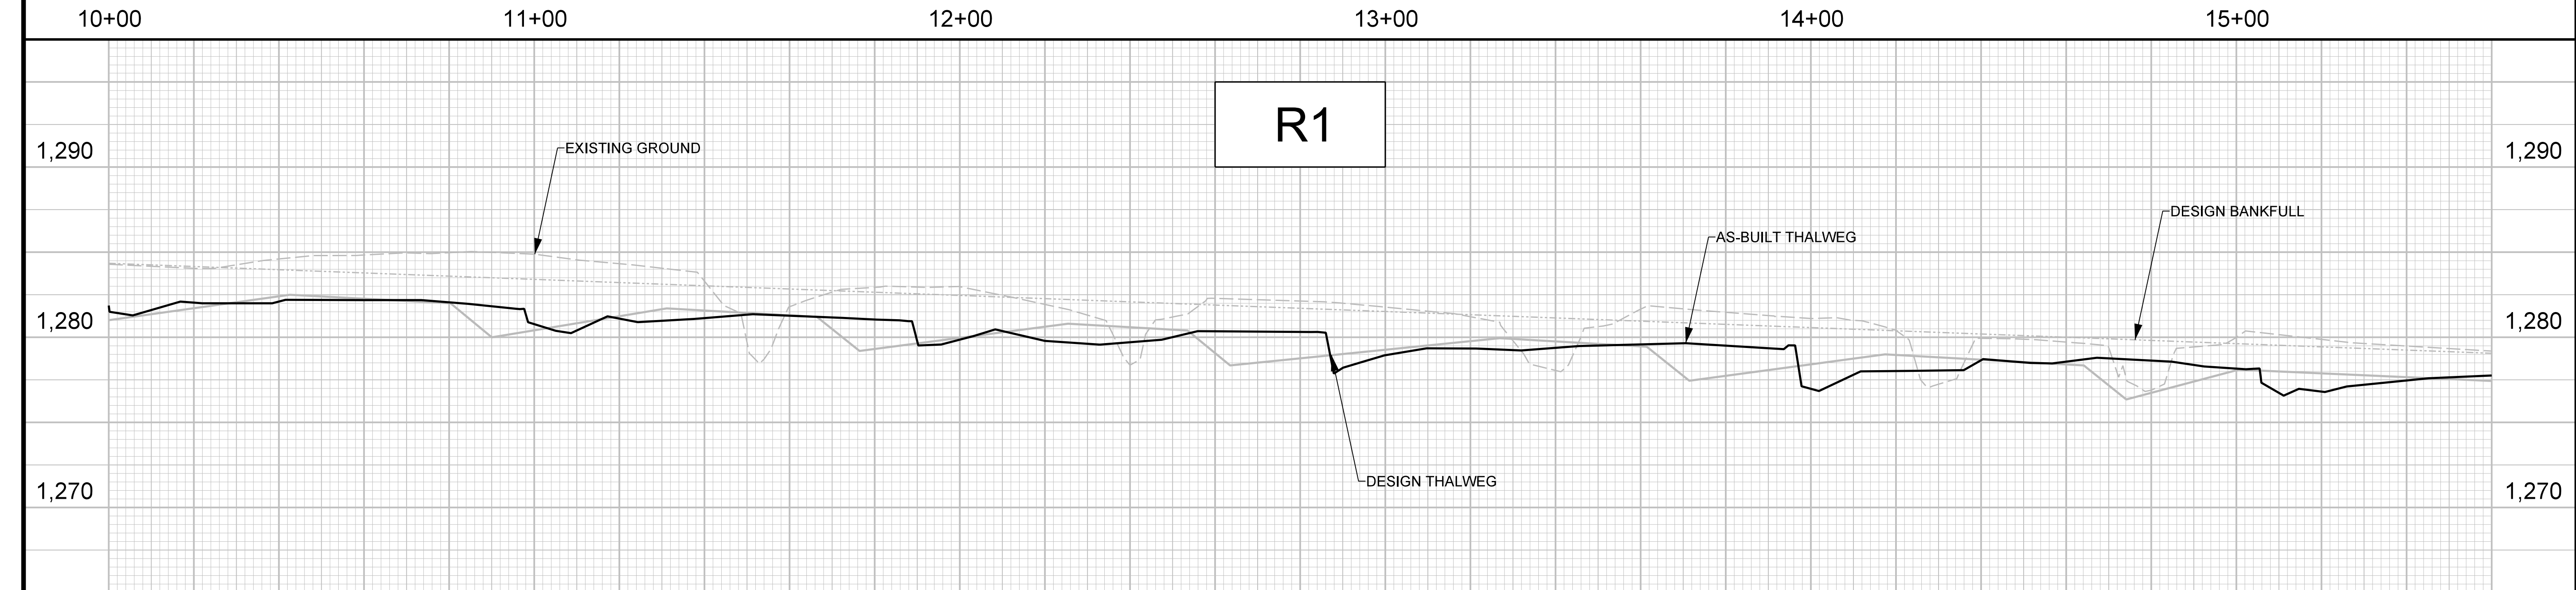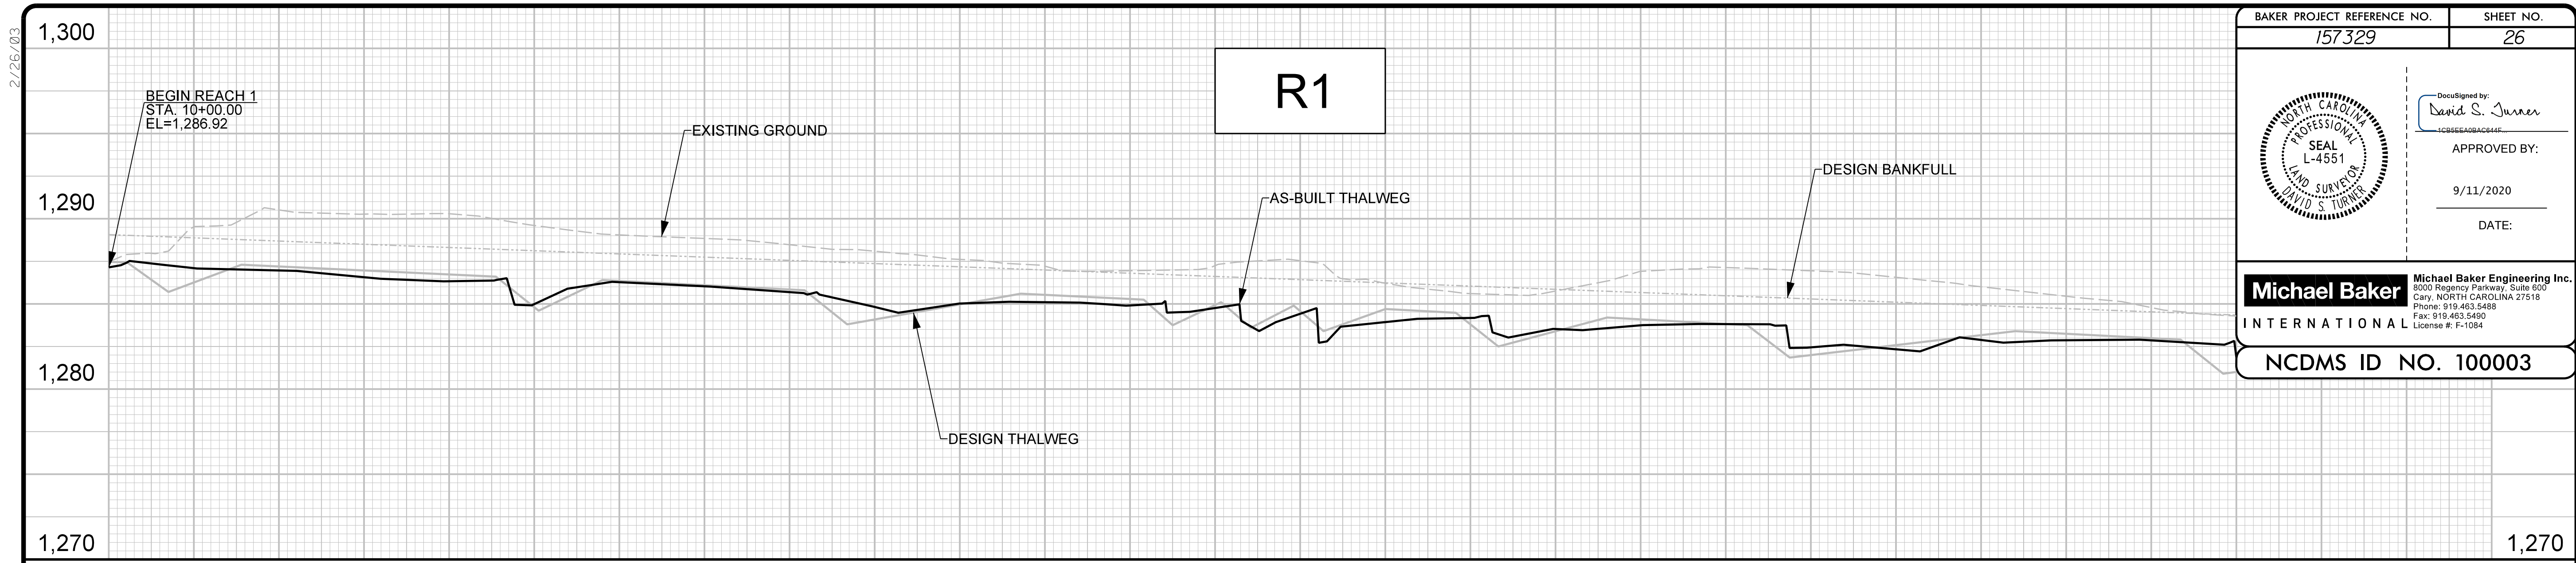

R:\2020\2020\_Russell1\_Gap\Design\AS-BUILT\PLANS\157329\_AB-PF1\_26.dgn  
9/11/2020  
3:03:44 PM



2/26/03




BAKER PROJECT REFERENCE NO. 157329	SHEET NO. 27
---------------------------------------	-----------------



DocuSigned by:  
*David S. Turner*  
APPROVED BY:  
9/11/2020  
DATE:

**Michael Baker International**  
Michael Baker Engineering Inc.  
3000 Regency Parkway, Suite 500  
Cary, NORTH CAROLINA 27518  
Phone: 919.463.6488  
Fax: 919.463.5490  
License #: F-1084

NCDMS ID NO. 100003

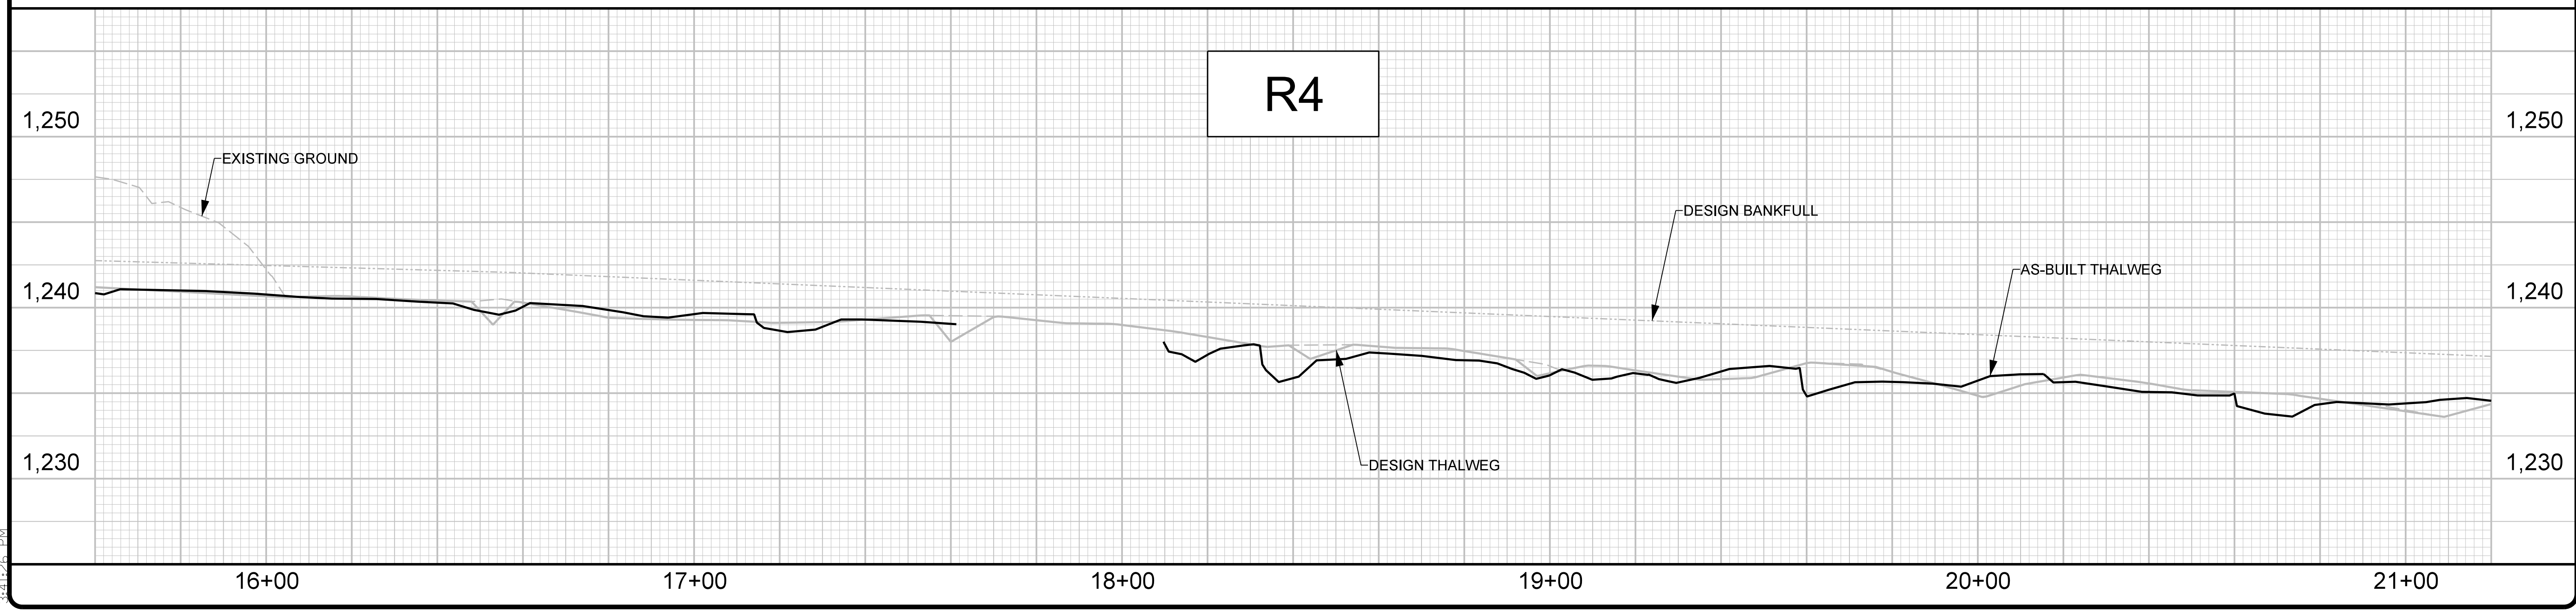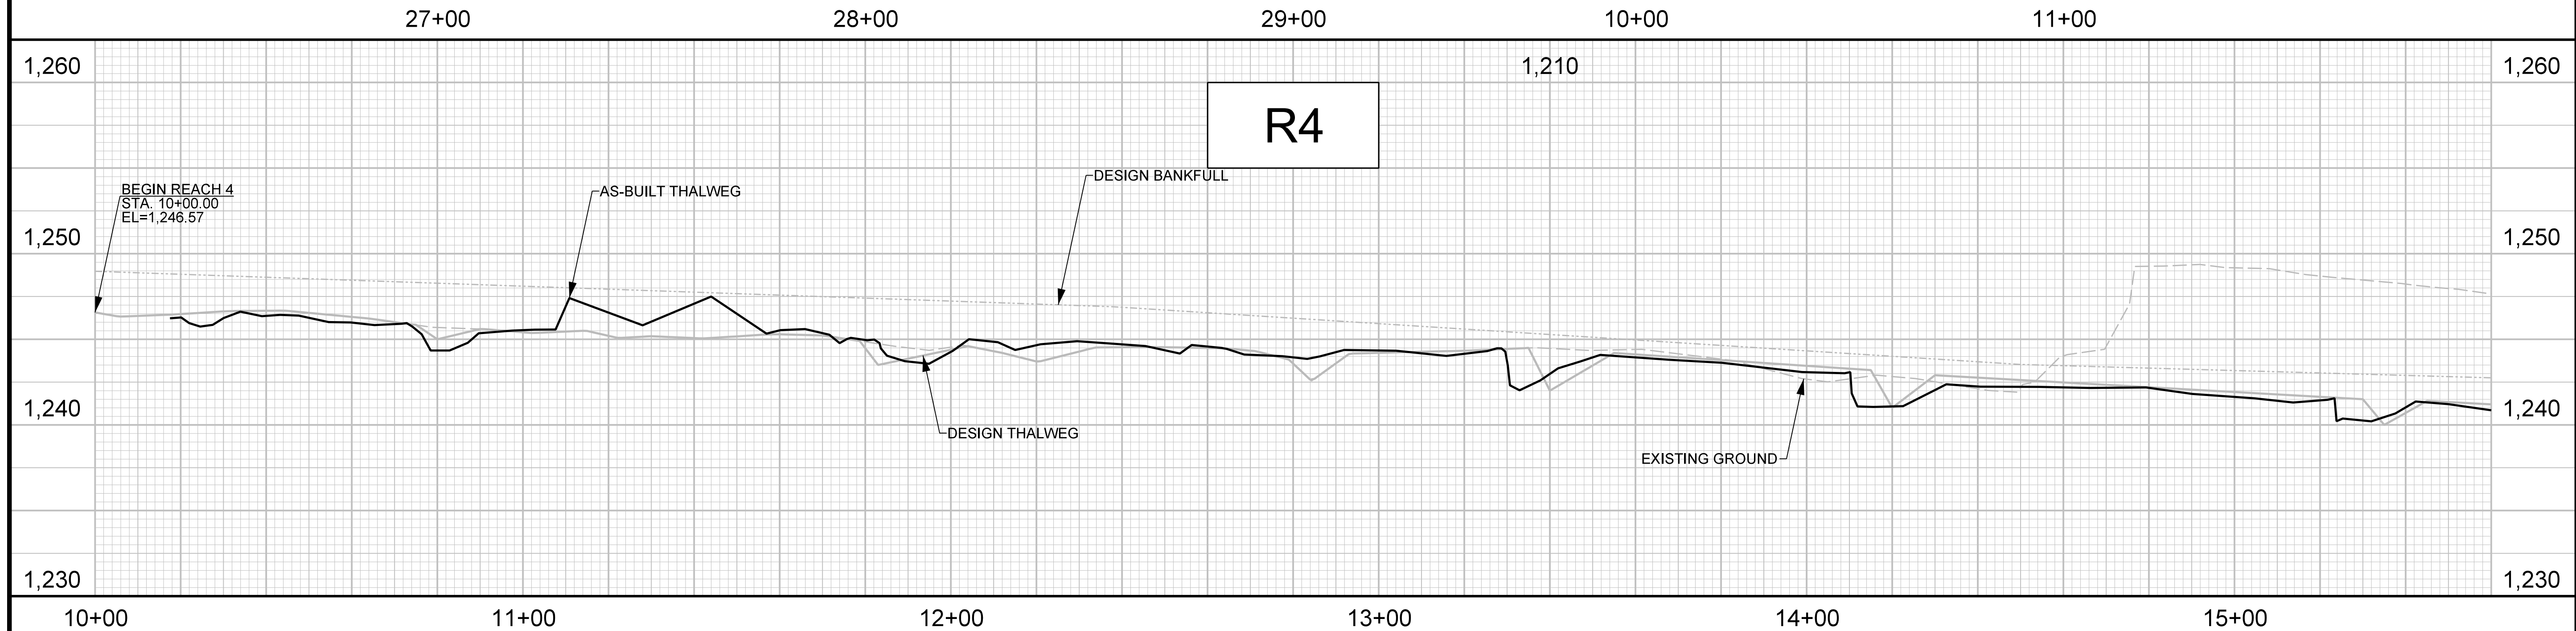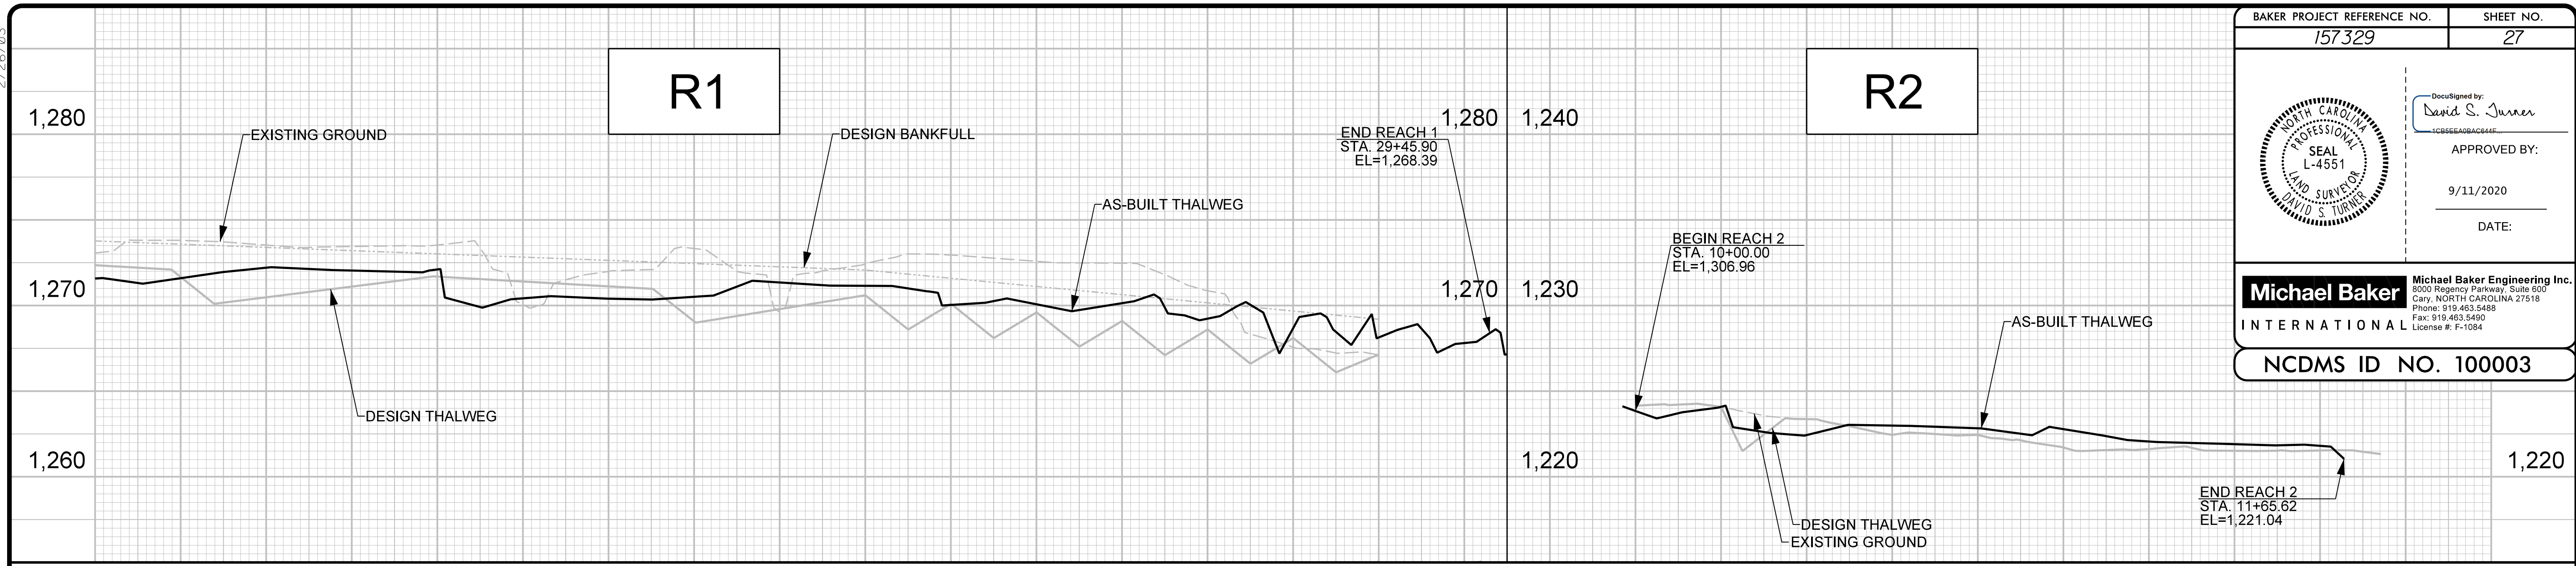

R:\2020\2020\_Russell\_Gap\Design\AS-BUILD\PLANS\157329\_AB-PFL\_27.dgn  
 9/11/2020 3:24:26 PM



2/26/03

BAKER PROJECT REFERENCE NO. 157329	SHEET NO. 28
---------------------------------------	-----------------






DocuSigned by:  
*David S. Turner*  
1C88E6A26AC64F

APPROVED BY:  
  
9/11/2020  
DATE:

**Michael Baker** International  
Michael Baker Engineering Inc.  
3000 Regency Parkway, Suite 500  
Cary, NORTH CAROLINA 27518  
Phone: 919.463.5488  
Fax: 919.463.5480  
License #: F-1084


NCDMS ID NO. 100003

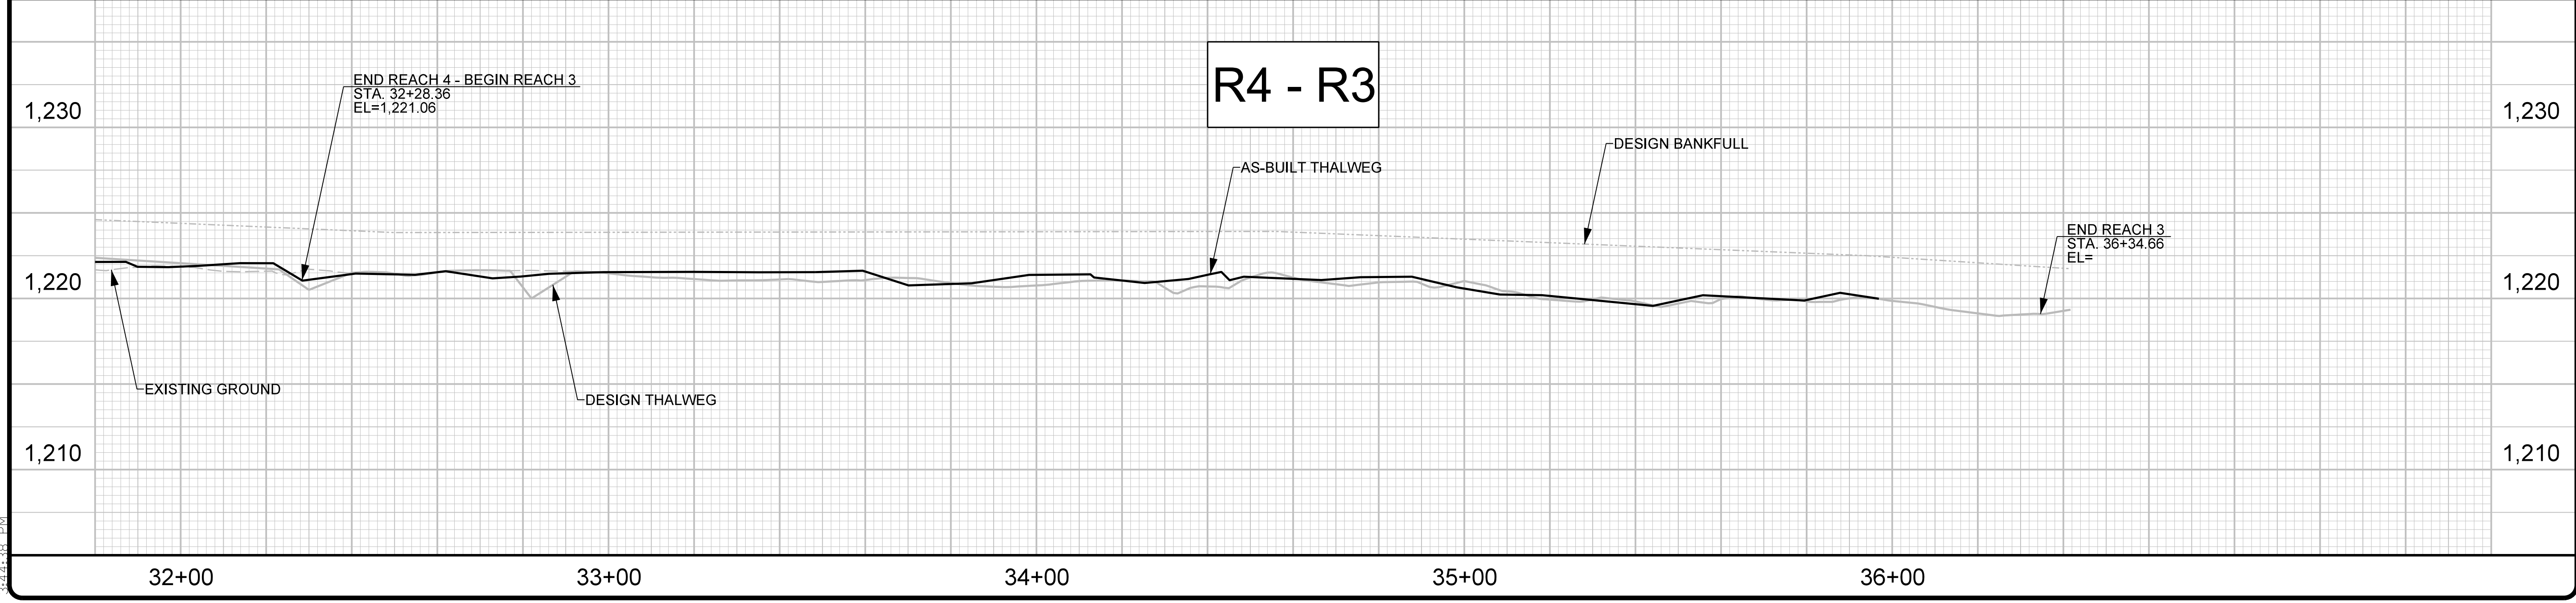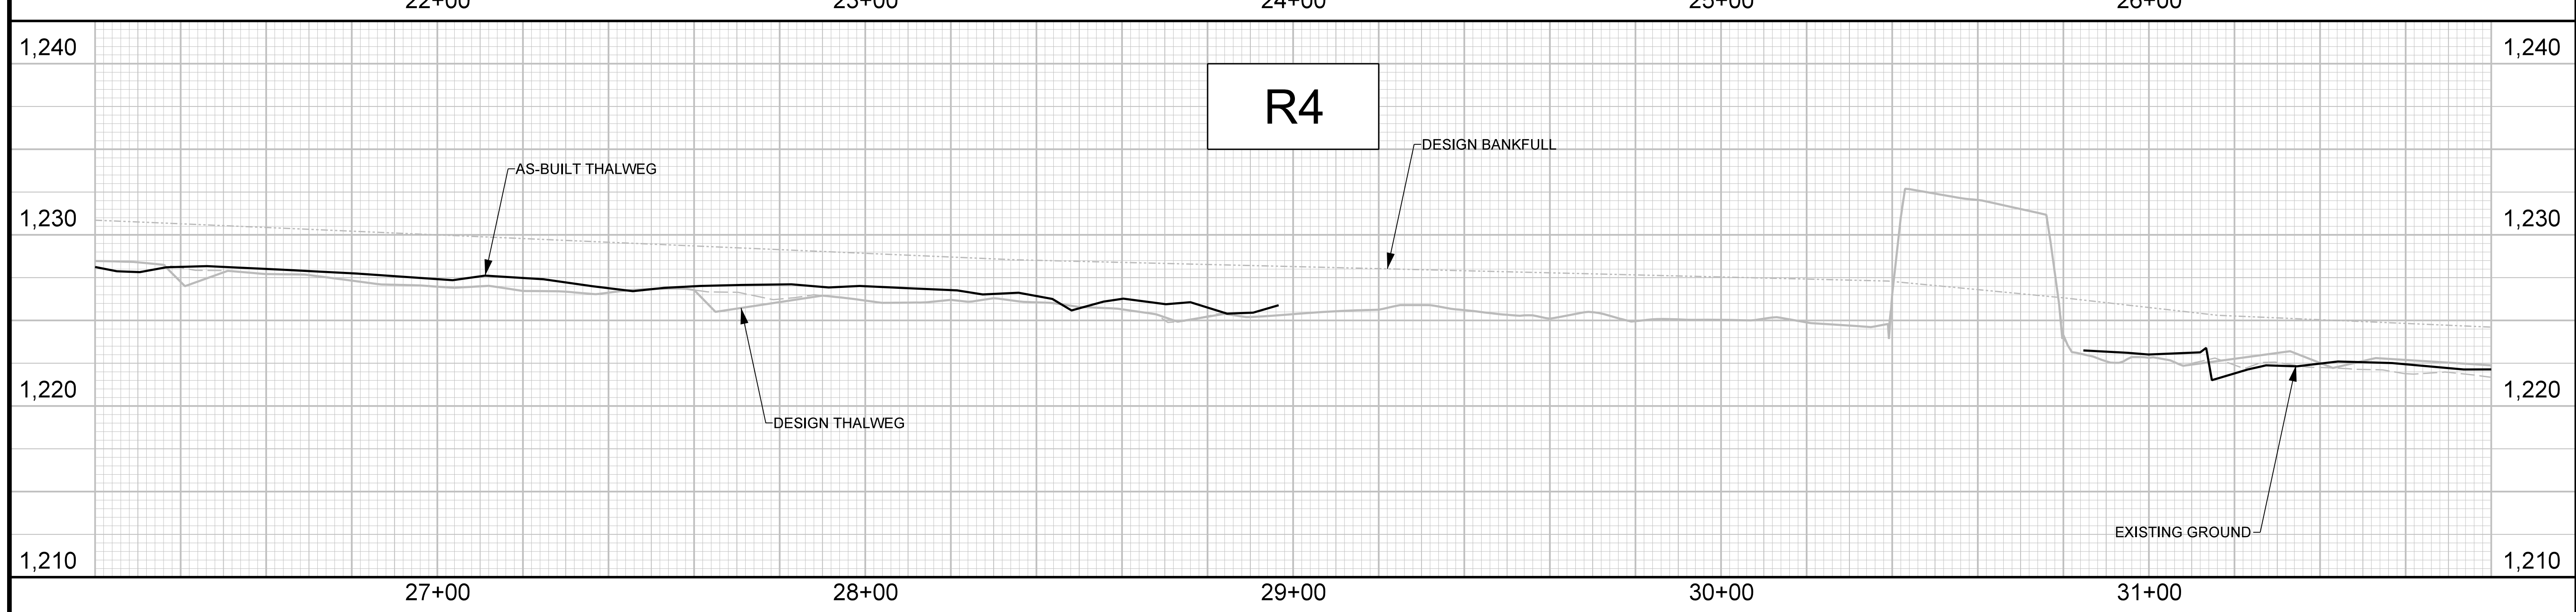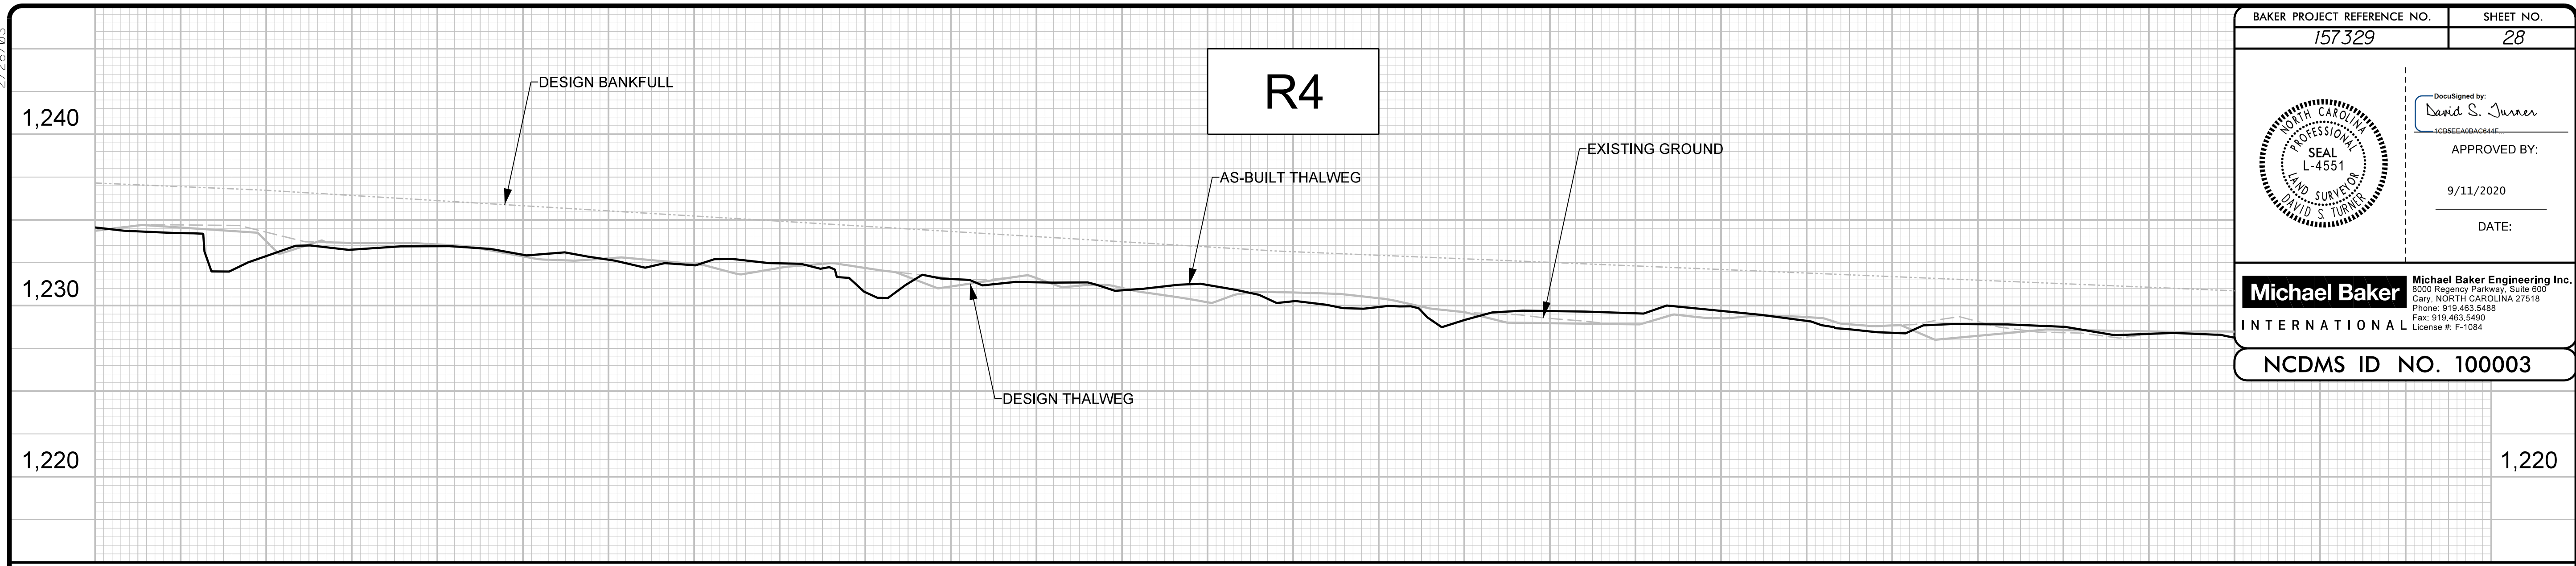

R:\2020\2020\_Russell\_Gap\Design\AS-BUILT\PLANS\157329\_AB-PFL\_28.dgn  
 9/11/2020 3:24:18 PM



2/26/20

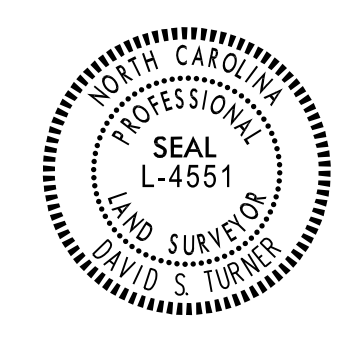




DocuSigned by:  
*David S. Turner*  
1CB5EACBAC6A4F

APPROVED BY:  
  
9/11/2020

DATE:

**Michael Baker** International  
Michael Baker Engineering Inc.  
3000 Regency Parkway, Suite 500  
Cary, NORTH CAROLINA 27518  
Phone: 919.463.5488  
Fax: 919.463.5480  
License #: F-1084


NCDMS ID NO. 100003

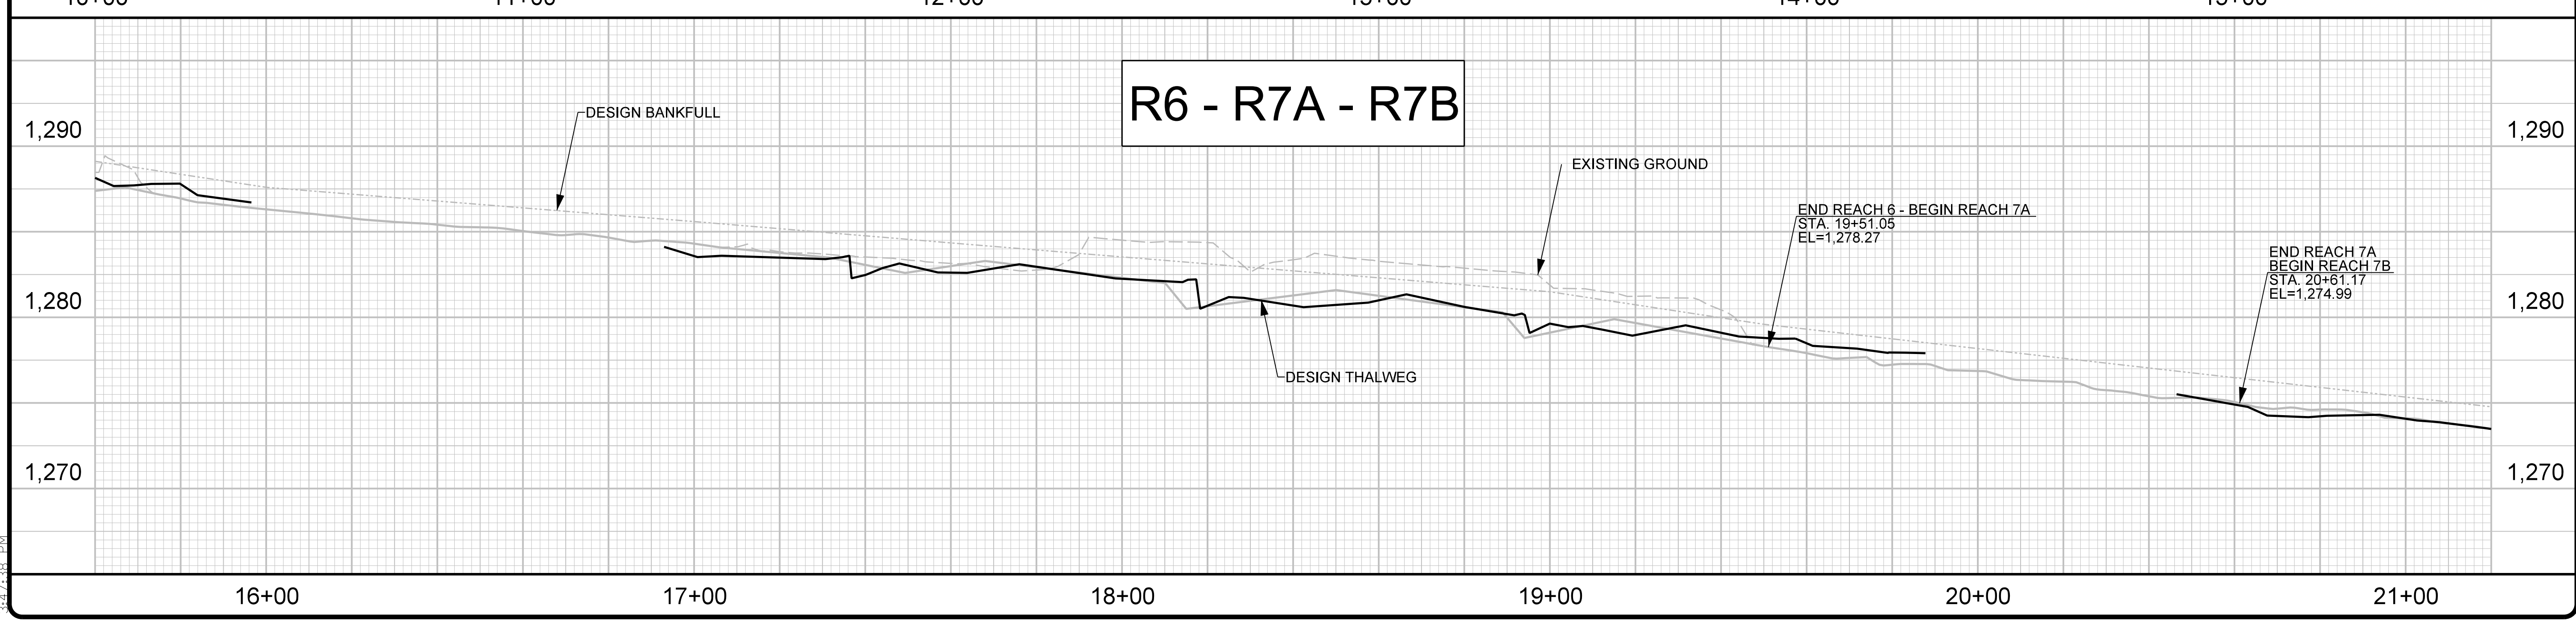
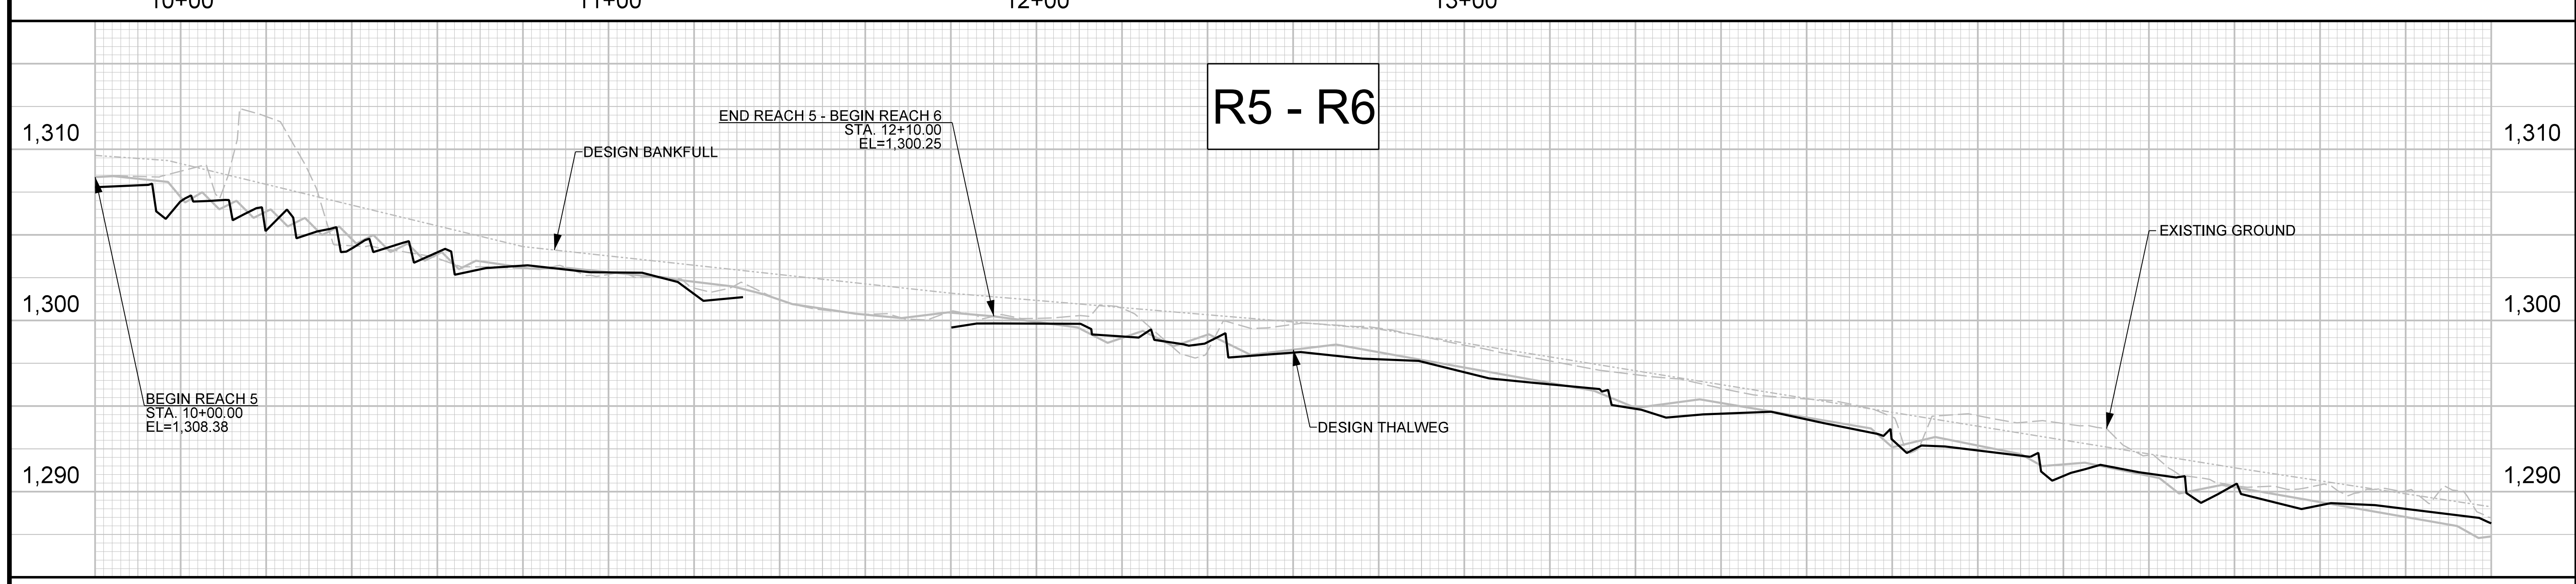
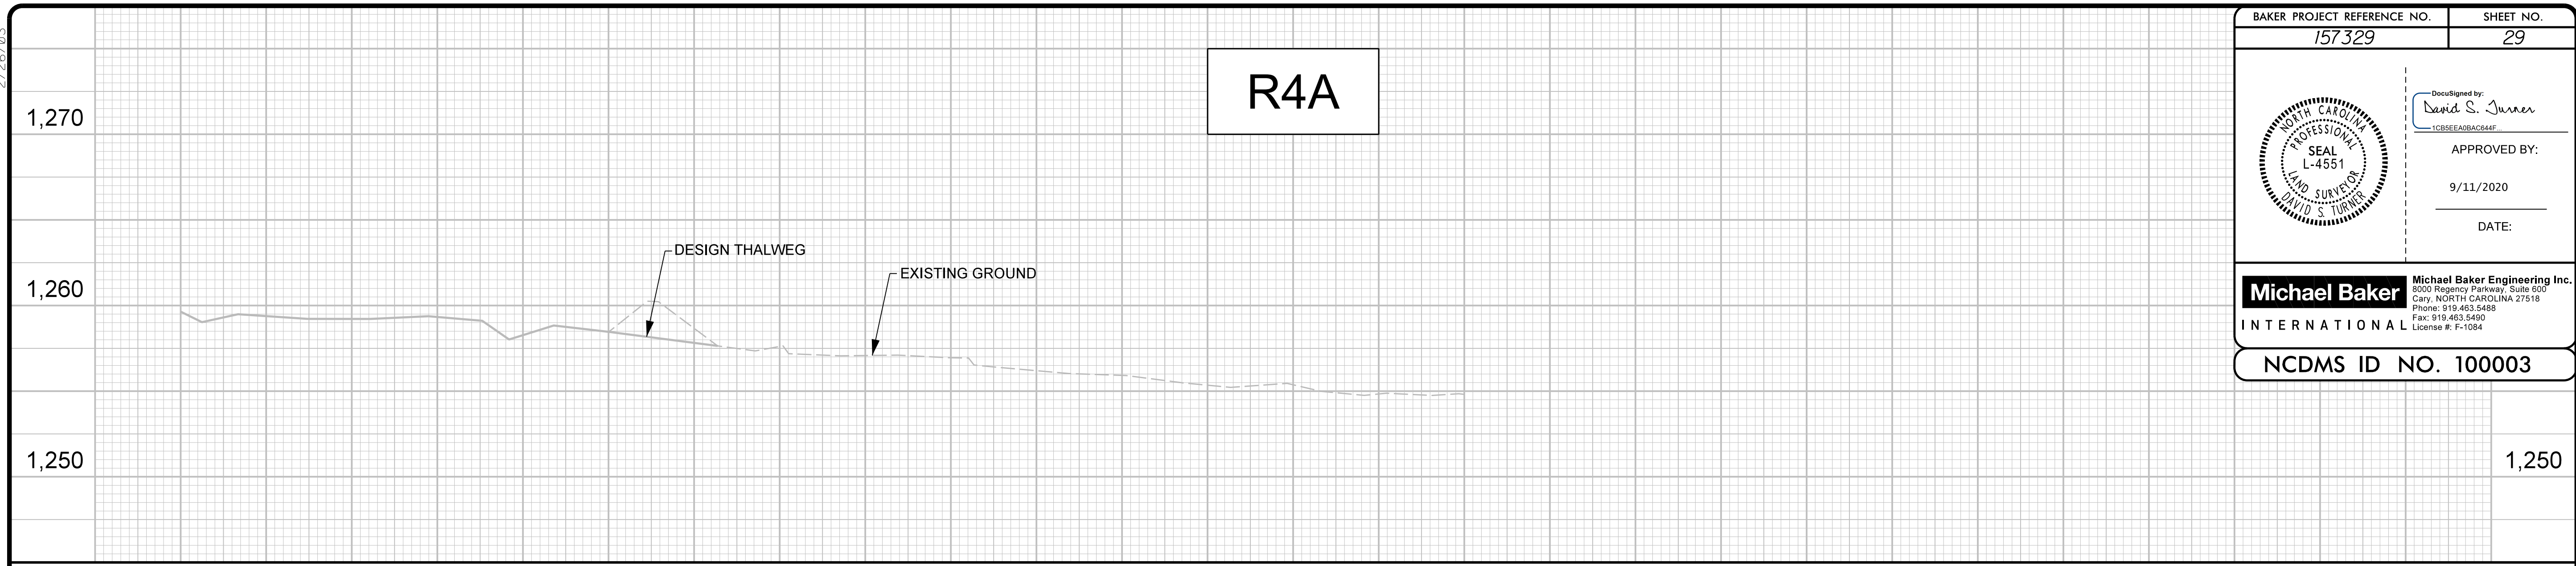


R:\2020\2020\_Russell\_Gap\Design\AS-BUILD\PLANS\157329\_AB-PFL\_29.dgn  
 9/11/2020 3:27:38 PM



2/26/20


BAKER PROJECT REFERENCE NO. 157329	SHEET NO. 30
	DocuSigned by: <i>David S. Turner</i> ICBEECAR04044F
	APPROVED BY:  9/11/2020
	DATE:
<b>Michael Baker International</b> Michael Baker Engineering Inc. <small>3000 Progress Parkway, Suite 500      Cary, NORTH CAROLINA 27518      Phone: 919.453.5488      Fax: 919.453.5480      License #: F-1084</small>	
<b>NCDMS ID NO. 100003</b>	

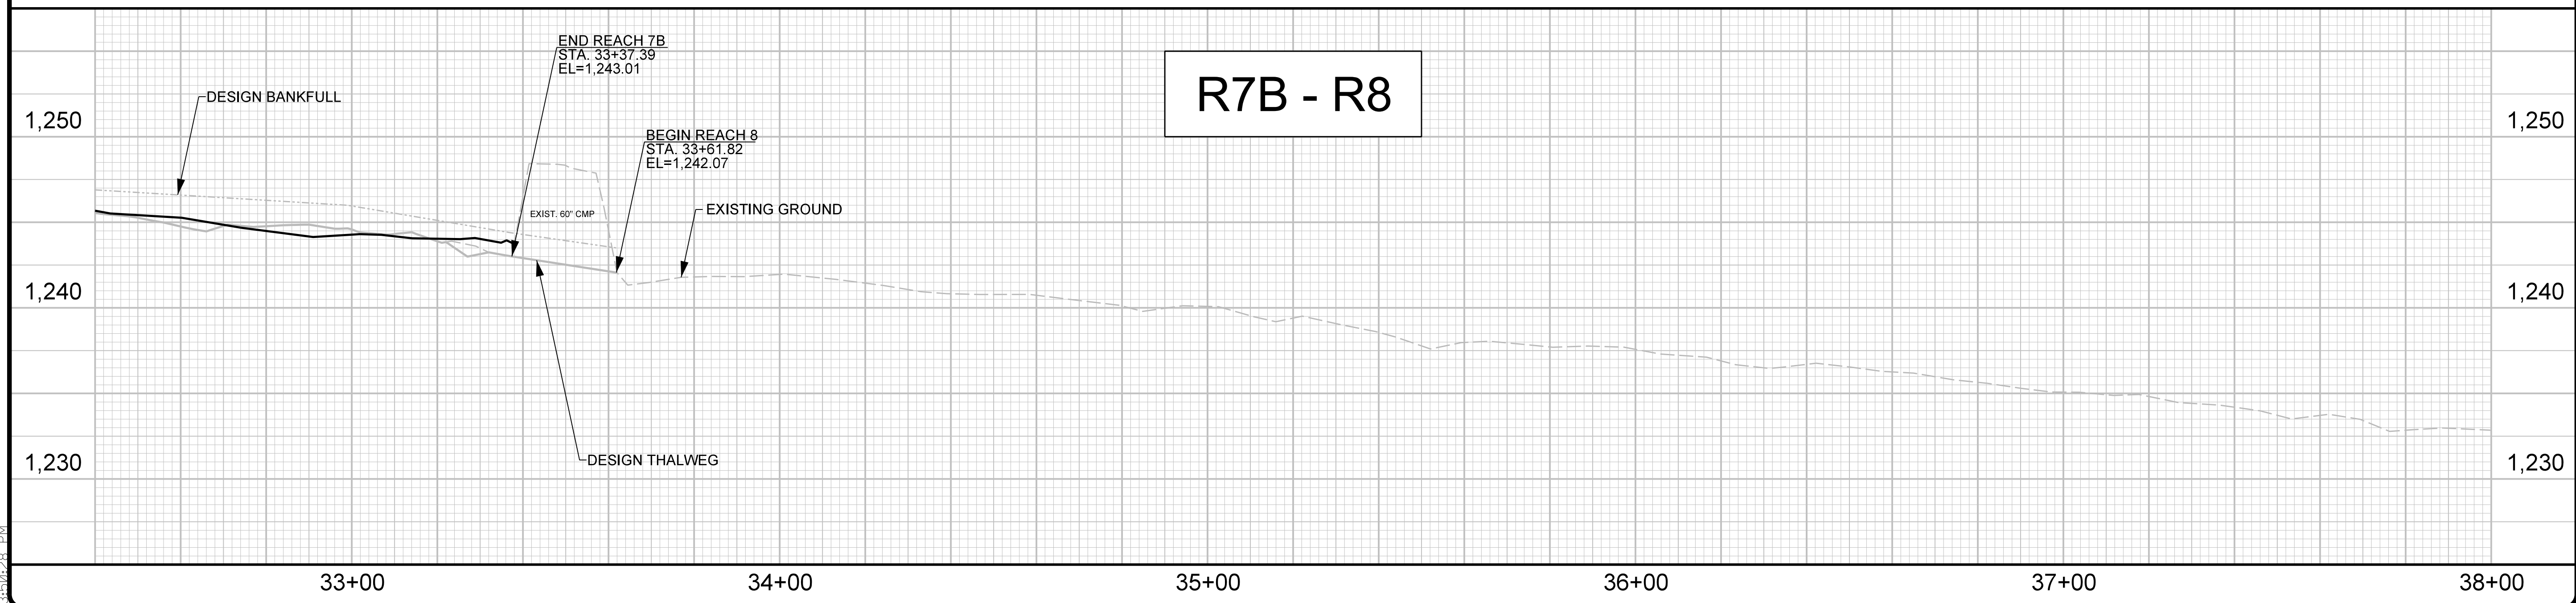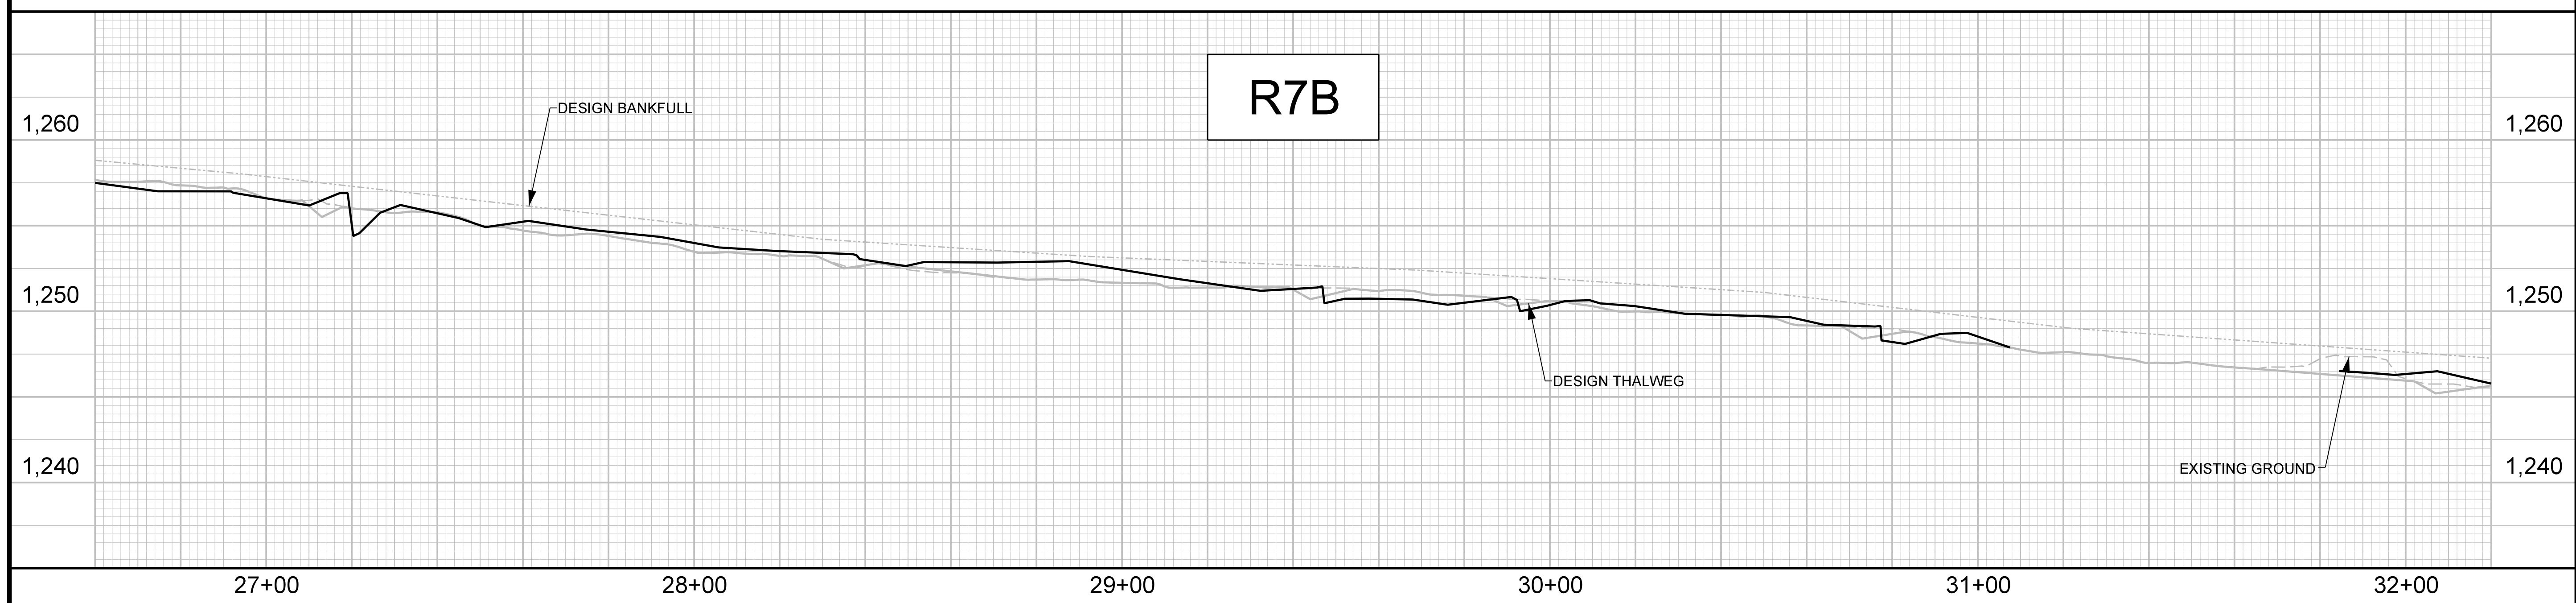
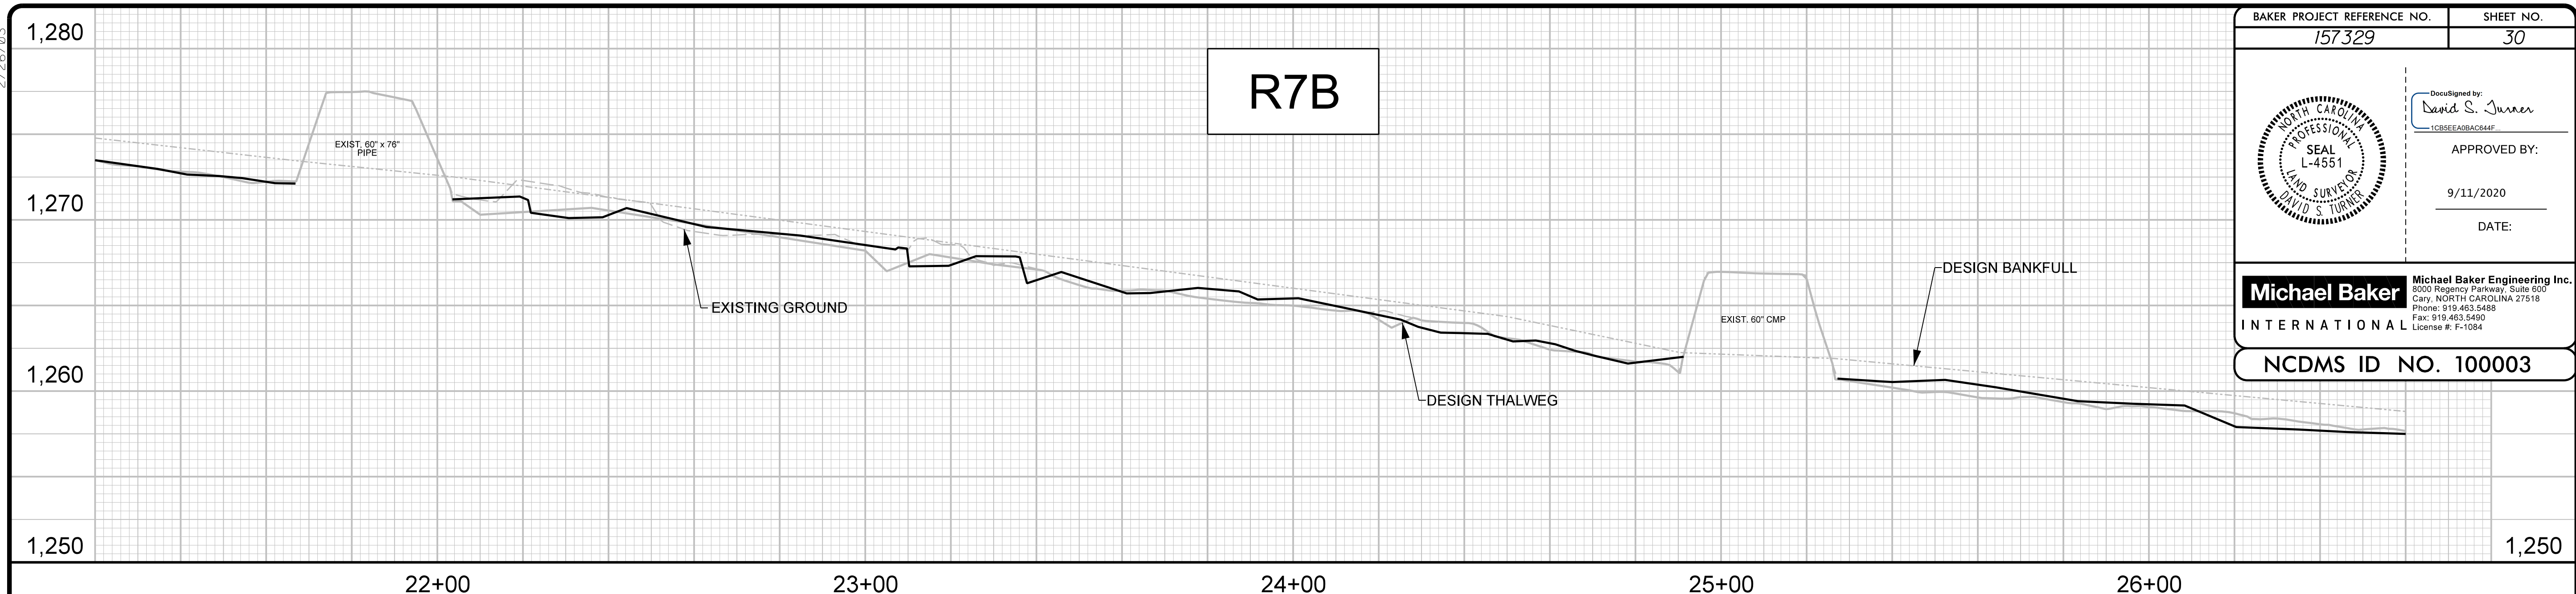


R:\2020\20\_Russell\_Gap\Design\AS-BUILD\PLANS\157329\_AB-PFL\_30.dgn  
9/11/2020  
3:00:28 PM



2/26/03


BAKER PROJECT REFERENCE NO. 157329	SHEET NO. 31
	
Documented by: <i>David S. Turner</i> APPROVED BY: _____ DATE: 9/11/2020	
<b>Michael Baker International</b>	
Michael Baker Engineering Inc. 5000 Regency Parkway, Suite 500 Cary, NORTH CAROLINA 27518 Phone: 919.463.5488 Fax: 919.463.5490 License #: F-1084	
<b>NCDMS ID NO. 100003</b>	

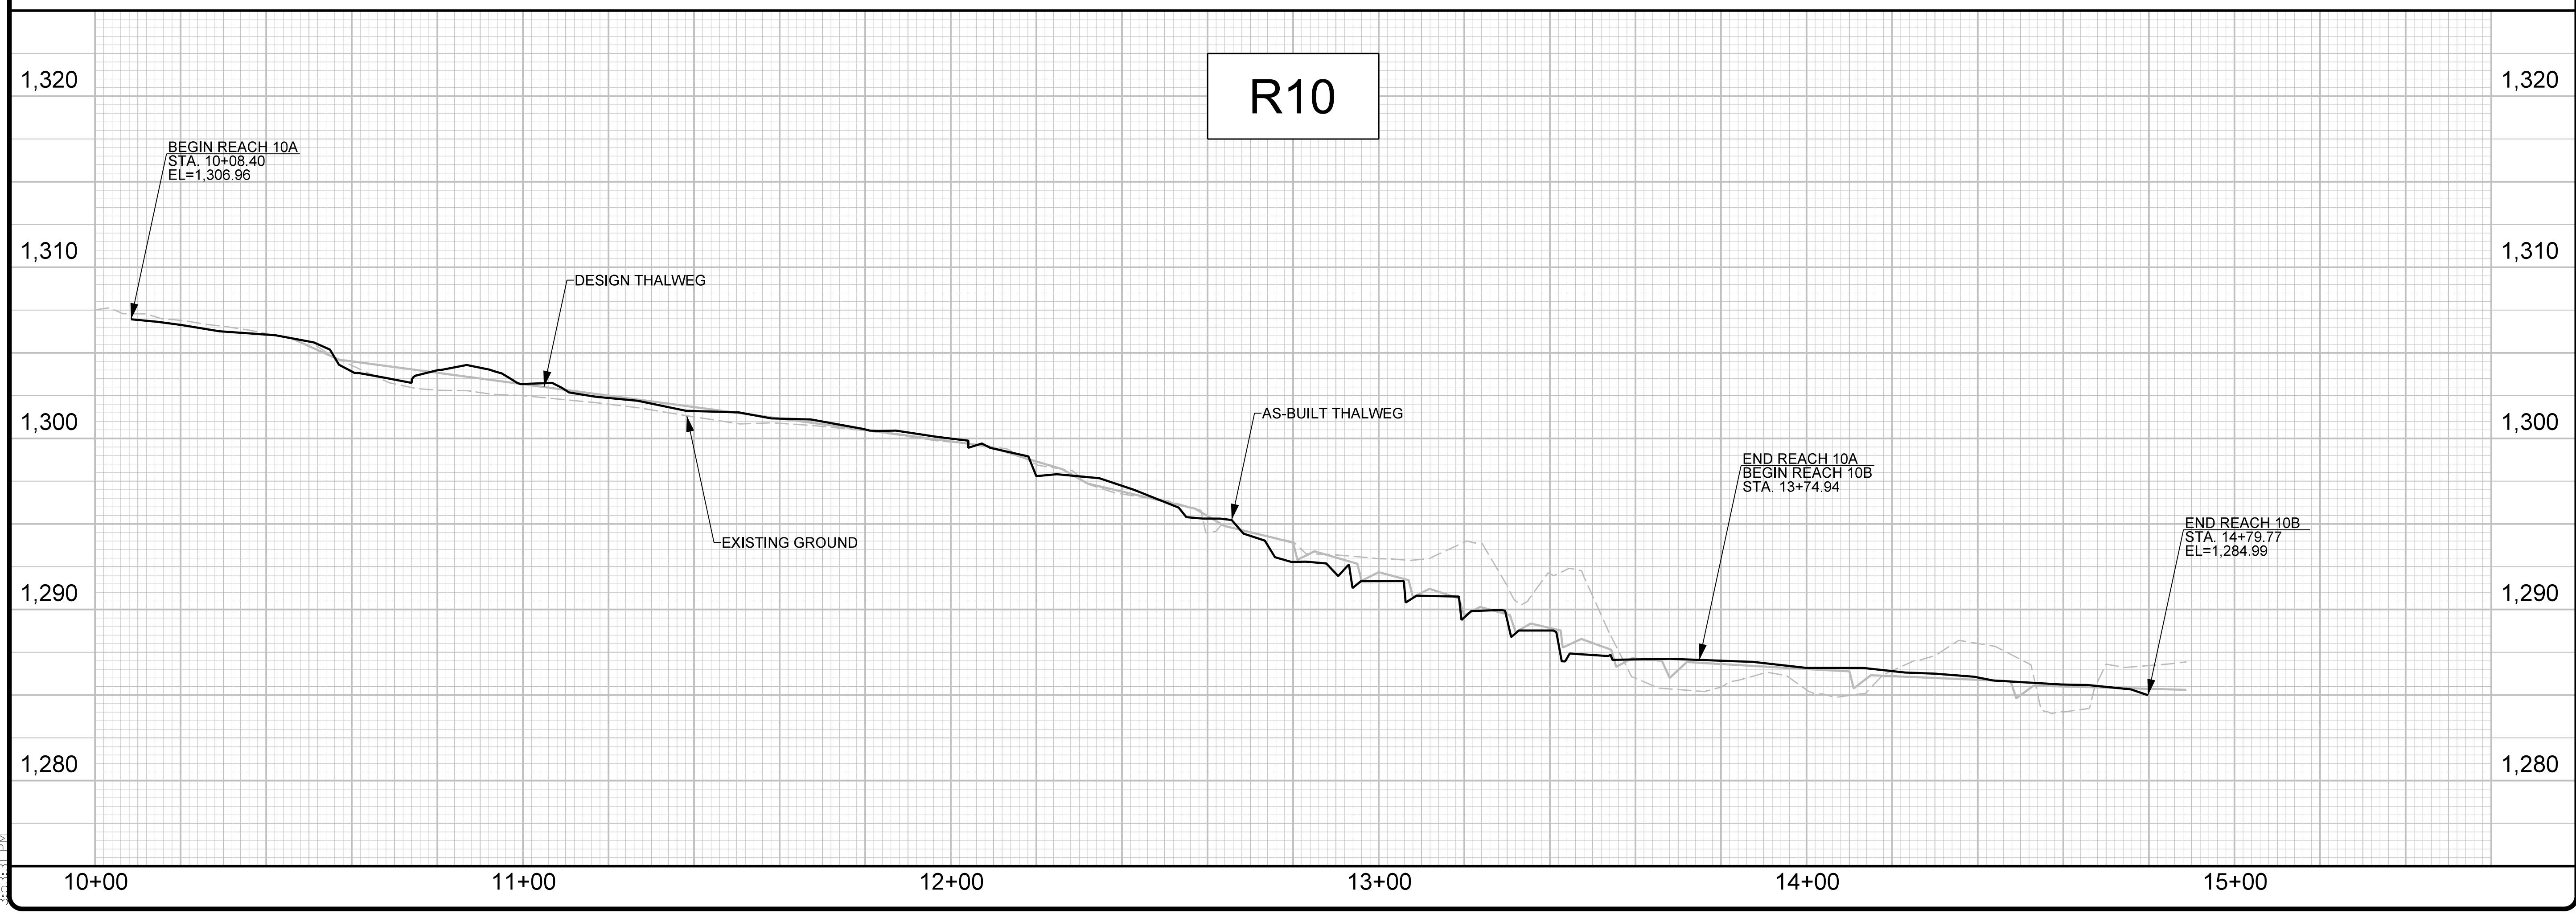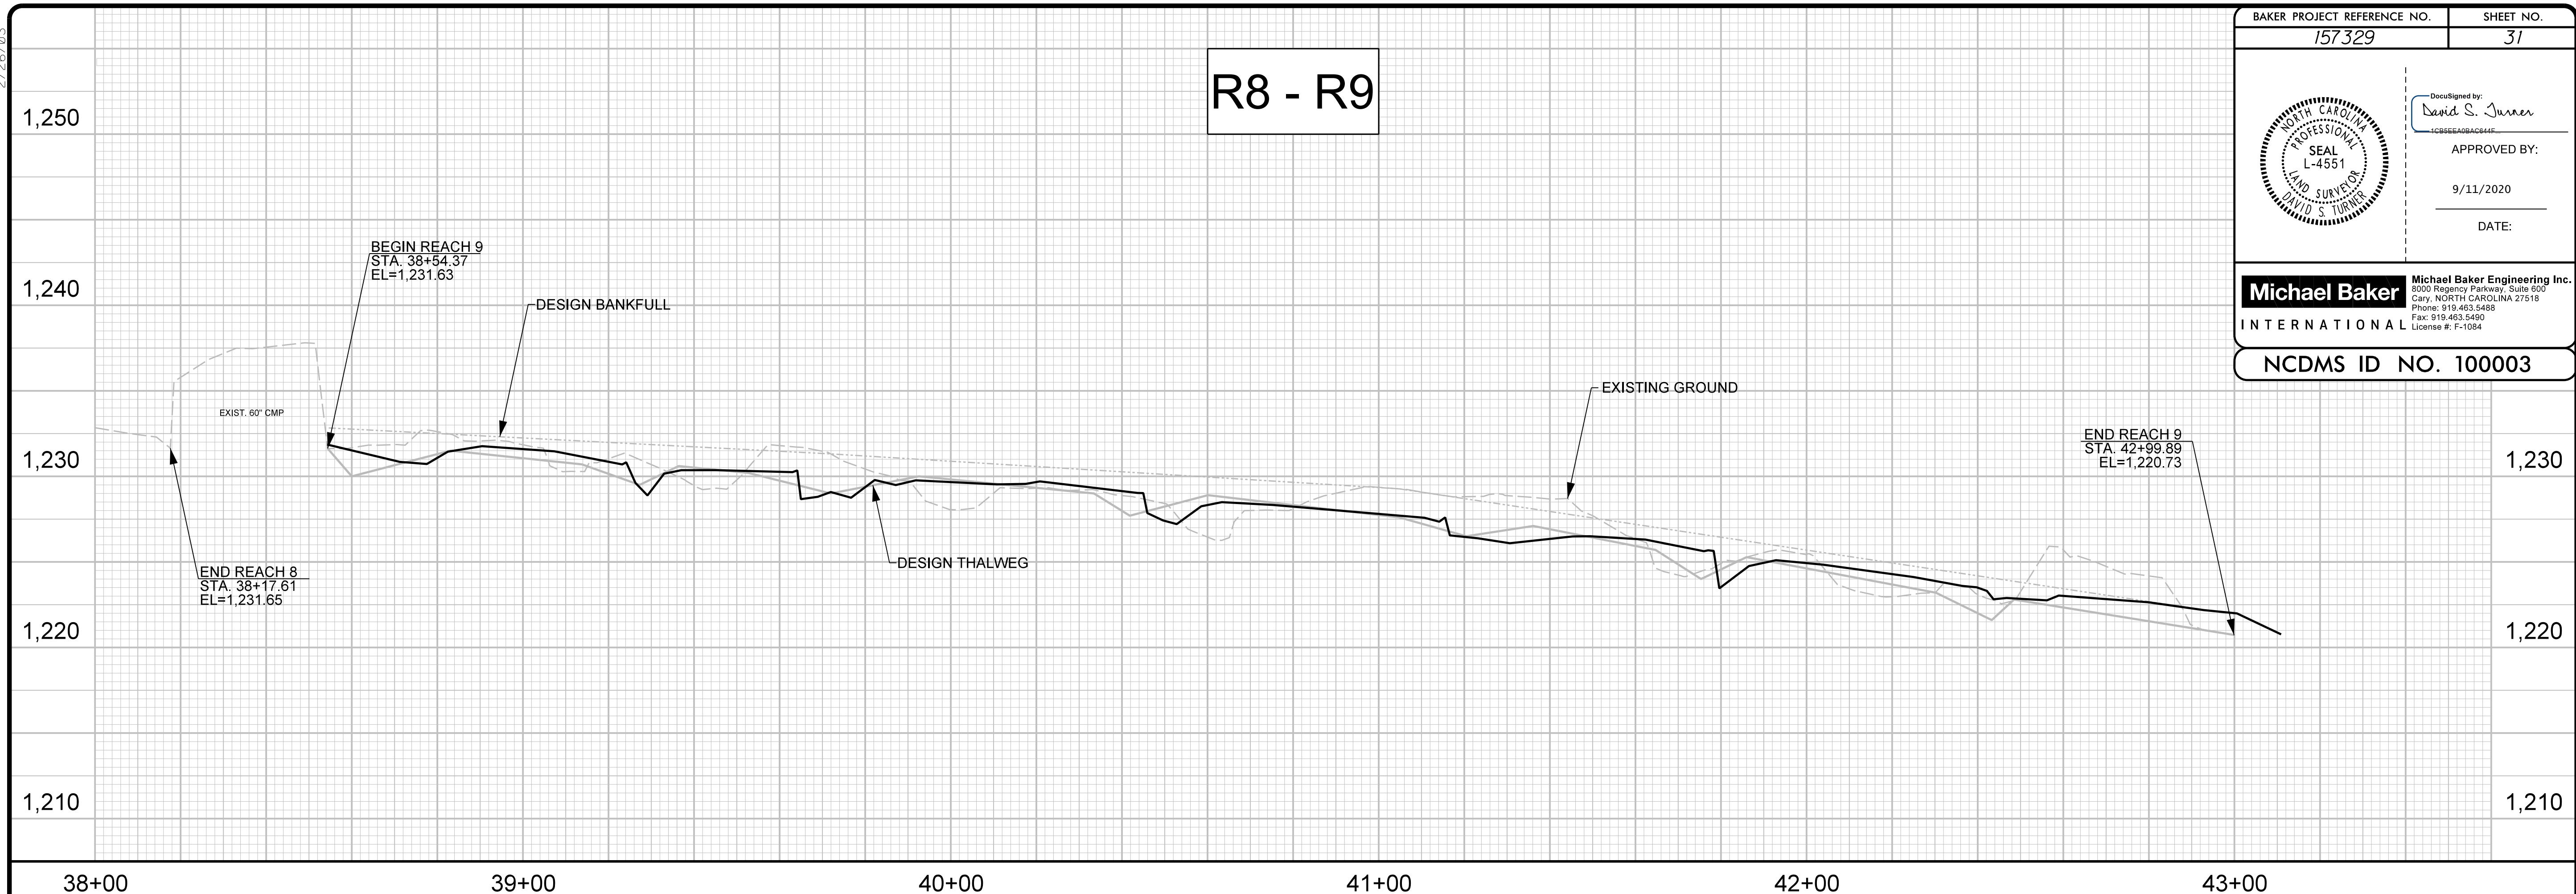

R:\2020\157329\AS-BUILT\PLANS\157329\_AB-PFL\_31.dgn





2/26/20

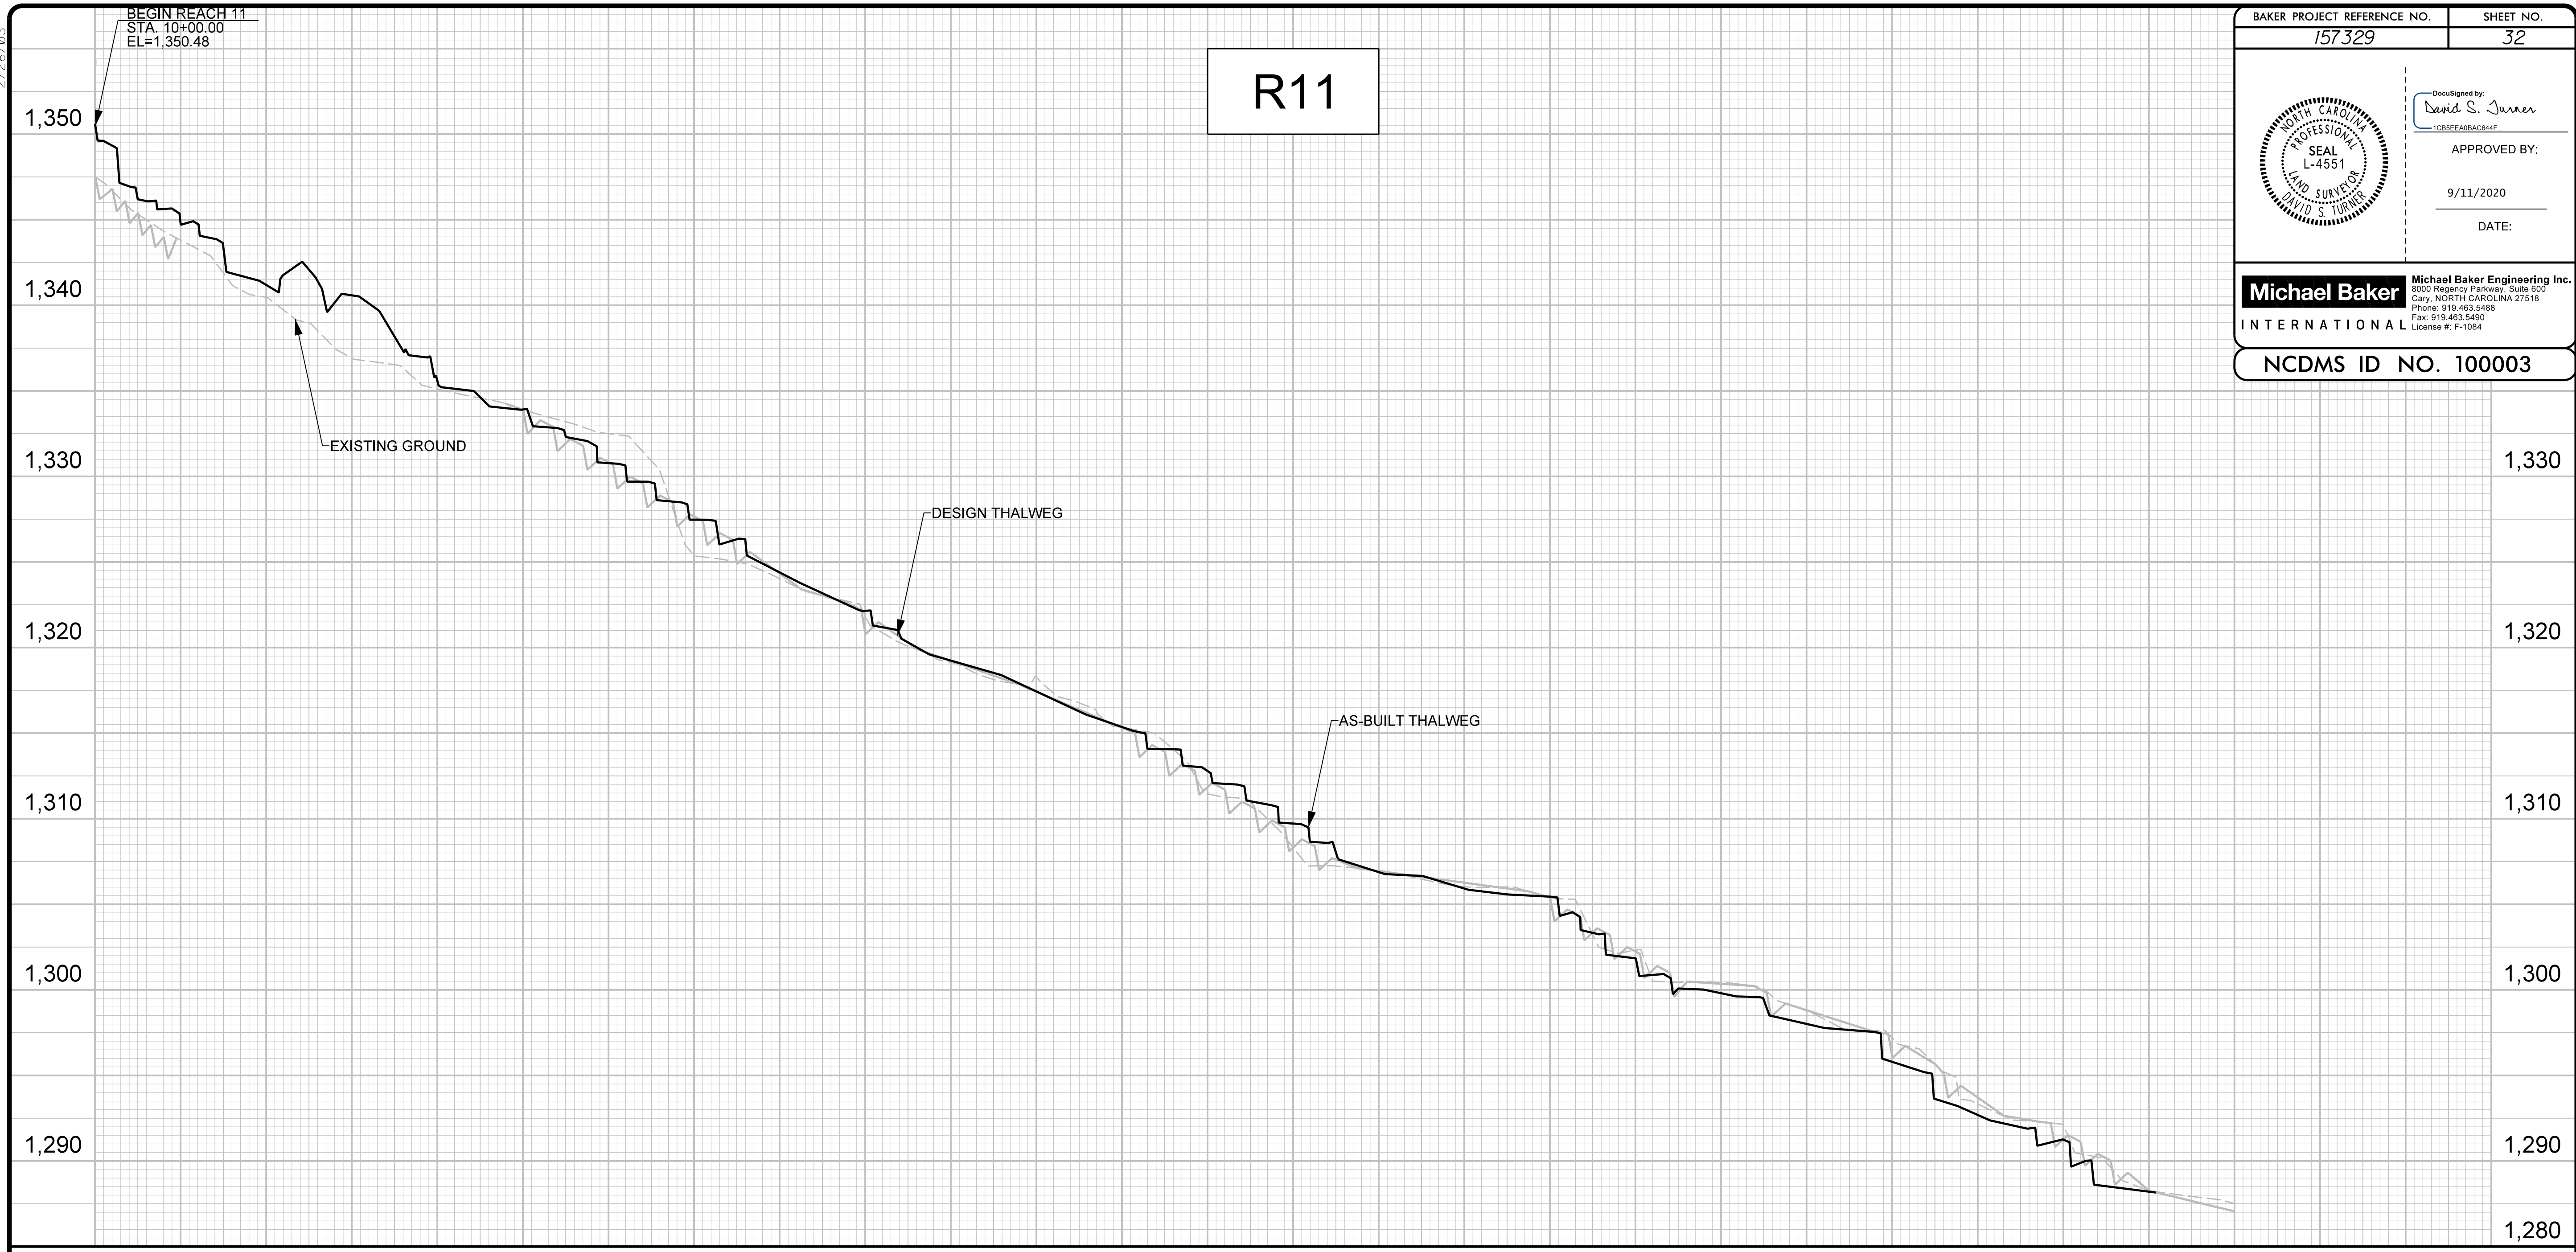


BAKER PROJECT REFERENCE NO. 157329	SHEET NO. 32
DocuSigned by: <i>David S. Turner</i> APPROVED BY: 9/11/2020 DATE:	
<b>Michael Baker International</b>	
Michael Baker Engineering Inc. 5000 Regency Parkway, Suite 500 Cary, NORTH CAROLINA 27518 Phone: 919.463.5488 Fax: 919.463.5490 License #: F-1084	
NCDMS ID NO. 100003	




R:\157329\20\_Russell11\_Gap\_Design\AS-BUILT\PLANS\157329\_AB-PFL\_32.dgn

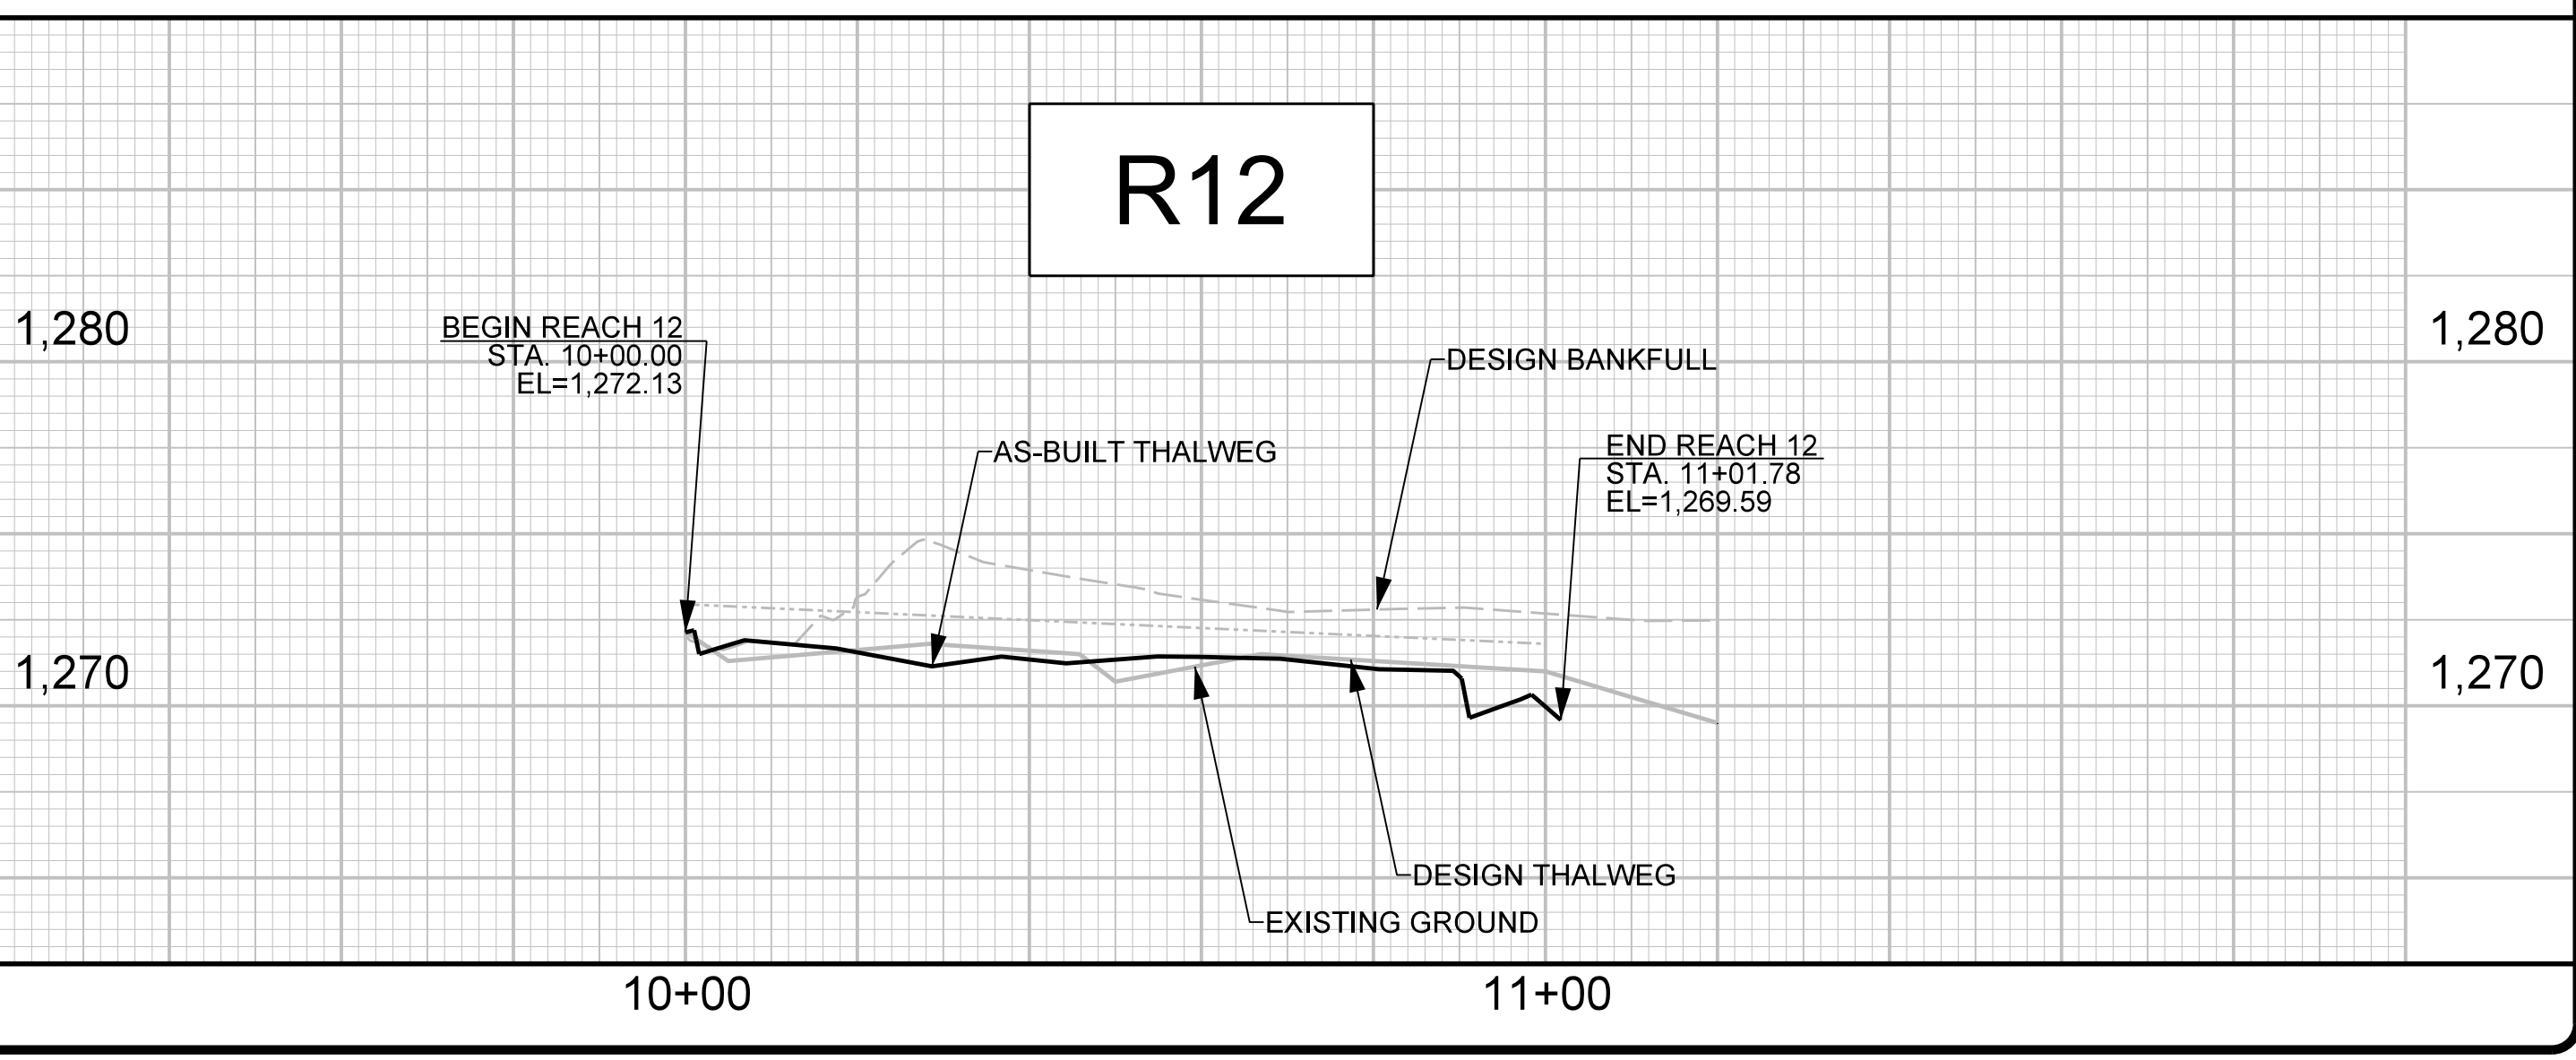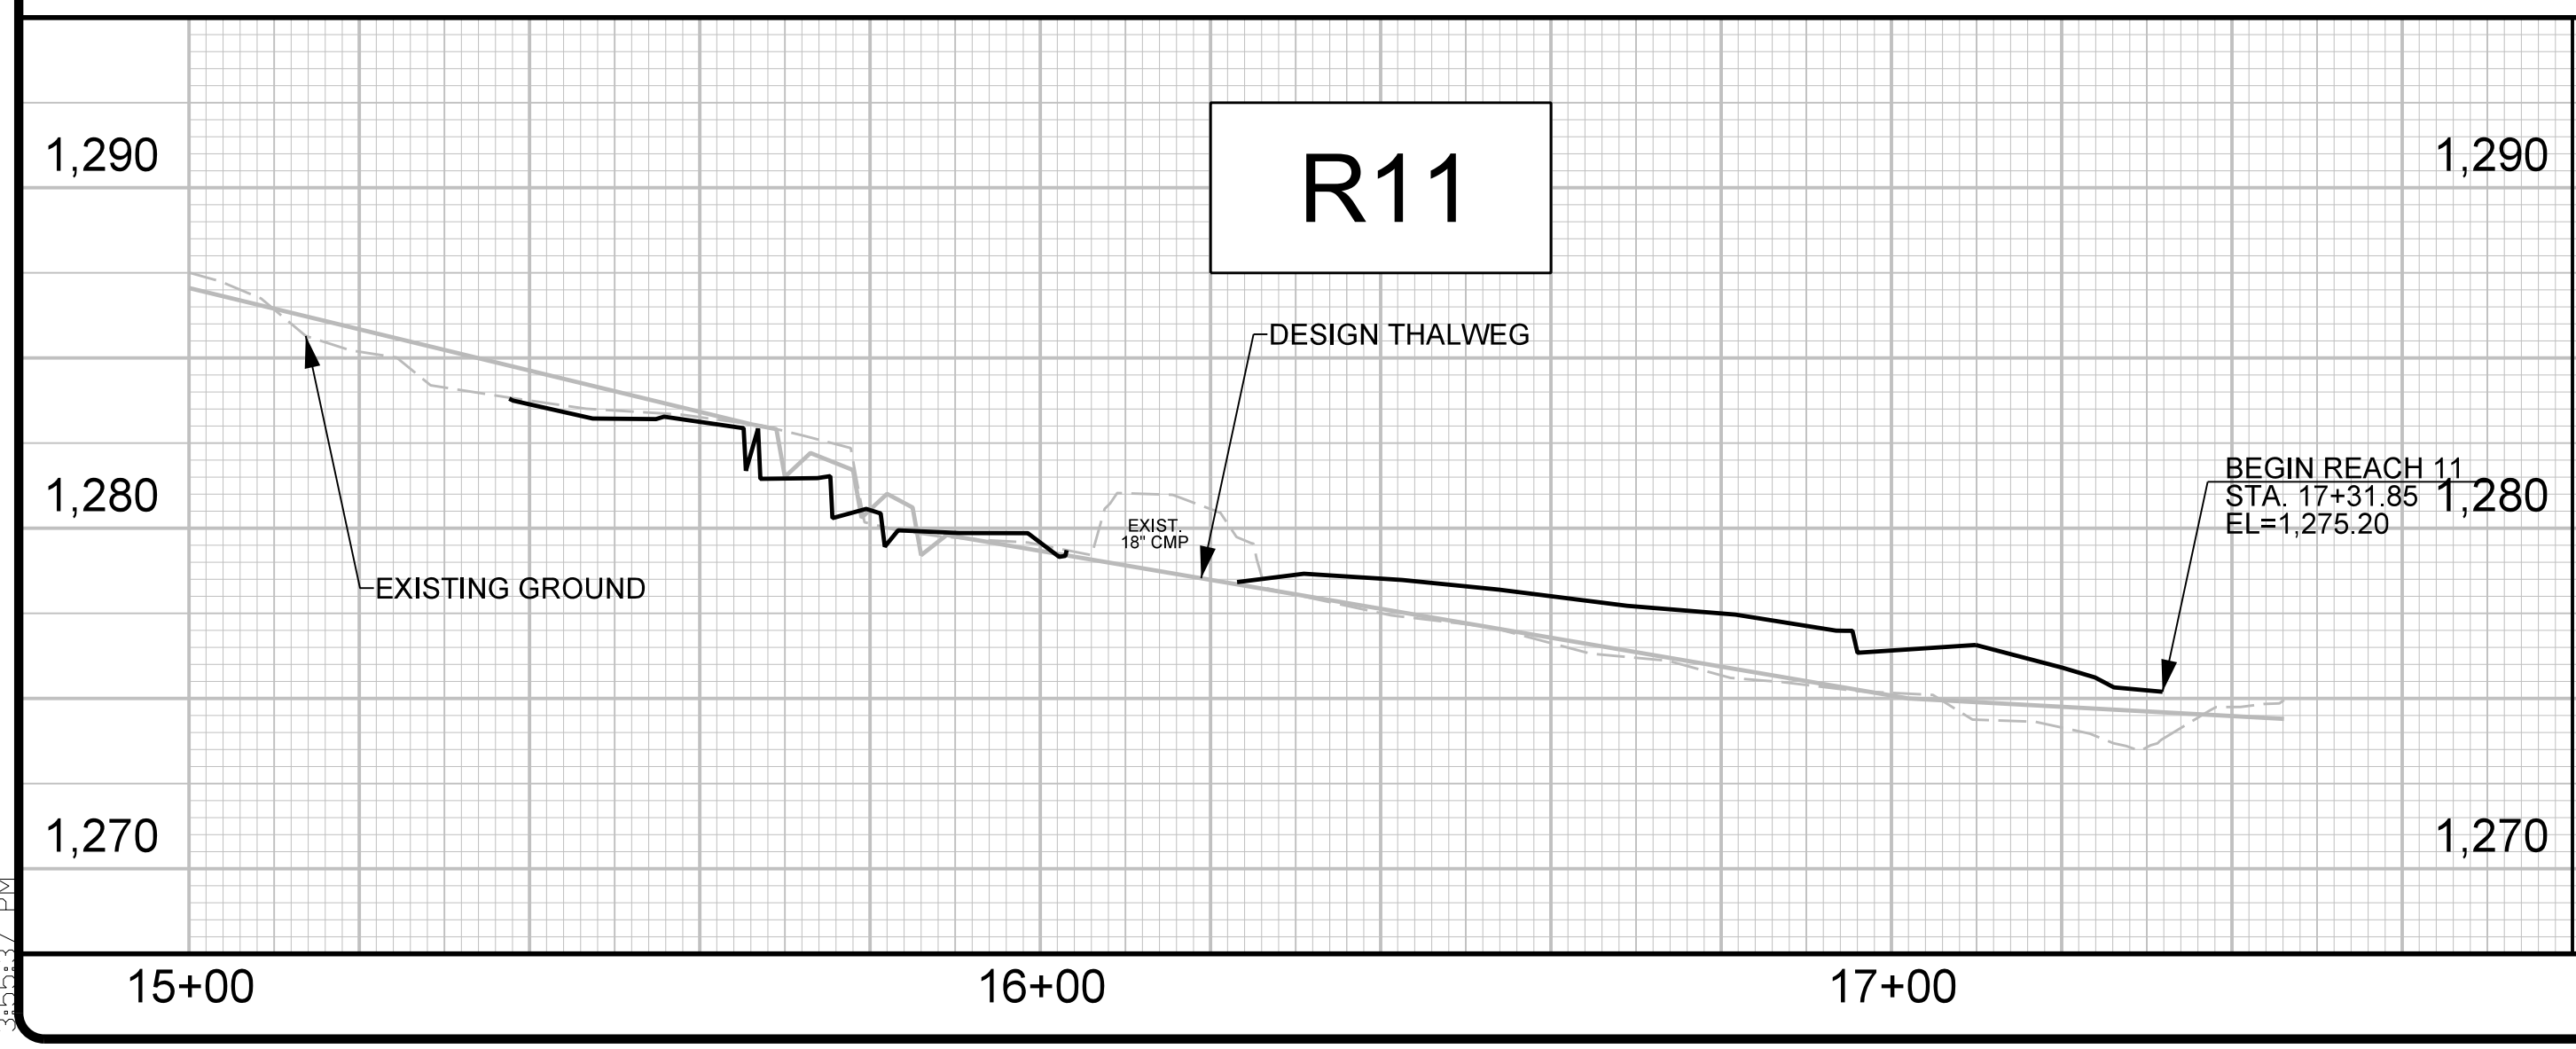



2/26/03


BAKER PROJECT REFERENCE NO. 157329	SHEET NO. 33
	DocuSigned by: David S. Turner 1C8EE4BAC6A4F
	APPROVED BY:  9/11/2020
	DATE:
<b>Michael Baker International</b> Michael Baker Engineering Inc. <small>3000 Regency Parkway, Suite 600      Cary, NORTH CAROLINA 27518      Phone: 919.463.5488      Fax: 919.463.5490      License #: F-1084</small>	
<b>NCDMS ID NO. 100003</b>	

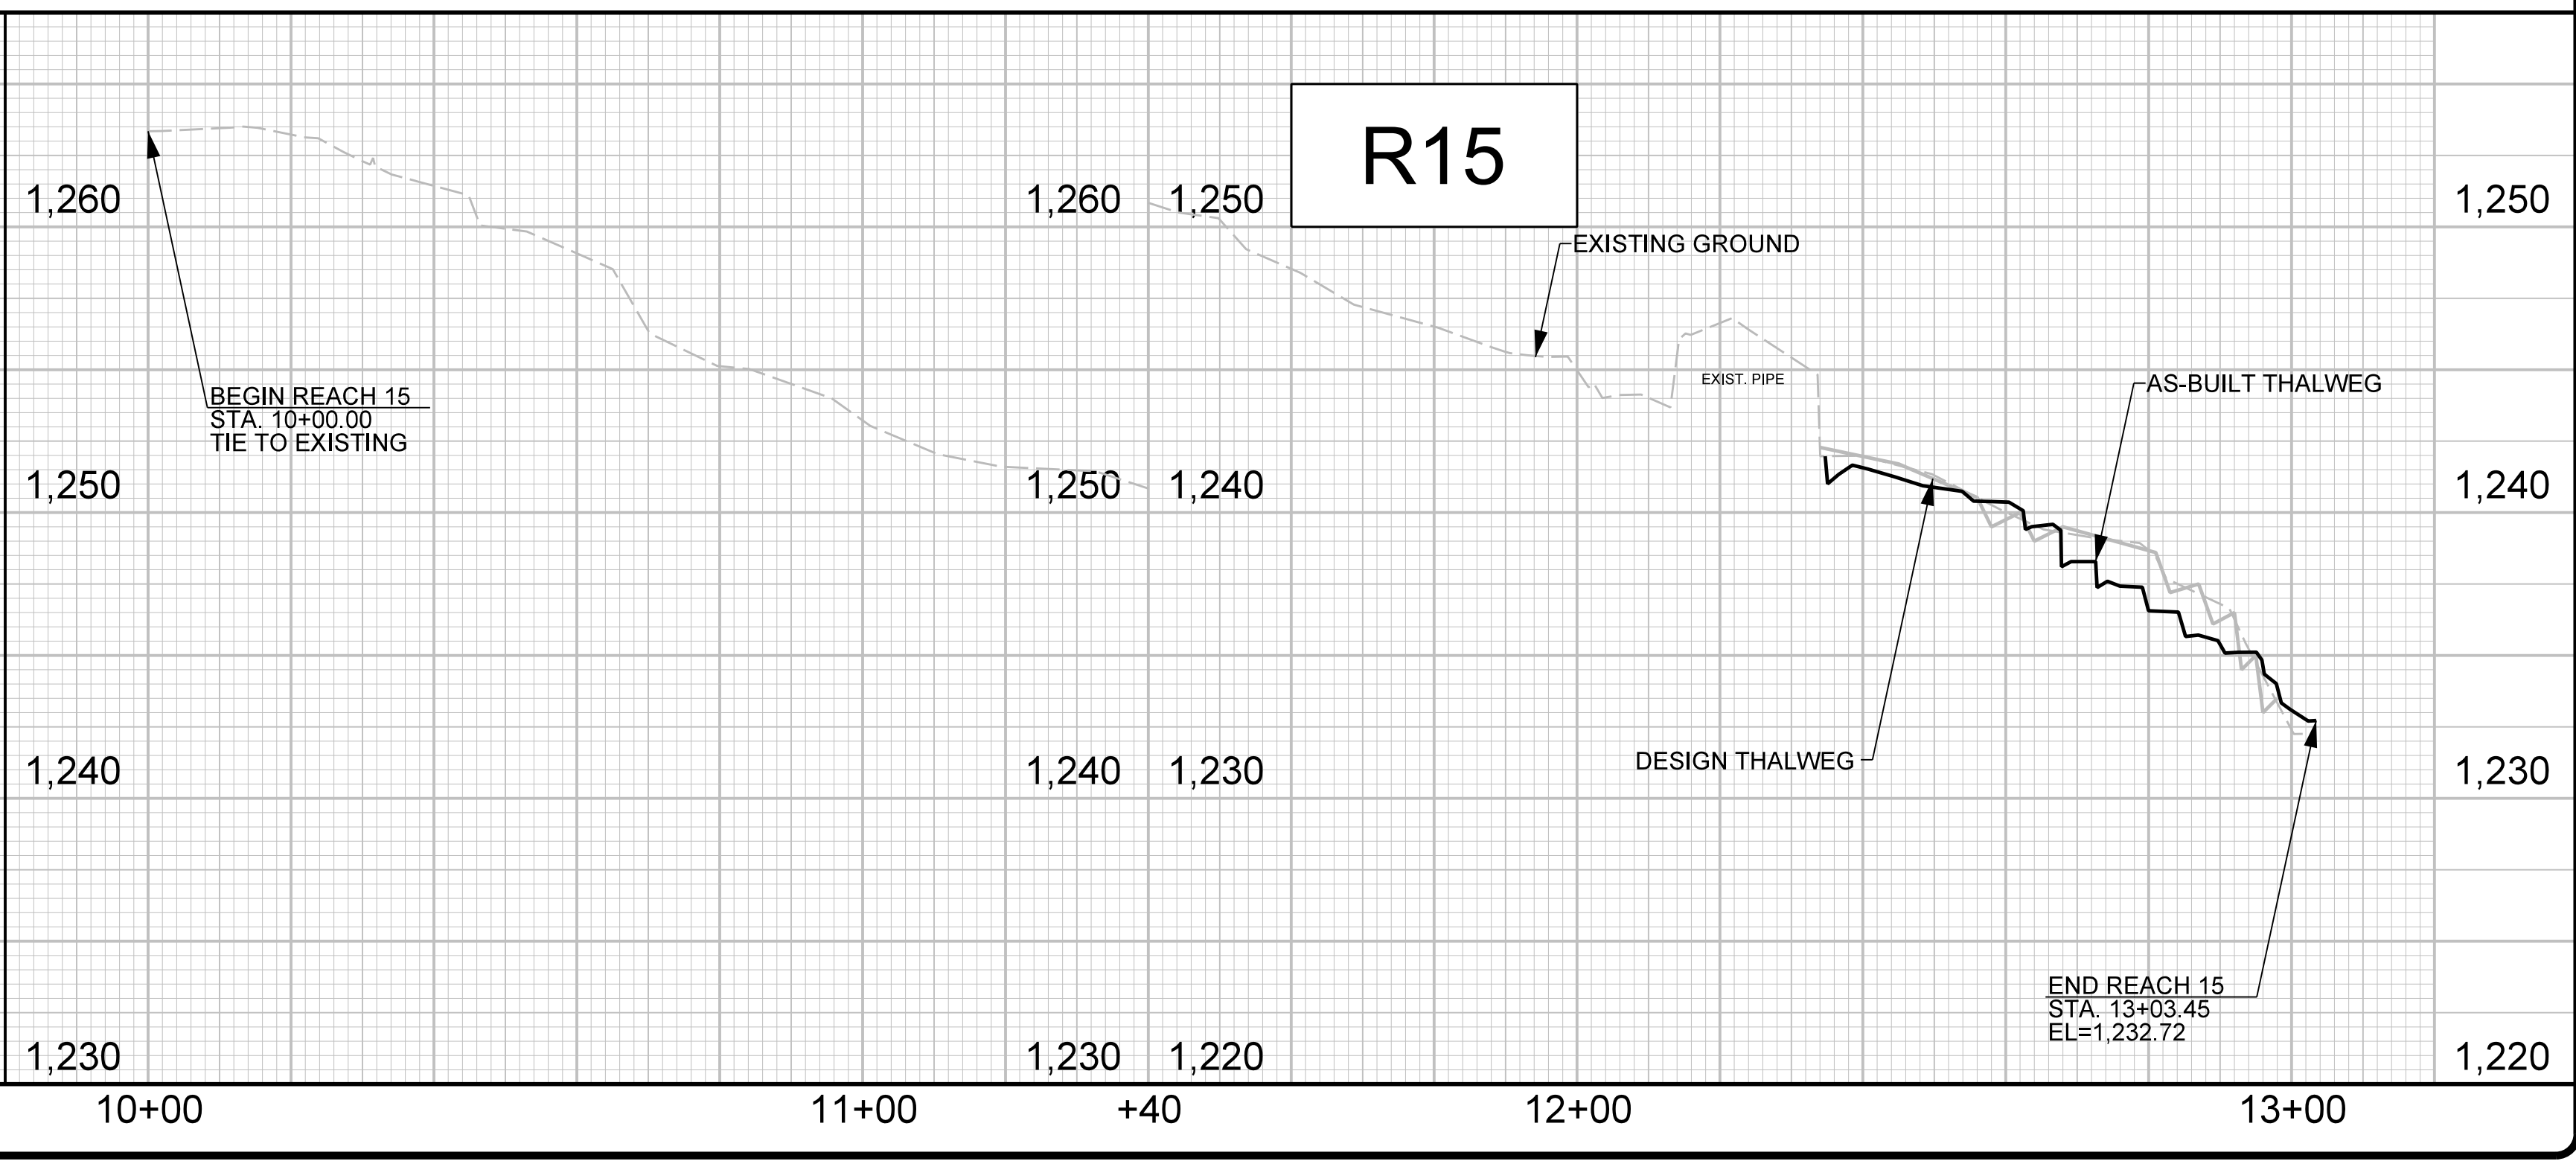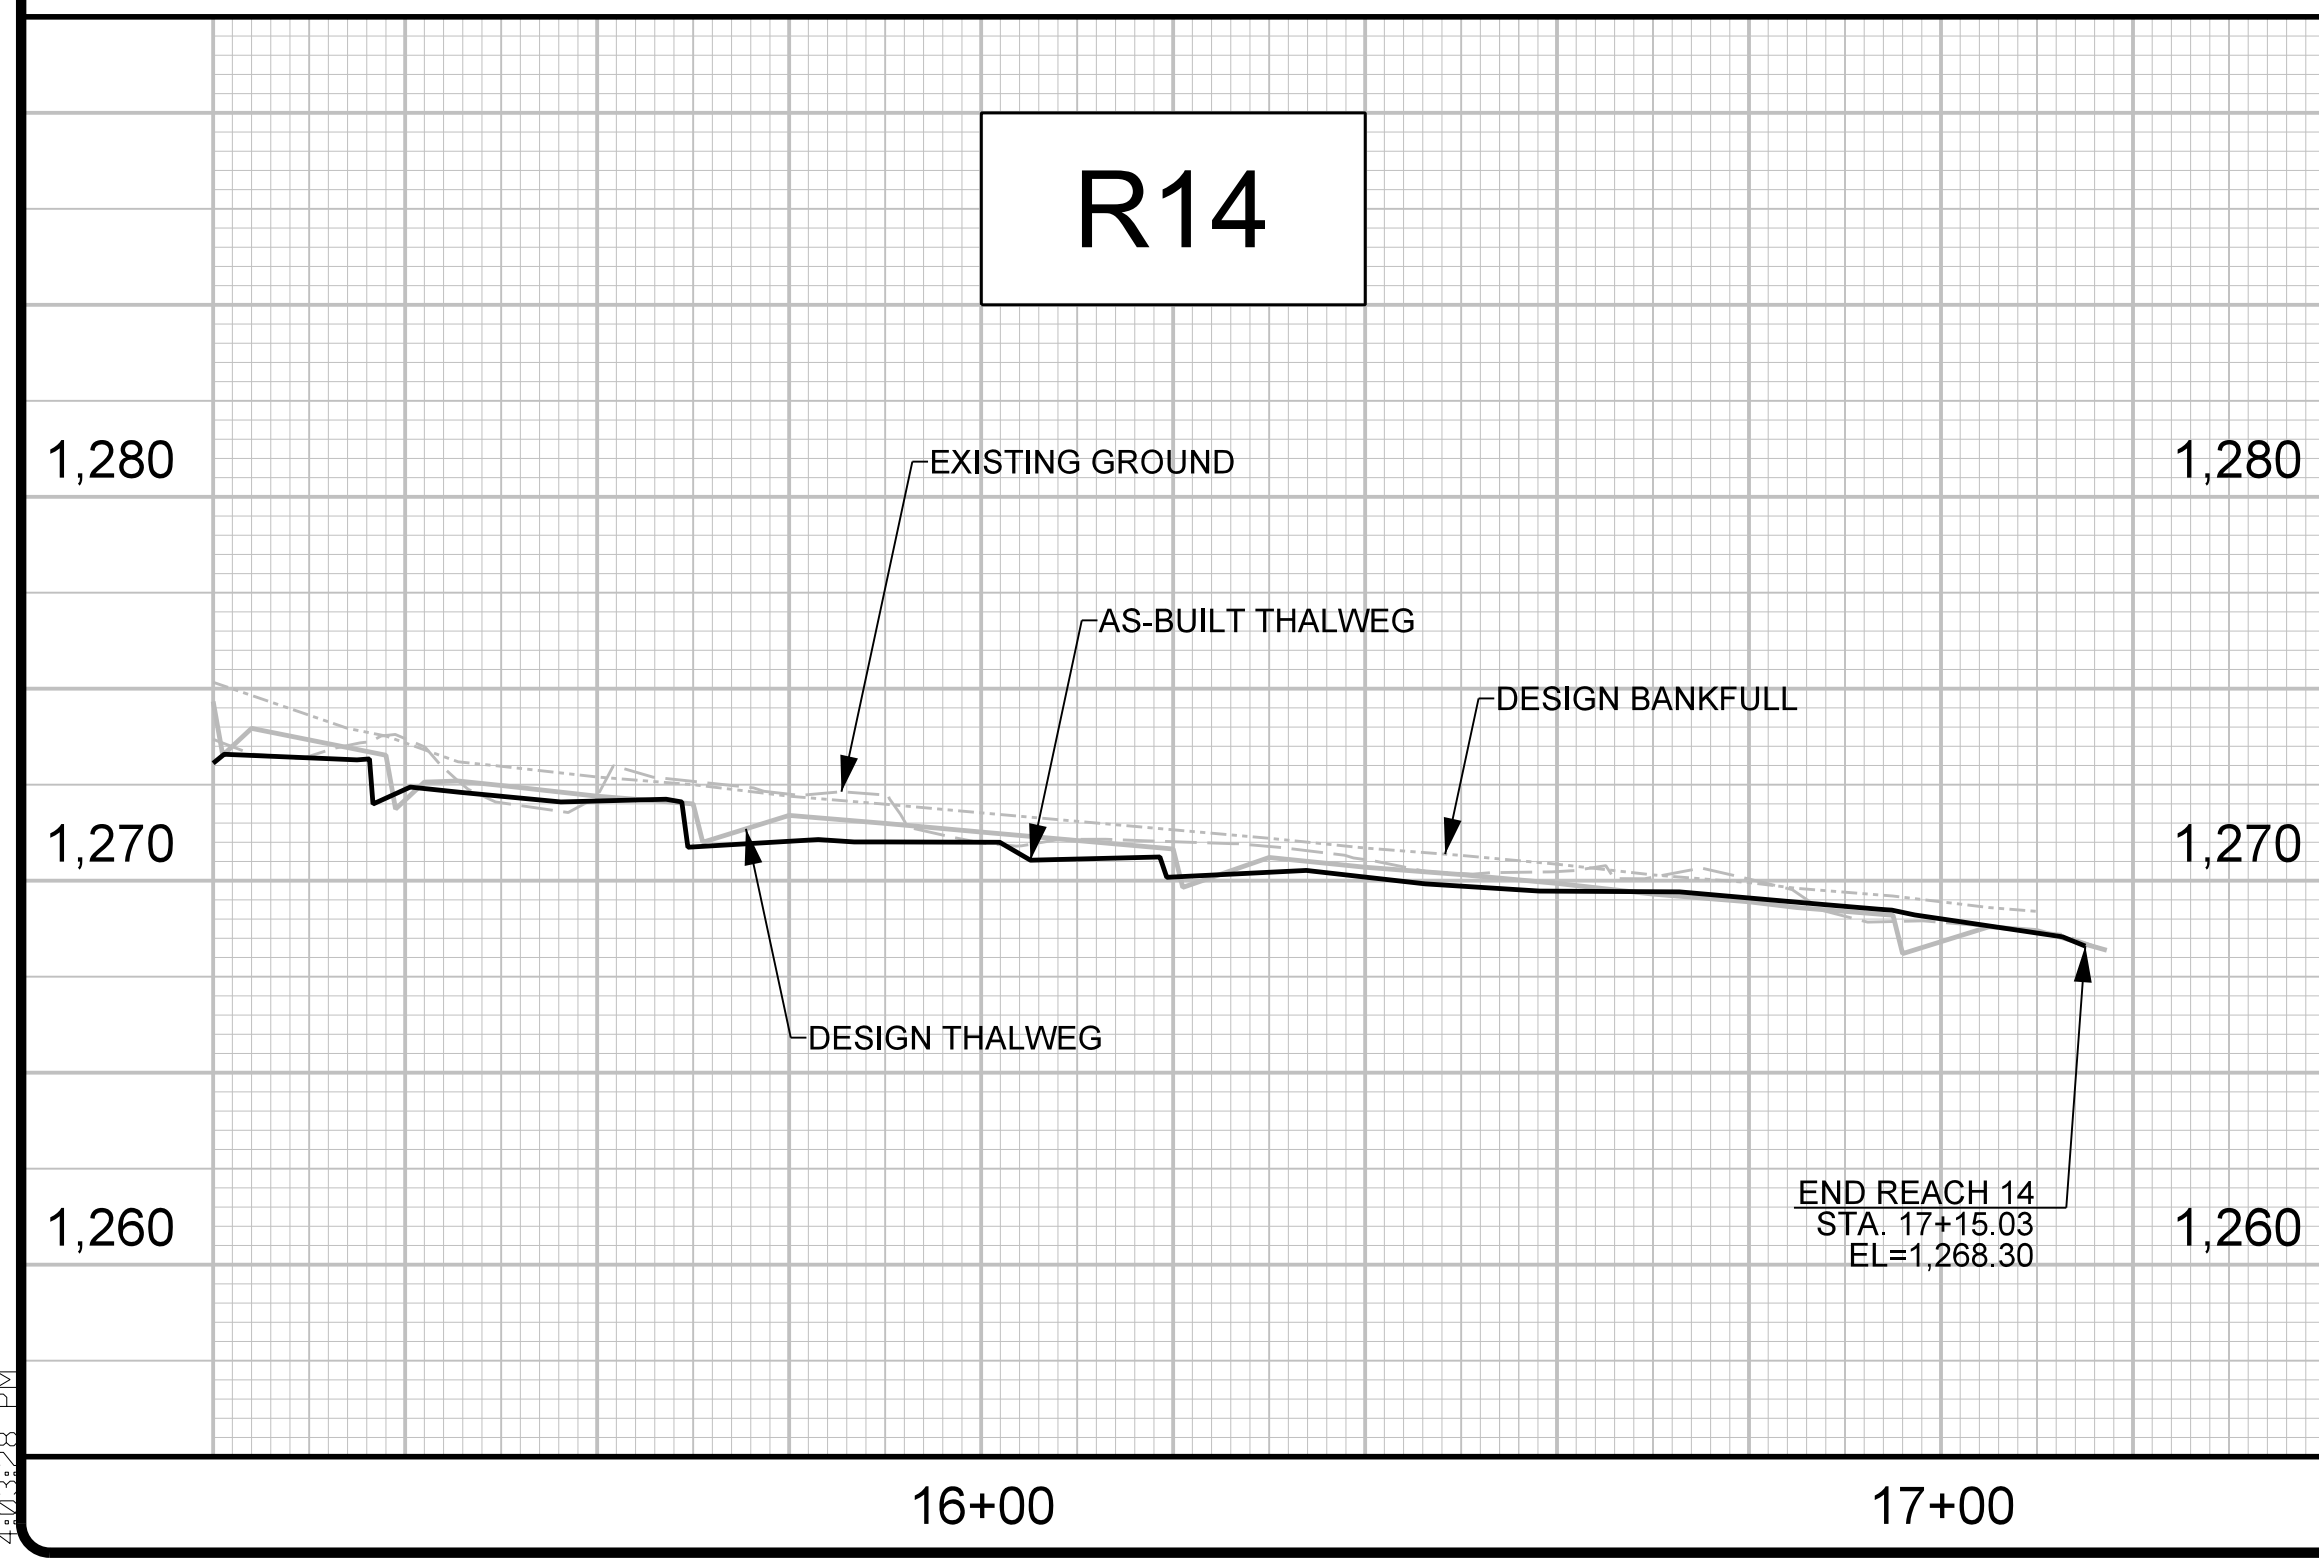
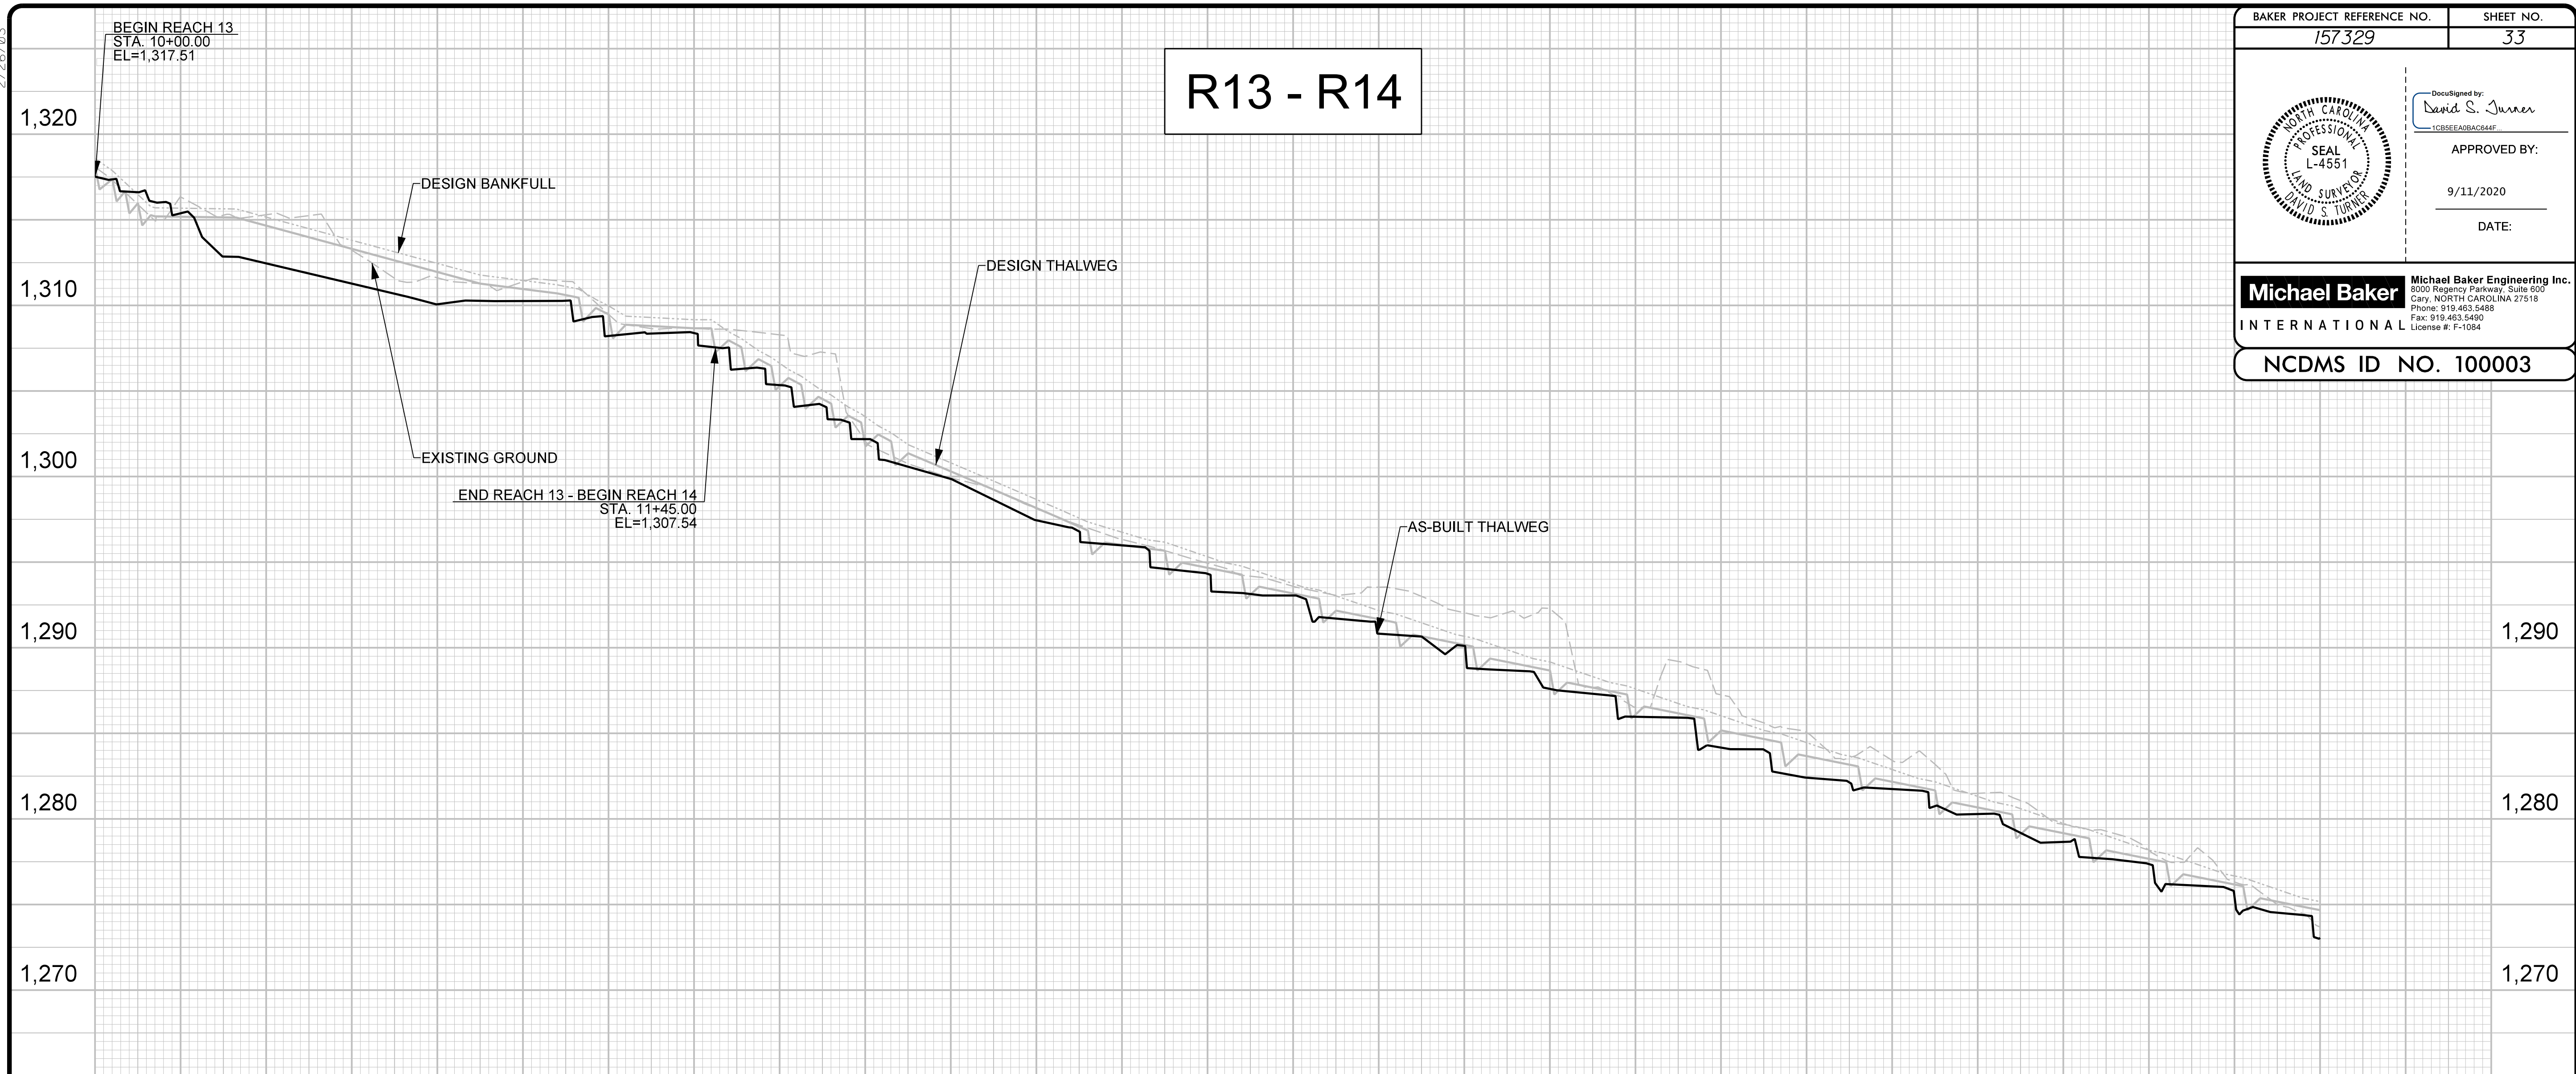


R:\3\2020\_Russell\_Gap\Design\AS-BUILT\PLANS\157329\_AB\_PEL\_33.dgn



2/26/20


BAKER PROJECT REFERENCE NO. 157329	SHEET NO. 34
	DocuSigned by: David S. Turner 1C85EA0BAC34F
	APPROVED BY:  9/11/2020
	DATE:
<b>Michael Baker International</b> Michael Baker Engineering Inc. <small>3000 Regency Parkway, Suite 500      Cary, NORTH CAROLINA 27518      Phone: 919.493.5488      Fax: 919.493.5489      License #: F-1084</small>	
<b>NCDMS ID NO. 100003</b>	


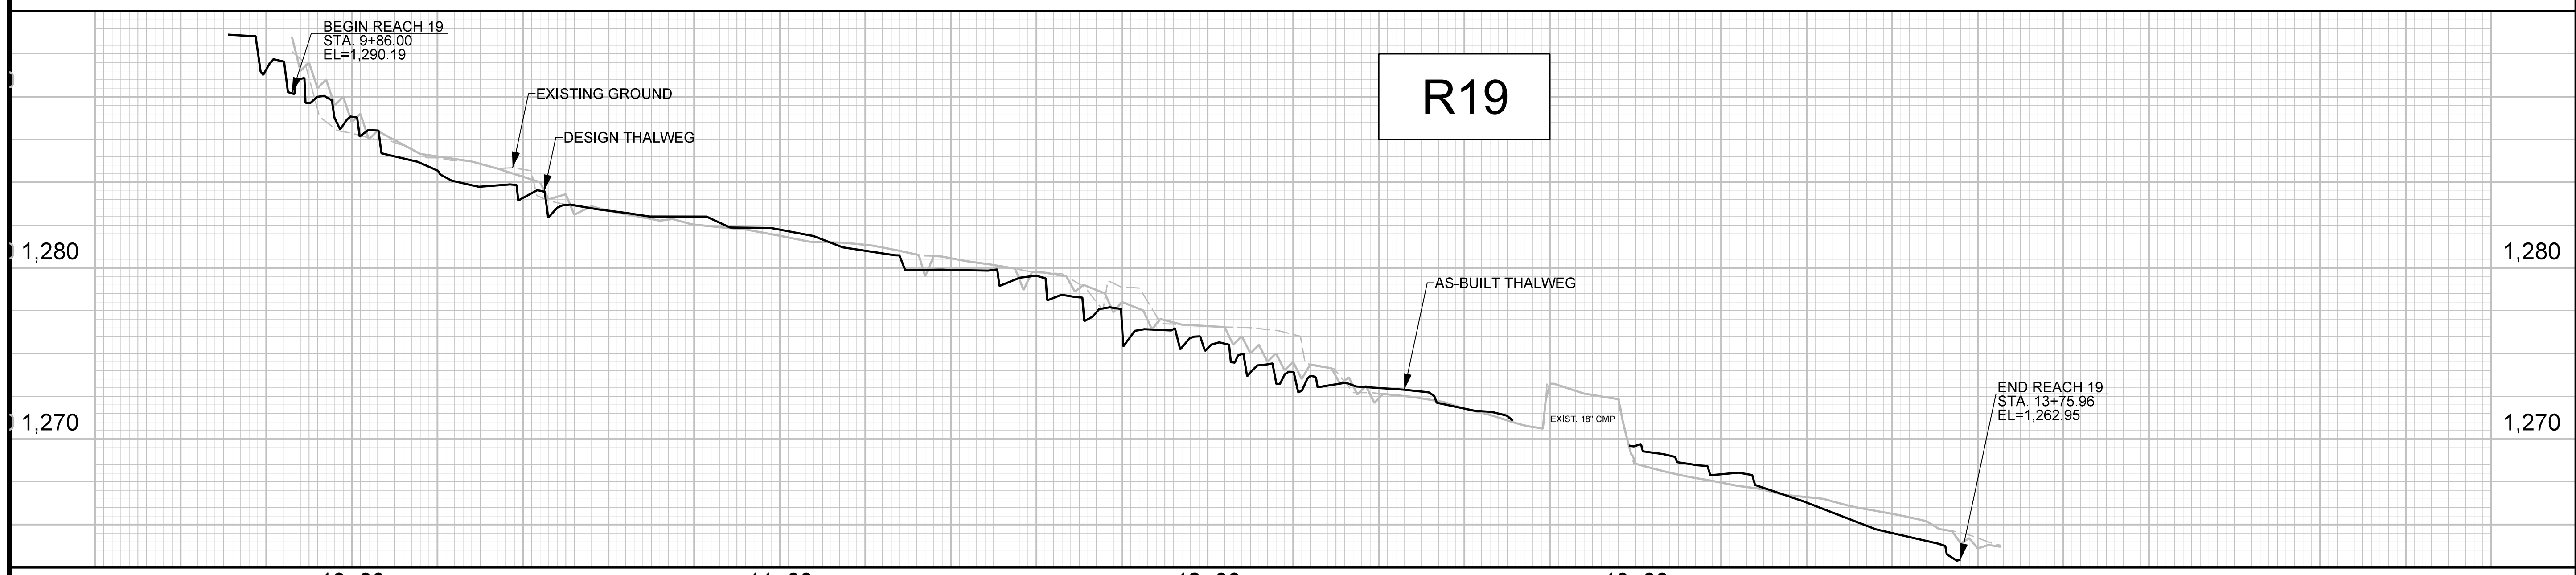
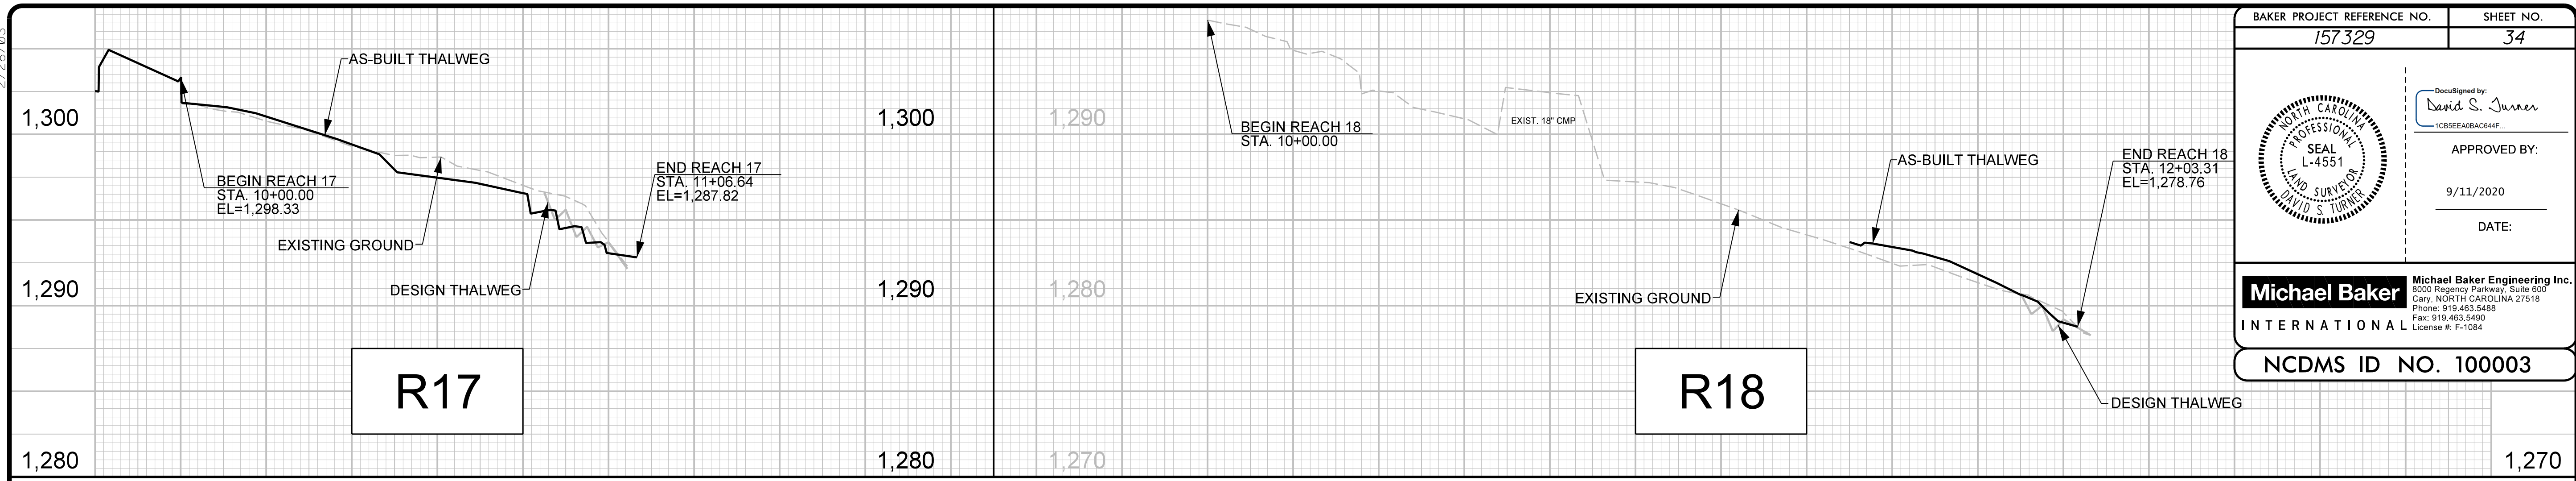


R:\2020\2020\_Russell\_Gap\Design\AS-BUILD\PLANS\157329\_AB-PFL\_34.dgn  
4/07/20 12:25 PM



2/26/03

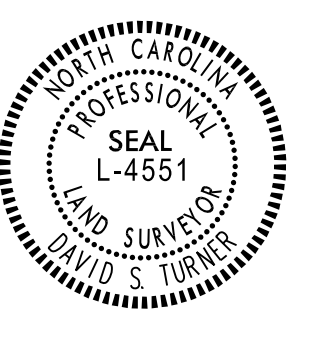
BAKER PROJECT REFERENCE NO. 157329	SHEET NO. 35
	DocuSigned by: <i>David S. Turner</i> 1C866EABAC641E
	APPROVED BY:  DATE: 9/11/2020
	Michael Baker Engineering Inc. 3000 Regency Parkway, Suite 500 Cary, NORTH CAROLINA 27518 Phone: 919.463.5488 Fax: 919.463.5490 License #: F-1084
INTERNATIONAL	
NCDMS ID NO. 100003	

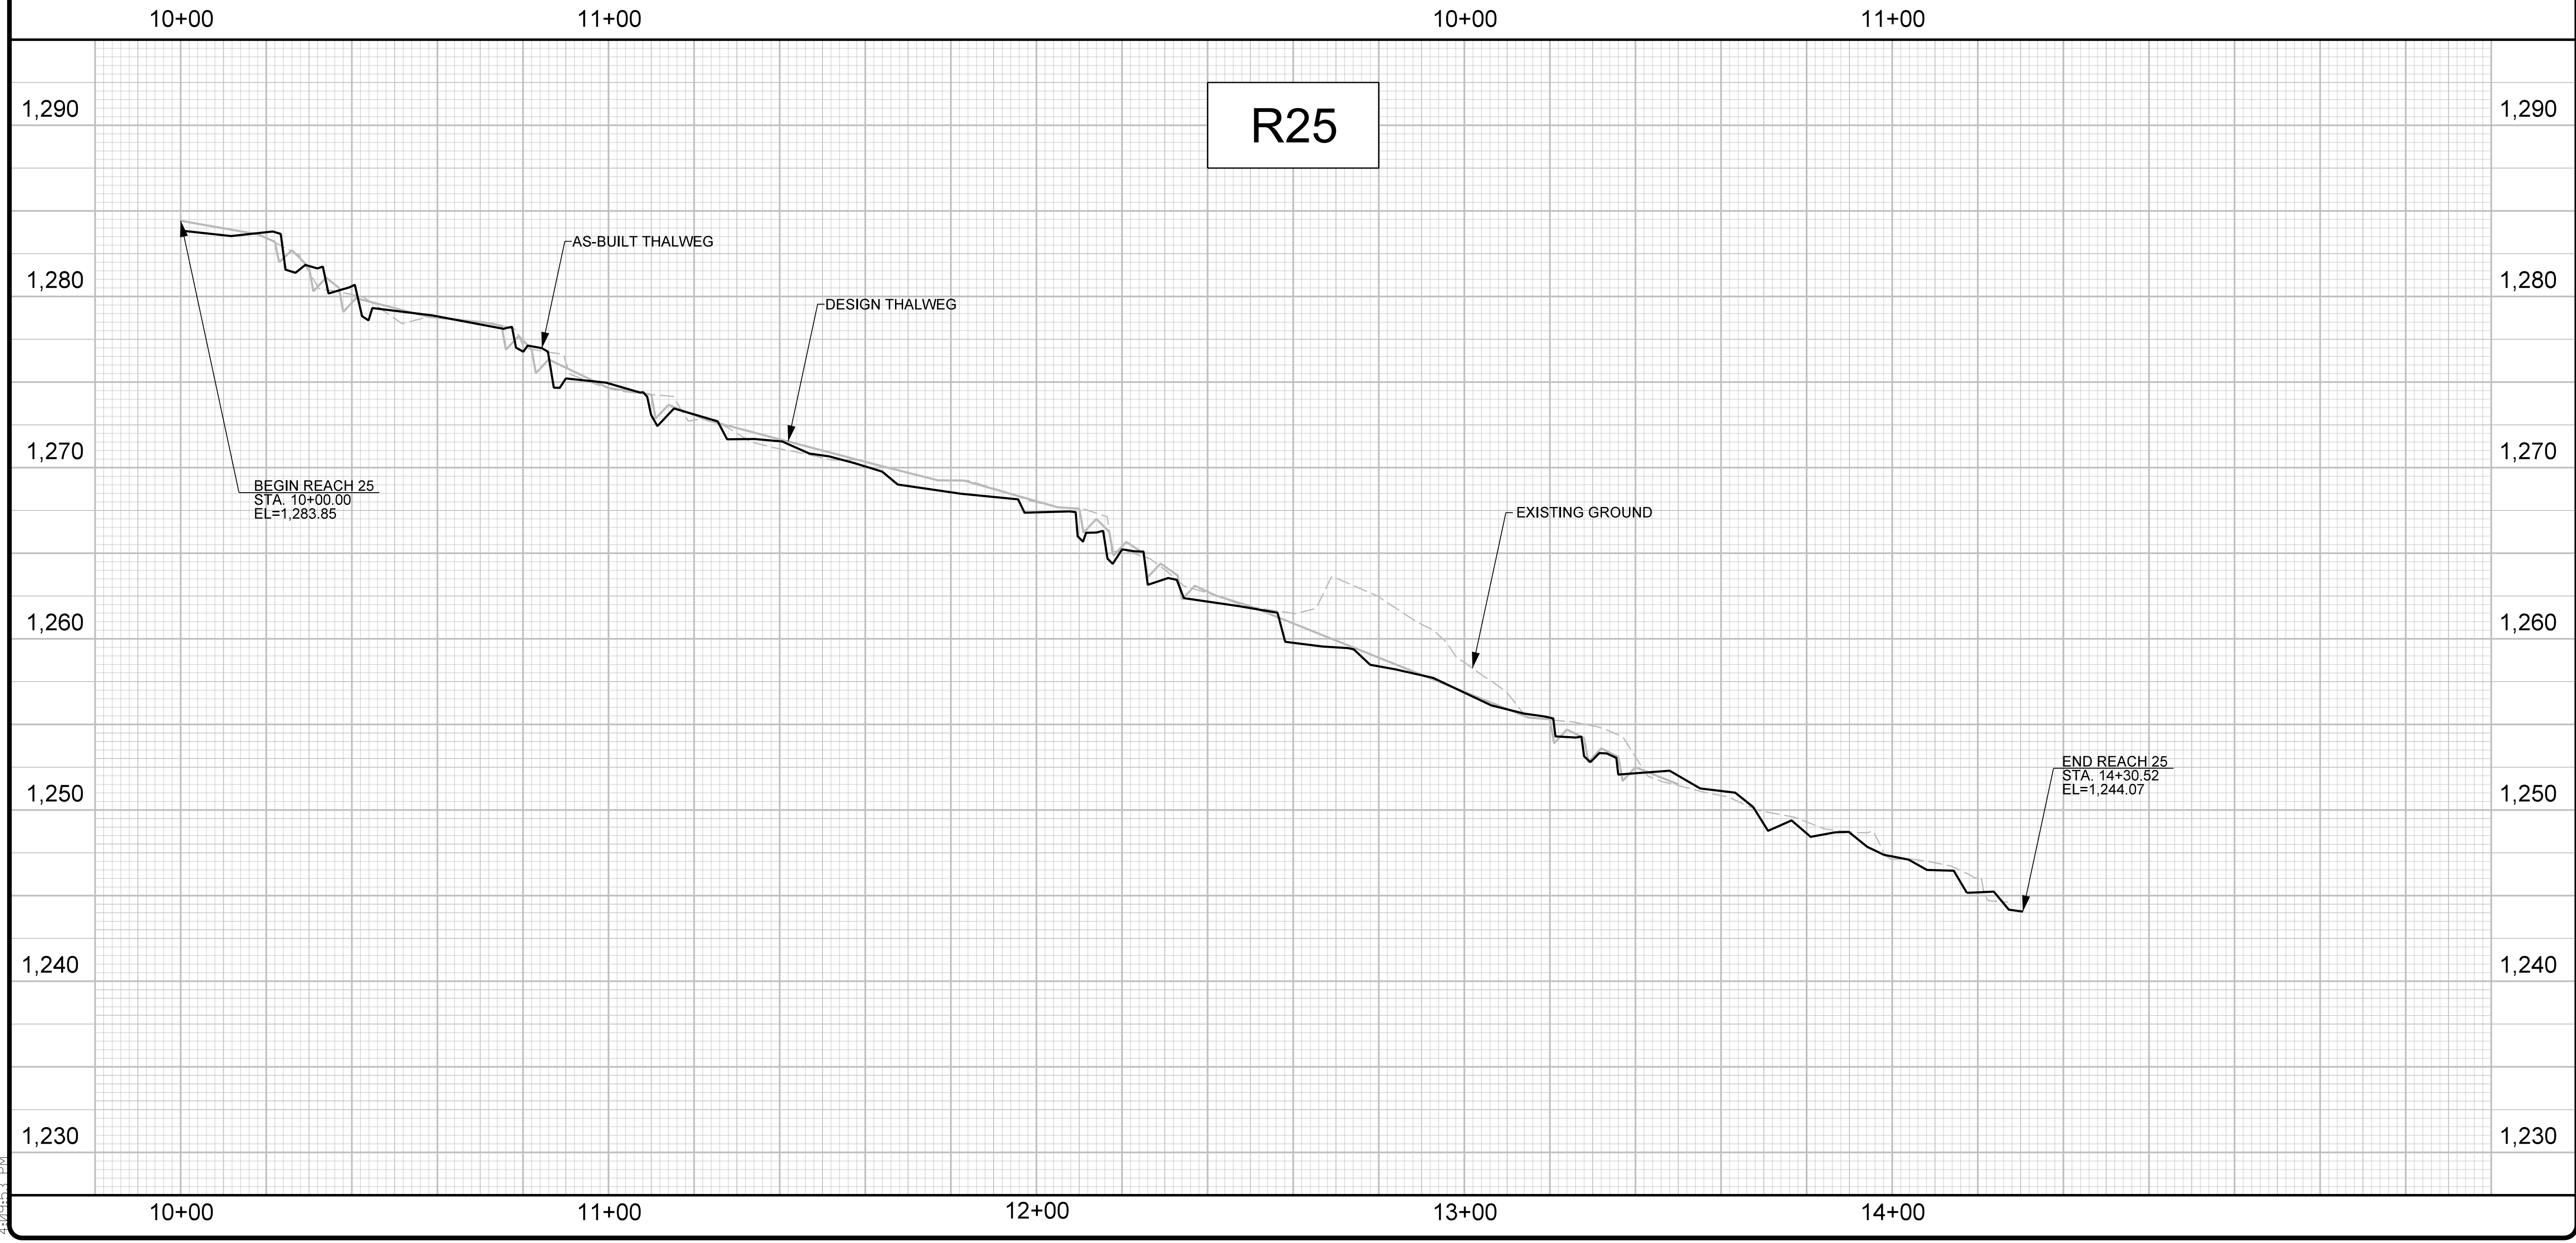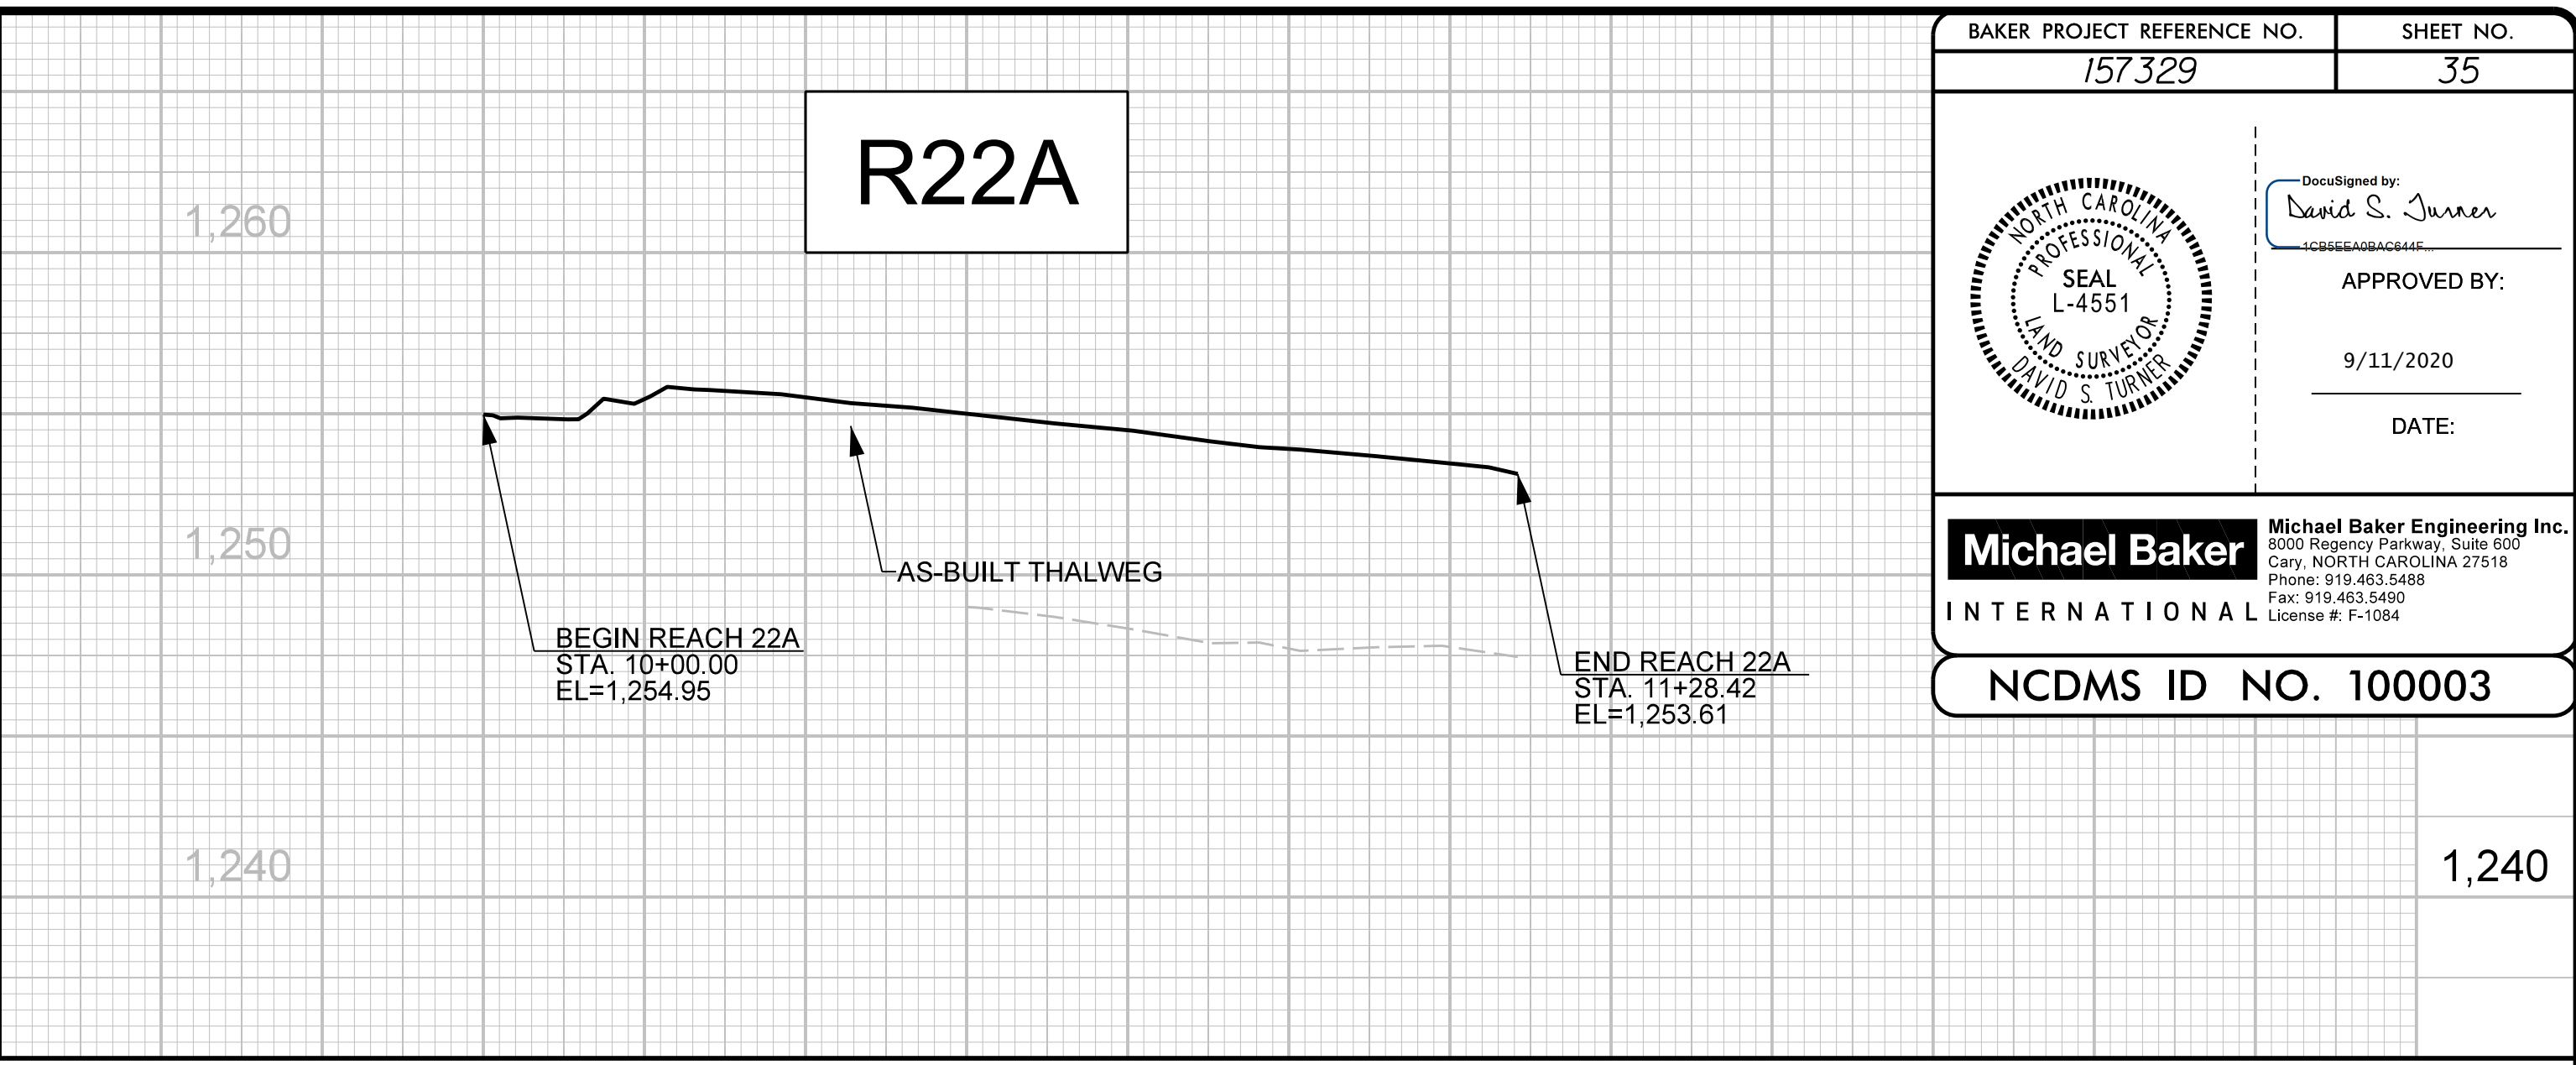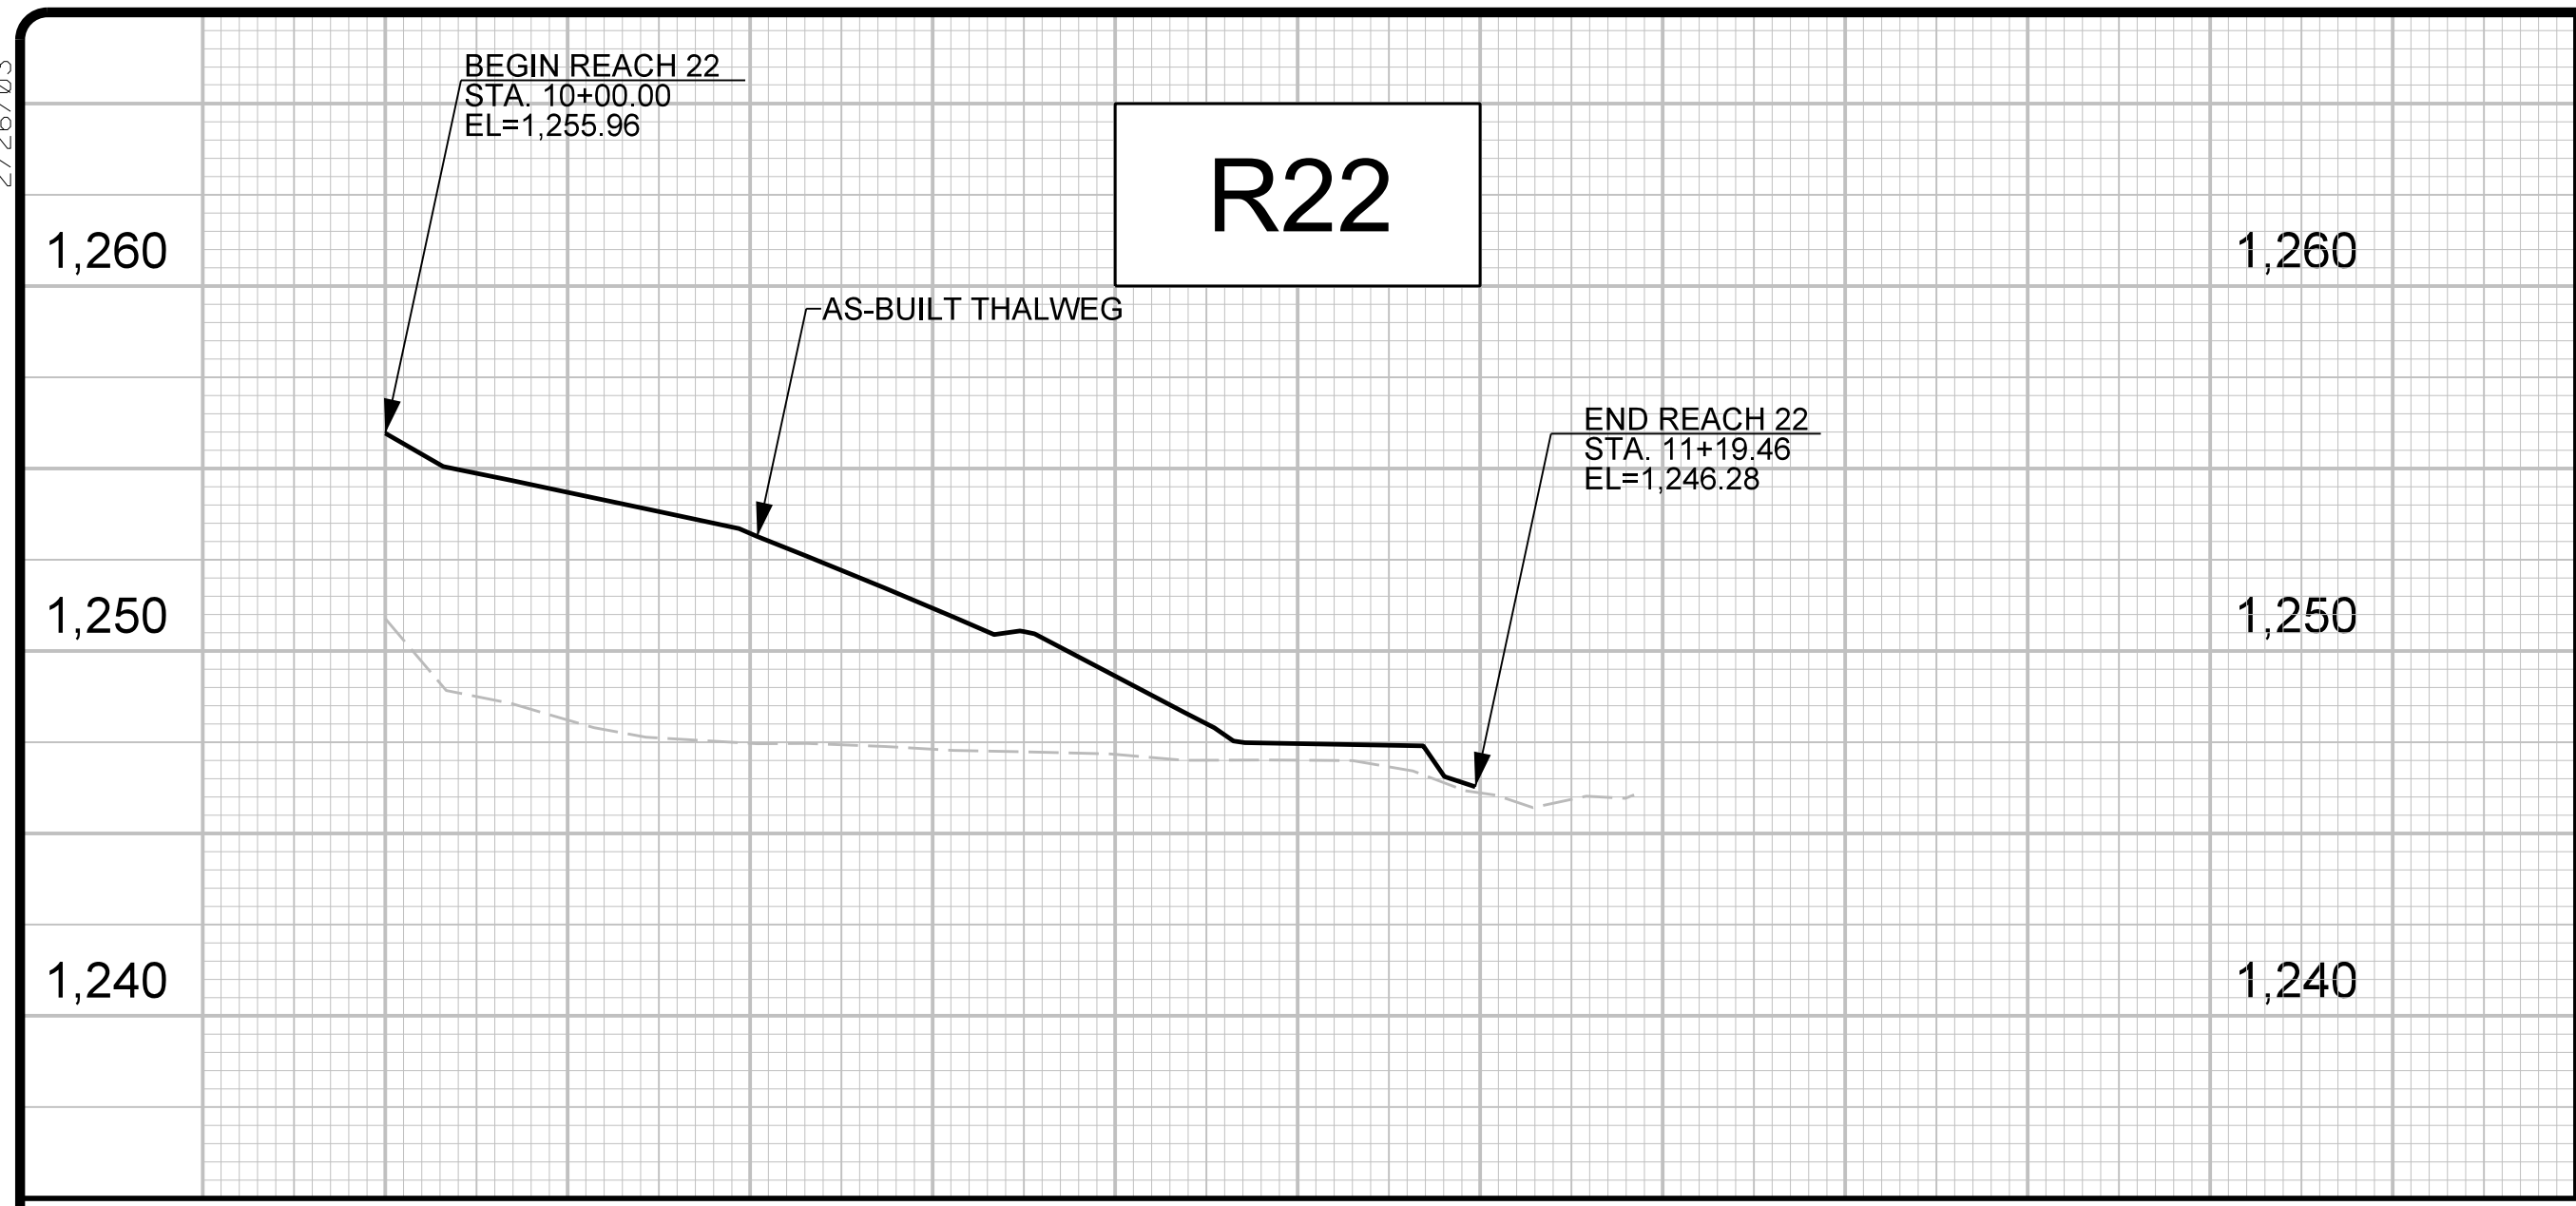

R:\2020\157329\Russell\_Gap\Design\AS-BUILT\PLANS\157329\_AB-PFL\_35.dgn  
4/20/20 10:53 AM



2/26/20

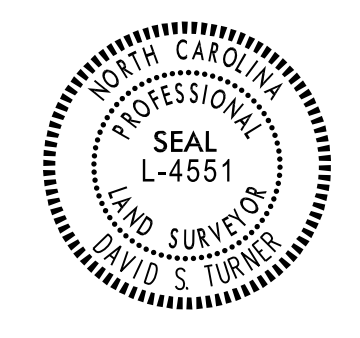


DocuSigned by:  
*David S. Turner*  
1C05EACBAC6E6F


APPROVED BY:  
  
DATE:  
*9/11/2020*

**Michael Baker** International  
Michael Baker Engineering Inc.  
3000 Regency Parkway, Suite 500  
Cary, NORTH CAROLINA 27518  
Phone: 919.493.5488  
Fax: 919.493.5490  
License #: F-1084

**NCDMS ID NO. 100003**

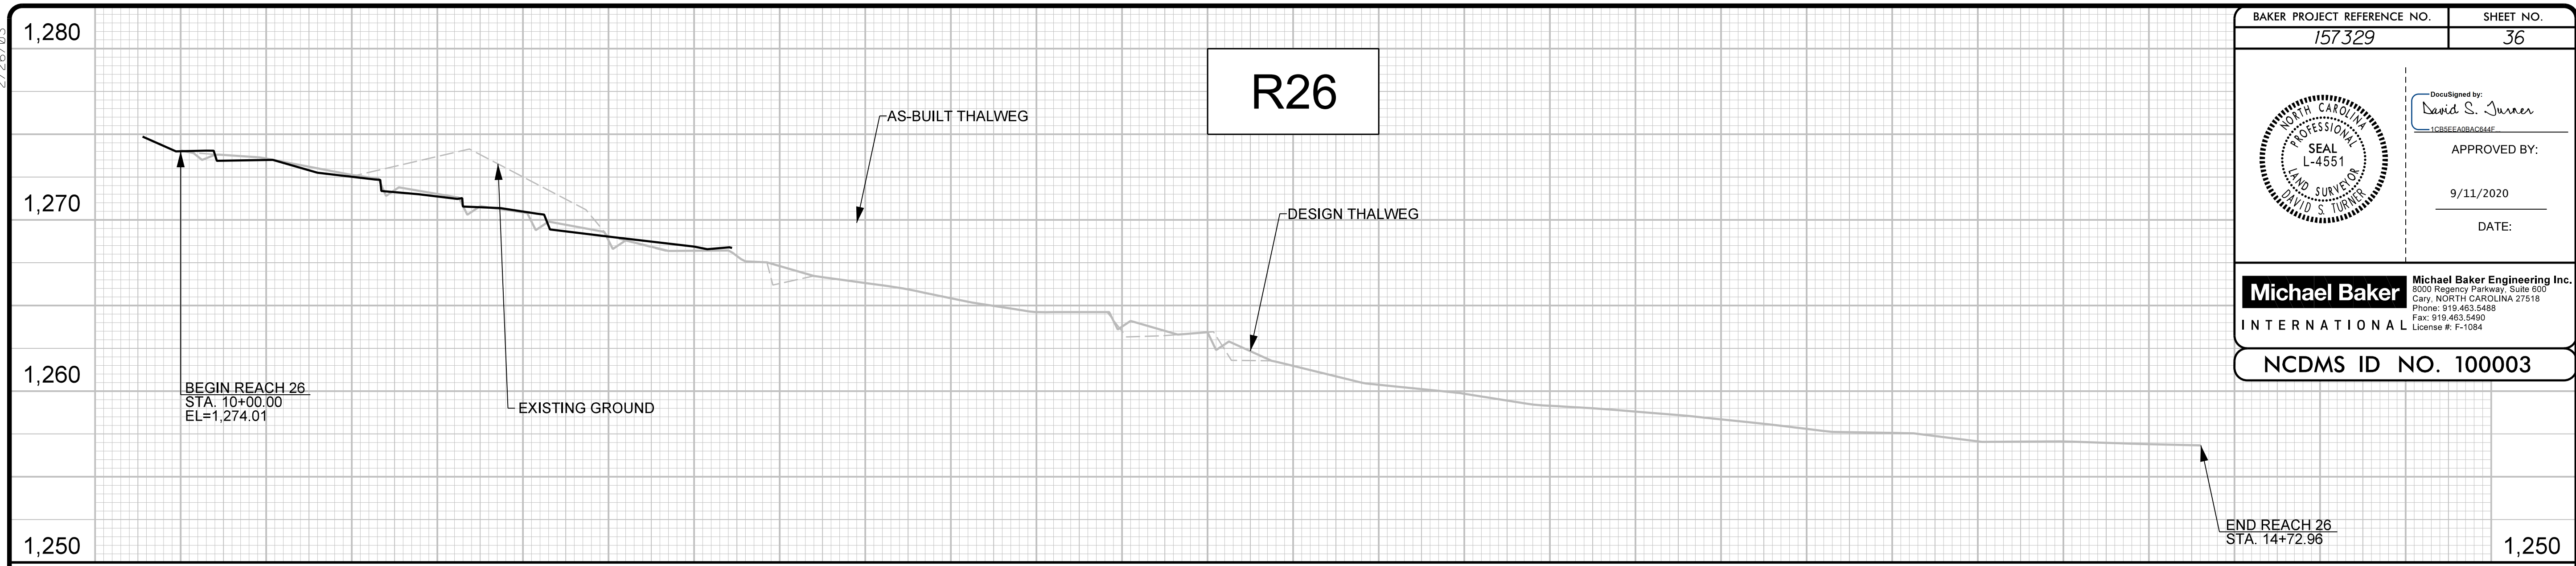

10+00    11+00    12+00    13+00    14+00

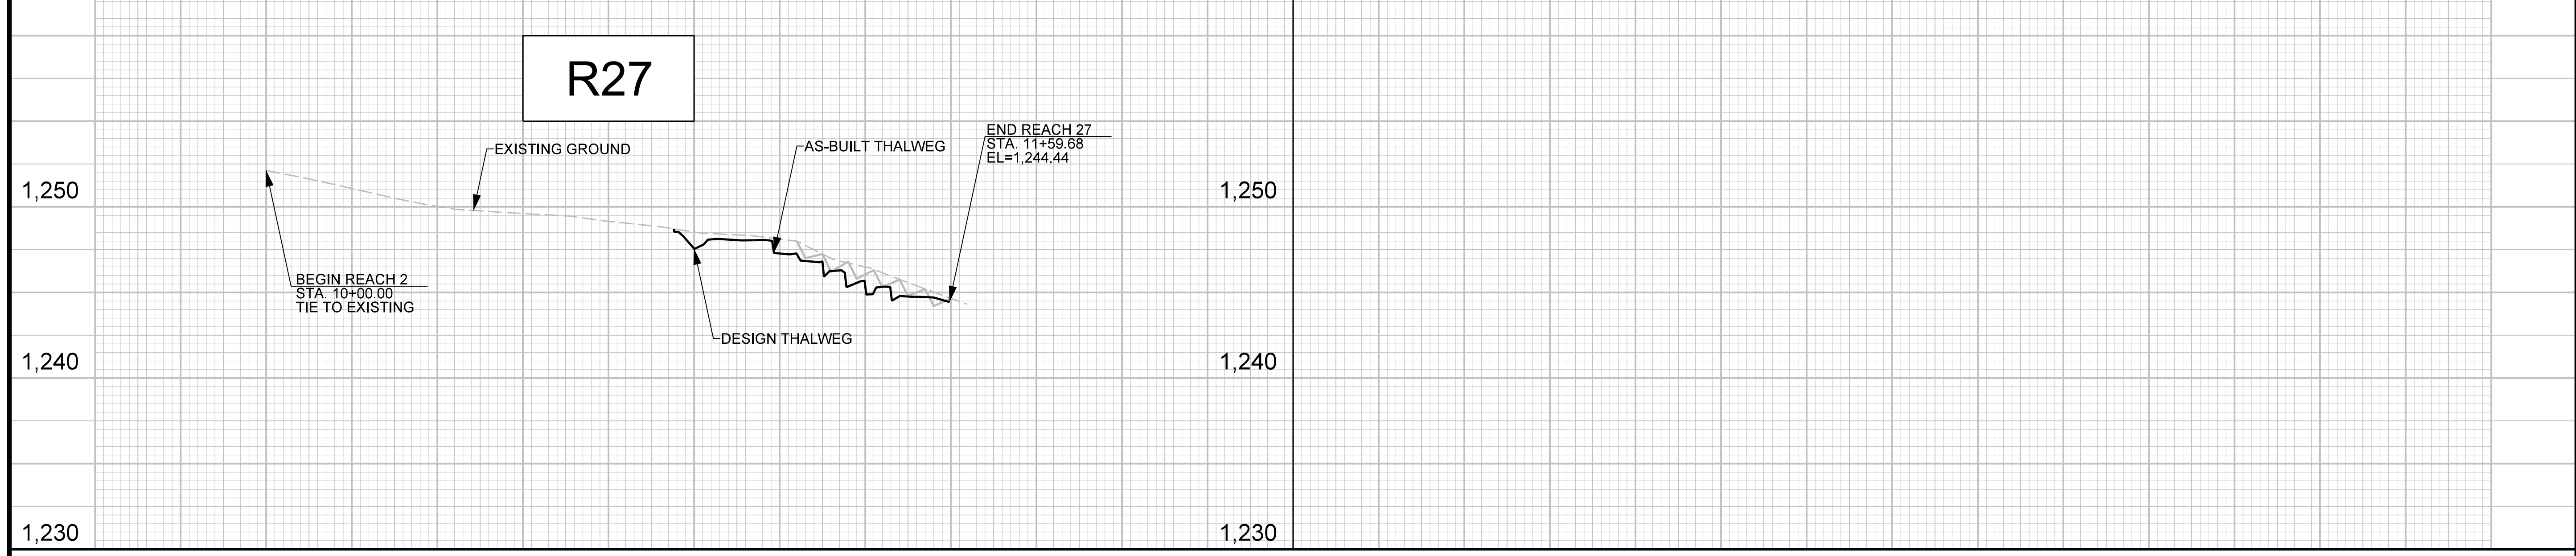

10+00    11+00

R:\3\2020\Russell\_Gap\Design\AS-BUILT\PLANS\157329\_AB-PFL\_36.dgn  
9/11/2020 4:12:12 PM