

- LEGEND**
- CE — CONSERVATION EASEMENT
 - AS—BUILT CONTOURS
 - ~~~~~ TREE LINE
 - GROUND WATER GAUGE LOCATION
 - VEGETATION PLOT AREA
 - ① PHOTO LOCATION

LIMITS OF WETLANDS AS MAPPED BY ECOLOGICAL CONSULTANTS 12-18-1997 INCLUDED WITH CONTRACT DOCUMENTS.

REFERENCE SITE GROUND WATER GAUGE ADJ. GROUND EL.=261.81

ZONE 1 - PERMANENT PONDING POTENTIAL FILL AREA TO ELEV. 261.5

Zone 3 - Island Monitor Hydrology

GROUND WATER GAUGE "B" ADJ. GROUND EL.=262.93

GROUND WATER GAUGE "A" ADJ. GROUND EL.=260.69


GROUND WATER GAUGE "C" ADJ. GROUND EL.=261.84

POTENTIAL BORROW AREA CUT FROM EL 262.0 - 265.0

SITE BENCHMARK 60d NAIL IN 8" RIVER BIRCH 33' NORTH OF BRIDGE TOP OF CREEK BANK ELEVATION = 264.81

AS-BUILTS SURVEYED BY:
COASTAL ENGINEERING & SURVEYING
 P.O. BOX 1129
 KITTY HAWK, NC 27949
 252-261-4151

WETLAND DESIGN & MONITORING
GROUND WATER GAUGES INSTALLED BY:
THE CATENA GROUP
 410-B MILLSTONE DRIVE
 HILLSBOROUGH, NC 27278
 919-732-1300

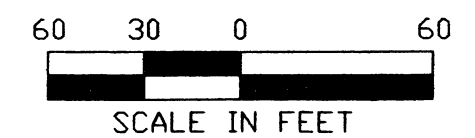


Becky Ward Consulting
 Water Management Engineering
 1512 Eglantyne Ct. (919) 870-0526
 Raleigh, NC 27613 FAX (919) 870-5359



SANDY CREEK AS-BUILTS
 STATE OF NC WETLANDS RESTORATION PROGRAM

DATE: 08-22-03
 REVISIONS:
 PROJECT NAME: SANDY CREEK
 DWG NAME: ob-wetland
 SCALE: 1"=60'
 SHEET NO.

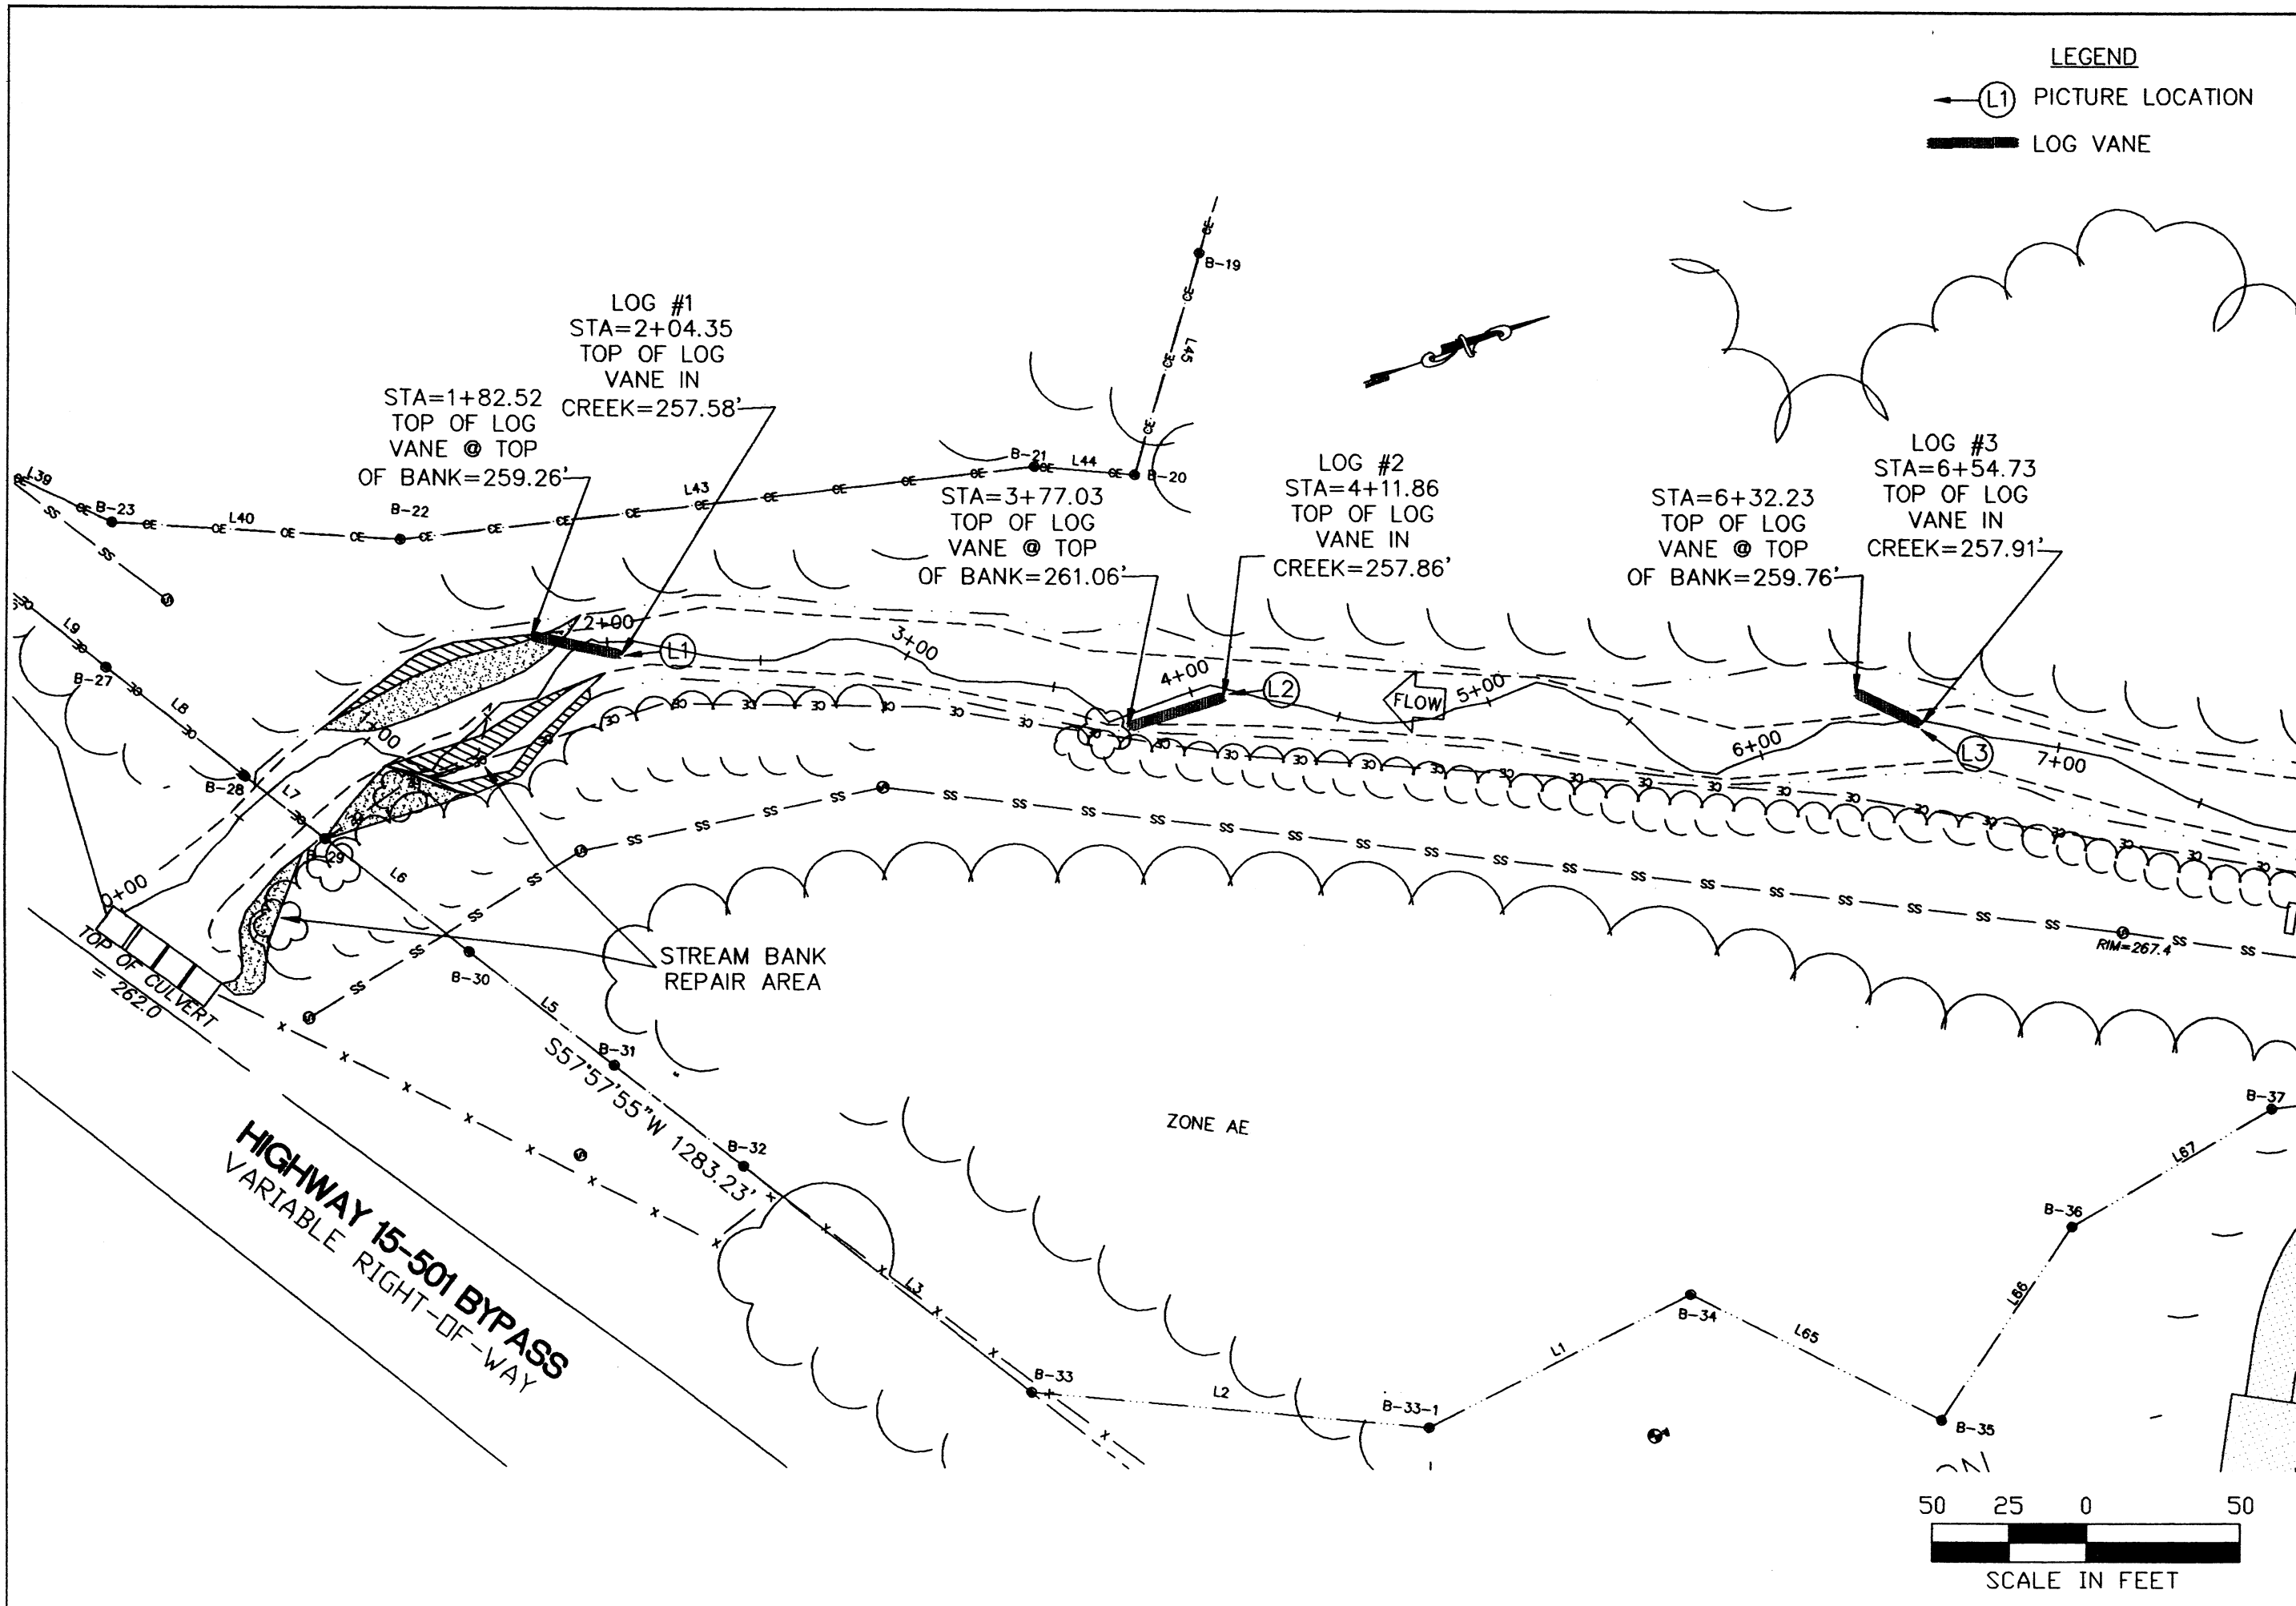


LEGEND
 ← (L1) PICTURE LOCATION
 ——— LOG VANE


Becky Ward Consulting
 Water Management Engineering
 1512 EGLANTYNE CT. (919) 870-0526
 Raleigh, NC 27613 FAX (919) 870-5359




SANDY CREEK AS-BUILT
 STATE OF NC WETLANDS RESTORATION PROGRAM

DATE: 08-22-03
 REVISIONS:
 PROJECT NAME: SANDY CREEK
 DWG NAME: ob-creek1
 SCALE: 1"=50'
 SHEET NO.

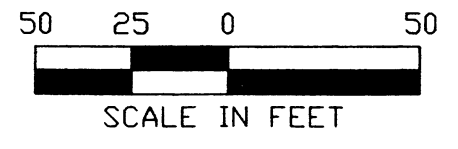

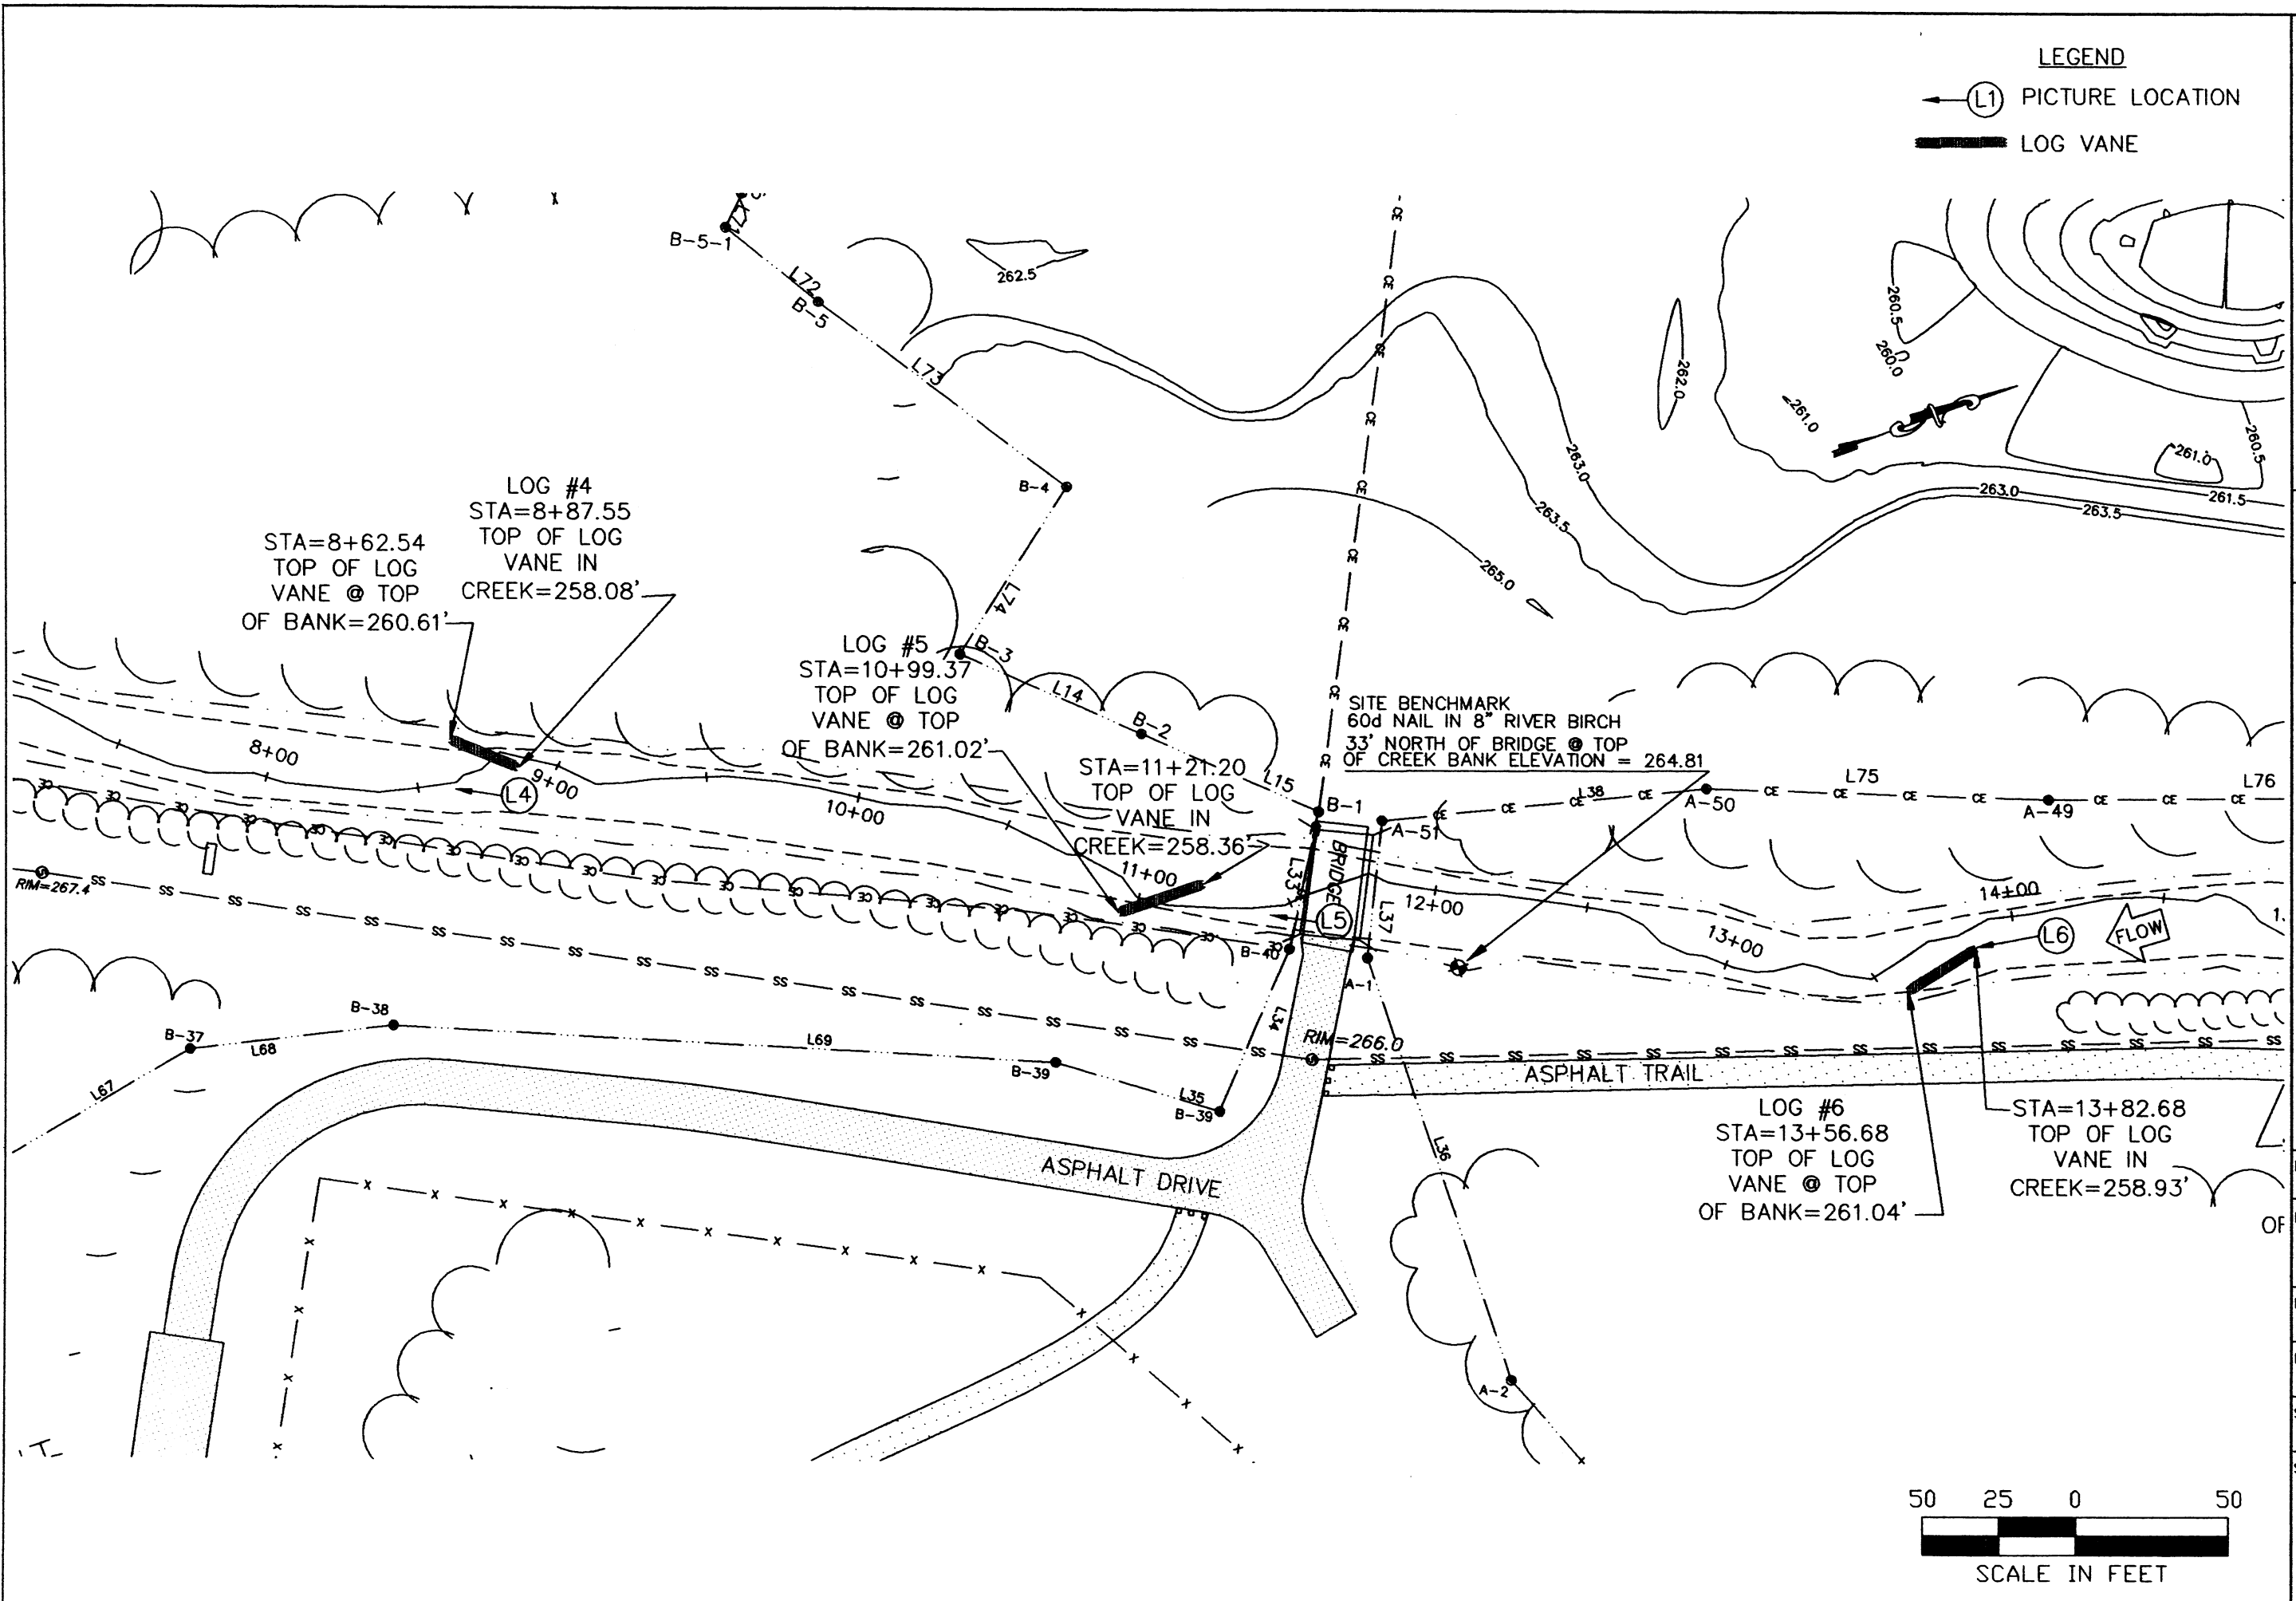

LEGEND
 (L1) PICTURE LOCATION
 LOG VANE

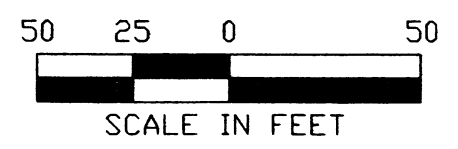


Becky Ward Consulting
 Water Management Engineering
 1512 EGLANTYNE CT. (919) 870-0526
 Raleigh, NC 27613 FAX (919) 870-5359



SANDY CREEK AS-BUILTS
 STATE OF NC WETLANDS RESTORATION PROGRAM

DATE:	08-22-03
REVISIONS:	
PROJECT NAME:	SANDY CREEK
DWG NAME:	ob-creek1
SCALE:	1" = 50'
SHEET NO.	3 OF 5

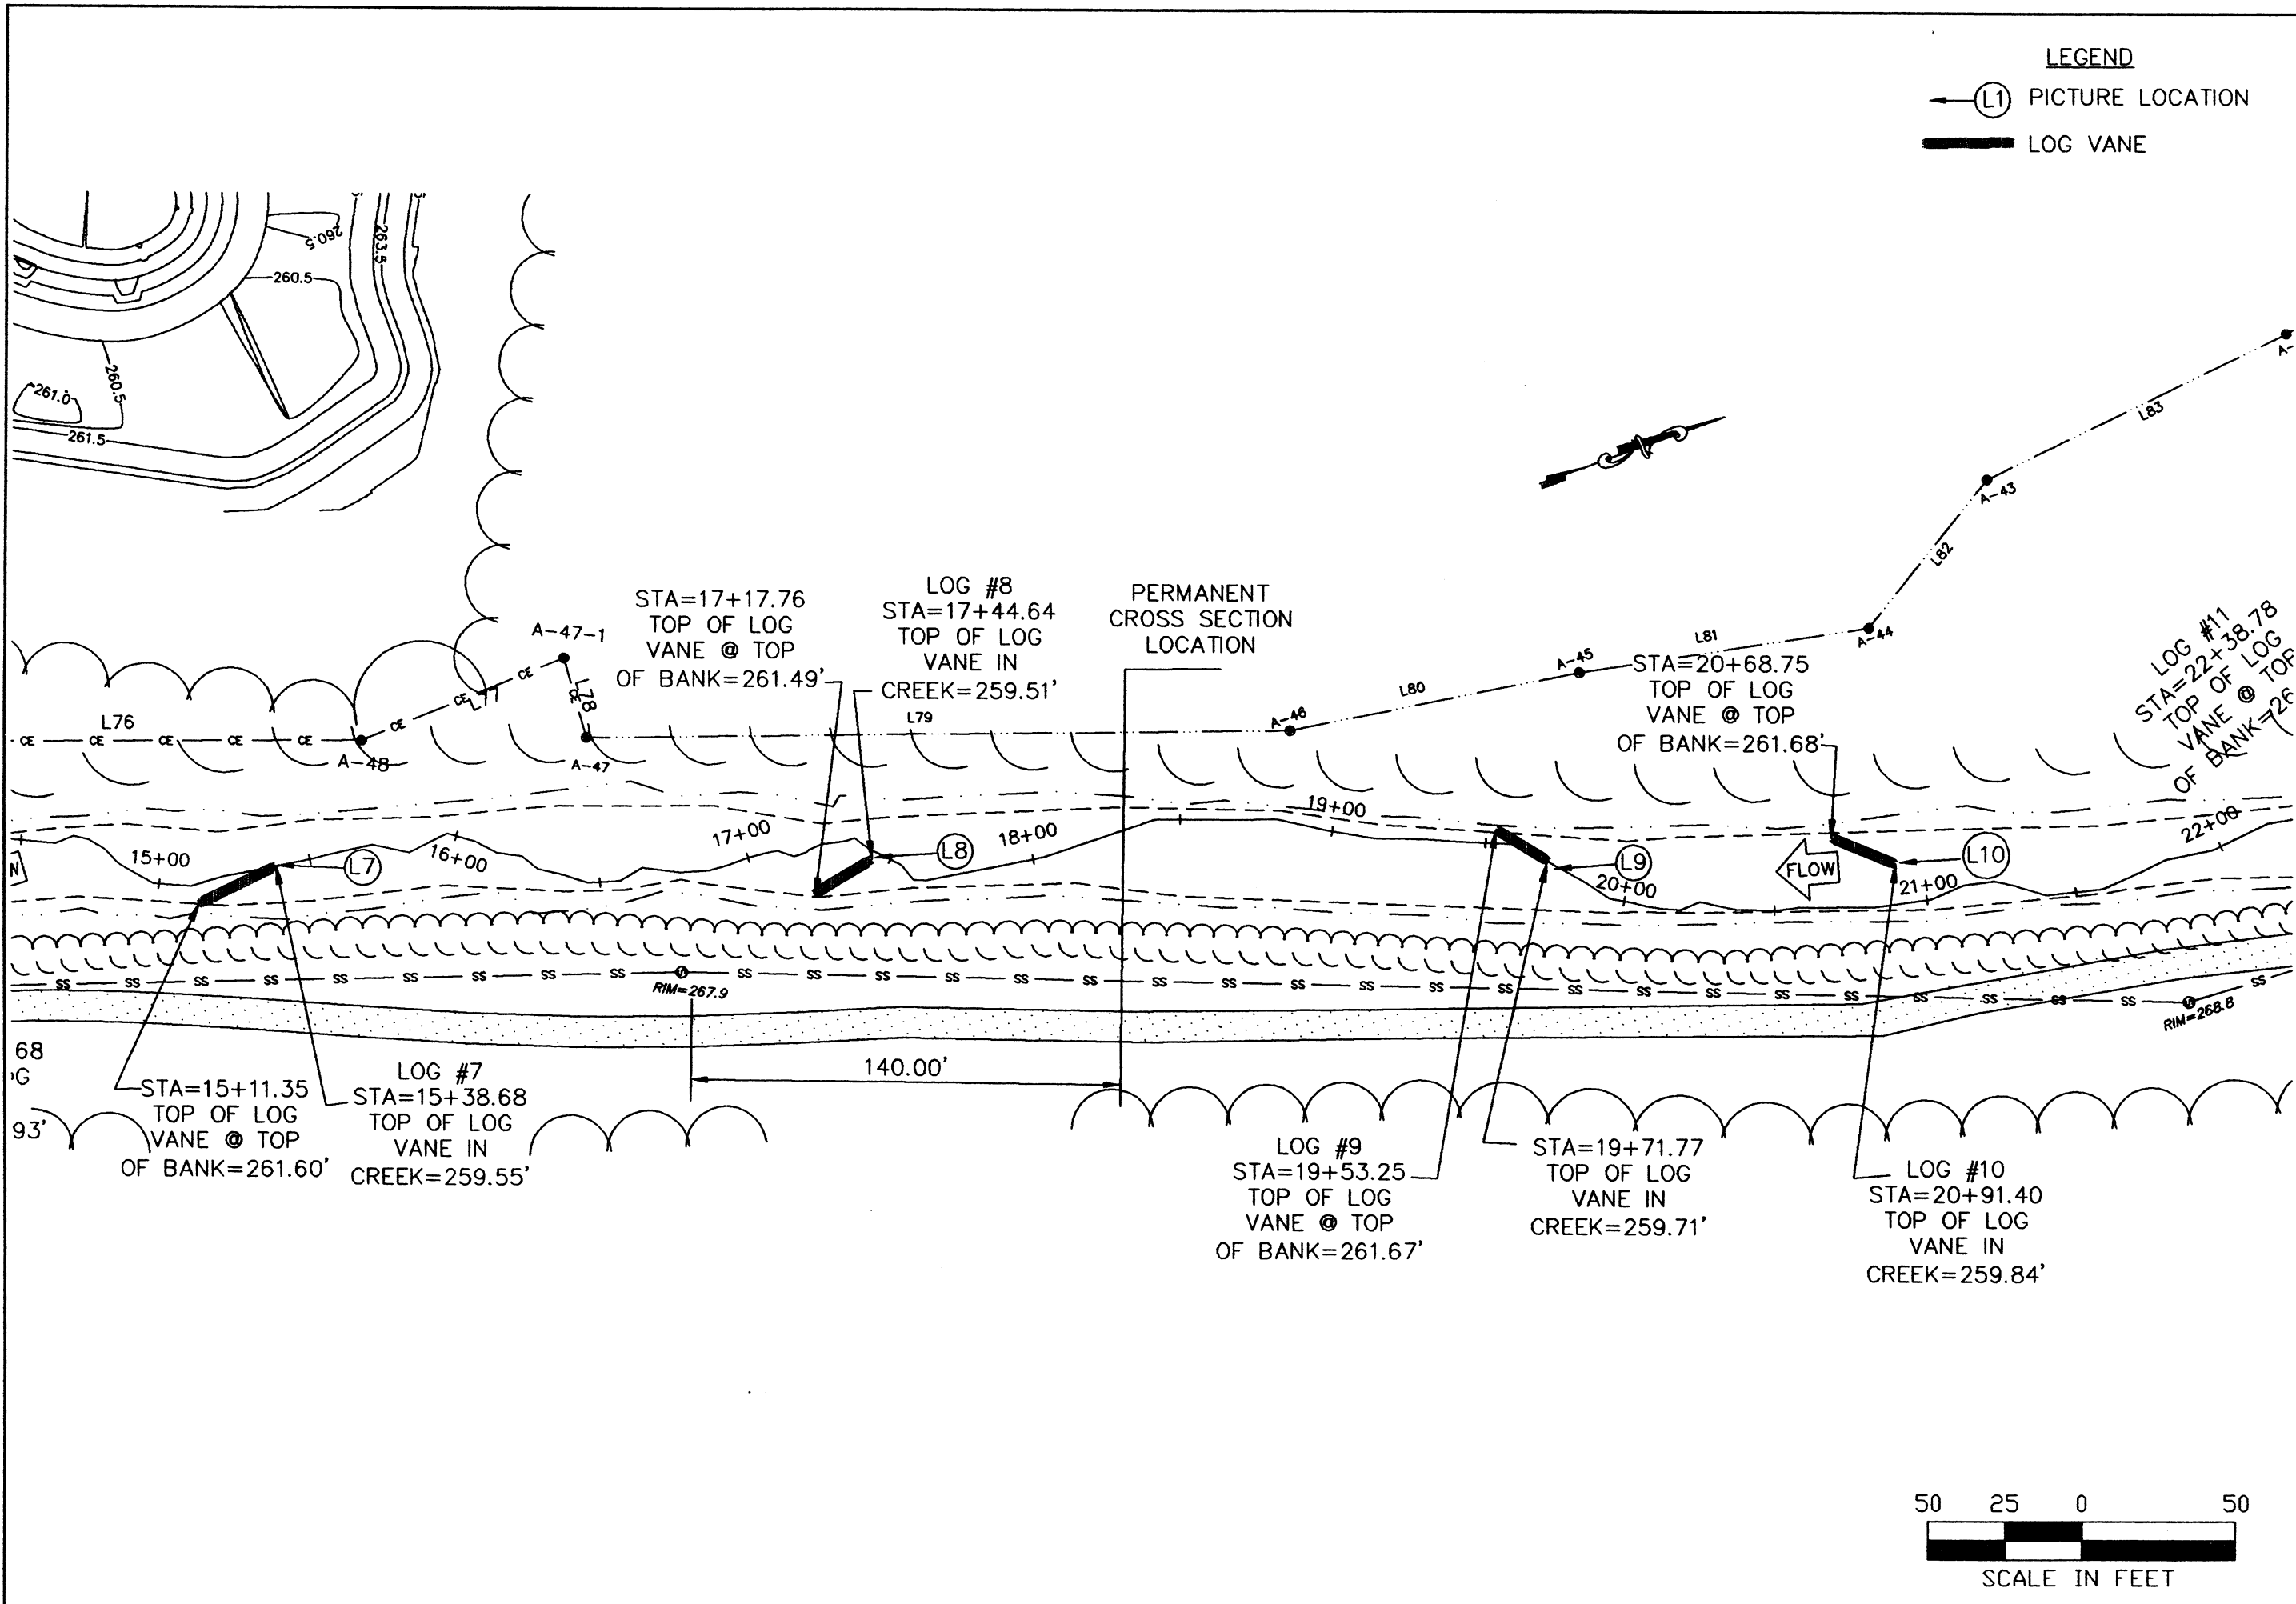

LEGEND


- ← (L1) PICTURE LOCATION
- ▬ LOG VANE


Becky Ward Consulting
 Water Management Engineering
 1512 EGLANTYNE CT. (919) 870-0526
 Raleigh, NC 27613 FAX (919) 870-5359



SANDY CREEK AS-BUILT
 STATE OF NC WETLANDS RESTORATION PROGRAM

DATE: 08-22-03
 REVISIONS:
 PROJECT NAME: SANDY CREEK
 DWG NAME: ob-creek1
 SCALE: 1"=50'
 SHEET NO.

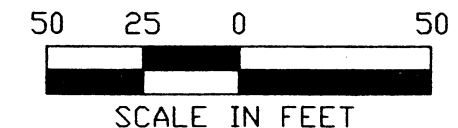

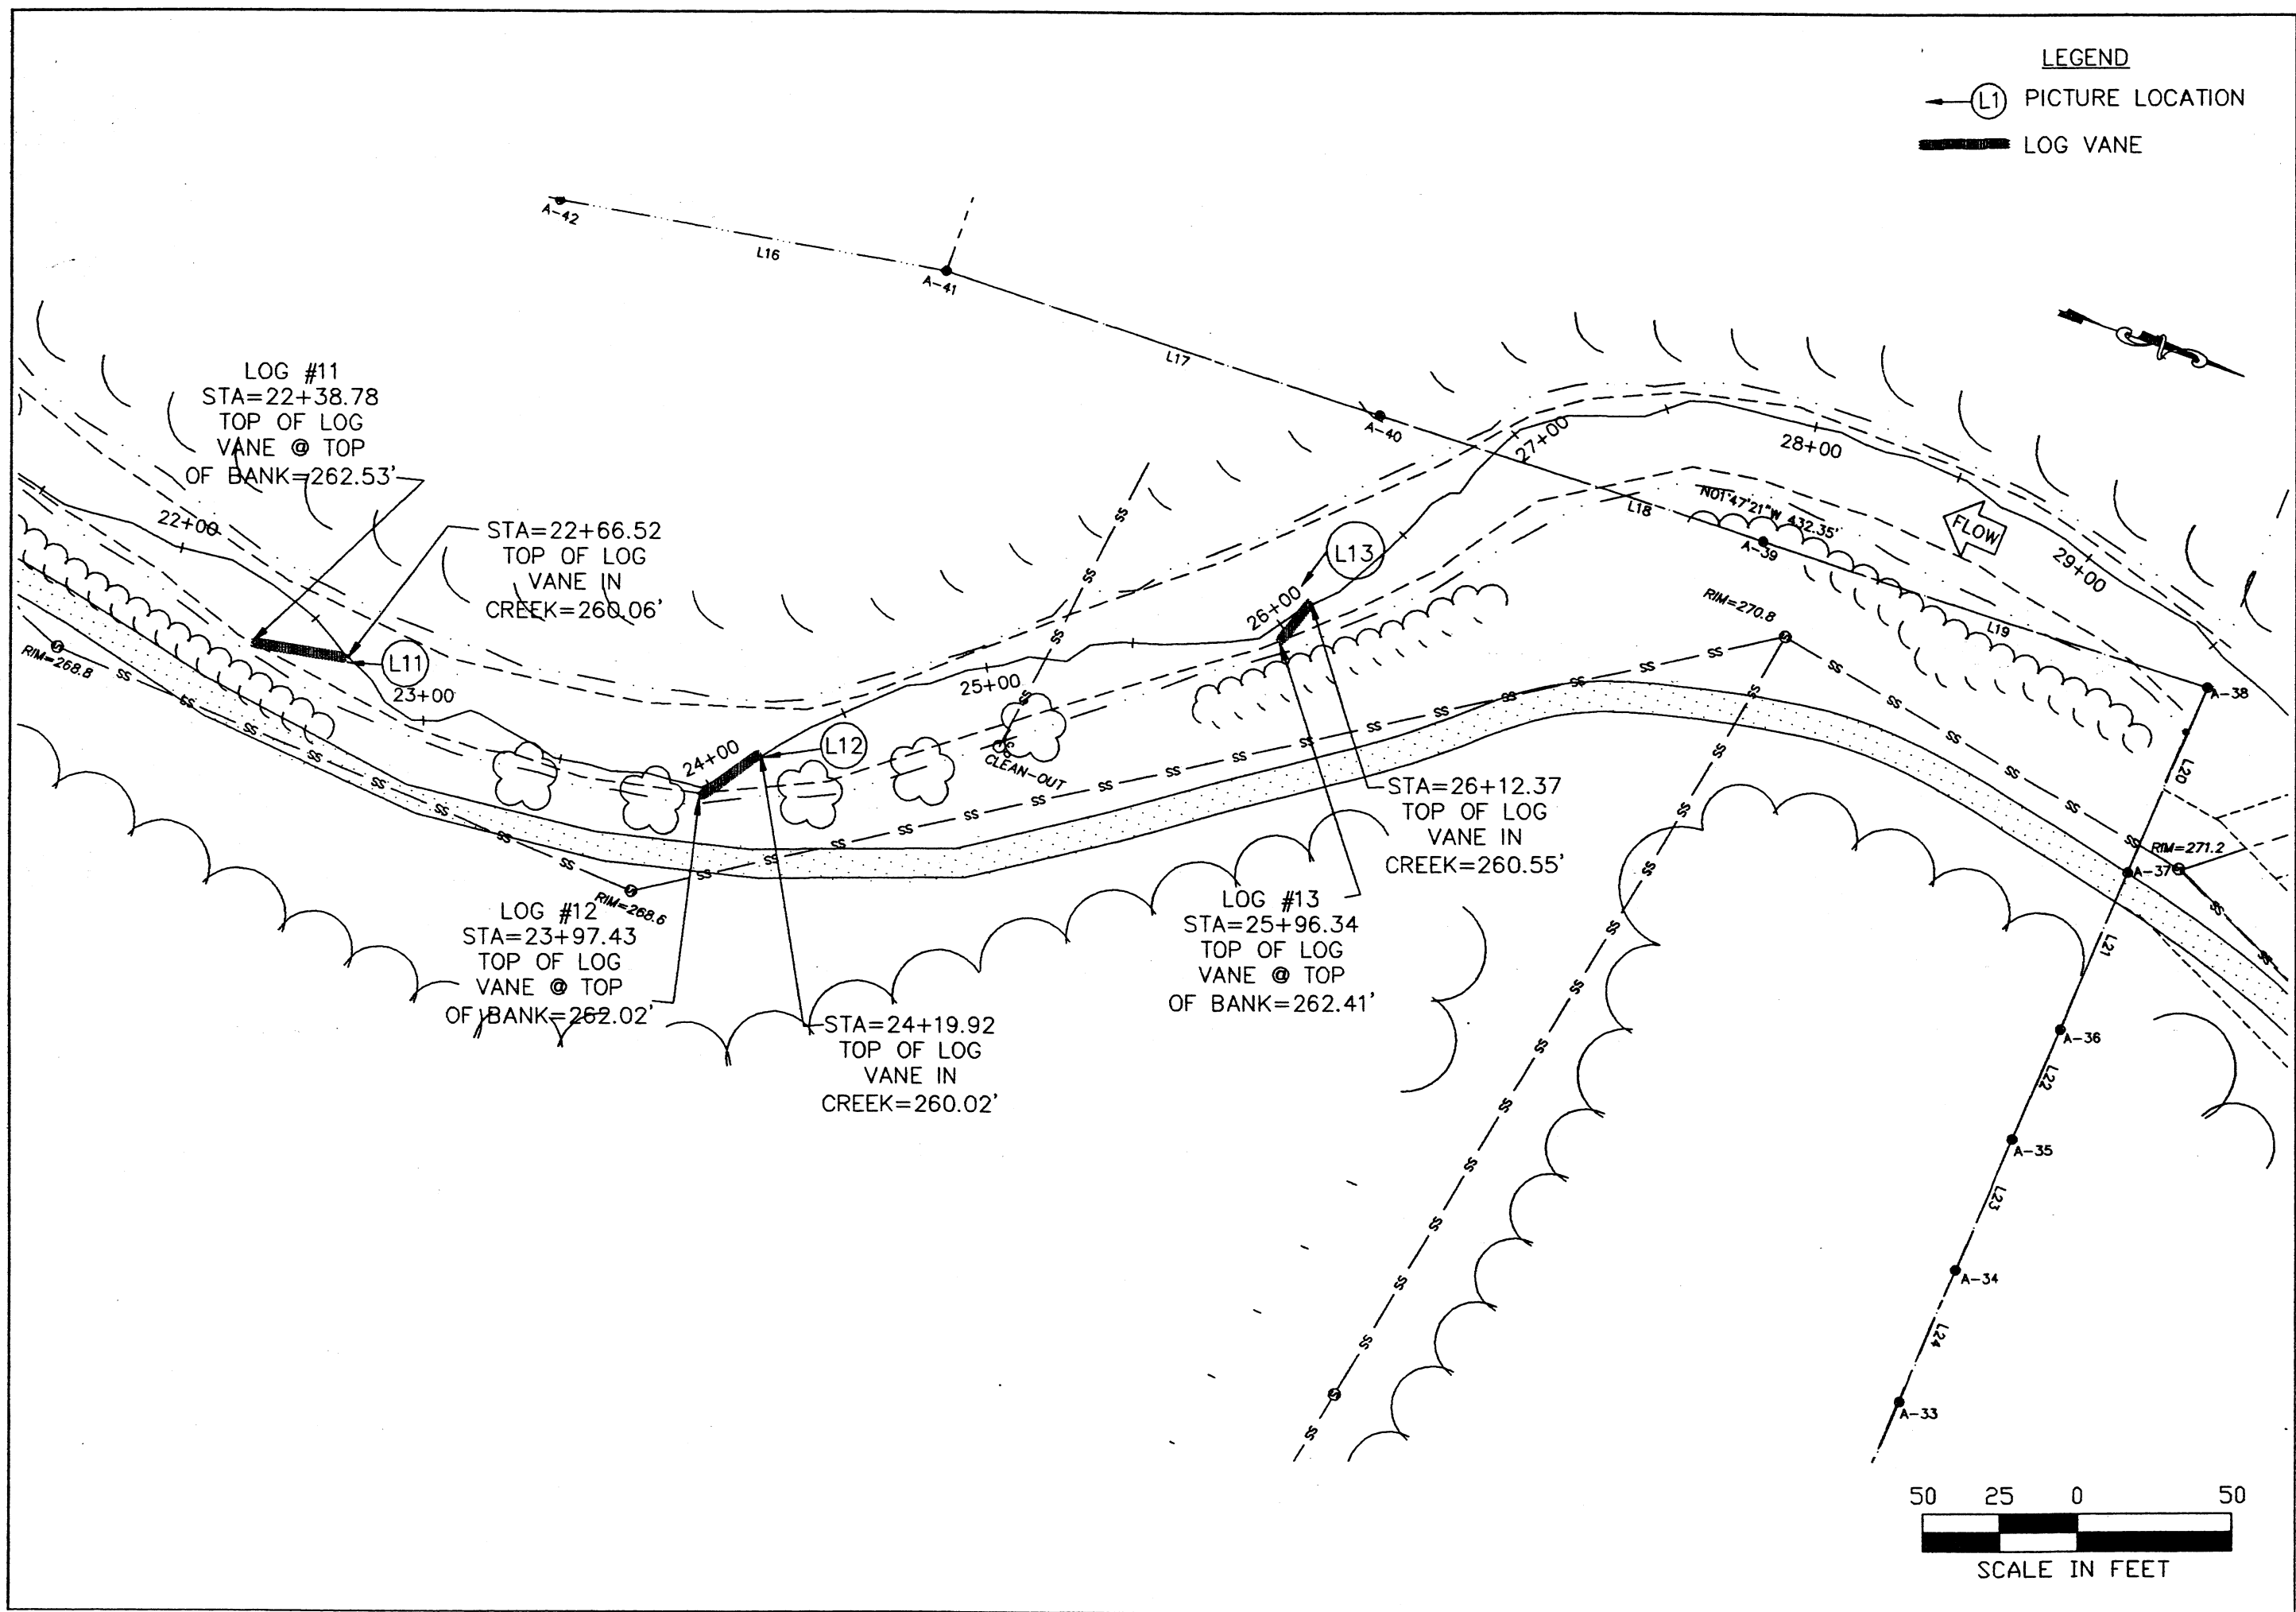

Becky Ward Consulting
 Water Management Engineering
 1512 EGLANTYNE CT. (919) 870-0526
 Raleigh, NC 27613 FAX (919) 870-5359



SANDY CREEK AS-BUILTS
 STATE OF NC WETLANDS RESTORATION PROGRAM

DATE:	08-22-03
REVISIONS:	
PROJECT NAME:	SANDY CREEK
DWG NAME:	ob-creek1
SCALE:	1"=50'
SHEET NO.	

