


STATE	STATE PROJECT REFERENCE NO.	SHEET NO.	TOTAL SHEETS
N.C.	R - 2239WM	1	67
STATE PROJ. NO.	F.A. PROJ. NO.	DESCRIPTION	
6.7690017		P.E. & CONST.	

STATE OF NORTH CAROLINA

DIVISION OF HIGHWAYS

IREDELL COUNTY

See Sheet 1-A For Index of Sheets

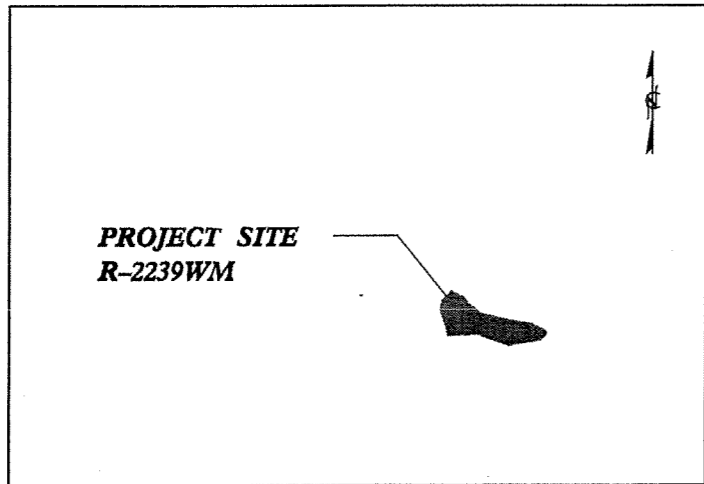

VICINITY MAP
NOT TO SCALE


LOCATION: SHEPHERDS TREE MITIGATION SITE LOCATED BETWEEN TRIPLETT ROAD (SR 2362) AND KNOX FARM ROAD (SR 2363) ADJACENT TO THIRD CREEK, SOUTHEAST OF STATESVILLE
TYPE OF WORK: GRADING, DITCH PLUG INSTALLATION, DITCH FILLING, PLANTING

AS-BUILT PLANS



PHASE I

PROJECT: 6.7690017 R-2239WM

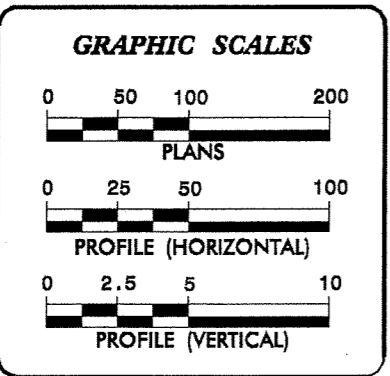

PROJECT LENGTH

TOTAL WETLAND RESTORATION = 15.0 ACRES

Prepared In the Office of:

2002 STANDARD SPECIFICATIONS

LETTING DATE:

DESIGN ENGINEER

P.E.

SIGNATURE: **WETLAND SCIENTIST**

SIGNATURE:

DIVISION OF HIGHWAYS
STATE OF NORTH CAROLINA

P.E.

STATE DESIGN ENGINEER

DEPARTMENT OF TRANSPORTATION
FEDERAL HIGHWAY ADMINISTRATION

APPROVED
DIVISION ADMINISTRATOR


DATE



DATE OF ORIGIN: 04-11-99		
DRAWN BY: . . .		
CHECKED BY: . . .		
REVISIONS		
NO.	DESCRIPTION	DATE
1.		
2.		
3.		
4.		
5.		
6.		

PROJECT NAME: . . .

SHEPHERDS TREE
GRADING PLAN

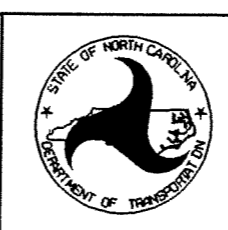


STATE OF NORTH CAROLINA
DEPT. OF TRANSPORTATION

SHEET TITLE: . . .
GRADING PLAN

SHEET NO. . .
1 OF 2


KCI JOB NO. 1298031

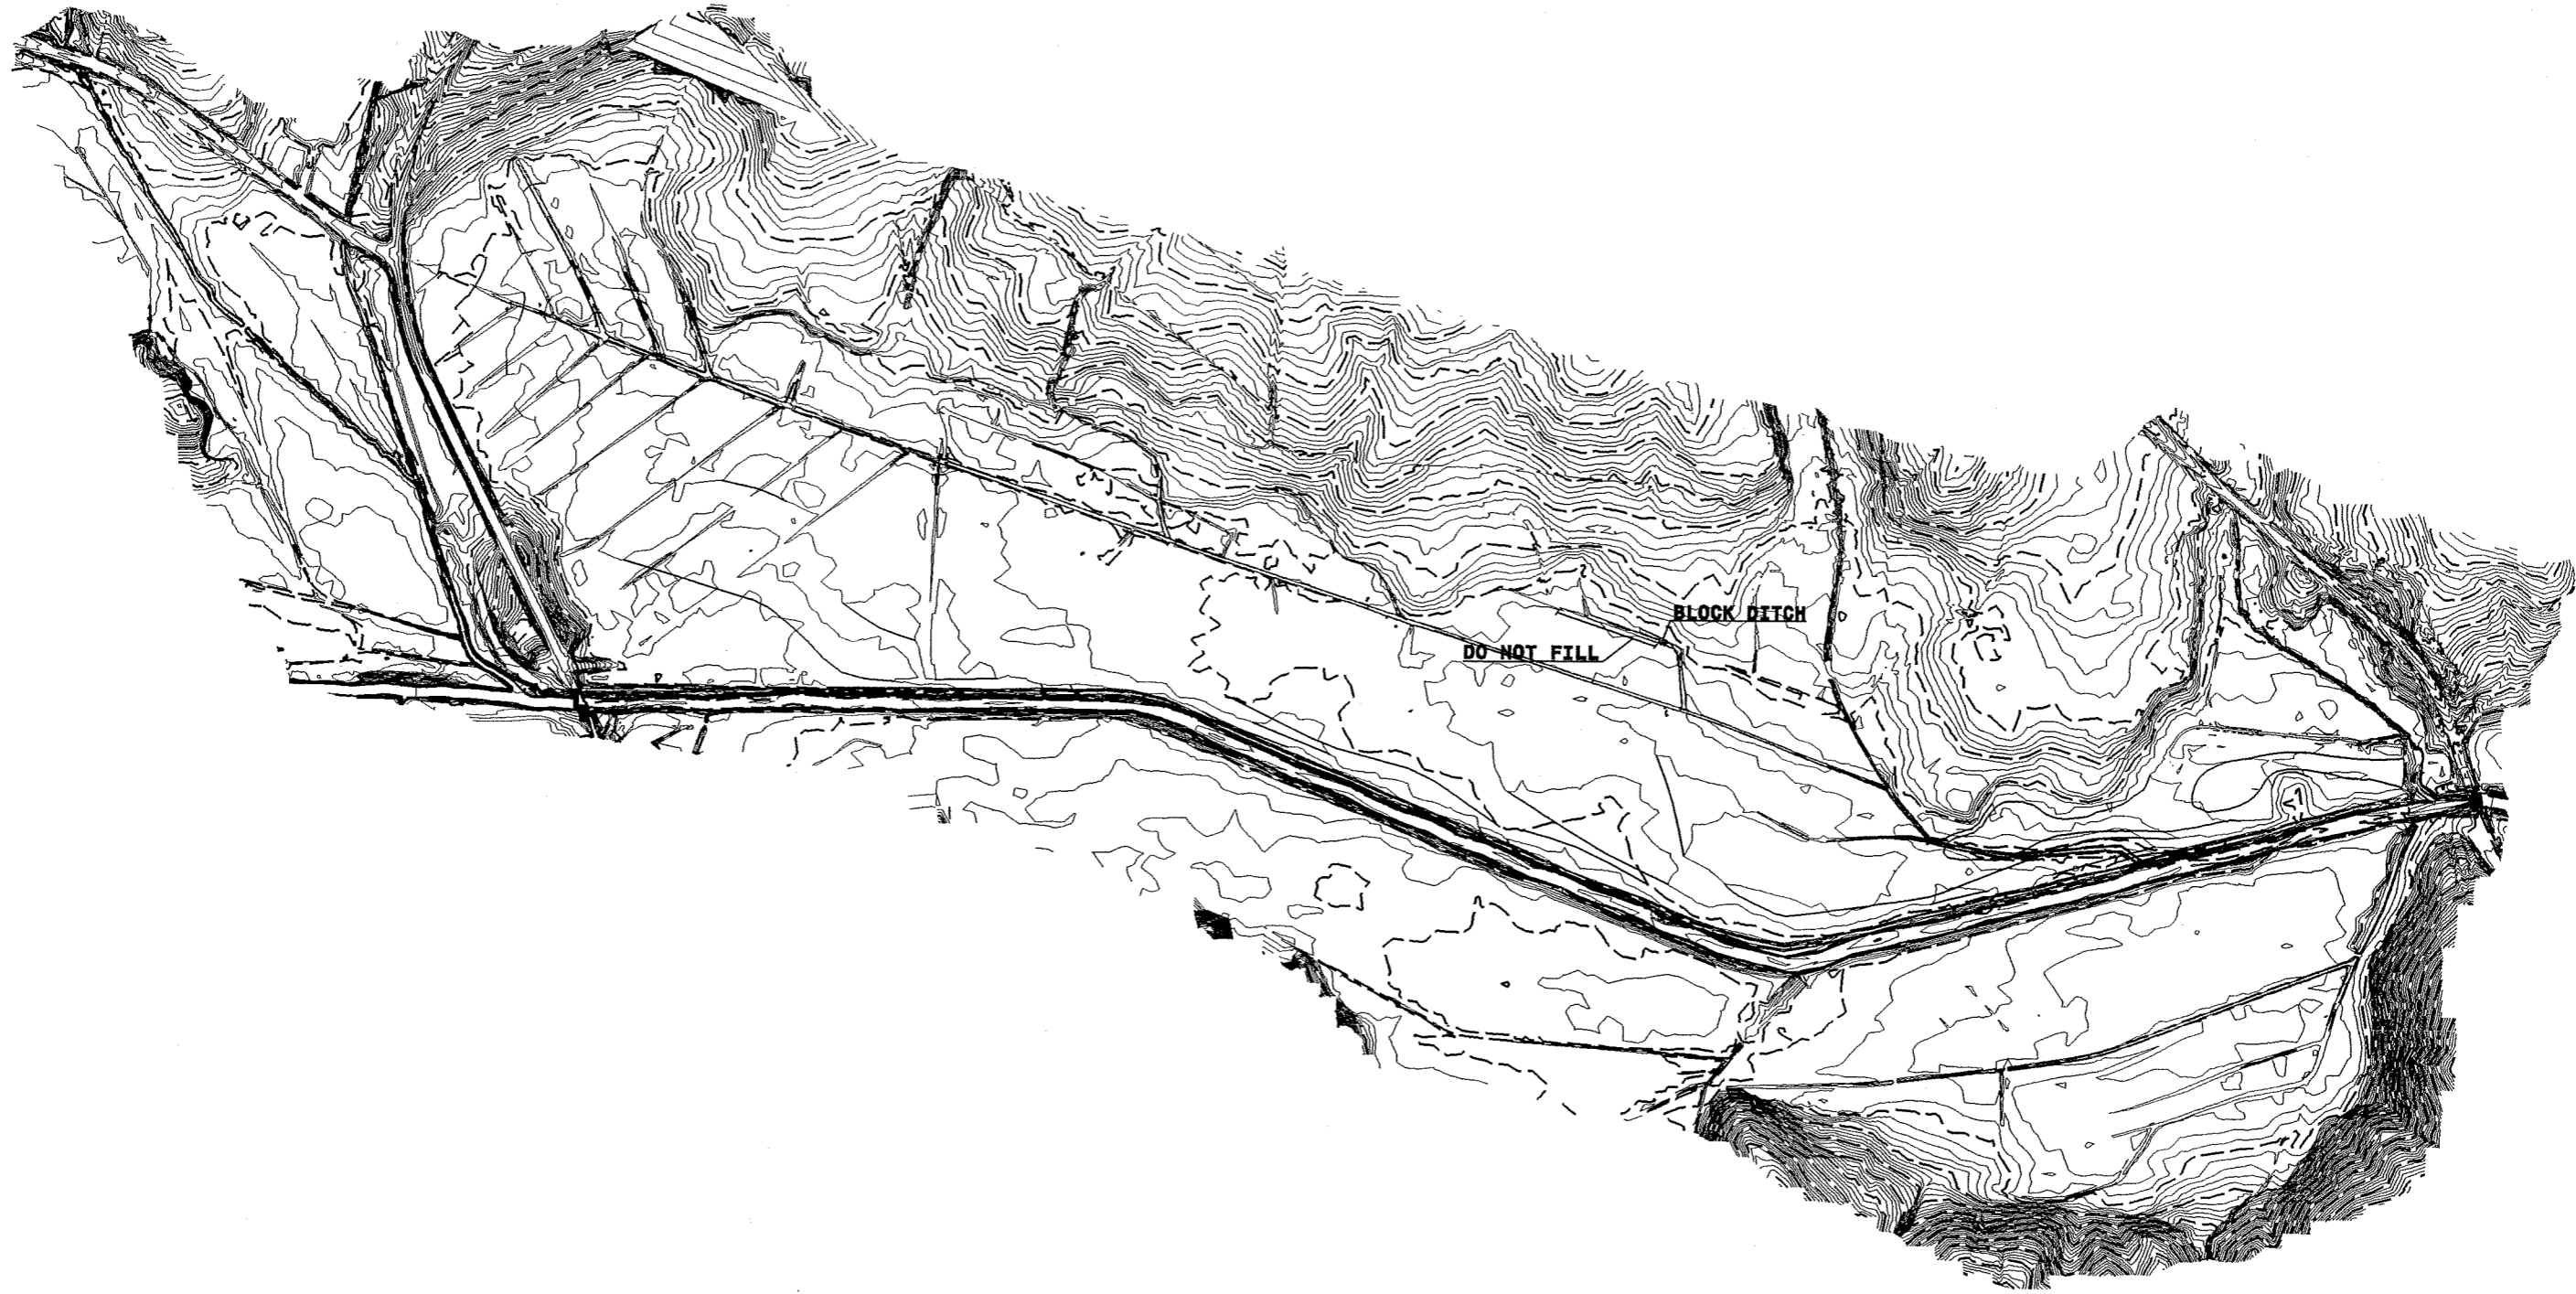

DATE OF ORIGIN: 04-11-99		
DRAWN BY: *		
CHECKED BY: **		
REVISIONS		
NO.	DESCRIPTION	DATE
1		
2		
3		
4		
5		
6		

PROJECT NAME:

SHEPHERDS TREE
GRADING PLAN

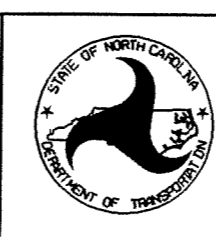
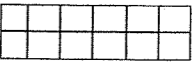
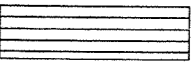
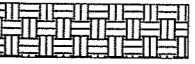




STATE OF NORTH CAROLINA
DEPT. OF TRANSPORTATION

SHEET TITLE:
GRADING PLAN

SHEET NO.:
2 OF 2

KCI JOB NO. 4298831

GRADING LEGEND		AREA
PHASE I LIMIT		34.8 Ac.
GRADING ONLY		1.5 Ac.
GRADING AND RIPPING		15.1 Ac.
PRESERVATION AREA (DO NOT DISTURB)		6.9 Ac.

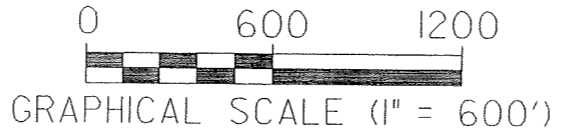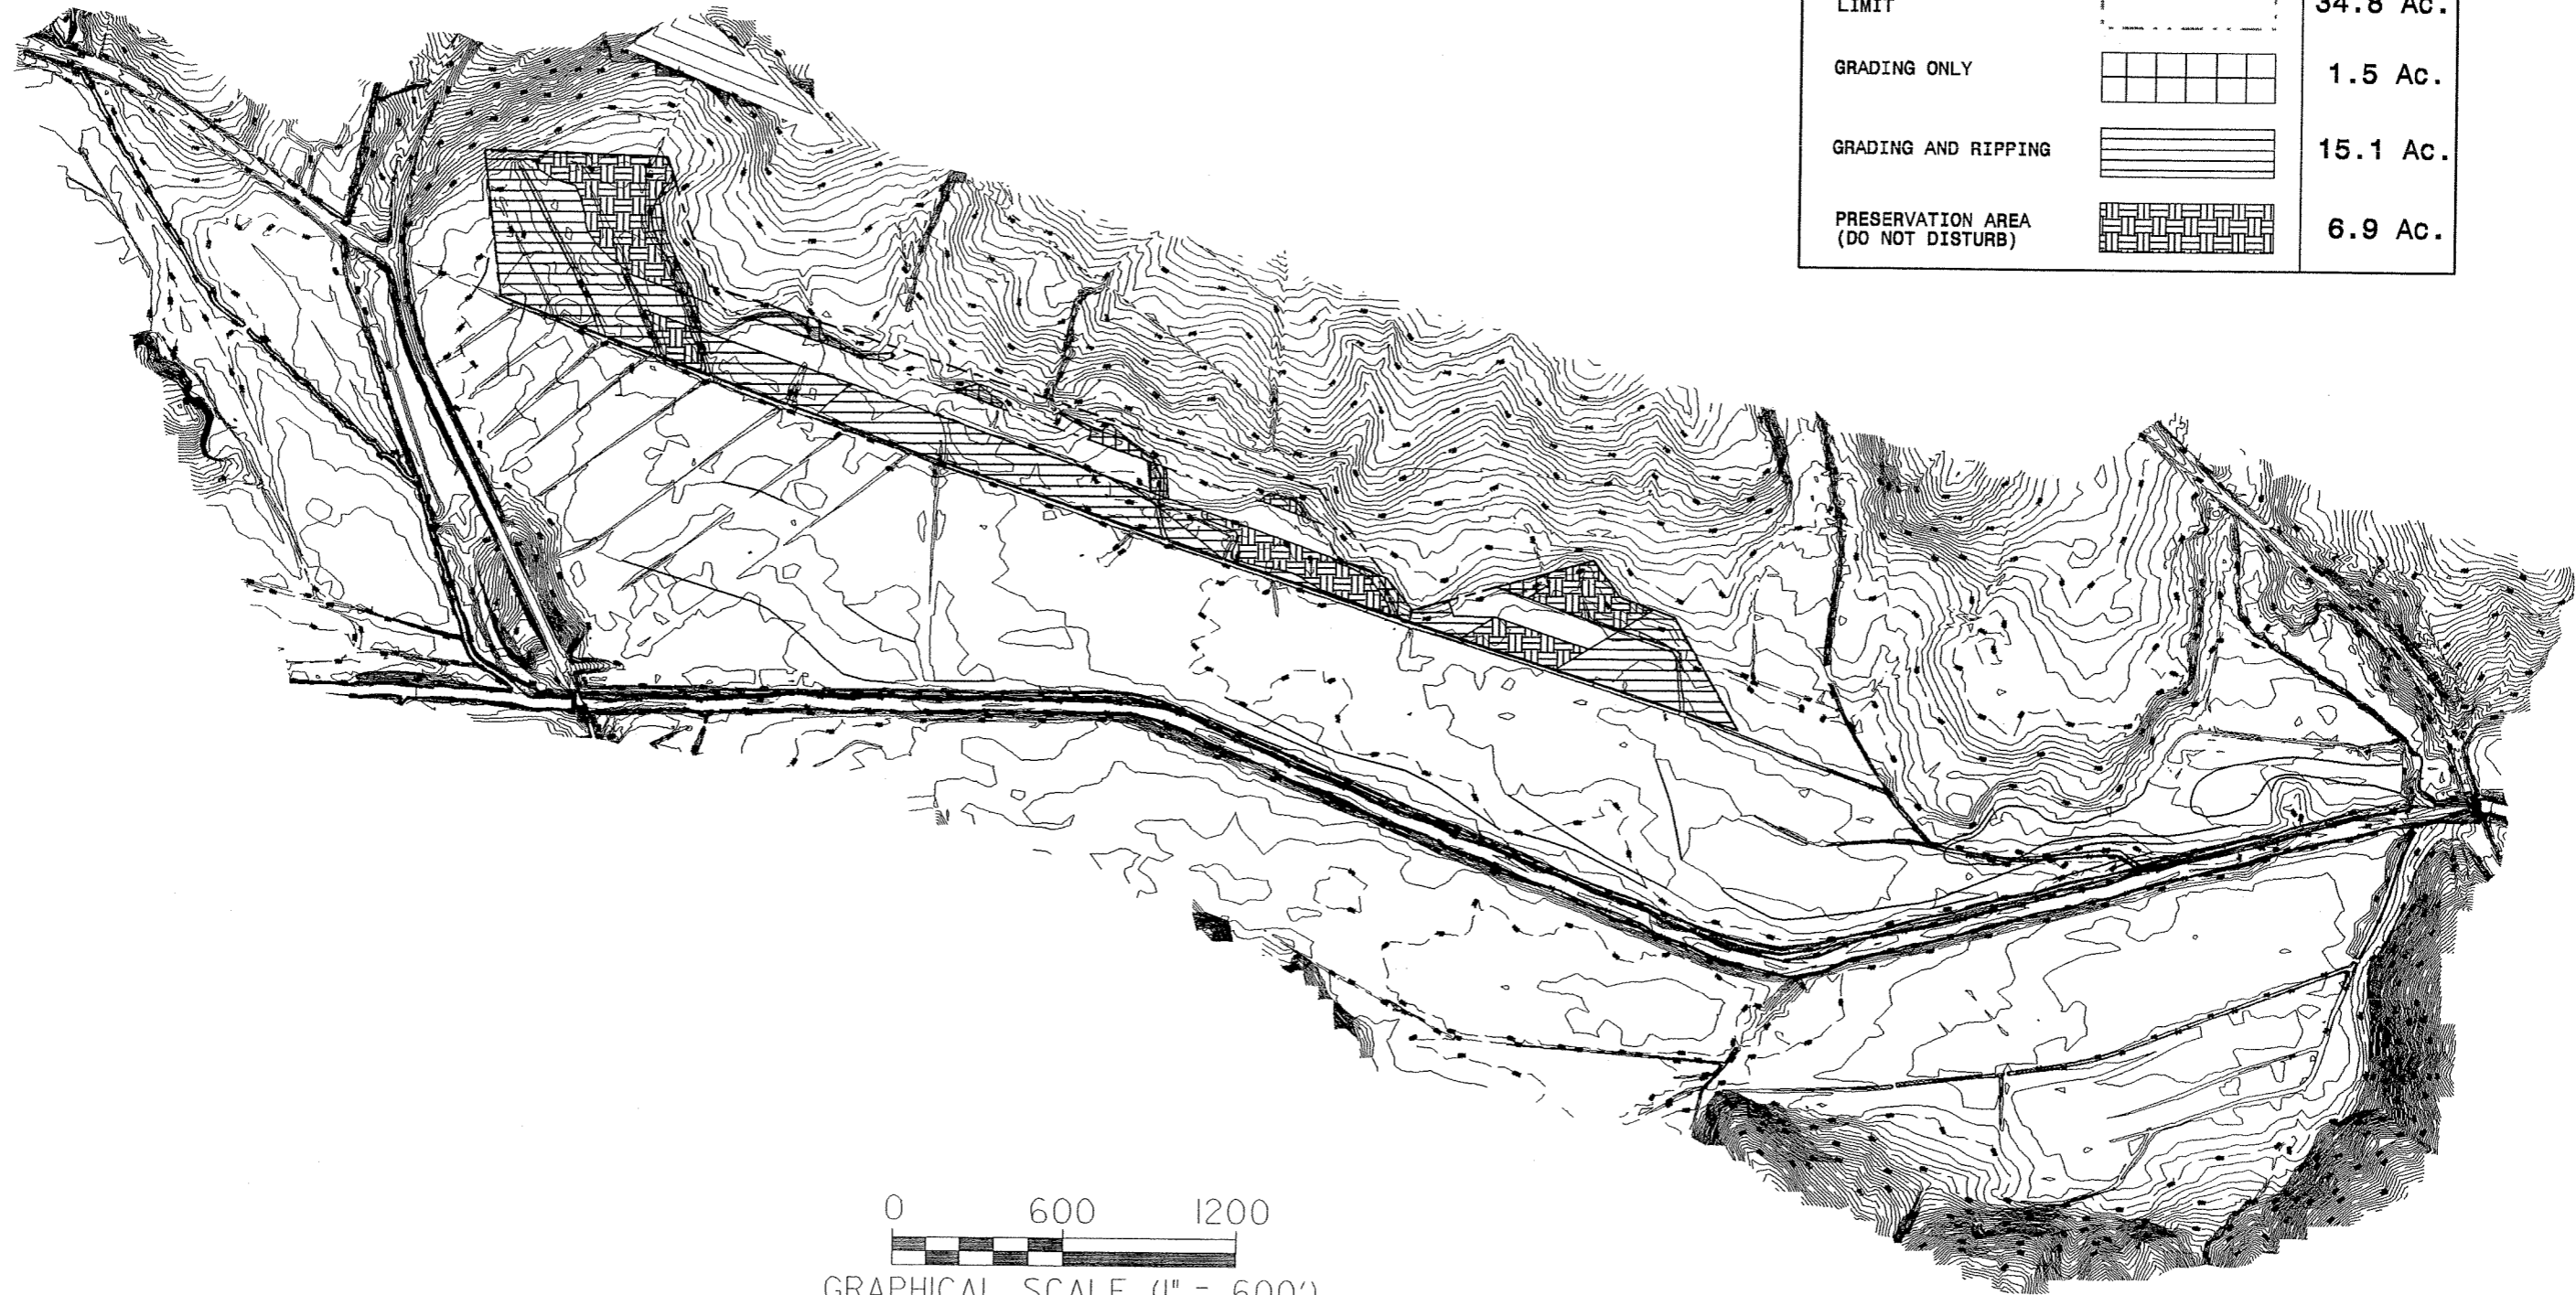

NO.	DESCRIPTION	DATE
1		
2		
3		
4		
5		
6		

SHEPHERDS TREE GRADING PLAN


STATE OF NORTH CAROLINA DEPT. OF TRANSPORTATION
--



STATE OF NORTH CAROLINA
 DEPT. OF TRANSPORTATION

GRADING PLAN
1 OF 2


PHASE 1: DITCH FILL/BLOCK LOCATIONS

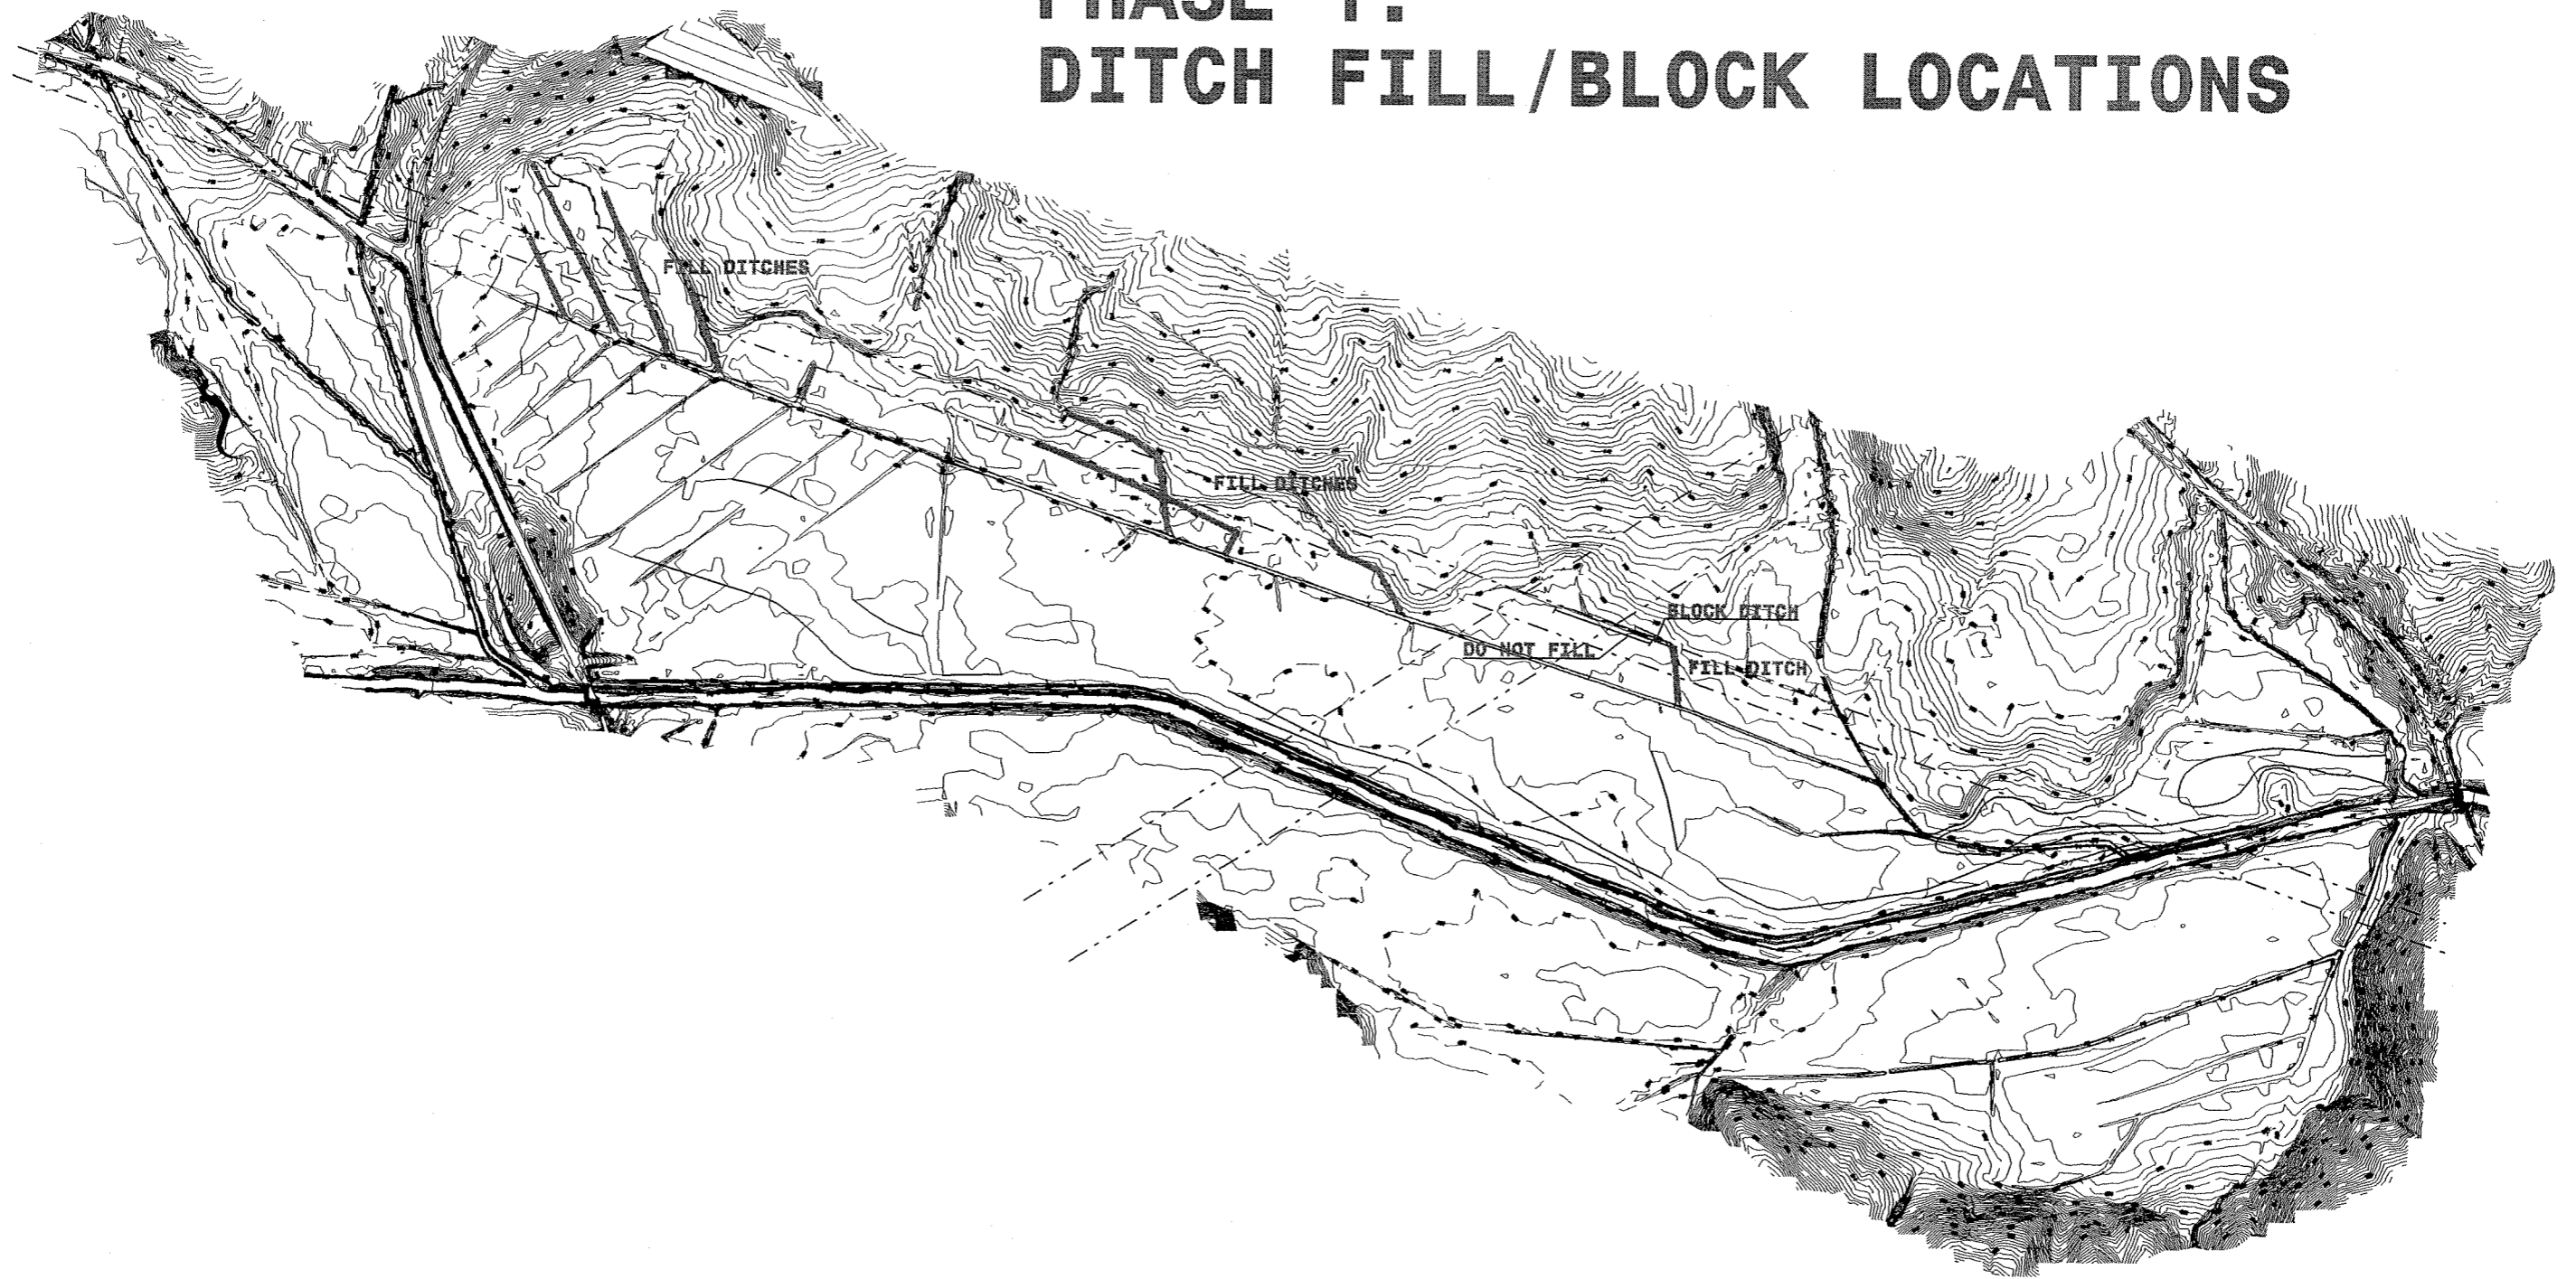

DATE OF SUBMITTAL	DESIGN	
PROJECT NO.		
SECTION NO.		
NO.	DESCRIPTION	DATE
1		
2		
3		
4		
5		
6		

PROJECT NAME	
PROJECT LOCATION	
PROJECT NUMBER	
PROJECT DATE	

SHEPHERDS TREE
GRADING PLAN

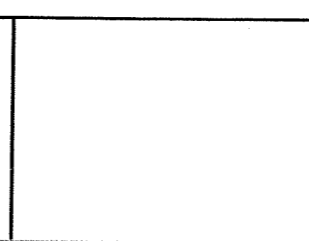


STATE OF NORTH CAROLINA
DEPT. OF TRANSPORTATION

STATE OF NORTH CAROLINA
DEPT. OF TRANSPORTATION

PROJECT TITLE	GRADING PLAN
PROJECT NO.	2 OF 2
DATE	

EROSION CONTROL PLAN

Std. #	Description	Symbol
	Reforestation	
1630.03	Temporary Silt Ditch	
1630.05	Temporary Diversion	
1605.01	Temporary Silt Fence	
1622.01	Temporary Berms and Slope Drains	
1630.01	Silt Basin Type A	
1630.02	Silt Basin Type B	
1633.01	Temporary Rock Silt Check Type-A	
1633.02	Temporary Rock Silt Check Type-B	
1634.01	Temporary Rock Sediment Dam Type-A	
1634.02	Temporary Rock Sediment Dam Type-B	
1635.01	Rock Pipe Inlet Sediment Trap Type-A	
1635.02	Rock Pipe Inlet Sediment Trap Type-B	
1636.01	Rock Silt Screen	
1630.04	Stilling Basin	
Rock Inlet Sediment Trap:		
1632.01	Type A	OR-A)
1632.02	Type B	OR-B)
1632.03	Type C	OR-C)

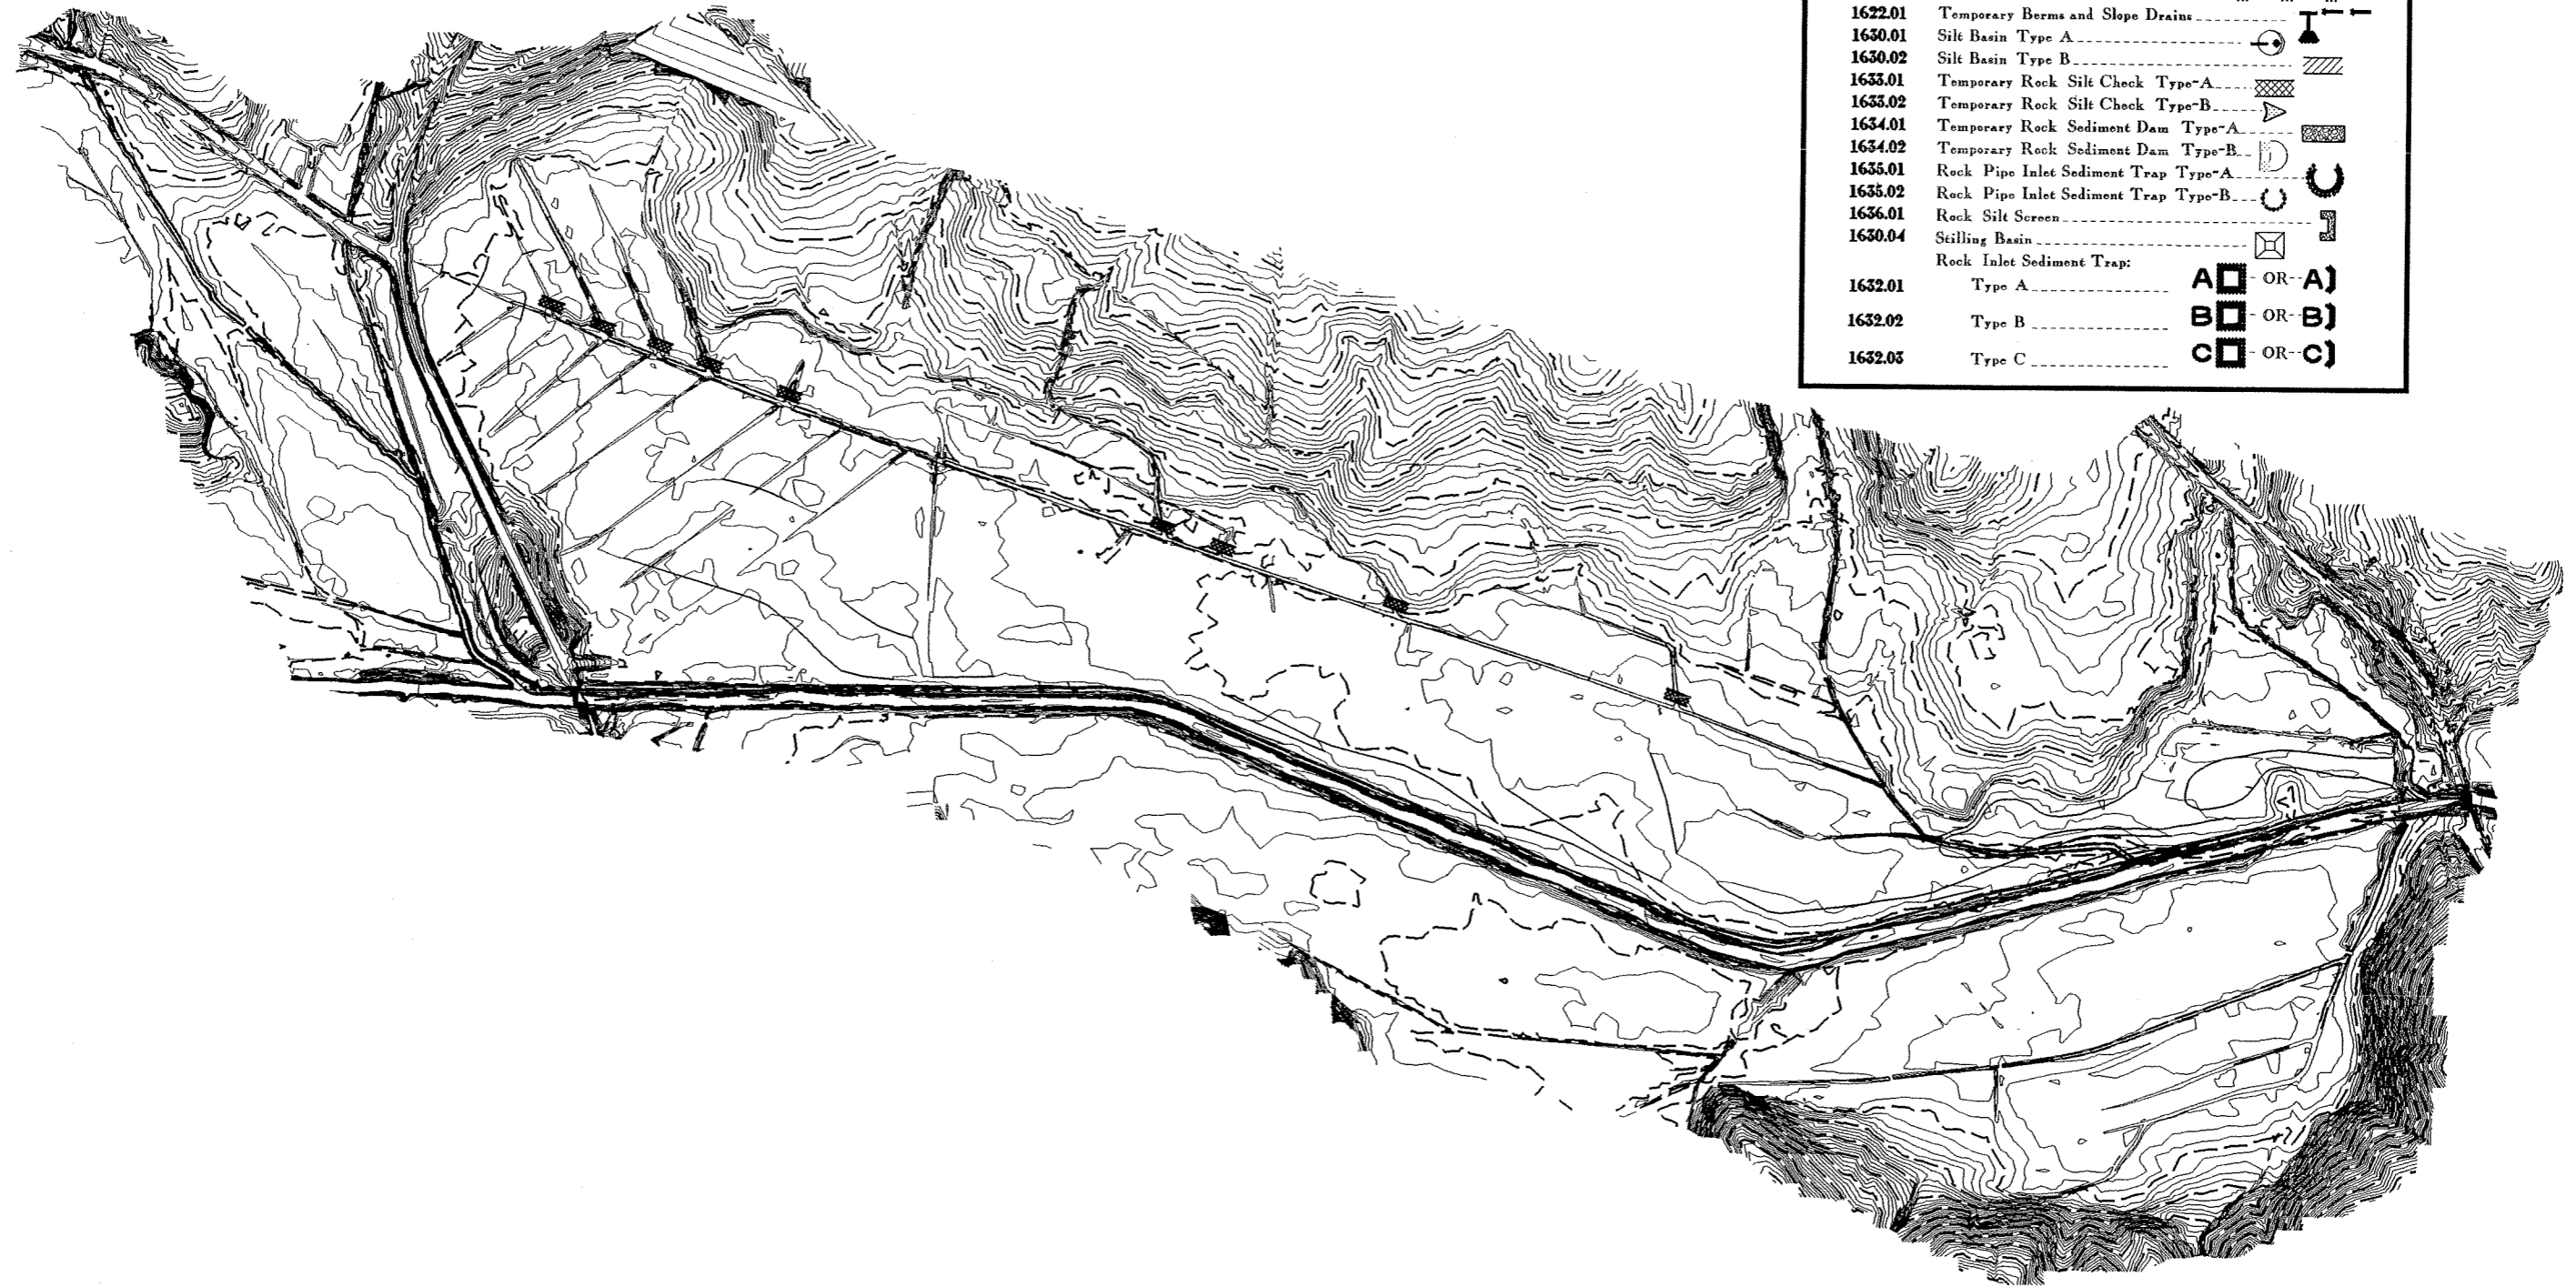

DATE OF ORIGIN: 04-11-99	
DRAWN BY: . . .	
CHECKED BY: . . .	
REVISIONS	
NO.	DESCRIPTION
1	
2	
3	
4	
5	
6	

PROJECT NAME	SHEPHERDS TREE GRADING PLAN
--------------	-----------------------------


STATE OF NORTH CAROLINA DEPT. OF TRANSPORTATION
--



STATE OF NORTH CAROLINA
DEPT. OF TRANSPORTATION

SHEET TITLE	GRADING PLAN
SHEET NO.	1 OF 2
KCI JOB NO. 4298831	

SHEPHERD'S TREE MITIGATION SITE PLANTING PLAN

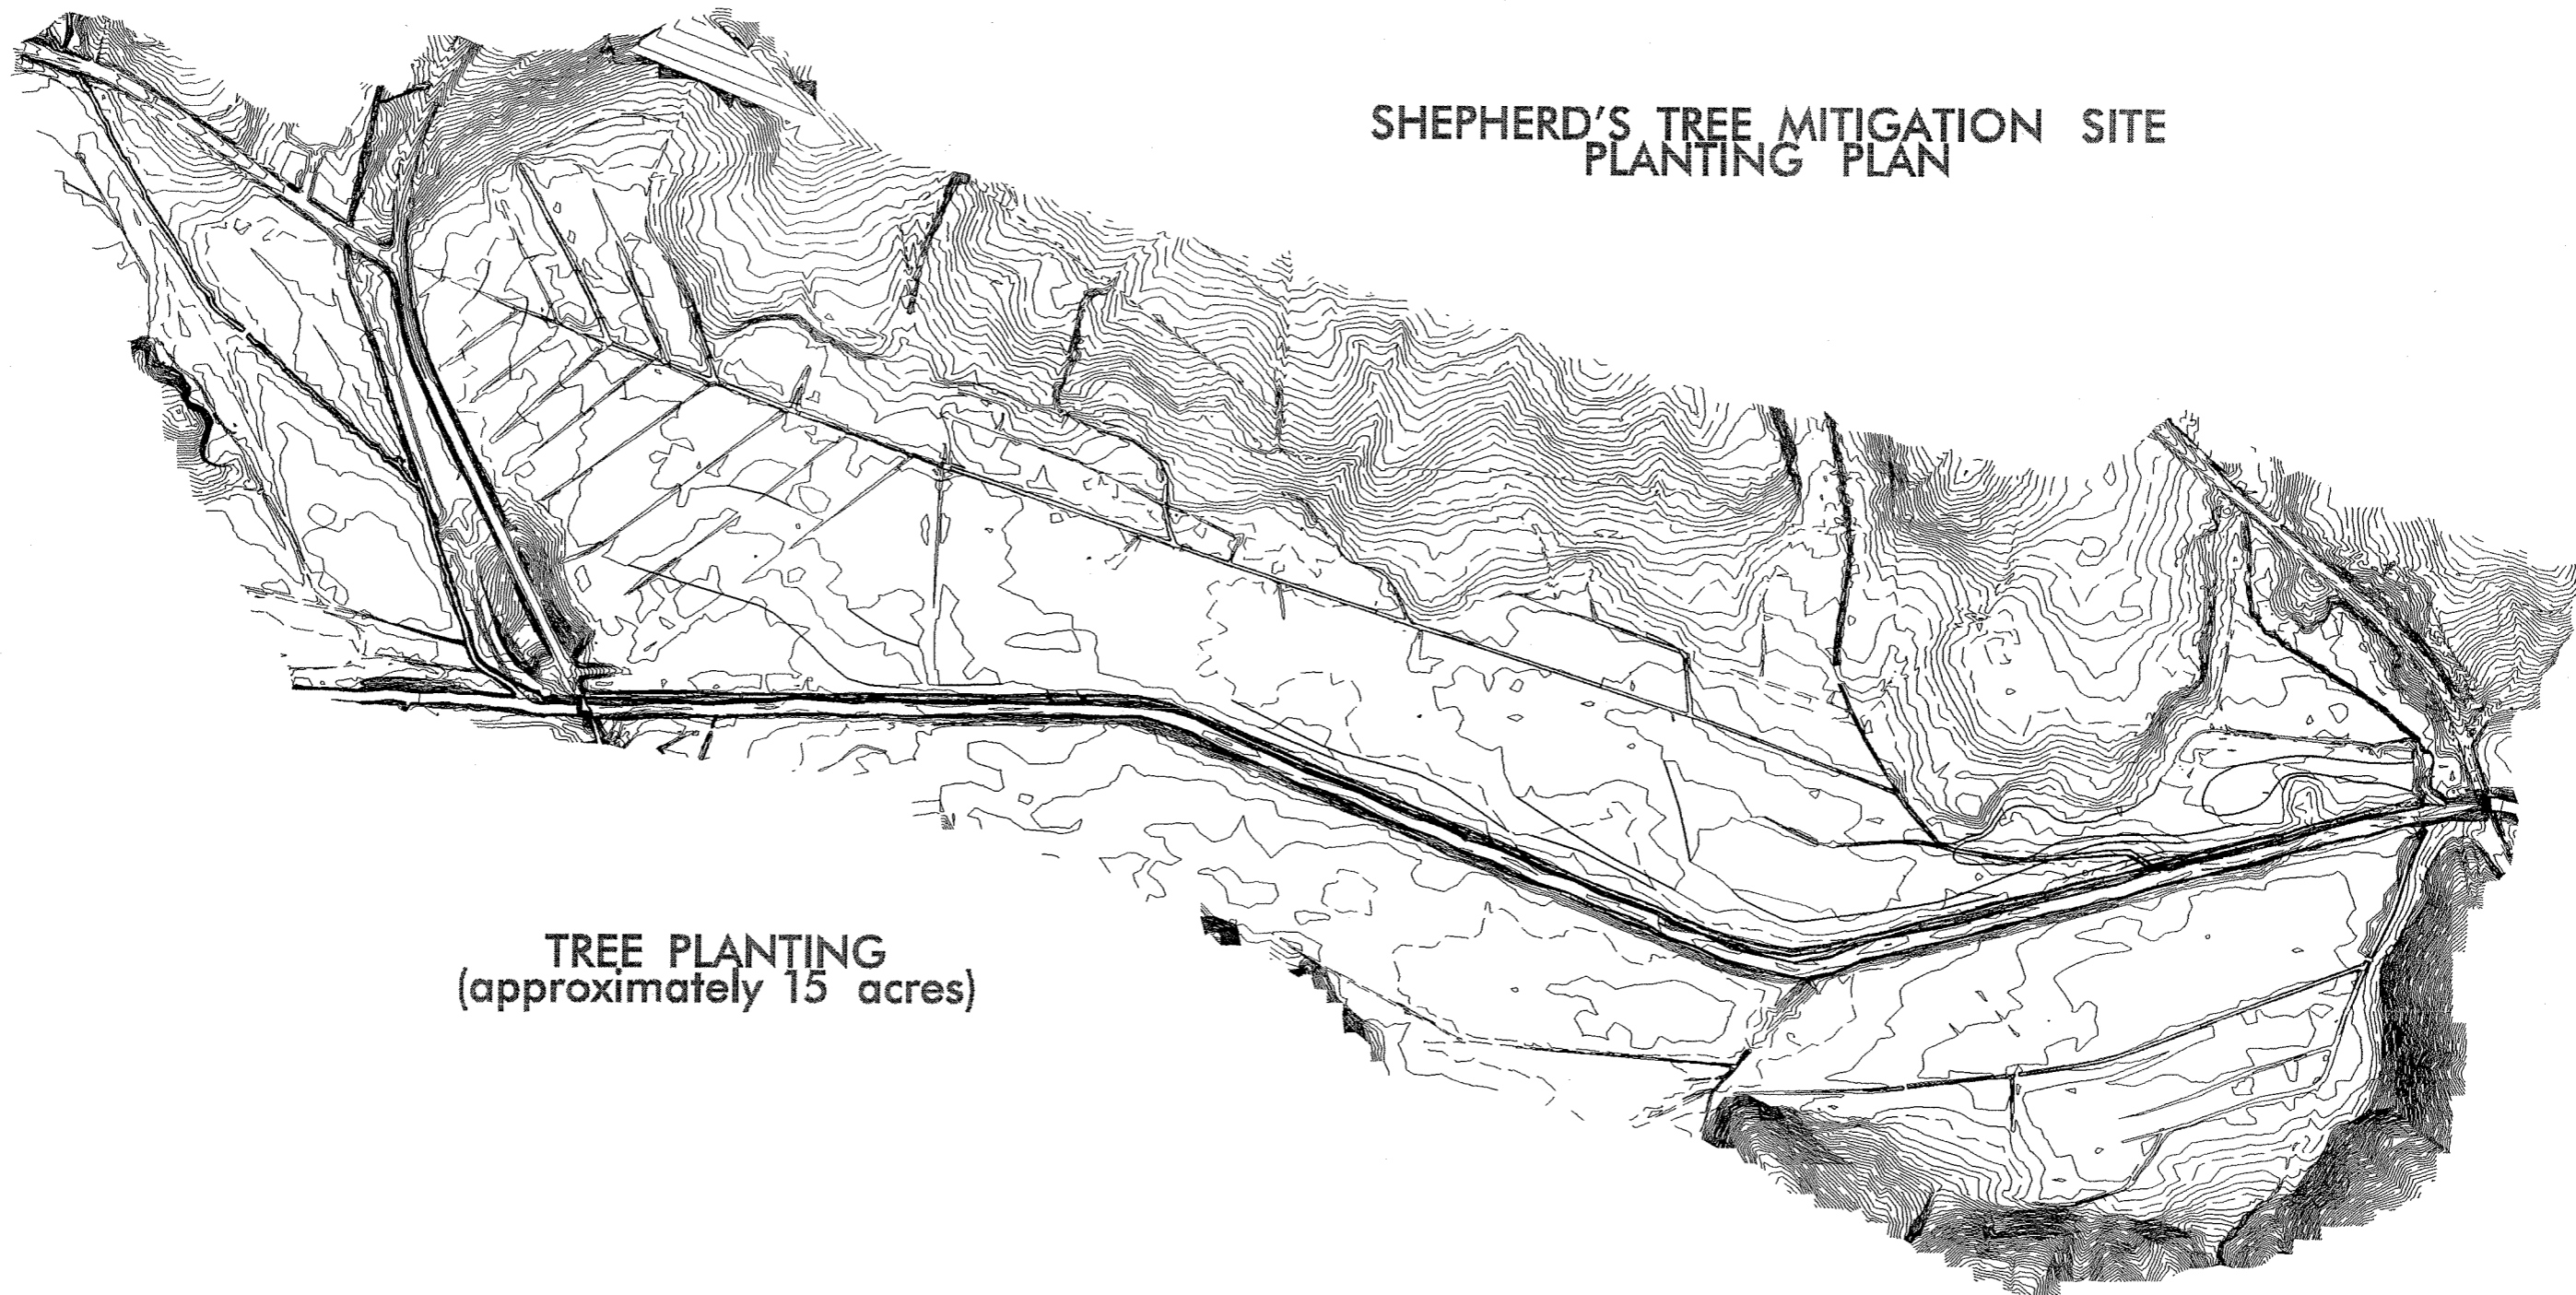

TREE PLANTING
(approximately 15 acres)

NO.	DESCRIPTION	DATE
1		
2		
3		
4		
5		
6		




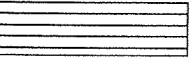
DATE OF MODIFICATION	REVISION


PROJECT NAME:
**SHEPHERD'S TREE
PLANTING PLAN**



STATE OF NORTH CAROLINA
DEPT. OF TRANSPORTATION

PROJECT NO.:
PLANTING PLAN
PROJECT SHEET:
1 OF 1
DATE PLOTTED:
10/20/01

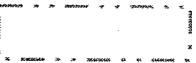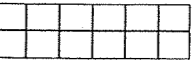PLANTING LEGEND		AREA
PHASE I LIMIT		34.8 Ac.
PIEDMONT/ MOUNTAIN SWAMP FOREST		8.2 Ac.
PIEDMONT/ MOUNTAIN BOTTOMLAND FOREST		5.8 Ac.
PRESERVATION AREA (DO NOT DISTURB)		6.9 Ac.

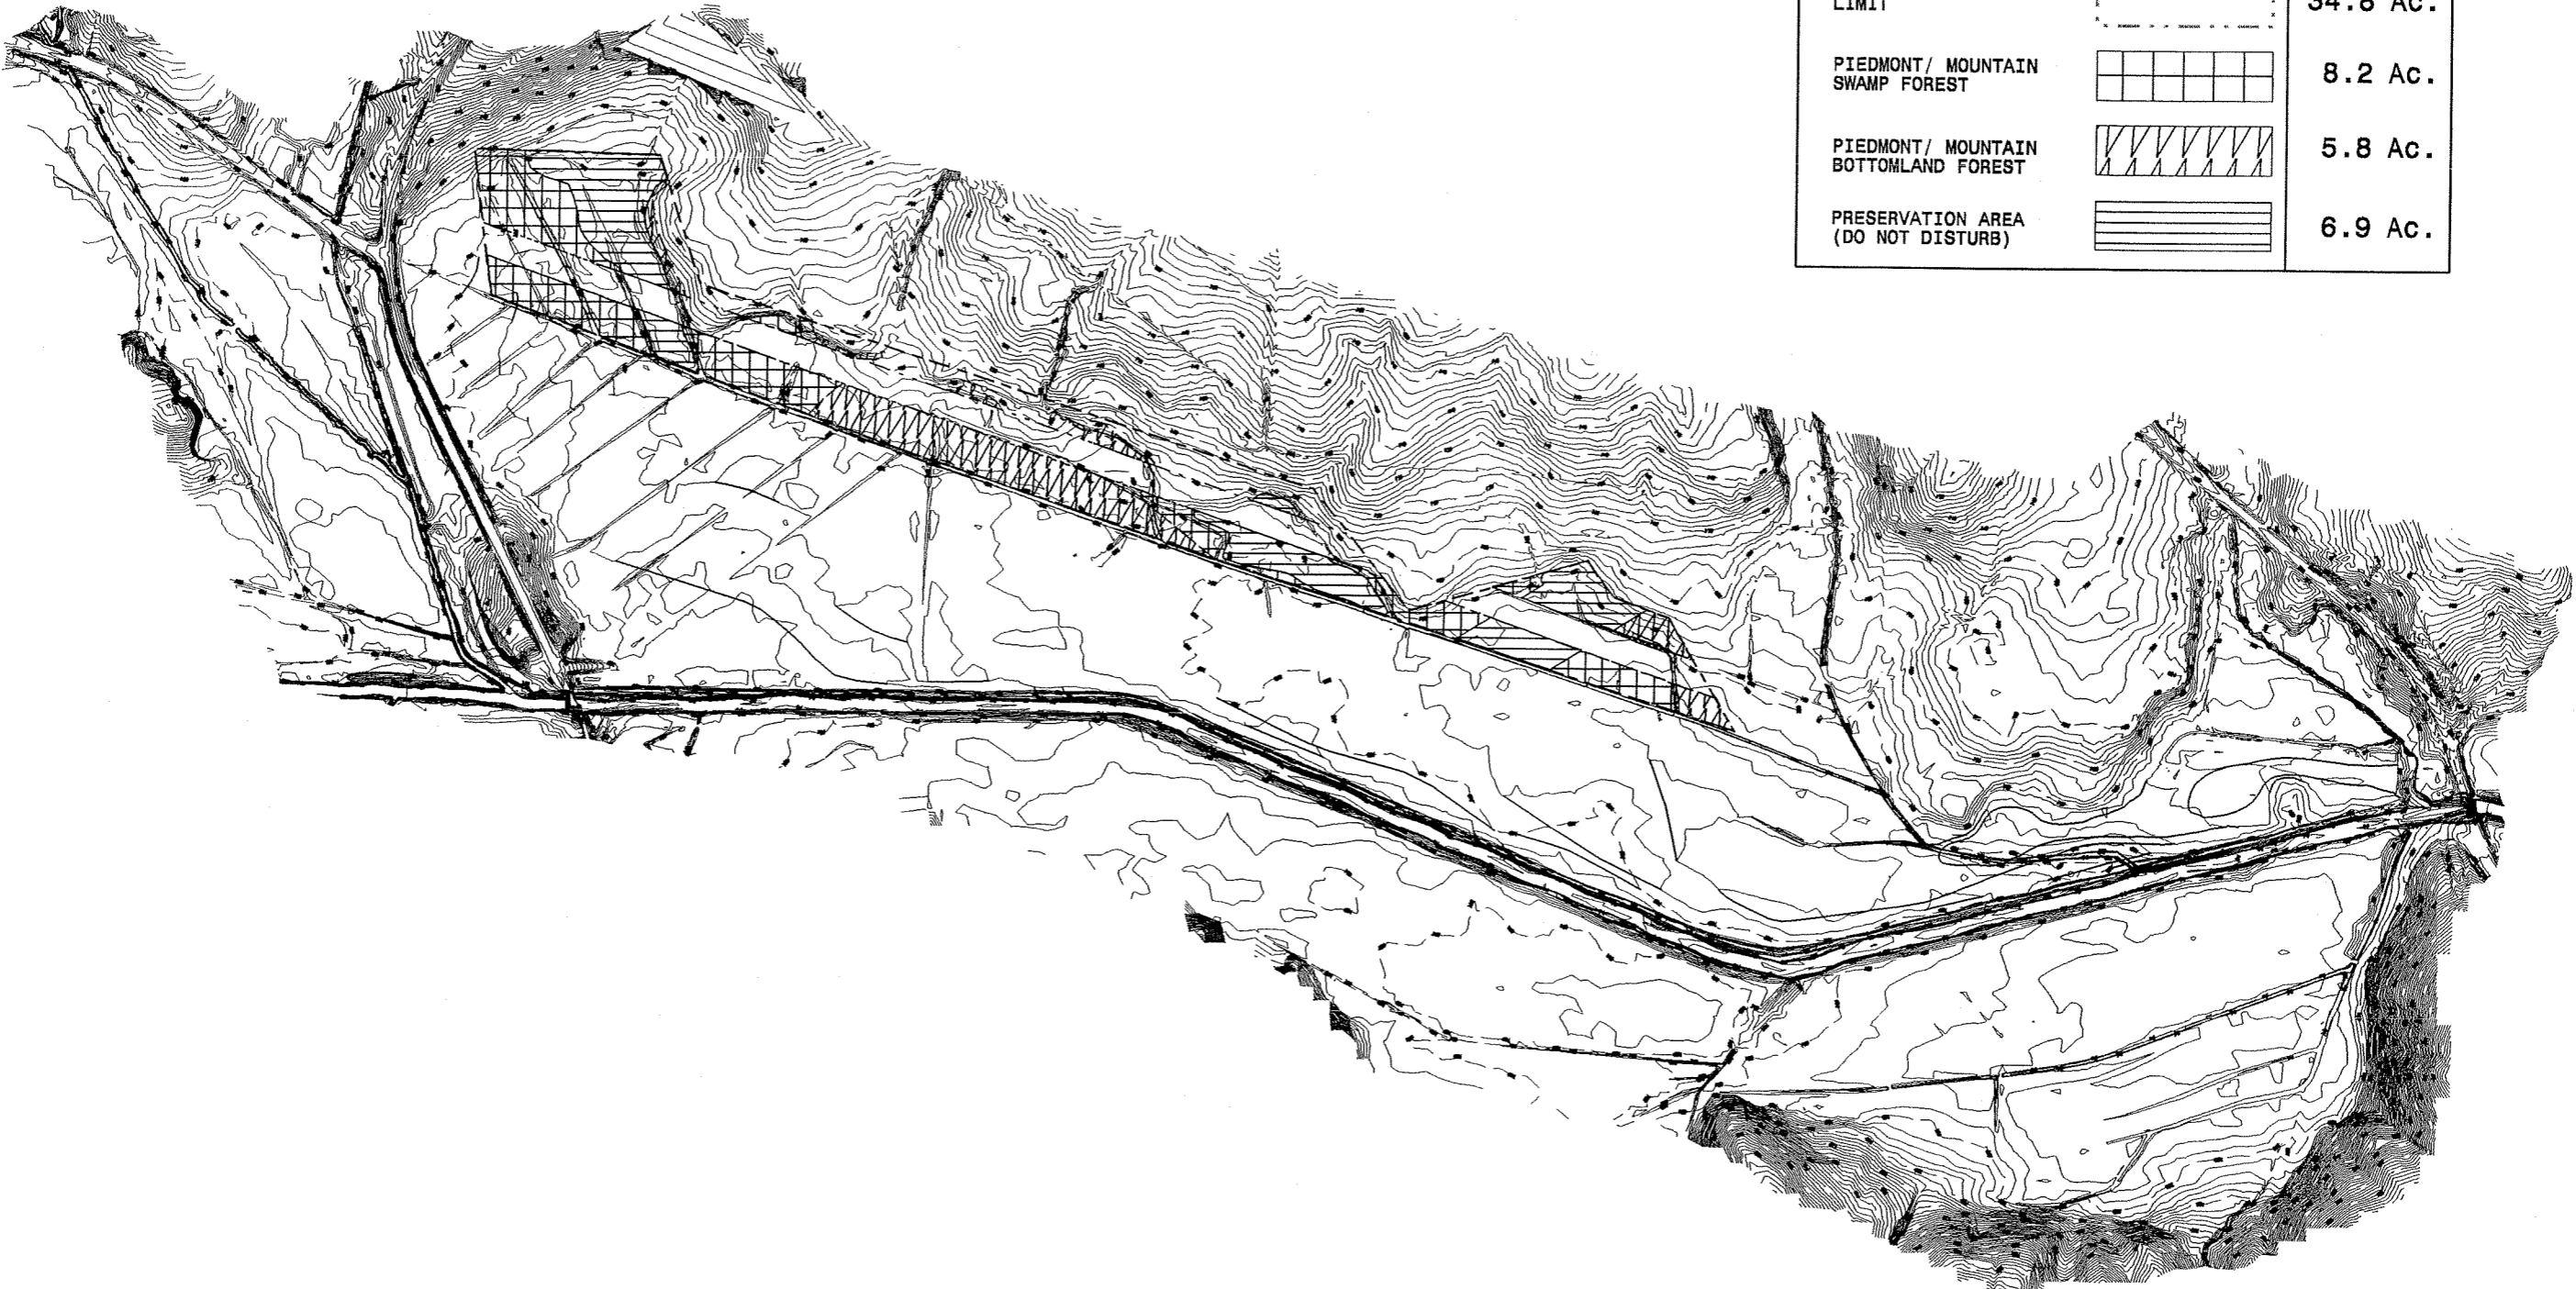

DATE OF REVISION:	REVISION	
DESIGNED BY:		
CHECKED BY:		
DATE:		
NO.	DESCRIPTION	DATE
1		
1		
PROJECT NAME:
**SHEPHERD'S TREE
PLANTING PLAN**



**STATE OF NORTH CAROLINA
DEPT. OF TRANSPORTATION**

PROJECT TITLE:	PLANTING PLAN
PROJECT NO.:	10E1
DATE PLOTTED:	


PLANTING DETAILS

SEEDLING / LINER BAREROOT PLANTING DETAIL


HEALING IN

1. Locate a healing-in site in a shady, well protected area.


2. Excavate a flat bottom trench 12" deep and provide drainage.

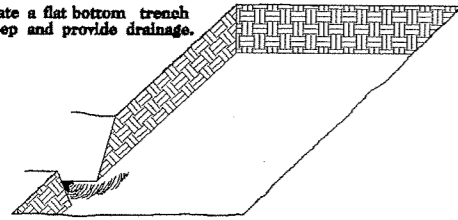


3. Backfill the trench with 2" well rotted sawdust. Place a 2" layer of well rotted sawdust at a sloping angle at one end of the trench.

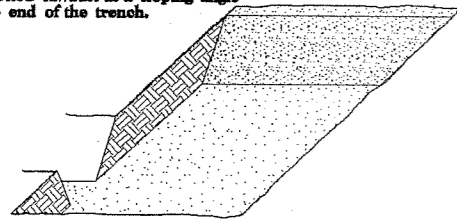

4. Place a single layer of plants against the sloping end so that the root collar is at ground level.

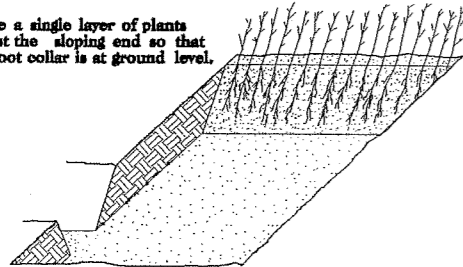


5. Place a 2" layer of well rotted sawdust over the roots maintaining a sloping angle.

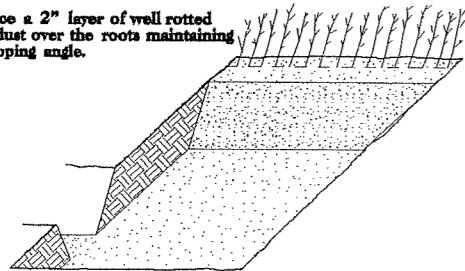

6. Repeat layers of plants and sawdust as necessary and water thoroughly.


DIBBLE PLANTING METHOD USING THE KBC PLANTING BAR

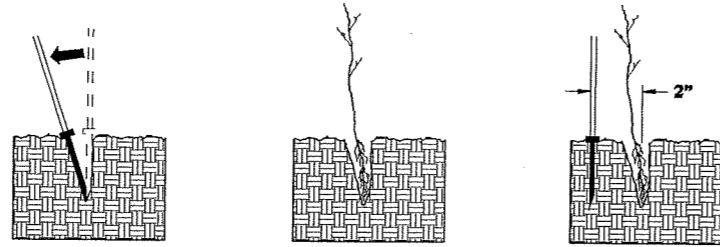

1. Insert planting bar as shown and pull handle toward planter.

2. Remove planting bar and place seedling at correct depth.

3. Insert planting bar 2" toward planter from seedling.

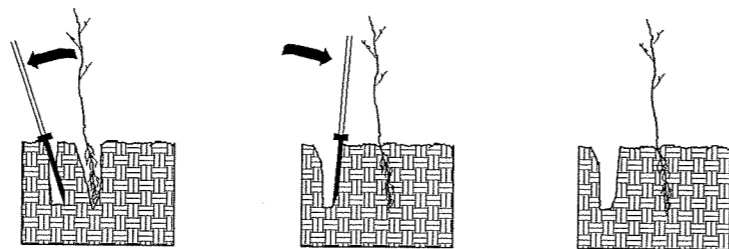

4. Pull handle of bar toward planter, firming soil at bottom.

5. Push handle forward firming soil at top.

6. Leave compaction hole open. Water thoroughly.

PLANTING NOTES:

PLANTING BAG
During planting, seedlings shall be kept in a moist canvas bag or similar container to prevent the root systems from drying.



KBC PLANTING BAR
Planting bar shall have a blade with a triangular cross section, and shall be 12" long, 4" wide and 1" thick at center.



ROOT PRUNING
All seedlings shall be root pruned, if necessary, so that no roots extend more than 10 inches (10") below the root collar.

SHEPHERD'S TREE WETLAND PLANT

STATE	STATE PROJECT REFERENCE NO.	SHEET NO.	TOTAL SHEETS
N.C.	R-2204WM	RF-1	
STATE PROJ. NO.	F.A. PROJ. NO.	DESCRIPTION	

WETLAND TREE REFORESTATION

MIXTURE, TYPE, SIZE, AND FURNISH SHALL CONFORM TO THE FOLLOWING:

PIEDMONTMOUNTAIN SWAMP FOREST

QUERCUS FALCATA VAR. PAGODAEFOLIA	CHERRYBARK OAK	12 - 18" SEEDLING
FRAXINUS PENNSYLVANICA	GREEN ASH	12 - 18" SEEDLING
QUERCUS LYRATA	OVERCUP OAK	12 - 18" SEEDLING
QUERCUS PHELLOS	WILLOW OAK	12 - 18" SEEDLING
QUERCUS NIGRA	WATER OAK	12 - 18" SEEDLING

TREE REFORESTATION SHALL BE PLANTED 6' TO 10' ON CENTER, RANDOM SPACING, AVERAGING 8' ON CENTER, APPROXIMATELY 680 PLANTS PER ACRE.

MIXTURE, TYPE, SIZE, AND FURNISH SHALL CONFORM TO THE FOLLOWING:

PIEDMONT MOUNTAIN BOTTOMLAND FOREST

QUERCUS FALCATA VAR. PAGODAEFOLIA	CHERRYBARK OAK	12 - 18" SEEDLING
FRAXINUS PENNSYLVANICA	GREEN ASH	12 - 18" SEEDLING
LIRIODENDRON TULIPIFERA	TULIP POPLAR	12 - 18" SEEDLING
QUERCUS PHELLOS	WILLOW OAK	12 - 18" SEEDLING
QUERCUS NIGRA	WATER OAK	12 - 18" SEEDLING

TREE REFORESTATION SHALL BE PLANTED 6' TO 10' ON CENTER, RANDOM SPACING, AVERAGING 8' ON CENTER, APPROXIMATELY 680 PLANTS PER ACRE.

SEE PLAN SHEETS FOR AREAS TO BE PLANTED

WETLAND REFORESTATION DETAIL SHEET

N.C.DOT. - ROADSIDE ENVIRONMENTAL UNIT

STATE OF NORTH CAROLINA


DIVISION OF HIGHWAYS

IREDELL COUNTY

STATE	STATE PROJECT REFERENCE NO.	SHEET NO.	TOTAL SHEETS
N.C.	R - 2239WM	1	67
STATE PROJECT NO.	F.A. PROJECT NO.	DESCRIPTION	
6.7690017		P.E. & CONST.	

AS-BUILT PLANS

LOCATION: SHEPHERDS TREE MITIGATION SITE LOCATED BETWEEN TRIPLETT ROAD (SR 2362) AND KNOX FARM ROAD (SR 2363) ADJACENT TO THIRD CREEK, SOUTHEAST OF STATESVILLE
TYPE OF WORK: GRADING, CLEARING AND GRUBBING, MOWING, RIPPING, DISCING, DRAINAGE, AND STREAM RESTORATION

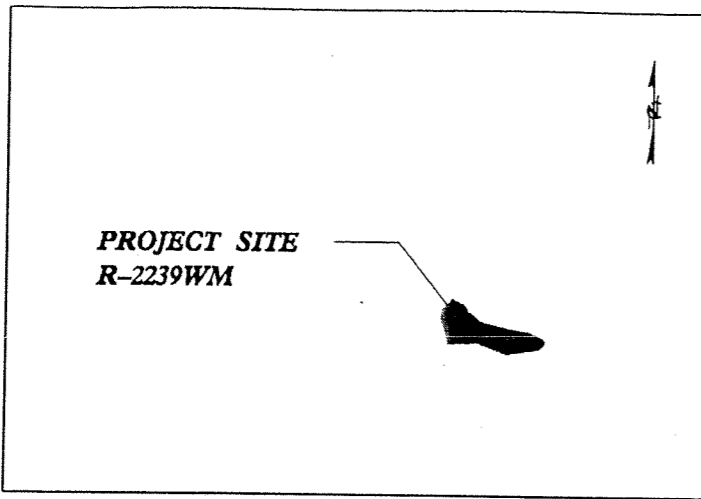


VICINITY MAP
NOT TO SCALE



PHASE II

PROJECT: 6.7690017 R-2239WM

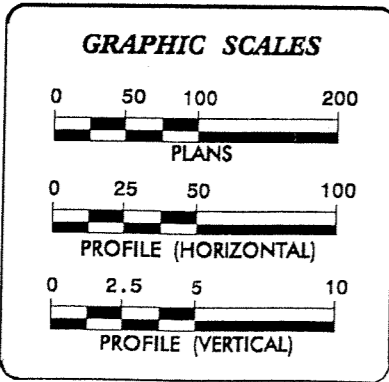

PROJECT LENGTH

TOTAL WETLAND MITIGATION = 74.9 ACRES

LENGTH OF STREAM RESTORATION = 10,704 FEET

Prepared In the Office of:

2002 STANDARD SPECIFICATIONS

LETTING DATE:

DESIGN ENGINEER

SIGNATURE

WETLAND SCIENTIST

SIGNATURE

DIVISION OF HIGHWAYS
STATE OF NORTH CAROLINA

P.E.

STATE DESIGN ENGINEER

DEPARTMENT OF TRANSPORTATION
FEDERAL HIGHWAY ADMINISTRATION

APPROVED

DIVISION ADMINISTRATOR

DATE

PROJECT REFERENCE NO.	SHEET NO.
R - 2235WM	1A
RW SHEET NO.	
ENGINEER	SCIENTIST

INDEX OF SHEETS

1	TITLE SHEET
1-A	INDEX OF SHEETS
1-B	STANDARD SYMBOLOLOGY SHEET
2	DETAILS: DITCH PLUG
2-A	DETAILS: STREAM SEGMENT 1- STATION 10+00 THRU 88+22
2-B	DETAILS: STREAM SEGMENT 2- STATION 88+22 THRU 109+04
2-C	DETAILS: TRIBUTARY- STATION 10+00 THRU 18+00
2-D	DETAILS: STREAM STABILIZATION TREATMENTS/ INSTREAM STRUCTURES
3	SUMMARY SHEET
4 THRU 7	SITE MAP WITH EXISTING CONTOURS
8 THRU 11	LIMITS OF OPERATION
12 THRU 15	GRADING PLAN
16 THRU 19	STRUCTURES PLAN
20 THRU 23	STREAM GEOMETRY
24 THRU 34	STREAM GEOMETRY DATA
35 THRU 39	STREAM PROFILE
40 THRU 43	WETLAND CROSS SECTION LAYOUT
XS1 THRU XS18	WETLAND CROSS SECTIONS
EC-1 THRU EC-6	EROSION CONTROL PLAN

ROADWAY STANDARD DRAWINGS:

(REV. JAN. 15, 2002)

THE FOLLOWING ROADWAY STANDARDS AS APPEAR IN "ROADWAY STANDARD DRAWINGS" - HIGHWAY DESIGN BRANCH - N.C. DEPARTMENT OF TRANSPORTATION - RALEIGH, N.C., DATED JANUARY 15, 2002 ARE APPLICABLE TO THIS PROJECT AND BY REFERENCE HEREBY ARE CONSIDERED A PART OF THESE PLANS:

STD. NO.	TITLE
866.02	WOVEN WIRE FENCE WITH WOOD POST
866.04	BARBED WIRE FENCE WITH WOOD POSTS (ALTERNATE CATTLE GATE)
904.50	MOUNTING OF TYPE 'D', 'E', AND 'F' SIGNS ON 'U' CHANNEL POSTS

GENERAL NOTES:

BEARING AND DISTANCES:

ALL BEARINGS ARE NAD '83 GRID BEARINGS.
ALL DISTANCES AND COORDINATES SHOWN ARE HORIZONTAL (GROUND) VALUES.
ALL INFORMATION IS BASED ON THE FOLLOWING NCGS CONTROL MONUMENTS.

"KIMMER"	N = 705,616.53	E = 1,497,413.15	ELEV. = 782.13'
"BEACON AZ"	N = 684,999.89	E = 1,463,959.23	ELEV. = 926.73'
"319 JAS"	N = 733,066.25	E = 1,477,188.81	ELEV. = 837.95'

ALL PROPERTY BOUNDARY DATA IS BASED ON DATA SUPPLIED BY NCDOT.

GRADING:

-THE GRADE LINES SHOWN DENOTE THE FINISHED ELEVATION OF THE PROPOSED OR FUTURE SURFACING AT GRADE POINTS SHOWN ON THE TYPICAL SECTIONS. GRADE LINES MAY BE ADJUSTED AT THEIR BEGINNING, ENDING AND AT STRUCTURES AS DIRECTED BY THE ENGINEER IN ORDER TO SECURE A PROPER TIE-IN.
-ALL EXCAVATED MATERIALS, INCLUDING NATURAL STONE MEETING SIZE LIMITATIONS, ARE TO BE SALVAGED FOR REUSE WITHIN THE PROJECT AT THE DISCRETION OF THE ENGINEER.
-ALL INFLECTION POINTS BETWEEN SLOPE ANGLES SHALL BE ROUNDED SLIGHTLY IN ORDER TO PROVIDE FOR SMOOTH TRANSITIONS AND A MORE NATURAL APPEARANCE.

SUBSURFACE PLANS:


-NO SUBSURFACE PLANS ARE AVAILABLE ON THIS PROJECT. THE CONTRACTOR SHOULD MAKE HIS OWN INVESTIGATION AS TO THE SUBSURFACE CONDITIONS.

UTILITIES:

-UTILITY LOCATIONS NOTED ON PLANS ARE FOR INFORMATIONAL PURPOSES ONLY. IT SHALL BE THE RESPONSIBILITY OF THE CONTRACTOR TO LOCATE ANY EXISTING UTILITIES. CONTACT 'NC ONE CALL', 1-800-632-4949, A MINIMUM OF 48 HOURS IN ADVANCE OF CONSTRUCTION, AS WELL AS NCDOT, FOR INFORMATION.

INDEX SHEET

PROJECT REFERENCE NO.	SHEET NO.
R-2239WM	2
RW SHEET NO.	
ENGINEER	SCIENTIST

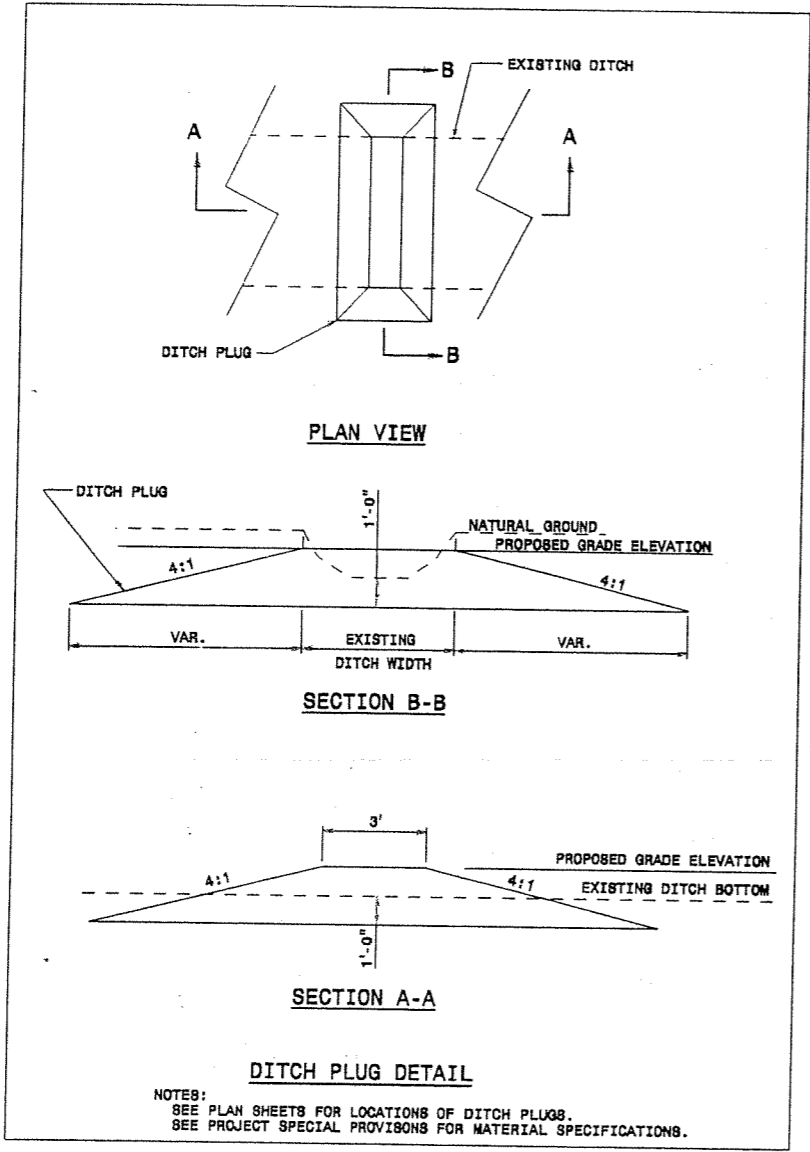



DETAIL SHEET 01

KCI Associates
of North Carolina, P.A.
 SUITE 200, LANDMARK CENTER 1, 4500 JX FORK RD.
 HALEGH, NC 27603-5200
 ENGINEERS • PLANNERS • ECOLOGISTS



PROJECT REFERENCE NO. R - 2239WM	SHEET NO. 2-A
RW SHEET NO.	
ENGINEER	SCIENTIST

TYPICAL CHANNEL CROSS SECTIONS

STREAM SEGMENT 1 - STATION 10+00 TO 88+22

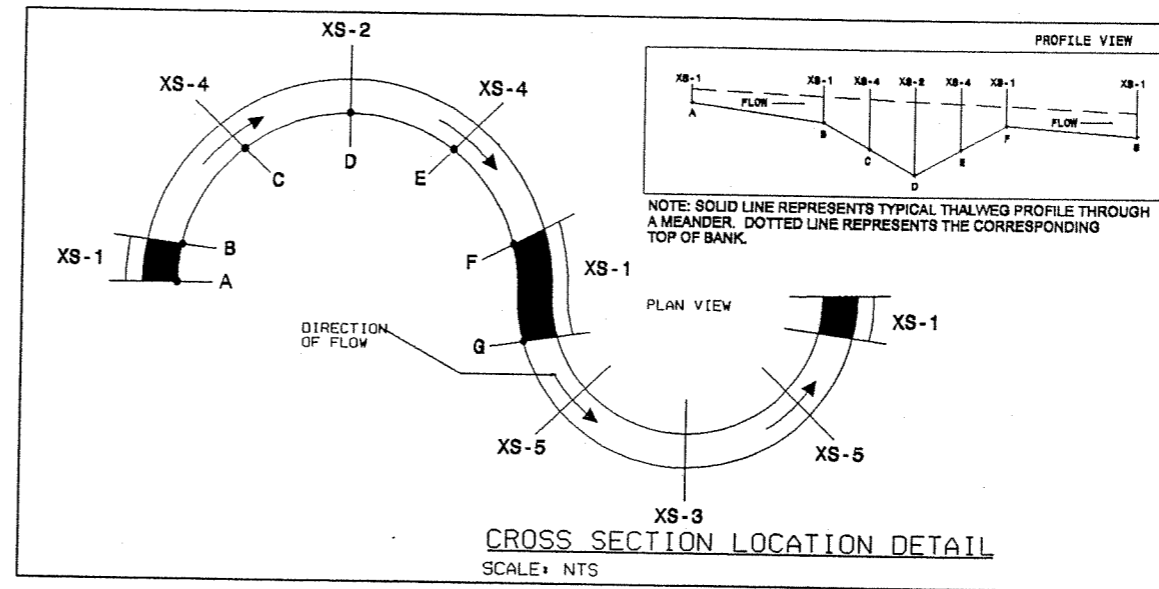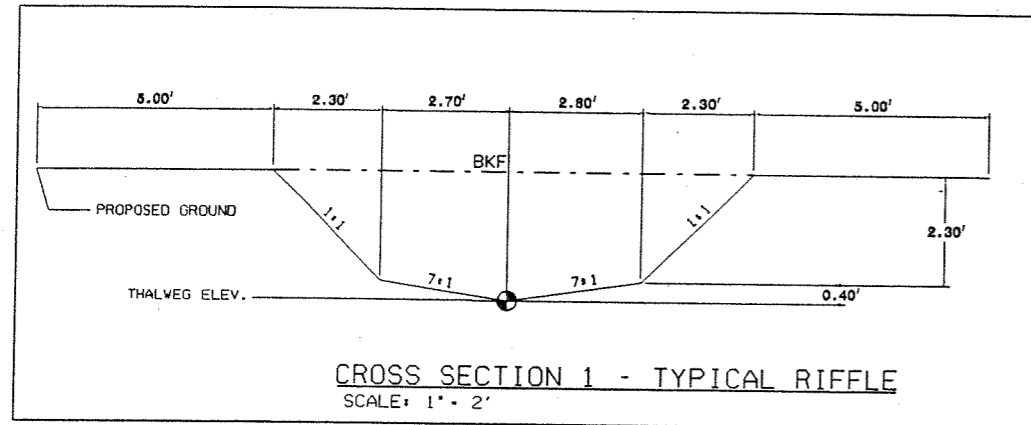



NOTE:
CHANNEL DIMENSIONS
BETWEEN TYPICAL
SECTIONS SHALL BE
CONSTRUCTED TO PROVIDE
FOR A SMOOTH TRANSITION.

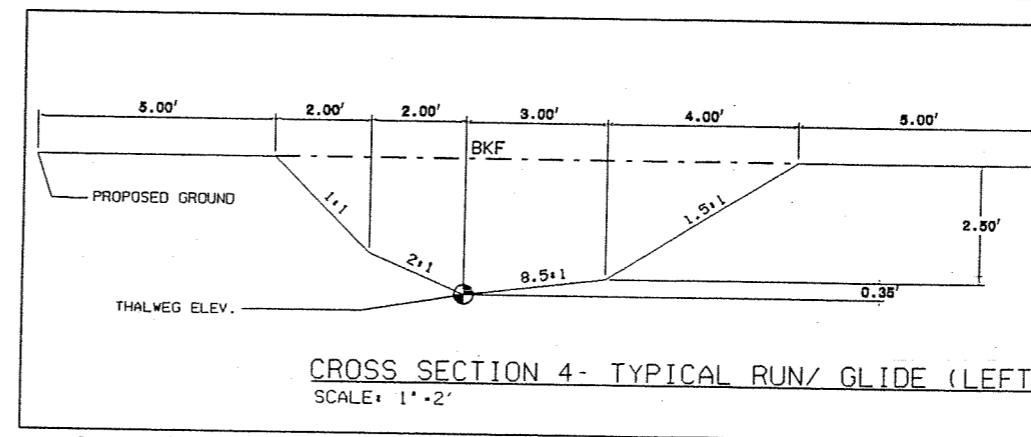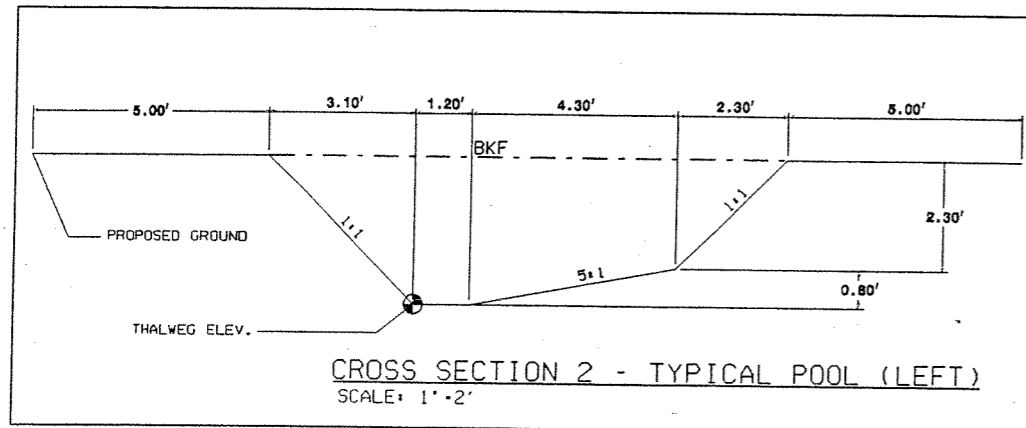

NOTE:
THALWEG ELEVATIONS
ARE EQUIVALENT TO
THE CHANNEL INVERT
ELEVATIONS THAT APPEAR
ON THE PROFILE SHEETS
(SEE SHEETS 35-39)

NOTE: CROSS SECTION 2 AND 3 ARE MIRROR IMAGES

NOTE: CROSS SECTION 4 AND 5 ARE MIRROR IMAGES

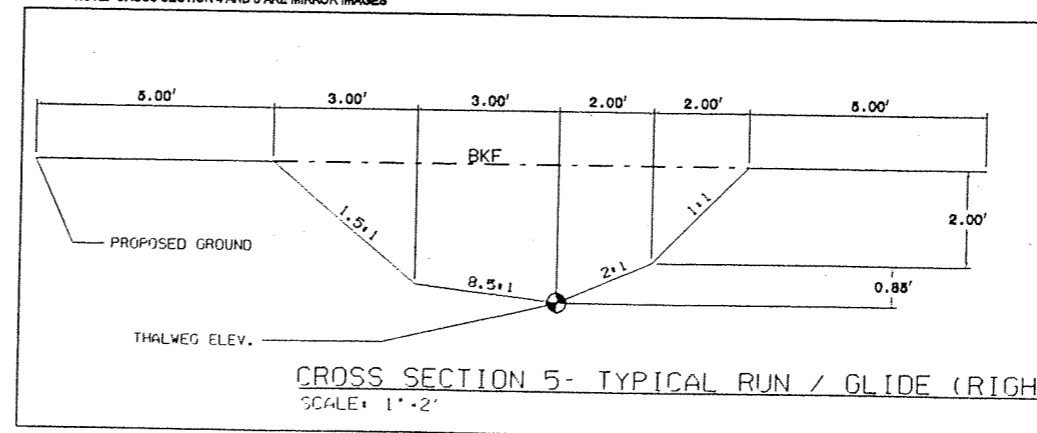
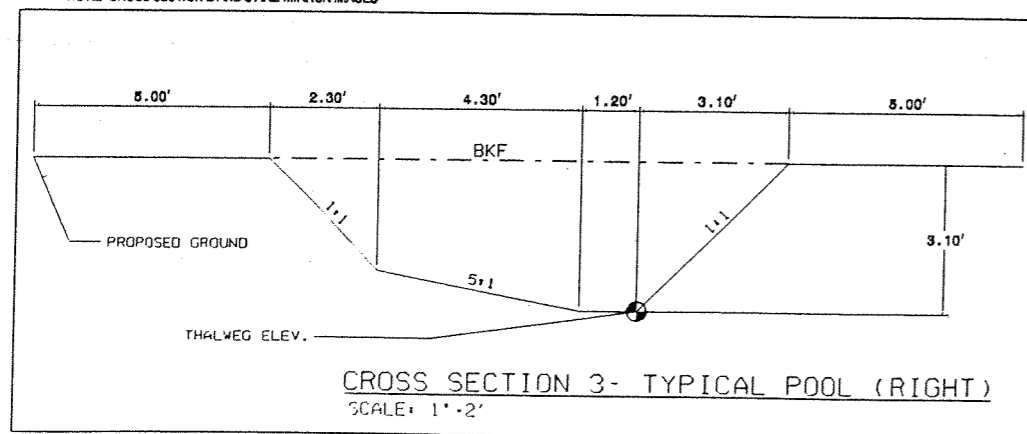


DETAIL SHEET 02


PROJECT REFERENCE NO. R - 2239WM	SHEET NO. 2-B
RW SHEET NO.	
ENGINEER	SCIENTIST

TYPICAL CHANNEL CROSS SECTIONS


STREAM SEGMENT 2 - STATION 88+22 TO 109+04

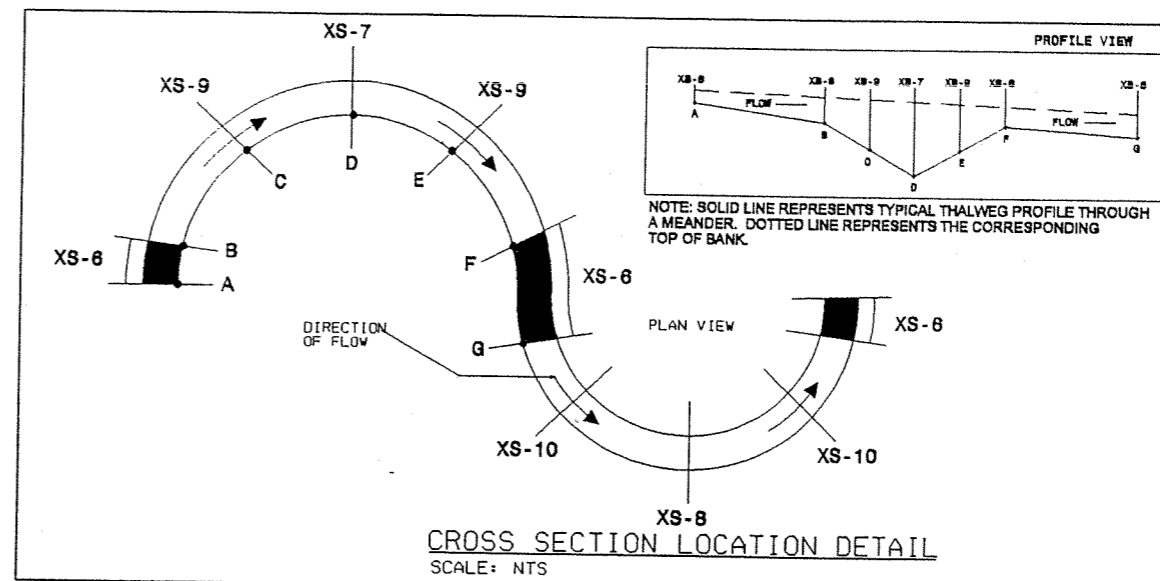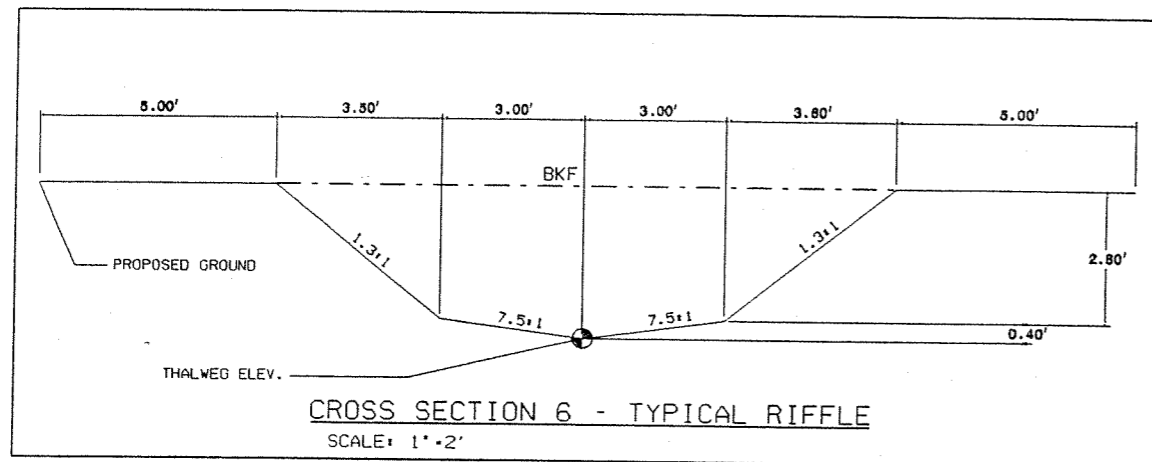

NOTE:
CHANNEL DIMENSIONS
BETWEEN TYPICAL
SECTIONS SHALL BE
CONSTRUCTED TO PROVIDE
FOR A SMOOTH TRANSITION.


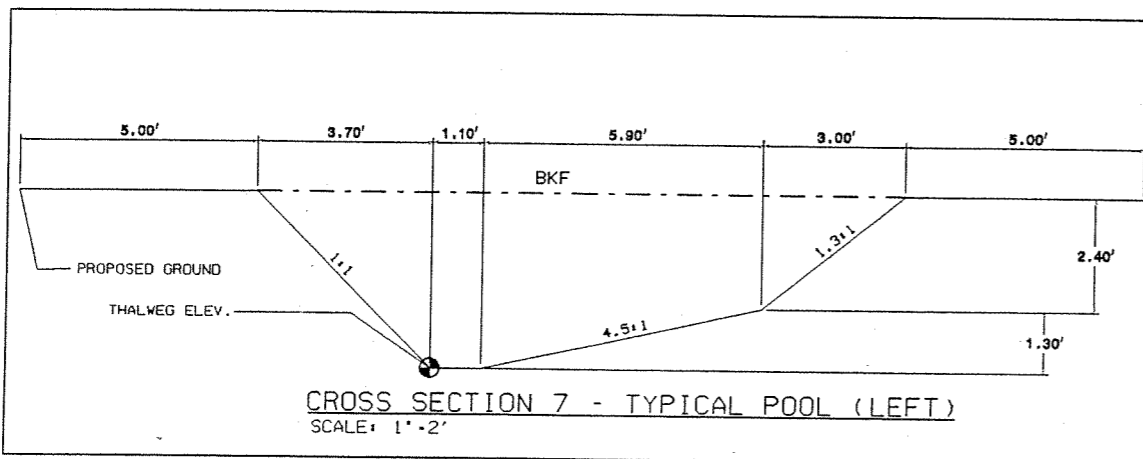


NOTE: CROSS SECTION 7 AND 8 ARE MIRROR IMAGES

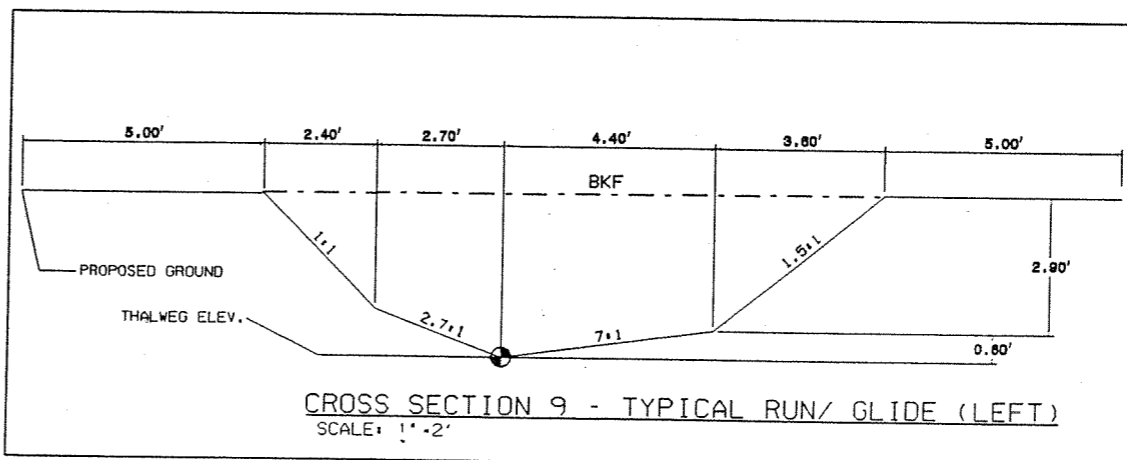

NOTE: CROSS SECTION 9 AND 10 ARE MIRROR IMAGES

NOTE:
THALWEG ELEVATIONS
ARE EQUIVALENT TO
THE CHANNEL INVERT
ELEVATIONS THAT APPEAR
ON THE PROFILE SHEETS
(SEE SHEETS 35-39)

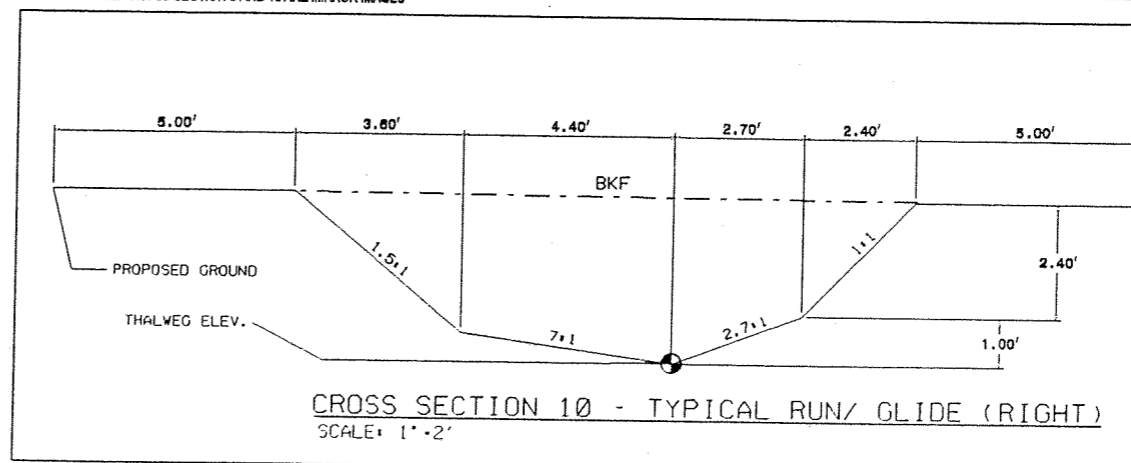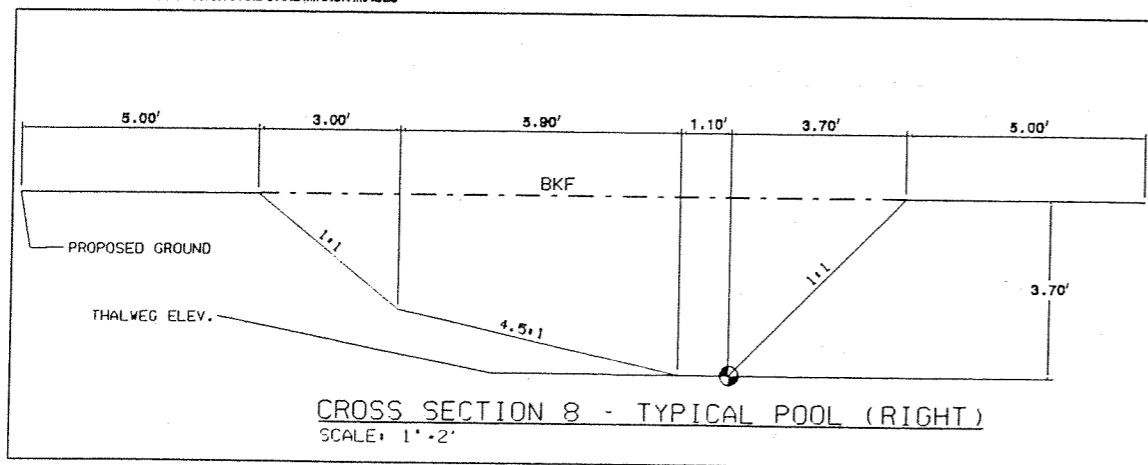


DETAIL SHEET 03


PROJECT REFERENCE NO. R - 2239WM	SHEET NO. 2-C
RW SHEET NO.	
ENGINEER	SCIENTIST

TYPICAL CHANNEL CROSS SECTIONS







STREAM SEGMENT: TRIBUTARY - STATION 10+00T TO 17+99T

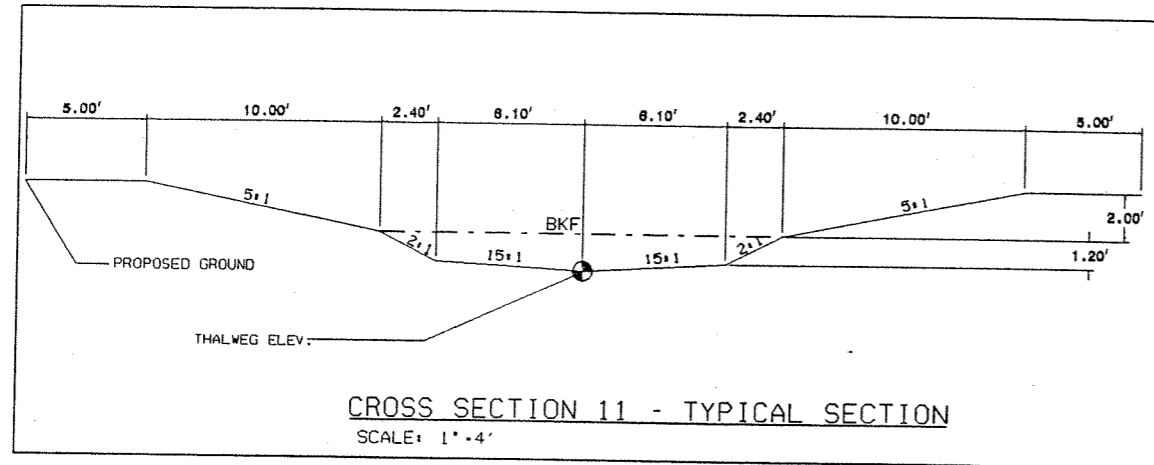

NOTE:
THALWEG ELEVATIONS
ARE EQUIVALENT TO
THE CHANNEL INVERT
ELEVATIONS THAT APPEAR
ON THE PROFILE SHEETS
(SEE SHEETS 35-39)

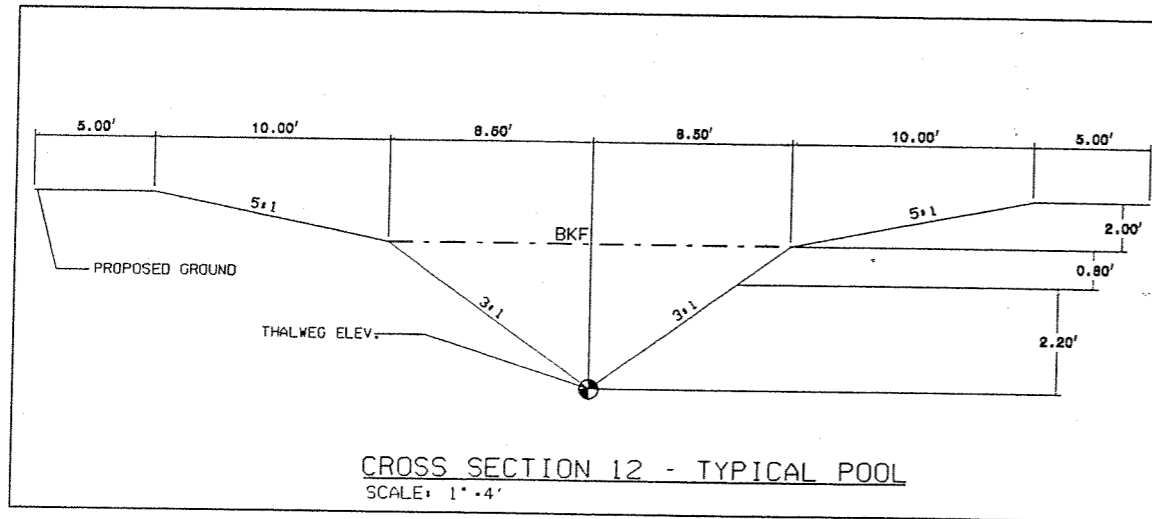

NOTE:
THALWEG ELEVATIONS
ARE EQUIVALENT TO
THE CHANNEL INVERT
ELEVATIONS THAT APPEAR
ON THE PROFILE SHEETS
(SEE SHEETS 35-39)

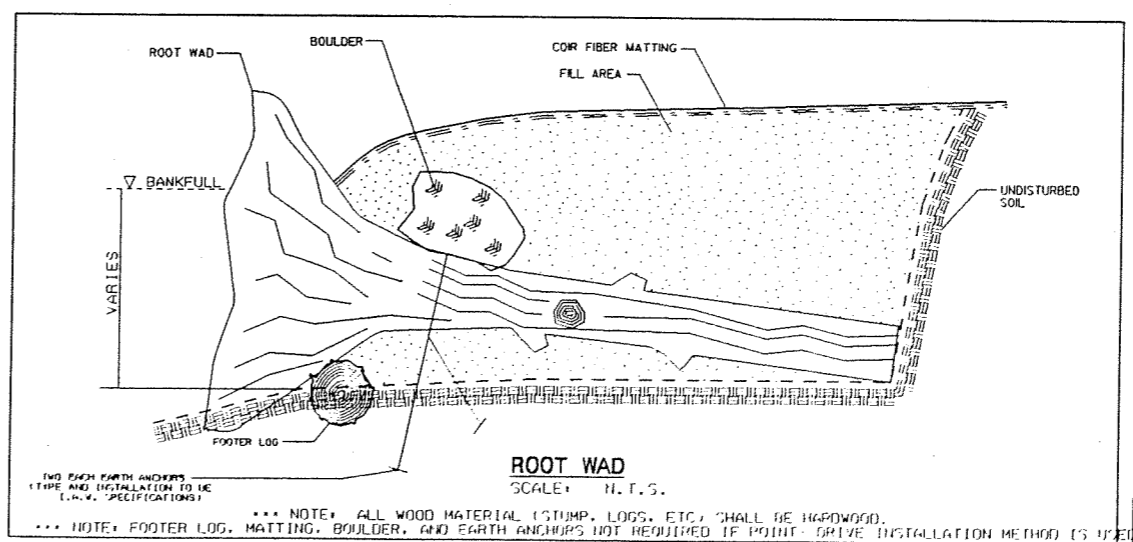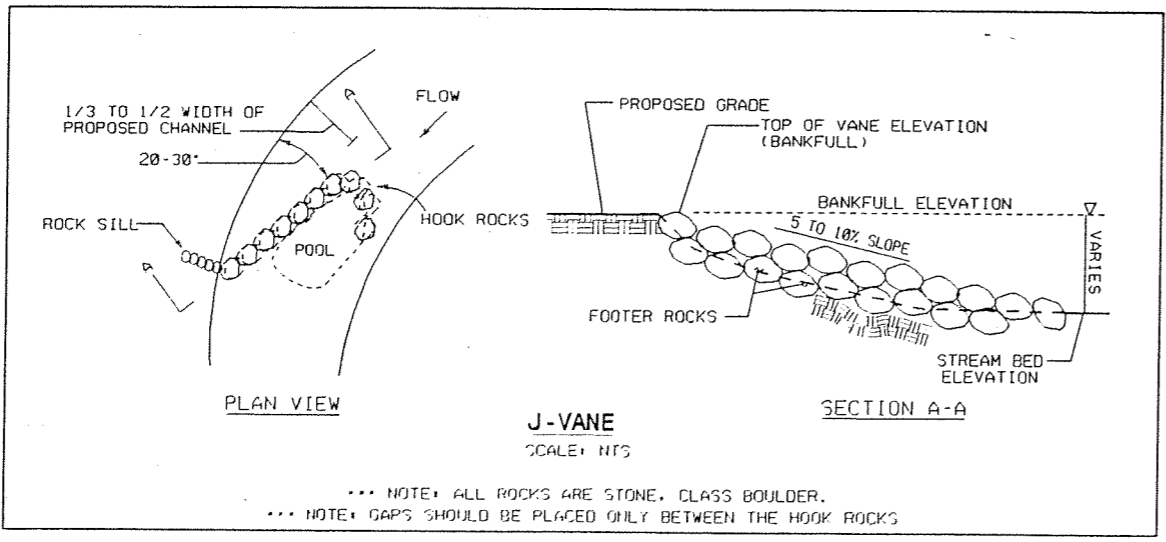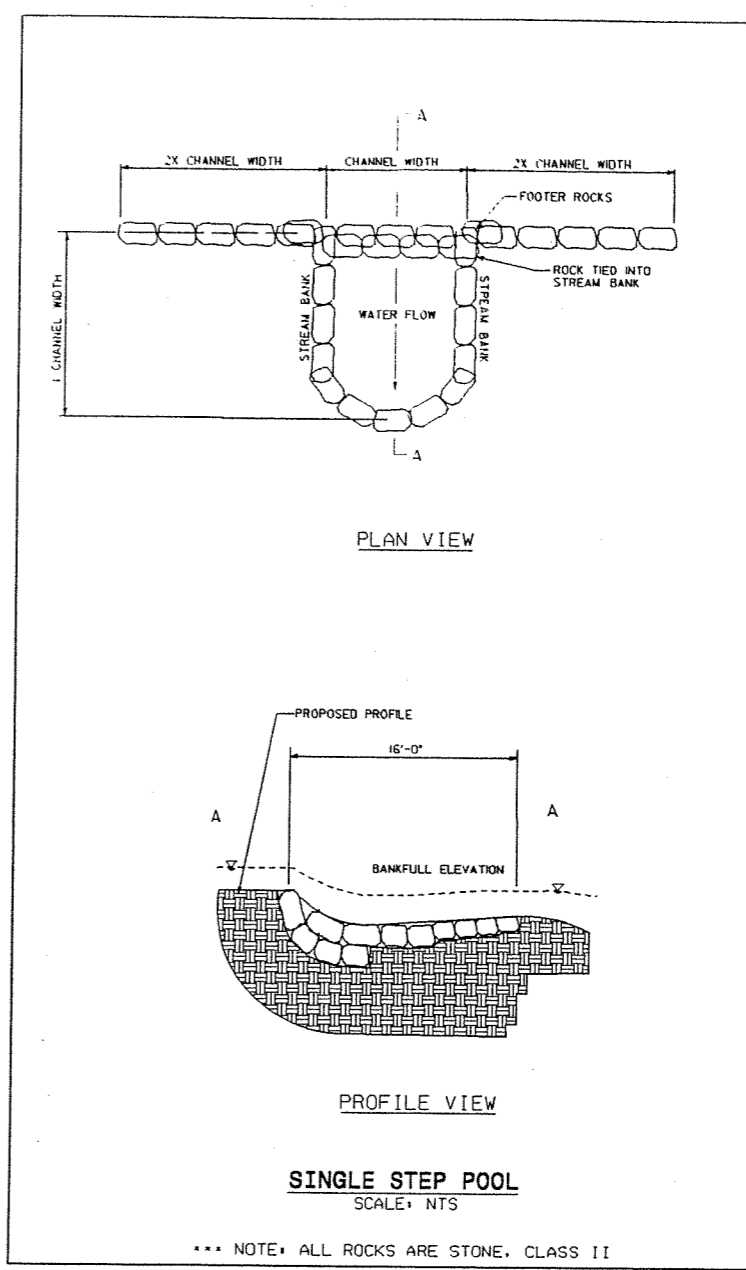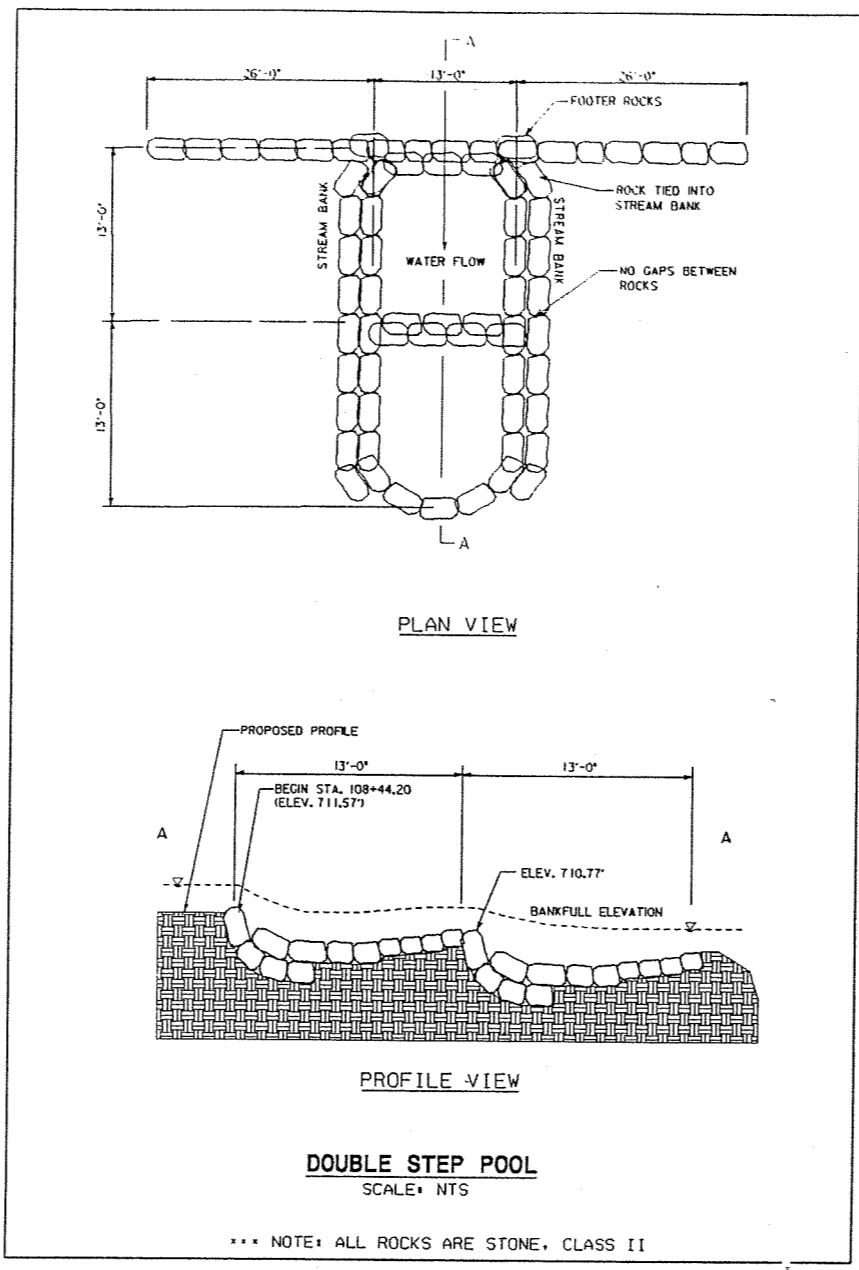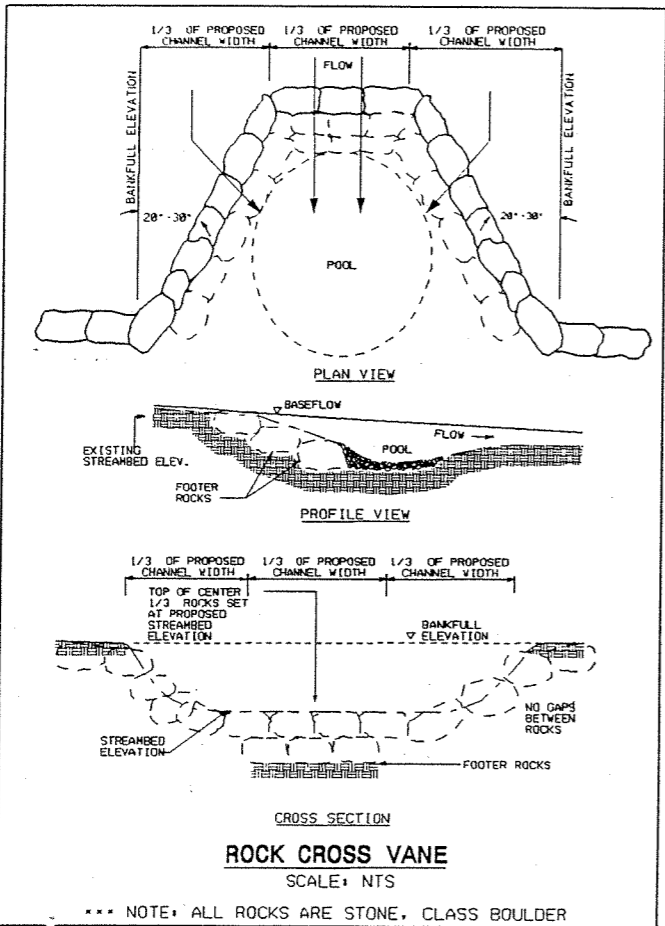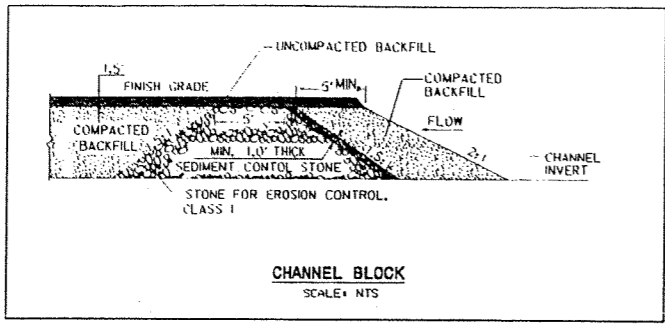

PROJECT REFERENCE NO.	SHEET NO.
R - 2239WM	3
RW SHEET NO.	
ENGINEER	SCIENTIST

DIVISION OF HIGHWAYS
STATE OF NORTH CAROLINA

SUMMARY OF QUANTITIES

SECT.	QUANTITY	UNIT	ITEM DESCRIPTION
800	1	LS	MOBILIZATION
200	1	LS	CLEARING AND GRUBBING
1880	70	AC	MOWING
210	1	LS	DEMOLITION OF BUILDINGS AND APPURTENANCES
228	1	LS	GRADING
1830	310	CY	SILT EXCAVATION
SP	100	CY	IMPERVIOUS SELECT MATERIAL
SP	80	AC	RIPPING
SP	80	AC	DISCING
1058	400	SY	FILTER FABRIC FOR DRAINAGE
1880	80	AC	SEEDING AND MULCHING
1815	42	AC	TEMPORARY MULCH
1820	1500	LB	SEED FOR TEMPORARY SEEDING
1820	8	TON	FERTILIZER FOR TEMPORARY SEEDING
1881	400	LB	SEED FOR REPAIR SEEDING
1881	1	TON	FERTILIZER FOR REPAIR SEEDING
1882	1000	LB	SEED FOR SUPPLEMENTAL SEEDING
1885	30	TON	FERTILIZER TOPDRESSING
1810	215	TON	SEDIMENT CONTROL STONE
1810	50	TON	STONE FOR EROSION CONTROL, CLASS A
1810	250	TON	STONE FOR EROSION CONTROL, CLASS B
1810	40	TON	STONE FOR EROSION CONTROL, CLASS 1
1832	500	FT	1/4" HARDWARE CLOTH
SP	300	TON	STONE, CLASS 2
SP	500	TON	STONE, BOULDER
SP	21	EA	ROOT WADS
SP	2000	SY	COIR MATTING
1080	300	SY	EROSION CONTROL MATTING FOR LEVEE BREAK
SP	2100	LF	TEMPORARY CHANNEL DIVERSION
SP	150	LF	IMPERVIOUS DIKE
888	10400	LF	WOVEN WIRE FENCE 47" FABRIC
888	800	EA	4" TIMBER FENCE POSTS, 8' LONG
888	2	EA	GATE, SGL, 52"x14'x14'
904	100	EA	SIGN ERECTION, TYPE F
1094	800	LF	SUPPORTS, 3-LB STEEL U-CHANNEL

SUMMARY OF EARTHWORK



IN CUBIC YARDS

SITE EXCAVATION =	49,000 CY
STREAM EXCAVATION =	9,500 CY
SITE EMBANKMENT =	37,500 CY
NET WASTE =	21,000 CY


SUMMARY SHEET 01

GENERAL PLAN LEGEND	
	SITE BOUNDARY
	PROPOSED STREAM CHANNEL PLATFORM
	EXISTING CONTOUR LINES
	PROPOSED 5' CONTOUR LINES
	PROPOSED 1' CONTOUR LINES
	FENCE LINE
	TREE LINE
	SURVEY CONTROL POINT
	EXISTING PROPERTY LINE

PROJECT REFERENCE NO. R - 2239WM	SHEET NO. 4
BY SHEET NO.	
ENGINEER	SCIENTIST

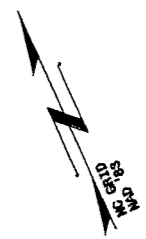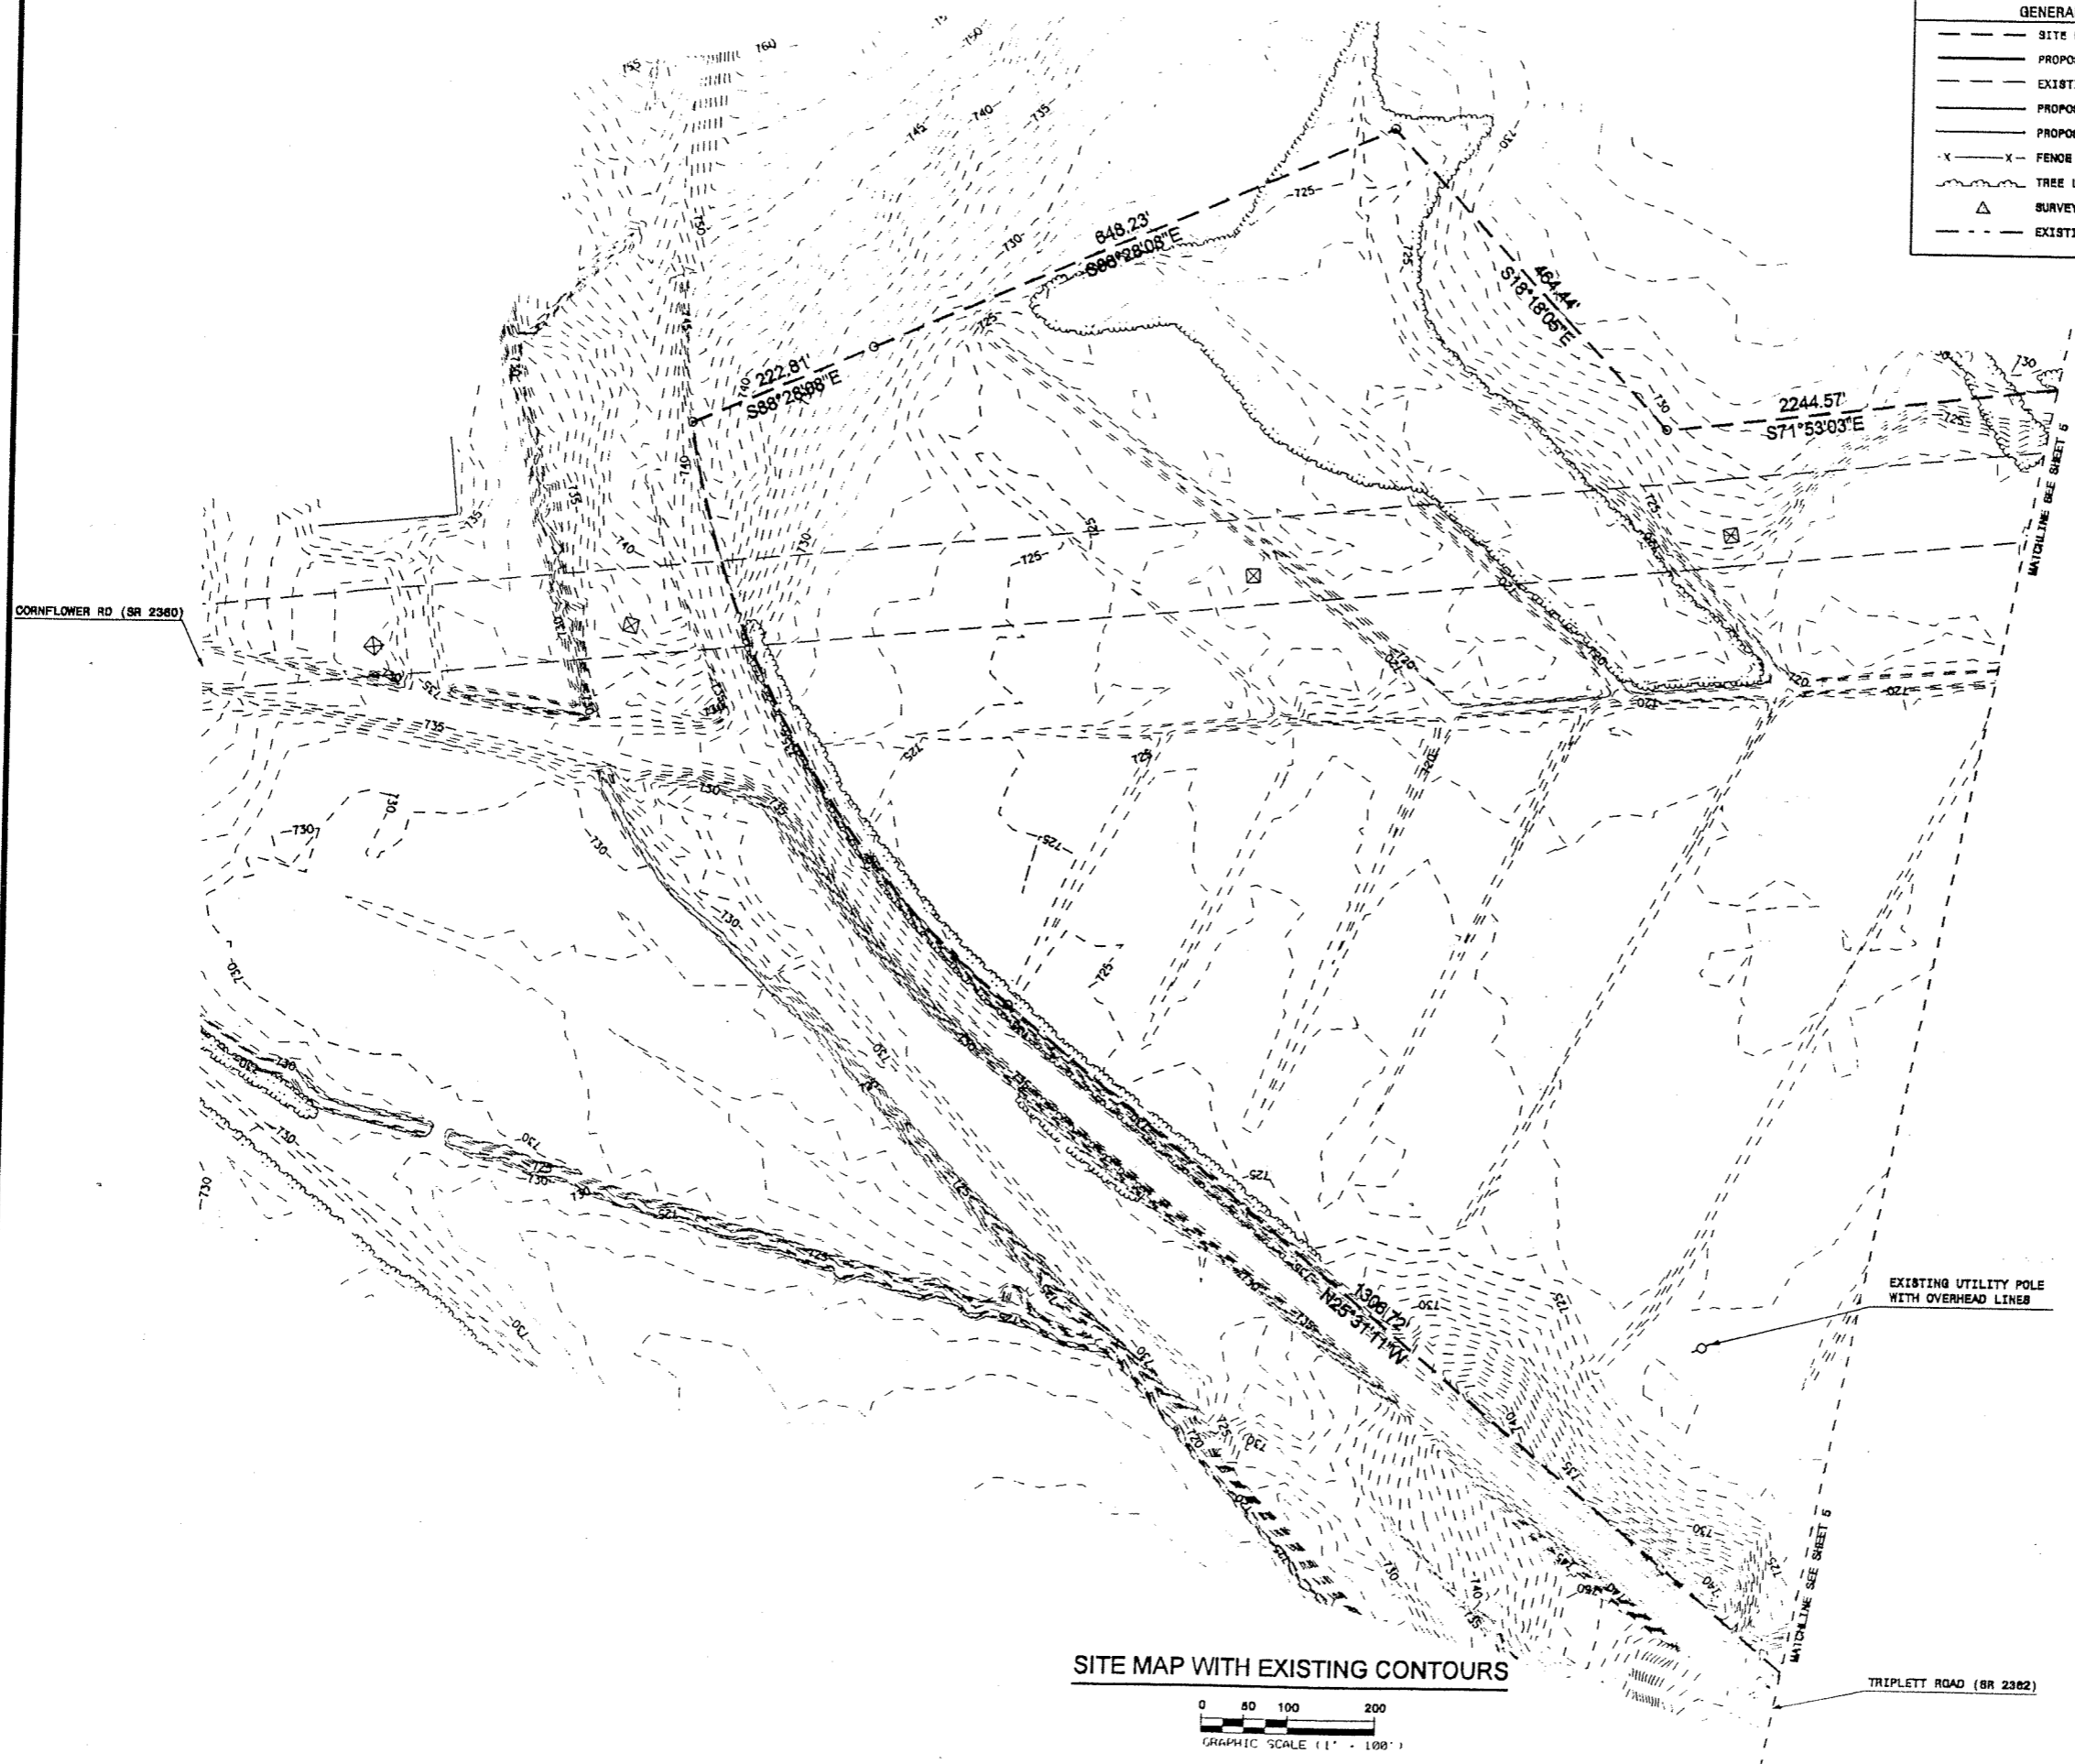

SITE MAP WITH EXISTING CONTOURS

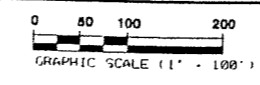

EXISTING UTILITY POLE WITH OVERHEAD LINES

MATCHLINE SEE SHEET 5

TRIPLETT ROAD (SR 2362)

SITE MAP W/ EXISTING CONTOURS 01


KCI Associates
of North Carolina, P.A.
200 LANDMARK CENTER L. AKA SIX FORKS RD.
HALEIGH, NC 27509-5200
ENGINEERS • PLANNERS • ECOLOGISTS

PROJECT REFERENCE NO.	SHEET NO.
R - 2239MM	5
RW SHEET NO.	
ENGINEER	SCIENTIST

GENERAL PLAN LEGEND	
	SITE BOUNDARY
	PROPOSED STREAM CHANNEL PLANFORM
	EXISTING CONTOUR LINES
	PROPOSED 5' CONTOUR LINES
	PROPOSED 1' CONTOUR LINES
	FENCE LINE
	TREE LINE
	SURVEY CONTROL POINT
	EXISTING PROPERTY LINE



SITE MAP WITH EXISTING CONTOURS

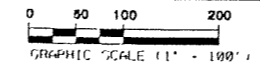


SITE MAP W/ EXISTING CONTOURS 02


KCI Associates
of North Carolina, P.A.
SUITE 200, LANDMARK CENTER 1, ASHEBORO, NC, 27809-5200
• ENGINEERS • PLANNERS • ECOLOGISTS

GENERAL PLAN LEGEND	
	SITE BOUNDARY
	PROPOSED STREAM CHANNEL PLANFORM
	EXISTING CONTOUR LINES
	PROPOSED 5' CONTOUR LINES
	PROPOSED 1' CONTOUR LINES
	FENCE LINE
	TREE LINE
	SURVEY CONTROL POINT
	EXISTING PROPERTY LINE


PROJECT REFERENCE NO. R - 2239WM	SHEET NO. 6
AW SHEET NO.	
ENGINEER	SCIENTIST

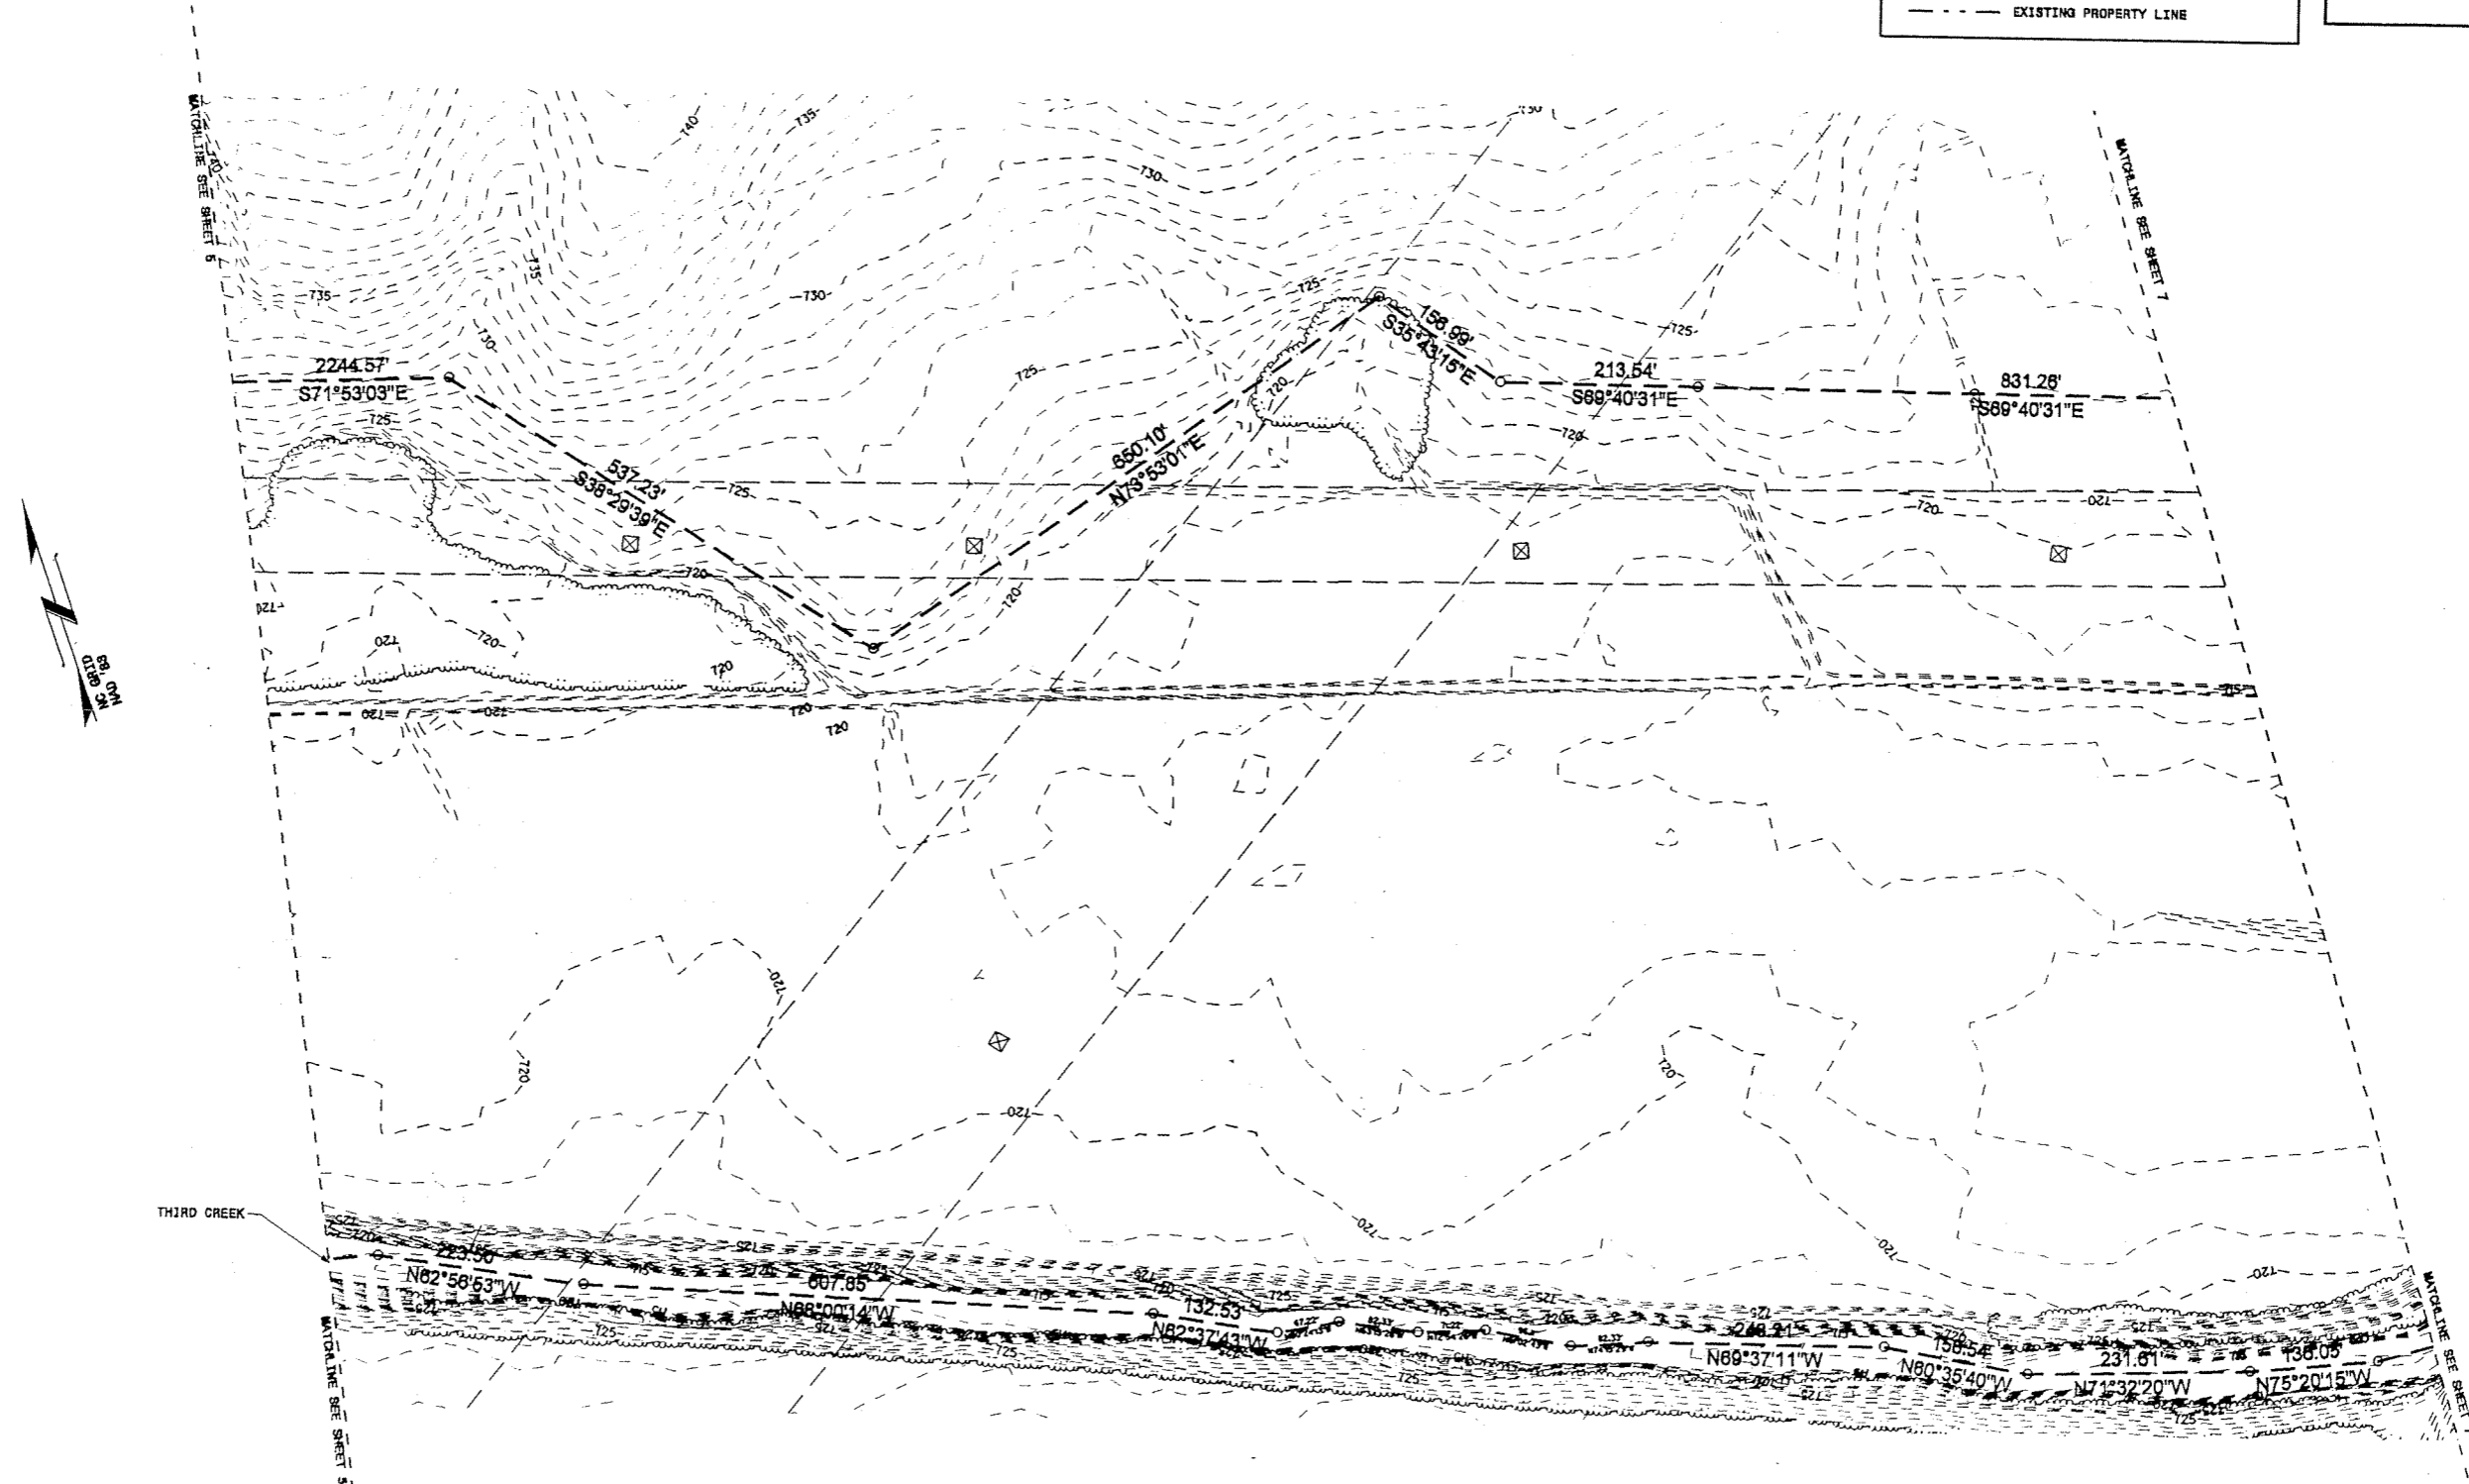

SITE MAP WITH EXISTING CONTOURS

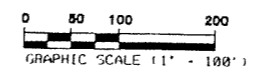


SITE MAP W/ EXISTING CONTOURS 03

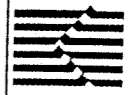
 **KCI Associates**
of North Carolina, P.A.
3115E 200, LANDMARK CENTER I, ASH FORK, NC, 27601
TEL: 704/215-5200 FAX: 704/215-5201
WWW.KCI-NC.COM

PROJECT REFERENCE NO.	SHEET NO.
R - 2259WM	7
RW SHEET NO.	
ENGINEER	SCIENTIST

GENERAL PLAN LEGEND	
	SITE BOUNDARY
	PROPOSED STREAM CHANNEL PLATFORM
	EXISTING CONTOUR LINES
	PROPOSED 5' CONTOUR LINES
	PROPOSED 1' CONTOUR LINES
	FENCE LINE
	TREE LINE
	SURVEY CONTROL POINT
	EXISTING PROPERTY LINE

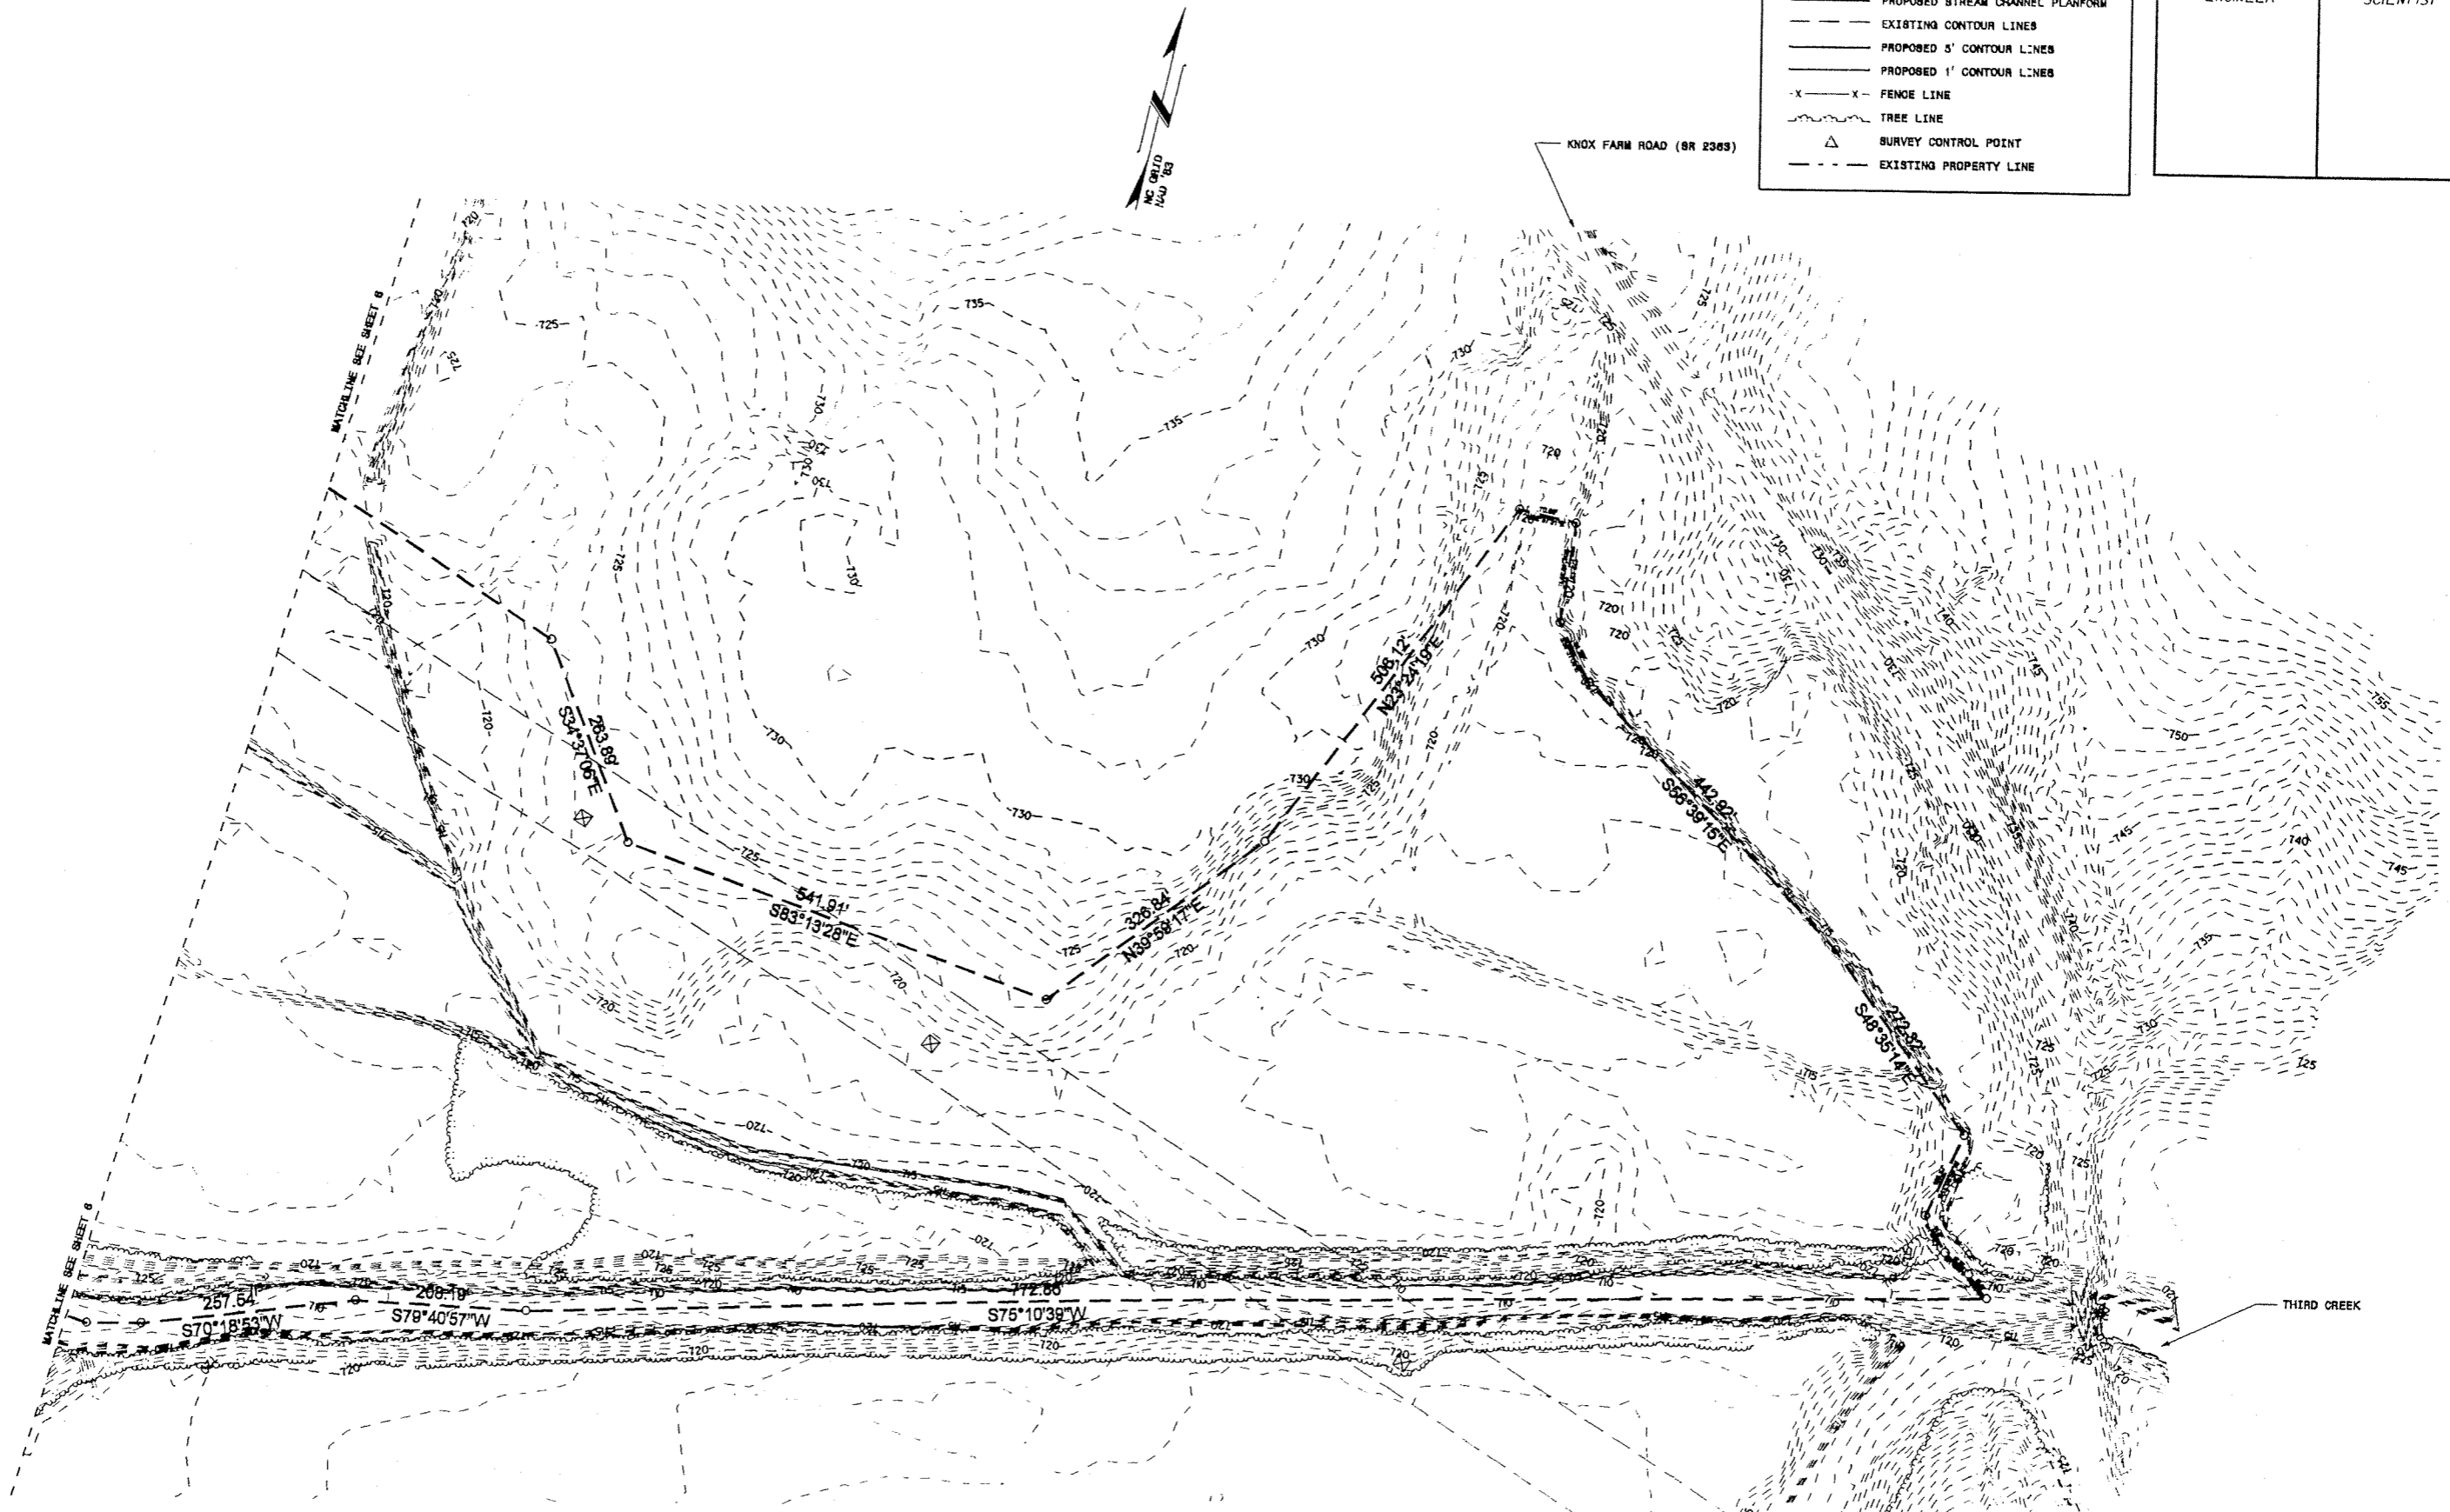

SITE MAP WITH EXISTING CONTOURS

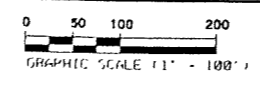


SITE MAP W/ EXISTING CONTOURS 04

KCI Associates
of North Carolina, P.A.
SUITE 250, LANGHAM CENTER I, 4508 24 FORK RD.
HALLER, NC 27509-5200
• SURVEYING • PLANNING • ECOLOGISTS

PROJECT REFERENCE NO.	SHEET NO.
R - 223-44M	3
RW SHEET NO.	
ENGINEER	SCIENTIST




PHASE I LIMITS
DO NOT DISTURB

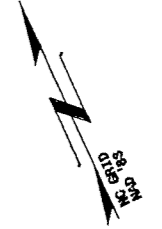


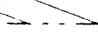
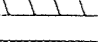

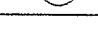
LIMITS LEGEND	
	LIMITS OF DISTURBANCE
	PHASE I LIMITS DO NOT DISTURB
	MOWING, RIPPING, & DISCING
	CLEARING & GRUBBING
	STREAM NON-RIP AREA 40' WIDE CENTERED ALONG STREAM

LIMITS OF OPERATION


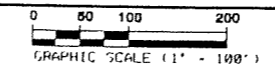


LIMITS SHEET 01

KCI Associates
of North Carolina, P.A.
SUITE 200, LANGHAM CENTER I, 4600 SIX FORKS RD.
FALEIGH, NC 27503-5200
• ENGINEERS • PLANNERS • ECOLOGISTS


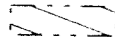
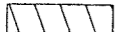


LIMITS LEGEND	
	LIMITS OF DISTURBANCE
	PHASE I LIMITS DO NOT DISTURB
	MOWING, RIPPING, & DISCING
	CLEARING & GRUBBING
	STREAM NON-RIP AREA 10' WIDE CENTERED ALONG STREAM

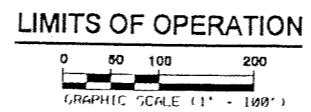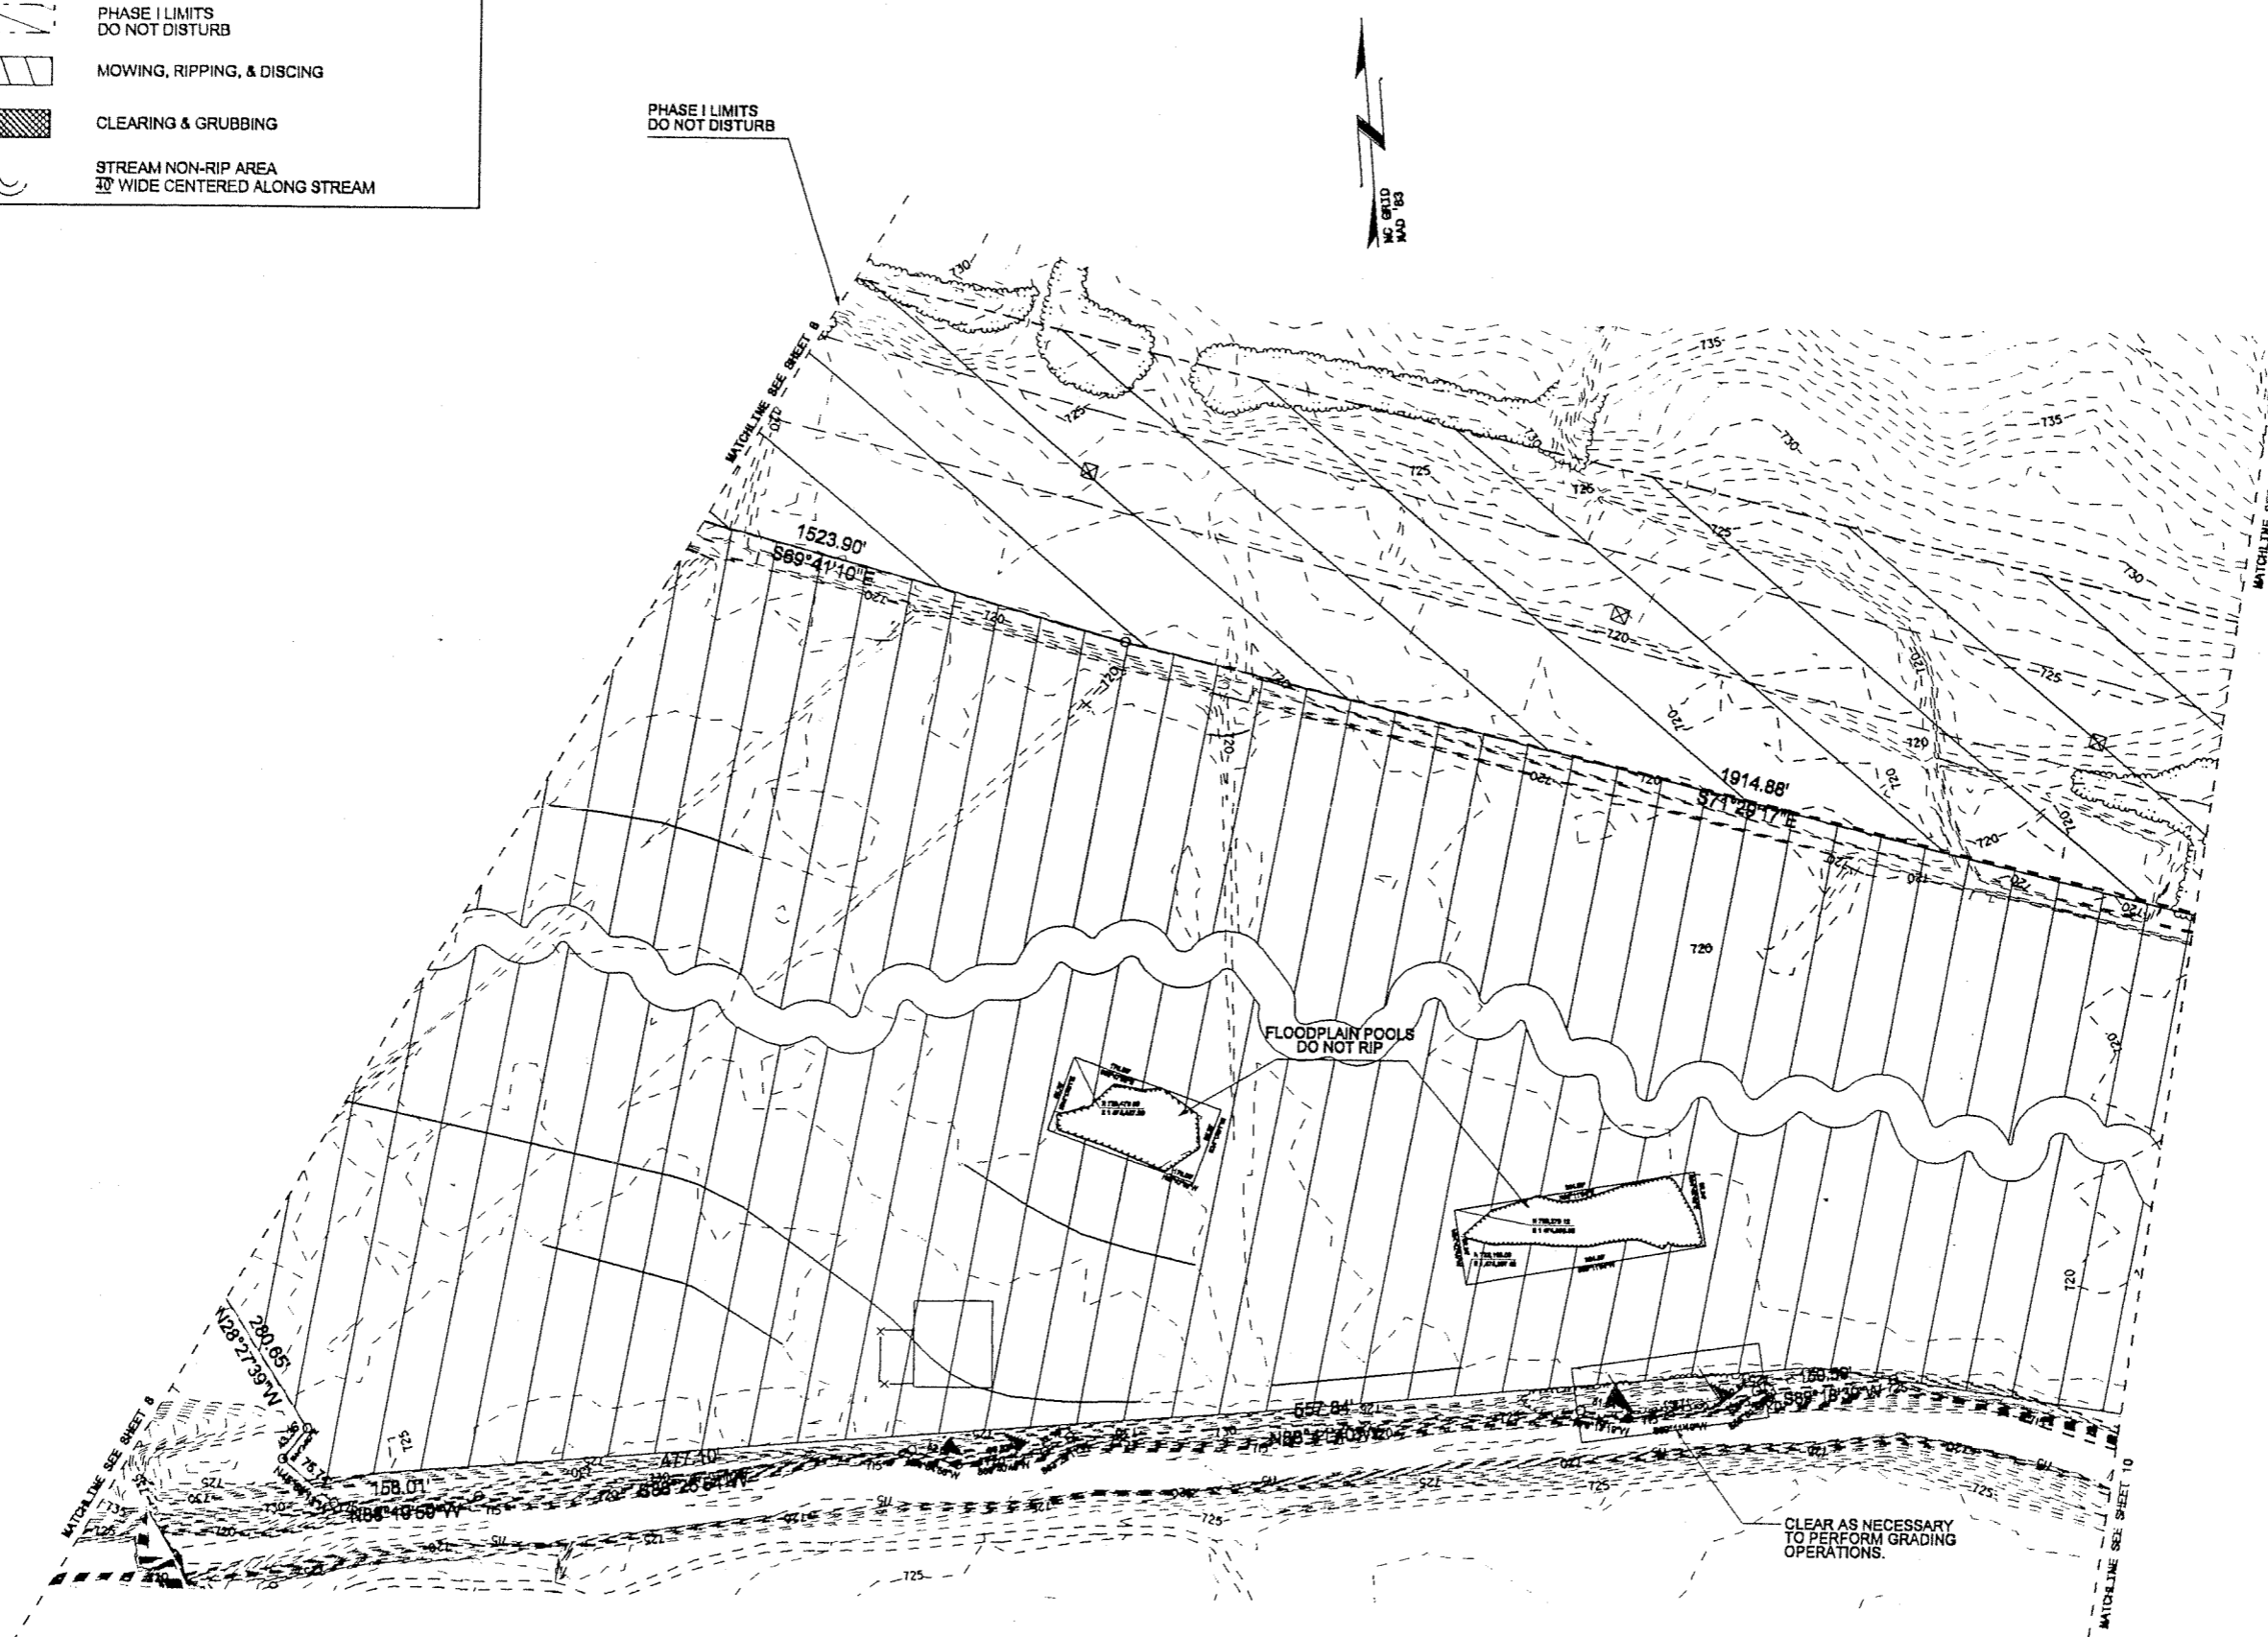PROJECT REFERENCE NO.	SHEET NO.
R - 2235MM	9
RW SHEET NO.	
ENGINEER	SCIENTIST




LIMITS SHEET 02

KCI Associates
of North Carolina, P.A.
2070 LAMARWAY CENTER I, 4001 AX FORTS RD.
RALEIGH, NC 27609-5200
• ENGINEERS • PLANNERS • GEOLOGISTS


LIMITS LEGEND	
	LIMITS OF DISTURBANCE
	PHASE I LIMITS DO NOT DISTURB
	MOWING, RIPPING, & DISCING
	CLEARING & GRUBBING
	STREAM NON-RIP AREA 40' WIDE CENTERED ALONG STREAM

PROJECT REFERENCE NO.	SHEET NO.
R - 2233WM	10
RW SHEET NO.	
ENGINEER	SCIENTIST

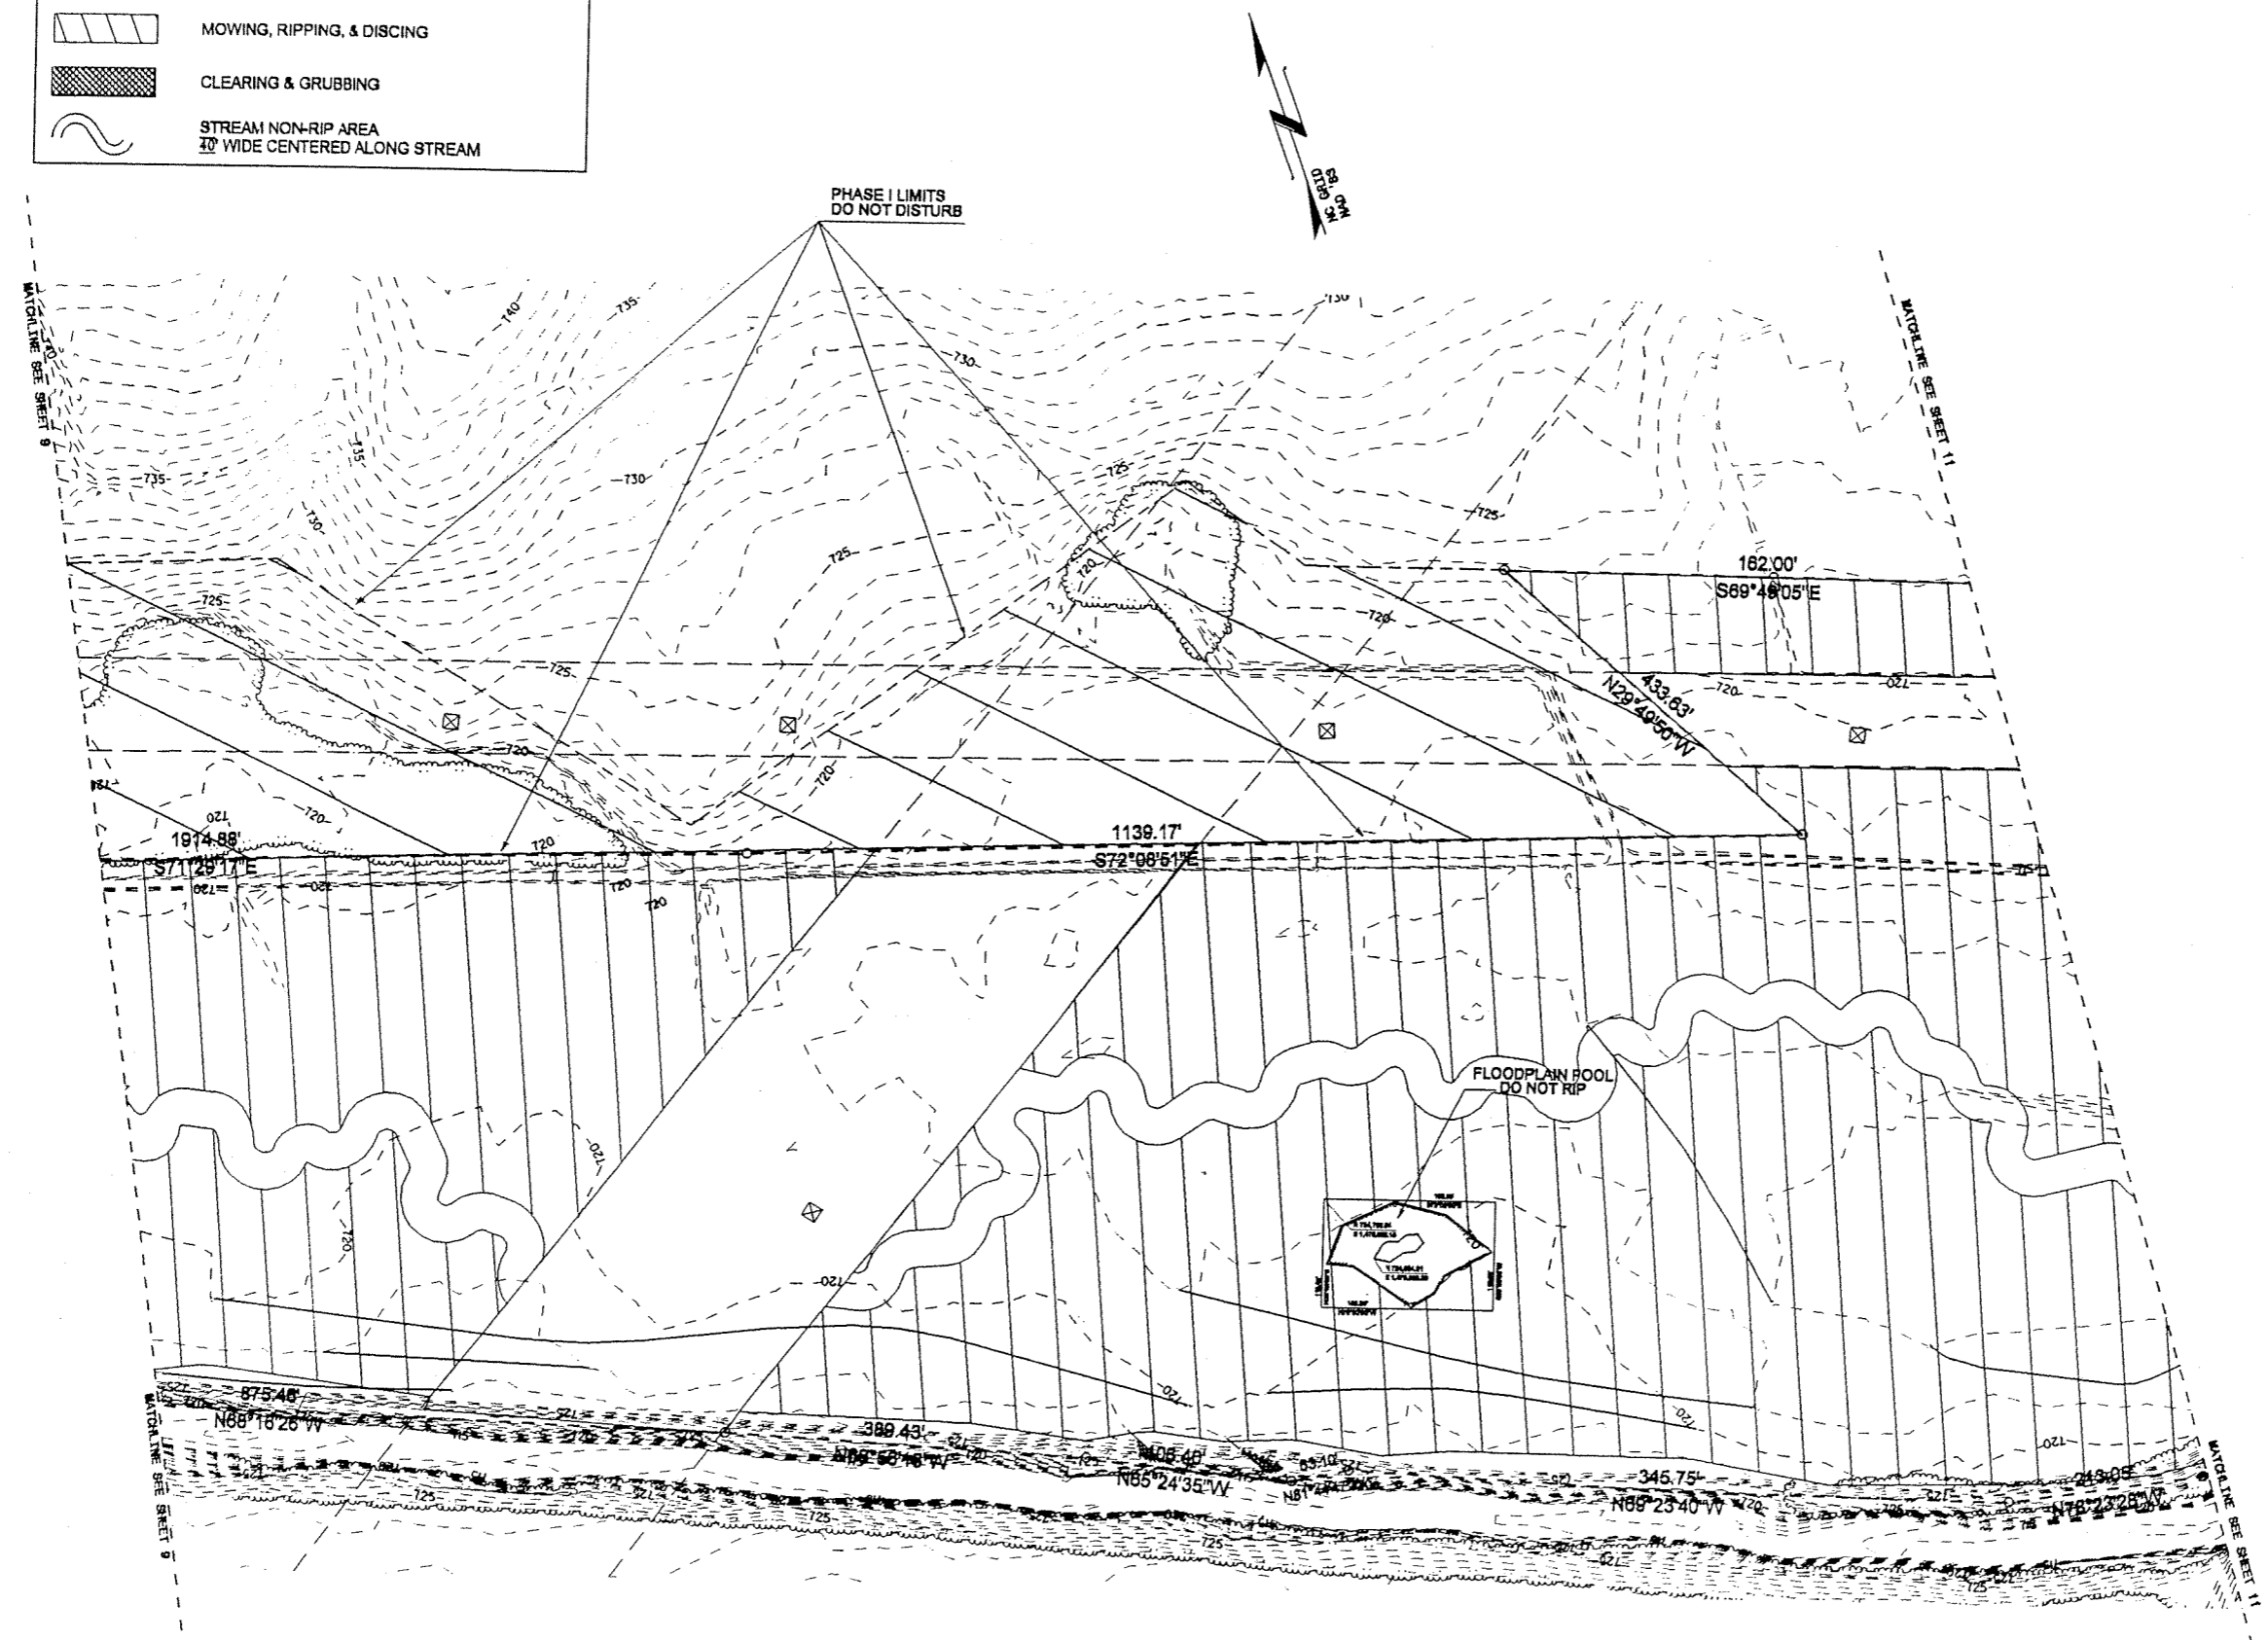

LIMITS OF OPERATION
 0 50 100 200
 GRAPHIC SCALE (1" = 100')

LIMITS SHEET 03

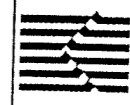


KCI Associates
 of North Carolina, P.A.
 201E 200, LANDMARK CENTER I, 4501 OX FORDS RD.
 RALEIGH, NC 27603-5200
 ENGINEERS • PLANNERS • ECOLOGISTS

PROJECT REFERENCE NO.	SHEET NO.
R - 2239WM	11
NW SHEET NO.	
ENGINEER	SCIENTIST

LIMITS LEGEND

- LIMITS OF DISTURBANCE
- PHASE I LIMITS DO NOT DISTURB
- MOWING, RIPPING, & DISCING
- CLEARING & GRUBBING
- STREAM NON-RIP AREA 10' WIDE CENTERED ALONG STREAM

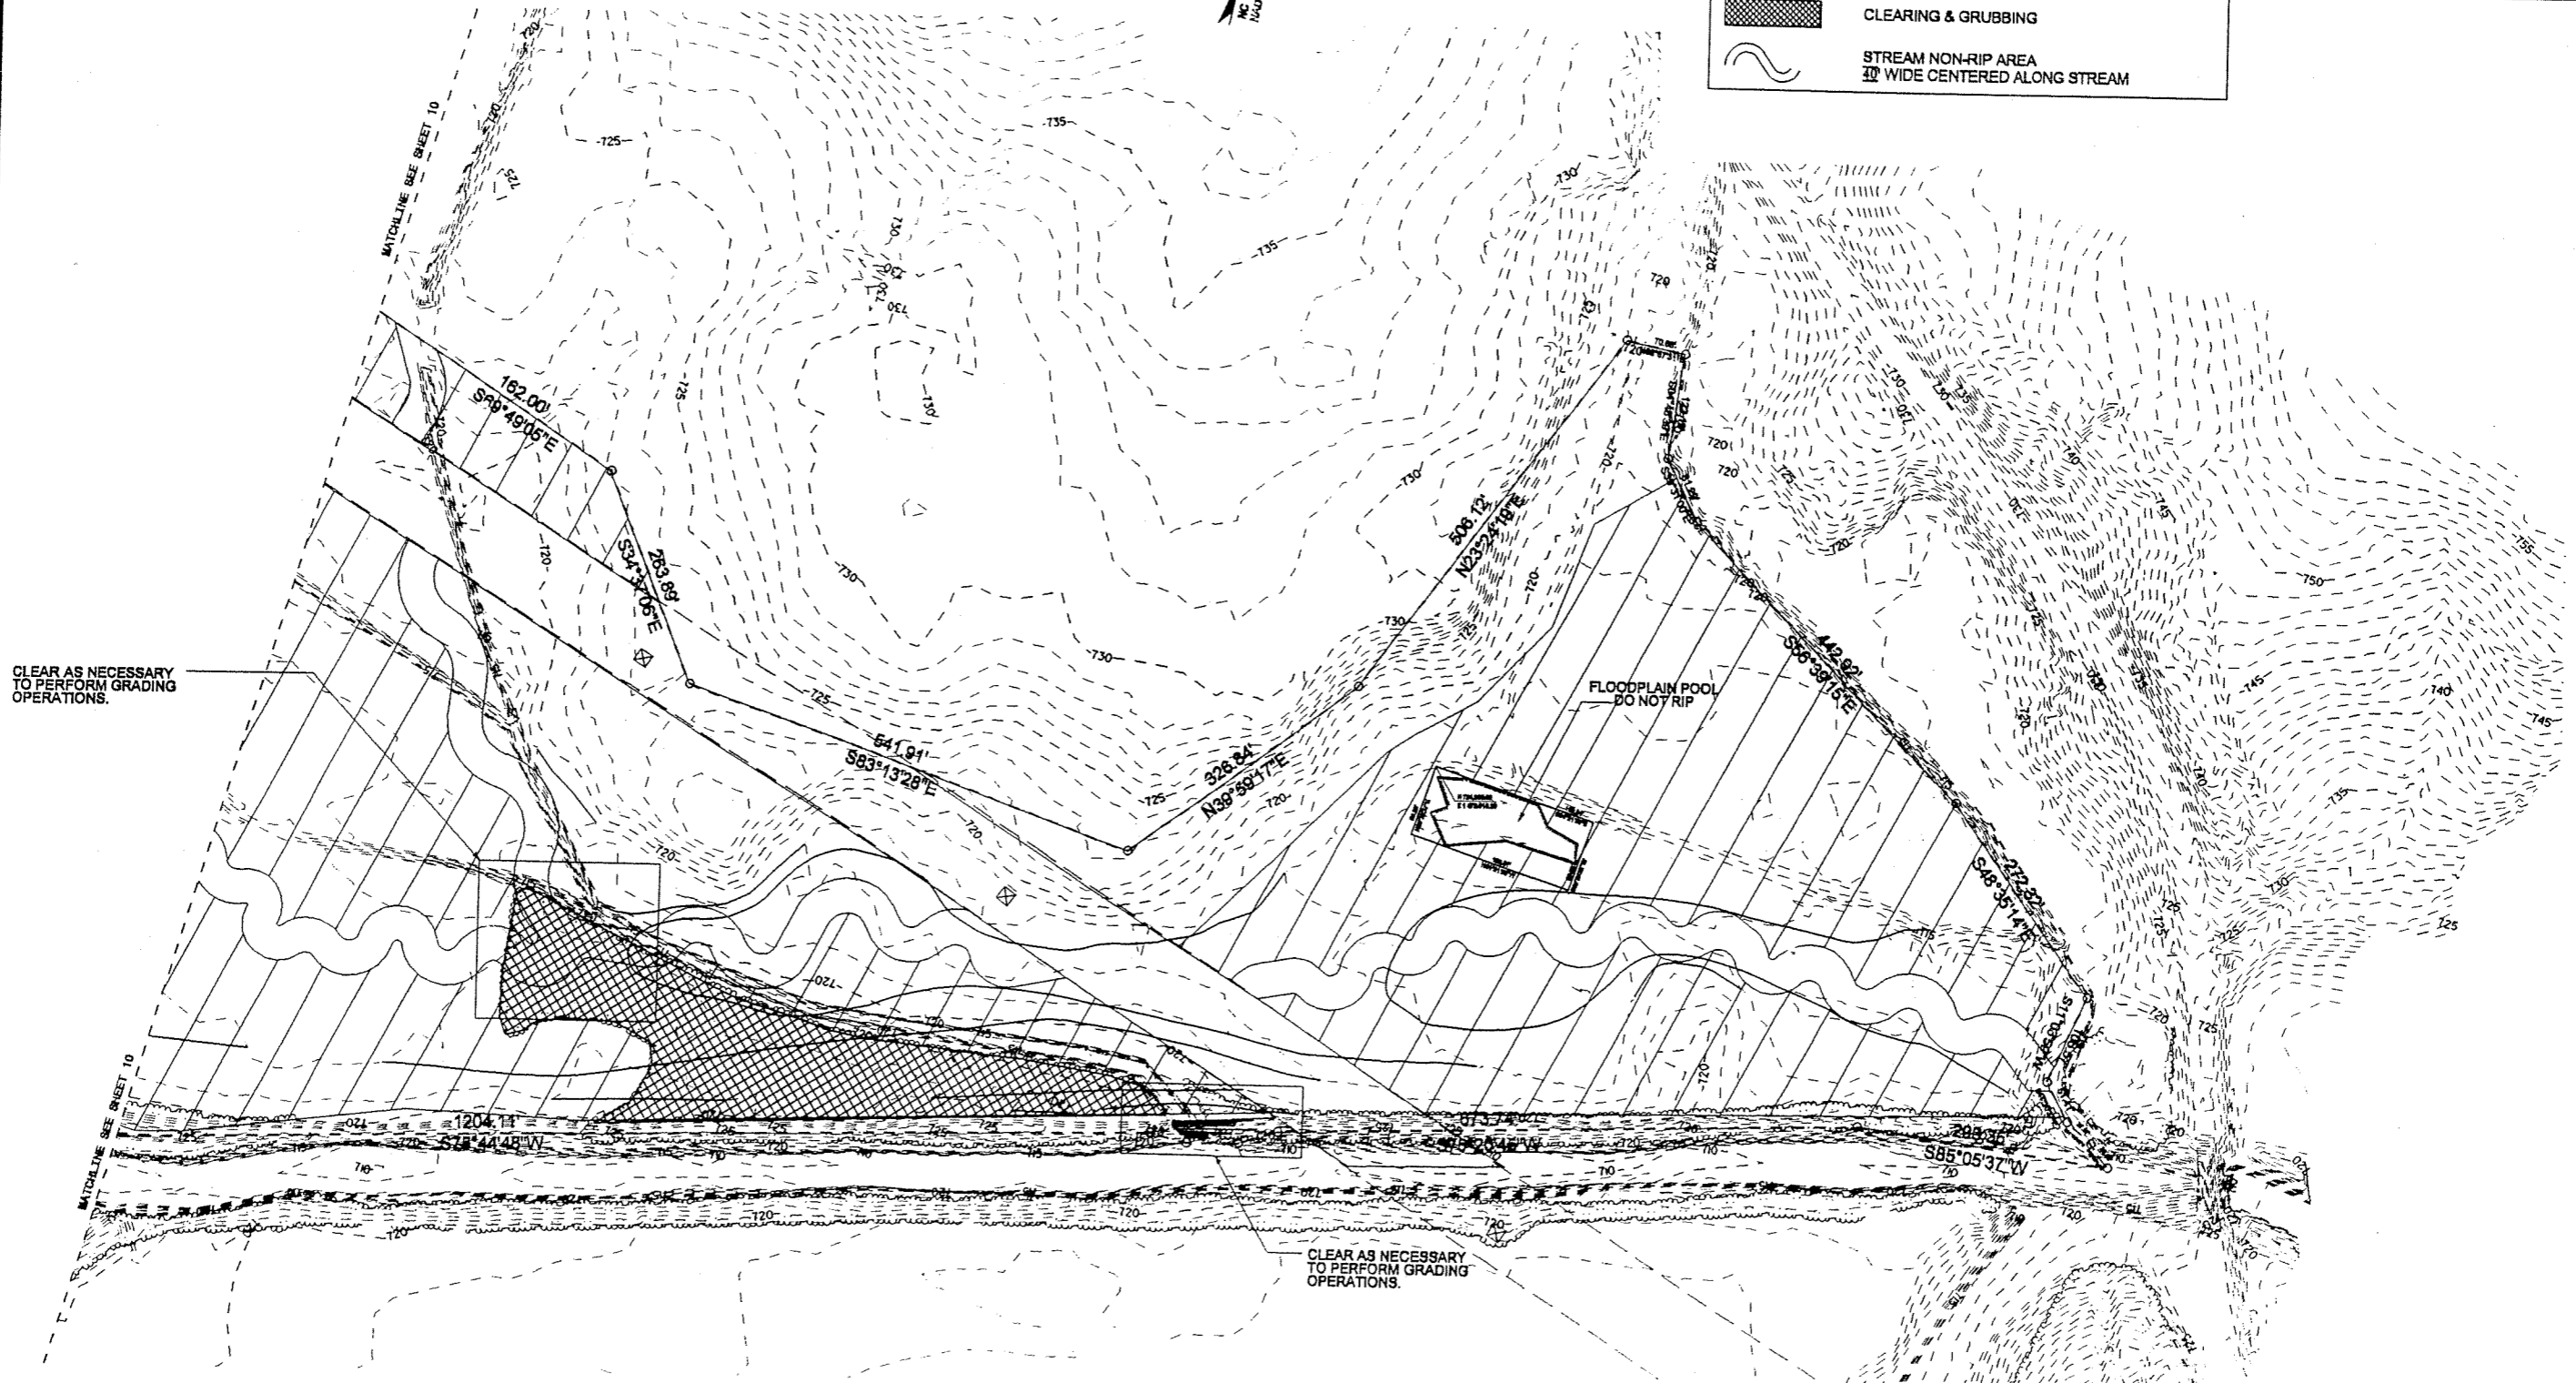


CLEAR AS NECESSARY TO PERFORM GRADING OPERATIONS.

FLOODPLAIN POOL DO NOT RIP

CLEAR AS NECESSARY TO PERFORM GRADING OPERATIONS.


LIMITS OF OPERATION

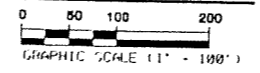

LIMITS SHEET 04

KCI Associates
of North Carolina, P.A.
SUITE 200, LANDMARK CENTER I, 4500 W. FORK RD.
WALKER, NC 27579-5200
• SURVEYORS • PLANNERS • GEOLOGISTS

PROJECT REFERENCE NO. R - 2239WM	SHEET NO. 12
RW SHEET NO.	
ENGINEER	SCIENTIST

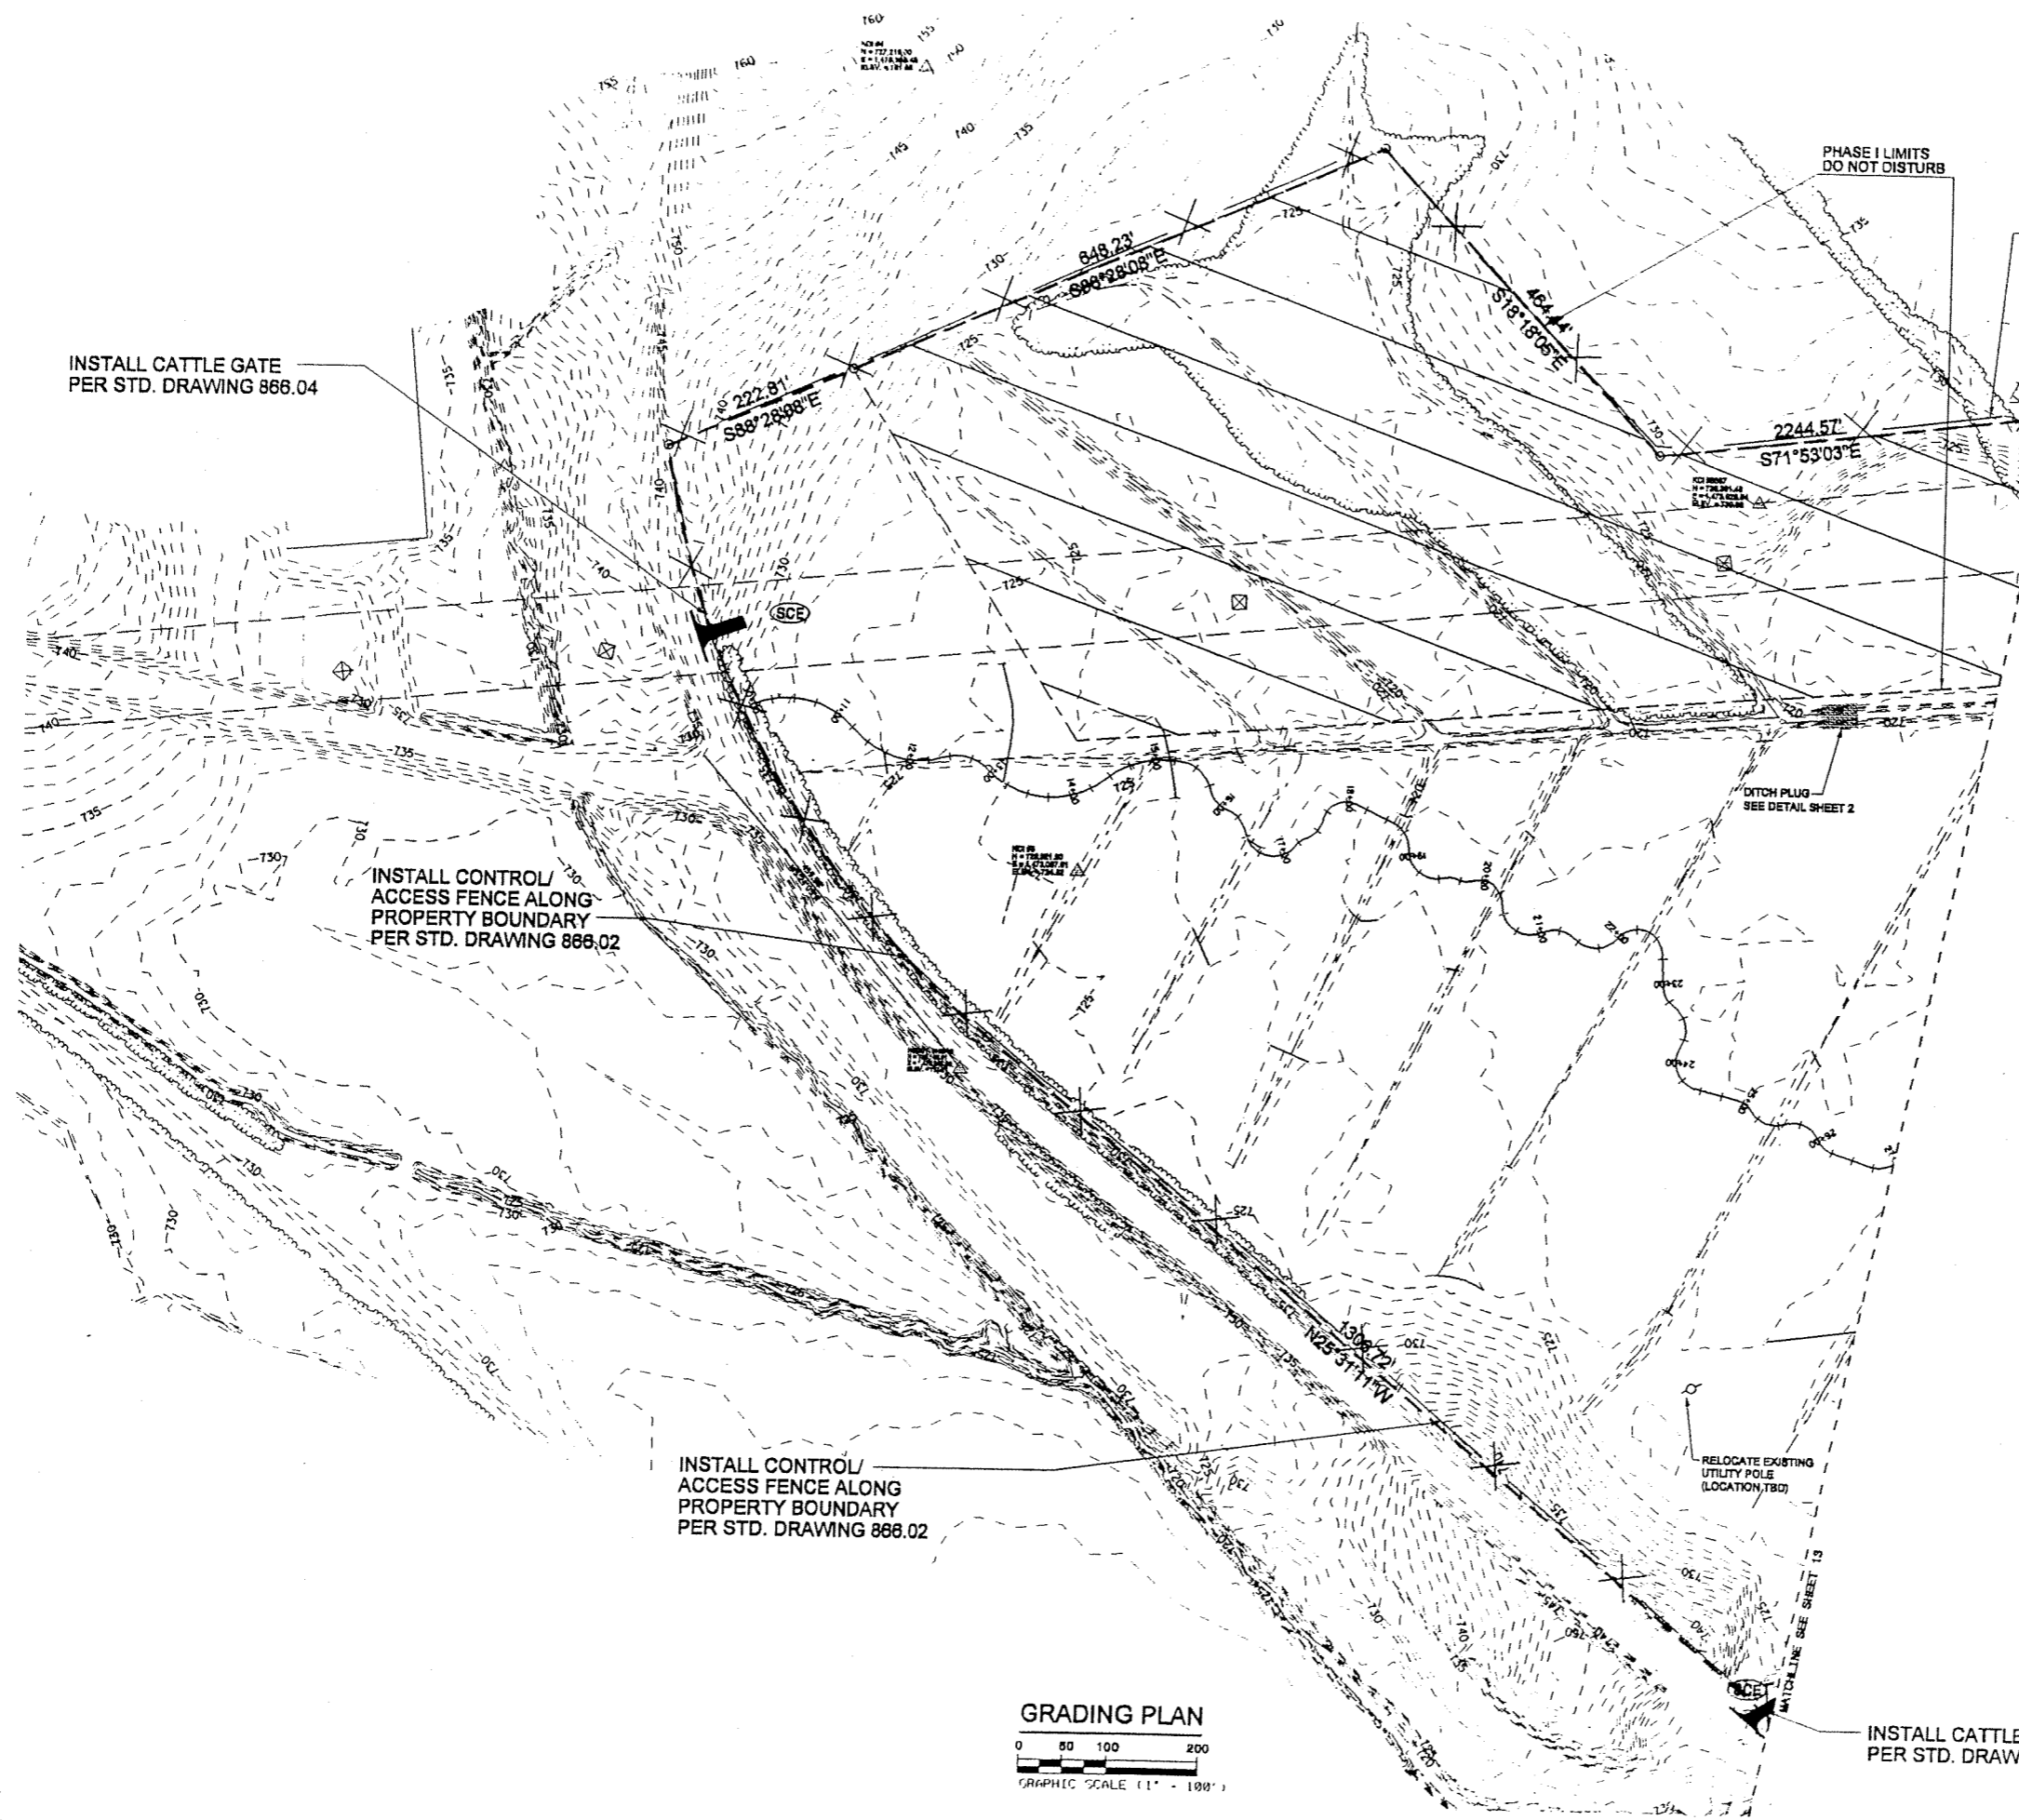

INSTALL CONTROL/
ACCESS FENCE ALONG
PROPERTY BOUNDARY
PER STD. DRAWING 866.02


INSTALL CATTLE GATE
PER STD. DRAWING 866.04

NOTE: STABILIZED CONSTRUCTION ENTRANCES (SCE)
HAVE BEEN INSTALLED AS PART OF PHASE I OPERATIONS.
IT WILL BE THE RESPONSIBILITY OF THE CONTRACTOR
TO MAINTAIN THE EXISTING SCE(S) THROUGH THE
CONSTRUCTION PERIOD.


INSTALL CONTROL/
ACCESS FENCE ALONG
PROPERTY BOUNDARY
PER STD. DRAWING 866.02

INSTALL CONTROL/
ACCESS FENCE ALONG
PROPERTY BOUNDARY
PER STD. DRAWING 866.02

INSTALL CATTLE GATE
PER STD. DRAWING 866.04


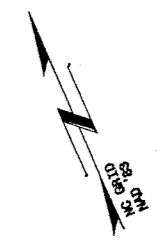


GRADING LEGEND	
	EXISTING MINOR CONTOURS
	EXISTING MAJOR CONTOURS
	PROPOSED CONTOURS
	MITIGATION BOUNDARY
	STABILIZED CONSTRUCTION ENTRANCE
	TREES
	TREELINE AND HEDGES
	UTILITY POLE
	DUKE POWER TOWER
	PROPOSED STREAM ALIGNMENT
	PHASE I LIMITS DO NOT DISTURB

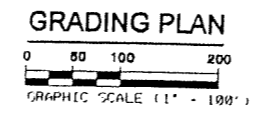

PROJECT REFERENCE NO. R - 2239WM	SHEET NO. 13
RW SHEET NO.	
ENGINEER	SCIENTIST


GRADING LEGEND	
	EXISTING MINOR CONTOURS
	EXISTING MAJOR CONTOURS
	PROPOSED CONTOURS
	MITIGATION BOUNDARY
	STABILIZED CONSTRUCTION ENTRANCE
	TREES
	TREELINE AND HEDGES
	UTILITY POLE
	DUKE POWER TOWER
	PROPOSED STREAM ALIGNMENT
	PHASE I LIMITS DO NOT DISTURB

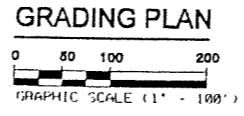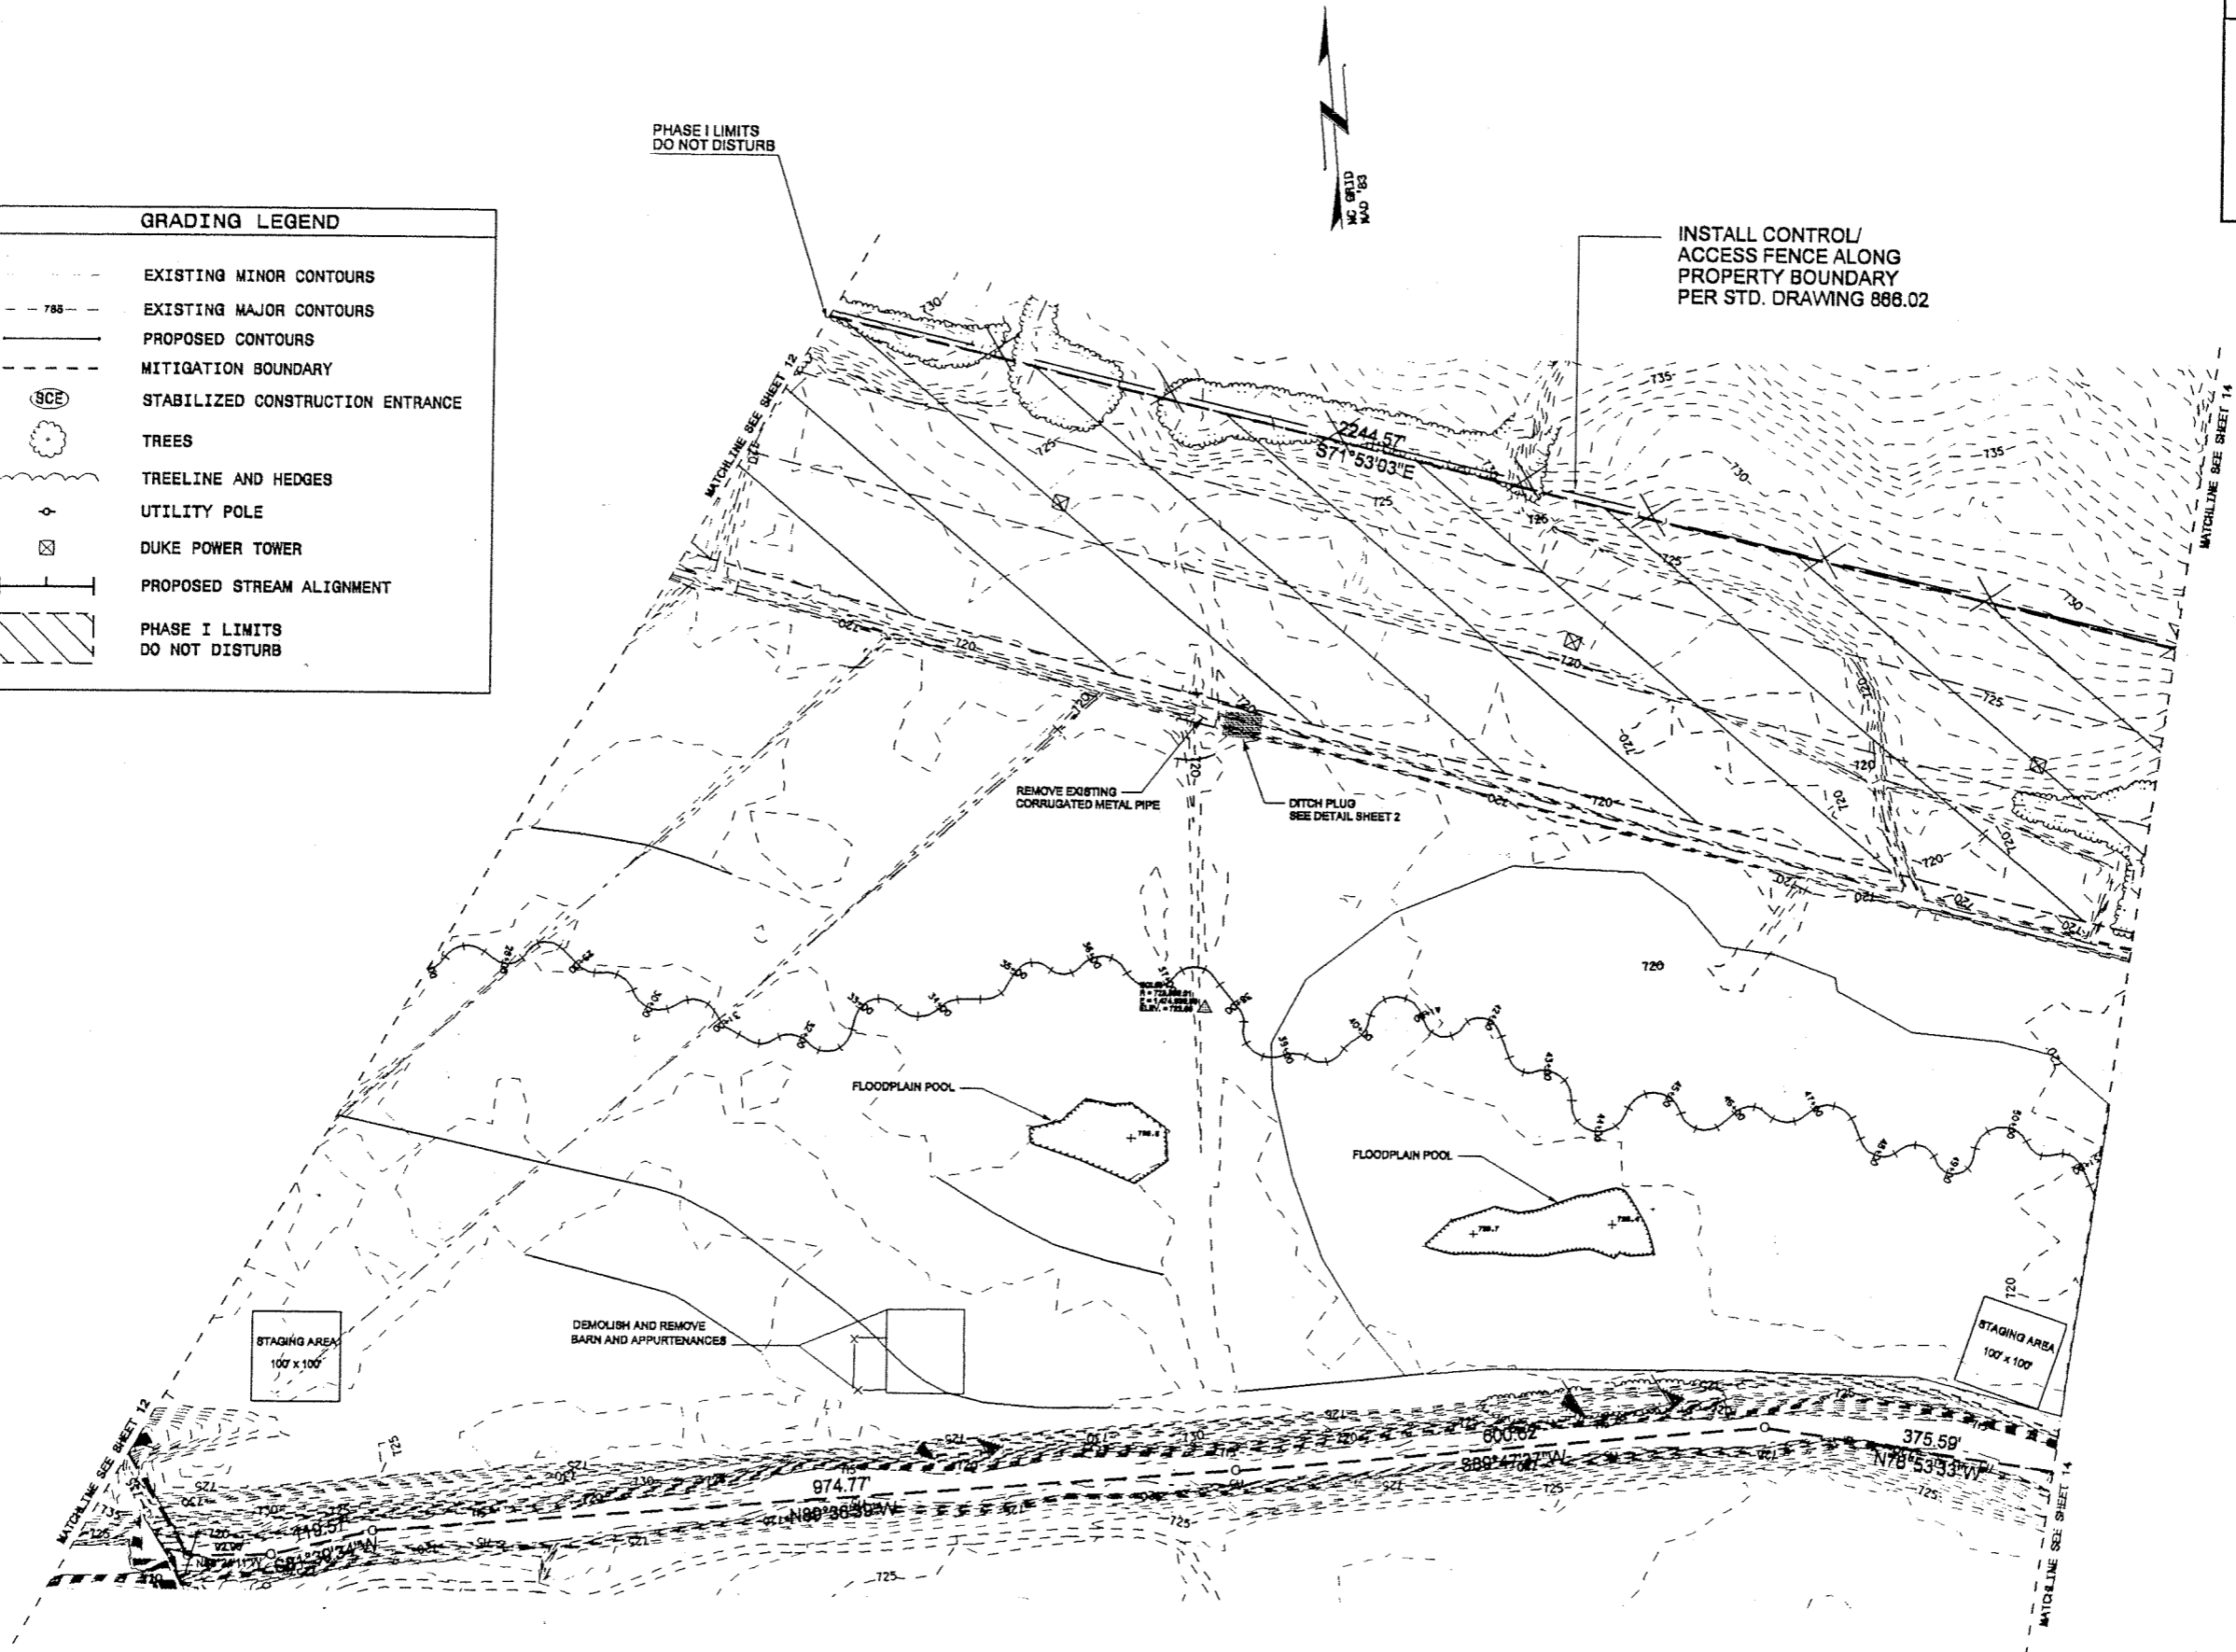


GRADING SHEET 02

KCI Associates of North Carolina, P.A.
 3101 W. LAMAR BLVD., SUITE 1, ASHEBORO, NC 27804
 ENGINEERS • PLANNERS • ECOLOGISTS

PROJECT REFERENCE NO. R - 2239WM	SHEET NO. 14
RAW SHEET NO.	
ENGINEER	SCIENTIST

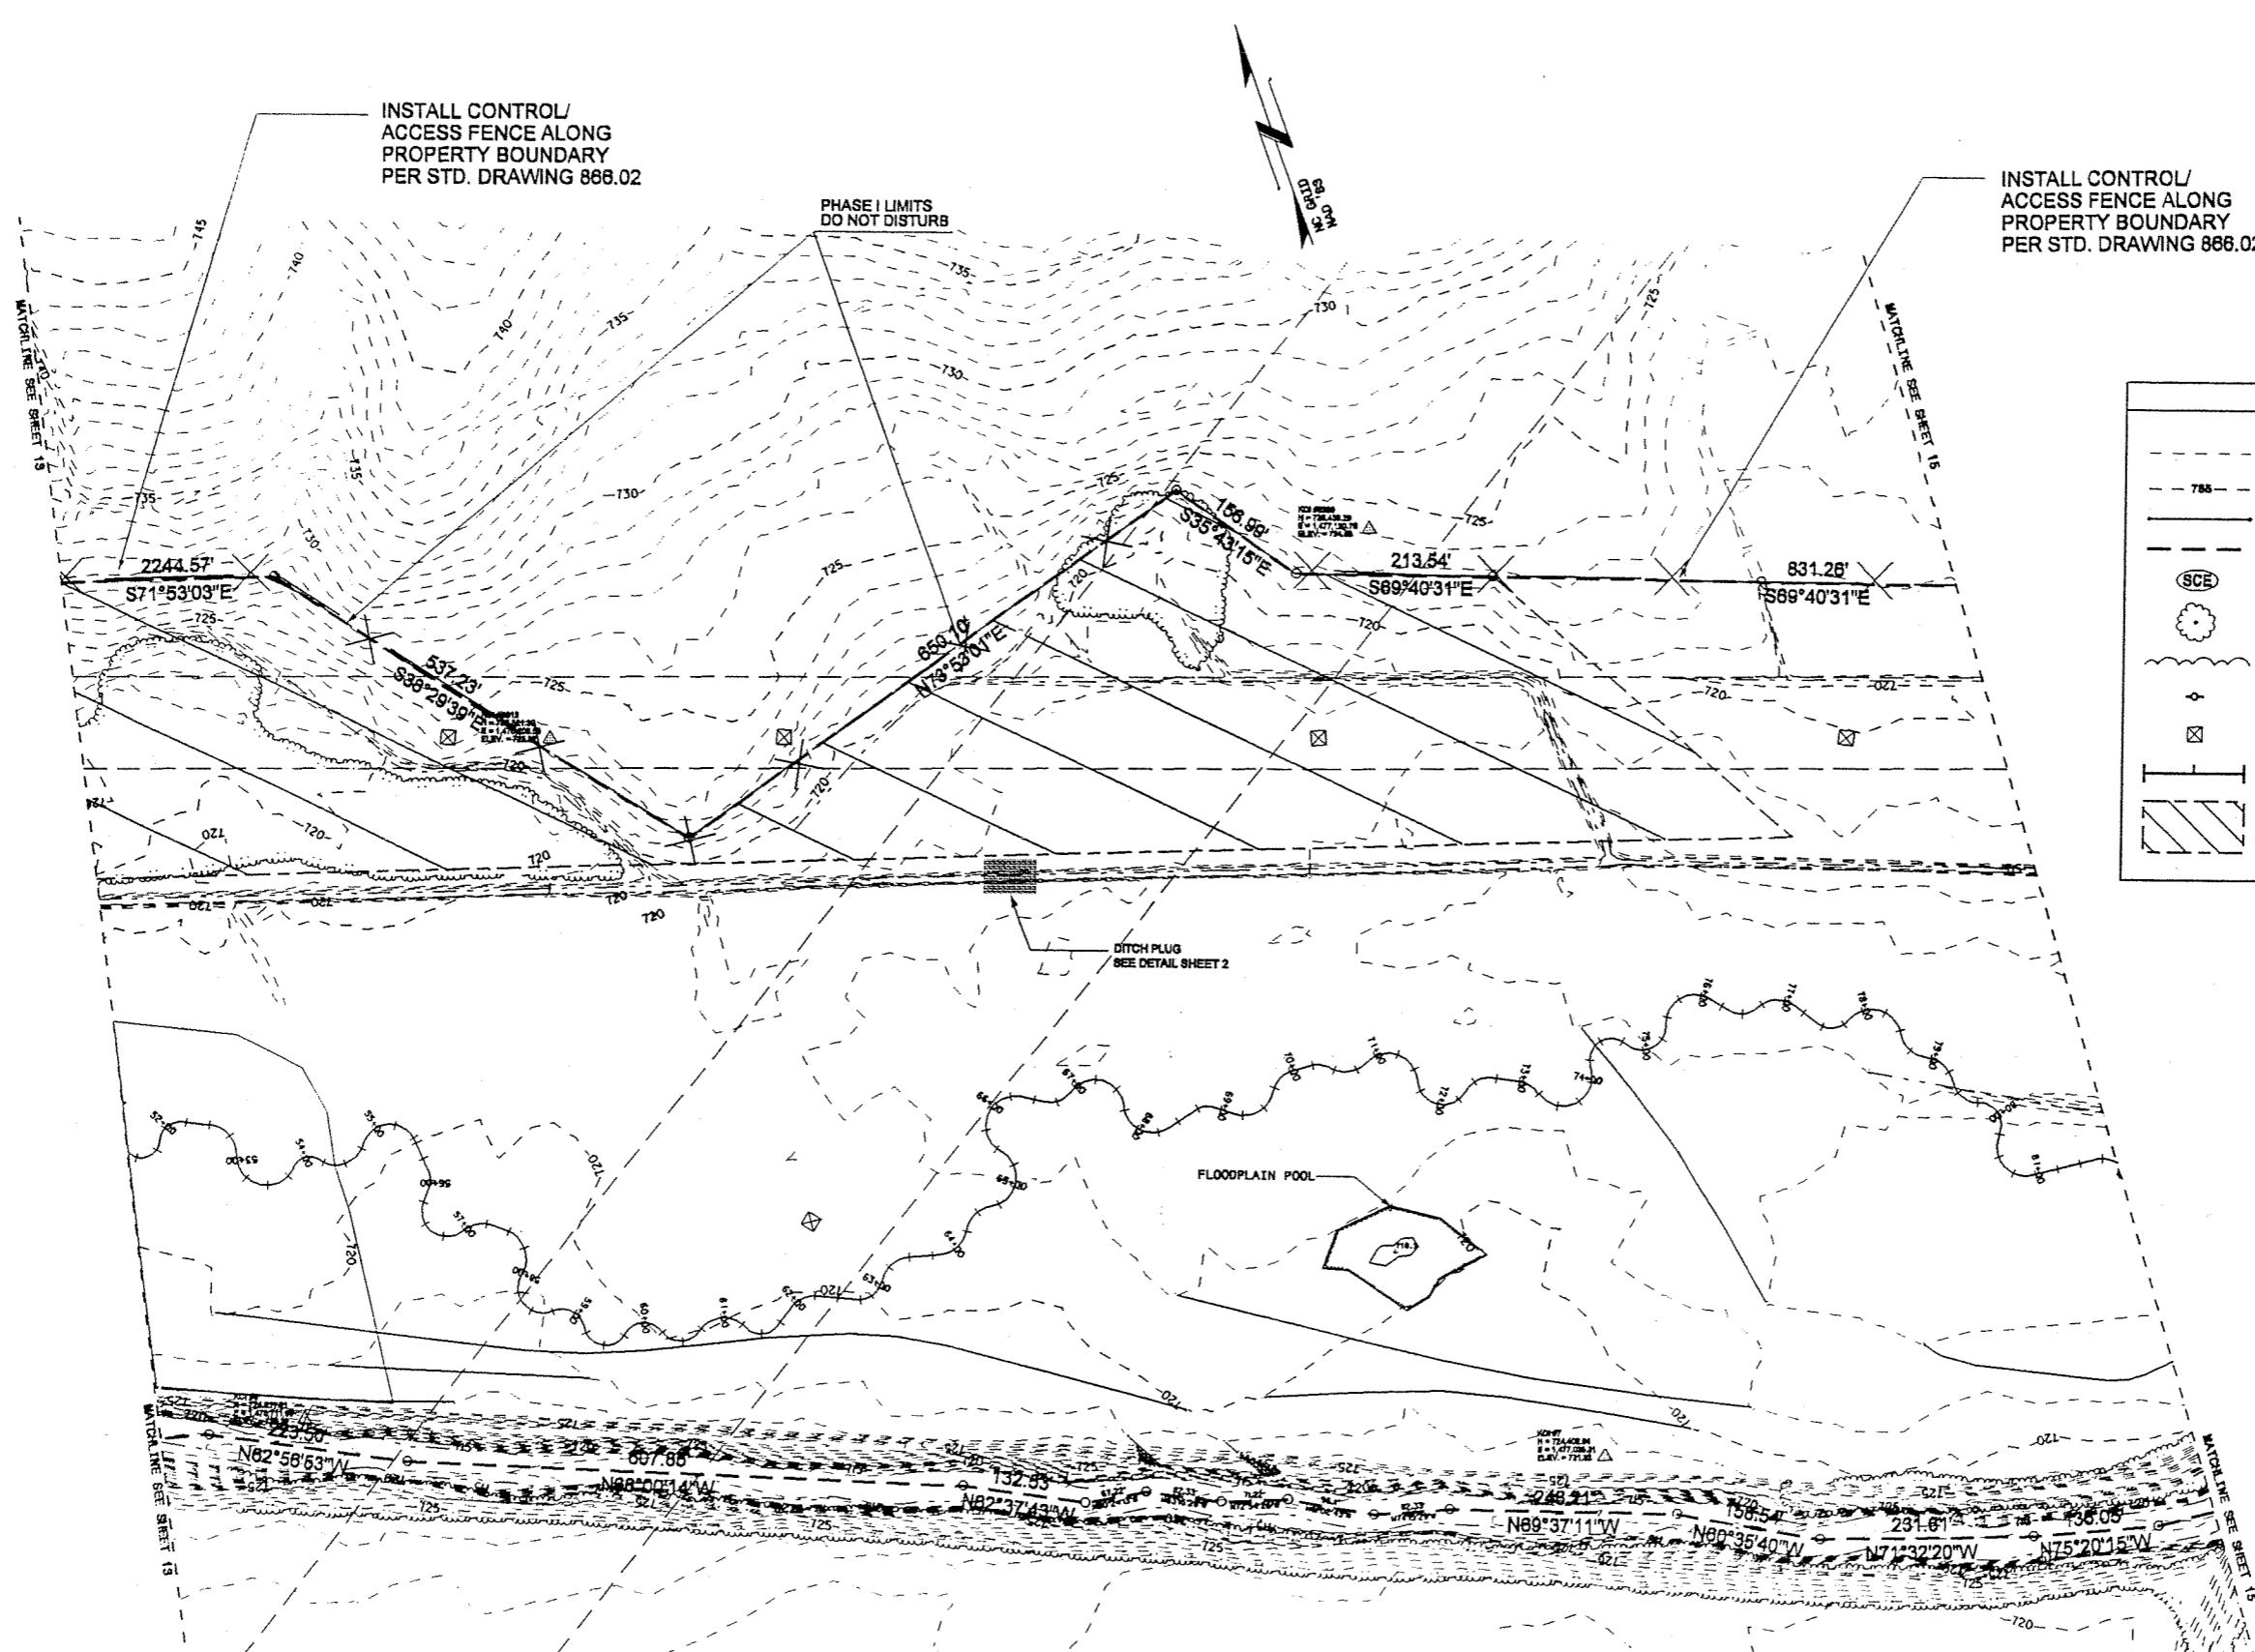

GRADING LEGEND	
	EXISTING MINOR CONTOURS
	EXISTING MAJOR CONTOURS
	PROPOSED CONTOURS
	MITIGATION BOUNDARY
	STABILIZED CONSTRUCTION ENTRANCE
	TREES
	TREELINE AND HEDGES
	UTILITY POLE
	DUKE POWER TOWER
	PROPOSED STREAM ALIGNMENT
	PHASE I LIMITS DO NOT DISTURB

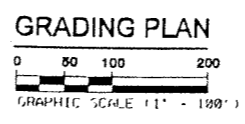


GRADING SHEET 03

KCI Associates
of North Carolina, P.A.
SUITE 200, LANDMARK CENTER I, 4508 SIX FORKS RD.
RALEIGH, NC 27609-5200
ENGINEERS • PLANNERS • ECOLOGISTS

PROJECT REFERENCE NO.	SHEET NO.
R - 2239WM	15
NW SHEET NO.	
ENGINEER	SCIENTIST

GRADING LEGEND	
	EXISTING MINOR CONTOURS
	EXISTING MAJOR CONTOURS
	PROPOSED CONTOURS
	MITIGATION BOUNDARY
	STABILIZED CONSTRUCTION ENTRANCE
	TREES
	TREELINE AND HEDGES
	UTILITY POLE
	DUKE POWER TOWER
	PROPOSED STREAM ALIGNMENT
	PHASE I LIMITS DO NOT DISTURB

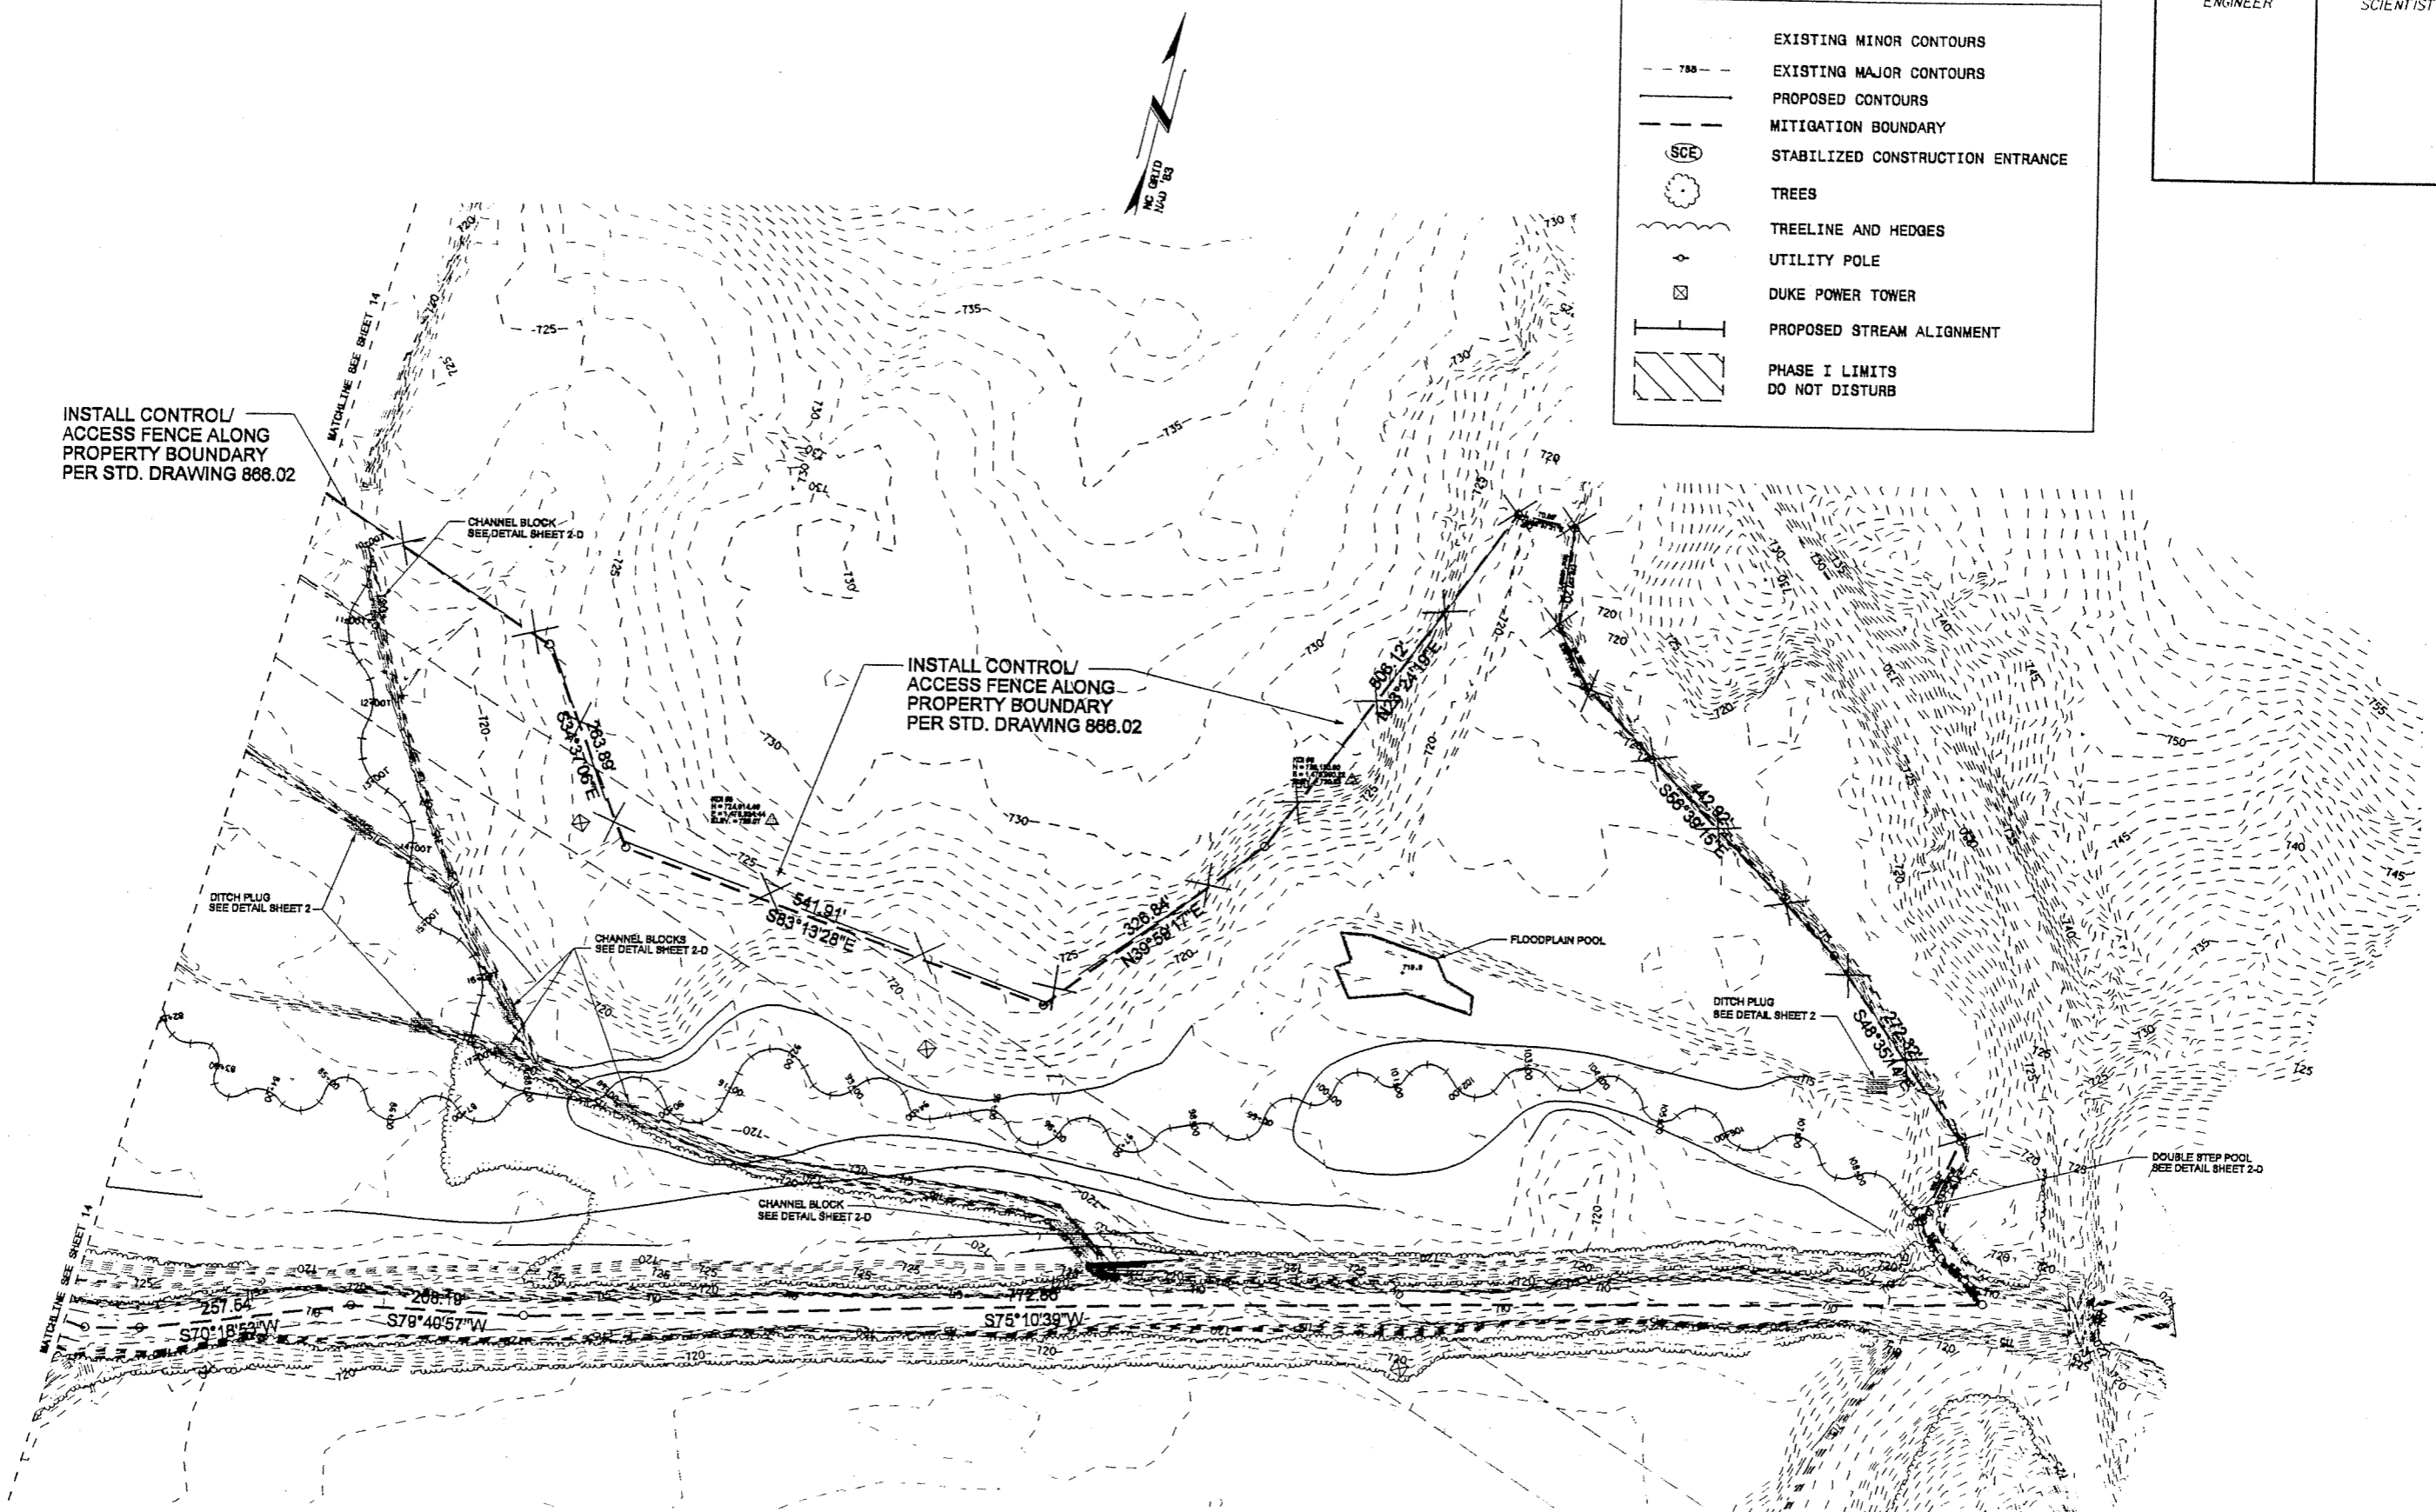

INSTALL CONTROL/
ACCESS FENCE ALONG
PROPERTY BOUNDARY
PER STD. DRAWING 888.02

CHANNEL BLOCK
SEE DETAIL SHEET 2-D

INSTALL CONTROL/
ACCESS FENCE ALONG
PROPERTY BOUNDARY
PER STD. DRAWING 888.02

DITCH PLUG
SEE DETAIL SHEET 2


CHANNEL BLOCKS
SEE DETAIL SHEET 2-D

FLOODPLAIN POOL

DITCH PLUG
SEE DETAIL SHEET 2

DOUBLE STEP POOL
SEE DETAIL SHEET 2-D


GRADING PLAN

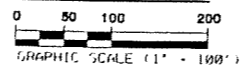

GRADING SHEET 04

KCI Associates
of North Carolina, P.A.
5115 E. 72nd, LANGHAM CENTER I, 46003 AK FORD, NC
919.487.5200
• ENGINEERS • PLANNERS • ECOLOGISTS


FENCE MOVED
 25' INSIDE
 TO AVOID EXTENSIVE
 CLEARING

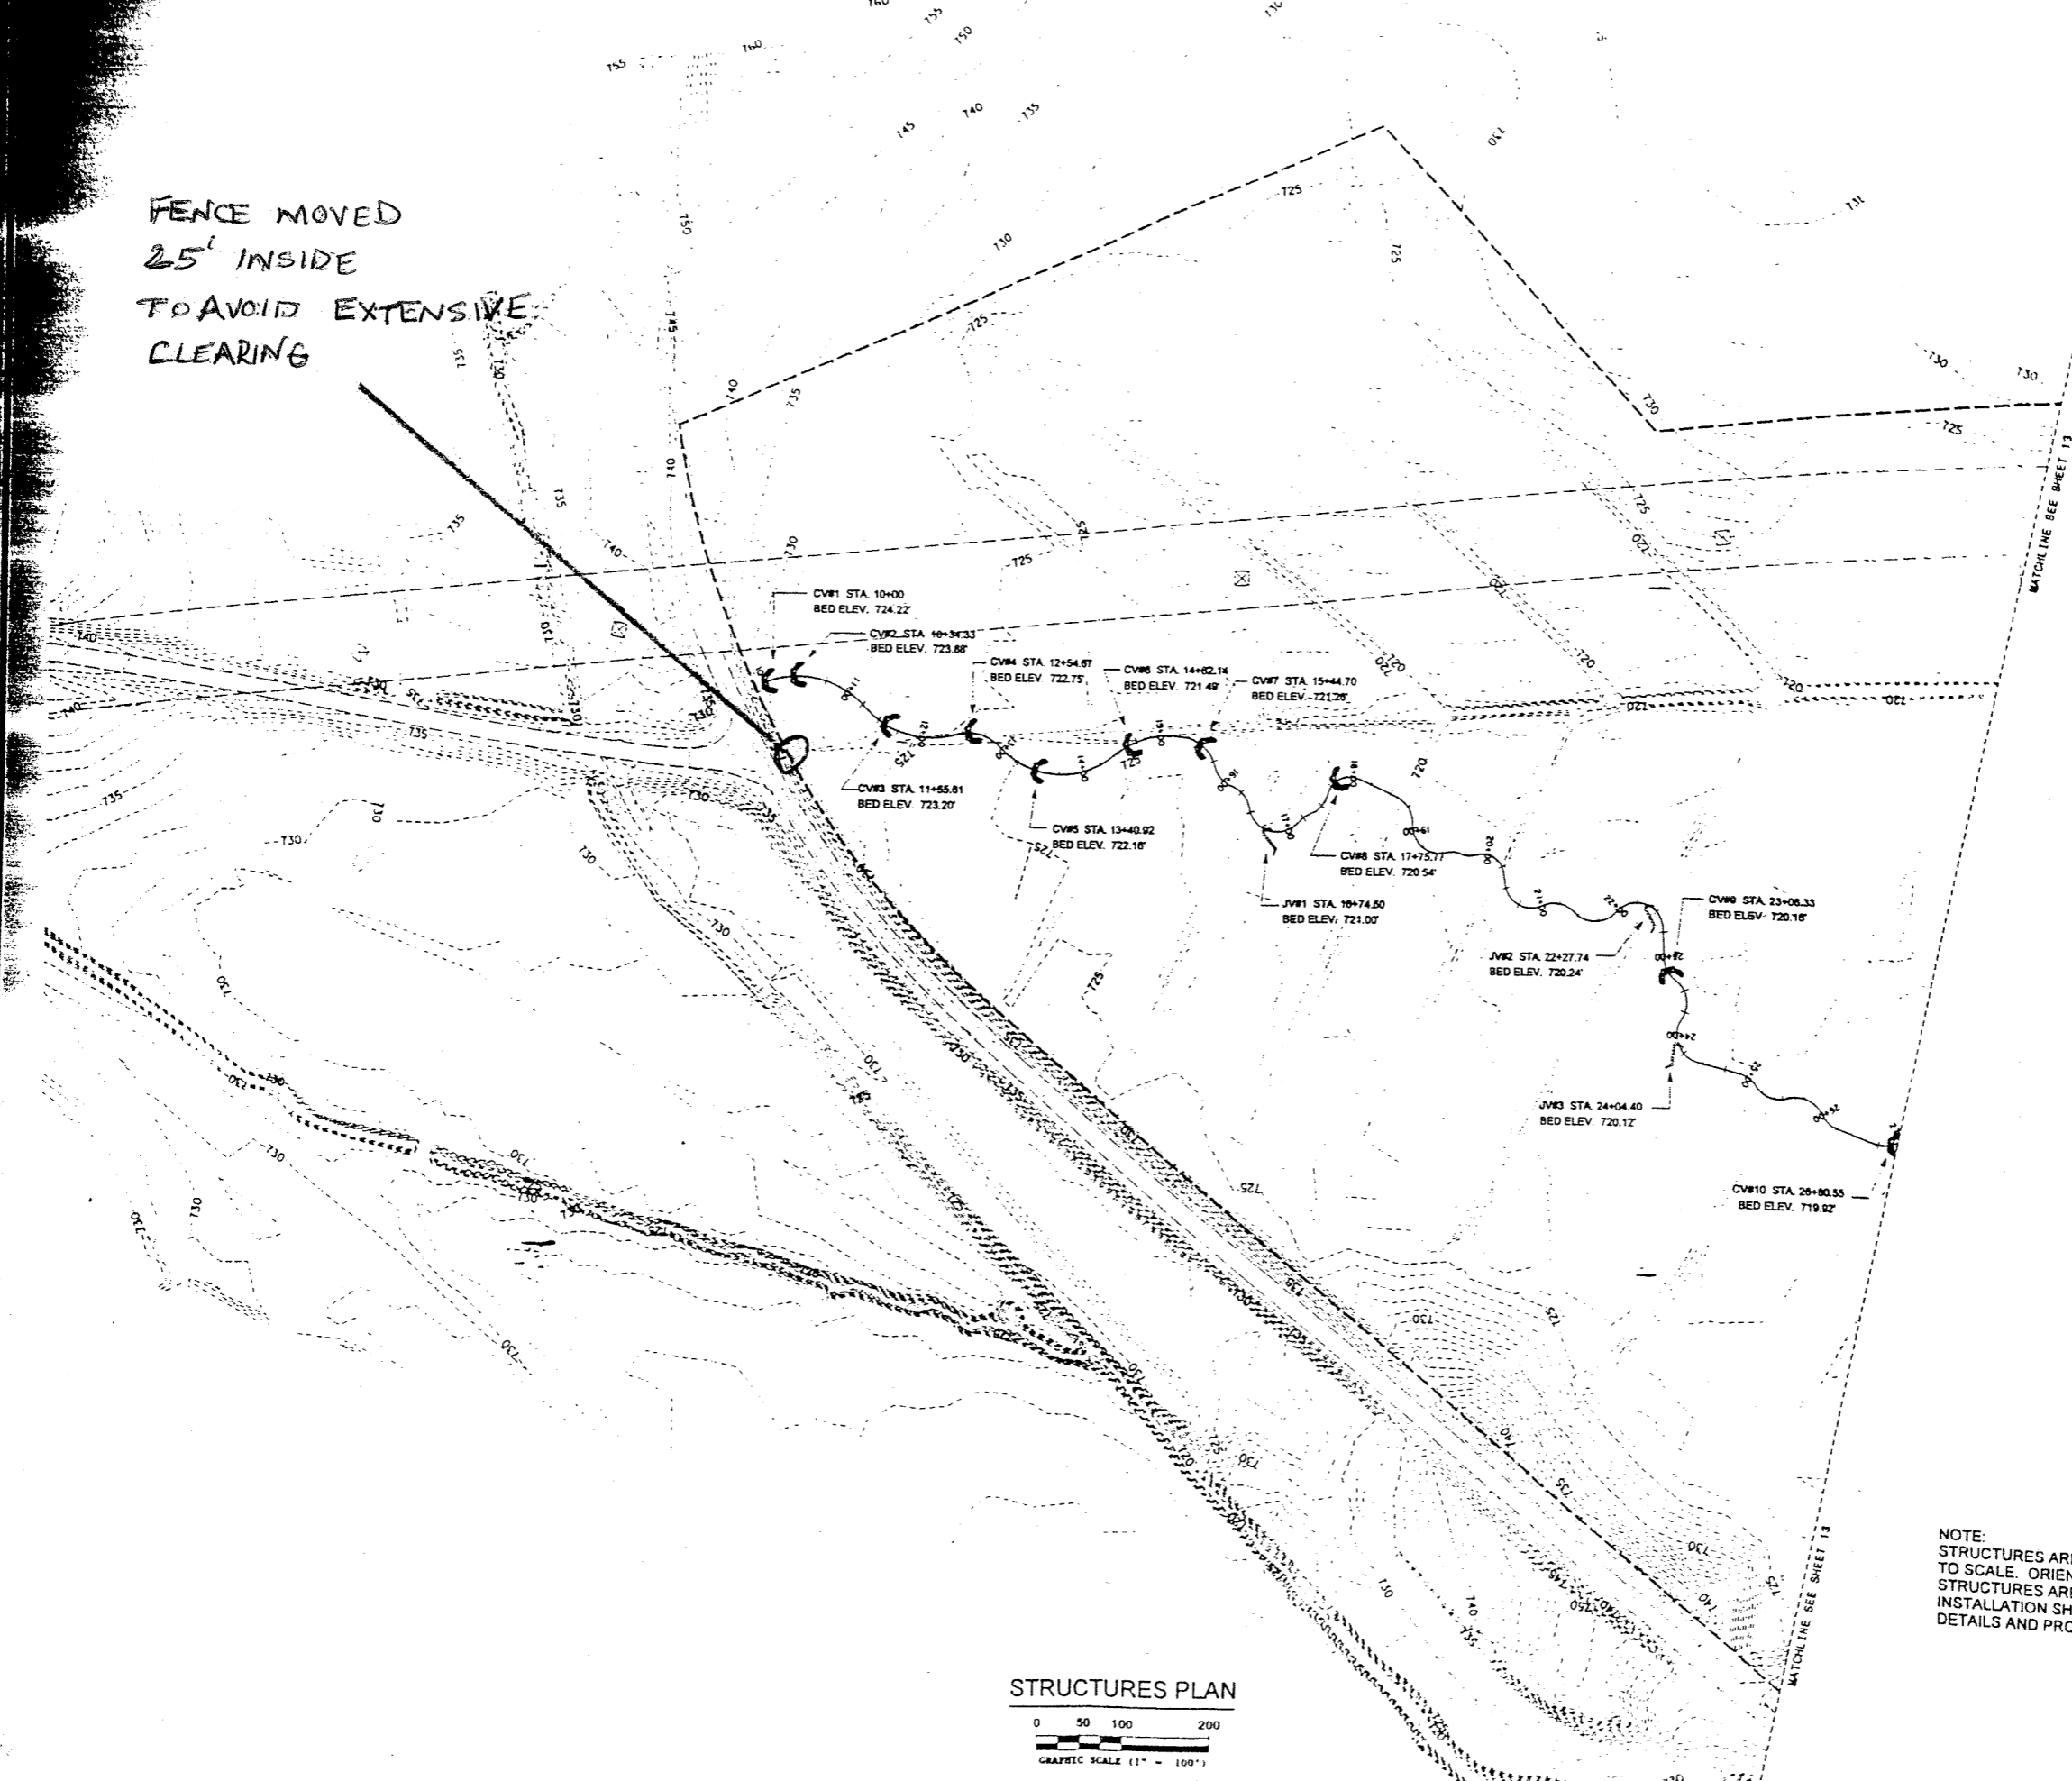







STRUCTURES LEGEND	
	PROPOSED STREAM ALIGNMENT
	CROSS VANE (CV)
	STEP POOL (SP)
	J - VANE (JV)
	ROOT WAD
	RIP RAP
(SEE DETAILS)	

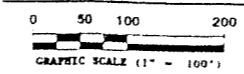NOTE:
 STRUCTURES ARE NOT DRAWN TO SCALE. ORIENTATION OF STRUCTURES ARE APPROXIMATE. INSTALLATION SHOULD FOLLOW DETAILS AND PROJECT SPECIAL PROVISIONS.


STRUCTURES PLAN

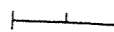

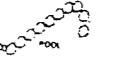STRUCTURES LEGEND

-  PROPOSED STREAM ALIGNMENT
-  CROSS VANE (CV)
-  STEP POOL (SP)
-  J - VANE (JV)
-  ROOT WAD
-  RIP RAP


(SEE DETAILS)

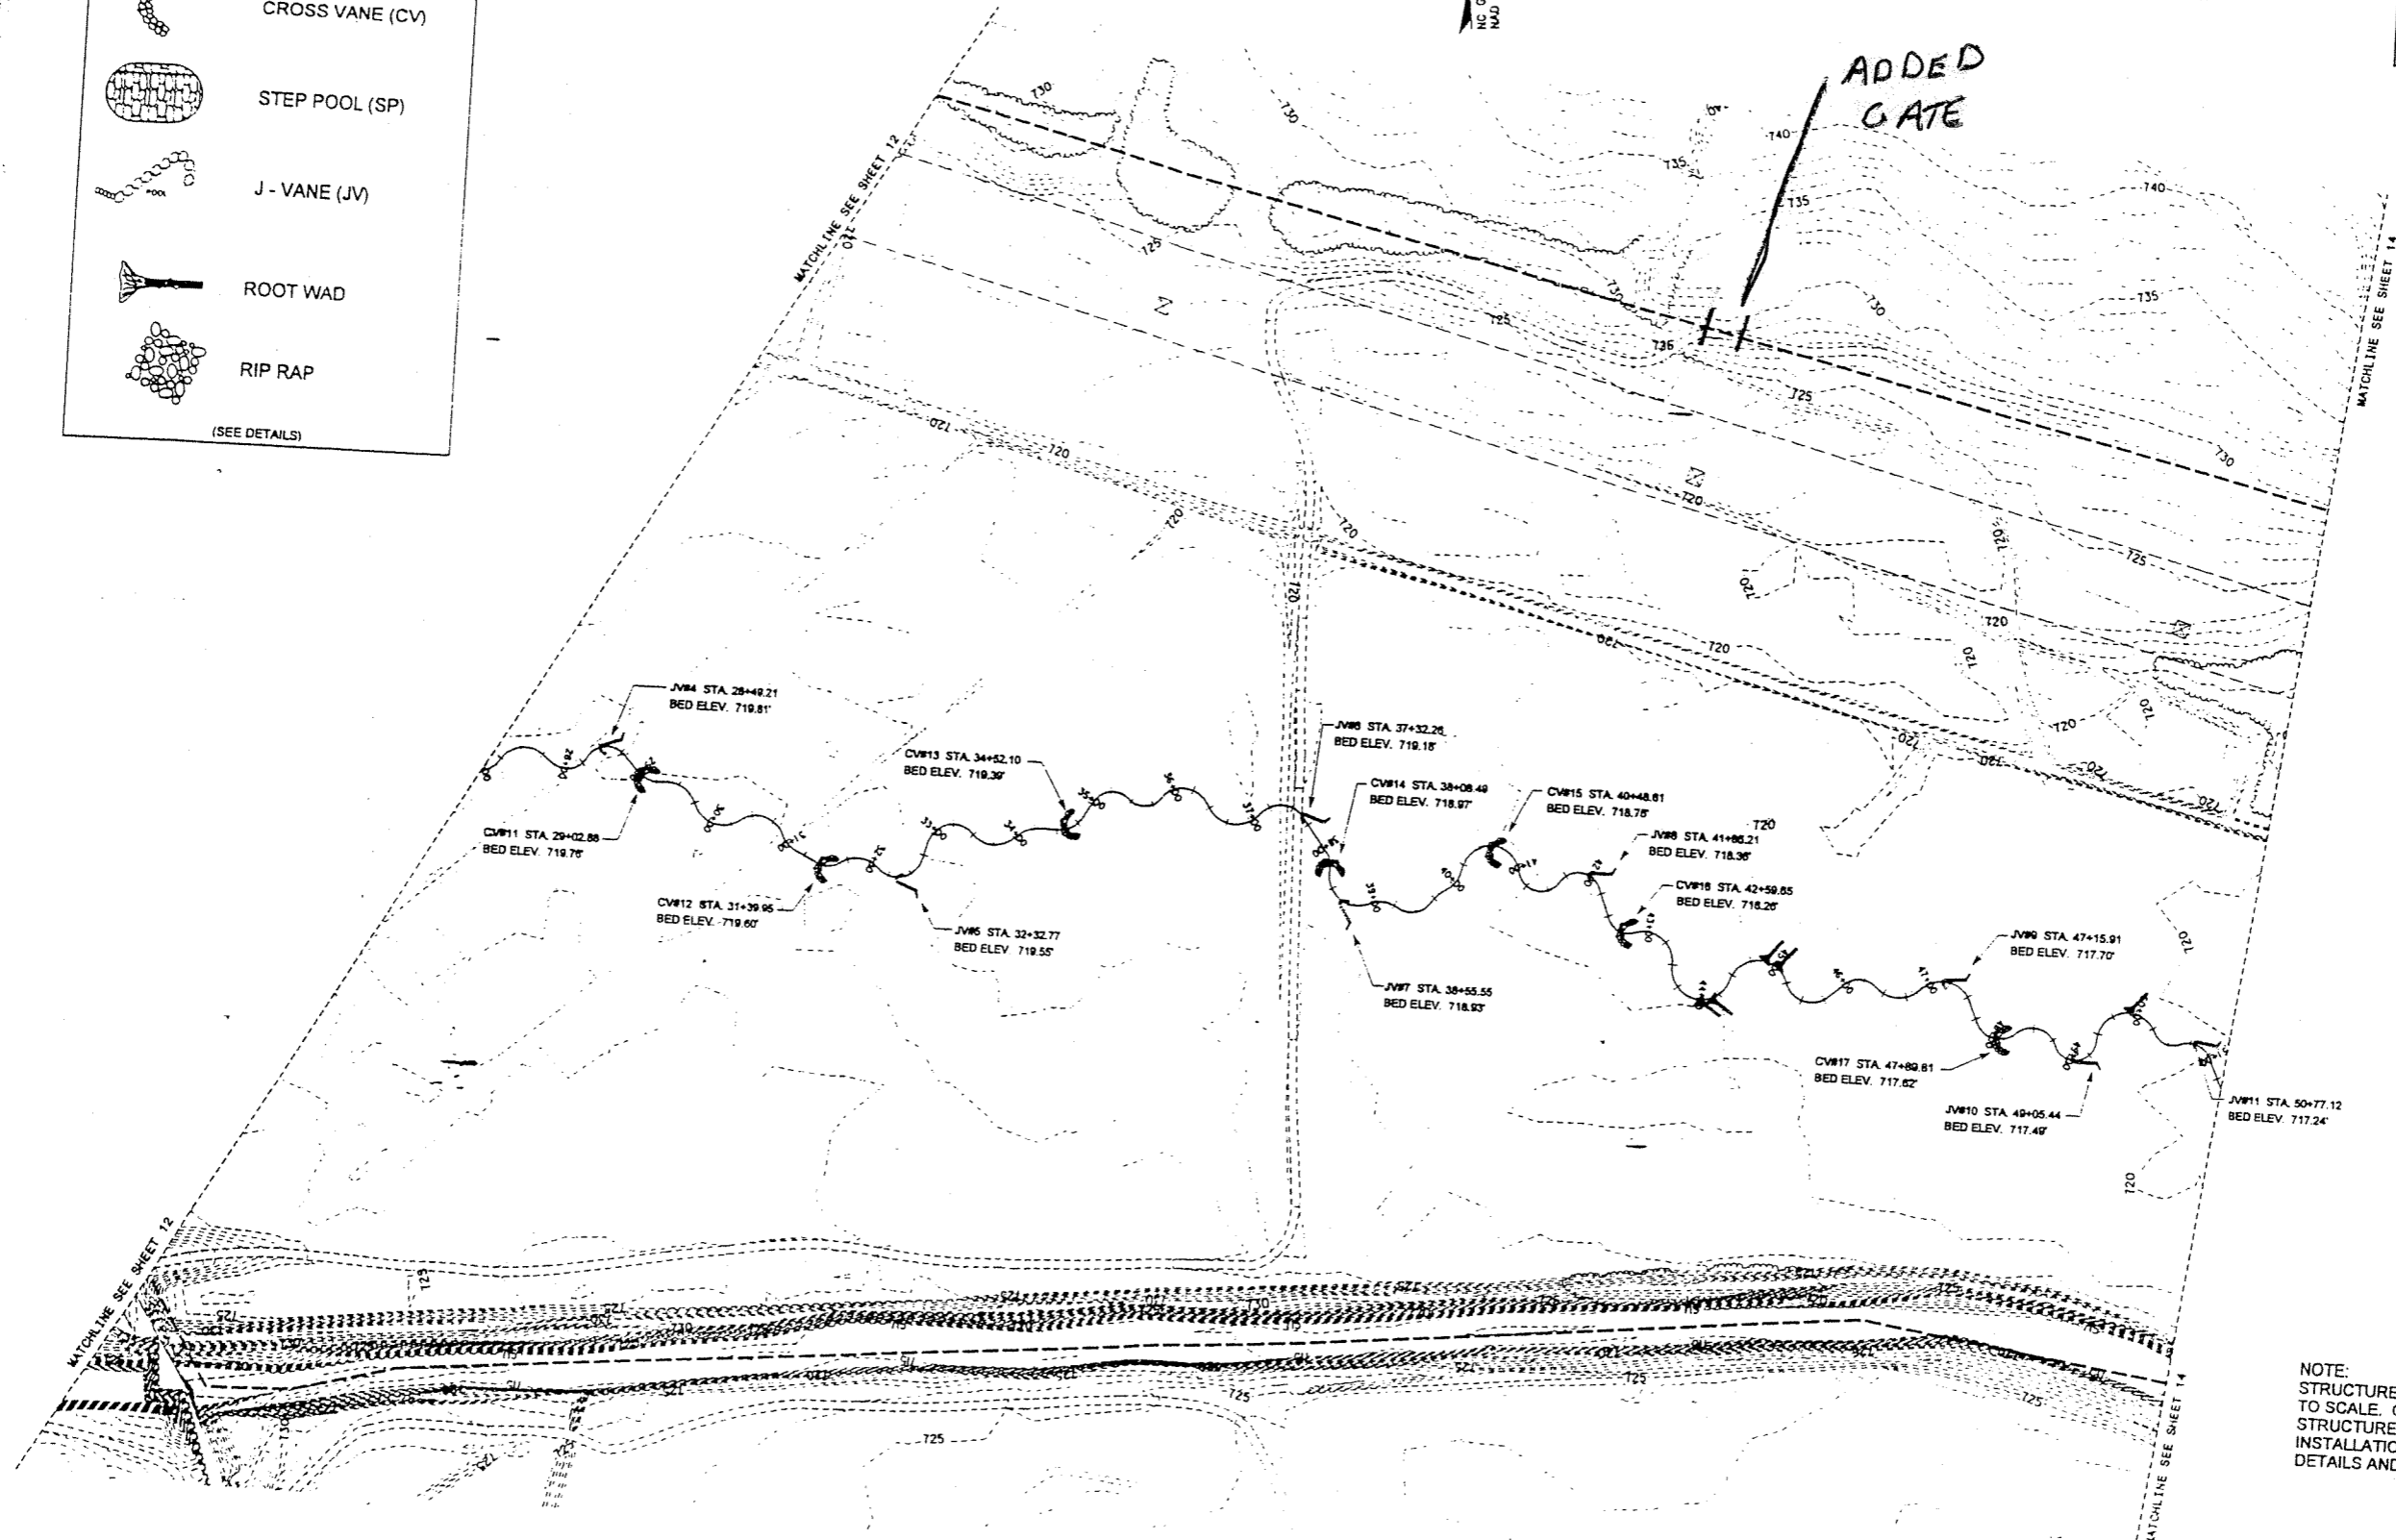

STRUCTURES PLAN

0 50 100 200
GRAPHIC SCALE (1" = 100')

NOTE:
STRUCTURES ARE NOT DRAWN TO SCALE. ORIENTATION OF STRUCTURES ARE APPROXIMATE. INSTALLATION SHOULD FOLLOW DETAILS AND PROJECT SPECIAL PROVISIONS.

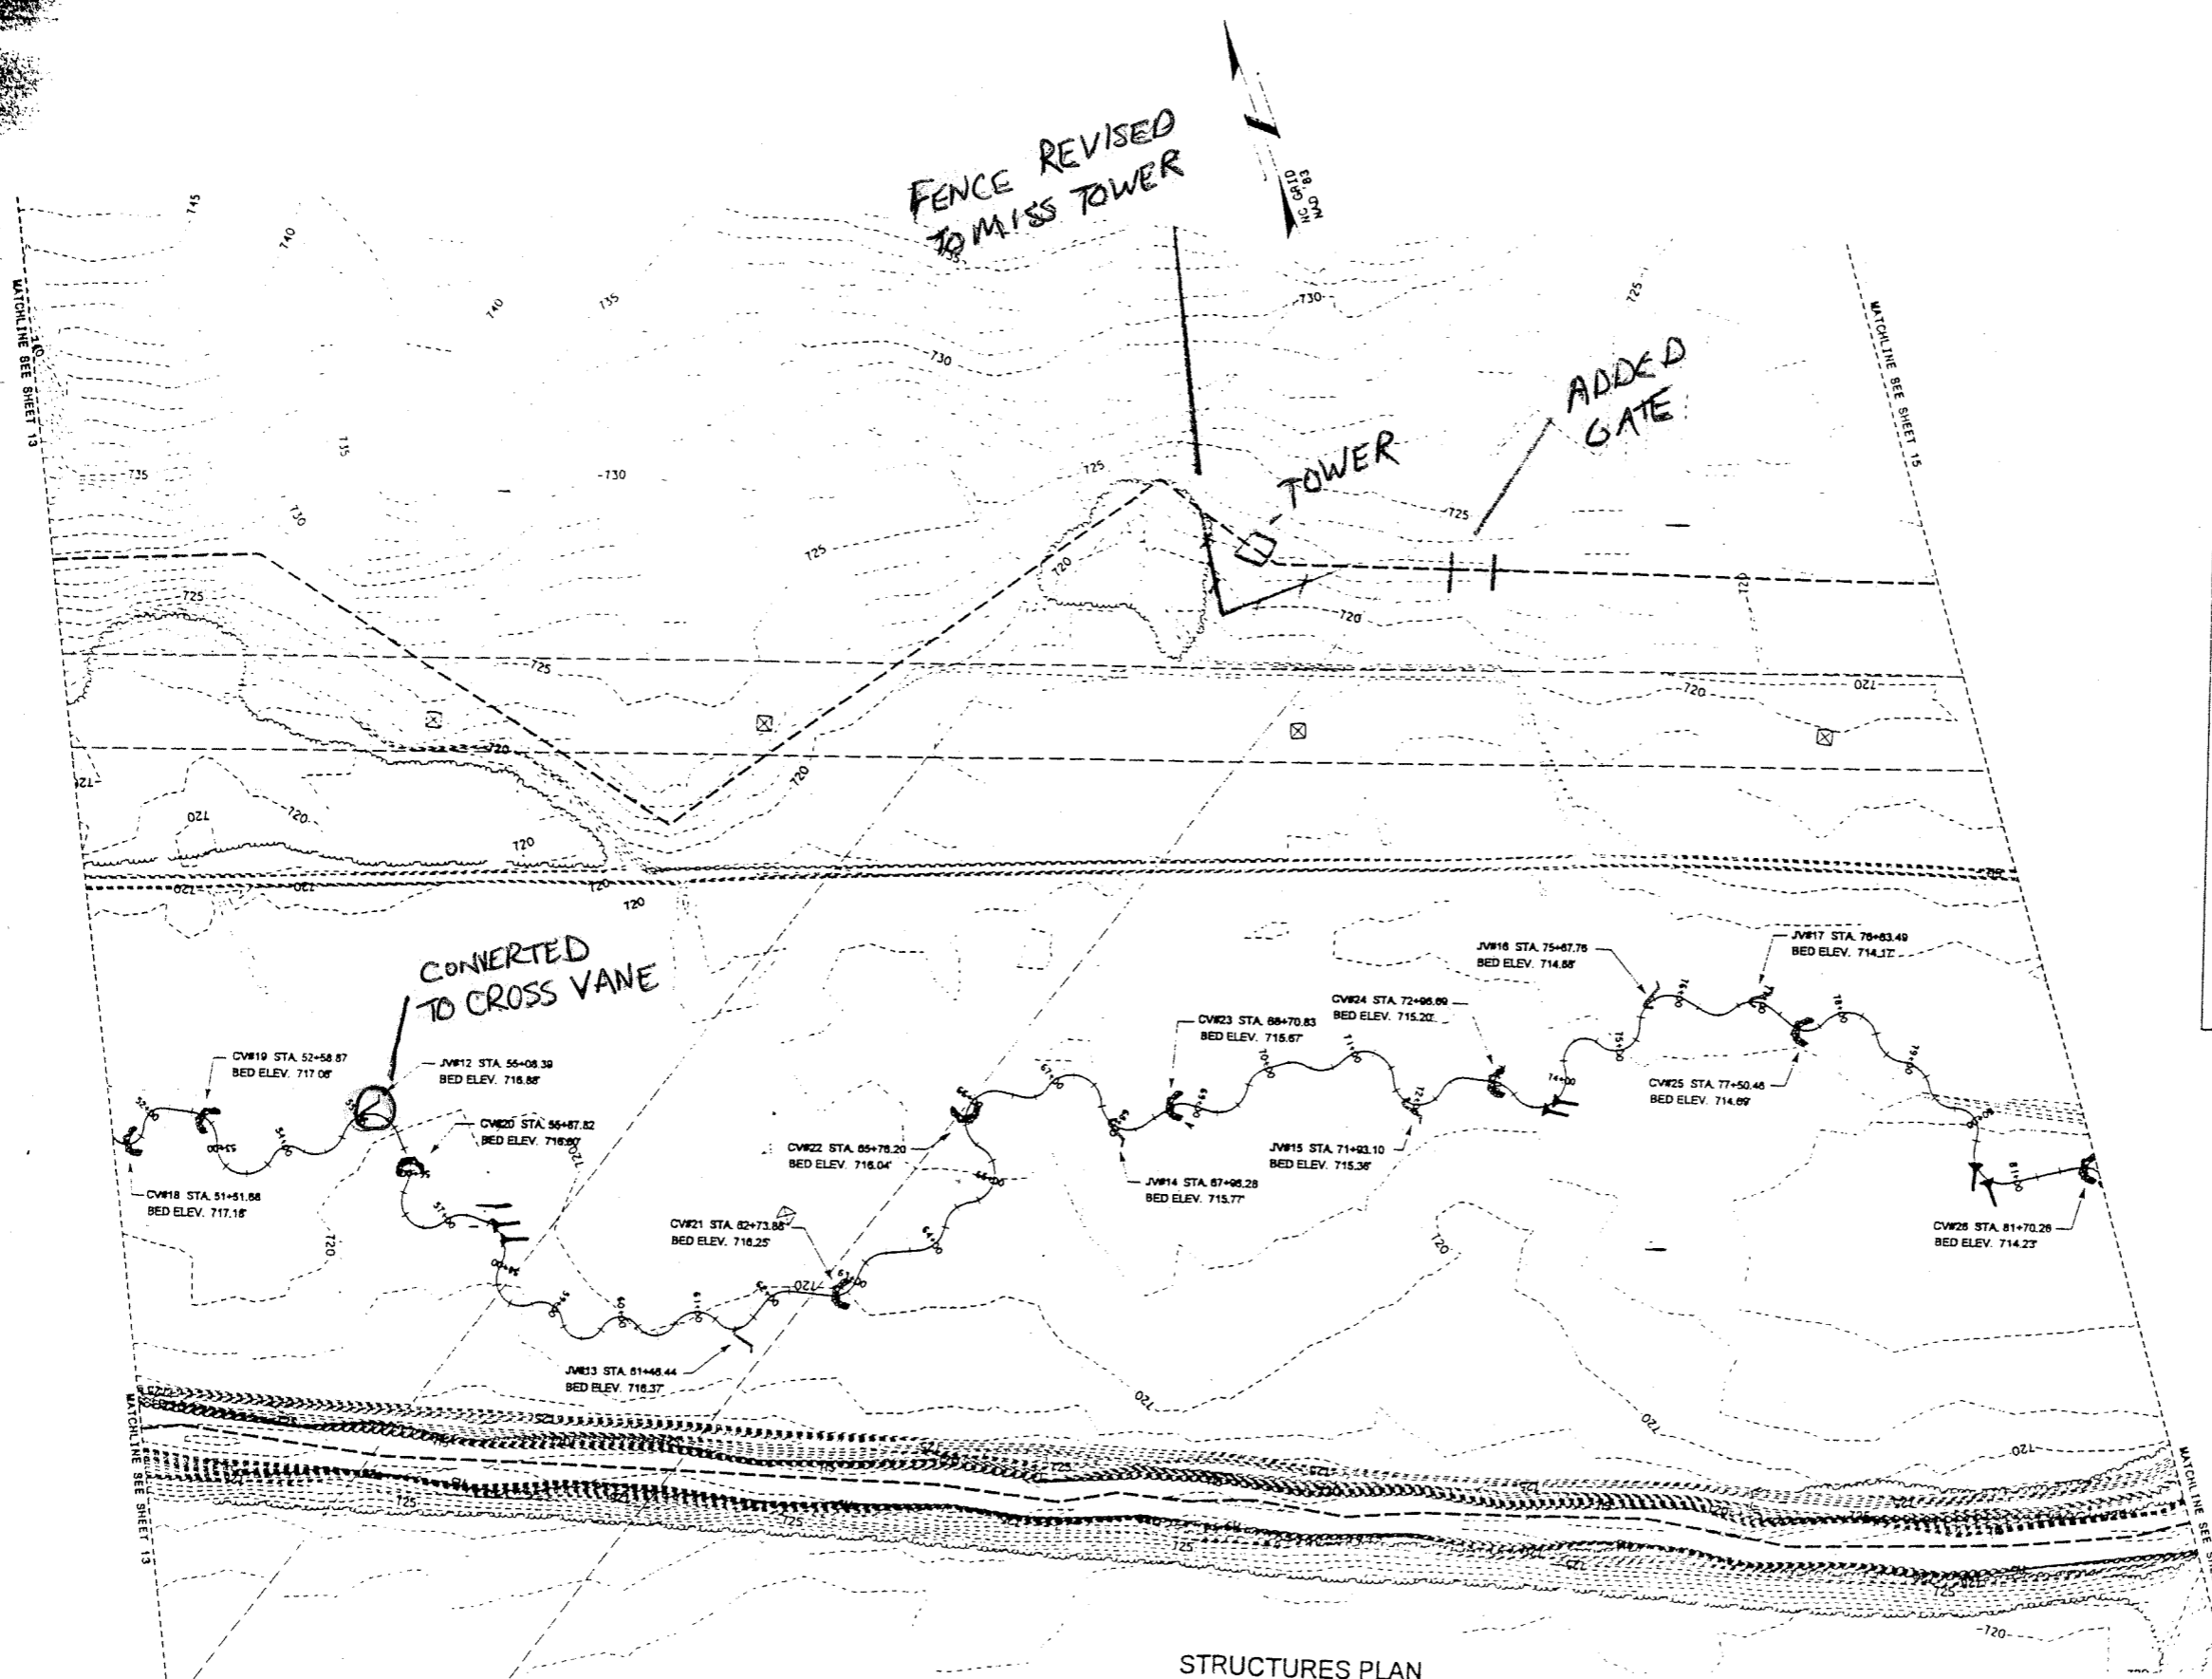







STRUCTURES LEGEND	
	PROPOSED STREAM ALIGNMENT
	CROSS VANE (CV)
	STEP POOL (SP)
	J - VANE (JV)
	ROOT WAD
	RIP RAP
(SEE DETAILS)	

- CV#19 STA. 52+58.87
BED ELEV. 717.08'
- CV#20 STA. 55+08.39
BED ELEV. 718.88'
- CV#21 STA. 55+47.82
BED ELEV. 718.90'
- CV#22 STA. 55+78.20
BED ELEV. 716.04'
- CV#23 STA. 68+70.83
BED ELEV. 715.67'
- CV#24 STA. 72+08.09
BED ELEV. 715.20'
- CV#25 STA. 77+50.46
BED ELEV. 714.09'
- CV#28 STA. 81+70.28
BED ELEV. 714.23'
- JV#13 STA. 61+48.44
BED ELEV. 718.37'
- JV#14 STA. 67+08.28
BED ELEV. 715.77'
- JV#15 STA. 71+03.10
BED ELEV. 715.38'
- JV#16 STA. 75+07.75
BED ELEV. 714.88'
- JV#17 STA. 78+03.49
BED ELEV. 714.17'

NOTE:
 STRUCTURES ARE NOT DRAWN TO SCALE. ORIENTATION OF STRUCTURES ARE APPROXIMATE. INSTALLATION SHOULD FOLLOW DETAILS AND PROJECT SPECIAL PROVISIONS.

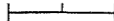STRUCTURES PLAN
 0 50 100 200
 GRAPHIC SCALE (1" = 100')

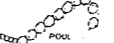
STRUCTURES LEGEND

-  PROPOSED STREAM ALIGNMENT
-  CROSS VANE (CV)
-  STEP POOL (SP)
-  J - VANE (JV)
-  ROOT WAD
-  RIP RAP

(SEE DETAILS)





NOTE:
 STRUCTURES ARE NOT DRAWN TO SCALE. ORIENTATION OF STRUCTURES ARE APPROXIMATE. INSTALLATION SHOULD FOLLOW DETAILS AND PROJECT SPECIAL PROVISIONS.

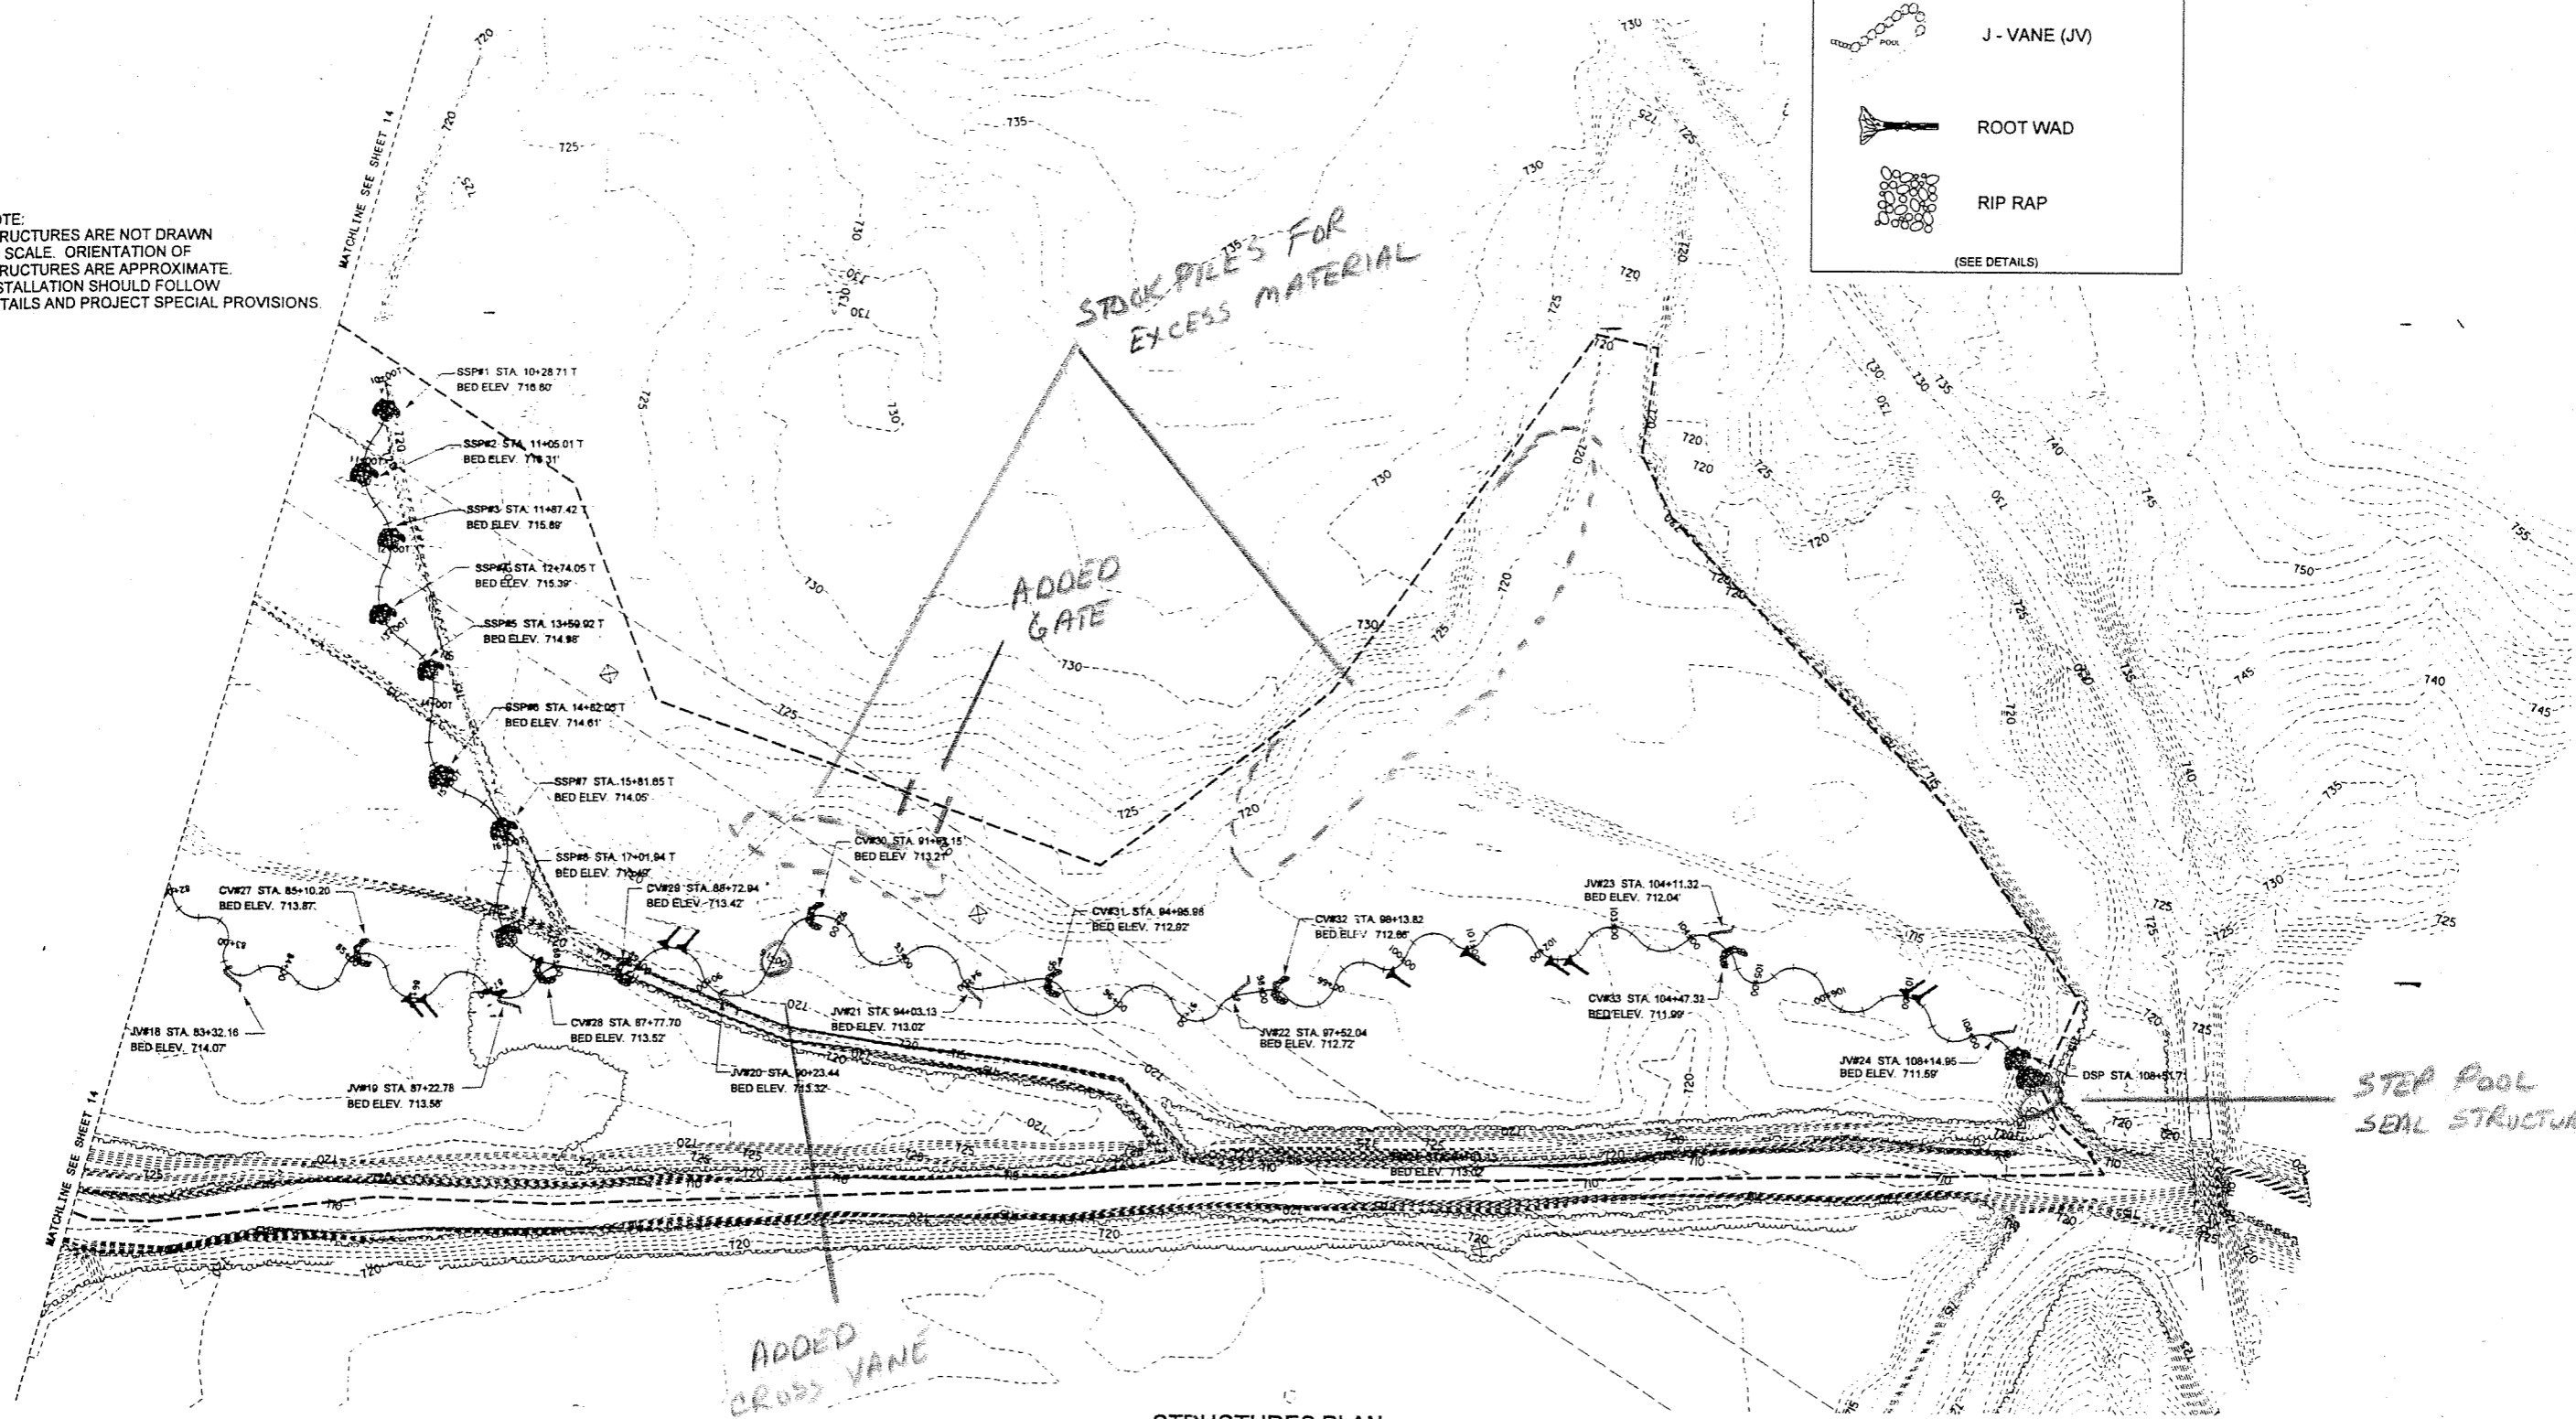


STRUCTURES PLAN
 0 50 100 200
 GRAPHIC SCALE (1" = 100')

PROJECT REFERENCE NO. R - 2239WM	SHEET NO. 20
RW SHEET NO.	
ENGINEER	SCIENTIST

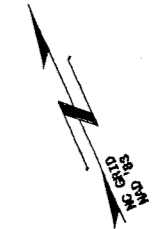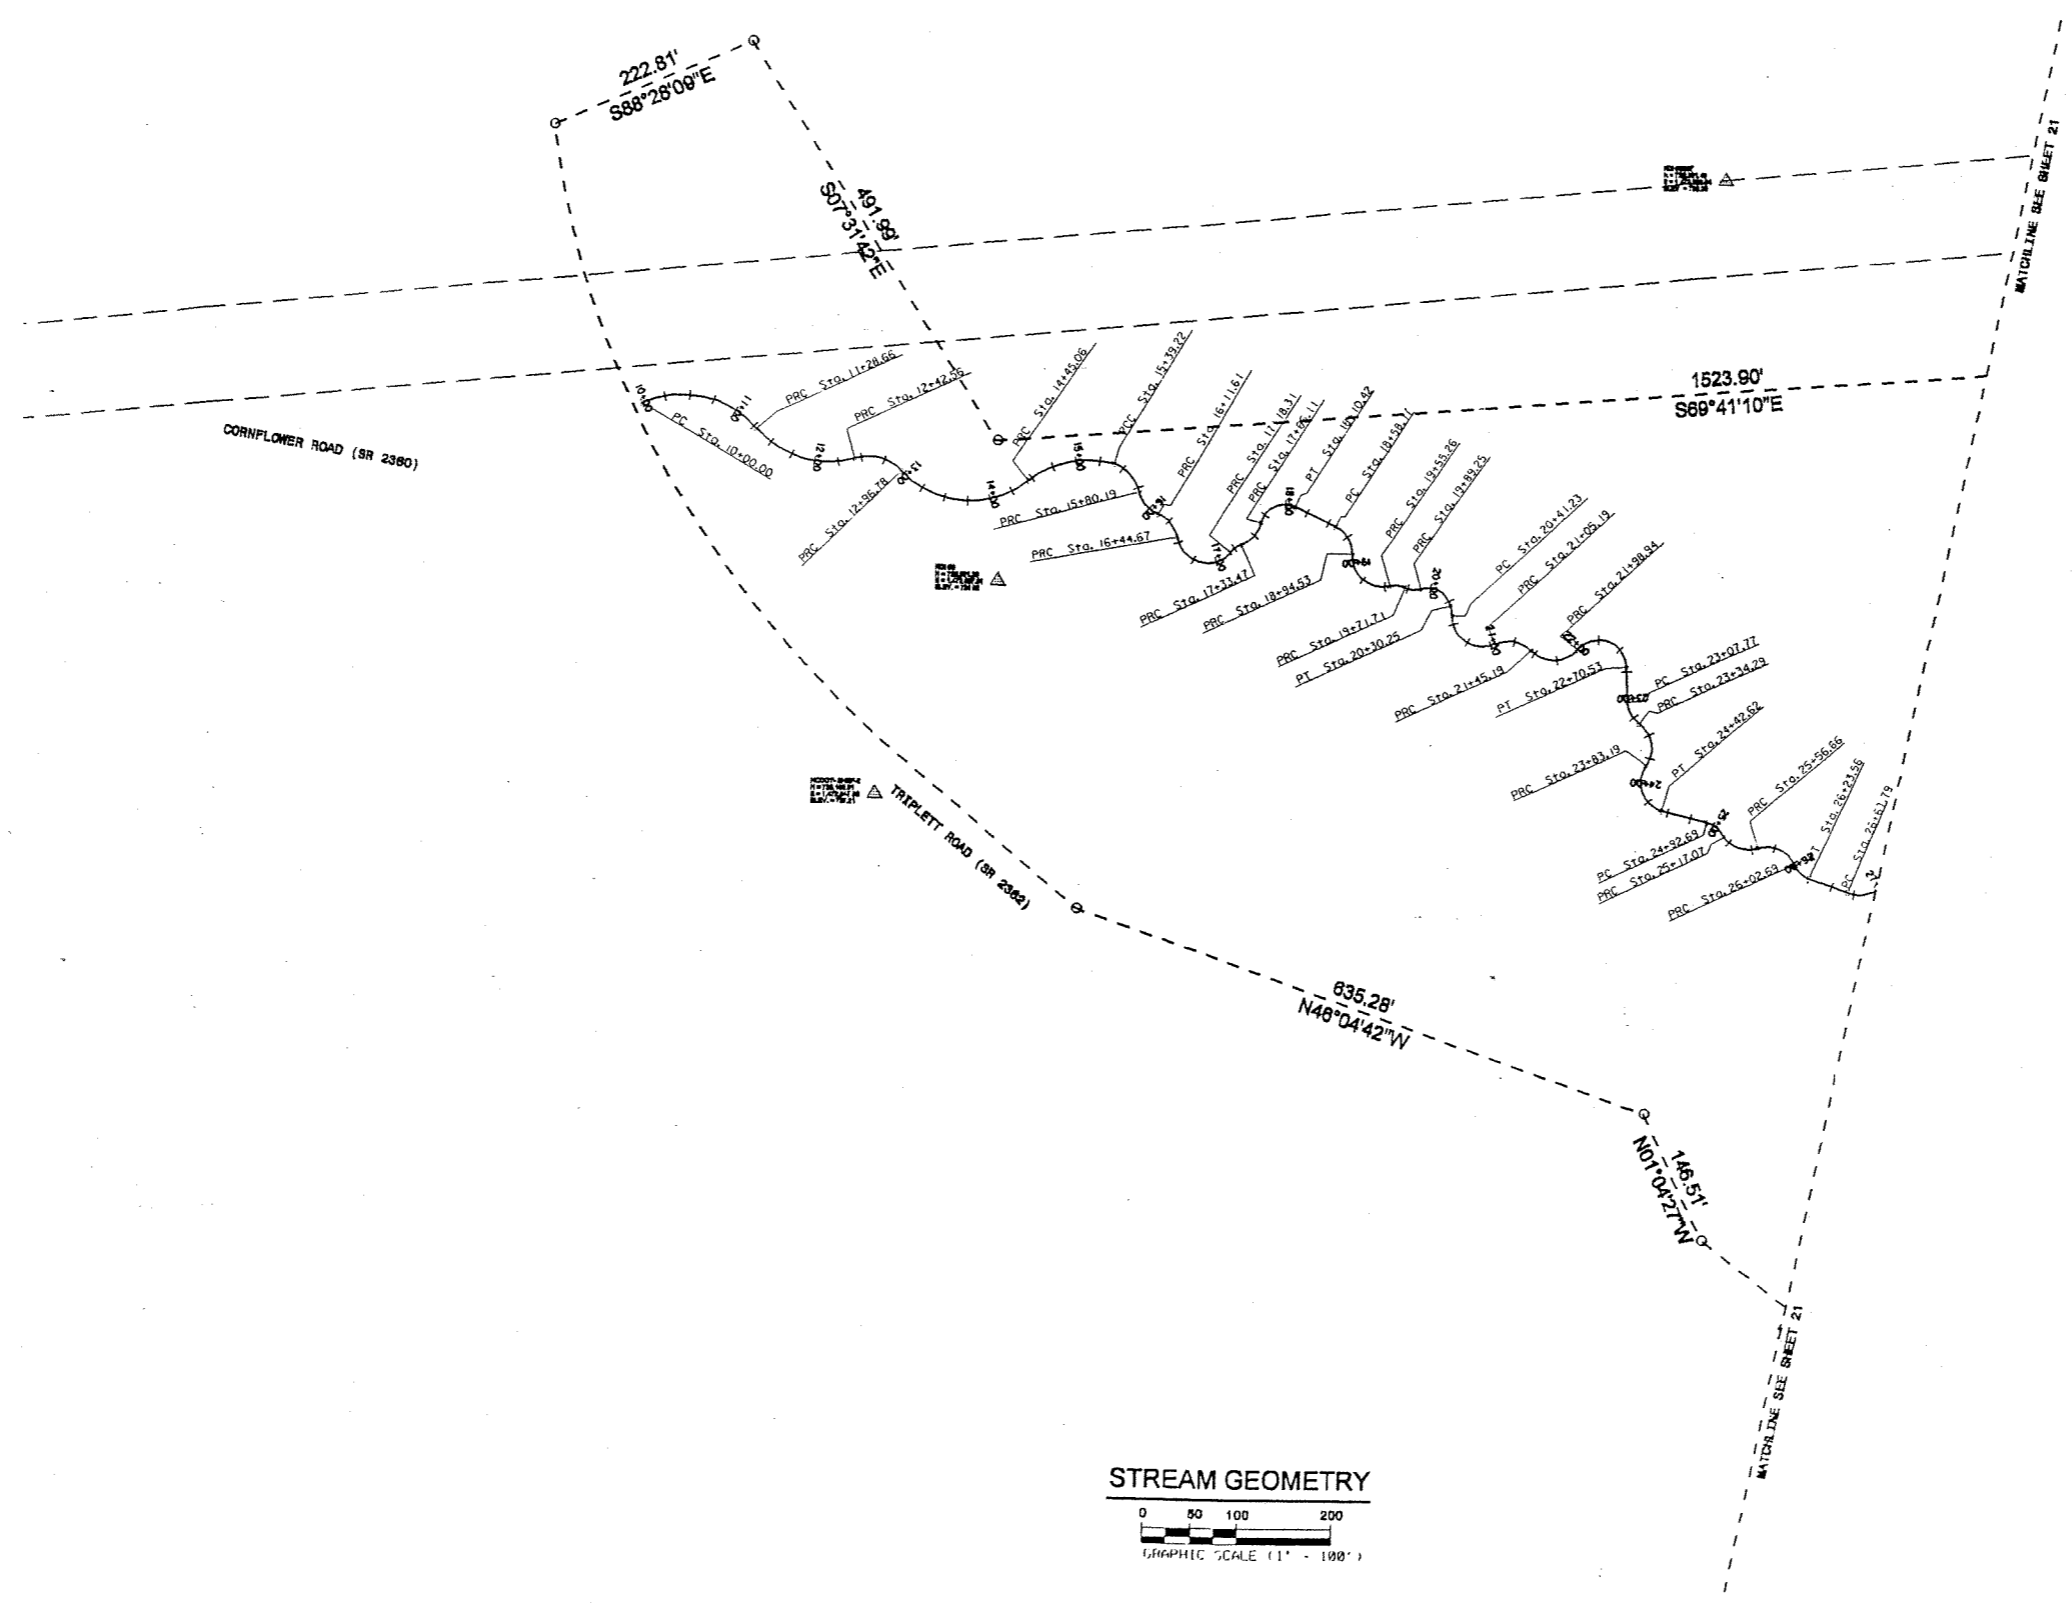

GEOMETRY LEGEND	
	PROPOSED STREAM ALIGNMENT
	DUKE POWER RIGHT-OF-WAY
	LIMITS OF DISTURBANCE
	SURVEY CONTROL POINT

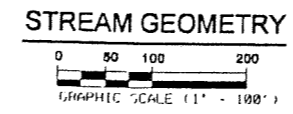

STREAM GEOMETRY 01


KCI Associates
of North Carolina, P.A.
317 E. 220, LANDMARK CENTER 1, 4500 SIX FORKS RD.
HALEIGH, NC 27509-0200
ENGINEERS • PLANNERS • ECOLOGISTS



	PROPOSED STREAM ALIGNMENT
	DUKE POWER RIGHT-OF-WAY
	LIMITS OF DISTURBANCE
	SURVEY CONTROL POINT




STREAM GEOMETRY

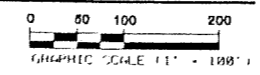


STREAM GEOMETRY 02

KCI Associates of North Carolina, P.A.
 2101 500 SANDHILL CENTER LANE, SUITE 2000
 RALEIGH, NC 27617-5200
 • ENGINEERS • PLANNERS • CONSULTANTS

PROJECT REFERENCE NO. R - 2239WM	SHEET NO. 22
RW SHEET NO.	
ENGINEER	SCIENTIST

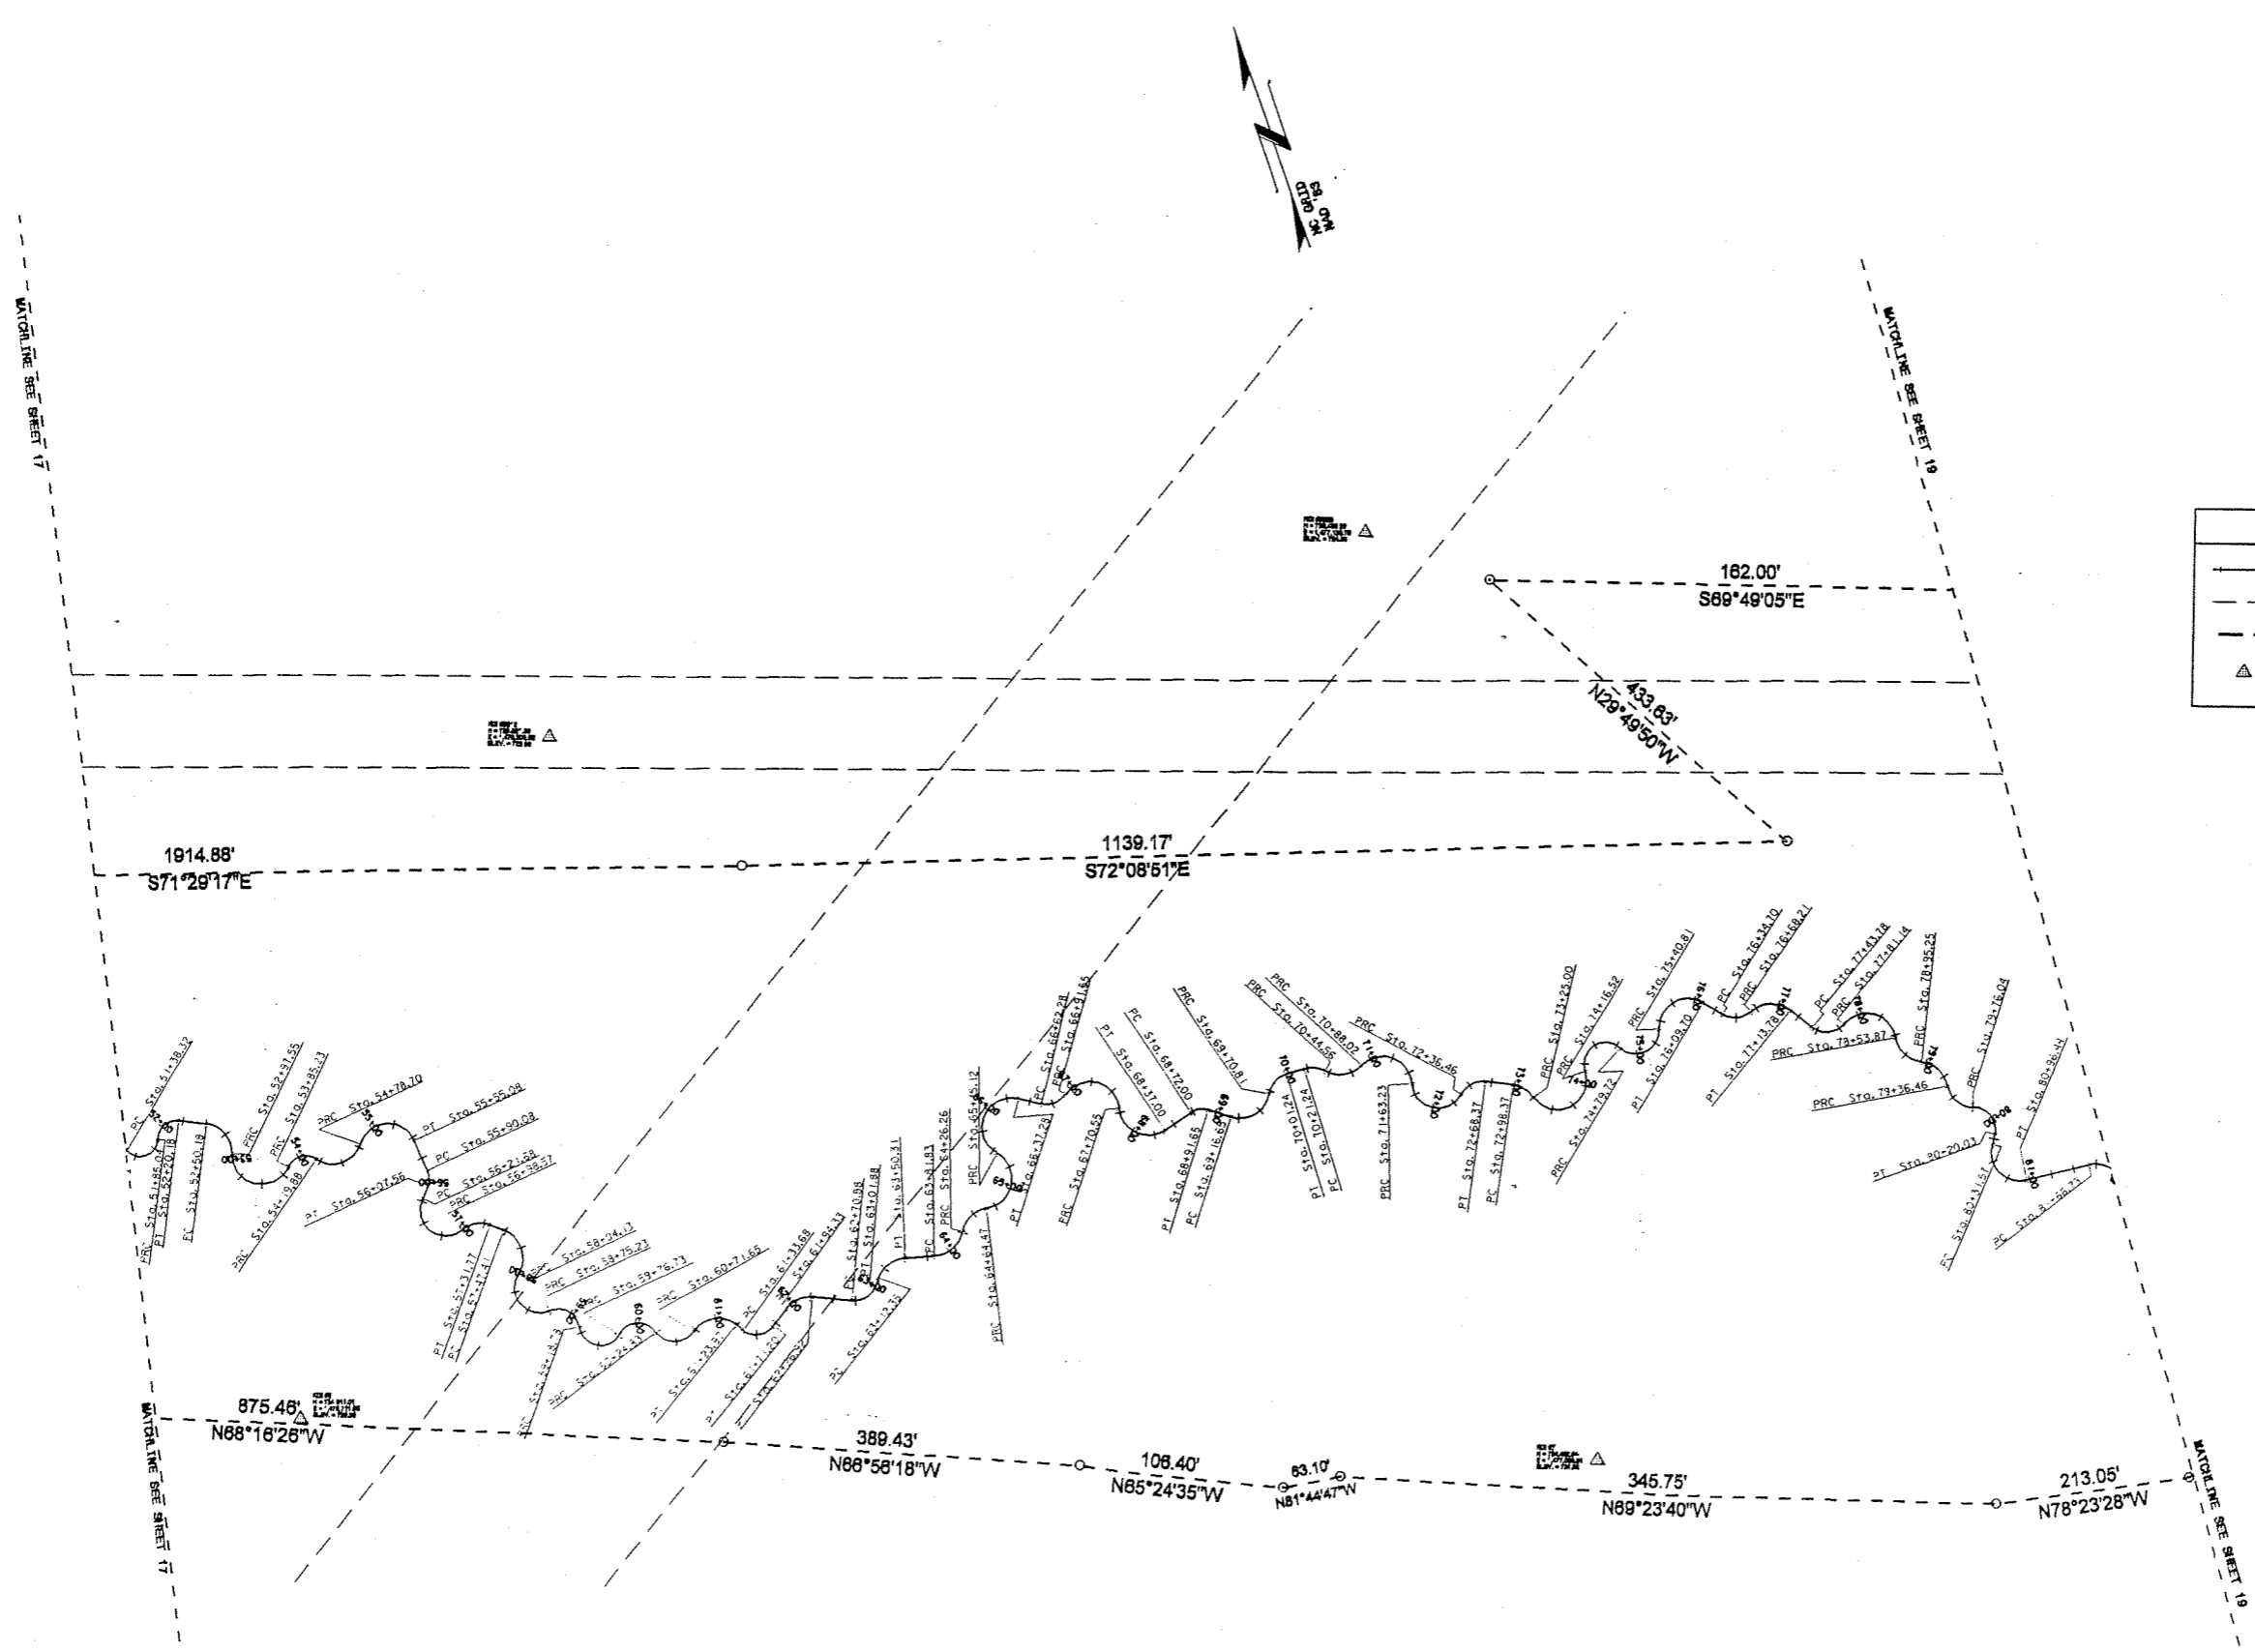

GEOMETRY LEGEND	
	PROPOSED STREAM ALIGNMENT
	DUKE POWER RIGHT-OF-WAY
	LIMITS OF DISTURBANCE
	SURVEY CONTROL POINT

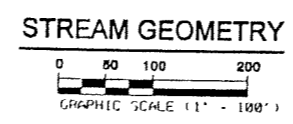



STREAM GEOMETRY 03

KCI Associates
of North Carolina, P.A.
2116 200 LANDMARK CENTER V, 4500 JX FORK, NC
DALEGA, NC 27601-5200
• ENGINEER • PLANNER • ECOLOGIST

PROJECT REFERENCE NO. R - 2234W	SHEET NO. 23
ENGINEER	SCIENTIST



GEOMETRY LEGEND	
	PROPOSED STREAM ALIGNMENT
	DUKE POWER RIGHT-OF-WAY
	LIMITS OF DISTURBANCE
	SURVEY CONTROL POINT

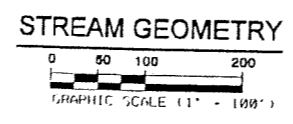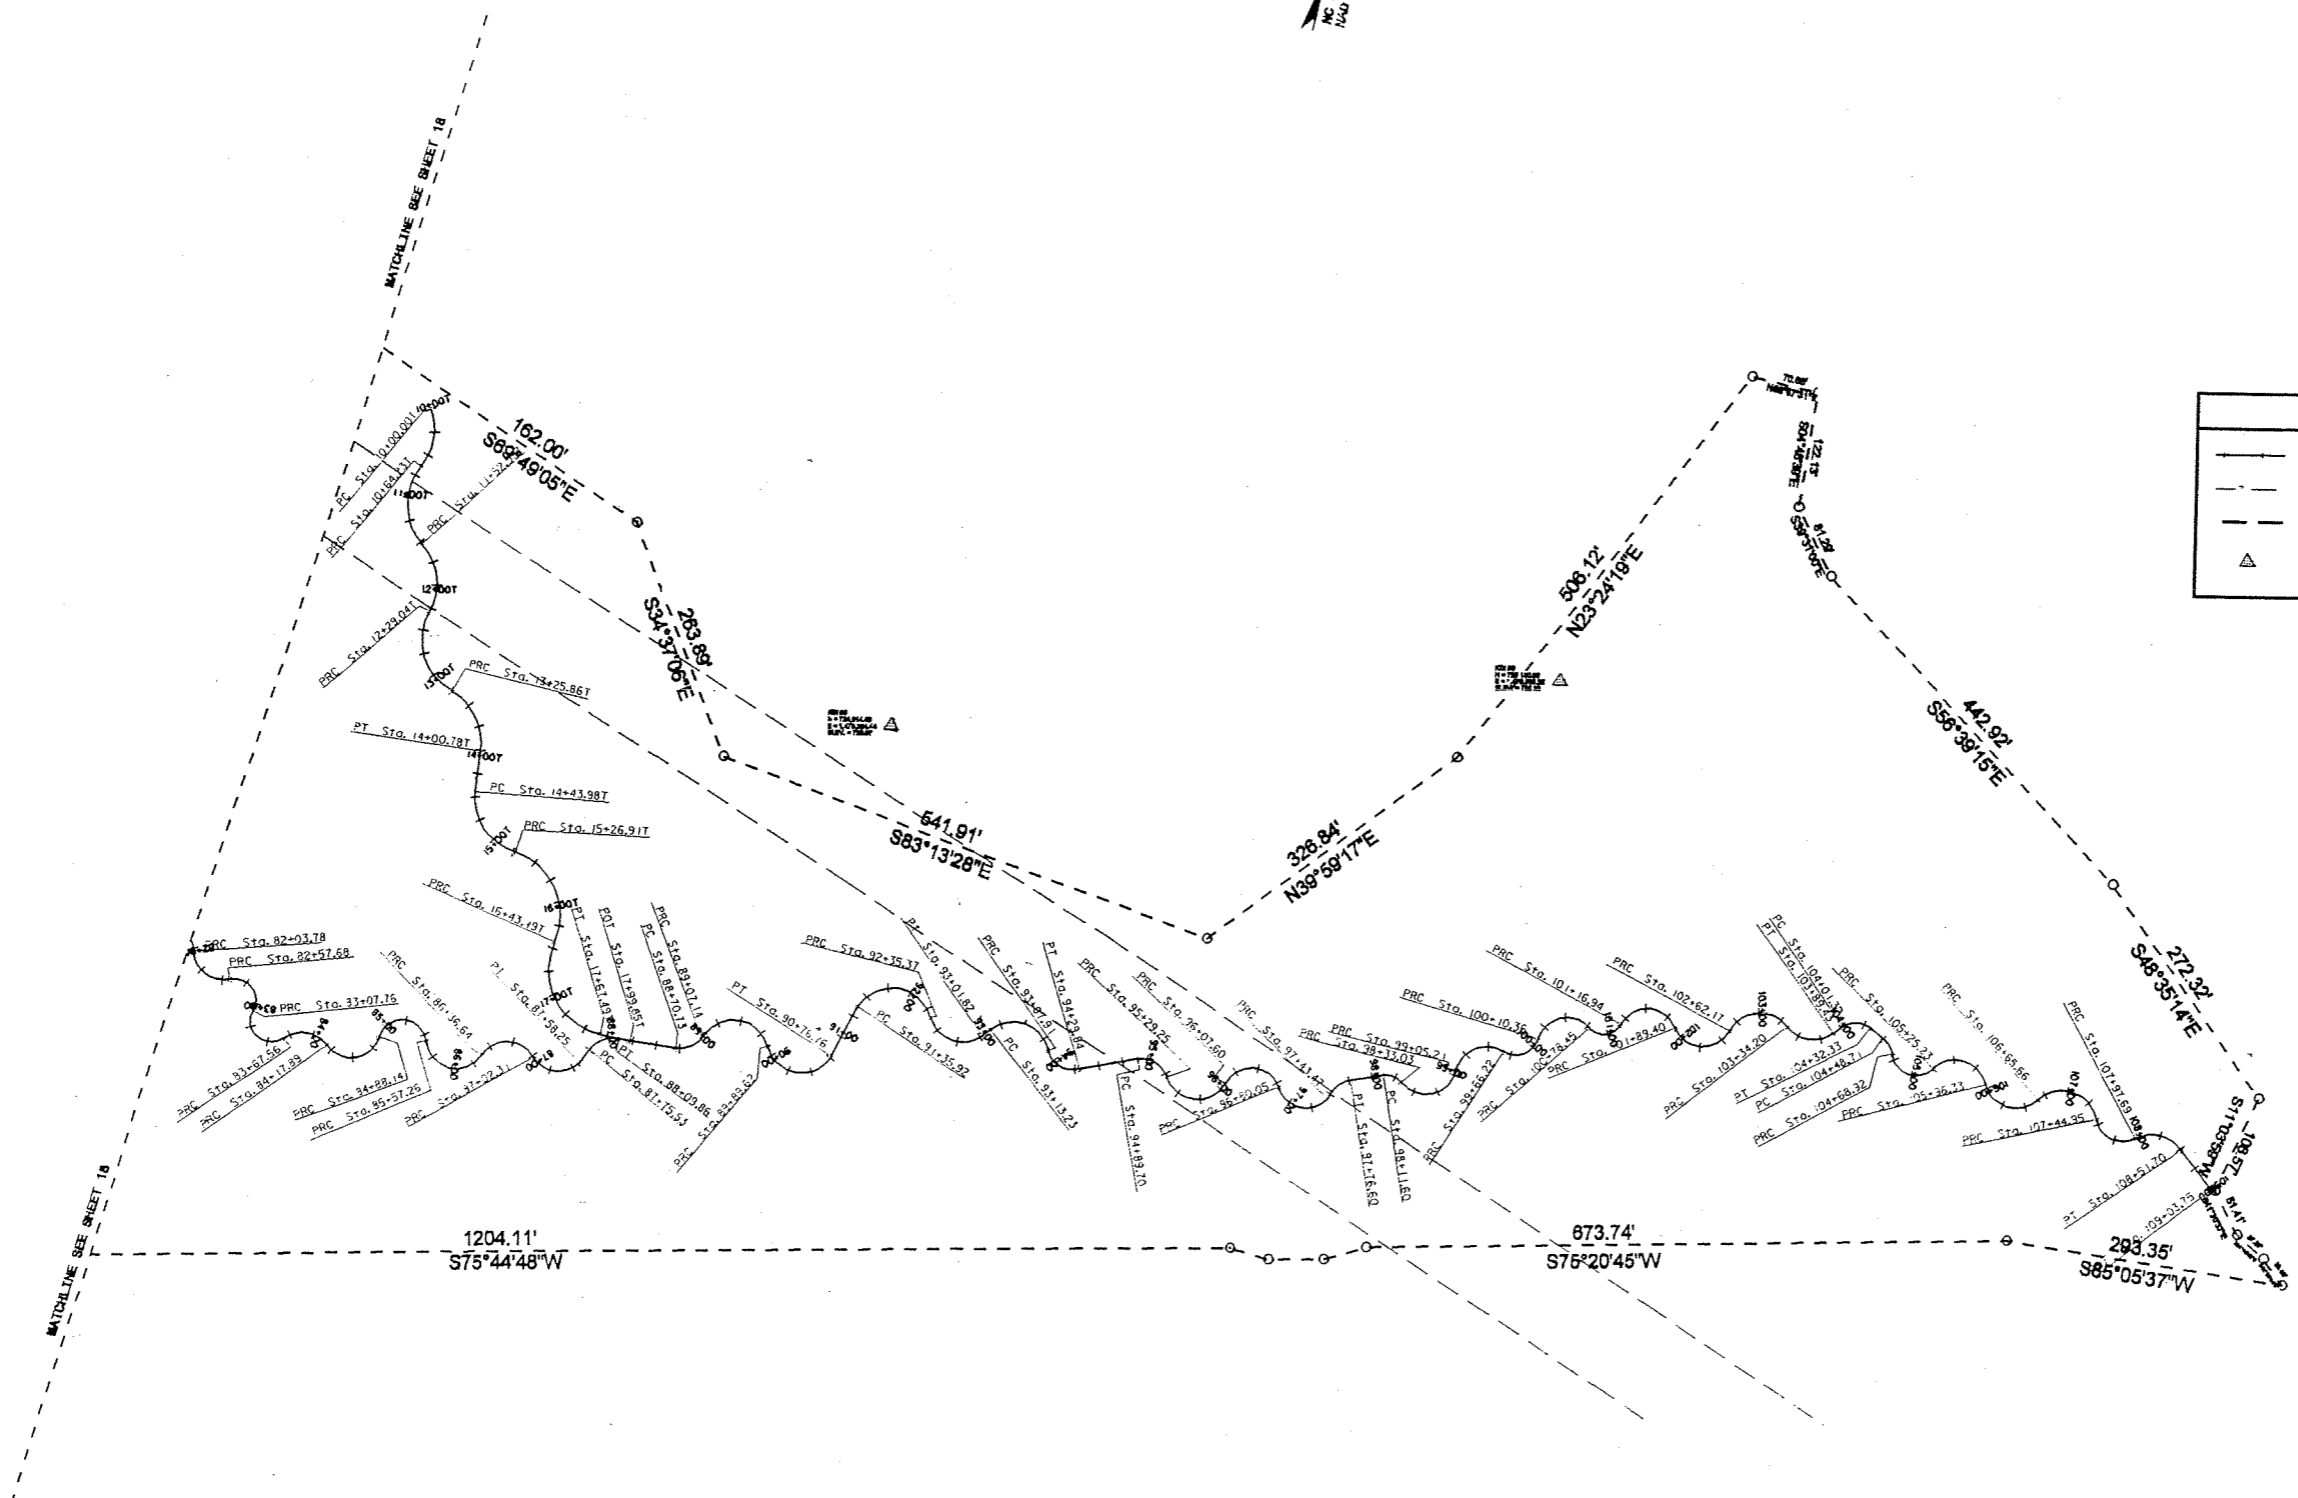

STREAM GEOMETRY 04

KCI Associates
of North Carolina, P.A.
SUITE 200, LANDMARK CENTER 1, MARKET FORTS, DR.
DALLAS, TX 75201-1200
MEMPHIS • PHOENIX • TAMPA • WASHINGTON

CURVE DATA

CURVE 1

P.I. STATION	10+74.968	N	726.643.731	E
DELTA	53° 42' 59.44"	(RT)		
DEGREE	53° 17' 44.81"			
TANGENT	74.968			
LENGTH	128.660			
RADIUS	100.000			
EXTERNAL	24.981			
LONG CHORD	119.967			
MID. ORD.	19.988			
P.C. STATION	10+00.000	N	726.643.905	E
P.T. STATION	11+28.660	N	726.571.722	E
C.C.		N	726.543.905	E
BACK	S 89° 52' 01.78" E			
AHEAD	S 16° 09' 02.33" E			
CHORD BEAR	S 53° 00' 32.05" E			

CURVE DATA

CURVE 7

P.I. STATION	15+92.297	N	726.329.152	E
DELTA	56° 15' 57.49"	(LT)		
DEGREE	179° 02' 57.50"			
TANGENT	17.110			
LENGTH	31.425			
RADIUS	32.000			
EXTERNAL	4.297			
LONG CHORD	30.177			
MID. ORD.	3.791			
P.C. STATION	15+90.197	N	726.345.992	E
P.T. STATION	16+11.612	N	726.316.913	E
C.C.		N	726.339.275	E
BACK	S 11° 56' 06.94" W			
AHEAD	S 44° 19' 50.54" E			
CHORD BEAR	S 16° 11' 51.90" E			

CURVE DATA

CURVE 12

P.I. STATION	17+96.009	N	726.237.748	E
DELTA	99° 50' 15.98"	(RT)		
DEGREE	220° 22' 39.64"			
TANGENT	30.895			
LENGTH	45.303			
RADIUS	25.939			
EXTERNAL	14.390			
LONG CHORD	39.795			
MID. ORD.	9.259			
P.C. STATION	17+65.113	N	726.263.738	E
P.T. STATION	18+10.417	N	726.264.487	E
C.C.		N	726.247.376	E
BACK	N 39° 00' 11.53" E			
AHEAD	S 41° 09' 32.49" E			
CHORD BEAR	N 38° 55' 19.52" E			

CURVE DATA

CURVE 2

P.I. STATION	11+92.686	N	726.510.222	E
DELTA	65° 15' 35.10"	(LT)		
DEGREE	57° 17' 44.81"			
TANGENT	64.026			
LENGTH	113.900			
RADIUS	100.000			
EXTERNAL	18.741			
LONG CHORD	107.942			
MID. ORD.	15.793			
P.C. STATION	11+28.660	N	726.571.722	E
P.T. STATION	12+42.559	N	726.500.660	E
C.C.		N	726.599.538	E
BACK	S 16° 09' 02.33" E			
AHEAD	S 81° 24' 37.43" E			
CHORD BEAR	S 48° 46' 49.88" E			

CURVE DATA

CURVE 8

P.I. STATION	16+29.787	N	726.304.022	E
DELTA	59° 11' 19.91"	(RT)		
DEGREE	179° 02' 57.54"			
TANGENT	18.174			
LENGTH	33.057			
RADIUS	32.000			
EXTERNAL	4.801			
LONG CHORD	31.607			
MID. ORD.	4.175			
P.C. STATION	16+11.612	N	726.316.913	E
P.T. STATION	16+44.670	N	726.286.416	E
C.C.		N	726.294.356	E
BACK	S 44° 49' 20.86" E			
AHEAD	S 14° 21' 59.05" W			
CHORD BEAR	S 15° 13' 40.90" E			

CURVE DATA

CURVE 13

P.I. STATION	18+78.599	N	726.212.355	E
DELTA	65° 06' 31.52"	(RT)		
DEGREE	179° 02' 57.52"			
TANGENT	20.429			
LENGTH	36.364			
RADIUS	32.000			
EXTERNAL	5.965			
LONG CHORD	34.438			
MID. ORD.	5.028			
P.C. STATION	18+58.170	N	726.228.096	E
P.T. STATION	18+94.533	N	726.193.917	E
C.C.		N	726.207.698	E
BACK	S 39° 36' 01.24" E			
AHEAD	S 25° 30' 30.29" W			
CHORD BEAR	S 7° 02' 45.47" E			

CURVE DATA

CURVE 3

P.I. STATION	12+72.684	N	726.496.160	E
DELTA	62° 08' 16.26"	(RT)		
DEGREE	114° 35' 29.61"			
TANGENT	30.125			
LENGTH	54.226			
RADIUS	50.000			
EXTERNAL	8.374			
LONG CHORD	51.607			
MID. ORD.	7.173			
P.C. STATION	12+42.559	N	726.500.660	E
P.T. STATION	12+96.795	N	726.467.724	E
C.C.		N	726.451.221	E
BACK	S 81° 24' 37.43" E			
AHEAD	S 19° 16' 21.17" E			
CHORD BEAR	S 50° 20' 29.30" E			

CURVE DATA

CURVE 9

P.I. STATION	17+16.292	N	726.217.542	E
DELTA	131° 51' 03.43"	(LT)		
DEGREE	179° 02' 57.51"			
TANGENT	71.622			
LENGTH	73.639			
RADIUS	32.000			
EXTERNAL	46.446			
LONG CHORD	58.433			
MID. ORD.	18.946			
P.C. STATION	16+44.670	N	726.286.416	E
P.T. STATION	17+18.309	N	726.248.858	E
C.C.		N	726.277.637	E
BACK	S 15° 55' 20.67" W			
AHEAD	N 64° 04' 17.23" E			
CHORD BEAR	S 50° 00' 11.05" E			

CURVE DATA

CURVE 14

P.I. STATION	19+39.179	N	726.154.766	E
DELTA	108° 44' 13.24"	(LT)		
DEGREE	179° 02' 57.54"			
TANGENT	44.645			
LENGTH	60.730			
RADIUS	32.000			
EXTERNAL	22.929			
LONG CHORD	52.018			
MID. ORD.	13.358			
P.C. STATION	18+94.533	N	726.193.917	E
P.T. STATION	19+55.264	N	726.147.024	E
C.C.		N	726.178.539	E
BACK	S 28° 43' 24.21" E			
AHEAD	S 80° 00' 49.03" W			
CHORD BEAR	S 25° 38' 42.41" E			

CURVE DATA

CURVE 4

P.I. STATION	13+98.347	N	726.381.293	E
DELTA	84° 57' 20.30"	(LT)		
DEGREE	57° 17' 44.81"			
TANGENT	91.962			
LENGTH	148.276			
RADIUS	100.000			
EXTERNAL	25.586			
LONG CHORD	135.051			
MID. ORD.	26.246			
P.C. STATION	12+96.795	N	726.467.724	E
P.T. STATION	14+45.060	N	726.403.797	E
C.C.		N	726.500.730	E
BACK	S 19° 16' 21.17" E			
AHEAD	S 75° 46' 18.53" E			
CHORD BEAR	S 61° 45' 01.32" E			

CURVE DATA

CURVE 10

P.I. STATION	17+26.033	N	726.252.218	E
DELTA	27° 08' 27.47"	(RT)		
DEGREE	179° 02' 57.59"			
TANGENT	7.724			
LENGTH	15.158			
RADIUS	32.000			
EXTERNAL	0.919			
LONG CHORD	15.017			
MID. ORD.	0.893			
P.C. STATION	17+18.309	N	726.248.858	E
P.T. STATION	17+33.467	N	726.252.034	E
C.C.		N	726.220.043	E
BACK	N 64° 13' 10.94" E			
AHEAD	S 88° 38' 21.59" E			
CHORD BEAR	N 77° 47' 24.68" E			

CURVE DATA

CURVE 15

P.I. STATION	19+63.797	N	726.145.544	E
DELTA	37° 39' 26.11"	(RT)		
DEGREE	228° 57' 13.43"			
TANGENT	8.533			
LENGTH	16.448			
RADIUS	25.025			
EXTERNAL	1.415			
LONG CHORD	16.153			
MID. ORD.	1.339			
P.C. STATION	19+55.264	N	726.147.024	E
P.T. STATION	19+71.711	N	726.139.238	E
C.C.		N	726.122.378	E
BACK	S 80° 00' 49.03" E			
AHEAD	S 42° 21' 22.93" E			
CHORD BEAR	S 61° 11' 05.98" E			

CURVE DATA

CURVE 5

P.I. STATION	14+95.957	N	726.416.307	E
DELTA	53° 56' 55.42"	(RT)		
DEGREE	57° 17' 44.81"			
TANGENT	50.896			
LENGTH	94.158			
RADIUS	100.000			
EXTERNAL	12.207			
LONG CHORD	90.719			
MID. ORD.	10.879			
P.C. STATION	14+45.060	N	726.403.797	E
P.T. STATION	15+39.219	N	726.383.782	E
C.C.		N	726.306.865	E
BACK	N 75° 46' 18.53" E			
AHEAD	S 50° 18' 46.05" E			
CHORD BEAR	S 77° 15' 13.76" E			

CURVE DATA

CURVE 11

P.I. STATION	17+50.720	N	726.250.331	E
DELTA	56° 39' 43.73"	(LT)		
DEGREE	179° 02' 57.49"			
TANGENT	17.253			
LENGTH	31.646			
RADIUS	32.000			
EXTERNAL	4.355			
LONG CHORD	30.372			
MID. ORD.	3.833			
P.C. STATION	17+33.467	N	726.252.034	E
P.T. STATION	17+65.113	N	726.263.738	E
C.C.		N	726.283.878	E
BACK	S 84° 20' 04.74" E			
AHEAD	N 39° 00' 11.53" E			
CHORD BEAR	N 67° 20' 03.40" E			

CURVE DATA

CURVE 16

P.I. STATION	19+80.357	N	726.132.342	E
DELTA	40° 13' 24.39"	(LT)		
DEGREE	229° 23' 49.43"			
TANGENT	9.146			
LENGTH	17.534			
RADIUS	24.977			
EXTERNAL	1.622			
LONG CHORD	17.177			
MID. ORD.	1.523			
P.C. STATION	19+71.711	N	726.139.238	E
P.T. STATION	19+89.246	N	726.130.955	E
C.C.		N	726.155.643	E
BACK	S 41° 03' 29.32" E			
AHEAD	S 31° 16' 52.71" E			
CHORD BEAR	S 61° 10' 10.52" E			

CURVE DATA

CURVE 6

P.I. STATION	15+61.252	N	726.367.630	E
DELTA	52° 15' 22.58"	(RT)		
DEGREE	127° 33' 06.16"			
TANGENT	22.033			
LENGTH	40.969			
RADIUS	44.320			
EXTERNAL	5.113			
LONG CHORD	39.563			
MID. ORD.	4.590			
P.C. STATION	15+39.219	N	726.383.782	E
P.T. STATION	15+80.187	N	726.345.992	E
C.C.		N	726.353.231	E
BACK	S 42° 51' 14.47" E			
AHEAD	S 9° 24' 08.11" W			
CHORD BEAR	S 16° 43' 33.18" E			

CURVE DATA

CURVE 12

P.I. STATION	17+96.009	N	726.237.748	E
DELTA	99° 50' 15.98"	(RT)		
DEGREE	220° 22' 39.64"			
TANGENT	30.895			
LENGTH	45.303			
RADIUS	25.939			
EXTERNAL	14.390			
LONG CHORD	39.795			
MID. ORD.	9.259			
P.C. STATION	17+65.113	N	726.263.738	E
P.T. STATION	18+10.417	N	726.264.487	E
C.C.		N	726.247.376	E
BACK	N 39° 00' 11.53" E			
AHEAD	S 41° 09' 32.49" E			
CHORD BEAR	N 38° 55' 19.52" E			

CURVE DATA

CURVE 17

P.I. STATION	19+80.357	N	726.132.342	E
DELTA	40° 13' 24.39"	(LT)		
DEGREE	229° 23' 49.43"			
TANGENT	9.146			
LENGTH	17.534			
RADIUS	24.977			
EXTERNAL	1.622			
LONG CHORD	17.177			
MID. ORD.	1.523			
P.C. STATION	19+71.711	N	726.139.238	E

PROJECT REFERENCE NO.		SHEET NO.
R - 2239WM		25
NW SHEET NO.		
ENGINEER	SCIENTIST	

CURVE DATA

CURVE 17 P.I. STATION DELTA DEGREE TANGENT LENGTH RADIUS EXTERNAL LONG CHORD MID. ORD. P.C. STATION P.T. STATION C.C. BACK AHEAD CHORD BEAR	20+16.049 N 38.61 12 37.33 26.803 41.000 24.997 11.654 36.562 7.948 19+89.246 20+30.253 N S 83° 22' 40.75" E S 10° 36' 57.86" W S 36° 22' 51.44" E	726,127.864 1,473,487.577 E
--	--	-----------------------------------

CURVE DATA

CURVE 23 P.I. STATION DELTA DEGREE TANGENT LENGTH RADIUS EXTERNAL LONG CHORD MID. ORD. P.C. STATION P.T. STATION C.C. BACK AHEAD CHORD BEAR	23+64.953 N 32° 53.56' 179° 02' 57.52" 30.660 48.897 32.000 12.317 44.277 8.894 23+34.293 23+83.190 N S 28° 50' 54.41" E S 58° 42' 04.15" W S 14° 55' 34.87" W	725,879.845 1,473,627.057 E
--	---	-----------------------------------

COURSE FROM PT 17 TO PC 18 S 15° 42' 08.00" W DIST 10.981

CURVE DATA

CURVE 18 P.I. STATION DELTA DEGREE TANGENT LENGTH RADIUS EXTERNAL LONG CHORD MID. ORD. P.C. STATION P.T. STATION C.C. BACK AHEAD CHORD BEAR	20+91.003 N 114° 31' 11.29' 179° 02' 57.52" 49.768 63.960 32.000 27.168 53.832 14.693 20+41.235 21+05.195 N S 24° 13' 22.08" W N 89° 42' 10.78" E S 33° 02' 13.57" E	726,045.562 1,473,459.247 E
--	---	-----------------------------------

CURVE DATA

CURVE 24 P.I. STATION DELTA DEGREE TANGENT LENGTH RADIUS EXTERNAL LONG CHORD MID. ORD. P.C. STATION P.T. STATION C.C. BACK AHEAD CHORD BEAR	24+25.970 N 106° 24' 21.90' 179° 02' 57.52" 42.780 59.428 32.000 21.424 51.249 12.833 23+83.190 24+42.618 N S 58° 42' 04.15" E S 47° 42' 17.75" E S 5° 29' 53.20" W	725,841.693 1,473,564.305 E
--	--	-----------------------------------

COURSE FROM PT 24 TO PC 25 S 51° 39' 54.31" E DIST 50.077

CURVE DATA

CURVE 19 P.I. STATION DELTA DEGREE TANGENT LENGTH RADIUS EXTERNAL LONG CHORD MID. ORD. P.C. STATION P.T. STATION C.C. BACK AHEAD CHORD BEAR	21+28.281 N 71° 37' 04.75' 179° 02' 57.52" 23.087 39.999 32.000 7.459 37.445 6.049 21+05.195 21+45.194 N S 89° 42' 10.78" E S 18° 40' 44.47" E S 54° 29' 16.84" E	726,045.939 1,473,532.102 E
--	--	-----------------------------------

CURVE DATA

CURVE 25 P.I. STATION DELTA DEGREE TANGENT LENGTH RADIUS EXTERNAL LONG CHORD MID. ORD. P.C. STATION P.T. STATION C.C. BACK AHEAD CHORD BEAR	25+05.506 N 43° 38' 10.36' 179° 02' 57.52" 12.811 24.371 32.000 2.469 23.786 2.232 24+92.695 25+17.066 N S 48° 35' 33.77" E S 4° 57' 23.41" E S 26° 46' 28.59" E	725,773.371 1,473,644.837 E
--	---	-----------------------------------

CURVE DATA

CURVE 29 P.I. STATION DELTA DEGREE TANGENT LENGTH RADIUS EXTERNAL LONG CHORD MID. ORD. P.C. STATION P.T. STATION C.C. BACK AHEAD CHORD BEAR	27+05.395 N 99° 12' 08.30' 179° 02' 57.52" 37.601 55.405 32.000 17.375 48.739 11.261 26+67.794 27+23.199 N S 42° 43' 36.83" E S 38° 04' 14.87" E N 87° 40' 19.02" E	725,626.634 1,473,766.211 E
--	--	-----------------------------------

CURVE DATA

CURVE 30 P.I. STATION DELTA DEGREE TANGENT LENGTH RADIUS EXTERNAL LONG CHORD MID. ORD. P.C. STATION P.T. STATION C.C. BACK AHEAD CHORD BEAR	27+54.777 N 89° 14' 22.14' 179° 02' 57.52" 31.578 49.841 32.000 12.957 44.953 9.223 27+23.199 27+73.040 N S 39° 00' 32.01" E S 51° 45' 05.85" E N 83° 37' 43.08" E	725,680.773 1,473,809.224 E
--	---	-----------------------------------

COURSE FROM PT 30 TO PC 31 S 48° 39' 41.23" E DIST 15.587

CURVE DATA

CURVE 20 P.I. STATION DELTA DEGREE TANGENT LENGTH RADIUS EXTERNAL LONG CHORD MID. ORD. P.C. STATION P.T. STATION C.C. BACK AHEAD CHORD BEAR	21+80.884 N 96° 14' 27.80' 179° 02' 57.52" 35.690 53.751 32.000 15.935 47.651 10.638 21+45.194 21+98.945 N S 18° 40' 44.47" E N 65° 04' 47.73" E S 66° 47' 58.37" E	725,990.258 1,473,550.926 E
--	--	-----------------------------------

CURVE DATA

CURVE 26 P.I. STATION DELTA DEGREE TANGENT LENGTH RADIUS EXTERNAL LONG CHORD MID. ORD. P.C. STATION P.T. STATION C.C. BACK AHEAD CHORD BEAR	25+39.844 N 70° 53' 14.16' 179° 02' 57.52" 22.778 39.591 32.000 7.279 37.114 5.930 25+17.066 25+56.657 N S 11° 57' 06.05" E S 82° 50' 20.25" E S 47° 23' 43.15" E	725,738.324 1,473,650.661 E
--	--	-----------------------------------

CURVE DATA

CURVE 31 P.I. STATION DELTA DEGREE TANGENT LENGTH RADIUS EXTERNAL LONG CHORD MID. ORD. P.C. STATION P.T. STATION C.C. BACK AHEAD CHORD BEAR	28+18.305 N 99° 46' 50.98' 229° 10' 59.22" 29.678 43.538 25.000 13.805 38.241 8.894 27+88.627 28+32.164 N S 45° 51' 20.75" E S 34° 21' 48.28" E N 84° 15' 13.77" E	725,630.259 1,473,867.023 E
--	---	-----------------------------------

CURVE DATA

CURVE 21 P.I. STATION DELTA DEGREE TANGENT LENGTH RADIUS EXTERNAL LONG CHORD MID. ORD. P.C. STATION P.T. STATION C.C. BACK AHEAD CHORD BEAR	22+74.550 N 136° 42' 48.96' 190° 59' 09.35" 75.605 71.593 30.000 51.339 55.770 18.935 21+98.945 22+70.528 N S 65° 04' 47.73" E S 21° 47' 36.69" W S 46° 33' 47.79" E	726,037.153 1,473,651.859 E
--	---	-----------------------------------

CURVE DATA

CURVE 27 P.I. STATION DELTA DEGREE TANGENT LENGTH RADIUS EXTERNAL LONG CHORD MID. ORD. P.C. STATION P.T. STATION C.C. BACK AHEAD CHORD BEAR	25+84.680 N 82° 25' 10.14' 179° 02' 57.52" 28.023 46.032 32.000 10.536 42.164 7.926 25+56.657 26+02.688 N S 82° 43' 07.91" E S 0° 17' 57.77" E S 41° 30' 32.84" E	725,731.933 1,473,701.059 E
--	--	-----------------------------------

CURVE DATA

CURVE 32 P.I. STATION DELTA DEGREE TANGENT LENGTH RADIUS EXTERNAL LONG CHORD MID. ORD. P.C. STATION P.T. STATION C.C. BACK AHEAD CHORD BEAR	28+65.838 N 106° 49' 06.20' 229° 10' 59.22" 33.674 46.608 25.000 16.940 40.146 10.098 28+32.164 28+78.773 N S 34° 21' 48.28" E S 38° 49' 05.52" E N 87° 46' 21.38" E	725,682.554 1,473,902.831 E
--	---	-----------------------------------

COURSE FROM PT 32 TO PC 33 S 38° 49' 05.52" E DIST 24.265

COURSE FROM PT 21 TO PC 22 S 21° 46' 48.76" W DIST 37.245


CURVE DATA

CURVE 22 P.I. STATION DELTA DEGREE TANGENT LENGTH RADIUS EXTERNAL LONG CHORD MID. ORD. P.C. STATION P.T. STATION C.C. BACK AHEAD CHORD BEAR	23+21.848 N 47° 29' 03.48' 179° 02' 57.52" 14.075 26.520 32.000 2.959 25.768 2.708 23+07.773 23+34.293 N S 18° 38' 09.07" W S 28° 50' 54.41" E S 5° 06' 22.67" E	725,919.029 1,473,605.473 E
--	---	-----------------------------------

CURVE DATA

CURVE 28 P.I. STATION DELTA DEGREE TANGENT LENGTH RADIUS EXTERNAL LONG CHORD MID. ORD. P.C. STATION P.T. STATION C.C. BACK AHEAD CHORD BEAR	26+13.513 N 37° 22' 36.10' 179° 02' 57.52" 10.824 20.875 32.000 1.781 20.507 1.687 26+02.688 26+23.563 N S 2° 53' 05.75" E S 40° 15' 41.85" E S 21° 34' 23.80" E	725,693.099 1,473,701.750 E
--	---	-----------------------------------

COURSE FROM PT 28 TO PC 29 S 46° 15' 15.28" E DIST 44.231

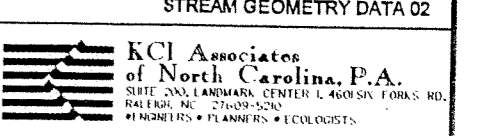

CURVE 33
P.I. STATION 29-19.044 N 725,625.248 E
DELTA 53' 02' 59.29' (LT)
DEGREE 179' 02' 57.52'
TANGENT 16.007
LENGTH 29.634
RADIUS 32.000
EXTERNAL 3.780
LONG CHORD 28.632
MID. ORD. 3.321
P.C. STATION 29-03.038 N 725,637.412 E
P.T. STATION 29-32.722 N 725,626.280 E
C.C. 29-32.722 N 725,658.213 E
BACK S 40' 32' 39.88' E
AHEAD N 86' 18' 20.83' E
CHORD BEAR S 67' 07' 09.52' E

CURVE 39
P.I. STATION 31-43.941 N 725,548.035 E
DELTA 77' 56' 53.86' (RT)
DEGREE 178' 58' 07.66'
TANGENT 25.401
LENGTH 43.554
RADIUS 32.014
EXTERNAL 9.165
LONG CHORD 40.272
MID. ORD. 7.125
P.C. STATION 31-68.050 N 725,536.029 E
P.T. STATION 32-11.605 N 725,526.133 E
C.C. 32-11.605 N 725,507.675 E
BACK S 62' 19' 55.83' E
AHEAD N 39' 43' 10.31' E
CHORD BEAR S 78' 41' 37.24' E

CURVE DATA
CURVE 34
P.I. STATION 29-58.775 N 725,627.958 E
DELTA 78' 18' 04.51' (RT)
DEGREE 179' 02' 57.52'
TANGENT 26.053
LENGTH 43.732
RADIUS 32.000
EXTERNAL 9.264
LONG CHORD 40.407
MID. ORD. 7.184
P.C. STATION 29-32.722 N 725,626.280 E
P.T. STATION 29-76.454 N 725,602.840 E
C.C. 29-76.454 N 725,594.346 E
BACK N 86' 18' 20.83' E
AHEAD S 15' 23' 34.66' E
CHORD BEAR S 54' 32' 36.91' E

CURVE DATA
CURVE 40
P.I. STATION 32-60.510 N 725,490.516 E
DELTA 120' 24' 51.71' (LT)
DEGREE 204' 37' 40.03'
TANGENT 48.905
LENGTH 58.846
RADIUS 28.000
EXTERNAL 28.353
LONG CHORD 48.598
MID. ORD. 14.088
P.C. STATION 32-11.605 N 725,528.133 E
P.T. STATION 32-70.450 N 725,536.511 E
C.C. 32-70.450 N 725,546.026 E
BACK S 39' 43' 10.31' E
AHEAD N 19' 51' 57.98' E
CHORD BEAR N 80' 04' 23.83' E
COURSE FROM PT 40 TO PC 41 N 19' 51' 57.98' E DIST 18.717

CURVE DATA
CURVE 35
P.I. STATION 30-17.392 N 725,563.370 E
DELTA 103' 58' 22.37' (LT)
DEGREE 179' 02' 57.52'
TANGENT 40.938
LENGTH 58.069
RADIUS 32.000
EXTERNAL 19.961
LONG CHORD 50.423
MID. ORD. 12.293
P.C. STATION 29-76.454 N 725,602.840 E
P.T. STATION 30-34.523 N 725,583.446 E
C.C. 30-34.523 N 725,611.334 E
BACK S 15' 23' 34.66' E
AHEAD N 60' 38' 02.97' E
CHORD BEAR S 67' 22' 45.85' E

CURVE DATA
CURVE 41
P.I. STATION 33-40.271 N 725,602.177 E
DELTA 122' 33' 49.79' (RT)
DEGREE 204' 37' 40.02'
TANGENT 51.105
LENGTH 59.896
RADIUS 28.000
EXTERNAL 30.273
LONG CHORD 49.112
MID. ORD. 14.546
P.C. STATION 32-89.167 N 725,554.114 E
P.T. STATION 33-49.063 N 725,561.671 E
C.C. 33-49.063 N 725,544.598 E
BACK N 19' 51' 57.98' E
AHEAD S 37' 34' 12.23' E
CHORD BEAR N 81' 08' 52.87' E

CURVE DATA
CURVE 36
P.I. STATION 30-78.317 N 725,607.233 E
DELTA 107' 41' 22.17' (RT)
DEGREE 179' 02' 57.81'
TANGENT 43.794
LENGTH 60.145
RADIUS 32.000
EXTERNAL 22.240
LONG CHORD 51.675
MID. ORD. 13.121
P.C. STATION 30-34.523 N 725,583.446 E
P.T. STATION 30-94.668 N 725,564.973 E
C.C. 30-94.668 N 725,556.578 E
BACK N 57' 06' 03.64' E
AHEAD S 15' 12' 34.19' E
CHORD BEAR S 69' 03' 15.27' E

CURVE DATA
CURVE 42
P.I. STATION 33-81.910 N 725,535.636 E
DELTA 91' 29' 46.86' (LT)
DEGREE 179' 02' 57.52'
TANGENT 32.847
LENGTH 51.101
RADIUS 32.000
EXTERNAL 13.858
LONG CHORD 45.842
MID. ORD. 9.670
P.C. STATION 33-49.063 N 725,561.671 E
P.T. STATION 34-00.164 N 725,556.337 E
C.C. 34-00.164 N 725,581.182 E
BACK S 37' 34' 12.23' E
AHEAD N 50' 56' 00.90' E
CHORD BEAR S 83' 19' 05.66' E

CURVE DATA
CURVE 37
P.I. STATION 31-04.161 N 725,555.940 E
DELTA 41' 22' 04.67' (LT)
DEGREE 227' 53' 17.76'
TANGENT 9.492
LENGTH 18.153
RADIUS 25.142
EXTERNAL 1.732
LONG CHORD 17.761
MID. ORD. 1.621
P.C. STATION 30-94.668 N 725,564.973 E
P.T. STATION 31-12.821 N 725,551.088 E
C.C. 31-12.821 N 725,572.699 E
BACK S 17' 53' 45.14' E
AHEAD S 59' 15' 49.80' E
CHORD BEAR S 38' 34' 47.47' E

CURVE DATA
CURVE 43
P.I. STATION 34-16.525 N 725,566.648 E
DELTA 44' 51' 39.64' (RT)
DEGREE 144' 33' 27.49'
TANGENT 16.361
LENGTH 31.033
RADIUS 39.635
EXTERNAL 3.244
LONG CHORD 30.247
MID. ORD. 2.999
P.C. STATION 34-00.164 N 725,556.337 E
P.T. STATION 34-31.197 N 725,564.996 E
C.C. 34-31.197 N 725,525.564 E
BACK N 50' 56' 00.90' E
AHEAD S 84' 12' 19.45' E
CHORD BEAR N 73' 21' 50.73' E

CURVE DATA
CURVE 38
P.I. STATION 31-54.849 N 725,526.620 E
DELTA 71' 30' 52.37' (LT)
DEGREE 229' 10' 59.22'
TANGENT 18.002
LENGTH 31.204
RADIUS 25.000
EXTERNAL 5.807
LONG CHORD 29.218
MID. ORD. 4.713
P.C. STATION 31-36.846 N 725,538.194 E
P.T. STATION 31-68.050 N 725,536.029 E
C.C. 31-68.050 N 725,557.343 E
BACK S 49' 59' 33.54' E
AHEAD N 58' 29' 34.09' E
CHORD BEAR S 85' 44' 59.73' E

CURVE DATA
CURVE 44
P.I. STATION 34-67.549 N 725,561.000 E
DELTA 57' 49' 18.96' (LT)
DEGREE 188' 45' 28.61'
TANGENT 16.764
LENGTH 30.633
RADIUS 30.354
EXTERNAL 4.352
LONG CHORD 29.349
MID. ORD. 3.783
P.C. STATION 34-00.164 N 725,563.200 E
P.T. STATION 34-81.418 N 725,573.895 E
C.C. 34-81.418 N 725,593.292 E
BACK S 82' 27' 32.02' E
AHEAD N 39' 43' 09.02' E
CHORD BEAR N 68' 37' 48.50' E
COURSE FROM PT 44 TO PC 45 N 35' 52' 11.52' E DIST 21.940


CURVE DATA
CURVE 45
P.I. STATION 35-32.745 N 725,614.526 E
DELTA 99' 13' 21.14' (RT)
DEGREE 229' 10' 59.22'
TANGENT 29.387
LENGTH 43.294
RADIUS 25.000
EXTERNAL 13.582
LONG CHORD 38.083
MID. ORD. 8.801
P.C. STATION 35-03.358 N 725,591.674 E
P.T. STATION 35-46.652 N 725,592.626 E
C.C. 35-46.652 N 725,575.956 E
BACK N 38' 57' 22.38' E
AHEAD S 41' 49' 16.48' E
CHORD BEAR N 88' 34' 02.95' E

CURVE DATA
CURVE 46
P.I. STATION 35-71.907 N 725,574.227 E
DELTA 90' 34' 55.28' (LT)
DEGREE 229' 10' 59.22'
TANGENT 25.255
LENGTH 39.524
RADIUS 25.000
EXTERNAL 10.536
LONG CHORD 35.534
MID. ORD. 7.412
P.C. STATION 35-46.652 N 725,592.626 E
P.T. STATION 35-86.176 N 725,591.712 E
C.C. 35-86.176 N 725,609.751 E
BACK S 43' 14' 04.06' E
AHEAD N 46' 11' 00.66' E
CHORD BEAR S 88' 31' 31.70' E

CURVE DATA
CURVE 47
P.I. STATION 36-33.236 N 725,627.354 E
DELTA 115' 11' 46.14' (RT)
DEGREE 191' 49' 55.12'
TANGENT 47.060
LENGTH 60.051
RADIUS 29.868
EXTERNAL 25.871
LONG CHORD 50.435
MID. ORD. 13.863
P.C. STATION 35-86.176 N 725,591.712 E
P.T. STATION 36-46.227 N 725,584.374 E
C.C. 36-46.227 N 725,572.208 E
BACK N 40' 46' 05.76' E
AHEAD S 24' 02' 08.10' E
CHORD BEAR S 81' 38' 01.17' E

CURVE DATA
CURVE 48
P.I. STATION 36-99.894 N 725,533.966 E
DELTA 116' 33' 21.09' (LT)
DEGREE 172' 42' 40.40'
TANGENT 53.668
LENGTH 67.486
RADIUS 33.174
EXTERNAL 29.919
LONG CHORD 56.437
MID. ORD. 15.731
P.C. STATION 36-46.227 N 725,584.374 E
P.T. STATION 37-13.712 N 725,572.979 E
C.C. 37-13.712 N 725,595.760 E
BACK S 20' 04' 25.02' E
AHEAD N 43' 22' 13.89' E
CHORD BEAR S 78' 21' 05.57' E

STREAM GEOMETRY DATA 03

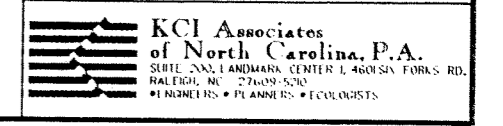

CURVE DATA
CURVE 49
P.I. STATION 37+49.243 N
DELTA 163° 31' 41.92" (RT)
DEGREE 264° 39' 23.22"
TANGENT 35.531
LENGTH 50.586
RADIUS 27.996
EXTERNAL 17.239
LONG CHORD 43.980
MID. ORD. 10.669
P.C. STATION 37+13.712 N
P.T. STATION 37+64.299 N
C.C. N
BACK N 43° 22' 13.89" E
AHEAD S 33° 06' 04.29" E
CHORD BEAR S 84° 51' 55.20" E

CURVE DATA
CURVE 55
P.I. STATION 40+05.949 N
DELTA 49° 51' 26.06" (LT)
DEGREE 179° 02' 57.66"
TANGENT 14.873
LENGTH 27.846
RADIUS 32.000
EXTERNAL 3.288
LONG CHORD 26.975
MID. ORD. 2.921
P.C. STATION 39+41.076 N
P.T. STATION 40+18.921 N
C.C. N
BACK N 64° 04' 01.26" E
AHEAD N 14° 12' 35.20" E
CHORD BEAR N 39° 08' 18.23" E

COURSE FROM PT 49 TO PC 50 S 33° 06' 03.12" E DIST 46.029

CURVE DATA
CURVE 50
P.I. STATION 38+20.052 N
DELTA 47° 41' 37.87" (RT)
DEGREE 260° 26' 07.30"
TANGENT 9.725
LENGTH 18.313
RADIUS 22.000
EXTERNAL 2.053
LONG CHORD 17.789
MID. ORD. 1.878
P.C. STATION 38+10.328 N
P.T. STATION 38+28.641 N
C.C. N
BACK S 33° 06' 04.29" E
AHEAD S 14° 35' 33.58" W
CHORD BEAR S 9° 15' 15.35" W

CURVE DATA
CURVE 56
P.I. STATION 42+00.601 N
DELTA 160° 01' 17.33" (RT)
DEGREE 179° 02' 57.51"
TANGENT 181.680
LENGTH 89.373
RADIUS 32.000
EXTERNAL 152.477
LONG CHORD 63.030
MID. ORD. 26.449
P.C. STATION 40+18.921 N
P.T. STATION 41+08.294 N
C.C. N
BACK S 14° 12' 35.20" E
AHEAD S 5° 46' 07.48" E
CHORD BEAR S 85° 46' 46.14" E

CURVE DATA
CURVE 51
P.I. STATION 38+87.843 N
DELTA 123° 12' 55.67" (LT)
DEGREE 179° 02' 57.52"
TANGENT 59.202
LENGTH 68.816
RADIUS 32.000
EXTERNAL 35.297
LONG CHORD 56.302
MID. ORD. 16.784
P.C. STATION 38+28.641 N
P.T. STATION 38+97.457 N
C.C. N
BACK S 14° 35' 33.58" W
AHEAD N 71° 22' 37.91" E
CHORD BEAR S 47° 00' 54.25" E

CURVE DATA
CURVE 57
P.I. STATION 41+59.375 N
DELTA 137° 05' 53.79" (LT)
DEGREE 238° 43' 56.74"
TANGENT 61.081
LENGTH 57.428
RADIUS 24.000
EXTERNAL 41.627
LONG CHORD 44.675
MID. ORD. 15.223
P.C. STATION 41+08.294 N
P.T. STATION 41+65.722 N
C.C. N
BACK S 5° 46' 07.48" E
AHEAD N 37° 07' 58.73" E
CHORD BEAR S 74° 19' 04.37" E

CURVE DATA
CURVE 52
P.I. STATION 39+15.286 N
DELTA 57° 25' 00.06" (RT)
DEGREE 176° 00' 02.86"
TANGENT 17.829
LENGTH 32.623
RADIUS 32.554
EXTERNAL 4.563
LONG CHORD 31.275
MID. ORD. 4.002
P.C. STATION 38+97.457 N
P.T. STATION 39+30.080 N
C.C. N
BACK N 71° 22' 37.91" E
AHEAD S 51° 12' 22.03" E
CHORD BEAR S 79° 54' 52.06" E

CURVE DATA
CURVE 58
P.I. STATION 42+13.321 N
DELTA 126° 29' 06.98" (RT)
DEGREE 238° 43' 56.63"
TANGENT 47.600
LENGTH 52.982
RADIUS 24.000
EXTERNAL 29.308
LONG CHORD 42.860
MID. ORD. 13.195
P.C. STATION 41+65.722 N
P.T. STATION 42+18.704 N
C.C. N
BACK N 37° 07' 58.73" E
AHEAD S 16° 22' 54.29" E
CHORD BEAR S 79° 37' 27.78" E

COURSE FROM PT 58 TO PC 59 S 16° 22' 54.29" E DIST 35.000

CURVE DATA
CURVE 53
P.I. STATION 39+54.416 N
DELTA 88° 46' 53.76" (LT)
DEGREE 230° 28' 51.18"
TANGENT 24.336
LENGTH 38.520
RADIUS 24.859
EXTERNAL 9.929
LONG CHORD 34.780
MID. ORD. 7.095
P.C. STATION 39+30.080 N
P.T. STATION 39+68.600 N
C.C. N
BACK S 51° 54' 56.22" E
AHEAD N 39° 18' 10.01" E
CHORD BEAR N 83° 41' 36.90" E

CURVE DATA
CURVE 59
P.I. STATION 42+75.037 N
DELTA 88° 14' 17.76" (LT)
DEGREE 260° 26' 07.30"
TANGENT 21.334
LENGTH 33.881
RADIUS 22.000
EXTERNAL 8.645
LONG CHORD 30.631
MID. ORD. 6.206
P.C. STATION 42+53.704 N
P.T. STATION 42+87.585 N
C.C. N
BACK S 16° 22' 54.29" E
AHEAD N 75° 22' 47.95" E
CHORD BEAR S 60° 30' 03.17" E

CURVE DATA
CURVE 54
P.I. STATION 39+80.016 N
DELTA 24° 45' 51.25" (RT)
DEGREE 110° 11' 02.98"
TANGENT 11.416
LENGTH 22.475
RADIUS 52.000
EXTERNAL 1.238
LONG CHORD 22.301
MID. ORD. 1.210
P.C. STATION 39+68.600 N
P.T. STATION 39+91.076 N
C.C. N
BACK N 39° 18' 10.01" E
AHEAD N 64° 04' 01.26" E
CHORD BEAR N 51° 41' 05.64" E

CURVE DATA
CURVE 60
P.I. STATION 43+36.536 N
DELTA 113° 39' 12.73" (RT)
DEGREE 179° 02' 57.52"
TANGENT 48.951
LENGTH 63.476
RADIUS 32.000
EXTERNAL 26.482
LONG CHORD 53.569
MID. ORD. 14.490
P.C. STATION 42+87.585 N
P.T. STATION 43+51.061 N
C.C. N
BACK N 75° 22' 47.95" E
AHEAD S 9° 02' 00.68" W
CHORD BEAR S 47° 47' 35.69" E

COURSE FROM PT 63 TO PC 64 N 55° 39' 18.93" E DIST 25.000

CURVE DATA
CURVE 61
P.I. STATION 46+20.570 N
DELTA 166° 27' 26.76" (LT)
DEGREE 179° 02' 57.52"
TANGENT 269.509
LENGTH 92.967
RADIUS 32.000
EXTERNAL 239.402
LONG CHORD 63.554
MID. ORD. 28.227
P.C. STATION 43+51.061 N
P.T. STATION 44+44.028 N
C.C. N
BACK S 9° 02' 00.68" W
AHEAD N 22° 34' 33.92" E
CHORD BEAR S 74° 11' 42.70" E

CURVE DATA
CURVE 62
P.I. STATION 45+43.929 N
DELTA 144° 28' 39.46" (RT)
DEGREE 179° 02' 57.52"
TANGENT 99.901
LENGTH 80.692
RADIUS 32.000
EXTERNAL 72.901
LONG CHORD 60.950
MID. ORD. 22.238
P.C. STATION 44+44.028 N
P.T. STATION 45+24.720 N
C.C. N
BACK N 22° 34' 33.92" E
AHEAD S 12° 56' 46.62" E
CHORD BEAR S 85° 11' 06.35" E

CURVE DATA
CURVE 63
P.I. STATION 45+65.765 N
DELTA 111° 23' 54.44" (LT)
DEGREE 204° 37' 40.02"
TANGENT 41.045
LENGTH 54.440
RADIUS 28.000
EXTERNAL 21.686
LONG CHORD 46.261
MID. ORD. 12.221
P.C. STATION 45+24.720 N
P.T. STATION 45+79.159 N
C.C. N
BACK S 12° 56' 46.62" E
AHEAD N 55° 39' 18.93" E
CHORD BEAR S 68° 38' 43.84" E

CURVE DATA
CURVE 64
P.I. STATION 46+26.370 N
DELTA 85° 33' 50.06" (RT)
DEGREE 238° 43' 56.69"
TANGENT 22.210
LENGTH 35.841
RADIUS 24.000
EXTERNAL 8.700
LONG CHORD 32.602
MID. ORD. 6.386
P.C. STATION 46+04.159 N
P.T. STATION 46+40.000 N
C.C. N
BACK N 55° 39' 18.93" E
AHEAD S 38° 46' 51.01" E
CHORD BEAR S 81° 33' 46.04" E

STREAM GEOMETRY DATA 04



CURVE DATA

CURVE 65
 P.I. STATION 46+77.577 N
 DELTA 42° 47' 20.39" (LT)
 DEGREE 179° 02' 57.52"
 TANGENT 33.547
 LENGTH 51.823
 RADIUS 32.000
 EXTERNAL 14.348
 LONG CHORD 46.343
 MID. ORD. 4.930
 P.C. STATION 46+40.000 N
 P.T. STATION 46+91.823 N
 C.C. 725+368.548 E
 BACK S 38° 46' 51.01" E
 AHEAD N 42° 25' 48.61" E
 CHORD BEAR S 85° 10' 31.20" E

CURVE DATA

CURVE 71
 P.I. STATION 725+204.448 E
 DELTA 88° 34' 11.18" (LT)
 DEGREE 260° 26' 07.30"
 TANGENT 21.458
 LENGTH 34.008
 RADIUS 22.000
 EXTERNAL 8.732
 LONG CHORD 30.722
 MID. ORD. 6.251
 P.C. STATION 725+263.928 N
 P.T. STATION 725+310.107 N
 C.C. 725+311.010 E
 BACK S 18° 23' 30.57" E
 AHEAD N 73° 02' 18.25" E
 CHORD BEAR S 62° 40' 36.16" E

CURVE DATA

CURVE 72
 P.I. STATION 725+304.230 E
 DELTA 87° 58' 35.18" (RT)
 DEGREE 220° 22' 06.18"
 TANGENT 25.098
 LENGTH 39.922
 RADIUS 26.000
 EXTERNAL 10.137
 LONG CHORD 36.115
 MID. ORD. 7.293
 P.C. STATION 725+296.908 E
 P.T. STATION 725+280.498 E
 C.C. 725+272.039 E
 BACK S 73° 02' 18.25" E
 AHEAD N 18° 59' 06.58" E
 CHORD BEAR S 62° 58' 24.16" E

CURVE DATA

CURVE 66
 P.I. STATION 725+396.853 E
 DELTA 113° 07' 13.55" (RT)
 DEGREE 179° 02' 57.52"
 TANGENT 48.457
 LENGTH 63.178
 RADIUS 32.000
 EXTERNAL 26.070
 LONG CHORD 53.406
 MID. ORD. 14.366
 P.C. STATION 46+91.823 N
 P.T. STATION 47+55.002 N
 C.C. 725+364.700 E
 BACK N 48° 25' 48.61" E
 AHEAD S 18° 26' 57.83" E
 CHORD BEAR S 75° 00' 34.61" E

CURVE DATA

CURVE 73
 P.I. STATION 725+381.215 E
 DELTA 140° 52' 32.45" (LT)
 DEGREE 301° 33' 24.24"
 TANGENT 46.716
 LENGTH 53.470
 RADIUS 26.000
 EXTERNAL 19.000
 LONG CHORD 37.745
 MID. ORD. 12.638
 P.C. STATION 725+369.607 N
 P.T. STATION 725+410.203 N
 C.C. 725+394.271 E
 BACK S 18° 59' 06.58" E
 AHEAD N 20° 08' 20.98" E
 CHORD BEAR S 89° 25' 22.80" E

CURVE DATA

CURVE 77
 P.I. STATION 725+188.778 E
 DELTA 99° 16' 28.43" (RT)
 DEGREE 286° 28' 44.03"
 TANGENT 23.531
 LENGTH 34.653
 RADIUS 20.000
 EXTERNAL 10.882
 LONG CHORD 30.478
 MID. ORD. 7.048
 P.C. STATION 725+171.812 E
 P.T. STATION 725+169.952 E
 C.C. 725+157.954 E
 BACK N 43° 51' 41.63" E
 AHEAD S 36° 51' 49.94" E
 CHORD BEAR S 86° 30' 04.16" E

CURVE DATA

CURVE 67
 P.I. STATION 725+292.376 E
 DELTA 109° 20' 27.24" (LT)
 DEGREE 220° 22' 06.18"
 TANGENT 36.681
 LENGTH 49.617
 RADIUS 26.000
 EXTERNAL 18.961
 LONG CHORD 42.424
 MID. ORD. 10.965
 P.C. STATION 47+80.002 N
 P.T. STATION 48+29.619 N
 C.C. 725+327.172 E
 BACK S 18° 26' 57.83" E
 AHEAD N 52° 12' 34.93" E
 CHORD BEAR S 73° 07' 11.45" E

CURVE DATA

CURVE 74
 P.I. STATION 725+441.408 E
 DELTA 95° 53' 22.73" (RT)
 DEGREE 272° 50' 13.36"
 TANGENT 23.278
 LENGTH 35.145
 RADIUS 21.000
 EXTERNAL 10.350
 LONG CHORD 31.185
 MID. ORD. 6.933
 P.C. STATION 725+410.203 N
 P.T. STATION 725+451.305 N
 C.C. 725+426.135 E
 BACK N 20° 08' 20.98" E
 AHEAD S 63° 58' 16.29" E
 CHORD BEAR S 68° 05' 02.34" E

CURVE DATA

CURVE 78
 P.I. STATION 725+136.404 E
 DELTA 105° 18' 05.98" (LT)
 DEGREE 179° 02' 57.52"
 TANGENT 41.931
 LENGTH 58.812
 RADIUS 32.000
 EXTERNAL 20.747
 LONG CHORD 50.877
 MID. ORD. 12.587
 P.C. STATION 725+169.952 E
 P.T. STATION 725+169.521 E
 C.C. 725+189.149 E
 BACK S 36° 51' 49.94" E
 AHEAD N 37° 50' 04.08" E
 CHORD BEAR S 89° 30' 52.93" E

CURVE DATA

CURVE 68
 P.I. STATION 725+339.050 E
 DELTA 113° 16' 29.27" (RT)
 DEGREE 220° 22' 06.18"
 TANGENT 39.487
 LENGTH 51.402
 RADIUS 26.000
 EXTERNAL 21.278
 LONG CHORD 43.431
 MID. ORD. 11.702
 P.C. STATION 48+29.619 N
 P.T. STATION 48+81.022 N
 C.C. 725+314.853 E
 BACK N 52° 12' 34.93" E
 AHEAD S 14° 30' 55.80" E
 CHORD BEAR S 71° 09' 10.43" E

CURVE DATA

CURVE 75
 P.I. STATION 725+232.689 E
 DELTA 84° 49' 06.09" (RT)
 DEGREE 179° 02' 57.52"
 TANGENT 29.229
 LENGTH 47.372
 RADIUS 32.000
 EXTERNAL 11.340
 LONG CHORD 43.163
 MID. ORD. 8.373
 P.C. STATION 725+247.041 E
 P.T. STATION 725+258.681 E
 C.C. 725+239.811 E
 BACK N 20° 08' 20.98" E
 AHEAD S 63° 58' 16.29" E
 CHORD BEAR S 68° 05' 02.34" E

CURVE DATA

CURVE 79
 P.I. STATION 725+233.308 E
 DELTA 136° 46' 18.29" (RT)
 DEGREE 179° 02' 57.52"
 TANGENT 80.765
 LENGTH 76.388
 RADIUS 32.000
 EXTERNAL 54.873
 LONG CHORD 59.500
 MID. ORD. 20.213
 P.C. STATION 725+169.952 E
 P.T. STATION 725+152.901 E
 C.C. 725+149.893 E
 BACK N 37° 50' 04.08" E
 AHEAD S 5° 23' 37.63" E
 CHORD BEAR S 73° 46' 46.78" E

CURVE DATA

CURVE 69
 P.I. STATION 725+181.739 E
 DELTA 159° 43' 12.37" (LT)
 DEGREE 260° 26' 07.30"
 TANGENT 123.010
 LENGTH 61.328
 RADIUS 22.000
 EXTERNAL 43.313
 LONG CHORD 43.313
 MID. ORD. 18.127
 P.C. STATION 48+81.022 N
 P.T. STATION 49+42.350 N
 C.C. 725+300.823 E
 BACK S 14° 30' 55.80" E
 AHEAD N 5° 45' 51.83" E
 CHORD BEAR N 85° 37' 28.01" E

CURVE DATA

CURVE 76
 P.I. STATION 725+058.480 E
 DELTA 156° 59' 08.17" (LT)
 DEGREE 179° 02' 57.52"
 TANGENT 157.184
 LENGTH 87.677
 RADIUS 32.000
 EXTERNAL 128.408
 LONG CHORD 62.714
 MID. ORD. 25.616
 P.C. STATION 725+494.491 N
 P.T. STATION 725+556.695 N
 C.C. 725+526.330 E
 BACK S 63° 58' 16.29" E
 AHEAD S 20° 50' 49.80" W
 CHORD BEAR S 21° 33' 43.25" E

CURVE DATA

CURVE 80
 P.I. STATION 725+108.869 E
 DELTA 45° 30' 31.30" (RT)
 DEGREE 260° 26' 07.30"
 TANGENT 9.227
 LENGTH 17.474
 RADIUS 22.000
 EXTERNAL 1.857
 LONG CHORD 17.018
 MID. ORD. 1.712
 P.C. STATION 725+118.056 E
 P.T. STATION 725+101.813 E
 C.C. 725+115.988 E
 BACK S 5° 23' 37.63" E
 AHEAD S 40° 06' 53.66" W
 CHORD BEAR S 17° 21' 38.02" W

CURVE DATA

CURVE 70
 P.I. STATION 725+452.917 E
 DELTA 155° 50' 37.60" (RT)
 DEGREE 179° 02' 57.52"
 TANGENT 149.545
 LENGTH 87.040
 RADIUS 32.000
 EXTERNAL 120.931
 LONG CHORD 63.583
 MID. ORD. 25.304
 P.C. STATION 49+42.350 N
 P.T. STATION 50+29.389 N
 C.C. 725+304.127 E
 BACK N 5° 45' 51.83" E
 AHEAD S 18° 23' 30.57" E
 CHORD BEAR N 83° 41' 10.63" E

CURVE DATA

CURVE 76
 P.I. STATION 725+058.480 E
 DELTA 156° 59' 08.17" (LT)
 DEGREE 179° 02' 57.52"
 TANGENT 157.184
 LENGTH 87.677
 RADIUS 32.000
 EXTERNAL 128.408
 LONG CHORD 62.714
 MID. ORD. 25.616
 P.C. STATION 725+494.491 N
 P.T. STATION 725+556.695 N
 C.C. 725+526.330 E
 BACK S 20° 50' 49.80" W
 AHEAD N 43° 51' 41.63" E
 CHORD BEAR S 57° 38' 44.79" E

CURVE DATA

CURVE 81
 P.I. STATION 725+735.103 E
 DELTA 5° 23' 37.63" (RT)
 DEGREE 40° 06' 53.66"
 TANGENT 37.633
 LENGTH 53.666
 RADIUS 38.020
 EXTERNAL 1.857
 LONG CHORD 38.020
 MID. ORD. 1.712
 P.C. STATION 725+735.103 E
 P.T. STATION 725+788.080 E
 C.C. 725+765.008 E
 BACK S 5° 23' 37.63" E
 AHEAD S 40° 06' 53.66" W
 CHORD BEAR S 17° 21' 38.02" W

COURSE FROM PT 66 TO PC 67 S 18° 26' 57.83" E DIST 25.000

COURSE FROM PT 72 TO PC 73 S 18° 59' 06.58" E DIST 35.000

COURSE FROM PT 74 TO PC 75 S 63° 58' 16.29" E DIST 30.000

COURSE FROM PT 79 TO PC 80 S 5° 23' 37.63" E DIST 35.000

COURSE FROM PT 80 TO PC 81 S 41° 16' 45.38" W DIST 14.122

STREAM GEOMETRY DATA 05

PROJECT REFERENCE NO.	SHEET NO.
R - 2239WM	29
NW SHEET NO.	
ENGINEER	SCIENTIST

CURVE DATA
 CURVE 81
 P.I. STATION 57+56.473 N 724,997.837 E
 DELTA 156° 23' 25.72" (LT)
 DEGREE 203° 22' 54.67"
 TANGENT 134.744
 LENGTH 76.895
 RADIUS 28.172
 EXTERNAL 109.534
 LONG CHORD 55.151
 MID. ORD. 22.400
 P.C. STATION 56+21.679 N 725,091.200 E
 P.T. STATION 56+98.574 N 725,044.446 E
 C.C. 725,070.880 E
 BACK S 46° 09' 39.25" W
 AHEAD N 69° 46' 13.53" E
 CHORD BEAR S 32° 02' 03.61" E

CURVE DATA
 CURVE 87
 P.I. STATION 60+14.125 N 724,904.919 E 1,476,100.850
 DELTA 114° 25' 51.87" (RT)
 DEGREE 237° 54' 14.07"
 TANGENT 37.393
 LENGTH 42.100
 RADIUS 24.084
 EXTERNAL 20.394
 LONG CHORD 40.495
 MID. ORD. 11.043
 P.C. STATION 59+76.733 N 724,880.381 E
 P.T. STATION 60+24.833 N 724,869.032 E
 C.C. 724,862.208 E
 BACK N 48° 59' 12.01" E
 AHEAD S 16° 34' 56.12" E
 CHORD BEAR S 73° 47' 52.06" E

CURVE DATA
 CURVE 82
 P.I. STATION 57+16.843 N 725,050.763 E
 DELTA 59° 26' 38.09" (RT)
 DEGREE 179° 02' 57.52"
 TANGENT 18.269
 LENGTH 33.200
 RADIUS 32.000
 EXTERNAL 4.848
 LONG CHORD 31.731
 MID. ORD. 4.210
 P.C. STATION 56+98.574 N 725,044.446 E
 P.T. STATION 57+31.774 N 725,039.214 E
 C.C. 725,014.420 E
 BACK N 69° 46' 13.53" E
 AHEAD S 50° 47' 08.39" E
 CHORD BEAR S 90° 30' 27.43" E

CURVE DATA
 CURVE 88
 P.I. STATION 60+60.257 N 724,835.130 E 1,476,121.642
 DELTA 111° 45' 54.16" (LT)
 DEGREE 238° 43' 56.67"
 TANGENT 35.425
 LENGTH 46.816
 RADIUS 24.000
 EXTERNAL 18.789
 LONG CHORD 39.739
 MID. ORD. 10.539
 P.C. STATION 60+24.833 N 724,869.032 E
 P.T. STATION 60+71.649 N 724,857.109 E
 C.C. 724,875.931 E
 BACK S 16° 34' 56.12" E
 AHEAD N 51° 39' 09.72" E
 CHORD BEAR S 72° 27' 53.20" E

CURVE DATA
 CURVE 92
 P.I. STATION 62+88.807 N 724,823.721 E 1,476,339.433
 DELTA 72° 03' 01.45" (LT)
 DEGREE 232° 24' 58.81"
 TANGENT 17.927
 LENGTH 31.001
 RADIUS 24.652
 EXTERNAL 5.829
 LONG CHORD 28.998
 MID. ORD. 4.715
 P.C. STATION 62+70.879 N 724,831.120 E
 P.T. STATION 63+01.880 N 724,836.976 E
 C.C. 724,853.575 E
 BACK S 65° 37' 31.24" E
 AHEAD N 42° 19' 27.31" E
 CHORD BEAR N 78° 20' 58.03" E

COURSE FROM PT 82 TO PC 83 S 50° 47' 08.39" E DIST 15.638
 CURVE DATA
 CURVE 83
 P.I. STATION 57+86.611 N 725,004.544 E
 DELTA 101° 32' 51.09" (RT)
 DEGREE 179° 02' 57.52"
 TANGENT 39.199
 LENGTH 56.715
 RADIUS 32.000
 EXTERNAL 18.602
 LONG CHORD 49.578
 MID. ORD. 11.764
 P.C. STATION 57+47.412 N 725,029.327 E
 P.T. STATION 58+04.127 N 724,979.749 E
 C.C. 725,004.534 E
 BACK S 50° 47' 08.39" E
 AHEAD S 50° 45' 42.70" W
 CHORD BEAR S 0° 00' 42.84" E

CURVE DATA
 CURVE 89
 P.I. STATION 61+06.362 N 724,878.646 E 1,476,176.648
 DELTA 96° 07' 47.96" (RT)
 DEGREE 183° 43' 47.34"
 TANGENT 34.713
 LENGTH 52.321
 RADIUS 31.185
 EXTERNAL 15.479
 LONG CHORD 46.397
 MID. ORD. 10.344
 P.C. STATION 60+71.649 N 724,857.109 E
 P.T. STATION 61+23.970 N 724,849.277 E
 C.C. 724,832.652 E
 BACK N 51° 39' 09.72" E
 AHEAD S 32° 13' 02.32" E
 CHORD BEAR S 80° 16' 56.30" E

COURSE FROM PT 92 TO PC 93 N 40° 18' 42.59" E DIST 10.471
 CURVE DATA
 CURVE 93
 P.I. STATION 63+33.918 N 724,861.821 E 1,476,371.726
 DELTA 67° 57' 29.43" (RT)
 DEGREE 179° 02' 57.52"
 TANGENT 21.567
 LENGTH 37.955
 RADIUS 32.000
 EXTERNAL 6.589
 LONG CHORD 39.769
 MID. ORD. 5.464
 P.C. STATION 63+12.350 N 724,844.960 E
 P.T. STATION 63+50.305 N 724,855.684 E
 C.C. 724,825.007 E
 BACK N 38° 34' 30.94" E
 AHEAD S 73° 27' 59.63" E
 CHORD BEAR N 72° 33' 15.65" E

CURVE DATA
 CURVE 84
 P.I. STATION 58+94.297 N 724,922.712 E
 DELTA 145° 29' 54.41" (LT)
 DEGREE 204° 37' 40.02"
 TANGENT 90.170
 LENGTH 71.104
 RADIUS 28.000
 EXTERNAL 66.418
 LONG CHORD 53.481
 MID. ORD. 19.696
 P.C. STATION 58+04.127 N 724,979.749 E
 P.T. STATION 58+75.231 N 724,930.158 E
 C.C. 724,958.062 E
 BACK S 50° 45' 42.70" W
 AHEAD N 85° 15' 48.29" E
 CHORD BEAR S 21° 59' 14.51" E

CURVE DATA
 CURVE 90
 P.I. STATION 61+57.589 N 724,821.013 E 1,476,213.242
 DELTA 90° 08' 04.58" (LT)
 DEGREE 240° 14' 39.34"
 TANGENT 23.305
 LENGTH 37.505
 RADIUS 23.518
 EXTERNAL 9.849
 LONG CHORD 33.767
 MID. ORD. 7.005
 P.C. STATION 61+33.684 N 724,840.628 E
 P.T. STATION 61+71.202 N 724,834.723 E
 C.C. 724,854.260 E
 BACK S 34° 51' 39.76" E
 AHEAD N 55° 00' 15.87" E
 CHORD BEAR S 79° 55' 42.04" E

COURSE FROM PT 93 TO PC 94 S 74° 57' 59.43" E DIST 31.529
 CURVE DATA
 CURVE 94
 P.I. STATION 64+08.473 N 724,839.011 E 1,476,448.099
 DELTA 79° 33' 04.46" (LT)
 DEGREE 179° 02' 57.52"
 TANGENT 26.638
 LENGTH 44.430
 RADIUS 32.000
 EXTERNAL 9.637
 LONG CHORD 40.946
 MID. ORD. 7.406
 P.C. STATION 63+81.835 N 724,847.506 E
 P.T. STATION 64+26.264 N 724,862.300 E
 C.C. 724,877.835 E
 BACK S 71° 24' 19.68" E
 AHEAD N 29° 02' 35.86" E
 CHORD BEAR N 68° 49' 08.09" E

CURVE DATA
 CURVE 85
 P.I. STATION 59+05.937 N 724,932.693 E
 DELTA 103° 58' 36.63" (RT)
 DEGREE 238° 43' 56.69"
 TANGENT 30.706
 LENGTH 43.554
 RADIUS 24.000
 EXTERNAL 14.972
 LONG CHORD 37.819
 MID. ORD. 9.220
 P.C. STATION 58+75.231 N 724,930.158 E
 P.T. STATION 59+18.785 N 724,902.386 E
 C.C. 724,906.240 E
 BACK N 85° 15' 48.29" E
 AHEAD S 9° 14' 24.92" W
 CHORD BEAR S 42° 44' 53.40" E


CURVE DATA
 CURVE 91
 P.I. STATION 62+12.193 N 724,857.253 E 1,476,267.070
 DELTA 58° 20' 38.79" (RT)
 DEGREE 179° 02' 57.52"
 TANGENT 17.864
 LENGTH 32.585
 RADIUS 32.000
 EXTERNAL 4.648
 LONG CHORD 31.196
 MID. ORD. 4.059
 P.C. STATION 61+71.202 N 724,847.435 E
 P.T. STATION 62+26.915 N 724,849.702 E
 C.C. 724,820.701 E
 BACK N 56° 39' 32.59" E
 AHEAD S 64° 59' 48.63" E
 CHORD BEAR N 85° 49' 51.98" E

CURVE DATA
 CURVE 95
 P.I. STATION 64+48.451 N 724,881.697 E 1,476,471.802
 DELTA 72° 58' 12.38" (RT)
 DEGREE 190° 59' 09.36"
 TANGENT 22.187
 LENGTH 38.207
 RADIUS 30.000
 EXTERNAL 7.313
 LONG CHORD 35.677
 MID. ORD. 5.880
 P.C. STATION 64+26.264 N 724,862.300 E
 P.T. STATION 64+64.472 N 724,877.079 E
 C.C. 724,847.736 E
 BACK N 29° 02' 35.86" E
 AHEAD S 77° 59' 11.77" E
 CHORD BEAR N 65° 31' 42.04" E

CURVE DATA
 CURVE 86
 P.I. STATION 59+83.238 N 724,838.769 E
 DELTA 139° 27' 07.38" (LT)
 DEGREE 240° 38' 54.61"
 TANGENT 64.454
 LENGTH 57.948
 RADIUS 23.809
 EXTERNAL 44.902
 LONG CHORD 44.668
 MID. ORD. 15.559
 P.C. STATION 59+18.785 N 724,902.386 E
 P.T. STATION 59+76.733 N 724,880.381 E
 C.C. 724,898.563 E
 BACK S 9° 14' 24.92" W
 AHEAD N 49° 47' 17.54" E
 CHORD BEAR S 60° 29' 08.77" E

COURSE FROM PT 91 TO PC 92 S 64° 59' 48.63" E DIST 43.964
 CURVE DATA
 CURVE 92
 P.I. STATION 64+48.451 N 724,881.697 E 1,476,471.802
 DELTA 72° 58' 12.38" (RT)
 DEGREE 190° 59' 09.36"
 TANGENT 22.187
 LENGTH 38.207
 RADIUS 30.000
 EXTERNAL 7.313
 LONG CHORD 35.677
 MID. ORD. 15.559
 P.C. STATION 64+26.264 N 724,902.386 E
 P.T. STATION 64+64.472 N 724,880.381 E
 C.C. 724,898.563 E
 BACK S 9° 14' 24.92" W
 AHEAD N 49° 47' 17.54" E
 CHORD BEAR S 60° 29' 08.77" E

STREAM GEOMETRY DATA 08

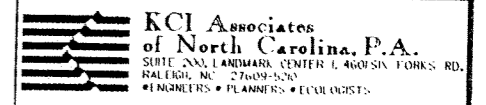

CURVE 96
P.I. STATION 65+64.121 N
DELTA 144° 21' 37.41" (LT)
DEGREE 179° 02' 57.52"
TANGENT 99.650
LENGTH 30.645
RADIUS 32.000
EXTERNAL 72.662
LONG CHORD 60.935
MID. ORD. 22.215
P.C. STATION 64+64.472 N
P.T. STATION 65+45.116 N
C.C. 724.877.079 E
BACK - S 77° 59' 11.77" E
AHEAD - N 42° 22' 49.17" W
CHORD BEAR - N 29° 48' 59.53" E

CURVE 102
P.I. STATION 69+52.733 N
DELTA 96° 58' 03.44" (LT)
DEGREE 179° 02' 57.52"
TANGENT 36.150
LENGTH 54.153
RADIUS 32.000
EXTERNAL 16.279
LONG CHORD 47.922
MID. ORD. 10.790
P.C. STATION 69+16.649 N
P.T. STATION 69+70.806 N
C.C. 724.884.443 E
BACK - S 53° 35' 31.37" E
AHEAD - N 29° 26' 19.69" E
CHORD BEAR - N 77° 55' 24.16" E

CURVE 101
P.I. STATION 724.862.987 E
DELTA 96° 58' 03.44" (LT)
DEGREE 179° 02' 57.52"
TANGENT 36.150
LENGTH 54.153
RADIUS 32.000
EXTERNAL 16.279
LONG CHORD 47.922
MID. ORD. 10.790
P.C. STATION 724.884.443 E
P.T. STATION 724.894.469 E
C.C. 724.910.197 E
BACK - S 53° 35' 31.37" E
AHEAD - N 29° 26' 19.69" E
CHORD BEAR - N 77° 55' 24.16" E

CURVE 97
P.I. STATION 67+88.500 N
DELTA 165° 01' 10.03" (RT)
DEGREE 179° 02' 57.52"
TANGENT 243.383
LENGTH 92.164
RADIUS 32.000
EXTERNAL 213.478
LONG CHORD 63.454
MID. ORD. 27.829
P.C. STATION 65+45.116 N
P.T. STATION 66+37.280 N
C.C. 724.929.948 E
BACK - N 42° 22' 49.17" W
AHEAD - S 57° 21' 39.15" E
CHORD BEAR - N 40° 07' 45.84" E

CURVE 103
P.I. STATION 69+87.723 N
DELTA 62° 16' 41.27" (RT)
DEGREE 204° 37' 40.02"
TANGENT 16.917
LENGTH 30.435
RADIUS 28.000
EXTERNAL 4.714
LONG CHORD 28.959
MID. ORD. 4.034
P.C. STATION 69+70.806 N
P.T. STATION 70+01.241 N
C.C. 724.894.469 E
BACK - N 29° 26' 19.69" E
AHEAD - S 88° 16' 59.05" E
CHORD BEAR - N 60° 34' 40.32" E

CURVE 104
P.I. STATION 70+33.624 N
DELTA 47° 42' 51.45" (RT)
DEGREE 204° 37' 40.02"
TANGENT 12.383
LENGTH 23.318
RADIUS 28.000
EXTERNAL 2.616
LONG CHORD 22.650
MID. ORD. 2.392
P.C. STATION 70+21.241 N
P.T. STATION 70+44.559 N
C.C. 724.908.096 E
BACK - S 88° 16' 59.05" E
AHEAD - N 40° 34' 07.60" E
CHORD BEAR - S 64° 25' 33.32" E

CURVE DATA
CURVE 108
P.I. STATION 72+54.776 N
DELTA 70° 18' 37.57" (RT)
DEGREE 220° 22' 06.18"
TANGENT 18.311
LENGTH 31.906
RADIUS 26.000
EXTERNAL 5.801
LONG CHORD 29.941
MID. ORD. 4.743
P.C. STATION 72+36.465 N
P.T. STATION 72+68.371 N
C.C. 724.825.707 E
BACK - N 46° 25' 39.37" E
AHEAD - S 63° 15' 43.06" E
CHORD BEAR - N 81° 34' 58.16" E

COURSE FROM PT 97 TO PC 98 S 57° 21' 39.15" E DIST 25.000

COURSE FROM PT 103 TO PC 104 S 88° 16' 59.05" E DIST 20.000

COURSE FROM PT 108 TO PC 109 S 63° 15' 43.06" E DIST 30.000

CURVE 98
P.I. STATION 66+79.045 N
DELTA 69° 52' 15.91" (LT)
DEGREE 238° 43' 56.69"
TANGENT 16.765
LENGTH 29.268
RADIUS 24.000
EXTERNAL 5.276
LONG CHORD 27.487
MID. ORD. 4.325
P.C. STATION 66+62.280 N
P.T. STATION 66+91.548 N
C.C. 724.964.980 E
BACK - S 57° 21' 39.15" E
AHEAD - N 52° 46' 04.94" E
CHORD BEAR - N 87° 42' 12.90" E

CURVE 105
P.I. STATION 70+70.384 N
DELTA 77° 48' 37.60" (LT)
DEGREE 179° 02' 57.52"
TANGENT 25.826
LENGTH 43.458
RADIUS 32.000
EXTERNAL 9.121
LONG CHORD 40.194
MID. ORD. 7.098
P.C. STATION 70+44.559 N
P.T. STATION 70+88.016 N
C.C. 724.898.318 E
BACK - S 40° 34' 07.60" E
AHEAD - N 61° 37' 14.80" E
CHORD BEAR - S 79° 28' 26.40" E

CURVE 109
P.I. STATION 73+12.511 N
DELTA 47° 40' 39.77" (RT)
DEGREE 179° 02' 57.52"
TANGENT 14.140
LENGTH 26.628
RADIUS 32.000
EXTERNAL 2.985
LONG CHORD 25.867
MID. ORD. 2.730
P.C. STATION 72+98.371 N
P.T. STATION 73+24.999 N
C.C. 724.816.592 E
BACK - S 63° 15' 43.06" E
AHEAD - S 15° 35' 03.29" E
CHORD BEAR - S 39° 25' 23.17" E

CURVE DATA
CURVE 109
P.I. STATION 73+12.511 N
DELTA 47° 40' 39.77" (RT)
DEGREE 179° 02' 57.52"
TANGENT 14.140
LENGTH 26.628
RADIUS 32.000
EXTERNAL 2.985
LONG CHORD 25.867
MID. ORD. 2.730
P.C. STATION 72+98.371 N
P.T. STATION 73+24.999 N
C.C. 724.816.592 E
BACK - S 63° 15' 43.06" E
AHEAD - S 15° 35' 03.29" E
CHORD BEAR - S 39° 25' 23.17" E

CURVE 99
P.I. STATION 67+83.066 N
DELTA 141° 27' 17.94" (RT)
DEGREE 179° 02' 57.52"
TANGENT 91.518
LENGTH 79.003
RADIUS 32.000
EXTERNAL 64.952
LONG CHORD 60.413
MID. ORD. 21.438
P.C. STATION 66+91.548 N
P.T. STATION 67+70.551 N
C.C. 724.966.082 E
BACK - N 52° 46' 04.94" E
AHEAD - S 14° 13' 22.88" W
CHORD BEAR - S 56° 30' 16.09" E

CURVE 106
P.I. STATION 71+64.642 N
DELTA 134° 40' 04.10" (RT)
DEGREE 179° 02' 57.52"
TANGENT 76.626
LENGTH 75.213
RADIUS 32.000
EXTERNAL 51.039
LONG CHORD 59.057
MID. ORD. 19.668
P.C. STATION 70+88.016 N
P.T. STATION 71+63.229 N
C.C. 724.890.976 E
BACK - N 61° 37' 14.80" E
AHEAD - S 16° 17' 18.90" W
CHORD BEAR - S 51° 02' 43.15" E

CURVE 110
P.I. STATION 75+50.697 N
DELTA 163° 51' 37.71" (LT)
DEGREE 179° 02' 57.52"
TANGENT 225.698
LENGTH 91.517
RADIUS 32.000
EXTERNAL 195.955
LONG CHORD 63.366
MID. ORD. 27.508
P.C. STATION 73+24.999 N
P.T. STATION 74+16.516 N
C.C. 724.796.611 E
BACK - S 15° 35' 03.29" E
AHEAD - N 0° 33' 19.00" E
CHORD BEAR - N 82° 29' 07.86" E

CURVE DATA
CURVE 110
P.I. STATION 75+50.697 N
DELTA 163° 51' 37.71" (LT)
DEGREE 179° 02' 57.52"
TANGENT 225.698
LENGTH 91.517
RADIUS 32.000
EXTERNAL 195.955
LONG CHORD 63.366
MID. ORD. 27.508
P.C. STATION 73+24.999 N
P.T. STATION 74+16.516 N
C.C. 724.796.611 E
BACK - S 15° 35' 03.29" E
AHEAD - N 0° 33' 19.00" E
CHORD BEAR - N 82° 29' 07.86" E

CURVE 100
P.I. STATION 68+24.855 N
DELTA 118° 58' 49.46" (LT)
DEGREE 179° 02' 57.52"
TANGENT 54.304
LENGTH 66.451
RADIUS 32.000
EXTERNAL 31.031
LONG CHORD 55.139
MID. ORD. 15.754
P.C. STATION 67+70.551 N
P.T. STATION 68+37.003 N
C.C. 724.932.741 E
BACK - S 14° 13' 22.88" W
AHEAD - N 75° 14' 33.42" E
CHORD BEAR - S 45° 16' 01.85" E

CURVE 107
P.I. STATION 72+67.222 N
DELTA 149° 51' 39.53" (LT)
DEGREE 204° 37' 40.02"
TANGENT 103.993
LENGTH 73.236
RADIUS 28.000
EXTERNAL 79.696
LONG CHORD 54.074
MID. ORD. 20.720
P.C. STATION 70+88.016 N
P.T. STATION 72+36.465 N
C.C. 724.853.846 E
BACK - N 61° 37' 14.80" E
AHEAD - S 16° 17' 18.90" W
CHORD BEAR - S 51° 02' 43.15" E

CURVE 111
P.I. STATION 75+08.943 N
DELTA 150° 53' 14.96" (RT)
DEGREE 238° 43' 56.69"
TANGENT 92.427
LENGTH 63.204
RADIUS 24.000
EXTERNAL 71.492
LONG CHORD 46.459
MID. ORD. 17.968
P.C. STATION 74+16.516 N
P.T. STATION 74+79.720 N
C.C. 724.804.898 E
BACK - N 0° 33' 19.00" E
AHEAD - S 28° 33' 26.05" E
CHORD BEAR - N 75° 59' 56.48" E

CURVE DATA
CURVE 111
P.I. STATION 75+08.943 N
DELTA 150° 53' 14.96" (RT)
DEGREE 238° 43' 56.69"
TANGENT 92.427
LENGTH 63.204
RADIUS 24.000
EXTERNAL 71.492
LONG CHORD 46.459
MID. ORD. 17.968
P.C. STATION 74+16.516 N
P.T. STATION 74+79.720 N
C.C. 724.804.898 E
BACK - N 0° 33' 19.00" E
AHEAD - S 28° 33' 26.05" E
CHORD BEAR - N 75° 59' 56.48" E

COURSE FROM PT 100 TO PC 101 N 75° 14' 33.42" E DIST 35.000

COURSE FROM PT 106 TO PC 107 S 51° 02' 43.15" E DIST 25.000

COURSE FROM PT 111 TO PC 112 S 75° 59' 56.48" E DIST 25.000

CURVE 101
P.I. STATION 68+82.535 N
DELTA 51° 09' 55.21" (RT)
DEGREE 260° 26' 07.30"
TANGENT 10.532
LENGTH 19.646
RADIUS 22.000
EXTERNAL 2.391
LONG CHORD 19.000
MID. ORD. 2.157
P.C. STATION 68+72.003 N
P.T. STATION 68+91.649 N
C.C. 724.902.850 E
BACK - N 75° 14' 33.42" E
AHEAD - S 53° 35' 31.37" E
CHORD BEAR - S 79° 10' 28.98" E

CURVE 108
P.I. STATION 70+33.624 N
DELTA 47° 42' 51.45" (RT)
DEGREE 204° 37' 40.02"
TANGENT 12.383
LENGTH 23.318
RADIUS 28.000
EXTERNAL 2.616
LONG CHORD 22.650
MID. ORD. 2.392
P.C. STATION 70+21.241 N
P.T. STATION 70+44.559 N
C.C. 724.908.096 E
BACK - S 88° 16' 59.05" E
AHEAD - N 40° 34' 07.60" E
CHORD BEAR - S 64° 25' 33.32" E

CURVE 112
P.I. STATION 74+16.516 N
DELTA 74° 16' 51.6" (RT)
DEGREE 179° 02' 57.52"
TANGENT 14.140
LENGTH 26.628
RADIUS 32.000
EXTERNAL 2.985
LONG CHORD 25.867
MID. ORD. 2.730
P.C. STATION 73+24.999 N
P.T. STATION 74+16.516 N
C.C. 724.816.592 E
BACK - S 63° 15' 43.06" E
AHEAD - S 15° 35' 03.29" E
CHORD BEAR - S 39° 25' 23.17" E

CURVE DATA
CURVE 112
P.I. STATION 74+16.516 N
DELTA 74° 16' 51.6" (RT)
DEGREE 179° 02' 57.52"
TANGENT 14.140
LENGTH 26.628
RADIUS 32.000
EXTERNAL 2.985
LONG CHORD 25.867
MID. ORD. 2.730
P.C. STATION 73+24.999 N
P.T. STATION 74+16.516 N
C.C. 724.816.592 E
BACK - S 63° 15' 43.06" E
AHEAD - S 15° 35' 03.29" E
CHORD BEAR - S 39° 25' 23.17" E

COURSE FROM PT 101 TO PC 102 S 53° 35' 31.37" E DIST 25.000

STREAM GEOMETRY DATA 07

CURVE DATA			
CURVE 112			
P.I. STATION	75+41.903	N	724.761.915 E
DELTA	134° 37' 20.95"	(LT)	1.477.223.095
DEGREE	220° 22' 06.18"		
TANGENT	62.184		
LENGTH	61.090		
RADIUS	26.000		
EXTERNAL	41.406		
LONG CHORD	47.976		
MID. ORD.	15.971		
P.C. STATION	74+79.720	N	724.816.138 E
P.T. STATION	75+40.809	N	724.821.043 E
C.C.		N	724.828.567 E
BACK	S 28° 33' 26.05"	E	
AHEAD	N 16° 49' 13.01"	E	
CHORD BEAR	N 84° 07' 53.48"	E	

CURVE DATA			
CURVE 118			
P.I. STATION	74+79.026	N	724.704.253 E
DELTA	74° 05' 17.32"	(LT)	1.477.432.773
DEGREE	173° 02' 57.52"		
TANGENT	24.152		
LENGTH	41.374		
RADIUS	32.000		
EXTERNAL	3.042		
LONG CHORD	38.555		
MID. ORD.	6.458		
P.C. STATION	74+53.874	N	724.728.117 E
P.T. STATION	78+95.252	N	724.694.107 E
C.C.		N	724.723.143 E
BACK	S 8° 56' 30.14"	W	
AHEAD	S 65° 08' 47.12"	E	
CHORD BEAR	S 28° 06' 08.52"	E	

CURVE DATA			
CURVE 113			
P.I. STATION	76+00.179	N	724.877.872 E
DELTA	123° 21' 02.00"	(RT)	1.477.265.162
DEGREE	179° 02' 57.52"		
TANGENT	59.369		
LENGTH	68.892		
RADIUS	32.000		
EXTERNAL	35.444		
LONG CHORD	56.337		
MID. ORD.	16.817		
P.C. STATION	75+40.809	N	724.821.043 E
P.T. STATION	76+09.701	N	724.832.279 E
C.C.		N	724.811.783 E
BACK	N 16° 49' 13.01"	E	
AHEAD	S 39° 49' 44.99"	E	
CHORD BEAR	N 78° 29' 44.01"	E	

CURVE DATA			
CURVE 119			
P.I. STATION	79+19.271	N	724.684.012 E
DELTA	73° 46' 54.03"	(RT)	1.477.526.487
DEGREE	179° 02' 57.50"		
TANGENT	24.018		
LENGTH	41.207		
RADIUS	32.000		
EXTERNAL	8.011		
LONG CHORD	38.419		
MID. ORD.	6.407		
P.C. STATION	78+95.252	N	724.694.107 E
P.T. STATION	79+36.460	N	724.660.266 E
C.C.		N	724.665.071 E
BACK	S 65° 08' 47.18"	E	
AHEAD	S 8° 38' 06.85"	W	
CHORD BEAR	S 28° 15' 20.17"	E	

COURSE FROM PT 113 TO PC 114 S 39° 49' 44.99" E DIST 25.000

CURVE DATA			
CURVE 114			
P.I. STATION	76+54.238	N	724.798.077 E
DELTA	73° 50' 38.67"	(LT)	1.477.331.711
DEGREE	220° 22' 06.18"		
TANGENT	19.837		
LENGTH	33.509		
RADIUS	26.000		
EXTERNAL	6.522		
LONG CHORD	31.238		
MID. ORD.	5.214		
P.C. STATION	76+34.701	N	724.813.080 E
P.T. STATION	76+68.211	N	724.805.921 E
C.C.		N	724.829.733 E
BACK	S 39° 49' 44.99"	E	
AHEAD	N 66° 19' 36.34"	E	
CHORD BEAR	S 76° 45' 04.33"	E	

CURVE DATA			
CURVE 120			
P.I. STATION	79+60.370	N	724.636.628 E
DELTA	80° 59' 21.09"	(LT)	1.477.519.291
DEGREE	204° 37' 40.04"		
TANGENT	23.910		
LENGTH	39.579		
RADIUS	28.000		
EXTERNAL	8.819		
LONG CHORD	36.365		
MID. ORD.	6.707		
P.C. STATION	79+36.460	N	724.660.266 E
P.T. STATION	79+76.039	N	724.629.380 E
C.C.		N	724.656.062 E
BACK	S 8° 38' 06.85"	W	
AHEAD	S 72° 21' 14.25"	E	
CHORD BEAR	S 31° 51' 33.70"	E	

CURVE DATA			
CURVE 115			
P.I. STATION	76+95.825	N	724.817.009 E
DELTA	81° 35' 03.39"	(RT)	1.477.374.891
DEGREE	179° 02' 57.52"		
TANGENT	27.614		
LENGTH	45.565		
RADIUS	32.000		
EXTERNAL	10.267		
LONG CHORD	41.812		
MID. ORD.	7.773		
P.C. STATION	76+68.211	N	724.805.921 E
P.T. STATION	77+13.776	N	724.793.614 E
C.C.		N	724.776.614 E
BACK	N 66° 19' 36.34"	E	
AHEAD	S 32° 05' 20.28"	E	
CHORD BEAR	S 72° 52' 51.97"	E	

CURVE DATA			
CURVE 121			
P.I. STATION	80+07.333	N	724.619.893 E
DELTA	105° 01' 49.22"	(RT)	1.477.571.898
DEGREE	238° 43' 56.66"		
TANGENT	31.295		
LENGTH	43.995		
RADIUS	24.000		
EXTERNAL	15.438		
LONG CHORD	38.089		
MID. ORD.	9.395		
P.C. STATION	79+76.039	N	724.629.380 E
P.T. STATION	80+20.034	N	724.593.552 E
C.C.		N	724.606.509 E
BACK	S 72° 21' 14.25"	E	
AHEAD	S 32° 40' 34.97"	W	
CHORD BEAR	S 19° 50' 19.64"	E	

COURSE FROM PT 115 TO PC 116 S 32° 05' 20.28" E DIST 30.000

CURVE DATA			
CURVE 116			
P.I. STATION	77+67.443	N	724.748.146 E
DELTA	89° 11' 57.26"	(LT)	1.477.418.071
DEGREE	238° 43' 56.69"		
TANGENT	23.667		
LENGTH	37.364		
RADIUS	24.000		
EXTERNAL	9.786		
LONG CHORD	33.703		
MID. ORD.	6.911		
P.C. STATION	77+43.776	N	724.768.197 E
P.T. STATION	77+81.140	N	724.760.437 E
C.C.		N	724.780.947 E
BACK	S 32° 05' 20.28"	E	
AHEAD	N 58° 42' 42.46"	E	
CHORD BEAR	N 76° 41' 18.91"	E	

CURVE DATA			
CURVE 122			
P.I. STATION	80+82.926	N	724.540.156 E
DELTA	116° 08' 34.00"	(LT)	1.477.521.769
DEGREE	179° 02' 57.52"		
TANGENT	51.353		
LENGTH	64.866		
RADIUS	32.000		
EXTERNAL	28.507		
LONG CHORD	54.317		
MID. ORD.	15.076		
P.C. STATION	80+31.573	N	724.583.754 E
P.T. STATION	80+96.440	N	724.535.007 E
C.C.		N	724.566.846 E
BACK	S 31° 53' 51.27"	W	
AHEAD	S 84° 14' 42.73"	E	
CHORD BEAR	S 26° 10' 25.73"	E	

CURVE DATA			
CURVE 117			
P.I. STATION	78+50.125	N	724.796.264 E
DELTA	130° 13' 47.68"	(RT)	1.477.497.251
DEGREE	179° 02' 57.52"		
TANGENT	68.985		
LENGTH	72.734		
RADIUS	32.000		
EXTERNAL	44.046		
LONG CHORD	58.058		
MID. ORD.	18.534		
P.C. STATION	77+81.140	N	724.760.437 E
P.T. STATION	78+53.874	N	724.728.117 E
C.C.		N	724.733.091 E
BACK	N 58° 42' 42.46"	E	
AHEAD	S 8° 56' 30.14"	W	
CHORD BEAR	S 56° 10' 23.70"	E	

CURVE DATA			
CURVE 123			
P.I. STATION	81+87.643	N	724.525.862 E
DELTA	66° 19' 16.88"	(RT)	1.477.663.607
DEGREE	179° 02' 57.52"		
TANGENT	20.909		
LENGTH	37.041		
RADIUS	32.000		
EXTERNAL	6.225		
LONG CHORD	35.007		
MID. ORD.	5.212		
P.C. STATION	81+66.734	N	724.527.958 E
P.T. STATION	82+03.775	N	724.505.968 E
C.C.		N	724.496.120 E
BACK	S 84° 14' 42.73"	E	
AHEAD	S 17° 55' 25.85"	E	
CHORD BEAR	S 51° 05' 04.19"	E	


CURVE DATA			
CURVE 124			
P.I. STATION	82+39.642	N	724.471.842 E
DELTA	96° 31' 17.99"	(LT)	1.477.681.000
DEGREE	179° 02' 57.52"		
TANGENT	35.267		
LENGTH	53.408		
RADIUS	32.000		
EXTERNAL	16.067		
LONG CHORD	47.756		
MID. ORD.	10.696		
P.C. STATION	82+03.775	N	724.505.968 E
P.T. STATION	82+57.683	N	724.486.684 E
C.C.		N	724.515.816 E
BACK	S 17° 55' 25.85"	E	
AHEAD	N 65° 33' 16.16"	E	
CHORD BEAR	S 66° 11' 04.84"	E	

CURVE DATA			
CURVE 125			
P.I. STATION	83+05.329	N	724.506.401 E
DELTA	130° 25' 49.66"	(RT)	1.477.757.106
DEGREE	260° 26' 07.30"		
TANGENT	47.646		
LENGTH	50.082		
RADIUS	22.000		
EXTERNAL	30.480		
LONG CHORD	39.947		
MID. ORD.	12.777		
P.C. STATION	82+57.683	N	724.486.684 E
P.T. STATION	83+07.765	N	724.460.598 E
C.C.		N	724.466.657 E
BACK	N 65° 33' 16.16"	E	
AHEAD	S 15° 59' 05.83"	W	
CHORD BEAR	S 49° 13' 49.00"	E	

CURVE DATA			
CURVE 126			
P.I. STATION	84+10.064	N	724.362.255 E
DELTA	155° 43' 33.89"	(LT)	1.477.715.814
DEGREE	260° 26' 07.30"		
TANGENT	102.299		
LENGTH	59.795		
RADIUS	22.000		
EXTERNAL	82.638		
LONG CHORD	43.017		
MID. ORD.	17.375		
P.C. STATION	83+07.765	N	724.460.598 E
P.T. STATION	83+67.559	N	724.440.322 E
C.C.		N	724.454.540 E
BACK	S 15° 59' 05.83"	W	
AHEAD	N 40° 15' 31.94"	E	
CHORD BEAR	S 61° 52' 41.11"	E	

CURVE DATA			
CURVE 127			
P.I. STATION	83+99.622	N	724.464.790 E
DELTA	90° 06' 42.13"	(RT)	1.477.802.644
DEGREE	179° 02' 57.52"		
TANGENT	32.062		
LENGTH	50.328		
RADIUS	32.000		
EXTERNAL	13.299		
LONG CHORD	45.299		
MID. ORD.	9.395		
P.C. STATION	83+67.559	N	724.440.322 E
P.T. STATION	84+17.887	N	724.444.022 E
C.C.		N	724.419.643 E
BACK	N 40° 15' 31.94"	E	
AHEAD	S 49° 37' 45.92"	E	
CHORD BEAR	N 85° 18' 53.01"	E	

STREAM GEOMETRY DATA 08

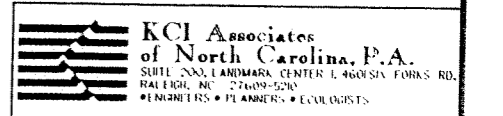

PROJECT REFERENCE NO. R - 2239NM SHEET NO. 33
ENGINEER SCIENTIST

CURVE DATA

CURVE 144					
P.I. STATION	97-31.949	N	724,539.767	E	1,478,938.935
DELTA	113° 05' 50.32"	(LT)			
DEGREE	137° 46' 51.47"				
TANGENT	51.900				
LENGTH	63.424				
RADIUS	30.512				
EXTERNAL	29.632				
LONG CHORD	52.606				
MID. ORD.	15.043				
P.C. STATION	96-80.049	N	724,644.447	E	1,478,812.528
P.T. STATION	97-43.473	N	724,644.568	E	1,478,865.135
C.C.			724,659.971	E	1,478,838.796
BACK	S 30° 35' 02.38"	E			
AHEAD	N 30° 19' 07.29"	E			
CHORD BEAR	N 89° 52' 02.46"	E			

CURVE DATA

CURVE 145					
P.I. STATION	97-61.697	N	724,662.634	E	1,478,867.531
DELTA	59° 19' 23.44"	(RT)			
DEGREE	179° 02' 57.49"				
TANGENT	18.224				
LENGTH	33.132				
RADIUS	32.000				
EXTERNAL	4.825				
LONG CHORD	31.672				
MID. ORD.	4.193				
P.C. STATION	97-43.473	N	724,644.568	E	1,478,865.135
P.T. STATION	97-76.605	N	724,669.790	E	1,478,884.291
C.C.			724,640.361	E	1,478,896.857
BACK	N 7° 33' 19.45"	E			
AHEAD	N 66° 52' 42.89"	E			
CHORD BEAR	N 37° 13' 01.17"	E			

COURSE FROM PT 145 TO PC 146 N 66° 52' 42.89" E DIST 35.000

CURVE DATA

CURVE 146					
P.I. STATION	98-23.473	N	724,688.195	E	1,478,927.395
DELTA	61° 22' 17.40"	(RT)			
DEGREE	286° 28' 44.03"				
TANGENT	11.868				
LENGTH	21.423				
RADIUS	20.000				
EXTERNAL	3.256				
LONG CHORD	20.413				
MID. ORD.	2.800				
P.C. STATION	98-11.605	N	724,683.534	E	1,478,916.480
P.T. STATION	98-33.028	N	724,680.847	E	1,478,936.715
C.C.			724,665.141	E	1,478,924.333
BACK	N 66° 52' 42.89"	E			
AHEAD	S 51° 44' 59.71"	E			
CHORD BEAR	S 82° 26' 08.41"	E			

CURVE DATA

CURVE 147					
P.I. STATION	99-00.483	N	724,639.086	E	1,478,989.689
DELTA	129° 14' 29.82"	(LT)			
DEGREE	179° 02' 57.52"				
TANGENT	67.455				
LENGTH	72.182				
RADIUS	32.000				
EXTERNAL	42.660				
LONG CHORD	57.823				
MID. ORD.	18.285				
P.C. STATION	98-33.028	N	724,680.847	E	1,478,936.715
P.T. STATION	99-05.210	N	724,705.531	E	1,478,988.521
C.C.			724,705.977	E	1,478,956.526
BACK	S 51° 44' 59.71"	E			
AHEAD	N 0° 59' 29.53"	W			
CHORD BEAR	N 63° 37' 45.38"	E			

CURVE DATA

CURVE 148					
P.I. STATION	99-50.273	N	724,751.588	E	1,478,987.742
DELTA	109° 14' 31.85"	(RT)			
DEGREE	179° 02' 57.50"				
TANGENT	45.063				
LENGTH	61.012				
RADIUS	32.000				
EXTERNAL	23.270				
LONG CHORD	52.182				
MID. ORD.	13.473				
P.C. STATION	99-05.210	N	724,706.531	E	1,478,988.521
P.T. STATION	99-66.222	N	724,737.475	E	1,479,030.538
C.C.			724,707.085	E	1,479,020.517
BACK	N 0° 59' 29.53"	W			
AHEAD	S 71° 44' 57.68"	E			
CHORD BEAR	N 53° 37' 46.40"	E			

CURVE DATA

CURVE 149					
P.I. STATION	99-97.715	N	724,727.612	E	1,479,060.447
DELTA	105° 22' 48.03"	(LT)			
DEGREE	238° 43' 56.73"				
TANGENT	31.493				
LENGTH	44.141				
RADIUS	24.000				
EXTERNAL	15.596				
LONG CHORD	38.178				
MID. ORD.	9.453				
P.C. STATION	99-66.222	N	724,737.475	E	1,479,030.538
P.T. STATION	100-10.364	N	724,754.066	E	1,479,062.024
C.C.			724,760.268	E	1,479,038.054
BACK	S 71° 44' 57.68"	E			
AHEAD	N 2° 52' 14.29"	E			
CHORD BEAR	N 55° 33' 38.31"	E			

CURVE DATA

CURVE 150					
P.I. STATION	100-67.399	N	724,816.619	E	1,479,064.910
DELTA	121° 54' 43.79"	(RT)			
DEGREE	179° 02' 57.49"				
TANGENT	57.625				
LENGTH	63.089				
RADIUS	32.000				
EXTERNAL	33.914				
LONG CHORD	55.952				
MID. ORD.	16.465				
P.C. STATION	100-10.364	N	724,759.066	E	1,479,062.024
P.T. STATION	100-78.452	N	724,783.745	E	1,479,112.239
C.C.			724,757.463	E	1,479,093.984
BACK	N 2° 52' 14.29"	E			
AHEAD	S 55° 13' 01.91"	E			
CHORD BEAR	N 63° 49' 36.19"	E			

CURVE DATA

CURVE 151					
P.I. STATION	101-07.154	N	724,767.372	E	1,479,135.812
DELTA	110° 15' 36.24"	(LT)			
DEGREE	286° 28' 44.13"				
TANGENT	28.701				
LENGTH	38.488				
RADIUS	20.000				
EXTERNAL	14.982				
LONG CHORD	32.818				
MID. ORD.	8.566				
P.C. STATION	100-78.452	N	724,783.745	E	1,479,112.239
P.T. STATION	101-16.940	N	724,795.157	E	1,479,143.009
C.C.			724,800.172	E	1,479,123.648
BACK	S 55° 13' 01.91"	E			
AHEAD	N 14° 31' 21.85"	E			
CHORD BEAR	N 69° 39' 09.97"	E			

CURVE DATA

CURVE 152					
P.I. STATION	101-85.164	N	724,861.201	E	1,479,160.117
DELTA	129° 44' 37.80"	(RT)			
DEGREE	179° 02' 57.49"				
TANGENT	68.224				
LENGTH	72.462				
RADIUS	32.000				
EXTERNAL	43.356				
LONG CHORD	57.411				
MID. ORD.	18.411				
P.C. STATION	101-16.940	N	724,795.157	E	1,479,143.009
P.T. STATION	101-89.402	N	724,805.821	E	1,479,179.962
C.C.			724,787.132	E	1,479,173.987
BACK	N 14° 31' 21.85"	E			
AHEAD	S 35° 44' 04.35"	E			
CHORD BEAR	N 79° 23' 38.75"	E			

CURVE DATA

CURVE 153					
P.I. STATION	102-58.489	N	724,749.741	E	1,479,240.311
DELTA	130° 17' 40.11"	(LT)			
DEGREE	179° 02' 57.55"				
TANGENT	69.087				
LENGTH	72.770				
RADIUS	32.000				
EXTERNAL	44.138				
LONG CHORD	58.073				
MID. ORD.	18.551				
P.C. STATION	101-89.402	N	724,805.821	E	1,479,199.962
P.T. STATION	102-62.172	N	724,816.784	E	1,479,256.991
C.C.			724,824.510	E	1,479,225.938
BACK	S 35° 44' 04.35"	E			
AHEAD	N 13° 58' 15.55"	E			
CHORD BEAR	N 79° 07' 05.60"	E			

CURVE DATA

CURVE 154					
P.I. STATION	103-18.288	N	724,871.239	E	1,479,270.539
DELTA	114° 38' 11.94"	(RT)			
DEGREE	159° 09' 17.77"				
TANGENT	56.115				
LENGTH	72.028				
RADIUS	36.000				
EXTERNAL	30.670				
LONG CHORD	60.601				
MID. ORD.	16.561				
P.C. STATION	102-62.172	N	724,816.784	E	1,479,256.991
P.T. STATION	103-34.201	N	724,836.225	E	1,479,314.390
C.C.			724,808.093	E	1,479,291.926
BACK	N 13° 58' 15.55"	E			
AHEAD	S 51° 23' 32.51"	E			
CHORD BEAR	N 71° 17' 21.52"	E			

CURVE DATA

CURVE 155					
P.I. STATION	103-68.956	N	724,814.538	E	1,479,341.549
DELTA	88° 08' 36.97"	(LT)			
DEGREE	159° 35' 53.82"				
TANGENT	34.755				
LENGTH	55.228				
RADIUS	35.900				
EXTERNAL	14.067				
LONG CHORD	49.941				
MID. ORD.	10.107				
P.C. STATION	103-34.201	N	724,836.225	E	1,479,314.390
P.T. STATION	103-89.429	N	724,840.980	E	1,479,364.104
C.C.			724,864.278	E	1,479,336.791
BACK	S 51° 23' 32.51"	E			
AHEAD	N 40° 27' 50.52"	E			
CHORD BEAR	N 84° 32' 09.01"	E			

COURSE FROM PT 155 TO PC 156 N 41° 29' 40.64" E DIST 11.890

CURVE DATA

CURVE 156					
P.I. STATION	104-19.411	N	724,863.437	E	1,479,383.965
DELTA	74° 01' 19.34"	(RT)			
DEGREE	238° 43' 56.69"				
TANGENT	18.093				
LENGTH	31.006				
RADIUS	24.000				
EXTERNAL	6.056				
LONG CHORD	28.894				
MID. ORD.	4.836				
P.C. STATION	104-01.319	N	724,849.886	E	1,479,371.965
P.T. STATION	104-32.325	N	724,855.643	E	1,479,400.225
C.C.			724,833.984	E	1,479,389.965
BACK	N 41° 29' 40.64"	E			
AHEAD	S 64° 29' 00.02"	E			
CHORD BEAR	N 78° 30' 20.31"	E			

COURSE FROM PT 156 TO PC 157 S 64° 29' 00.02" E DIST 16.390

CURVE DATA

CURVE 157					
P.I. STATION	104-59.404	N	724,844.883	E	1,479,425.115
DELTA	46° 17' 54.38"	(RT)			
DEGREE	229° 10' 59.22"				
TANGENT	10.689				
LENGTH	20.202				
RADIUS	25.000				
EXTERNAL	2.189				
LONG CHORD	19.656				
MID. ORD.	2.013				
P.C. STATION	104-48.715	N	724,848.583	E	1,479,415.008
P.T. STATION	104-68.916	N	724,835.077	E	1,479,429.365
C.C.			724,825.129	E	1,479,406.489
BACK	S 69° 44' 49.11"	E			
AHEAD	S 23° 26' 54.73"	E			
CHORD BEAR	S 46° 35' 51.92"	E			

CURVE DATA

CURVE 158					
P.I. STATION	105-21.407	N	724,785.914	E	1,479,447.755
DELTA	129° 03' 55.11"	(LT)			
DEGREE	229° 10' 59.23"				
TANGENT	52.491				
LENGTH	56.315				
RADIUS	25.000				
EXTERNAL	35.140				
LONG CHORD	45.142				
MID. ORD.	14.250				
P.C. STATION	104-68.916	N	724,835.077	E	1,479,429.365
P.T. STATION	105-25.232	N	724,831.177	E	1,479,474.365
C.C.			724,843.837	E	1,479,452.785
BACK	S 20° 30' 40.23"	E			
AHEAD	N 30° 25' 24.66"	E			

CURVE DATA

CURVE 160
P.I. STATION 106.50.321 N 724.731.450 E 1.479.561.148
DELTA 115° 23' 23.11" (LT)
DEGREE 166° 33' 27.00"
TANGENT 54.494
LENGTH 64.330
RADIUS 34.400
EXTERNAL 30.043
LONG CHORD 58.178
MID. ORD. 16.037
P.C. STATION 105.96.327 N 724.826.335 E 1.479.533.374
P.T. STATION 106.65.657 N 724.826.690 E 1.479.591.529
C.C. 724.845.868 E 1.479.562.971
BACK - S 30° 38' 29.99" E
AHEAD - N 33° 53' 01.10" E
CHORD BEAR - S 88° 22' 44.44" E

CURVE DATA

CURVE 2
P.I. STATION 11.17.612 N 725.010.463 E 1.477.751.614
DELTA 91° 00' 24.28" (LT)
DEGREE 91° 40' 23.69"
TANGENT 53.386
LENGTH 88.365
RADIUS 62.500
EXTERNAL 19.697
LONG CHORD 81.187
MID. ORD. 14.977
P.C. STATION 10.64.225 N 725.058.697 E 1.477.774.507
P.T. STATION 11.52.590 N 724.980.317 E 1.477.795.671
C.C. 725.031.895 E 1.477.830.969
BACK - S 25° 23' 35.00" W
AHEAD - S 55° 36' 49.28" E
CHORD BEAR - S 15° 06' 37.14" E

CURVE DATA

CURVE 161
P.I. STATION 107.32.133 N 724.881.876 E 1.479.628.589
DELTA 121° 08' 37.47" (RT)
DEGREE 152° 47' 19.48"
TANGENT 66.475
LENGTH 79.288
RADIUS 37.500
EXTERNAL 38.823
LONG CHORD 65.323
MID. ORD. 19.075
P.C. STATION 106.65.657 N 724.826.690 E 1.479.591.529
P.T. STATION 107.44.945 N 724.821.615 E 1.479.656.654
C.C. 724.805.783 E 1.479.622.660
BACK - N 33° 53' 01.10" E
AHEAD - N 24° 58' 21.43" E
CHORD BEAR - S 85° 32' 40.16" E

CURVE DATA

CURVE 3
P.I. STATION 11.96.423 N 724.955.562 E 1.477.831.844
DELTA 70° 05' 10.34" (RT)
DEGREE 91° 40' 23.69"
TANGENT 43.833
LENGTH 76.452
RADIUS 62.500
EXTERNAL 13.839
LONG CHORD 71.774
MID. ORD. 11.330
P.C. STATION 11.52.590 N 724.980.317 E 1.477.795.671
P.T. STATION 12.29.042 N 724.913.119 E 1.477.820.889
C.C. 724.928.739 E 1.477.760.373
BACK - S 55° 36' 49.28" E
AHEAD - S 14° 28' 21.06" W
CHORD BEAR - S 20° 34' 14.11" E

CURVE DATA

CURVE 162
P.I. STATION 107.83.296 N 724.786.850 E 1.479.672.845
DELTA 107° 32' 16.12" (LT)
DEGREE 203° 53' 58.46"
TANGENT 38.350
LENGTH 52.741
RADIUS 28.100
EXTERNAL 19.443
LONG CHORD 45.333
MID. ORD. 11.492
P.C. STATION 107.44.945 N 724.821.615 E 1.479.656.654
P.T. STATION 107.97.686 N 724.812.764 E 1.479.701.115
C.C. 724.833.478 E 1.479.682.127
BACK - S 24° 58' 21.43" E
AHEAD - N 47° 29' 22.45" E
CHORD BEAR - S 78° 44' 29.49" E

CURVE DATA

CURVE 4
P.I. STATION 12.90.201 N 724.853.901 E 1.477.805.605
DELTA 88° 45' 26.43" (LT)
DEGREE 91° 40' 23.69"
TANGENT 61.159
LENGTH 96.819
RADIUS 62.500
EXTERNAL 24.945
LONG CHORD 87.425
MID. ORD. 17.829
P.C. STATION 12.29.042 N 724.913.119 E 1.477.820.889
P.T. STATION 13.25.862 N 724.837.336 E 1.477.864.478
C.C. 724.897.500 E 1.477.881.406
BACK - S 14° 28' 21.06" W
AHEAD - S 74° 17' 05.37" E
CHORD BEAR - S 29° 54' 22.15" E

CURVE DATA

CURVE 8
P.I. STATION 17.29.233 N 724.521.665 E 1.478.019.876
DELTA 101° 44' 35.56" (LT)
DEGREE 81° 51' 04.01"
TANGENT 86.048
LENGTH 124.303
RADIUS 70.000
EXTERNAL 40.924
LONG CHORD 108.633
MID. ORD. 25.826
P.C. STATION 16.43.186 N 724.606.447 E 1.478.034.582
P.T. STATION 17.67.488 N 724.524.524 E 1.478.105.876
C.C. 724.594.486 E 1.478.103.582
BACK - S 9° 50' 20.17" W
AHEAD - N 88° 05' 44.61" E
CHORD BEAR - S 41° 01' 57.61" E

COURSE FROM PT 8 TO 9001 N 88° 05' 44.61" E DIST 32.361
POINT 9001 N 724.525.600 E 1.478.138.222 STA 17.99.850

CURVE DATA

CURVE 163
P.I. STATION 108.30.593 N 724.834.098 E 1.479.726.170
DELTA 82° 32' 05.00" (RT)
DEGREE 152° 47' 19.48"
TANGENT 32.907
LENGTH 54.019
RADIUS 37.500
EXTERNAL 12.391
LONG CHORD 49.468
MID. ORD. 9.314
P.C. STATION 107.97.686 N 724.812.764 E 1.479.701.115
P.T. STATION 108.51.705 N 724.812.027 E 1.479.750.577
C.C. 724.784.212 E 1.479.725.426
BACK - N 49° 35' 13.20" E
AHEAD - S 47° 52' 41.80" E
CHORD BEAR - S 89° 08' 44.30" E

CURVE DATA

CURVE 5
P.I. STATION 13.68.558 N 724.825.771 E 1.477.905.578
DELTA 68° 40' 37.52" (RT)
DEGREE 91° 40' 23.69"
TANGENT 42.696
LENGTH 74.915
RADIUS 62.500
EXTERNAL 13.192
LONG CHORD 70.510
MID. ORD. 10.893
P.C. STATION 13.25.862 N 724.837.336 E 1.477.864.478
P.T. STATION 14.00.777 N 724.783.280 E 1.477.909.750
C.C. 724.777.172 E 1.477.847.549
BACK - S 74° 17' 05.37" E
AHEAD - S 5° 36' 27.84" E
CHORD BEAR - S 39° 56' 46.60" E

COURSE FROM PT 163 TO 8001 S 50° 52' 35.81" E DIST 52.049
POINT 8001 N 724.779.184 E 1.479.790.956 STA 109.03.753

COURSE FROM PT 5 TO PC 6 S 6° 36' 05.26" E DIST 43.208

TRIBUTARY GEOMETRY DATA

CURVE 1
P.I. STATION 10.35.273 N 725.090.562 E 1.477.789.633
DELTA 58° 52' 39.31" (RT)
DEGREE 91° 40' 23.69"
TANGENT 35.273
LENGTH 64.225
RADIUS 62.500
EXTERNAL 9.266
LONG CHORD 61.437
MID. ORD. 8.070
P.C. STATION 10.00.000 N 725.119.980 E 1.477.770.173
P.T. STATION 10.64.225 N 725.058.697 E 1.477.774.507
C.C. 725.085.498 E 1.477.718.046
BACK - S 33° 29' 04.31" E
AHEAD - S 25° 23' 35.00" W
CHORD BEAR - S 4° 02' 44.65" E


CURVE DATA

CURVE 6
P.I. STATION 14.92.834 N 724.692.152 E 1.477.922.620
DELTA 76° 01' 19.51" (LT)
DEGREE 91° 40' 23.69"
TANGENT 48.850
LENGTH 82.927
RADIUS 62.500
EXTERNAL 16.826
LONG CHORD 76.977
MID. ORD. 13.257
P.C. STATION 14.43.985 N 724.740.358 E 1.477.914.717
P.T. STATION 15.26.912 N 724.688.176 E 1.477.971.308
C.C. 724.750.469 E 1.477.976.394
BACK - S 9° 18' 36.72" E
AHEAD - S 85° 19' 56.23" E
CHORD BEAR - S 47° 19' 16.48" E



CURVE DATA



CURVE 7
P.I. STATION 16.03.533 N 724.681.941 E 1.478.047.675
DELTA 95° 10' 16.40" (RT)
DEGREE 81° 51' 04.01"
TANGENT 76.621
LENGTH 116.274
RADIUS 70.000
EXTERNAL 33.782
LONG CHORD 103.360
MID. ORD. 22.786
P.C. STATION 15.26.912 N 724.688.176 E 1.477.971.308
P.T. STATION 16.43.186 N 724.606.447 E 1.478.034.582
C.C. 724.618.409 E 1.477.965.612
BACK - S 85° 19' 56.23" E
AHEAD - S 9° 50' 20.17" W
CHORD BEAR - S 37° 44' 48.03" E

STREAM GEOMETRY DATA 11

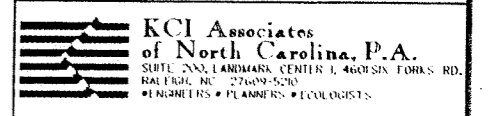

R - 2239NM
 ROADWAY DESIGN ENGINEER
 HYDRAULICS ENGINEER
 PRELIMINARY PLANS
 DO NOT USE FOR CONSTRUCTION
 INCOMPLETE PLANS
 DO NOT USE FOR ACQUISITION

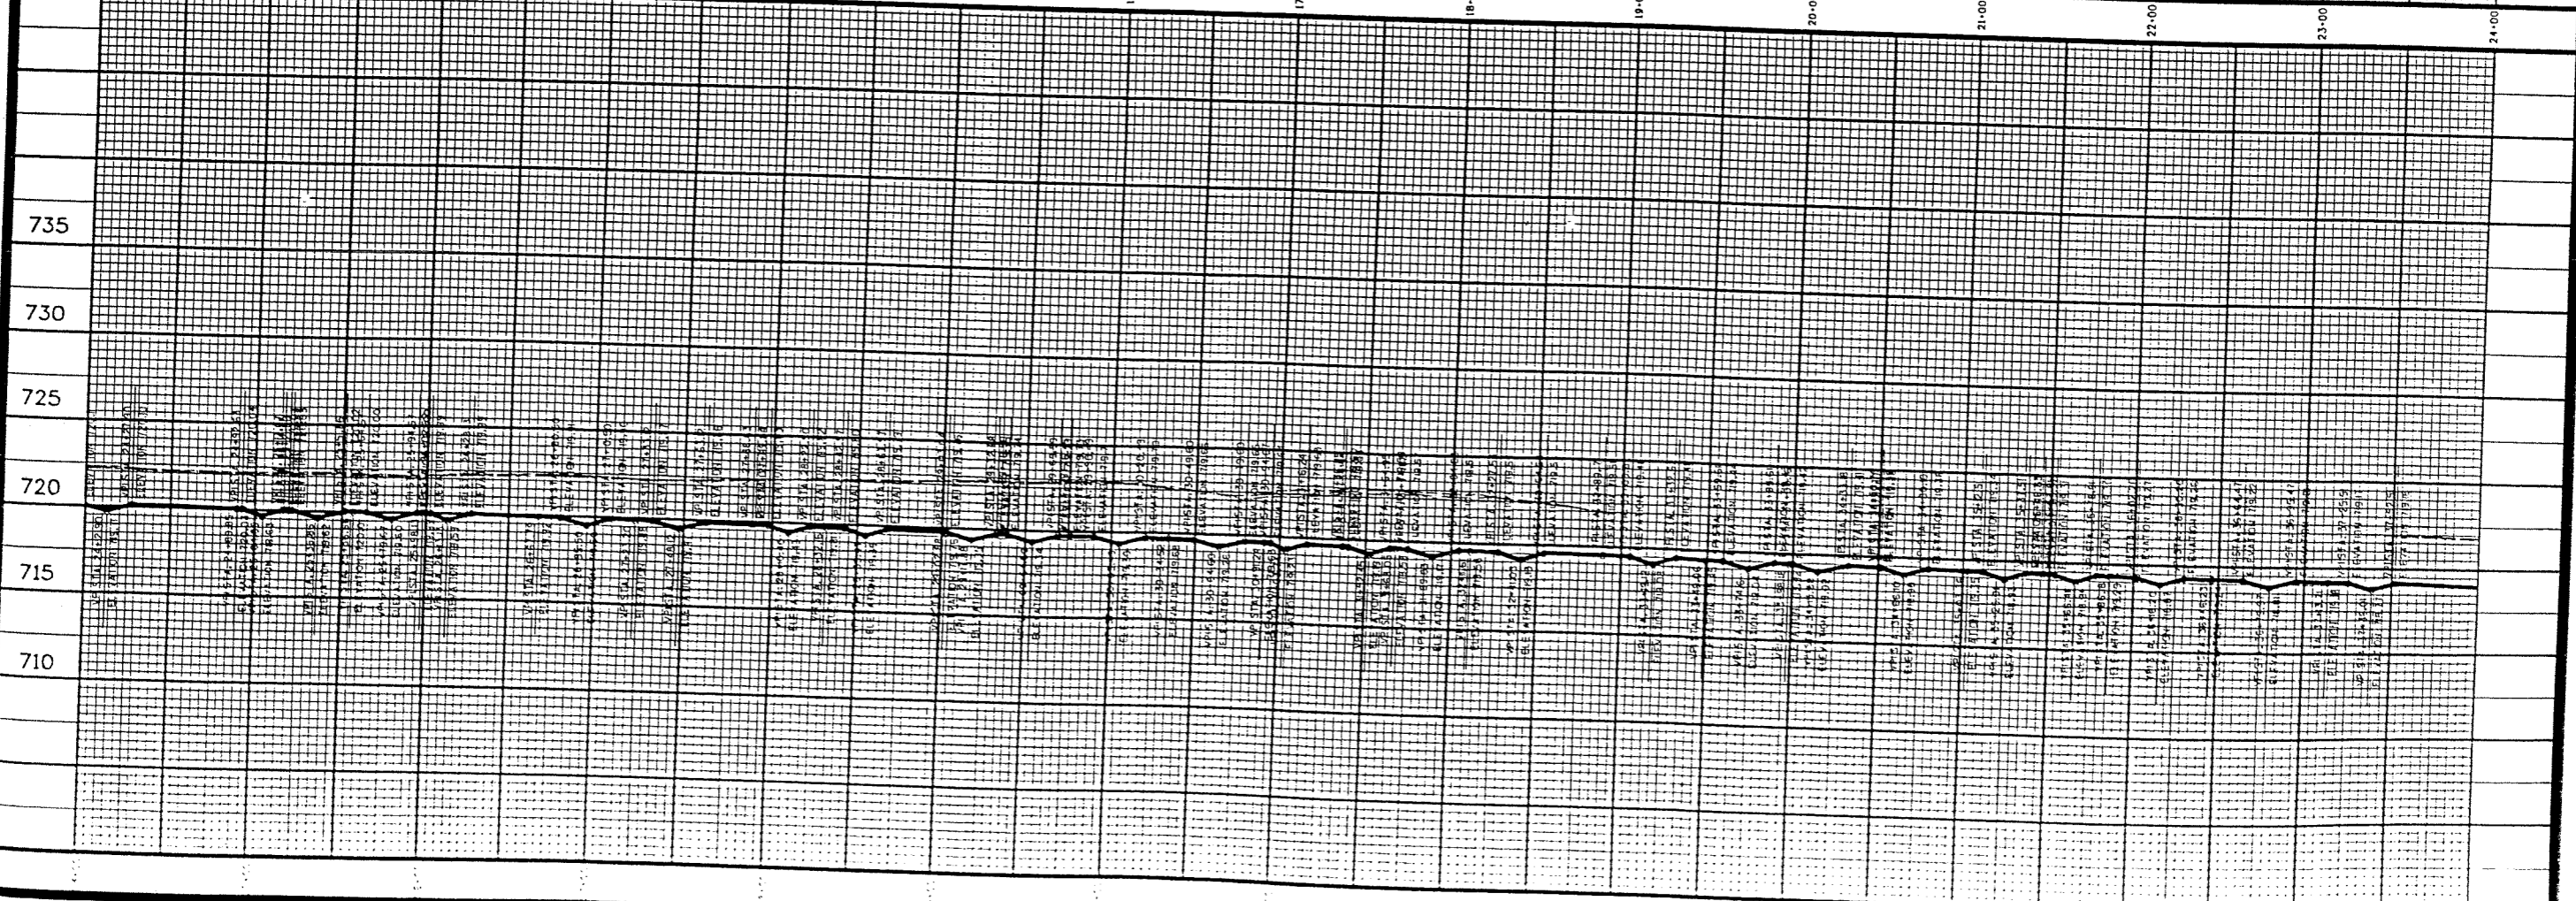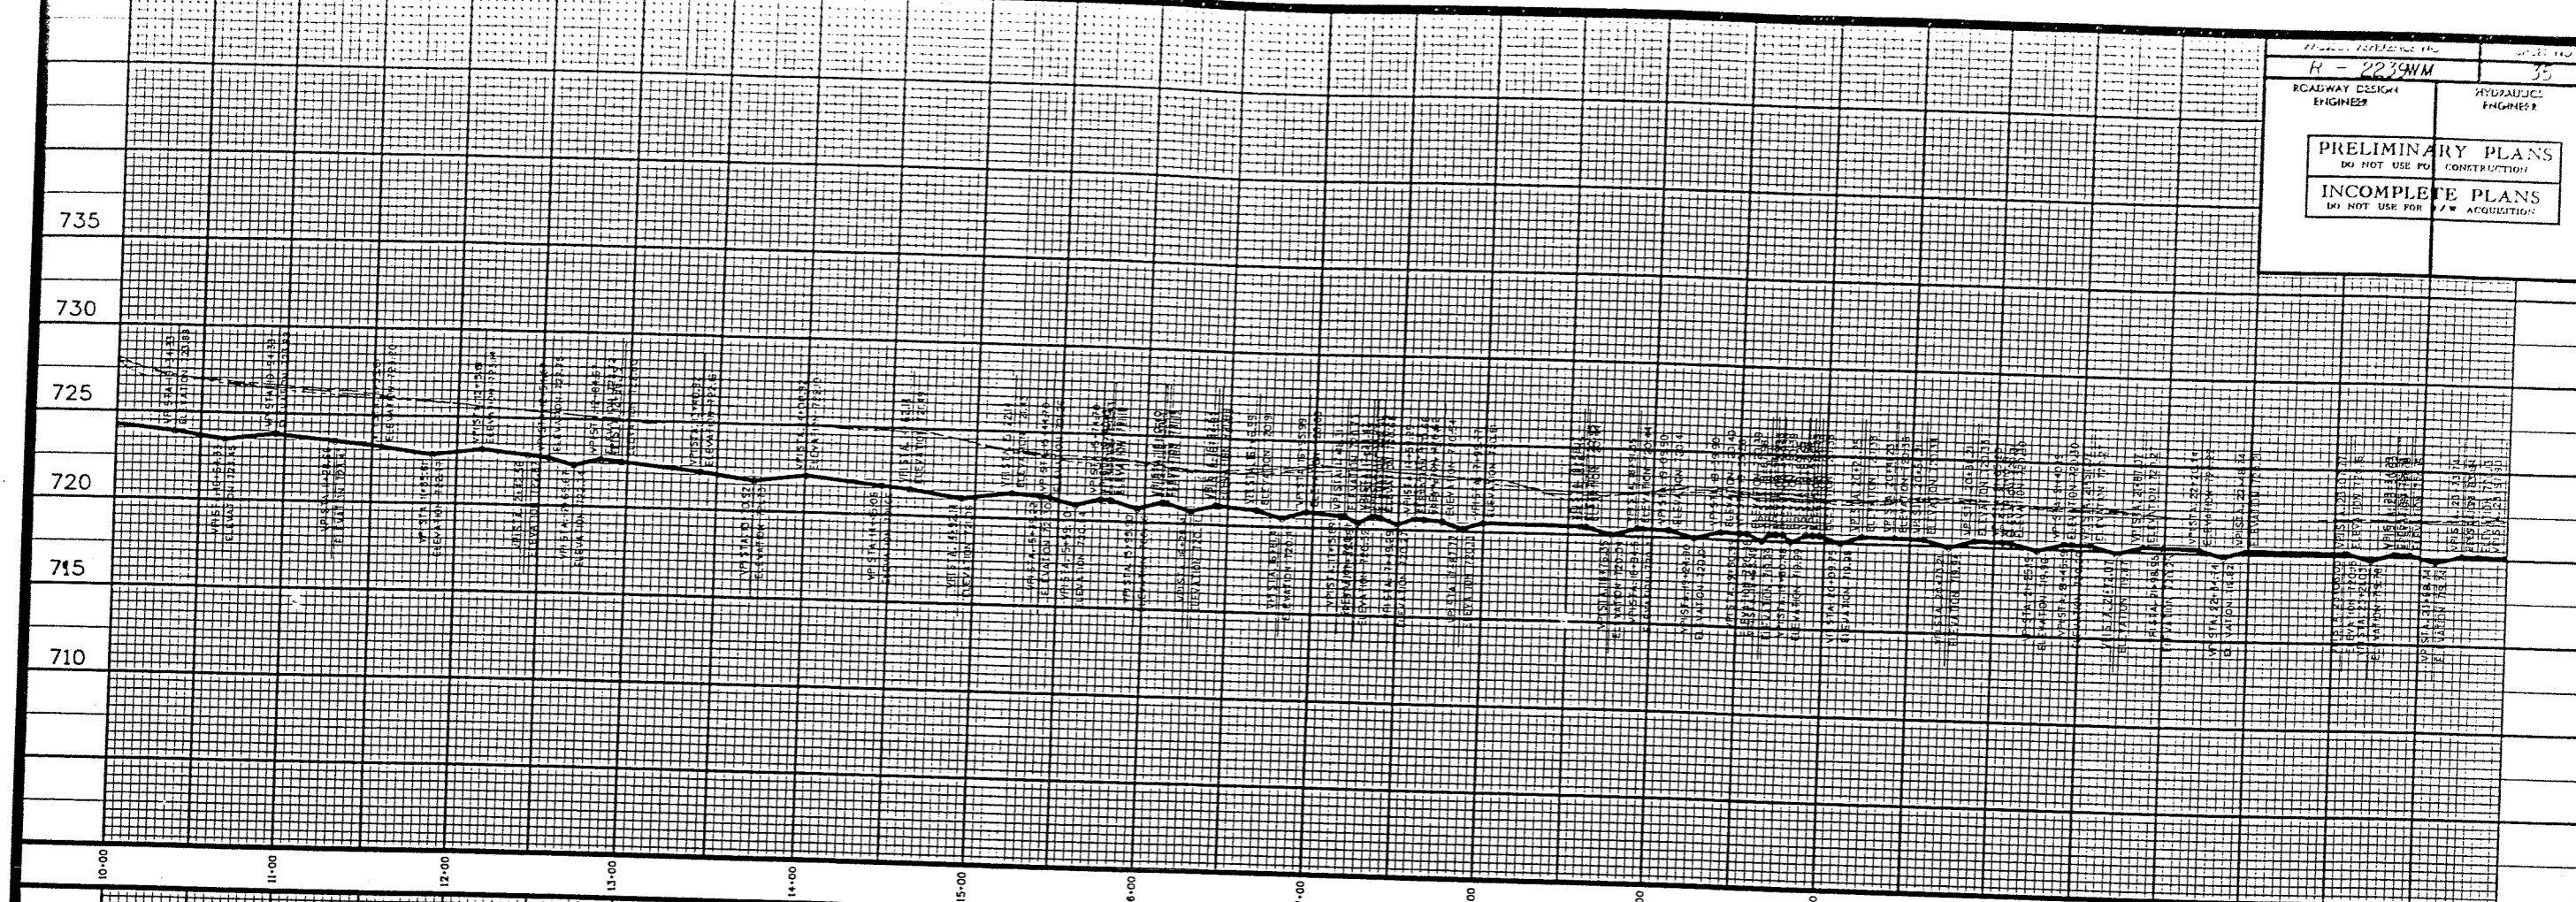

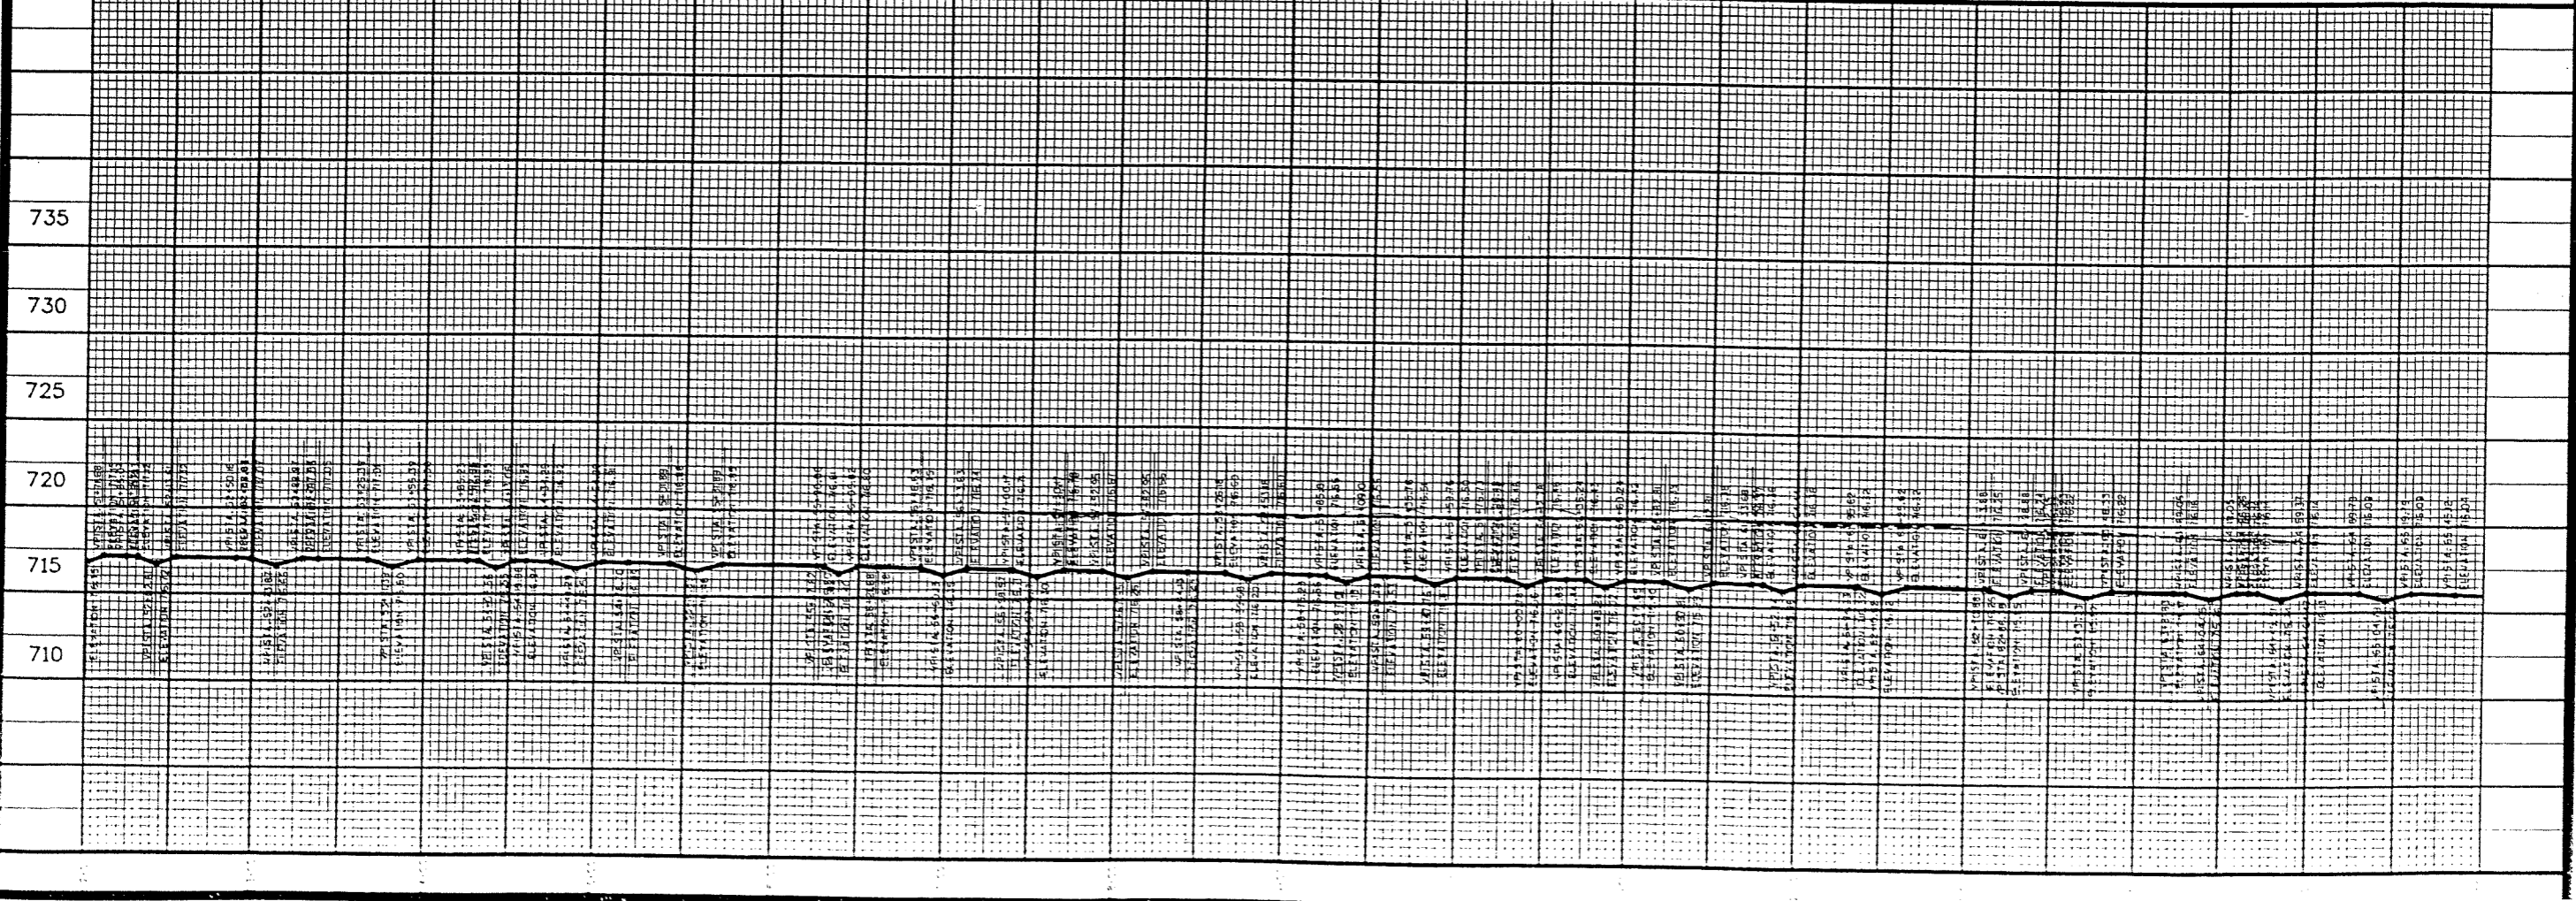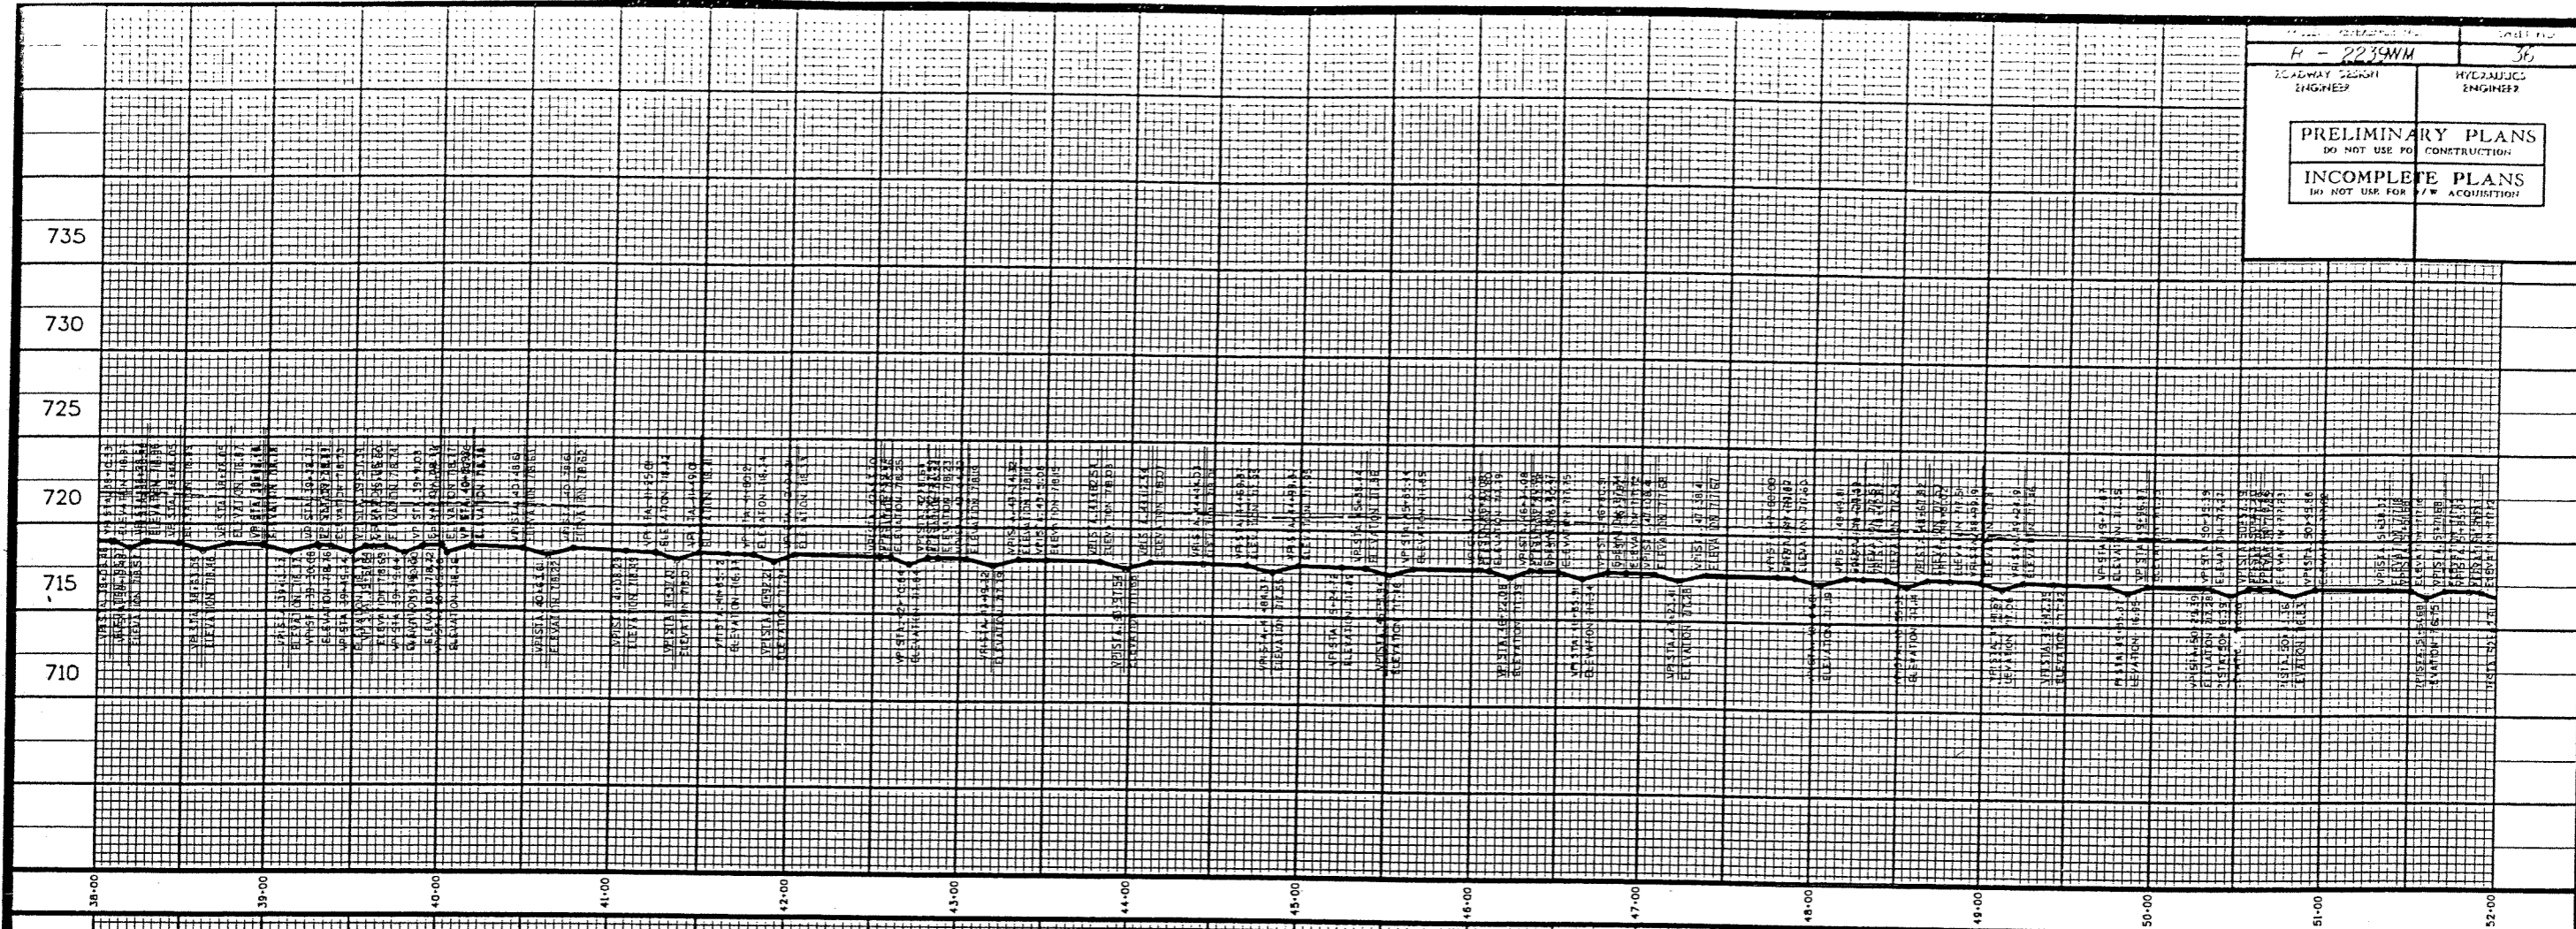

H - 2239NM
 31
 PRELIMINARY PLANS
 DO NOT USE FOR CONSTRUCTION
 INCOMPLETE PLANS
 DO NOT USE FOR ACQUISITION

735

730

725

720

715

710

86-00

87-00

88-00

89-00

90-00

91-00

92-00

93-00

94-00

95-00

96-00

97-00

98-00

99-00

00-00

735

730

725

720

715

710

86-00

87-00

88-00

89-00

90-00

91-00

92-00

93-00

94-00

95-00

96-00



97-00

98-00

99-00

00-00

PRELIMINARY PLANS
DO NOT USE FOR CONSTRUCTION
INCOMPLETE PLANS
DO NOT USE FOR ACQUISITION

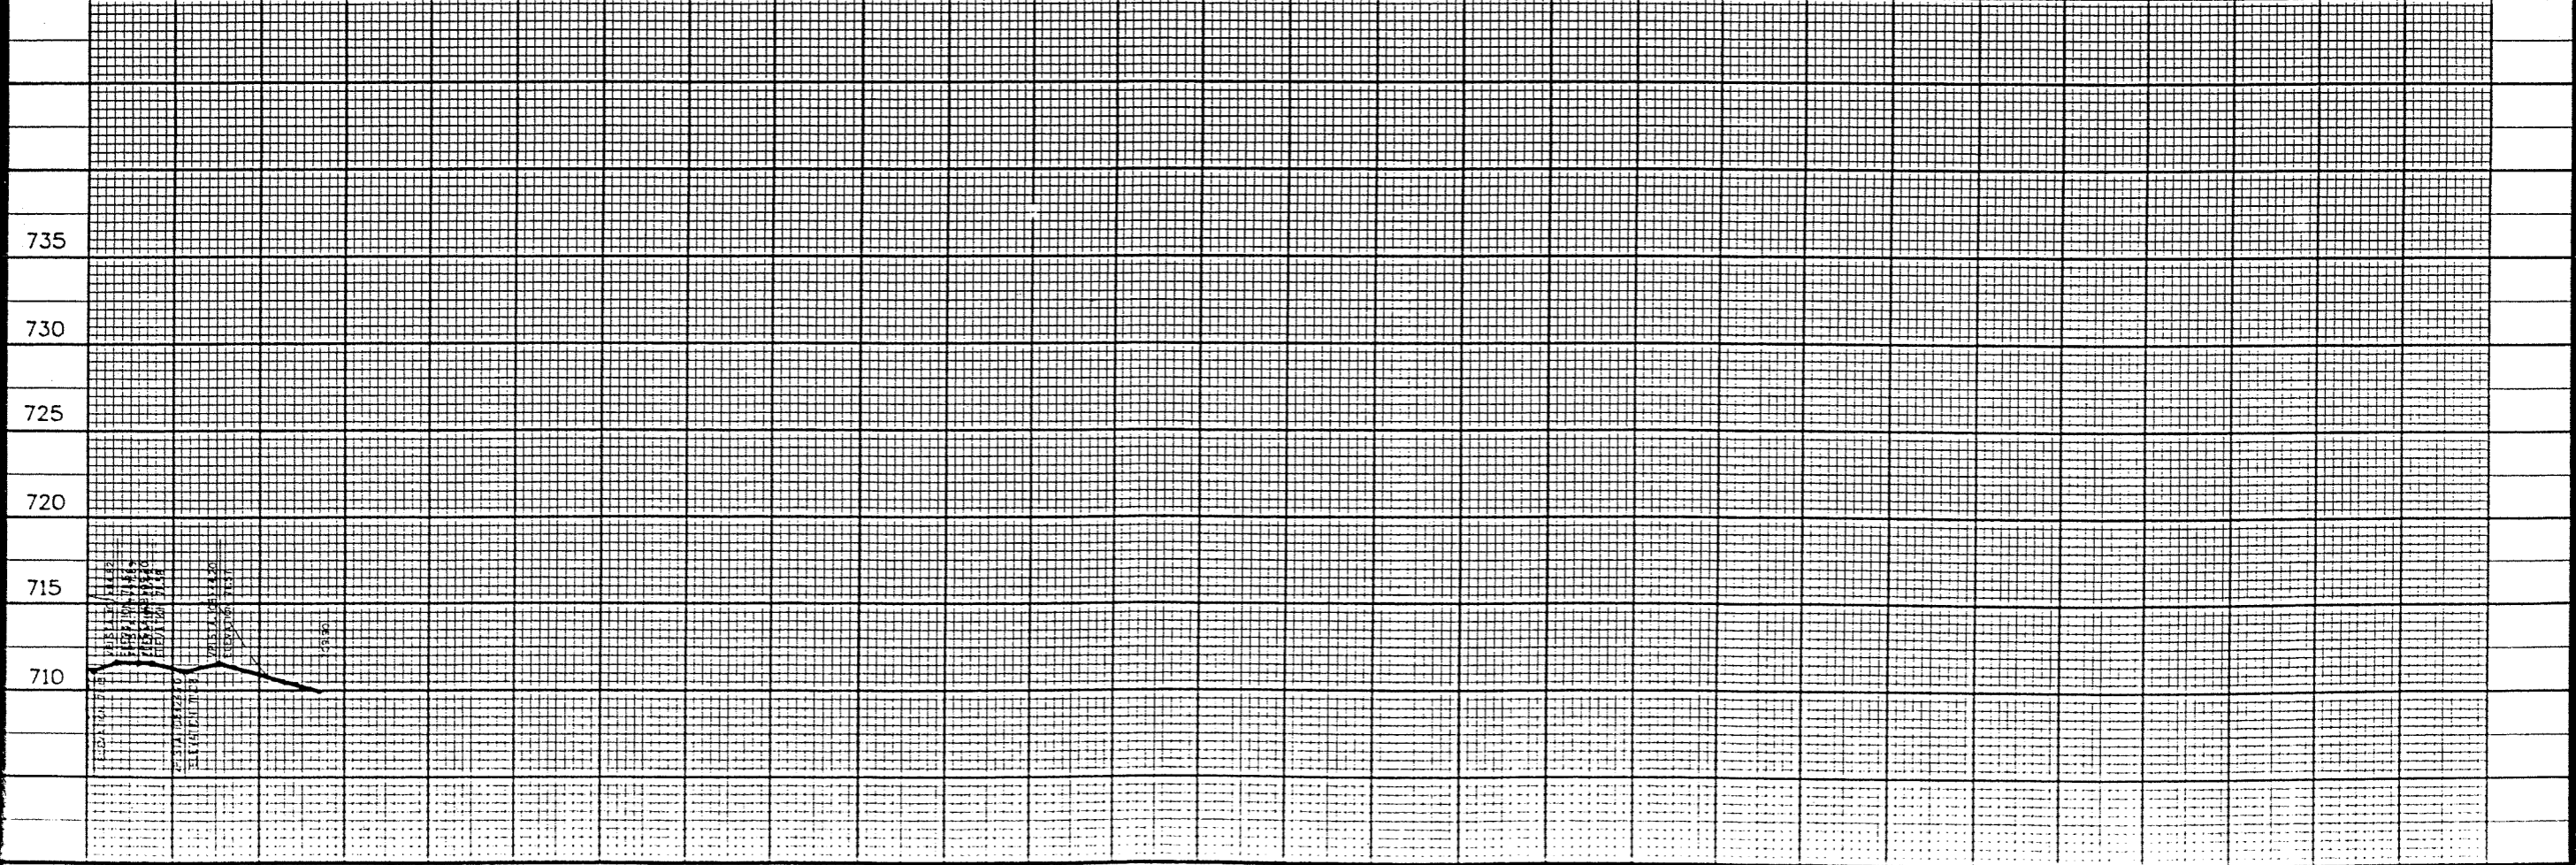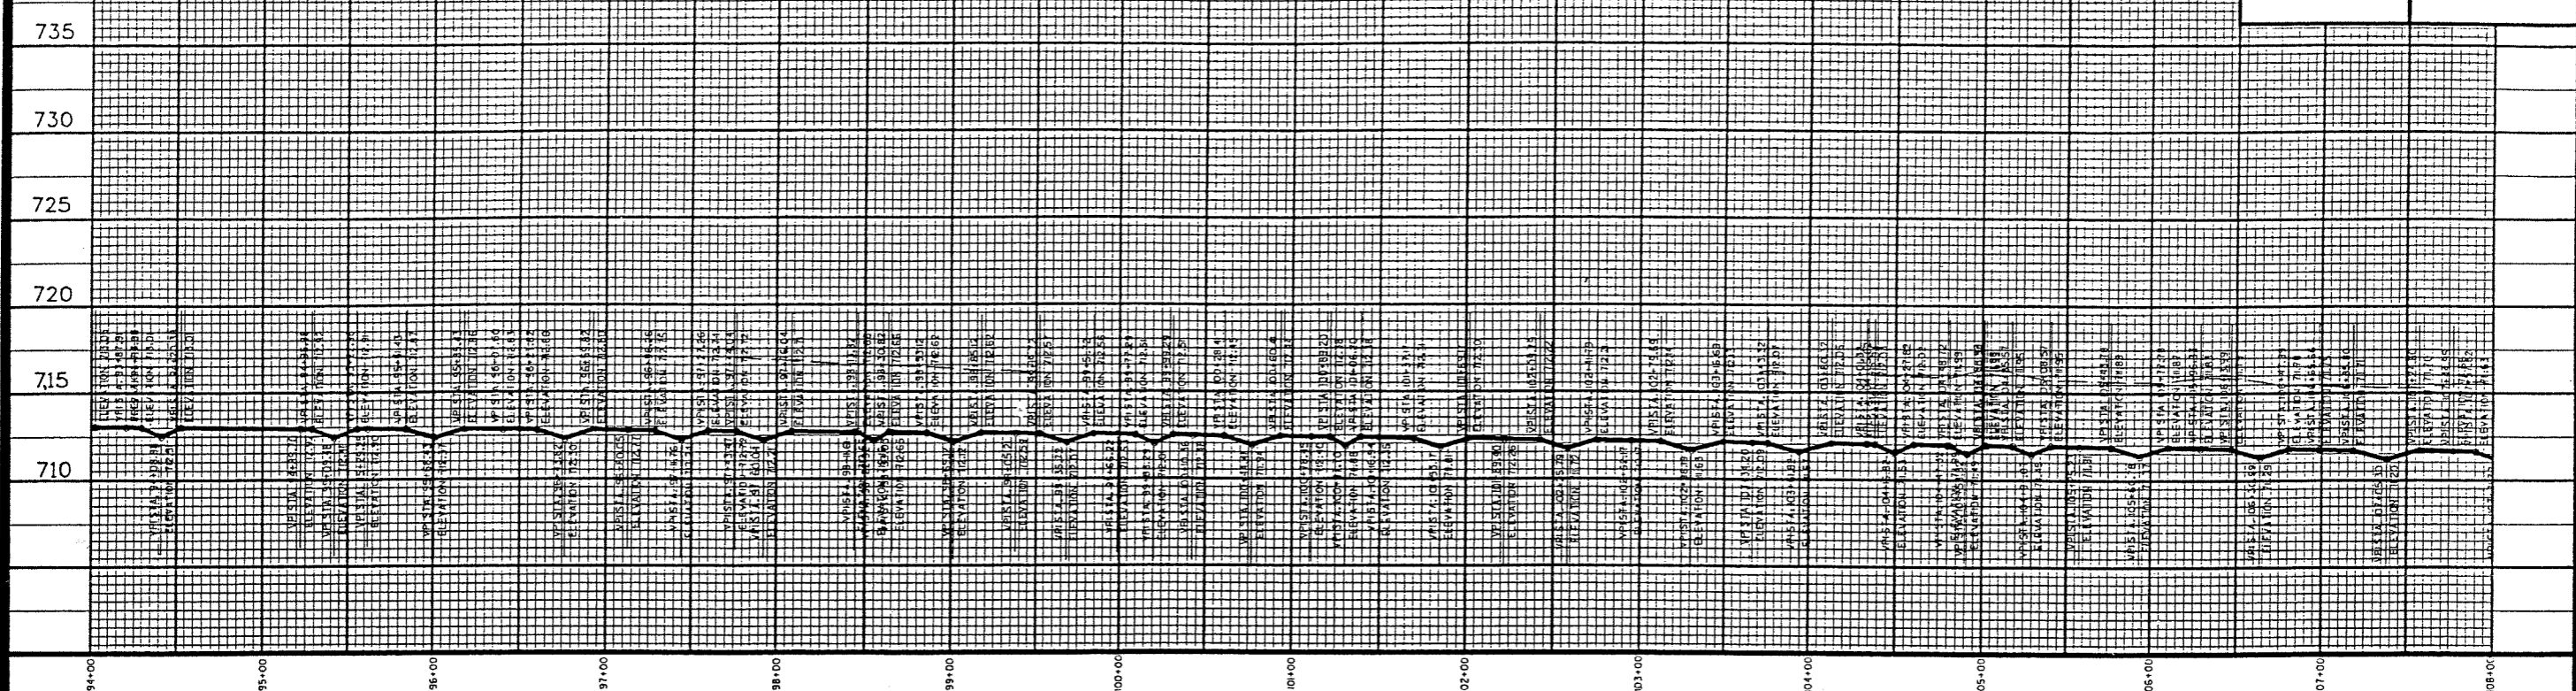

735


730

725

720

715



710

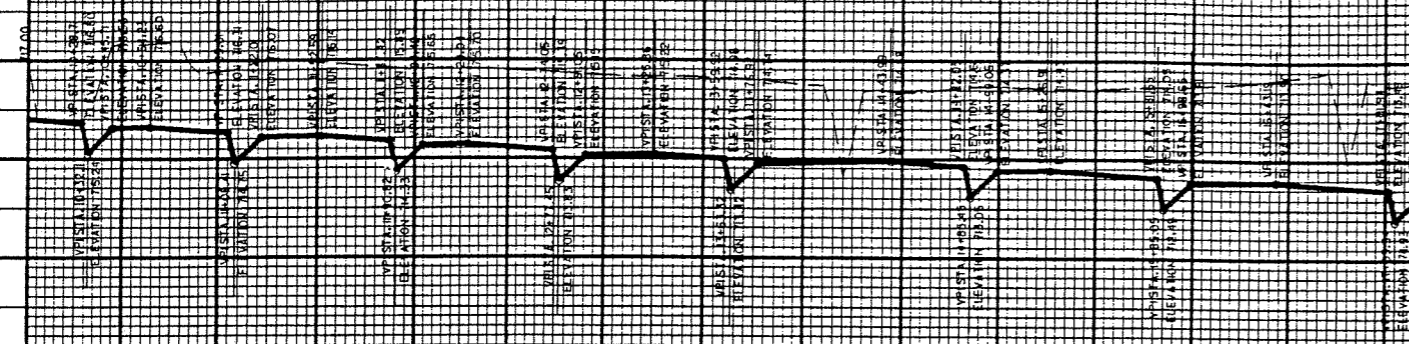


10+00 11+00 12+00 13+00 14+00 15+00 16+00 17+00 18+00 19+00 20+00 21+00 22+00 23+00 24+00

R - 2239MM		40
ENGINEER	SCIENTIST	

- BITE BOUNDARY
- PROPOSED STREAM CHANNEL PLATFORM
- EXISTING CONTOUR LINES
- PROPOSED 5' CONTOUR LINES
- PROPOSED 1' CONTOUR LINES
- Z-Z- FENCE LINE
- ~~~ TREE LINE
- △ SURVEY CONTROL POINT
- EXISTING PROPERTY LINE

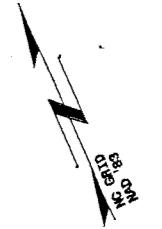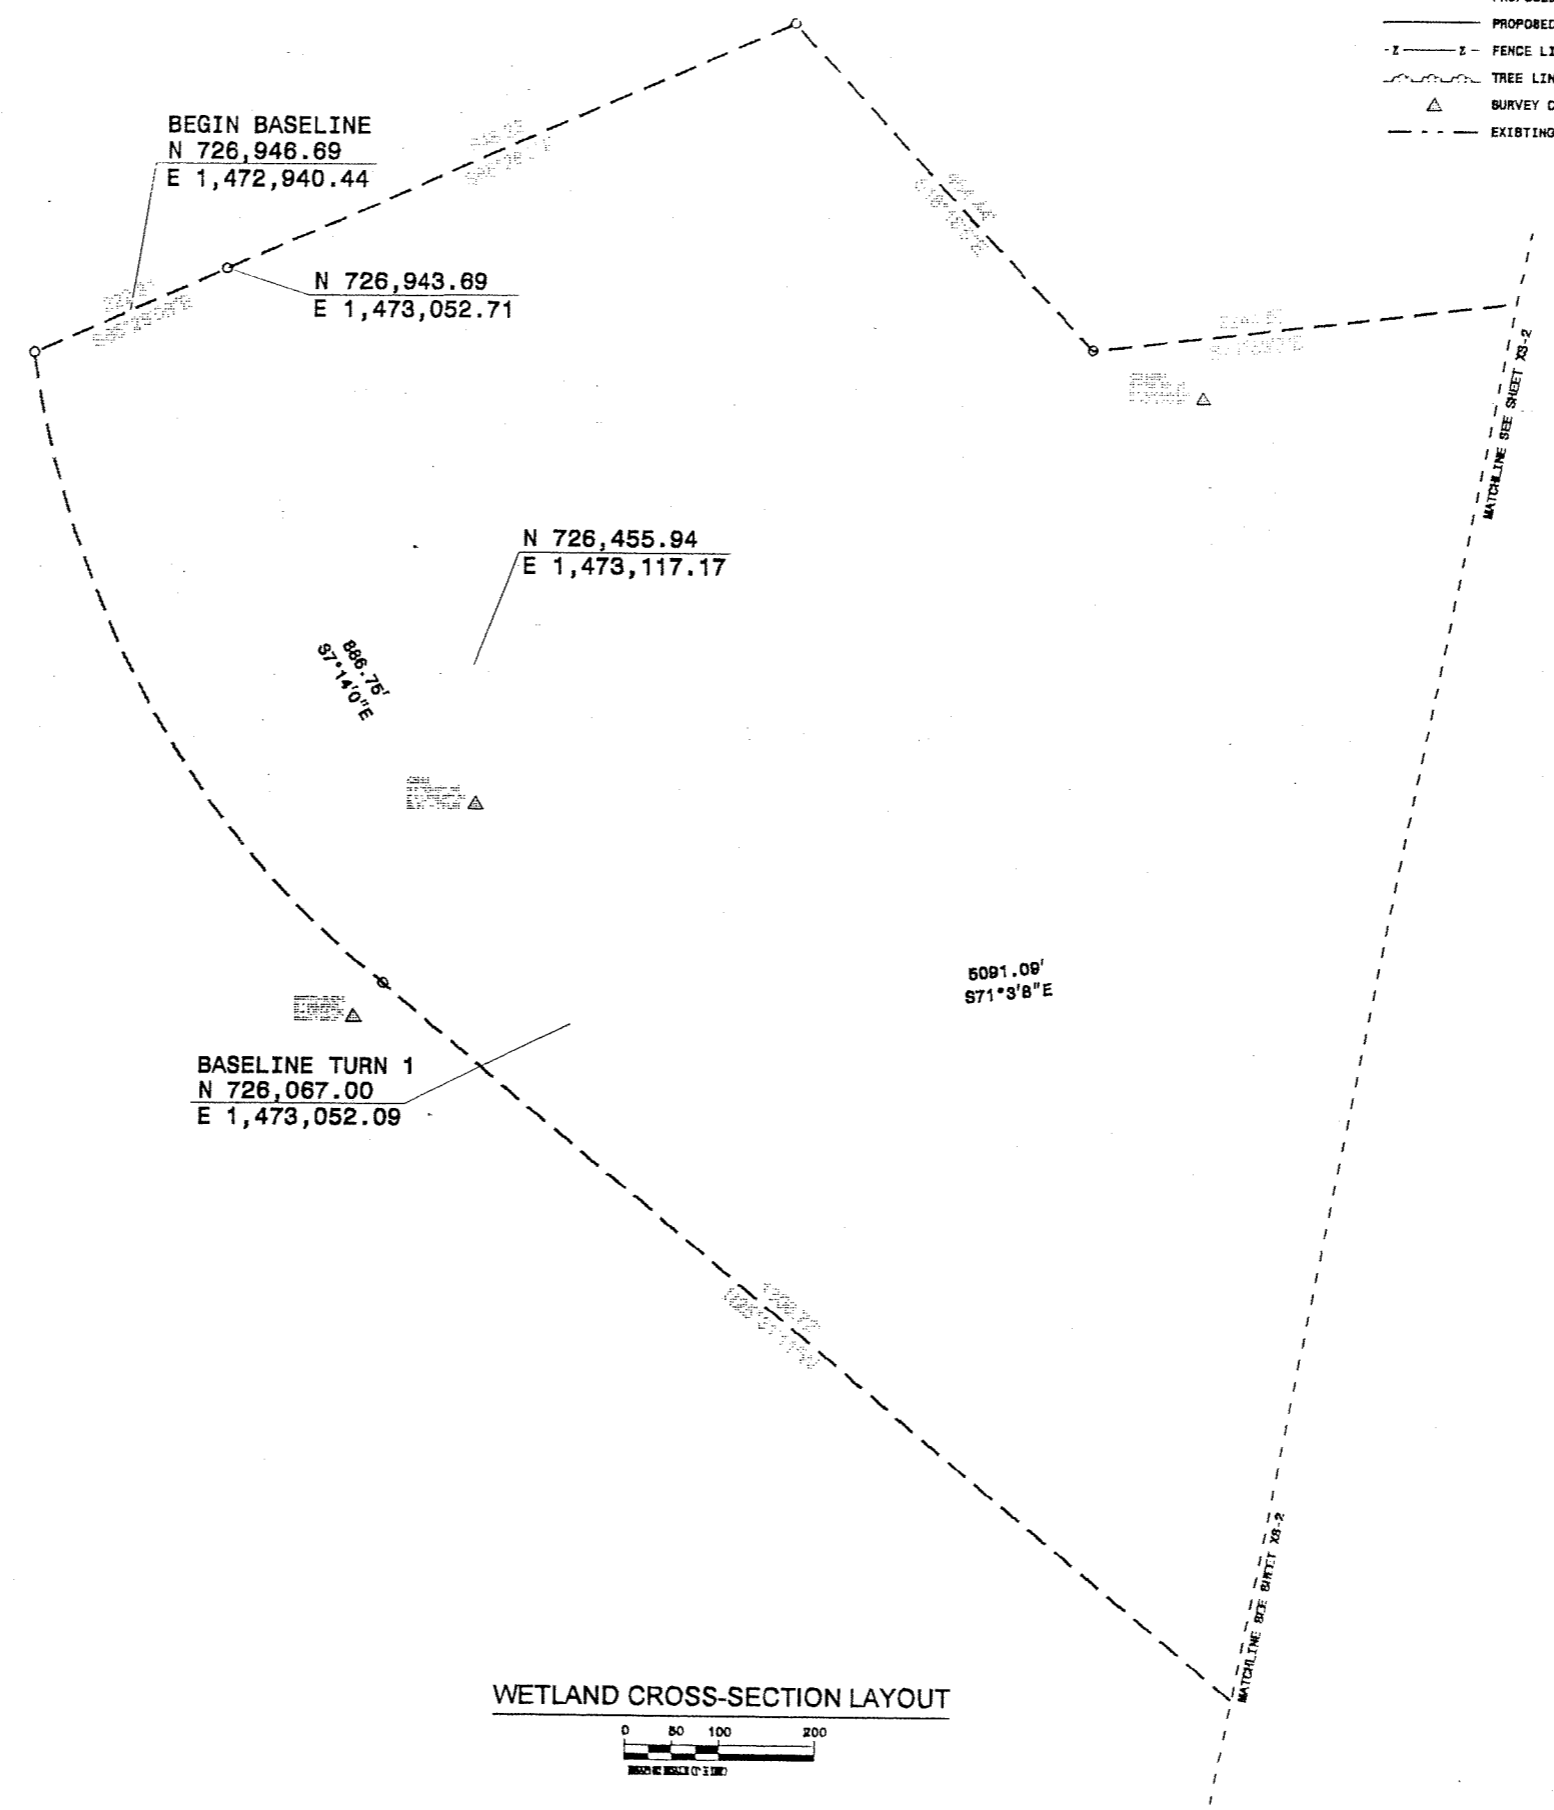

WETLAND CROSS-SECTION LAYOUT

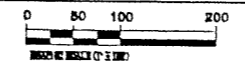


WETLAND CROSS SECTION LAYOUT 01


KCI Associates
of North Carolina, P.A.
SUITE 200, LANDMARK CENTER 1, 4605 IN. FORAS RD.
RALEIGH, NC 27604-5201
ENGINEERS • PLANNERS • ECOLOGISTS

H - 2239NM		41
ENGINEER	SCIENTIST	


- SITE BOUNDARY
- PROPOSED STREAM CHANNEL PLANFORM
- EXISTING CONTOUR LINES
- PROPOSED 5' CONTOUR LINES
- PROPOSED 1' CONTOUR LINES
- - - FENCE LINE
- TREE LINE
- △ SURVEY CONTROL POINT
- EXISTING PROPERTY LINE

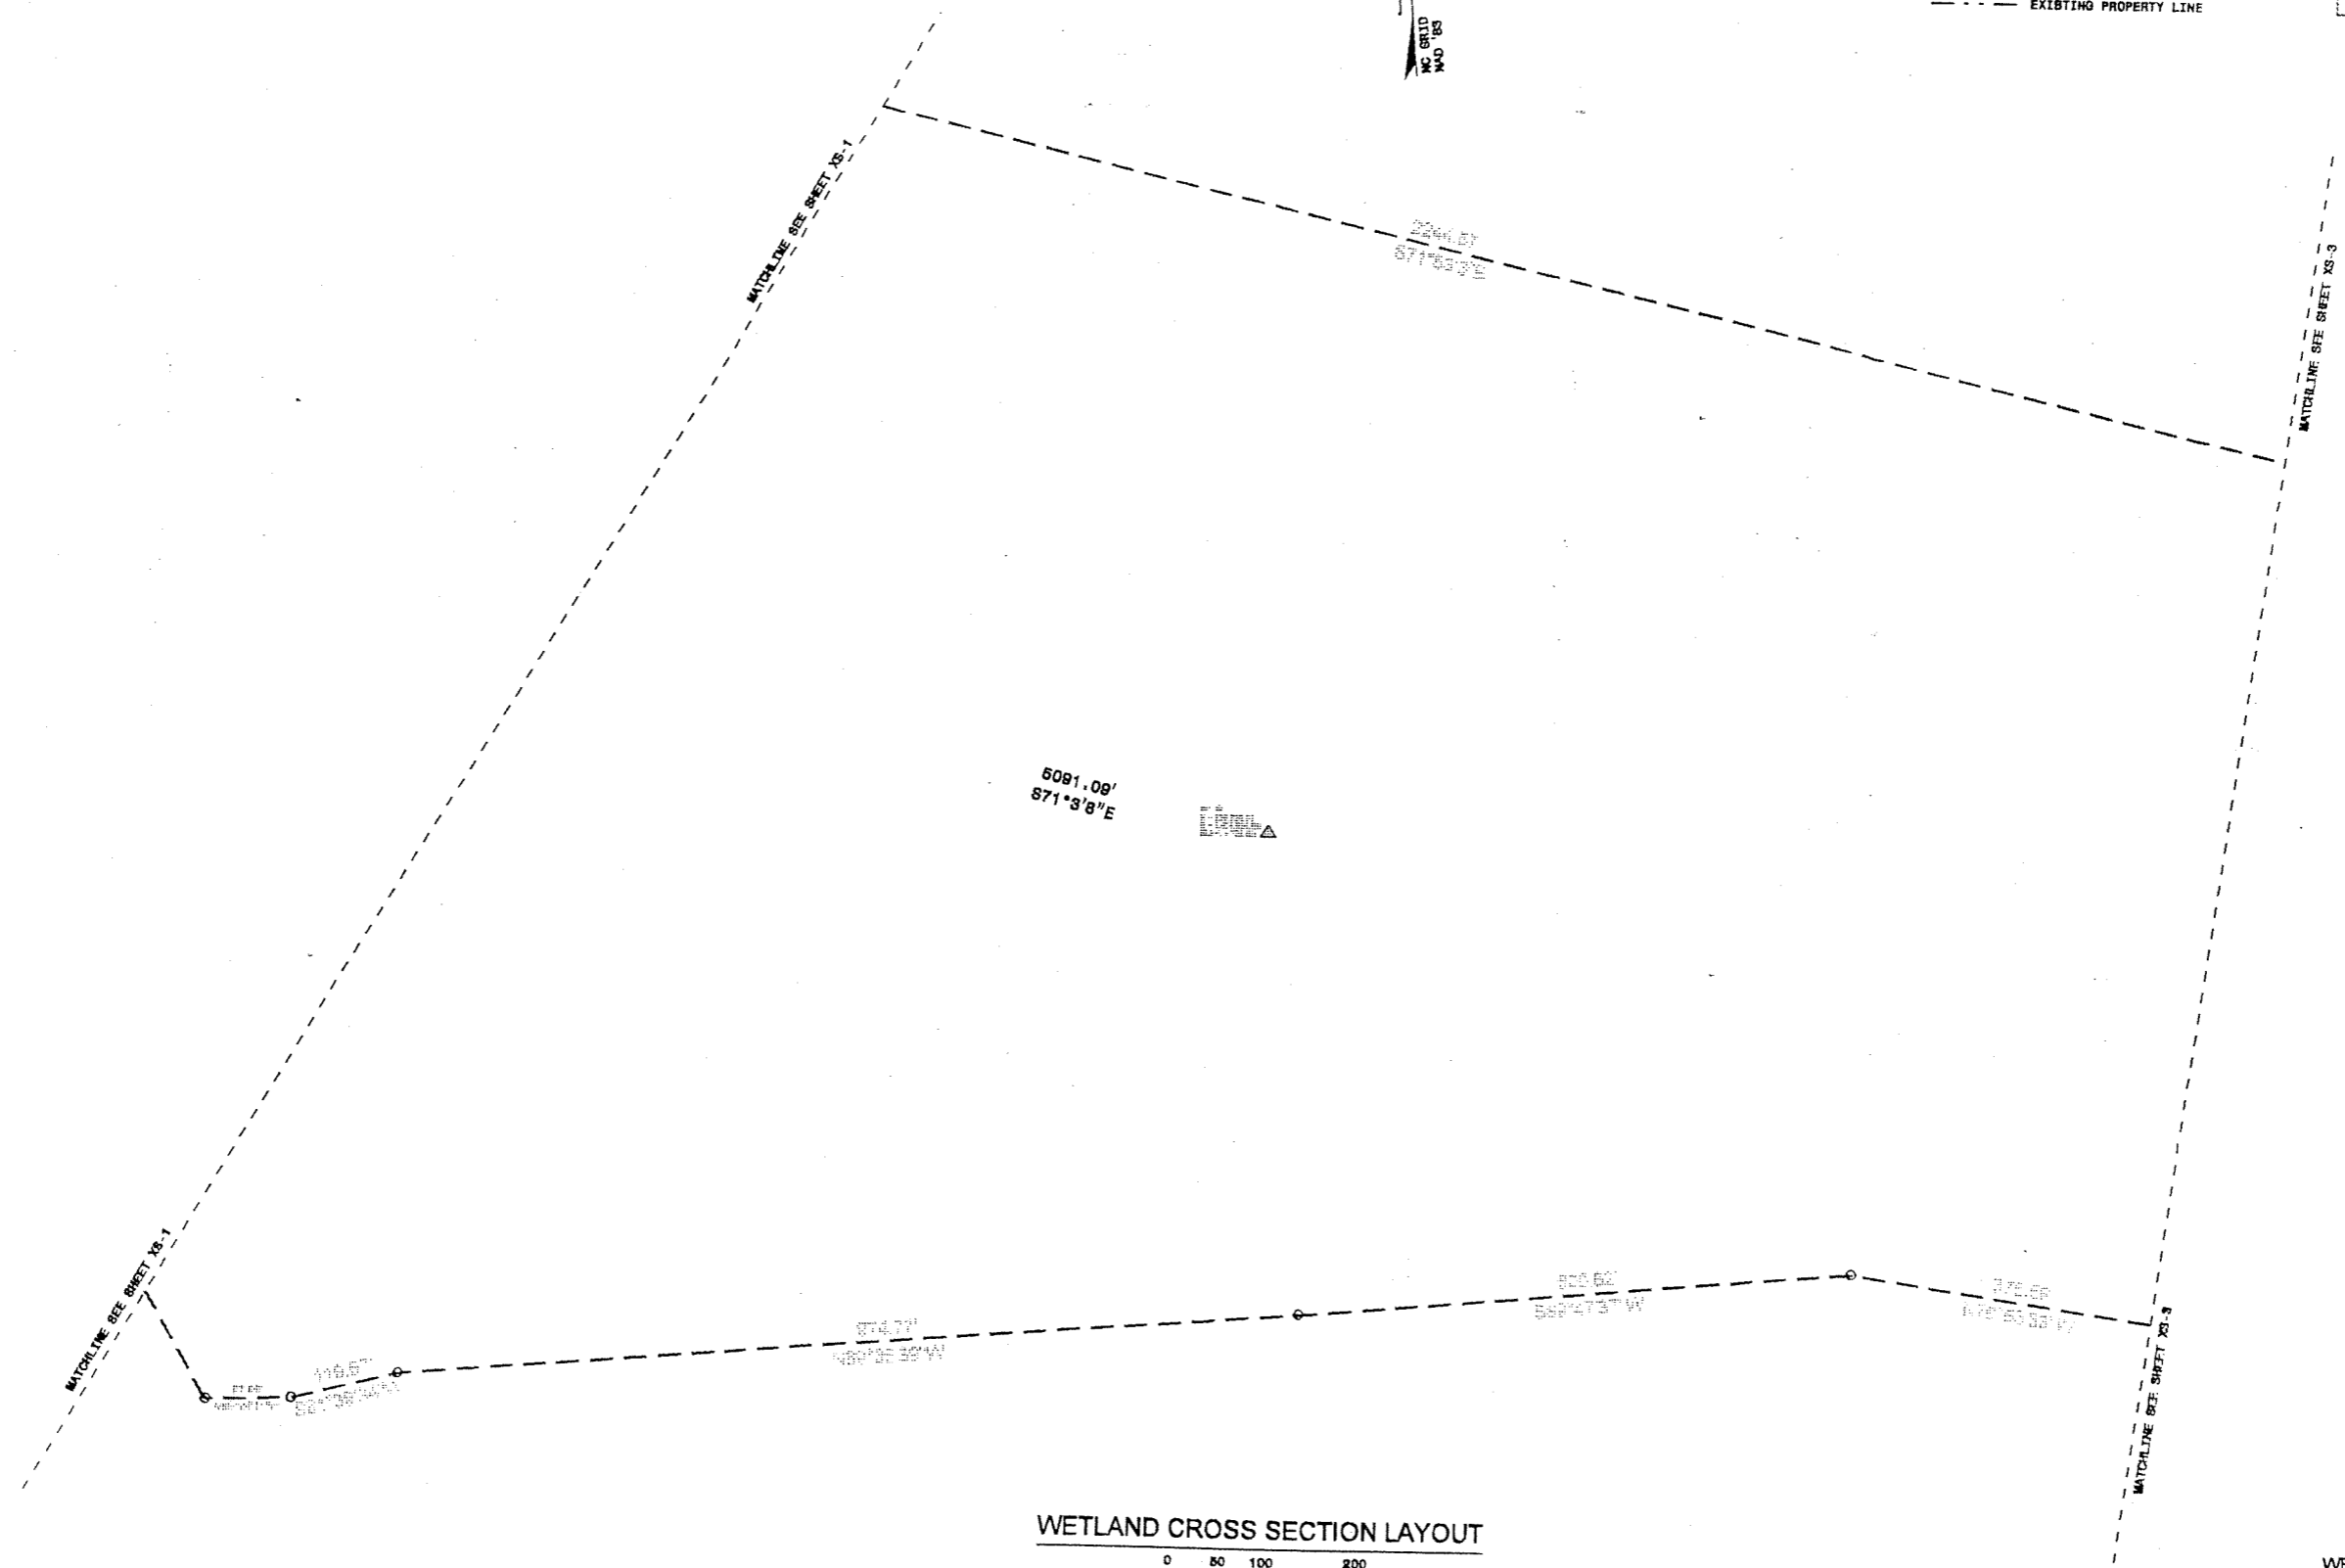

WETLAND CROSS SECTION LAYOUT

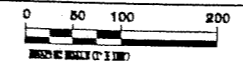



WETLAND CROSS SECTION LAYOUT 02

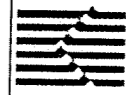


**KCI Associates
of North Carolina, P.A.**
 200 LANDMARK CENTER E, 4605 IN FORKS RD.
 HALF HOLLOW, NC 27609-5230
 ENGINEERS • PLANNERS • ECOLOGISTS

R - 2239WM		42
ENGINEER	SCIENTIST	

- SITE BOUNDARY
- PROPOSED STREAM CHANNEL PLANFORM
- EXISTING CONTOUR LINES
- PROPOSED 5' CONTOUR LINES
- PROPOSED 1' CONTOUR LINES
- x-x- FENCE LINE
- o-o- TREE LINE
- ▲ SURVEY CONTROL POINT
- - - EXISTING PROPERTY LINE

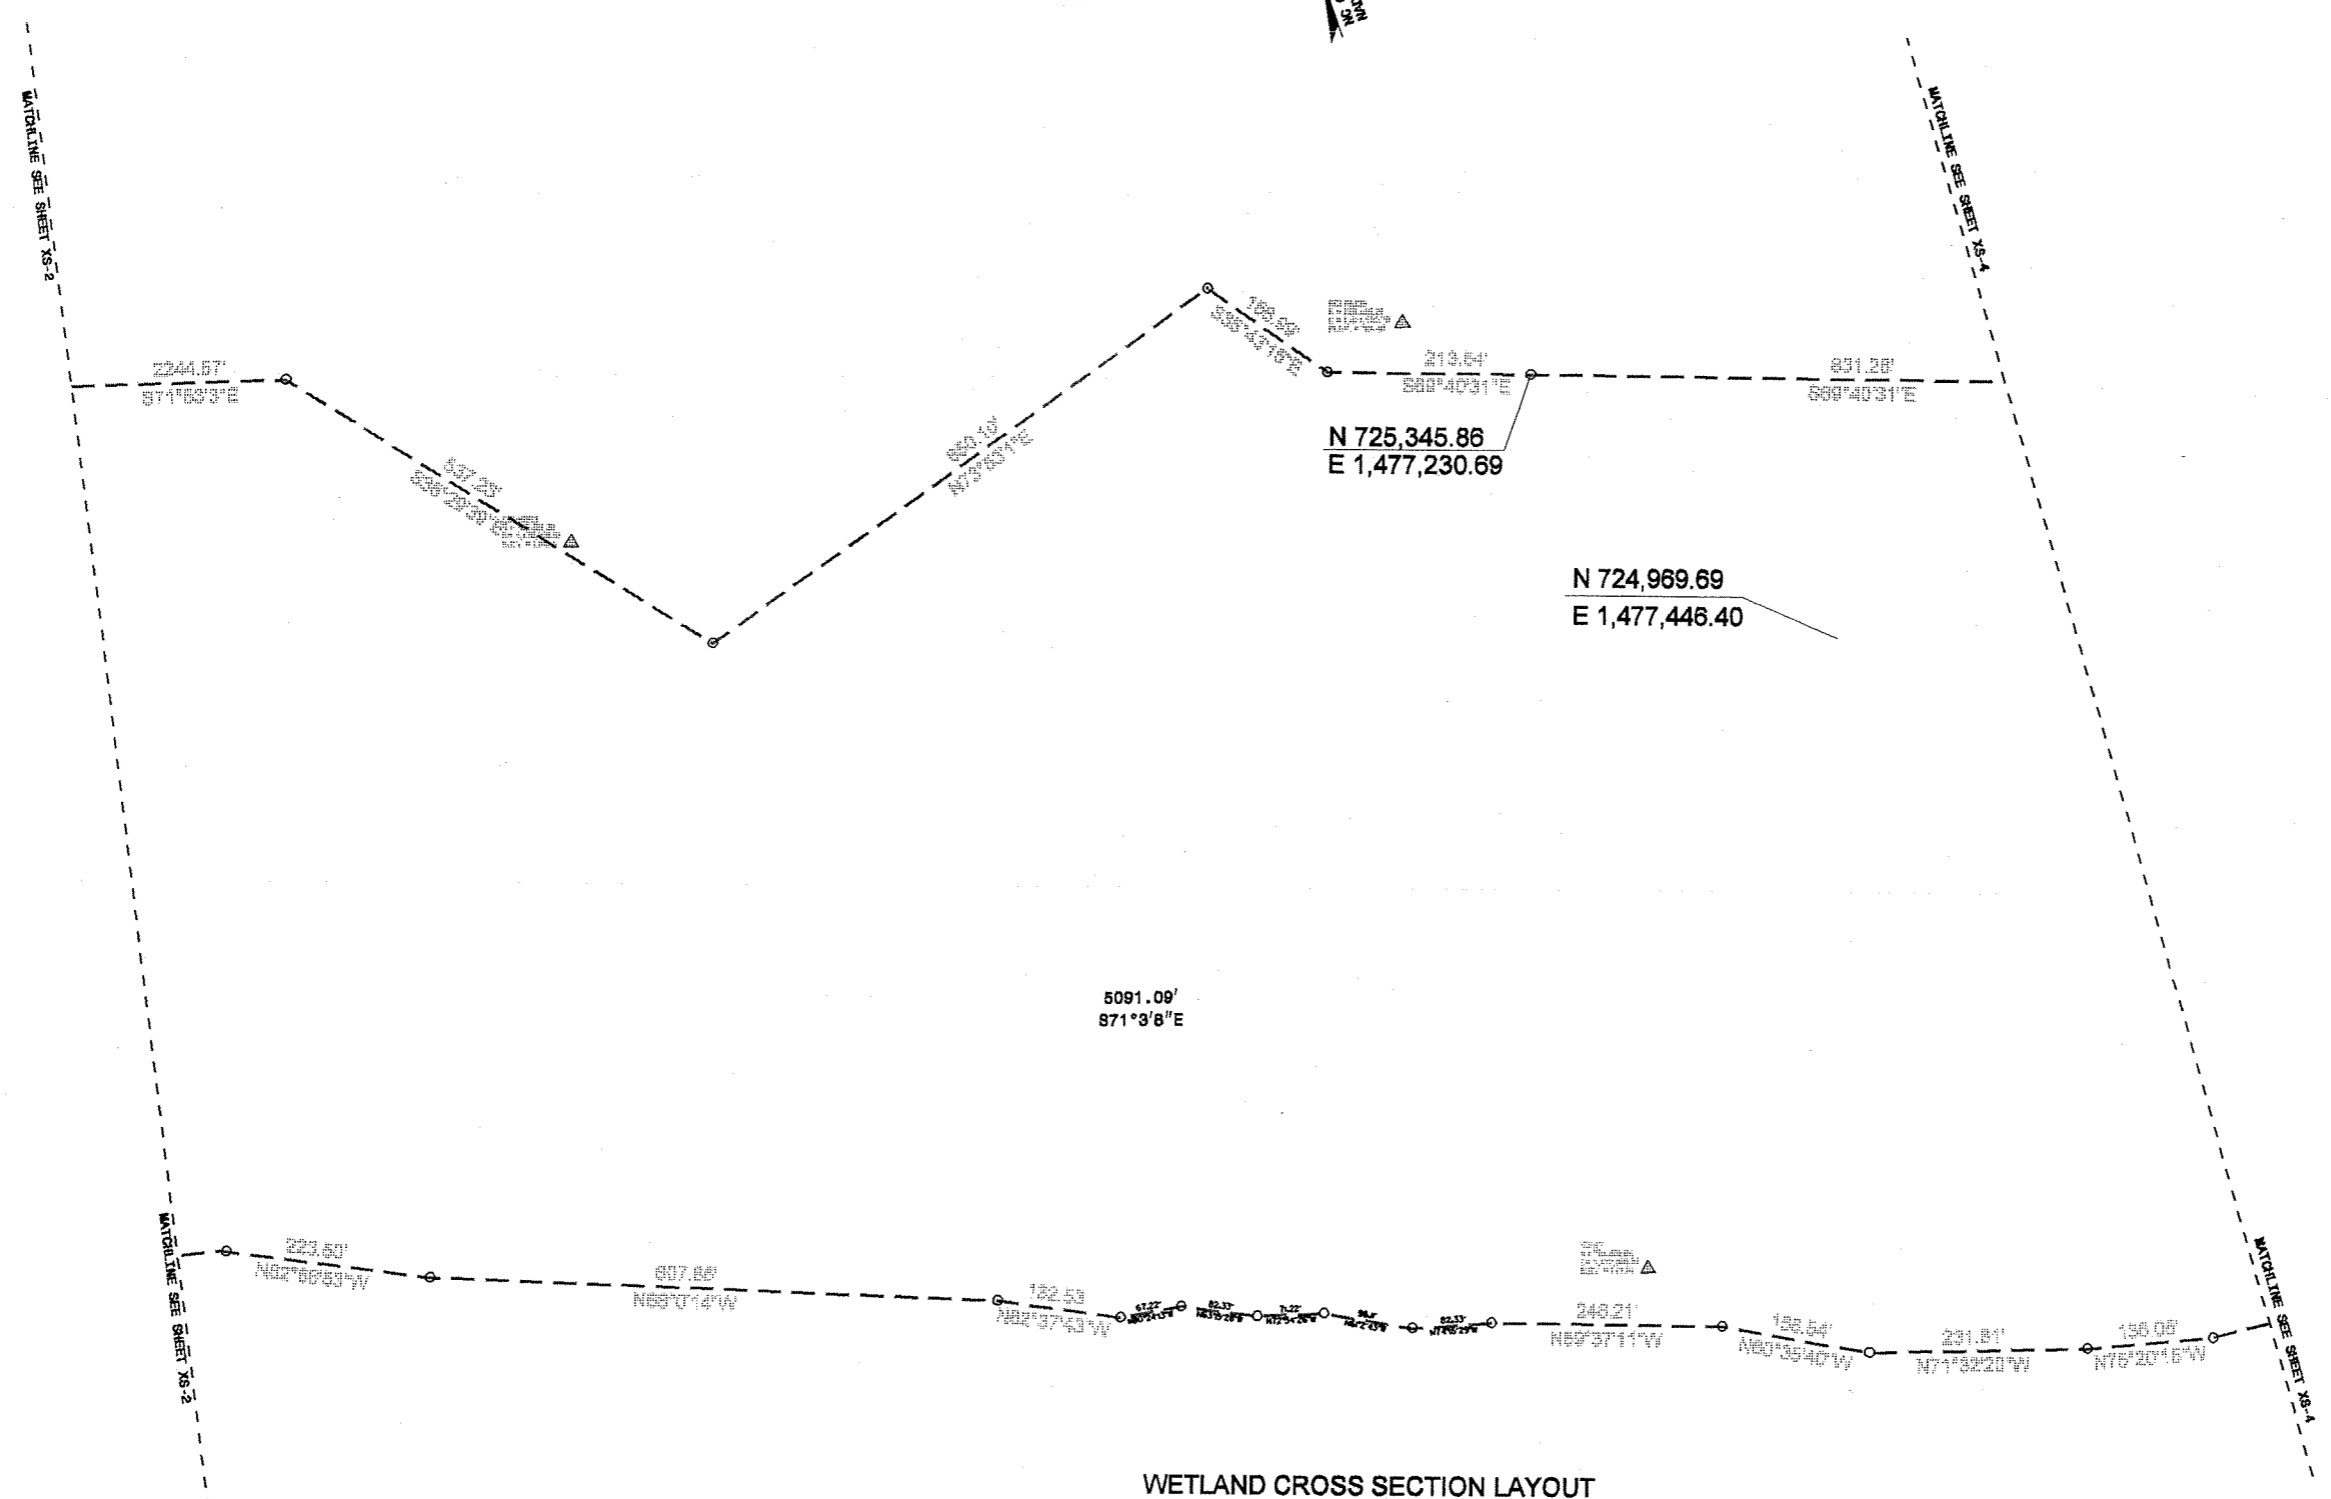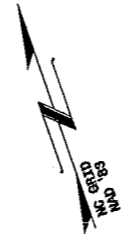

WETLAND CROSS SECTION LAYOUT

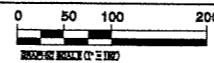


WETLAND CROSS SECTION LAYOUT 03


KCI Associates
of North Carolina, P.A.
SUITE 200, LANDMARK CENTER I, 4601 SIX FORKS RD.
RALEIGH, NC 27609-5210
• ENGINEERS • PLANNERS • ECOLOGISTS

R - 2239NM		43
ENGINEER	SCIENTIST	

- SITE BOUNDARY
- PROPOSED STREAM CHANNEL PLANFORM
- EXISTING CONTOUR LINES
- PROPOSED 5' CONTOUR LINES
- PROPOSED 1' CONTOUR LINES
- X-X- FENCE LINE
- ~~~ TREE LINE
- ▲ SURVEY CONTROL POINT
- - - EXISTING PROPERTY LINE

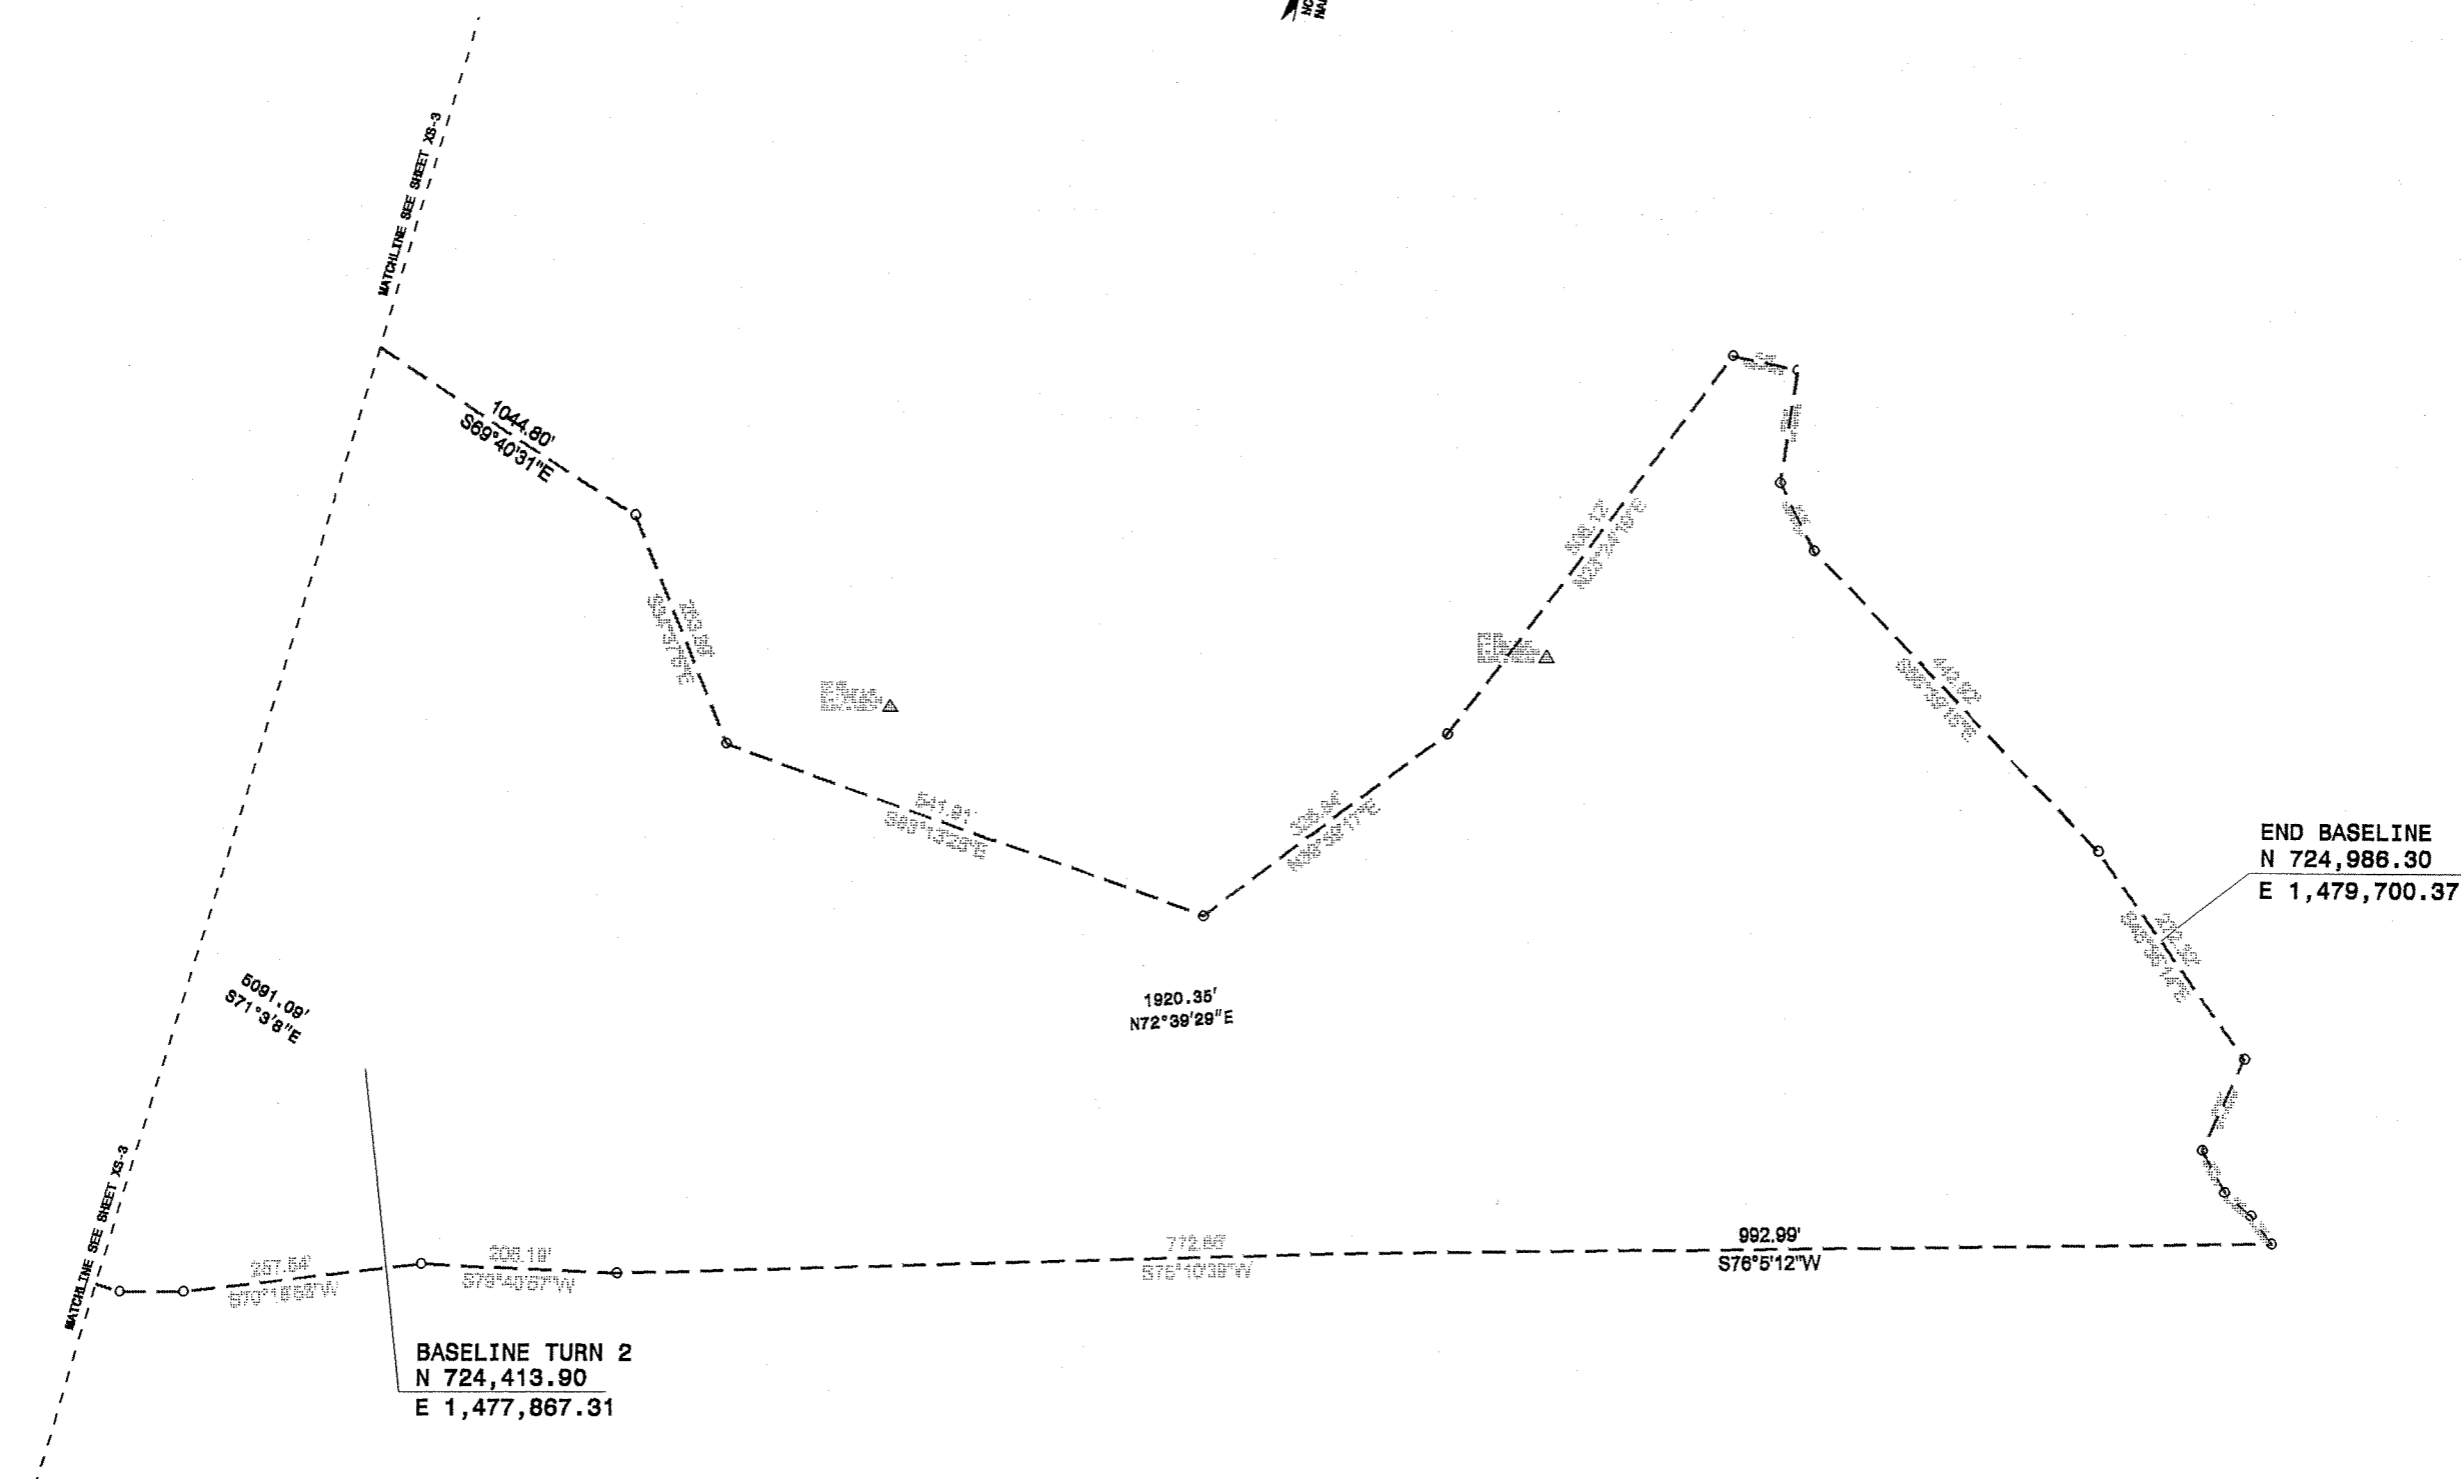

WETLAND CROSS SECTION LAYOUT

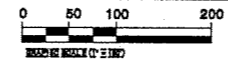

WETLAND CROSS SECTION LAYOUT 04


KCI Associates
of North Carolina, P.A.
SUITE 200, LANDMARK CENTER I, 4601 SIX FORKS RD.
RALEIGH, NC 27609-5210
• ENGINEERS • PLANNERS • ECOLOGISTS

PROJECT: 6.769001T R-223911M

STATE OF NORTH CAROLINA
 DIVISION OF HIGHWAYS
 PLAN FOR PROPOSED
 HIGHWAY EROSION CONTROL

IREDELL COUNTY


LOCATION: SHEPHERD'S TREE MITIGATION SITE LOCATED BETWEEN
 TRIPLETT ROAD (SR 2362) AND KNOX FARM ROAD (SR 2363)
 ADJACENT TO THIRD CREEK, SOUTHEAST OF STATESVILLE
 TYPE OF WORK: GRADING, CLEARING AND GRUBBING, MOWING, RIPPING,

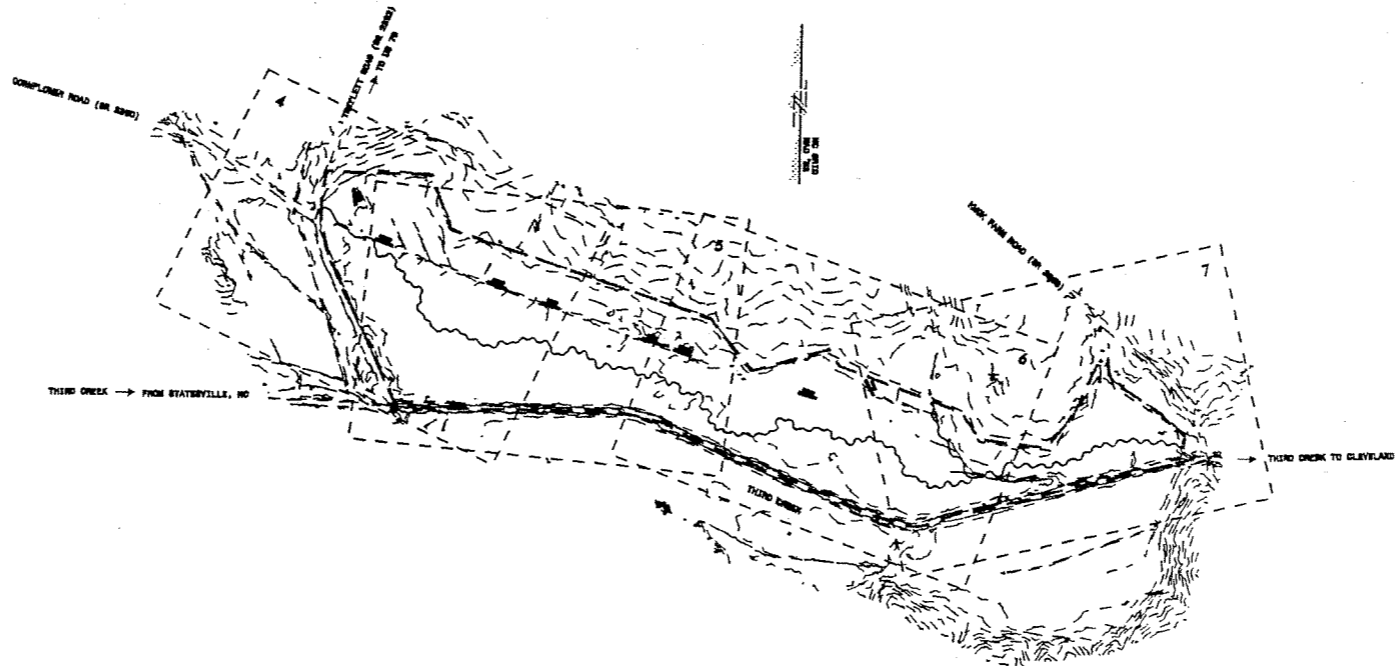

STATE	STATE PROJECT REFERENCE NO.	SHEET NO.	TOTAL SHEETS
N.C.		EC-1	
STATE PROJ. NO.	F.A. PROJ. NO.	DESCRIPTION	

EROSION AND SEDIMENT CONTROL MEASURES

Sed. #	Description	Symbol
	Reforestation	
1630.03	Temporary Silt Ditch	
1630.05	Temporary Diversion	
1605.01	Temporary Silt Fence	
1606.01	Special Sediment Control Fence	
1622.01	Temporary Berms and Slope Drains	
1630.01	Rise Basin	
1630.02	Silt Basin Type B	
1633.01	Temporary Rock Silt Check Type-A	
1633.02	Temporary Rock Silt Check Type-B	
1634.01	Temporary Rock Sediment Dam Type-A	
1634.02	Temporary Rock Sediment Dam Type-B	
1635.01	Rock Pipe Inlet Sediment Trap Type-A	
1635.02	Rock Pipe Inlet Sediment Trap Type-B	
1636.01	Rock Silt Screen	
1630.04	Stilling Basin	
	Rock Inlet Sediment Trap:	
1632.01	Type A	
1632.02	Type B	
1632.03	Type C	

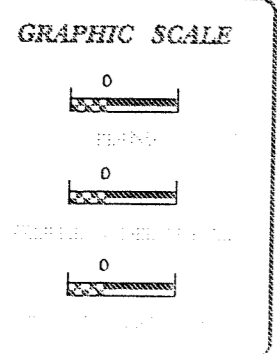

ROADSIDE ENVIRONMENTAL UNIT
 DIVISION OF HIGHWAYS
 STATE OF NORTH CAROLINA

Prepared in the Office of:
ROADSIDE ENVIRONMENTAL UNIT
 1 South Wilmington St.
 Raleigh, NC 27617


2002 STANDARD SPECIFICATIONS

Roadway Standard Drawings
 The following roadway English standards as appear in "Roadway Standard Drawings"- Roadway Design Unit - N. C. Department of Transportation - Raleigh, N. C., dated January 20, 2002 and the latest revision thereto are applicable to this project and by reference hereby are considered a part of these plans.

1608.01 Temporary Silt Fence 1636.01 Rock Silt Screen
 1633.01 Temporary Rock Silt Check Type A

PROJ. REFERENCE NO. R-2239WM	SHEET NO. BC-2	TOTAL SHEETS
STATE PROJECT NO.	F.A. PROJ. NO.	DESCRIPTION


TEMPORARY GRAVEL CONSTRUCTION ENTRANCE

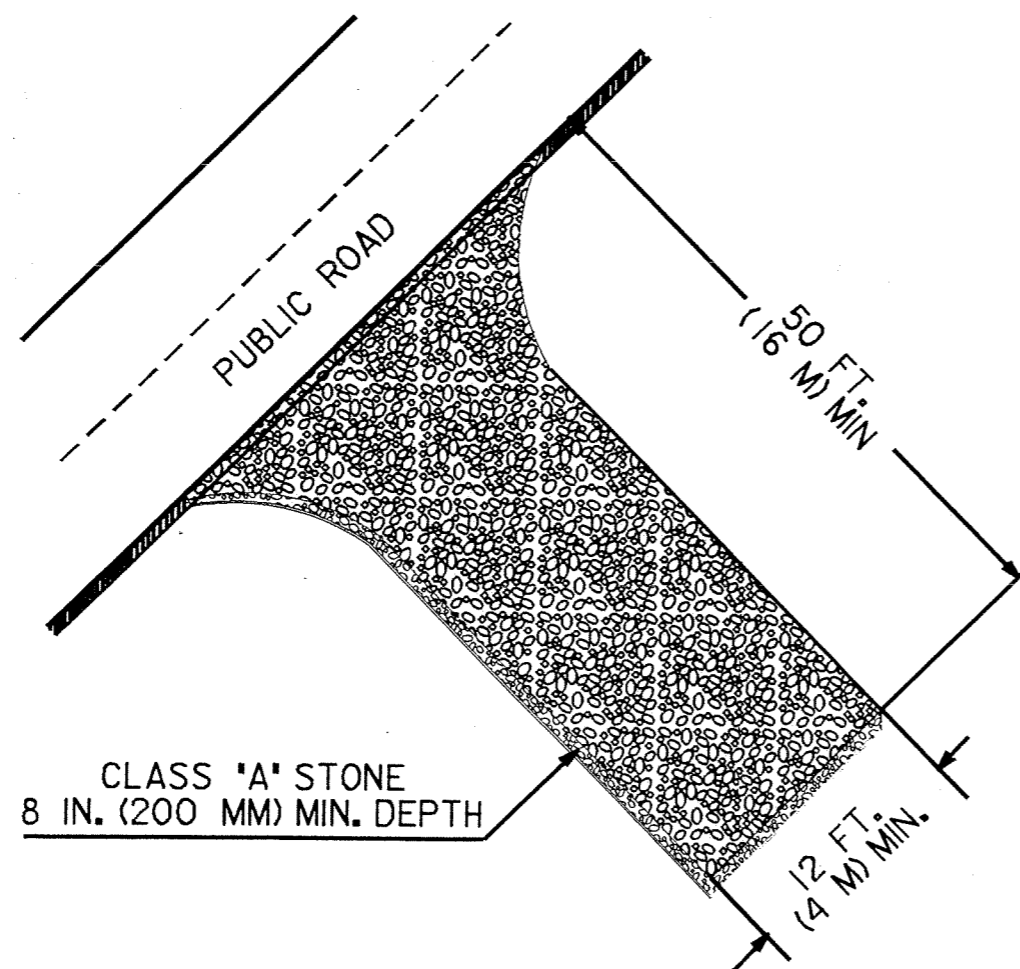

NOTES:

1. TURNING RADIUS SUFFICIENT TO ACCOMODATE LARGE TRUCKS SHALL BE PROVIDED.
2. ENTRANCE(S) SHOULD BE LOCATED TO PROVIDE FOR UTILIZATION BY ALL CONSTRUCTION VEHICLES.
3. MUST BE MAINTAINED IN A CONDITION WHICH WILL PREVENT TRACKING OR DIRECT FLOW OF MUD ONTO STREETS. PERIODIC TOPDRESSING WITH STONE WILL BE NECESSARY.
4. ANY MATERIAL TRACKED ONTO THE ROADWAY MUST BE CLEANED UP IMMEDIATELY.
5. GRAVEL CONSTRUCTION ENTRANCE SHALL BE LOCATED AT ALL POINTS OF INGRESS AND EGRESS UNTIL SITE IS STABILIZED. FREQUENT CHECKS OF THE DEVICE AND TIMELY MAINTENANCE MUST BE PROVIDED.
6. NUMBER AND LOCATION OF CONSTRUCTION ENTRANCES TO BE DETERMINED BY THE ENGINEER

NOTE: FILTER FABRIC TO BE PLACED BENEATH STONE

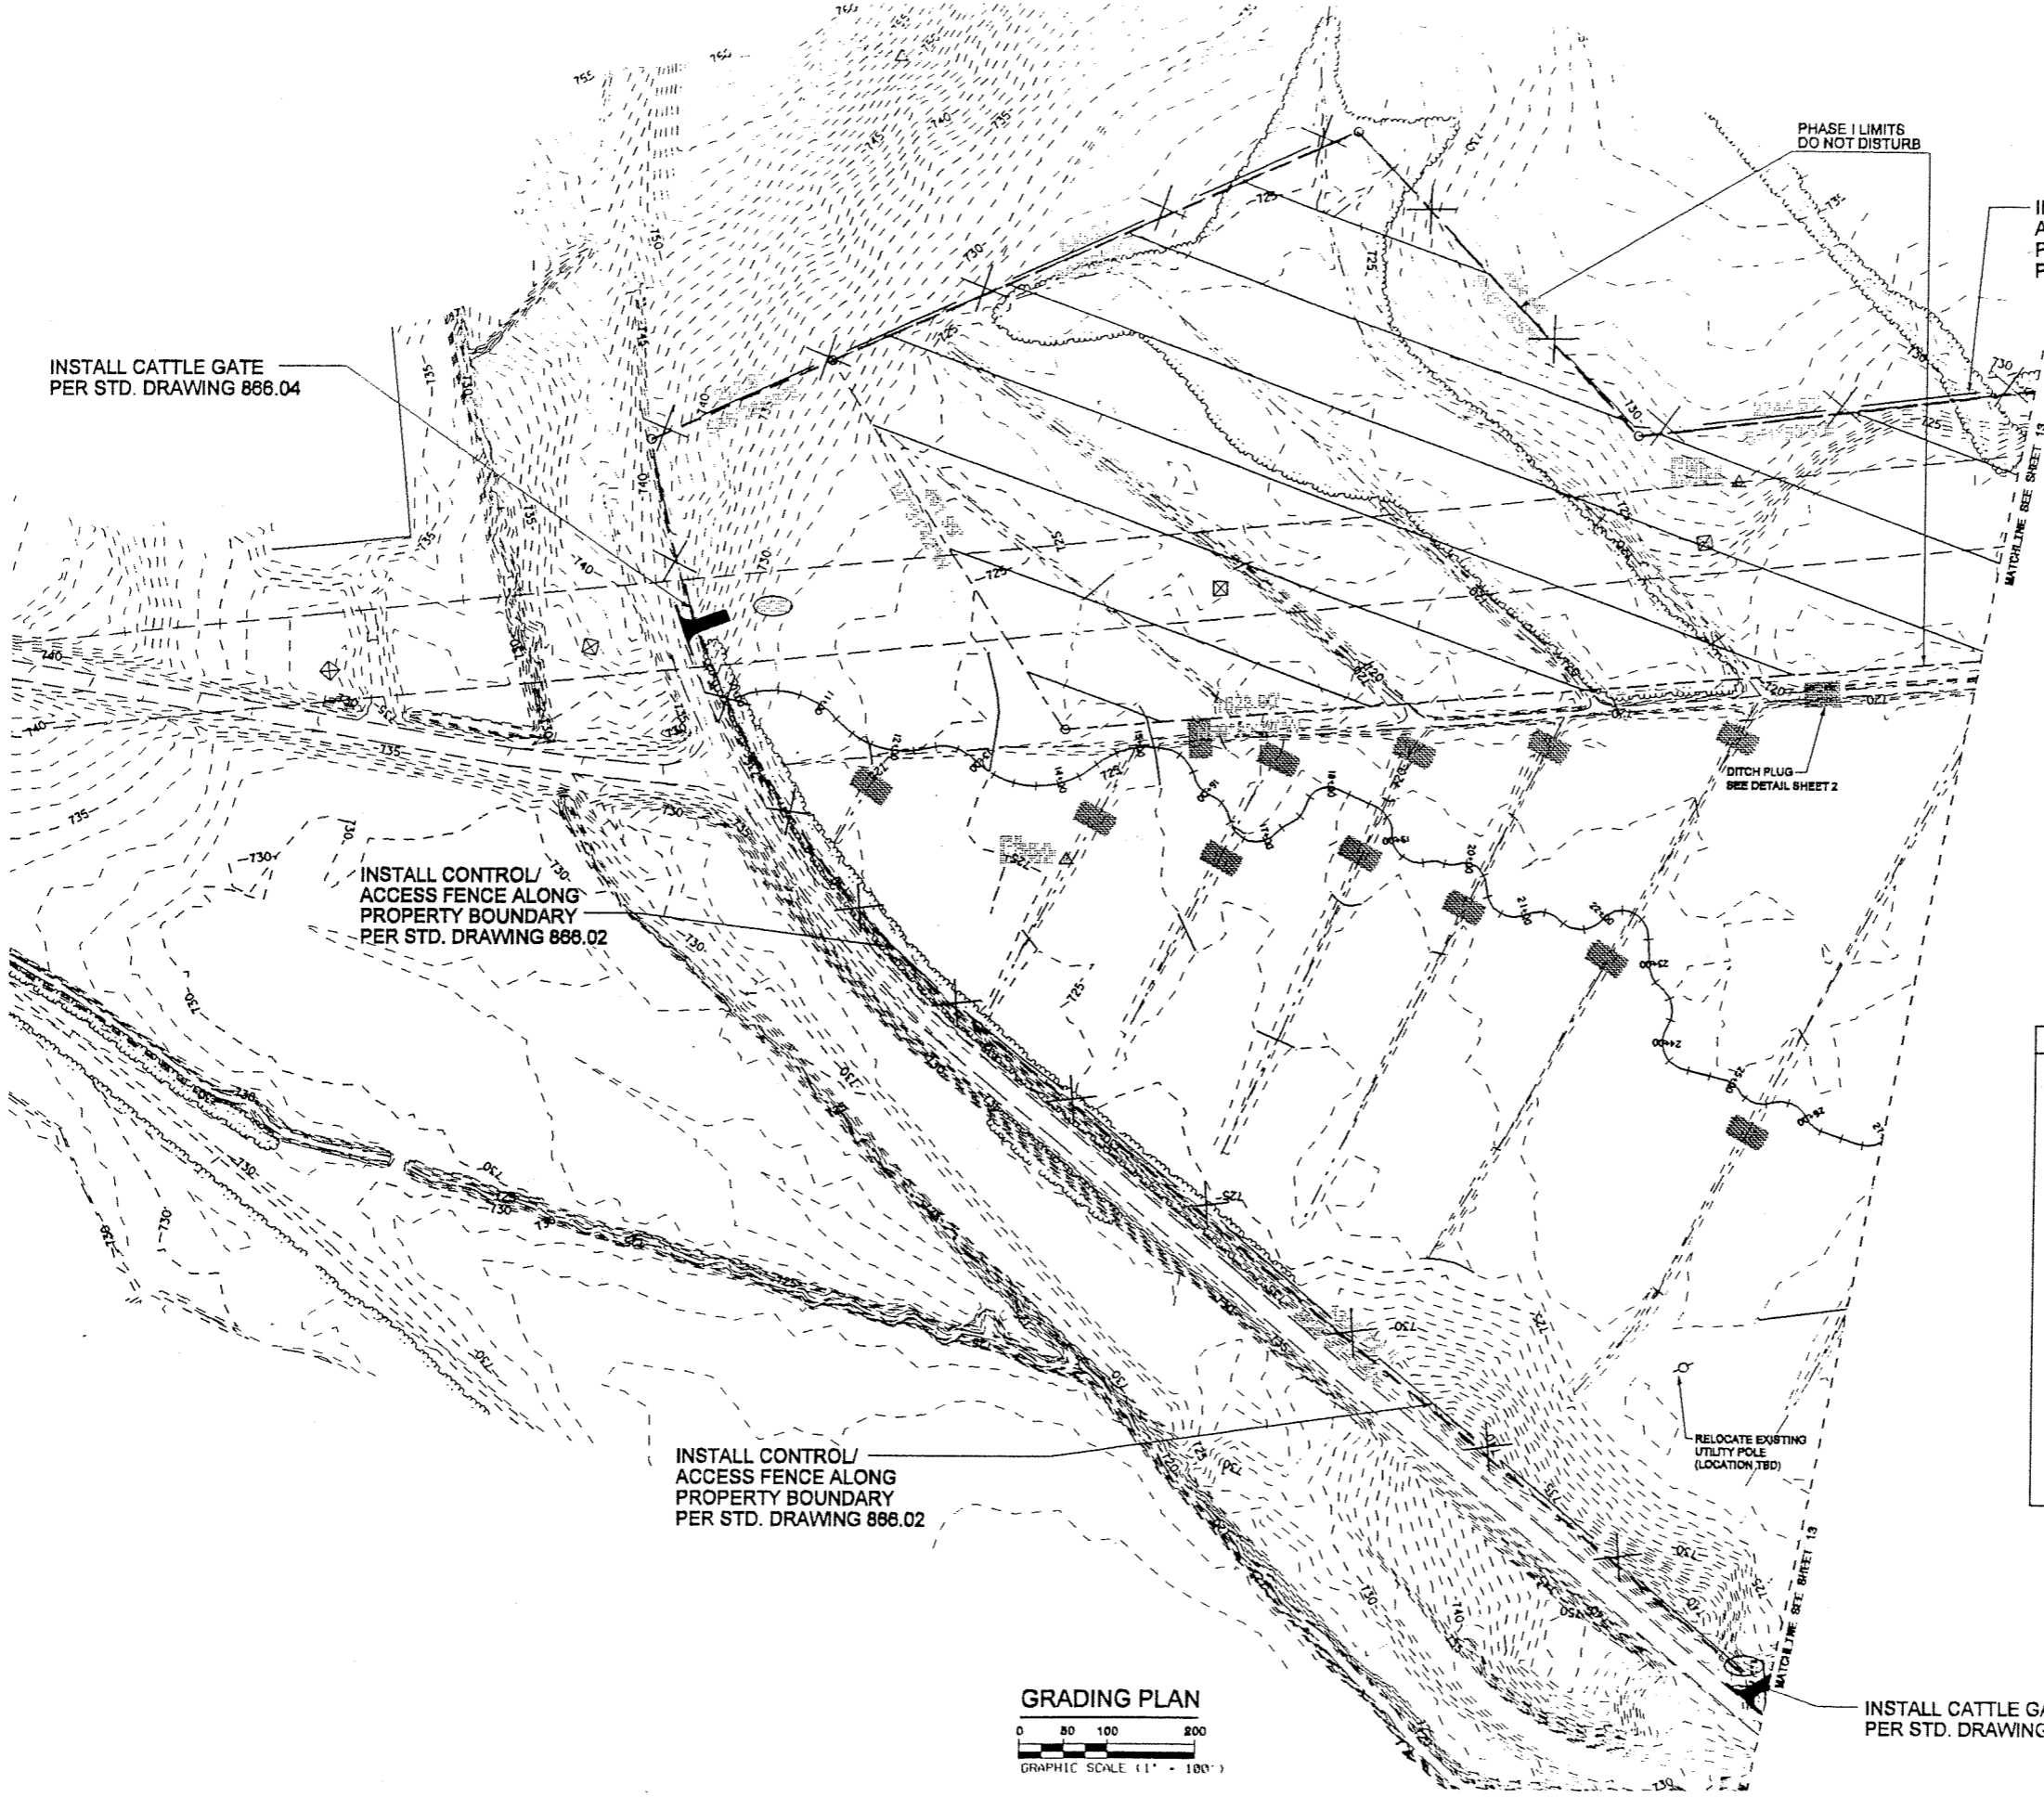

INSTALL CONTROL/ ACCESS FENCE ALONG PROPERTY BOUNDARY PER STD. DRAWING 866.02

INSTALL CATTLE GATE PER STD. DRAWING 866.04

INSTALL CONTROL/ ACCESS FENCE ALONG PROPERTY BOUNDARY PER STD. DRAWING 866.02


INSTALL CONTROL/ ACCESS FENCE ALONG PROPERTY BOUNDARY PER STD. DRAWING 866.02

NOTE: STABILIZED CONSTRUCTION ENTRANCES (SCE) HAVE BEEN INSTALLED AS PART OF PHASE I OPERATIONS. IT WILL BE THE RESPONSIBILITY OF THE CONTRACTOR TO MAINTAIN THE EXISTING SCE(S) THROUGH THE CONSTRUCTION PERIOD.



GRADING LEGEND	
---	EXISTING MINOR CONTOURS
- - -	EXISTING MAJOR CONTOURS
---	PROPOSED CONTOURS
- - -	MITIGATION BOUNDARY
(SCE)	STABILIZED CONSTRUCTION ENTRANCE
(Tree symbol)	TREES
(Wavy line symbol)	TREELINE AND HEDGES
(Circle with cross symbol)	UTILITY POLE
(Square with cross symbol)	DUKE POWER TOWER
(Line with cross symbol)	PROPOSED STREAM ALIGNMENT
(Hatched area symbol)	PHASE I LIMITS DO NOT DISTURB

GRADING PLAN

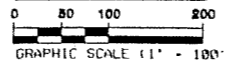

INSTALL CATTLE GATE PER STD. DRAWING 866.04


RELOCATE EXISTING UTILITY POLE (LOCATION TBD)

DITCH PLUG SEE DETAIL SHEET 2

MATCHLINE SEE SHEET 19

PHASE I LIMITS DO NOT DISTURB


GRADING LEGEND	
	EXISTING MINOR CONTOURS
	EXISTING MAJOR CONTOURS
	PROPOSED CONTOURS
	MITIGATION BOUNDARY
	STABILIZED CONSTRUCTION ENTRANCE
	TREES
	TREELINE AND HEDGES
	UTILITY POLE
	DUKE POWER TOWER
	PROPOSED STREAM ALIGNMENT
	PHASE I LIMITS DO NOT DISTURB

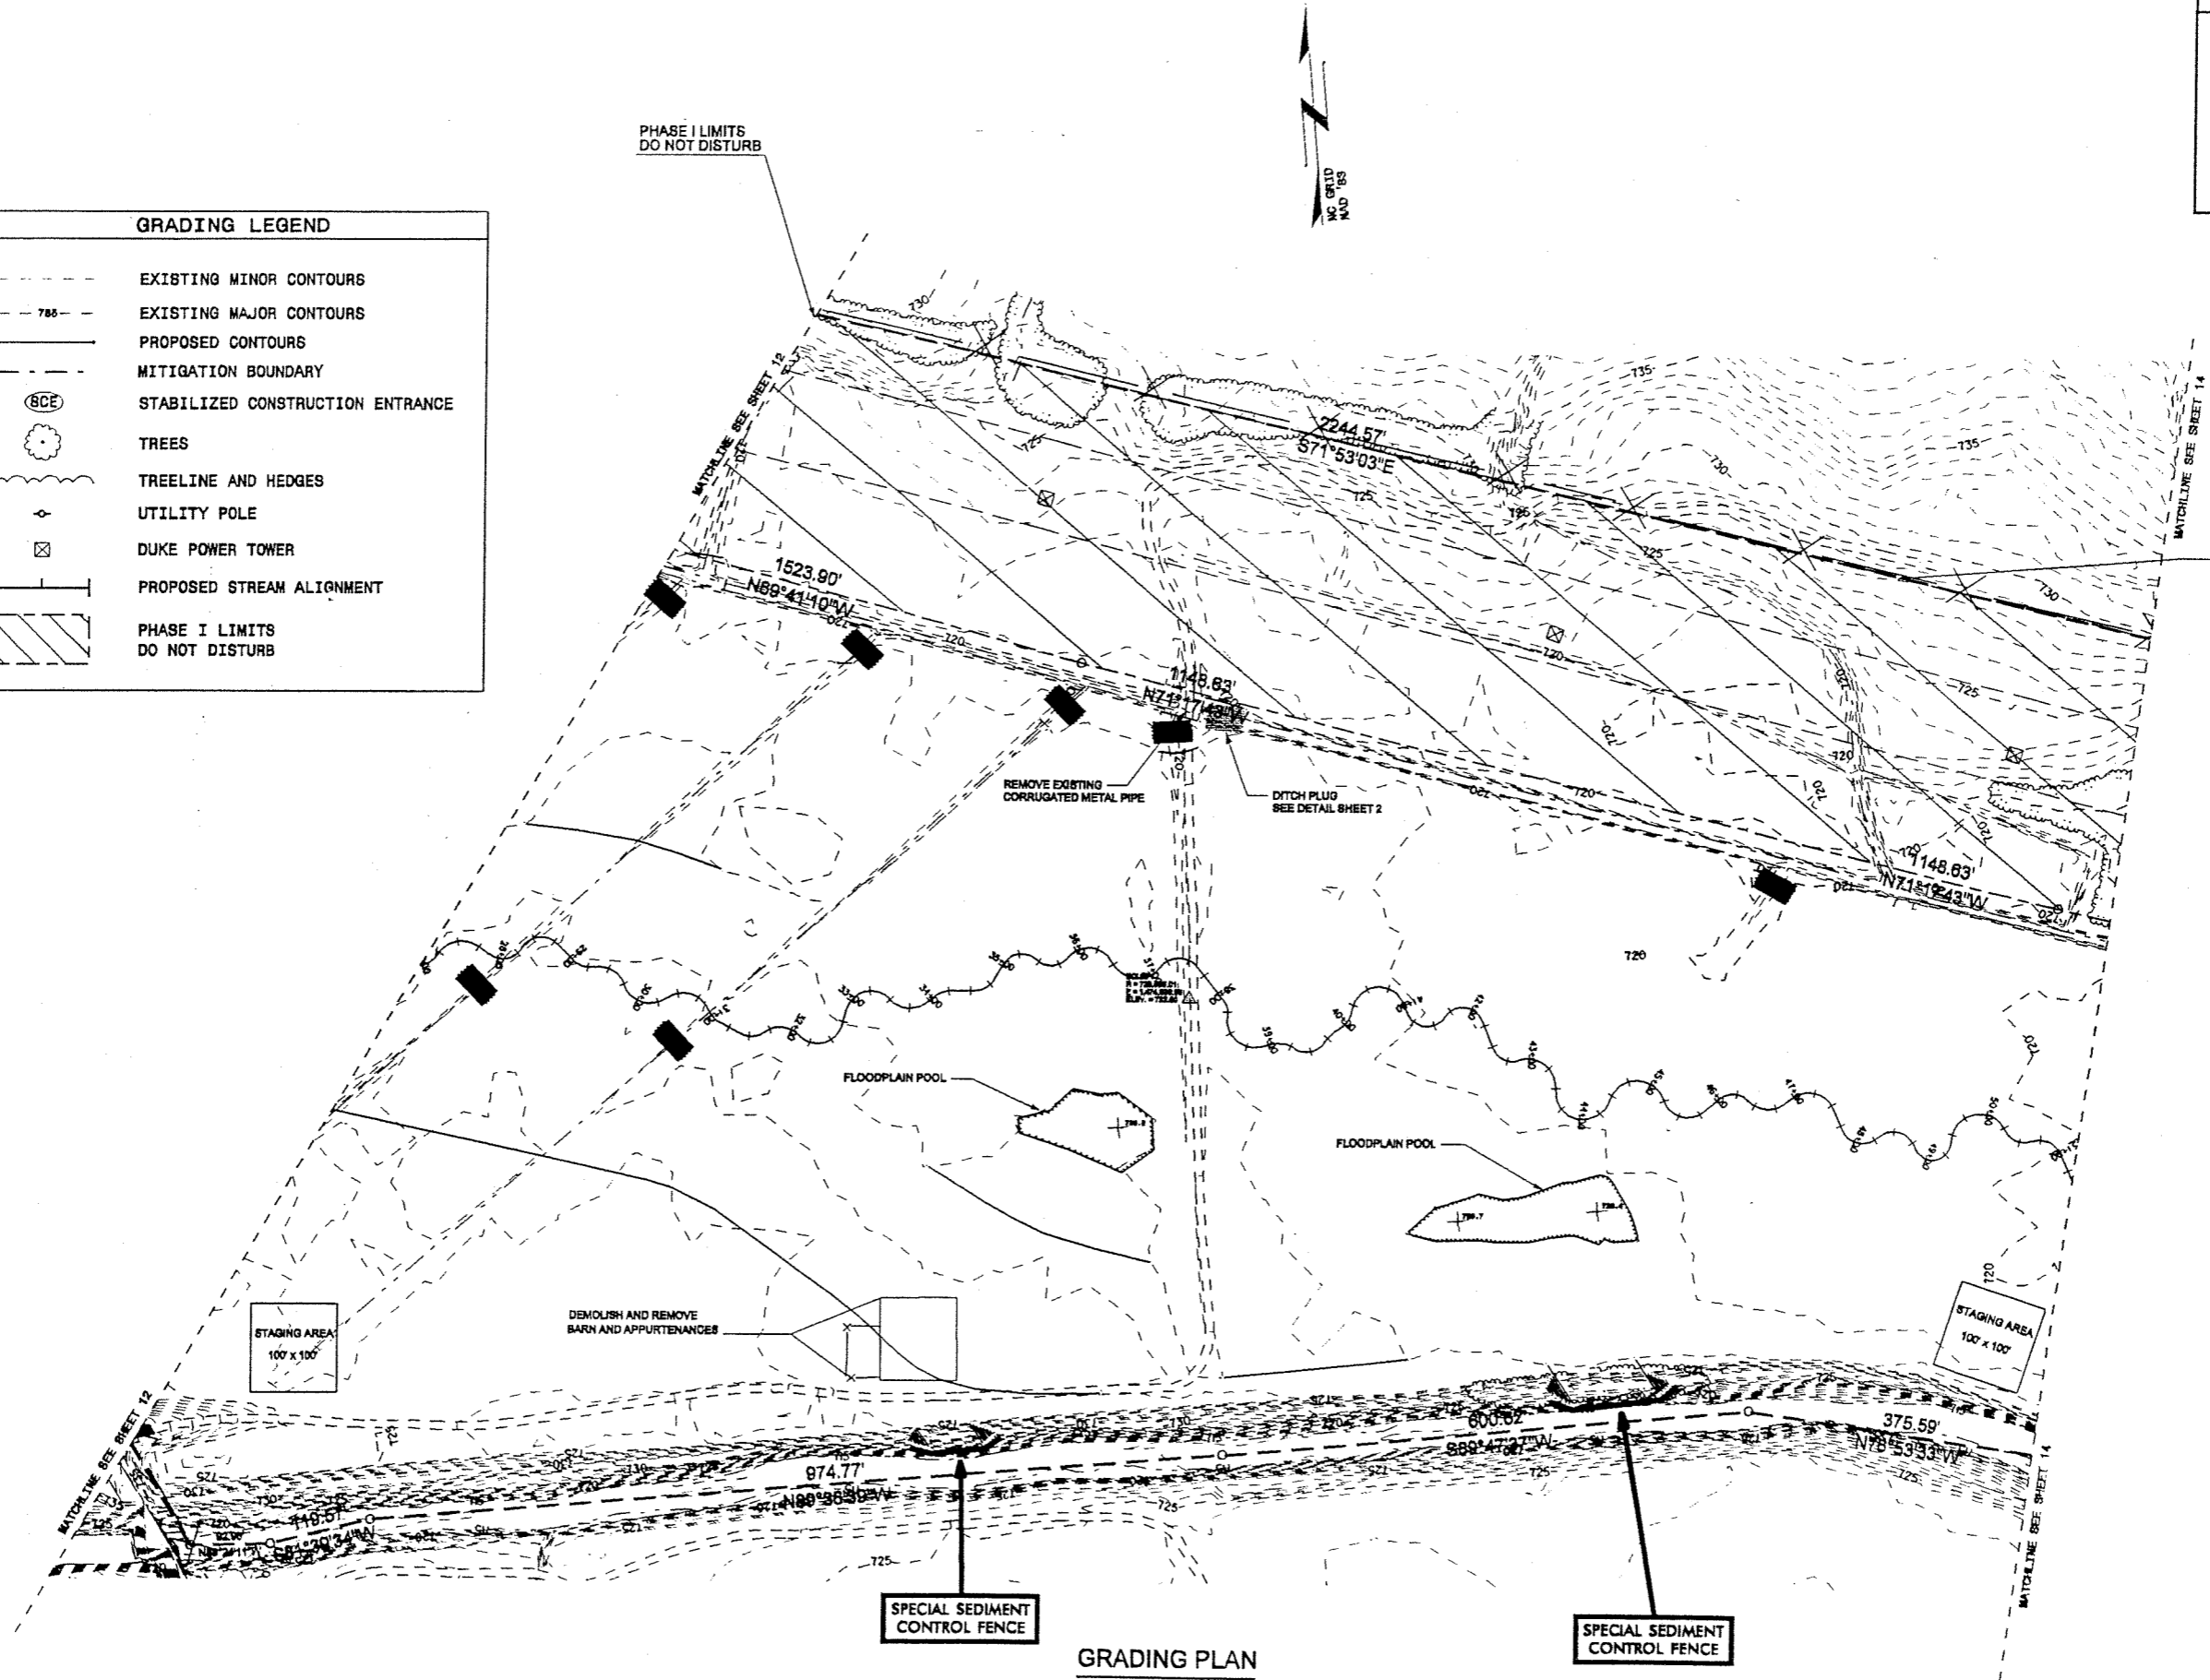


INSTALL CONTROL/
ACCESS FENCE ALONG
PROPERTY BOUNDARY
PER STD. DRAWING 886.02

SPECIAL SEDIMENT
CONTROL FENCE

SPECIAL SEDIMENT
CONTROL FENCE

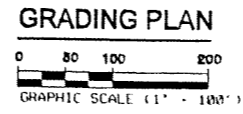


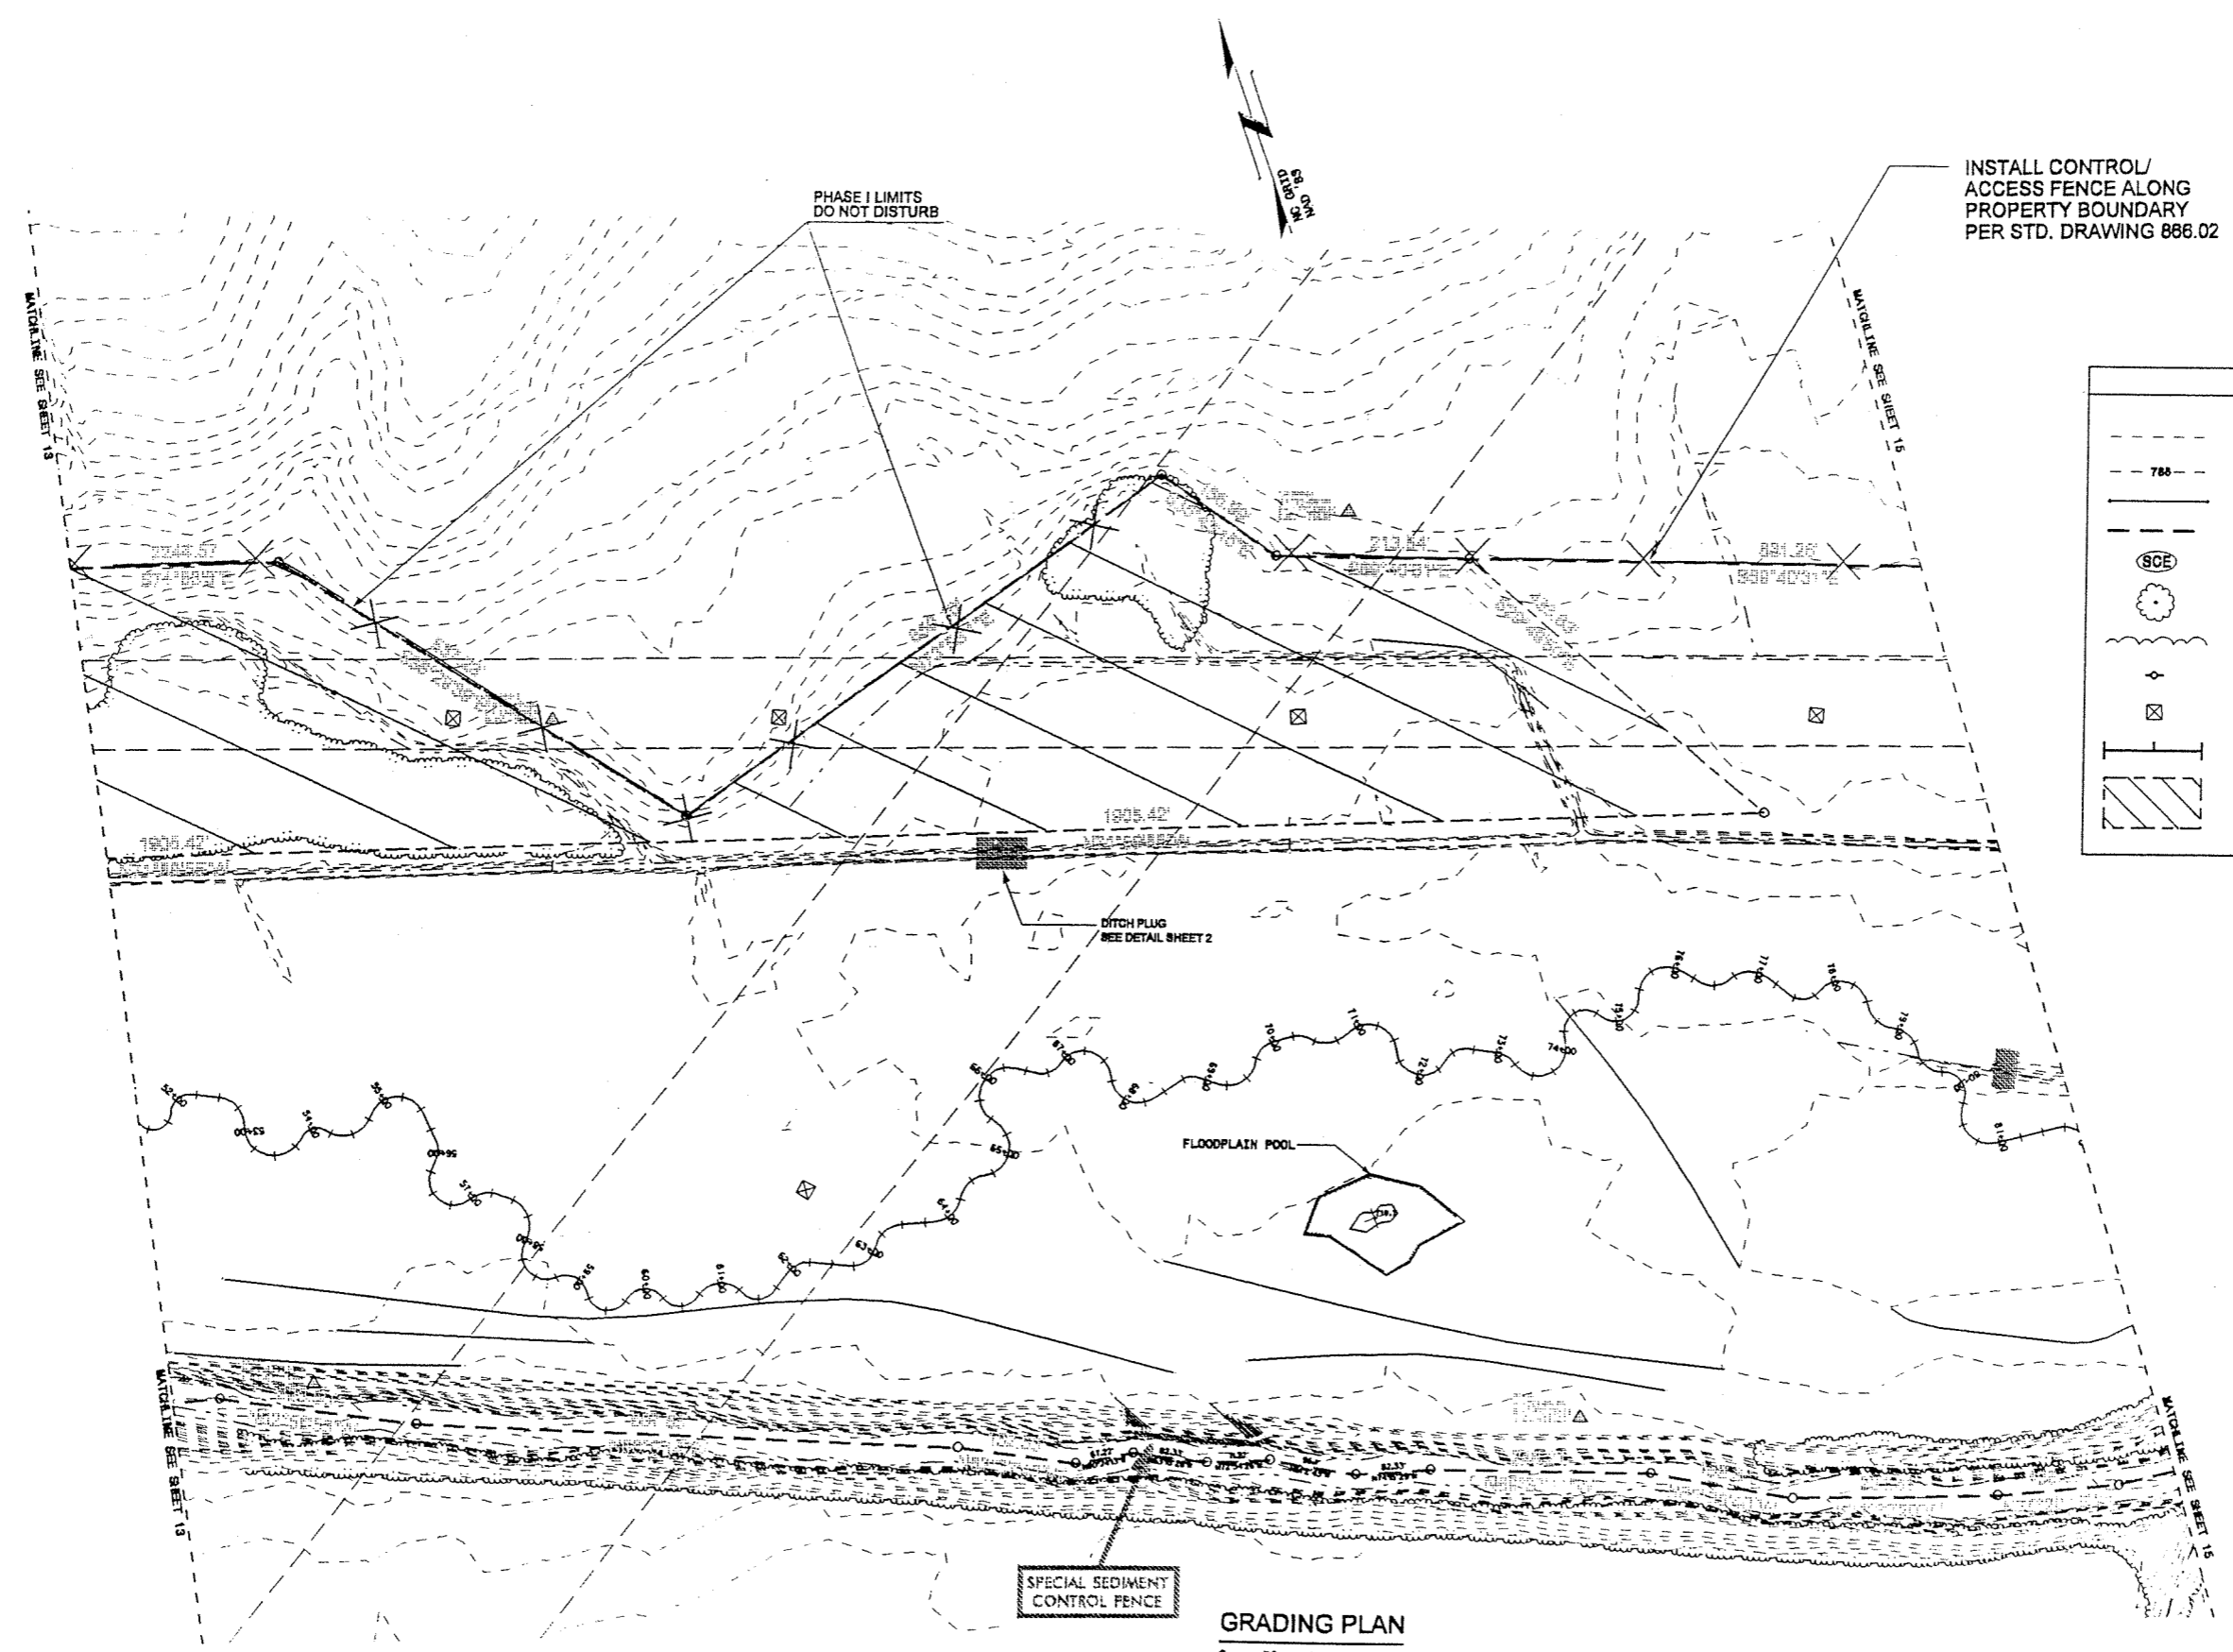


 





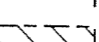
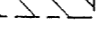

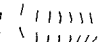
INSTALL CONTROL/
ACCESS FENCE ALONG
PROPERTY BOUNDARY
PER STD. DRAWING 888.02

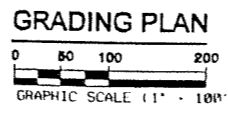GRADING LEGEND	
	EXISTING MINOR CONTOURS
	EXISTING MAJOR CONTOURS
	PROPOSED CONTOURS
	LIMITS OF DISTURBANCE
	STABILIZED CONSTRUCTION ENTRANCE
	TREES
	TREELINE AND HEDGES
	UTILITY POLE
	DUKE POWER TOWER
	PROPOSED STREAM ALIGNMENT
	PHASE I LIMITS DO NOT DISTURB


SPECIAL SEDIMENT
CONTROL FENCE




GRADING LEGEND

-  EXISTING MINOR CONTOURS
-  EXISTING MAJOR CONTOURS
-  PROPOSED CONTOURS
-  LIMITS OF DISTURBANCE
-  STABILIZED CONSTRUCTION ENTRANCE
-  TREES
-  TREELINE AND HEDGES
-  UTILITY POLE
-  DUKE POWER TOWER
-  PROPOSED STREAM ALIGNMENT
-  PHASE I LIMITS
DO NOT DISTURB

INSTALL CONTROL/
ACCESS FENCE ALONG
PROPERTY BOUNDARY
PER STD. DRAWING 886.02

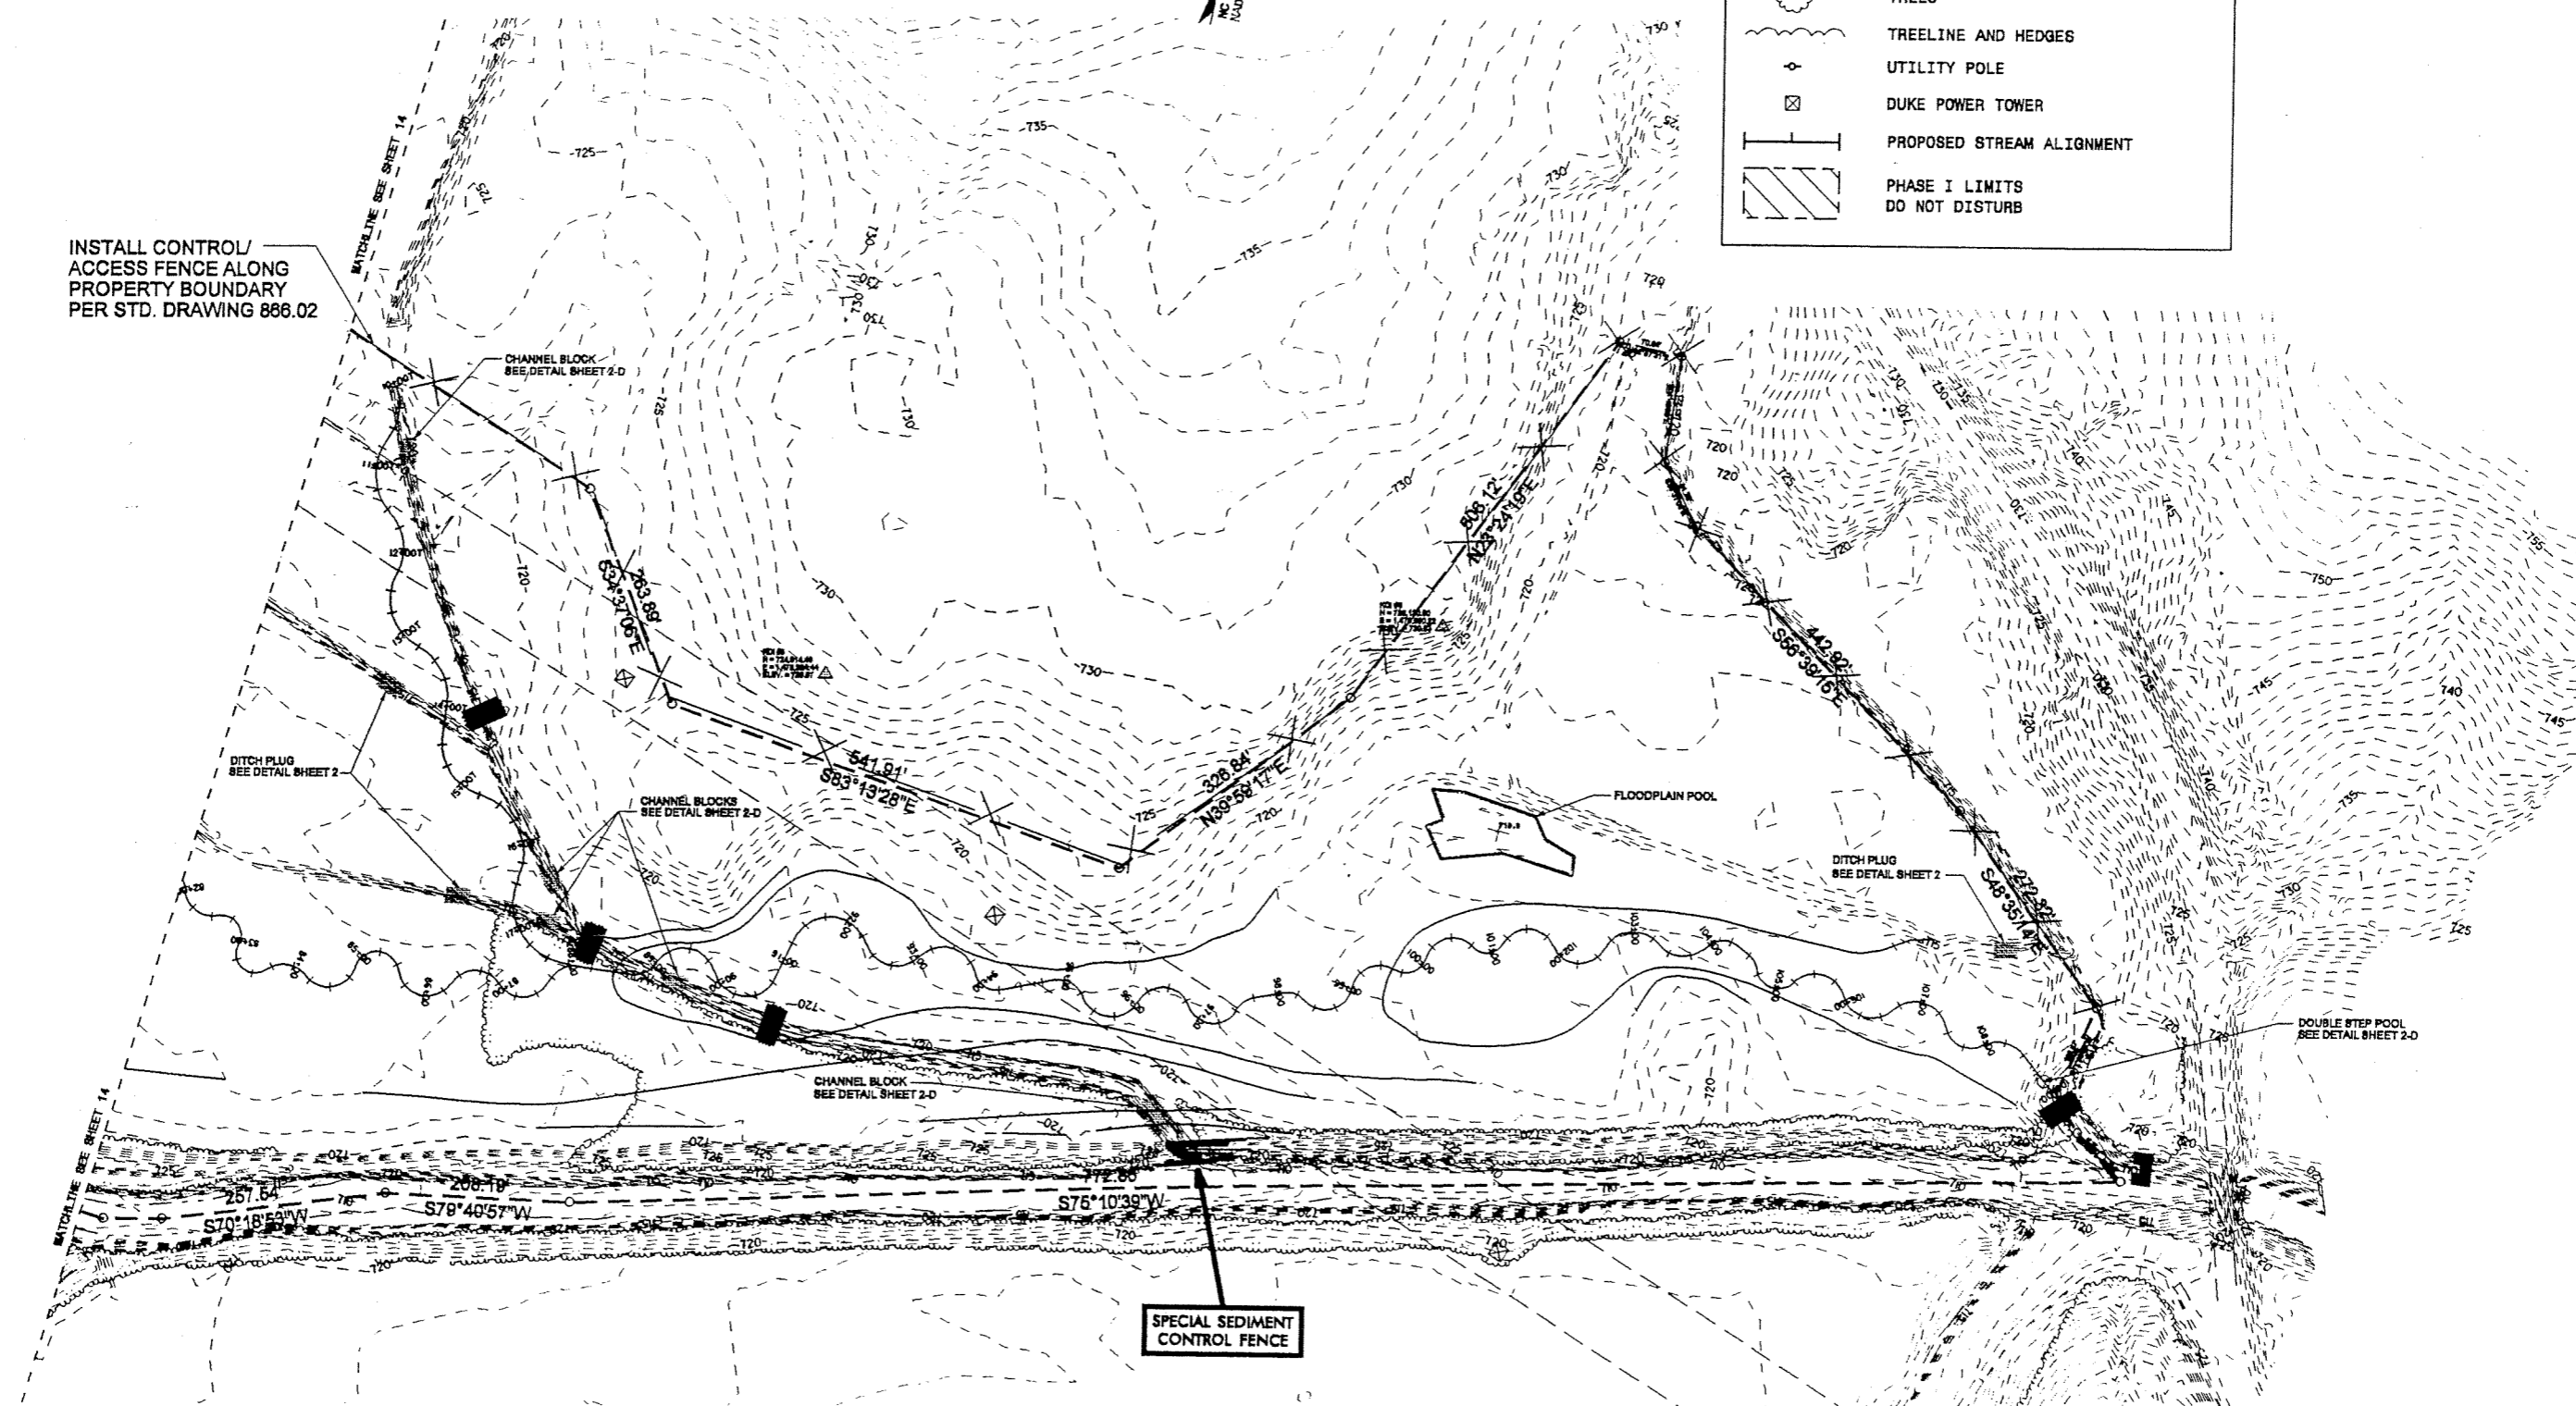

SPECIAL SEDIMENT
CONTROL FENCE

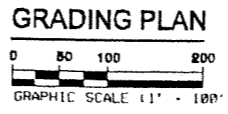


PLANTING DETAILS

SEEDLING / LINER BAREROOT PLANTING DETAIL


HEALING IN

1. Locate a healing-in site in a shady, well protected area.


2. Excavate a flat bottom trench 12" deep and provide drainage.

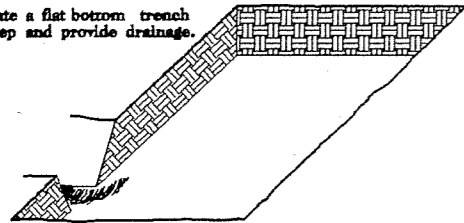


3. Backfill the trench with 2" well rotted sawdust. Place a 2" layer of well rotted sawdust at a sloping angle at one end of the trench.

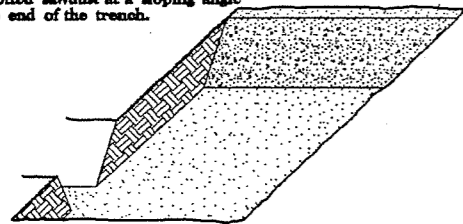

4. Place a single layer of plants against the sloping end so that the root collar is at ground level.

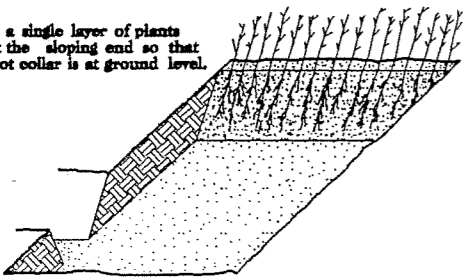


5. Place a 2" layer of well rotted sawdust over the roots maintaining a sloping angle.

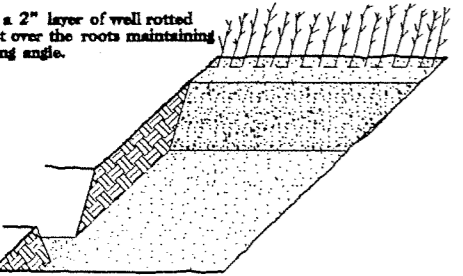


6. Repeat layers of plants and sawdust as necessary and water thoroughly.


DIBBLE PLANTING METHOD USING THE KBC PLANTING BAR

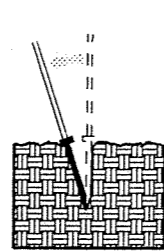


1. Insert planting bar as shown and pull handle toward planter.

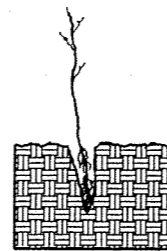


2. Remove planting bar and place seedling at correct depth.

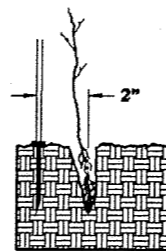


3. Insert planting bar 2" toward planter from seedling.

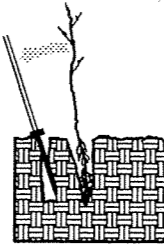

4. Pull handle of bar toward planter, firming soil at bottom.

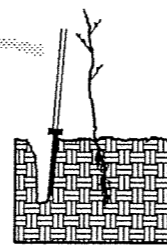

5. Push handle forward firming soil at top.

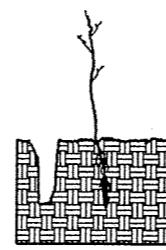

6. Leave compaction hole open. Water thoroughly.

PLANTING NOTES:

PLANTING BAG
During planting, seedlings shall be kept in a moist canvas bag or similar container to prevent the root systems from drying.



KBC PLANTING BAR
Planting bar shall have a blade with a triangular cross section, and shall be 12" long, 4" wide and 1" thick at center.



ROOT PRUNING
All seedlings shall be root pruned, if necessary, so that no roots extend more than 10 inches (10") below the root collar.

SHEPHERD'S TREE WETLAND PLANTING

STATE	STATE PROJECT REFERENCE NO.	PROJECT NO.	TOTAL SHEETS
N.C.	R-2239 WM	RF-1	
STATE PROJ. NO.	F.A. PROJ. NO.	DESCRIPTION	

WETLAND TREE REFORESTATION

MIXTURE, TYPE, SIZE, AND FURNISH SHALL CONFORM TO THE FOLLOWING:

PLATANUS OCCIDENTALIS	AMERICAN SYCAMORE	BAREROOT SEEDLING
FRAXINUS PENNSYLVANICA	GREEN ASH	BAREROOT SEEDLING
QUERCUS LYRATA	OVERCUP OAK	BAREROOT SEEDLING
QUERCUS NIGRA	WATER OAK	BAREROOT SEEDLING
QUERCUS MICHAUXII	SWAMP CHESTNUT OAK	BAREROOT SEEDLING
LIRIODENDRON TULIPIFERA	TULIP POPLAR	BAREROOT SEEDLING
NYSSA AQUATICA	WATER TUPELO	BAREROOT SEEDLING
QUERCUS FALCATA VAR. PAGODAEFOLIA	CHERRYBARK OAK	BAREROOT SEEDLING
QUERCUS PHELLOS	WILLOW OAK	BAREROOT SEEDLING

TREE REFORESTATION SHALL BE PLANTED 6' TO 10' ON CENTER, RANDOM SPACING, AVERAGING 8' ON CENTER, APPROXIMATELY 680 PLANTS PER ACRE.

STREAMBANK REFORESTATION

MIXTURE, TYPE, SIZE, AND FURNISH SHALL CONFORM TO THE FOLLOWING:

SALIX NIGRA	BLACK WILLOW	LIVE STAKE
CORNUS AMOMUM	SILKY DOGWOOD	LIVE STAKE

TREE REFORESTATION SHALL BE PLANTED 2' TO 6' ON CENTER, RANDOM SPACING, AVERAGING 4' ON CENTER.


SEE PLAN SHEETS FOR AREAS TO BE PLANTED

WETLAND AND STREAM REFORESTATION DETAIL SHEET

N.C.D.O.T. - ROADSIDE ENVIRONMENTAL UNIT


SHEPHERD'S TREE MITIGATION SITE MONITORING GAUGE AND PLOT LOCATIONS

DATE	SCALE

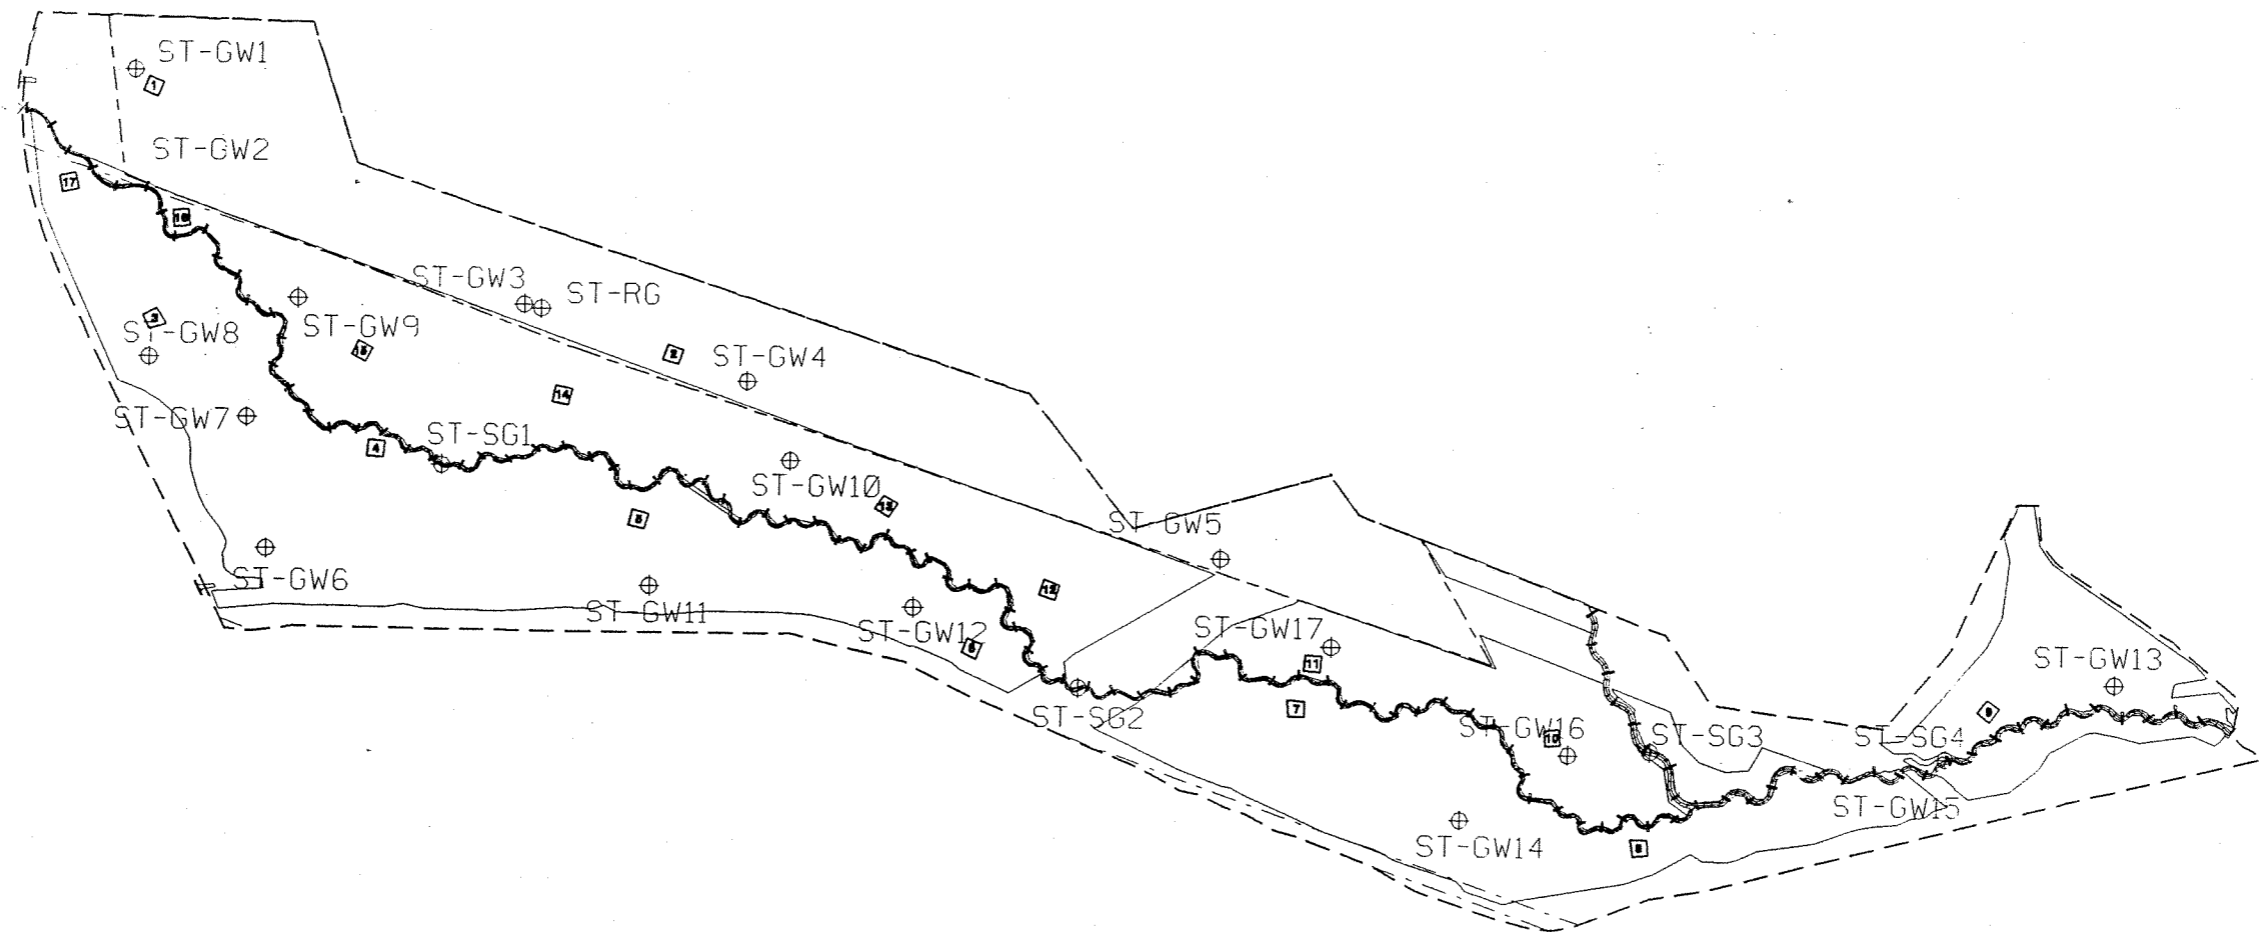

WBS ELEMENT: 34404.4.1 R-2239WM

See Sheet 1-A For Index of Sheets

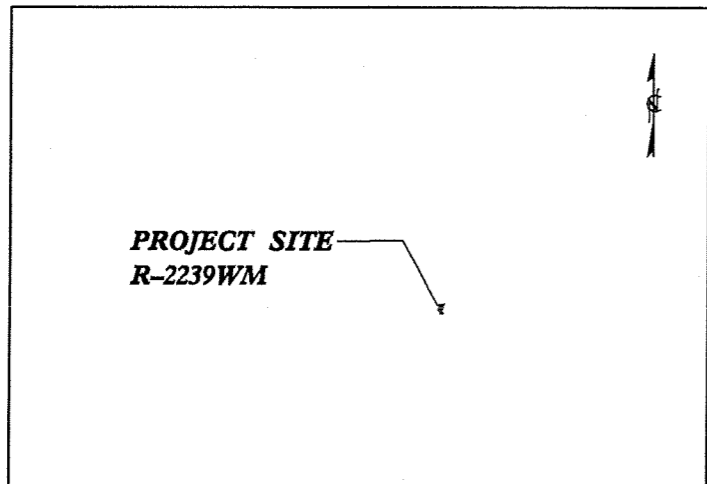

VICINITY MAP
NOT TO SCALE


STATE OF NORTH CAROLINA

DIVISION OF HIGHWAYS


IREDELL COUNTY

LOCATION: DUKE POWER PROPERTY ADJACENT TO SHEPHERDS TREE
MITIGATION SITE BETWEEN TRIPLETT ROAD (SR 2362) AND
CORNFLOWER (SR 2360), SOUTHEAST OF STATESVILLE
TYPE OF WORK: DRAINAGE

As-Built Plans

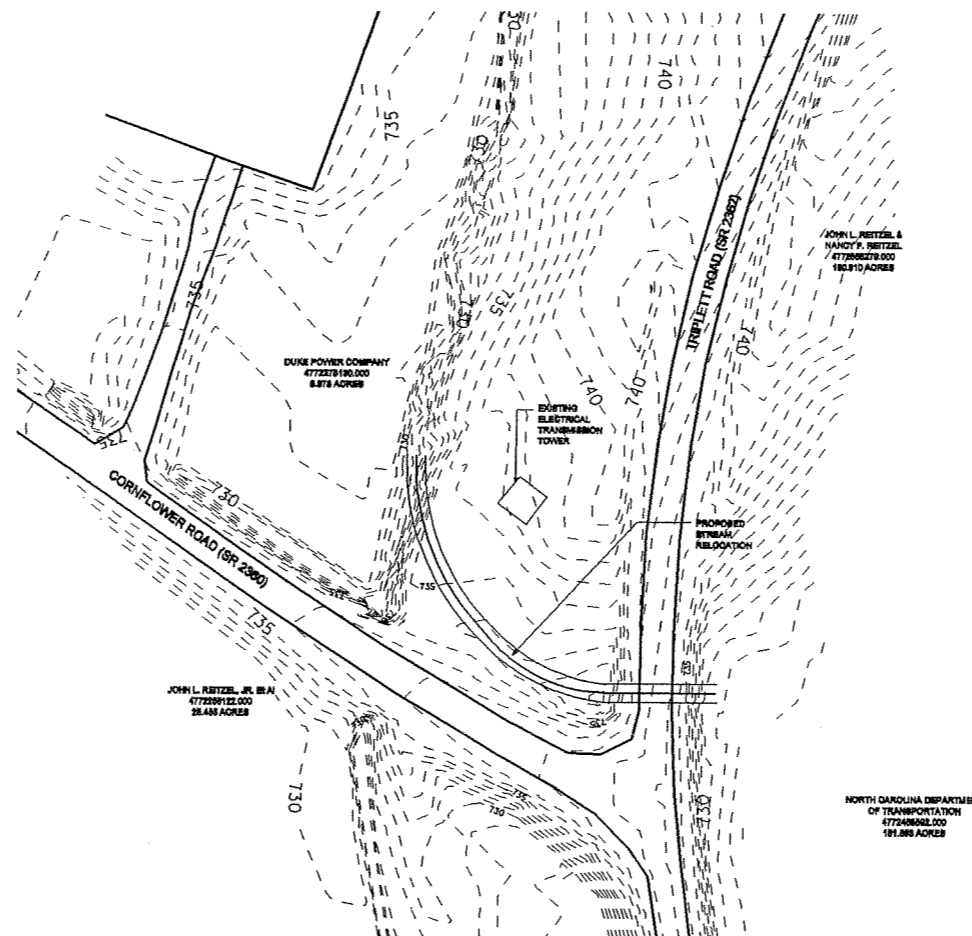

PHASE III

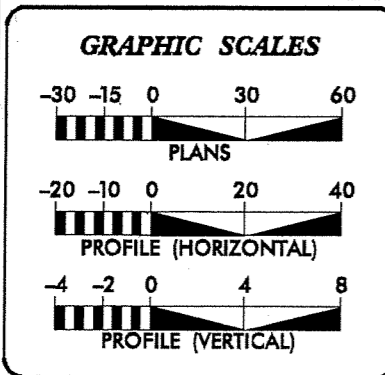

PROJECT LENGTH

CHANNEL RELOCATION = 284 FEET

Prepared in the Office of:

KCI Associates
of North Carolina, P.A.
SUITE 220 LANDMARK CENTER II, 4601 SIX FORKS RD., RALEIGH NC
ENGINEERS • PLANNERS • ECOLOGISTS

for the:
DIVISION OF HIGHWAYS
2002 STANDARD SPECIFICATIONS

LETTING DATE: _____

JAMES W. BLAKE, PE
PROJECT ENGINEER

GARY M. MRYNCZA, PH
DESIGN ENGINEER

DESIGN ENGINEER

SIGNATURE: _____ P.E.

DIVISION OF HIGHWAYS
STATE OF NORTH CAROLINA

STATE DESIGN ENGINEER P.E.
DEPARTMENT OF TRANSPORTATION
FEDERAL HIGHWAY ADMINISTRATION

APPROVED DIVISION ADMINISTRATOR DATE

STATE	STATE PROJECT REFERENCE NO.	SHEET NO.	TOTAL SHEETS
N.C.	R-2239WM	1	18
WBS ELEMENT	P.A. FEEDING	DESCRIPTION	
34404.1.1		P.E.	
34404.2.1		R/W	
34404.4.1		CONST.	

REVISIONS

PROJECT REFERENCE NO. SHEET NO.

R - 2239WM IA

RW SHEET NO.

ENGINEER

INDEX OF SHEETS

1	TITLE SHEET
1-A	INDEX OF SHEETS
1-B	STANDARD SYMBOLOGY SHEET
2	DETAILS (TYPICALS & STABILIZATION)
2-A	DETAILS (PROFILE VIEW & DS CROSS SECTION)
2-B	DETAILS (PIPE ARCH)
2-C	DETAILS (PAVEMENT AND DETOUR)
3	SUMMARY SHEET
4	LIMITS OF OPERATION
5	GRADING PLAN
6	RELOCATE GEOMETRY
7	RELOCATE PROFILE
XS1 THRU XS2	CROSS-SECTIONS
EC-1 THRU EC-3	EROSION CONTROL PLAN (REU)

ROADWAY STANDARD DRAWINGS:

(REV. JAN. 2002)

STD NO.	TITLE
310.10	DRIVEWAY PIPE CONSTRUCTION
840.71	CONCRETE AND BRICK PIPE PLUG

GENERAL NOTES:

BEARING AND DISTANCES:

ALL BEARINGS ARE NAD '83 GRID BEARINGS.
 ALL DISTANCES AND COORDINATES SHOWN ARE HORIZONTAL (GROUND) VALUES.
 ALL INFORMATION IS BASED ON THE FOLLOWING NCGS CONTROL MONUMENTS.

"KIMMER"	N = 705,616.53	E = 1,497,413.15	ELEV. = 782.13'
"BEACON AZ"	N = 684,999.89	E = 1,463,959.23	ELEV. = 926.73'
"319 JAS"	N = 733,066.25	E = 1,477,188.81	ELEV. = 837.95'

ALL PROPERTY BOUNDARY DATA IS BASED ON DATA SUPPLIED BY NCDOT.

GRADING:

-THE GRADE LINES SHOWN DENOTE THE FINISHED ELEVATION OF THE PROPOSED OR FUTURE SURFACING AT GRADE POINTS SHOWN ON THE TYPICAL SECTIONS. GRADE LINES MAY BE ADJUSTED AT THEIR BEGINNING, ENDING AND AT STRUCTURES AS DIRECTED BY THE ENGINEER IN ORDER TO SECURE A PROPER TIE-IN.


SUBSURFACE PLANS:

-NO SUBSURFACE PLANS ARE AVAILABLE ON THIS PROJECT. THE CONTRACTOR SHOULD MAKE HIS OWN INVESTIGATION AS TO THE SUBSURFACE CONDITIONS.

UTILITIES:

-UTILITY LOCATIONS NOTED ON PLANS ARE FOR INFORMATIONAL PURPOSES ONLY. IT SHALL BE THE RESPONSIBILITY OF THE CONTRACTOR TO LOCATE ANY EXISTING UTILITIES. CONTACT 'NC ONE CALL', 1-800-632-4949, A MINIMUM OF 48 HOURS IN ADVANCE OF CONSTRUCTION, AS WELL AS NCDOT, FOR INFORMATION.

CONVENTIONAL SYMBOLS

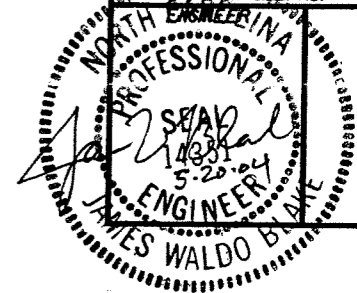

ROADS & RELATED ITEMS

Edge of Pavement	-----
Curb	-----
Prop. Slope Stakes Cut	----- C
Prop. Slope Stakes Fill	----- F
Prop. Woven Wire Fence	----- ○ ○
Prop. Chain Link Fence	----- □ □
Prop. Barbed Wire Fence	----- ◇ ◇
Prop. Wheelchair Ramp	----- WCR
Exist. Guardrail	-----
Prop. Guardrail	-----
Equality Symbol	----- ⊕
Pavement Removal	----- XXXXXX

RIGHT OF WAY

Baseline Control Point	----- ◆
Existing Right of Way Marker	----- △
Exist. Right of Way Line w/Marker	----- △
Prop. Right of Way Line with Proposed RW Marker (Iron Pin & Cap)	----- ▲
Prop. Right of Way Line with Proposed (Concrete or Granite) RW Marker	----- ●
Exist. Control of Access Line	----- ⊙
Prop. Control of Access Line	----- ⊙
Exist. Easement Line	----- E
Prop. Temp. Construction Easement Line	----- E
Prop. Temp. Drainage Easement Line	----- TDE
Prop. Perm. Drainage Easement Line	----- PDE

HYDROLOGY

Stream or Body of Water	-----
Flow Arrow	----- →
Disappearing Stream	----- └──┘
Spring	----- ○
Swamp Marsh	----- ✱
Shoreline	-----
Falls, Rapids	----- └──┘
Prop Lateral, Tail, Head Ditches	----- └──┘

STRUCTURES

MAJOR	
Bridge, Tunnel, or Box Culvert	----- CONC
Bridge Wing Wall, Head Wall and End Wall	-----) CONC HW (

MINOR	
Head & End Wall	----- CONC HW
Pipe Culvert	----- =====
Footbridge	----- >-----<
Drainage Boxes	----- □ CB
Paved Ditch Gutter	-----

UTILITIES

Exist. Pole	----- ●
Exist. Power Pole	----- ○
Prop. Power Pole	----- ○
Exist. Telephone Pole	----- ○
Prop. Telephone Pole	----- ○
Exist. Joint Use Pole	----- +
Prop. Joint Use Pole	----- +
Telephone Pedestal	----- □
Cable TV Pedestal	----- □
Hydrant	----- ◆
Satellite Dish	----- ⌘
Exist. Water Valve	----- ⊗
Sewer Clean Out	----- ⊕
Power Manhole	----- ⊙
Telephone Booth	----- ■
Water Manhole	----- ⊙
Light Pole	----- □
H-Frame Pole	----- ⊕
Power Line Tower	----- ⊗
Pole with Base	----- □
Gas Valve	----- ◇
Gas Meter	----- ◇
Telephone Manhole	----- ⊙
Power Transformer	----- ⊕
Sanitary Sewer Manhole	----- ⊙
Storm Sewer Manhole	----- ⊙
Tank; Water, Gas, Oil	----- ○
Water Tank With Legs	----- ○
Traffic Signal Junction Box	----- ⊕
Fiber Optic Splice Box	----- ⊕
Television or Radio Tower	----- ⊕
Utility Power Line Connects to Traffic Signal Lines Cut Into the Pavement	----- TS-----TS

Water Line	-----
Sanitary Sewer	----- SS-----SS
Sanitary Sewer Force Main	----- FSS-----FSS
Gas Line	----- G-----G
Storm Sewer	----- S-----S
Power Line	----- P-----P
Telephone Cable	----- T-----T
UG Telephone Conduit	----- TC-----TC
Unknown Utility	----- UTL-----UTL
Television Cable	----- TV-----TV
Fiber Optics Cable	----- FO-----FO
Exist. Water Meter	----- ○
Drawn According to U/G Records	----- DATUR
Abandoned According to U/G Records	----- AATUR
End Of Information	----- EOL

BOUNDARIES & PROPERTIES

State Line	-----
County Line	-----
Township Line	-----
City Line	-----
Reservation Line	-----
Property Line	-----
Property Line Symbol	----- PL
Exist. Iron Pin	----- ⊙
Property Corner	----- +
Property Monument	----- ⊕
Property Number	----- 123
Parcel Number	----- 6
Fence Line	----- X X X X X X
Existing Wetland Boundaries	----- WLB
Proposed Wetland Boundaries	----- WLB
Existing Endangered Animal Boundaries	----- EAB
Existing Endangered Plant Boundaries	----- EPB

BUILDINGS & OTHER CULTURE

Buildings	----- ┌──┐
Foundations	----- ┌──┐
Area Outline	----- ┌──┐
Gate	----- ┌──┐

Gas Pump Vent or U/G Tank Cap	----- +
Church	----- +
School	----- +
Park	----- +
Cemetery	----- +
Dam	----- +
Sign	----- +
Well	----- +
Small Mine	----- +
Swimming Pool	----- ▨

TOPOGRAPHY







Loose Surface	-----
Hard Surface	-----
Change in Road Surface	-----
Curb	-----
Right of Way Symbol	----- R/W
Guard Post	----- ○ GP
Paved Walk	-----
Bridge	-----
Box Culvert or Tunnel	-----
Ferry	-----
Culvert	-----
Footbridge	-----
Trail, Footpath	-----
Light House	----- ★



VEGETATION

Single Tree	----- +
Single Shrub	----- +
Hedge	----- ┌──┐
Woods Line	----- ┌──┐
Orchard	----- + + + + +
Vineyard	----- + + + + +


RAILROADS

Standard Gauge	----- CSX TRANSPORTATION
RR Signal Milepost	----- MILEPOST 35
Switch	----- +

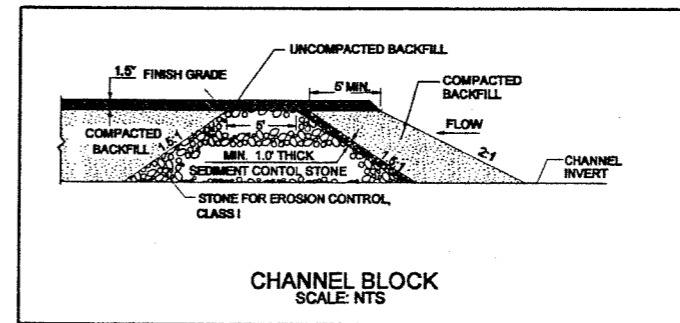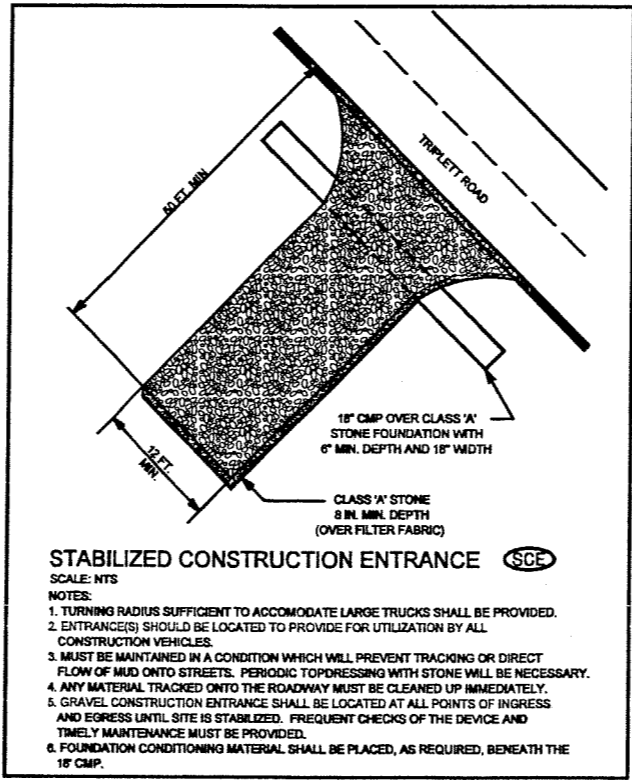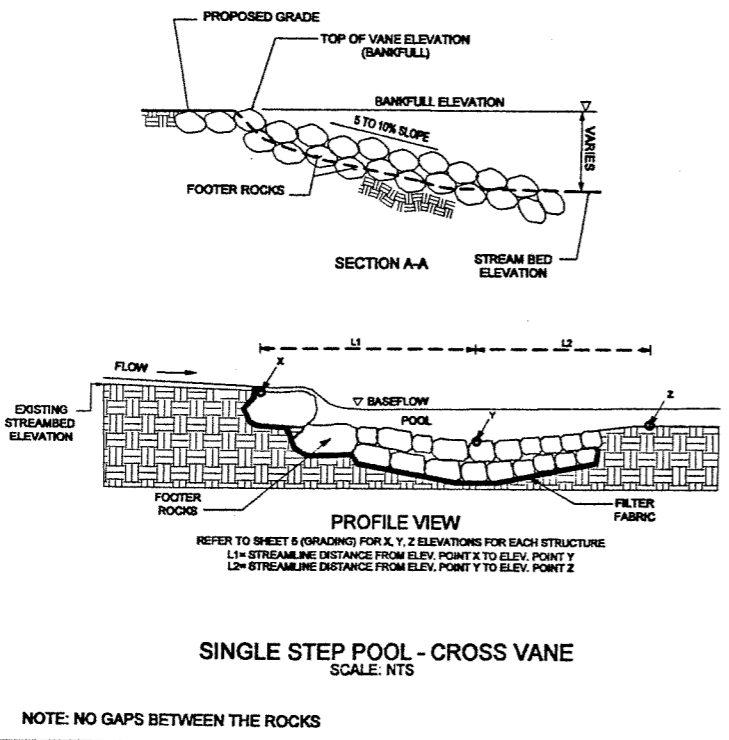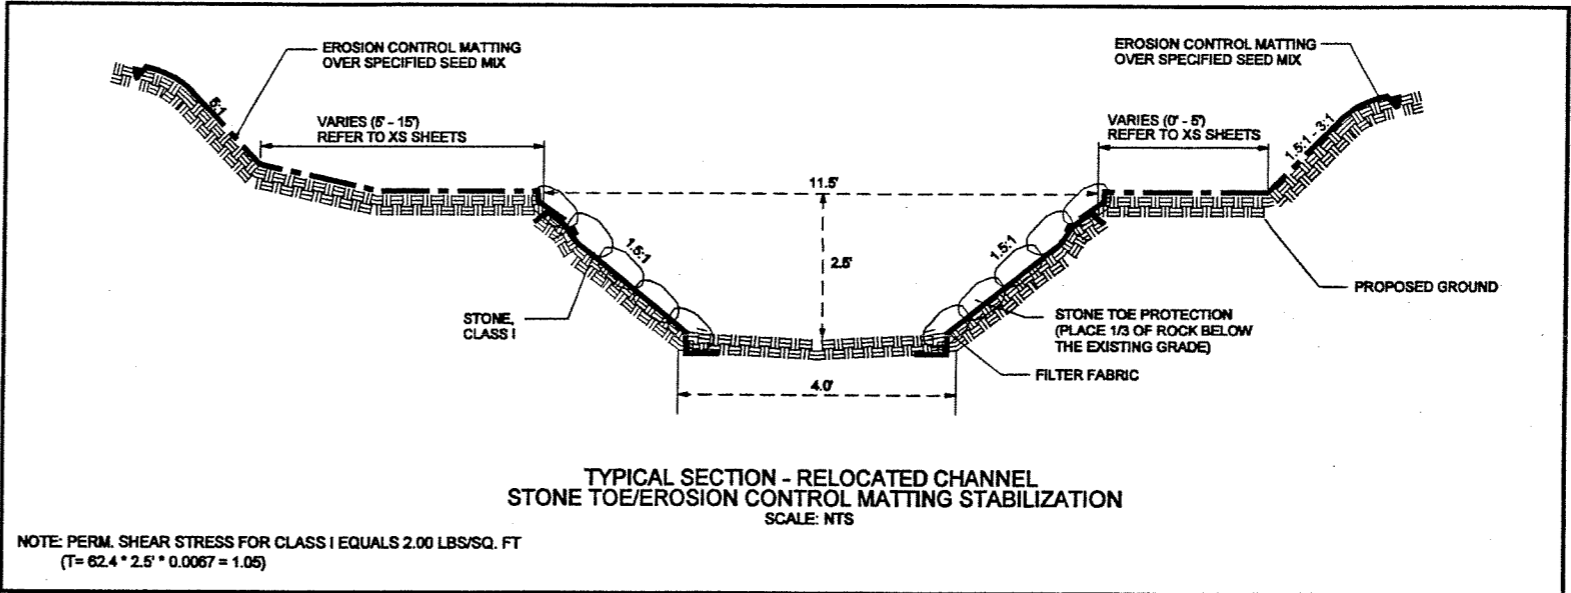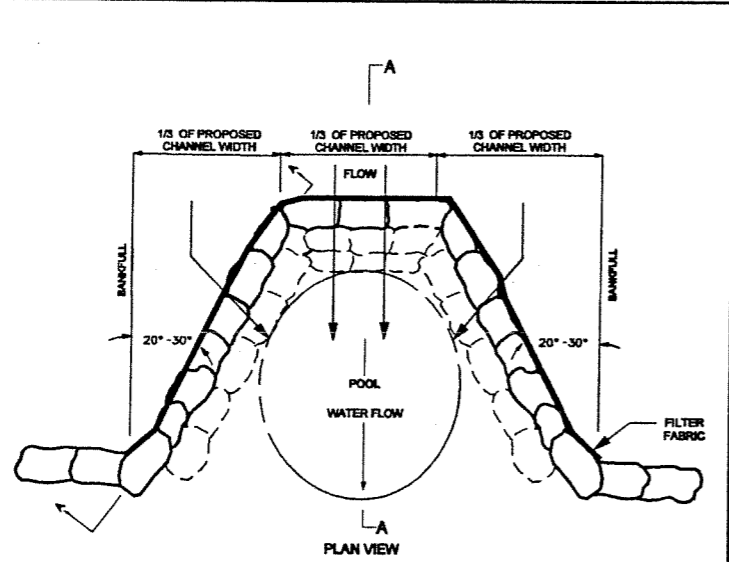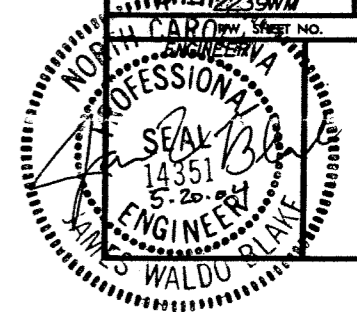


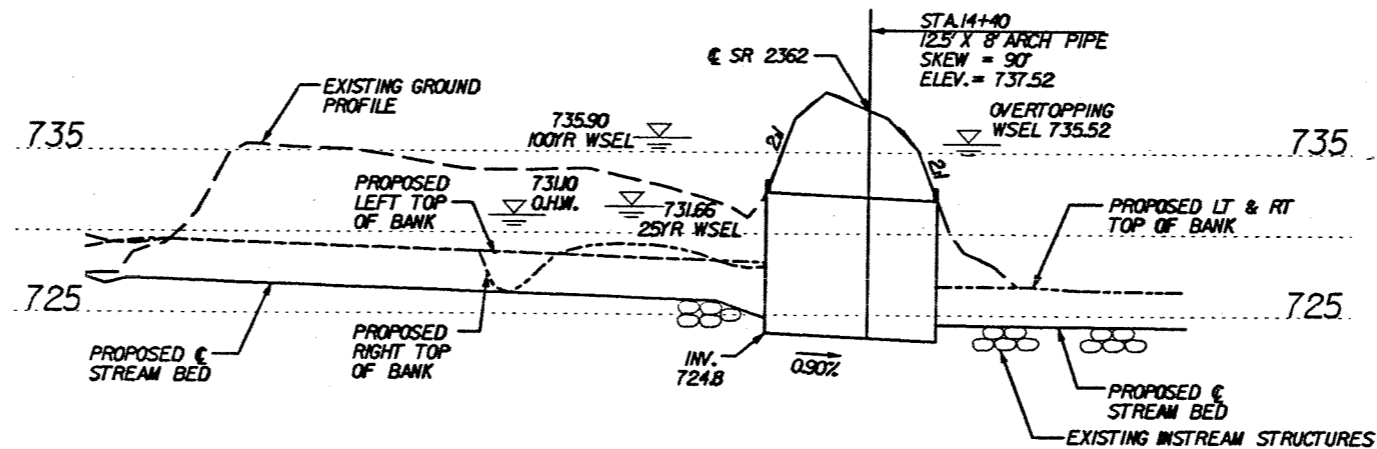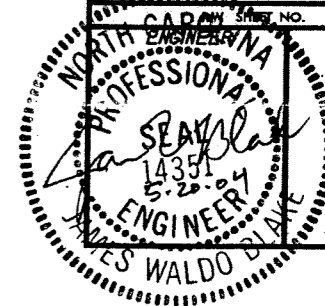


PROFILE VIEW OF RELOCATED
STREAM AND CULVERT
REFER TO CULVERT SURVEY REPORT
SCALE: 1" = 30' (5H: 1V)

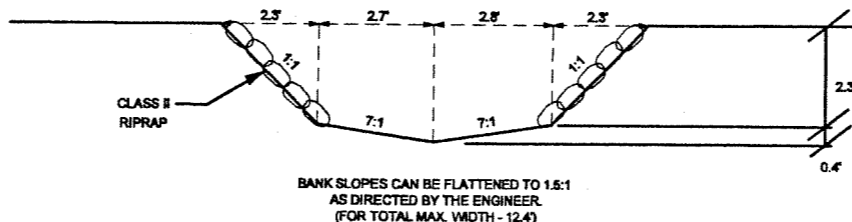


TYPICAL SECTION - DOWNSTREAM OF CULVERT
TIE-IN WITH EXISTING RESTORED CHANNEL
REFER TO CULVERT SURVEY REPORT
SCALE: NTS

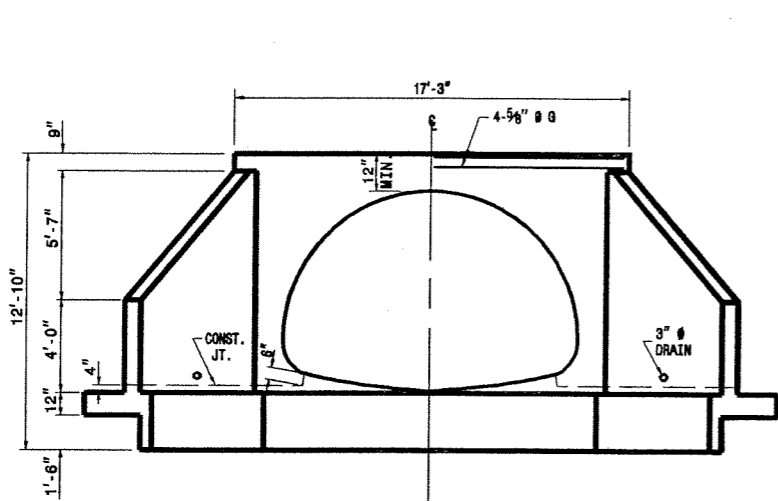


END ELEVATION

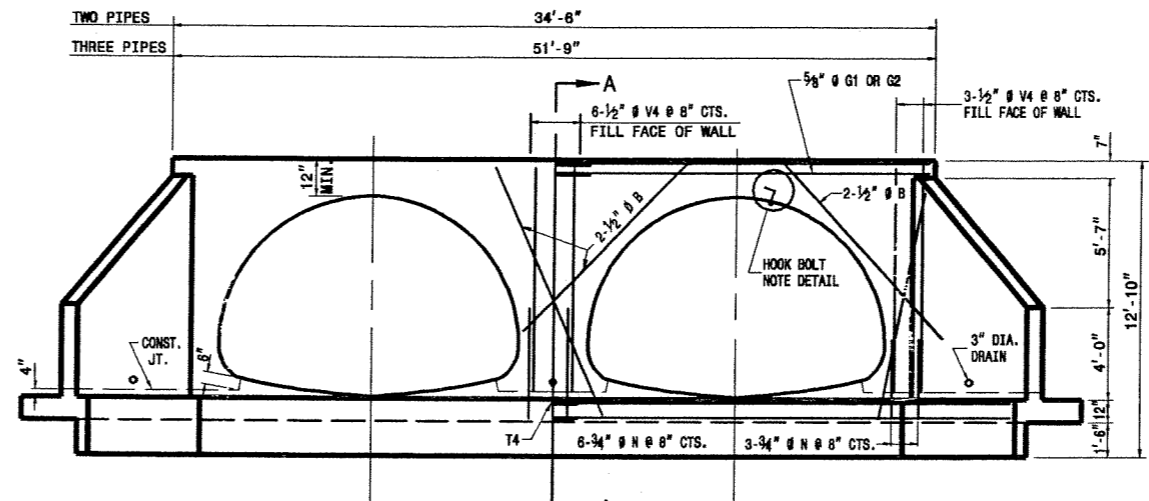


END ELEVATION

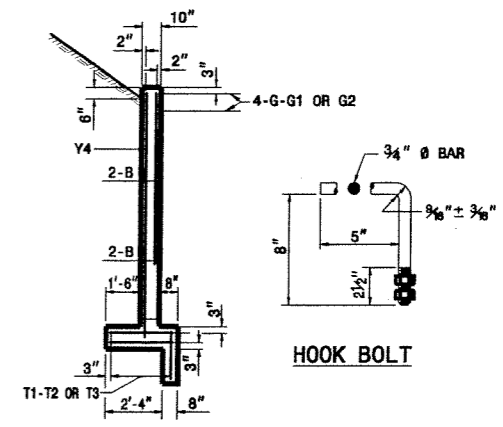

SECTION A-A FOR ALL ENDWALLS

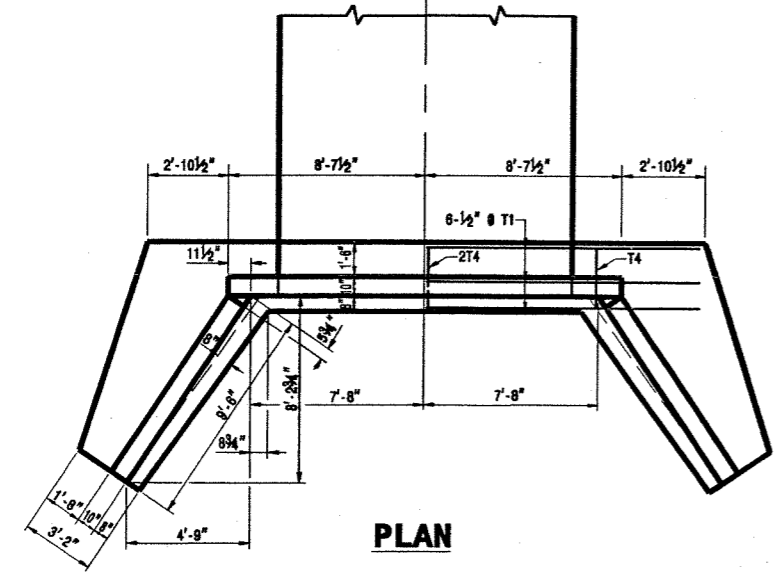


PLAN

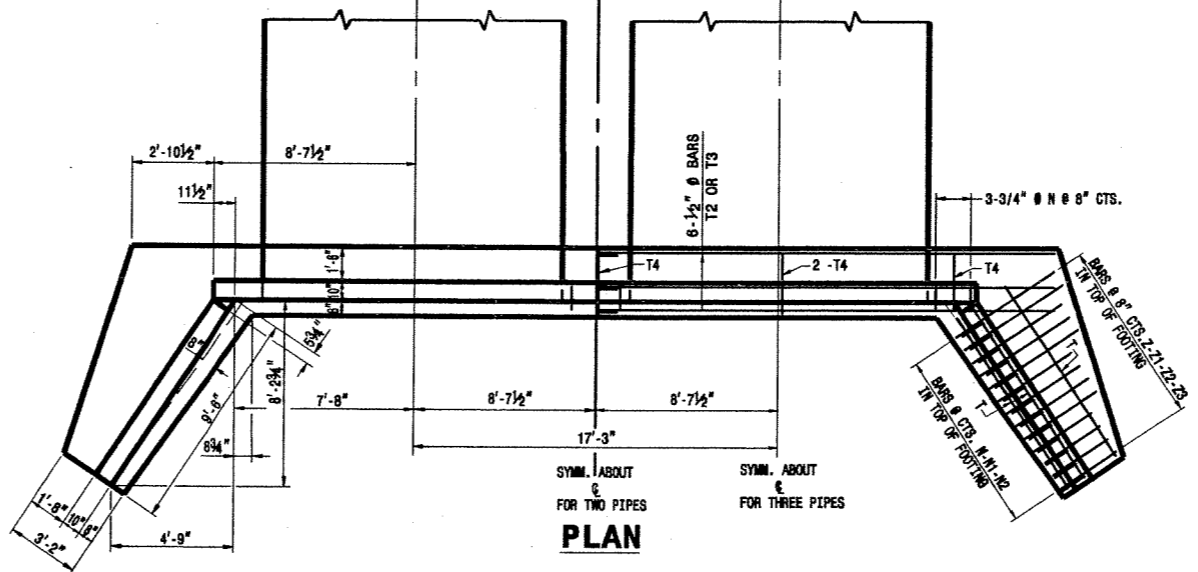


PLAN

BILL OF MATERIAL FOR ONE ENDWALL

BAR	SIZE	LENGTH	1 PIPE		2 PIPES		3 PIPES	
			NO.	WEIGHT	NO.	WEIGHT	NO.	WEIGHT
B	#4	10'-0"	8	53	16	107	24	160
G	#5	17'-0"	4	71	-	-	-	-
G1	#5	18'-3"	-	-	8	152	-	-
G2	#5	18'-9"	-	-	-	-	12	235
H	#4	11'-6"	12	92	12	92	12	92
H1	#4	9'-0"	4	24	4	24	4	24
H2	#4	5'-9"	6	23	6	23	6	23
N	#8	5'-0"	12	90	18	135	24	180
N1	#5	4'-6"	6	28	6	28	6	28
N2	#4	4'-1"	16	44	16	44	16	44
T	#4	9'-6"	6	38	6	38	6	38
T1	#4	23'-0"	6	92	-	-	-	-
T2	#4	20'-11"	-	-	12	167	-	-
T3	#4	20'-5"	-	-	-	-	18	245
T4	#4	2'-9"	4	7	7	13	10	19
V	#5	8'-0"	8	67	8	67	8	67
V1	#4	6'-0"	10	40	10	40	10	40
V2	#4	4'-9"	6	19	6	19	6	19
V3	#4	3'-9"	6	15	6	15	6	15
V4	#4	9'-10"	6	39	12	79	18	118
Z	#8	5'-8"	6	51	6	51	6	51
Z1	#5	5'-2"	6	32	6	32	6	32
Z2	#4	4'-7"	8	24	8	24	8	24
Z3	#4	3'-11"	8	21	8	21	8	21
TOTAL REINF. STEEL (lbs.)			870		1171		1475	
CLASS "A" CONC. (cu. yds.)			13.2		18.8		24.4	

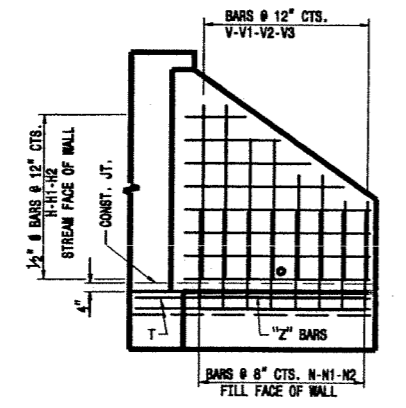

ELEVATION OF WING

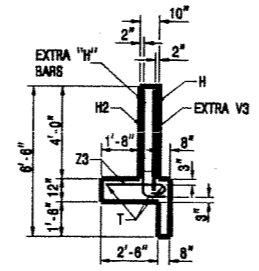


END OF WING


SHOWING REINFORCEMENT

GENERAL NOTES


- ALL CONCRETE TO BE CLASS "A".
- ALL REINFORCING STEEL SHALL BE ASTM A615-GRADE 60.
- ALL REINFORCING STEEL SHALL BE DEFORMED BARS. WHERE SPLICING OF REINFORCEMENT IS NECESSARY, BARS ARE TO BE LAPPED 45 DIAMETERS. ALL DIMENSIONS RELATIVE TO REINFORCEMENT ARE TO CENTERS OF BARS.
- THE FOOTING, CURTAIN WALL AND 4" OF WALL ARE TO BE POURED IN ONE OPERATION ALLOWING NO TIME FOR INITIAL SET TO TAKE PLACE BETWEEN THEM. THE REMAINING WALL SHALL THEN BE POURED IN ONE OPERATION.
- ALL EXPOSED CORNERS ARE TO BE CHAMFERED 1".
- 3" DIAMETER DRAINS SHALL BE PLACED IN WALL AS SHOWN AND BE 6" ABOVE NORMAL FLOW LINE.
- ALL MATERIAL AND WORKMANSHIP AS PER SPECIFICATIONS OF THE N.C. DEPARTMENT OF TRANSPORTATION.
- THE FOLLOWING EXTRA BARS ARE PROVIDED FOR HOLDING REINFORCING STEEL IN CORRECT POSITION IN WINGS: 2H-1H2-2H4-1H6-3T-3T1-2V-1V1-2V2.

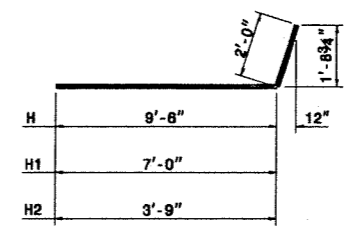

BAR H1-H2-H3

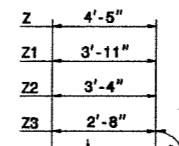

BAR Z-Z1-Z2-Z3

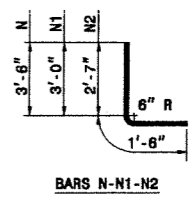

BAR N-N1-N2


DESIGN SERVICES UNIT
STANDARDS AND SPECIAL DESIGN
 Office 919-250-4128 FAX 919-250-4119

DETAIL OF REINFORCED CONCRETE ENDWALL FOR 150" X 96" PIPE ARCH - 90°


ORIGINAL BY: T. Spell DATE: Oct. 1998
 MODIFIED BY: DATE: _____
 CHECKED BY: DATE: _____
 FILE: RPEC - ds174/wr/deta119/stand/andsp1narch.dgn

PROJECT REFERENCE NO.
R-2239 WM

PROJECT TYPICAL

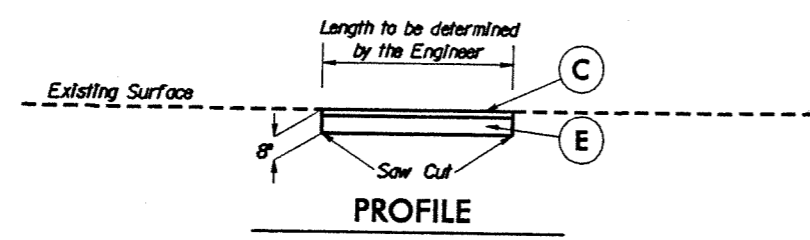

PAVEMENT SCHEDULE	
C	PROP. APPROX. 2" ASPHALT CONCRETE SURFACE COURSE, TYPE S9.5B, AT AN AVERAGE RATE OF 112 LBS. PER SQ. YD. IN EACH OF TWO LAYERS.
E	PROP. APPROX. 6" ASPHALT CONCRETE BASE COURSE, TYPE B25.0B, AT AN AVERAGE RATE OF 342 LBS. PER SQ. YD. IN EACH OF TWO LAYERS.

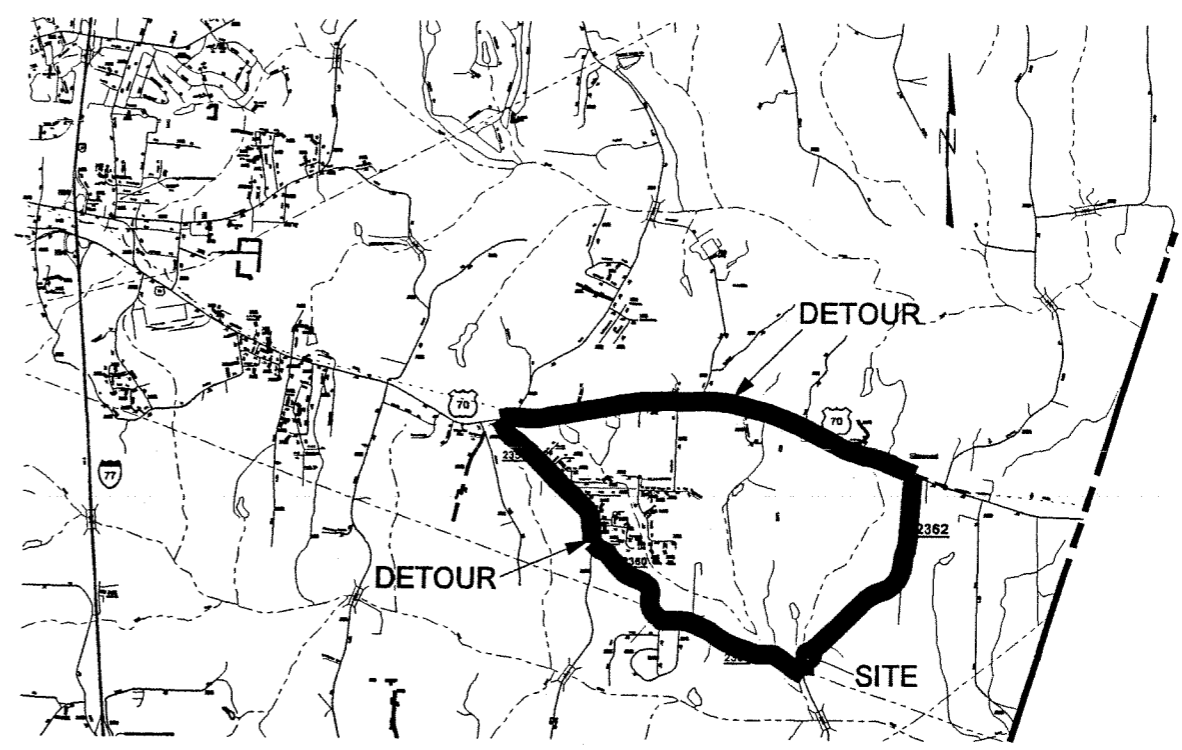

VICINITY MAP

DIVISION OF HIGHWAYS
STATE OF NORTH CAROLINA



SUMMARY OF QUANTITIES

<u>SECT.</u>	<u>QUANTITY</u>	<u>UNIT</u>	<u>ITEM DESCRIPTION</u>
800	1	LS	MOBILIZATION
228	1	AC	SUPPLEMENTAL CLEARING AND GRUBBING
228	1	LS	GRADING
867	100	LF	FENCE RESET
1660	2	AC	SEEDING AND MULCHING
1056	85	SY	FILTER FABRIC FOR DRAINAGE
1610	20	TON	SEDIMENT CONTROL STONE
1610	85	TON	STONE FOR EROSION CONTROL, CLASS A
1610	20	TON	STONE FOR EROSION CONTROL, CLASS B
1610	15	TON	STONE FOR EROSION CONTROL, CLASS 1
SP	160	TON	STONE, CLASS 1
SP	15	TON	STONE, CLASS 2
SP	50	TON	STONE, BOULDER
520	50	TON	ABC - INCIDENTAL STONE
300	50	TON	FOUNDATION CONDITIONING MATERIAL
SP	1600	SY	EROSION CONTROL (COIR) MATTING
1630	5	CY	SILT EXCAVATION
840	1	CY	PIPE PLUGS
310	20	LF	18" CS PIPE CULV, 0.064" THICK
310	55	LF	12.5' X 8' ARCH PIPE
838	25	CY	REINFORCED ENDWALL
SP	150	LF	SAFETY FENCE

SUMMARY OF EARTHWORK

IN CUBIC YARDS

SITE EXCAVATION =	2,400 CY
SITE EMBANKMENT =	160 CY
NET WASTE =	2,240 CY

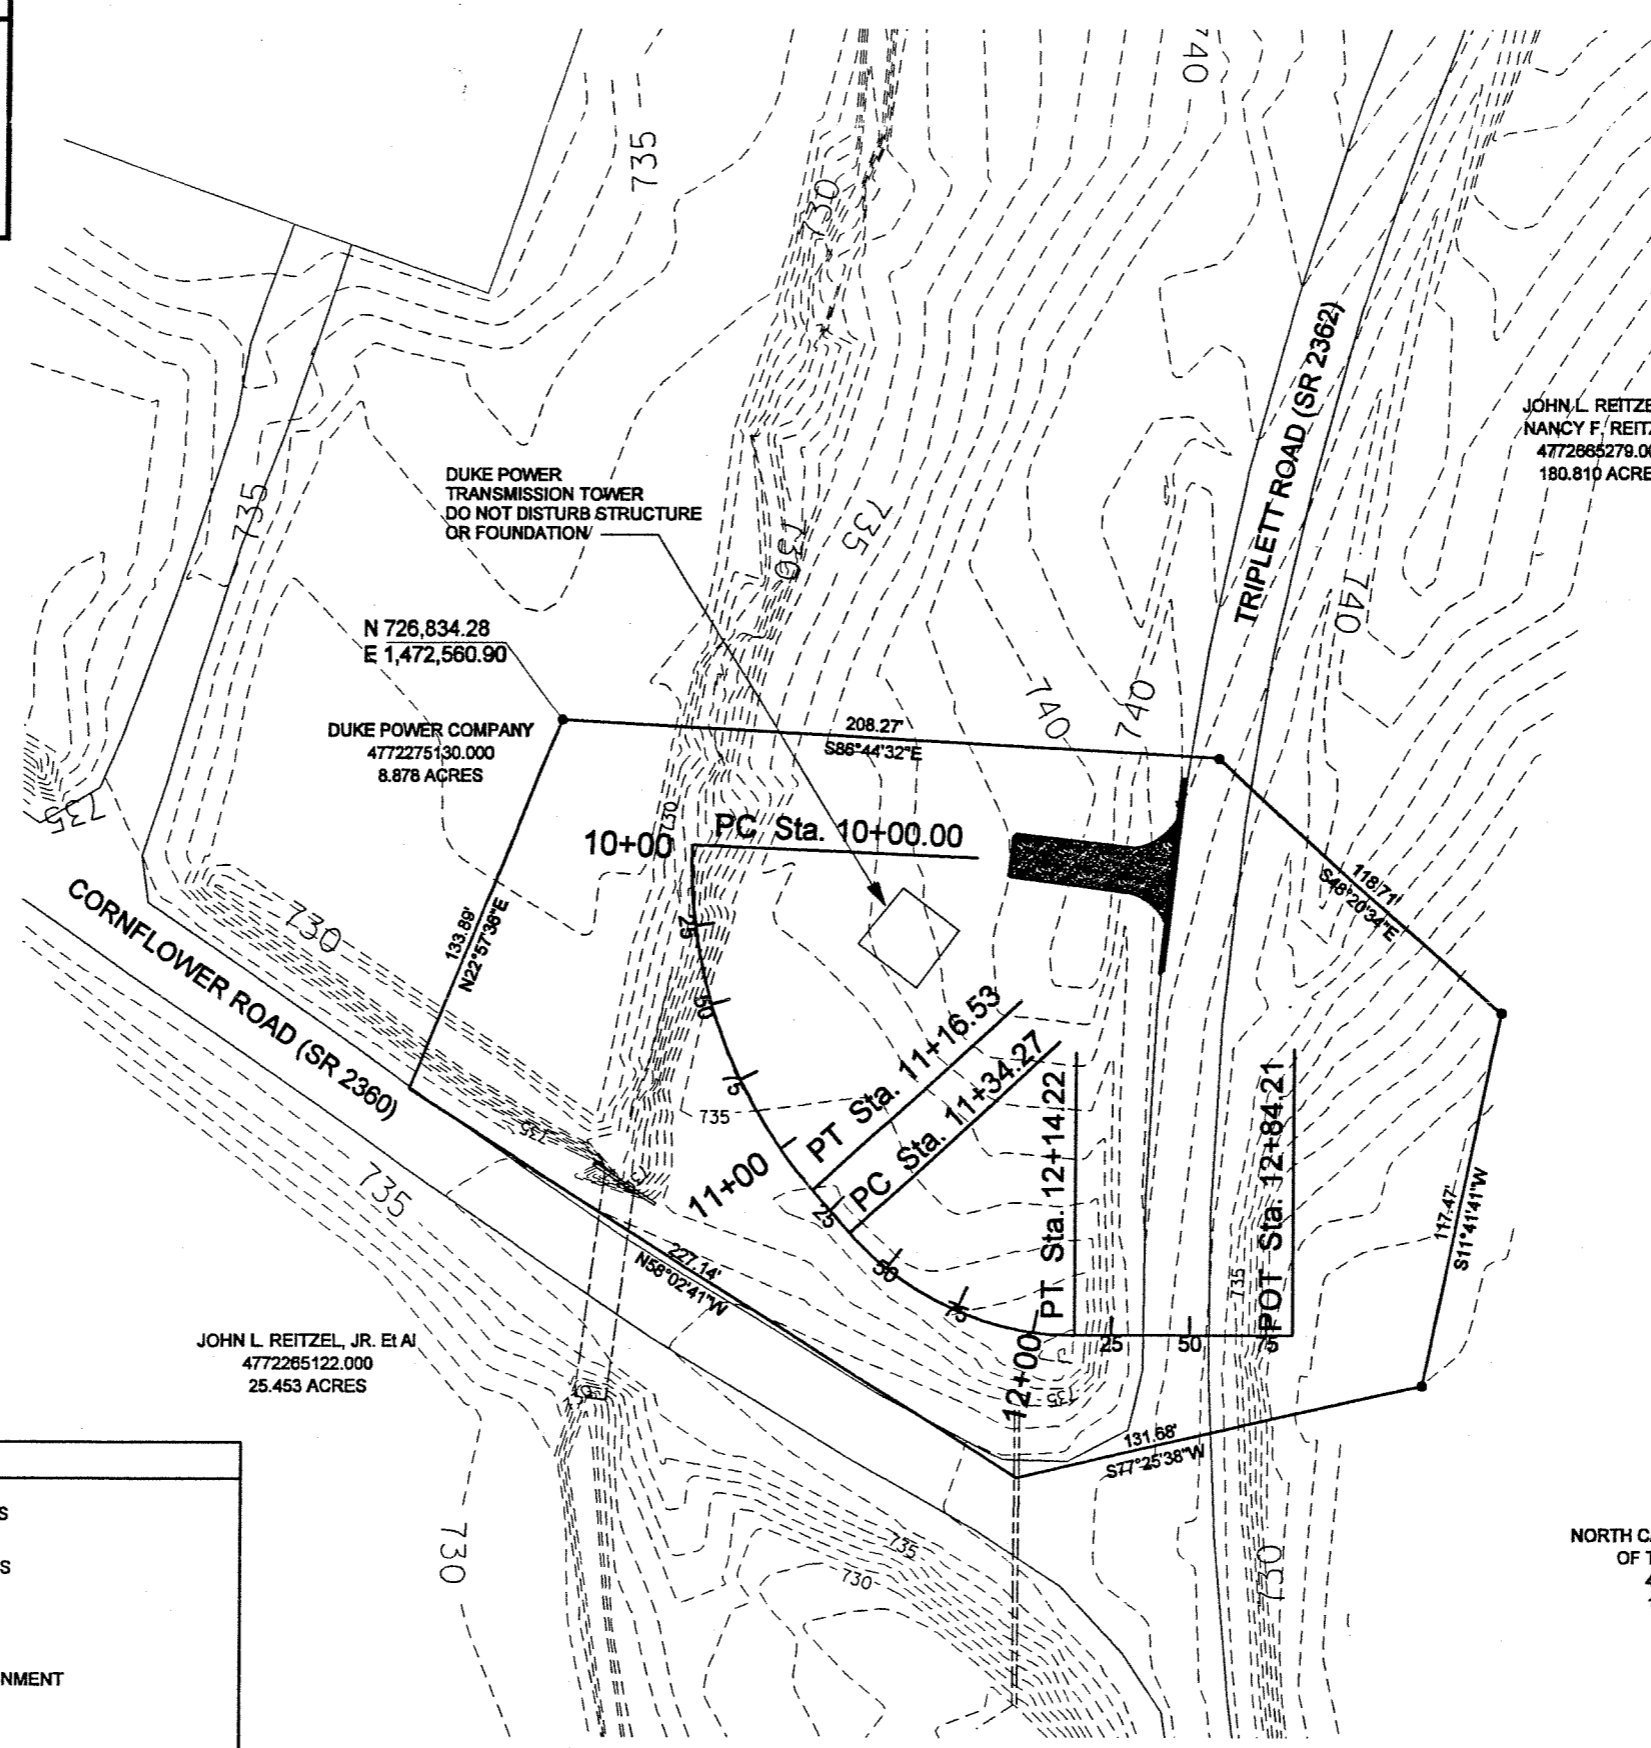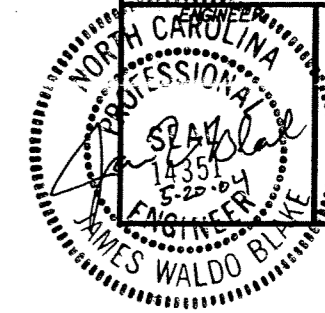

JOHN L. REITZEL & NANCY F. REITZEL
4772865279.000
180.810 ACRES


DUKE POWER COMPANY
4772275130.000
8.878 ACRES



JOHN L. REITZEL, JR. Et Al
4772285122.000
25.453 ACRES

NORTH CAROLINA DEPARTMENT OF TRANSPORTATION
4772456582.000
161.863 ACRES

LIMITS LEGEND	
	EXISTING MINOR CONTOURS
	EXISTING MAJOR CONTOURS
	LIMIT OF DISTURBANCE
	PROPOSED RELOCATE ALIGNMENT
	DUKE POWER TOWER

LIMITS OF OPERATION

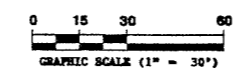

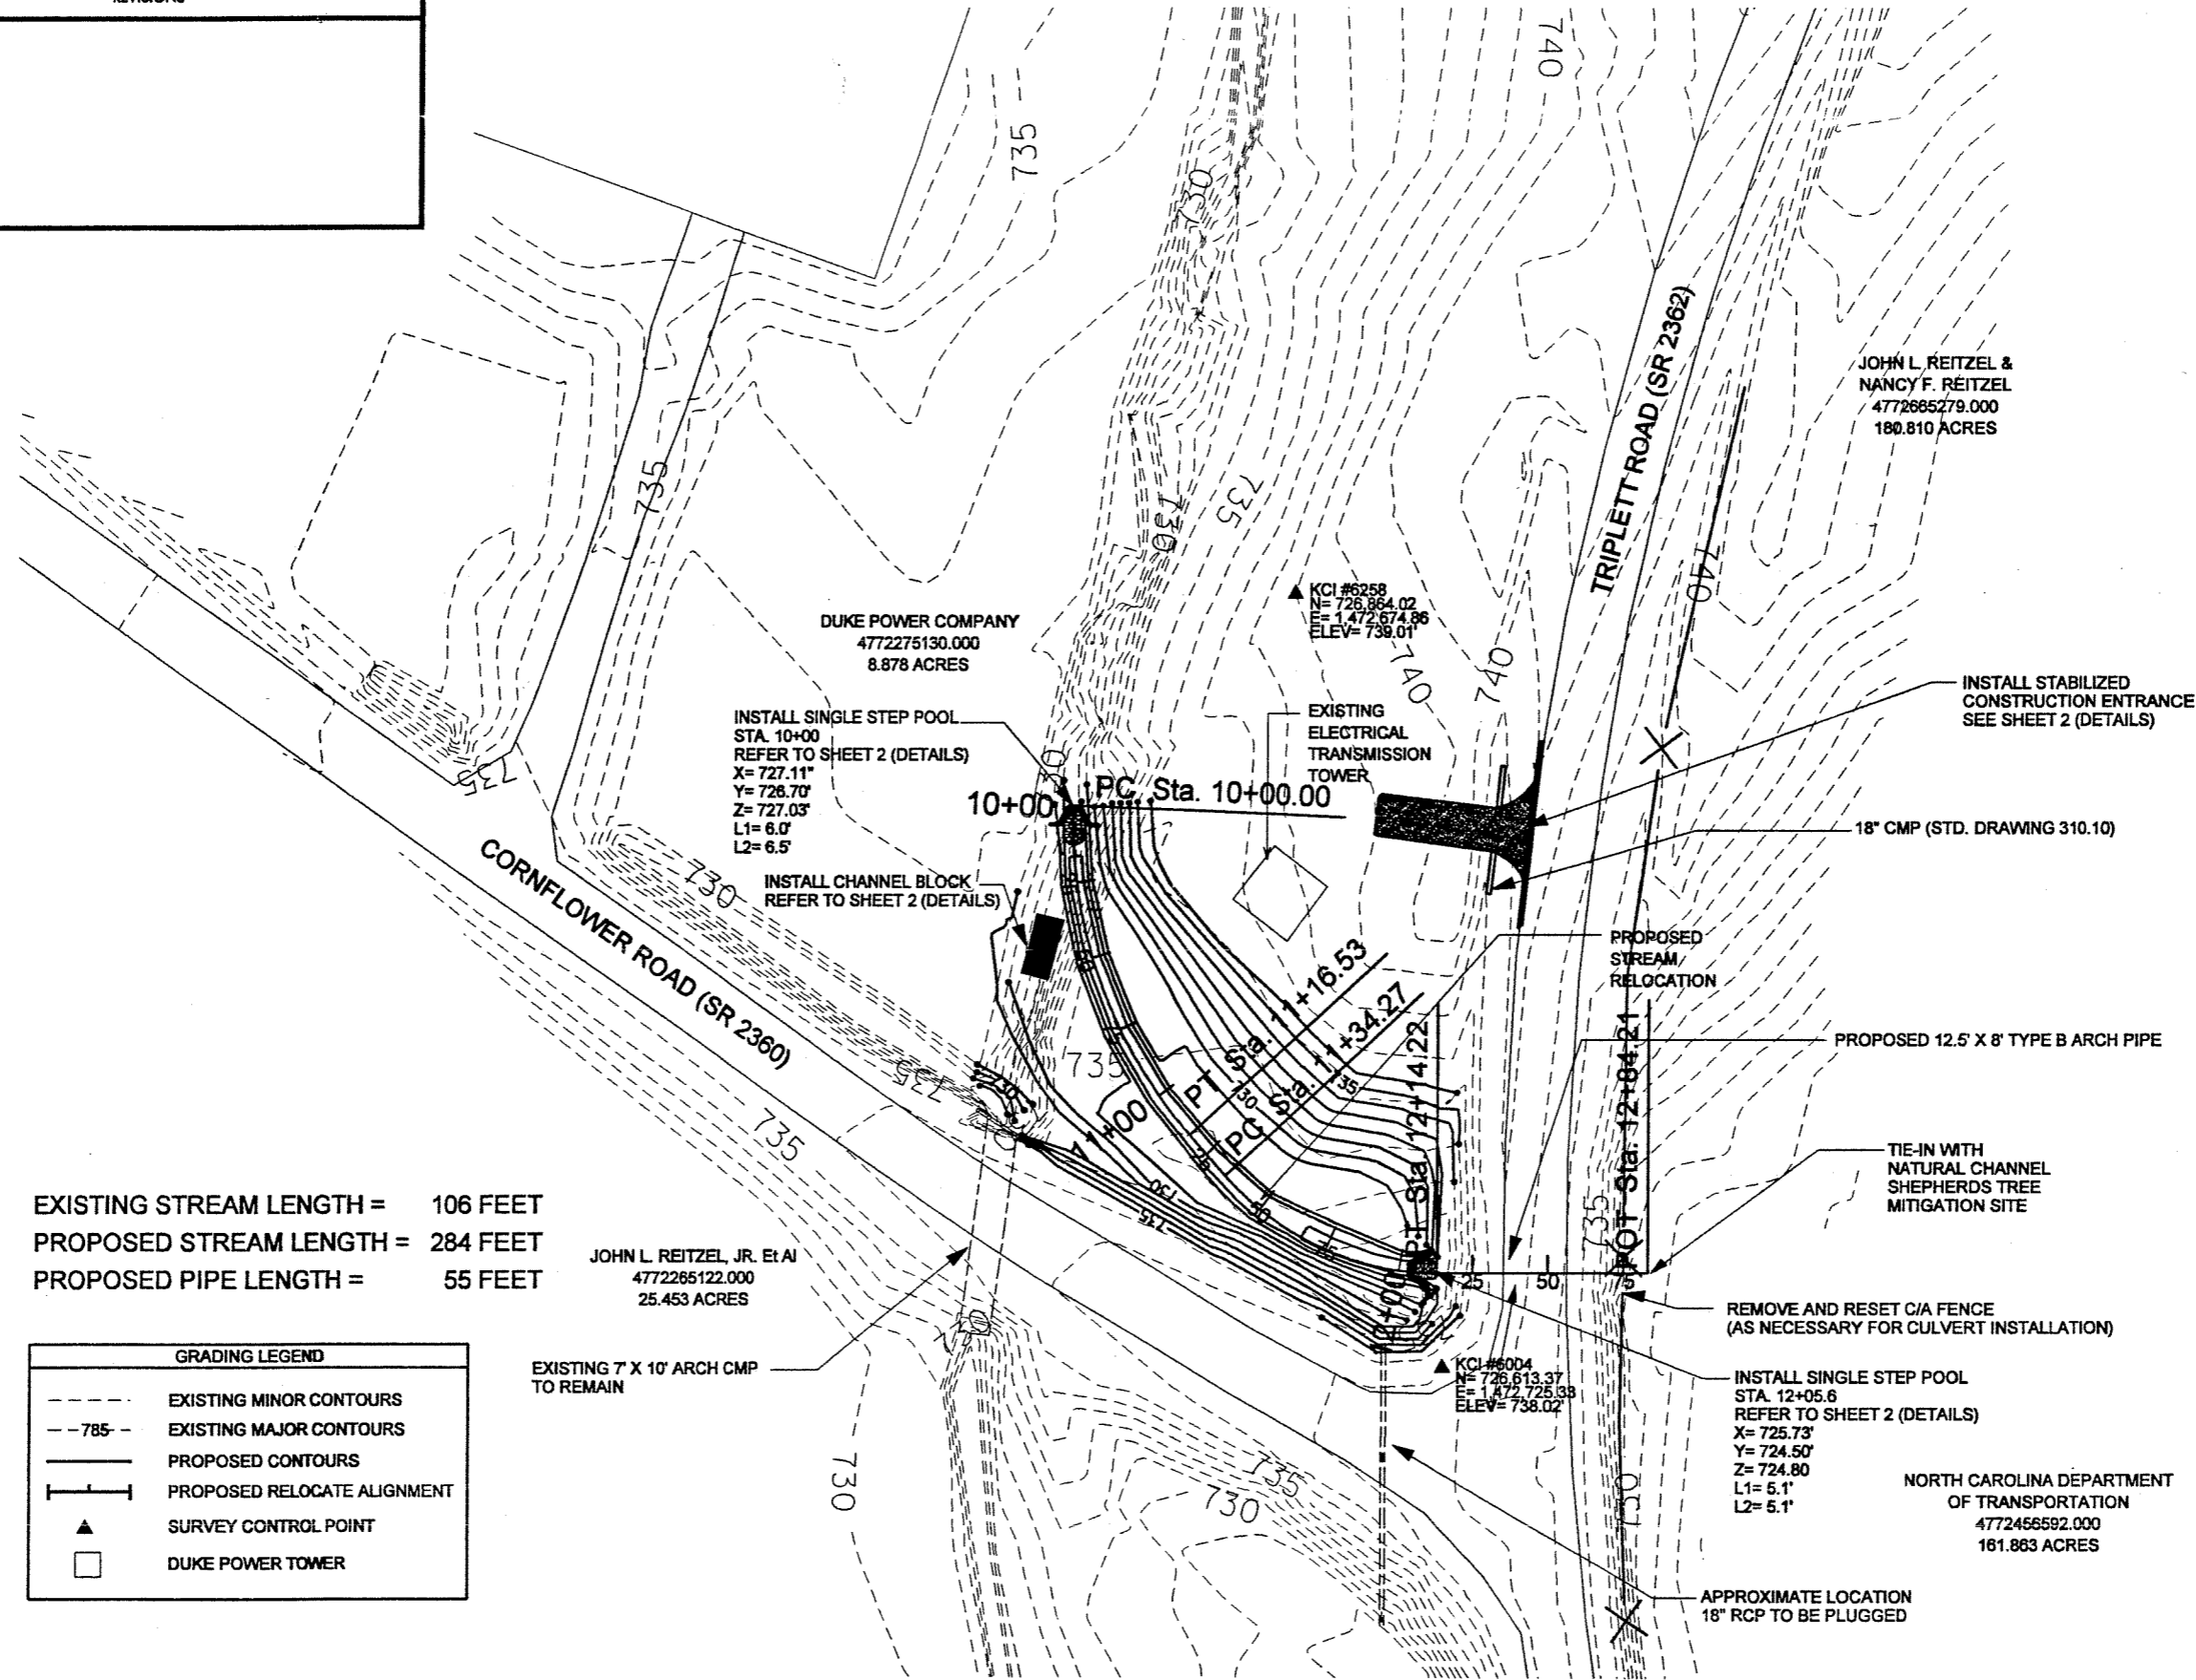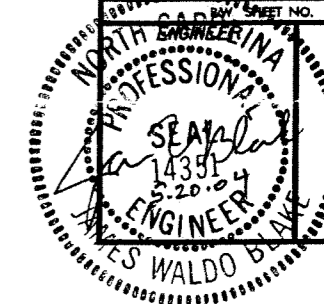

EXISTING STREAM LENGTH = 106 FEET
PROPOSED STREAM LENGTH = 284 FEET
PROPOSED PIPE LENGTH = 55 FEET


GRADING LEGEND	
---	EXISTING MINOR CONTOURS
- - - 785 - - -	EXISTING MAJOR CONTOURS
---	PROPOSED CONTOURS
---	PROPOSED RELOCATE ALIGNMENT
▲	SURVEY CONTROL POINT
□	DUKE POWER TOWER


JOHN L. REITZEL, JR. Et Al
4772285122.000
25.453 ACRES

JOHN L. REITZEL &
NANCY F. REITZEL
4772685279.000
180.810 ACRES

NORTH CAROLINA DEPARTMENT
OF TRANSPORTATION
4772456592.000
181.863 ACRES

GRADING

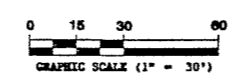

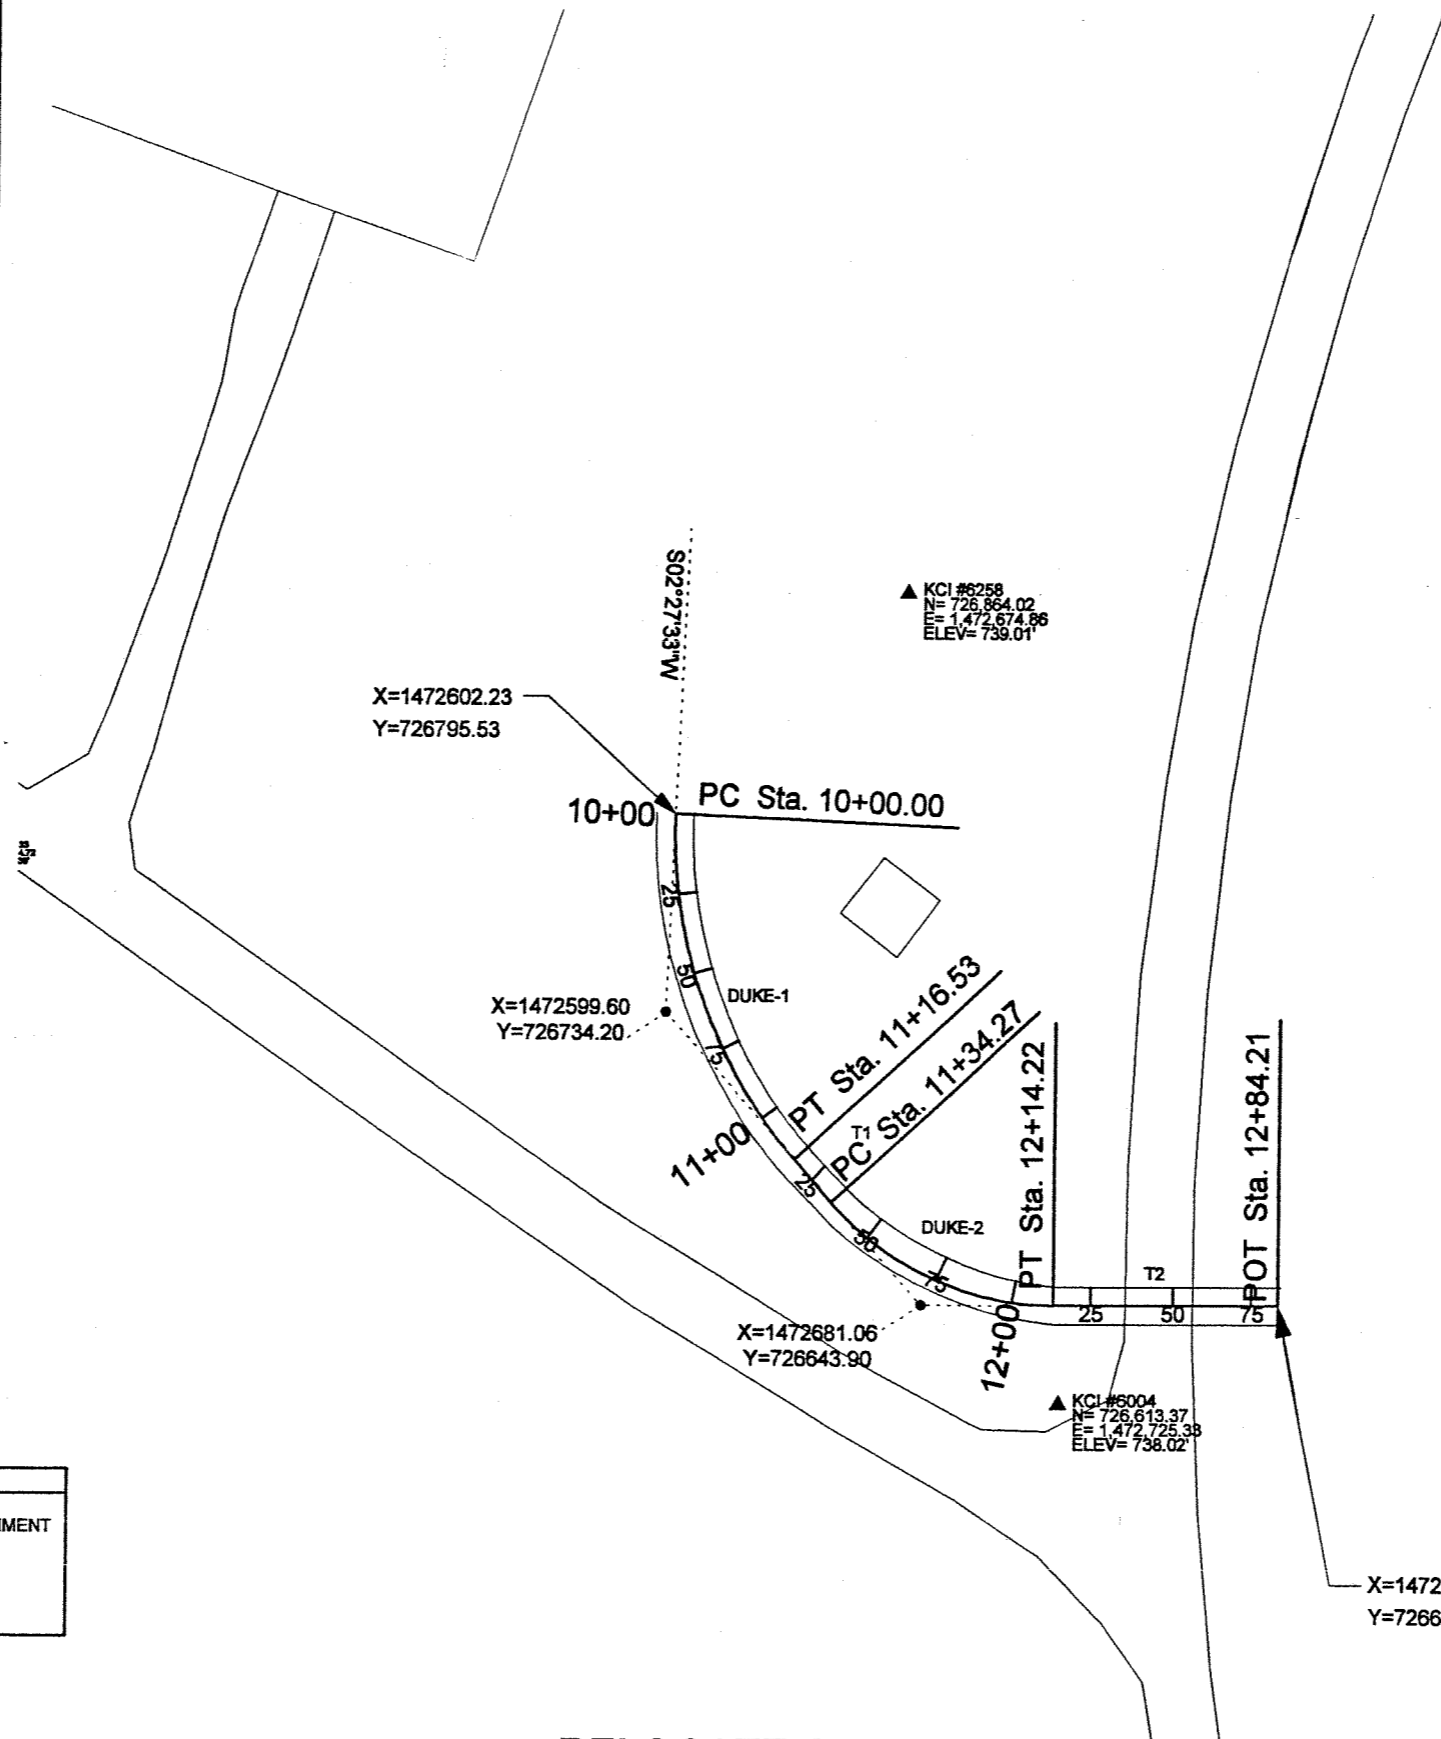

Curve DUKE-1
 P.I. Station 10+61.38 N 726,734.20 E 1,472,599.60
 Delta = 44° 30' 39.79" (LT)
 Degree = 38° 11' 49.87"
 Tangent = 61.38
 Length = 116.53
 Radius = 150.00
 External = 12.07
 Long Chord = 113.62
 Mid. Ord. = 11.17
 P.C. Station 10+00.00 N 726,795.53 E 1,472,602.24
 P.T. Station 11+16.53 N 726,688.62 E 1,472,640.72
 C.C. N 726,789.09 E 1,472,752.10
 Back = S 2° 27' 32.81" W
 Ahead = S 42° 03' 06.98" E
 Chord Bear = S 19° 47' 47.08" E

Course from PT DUKE-1 to PC DUKE-2 S 42° 03' 06.98" E Dist 17.74


Curve DUKE-2
 P.I. Station 11+76.76 N 726,643.90 E 1,472,681.06
 Delta = 47° 56' 53.02" (LT)
 Degree = 59° 58' 29.31"
 Tangent = 42.48
 Length = 79.95
 Radius = 95.53
 External = 9.02
 Long Chord = 77.63
 Mid. Ord. = 8.24
 P.C. Station 11+34.27 N 726,675.45 E 1,472,652.60
 P.T. Station 12+14.22 N 726,643.90 E 1,472,723.54
 C.C. N 726,739.44 E 1,472,723.54
 Back = S 42° 03' 06.98" E
 Ahead = Due East
 Chord Bear = S 66° 01' 33.49" E


Course from PT DUKE-2 to 101 Due East Dist 69.98

Point 101 N 726,643.90 E 1,472,793.65 Sta 12+84.21


GEOMETRY LEGEND	
	PROPOSED RELOCATE ALIGNMENT
	SURVEY CONTROL POINT
	DUKE POWER TOWER

RELOCATE GEOMETRY

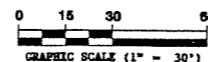


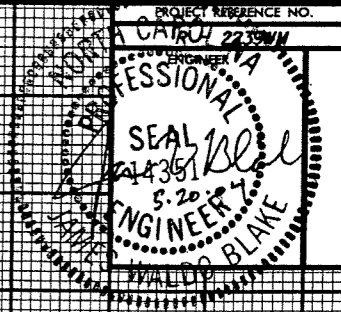

--- EXISTING SECTION
— PROPOSED SECTION
SCALE: P = 20' HORIZ.
SCALE: V = 4' VERT.

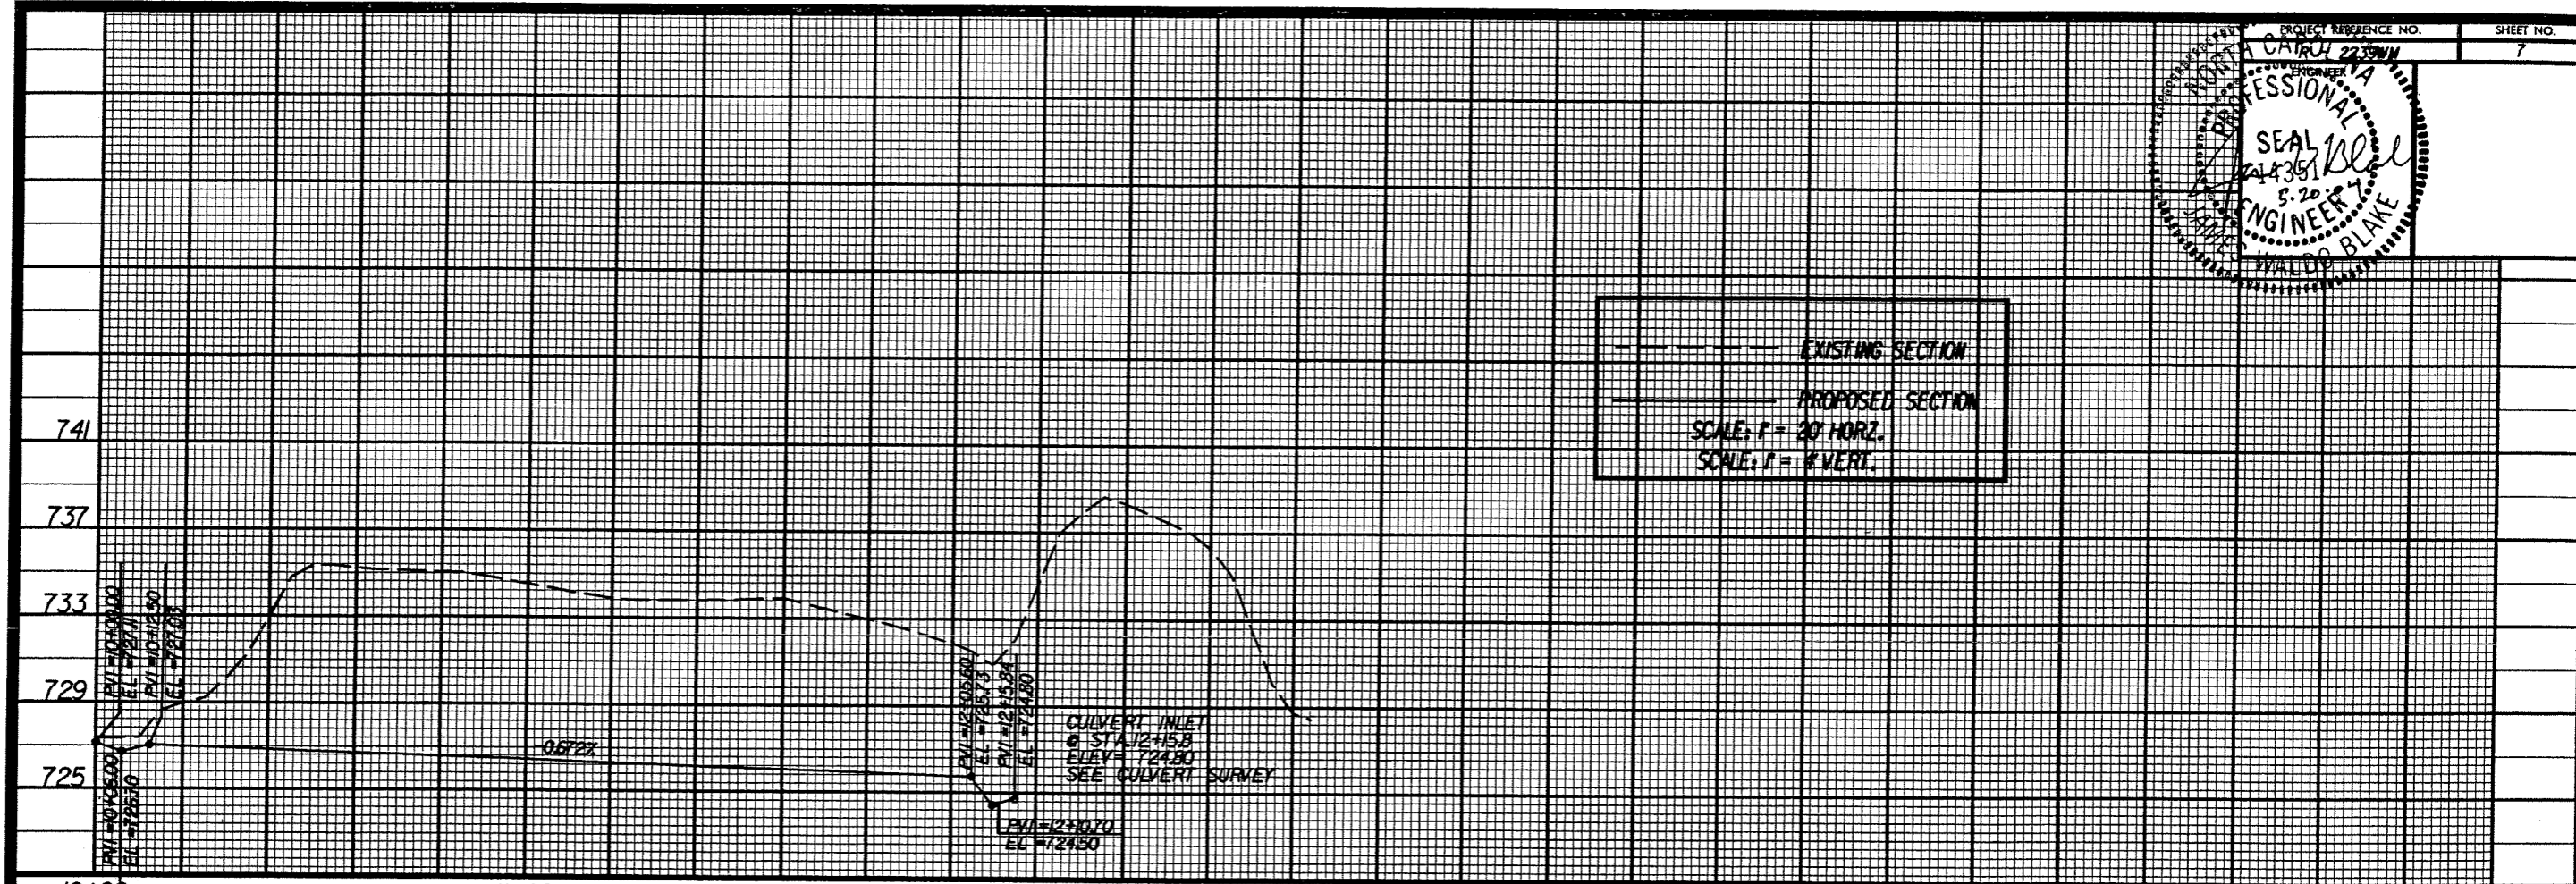

10+00 11+00 12+00 13+00 14+00 15+00

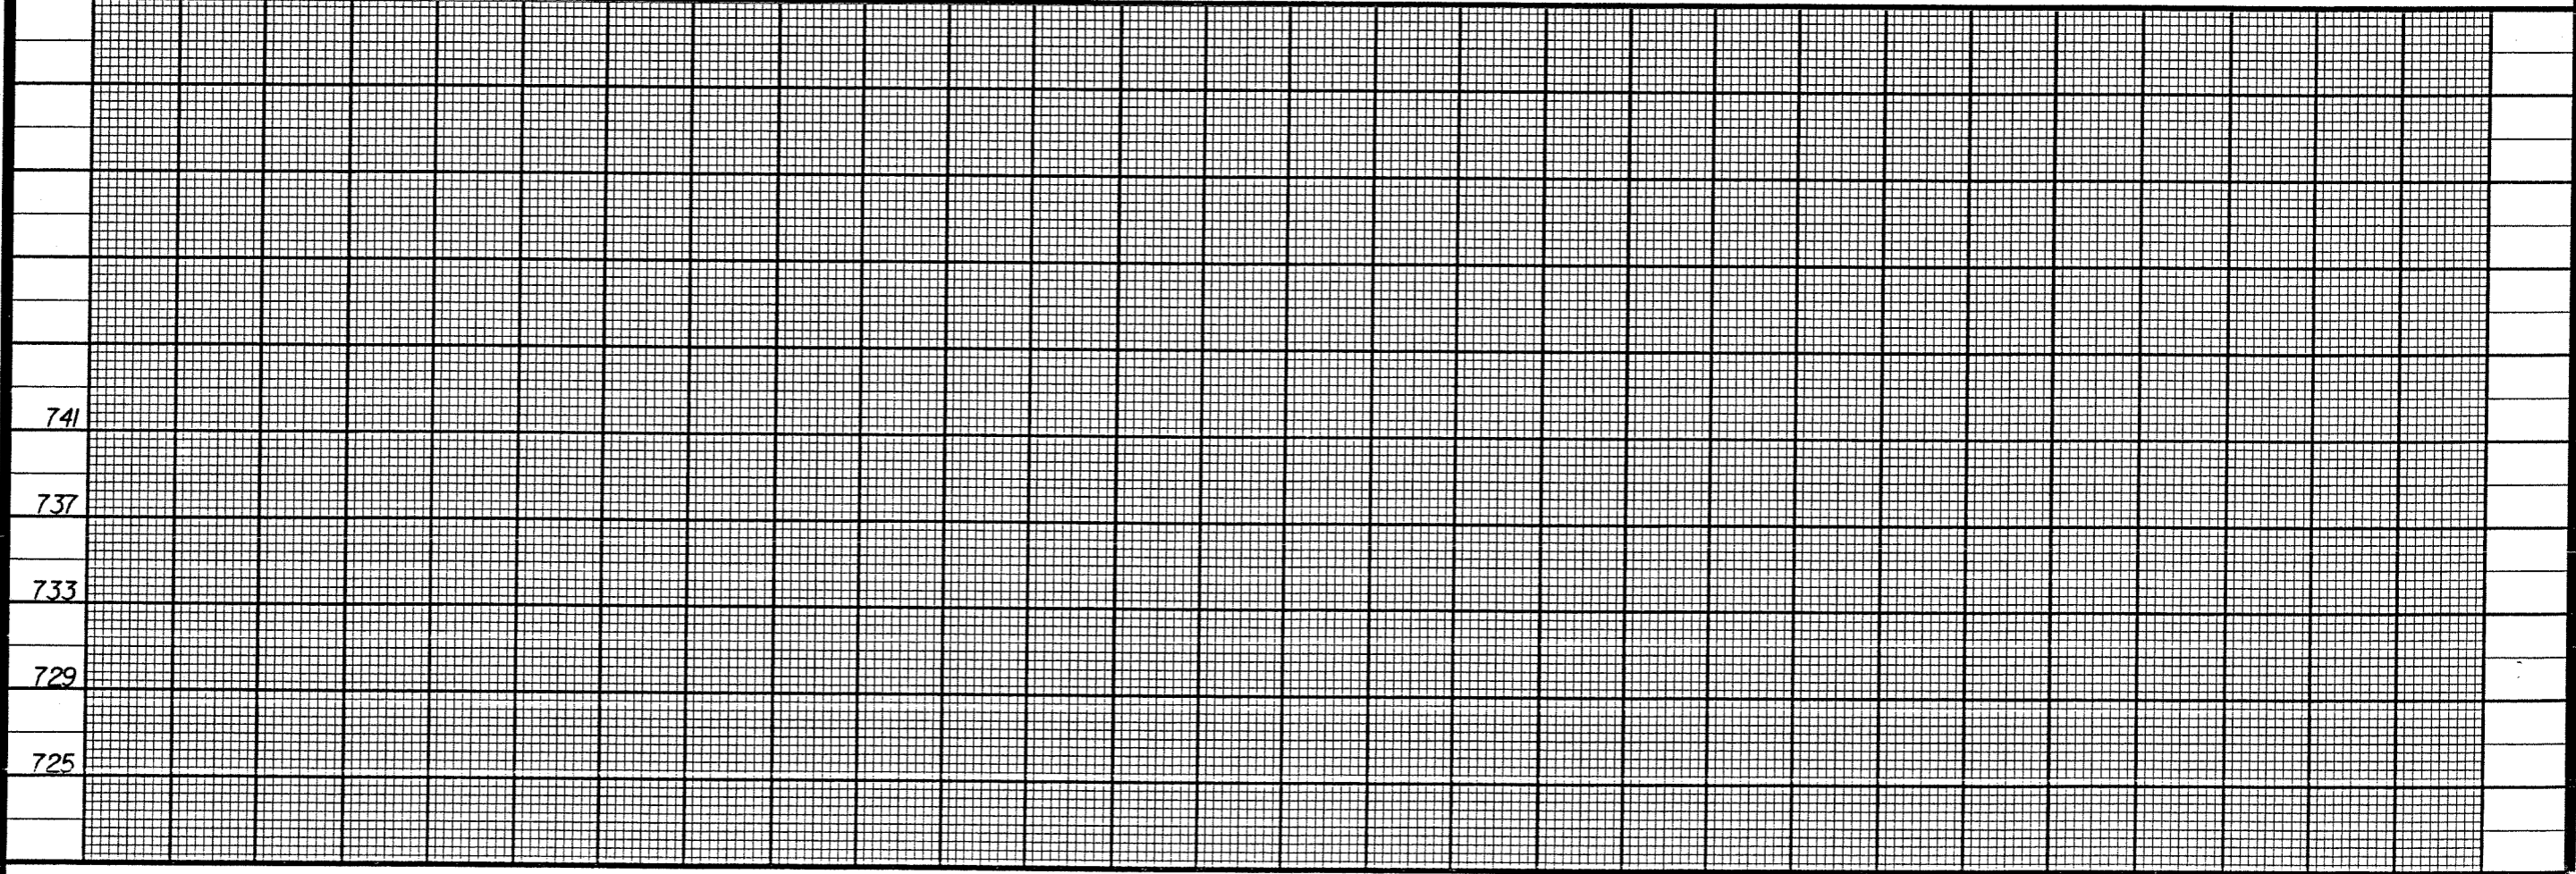






02.10.1.58

150 120 90 60 30 0 30 60 90 120 150

150 120 90 60 30 0 30 60

PROJ. REFERENCE NO.	SHEET NO.	TOTAL SHEETS
R-2239mm	XS-1	2

 EXISTING SECTION
 PROPOSED SECTION
 SCALE = 3" = 1"

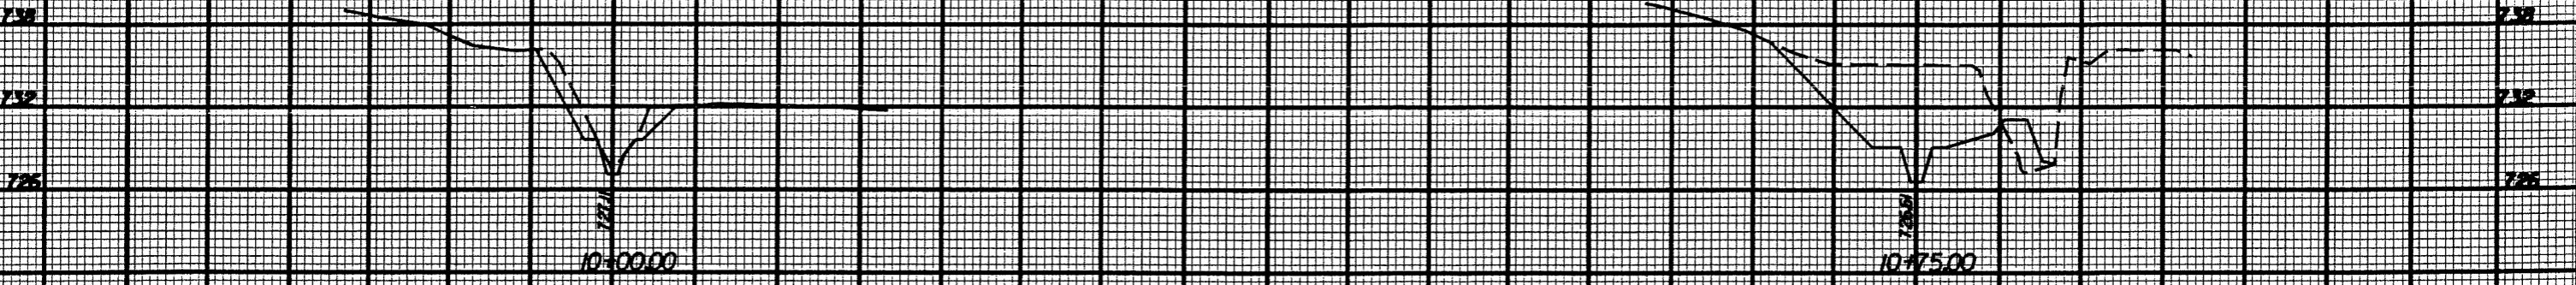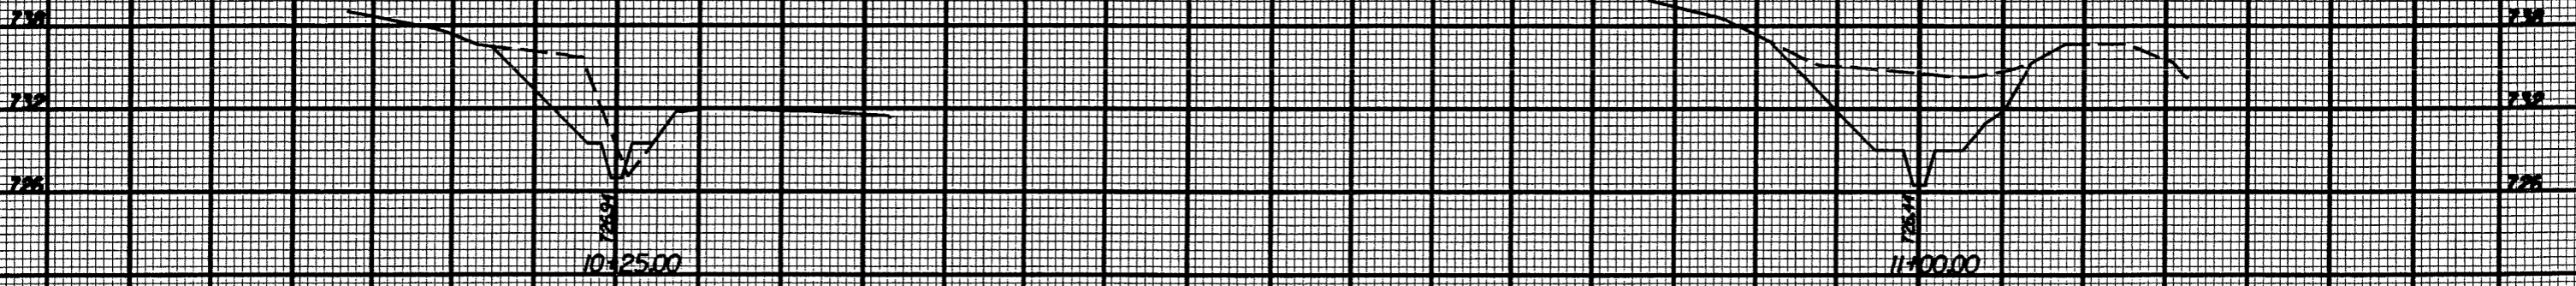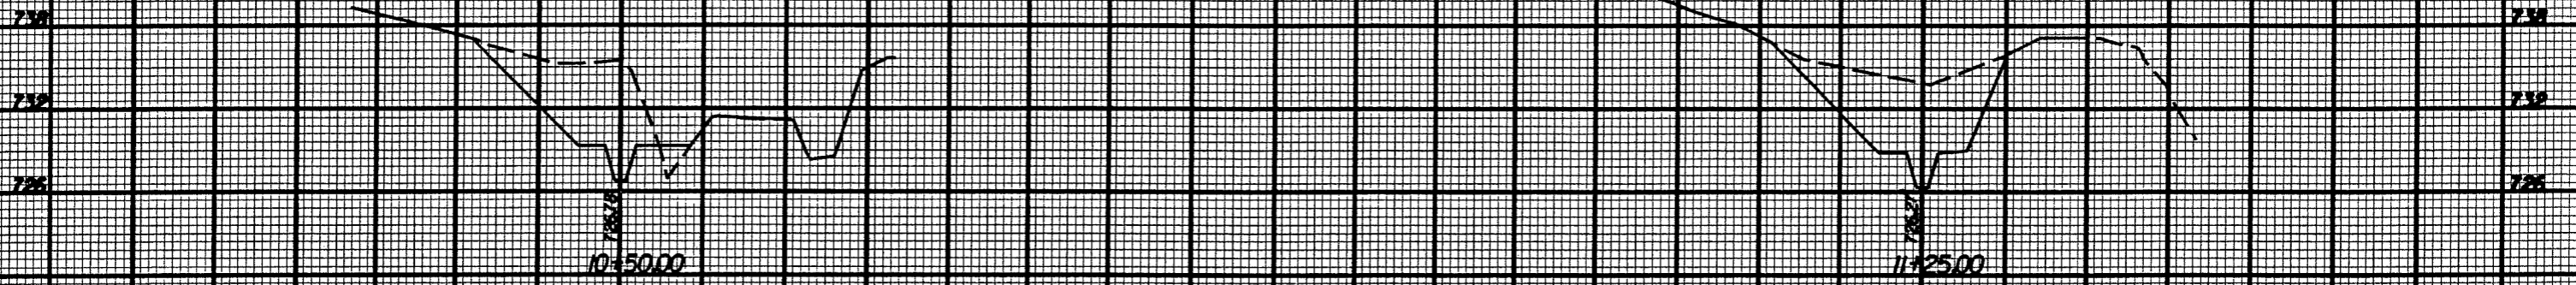

150 120 90 60 30 0 30 60 90 120 150




60
50
40
30
20
10
0
10
20
30
40
50
60

150 120 90 60 30 0 30 60 90 120 150

150 120 90 60 30 0 30 60 90 120 150

PROJ. REFERENCE NO. R-7239MM	SHEET NO. XS-2	TOTAL SHEETS 2
---------------------------------	-------------------	-------------------

— — — — — EXISTING SECTION
 — — — — — PROPOSED SECTION
 SCALE: 1" = 30' 5/11/14

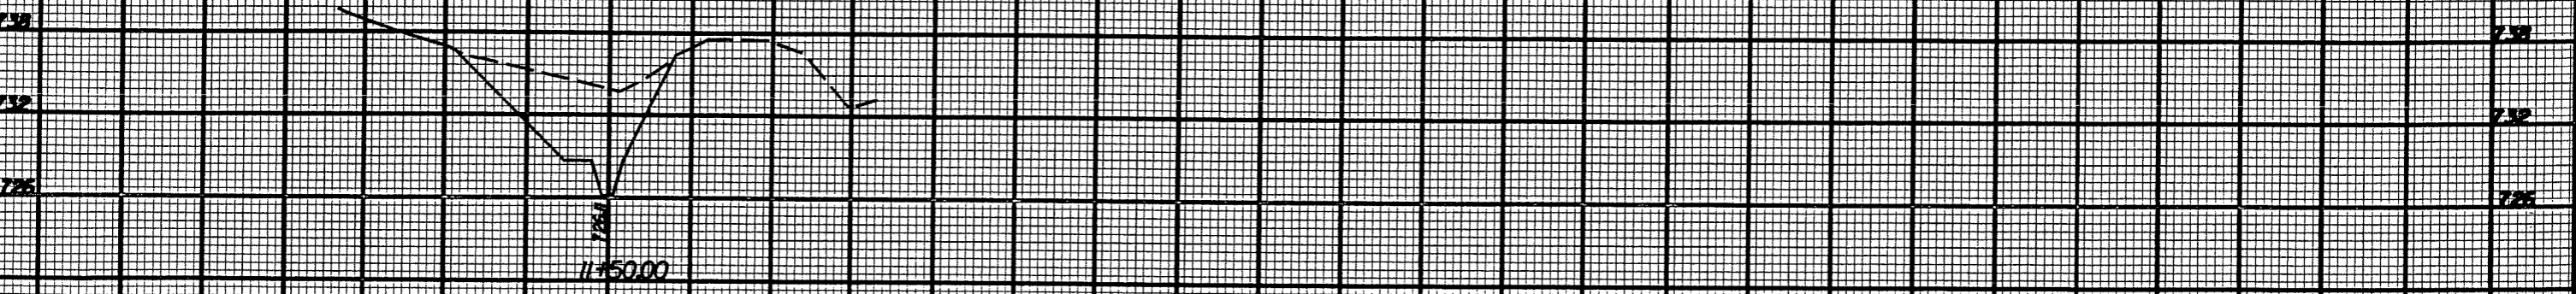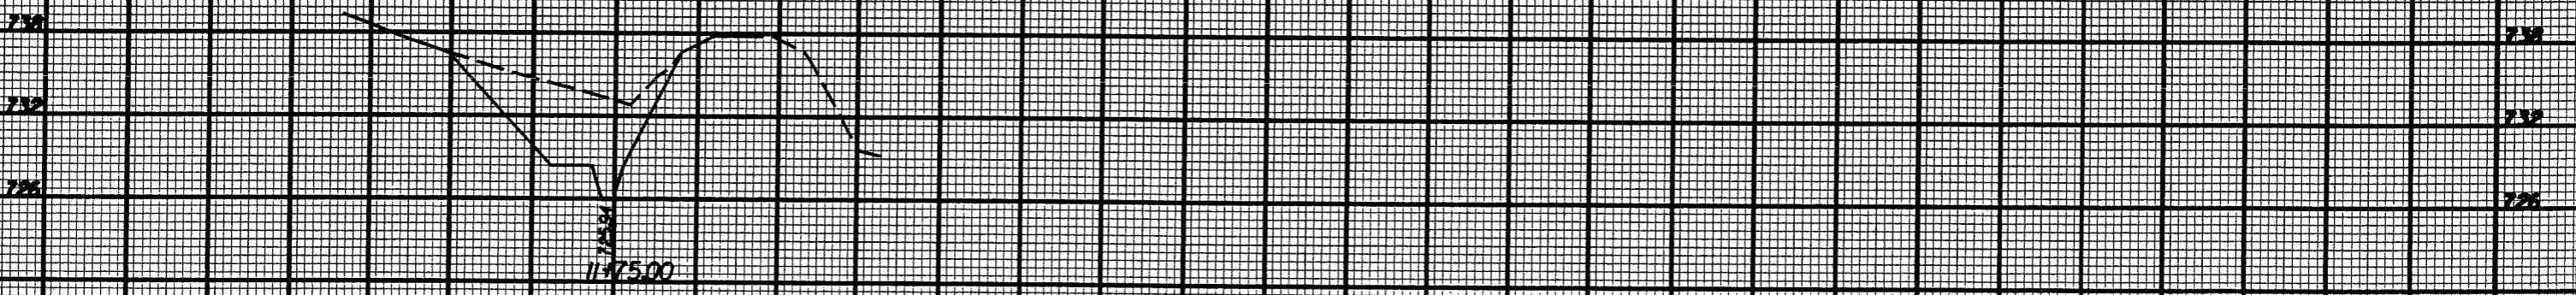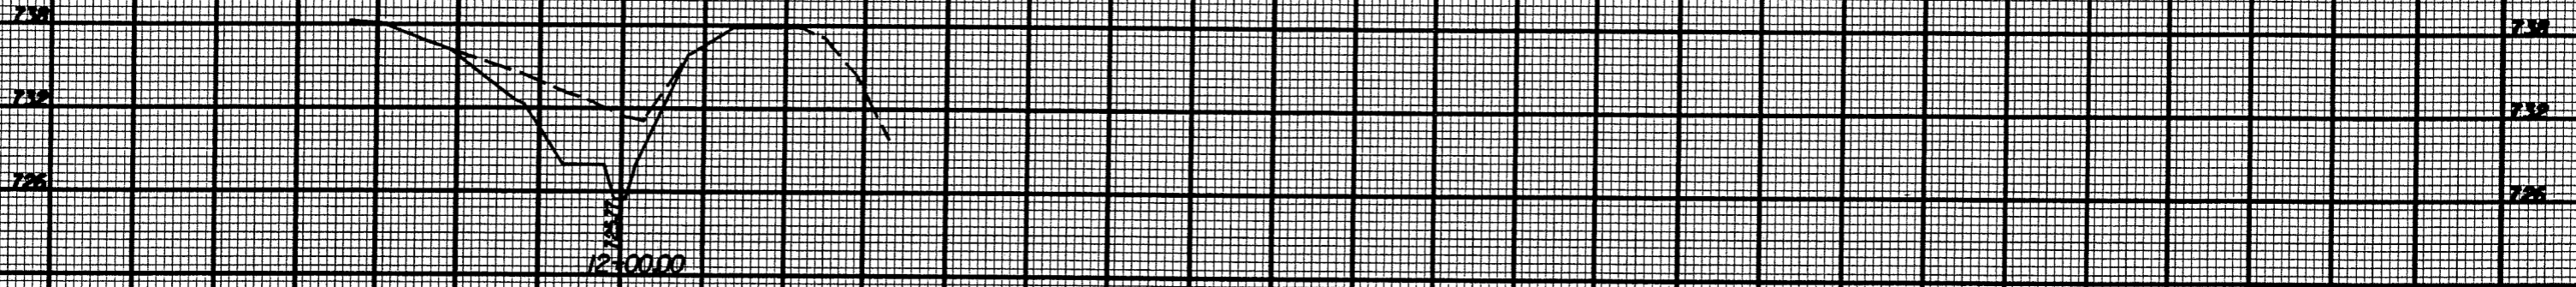

150 120 90 60 30 0 30 60 90 120 150


150 120 90 60 30 0 30 60 90 120 150

PROJECT REFERENCE NO. R-2239WM	SHEET NO. EC-2
RW SHEET NO.	
ROADWAY DESIGN ENGINEER	HYDRAULICS ENGINEER


NOTES:

- 1) All excavation shall be performed in only dry or isolated sections of channel.
- 2) Impervious dikes are to be used to isolate work from stream flow when necessary.
- 3) All graded areas shall be stabilized within 24 hours.
- 4) Maintenance of stream flow operations shall be incidental to the work. This includes polyethylene sheeting, diversion pipes, pumps and hoses.
- 5) Pumps and hoses shall be of sufficient size to dewater the work area.


EXAMPLE OF PUMP-AROUND OPERATION

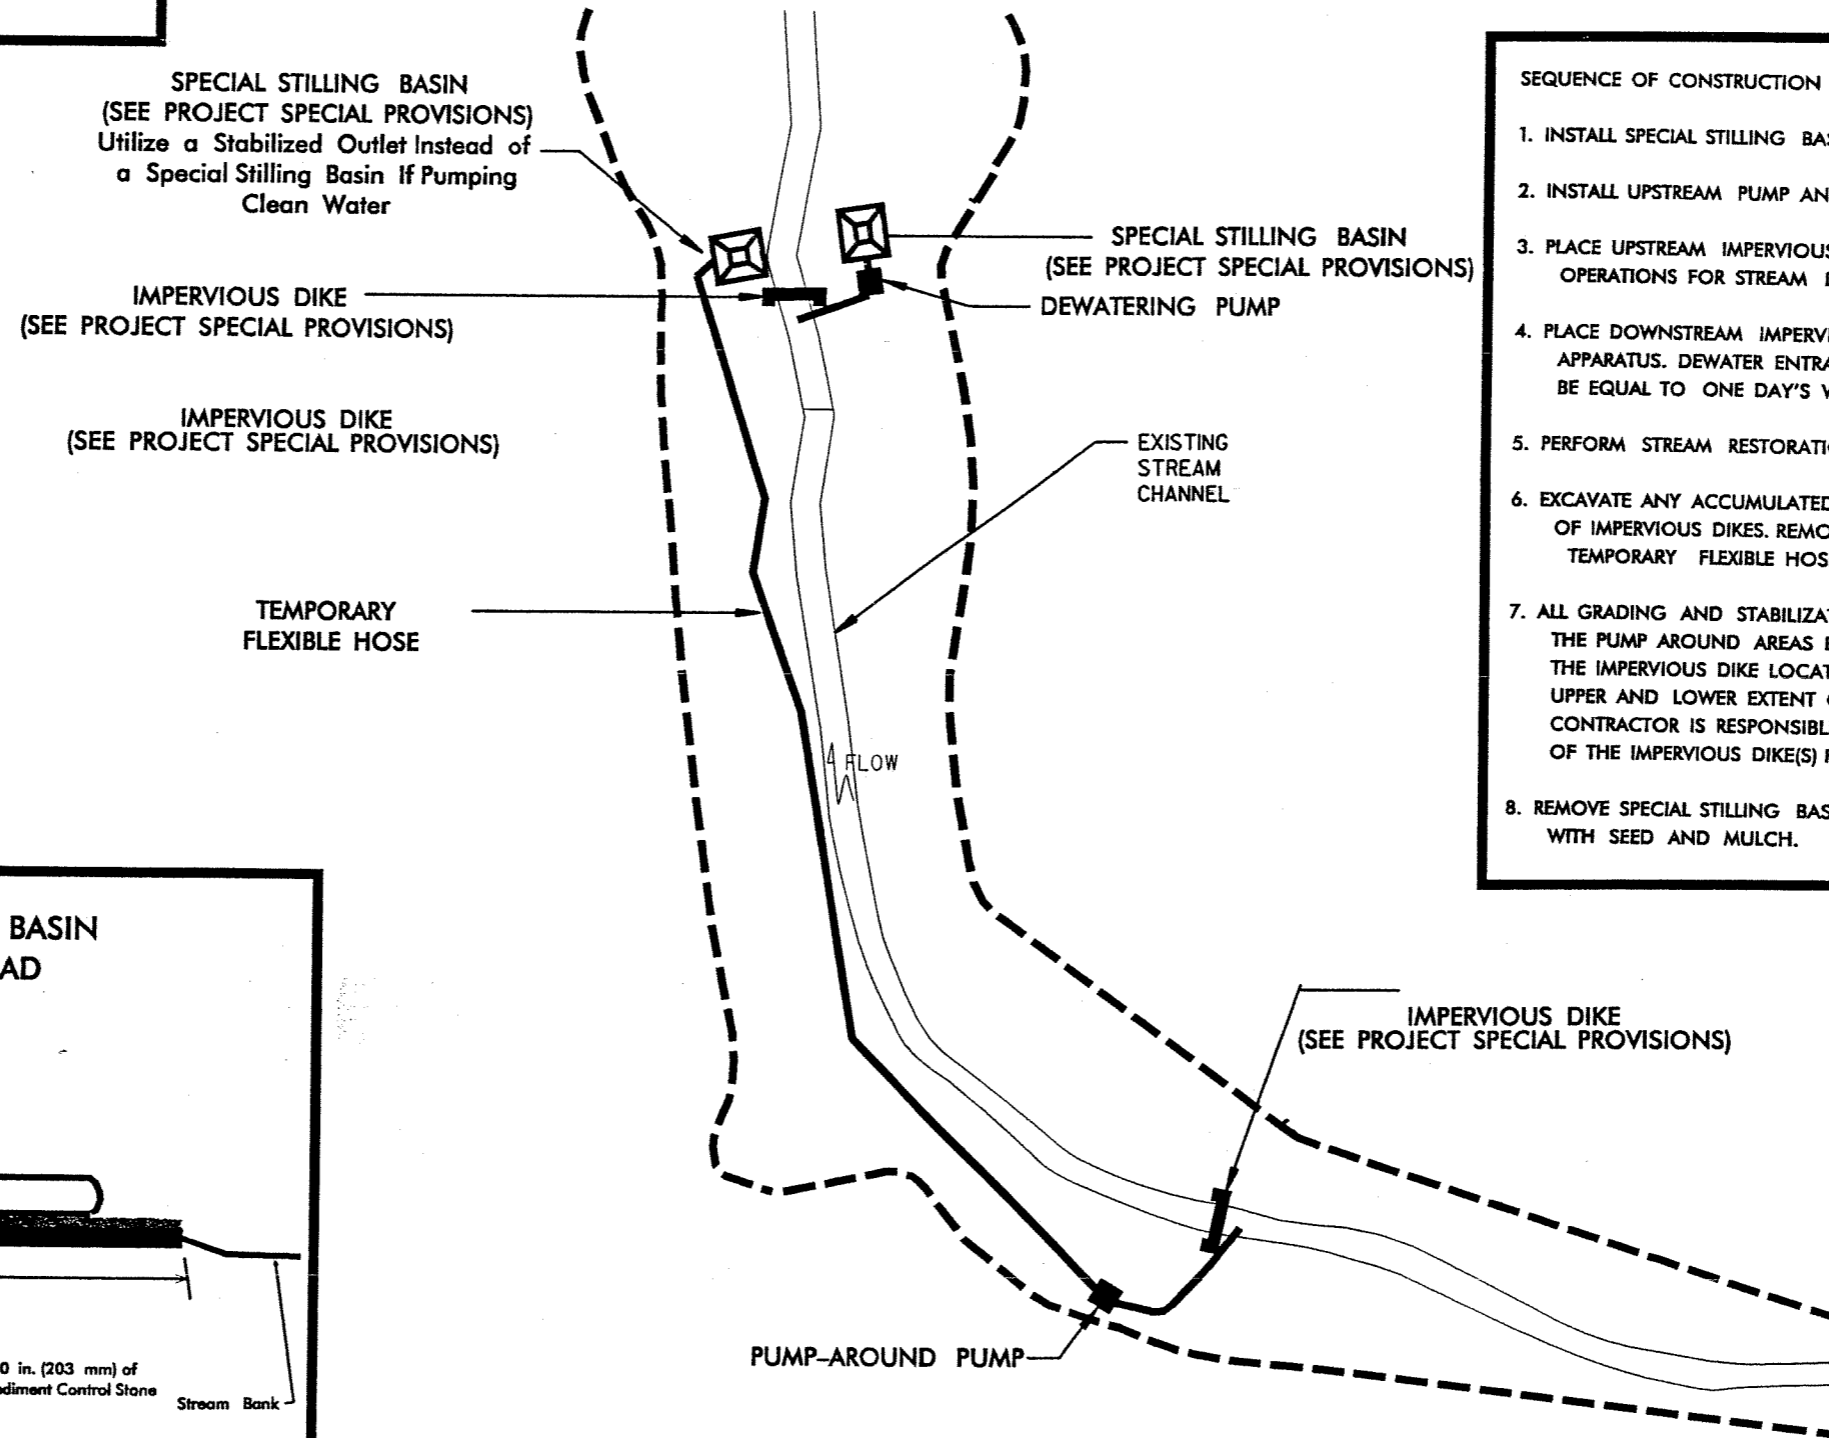


- SEQUENCE OF CONSTRUCTION FOR TYPICAL WORK AREA
1. INSTALL SPECIAL STILLING BASIN(S)..
 2. INSTALL UPSTREAM PUMP AND TEMPORARY FLEXIBLE HOSE.
 3. PLACE UPSTREAM IMPERVIOUS DIKE AND BEGIN PUMPING OPERATIONS FOR STREAM DIVERSION.
 4. PLACE DOWNSTREAM IMPERVIOUS DIKE AND PUMPING APPARATUS. DEWATER ENTRAPPED AREA. AREA TO BE DEWATERED SHALL BE EQUAL TO ONE DAY'S WORK.
 5. PERFORM STREAM RESTORATION WORK IN ACCORDANCE WITH THE PLANS.
 6. EXCAVATE ANY ACCUMULATED SILT AND DEWATER BEFORE REMOVAL OF IMPERVIOUS DIKES. REMOVE IMPERVIOUS DIKES, PUMPS, AND TEMPORARY FLEXIBLE HOSE. (DOWNSTREAM IMPERVIOUS DIKES FIRST).
 7. ALL GRADING AND STABILIZATION MUST BE COMPLETED IN ONE DAY WITHIN THE PUMP AROUND AREAS BETWEEN THE IMPERVIOUS DIKES. THE IMPERVIOUS DIKE LOCATIONS AS SHOWN ON THIS SHEET ONLY SHOW THE UPPER AND LOWER EXTENT OF WORK FOR EACH STREAM SEGMENT. THE CONTRACTOR IS RESPONSIBLE FOR DETERMINING THE LOCATION OF THE IMPERVIOUS DIKE(S) FOR EACH DAY'S WORK.
 8. REMOVE SPECIAL STILLING BASIN(S) AND BACKFILL. STABILIZE DISTURBED AREA WITH SEED AND MULCH.

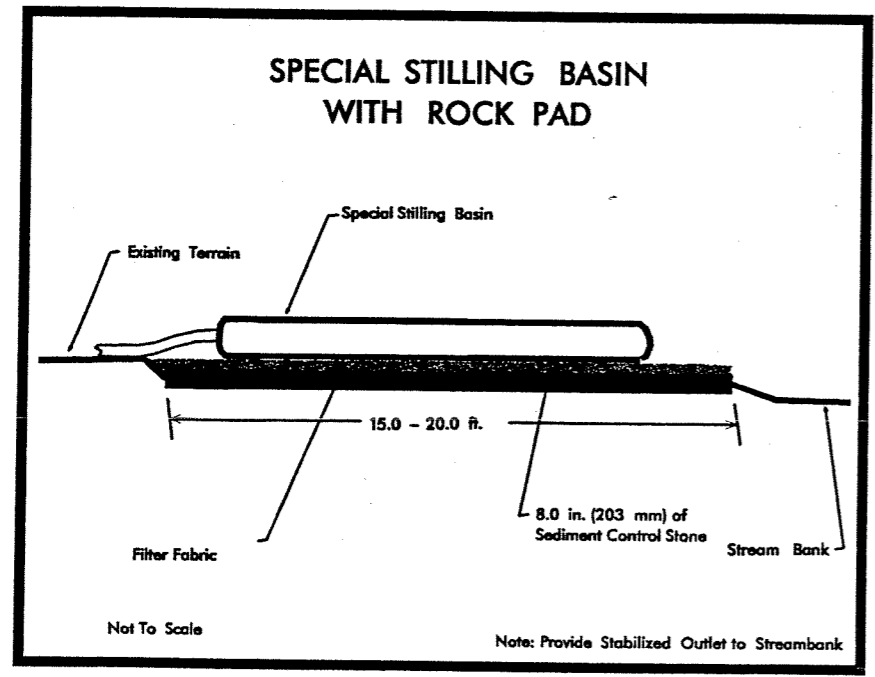


01
02
00

	PROJECT REFERENCE NO.	SHEET NO.
	R-2230MM	FC-2A
	R/W SHEET NO.	
NOT TO SCALE		
CONST. REV.		
R/W REV.		

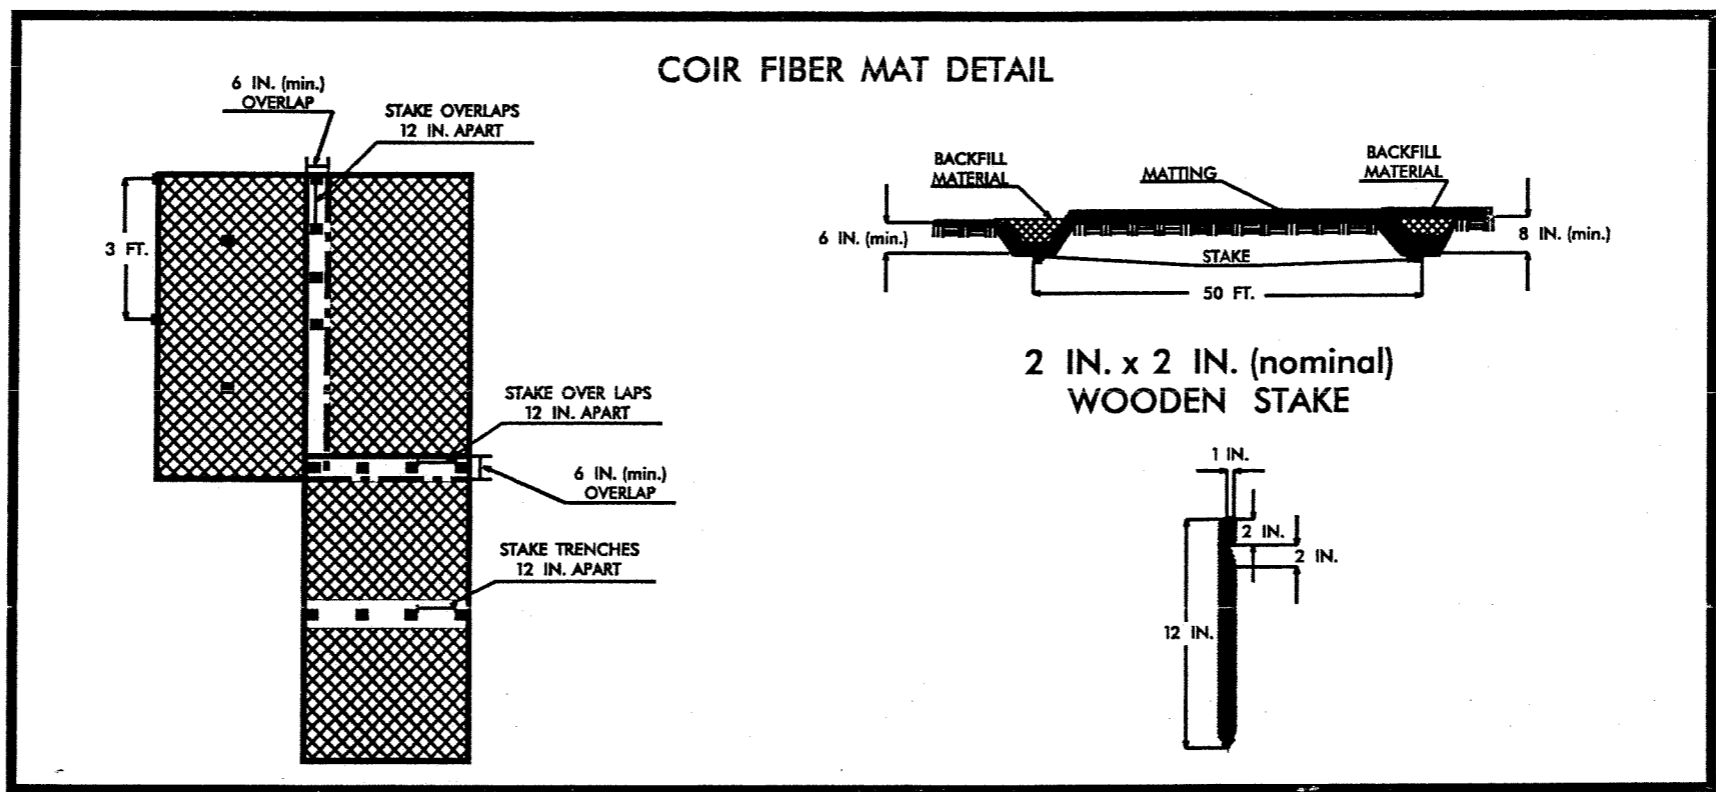

EC-3 ONLY

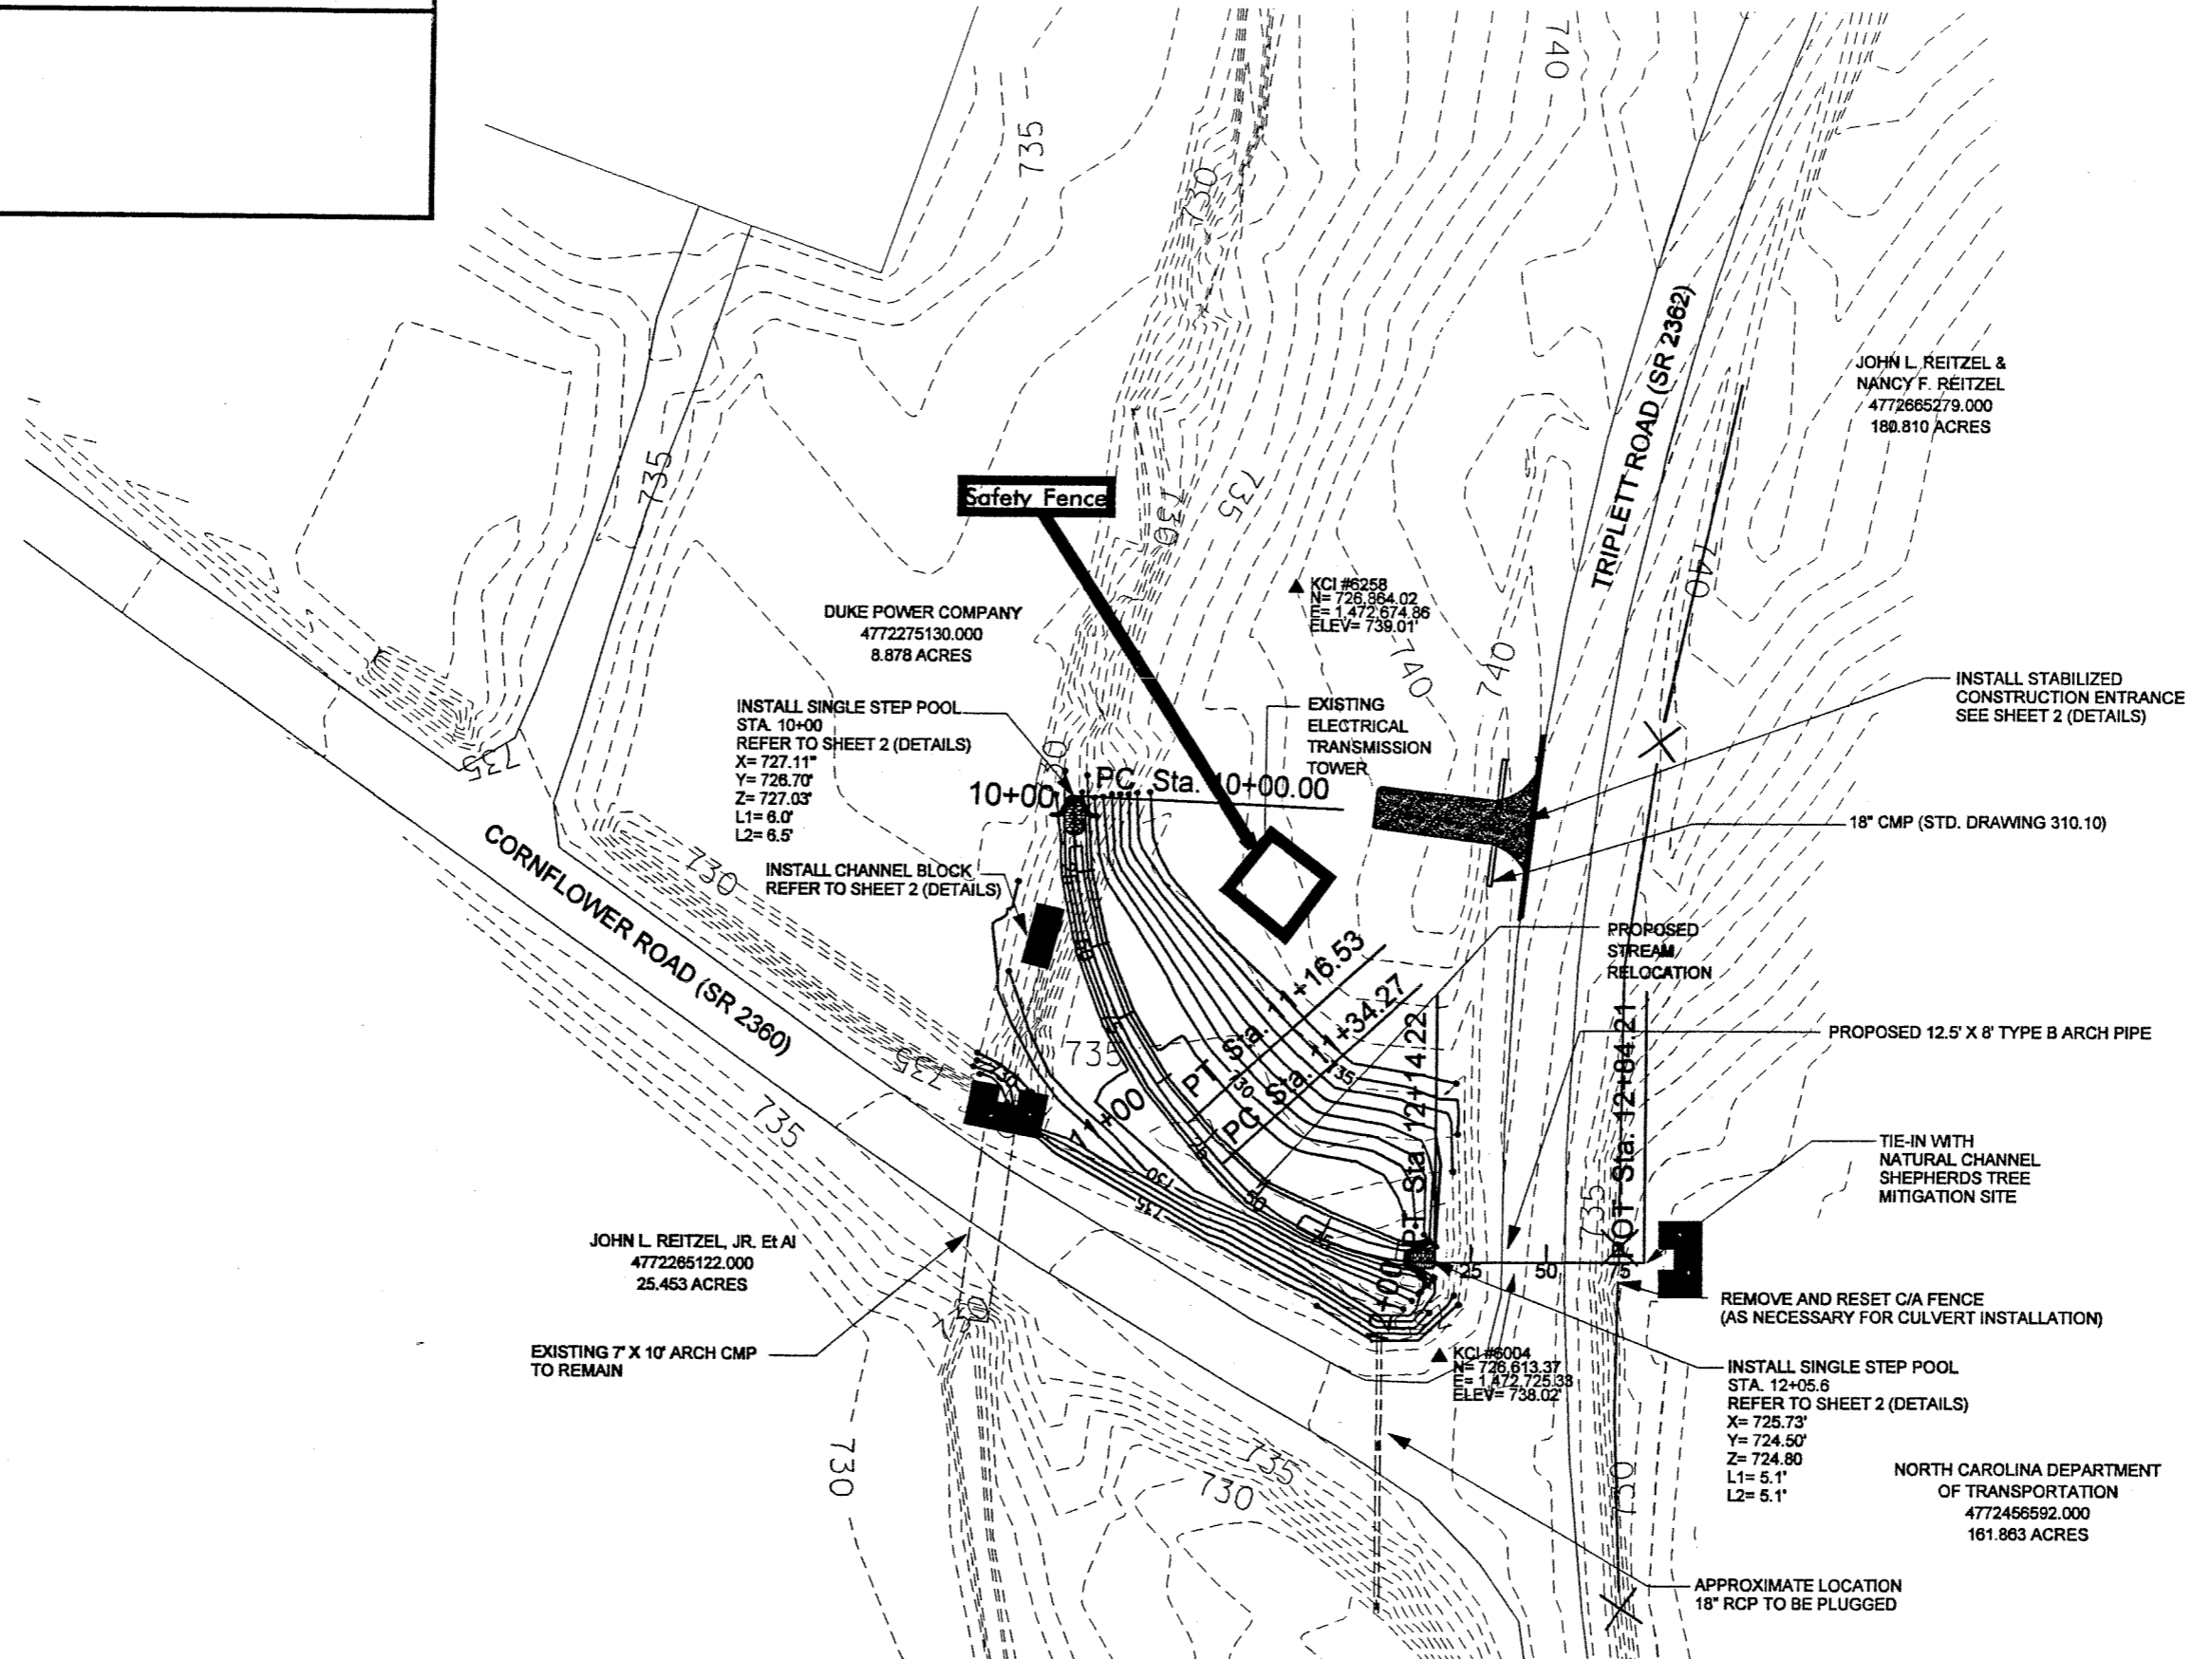

DUKE POWER COMPANY
4772275130.000
8.878 ACRES

JOHN L. REITZEL &
NANCY F. REITZEL
4772665279.000
180.810 ACRES

INSTALL SINGLE STEP POOL
STA. 10+00
REFER TO SHEET 2 (DETAILS)
X= 727.11'
Y= 726.70'
Z= 727.03'
L1= 6.0'
L2= 6.5'

KCI #6258
N= 726,864.02
E= 1,472,674.86
ELEV= 739.01'

EXISTING ELECTRICAL TRANSMISSION TOWER

INSTALL STABILIZED CONSTRUCTION ENTRANCE
SEE SHEET 2 (DETAILS)

Safety Fence

18" CMP (STD. DRAWING 310.10)

INSTALL CHANNEL BLOCK
REFER TO SHEET 2 (DETAILS)

PROPOSED STREAM RELOCATION

PROPOSED 12.5' X 8' TYPE B ARCH PIPE

CORNFLOWER ROAD (SR 2360)

TRIPLETT ROAD (SR 2362)

TIE-IN WITH NATURAL CHANNEL
SHEPHERDS TREE MITIGATION SITE

JOHN L. REITZEL, JR. Et Al
4772285122.000
25.453 ACRES

REMOVE AND RESET C/A FENCE
(AS NECESSARY FOR CULVERT INSTALLATION)

EXISTING 7' X 10' ARCH CMP TO REMAIN

INSTALL SINGLE STEP POOL
STA. 12+05.6
REFER TO SHEET 2 (DETAILS)
X= 725.73'
Y= 724.50'
Z= 724.80'
L1= 5.1'
L2= 5.1'

NORTH CAROLINA DEPARTMENT OF TRANSPORTATION
4772456592.000
161.863 ACRES

KCI #6004
N= 726,613.37
E= 1,472,725.38
ELEV= 738.02'

APPROXIMATE LOCATION 18" RCP TO BE PLUGGED

