

# **FINAL (MYO) BASELINE MONITORING REPORT** **SIX RUNS STREAM AND WETLAND MITIGATION PROJECT**

Sampson County, North Carolina  
Cape Fear River Basin  
HUC 03030006

NCDMS Project #100170  
DMS Contract #0303-01  
RFP: 16-20190303 (Issued 12/20/2019)  
USACE Action ID: SAW-2020-01964 | DWR Project #20201798 v1



**Provided by:**



Resource Environmental Solutions, LLC  
*for* Environmental Banc & Exchange, LLC

**Prepared for:**

NC Department of Environmental Quality  
Division of Mitigation Services  
1652 Mail Service Center  
Raleigh, NC 27699-1652

**August 2023**



3600 Glenwood Avenue, Suite 100  
Raleigh, NC 27612

**Corporate Headquarters**  
6575 W Loop S #300  
Bellaire, TX 77401  
Main: 713.520.5400

August 17, 2023

Jeremiah Dow  
NC DEQ Division of Mitigation Services  
217 West Jones Street  
Raleigh, NC 27604

RE: DMS Comments on the MY0 Report Six Runs, Project ID #100170, DMS Contract #0303-01, RFP 16-20190303

Listed below are comments provided by DMS on July 31, 2023 regarding the Six Runs Stream and Wetland Mitigation Project As-built and MY0 Baseline Monitoring Report and RES' responses.

**Report Comments:**

1. Title Page(s) – Please add RFP issue date (12/20/2019).  
[RFP issue date added to title page.](#)
2. Table 1 – Why did the total wetland acreage change from 13.798 acres at mitigation plan to 13.670 acres at as-built? We typically see little to no change in acreage.  
[The change is due to the as-built survey of top-of-bank \(TOB\) being slightly different than design TOB and the wetland polygons being redrawn to abut the surveyed TOB. Note that the deviation in TOB is due to survey drawing straight lines between shots versus designed TOB using actual curves.](#)
3. Table 2 – Recommend adding the specific growing start and end dates to Success Criteria column where applicable.  
[Growing season dates have been added to Table 2 in applicable cells.](#)
4. CCPV – We recommend re-working the cross-section labeling/line thickness so labels for cross sections 1, 3, 5, 9, and 31 are visible.  
[The cross-section labeling has been revised.](#)
5. Photo Log – Are any of the photos in the “General Photos” section going to be taken annually? If so, the photo points should be shown on the CCPV.  
[RES does not intend to take any of these annually, necessarily. The “General Photos” section is meant to present additional photos besides the customary monitoring photos, and they will likely be different from year-to-year.](#)



6. Table 11 – It is not necessary to calculate BHR on pool cross sections. Recommend removing this data point.  
BHR calculations have been omitted from pool cross sections in Table 11.
7. Appendix C – Please include the cross-section plots/photos.  
The Cross Section Overlay Plots/photos have been included in Appendix C.

**Record Drawings:**

8. Please add Post Assisted Log Structure (PALS) to the Legend.  
“As-built Post Assisted Log Structure” has been added to the legend.
9. Sheet S1 – There was a PALS added between stations 5+00 and 6+00 that should receive a red callout.  
Red callout has been added for the PALS.
10. Sheet S5 – A stone toe was installed in place of a brush toe at the location of XS 12 and should receive a red line callout.  
Red callout has been added for the stone toe.
11. Sheet S6 – Log structure upstream of Sta. 35+00 was not surveyed but was found in the field. Also, log structure at Sta. 30+00 is shown as surveyed in as-built survey drawings (S7), but not the record drawings.  
Log sill upstream of Sta. 35+00 has been added along with a red callout.  
The surveyed log sill at Sta. 30+00 has been added to the record drawing sheets.
12. Sheet S7 – Immediately downstream of Sta. 37+00 a stone toe was installed in place of a brush toe and should be called out.  
Red callout has been added for the stone toe.

**Boundary Inspection:**

13. Affirm by email to the project manager that the landowner is aware of the fence location as it relates to the easement and that they are ok with the signs being posted on the fence which extend well over 5 feet away from the easement boundary.  
RES will send such email to Jeremiah Dow upon submittal of the Final As-built and MYO Report.
14. Corner # 172 – add rebar and aluminum cap per the RFP specifications and the survey plat legend.  
The surveyor has been notified and is scheduled to perform the task promptly.
15. Ensure that each corner is witnessed and signed. This is especially important for the areas where there was no fence installed. Because the pre-existing fence line was removed by clipping the wire and leaving the t-posts there is some potential confusion in areas where the same type of white topped t-post was used to witness the easement corner. Signing all the witness posts will take care of this confusion. It would also be helpful to paint the top 6 inches



of the corner t-posts yellow so that it is easy to distinguish the old fence line from the witness posts.

RES will perform such action items promptly.

16. A KML file has been included with this letter for reference and location details of the boundary inspection action items.

RES appreciates the KML and will perform such action items promptly.



**Table of Contents**

1 Project Summary ..... 1  
    1.1 Project Location and Description ..... 1  
    1.2 Project Components ..... 1  
    1.3 Project Goals and Objectives ..... 3  
    1.4 Construction and As-Built Conditions ..... 6  
    1.5 Baseline Monitoring Performance (MY0) ..... 6  
        1.5.1 Vegetation ..... 6  
        1.5.2 Stream Hydrology ..... 6  
        1.5.3 Stream Geomorphology ..... 7  
        1.5.4 Wetland Hydrology ..... 7  
2 References ..... 8

**Appendix A: Visual Assessment Data**

- Figure 1. Site Location Map
- Figures 2a-c. Current Conditions Plan View
- Table 5. Visual Stream Morphology Assessment
- Table 6. Vegetation Condition Assessment Table
- General Site Photos
- Crossing Photos
- Monitoring Device Photos

**Appendix B: Vegetation Plot Data**

- Table 7. Planted Species Summary
- Table 8. Vegetation Plot Mitigation Success Summary
- Table 9. Stem Count Total and Planted by Plot Species
- Vegetation Plot Photos

**Appendix C: Stream Morphology Data**

- Table 10. Baseline Stream Data Summary
- Table 11. Cross Section Morphology Data Table
- Cross Section Overlay Plots

**Appendix D: Hydrologic Data**

- Wetland Well Soil Profile Characterization Forms

**Appendix E: Project Timeline and Contact Information**

- Table 4. Project Timeline and Contact Information

**Appendix F: Other Data**

- As-built Survey
- As-built Record Drawing

# 1 Project Summary

## 1.1 Project Location and Description

The Six Runs Stream and Wetland Mitigation Project (Project) is located within Sampson County, approximately six and a half miles west of Faison, NC. The Project lies within the Cape Fear River Basin, North Carolina Department of Water Resources (NCDWR) sub-basin 03-06-19 and United States Geological Survey (USGS) 14-digit hydrologic unit code (HUC) 03030006110010 (Six Runs Creek Watershed; **Figure 1**). The Project was designed to help meet compensatory mitigation requirements for stream and wetland impacts in the HUC 03030006. The Project restores 5,788 linear feet (LF) and enhances 1,656 LF of stream as well as re-establishes 6.221 acres (ac), rehabilitates 4.913 ac, enhances 1.008 ac, and preserves 1.656 ac of wetlands that will ultimately provide water quality benefits and ecosystem uplift for the Project's 0.89 mi<sup>2</sup> (570 ac) drainage area.

The Project is comprised of a 30.94-acre easement located along Six Runs Creek, encompassing a portion of the Six Runs Creek floodplain and several tributaries. The Project involves Brad's Branch (a colloquial name for the primary tributary feature draining to Six Runs Creek), five of its unnamed tributaries, and riparian wetlands that all drain into Six Runs Creek which eventually drains south to the Black River. The stream and wetland mitigation components are summarized in **Table 1**. The upstream extent of the Project begins at a property boundary upstream of E Darden Road and the downstream extent ends within the Six Runs Creek swamp. The site is easily accessible from E Darden Road. Coordinates for the Project are as follows: 35.0962°, -78.2304°.

## 1.2 Project Components

Prior to restoration, the riparian corridors within the Project had been manipulated by agricultural practices over time, thereby adversely impacting both streams and wetlands. Most streams were degraded in varying degrees and were restored or enhanced to attain higher function. Non-jurisdictional areas of hydric soil within riparian areas were restored via re-establishment to improve both hydrologic and vegetative functions. Jurisdictional riparian wetland areas that were severely degraded in terms of vegetation and riparian function were rehabilitated to improve vegetative function and stream interaction. Other jurisdictional wetland areas that were partially forested but degraded from constant cattle pressure were enhanced to improve vegetative function. A small area of mixed, jurisdictional wetland types, including frequently inundated marsh and forested swamp, within the Six Runs floodplain, were preserved. Importantly, cattle no longer have access to the aquatic resources within the Project. These improvements to the Project will help meet the river basin needs expressed in the Division of Mitigation Services' (DMS) 2009 Cape Fear River Basin Restoration Priorities (RBRP).

Through stream restoration and enhancement, the Project presented 7,444 LF of stream mitigation, generating 6,660.599 Warm Stream Mitigation Units (SMUs). By incorporating wider buffers, the total adjusted SMUs for the Project amounted to 6,724.599 SMU (**Table 1**). Additionally, the Project presented 13.798 acres of wetland re-establishment, rehabilitation, enhancement, and preservation, generating 10.044 Riparian Wetland Mitigation Units (WMU; **Table 1**). Additional wetland areas amounting to 1.379 acres were presented that will not generate mitigation credit but are protected within the conservation easement. These asset numbers reflect those in the approved mitigation plan.

**Table 1. Six Runs (#100170) Mitigation Quantities and Credits**

Project Segment	Original Mitigation Plan Ft/Ac	As-Built Ft/Ac	Original Mitigation Category	Original Restoration Level	Original Mitigation Ratio (X:1)	Credits	Comments
<b>Stream</b>							
BB-A	452	452	Warm	E1	1.50000	301.333	Structure installation, supplemental planting, invasives treatment, livestock exclusion
BB-B	562	562	Warm	E1	1.50000	374.666	Structure installation, meander stabilization, supplemental planting, invasives treatment, livestock exclusion
BB-C	4,357	4,357	Warm	R	1.00000	4,357.000	Channel restoration, riparian planting, invasives treatment, livestock exclusion
DE2-A	231	231	Warm	E2	2.50000	92.400	ESP installation, supplemental planting, invasives treatment, livestock exclusion
DE2-B	156	156	Warm	R	1.00000	156.000	Channel restoration, riparian planting, invasives treatment, livestock exclusion
DE4-A	301	301	Warm	E2	5.00000	60.200	Supplemental planting, invasives treatment, livestock exclusion
DE4-B	992	992	Warm	R	1.00000	992.000	Channel restoration, riparian planting, invasives treatment, livestock exclusion
DE7	112	108	Warm	R	1.00000	112.000	Channel restoration, riparian planting, invasives treatment, livestock exclusion
DE8	171	171	Warm	R	1.00000	171.000	Hydrologic reconnection, channel restoration, riparian planting, invasives treatment, livestock exclusion
MT2	110	110	Warm	E2	2.50000	44.000	Supplemental planting, invasives treatment, livestock exclusion
<b>Wetland</b>							
WC-1	4.903	4.859	R	RH	1.50000	3.269	Reconnect to stream via stream restoration, wetland planting, livestock exclusion
WC-2	1.656	1.656	R	P	10.00000	0.166	Livestock exclusion
WD	0.010	0.009	R	RH	1.50000	0.007	Reconnect to stream via stream restoration, riparian planting, livestock exclusion
WE-1	0.411	0.410	R	E	5.00000	0.082	Supplemental planting, invasives treatment, livestock exclusion
WE-2	0.597	0.586	R	E	2.00000	0.299	Wetland planting, invasives treatment, livestock exclusion
WL	5.759	5.693	R	REE	1.00000	5.759	Stream restoration, spoil/berm removal/grading, native planting, livestock exclusion
WM	0.462	0.457	R	REE	1.00000	0.462	Stream restoration, spoil/berm removal/grading, native planting, livestock exclusion

**Project Credits**

Restoration Level	Stream			Riparian	Non-Rip	Coastal
	Warm	Cool	Cold	Wetland	Wetland	Marsh
Restoration	5,788.000					
Re-establishment				6.221		
Rehabilitation				3.276		
Enhancement				0.082		
Enhancement I	675.999			0.299		
Enhancement II (2.5)	136.400					
Enhancement II (5.0)	60.200					
Creation						
Preservation				0.166		

**Totals 6,660.599**

**Non-Standard Buffer**

**Width Adjustment 64.00**  
**Total Stream Credit 6,724.599**  
**Total Wetland Credit 10.044**

### **1.3 Project Goals and Objectives**

Prior to construction the streams and wetlands had been significantly impacted by historic relocation and straightening of stream channels, hay production, cattle farming, and lack of riparian buffer. The past land use disturbances, absence of buffer vegetation, and current agricultural practices presented a significant opportunity for water quality and ecosystem improvements through the implementation of this Project. Through the comprehensive analysis of the Project's maximum functional uplift using the Stream Functions Pyramid Framework, specific, attainable goals and objectives are being realized by the Project. These goals clearly help to address the degraded hydrology, water quality, and habitat from agricultural practices that were identified as major watershed stressors in the DMS 2009 Cape Fear River Basin Restoration Priorities (RBRP) and within DMS' Targeted Resource Areas (TRA). Ultimately, the Project supports DMS' watershed goals listed in the Approved Mitigation Plan. The Project Summary Goals, Performance, and Results are provided below in **Table 2**. The Project Attributes are found in **Table 3**.

**Table 2. Project Summary Goals, Performance, and Results**

Objective	Treatment	Monitoring Metric	Success Criteria	Measurement	Cumulative Monitoring Results
Improve the transport of water from the watershed to the Project reaches in a non-erosive way and maintain appropriate wetland hydrology for Bibb and Johnston soil series	Converted land-use of some Project reaches from pasture to riparian forest. Restored and enhanced wetland hydrology through stream restoration activities and spoil removal	Groundwater wells with pressure transducers: Downloaded quarterly	Water table within 12 inches of the ground surface for 12% of growing season (approx. 31 days) <u>Growing season: 3/14 - 11/22</u>	11 groundwater wells	<i>Data is being collected and will be submitted in the next report.</i>
Improve flood-bank connectivity by reducing bank height ratios and increase entrenchment ratios  Maintain regular, seasonal flow in restored, intermittent streams	Reduced bank height ratios and increased entrenchment ratios by reconstructing channels to mimic reference reach conditions	Stage recorders: Inspected semiannually	Four bankfull events occurring in separate years	Continuous stage recorders on BB-C upper, DE4-A, and BB-C lower	<i>Data is being collected and will be submitted in the next report.</i>
		Flow gauges: Inspected quarterly	30+ days of continuous flow each year	Flow gauges on BB-A, DE7, DE2-A, DE8, and MT2	<i>Data is being collected and will be submitted in the next report.</i>
		Cross sections: Surveyed in MY 1, 2, 3, 5 and 7	Bank height ratio shall not exceed 1.2	36 Cross section surveys	36/36 with BHR<1.2 - MY0
Limit erosion rates and maintain channel stability  Improve bedform diversity (pool spacing, percent riffles, etc.)  Increase buffer width to 50 feet	Established a riparian buffer to reduce erosion and sediment transport into project streams.  Established stable banks with livestakes, erosion control matting, and other in stream structures.	As-built stream profile	N/A	N/A	Survey conducted
		Cross sections: Surveyed in MY 1, 2, 3, 5 and 7	Bank height ratio shall not exceed 1.2	36 Cross section surveys	36/36 with BHR<1.2 - MY0
		Visual monitoring: Performed at least semiannually	Identify and document significant stream problem areas; i.e. erosion, degradation, aggradation, etc.	Visual Assessment conducted	No problem areas
		Vegetation plots: Surveyed in MY 1, 2, 3, 5 and 7	MY 1-3: ≥320 trees/acre MY 5: ≥260 trees/acre (7 ft. tall) MY 7: ≥210 trees/acre (10 ft. tall)	13 fixed veg plots and 6 random plots (19 total)	19/19 passed - MY0
Promote sediment filtration, nutrient cycling, and organic accumulation through natural wetland biogeochemical processes  Establish native hardwood riparian buffer  Protect aquatic resources in perpetuity	Restored and enhance wetland hydrology  Planted a riparian buffer  Established permanent conservation easement	Groundwater wells with pressure transducers: Downloaded quarterly	Water table within 12 inches of the ground surface for 12% of growing season (approx. 31 days) <u>Growing season: 3/14 - 11/22</u>	11 groundwater wells installed	<i>Data is being collected and will be submitted in the next report.</i>
		Vegetation plots: Surveyed in MY 1, 2, 3, 5 and 7	MY 1-3: ≥320 trees/acre MY 5: ≥260 trees/acre (7 ft. tall) MY 7: ≥210 trees/acre (10 ft. tall)	13 fixed veg plots and 6 random plots (19 total)	19/19 passed - MY0
		Visual assessment of established fencing and conservation signage: Performed at least semiannually	Inspect fencing and signage. Identify and document any damaged or missing fencing and/or signs	Visual Assessment conducted	Fencing and signage are in place

**Table 3. Project Attributes**

Table 3. Project Attribute Table															
Project Name	Six Runs Stream and Wetland Mitigation Project														
County	Sampson														
Project Area (acres)	30.94														
Area to be planted (acres)	22.59														
Project Coordinates (latitude and longitude decimal)	35.0962°, -78.2304°														
Project Watershed Summary Information															
Physiographic Province	Rolling Coastal Plain														
River Basin	Cape Fear														
USGS Hydrologic Unit 8-	3030006														
DWR Sub-basin	03-06-19														
Project Drainage Area (acres)	570														
Project Drainage Area Percentage of Impervious Area	1%														
Land Use Classification	Agriculture, forest, residential														
Reach Summary Information															
Parameters	BB-A	BB-B	BB-C	DE2-A	DE2-B	DE3	DE4-A	DE4-B	DE7	DE8	MT2				
Pre-project length (feet)	453	572	4207	231	114	128	301	667	251	61	110				
Post-project (feet)	452	562	4357	231	156	0	301	992	112	171	110				
Valley confinement (Confined, moderately confined, unconfined)	Moderately confined	Moderately confined	Unconfined	Moderately confined	Moderately confined	NA	Unconfined	Unconfined	NA	Moderately confined	Moderately confined				
Drainage area (acres)	93	125	570	N/A	10	26	287	295	21	26	9				
Perennial, Intermittent, Ephemeral	Intermittent	Intermittent	Perennial	Intermittent	Intermittent	Intermittent	Perennial	Perennial	Intermittent	Intermittent	Intermittent				
NCDWR Water Quality Classification	C, Sw	C, Sw	C, Sw	C, Sw	C, Sw	C, Sw	C, Sw	C, Sw	C, Sw	C, Sw	C, Sw				
Dominant Stream Classification (existing)	C4/5	G4/5c	G4/5c - F4/5	E5	E5	F5	C5	G4/5c - F4/5	G5c	F5b	E4/5				
Dominant Stream Classification (proposed)	C4/5	G4/5c	C4/E4	E5	C4b	N/A	C5	C4/E4	B4a to E4	C4/E4	E4/5				
Dominant Evolutionary class (Simon) if applicable	III	III	IV	II	II	III	I	III	III	II	I				
Wetland Summary Information															
Parameters	WA	WB	WC-1	WC-2	WD	WE-1	WE-2	WF	WG	WH	WI	WJ	WK	WL	WM
Pre-project (acres)	0.081	0.057	5.146	1.656	0.016	0.849	0.767	0.348	0.002	0.057	0.204	0.123	0.034	0	0
Post-project (acres)	0.081	0.057	4.903	1.656	0.01	0.848	0.689	0.299	0.001	0.057	0.198	0.123	0.034	5.759	0.462
Wetland Type (non-riparian, riparian)	Riparian	Riparian	Riparian	Riparian	Riparian	Riparian	Riparian	Riparian	Riparian	Riparian	Riparian	Riparian	Riparian	Riparian	Riparian
Mapped Soil Series	Norfolk loamy sand	Norfolk loamy sand	Bibb and Johnston soils	Bibb and Johnston soils	Bibb and Johnston soils	Bibb and Johnston soils	Bibb and Johnston soils	Bibb and Johnston soils	Bibb and Johnston soils	Bibb and Johnston soils	Bibb and Johnston soils	Bibb and Johnston soils	Bibb and Johnston soils	Bibb and Johnston soils	Bibb and Johnston soils
Soil Hydric Status	Non-hydric	Non-hydric	Hydric	Hydric	Hydric	Hydric	Hydric	Hydric	Hydric	Hydric	Hydric	Hydric	Hydric	Hydric	Hydric
Regulatory Considerations															
Parameters	Applicable?	Resolved?	Supporting Docs?												
Water of the United States - Section 404	Yes	No	PCN												
Water of the United States - Section 401	Yes	No	PCN												
Endangered Species Act	Yes	Yes	Mitigation Plan												
Historic Preservation Act	Yes	Yes	Mitigation Plan												
Coastal Zone Management Act (CZMA or CAMA)	No	N/A	N/A												
FEMA Floodplain Compliance	Yes	No	Mitigation Plan												
Essential Fisheries Habitat	No	N/A	N/A												
DOT Right-of-way Permit	Yes	Yes	N/A												

## **1.4 Construction and As-Built Conditions**

Project construction was completed on March 3<sup>rd</sup>, 2023, and planting was completed on March 3<sup>rd</sup>, 2023. The Six Runs Project was built to design plans and guidelines with some minor modifications. Such modifications are summarized below:

- Added several Post-Assisted Log Structures (PALS) to reaches BB-A/B;
- Swapped several brush toes for stone toes;
- Swapped two brush toes for sod mats in lower portion of reach BB-C;
- Added floodplain sills in very wet areas susceptible to erosion;
- Minor alignment change at upper segment of BB-C – This was a design revision in the Final Construction Plans. This did not result in change in LF.
- Minor alignment change at lower segment of DE7 – This was a field-adjustment to avoid an existing mature tree. This resulted in minor loss of LF.

The as-built survey and record drawings are included in **Appendix F**.

There were no changes to the planting plan (Table 7 in **Appendix B**). Minor monitoring device location changes were made during as-built installation, however, the quantities remained as proposed in the Mitigation Plan.

## **1.5 Baseline Monitoring Performance (MY0)**

The Six Runs Baseline Monitoring activities were performed in March 2023. All Baseline Monitoring data is presented below and in the appendices. The Project is on track to meeting stream, wetland, and vegetation interim success criteria.

### **1.5.1 Vegetation**

Setup and monitoring of the 13 permanent vegetation plots and 6 random vegetation plots were completed after stream construction and planting, on March 23<sup>rd</sup>, 2023. Vegetation data are in **Appendix B**, and associated photos and plot locations are in **Appendix A**. MY0 monitoring data indicates that all plots are exceeding the interim success criteria of 320 planted stems per acre. Planted stem densities ranged from 567 to 1,012 planted stems per acre with a mean of 737 planted stems per acre across all plots. A total of twenty planted species were documented within the plots. The average stem height in the vegetation plots was 1.3 feet.

Visual assessment of vegetation outside of the monitoring plots indicates that herbaceous vegetation is establishing throughout the project area (**Appendix A**).

### **1.5.2 Stream Hydrology**

Three stage recorders and five flow gauges were installed on March 28<sup>th</sup>, 2023. The stage recorders are in place to document bankfull events. Two stage recorders were installed on BB-C and one was installed on DE-4. The flow gauges are in place to document presence and persistence of stream flow in the intermittent channel. One flow gauge was installed on each of the reaches: BB-A, MT-2, DE7, DE2-B, and DE8. Stream hydrology data will be included in the Monitoring Year 1 Report in this section and in the appendices. Gauge locations can be found on **Figures 2a-c** and photos are in **Appendix A**.



### 1.5.3 Stream Geomorphology

Cross section setup and geomorphology data collection for MY0 was collected on March 30<sup>th</sup>, 2023. Summary tables and cross section plots are in **Appendix C**. Overall, the baseline cross sections and profile relatively match the proposed design. The as-built conditions show that shear stress and velocities have been reduced for all restoration reaches. All reaches were designed as gravel bed channels and remain classified as gravel bed channels post-construction.

Visual assessment of the stream channel was performed to document signs of instability, such as eroding banks, structural instability, or excessive sedimentation. The channel is transporting sediment as designed and will continue to be monitored for aggradation and degradation (**Appendix C**).

### 1.5.4 Wetland Hydrology

Wetland hydrology is being monitored to document success of wetland restoration areas as well as conditions of wetland enhancement and preservation areas. This is accomplished with eleven automatic pressure transducer gauges (located in groundwater wells) that record daily groundwater levels. Six groundwater wells were installed in wetland re-establishment areas; two were installed in wetland enhancement areas; two were installed in wetland rehabilitation areas; and one was installed in a wetland preservation area to serve as references. One automatic pressure transducer was installed above ground to record ambient air pressure and is used to correct all other pressure transducers onsite. These gauges were installed on March 28<sup>th</sup>, 2023.

Gauges are downloaded quarterly and wetland hydroperiods are calculated during the growing season. Gauge installation followed current regulatory guidance. Visual observations of primary and secondary wetland hydrology indicators are also recorded during quarterly site visits. As mentioned earlier, soil was characterized at each groundwater well.


Soil borings were taken at each groundwater well and characterized in accordance with the Soil Characterization Data Forms provided in the USACE's *Technical Standard for Water-Table Monitoring of Potential Wetland Sites*, and includes parameters of soil horizon depths, texture, colors, redoximorphic features, induration, and roots, as well as a photo of each soil profile (**Appendix D**). Exact well locations can be found in **Figures 2a-c** and wetland hydrology data will be included in subsequent monitoring reports.

## **2 References**

- Griffith, G.E., J.M.Omernik, J.A. Comstock, M.P. Schafale, W.H.McNab, D.R.Lenat, T.F.MacPherson, J.B. Glover, and V.B. Shelburne. (2002). "Ecoregions of North Carolina and South Carolina." (color Poster with map, descriptive text, summary tables, and photographs): Reston, Virginia, U.S. Geological Survey (map scale 1:1,500,000).
- Lee Michael T., Peet Robert K., Roberts Steven D., and Wentworth Thomas R., 2008. "CVS-EEP Protocol for Recording Vegetation Level." Version 4.2
- North Carolina Division of Mitigation Services (NCDMS). "Neuse River Basin Restoration Priorities 2010. Amended August 2018."
- Peet, R.K., Wentworth, T.S., and White, P.S. (1998). "A flexible, multipurpose method for recording vegetation composition and structure." *Castanea* 63:262-274
- Resource Environmental Solutions (2022). "Six Runs Final Mitigation Plan".
- US Army Corps of Engineers (USACE). (2016). "Wilmington District Stream and Wetland Compensatory Mitigation Update." NC: Interagency Review Team (IRT).

# **Appendix A**


## Visual Assessment Data

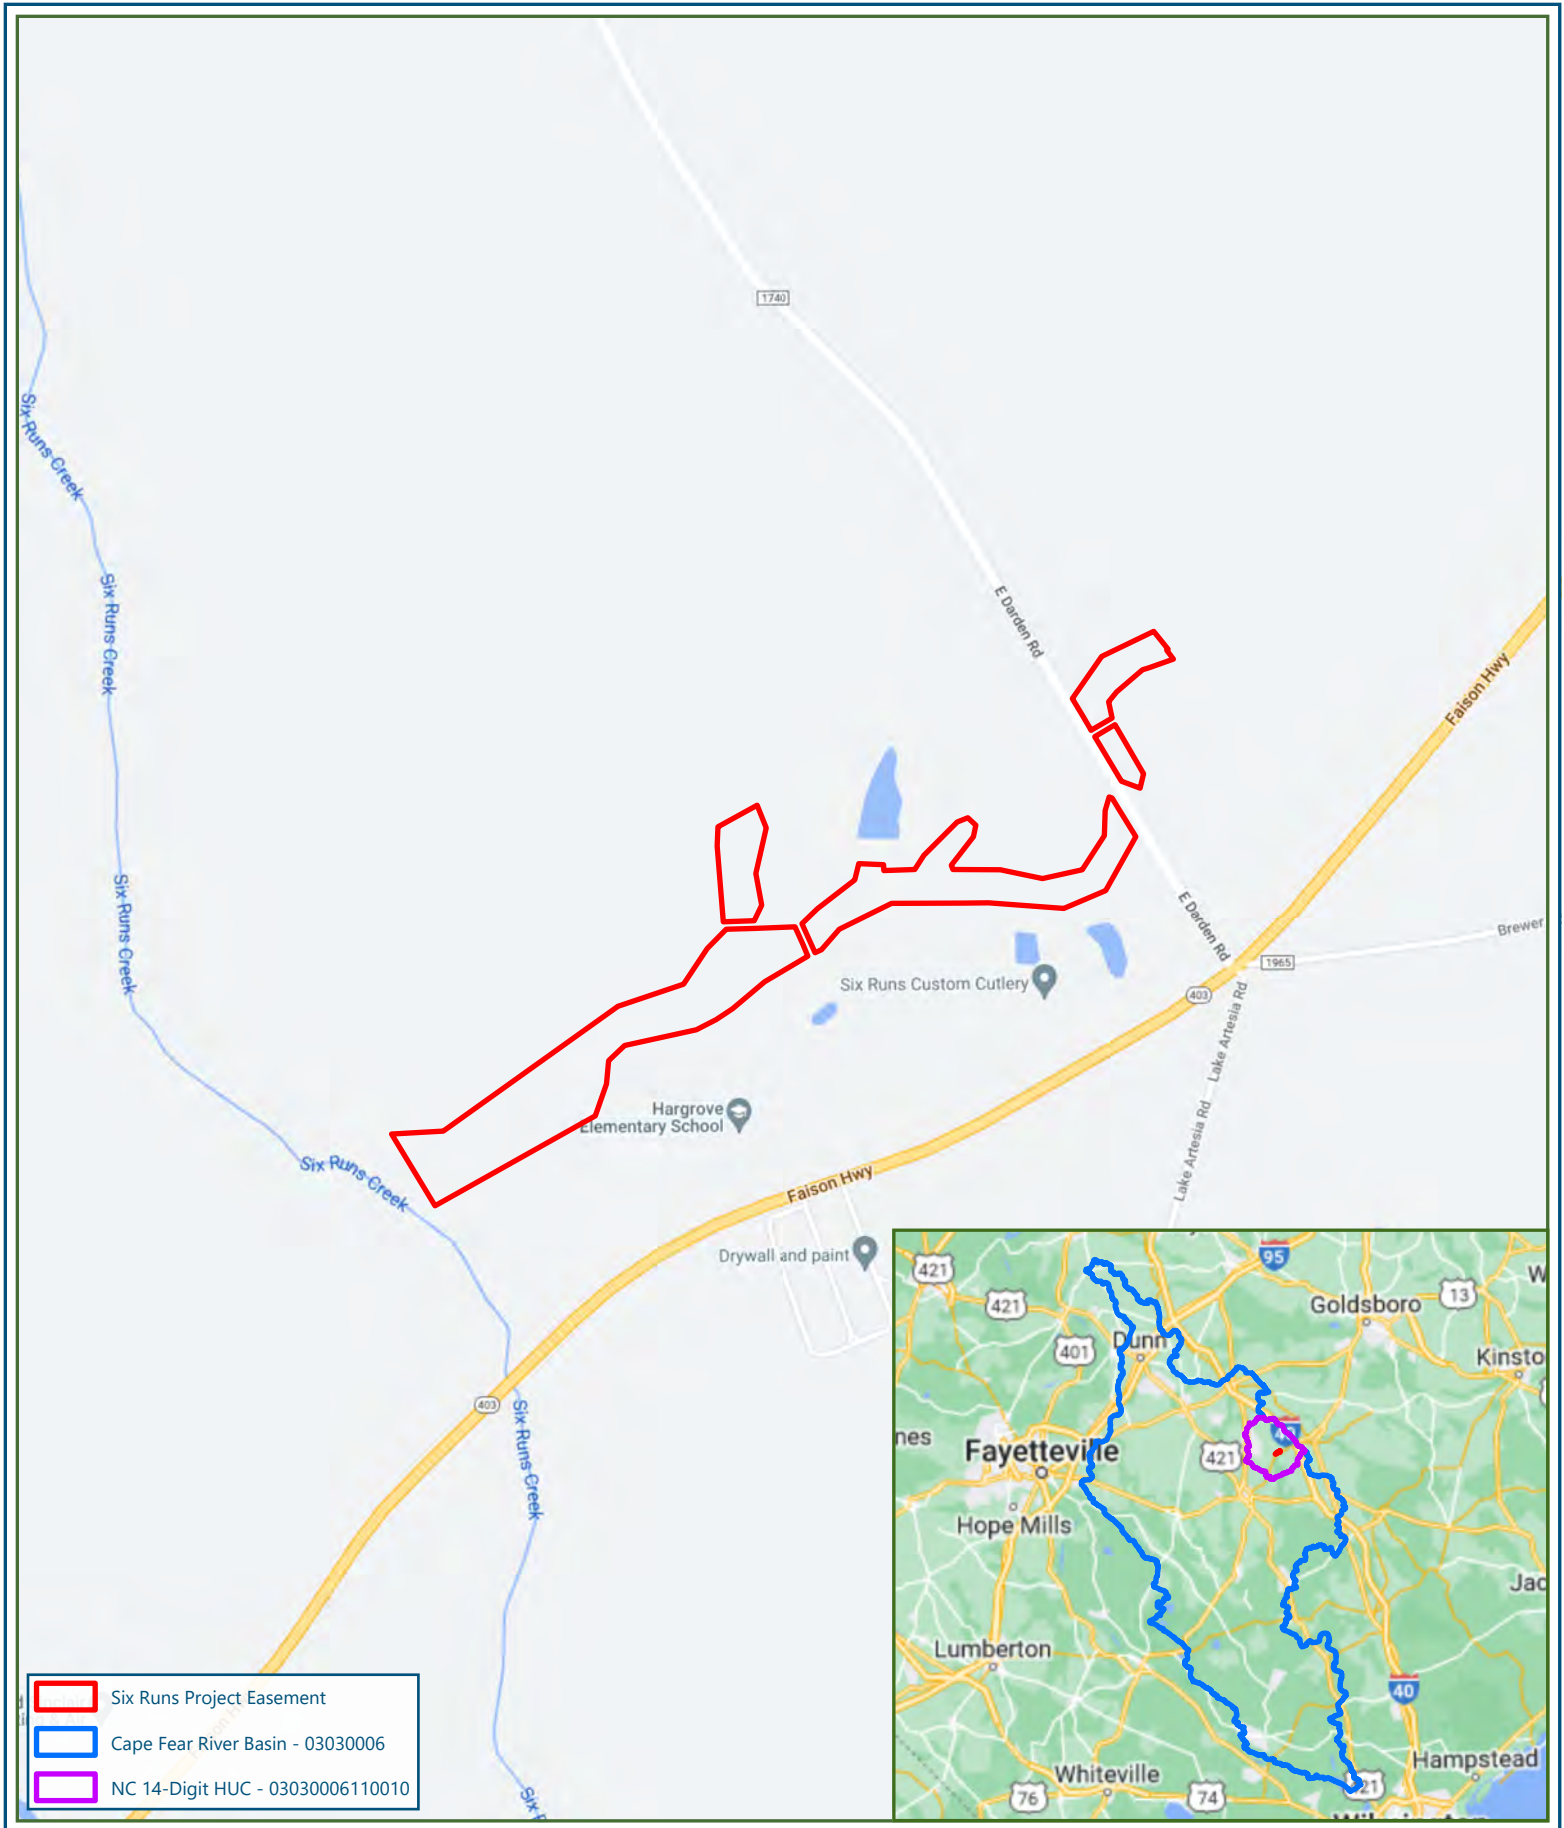

- Six Runs Project Easement
- Cape Fear River Basin - 03030006
- NC 14-Digit HUC - 03030006110010

**Figure 1**  
Project Vicinity

**Six Runs**  
Sampson County, North Carolina  
78.2361°W 35.0952°N

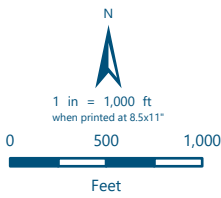

Reference: This information is not to be used as final legal boundaries.  
Data Source: USGS, GoogleMaps  
Spatial Reference: NAD 1983 StatePlane North Carolina FIPS 3200

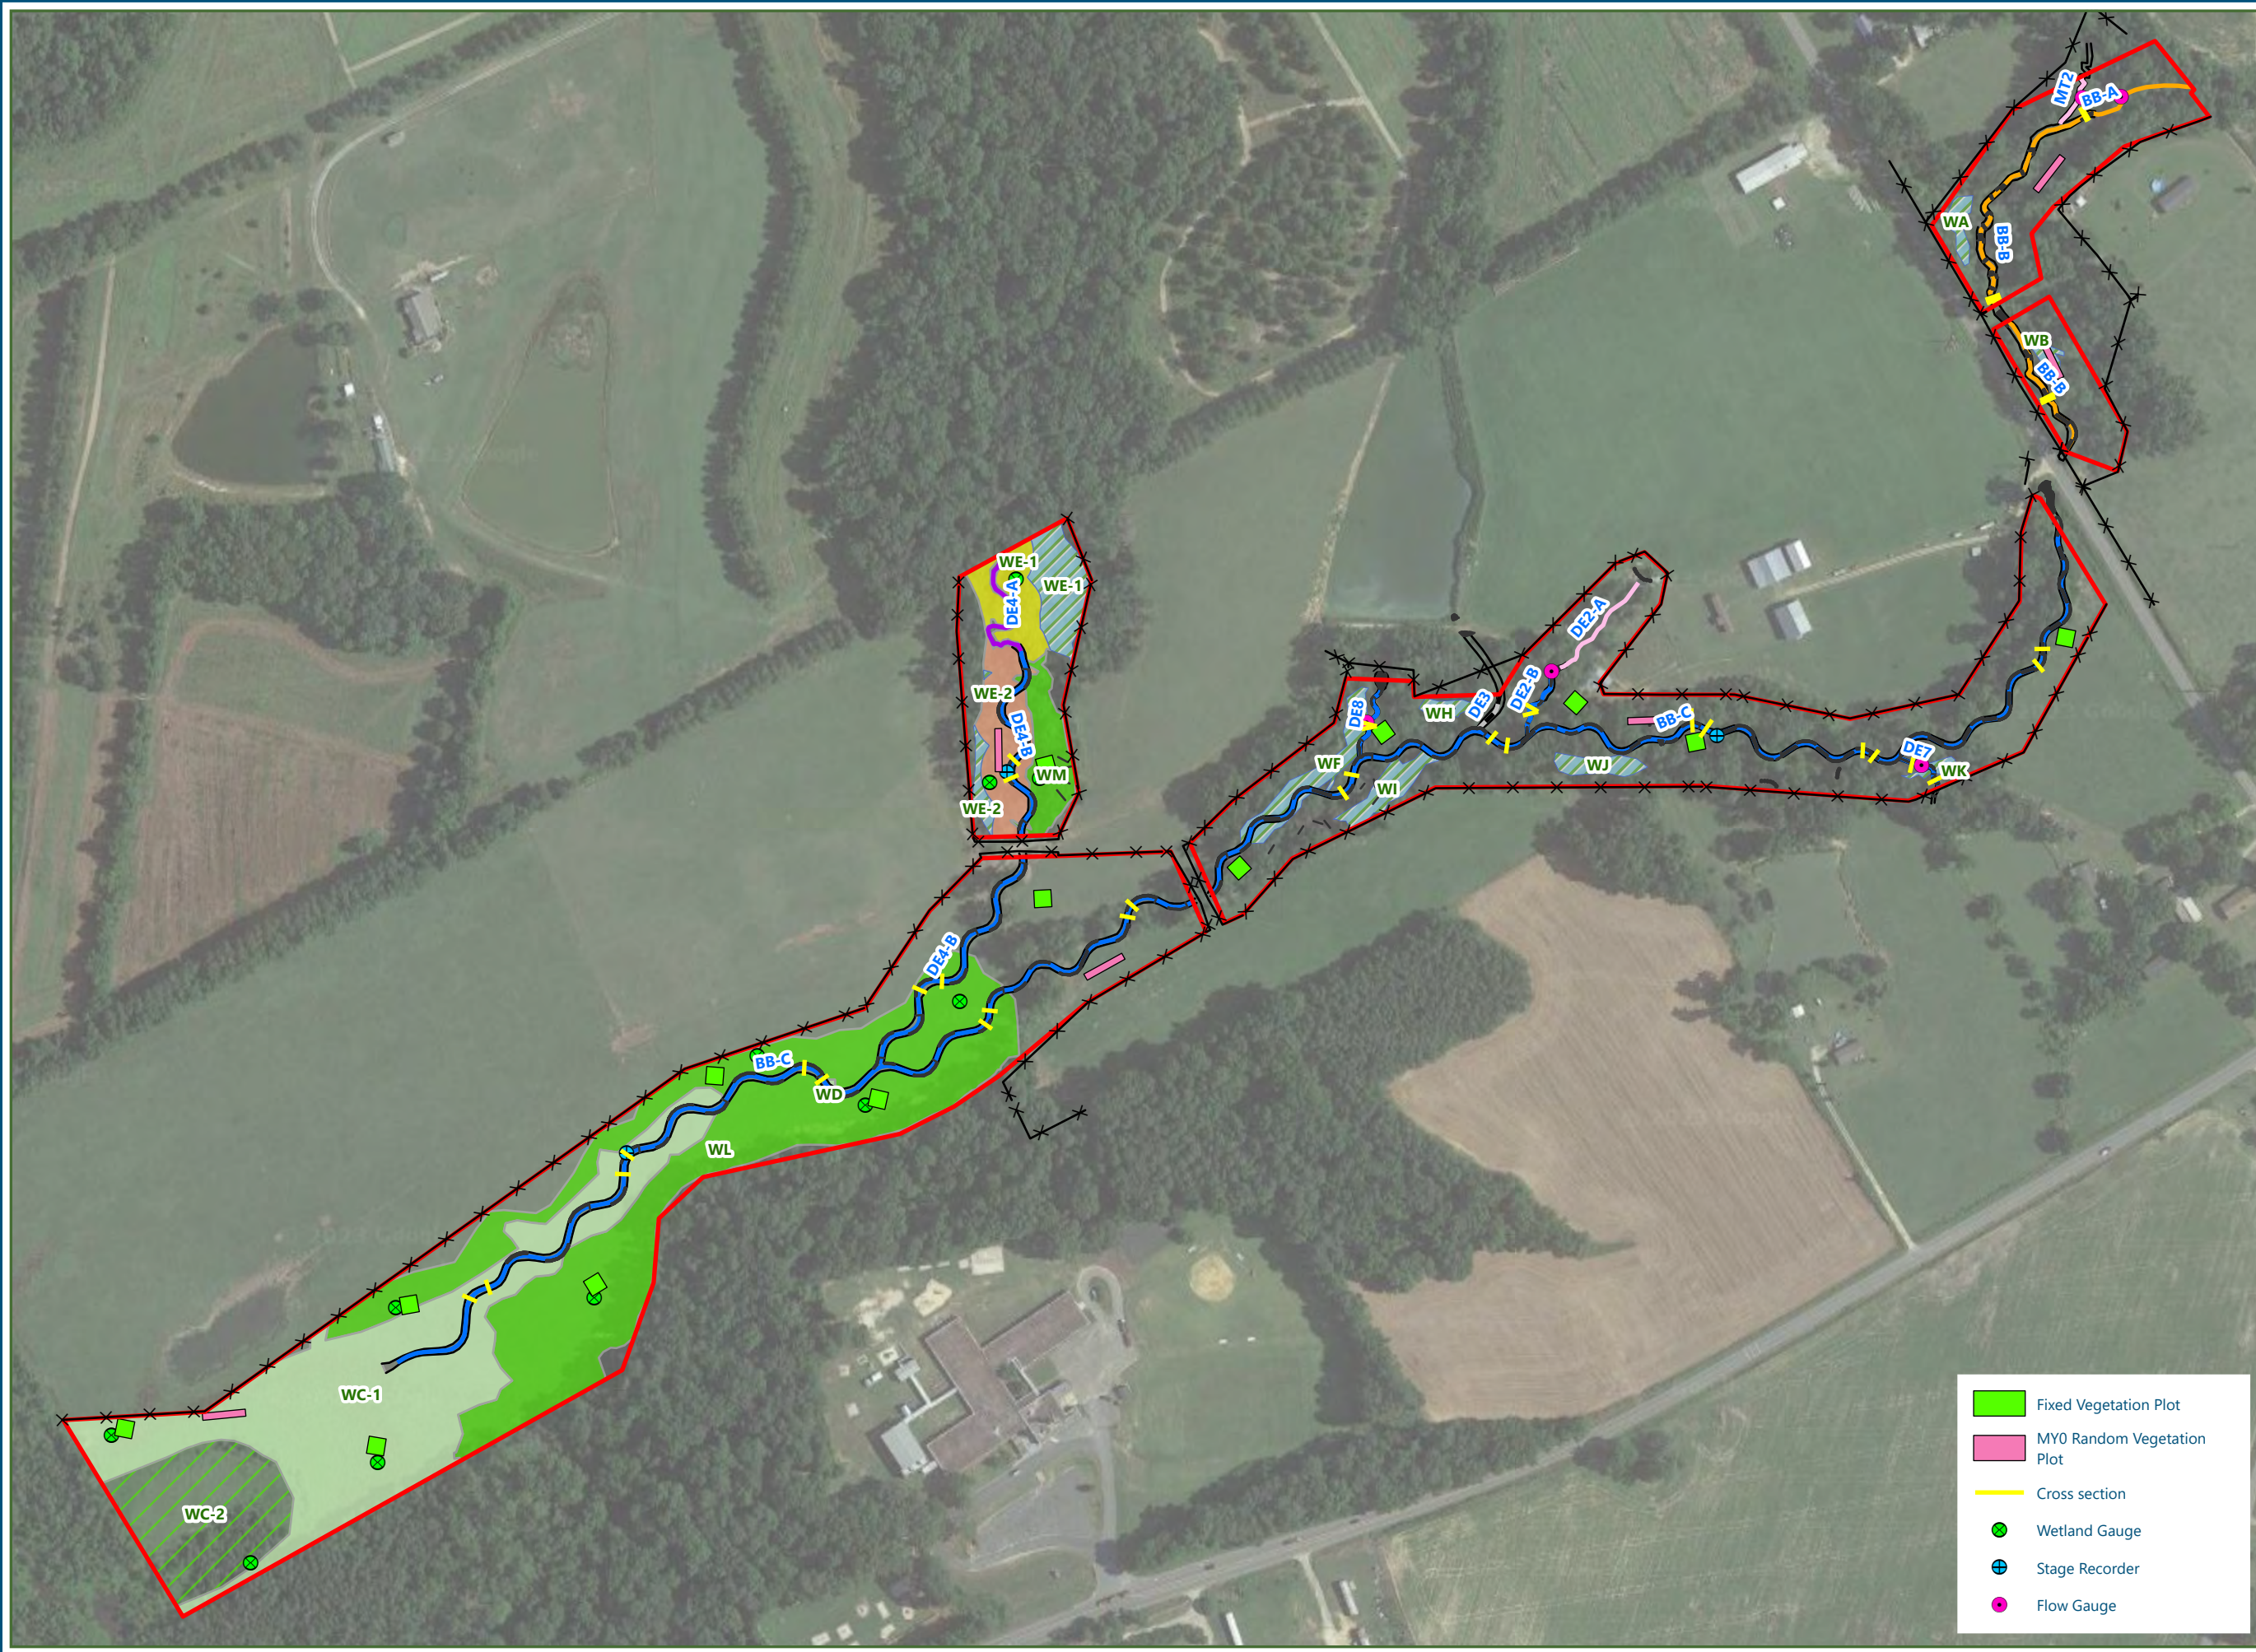




**Figure 2a**  
Current Conditions Plan View

MY0 2023


**Six Runs**  
Sampson County, North Carolina  
78.2361°W 35.0952°N



- Recorded Easement (30.94 ac.)
- Wetland Approach**
- Re-establishment
- Rehabilitation (1.5)
- Enhancement (High) (2)
- Enhancement (Low) (5)
- Preservation (10)
- No Credit
- Stream Approach**
- Restoration
- Enhancement I (1.5)
- Enhancement II (2.5)
- Enhancement II (5)
- No Credit
- Fencing
- Stream Structures
- As-built Top of Bank

**Vegetation Condition Assessment**

Invasive Species	Target Community		
	Present	Marginal	Absent
Absent			
Present			

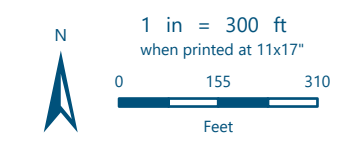


- Fixed Vegetation Plot
- MY0 Random Vegetation Plot
- Cross section
- Wetland Gauge
- Stage Recorder
- Flow Gauge

Reference: This information is not to be used as final legal boundaries.  
Imagery Source: Google  
Spatial Reference: NAD 1983 StatePlane North Carolina FIPS 3200 Feet  
Date Exported: 8/14/2023






**Figure 2b**  
**Current Conditions Plan View**  
 MY0 2023  
**Six Runs**  
 Sampson County, North Carolina  
 78.2325°W 35.097°N

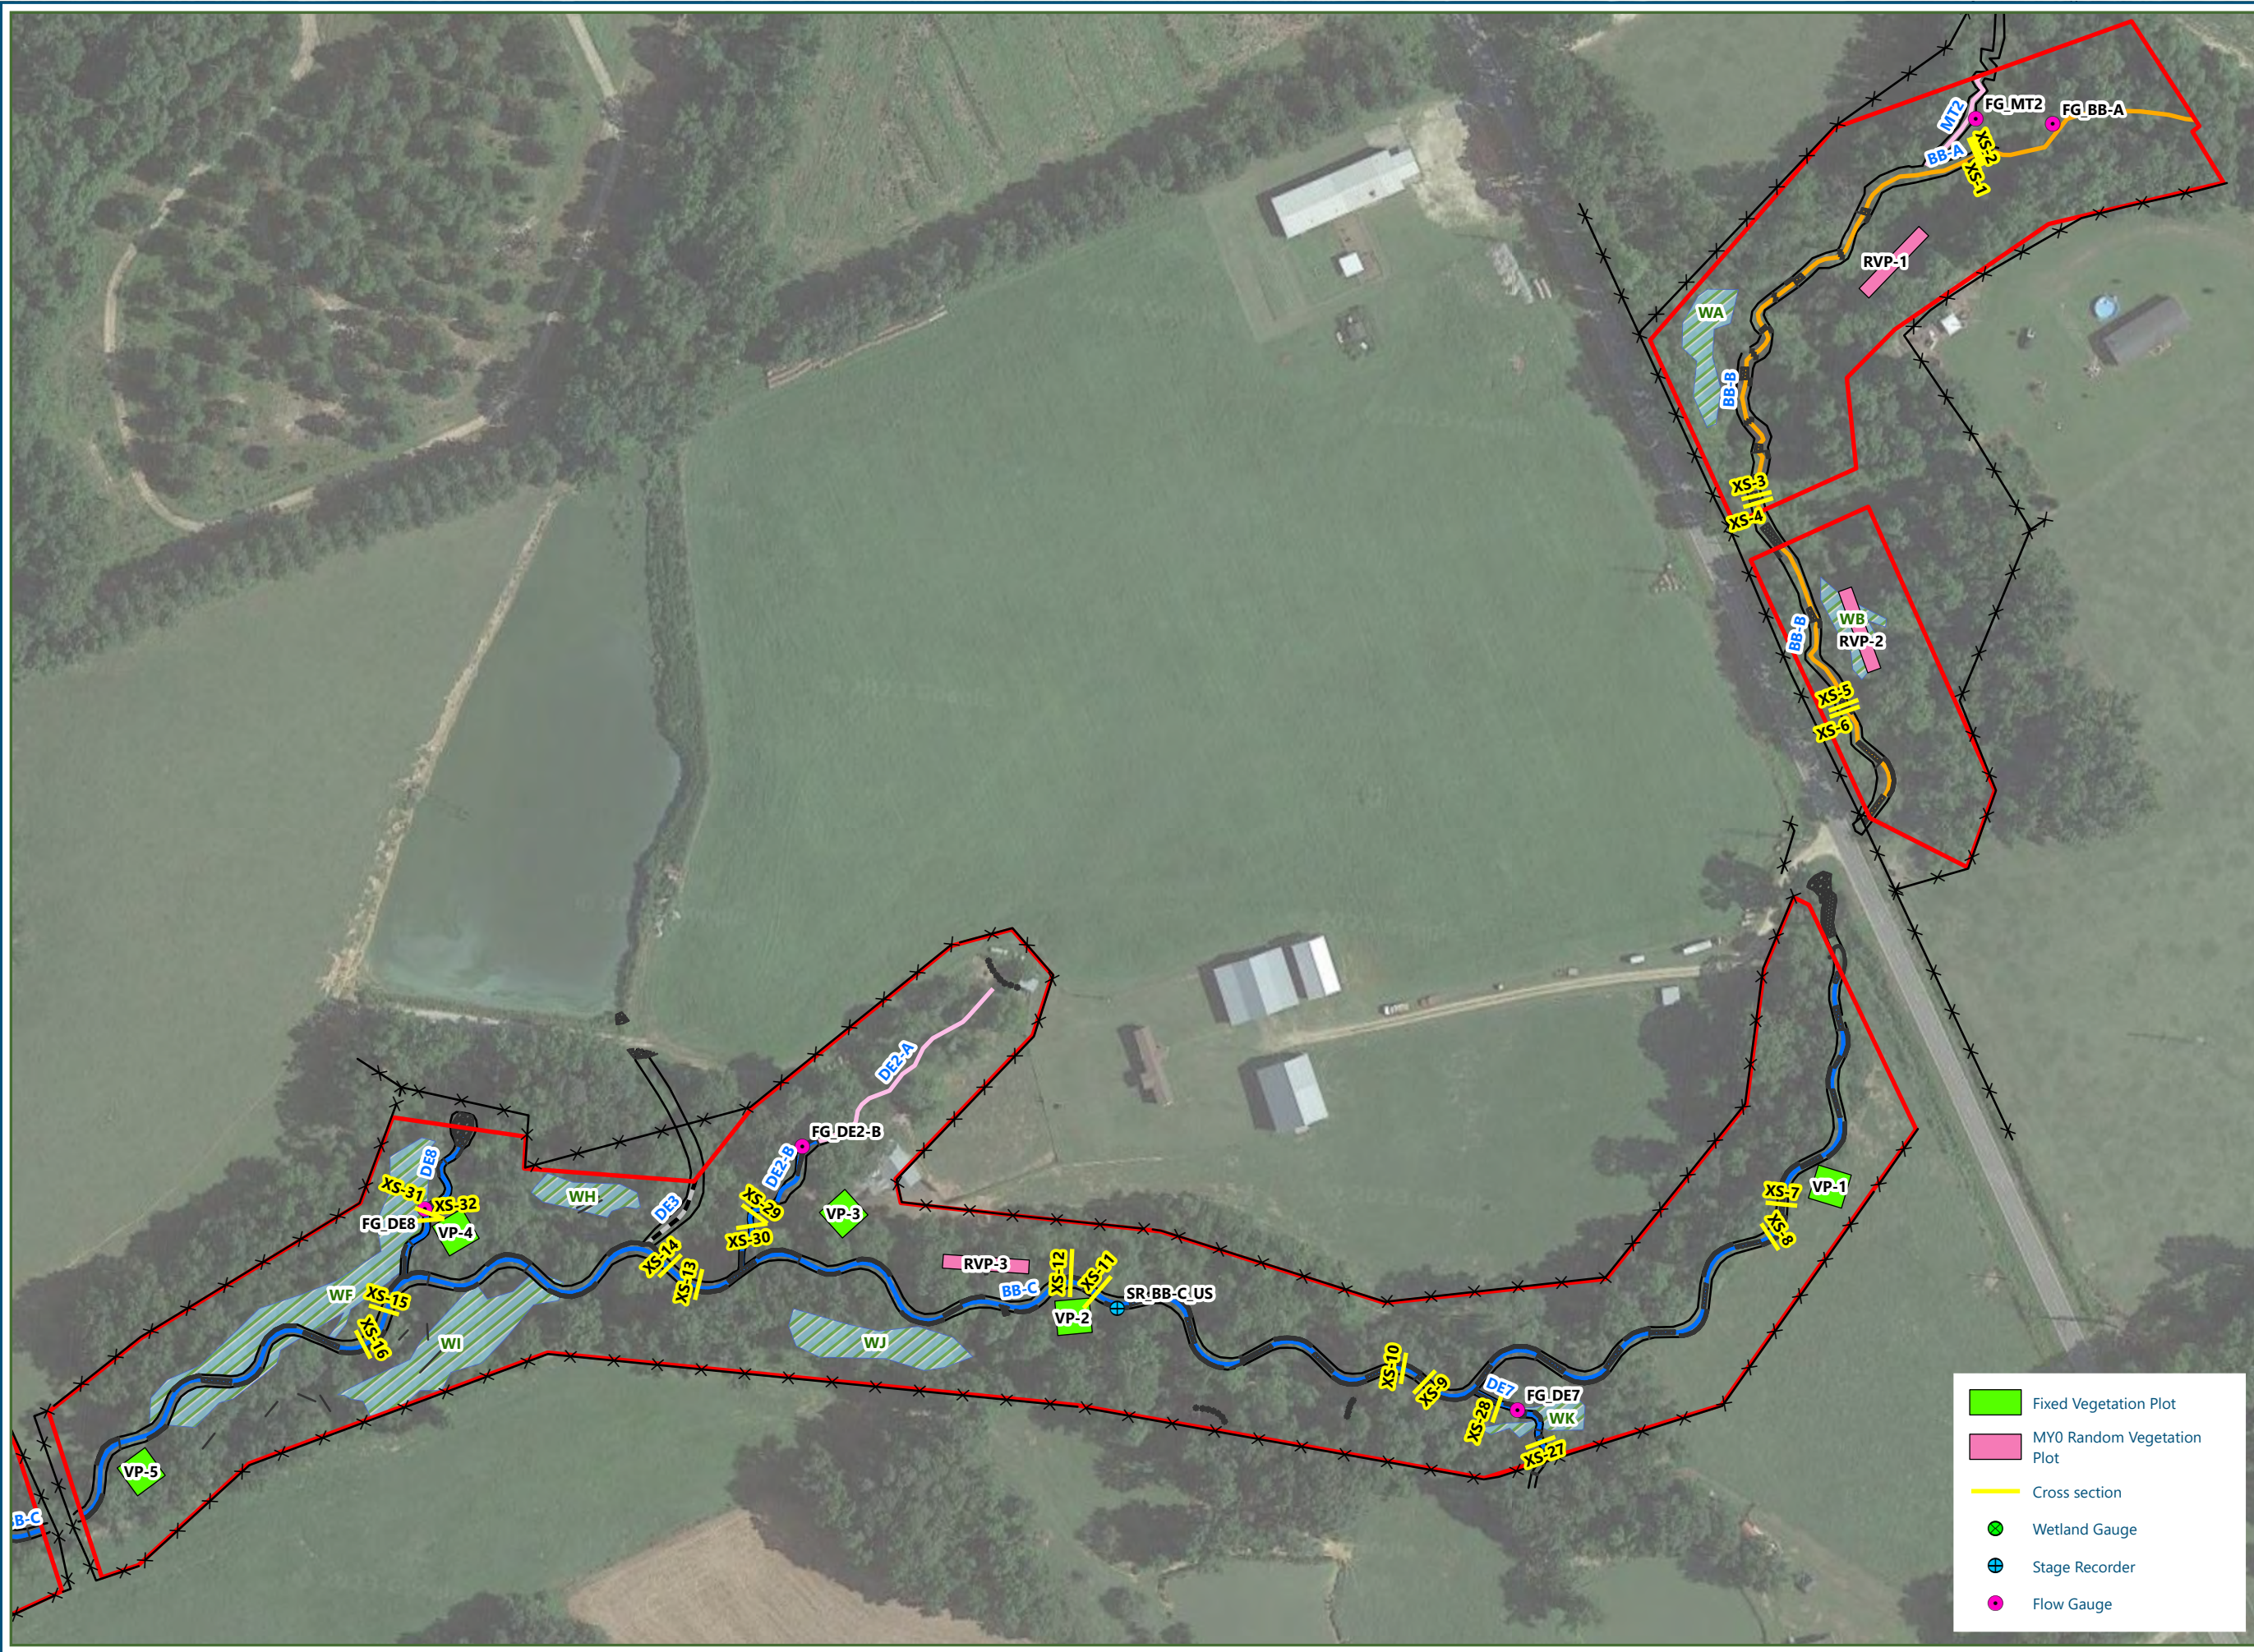

- Recorded Easement (30.94 ac.)
- Wetland Approach**
- Re-establishment
- Rehabilitation (1.5)
- Enhancement (High) (2)
- Enhancement (Low) (5)
- Preservation (10)
- No Credit
- Stream Approach**
- Restoration
- Enhancement I (1.5)
- Enhancement II (2.5)
- Enhancement II (5)
- No Credit
- Fencing
- Stream Structures
- As-built Top of Bank

**Vegetation Condition Assessment**

Invasive Species	Target Community		
	Present	Marginal	Absent
Absent			
Present			

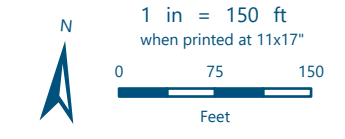

Reference: This information is not to be used as final legal boundaries.  
 Imagery Source: Google  
 Spatial Reference: NAD 1983 StatePlane North Carolina FIPS 3200 Feet  
 Date Exported: 8/16/2023


- Fixed Vegetation Plot
- MY0 Random Vegetation Plot
- Cross section
- Wetland Gauge
- Stage Recorder
- Flow Gauge





**Figure 2c**  
Current Conditions Plan View  
MY0 2023


**Six Runs**  
Sampson County, North Carolina  
78.2394°W 35.094°N

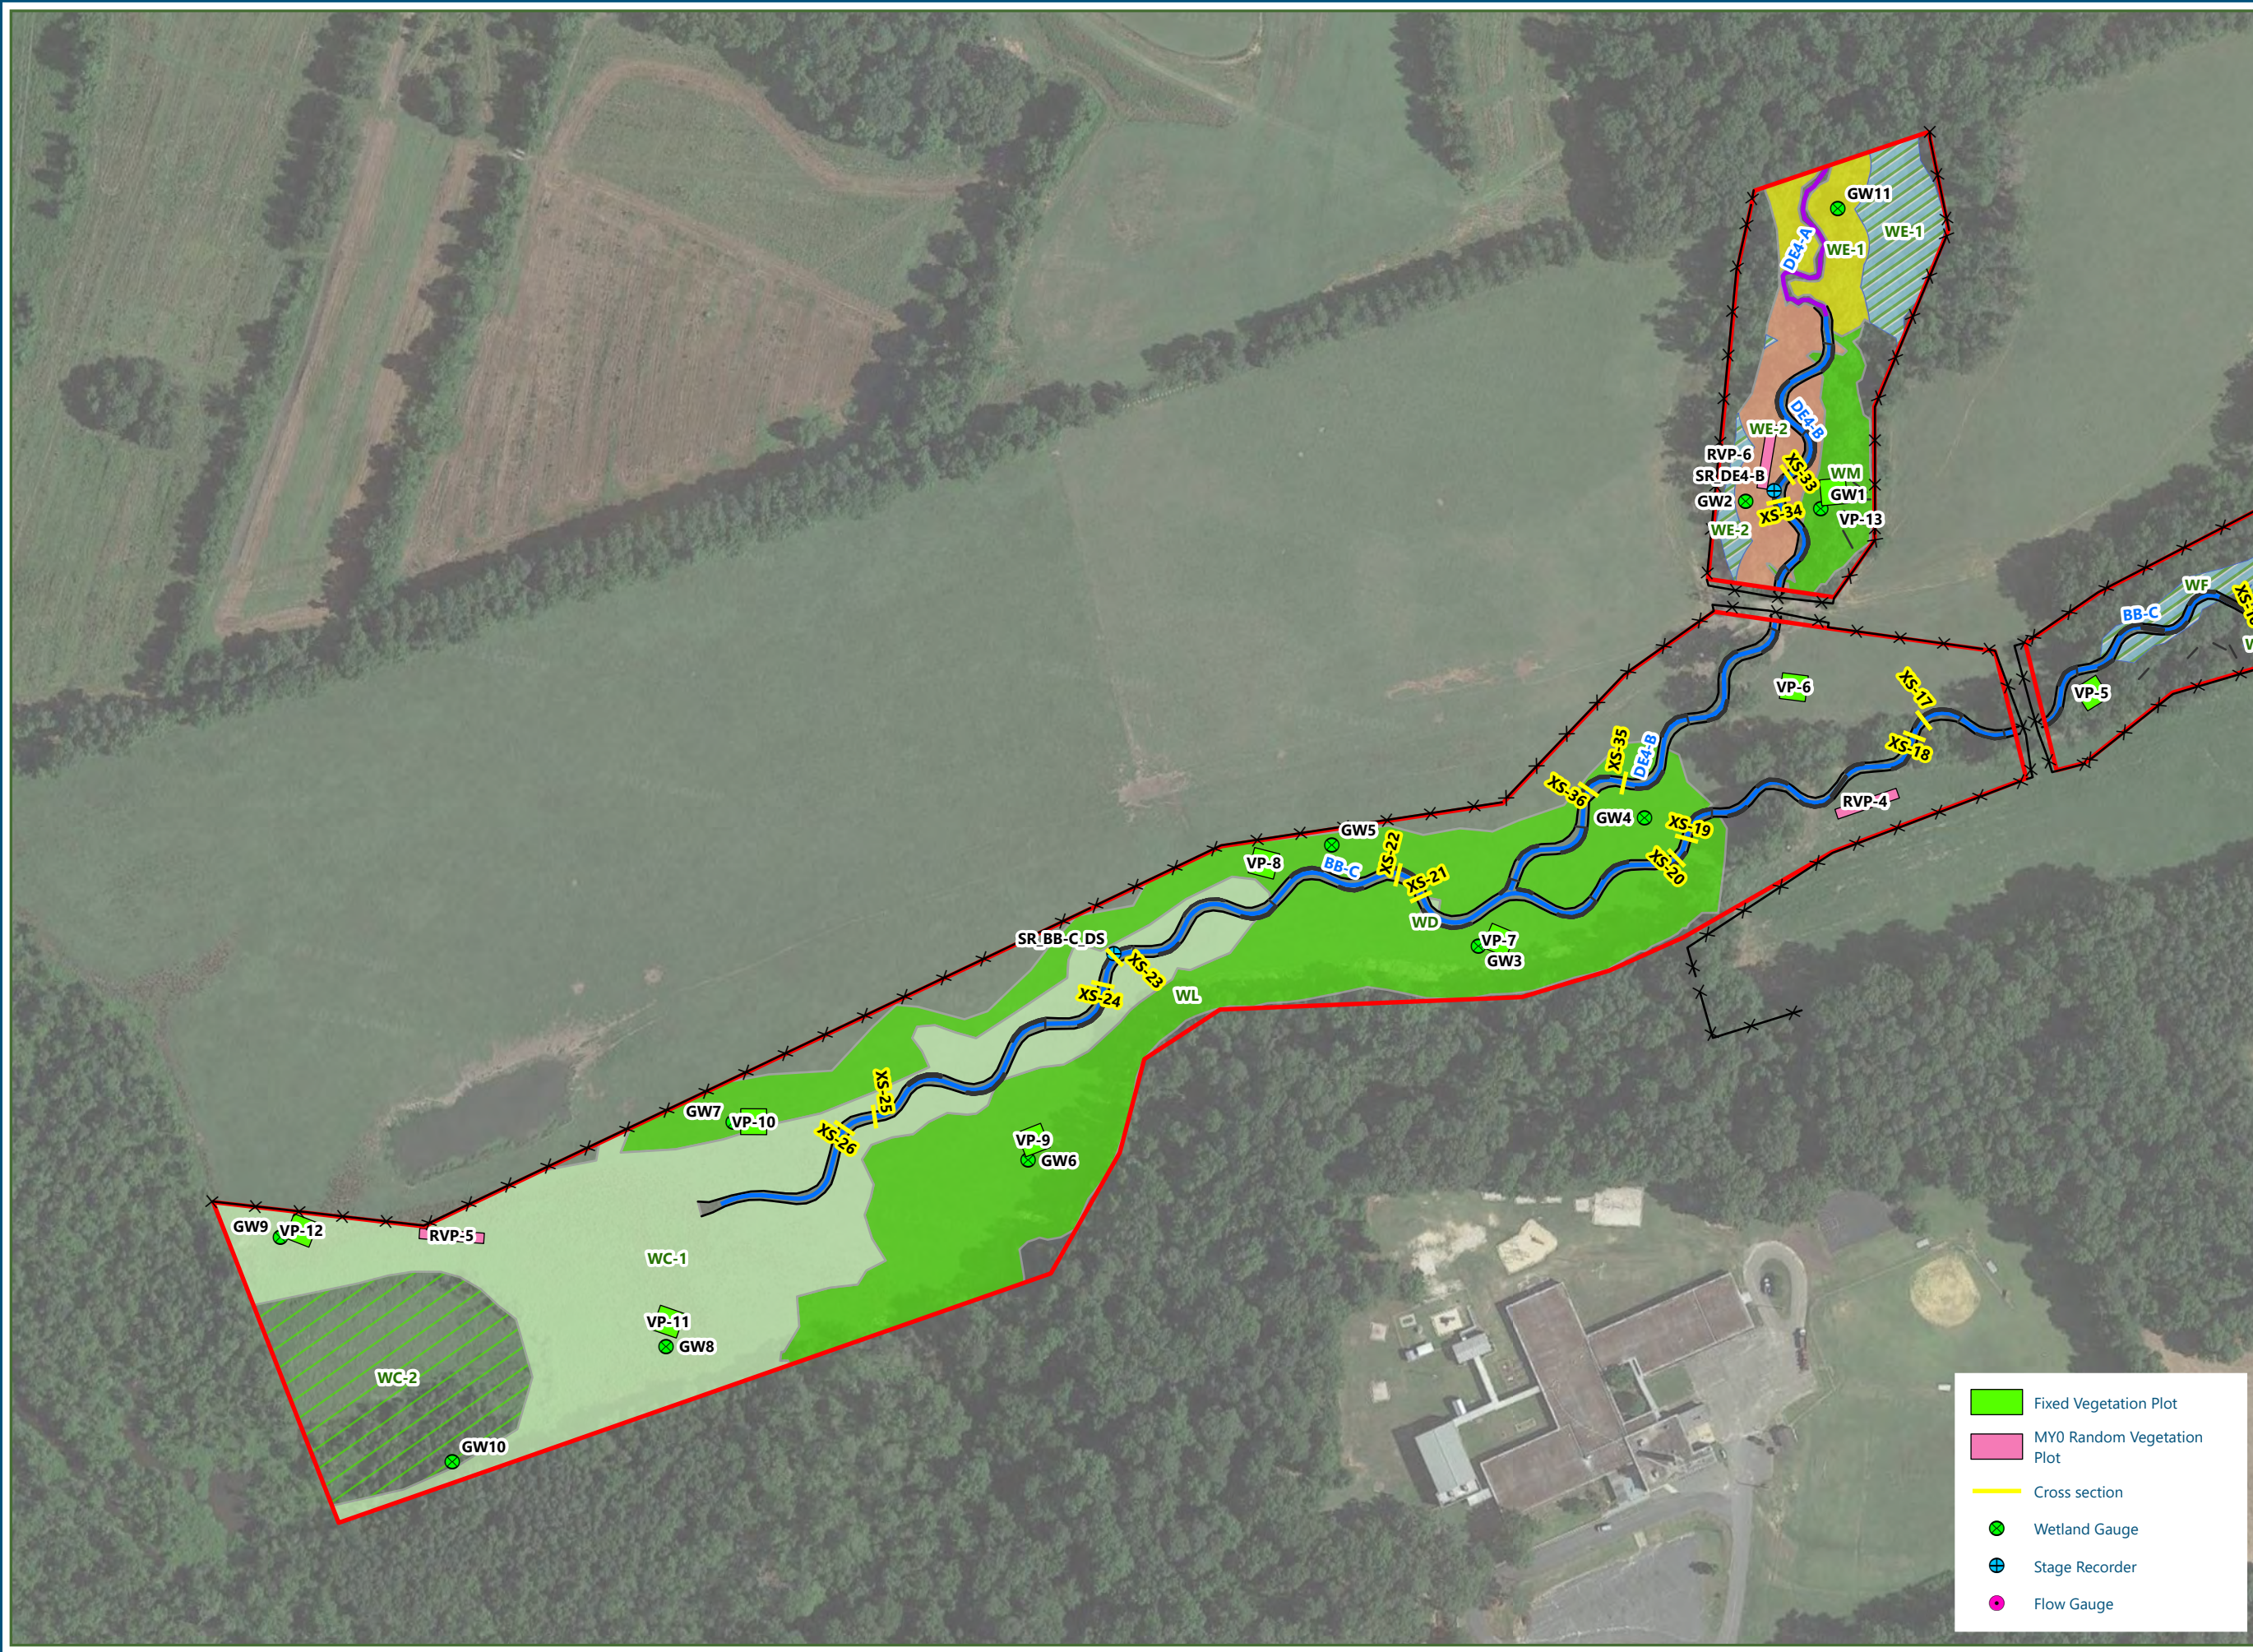

- Recorded Easement (30.94 ac.)
- Wetland Approach**
- Re-establishment
- Rehabilitation (1.5)
- Enhancement (High) (2)
- Enhancement (Low) (5)
- Preservation (10)
- No Credit
- Stream Approach**
- Restoration
- Enhancement I (1.5)
- Enhancement II (2.5)
- Enhancement II (5)
- No Credit
- Fencing
- Stream Structures
- As-built Top of Bank

**Vegetation Condition Assessment**

Invasive Species	Target Community		
	Present	Marginal	Absent
Absent			
Present			

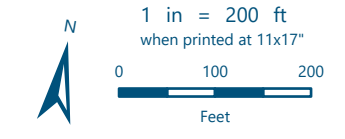

Reference: This information is not to be used as final legal boundaries.  
Imagery Source: Google  
Spatial Reference: NAD 1983 StatePlane North Carolina FIPS 3200 Feet  
Date Exported: 8/16/2023

- Fixed Vegetation Plot
- MY0 Random Vegetation Plot
- Cross section
- Wetland Gauge
- Stage Recorder
- Flow Gauge





**Six Runs General Photos (MY0)**



PALS on BB-B (03/28/2023)



ESP (03/01/2023)



BB-C (downstream) (03/23/2023)



BB-C (upstream) (03/30/2023)





Floodplain (03/01/2023)



Brush toe and spillway (03/01/2023)



Brush toe (03/01/2023)



Siphon to stream (03/23/2023)





Floodplain (03/01/2023)



Floodplain (03/30/2023)



DE4-B (downstream) (03/23/2023)



Wetland and stream (03/01/2023)



Juncus swale (03/01/2023)



Fence (03/14/2023)



Fence (03/14/2023)



BB-C restoration terminus (downstream) (03/01/2023)






BB-C (upstream) (03/01/2023)



Braiding downstream of BB-C terminus (03/01/2023)



Sign (03/01/2023)

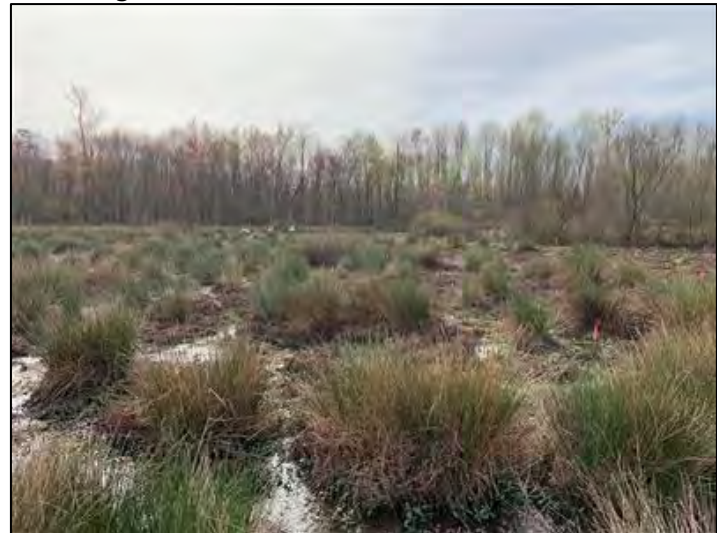

Wetland (03/01/2023)



**Six Runs Crossings (MY0)**



BB-B - E Darden Rd. Culvert Entrance - (03/23/2023)



BB-C - E Darden Rd. Culvert Exit (03/30/2023)



BB-C - Farm Culvert Entrance - (03/30/2023)



BB-C - Farm Culvert Exit - (03/30/2023)



DE4-B – Farm Culvert Entrance - (03/1/2023)



DE4-B – Farm Culvert Exit - (03/30/2023)



## Six Runs Monitoring Device Photos (MY0)



Flow Gauge MT2 (Looking Upstream) (03/28/2023)



Flow Gauge BB-A (Looking Upstream) (03/28/2023)



Ambient (03/28/2023)



Flow Gauge DE7 (Looking Upstream) (03/28/2023)





Stage Recorder BB-C\_US (Looking Upstream) (03/28/2023)



Flow Gauge DE2-B (Looking Upstream) (03/28/2023)



Flow Gauge DE8 (Looking Upstream) (03/28/2023)



Stage Recorder DE4-B (Looking Upstream) (03/28/2023)





Stage Recorder BB-C\_DS (Looking Upstream) (03/28/2023)



GW-01 (03/28/2023)



GW-02 (03/28/2023)



GW-03 (03/28/2023)





GW-04 (03/28/2023)



GW-05 (03/28/2023)



GW-06 (03/28/2023)



GW-07 (03/28/2023)





GW-08 (03/28/2023)



GW-09 (03/28/2023)



GW-10 (03/28/2023)



GW-11 (03/28/2023)



### Six Runs Vegetation Plot Photos (MY0)



Vegetation Plot 01 (03/23/2023)



Vegetation Plot 02 (03/23/2023)



Vegetation Plot 03 (03/23/2023)



Vegetation Plot 04 (03/23/2023)





Vegetation Plot 05 (03/23/2023)



Vegetation Plot 06 (03/23/2023)



Vegetation Plot 07 (03/23/2023)



Vegetation Plot 08 (03/23/2023)







Vegetation Plot 09 (03/23/2023)



Vegetation Plot 10 (03/23/2023)

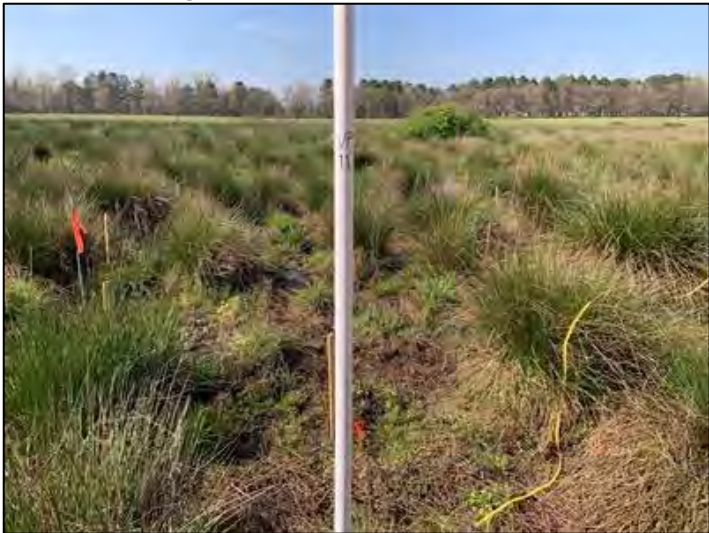

Vegetation Plot 11 (03/23/2023)

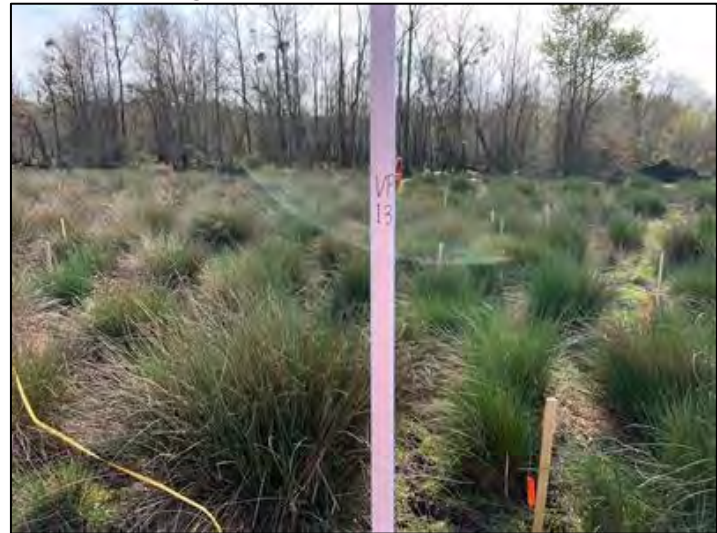

Vegetation Plot 12 (03/23/2023)





Vegetation Plot 13 (03/23/2023)



Random Vegetation Plot 01 (03/23/2023)



Random Vegetation Plot 02 (03/23/2023)



Random Vegetation Plot 03 (03/23/2023)





Random Vegetation Plot 04 (03/23/2023)



Random Vegetation Plot 05 (03/28/2023)



Random Vegetation Plot 06 (03/28/2023)

Visual Stream Stability Assessment

Reach BB-A  
 Assessed Stream Length 452  
 Assessed Bank Length 904

Major Channel Category		Metric	Number Stable, Performing as Intended	Total Number in As-built	Amount of Unstable Footage	% Stable, Performing as Intended
Bank	Surface Scour/Bare Bank	Bank lacking vegetative cover resulting simply from poor growth and/or surface scour			0	100%
	Toe Erosion	Bank toe eroding to the extent that bank failure appears likely. Does <u>NOT</u> include undercuts that are modest, appear sustainable and are providing habitat.			0	100%
	Bank Failure	Fluvial and geotechnical - rotational, slumping, calving, or collapse			0	100%
<b>Totals</b>					0	100%
Structure	Grade Control	Grade control structures exhibiting maintenance of grade across the sill.	3	3		100%
	Bank Protection	Bank erosion within the structures extent of influence does <u>not</u> exceed 15%. (See guidance for this table in DMS monitoring guidance document)	3	3		100%

Visual Stream Stability Assessment

Reach BB-B  
 Assessed Stream Length 562  
 Assessed Bank Length 1124

Major Channel Category		Metric	Number Stable, Performing as Intended	Total Number in As-built	Amount of Unstable Footage	% Stable, Performing as Intended
Bank	Surface Scour/Bare Bank	Bank lacking vegetative cover resulting simply from poor growth and/or surface scour			0	100%
	Toe Erosion	Bank toe eroding to the extent that bank failure appears likely. Does <u>NOT</u> include undercuts that are modest, appear sustainable and are providing habitat.			0	100%
	Bank Failure	Fluvial and geotechnical - rotational, slumping, calving, or collapse			0	100%
<b>Totals</b>					0	100%
Structure	Grade Control	Grade control structures exhibiting maintenance of grade across the sill.	8	8		100%
	Bank Protection	Bank erosion within the structures extent of influence does <u>not</u> exceed 15%. (See guidance for this table in DMS monitoring guidance document)	7	7		100%

Visual Stream Stability Assessment

Reach BB-C  
 Assessed Stream Length 4357  
 Assessed Bank Length 8714

Major Channel Category		Metric	Number Stable, Performing as Intended	Total Number in As-built	Amount of Unstable Footage	% Stable, Performing as Intended
Bank	Surface Scour/Bare Bank	Bank lacking vegetative cover resulting simply from poor growth and/or surface scour			0	100%
	Toe Erosion	Bank toe eroding to the extent that bank failure appears likely. Does <u>NOT</u> include undercuts that are modest, appear sustainable and are providing habitat.			0	100%
	Bank Failure	Fluvial and geotechnical - rotational, slumping, calving, or collapse			0	100%
<b>Totals</b>					0	100%
Structure	Grade Control	Grade control structures exhibiting maintenance of grade across the sill.	21	21		100%
	Bank Protection	Bank erosion within the structures extent of influence does <u>not</u> exceed 15%. (See guidance for this table in DMS monitoring guidance document)	58	58		100%

Visual Stream Stability Assessment

Reach MT2  
 Assessed Stream Length 110  
 Assessed Bank Length 220

Major Channel Category		Metric	Number Stable, Performing as Intended	Total Number in As-built	Amount of Unstable Footage	% Stable, Performing as Intended
Bank	Surface Scour/Bare Bank	Bank lacking vegetative cover resulting simply from poor growth and/or surface scour			0	100%
	Toe Erosion	Bank toe eroding to the extent that bank failure appears likely. Does <u>NOT</u> include undercuts that are modest, appear sustainable and are providing habitat.			0	100%
	Bank Failure	Fluvial and geotechnical - rotational, slumping, calving, or collapse			0	100%
<b>Totals</b>					0	100%
Structure	Grade Control	Grade control structures exhibiting maintenance of grade across the sill.	0	0		N/A
	Bank Protection	Bank erosion within the structures extent of influence does <u>not</u> exceed 15%. (See guidance for this table in DMS monitoring guidance document)	0	0		N/A

Visual Stream Stability Assessment

Reach DE7  
 Assessed Stream Length 112  
 Assessed Bank Length 224

Major Channel Category		Metric	Number Stable, Performing as Intended	Total Number in As-built	Amount of Unstable Footage	% Stable, Performing as Intended
Bank	Surface Scour/Bare Bank	Bank lacking vegetative cover resulting simply from poor growth and/or surface scour			0	100%
	Toe Erosion	Bank toe eroding to the extent that bank failure appears likely. Does <u>NOT</u> include undercuts that are modest, appear sustainable and are providing habitat.			0	100%
	Bank Failure	Fluvial and geotechnical - rotational, slumping, calving, or collapse			0	100%
<b>Totals</b>					0	100%
Structure	Grade Control	Grade control structures exhibiting maintenance of grade across the sill.	6	6		100%
	Bank Protection	Bank erosion within the structures extent of influence does <u>not</u> exceed 15%. (See guidance for this table in DMS monitoring guidance document)	3	3		100%



Visual Stream Stability Assessment

Reach DE2-A  
 Assessed Stream Length 231  
 Assessed Bank Length 462

Major Channel Category		Metric	Number Stable, Performing as Intended	Total Number in As-built	Amount of Unstable Footage	% Stable, Performing as Intended
Bank	Surface Scour/Bare Bank	Bank lacking vegetative cover resulting simply from poor growth and/or surface scour			0	100%
	Toe Erosion	Bank toe eroding to the extent that bank failure appears likely. Does <u>NOT</u> include undercuts that are modest, appear sustainable and are providing habitat.			0	100%
	Bank Failure	Fluvial and geotechnical - rotational, slumping, calving, or collapse			0	100%
<b>Totals</b>					0	100%
Structure	Grade Control	Grade control structures exhibiting maintenance of grade across the sill.	0	0		N/A
	Bank Protection	Bank erosion within the structures extent of influence does <u>not</u> exceed 15%. (See guidance for this table in DMS monitoring guidance document)	0	0		N/A

Visual Stream Stability Assessment

Reach DE2-B  
 Assessed Stream Length 156  
 Assessed Bank Length 312

Major Channel Category		Metric	Number Stable, Performing as Intended	Total Number in As-built	Amount of Unstable Footage	% Stable, Performing as Intended
Bank	Surface Scour/Bare Bank	Bank lacking vegetative cover resulting simply from poor growth and/or surface scour			0	100%
	Toe Erosion	Bank toe eroding to the extent that bank failure appears likely. Does <u>NOT</u> include undercuts that are modest, appear sustainable and are providing habitat.			0	100%
	Bank Failure	Fluvial and geotechnical - rotational, slumping, calving, or collapse			0	100%
<b>Totals</b>					0	100%
Structure	Grade Control	Grade control structures exhibiting maintenance of grade across the sill.	3	3		100%
	Bank Protection	Bank erosion within the structures extent of influence does <u>not</u> exceed 15%. (See guidance for this table in DMS monitoring guidance document)	2	2		100%

Visual Stream Stability Assessment

Reach DE8  
 Assessed Stream Length 171  
 Assessed Bank Length 342

Major Channel Category		Metric	Number Stable, Performing as Intended	Total Number in As-built	Amount of Unstable Footage	% Stable, Performing as Intended
Bank	Surface Scour/Bare Bank	Bank lacking vegetative cover resulting simply from poor growth and/or surface scour			0	100%
	Toe Erosion	Bank toe eroding to the extent that bank failure appears likely. Does <u>NOT</u> include undercuts that are modest, appear sustainable and are providing habitat.			0	100%
	Bank Failure	Fluvial and geotechnical - rotational, slumping, calving, or collapse			0	100%
<b>Totals</b>					0	100%
Structure	Grade Control	Grade control structures exhibiting maintenance of grade across the sill.	3	3		100%
	Bank Protection	Bank erosion within the structures extent of influence does <u>not</u> exceed 15%. (See guidance for this table in DMS monitoring guidance document)	4	4		100%

Visual Stream Stability Assessment

Reach DE4-A  
 Assessed Stream Length 301  
 Assessed Bank Length 602

Major Channel Category		Metric	Number Stable, Performing as Intended	Total Number in As-built	Amount of Unstable Footage	% Stable, Performing as Intended
Bank	Surface Scour/Bare Bank	Bank lacking vegetative cover resulting simply from poor growth and/or surface scour			0	100%
	Toe Erosion	Bank toe eroding to the extent that bank failure appears likely. Does <u>NOT</u> include undercuts that are modest, appear sustainable and are providing habitat.			0	100%
	Bank Failure	Fluvial and geotechnical - rotational, slumping, calving, or collapse			0	100%
<b>Totals</b>					0	100%
Structure	Grade Control	Grade control structures exhibiting maintenance of grade across the sill.	0	0		N/A
	Bank Protection	Bank erosion within the structures extent of influence does <u>not</u> exceed 15%. (See guidance for this table in DMS monitoring guidance document)	0	0		N/A



Visual Stream Stability Assessment

Reach DE4-B  
 Assessed Stream Length 992  
 Assessed Bank Length 1984

Major Channel Category		Metric	Number Stable, Performing as Intended	Total Number in As-built	Amount of Unstable Footage	% Stable, Performing as Intended
Bank	Surface Scour/Bare Bank	Bank lacking vegetative cover resulting simply from poor growth and/or surface scour			0	100%
	Toe Erosion	Bank toe eroding to the extent that bank failure appears likely. Does <u>NOT</u> include undercuts that are modest, appear sustainable and are providing habitat.			0	100%
	Bank Failure	Fluvial and geotechnical - rotational, slumping, calving, or collapse			0	100%
<b>Totals</b>					0	100%
Structure	Grade Control	Grade control structures exhibiting maintenance of grade across the sill.	7	7		100%
	Bank Protection	Bank erosion within the structures extent of influence does <u>not</u> exceed 15%. (See guidance for this table in DMS monitoring guidance document)	15	15		100%

**Visual Vegetation Assessment**

**Planted acreage 26.19**

Vegetation Category	Definitions	Mapping Threshold	Combined Acreage	% of Planted Acreage
Bare Areas	Very limited cover of both woody and herbaceous material.	0.1 acres	0.00	0.0%
Low Stem Density Areas*	Woody stem densities clearly below target levels based on current MY stem count criteria.	0.1 acres	0.00	0.0%
<b>Total</b>				
Areas of Poor Growth Rates	Planted areas where average height is not meeting current MY Performance Standard.	0.25 acres	0.00	0.0%
<b>Cumulative Total</b>				0.0%

**Easement Acreage 30.94**

Vegetation Category	Definitions	Mapping Threshold	Combined Acreage	% of Easement Acreage
Invasive Areas of Concern	Invasives may occur outside of planted areas and within the easement and will therefore be calculated against the total easement acreage- Include species with the potential to directly outcompete native, young, woody stems in the short-term or community structure for existing communities. Species included in summation above should be identified in report summary.	1000 SF	0.00	0.0%
Easement Encroachment Areas	Encroachment may be point, line, or polygon. Encroachment to be mapped consists of any violation of restrictions specified in the conservation easement. Common encroachments are mowing, cattle access, vehicular access. Encroachment has no threshold value as will need to be addressed regardless of impact area.	none	N/A	

# **Appendix B**

## Vegetation Plot Data

## Table 7. Six Runs As-Built Planting Lists

Zone 1-A & B (Wetlands and Floodplains)			
Bare Roots			
Common Name	Scientific Name	Percent Composition	QTY
Bald cypress	<i>Taxodium distichum</i>	10%	1,700
Swamp tupelo	<i>Nyssa biflora</i>	10%	1,700
Buttonbush	<i>Cephalanthus occidentalis</i>	10%	1,700
Overcup oak	<i>Quercus lyrata</i>	10%	1,700
River birch	<i>Betula nigra</i>	10%	1,700
Laurel oak	<i>Quercus laurifolia</i>	5%	900
Water hickory	<i>Carya aquatica</i>	5%	900
Hazel alder	<i>Alnus serrulata</i>	5%	900
Green ash	<i>Fraxinus pennsylvanica</i>	5%	850
American sycamore	<i>Platanus occidentalis</i>	5%	850
American elm	<i>Ulmus American</i>	5%	850
Swamp chestnut oak	<i>Quercus michauxii</i>	5%	900
Willow oak	<i>Quercus phellos</i>	5%	900
Wax myrtle	<i>Morella cerifera</i>	5%	850
		<b>Total Bare Roots</b>	<b>16,400</b>
Containerized (Zone 1-B Only)			
Bald cypress	<i>Taxodium distichum</i>	24%	70
Swamp tupelo	<i>Nyssa biflora</i>	24%	70
Buttonbush	<i>Cephalanthus occidentalis</i>	24%	70
Overcup oak	<i>Quercus lyrata</i>	28%	80
		<b>Total Containerized</b>	<b>290</b>
Live Stakes (Zone 1-B Only)			
Black willow	<i>Salix nigra</i>	66%	1,200
Hazel alder	<i>Alnus serrulata</i>	17%	300
Buttonbush	<i>Cephalanthus occidentalis</i>	17%	300
		<b>Total Live Stakes</b>	<b>1,800</b>



<b>Zone 2 (Uplands and Slopes)</b>			
<b>Bare Roots</b>			
<b>Common Name</b>	<b>Scientific Name</b>	<b>Percent Composition</b>	<b>QTY</b>
Green ash	<i>Fraxinus pennsylvanica</i>	5%	250
American sycamore	<i>Platanus occidentalis</i>	5%	250
American elm	<i>Ulmus American</i>	5%	250
Swamp chestnut oak	<i>Quercus michauxii</i>	10%	500
Willow oak	<i>Quercus phellos</i>	10%	500
Wax myrtle	<i>Morella cerifera</i>	5%	250
American hornbeam	<i>Carpinus caroliniana</i>	10%	500
Water oak	<i>Quercus nigra</i>	10%	500
White oak	<i>Quercus alba</i>	15%	800
Northern red oak	<i>Quercus rubra</i>	15%	800
Yellow poplar	<i>Liriodendron tulipifera</i>	10%	500
		<b>Total Bare Roots</b>	<b>5,100</b>

<b>Stream Bank Live Staking</b>			
<b>Live Stakes</b>			
<b>Common Name</b>	<b>Scientific Name</b>	<b>Percent Composition</b>	<b>QTY</b>
Black Willow	<i>Salix nigra</i>	40%	3,450
Buttonbush	<i>Cephalanthus occidentalis</i>	30%	2,600
Silky Dogwood	<i>Cornus amomum</i>	30%	2,600
		<b>Total Live Stakes</b>	<b>8,650</b>

**Table 8. Vegetation Plot Data**

Planted Acreage	26.19
Date of Initial Plant	2023-03-02
Date(s) of Supplemental Plant(s)	NA
Date(s) Mowing	NA
Date of Current Survey	2023-03-02
Plot size (ACRES)	0.0247

	Scientific Name	Common Name	Tree/Shrub	Indicator Status	Veg Plot 1 F		Veg Plot 2 F		Veg Plot 3 F		Veg Plot 4 F		Veg Plot 5 F		Veg Plot 6 F		Veg Plot 7 F		Veg Plot 8 F		Veg Plot 9 F		Veg Plot 10 F		Veg Plot 11 F		Veg Plot 12 F		Veg Plot 13 F		Veg Plot 1 R	Veg Plot 2 R	Veg Plot 3 R	Veg Plot 4 R	Veg Plot 5 R	Veg Plot 6 R			
					Planted	Total	Planted	Total	Planted	Total	Planted	Total	Planted	Total	Planted	Total	Planted	Total	Planted	Total	Planted	Total	Planted	Total	Planted	Total	Planted	Total	Planted	Total	Planted	Total	Planted	Total	Planted	Total	Planted	Total	
Species Included In Approved Mitigation Plan	<i>Alnus serrulata</i>	hazel alder	Tree	FACW	2	2	1	1					3	3			2	2	4	4	1	1			3	3	1	1	1	1			1						
	<i>Betula nigra</i>	river birch	Tree	FACW	1	1	1	1	2	2							2	2	3	3	2	2	1	1	1	1	2	2	4	4				1			1		
	<i>Carpinus caroliniana</i>	American hornbeam	Tree	FAC					1	1																					2	3	1						
	<i>Carya aquatica</i>	water hickory	Tree	OBL			2	2			5	5	1	1	1	1							4	4	3	3			1	1	2	2			1				
	<i>Cephalanthus occidentalis</i>	common buttonbush	Shrub	OBL	1	1	2	2									2	2	2	2	1	1	1	1	2	2	1	1							2	3			
	<i>Fraxinus pennsylvanica</i>	green ash	Tree	FACW							5	5			1	1																				1		2	
	<i>Liriodendron tulipifera</i>	tuliptree	Tree	FACU					3	3																								1					
	<i>Morella cerifera</i>	wax myrtle	Tree	FACU			1	1			2	2	1	1	5	5			1	1					2	2	1	1					3			1			
	<i>Nyssa biflora</i>	swamp tupelo	Tree	OBL	1	1					4	4							1	1					2	2			1	1					1	2			
	<i>Platanus occidentalis</i>	American sycamore	Tree	FACW	1	1	3	3	1	1							2	2			1	1	2	2	2	2			1	1	1	1	2	2	3			2	
	<i>Quercus alba</i>	white oak	Tree	FACU																																			
	<i>Quercus laurifolia</i>	laurel oak	Tree	FACW	3	3	1	1			1	1	4	4	4	4	4	4							2	2	1	1	3	3	5	5			3	1			
	<i>Quercus lyrata</i>	overcup oak	Tree	OBL	1	1	2	2					1	1			1	1	3	3	1	1	1	1	3	3	5	5	2	2			3	3	1		3		
	<i>Quercus michauxii</i>	swamp chestnut oak	Tree	FACW																					2	2	1	1	4	4			4						
	<i>Quercus nigra</i>	water oak	Tree	FAC	1	1	1	1	2	2															2	2	1	1					2	1					
	<i>Quercus phellos</i>	willow oak	Tree	FACU			1	1					5	5									1	1	1	1	1	1			2	2	3	1	2	1			
	<i>Quercus rubra</i>	northern red oak	Tree	FACU					2	2																													
	<i>Salix nigra</i>	black willow	Tree	OBL													2	2	1	1				2	2			2	2			7	4	1					
	<i>Taxodium distichum</i>	bald cypress	Tree	OBL			2	2			1	1	3	3	4	4	4	4	3	3	4	4	2	2	2	2	2	1	1							3	5	3	
	<i>Ulmus americana</i>	American elm	Tree	FAC	4	4	1	1	4	4	1	1	1	1	1	1	1	1	2	2	1	1	1	1	1	1	1	1	2	2	4	4					1	3	
Sum	Performance Standard				15	15	18	18	15	15	20	20	17	17	18	18	22	22	20	20	17	17	20	20	16	16	17	17	25	25	22	22	16	15	17	14			
Mitigation Plan Performance Standard	Current Year Stem Count				15	18	15	20	17	18	22	20	17	20	17	20	16	17	25	22	22	16	15	17	14														
	Stems/Acre				607	729	607	810	688	729	891	810	688	810	688	810	648	688	1012	891	891	648	607	688	567														
	Species Count				9	12	7	8	6	7	10	9	9	12	10	9	10	9	10	8	8	8	8	9	6														
	Dominant Species Composition (%)				27	17	27	25	29	28	18	20	24	15	19	29	20	32	18	19	20	29	21																
	Average Plot Height (ft.)				1	1	1	1	2	2	1	1	1	2	2	1	2	2	1	1	1	1	1	2	1														
% Invasives				0	0	0	0	0	0	0	0	0	0	0	0	0	0	0	0	0	0	0	0	0															
Post Mitigation Plan Performance Standard	Current Year Stem Count				15	18	15	20	17	18	22	20	17	20	17	20	16	17	25	22	22	16	15	17	14														
	Stems/Acre				607	729	607	810	688	729	891	810	688	810	688	810	648	688	1012	891	891	648	607	688	567														
	Species Count				9	12	7	8	6	7	10	9	9	12	10	9	10	9	10	8	8	8	8	9	6														
	Dominant Species Composition (%)				27	17	27	25	29	28	18	20	24	15	19	29	20	32	18	19	20	29	21																
	Average Plot Height (ft.)				1	1	1	1	2	2	1	1	1	2	2	1	2	2	1	1	1	1	1	2	1														
% Invasives				0	0	0	0	0	0	0	0	0	0	0	0	0	0	0	0	0	0	0	0	0															

1). Bolded species are proposed for the current monitoring year, italicized species are not approved, and a regular font indicates that the species has been approved.  
 2). The "Species Included in Approved Mitigation Plan" section contains only those species that were included in the original approved mitigation plan. The "Post Mitigation Plan Species" section includes species that are being proposed through a mitigation plan addendum for the current monitoring year (bolded), species that have been approved in prior monitoring years through a mitigation plan addendum (regular font), and species that are not approved (italicized).  
 3). The "Mitigation Plan Performance Standard" section is derived only from stems included in the original mitigation plan, whereas the "Post Mitigation Plan Performance Standard" includes data from mitigation plan approved, post mitigation plan approved, and proposed stems.

**Table 9. Vegetation Plot Summary**

Vegetation Performance Standards Summary Table												
	Veg Plot 1 F				Veg Plot 2 F				Veg Plot 3 F			
	Stems/Ac.	Av. Ht. (ft)	# Species	% Invasives	Stems/Ac.	Av. Ht. (ft)	# Species	% Invasives	Stems/Ac.	Av. Ht. (ft)	# Species	% Invasives
Monitoring Year 7												
Monitoring Year 5												
Monitoring Year 3												
Monitoring Year 2												
Monitoring Year 1												
Monitoring Year 0	607	1	9	0	729	1	12	0	607	1	7	0
	Veg Plot 4 F				Veg Plot 5 F				Veg Plot 6 F			
	Stems/Ac.	Av. Ht. (ft)	# Species	% Invasives	Stems/Ac.	Av. Ht. (ft)	# Species	% Invasives	Stems/Ac.	Av. Ht. (ft)	# Species	% Invasives
Monitoring Year 7												
Monitoring Year 5												
Monitoring Year 3												
Monitoring Year 2												
Monitoring Year 1												
Monitoring Year 0	810	1	8	0	688	2	6	0	729	2	7	0
	Veg Plot 7 F				Veg Plot 8 F				Veg Plot 9 F			
	Stems/Ac.	Av. Ht. (ft)	# Species	% Invasives	Stems/Ac.	Av. Ht. (ft)	# Species	% Invasives	Stems/Ac.	Av. Ht. (ft)	# Species	% Invasives
Monitoring Year 7												
Monitoring Year 5												
Monitoring Year 3												
Monitoring Year 2												
Monitoring Year 1												
Monitoring Year 0	891	1	10	0	810	1	9	0	688	1	9	0
	Veg Plot 10 F				Veg Plot 11 F				Veg Plot 12 F			
	Stems/Ac.	Av. Ht. (ft)	# Species	% Invasives	Stems/Ac.	Av. Ht. (ft)	# Species	% Invasives	Stems/Ac.	Av. Ht. (ft)	# Species	% Invasives
Monitoring Year 7												
Monitoring Year 5												
Monitoring Year 3												
Monitoring Year 2												
Monitoring Year 1												
Monitoring Year 0	810	1	12	0	648	2	10	0	688	2	9	0
	Veg Plot 13 F				Veg Plot Group 1 R				Veg Plot Group 2 R			
	Stems/Ac.	Av. Ht. (ft)	# Species	% Invasives	Stems/Ac.	Av. Ht. (ft)	# Species	% Invasives	Stems/Ac.	Av. Ht. (ft)	# Species	% Invasives
Monitoring Year 7												
Monitoring Year 5												
Monitoring Year 3												
Monitoring Year 2												
Monitoring Year 1												
Monitoring Year 0	1012	1	10	0	891	1	8	0	891	1	8	0
	Veg Plot Group 3 R				Veg Plot Group 4 R				Veg Plot Group 5 R			
	Stems/Ac.	Av. Ht. (ft)	# Species	% Invasives	Stems/Ac.	Av. Ht. (ft)	# Species	% Invasives	Stems/Ac.	Av. Ht. (ft)	# Species	% Invasives
Monitoring Year 7												
Monitoring Year 5												
Monitoring Year 3												
Monitoring Year 2												
Monitoring Year 1												
Monitoring Year 0	648	1	8	0	607	1	9	0	688	2	8	0
	Veg Plot Group 6 R											
	Stems/Ac.	Av. Ht. (ft)	# Species	% Invasives								
Monitoring Year 7												
Monitoring Year 5												
Monitoring Year 3												
Monitoring Year 2												
Monitoring Year 1												
Monitoring Year 0	567	1	6	0								

\*Each monitoring year represents a different plot for the random vegetation plot "groups". Random plots are denoted with an R, and fixed plots with an F.



# **Appendix C**

## **Stream Morphology Data**

**Table 10: Baseline Stream Data Summary  
Six Runs BB-A**

Parameter	Pre-Existing Condition (applicable)					Design		Monitoring Baseline (MY0)		
	Min	Mean	Med	Max	n	Min	Max	Min	Max	n
<b>Riffle Only</b>										
Bankfull Width (ft)	5.4	7.2	7.2	9.0	2		---		9.5	1
Floodprone Width (ft)	6.5	12.0	12.0	17.5	2		---		>29.9	1
Bankfull Mean Depth (ft)	0.7	1.0	1.0	1.2	2		---		0.8	1
Bankfull Max Depth (ft)	1	1.4	1.4	1.7	2		---		1.3	1
Bankfull Cross Sectional Area (ft <sup>2</sup> )	6.3	6.4	6.4	6.4	2		---		8.0	1
Width/Depth Ratio	4.6	8.7	8.7	12.7	2		---		11.3	1
Entrenchment Ratio	1.2	1.6	1.6	2.0	2		---		>3.1	1
Bank Height Ratio	1.3	1.6	1.6	1.9	2		---		1.0	1
Max part size (mm) mobilized at bankfull										
Rosgen Classification	C4/5					---		---		
Bankfull Discharge (cfs)										
Sinuosity (ft)	1.04					---		---		
Water Surface Slope (Channel) (ft/ft)										
Other										

**Table 10: Baseline Stream Data Summary  
Six Runs BB-B**

Parameter	Pre-Existing Condition (applicable)					Design		Monitoring Baseline (MY0)		
	Min	Mean	Med	Max	n	Min	Max	Min	Max	n
<b>Riffle Only</b>										
Bankfull Width (ft)				5.3	1		---	9.4	10.8	2
Floodprone Width (ft)				8.6	1		---	>27.6	>30.2	2
Bankfull Mean Depth (ft)				1.1	1		---			2
Bankfull Max Depth (ft)				1.3	1		---	1.1	1.8	2
Bankfull Cross Sectional Area (ft <sup>2</sup> )				5.7	1		---	7.8	12.2	2
Width/Depth Ratio				4.8	1		---			2
Entrenchment Ratio				1.6	1		---	>2.8	>2.9	2
Bank Height Ratio				1.9	1		---	1.0	1.0	2
Max part size (mm) mobilized at bankfull										
Rosgen Classification	G4/5c					---		---		
Bankfull Discharge (cfs)										
Sinuosity (ft)	1.10					---		---		
Water Surface Slope (Channel) (ft/ft)										
Other										



**Table 10: Baseline Stream Data Summary  
Six Runs BB-C**

Parameter	Pre-Existing Condition (applicable)					Design		Monitoring Baseline (MY0)		
	Min	Mean	Med	Max	n	Min	Max	Min	Max	n
<b>Riffle Only</b>										
Bankfull Width (ft)	7.3	10.1	8.9	15.2	4		11.8	8.5	12.7	10
Floodprone Width (ft)	9.8	14.4	10.8	26.4	4		>50	>29	>29	10
Bankfull Mean Depth (ft)	1.0	1.2	1.2	1.4	4		1.1	0.7	1.3	10
Bankfull Max Depth (ft)	1.3	1.5	1.5	1.9	4		1.6	1.1	2.0	10
Bankfull Cross Sectional Area (ft <sup>2</sup> )	8.3	11.8	10.4	18.0	4		13.0	6.4	15.3	10
Width/Depth Ratio	5.3	8.7	8.4	12.9	4		10.7	9.5	14.0	10
Entrenchment Ratio	1.2	1.4	1.3	1.7	4		>2.2	>2.4	>2.4	10
Bank Height Ratio	1.7	2.7	2.1	5.0	4		1.0	1.0	1.0	10
Max part size (mm) mobilized at bankfull										
Rosgen Classification	G4/5c to F4/5					C4/E4		C4/E4		
Bankfull Discharge (cfs)										
Sinuosity (ft)	1.12 - 1.26					1.15 - 1.17		1.15 - 1.17		
Water Surface Slope (Channel) (ft/ft)										
Other										

**Table 10: Baseline Stream Data Summary  
Six Runs DE2-B**

Parameter	Pre-Existing Condition (applicable)					Design		Monitoring Baseline (MY0)		
	Min	Mean	Med	Max	n	Min	Max	Min	Max	n
<b>Riffle Only</b>										
Bankfull Width (ft)				2.8	1		3.8		4.9	1
Floodprone Width (ft)				>15	1		>20		>30.1	1
Bankfull Mean Depth (ft)				0.4	1		0.4		0.4	1
Bankfull Max Depth (ft)				0.6	1		0.5		0.8	1
Bankfull Cross Sectional Area (ft <sup>2</sup> )				1.2	1		1.4		1.8	1
Width/Depth Ratio				6.4	1		10.7		12.9	1
Entrenchment Ratio				>2.2	1		>2.2		>6.2	1
Bank Height Ratio				1.5	1		1.0		1.0	1
Max part size (mm) mobilized at bankfull										
Rosgen Classification	E5					C4b		C4b		
Bankfull Discharge (cfs)										
Sinuosity (ft)	1.07					1.12		1.12		
Water Surface Slope (Channel) (ft/ft)										
Other										

**Table 10: Baseline Stream Data Summary  
Six Runs DE4-B**

Parameter	Pre-Existing Condition (applicable)					Design		Monitoring Baseline (MY0)		
	Min	Mean	Med	Max	n	Min	Max	Min	Max	n
<b>Riffle Only</b>										
Bankfull Width (ft)				6.0	1		10.3	10.1	10.1	2
Floodprone Width (ft)				9.6	1		>50	>29.7	>30.1	2
Bankfull Mean Depth (ft)				1.0	1		1.0	1	1.1	2
Bankfull Max Depth (ft)				1.4	1		1.5	1.4	1.7	2
Bankfull Cross Sectional Area (ft <sup>2</sup> )				6.3	1		10.4	10.3	10.8	2
Width/Depth Ratio				5.8	1		10.3	9.4	11.4	2
Entrenchment Ratio				1.6	1		>2.2	>2.8	>2.9	2
Bank Height Ratio				1.7	1		1.0	1	1.0	2
Max part size (mm) mobilized at bankfull										
Rosgen Classification	G4/5c to F4/4/5					C4/E4		C4/E4		
Bankfull Discharge (cfs)										
Sinuosity (ft)	1.27					1.18		1.18		
Water Surface Slope (Channel) (ft/ft)										
Other										



**Table 10: Baseline Stream Data Summary  
Six Runs DE7**

Parameter	Pre-Existing Condition (applicable)					Design		Monitoring Baseline (MY0)		
	Min	Mean	Med	Max	n	Min	Max	Min	Max	n
<b>Riffle Only</b>										
Bankfull Width (ft)				3.2	1		3.5		4.3	1
Floodprone Width (ft)				4.2	1		>15		>29.5	1
Bankfull Mean Depth (ft)				0.3	1		0.4		0.5	1
Bankfull Max Depth (ft)				0.5	1		0.5		0.8	1
Bankfull Cross Sectional Area (ft <sup>2</sup> )				0.9	1		1.3		2.1	1
Width/Depth Ratio				11.6	1		9.8		8.4	1
Entrenchment Ratio				1.3	1		>2.2		>6.9	1
Bank Height Ratio				2.9	1		1.0		1.0	1
Max part size (mm) mobilized at bankfull										
Rosgen Classification	G5c					B4a to E4		B4a to E4		
Bankfull Discharge (cfs)										
Sinuosity (ft)	1.01					1.05		1.05		
Water Surface Slope (Channel) (ft/ft)										
Other										

**Table 10: Baseline Stream Data Summary  
Six Runs DE8**

Parameter	Pre-Existing Condition (applicable)					Design		Monitoring Baseline (MY0)		
	Min	Mean	Med	Max	n	Min	Max	Min	Max	n
<b>Riffle Only</b>										
Bankfull Width (ft)				5.5	1		4.5		3.9	1
Floodprone Width (ft)				8.5	1		>20		>29.9	1
Bankfull Mean Depth (ft)				0.3	1		0.4		0.3	1
Bankfull Max Depth (ft)				0.6	1		0.6		0.6	1
Bankfull Cross Sectional Area (ft <sup>2</sup> )				1.8	1		1.8		1.3	1
Width/Depth Ratio				17.0	1		11.3		11.6	1
Entrenchment Ratio				1.5	1		>2.2		>7.6	1
Bank Height Ratio				3.5	1		1.0		1.0	1
Max part size (mm) mobilized at bankfull										
Rosgen Classification	F5b					C4/E4		C4/E4		
Bankfull Discharge (cfs)										
Sinuosity (ft)	1.11					1.14		1.14		
Water Surface Slope (Channel) (ft/ft)										
Other										

**Monitoring Data - Cross Section Morphology Monitoring Summary**  
**Six Runs Stream and Wetland Mitigation Project / DMS:100170 Reaches: BB-A, BB-B, BB-C**

	Cross Section 1 (Riffle - BB-A)							Cross Section 2 (Pool - BB-A)							Cross Section 3 (Riffle - BB-B)							Cross Section 4 (Pool - BB-B)							Cross Section 5 (Riffle - BB-B)							
	MY0	MY1	MY2	MY3	MY5	MY7	MY+	MY0	MY1	MY2	MY3	MY5	MY7	MY+	MY0	MY1	MY2	MY3	MY5	MY7	MY+	MY0	MY1	MY2	MY3	MY5	MY7	MY+	MY0	MY1	MY2	MY3	MY5	MY7	MY+	
Bankfull Elevation (ft) - Based on AB-Bankfull <sup>1</sup> Area	148.22							148.04							144.23								144.13							142.18						
Bank Height Ratio - Based on AB Bankfull <sup>1</sup> Area	1.0														1.0															1.0						
Thalweg Elevation	146.95							145.23							142.41								140.94							141.06						
LTOB <sup>2</sup> Elevation	148.22							148.04							144.23								144.13							142.18						
LTOB <sup>2</sup> Max Depth (ft)	1.3							2.8							1.8								3.2							1.1						
LTOB <sup>2</sup> Cross Sectional Area (ft <sup>2</sup> )	8.0							11.7							12.2								17.2							7.8						
	Cross Section 6 (Pool - BB-B)							Cross Section 7 (Riffle - BB-C)							Cross Section 8 (Pool - BB-C)							Cross Section 9 (Riffle - BB-C)							Cross Section 10 (Pool BB-C)							
	MY0	MY1	MY2	MY3	MY5	MY7	MY+	MY0	MY1	MY2	MY3	MY5	MY7	MY+	MY0	MY1	MY2	MY3	MY5	MY7	MY+	MY0	MY1	MY2	MY3	MY5	MY7	MY+	MY0	MY1	MY2	MY3	MY5	MY7	MY+	
Bankfull Elevation (ft) - Based on AB-Bankfull <sup>1</sup> Area	141.96							136.98							136.71								133.71							133.31						
Bank Height Ratio - Based on AB Bankfull <sup>1</sup> Area								1.0															1.0													
Thalweg Elevation	140.45							135.58							134.49								132.60							130.70						
LTOB <sup>2</sup> Elevation	141.96							136.98							136.71								133.70							133.31						
LTOB <sup>2</sup> Max Depth (ft)	1.5							1.4							2.2								1.1							2.6						
LTOB <sup>2</sup> Cross Sectional Area (ft <sup>2</sup> )	9.1							7.7							10.7								6.4							12.2						
	Cross Section 11 (Riffle - BB-C)							Cross Section 12 (Pool - BB-C)							Cross Section 13 (Pool - BB-C)							Cross Section 14 (Riffle - BB-C)							Cross Section 15 (Riffle - BB-C)							
	MY0	MY1	MY2	MY3	MY5	MY7	MY+	MY0	MY1	MY2	MY3	MY5	MY7	MY+	MY0	MY1	MY2	MY3	MY5	MY7	MY+	MY0	MY1	MY2	MY3	MY5	MY7	MY+	MY0	MY1	MY2	MY3	MY5	MY7	MY+	
Bankfull Elevation (ft) - Based on AB-Bankfull <sup>1</sup> Area	130.27							129.79							126.77								126.29							123.45						
Bank Height Ratio - Based on AB Bankfull <sup>1</sup> Area	1.0																						1.0							1.0						
Thalweg Elevation	128.99							127.65							124.66								125.12							122.11						
LTOB <sup>2</sup> Elevation	130.27							129.79							126.77								126.29							123.45						
LTOB <sup>2</sup> Max Depth (ft)	1.3							2.1							2.1								1.2							1.3						
LTOB <sup>2</sup> Cross Sectional Area (ft <sup>2</sup> )	6.9							8.6							11.9								7.1							7.5						

Note: The smaller the channel the closer the survey measurements are to their limit of reliable detection, therefore inter-annual variation in morphological measurement (as a percentage) is by default magnified as channel size decreases. Some of the variability above is the result of this factor and some is due to the large amount of depositional sediments observed.



**Monitoring Data - Cross Section Morphology Monitoring Summary**

**Six Runs Stream and Wetland Mitigation Project / DMS:100170 Reaches: BB-C, DE7, DE2-B**

	Cross Section 16 (Pool - BB-C)							Cross Section 17 (Pool - BB-C)							Cross Section 18 (Riffle - BB-C)							Cross Section 19 (Riffle - BB-C)							Cross Section 20 (Pool - BB-C)								
	MY0	MY1	MY2	MY3	MY5	MY7	MY+	MY0	MY1	MY2	MY3	MY5	MY7	MY+	MY0	MY1	MY2	MY3	MY5	MY7	MY+	MY0	MY1	MY2	MY3	MY5	MY7	MY+	MY0	MY1	MY2	MY3	MY5	MY7	MY+		
Bankfull Elevation (ft) - Based on AB-Bankfull <sup>1</sup> Area	123.34							119.65							119.76								117.02								116.74						
Bank Height Ratio - Based on AB Bankfull <sup>1</sup> Area															1.0								1.0														
Thalweg Elevation	120.67							117.18							118.29								115.47								114.07						
LTOB <sup>2</sup> Elevation	123.34							119.65							119.76								117.02								116.74						
LTOB <sup>2</sup> Max Depth (ft)	2.7							2.5							1.5								1.6								2.7						
LTOB <sup>2</sup> Cross Sectional Area (ft <sup>2</sup> )	15.0							11.8							9.6								9.2								13.4						
	Cross Section 21 (Riffle - BB-C)							Cross Section 22 (Pool - BB-C)							Cross Section 23 (Pool - BB-C)							Cross Section 24 (Riffle - BB-C)							Cross Section 25 (Riffle - BB-C)								
	MY0	MY1	MY2	MY3	MY5	MY7	MY+	MY0	MY1	MY2	MY3	MY5	MY7	MY+	MY0	MY1	MY2	MY3	MY5	MY7	MY+	MY0	MY1	MY2	MY3	MY5	MY7	MY+	MY0	MY1	MY2	MY3	MY5	MY7	MY+		
Bankfull Elevation (ft) - Based on AB-Bankfull <sup>1</sup> Area	115.12							114.46							112.47								112.61								110.45						
Bank Height Ratio - Based on AB Bankfull <sup>1</sup> Area	1.0																						1.0								1.0						
Thalweg Elevation	113.17							111.51							109.60								110.64								108.65						
LTOB <sup>2</sup> Elevation	115.12							114.46							112.47								112.61								110.45						
LTOB <sup>2</sup> Max Depth (ft)	2.0							2.9							2.9								2.0								1.8						
LTOB <sup>2</sup> Cross Sectional Area (ft <sup>2</sup> )	15.3							20.8							17.1								13.6								12.2						
	Cross Section 26 (Pool - BB-C)							Cross Section 27 (Pool - DE7)							Cross Section 28 (Riffle - DE7)							Cross Section 29 (Pool - DE2-B)							Cross Section 30 (Riffle - DE2-B)								
	MY0	MY1	MY2	MY3	MY5	MY7	MY+	MY0	MY1	MY2	MY3	MY5	MY7	MY+	MY0	MY1	MY2	MY3	MY5	MY7	MY+	MY0	MY1	MY2	MY3	MY5	MY7	MY+	MY0	MY1	MY2	MY3	MY5	MY7	MY+		
Bankfull Elevation (ft) - Based on AB-Bankfull <sup>1</sup> Area	110.39							137.08							134.62								128.81								128.31						
Bank Height Ratio - Based on AB Bankfull <sup>1</sup> Area															1.0																1.0						
Thalweg Elevation	107.53							135.46							133.80								127.82								127.48						
LTOB <sup>2</sup> Elevation	110.39							137.08							134.62								128.81								128.31						
LTOB <sup>2</sup> Max Depth (ft)	2.9							1.6							0.8								1.0								0.8						
LTOB <sup>2</sup> Cross Sectional Area (ft <sup>2</sup> )	23.4							4.3							2.1								1.8								1.8						

Note: The smaller the channel the closer the survey measurements are to their limit of reliable detection, therefore inter-annual variation in morphological measurement (as a percentage) is by default magnified as channel size decreases. Some of the variability above is the result of this factor and some is due to the large amount of depositional sediments observed.

**Monitoring Data - Cross Section Morphology Monitoring Summary**  
**Six Runs Stream and Wetland Mitigation Project / DMS:100170 Reach: DE8, DE4-B**

	Cross Section 31 (Pool - DE8)							Cross Section 32 (Riffle - DE8)							Cross Section 32 (Riffle - DE4-B)							Cross Section 31 (Pool - DE4-B)							Cross Section 32 (Riffle - DE4-B)							
	MY0	MY1	MY2	MY3	MY5	MY7	MY+	MY0	MY1	MY2	MY3	MY5	MY7	MY+	MY0	MY1	MY2	MY3	MY5	MY7	MY+	MY0	MY1	MY2	MY3	MY5	MY7	MY+	MY0	MY1	MY2	MY3	MY5	MY7	MY+	
Bankfull Elevation (ft) - Based on AB-Bankfull <sup>1</sup> Area	125.71							125.05							119.09								118.53							116.71						
Bank Height Ratio - Based on AB Bankfull <sup>1</sup> Area								1.0							1.0															1.0						
Thalweg Elevation	124.18							124.46							117.65								115.99							115.02						
LTOB <sup>2</sup> Elevation	125.71							125.05							119.09								118.53							116.71						
LTOB <sup>2</sup> Max Depth (ft)	1.5							0.6							1.4								2.5							1.7						
LTOB <sup>2</sup> Cross Sectional Area (ft <sup>2</sup> )	2.4							1.3							10.3								14.6							10.8						
	<b>Cross Section 31 (Pool - DE4-B)</b>																																			
	MY0	MY1	MY2	MY3	MY5	MY7	MY+																													
Bankfull Elevation (ft) - Based on AB-Bankfull <sup>1</sup> Area	115.86																																			
Bank Height Ratio - Based on AB Bankfull <sup>1</sup> Area																																				
Thalweg Elevation	113.76																																			
LTOB <sup>2</sup> Elevation	115.86																																			
LTOB <sup>2</sup> Max Depth (ft)	2.1																																			
LTOB <sup>2</sup> Cross Sectional Area (ft <sup>2</sup> )	9.8																																			


Note: The smaller the channel the closer the survey measurements are to their limit of reliable detection, therefore inter-annual variation in morphological measurement (as a percentage) is by default magnified as channel size decreases. Some of the variability above is the result of this factor and some is due to the large amount of depositional sediments observed.



Upstream



Downstream

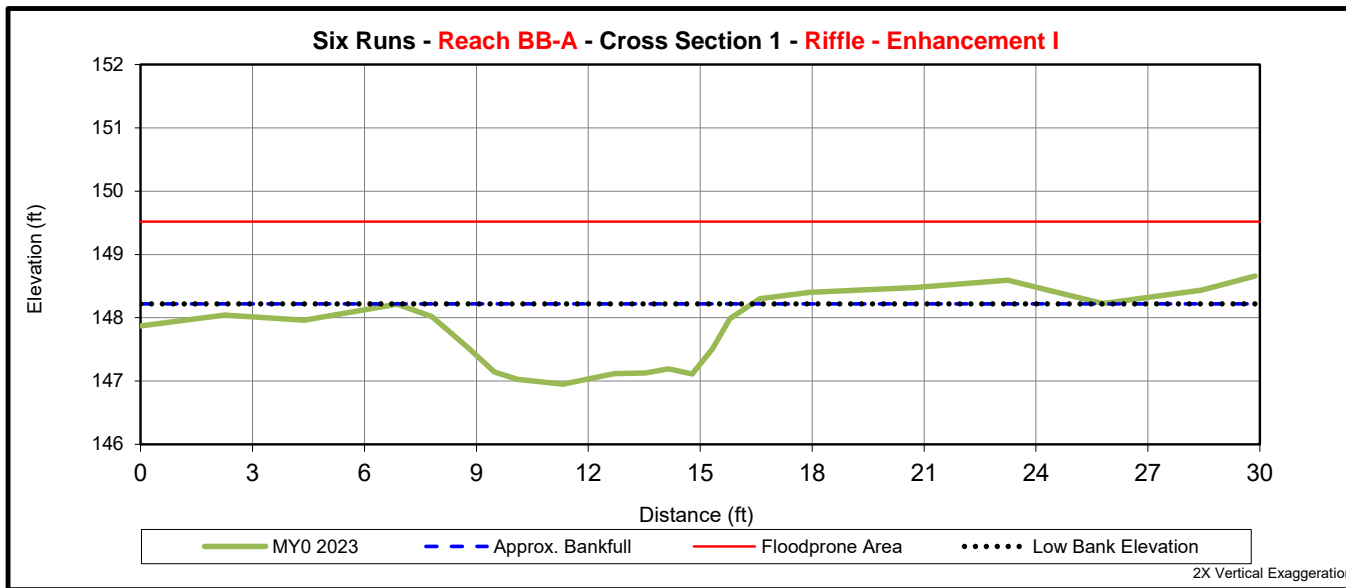

	Cross Section 1 (Riffle - BB-A)						
	MY0	MY1	MY2	MY3	MY5	MY7	MY+
Bankfull Elevation (ft) - Based on AB-Bankfull <sup>1</sup> Area	148.22						
Bank Height Ratio - Based on AB Bankfull <sup>1</sup> Area	1.0						
Thalweg Elevation	146.95						
LTOB <sup>2</sup> Elevation	148.22						
LTOB <sup>2</sup> Max Depth (ft)	1.3						
LTOB <sup>2</sup> Cross Sectional Area (ft <sup>2</sup> )	8.0						

1 - Uses the as-built cross sectional area as the basis for adjusting each subsequent years bankfull elevation  
 2 - Uses the current years low top of bank as the basis for adjusting each subsequent years bankfull elevation






Upstream



Downstream

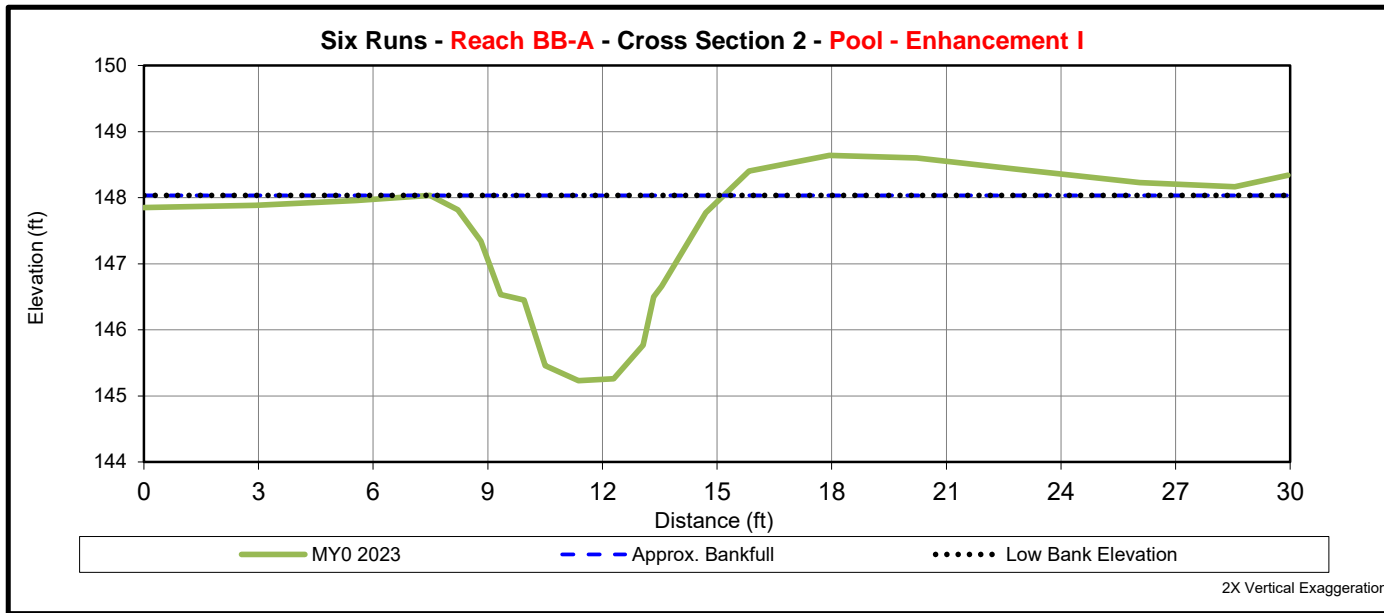

	Cross Section 2 (Pool - BB-A)						
	MY0	MY1	MY2	MY3	MY5	MY7	MY+
Bankfull Elevation (ft) - Based on AB-Bankfull <sup>1</sup> Area	148.04						
Bank Height Ratio - Based on AB Bankfull <sup>1</sup> Area							
Thalweg Elevation	145.23						
LTOB <sup>2</sup> Elevation	148.04						
LTOB <sup>2</sup> Max Depth (ft)	2.8						
LTOB <sup>2</sup> Cross Sectional Area (ft <sup>2</sup> )	11.7						

1 - Uses the as-built cross sectional area as the basis for adjusting each subsequent years bankfull elevation


2 - Uses the current years low top of bank as the basis for adjusting each subsequent years bankfull elevation



Upstream



Downstream

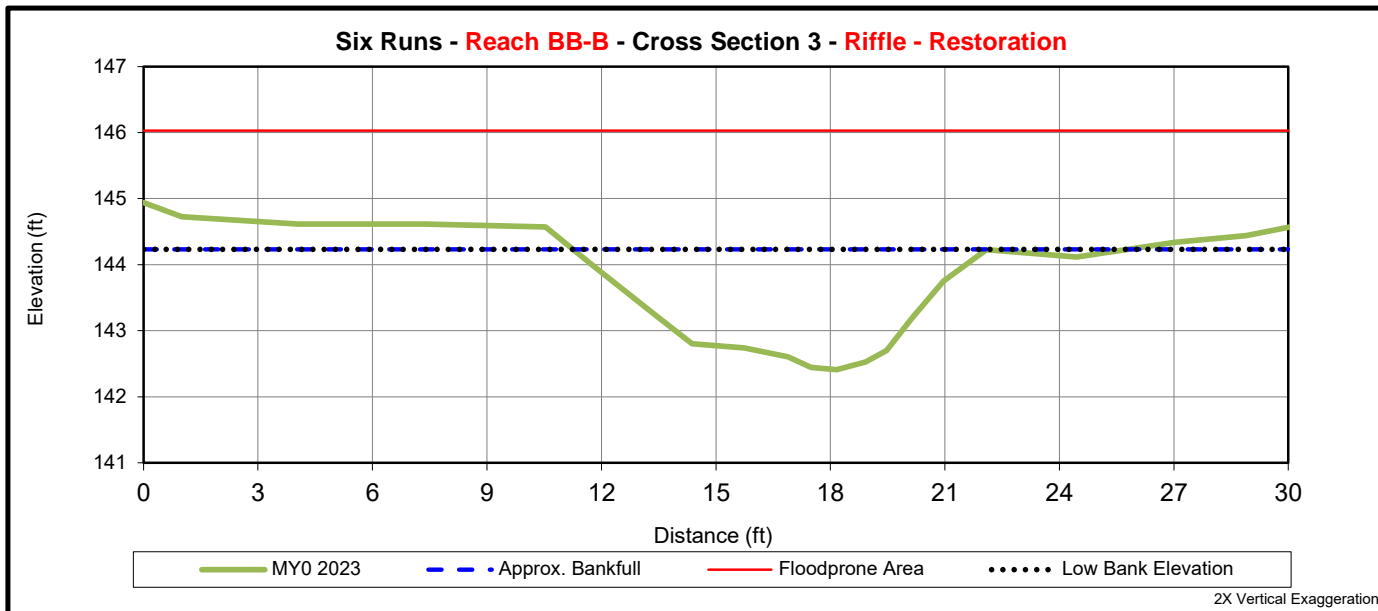

	Cross Section 3 (Riffle - BB-B)						
	MY0	MY1	MY2	MY3	MY5	MY7	MY+
Bankfull Elevation (ft) - Based on AB-Bankfull <sup>1</sup> Area	144.23						
Bank Height Ratio - Based on AB Bankfull <sup>1</sup> Area	1.0						
Thalweg Elevation	142.41						
LTOB <sup>2</sup> Elevation	144.23						
LTOB <sup>2</sup> Max Depth (ft)	1.8						
LTOB <sup>2</sup> Cross Sectional Area (ft <sup>2</sup> )	12.2						

1 - Uses the as-built cross sectional area as the basis for adjusting each subsequent years bankfull elevation


2 - Uses the current years low top of bank as the basis for adjusting each subsequent years bankfull elevation



Upstream



Downstream

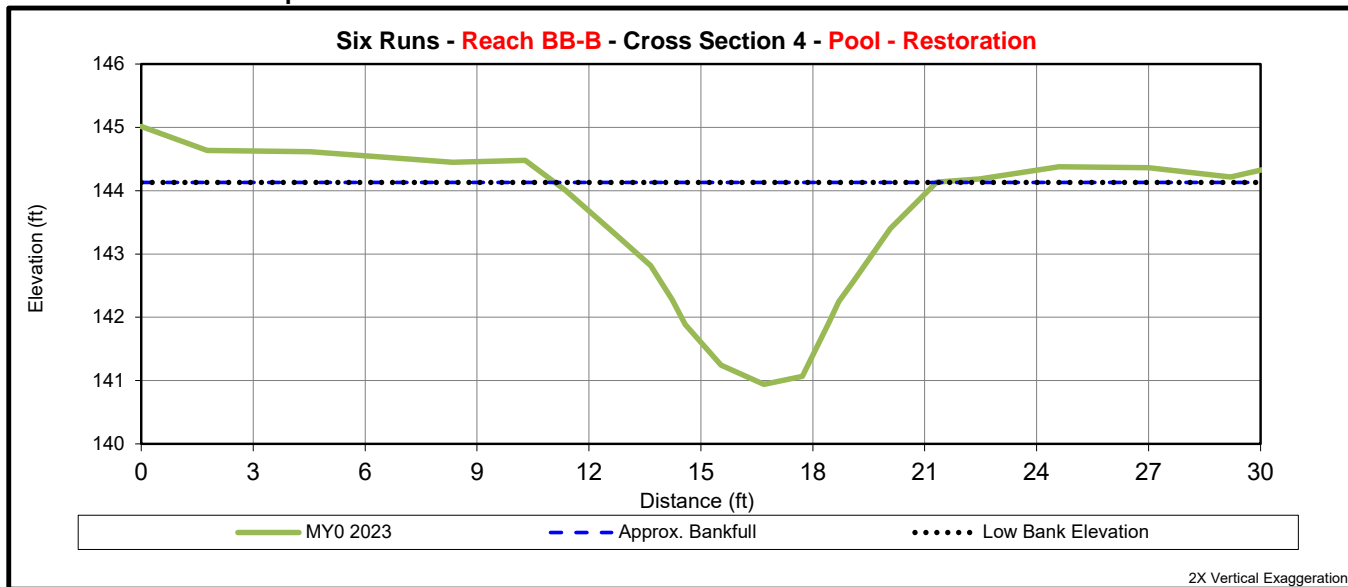

	Cross Section 4 (Pool - BB-B)						
	MY0	MY1	MY2	MY3	MY5	MY7	MY+
Bankfull Elevation (ft) - Based on AB-Bankfull <sup>1</sup> Area	144.13						
Bank Height Ratio - Based on AB Bankfull <sup>1</sup> Area							
Thalweg Elevation	140.94						
LTOB <sup>2</sup> Elevation	144.13						
LTOB <sup>2</sup> Max Depth (ft)	3.2						
LTOB <sup>2</sup> Cross Sectional Area (ft <sup>2</sup> )	17.2						

1 - Uses the as-built cross sectional area as the basis for adjusting each subsequent years bankfull elevation  
 2 - Uses the current years low top of bank as the basis for adjusting each subsequent years bankfull elevation






Upstream



Downstream

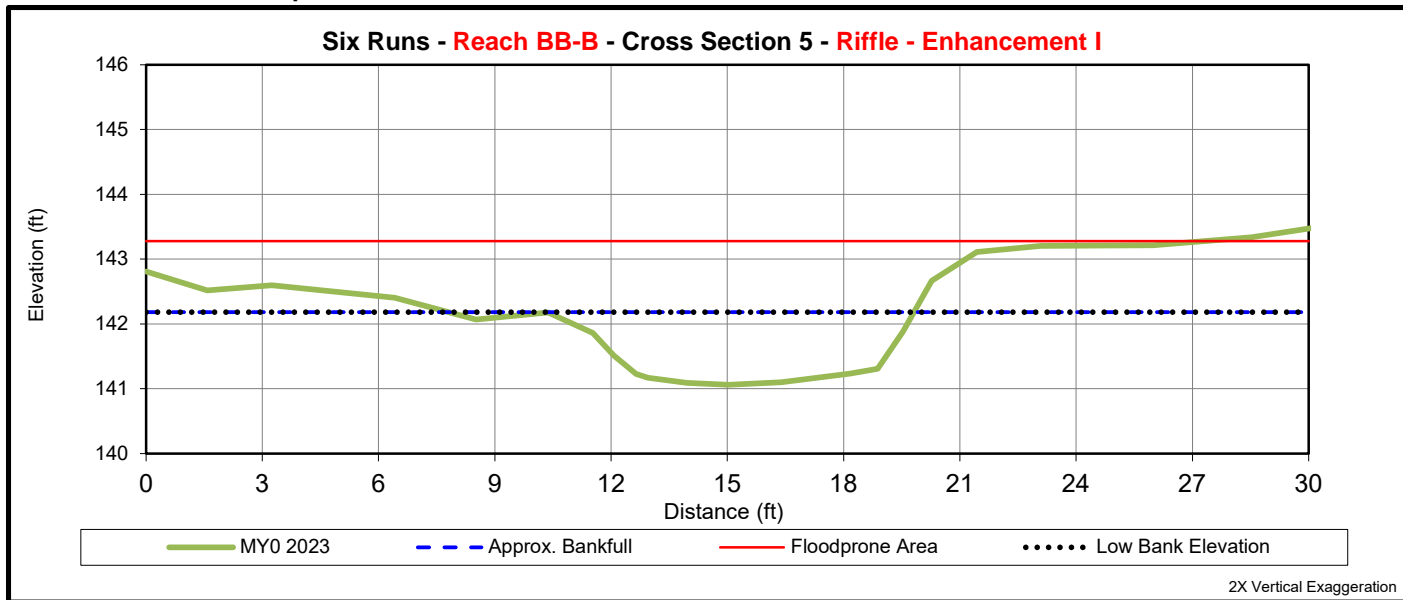

	Cross Section 5 (Riffle - BB-B)						
	MY0	MY1	MY2	MY3	MY5	MY7	MY+
Bankfull Elevation (ft) - Based on AB-Bankfull <sup>1</sup> Area	142.18						
Bank Height Ratio - Based on AB Bankfull <sup>1</sup> Area	1.0						
Thalweg Elevation	141.06						
LTOB <sup>2</sup> Elevation	142.18						
LTOB <sup>2</sup> Max Depth (ft)	1.1						
LTOB <sup>2</sup> Cross Sectional Area (ft <sup>2</sup> )	7.8						

1 - Uses the as-built cross sectional area as the basis for adjusting each subsequent years bankfull elevation

2 - Uses the current years low top of bank as the basis for adjusting each subsequent years bankfull elevation






Upstream



Downstream

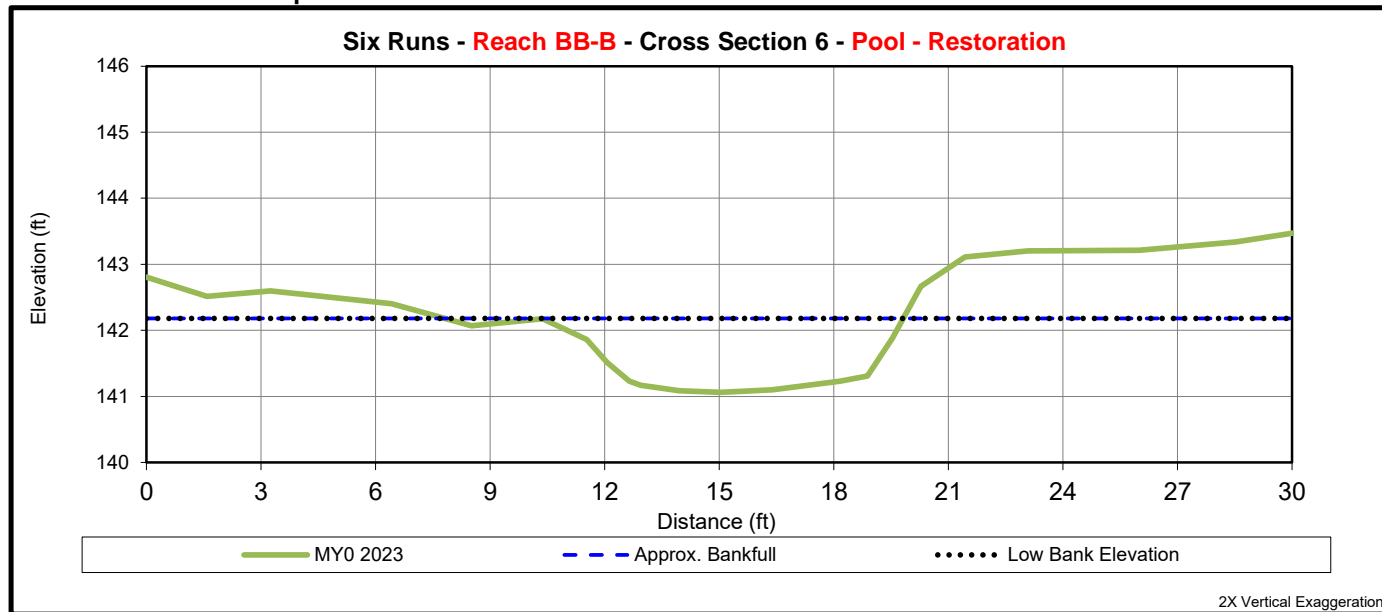

	Cross Section 6 (Pool - BB-B)						
	MY0	MY1	MY2	MY3	MY5	MY7	MY+
Bankfull Elevation (ft) - Based on AB-Bankfull <sup>1</sup> Area	141.96						
Bank Height Ratio - Based on AB Bankfull <sup>1</sup> Area							
Thalweg Elevation	140.45						
LTOB <sup>2</sup> Elevation	141.96						
LTOB <sup>2</sup> Max Depth (ft)	1.5						
LTOB <sup>2</sup> Cross Sectional Area (ft <sup>2</sup> )	9.1						

1 - Uses the as-built cross sectional area as the basis for adjusting each subsequent years bankfull elevation


2 - Uses the current years low top of bank as the basis for adjusting each subsequent years bankfull elevation



Upstream



Downstream

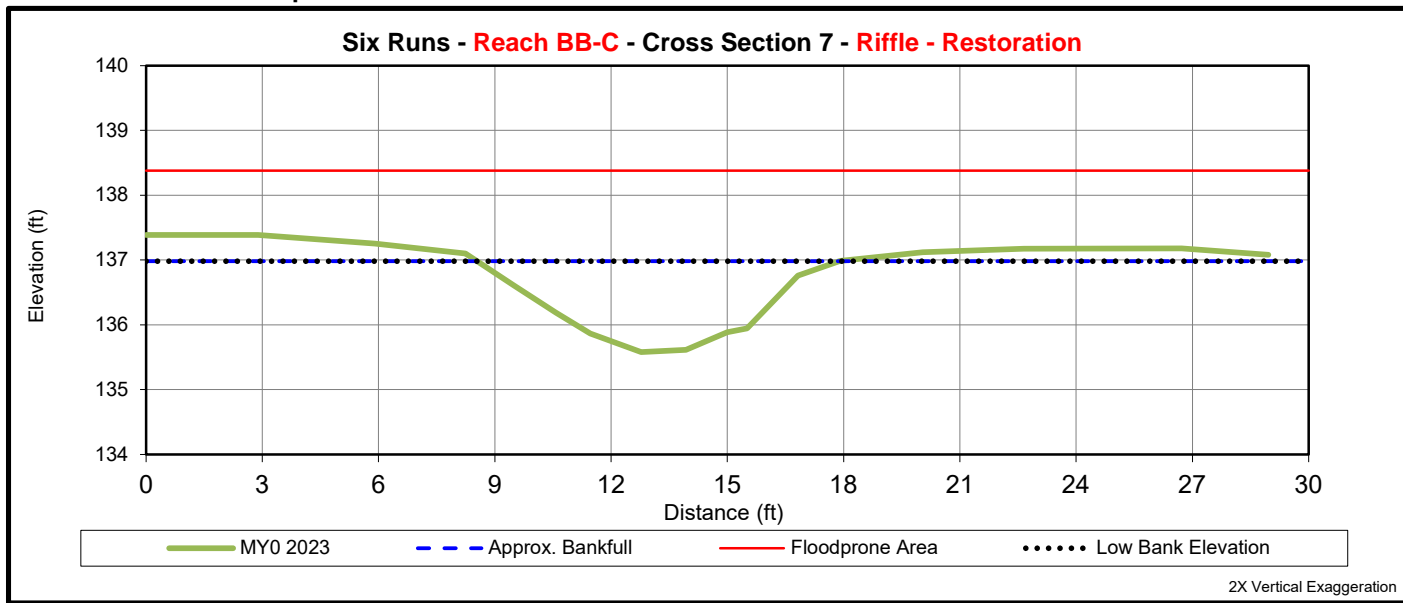

	Cross Section 7 (Riffle - BB-C)						
	MY0	MY1	MY2	MY3	MY5	MY7	MY+
Bankfull Elevation (ft) - Based on AB-Bankfull <sup>1</sup> Area	136.98						
Bank Height Ratio - Based on AB Bankfull <sup>1</sup> Area	1.0						
Thalweg Elevation	135.58						
LTOB <sup>2</sup> Elevation	136.98						
LTOB <sup>2</sup> Max Depth (ft)	1.4						
LTOB <sup>2</sup> Cross Sectional Area (ft <sup>2</sup> )	7.7						

1 - Uses the as-built cross sectional area as the basis for adjusting each subsequent years bankfull elevation


2 - Uses the current years low top of bank as the basis for adjusting each subsequent years bankfull elevation



Upstream



Downstream

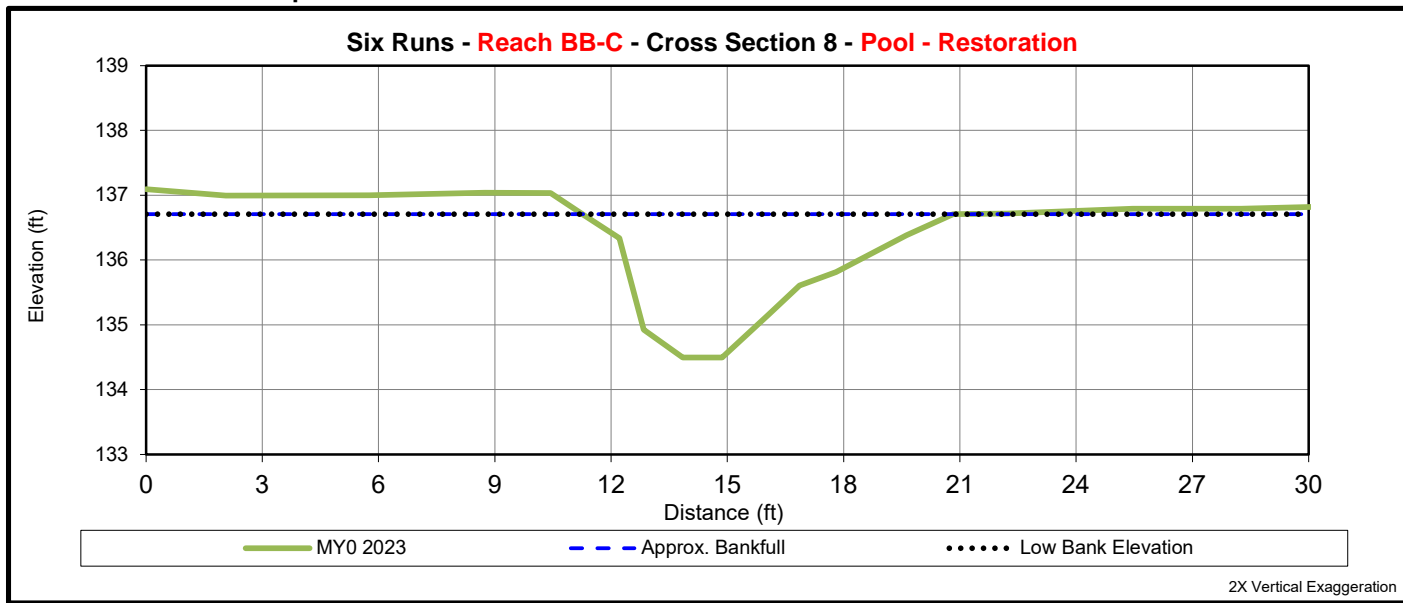

	Cross Section 8 (Pool - BB-C)						
	MY0	MY1	MY2	MY3	MY5	MY7	MY+
Bankfull Elevation (ft) - Based on AB-Bankfull <sup>1</sup> Area	136.71						
Bank Height Ratio - Based on AB Bankfull <sup>1</sup> Area							
Thalweg Elevation	134.49						
LTOB <sup>2</sup> Elevation	136.71						
LTOB <sup>2</sup> Max Depth (ft)	2.2						
LTOB <sup>2</sup> Cross Sectional Area (ft <sup>2</sup> )	10.7						

1 - Uses the as-built cross sectional area as the basis for adjusting each subsequent years bankfull elevation

2 - Uses the current years low top of bank as the basis for adjusting each subsequent years bankfull elevation






Upstream



Downstream

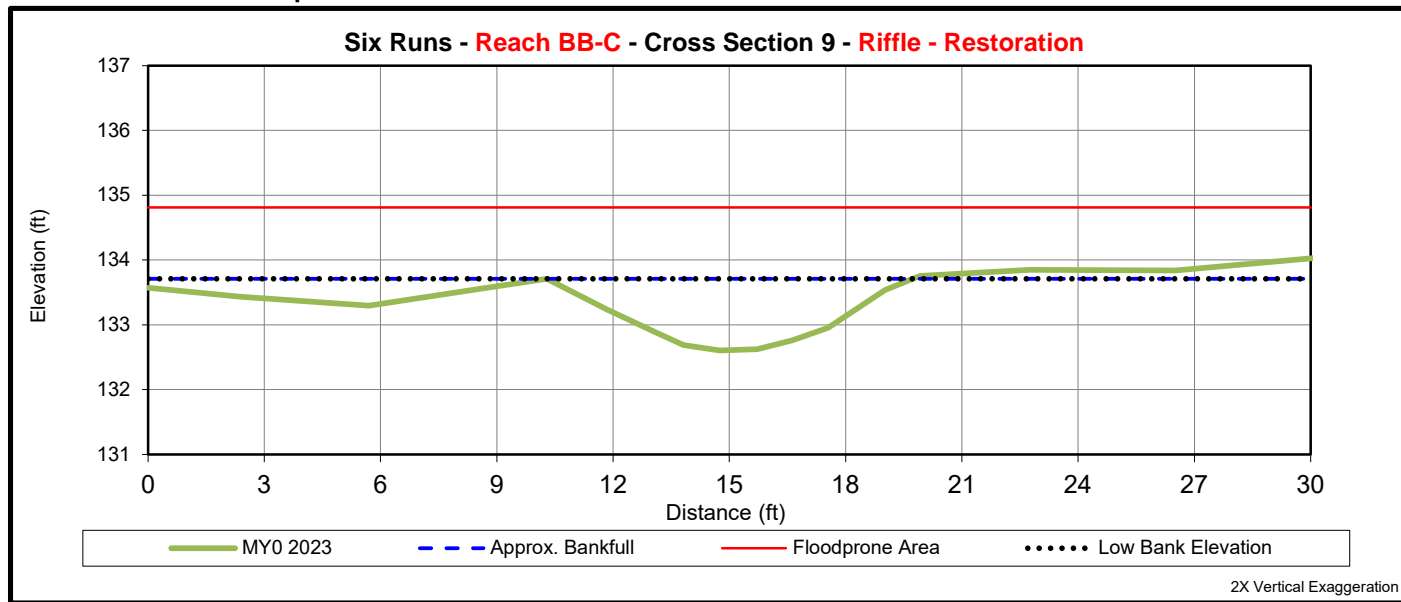

	Cross Section 9 (Riffle - BB-C)						
	MY0	MY1	MY2	MY3	MY5	MY7	MY+
Bankfull Elevation (ft) - Based on AB-Bankfull <sup>1</sup> Area	133.71						
Bank Height Ratio - Based on AB Bankfull <sup>1</sup> Area	1.0						
Thalweg Elevation	132.60						
LTOB <sup>2</sup> Elevation	133.70						
LTOB <sup>2</sup> Max Depth (ft)	1.1						
LTOB <sup>2</sup> Cross Sectional Area (ft <sup>2</sup> )	6.4						

1 - Uses the as-built cross sectional area as the basis for adjusting each subsequent years bankfull elevation


2 - Uses the current years low top of bank as the basis for adjusting each subsequent years bankfull elevation



Upstream



Downstream

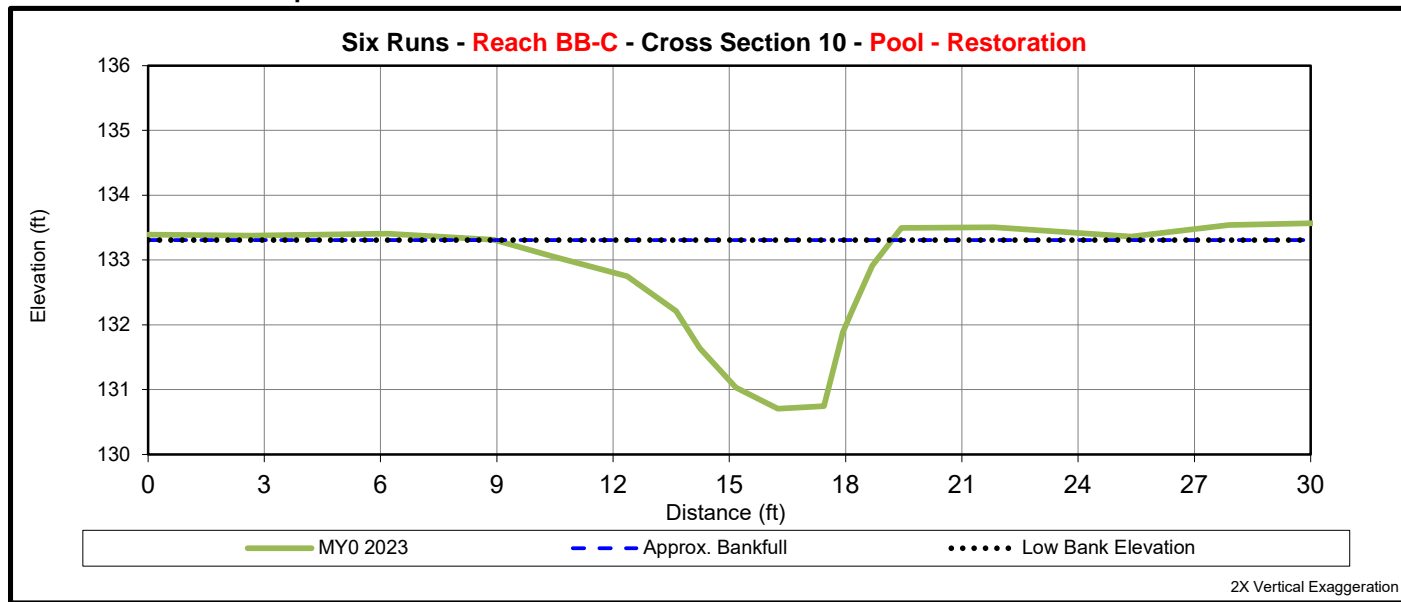

	Cross Section 10 (Pool BB-C)						
	MY0	MY1	MY2	MY3	MY5	MY7	MY+
Bankfull Elevation (ft) - Based on AB-Bankfull <sup>1</sup> Area	133.31						
Bank Height Ratio - Based on AB Bankfull <sup>1</sup> Area							
Thalweg Elevation	130.70						
LTOB <sup>2</sup> Elevation	133.31						
LTOB <sup>2</sup> Max Depth (ft)	2.6						
LTOB <sup>2</sup> Cross Sectional Area (ft <sup>2</sup> )	12.2						

1 - Uses the as-built cross sectional area as the basis for adjusting each subsequent years bankfull elevation


2 - Uses the current years low top of bank as the basis for adjusting each subsequent years bankfull elevation



Upstream



Downstream

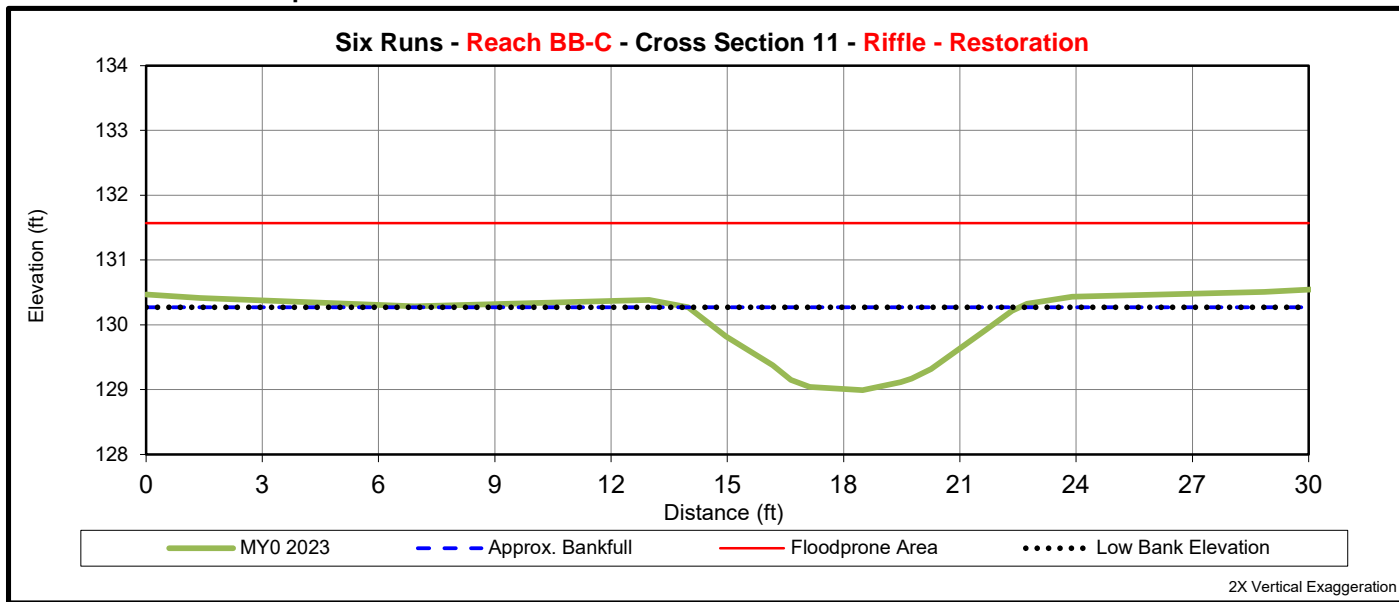

	Cross Section 11 (Riffle - BB-C)						
	MY0	MY1	MY2	MY3	MY5	MY7	MY+
Bankfull Elevation (ft) - Based on AB-Bankfull <sup>1</sup> Area	130.27						
Bank Height Ratio - Based on AB Bankfull <sup>1</sup> Area	1.0						
Thalweg Elevation	128.99						
LTOB <sup>2</sup> Elevation	130.27						
LTOB <sup>2</sup> Max Depth (ft)	1.3						
LTOB <sup>2</sup> Cross Sectional Area (ft <sup>2</sup> )	6.9						

1 - Uses the as-built cross sectional area as the basis for adjusting each subsequent years bankfull elevation

2 - Uses the current years low top of bank as the basis for adjusting each subsequent years bankfull elevation






Upstream



Downstream

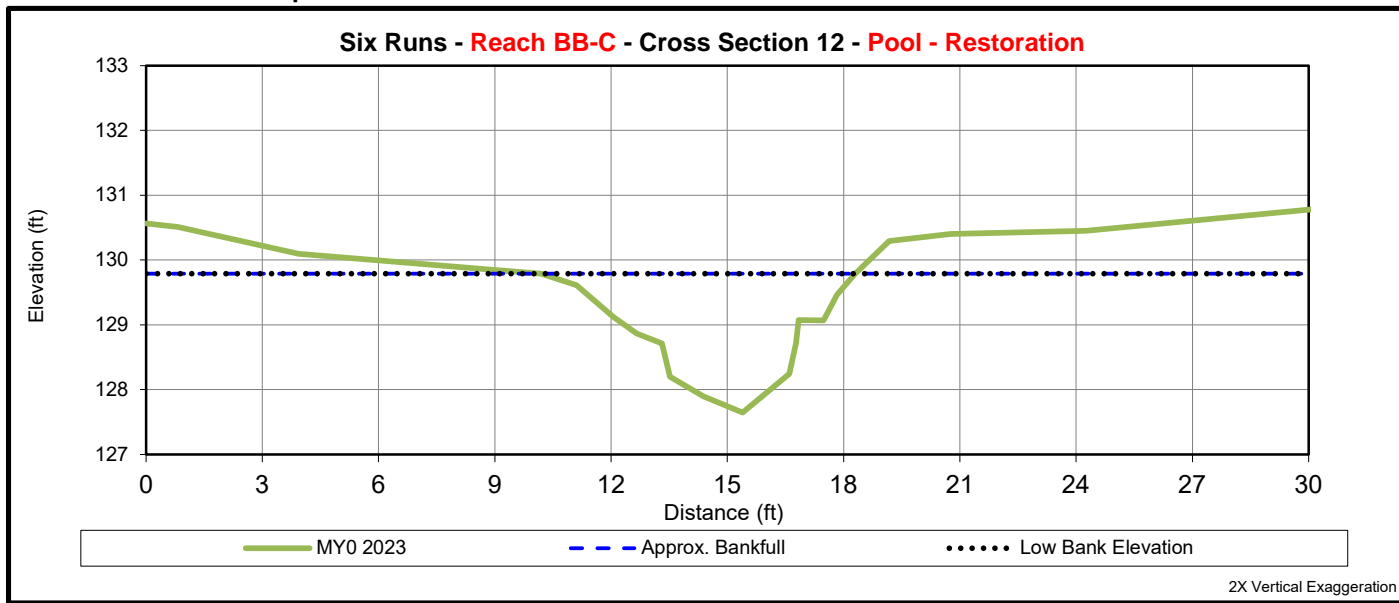

	Cross Section 12 (Pool - BB-C)						
	MY0	MY1	MY2	MY3	MY5	MY7	MY+
Bankfull Elevation (ft) - Based on AB-Bankfull <sup>1</sup> Area	129.79						
Bank Height Ratio - Based on AB Bankfull <sup>1</sup> Area							
Thalweg Elevation	127.65						
LTOB <sup>2</sup> Elevation	129.79						
LTOB <sup>2</sup> Max Depth (ft)	2.1						
LTOB <sup>2</sup> Cross Sectional Area (ft <sup>2</sup> )	8.6						

1 - Uses the as-built cross sectional area as the basis for adjusting each subsequent years bankfull elevation


2 - Uses the current years low top of bank as the basis for adjusting each subsequent years bankfull elevation



Upstream



Downstream

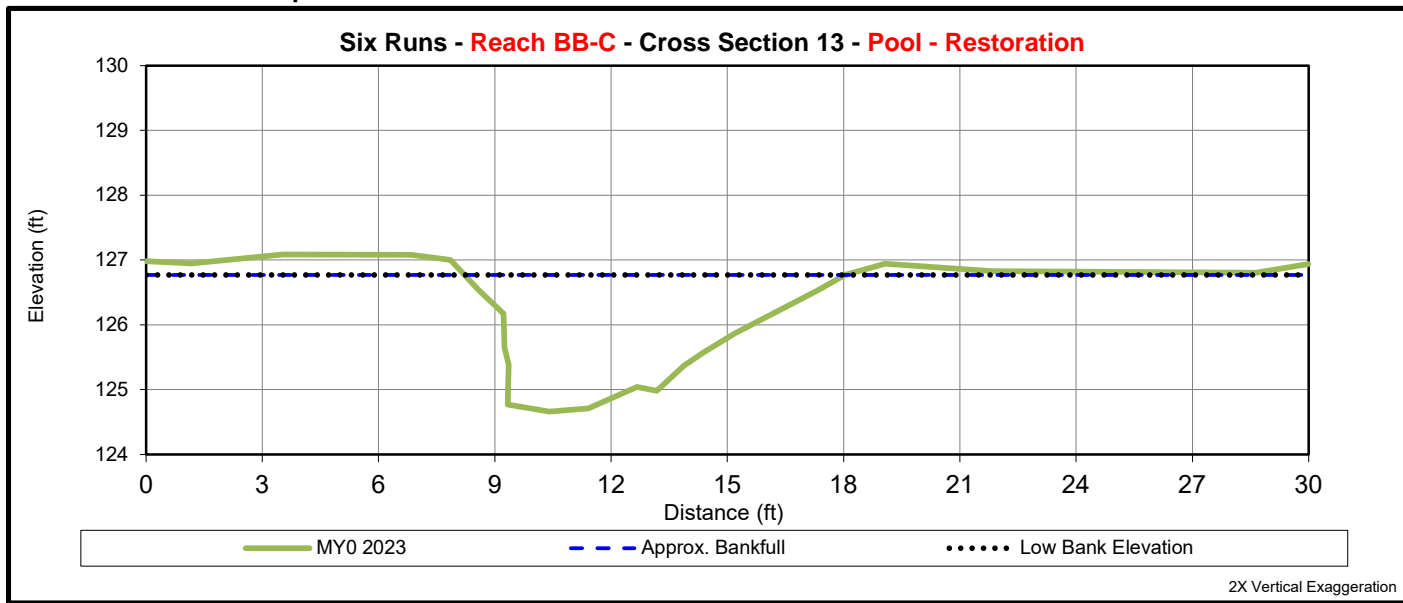

	Cross Section 13 (Pool - BB-C)						
	MY0	MY1	MY2	MY3	MY5	MY7	MY+
Bankfull Elevation (ft) - Based on AB-Bankfull <sup>1</sup> Area	126.77						
Bank Height Ratio - Based on AB Bankfull <sup>1</sup> Area							
Thalweg Elevation	124.66						
LTOB <sup>2</sup> Elevation	126.77						
LTOB <sup>2</sup> Max Depth (ft)	2.1						
LTOB <sup>2</sup> Cross Sectional Area (ft <sup>2</sup> )	11.9						

1 - Uses the as-built cross sectional area as the basis for adjusting each subsequent years bankfull elevation


2 - Uses the current years low top of bank as the basis for adjusting each subsequent years bankfull elevation



Upstream



Downstream

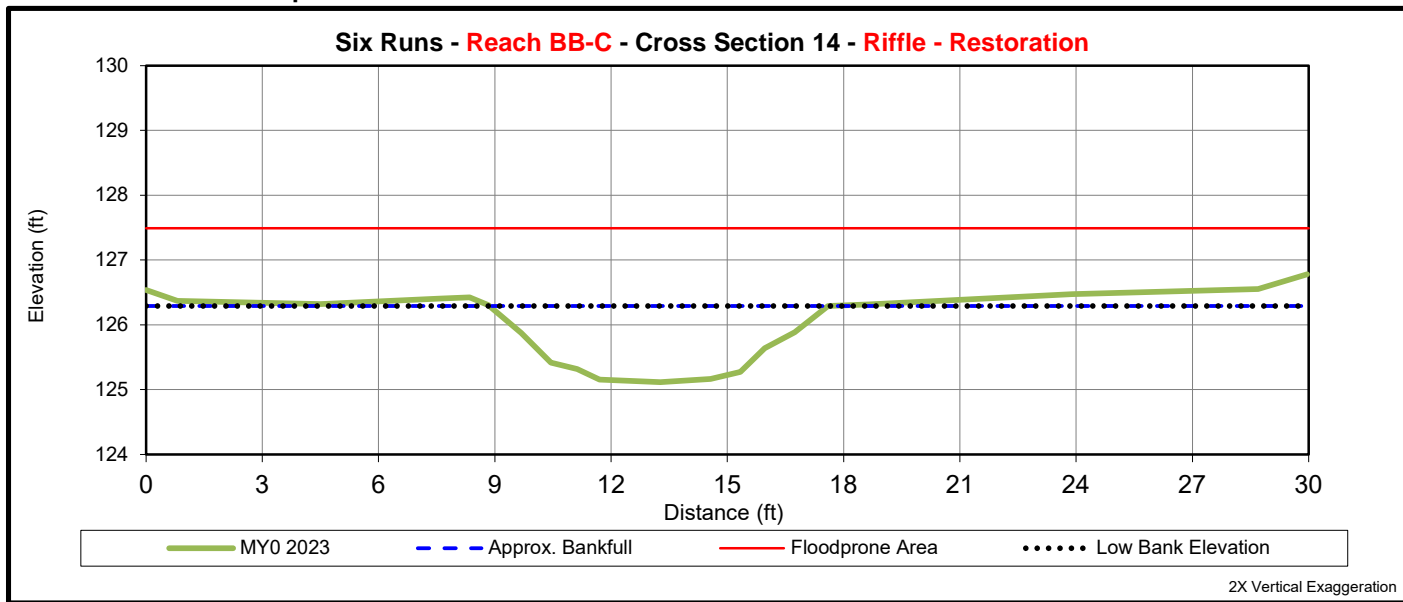

	Cross Section 14 (Riffle - BB-C)						
	MY0	MY1	MY2	MY3	MY5	MY7	MY+
Bankfull Elevation (ft) - Based on AB-Bankfull <sup>1</sup> Area	126.29						
Bank Height Ratio - Based on AB Bankfull <sup>1</sup> Area	1.0						
Thalweg Elevation	125.12						
LTOB <sup>2</sup> Elevation	126.29						
LTOB <sup>2</sup> Max Depth (ft)	1.2						
LTOB <sup>2</sup> Cross Sectional Area (ft <sup>2</sup> )	7.1						

1 - Uses the as-built cross sectional area as the basis for adjusting each subsequent years bankfull elevation

2 - Uses the current years low top of bank as the basis for adjusting each subsequent years bankfull elevation






Upstream



Downstream

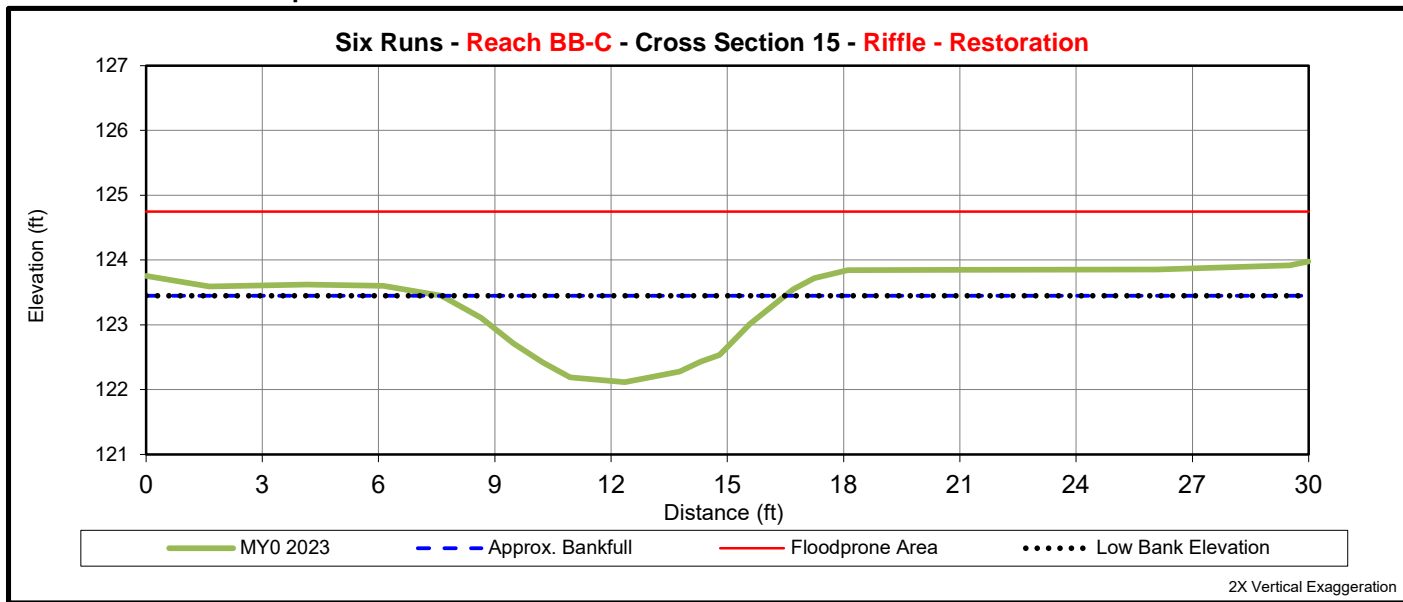

	Cross Section 15 (Riffle - BB-C)						
	MY0	MY1	MY2	MY3	MY5	MY7	MY+
Bankfull Elevation (ft) - Based on AB-Bankfull <sup>1</sup> Area	123.45						
Bank Height Ratio - Based on AB Bankfull <sup>1</sup> Area	1.0						
Thalweg Elevation	122.11						
LTOB <sup>2</sup> Elevation	123.45						
LTOB <sup>2</sup> Max Depth (ft)	1.3						
LTOB <sup>2</sup> Cross Sectional Area (ft <sup>2</sup> )	7.5						

1 - Uses the as-built cross sectional area as the basis for adjusting each subsequent years bankfull elevation


2 - Uses the current years low top of bank as the basis for adjusting each subsequent years bankfull elevation



Upstream



Downstream

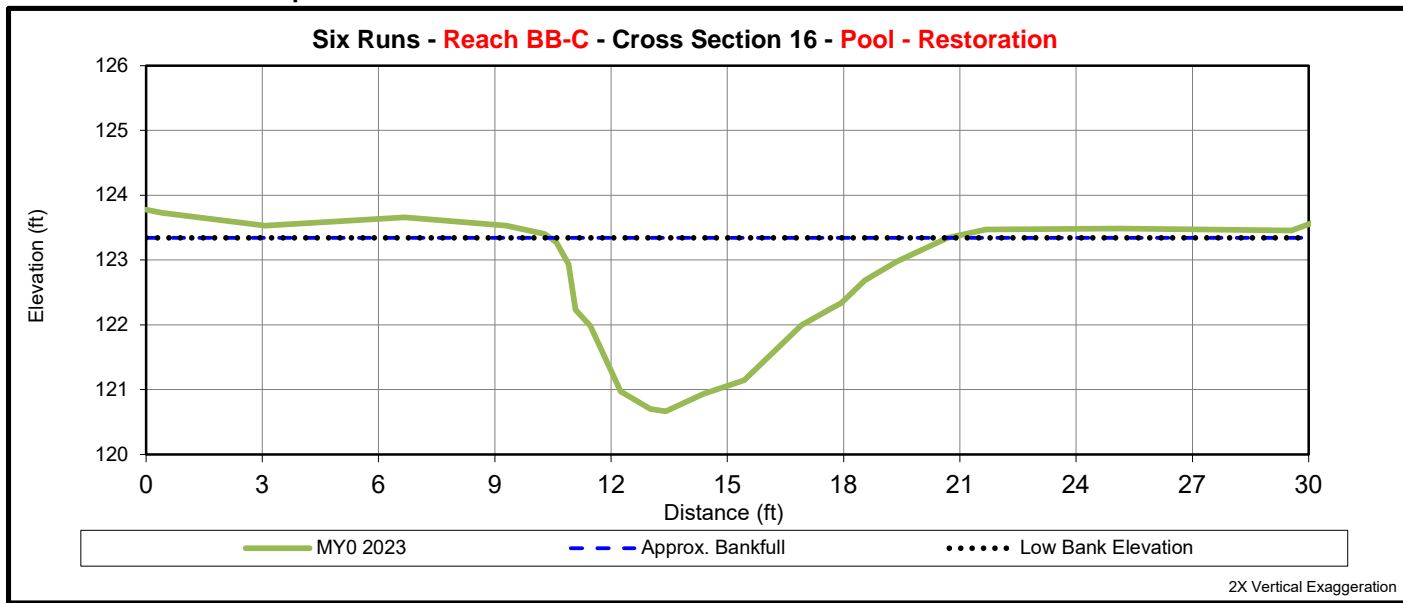

	Cross Section 16 (Pool - BB-C)						
	MY0	MY1	MY2	MY3	MY5	MY7	MY+
Bankfull Elevation (ft) - Based on AB-Bankfull <sup>1</sup> Area	123.34						
Bank Height Ratio - Based on AB Bankfull <sup>1</sup> Area							
Thalweg Elevation	120.67						
LTOB <sup>2</sup> Elevation	123.34						
LTOB <sup>2</sup> Max Depth (ft)	2.7						
LTOB <sup>2</sup> Cross Sectional Area (ft <sup>2</sup> )	15.0						

1 - Uses the as-built cross sectional area as the basis for adjusting each subsequent years bankfull elevation


2 - Uses the current years low top of bank as the basis for adjusting each subsequent years bankfull elevation



Upstream



Downstream

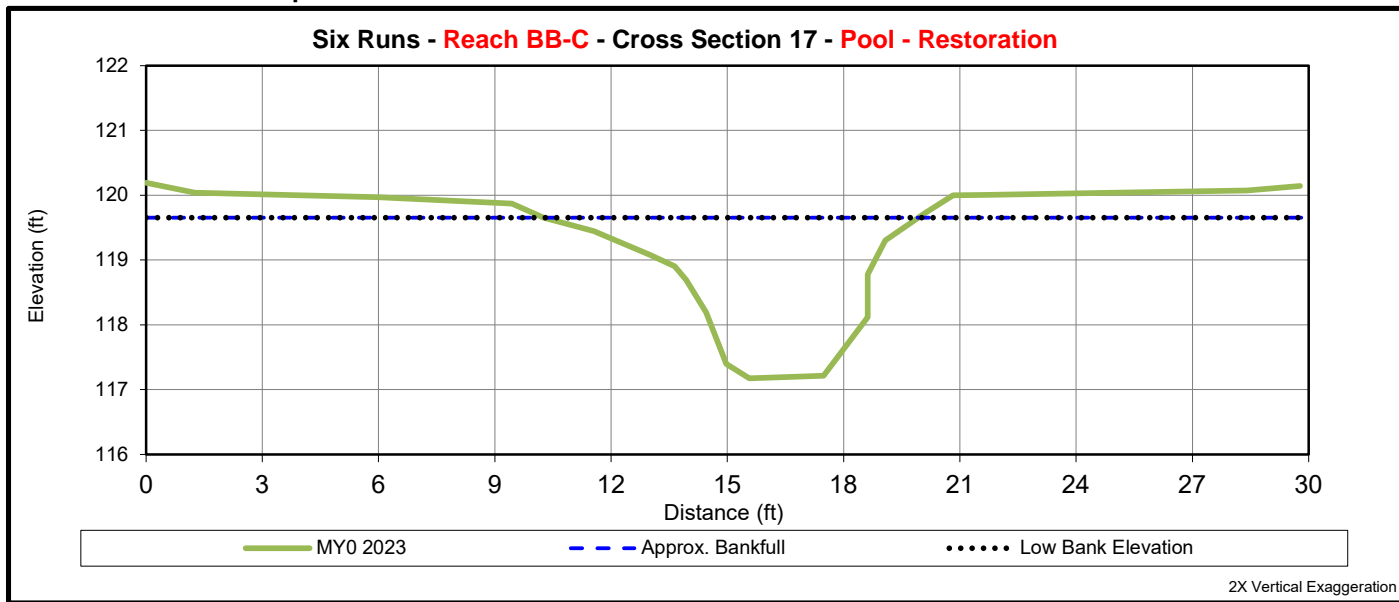

	Cross Section 17 (Pool - BB-C)						
	MY0	MY1	MY2	MY3	MY5	MY7	MY+
Bankfull Elevation (ft) - Based on AB-Bankfull <sup>1</sup> Area	119.65						
Bank Height Ratio - Based on AB Bankfull <sup>1</sup> Area							
Thalweg Elevation	117.18						
LTOB <sup>2</sup> Elevation	119.65						
LTOB <sup>2</sup> Max Depth (ft)	2.5						
LTOB <sup>2</sup> Cross Sectional Area (ft <sup>2</sup> )	11.8						

1 - Uses the as-built cross sectional area as the basis for adjusting each subsequent years bankfull elevation

2 - Uses the current years low top of bank as the basis for adjusting each subsequent years bankfull elevation






Upstream



Downstream

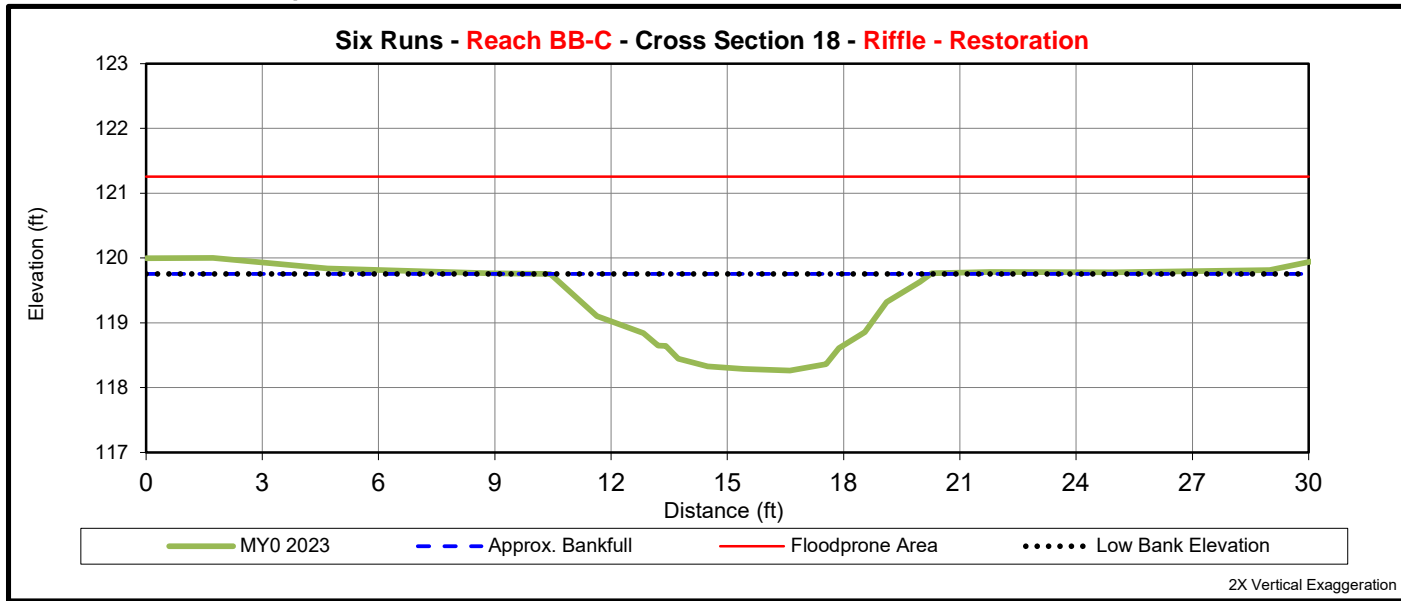

	Cross Section 18 (Riffle - BB-C)						
	MY0	MY1	MY2	MY3	MY5	MY7	MY+
Bankfull Elevation (ft) - Based on AB-Bankfull <sup>1</sup> Area	119.76						
Bank Height Ratio - Based on AB Bankfull <sup>1</sup> Area	1.0						
Thalweg Elevation	118.29						
LTOB <sup>2</sup> Elevation	119.76						
LTOB <sup>2</sup> Max Depth (ft)	1.5						
LTOB <sup>2</sup> Cross Sectional Area (ft <sup>2</sup> )	9.6						


1 - Uses the as-built cross sectional area as the basis for adjusting each subsequent years bankfull elevation  
 2 - Uses the current years low top of bank as the basis for adjusting each subsequent years bankfull elevation



Upstream



Downstream

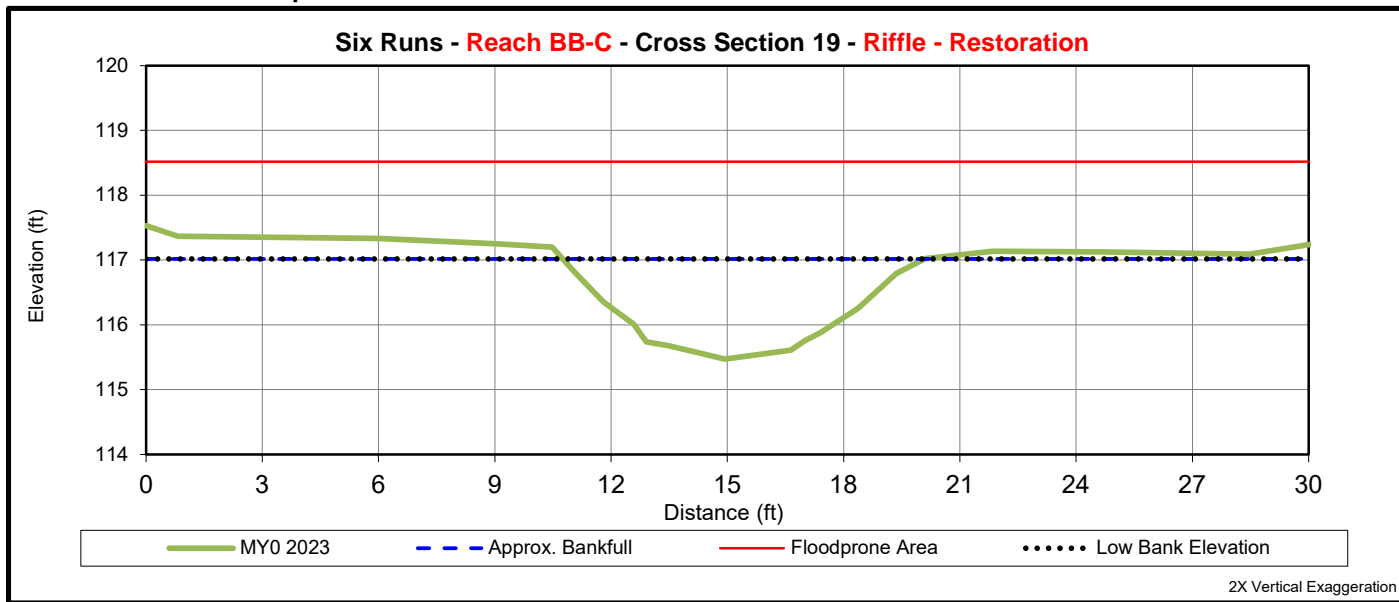

	Cross Section 19 (Riffle - BB-C)						
	MY0	MY1	MY2	MY3	MY5	MY7	MY+
Bankfull Elevation (ft) - Based on AB-Bankfull <sup>1</sup> Area	117.02						
Bank Height Ratio - Based on AB Bankfull <sup>1</sup> Area	1.0						
Thalweg Elevation	115.47						
LTOB <sup>2</sup> Elevation	117.02						
LTOB <sup>2</sup> Max Depth (ft)	1.6						
LTOB <sup>2</sup> Cross Sectional Area (ft <sup>2</sup> )	9.2						

1 - Uses the as-built cross sectional area as the basis for adjusting each subsequent years bankfull elevation


2 - Uses the current years low top of bank as the basis for adjusting each subsequent years bankfull elevation



Upstream



Downstream

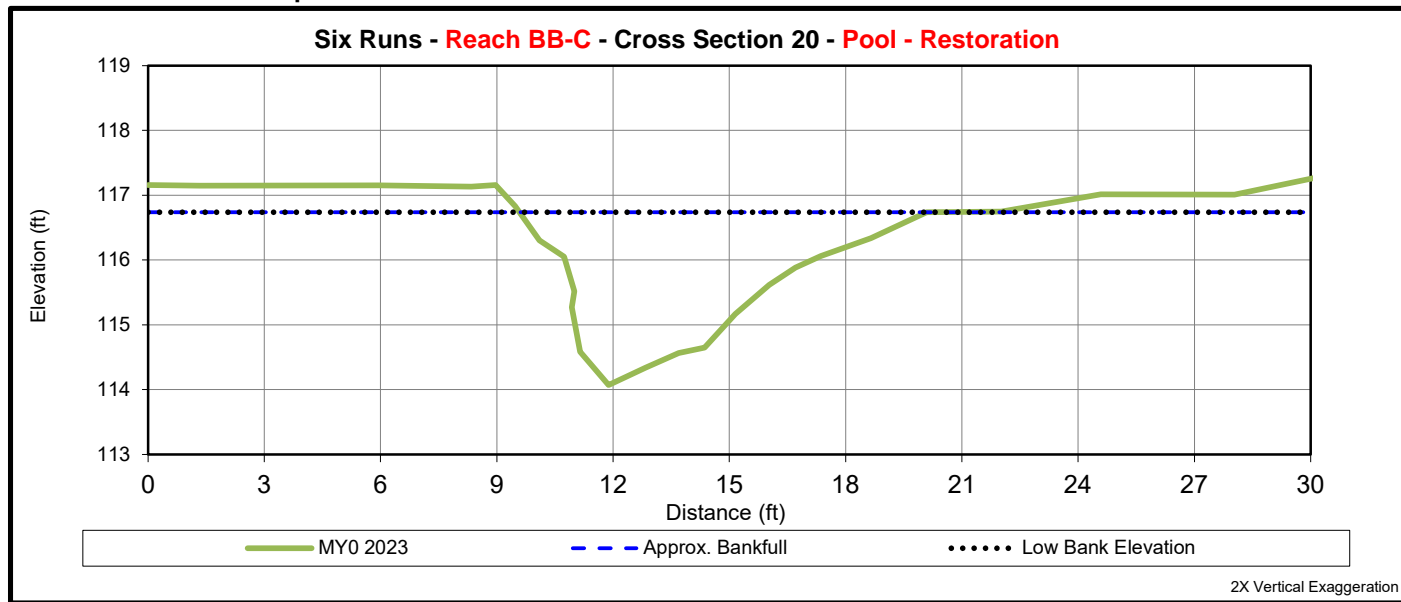

	Cross Section 20 (Pool - BB-C)						
	MY0	MY1	MY2	MY3	MY5	MY7	MY+
Bankfull Elevation (ft) - Based on AB-Bankfull <sup>1</sup> Area	116.74						
Bank Height Ratio - Based on AB Bankfull <sup>1</sup> Area							
Thalweg Elevation	114.07						
LTOB <sup>2</sup> Elevation	116.74						
LTOB <sup>2</sup> Max Depth (ft)	2.7						
LTOB <sup>2</sup> Cross Sectional Area (ft <sup>2</sup> )	13.4						

1 - Uses the as-built cross sectional area as the basis for adjusting each subsequent years bankfull elevation

2 - Uses the current years low top of bank as the basis for adjusting each subsequent years bankfull elevation






Upstream



Downstream

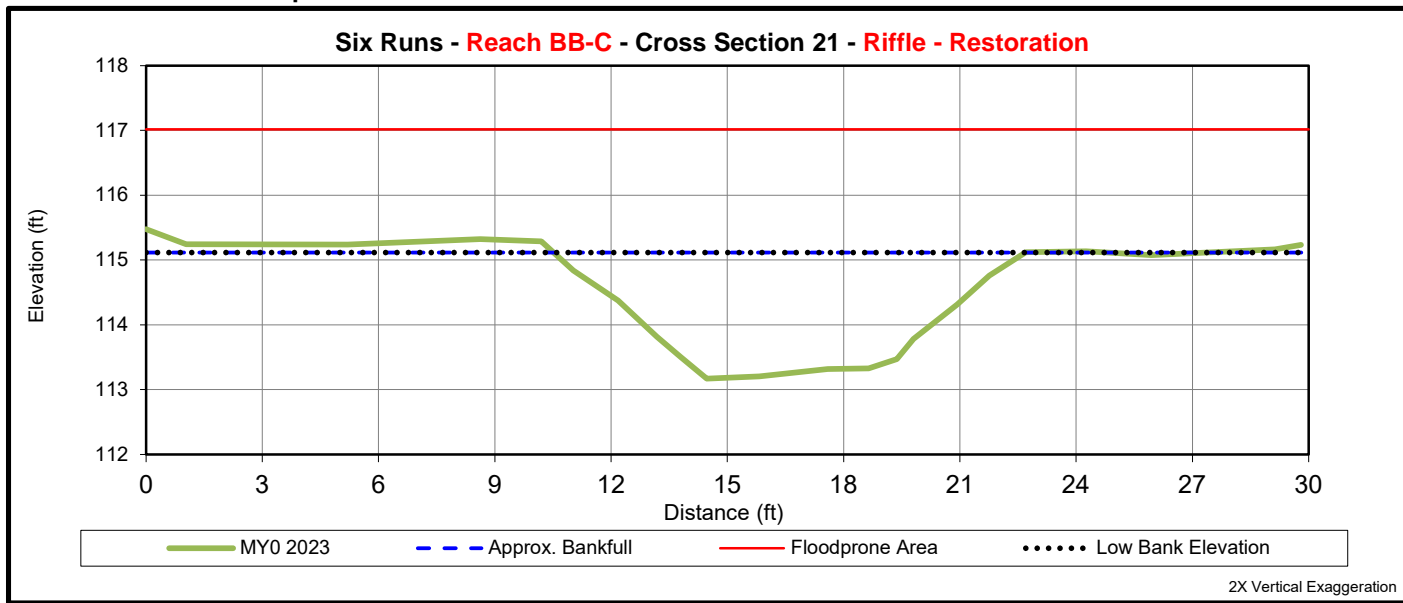

	Cross Section 21 (Riffle - BB-C)						
	MY0	MY1	MY2	MY3	MY5	MY7	MY+
Bankfull Elevation (ft) - Based on AB-Bankfull <sup>1</sup> Area	115.12						
Bank Height Ratio - Based on AB Bankfull <sup>1</sup> Area	1.0						
Thalweg Elevation	113.17						
LTOB <sup>2</sup> Elevation	115.12						
LTOB <sup>2</sup> Max Depth (ft)	2.0						
LTOB <sup>2</sup> Cross Sectional Area (ft <sup>2</sup> )	15.3						

1 - Uses the as-built cross sectional area as the basis for adjusting each subsequent years bankfull elevation


2 - Uses the current years low top of bank as the basis for adjusting each subsequent years bankfull elevation



Upstream



Downstream

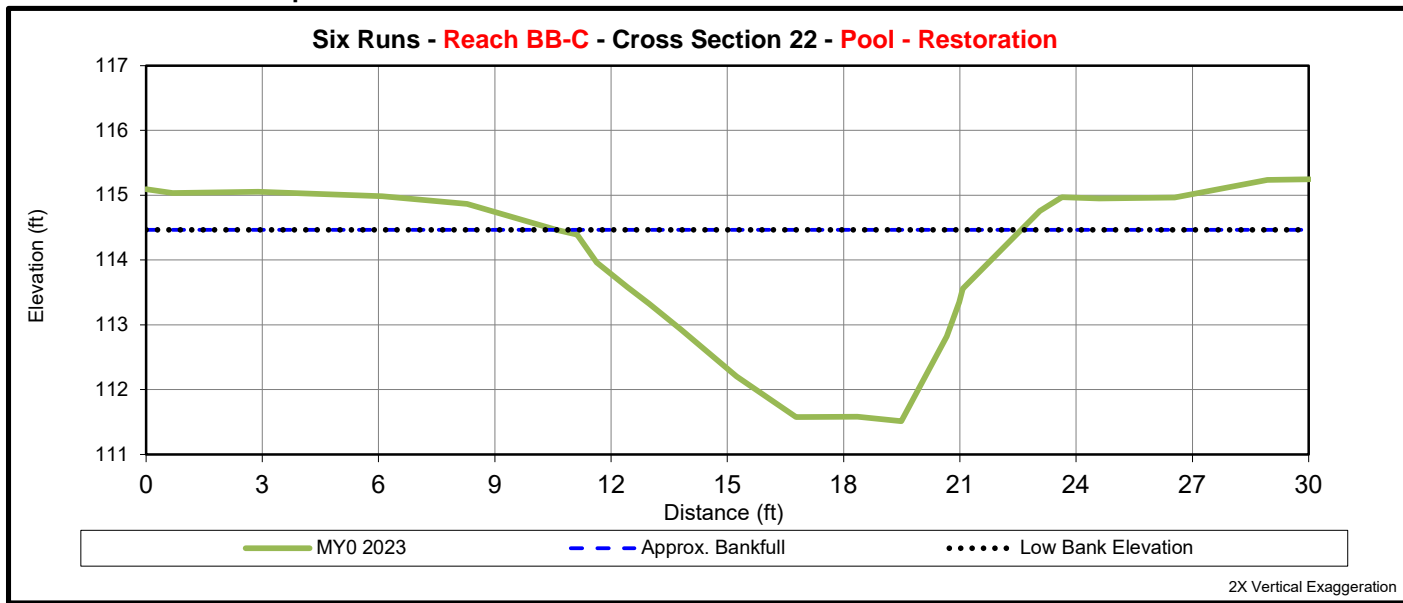

	Cross Section 22 (Pool - BB-C)						
	MY0	MY1	MY2	MY3	MY5	MY7	MY+
Bankfull Elevation (ft) - Based on AB-Bankfull <sup>1</sup> Area	114.46						
Bank Height Ratio - Based on AB Bankfull <sup>1</sup> Area							
Thalweg Elevation	111.51						
LTOB <sup>2</sup> Elevation	114.46						
LTOB <sup>2</sup> Max Depth (ft)	2.9						
LTOB <sup>2</sup> Cross Sectional Area (ft <sup>2</sup> )	20.8						

1 - Uses the as-built cross sectional area as the basis for adjusting each subsequent years bankfull elevation


2 - Uses the current years low top of bank as the basis for adjusting each subsequent years bankfull elevation



Upstream



Downstream

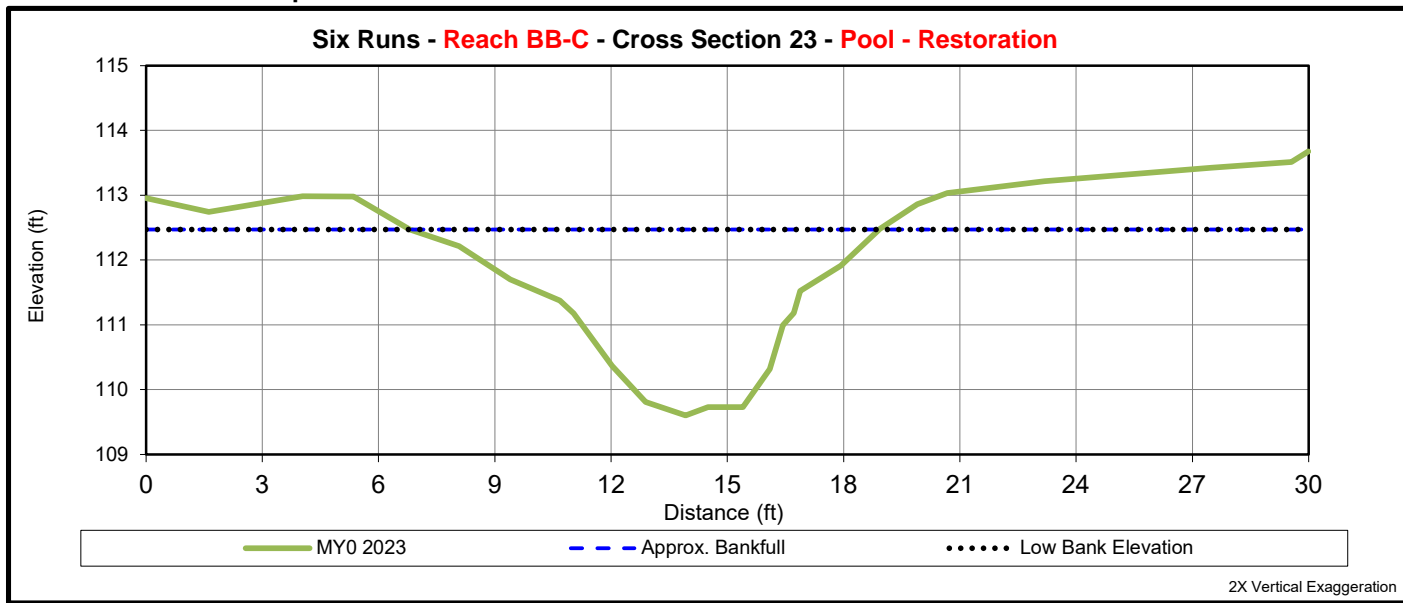

	Cross Section 23 (Pool - BB-C)						
	MY0	MY1	MY2	MY3	MY5	MY7	MY+
Bankfull Elevation (ft) - Based on AB-Bankfull <sup>1</sup> Area	112.47						
Bank Height Ratio - Based on AB Bankfull <sup>1</sup> Area							
Thalweg Elevation	109.60						
LTOB <sup>2</sup> Elevation	112.47						
LTOB <sup>2</sup> Max Depth (ft)	2.9						
LTOB <sup>2</sup> Cross Sectional Area (ft <sup>2</sup> )	17.1						

1 - Uses the as-built cross sectional area as the basis for adjusting each subsequent years bankfull elevation

2 - Uses the current years low top of bank as the basis for adjusting each subsequent years bankfull elevation






Upstream



Downstream

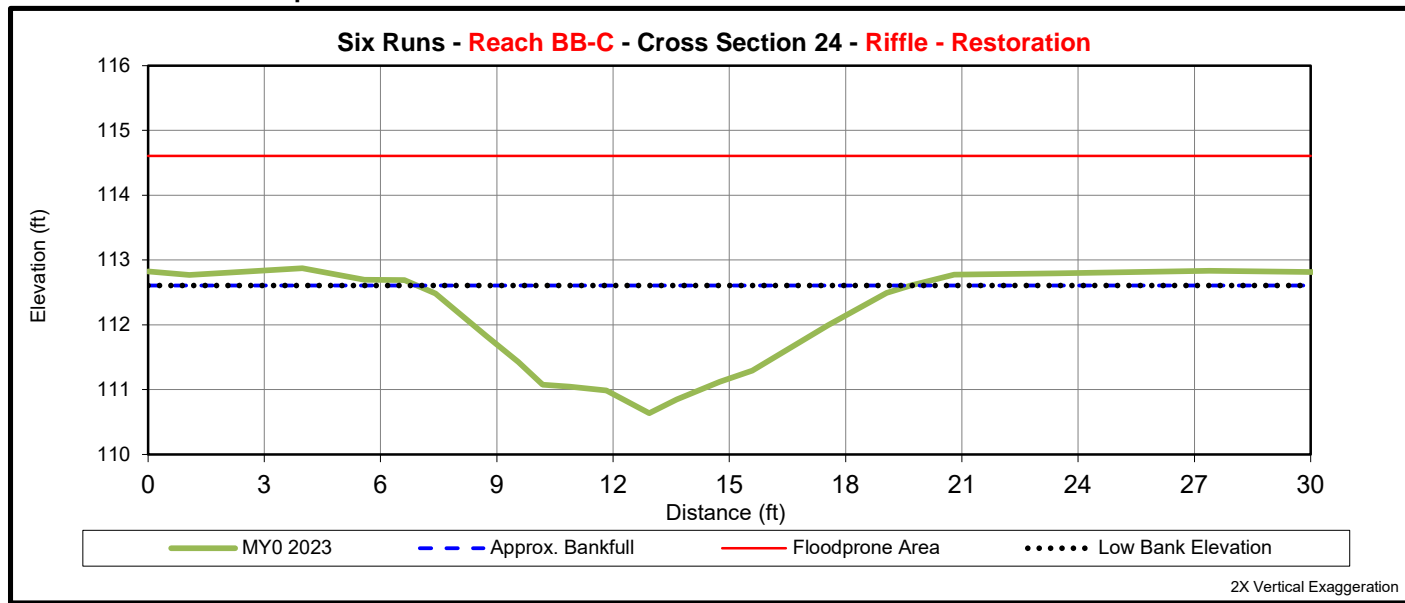

	Cross Section 24 (Riffle - BB-C)						
	MY0	MY1	MY2	MY3	MY5	MY7	MY+
Bankfull Elevation (ft) - Based on AB-Bankfull <sup>1</sup> Area	112.61						
Bank Height Ratio - Based on AB Bankfull <sup>1</sup> Area	1.0						
Thalweg Elevation	110.64						
LTOB <sup>2</sup> Elevation	112.61						
LTOB <sup>2</sup> Max Depth (ft)	2.0						
LTOB <sup>2</sup> Cross Sectional Area (ft <sup>2</sup> )	13.6						

1 - Uses the as-built cross sectional area as the basis for adjusting each subsequent years bankfull elevation


2 - Uses the current years low top of bank as the basis for adjusting each subsequent years bankfull elevation



Upstream



Downstream

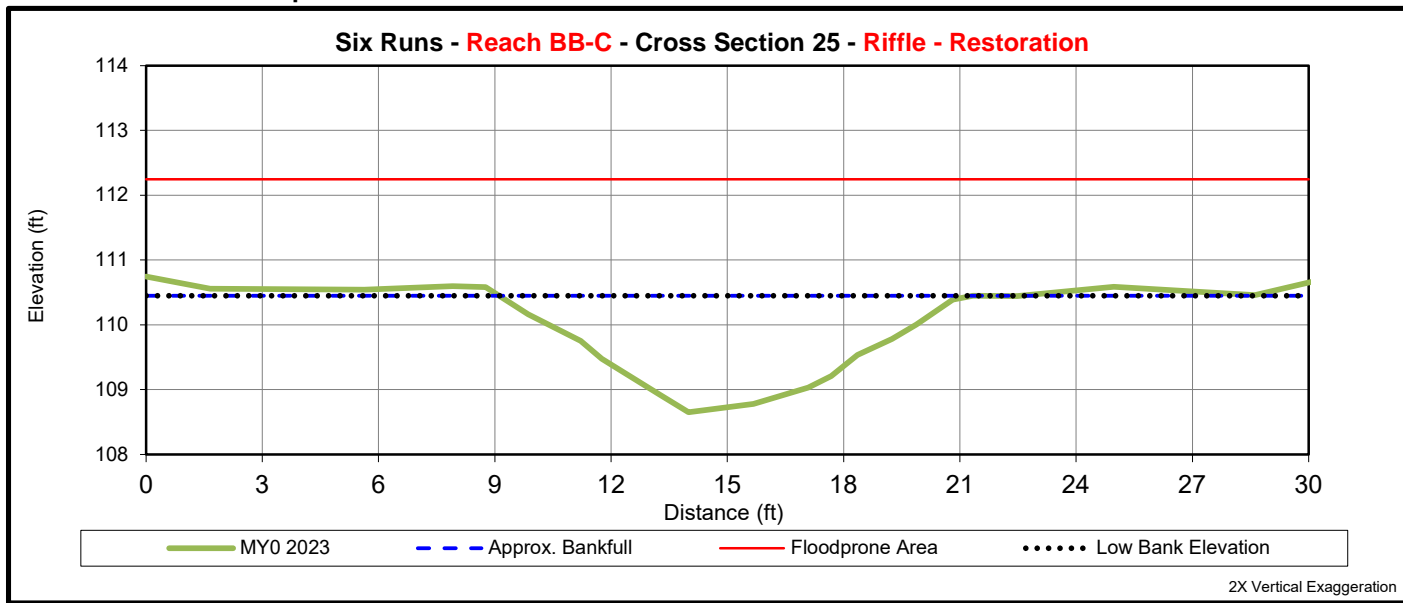

	Cross Section 25 (Riffle - BB-C)						
	MY0	MY1	MY2	MY3	MY5	MY7	MY+
Bankfull Elevation (ft) - Based on AB-Bankfull <sup>1</sup> Area	110.45						
Bank Height Ratio - Based on AB Bankfull <sup>1</sup> Area	1.0						
Thalweg Elevation	108.65						
LTOB <sup>2</sup> Elevation	110.45						
LTOB <sup>2</sup> Max Depth (ft)	1.8						
LTOB <sup>2</sup> Cross Sectional Area (ft <sup>2</sup> )	12.2						


1 - Uses the as-built cross sectional area as the basis for adjusting each subsequent years bankfull elevation  
 2 - Uses the current years low top of bank as the basis for adjusting each subsequent years bankfull elevation



Upstream



Downstream

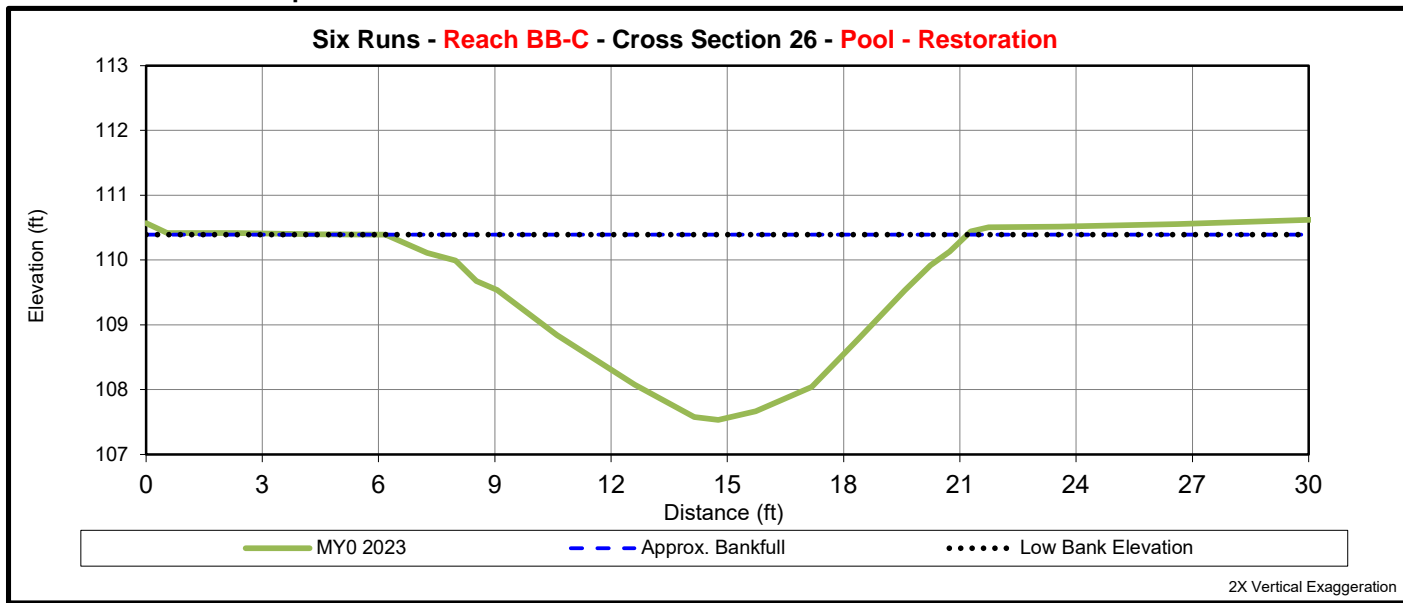

	Cross Section 26 (Pool - BB-C)						
	MY0	MY1	MY2	MY3	MY5	MY7	MY+
Bankfull Elevation (ft) - Based on AB-Bankfull <sup>1</sup> Area	110.39						
Bank Height Ratio - Based on AB Bankfull <sup>1</sup> Area							
Thalweg Elevation	107.53						
LTOB <sup>2</sup> Elevation	110.39						
LTOB <sup>2</sup> Max Depth (ft)	2.9						
LTOB <sup>2</sup> Cross Sectional Area (ft <sup>2</sup> )	23.4						

1 - Uses the as-built cross sectional area as the basis for adjusting each subsequent years bankfull elevation

2 - Uses the current years low top of bank as the basis for adjusting each subsequent years bankfull elevation






Upstream



Downstream

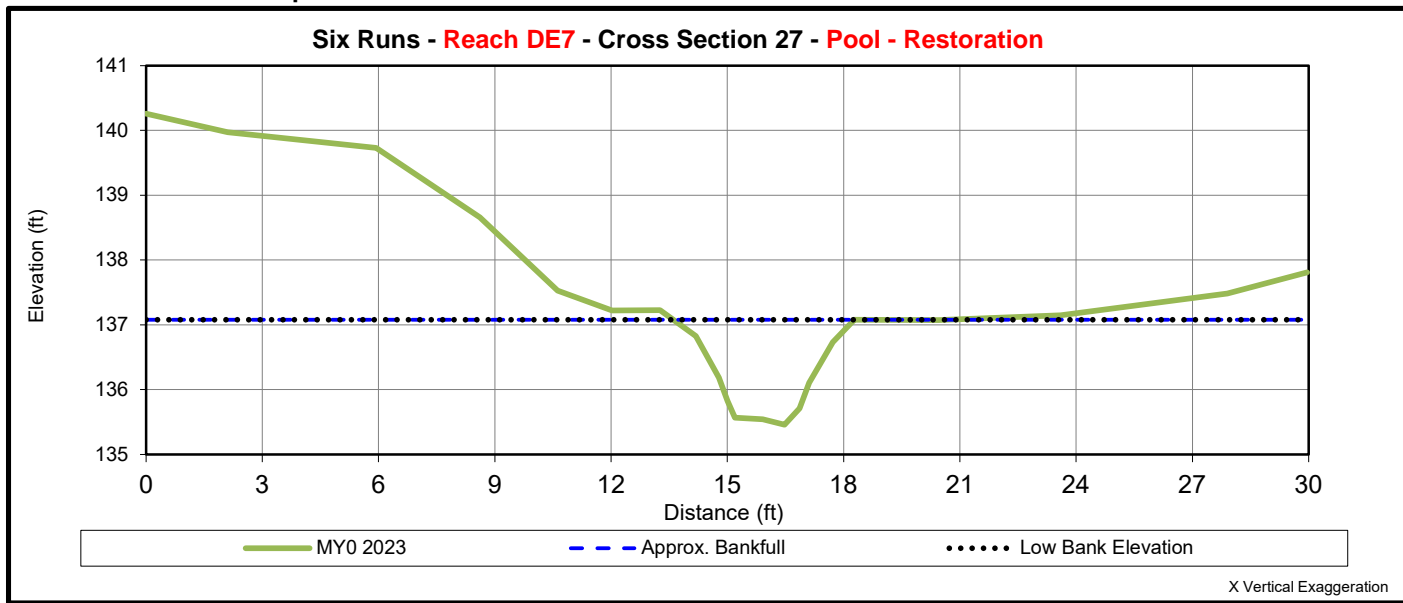

	Cross Section 27 (Pool - DE7)						
	MY0	MY1	MY2	MY3	MY5	MY7	MY+
Bankfull Elevation (ft) - Based on AB-Bankfull <sup>1</sup> Area	137.08						
Bank Height Ratio - Based on AB Bankfull <sup>1</sup> Area							
Thalweg Elevation	135.46						
LTOB <sup>2</sup> Elevation	137.08						
LTOB <sup>2</sup> Max Depth (ft)	1.6						
LTOB <sup>2</sup> Cross Sectional Area (ft <sup>2</sup> )	4.3						

1 - Uses the as-built cross sectional area as the basis for adjusting each subsequent years bankfull elevation


2 - Uses the current years low top of bank as the basis for adjusting each subsequent years bankfull elevation



Upstream



Downstream

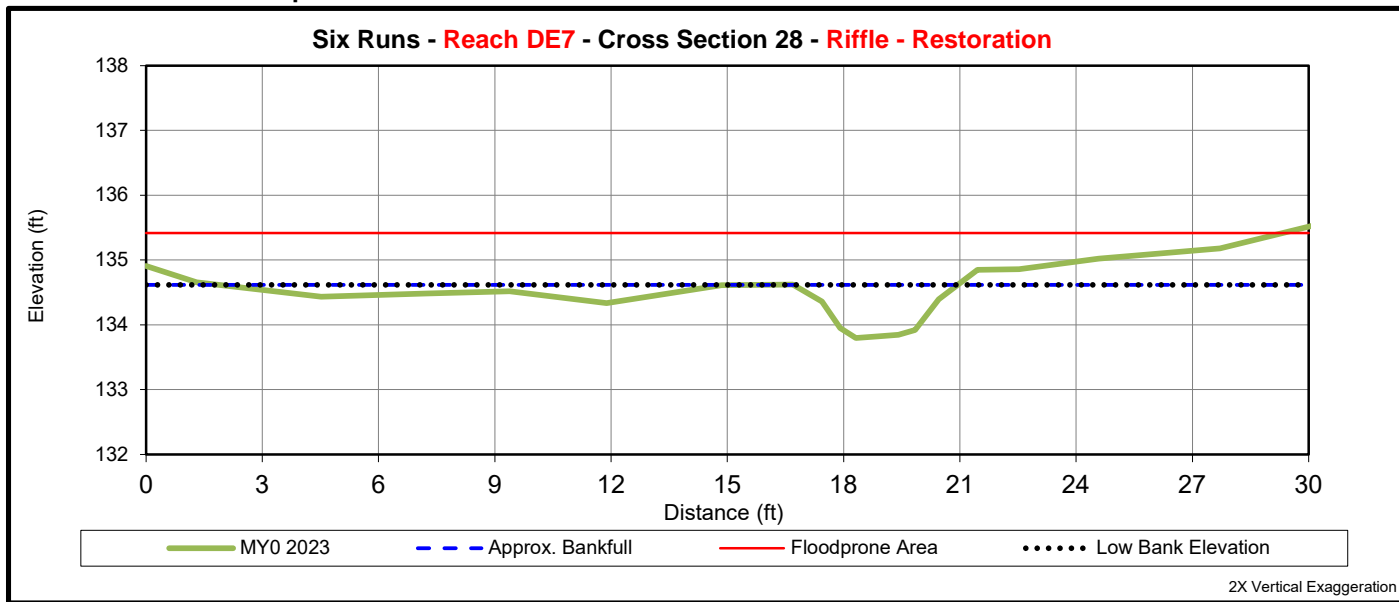

	Cross Section 28 (Riffle - DE7)						
	MY0	MY1	MY2	MY3	MY5	MY7	MY+
Bankfull Elevation (ft) - Based on AB-Bankfull <sup>1</sup> Area	134.62						
Bank Height Ratio - Based on AB Bankfull <sup>1</sup> Area	1.0						
Thalweg Elevation	133.80						
LTOB <sup>2</sup> Elevation	134.62						
LTOB <sup>2</sup> Max Depth (ft)	0.8						
LTOB <sup>2</sup> Cross Sectional Area (ft <sup>2</sup> )	2.1						

1 - Uses the as-built cross sectional area as the basis for adjusting each subsequent years bankfull elevation


2 - Uses the current years low top of bank as the basis for adjusting each subsequent years bankfull elevation



Upstream



Downstream

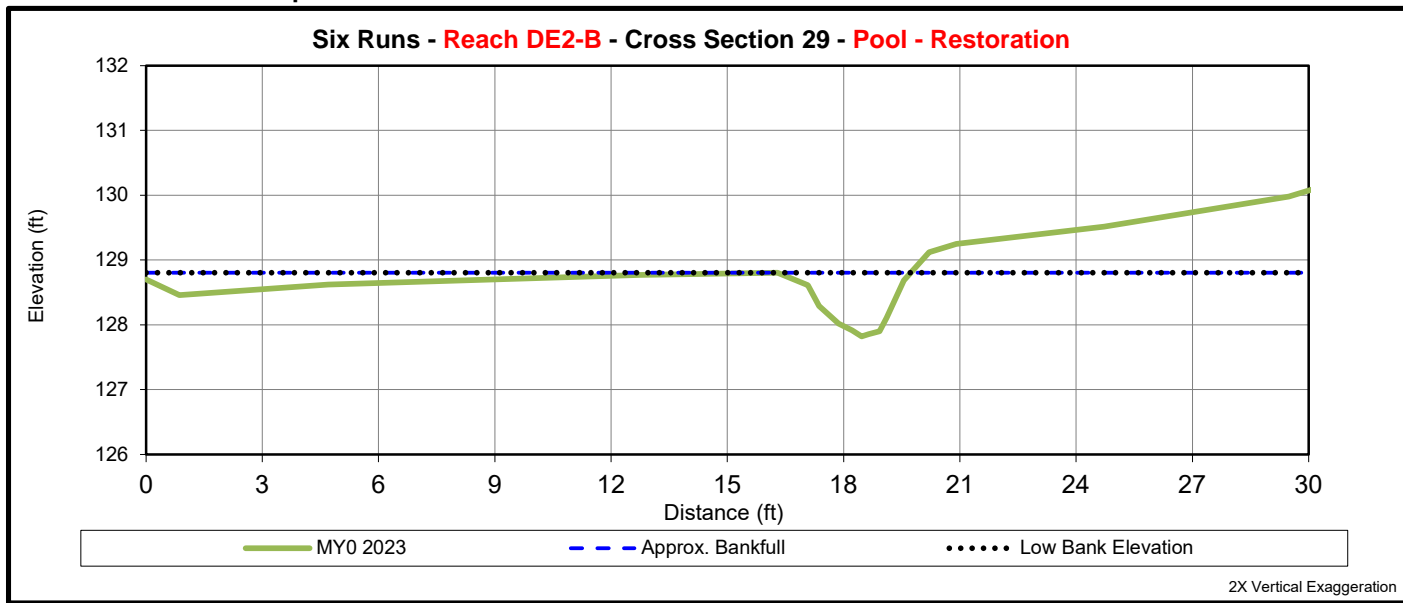

	Cross Section 29 (Pool - DE2-B)						
	MY0	MY1	MY2	MY3	MY5	MY7	MY+
Bankfull Elevation (ft) - Based on AB-Bankfull <sup>1</sup> Area	128.81						
Bank Height Ratio - Based on AB Bankfull <sup>1</sup> Area							
Thalweg Elevation	127.82						
LTOB <sup>2</sup> Elevation	128.81						
LTOB <sup>2</sup> Max Depth (ft)	1.0						
LTOB <sup>2</sup> Cross Sectional Area (ft <sup>2</sup> )	1.8						

1 - Uses the as-built cross sectional area as the basis for adjusting each subsequent years bankfull elevation

2 - Uses the current years low top of bank as the basis for adjusting each subsequent years bankfull elevation






Upstream



Downstream

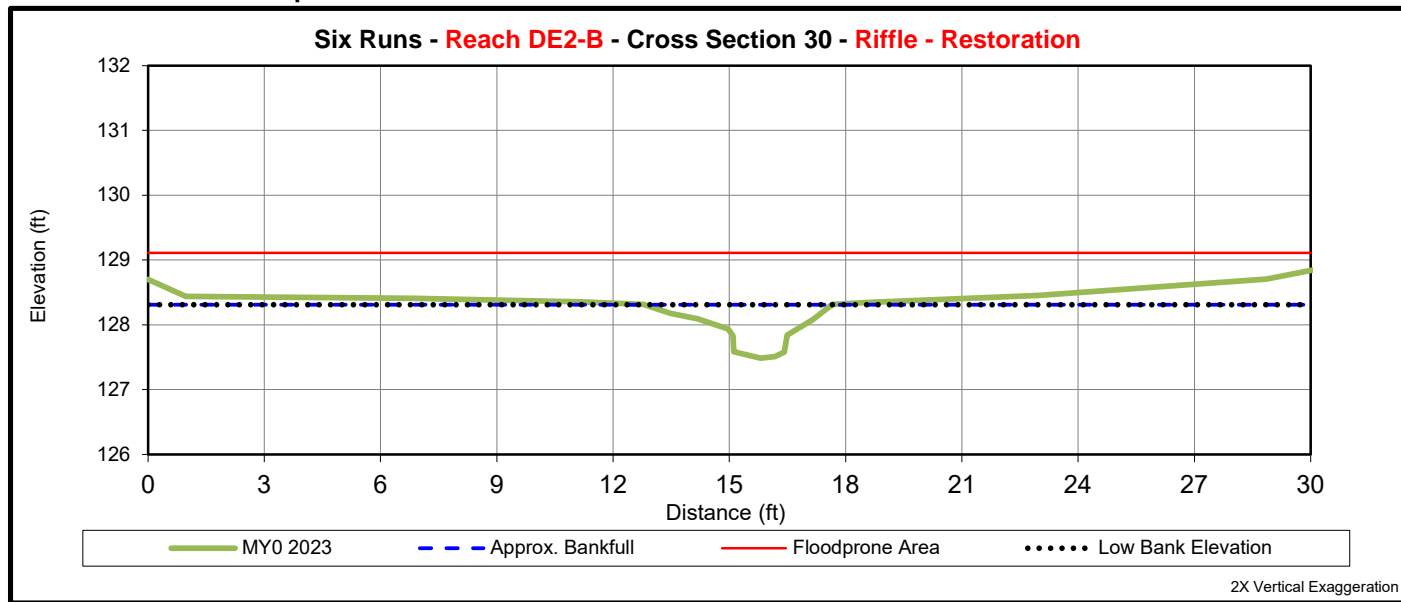

	Cross Section 30 (Riffle - DE2-B)						
	MY0	MY1	MY2	MY3	MY5	MY7	MY+
Bankfull Elevation (ft) - Based on AB-Bankfull <sup>1</sup> Area	128.31						
Bank Height Ratio - Based on AB Bankfull <sup>1</sup> Area	1.0						
Thalweg Elevation	127.48						
LTOB <sup>2</sup> Elevation	128.31						
LTOB <sup>2</sup> Max Depth (ft)	0.8						
LTOB <sup>2</sup> Cross Sectional Area (ft <sup>2</sup> )	1.8						


1 - Uses the as-built cross sectional area as the basis for adjusting each subsequent years bankfull elevation  
 2 - Uses the current years low top of bank as the basis for adjusting each subsequent years bankfull elevation



Upstream



Downstream

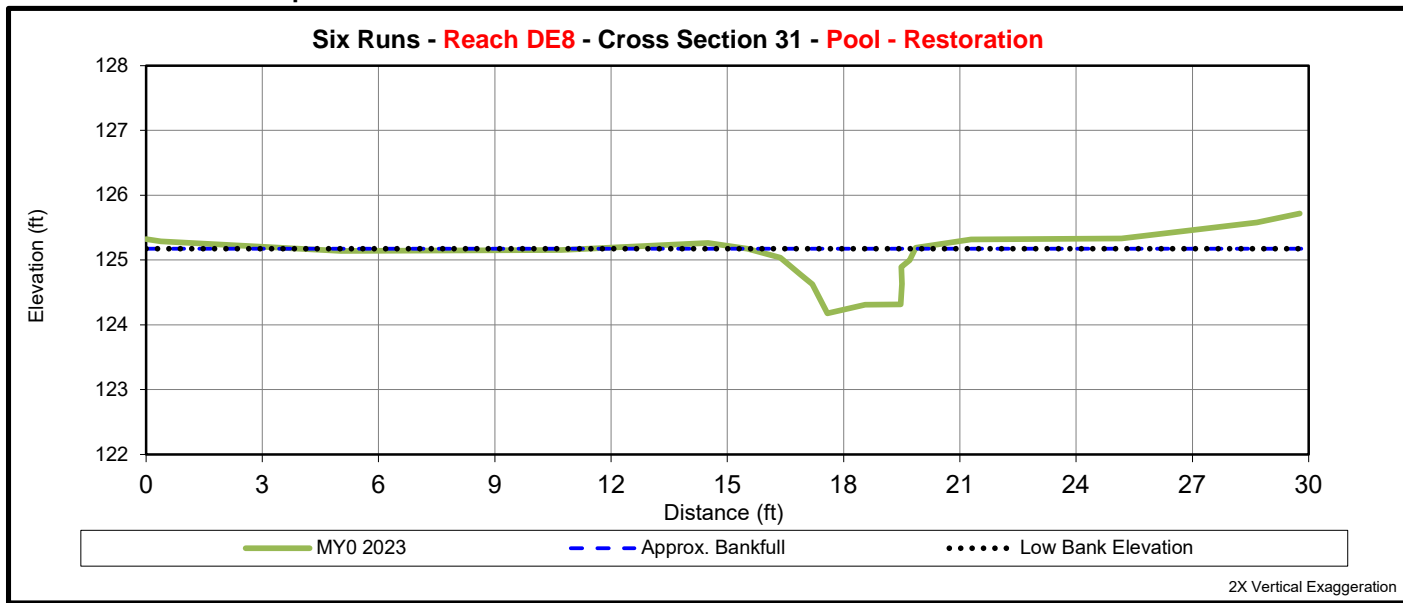

	Cross Section 31 (Pool - DE8)						
	MY0	MY1	MY2	MY3	MY5	MY7	MY+
Bankfull Elevation (ft) - Based on AB-Bankfull <sup>1</sup> Area	125.71						
Bank Height Ratio - Based on AB Bankfull <sup>1</sup> Area							
Thalweg Elevation	124.18						
LTOB <sup>2</sup> Elevation	125.71						
LTOB <sup>2</sup> Max Depth (ft)	1.5						
LTOB <sup>2</sup> Cross Sectional Area (ft <sup>2</sup> )	2.4						

1 - Uses the as-built cross sectional area as the basis for adjusting each subsequent years bankfull elevation


2 - Uses the current years low top of bank as the basis for adjusting each subsequent years bankfull elevation



Upstream



Downstream

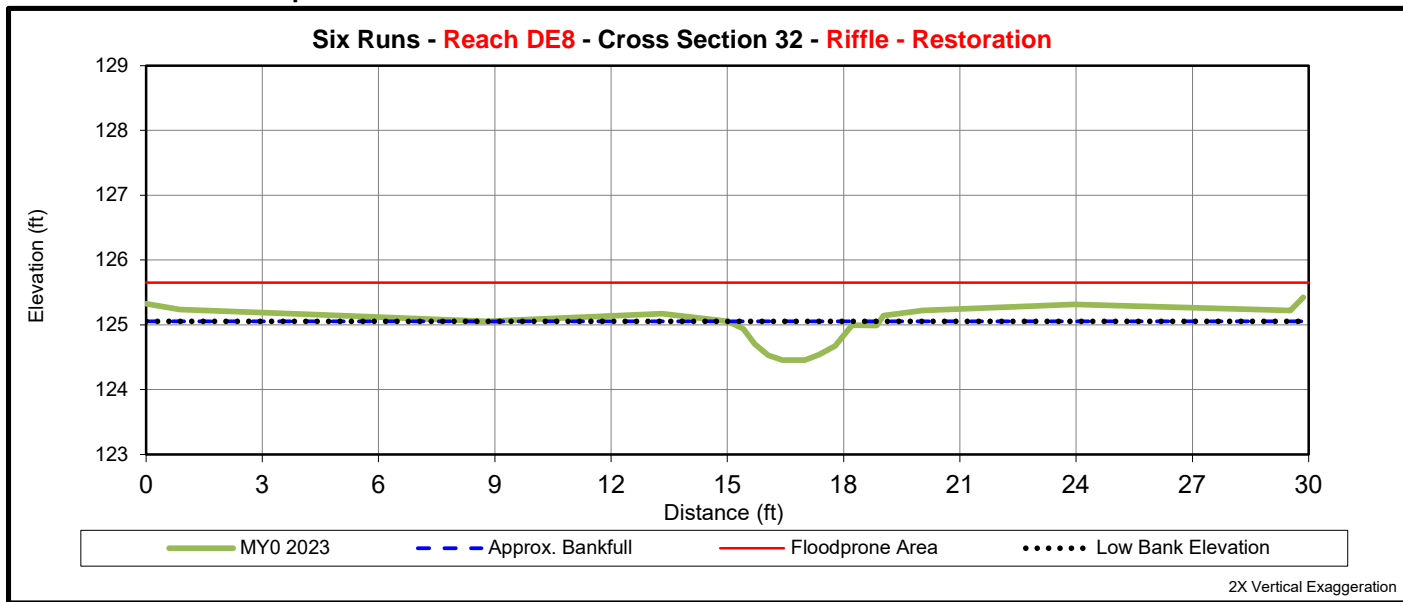

	Cross Section 32 (Riffle - DE8)						
	MY0	MY1	MY2	MY3	MY5	MY7	MY+
Bankfull Elevation (ft) - Based on AB-Bankfull <sup>1</sup> Area	125.05						
Bank Height Ratio - Based on AB Bankfull <sup>1</sup> Area	1.0						
Thalweg Elevation	124.46						
LTOB <sup>2</sup> Elevation	125.05						
LTOB <sup>2</sup> Max Depth (ft)	0.6						
LTOB <sup>2</sup> Cross Sectional Area (ft <sup>2</sup> )	1.3						

1 - Uses the as-built cross sectional area as the basis for adjusting each subsequent years bankfull elevation  
 2 - Uses the current years low top of bank as the basis for adjusting each subsequent years bankfull elevation






Upstream



Downstream

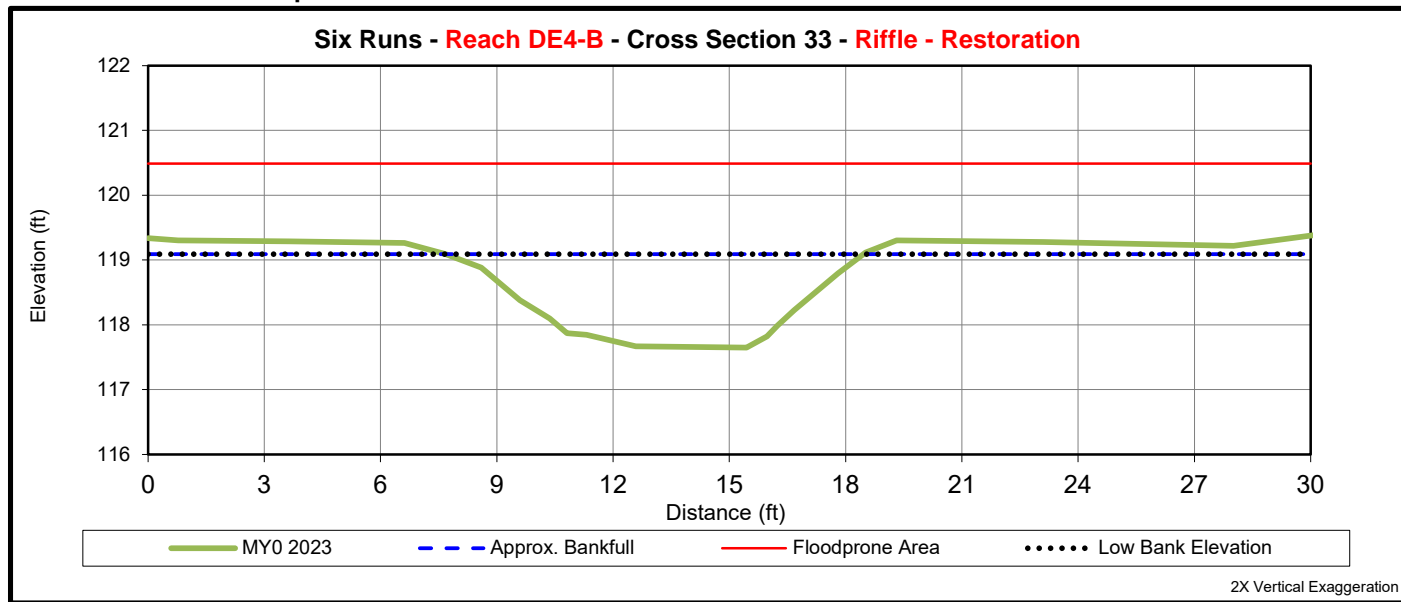

	Cross Section 33 (Riffle - DE4-B)						
	MY0	MY1	MY2	MY3	MY5	MY7	MY+
Bankfull Elevation (ft) - Based on AB-Bankfull <sup>1</sup> Area	119.09						
Bank Height Ratio - Based on AB Bankfull <sup>1</sup> Area	1.0						
Thalweg Elevation	117.65						
LTOB <sup>2</sup> Elevation	119.09						
LTOB <sup>2</sup> Max Depth (ft)	1.4						
LTOB <sup>2</sup> Cross Sectional Area (ft <sup>2</sup> )	10.3						

1 - Uses the as-built cross sectional area as the basis for adjusting each subsequent years bankfull elevation


2 - Uses the current years low top of bank as the basis for adjusting each subsequent years bankfull elevation



Upstream



Downstream

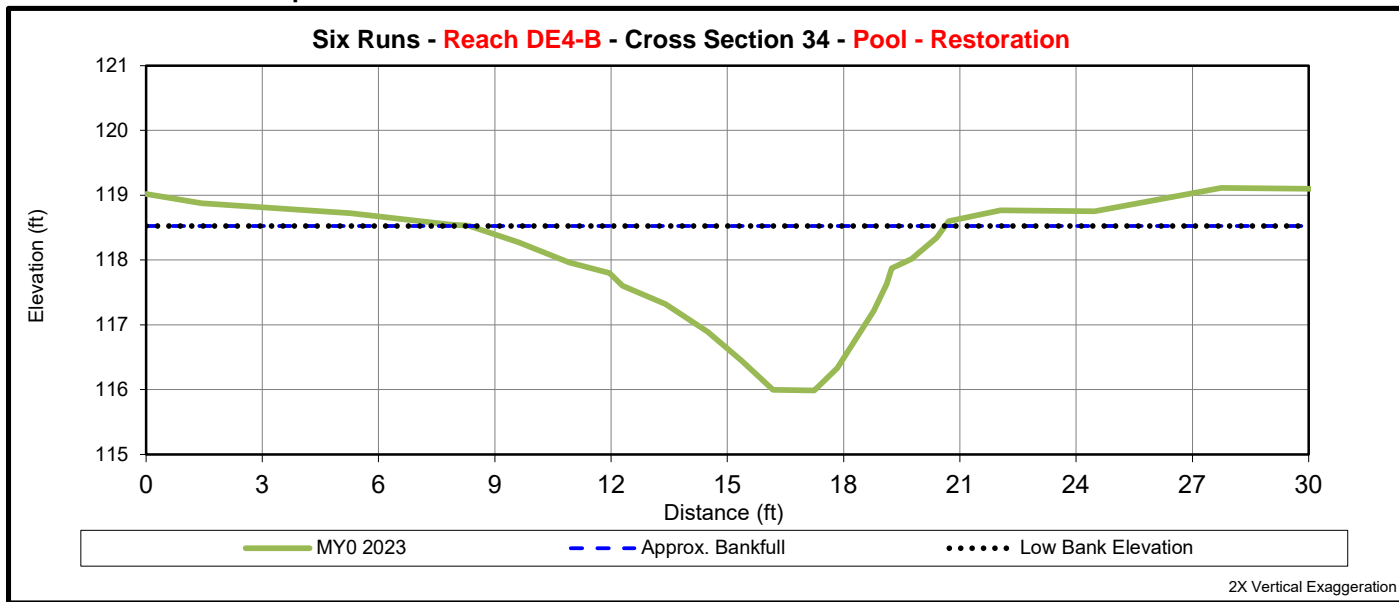

	Cross Section 34 (Pool - DE4-B)						
	MY0	MY1	MY2	MY3	MY5	MY7	MY+
Bankfull Elevation (ft) - Based on AB-Bankfull <sup>1</sup> Area	118.53						
Bank Height Ratio - Based on AB Bankfull <sup>1</sup> Area							
Thalweg Elevation	115.99						
LTOB <sup>2</sup> Elevation	118.53						
LTOB <sup>2</sup> Max Depth (ft)	2.5						
LTOB <sup>2</sup> Cross Sectional Area (ft <sup>2</sup> )	14.6						


1 - Uses the as-built cross sectional area as the basis for adjusting each subsequent years bankfull elevation  
 2 - Uses the current years low top of bank as the basis for adjusting each subsequent years bankfull elevation



Upstream



Downstream

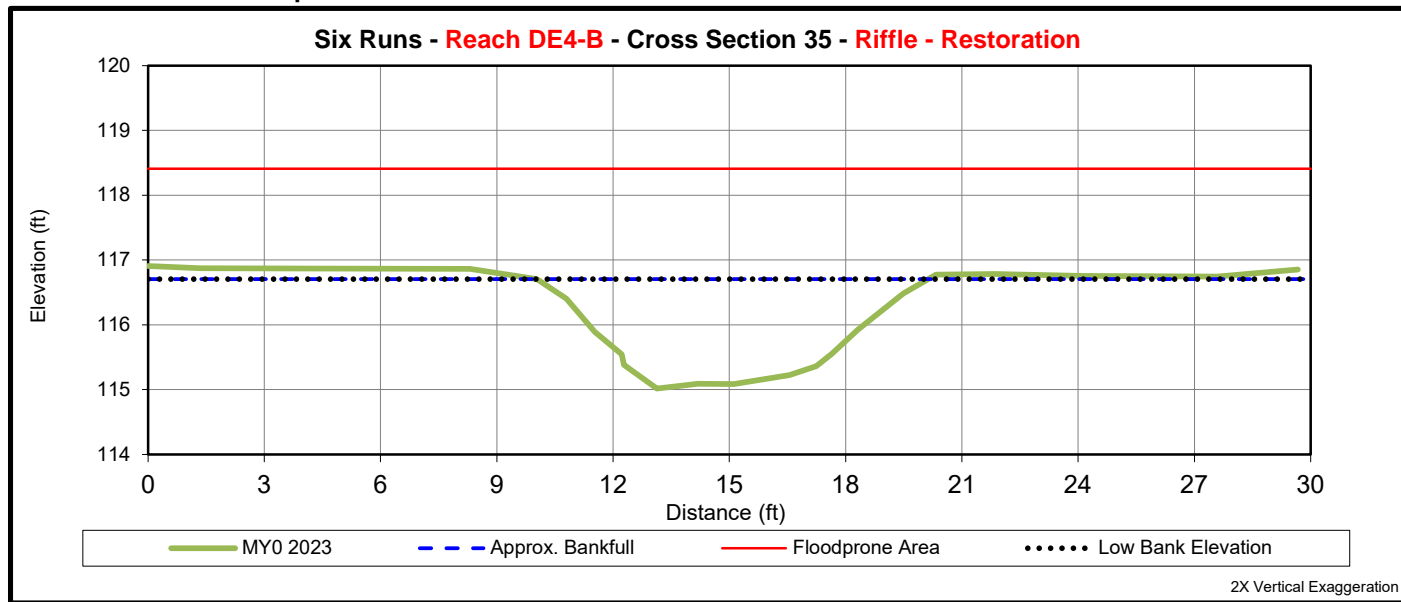

	Cross Section 35 (Riffle - DE4-B)						
	MY0	MY1	MY2	MY3	MY5	MY7	MY+
Bankfull Elevation (ft) - Based on AB-Bankfull <sup>1</sup> Area	116.71						
Bank Height Ratio - Based on AB Bankfull <sup>1</sup> Area	1.0						
Thalweg Elevation	115.02						
LTOB <sup>2</sup> Elevation	116.71						
LTOB <sup>2</sup> Max Depth (ft)	1.7						
LTOB <sup>2</sup> Cross Sectional Area (ft <sup>2</sup> )	10.8						

1 - Uses the as-built cross sectional area as the basis for adjusting each subsequent years bankfull elevation

2 - Uses the current years low top of bank as the basis for adjusting each subsequent years bankfull elevation






Upstream



Downstream

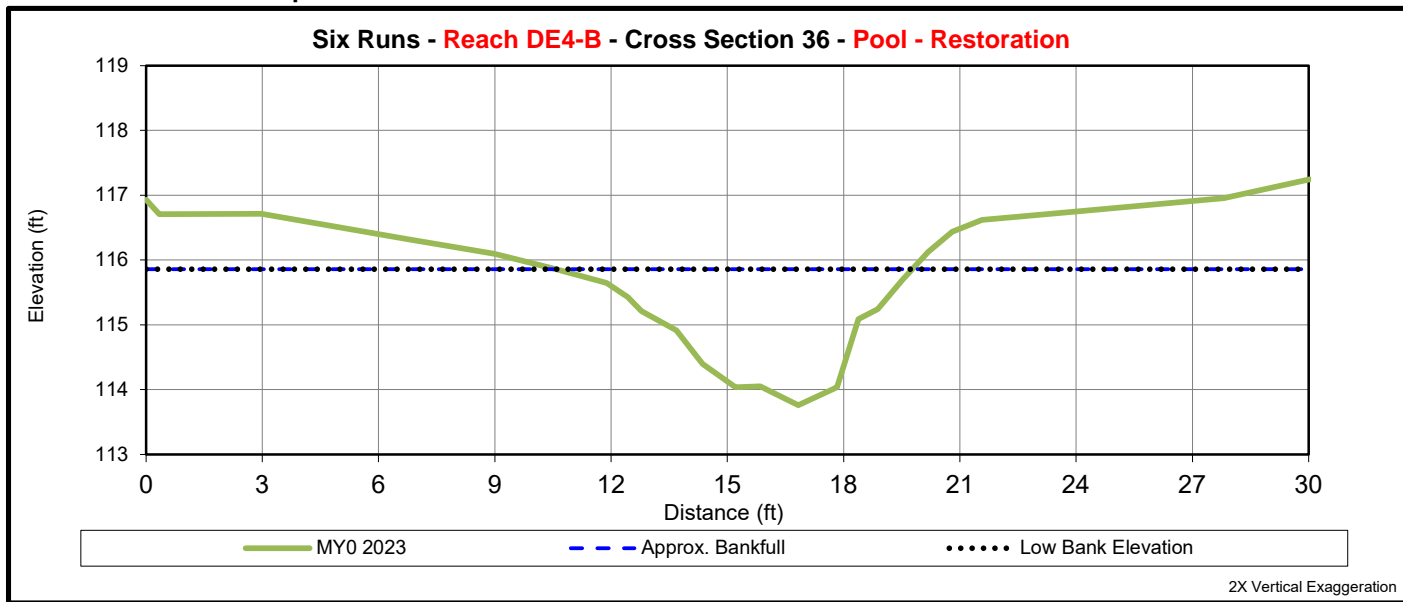

	Cross Section 36 (Pool - DE4-B)						
	MY0	MY1	MY2	MY3	MY5	MY7	MY+
Bankfull Elevation (ft) - Based on AB-Bankfull <sup>1</sup> Area	115.86						
Bank Height Ratio - Based on AB Bankfull <sup>1</sup> Area							
Thalweg Elevation	113.76						
LTOB <sup>2</sup> Elevation	115.86						
LTOB <sup>2</sup> Max Depth (ft)	2.1						
LTOB <sup>2</sup> Cross Sectional Area (ft <sup>2</sup> )	9.8						


1 - Uses the as-built cross sectional area as the basis for adjusting each subsequent years bankfull elevation  
 2 - Uses the current years low top of bank as the basis for adjusting each subsequent years bankfull elevation

# **Appendix D**


## Hydrologic Data

Soil Characterization Data Form						
<b>Project Name:</b>		Six Runs		<b>Date:</b>		March 28, 2023
<b>Personnel:</b>		Jack Duffus		<b>Soil Pit ID:</b>		GW-01
				<b>Latitude, Longitude</b>		(35.0955104333811, -78.2366867369408)
Horizon Depths (inches)	Texture	Matrix Color (Munsell moist)	Redoximorphic Features		Induration (none, weak, strong)	Roots
			Color	Abundance		
0-4	Sandy Loam Texture Modifier: NA	10YR 7/3	10YR 5/8	5%	None	Few
4-11	Loam Texture Modifier: NA	10YR 3/2			None	Few
11-14	Clay Loam Texture Modifier: NA	10YR 4/1			None	Few
14-19	Silty Clay Texture Modifier: NA	Gley 1 3/N			None	Few
19-30	Clay Texture Modifier: NA	Gley 1 5/N	10YR 5/8	15%	None	None

<b>Comments:</b> NA	<b>Soil Profile:</b> 
------------------------	--



Soil Characterization Data Form						
<b>Project Name:</b>		Six Runs		<b>Date:</b>		March 28, 2023
<b>Personnel:</b>		Jack Duffus		<b>Soil Pit ID:</b>		GW-02
				<b>Latitude, Longitude</b>		(35.0955264766183, -78.2370435930126)
Horizon Depths (inches)	Texture	Matrix Color (Munsell moist)	Redoximorphic Features		Induration (none, weak, strong)	Roots
			Color	Abundance		
0-14	Loam Texture Modifier: NA	10YR 4/1	5YR 4/6	5%	None	Common
14-17	Sandy Loam Texture Modifier: NA	10YR 4/1	5YR 4/6	20	None	Few
17-30	Sandy_Clay_Loam Texture Modifier: NA	Gley 1 3/N	5YR 4/6	10	None	Few
<b>Comments:</b> NA				<b>Soil Profile:</b>		
						

**Soil Characterization Data Form**

**Project Name:** Six Runs **Date:** March 28, 2023

**Personnel:** Jack Duffus **Soil Pit ID:** GW-03

**Latitude, Longitude** (35.0937952040874, -78.2378309543405)


Horizon Depths (inches)	Texture	Matrix Color (Munsell moist)	Redoximorphic Features		Induration (none, weak, strong)	Roots
			Color	Abundance		
0-3	Sandy_Clay_Loam Texture Modifier: NA	10YR 5/4	10YR 5/8	10%	None	Few
3-15	Silt Loam Texture Modifier: NA	10YR 5/2	7.5YR 5/8	10	None	Few
15-30	Silt Loam Texture Modifier: NA	10YR 5/1	7.5YR 5/8	25	None	None

**Comments:**

NA

**Soil Profile:**



Soil Characterization Data Form						
<b>Project Name:</b>		Six Runs		<b>Date:</b>		March 28, 2023
<b>Personnel:</b>		Jack Duffus		<b>Soil Pit ID:</b>		GW-04
				<b>Latitude, Longitude</b>		(35.094311089112, -78.2372384550558)
Horizon Depths (inches)	Texture	Matrix Color (Munsell moist)	Redoximorphic Features		Induration (none, weak, strong)	Roots
			Color	Abundance		
0-3	Silt Loam Texture Modifier: NA	10YR 5/4			None	Common
3-17	Silt Loam Texture Modifier: NA	10YR 4/1	7.5YR 4/6	10%	None	Few
17-24	Loam Texture Modifier: NA	10YR 6/1	10YR 6/8	25%	None	Few
24-30	Silty Clay Texture Modifier: NA	10YR 6/1	10YR 6/8	35%	None	None
<b>Comments:</b> NA				<b>Soil Profile:</b>		
						

**Soil Characterization Data Form**

**Project Name:** Six Runs **Date:** March 28, 2023

**Personnel:** Jack Duffus **Soil Pit ID:** GW-05


**Latitude, Longitude** (35.0940579638133, -78.2385256448011)

Horizon Depths (inches)	Texture	Matrix Color (Munsell moist)	Redoximorphic Features		Induration (none, weak, strong)	Roots
			Color	Abundance		
0-3	Sandy Loam Texture Modifier: NA	10YR 4/1			None	Many
3-18	Silt Loam Texture Modifier: NA	10YR 4/2	7.5YR 5/6	10	None	Few
18-30	Sandy Loam Texture Modifier: NA	10YR 5/2	10YR 4/6	10%	None	None

**Comments:**  
NA





Soil Characterization Data Form						
<b>Project Name:</b>		Six Runs		<b>Date:</b>		March 28, 2023
<b>Personnel:</b>		Jack Duffus		<b>Soil Pit ID:</b>		GW-06
				<b>Latitude, Longitude</b>		(35.0928398449714, -78.2395972584319)
Horizon Depths (inches)	Texture	Matrix Color (Munsell moist)	Redoximorphic Features		Induration (none, weak, strong)	Roots
			Color	Abundance		
0-18	Clay Loam Texture Modifier: NA	10YR 4/17.5YR 4/6	7.5YR 4/6	15	None	Common
18-30	Silt Loam Texture Modifier: NA	Gley 1 3/N			None	Few
<b>Comments:</b> NA				<b>Soil Profile:</b>		
						

**Soil Characterization Data Form**

**Project Name:** Six Runs **Date:** March 28, 2023

**Personnel:** Jack Duffus **Soil Pit ID:** GW-07

**Latitude, Longitude** (35.0928168937897, -78.2408899079725)


Horizon Depths (inches)	Texture	Matrix Color (Munsell moist)	Redoximorphic Features		Induration (none, weak, strong)	Roots
			Color	Abundance		
0-11	Sandy Loam Texture Modifier: NA	10YR 4/1	7.5YR 4/6	15	None	Common
11-26	Sandy_Clay_Loam Texture Modifier: NA	10YR 5/1	7.5YR 5/8	20	None	Few
26-30	Clay Loam Texture Modifier: NA	10YR 3/1	7.5YR 5/8	10	None	None

**Comments:**

NA

**Soil Profile:**



Soil Characterization Data Form						
<b>Project Name:</b>		Six Runs		<b>Date:</b>		March 28, 2023
<b>Personnel:</b>		Jack Duffus		<b>Soil Pit ID:</b>		GW-08
				<b>Latitude, Longitude</b>		(35.0919699197121, -78.2409562722684)
Horizon Depths (inches)	Texture	Matrix Color (Munsell moist)	Redoximorphic Features		Induration (none, weak, strong)	Roots
			Color	Abundance		
0-8	Loam Texture Modifier: Muck	10YR 4/1	7.5YR 4/6	10	None	Common
8-10	Sand Texture Modifier: Muck	10YR 6/2	7.5YR 5/6	10	None	Few
10-22	Sandy Loam Texture Modifier: NA	Gley 1 4/n			None	Few
22-30	Sandy_Clay_Loam Texture Modifier: NA	Gley 1 6/n			None	None
<b>Comments:</b> NA				<b>Soil Profile:</b>		
						

**Soil Characterization Data Form**

**Project Name:** Six Runs **Date:** March 28, 2023

**Personnel:** Jack Duffus **Soil Pit ID:** GW-09


**Latitude, Longitude** (35.0921133635085, -78.2426516478521)


Horizon Depths (inches)	Texture	Matrix Color (Munsell moist)	Redoximorphic Features		Induration (none, weak, strong)	Roots
			Color	Abundance		
0-4	Sandy Loam Texture Modifier: NA	10YR 4/2	7.5YR 4/6	10	None	Common
4-22	Loamy Sand Texture Modifier: NA	10YR 5/1	7.5YR 4/6	20	None	Few
22-30	Loamy Sand Texture Modifier: NA	10YR 6/2	10YR 5/8	15	None	None

**Comments:**  
NA





Soil Characterization Data Form						
<b>Project Name:</b>		Six Runs		<b>Date:</b>		March 28, 2023
<b>Personnel:</b>		Jack Duffus		<b>Soil Pit ID:</b>		GW-10
				<b>Latitude, Longitude</b>		(35.0914360429964, -78.2417855675516)
Horizon Depths (inches)	Texture	Matrix Color (Munsell moist)	Redoximorphic Features		Induration (none, weak, strong)	Roots
			Color	Abundance		
0-4	Sandy Loam Texture Modifier: Muck	10YR 4/1	7.5YR 4/6	5	None	Few
4-18	Sand Texture Modifier: Muck	10YR 7/1			None	None
18-2610	Clay Loam Texture Modifier: NA	10YR 5/1			None	None
<b>Comments:</b> NA				<b>Soil Profile:</b>		
						

<b>Project Name:</b>	Six Runs	<b>Date:</b>	March 28, 2023			
<b>Personnel:</b>	Jack Duffus	<b>Soil Pit ID:</b>	GW-11			
		<b>Latitude, Longitude</b>	(35.0965616320589, -78.2368171458792)			
Horizon Depths (inches)	Texture	Matrix Color (Munsell moist)	Redoximorphic Features		Induration (none, weak, strong)	Roots
			Color	Abundance		
0-10	Loam Texture Modifier: NA	10YR 4/2	5YR 4/6	3%	None	Common
10-30	Sandy_Clay_Loam Texture Modifier: NA	10YR 4/1			None	Few
<b>Comments:</b> NA			<b>Soil Profile:</b> 			

**Appendix E**  
Project Timeline and  
Contact Information

**Table 4. Project Timeline and Contact Information**

<b>Activity or Deliverable</b>	<b>Data Collection Complete</b>	<b>Task Completion or Deliverable Submission</b>
Project Instituted	NA	Oct-20
Mitigation Plan Approved	NA	Jul-22
Construction (Grading) Completed	NA	Mar-23
Planting Completed	NA	Mar-23
As-built Survey Completed	NA	Aug-23
MY-0 Baseline Report	XS Monitoring - 3/30/2023 VP Monitoring - 3/23/2023	Aug-23


<b>Project Name/Number</b>	
<b>Provider</b>	RES / 3600 Glenwood Ave., Suite 100, Raleigh, NC 27612
Mitigation Provider POC	Jamey Mceachran (919) 623-9889
<b>Designer</b>	RES / 3600 Glenwood Ave., Suite 100, Raleigh, NC 27612
Primary project design POC	Frasier Mullen, PE (919) 412-3866
<b>Construction Contractor</b>	RES / 3600 Glenwood Ave., Suite 100, Raleigh, NC 27612
Construction contractor POC	Daniel Burnette



# **Appendix F**

## **As-built Survey & Record Drawings**



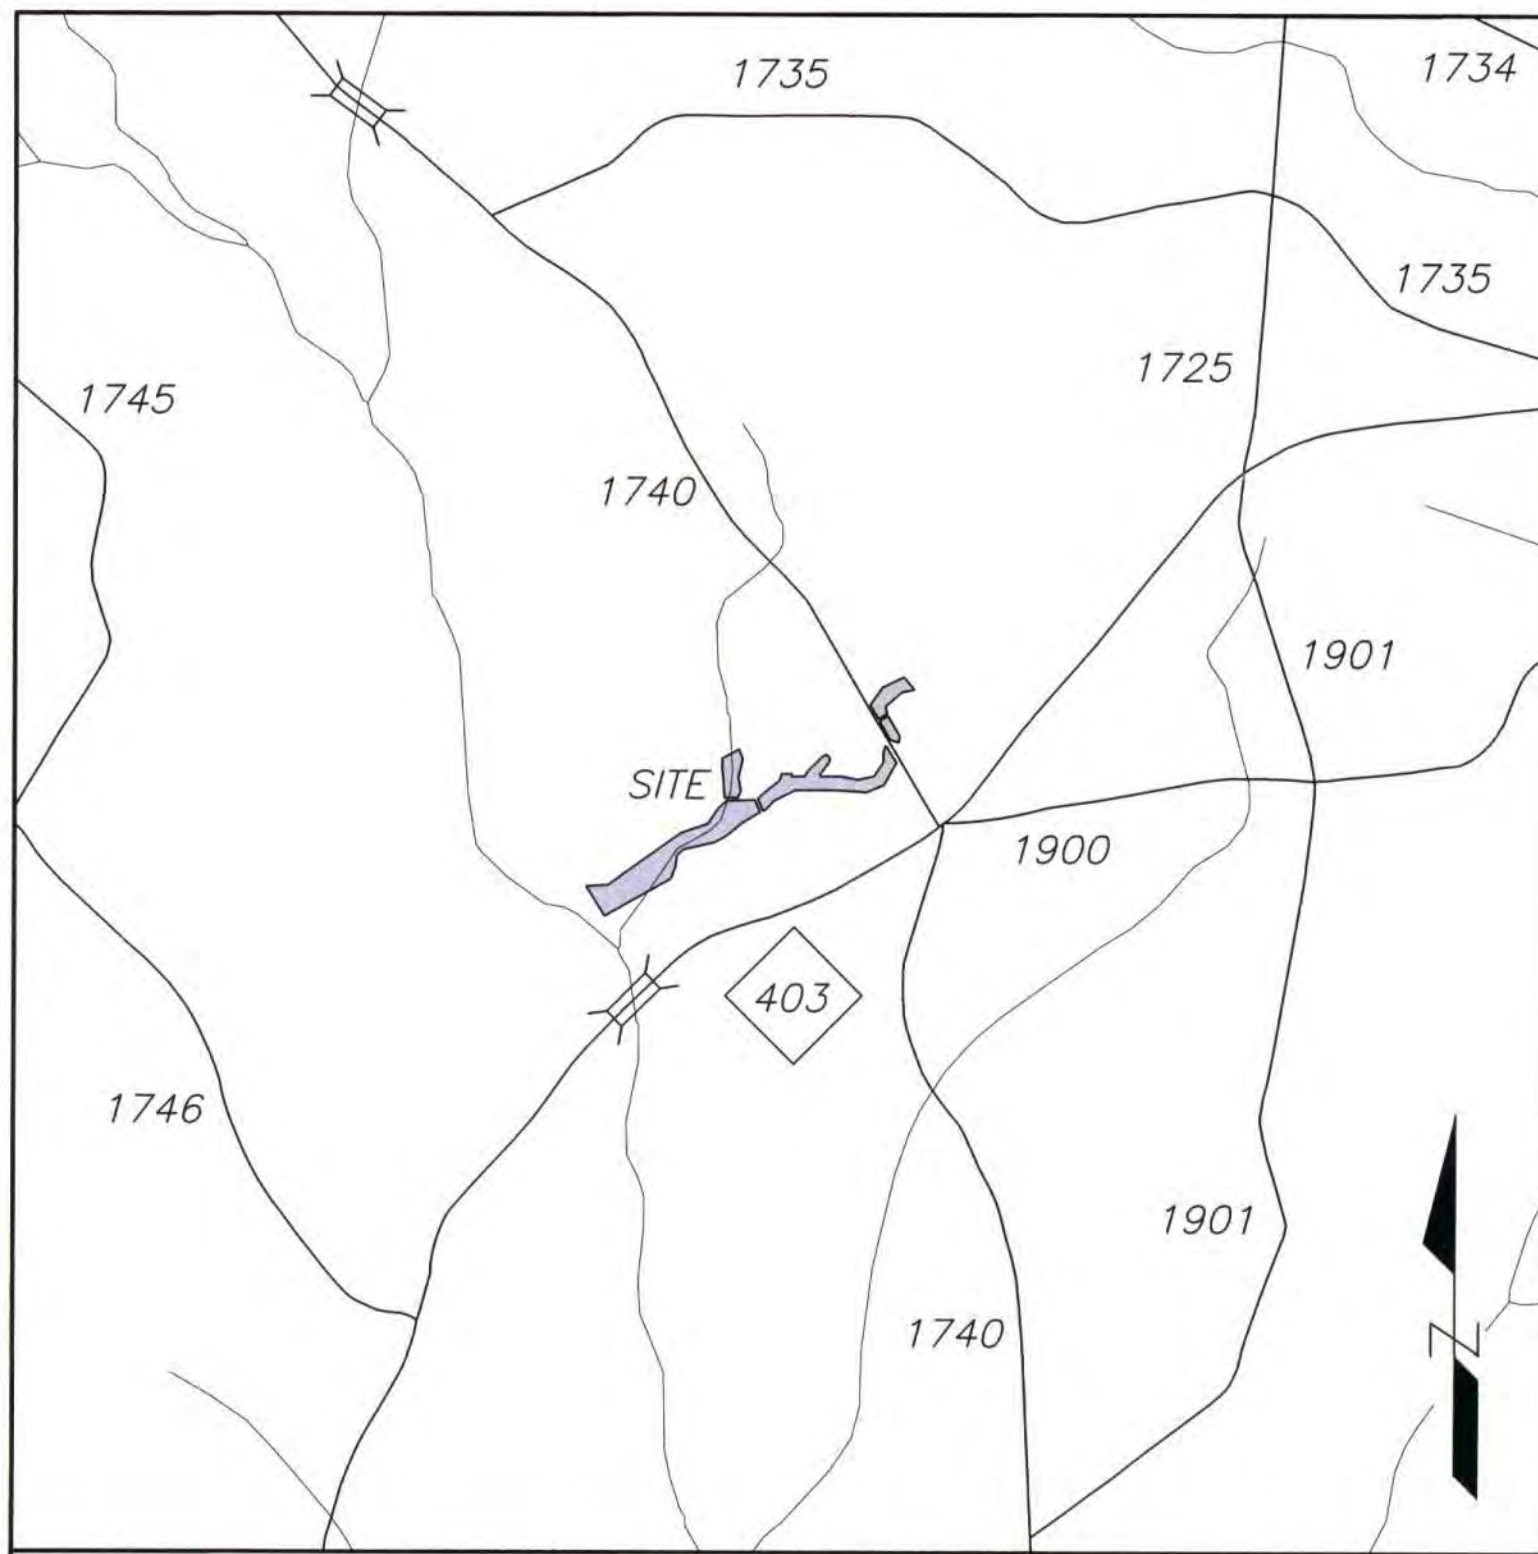

VICINITY MAP  
NOT TO SCALE

I, **JAMES R. WATSON**, CERTIFY THAT THIS PROJECT WAS COMPLETED UNDER MY DIRECT AND RESPONSIBLE CHARGE FROM AN ACTUAL SURVEY MADE UNDER MY SUPERVISION; THAT THIS GROUND SURVEY WAS PERFORMED AT THE 95 PERCENT CONFIDENCE LEVEL (2 SIGMA) TO MEET FEDERAL GEOGRAPHIC DATA COMMITTEE STANDARDS; THAT THE HORIZONTAL ACCURACY IS 0.10'; THAT THE VERTICAL ACCURACY IS 0.15'; AND THAT THE ORIGINAL DATA WAS OBTAINED ON 12/8/2020; THAT THE SURVEY WAS COMPLETED ON 4/28/2023; THAT CONTOURS SHOWN HEREON MAY NOT MEET THE STATED STANDARDS; AND ALL COORDINATES ARE BASED ON NAD 83(2011); AND ALL ELEVATIONS ARE BASED ON NAVD 88.

WITNESS MY ORIGINAL SIGNATURE, REGISTRATION NUMBER AND SEAL THIS 11TH DAY OF MAY, A.D., 2023.

*James R. Watson*  
L-4712



THE FOLLOWING INFORMATION WAS USED TO PERFORM THIS GNSS SURVEY:

CLASS OF SURVEY: A  
POSITIONAL ACCURACY: 0.10'  
TYPE OF GPS FIELD PROCEDURE: RTK  
DATES OF SURVEY: 12/8/2020 & 4/28/2023  
DATUM / EPOCH: NAD 83(2011)  
PUBLISHED / FIXED CONTROL USED: OPUS SOLUTION  
GEOID MODEL: GEOID12  
COMBINED GRID FACTOR: 0.99987403  
UNITS: U.S. SURVEY FEET

- NOTES:
- ALL DISTANCES ARE HORIZONTAL GROUND DISTANCES UNLESS OTHERWISE NOTED.
  - THE HORIZONTAL DATUM IS NAD 83(2011) AND THE VERTICAL DATUM IS NAVD 88.
  - THIS MAP IS NOT FOR RECORDATION, SALES, OR CONVEYANCES.
  - THE PURPOSE OF THIS MAP IS TO SHOW POST CONSTRUCTION AS-BUILT CONDITIONS OF THE STREAM RESTORATION AND MAY NOT SHOW ALL UTILITIES, STRUCTURES, AND BOUNDARIES.
  - NO PROPERTY LINES WERE SURVEYED DURING THIS SURVEY. ALL CONSERVATION EASEMENTS, PROPERTY LINES, AND ADJOINING PROPERTY OWNERS ARE SHOWN BY PREVIOUS SURVEYS BY MATRIX EAST, PLLC AS RECORDED IN PLAT CABINET 110, PAGES 78 - 84 IN THE SAMPSON COUNTY REGISTRY.
  - THE LOCATION OF FLOW GAUGE DE2-B, WETLAND GAUGES GW3, GW5, & GW11; VEGETATION PLOTS 1, 6, 7, & 8; AND THE AMBIENT SHOWN HEREON WERE PROVIDED BY RESOURCE ENVIRONMENTAL SOLUTIONS, LLC AND WERE NOT SURVEYED BY MATRIX EAST, PLLC AT THIS TIME.
  - UNLESS OTHERWISE NOTED, COORDINATES SHOWN HEREON ARE GROUND COORDINATES BASED ON A PROJECT CONTROL POINT HAVING NGS OPUS DERIVED NC STATE PLANE COORDINATES (NAD 83/2011 DATUM) OF N=491,613.9706', E=2,228,674.2260' AND A COMBINED SCALE FACTOR OF 0.99987403 FOR THIS SITE.
  - ALL WETLAND BOUNDARIES SHOWN HEREON WERE PROVIDED BY RESOURCE ENVIRONMENTAL SOLUTIONS, LLC. NO WETLAND DETERMINATION WAS PERFORMED BY MATRIX EAST, PLLC. THE WETLAND ACREAGE SHOWN IN THE WETLAND TABLE ON SHEET S2 WAS CALCULATED BY MATRIX EAST, PLLC USING THE BOUNDARIES PROVIDED BY RESOURCE ENVIRONMENTAL SOLUTIONS, LLC.

## SIX RUNS MITIGATION SITE SAMPSON COUNTY, NORTH CAROLINA

CAPE FEAR RIVER BASIN: HUC 03030006  
DMS PROJECT #: 100170  
CONTRACT #: 0303-01  
USACE ACTION ID #: SAW-2020-01964  
REF #: 16-20190303  
DWR #: 20201798V1

### AS-BUILT SURVEY

#### LEGEND

- C/L = CENTERLINE
- R/W = RIGHT OF WAY
- CMP = CORRUGATED METAL PIPE
- CMPA = ARCH CORRUGATED METAL PIPE
- PVC = PVC PIPE
- HDPE = HDPE PIPE
- XS = CROSS-SECTION
- VP = VEGETATION PLOT
- WE = WATER ELEVATION AT THE TIME OF SURVEY
- = LOG STRUCTURE
- = ROCK STRUCTURE
- ⊗ = GAUGE
- \* = ENGINEERED SEDIMENT PACK
- ⊗ = POST ASSISTED LOG STRUCTURE
- = STONE TOE
- = BRUSH TOE
- = CONSTRUCTED RIFFLE GRADE CONTROL
- = GRAVEL PATH / CROSSING
- = RIP RAP
- LCE = CONSERVATION EASEMENT LINE
- ADJOINER BOUNDARY LINE
- WOODLINE
- WIRE FENCE

#### PROJECT COORDINATES:

LATITUDE: 35.096223° N  
LONGITUDE: 78.229693° W

#### PROJECT DIRECTORY

<b>DESIGNER:</b> RESOURCE ENVIRONMENTAL SOLUTIONS, LLC 3600 GLENWOOD AV., SUITE 100 RALEIGH, NC 27612 (919)209-1061	<b>MONITORING PERFORMERS:</b> RESOURCE ENVIRONMENTAL SOLUTIONS, LLC 3600 GLENWOOD AV., SUITE 100 RALEIGH, NC 27612 (919)209-1061
<b>CONSTRUCTION CONTRACTOR:</b> RESOURCE ENVIRONMENTAL SOLUTIONS, LLC 3600 GLENWOOD AV., SUITE 100 RALEIGH, NC 27612 (919)209-1061	<b>SURVEYING:</b> MATRIX EAST, PLLC 906 N. QUEEN ST., SUITE A KINSTON, NC 28501 (252)522-2500
<b>DMS PROJECT MANAGER:</b> JEREMIAH DOW NC DEPARTMENT OF ENVIRONMENTAL QUALITY DIVISION OF MITIGATION SERVICES 217 WEST JONES ST., SUITE 3000A RALEIGH, NC 27603	

#### SHEET INDEX

COVER SHEET	S1
STREAM BASELINE OVERVIEW	S2
STREAM MONITORING OVERVIEW	S3
STREAM BASELINE AS-BUILT (BB)	S4 THROUGH S11
STREAM BASELINE AS-BUILT (DE2)	S12
STREAM BASELINE AS-BUILT (DE4)	S13 & S14
STREAM BASELINE AS-BUILT (DE7)	S15
STREAM BASELINE AS-BUILT (DE8)	S16

SEAL: DRAWING NO. **S1**  
SHEET No. 1 OF 16

**RESOURCE ENVIRONMENTAL SOLUTIONS, LLC**  
**SIX RUNS MITIGATION SITE**  
**SAMPSON COUNTY, N.C.**

**MATRIX EAST, PLLC**

906 N. QUEEN ST., SUITE A  
KINSTON, NC 28501  
TEL: 252-522-2500  
FAX: 252-522-4747  
FIRM LIC. # P-0221  
EMAIL: surveyor@matriceast.net

DRAWN BY: JRW DATE: 5/11/2023 SCALE:  
PROJECT NO.: 20200258  
DRAWING NAME: 20200258-AS BUILT.DWG




NOV 2023



WETLAND ID	MITIGATION TYPE	AREA (AC.)
WA	NO CREDIT	0.081
WB	NO CREDIT	0.057
WC-1	REHABILITATION	4.859
WC-2	PRESERVATION	1.656
WD	REHABILITATION	0.009
WE-1	NO CREDIT	0.439
WE-1	ENHANCEMENT (LOW)	0.410
WE-2	ENHANCEMENT (HIGH)	0.586
WE-2	NO CREDIT	0.092
WF	NO CREDIT	0.292
WH	NO CREDIT	0.057
WI	NO CREDIT	0.197
WJ	NO CREDIT	0.123
WK	NO CREDIT	0.036
WL	RE-ESTABLISHMENT	5.693
WM	RE-ESTABLISHMENT	0.457
TOTAL		15.044

WETLAND LEGEND

- = WETLAND RE-ESTABLISHMENT
- = WETLAND REHABILITATION
- = WETLAND ENHANCEMENT (HIGH)
- = WETLAND ENHANCEMENT (LOW)
- = WETLAND PRESERVATION
- = WETLAND NO CREDIT

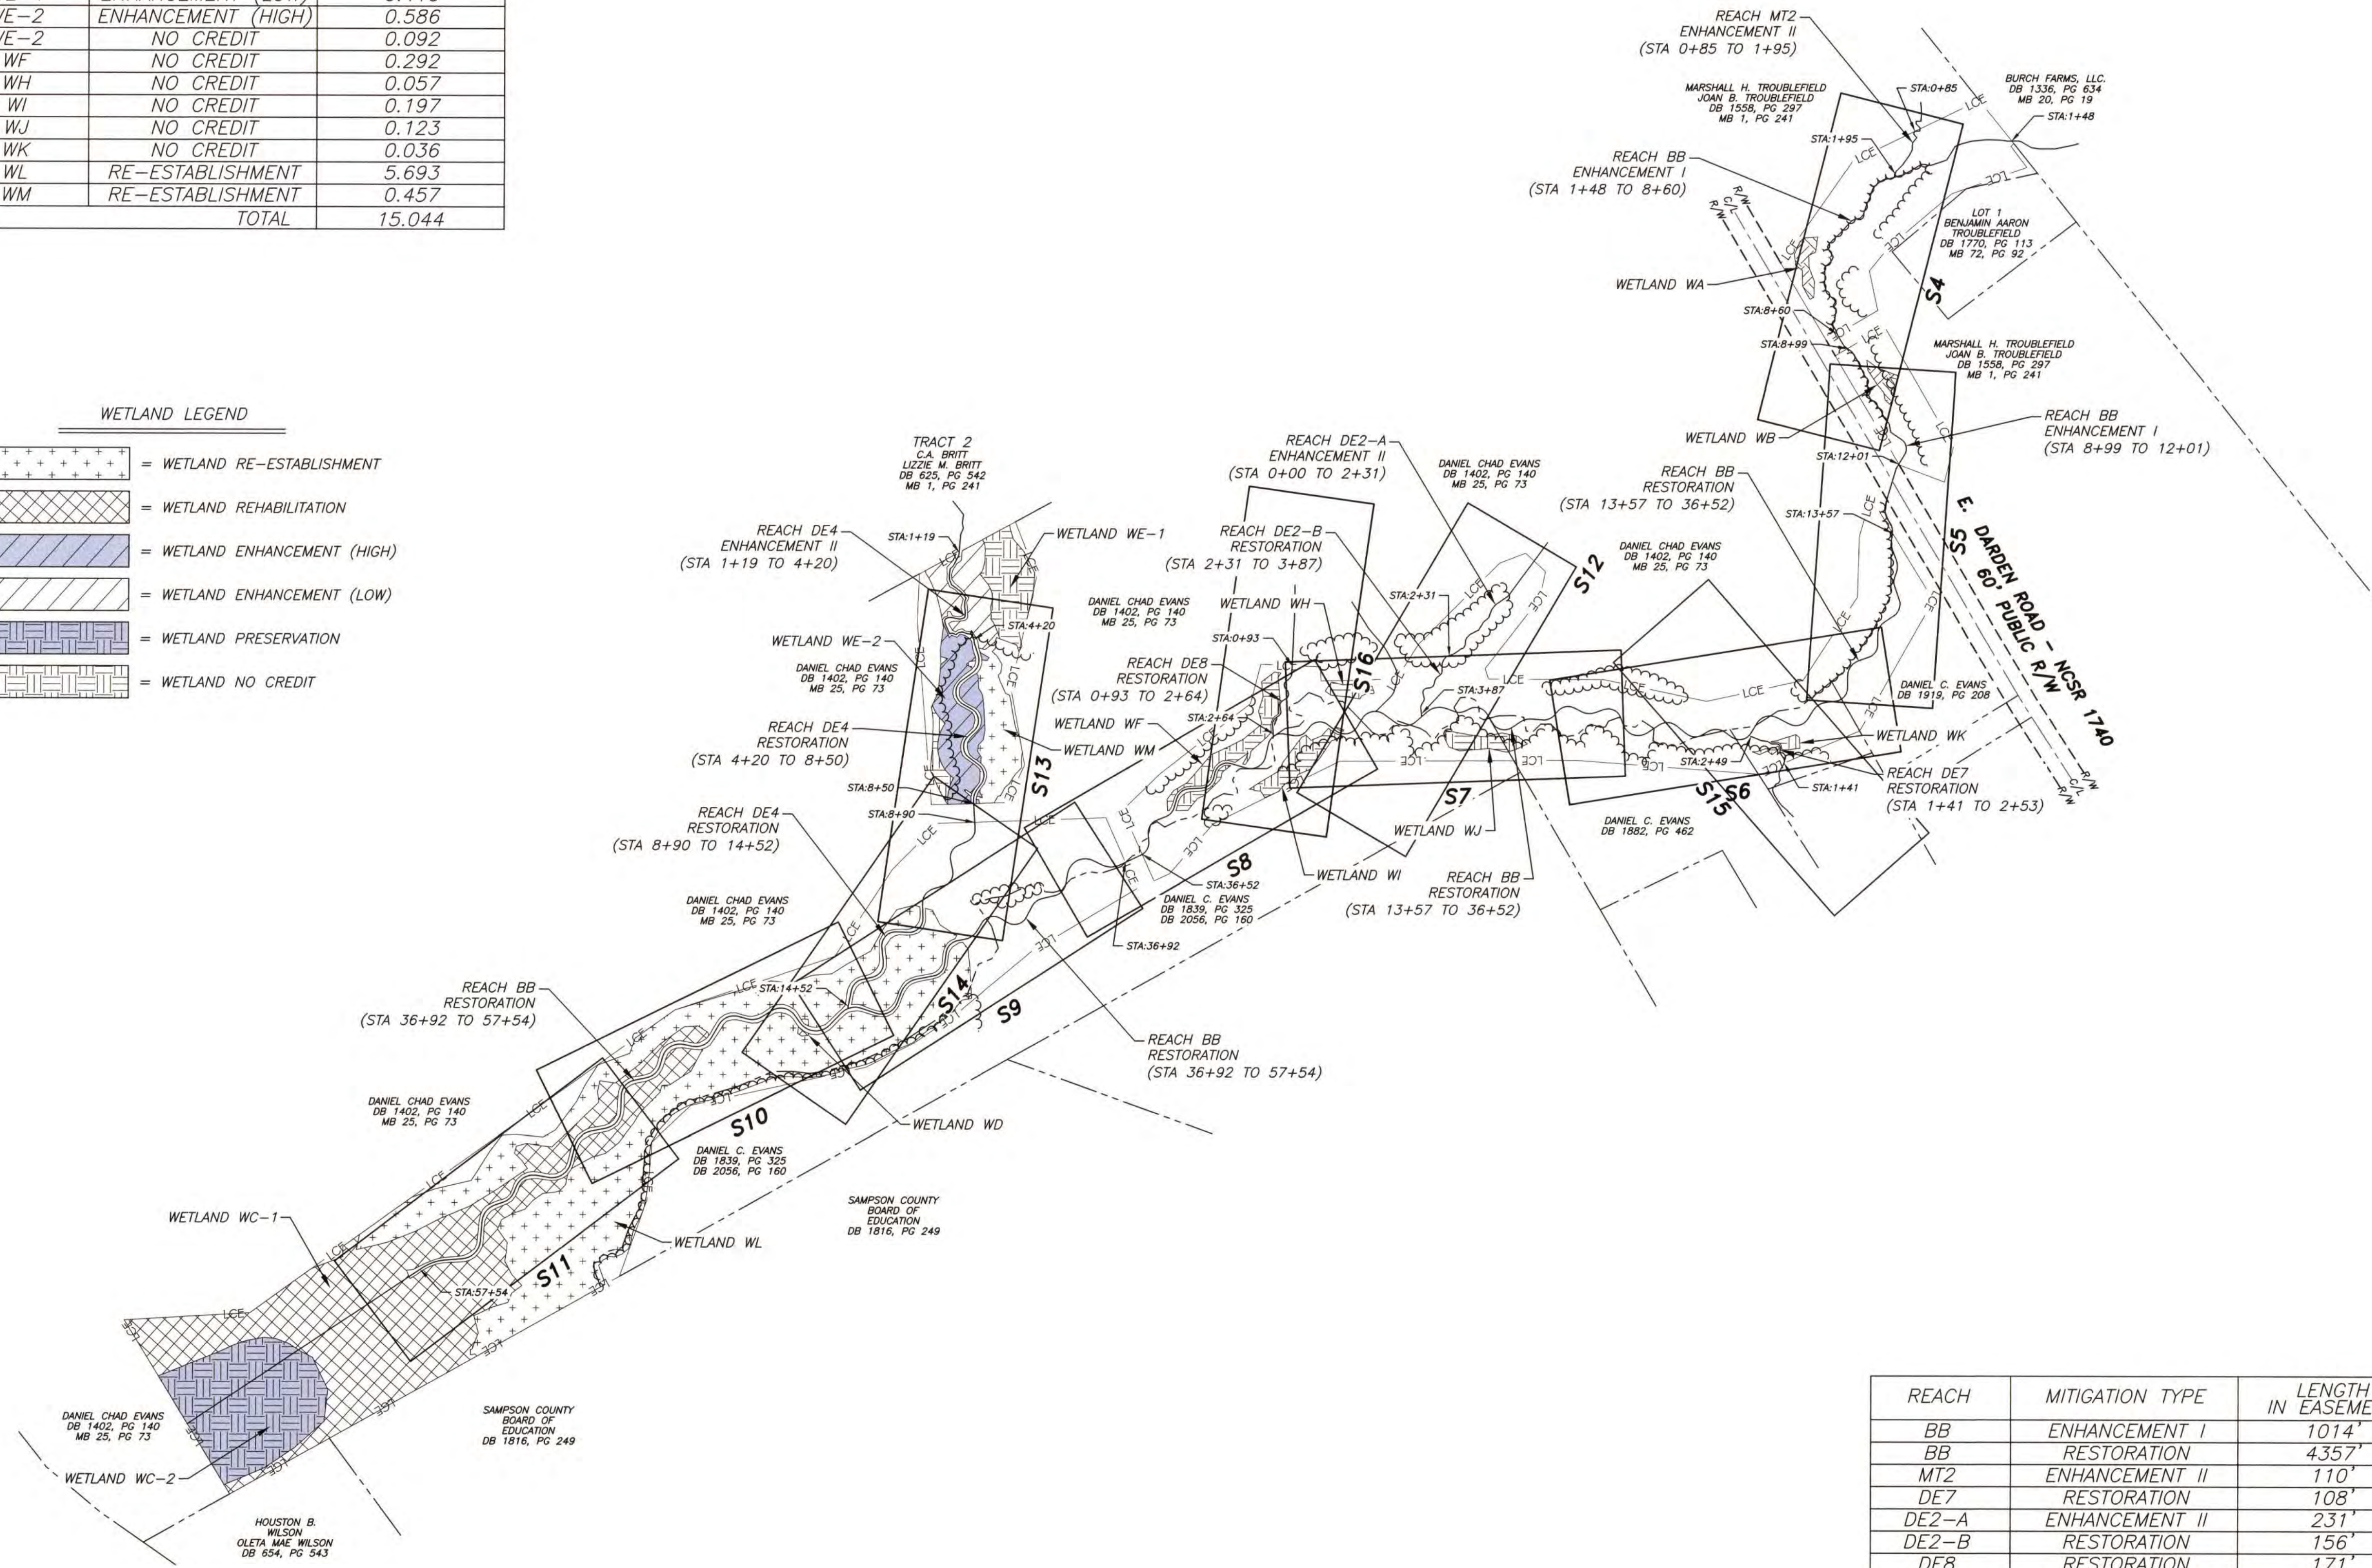

REACH	MITIGATION TYPE	LENGTH IN EASEMENT
BB	ENHANCEMENT I	1014'
BB	RESTORATION	4357'
MT2	ENHANCEMENT II	110'
DE7	RESTORATION	108'
DE2-A	ENHANCEMENT II	231'
DE2-B	RESTORATION	156'
DE8	RESTORATION	171'
DE4	ENHANCEMENT II	301'
DE4	RESTORATION	992'
TOTAL		7440'

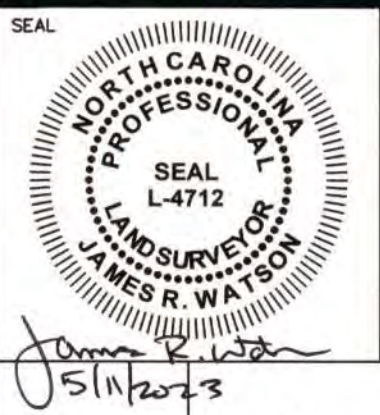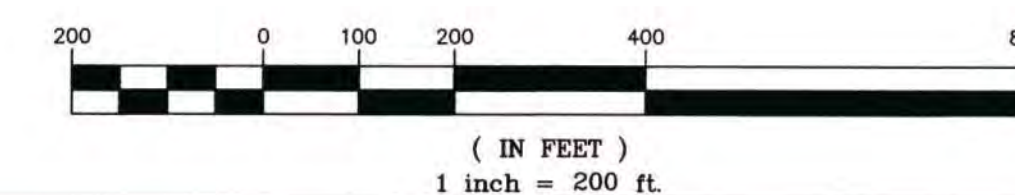

DRAWING NO. **S2**  
SHEET No. 2 OF 16

**RESOURCE ENVIRONMENTAL SOLUTIONS, LLC**  
**SIX RUNS MITIGATION SITE**  
**SAMPSON COUNTY, N.C.**

**STREAM AS BUILT SURVEY**  
**STREAM BASELINE & WETLANDS OVERVIEW**





906 N. QUEEN ST., SUITE A  
KINSTON, NC 28501  
TEL: 252-522-2500  
FAX: 252-522-4747  
FIRM LIC. # P-0221  
EMAIL: surveyor@matrixeast.net

DRAWN BY: JRW      DATE: 5/11/2023      SCALE: 1" = 200'  
PROJECT NO: 20200258  
DRAWING NAME: 20200258-AS\_BUILT.DWG



**BASELINE MONITORING CROSS SECTION CONTROL**

DESCRIPTION	NORTHING	EASTING	ELEVATION
ESPXS01LP	490,564.2448'	2,229,823.2790'	134.32'
ESPXS01RP	490,584.1724'	2,229,825.0910'	133.19'
XS01LP	491,814.6491'	2,230,293.8453'	147.87'
XS01RP	491,840.5225'	2,230,279.0890'	148.66'
XS02LP	491,812.7582'	2,230,290.3786'	147.85'
XS02RP	491,838.9100'	2,230,275.9190'	148.34'
XS03LP	491,484.3536'	2,230,124.7907'	144.94'
XS03RP	491,474.3816'	2,230,096.9992'	144.88'
XS04LP	491,478.5671'	2,230,126.8008'	145.02'
XS04RP	491,467.1997'	2,230,099.5289'	144.35'
XS05LP	491,296.3261'	2,230,227.5646'	142.81'
XS05RP	491,283.0521'	2,230,200.6126'	143.48'
XS06LP	491,290.1294'	2,230,229.3850'	142.79'
XS06RP	491,277.4568'	2,230,202.0659'	143.34'
XS07LP	490,811.7447'	2,230,219.9134'	137.39'
XS07RP	490,811.4949'	2,230,189.8308'	137.08'
XS08LP	490,768.0955'	2,230,206.8246'	137.09'
XS08RP	490,791.3778'	2,230,187.7658'	136.82'
XS09LP	490,596.1914'	2,229,875.9509'	133.57'
XS09RP	490,619.9190'	2,229,894.3577'	134.03'
XS10LP	490,603.8280'	2,229,862.9742'	133.39'
XS10RP	490,633.8318'	2,229,864.7093'	133.57'
XS11LP	490,643.7535'	2,229,555.3830'	130.47'
XS11RP	490,676.6922'	2,229,578.3000'	131.20'
XS12LP	490,653.0479'	2,229,541.4003'	130.56'
XS12RP	490,698.9469'	2,229,538.7215'	133.69'
XS13LP	490,613.1612'	2,229,187.0461'	126.98'
XS13RP	490,642.9207'	2,229,191.0888'	126.94'
XS14LP	490,631.4085'	2,229,150.6673'	126.54'
XS14RP	490,654.6224'	2,229,169.7408'	126.78'
XS15LP	490,569.9409'	2,228,908.7394'	123.76'
XS15RP	490,575.5157'	2,228,879.3249'	123.98'
XS16LP	490,525.5223'	2,228,886.3670'	123.78'
XS16RP	490,550.6674'	2,228,869.4271'	123.65'
XS17LP	490,314.8510'	2,228,488.4674'	120.19'
XS17RP	490,334.7318'	2,228,466.2055'	120.14'
XS18LP	490,300.0724'	2,228,483.6058'	120.00'
XS18RP	490,305.5651'	2,228,454.0925'	119.95'
XS19LP	490,123.4912'	2,228,222.2166'	117.53'
XS19RP	490,126.5206'	2,228,192.3317'	117.25'
XS20LP	490,090.0692'	2,228,211.3037'	117.16'
XS20RP	490,107.4081'	2,228,186.8672'	117.26'
XS21LP	489,985.5411'	2,227,876.3201'	115.47'
XS21RP	490,002.4397'	2,227,901.0876'	115.23'
XS22LP	490,001.3332'	2,227,854.2088'	115.09'
XS22RP	490,031.2479'	2,227,856.1092'	115.25'
XS23LP	489,842.2530'	2,227,531.8984'	112.96'
XS23RP	489,859.5932'	2,227,507.4439'	113.68'
XS24LP	489,813.8615'	2,227,526.2068'	112.82'
XS24RP	489,815.2001'	2,227,496.1125'	112.81'
XS25LP	489,585.3781'	2,227,260.0596'	110.74'
XS25RP	489,613.9129'	2,227,250.6246'	110.66'
XS26LP	489,572.4550'	2,227,234.0962'	110.57'
XS26RP	489,584.5923'	2,227,206.5522'	110.62'
XS27LP	490,555.7329'	2,229,987.3885'	140.26'
XS27RP	490,568.9898'	2,230,014.1935'	137.81'
XS28LP	490,576.5012'	2,229,953.3351'	134.91'
XS28RP	490,605.9805'	2,229,960.0883'	135.57'
XS29/30LP	490,692.6264'	2,229,248.1893'	128.70'
XS29RP	490,707.7822'	2,229,222.1643'	130.10'
XS30RP	490,685.1793'	2,229,219.0272'	128.85'
XS31/32LP	490,664.8398'	2,228,942.0801'	125.32'
XS31RP	490,672.2279'	2,228,913.0861'	125.72'
XS32RP	490,659.3846'	2,228,912.6583'	125.42'
XS33LP	490,590.5492'	2,228,263.9754'	119.34'
XS33RP	490,611.5871'	2,228,242.4367'	119.39'
XS34LP	490,572.1023'	2,228,261.9257'	119.02'
XS34RP	490,560.1854'	2,228,233.4836'	119.27'
XS35LP	490,165.8133'	2,228,116.1611'	116.91'
XS35RP	490,195.3867'	2,228,117.2932'	116.85'
XS36LP	490,158.3945'	2,228,087.8096'	116.93'
XS36RP	490,170.7255'	2,228,060.4616'	117.24'

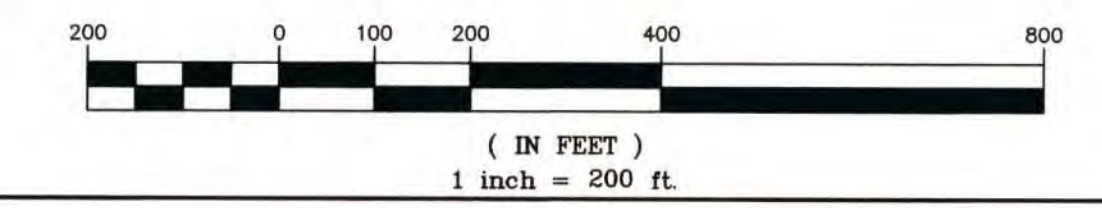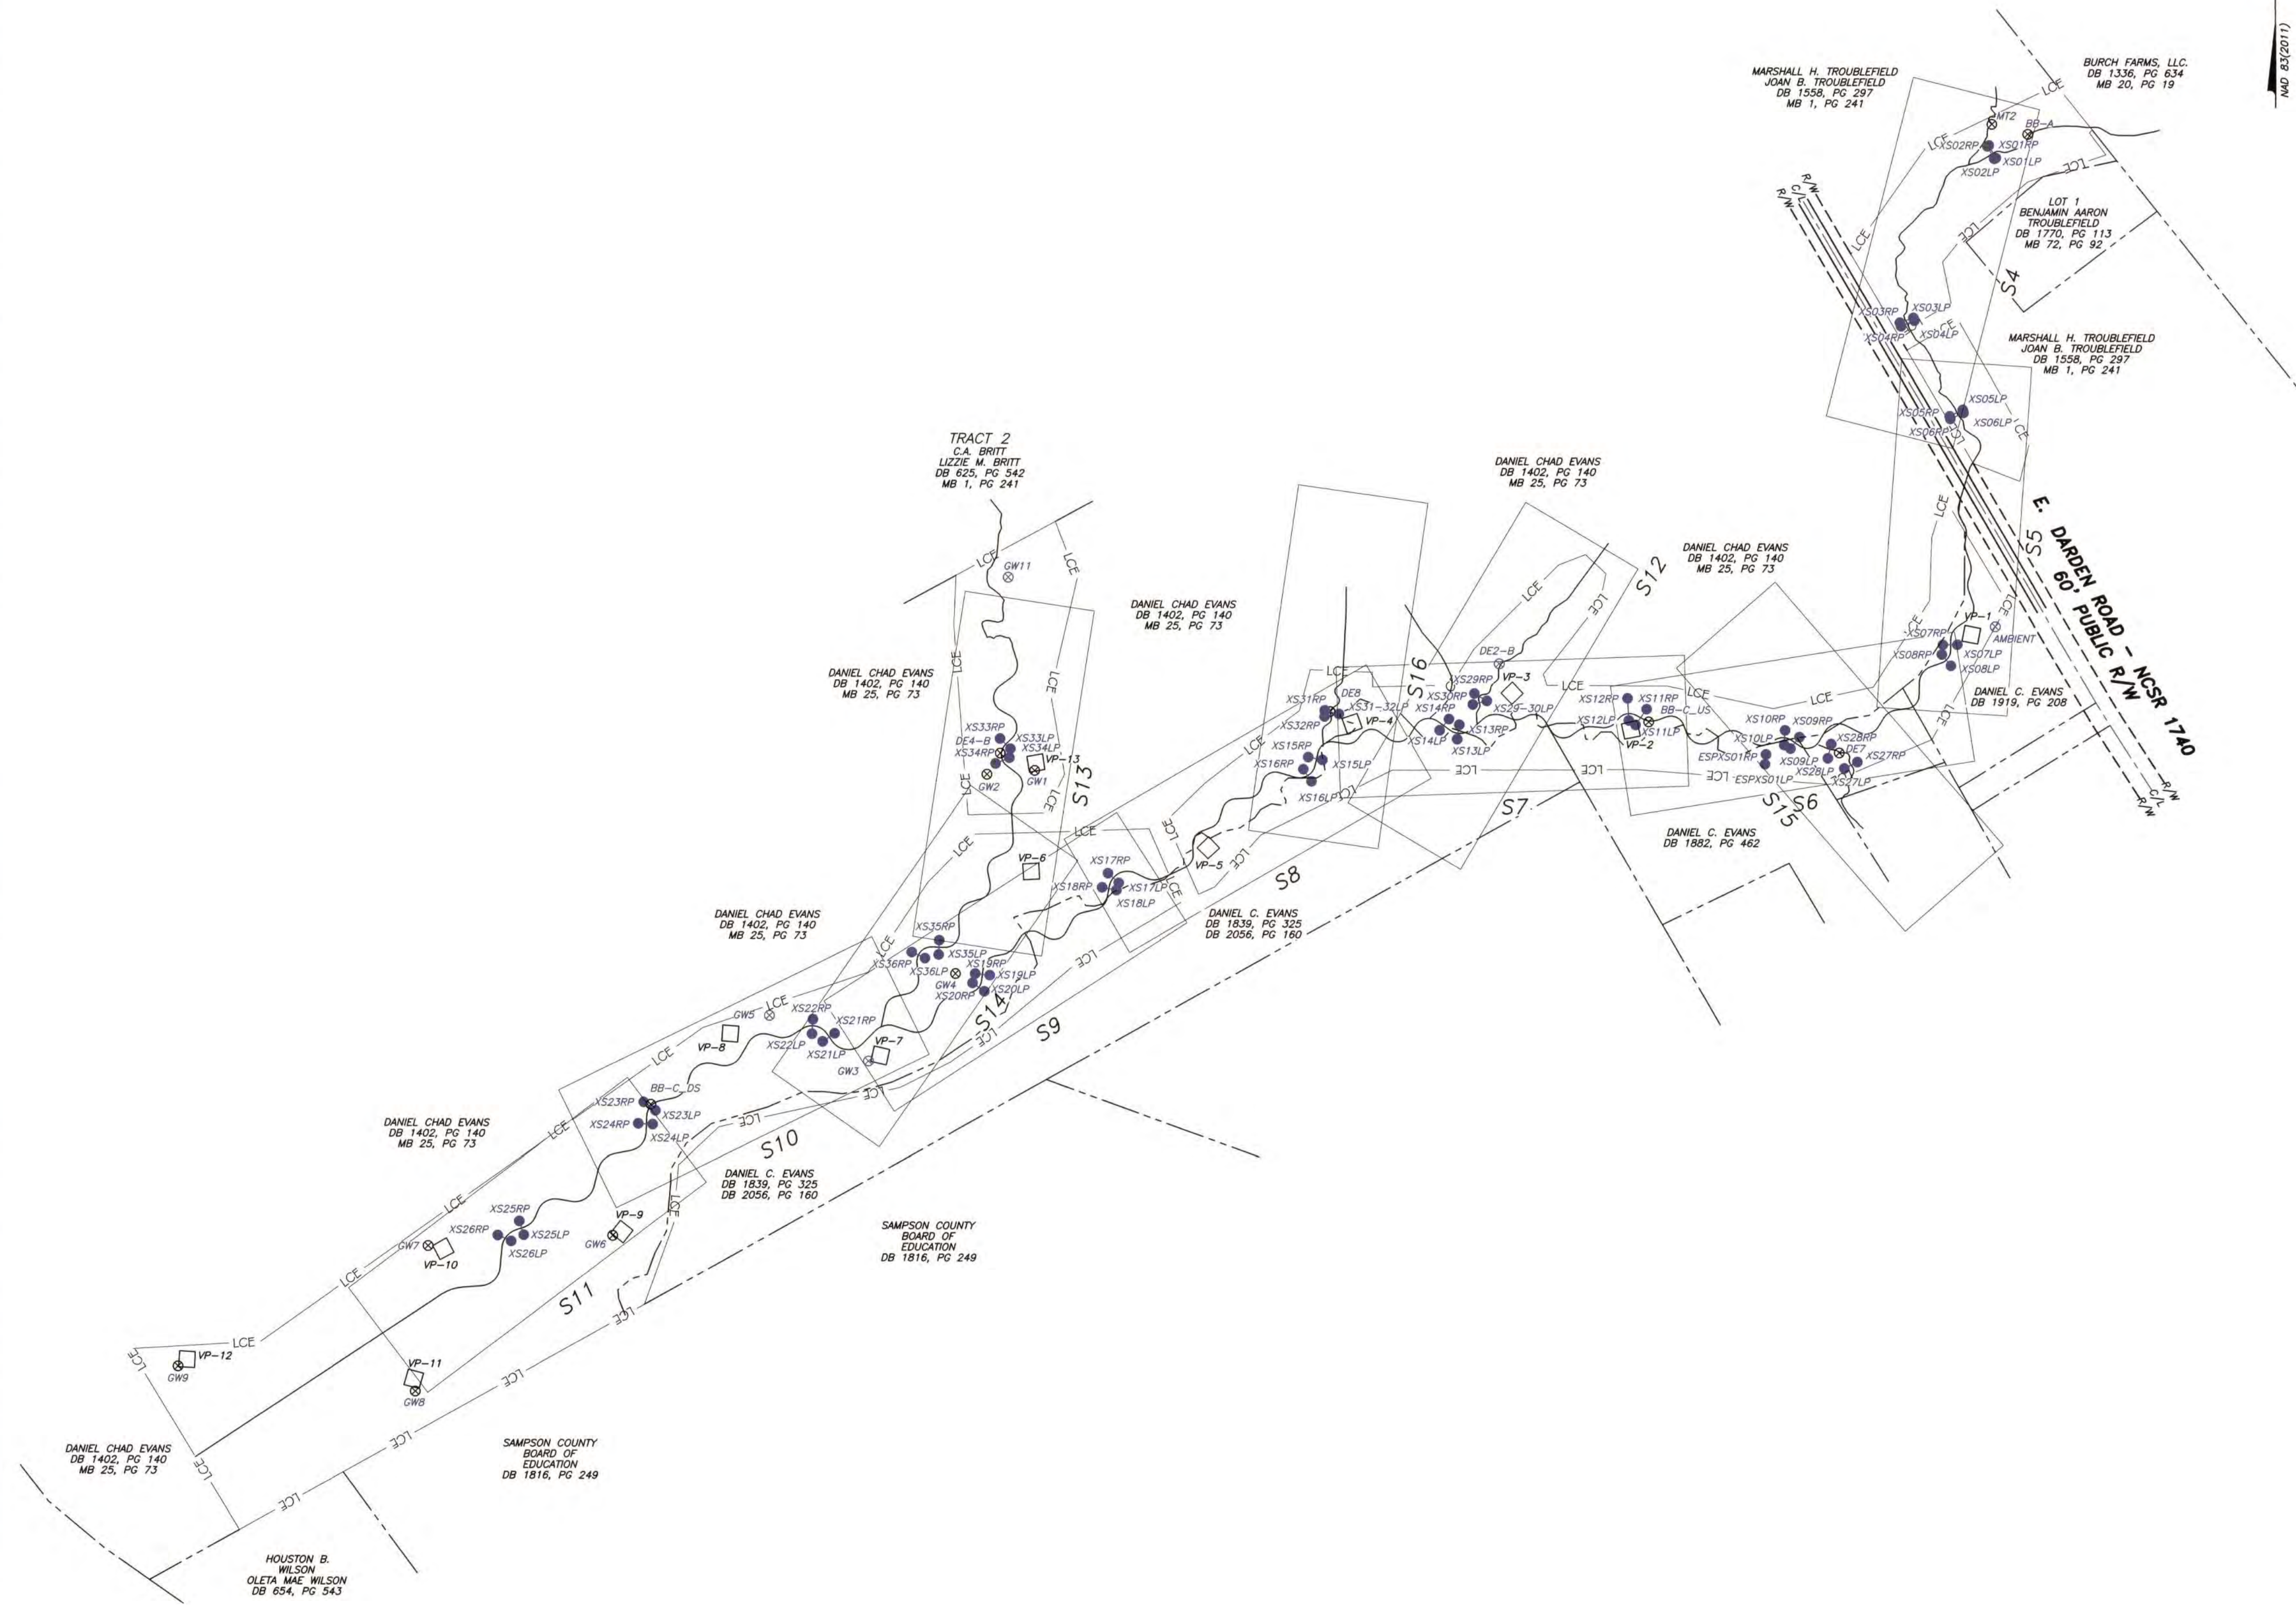

SEAL  
 NORTH CAROLINA  
 PROFESSIONAL  
 SEAL  
 L-4712  
 LAND SURVEYOR  
 JAMES R. WATSON  
 11/12/23

DRAWING NO.  
**S3**

SHEET No.  
 3 OF 16

**STREAM AS BUILT SURVEY  
 STREAM MONITORING OVERVIEW**

**RESOURCE ENVIRONMENTAL SOLUTIONS, LLC**

**SIX RUNS MITIGATION SITE**

**SAMPSON COUNTY, N.C.**

**MATRIX EAST, PLLC**





906 N. QUEEN ST., SUITE A  
 KINSTON, NC 28501  
 TEL: 252-522-2500  
 FAX: 252-522-4747  
 FIRM LIC. # P-0221  
 EMAIL: [surveyor@matrixeast.net](mailto:surveyor@matrixeast.net)

DRAWN BY: JRW DATE: 5/11/2023 SCALE: 1" = 200'

PROJECT NO.: 20200258

DRAWING NAME: 20200258-AS BUILT.DWG



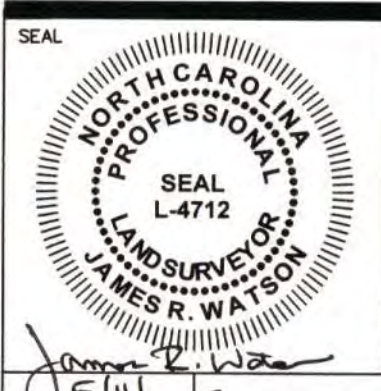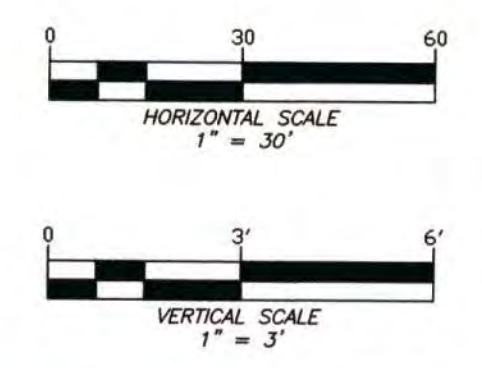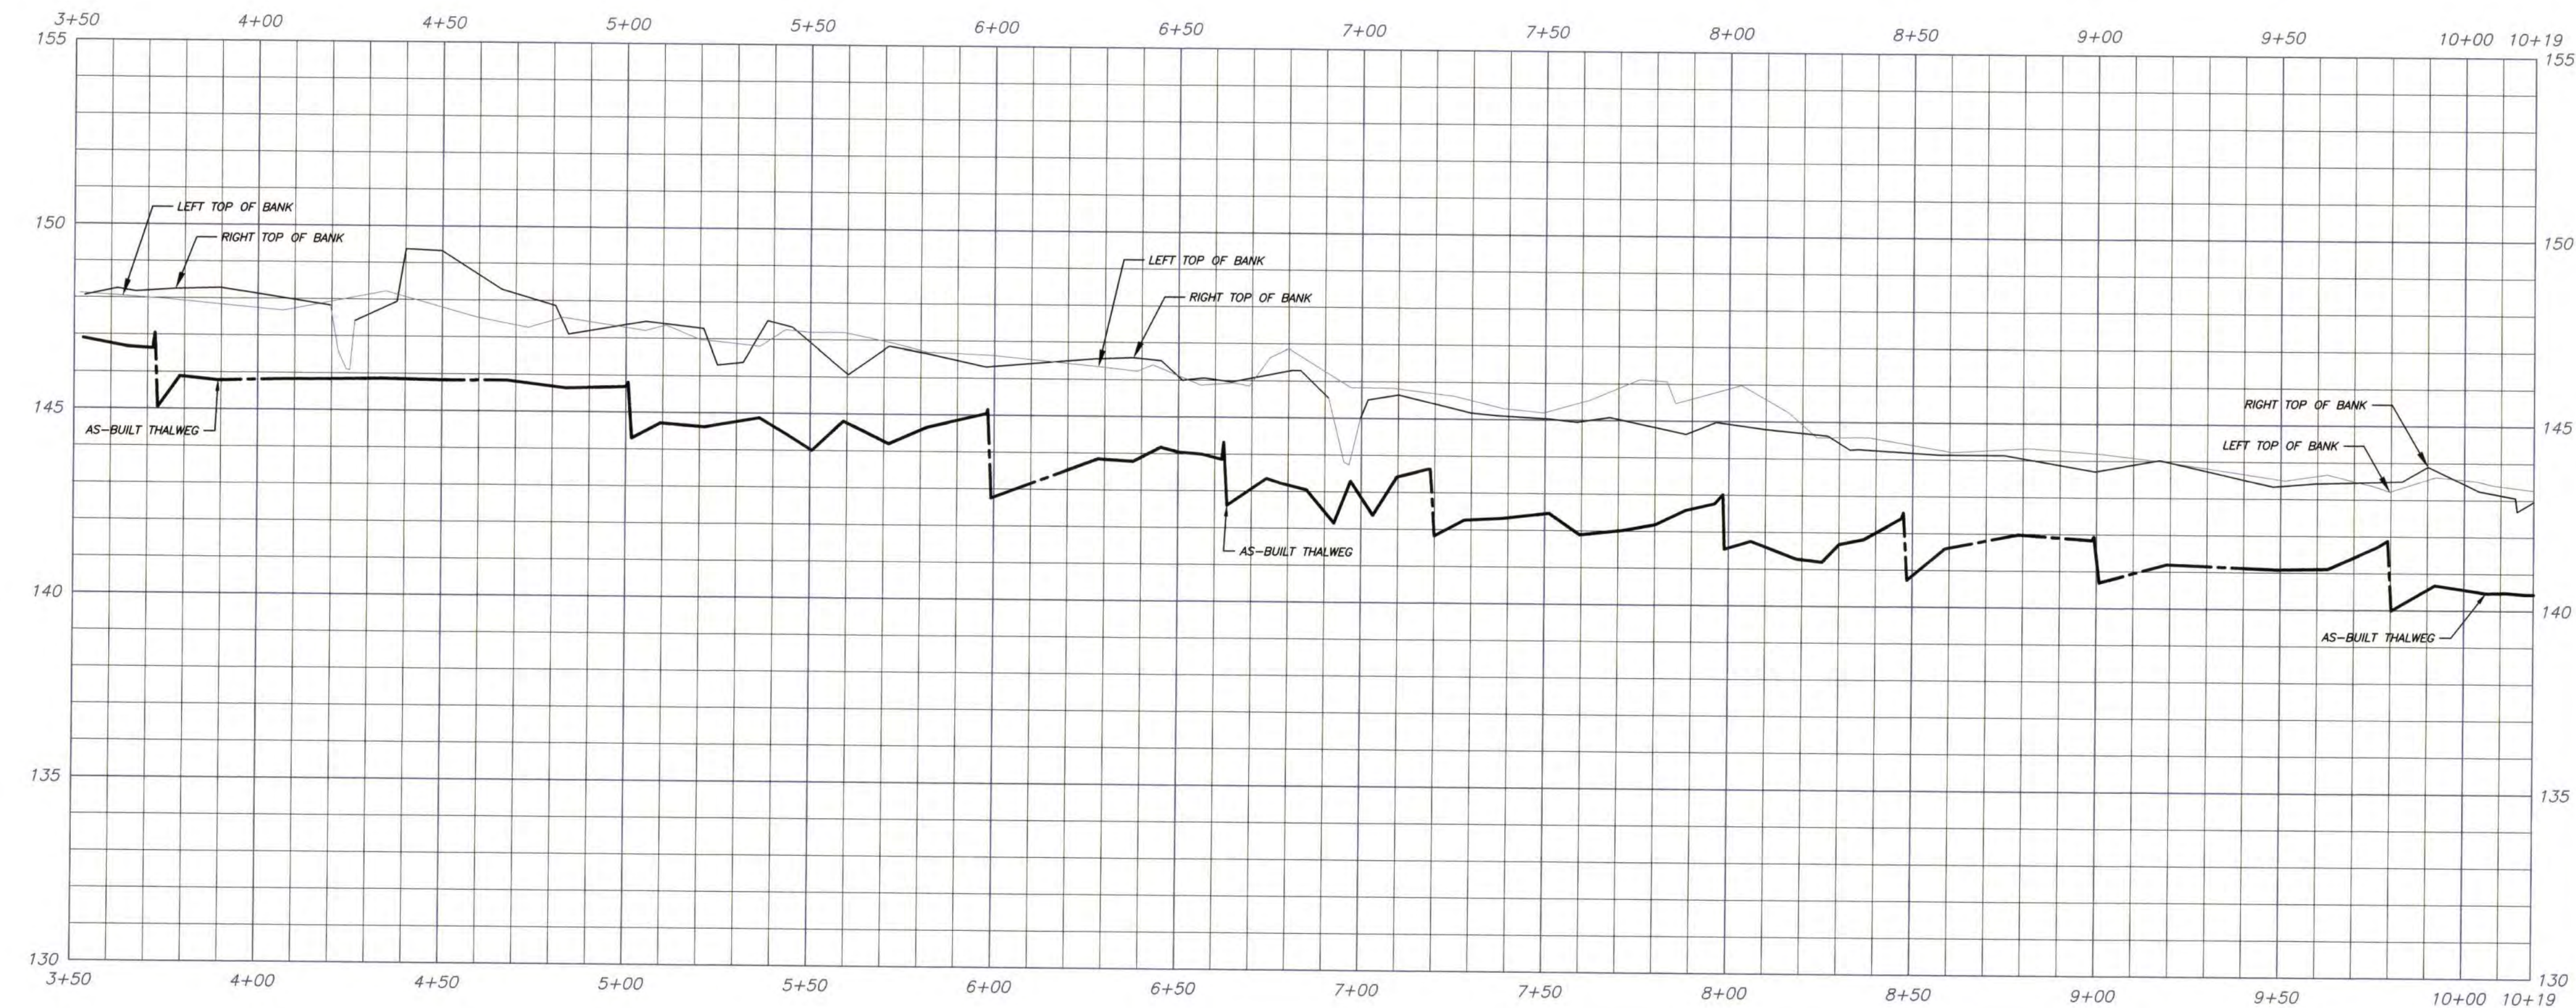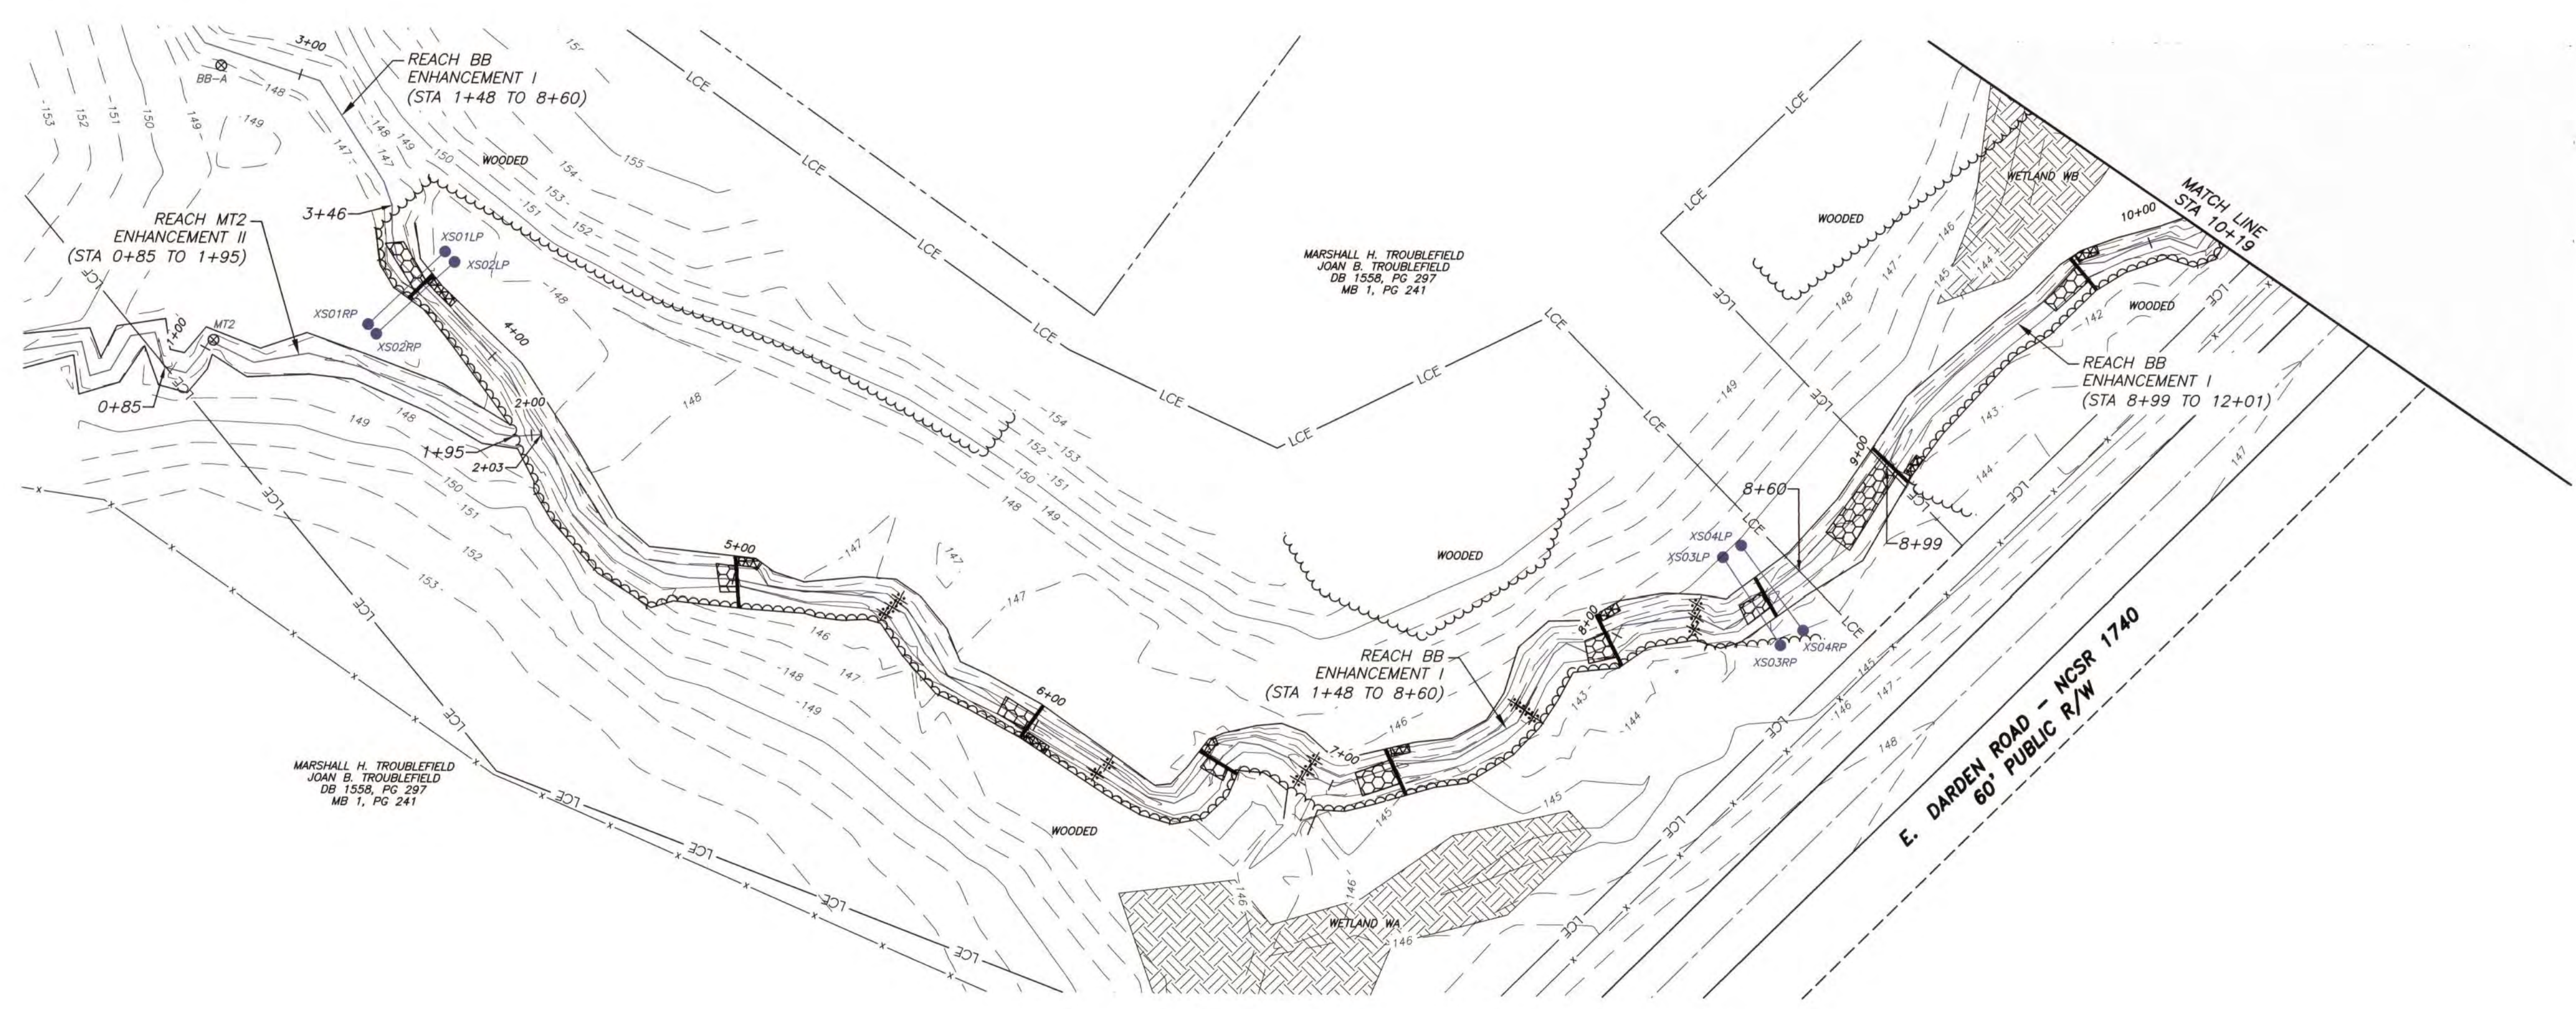

DRAWING NO. **S4**  
SHEET No. 4 OF 16

**RESOURCE ENVIRONMENTAL SOLUTIONS, LLC**  
**SIX RUNS MITIGATION SITE**  
**SAMPSON COUNTY, N.C.**





**STREAM AS BUILT SURVEY**  
**REACH BB PLAN & PROFILE (STA 03+50 - 10+19)**



906 N. QUEEN ST., SUITE A  
 KINSTON, NC 28501  
 TEL: 252-522-2500  
 FAX: 252-522-4747  
 FIRM LIC. # P-0221  
 EMAIL: [surveyor@matriceast.net](mailto:surveyor@matriceast.net)

DRAWN BY: JRW DATE: 5/11/2023 SCALE: 1" = 30'  
 PROJECT NO: 20200258  
 DRAWING NAME: 20200258-AS BUILT.DWG



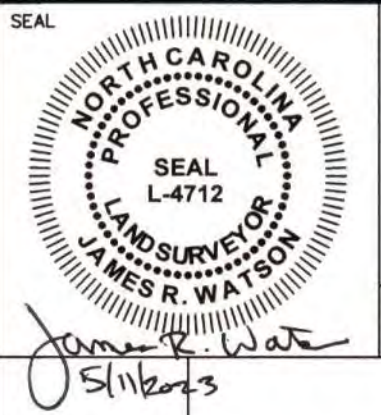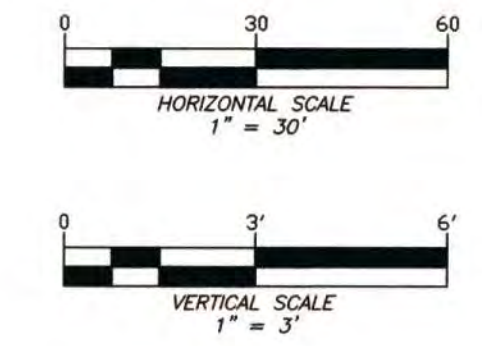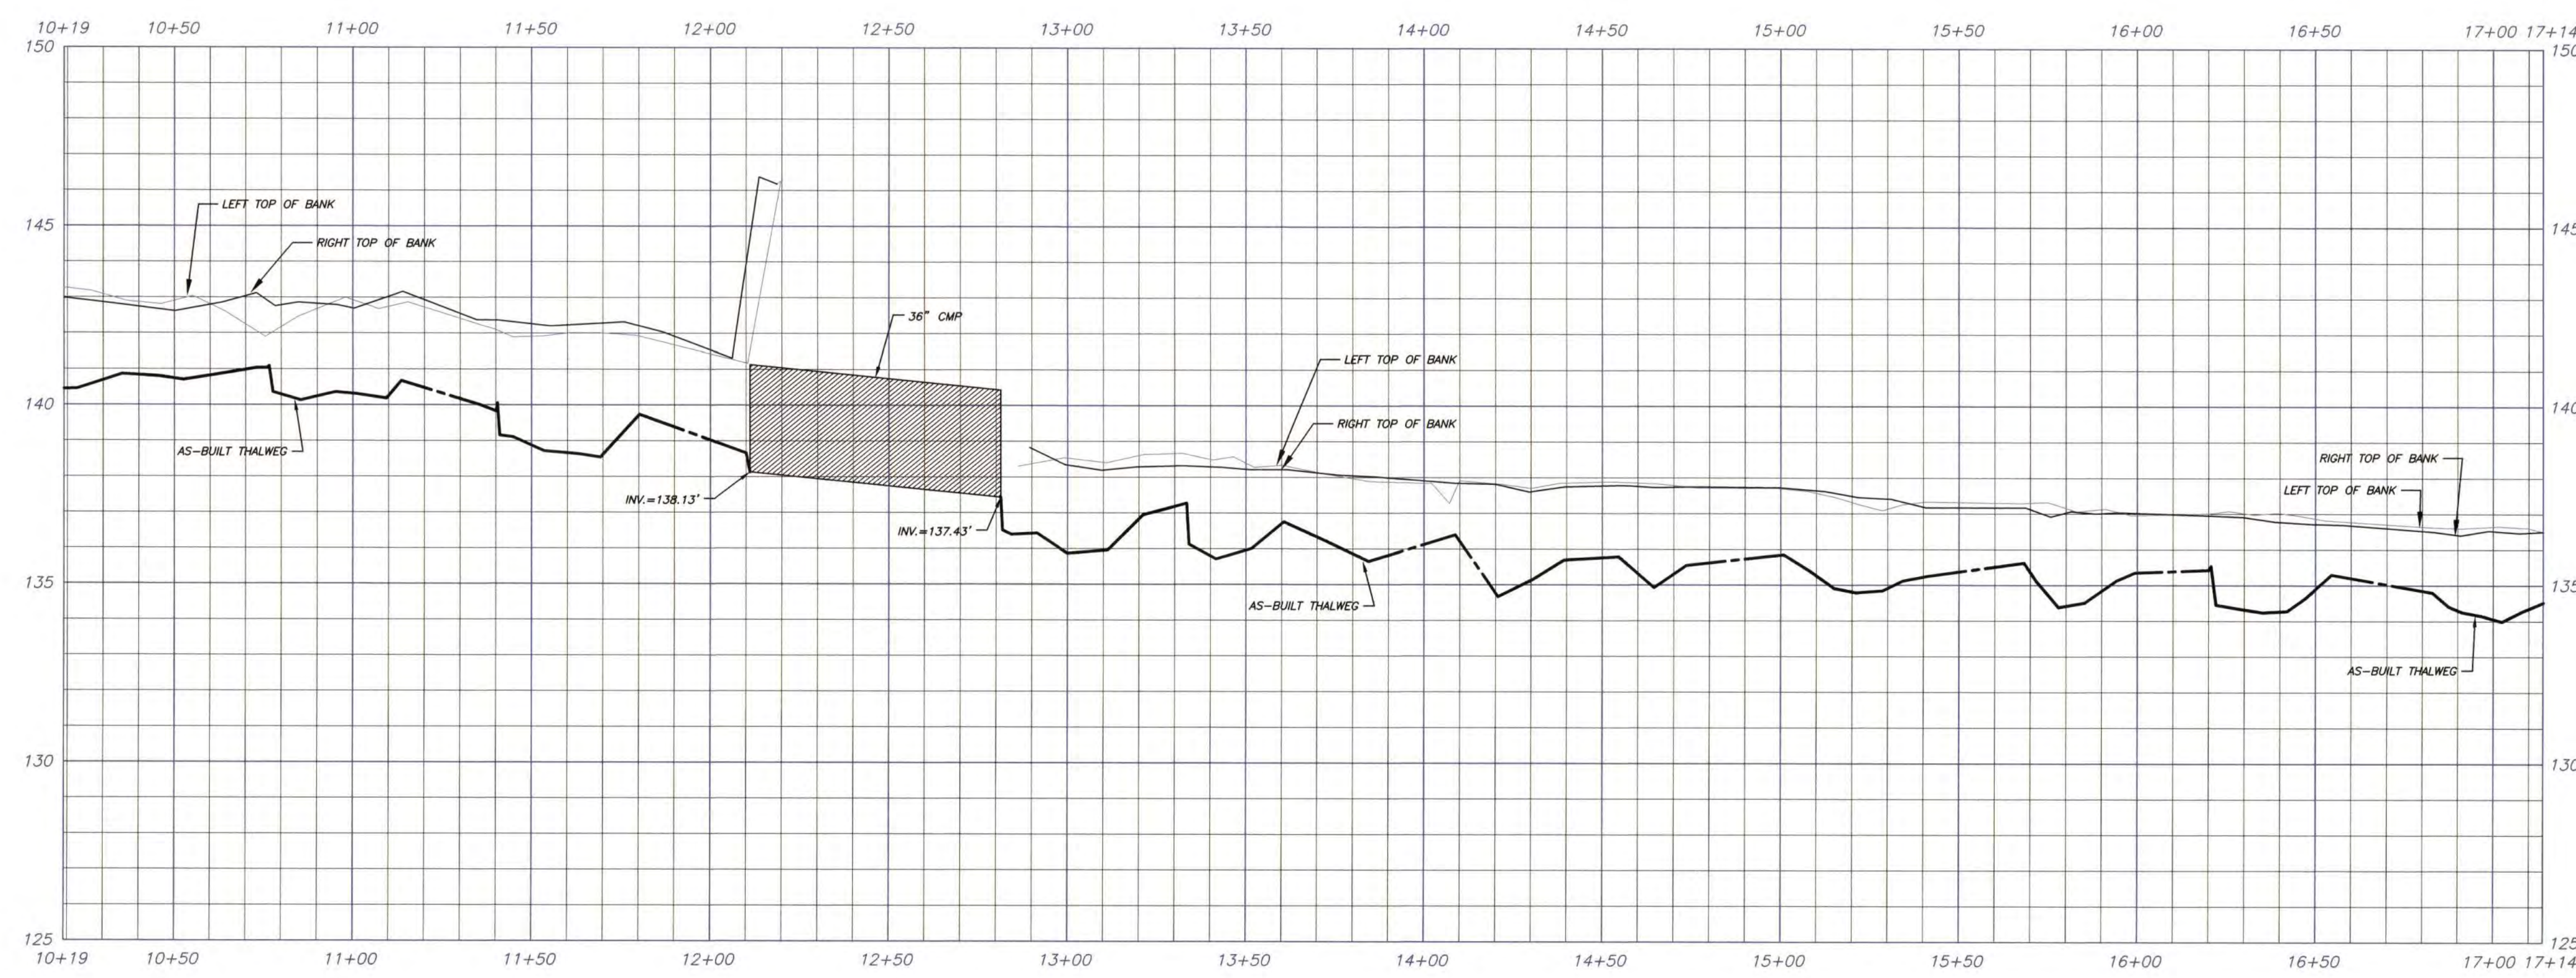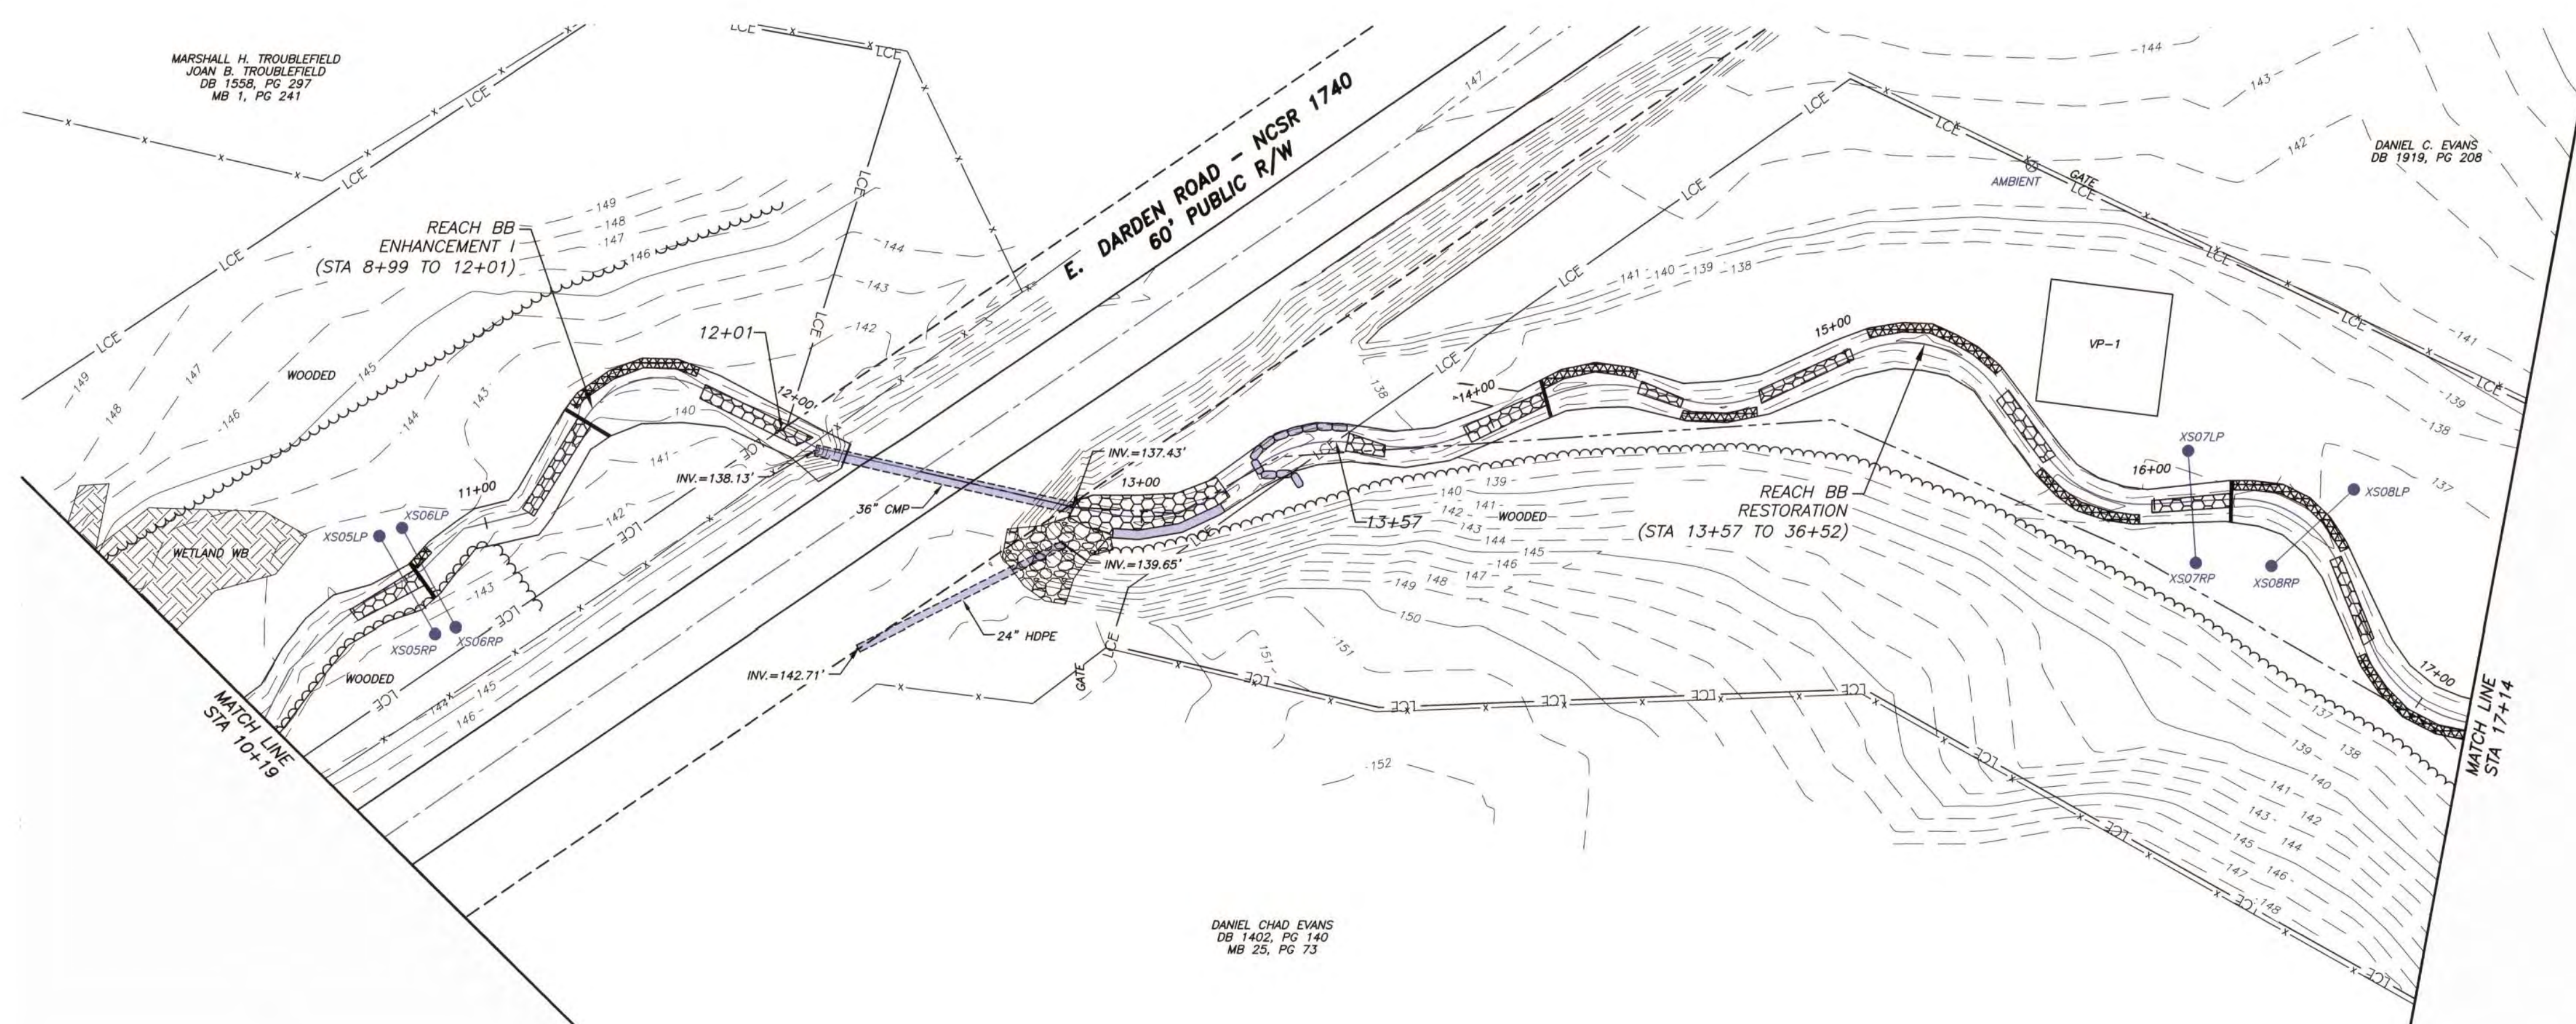

DRAWING NO. **S5**  
 SHEET No. 5 OF 16

**RESOURCE ENVIRONMENTAL SOLUTIONS, LLC**  
**SIX RUNS MITIGATION SITE**  
**SAMPSON COUNTY, N.C.**

STREAM AS BUILT SURVEY  
 REACH BB PLAN & PROFILE (STA 10+19 - 17+14)






906 N. QUEEN ST., SUITE A  
 KINSTON, NC 28501  
 TEL: 252-522-2500  
 FAX: 252-522-4747  
 FIRM LIC. # P-0221  
 EMAIL: [surveyor@matriceast.net](mailto:surveyor@matriceast.net)

DRAWN BY JRW	DATE 5/11/2023	SCALE 1" = 30'
PROJECT NO. 20200258		
DRAWING NAME 20200258-AS BUILT.DWG		



NOV 21/2023

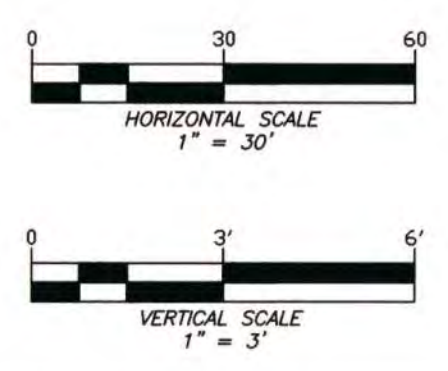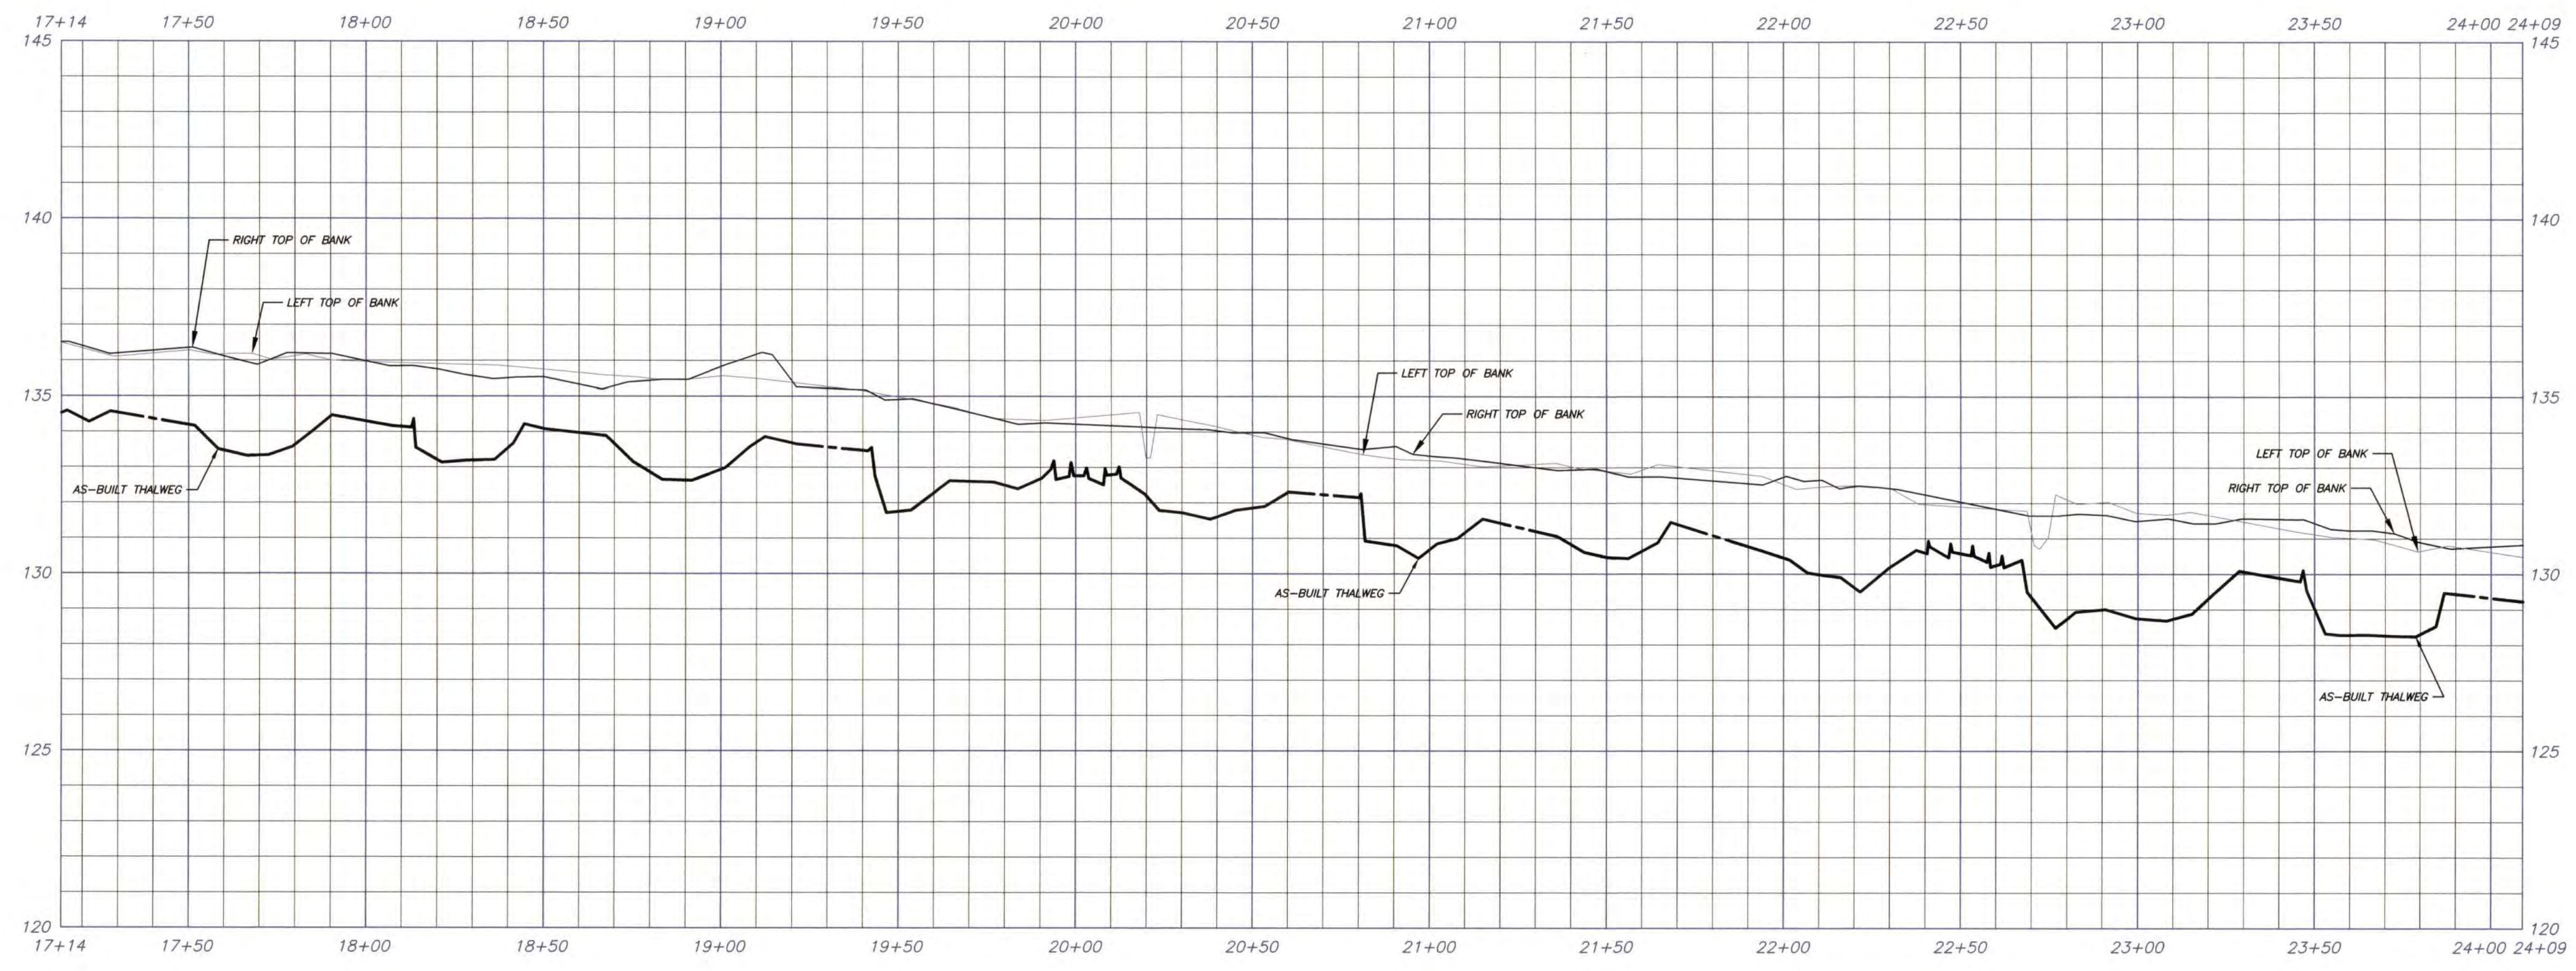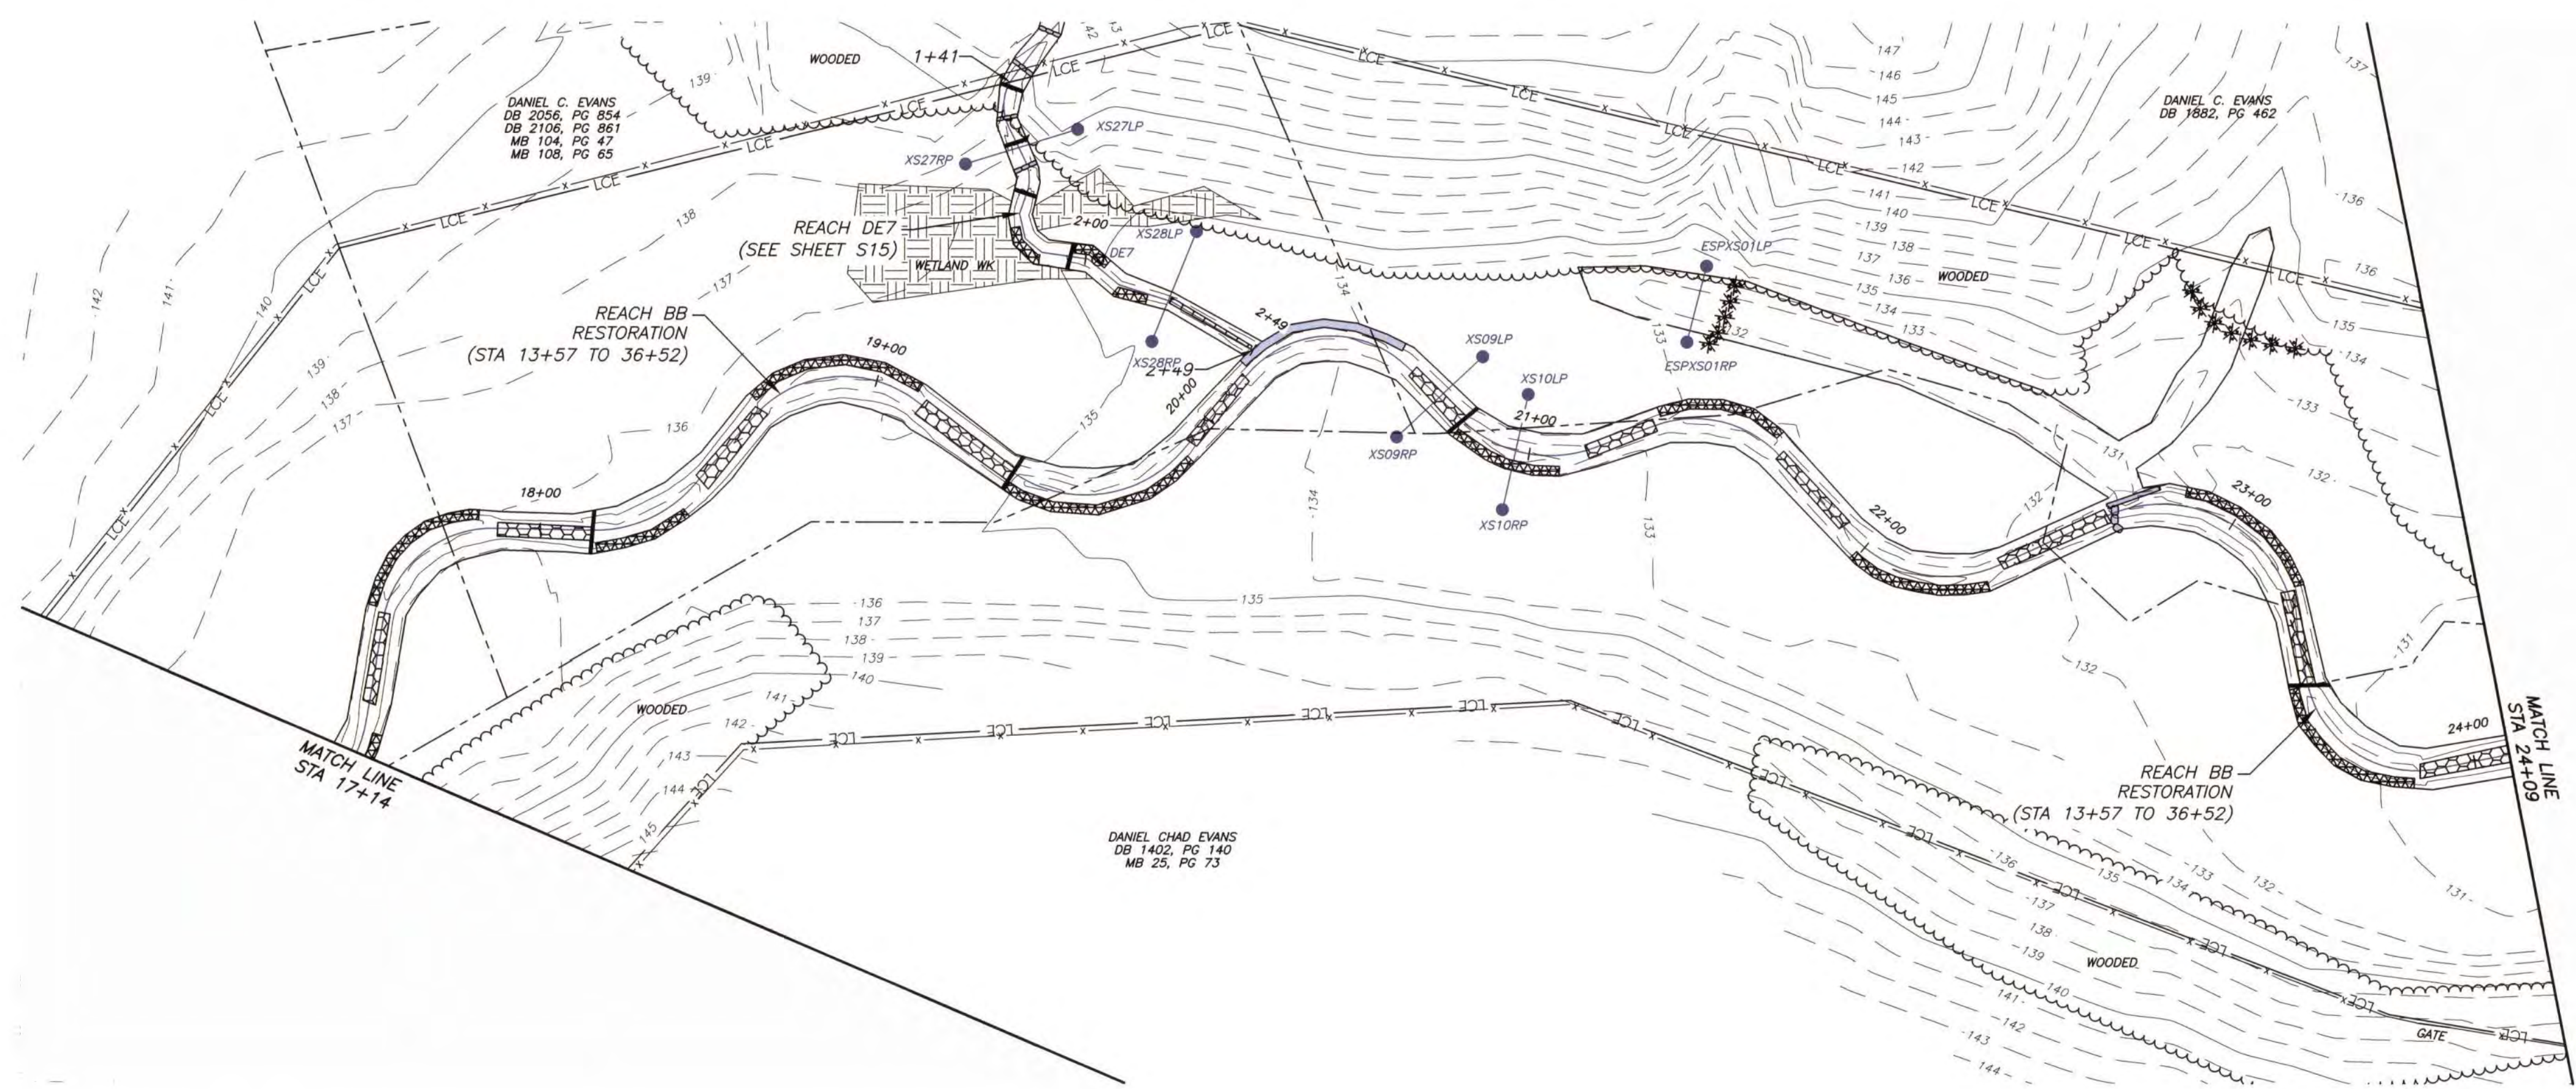

**RESOURCE ENVIRONMENTAL SOLUTIONS, LLC**  
**SIX RUNS MITIGATION SITE**  
**SAMPSON COUNTY, N.C.**

**STREAM AS BUILT SURVEY**  
**REACH BB PLAN & PROFILE (STA 17+14 - 24+09)**





**MATRIX EAST, PLLC**

906 N. QUEEN ST., SUITE A  
 KINSTON, NC 28501  
 TEL: 252-522-2500  
 FAX: 252-522-4747  
 FIRM LIC. # P-0221  
 EMAIL: surveyor@matriceast.net

DRAWN BY JRW	DATE 5/11/2023	SCALE 1" = 30'
PROJECT NO. 20200258		
DRAWING NAME 20200258-AS BUILT.DWG		



MAD 8.3(2011)

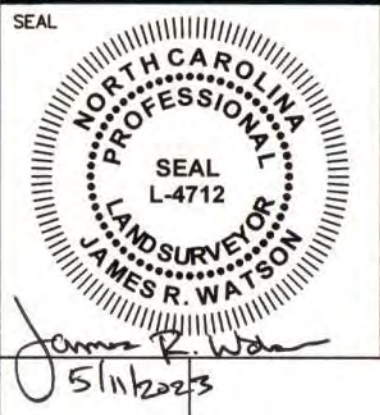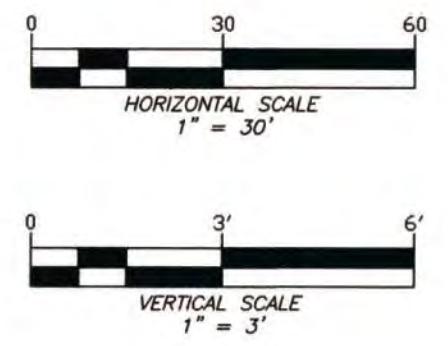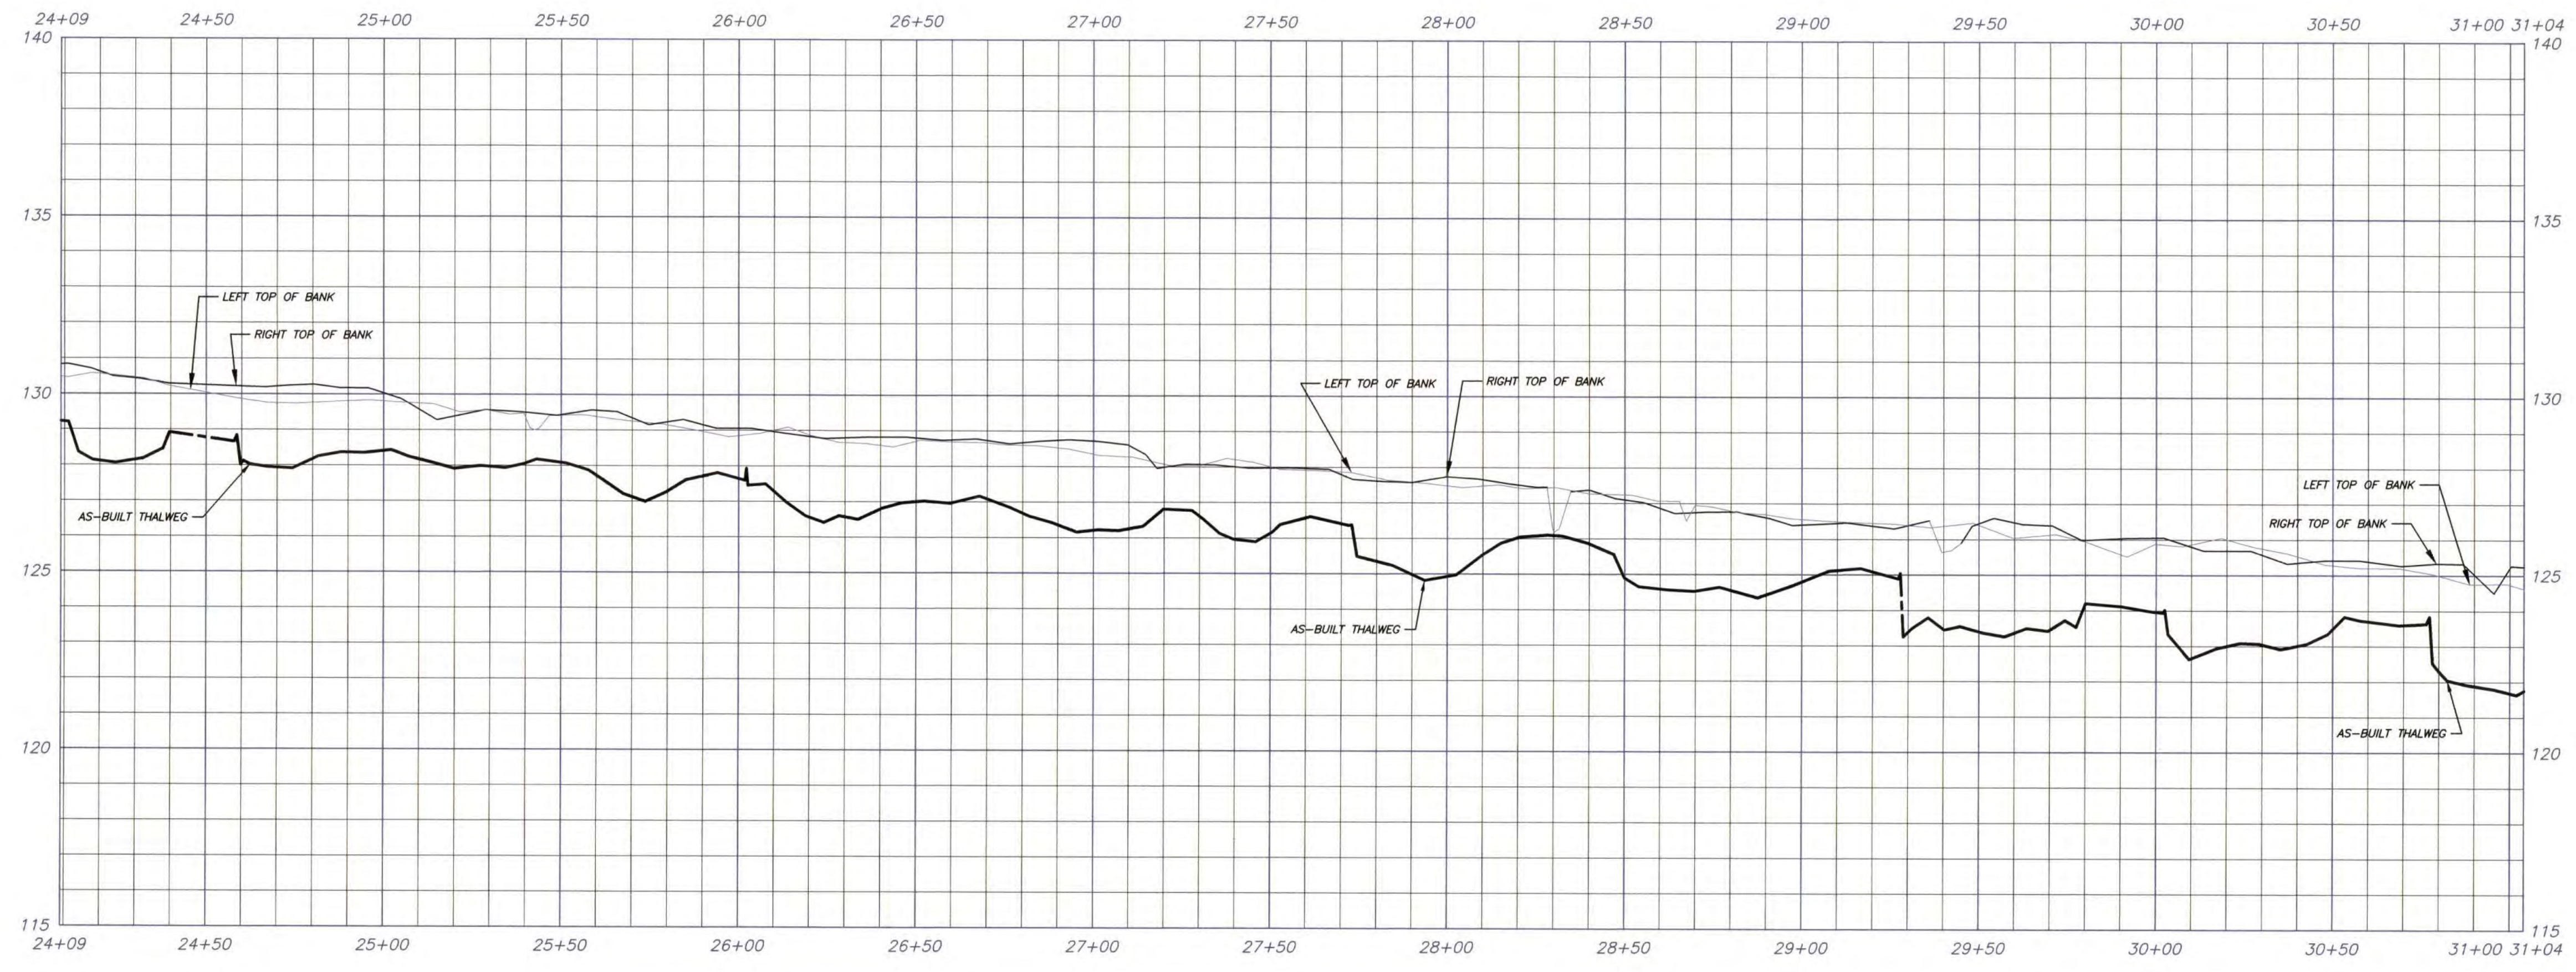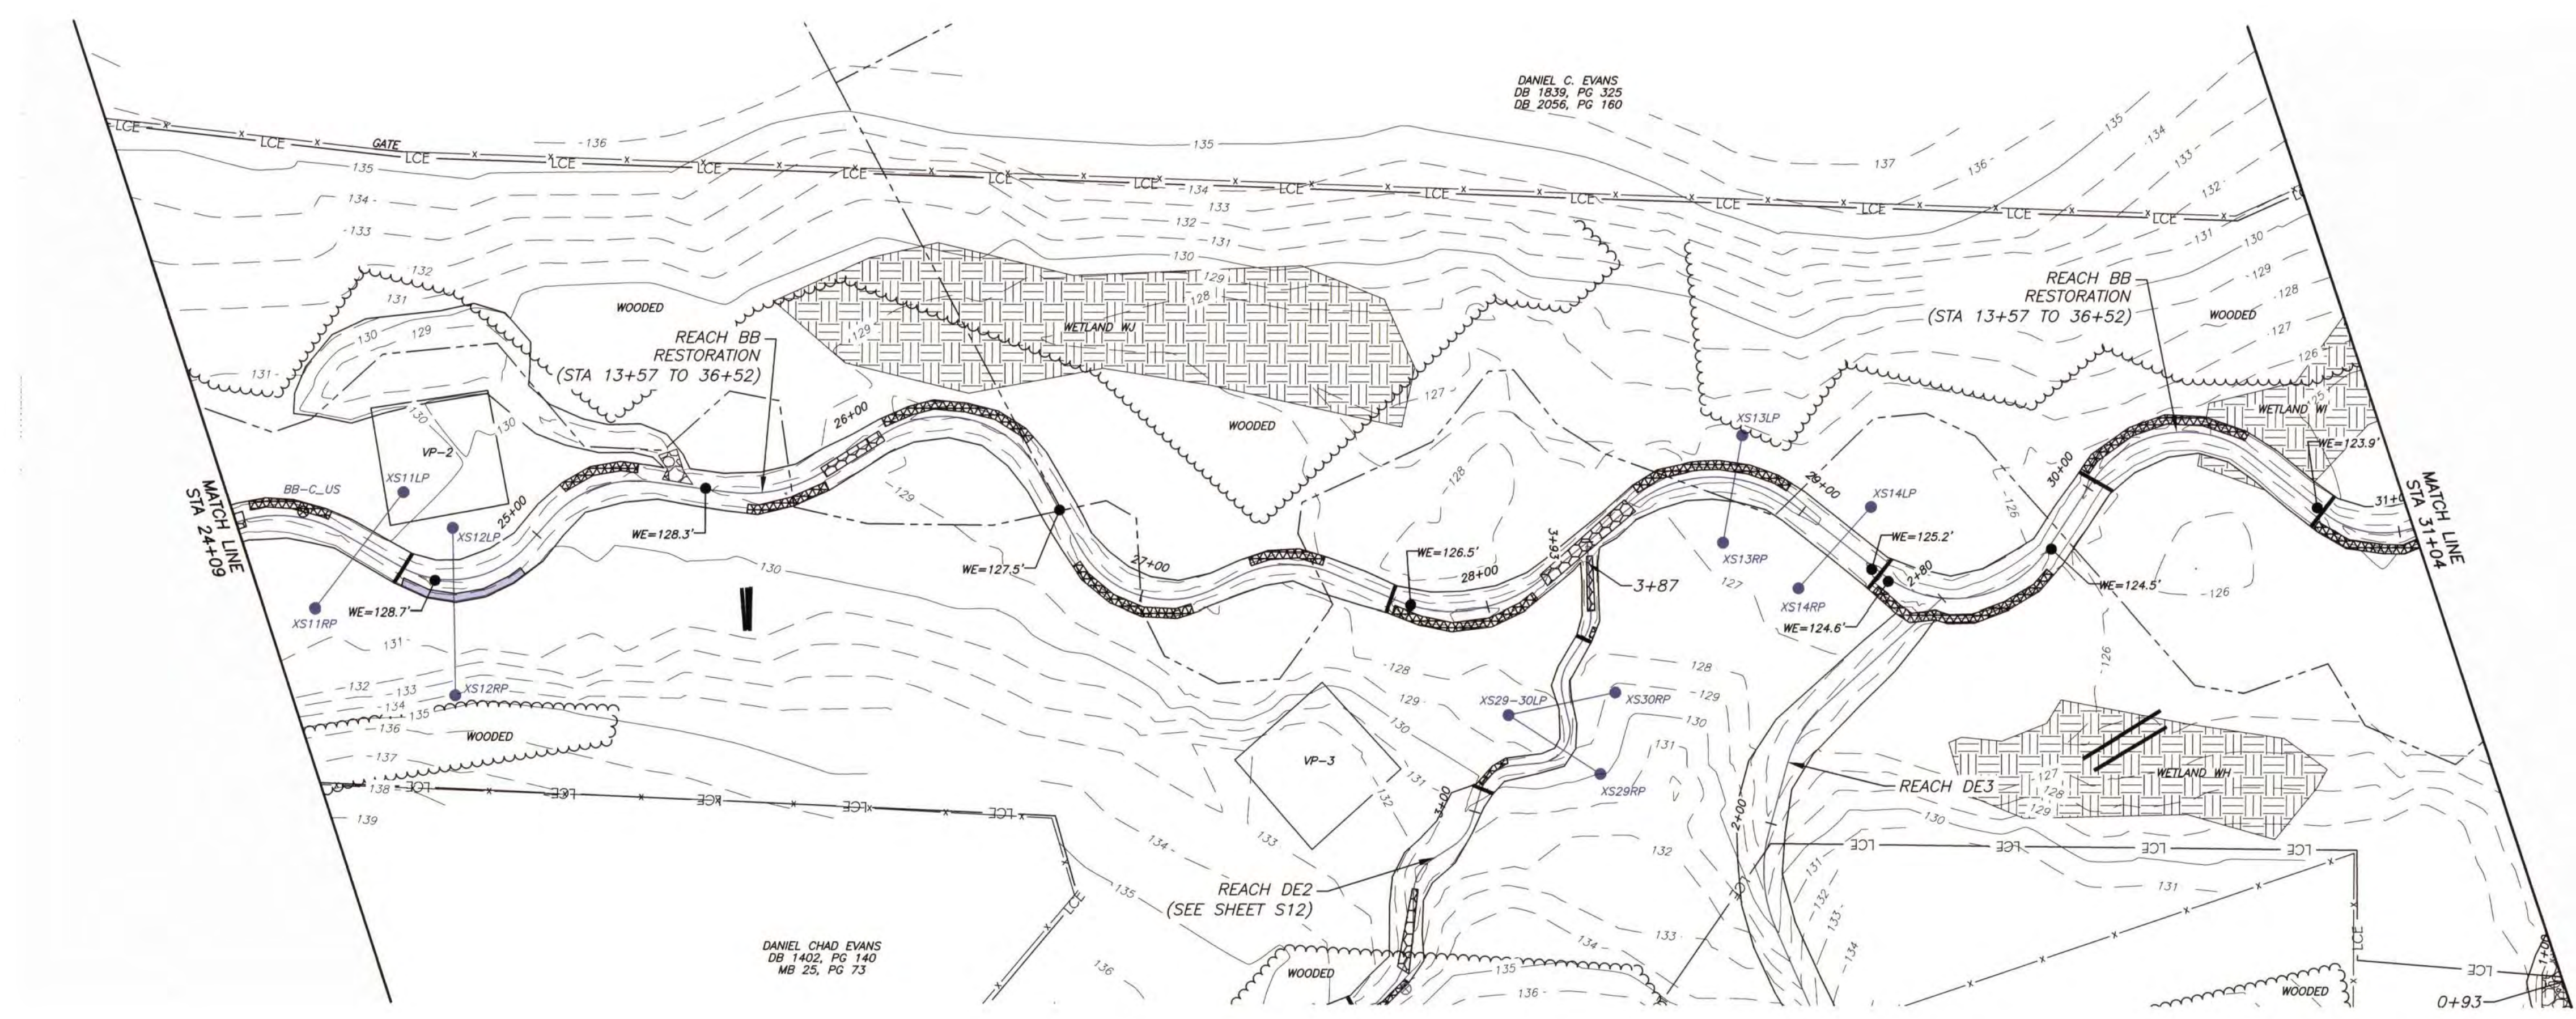

DRAWING NO. **S7**  
 SHEET No. 7 OF 16

STREAM AS BUILT SURVEY  
 REACH BB PLAN & PROFILE (STA 24+09 - 31 +04)





**RESOURCE ENVIRONMENTAL SOLUTIONS, LLC**  
**SIX RUNS MITIGATION SITE**  
**SAMPSON COUNTY, N.C.**



906 N. QUEEN ST., SUITE A  
 KINSTON, NC 28501  
 TEL: 252-522-2500  
 FAX: 252-522-4747  
 FIRM LIC. # P-0221  
 EMAIL: surveyor@matrixeast.net

DRAWN BY JRW	DATE 5/11/2023	SCALE 1" = 30'
PROJECT NO. 20200258		
DRAWING NAME 20200258-AS BUILT.DWG		



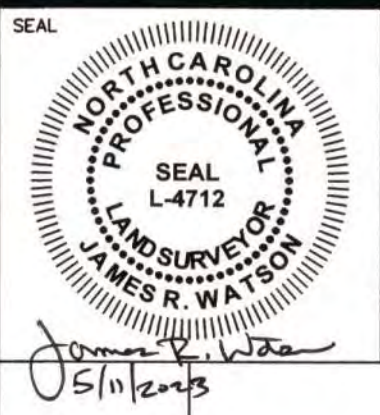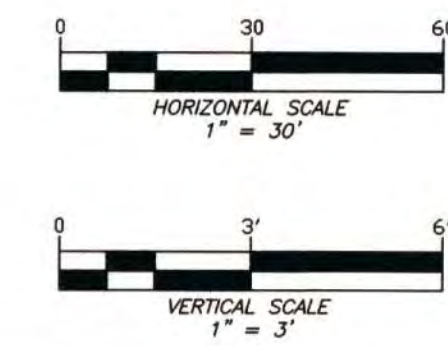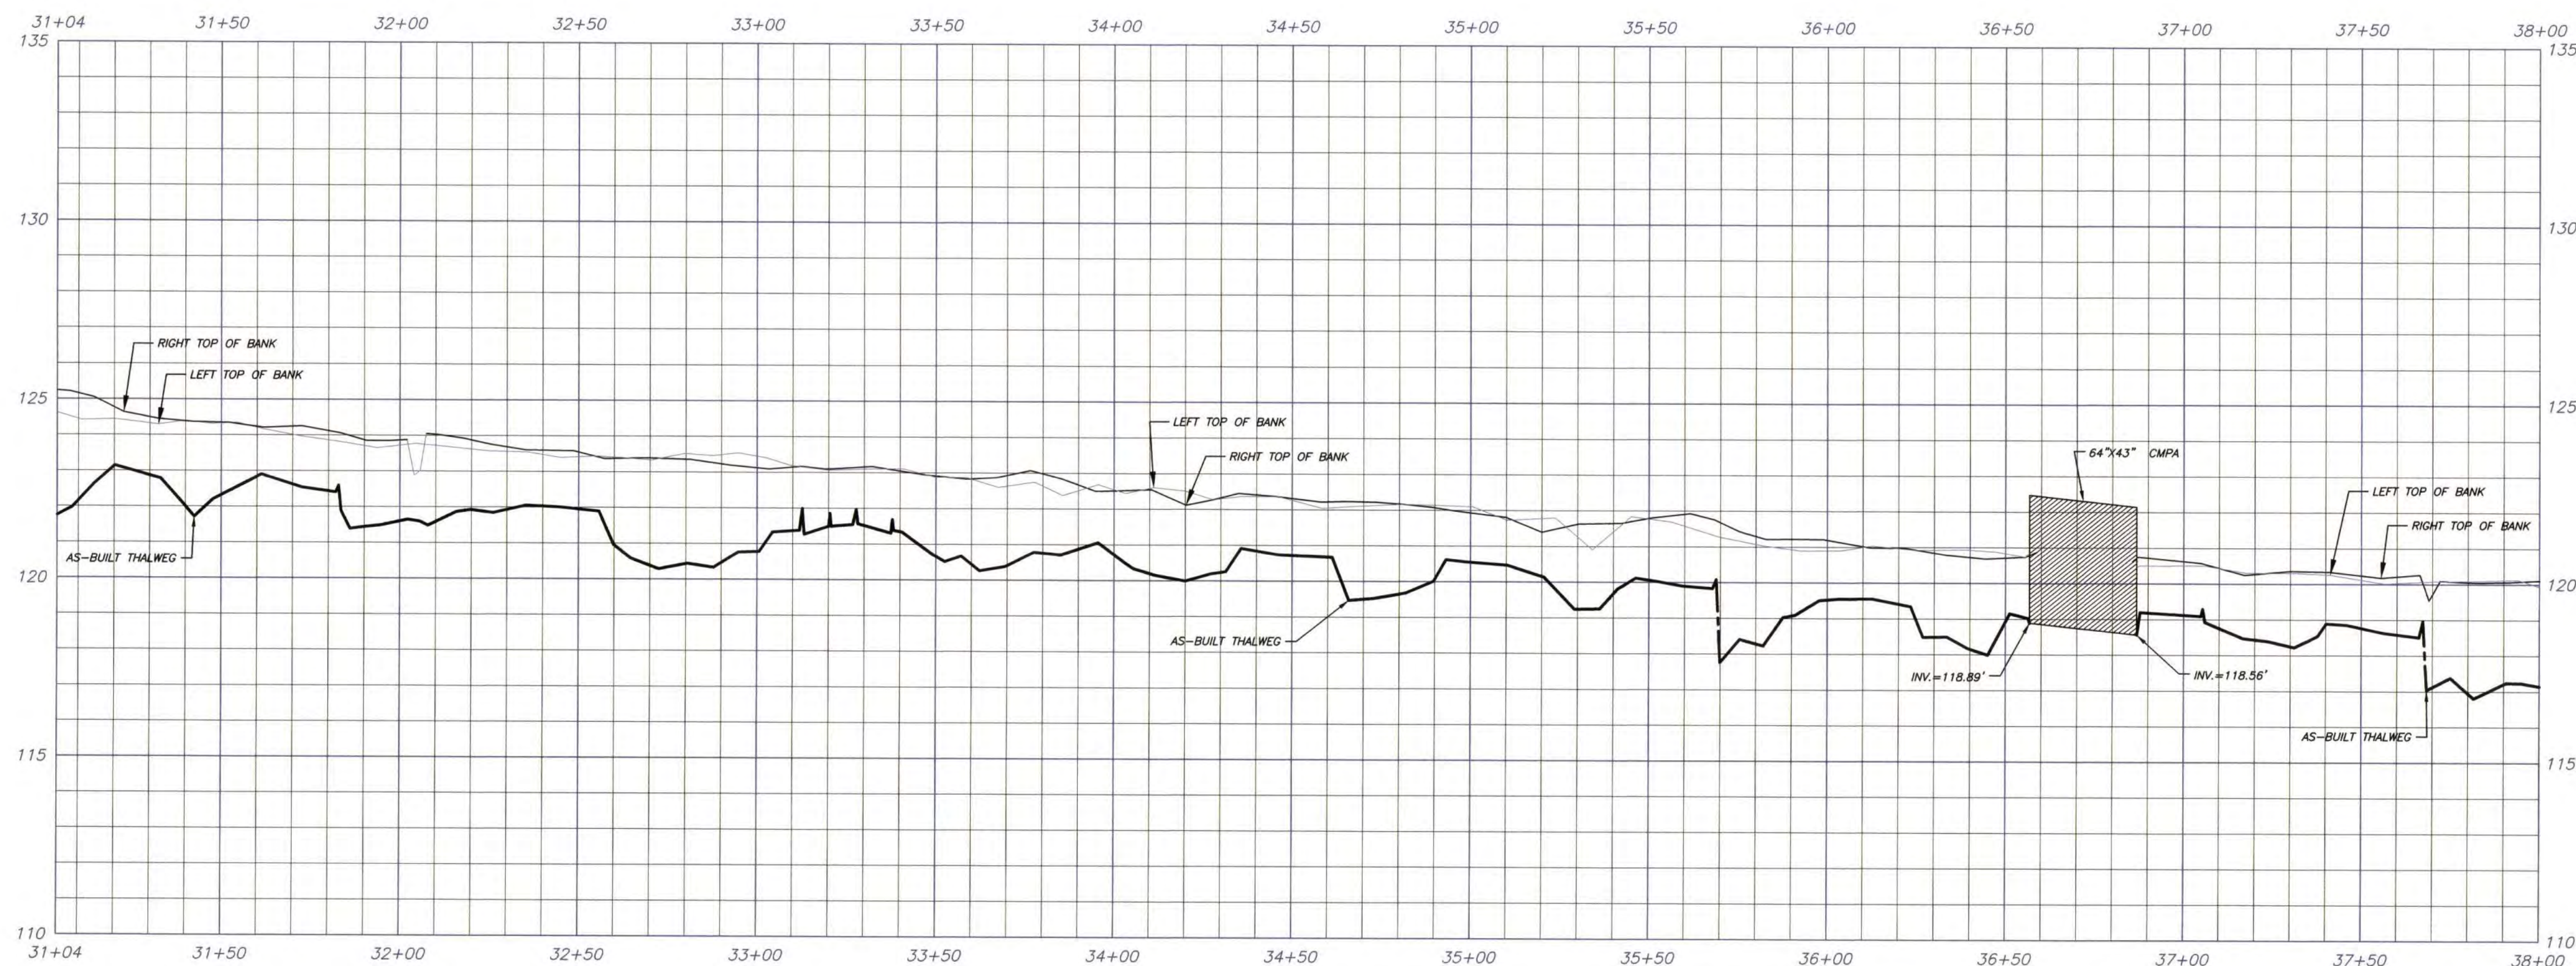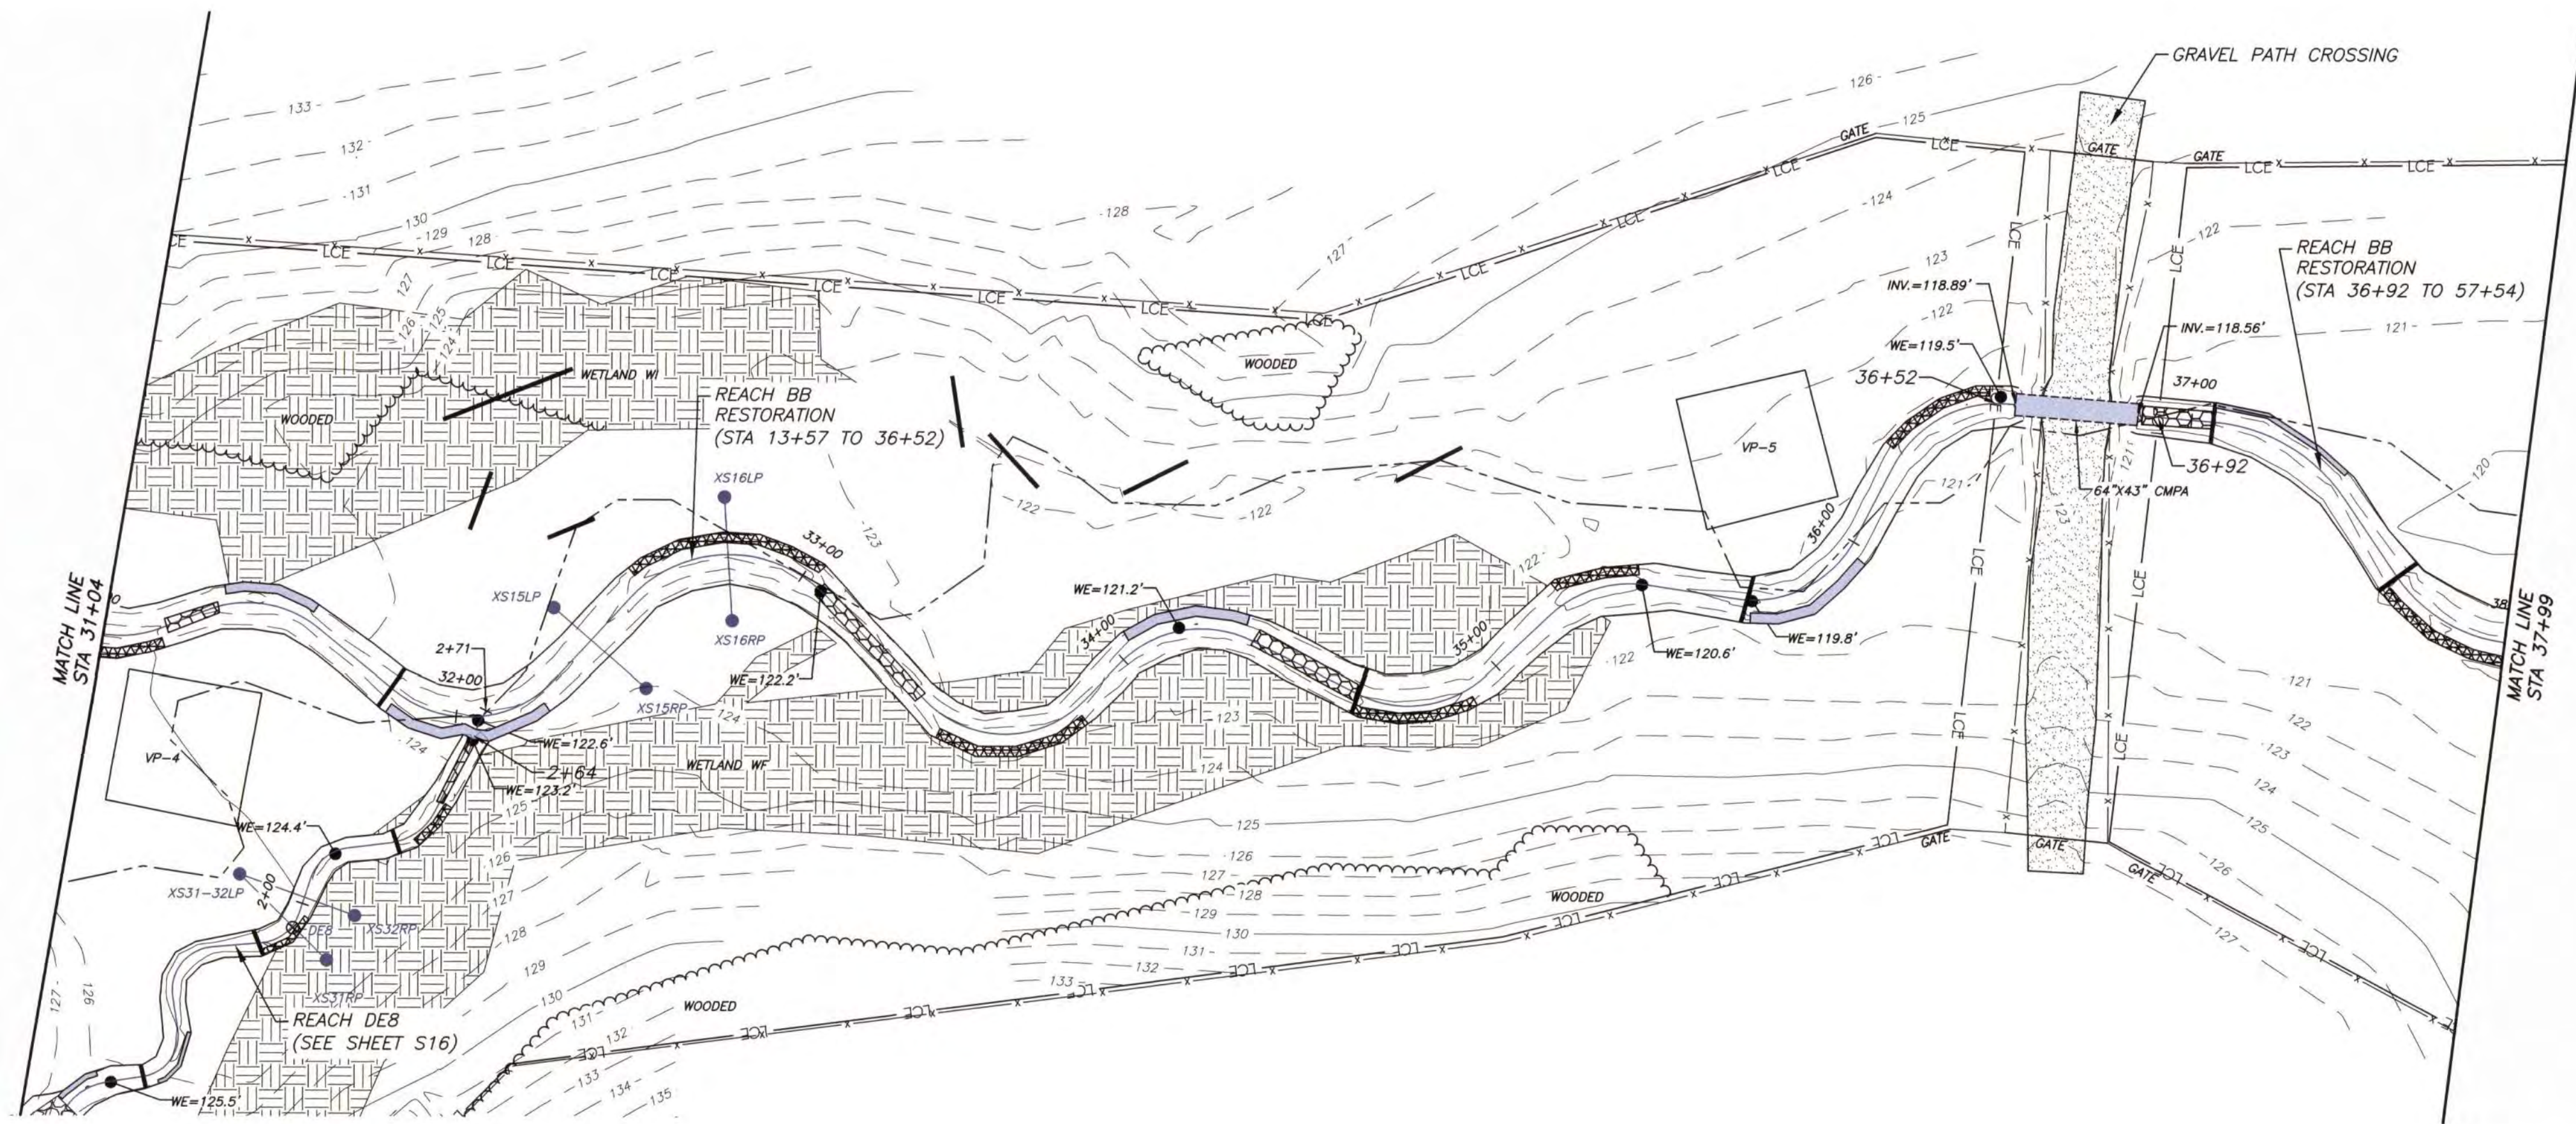

DRAWING NO. **S8**  
SHEET No. 8 OF 16

**RESOURCE ENVIRONMENTAL SOLUTIONS, LLC**  
**SIX RUNS MITIGATION SITE**  
**SAMPSON COUNTY, N.C.**







STREAM AS BUILT SURVEY  
REACH BB PLAN & PROFILE (STA 31+04 - 37+99)



906 N. QUEEN ST., SUITE A  
KINSTON, NC 28501  
TEL: 252-522-2500  
FAX: 252-522-4747  
FIRM LIC. # P-0221  
EMAIL: surveyor@matriceast.net

DRAWN BY: JRW	DATE: 5/11/2023	SCALE: 1" = 30'
PROJECT NO: 20200258		
DRAWING NAME: 20200258-AS BUILT.DWG		



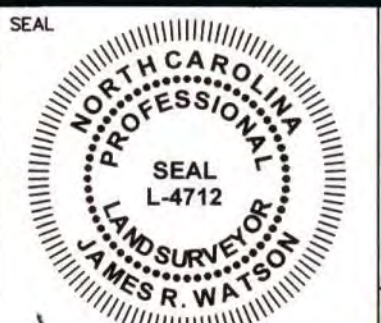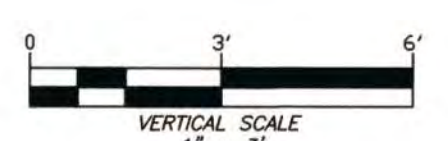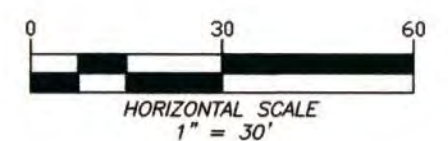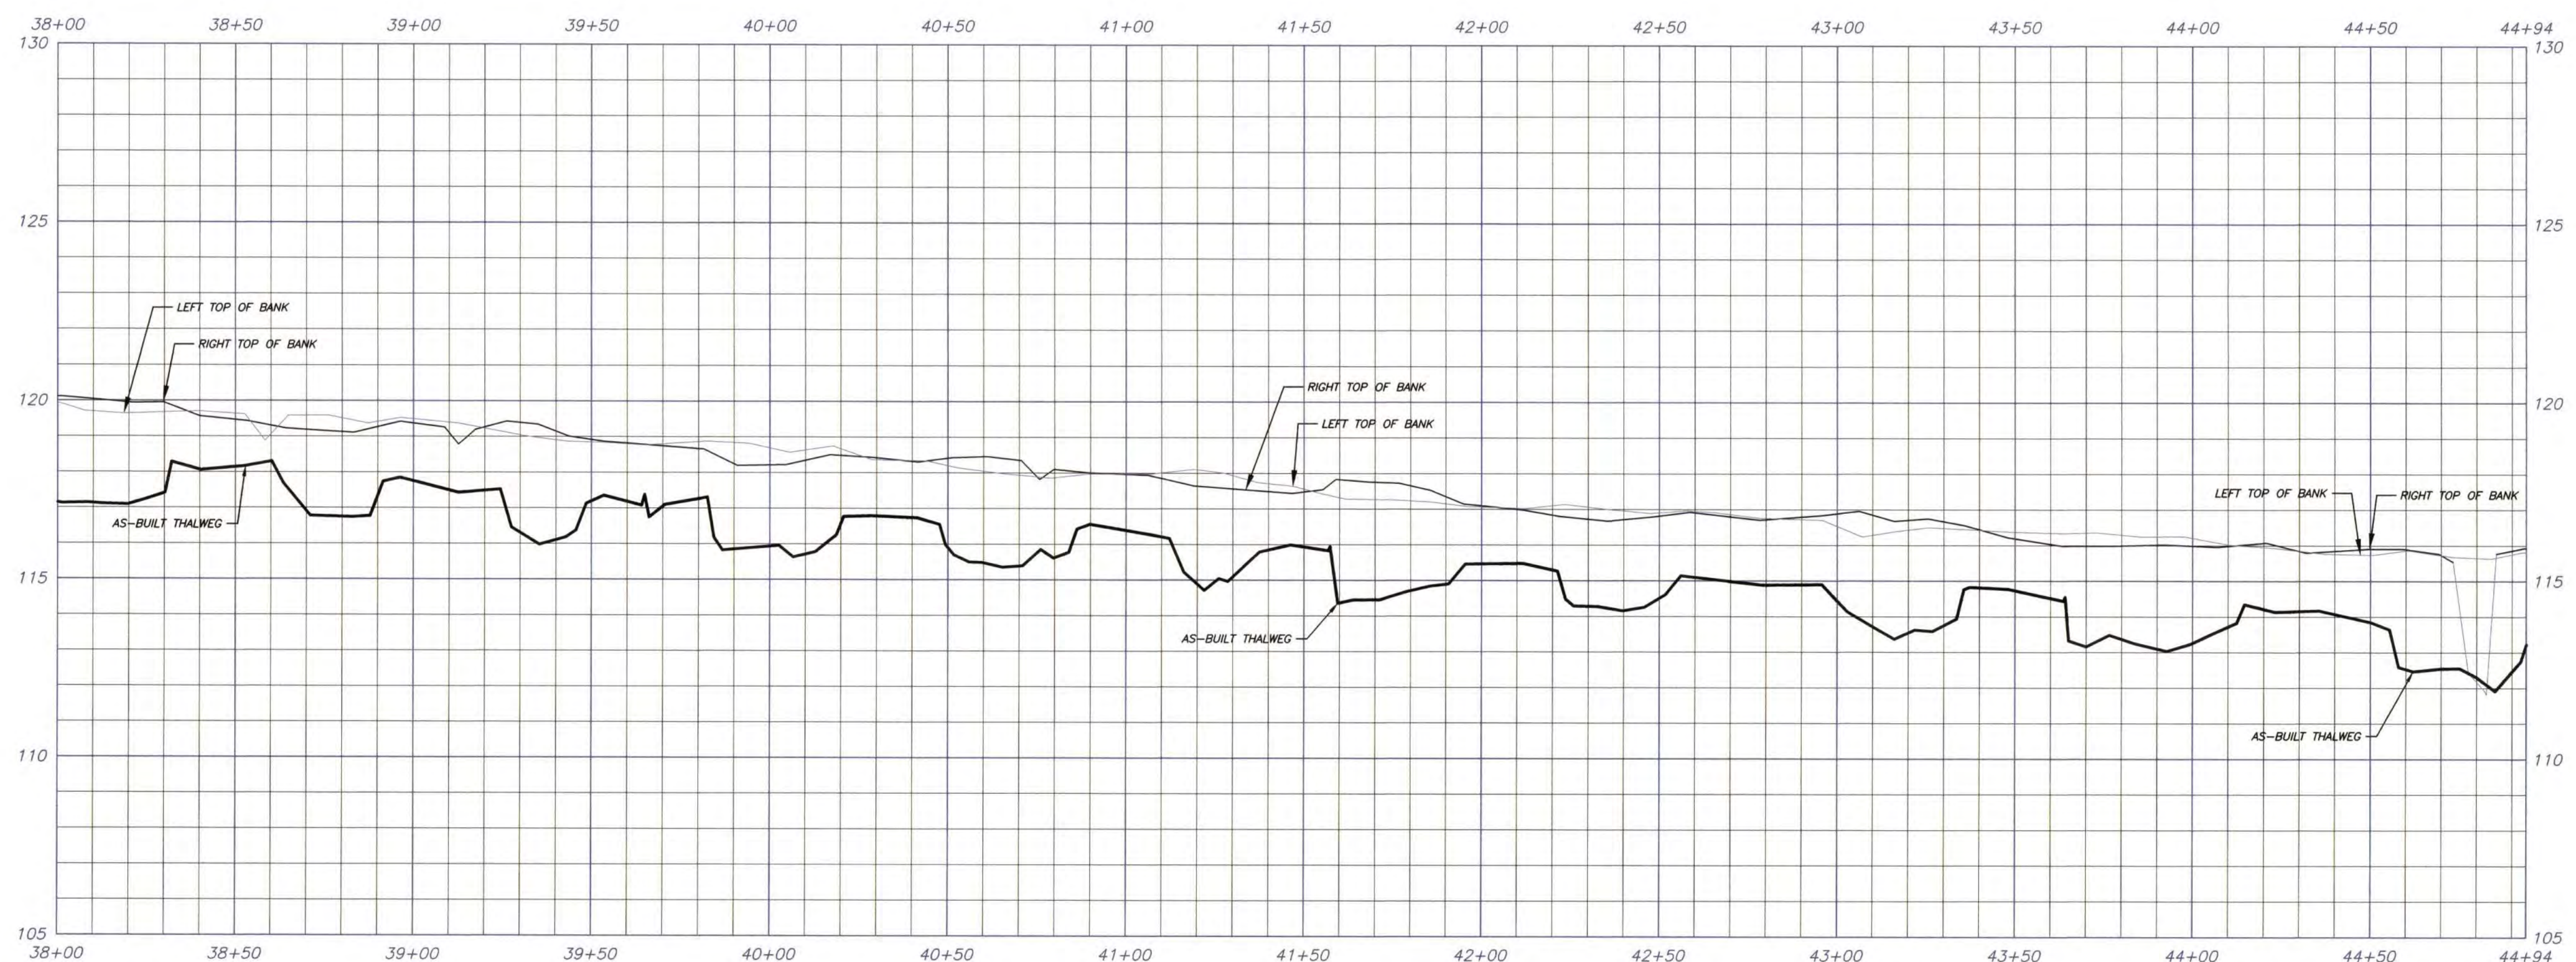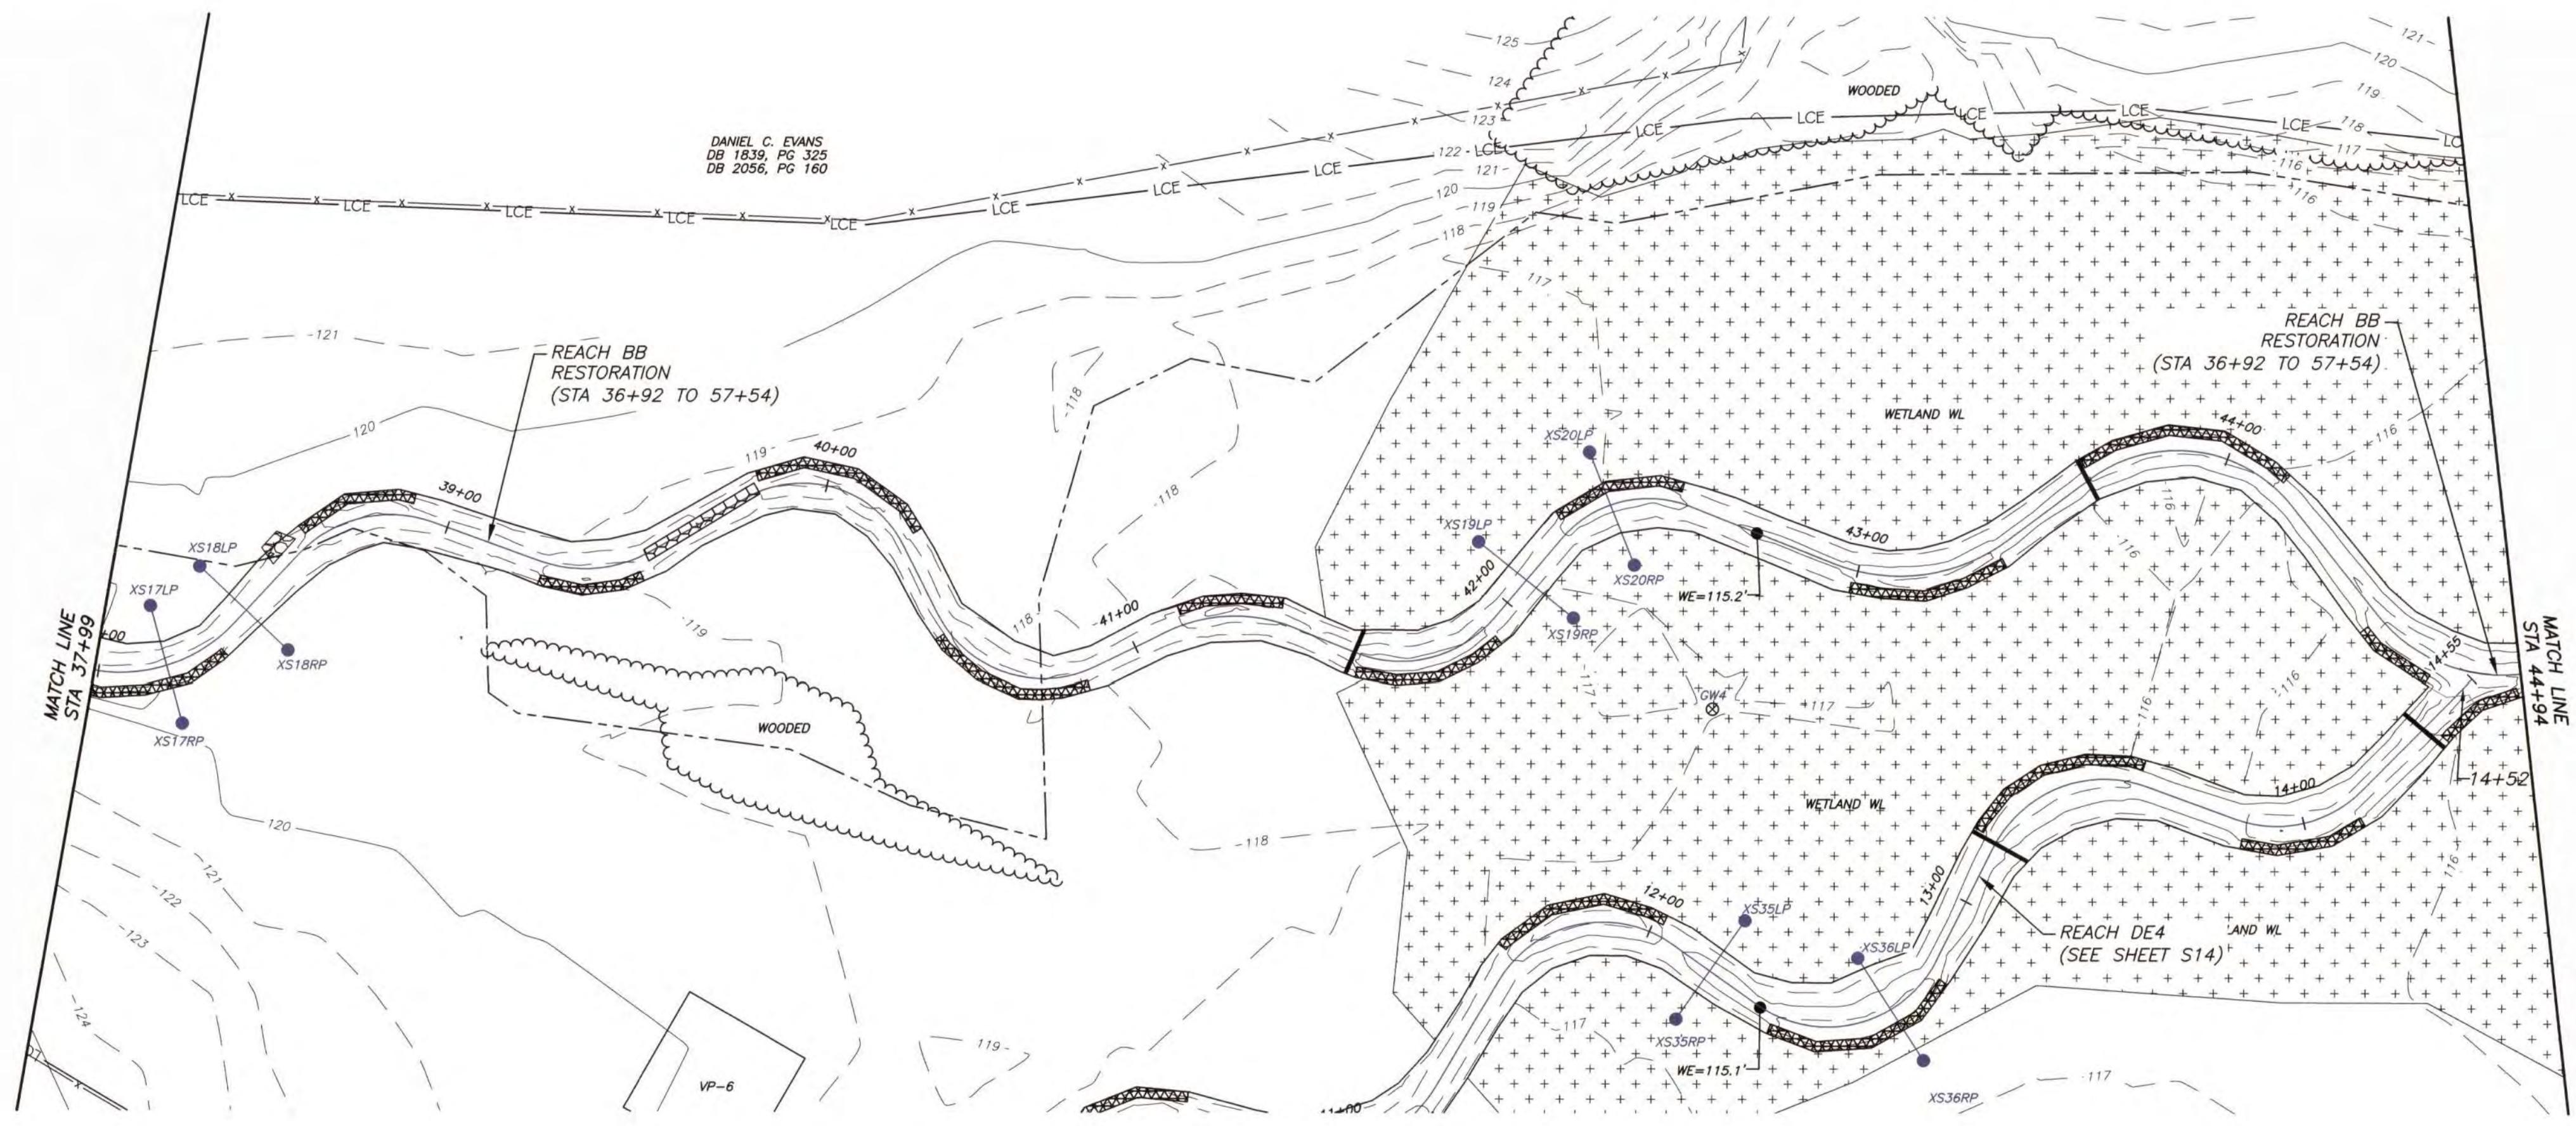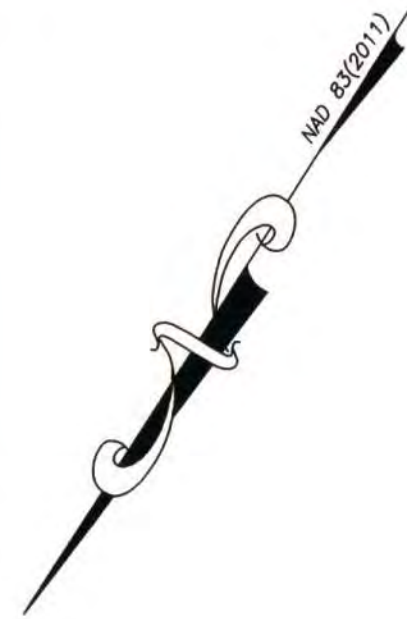

DRAWING NO. **S9**  
 SHEET No. 9 OF 16

**RESOURCE ENVIRONMENTAL SOLUTIONS, LLC**  
**SIX RUNS MITIGATION SITE**  
**SAMPSON COUNTY, N.C.**






**STREAM AS BUILT SURVEY**  
**REACH BB PLAN & PROFILE (STA 37+99 - 44+94)**



906 N. QUEEN ST., SUITE A  
 KINSTON, NC 28501  
 TEL: 252-522-2500  
 FAX: 252-522-4747  
 FIRM LIC. # P-0221  
 EMAIL: [surveyor@matriceast.net](mailto:surveyor@matriceast.net)

DRAWN BY: JRW      DATE: 5/11/2023      SCALE: 1" = 30'  
 PROJECT NO.: 20200258  
 DRAWING NAME: 20200258-AS BUILT.DWG



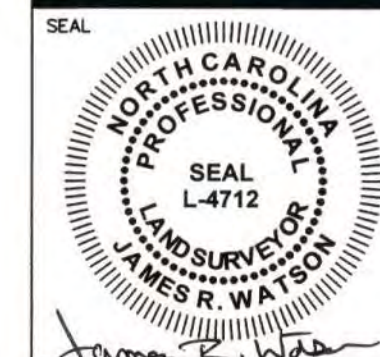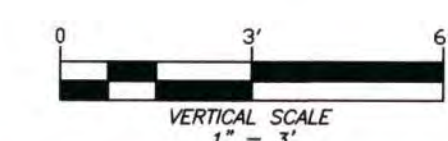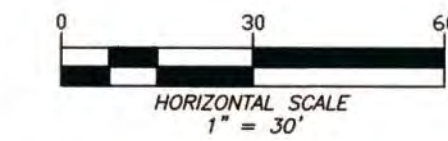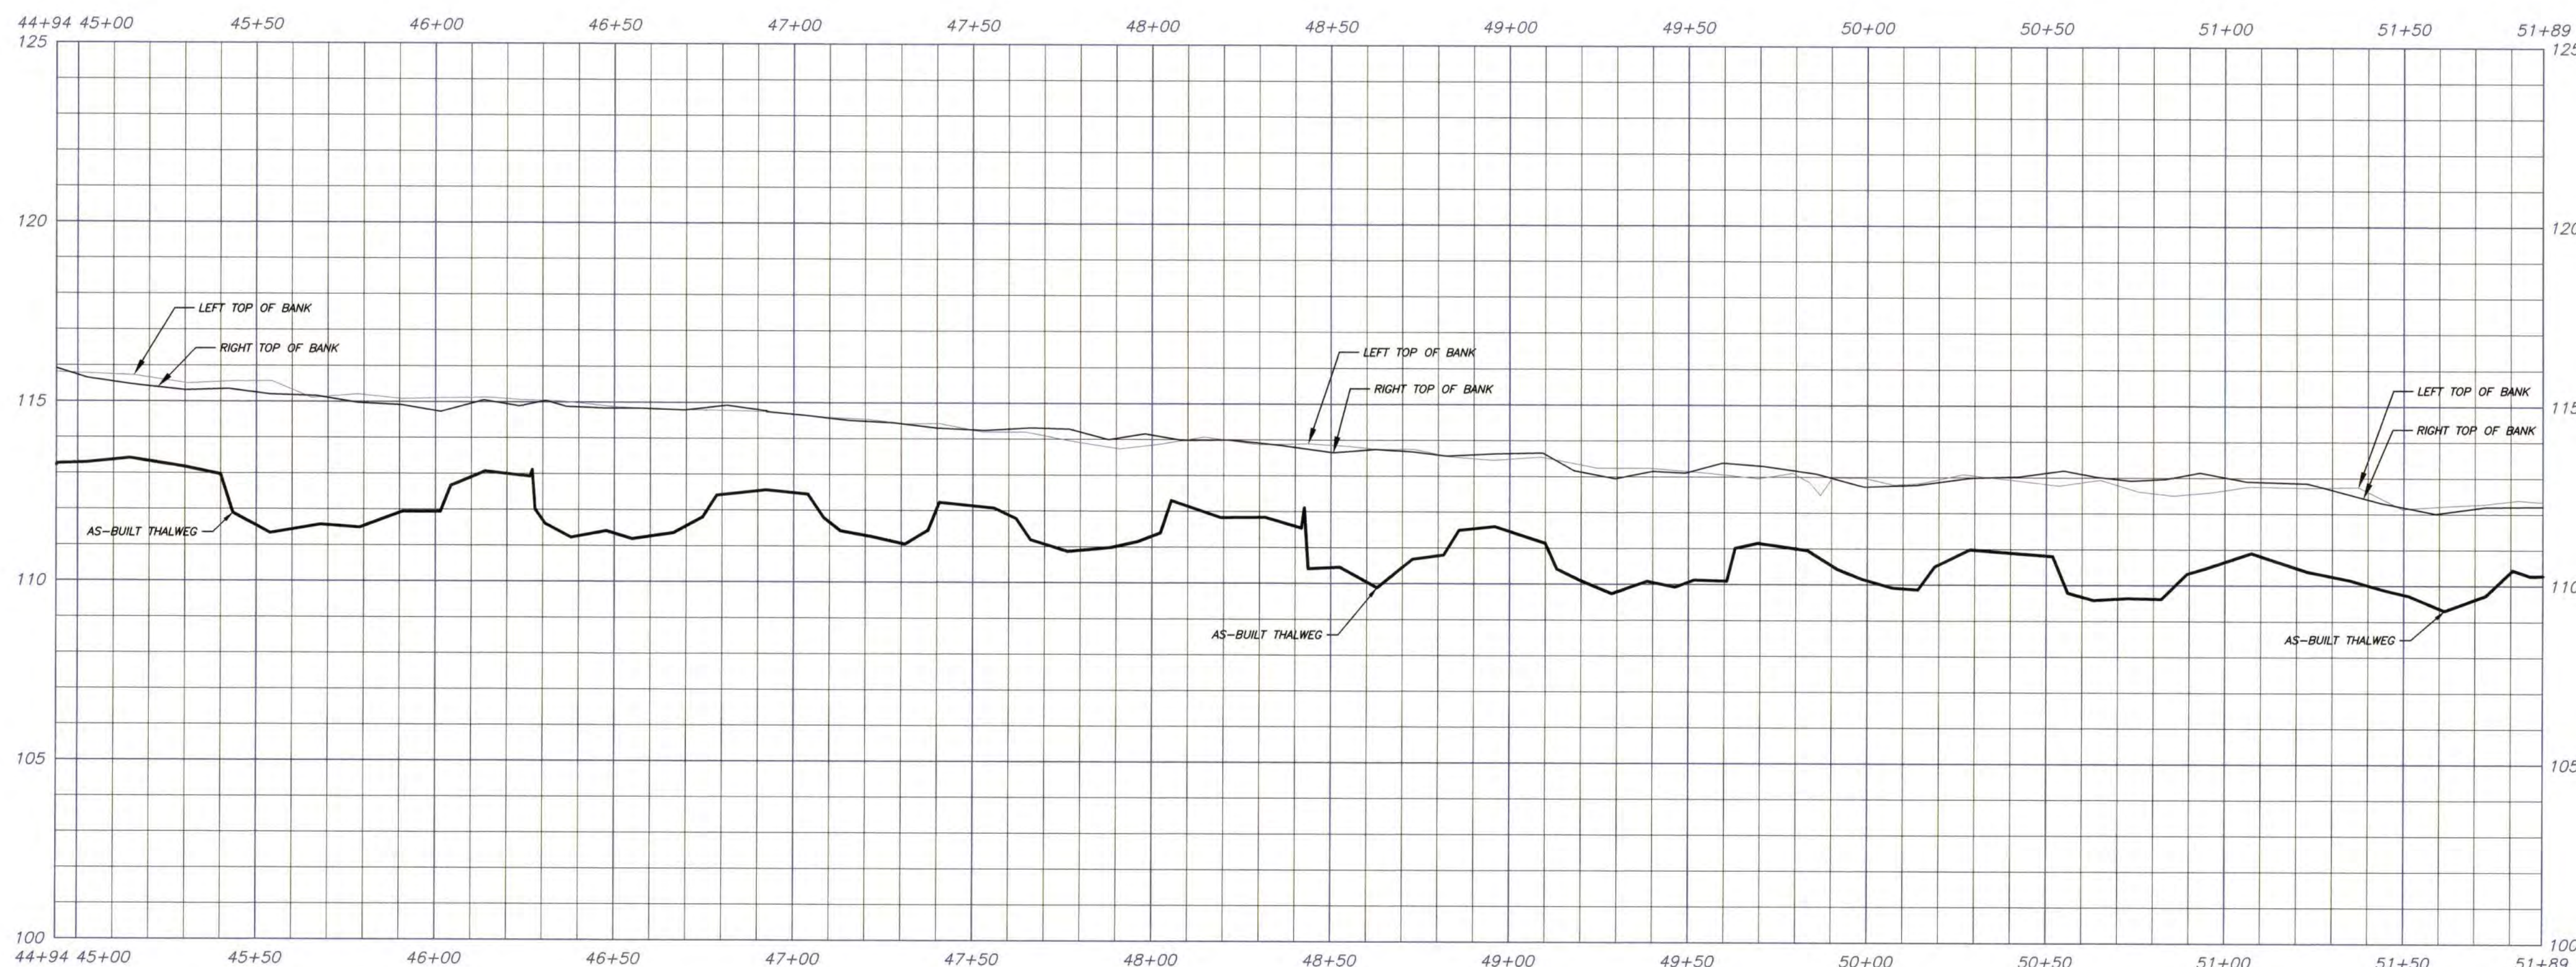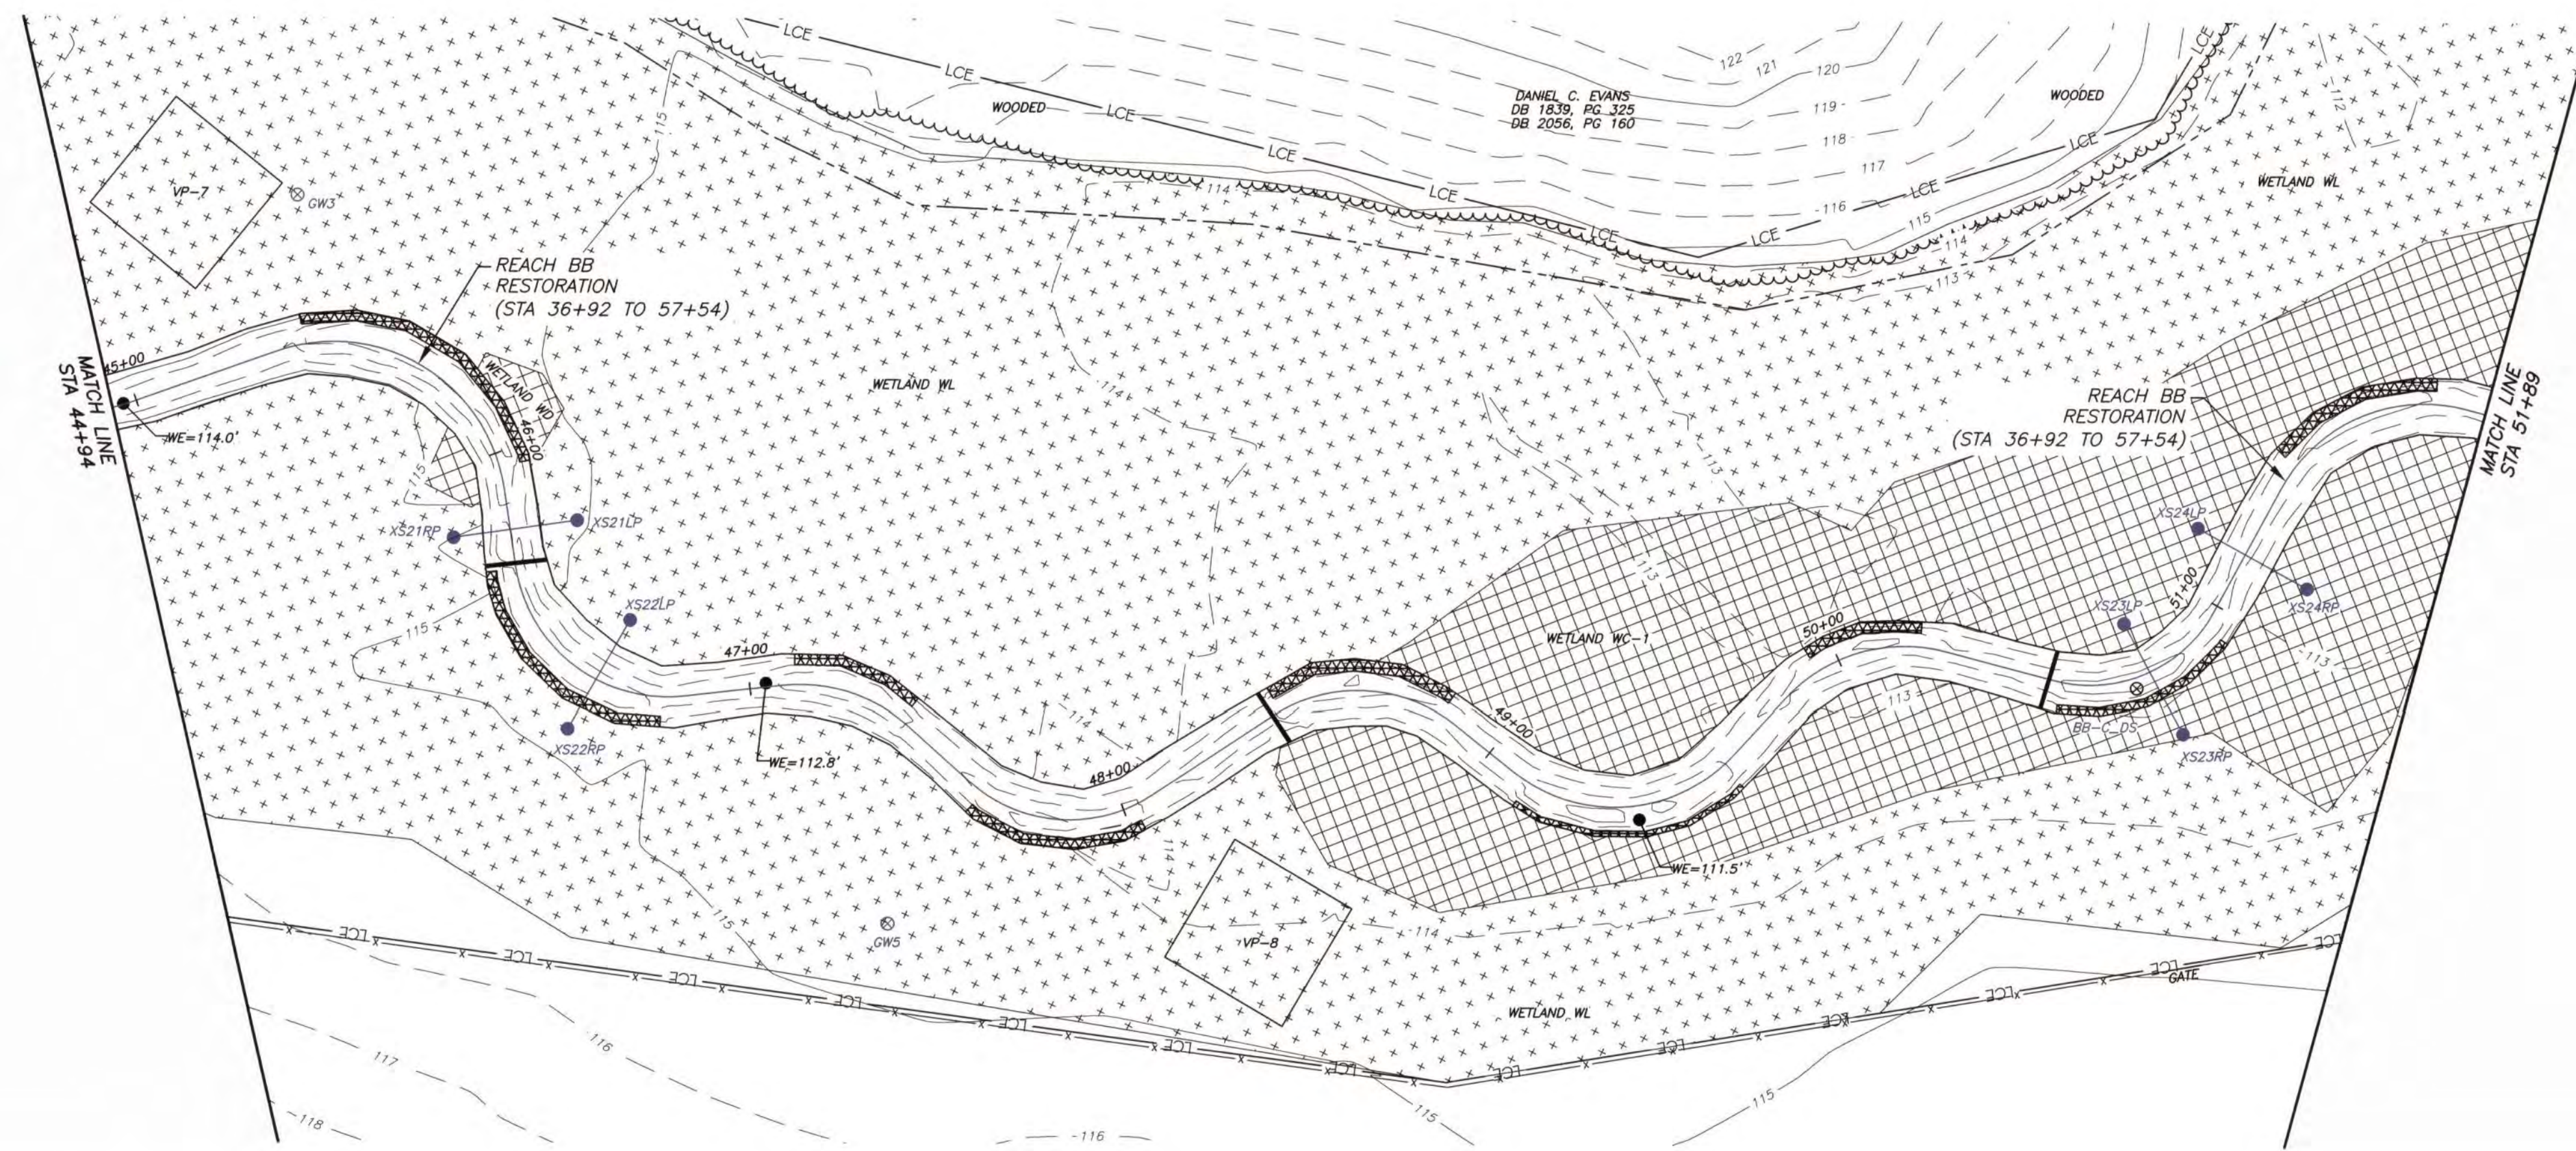

DRAWING NO. **S10**  
 SHEET No. 10 OF 16

**RESOURCE ENVIRONMENTAL SOLUTIONS, LLC**  
**SIX RUNS MITIGATION SITE**  
**SAMPSON COUNTY, N.C.**





STREAM AS BUILT SURVEY  
 REACH BB PLAN & PROFILE (STA 44+94 - 51+89)



906 N. QUEEN ST., SUITE A  
 KINSTON, NC 28501  
 TEL: 252-522-2500  
 FAX: 252-522-4747  
 FIRM LIC. # P-0221  
 EMAIL: [surveyor@matriceast.net](mailto:surveyor@matriceast.net)

DRAWN BY JRW	DATE 5/11/2023	SCALE 1" = 30'
PROJECT NO. 20200258		
DRAWING NAME 20200258-AS BUILT.DWG		



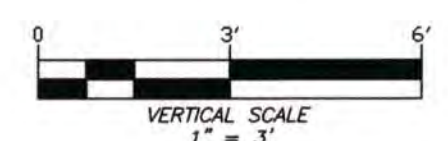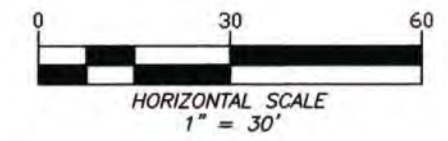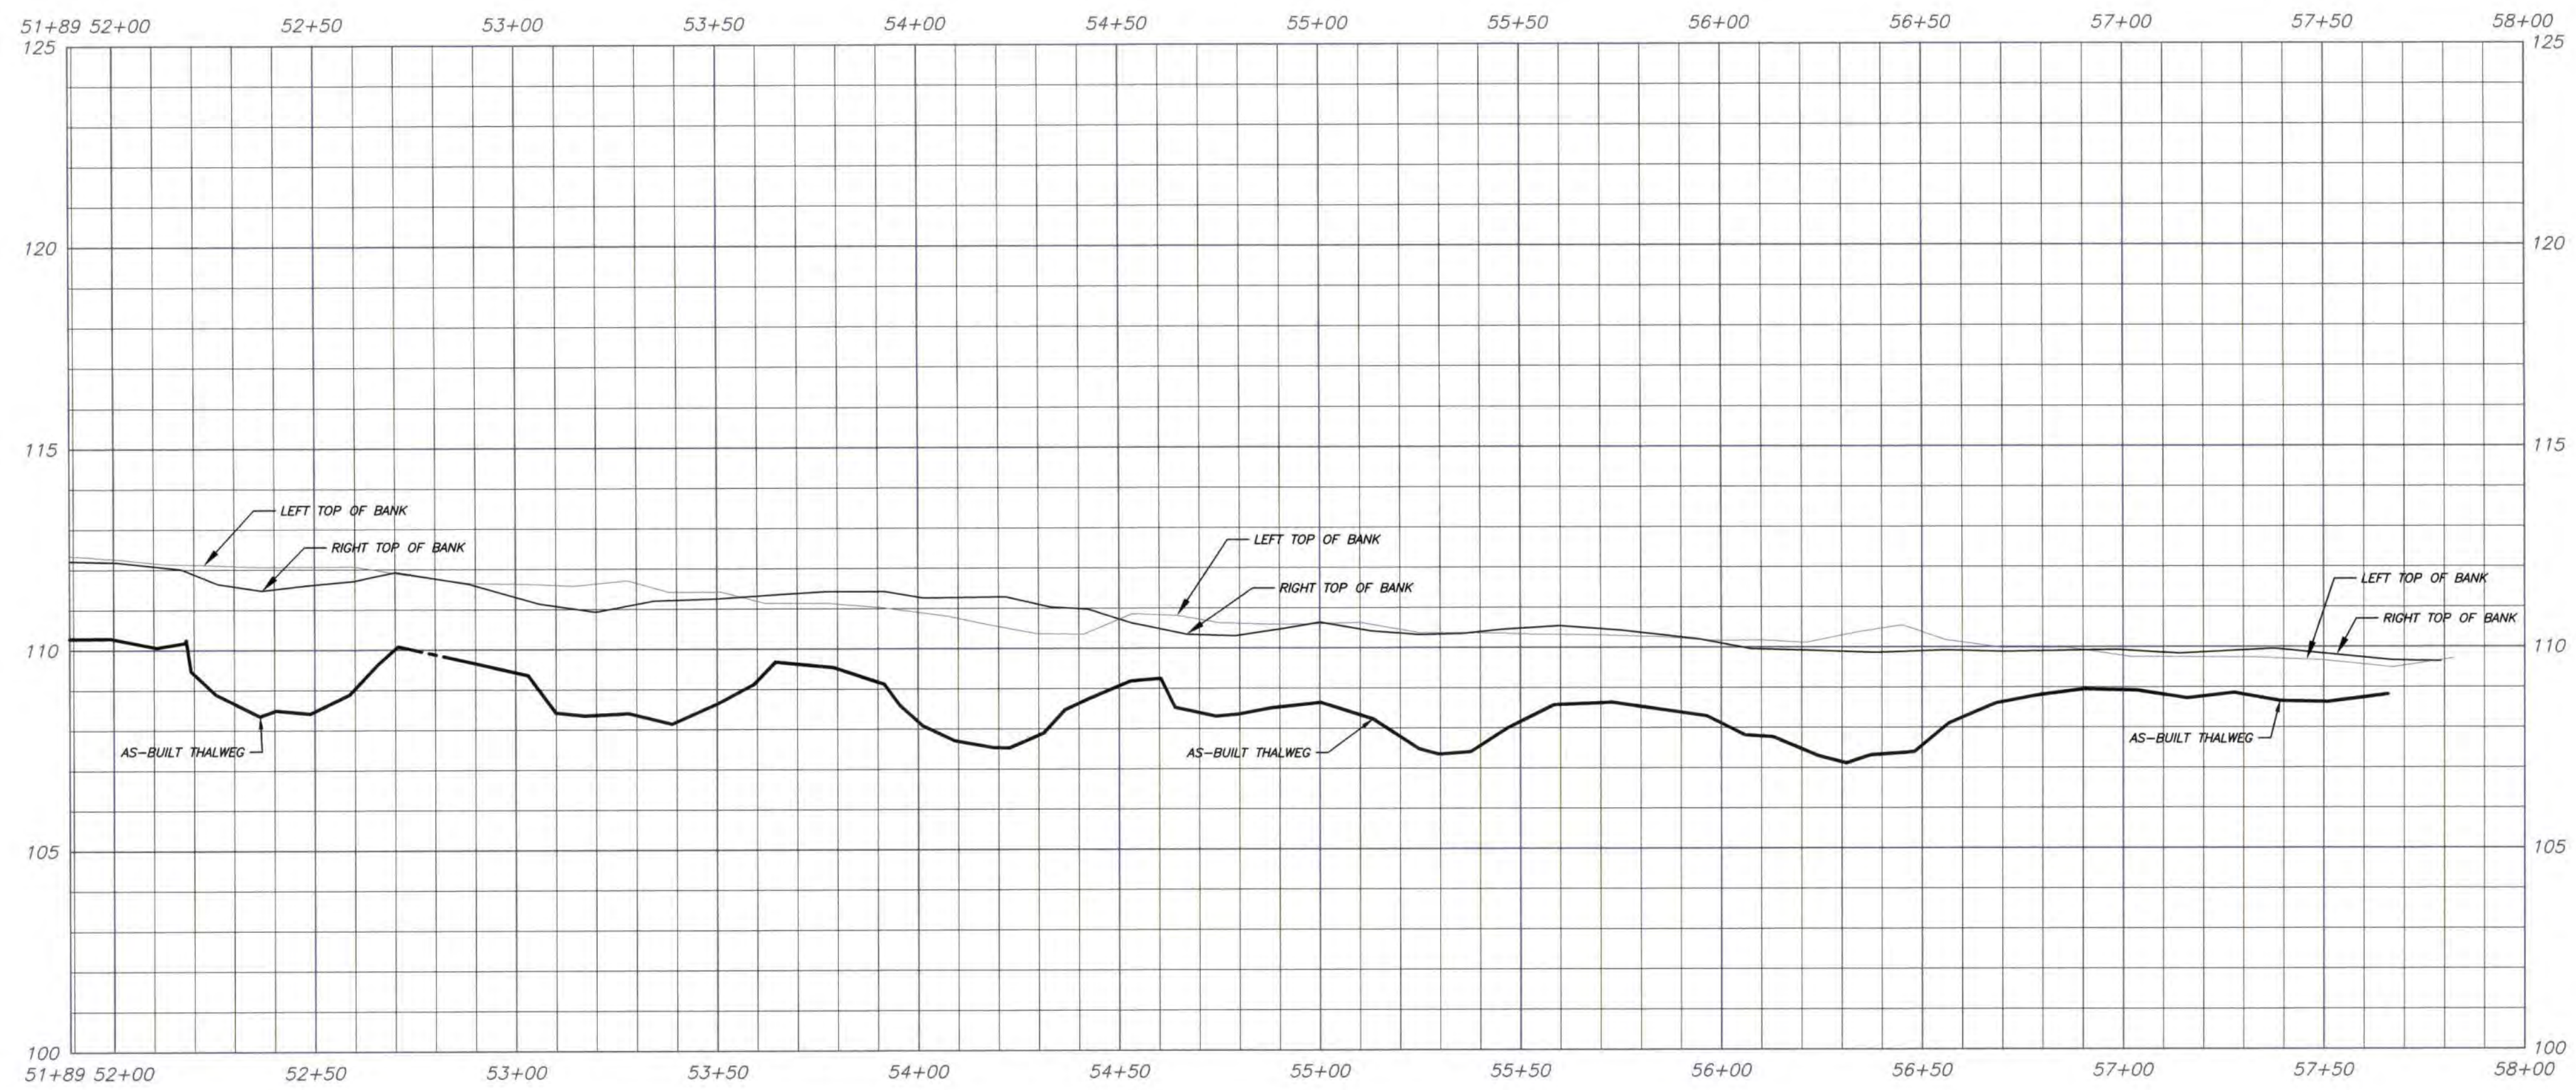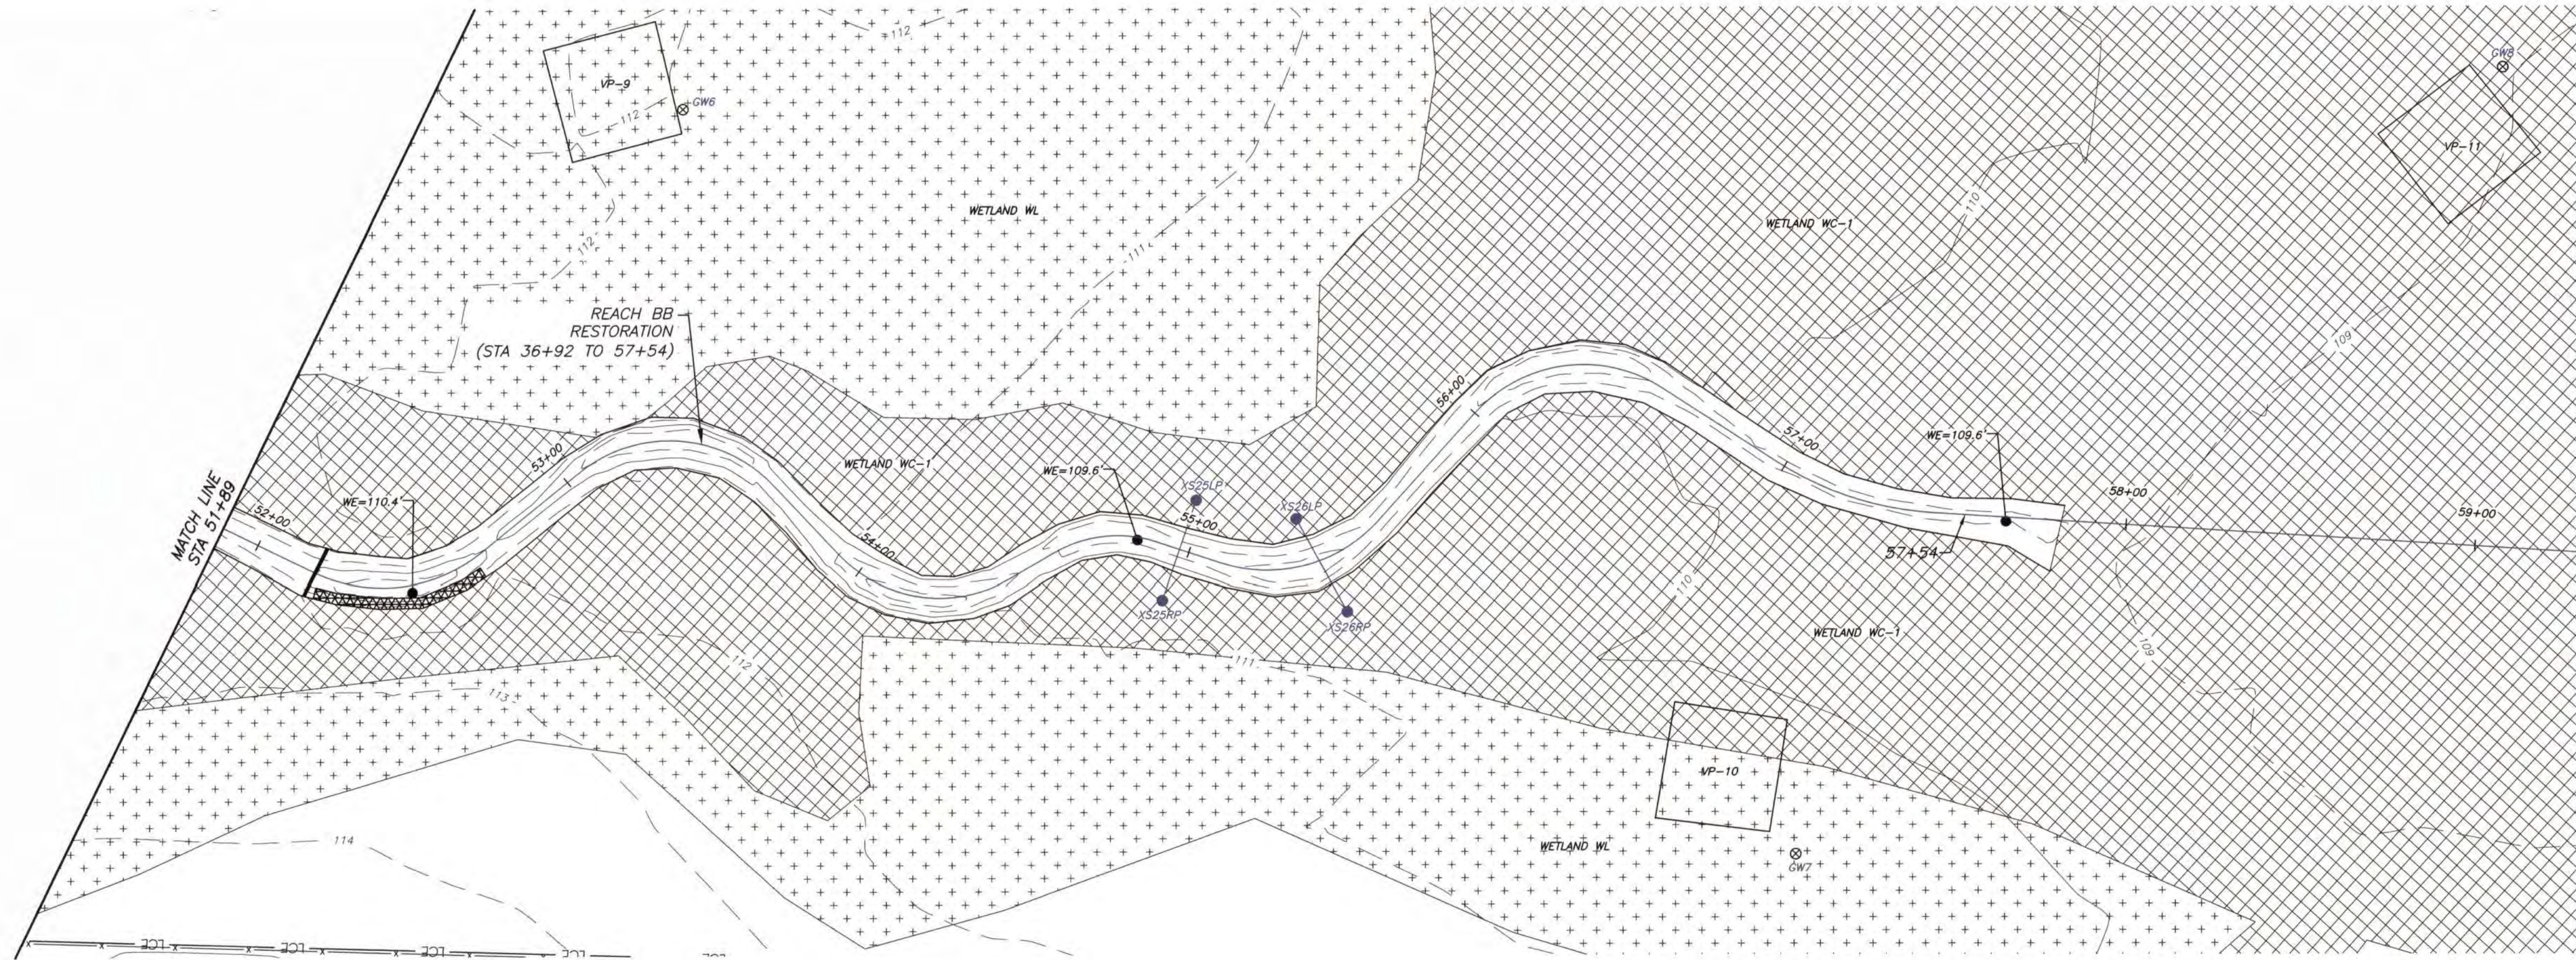

SEAL  
 NORTH CAROLINA  
 PROFESSIONAL  
 LAND SURVEYOR  
 JAMES R. WATSON  
 L-4712  
 DATE: 5/11/2023

DRAWING NO.  
**S11**

SHEET No.  
 11 OF 16

**RESOURCE ENVIRONMENTAL SOLUTIONS, LLC**

**STREAM AS BUILT SURVEY**  
**REACH BB PLAN & PROFILE (STA 51+89 - 58+00)**

**SIX RUNS MITIGATION SITE**  
**SAMPSON COUNTY, N.C.**






**MATRIX EAST, PLLC**

906 N. QUEEN ST., SUITE A  
 KINSTON, NC 28501  
 TEL: 252-522-2500  
 FAX: 252-522-4747  
 FIRM LIC. # P-0221  
 EMAIL: surveyor@matrixeast.net

DRAWN BY: JRW  
 DATE: 5/11/2023  
 SCALE: 1" = 30'

PROJECT NO: 20200258  
 DRAWING NAME: 20200258-AS BUILT.DWG



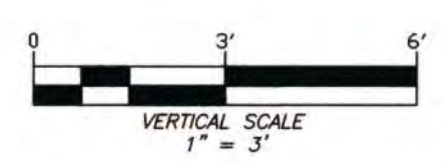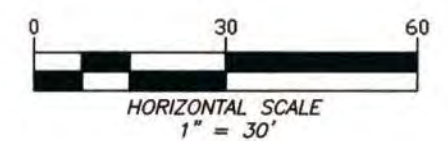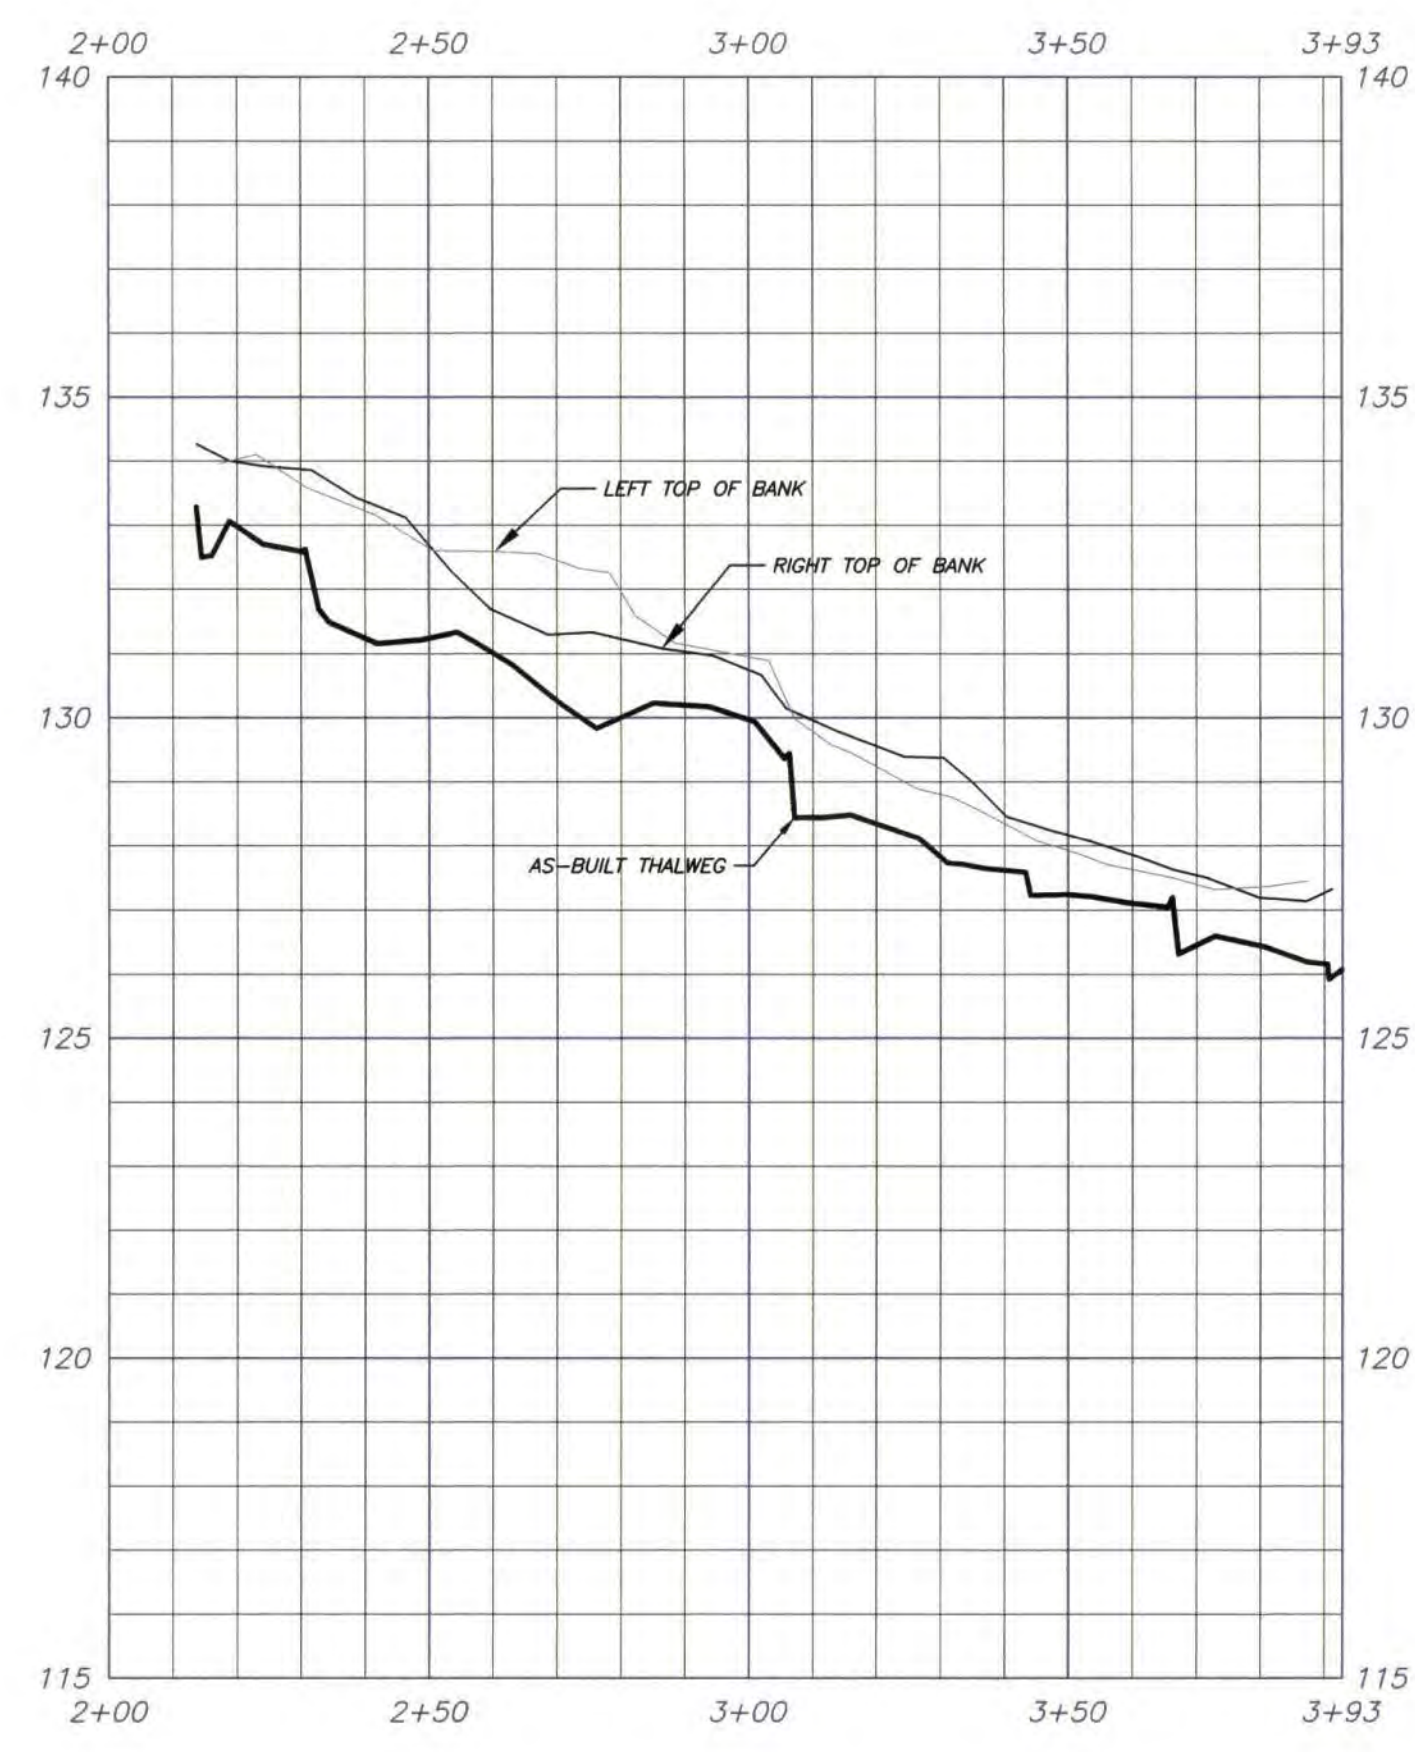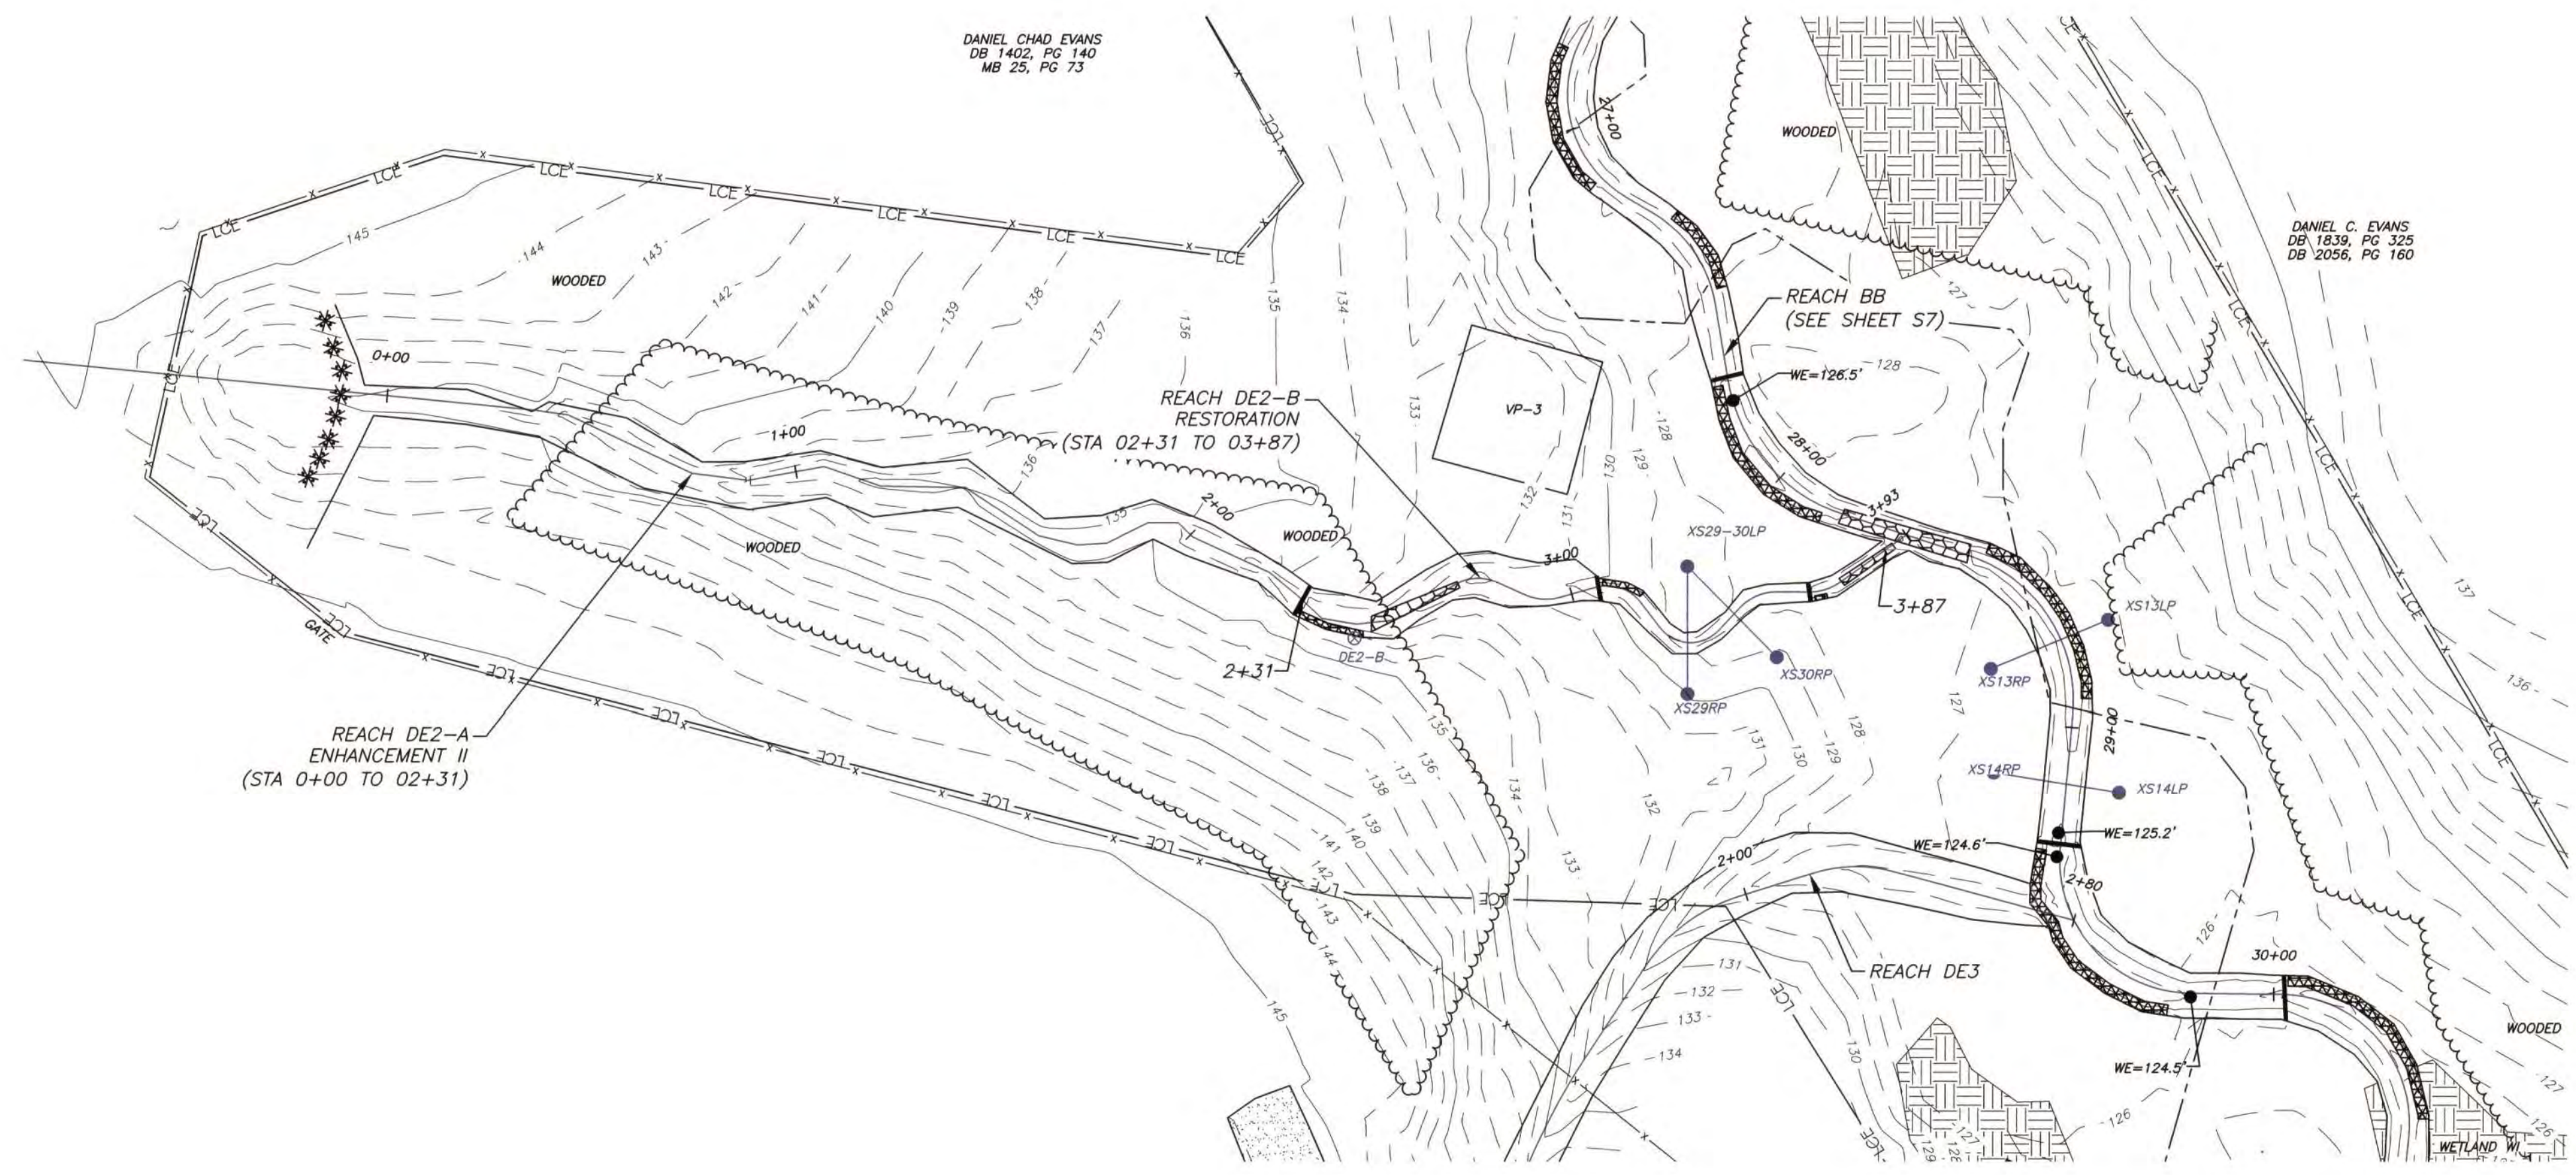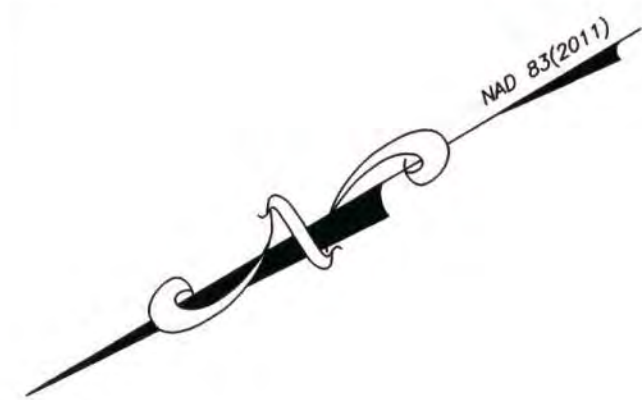

SEAL  
 NORTH CAROLINA  
 PROFESSIONAL  
 LAND SURVEYOR  
 L. JAMES R. WATSON  
 L-4712

DRAWING NO.  
**S12**

SHEET No.  
 12 OF 16

**STREAM AS BUILT SURVEY**  
**REACH DE2 PLAN & PROFILE (STA 02+00 - 03+93)**






**RESOURCE ENVIRONMENTAL SOLUTIONS, LLC**  
**SIX RUNS MITIGATION SITE**  
**SAMPSON COUNTY, N.C.**

**MATRIX EAST, PLLC**

906 N. QUEEN ST., SUITE A  
 KINSTON, NC 28501  
 TEL: 252-522-2500  
 FAX: 252-522-4747  
 FIRM LIC. # P-0221  
 EMAIL: [surveyor@matrixeast.net](mailto:surveyor@matrixeast.net)

DRAWN BY JRW	DATE 5/11/2023	SCALE 1" = 30'
PROJECT NO. 20200258		
DRAWING NAME 20200258-AS BUILT.DWG		



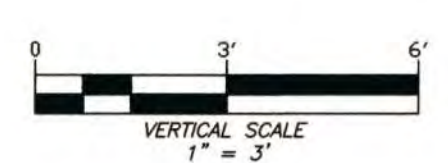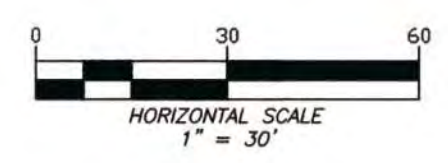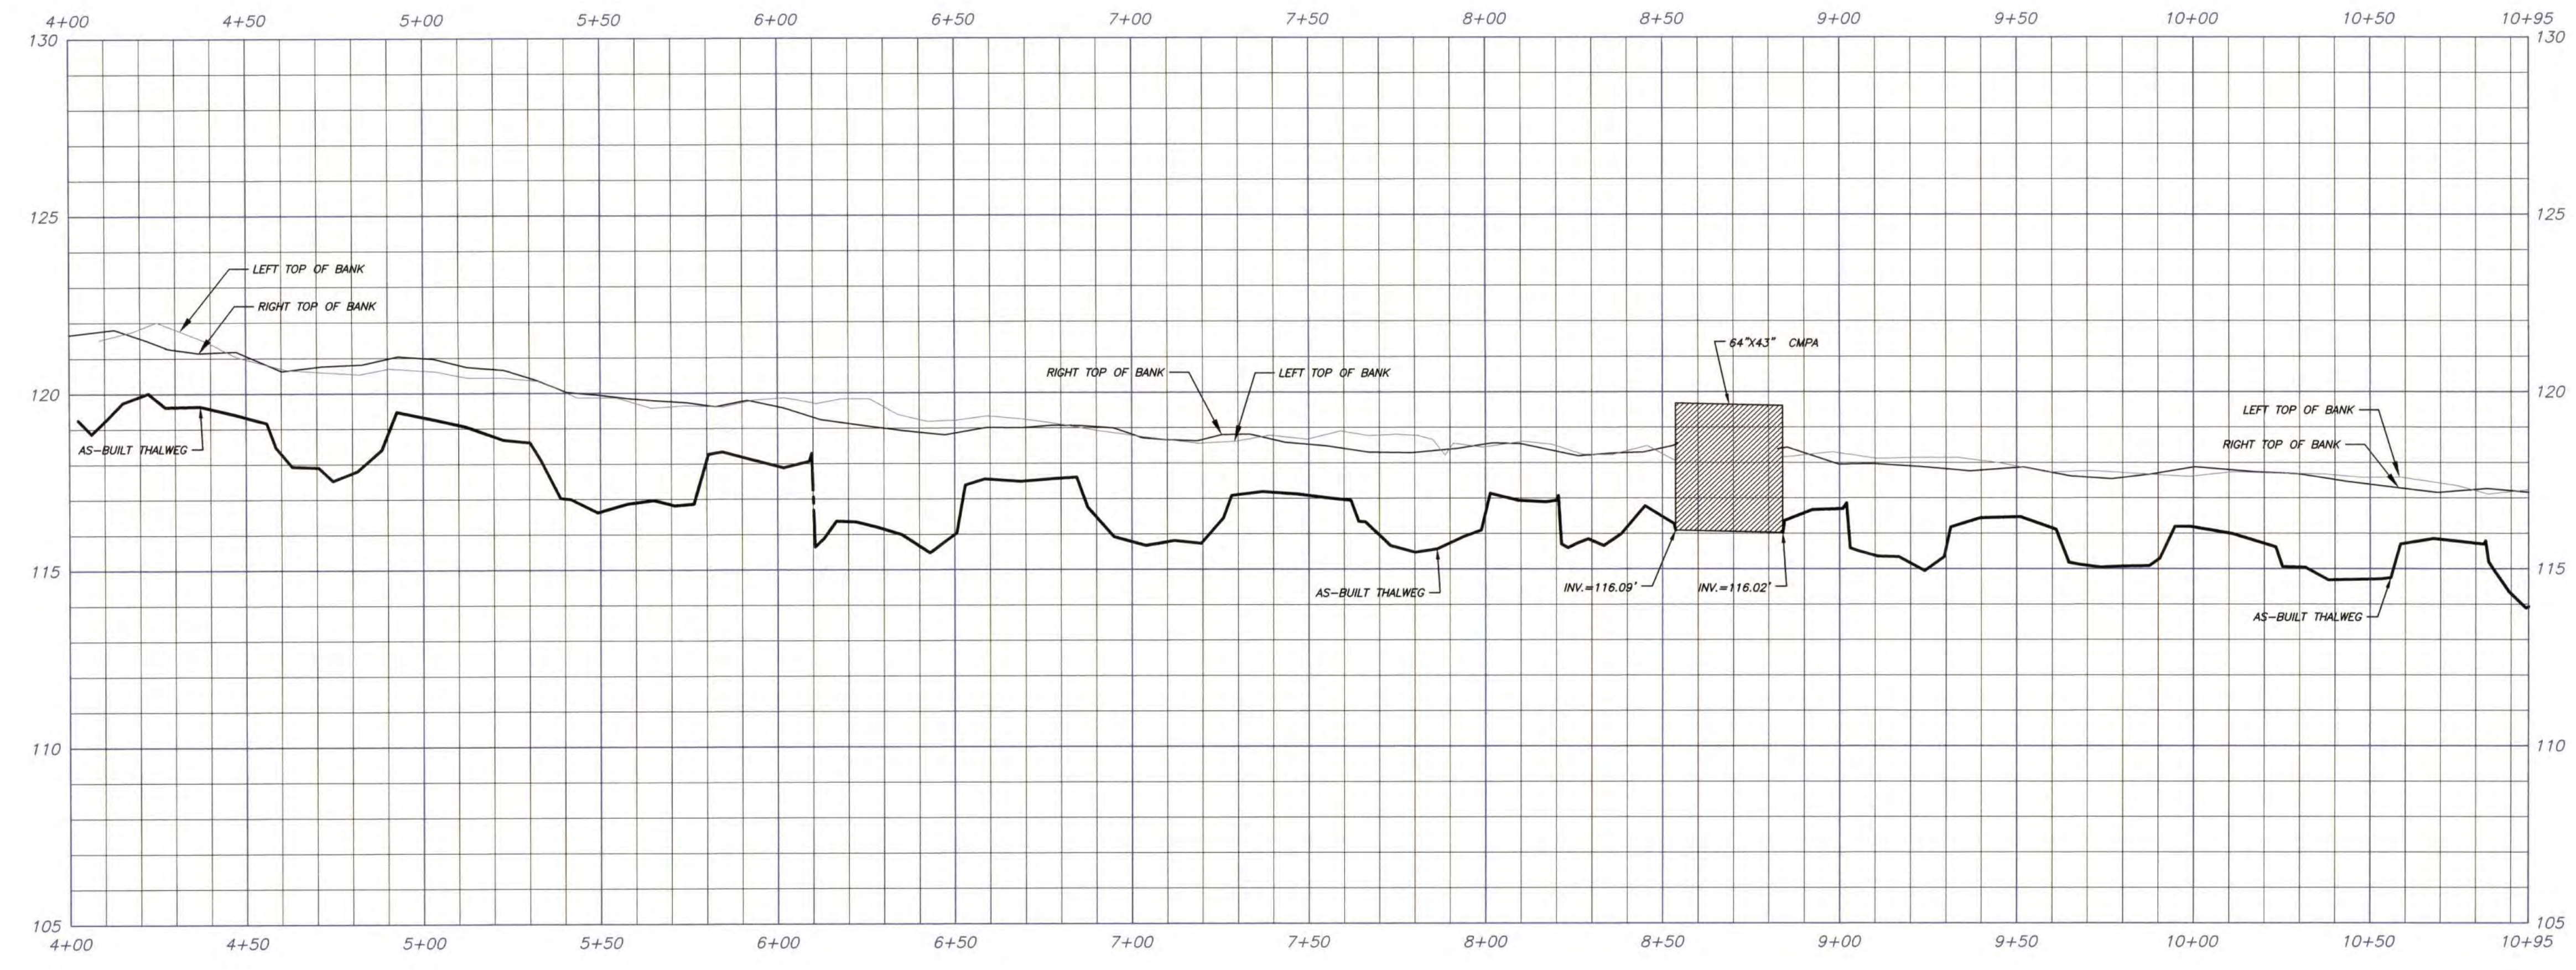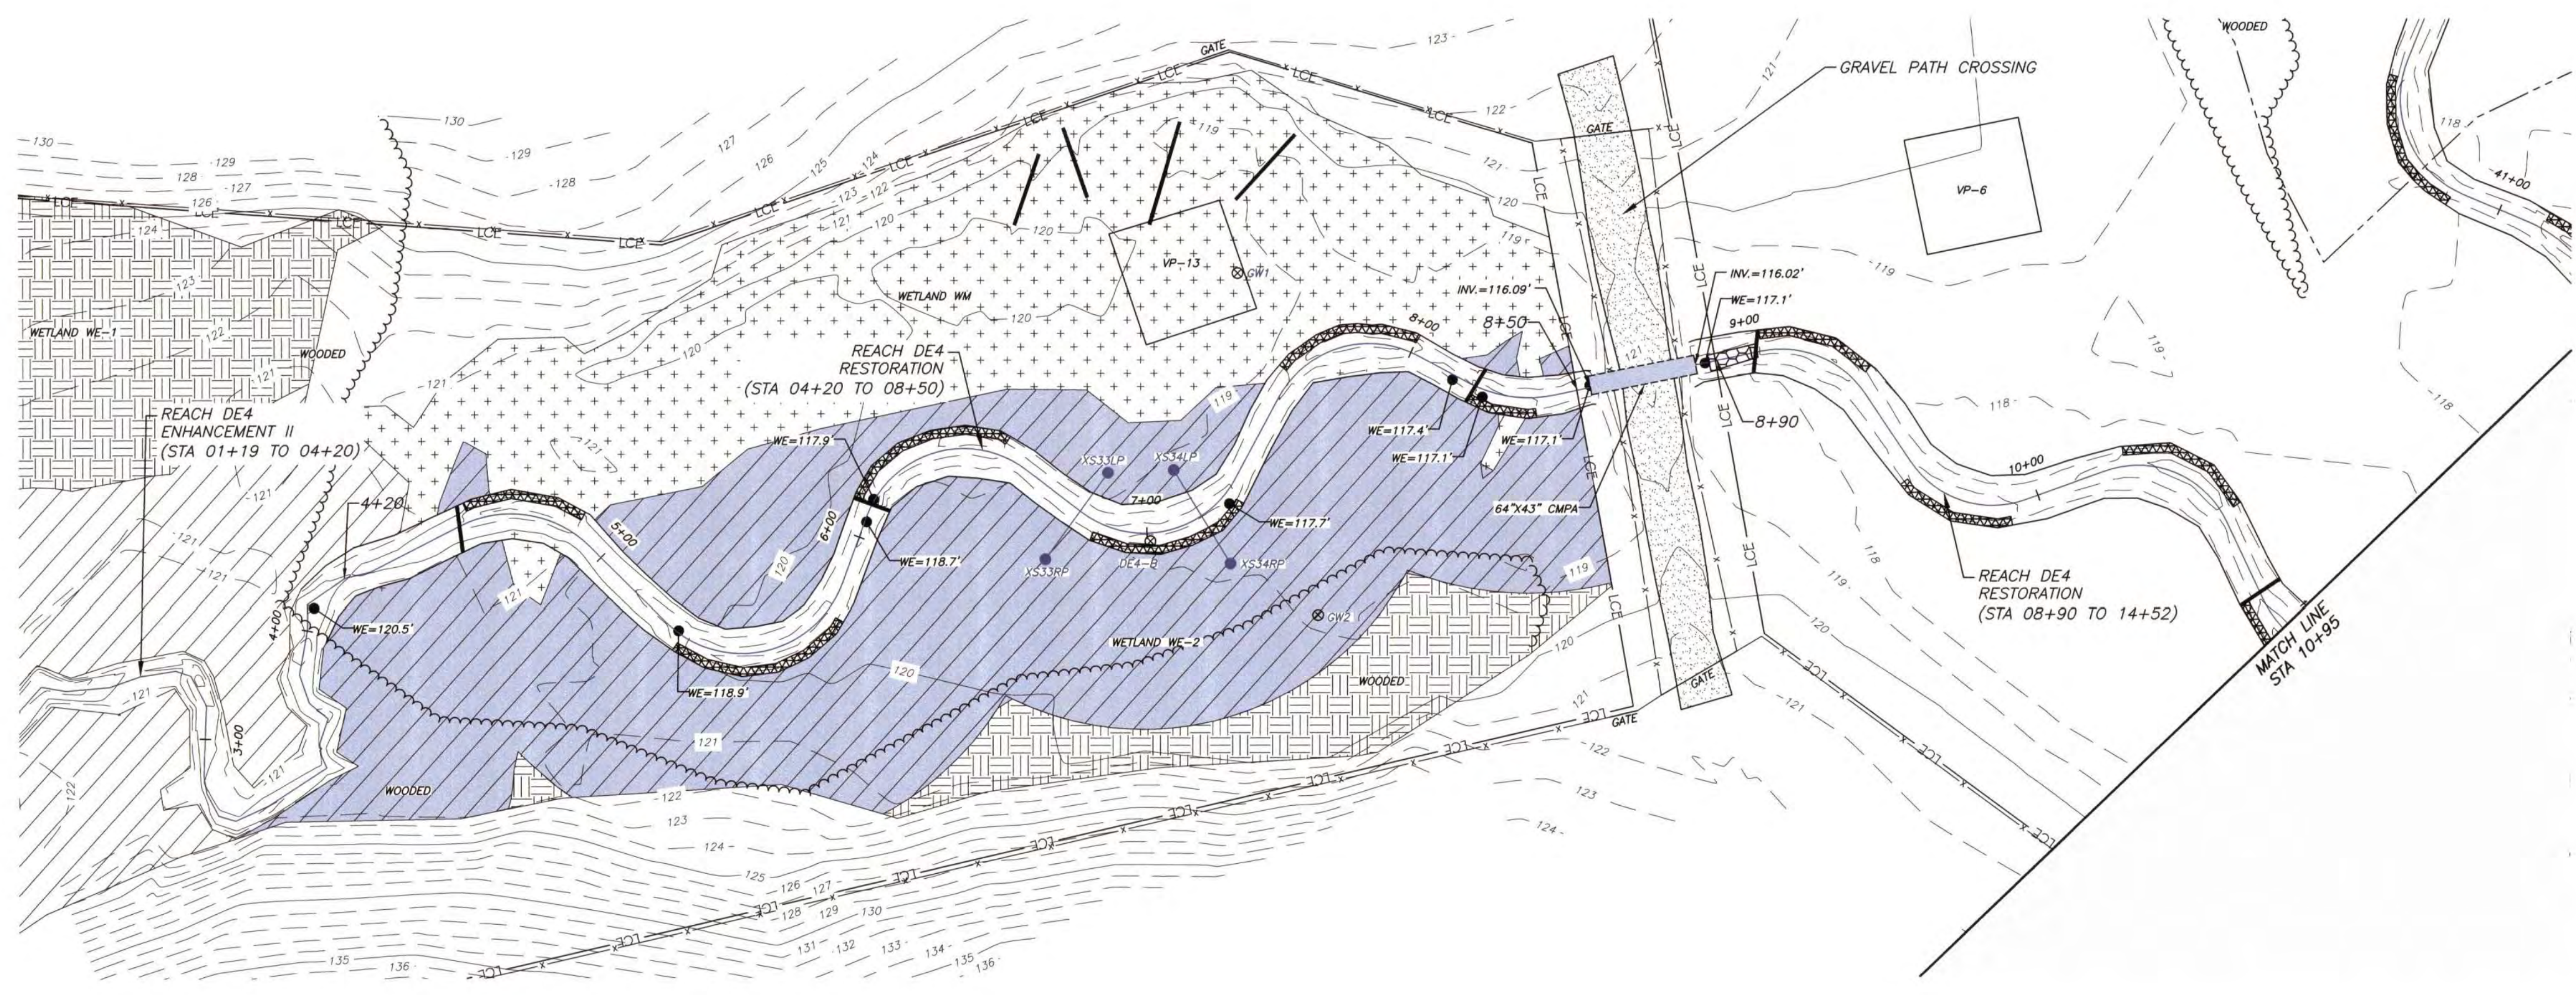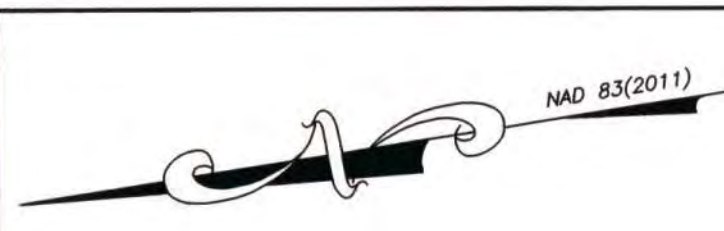

SEAL  
 NORTH CAROLINA  
 PROFESSIONAL  
 LAND SURVEYOR  
 JAMES R. WATSON  
 L-4712

DRAWING NO.  
**S13**

SHEET No. 13 OF 16

**RESOURCE ENVIRONMENTAL SOLUTIONS, LLC**  
**SIX RUNS MITIGATION SITE**  
**SAMPSON COUNTY, N.C.**





**STREAM AS BUILT SURVEY**  
**REACH DE4 PLAN & PROFILE (STA 04+00 - 10+95)**

**MATRIX EAST, PLLC**

906 N. QUEEN ST., SUITE A  
 KINSTON, NC 28501  
 TEL: 252-522-2500  
 FAX: 252-522-4747  
 FIRM LIC. # P-0221  
 EMAIL: [surveyor@matrixeast.net](mailto:surveyor@matrixeast.net)

DRAWN BY JRW	DATE 5/11/2023	SCALE 1" = 30'
PROJECT NO. 20200258		
DRAWING NAME 20200258-AS BUILT.DWG		



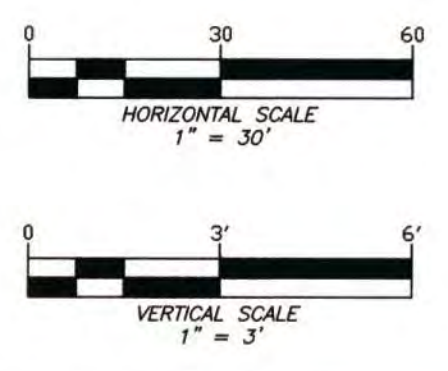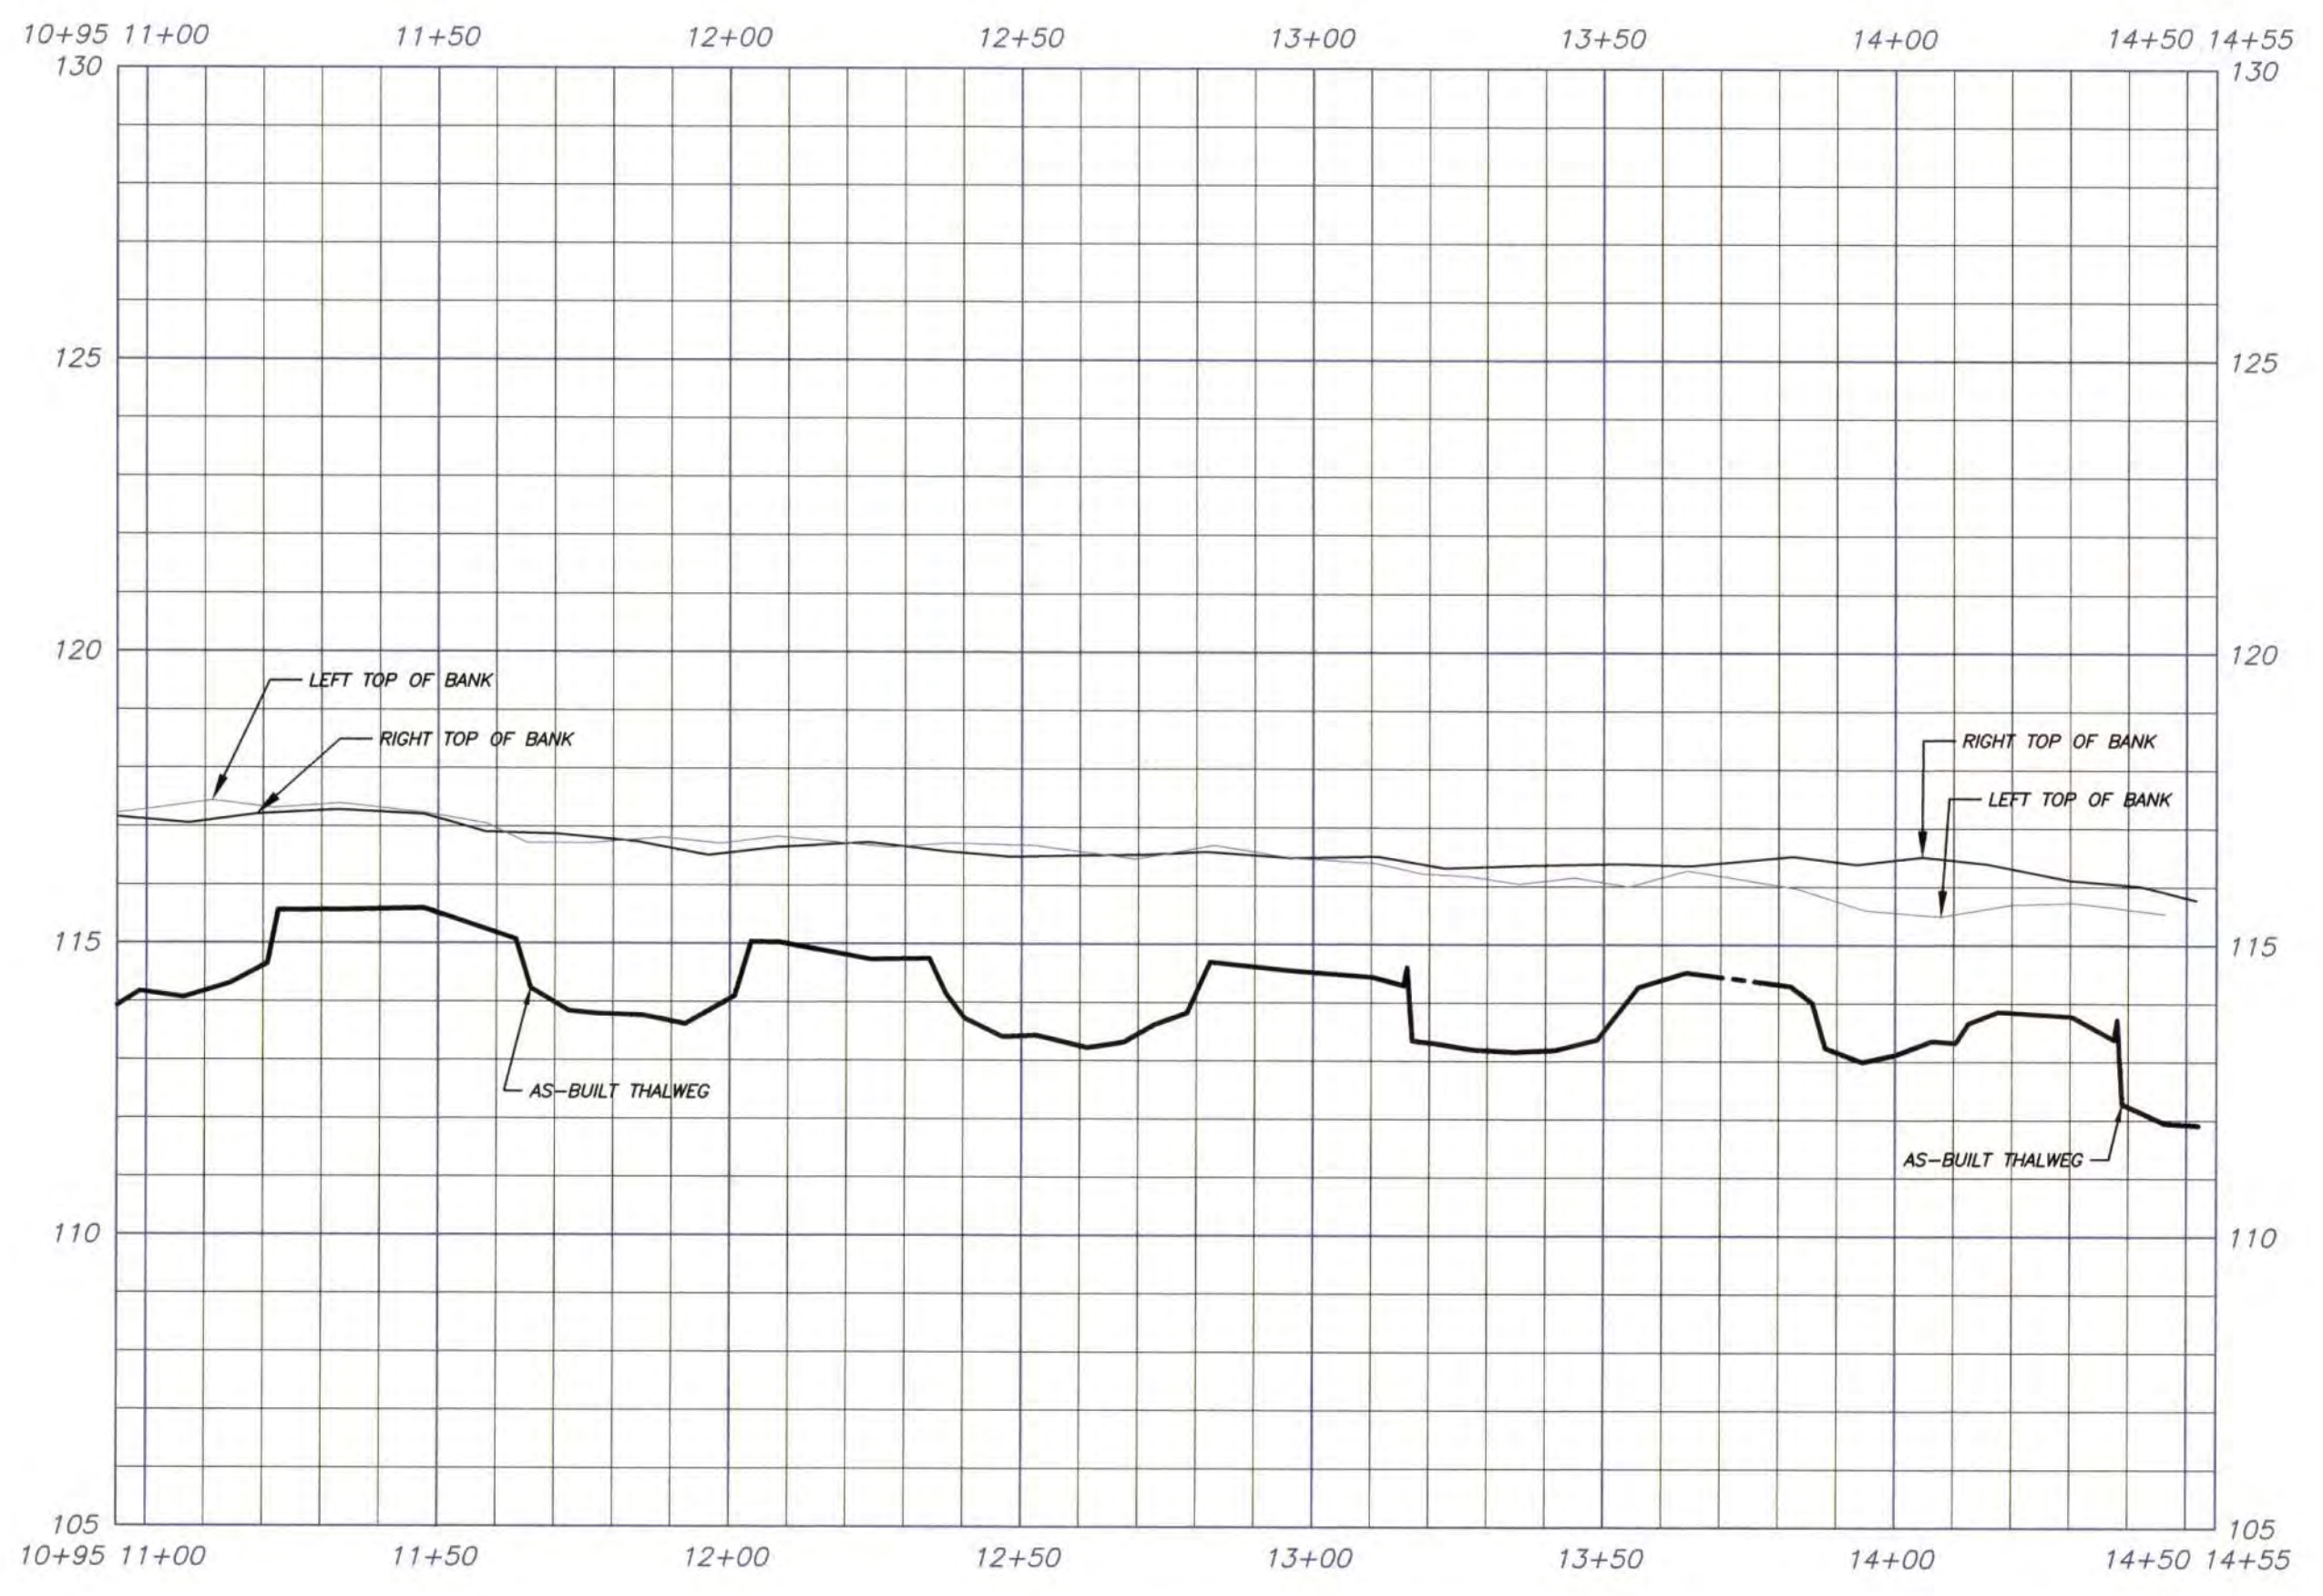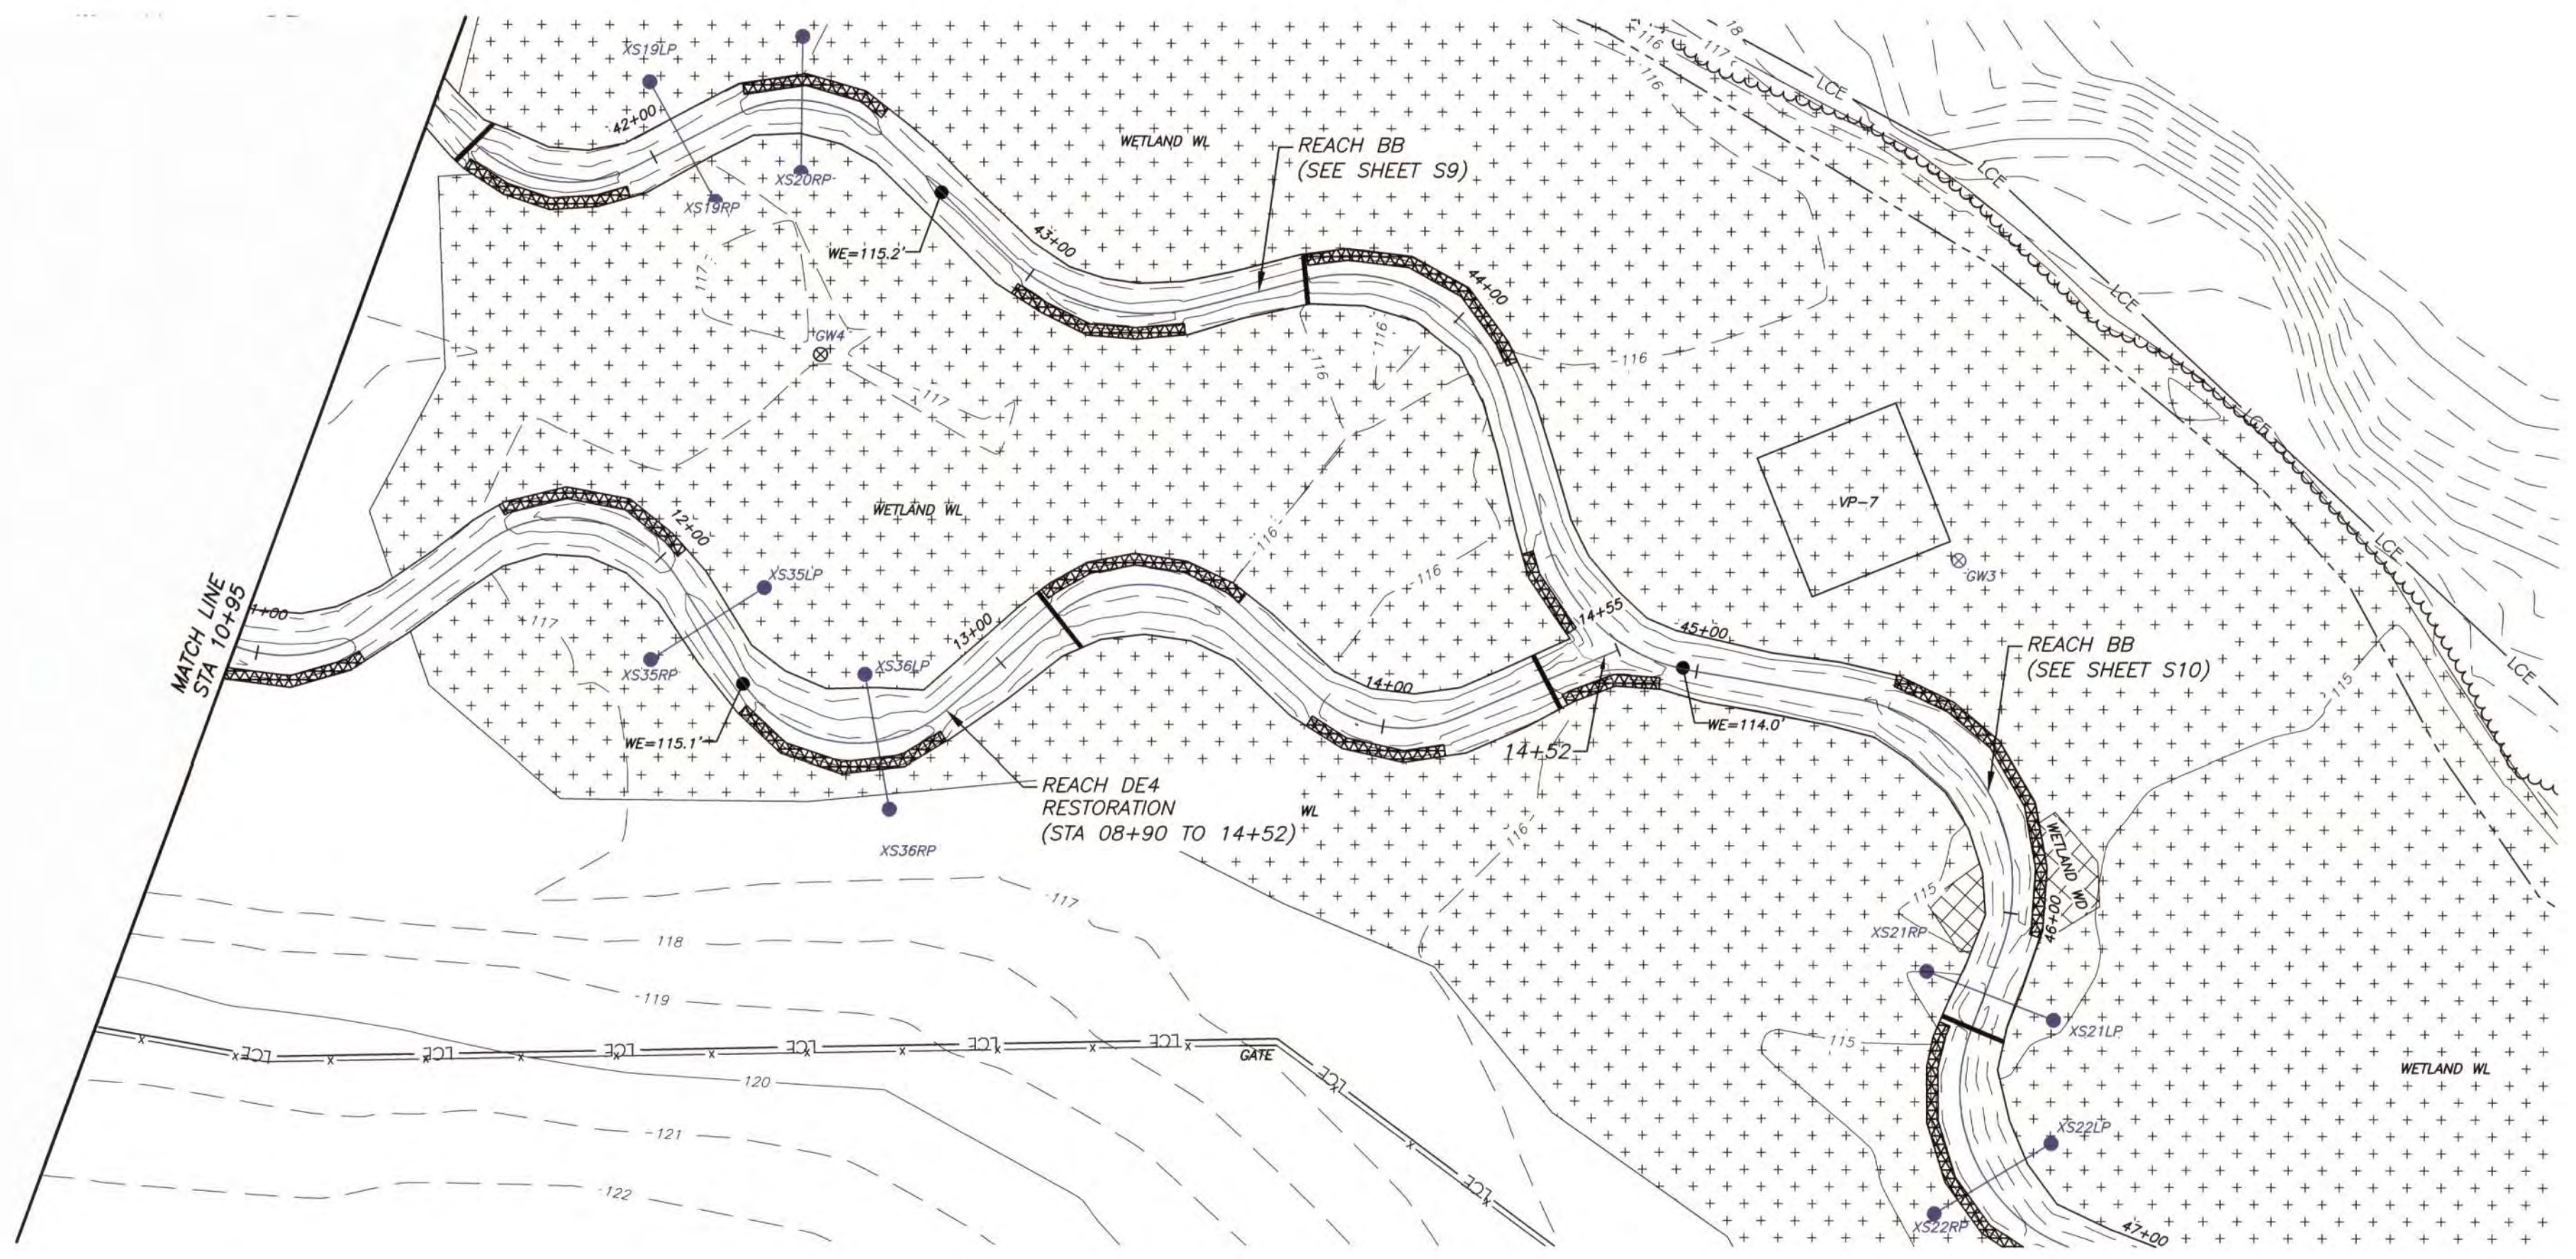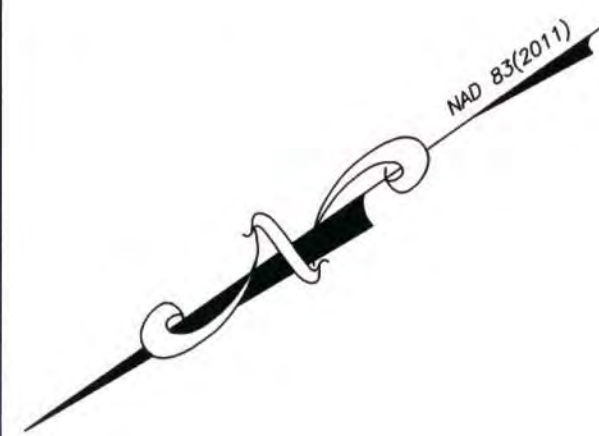

SEAL  
 NORTH CAROLINA  
 PROFESSIONAL  
 LAND SURVEYOR  
 L-4712  
 JAMES R. WATSON  
 5/11/2023

DRAWING NO.  
**S14**

SHEET No.  
 14 OF 16

**RESOURCE ENVIRONMENTAL SOLUTIONS, LLC**

**STREAM AS BUILT SURVEY**  
**REACH DE4 PLAN & PROFILE (STA 10+95 - 14+55)**






**SIX RUNS MITIGATION SITE**  
**SAMPSON COUNTY, N.C.**

**MATRIX EAST, PLLC**

906 N. QUEEN ST., SUITE A  
 KINSTON, NC 28501  
 TEL: 252-522-2500  
 FAX: 252-522-4747  
 FIRM LIC. # P-0221  
 EMAIL: surveyor@matrixeast.net

DRAWN BY JRW	DATE 5/11/2023	SCALE 1" = 30'
PROJECT NO. 20200258		
DRAWING NAME 20200258-AS BUILT.DWG		



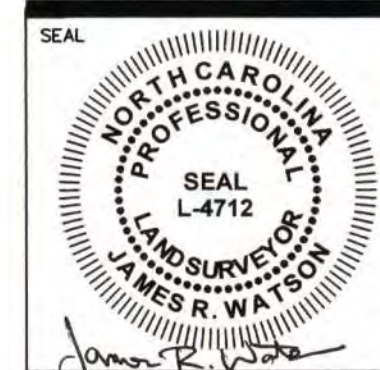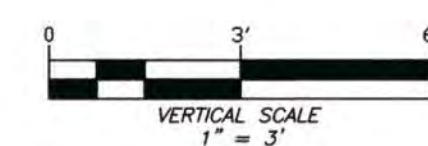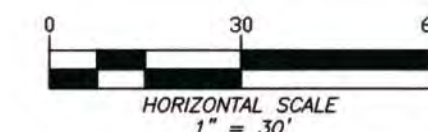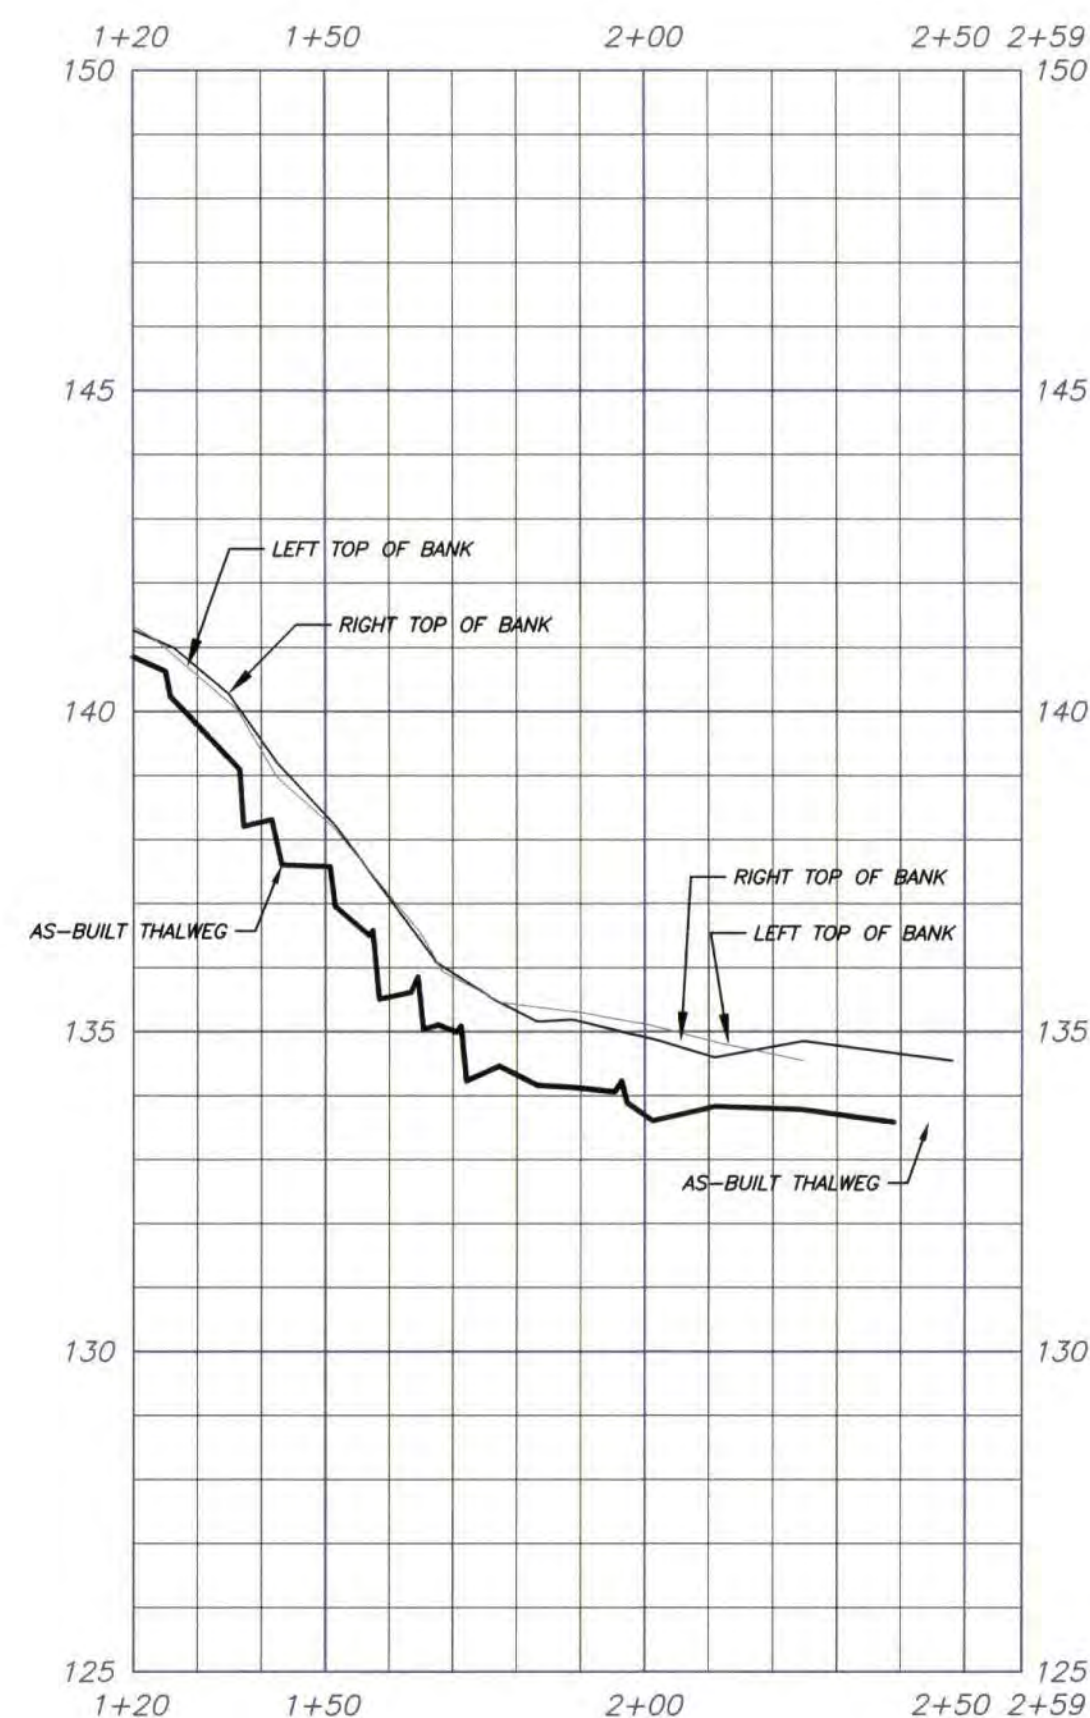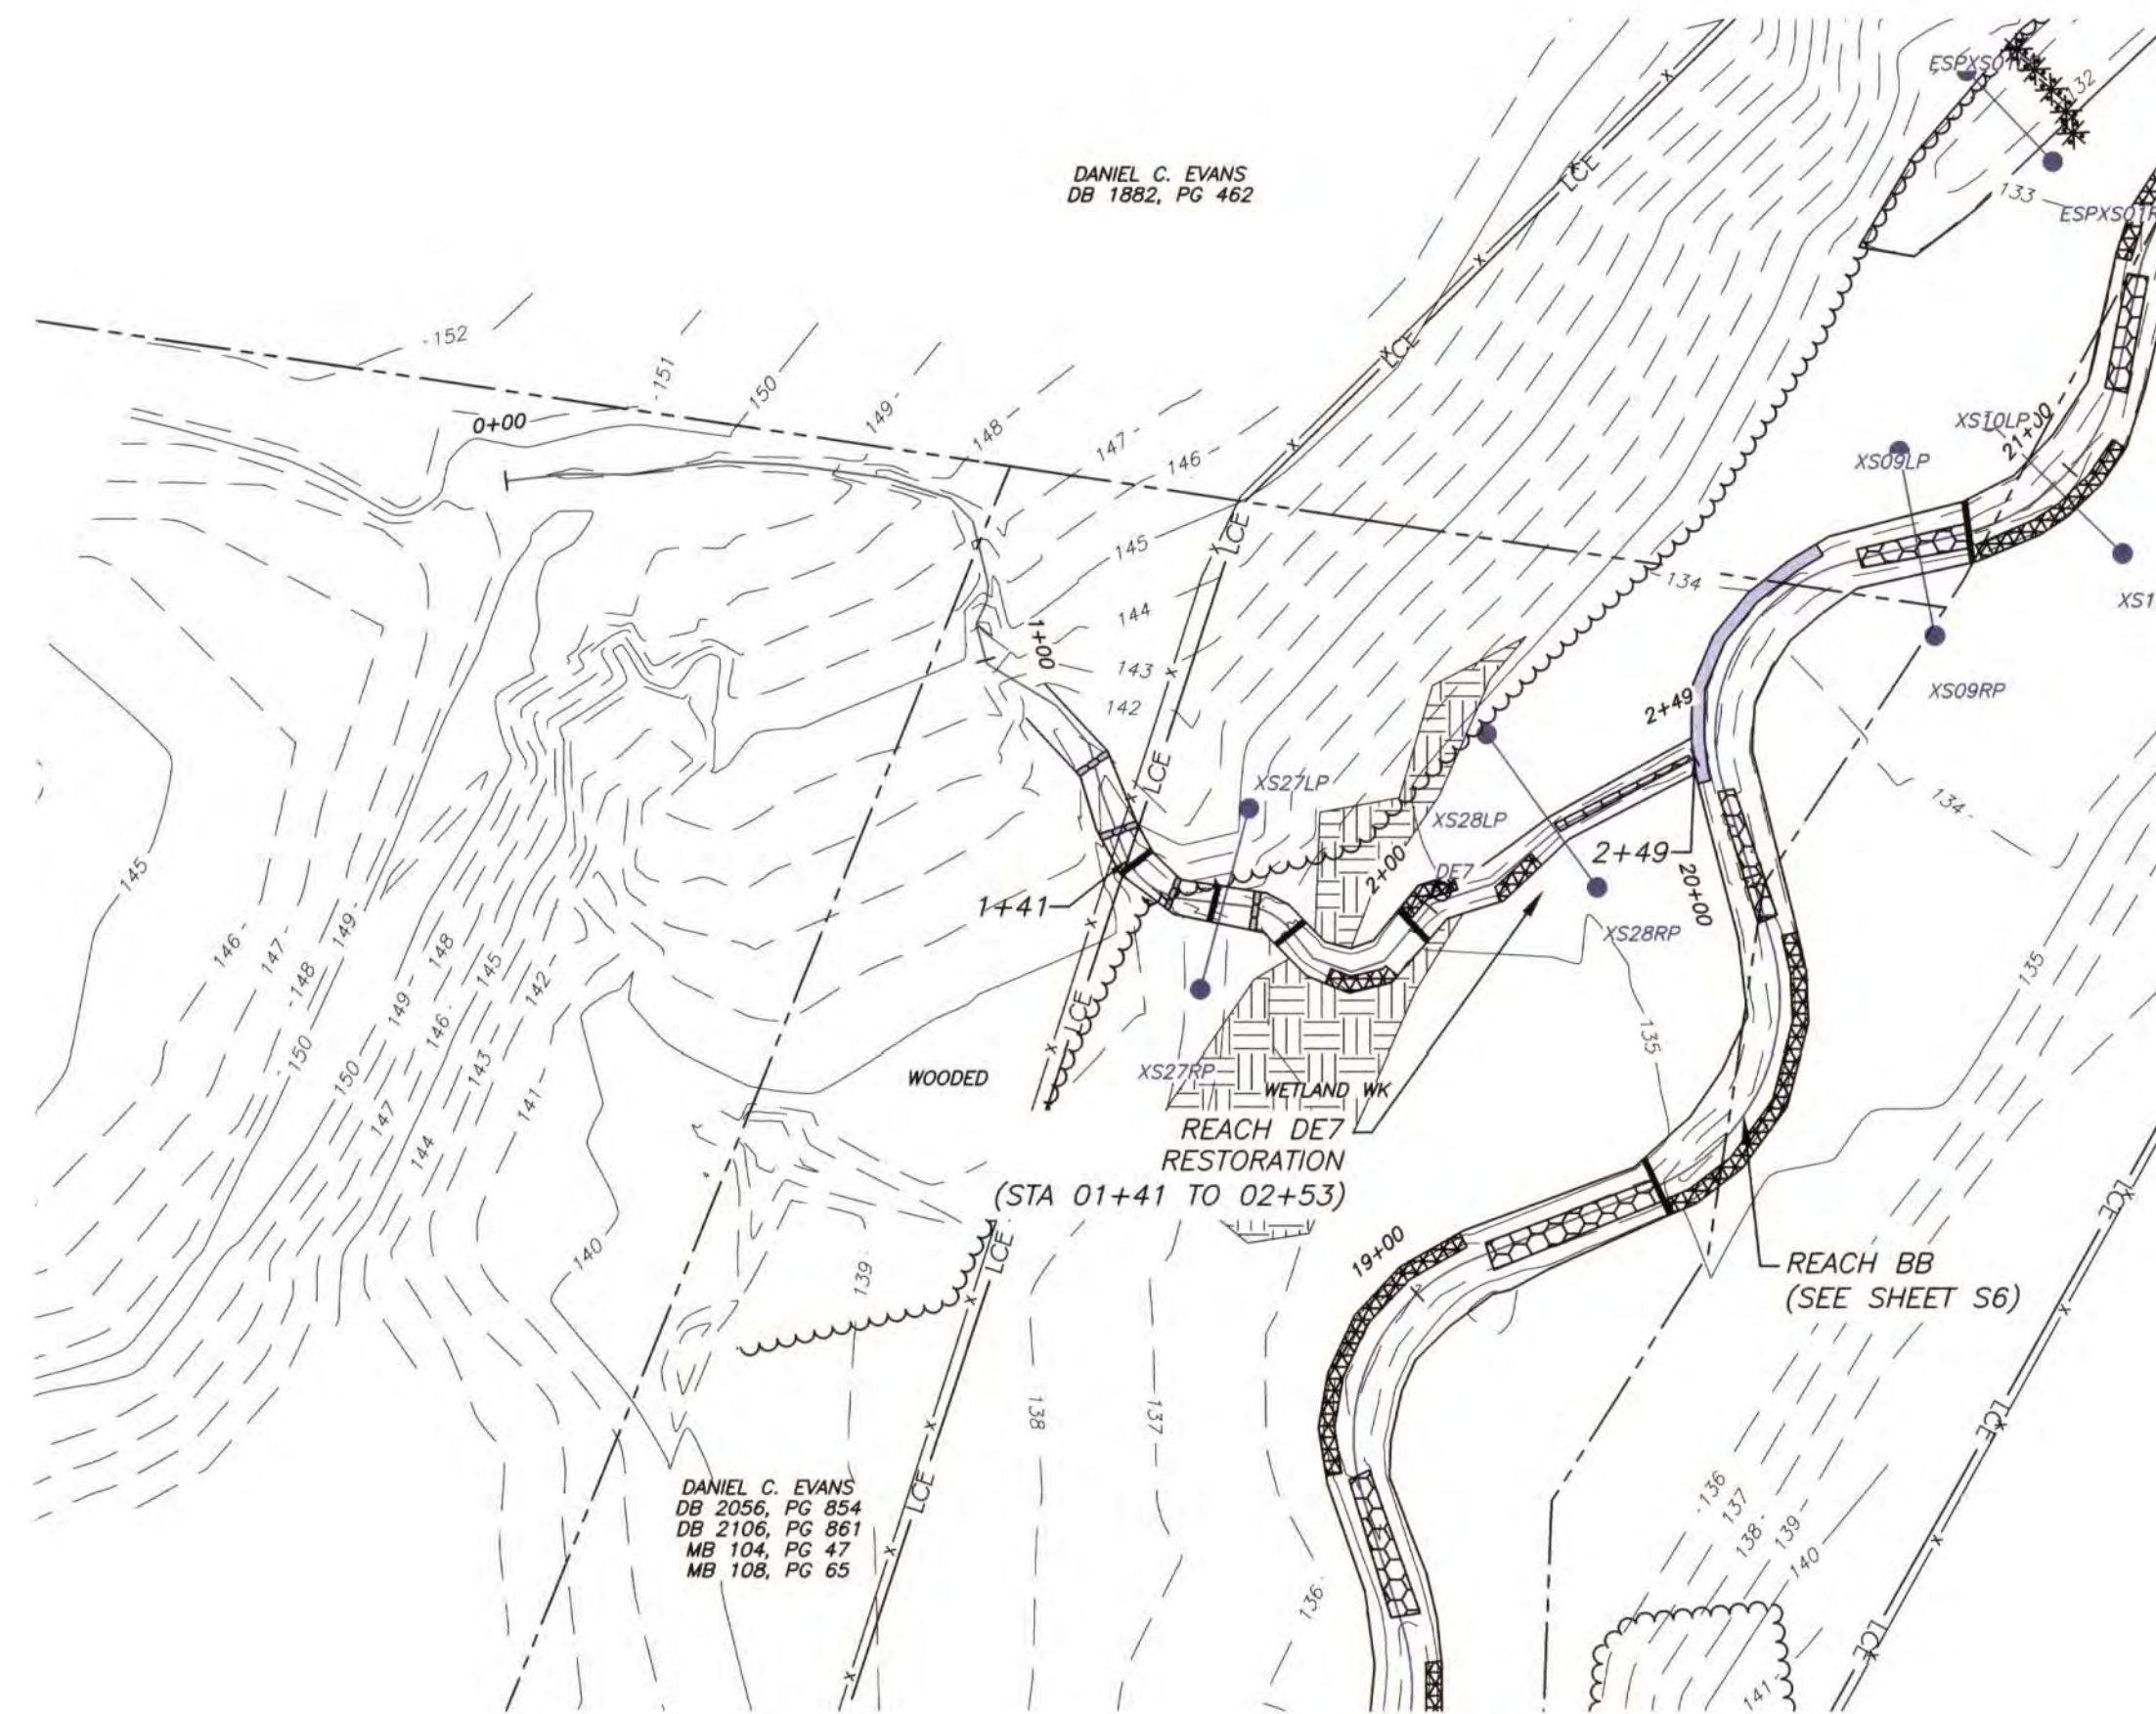

DRAWING NO. **S15**  
 SHEET No. 15 OF 16

STREAM AS BUILT SURVEY  
 REACH DE7 PLAN & PROFILE (STA 01+41 - 02+49)






**RESOURCE ENVIRONMENTAL SOLUTIONS, LLC**  
**SIX RUNS MITIGATION SITE**  
**SAMPSON COUNTY, N.C.**



906 N. QUEEN ST., SUITE A  
 KINSTON, NC 28501  
 TEL: 252-522-2500  
 FAX: 252-522-4747  
 FIRM LIC. # P-0221  
 EMAIL: surveyor@matrixeast.net

DRAWN BY JRW	DATE 5/11/2023	SCALE 1" = 30'
PROJECT NO. 20200258		
DRAWING NAME 20200258-AS BUILT.DWG		



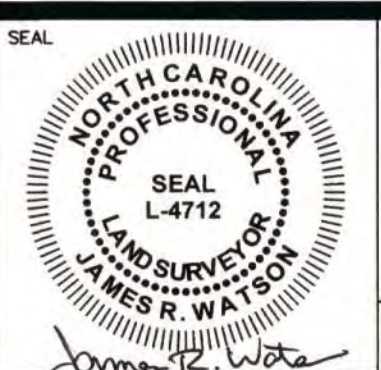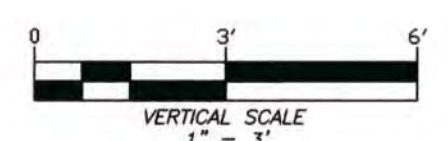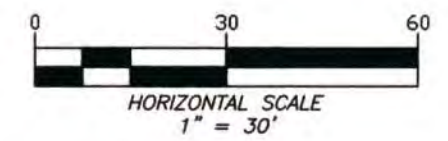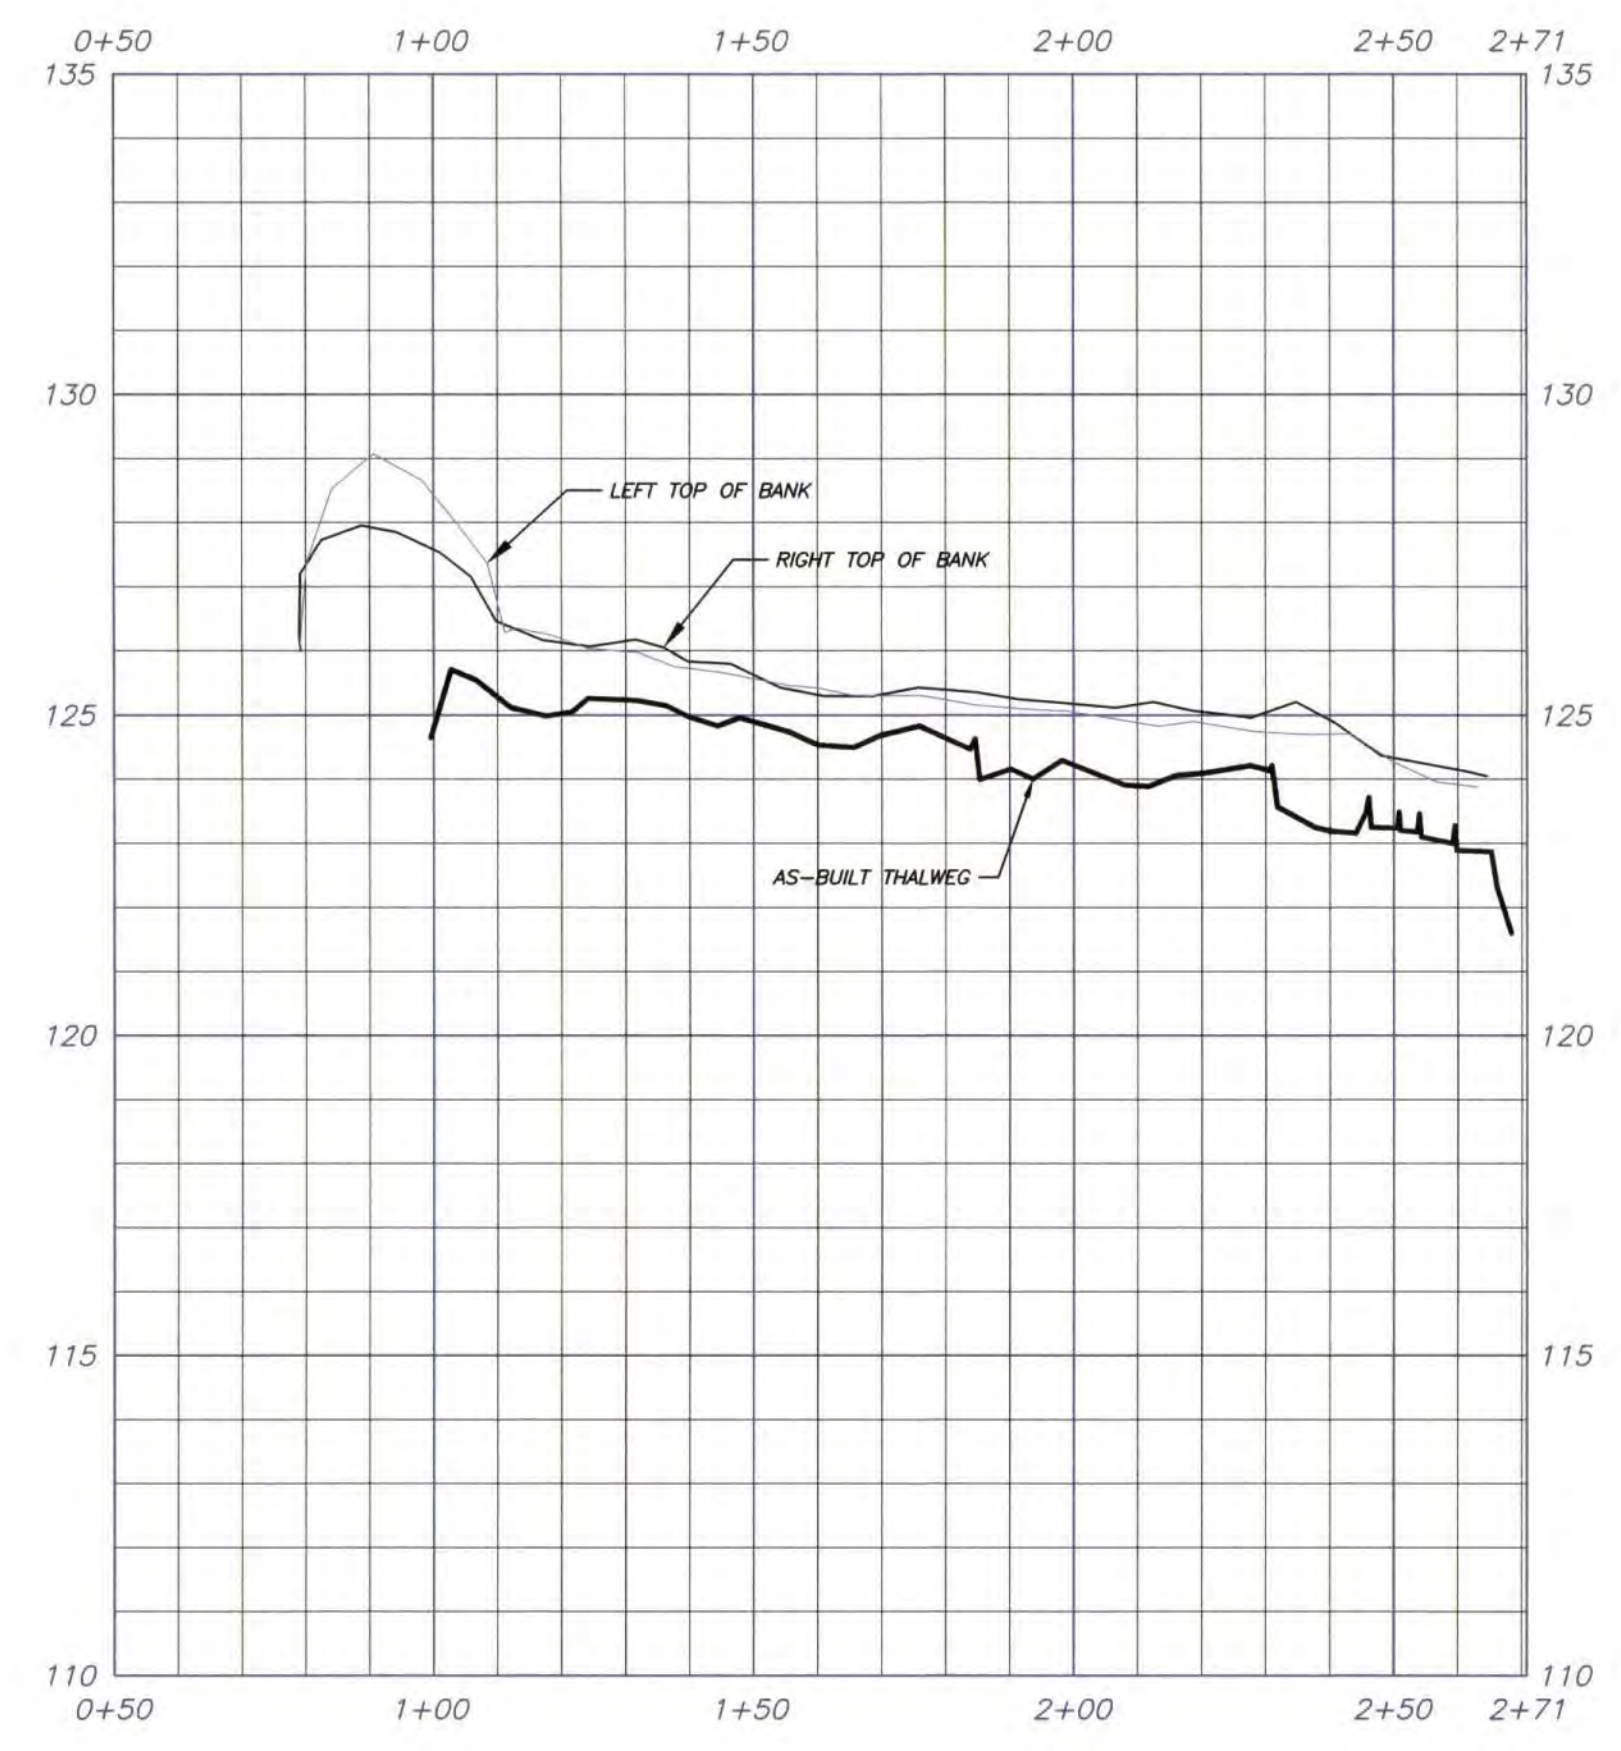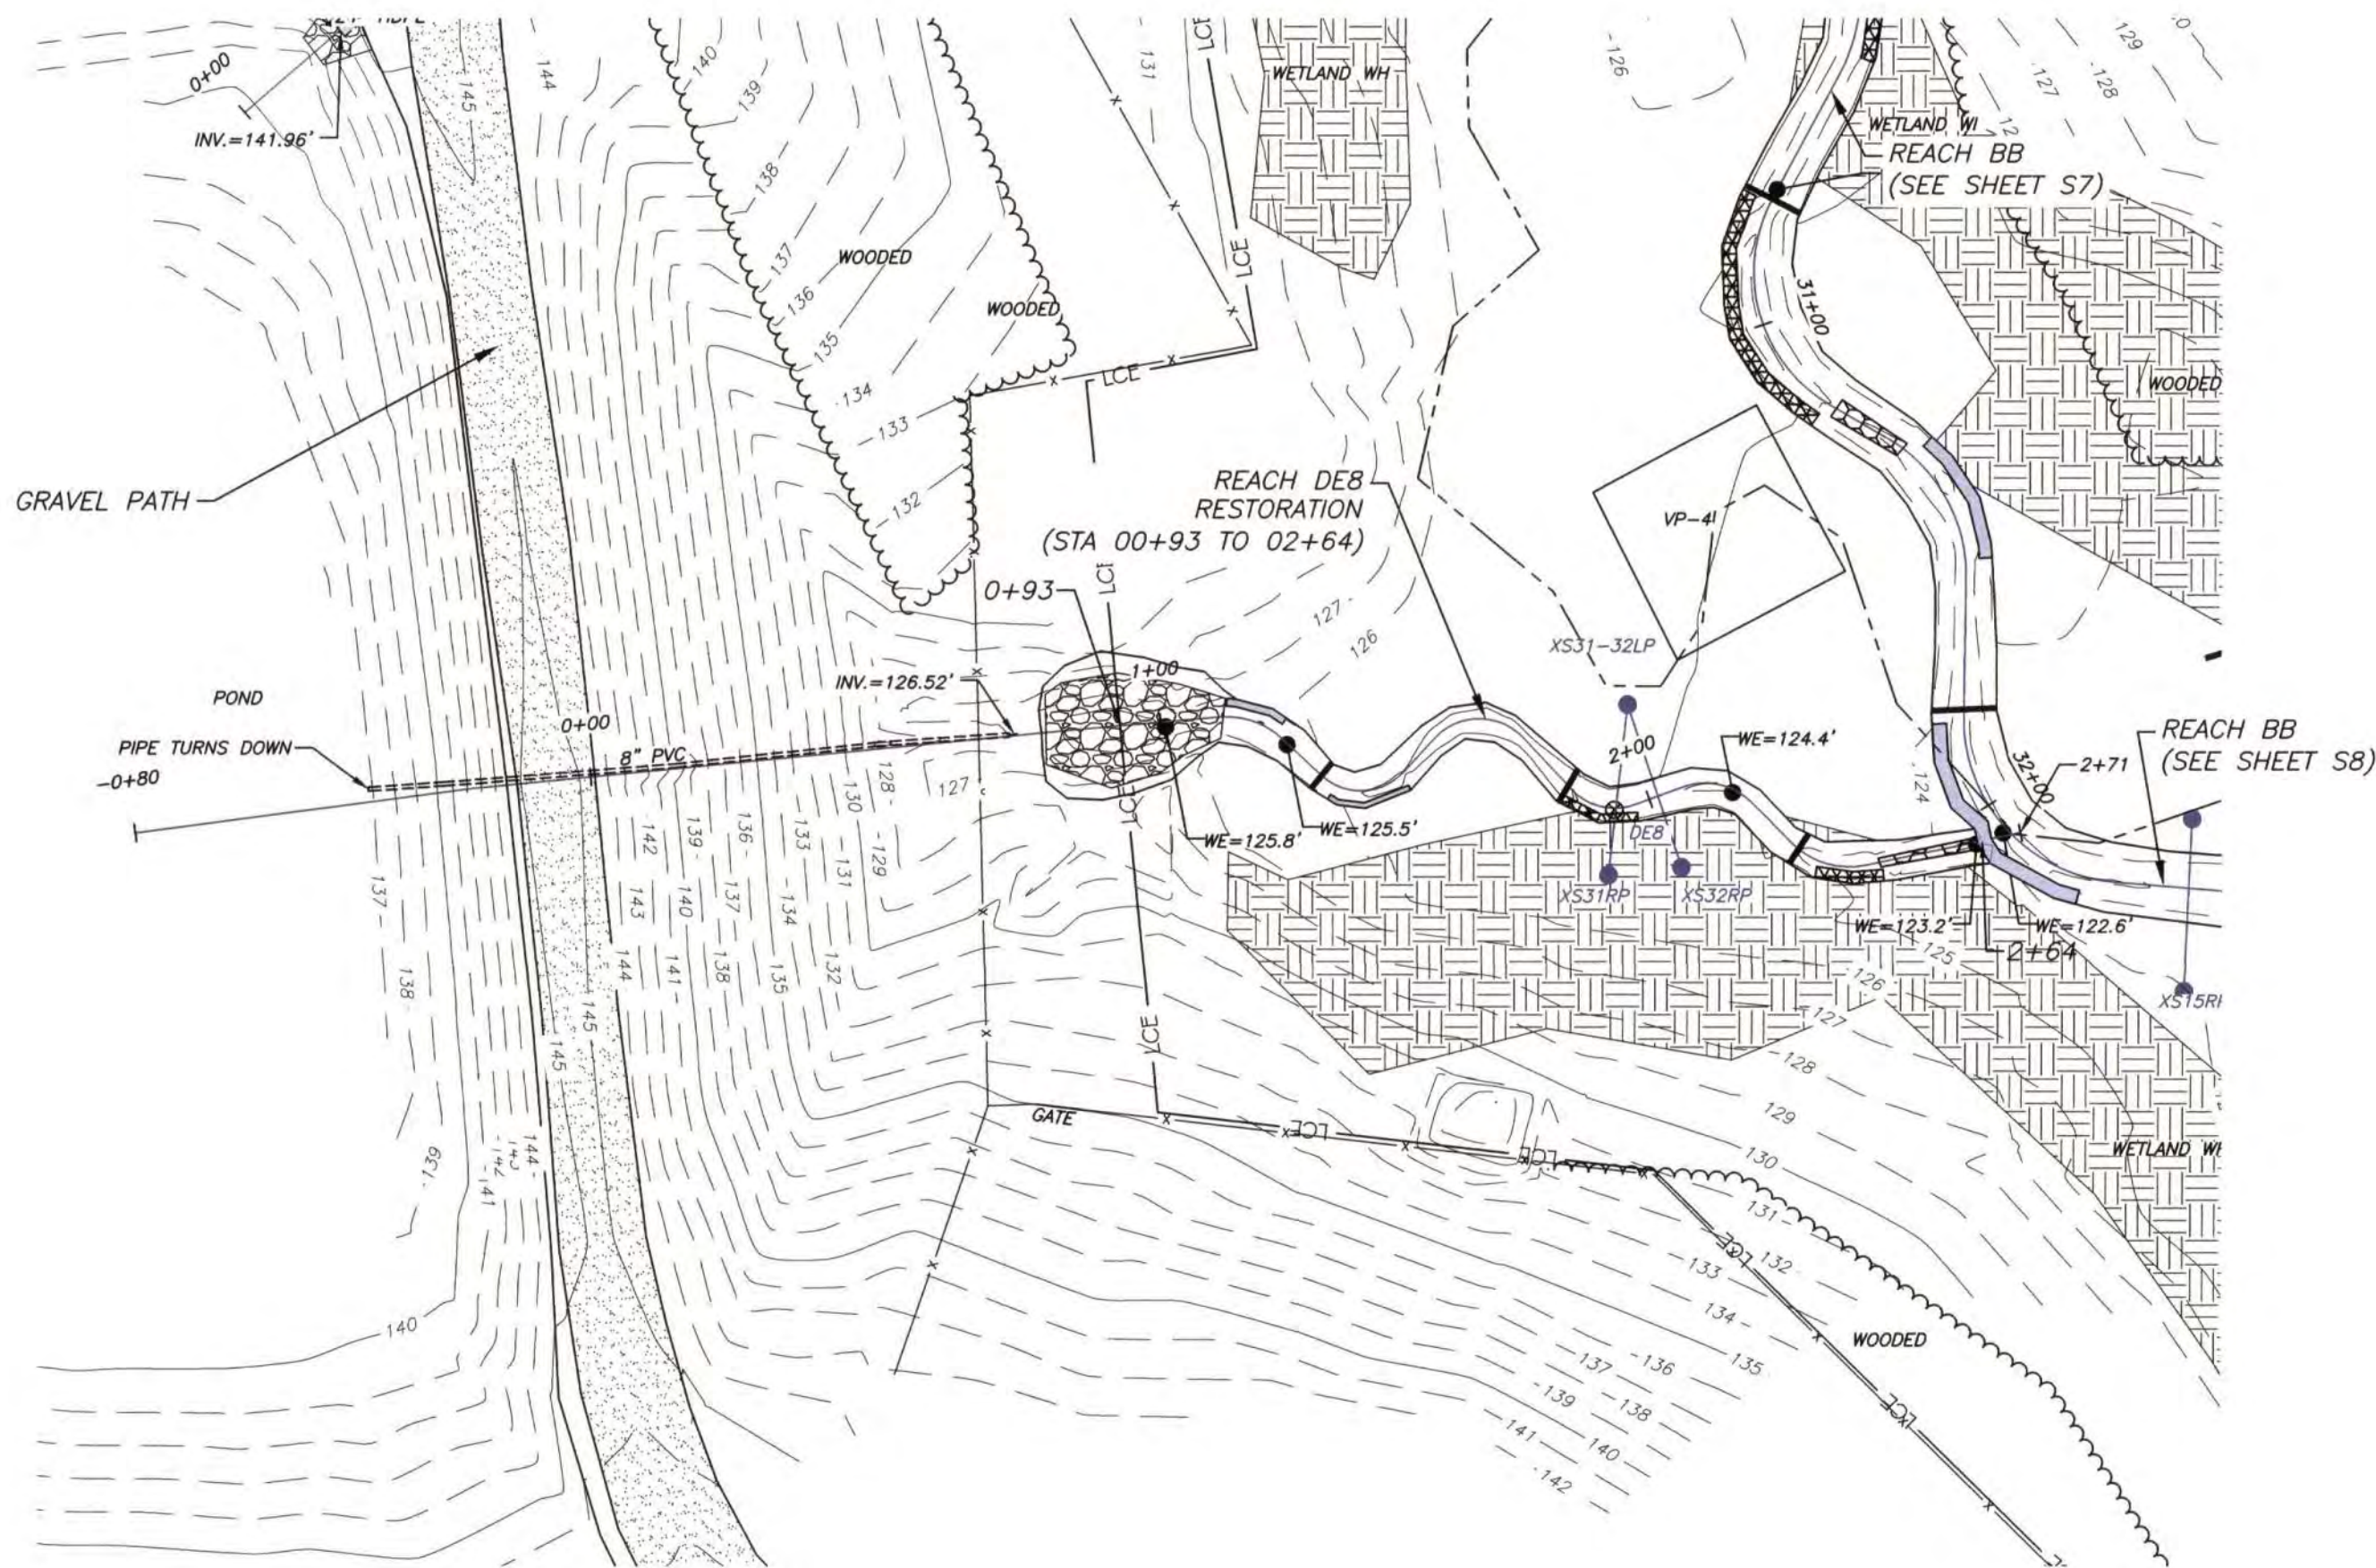

DRAWING NO. **S16**  
SHEET No. 16 OF 16

**RESOURCE ENVIRONMENTAL SOLUTIONS, LLC**  
**SIX RUNS MITIGATION SITE**  
**SAMPSON COUNTY, N.C.**


**STREAM AS BUILT SURVEY**  
**REACH DEB PLAN & PROFILE (STA 00+50 - 02+71)**



906 N. QUEEN ST., SUITE A  
KINSTON, NC 28501  
TEL: 252-522-2500  
FAX: 252-522-4747  
FIRM LIC. # P-0221  
EMAIL: surveyor@matrixeast.net

DRAWN BY: JRW DATE: 5/11/2023 SCALE: 1" = 30'  
PROJECT NO.: 20200258  
DRAWING NAME: 20200258-AS BUILT.DWG



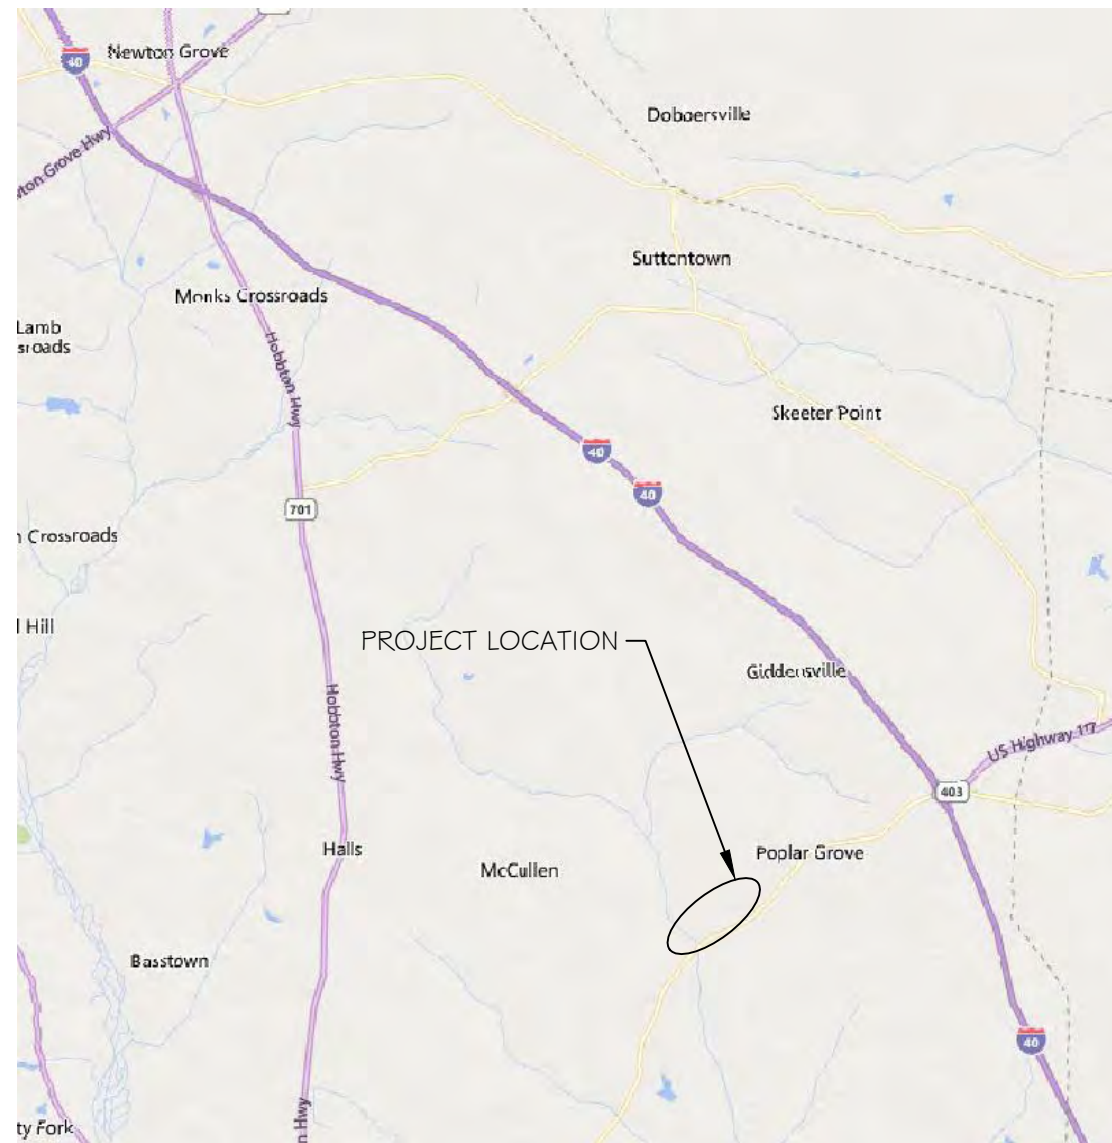

VICINITY MAP  
NTS


# SIX RUNS RECORD DRAWINGS

SAMPSON COUNTY, NORTH CAROLINA  
(35.0962, -78.2297)

CAPE FEAR RIVER BASIN/ HUC: 03030006110010  
AUGUST 2023

## RESOURCE ENVIRONMENTAL SOLUTIONS, LLC

3600 GLENWOOD AVE, SUITE 100  
RALEIGH, NC 27612

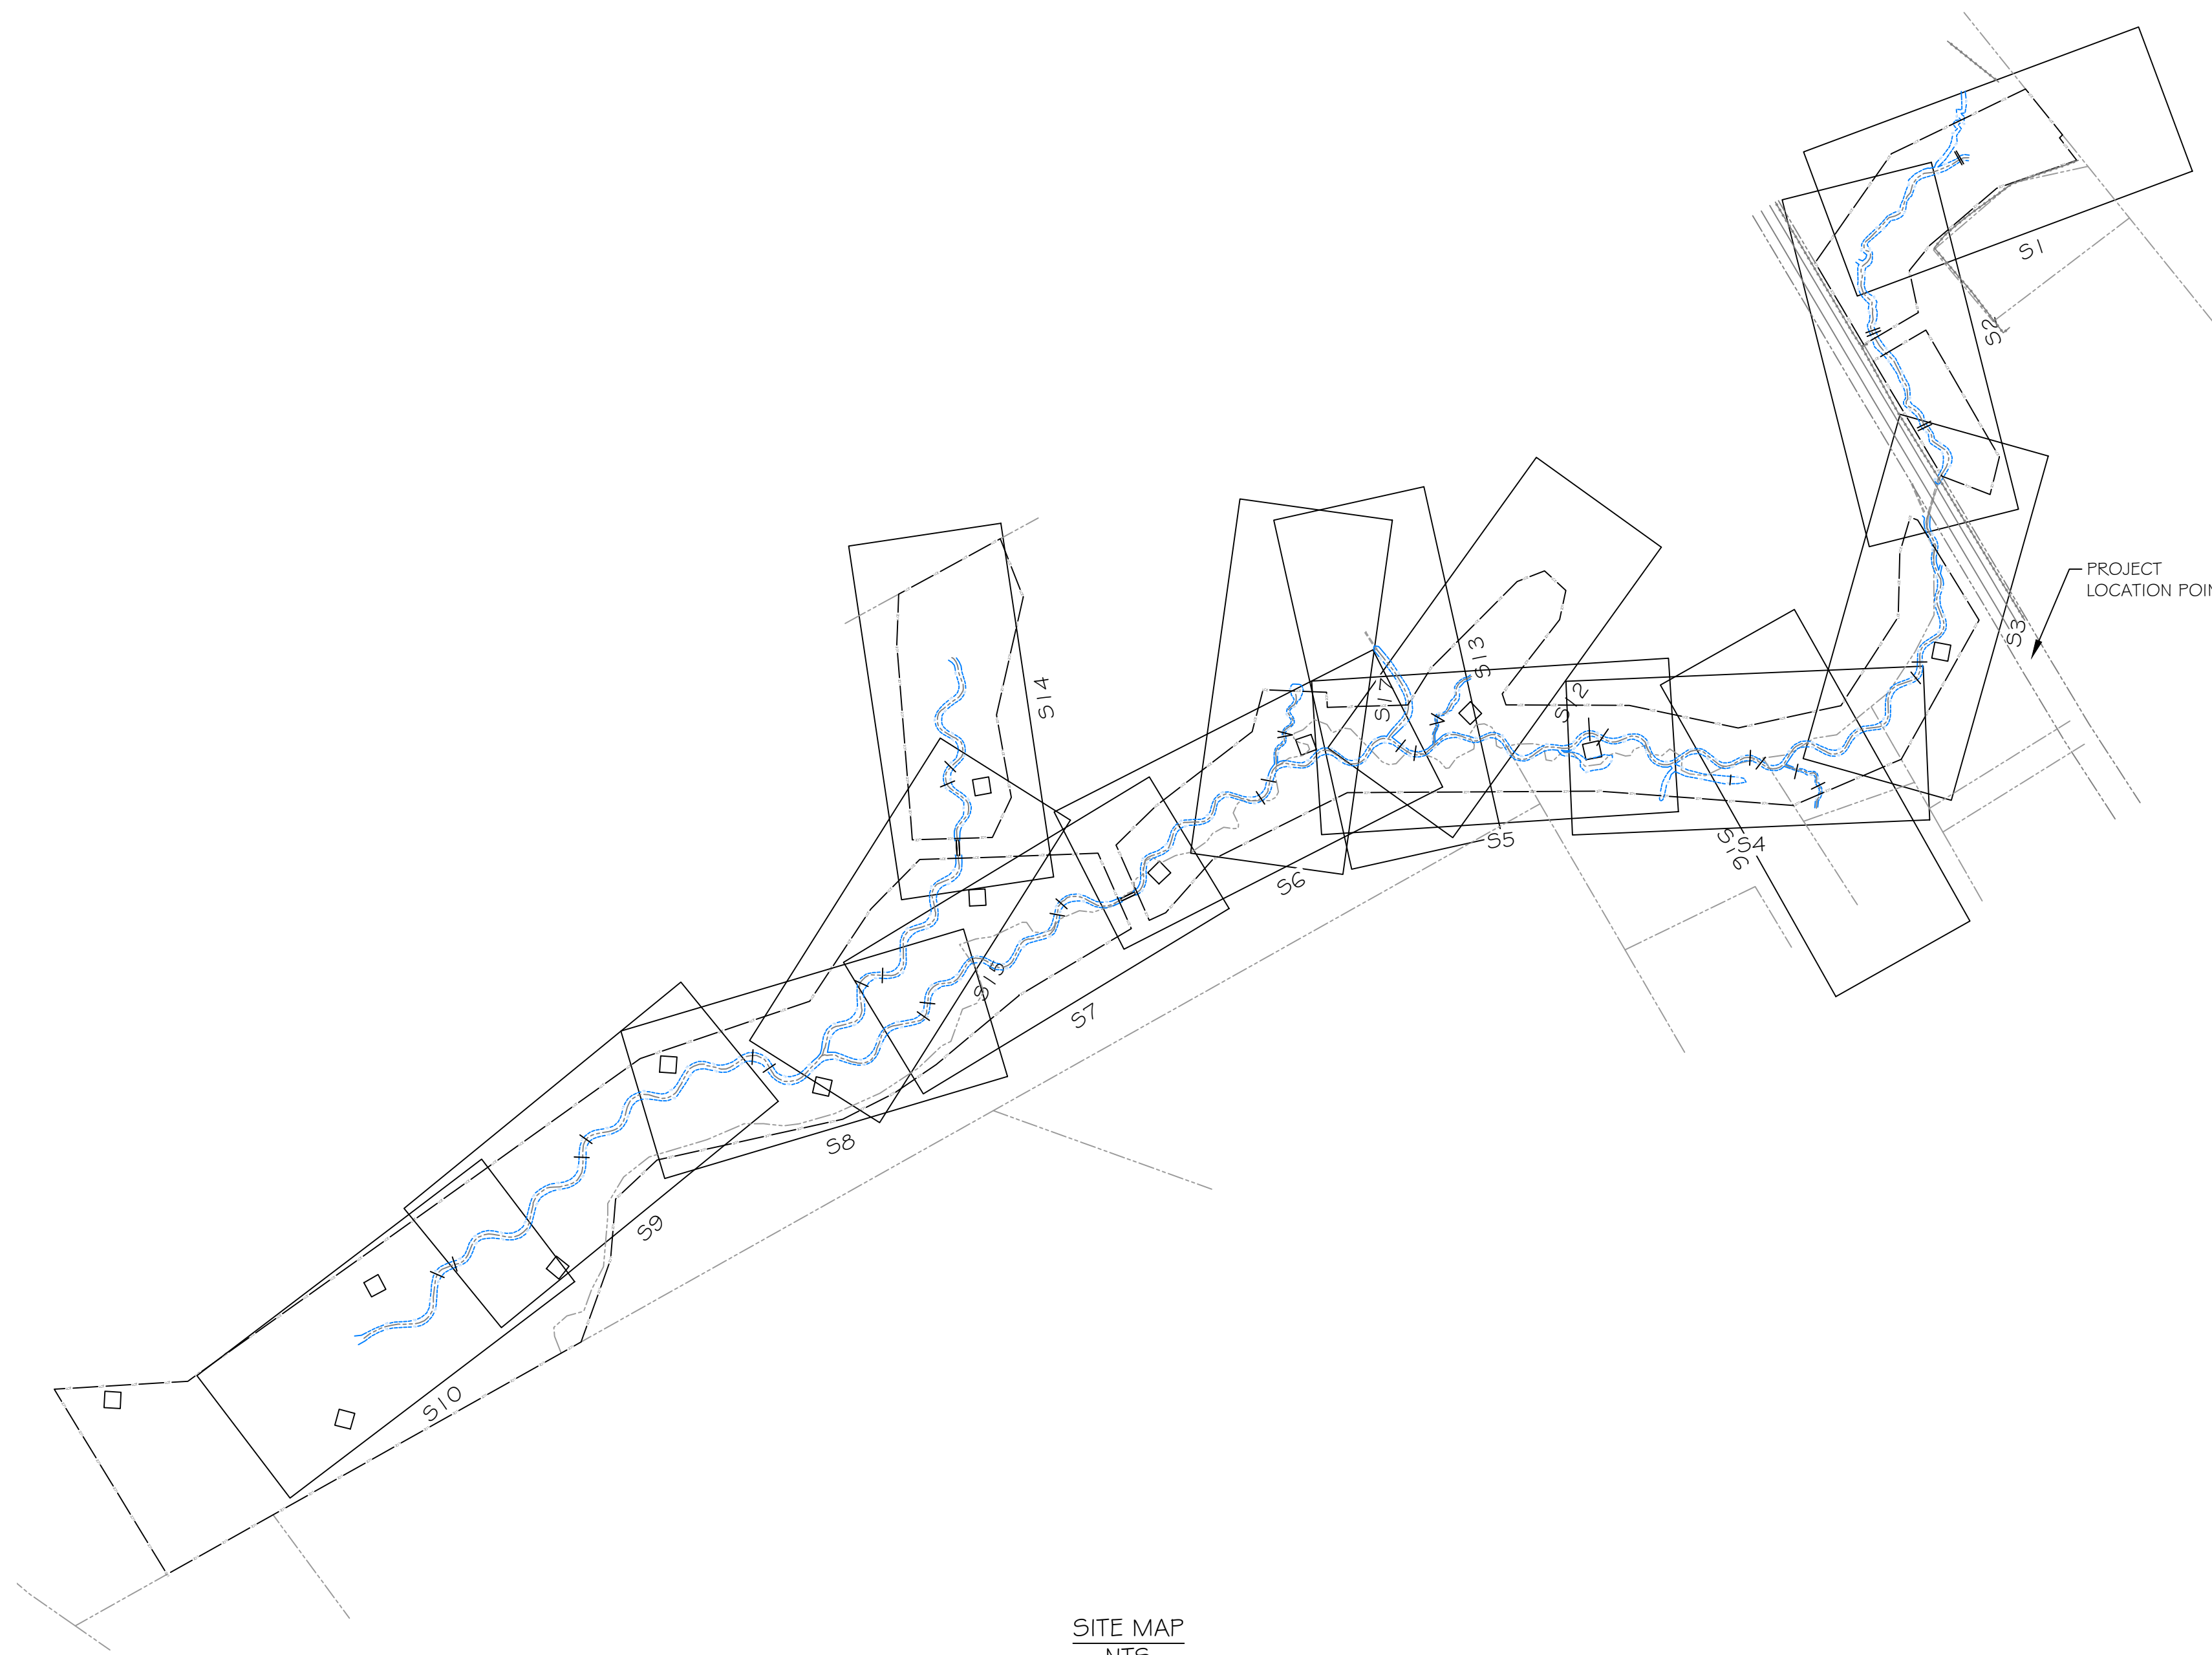

SITE MAP  
NTS

Sheet List Table	
Sheet Number	Sheet Title
--	COVER
S1	REACH BB
S2	REACH BB
S3	REACH BB
S4	REACH BB
S5	REACH BB
S6	REACH BB
S7	REACH BB
S8	REACH BB
S9	REACH BB
S10	REACH BB
S11	REACH DE2
S12	REACH DE3
S13	REACH DE4
S14	REACH DE4
S15	REACH DE7
S16	REACH DE8
W1	WETLANDS

### PROJECT DIRECTORY

DESIGNED BY:  
RESOURCE ENVIRONMENTAL SOLUTIONS, LLC  
3600 GLENWOOD AVE, SUITE 100  
RALEIGH, NC 27612

DESIGNED FOR:  
LINDSAY CROCKER  
NC DEPARTMENT OF ENVIRONMENTAL QUALITY  
DIVISION OF MITIGATION SERVICES  
217 WEST JONES ST., SUITE 300A  
RALEIGH, NC 27603

SURVEYED BY:  
MATRIX EAST, PLLC  
906 N. QUEEN ST., SUITE A  
KINSTON, NC 28501

DMS PROJECT #: 100170  
CONTRACT #: 0303-01  
USACE ACTION ID #: SAW-2020-01964  
RFP #: 16-20190303



AS-BUILT TOPOGRAPHY AND PLANIMETRICS SURVEY  
WAS PROVIDED BY MATRIX EAST, PLLC (NC FIRM  
LICENSE NUMBER P-0221, CHRISTOPHER K.  
PADERICK, NC PLS L-4189), DATED JUNE 21, 2023



3600 Glenwood Ave, Suite 100  
Raleigh, NC 27612  
Main: 919.829.9909  
www.res.us

Engineering Services Provided By:  
RES Environmental Operating Company, LLC  
License: F-1428

SEAL

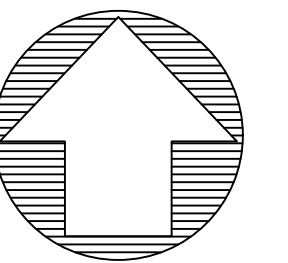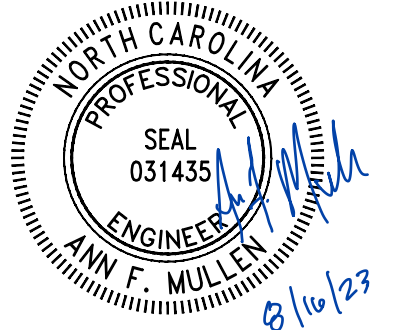

PLOT DATE:  
8/16/2023

REVISIONS:



RELEASED FOR:  
RECORD DRAWINGS

PROJECT NUMBER: 103205  
PROJECT MANAGER: JRM  
DESIGNED: AFM  
DRAWN: SLB  
CHECKED: TRS

SHEET NUMBER:  
-----



FILE NAME: F:\Rescad\Projects\103205-Six Runs\ABRD\103205\_L\_RD\_DESIGN.dwg SAVED BY: Tswartzfager

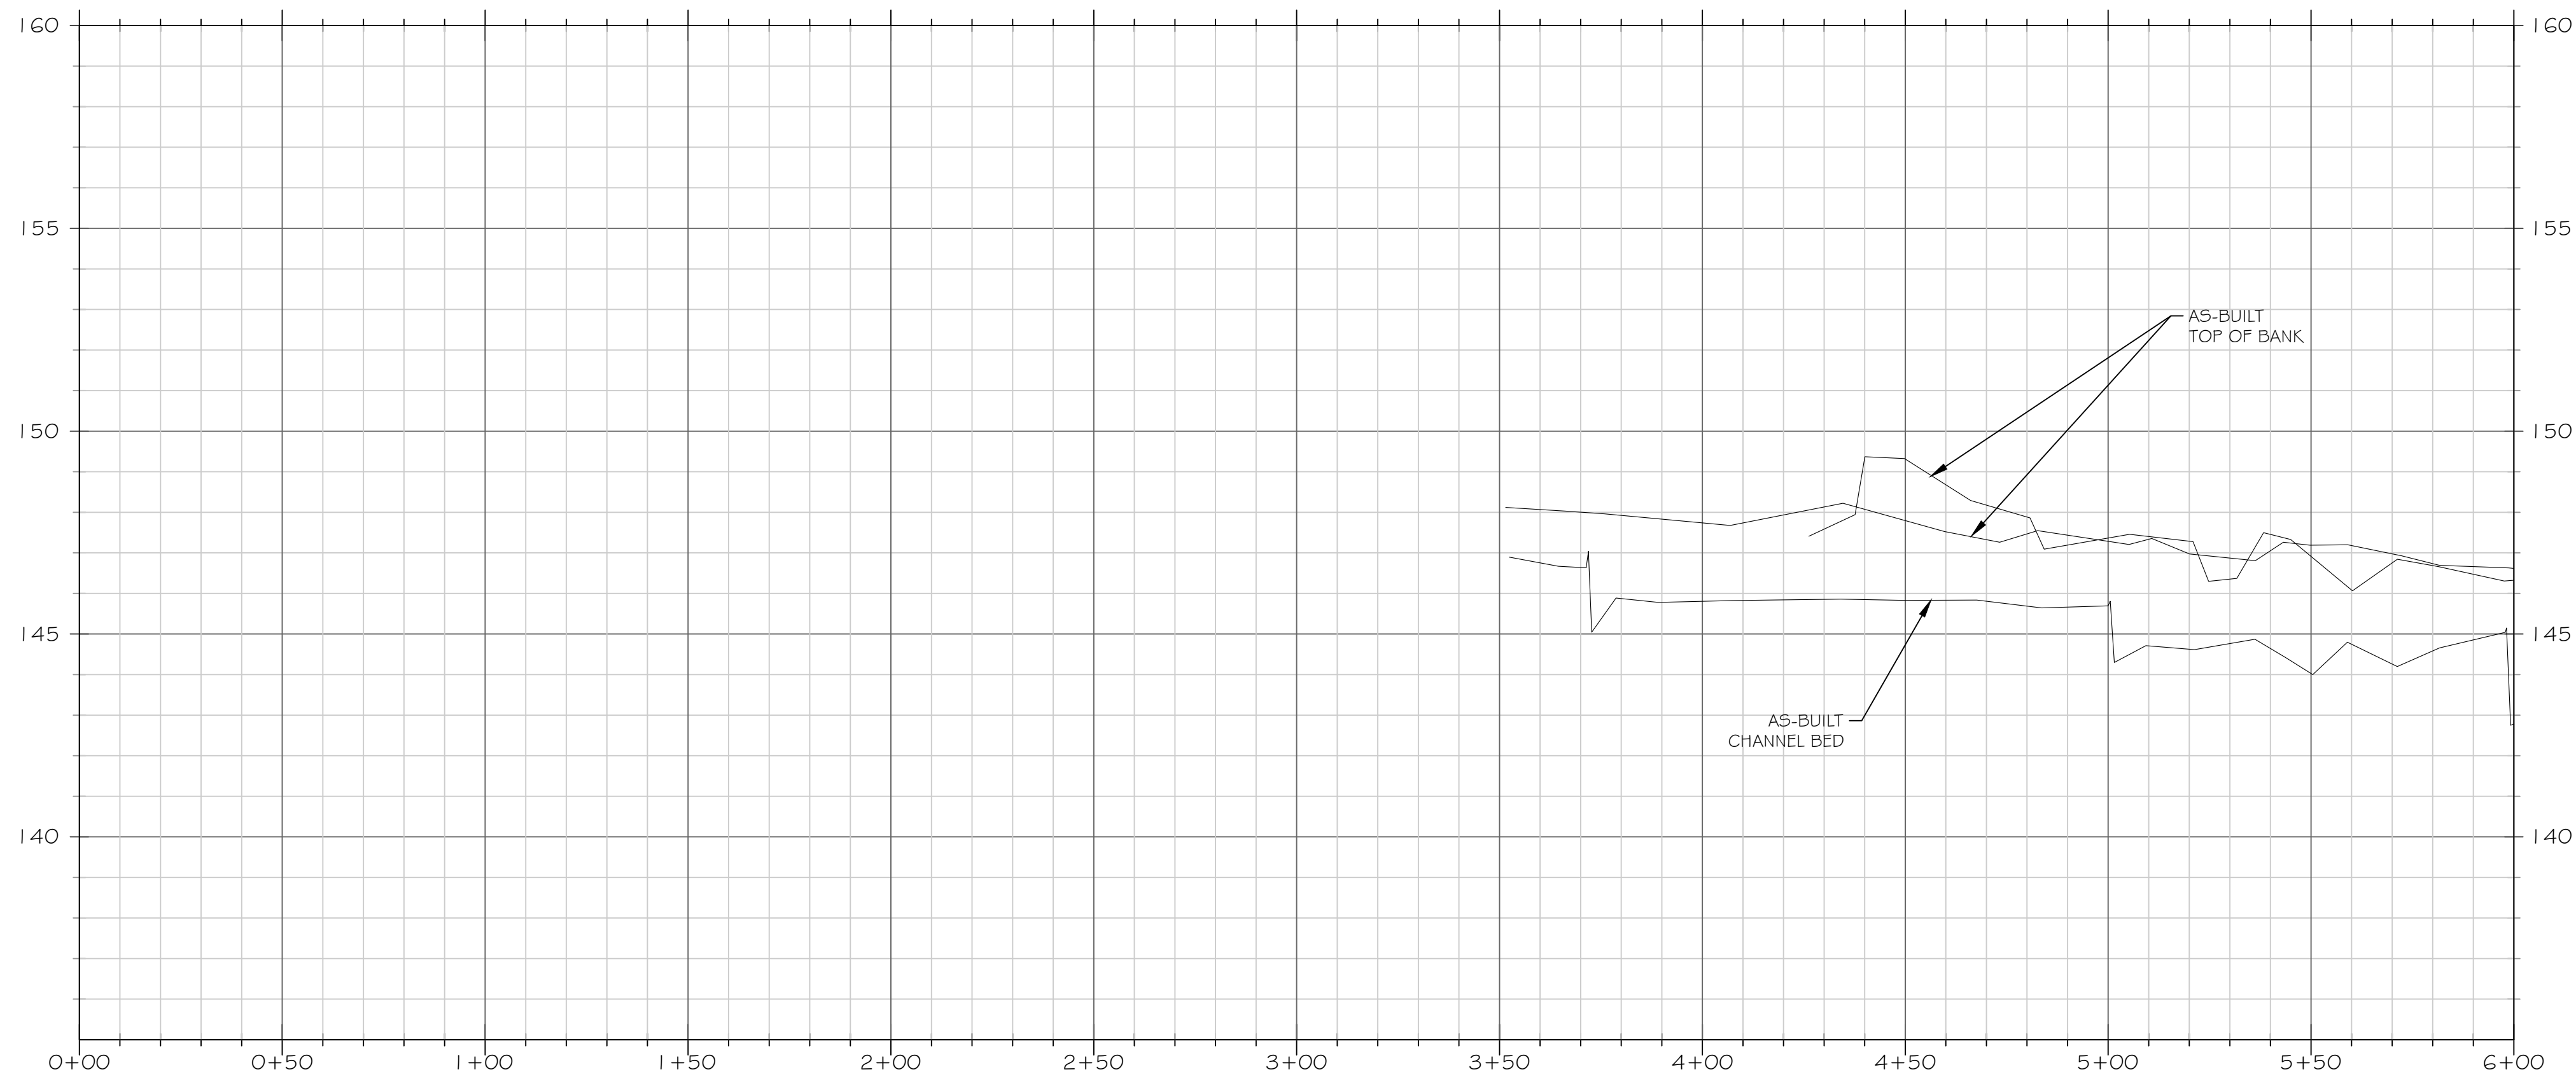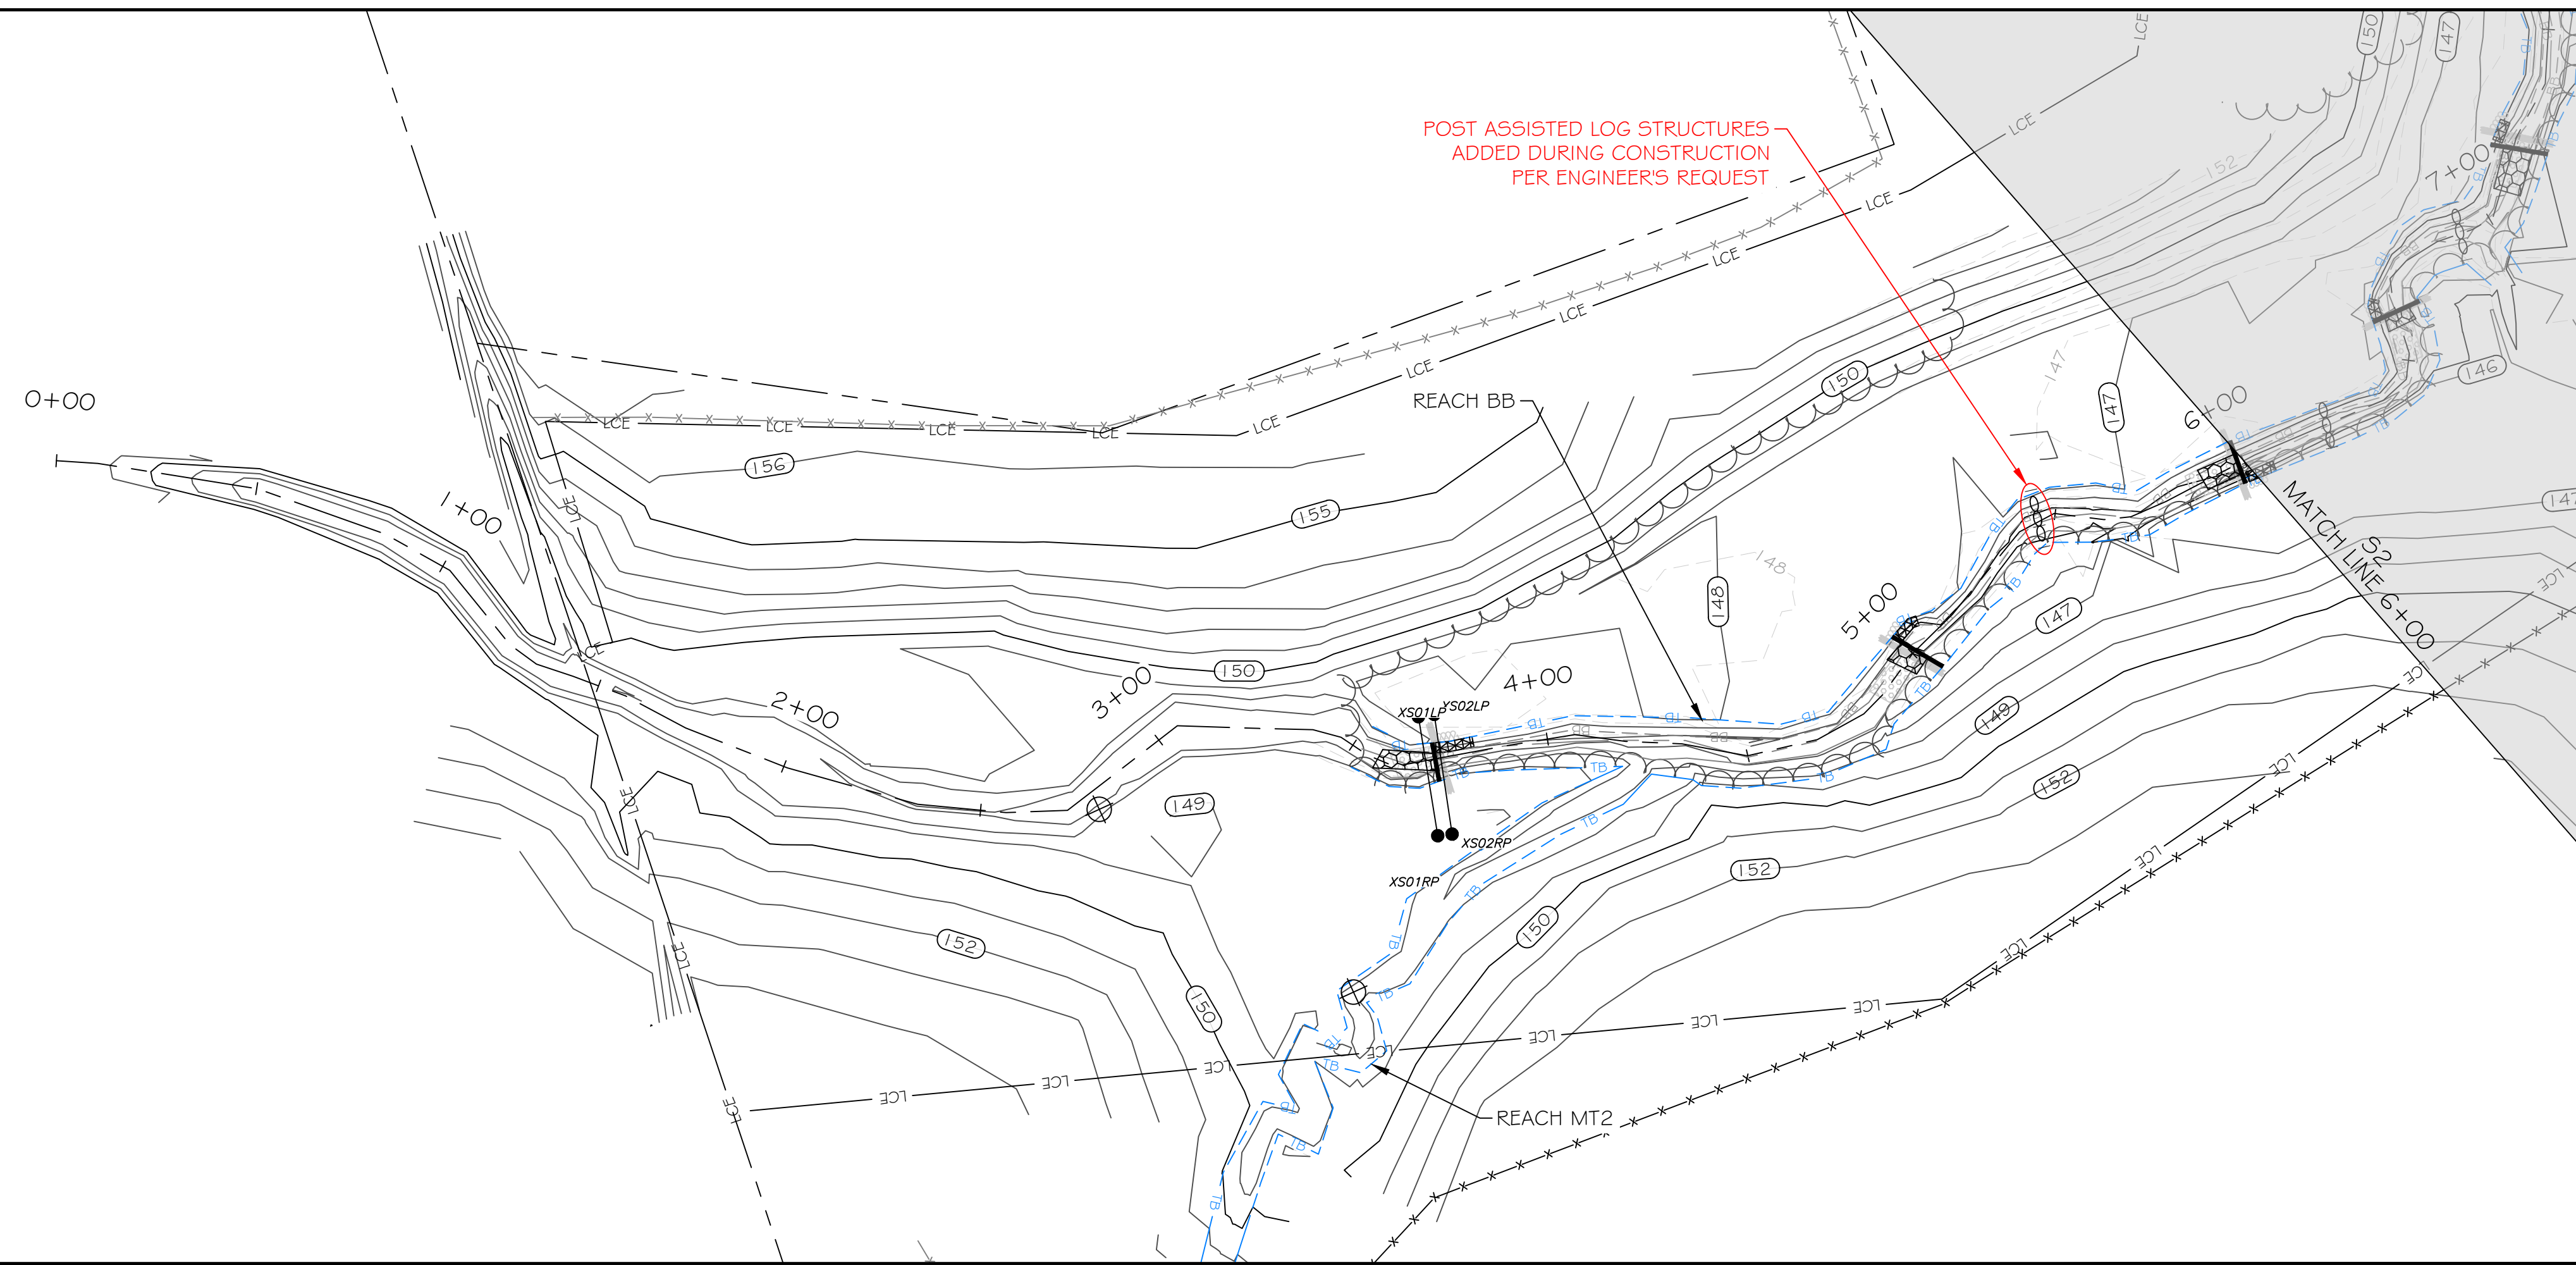

SCALE: HOR 1"=30'; VERT 1"=3'

### LEGEND



PROPERTY LINE	---
LIMITS OF PROPOSED CONSERVATION EASEMENT	-LCE-
WETLAND	
TREELINE	
AS-BUILT CONTOUR MAJOR	50
AS-BUILT CONTOUR MINOR	46
PROPOSED CONTOUR MAJOR	50
PROPOSED CONTOUR MINOR	46
EXISTING FENCING	---
AS-BUILT FENCING	---
AS-BUILT TOP OF BANK	-TB-
AS-BUILT BOTTOM OF BANK	-BB-
PROPOSED TOP OF BANK	---
AS-BUILT BRUSH TOE PROTECTION	
PROPOSED BRUSH TOE PROTECTION	
AS-BUILT ENGINEERED SEDIMENT PACK	
PROPOSED ENGINEERED SEDIMENT PACK	
AS-BUILT POST ASSISTED LOG STRUCTURE	
AS-BUILT LOG STRUCTURE	
PROPOSED LOG STRUCTURE	
AS-BUILT ROCK STRUCTURE	
PROPOSED ROCK STRUCTURE	
AS-BUILT STONE TOE	
PROPOSED STONE TOE	
AS-BUILT CONSTRUCTED RIFFLE	
PROPOSED CONSTRUCTED RIFFLE	
GROUNDWATER MONITORING WELL	
STAGE RECORDER	
FLOW GAUGE	
MONITORING CROSS SECTION	
VEGETATION MONITORING PLOT	VP#

NOTE: ALL SIGNIFICANT CHANGES FROM THE DESIGN ARE SHOWN IN RED



3600 Glenwood Ave, Suite 100  
Raleigh, NC 27612  
Main: 919.829.9909  
www.res.us

Engineering Services Provided By:  
RES Environmental Operating Company, LLC  
License: F-1428

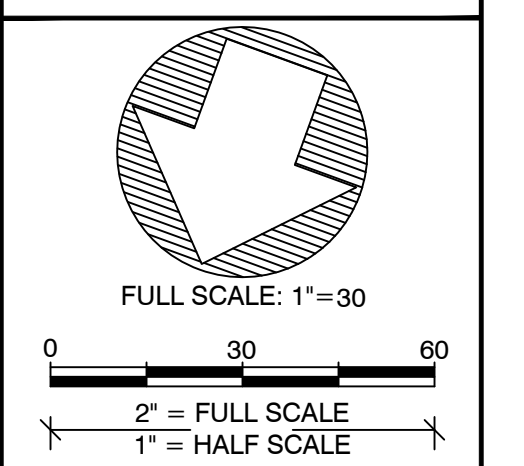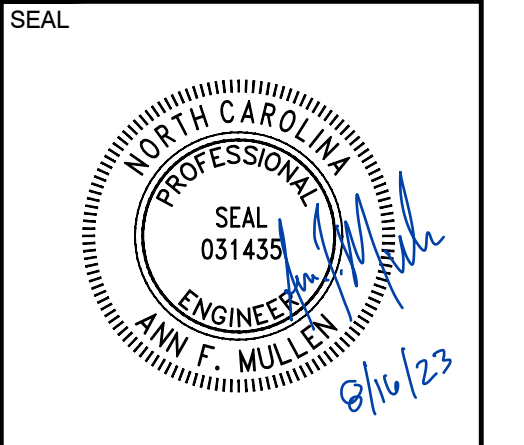

PLOT DATE:  
8/16/2023

REVISIONS:

RELEASED FOR:  
RECORD DRAWINGS


PROJECT NAME:  
**SIX RUNS RECORD DRAWINGS  
SAMPSON COUNTY, NORTH CAROLINA**

DRAWING TITLE:  
**REACH BB**

PROJECT NUMBER: 103205  
PROJECT MANAGER: JRM  
DESIGNED: AFM  
DRAWN: SLB  
CHECKED: TRS

SHEET NUMBER:  
**S1**



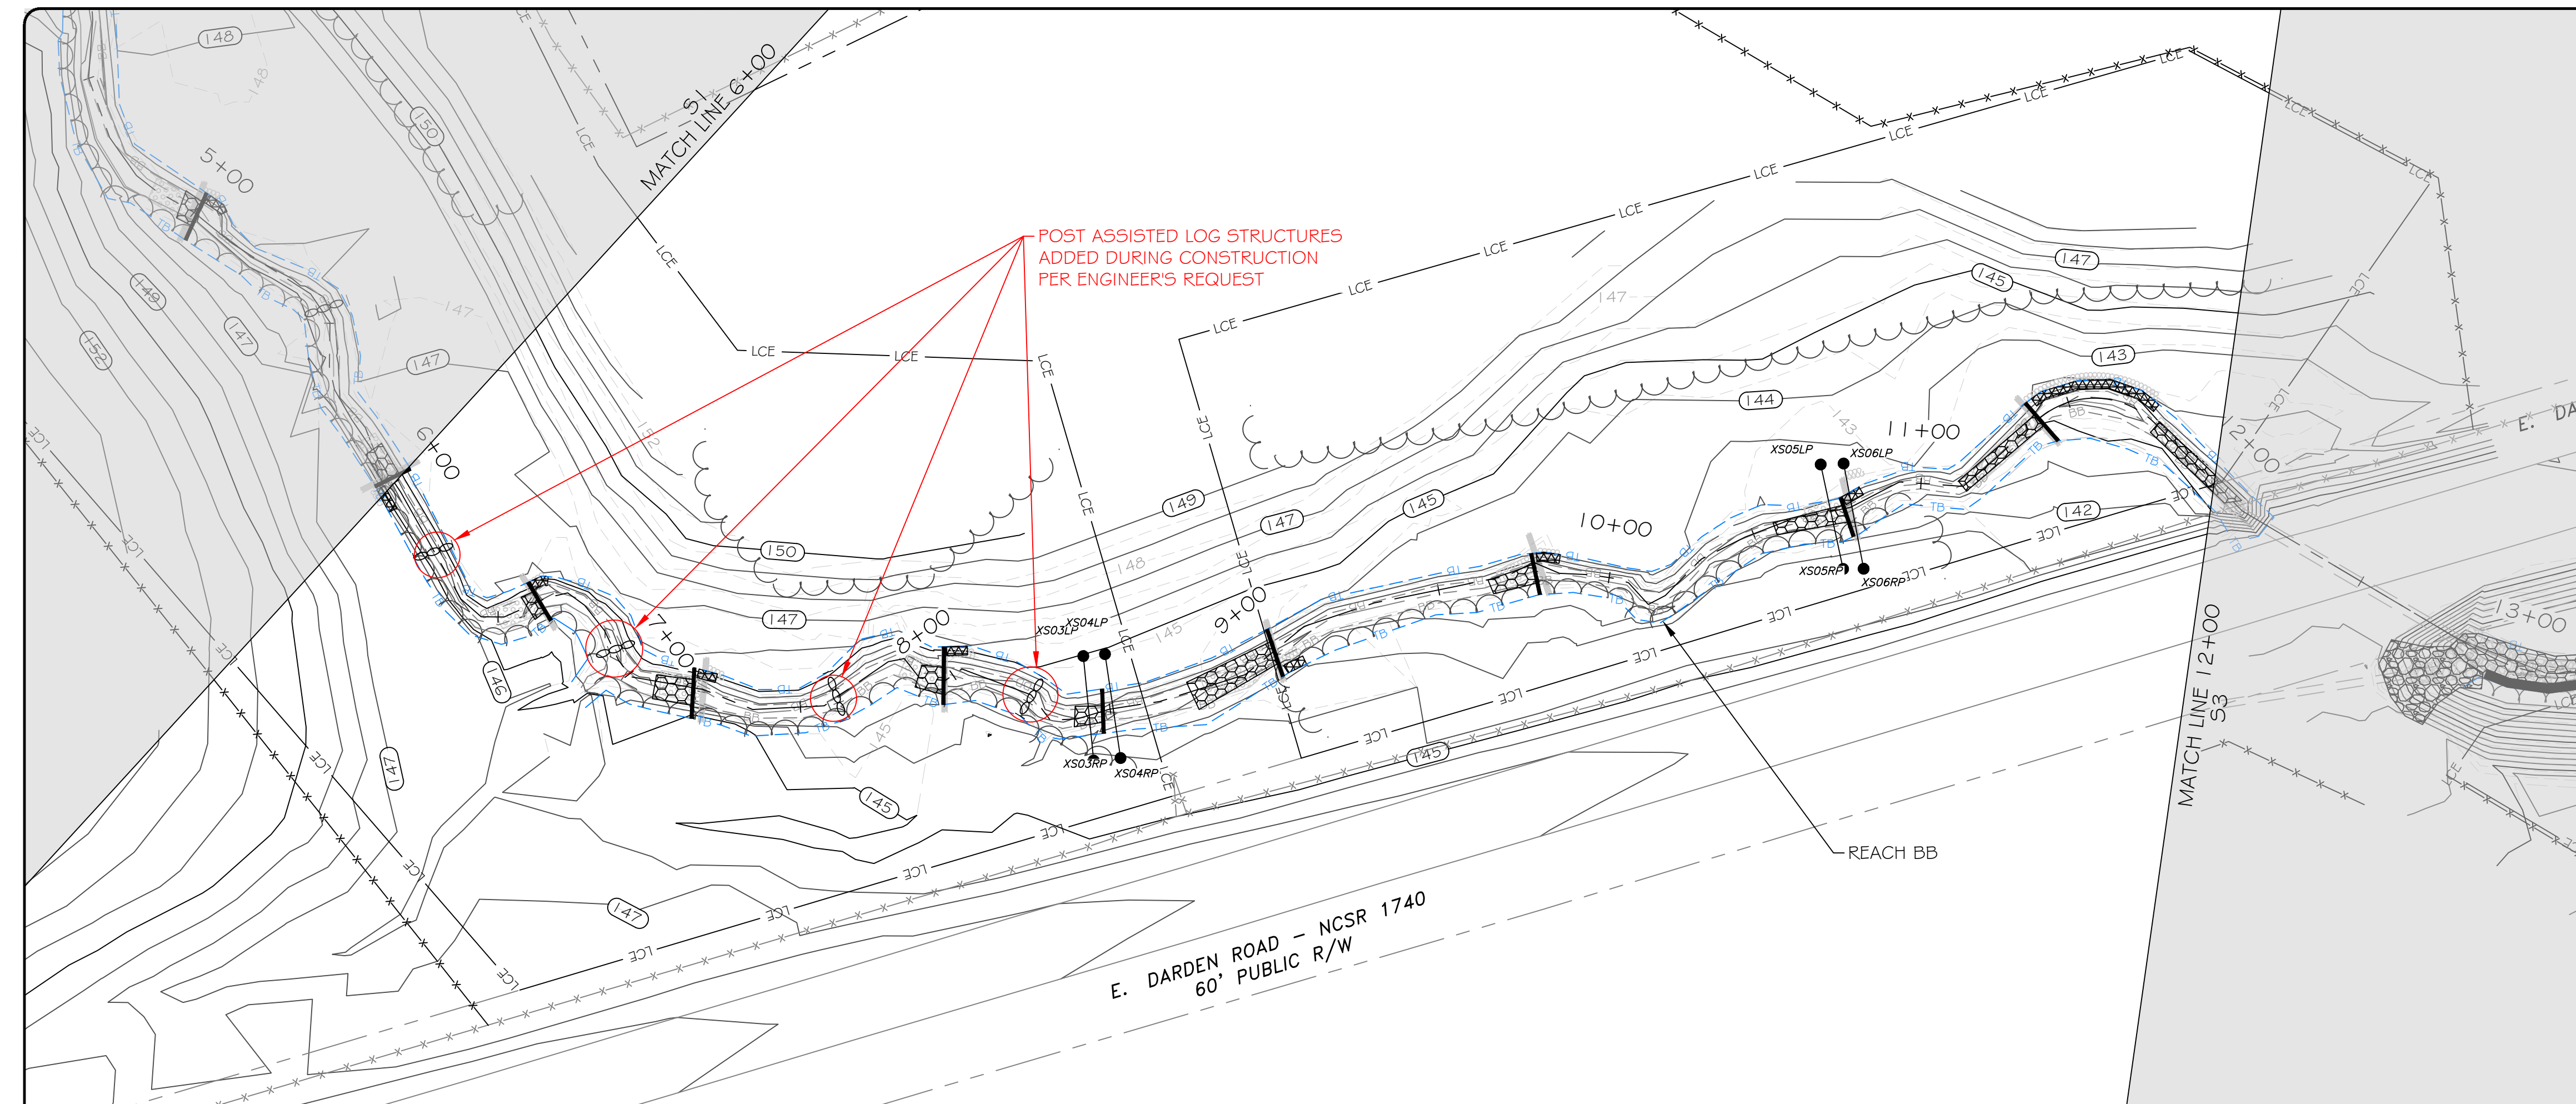

### LEGEND

- PROPERTY LINE ---
- LIMITS OF PROPOSED CONSERVATION EASEMENT --- LCE
- WETLAND [Symbol]
- TREELINE [Symbol]
- AS-BUILT CONTOUR MAJOR --- 50
- AS-BUILT CONTOUR MINOR --- 46
- PROPOSED CONTOUR MAJOR --- 50
- PROPOSED CONTOUR MINOR --- 46
- EXISTING FENCING [Symbol]
- AS-BUILT FENCING [Symbol]
- AS-BUILT TOP OF BANK --- TB
- AS-BUILT BOTTOM OF BANK --- BB
- PROPOSED TOP OF BANK ---
- AS-BUILT BRUSH TOE PROTECTION [Symbol]
- PROPOSED BRUSH TOE PROTECTION [Symbol]
- AS-BUILT ENGINEERED SEDIMENT PACK [Symbol]
- PROPOSED ENGINEERED SEDIMENT PACK [Symbol]
- AS-BUILT POST ASSISTED LOG STRUCTURE [Symbol]
- AS-BUILT LOG STRUCTURE [Symbol]
- PROPOSED LOG STRUCTURE [Symbol]
- AS-BUILT ROCK STRUCTURE [Symbol]
- PROPOSED ROCK STRUCTURE [Symbol]
- AS-BUILT STONE TOE [Symbol]
- PROPOSED STONE TOE [Symbol]
- AS-BUILT CONSTRUCTED RIFFLE [Symbol]
- PROPOSED CONSTRUCTED RIFFLE [Symbol]
- GROUNDWATER MONITORING WELL [Symbol]
- STAGE RECORDER [Symbol]
- FLOW GAUGE [Symbol]
- MONITORING CROSS SECTION [Symbol]
- VEGETATION MONITORING PLOT [Symbol] VP#

NOTE: ALL SIGNIFICANT CHANGES FROM THE DESIGN ARE SHOWN IN RED

3600 Glenwood Ave, Suite 100  
Raleigh, NC 27612  
Main: 919.829.9909  
www.res.us

Engineering Services Provided By:  
RES Environmental Operating Company, LLC  
License: F-1428

SEAL

FULL SCALE: 1"=30

2" = FULL SCALE  
1" = HALF SCALE

PLOT DATE:  
8/16/2023

REVISIONS:


RELEASED FOR:  
RECORD DRAWINGS

PROJECT NAME:  
**SIX RUNS RECORD DRAWINGS  
SAMPSON COUNTY, NORTH CAROLINA**

DRAWING TITLE:  
**REACH BB**

PROJECT NUMBER: 103205  
PROJECT MANAGER: JRM  
DESIGNED: AFM  
DRAWN: SLB  
CHECKED: TRS



SHEET NUMBER:  
**S2**

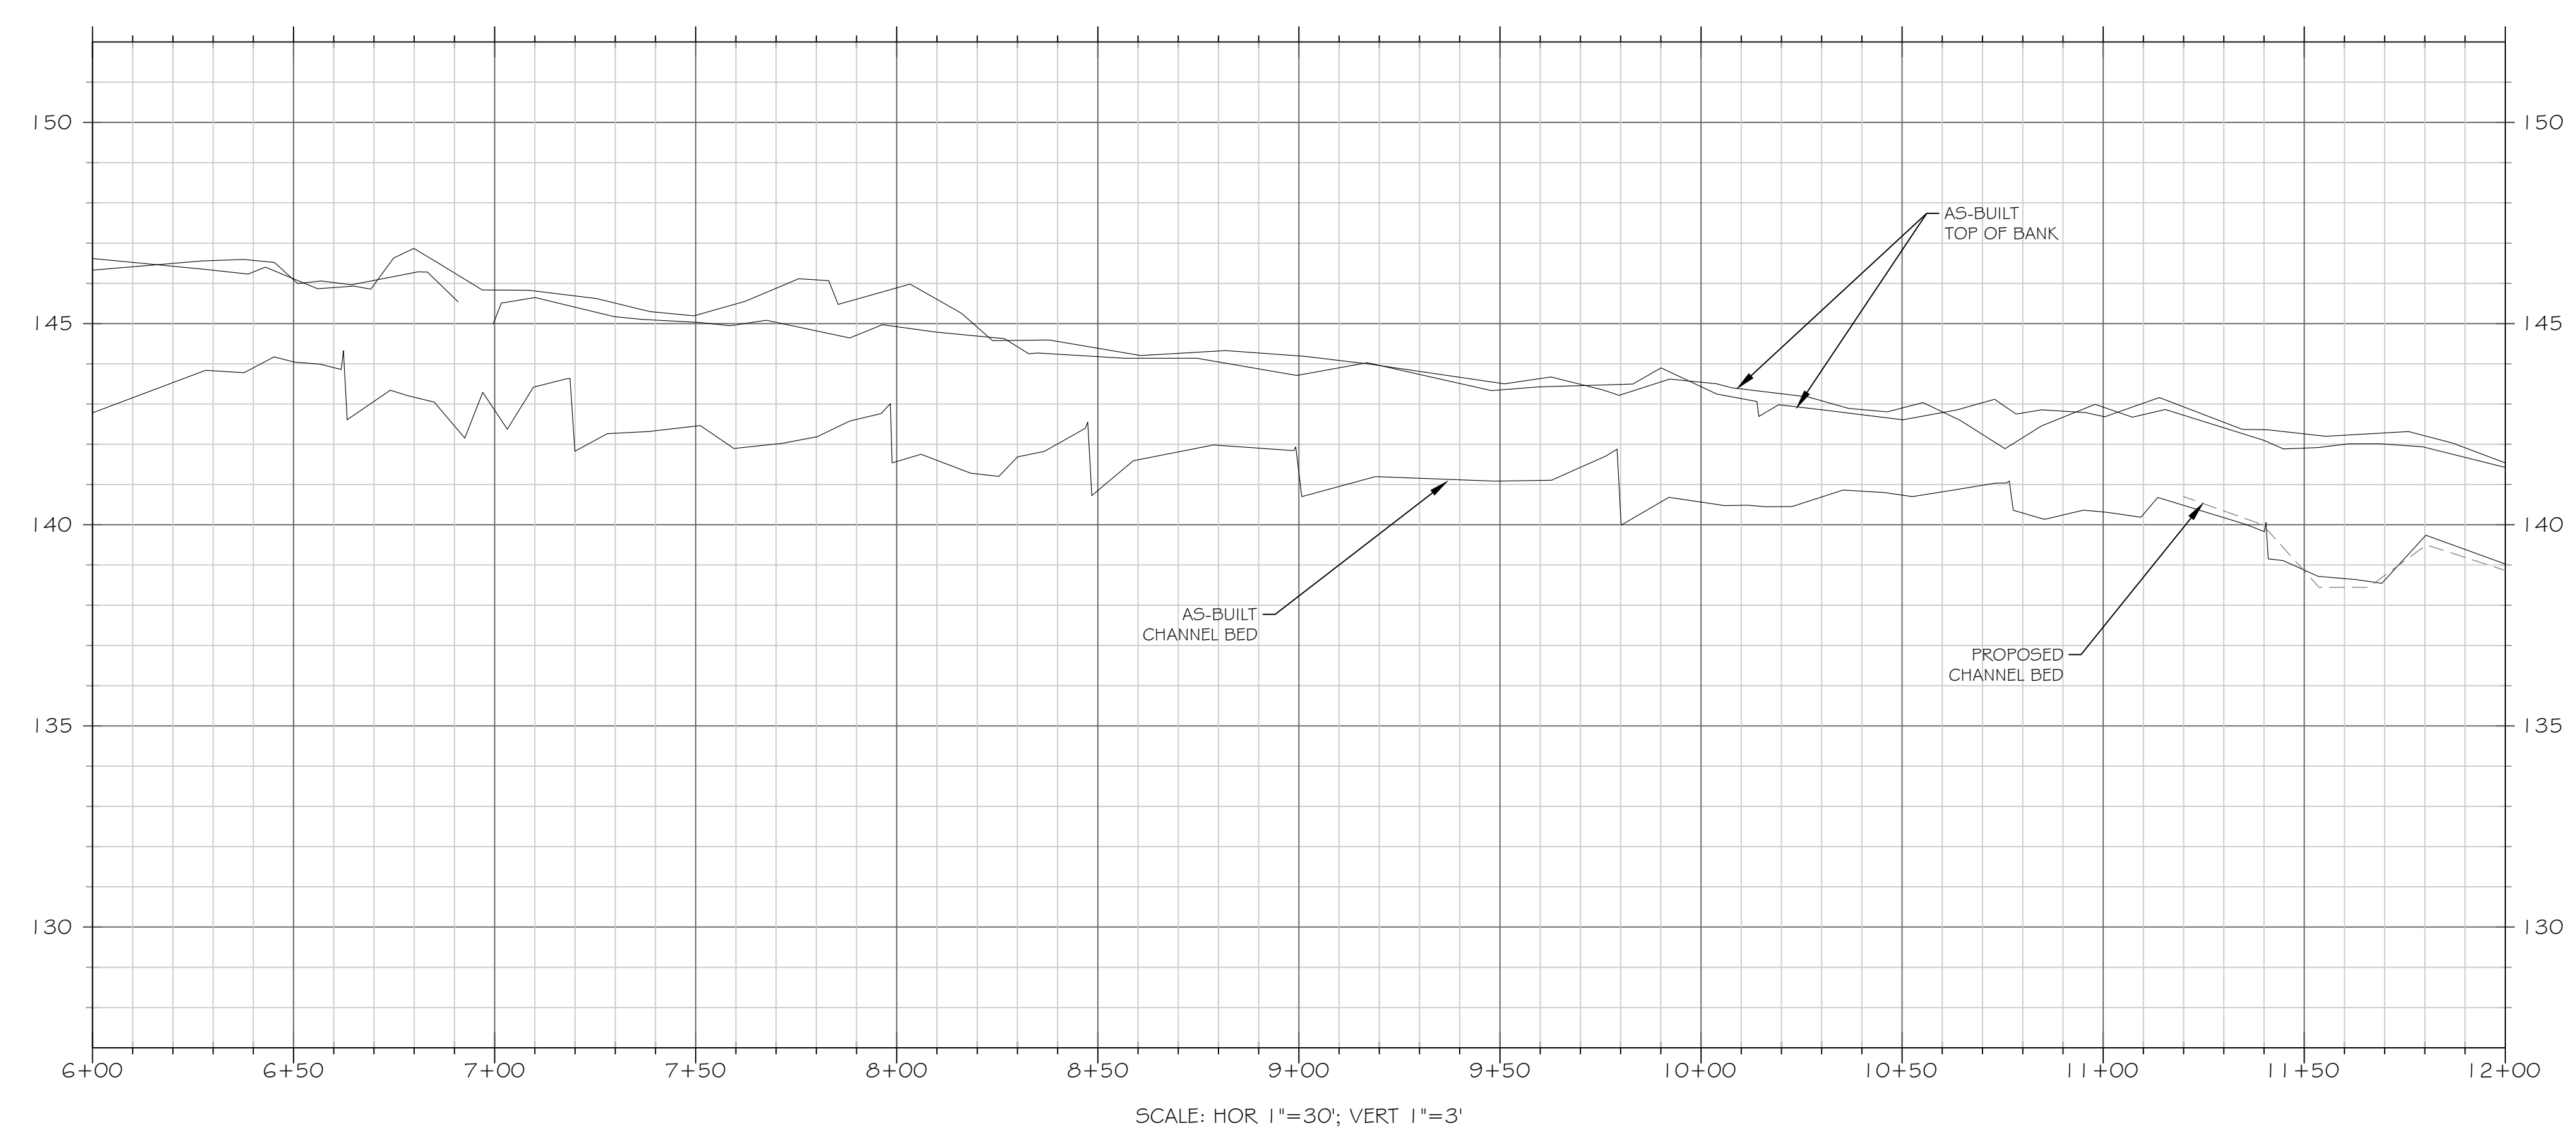

FILE NAME: R:\ResCAD\Projects\103205-Six Runs\ABRD\103205\_RD\_DESIGN.dwg SAVED BY: Tswartzfager



FILE NAME: F:\Research\Projects\103205-Six Runs\ABRD\103205\_LF\_DESIGN.dwg SAVED BY: Tswartzfager

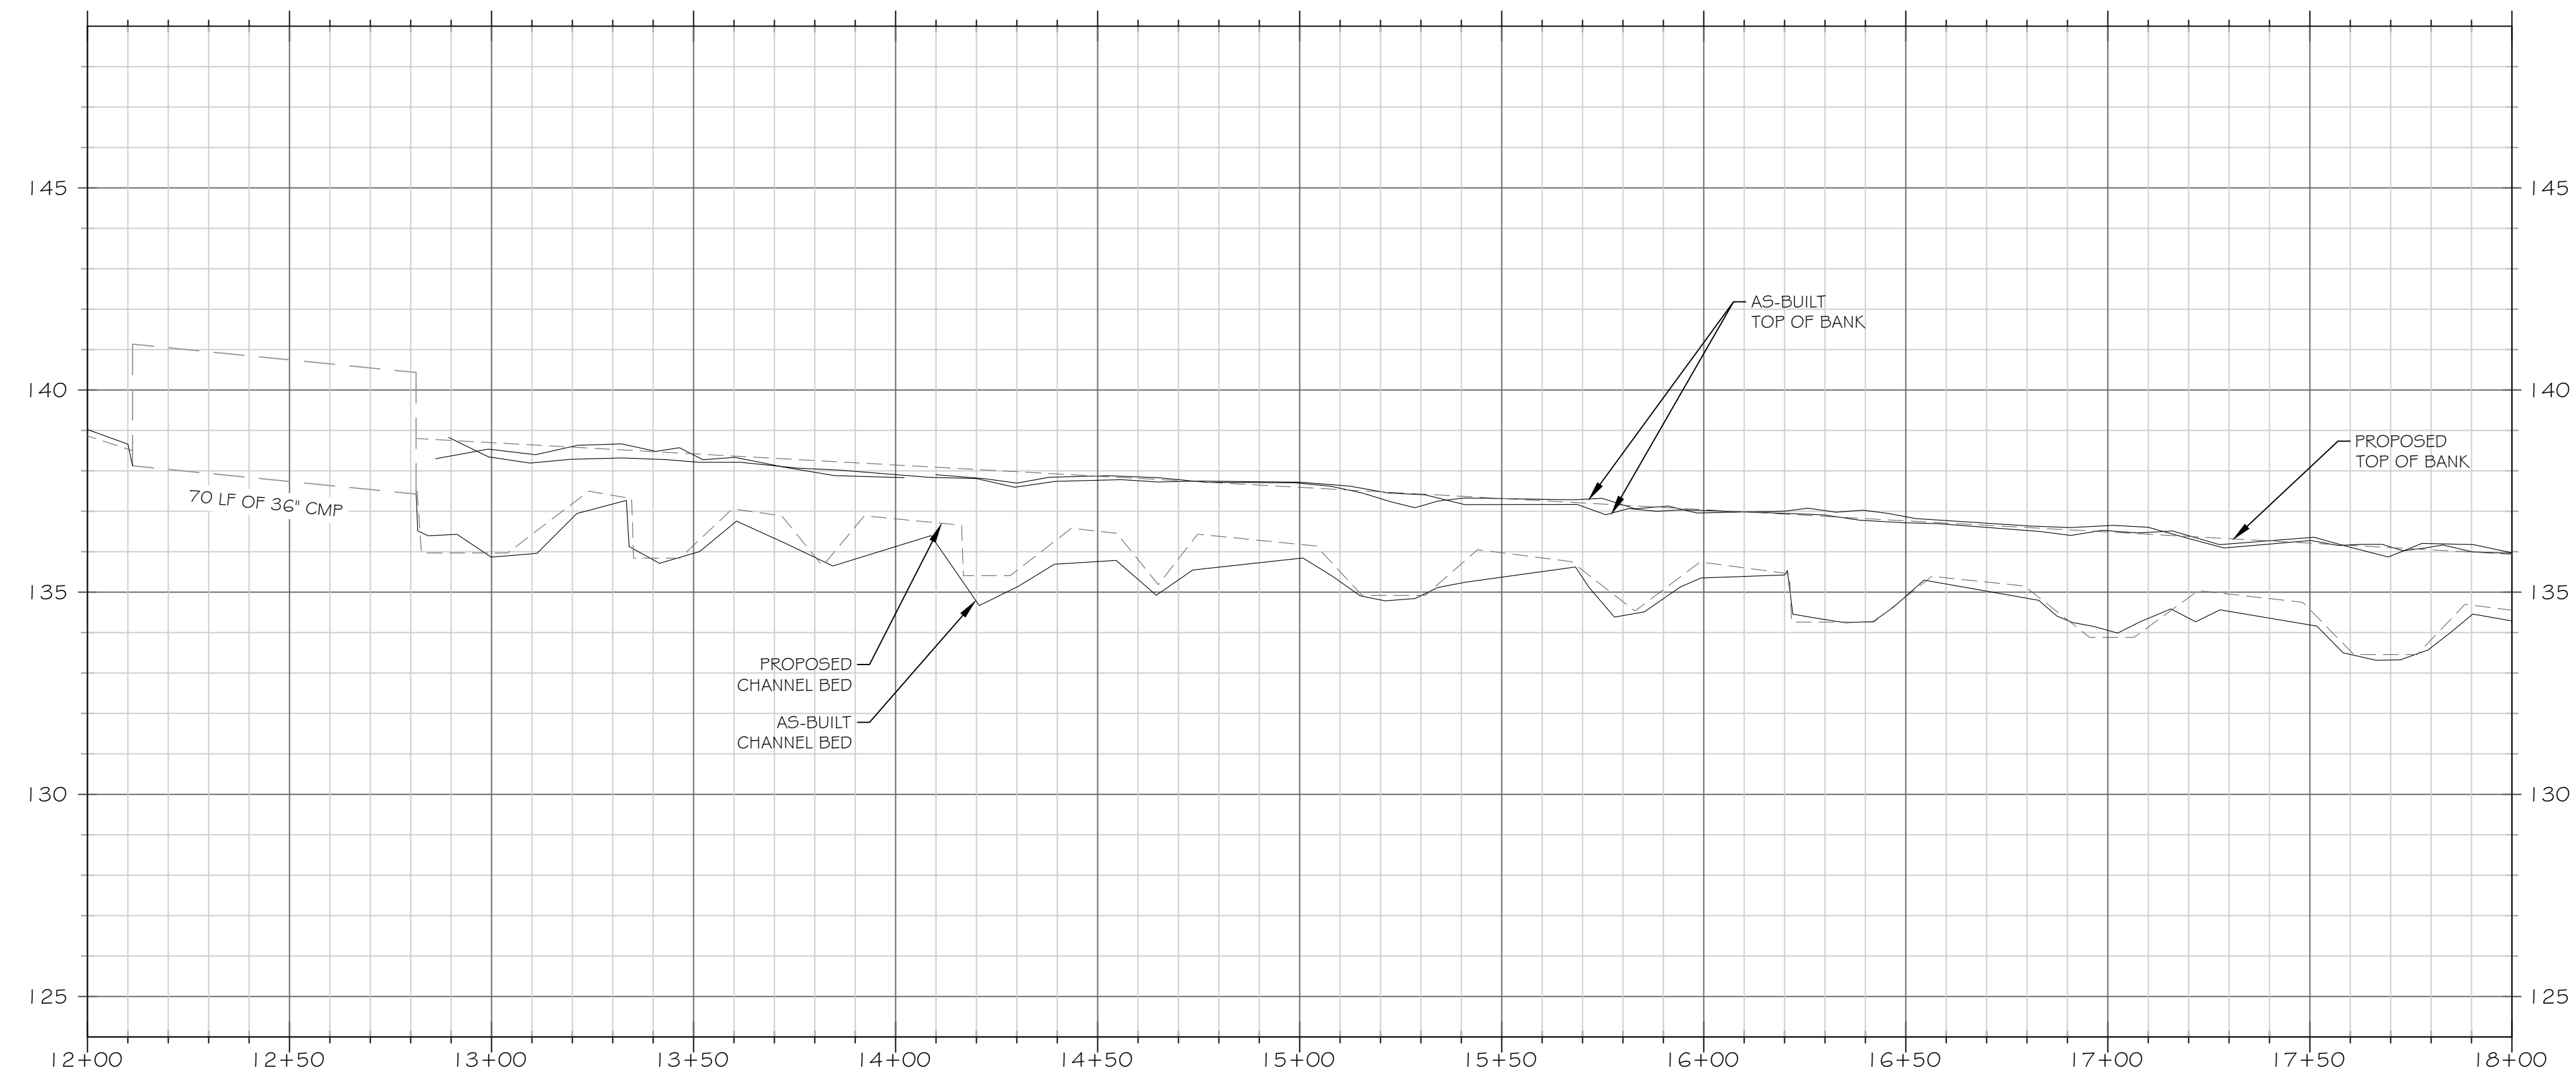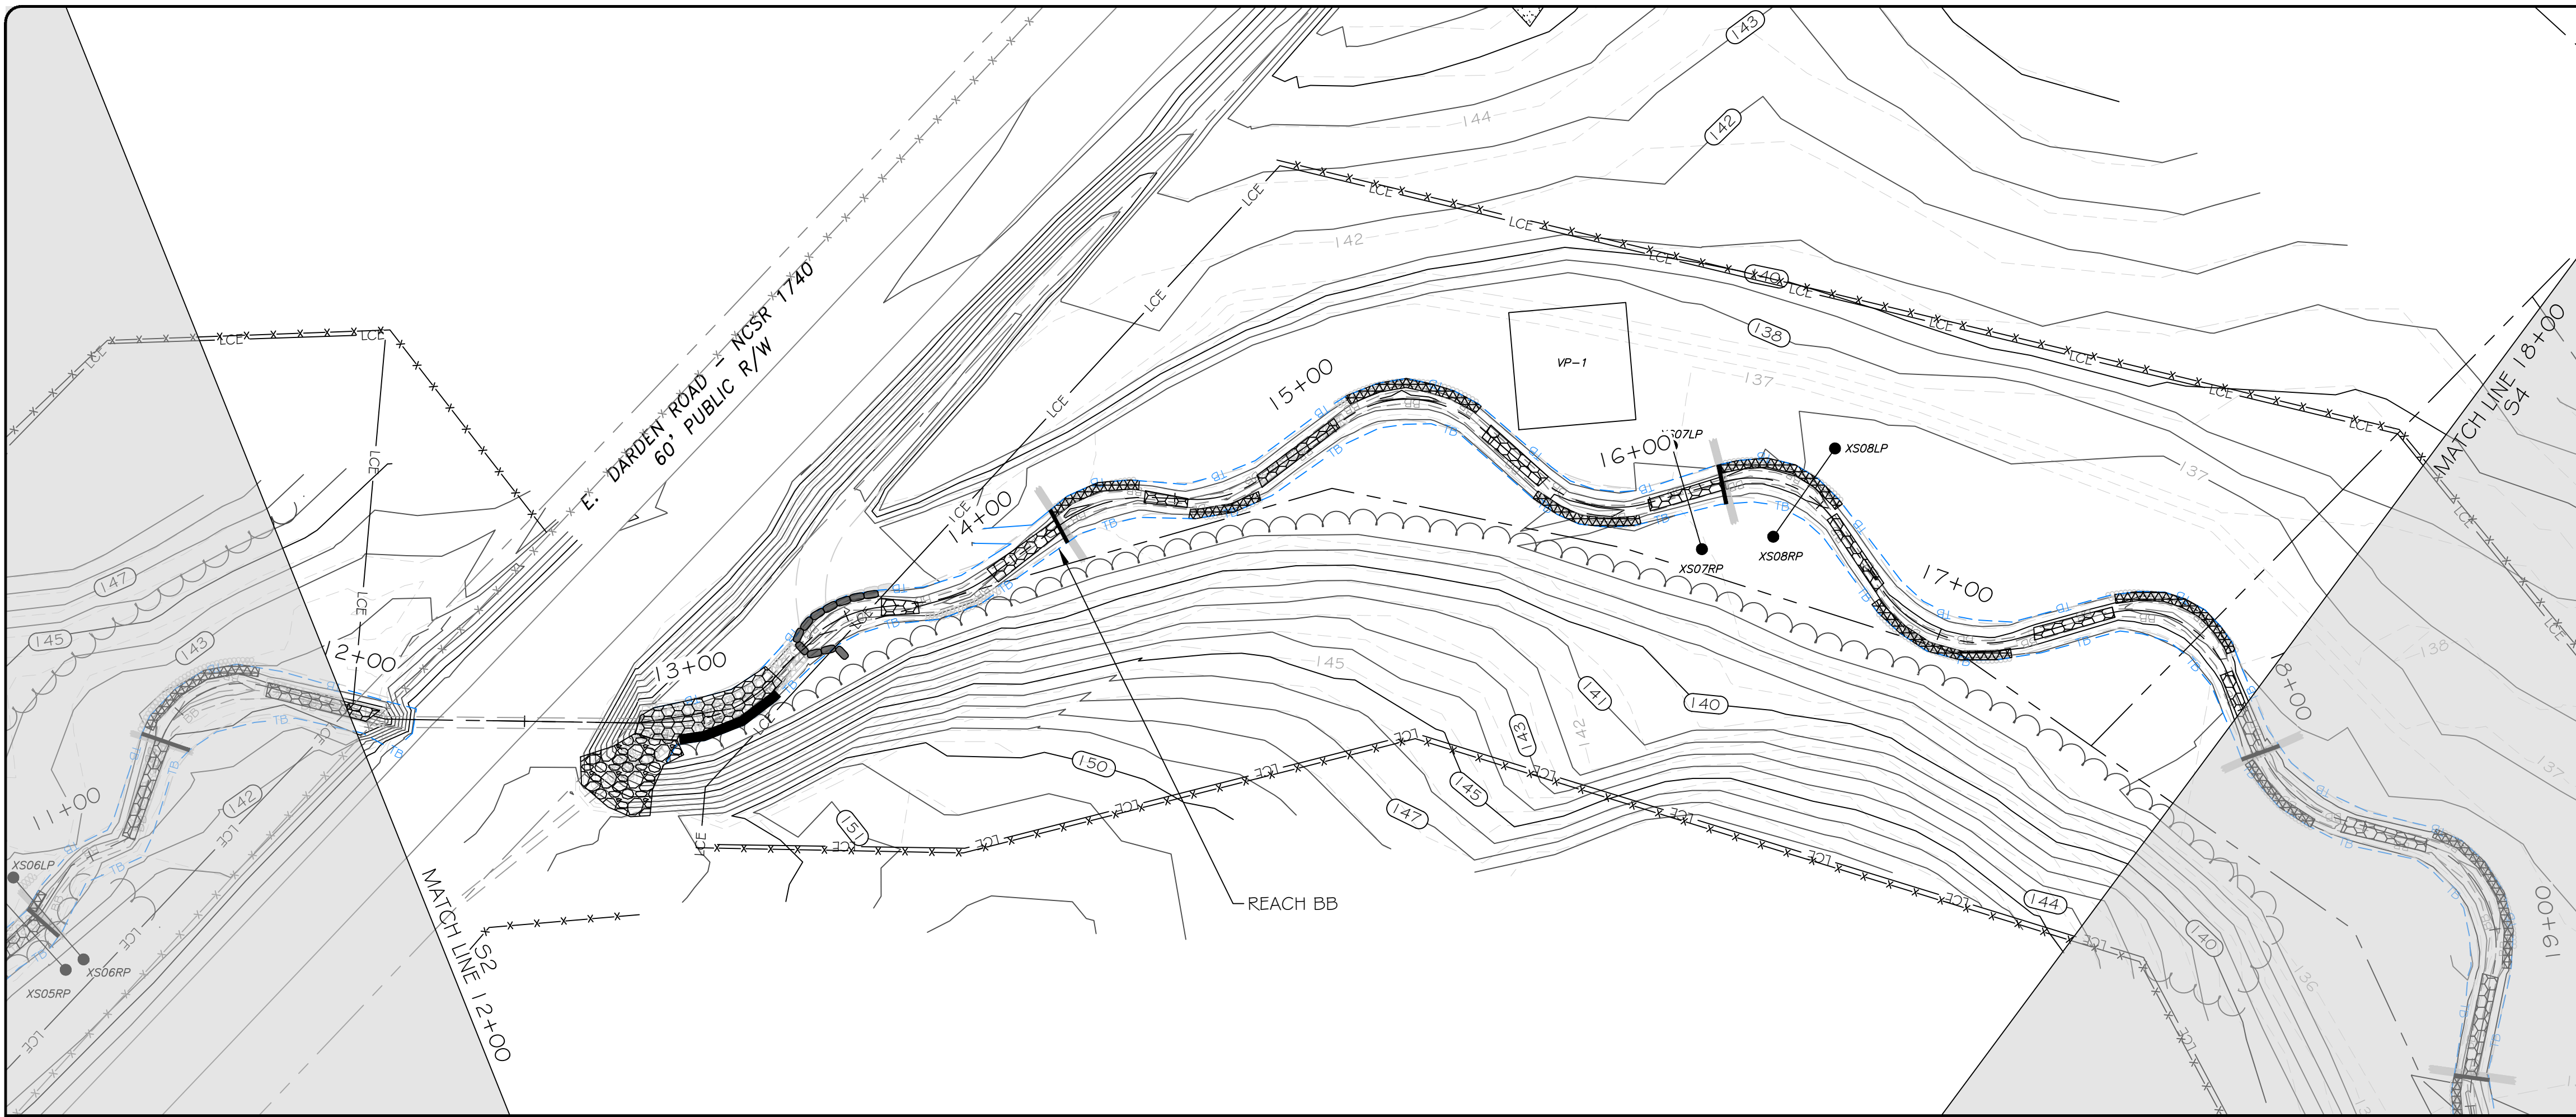

SCALE: HOR 1"=30'; VERT 1"=3'

### LEGEND



PROPERTY LINE	---
LIMITS OF PROPOSED CONSERVATION EASEMENT	--- LCE
WETLAND	▾ ▾ ▾
TREELINE	~~~~~
AS-BUILT CONTOUR MAJOR	— 50
AS-BUILT CONTOUR MINOR	— 46
PROPOSED CONTOUR MAJOR	- - 50
PROPOSED CONTOUR MINOR	- - 46
EXISTING FENCING	× × × × ×
AS-BUILT FENCING	× × × × ×
AS-BUILT TOP OF BANK	— TB
AS-BUILT BOTTOM OF BANK	- - BB
PROPOSED TOP OF BANK	- - - -
AS-BUILT BRUSH TOE PROTECTION	▨ ▨ ▨ ▨ ▨
PROPOSED BRUSH TOE PROTECTION	▨ ▨ ▨ ▨ ▨
AS-BUILT ENGINEERED SEDIMENT PACK	* * * * *
PROPOSED ENGINEERED SEDIMENT PACK	* * * * *
AS-BUILT POST ASSISTED LOG STRUCTURE	— — — — —
AS-BUILT LOG STRUCTURE	— — — — —
PROPOSED LOG STRUCTURE	— — — — —
AS-BUILT ROCK STRUCTURE	— — — — —
PROPOSED ROCK STRUCTURE	— — — — —
AS-BUILT STONE TOE	— — — — —
PROPOSED STONE TOE	— — — — —
AS-BUILT CONSTRUCTED RIFFLE	▢ ▢ ▢ ▢ ▢
PROPOSED CONSTRUCTED RIFFLE	▢ ▢ ▢ ▢ ▢
GROUNDWATER MONITORING WELL	⊙
STAGE RECORDER	⊙
FLOW GAUGE	⊗
MONITORING CROSS SECTION	— ● — ● —
VEGETATION MONITORING PLOT	▢ VP#

NOTE: ALL SIGNIFICANT CHANGES FROM THE DESIGN ARE SHOWN IN RED



3600 Glenwood Ave, Suite 100  
Raleigh, NC 27612  
Main: 919.829.9909  
www.res.us

Engineering Services Provided By:  
RES Environmental Operating Company, LLC  
License: F-1428

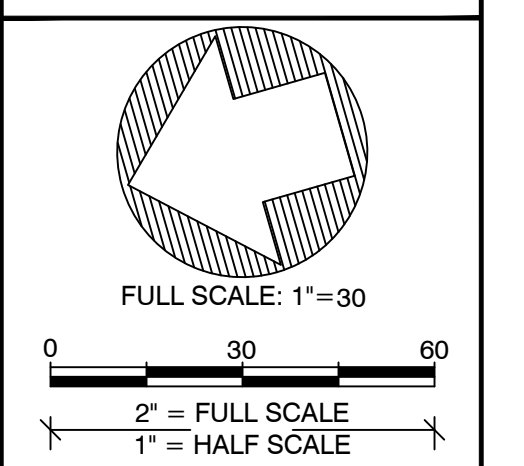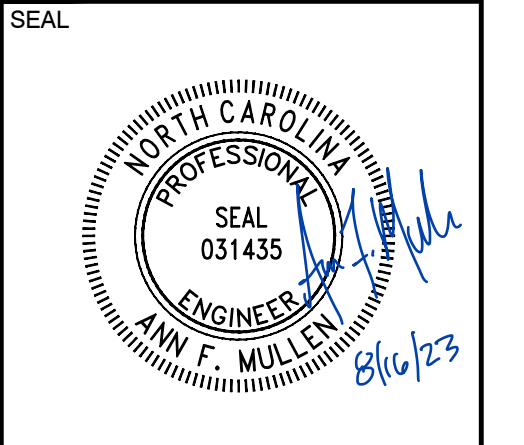

PLOT DATE:  
8/16/2023

REVISIONS:

RELEASED FOR:  
RECORD DRAWINGS

PROJECT NAME:  
**SIX RUNS RECORD DRAWINGS  
SAMPSON COUNTY, NORTH CAROLINA**



DRAWING TITLE:  
**REACH BB**

PROJECT NUMBER: 103205  
PROJECT MANAGER: JRM  
DESIGNED: AFM  
DRAWN: SLB  
CHECKED: TRS

SHEET NUMBER:  
**53**



FILE NAME: F:\res\ad\Projects\103205-Six Runs\ABRD\103205\_RD\_DESIGN.dwg SAVED BY: Tswartzfager

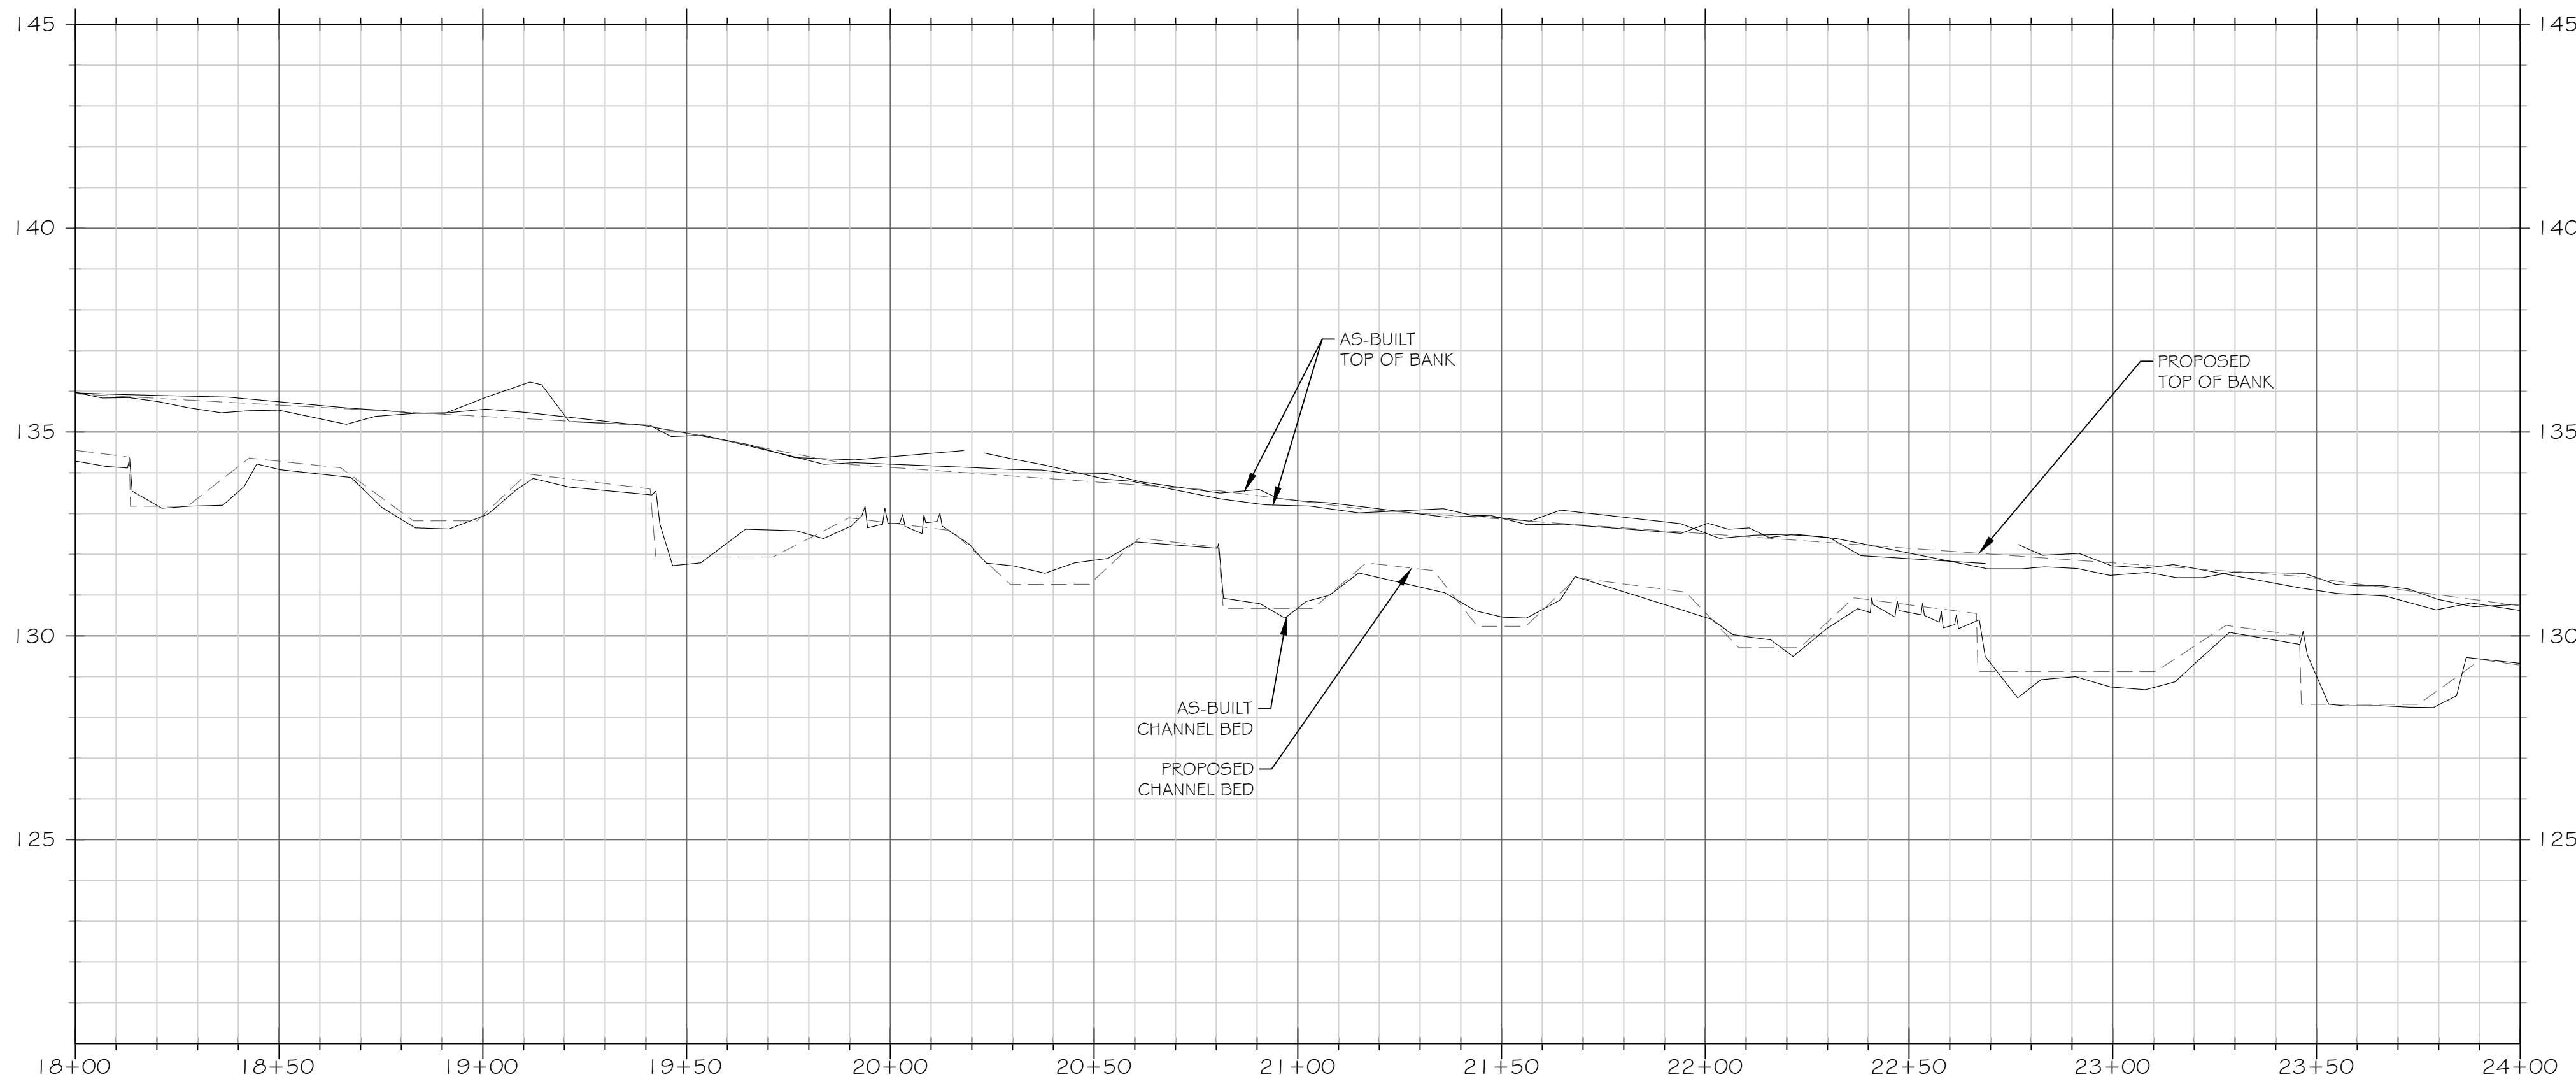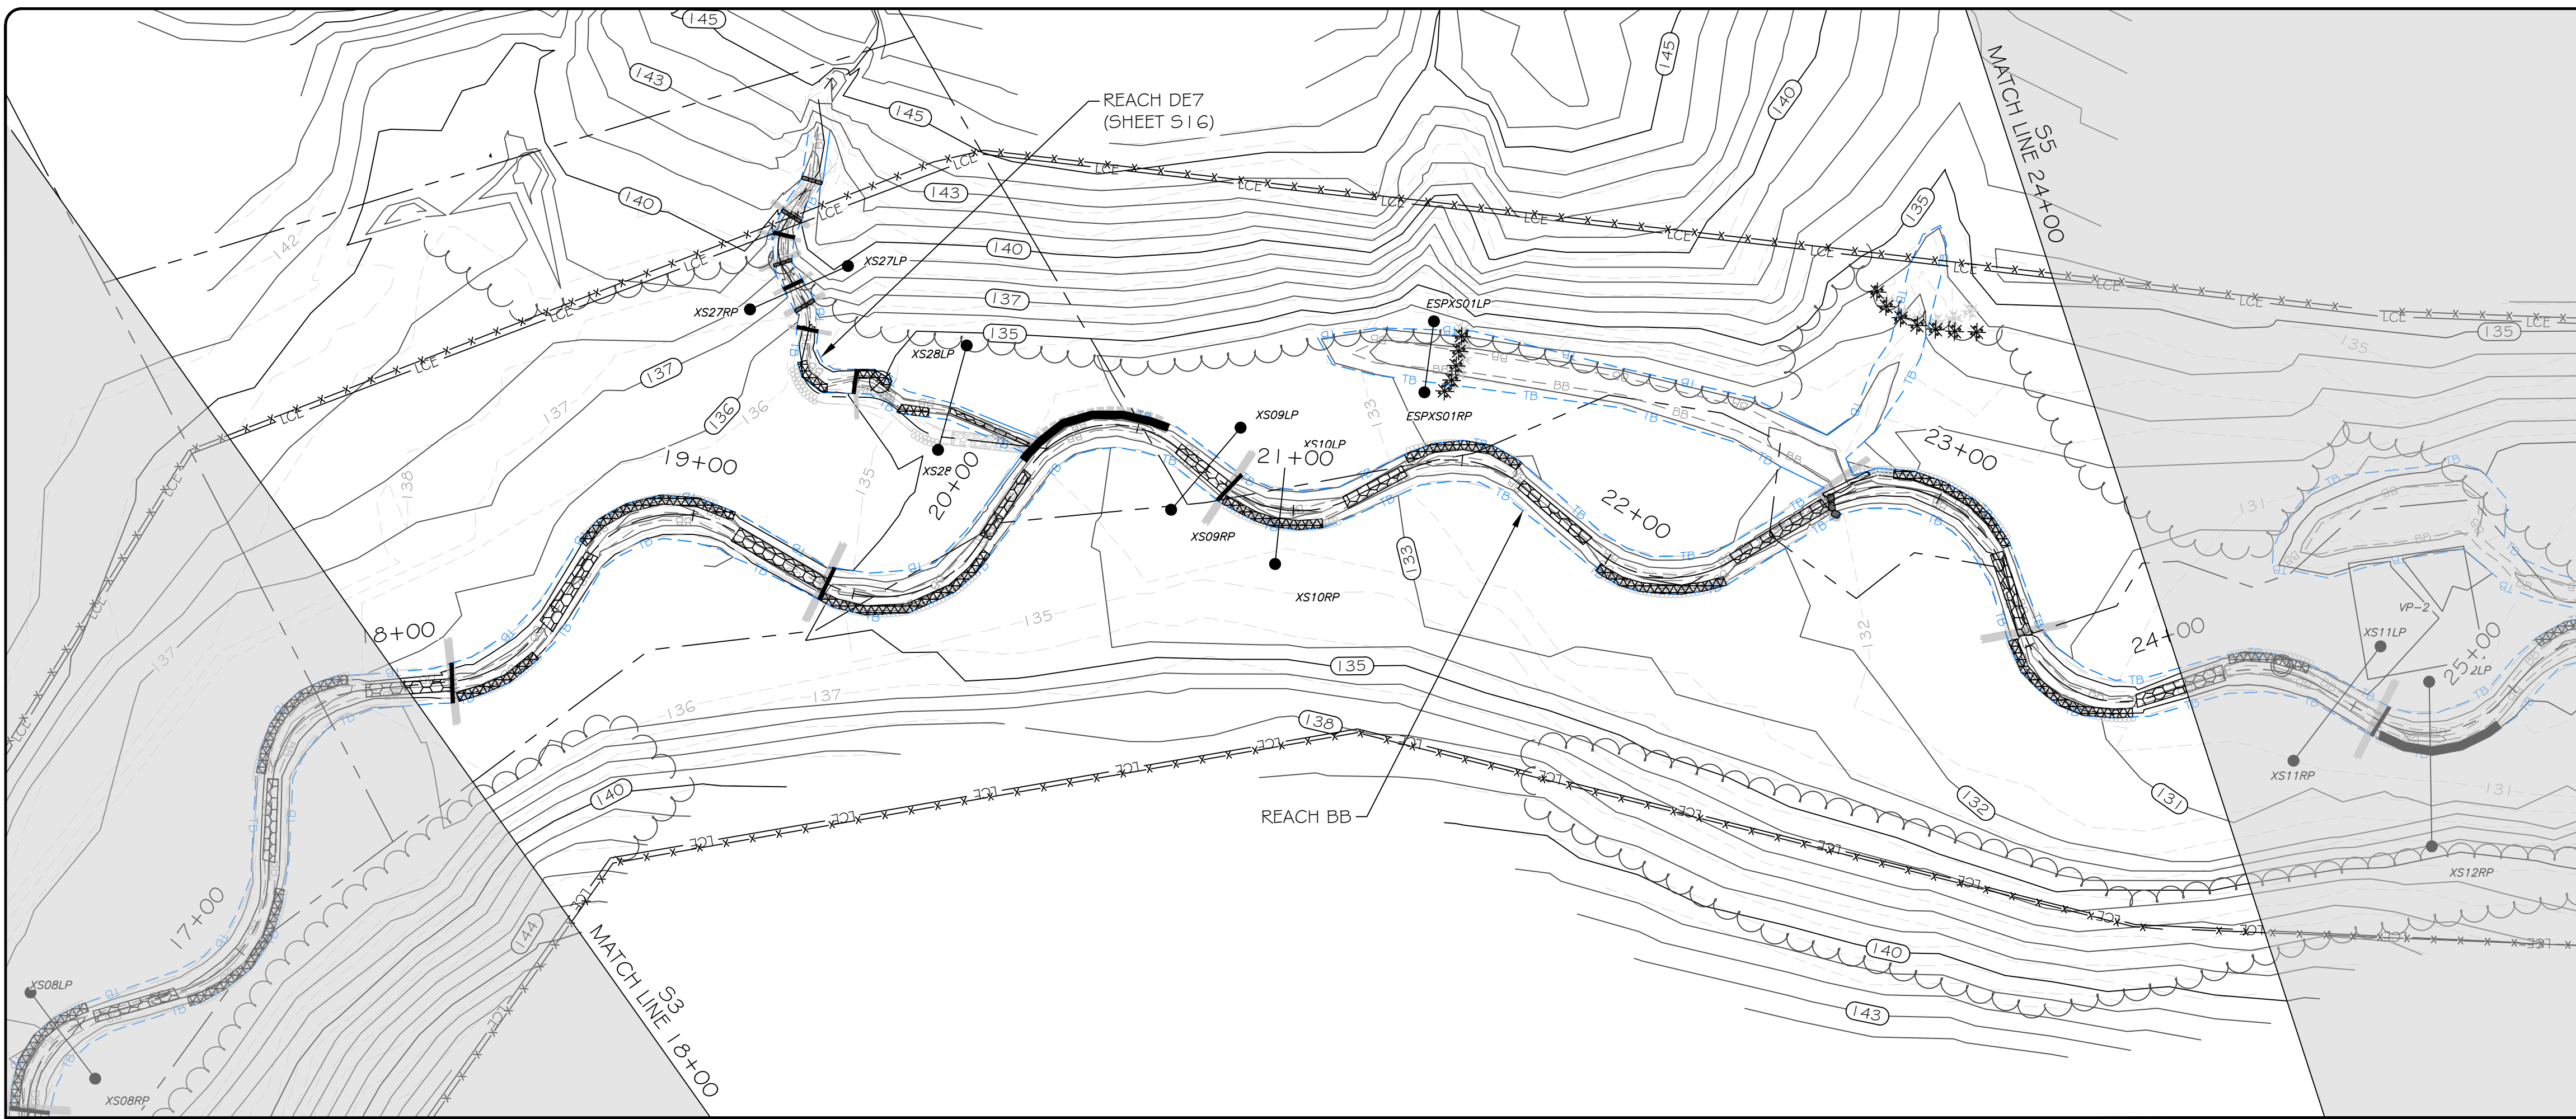

SCALE: HOR 1"=30'; VERT 1"=3'



LEGEND	
PROPERTY LINE	---
LIMITS OF PROPOSED CONSERVATION EASEMENT	--- LCE
WETLAND	
TREELINE	
AS-BUILT CONTOUR MAJOR	--- 50
AS-BUILT CONTOUR MINOR	--- 46
PROPOSED CONTOUR MAJOR	--- 50
PROPOSED CONTOUR MINOR	--- 46
EXISTING FENCING	---x---x---x---
AS-BUILT FENCING	---x---x---x---
AS-BUILT TOP OF BANK	--- TB ---
AS-BUILT BOTTOM OF BANK	--- BB ---
PROPOSED TOP OF BANK	--- TB ---
AS-BUILT BRUSH TOE PROTECTION	
PROPOSED BRUSH TOE PROTECTION	
AS-BUILT ENGINEERED SEDIMENT PACK	
PROPOSED ENGINEERED SEDIMENT PACK	
AS-BUILT POST ASSISTED LOG STRUCTURE	
AS-BUILT LOG STRUCTURE	
PROPOSED LOG STRUCTURE	
AS-BUILT ROCK STRUCTURE	
PROPOSED ROCK STRUCTURE	
AS-BUILT STONE TOE	
PROPOSED STONE TOE	
AS-BUILT CONSTRUCTED RIFFLE	
PROPOSED CONSTRUCTED RIFFLE	
GROUNDWATER MONITORING WELL	
STAGE RECORDER	
FLOW GAUGE	
MONITORING CROSS SECTION	
VEGETATION MONITORING PLOT	

NOTE: ALL SIGNIFICANT CHANGES FROM THE DESIGN ARE SHOWN IN RED



3600 Glenwood Ave, Suite 100  
Raleigh, NC 27612  
Main: 919.829.9909  
www.res.us

Engineering Services Provided By:  
RES Environmental Operating Company, LLC  
License: F-1428

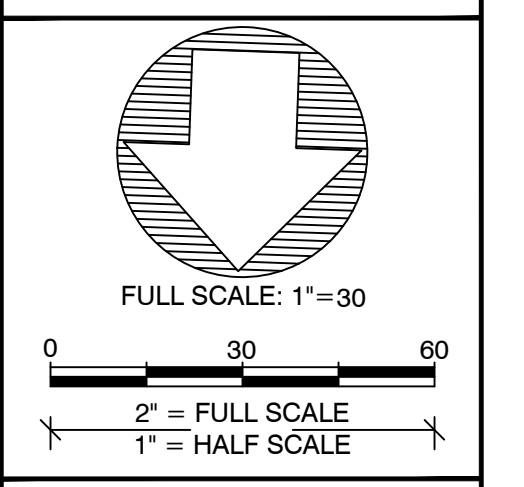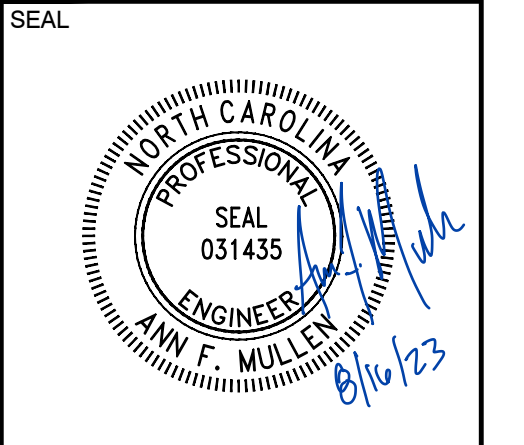

PLOT DATE:  
8/16/2023

REVISIONS:

RELEASED FOR:  
RECORD DRAWINGS


PROJECT NAME:  
**SIX RUNS RECORD DRAWINGS  
SAMPSON COUNTY, NORTH CAROLINA**

DRAWING TITLE:  
**REACH BB**

PROJECT NUMBER: 103205  
PROJECT MANAGER: JRM  
DESIGNED: AFM  
DRAWN: SLB  
CHECKED: TRS

SHEET NUMBER:  
**S4**




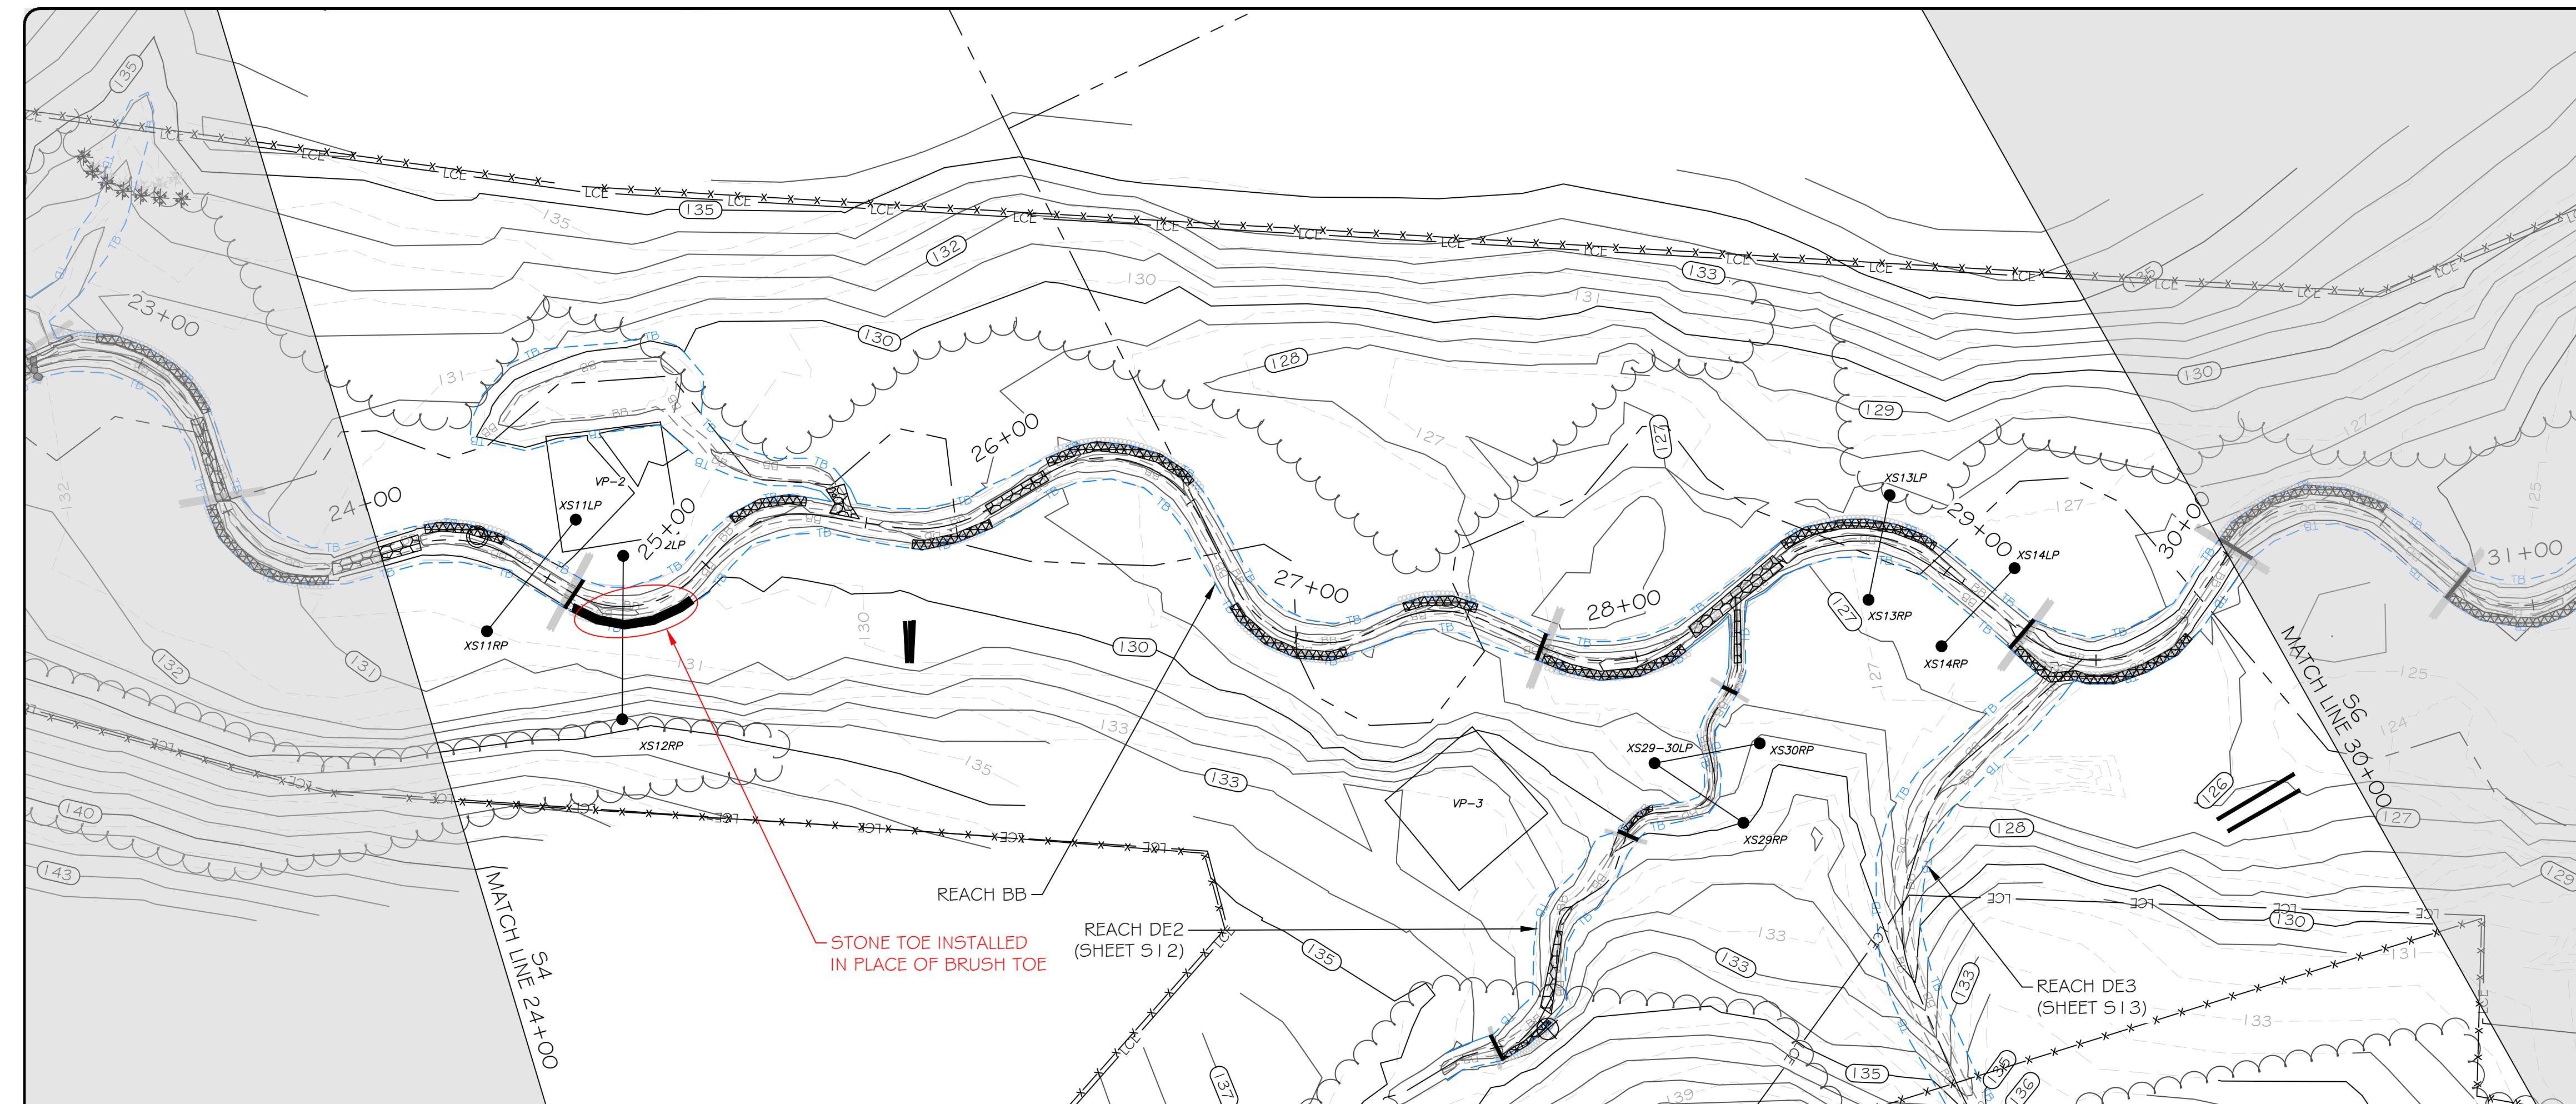



**LEGEND**

PROPERTY LINE	---
LIMITS OF PROPOSED CONSERVATION EASEMENT	-LCE-
WETLAND	
TREELINE	
AS-BUILT CONTOUR MAJOR	50
AS-BUILT CONTOUR MINOR	46
PROPOSED CONTOUR MAJOR	50
PROPOSED CONTOUR MINOR	46
EXISTING FENCING	---
AS-BUILT FENCING	---
AS-BUILT TOP OF BANK	---TB---
AS-BUILT BOTTOM OF BANK	---BB---
PROPOSED TOP OF BANK	---
AS-BUILT BRUSH TOE PROTECTION	
PROPOSED BRUSH TOE PROTECTION	
AS-BUILT ENGINEERED SEDIMENT PACK	*****
PROPOSED ENGINEERED SEDIMENT PACK	*****
AS-BUILT POST ASSISTED LOG STRUCTURE	
AS-BUILT LOG STRUCTURE	
PROPOSED LOG STRUCTURE	
AS-BUILT ROCK STRUCTURE	
PROPOSED ROCK STRUCTURE	
AS-BUILT STONE TOE	
PROPOSED STONE TOE	
AS-BUILT CONSTRUCTED RIFFLE	
PROPOSED CONSTRUCTED RIFFLE	
GROUNDWATER MONITORING WELL	
STAGE RECORDER	
FLOW GAUGE	
MONITORING CROSS SECTION	
VEGETATION MONITORING PLOT	VP#

NOTE: ALL SIGNIFICANT CHANGES FROM THE DESIGN ARE SHOWN IN RED

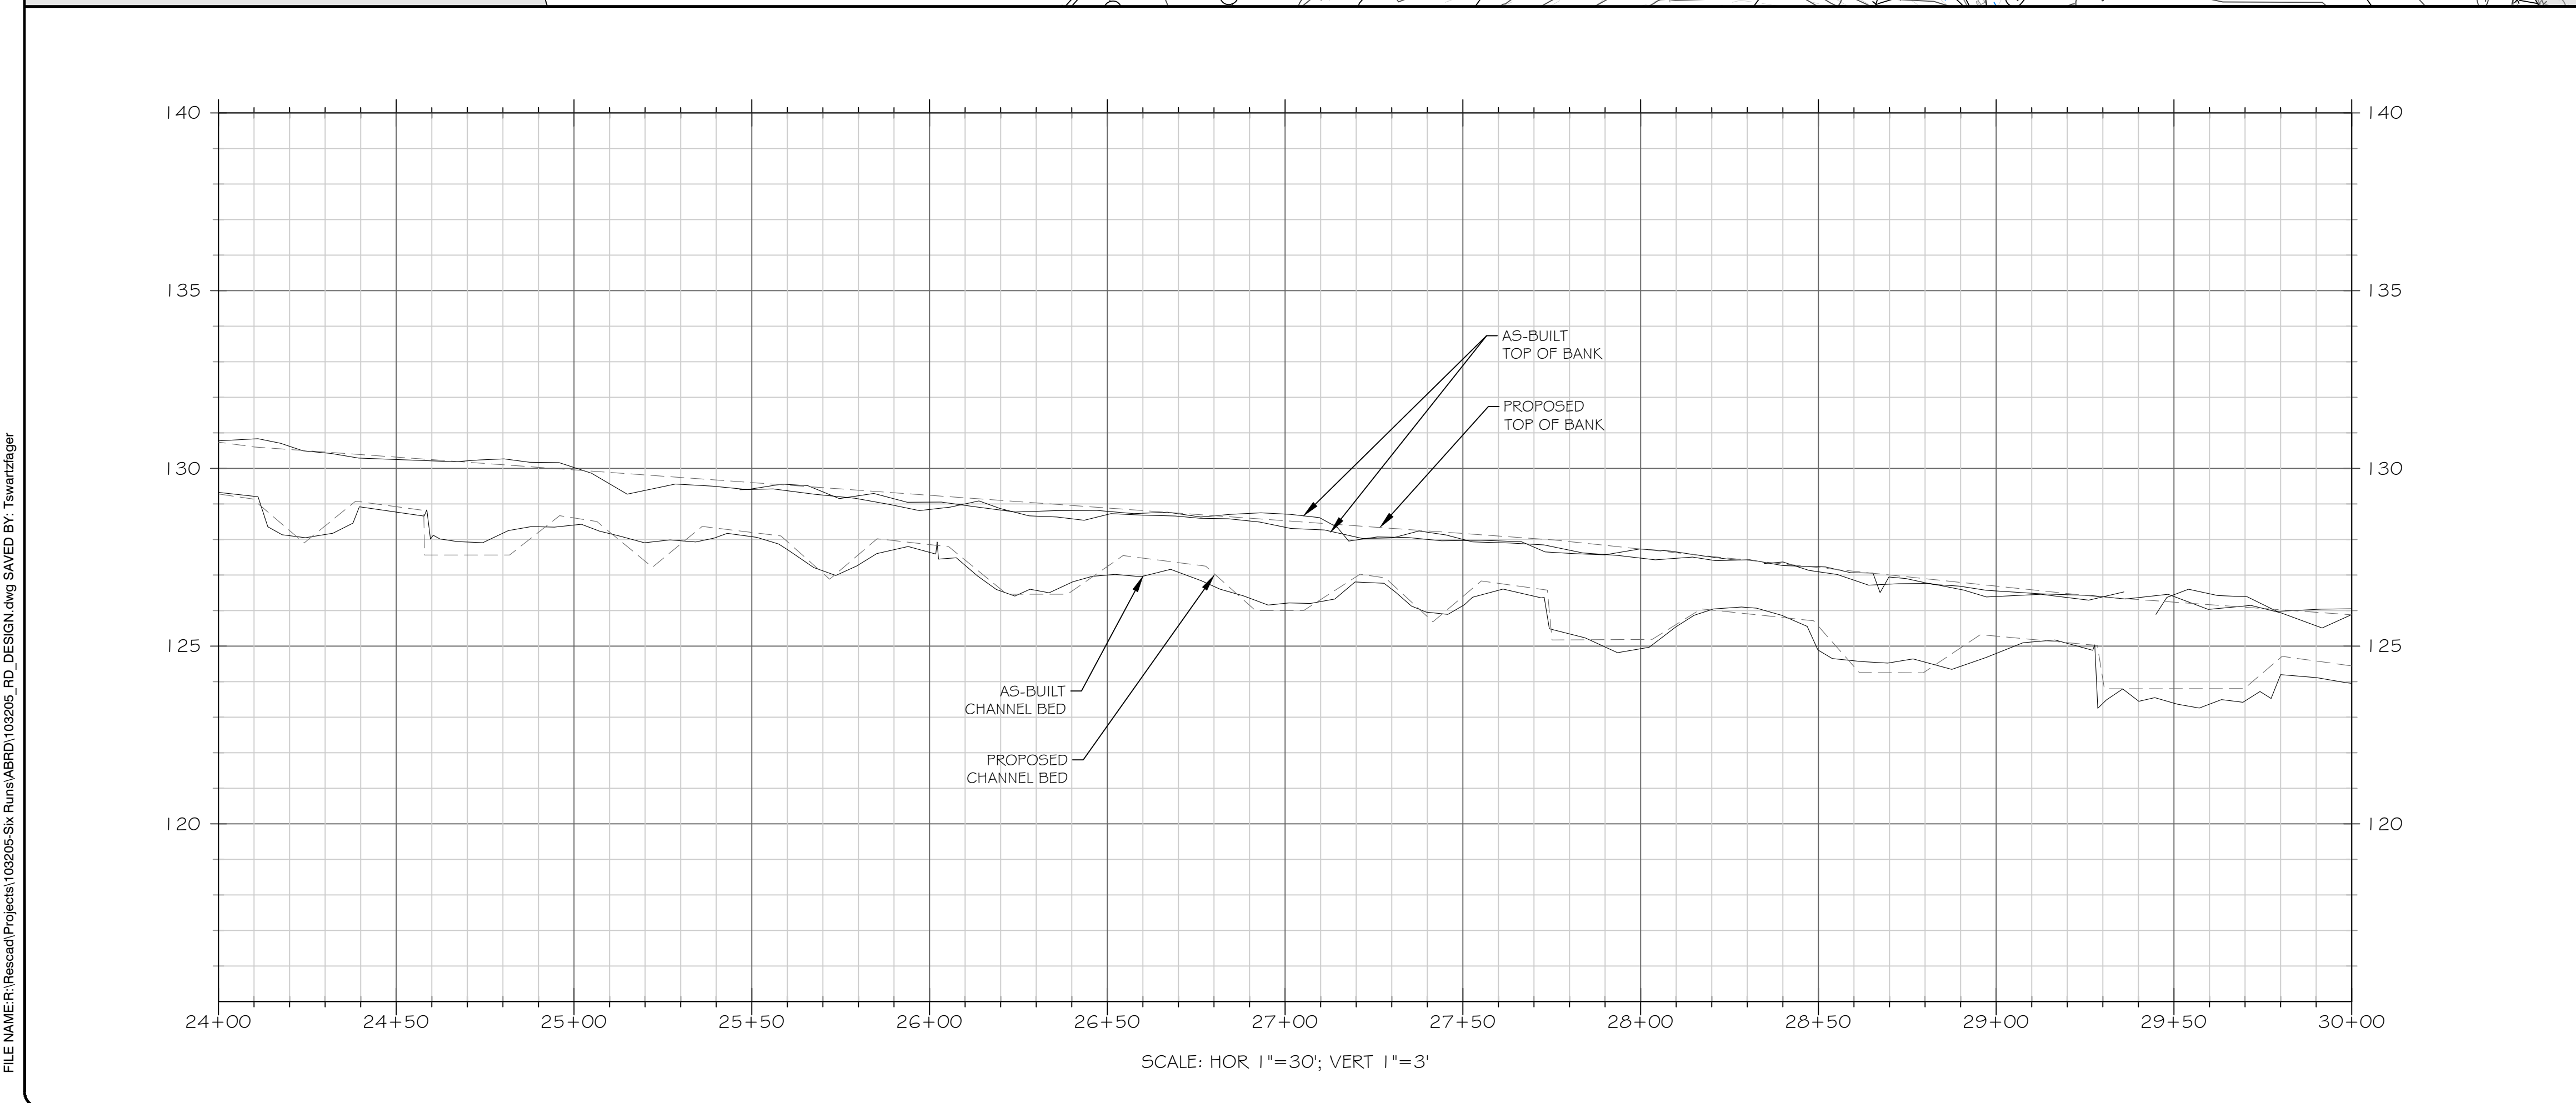

Engineering Services Provided By:  
RES Environmental Operating Company, LLC  
License: F-1428

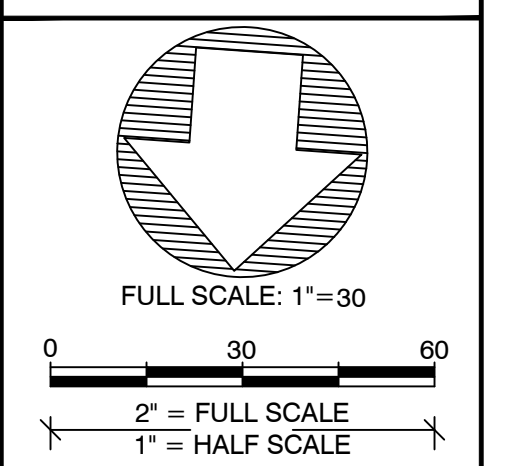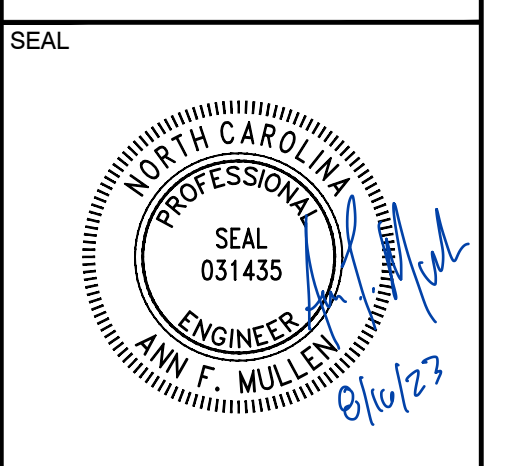

PLOT DATE:  
8/16/2023

REVISIONS:

RELEASED FOR:  
RECORD DRAWINGS

PROJECT NAME:  
**SIX RUNS RECORD DRAWINGS  
SAMPSON COUNTY, NORTH CAROLINA**


DRAWING TITLE:  
**REACH BB**

PROJECT NUMBER: 103205  
PROJECT MANAGER: JRM  
DESIGNED: AFM  
DRAWN: SLB  
CHECKED: TRS

SHEET NUMBER:  
**S5**



FILE NAME: F:\Rescad\Projects\103205-Six Runs\ABRD\103205\_RD\_DESIGN.dwg SAVED BY: Tswartzfager

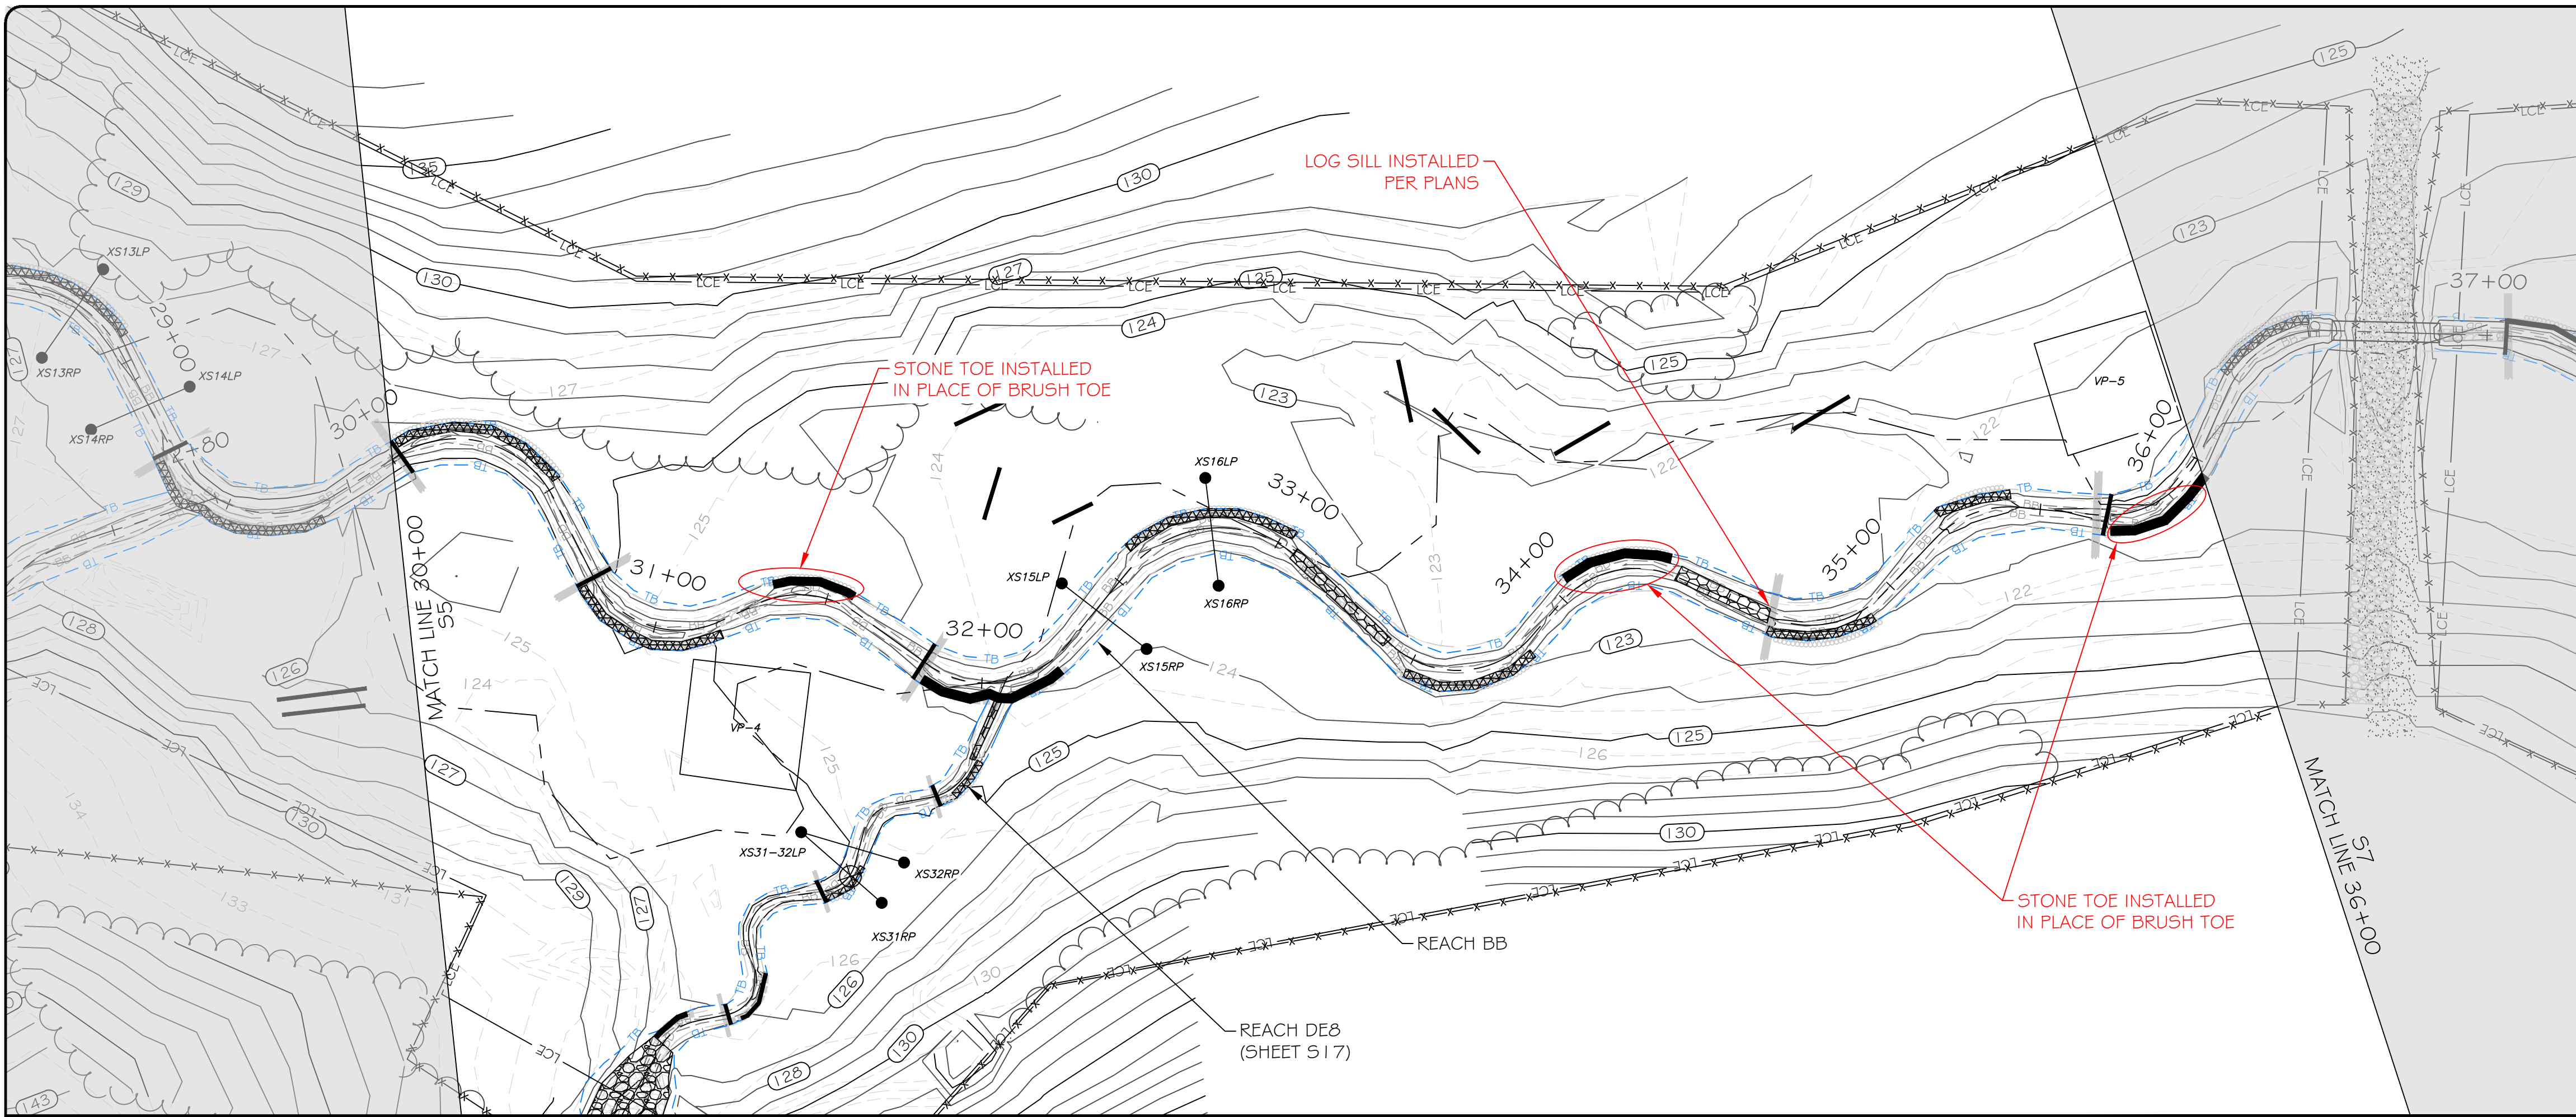

**LEGEND**

PROPERTY LINE	---
LIMITS OF PROPOSED CONSERVATION EASEMENT	---
WETLAND	[Symbol]
TREELINE	[Symbol]
AS-BUILT CONTOUR MAJOR	50
AS-BUILT CONTOUR MINOR	46
PROPOSED CONTOUR MAJOR	50
PROPOSED CONTOUR MINOR	46
EXISTING FENCING	[Symbol]
AS-BUILT FENCING	[Symbol]
AS-BUILT TOP OF BANK	TB
AS-BUILT BOTTOM OF BANK	BB
PROPOSED TOP OF BANK	[Symbol]
AS-BUILT BRUSH TOE PROTECTION	[Symbol]
PROPOSED BRUSH TOE PROTECTION	[Symbol]
AS-BUILT ENGINEERED SEDIMENT PACK	[Symbol]
PROPOSED ENGINEERED SEDIMENT PACK	[Symbol]
AS-BUILT POST ASSISTED LOG STRUCTURE	[Symbol]
AS-BUILT LOG STRUCTURE	[Symbol]
PROPOSED LOG STRUCTURE	[Symbol]
AS-BUILT ROCK STRUCTURE	[Symbol]
PROPOSED ROCK STRUCTURE	[Symbol]
AS-BUILT STONE TOE	[Symbol]
PROPOSED STONE TOE	[Symbol]
AS-BUILT CONSTRUCTED RIFFLE	[Symbol]
PROPOSED CONSTRUCTED RIFFLE	[Symbol]
GROUNDWATER MONITORING WELL	[Symbol]
STAGE RECORDER	[Symbol]
FLOW GAUGE	[Symbol]
MONITORING CROSS SECTION	[Symbol]
VEGETATION MONITORING PLOT	VP#

**NOTE: ALL SIGNIFICANT CHANGES FROM THE DESIGN ARE SHOWN IN RED**

**REVISIONS:**


**RELEASED FOR:** RECORD DRAWINGS

**PROJECT NAME:** SIX RUNS RECORD DRAWINGS  
SAMPSON COUNTY, NORTH CAROLINA

**DRAWING TITLE:** REACH BB

**PROJECT NUMBER:** 103205  
**PROJECT MANAGER:** JRM  
**DESIGNED:** AFM  
**DRAWN:** SLB  
**CHECKED:** TRS



**SHEET NUMBER:** S6

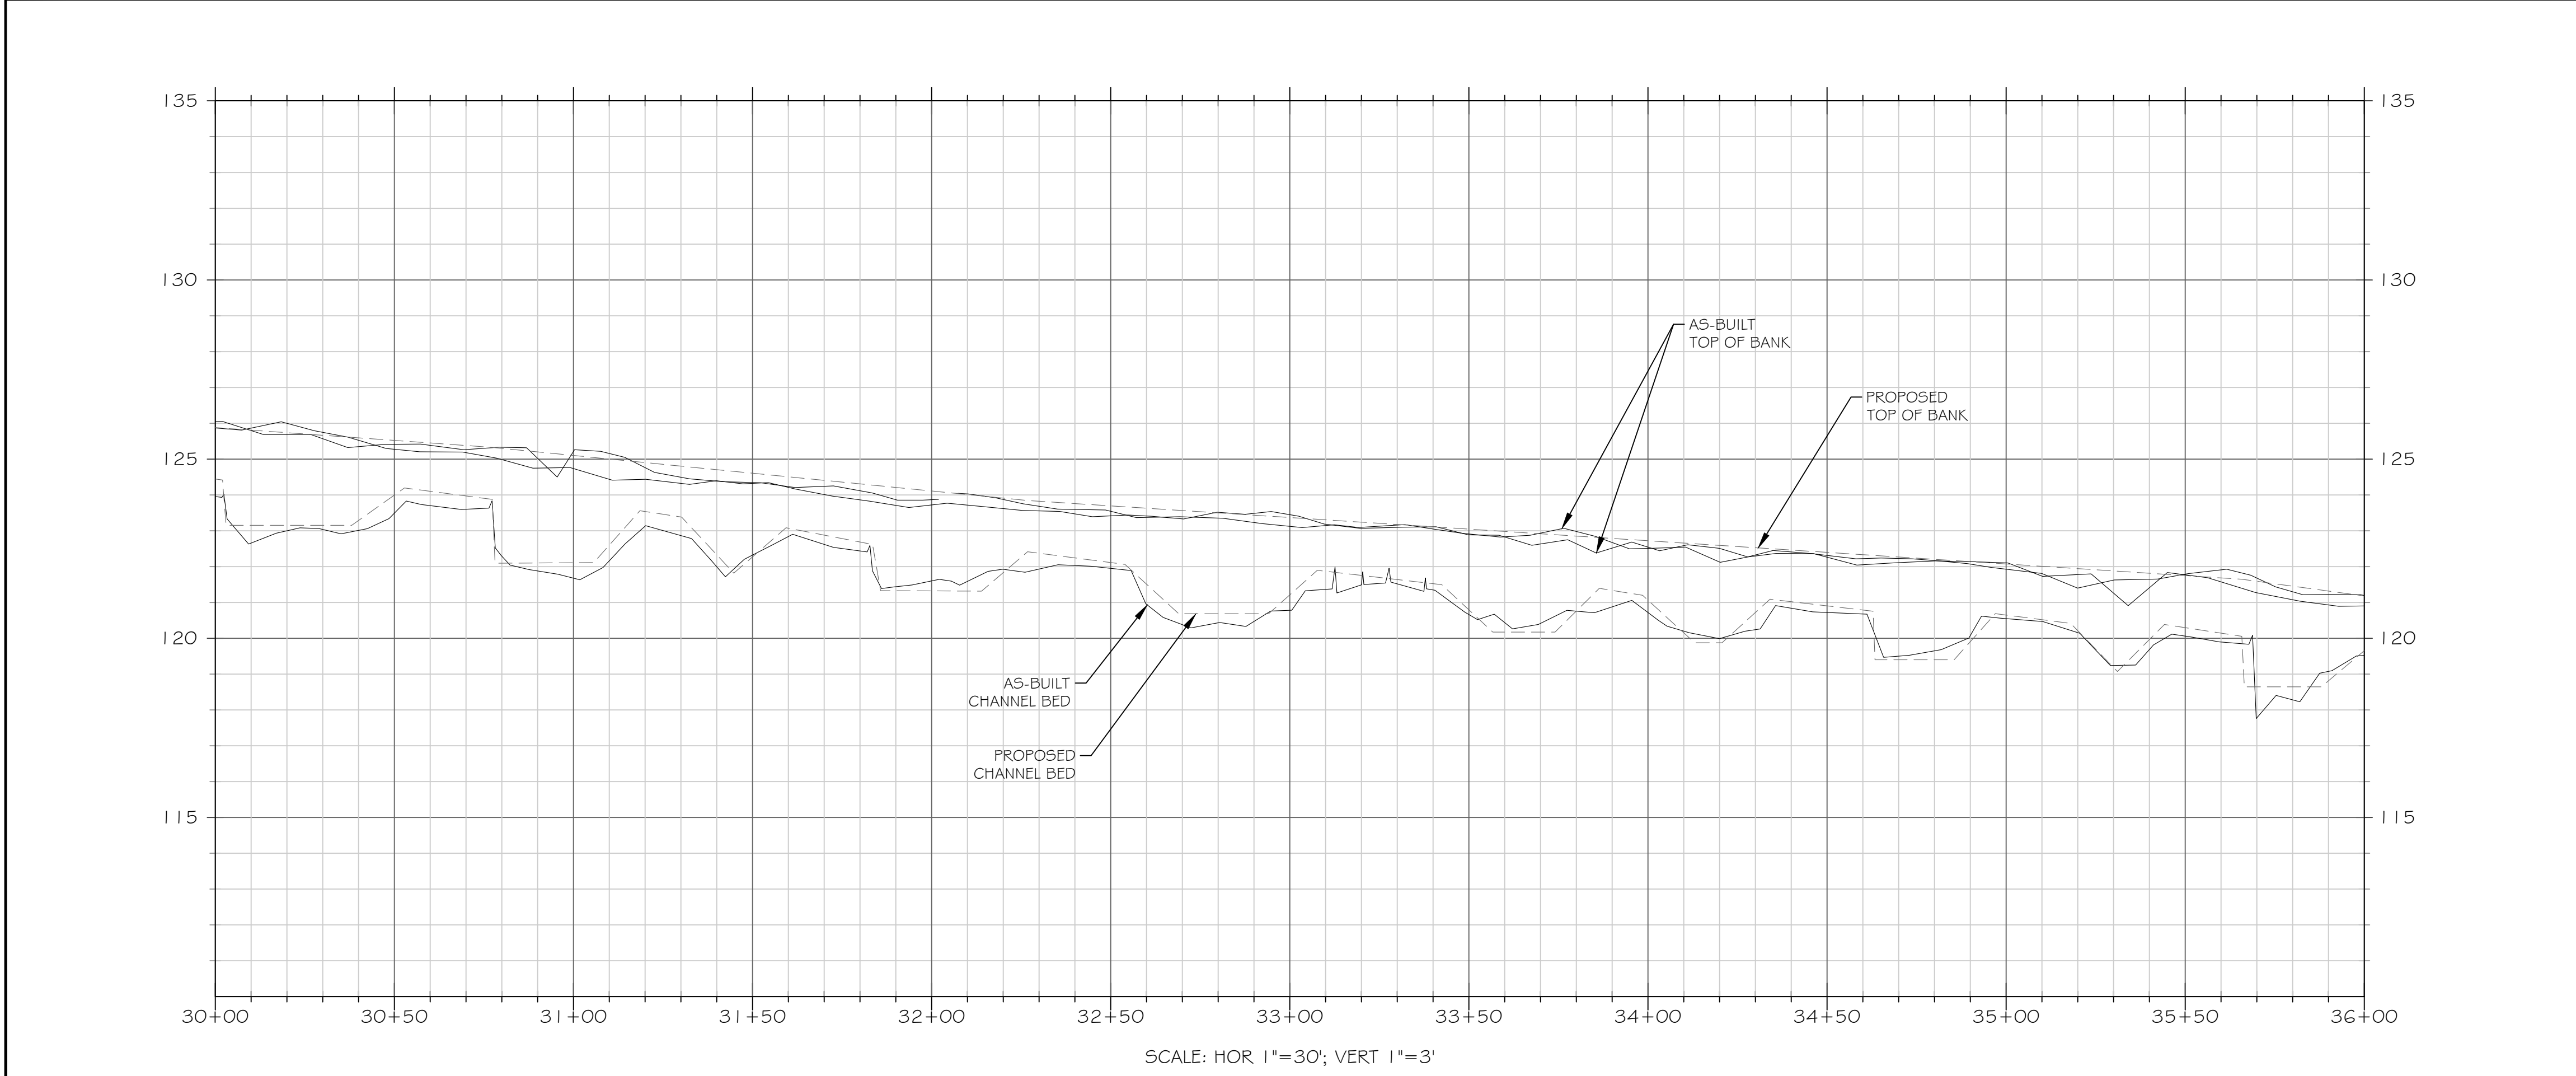

**res**

3600 Glenwood Ave, Suite 100  
Raleigh, NC 27612  
Main: 919.829.9909  
www.res.us

Engineering Services Provided By:  
RES Environmental Operating Company, LLC  
License: F-1428

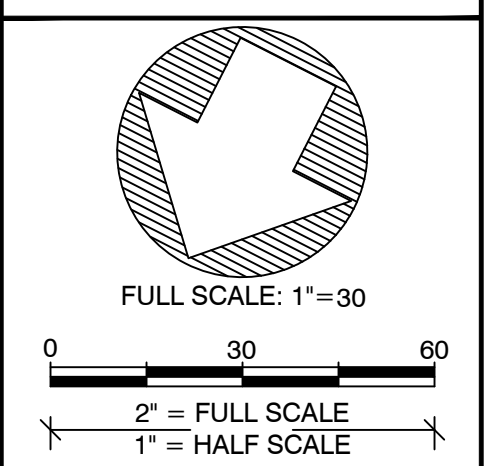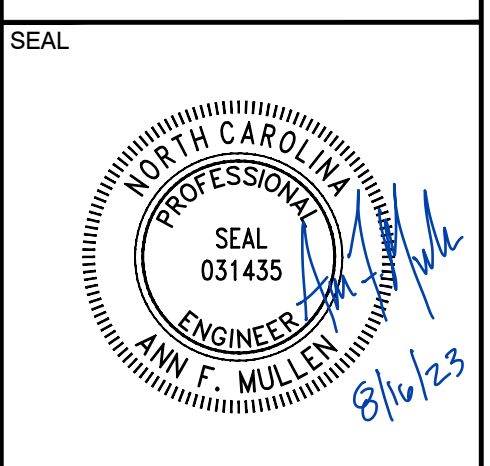

**PLOT DATE:** 8/16/2023

**REVISIONS:**

**RELEASED FOR:** RECORD DRAWINGS


**PROJECT NAME:** SIX RUNS RECORD DRAWINGS  
SAMPSON COUNTY, NORTH CAROLINA

**DRAWING TITLE:** REACH BB

**PROJECT NUMBER:** 103205  
**PROJECT MANAGER:** JRM  
**DESIGNED:** AFM  
**DRAWN:** SLB  
**CHECKED:** TRS

**SHEET NUMBER:** S6




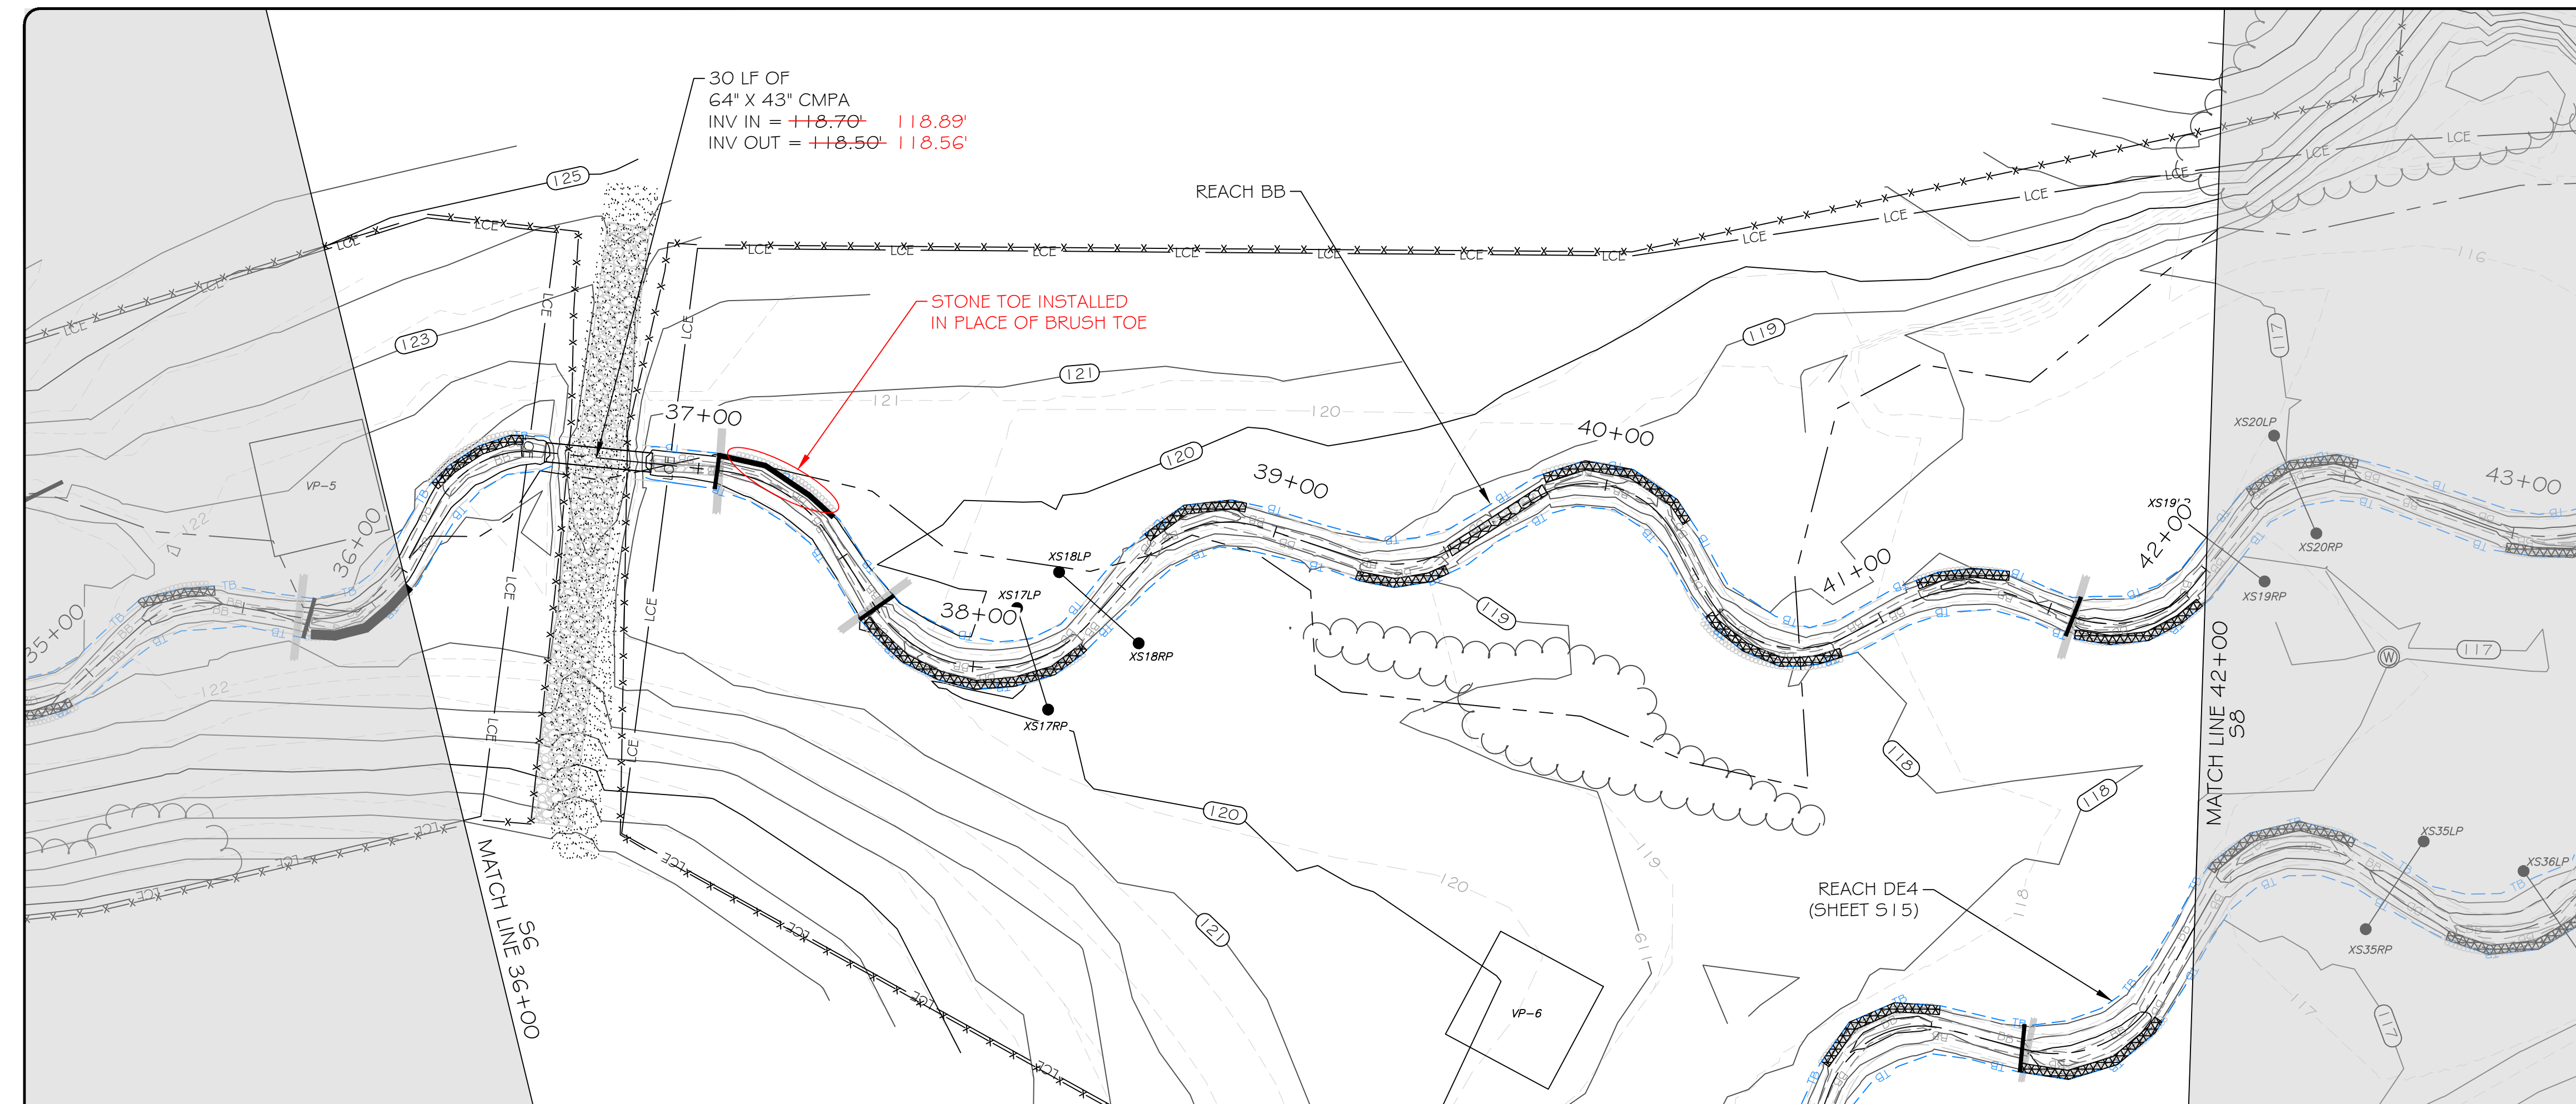


**LEGEND**

PROPERTY LINE	---
LIMITS OF PROPOSED CONSERVATION EASEMENT	LCE
WETLAND	
TREELINE	
AS-BUILT CONTOUR MAJOR	50
AS-BUILT CONTOUR MINOR	46
PROPOSED CONTOUR MAJOR	50
PROPOSED CONTOUR MINOR	46
EXISTING FENCING	---
AS-BUILT FENCING	---
AS-BUILT TOP OF BANK	TB
AS-BUILT BOTTOM OF BANK	BB
PROPOSED TOP OF BANK	---
AS-BUILT BRUSH TOE PROTECTION	
PROPOSED BRUSH TOE PROTECTION	
AS-BUILT ENGINEERED SEDIMENT PACK	
PROPOSED ENGINEERED SEDIMENT PACK	
AS-BUILT POST ASSISTED LOG STRUCTURE	
AS-BUILT LOG STRUCTURE	
PROPOSED LOG STRUCTURE	
AS-BUILT ROCK STRUCTURE	
PROPOSED ROCK STRUCTURE	
AS-BUILT STONE TOE	
PROPOSED STONE TOE	
AS-BUILT CONSTRUCTED RIFFLE	
PROPOSED CONSTRUCTED RIFFLE	
GROUNDWATER MONITORING WELL	
STAGE RECORDER	
FLOW GAUGE	
MONITORING CROSS SECTION	
VEGETATION MONITORING PLOT	VP#

**res**  
 3600 Glenwood Ave, Suite 100  
 Raleigh, NC 27612  
 Main: 919.829.9909  
 www.res.us

Engineering Services Provided By:  
 RES Environmental Operating Company, LLC  
 License: F-1428

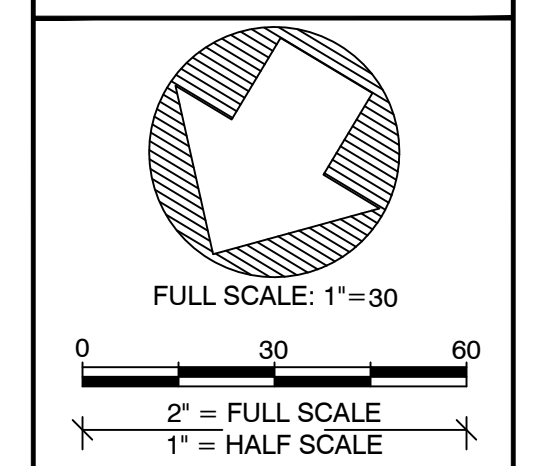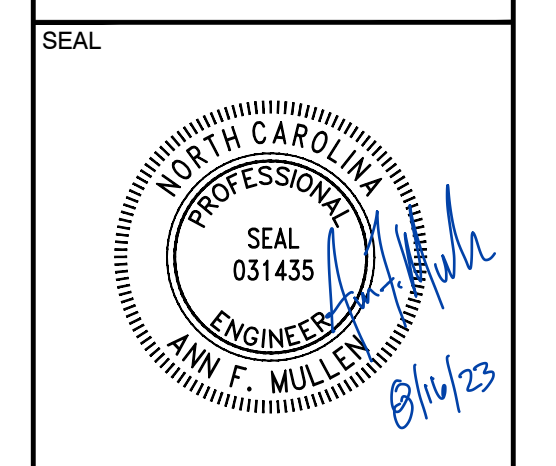

PLOT DATE:  
8/16/2023

REVISIONS:


RELEASED FOR:  
RECORD DRAWINGS

PROJECT NAME:  
**SIX RUNS RECORD DRAWINGS  
SAMPSON COUNTY, NORTH CAROLINA**

DRAWING TITLE:  
**REACH BB**


PROJECT NUMBER: 103205  
 PROJECT MANAGER: JRM  
 DESIGNED: AFM  
 DRAWN: SLB  
 CHECKED: TRS

SHEET NUMBER:  
**S7**

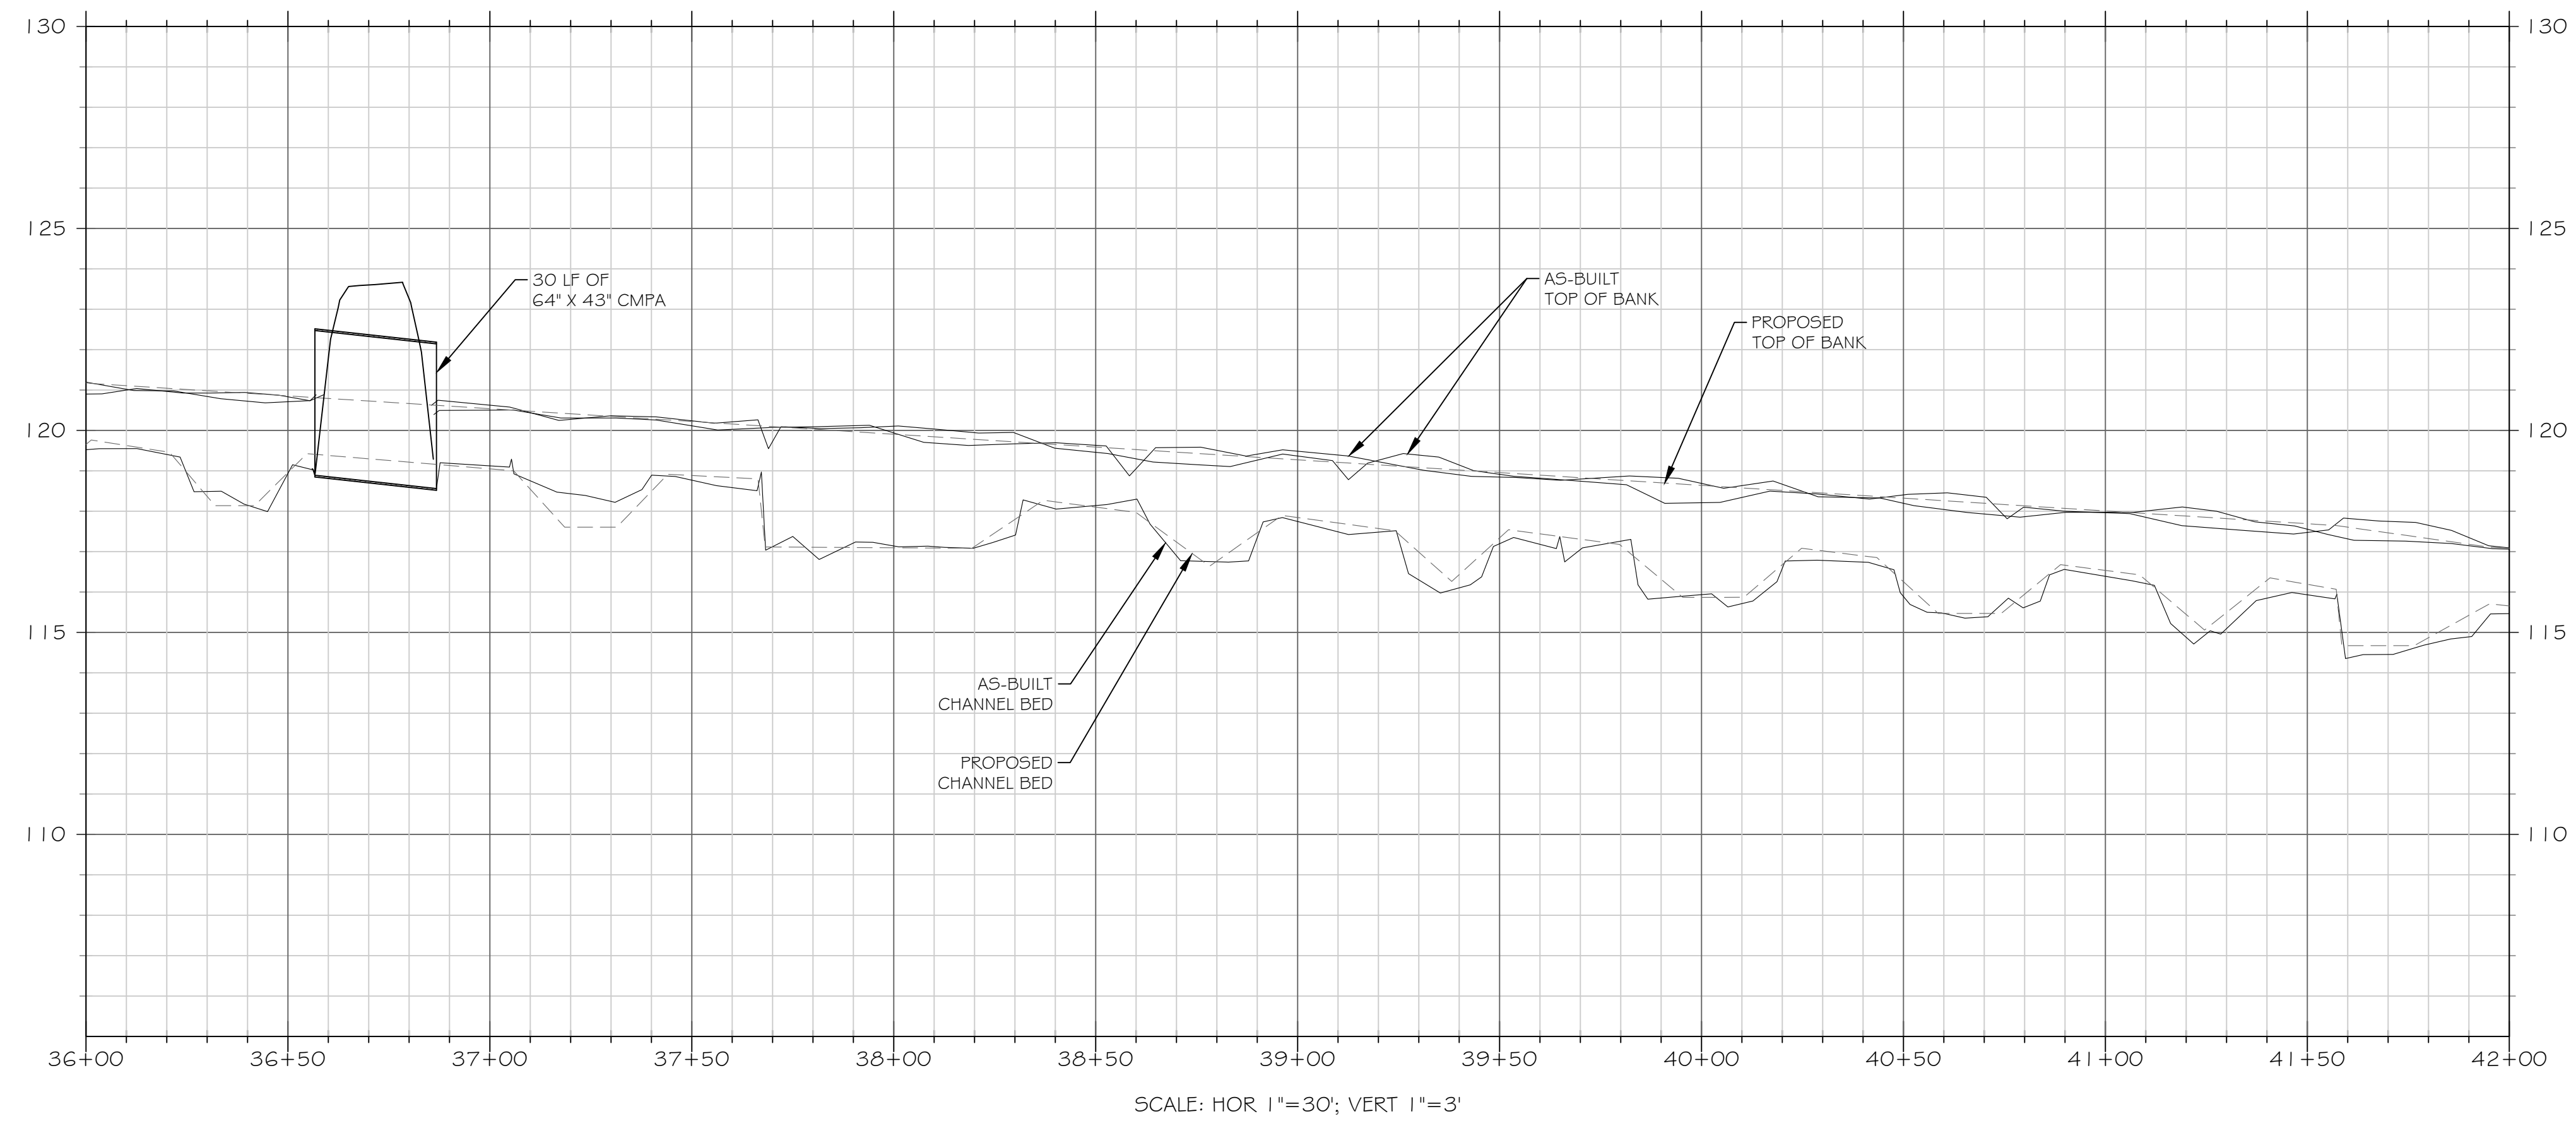

FILE NAME: F:\Resoad\Projects\103205-Six Runs\ABRD\103205\_RD\_DESIGN.dwg SAVED BY: Tswartzfager




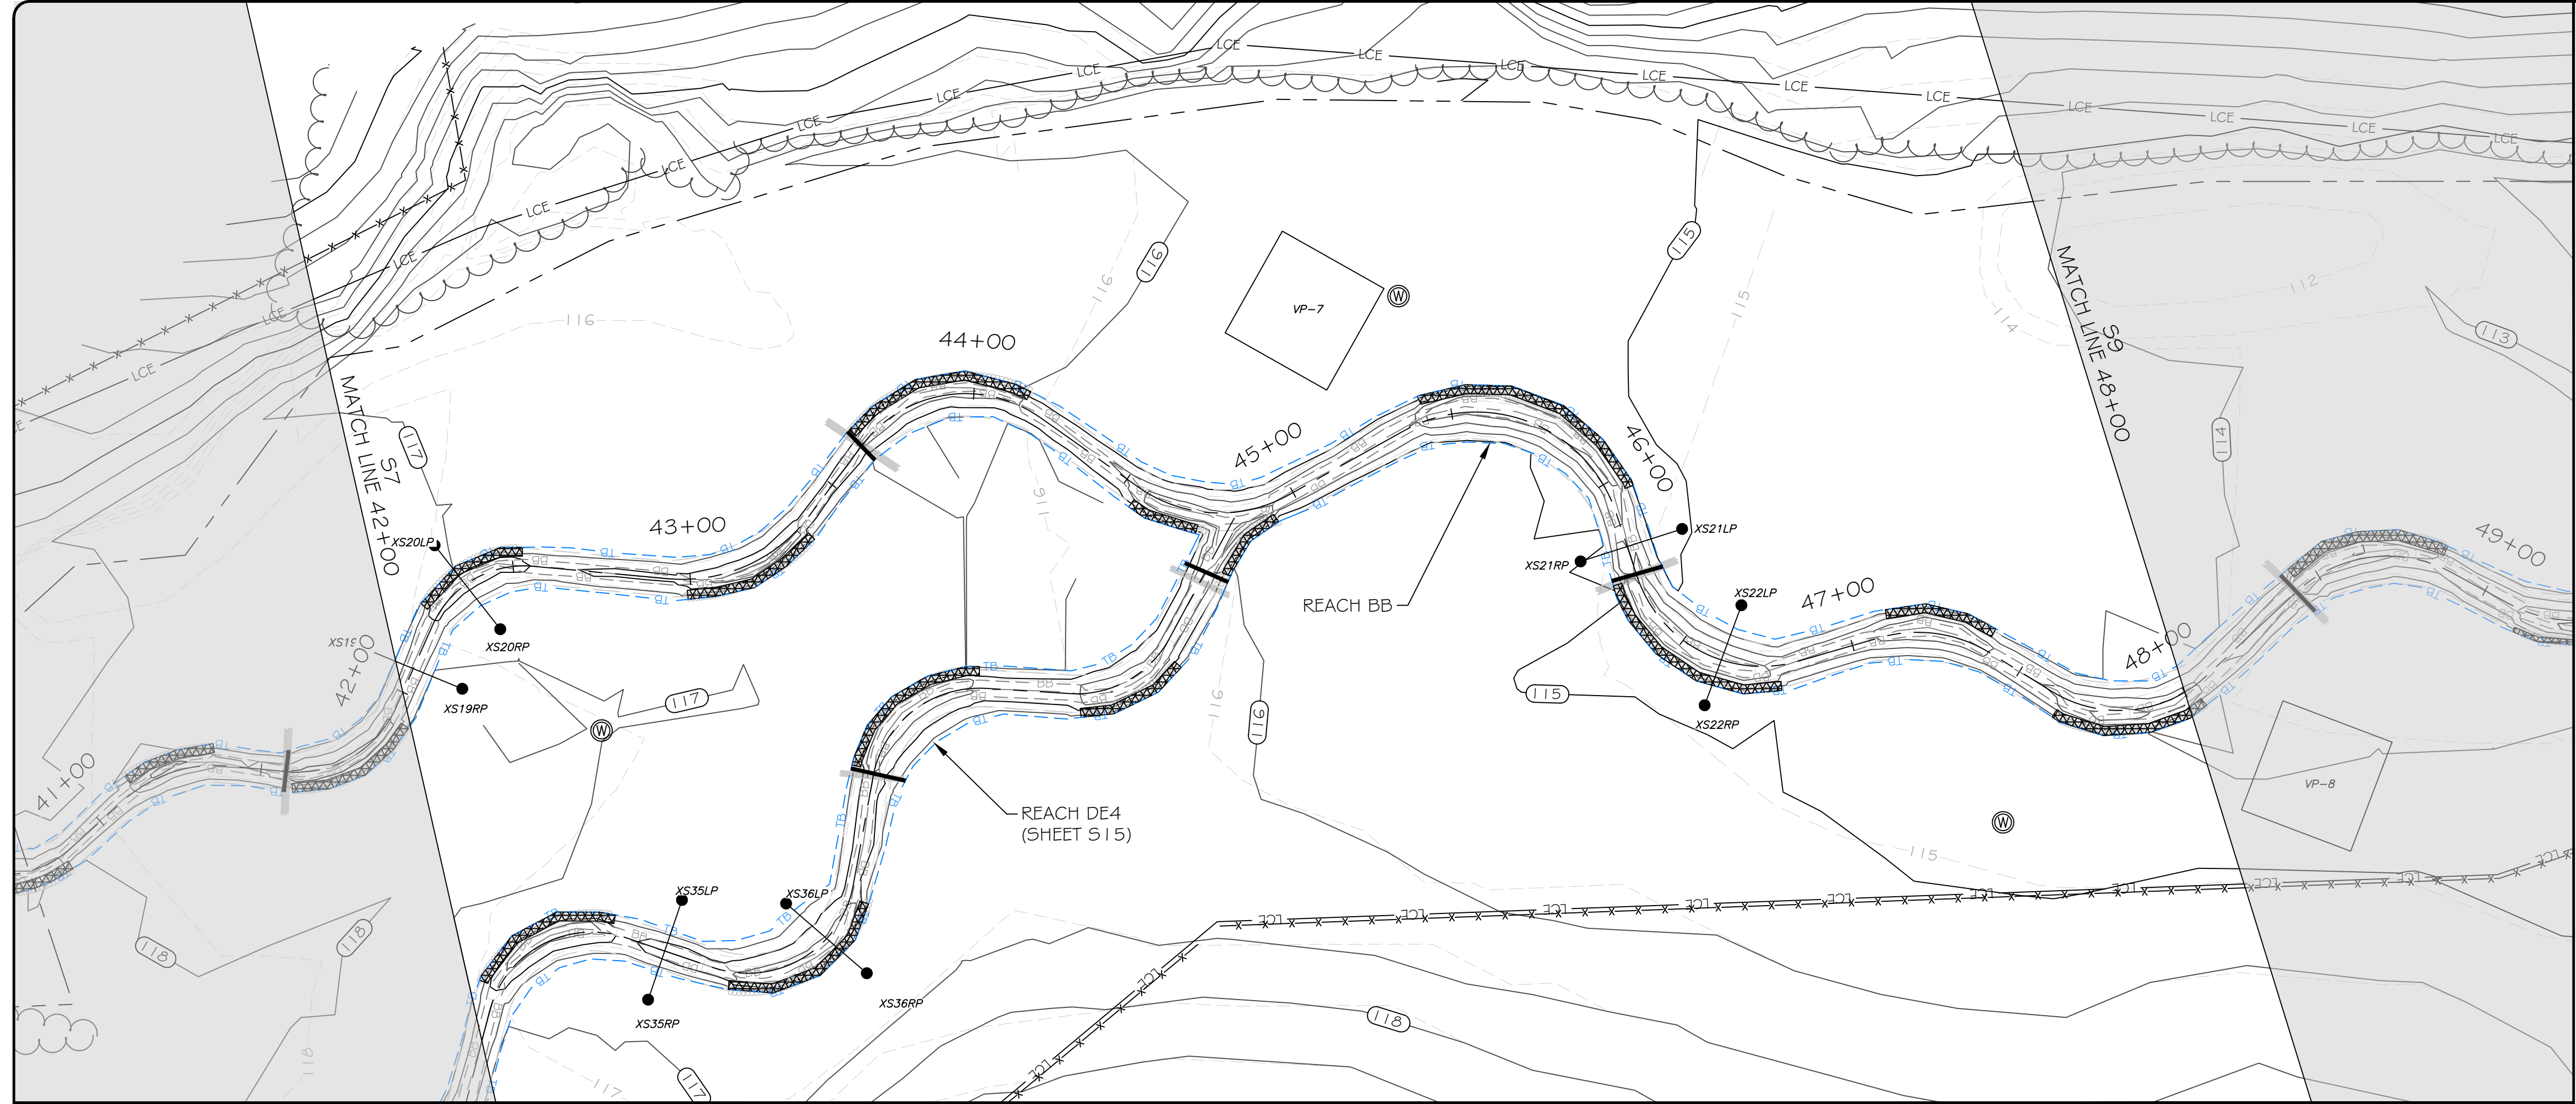

**LEGEND**



PROPERTY LINE	- - - - -
LIMITS OF PROPOSED CONSERVATION EASEMENT	- - - - - LCE
WETLAND	[Symbol]
TREELINE	[Symbol]
AS-BUILT CONTOUR MAJOR	— 50 —
AS-BUILT CONTOUR MINOR	— 46 —
PROPOSED CONTOUR MAJOR	- - - 50 - - -
PROPOSED CONTOUR MINOR	- - - 46 - - -
EXISTING FENCING	[Symbol]
AS-BUILT FENCING	[Symbol]
AS-BUILT TOP OF BANK	— TB —
AS-BUILT BOTTOM OF BANK	— BB —
PROPOSED TOP OF BANK	- - - - -
AS-BUILT BRUSH TOE PROTECTION	[Symbol]
PROPOSED BRUSH TOE PROTECTION	[Symbol]
AS-BUILT ENGINEERED SEDIMENT PACK	[Symbol]
PROPOSED ENGINEERED SEDIMENT PACK	[Symbol]
AS-BUILT POST ASSISTED LOG STRUCTURE	[Symbol]
AS-BUILT LOG STRUCTURE	[Symbol]
PROPOSED LOG STRUCTURE	[Symbol]
AS-BUILT ROCK STRUCTURE	[Symbol]
PROPOSED ROCK STRUCTURE	[Symbol]
AS-BUILT STONE TOE	[Symbol]
PROPOSED STONE TOE	[Symbol]
AS-BUILT CONSTRUCTED RIFFLE	[Symbol]
PROPOSED CONSTRUCTED RIFFLE	[Symbol]
GROUNDWATER MONITORING WELL	[Symbol]
STAGE RECORDER	[Symbol]
FLOW GAUGE	[Symbol]
MONITORING CROSS SECTION	[Symbol]
VEGETATION MONITORING PLOT	[Symbol] VP#

NOTE: ALL SIGNIFICANT CHANGES FROM THE DESIGN ARE SHOWN IN RED

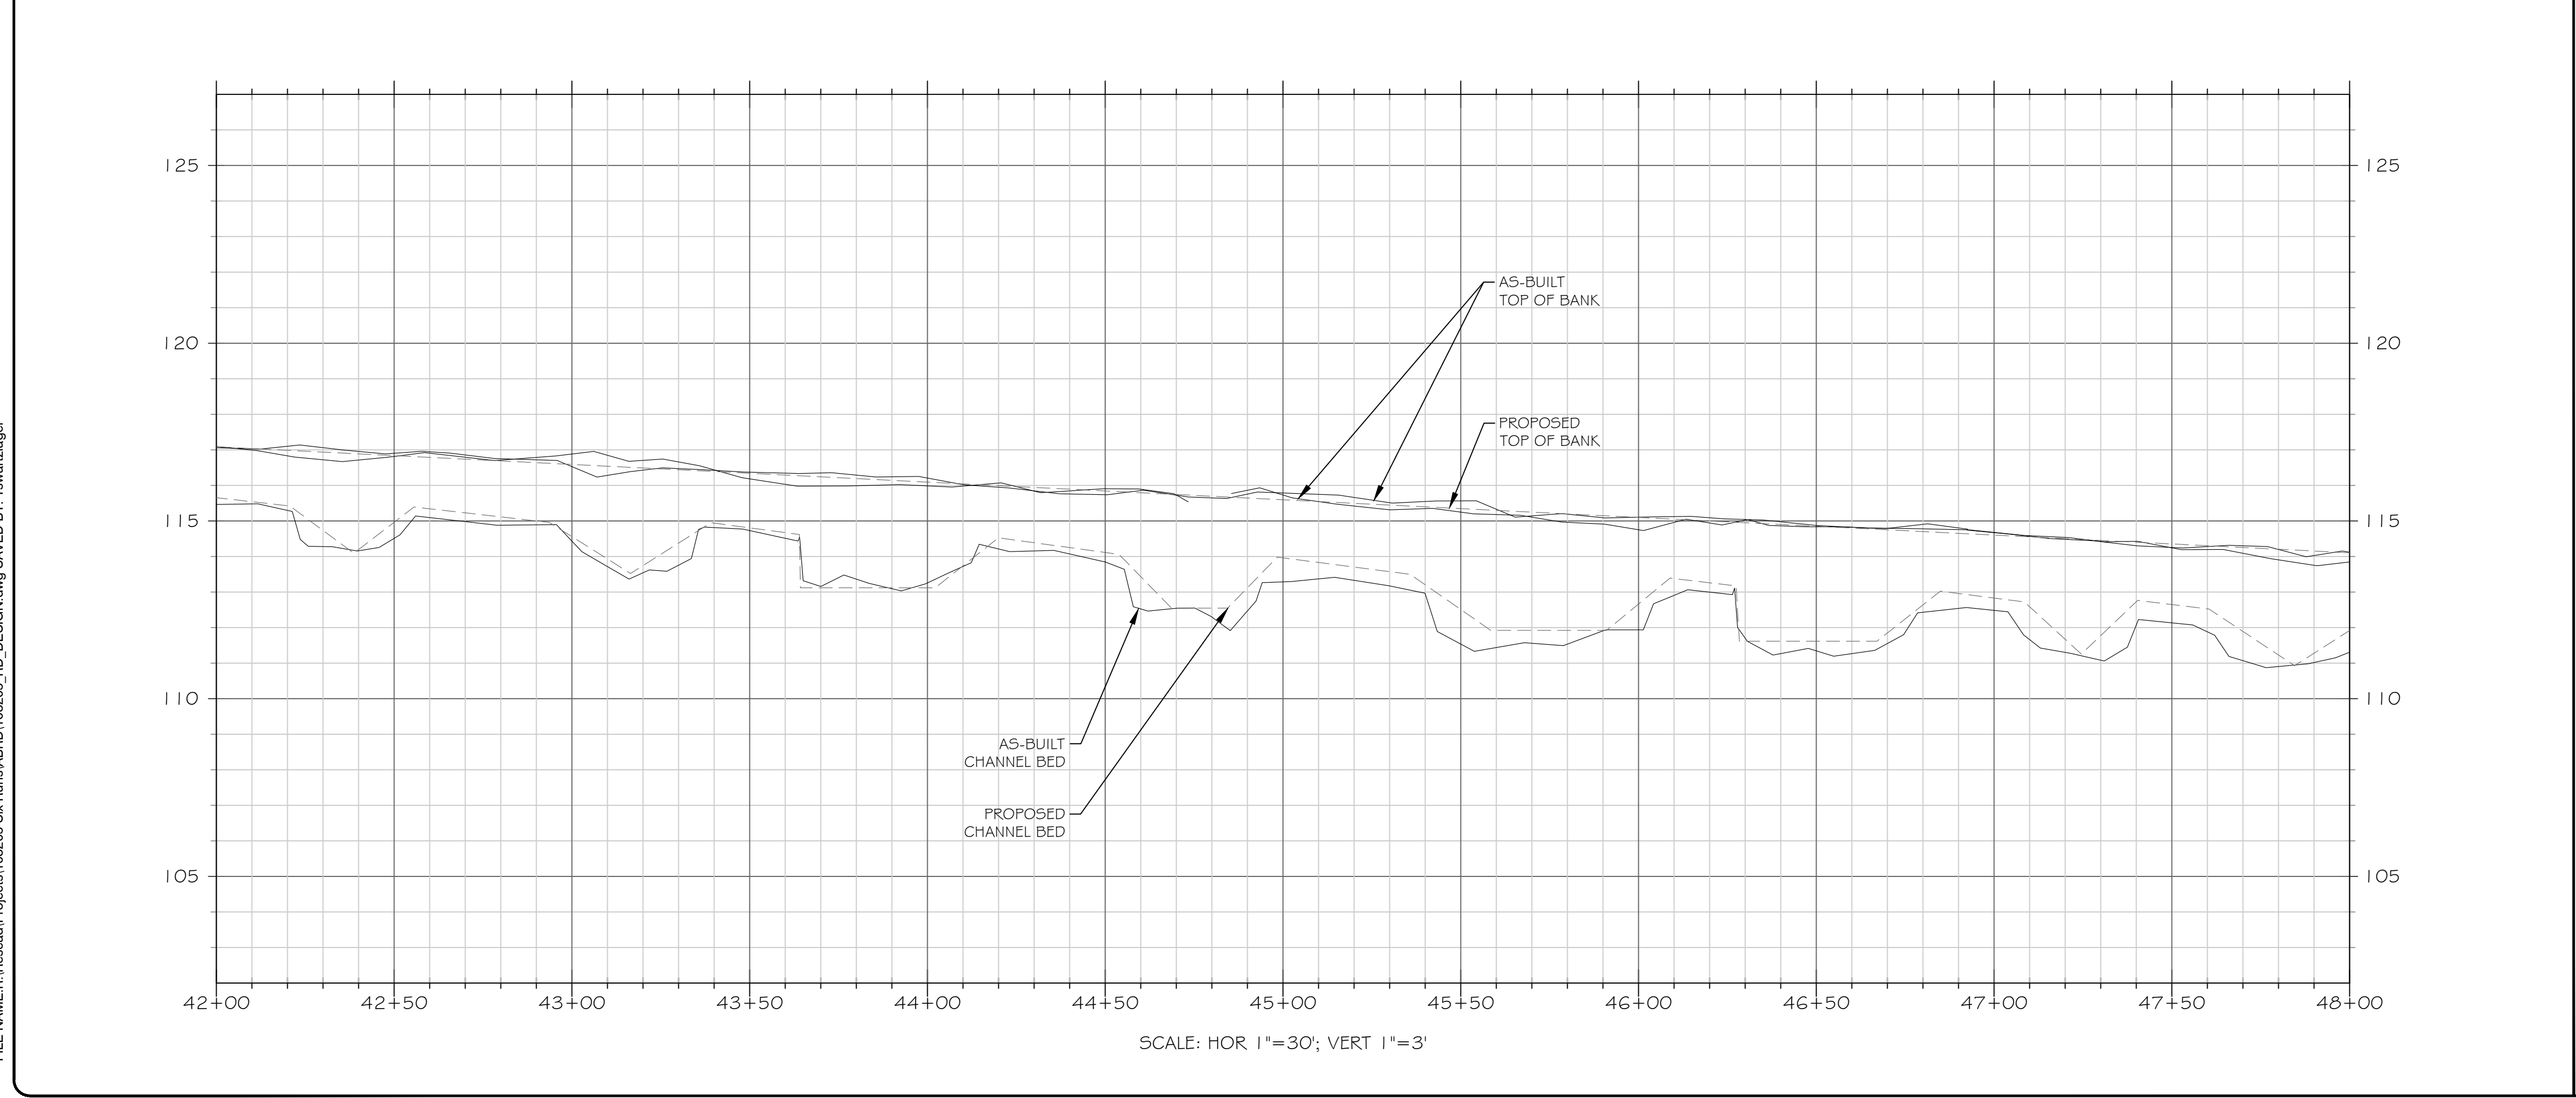

3600 Glenwood Ave, Suite 100  
Raleigh, NC 27612  
Main: 919.829.9909  
www.res.us

Engineering Services Provided By:  
RES Environmental Operating Company, LLC  
License: F-1428

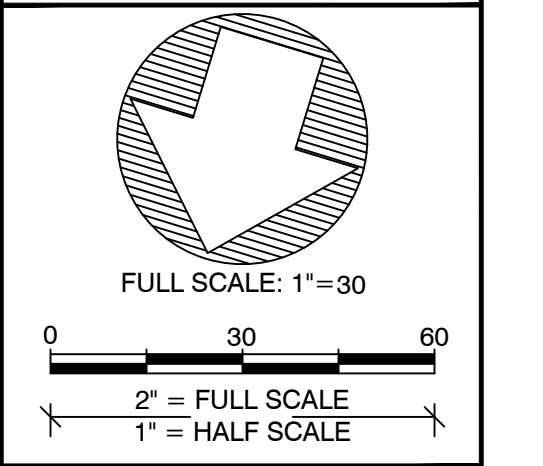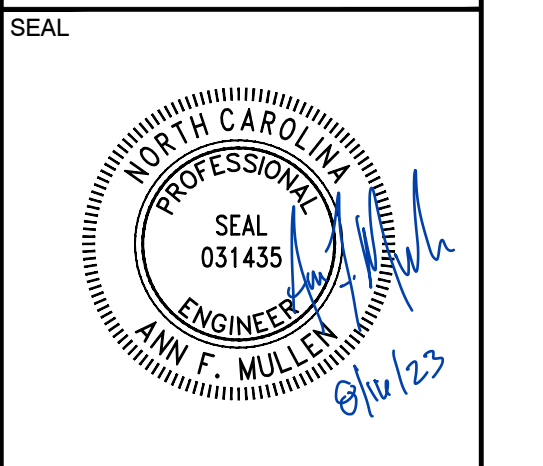

PLOT DATE:  
8/16/2023

REVISIONS:

RELEASED FOR:  
RECORD DRAWINGS

PROJECT NAME:  
**SIX RUNS RECORD DRAWINGS  
SAMPSON COUNTY, NORTH CAROLINA**



DRAWING TITLE:  
**REACH BB**

PROJECT NUMBER: 103205  
PROJECT MANAGER: JRM  
DESIGNED: AFM  
DRAWN: SLB  
CHECKED: TRS


SHEET NUMBER:  
**S8**



FILE NAME: F:\ResCAD\Projects\103205-Six Runs\ABRD\103205\_RD\_DESIGN.dwg SAVED BY: Tswartzfeger

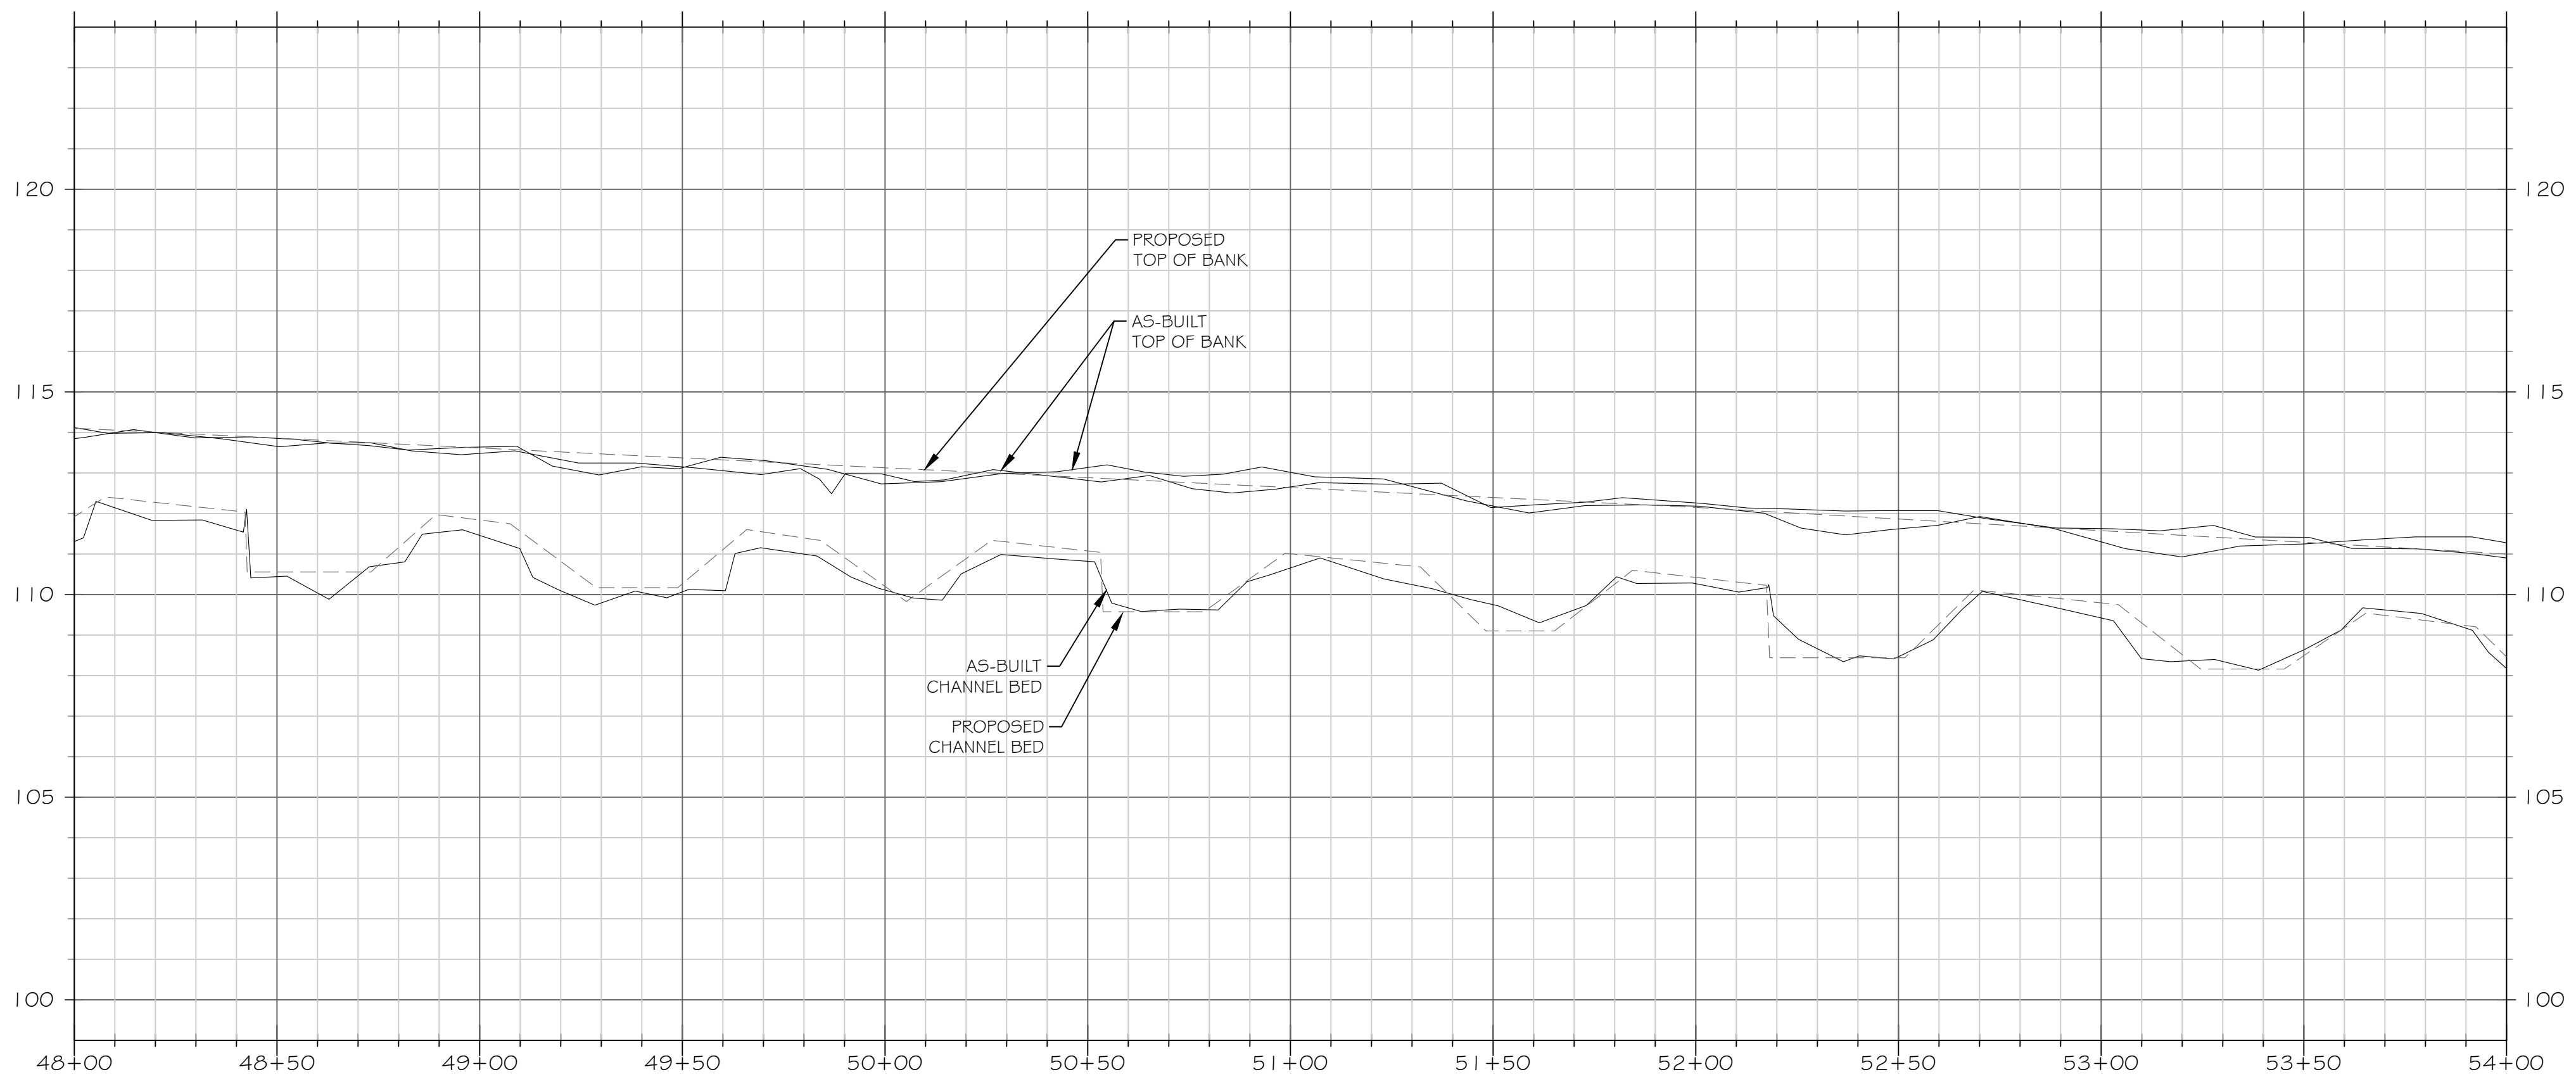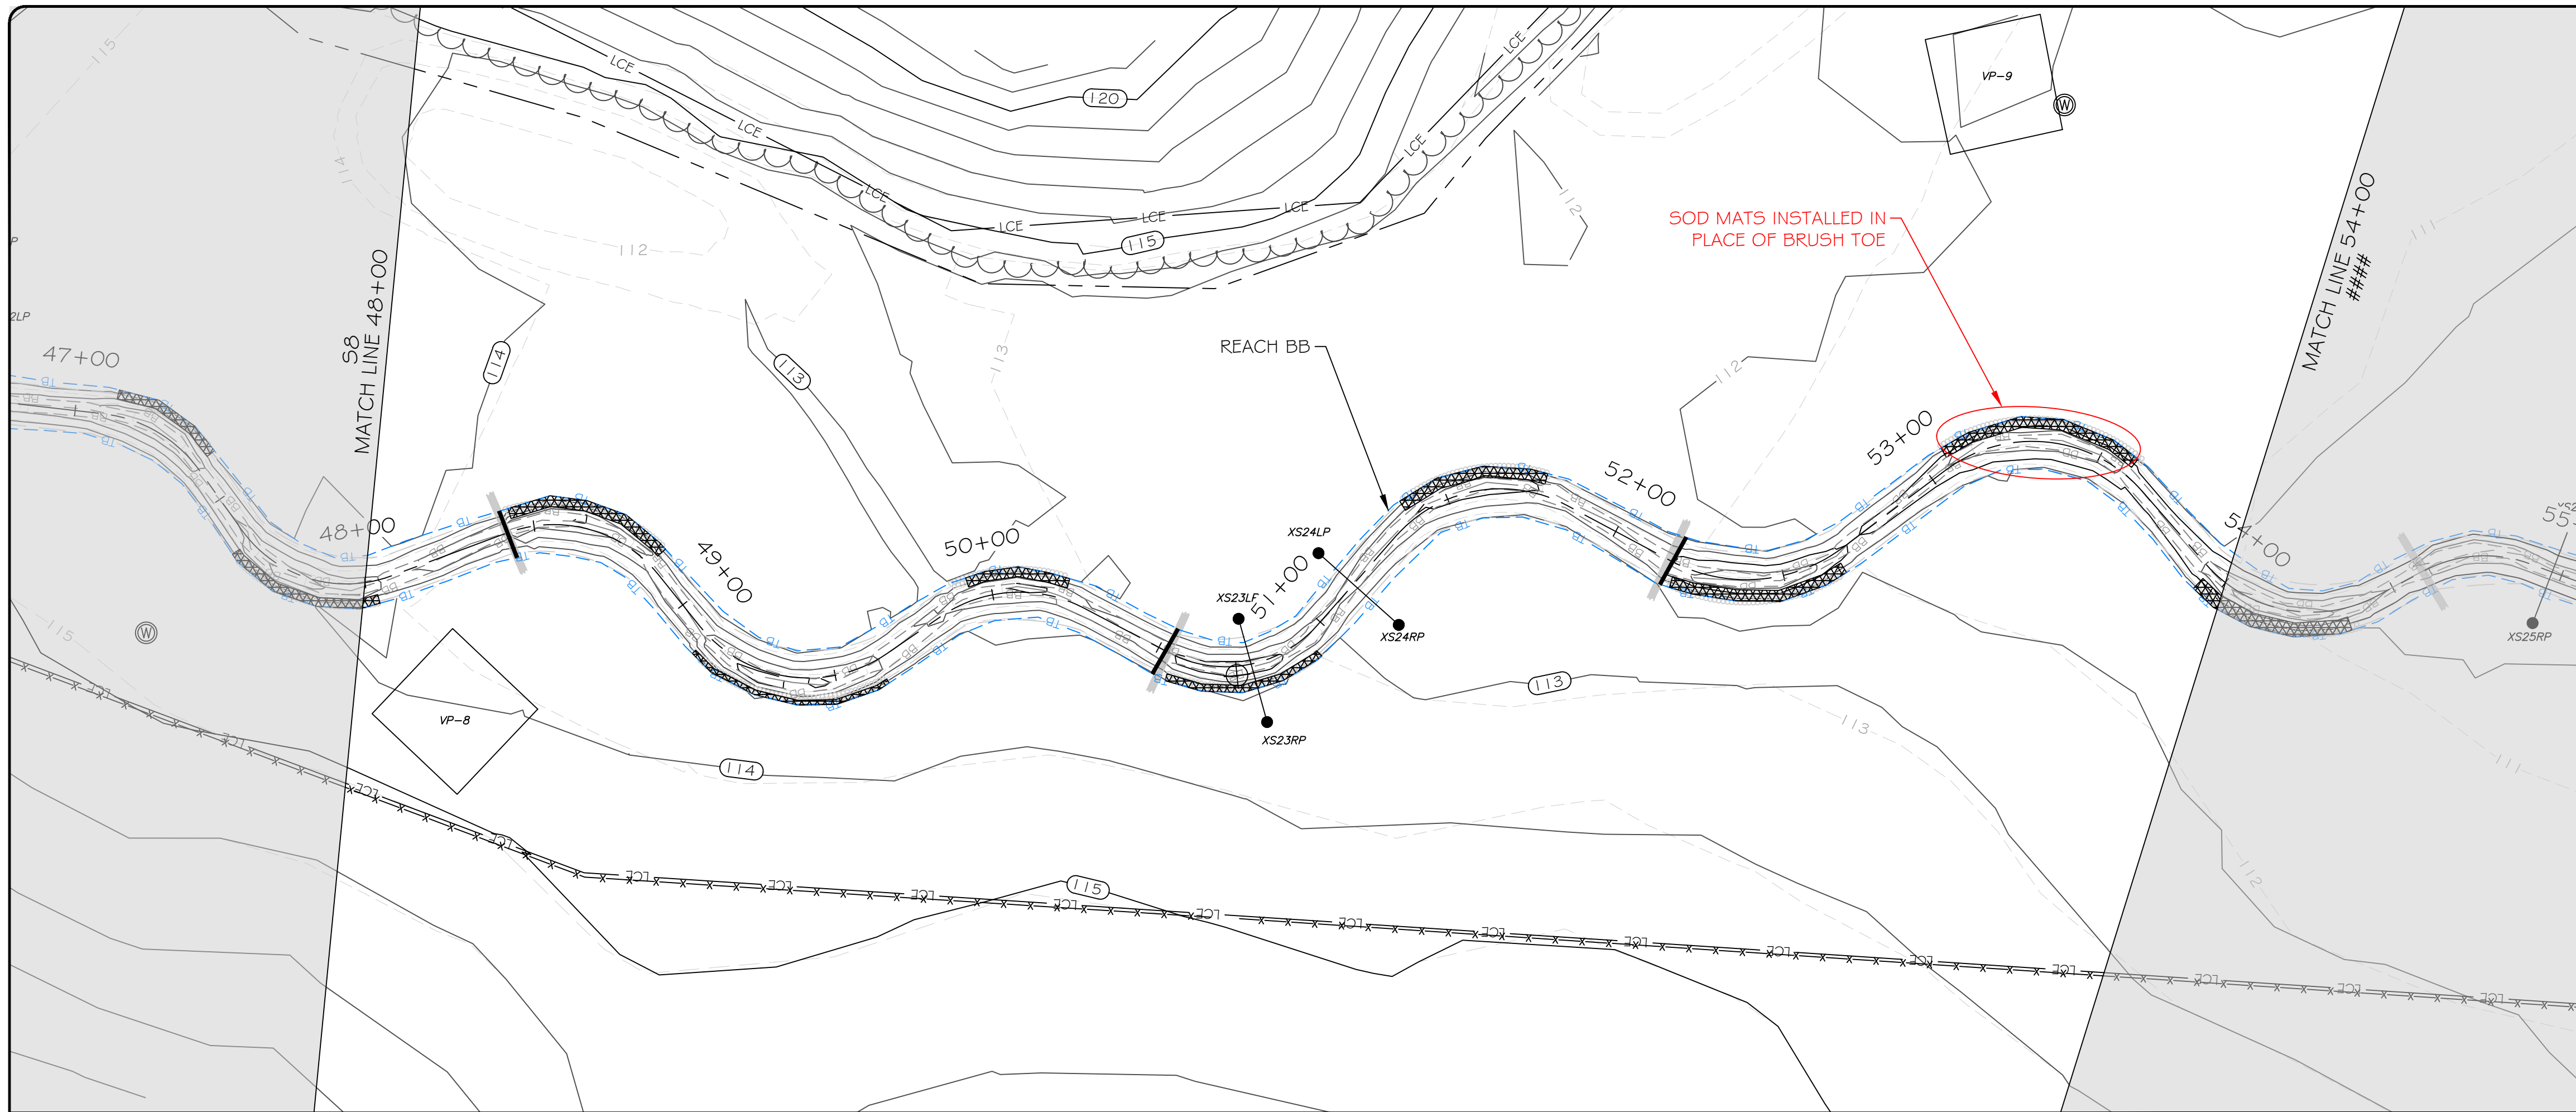



SCALE: HOR 1"=30'; VERT 1"=3'

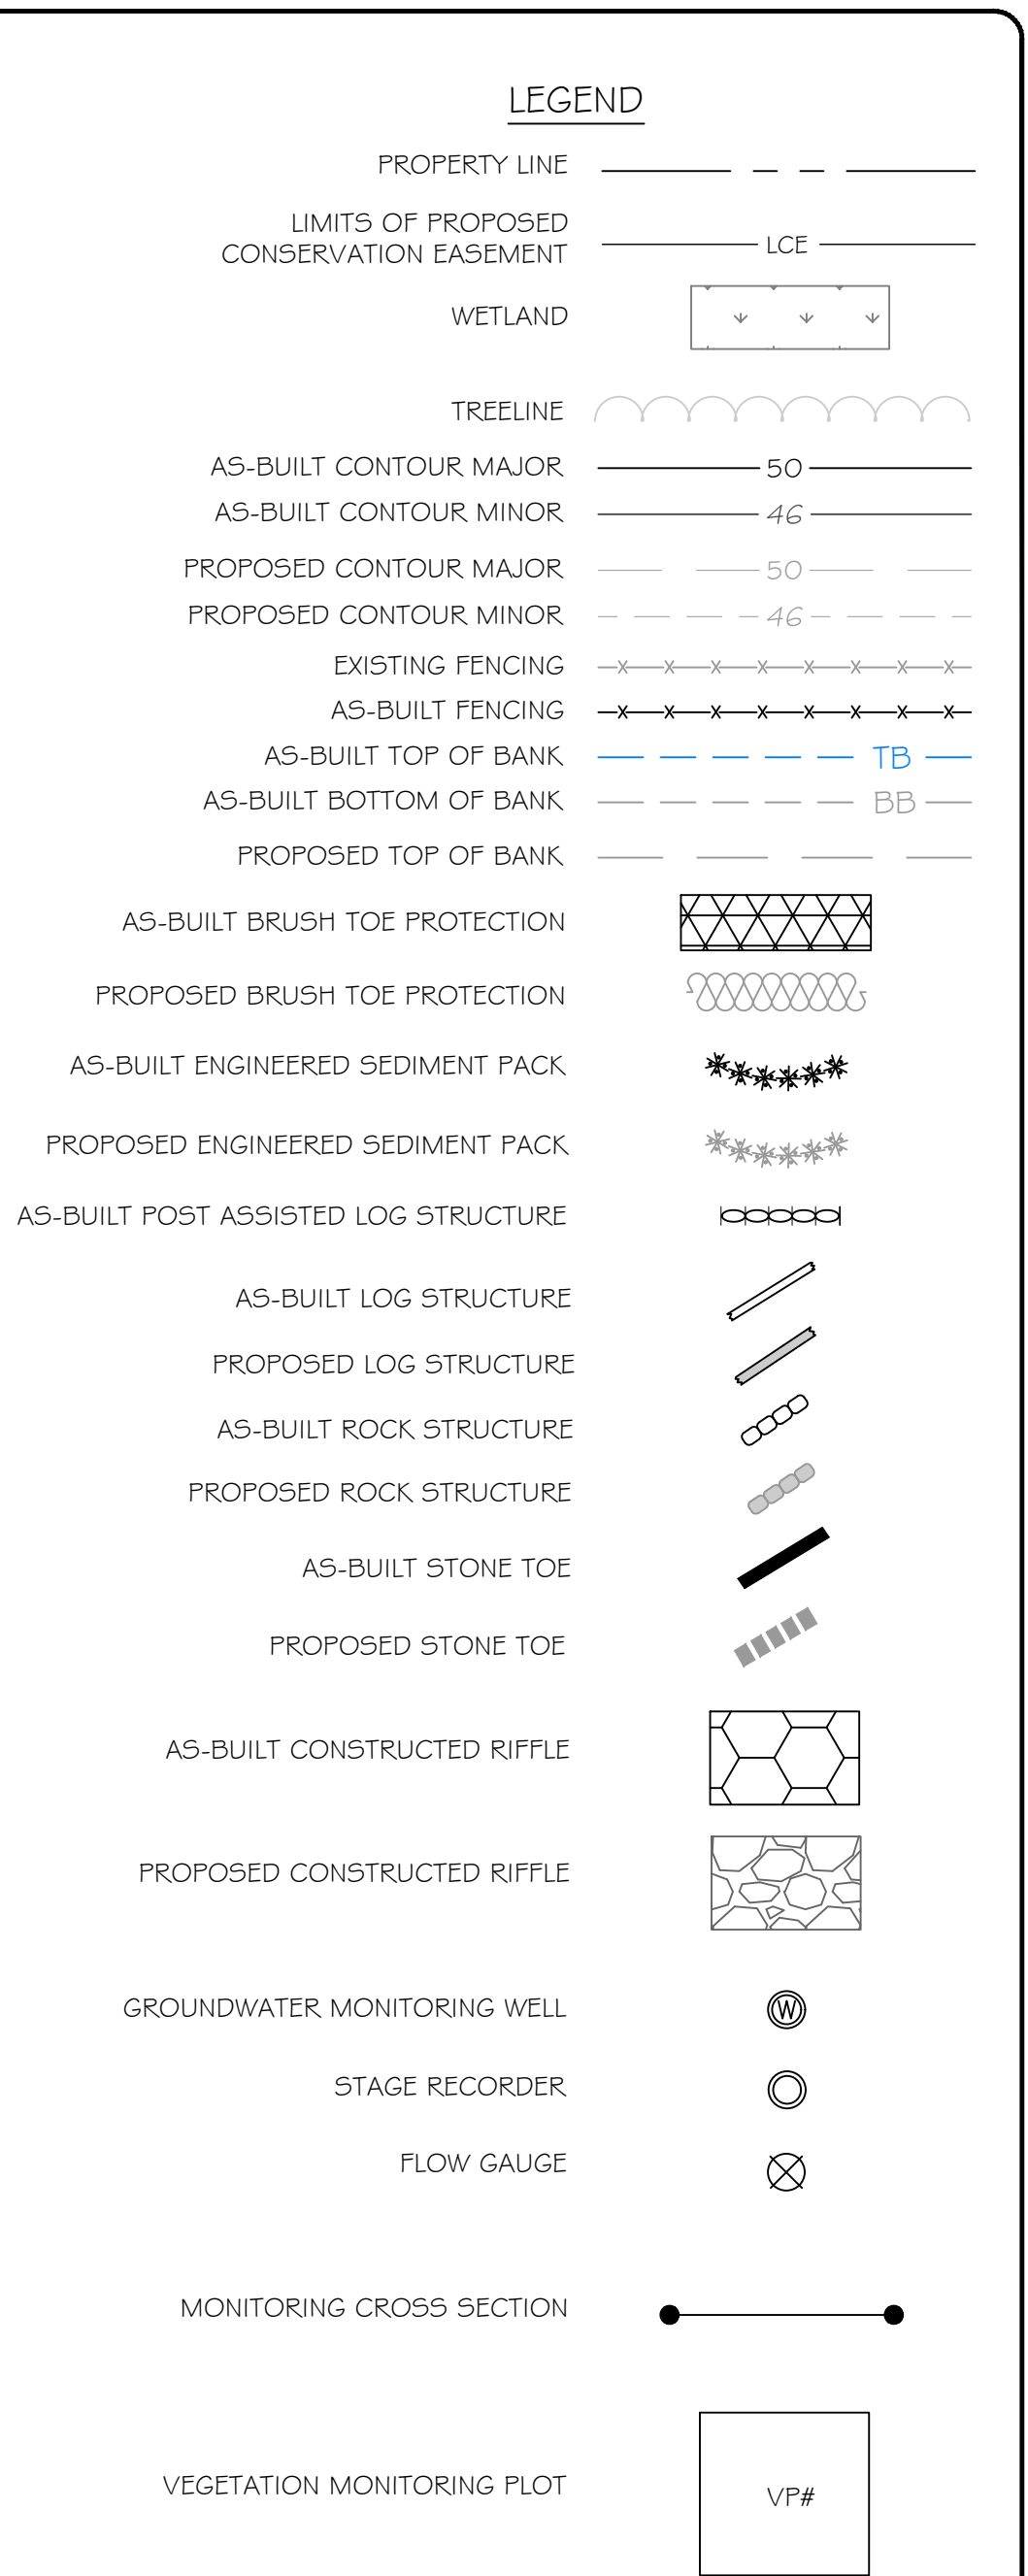

NOTE: ALL SIGNIFICANT CHANGES FROM THE DESIGN ARE SHOWN IN RED

3600 Glenwood Ave, Suite 100  
 Raleigh, NC 27612  
 Main: 919.829.9909  
 www.res.us

Engineering Services Provided By:  
 RES Environmental Operating Company, LLC  
 License: F-1428

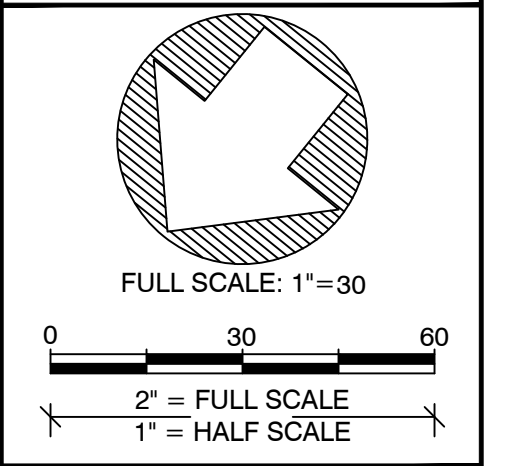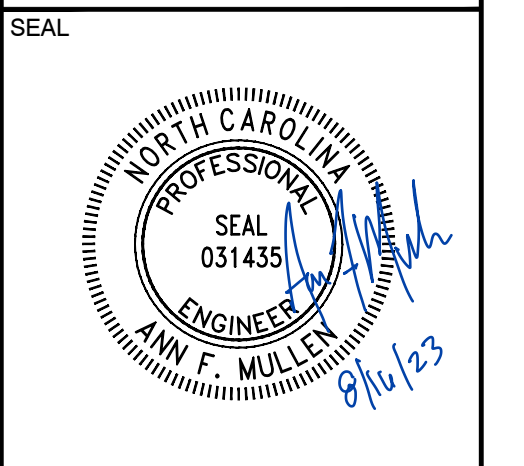

PLOT DATE:  
 8/16/2023

REVISIONS:

RELEASED FOR:  
 RECORD DRAWINGS


PROJECT NAME:  
 SIX RUNS RECORD DRAWINGS  
 SAMPSON COUNTY, NORTH CAROLINA

DRAWING TITLE:  
 REACH BB

PROJECT NUMBER: 103205  
 PROJECT MANAGER: JRM  
 DESIGNED: AFM  
 DRAWN: SLB  
 CHECKED: TRS

SHEET NUMBER:  
**S9**




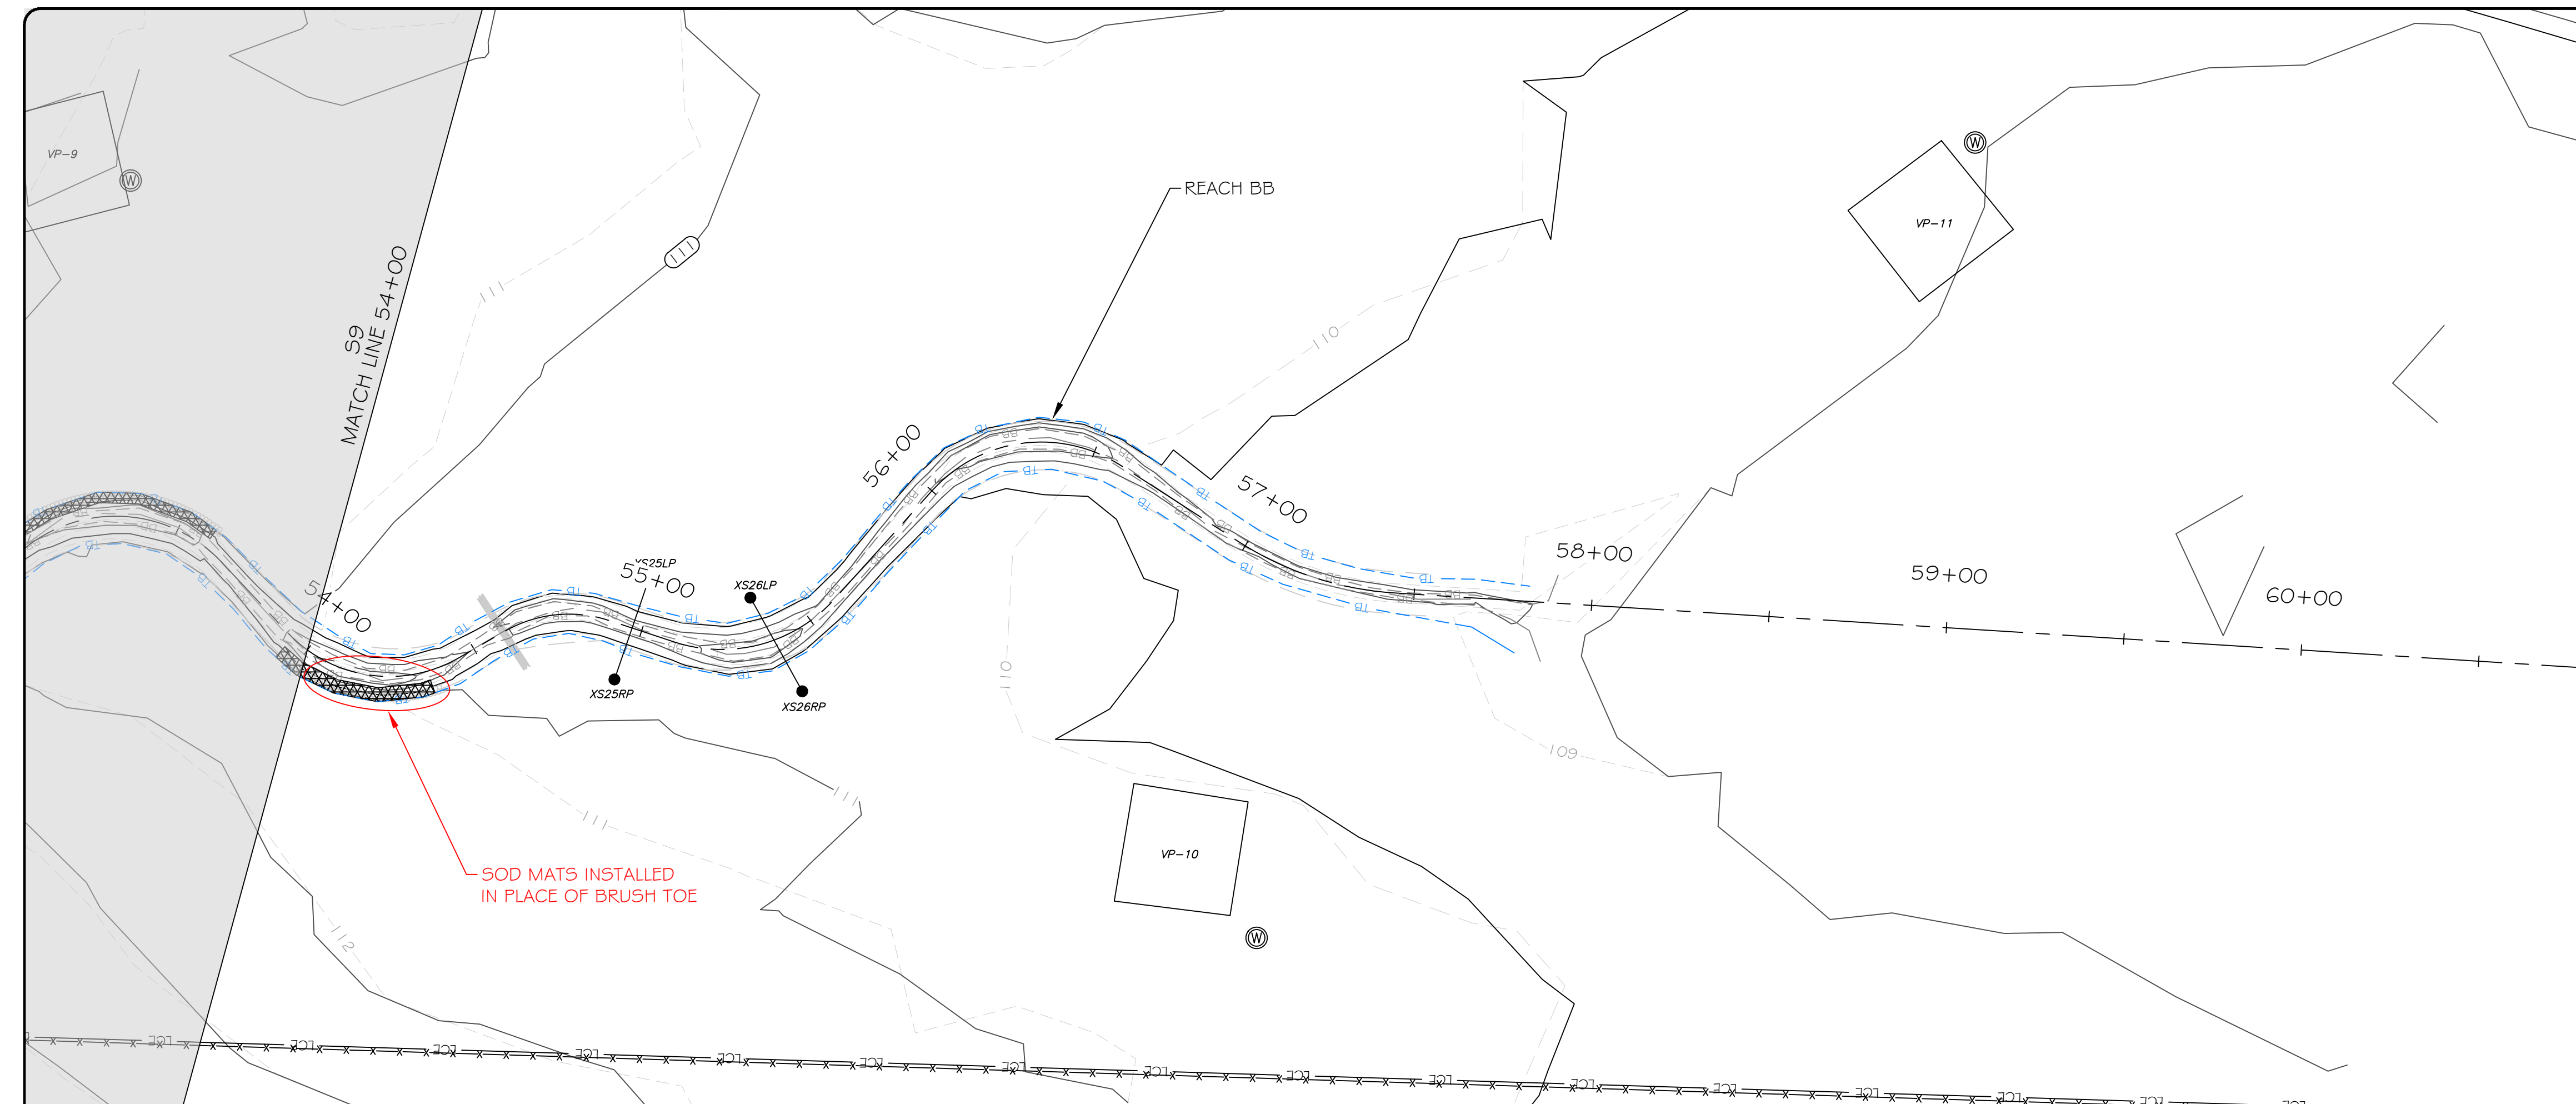


**LEGEND**

PROPERTY LINE	---
LIMITS OF PROPOSED CONSERVATION EASEMENT	---
WETLAND	---
TREELINE	---
AS-BUILT CONTOUR MAJOR	50
AS-BUILT CONTOUR MINOR	46
PROPOSED CONTOUR MAJOR	50
PROPOSED CONTOUR MINOR	46
EXISTING FENCING	---
AS-BUILT FENCING	---
AS-BUILT TOP OF BANK	---
AS-BUILT BOTTOM OF BANK	---
PROPOSED TOP OF BANK	---
AS-BUILT BRUSH TOE PROTECTION	---
PROPOSED BRUSH TOE PROTECTION	---
AS-BUILT ENGINEERED SEDIMENT PACK	---
PROPOSED ENGINEERED SEDIMENT PACK	---
AS-BUILT POST ASSISTED LOG STRUCTURE	---
AS-BUILT LOG STRUCTURE	---
PROPOSED LOG STRUCTURE	---
AS-BUILT ROCK STRUCTURE	---
PROPOSED ROCK STRUCTURE	---
AS-BUILT STONE TOE	---
PROPOSED STONE TOE	---
AS-BUILT CONSTRUCTED RIFFLE	---
PROPOSED CONSTRUCTED RIFFLE	---
GROUNDWATER MONITORING WELL	⊙
STAGE RECORDER	⊙
FLOW GAUGE	⊗
MONITORING CROSS SECTION	—●—
VEGETATION MONITORING PLOT	VP#

**res**  
 3600 Glenwood Ave, Suite 100  
 Raleigh, NC 27612  
 Main: 919.829.9909  
 www.res.us


Engineering Services Provided By:  
 RES Environmental Operating Company, LLC  
 License: F-1428

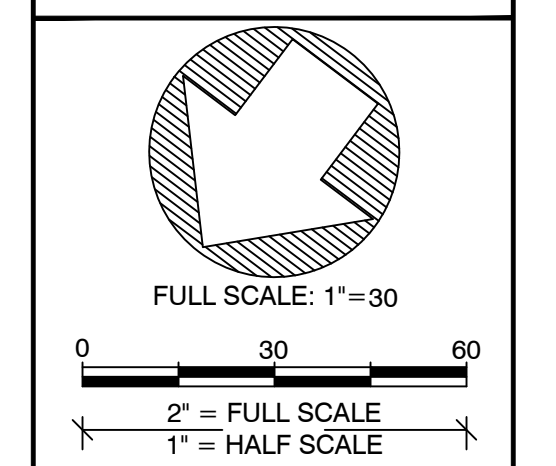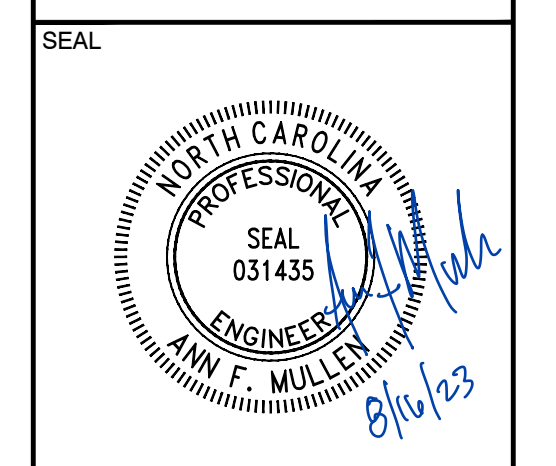

PLOT DATE:  
8/16/2023

REVISIONS:

RELEASED FOR:  
RECORD DRAWINGS

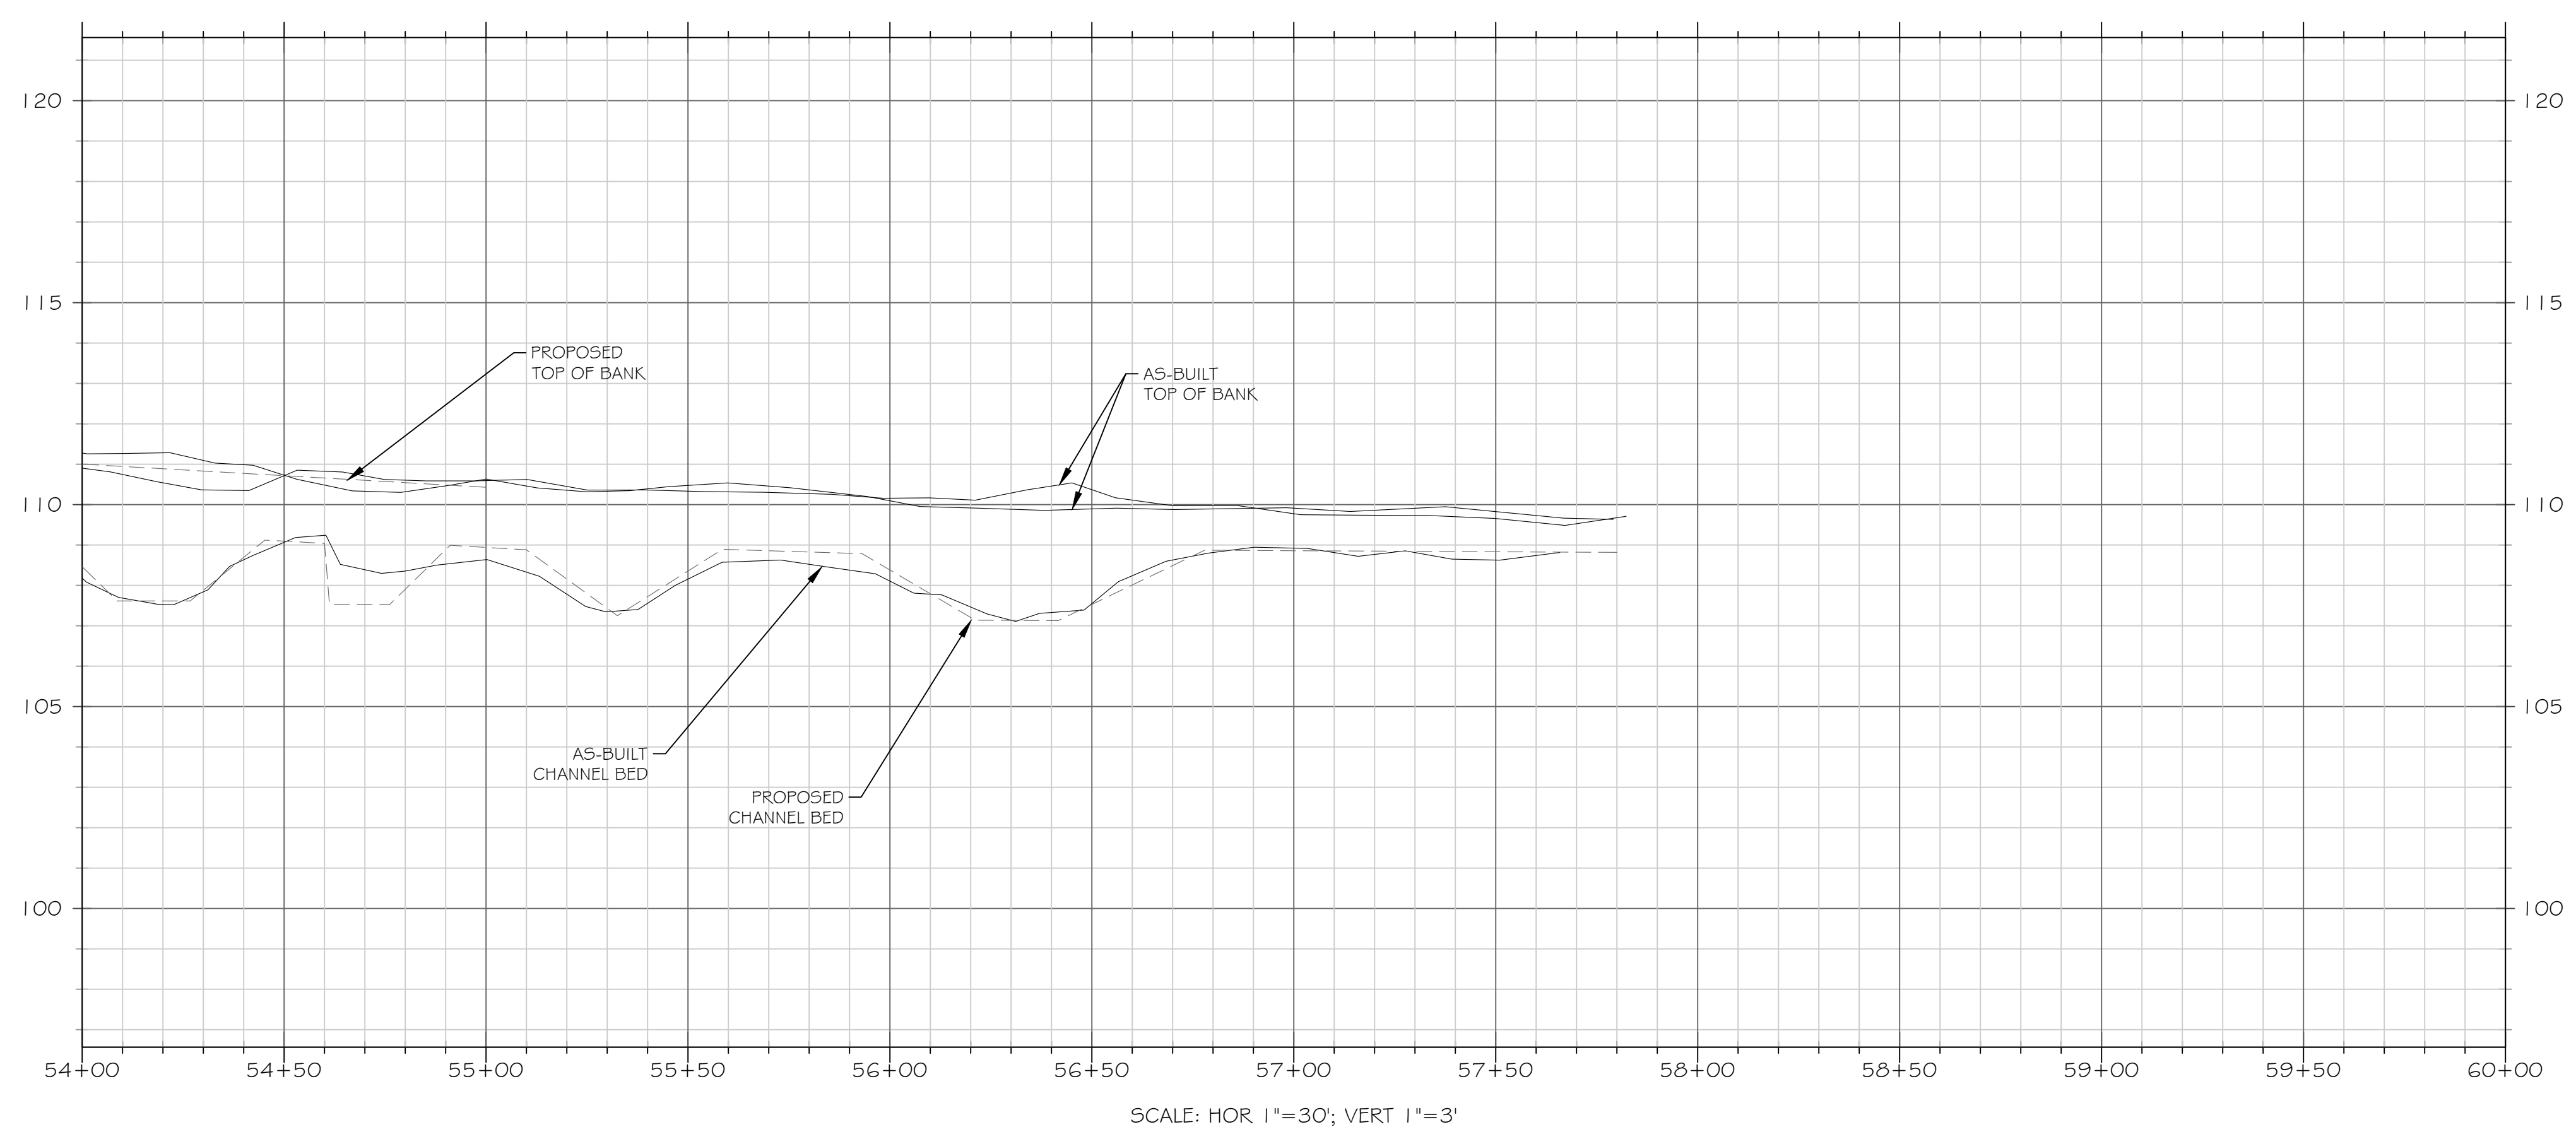

SCALE: HOR. 1"=30'; VERT. 1"=3'

FILE NAME: F:\rescad\Projects\103205-Six Runs\ABRD\103205\_Six Runs\ABRD\103205\_RD\_DESIGN.dwg SAVED BY: Tswartzfager

PROJECT NAME:  
**SIX RUNS RECORD DRAWINGS  
SAMPSON COUNTY, NORTH CAROLINA**



DRAWING TITLE:  
**REACH BB**

PROJECT NUMBER: 103205  
 PROJECT MANAGER: JRM  
 DESIGNED: AFM  
 DRAWN: SLB  
 CHECKED: TRS

SHEET NUMBER:  
**S10**



FILE NAME: F:\Rescad\Projects\103205-Six Runs\ABRD\103205\_LD\_DESIGN.dwg SAVED BY: Tswartzfager

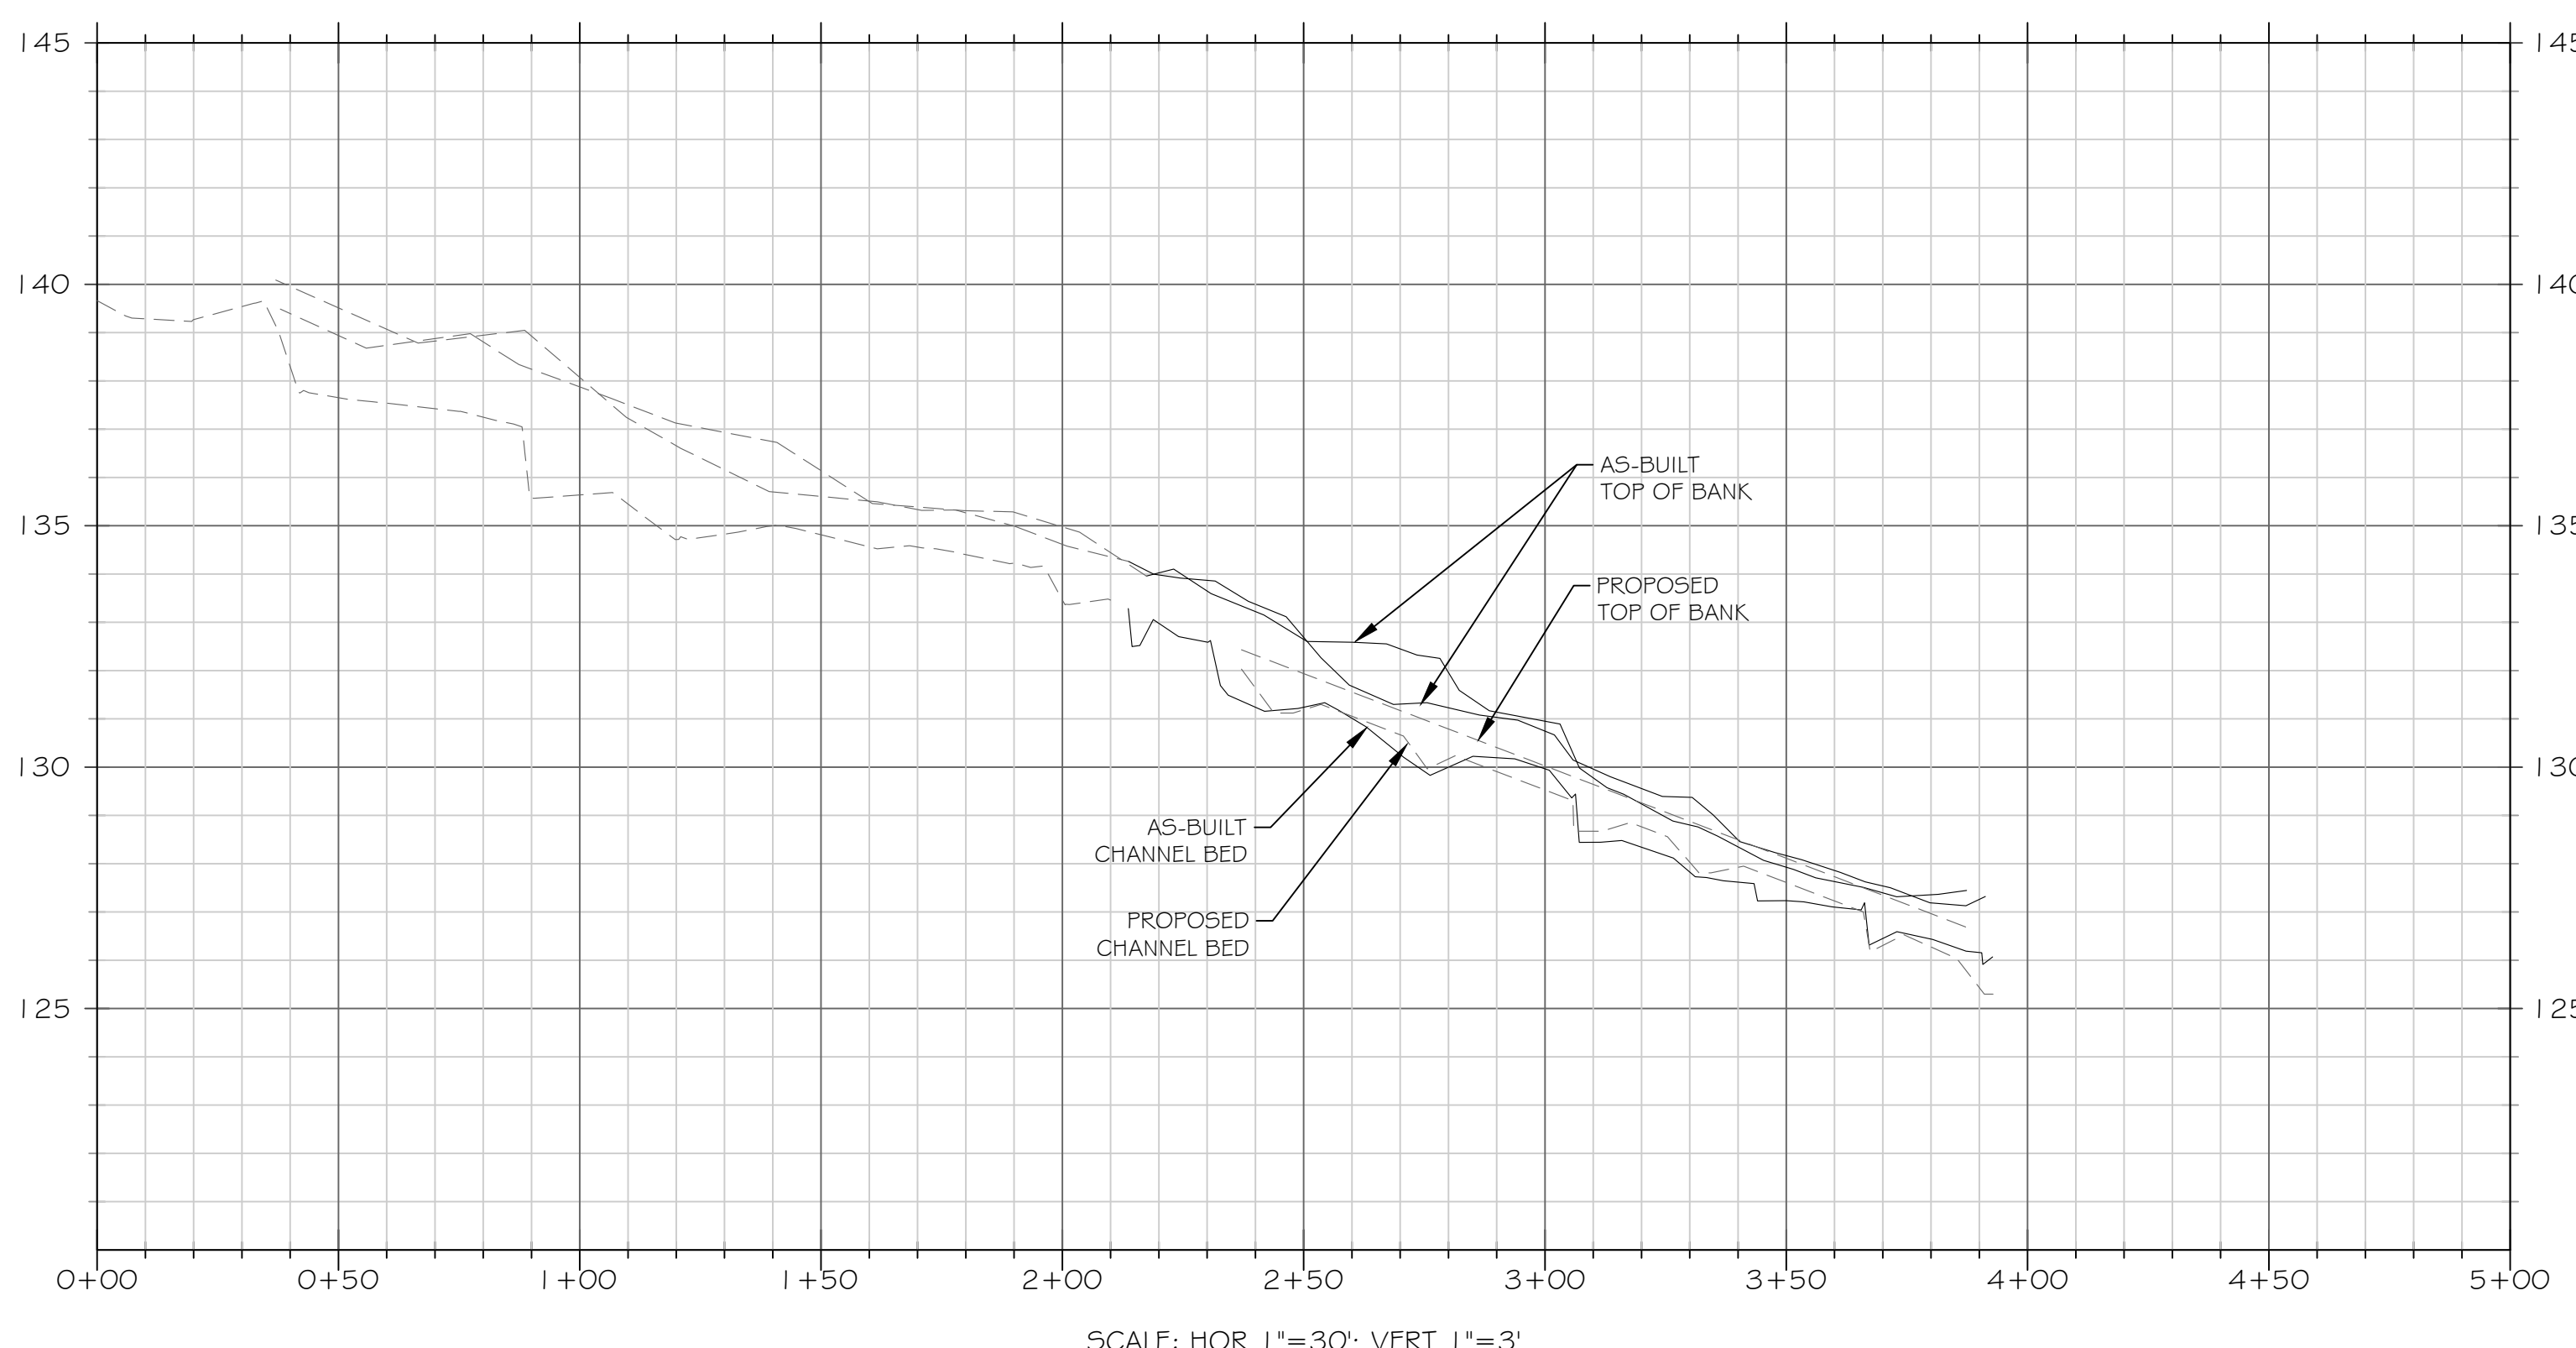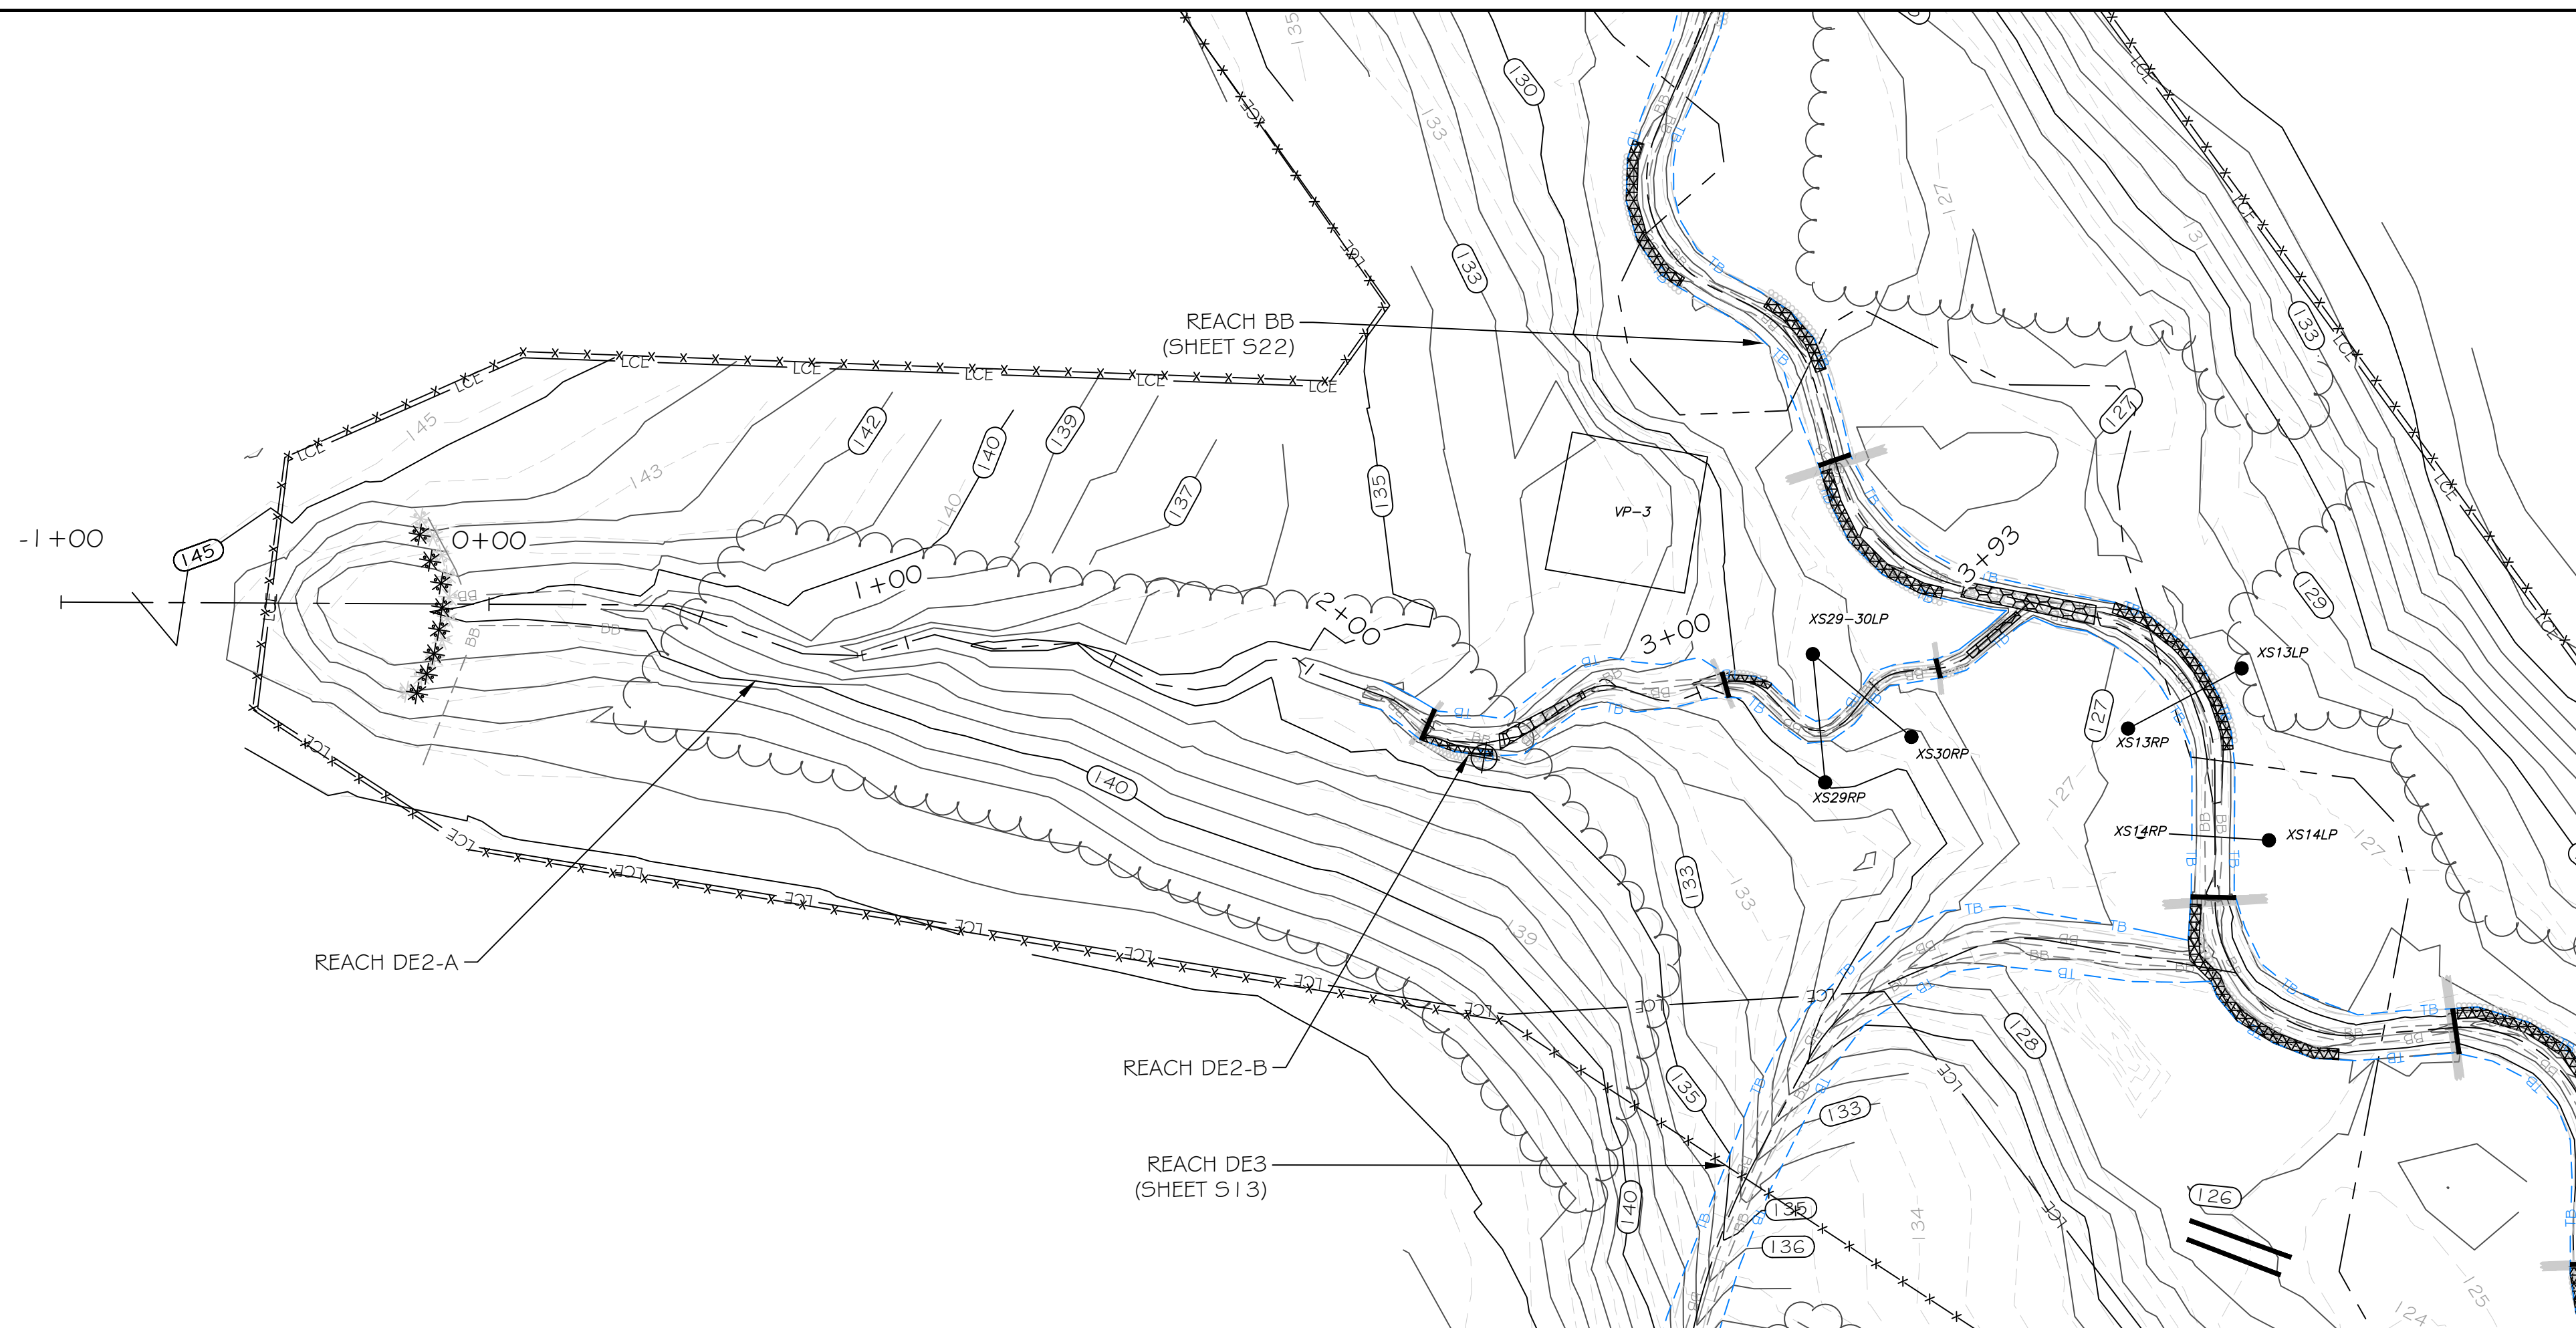



SCALE: HOR 1"=30'; VERT 1"=3'

LEGEND	
PROPERTY LINE	---
LIMITS OF PROPOSED CONSERVATION EASEMENT	--- LCE
WETLAND	
TREELINE	
AS-BUILT CONTOUR MAJOR	50
AS-BUILT CONTOUR MINOR	46
PROPOSED CONTOUR MAJOR	50
PROPOSED CONTOUR MINOR	46
EXISTING FENCING	---x---x---x---
AS-BUILT FENCING	---x---x---x---
AS-BUILT TOP OF BANK	--- TB
AS-BUILT BOTTOM OF BANK	--- BB
PROPOSED TOP OF BANK	---
AS-BUILT BRUSH TOE PROTECTION	
PROPOSED BRUSH TOE PROTECTION	
AS-BUILT ENGINEERED SEDIMENT PACK	*****
PROPOSED ENGINEERED SEDIMENT PACK	*****
AS-BUILT POST ASSISTED LOG STRUCTURE	
AS-BUILT LOG STRUCTURE	
PROPOSED LOG STRUCTURE	
AS-BUILT ROCK STRUCTURE	
PROPOSED ROCK STRUCTURE	
AS-BUILT STONE TOE	
PROPOSED STONE TOE	
AS-BUILT CONSTRUCTED RIFFLE	
PROPOSED CONSTRUCTED RIFFLE	
GROUNDWATER MONITORING WELL	
STAGE RECORDER	
FLOW GAUGE	
MONITORING CROSS SECTION	
VEGETATION MONITORING PLOT	VP#

NOTE: ALL SIGNIFICANT CHANGES FROM THE DESIGN ARE SHOWN IN RED



Engineering Services Provided By:  
RES Environmental Operating Company, LLC  
License: F-1428

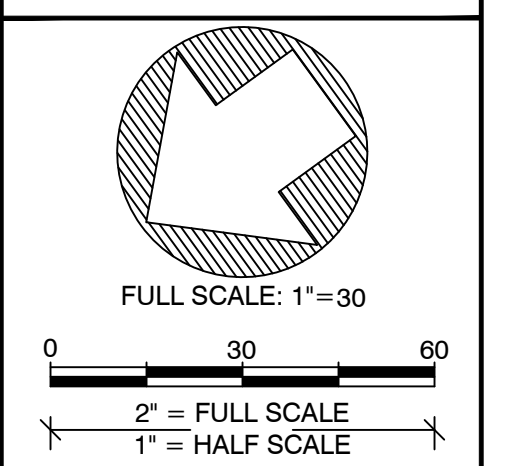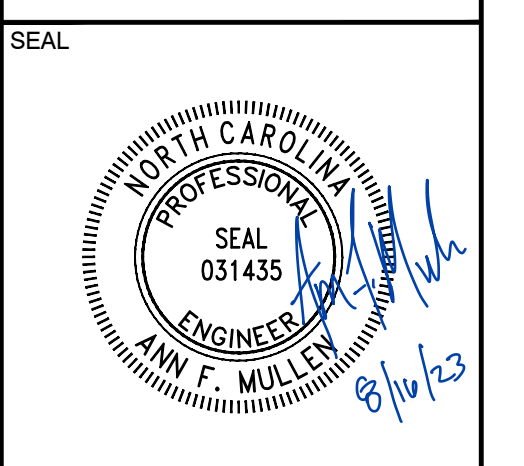

PLOT DATE: 8/16/2023	REVISIONS:	RELEASED FOR: RECORD DRAWINGS

PROJECT NAME:  
**SIX RUNS RECORD DRAWINGS  
SAMPSON COUNTY, NORTH CAROLINA**



DRAWING TITLE:  
**REACH DE2**

PROJECT NUMBER: 103205  
PROJECT MANAGER: JRM  
DESIGNED: AFM  
DRAWN: SLB  
CHECKED: TRS

SHEET NUMBER:  
**S11**



FILE NAME: F:\Rescad\Projects\103205-Six Runs\ABRD\103205\_LRD\_DESIGN.dwg SAVED BY: Tswartzfeger

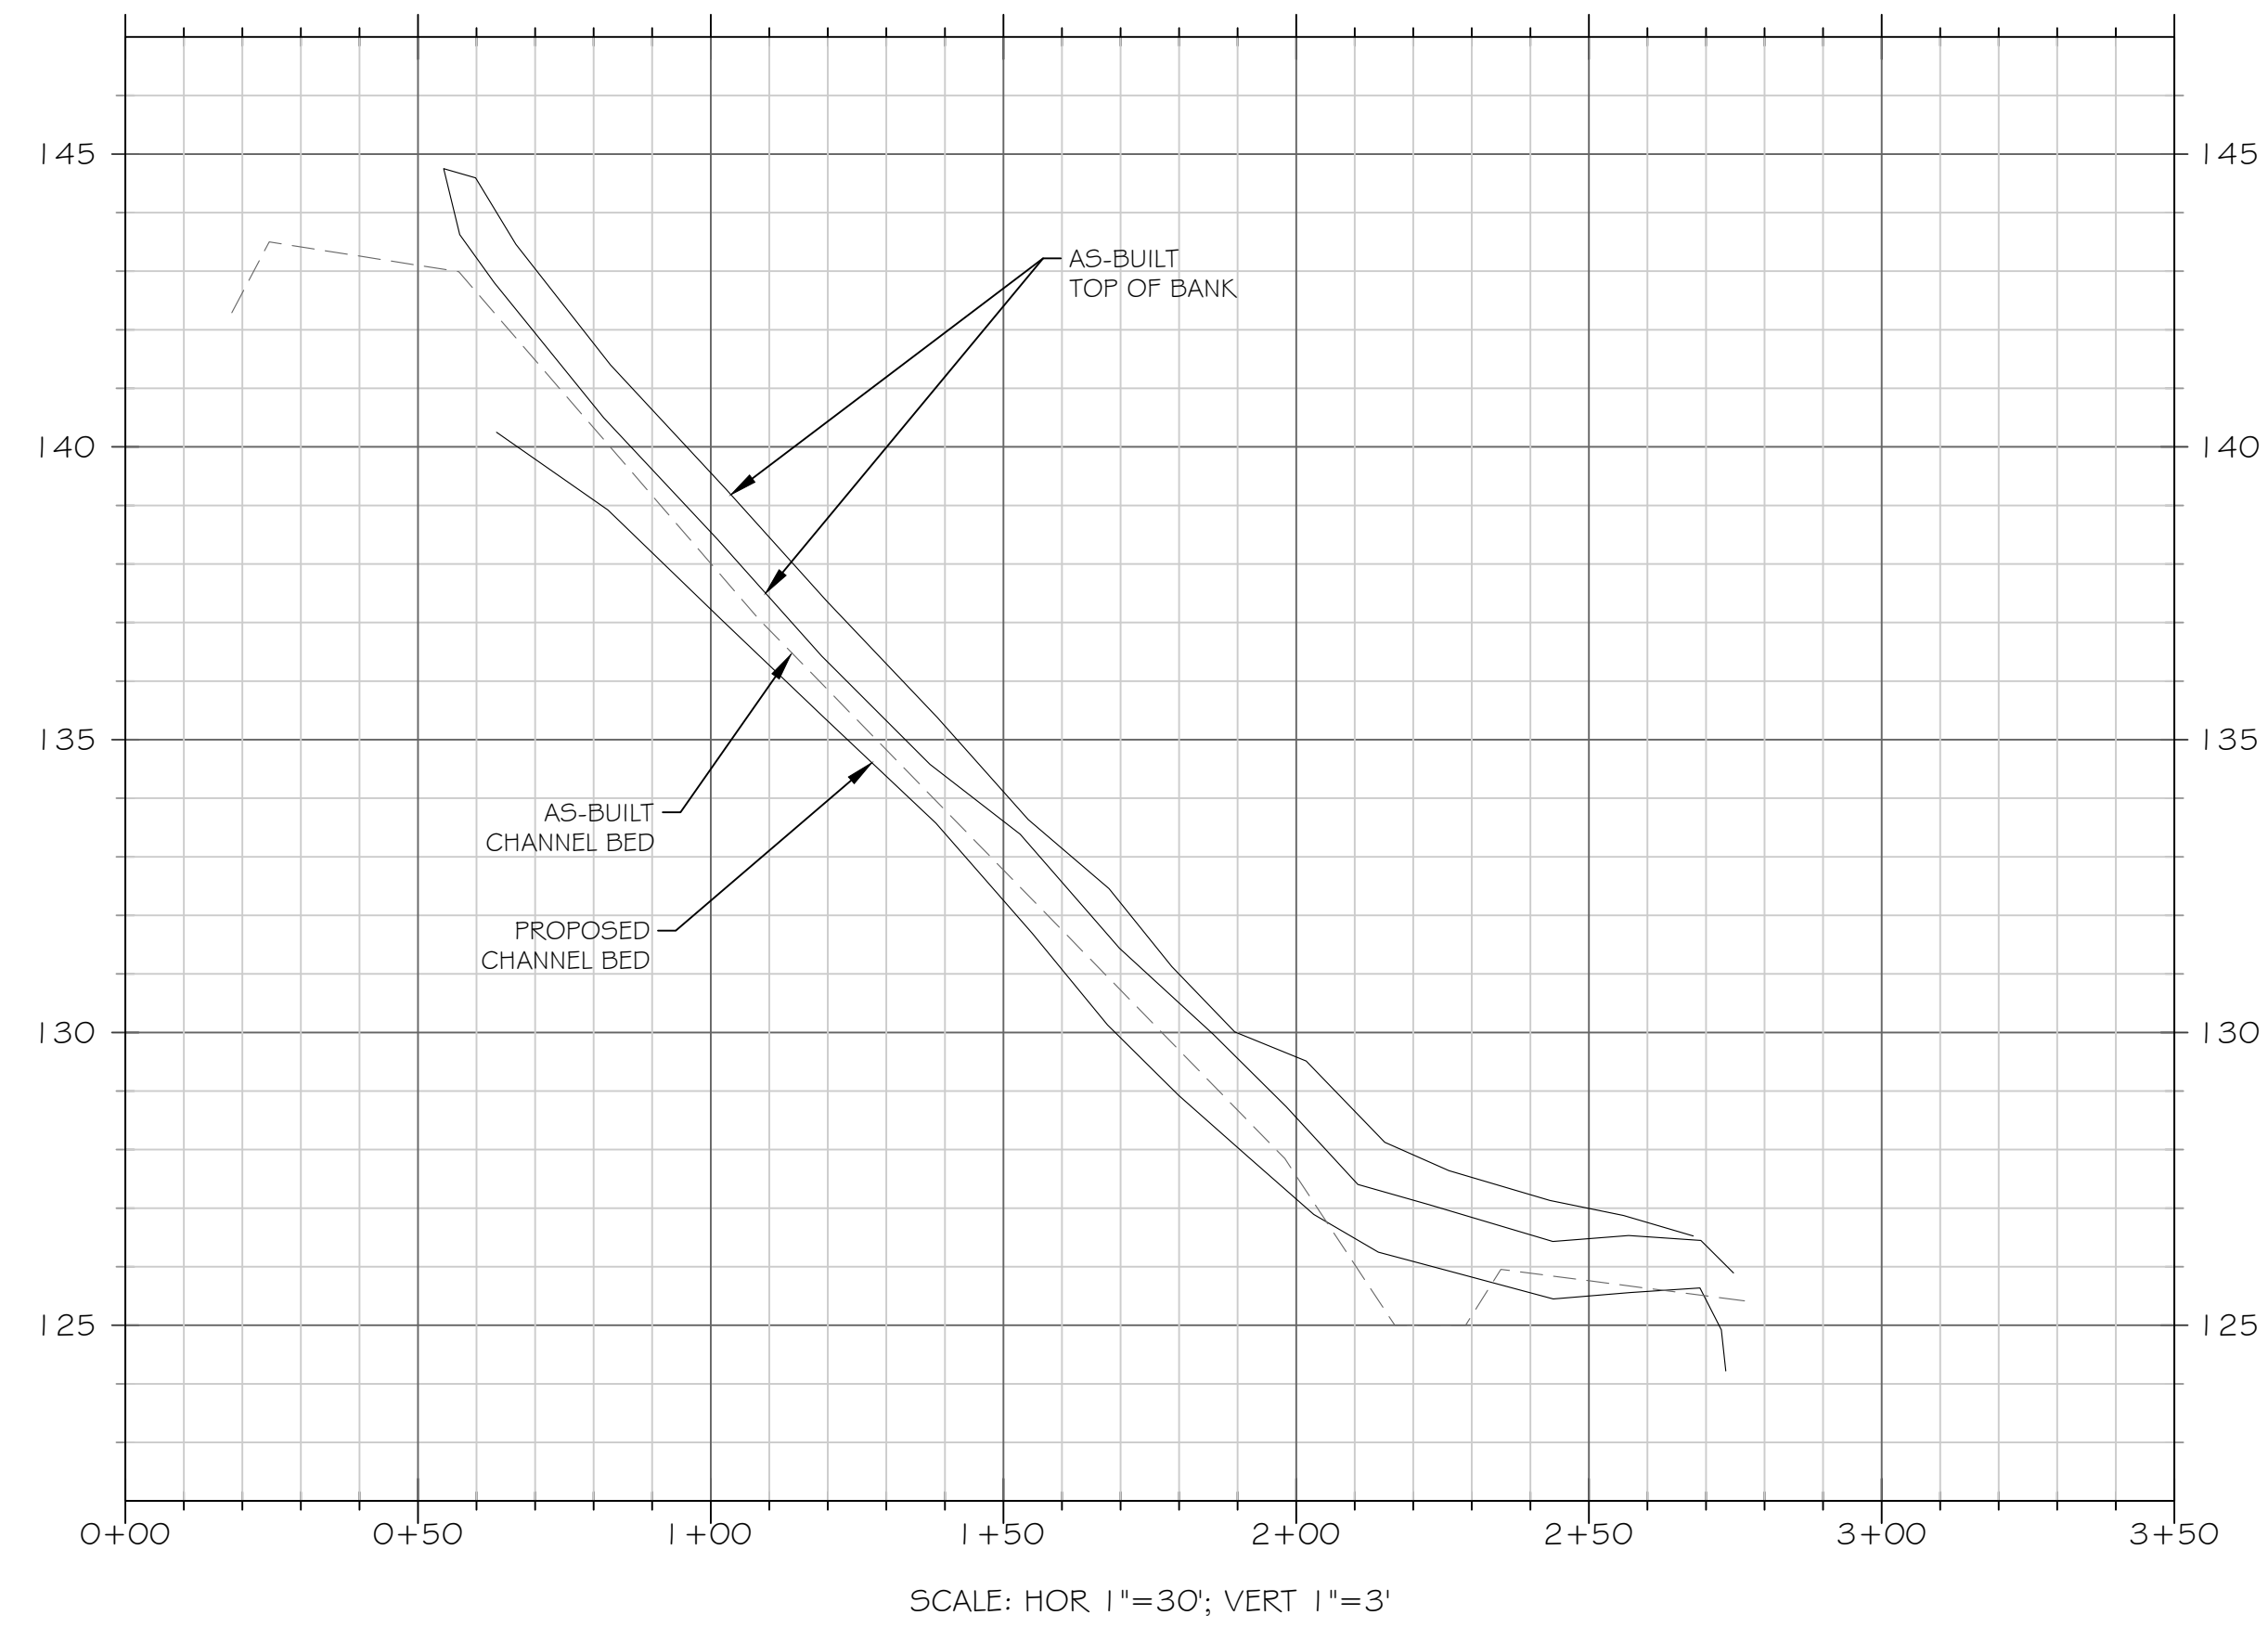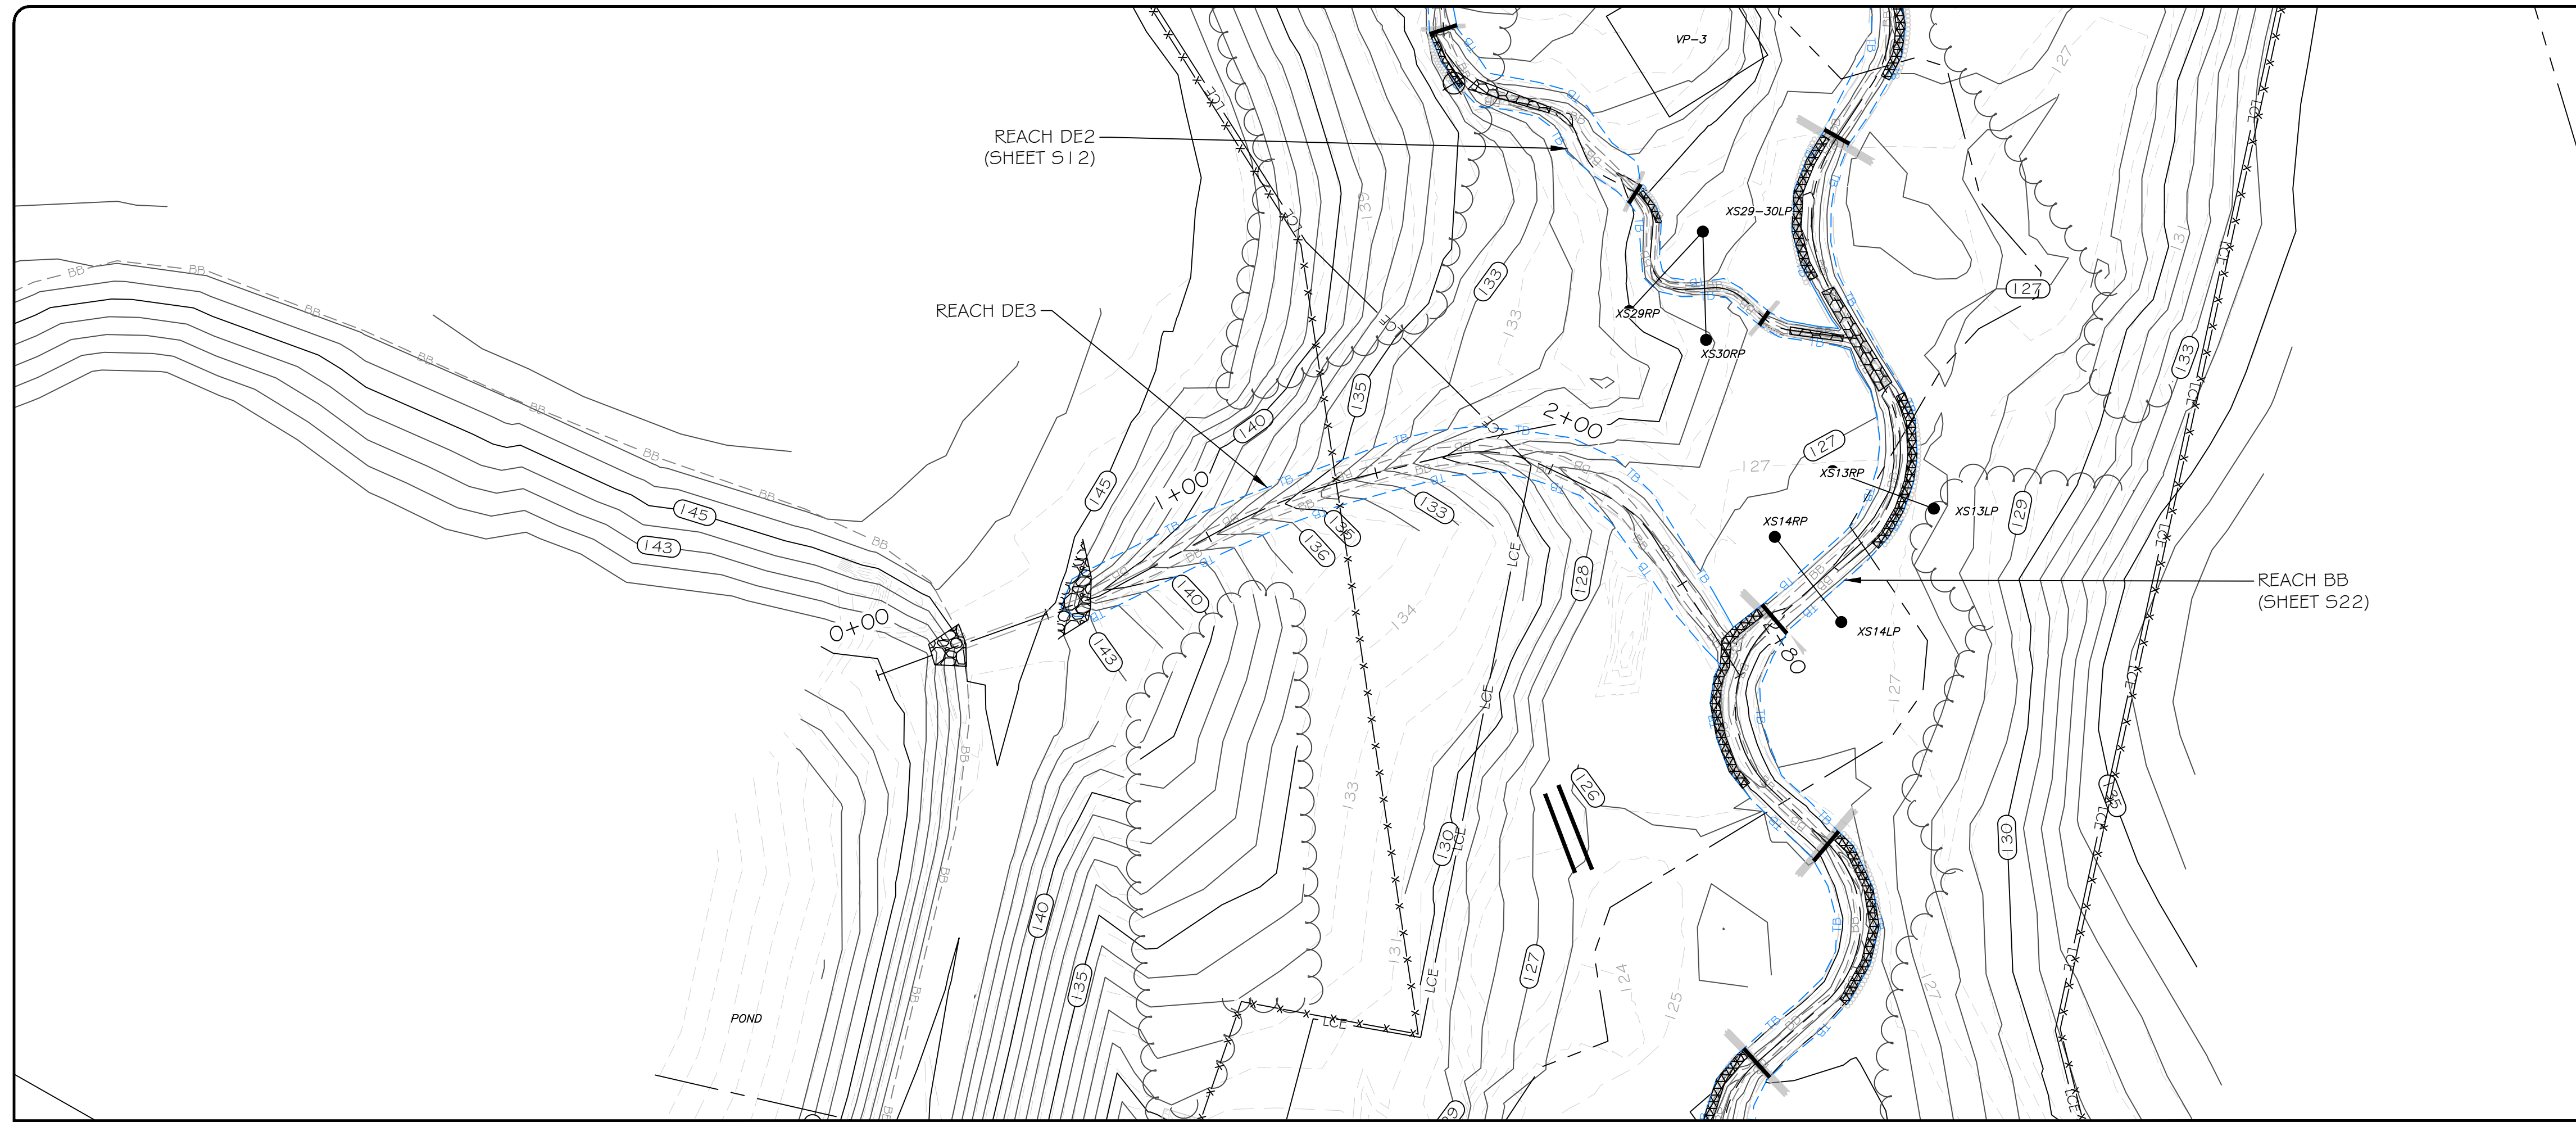

**LEGEND**



PROPERTY LINE	---
LIMITS OF PROPOSED CONSERVATION EASEMENT	-LCE-
WETLAND	
TREELINE	
AS-BUILT CONTOUR MAJOR	50
AS-BUILT CONTOUR MINOR	46
PROPOSED CONTOUR MAJOR	50
PROPOSED CONTOUR MINOR	46
EXISTING FENCING	-x-x-x-x-x-x-x-x-
AS-BUILT FENCING	-x-x-x-x-x-x-x-x-
AS-BUILT TOP OF BANK	-TB-
AS-BUILT BOTTOM OF BANK	-BB-
PROPOSED TOP OF BANK	-TB-
AS-BUILT BRUSH TOE PROTECTION	
PROPOSED BRUSH TOE PROTECTION	
AS-BUILT ENGINEERED SEDIMENT PACK	
PROPOSED ENGINEERED SEDIMENT PACK	
AS-BUILT POST ASSISTED LOG STRUCTURE	
AS-BUILT LOG STRUCTURE	
PROPOSED LOG STRUCTURE	
AS-BUILT ROCK STRUCTURE	
PROPOSED ROCK STRUCTURE	
AS-BUILT STONE TOE	
PROPOSED STONE TOE	
AS-BUILT CONSTRUCTED RIFFLE	
PROPOSED CONSTRUCTED RIFFLE	
GROUNDWATER MONITORING WELL	
STAGE RECORDER	
FLOW GAUGE	
MONITORING CROSS SECTION	
VEGETATION MONITORING PLOT	VP#

NOTE: ALL SIGNIFICANT CHANGES FROM THE DESIGN ARE SHOWN IN RED



3600 Glenwood Ave, Suite 100  
Raleigh, NC 27612  
Main: 919.829.9909  
www.res.us

Engineering Services Provided By:  
RES Environmental Operating Company, LLC  
License: F-1428

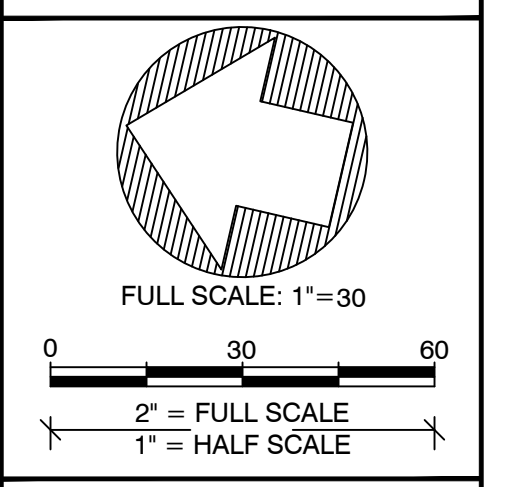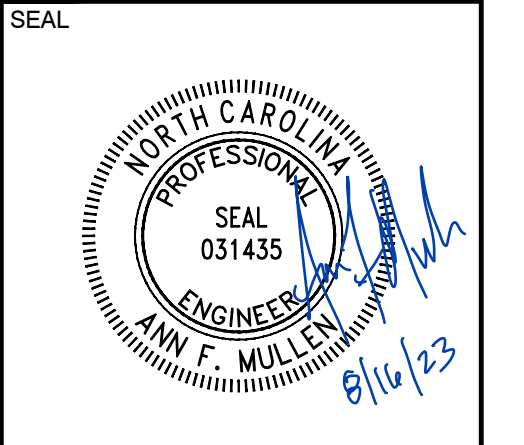

PLOT DATE:  
8/16/2023

REVISIONS:

RELEASED FOR:  
RECORD DRAWINGS


PROJECT NAME:  
SIX RUNS RECORD DRAWINGS  
SAMPSON COUNTY, NORTH CAROLINA

DRAWING TITLE:  
REACH DE3

PROJECT NUMBER: 103205  
PROJECT MANAGER: JRM  
DESIGNED: AFM  
DRAWN: SLB  
CHECKED: TRS

SHEET NUMBER:  
**S12**




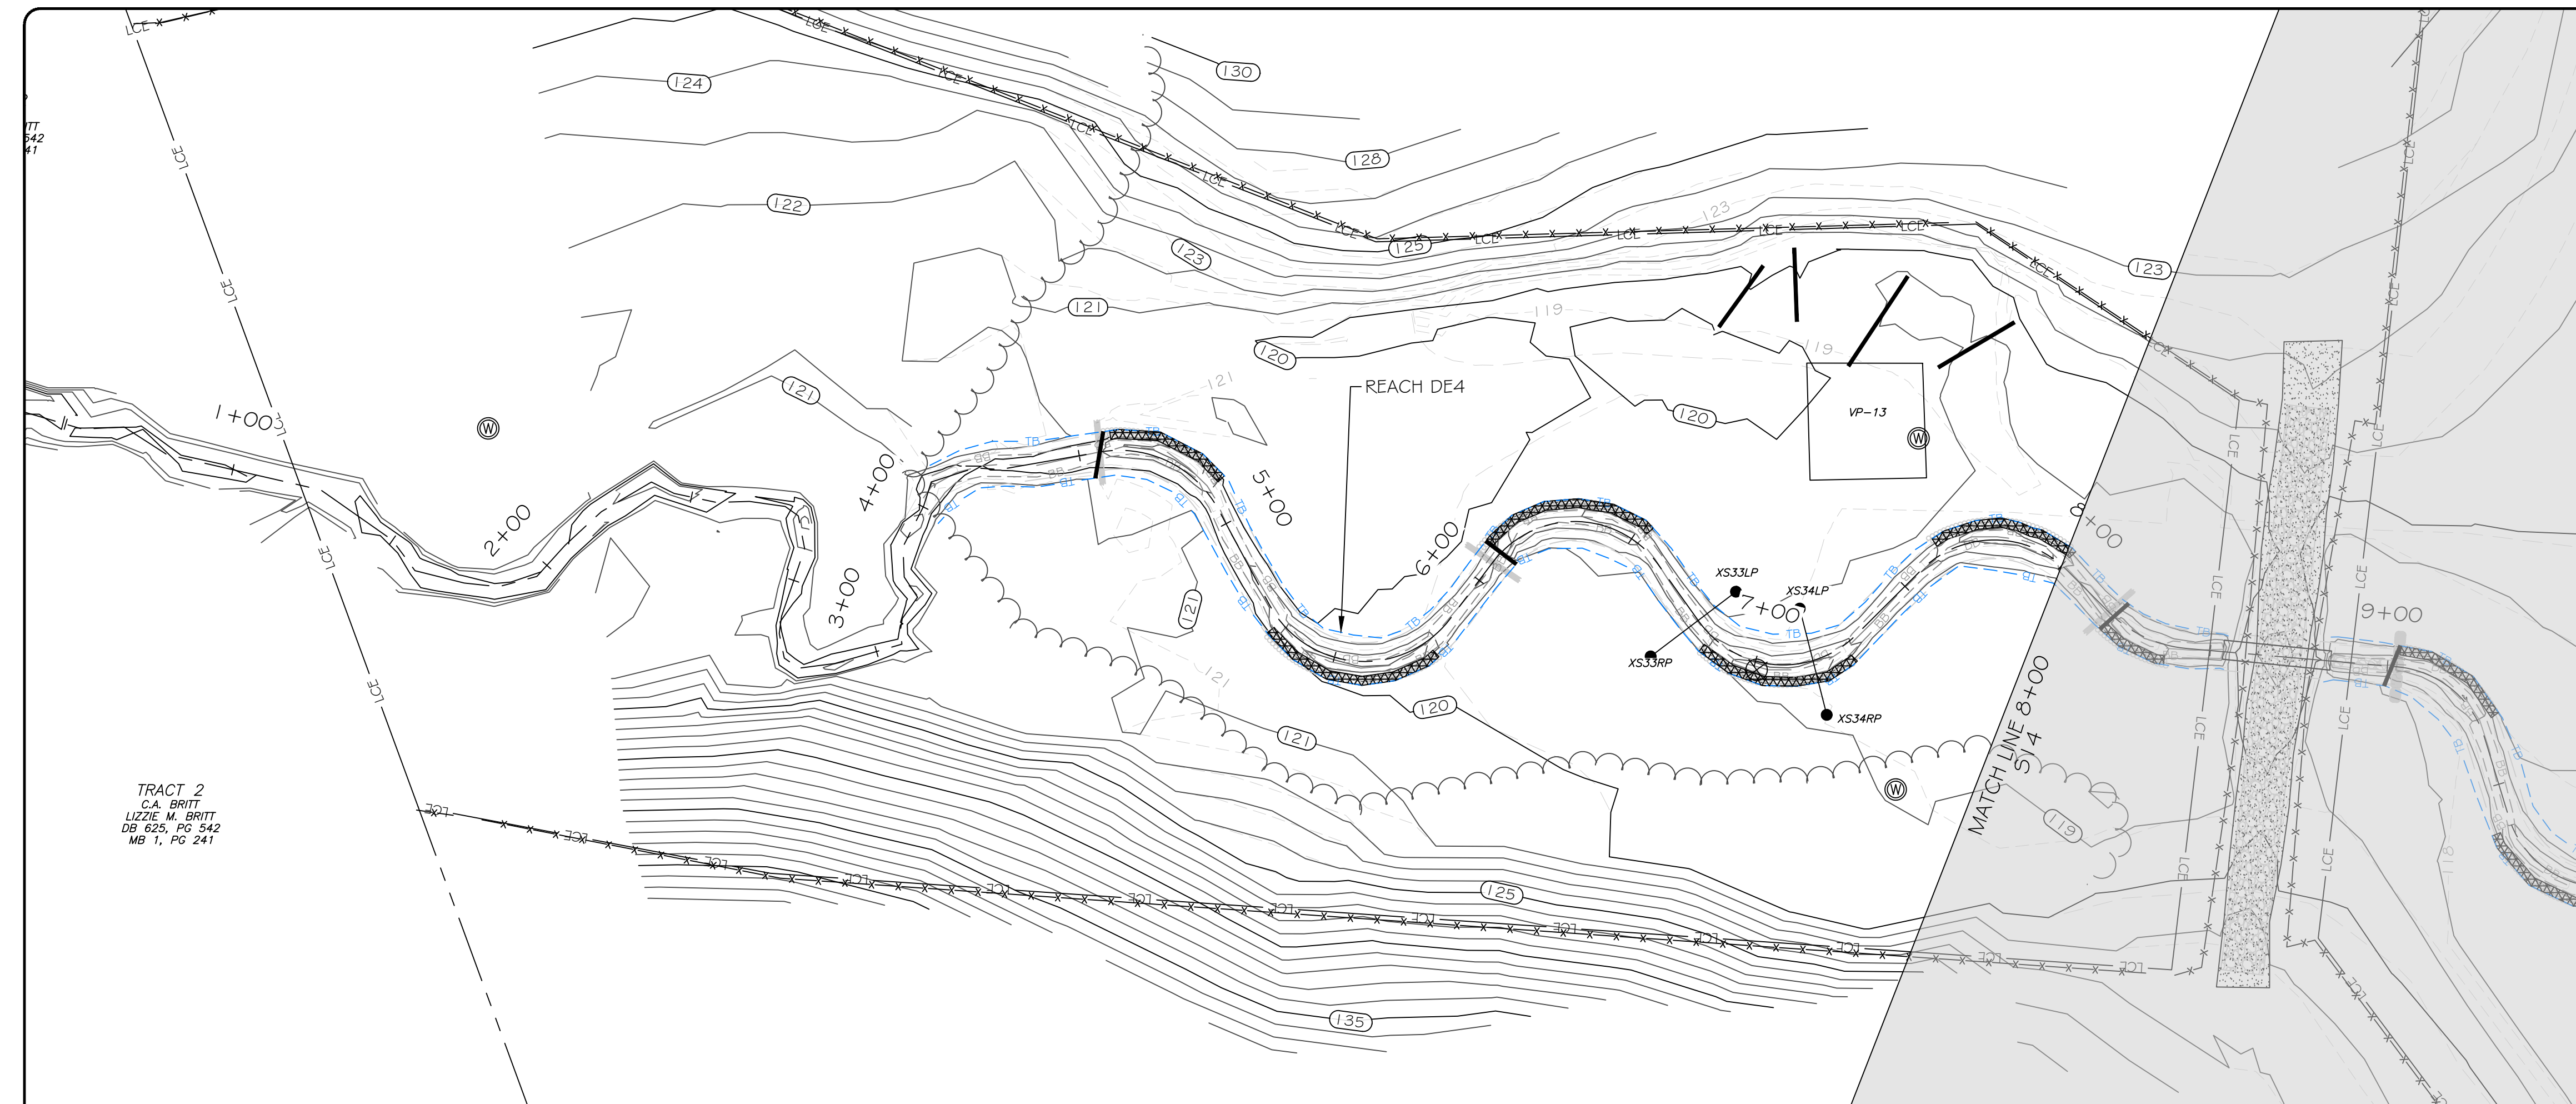


### LEGEND

PROPERTY LINE	---
LIMITS OF PROPOSED CONSERVATION EASEMENT	LCE
WETLAND	⏏
TREELINE	~
AS-BUILT CONTOUR MAJOR	—50—
AS-BUILT CONTOUR MINOR	—46—
PROPOSED CONTOUR MAJOR	-50-
PROPOSED CONTOUR MINOR	-46-
EXISTING FENCING	x-x-x-x-x-x-x-x
AS-BUILT FENCING	x-x-x-x-x-x-x-x
AS-BUILT TOP OF BANK	---TB---
AS-BUILT BOTTOM OF BANK	---BB---
PROPOSED TOP OF BANK	---
AS-BUILT BRUSH TOE PROTECTION	▨
PROPOSED BRUSH TOE PROTECTION	⊘
AS-BUILT ENGINEERED SEDIMENT PACK	* * * * *
PROPOSED ENGINEERED SEDIMENT PACK	* * * * *
AS-BUILT POST ASSISTED LOG STRUCTURE	⊞
AS-BUILT LOG STRUCTURE	▮
PROPOSED LOG STRUCTURE	▮
AS-BUILT ROCK STRUCTURE	▮
PROPOSED ROCK STRUCTURE	▮
AS-BUILT STONE TOE	▮
PROPOSED STONE TOE	▮
AS-BUILT CONSTRUCTED RIFFLE	⊞
PROPOSED CONSTRUCTED RIFFLE	⊞
GROUNDWATER MONITORING WELL	⊞
STAGE RECORDER	⊞
FLOW GAUGE	⊞
MONITORING CROSS SECTION	●—●
VEGETATION MONITORING PLOT	VP#

**res**  
 3600 Glenwood Ave, Suite 100  
 Raleigh, NC 27612  
 Main: 919.829.9909  
 www.res.us

Engineering Services Provided By:  
 RES Environmental Operating Company, LLC  
 License: F-1428

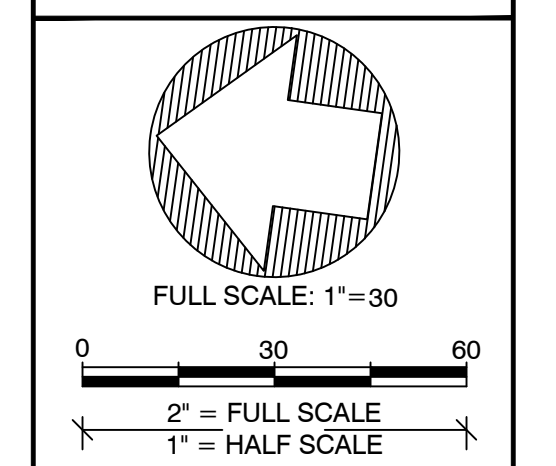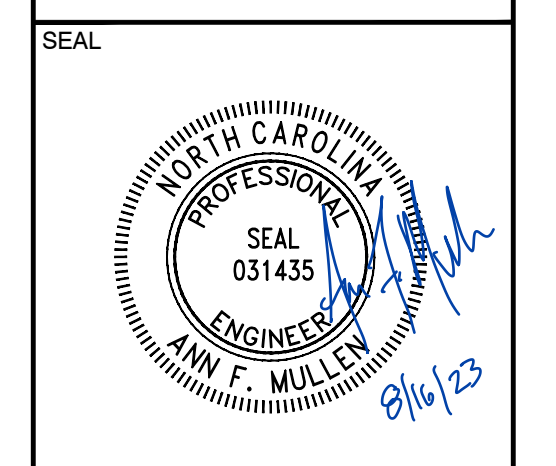

PLOT DATE:  
8/16/2023

REVISIONS:


RELEASED FOR:  
RECORD DRAWINGS

PROJECT NAME:  
**SIX RUNS RECORD DRAWINGS  
SAMPSON COUNTY, NORTH CAROLINA**

DRAWING TITLE:  
**REACH DE4**

PROJECT NUMBER: 103205  
 PROJECT MANAGER: JRM  
 DESIGNED: AFM  
 DRAWN: SLB  
 CHECKED: TRS



SHEET NUMBER:  
**S13**

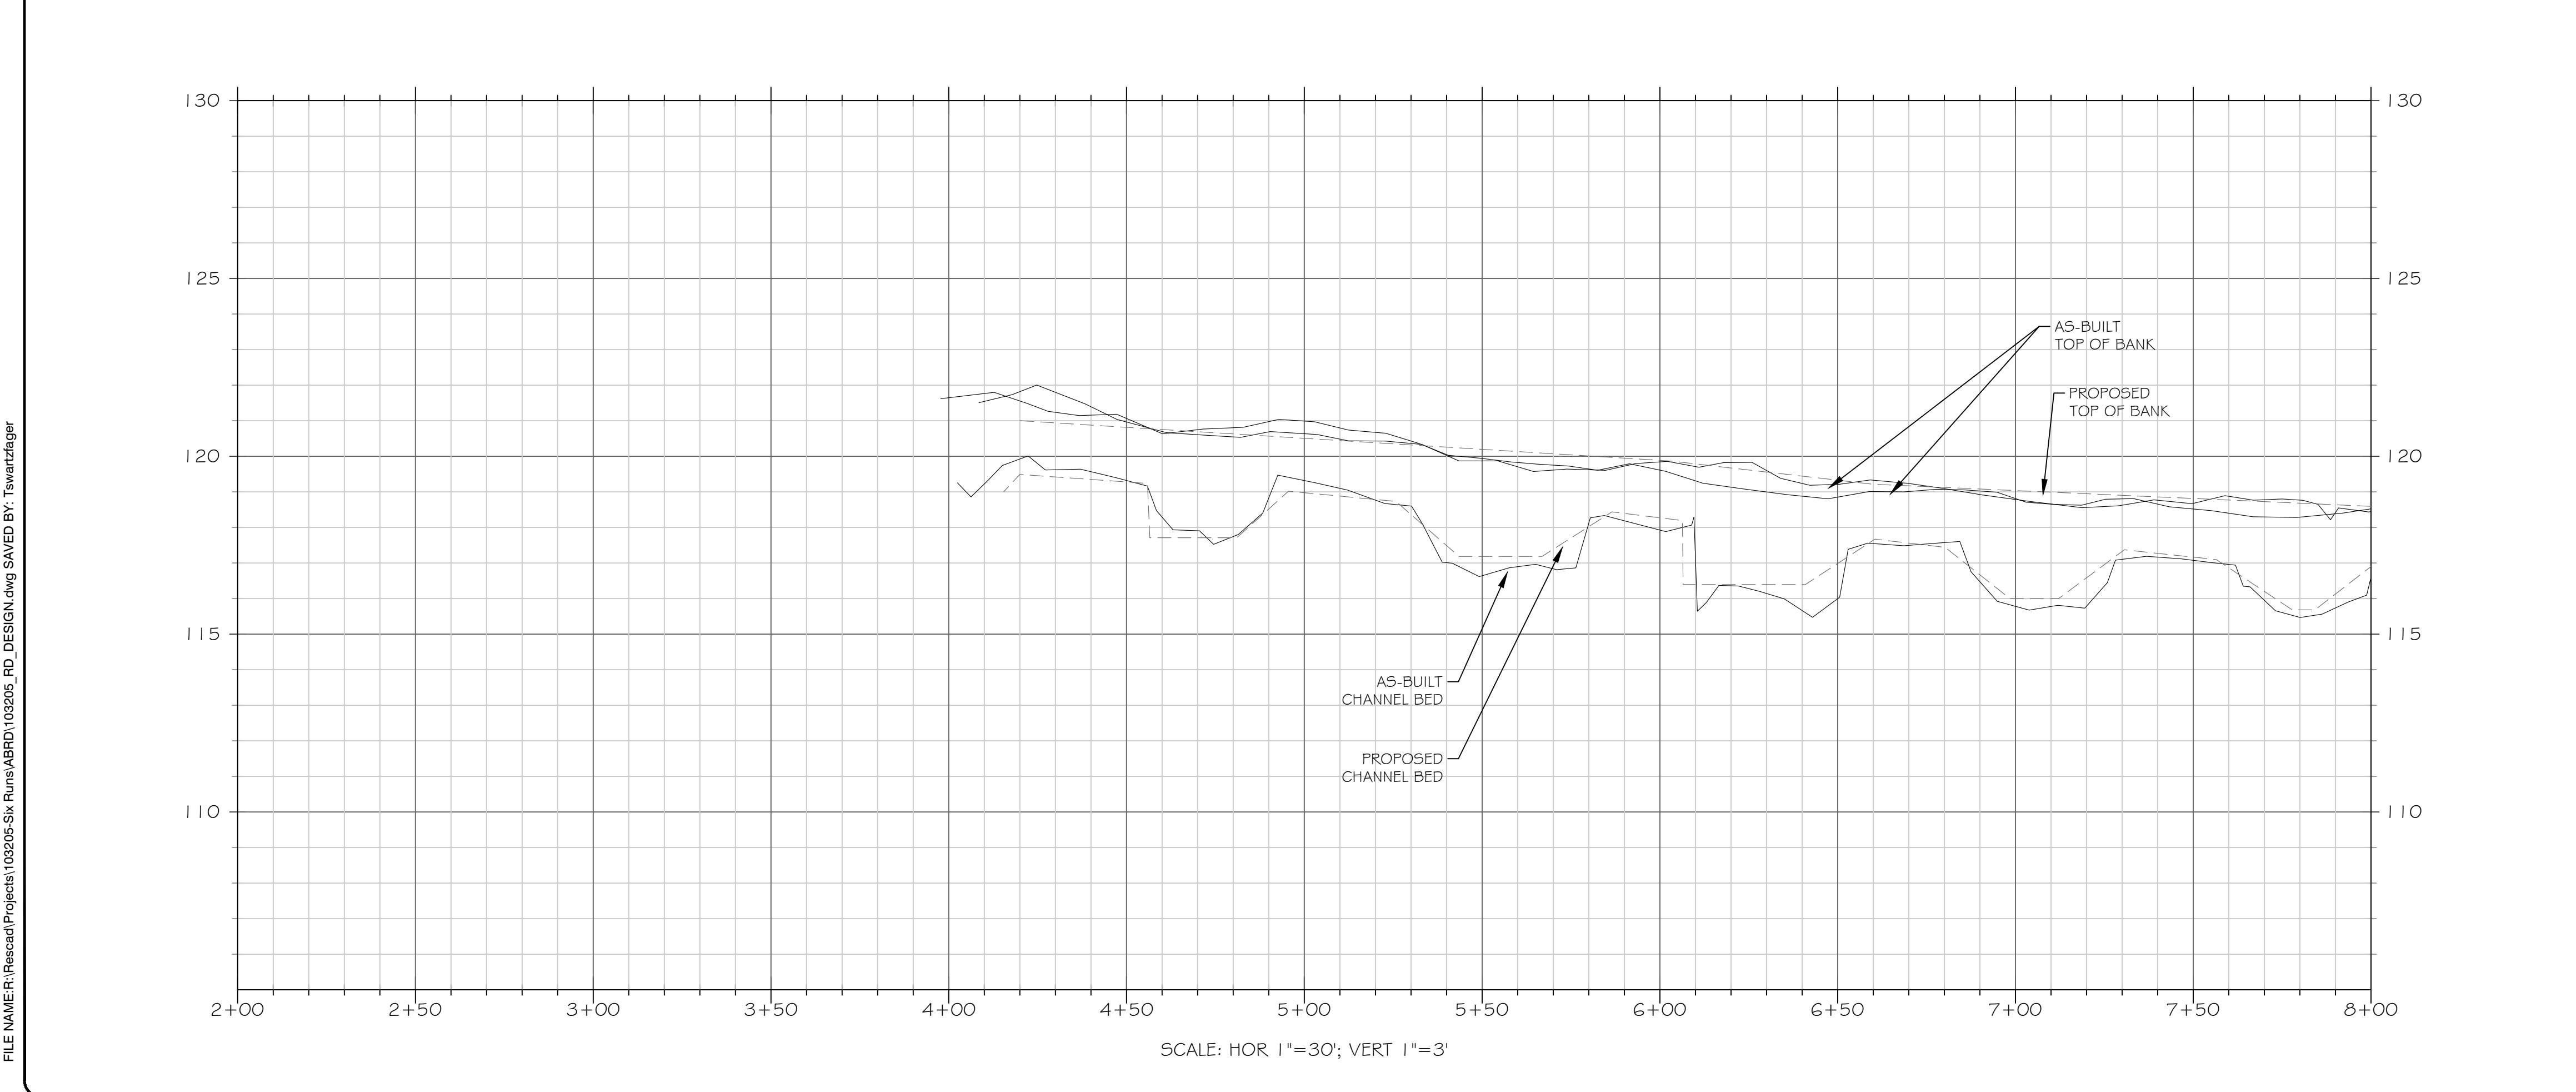

FILE NAME: F:\rescad\Projects\103205-Six Runs\ABRD\103205\_L\_PD\_DESIGN.dwg SAVED BY: Tswartzfager



FILE NAME: F:\Rescad\Projects\103205-Six Runs\ABRD\103205\_RD\_DESIGN.dwg SAVED BY: Tswartzfager

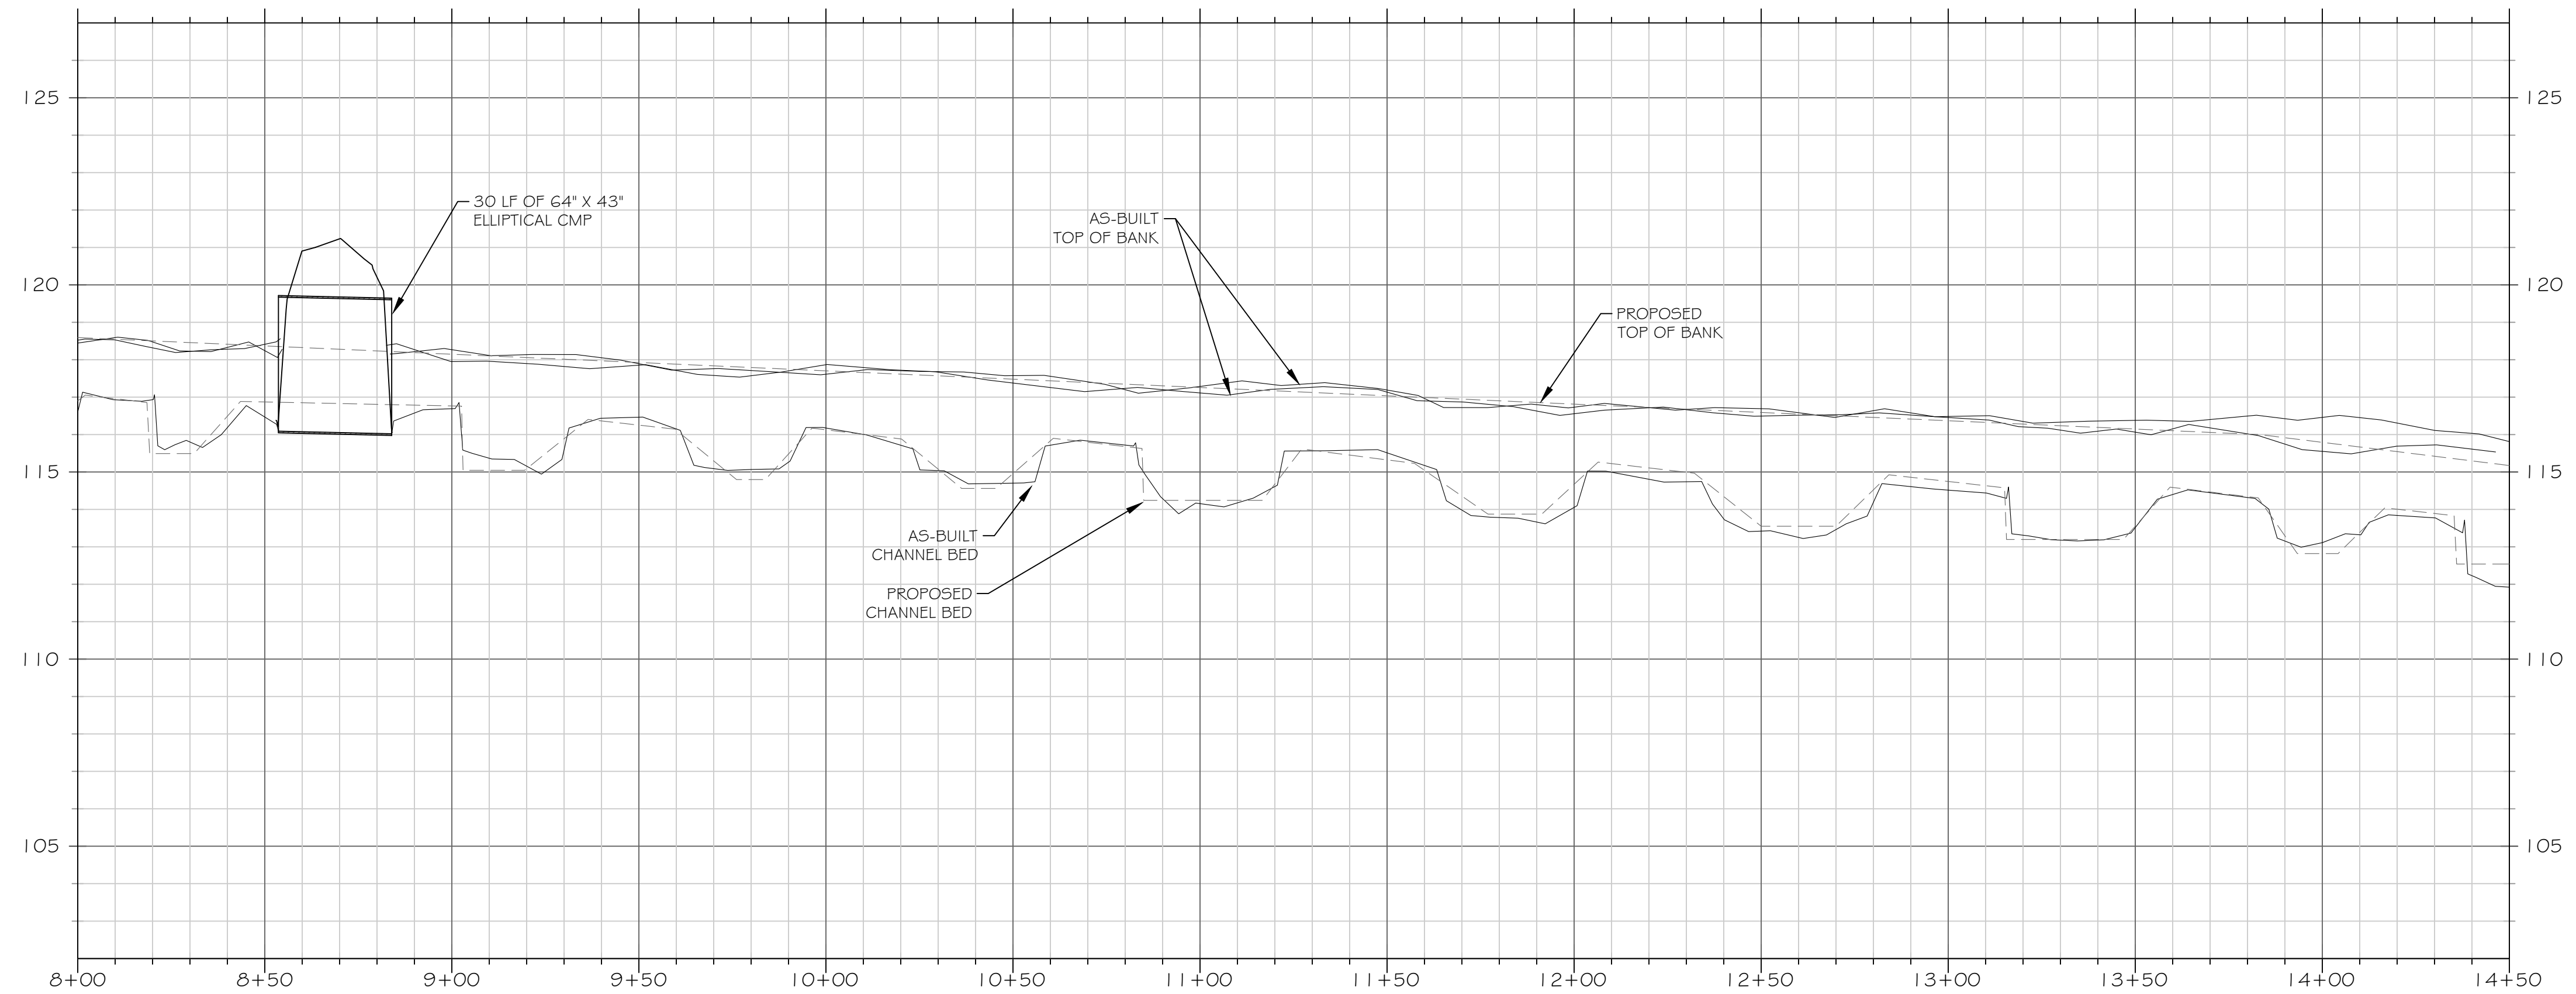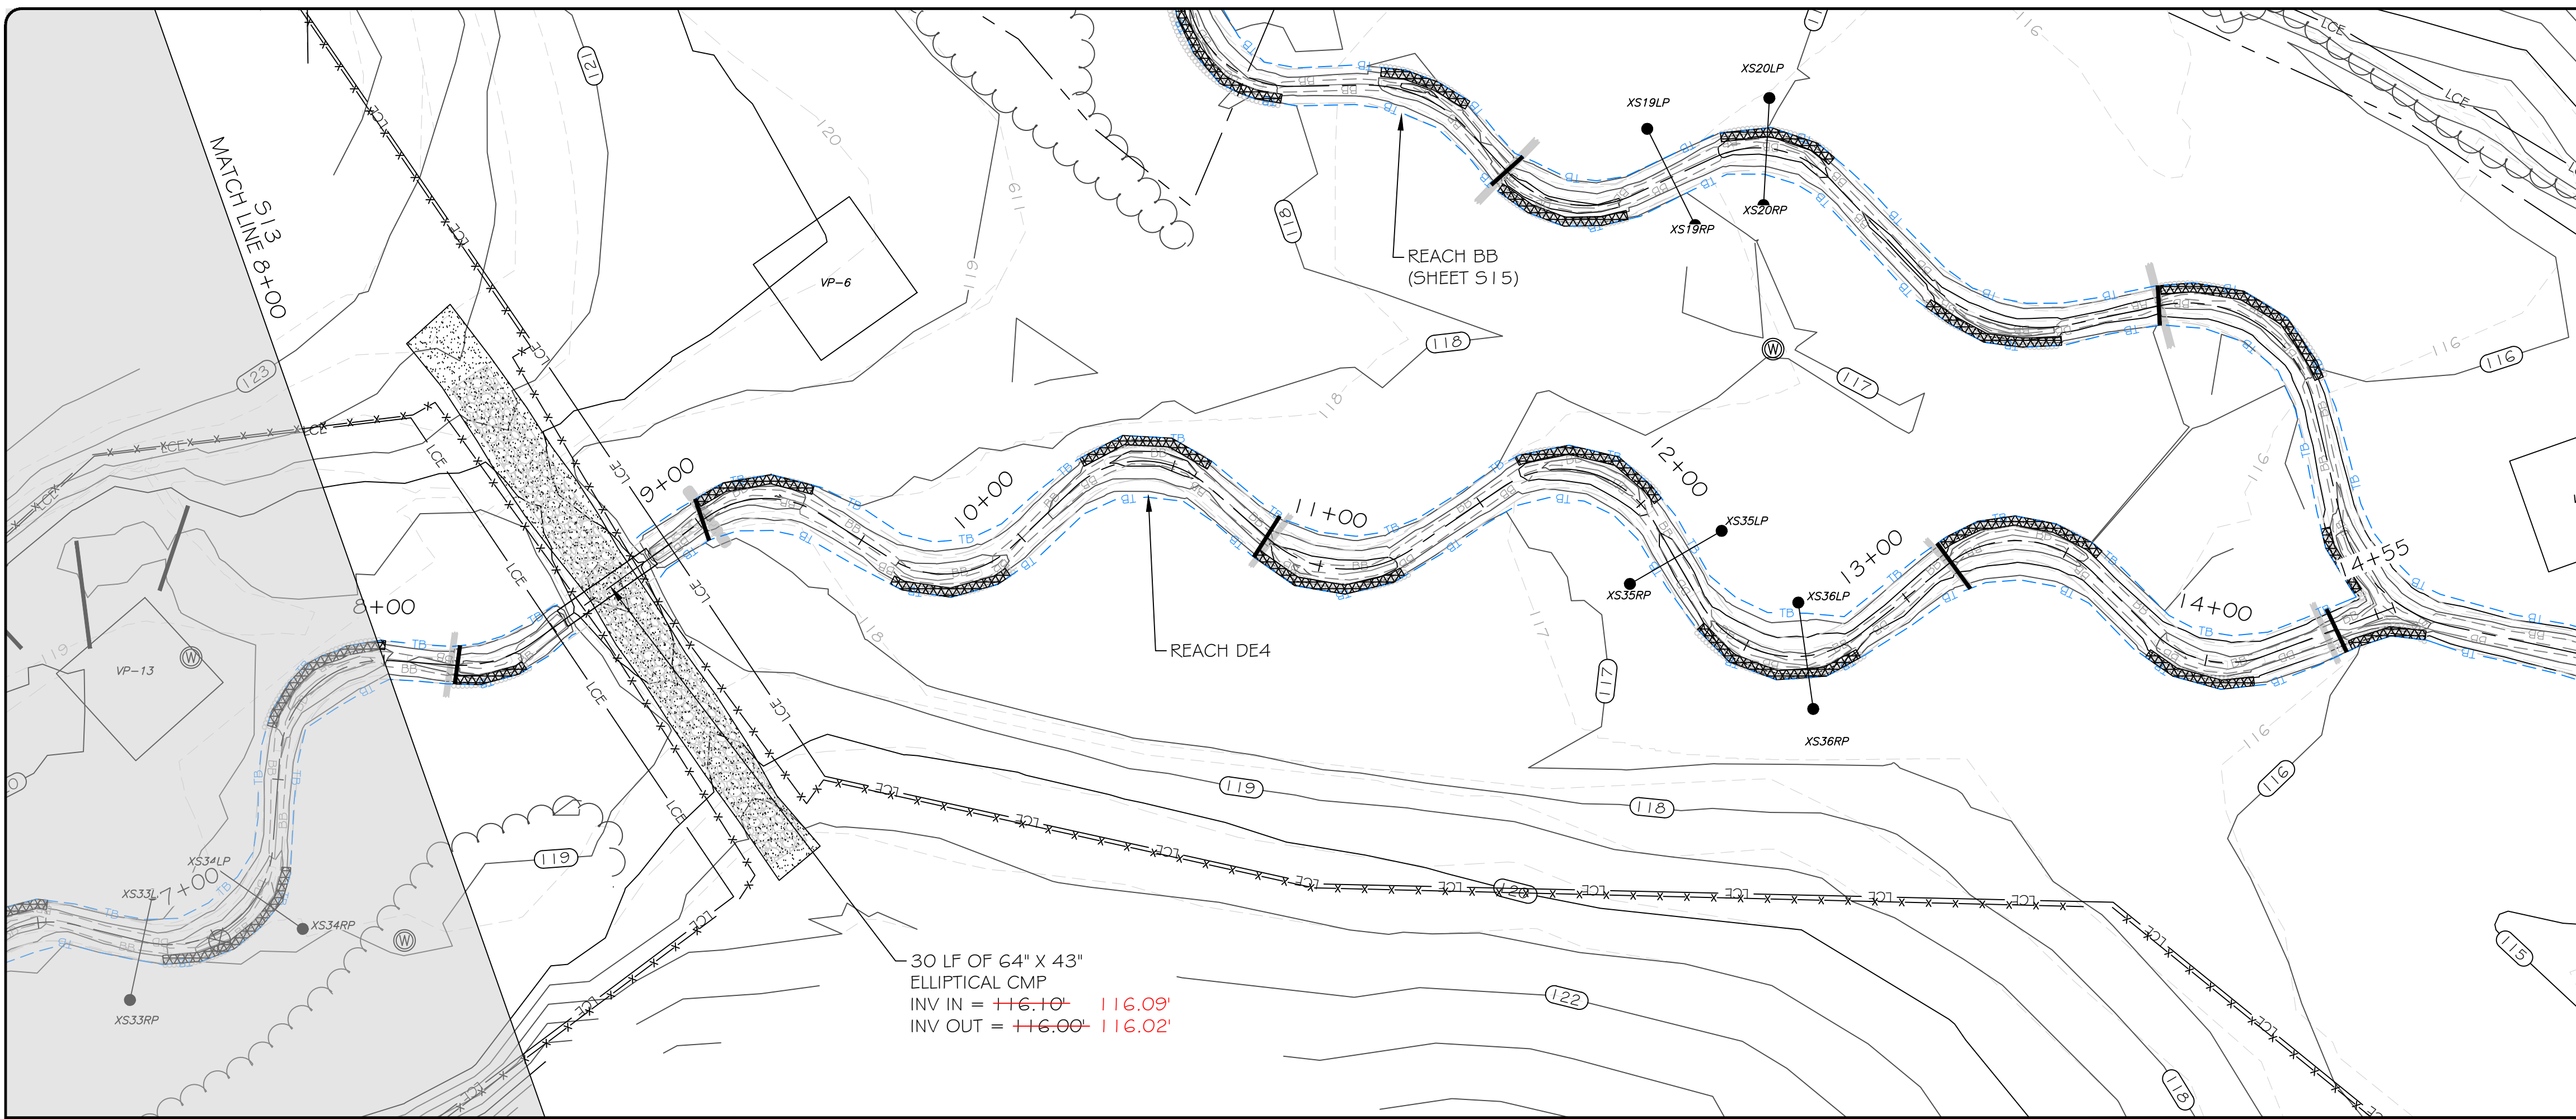

SCALE: HOR 1"=30'; VERT 1"=3'



LEGEND	
PROPERTY LINE	---
LIMITS OF PROPOSED CONSERVATION EASEMENT	LCE
WETLAND	W
TREELINE	~
AS-BUILT CONTOUR MAJOR	50
AS-BUILT CONTOUR MINOR	46
PROPOSED CONTOUR MAJOR	50
PROPOSED CONTOUR MINOR	46
EXISTING FENCING	x-x-x-x-x-x-x-x
AS-BUILT FENCING	x-x-x-x-x-x-x-x
AS-BUILT TOP OF BANK	TB
AS-BUILT BOTTOM OF BANK	BB
PROPOSED TOP OF BANK	TB
AS-BUILT BRUSH TOE PROTECTION	[Symbol]
PROPOSED BRUSH TOE PROTECTION	[Symbol]
AS-BUILT ENGINEERED SEDIMENT PACK	[Symbol]
PROPOSED ENGINEERED SEDIMENT PACK	[Symbol]
AS-BUILT POST ASSISTED LOG STRUCTURE	[Symbol]
PROPOSED LOG STRUCTURE	[Symbol]
AS-BUILT ROCK STRUCTURE	[Symbol]
PROPOSED ROCK STRUCTURE	[Symbol]
AS-BUILT STONE TOE	[Symbol]
PROPOSED STONE TOE	[Symbol]
AS-BUILT CONSTRUCTED RIFFLE	[Symbol]
PROPOSED CONSTRUCTED RIFFLE	[Symbol]
GROUNDWATER MONITORING WELL	W
STAGE RECORDER	○
FLOW GAUGE	⊗
MONITORING CROSS SECTION	—●—●—
VEGETATION MONITORING PLOT	VP#

NOTE: ALL SIGNIFICANT CHANGES FROM THE DESIGN ARE SHOWN IN RED



3600 Glenwood Ave, Suite 100  
Raleigh, NC 27612  
Main: 919.829.9909  
www.res.us

Engineering Services Provided By:  
RES Environmental Operating Company, LLC  
License: F-1428

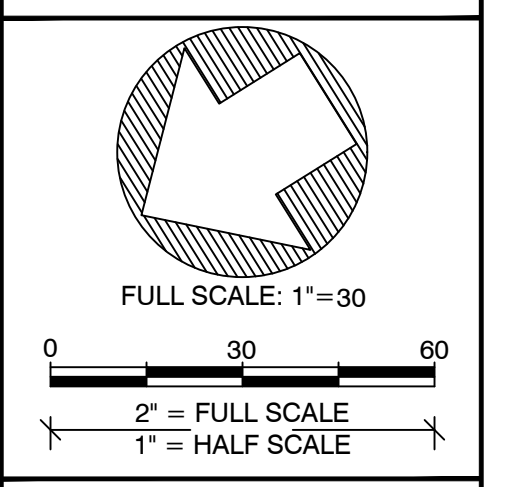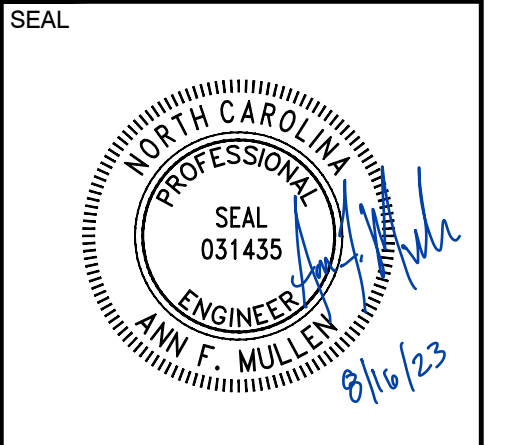

PLOT DATE:  
8/16/2023

REVISIONS:

RELEASED FOR:  
RECORD DRAWINGS

PROJECT NAME:  
**SIX RUNS RECORD DRAWINGS  
SAMPSON COUNTY, NORTH CAROLINA**



DRAWING TITLE:  
**REACH DE4**

PROJECT NUMBER: 103205  
PROJECT MANAGER: JRM  
DESIGNED: AFM  
DRAWN: SLB  
CHECKED: TRS

SHEET NUMBER:  
**S14**



FILE NAME: F:\rescad\Projects\103205-Six Runs\ABRD\103205\_RD\_DESIGN.dwg SAVED BY: Tswartzfager

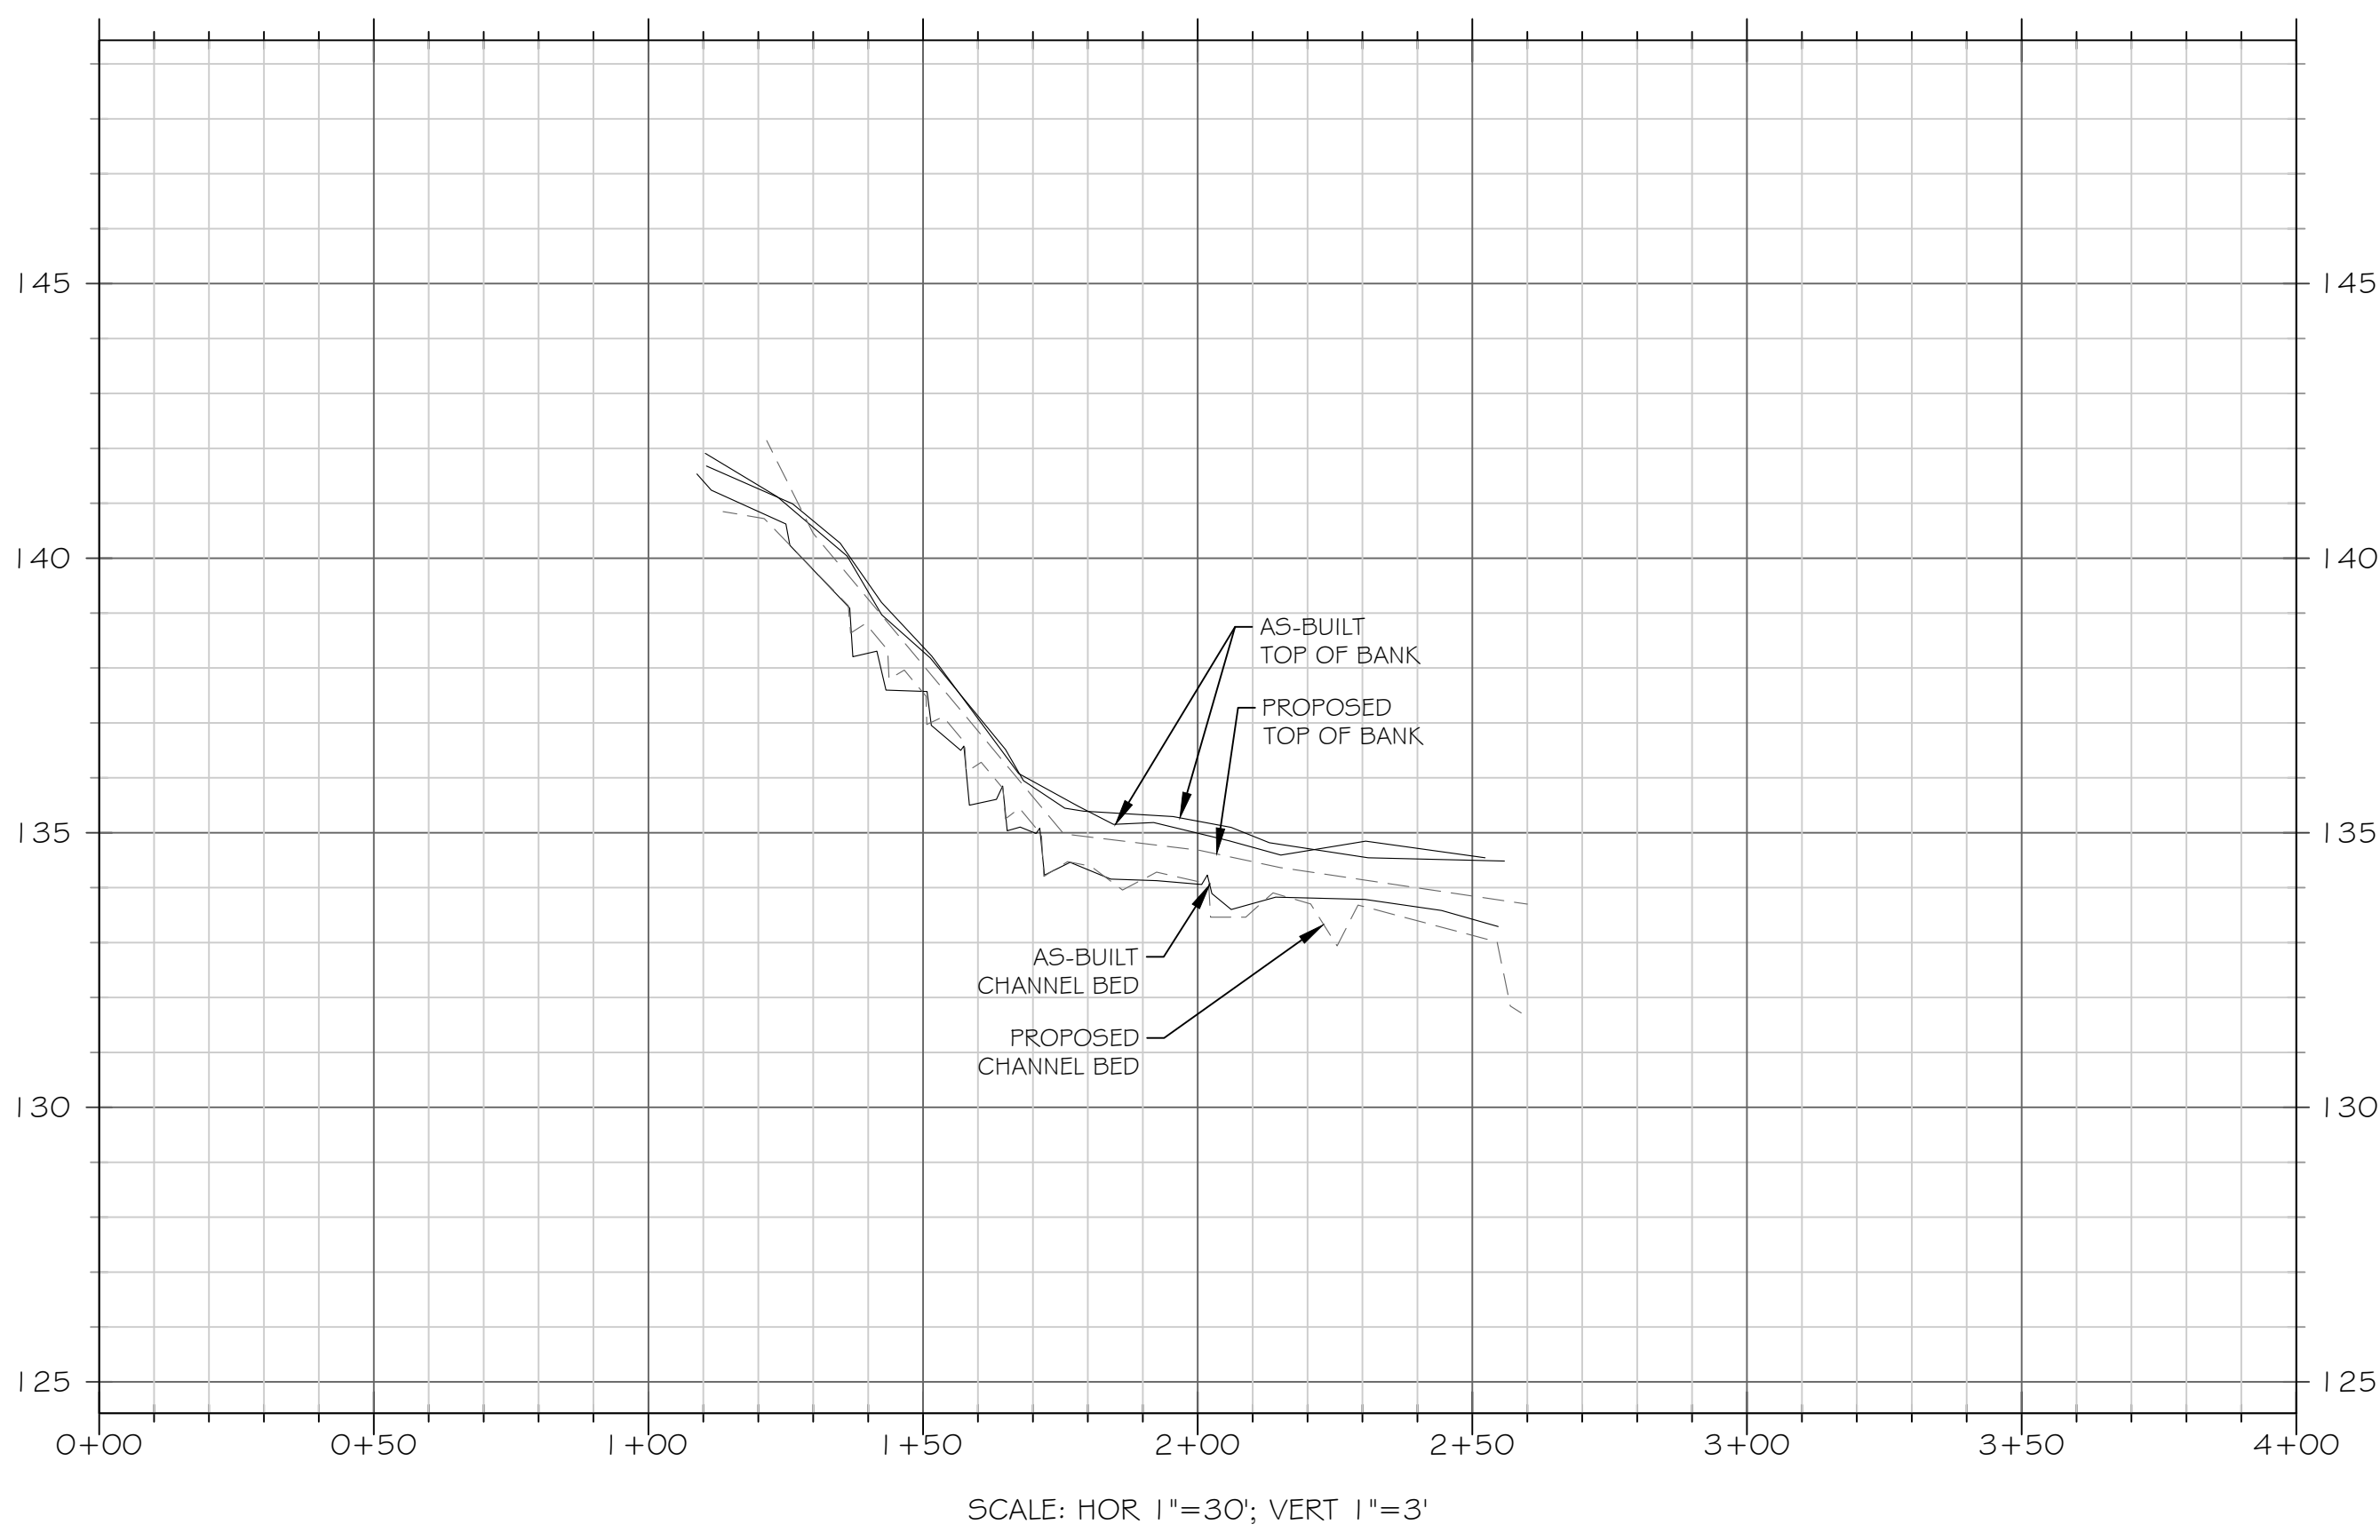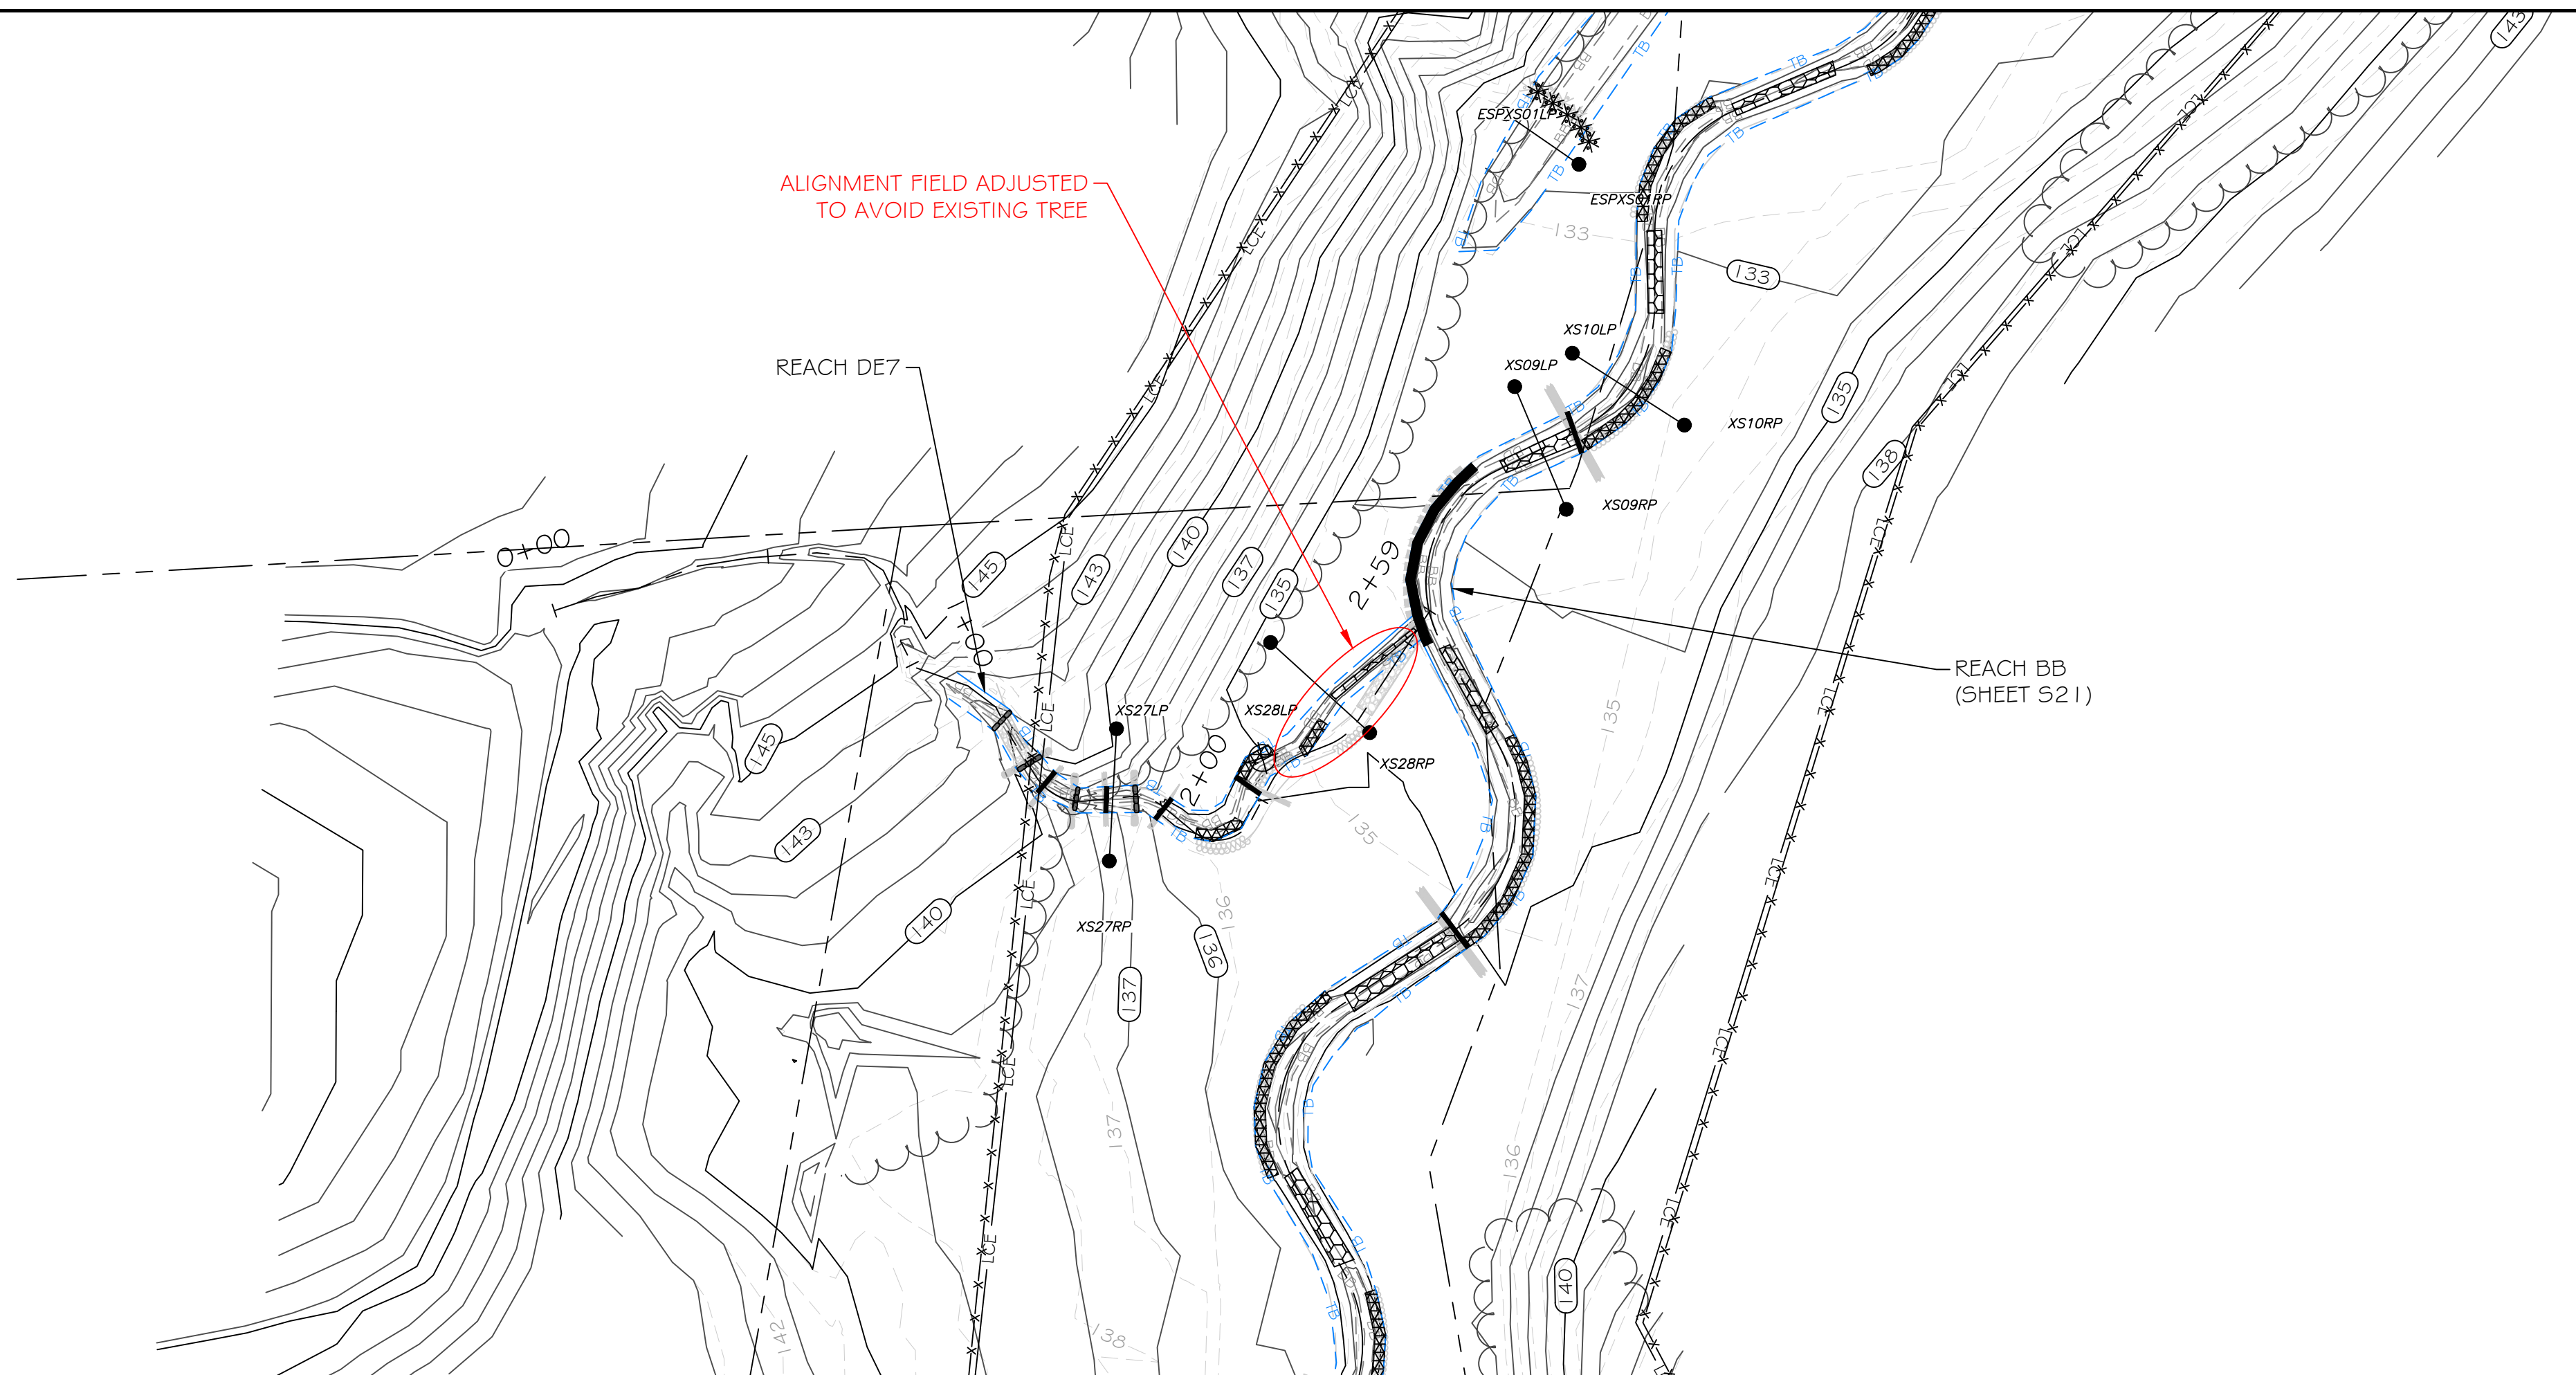

**LEGEND**



PROPERTY LINE	---
LIMITS OF PROPOSED CONSERVATION EASEMENT	---
WETLAND	▾ ▾ ▾
TREELINE	~~~~~
AS-BUILT CONTOUR MAJOR	—50—
AS-BUILT CONTOUR MINOR	—46—
PROPOSED CONTOUR MAJOR	-50-
PROPOSED CONTOUR MINOR	-46-
EXISTING FENCING	-x-x-x-x-
AS-BUILT FENCING	-x-x-x-x-
AS-BUILT TOP OF BANK	---TB---
AS-BUILT BOTTOM OF BANK	---BB---
PROPOSED TOP OF BANK	---
AS-BUILT BRUSH TOE PROTECTION	▨▨▨▨▨
PROPOSED BRUSH TOE PROTECTION	▨▨▨▨▨
AS-BUILT ENGINEERED SEDIMENT PACK	*~*~*~*
PROPOSED ENGINEERED SEDIMENT PACK	*~*~*~*
AS-BUILT POST ASSISTED LOG STRUCTURE	▬▬▬▬▬
AS-BUILT LOG STRUCTURE	▬▬▬▬▬
PROPOSED LOG STRUCTURE	▬▬▬▬▬
AS-BUILT ROCK STRUCTURE	▬▬▬▬▬
PROPOSED ROCK STRUCTURE	▬▬▬▬▬
AS-BUILT STONE TOE	▬▬▬▬▬
PROPOSED STONE TOE	▬▬▬▬▬
AS-BUILT CONSTRUCTED RIFFLE	▨▨▨▨▨
PROPOSED CONSTRUCTED RIFFLE	▨▨▨▨▨
GROUNDWATER MONITORING WELL	⊙
STAGE RECORDER	⊙
FLOW GAUGE	⊗
MONITORING CROSS SECTION	—●—
VEGETATION MONITORING PLOT	VP#

NOTE: ALL SIGNIFICANT CHANGES FROM THE DESIGN ARE SHOWN IN RED



3600 Glenwood Ave, Suite 100  
Raleigh, NC 27612  
Main: 919.829.9909  
www.res.us

Engineering Services Provided By:  
RES Environmental Operating Company, LLC  
License: F-1428

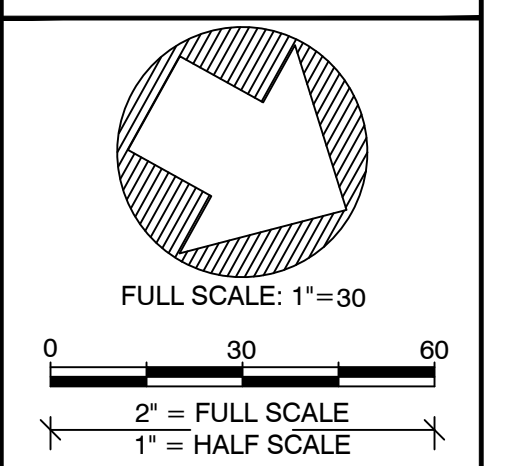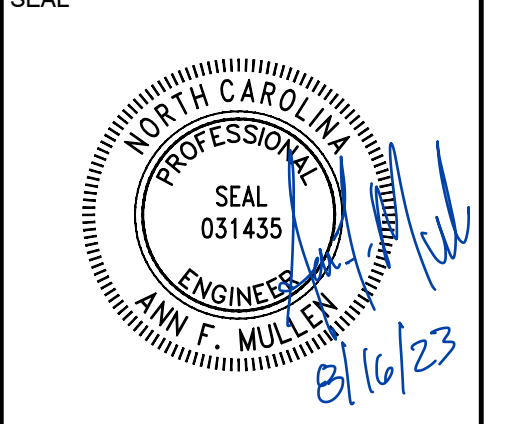

PLOT DATE:  
8/16/2023

REVISIONS:

RELEASED FOR:  
RECORD DRAWINGS


PROJECT NAME:  
**SIX RUNS RECORD DRAWINGS  
SAMPSON COUNTY, NORTH CAROLINA**

DRAWING TITLE:  
**REACH DE7**

PROJECT NUMBER: 103205  
PROJECT MANAGER: JRM  
DESIGNED: AFM  
DRAWN: SLB  
CHECKED: TRS

SHEET NUMBER:  
**S15**




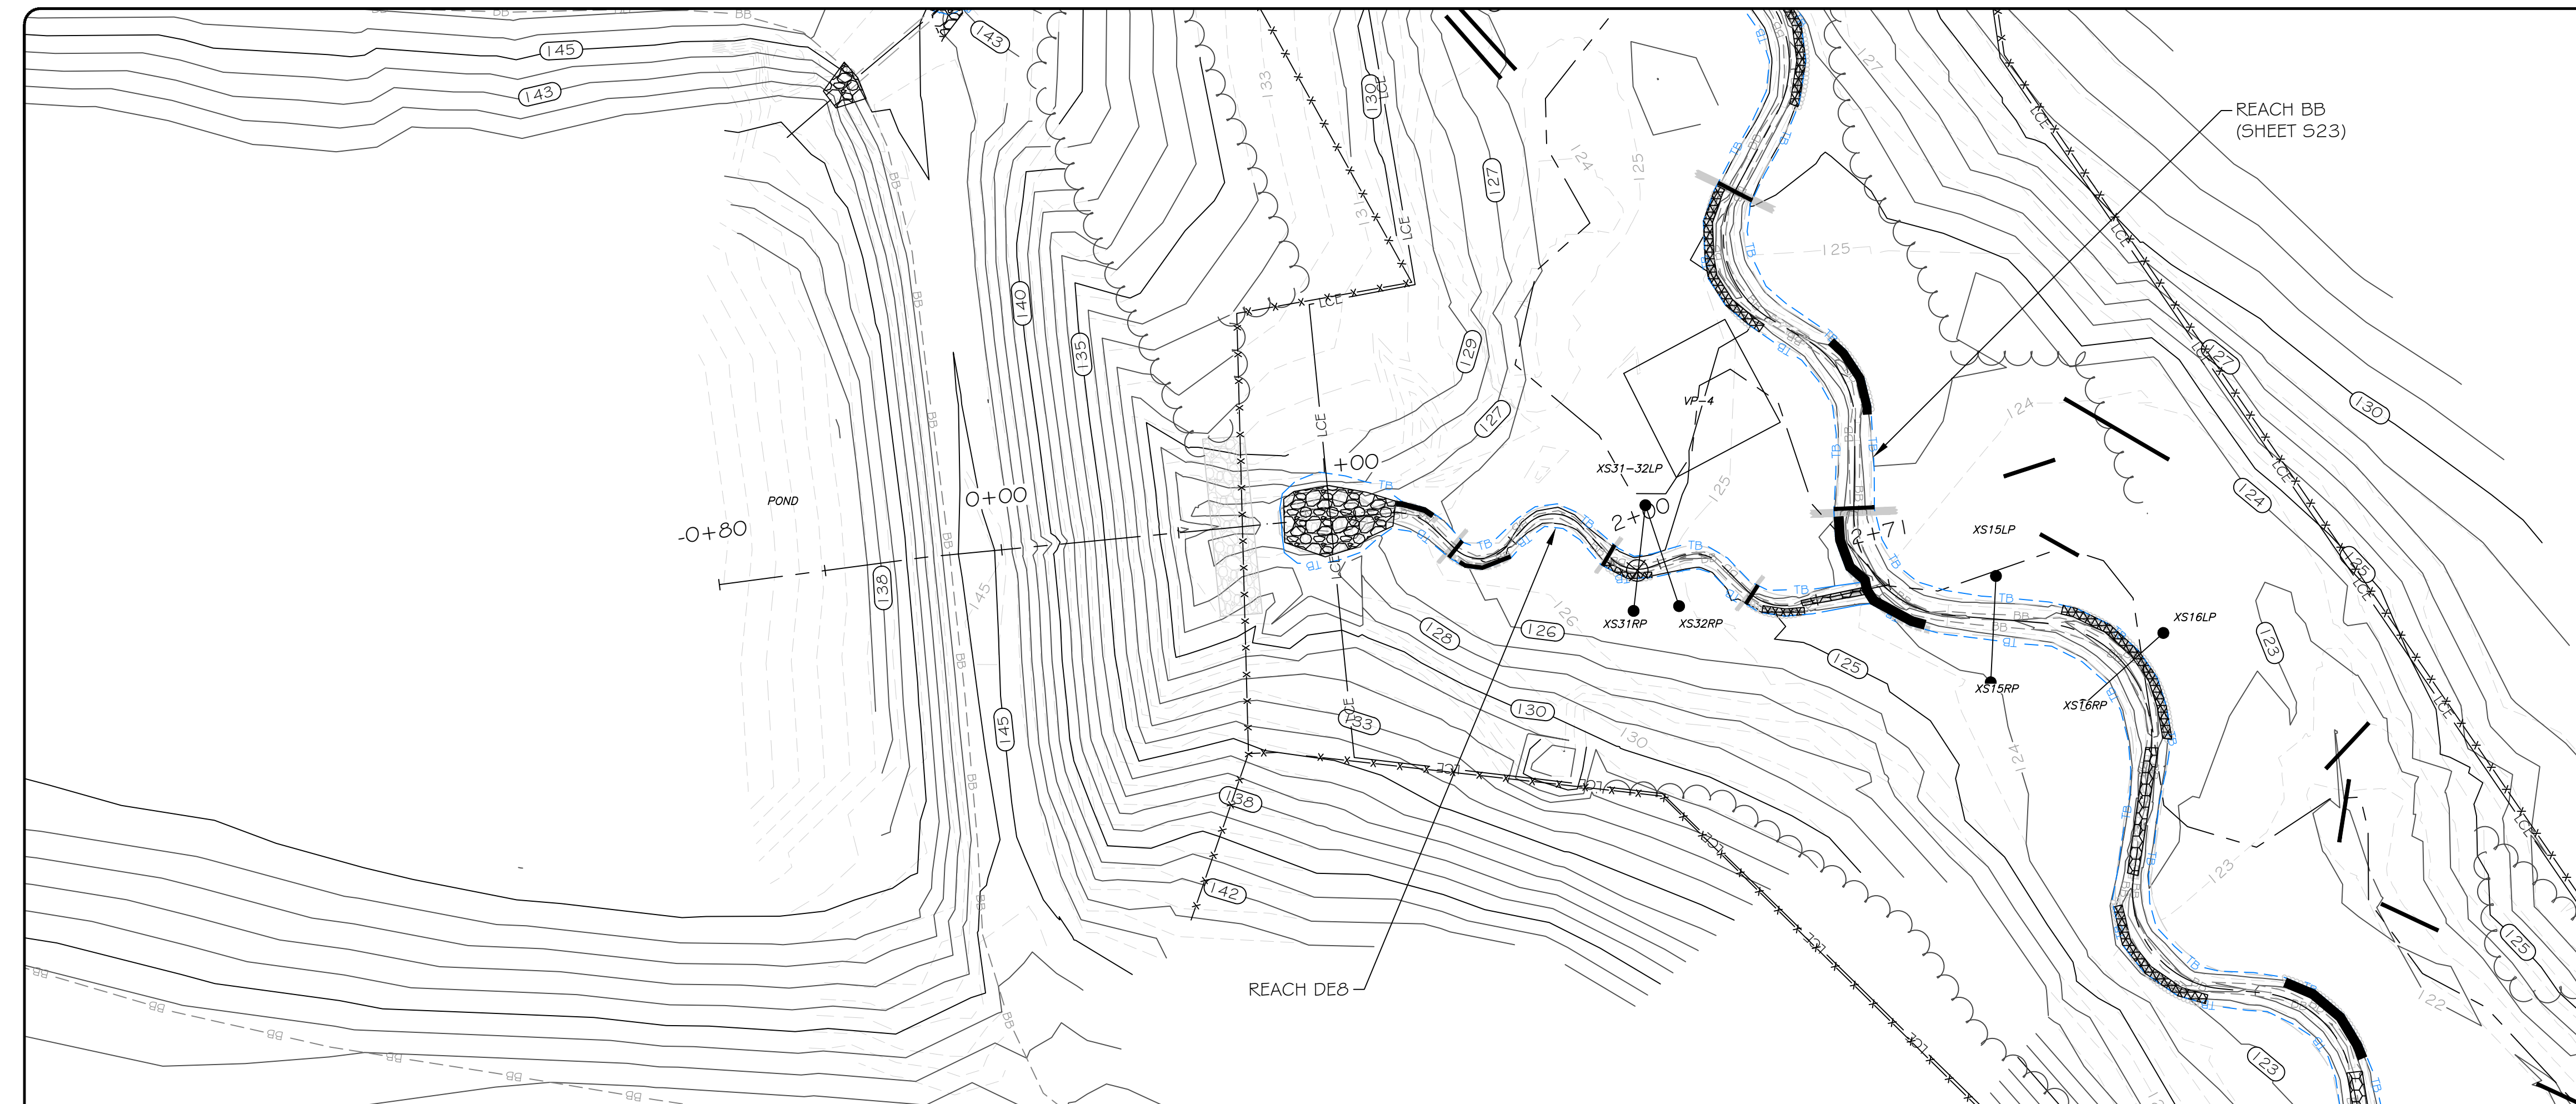



**LEGEND**

PROPERTY LINE	---
LIMITS OF PROPOSED CONSERVATION EASEMENT	--- LCE
WETLAND	
TREELINE	
AS-BUILT CONTOUR MAJOR	50
AS-BUILT CONTOUR MINOR	46
PROPOSED CONTOUR MAJOR	50
PROPOSED CONTOUR MINOR	46
EXISTING FENCING	---x---x---
AS-BUILT FENCING	---x---x---
AS-BUILT TOP OF BANK	--- TB ---
AS-BUILT BOTTOM OF BANK	--- BB ---
PROPOSED TOP OF BANK	--- TB ---
AS-BUILT BRUSH TOE PROTECTION	
PROPOSED BRUSH TOE PROTECTION	
AS-BUILT ENGINEERED SEDIMENT PACK	
PROPOSED ENGINEERED SEDIMENT PACK	
AS-BUILT POST ASSISTED LOG STRUCTURE	
AS-BUILT LOG STRUCTURE	
PROPOSED LOG STRUCTURE	
AS-BUILT ROCK STRUCTURE	
PROPOSED ROCK STRUCTURE	
AS-BUILT STONE TOE	
PROPOSED STONE TOE	
AS-BUILT CONSTRUCTED RIFFLE	
PROPOSED CONSTRUCTED RIFFLE	
GROUNDWATER MONITORING WELL	
STAGE RECORDER	
FLOW GAUGE	
MONITORING CROSS SECTION	
VEGETATION MONITORING PLOT	VF#

NOTE: ALL SIGNIFICANT CHANGES FROM THE DESIGN ARE SHOWN IN RED

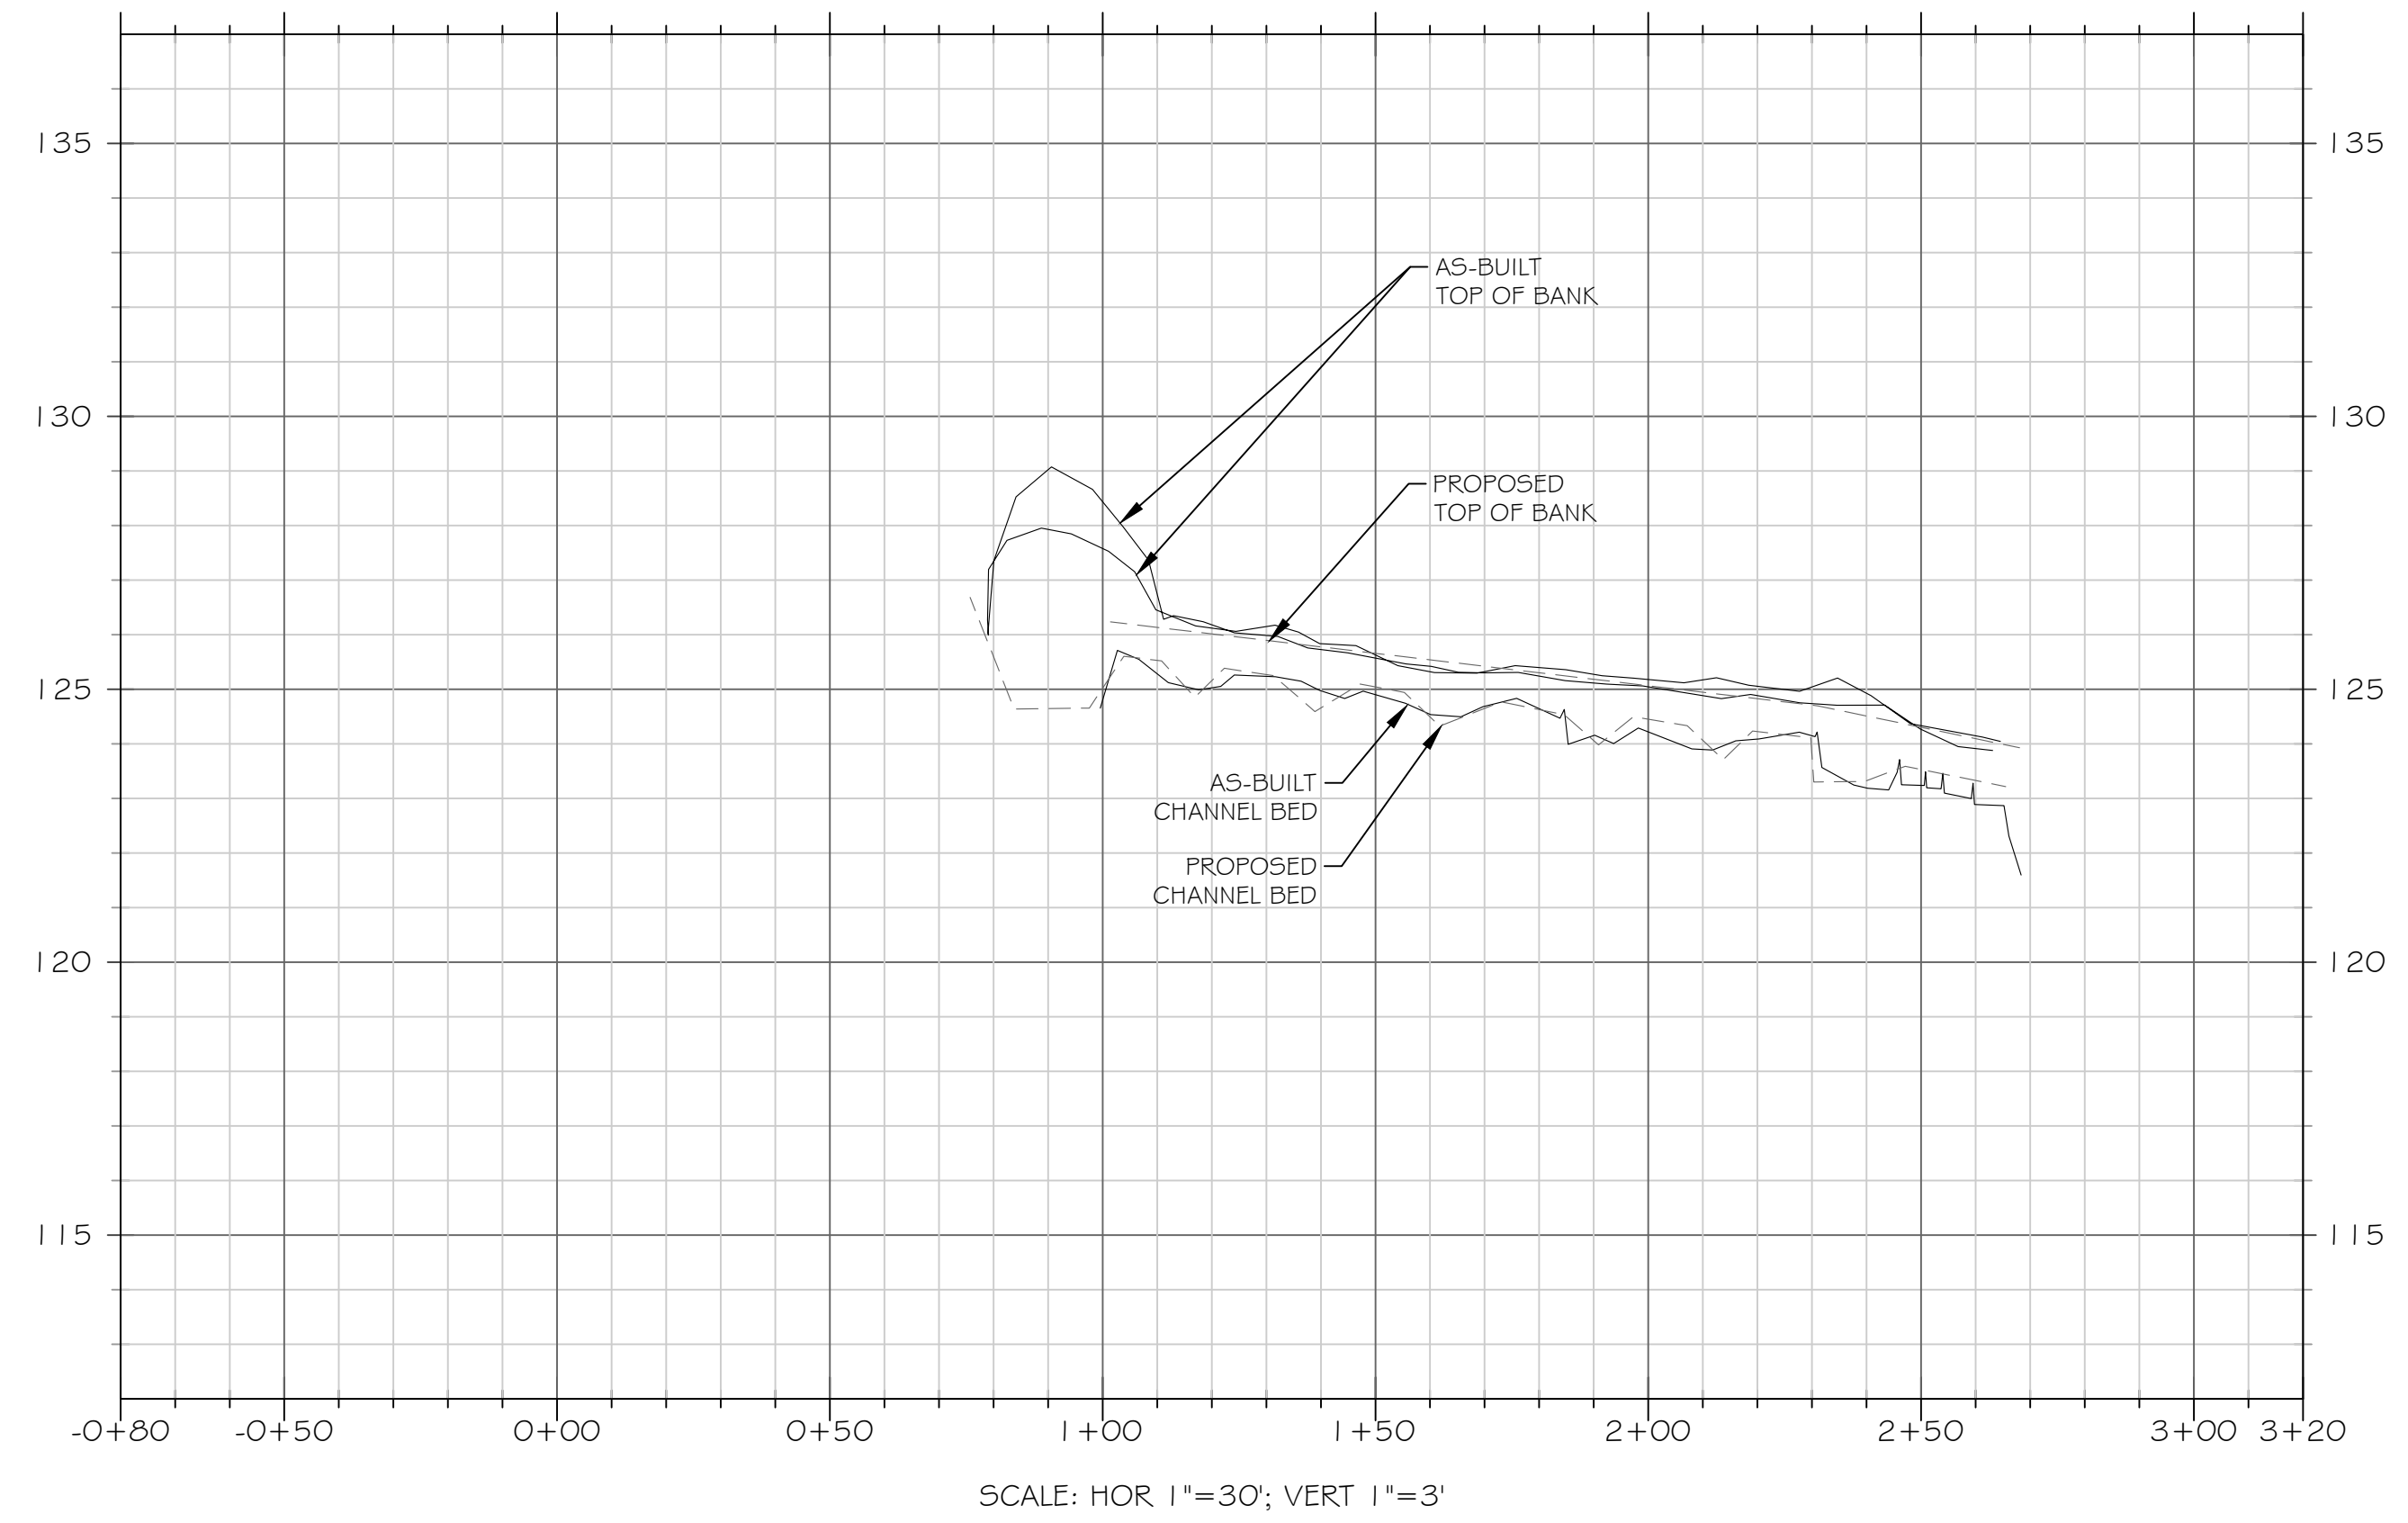

Engineering Services Provided By:  
RES Environmental Operating Company, LLC  
License: F-1428

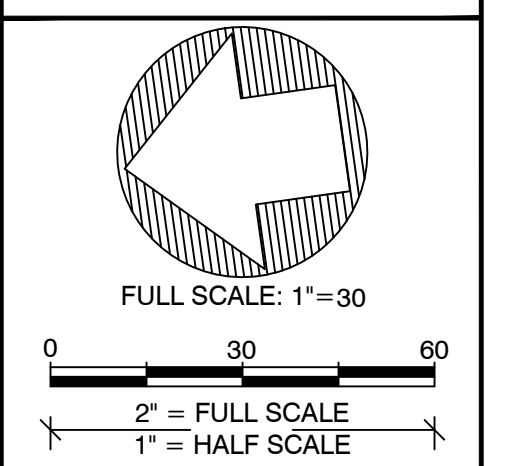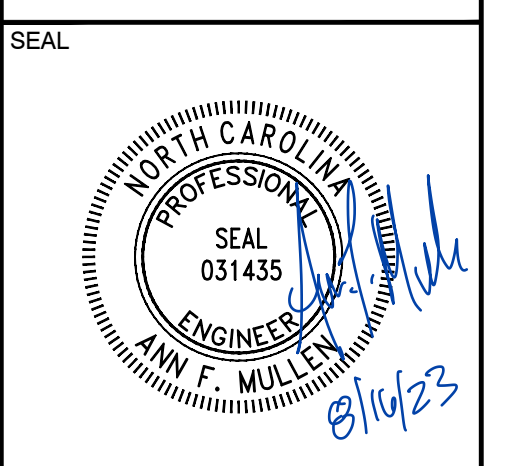

PLOT DATE:  
8/16/2023

REVISIONS:

RELEASED FOR:  
RECORD DRAWINGS

PROJECT NAME:  
**SIX RUNS RECORD DRAWINGS  
SAMPSON COUNTY, NORTH CAROLINA**


DRAWING TITLE:  
**REACH DE8**

PROJECT NUMBER: 103205  
PROJECT MANAGER: JRM  
DESIGNED: AFM  
DRAWN: SLB  
CHECKED: TRS

SHEET NUMBER:  
**S16**





WETLAND ID	MITIGATION TYPE	AREA (AC.)
WA	NO CREDIT	0.081
WB	NO CREDIT	0.057
WC-1	REHABILITATION	4.859
WC-2	PRESERVATION	1.656
WD	REHABILITATION	0.009
WE-1	NO CREDIT	0.439
WE-1	ENHANCEMENT (LOW)	0.410
WE-2	ENHANCEMENT (HIGH)	0.586
WE-2	NO CREDIT	0.092
WF	NO CREDIT	0.292
WH	NO CREDIT	0.057
WI	NO CREDIT	0.197
WJ	NO CREDIT	0.123
WK	NO CREDIT	0.036
WL	RE-ESTABLISHMENT	5.693
WM	RE-ESTABLISHMENT	0.457
TOTAL		15.044

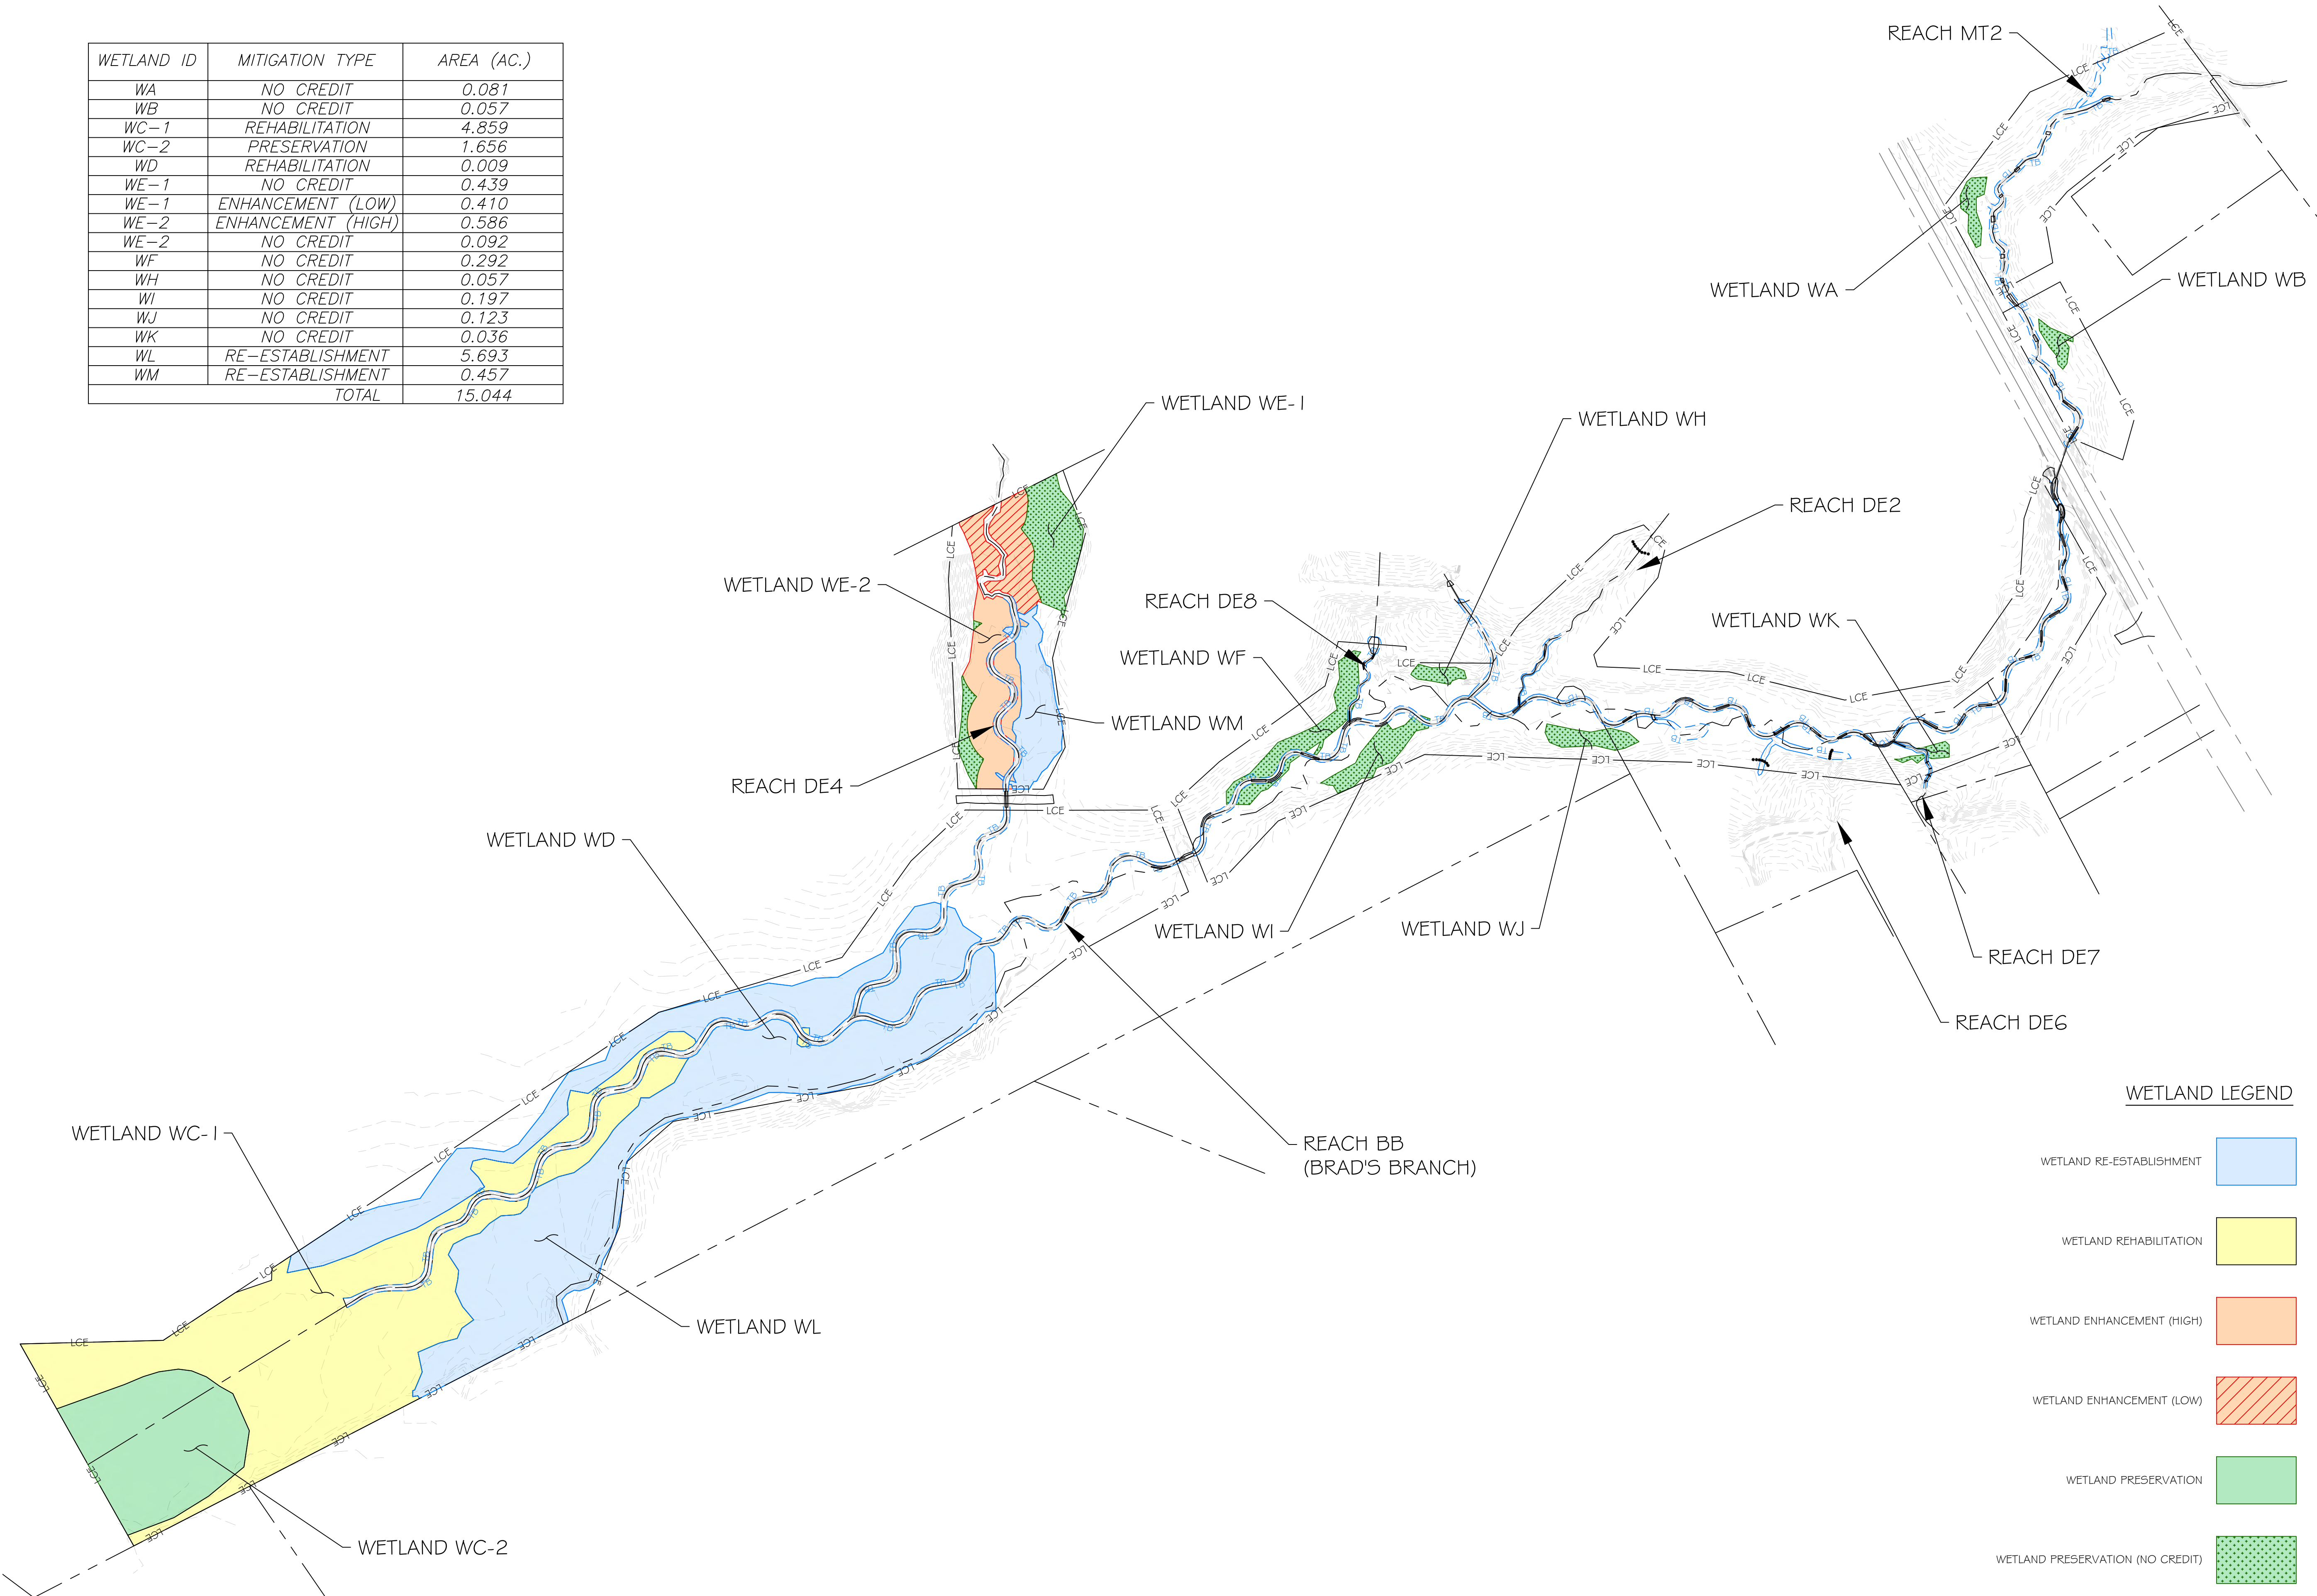

**WETLAND LEGEND**

- WETLAND RE-ESTABLISHMENT
- WETLAND REHABILITATION
- WETLAND ENHANCEMENT (HIGH)
- WETLAND ENHANCEMENT (LOW)
- WETLAND PRESERVATION
- WETLAND PRESERVATION (NO CREDIT)

**res**  
 3600 Glenwood Ave, Suite 100  
 Raleigh, NC 27612  
 Main: 919.829.9909  
 www.res.us  
 Engineering Services Provided By:  
 RES Environmental Operating Company, LLC  
 License: F-1428

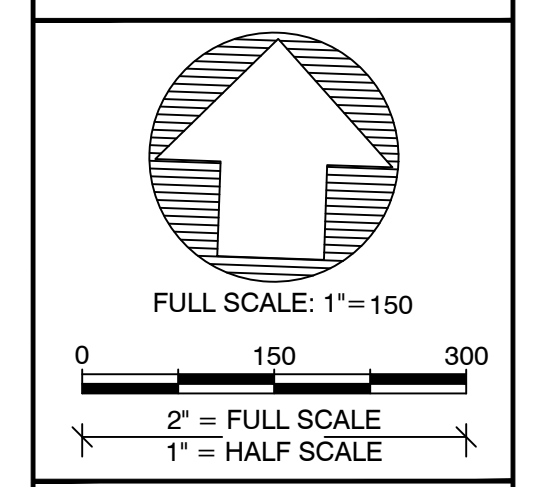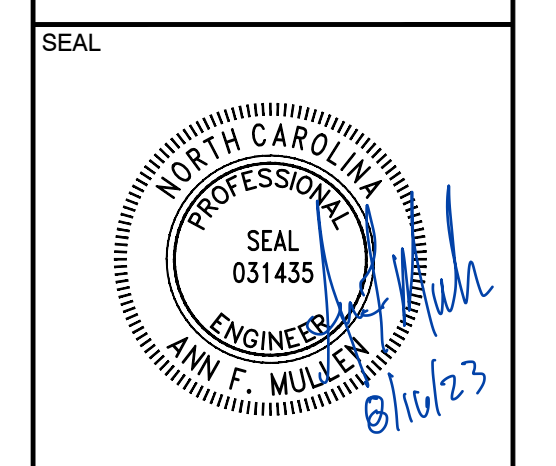

PLOT DATE:  
8/16/2023

REVISIONS:

RELEASED FOR:  
RECORD DRAWINGS

PROJECT NAME:  
**SIX RUNS RECORD DRAWINGS  
SAMPSON COUNTY, NORTH CAROLINA**

DRAWING TITLE:  
**WETLANDS**

PROJECT NUMBER: 103205  
 PROJECT MANAGER: JRM  
 DESIGNED: AFM  
 DRAWN: SLB  
 CHECKED: TRS

SHEET NUMBER:  
**W1**

FILE NAME: R:\Rescard\Projects\103205-Six Runs\ABRD\103205\_RD\_DESIGN.dwg SAVED BY: Tswartzfager