

**As-built Baseline Monitoring Report**

**FINAL**

**Stewarts Creek Tributaries Stream Restoration Project**

**Surry County, North Carolina**

**Monitoring Year 0**

**Data Collection Period:**

May 2020 – June 2020

**Submission Date:**

October 2020



NCDEQ Contract No. 7183

DMS ID No. 100023

USACE Action ID No. SAW-2017-01508

DWR ID No. 20171043

Prepared For:



**NC Department of Environmental Quality**  
**Division of Mitigation Services**  
217 West Jones Street; 3<sup>rd</sup> Floor  
Raleigh, NC 27603



**Ecosystem Planning and Restoration**  
1150 SE Maynard Road, Suite 140  
Cary, NC 27511

Prepared By:



Ecosystem Planning and Restoration, LLC  
1150 SE Maynard Road, Suite 140  
Raleigh, NC 27511

Phone: (919) 388-0787  
www.eprusa.net

Mr. Paul Wiesner  
NCDEQ – Division of Mitigation Services  
5 Ravencroft Dr., Suite 102  
Asheville, NC 28801

October 9, 2020

**RE: Response to Draft As-Built Baseline Monitoring Report (MY0) Comments dated August 18, 2020**  
**Stewarts Creek Stream Restoration Project**  
**Yadkin River Basin – CU# 03040101 – Surry County, North Carolina**  
**NCDMS Project # 100023, Contract # 7183**

Dear Mr. Wiesner,

Ecosystem Planning and Restoration (EPR) has reviewed the comments on the Draft As-Built Baseline Monitoring Report provided August 18, 2020. The comments have been addressed as described below and the Final Baseline Report and electronic deliverables have been revised in response to this review.

- *General & Table 1: There was a very minor rounding error in the IRT approved mitigation plan. The error is associated with Moores Fork (Reach 1); 1,573 linear feet @ 2.5:1 = 629.2 SMUs. Total project assets should be updated to 10,649.2 SMUs. Please update the report text (report wide) and Table I accordingly. A footnote should be added to Table I to explain the minor discrepancy.*
  - **Updated.**
  
- *Report Cover: Please include the project's DWR# on the report cover. DWR# 20171043*
  - **Updated.**
  
- *Report Cover: The report cover indicates that MY0 data was collected from April – July 2020. Table 2 notes that MY0 data was collected in March 2020. The report text notes that MY0 data was collected from May-June. Please review for consistency and update the cover, report and Table 2 as necessary.*
  - **Updated all accounts to indicate MY0 data was collected from May – June 2020.**

- *Section 1.1 Goals and Objectives: The goals and objectives in the MY0 report should match the goals and objectives in the IRT approved mitigation plan. Please revise accordingly. DMS recommends utilizing Table 8 from the IRT approved mitigation plan in the final MY0 report for consistency.*
  - **Updated.**
  
- *CCPV Sheets-Moores Fork: Please explain why a portion of the project fencing is located inside the conservation easement on the south west portion of Moores Fork-Reach 2. Project fencing should be located outside of the conservation easement or on the easement line if no fencing maintenance (spraying/cutting) is planned. Please review and confirm that all project fencing has been installed directly outside the conservation easement or on the easement line as required. If project fencing has been installed within the conservation easement, please provide a proposed resolution.*
  - **No fencing was installed in the conservation easement. What was indicated in the CCPV sheets was existing fencing that does not affect the success of the project. This existing fencing has been taken out of the CCPV maps.**
  
- *Table 7: In the Annual Means column, the “size (ACRES)” cell is currently 0.271821. Please QA/ QC the table and update as necessary. Electronic support files should also be updated.*
  - **Table 7 has been updated to match the electronic supporting files and stems per acre in the report have been adjusted.**
  
- *Longitudinal Profile: Please add the reach break for UT3 Reach1/ Reach 2.*
  - **Updated.**
  
- *Record Drawings: The general notes on sheet 2 indicate that construction was completed in April 2020 and the as-built completed in July 2020. This is not consistent with Table 2. As requested in the earlier comment, please review for consistency and update the Record Drawings, report and Table 2 as necessary.*
  - **Updated.**

- *Record Drawings: The crossing on UT3 Reach 1 and the crossing upstream of UT2 appear to extend into the conservation easement. Please confirm that all project crossing pipes and associated rip rap aprons are located outside of the conservation easement. If crossings have been installed inside the conservation easement, an easement modification may be necessary. Project assets should also be reviewed if crossings extend into the conservation easement and updated accordingly. Please review and provide a proposed resolution if applicable.*
  - **Contractor located the pipe and associated rip rap in the easement break. This is portrayed in the updated record drawings.**
  
- *Record Drawings: Please include the as-built fencing line and as-built witness post locations on the Record Drawings and make sure the symbology matches what is presented on sheet 2. As requested in the earlier comment, please confirm that no fencing is located within the project conservation easement. If project fencing has been installed within the conservation easement, please provide a proposed resolution.*
  - **As-built fencing and as-built witness posts have been added to the Record Drawings. No fencing was installed in the conservation easement.**
  
- *Electronic Support Files: The following stream features have feature lengths that do not match the creditable footage reported in the project asset table, reported below as feature length vs. asset table length: Moores Fork R1: 1638 ft vs. 1573 ft and UT3 R2: 2452 ft vs. 2421*
  - **SCT\_Stream.shp has been updated. The conversion between CADD and GIS still has some of the lengths off by one foot but that is because GIS cannot draw the arcs with the same precision as CADD.**
  
- *Electronic Support Files: Please reproduce Table 7 and re-submit the CVS entry tool, so that species counts are included in the table.*
  - **Table 7 has been reproduced. In the report Section 2.3.1 Baseline Vegetation Monitoring, EPR noted that species data will be collected during Monitoring Year 1.**



Ecosystem Planning and Restoration, LLC  
1150 SE Maynard Road, Suite 140  
Raleigh, NC 27511

Phone: (919) 388-0787  
www.eprusa.net

- *Electronic Support Files: Please provide PDFs of any permits or associated permit correspondence acquired during design development that wasn't submitted during the Mitigation Plan development (i.e. FEMA Floodplain Compliance permit; DEQ Land Quality permit: etc.). This should include in a separate "Projects Permits" folder in final electronic submittal. The "Project Permits" folder was provided in the DRAFT support files but is currently empty.*
  - **Permits added to the folder.**
  
- *Electronic Support Files: Please provide the stand alone as-built .pdf and .dwg files with the final electronic submittal. This as-built survey should bear a Professional Land Surveyor (PLS) seal. The .dwg files appear to be included; however, the .pdf file/s are missing. Please review and update as necessary.*
  - **Included.**
  
- *Electronic Support Files: Please provide the final stand alone Ecosystem Planning & Restoration, PLLC (EPR) design plan .pdf and .dwg files with the final electronic submittal. The design plan should bear a Professional Engineer's seal.*
  - **Included.**

If you have any questions regarding the As-Built Baseline Report, please contact me at 919-388-0787 or via email at [ebennett@eprusa.net](mailto:ebennett@eprusa.net).

Sincerely,

Erin M. Bennett, PE

## TABLE OF CONTENTS

1.0	PROJECT SUMMARY .....	1
1.1	Goals and Objectives .....	1
1.2	Mitigation Components.....	2
1.3	Construction .....	3
1.3.1	In-Stream Work and Floodplain Grading .....	3
1.4	Site Planting.....	4
2.0	BASELINE DATA ASSESSMENT .....	4
2.1	Performance Criteria .....	4
2.2	Stream Monitoring .....	5
2.2.1	Stream Profile .....	5
2.2.2	Stream Dimension .....	6
2.2.3	Channel Stability .....	6
2.2.4	Stream Hydrology .....	6
2.3	Riparian Vegetation .....	7
2.3.1	Baseline Vegetation Monitoring.....	7
3.0	REFERENCES .....	8



## **TABLES**

Table A. USACE Mitigation Success Criteria

Table B. Stream Monitoring Summary

Table C. Riparian Vegetation Monitoring Summary

## **APPENDICES**

### **Appendix A: Project Information Tables**

Table 1. Project Mitigation Components

Table 2. Project Activity and Reporting History

Table 3. Project Contacts Table

Table 4. Project Baseline Information and Attributes

### **Appendix B: Visual Exhibits and Guidance**

Figure 1. Vicinity Map

Figure 2. Current Condition Plan View (CCPV)

Baseline Photo Log

Vegetation Photo Log

### **Appendix C: Vegetation Plot Data**

Table 5. Vegetation Planting Information

Table 6. Riparian Buffer Vegetation Totals

Table 7. Stem Count by Plot

### **Appendix D: Stream Measurement and Geomorphology Data**

Table 8. Baseline Stream Data Summary

Table 9. Monitoring Data – Dimensional Morphology Summary

Table 10. Monitoring Data – Stream Reach Data

Table 11. Structure Changes Summary

Longitudinal Profile Plots

Cross Section Plots

### **Appendix E: As-Built Plan Drawings**



## 1.0 PROJECT SUMMARY

Ecosystem Planning and Restoration, PLLC (EPR) implemented the Stewarts Creek Tributaries Stream Restoration Project (Project; Site) for the North Carolina Division of Mitigation Services (DMS) to provide 10,649.2 stream mitigation units (SMUs) in the Yadkin River Basin, Hydrologic Unit Code (HUC) 03040101. The Stewarts Creek Tributaries Stream Restoration Project was instituted via NCDEQ-DMS RFP #16-006993. As approved by the North Carolina Interagency Review Team (NCIRT), all projects contracted under the 16-006993 RFP have a cool or warm service type. Penalties will not be assessed for using these project mitigation credits to satisfy cool or warm requirements. The Project restored 9,498 linear feet and enhanced 1,573 linear feet of three Unnamed tributaries (UTs) to Stewarts Creek and Moores Fork within a 30-acre conservation easement. Mitigation assets are listed in Table 1 of Appendix A.

The Site is located in NC Division of Water Resources (NCDWR) sub-basin 03-07-03 and DMS targeted local watershed 03040101100010. The Site was historically utilized for agricultural and cattle practices. As such, wetlands and streams in the project area were adversely impacted by direct cattle access, farming activities, and stream channelization. The Site is situated on historic pastureland in a WS-IV watershed that is 49% agricultural land, 37% forest, 11% residential, and 1% impervious. Prior to construction activities, all project streams were incised, the UTs were straightened and had adjacent row crops, and Moores Fork suffered from cattle damage. Pre-construction, or pre-existing, site conditions are provided in Table 4 of Appendix A and the Baseline Stream Data Summary Tables in Appendix D. Photos and a more detailed description of Site conditions before restoration are available in the Mitigation Plan (Final version submitted May 2019).

### 1.1 Goals and Objectives

The Project goals were established based on an assessment of site conditions and restoration potential with careful consideration of the stressors identified in the Upper Yadkin Pee-Dee River Basin Restoration Priorities (RBRP) report (NCEEP, 2009) and Yadkin Pee-Dee Basinwide Water Quality Plan (NCDWQ, 2008). As such, the established project goals include:

- Reduce sediment inputs and stream turbidity;
- Reduce nutrient inputs;
- Reduce fecal coliform inputs;
- Restore/enhance degraded riparian buffers;
- Reduce urban/suburban stormwater runoff;
- Reduce stream channel and stream bank instability; and
- Implement structural agricultural BMPs in agricultural watersheds.





Site construction was completed in May 2020 and the as-built survey was completed in June 2020. Planting and baseline vegetation data collection occurred in May – June 2020. A detailed timeline of the Project activity and reporting history are provided in Table 2 of Appendix A. During construction, multiple grade control and lateral stability structures were added as a response to the lack of sod mats on site. These modifications had the added benefit of adding additional woody debris to the restored stream systems. Also, UT2 and UT3 profiles were adjusted to account for differences between the design elevation model and the actual ground surface during construction. All changes from the design are detailed below in Section 1.3.1. Baseline (MY0) profiles and cross-section dimensions closely match the design parameters with little variation. The Site was built as designed and is expected to meet the upcoming monitoring year’s success criteria.

The proposed streams were broken into seven reaches for design purposes. UT1 and UT2 are comprised of one reach each, UT3 is broken into two reaches at the point where it merges with UT2, and Moores Fork is broken into three reaches. Moores Fork Reach 1 is an enhancement reach that includes creating a bankfull bench, sloping, and riparian buffer planting. Moores Fork Reach 2 and 3 are separated by the bridge at Race Track Road. The design criteria were based on surveys of multiple reference reaches, published reference reach data, and design criteria and monitoring data from past successful restoration projects performed throughout the Piedmont region of North Carolina. Restoration practices involved raising the streambeds of the project streams and restoring them back to their historic locations along the fall of the valley, thereby restoring historic flow dynamics and a healthy headwater stream complex. Buffers in excess of 30 feet were established along most reaches.

Ecological uplift will come from: 1) excluding livestock from all streams and buffers, 2) restoring the project streams to a stable, functioning condition, 3) restoring natural riparian vegetation, 4) conversion of row crops to forested buffer, and 5) protecting all areas with a conservation easement. The exclusion of livestock will remove a direct source of nutrients, fecal coliform, and sediment from the system. The Project has restored the plan form and bed form diversity to conditions similar to reference channels (Appendix D, Table 8). Functional uplift was achieved by incorporating woody structures throughout the reach and by planting a forested buffer that will serve as a source of large woody debris in the future. Additionally, lateral stability was improved in the short term by removing the cattle and reducing shear stresses in the channel. As the riparian buffer continues to establish, lateral stability should improve further and increase the resiliency of the restored channels.

## **1.2 Mitigation Components**

The current condition plan view (CCPV) in Appendix B (Figure 2) shows the mitigation assets along with the location of monitoring features. Post-construction conditions (Appendix A, Table 1) at the Site generated 10,649.2 SMUs as a result of the following:

- 9,498 linear feet of Priority 1 and 2 stream restoration
- 1,573 linear feet of Enhancement 2



- 522 SMUs for riparian buffers outside of the required 30-foot stream buffers were protected and planted within the conservation easement.

As illustrated in the As-Built Plan Sheets in Appendix E, the plan form of the proposed streams did not deviate significantly from the proposed design and the stream lengths are unchanged from the approved mitigation plan.

Additional construction activities performed at the Site included the following:

- Planting approximately 6,800 live stakes and 16,300 bare root seedlings within the easement,
- Fencing of the conservation easement in locations with livestock,
- Installing a well, multiple cattle waterers, water lines, and fencing to support these facilities, and
- Treating agriculture drainage with BMPs.

### **1.3 Construction**

Construction began in October 2019 and site earthwork was completed in May 2020. Construction progress was slow due to almost weekly precipitation during this time frame. During construction, there were multiple bankfull, or near bankfull, discharge events. Site visits frequently documented rack lines and recent sediment deposition in the floodplain of the newly built channels. The gage records at the Yadkin River in Elkin confirm that at least two events above bankfull occurred during construction.

Deviations from the design are shown in the As-Built Plan Sheets (Appendix E) and are described in detail within this section.

#### **1.3.1 In-Stream Work and Floodplain Grading**

The As-Built Plan Sheets (Appendix E) provide a visual markup of the design to show what was installed during construction. The Site was built as designed and is expected to meet the upcoming monitoring year's success criteria.

During construction, the Site experienced multiple bankfull flow events with minimal lateral and vertical adjustment. Additional structures were added throughout the UTs and Moores Fork to address any adjustments to the flood events and are listed in Appendix D in Table 11. The adjustments for the UT2 and UT3 profiles are depicted in the As-Built Plan Sheets (Appendix E).

As shown in Appendix D, the dimensions of the surveyed cross sections closely matched the design criteria. The location of some monitoring cross sections were moved from the Mitigation Plan proposed locations due to the additional structures that were added during construction. Monitoring locations were kept as close as possible to the locations shown in the Approved Mitigation Plan.

As shown in the As-built Plan Sheets in Appendix E, the centerline profile was built roughly to the planned dimensions.



### 1.4 Site Planting

Approximately 90% of the site planting occurred by March 31, 2020 with the rest being planted on May 3, 2020. All planting was completed according to the design and there were no deviations from the planting plan.

## 2.0 BASELINE DATA ASSESSMENT

This report establishes the baseline data that will be used to determine the success of the Stewarts Creek Stream Restoration Project. The performance criteria and as-built site conditions are described in the following sections to evaluate whether the project is meeting the success criteria in subsequent monitoring years.

### 2.1 Performance Criteria

Project success criteria were established in accordance with the *NCDMS Mitigation Plan Template* (ver. 06/2017), and *U.S. Army Corps of Engineers – Wilmington District Public Notice: Notification of Issuance of Guidance for Compensatory Stream and Wetland Mitigation Conducted for Wilmington District* (October 24, 2016). The monitoring plan for the site will follow this guidance. Table A details the USACE success criteria that evaluate whether project goals have been met throughout the monitoring period.

**Table A. USACE Mitigation Success Criteria**

<b>Restored Stream Channels</b>
<ul style="list-style-type: none"><li>• All streams must maintain an Ordinary High-Water Mark (OHWM), per RGL 05-05.</li><li>• Continuous surface flow must be documented each year for at least 30 consecutive days.</li><li>• Bank height ratio (BHR) cannot exceed 1.2 for all measured cross sections on a given reach.</li><li>• Entrenchment ratio (ER) must be above 2.2 for all measured riffle cross-sections on a given reach (for C and E streams).</li><li>• BHR and ER should not change by more than 10% in any given year for all measured cross sections on a given reach.</li><li>• Must document occurrence of at least 4 bankfull events in separate years during the monitoring period.</li></ul>
<b>Riparian Vegetation</b>
<ul style="list-style-type: none"><li>• Within planted portions of the site, a minimum of 320 stems per acre must be present at year 3; a minimum of 260 stems per acre must be present at year 4; and a minimum of 210 stems per acre must be present at year 7.</li><li>• Trees must average 7 feet in height at year 5, and 10 feet in height at year 7.</li><li>• Planted and volunteer stems are counted, provided they are included in the approved planting list for the site.</li></ul>



- Any single species can only account for 50% of the required stems per monitoring plot.

## 2.2 Stream Monitoring

Stream monitoring will include monitoring of the hydrologic and geomorphic functions of UT1, UT2, UT3, and Moores Fork. Monitored parameters, methods, schedule/frequency, and extent are summarized in Table B. These monitoring parameters follow USACE guidance, but will also allow for monitoring of other parameters to document site performance related to the project goals listed in Section 1.1. The locations of the established monitoring cross sections are shown in Figure 2 (Appendix B).

**Table B. Stream Monitoring Summary**

Parameter	Method	Schedule/ Frequency	Number/ Extent
Stream Profile	Full longitudinal survey	As-built only (unless otherwise required)	All restored and enhanced stream channels
Stream Dimension <sup>A</sup>	Cross sections	Years 1, 2, 3, 5, and 7	17 cross sections on UTs 9 cross sections on Moores Fork
Channel Stability	Photo Points	Yearly	38 photo points
	Visual Assessment	Yearly	All restored stream channels
	Additional Cross sections	Yearly	Only if instability is documented during monitoring
Stream Hydrology	Pressure transducers Precipitation recorder Photos of flood indicators	Continuous recording through monitoring period	Two gauges on UT1 and UT3; one gauge on UT2

<sup>A</sup> Parameters for stream dimension to be measured as described in the 2018 Standard Measurement of the bank height ratio monitoring parameter technical workgroup.

### 2.2.1 Stream Profile

A full longitudinal profile was surveyed for the entire length of the restored stream in May - June 2020 to document as-built conditions. This survey is tied to a permanent benchmark and includes thalweg, water surface, right bank, and left bank features. Profile measurements were taken at the head of each feature (e.g. riffle, pool) and at the max depth of pools. The locations of cross-sections are shown on the profile plot as well, which is included in Appendix D.

The data derived from the surveyed longitudinal profile shows that the constructed bedform features are consistent with the reference and design criteria. Table 8 in Appendix D summarizes the measured profile data. The longitudinal profile will not be surveyed in subsequent years unless vertical channel instability has been observed during monitoring and remedial actions or repairs are needed.



### **2.2.2 Stream Dimension**

Permanent cross sections were installed across the site to monitor stream stability through dimension change. Of the 26 permanent cross sections installed, 9 were located on Moores Fork and 17 on the UTs with 12 permanent cross sections installed in riffles and 14 in pools. Each cross-section was marked using a length of rebar and PVC pipe on both streambanks. The location and elevation of each pin was recorded to facilitate data comparison from year to year. Cross-sections will be surveyed in Monitoring Years 1, 2, 3, 5, and 7 and reported data will include measurements of Bank Height Ratio (BHR) and Entrenchment Ratio (ER). Reference photos will be taken of both streambanks every year to provide a visual assessment of any changes that may occur.

The surveyed cross-sections indicate that the as-built stream dimensions are consistent with the reference and design criteria. The cross-section plots, photos, and data summary (Tables 8 and 9) are included in Appendix D. These two tables will be updated in subsequent monitoring years to facilitate comparison between monitoring years. There should be little change in the channel dimension data over the monitoring period, but if changes do take place they will be documented and evaluated to determine if they indicate a shift toward stability (potentially represented by settling, vegetative changes, or deposition on top of stream banks) or instability (represented by erosion and down-cutting). Any unstable areas will be assessed to determine whether they are systemic and repairs are needed.

### **2.2.3 Channel Stability**

Channel stability will be assessed on a yearly basis using photographs to visually document the condition of the restored project streams. Photographs will be taken from the same location in the same direction each year. 38 photo points were established during baseline monitoring and are shown in the CCPV (Figure 2) and As-Built Plan Sheets (Appendix E).

Visual assessments of channel stability will also be made regularly throughout the monitoring year. Any potential issues with the site will be documented, photographed, and reported in the yearly monitoring report. Additional cross-sections will only be surveyed if instability is documented during monitoring.

### **2.2.4 Stream Hydrology**

Five pressure transducers were installed on to UTs to document stream flow and the occurrence of bankfull events within the monitoring period. The locations of these gauges are shown in the CCPV (Figure 2 in Appendix B) and As-Built Plan Sheets (Appendix E). All gauges were installed in the downstream end of pools. The constructed bankfull elevation at each gauge was recorded. This elevation will be compared with the gauge readings to determine whether a bankfull event has occurred. Photos will be taken of flood indicators such as debris lines and sediment deposition on the floodplain whenever it is apparent that a bankfull event has occurred.



A tipping bucket rain gauge was also installed at an adjacent site to accurately document rainfall at the Site. The rainfall data will be compared to the flow gauge data to verify that high flows at the Site are correlated with rainfall events. The monitoring gauges will be downloaded regularly throughout each monitoring year and data will be presented in the annual monitoring reports.

### 2.3 Riparian Vegetation

Riparian vegetation monitoring will evaluate the establishment of planted and volunteer vegetation across the site. Monitored parameters, methods, schedule/frequency, and extent are summarized in Table C. These monitoring parameters follow USACE guidance, but will also allow for monitoring of other parameters to document site performance related to the project goals listed in Section 1.1.

**Table C. Riparian Vegetation Monitoring Summary**

Parameter	Method	Schedule/ Frequency	Number/ Extent	Data Collected
Vegetation establishment and vigor	Permanent vegetation plots, 0.02* acre in size (minimum)	Between July 1st and leaf drop. As-built, Years 1, 2, 3, 5, and 7	11 plots, spread across site	Species, height, location, planted vs. volunteer, and age.
	Annual random vegetation plots, 0.02* acre in size (minimum)	Between July 1st and leaf drop. Years 1, 2, 3, 5, and 7	11 plots, randomly selected each year	Species, and height.

\* Plots will be between 0.020 and 0.024 acre in size, at a minimum.

#### 2.3.1 Baseline Vegetation Monitoring

Baseline vegetation monitoring occurred in May - June 2020, soon after site planting was completed. Final vegetation plot location did not vary significantly from the locations suggested in the mitigation plan. The corners of the permanent vegetation plots were marked using steel t-posts and the location of each plot was recorded using GPS. The individual trees within each permanent plot were tagged and labeled to facilitate monitoring efforts in future years. The planted stems were counted and measured during baseline monitoring. Species data will be collected during Monitoring Year 1. In subsequent monitoring years, the location of the temporary random vegetation plots will be recorded using GPS and species and height data will be collected.

Planted stems per plot ranged from 9 to 19, or 364 to 769 stems per acre. The locations of the 11 permanent vegetation plots are shown in the CCPV (Figure 2).



### 3.0 REFERENCES

North Carolina Ecosystem Enhancement Program. 2009. Upper Yadkin Pee-Dee River Basin Restoration Priorities.

North Carolina Department of Environmental Quality, Division of Mitigation Services. 2017. As-built Baseline Monitoring Report Format, Data, and Content Requirement June 2017.

North Carolina Division of Water Quality. 2008. Yadkin Pee-Dee Basinwide Water Quality Plan.

U.S. Army Corps of Engineers. 2016. Wilmington District Public Notice: Notification of Issuance of Guidance for Compensatory Stream and Wetland Mitigation Conducted for Wilmington District.



## Appendix A: Project Information Tables

**Table 1. Project Mitigation Components**

**Table 2. Project Activity and Reporting History**

**Table 3. Project Contacts Table**

**Table 4. Project Baseline Information and Attributes**



**Table 1. Mitigation Assets and Components**

**Stewarts Creek Tributaries Stream Restoration Project (NCDMS Project No. 100023)**

Project Component (reach ID, etc.) <sup>1</sup>	Wetland Position and HydroType <sup>2</sup>	Existing Footage or Acreage	Stationing	Mitigation Plan Footage or Acreage	As-Built Footage or Acreage	Restoration Level	Approach Priority Level	Mitigation Ratio (X:1)	Mitigation Credits	Notes/Comments
UT 1		2,373	10+00 - 38+00	2,742	2,742	R	P1, P2	1	2742	Full Channel Restoration, Planted Buffer, Exclusion of Livestock, and Permanent Conservation Easement.
UT 2		397	10+00 -20+60	1,009	1,009	R	P1, P2	1	1009	
UT 3 R1		1,814	10+00 -19+95	944	944	R	P1, P2	1	944	
UT 3 R2		N/A	19+95 -44+81	2,421	2,421	R	P1, P2	1	2421	
Moores Fork R1		1,660	10+00 - 25+72.5	1,573	1,573	E2	E2	2.5	629.2*	Habitat Structures, Benching, Planted Buffer, Exclusion of Livestock, and Permanent Conservation Easement.
Moores Fork R2		2,007	25+72.5 - 47+67	1,998	1,998	R	P2	1	1998	Full Channel Restoration, Planted Buffer, Exclusion of Livestock, and Permanent Conservation Easement.
Moores Fork R3		380	47+67 - 52+19	384	384	R	P2	1	384	
Net Change in Credit from Buffers		-	-	-	-	-	-	-	522	Wilmington District Stream Buffer Credit Calculator (Updated 1/19/2018)
<b>Total Assets Summary: 10,649.2 SMUs</b>										

**Length and Area Summations by Mitigation Category**

Restoration Level	Stream (linear feet)	Riparian Wetland (acres)		Non-riparian Wetland (acres)
		Riverine	Non-Riverine	
Restoration	9,498			
Enhancement				
Enhancement I				
Enhancement II	1,573			
Rehabilitation				
Preservation				
High Quality Pres				

**Overall Assets Summary**

Asset Category	Overall Credits
Stream	10,649.2

\*Moores Fork R1 mitigation credits were miscalculated in the draft as-built monitoring report and have been updated.

**Table 2. Project Activity and Reporting History**  
**Stewarts Creek Tributaries Stream Restoration Project (NCDMS Project No. 100023)**

Elapsed Time Since grading complete: 0 yrs 3 months  
 Elapsed Time Since planting complete: 0 yrs 3 months  
 Number of reporting Years: 0

<b>Activity or Deliverable</b>	<b>Data Collection Complete</b>	<b>Completion or Delivery</b>
Institution Date	NA	May-17
404 permit date	NA	Jul-19
Final Mitigation Plan	2017 to 2019	May-19
Final Design – Construction Plans	2017 to 2019	Sep-19
Site Earthwork	NA	May-20
As-Built Survey Performed	May - June 2020	Jun-20
Bare root plantings	NA	Mar-20
As-built monitoring report (Year 0 Monitoring – baseline)	Jun-20	Oct-20
Year 1 Monitoring	2020	Nov-20
Year 2 Monitoring	2021	Nov-21
Year 3 Monitoring	2022	Nov-22
Year 4 Monitoring	2023	Nov-23
Year 5 Monitoring	2024	Nov-24
Year 6 Monitoring	2025	Nov-25
Year 7 Monitoring	2026	Nov-26

**Table 3. Project Contacts Table**  
**Stewarts Creek Tributaries Stream Restoration Project (NCDMS Project No. 100023)**

<b>Designer</b>	Ecosystem Planning and Restoration, PLLC 1150 SE Maynard Road, Suite 140 Cary, NC 27511
Primary project design POC	Kevin Tweedy, PE (919) 388-0787
<b>Construction Contractor</b>	Carolina Environmental Contracting 150 Pine Ridge Rd, Mt Airy, NC 27030
Construction contractor POC	Wayne Taylor
<b>Survey Contractor</b>	Turner Land Surveying, PLLC PO Box 148, Swannanoa, NC 28778
Survey contractor POC	Lissa Turner (919) 827-0745
<b>Planting Contractor</b>	Bruton Natural Systems, Inc.
Planting contractor POC	Charlie Bruton
<b>Seeding Contractor</b>	Carolina Environmental Contracting 150 Pine Ridge Rd, Mt Airy, NC 27030
Contractor point of contact	Wayne Taylor
<b>Seed Mix Sources</b>	Green Resource
<b>Nursery Stock Suppliers</b>	Dykes & Son Nursery (931) 668-8833
<b>Monitoring Performers</b>	Ecosystem Planning and Restoration, PLLC
<b>Stream Monitoring POC</b>	Erin Bennett, EPR (919) 388-0787
<b>Vegetation Monitoring POC</b>	Tom Barrett, EPR (919) 388-0787

**Table 4. Project Background Information**  
**Stewarts Creek Tributaries Stream Restoration Project (NCDMS Project No. 100023)**

Project Background Information	
Project Name	Stewarts Creek Tributaries Stream Restoration Project
County	Surry
Project Area (acres)	30
Project Coordinates (latitude and longitude)	latitude 36 deg 30' 55" N, longitude 80 deg 41' 41" W and latitude 36 deg 30' 37" N, longitude 80 deg 42' 01" W
Planted Acreage (Acres of Woody Stems Planted)	30

Project Watershed Summary Information	
Physiographic Province	Piedmont
River Basin	Yadkin Pee-Dee
USGS Hydrologic Unit 8-digit/14-digit	03040101/3040101100010
DWR Sub-basin	03-07-03
Project Drainage Area (Acres and Square Miles)	3001 acres/ 4.69 Sq.Mi. (Total)
Project Drainage Area Percentage of Impervious Area	Average 1%
Project Stream Thermal Regime	Cool
CGIA Land Use Classification	Average 35% Agriculture 50% Forested/Scrubland 11% Residential

Reach Summary Information				
Parameters	Moores Fork	UT 1	UT 2	UT 3
Length of reach (linear feet)	3955	2742	1009	3365
Valley confinement	Unconfined	Unconfined	Unconfined	Unconfined
Drainage area (Acres and Square Miles)	4.4 Sq.Mi., 2816 Ac	0.11 Sq.Mi., 70 Ac	0.07 Sq.Mi., 45 Ac	0.11 Sq.Mi., 70 Ac
Perennial, Intermittent, Ephemeral	Perennial	Perennial	Perennial	Perennial
NCDWR Water Quality Classification	47	39	38	37
Stream Classification (existing)	F4	G4 -> F4	Channelized E4	F4
Stream Classification (proposed)	C4	C4	C4	C4
Evolutionary trend (Simon)	V	IV	IV	IV
FEMA classification	AE	AE	AE	AE

Regulatory Considerations			
Parameters	Applicable?	Resolved?	Supporting Docs?
Water of the United States - Section 404	Yes	Yes	SAW-2017-01508
Water of the United States - Section 401	Yes	Yes	DWR #17-1043
Endangered Species Act	Yes	Yes	Categorical Exclusion Packet
Historic Preservation Act	No	Yes	Categorical Exclusion Packet
Coastal Zone Management Act (CZMA or CAMA)	No	NA	NA
FEMA Floodplain Compliance	Yes	Yes	CLOMR 19-04-3237R and Floodplain Development Permit PL201900063
Essential Fisheries Habitat	No	NA	NA


## Appendix B: Visual Exhibits and Guidance

**Figure 1. Vicinity Map**

**Figure 2. Current Condition Plan View (CCPV)**


**Baseline Photo Log**

**Vegetation Photo Log**

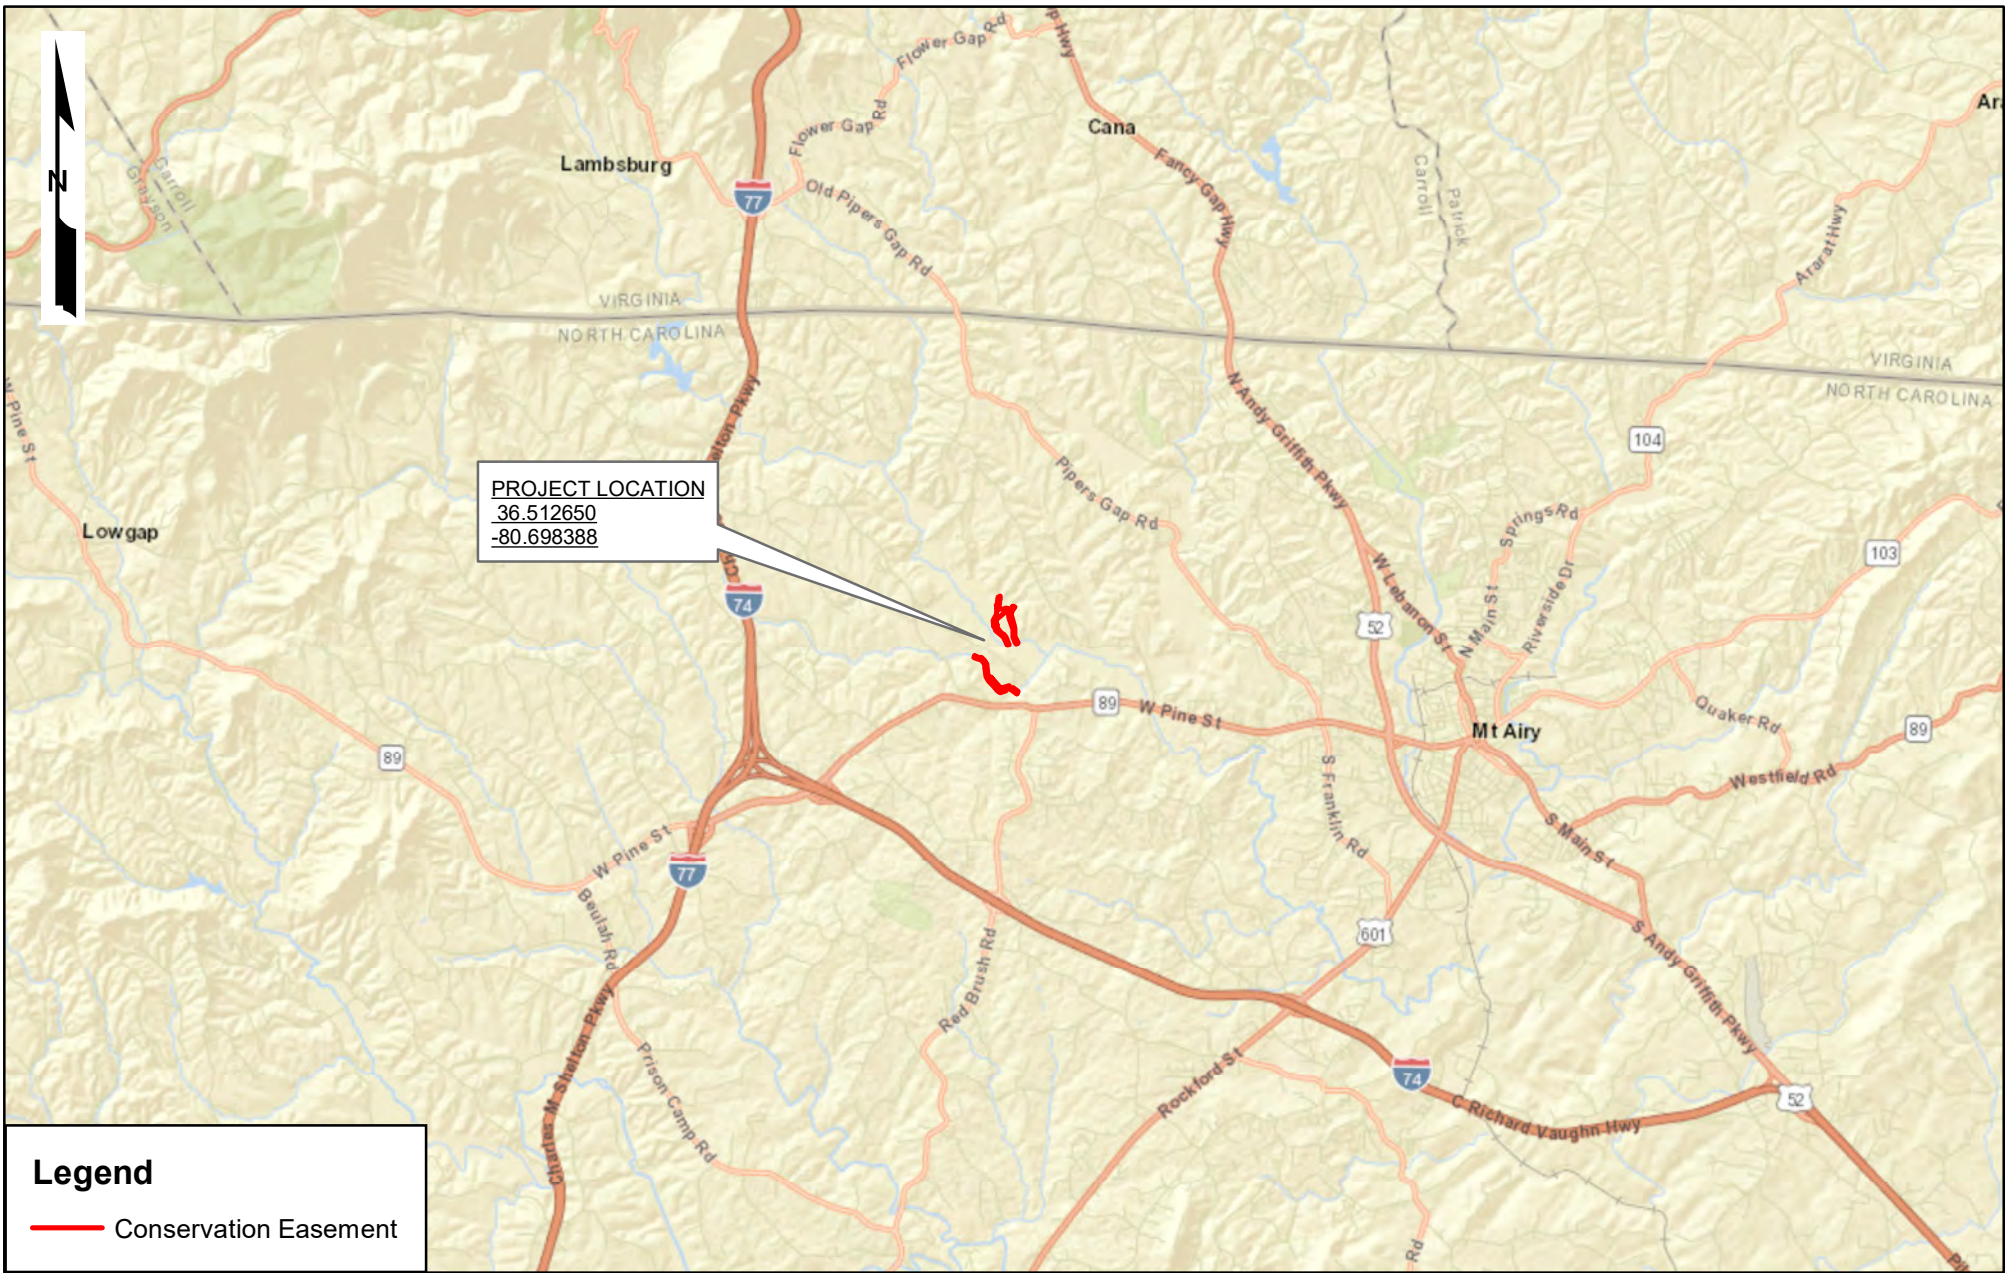

**Legend**

— Conservation Easement

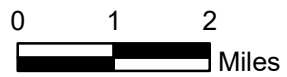


**STEWARTS CREEK TRIBUTARIES  
VICINITY MAP**

PREPARED FOR:  
NCDEQ  
DIVISION OF  
MITIGATION SERVICES

FIGURE 1


SURRY COUNTY, NC

PREPARED BY:  
ECOSYSTEM  
PLANNING &  
RESTORATION

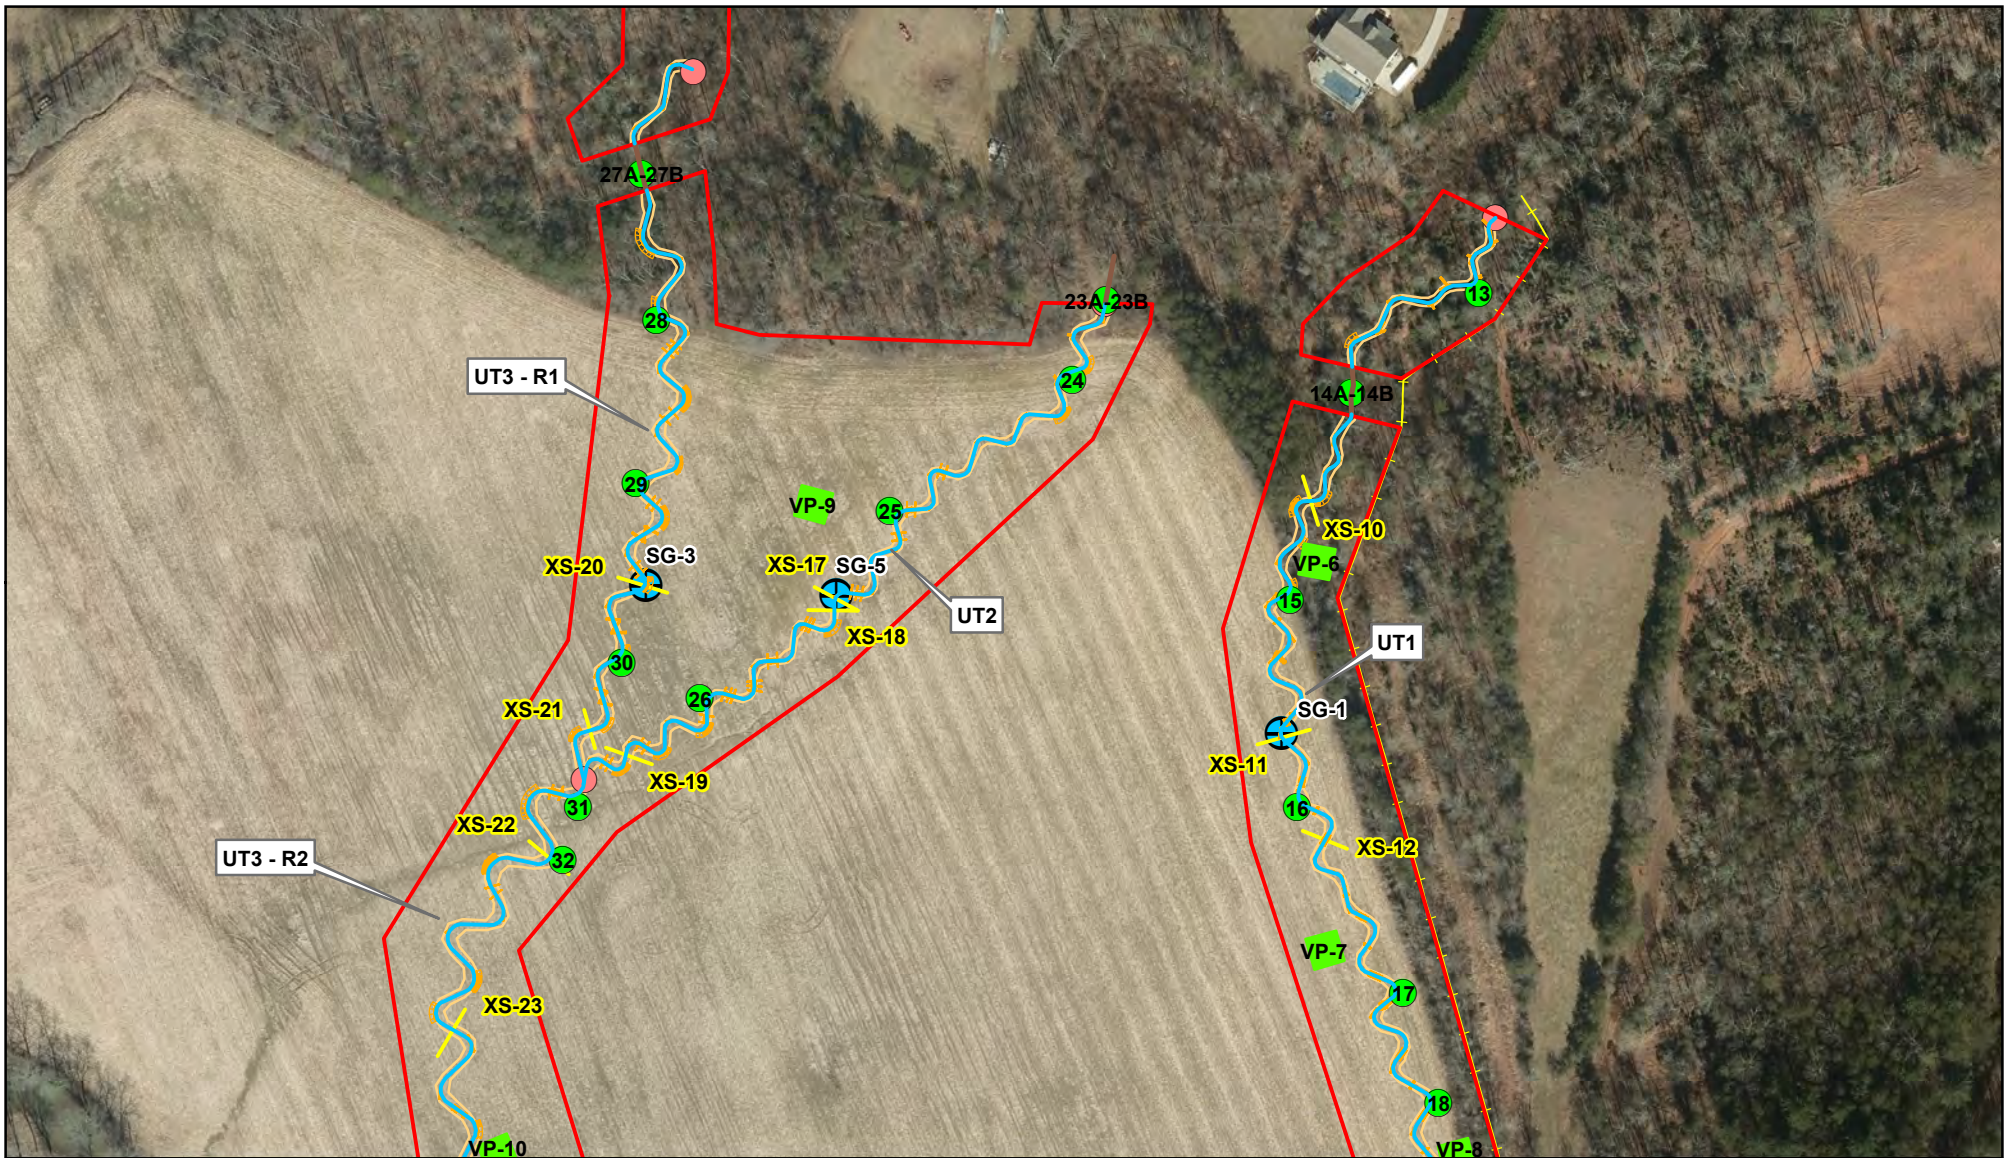

Streams - Enhancement	Conservation Easement	Photo Points	Veg Plots
Streams - Restoration	Structures	Stream Gauges	Reach Breaks
No Credit	Top of Bank	Cross Sections	Fence

NC OneMap Orthoimagery (2018)

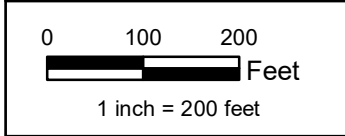

**STEWARTS CREEK TRIBUTARIES**  
**STREAM RESTORATION PROJECT**  
 CURRENT CONDITION PLAN VIEW: ASSET MAP  
 MYO: 2020




DMS PROJECT  
 ID# 100023  
 OCTOBER 2020

FIGURE 2A


SURRY COUNTY, NC



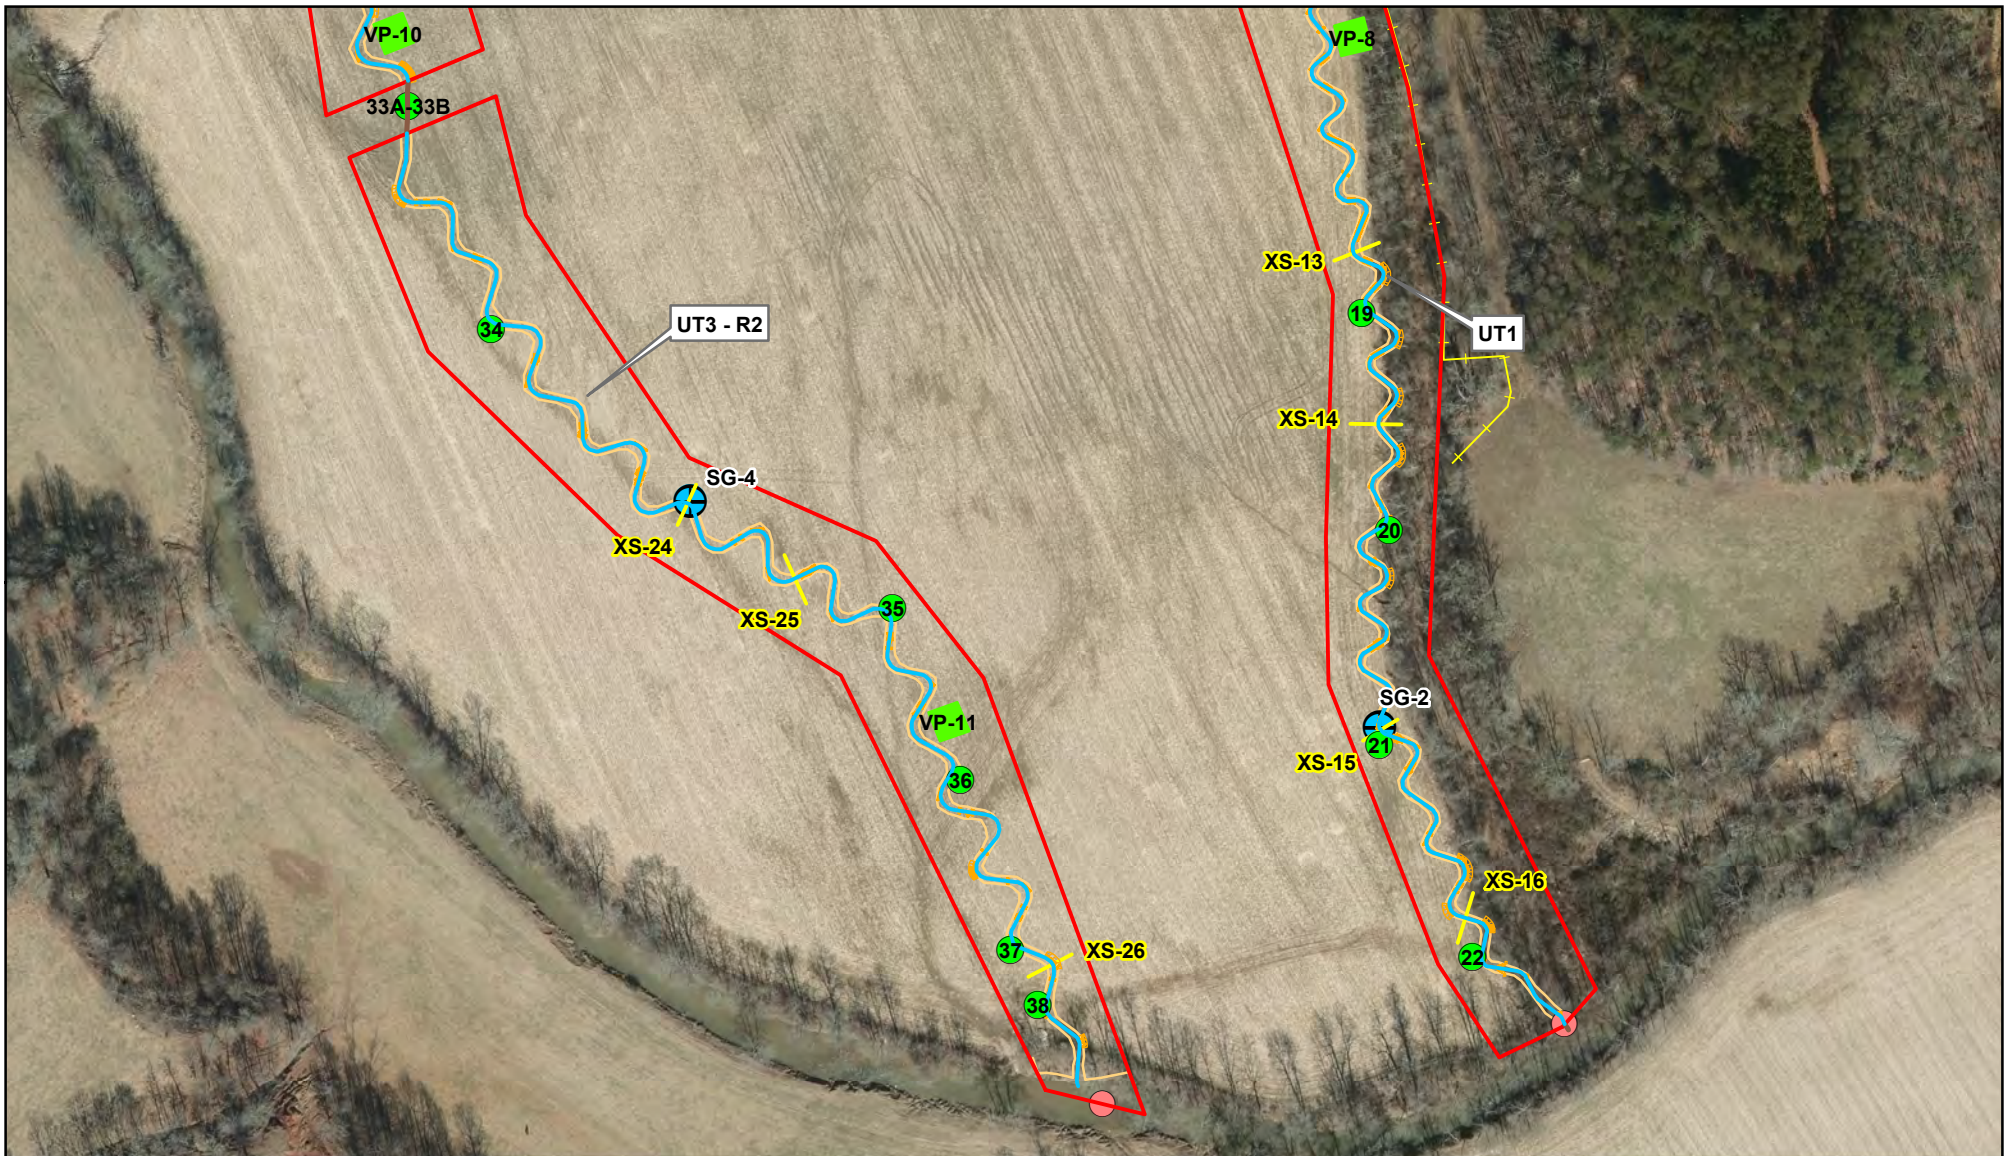

Streams - Enhancement	Conservation Easement	Photo Points	Veg Plots
Streams - Restoration	Structures	Stream Gauges	Reach Breaks
No Credit	Top of Bank	Cross Sections	Fence

NC OneMap Orthoimagery (2018)

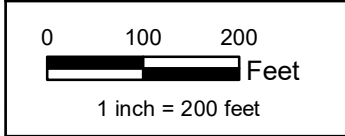

**STEWARTS CREEK TRIBUTARIES  
 STREAM RESTORATION PROJECT**  
 CURRENT CONDITION PLAN VIEW: ASSET MAP  
 MYO: 2020





DMS PROJECT  
 ID# 100023  
 OCTOBER 2020

FIGURE 2B


SURRY COUNTY, NC





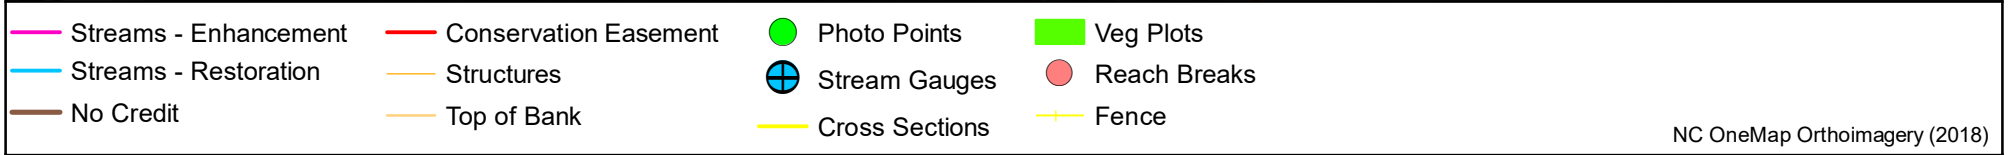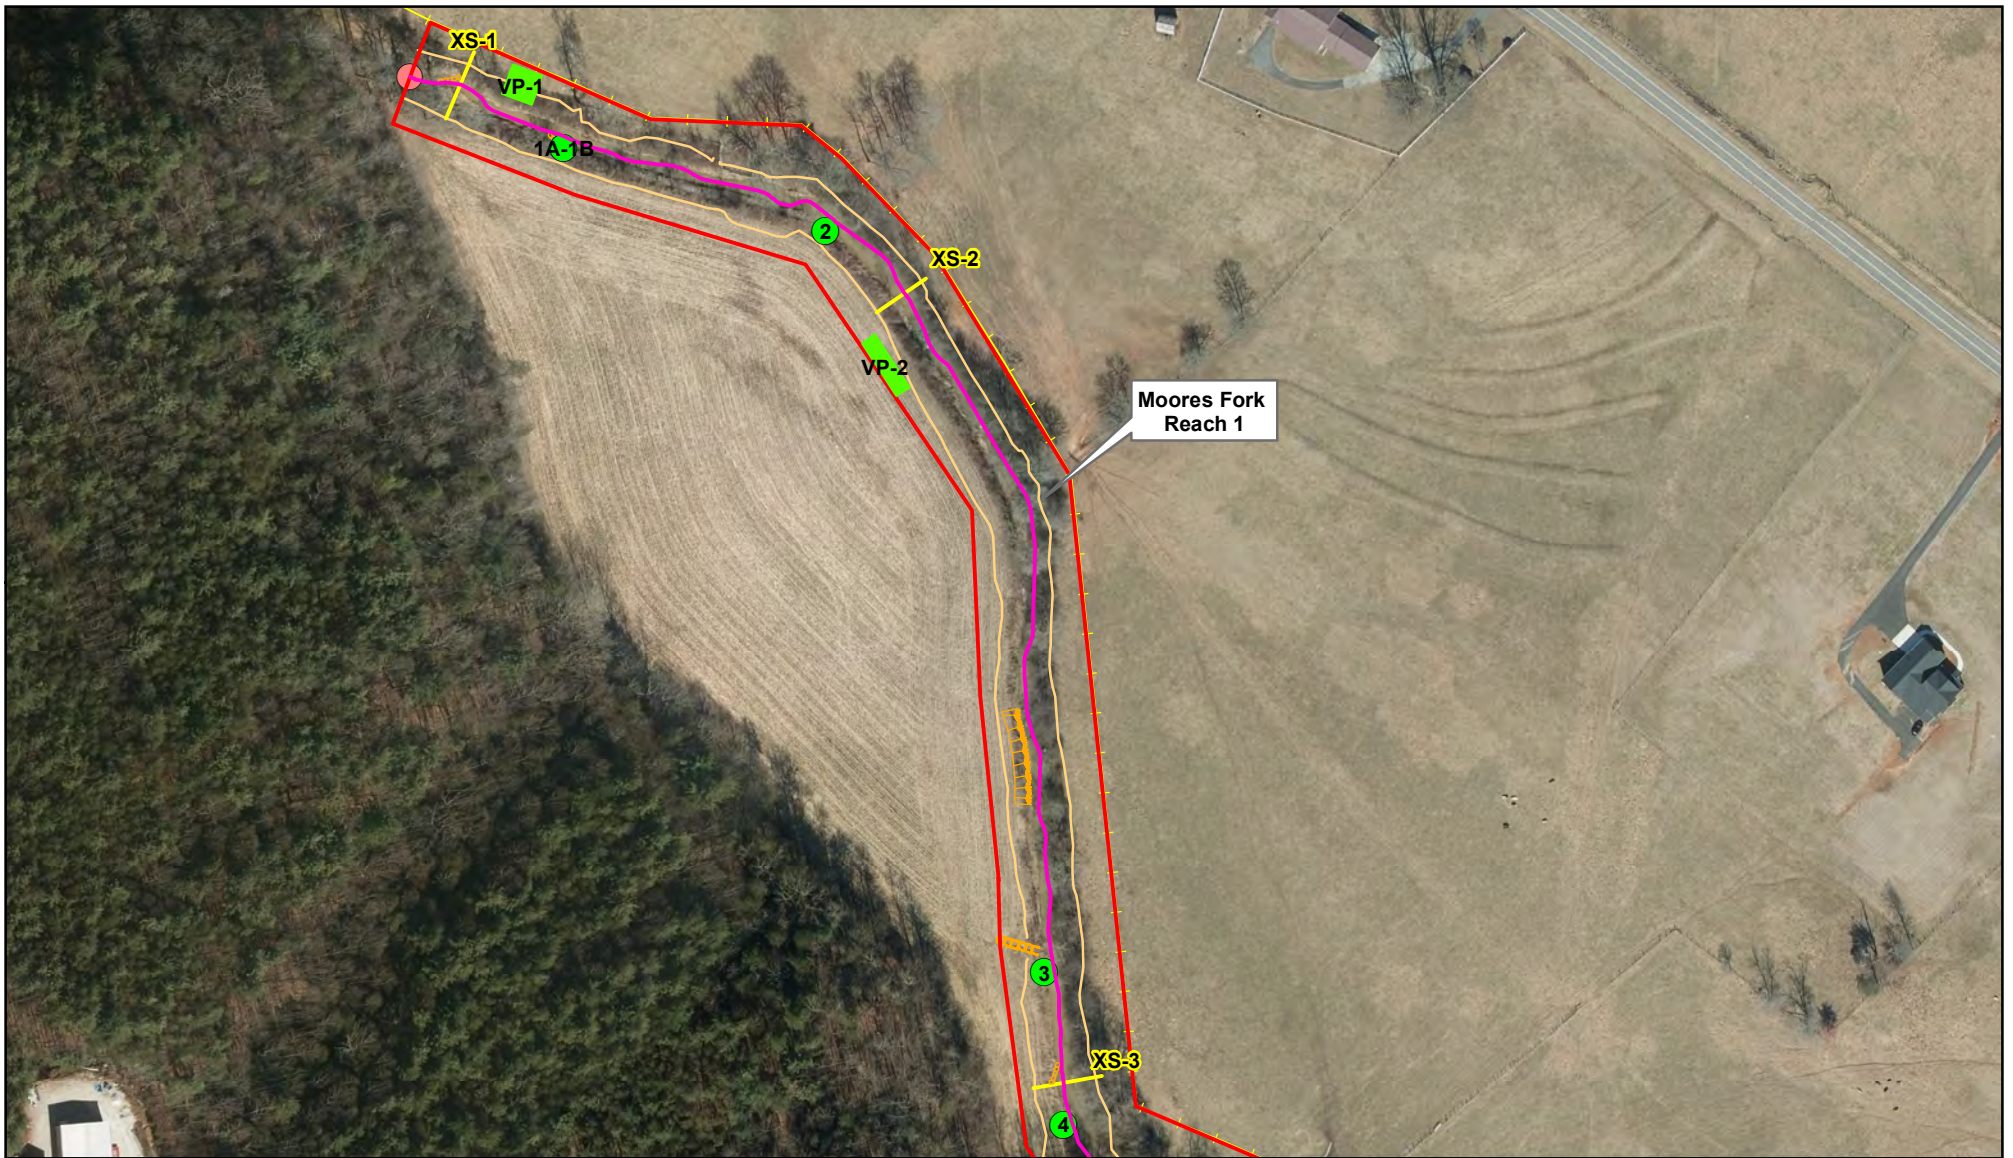

NC OneMap Orthoimagery (2018)

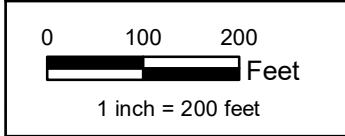

**STEWARTS CREEK TRIBUTARIES  
 STREAM RESTORATION PROJECT**  
 CURRENT CONDITION PLAN VIEW: ASSET MAP  
 MYO: 2020





DMS PROJECT  
 ID# 100023  
 OCTOBER 2020


FIGURE 2C

SURRY COUNTY, NC



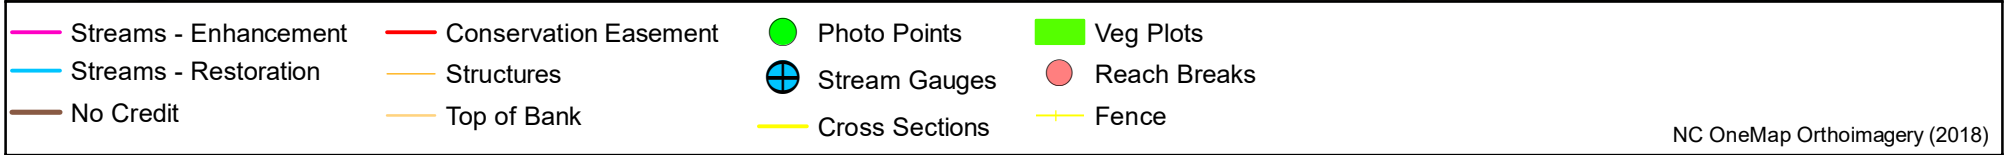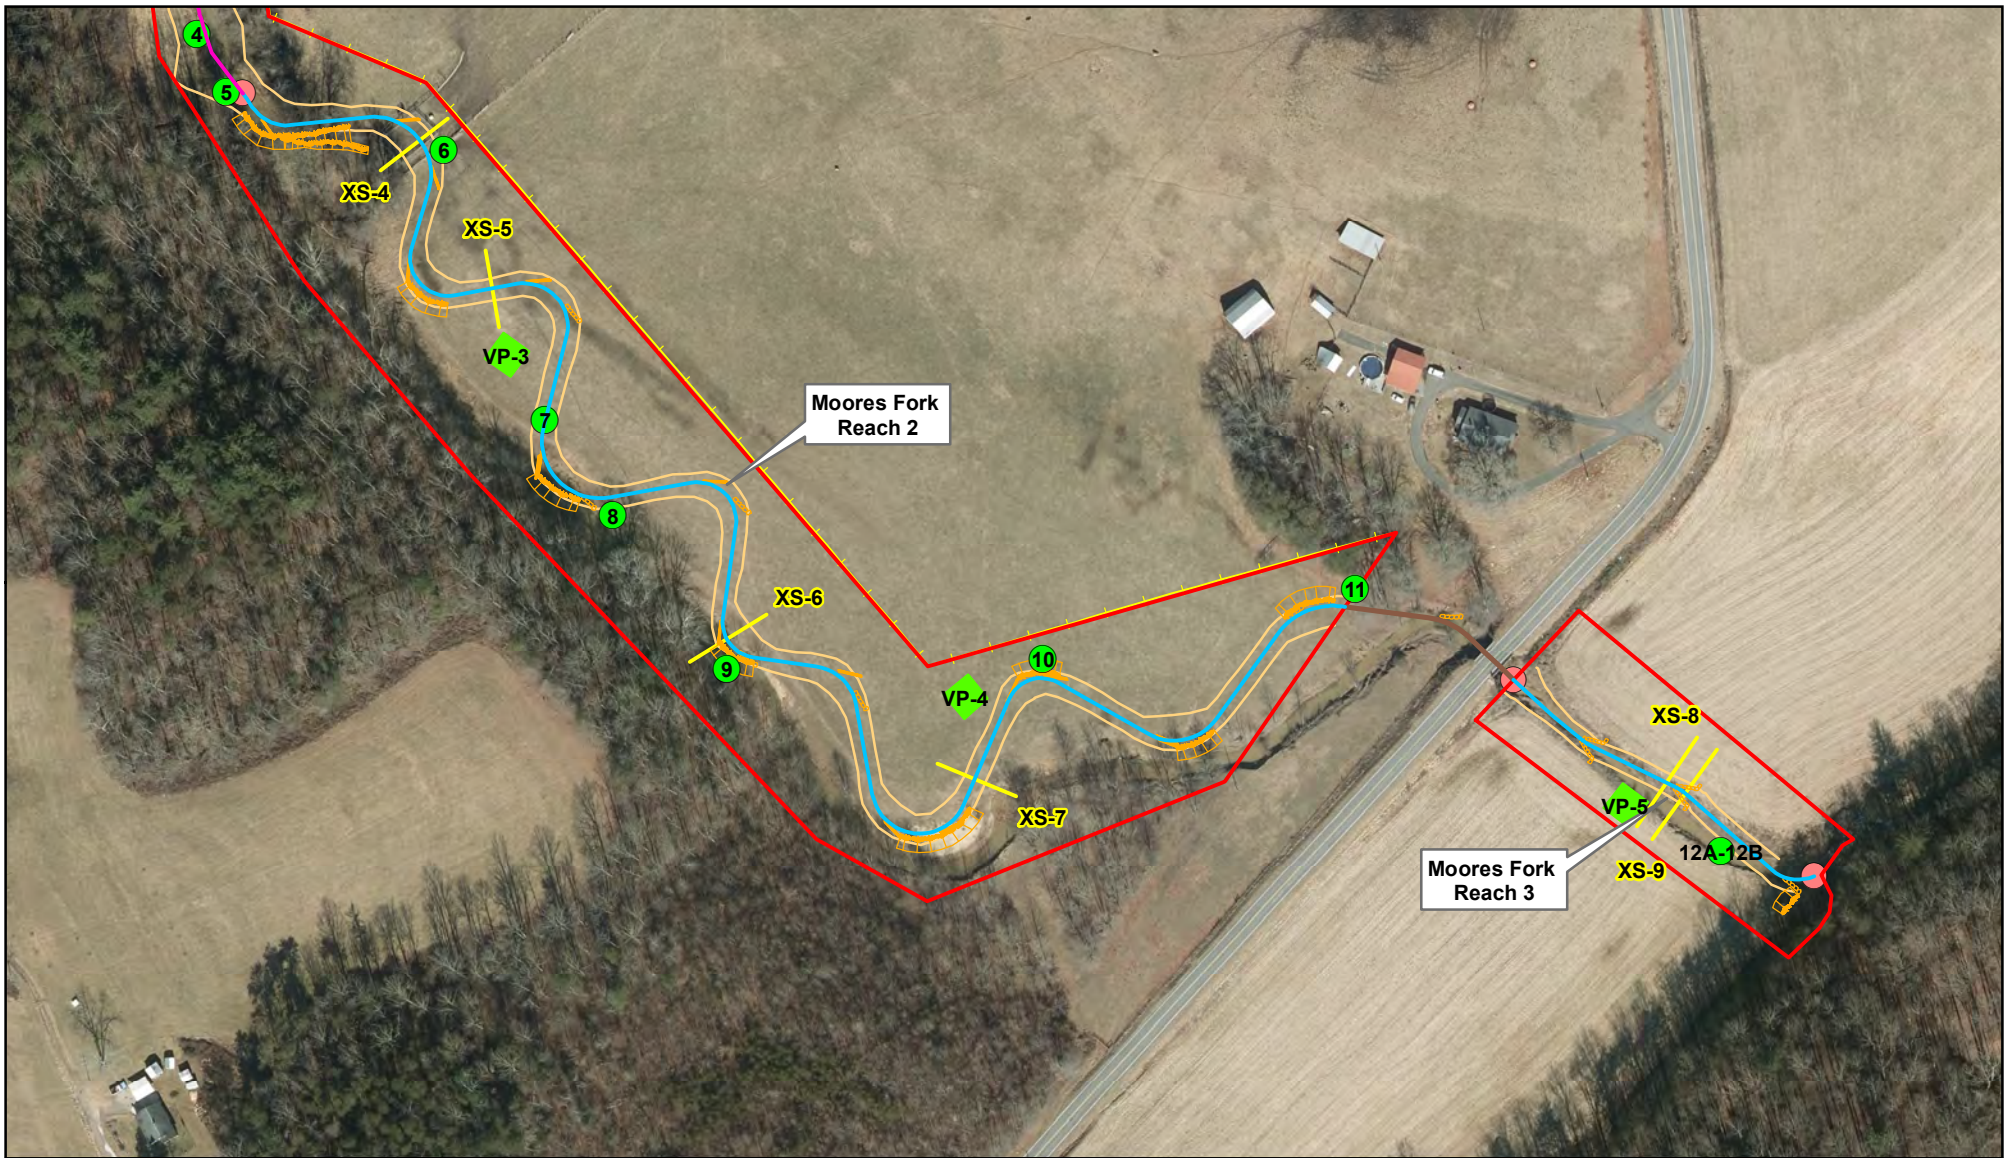

NC OneMap Orthoimagery (2018)

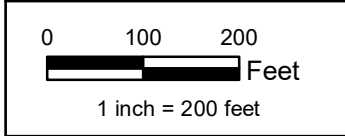

STEWARTS CREEK TRIBUTARIES  
 STREAM RESTORATION PROJECT  
 CURRENT CONDITION PLAN VIEW: ASSET MAP  
 MYO: 2020



DMS PROJECT  
 ID# 100023  
 OCTOBER 2020

FIGURE 2D

SURRY COUNTY, NC



**Stewarts Creek Tributaries Stream Restoration Project  
Baseline - Photo Log**



Photo Point 1A – Moores Fork Reach 1, Sta. 11+81  
Facing Upstream (6/11/2020)



Photo Point 1B – Moores Fork Reach 1, Sta. 11+81  
Facing Downstream (6/11/2020)



Photo Point 2 – Moores Fork Reach 1, Sta. 14+79  
Facing Downstream (6/11/2020)



Photo Point 3 – Moores Fork Reach 1, Sta. 23+37  
Facing Downstream (6/11/2020)



Photo Point 4 – Moores Fork Reach 1, Sta. 24+96  
Facing Upstream (6/11/2020)



Photo Point 5 – Moores Fork Reach 2, Sta. 25+61  
Facing Downstream (6/11/2020)

**Stewarts Creek Tributaries Stream Restoration Project  
Baseline - Photo Log**



Photo Point 6 – Moores Fork Reach 2, Sta. 27+97  
Facing Downstream (6/11/2020)



Photo Point 7 – Moores Fork Reach 2, Sta. 32+21  
Facing Upstream (6/11/2020)



Photo Point 8 – Moores Fork Reach 2, Sta. 33+48  
Facing Upstream (6/11/2020)



Photo Point 9 – Moores Fork Reach 2, Sta. 36+47  
Facing Upstream (6/11/2020)



Photo Point 10 – Moores Fork Reach 2, Sta. 41+77  
Facing Upstream (6/11/2020)



Photo Point 11A – Moores Fork Reach 2, Sta. 45+79  
Facing Upstream (6/11/2020)

## Stewarts Creek Tributaries Stream Restoration Project Baseline - Photo Log



Photo Point 11B – Moores Fork Reach 2, Sta. 45+79  
Facing Downstream (6/11/2020)



Photo Point 12A – Moores Fork Reach 3, Sta. 50+54  
Facing Upstream (6/11/2020)



Photo Point 12B – Moores Fork Reach 3, Sta. 50+54  
Facing Downstream (6/11/2020)



Photo Point 13 – UT1, Sta. 10+84  
Facing Upstream (6/11/2020)



Photo Point 14A – UT1, Sta. 12+91  
Facing Upstream (6/11/2020)



Photo Point 14B – UT1, Sta. 12+91  
Facing Downstream (6/11/2020)

## Stewarts Creek Tributaries Stream Restoration Project Baseline - Photo Log



Photo Point 15 – UT1, Sta. 15+52  
Facing Upstream (6/11/2020)



Photo Point 16 – UT1, Sta. 18+34  
Facing Upstream (6/11/2020)



Photo Point 17 – UT1, Sta. 21+12  
Facing Upstream (6/11/2020)



Photo Point 18 – UT1, Sta. 22+81  
Facing Upstream (6/11/2020)



Photo Point 19 – UT1, Sta. 27+39  
Facing Upstream (6/11/2020)



Photo Point 20 – UT1, Sta. 30+35  
Facing Upstream (6/11/2020)

**Stewarts Creek Tributaries Stream Restoration Project  
Baseline - Photo Log**



Photo Point 21 – UT1, Sta. 33+42  
Facing Upstream (6/11/2020)



Photo Point 22 – UT1, Sta. 36+73  
Facing Downstream (6/11/2020)



Photo Point 23A – UT2, Sta. 10+47  
Facing Upstream (6/11/2020)



Photo Point 23B – UT2, Sta. 10+47  
Facing Downstream (6/11/2020)



Photo Point 24 – UT2, Sta. 11+57  
Facing Upstream (6/11/2020)



Photo Point 25 – UT2, Sta. 14+65  
Facing Upstream (6/11/2020)

**Stewarts Creek Tributaries Stream Restoration Project  
Baseline - Photo Log**



Photo Point 26 – UT2, Sta. 18+32  
Facing Upstream (6/11/2020)



Photo Point 27A – UT3 Reach 1, Sta. 11+51  
Facing Upstream (6/11/2020)



Photo Point 27B – UT3 Reach 1, Sta. 11+51  
Facing Downstream (6/11/2020)



Photo Point 28 – UT3 Reach 1, Sta. 13+35  
Facing Upstream (6/11/2020)



Photo Point 29 – UT3 Reach 1, Sta. 15+88  
Facing Upstream (6/11/2020)



Photo Point 30 – UT3 Reach 1, Sta. 18+28  
Facing Upstream (6/11/2020)



## Stewarts Creek Tributaries Stream Restoration Project Baseline - Photo Log



Photo Point 31 – UT3 Reach 2, Sta. 20+10  
Facing Upstream (6/11/2020)



Photo Point 32 – UT3 Reach 2, Sta. 21+27  
Facing Upstream (6/11/2020)



Photo Point 33A – UT3 Reach 2, Sta. 27+44  
Facing Upstream (6/11/2020)



Photo Point 33B – UT3 Reach 2, Sta. 27+44  
Facing Downstream (6/11/2020)



Photo Point 34 – UT3 Reach 2, Sta. 30+47  
Facing Upstream (6/11/2020)



Photo Point 35 – UT3 Reach 2, Sta. 37+79  
Facing Upstream (6/11/2020)

## Stewarts Creek Tributaries Stream Restoration Project Baseline - Photo Log



Photo Point 36 – UT3 Reach 2, Sta. 40+06  
Facing Upstream (6/11/2020)



Photo Point 37 – UT3 Reach 2, Sta. 42+81  
Facing Upstream (6/11/2020)



Photo Point 38 – UT3 Reach 2, Sta. 43+70  
Facing Downstream (6/11/2020)

**Stewarts Creek Tributaries Stream Restoration Project  
Vegetation Photo Log**



Veg Plot 1 – E Corner (5/26/2020)



Veg Plot 2 – NW Corner (5/26/2020)



Veg Plot 3 – N Corner (6/11/2020)



Veg Plot 4 – S Corner (6/11/2020)



Veg Plot 5 – S Corner (6/11/2020)



Veg Plot 6 –SE Corner (6/11/2020)



Veg Plot 7 – SE Corner (6/11/2020)



Veg Plot 8 – SW Corner (6/11/2020)



Veg Plot 9 – SE Corner (6/11/2020)



Veg Plot 10 – N Corner (6/11/2020)



Veg Plot 11 – SW Corner (6/11/2020)

## Appendix C: Vegetation Plot Data

**Table 5. Vegetation Planting Information**

**Table 6. Riparian Buffer Vegetation Totals**

**Table 7. Stem Count by Plot**

**Table 5. Vegetation Planting Information**  
**Stewarts Creek Tributaries Stream Restoration Project (DMS No.100023)**

<b>Zone 1 - Livestake Planting (2.4 acres)</b>				
<b>Scientific Name</b>	<b>Common Name</b>	<b>% by Species</b>	<b>Approx. Stem Count</b>	
<i>Cornus amomum</i>	Silky Dogwood	40%	2722	
<i>Salix sericea</i>	Silky Willow	30%	2041	
<i>Salix nigra</i>	Black Willow	20%	1361	
<i>Sambucus canadensis</i>	Elderberry	10%	680	
	Total	100%	6804	
<b>Zone 2 - Riparian Vegetation (8'x8' spacing, 680 stems/acre)</b>				
<b>Scientific Name</b>	<b>Common Name</b>	<b>% by Species</b>	<b>Approx. Stem Count</b>	<b>Wetland Indicator Status</b>
<i>Betula nigra</i>	River Birch	15%	2224	FACW
<i>Carpinus caroliniana</i>	Ironwood	10%	1482	FAC
<i>Celtis laevigata</i>	Sugarberry	5%	741	FACW
<i>Diospyros virginiana</i>	Persimmon	10%	1482	FAC
<i>Fraxinus pennsylvanica</i>	Green Ash	5%	741	FACW
<i>Platanus occidentalis</i>	Sycamore	20%	2965	FACW
<i>Quercus nigra</i>	Water Oak	10%	1482	FAC
<i>Quercus phellos</i>	Willow Oak	15%	2224	FAC
<i>Ulmus americana</i>	American Elm	10%	1482	FACW
	Total	100%	14824	
<b>Zone 3 - Upland Vegetation (8'x8' spacing, 680 stems/acre)</b>				
<b>Scientific Name</b>	<b>Common Name</b>	<b>% by Species</b>	<b>Approx. Stem Count</b>	<b>Wetland Indicator Status</b>
<i>Carya glabra</i>	Pignut Hickory	10%	150	FACU
<i>Carya tomentosa</i>	Mockernut Hickory	10%	150	NI
<i>Cercis canadensis</i>	Redbud	5%	75	FACU
<i>Cornus florida</i>	Flowering Dogwood	5%	75	FACU
<i>Diospyros virginiana</i>	Persimmon	10%	150	FAC
<i>Ilex opaca</i>	American Holly	5%	75	FACU
<i>Juniperus virginiana</i>	Eastern Red Cedar	5%	75	FACU
<i>Liriodendron tulipifera</i>	Tulip Poplar	10%	150	FACU
<i>Oxydendrum arboreum</i>	Sourwood	5%	75	UPL
<i>Prunus serotina</i>	Black Cherry	5%	75	FACU
<i>Quercus alba</i>	White Oak	10%	150	FACU
<i>Quercus falcata</i>	Southern Red Oak	10%	150	FACU
<i>Quercus rubra</i>	Northern Red Oak	10%	150	FACU
	Total	100%	1496	

**Table 6. Riparian Buffer Vegetation Totals**

<b>Plot #</b>	<b>Total Stems per Acre</b>	<b>Success Criteria Met?</b>
1	728	Yes
2	769	Yes
3	364	Yes
4	688	Yes
5	486	Yes
6	688	Yes
7	688	Yes
8	607	Yes
9	567	Yes
10	526	Yes
11	567	Yes
<b>Project Avg</b>	<b>607</b>	<b>Yes</b>

**Table 7. Stem Count By Plot**  
**Stewarts Creek Tributaries Stream Restoration Project (DMS No.100023)**

Scientific Name	Common Name	Species Type	Current Plot Data (MY0 2020)																	
			VP-1			VP-2			VP-3			VP-4			VP-5			VP-6		
			Planted	Vol	Total	Planted	Vol	Total	Planted	Vol	Total	Planted	Vol	Total	Planted	Vol	Total	Planted	Vol	Total
<i>Betula nigra</i>	River Birch	Tree																		
<i>Carpinus caroliniana</i>	Ironwood	Tree																		
<i>Carya glabra</i>	Pignut Hickory	Tree																		
<i>Carya tomentosa</i>	Mockernut Hickory	Tree																		
<i>Celtis laevigata</i>	Sugarberry	Tree																		
<i>Cercis canadensis</i>	Redbud	Tree																		
<i>Cornus florida</i>	Flowering Dogwood	Tree																		
<i>Diospyros virginiana</i>	Persimmon	Tree																		
<i>Fraxinus pennsylvanica</i>	Green Ash	Tree																		
<i>Ilex opaca</i>	American Holly	Tree																		
<i>Juniperus virginiana</i>	Eastern Red Cedar	Tree																		
<i>Liriodendron tulipifera</i>	Tulip Poplar	Tree																		
<i>Oxydendrum arboreum</i>	Sourwood	Tree																		
<i>Platanus occidentalis</i>	Sycamore	Tree																		
<i>Prunus serotina</i>	Black Cherry	Tree																		
<i>Quercus alba</i>	White Oak	Tree																		
<i>Quercus falcata</i>	Southern Red Oak	Tree																		
<i>Quercus nigra</i>	Water Oak	Tree																		
<i>Quercus phellos</i>	Willow Oak	Tree																		
<i>Quercus rubra</i>	Northern Red Oak	Tree																		
<i>Ulmus americana</i>	American Elm	Tree																		
Initial count of bare root planted stems, species TBD			18	0	18	19	0	19	9	0	9	17	0	17	12	0	12	17	0	17
<b>Stem count</b>			18	0	18	19	0	19	9	0	9	17	0	17	12	0	12	17	0	17
<b>size (ares)</b>			1			1			1			1			1					
<b>size (ACRES)</b>			0.024710			0.024710			0.024710			0.024710			0.024710					
<b>Species count</b>			1	1	1	1	1	1	1	1	1	1	1	1	1	1	1	1	1	1
<b>Stems per ACRE</b>			728	0	728	769	0	769	364	0	364	688	0	688	486	0	486	688	0	688

**Color for Density**

Exceeds requirements by 10%
Exceeds requirements, but by less than 10%
Fails to meet requirements, by less than 10%
Fails to meet requirements by more than 10%
Volunteer Species Included in Total

**Table 7. Stem Count By Plot (continued)**  
**Stewarts Creek Tributaries Stream Restoration Project (DMS No.100023)**

Scientific Name	Common Name	Species Type	Current Plot Data (MY0 2020)															Annual Means			
			VP-7			VP-8			VP-9			VP-10			VP-11			MY0 (2020)			
			Planted	Vol	Total	Planted	Vol	Total	Planted	Vol	Total	Planted	Vol	Total	Planted	Vol	Total	Planted	Vol	Total	
<i>Betula nigra</i>	River Birch	Tree																0	0	0	
<i>Carpinus caroliniana</i>	Ironwood	Tree																0	0	0	
<i>Carya glabra</i>	Pignut Hickory	Tree																0	0	0	
<i>Carya tomentosa</i>	Mockernut Hickory	Tree																0	0	0	
<i>Celtis laevigata</i>	Sugarberry	Tree																0	0	0	
<i>Cercis canadensis</i>	Redbud	Tree																0	0	0	
<i>Cornus florida</i>	Flowering Dogwood	Tree																0	0	0	
<i>Diospyros virginiana</i>	Persimmon	Tree																0	0	0	
<i>Fraxinus pennsylvanica</i>	Green Ash	Tree																0	0	0	
<i>Ilex opaca</i>	American Holly	Tree																0	0	0	
<i>Juniperus virginiana</i>	Eastern Red Cedar	Tree																0	0	0	
<i>Liriodendron tulipifera</i>	Tulip Poplar	Tree																0	0	0	
<i>Oxydendrum arboreum</i>	Sourwood	Tree																0	0	0	
<i>Platanus occidentalis</i>	Sycamore	Tree																0	0	0	
<i>Prunus serotina</i>	Black Cherry	Tree																0	0	0	
<i>Quercus alba</i>	White Oak	Tree																0	0	0	
<i>Quercus falcata</i>	Southern Red Oak	Tree																0	0	0	
<i>Quercus nigra</i>	Water Oak	Tree																0	0	0	
<i>Quercus phellos</i>	Willow Oak	Tree																0	0	0	
<i>Quercus rubra</i>	Northern Red Oak	Tree																0	0	0	
<i>Ulmus americana</i>	American Elm	Tree																0	0	0	
Initial count of bare root planted stems, species TBD			17	0	17	15	0	15	14	0	14	13	0	13	14	0	14	165	0	165	
<b>Stem count</b>			17	0	17	15	0	15	14	0	14	13	0	13	14	0	14	165	0	165	
<b>size (ares)</b>			1			1			1			1			1			11			
<b>size (ACRES)</b>			0.024710			0.024710			0.024710			0.024710			0.024710			0.271813			
<b>Species count</b>			1	1	1	1	1	1	1	1	1	1	1	1	1	1	1	1	1	1	1
<b>Stems per ACRE</b>			688	0	688	607	0	607	567	0	567	526	0	526	567	0	567	607	0	607	

**Color for Density**

Exceeds requirements by 10%
Exceeds requirements, but by less than 10%
Fails to meet requirements, by less than 10%
Fails to meet requirements by more than 10%
Volunteer Species Included in Total



## Appendix D: Stream Measurements and Geomorphology Data

**Table 8. Baseline Stream Data Summary**

**Table 9. Monitoring Data – Dimensional Morphology Summary**

**Table 10. Monitoring Data – Stream Reach Data**

**Table 11. Structure Changes Summary**

**Longitudinal Profile**

**Cross Section Plots**

**Table 8a. Baseline Stream Data Summary**  
**Stewarts Creek Tributaries Stream Restoration Project (DMS No. 100023) - UT 1 (2742 feet)**

Parameter	Regional Curve			Pre-Existing Condition						Reference Reach(es) Data						Design			Monitoring Baseline								
	LL	UL	Eq.	Min	Mean	Med	Max	SD <sup>5</sup>	n	Min	Mean	Med	Max	SD <sup>5</sup>	n	Min	Med	Max	Min	Mean	Med	Max	SD <sup>5</sup>	n			
<b>Dimension and Substrate - Riffle Only</b>																											
Bankfull Width (ft)	4	7	4.6	4.3	5.0	5.1	5.7	0.6	4	5.6	6.1	-	6.6	-	-	5.6	6.1	6.6	6.0	6.6	7.0	7.0	-	3			
Floodprone Width (ft)				5.7	7.3	7.0	9.7	1.9	4	13.4	18.9	-	24.4	-	-	13.4	18.9	24.4	49.7	52.1	52.2	54.3	-	3			
Bankfull Mean Depth (ft)	0.5	0.8	0.7	0.5	0.5	0.5	0.6	0.1	4	0.4	0.6	-	0.7	-	-	0.4	0.5	0.7	0.6	0.6	0.6	0.6	-	3			
<sup>1</sup> Bankfull Max Depth (ft)				0.7	0.7	0.7	0.8	0.1	4	1.2	1.3	-	1.4	-	-	0.6	0.7	0.8	0.8	0.9	0.8	1.0	-	3			
Bankfull Cross Sectional Area (ft <sup>2</sup> )	3.1	4.8	3.1	2.0	2.6	2.7	3.1	0.5	4	2.2	3.4	-	4.6	-	-	3.2	3.2	3.2	3.7	3.8	3.9	3.9	-	3			
Width/Depth Ratio				8.5	10.0	9.7	12.0	1.5	4	10.0	12.0	-	14	-	-	10.0	12.0	14.0	9.6	11.6	12.5	12.6	-	3			
Entrenchment Ratio				1.2	1.5	1.4	1.9	0.3	4	2.2	3.1	-	4.0	-	-	2.2	3.1	4.0	7.1	7.9	7.5	9.1	-	3			
<sup>1</sup> Bank Height Ratio				5.6	8.4	7.7	12.5	3.1	4	1.0	1.0	-	1	-	-	1.0	1.05	1.1	1.0	1.0	1.0	1.1	-	3			
<b>Profile</b>																											
Riffle Length (ft)				5.0	26.2	20.7	94.4	23.0	13	Total riffle length 60-70% of reach length						5.0	29.0	41.0	5.3	15.1	14.3	39.1	6.2	56			
Riffle Slope (ft/ft)				0.012	0.044	0.038	0.084	0.025	13	-	-	-	-	-	-	0.009	0.024	0.075	0.008	0.037	0.034	0.086	0.019	56			
Pool Length (ft)				5.8	11.3	9.5	22.0	4.6	13	Total pool length 30-40% of reach length						3.0	11.0	16.0	7.4	21.2	20.9	39.1	8.0	56			
Pool Max depth (ft)				0.8	1.0	1.0	1.4	0.1	4	0.8	1.6	-	2.5	-	-	1.1	1.2	1.9	1.0	1.5	1.4	2.2	0.3	57			
Pool Spacing (ft)				9.6	24.00	20.3	59.9	12.7	25	18	33.5	-	49	-	-	18.0	33.5	49.0	19.0	38.4	40.0	71.3	8.8	72			
<b>Pattern</b>																											
Channel Beltwidth (ft)				6.2	16.9	16.5	34.1	7.5	18	18.3	27.5	-	36.6	-	-	18.3	27.5	36.6	12.7	28.4	30.4	37.0	6.5	67			
Radius of Curvature (ft)				5.3	11.1	12.3	18.3	3.6	20	12.2	16.8	-	21.4	-	-	12.2	16.8	21.4	9.3	14.8	14.3	21.3	2.1	69			
Rc:Bankfull width (ft/ft)				1.1	2.2	2.4	3.6	0.7	20	2.0	2.8	-	3.5	-	-	2.0	2.8	3.5	1.4	2.2	2.2	3.2	0.4	69			
Meander Wavelength (ft)				24.3	45.7	41.8	79.0	14.2	18	42.7	58.0	-	73.2	-	-	30.5	51.9	73.2	35.7	60.0	61.4	73.4	8.9	71			
Meander Width Ratio				4.8	9.1	8.3	15.7	14.2	18	3.0	4.5	-	6.0	-	-	3.0	4.5	6.0	1.9	4.3	4.6	5.6	1.5	67			
<b>Transport parameters</b>																											
Reach Shear Stress (competency) lb/ft <sup>2</sup>				0.66												0.56			0.65								
Max part size (mm) mobilized at bankfull				72												72			111								
Stream Power (transport capacity) lb/s				10												9			9								
<b>Additional Reach Parameters</b>																											
Rosgen Classification				G4->F4												C4			Cb4			C4					
Bankfull Velocity (fps)	1.0	10.8	5.8	3.2												2.5			2.1								
Bankfull Discharge (cfs)	4	40	18.1	8 to 16												8											
Valley length (ft)				1840												2158											
Channel Thalweg length (ft)				2373												2805			2805								
Sinuosity (ft)				1.29												1.2 to 1.4			1.3			1.3					
Water Surface Slope (Channel) (ft/ft)				0.021												-			0.018			0.018					
BF slope (ft/ft)				0.021												-			0.018			0.018					
<sup>3</sup> Bankfull Floodplain Area (acres)				0.310												-			0.9			0.9					
<sup>4</sup> % of Reach with Eroding Banks				80%												-											
Channel Stability or Habitat Metric				0.58												-											
Biological or Other				-												-											

Shaded cells indicate that these will typically not be filled in.

1 = The distributions for these parameters can include information from both the cross-section measurements and the longitudinal profile. 2 = For projects with a proximal USGS gauge in-line with the project reach (added bankfull verification - rare).

3. Utilizing XS measurement data produce an estimate of the bankfull floodplain area in acres, which should be the area from the top of bank to the toe of the terrace riser/slope.

4 = Proportion of reach exhibiting banks that are eroding based on the visual survey for comparison to monitoring data; 5. Of value/needed only if the n exceeds 3

**Table 8b. Baseline Stream Data Summary**  
**Stewarts Creek Tributaries Stream Restoration Project (DMS No. 100023) - UT 2 (1009 feet)**

Parameter	Regional Curve			Pre-Existing Condition						Reference Reach(es) Data						Design			Monitoring Baseline					
	LL	UL	Eq.	Min	Mean	Med	Max	SD <sup>5</sup>	n	Min	Mean	Med	Max	SD <sup>5</sup>	n	Min	Med	Max	Min	Mean	Med	Max	SD <sup>5</sup>	n
<b>Dimension and Substrate - Riffle Only</b>																								
Bankfull Width (ft)	4	7	3.8	2.5	3.5	3.5	4.5	-	2	4.7	5.1	-	5.5	-	-	4.7	5.1	5.5	5.5	5.8	5.8	6.1	-	2
Floodprone Width (ft)				6.5	9.3	9.3	12.0	-	2	11.2	15.8	-	20.4	-	-	11.2	15.8	20.4	50.8	51.4	51.4	52.0	-	2
Bankfull Mean Depth (ft)	0.5	0.8	0.6	0.5	0.7	0.7	0.9	-	2	0.3	0.5	-	0.6	-	-	0.3	0.4	0.6	0.4	0.5	0.5	0.5	-	2
<sup>1</sup> Bankfull Max Depth (ft)				0.7	0.9	0.9	1.0	-	2	1.1	1.8	-	2.4	-	-	0.5	0.6	0.7	0.7	0.7	0.7	0.7	-	2
Bankfull Cross Sectional Area (ft <sup>2</sup> )	2	3	2.2	2.1	2.2	2.2	2.3	-	2	1.4	2.4	-	3.3	-	-	11.2	15.8	20.4	2.4	2.8	2.8	3.1	-	2
Width/Depth Ratio				2.8	6.2	6.2	9.5	-	2	10.0	12.0	-	14	-	-	10.0	12.0	14.0	12.0	12.2	12.2	12.5	-	2
Entrenchment Ratio				1.5	3.2	3.2	4.8	-	2	2.2	3.1	-	4.0	-	-	2.2	3.1	4.0	8.3	8.9	8.9	9.5	-	2
<sup>1</sup> Bank Height Ratio				4.0	7.5	7.5	10.9	-	2	1.0	1.0	-	1.0	-	-	1.0	1.0	1.1	1.0	1.1	1.1	1.1	-	2
<b>Profile</b>																								
Riffle Length (ft)				6.6	19.3	14.0	35.9	11.8	7	Total riffle length 60-70% of reach length						22.0	25.0	32.0	5.0	16.4	18.0	27.1	6.0	25
Riffle Slope (ft/ft)				0.015	0.027	0.023	0.047	0.011	7	-	-	-	-	-	-	0.011	0.027	0.045	0.02	0.045	0.043	0.083	0.017	25
Pool Length (ft)				7.1	10.6	8.5	20.3	4.7	8	Total pool length 30-40% of reach length						6.0	10.0	21.0	5.1	14.5	14.3	21.9	4.2	26
Pool Max depth (ft)				0.7	0.8	0.8	1.5	-	2	0.6	1.4	-	2.1	-	-	0.9	1.0	1.6	0.8	1.2	1.1	1.8	0.2	26
Pool Spacing (ft)				13.3	23.6	18.9	44.8	10.3	15	20.4	28.1	-	35.7	-	-	15.3	28.1	40.8	24.9	36.0	35.0	42.0	2.8	27
<b>Pattern</b>																								
Channel Beltwidth (ft)				4.8	7.9	7.3	12.3	2.2	15	15.3	23.0	-	30.6	-	-	15.3	23.0	30.6	23.2	27.2	27.5	32.6	2.5	27
Radius of Curvature (ft)				4.8	8.0	7.8	13.8	2.1	16	10.2	14.0	-	17.9	-	-	10.2	14.1	17.9	10.6	12.7	12.4	15.9	1.7	28
Rc:Bankfull width (ft/ft)				1.4	2.3	2.2	3.9	0.6	16	2.0	2.8	-	3.5	-	-	2.0	2.8	3.5	1.8	2.2	2.1	2.7	0.3	28
Meander Wavelength (ft)				13.6	37.4	37.0	68.3	18.7	15	35.7	48.5	-	61.2	-	-	25.5	43.4	61.2	40.4	54.4	52.9	92.0	9.2	28
Meander Width Ratio				3.9	10.7	10.6	19.5	18.7	15	3.0	4.5	-	6.0	-	-	3.0	4.5	6.0	4.0	4.7	4.7	5.6	1.5	27
<b>Transport parameters</b>																								
Reach Shear Stress (competency) lb/ft <sup>2</sup>							1.1									0.5						0.62		
Max part size (mm) mobilized at bankfull							67									67						107		
Stream Power (transport capacity) lb/s							13									10						10		
<b>Additional Reach Parameters</b>																								
Rosgen Classification				Channelized E4						Cb						Cb4			Cb4					
Bankfull Velocity (fps)	1.0	10.8	5.9	3.7												3.6			2.9					
Bankfull Discharge (cfs)	4	40	13.0	8												8								
Valley length (ft)				374						-						1358								
Channel Thalweg length (ft)				397						-						1060			1060					
Sinuosity (ft)				1.06						1.2 to 1.4						1.34			1.3					
Water Surface Slope (Channel) (ft/ft)				0.026						-						0.022			0.0208					
BF slope (ft/ft)				0.026						-						0.022			0.0208					
<sup>3</sup> Bankfull Floodplain Area (acres)				0.1						-						0.5			0.5					
<sup>4</sup> % of Reach with Eroding Banks				70%						-														
Channel Stability or Habitat Metric				0.24						-														
Biological or Other				-						-														

Shaded cells indicate that these will typically not be filled in.

1 = The distributions for these parameters can include information from both the cross-section measurements and the longitudinal profile. 2 = For projects with a proximal USGS gauge in-line with the project reach (added bankfull verification - rare).

3. Utilizing XS measurement data produce an estimate of the bankfull floodplain area in acres, which should be the area from the top of bank to the toe of the terrace riser/slope.

4 = Proportion of reach exhibiting banks that are eroding based on the visual survey for comparison to monitoring data; 5. Of value/needed only if the n exceeds 3

**Table 8c. Baseline Stream Data Summary**  
**Stewarts Creek Tributaries Stream Restoration Project (DMS No. 100023) - UT 3 R1 (994 feet)**

Parameter	Regional Curve			Pre-Existing Condition						Reference Reach(es) Data						Design			Monitoring Baseline					
	LL	UL	Eq.	Min	Mean	Med	Max	SD <sup>5</sup>	n	Min	Mean	Med	Max	SD <sup>5</sup>	n	Min	Med	Max	Min	Mean	Med	Max	SD <sup>5</sup>	n
<b>Dimension and Substrate - Riffle Only</b>																								
Bankfull Width (ft)	4	7	4.6	4.1	4.9	4.9	5.8	-	3	4.7	5.1	-	5.5	-	-	5.6	6.1	6.6	5.9	5.9	5.9	5.9	-	1
Floodprone Width (ft)				5.8	11.4	7.6	20.7	-	3	11.2	15.8	-	20.4	-	-	13.4	18.9	24.4	41.6	41.6	41.6	41.6	-	1
Bankfull Mean Depth (ft)	0.5	0.8	0.7	0.4	0.6	0.7	0.7	-	3	0.3	0.5	-	0.6	-	-	0.4	0.5	0.7	0.5	0.5	0.5	0.5	-	1
<sup>1</sup> Bankfull Max Depth (ft)				0.6	1.0	1.0	1.4	-	3	1.1	1.8	-	2.4	-	-	0.6	0.7	0.8	0.7	0.7	0.7	0.7	-	1
Bankfull Cross Sectional Area (ft <sup>2</sup> )	3.1	4.8	3.1	2.3	3.0	2.9	3.7	-	3	1.4	2.4	-	3.3	-	-	3.2	3.2	3.2	3.2	3.2	3.2	3.2	-	1
Width/Depth Ratio				5.9	9.0	6.6	14.4	-	3	10.0	12.0	-	14	-	-	10.0	12.0	14.0	11.1	11.1	11.1	11.1	-	1
Entrenchment Ratio				1.0	2.5	1.6	5.0	-	3	2.2	3.1	-	4.0	-	-	2.2	3.1	4.0	7.1	7.1	7.1	7.1	-	1
<sup>1</sup> Bank Height Ratio				2.7	4.2	4.0	5.8	-	3	1.0	1.0	-	1	-	-	1.0	1.05	1.1	1.1	1.1	1.1	1.1	-	1
<b>Profile</b>																								
Riffle Length (ft)				9.1	34.4	32.4	89.8	25.6	10	Total riffle length 60-70% of reach length						11.0	31.0	46.0	6.4	16.6	14.7	32.3	8.1	22
Riffle Slope (ft/ft)				0.001	0.029	0.030	0.051	0.015	10	-	-	-	-	-	-	0.016	0.027	0.064	0.020	0.047	0.044	0.089	0.018	22
Pool Length (ft)				7.7	17.9	16.3	29.8	7.5	10	Total pool length 30-40% of reach length						7.0	11.0	18.0	5.0	13.6	13.1	25.6	5.3	23
Pool Max depth (ft)				0.9	1.0	1.0	1.0	-	3	0.6	1.4	-	2.1	-	-	1.1	1.2	1.9	0.8	1.3	1.3	1.7	0.3	23
Pool Spacing (ft)				14.5	27.2	22.8	55.6	12.2	23	20.4	28.1	-	35.7	-	-	18.0	33.5	49.0	33.0	45.1	44.0	56.0	6.1	18
<b>Pattern</b>																								
Channel Beltwidth (ft)				6.0	12.8	8.7	37.0	8.6	21	15.3	23.0	-	30.6	-	-	18.3	27.5	36.6	16.4	31.0	32.4	39.3	5.5	20
Radius of Curvature (ft)				5.7	11.0	11.7	22.7	4.1	27	10.2	14.0	-	17.9	-	-	12.2	16.8	21.4	12.4	15.0	14.9	20.9	2.2	21
Rc:Bankfull width (ft/ft)				1.2	2.2	2.4	4.6	0.8	27	2.0	2.8	-	3.5	-	-	2.0	2.8	3.5	2.1	2.6	2.5	3.6	0.4	21
Meander Wavelength (ft)				16.7	34.9	31.7	68.3	14.7	23	35.7	48.5	-	61.2	-	-	30.5	51.9	73.2	57.6	73.3	70.0	117.0	14.3	20
Meander Width Ratio				3.4	7.1	6.4	13.8	14.7	23	3.0	4.5	-	6.0	-	-	3.0	4.5	6.0	2.8	5.3	5.5	6.7	2.3	20
<b>Transport parameters</b>																								
Reach Shear Stress (competency) lb/ft <sup>2</sup>				0.58												0.62			0.69					
Max part size (mm) mobilized at bankfull				62												62			116					
Stream Power (transport capacity) lb/s				9												11			12					
<b>Additional Reach Parameters</b>																								
Rosgen Classification				F4						Cb						Cb4			Cb4					
Bankfull Velocity (fps)	1.0	10.8	4.2	3												2.8			2.9					
Bankfull Discharge (cfs)	4	40	13.0	9												9								
Valley length (ft)				1385												802								
Channel Thalweg length (ft)				1814												994			994					
Sinuosity (ft)				1.31						1.2 to 1.4						1.24			1.2					
Water Surface Slope (Channel) (ft/ft)				0.016												0.02			0.0209					
BF slope (ft/ft)				0.016												0.02			0.0209					
<sup>3</sup> Bankfull Floodplain Area (acres)				0.4												0.3			0.3					
<sup>4</sup> % of Reach with Eroding Banks				60%																				
Channel Stability or Habitat Metric				0.55																				
Biological or Other				-																				

Shaded cells indicate that these will typically not be filled in.

1 = The distributions for these parameters can include information from both the cross-section measurements and the longitudinal profile. 2 = For projects with a proximal USGS gauge in-line with the project reach (added bankfull verification - rare).

3. Utilizing XS measurement data produce an estimate of the bankfull floodplain area in acres, which should be the area from the top of bank to the toe of the terrace riser/slope.

4 = Proportion of reach exhibiting banks that are eroding based on the visual survey for comparison to monitoring data; 5. Of value/needed only if the n exceeds 3

**Table 8d. Baseline Stream Data Summary**  
**Stewarts Creek Tributaries Stream Restoration Project (DMS No. 100023) - UT 3 R2 (2421 feet)**

Parameter	Regional Curve			Pre-Existing Condition						Reference Reach(es) Data						Design			Monitoring Baseline																	
	LL	UL	Eq.	Min	Mean	Med	Max	SD <sup>5</sup>	n	Min	Mean	Med	Max	SD <sup>5</sup>	n	Min	Med	Max	Min	Mean	Med	Max	SD <sup>5</sup>	n												
<b>Dimension and Substrate - Riffle Only</b>																																				
Bankfull Width (ft)	5	9	5.7	No Existing Stream						4.7	5.1	-	5.5	-	-	6.8	7.3	7.8	7.2	7.7	7.7	8.2	-	2												
Floodprone Width (ft)										11.2	15.8	-	20.4	-	-	16.1	22.6	29.2	55.6	56.0	56.0	56.3	-	2												
Bankfull Mean Depth (ft)	0.8	1.2	0.9							0.3	0.5	-	0.6	-	-	0.5	0.6	0.8	0.6	0.6	0.6	0.6	-	2												
<sup>1</sup> Bankfull Max Depth (ft)										1.1	1.8	-	2.4	-	-	0.7	0.8	0.9	0.9	1.0	1.0	1.0	-	2												
Bankfull Cross Sectional Area (ft <sup>2</sup> )	4	5	4.4							1.4	2.4	-	3.3	-	-	4.4	4.4	4.4	4.5	4.7	4.7	4.9	-	2												
Width/Depth Ratio										10.0	12.0	-	14	-	-	10.0	12.0	14.0	11.5	12.7	12.7	13.9	-	2												
Entrenchment Ratio										2.2	3.1	-	4.0	-	-	2.2	3.1	4.0	6.9	7.3	7.3	7.7	-	2												
<sup>1</sup> Bank Height Ratio										1.0	1.0	-	1	-	-	1.0	1.05	1.1	1.0	1.1	1.1	1.1	-	2												
<b>Profile</b>																																				
Riffle Length (ft)				No Existing Stream						Total riffle length 60-70% of reach length						12.0	41.0	57.0	5.0	18.1	16.2	39.3	9.8	40												
Riffle Slope (ft/ft)										-						-						0.004	0.01	0.018	0.004	0.022	0.018	0.063	0.016	40						
Pool Length (ft)										No Existing Stream						Total pool length 30-40% of reach length						8.0	15.0	22.0	7.9	17.4	16.2	38.3	6.4	41						
Pool Max depth (ft)																0.6						1.4						1.3	1.4	2.2	1.2	1.6	1.6	2.5	0.2	41
Pool Spacing (ft)																20.4						28.1						29.2	86.0	58.4	43.0	55.6	56.0	70.0	6.0	43
<b>Pattern</b>																																				
Channel Beltwidth (ft)				No Existing Stream						15.3	23.0	-	30.6	-	-	25.6	42	58.4	26.5	42.1	42.1	56.6	6.9	43												
Radius of Curvature (ft)										10.2						14.0						14.6	20.1	25.6	15.7	18.6	19.0	23.0	1.7	45						
Rc:Bankfull width (ft/ft)										2.0						2.8						2.0	2.8	3.5	2.0	2.4	2.5	3.0	0.3	45						
Meander Wavelength (ft)										35.7						48.5						51.1	69.4	87.6	66.9	81.9	81.2	130.3	10.9	44						
Meander Width Ratio										3.0						4.5						3.5	5.8	8.0	3.4	5.4	5.5	7.3	1.8	43						
<b>Transport parameters</b>																																				
Reach Shear Stress (competency) lb/ft <sup>2</sup>				No Existing Stream												0.25			0.24																	
Max part size (mm) mobilized at bankfull																						62			54											
Stream Power (transport capacity) lb/s																						7			7											
<b>Additional Reach Parameters</b>																																				
Rosgen Classification				No Existing Stream						C4						C4			C4																	
Bankfull Velocity (fps)	2.3	22.5	5.9																			3.9			3.6											
Bankfull Discharge (cfs)	9	90	25.8																			17														
Valley length (ft)																						-			1802											
Channel Thalweg length (ft)																						-			2523											
Sinuosity (ft)																1.2 to 1.4						1.4			1.4											
Water Surface Slope (Channel) (ft/ft)																						-			0.0067											
BF slope (ft/ft)																						-			0.0067											
<sup>3</sup> Bankfull Floodplain Area (acres)																						-			0.9											
<sup>4</sup> % of Reach with Eroding Banks																						-														
Channel Stability or Habitat Metric																						-														
Biological or Other																						-														

Shaded cells indicate that these will typically not be filled in.

1 = The distributions for these parameters can include information from both the cross-section measurements and the longitudinal profile. 2 = For projects with a proximal USGS gauge in-line with the project reach (added bankfull verification - rare).

3. Utilizing XS measurement data produce an estimate of the bankfull floodplain area in acres, which should be the area from the top of bank to the toe of the terrace riser/slope.

4 = Proportion of reach exhibiting banks that are eroding based on the visual survey for comparison to monitoring data; 5. Of value/needed only if the n exceeds 3

**Table 8e. Baseline Stream Data Summary**  
**Stewarts Creek Tributaries Stream Restoration Project (DMS No. 100023) - Moores Fork R1 (1573 feet)**

Parameter	Regional Curve			Pre-Existing Condition						Reference Reach(es) Data						Design			Monitoring Baseline					
	LL	UL	Eq.	Min	Mean	Med	Max	SD <sup>5</sup>	n	Min	Mean	Med	Max	SD <sup>5</sup>	n	Min	Med	Max	Min	Mean	Med	Max	SD <sup>5</sup>	n
<b>Dimension and Substrate - Riffle Only</b>																								
Bankfull Width (ft)	20	30	22.5	30.7	30.7	30.7	30.7	-	1	21.9	23.9	-	25.9	-	-	21.9	23.9	25.9	33.2	33.2	33.2	33.2	-	1
Floodprone Width (ft)				35.0	35.0	35.0	35.0	-	1	52.6	74.1	-	95.6	-	-	52.6	74.1	95.6	43.0	43.0	43.0	43.0	-	1
Bankfull Mean Depth (ft)	1.8	3	2.4	1.7	1.7	1.7	1.7	-	1	1.6	2.1	-	2.6	-	-	1.6	2.1	2.6	1.8	1.8	1.8	1.8	-	1
<sup>1</sup> Bankfull Max Depth (ft)				2.7	2.7	2.7	2.7	-	1	1.2	1.3	-	1.4	-	-	2.3	3.0	3.8	2.4	2.4	2.4	2.4	-	1
Bankfull Cross Sectional Area (ft <sup>2</sup> )	40	50	47.8	51.6	51.6	51.6	51.6	-	1	35.0	51.2	-	67.3	-	-	47.7	47.7	47.7	61.1	61.1	61.1	61.1	-	1
Width/Depth Ratio				18.2	18.2	18.2	18.2	-	1	10.0	12.0	-	14	-	-	10.0	12.0	14.0	18.1	18.1	18.1	18.1	-	1
Entrenchment Ratio				1.1	1.1	1.1	1.1	-	1	2.2	3.1	-	4.0	-	-	2.2	3.1	4.0	1.3	1.3	1.3	1.3	-	1
<sup>1</sup> Bank Height Ratio				3.2	3.2	3.2	3.2	-	1	1.0	1.0	-	1	-	-	1.0	1.05	1.1	1.2	1.2	1.2	1.2	-	1
<b>Profile</b>																								
Riffle Length (ft)				20.3	48.1	32.0	126.8	36.5	8	Total riffle length 60-70% of reach length						20.3	32.0	126.8	79	108.3	89	190	38.77	7
Riffle Slope (ft/ft)				0.002	0.013	0.013	0.025	0.007	8	-	-	-	-	-	-	0.002	0.013	0.025	0.002	0.005	0.004	0.009	0.002	7
Pool Length (ft)				30.9	61.8	55.4	98.0	20.8	8	Total pool length 30-40% of reach length						30.9	55.4	98.0	40	94.57	97	150	30.77	7
Pool Max depth (ft)				0.8	3.4	3.4	1.4	-	1	3.2	6.2	-	9.1	-	-	0.8	3.4	1.4	5.11	6.14	6.17	7.28	0.792	7
Pool Spacing (ft)				16.3	76.5	64.6	199.2	41.0	21	95.6	131.5	-	167.3	-	-	16.3	64.6	199.2	111	206.1	187.2	330.6	71.09	6
<b>Pattern</b>																								
Channel Beltwidth (ft)				31.2	37.9	35.5	85.1	8.1	44	83.7	137.4	-	191.2	-	-	31.2	35.5	85.1	31.2	37.9	35.5	85.1	8.1	44
Radius of Curvature (ft)				18.1	32.0	26.6	85.1	15.9	47	47.8	65.7	-	83.7	-	-	18.1	26.6	85.1	18.1	32.0	26.6	85.1	15.9	47
Rc:Bankfull width (ft/ft)				0.6	1.0	0.9	2.8	0.5	47	2.0	2.8	-	3.5	-	-	0.6	0.9	2.8	0.6	0.96	0.9	2.8	0.5	47
Meander Wavelength (ft)				14.8	76.4	52.6	281.1	66.0	45	167.3	227.1	-	286.8	-	-	14.8	52.6	281.1	14.8	76.4	52.6	281.1	66.0	45
Meander Width Ratio				0.5	2.5	1.7	9.2	2.1	45	3.5	5.8	-	8.0	-	-	0.5	1.7	9.2	0.5	2.3	1.7	9.2	2.0	45
<b>Transport parameters</b>																								
Reach Shear Stress (competency) lb/ft <sup>2</sup>				0.4												0.46			0.26					
Max part size (mm) mobilized at bankfull				90												90			56					
Stream Power (transport capacity) lb/s				37												35			22					
<b>Additional Reach Parameters</b>																								
Rosgen Classification				F4						C4						C4			B4					
Bankfull Velocity (fps)	2.5	20.0	5.4	3.1												3.1			2.5					
Bankfull Discharge (cfs)	100	800	259.8	150												150								
Valley length (ft)				1470												1470								
Channel Thalweg length (ft)				1573												1573			1573					
Sinuosity (ft)				1.07						1.2 to 1.4						1.07			1.07					
Water Surface Slope (Channel) (ft/ft)				0.003												0.003			0.0023					
BF slope (ft/ft)				0.003												0.003			0.0023					
<sup>3</sup> Bankfull Floodplain Area (acres)				1.2												2.5			2.5					
<sup>4</sup> % of Reach with Eroding Banks				33%																				
Channel Stability or Habitat Metric				0.20																				
Biological or Other				-																				

Shaded cells indicate that these will typically not be filled in.

1 = The distributions for these parameters can include information from both the cross-section measurements and the longitudinal profile. 2 = For projects with a proximal USGS gauge in-line with the project reach (added bankfull verification - rare).

3. Utilizing XS measurement data produce an estimate of the bankfull floodplain area in acres, which should be the area from the top of bank to the toe of the terrace riser/slope.

4 = Proportion of reach exhibiting banks that are eroding based on the visual survey for comparison to monitoring data; 5. Of value/needed only if the n exceeds 3

Table 8f. Baseline Stream Data Summary																								
Stewarts Creek Tributaries Stream Restoration Project (DMS No. 100023) - Moores Fork R2 (1998 feet)																								
Parameter	Regional Curve			Pre-Existing Condition						Reference Reach(es) Data						Design			Monitoring Baseline					
Dimension and Substrate - Riffle Only	LL	UL	Eq.	Min	Mean	Med	Max	SD <sup>5</sup>	n	Min	Mean	Med	Max	SD <sup>5</sup>	n	Min	Med	Max	Min	Mean	Med	Max	SD <sup>5</sup>	n
Bankfull Width (ft)	20	30	22.5	28.5	30.8	30.8	33.0	-	2	21.9	23.9	-	25.9	-	-	21.9	23.9	25.9	20.2	20.7	20.7	21.3		2
Floodprone Width (ft)				45.0	45.5	45.5	46.0	-	2	52.6	74.1	-	95.6	-	-	52.6	74.1	95.6	81.2	>88.6	>88.6	>88.6		2
Bankfull Mean Depth (ft)	1.8	3	2.4	1.4	1.6	1.6	1.7	-	2	1.6	2.1	-	2.6	-	-	1.6	2.1	2.6	1.6	1.6	1.6	1.7		2
<sup>1</sup> Bankfull Max Depth (ft)				2.1	2.3	2.3	2.5	-	2	1.2	1.3	-	1.4	-	-	2.3	3.0	3.8	2.4	2.5	2.5	2.5		2
Bankfull Cross Sectional Area (ft <sup>2</sup> )	40	50	47.8	47.0	47.9	47.9	48.8	-	2	35.0	51.2	-	67.3	-	-	47.7	47.7	47.7	33.7	33.9	33.9	34.1		2
Width/Depth Ratio				16.6	19.9	19.9	23.2	-	2	10.0	12.0	-	14	-	-	10.0	12.0	14.0	12.0	12.7	12.7	13.4		2
Entrenchment Ratio				1.4	1.5	1.5	1.6	-	2	2.2	3.1	-	4.0	-	-	2.2	3.1	4.0	4.0	>4.14	>4.14	>4.14		2
<sup>1</sup> Bank Height Ratio				2.7	2.9	2.9	3.0	-	2	1.0	1.0	-	1	-	-	1.0	1.05	1.1	1.0	1.1	1.1	1.1		2
<b>Profile</b>																								
Riffle Length (ft)				15.3	66.6	53.7	179.0	50.1	9	Total riffle length 60-70% of reach length						29.0	121.0	167.0	73.6	113.0	118.1	169.4	28.7	13
Riffle Slope (ft/ft)				0.006	0.011	0.007	0.024	0.007	9	-	-	-	-	-	-	0.004	0.005	0.007	0.004	0.005	0.006	0.007	7.7E-04	13
Pool Length (ft)				15.3	71.2	71.6	147.0	38.6	9	Total pool length 30-40% of reach length						26.0	45.0	67.0	38.0	57.5	59.0	67.0	7.1	13
Pool Max depth (ft)				0.8	3.1	3.1	1.4	0.2	2	3.2	6.2	-	9.1	-	-	4.2	4.6	7.3	2.7	3.3	3.4	3.8	0.3	13
Pool Spacing (ft)				54.0	122.7	89.1	287.6	70.2	13	95.6	131.5	-	167.3	-	-	96.0	143.5	191.0	134.0	178.7	173.0	271.0	36.6	12
<b>Pattern</b>																								
Channel Beltwidth (ft)				47.4	85.9	75.3	174.1	40.2	9	83.7	137.4	-	191.2	-	-	83.7	137.5	191.2	83.7	126.2	126.7	176.7	24.8	10
Radius of Curvature (ft)				33.7	86.3	88.7	159.1	37.1	9	47.8	65.7	-	83.7	-	-	47.8	65.8	83.7	46.4	60.8	60.4	81.4	12.0	13
Rc:Bankfull width (ft/ft)				1.1	2.8	2.9	5.2	1.2	9	2.0	2.8	-	3.5	-	-	2.0	2.8	3.5	2.2	2.9	2.9	3.9	0.6	13
Meander Wavelength (ft)				214.5	296.9	303.9	414.1	75.2	9	167.3	227.1	-	286.8	-	-	167.3	138.1	286.8	188.0	246.7	243.5	304.0	33.2	10
Meander Width Ratio				7.0	9.7	9.9	13.5	2.4	9	3.5	5.8	-	8.0	-	-	3.5	5.8	8.0	4.0	6.1	6.1	8.5	1.6	10
<b>Transport parameters</b>																								
Reach Shear Stress (competency) lb/ft <sup>2</sup>				0.4												0.46			0.39					
Max part size (mm) mobilized at bankfull				90												90			76					
Stream Power (transport capacity) lb/s				37												35			37					
<b>Additional Reach Parameters</b>																								
Rosgen Classification				F4						C4						C4			C4					
Bankfull Velocity (fps)	2.5	20.0	5.4	3.1												3.1			4.4					
Bankfull Discharge (cfs)	100	800	259.8	150												150								
Valley length (ft)				1808												1700								
Channel Thalweg length (ft)				2007												2176			2176					
Sinuosity (ft)				1.11						1.2 to 1.4						1.28			1.28					
Water Surface Slope (Channel) (ft/ft)				0.004												0.0037			0.0039					
BF slope (ft/ft)				0.004												0.0037			0.0039					
<sup>3</sup> Bankfull Floodplain Area (acres)				1.9												2.9			2.9					
<sup>4</sup> % of Reach with Eroding Banks				30%																				
Channel Stability or Habitat Metric				0.26																				
Biological or Other				-																				

Shaded cells indicate that these will typically not be filled in.

1 = The distributions for these parameters can include information from both the cross-section measurements and the longitudinal profile. 2 = For projects with a proximal USGS gauge in-line with the project reach (added bankfull verification - rare).

3. Utilizing XS measurement data produce an estimate of the bankfull floodplain area in acres, which should be the area from the top of bank to the toe of the terrace riser/slope.

4 = Proportion of reach exhibiting banks that are eroding based on the visual survey for comparison to monitoring data; 5. Of value/needed only if the n exceeds 3

**Table 8g. Baseline Stream Data Summary**  
**Stewarts Creek Tributaries Stream Restoration Project (DMS No. 100023) - Moores Fork R3 (384 feet)**

Parameter	Regional Curve			Pre-Existing Condition						Reference Reach(es) Data						Design			Monitoring Baseline					
	LL	UL	Eq.	Min	Mean	Med	Max	SD <sup>5</sup>	n	Min	Mean	Med	Max	SD <sup>5</sup>	n	Min	Med	Max	Min	Mean	Med	Max	SD <sup>5</sup>	n
<b>Dimension and Substrate - Riffle Only</b>																								
Bankfull Width (ft)	20	30	22.5	22.8	22.8	22.8	22.8	-	1	21.9	23.9	-	25.9	-	-	21.9	23.9	25.9	20.9	20.9	20.9	20.9	-	1
Floodprone Width (ft)				144.4	144.4	144.4	144.4	-	1	52.6	74.1	-	95.6	-	-	52.6	74.1	95.6	106.9	106.9	106.9	106.9	-	1
Bankfull Mean Depth (ft)	1.8	3	2.4	2.3	2.3	2.3	2.3	-	1	1.6	2.1	-	2.6	-	-	1.6	2.1	2.6	1.6	1.6	1.6	1.6	-	1
<sup>1</sup> Bankfull Max Depth (ft)				3.2	3.2	3.2	3.2	-	1	1.2	1.3	-	1.4	-	-	2.3	3.0	3.8	2.6	2.6	2.6	2.6	-	1
Bankfull Cross Sectional Area (ft <sup>2</sup> )	40	50	47.8	52.4	52.4	52.4	52.4	-	1	35.0	51.2	-	67.3	-	-	47.7	47.7	47.7	33.7	33.7	33.7	33.7	-	1
Width/Depth Ratio				9.9	9.9	9.9	9.9	-	1	10.0	12.0	-	14	-	-	10.0	12.0	14.0	13.0	13.0	13.0	13.0	-	1
Entrenchment Ratio				6.3	6.3	6.3	6.3	-	1	2.2	3.1	-	4.0	-	-	2.2	3.1	4.0	5.0	5.0	5.0	5.0	-	1
<sup>1</sup> Bank Height Ratio				1.4	1.4	1.4	1.4	-	1	1.0	1.0	-	1	-	-	1.0	1.05	1.1	1.0	1.0	1.0	1.0	-	1
<b>Profile</b>																								
Riffle Length (ft)				24.5	45.0	44.1	67.2	21.3	4	Total riffle length 60-70% of reach length						29.0	121.0	167.0	20.0	63.7	54.2	126.7	41.7	4
Riffle Slope (ft/ft)				0.003	0.009	0.008	0.016	0.006	4	-	-	-	-	-	-	0.004	0.005	0.007	0.004	0.006	0.005	0.011	0.003	4
Pool Length (ft)				16.4	41.4	33.6	92.0	30.0	5	Total pool length 30-40% of reach length						26.0	45.0	67.0	30	40	40	50	8.6	4
Pool Max depth (ft)				0.8	4.6	4.6	1.4	-	1	3.2	6.2	-	9.1	-	-	4.2	4.6	7.3	2.1	3.2	3.4	4.0	0.7	4
Pool Spacing (ft)				21.6	67.1	70.2	101.5	30.6	8	95.6	131.5	-	167.3	-	-	96.0	143.5	191.0	77.0	107.5	100.0	153.0	28.5	4
<b>Pattern</b>																								
Channel Beltwidth (ft)				23.2	30.8	28.1	53.7	8.9	10	83.7	137.4	-	191.2	-	-	83.7	137.5	191.2	63.9	63.9	63.9	63.9	-	1
Radius of Curvature (ft)				17.0	26.5	26.5	47.1	7.5	13	47.8	65.7	-	83.7	-	-	47.8	65.8	83.7	50.5	63.8	70.5	70.5	-	3
Rc:Bankfull width (ft/ft)				0.7	1.2	1.2	2.1	0.3	13	2.0	2.8	-	3.5	-	-	2.0	2.8	3.5	2.4	3.1	3.4	3.4	-	3
Meander Wavelength (ft)				18.0	82.0	84.2	139.5	36.6	12	167.3	227.1	-	286.8	-	-	167.3	138.1	286.8	241.0	241.0	241.0	241.0	-	1
Meander Width Ratio				0.8	3.6	3.7	6.1	1.6	12	3.5	5.8	-	8.0	-	-	3.5	5.8	8.0	3.1	3.1	3.1	3.1	-	1
<b>Transport parameters</b>																								
Reach Shear Stress (competency) lb/ft <sup>2</sup>							0.4									0.46						0.27		
Max part size (mm) mobilized at bankfull							90									90						58		
Stream Power (transport capacity) lb/s							37									35						25		
<b>Additional Reach Parameters</b>																								
Rosgen Classification							F4						C4			C4					C4			
Bankfull Velocity (fps)	2.5	20.0	5.4				3.1									3.1						4.5		
Bankfull Discharge (cfs)	100	800	259.8				150									150								
Valley length (ft)							373						-			373								
Channel Thalweg length (ft)							380						-			384						384		
Sinuosity (ft)							1.02						1.2 to 1.4			1.03						1.03		
Water Surface Slope (Channel) (ft/ft)							0.0076						-			0.0037						0.0027		
BF slope (ft/ft)							0.0076						-			0.0037						0.0027		
<sup>3</sup> Bankfull Floodplain Area (acres)							1.2						-			0.6						0.6		
<sup>4</sup> % of Reach with Eroding Banks							25%						-											
Channel Stability or Habitat Metric							0.14						-											
Biological or Other							-						-											

Shaded cells indicate that these will typically not be filled in.

1 = The distributions for these parameters can include information from both the cross-section measurements and the longitudinal profile. 2 = For projects with a proximal USGS gauge in-line with the project reach (added bankfull verification - rare).

3. Utilizing XS measurement data produce an estimate of the bankfull floodplain area in acres, which should be the area from the top of bank to the toe of the terrace riser/slope.

4 = Proportion of reach exhibiting banks that are eroding based on the visual survey for comparison to monitoring data; 5. Of value/needed only if the n exceeds 3



**Table 9. Monitoring Data - Dimensional Morphology Summary (Dimensional Parameters – Cross Sections)  
Stewarts Creek Tributaries Stream Restoration Project (DMS No. 100023)**

	MF R1														MF R2																											
	Cross Section 1 (Pool)							Cross Section 2 (Riffle)							Cross Section 3 (Pool)							Cross Section 4 (Pool)							Cross Section 5 (Riffle)													
Based on fixed baseline bankfull elevation <sup>1</sup>	Base	MY1	MY2	MY3	MY4	MY5	MY+	Base	MY1	MY2	MY3	MY4	MY5	MY+	Base	MY1	MY2	MY3	MY4	MY5	MY+	Base	MY1	MY2	MY3	MY4	MY5	MY+	Base	MY1	MY2	MY3	MY4	MY5	MY+							
Record elevation (datum) used	1097.06							1094.84							1088.77							1087.94							1087.06													
Bankfull Width (ft)	33.2							33.2							29.1							25.6							20.2													
Floodprone Width (ft)	N/A							43.0							N/A							N/A							>81.2													
Bankfull Mean Depth (ft)	2.2							1.8							1.6							1.8							1.7													
Bankfull Max Depth (ft)	3.0							2.4							2.6							3.3							2.4													
Bankfull Cross Sectional Area (ft <sup>2</sup> )	71.8							61.1							45.1							47.1							34.1													
Bankfull Width/Depth Ratio	15.4							18.1							18.8							13.9							12.0													
Bankfull Entrenchment Ratio	N/A							1.3							N/A							N/A							>4.01													
Bankfull Bank Height Ratio	1.2							1.2							1.0							1.0							1.1													
	MF R2														MF R3														UT1													
	Cross Section 6 (Pool)							Cross Section 7 (Riffle)							Cross Section 8 (Riffle)							Cross Section 9 (Pool)							Cross Section 10 (Riffle)													
Based on fixed baseline bankfull elevation <sup>1</sup>	Base	MY1	MY2	MY3	MY4	MY5	MY+	Base	MY1	MY2	MY3	MY4	MY5	MY+	Base	MY1	MY2	MY3	MY4	MY5	MY+	Base	MY1	MY2	MY3	MY4	MY5	MY+	Base	MY1	MY2	MY3	MY4	MY5	MY+							
Record elevation (datum) used	1084.62							1083.10							1079.96							1080.16							1111.02													
Bankfull Width (ft)	33.6							21.3							20.9							29.2							7.0													
Floodprone Width (ft)	N/A							>88.6							106.9							N/A							52.2													
Bankfull Mean Depth (ft)	1.6							1.6							1.6							4.8							0.6													
Bankfull Max Depth (ft)	2.7							2.5							2.6							4.0							0.8													
Bankfull Cross Sectional Area (ft <sup>2</sup> )	53.6							33.7							33.7							52.6							3.9													
Bankfull Width/Depth Ratio	21.0							13.4							13.0							16.2							12.6													
Bankfull Entrenchment Ratio	N/A							>4.14							5.1							N/A							7.5													
Bankfull Bank Height Ratio	1.0							1.0							1.0							1.0							1.1													
	UT1																																									
	Cross Section 11 (Pool)							Cross Section 12 (Riffle)							Cross Section 13 (Pool)							Cross Section 14 (Pool)							Cross Section 15 (Pool)													
Based on fixed baseline bankfull elevation <sup>1</sup>	Base	MY1	MY2	MY3	MY4	MY5	MY+	Base	MY1	MY2	MY3	MY4	MY5	MY+	Base	MY1	MY2	MY3	MY4	MY5	MY+	Base	MY1	MY2	MY3	MY4	MY5	MY+	Base	MY1	MY2	MY3	MY4	MY5	MY+							
Record elevation (datum) used	1104.40							1102.01							1088.55							1085.64							1080.95													
Bankfull Width (ft)	9.0							7.0							8.9							9.3							16.2													
Floodprone Width (ft)	N/A							49.7							N/A							N/A							N/A													
Bankfull Mean Depth (ft)	0.6							0.6							0.6							0.5							0.4													
Bankfull Max Depth (ft)	1.3							0.8							1.2							1.1							1.5													
Bankfull Cross Sectional Area (ft <sup>2</sup> )	5.5							3.9							5.5							4.6							6.9													
Bankfull Width/Depth Ratio	14.8							12.5							14.3							18.6							37.7													
Bankfull Entrenchment Ratio	N/A							7.1							N/A							N/A							N/A													
Bankfull Bank Height Ratio	1.0							1.0							1.1							1.0							1.0													

**Table 9. Monitoring Data - Dimensional Morphology Summary (Dimensional Parameters – Cross Sections) (continued)**  
**Stewarts Creek Tributaries Stream Restoration Project (DMS No. 100023)**

Based on fixed baseline bankfull elevation <sup>1</sup>	UT1								UT2																UT3 R1															
	Cross Section 16 (Riffle)								Cross Section 17 (Pool)								Cross Section 18 (Riffle)								Cross Section 19 (Riffle)								Cross Section 20 (Pool)							
	Base	MY1	MY2	MY3	MY4	MY5	MY+		Base	MY1	MY2	MY3	MY4	MY5	MY+		Base	MY1	MY2	MY3	MY4	MY5	MY+		Base	MY1	MY2	MY3	MY4	MY5	MY+		Base	MY1	MY2	MY3	MY4	MY5	MY+	
Record elevation (datum) used	1078.41							1098.12								1097.77								1092.07								1095.67								
Bankfull Width (ft)	6.0							8.3							5.5								6.1								11.2									
Floodprone Width (ft)	54.3							N/A							52.0								50.8								N/A									
Bankfull Mean Depth (ft)	0.6							0.7							0.4								0.5								0.5									
Bankfull Max Depth (ft)	1.0							1.4							0.7								0.7								1.2									
Bankfull Cross Sectional Area (ft <sup>2</sup> )	3.7							5.4							2.4								3.1								5.7									
Bankfull Width/Depth Ratio	9.6							12.8							12.5								12.0								21.9									
Bankfull Entrenchment Ratio	9.1							N/A							9.5								8.3								N/A									
Bankfull Bank Height Ratio	1.0							1.0							1.0								1.1								1.0									
	UT3 R1								UT3 R2																															
	Cross Section 21 (Riffle)								Cross Section 22 (Pool)								Cross Section 23 (Riffle)								Cross Section 24 (Pool)								Cross Section 25 (Riffle)							
Based on fixed baseline bankfull elevation <sup>1</sup>	Base	MY1	MY2	MY3	MY4	MY5	MY+		Base	MY1	MY2	MY3	MY4	MY5	MY+		Base	MY1	MY2	MY3	MY4	MY5	MY+		Base	MY1	MY2	MY3	MY4	MY5	MY+		Base	MY1	MY2	MY3	MY4	MY5	MY+	
Record elevation (datum) used	1092.21							1089.56							1087.39								1081.92								1081.58									
Bankfull Width (ft)	5.9							11.3							8.22								9.2								7.2									
Floodprone Width (ft)	41.6							N/A							56.3								N/A								55.6									
Bankfull Mean Depth (ft)	0.5							0.6							0.6								0.8								0.6									
Bankfull Max Depth (ft)	0.7							1.3							0.9								1.4								1.0									
Bankfull Cross Sectional Area (ft <sup>2</sup> )	3.2							6.9							4.9								7.1								4.5									
Bankfull Width/Depth Ratio	11.1							18.4							13.9								12.0								11.5									
Bankfull Entrenchment Ratio	7.1							N/A							6.9								N/A								7.7									
Bankfull Bank Height Ratio	1.1							1.0							1.1								1.1								1.0									
	UT3 R2																																							
	Cross Section 26 (Pool)																																							
Based on fixed baseline bankfull elevation <sup>1</sup>	Base	MY1	MY2	MY3	MY4	MY5	MY+																																	
Record elevation (datum) used	1077.31																																							
Bankfull Width (ft)	9.8																																							
Floodprone Width (ft)	N/A																																							
Bankfull Mean Depth (ft)	0.8																																							
Bankfull Max Depth (ft)	1.4																																							
Bankfull Cross Sectional Area (ft <sup>2</sup> )	7.6																																							
Bankfull Width/Depth Ratio	12.8																																							
Bankfull Entrenchment Ratio	N/A																																							
Bankfull Bank Height Ratio	1.0																																							

1 = Widths and depths for annual measurements will be based on the baseline bankfull datum regardless of dimensional/depositional development. Input the elevation used as the datum, which should be consistent and based on the baseline datum established. If the performer has inherited the project and cannot acquire the datum used for prior years this must be discussed with EEP. If this cannot be resolved in time for a given years report submission a footnote in this should be included that states: "It is uncertain if the monitoring datum has been consistent over the monitoring history, which may influence calculated values. Additional data from a prior performer is being acquired to provide confirmation. Values will be recalculated in a future submission based on a consistent datum if determined to be necessary."

**Table 10a. Monitoring Data - Stream Reach Data Summary**  
**Stewarts Creek Tributaries Stream Restoration Project (DMS No. 100023) - UT1 (2742 feet)**

Parameter	Baseline						MY-1						MY-2						MY-3						MY-4						MY-5					
	Min	Mean	Med	Max	SD <sup>4</sup>	n	Min	Mean	Med	Max	SD <sup>4</sup>	n	Min	Mean	Med	Max	SD <sup>4</sup>	n	Min	Mean	Med	Max	SD <sup>4</sup>	n	Min	Mean	Med	Max	SD <sup>4</sup>	n	Min	Mean	Med	Max	SD <sup>4</sup>	n
<b>Dimension and Substrate - Riffle only</b>																																				
Bankfull Width (ft)	6.0	6.6	7.0	7.0	-	3																														
Floodprone Width (ft)	49.7	52.1	52.2	54.3	-	3																														
Bankfull Mean Depth (ft)	0.6	0.6	0.6	0.6	-	3																														
<sup>1</sup> Bankfull Max Depth (ft)	0.8	0.9	0.8	1.0	-	3																														
Bankfull Cross Sectional Area (ft <sup>2</sup> )	3.7	3.8	3.9	3.9	-	3																														
Width/Depth Ratio	9.6	11.6	12.5	12.6	-	3																														
Entrenchment Ratio	7.1	7.9	7.5	9.1	-	3																														
<sup>1</sup> Bank Height Ratio	1.0	1.0	1.0	1.1	-	3																														
<b>Profile</b>																																				
Riffle Length (ft)	5.3	15.1	14.3	39.1	6.2	56																														
Riffle Slope (ft/ft)	0.008	0.037	0.034	0.086	0.019	56																														
Pool Length (ft)	7.4	21.2	20.9	39.1	8.0	56																														
Pool Max depth (ft)	1.0	1.5	1.4	2.2	0.3	57																														
Pool Spacing (ft)	19.0	38.4	40.0	71.3	8.8	72																														
<b>Pattern</b>																																				
Channel Beltwidth (ft)	12.674	28.445	30.41	37.04	6.4567	67																														
Radius of Curvature (ft)	9.315	14.753	14.315	21.315	2.1451	69																														
Rc:Bankfull width (ft/ft)	1.4	2.2	2.2	3.2	0.4	69																														
Meander Wavelength (ft)	35.65	60.001	61.42	73.4	8.9143	71																														
Meander Width Ratio	1.9	4.3	4.6	5.6	1.5	67																														
<b>Additional Reach Parameters</b>																																				
Rosgen Classification	C4																																			
Channel Thalweg length (ft)	2805																																			
Sinuosity (ft)	1.30																																			
Water Surface Slope (Channel) (ft/ft)	0.0180																																			
BF slope (ft/ft)	0.0180																																			
<sup>3</sup> Ri% / Ru% / P% / G% / S%																																				
<sup>3</sup> SC% / Sa% / G% / C% / B% / Be%																																				
<sup>3</sup> d16 / d35 / d50 / d84 / d95 /																																				
<sup>2</sup> % of Reach with Eroding Banks																																				
Channel Stability or Habitat Metric																																				
Biological or Other																																				

Pattern data will not typically be collected unless visual data, dimensional data or profile data indicate significant shifts from baseline

Shaded cells indicate that these will typically not be filled in.  
 1 = The distributions for these parameters can include information from both the cross-section measurements and the longitudinal profile.  
 2 = Proportion of reach exhibiting banks that are eroding based on the visual survey from visual assessment table  
 3 = Riffle, Run, Pool, Glide, Step; Silt/Clay, Sand, Gravel, Cobble, Boulder, Bedrock; dip = max pave, disp = max subpave  
 4. = Of value/needed only if the n exceeds 3

**Table 10b. Monitoring Data - Stream Reach Data Summary  
Stewarts Creek Tributaries Stream Restoration Project (DMS No. 100023) - UT2 (1009 feet)**

Parameter	Baseline						MY-1						MY-2						MY-3						MY-4						MY-5					
	Min	Mean	Med	Max	SD <sup>4</sup>	n	Min	Mean	Med	Max	SD <sup>4</sup>	n	Min	Mean	Med	Max	SD <sup>4</sup>	n	Min	Mean	Med	Max	SD <sup>4</sup>	n	Min	Mean	Med	Max	SD <sup>4</sup>	n	Min	Mean	Med	Max	SD <sup>4</sup>	n
<b>Dimension and Substrate - Riffle only</b>																																				
Bankfull Width (ft)	5.5	5.8	5.8	6.1	-	2																														
Floodprone Width (ft)	50.8	51.4	51.4	52.0	-	2																														
Bankfull Mean Depth (ft)	0.4	0.5	0.5	0.5	-	2																														
<sup>1</sup> Bankfull Max Depth (ft)	0.7	0.7	0.7	0.7	-	2																														
Bankfull Cross Sectional Area (ft <sup>2</sup> )	2.4	2.8	2.8	3.1	-	2																														
Width/Depth Ratio	12.0	12.2	12.2	12.5	-	2																														
Entrenchment Ratio	8.3	8.9	8.9	9.5	-	2																														
<sup>1</sup> Bank Height Ratio	1.0	1.1	1.1	1.1	-	2																														
<b>Profile</b>																																				
Riffle Length (ft)	5.0	16.4	18.0	27.1	6.0	25																														
Riffle Slope (ft/ft)	0.020	0.045	0.043	0.083	0.017	25																														
Pool Length (ft)	5.1	14.5	14.3	21.9	4.2	26																														
Pool Max depth (ft)	0.8	1.2	1.1	1.8	0.2	26																														
Pool Spacing (ft)	24.9	36.0	35.0	42.0	2.8	27																														
<b>Pattern</b>																																				
Channel Beltwidth (ft)	23.215	27.239	27.475	32.565	2.5416	27																														
Radius of Curvature (ft)	10.598	12.676	12.398	15.898	1.6699	28																														
Rc:Bankfull width (ft/ft)	1.8	2.2	2.1	2.7	0.3	28																														
Meander Wavelength (ft)	40.4	54.356	52.93	92.0	9.2424	28																														
Meander Width Ratio	4.0	4.7	4.7	5.6	1.5	27																														
<b>Additional Reach Parameters</b>																																				
Rosgen Classification	Cb4																																			
Channel Thalweg length (ft)	1060																																			
Sinuosity (ft)	1.34																																			
Water Surface Slope (Channel) (ft/ft)	0.0208																																			
BF slope (ft/ft)	0.0208																																			
<sup>3</sup> Ri% / Ru% / P% / G% / S%																																				
<sup>3</sup> SC% / Sa% / G% / C% / B% / Be%																																				
<sup>3</sup> d16 / d35 / d50 / d84 / d95 /																																				
<sup>2</sup> % of Reach with Eroding Banks																																				
Channel Stability or Habitat Metric																																				
Biological or Other																																				

Pattern data will not typically be collected unless visual data, dimensional data or profile data indicate significant shifts from baseline

Shaded cells indicate that these will typically not be filled in.  
 1 = The distributions for these parameters can include information from both the cross-section measurements and the longitudinal profile.  
 2 = Proportion of reach exhibiting banks that are eroding based on the visual survey from visual assessment table  
 3 = Riffle, Run, Pool, Glide, Step; Silt/Clay, Sand, Gravel, Cobble, Boulder, Bedrock; dip = max pave, disp = max subpave  
 4 = Of value/needed only if the n exceeds 3

**Table 10c. Monitoring Data - Stream Reach Data Summary**  
**Stewarts Creek Tributaries Stream Restoration Project (DMS No. 100023) - UT3 R1 (994 feet)**

Parameter	Baseline						MY-1						MY-2						MY-3						MY-4						MY-5					
	Min	Mean	Med	Max	SD <sup>4</sup>	n	Min	Mean	Med	Max	SD <sup>4</sup>	n	Min	Mean	Med	Max	SD <sup>4</sup>	n	Min	Mean	Med	Max	SD <sup>4</sup>	n	Min	Mean	Med	Max	SD <sup>4</sup>	n	Min	Mean	Med	Max	SD <sup>4</sup>	n
<b>Dimension and Substrate - Riffle only</b>																																				
Bankfull Width (ft)	5.9	5.9	5.9	5.9	-	1																														
Floodprone Width (ft)	41.6	41.6	41.6	41.6	-	1																														
Bankfull Mean Depth (ft)	0.5	0.5	0.5	0.5	-	1																														
<sup>1</sup> Bankfull Max Depth (ft)	0.7	0.7	0.7	0.7	-	1																														
Bankfull Cross Sectional Area (ft <sup>2</sup> )	3.2	3.2	3.2	3.2	-	1																														
Width/Depth Ratio	11.1	11.1	11.1	11.1	-	1																														
Entrenchment Ratio	7.1	7.1	7.1	7.1	-	1																														
<sup>1</sup> Bank Height Ratio	1.1	1.1	1.1	1.1	-	1																														
<b>Profile</b>																																				
Riffle Length (ft)	6.4	16.6	14.7	32.3	8.1	22																														
Riffle Slope (ft/ft)	0.020	0.047	0.044	0.089	0.018	22																														
Pool Length (ft)	5.0	13.6	13.1	25.6	5.3	23																														
Pool Max depth (ft)	0.8	1.3	1.3	1.7	0.3	23																														
Pool Spacing (ft)	33.0	45.1	44.0	56.0	6.1	18																														
<b>Pattern</b>																																				
Channel Beltwidth (ft)	16.43	30.986	32.365	39.27	5.4868	20																														
Radius of Curvature (ft)	12.445	15.04	14.945	20.945	2.1658	21																														
Rc:Bankfull width (ft/ft)	2.1	2.6	2.5	3.6	0.4	21																														
Meander Wavelength (ft)	57.58	73.258	70.025	116.98	14.31	20																														
Meander Width Ratio	2.8	5.3	5.5	6.7	2.3	20																														
<b>Additional Reach Parameters</b>																																				
Rosgen Classification	Cb4																																			
Channel Thalweg length (ft)	994																																			
Sinuosity (ft)	1.24																																			
Water Surface Slope (Channel) (ft/ft)	0.0209																																			
BF slope (ft/ft)	0.0209																																			
<sup>3</sup> Ri% / Ru% / P% / G% / S%																																				
<sup>3</sup> SC% / Sa% / G% / C% / B% / Be%																																				
<sup>3</sup> d16 / d35 / d50 / d84 / d95 /																																				
<sup>2</sup> % of Reach with Eroding Banks																																				
Channel Stability or Habitat Metric																																				
Biological or Other																																				

Pattern data will not typically be collected unless visual data, dimensional data or profile data indicate significant shifts from baseline

Shaded cells indicate that these will typically not be filled in.  
 1 = The distributions for these parameters can include information from both the cross-section measurements and the longitudinal profile.  
 2 = Proportion of reach exhibiting banks that are eroding based on the visual survey from visual assessment table  
 3 = Riffle, Run, Pool, Glide, Step; Silt/Clay, Sand, Gravel, Cobble, Boulder, Bedrock; dip = max pave, disp = max subpave  
 4. = Of value/needed only if the n exceeds 3

**Table 10d. Monitoring Data - Stream Reach Data Summary**  
**Stewarts Creek Tributaries Stream Restoration Project (DMS No. 100023) - UT3 R2 (2421 feet)**

Parameter	Baseline						MY-1						MY-2						MY-3						MY-4						MY-5					
	Min	Mean	Med	Max	SD <sup>4</sup>	n	Min	Mean	Med	Max	SD <sup>4</sup>	n	Min	Mean	Med	Max	SD <sup>4</sup>	n	Min	Mean	Med	Max	SD <sup>4</sup>	n	Min	Mean	Med	Max	SD <sup>4</sup>	n	Min	Mean	Med	Max	SD <sup>4</sup>	n
<b>Dimension and Substrate - Riffle only</b>																																				
Bankfull Width (ft)	7.2	7.7	7.7	8.2	-	2																														
Floodprone Width (ft)	55.6	56.0	56.0	56.3	-	2																														
Bankfull Mean Depth (ft)	0.6	0.6	0.6	0.6	-	2																														
<sup>1</sup> Bankfull Max Depth (ft)	0.9	1.0	1.0	1.0	-	2																														
Bankfull Cross Sectional Area (ft <sup>2</sup> )	4.5	4.7	4.7	4.9	-	2																														
Width/Depth Ratio	11.5	12.7	12.7	13.9	-	2																														
Entrenchment Ratio	6.9	7.3	7.3	7.7	-	2																														
<sup>1</sup> Bank Height Ratio	1.0	1.1	1.1	1.1	-	2																														
<b>Profile</b>																																				
Riffle Length (ft)	5.0	18.1	16.2	39.3	9.8	40																														
Riffle Slope (ft/ft)	0.004	0.022	0.018	0.063	0.016	40																														
Pool Length (ft)	7.9	17.4	16.2	38.3	6.4	41																														
Pool Max depth (ft)	1.2	1.6	1.6	2.5	0.2	41																														
Pool Spacing (ft)	43.0	55.6	56.0	70.0	6.0	43																														
<b>Pattern</b>																																				
Channel Beltwidth (ft)	26.545	42.079	42.125	56.565	6.8631	43																														
Radius of Curvature (ft)	15.7	18.6	19.0	23.0	1.7	45																														
Rc:Bankfull width (ft/ft)	2.0	2.4	2.5	3.0	0.3	45																														
Meander Wavelength (ft)	66.94	81.913	81.155	130.29	10.927	44																														
Meander Width Ratio	3.4	5.4	5.5	7.3	1.8	43																														
<b>Additional Reach Parameters</b>																																				
Rosgen Classification	C4																																			
Channel Thalweg length (ft)	2523																																			
Sinuosity (ft)	1.40																																			
Water Surface Slope (Channel) (ft/ft)	0.0063																																			
BF slope (ft/ft)	0.0063																																			
<sup>3</sup> Ri% / Ru% / P% / G% / S%																																				
<sup>3</sup> SC% / Sa% / G% / C% / B% / Be%																																				
<sup>3</sup> d16 / d35 / d50 / d84 / d95 /																																				
<sup>2</sup> % of Reach with Eroding Banks																																				
Channel Stability or Habitat Metric																																				
Biological or Other																																				

Pattern data will not typically be collected unless visual data, dimensional data or profile data indicate significant shifts from baseline

Shaded cells indicate that these will typically not be filled in.  
 1 = The distributions for these parameters can include information from both the cross-section measurements and the longitudinal profile.  
 2 = Proportion of reach exhibiting banks that are eroding based on the visual survey from visual assessment table  
 3 = Riffle, Run, Pool, Glide, Step; Silt/Clay, Sand, Gravel, Cobble, Boulder, Bedrock; dip = max pave, disp = max subpave  
 4. = Of value/needed only if the n exceeds 3

**Table 10e. Monitoring Data - Stream Reach Data Summary**  
**Stewarts Creek Tributaries Stream Restoration Project (DMS No. 100023) - Moores Fork R1 (1573 feet)**

Parameter	Baseline						MY-1						MY-2						MY-3						MY-4						MY-5					
	Min	Mean	Med	Max	SD <sup>4</sup>	n	Min	Mean	Med	Max	SD <sup>4</sup>	n	Min	Mean	Med	Max	SD <sup>4</sup>	n	Min	Mean	Med	Max	SD <sup>4</sup>	n	Min	Mean	Med	Max	SD <sup>4</sup>	n	Min	Mean	Med	Max	SD <sup>4</sup>	n
<b>Dimension and Substrate - Riffle only</b>																																				
Bankfull Width (ft)	33.2	33.2	33.2	33.2	-	1																														
Floodprone Width (ft)	43.0	43.0	43.0	43.0	-	1																														
Bankfull Mean Depth (ft)	1.8	1.8	1.8	1.8	-	1																														
<sup>1</sup> Bankfull Max Depth (ft)	2.4	2.4	2.4	2.4	-	1																														
Bankfull Cross Sectional Area (ft <sup>2</sup> )	61.1	61.1	61.1	61.1	-	1																														
Width/Depth Ratio	18.1	18.1	18.1	18.1	-	1																														
Entrenchment Ratio	1.3	1.3	1.3	1.3	-	1																														
<sup>1</sup> Bank Height Ratio	1.2	1.2	1.2	1.2	-	1																														
<b>Profile</b>																																				
Riffle Length (ft)	79.0	108.3	89.0	190.0	38.8	7																														
Riffle Slope (ft/ft)	0.002	0.005	0.004	0.009	0.002	7																														
Pool Length (ft)	40.0	94.6	97.0	150.0	30.8	7																														
Pool Max depth (ft)	5.1	6.1	6.2	7.3	0.8	7																														
Pool Spacing (ft)	111.0	206.1	187.2	330.6	71.1	6																														
<b>Pattern</b>																																				
Channel Beltwidth (ft)	31.2	37.9	35.5	85.1	8.1088	44																														
Radius of Curvature (ft)	18.1	31.95	26.6	85.1	15.917	47																														
Rc:Bankfull width (ft/ft)	0.6	1.0	0.9	2.8	0.5	47																														
Meander Wavelength (ft)	14.8	76.4	52.6	281.1	66.037	45																														
Meander Width Ratio	0.5	2.3	1.7	9.2	2.0	45																														
<b>Additional Reach Parameters</b>																																				
Rosgen Classification	B4																																			
Channel Thalweg length (ft)	1573																																			
Sinuosity (ft)	1.07																																			
Water Surface Slope (Channel) (ft/ft)	0.0023																																			
BF slope (ft/ft)	0.0023																																			
<sup>3</sup> Ri% / Ru% / P% / G% / S%																																				
<sup>3</sup> SC% / Sa% / G% / C% / B% / Be%																																				
<sup>3</sup> d16 / d35 / d50 / d84 / d95 /																																				
<sup>2</sup> % of Reach with Eroding Banks																																				
Channel Stability or Habitat Metric																																				
Biological or Other																																				

Pattern data will not typically be collected unless visual data, dimensional data or profile data indicate significant shifts from baseline

Shaded cells indicate that these will typically not be filled in.  
 1 = The distributions for these parameters can include information from both the cross-section measurements and the longitudinal profile.  
 2 = Proportion of reach exhibiting banks that are eroding based on the visual survey from visual assessment table  
 3 = Riffle, Run, Pool, Glide, Step; Silt/Clay, Sand, Gravel, Cobble, Boulder, Bedrock; dip = max pave, disp = max subpave  
 4. = Of value/needed only if the n exceeds 3

**Table 10f. Monitoring Data - Stream Reach Data Summary**  
**Stewarts Creek Tributaries Stream Restoration Project (DMS No. 100023) - Moores Fork R2 (1998 feet)**

Parameter	Baseline						MY-1						MY-2						MY-3						MY-4						MY-5					
	Min	Mean	Med	Max	SD <sup>4</sup>	n	Min	Mean	Med	Max	SD <sup>4</sup>	n	Min	Mean	Med	Max	SD <sup>4</sup>	n	Min	Mean	Med	Max	SD <sup>4</sup>	n	Min	Mean	Med	Max	SD <sup>4</sup>	n	Min	Mean	Med	Max	SD <sup>4</sup>	n
<b>Dimension and Substrate - Riffle only</b>																																				
Bankfull Width (ft)	20.2	20.7	20.7	21.3	-	2																														
Floodprone Width (ft)	81.2	>88.6	>88.6	>88.6	-	2																														
Bankfull Mean Depth (ft)	1.6	1.6	1.6	1.7	-	2																														
<sup>1</sup> Bankfull Max Depth (ft)	2.4	2.5	2.5	2.5	-	2																														
Bankfull Cross Sectional Area (ft <sup>2</sup> )	33.7	33.9	33.9	34.1	-	2																														
Width/Depth Ratio	12.0	12.7	12.7	13.4	-	2																														
Entrenchment Ratio	4.0	>4.14	>4.14	>4.14	-	2																														
<sup>1</sup> Bank Height Ratio	1.0	1.1	1.1	1.1	-	2																														
<b>Profile</b>																																				
Riffle Length (ft)	73.6	113.0	118.1	169.4	28.7	13																														
Riffle Slope (ft/ft)	0.004	0.005	0.006	0.007	0.001	13																														
Pool Length (ft)	38.0	57.5	59.0	67.0	7.1	13																														
Pool Max depth (ft)	2.7	3.3	3.4	3.8	0.3	13																														
Pool Spacing (ft)	134.0	178.7	173.0	271.0	36.6	12																														
<b>Pattern</b>																																				
Channel Beltwidth (ft)	83.7	126.2	126.7	176.7	24.771	10																														
Radius of Curvature (ft)	46.35	60.812	60.35	81.35	11.963	13																														
Rc:Bankfull width (ft/ft)	2.2	2.9	2.9	3.9	0.6	13																														
Meander Wavelength (ft)	188.0	246.7	243.5	304.0	33.213	10																														
Meander Width Ratio	4.0	6.1	6.1	8.5	1.6045	10																														
<b>Additional Reach Parameters</b>																																				
Rosgen Classification				C4																																
Channel Thalweg length (ft)				2176																																
Sinuosity (ft)				1.28																																
Water Surface Slope (Channel) (ft/ft)				0.0039																																
BF slope (ft/ft)				0.0039																																
<sup>3</sup> Ri% / Ru% / P% / G% / S%																																				
<sup>3</sup> SC% / Sa% / G% / C% / B% / Be%																																				
<sup>3</sup> d16 / d35 / d50 / d84 / d95 /																																				
<sup>2</sup> % of Reach with Eroding Banks																																				
Channel Stability or Habitat Metric																																				
Biological or Other																																				

Pattern data will not typically be collected unless visual data, dimensional data or profile data indicate significant shifts from baseline

Shaded cells indicate that these will typically not be filled in.  
 1 = The distributions for these parameters can include information from both the cross-section measurements and the longitudinal profile.  
 2 = Proportion of reach exhibiting banks that are eroding based on the visual survey from visual assessment table  
 3 = Riffle, Run, Pool, Glide, Step; Silt/Clay, Sand, Gravel, Cobble, Boulder, Bedrock; dip = max pave, disp = max subpave  
 4. = Of value/needed only if the n exceeds 3



**Table 10g. Monitoring Data - Stream Reach Data Summary**  
**Stewarts Creek Tributaries Stream Restoration Project (DMS No. 100023) - Moores Fork R3 (384 feet)**

Parameter	Baseline						MY-1						MY-2						MY-3						MY-4						MY-5					
	Min	Mean	Med	Max	SD <sup>4</sup>	n	Min	Mean	Med	Max	SD <sup>4</sup>	n	Min	Mean	Med	Max	SD <sup>4</sup>	n	Min	Mean	Med	Max	SD <sup>4</sup>	n	Min	Mean	Med	Max	SD <sup>4</sup>	n	Min	Mean	Med	Max	SD <sup>4</sup>	n
<b>Dimension and Substrate - Riffle only</b>																																				
Bankfull Width (ft)	20.9	20.9	20.9	20.9	-	1																														
Floodprone Width (ft)	106.9	106.9	106.9	106.9	-	1																														
Bankfull Mean Depth (ft)	1.6	1.6	1.6	1.6	-	1																														
<sup>1</sup> Bankfull Max Depth (ft)	2.6	2.6	2.6	2.6	-	1																														
Bankfull Cross Sectional Area (ft <sup>2</sup> )	33.7	33.7	33.7	33.7	-	1																														
Width/Depth Ratio	13.0	13.0	13.0	13.0	-	1																														
Entrenchment Ratio	5.0	5.0	5.0	5.0	-	1																														
<sup>1</sup> Bank Height Ratio	1.0	1.0	1.0	1.0	-	1																														
<b>Profile</b>																																				
Riffle Length (ft)	20.0	63.7	54.2	126.7	41.7	4																														
Riffle Slope (ft/ft)	0.004	0.006	0.005	0.011	0.003	4																														
Pool Length (ft)	30.0	40.0	40.0	50.0	8.6	4																														
Pool Max depth (ft)	2.1	3.2	3.4	4.0	0.7	4																														
Pool Spacing (ft)	77.0	107.5	100.0	153.0	28.5	4																														
<b>Pattern</b>																																				
Channel Beltwidth (ft)	63.9	63.9	63.9	63.9	-	1																														
Radius of Curvature (ft)	50.45	63.783	70.45	70.45	-	3																														
Rc:Bankfull width (ft/ft)	2.4	3.1	3.4	3.4	-	3																														
Meander Wavelength (ft)	241.0	241.0	241.0	241.0	-	1																														
Meander Width Ratio	3.1	3.1	3.1	3.1	-	1																														
<b>Additional Reach Parameters</b>																																				
Rosgen Classification	C4																																			
Channel Thalweg length (ft)	384																																			
Sinuosity (ft)	1.03																																			
Water Surface Slope (Channel) (ft/ft)	0.0027																																			
BF slope (ft/ft)	0.0027																																			
<sup>3</sup> Ri% / Ru% / P% / G% / S%																																				
<sup>3</sup> SC% / Sa% / G% / C% / B% / Be%																																				
<sup>3</sup> d16 / d35 / d50 / d84 / d95 /																																				
<sup>2</sup> % of Reach with Eroding Banks																																				
Channel Stability or Habitat Metric																																				
Biological or Other																																				

Pattern data will not typically be collected unless visual data, dimensional data or profile data indicate significant shifts from baseline

Shaded cells indicate that these will typically not be filled in.

- 1 = The distributions for these parameters can include information from both the cross-section measurements and the longitudinal profile.
- 2 = Proportion of reach exhibiting banks that are eroding based on the visual survey from visual assessment table
- 3 = Riffle, Run, Pool, Glide, Step; Silt/Clay, Sand, Gravel, Cobble, Boulder, Bedrock; dip = max pave, disp = max subpave
- 4 = Of value/needed only if the n exceeds 3

**Table 11. Structure Changes Summary****Table 11a. Moores Fork Log Vanes**

Note	Station (ft)	
	Point 1	Point 2
Changed to Rock Vanes	36+51.00	36+74.00
Changed to Rock Vanes	37+75.00	37+98.00

**Table 11b. UT 1 Constructed Riffles**

Note	Point 1	Point 2
	Station	Station
Added	11+82.00	12+06.00
Added	13+53.00	13+62.00
Added	14+23.00	14+34.00
Added	14+86.00	15+03.00
Added	16+70.00	16+75.00
Added	16+83.00	16+88.00
Added	24+53.00	24+71.00
Added	29+14.00	29+38.00
Added	32+58.00	32+64.00
Added	32+77.00	32+83.00

**Table 11c. UT 2 Constructed Riffles**

Note	Point 1	Point 2
	Station	Station
Additional Length	11+80.00	11+95.00
Added	12+86.00	13+07.00
Added	16+51.00	16+55.00
Added	16+84.00	17+02.00
Changed from Woody Riffle	17+24.00	17+35.00
Changed from Woody Riffle	18+42.00	18+50.00
Added	18+72.00	18+91.00
Added	19+11.00	19+27.00
Added	19+78.00	19+92.00

**Table 11d. UT 3 Constructed Riffles**

Note	Point 1	Point 2
	Station	Station
Added	12+41.00	12+58.00
Added	16+01.00	16+07.00
Added	18+29.00	18+47.00
Added	19+18.00	19+36.00
Added	24+50.00	24+75.00
Added	26+11.00	26+36.00
Added	28+10.00	28+27.00
Added	42+88.00	43+12.00
Added	43+85.00	44+12.00

**Table 11e. UT 1 Toewood**

Toe Wood Dimensions		
STA Length (ft)	Begin Station (ft)	End Station (ft)
Added	36+81.00	36+87.00

**Table 11f. UT 3 Toewood**

Toe Wood Dimensions		
STA Length (ft)	Begin Station (ft)	End Station (ft)
Added	12+13.00	12+41.00
Added	14+40.00	14+66.00
Added	20+00.00	20+25.00
Additonal Length	20+39.00	20+80.00

**Table 11g. Moores Fork Toewood**


Toe Wood Dimensions		
Note	Begin Station (ft)	End Station (ft)
Additonal Length	25+88.00	26+56.00

**Table 11h. UT 1 Woody Riffles**


Type	Point 1	Point 2
	Station	Station
Added	26+12.00	26+44.00

**\*Note that all sod mats from the design were removed from the UTs.**


Longitudinal Profile - Baseline (June 2020)  
Moores Fork - Sta. 10+00 - 15+00

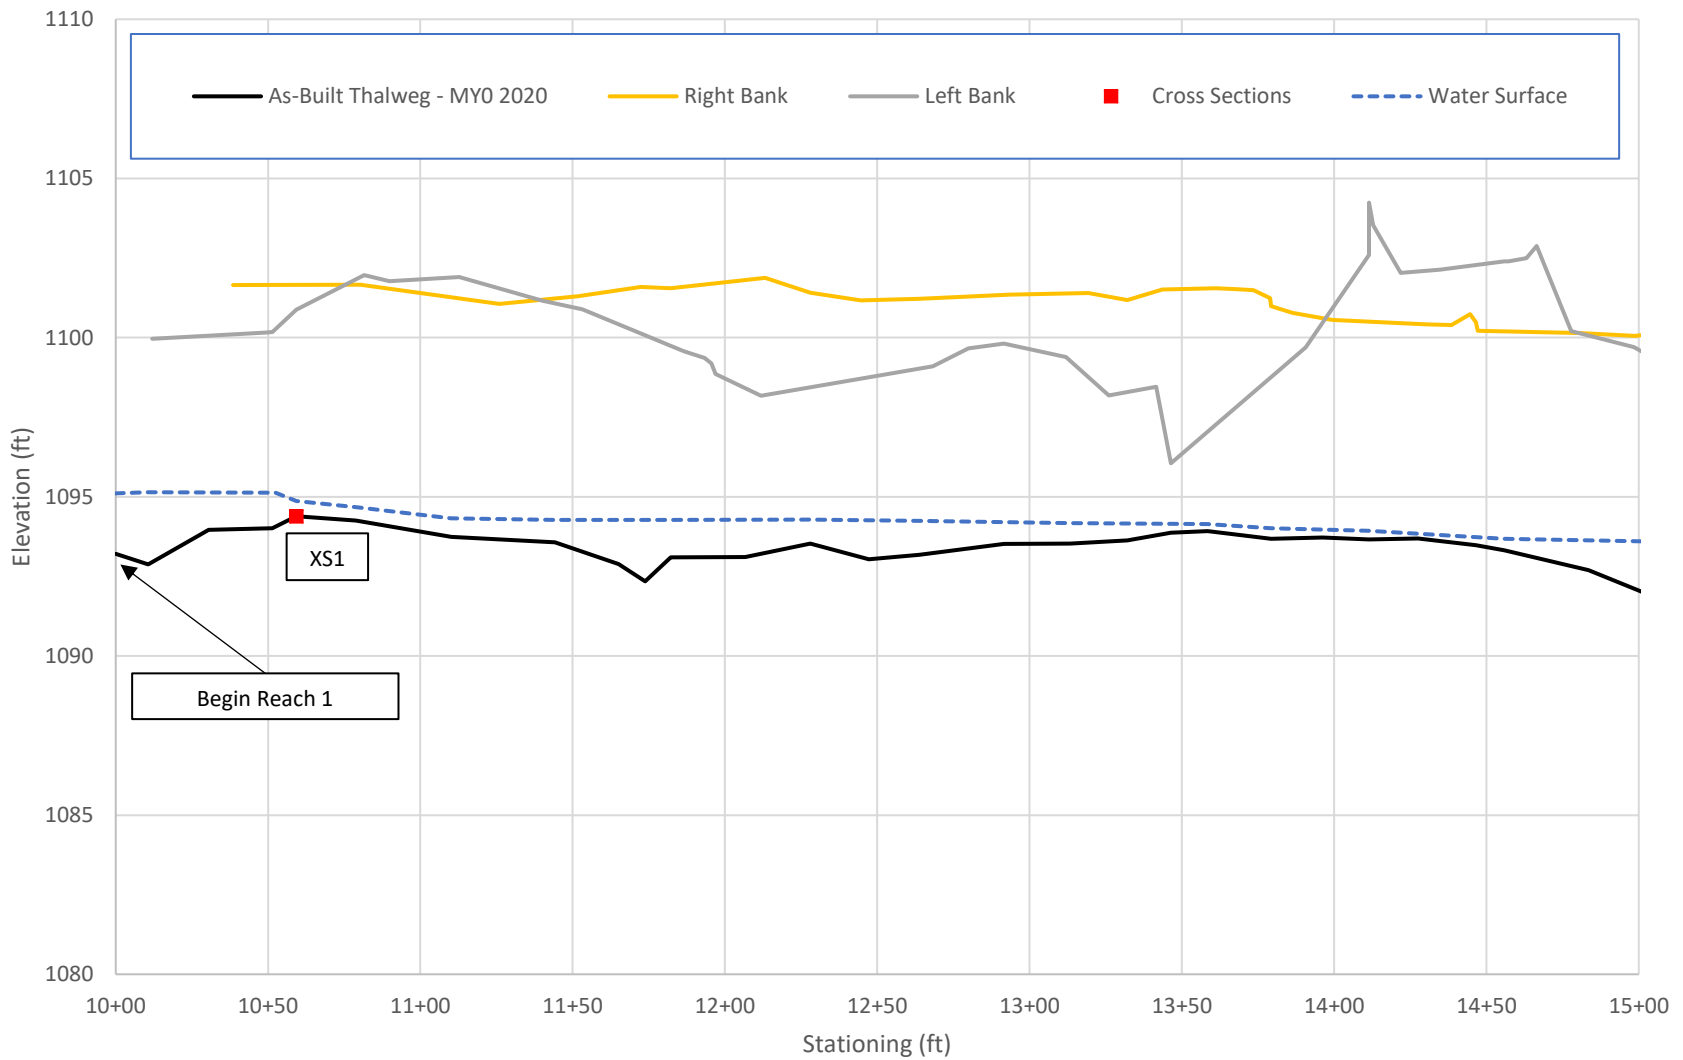


### Longitudinal Profile - Baseline (June 2020) Moores Fork - Sta. 15+00 - 20+00

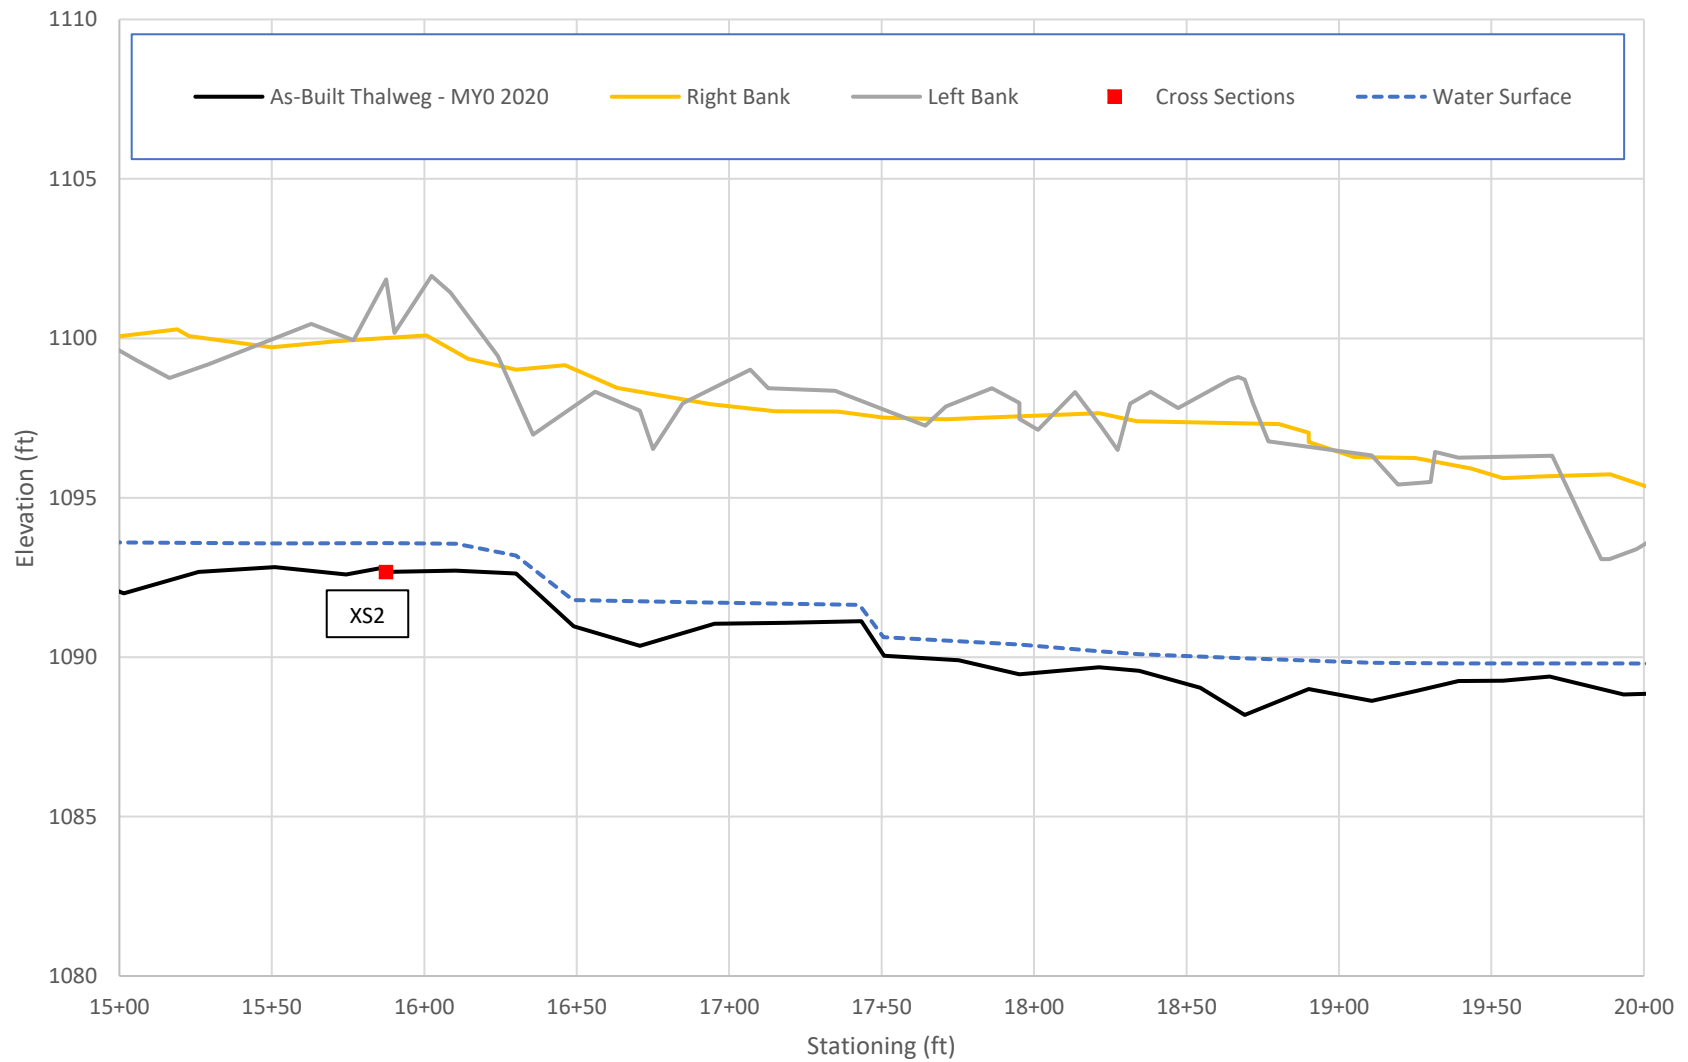


Longitudinal Profile - Baseline (June 2020)  
Moores Fork - Sta. 20+00 - 25+00

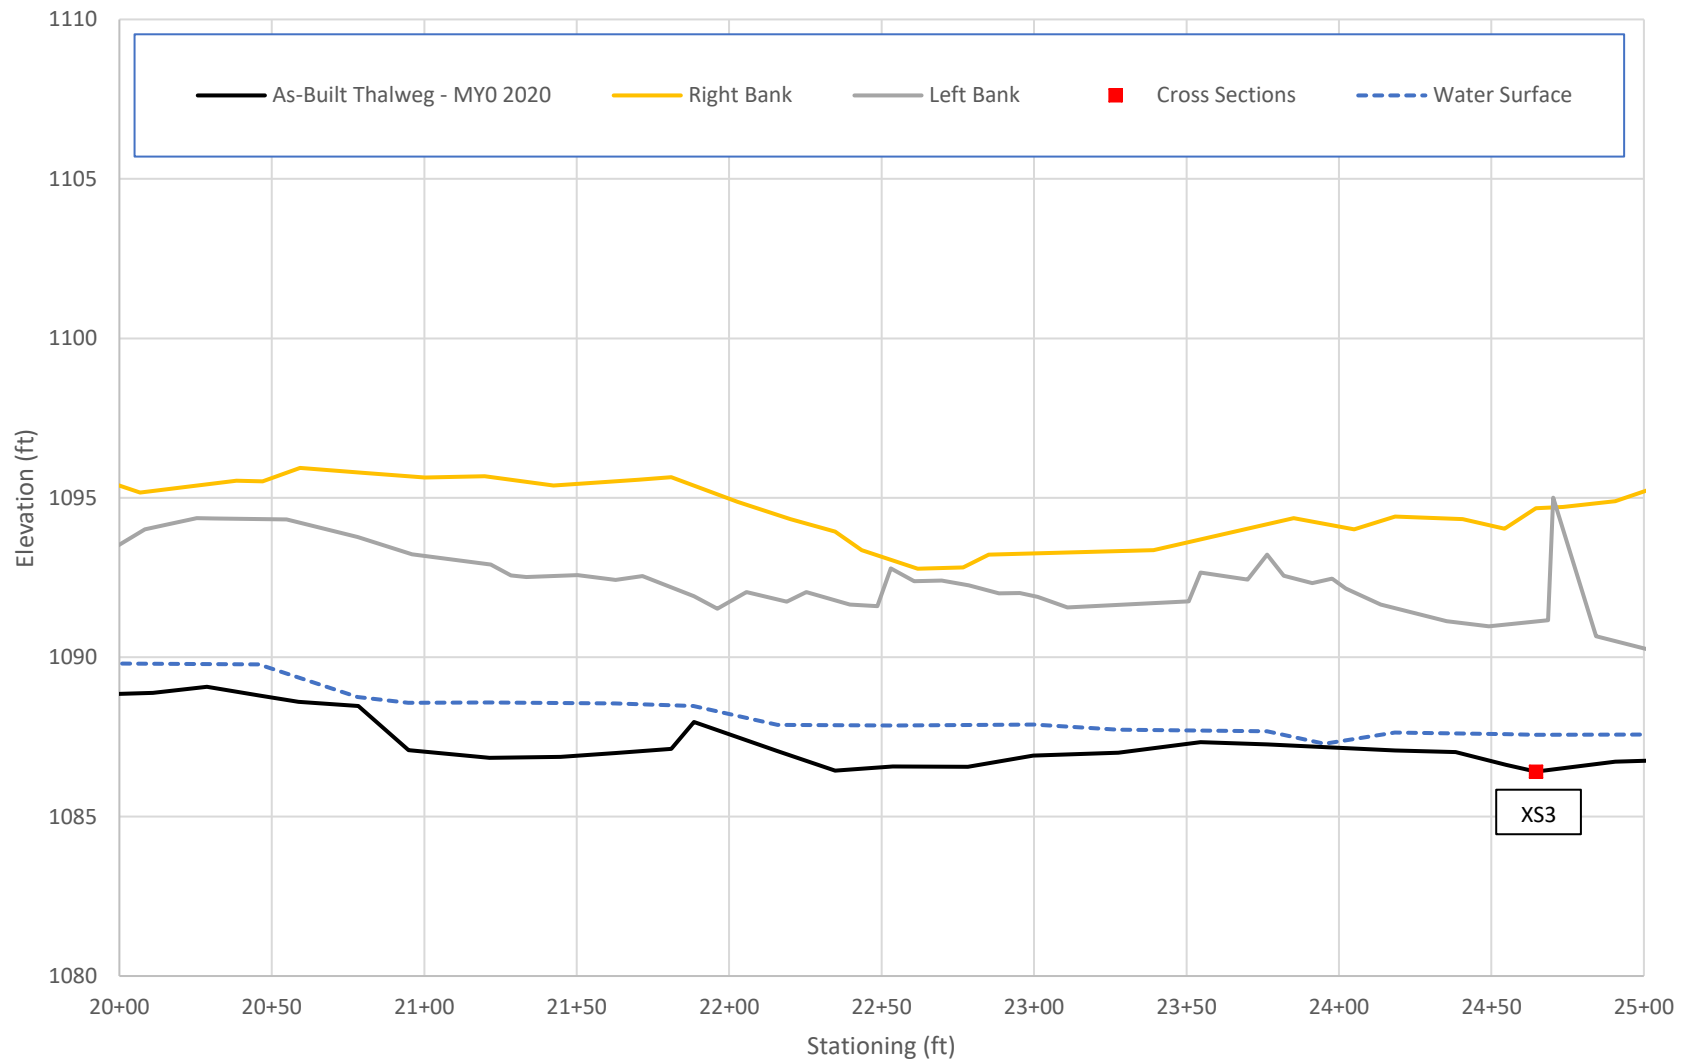

Longitudinal Profile - Baseline (June 2020)  
Moores Fork - Sta. 25+00 - 30+00

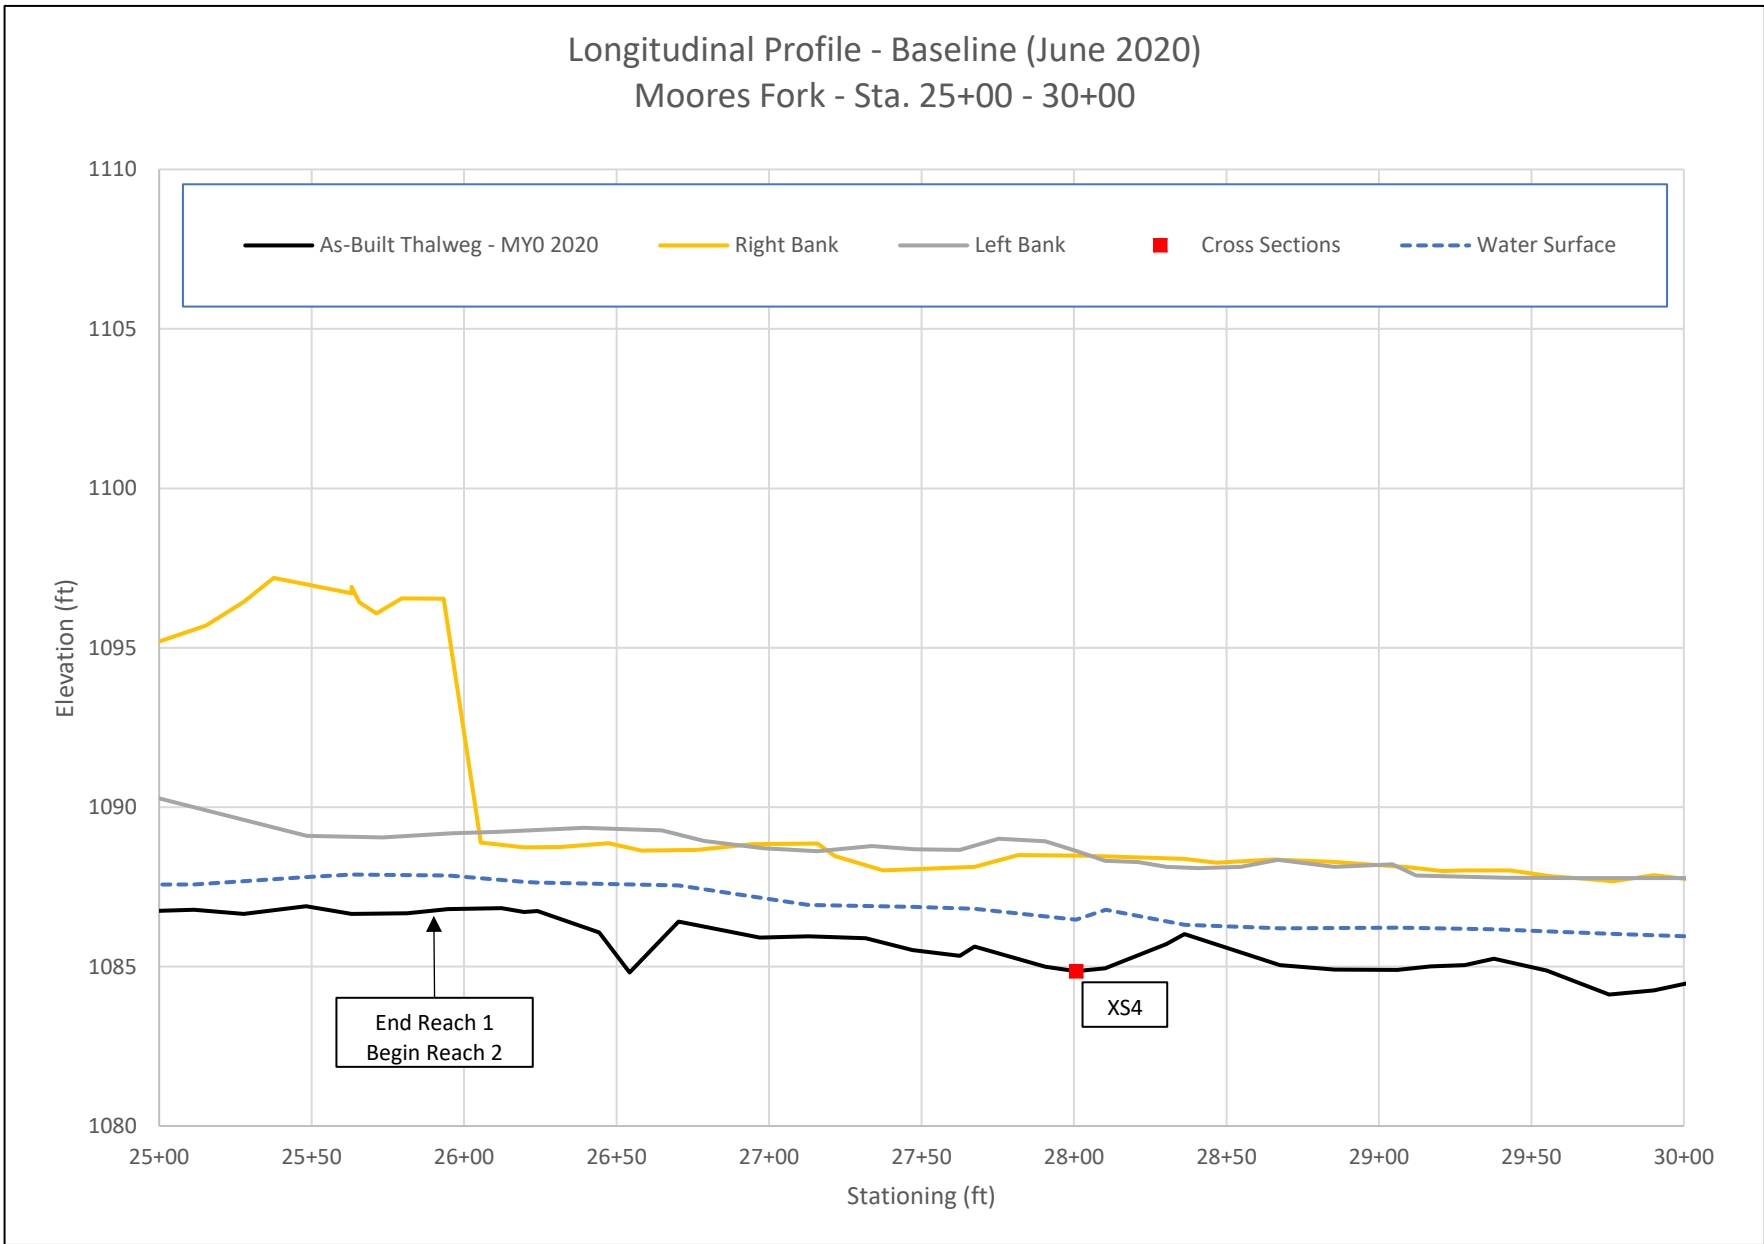


### Longitudinal Profile - Baseline (June 2020) Moores Fork- Sta. 30+00 - 35+00

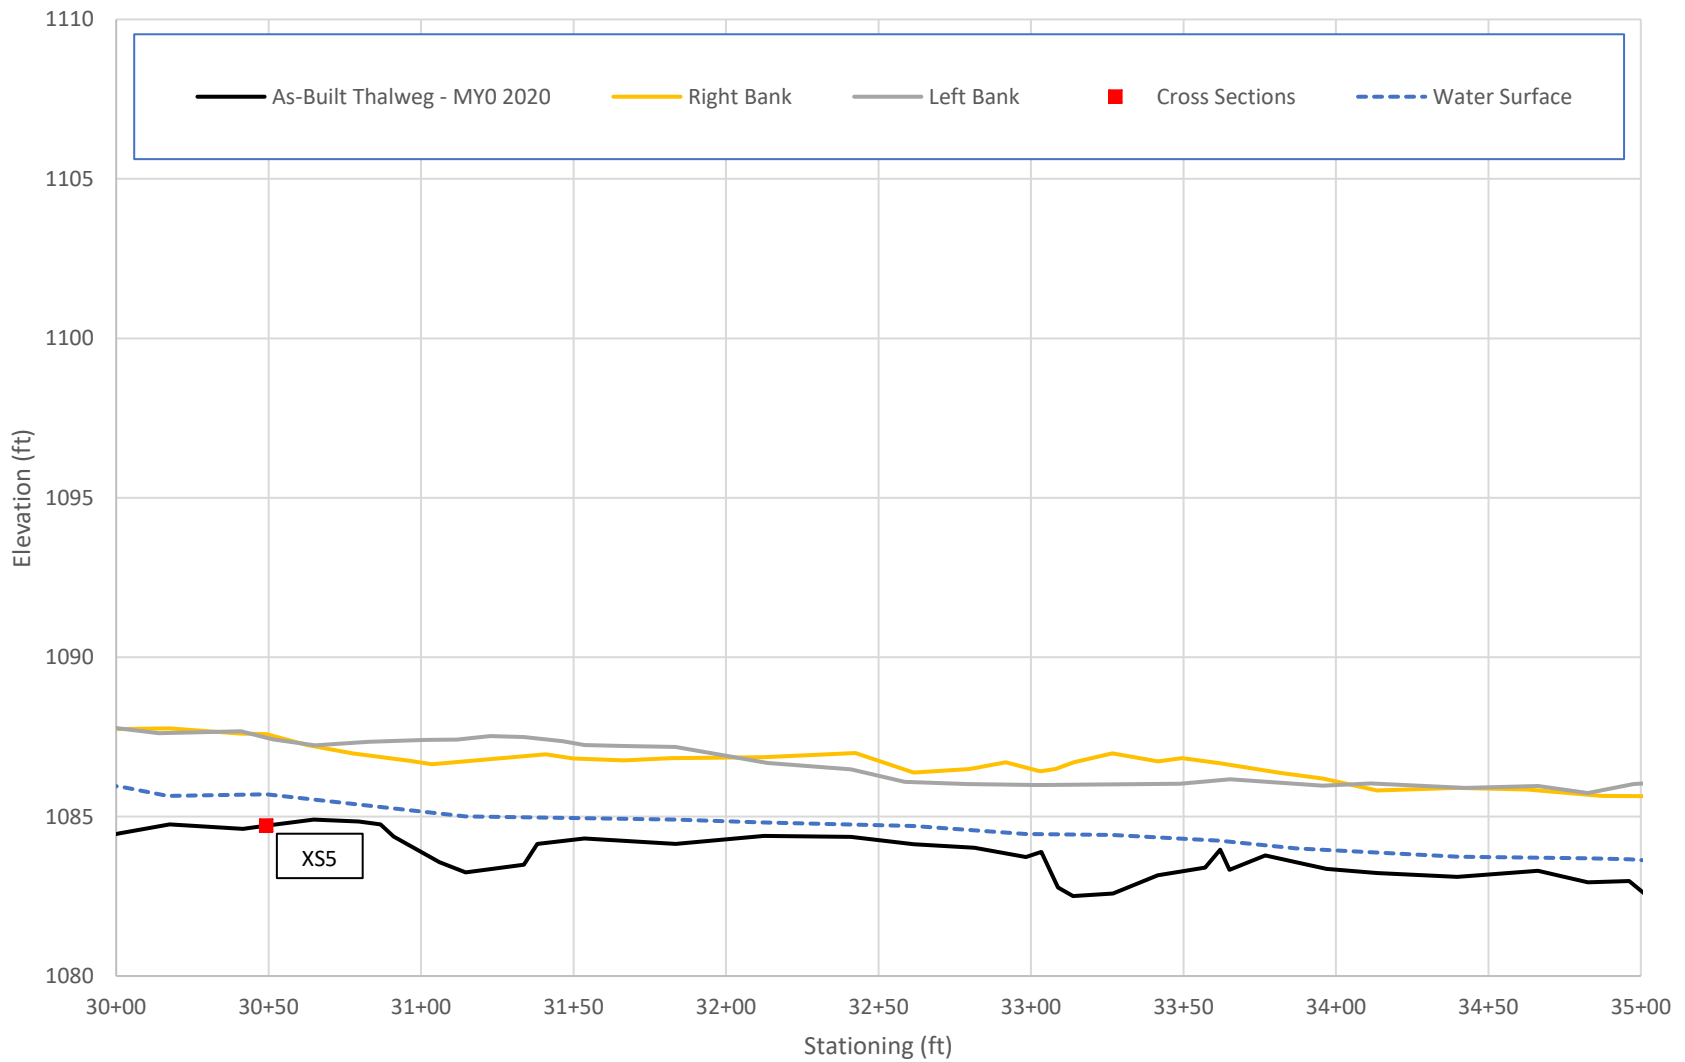





### Longitudinal Profile - Baseline (June 2020) Moores Fork - Sta. 35+00 - 40+00

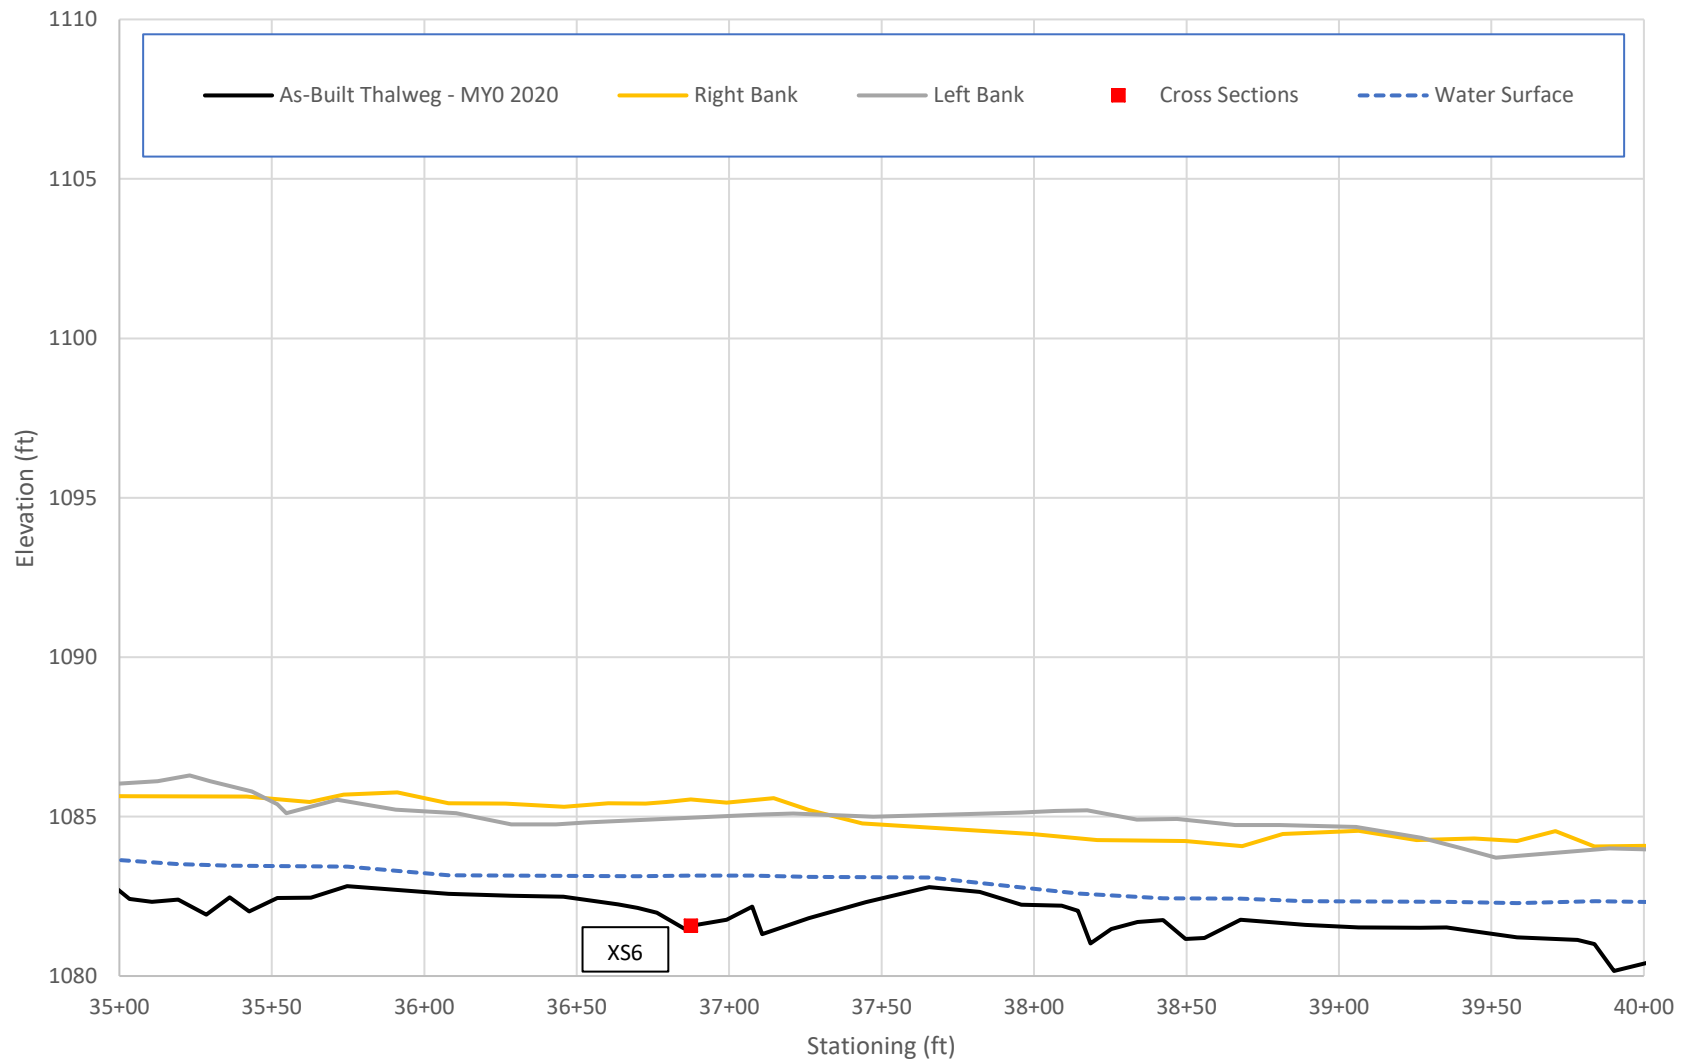

### Longitudinal Profile - Baseline (June 2020) Moores Fork - Sta. 40+00 - 45+00

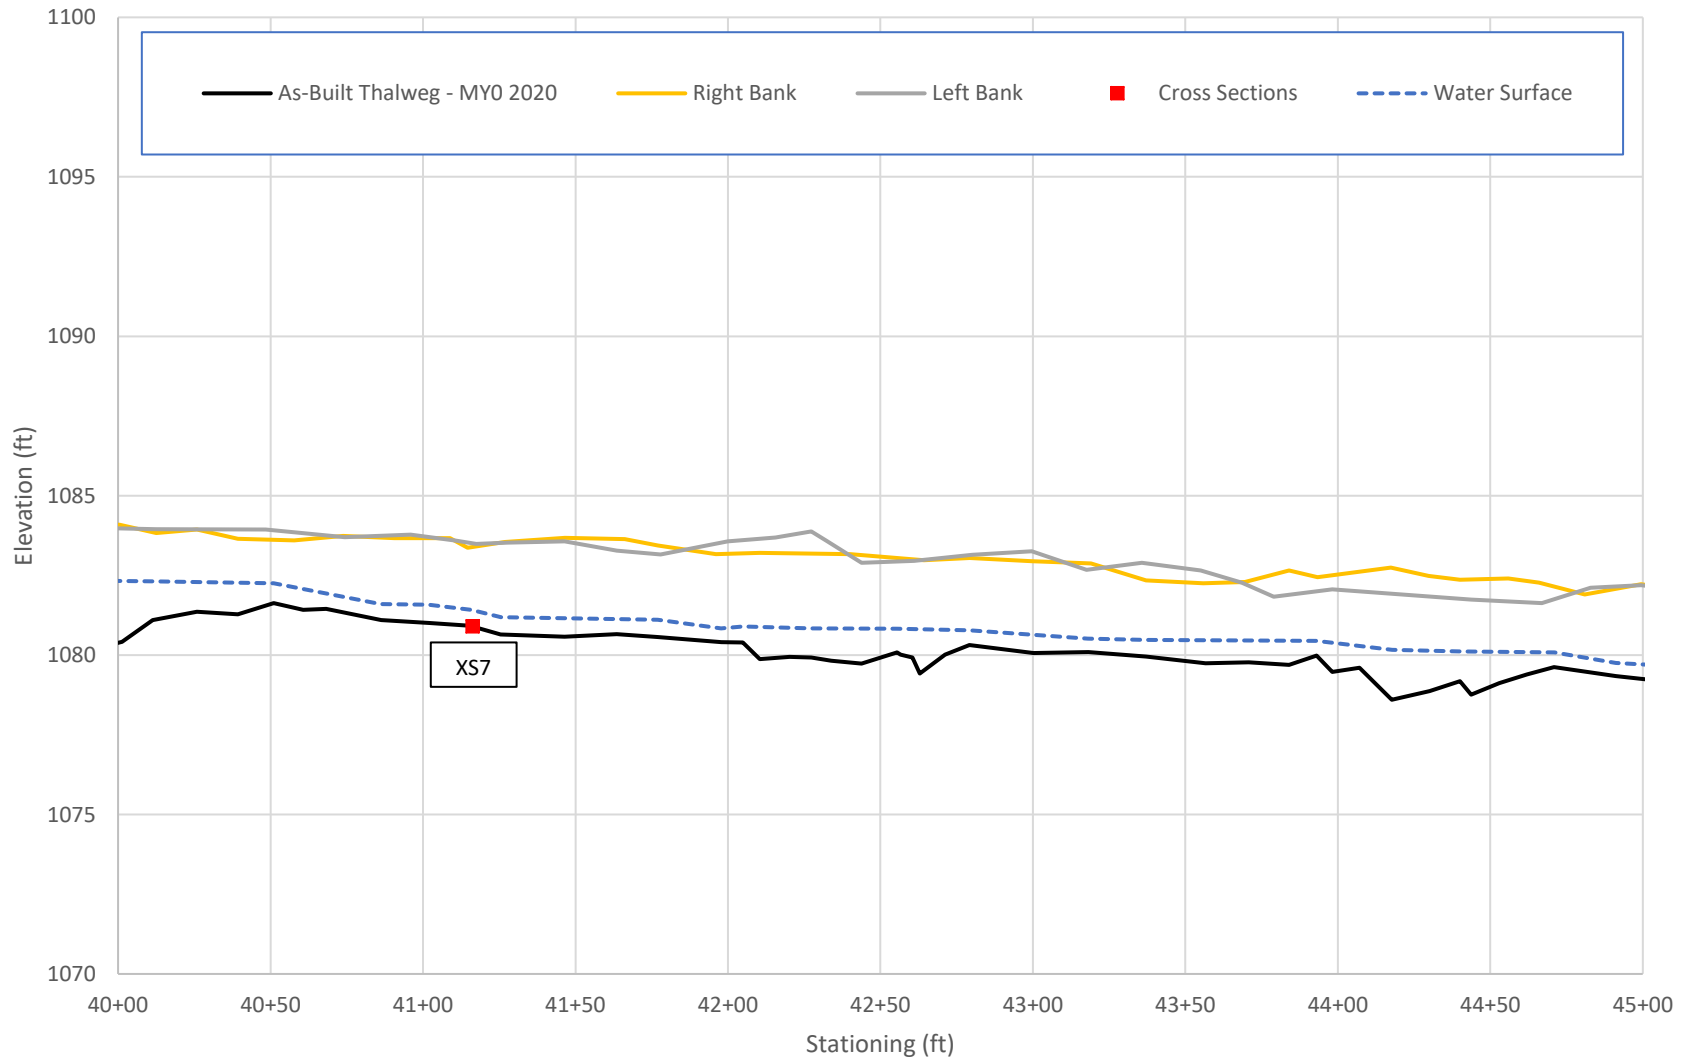


Longitudinal Profile - Baseline (June 2020)  
Moore's Fork - Sta. 45+00 - 50+00

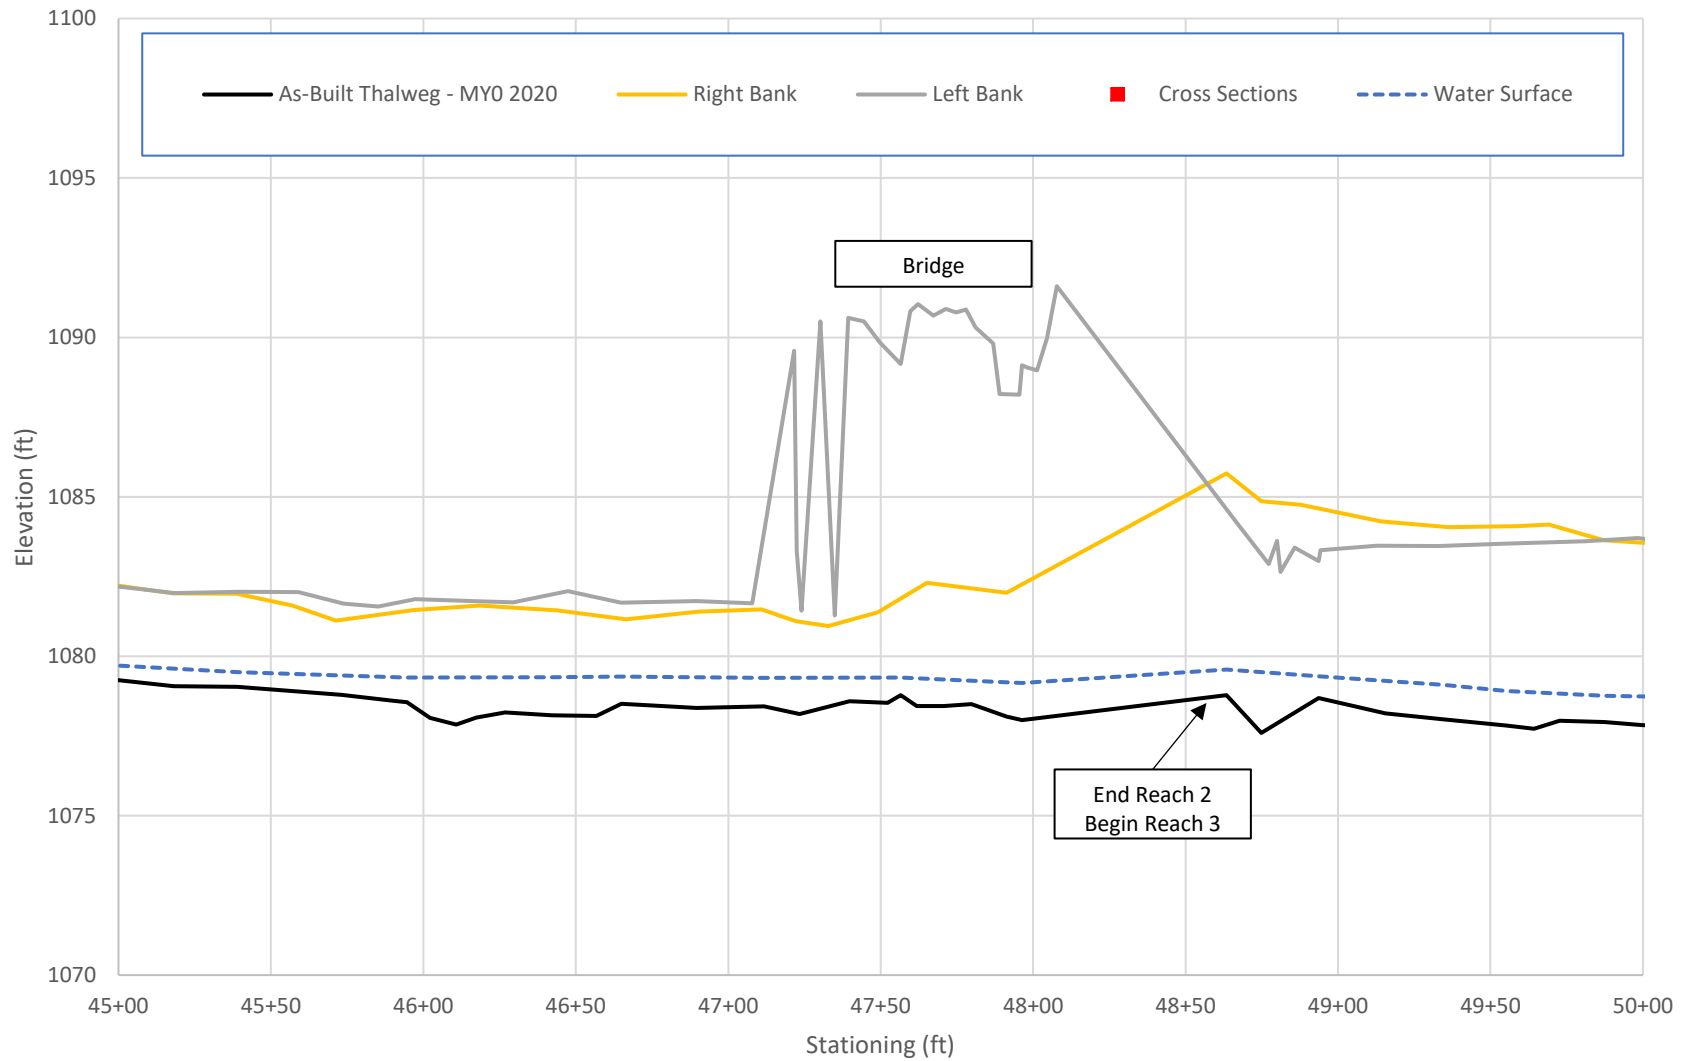


### Longitudinal Profile - Baseline (June 2020) Moores Fork - Sta. 50+00 - 52+34




### Longitudinal Profile - Baseline (June 2020) UT1 - Sta. 10+00 - 15+00

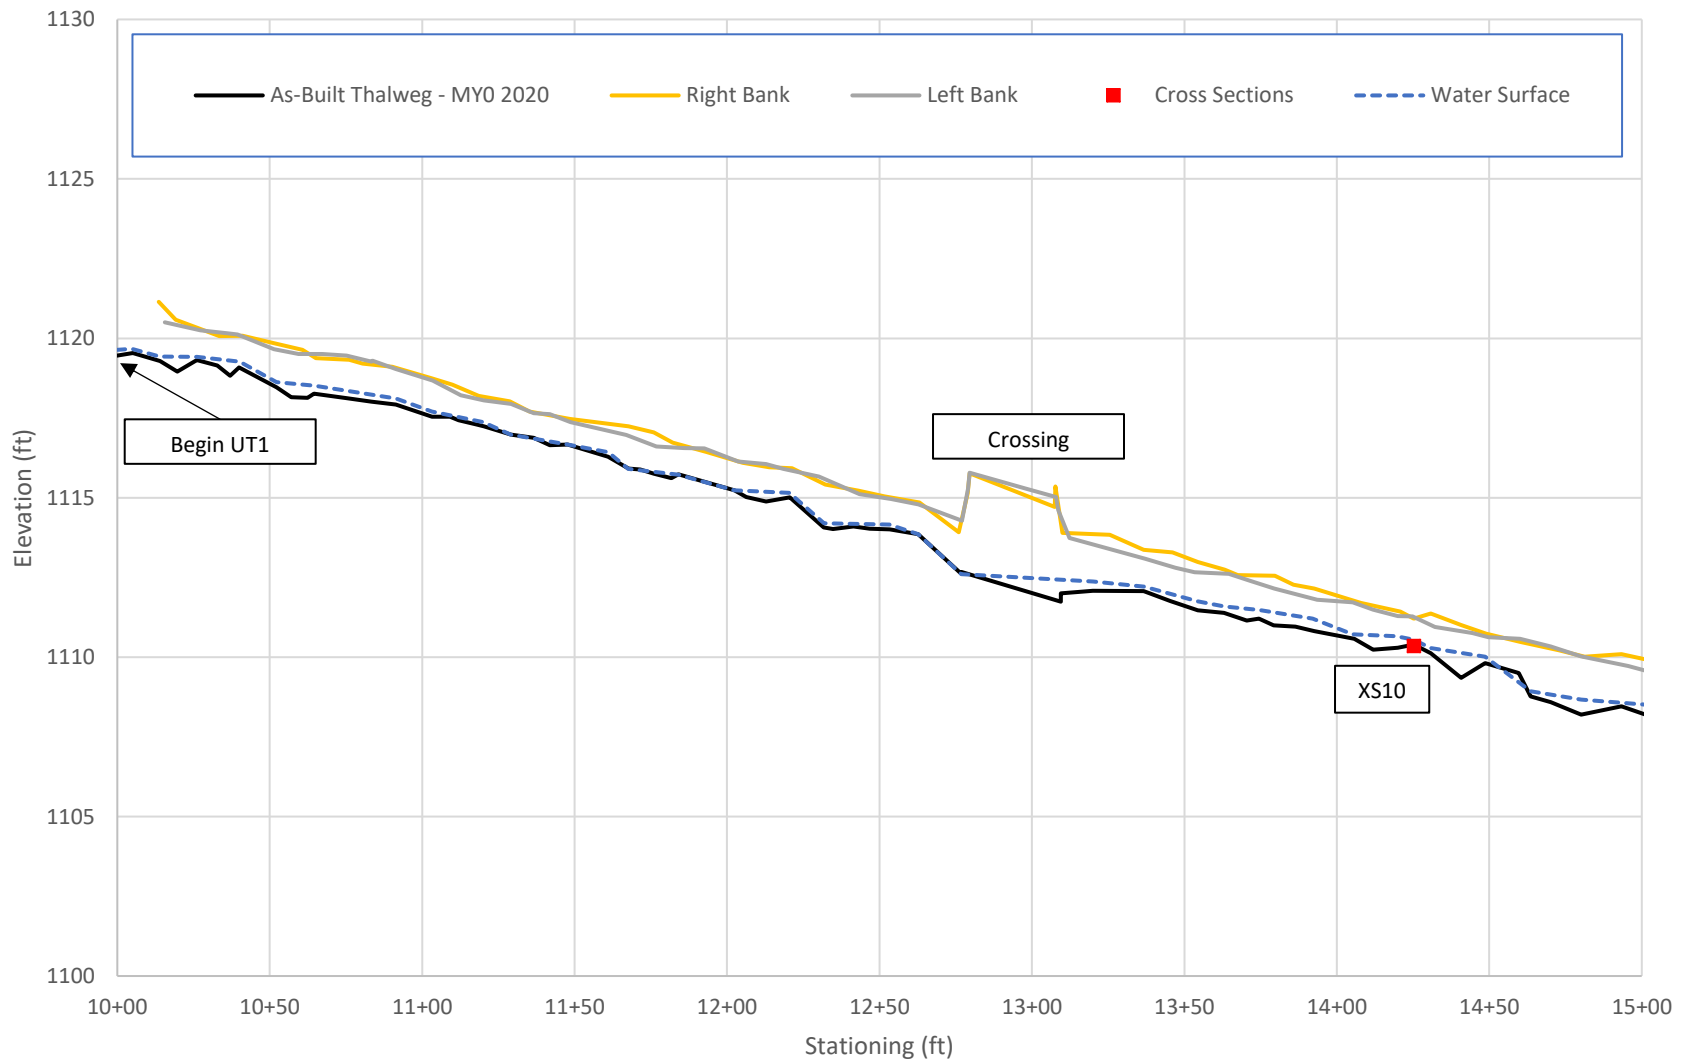


### Longitudinal Profile - Baseline (June 2020) UT1 - Sta. 15+00 - 20+00

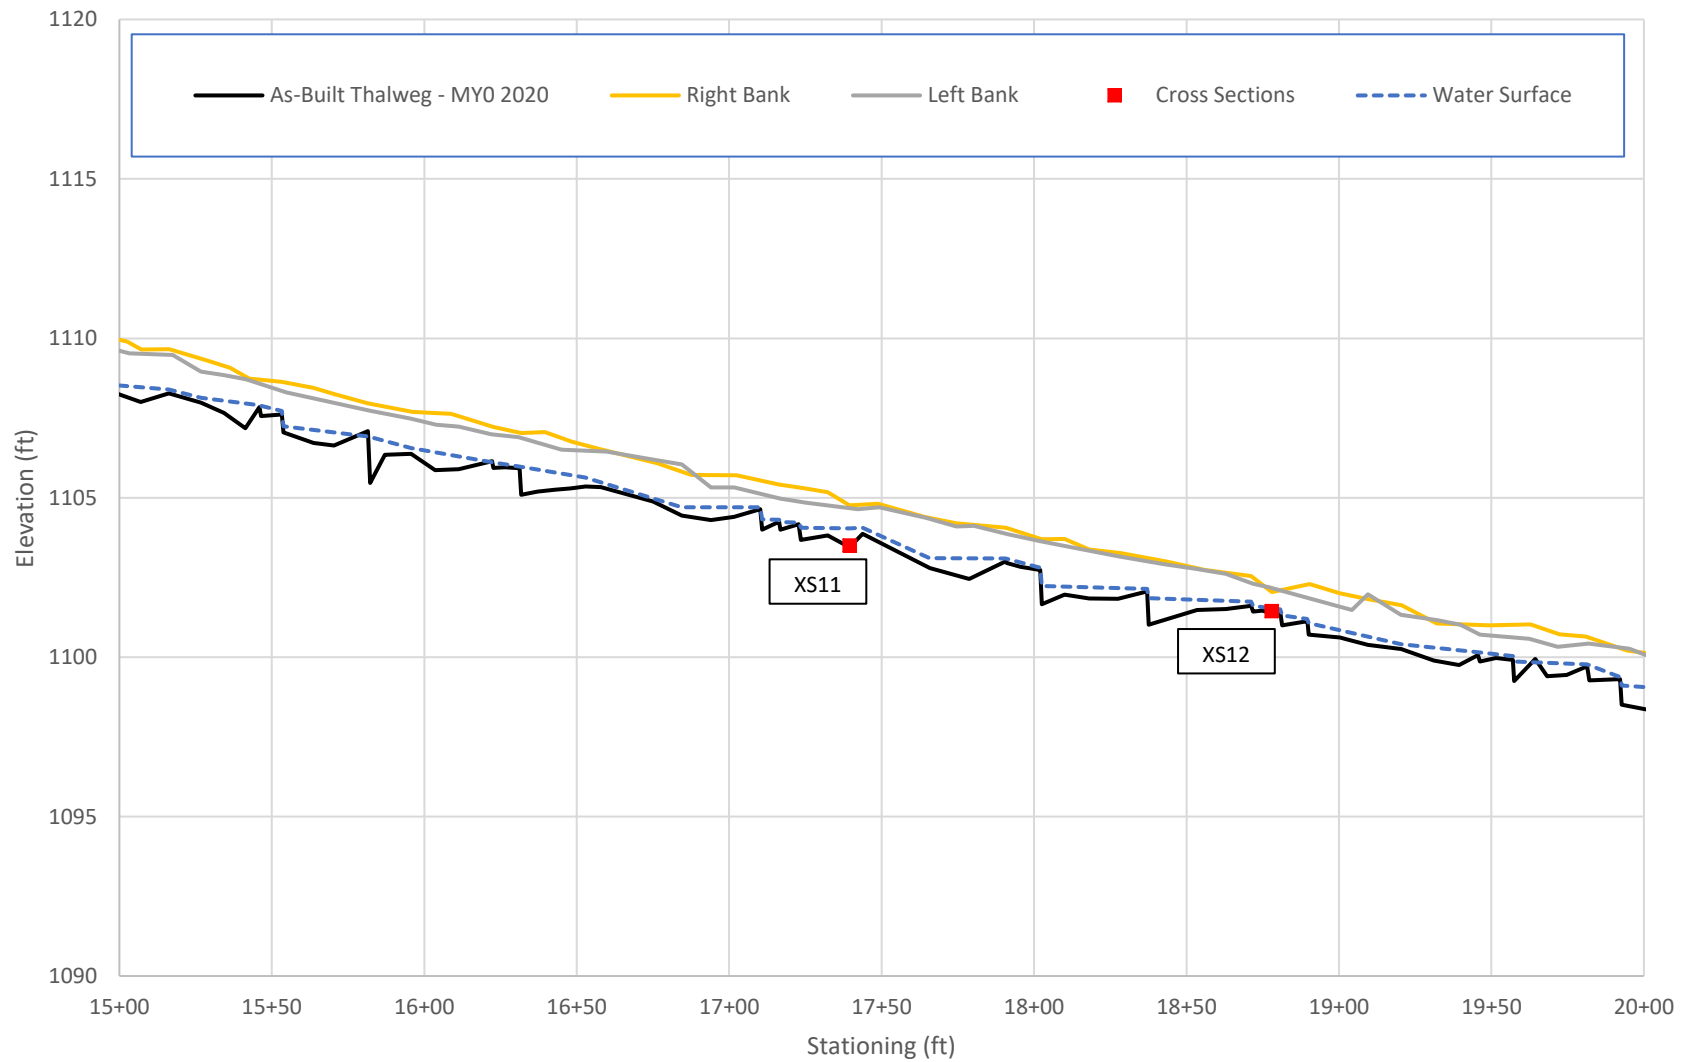

Longitudinal Profile - Baseline (June 2020)  
UT1 - Sta. 20+00 - 25+00

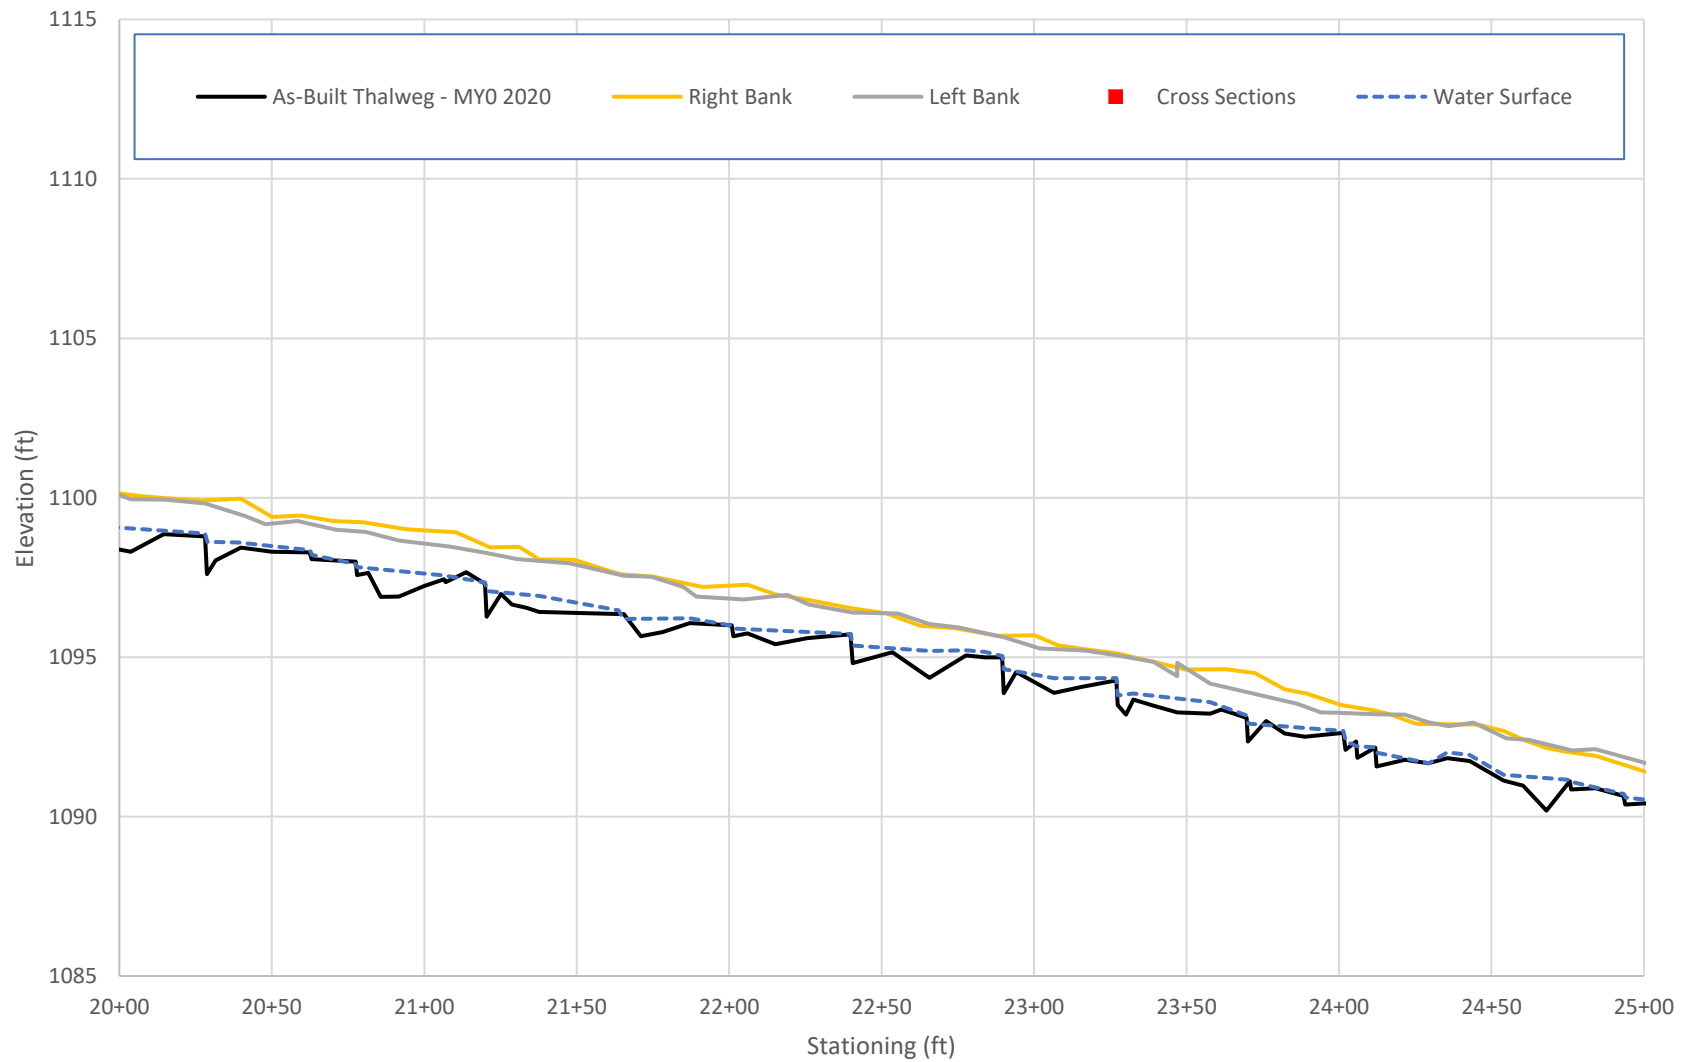


Longitudinal Profile - Baseline (June 2020)  
UT1 - Sta. 25+00 - 30+00

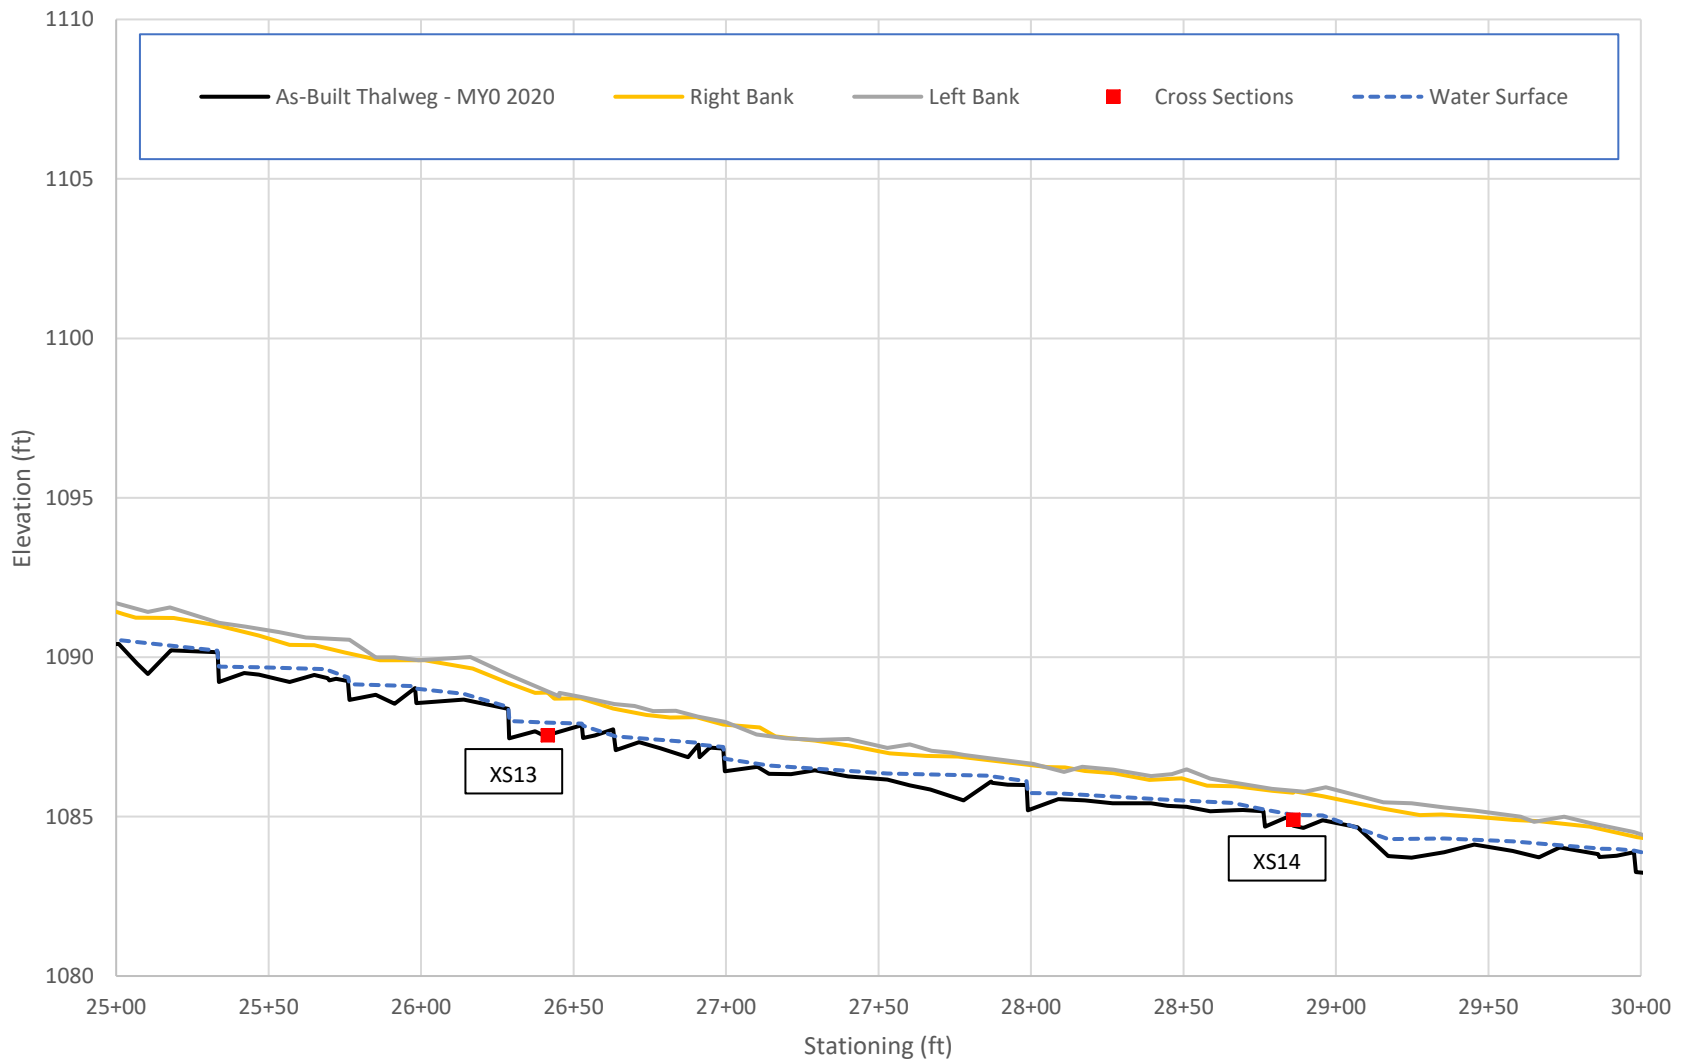





### Longitudinal Profile - Baseline (June 2020) UT1 - Sta. 30+00 - 35+00

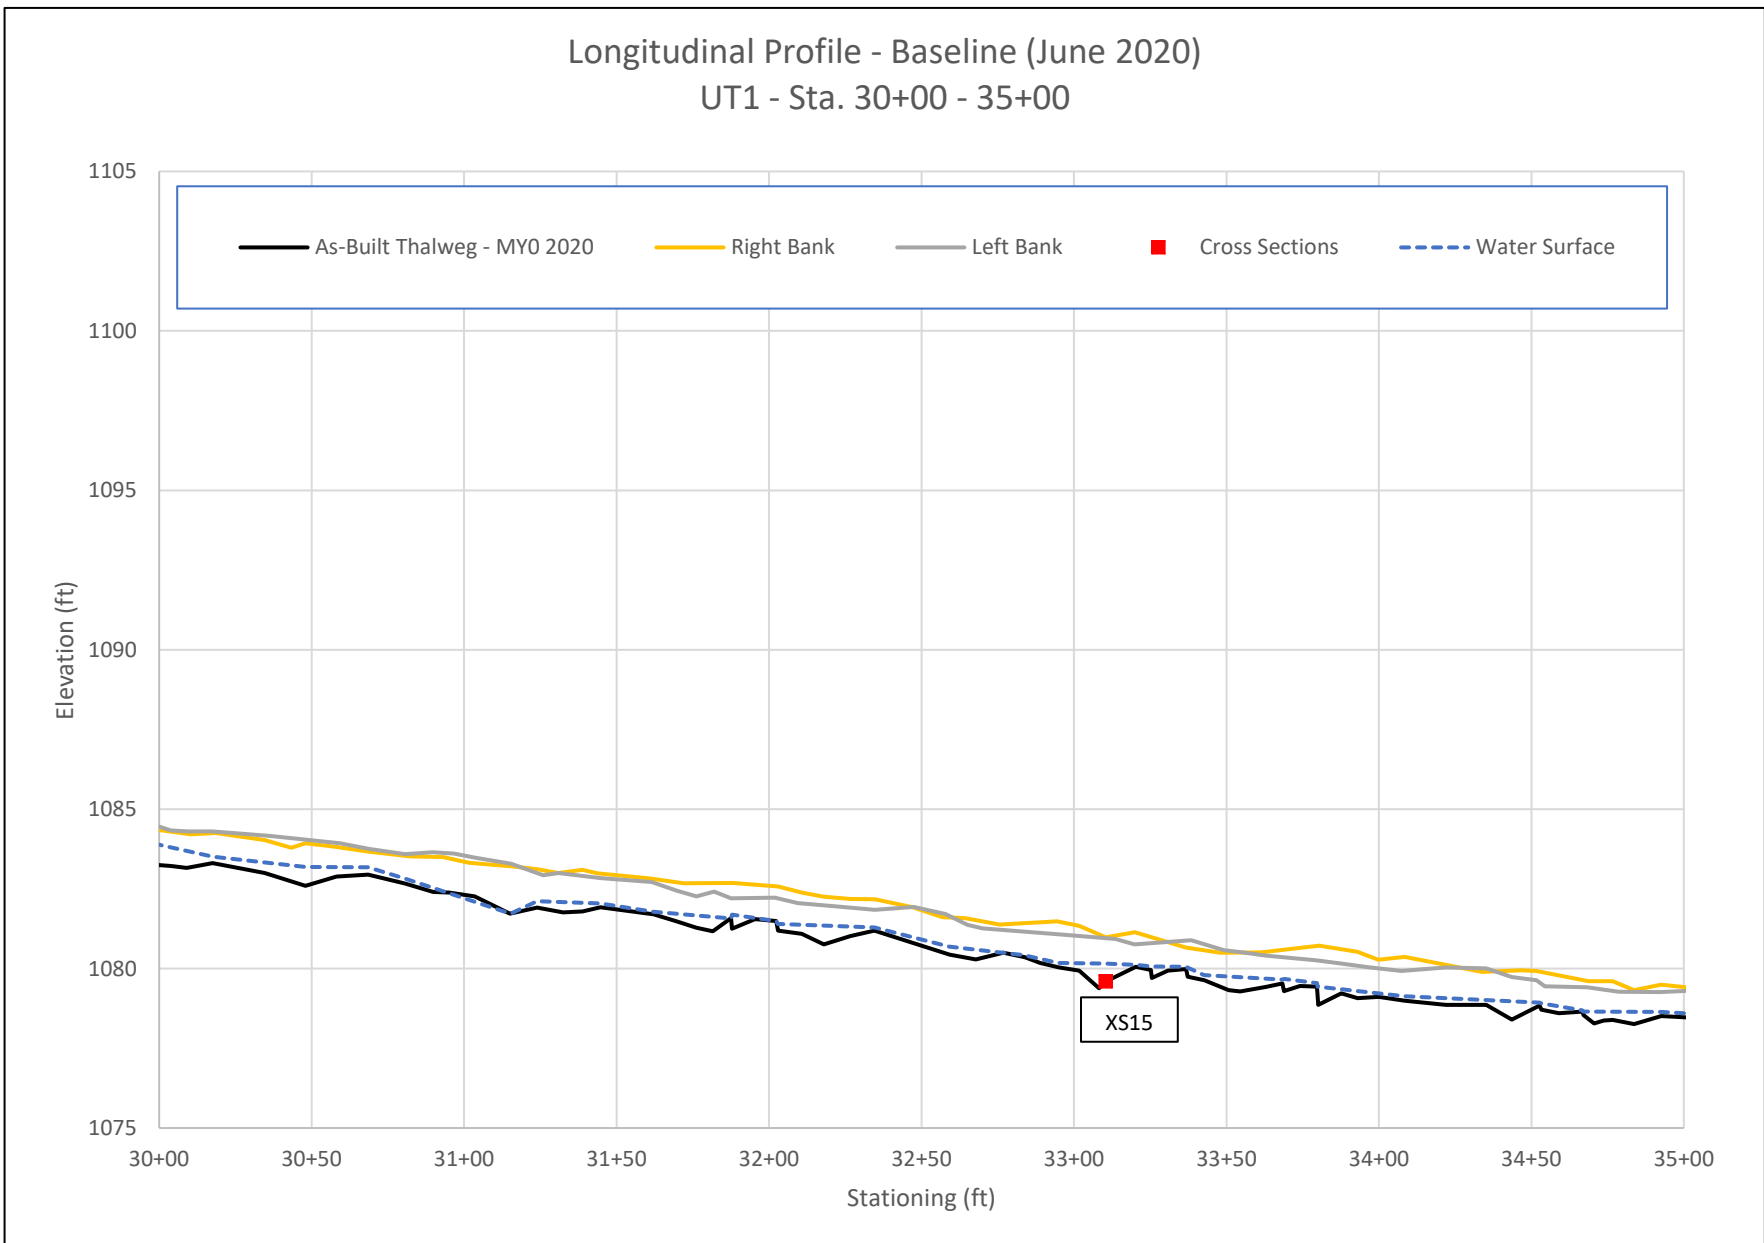


### Longitudinal Profile - Baseline (June 2020) UT1 - Sta. 35+00 - 37+71

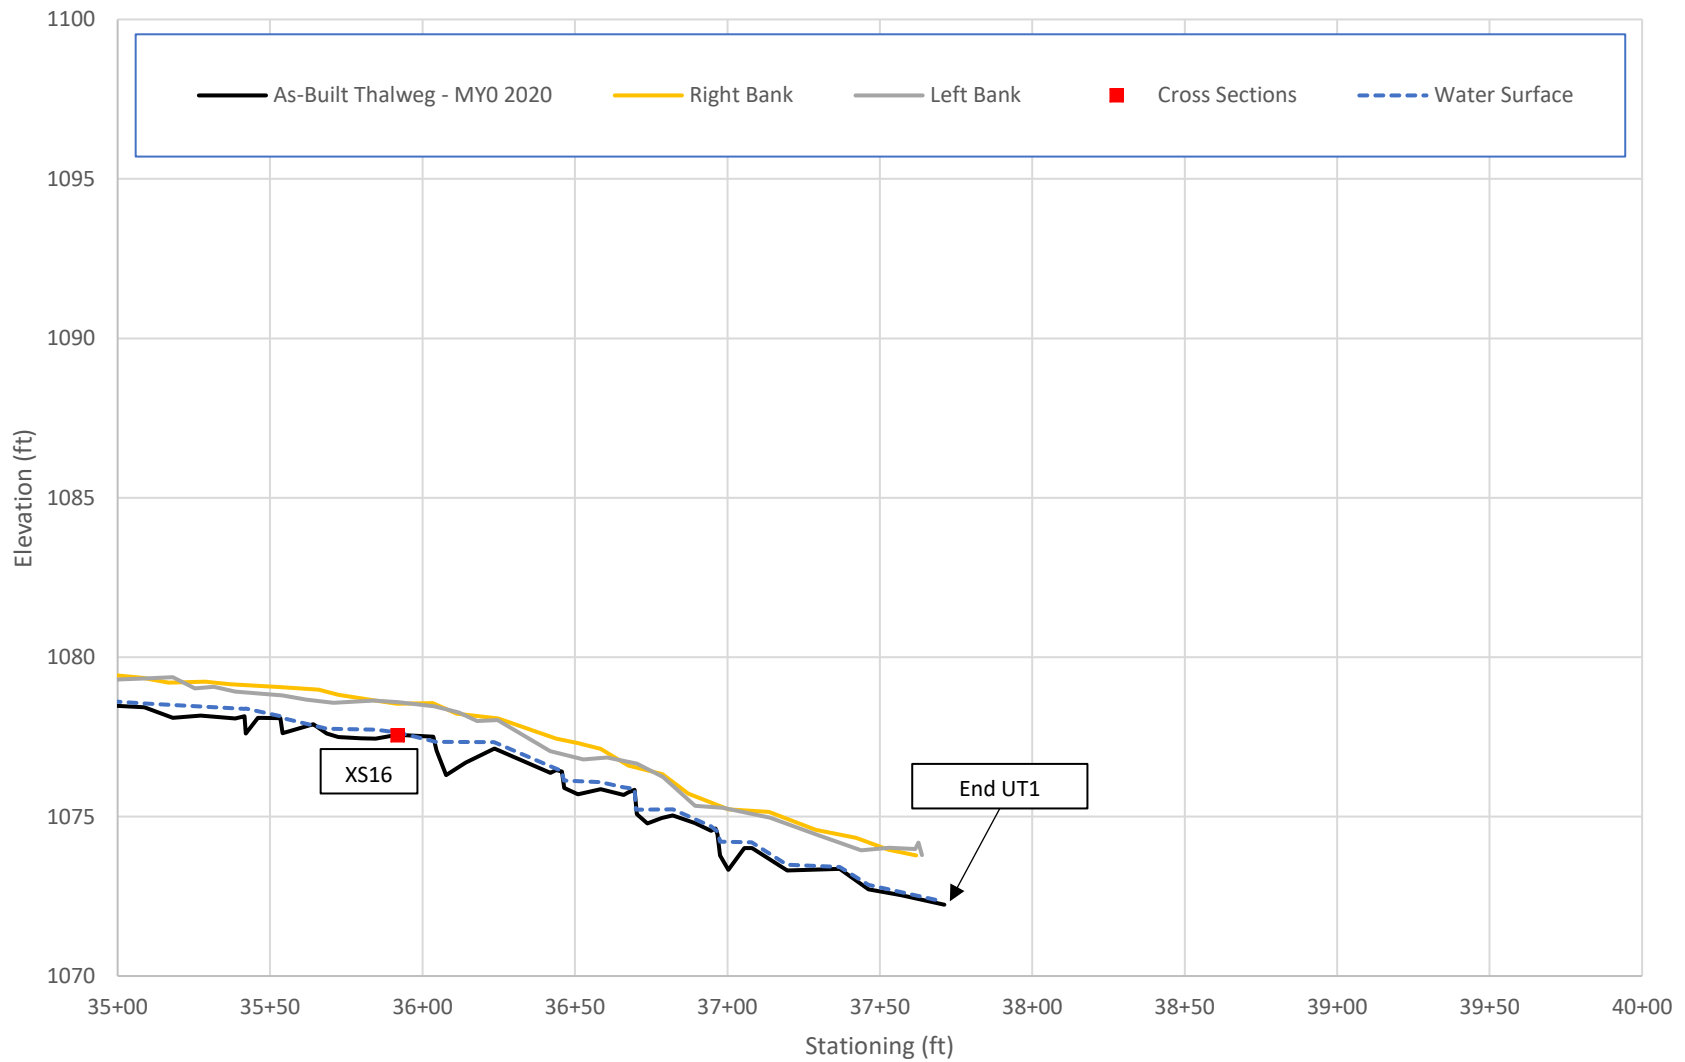


### Longitudinal Profile - Baseline (June 2020) UT2 - Sta. 10+00 - 15+00

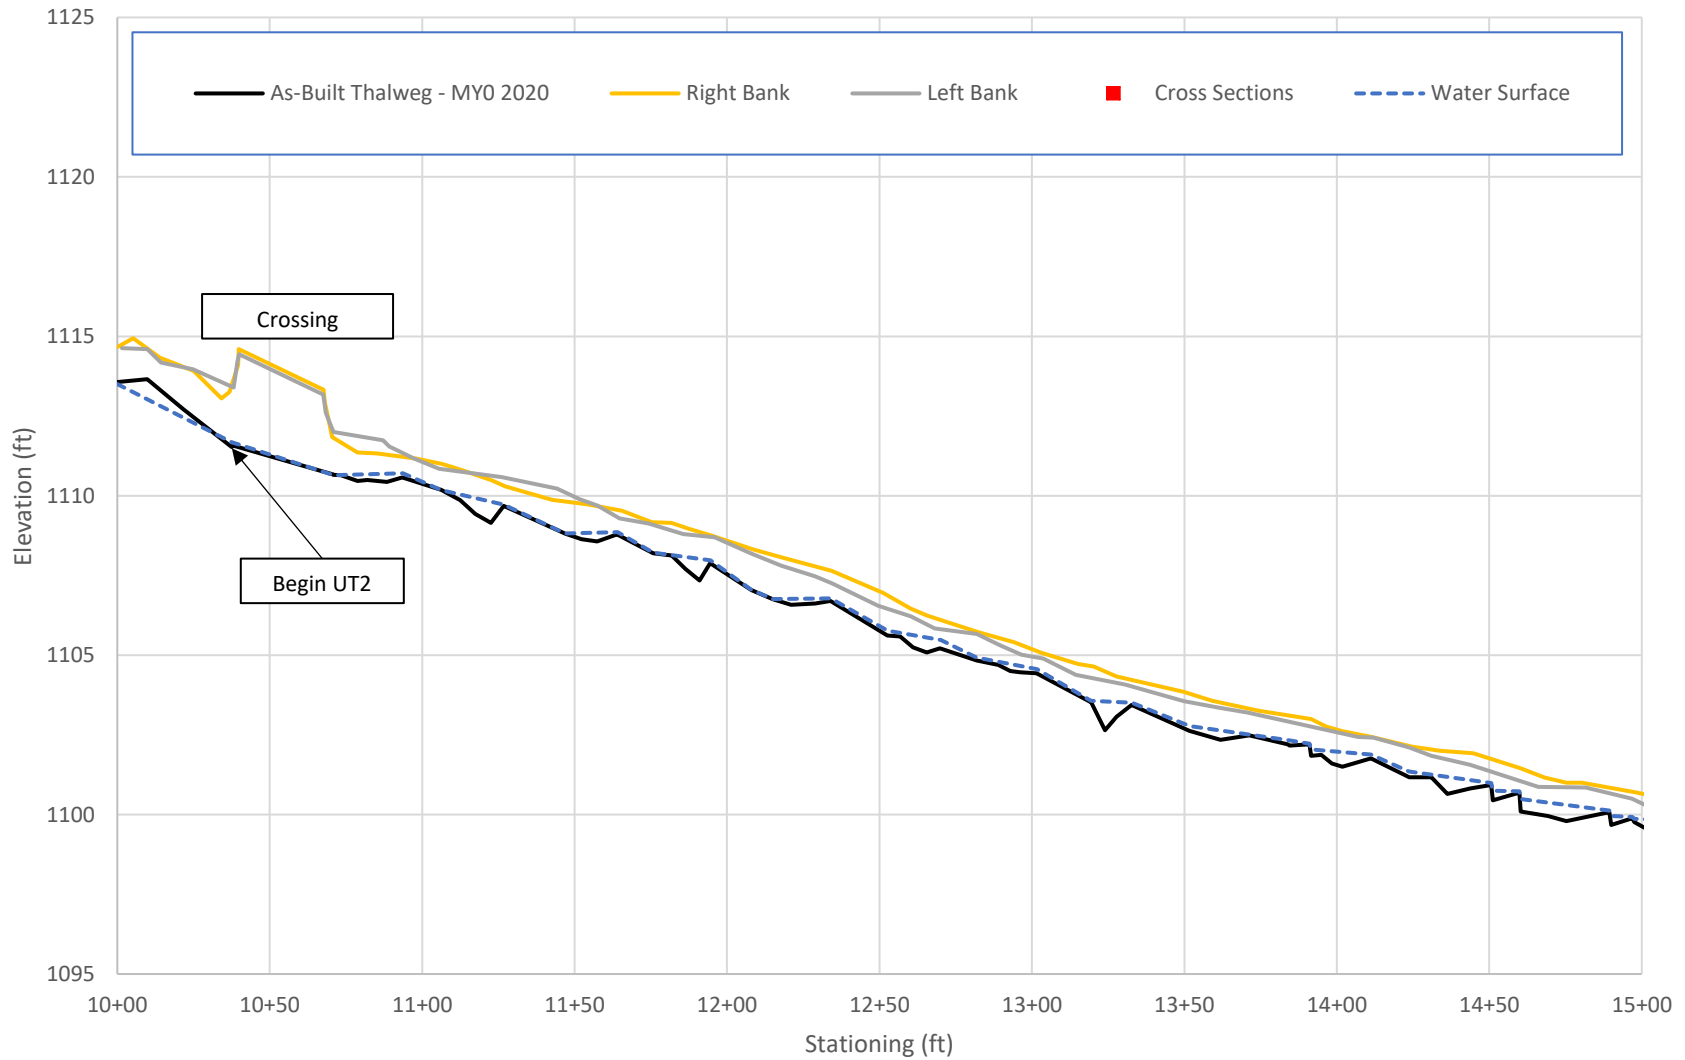


Longitudinal Profile - Baseline (June 2020)  
UT2 - Sta. 15+00 - 20+00

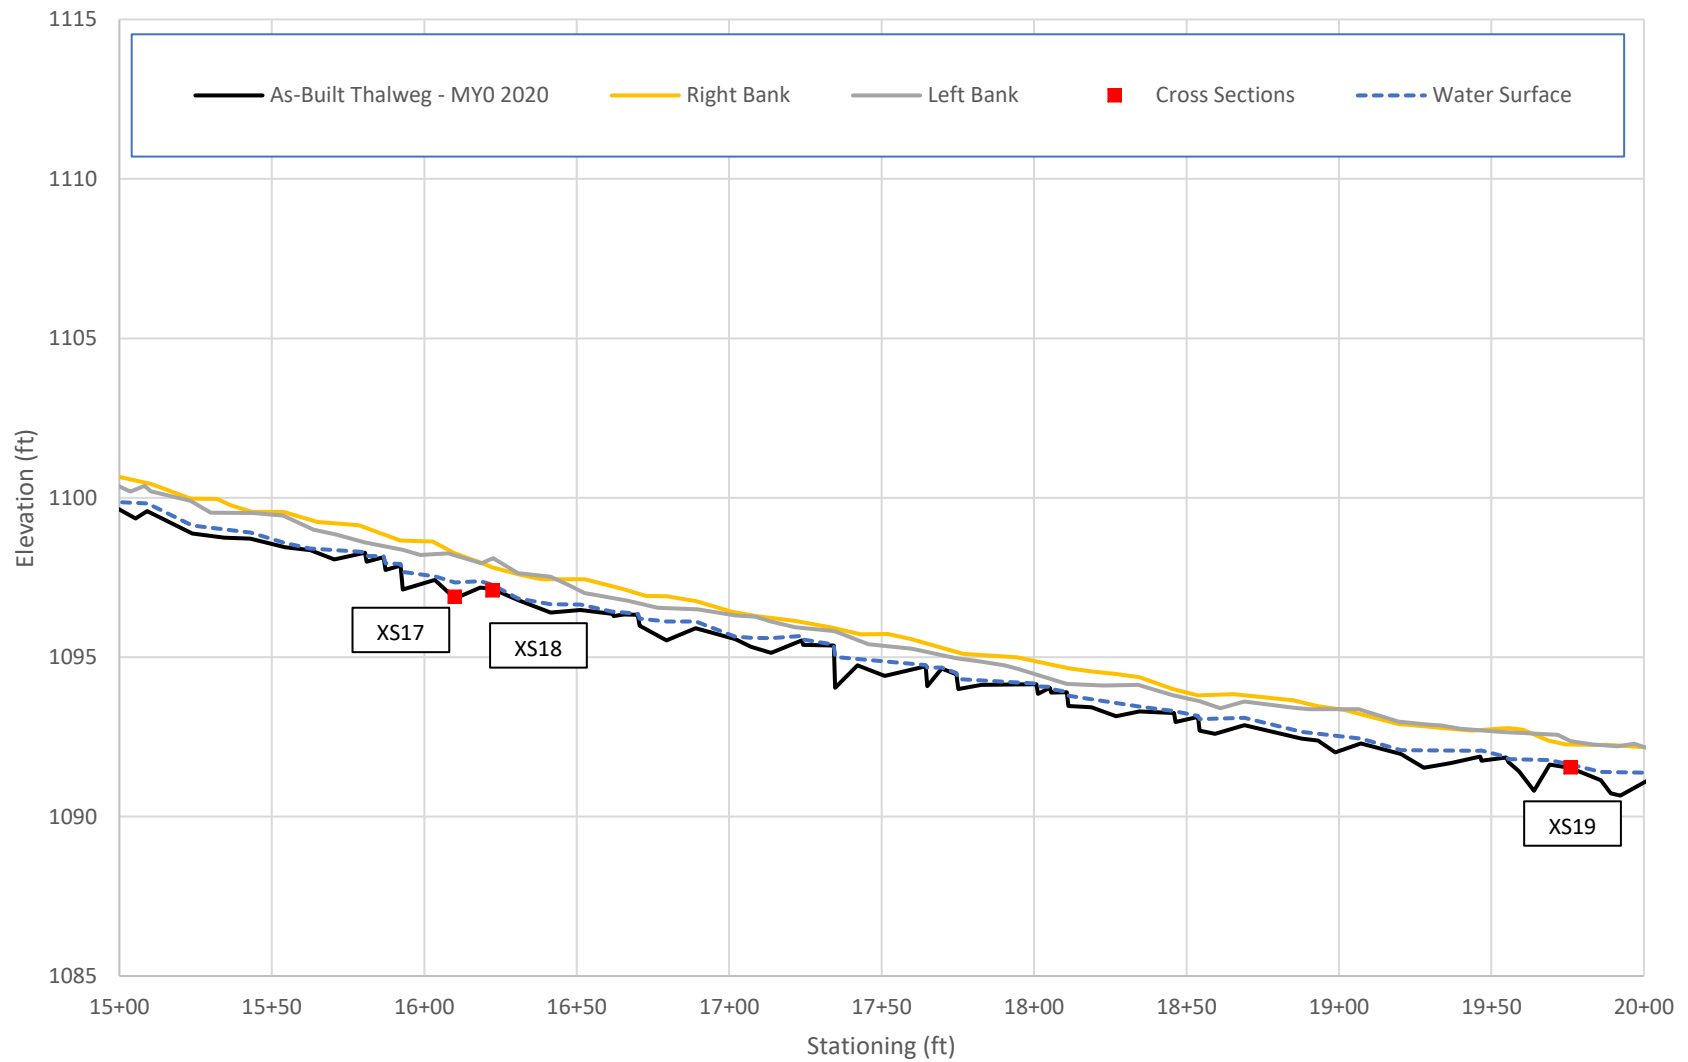


### Longitudinal Profile - Baseline (June 2020) UT2 - Sta. 20+00 - 20+48

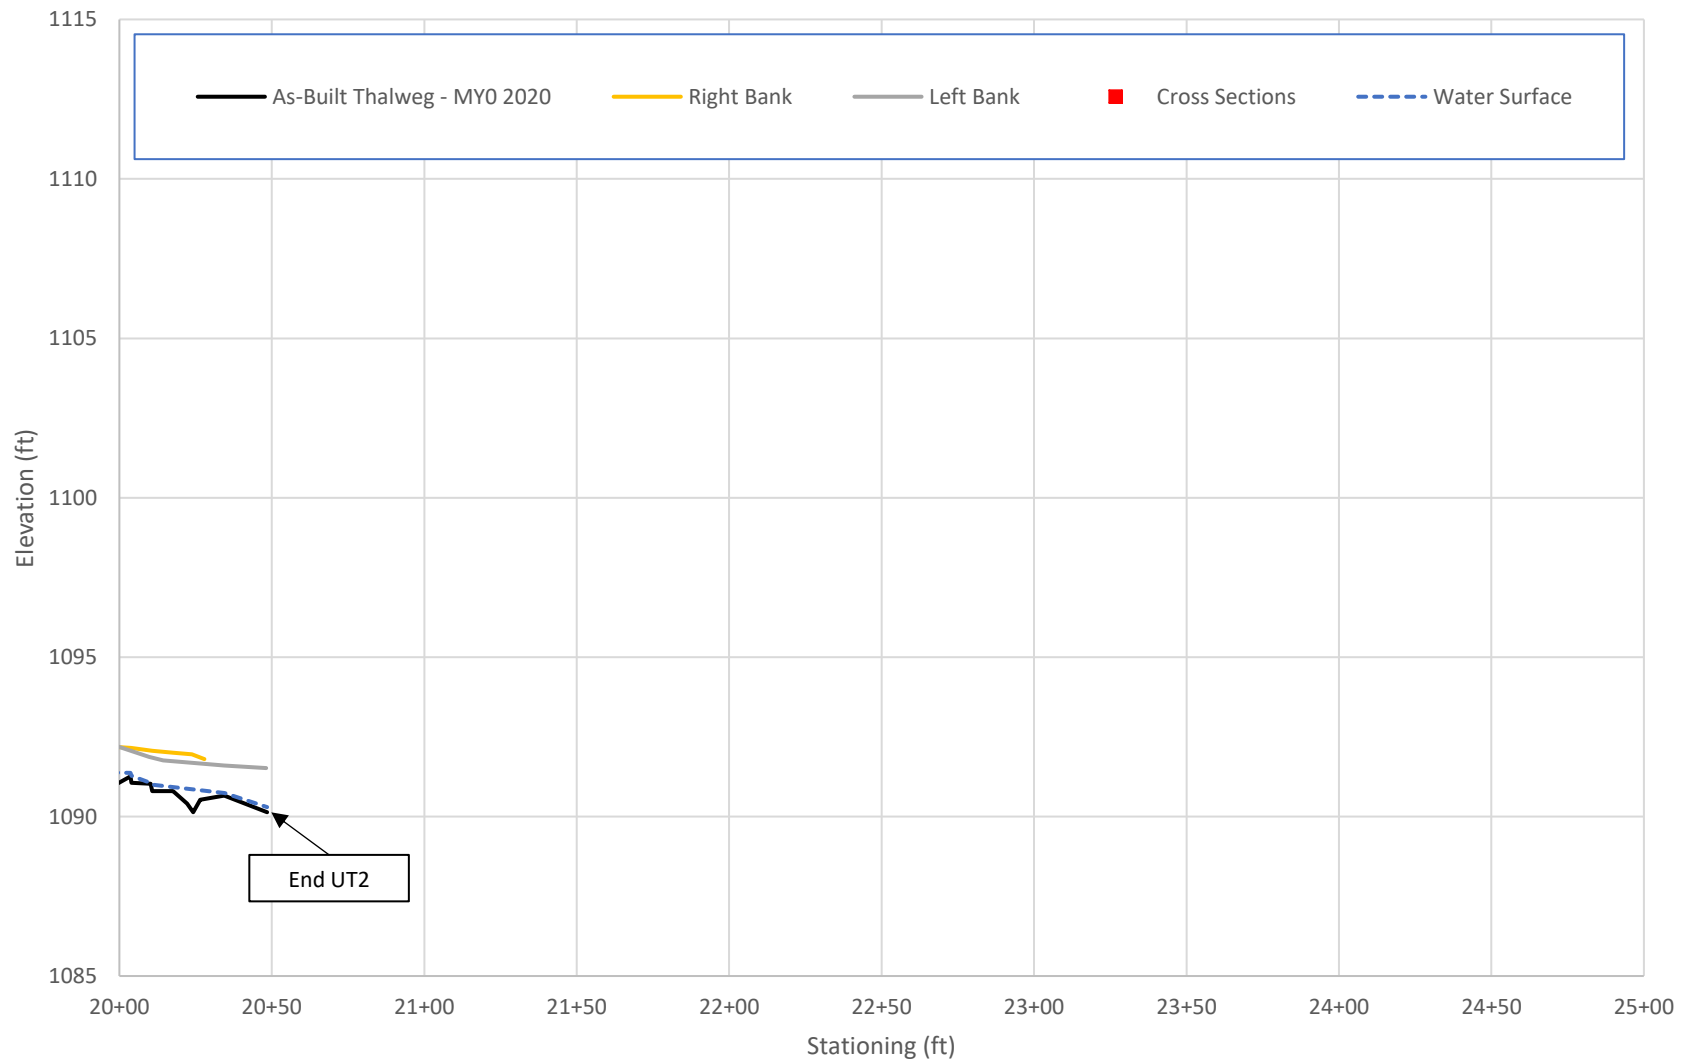


### Longitudinal Profile - Baseline (June 2020) UT3 - Sta. 10+00 - 15+00

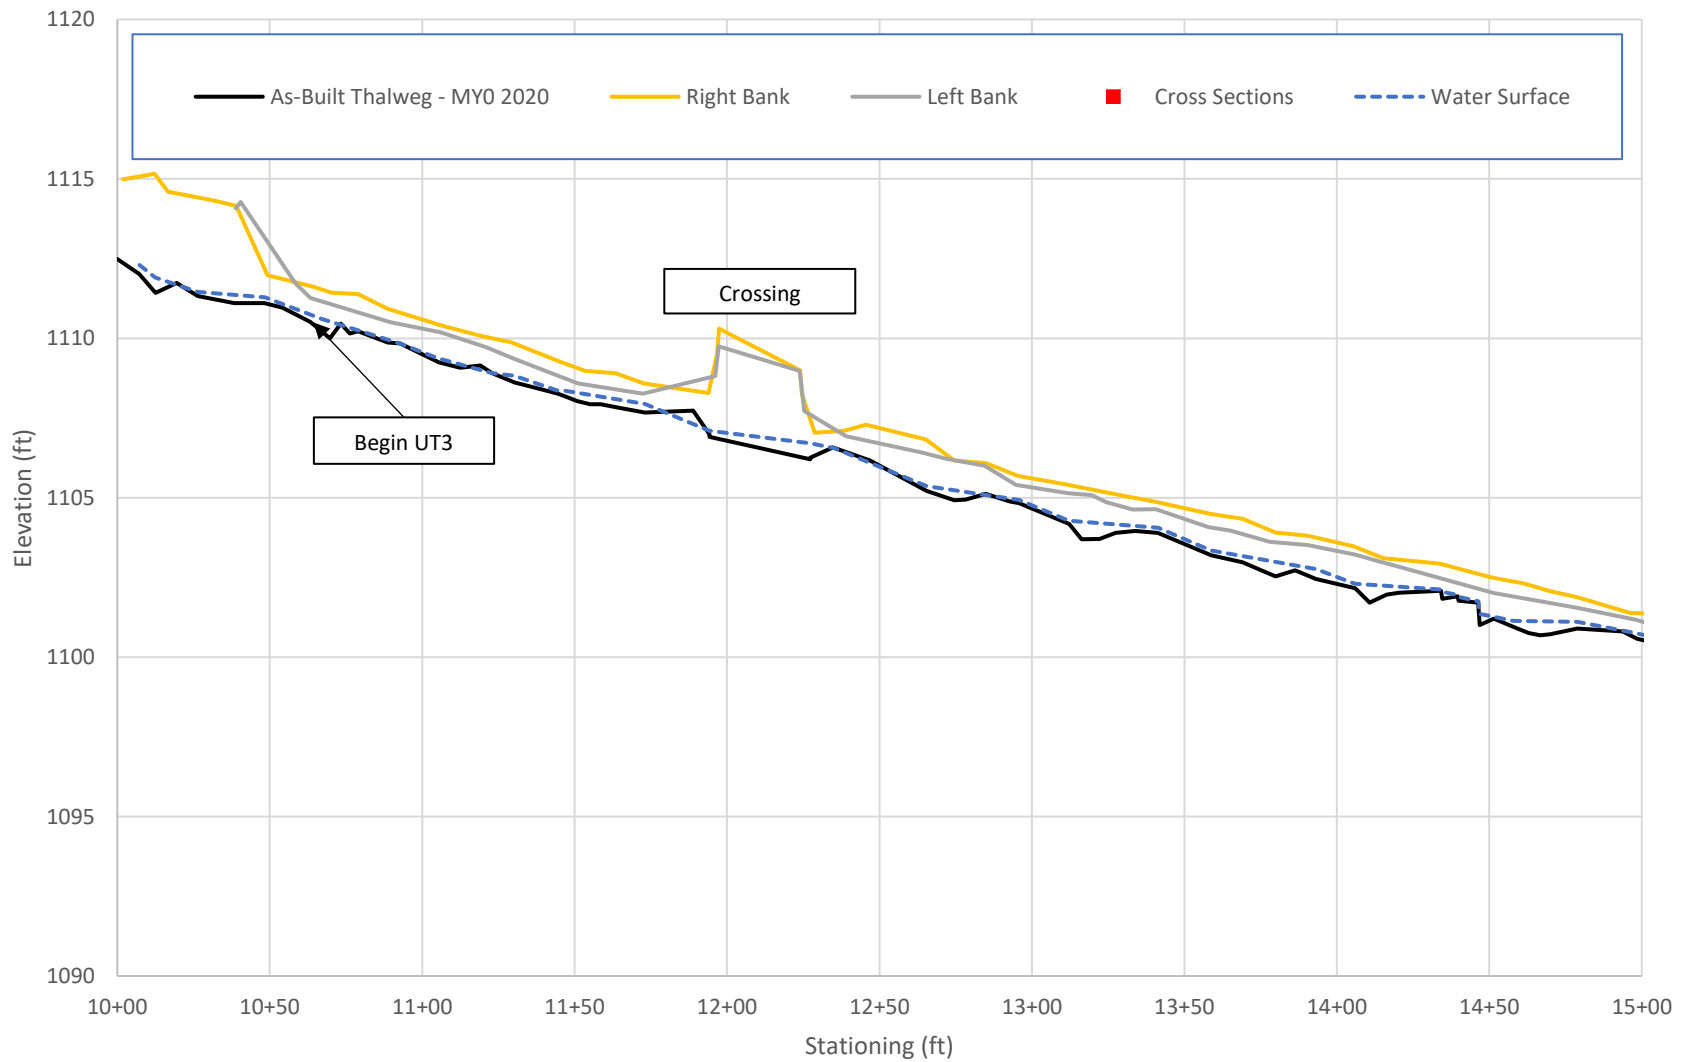

Longitudinal Profile - Baseline (June 2020)  
UT3 - Sta. 15+00 - 20+00

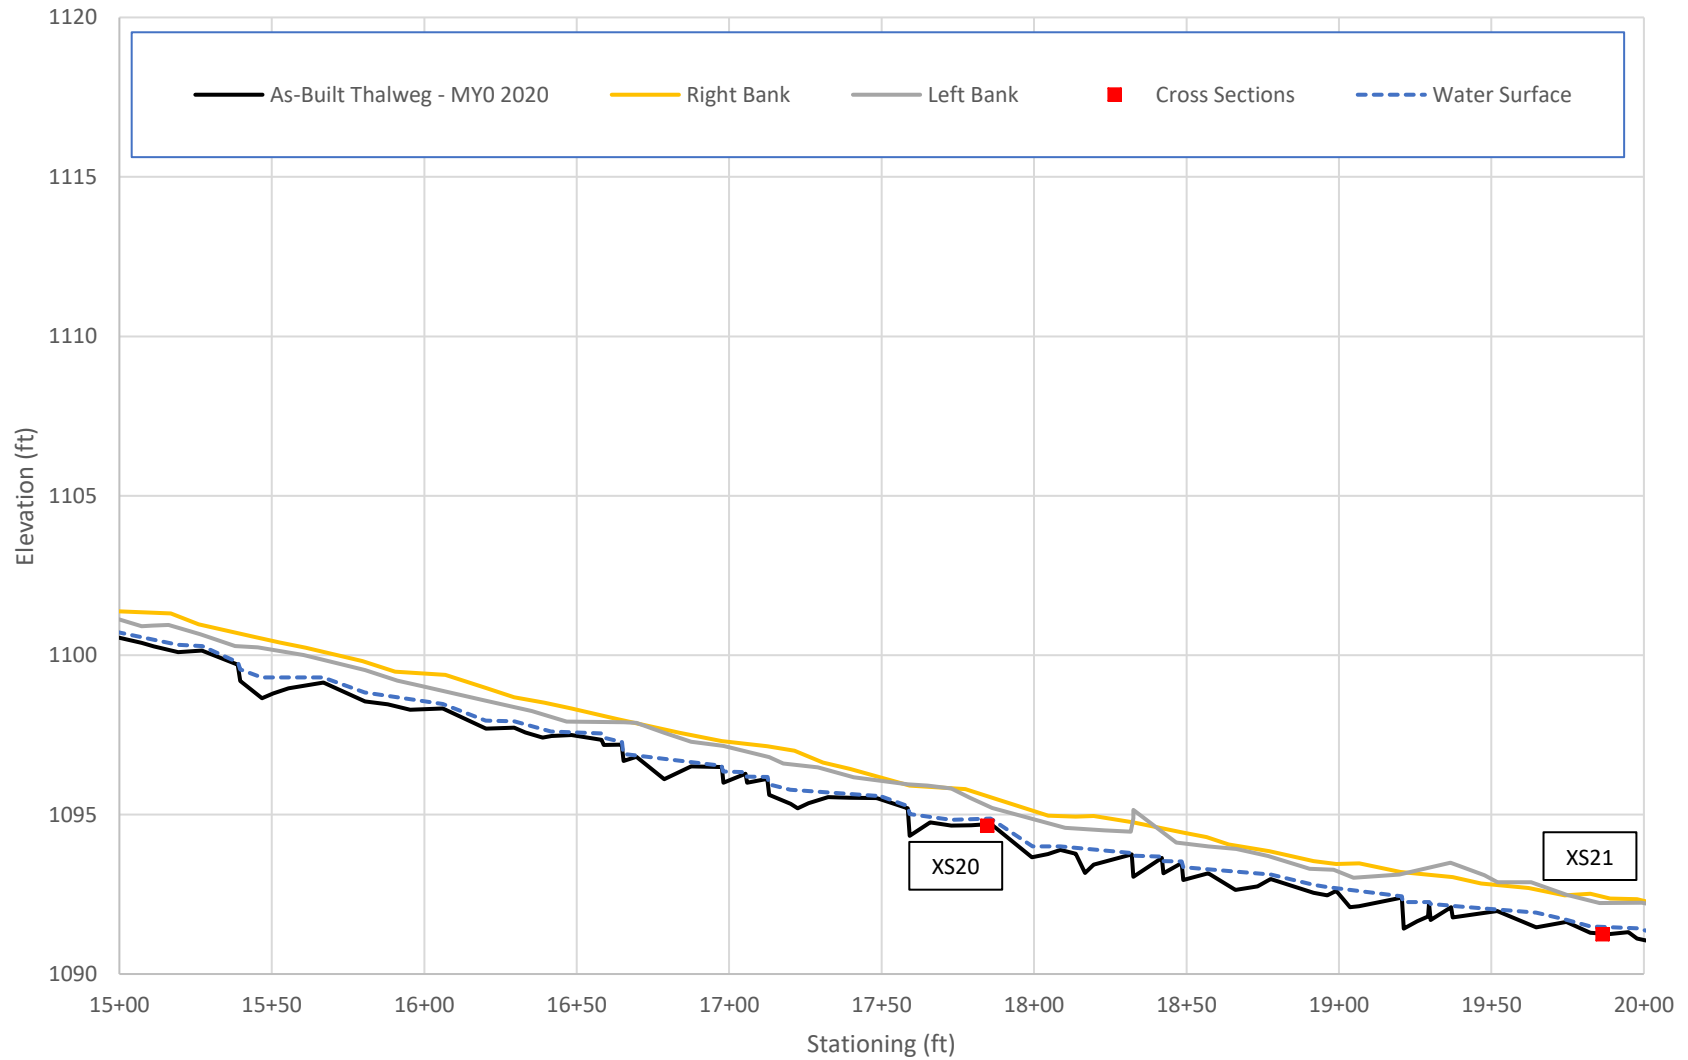


### Longitudinal Profile - Baseline (June 2020) UT3 - Sta. 20+00 - 25+00

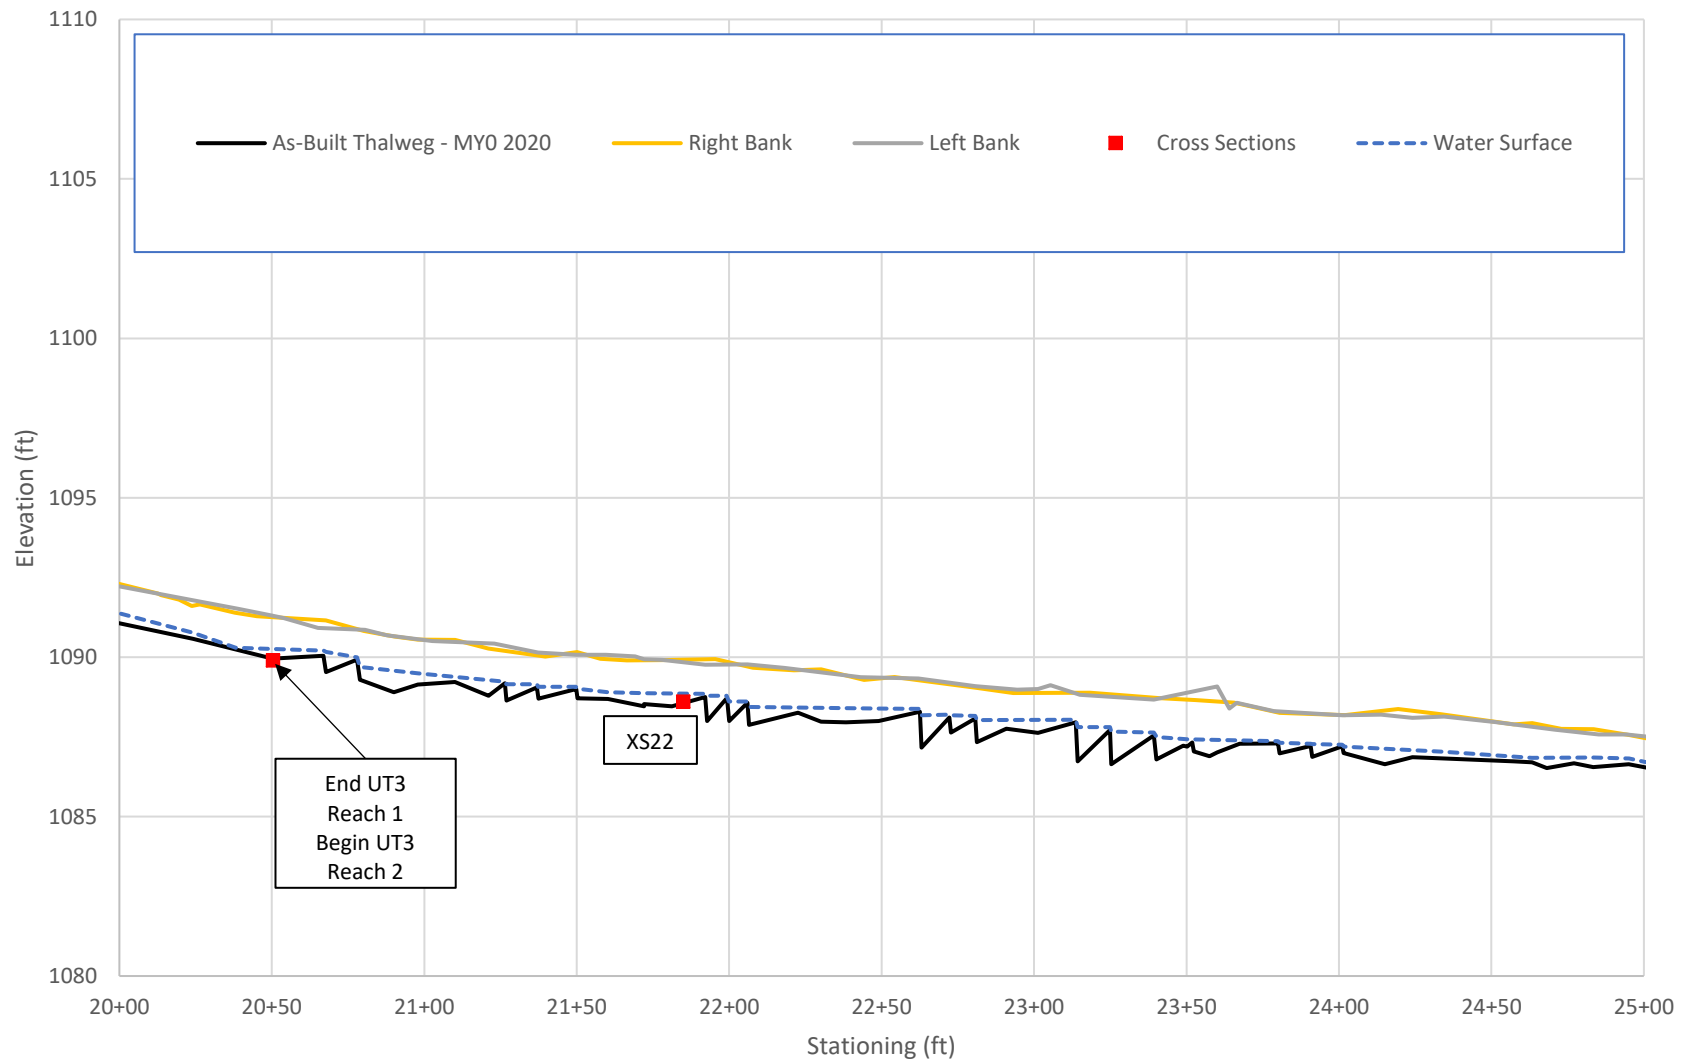





### Longitudinal Profile - Baseline (June 2020) UT3 - Sta. 25+00 - 30+00

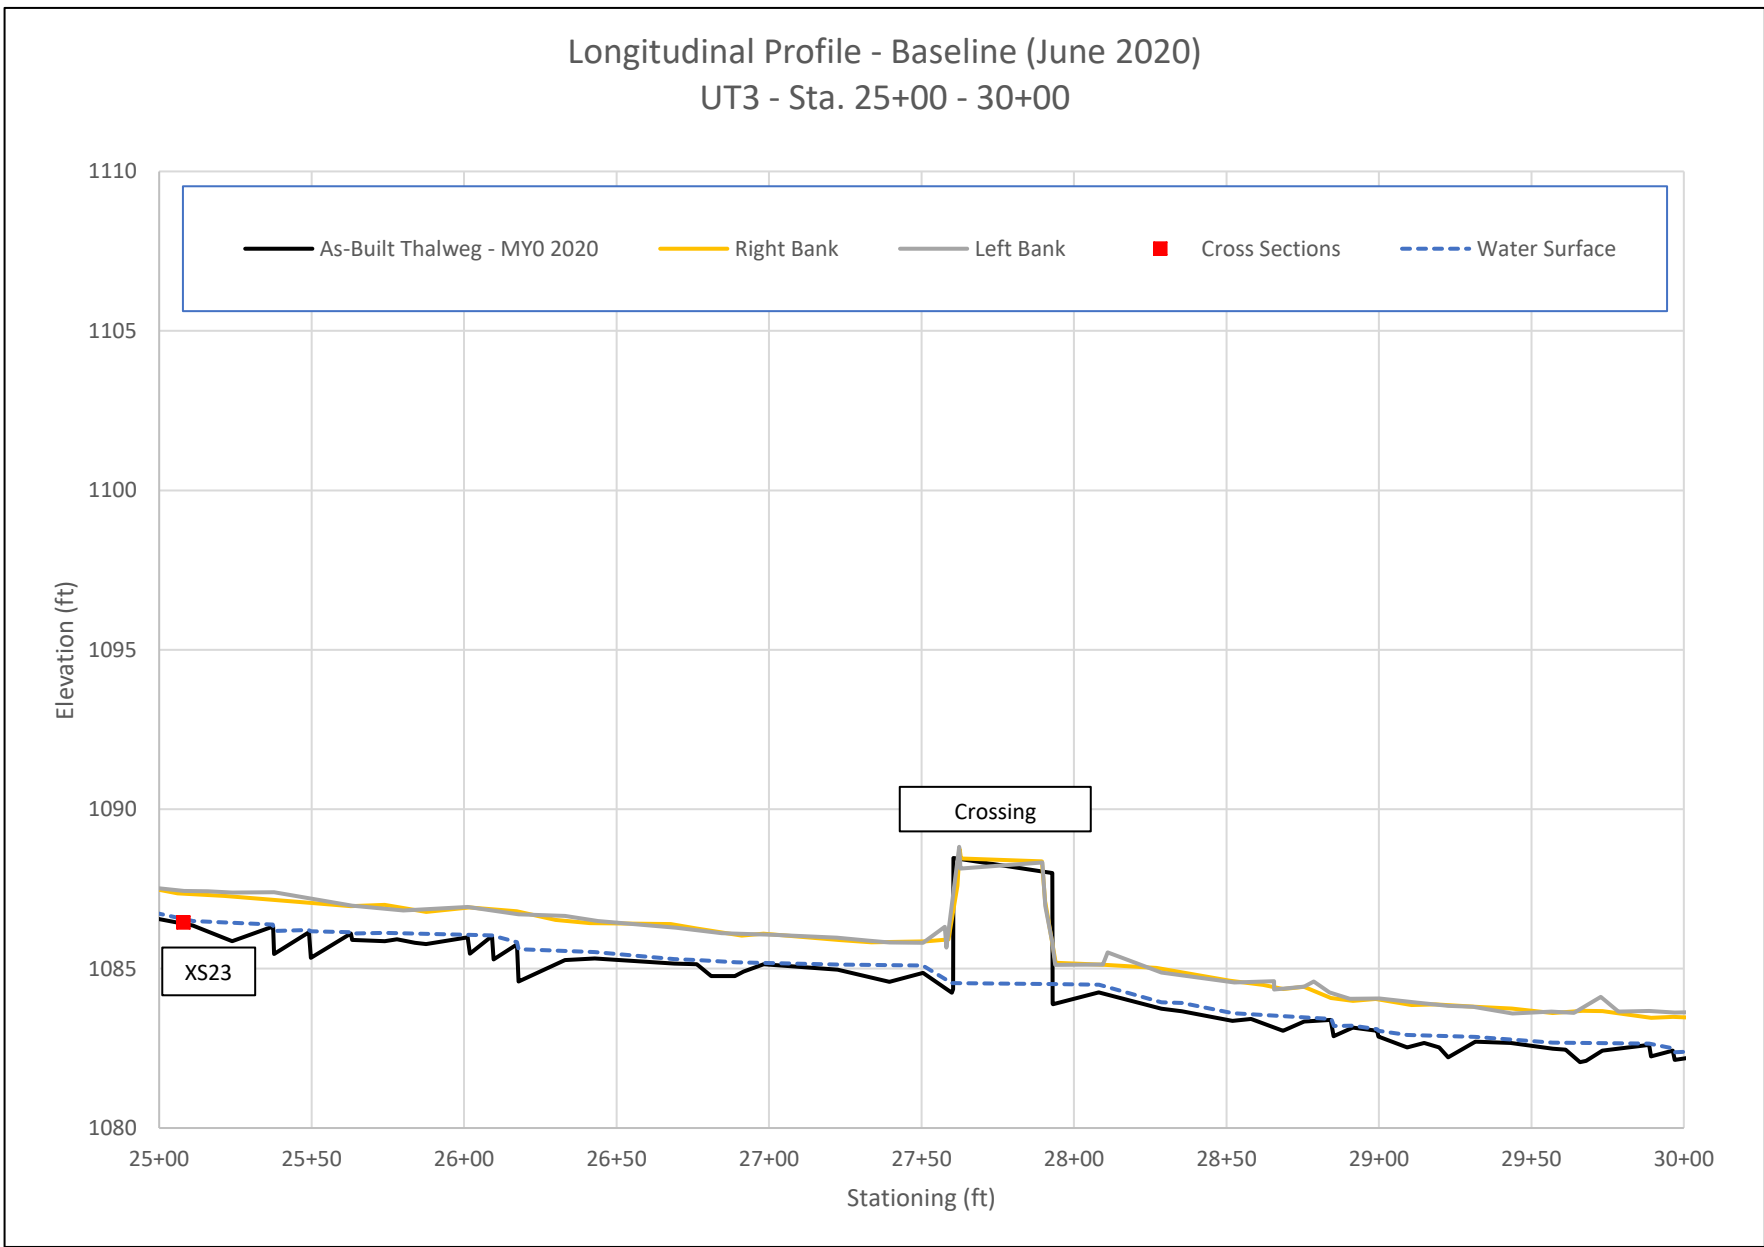


### Longitudinal Profile - Baseline (June 2020) UT3 - Sta. 30+00 - 35+00

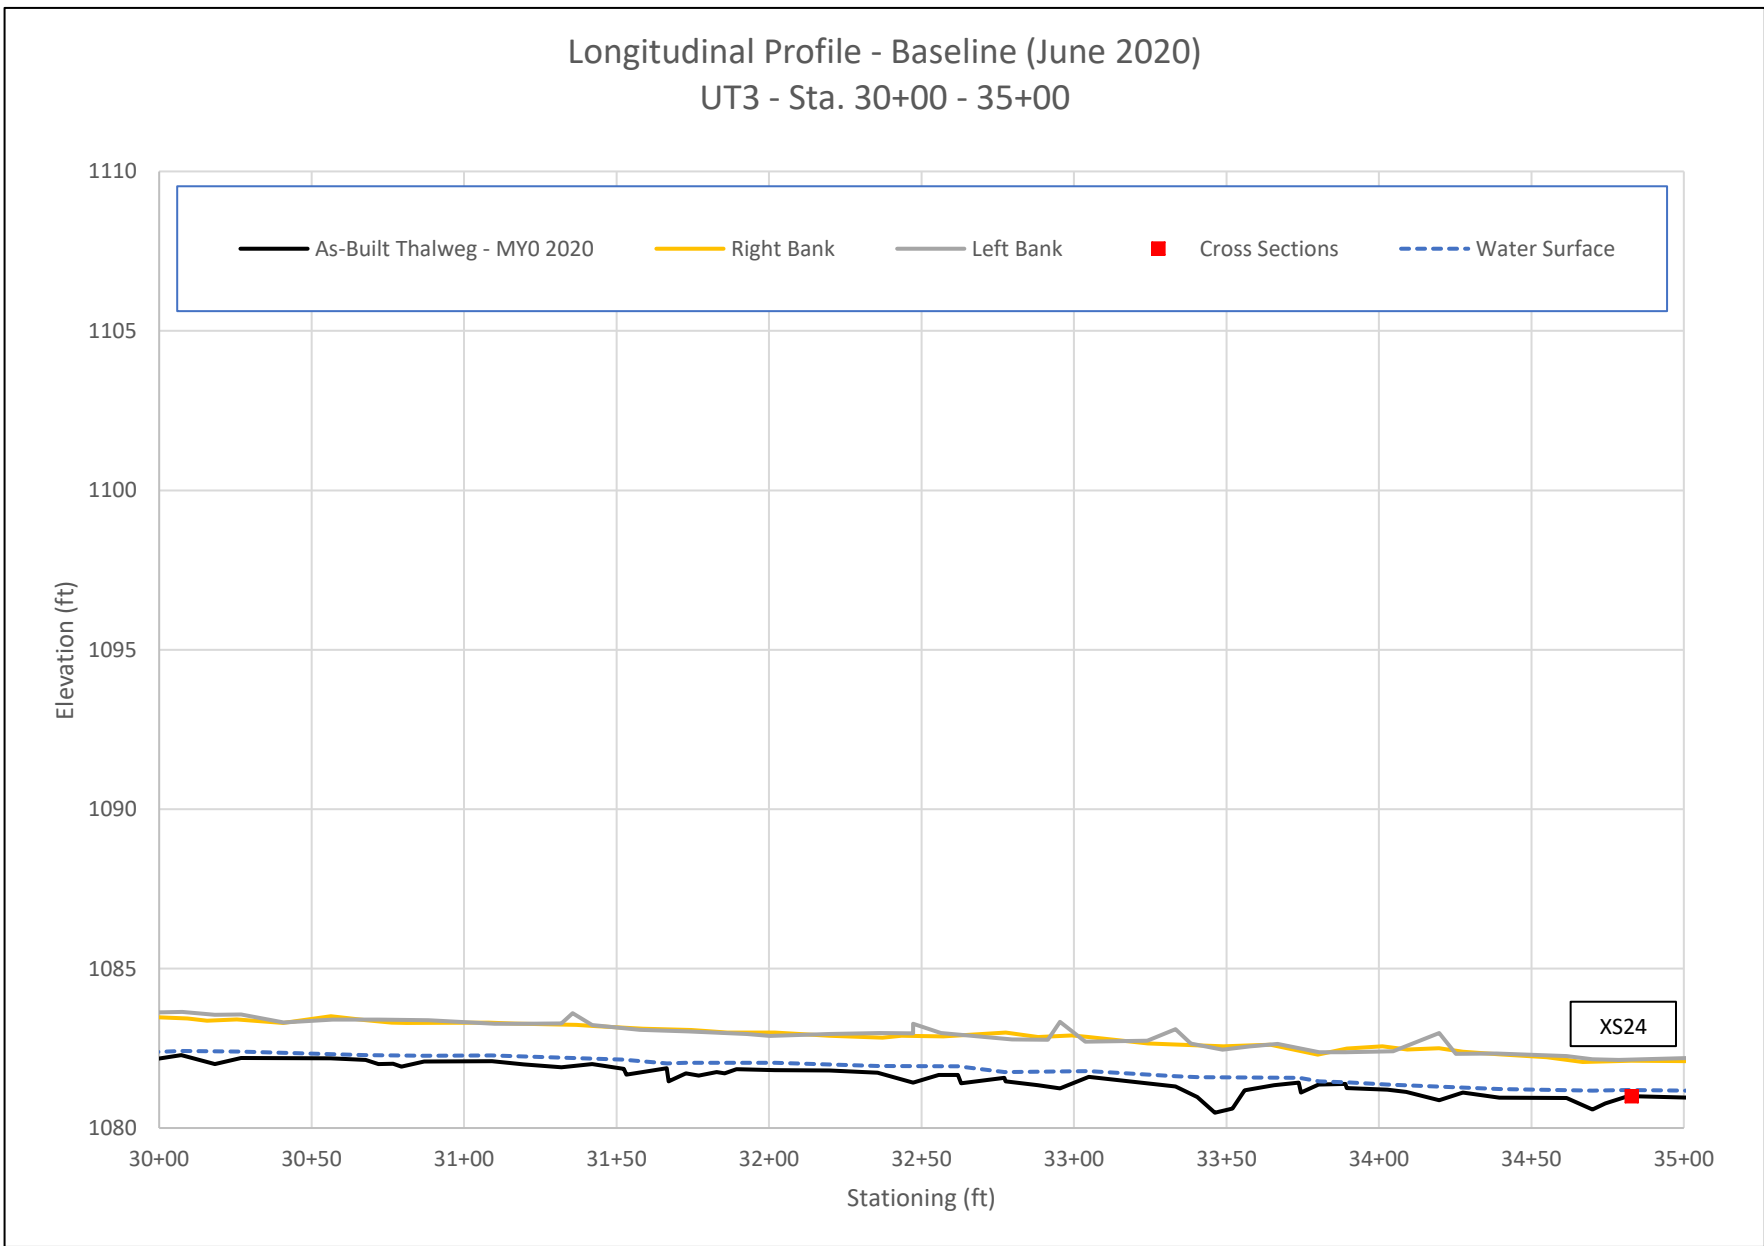

Longitudinal Profile - Baseline (June 2020)  
UT3 - Sta. 35+00 - 40+00

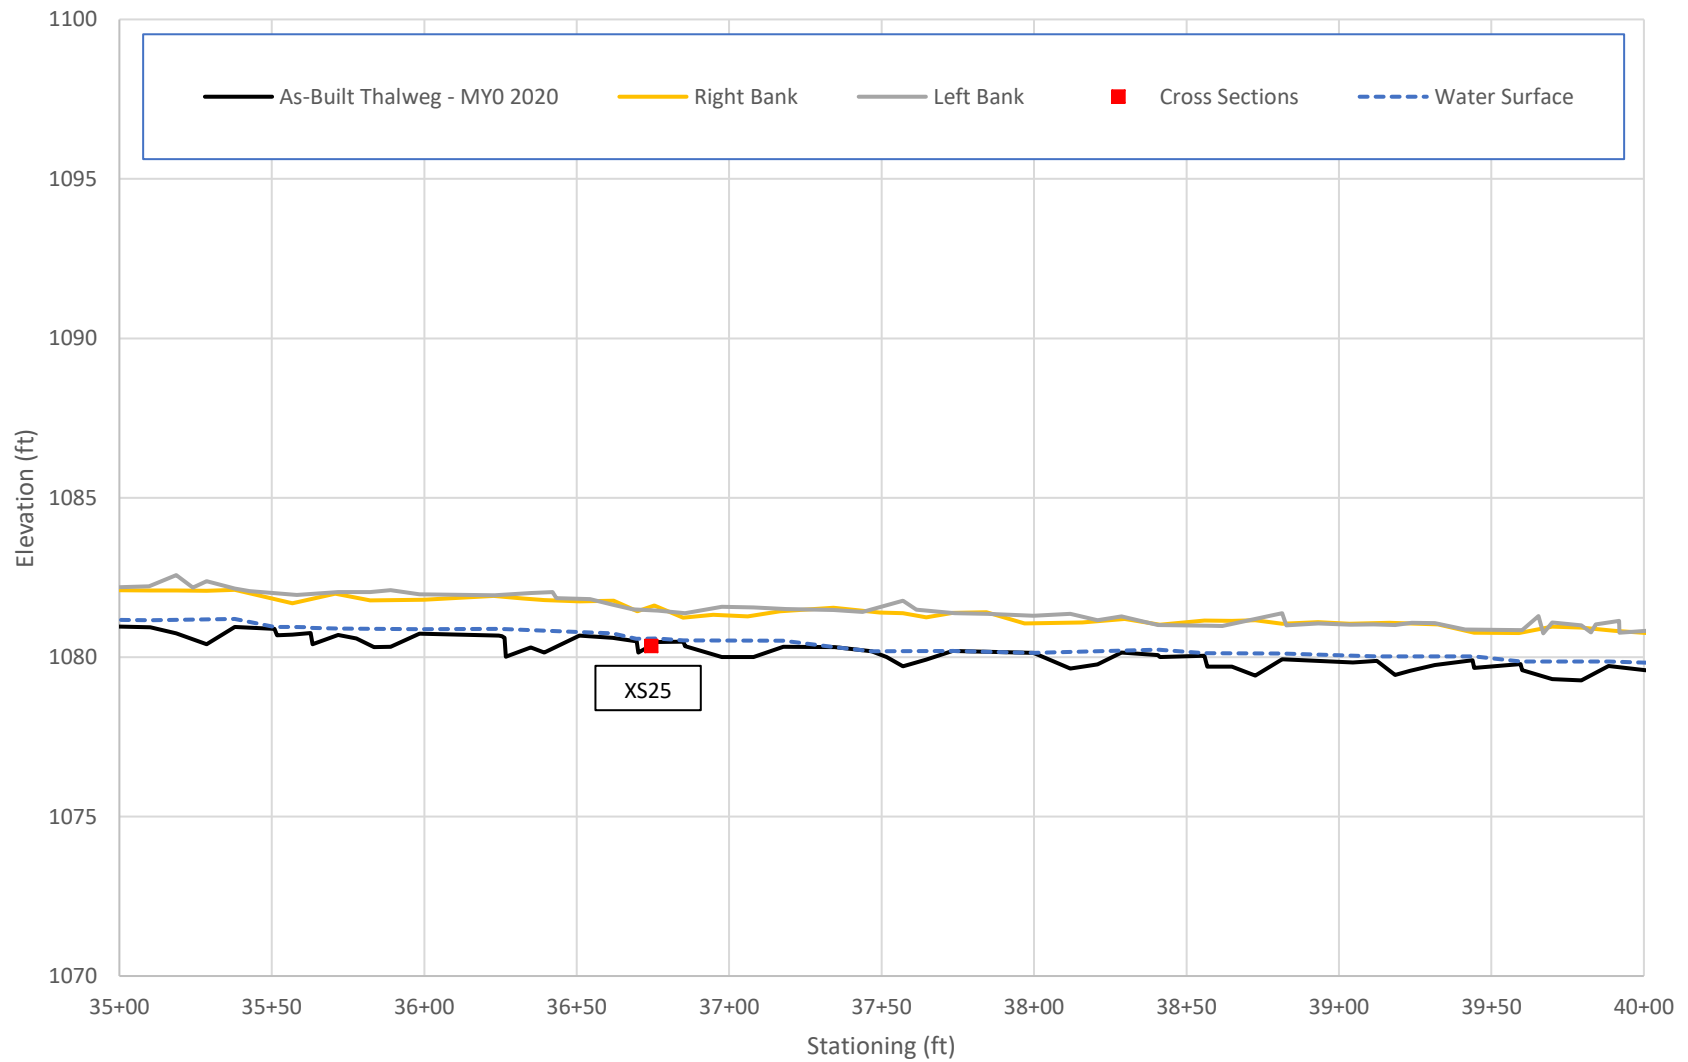

Longitudinal Profile - Baseline (June 2020)  
UT3 - Sta.40+00 - 45+00

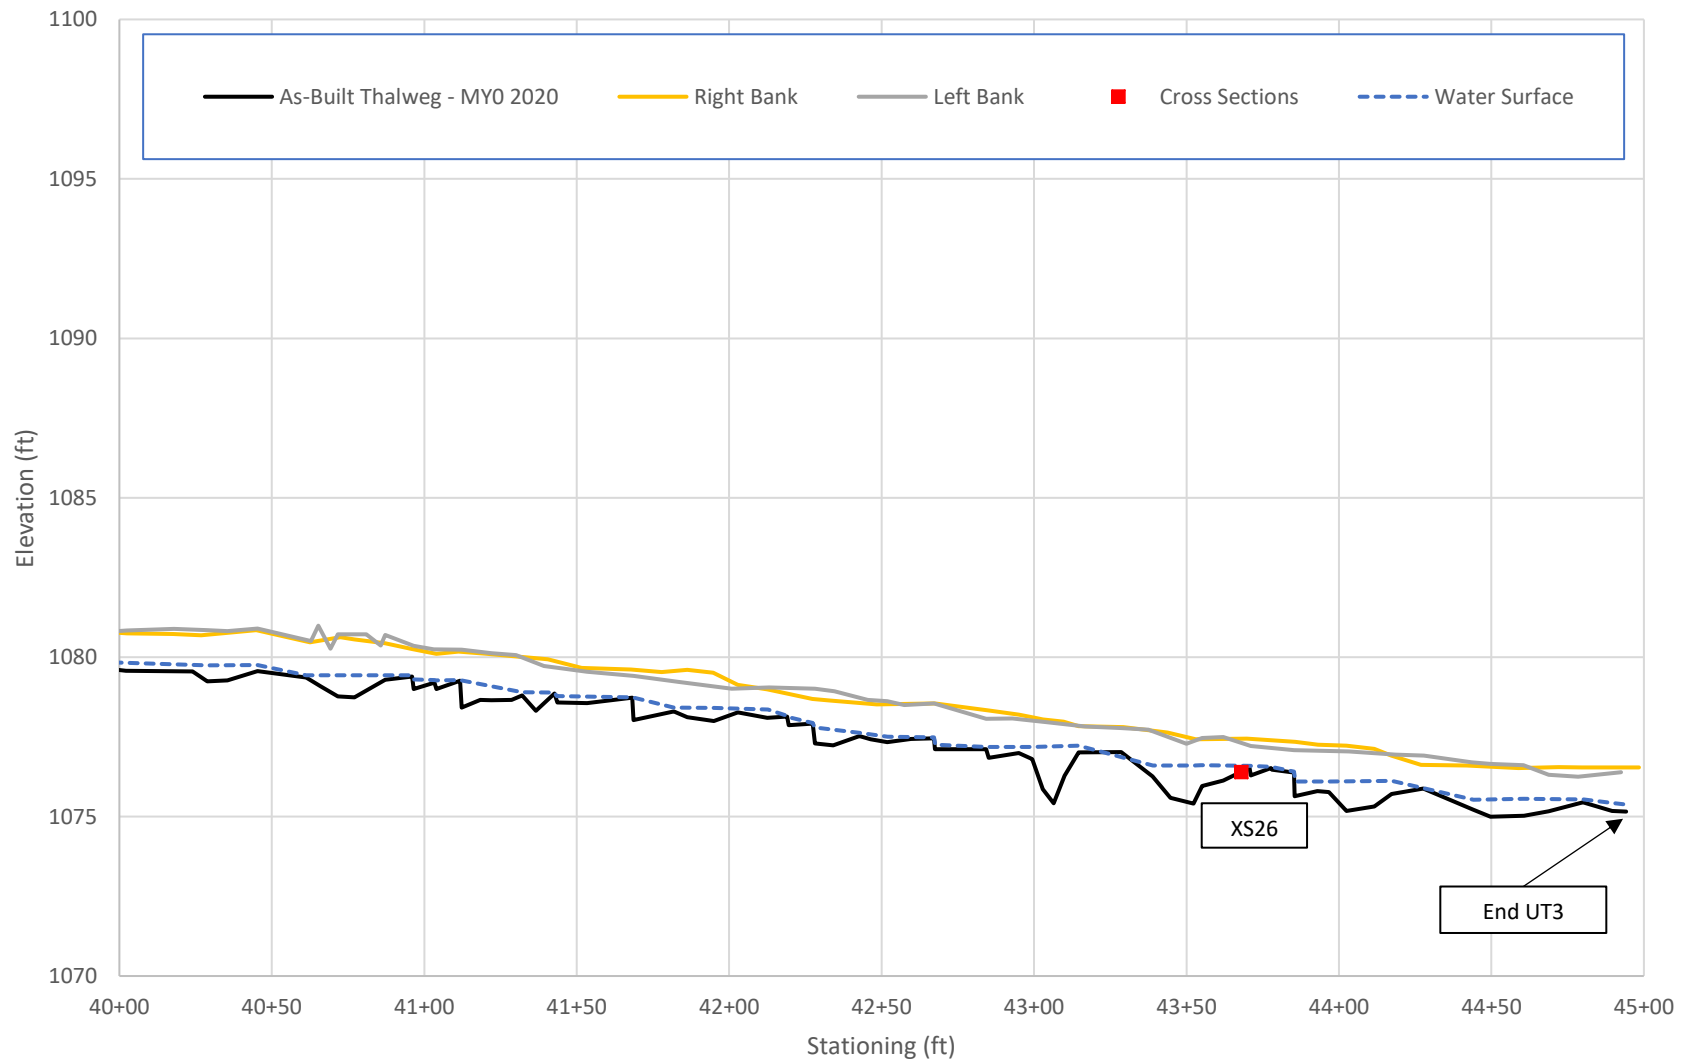

### Cross Section Plot - Baseline - June 2020

XS1 - Moores Fork Reach 1

Station 10+53 - Pool




XS1 looking upstream



XS1 looking downstream

Bankfull Elevation (ft)	Bankfull Area (ft <sup>2</sup> )	Bankfull Width (ft)	Floodprone Elevation (ft)	Floodprone Width (ft)	Max Depth (ft)	Mean Depth (ft)	W/D Ratio	ER	Bank Height Ratio
1097.06	71.8	33.2	N/A	N/A	2.96	2.16	15.39	N/A	1.2

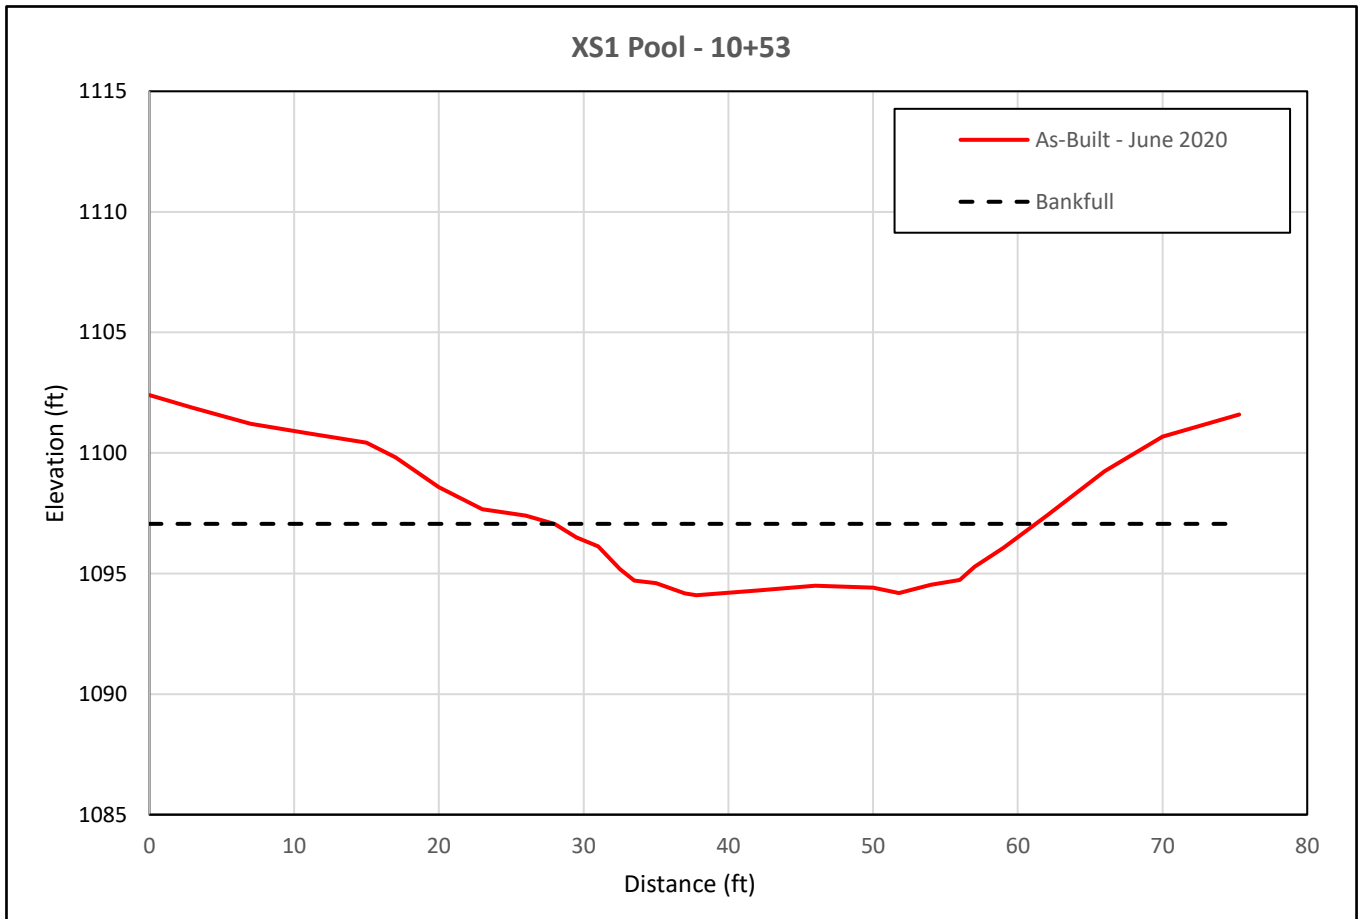

### Cross Section Plot - Baseline - June 2020

XS2 - Moores Fork Reach 1

Station 15+88 - Riffle




XS2 looking upstream



XS2 looking downstream

Bankfull Elevation (ft)	Bankfull Area (ft <sup>2</sup> )	Bankfull Width (ft)	Floodprone Elevation (ft)	Floodprone Width (ft)	Max Depth (ft)	Mean Depth (ft)	W/D Ratio	ER	Bank Height Ratio
1094.84	61.1	33.22	1094.27	42.97	2.43	1.84	18.05	1.29	1.2

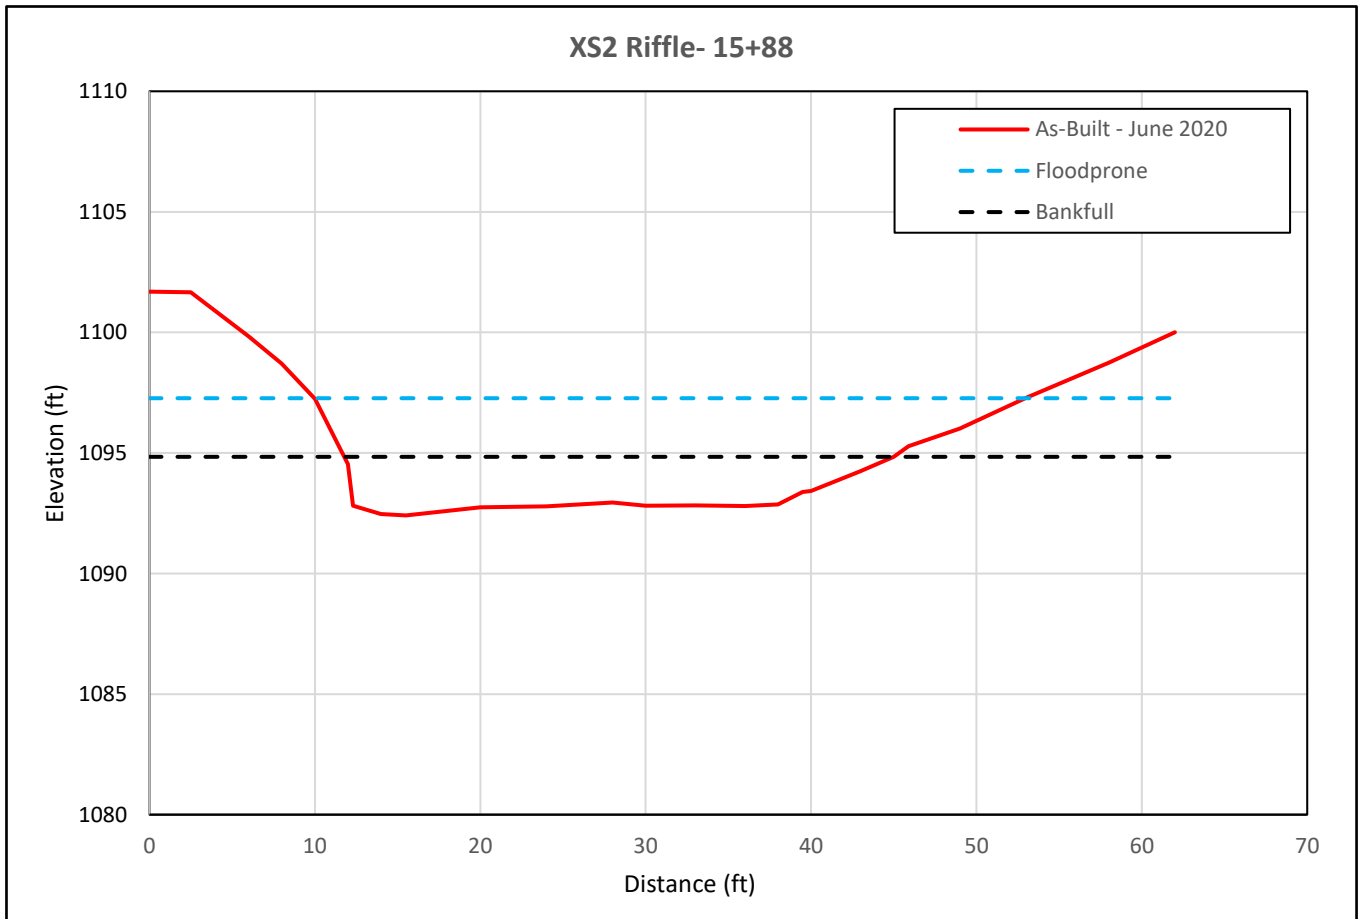

### Cross Section Plot - Baseline - June 2020

XS3 - Moores Fork Reach 1

Station 24+54 - Pool




XS3 looking upstream



XS3 looking downstream

Bankfull Elevation (ft)	Bankfull Area (ft <sup>2</sup> )	Bankfull Width (ft)	Floodprone Elevation (ft)	Floodprone Width (ft)	Max Depth (ft)	Mean Depth (ft)	W/D Ratio	ER	Bank Height Ratio
1088.77	45.1	29.1	N/A	N/A	2.63	1.55	18.8	N/A	1.0

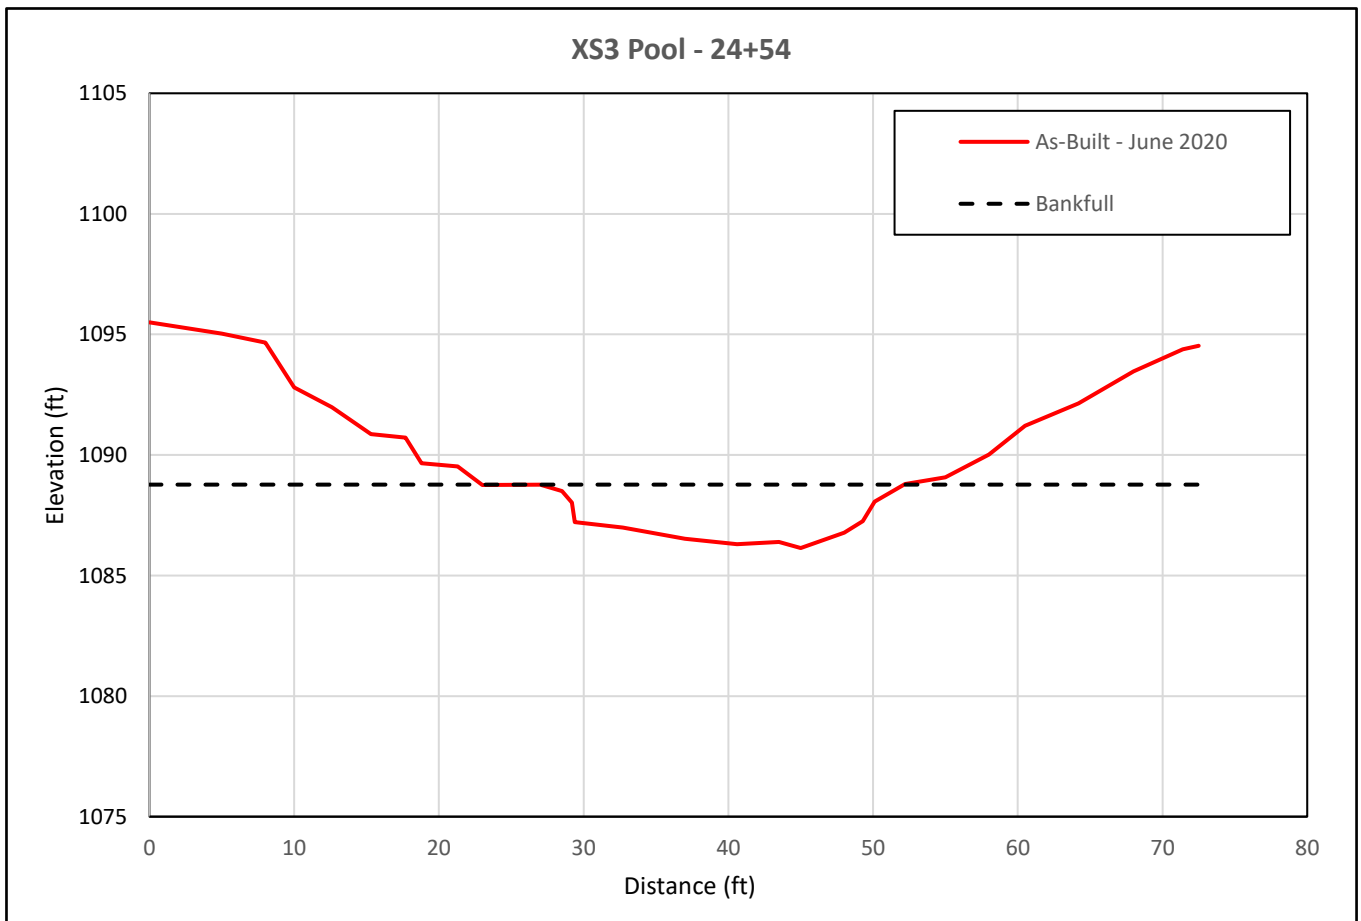

### Cross Section Plot - Baseline - June 2020

XS4 - Moores Fork Reach 2

Station 27+79 - Pool




XS4 looking upstream



XS4 looking downstream

Bankfull Elevation (ft)	Bankfull Area (ft <sup>2</sup> )	Bankfull Width (ft)	Floodprone Elevation (ft)	Floodprone Width (ft)	Max Depth (ft)	Mean Depth (ft)	W/D Ratio	ER	Bank Height Ratio
1087.94	47.12	25.55	N/A	N/A	3.34	1.84	13.89	N/A	1.0

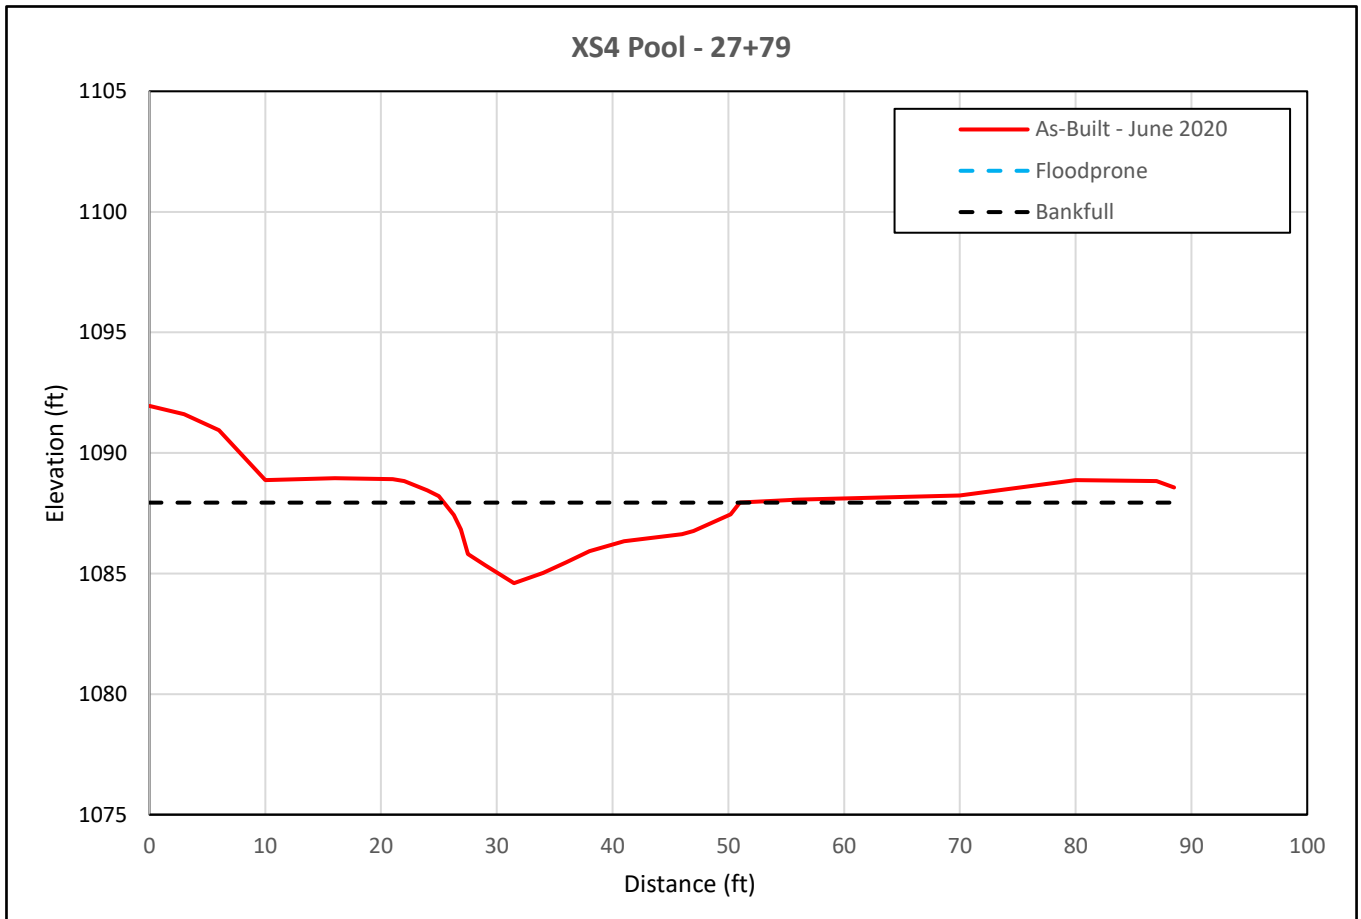



### Cross Section Plot - Baseline - June 2020

XS5 - Moores Fork Reach 2

Station 30+16 - Riffle




XS5 looking upstream



XS5 looking downstream

Bankfull Elevation (ft)	Bankfull Area (ft <sup>2</sup> )	Bankfull Width (ft)	Floodprone Elevation (ft)	Floodprone Width (ft)	Max Depth (ft)	Mean Depth (ft)	W/D Ratio	ER	Bank Height Ratio
1087.06	34.13	20.24	1089.49	>81.2	2.43	1.69	11.98	>4.01	1.12

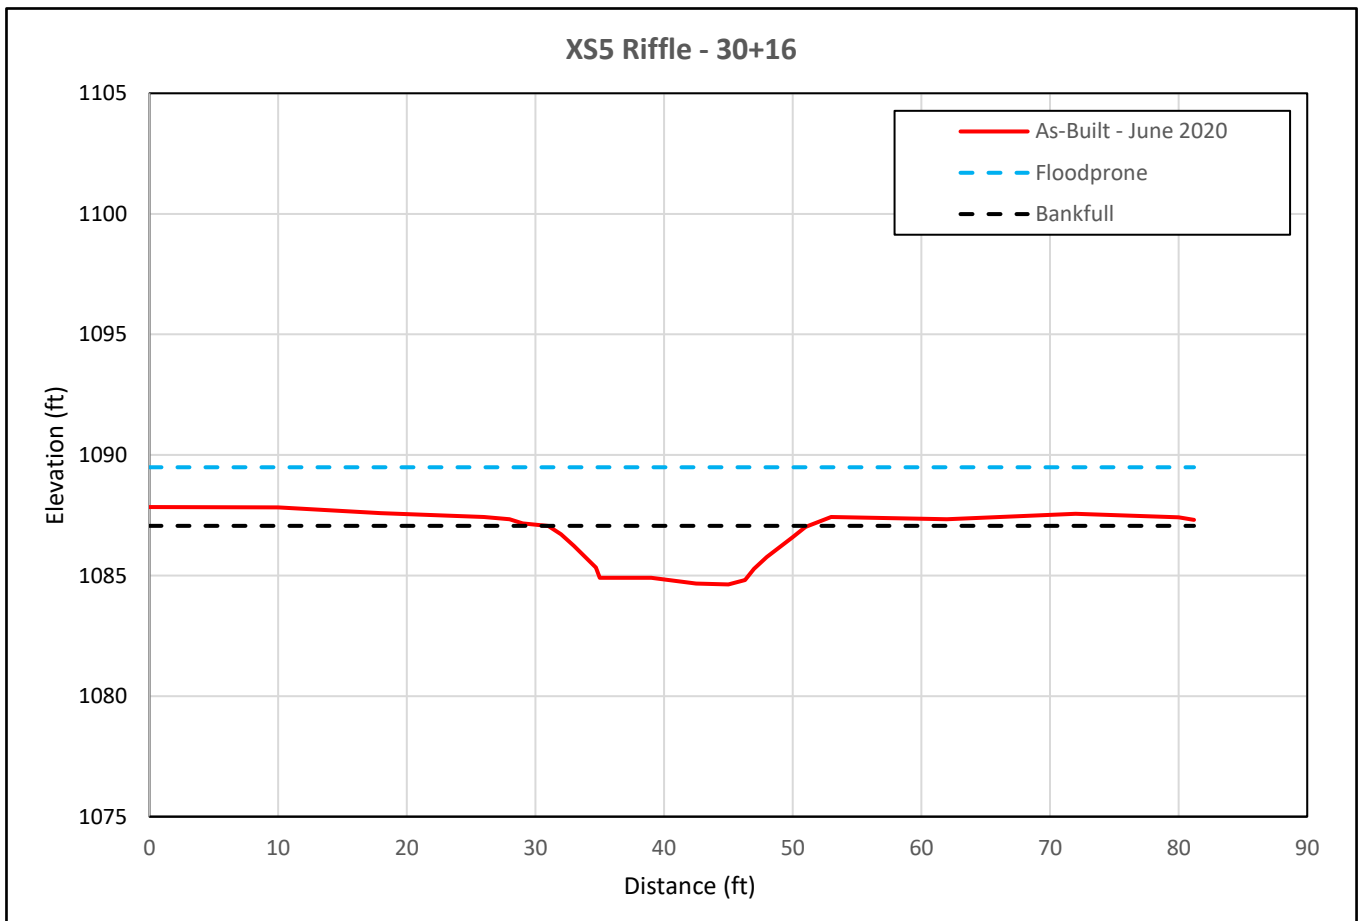

### Cross Section Plot - Baseline - June 2020

XS6 - Moores Fork Reach 2

Station 36+29 - Pool




XS6 looking upstream



XS6 looking downstream

Bankfull Elevation (ft)	Bankfull Area (ft <sup>2</sup> )	Bankfull Width (ft)	Floodprone Elevation (ft)	Floodprone Width (ft)	Max Depth (ft)	Mean Depth (ft)	W/D Ratio	ER	Bank Height Ratio
1084.62	53.58	33.56	N/A	N/A	2.67	1.6	20.98	N/A	1.0

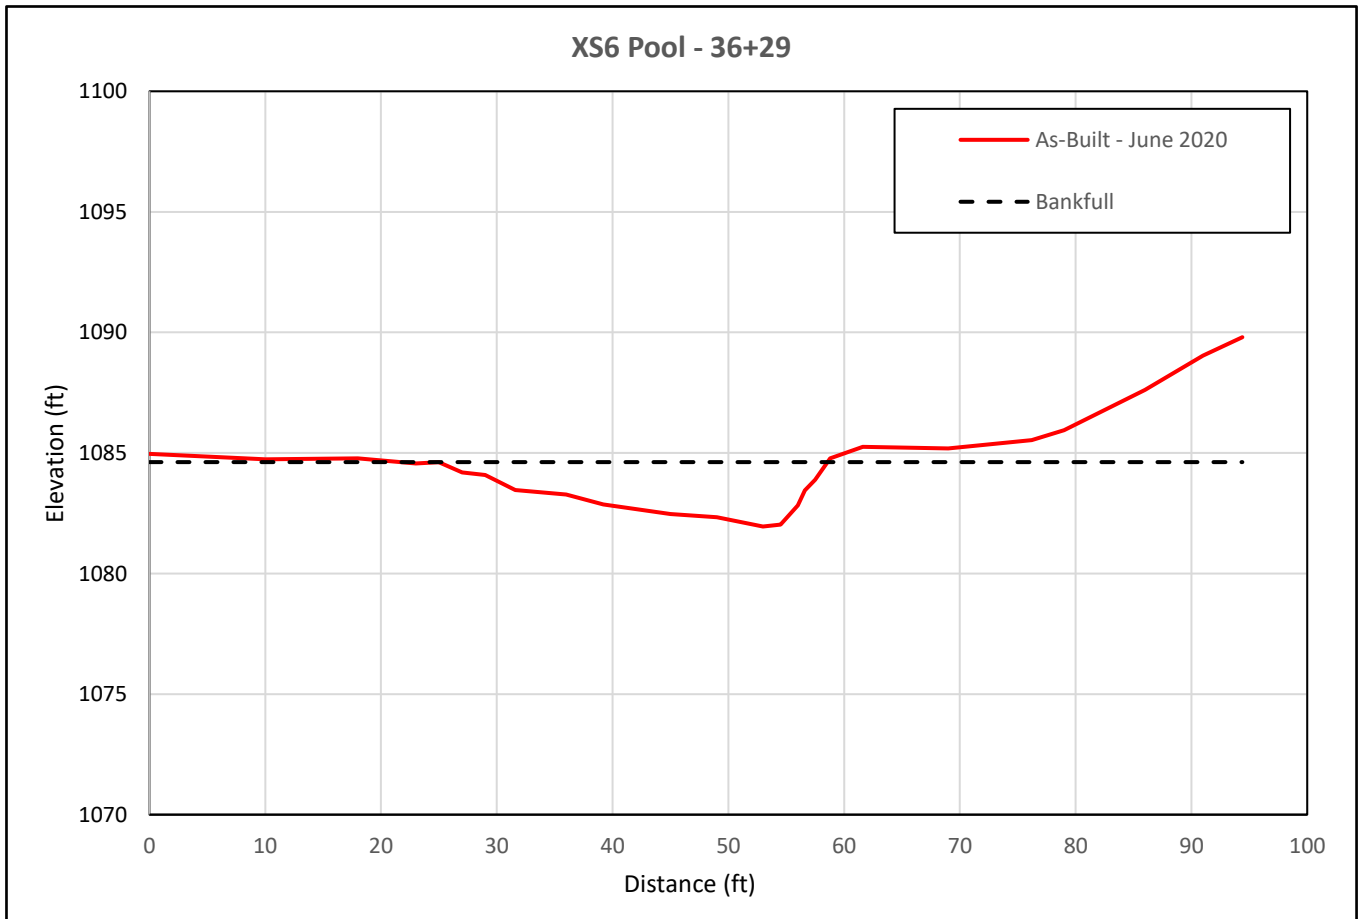

### Cross Section Plot - Baseline - June 2020

XS7 - Moores Fork Reach 2

Station 40+43 - Riffle




XS7 looking upstream



XS7 looking downstream

Bankfull Elevation (ft)	Bankfull Area (ft <sup>2</sup> )	Bankfull Width (ft)	Floodprone Elevation (ft)	Floodprone Width (ft)	Max Depth (ft)	Mean Depth (ft)	W/D Ratio	ER	Bank Height Ratio
1083.1	33.72	21.25	1085.64	>88.6	2.54	1.59	13.36	>4.14	1.0

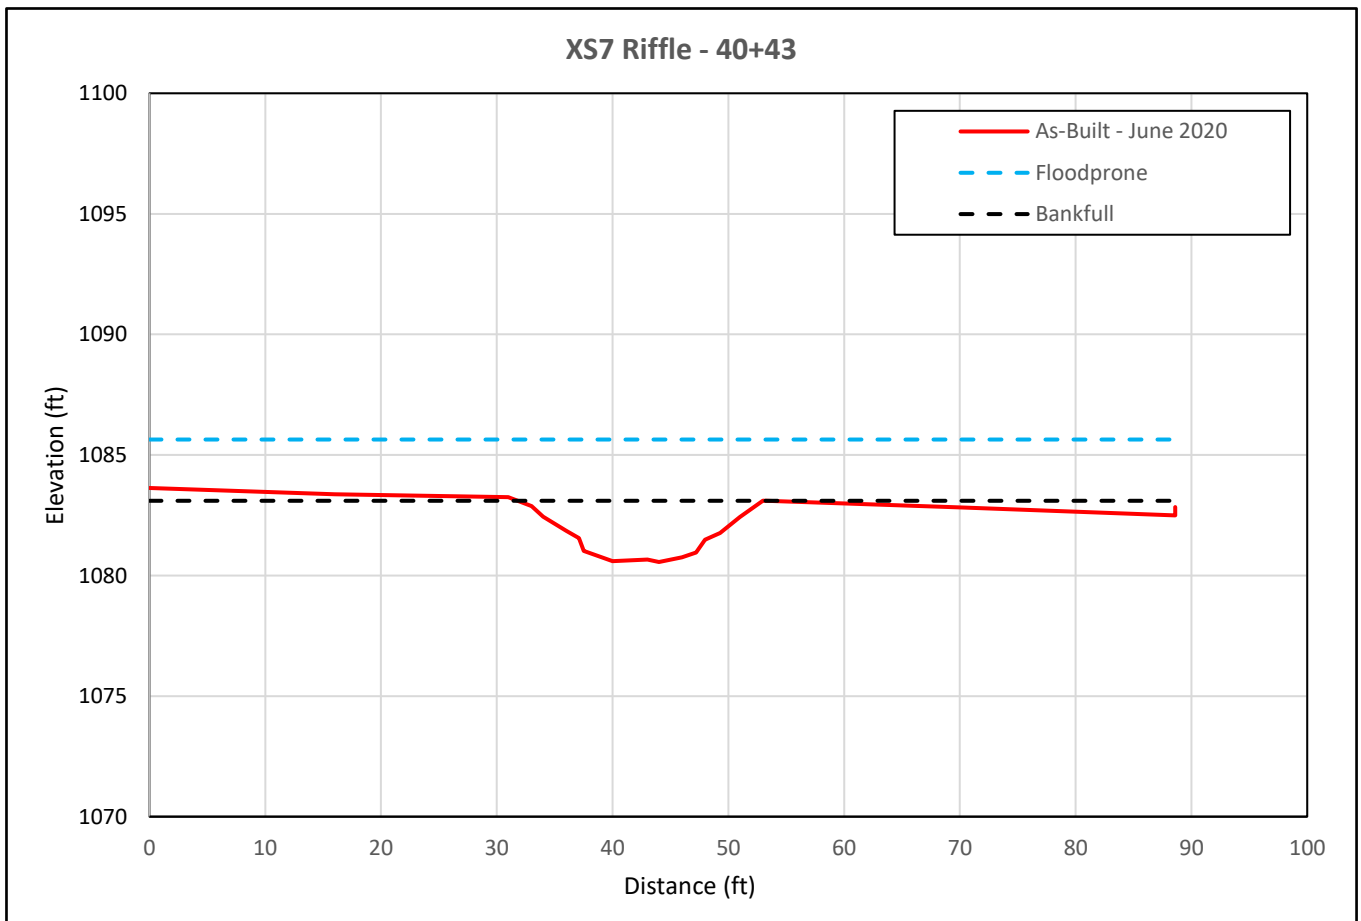

### Cross Section Plot - Baseline - June 2020

XS8 - Moores Fork Reach 3

Station 49+64 - Riffle




XS8 looking upstream



XS8 looking downstream

Bankfull Elevation (ft)	Bankfull Area (ft <sup>2</sup> )	Bankfull Width (ft)	Floodprone Elevation (ft)	Floodprone Width (ft)	Max Depth (ft)	Mean Depth (ft)	W/D Ratio	ER	Bank Height Ratio
1079.96	33.68	20.87	1082.51	106.9	2.55	1.61	12.96	5.12	1.0

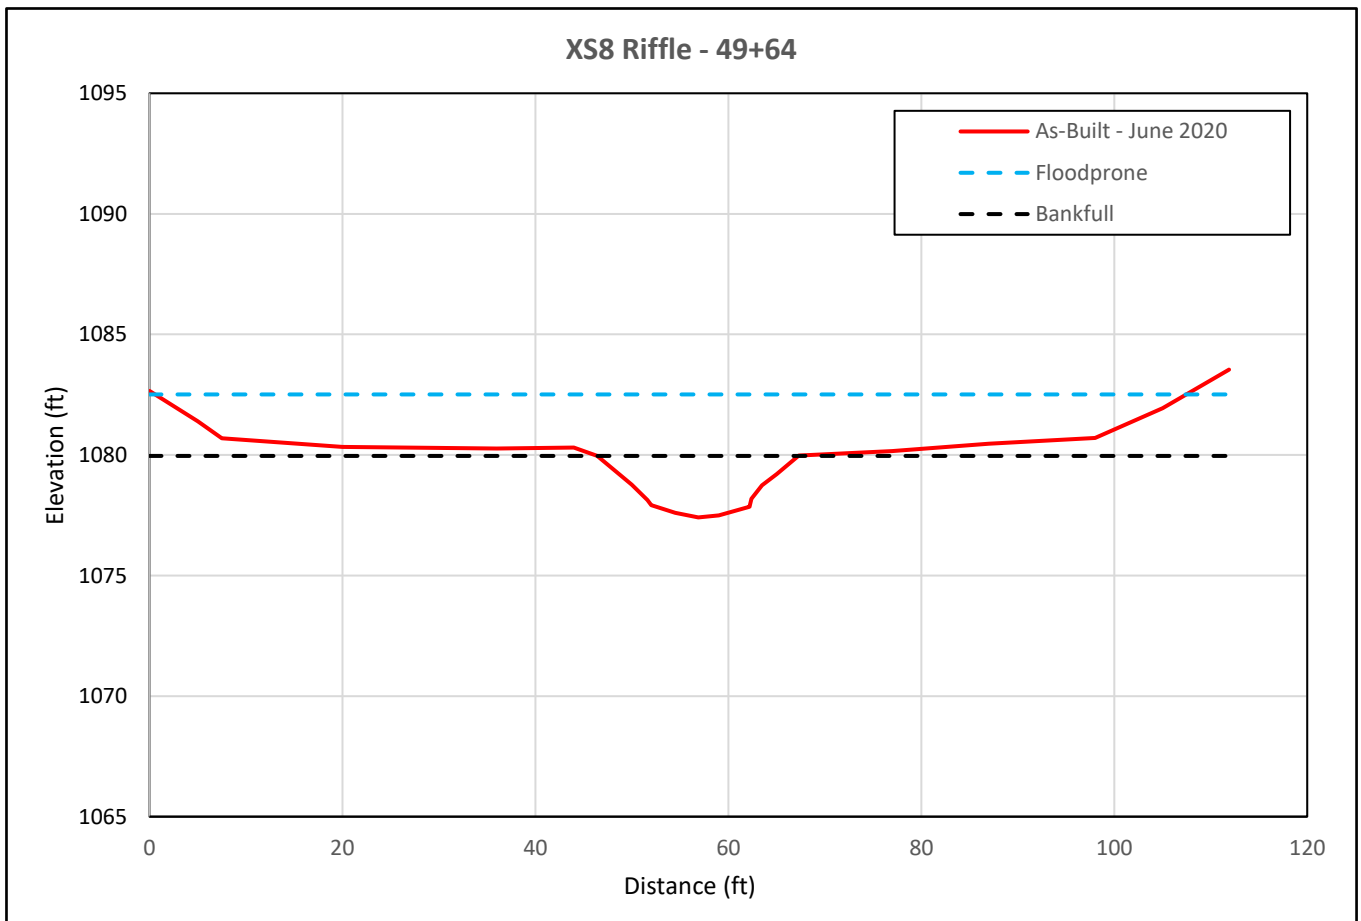

### Cross Section Plot - Baseline - June 2020

XS9 - Moores Fork Reach 3

Station 49+87 - Pool




XS9 looking upstream



XS9 looking downstream

Bankfull Elevation (ft)	Bankfull Area (ft <sup>2</sup> )	Bankfull Width (ft)	Floodprone Elevation (ft)	Floodprone Width (ft)	Max Depth (ft)	Mean Depth (ft)	W/D Ratio	ER	Bank Height Ratio
1080.16	52.58	29.24	N/A	N/A	4.04	4.8	16.24	N/A	1.0

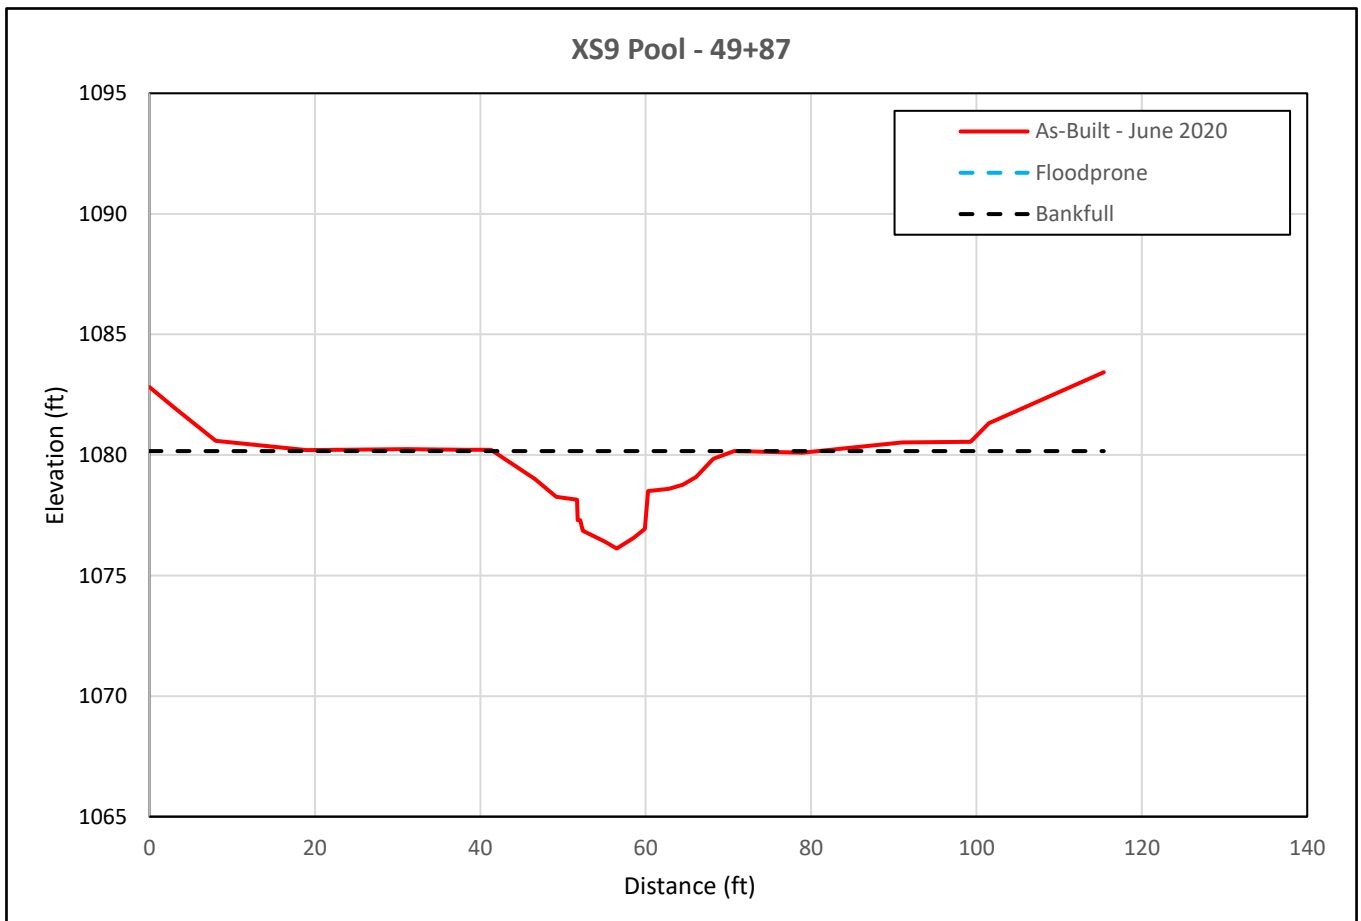

# Cross Section Plot - Baseline - June 2020

XS10 - UT1

Station 14+28 - Riffle




XS10 looking upstream



XS10 looking downstream

Bankfull Elevation (ft)	Bankfull Area (ft <sup>2</sup> )	Bankfull Width (ft)	Floodprone Elevation (ft)	Floodprone Width (ft)	Max Depth (ft)	Mean Depth (ft)	W/D Ratio	ER	Bank Height Ratio
1111.02	3.85	6.95	1111.82	52.15	0.8	0.6	12.64	7.5	1.1

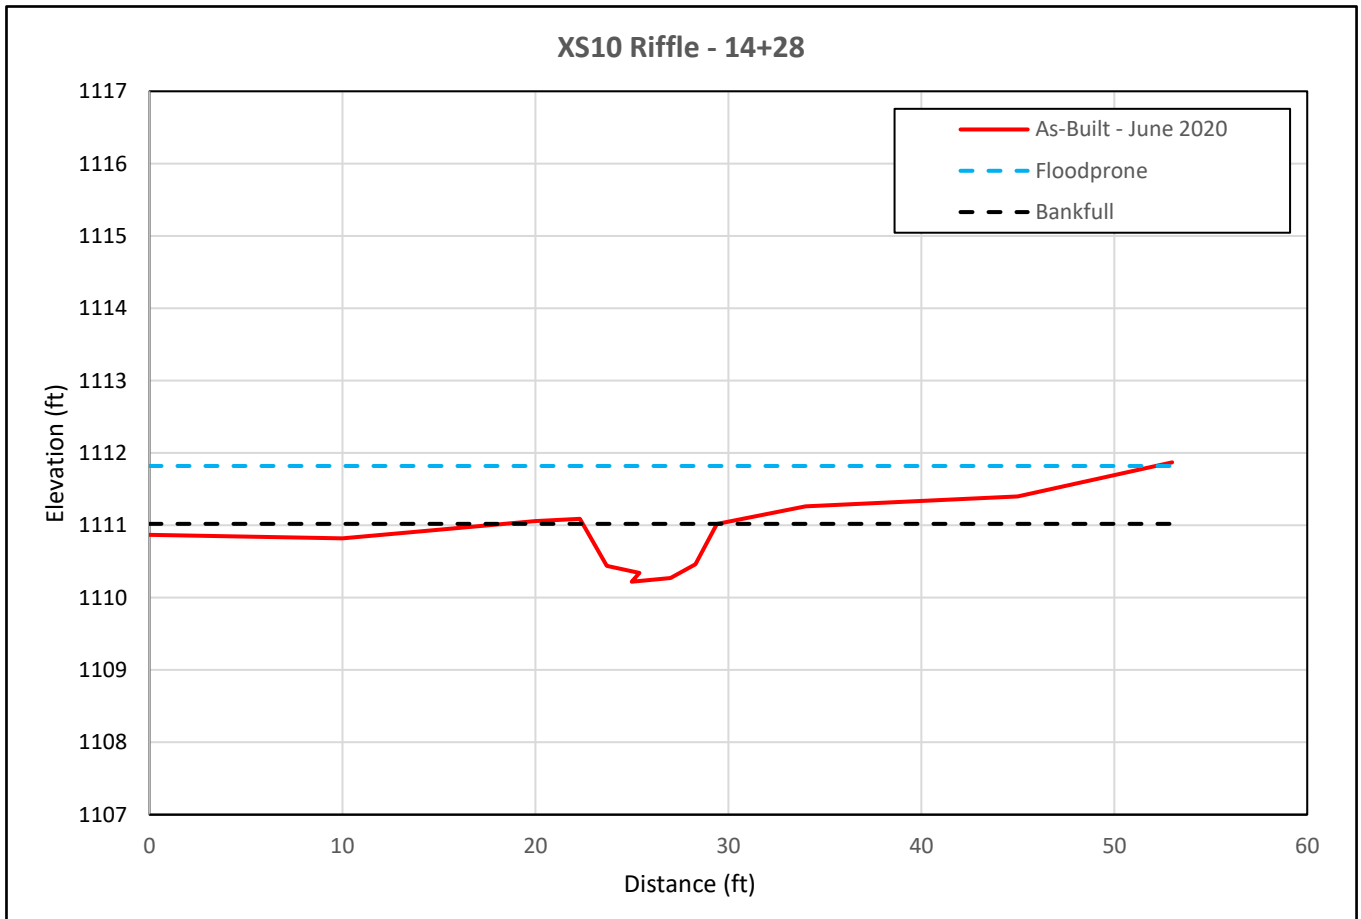

### Cross Section Plot - Baseline - June 2020

XS11 - UT1

Station 17+53 - Pool




XS11 looking upstream



XS11 looking downstream

Bankfull Elevation (ft)	Bankfull Area (ft <sup>2</sup> )	Bankfull Width (ft)	Floodprone Elevation (ft)	Floodprone Width (ft)	Max Depth (ft)	Mean Depth (ft)	W/D Ratio	ER	Bank Height Ratio
1104.4	5.48	9.02	N/A	N/A	1.25	0.61	14.79	N/A	1.0

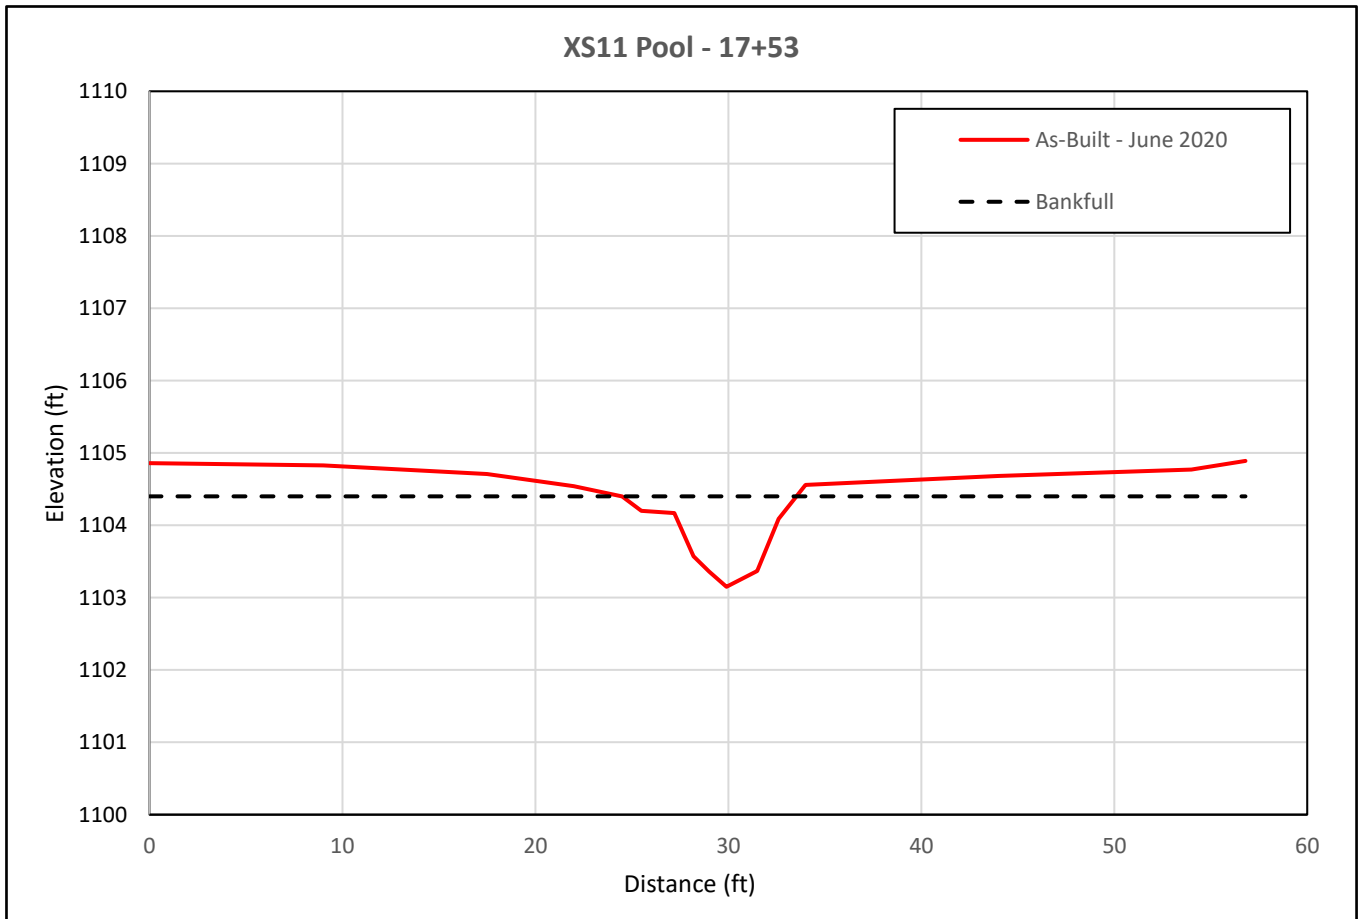

## Cross Section Plot - Baseline - June 2020

XS12 - UT1

Station 18+92 - Riffle




XS12 looking upstream



XS12 looking downstream

Bankfull Elevation (ft)	Bankfull Area (ft <sup>2</sup> )	Bankfull Width (ft)	Floodprone Elevation (ft)	Floodprone Width (ft)	Max Depth (ft)	Mean Depth (ft)	W/D Ratio	ER	Bank Height Ratio
1102.01	3.92	6.98	1102.82	49.7	0.81	0.56	12.46	7.12	1.0

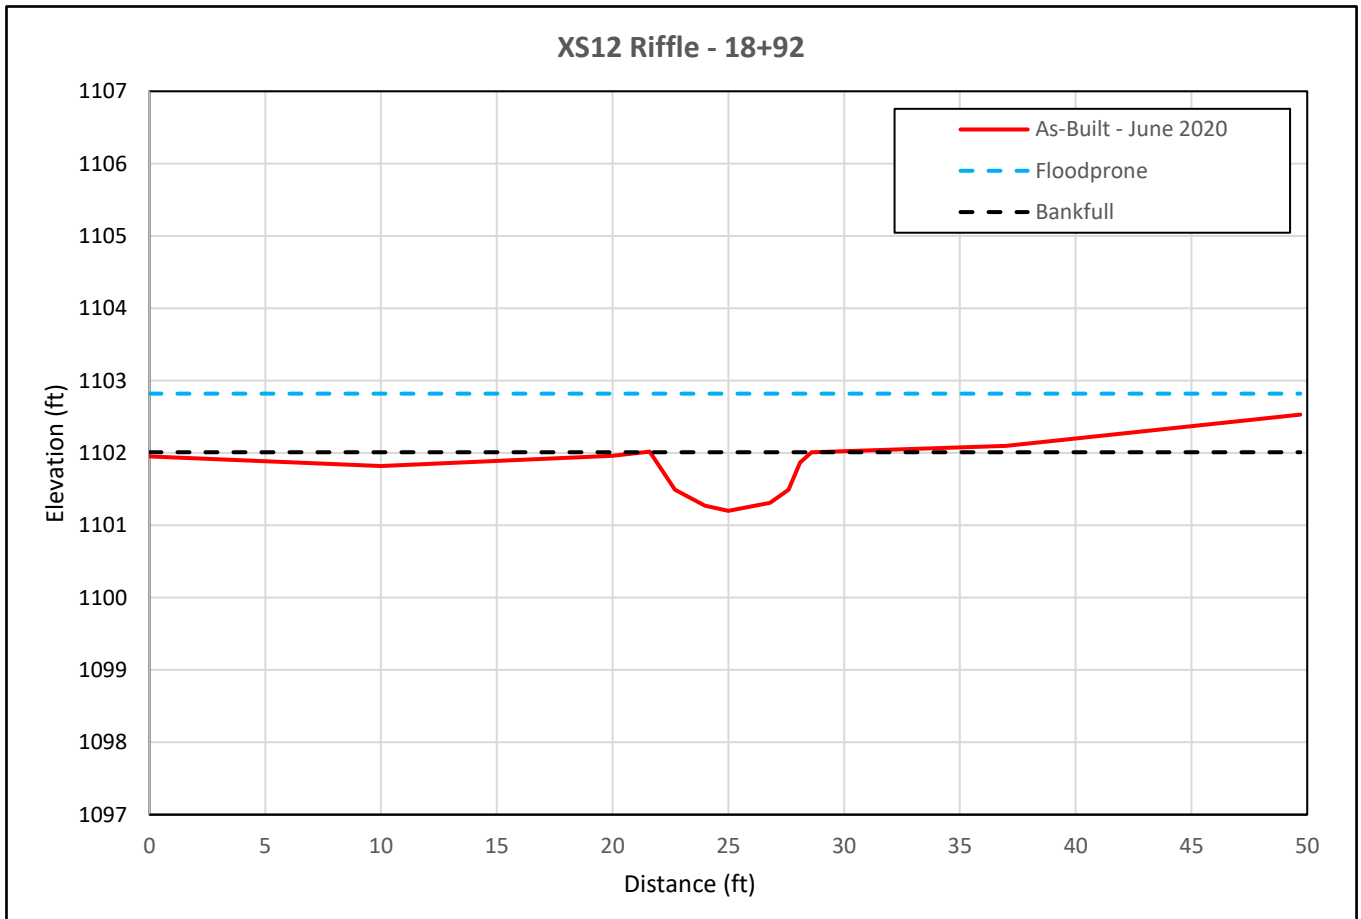



### Cross Section Plot - Baseline - June 2020

XS13 - UT1

Station 26+55 - Pool




XS13 looking upstream



XS13 looking downstream

Bankfull Elevation (ft)	Bankfull Area (ft <sup>2</sup> )	Bankfull Width (ft)	Floodprone Elevation (ft)	Floodprone Width (ft)	Max Depth (ft)	Mean Depth (ft)	W/D Ratio	ER	Bank Height Ratio
1088.55	5.49	8.89	N/A	N/A	1.15	0.62	14.34	N/A	1.1

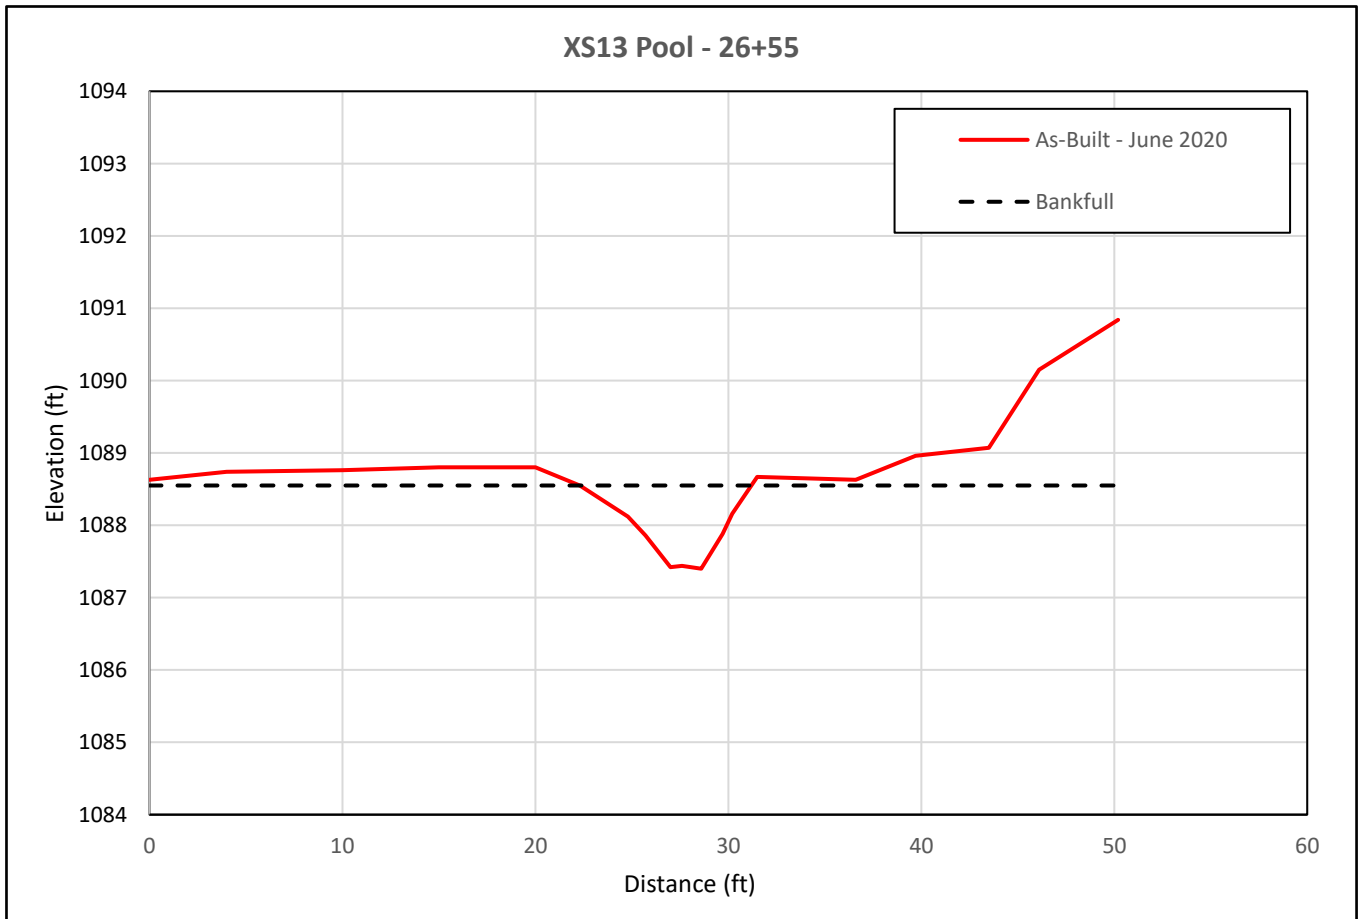

## Cross Section Plot - Baseline - June 2020

XS14 - UT1

Station 29+07 - Pool




XS14 looking upstream



XS14 looking downstream

Bankfull Elevation (ft)	Bankfull Area (ft <sup>2</sup> )	Bankfull Width (ft)	Floodprone Elevation (ft)	Floodprone Width (ft)	Max Depth (ft)	Mean Depth (ft)	W/D Ratio	ER	Bank Height Ratio
1085.64	4.63	9.31	N/A	N/A	1.14	0.5	18.62	N/A	1.0

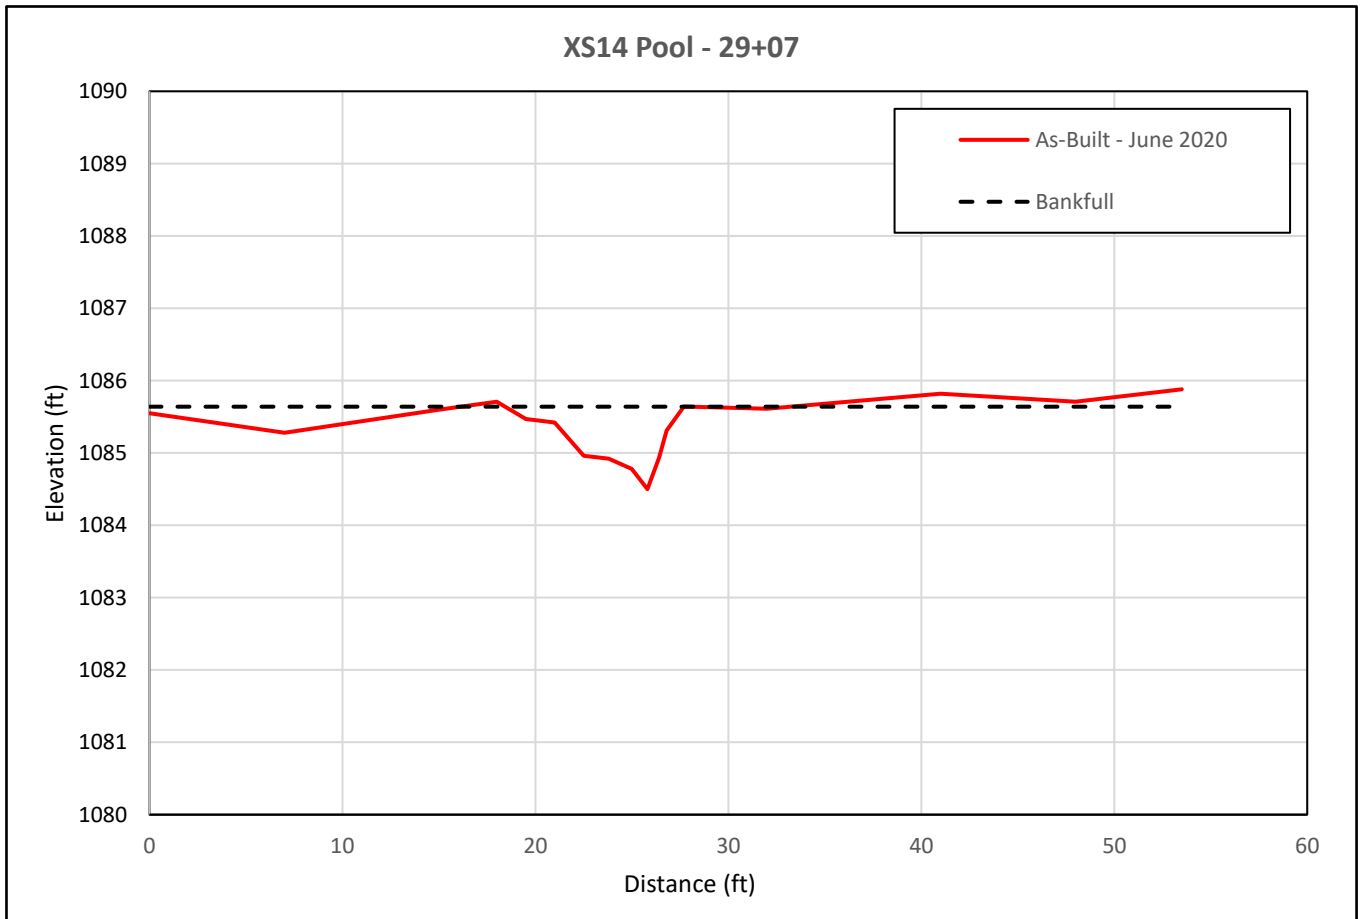

### Cross Section Plot - Baseline - June 2020

XS15 - UT1

Station 33+35 - Pool




XS15 looking upstream



XS15 looking downstream

Bankfull Elevation (ft)	Bankfull Area (ft <sup>2</sup> )	Bankfull Width (ft)	Floodprone Elevation (ft)	Floodprone Width (ft)	Max Depth (ft)	Mean Depth (ft)	W/D Ratio	ER	Bank Height Ratio
1080.95	6.9	16.23	N/A	N/A	1.53	0.43	37.74	N/A	1.0

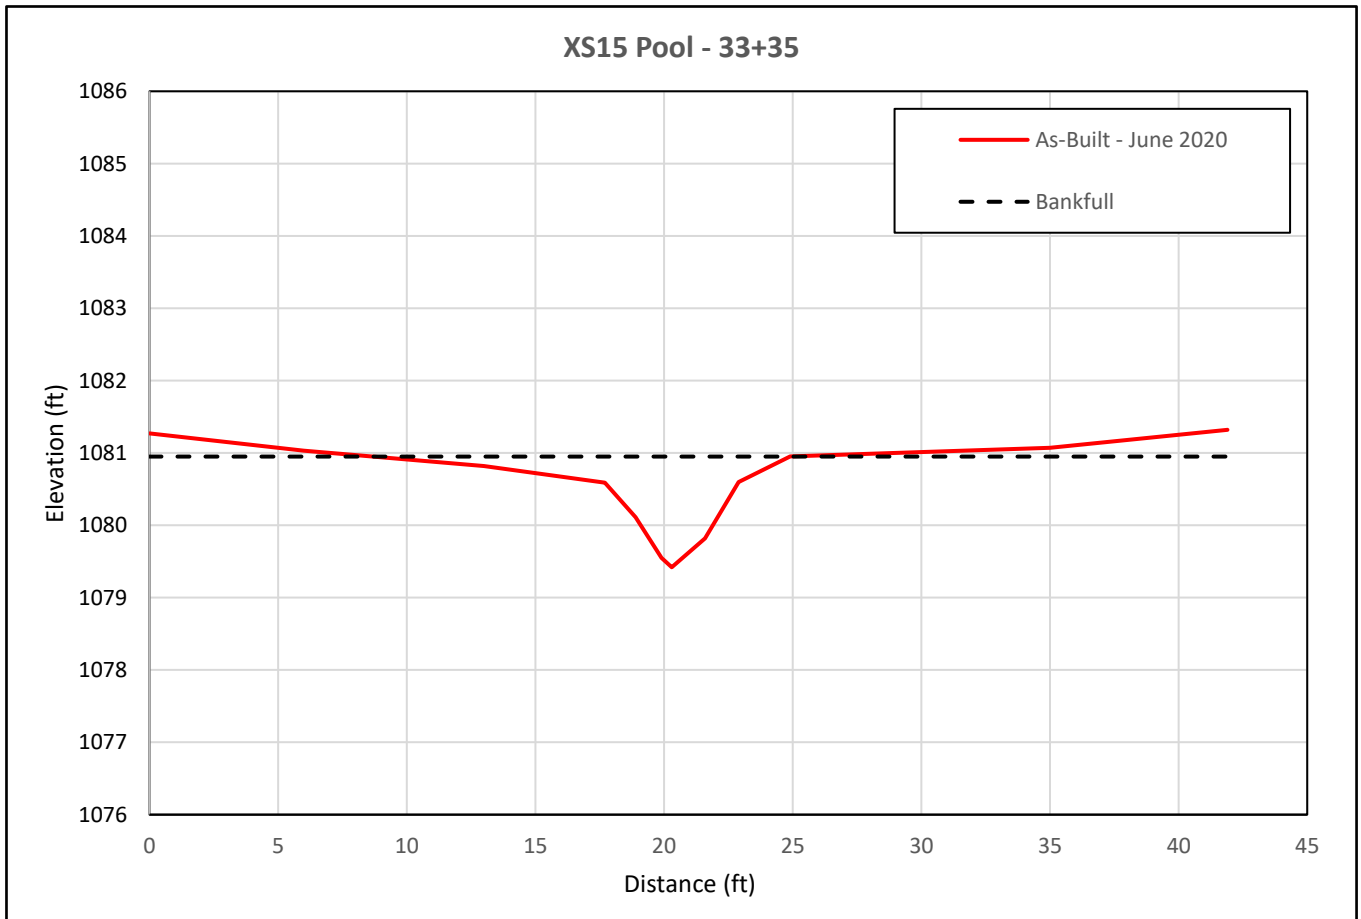

### Cross Section Plot - Baseline - June 2020

XS16 - UT1

Station 36+17 - Riffle




XS16 looking upstream



XS16 looking downstream

Bankfull Elevation (ft)	Bankfull Area (ft <sup>2</sup> )	Bankfull Width (ft)	Floodprone Elevation (ft)	Floodprone Width (ft)	Max Depth (ft)	Mean Depth (ft)	W/D Ratio	ER	Bank Height Ratio
1078.41	3.69	5.96	1079.38	54.3	0.97	0.62	9.61	9.12	1.0

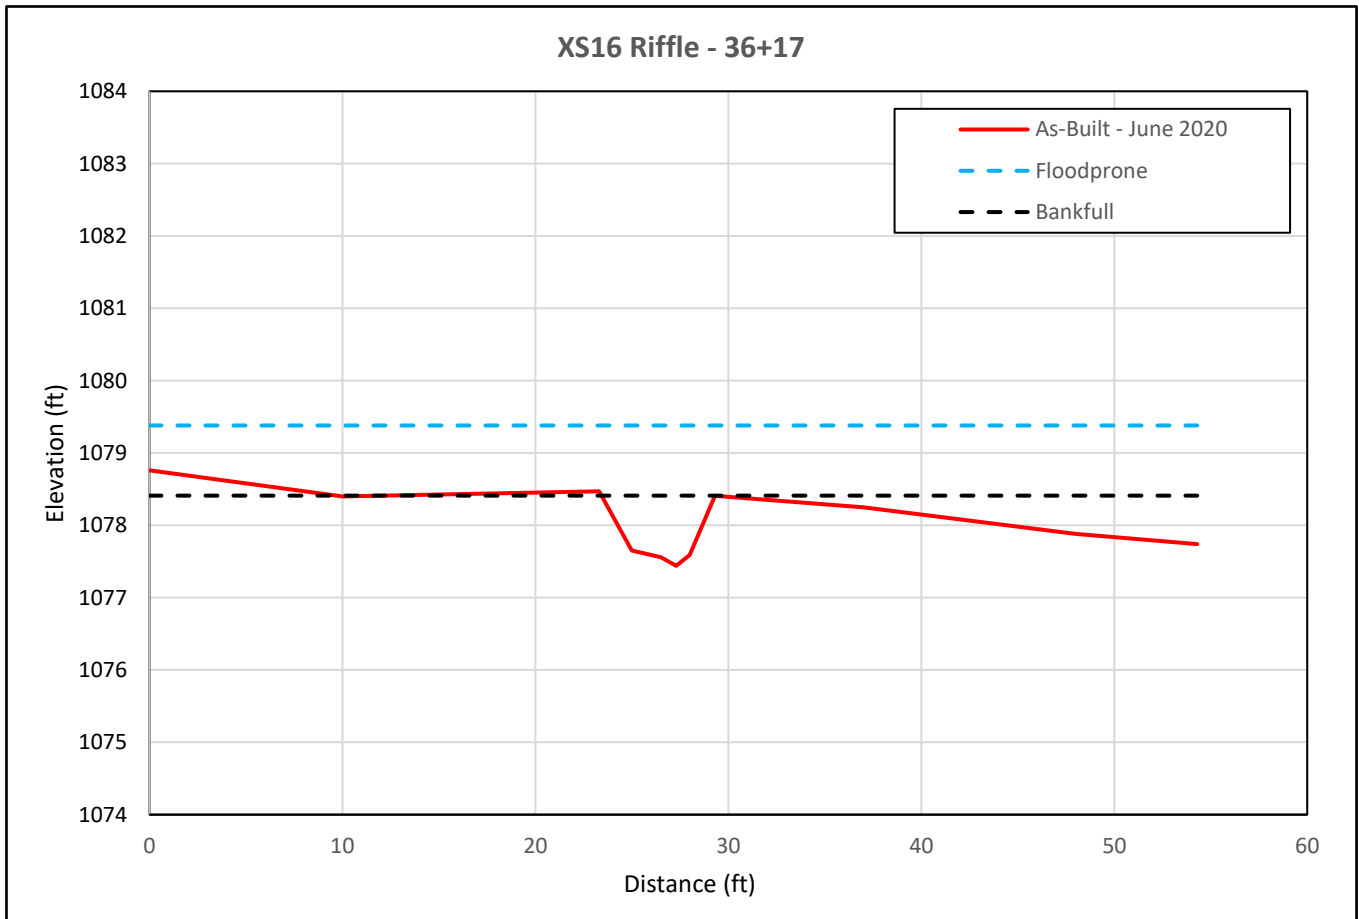

### Cross Section Plot - Baseline - June 2020

XS17 - UT2

Station 16+07 - Pool




XS17 looking upstream



XS17 looking downstream

Bankfull Elevation (ft)	Bankfull Area (ft <sup>2</sup> )	Bankfull Width (ft)	Floodprone Elevation (ft)	Floodprone Width (ft)	Max Depth (ft)	Mean Depth (ft)	W/D Ratio	ER	Bank Height Ratio
1098.12	5.42	8.33	N/A	N/A	1.39	0.65	12.82	N/A	1.0

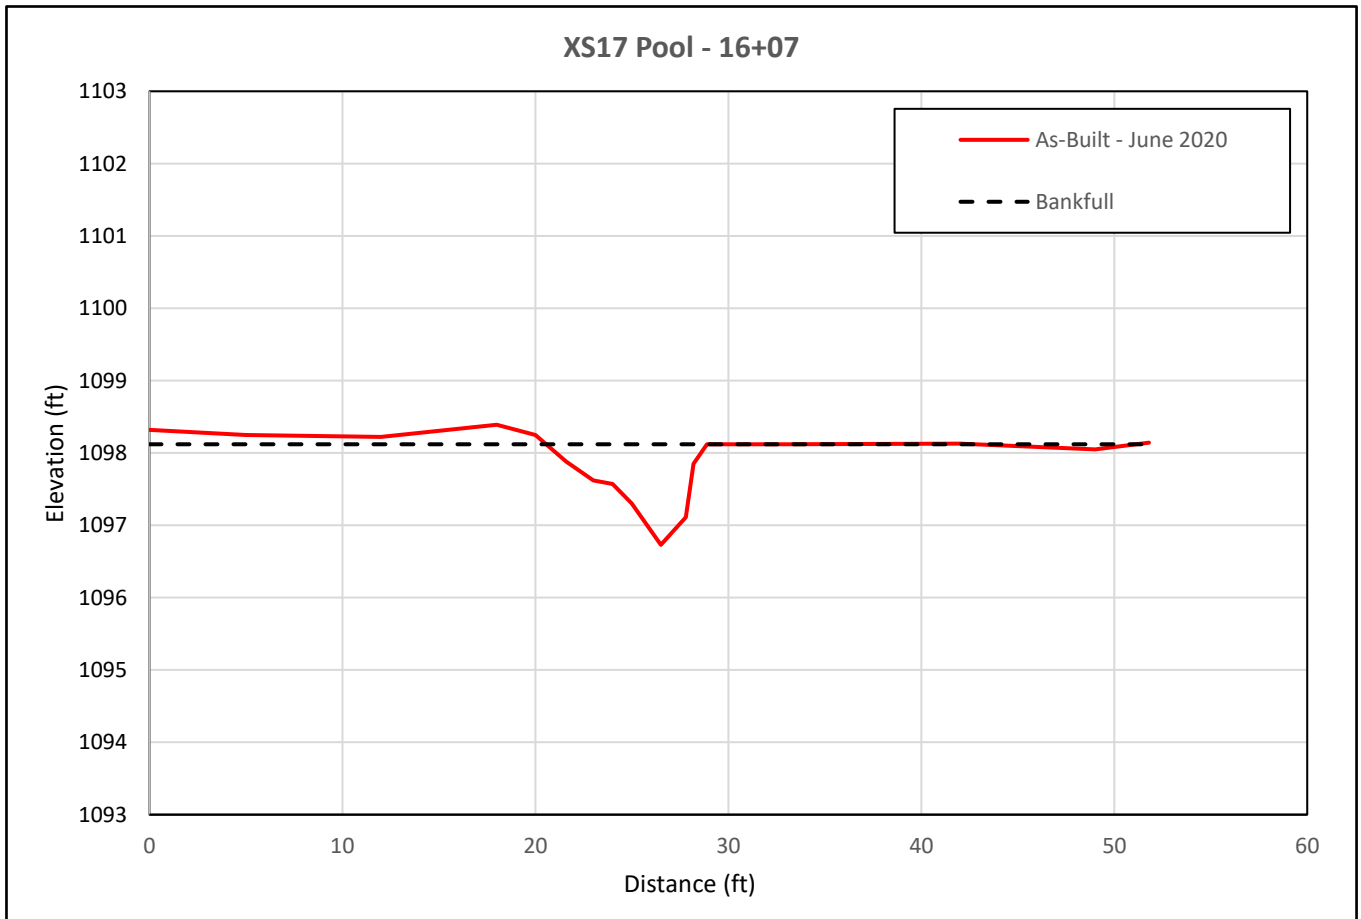

### Cross Section Plot - Baseline - June 2020

XS18 - UT2

Station 16+20 - Riffle




XS18 looking upstream



XS18 looking downstream

Bankfull Elevation (ft)	Bankfull Area (ft <sup>2</sup> )	Bankfull Width (ft)	Floodprone Elevation (ft)	Floodprone Width (ft)	Max Depth (ft)	Mean Depth (ft)	W/D Ratio	ER	Bank Height Ratio
1097.77	2.41	5.48	1098.46	52	0.69	0.44	12.45	9.48	1.0

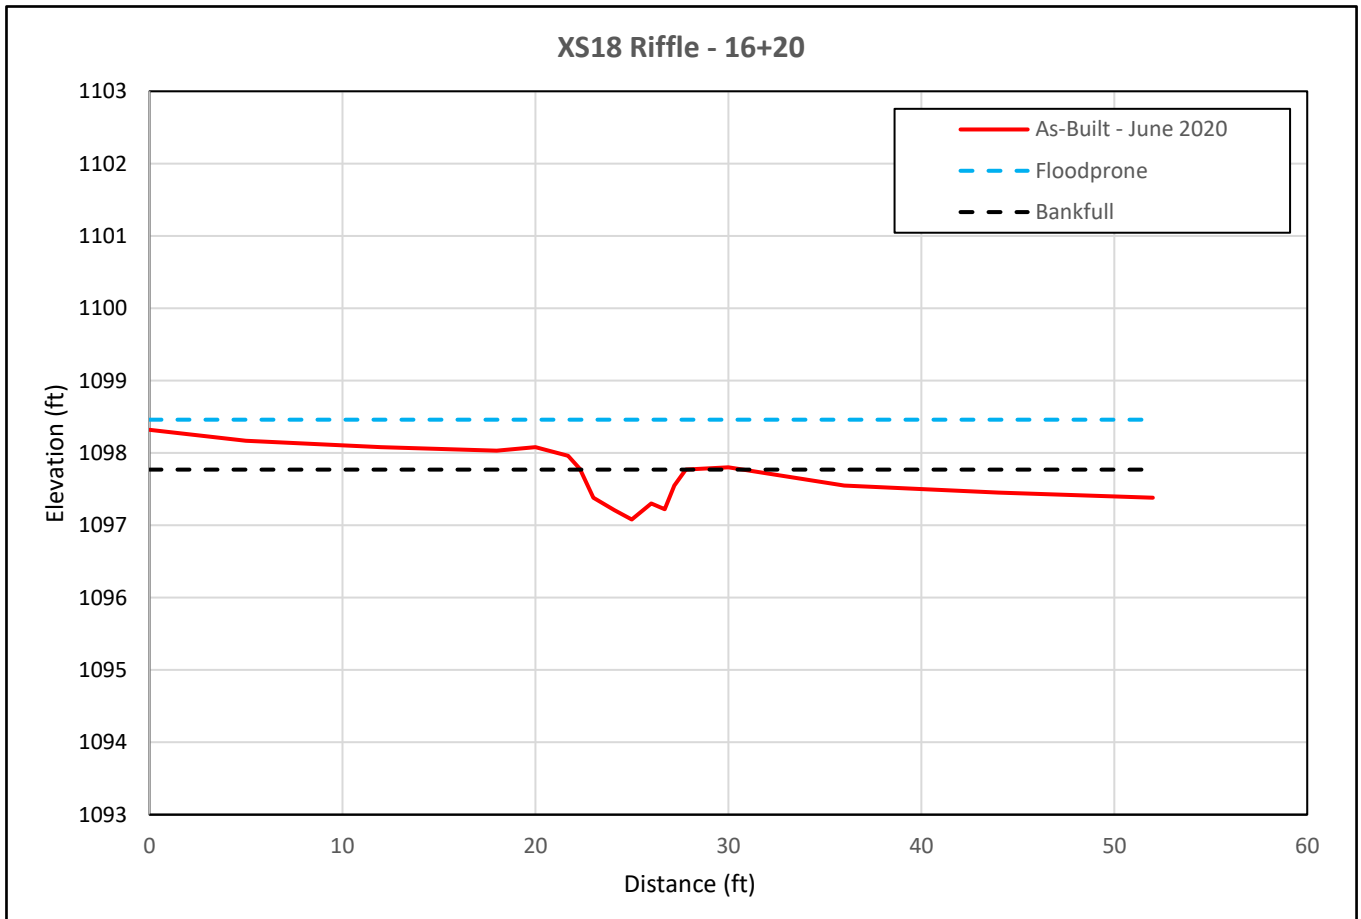

### Cross Section Plot - Baseline - June 2020

XS19 - UT2

Station 19+83 - Riffle




XS19 looking upstream



XS19 looking downstream

Bankfull Elevation (ft)	Bankfull Area (ft <sup>2</sup> )	Bankfull Width (ft)	Floodprone Elevation (ft)	Floodprone Width (ft)	Max Depth (ft)	Mean Depth (ft)	W/D Ratio	ER	Bank Height Ratio
1092.07	3.09	6.11	1092.81	50.8	0.74	0.51	11.98	8.32	1.1

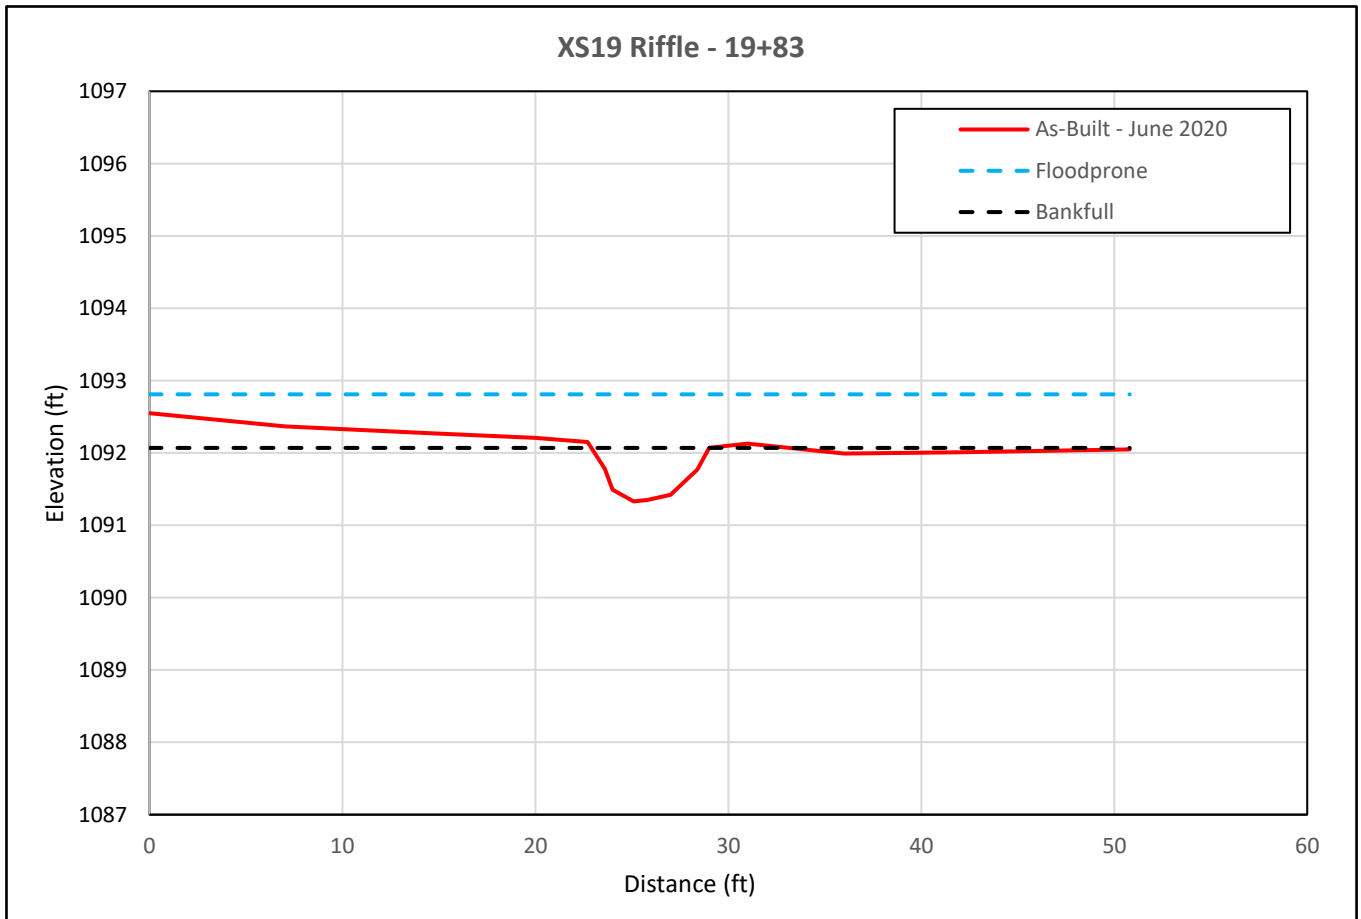

### Cross Section Plot - Baseline - June 2020

XS20 - UT3 Reach 1

Station 17+25 - Pool




XS20 looking upstream



XS20 looking downstream

Bankfull Elevation (ft)	Bankfull Area (ft <sup>2</sup> )	Bankfull Width (ft)	Floodprone Elevation (ft)	Floodprone Width (ft)	Max Depth (ft)	Mean Depth (ft)	W/D Ratio	ER	Bank Height Ratio
1095.67	5.72	11.19	N/A	N/A	1.16	0.51	21.94	N/A	1.0

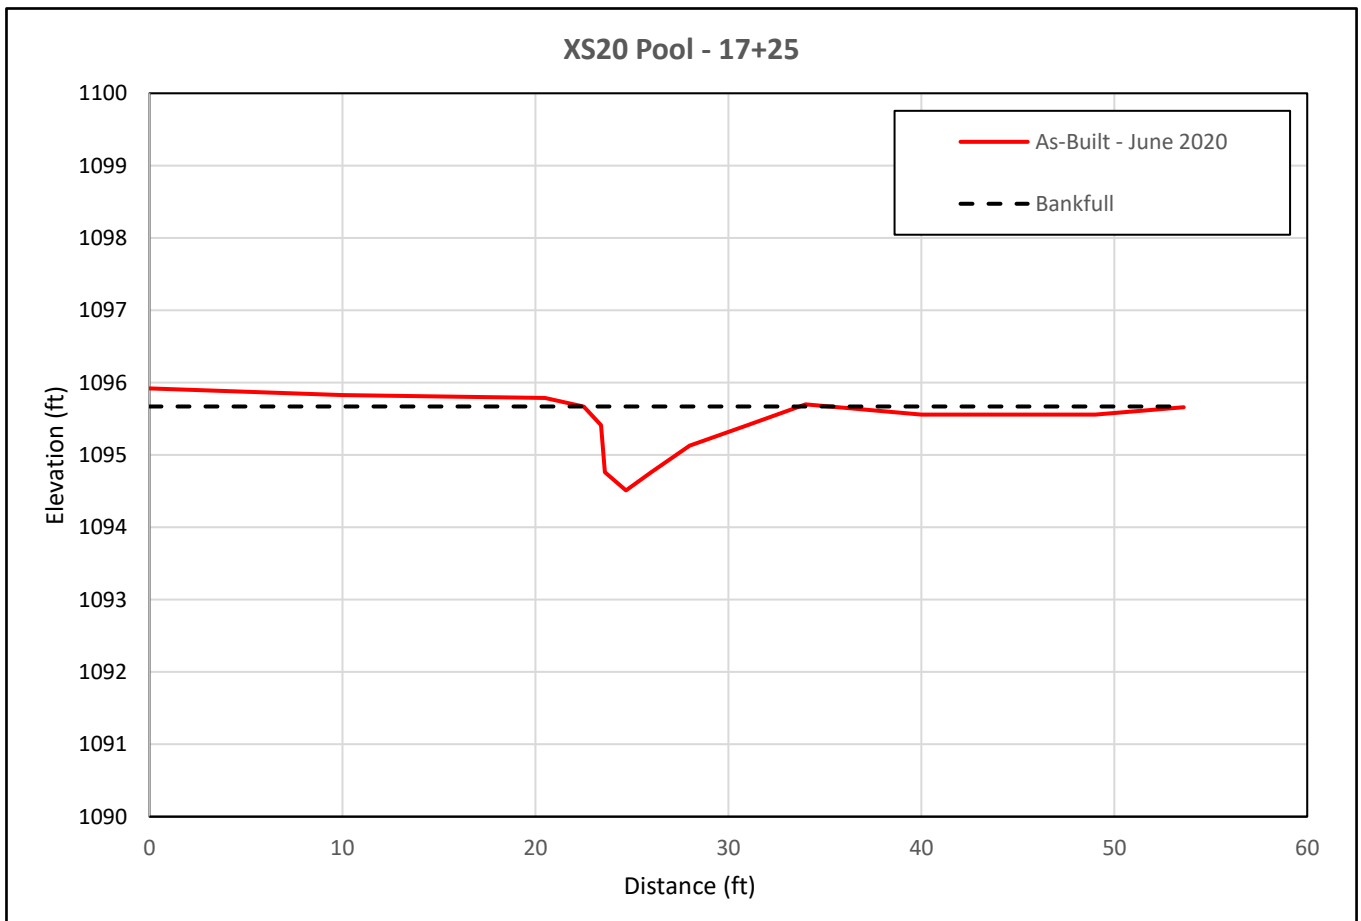



### Cross Section Plot - Baseline - June 2020

XS21 - UT3 Reach 1

Station 19+28 - Riffle




XS21 looking upstream



XS21 looking downstream

Bankfull Elevation (ft)	Bankfull Area (ft <sup>2</sup> )	Bankfull Width (ft)	Floodprone Elevation (ft)	Floodprone Width (ft)	Max Depth (ft)	Mean Depth (ft)	W/D Ratio	ER	Bank Height Ratio
1092.21	3.15	5.89	1092.94	41.6	0.73	0.53	11.11	7.06	1.1

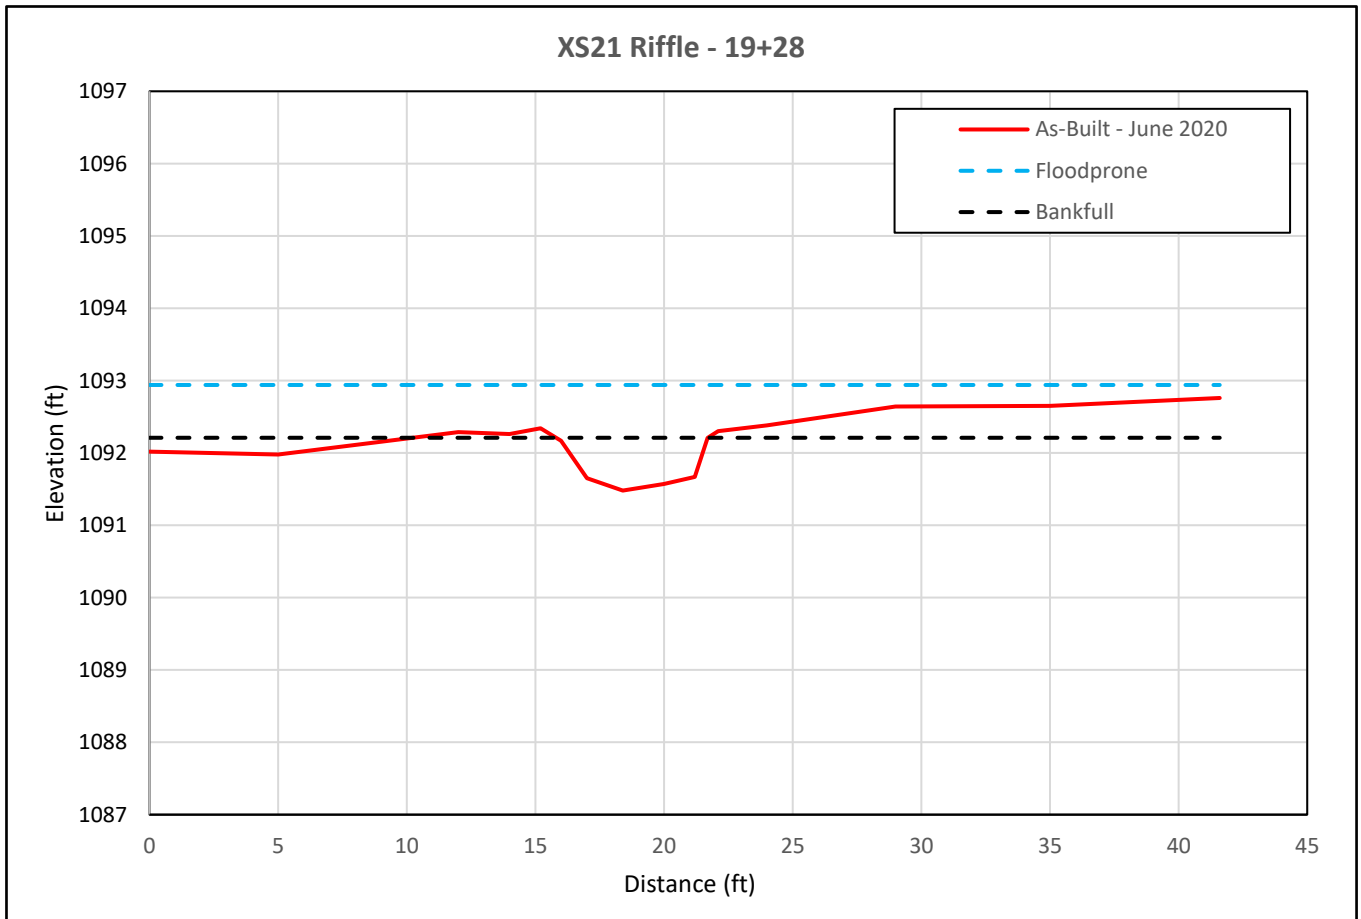

### Cross Section Plot - Baseline - June 2020

XS22 - UT3 Reach 2

Station 21+31 - Pool




XS22 looking upstream



XS22 looking downstream

Bankfull Elevation (ft)	Bankfull Area (ft <sup>2</sup> )	Bankfull Width (ft)	Floodprone Elevation (ft)	Floodprone Width (ft)	Max Depth (ft)	Mean Depth (ft)	W/D Ratio	ER	Bank Height Ratio
1089.56	6.88	11.25	N/A	N/A	1.25	0.61	18.44	N/A	1.0

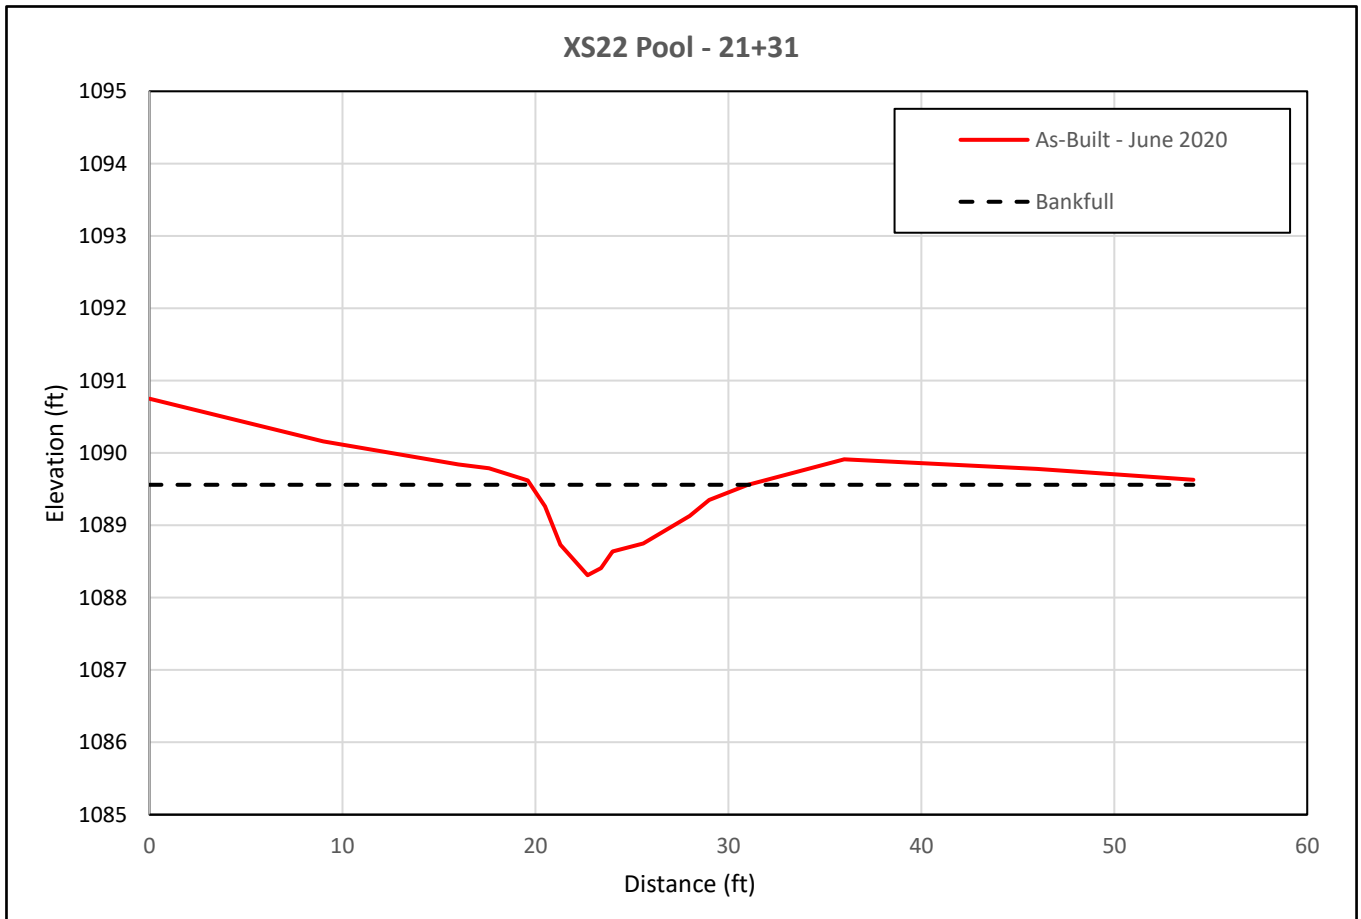

### Cross Section Plot - Baseline - June 2020

XS23- UT3 Reach 2

Station 24+61 - Riffle




XS23 looking upstream



XS23 looking downstream

Bankfull Elevation (ft)	Bankfull Area (ft <sup>2</sup> )	Bankfull Width (ft)	Floodprone Elevation (ft)	Floodprone Width (ft)	Max Depth (ft)	Mean Depth (ft)	W/D Ratio	ER	Bank Height Ratio
1087.39	4.88	8.22	1088.25	56.3	0.86	0.59	13.93	6.85	1.1

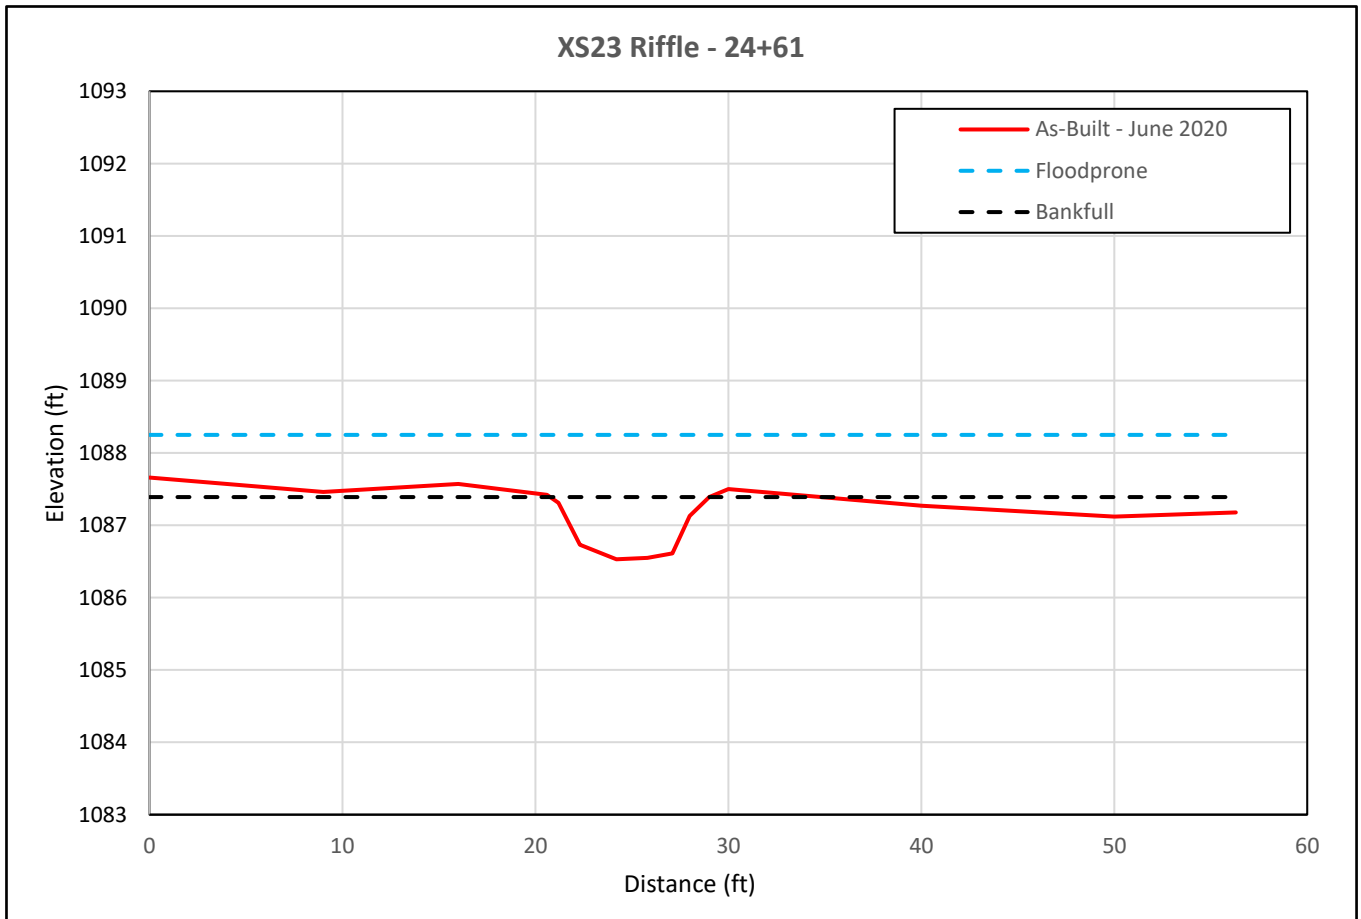

### Cross Section Plot - Baseline - June 2020

XS24 - UT3 Reach 2

Station 34+36 - Pool




XS24 looking upstream



XS24 looking downstream

Bankfull Elevation (ft)	Bankfull Area (ft <sup>2</sup> )	Bankfull Width (ft)	Floodprone Elevation (ft)	Floodprone Width (ft)	Max Depth (ft)	Mean Depth (ft)	W/D Ratio	ER	Bank Height Ratio
1081.92	7.06	9.2	N/A	N/A	1.44	0.77	11.95	N/A	1.1

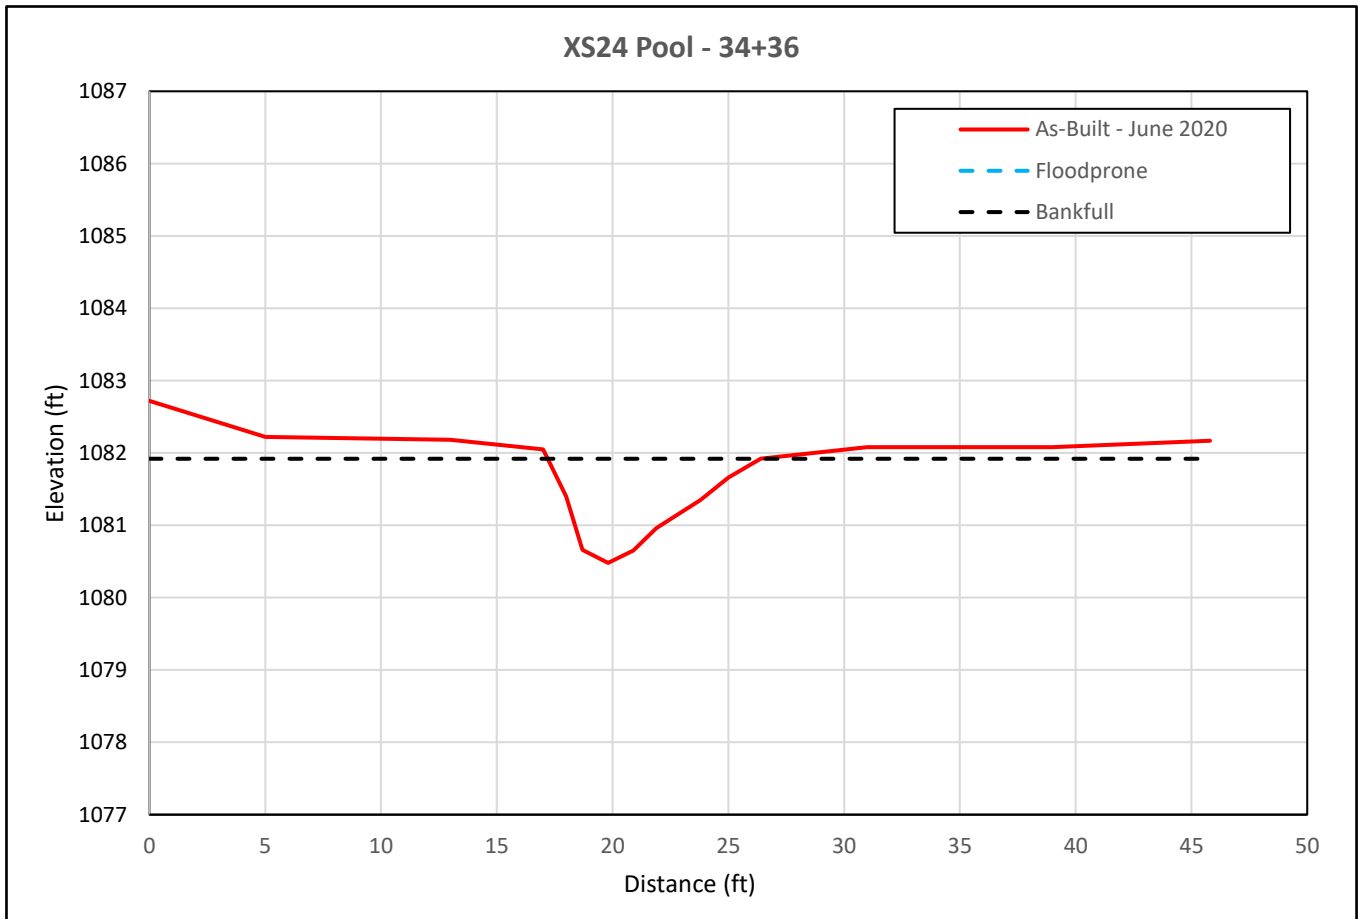

### Cross Section Plot - Baseline - June 2020

XS25 - UT3 Reach 2

Station 36+26 - Riffle




XS25 looking upstream



XS25 looking downstream

Bankfull Elevation (ft)	Bankfull Area (ft <sup>2</sup> )	Bankfull Width (ft)	Floodprone Elevation (ft)	Floodprone Width (ft)	Max Depth (ft)	Mean Depth (ft)	W/D Ratio	ER	Bank Height Ratio
1081.58	4.54	7.23	1082.62	55.6	1.04	0.63	11.48	7.7	1.0

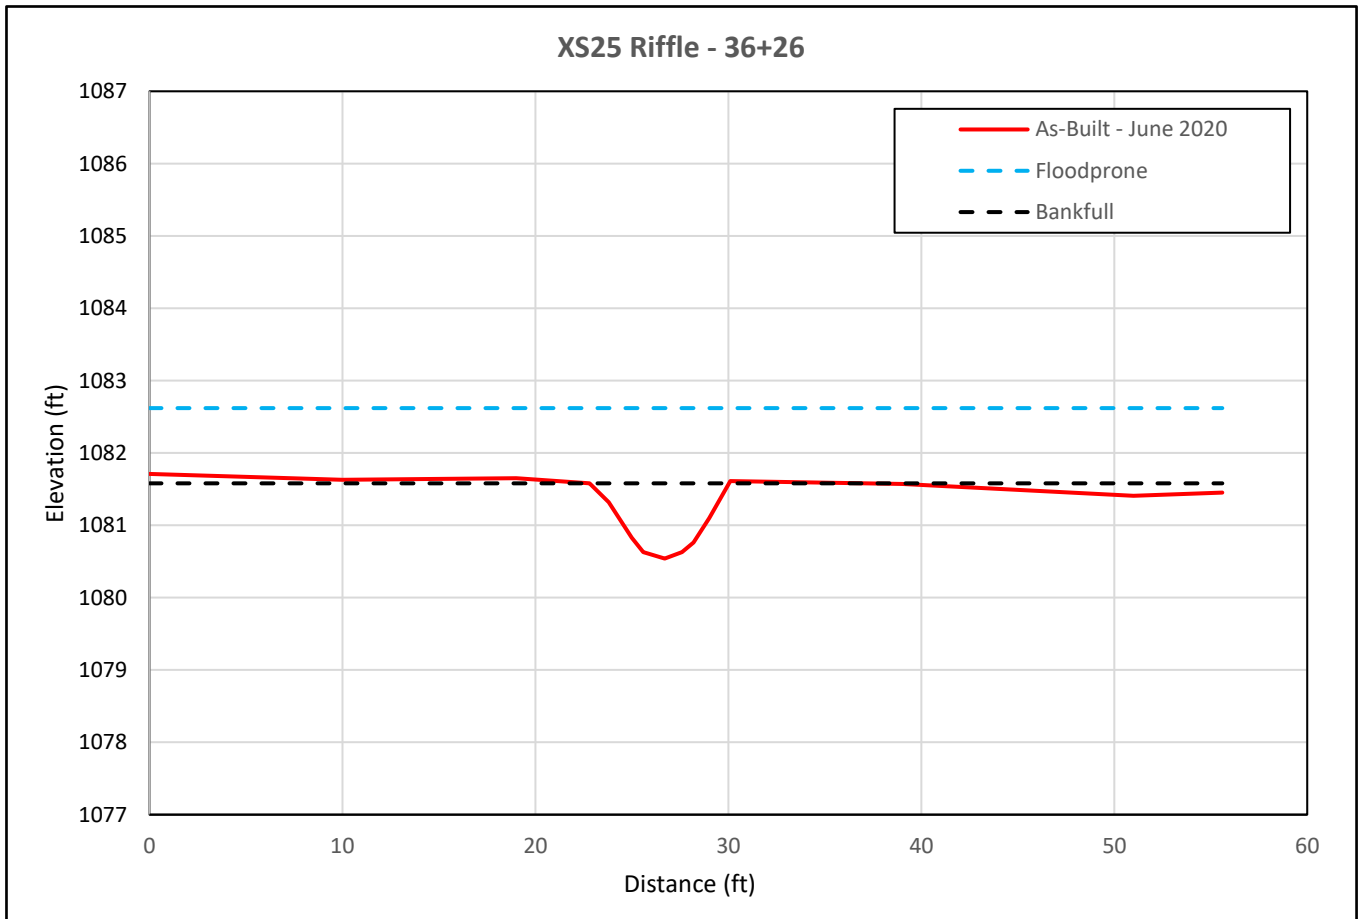

### Cross Section Plot - Baseline - June 2020

XS26 - UT3 Reach 2

Station 43+26 - Pool




XS26 looking upstream



XS26 looking downstream

Bankfull Elevation (ft)	Bankfull Area (ft <sup>2</sup> )	Bankfull Width (ft)	Floodprone Elevation (ft)	Floodprone Width (ft)	Max Depth (ft)	Mean Depth (ft)	W/D Ratio	ER	Bank Height Ratio
1077.31	7.58	9.84	N/A	N/A	1.41	0.77	12.78	N/A	1.0

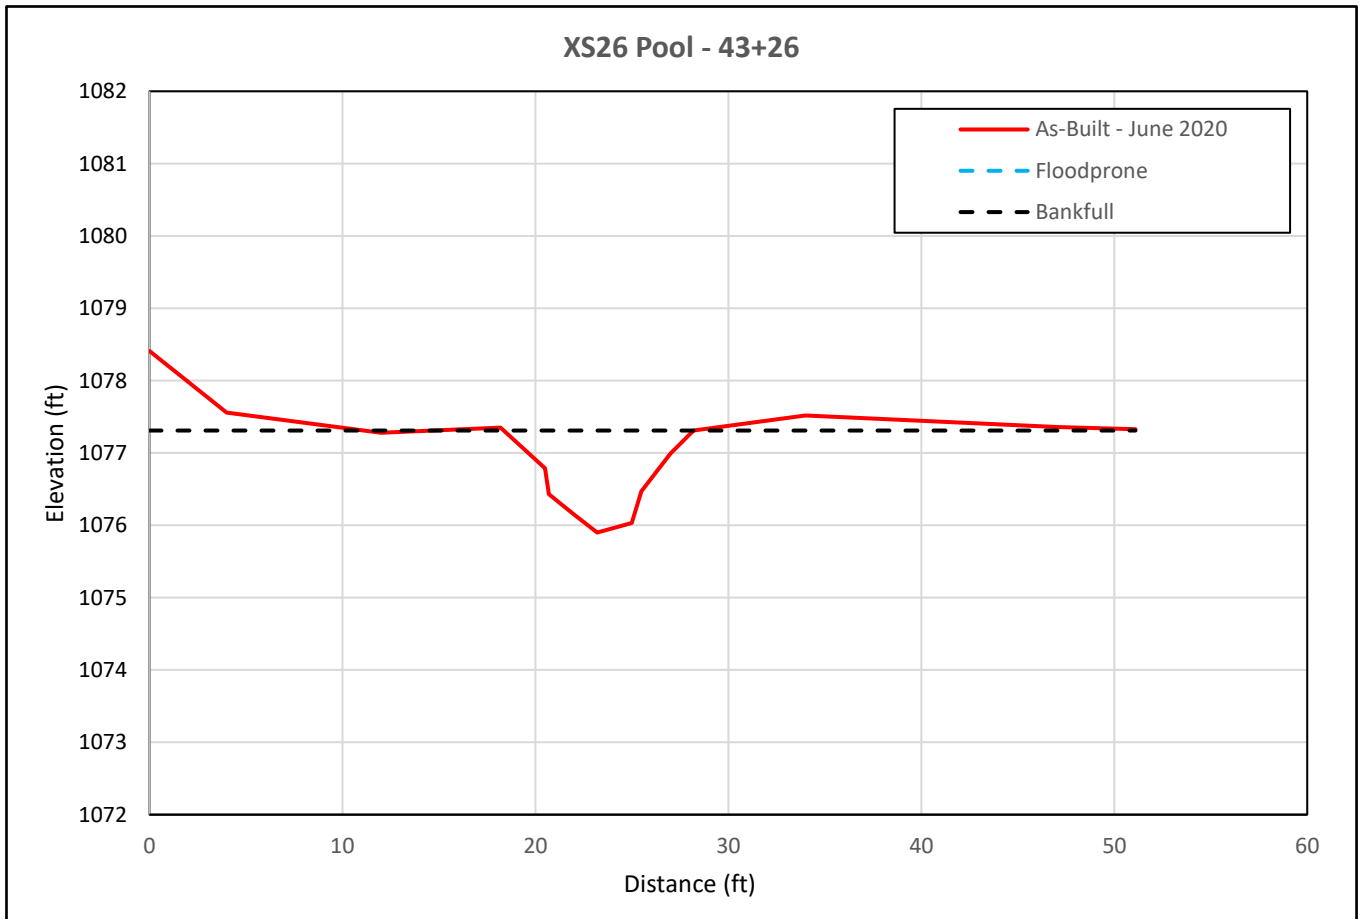


## Appendix E: As-Built Drawings

PROJECT: STEWARTS CREEK TRIBUTARIES

NC DEPARTMENT OF ENVIRONMENTAL QUALITY  
DIVISION OF MITIGATION SERVICES

STATE	PROJECT REFERENCE NO.	SHEET NO.	TOTAL SHEETS
NC	083	1	30

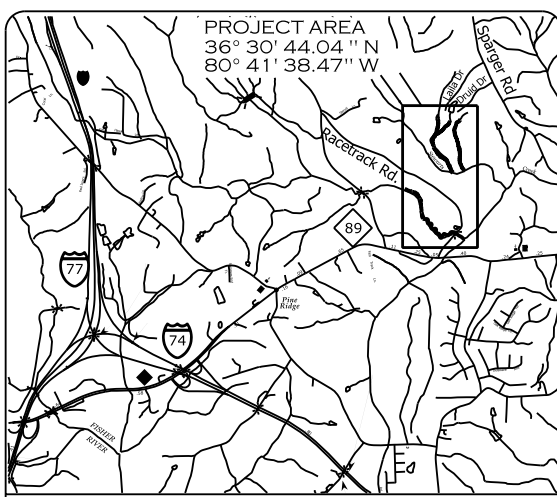

VICINITY MAP

INDEX OF SHEETS





1...	TITLE SHEET
2...	STREAM CONVENTIONAL SYMBOLS GENERAL NOTES
3-26...	PLAN AND PROFILE
27-30...	VEGETATION PLAN / FENCING PLAN

# SURRY COUNTY

LOCATION: SURRY COUNTY, NC

TYPE OF WORK: RECORD DRAWINGS

I, DAVID S. TURNER, AS A DULY REGISTERED PROFESSIONAL LAND SURVEYOR IN THE STATE OF NORTH CAROLINA, HEREBY CERTIFY THAT THE SURVEY DATA SHOWN WAS OBTAINED UNDER MY SUPERVISION, IS AN ACCURATE AND COMPLETE REPRESENTATION OF WHAT WAS CONSTRUCTED IN THE FIELD, AND THAT THE PHYSICAL DIMENSIONS OR ELEVATIONS SHOWN THIS ARE AS-BUILT CONDITIONS EXCEPT WHERE OTHERWISE NOTED HEREON. WITNESS- MY ORIGINAL SIGNATURE, REGISTRATION NUMBER, AND SEAL THIS 9th DAY OF OCTOBER, 2020.

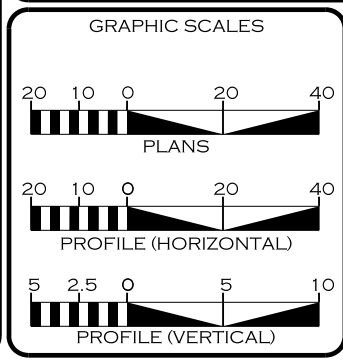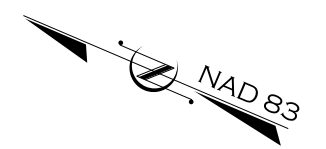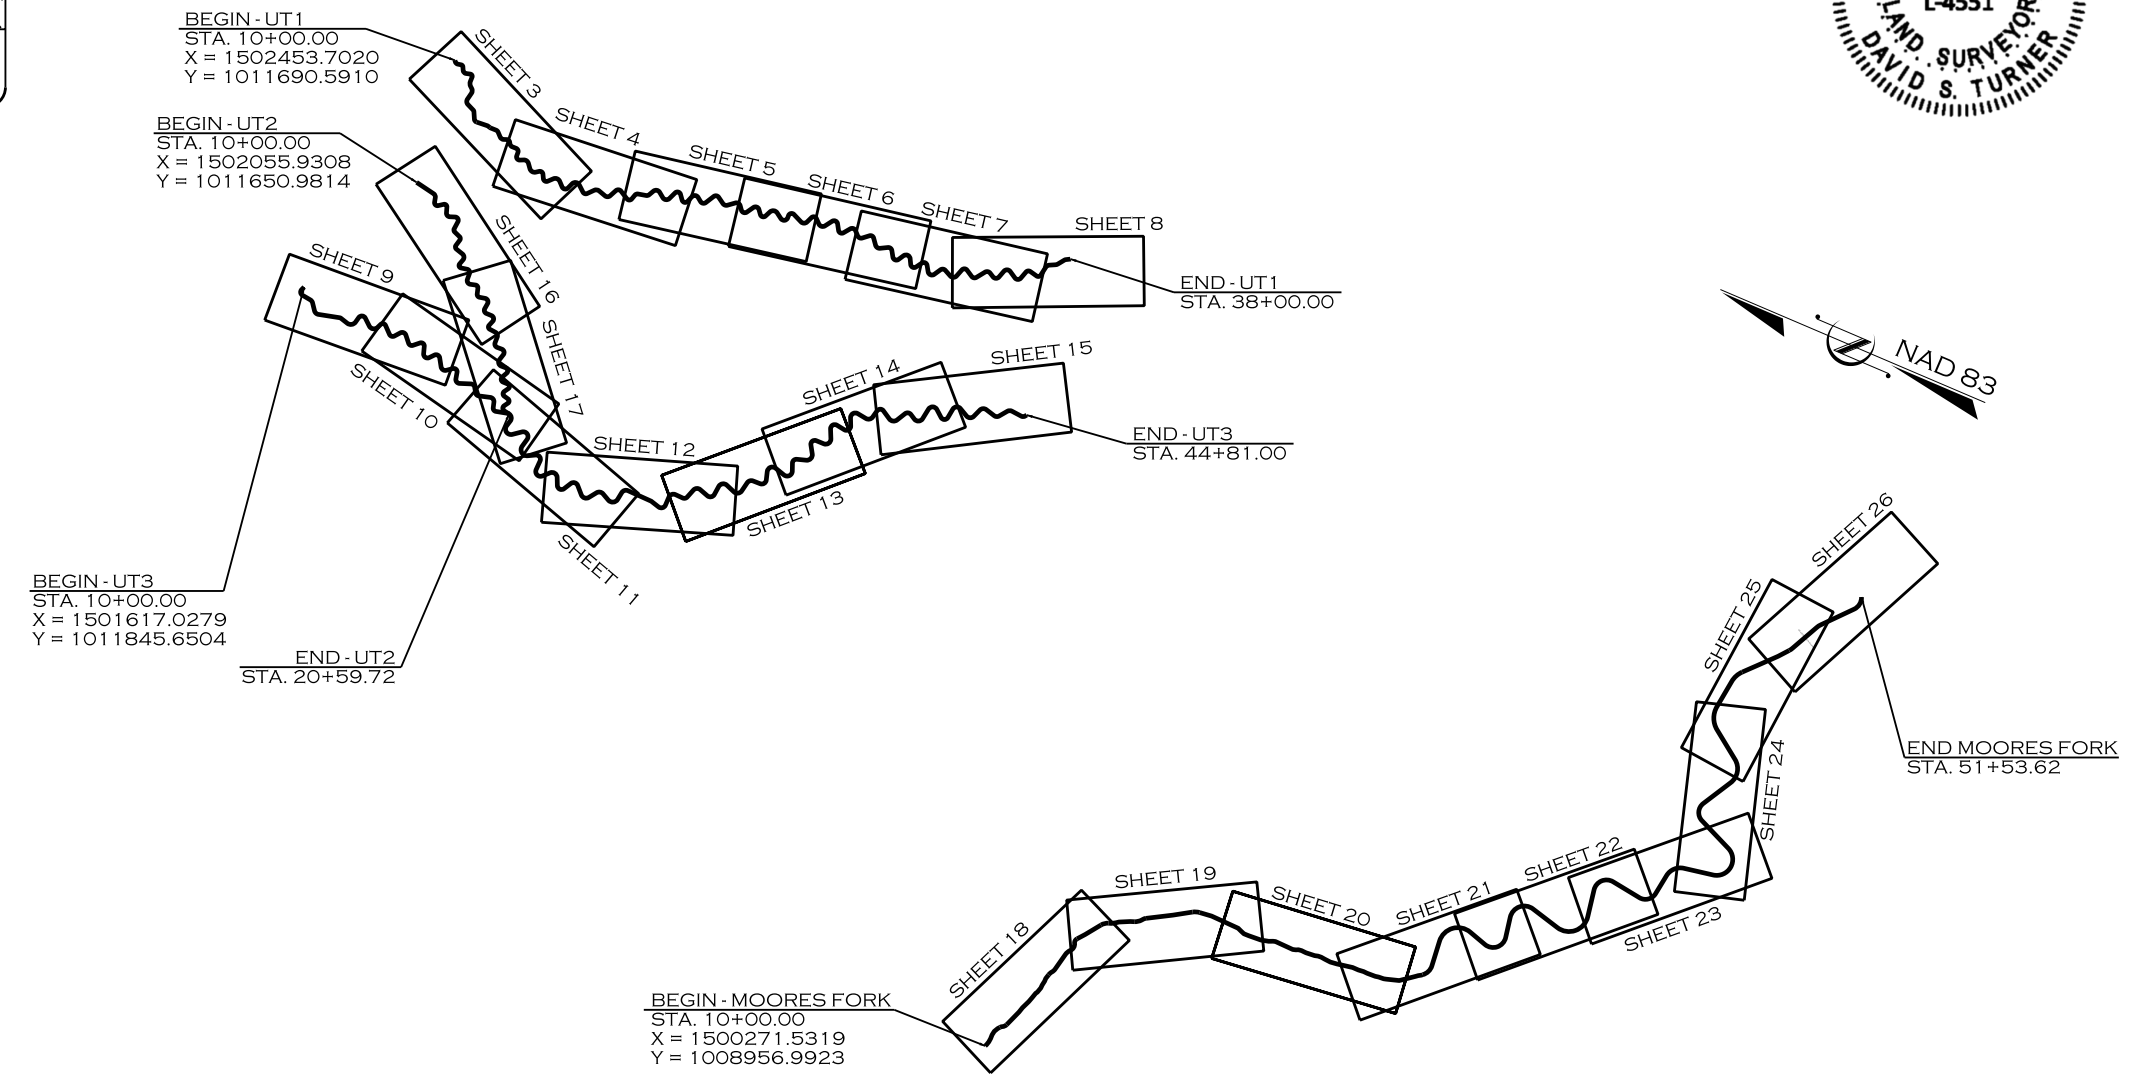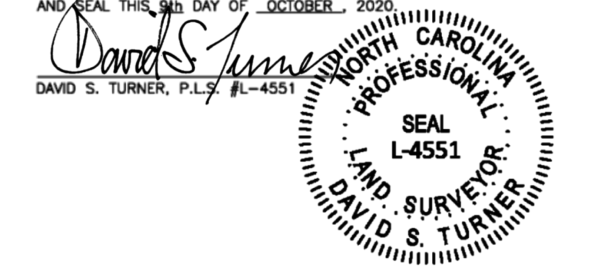

REVISIONS				
NO.	DESCRIPTION	ENGR.	APPROV.	DATE
1	RECORD DRAWINGS	EMB	KLT	10/9/20

PREPARED FOR:

NC DEPARTMENT OF ENVIRONMENTAL QUALITY  
DIVISION OF MITIGATION SERVICES  
1652 MAIL SERVICE CENTER  
RALEIGH, NC 27699-1652

PAUL WIESNER  
PROJECT MANAGER

PREPARED IN THE OFFICE OF:

ECOSYSTEM PLANNING & RESTORATION  
1150 SE MAYNARD RD  
SUITE 140  
CARY, NC 27511  
LICENSE # P-1182

SPRING 2020  
COMPLETION DATE:

ERIN BENNETT, PE  
PROJECT ENGINEER

PROJECT ENGINEER

ERIN M. BENNETT  
P.E.



# STREAM CONVENTIONAL SYMBOLS

SYMBOLY / NOTES


- ROCK J-HOOK (JH)
- ROCK VANE (RV)
- OFFSET ROCK CROSS VANE (OV)
- ROCK CROSS VANE (XV)
- TEMPORARY SILT CHECK
- ROOT WAD (RW)
- GRADE CONTROL LOG J-HOOK (LJH)
- LOG VANE (LV)
- LOG STEP (LS)
- ROCK STEP (RS)
- LOG CROSS VANE (XV)
- CONSTRUCTED CASCADE (CC)
- CONSTRUCTED RIFFLE (CR)
- BOULDER CLUSTER
- LOG ROLLER (LR)
- GRADE CONTROL WOODY RIFFLE (WR)
- TOEWOOD WITH GEOLIFT (TW)
- SOD MAT (SM)
- DEBRIS JAM (DJ-T#)
- SINGLE WING DEFLECTOR (SW)
- DOUBLE WING DEFLECTOR (DW)
- FLOODPLAIN SILLS
- SF — SAFETY FENCE
- TP — TAPE FENCE
- ||| — SILT FENCE
- CE — CONSERVATION EASEMENT
- 20 — EXISTING MAJOR CONTOUR
- — — EXISTING MINOR CONTOUR
- - - - - LIMITS OF DISTURBANCE
- - - - - BANKFULL BENCH (GRADE)
- - - - - PROPERTY LINE
- == == == ACCESS ROAD
- 10+00 STREAM THALWEG
- STREAM TOP OF BANKS
- ( ) FOOT BRIDGE
- ( ) TEMPORARY STREAM CROSSING
- ( ) PERMANENT FORD STREAM CROSSING (PFC)
- ( ) TRANSPLANTED VEGETATION
- ( ) TREE REMOVAL
- ( ) TREE PROTECTION
- ( ) GEOLIFT
- ( ) CHANNEL FILL / DITCH PLUG
- ( ) GRADE BANK 2:1 OR FLATTER
- ( ) EXISTING WETLANDS
- ( ) EXISTING BEDROCK
- ( ) OUTLET PROTECTION (OP)
- ( ) IMPERVIOUS DIKE
- x — x — FENCING
- ( ) WITNESS POST
- ( ) EXISTING FENCE REMOVAL

- MONITORING FEATURES
- VP VEGETATION MONITORING PLOT
  - MONITORING GAUGE
  - PHOTO POINT
  - XS MONITORING CROSS SECTION

\*\*NOTE: ALL ITEMS ABOVE MAY NOT BE USED ON THIS PROJECT

## GENERAL NOTES

1. CONSTRUCTION WAS COMPLETED IN MAY 2020.
2. TOPOGRAPHIC SURVEY WAS COMPLETED BY TURNER LAND SURVEYING IN JUNE 2020 AND OCTOBER 2020.
3. NO SOD MATS WERE CONSTRUCTED AND OTHER STRUCTURES WERE ADDED PER DIRECTION OF THE ENGINEER.
4. SURVEYED ASBUILT FEATURES ARE SHOWN IN DARK BLACK, DESIGN FEATURES ARE SHOWN IN GREY, AND ANY FIELD CHANGES THAT WERE MADE DURING CONSTRUCTION ARE SHOWN IN RED. THE CONTOURS SHOWN ARE ASBUILT CONTOURS.

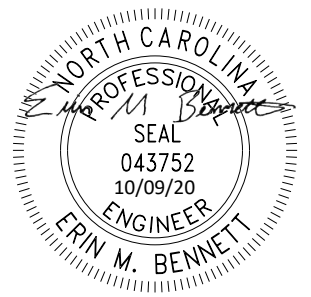

10/8/2020 R:\PROJECTS\RD\0083\_NCDEQ\_STEWARTS CREEK\_FD\CADD\PLANS\ASBUILT\MF\_ASB\_PSH\_02.DGN

REVISIONS				
NO.	DESCRIPTION	ENGR.	APPROV.	DATE
1	RECORD DRAWINGS	EMB	KLT	10/9/20

PREPARED FOR:




NC DEPARTMENT OF ENVIRONMENTAL QUALITY  
DIVISION OF MITIGATION SERVICES  
1652 MAIL SERVICE CENTER  
RALEIGH, NC 27699-1652

STEWARTS CREEK TRIBUTARIES PROJECT  
SURRY COUNTY, NC

PREPARED IN THE OFFICE OF:

1150 SE MAYNARD RD, SUITE 140  
CARY, NC 27511  
LICENSE # P-1182

PROJECT ENGINEER

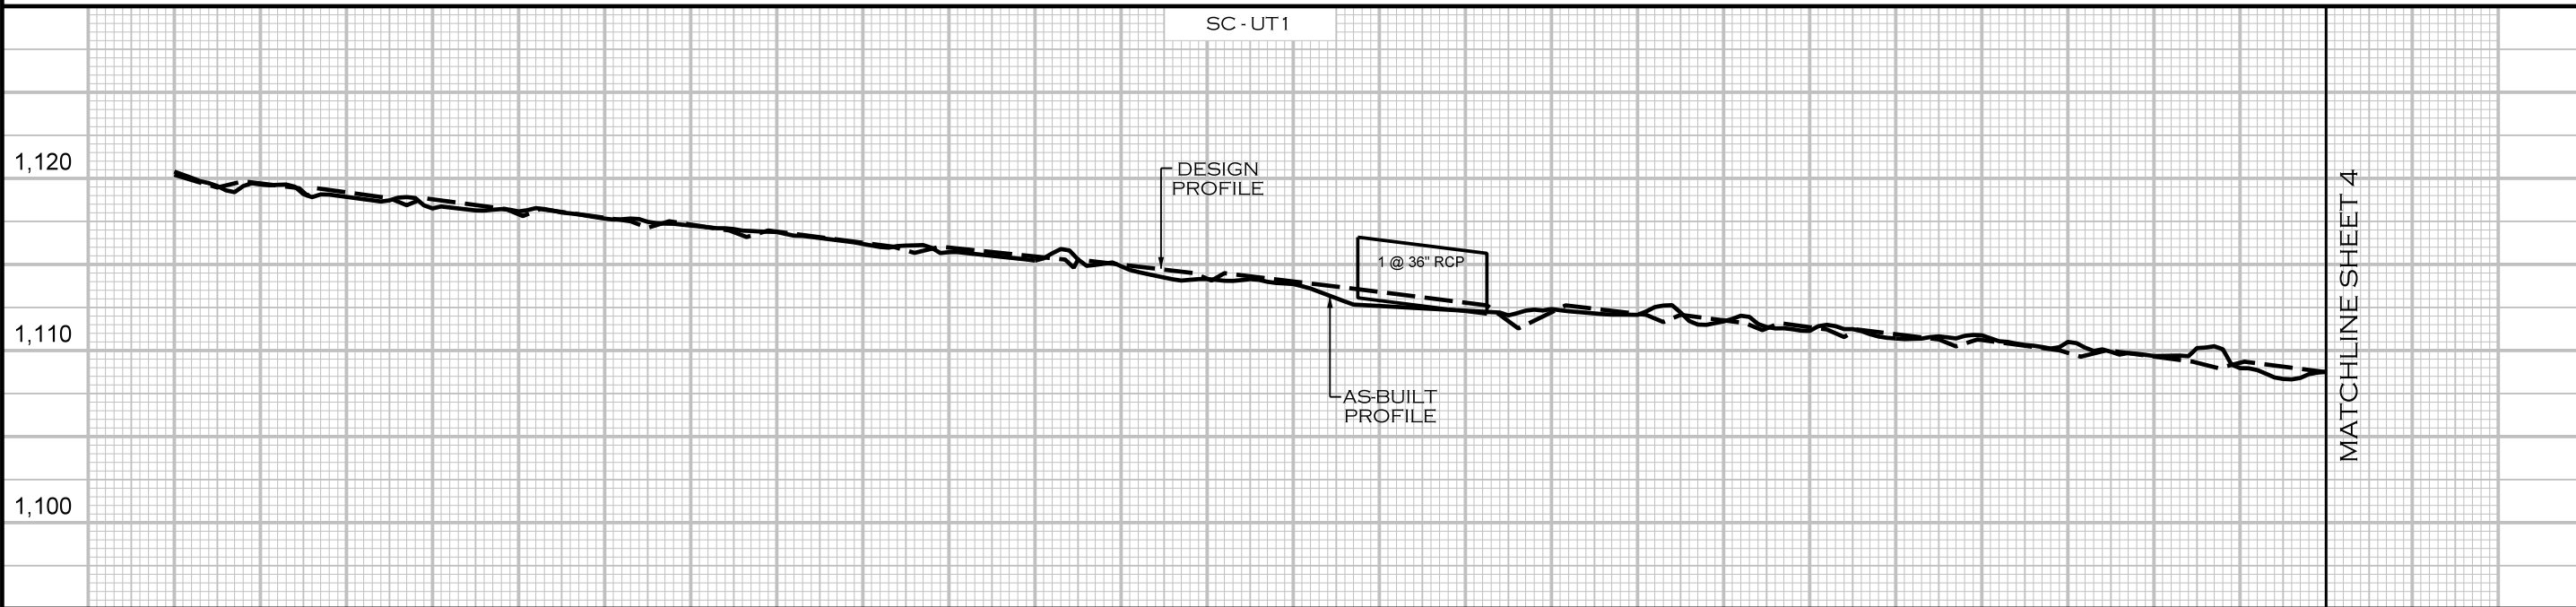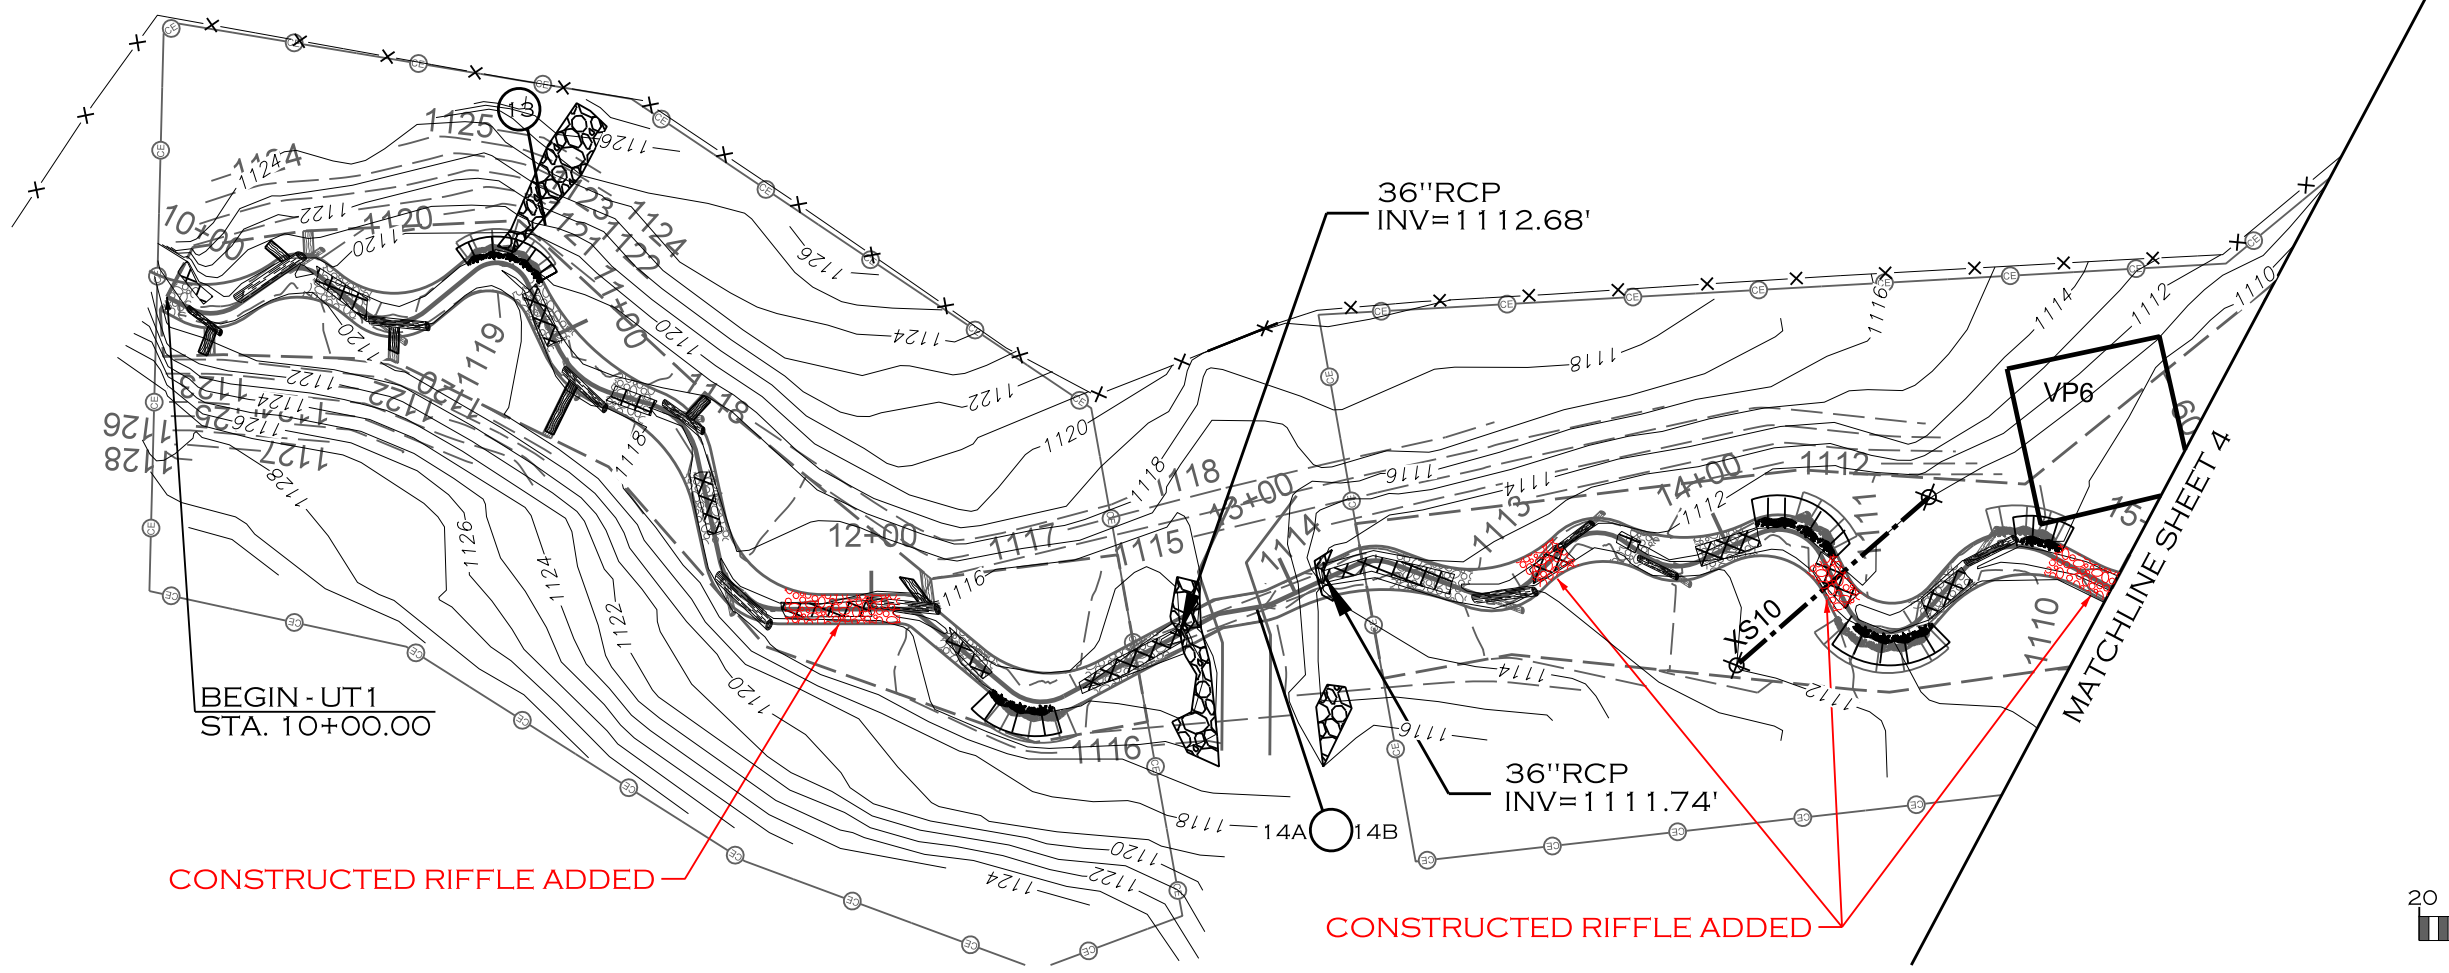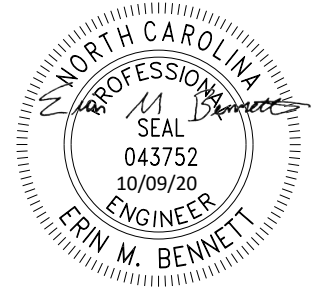

REVISIONS				
NO.	DESCRIPTION	ENGR.	APPROV.	DATE
1	RECORD DRAWINGS	EMB	KLT	10/9/20

PREPARED FOR:

NC DEPARTMENT OF ENVIRONMENTAL QUALITY  
DIVISION OF MITIGATION SERVICES  
1652 MAIL SERVICE CENTER  
RALEIGH, NC 27699-1652





STEWARTS CREEK TRIBUTARIES PROJECT  
SURRY COUNTY, NC

PREPARED IN THE OFFICE OF:

ECOSYSTEM PLANNING & RESTORATION  
1150 SE MAYNARD RD, SUITE 140  
CARY, NC 27511  
LICENSE # P-1182

PROJECT ENGINEER

10/8/2020 R:\PROJECTS\RD\0083\_NCDEQ\_STEWARTS CREEK\_FD\CADD\PLANS\AS-BUILT\MF\_ASB\_PSH\_03.DGN

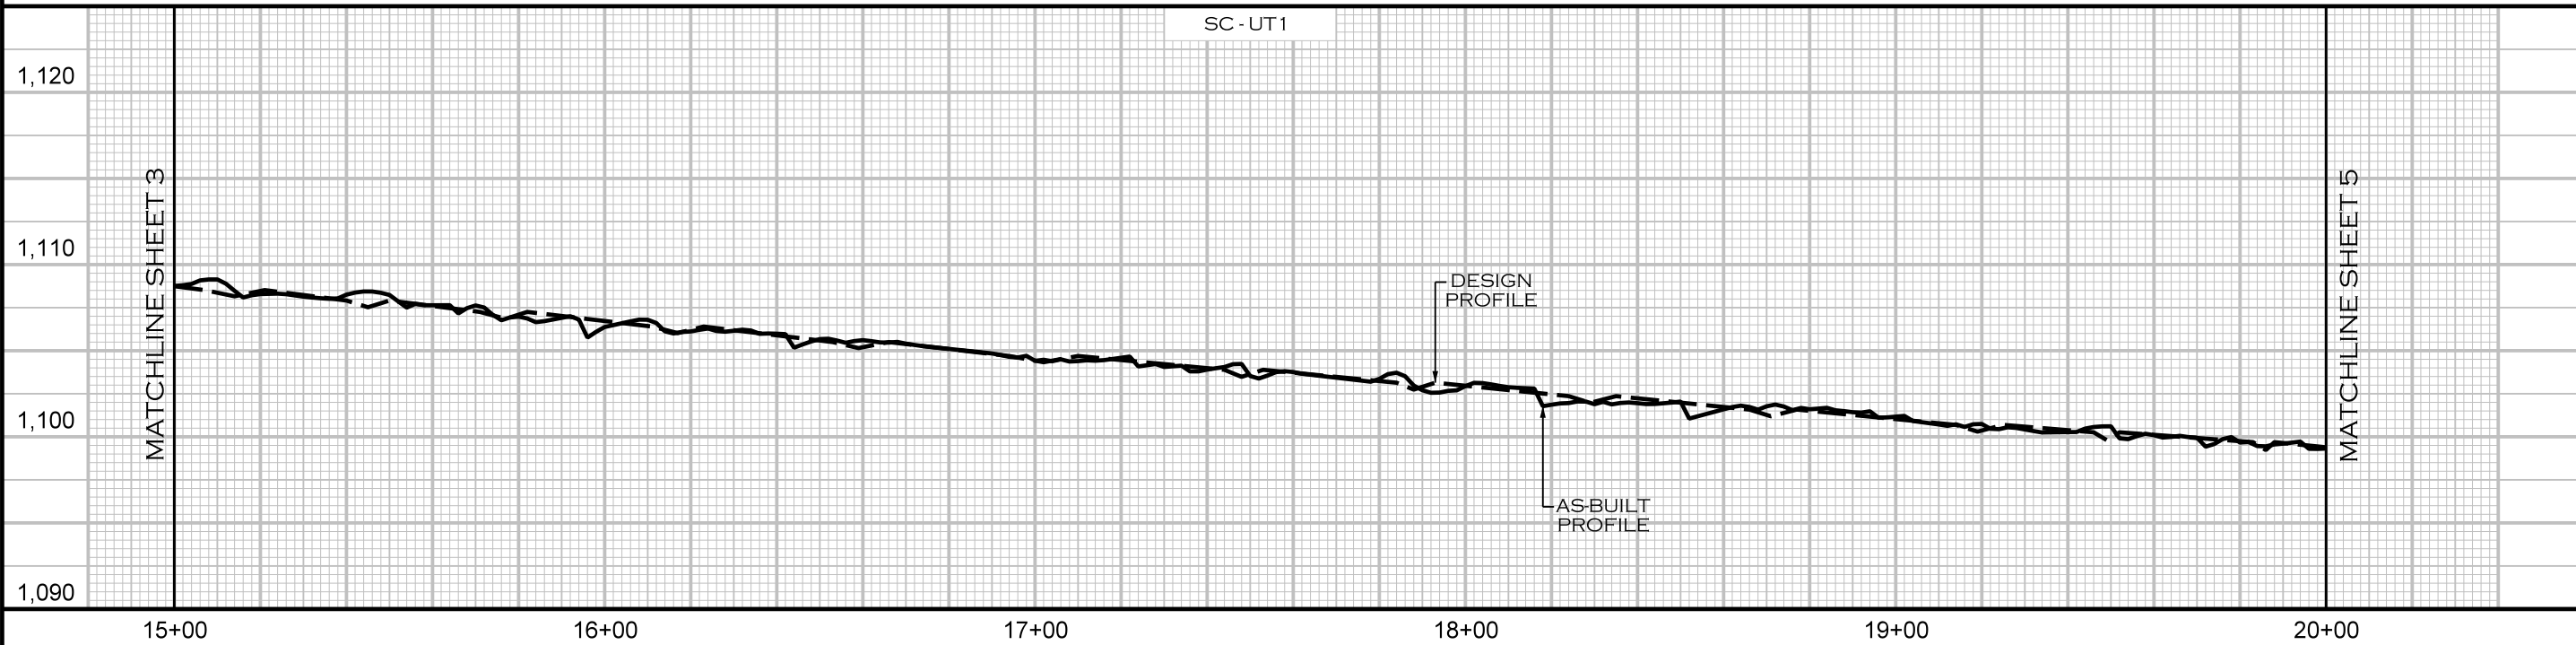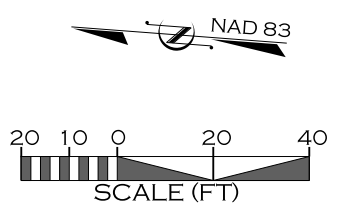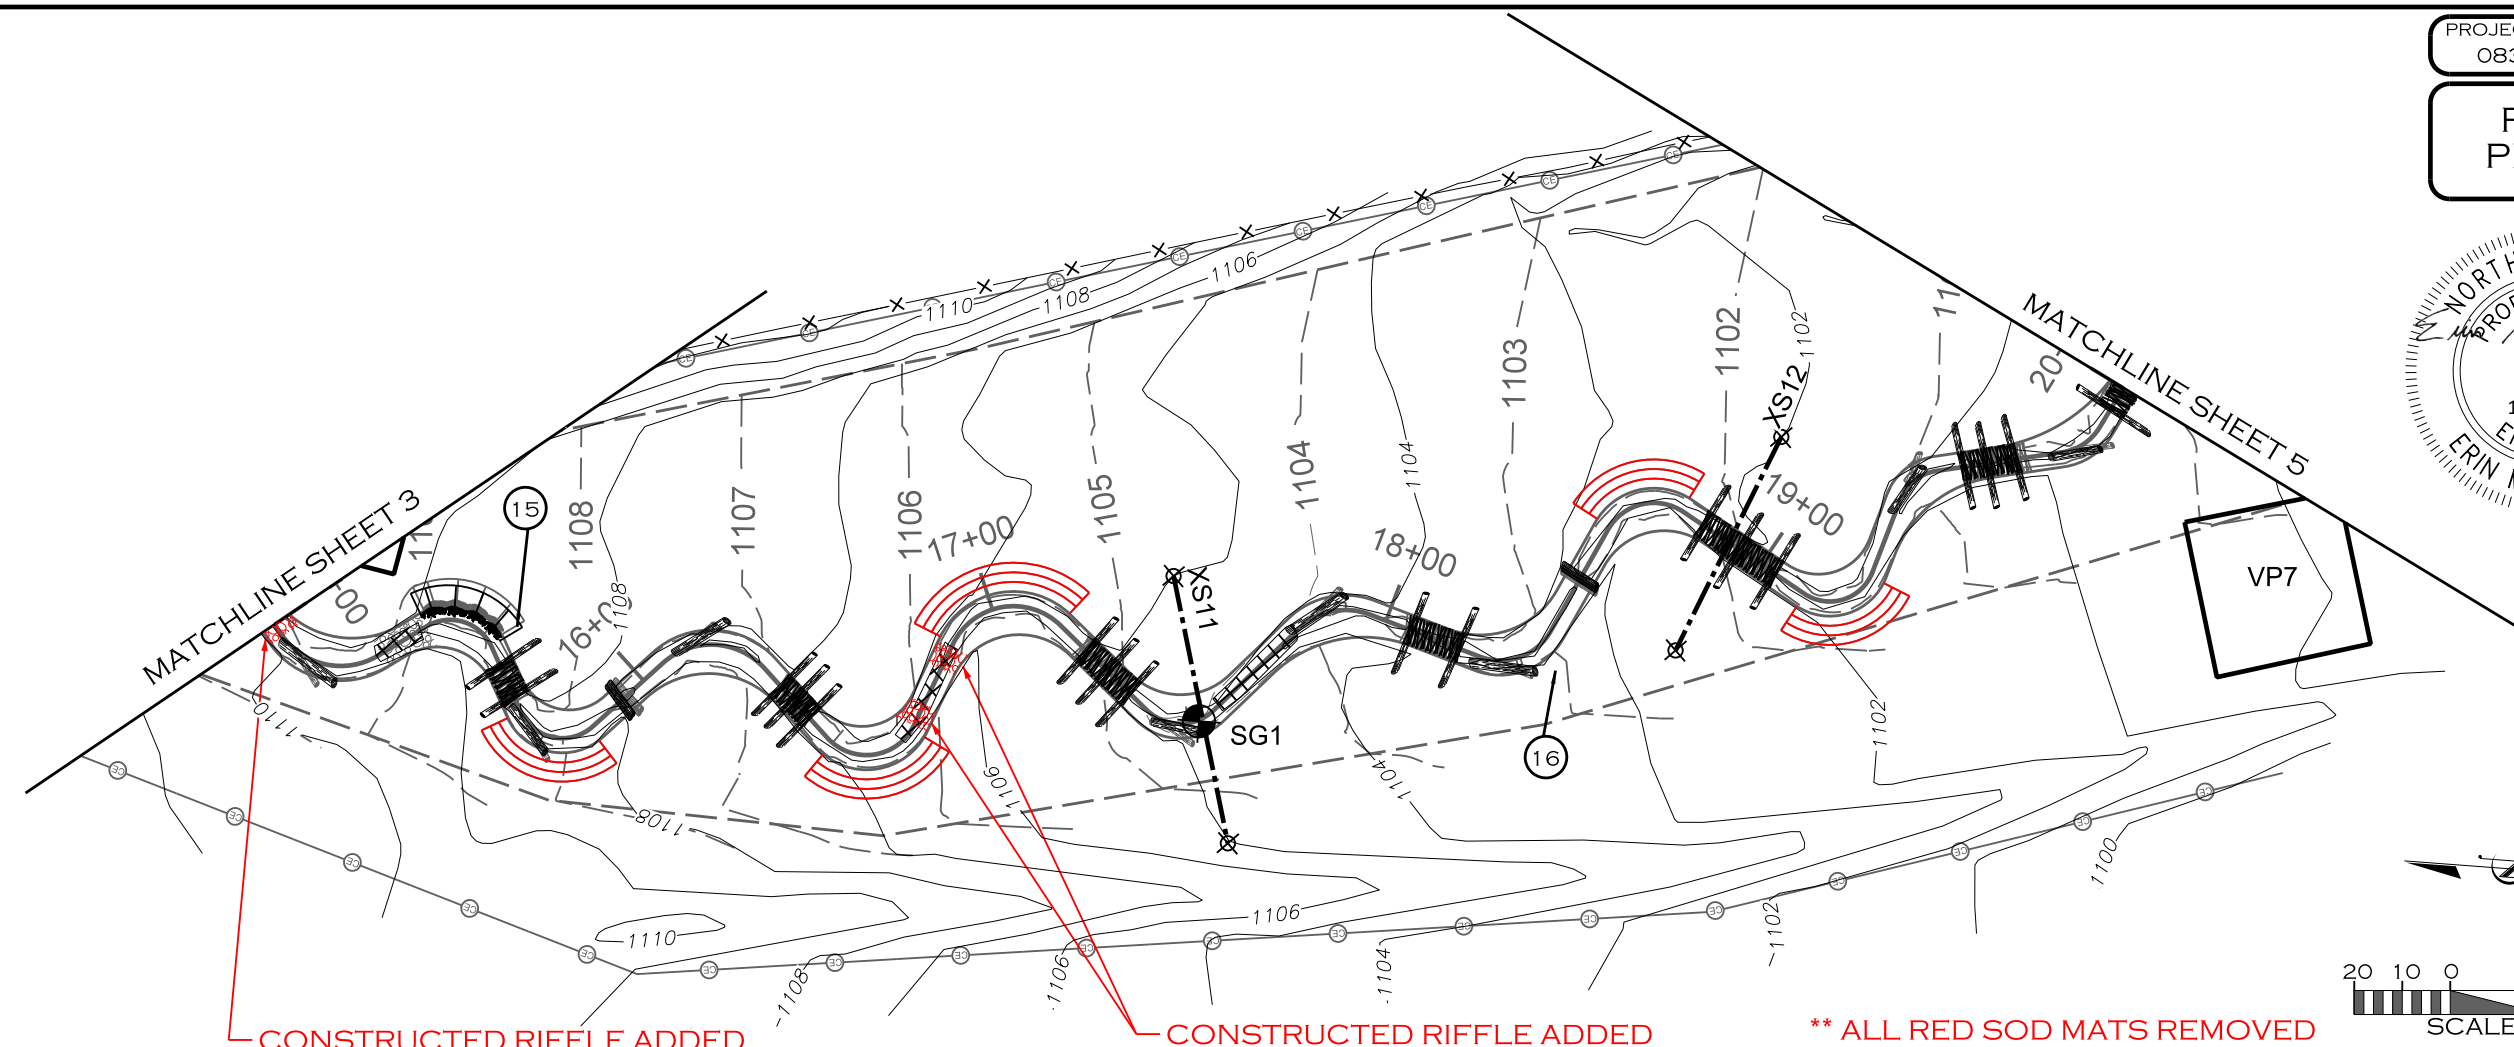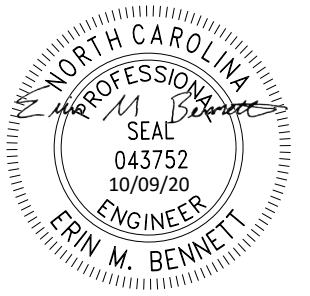

10/8/2020 R:\PROJECTS\RD\0083\_NCDEQ\_STEWARTS CREEK\_FD\CADD\PLANS\AS-BUILT\MF\_ASB\_PSH\_04.DGN

REVISIONS				
NO.	DESCRIPTION	ENGR.	APPROV.	DATE
1	RECORD DRAWINGS	EMB	KLT	10/9/20

PREPARED FOR:


NC DEPARTMENT OF ENVIRONMENTAL QUALITY  
DIVISION OF MITIGATION SERVICES  
1652 MAIL SERVICE CENTER  
RALEIGH, NC 27699-1652

STEWARTS CREEK TRIBUTARIES PROJECT  
SURRY COUNTY, NC


PREPARED IN THE OFFICE OF:

ECOSYSTEM PLANNING & RESTORATION  
1150 SE MAYNARD RD, SUITE 140  
CARY, NC 27511  
LICENSE # P-1182

PROJECT ENGINEER

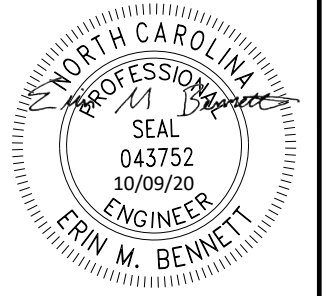

\*\* ALL RED SOD MATS REMOVED

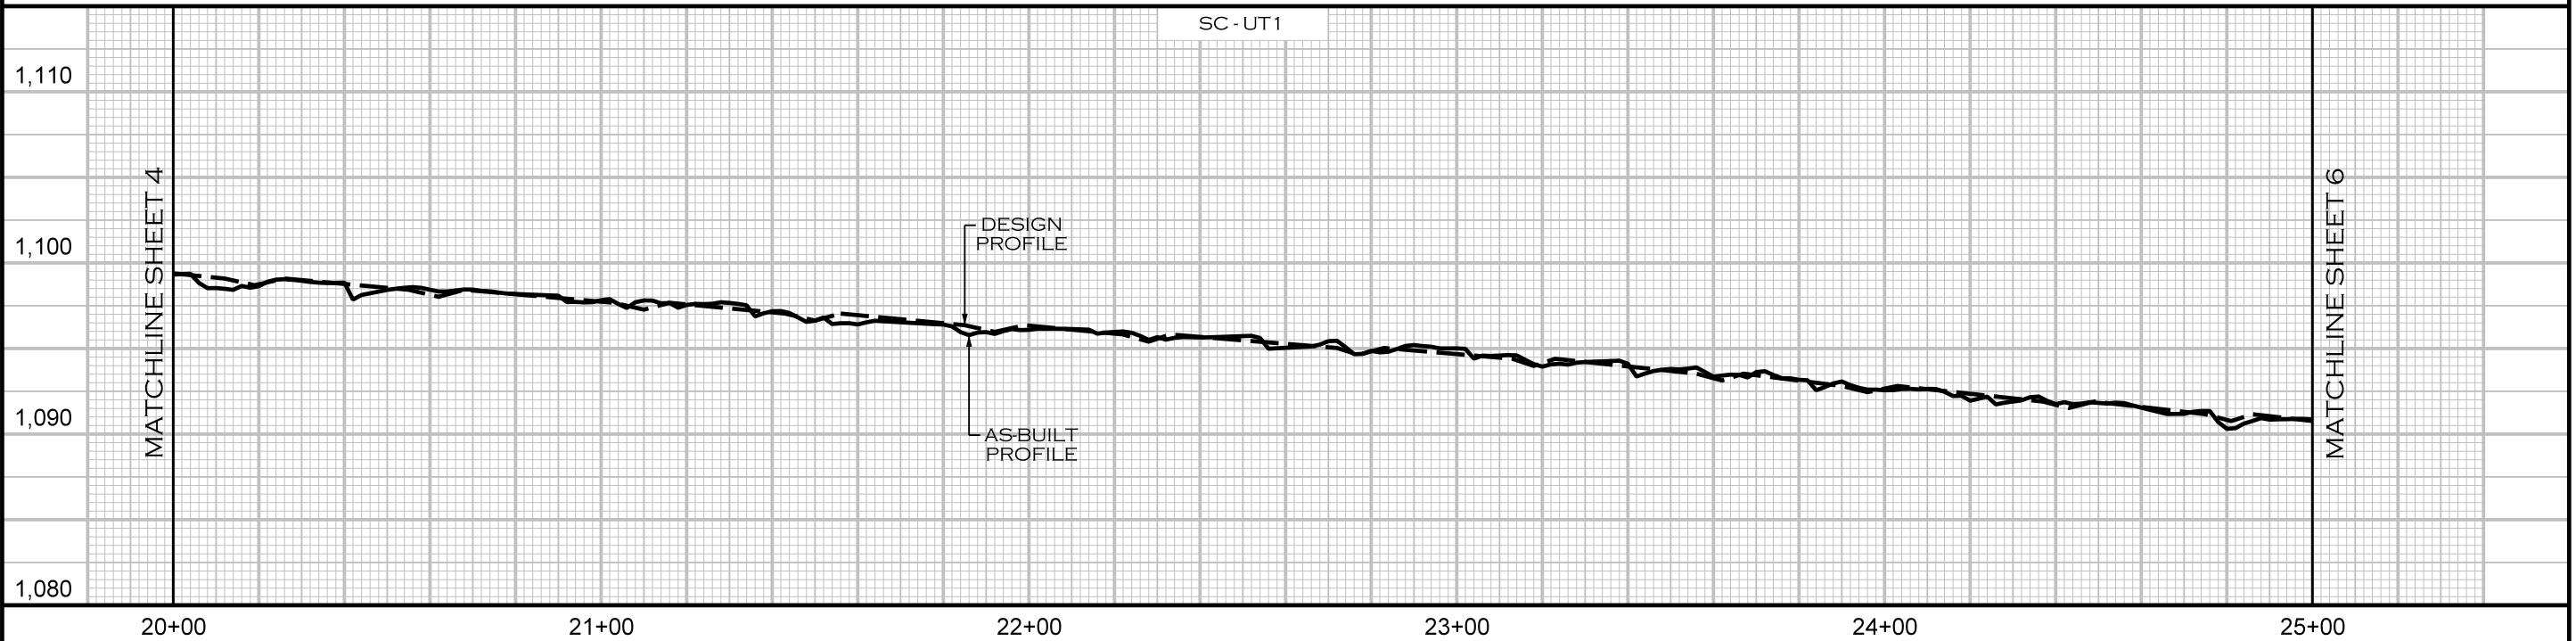

REVISIONS				
NO.	DESCRIPTION	ENGR.	APPROV.	DATE
1	RECORD DRAWINGS	EMB	KLT	10/9/20

PREPARED FOR:

NC DEPARTMENT OF ENVIRONMENTAL QUALITY  
DIVISION OF MITIGATION SERVICES  
1652 MAIL SERVICE CENTER  
RALEIGH, NC 27699-1652


STEWARTS CREEK TRIBUTARIES PROJECT  
SURRY COUNTY, NC

PREPARED IN THE OFFICE OF:

ECOSYSTEM PLANNING & RESTORATION  
1150 SE MAYNARD RD, SUITE 140  
CARY, NC 27511  
LICENSE # P-1182

PROJECT ENGINEER



10/8/2020 R:\PROJECTS\RD\0083\_NCDEQ\_STEWARTS CREEK\_FD\CADD\PLANS\AS-BUILT\MF\_ASB\_PSH\_05.DGN

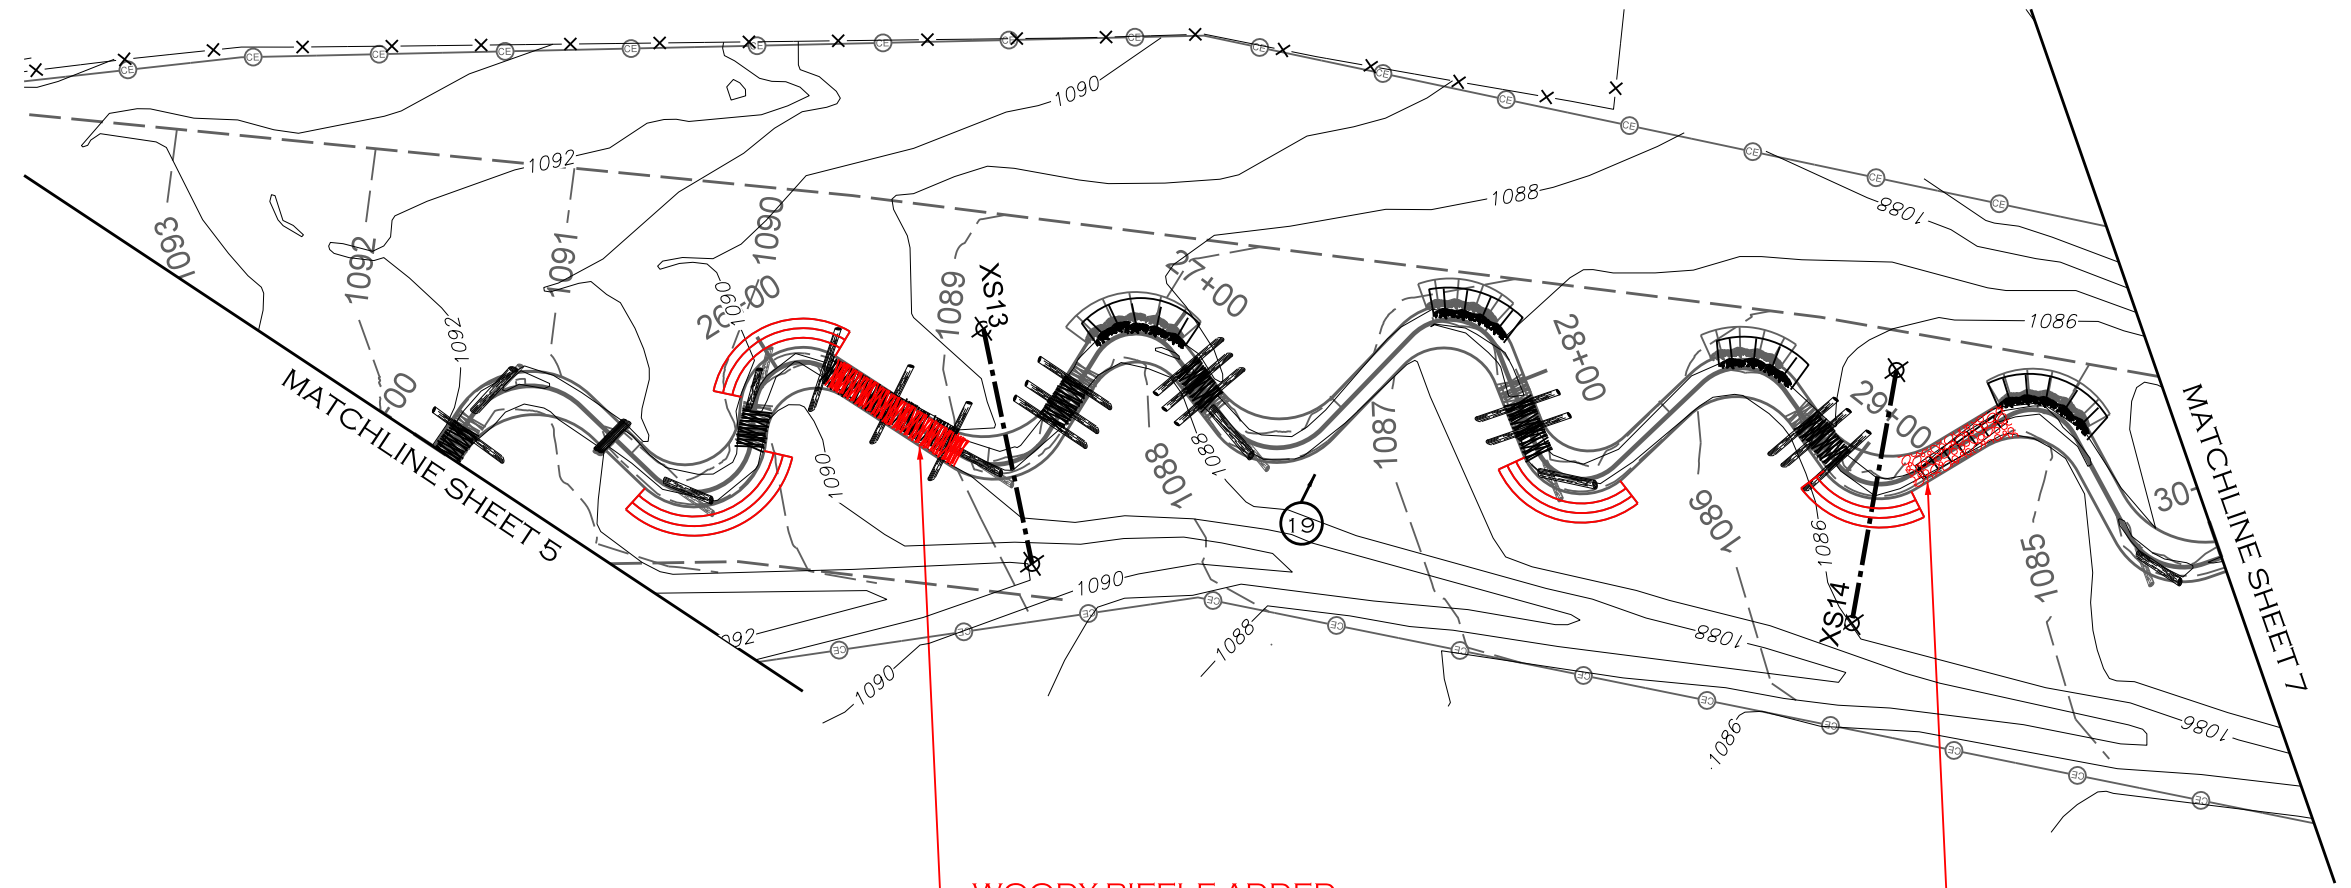

WOODY RIFFLE ADDED

CONSTRUCTED RIFFLE ADDED

\*\* ALL RED SOD MATS REMOVED

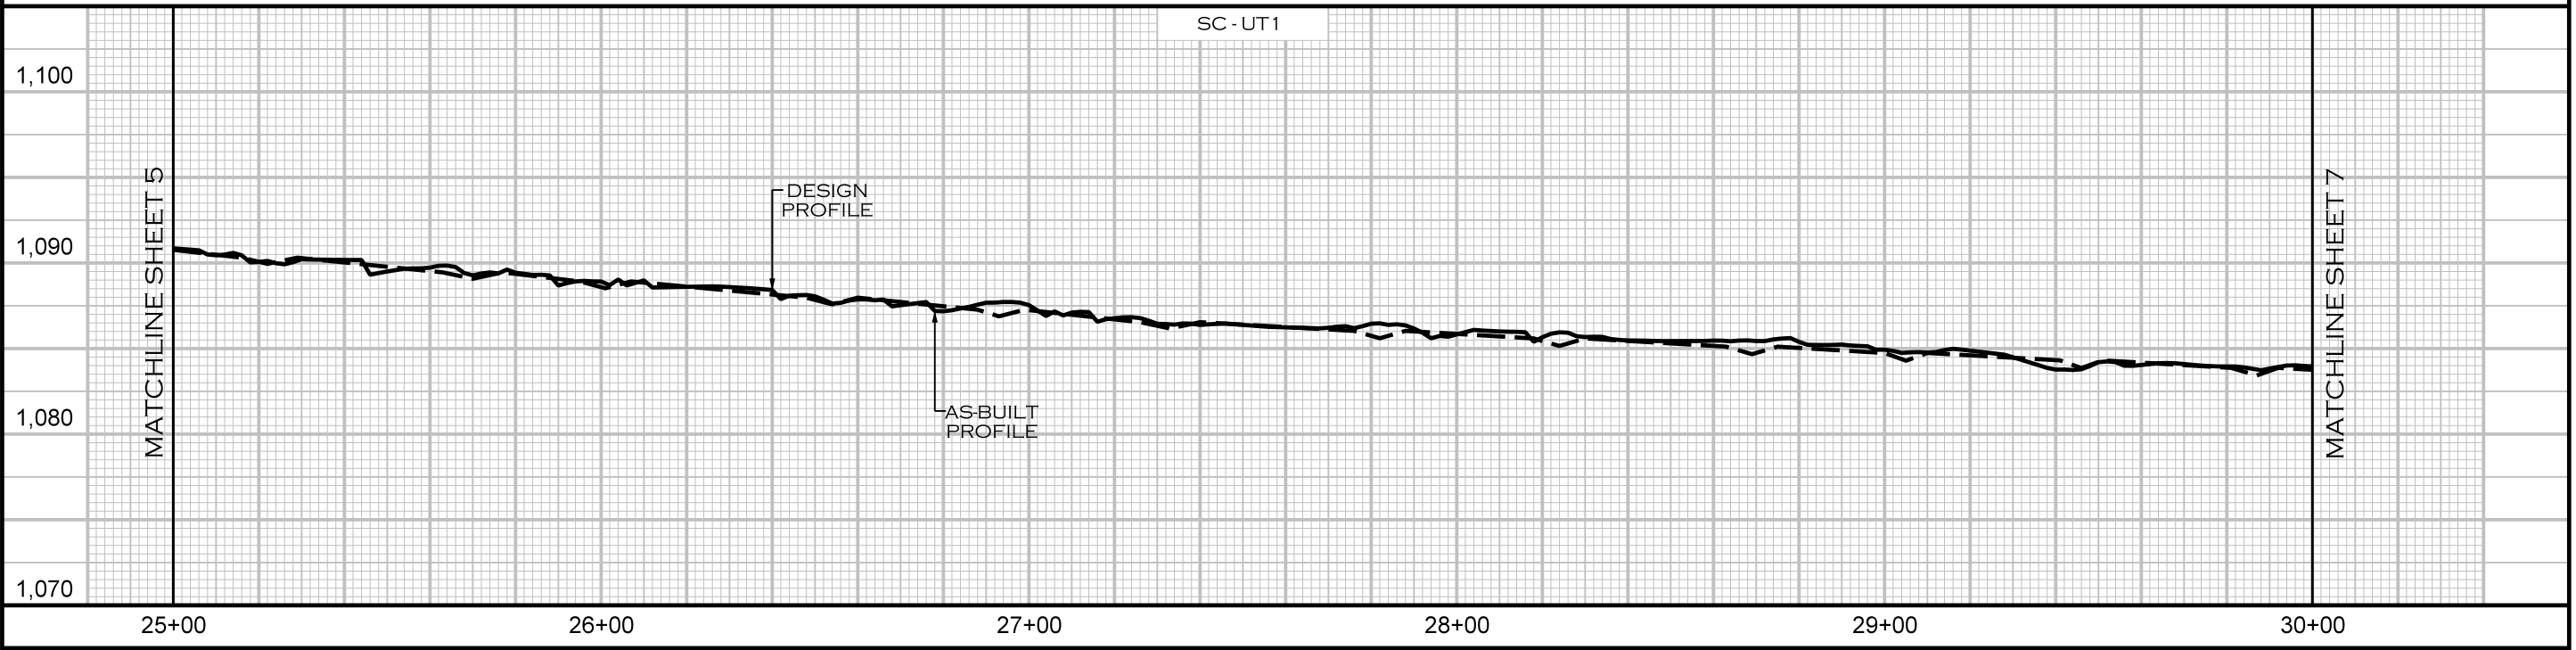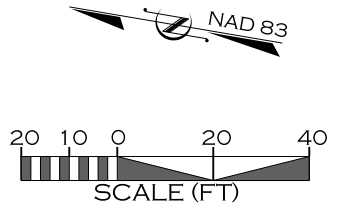

10/8/2020 R:\PROJECTS\RD\0083\_NCDEQ\_STEWARTS CREEK\_FD\CADD\PLANS\AS-BUILT\MF\_ASB\_PSH\_06.DGN

REVISIONS				
NO.	DESCRIPTION	ENGR.	APPROV.	DATE
1	RECORD DRAWINGS	EMB	KLT	10/9/20

PREPARED FOR:


NC DEPARTMENT OF ENVIRONMENTAL QUALITY  
DIVISION OF MITIGATION SERVICES  
1652 MAIL SERVICE CENTER  
RALEIGH, NC 27699-1652

STEWARTS CREEK TRIBUTARIES PROJECT  
SURRY COUNTY, NC

PREPARED IN THE OFFICE OF:



ECOSYSTEM PLANNING & RESTORATION  
1150 SE MAYNARD RD, SUITE 140  
CARY, NC 27511  
LICENSE # P-1182

PROJECT ENGINEER

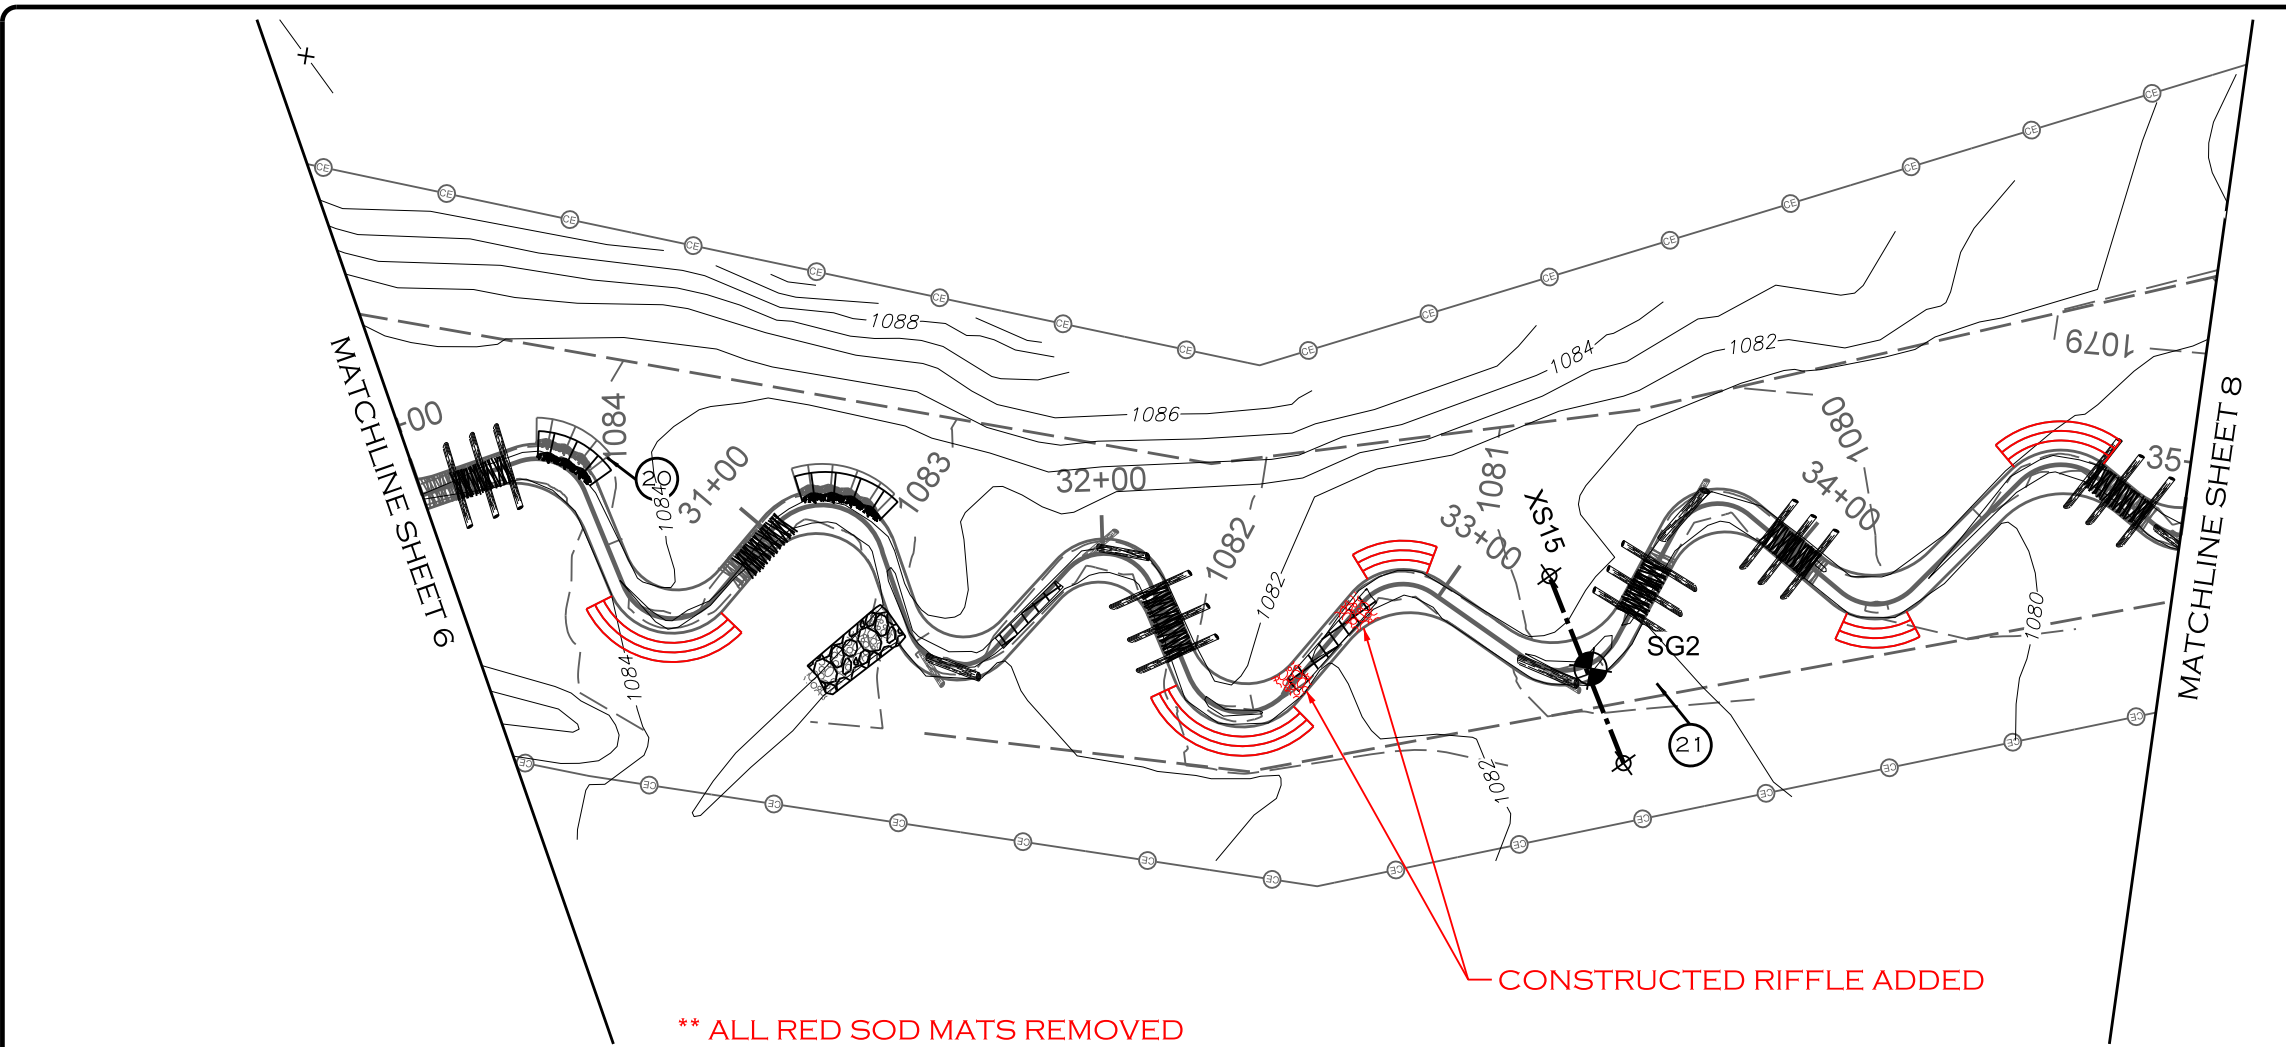

\*\* ALL RED SOD MATS REMOVED

CONSTRUCTED RIFFLE ADDED

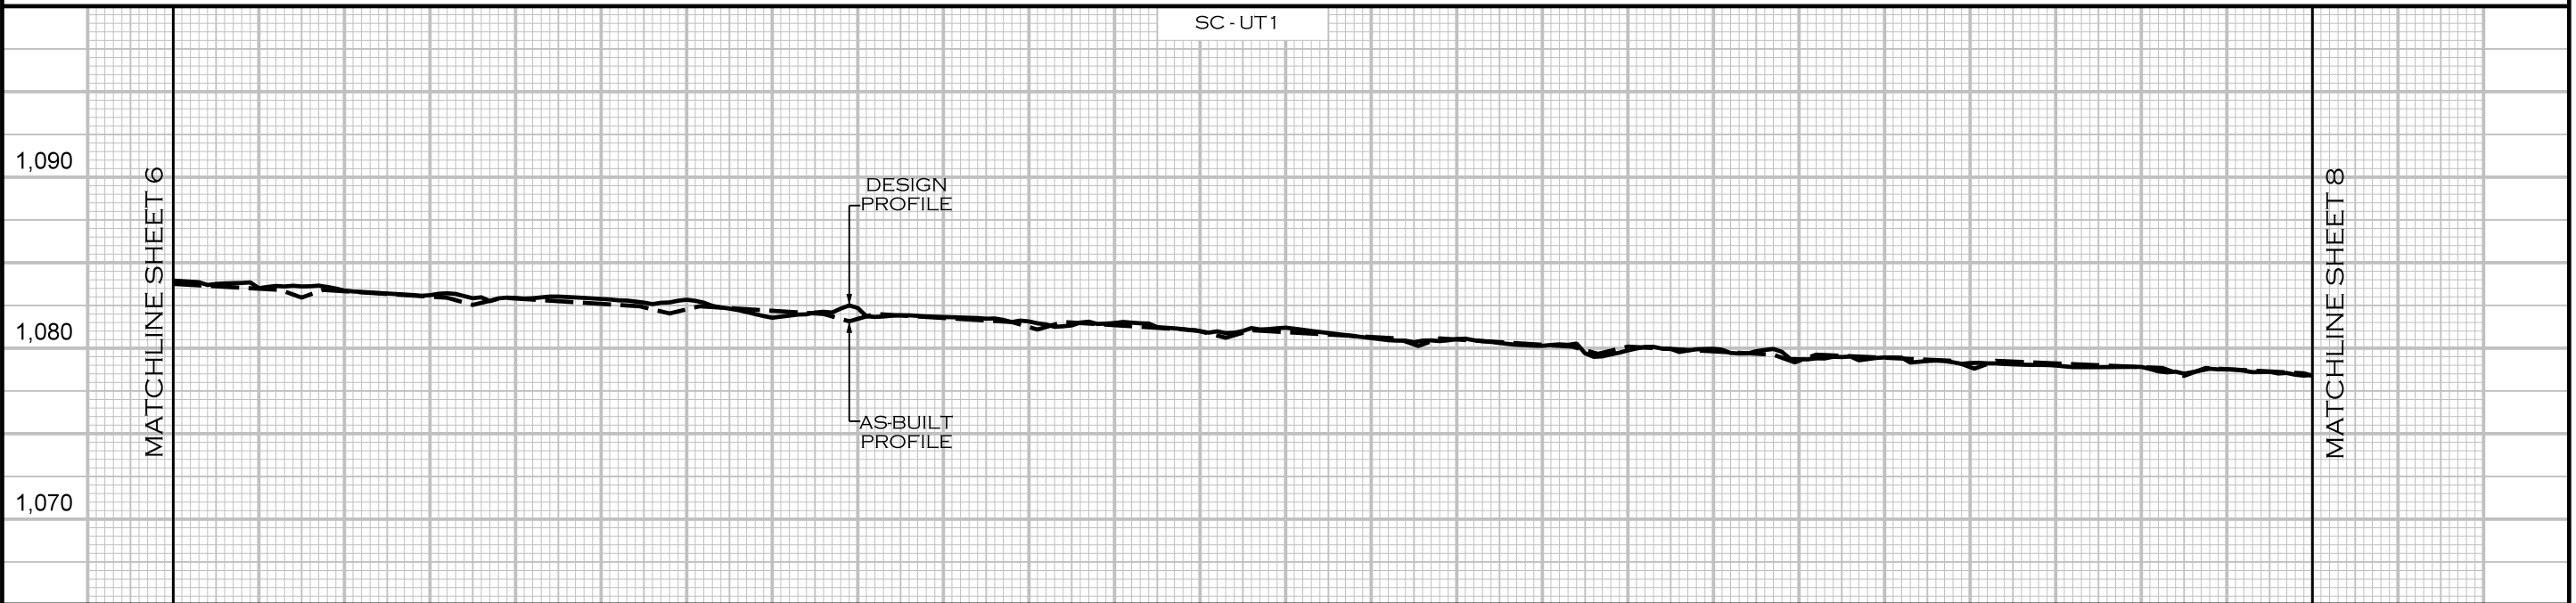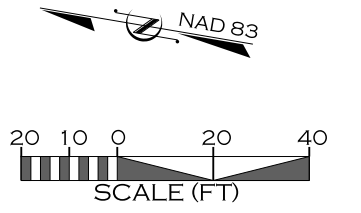

30+00 31+00 32+00 33+00 34+00 35+00

REVISIONS				
NO.	DESCRIPTION	ENGR.	APPROV.	DATE
1	RECORD DRAWINGS	EMB	KLT	10/9/20

PREPARED FOR:

NC DEPARTMENT OF ENVIRONMENTAL QUALITY  
DIVISION OF MITIGATION SERVICES  
1652 MAIL SERVICE CENTER  
RALEIGH, NC 27699-1652

STEWARTS CREEK TRIBUTARIES PROJECT  
SURRY COUNTY, NC



PREPARED IN THE OFFICE OF:

ECOSYSTEM PLANNING & RESTORATION  
1150 SE MAYNARD RD, SUITE 140  
CARY, NC 27511  
LICENSE # P-1182



PROJECT ENGINEER

10/8/2020 R:\PROJECTS\RD\0083\_NCDEQ\_STEWARTS CREEK\_FD\CADD\PLANS\AS-BUILT\MF\_ASB\_PSH\_07.DGN

PLAN / PROFILE

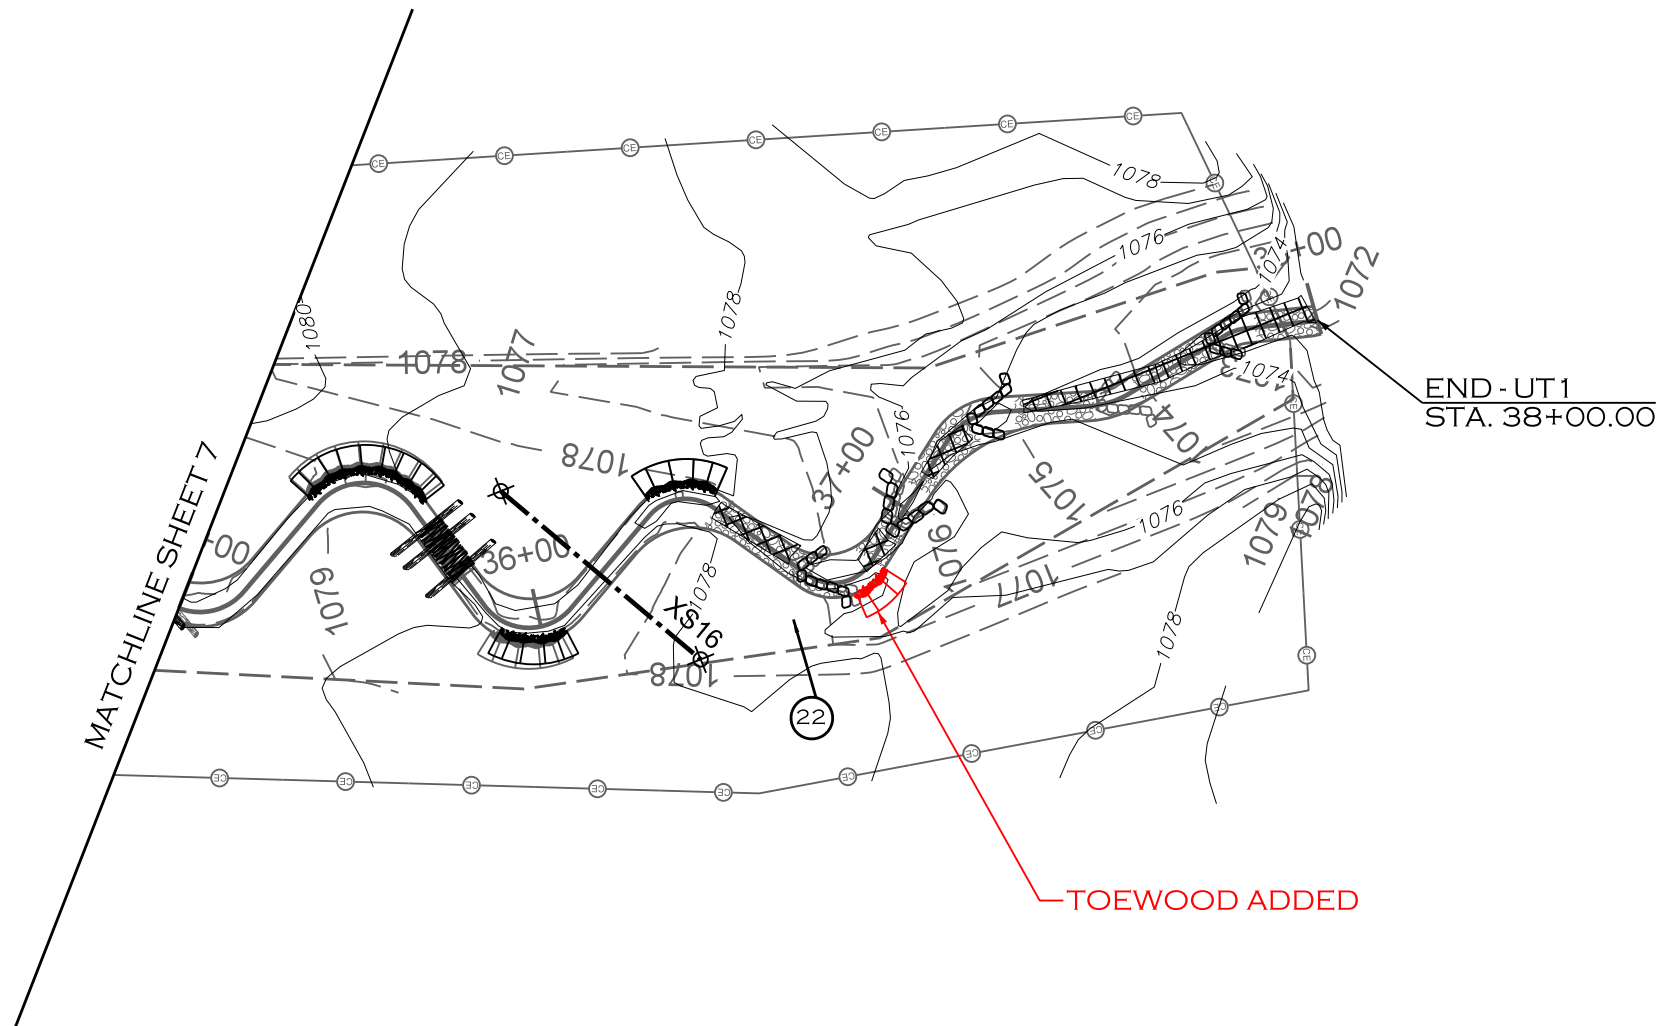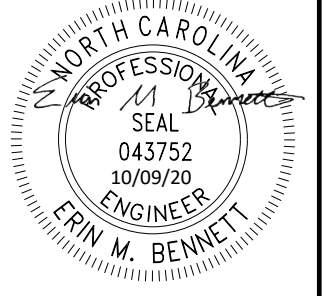

END - UT1  
STA. 38+00.00

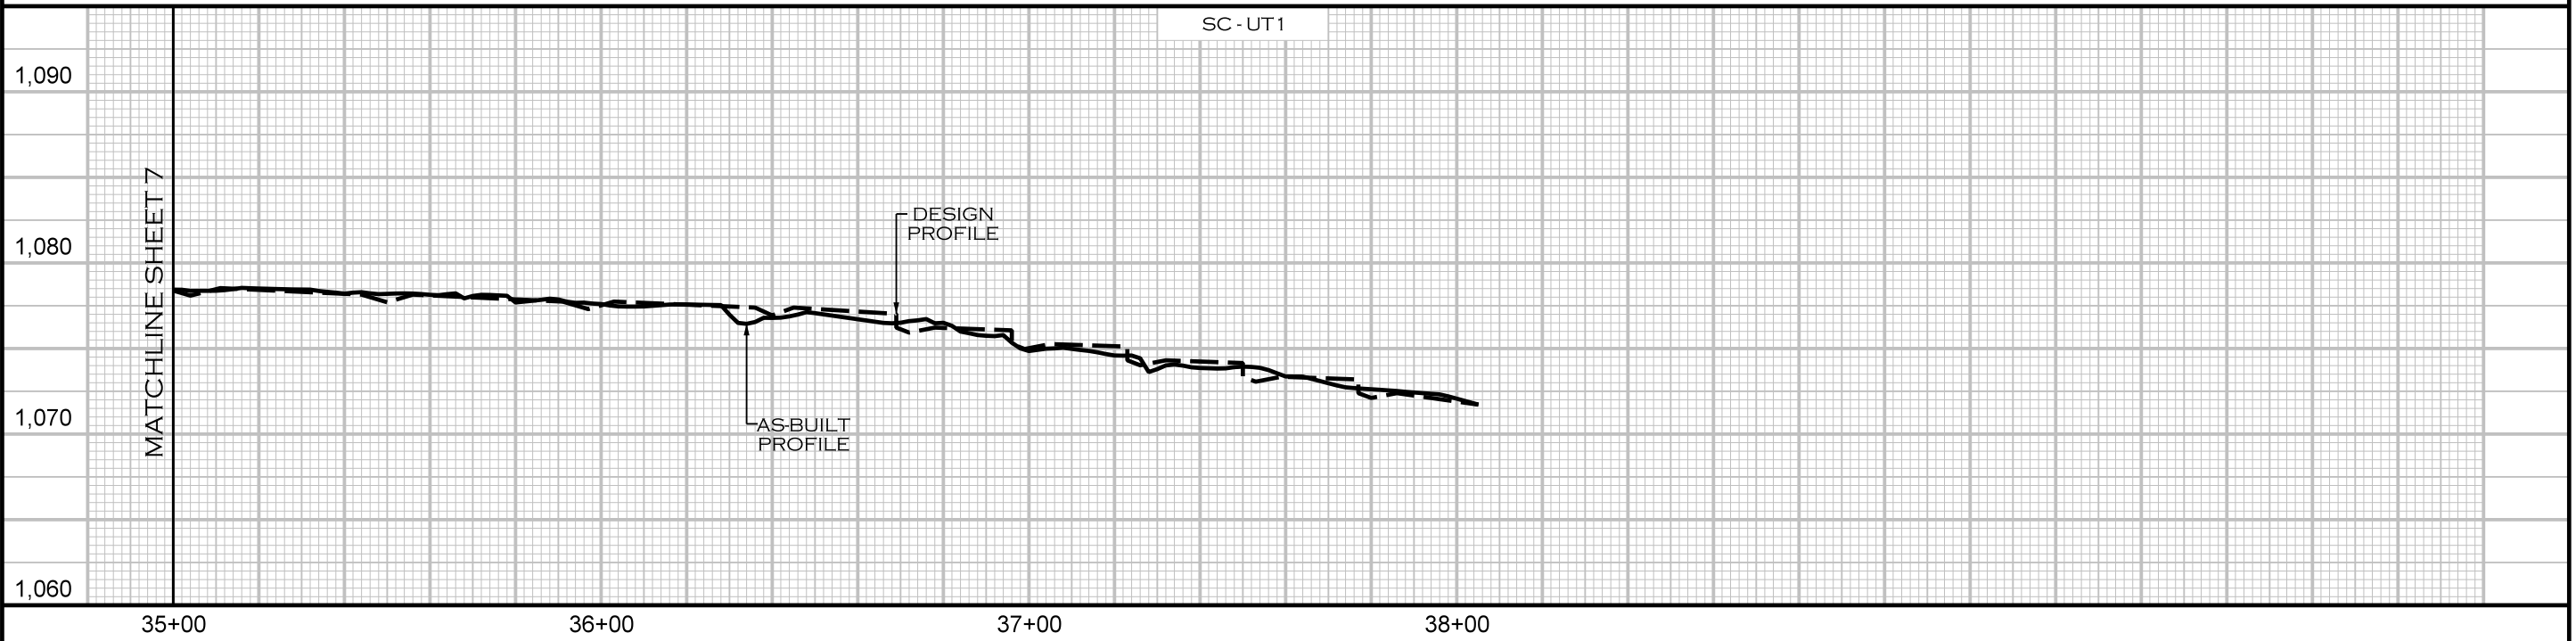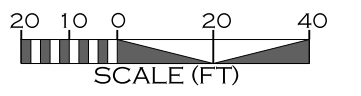

REVISIONS				
NO.	DESCRIPTION	ENGR.	APPROV.	DATE
1	RECORD DRAWINGS	EMB	KLT	10/9/20

PREPARED FOR:

NC DEPARTMENT OF ENVIRONMENTAL QUALITY  
DIVISION OF MITIGATION SERVICES  
1652 MAIL SERVICE CENTER  
RALEIGH, NC 27699-1652




STEWARTS CREEK TRIBUTARIES PROJECT  
SURRY COUNTY, NC

PREPARED IN THE OFFICE OF:

1150 SE MAYNARD RD, SUITE 140  
CARY, NC 27511  
LICENSE # P-1182

PROJECT ENGINEER

10/8/2020 R:\PROJECTS\RD\0083\_NCDEQ\_STEWARTS CREEK\_FD\CADD\PLANS\AS-BUILT\MF\_ASB\_PSH\_08.DGN

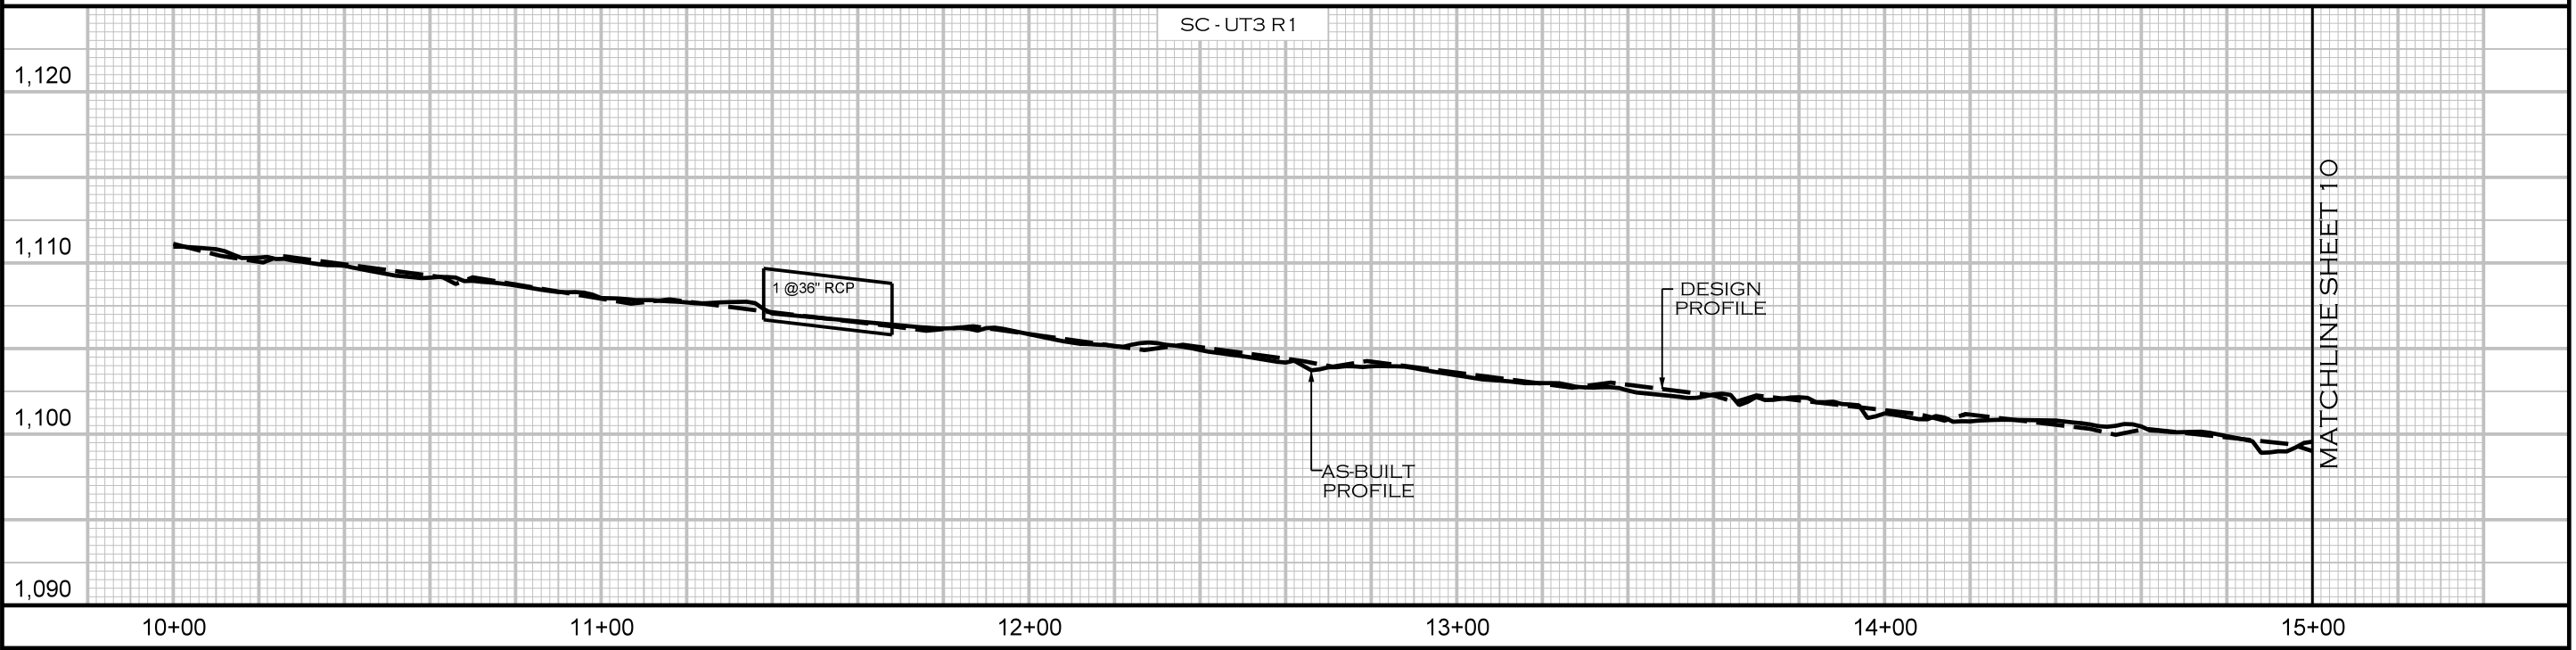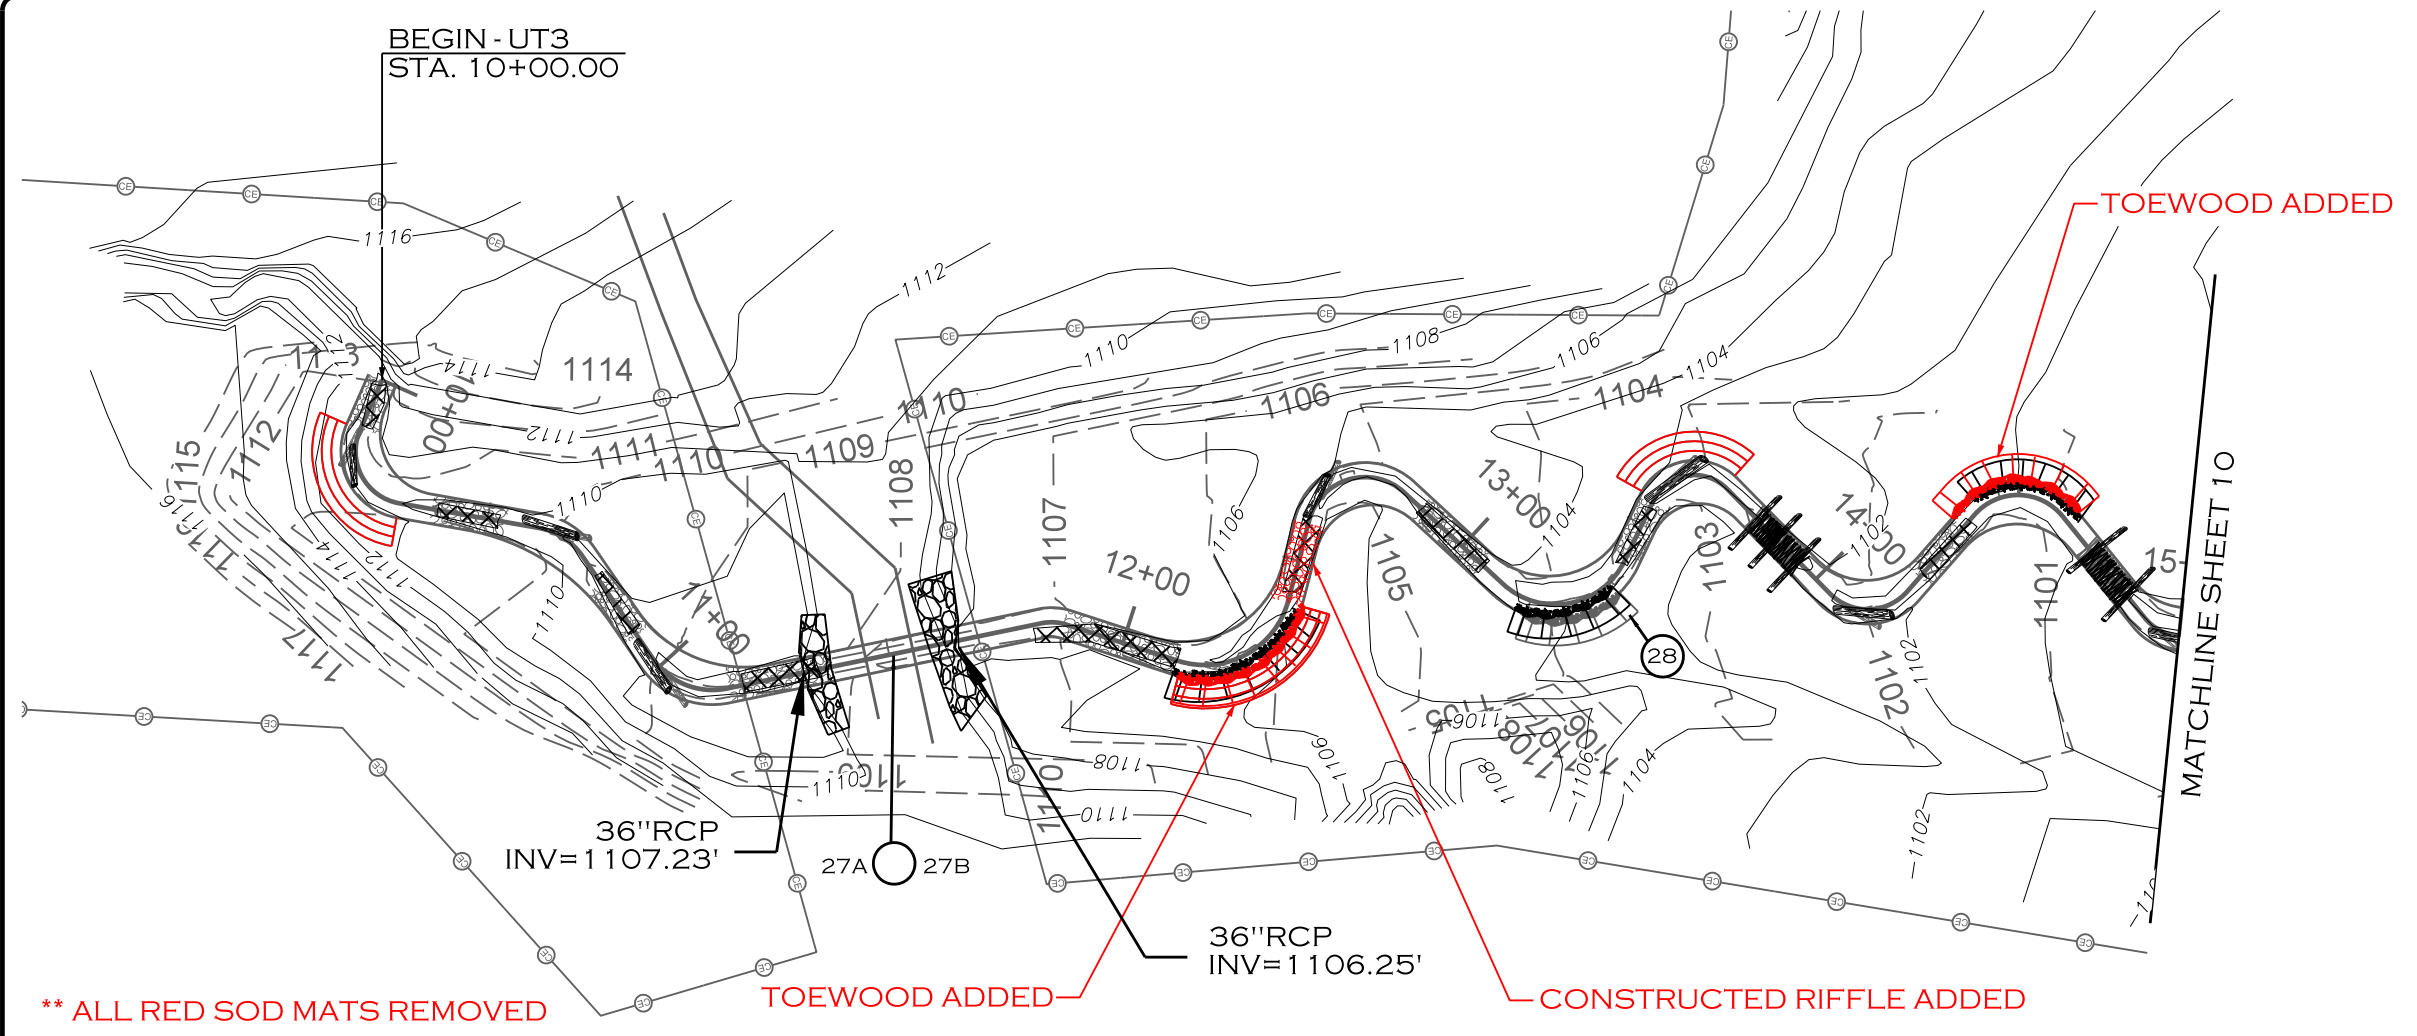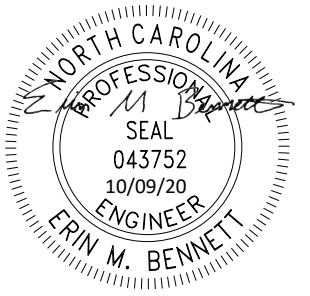

REVISIONS				
NO.	DESCRIPTION	ENGR.	APPROV.	DATE
1	RECORD DRAWINGS	EMB	KLT	10/9/20

PREPARED FOR:  
  
 NC DEPARTMENT OF ENVIRONMENTAL QUALITY  
 DIVISION OF MITIGATION SERVICES  
 1652 MAIL SERVICE CENTER  
 RALEIGH, NC 27699-1652



STEWARTS CREEK TRIBUTARIES PROJECT  
 SURRY COUNTY, NC

PREPARED IN THE OFFICE OF:  
  
 ECOSYSTEM PLANNING & RESTORATION  
 1150 SE MAYNARD RD, SUITE 140  
 CARY, NC 27511  
 LICENSE # P-1182



PROJECT ENGINEER

10/8/2020 R:\PROJECTS\RD\083\_NCDEQ\_STEWARTS CREEK\_FD\CADD\PLANS\AS-BUILT\MF\_ASB\_PSH\_09.DGN



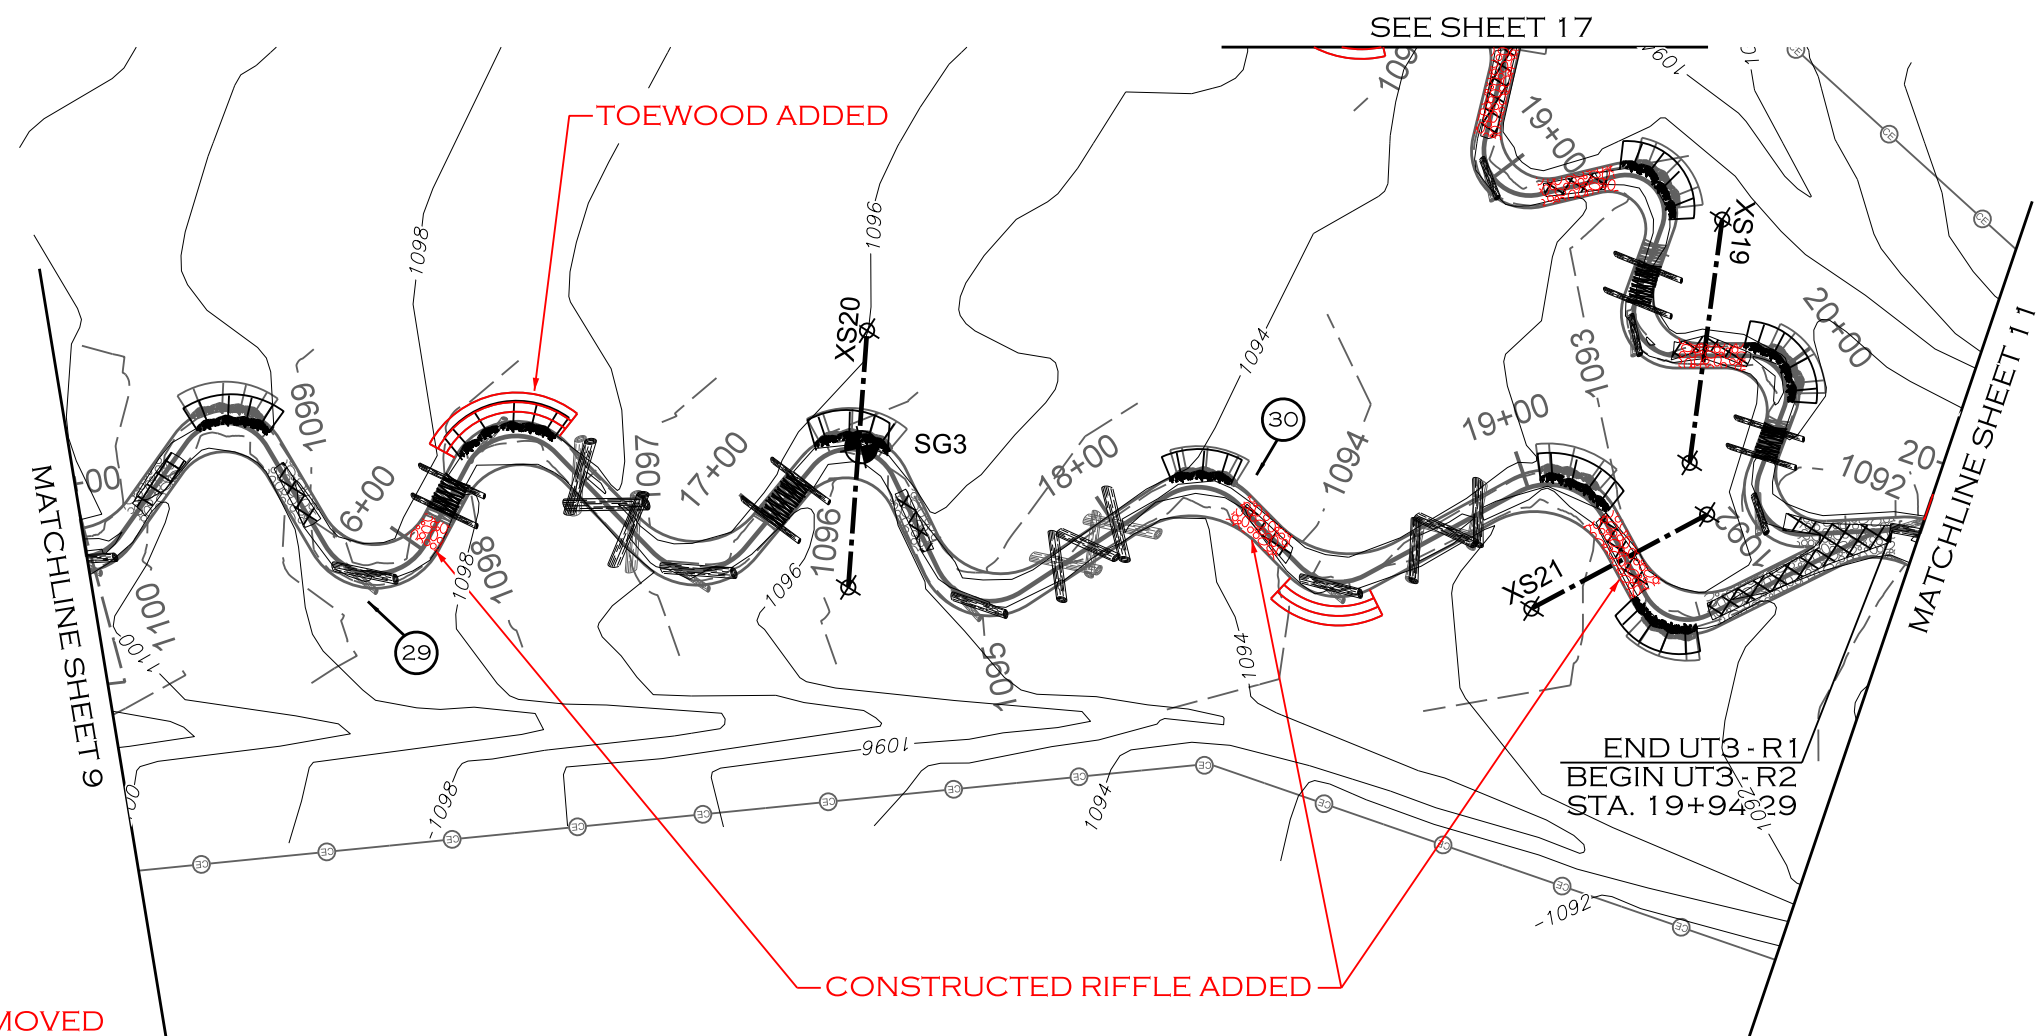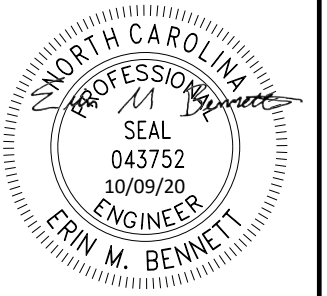

\*\* ALL RED SOD MATS REMOVED

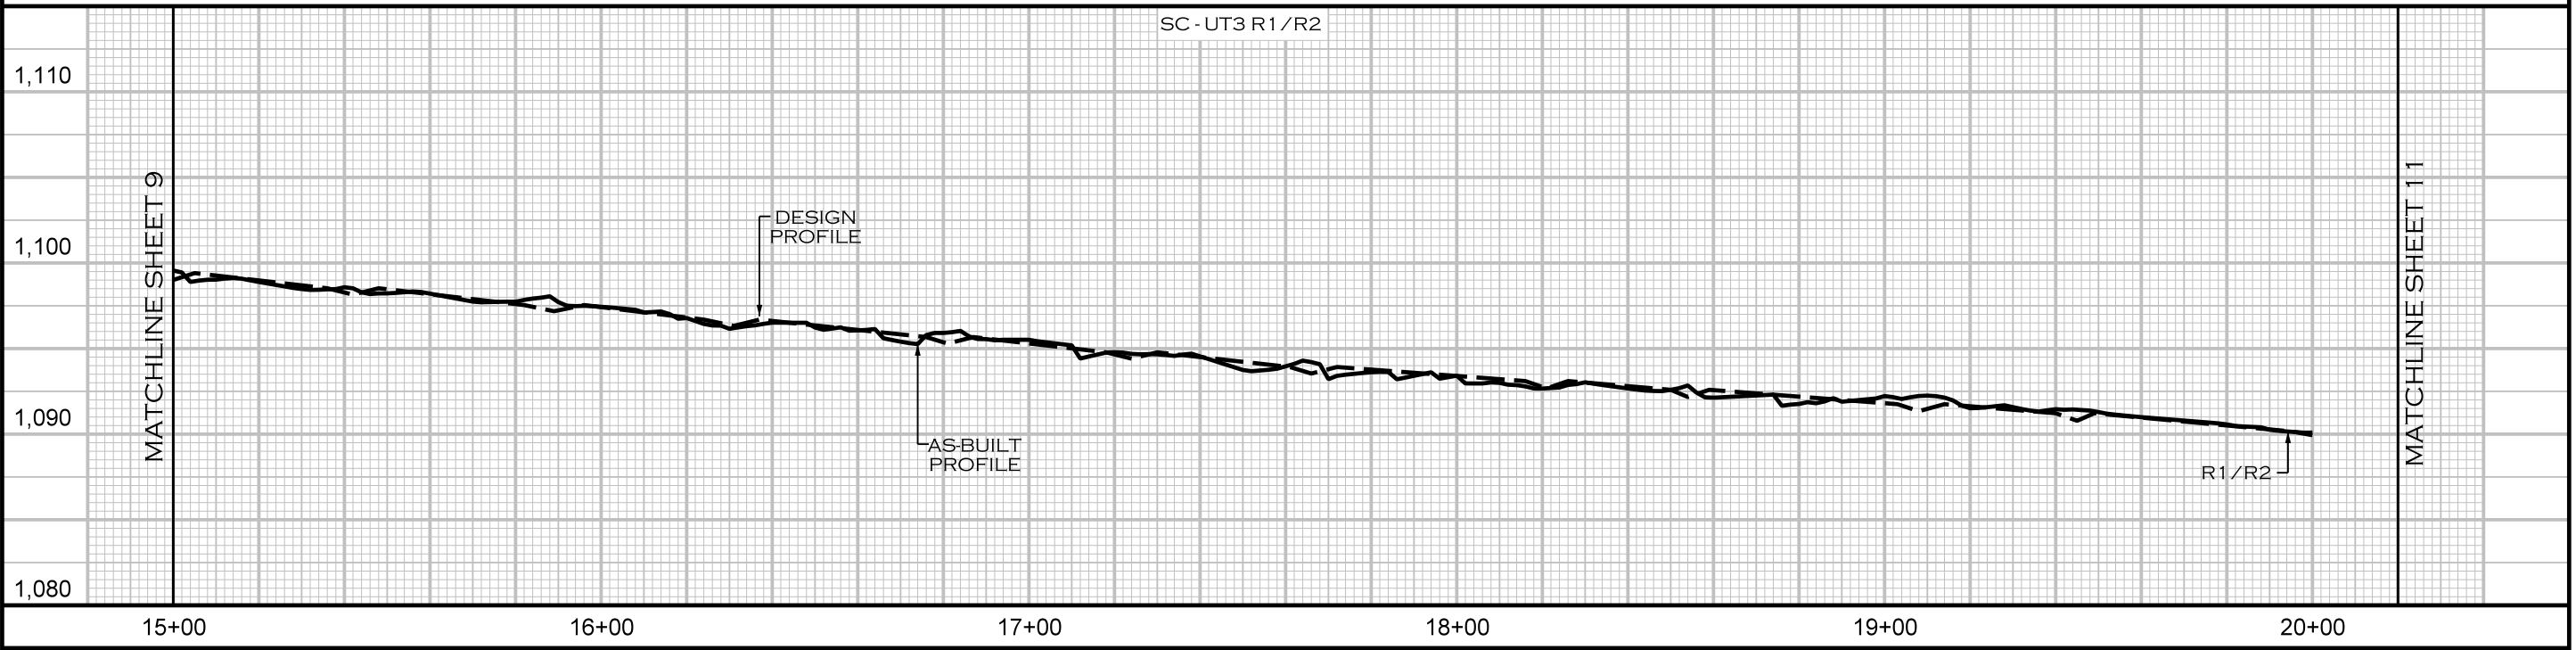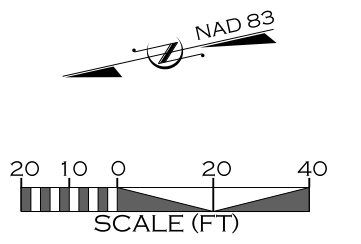

REVISIONS				
NO.	DESCRIPTION	ENGR.	APPROV.	DATE
1	RECORD DRAWINGS	EMB	KLT	10/9/20

PREPARED FOR:

NC DEPARTMENT OF ENVIRONMENTAL QUALITY  
DIVISION OF MITIGATION SERVICES  
1652 MAIL SERVICE CENTER  
RALEIGH, NC 27699-1652




STEWARTS CREEK TRIBUTARIES PROJECT  
SURRY COUNTY, NC

PREPARED IN THE OFFICE OF:


ECOSYSTEM PLANNING & RESTORATION  
1150 SE MAYNARD RD, SUITE 140  
CARY, NC 27511  
LICENSE # P-1182

PROJECT ENGINEER

10/8/2020 R:\PROJECTS\RD\0083\_NCDEQ\_STEWARTS CREEK\_FD\CADD\PLANS\AS-BUILT\MF\_ASB\_PSH\_10.DGN

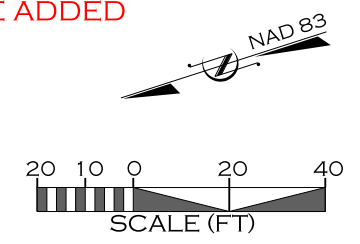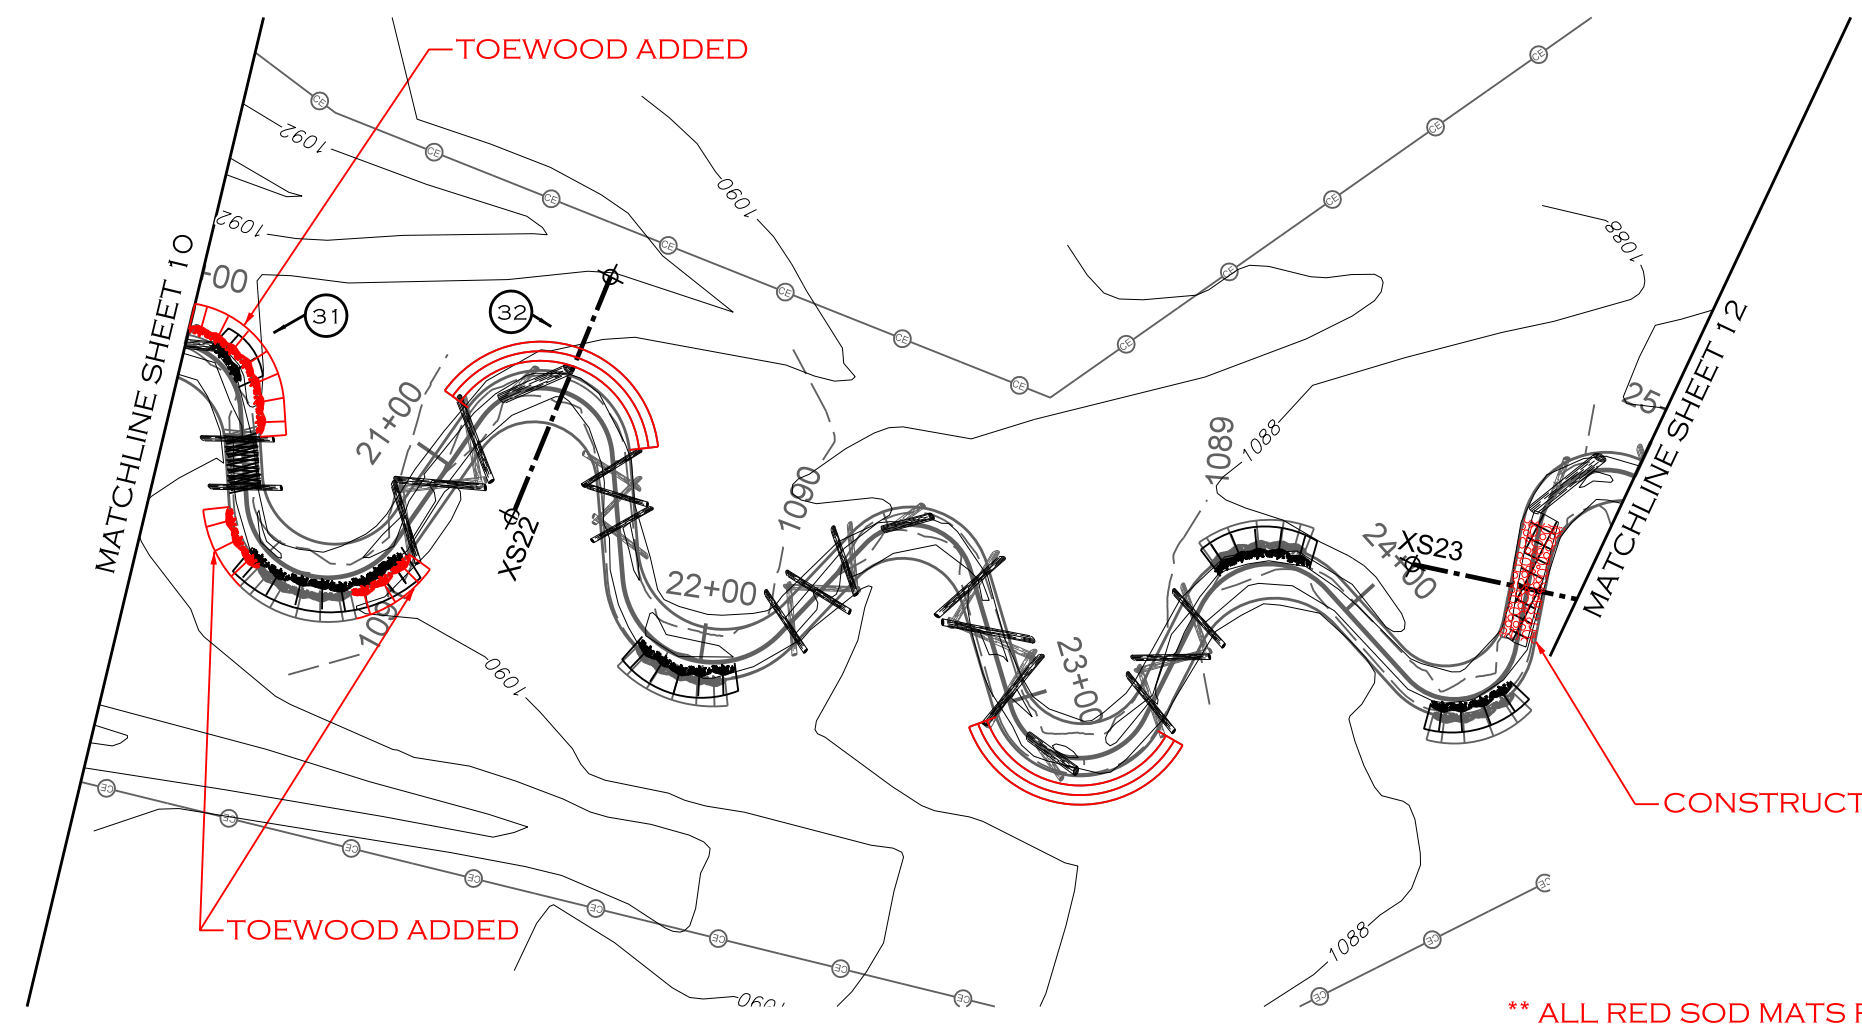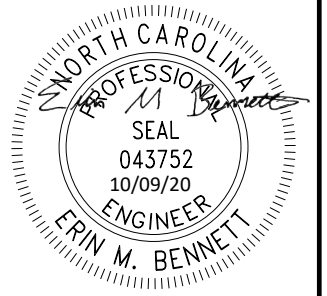

\*\* ALL RED SOD MATS REMOVED

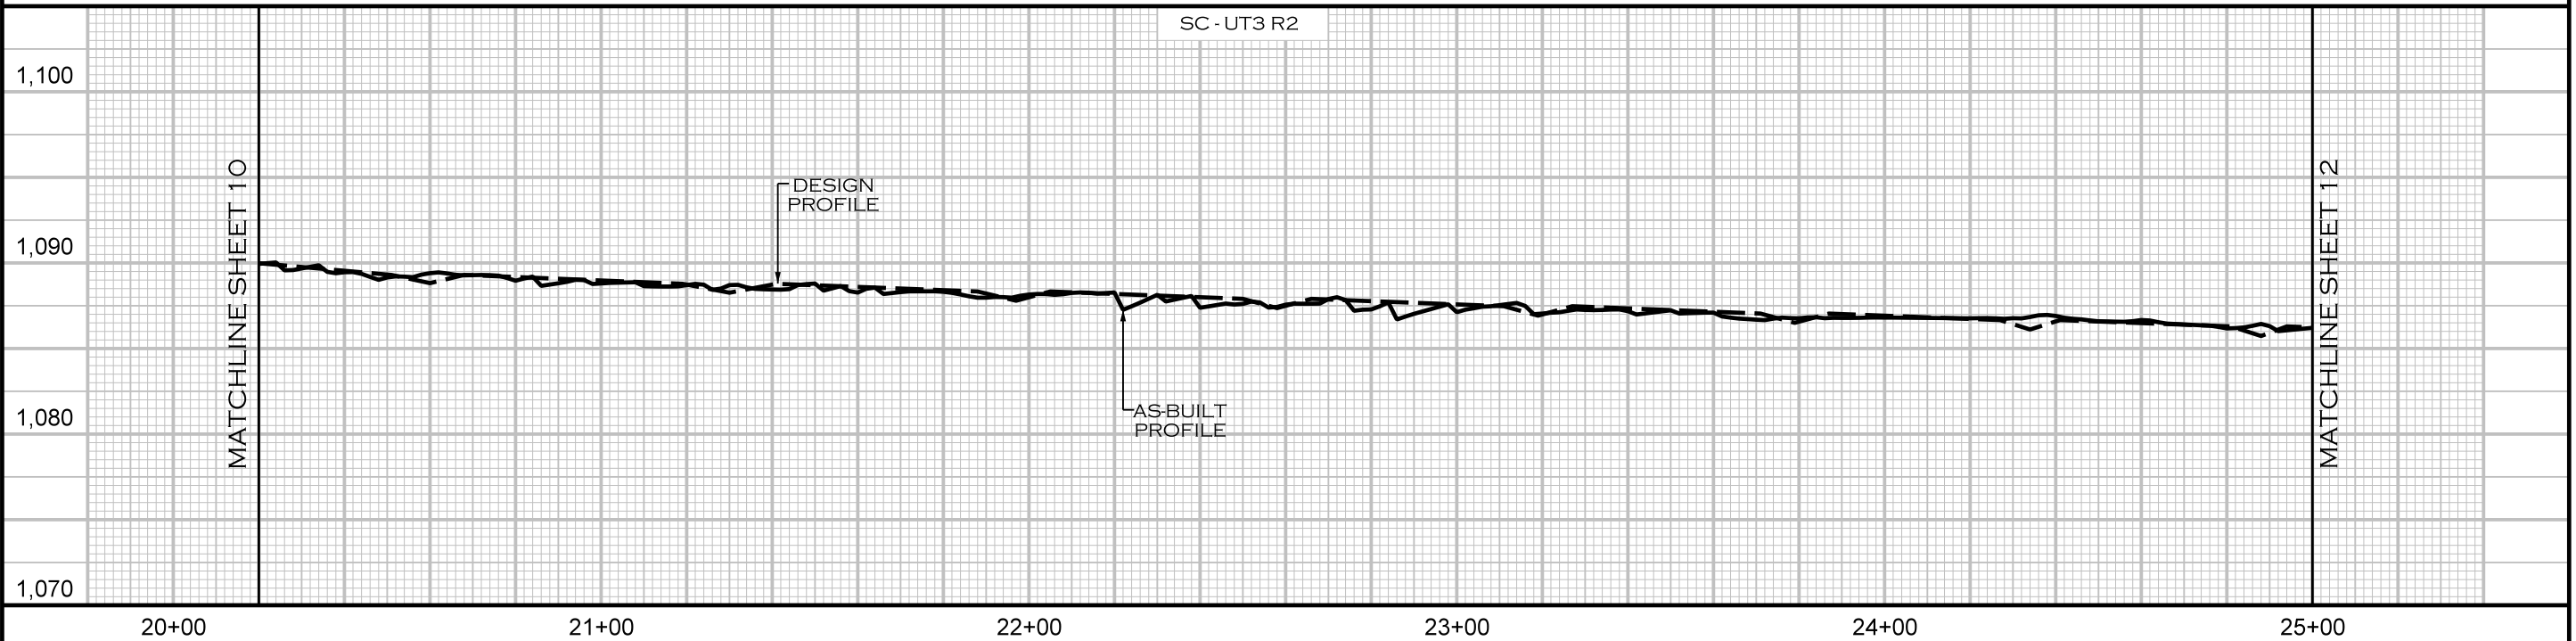

REVISIONS				
NO.	DESCRIPTION	ENGR.	APPROV.	DATE
1	RECORD DRAWINGS	EMB	KLT	10/9/20

PREPARED FOR:

NC DEPARTMENT OF ENVIRONMENTAL QUALITY  
DIVISION OF MITIGATION SERVICES  
1652 MAIL SERVICE CENTER  
RALEIGH, NC 27699-1652



STEWARTS CREEK TRIBUTARIES PROJECT  
SURRY COUNTY, NC

PREPARED IN THE OFFICE OF:



ECOSYSTEM PLANNING & RESTORATION  
1150 SE MAYNARD RD, SUITE 140  
CARY, NC 27511  
LICENSE # P-1182

PROJECT ENGINEER

10/8/2020 R:\PROJECTS\RD\0083\_NCDEQ\_STEWARTS CREEK\_FD\CADD\PLANS\AS-BUILT\MF\_ASB\_PSH\_11.DGN

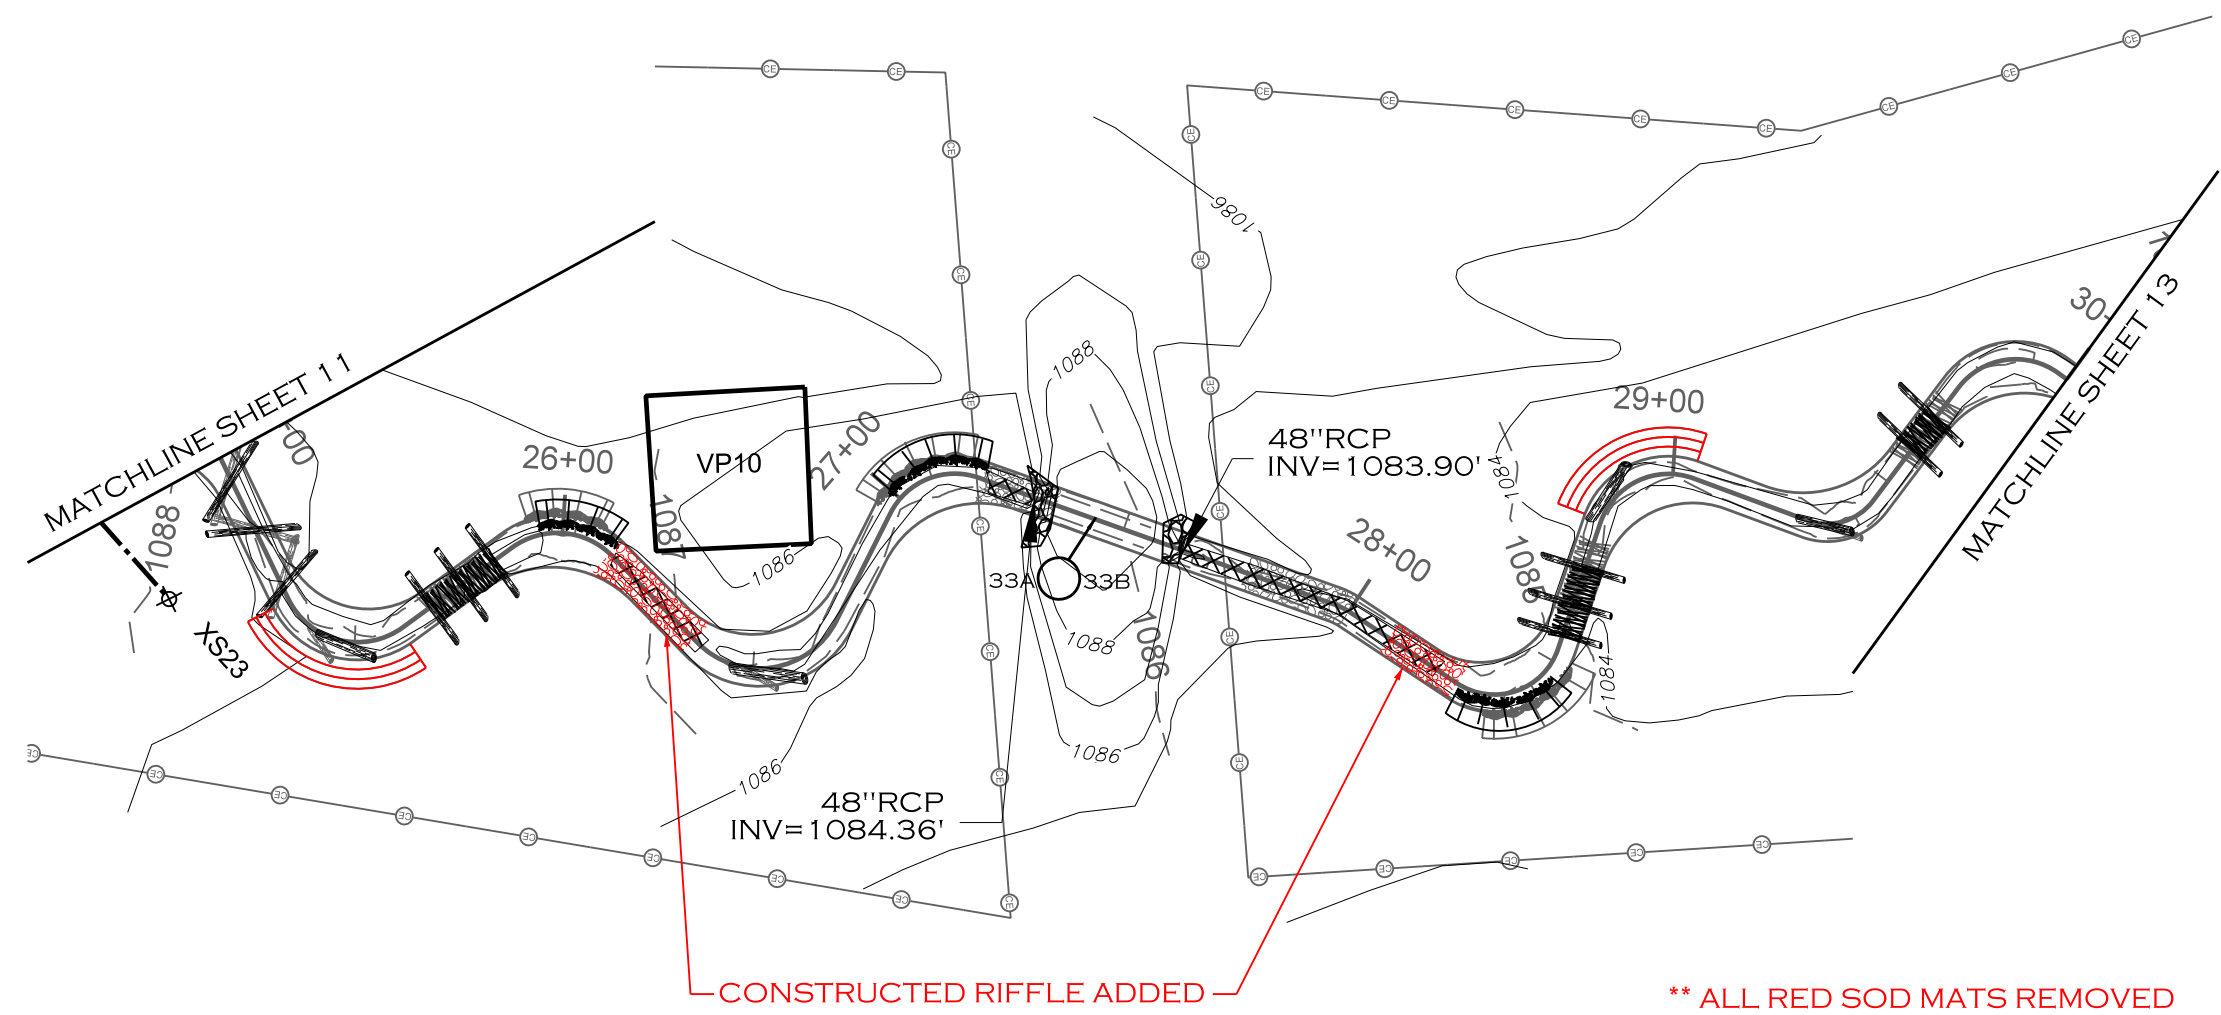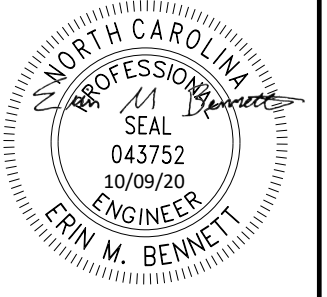

CONSTRUCTED RIFFLE ADDED \*\* ALL RED SOD MATS REMOVED

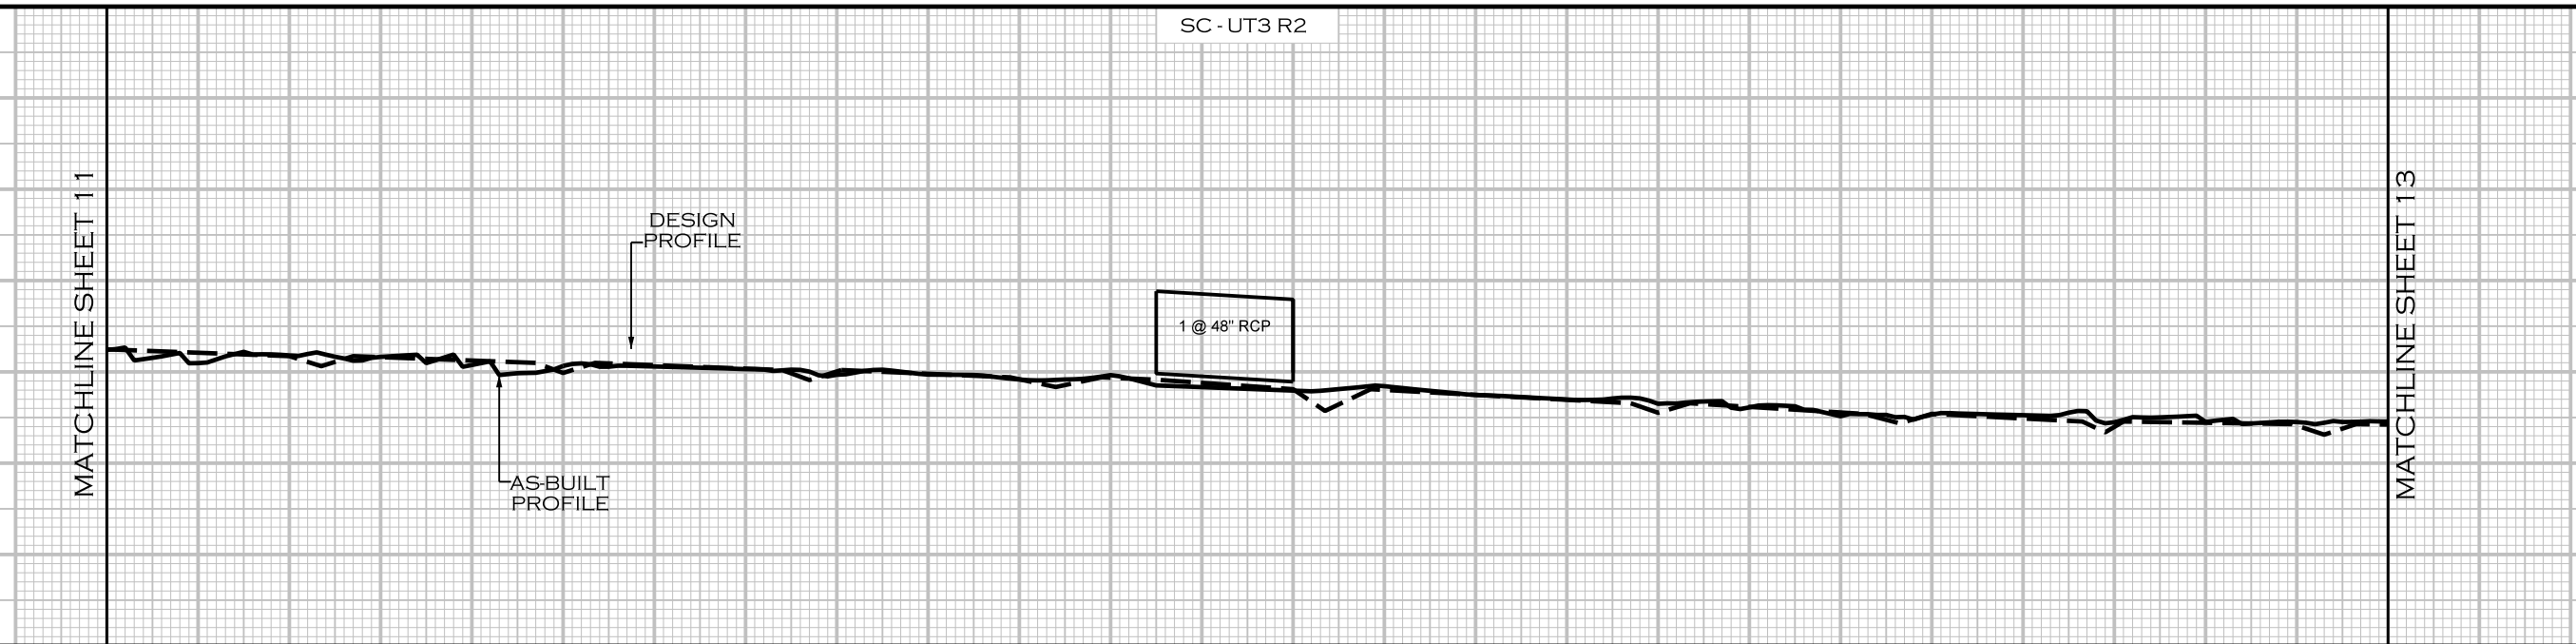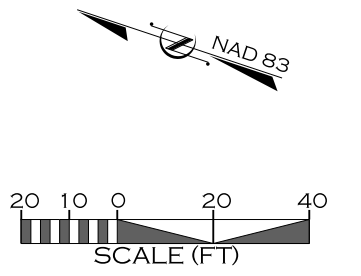

25+00 26+00 27+00 28+00 29+00 30+00

REVISIONS				
NO.	DESCRIPTION	ENGR.	APPROV.	DATE
1	RECORD DRAWINGS	EMB	KLT	10/9/20

PREPARED FOR:

NC DEPARTMENT OF ENVIRONMENTAL QUALITY  
DIVISION OF MITIGATION SERVICES  
1652 MAIL SERVICE CENTER  
RALEIGH, NC 27699-1652

STEWARTS CREEK TRIBUTARIES PROJECT  
SURRY COUNTY, NC



PREPARED IN THE OFFICE OF:

ECOSYSTEM PLANNING & RESTORATION  
1150 SE MAYNARD RD, SUITE 140  
CARY, NC 27511  
LICENSE # P-1182



PROJECT ENGINEER

10/8/2020 R:\PROJECTS\RD\0083\_NCDEQ\_STEWARTS CREEK\_FD\CADD\PLANS\AS-BUILT\MF\_ASB\_PSH\_12.DGN

PLAN / PROFILE

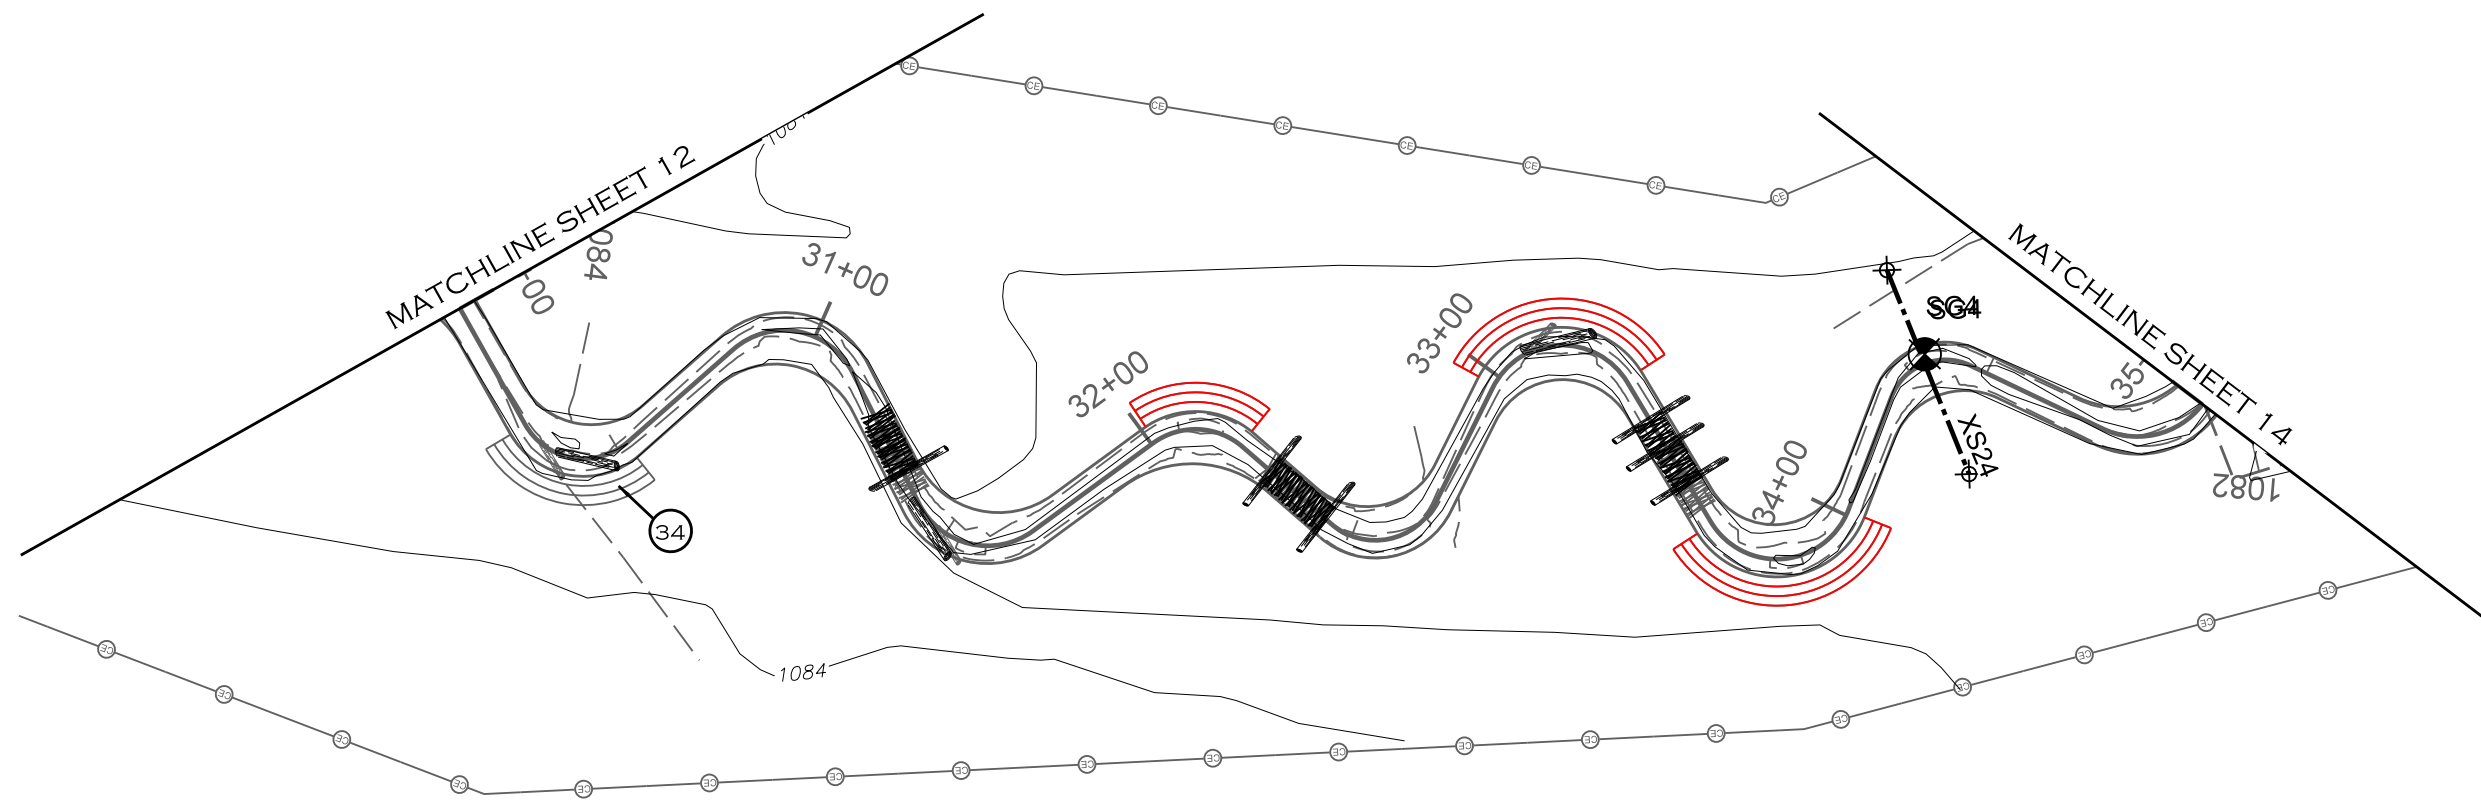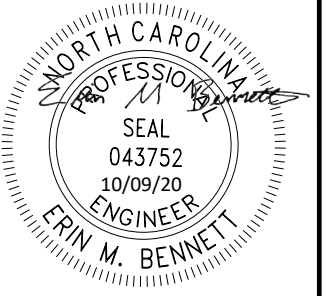

\*\* ALL RED SOD MATS REMOVED

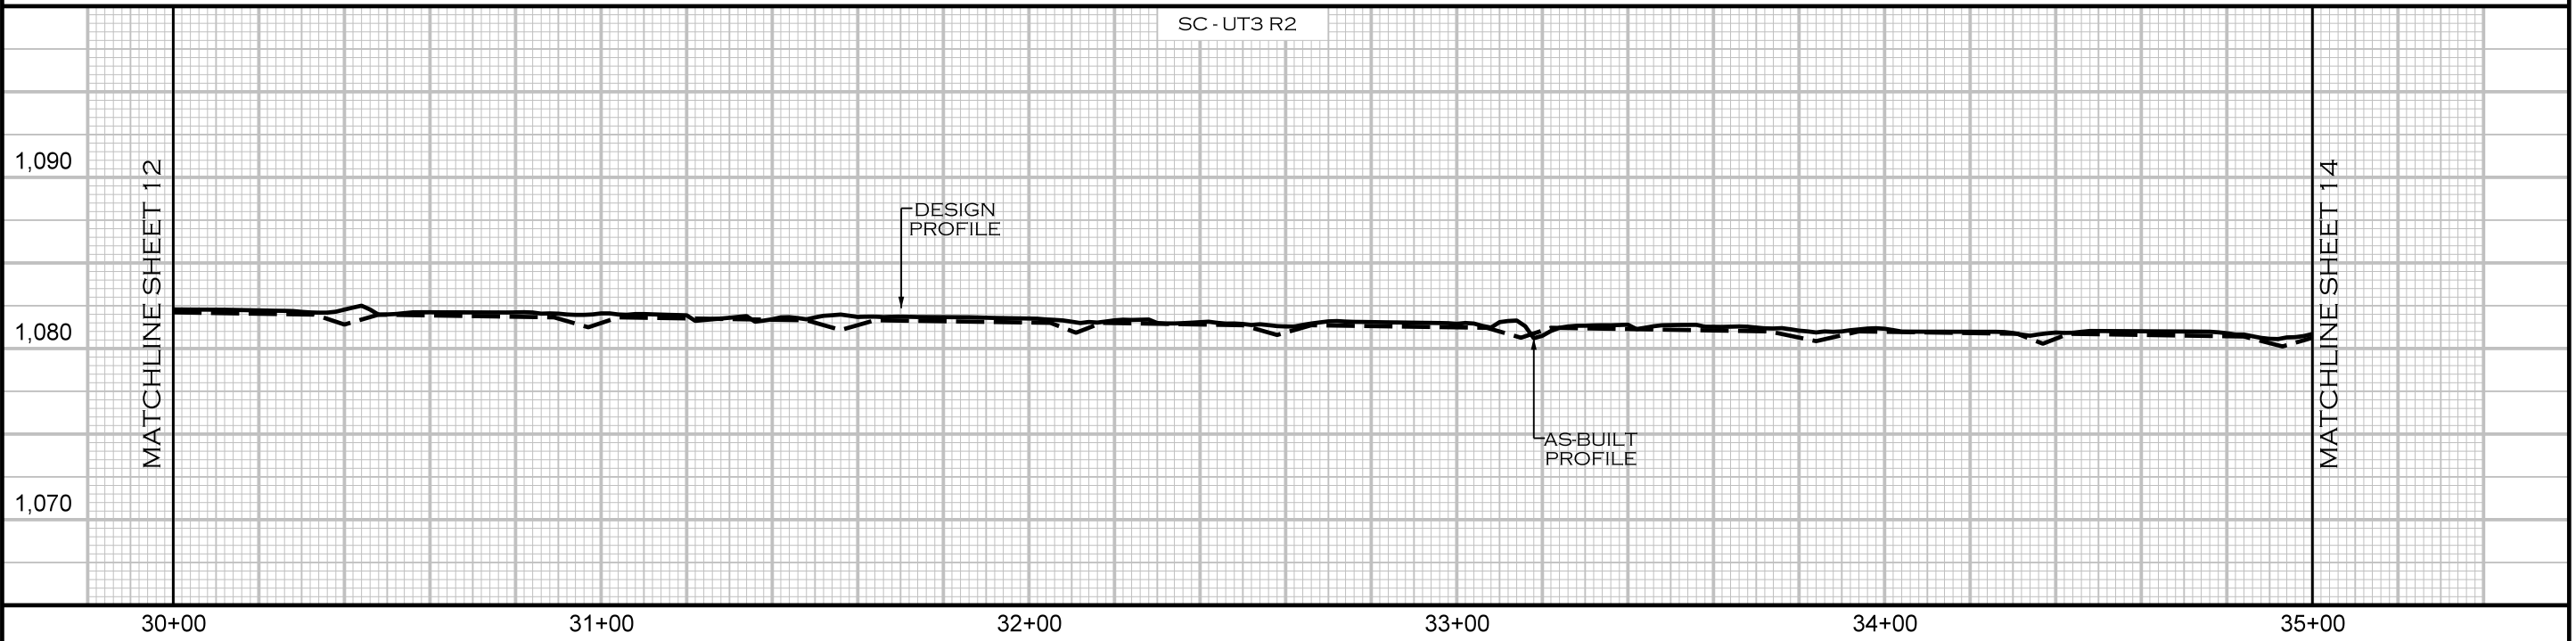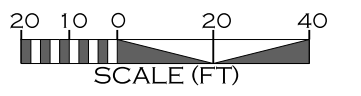

10/8/2020 R:\PROJECTS\RD\0083\_NCDEQ\_STEWARTS CREEK\_FD\CADD\PLANS\AS-BUILT\MF\_ASB\_PSH\_13.DGN

REVISIONS				
NO.	DESCRIPTION	ENGR.	APPROV.	DATE
1	RECORD DRAWINGS	EMB	KLT	10/9/20

PREPARED FOR:




NC DEPARTMENT OF ENVIRONMENTAL QUALITY  
DIVISION OF MITIGATION SERVICES  
1652 MAIL SERVICE CENTER  
RALEIGH, NC 27699-1652

STEWARTS CREEK TRIBUTARIES PROJECT  
SURRY COUNTY, NC


PREPARED IN THE OFFICE OF:

1150 SE MAYNARD RD, SUITE 140  
CARY, NC 27511  
LICENSE # P-1182

PROJECT ENGINEER

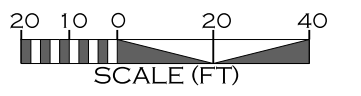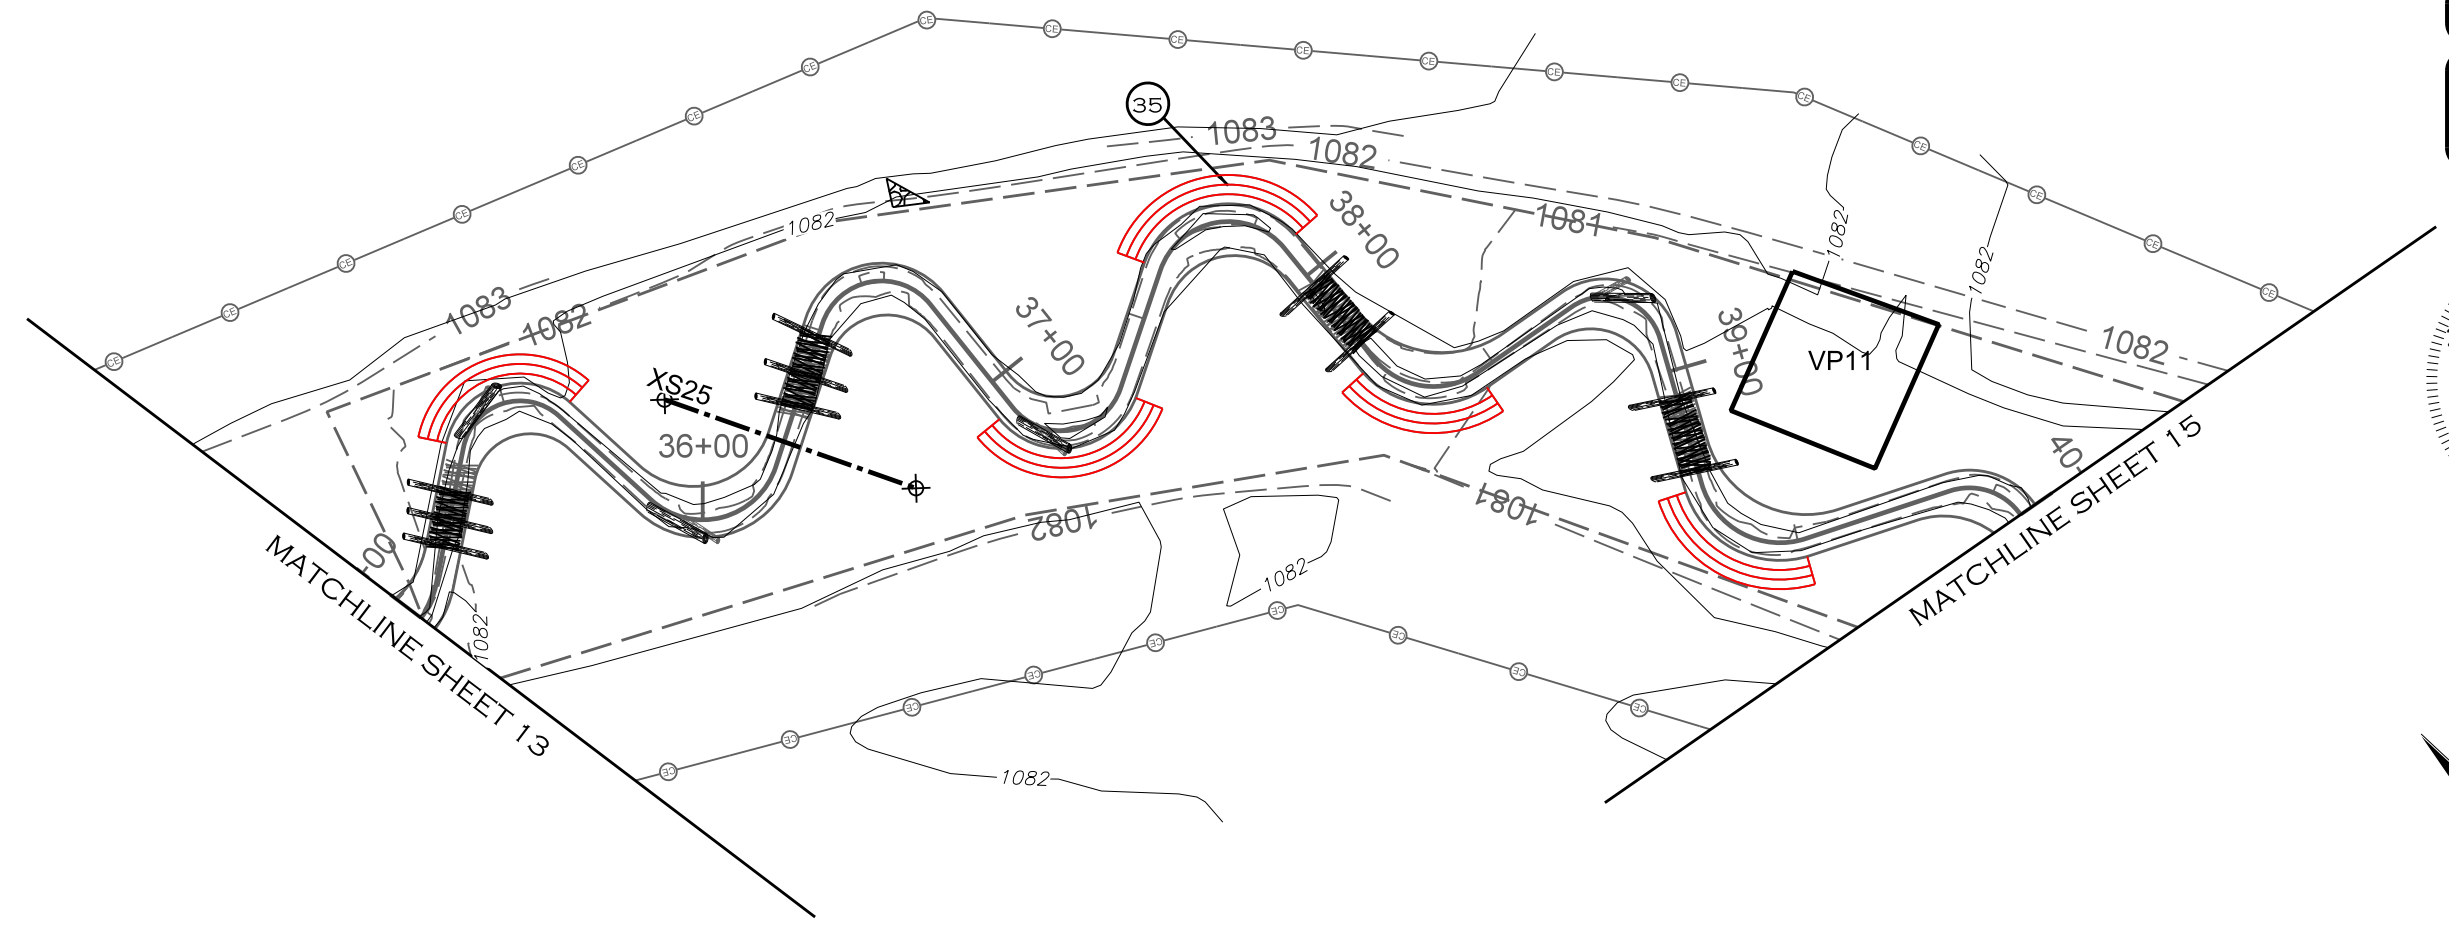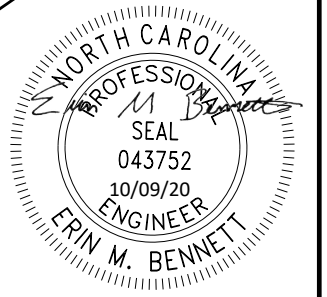

\*\* ALL RED SOD MATS REMOVED

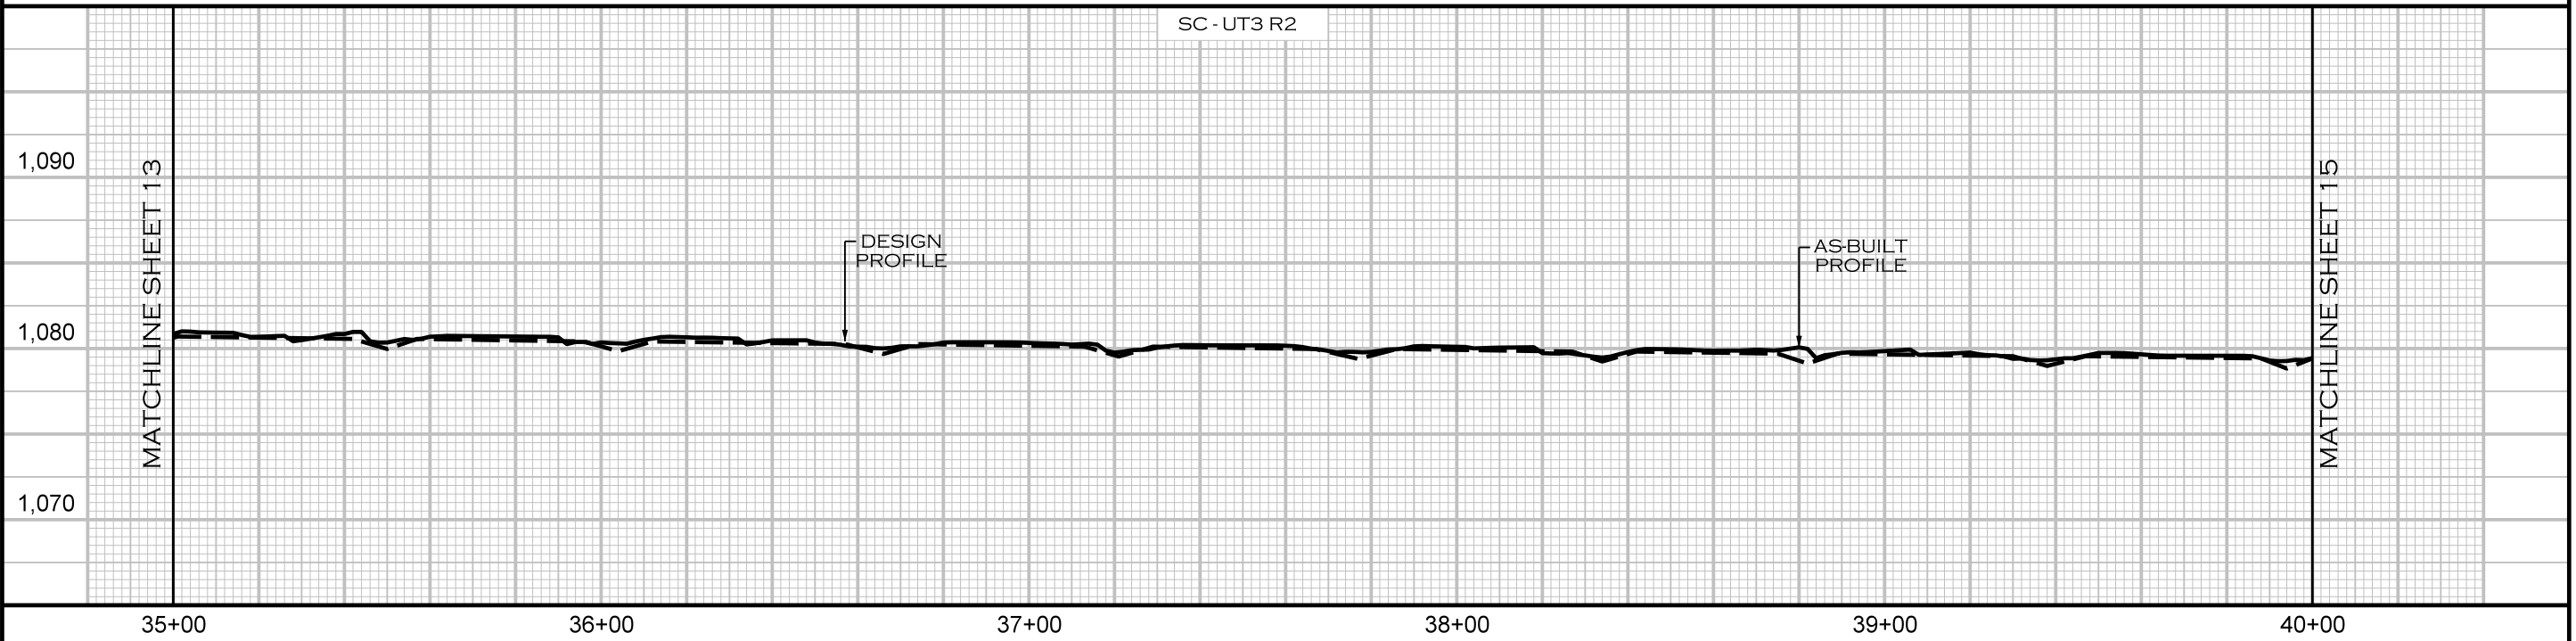

REVISIONS				
NO.	DESCRIPTION	ENGR.	APPROV.	DATE
1	RECORD DRAWINGS	EMB	KLT	10/9/20

PREPARED FOR:

NC DEPARTMENT OF ENVIRONMENTAL QUALITY  
DIVISION OF MITIGATION SERVICES  
1652 MAIL SERVICE CENTER  
RALEIGH, NC 27699-1652

STEWARTS CREEK TRIBUTARIES PROJECT  
SURRY COUNTY, NC



PREPARED IN THE OFFICE OF:

ECOSYSTEM PLANNING & RESTORATION  
1150 SE MAYNARD RD, SUITE 140  
CARY, NC 27511  
LICENSE # P-1182



PROJECT ENGINEER

10/8/2020 R:\PROJECTS\RD\0083\_NCDEQ\_STEWARTS CREEK\_FD\CADD\PLANS\AS-BUILT\MF\_ASB\_PSH\_14.DGN

PLAN / PROFILE

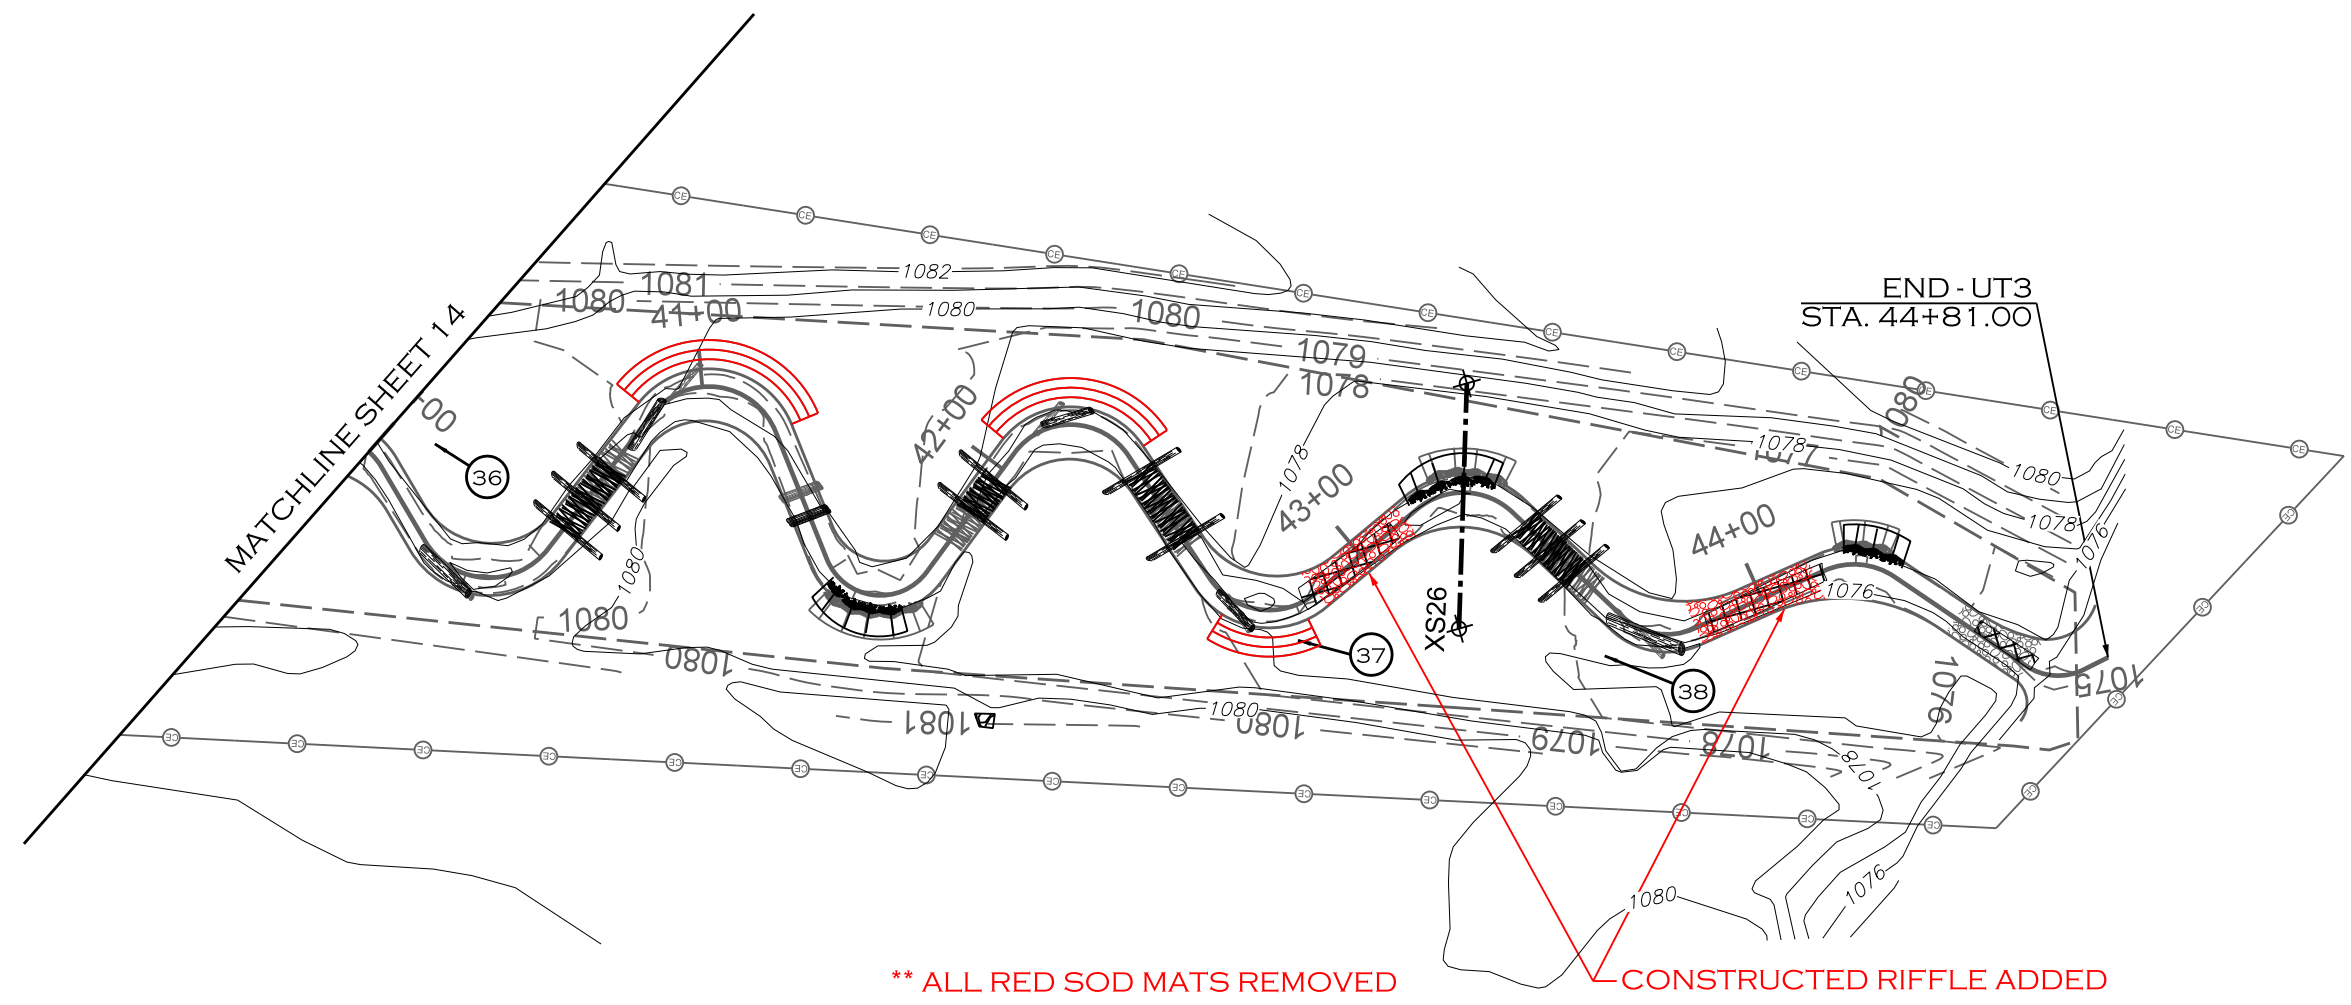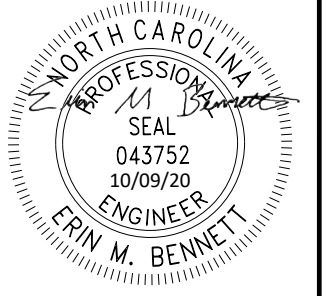

\*\* ALL RED SOD MATS REMOVED CONSTRUCTED RIFFLE ADDED

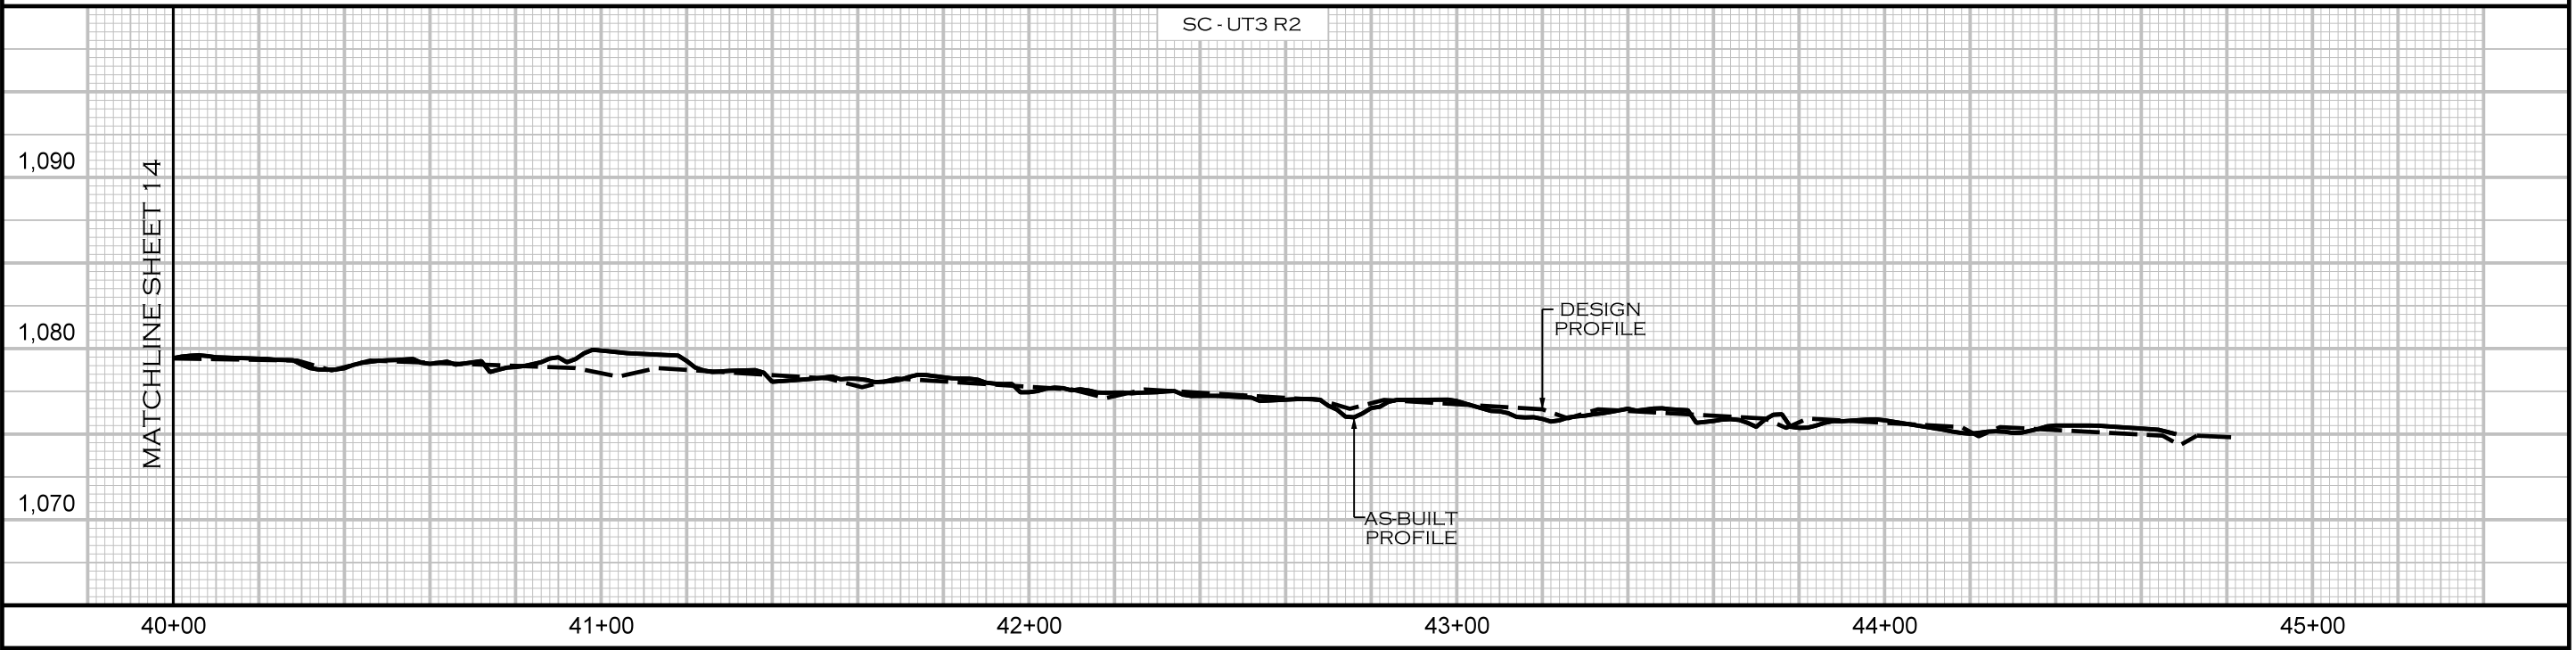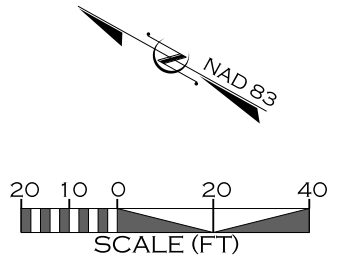

10/8/2020 R:\PROJECTS\RD\0083\_NCDEQ\_STEWARTS CREEK\_FD\CADD\PLANS\AS-BUILT\MF\_ASB\_PSH\_15.DGN

REVISIONS				
NO.	DESCRIPTION	ENGR.	APPROV.	DATE
1	RECORD DRAWINGS	EMB	KLT	10/9/20

PREPARED FOR:

NC DEPARTMENT OF ENVIRONMENTAL QUALITY  
DIVISION OF MITIGATION SERVICES  
1652 MAIL SERVICE CENTER  
RALEIGH, NC 27699-1652



STEWARTS CREEK TRIBUTARIES PROJECT  
SURRY COUNTY, NC

PREPARED IN THE OFFICE OF:

ECOSYSTEM PLANNING & RESTORATION  
1150 SE MAYNARD RD, SUITE 140  
CARY, NC 27511  
LICENSE # P-1182



PROJECT ENGINEER

PLAN / PROFILE

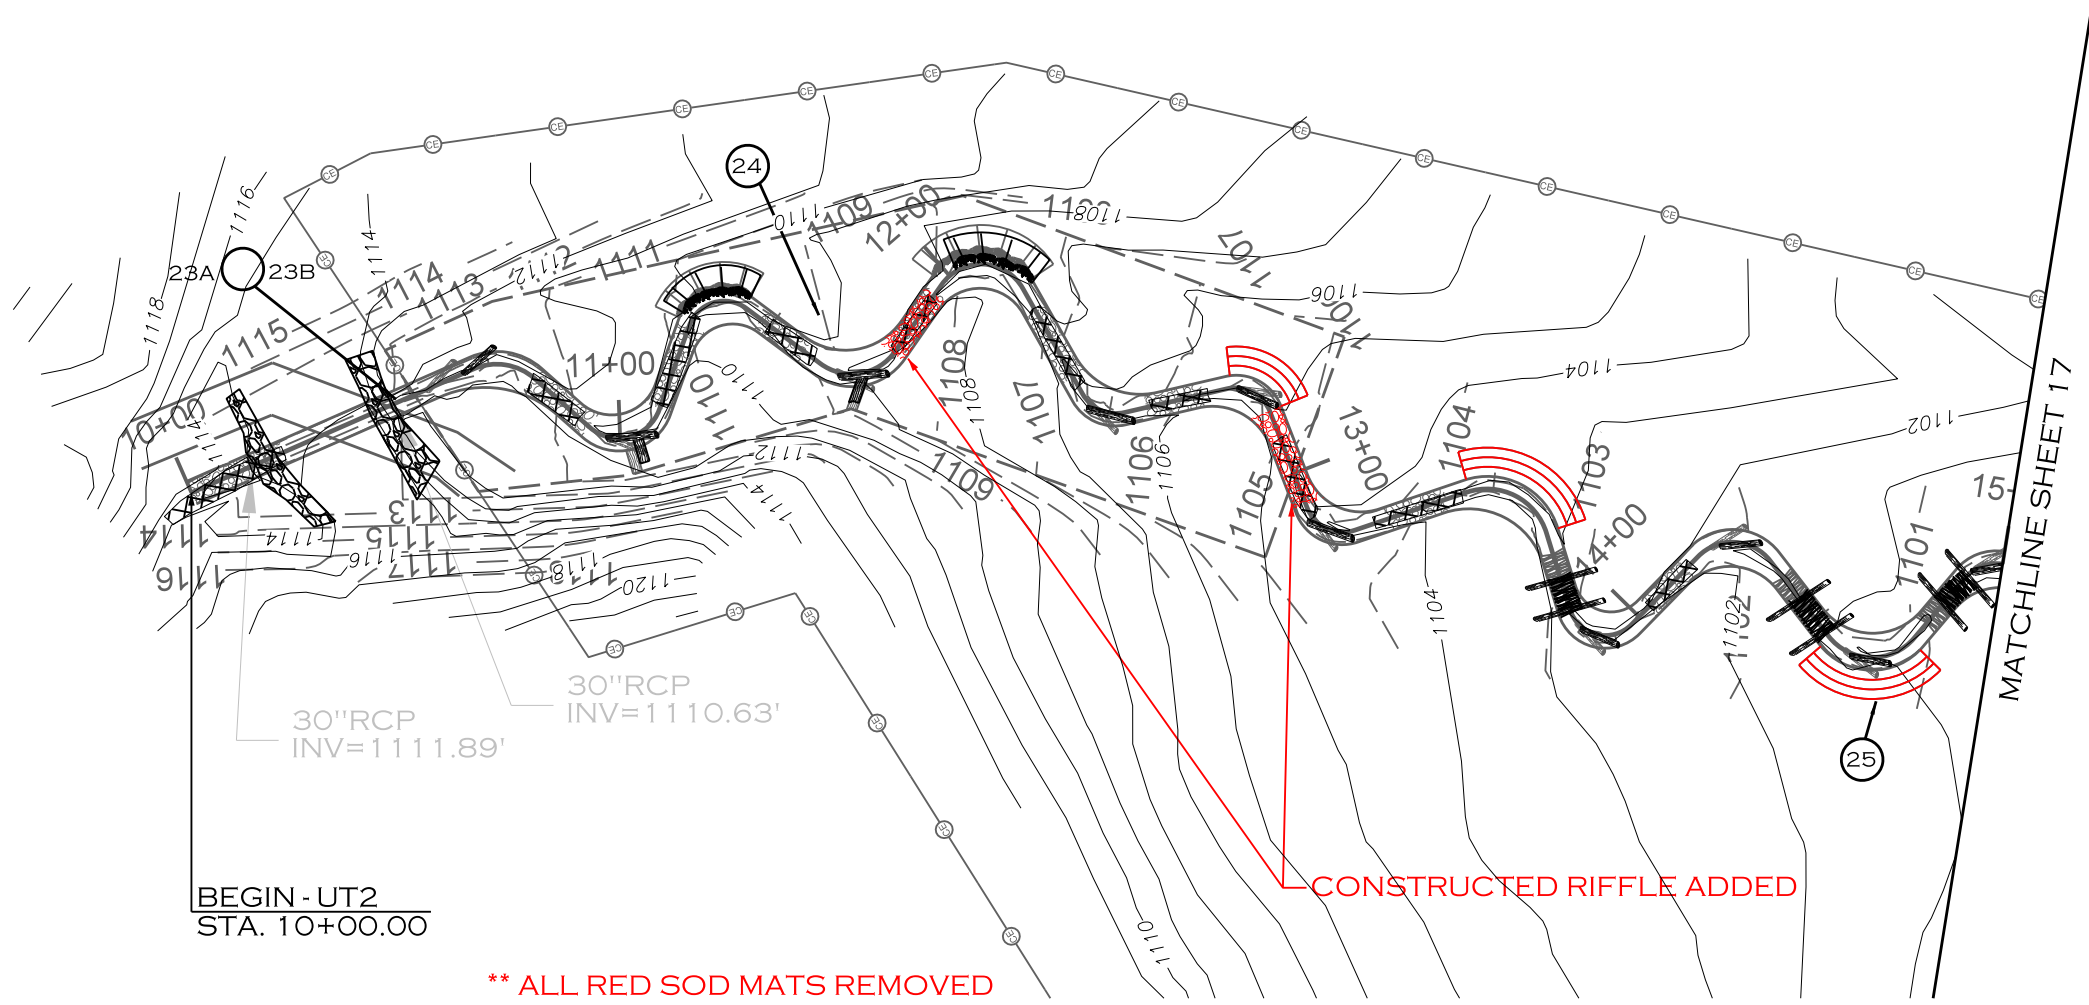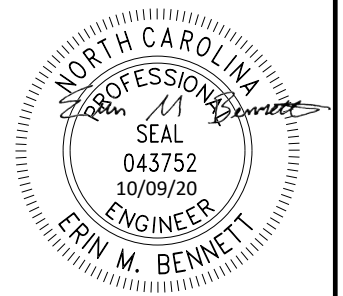

BEGIN - UT2  
STA. 10+00.00

\*\* ALL RED SOD MATS REMOVED

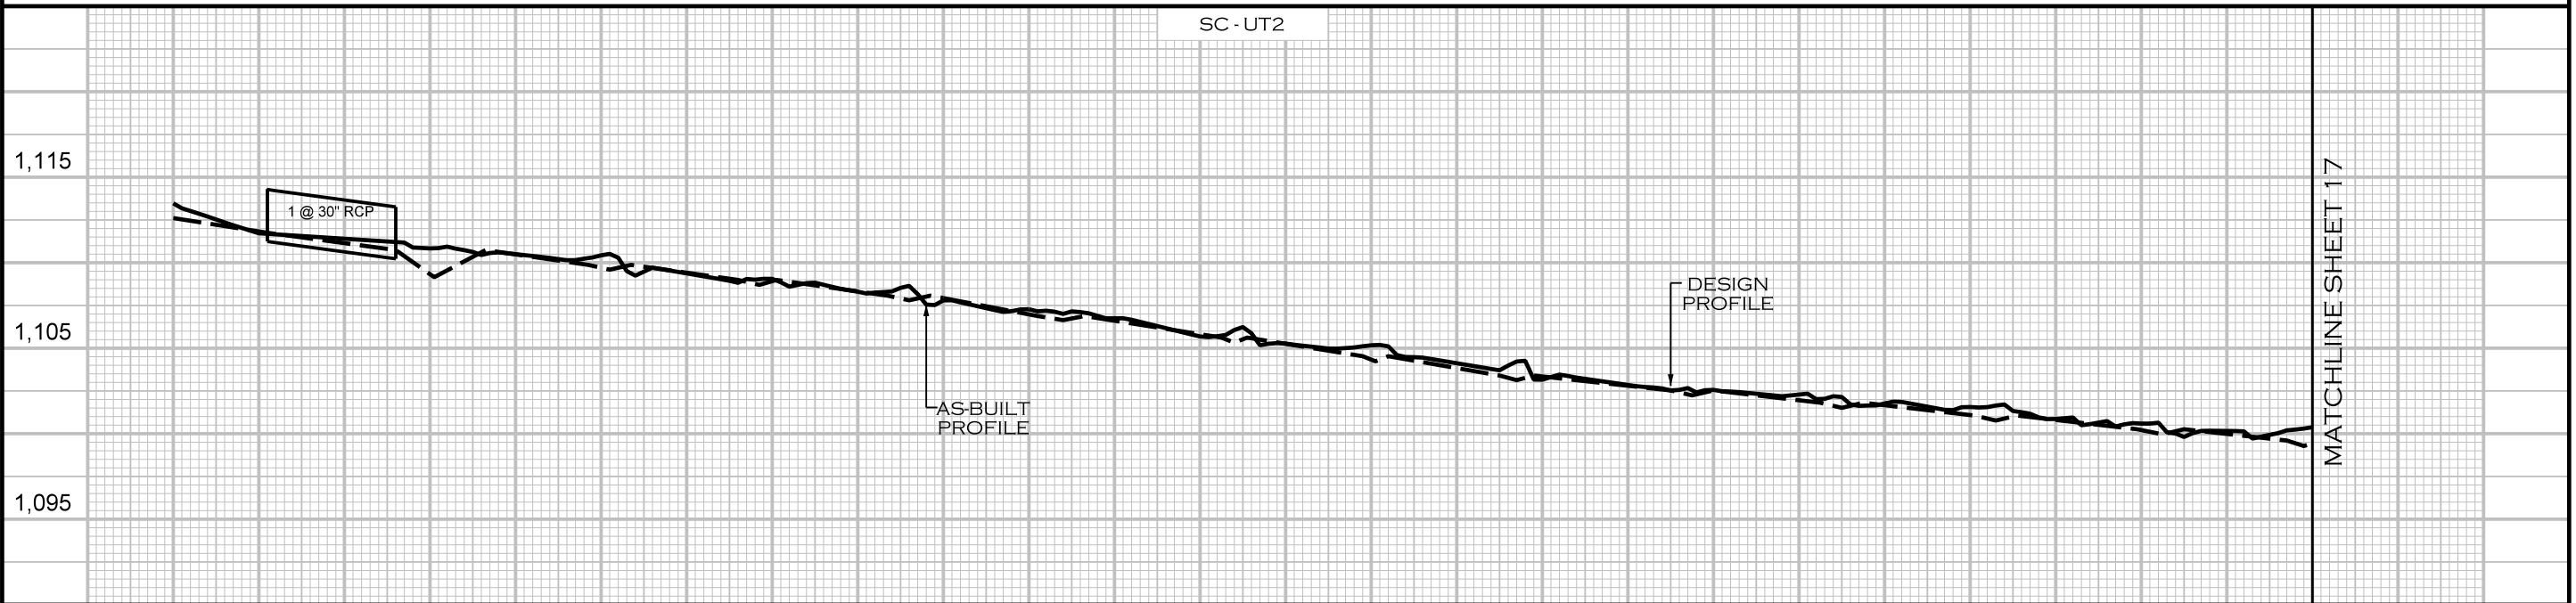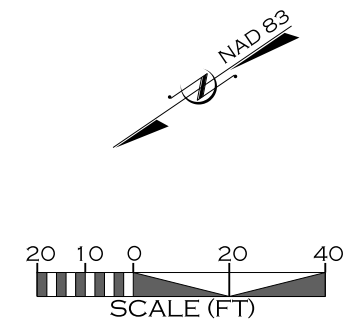

10+00 11+00 12+00 13+00 14+00 15+00

REVISIONS				
NO.	DESCRIPTION	ENGR.	APPROV.	DATE
1	RECORD DRAWINGS	EMB	KLT	10/9/20

PREPARED FOR:

NC DEPARTMENT OF ENVIRONMENTAL QUALITY  
DIVISION OF MITIGATION SERVICES  
1652 MAIL SERVICE CENTER  
RALEIGH, NC 27699-1652




STEWARTS CREEK TRIBUTARIES PROJECT  
SURRY COUNTY, NC

PREPARED IN THE OFFICE OF:


ECOSYSTEM PLANNING & RESTORATION  
1150 SE MAYNARD RD, SUITE 140  
CARY, NC 27511  
LICENSE # P-1182

PROJECT ENGINEER

10/8/2020 R:\PROJECTS\RD\0083\_NCDEQ\_STEWARTS CREEK\_FD\CADD\PLANS\AS-BUILT\MF\_ASB\_PSH\_16.DGN

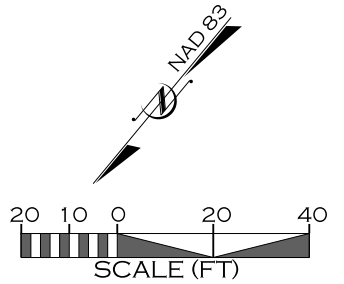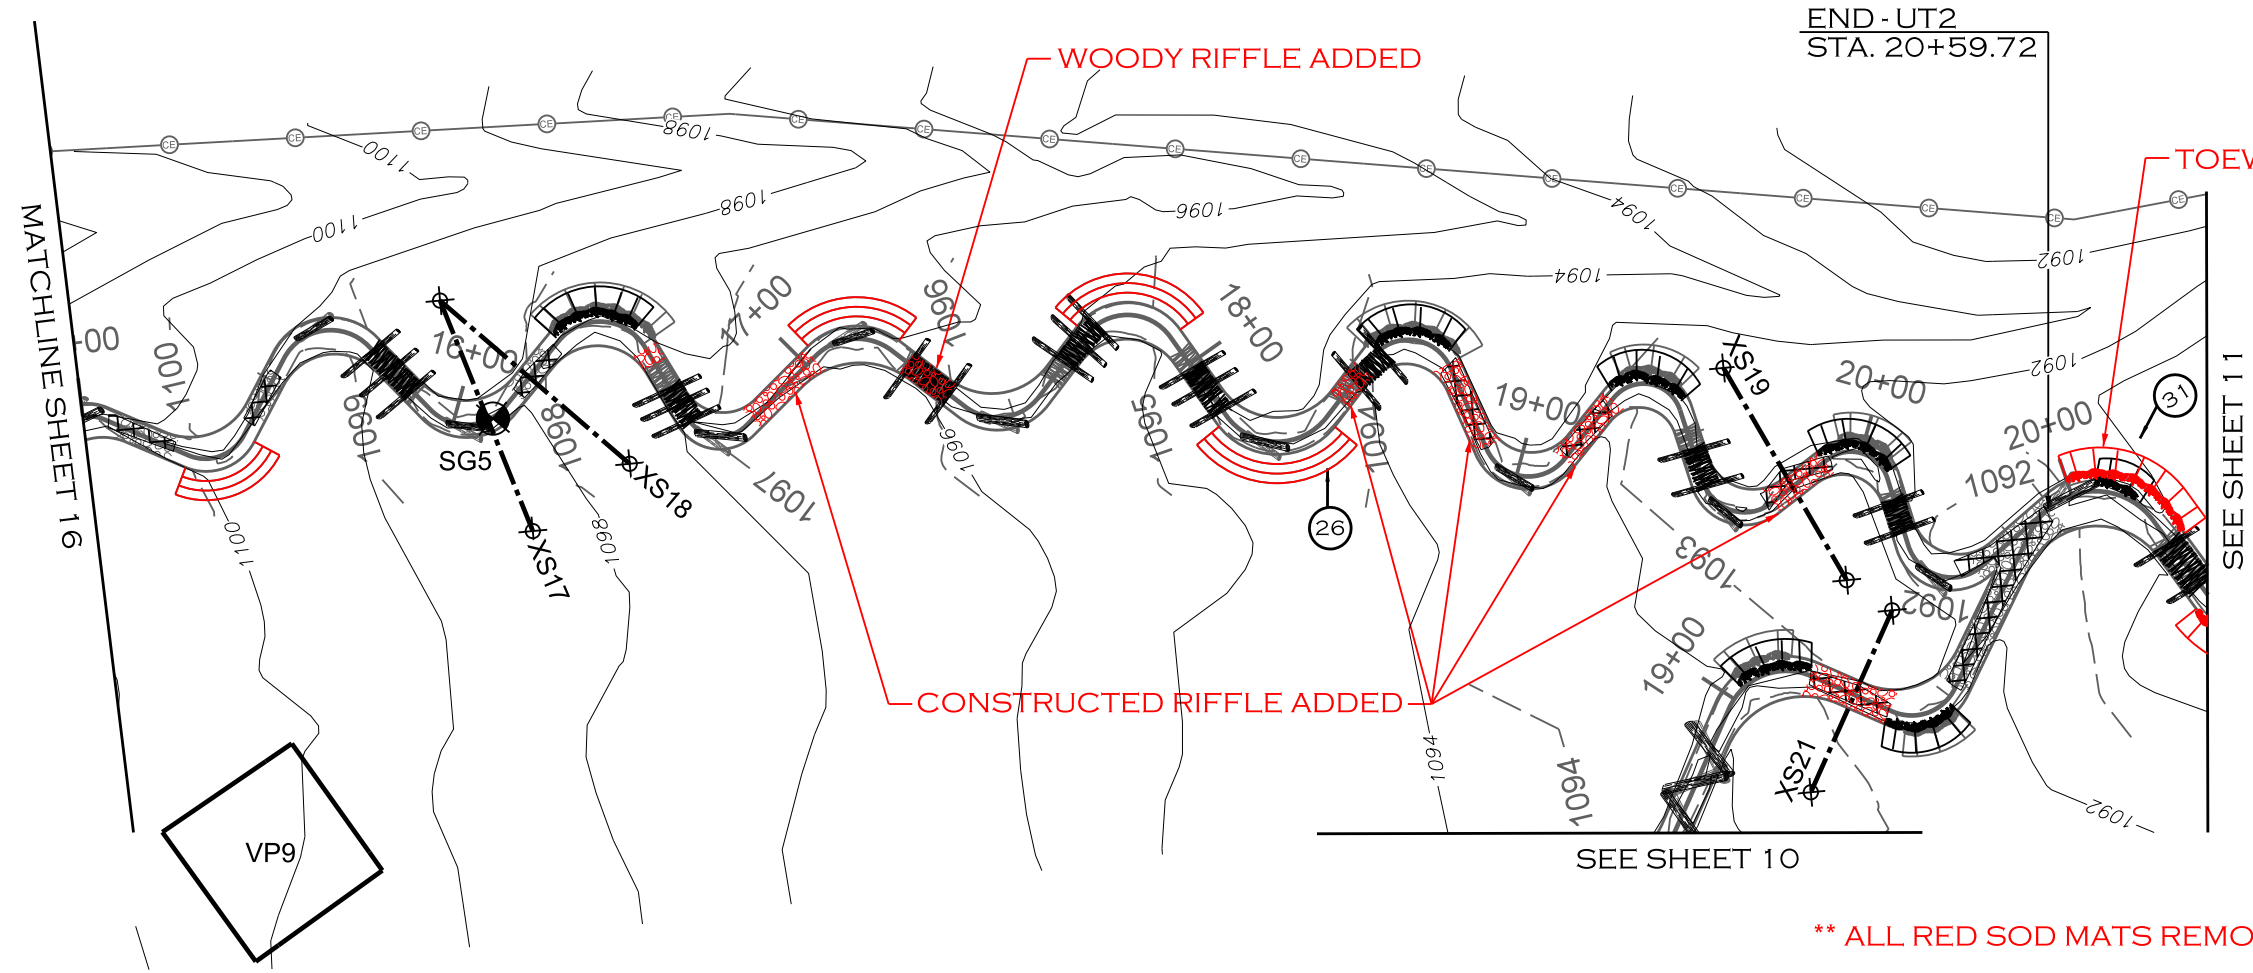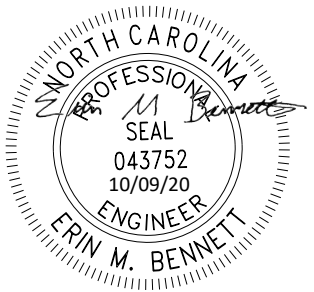

\*\* ALL RED SOD MATS REMOVED

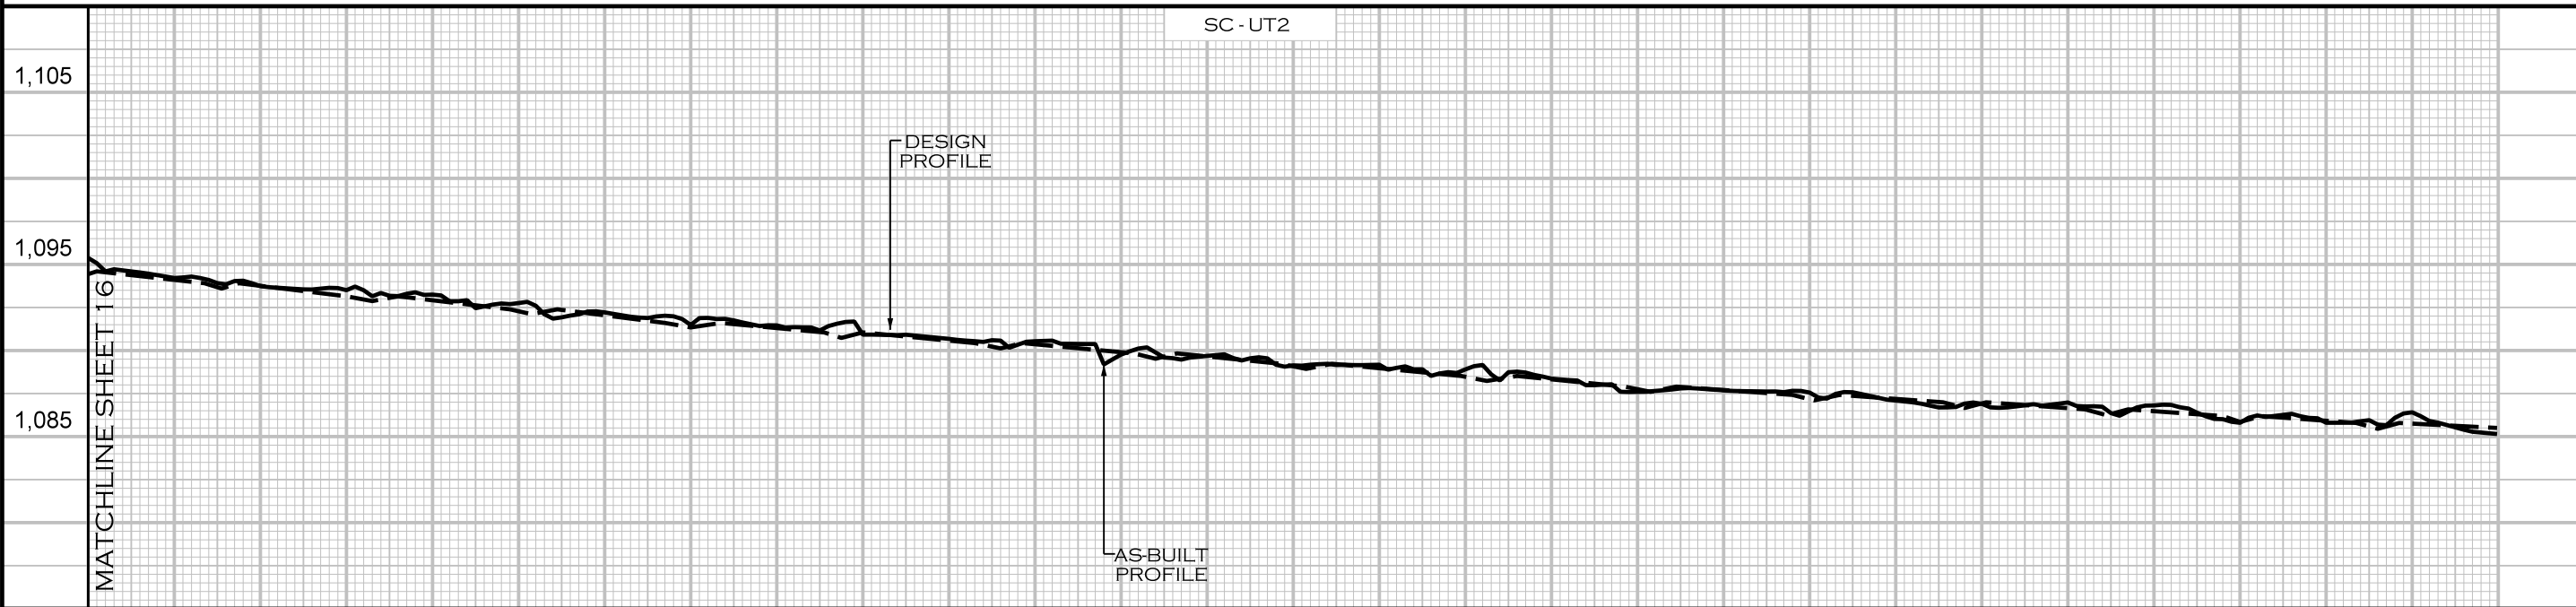

15+00 16+00 17+00 18+00 19+00 20+00

REVISIONS				
NO.	DESCRIPTION	ENGR.	APPROV.	DATE
1	RECORD DRAWINGS	EMB	KLT	10/9/20

PREPARED FOR:

NC DEPARTMENT OF ENVIRONMENTAL QUALITY  
DIVISION OF MITIGATION SERVICES  
1652 MAIL SERVICE CENTER  
RALEIGH, NC 27699-1652

STEWARTS CREEK TRIBUTARIES PROJECT  
SURRY COUNTY, NC




PREPARED IN THE OFFICE OF:

ECOSYSTEM PLANNING & RESTORATION  
1150 SE MAYNARD RD, SUITE 140  
CARY, NC 27511  
LICENSE # P-1182

PROJECT ENGINEER

10/8/2020 R:\PROJECTS\RD\0083\_NCDEQ\_STEWARTS CREEK\_FD\CADD\PLANS\AS-BUILT\MF\_ASB\_PSH\_17.DGN



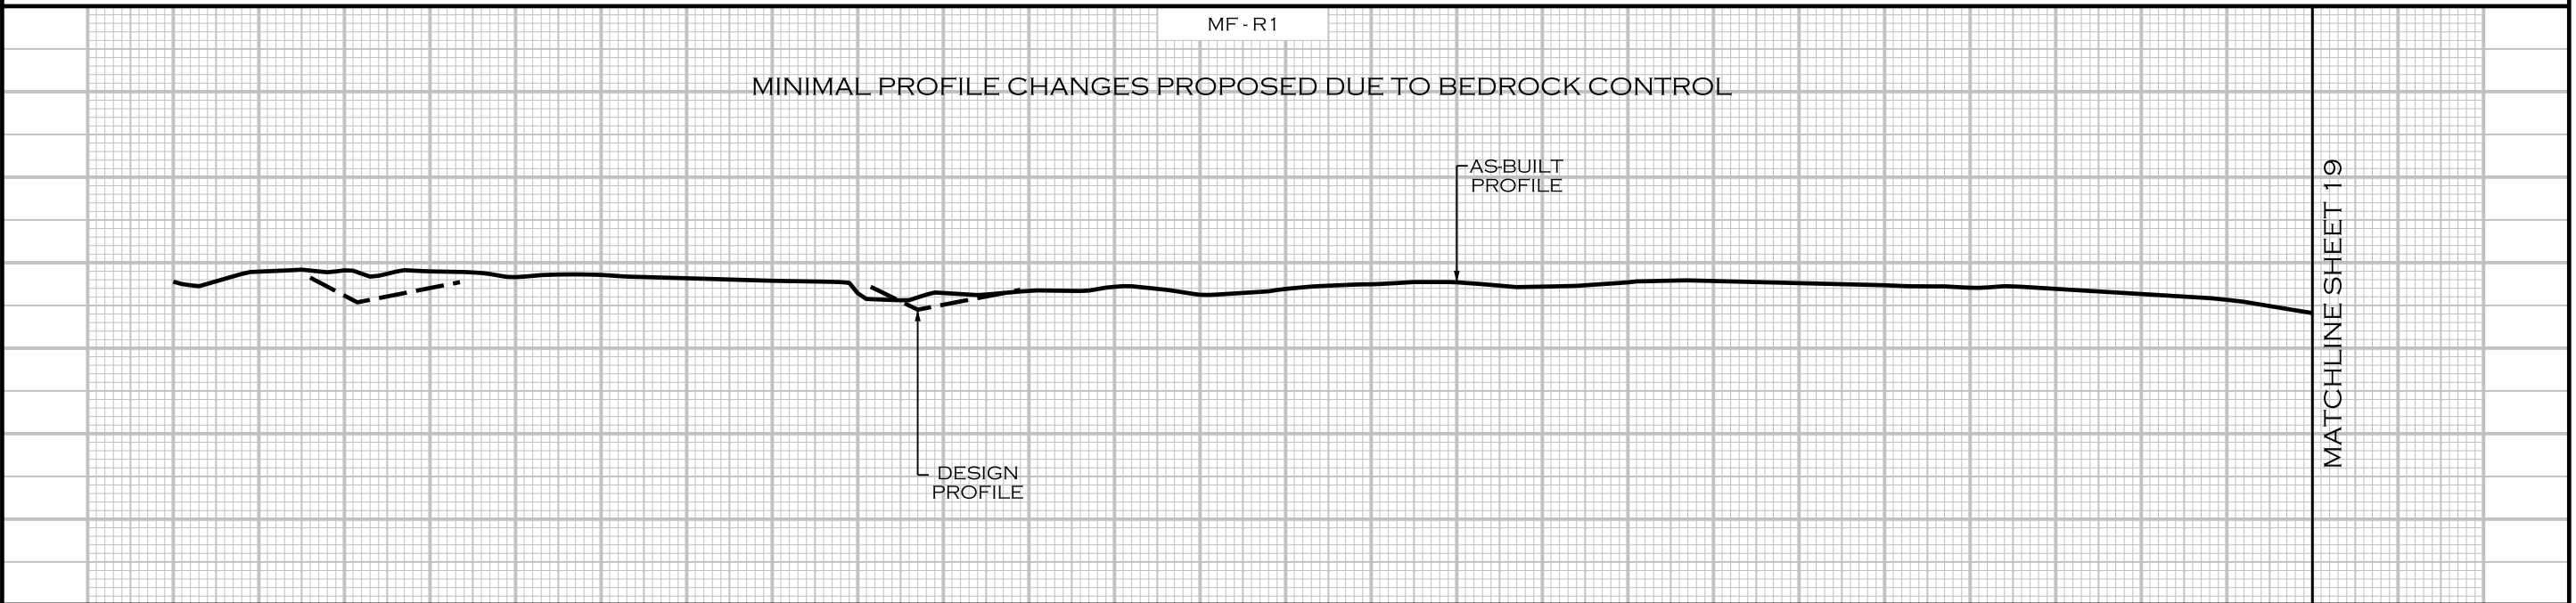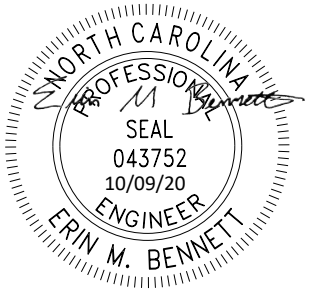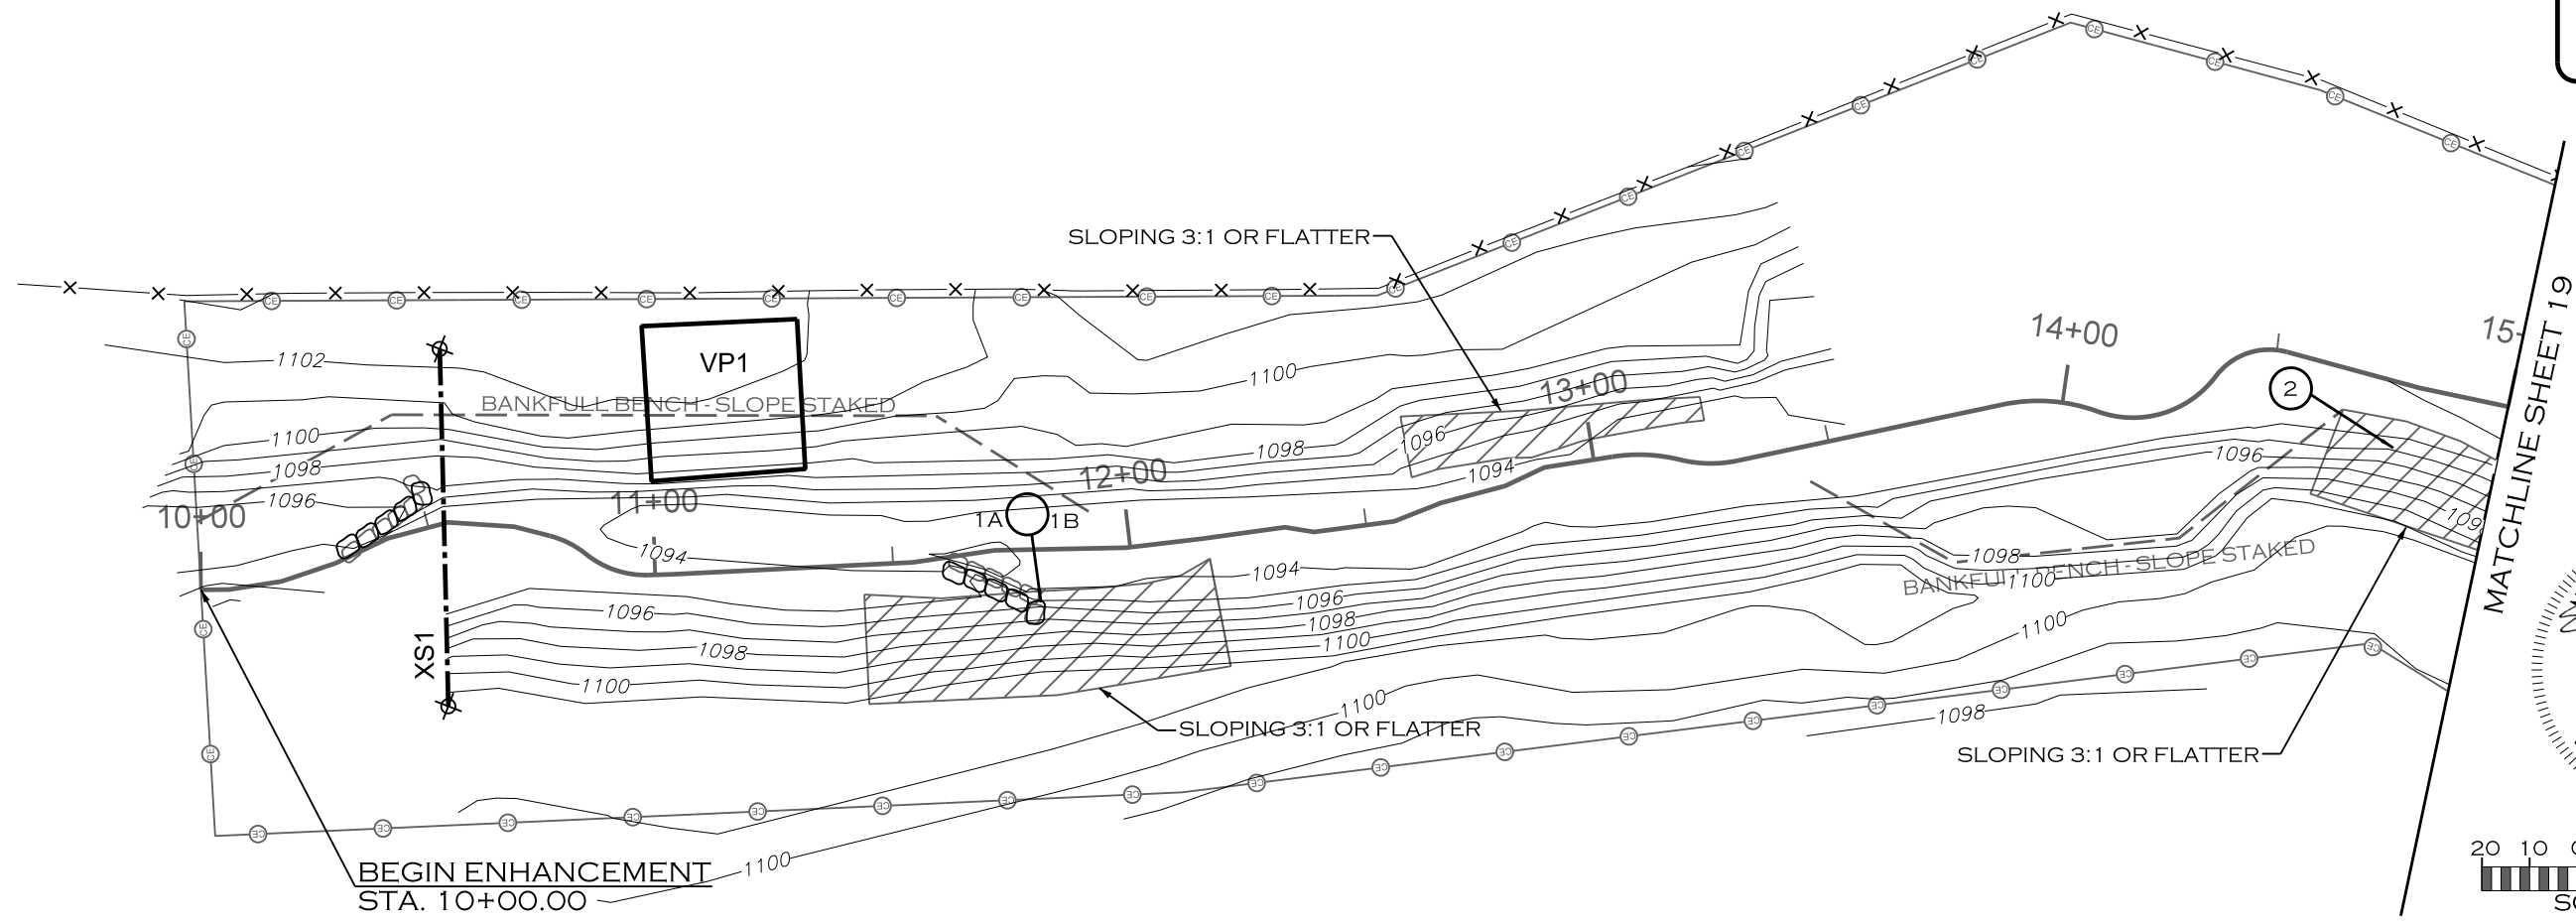

10+00 11+00 12+00 13+00 14+00 15+00

REVISIONS				
NO.	DESCRIPTION	ENGR.	APPROV.	DATE
1	RECORD DRAWINGS	EMB	KLT	10/9/20

PREPARED FOR:

NC DEPARTMENT OF ENVIRONMENTAL QUALITY  
DIVISION OF MITIGATION SERVICES  
1652 MAIL SERVICE CENTER  
RALEIGH, NC 27699-1652

STEWARTS CREEK TRIBUTARIES PROJECT  
SURRY COUNTY, NC

PREPARED IN THE OFFICE OF:




ECOSYSTEM PLANNING & RESTORATION  
1150 SE MAYNARD RD, SUITE 140  
CARY, NC 27511  
LICENSE # P-1182

PROJECT ENGINEER

10/8/2020 R:\PROJECTS\RD\0083\_NCDEQ\_STEWARTS CREEK\_FD\CADD\PLANS\AS-BUILT\MF\_ASB\_PSH\_18.DGN



PLAN / PROFILE

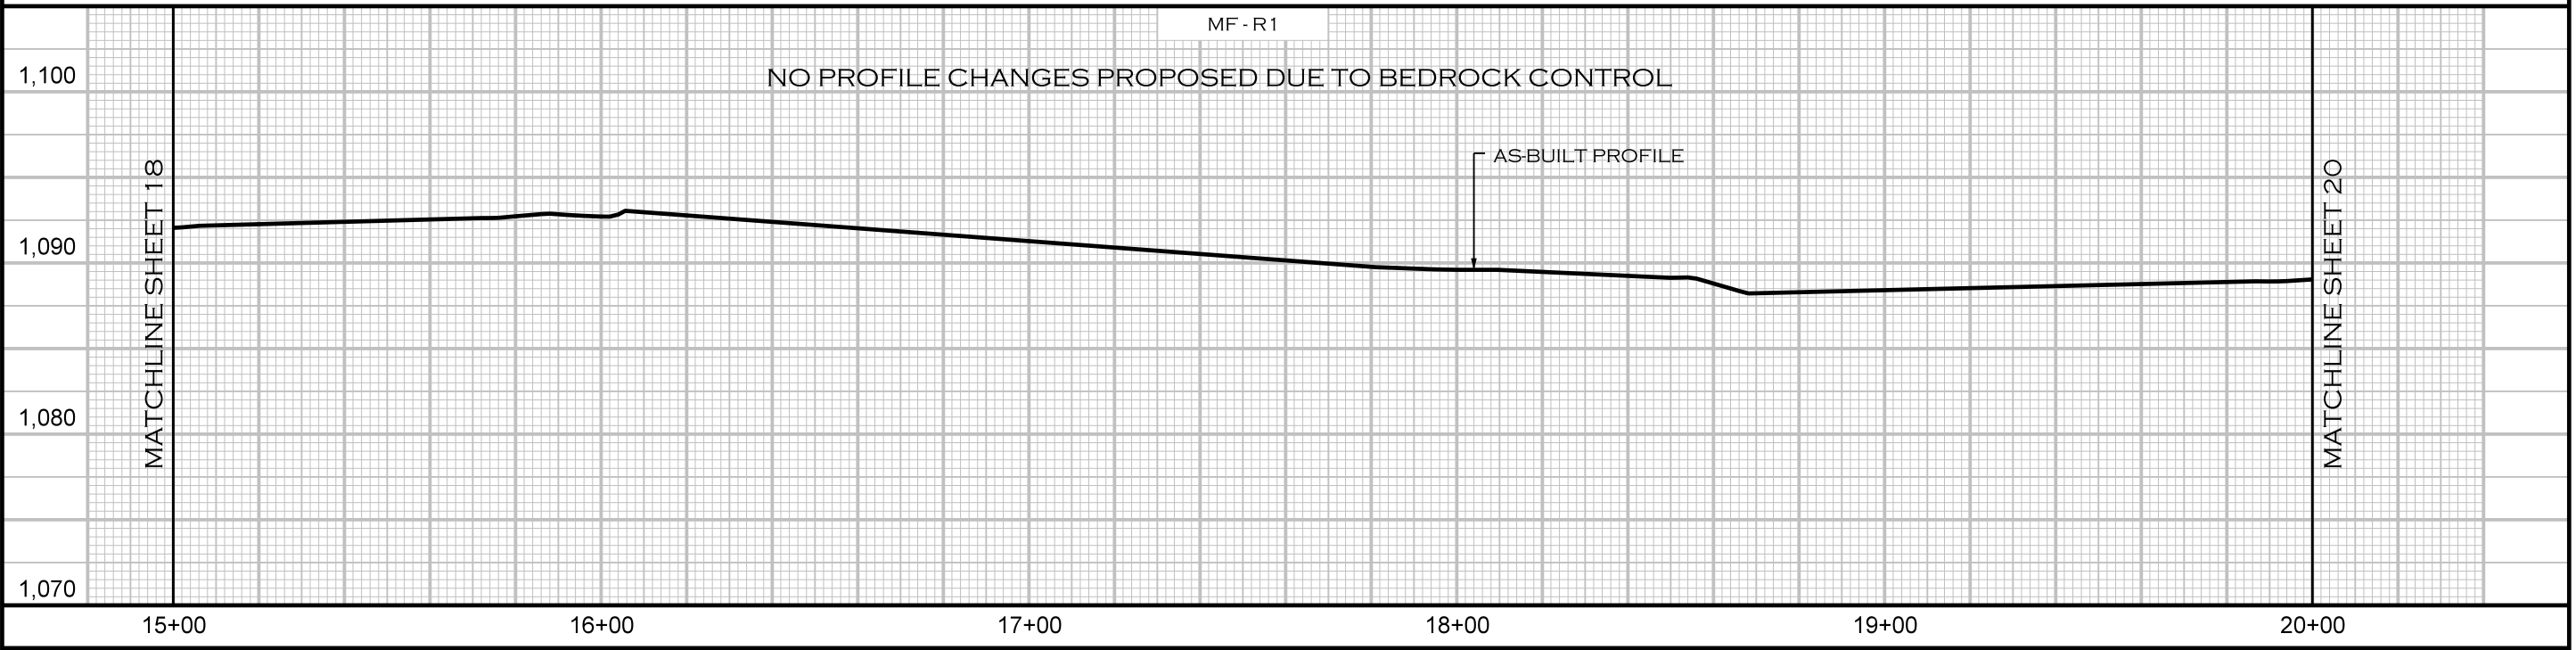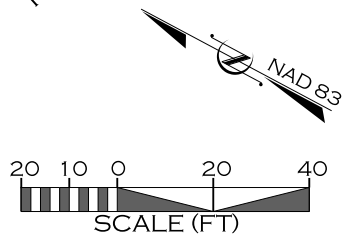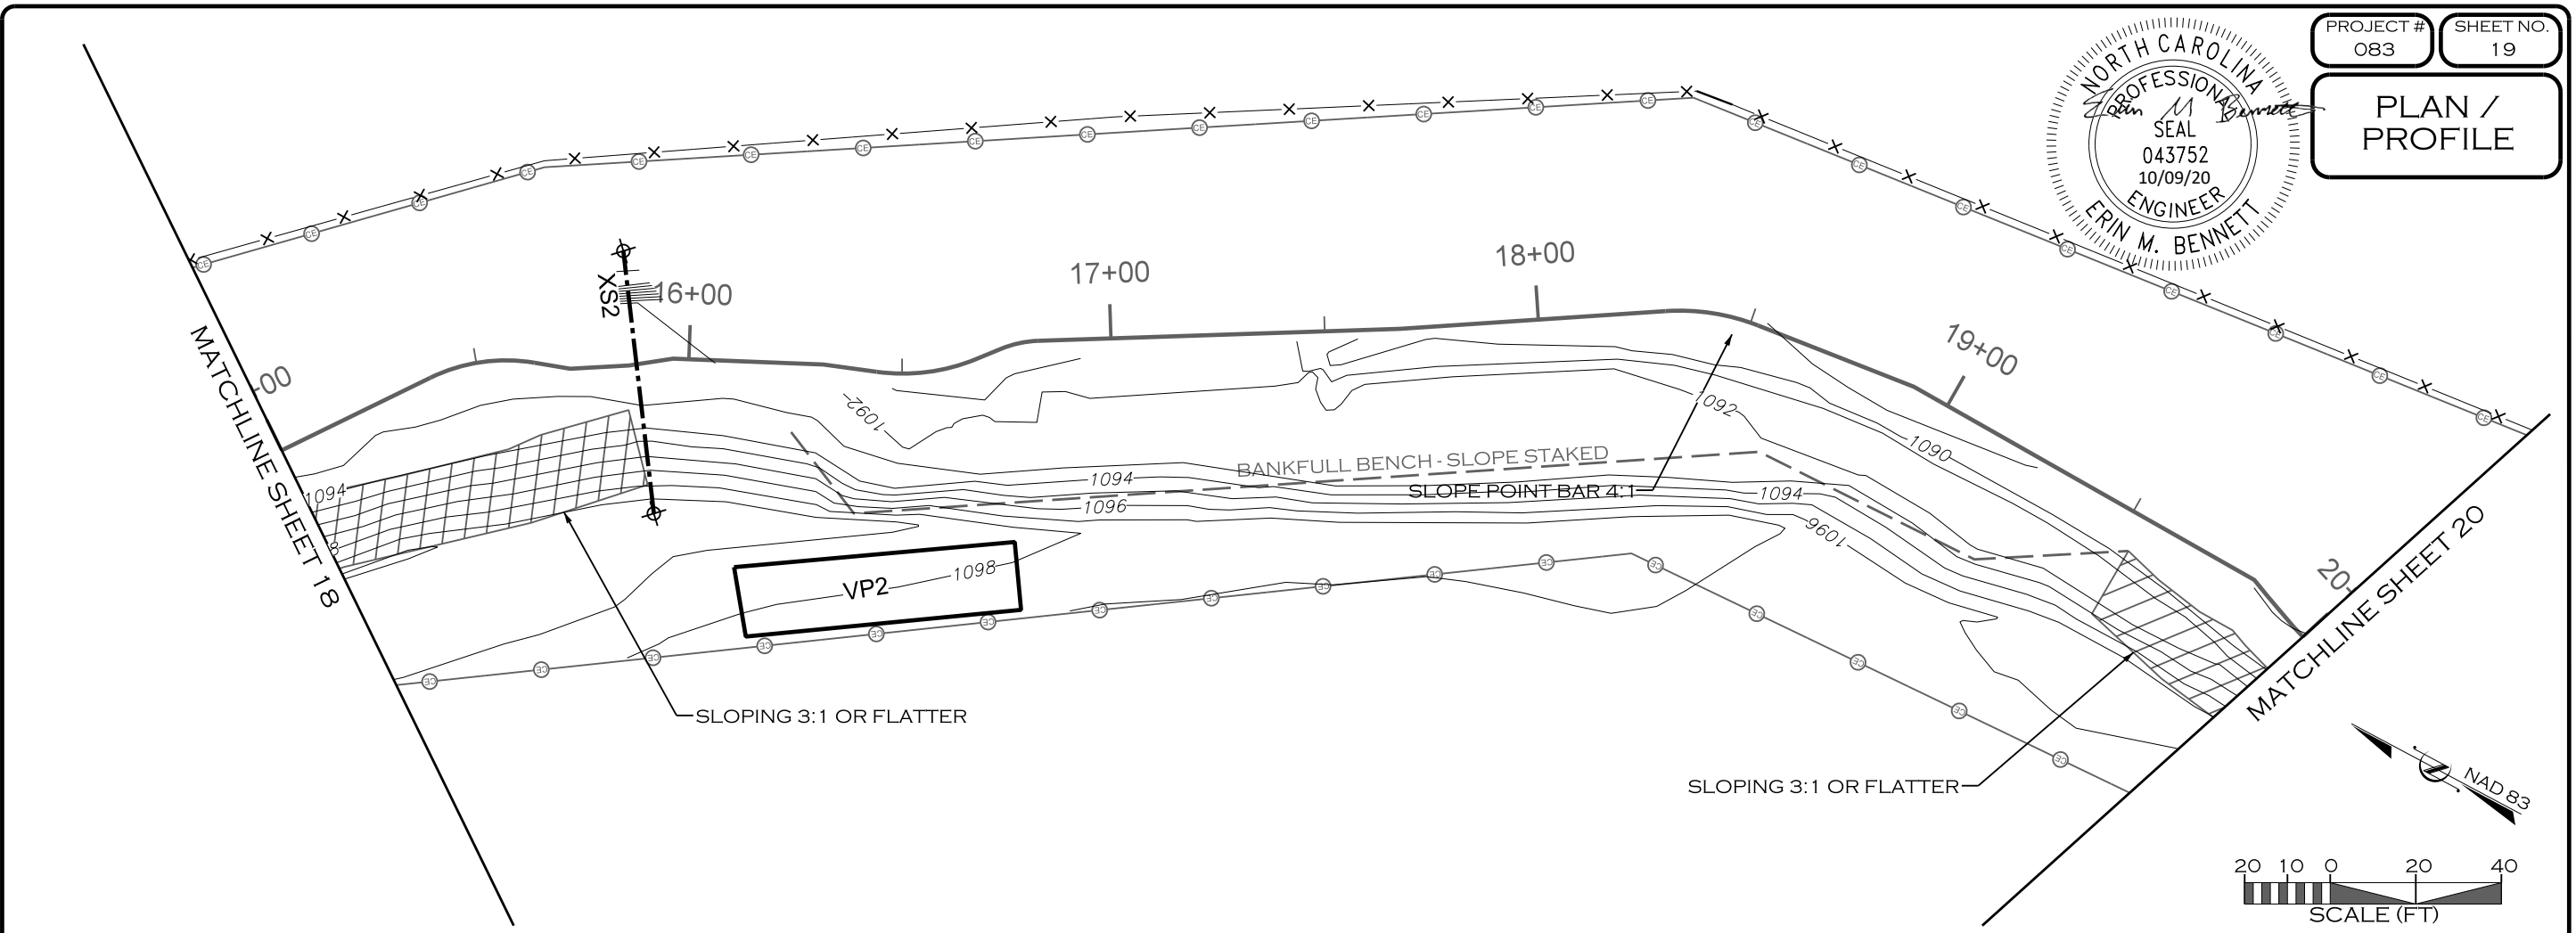

REVISIONS				
NO.	DESCRIPTION	ENGR.	APPROV.	DATE
1	RECORD DRAWINGS	EMB	KLT	10/9/20

PREPARED FOR:

NC DEPARTMENT OF ENVIRONMENTAL QUALITY  
DIVISION OF MITIGATION SERVICES  
1652 MAIL SERVICE CENTER  
RALEIGH, NC 27699-1652

STEWARTS CREEK TRIBUTARIES PROJECT  
SURRY COUNTY, NC


PREPARED IN THE OFFICE OF:

ECOSYSTEM PLANNING & RESTORATION  
1150 SE MAYNARD RD, SUITE 140  
CARY, NC 27511  
LICENSE # P-1182


PROJECT ENGINEER

10/8/2020 R:\PROJECTS\RD\0083\_NCDEQ\_STEWARTS CREEK\_FD\CADD\PLANS\AS-BUILT\MF\_ASB\_PSH\_19.DGN



PLAN / PROFILE

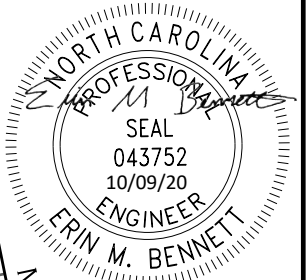

NAD 83

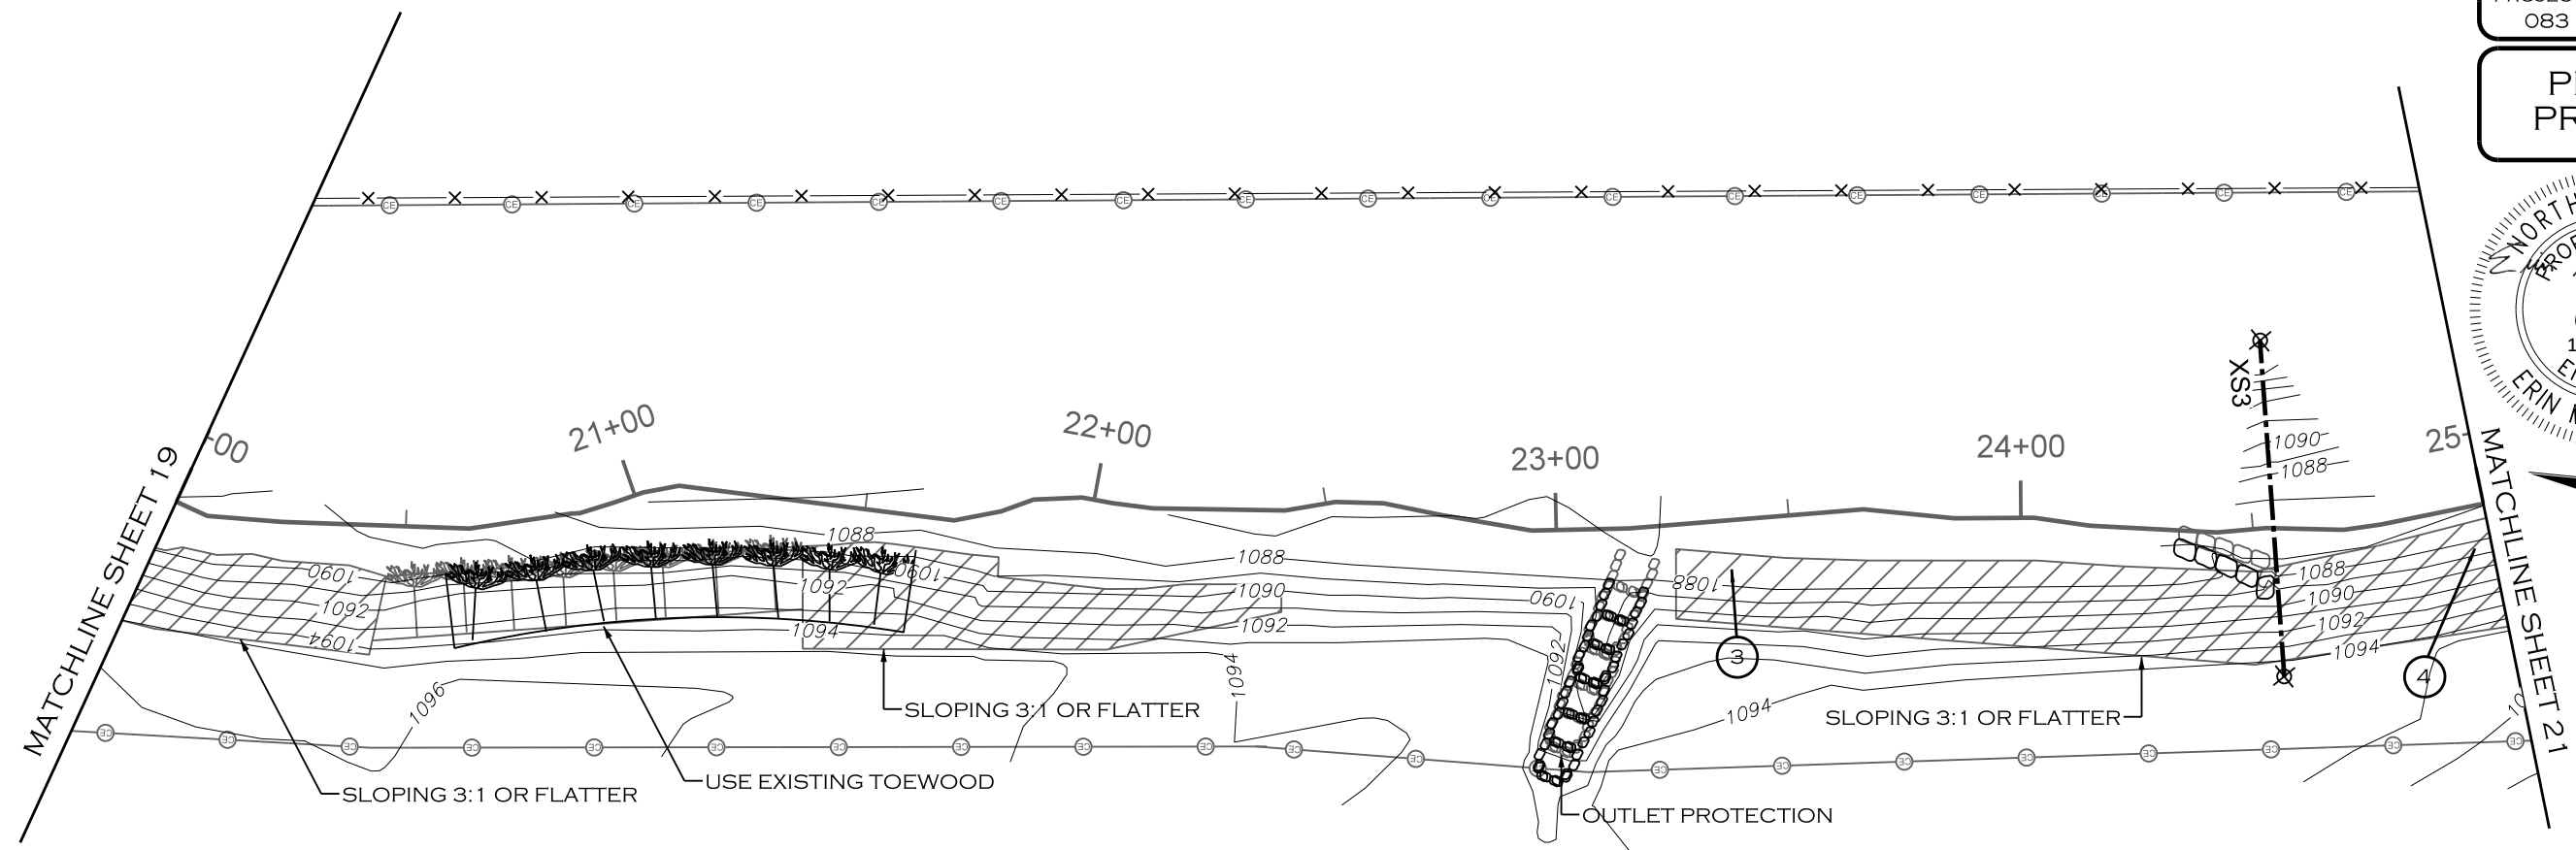

NOTE:  
1. POOL DEPTHS MAY VARY DUE TO BEDROCK.

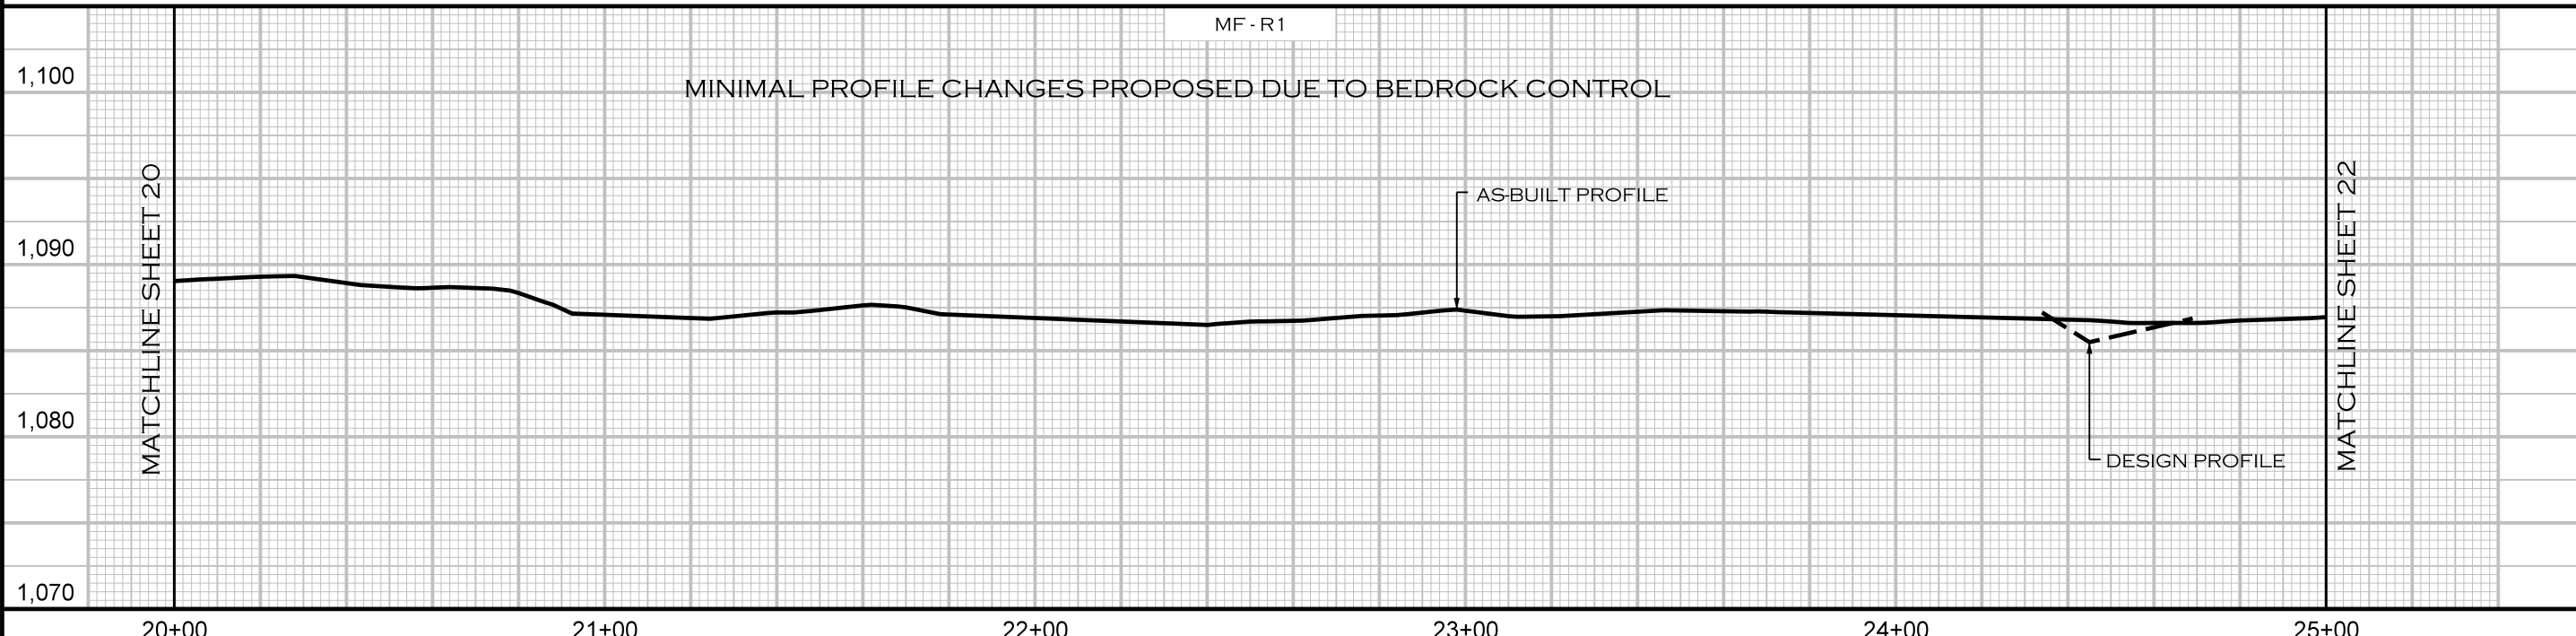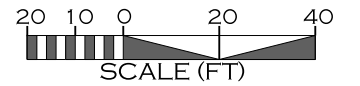

10/8/2020 R:\PROJECTS\RD\0083\_NCDEQ\_STEWARTS CREEK\_FD\CADD\PLANS\AS-BUILT\MF\_ASB\_PSH\_20.DGN

REVISIONS				
NO.	DESCRIPTION	ENGR.	APPROV.	DATE
1	RECORD DRAWINGS	EMB	KLT	10/9/20

PREPARED FOR:





NC DEPARTMENT OF ENVIRONMENTAL QUALITY  
DIVISION OF MITIGATION SERVICES  
1652 MAIL SERVICE CENTER  
RALEIGH, NC 27699-1652

STEWARTS CREEK TRIBUTARIES PROJECT  
SURRY COUNTY, NC

PREPARED IN THE OFFICE OF:

ECOSYSTEM PLANNING & RESTORATION  
1150 SE MAYNARD RD, SUITE 140  
CARY, NC 27511  
LICENSE # P-1182

PROJECT ENGINEER

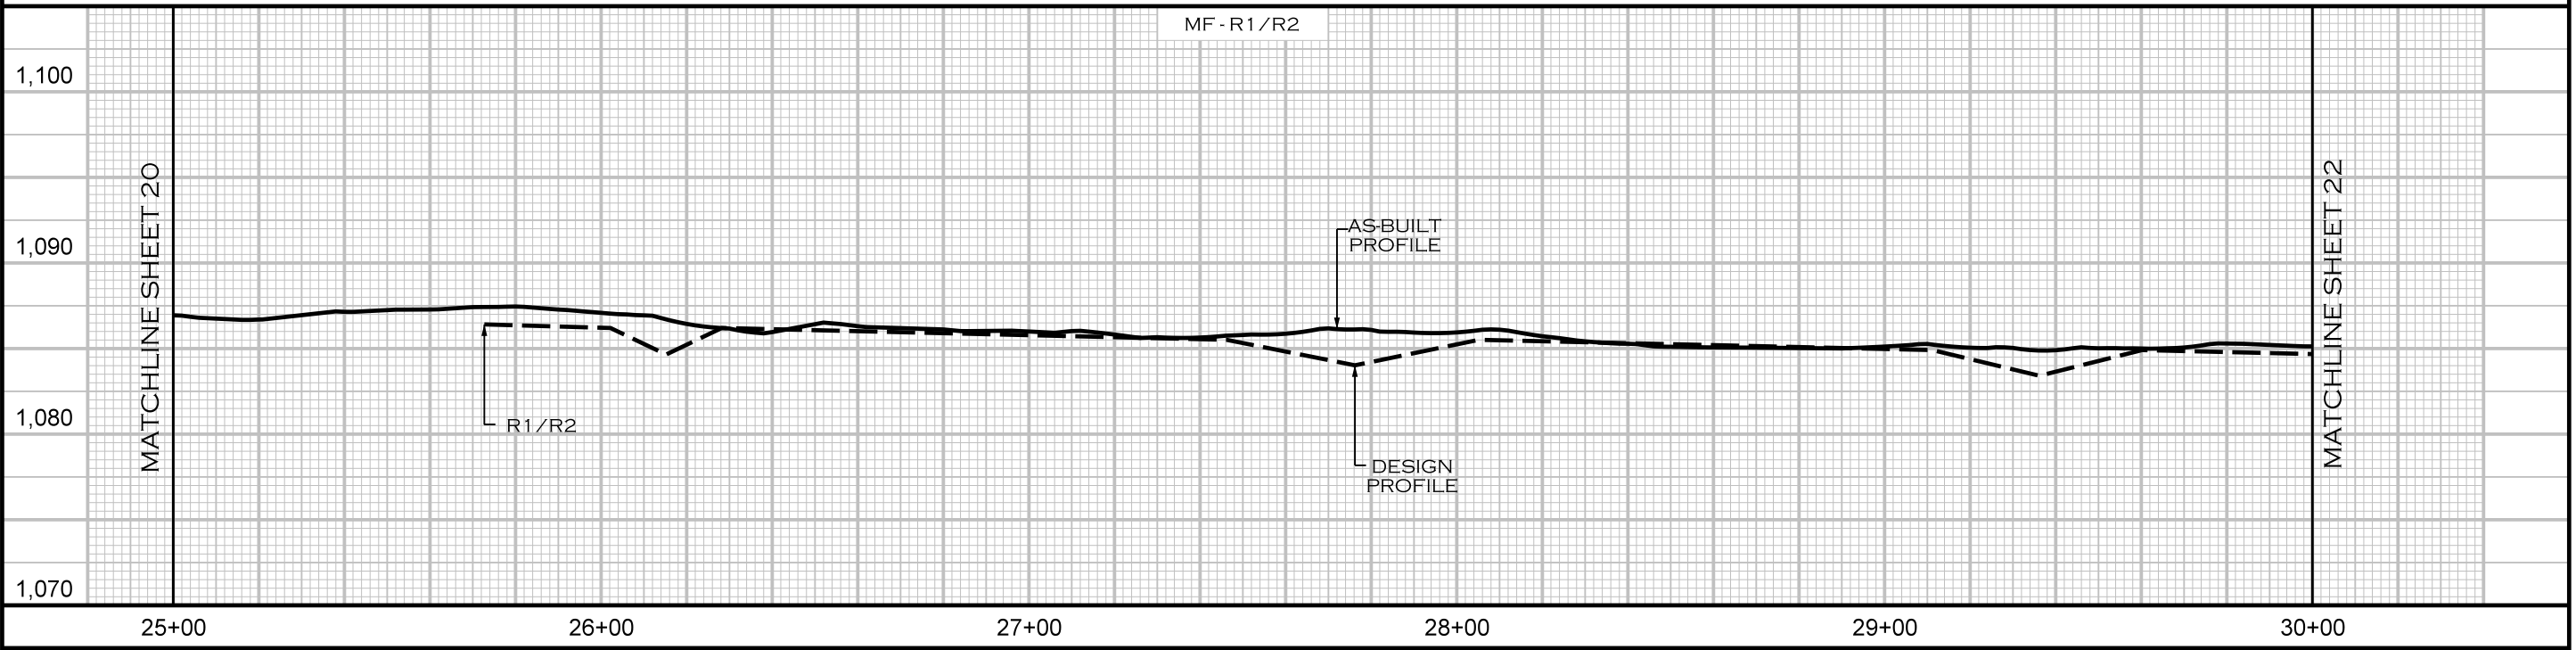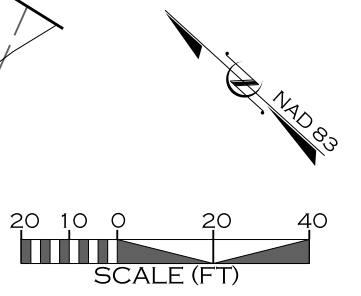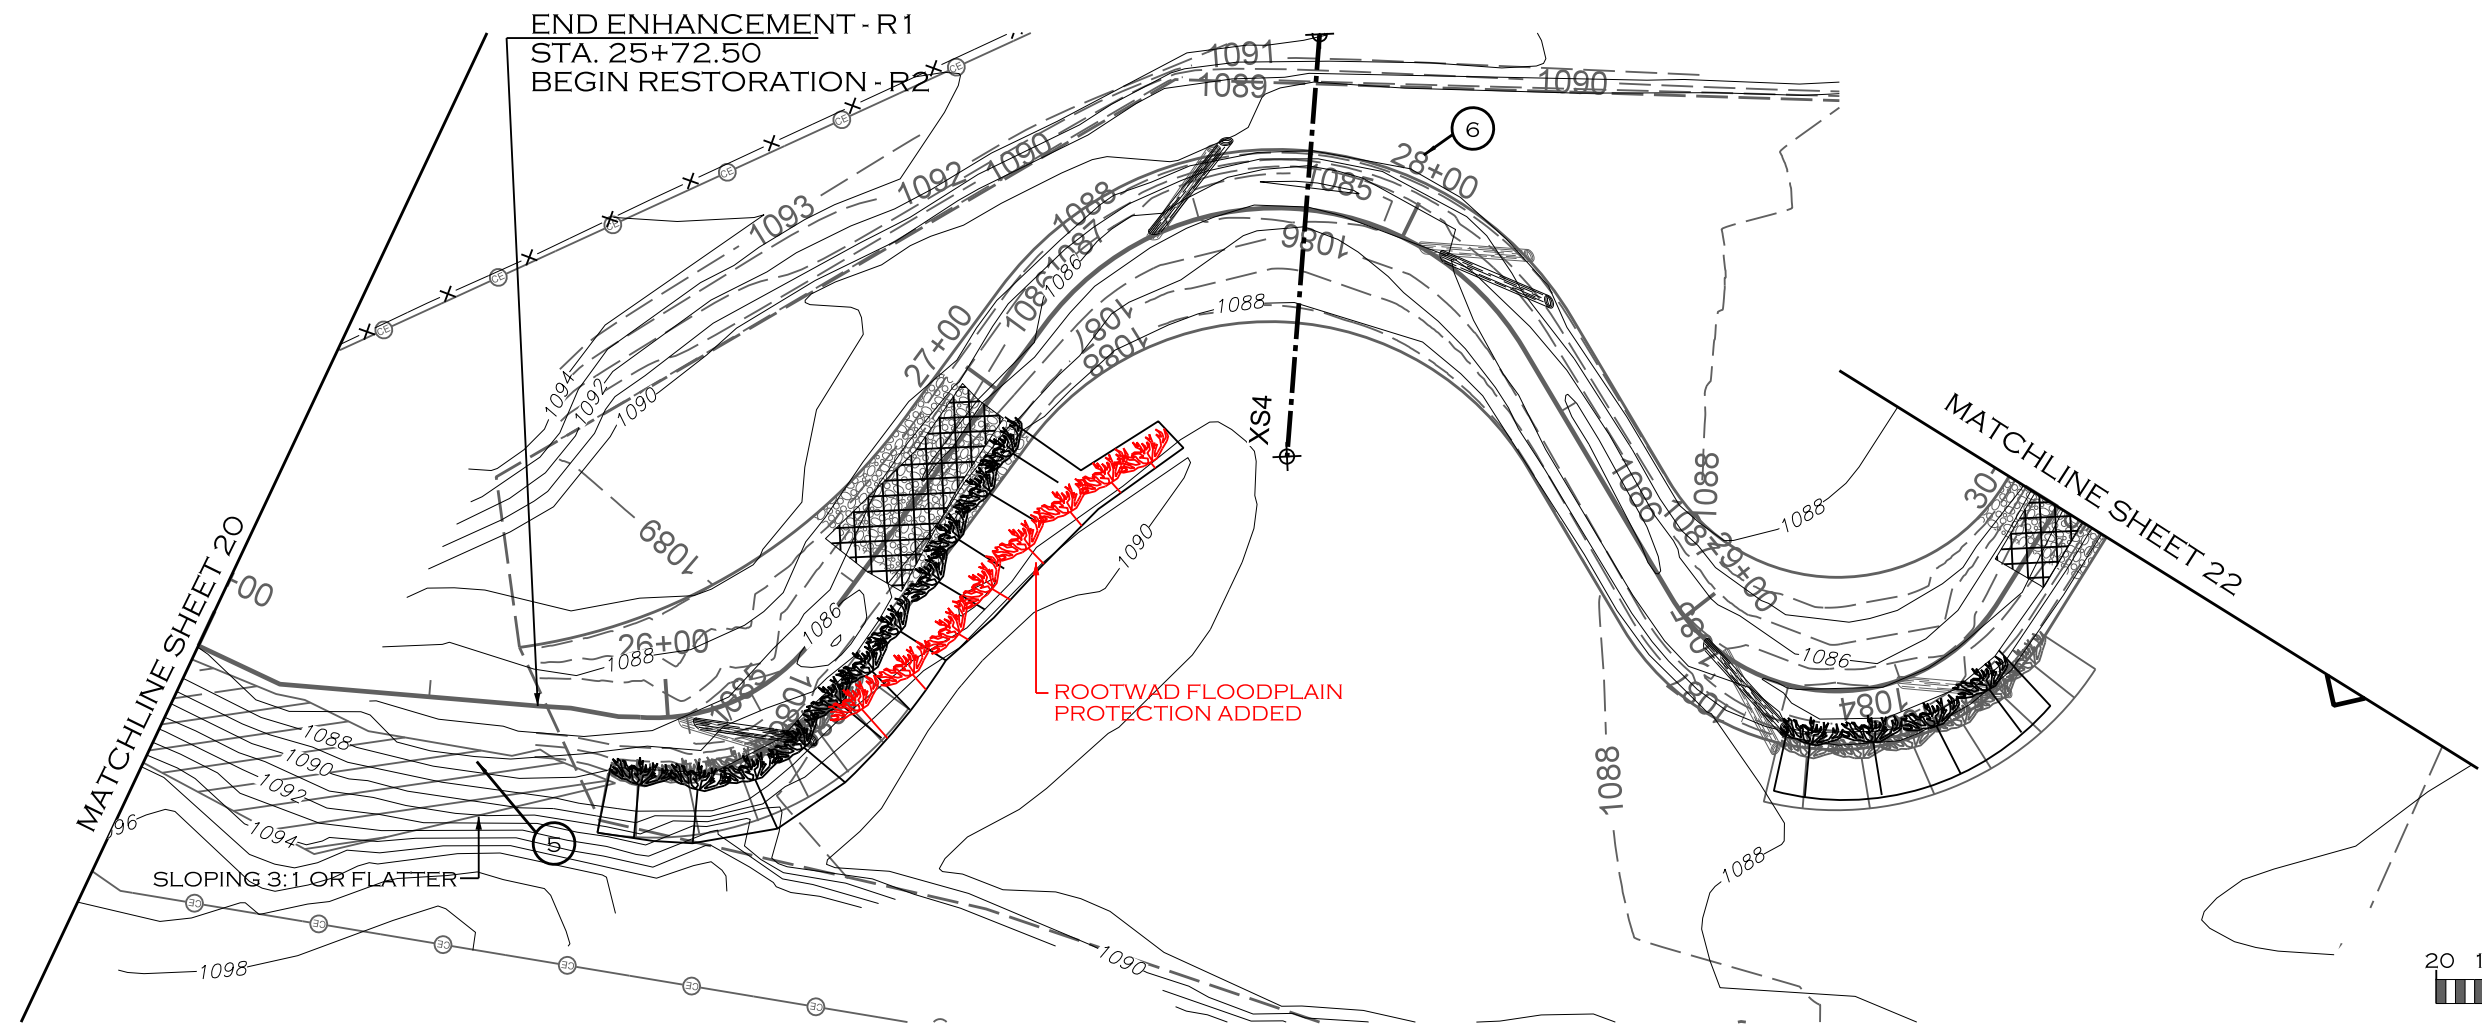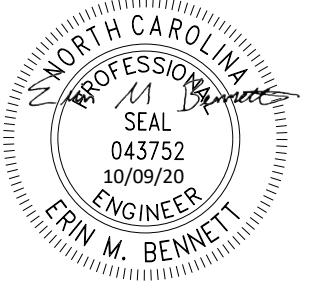

10/9/2020 R:\PROJECTS\RD\0083\_NCDEQ\_STEWARTS CREEK\_FD\CADD\PLANS\AS-BUILT\MF\_ASB\_PSH\_21.DGN

REVISIONS				
NO.	DESCRIPTION	ENGR.	APPROV.	DATE
1	RECORD DRAWINGS	EMB	KLT	10/9/20

PREPARED FOR:




NC DEPARTMENT OF ENVIRONMENTAL QUALITY  
DIVISION OF MITIGATION SERVICES  
1652 MAIL SERVICE CENTER  
RALEIGH, NC 27699-1652

STEWARTS CREEK TRIBUTARIES PROJECT  
SURRY COUNTY, NC

PREPARED IN THE OFFICE OF:

ECOSYSTEM PLANNING & RESTORATION  
1150 SE MAYNARD RD, SUITE 140  
CARY, NC 27511  
LICENSE # P-1182

PROJECT ENGINEER

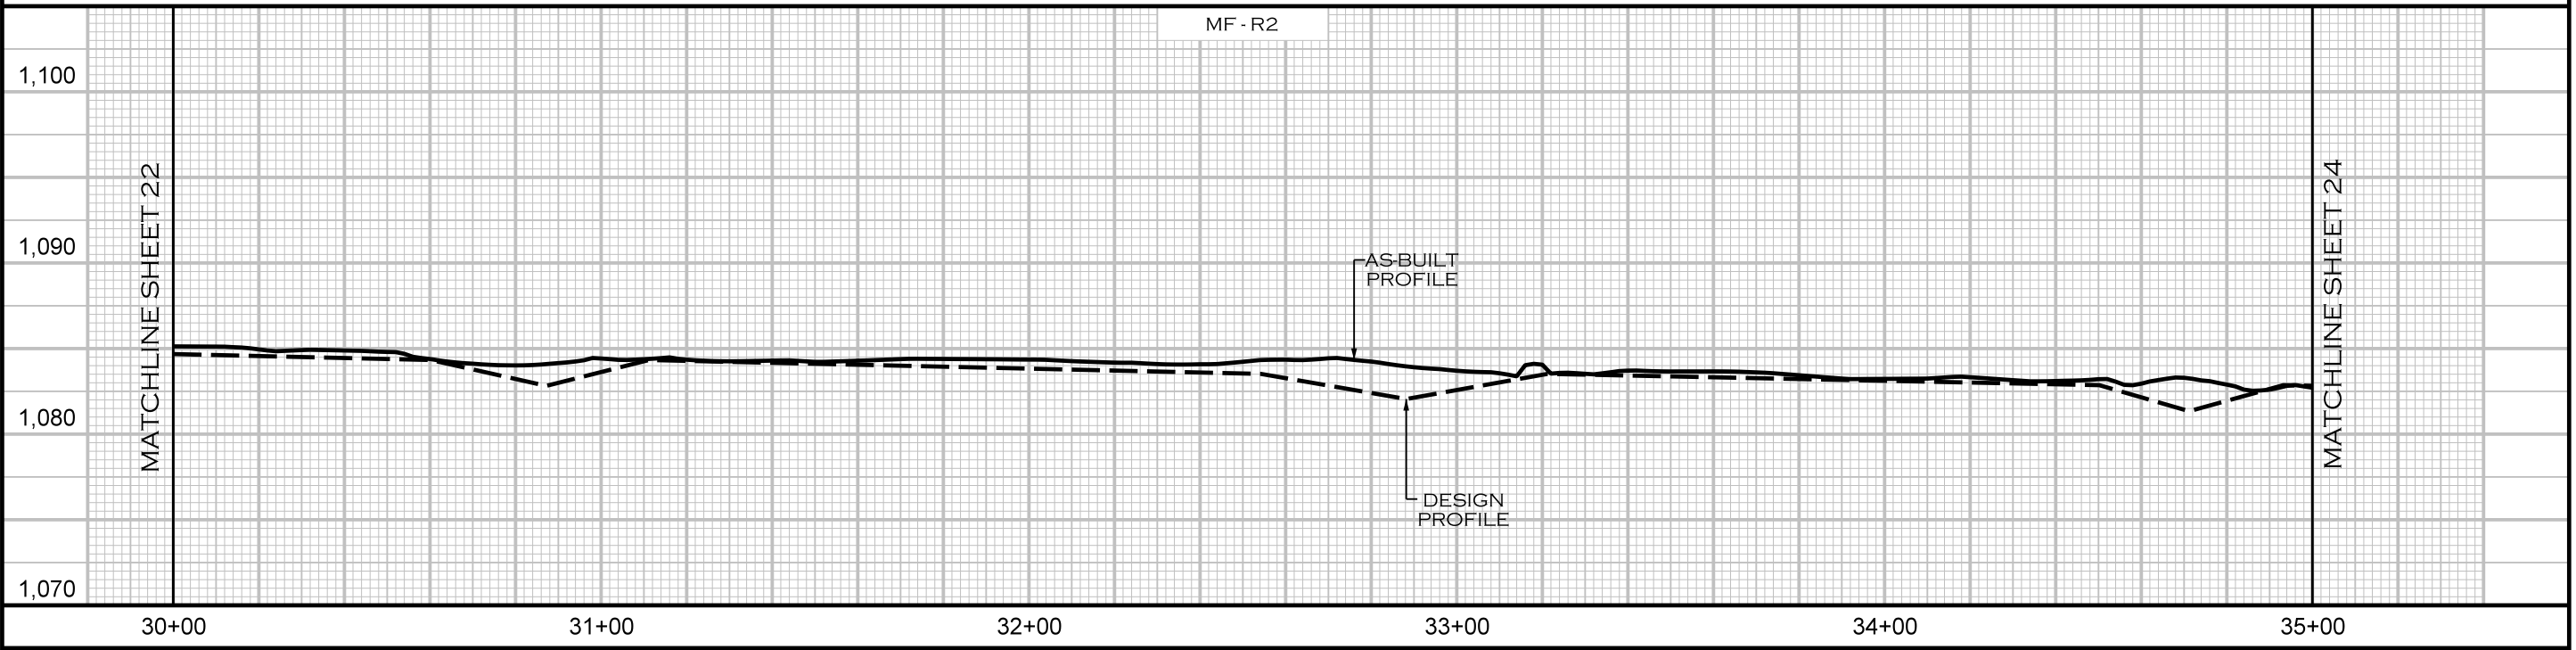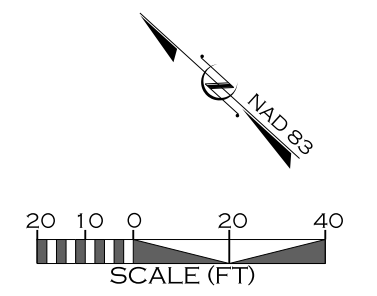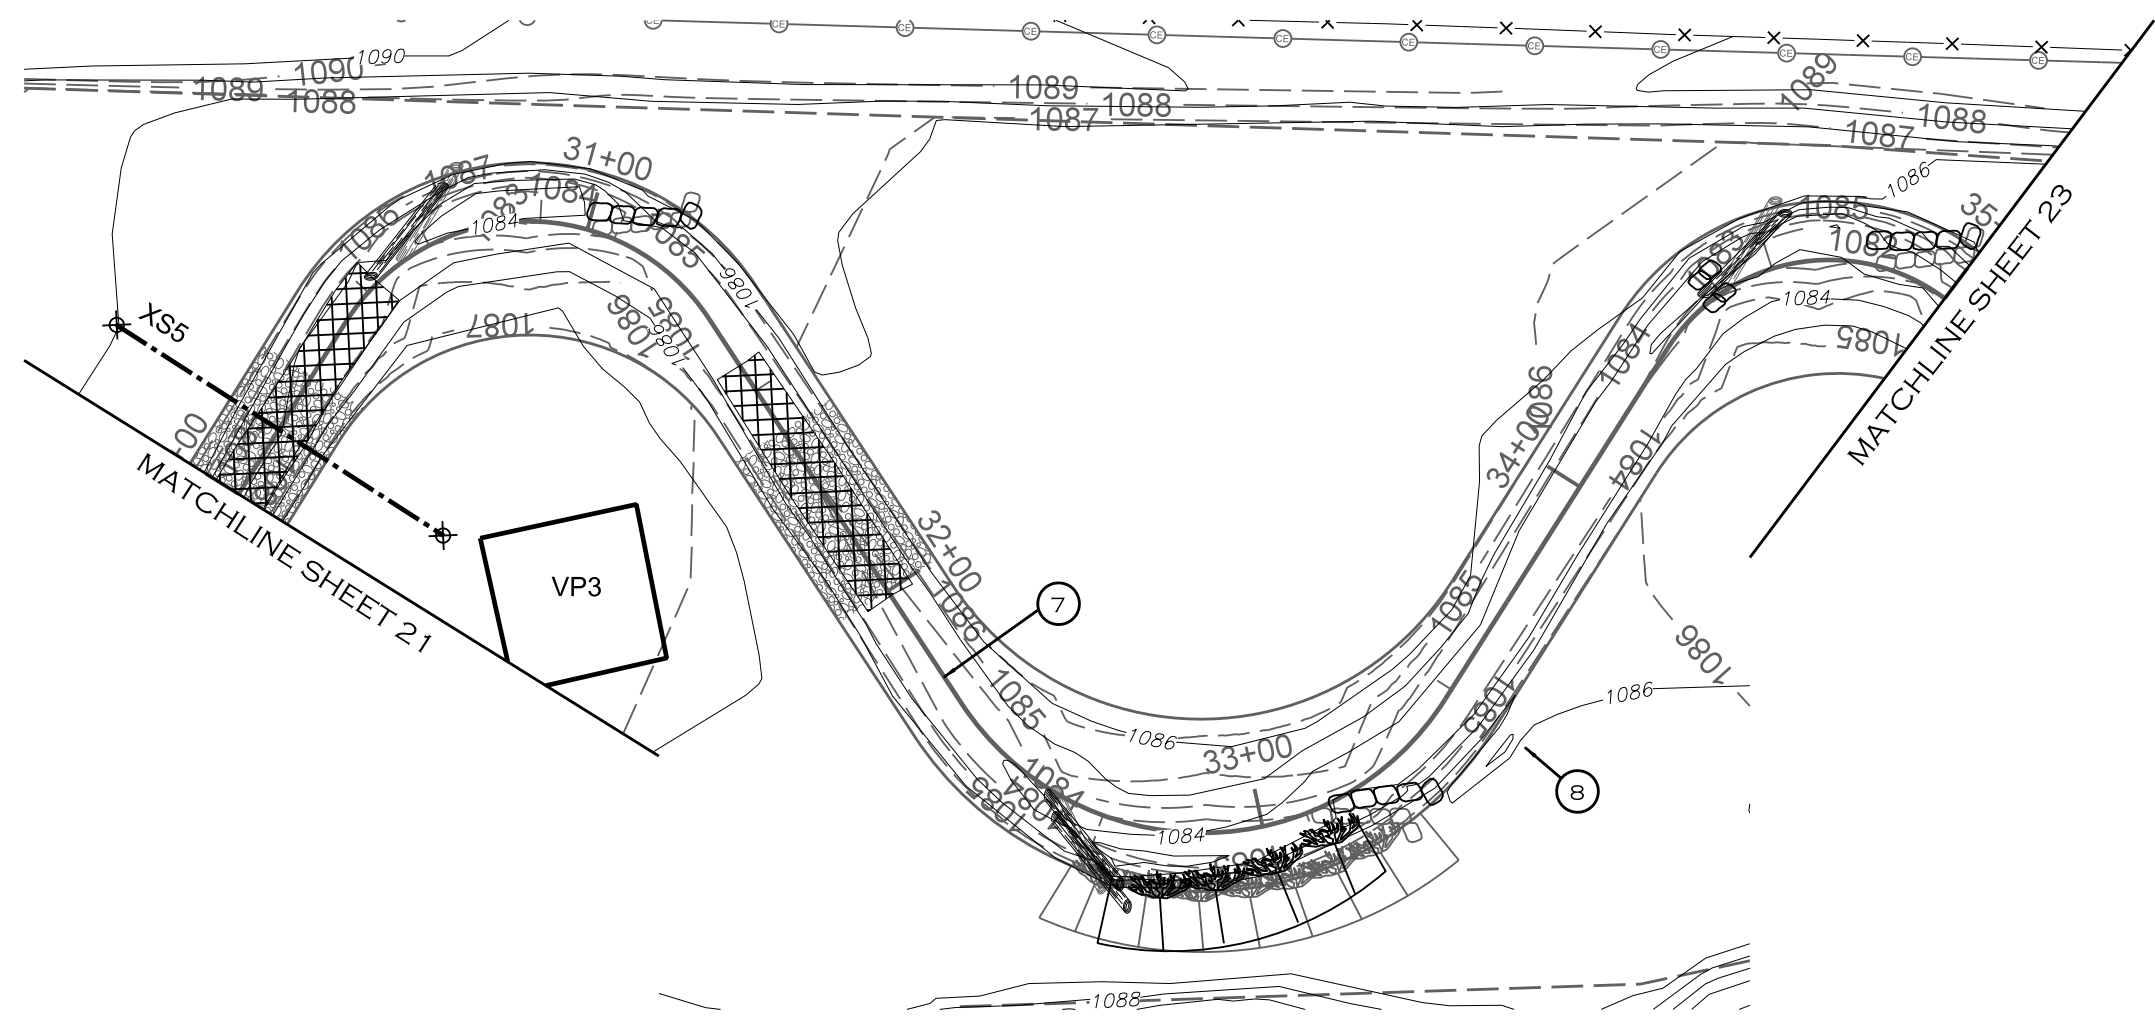

10/8/2020 R:\PROJECTS\RD\0083\_NCDEQ\_STEWARTS CREEK\_FD\CADD\PLANS\AS-BUILT\MF\_ASB\_PSH\_22.DGN

REVISIONS				
NO.	DESCRIPTION	ENGR.	APPROV.	DATE
1	RECORD DRAWINGS	EMB	KLT	10/9/20

PREPARED FOR:




NC DEPARTMENT OF ENVIRONMENTAL QUALITY  
DIVISION OF MITIGATION SERVICES  
1652 MAIL SERVICE CENTER  
RALEIGH, NC 27699-1652

STEWARTS CREEK TRIBUTARIES PROJECT  
SURRY COUNTY, NC

PREPARED IN THE OFFICE OF:

ECOSYSTEM PLANNING & RESTORATION  
1150 SE MAYNARD RD, SUITE 140  
CARY, NC 27511  
LICENSE # P-1182

PROJECT ENGINEER

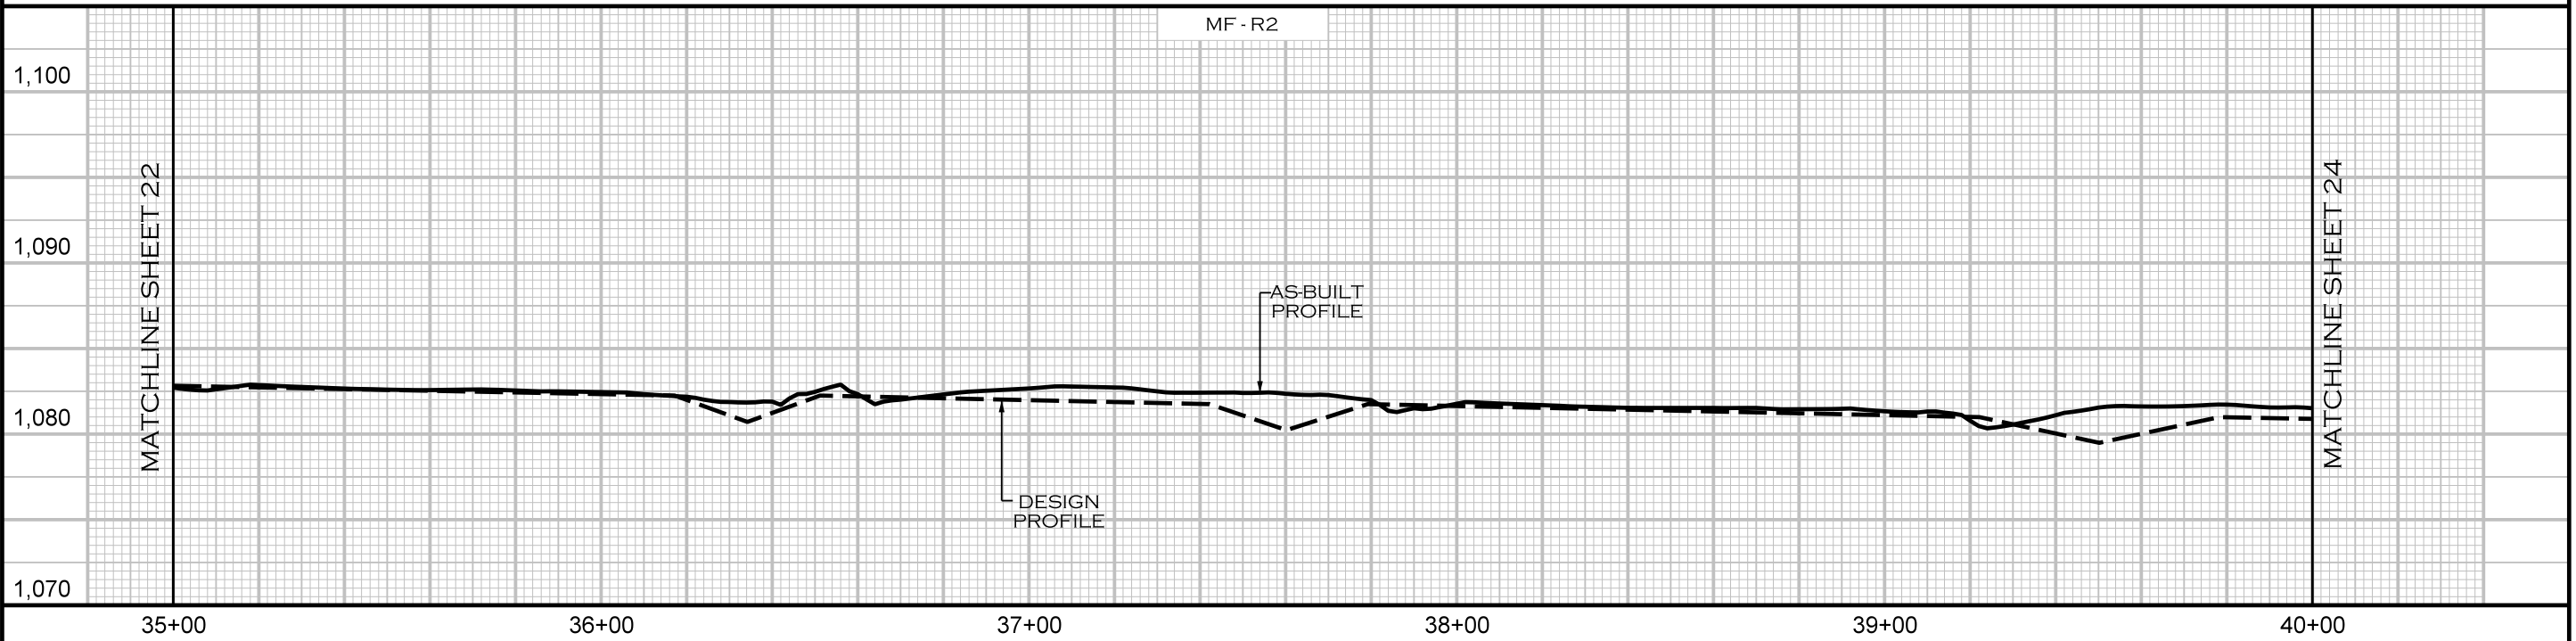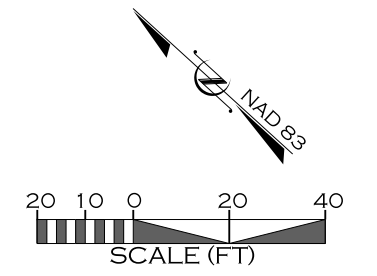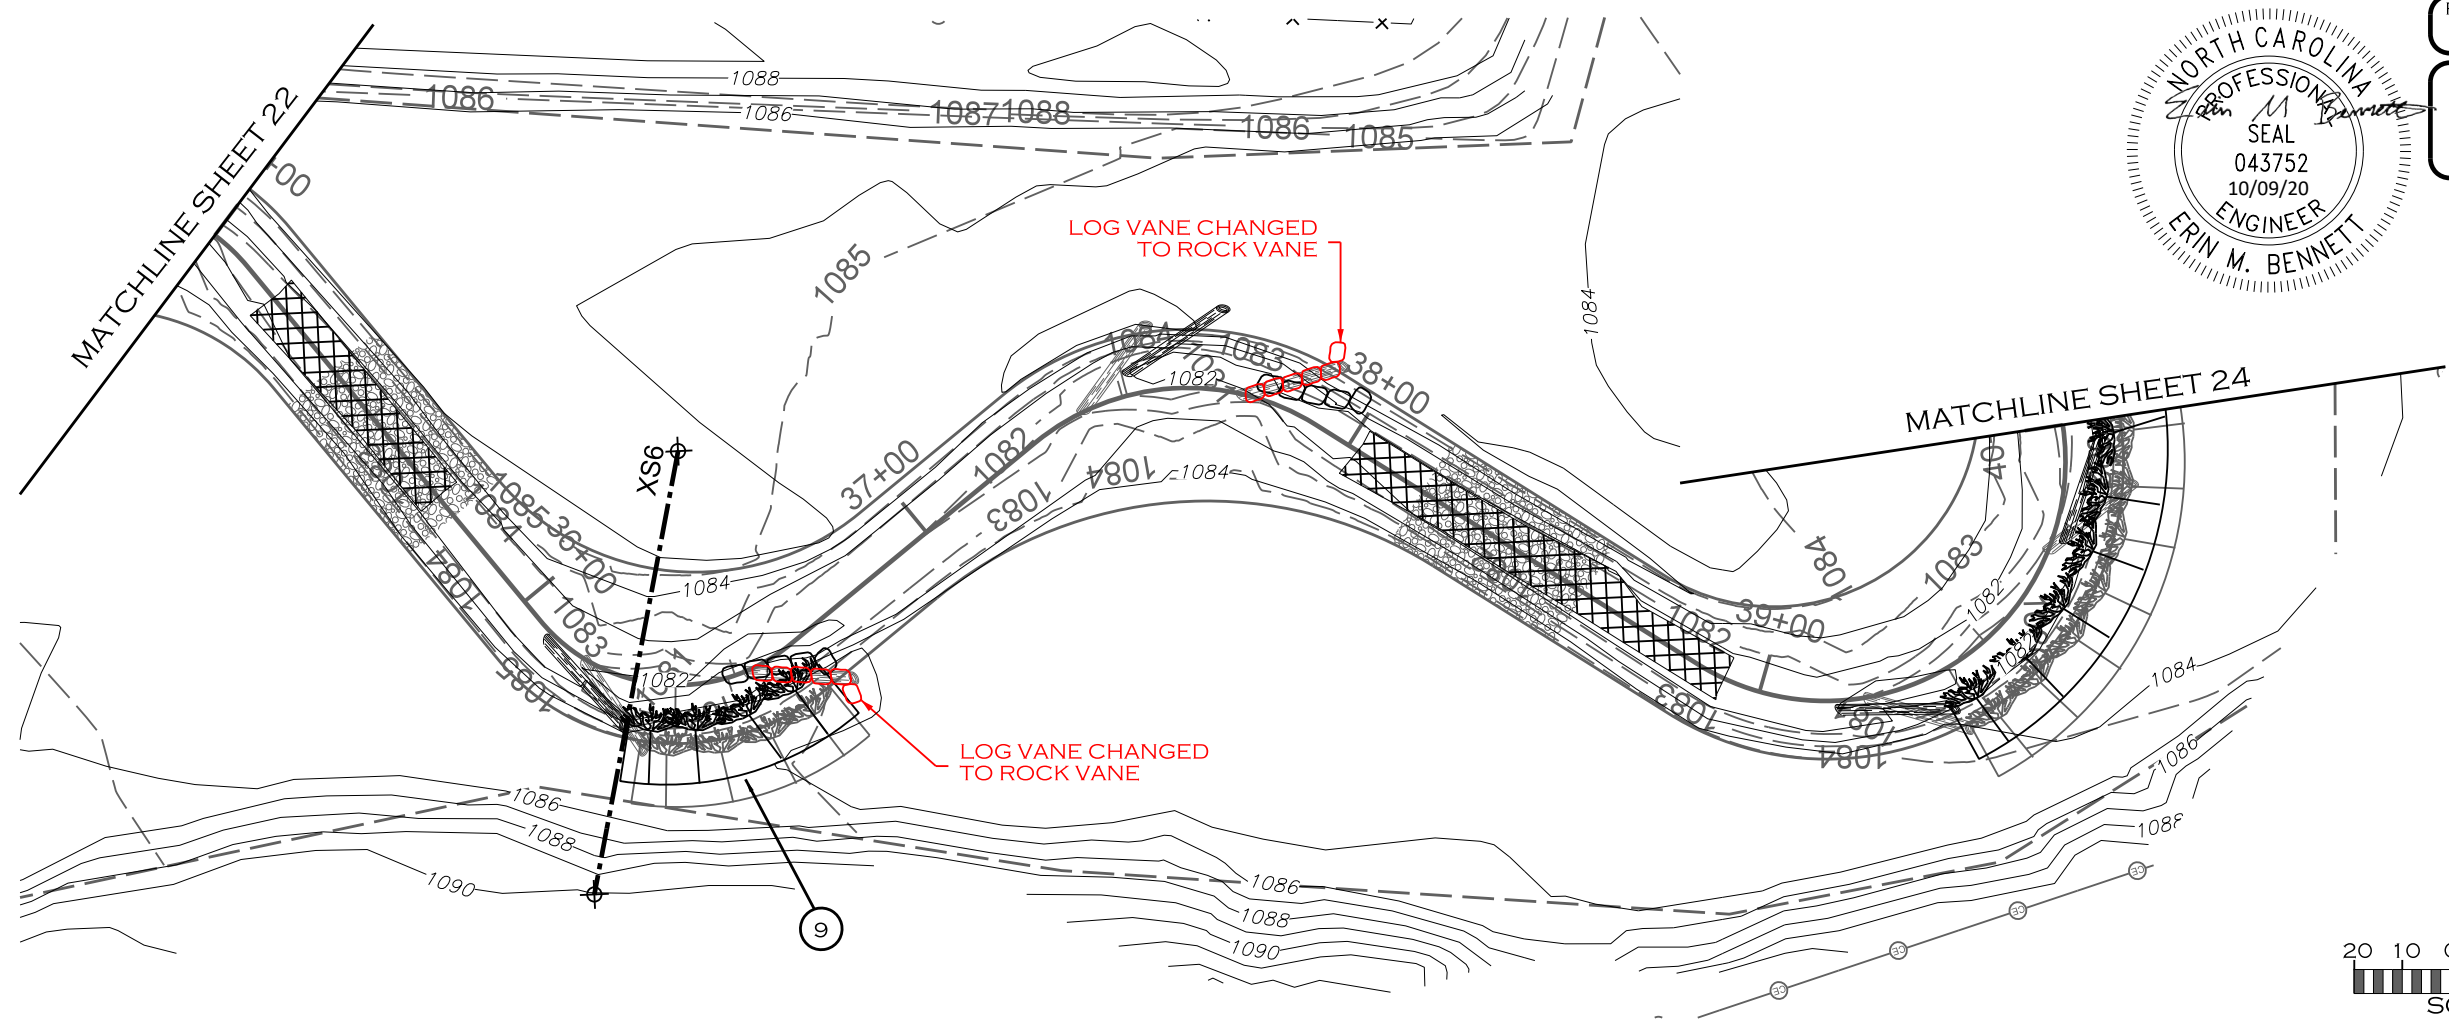

10/8/2020 R:\PROJECTS\RD\0083\_NCDEQ\_STEWARTS CREEK\_FD\CADD\PLANS\AS-BUILT\MF\_ASB\_PSH\_23.DGN

REVISIONS				
NO.	DESCRIPTION	ENGR.	APPROV.	DATE
1	RECORD DRAWINGS	EMB	KLT	10/9/20

PREPARED FOR:

NC DEPARTMENT OF ENVIRONMENTAL QUALITY  
DIVISION OF MITIGATION SERVICES  
1652 MAIL SERVICE CENTER  
RALEIGH, NC 27699-1652





STEWARTS CREEK TRIBUTARIES PROJECT  
SURRY COUNTY, NC

PREPARED IN THE OFFICE OF:

1150 SE MAYNARD RD, SUITE 140  
CARY, NC 27511  
LICENSE # P-1182

PROJECT ENGINEER

PLAN / PROFILE

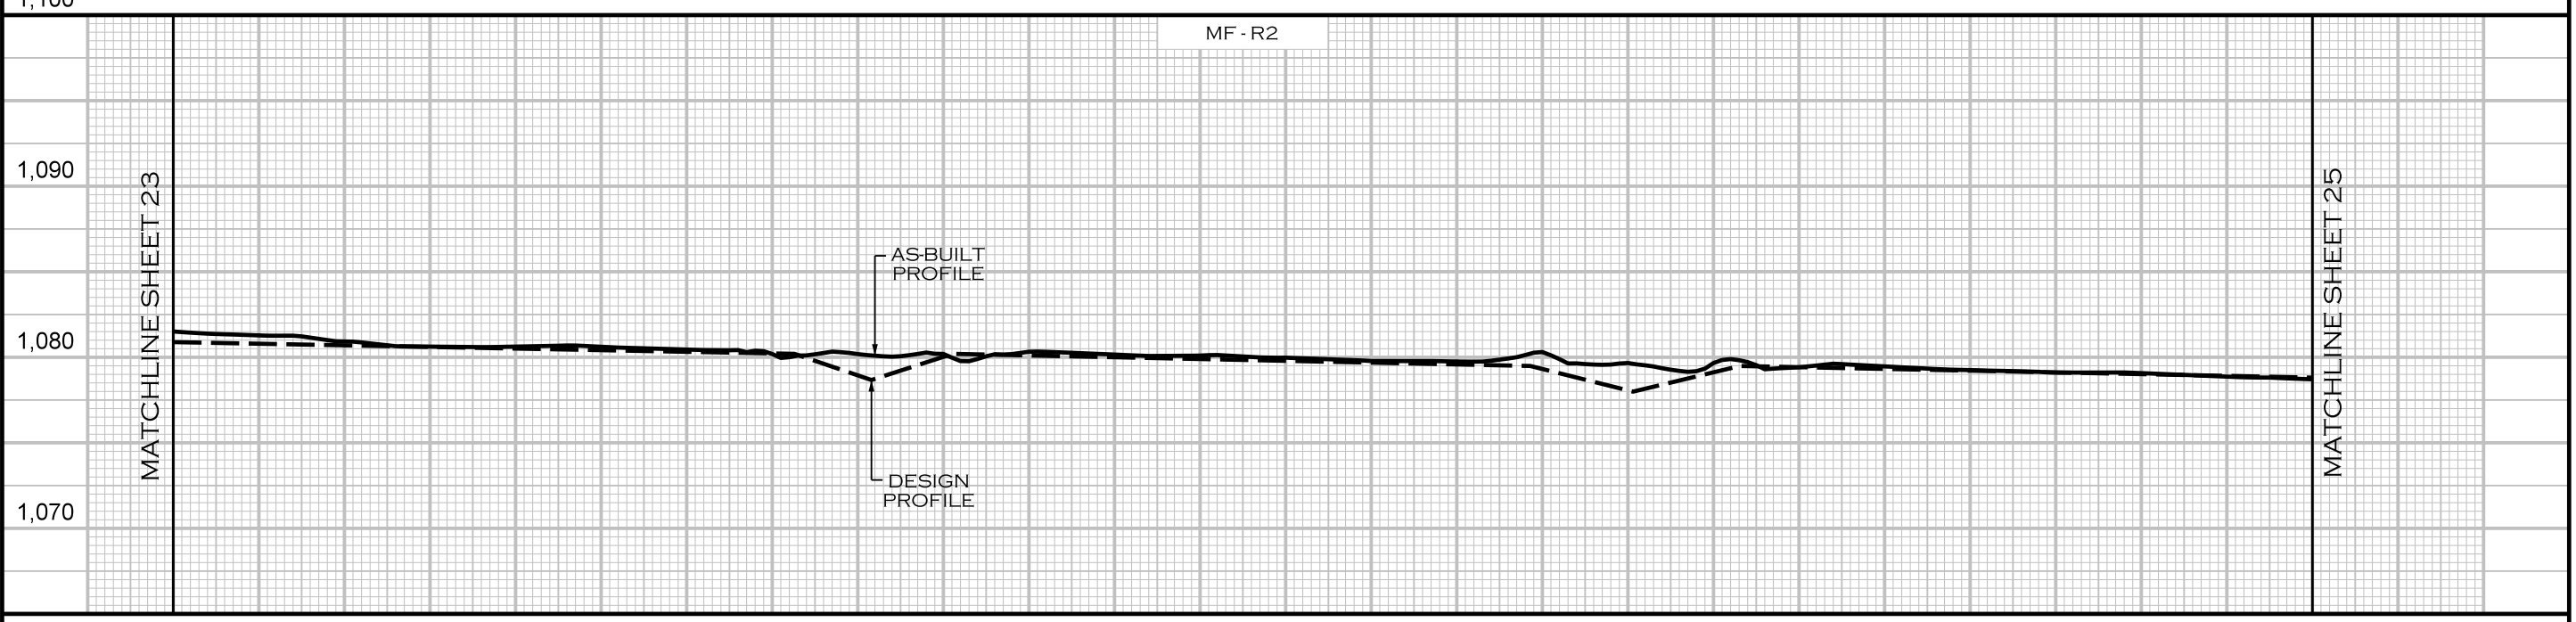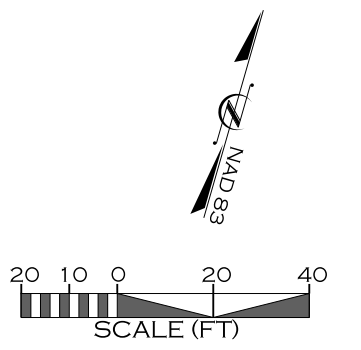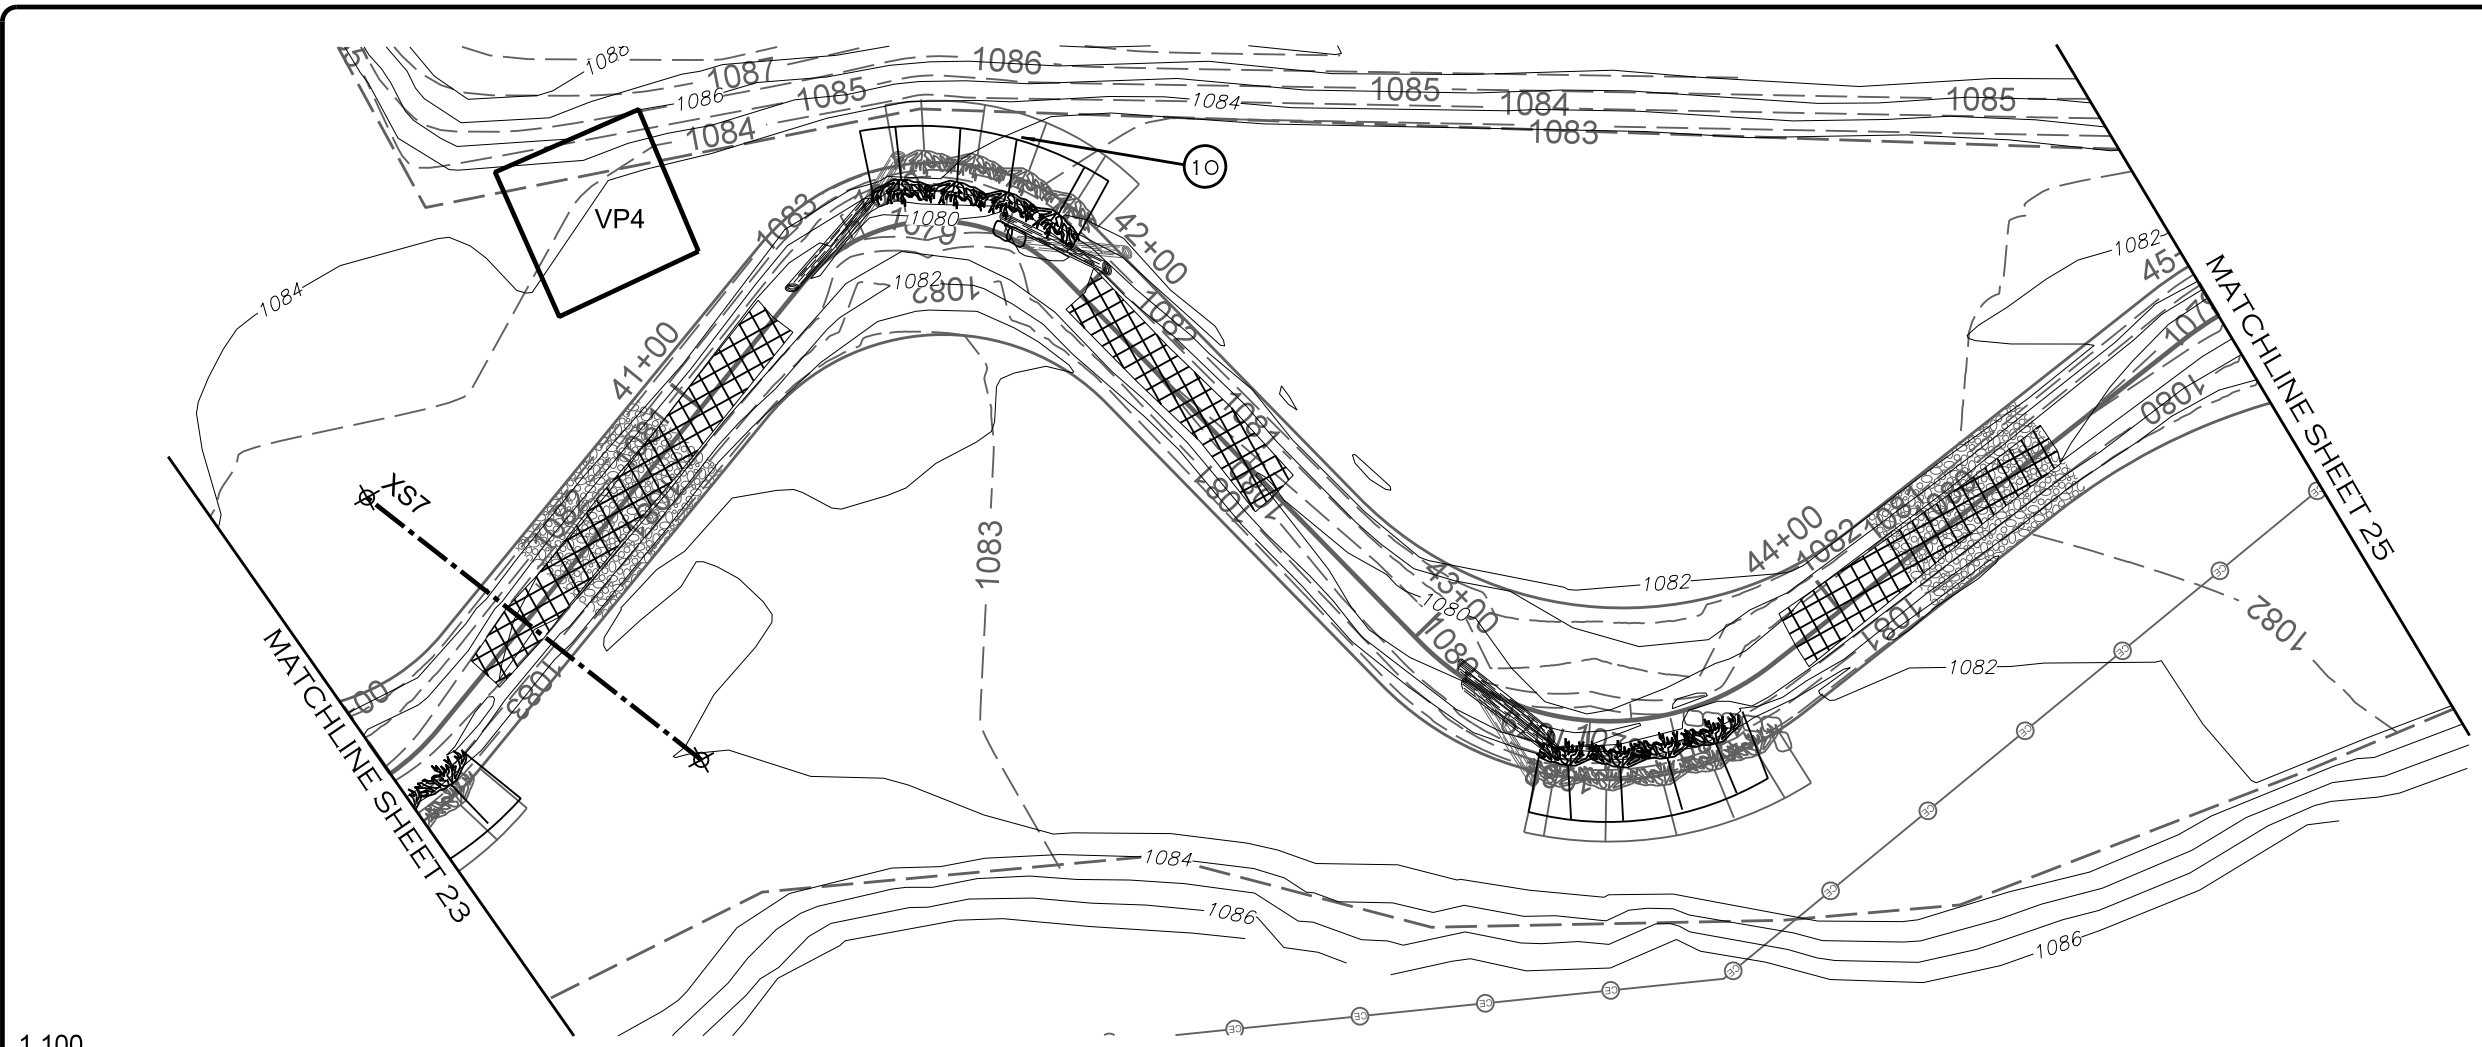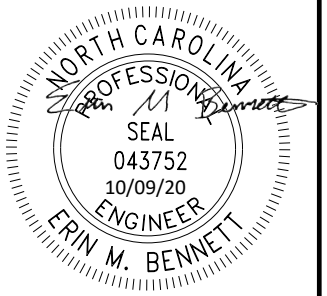

40+00 41+00 42+00 43+00 44+00 45+00

REVISIONS				
NO.	DESCRIPTION	ENGR.	APPROV.	DATE
1	RECORD DRAWINGS	EMB	KLT	10/9/20

PREPARED FOR:

NC DEPARTMENT OF ENVIRONMENTAL QUALITY  
DIVISION OF MITIGATION SERVICES  
1652 MAIL SERVICE CENTER  
RALEIGH, NC 27699-1652

STEWARTS CREEK TRIBUTARIES PROJECT  
SURRY COUNTY, NC

PREPARED IN THE OFFICE OF:

1150 SE MAYNARD RD, SUITE 140  
CARY, NC 27511  
LICENSE # P-1182



PROJECT ENGINEER

10/8/2020 R:\PROJECTS\RD\0083\_NCDEQ\_STEWARTS CREEK\_FD\CADD\PLANS\AS-BUILT\MF\_ASB\_PSH\_24.DGN







PLAN / PROFILE

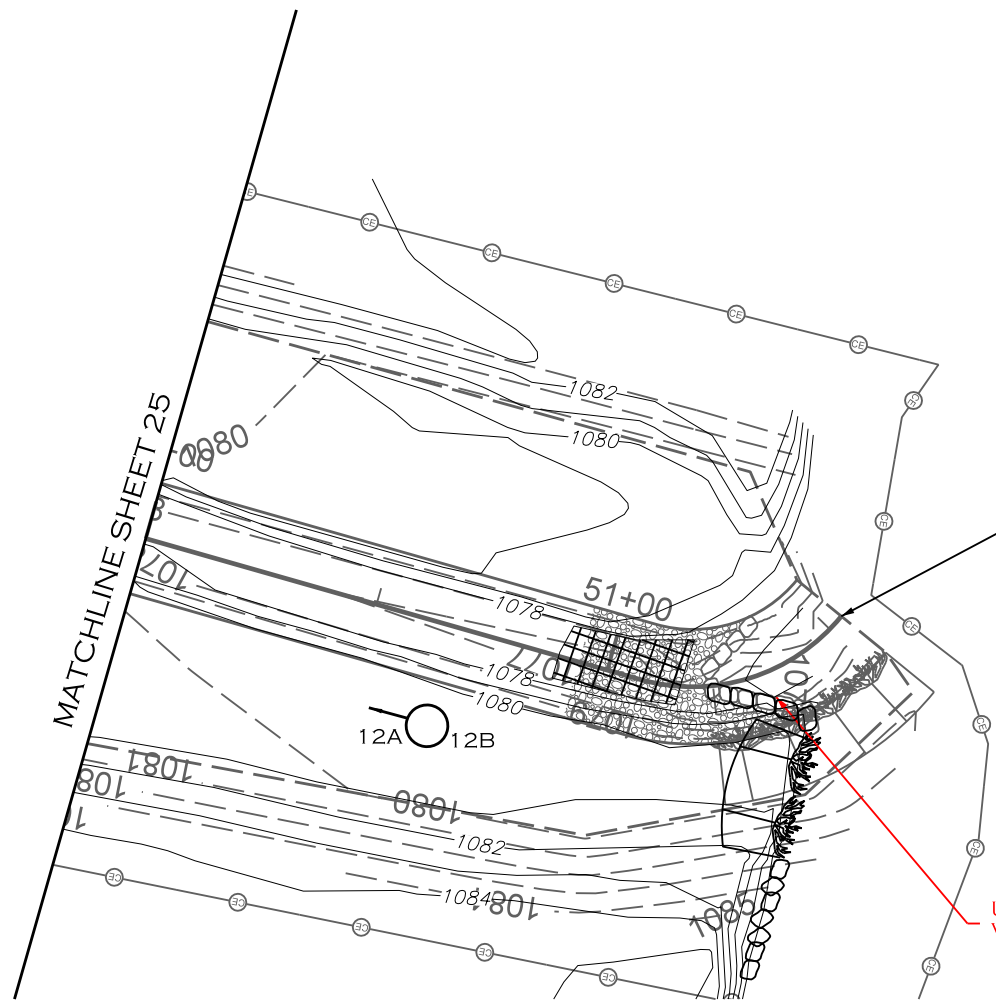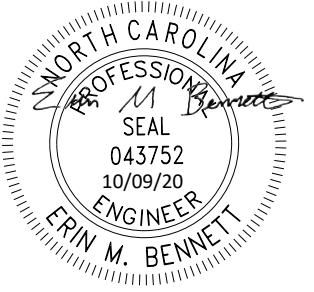

END RESTORATION  
STA. 51+53.62

UPDATED TO A ROCK  
VANE WITH TOEWOOD

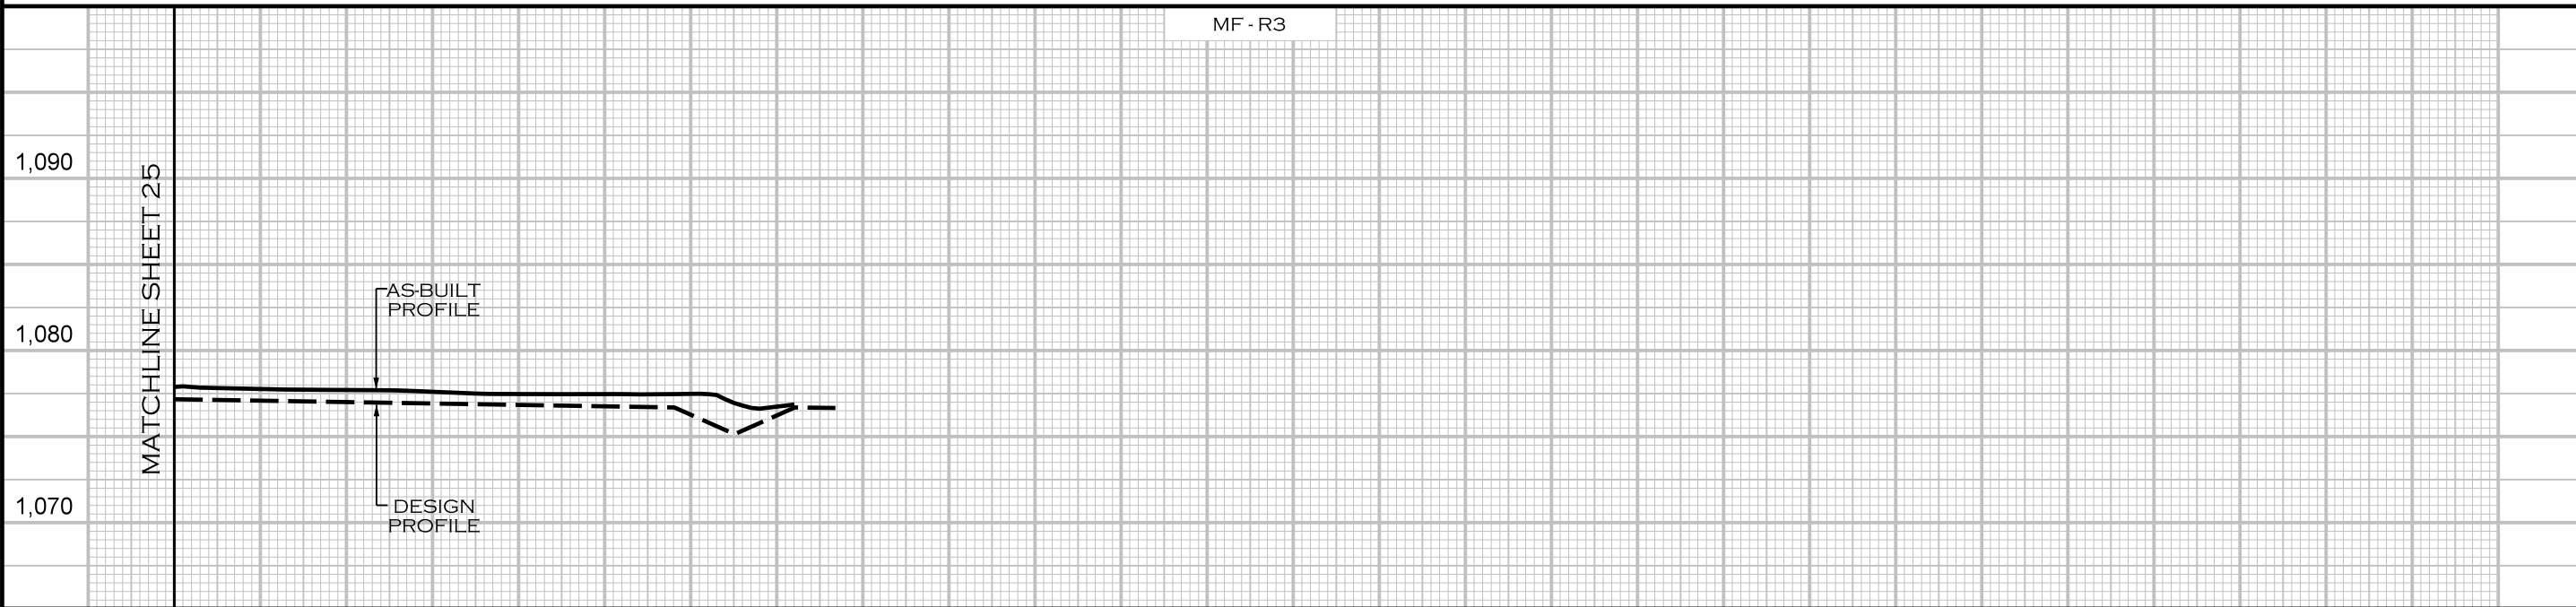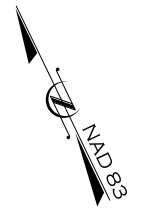

MATCHLINE SHEET 25

AS-BUILT  
PROFILE  
  
DESIGN  
PROFILE

50+00

51+00

52+00

10/8/2020 R:\PROJECTS\RD\0083\_NCDEQ\_STEWARTS CREEK\_FD\CADD\PLANS\AS-BUILT\MF\_ASB\_PSH\_26.DGN

REVISIONS				
NO.	DESCRIPTION	ENGR.	APPROV.	DATE
1	RECORD DRAWINGS	EMB	KLT	10/9/20

PREPARED FOR:

NC DEPARTMENT OF ENVIRONMENTAL QUALITY  
DIVISION OF MITIGATION SERVICES  
1652 MAIL SERVICE CENTER  
RALEIGH, NC 27699-1652


STEWARTS CREEK TRIBUTARIES PROJECT  
SURRY COUNTY, NC

PREPARED IN THE OFFICE OF:





1150 SE MAYNARD RD, SUITE 140  
CARY, NC 27511  
LICENSE # P-1182


PROJECT ENGINEER

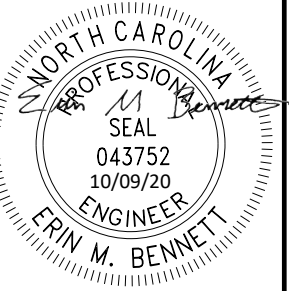VEGETATION AND FENCING PLAN



**NOTE:**  
ALL PLANTING WAS COMPLETED  
ACCORDING TO THE DESIGN AND  
THERE WERE NO DEVIATIONS FROM  
THE PLANTING PLAN.

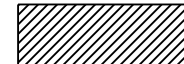-  ZONE 1 - STREAMBANKS
-  ZONE 2 - RIPARIAN BUFFER
-  ZONE 3 - UPLANDS
-  ZONE 4 - PERMANENT SEEDING - AREA OUTSIDE EASEMENT

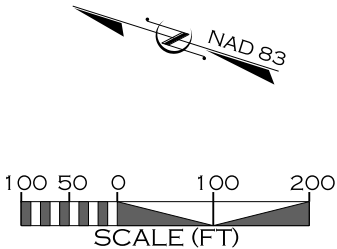

10/8/2020 R:\PROJECTS\RD\0083\_NCDEQ\_STEWARTS CREEK\FD\CADD\PLANS\ASB\BUILT\MF\_ASB\_PSH\_27.DGN

REVISIONS				
NO.	DESCRIPTION	ENGR.	APPROV.	DATE
1	RECORD DRAWINGS	EMB	KLT	10/9/20


PREPARED FOR:



NC DEPARTMENT OF ENVIRONMENTAL QUALITY  
DIVISION OF MITIGATION SERVICES  
1652 MAIL SERVICE CENTER  
RALEIGH, NC 27699-1652

STEWARTS CREEK TRIBUTARIES PROJECT  
SURRY COUNTY, NC

PREPARED IN THE OFFICE OF:







**ECOSYSTEM  
PLANNING &  
RESTORATION**

1150 SE MAYNARD RD, SUITE 140  
CARY, NC 27511  
LICENSE # P-1182

PROJECT ENGINEER


VEGETATION AND FENCING PLAN

NOTE:  
ALL PLANTING WAS COMPLETED  
ACCORDING TO THE DESIGN AND  
THERE WERE NO DEVIATIONS FROM  
THE PLANTING PLAN.

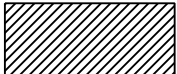-  ZONE 1 - STREAMBANKS
-  ZONE 2 - RIPARIAN BUFFER
-  ZONE 3 - UPLANDS
-  ZONE 4 - PERMANENT SEEDING - AREA OUTSIDE EASEMENT



MATCHLINE SHEET 27

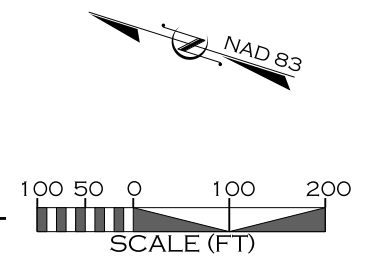

10/8/2020 R:\PROJECTS\RD\0083\_NCDEQ\_STEWARTS CREEK\_FDI\CADD\PLANS\ASB\BUILT\MF\_ASB\_PSH\_28.DGN

REVISIONS				
NO.	DESCRIPTION	ENGR.	APPROV.	DATE
1	RECORD DRAWINGS	EMB	KLT	10/9/20

PREPARED FOR:



NC DEPARTMENT OF ENVIRONMENTAL QUALITY  
DIVISION OF MITIGATION SERVICES  
1652 MAIL SERVICE CENTER  
RALEIGH, NC 27699-1652

STEWARTS CREEK TRIBUTARIES PROJECT  
SURRY COUNTY, NC



PREPARED IN THE OFFICE OF:







ECOSYSTEM  
PLANNING &  
RESTORATION


1150 SE MAYNARD RD, SUITE 140  
CARY, NC 27511  
LICENSE # P-1182

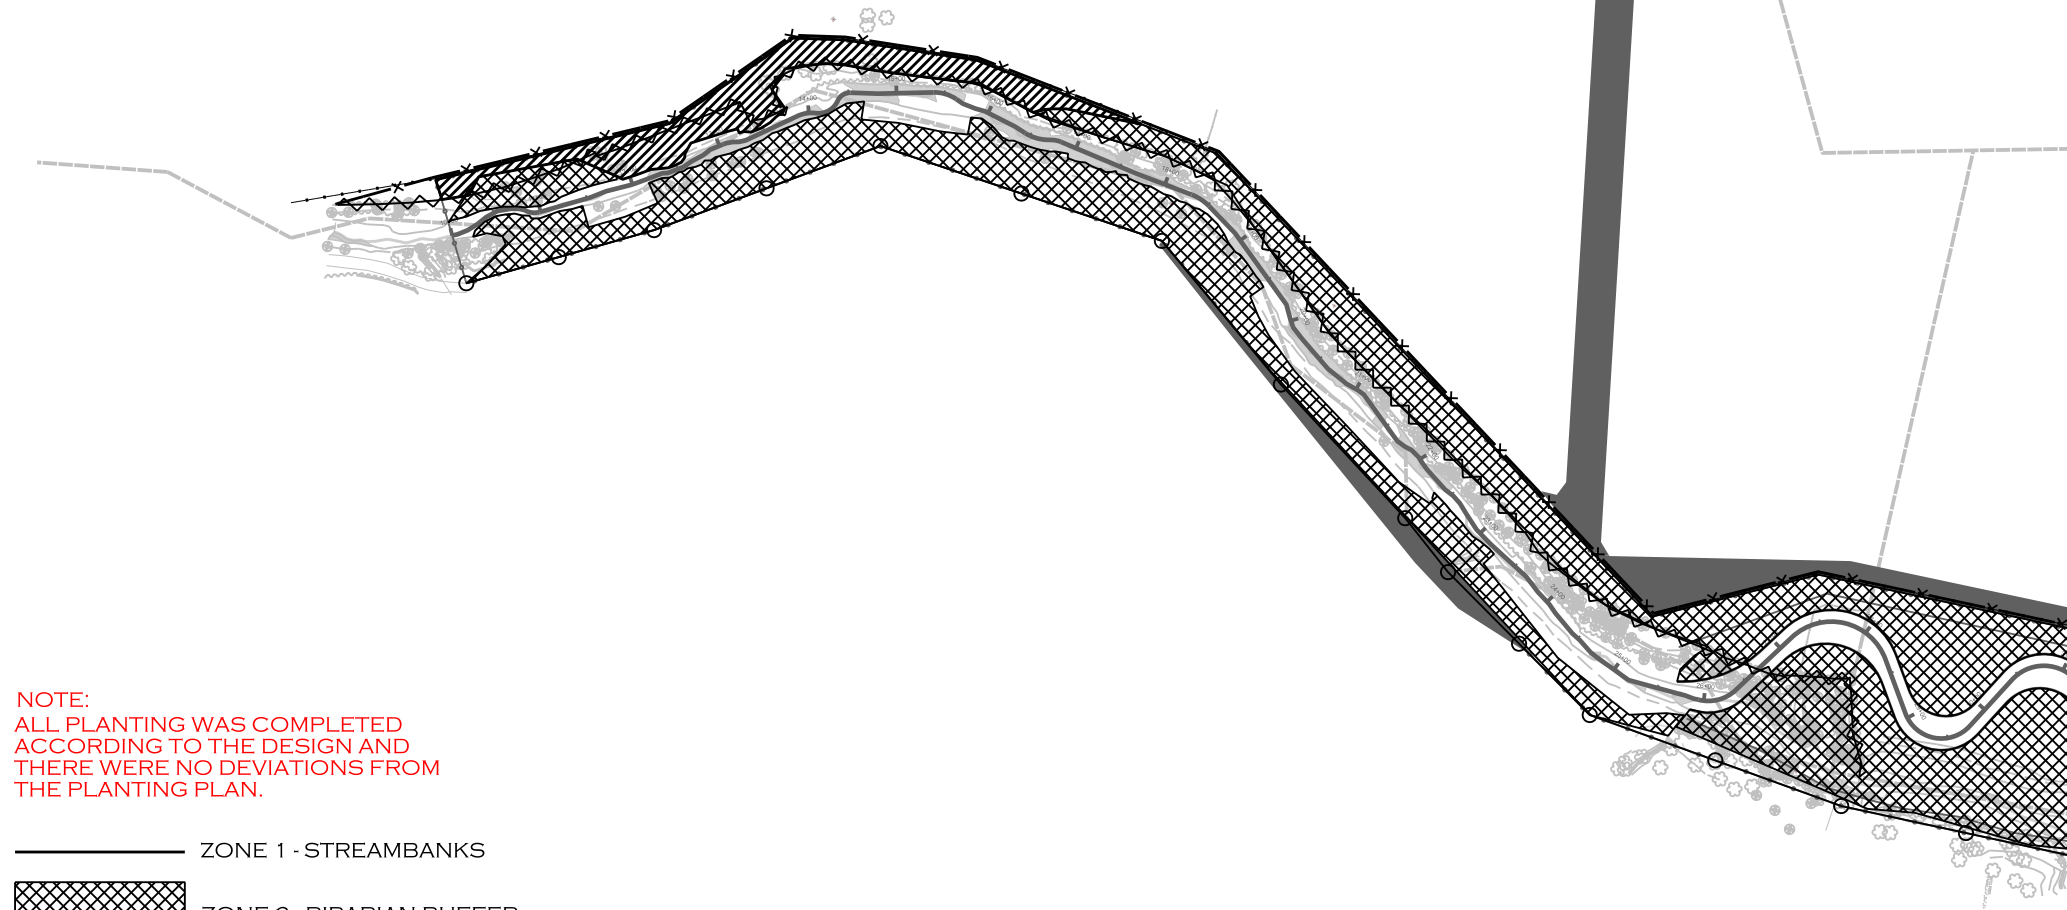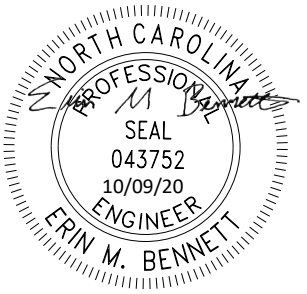PROJECT ENGINEER

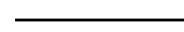

**NOTE:**  
ALL PLANTING WAS COMPLETED  
ACCORDING TO THE DESIGN AND  
THERE WERE NO DEVIATIONS FROM  
THE PLANTING PLAN.

-  ZONE 1 - STREAMBANKS
-  ZONE 2 - RIPARIAN BUFFER
-  ZONE 3 - UPLANDS
-  ZONE 4 - PERMANENT SEEDING - AREA OUTSIDE EASEMENT

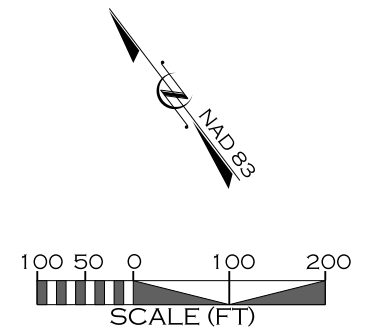

10/8/2020 R:\PROJECTS\RD\0083\_NCDEQ\_STEWARTS CREEK\_FD\CADD\PLANS\AS-BUILT\MF\_ASB\_PSH\_29.DGN

REVISIONS				
NO.	DESCRIPTION	ENGR.	APPROV.	DATE
1	RECORD DRAWINGS	EMB	KLT	10/9/20

PREPARED FOR:



NC DEPARTMENT OF ENVIRONMENTAL QUALITY  
DIVISION OF MITIGATION SERVICES  
1652 MAIL SERVICE CENTER  
RALEIGH, NC 27699-1652

STEWARTS CREEK TRIBUTARIES PROJECT  
SURRY COUNTY, NC

PREPARED IN THE OFFICE OF:









ECOSYSTEM PLANNING & RESTORATION  
1150 SE MAYNARD RD, SUITE 140  
CARY, NC 27511  
LICENSE # P-1182

PROJECT ENGINEER

VEGETATION AND FENCING PLAN

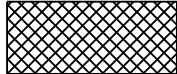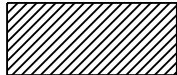NOTE:  
ALL PLANTING WAS COMPLETED  
ACCORDING TO THE DESIGN AND  
THERE WERE NO DEVIATIONS FROM  
THE PLANTING PLAN.

- ZONE 1 - STREAMBANKS
-  ZONE 2 - RIPARIAN BUFFER
-  ZONE 3 - UPLANDS
-  ZONE 4 - PERMANENT SEEDING - AREA OUTSIDE EASEMENT
-  ZONE 5 - TEMPORARY SEEDING - STOCKPILE AREA

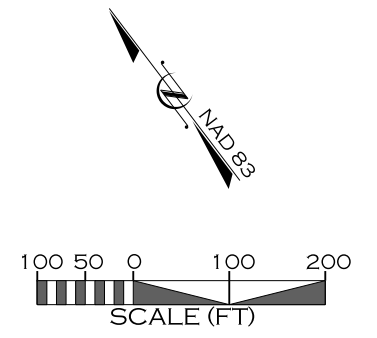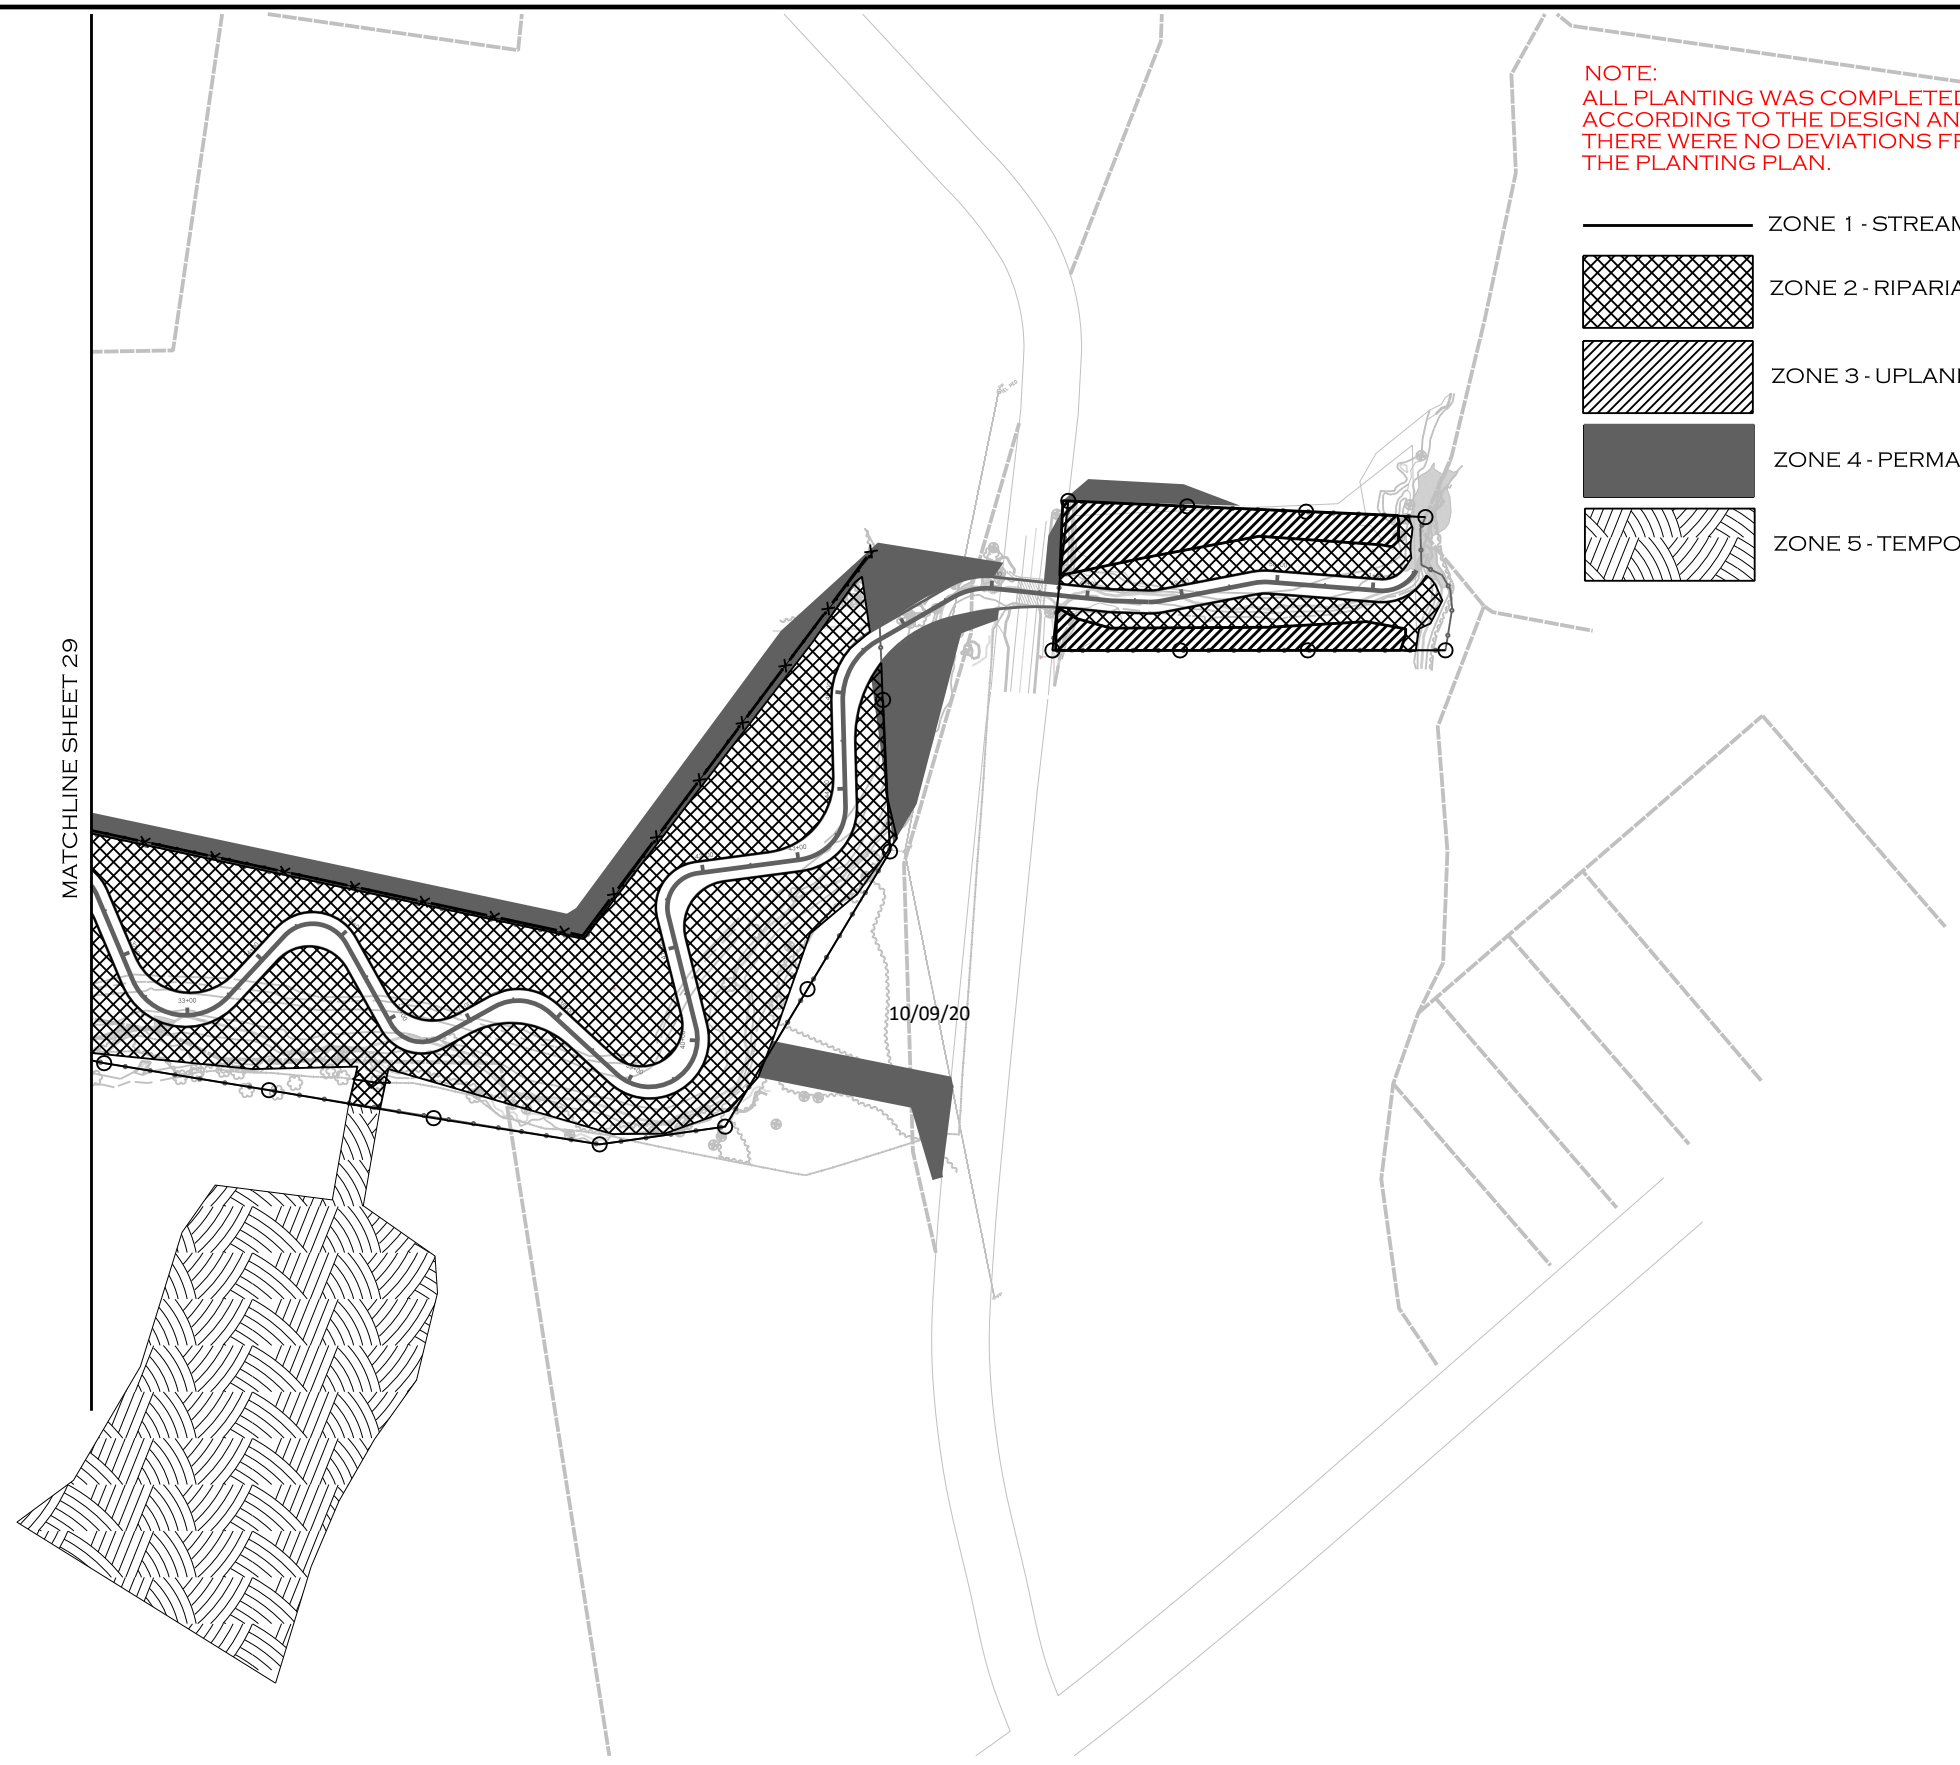

10/8/2020 R:\PROJECTS\RD\0083\_NCDEQ\_STEWARTS CREEK\_FD\CADD\PLANS\AS-BUILT\MF\_ASB\_PSH\_30.DGN

REVISIONS				
NO.	DESCRIPTION	ENGR.	APPROV.	DATE
1	RECORD DRAWINGS	EMB	KLT	10/9/20

PREPARED FOR:



NC DEPARTMENT OF ENVIRONMENTAL QUALITY  
DIVISION OF MITIGATION SERVICES  
1652 MAIL SERVICE CENTER  
RALEIGH, NC 27699-1652

STEWARTS CREEK TRIBUTARIES PROJECT  
SURRY COUNTY, NC

PREPARED IN THE OFFICE OF:



ECOSYSTEM PLANNING & RESTORATION  
1150 SE MAYNARD RD, SUITE 140  
CARY, NC 27511  
LICENSE # P-1182

PROJECT ENGINEER