

East Prong of the Roaring River at Stone Mountain State Park Stream Restoration Annual Monitoring Report

Monitoring Year: 2007

Measurement Year: 7

As-built Date: 2000

NCEEP Project Number: 364



Submitted to: NCDENR-Ecosystem Enhancement Program
1619 Mail Service Center
Raleigh, NC 27699-1619

Draft Submitted: December, 2007
Final Submitted: March, 2008



**EAST PRONG OF THE ROARING RIVER at STONE MOUNTAIN STREAM
RESTORATION
2007 MONITORING REPORT**

**CONDUCTED FOR THE NORTH CAROLINA
DEPARTMENT OF ENVIRONMENT AND NATURAL RESOURCES**



Table of Contents

Title Page	
Table of Contents	
I. Executive Summary / Project Abstract	Page 1
II. Project Background	Page 1
1. Structure and Objectives	Page 2
2. Project Location	Page 5
3. Monitoring Plan View	Page 7
III. Project Condition and Monitoring Results	Page 9
A. Vegetation Assessment	Page 9
B. Stream Assessment	Page 10
1. Hydrologic Assessment	Page 10
2. Project Problem Areas	Page 10
3. Stability Assessment	Page 11
4. Quantitative Measures	Page 11
IV. Methodology Section	Page 16

TABLES

Table I.	Project Mitigation Structure and Objectives	Page 2
Table II.	Project Activity and Reporting History	Page 3
Table III.	Project Contact Table	Page 4
Table IV.	Project Background Table	Page 4
Table V.	Verification of Bankfull Events	Page 10
Table VI.	BEHI and Sediment Export Estimates (MY05)	NA
Table VII.	Categorical Stream Feature Visual Stability Assessment	Page 11
Table VIII.	Baseline Morphology and Hydraulic Summary	Page 12
Table IX.	Morphology and Hydraulic Monitoring Summary	Page 13

Appendix A Vegetation Raw Data

1. Stem Counts by Plot
2. Vegetation Problem Areas

Appendix B Morphology Raw Data

1. Current Condition Plan View
2. Stream Problem Area Table
3. Project Photo Log/Stream Problem Area Photos
4. Qualitative Visual Stability Assessment Tables
5. Cross section and Pebble Count Plots and Raw Data Tables
6. Longitudinal Plots and Raw Data Tables
7. Slope Calculation Table
8. Pattern Data
9. GPS Coordinates

I. Executive Summary/Project Abstract

This report represents monitoring year 7 for Reach 2 and Reach 4 of the East Prong of the Roaring River restoration located in Stone Mountain State Park. The project background is summarized in Section II of this report. Overall, the majority of the restored stream is functioning well. Multiple areas of concern from previous monitoring years were addressed with significant repair work in fall 2006 and summer 2007. Several failing vanes were replaced or repaired and areas of bank erosion on the outside of meander bends were stabilized with new rock and log vane structures. These areas shall be monitored for continued stability in the upcoming monitoring years.

A summary of monitoring measurement results is found in Table VII. The majority of the restored stream classifies as a C4 with rock cross vanes to establish grade control. The channel dimension for most of the restored section, as represented by the permanent cross-sections, has not changed significantly from as-built conditions and appears stable. Both reaches have well defined riffles, runs, pools and glides. These features are located in the expected plan-form locations.

Planted vegetation is not succeeding to levels required for mitigation credit. Natural regeneration was surveyed with the regular plots again this growing season. Seedlings ranging from 1 to 7 years old are abundant throughout the project area. Overall naturally regenerating stems per acre for the entire project area in 2007 is approximately 5060. Bare root survival was poor in all plots. Overall planted bare root stems per acre for the entire project area in 2007 is approximately 40. Herbaceous cover was determined in bare root plots and was again greater than 90% in all plots. No more seeding is required at present.

Invasive vegetation continues to be an issue on this project site. Maintenance is highly recommended for next season. Kudzu has not been controlled and continues to expand throughout the floodplain, overtopping riparian vegetation.

II. Project Background

Project planning was initiated for the East Prong of the Roaring River Restoration in 1999 for the implementation of a developing watershed stream restoration project at Stone Mountain State Park in North Carolina (Figure 1 and Figure 2). Natural Channel Design techniques and procedures were employed in the restoration of the East Prong Roaring River in Wilkes County, NC.

The East Prong Roaring River stream restoration project has been a collaborative effort between the North Carolina Ecosystem Enhancement Program, North Carolina Division of Parks and Recreation, the North Carolina Stream Restoration Program at NCSU, and Buck Engineering. The project includes nearly two miles of stream restoration within the boundaries of Stone Mountain State Park in Wilkes and Alleghany Counties. The drainage area for the section of river being restored is approximately 22 square miles. This project was constructed from July 2000 to October 2000. Floodplain and stream bank planting continued through February 2001.

Stone Mountain State Park was purchased by the State of North Carolina in the early 1960s. Prior to this purchase, all of the streams in the alluvial valley portion of the park were modified to improve agricultural production. Field observations suggest that tributary streams in the alluvial valley were straightened. A large area of the downstream portion of the restoration site was used for gravel mining. As part of this operation, the East Prong was channelized, impounded, and moved several times, resulting in destabilization of the channel. Spoil piles that were created during the mining

operation created overly high bank heights and as a result were being eroded away during high flows. Aerial photos and the USGS Glade Valley Quadrangle indicate locations of the historic channels.

The project consisted of the analysis of the 22.0 square mile portion of the East Prong Roaring River watershed (located within USGS Hydrologic Unit Code 03040101, NCDWQ Sub-basin 03-07-01 of the Upper Yadkin River Basin) that contributes drainage to the project site. The restoration of these portions of the East Prong of the Roaring River Restoration, located in Stone Mountain State Park, was conducted to correct identified system deficiencies including severe bank erosion, channel widening, and the loss of aquatic habitat resulting from stream channelization, the loss of riparian vegetation, and watershed development. The goal of the project was to develop a stable stream channel with reduced bank erosion, efficient sediment transport, enhanced warm water fisheries, and improved overall stream habitat and site aesthetics. Implementation of the project was completed by October 2000.

Table I. Project Mitigation Structure and Objectives					
East Prong of the Roaring River at Stone Mountain State Park/Project # 364					
Project Segment or Reach ID	Mitigation Type	Approach	Linear Footage or Acreage	Stationing	Comment
Reach 2	R	P1	1,500 lf	0+00 to 15+00	
Reach 4	R	P1	3,500 lf	0+00 to 35+00	
Total Project			5,000 lf		

R = Restoration

EI = Enhancement I

EII = Enhancement II

S = Stabilization

P1 = Priority I

P2 = Priority II

P3 = Priority III

SS = Stream Bank stabilization

**Table II. Project Activity and Reporting History
East Prong of the Roaring River at Stone Mountain State Park/Project # 364**


Activity or Report	Scheduled Completion	Data Collection Complete	Actual Completion or Delivery
Restoration Plan	1999	1999	1999
Final Design - 90%	2000	N/A	N/A
Construction	2000	N/A	2000
Temporary S&E mix applied to entire project area	October 2000	N/A	Oct - 2000
Permanent seed mix applied to reach	Winter 2001	N/A	Winter 2001
Containerized and B&B plantings	N/A	N/A	N/A
Mitigation Plan / As-built (Year 0 Monitoring – baseline)	December 2000	Dec - 00	Dec - 00
Initial – Year 1 monitoring	June 2001	June 2001	Dec-01
Year 2 Monitoring	June 2002	June 2002	Dec-02
Structural maintenance (Bank repair and revegetation)	Summer 2002	NA	Summer 2002
Year 3 Monitoring	June 2003	June 2003	Dec-03
Year 4 Monitoring	June 2004	June 2004	Dec-04
Year 5 Monitoring	June 2005	June 2005	Dec-05
Year 6 Monitoring	June 2006	June 2006	Dec-06
Structural maintenance (Bank repair and revegetation)	Fall 2006 and Summer 2007	NA	Fall 2006 and Summer 2007
Year 7 Monitoring	July 2007	July 2007	Dec-07

*Historical documents necessary to provide these data were unavailable at the time of report submission

Table III. Project Contact Table	
East Prong of the Roaring River at Stone Mountain State Park/Project # 364	
Designer	Biological & Agricultural Engineering North Carolina State University Campus Box 7625 Raleigh, NC 27695
Primary project design POC	(919) 515-6771
Construction Contractor	SEI Environmental
Construction contractor POC	(704) 596-8624
Planting Contractor	SEI Environmental
Planting contractor POC	(704) 596-8624
Seeding Contractor	SEI Environmental
Seeding contractor point of contact	(704) 596-8624
Seed Mix Sources	N/A
Nursery Stock Suppliers	N/A
Monitoring Performers	Biological & Agricultural Engineering North Carolina State University Campus Box 7625 Raleigh, NC 27695
Stream Monitoring POC	Zan Price (828) 545-8347
Vegetation Monitoring POC	Zan Price (828) 545-8347

Table IV. Project Background Table	
East Prong of the Roaring River at Stone Mountain State Park/Project # 364	
Project County	Wilkes
Drainage Area	22.0 sq miles
Drainage impervious cover estimate (%)	Estimated at <5%
Stream Order	4th order
Physiographic Region	Piedmont
Ecoregion	Northern Inner Piedmont (45e)
Rosgen Classification of As-built	C-Stream Type
Cowardin Classification	Riverine
Dominant soil types	Enon
Reference site ID	Basin Creek, Wilkes County
USGS HUC for Project and Reference	3040101
NCDWQ Sub-basin for Project and Reference	03-07-01 – Upper Yadkin
NCDWQ classification for Project and Reference	C
Any portion of any project segment 303d listed?	No
Any portion of any project segment upstream of a 303d listed segment?	No
Reasons for 303d listing or stressor	N/A
% of project easement fenced	0%

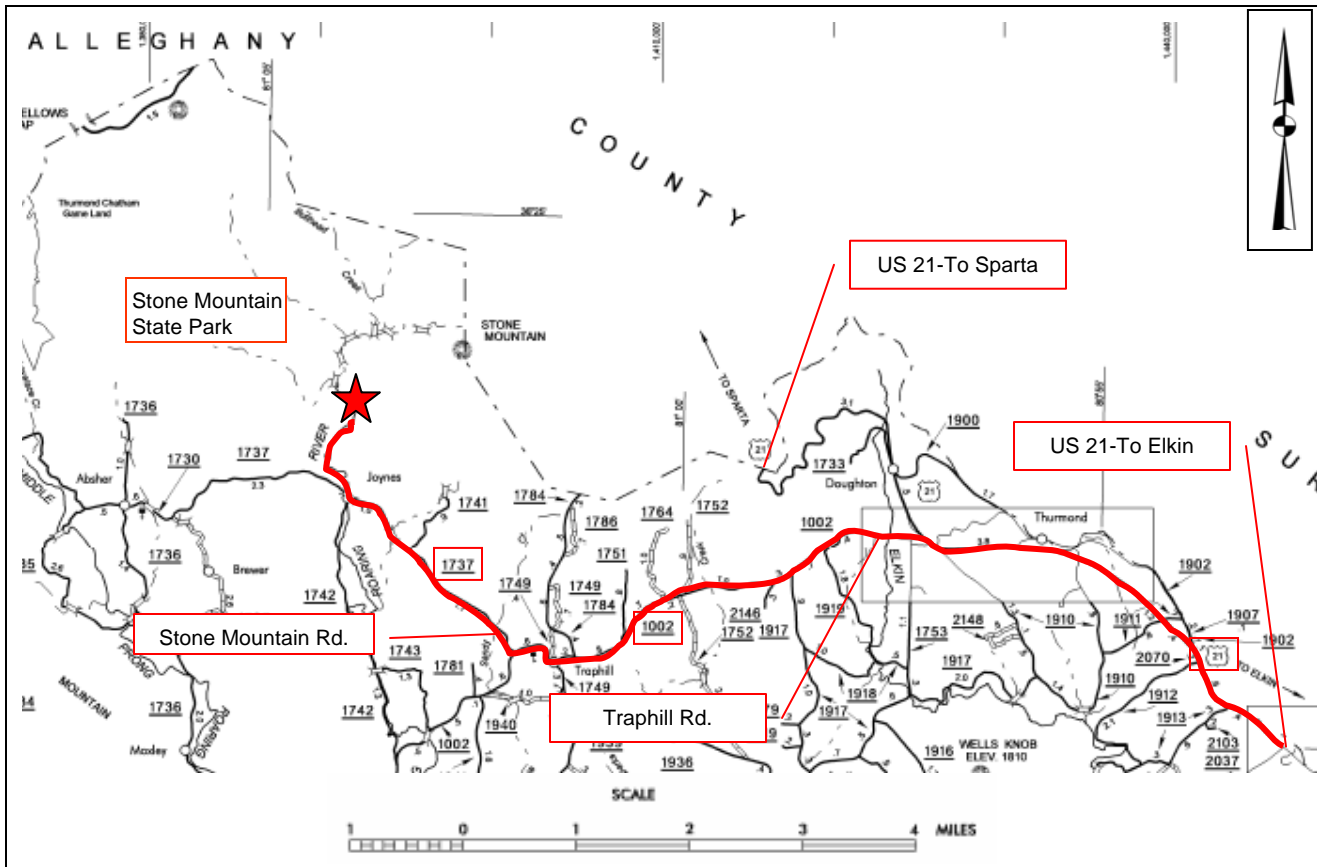

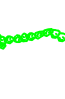




Figure 1. Project Location





Directions from NC 421 and I-77 intersection:

Follow I-77 North to US-21 at Elkin. Follow US-21 bypass toward Sparta for 7.9 miles. Turn left onto Traphill Road (SR 1002) and follow for 5.1 miles. Turn Right onto Long Bottom Road (SR 1737) and follow for 2.9 miles to Stone Mountain Road. Turn Right on to Stone Mountain Road and follow into Stone Mountain State Park. The upstream end of Reach 4 is located at the first parking lot on the right. Reach 2 begins at the next parking lot down the road.

LEGEND

	ROCK CROSS VANE		STATION ALIGNMENT & ASBUILT THALWEG (2000)
	ROCK J-HOOK		2007 THALWEG
	LOG J-HOOK		2007 WATER EDGE
			2007 TOP OF BANK

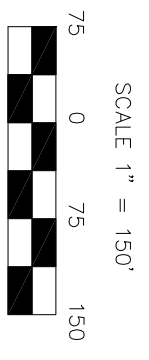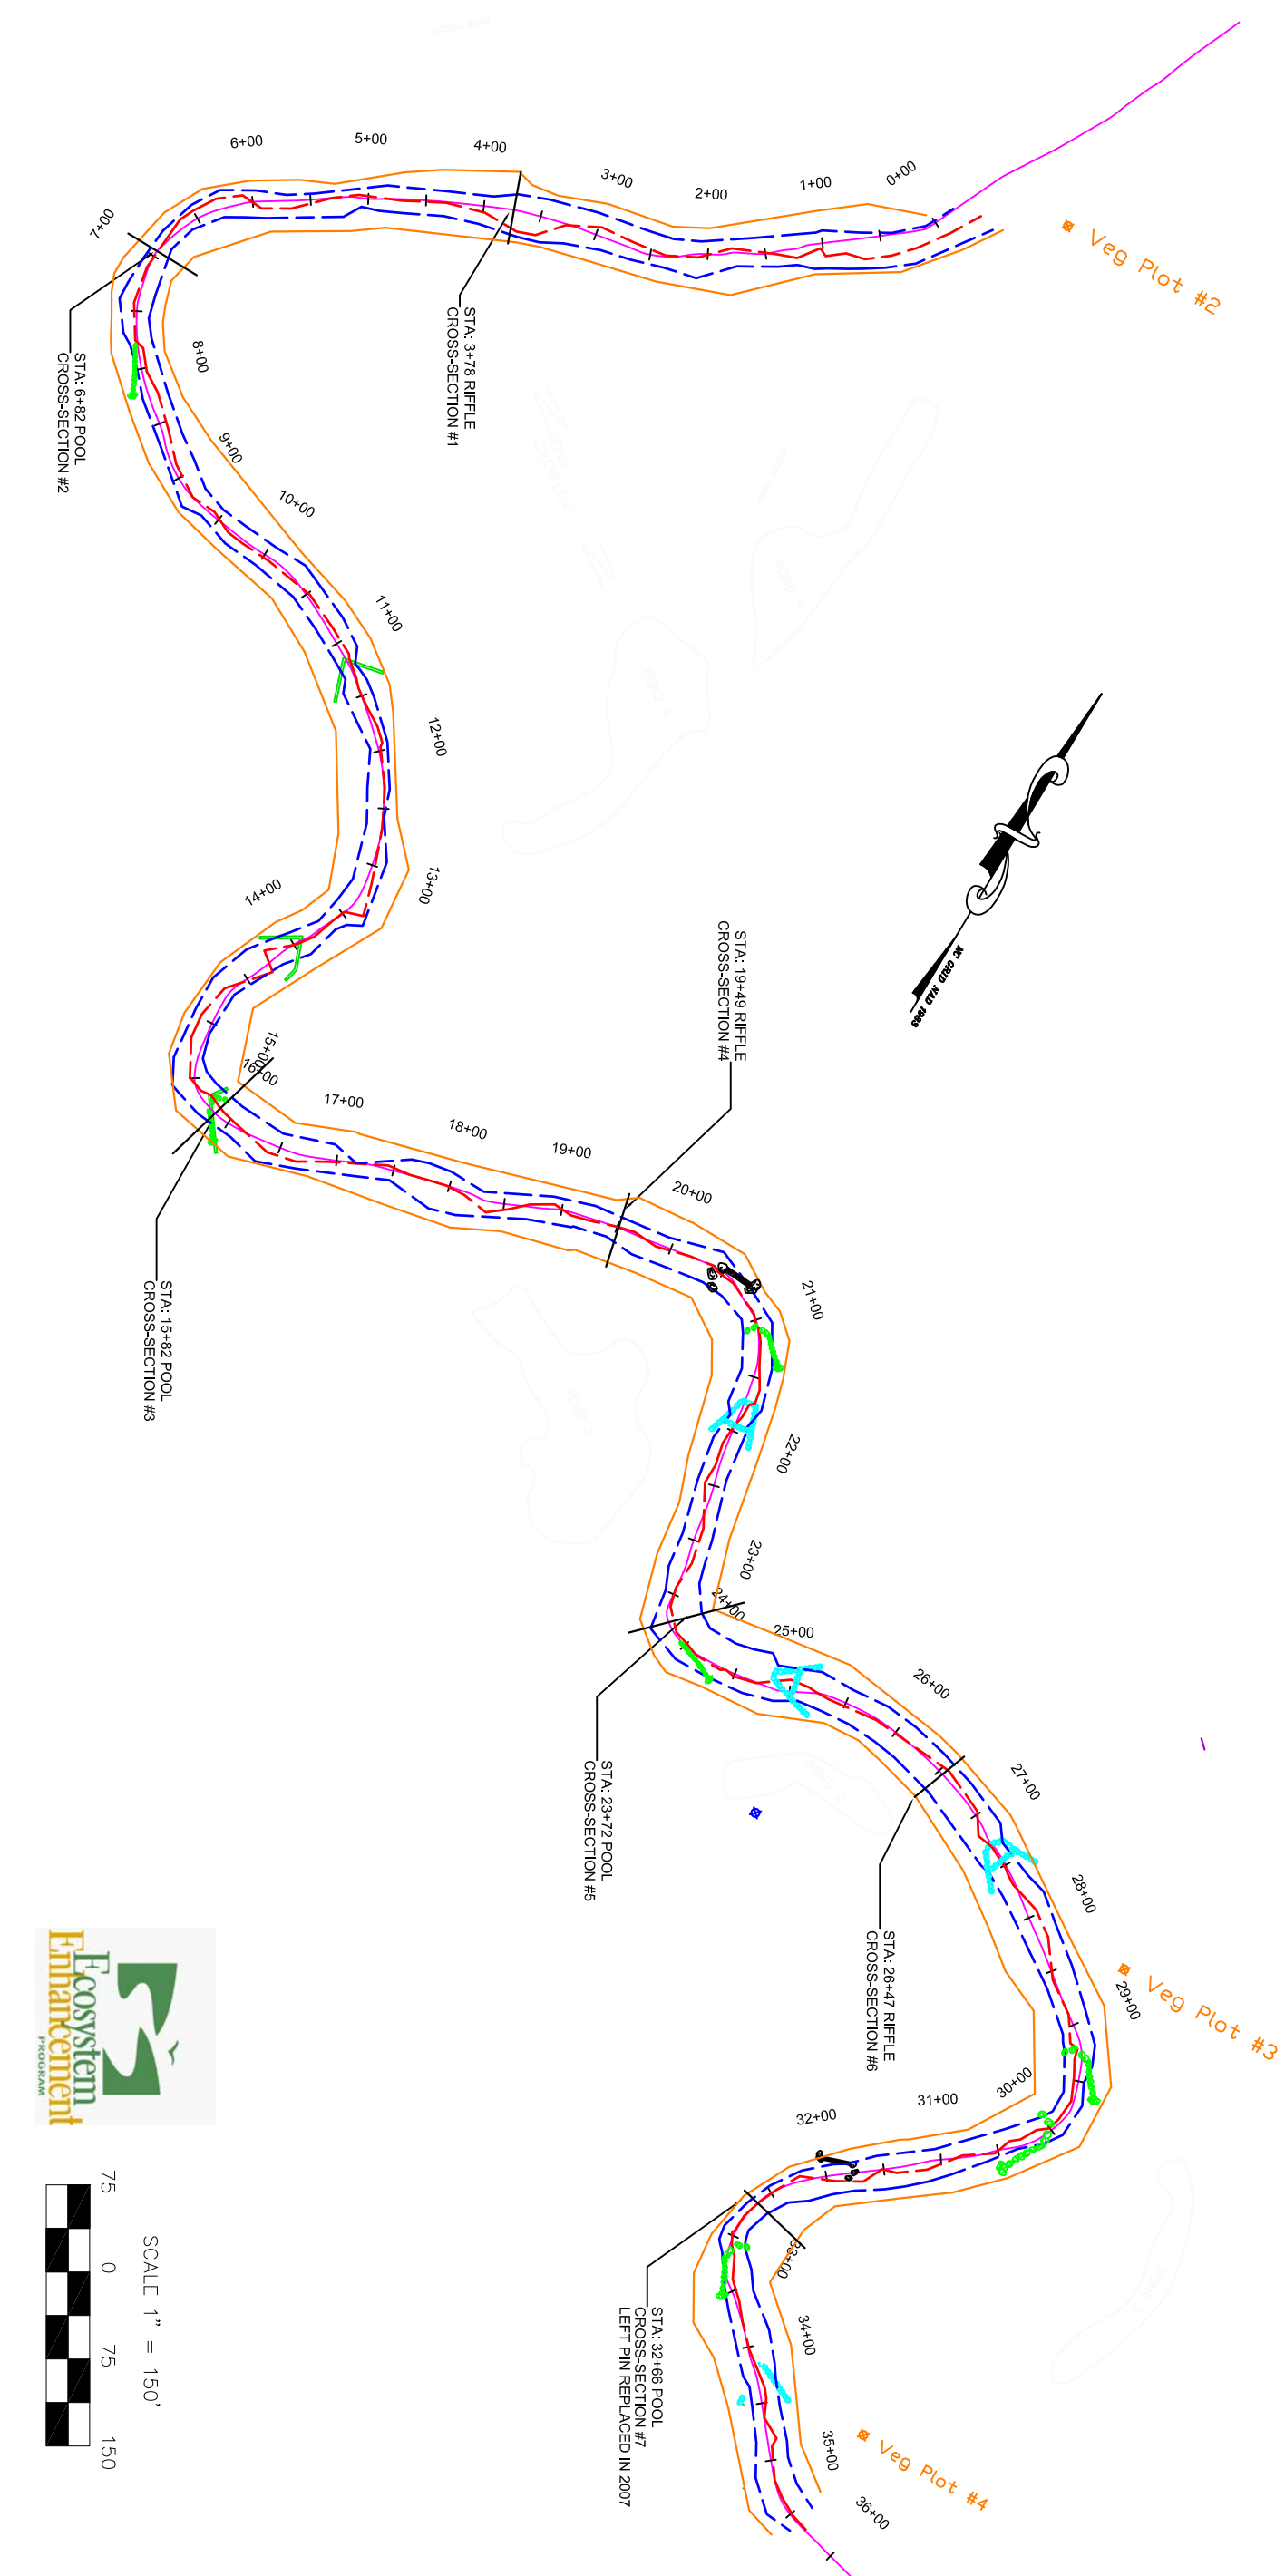

STONE MOUNTAIN STATE PARK EAST PRONG OF THE ROARING RIVER WILKES COUNTY, N.C.		NC STATE UNIVERSITY		1 2005 MONITORING JMP DRC 12/01/06 2 REVIEW EDITS JMP DRC 01/11/07 3 2007 MONITORING ZP JP 12/01/07	
2007 MONITORING WITH CONTOURS FIGURE 3b. PLAN VIEW REACH-4		BIOLOGICAL & AGRICULTURAL ENGINEERING Weaver Labs Campus Box 7625 North Carolina State University Raleigh, NC 27695		NO REVISIONS DRN CHK DATE	
DATE	12/01/2007	PROJECT NO.		FILENAME	STONE_MTN.DWG
SHEET NO.		DRAWING NO.			

III. Project Condition and Monitoring Results

A. Vegetation Assessment

As part of the stream channel repairs, it appeared that additional large trees and live stakes were installed in select areas in 2007. Several large trees were noted along the streamside. Mortality of these trees was approximately 75%. Bare root plants planted in previous years in Reach 2 and Reach 4 had survival rates similar to that in 2006-low survival. Deer browse continues to be a problem at this site. A very few bare root plants and live stakes have survived deer browse, but have been limited in vertical growth as a result. Browse has occurred from the top down. Only the taller planted trees performed well against the deer browse. Sycamore (*Platanus occidentalis*) continues to be the least browsed species. Increased beaver activity was observed again this year. No indication of deer scraping was seen on any of the surveyed trees.

Natural regeneration was surveyed with the regular plots again this growing season. Seedlings ranging from 1 to 7 years old are abundant throughout the project area. The majority species is sycamore, tulip poplar (*Liriodendron tulipifera*), river birch (*Betula nigra*), Virginia pine (*Pinus virginiana*), sweet gum (*Liquidambar styraciflua*), black cherry (*Prunus serotina*), tag alder (*Alnus serrulata*), and spice bush (*Lindera benzoin*). Virginia pine, tag alder, and sycamore continued to have robust growth. Point bars in certain areas had high densities of natural regeneration, though these areas are prone to frequent disturbance. Overall naturally regenerating stems per acre for the entire project area in 2007 is approximately **5060**.

Bare root survival was poor in all plots. As in 2006, only one plot had a total of 4 planted trees. These were sycamores. All other plots contained dead planted trees or no evidence of planted trees. It should be noted however that naturally regenerating sycamore in select areas continues to have heights close to that of the 4 remaining planted sycamores. Overall planted bare root stems per acre for the entire project area in 2007 is approximately **40**.

Live stake survival was again extremely low, despite the apparent new planting of livestakes along areas where repair was performed. Deer browse continued to be evident. As with last year, it was noted that foot traffic up and down the staked banks was often heavy in select places and that many stakes were dislodged or removed completely.

Herbaceous cover was determined in bare root plots and was again greater than 90% in all plots. Switchgrass, rushes, and sedges continue to dominate the floodplain and wetter areas. No more seeding is required at present.

Invasive vegetation control was again not employed this growing season. Maintenance is highly recommended for next season. Kudzu (*Pueraria lobata*) was observed in even larger patches throughout the area than in 2006 and continues regaining a strong foothold in areas where it had been continually maintained and controlled in past years.

Vegetation table 1 in Appendix A summarizes the stem count results for the 2007 monitoring period.

B. Stream Assessment

Both reaches of the East Prong of the Roaring River at Stone Mountain State Park have had significant channel stability concerns during previous monitoring years. Extensive repair work was completed on both reaches in October 2006 and again in summer 2007 by Shamrock Environmental. Problem areas identified in previous monitoring reports were repaired by installing new rock and log vane structures. Additionally, existing cross vanes that had water piping around the structure were repaired. No new problems arose in the 2007 monitoring period.

The following summarizes the hydrologic, bank stability, and channel morphology monitoring results of the 2007 monitoring period. Data was collected in July and August 2007.

Hydrologic Assessment

Peak Stage Recorders were installed in the winter of 2005. August 2006 they were inspected. Both recorders were bent over as a result of flow events and the tops were popped off. No actual elevation could be recorded but the flow was clearly greater than bankfull. New recorders were installed in November 2006. Table V lists the number of events equal to or greater than bankfull.

The maximum stage measured from the crest gauge during the 2007 monitoring period was below the bankfull elevation.

Table V. Verification of Bankfull Events				
East Prong of the Roaring River at Stone Mountain State Park/Project # 364				
Date of Data Collection	Date of Occurrence	Method	Photo # (if available)	Notes
8/1/2006	Spring/Summer 06	Crest Gauge	N/A	Peak Stage Recorders were installed in the winter of 2005 and damaged in the summer 2006. New recorders were installed in November 2006.

Note: No peak flow data was collected prior to 2006. Peak flow during the 2007 monitoring period was below the bankfull elevation.

Table VI. BEHI and Sediment Export Estimates is not included in the monitoring year 7 report.

Project Problem Areas

The problem area Table B1, plan sheet and photographs can be found in Appendix B. As mentioned earlier in the report, many of the problem areas identified in previous monitoring reports were repaired in fall 2006 and summer 2007. These areas were removed from the problem area table, photograph log, and plan sheet since they are not currently considered problem areas. However, these areas shall continue to be monitored on an annual basis for stability.

Stability Assessment Table

Table VII lists the results of a visual assessment that was conducted over each study reach. The data used to calculate the percentages listed in this table is found in Table B2 in Appendix B.

Table VII. Categorical Stream Feature Visual Stability Assessment				
East Prong of the Roaring River at Stone Mountain State Park/Project # 364				
Reach 2 - 1500 Feet, Reach 4 - 3500 Feet				
Feature	Initial	MY-01 through MY-05	MY-06	MY-07
A. Riffles		Data not collected		
Reach 2	100%		96%	100%
Reach 4	100%		100%	96%
B. Pools				
Reach 2	100%		85%	100%
Reach 4	100%		90%	100%
C. Thalweg				
Reach 2	100%		50%	100%
Reach 4	100%		63%	100%
D. Meanders				
Reach 2	100%		63%	100%
Reach 4	100%		100%	100%
E. Bed General				
Reach 2	100%		93%	100%
Reach 4	100%		86%	100%
F. Bank Condition				
Reach 2	100%			100%
Reach 4	100%			98%
F. Vanes / J Hooks etc.				
Reach 2	100%		96%	95%
Reach 4	100%		55%	97%
G. Wads and Boulders				
Reach 2	N/A		50%	100%
Reach 4	N/A		33%	50%

*Note: Significant repairs completed in 2006/2007 after the 2006 monitoring event and prior to the 2007 monitoring event. As shown in this table, the 2007 data was impacted by the repairs.

Quantitative Measures Summary Tables

The tables below present all of the quantitative summary data from the survey cross-sectional surveys, longitudinal surveys, and pebble counts. The associated raw data and plots are located in Appendix B of this report.

**Table VIII. Baseline Morphology and Hydraulic Summary
East Prong of the Roaring River at Stone Mountain State Park/Project # 364
Reach 2 (1500 Feet) and Reach 4 (3500 Feet)**

Parameter	USGS Gage Data			Regional Curve Interval			Pre-Existing Condition			Project Reference Stream			Design			As-built		
	Min	Max	Med	Min	Max	Med	Min	Max	Med	Min	Max	Med	Min	Max	Med	Min	Max	Med
Dimension																		
BF Width (ft)						60	48	110	75			31			60			60
Floodprone Width (ft)						300	125	300	220			90			240			240
BF Cross Sectional Area (ft ²)						180	190	400	310			57			180			180
BF Mean Depth (ft)						3	4.5	5.8	5			2			3			3
BF Max Depth (ft)							5	7.5	6.2			2.8			4			4
Width/Depth Ratio							12	28	18			16			15			15
Entrenchment Ratio							3.2	8.5	5			2.8			4			4
Bank Height Ratio																		
Wetted Perimeter(ft)							60	120	80			36			70			70
Hydraulic radius (ft)							3.5	5.6	5			1.8			3			3
Pattern																		
Channel Beltwidth (ft)							120	250	180	60	105	75			240			240
Radius of Curvature (ft)							75	200	120	40	77	60			100			100
Meander Wavelength (ft)							450	900	700			350			480			480
Meander Width ratio							2.5	5	4	2	3.5	2.5			4			4
Profile																		
Riffle length (ft)							60	180	120			55			120			120
Riffle slope (ft/ft)							0.02	0.04	0.03	0.018	0.1	0.035	0.01	0.03	0.02	0.01	0.03	0.02
Pool length (ft)							90	180	135			70	60	90	75	60	90	75
Pool spacing (ft)							150	350	250	270	330	300	120	240	180	120	240	180
Substrate																		
d50 (mm)							1	50	20			38			25			25
d84 (mm)							80	120	100			130			120			120
Additional Reach Parameters																		
Valley Length (ft)								4000			1000			4000				4000
Channel Length (ft)								5800			1020			6000				6000
Sinuosity								1.4			1.02			1.5				1.5
Water Surface Slope (ft/ft)								0.005			0.014			0.005				0.005
BF slope (ft/ft)								0.007			0.014			0.007				0.007
Rosgen Classification								C4			C4			C4				C4
Number of Bankfull Events								NA			NA			NA				NA
*Habitat Index								NA			NA			NA				NA
*Macrobenthos								NA			NA			NA				low

Table IXa. Morphology and Hydraulic Monitoring Summary
East Prong of the Roaring River at Stone Mountain State Park Reach 2/Project # 364
Reach 2 - 1500 Feet

Parameter	Cross Section 1							Cross Section 2							Cross Section 3							Cross Section 4						
	Riffle							Pool							Riffle							Riffle						
Dimension	MY1	MY2	MY3	MY4	MY5	MY6	MY7	MY1	MY2	MY3	MY4	MY5	MY6	MY7	MY1	MY2	MY3	MY4	MY5	MY6	MY7	MY1	MY2	MY3	MY4	MY5	MY6	MY7
BF Width (ft)	61.9	62	62	61.1	61.8	61.9	62.1	53.9	53	53.4	53.3	53.5	60.3	51.1	60.2	59.7	58.3	60.1	60.1	60.1	59.1	54	53	56.5	52.9	52.8	53.2	53
Floodprone Width (ft)																												
BF Cross Sectional Area (ft ²)	319.8	306	297	307	319	295	310	158.4	158.7	170.3	155.6	165.8	166	176	166.2	169.5	169.6	194.5	191.7	195	194	136.3	124.8	156.5	130.6	135	150.1	169
BF Mean Depth (ft)	5.2	4.9	4.8	5	5.2	4.8	5.0	2.9	3	3.2	2.9	3.1	2.8	3.4	2.8	2.8	2.9	3.2	3.2	3.2	3.6	2.5	2.4	2.8	2.5	2.6	2.8	3.2
BF Max Depth (ft)	6.4	6.1	5.7	5.9	5.9	6	5.8	5.6	4.6	5.7	5.6	5.8	5.9	5.2	4.7	4.5	4.5	5.8	5.5	5.5	5.1	3.5	3.4	4.3	3.8	4	4.3	5.1
Width/Depth Ratio	12	12.6	13	12.2	12	13.0	12.4	18.3	17.7	16.7	18.3	17.3	21.9	14.8	21.8	21	20	18.6	18.8	18.5	15.2	21.4	22.5	20.4	21.4	20.7	18.9	16.7
Entrenchment Ratio	>5.0	>5.0	>5.0	>5.0	>5.0	>5.0	>5.0	>5.0	>5.0	>5.0	>5.0	>5.0	>5.0	>5.0	>5.0	>5.0	>5.0	>5.0	>5.0	>5.0	>5.0	>5.0	>5.0	>5.0	>5.0	>5.0	>5.0	
Bank Height Ratio	1.1	1.1	1.1	1.1	1.1	1.1	1.1	1.1	1.0	1.0	1.0	1.0	1.0	1.0	1.0	1.0	1.0	1.0	1.0	1.0	1.0	1.0	1.0	1.0	1.0	1.0	1.0	1.0
Wetted Perimeter(ft)	72.3	71.8	71.6	71.1	72.2	71.4	72.1	59.7	59.0	59.8	59.1	59.7	65.8	57.9	65.8	65.3	64.1	66.5	66.5	66.6	66.3	59.0	57.8	62.1	57.9	58.0	58.8	59.4
Hydraulic radius (ft)	4.4	4.3	4.1	4.3	4.4	4.1	4.3	2.7	2.7	2.8	2.6	2.8	2.5	3.0	2.5	2.6	2.6	2.9	2.9	2.9	2.9	2.3	2.2	2.5	2.3	2.3	2.6	2.8
Substrate																												
d50 (mm)				38	16	26	39				3.5		2.9	37	18	17	19	20	24	12	16	15		14	36	17	11	12
d84 (mm)				147	72	143	127				91		76	99	54	71	77	83	50	46	88	64		71	82	53	50	37

Parameter	MY-01 (2001)			MY-02 (2002)			MY-03 (2003)			MY-04 (2004)			MY-05 (2005)			MY6 (2006)			MY7 (2007)		
Pattern	Min	Max	Med	Min	Max	Med	Min	Max	Med	Min	Max	Med	Min	Max	Med	Min	Max	Med	Min	Max	Med
Channel Beltwidth (ft)										162	328	177	162	332	178	177	343	260	163	333	177
Radius of Curvature (ft)										145	196	166	145	198	166	144	157	145	144	157	145
Meander Wavelength (ft)										507	614	559	505	616	559			614	557	588	586
Meander Width ratio										3.2	6.6	3.5	3.2	6.6	3.6	3.3	6.5	4.9	3.1	6.3	3.3
Profile																					
Riffle length (ft)										35	104	61	35	85	52	33	161	86	39	72	63
Riffle slope (ft/ft)										0.004	0.024	0.013	0.004	0.025	0.013	0.008	0.028	0.016	0.009	0.024	0.012
Pool length (ft)										45	77	66	52	81	65	62	209	189	60	191	156
Pool spacing (ft)										83	391	163	83	285	158	117	367	218	101	372	234
Additional Reach Parameters																					
Valley Length (ft)										1160											
Channel Length (ft)																			1500		
Sinuosity																			1.3		
Water Surface Slope (ft/ft)																			0.0058		
BF slope (ft/ft)																			0.0051		
Rosgen Classification																			0.006		
Habitat Index*																			C4		
Macrobenthos*																					

Note: Missing data not collected or not reported.

Table XIIIb. Morphology and Hydraulic Monitoring Summary
East Prong of the Roaring River at Stone Mountain State Park /Project # 364
Reach 4 - 3500 Feet

Parameter	Cross Section 1							Cross Section 2							Cross Section 3							Cross Section 4						
	Riffle							Pool							Pool							Riffle						
Dimension	MY1	MY2	MY3	MY4	MY5	MY6	MY7	MY1	MY2	MY3	MY4	MY5	MY6	MY7	MY1	MY2	MY3	MY4	MY5	MY6	MY7	MY1	MY2	MY3	MY4	MY5	MY6	MY7
BF Width (ft)	57	58.2	59.3	57.7	58.3	62.6	57.7	43	42.1	41.5	42.5	41.3	42.7	43.3	66	65	61.3	58	50.7	53.8	52.8	46	45.9	45.5	46.5	46.4	45.5	44.2
Floodprone Width (ft)																												
BF Cross Sectional Area (ft ²)	206.6	202.5	215.8	196.1	195.9	187.3	198.5	179.6	182.8	210.6	224.4	223.7	220.3	208.6	170	181.3	173	162.2	161.8	161.1	151.2	139.7	140.7	139.1	140.4	154.7	141.2	143.9
BF Mean Depth (ft)	3.6	3.5	3.6	3.4	3.4	3.0	3.4	4.2	4.3	5.1	5.3	5.4	5.2	4.8	2.6	2.8	2.8	2.8	3.2	3.0	2.9	3	3.1	3.1	3	3.3	3.1	3.3
BF Max Depth (ft)	4.7	4.9	5.6	5.9	4.9	4.8	4.9	6.8	6.9	7.8	8.1	8.1	7.8	7.3	5.7	5.4	5.6	5.5	5.5	5.9	6	3.9	4	4.5	5	4.9	4.9	4.7
Width/Depth Ratio	15.7	16.7	16.3	16.9	17.3	20.9	16.8	10.3	9.7	8.2	8.1	7.6	8.3	9.0	25.6	23.3	21.7	20.7	15.9	18.0	18.5	15.1	15	14.9	15.4	13.9	14.7	13.6
Entrenchment Ratio	>5.0	>5.0	>5.0	>5.0	>5.0	>5.0	>5.0	>5.0	>5.0	>5.0	>5.0	>5.0	>5.0	>5.0	>5.0	>5.0	>5.0	>5.0	>5.0	>5.0	>5.0	>5.0	>5.0	>5.0	>5.0	>5.0	>5.0	>5.0
Bank Height Ratio	1.0	1.0	1.0	1.0	1.0	1.0	1.0	1.0	1.0	1.0	1.0	1.0	1.0	1.0	1.0	1.0	1.0	1.0	1.0	1.0	1.0	1.0	1.0	1.0	1.0	1.0	1.0	1.0
Wetted Perimeter(ft)	64.2	65.2	66.5	64.5	65.1	68.6	64.5	51.4	50.7	51.7	53.1	52.1	53.0	52.9	71.2	70.6	66.9	63.6	57.1	59.8	58.6	52.0	52.1	51.7	52.5	53.0	51.7	50.8
Hydraulic radius (ft)	3.2	3.1	3.2	3.0	3.0	2.7	3.1	3.5	3.6	4.1	4.2	4.3	4.2	3.9	2.4	2.6	2.6	2.6	2.8	2.7	2.6	2.7	2.7	2.7	2.7	2.9	2.7	2.8
Substrate																												
d50 (mm)					14	27	55						14	18						0.5	10	15		14	36	11	29	36
d84 (mm)					46	54	125						61	92						8.7	38	64		71	81	57	63	92

Parameter	MY-01 (2001)			MY-02 (2002)			MY-03 (2003)			MY-04 (2004)			MY-05 (2005)			MY6 (2006)			MY7 (2007)					
	Min	Max	Med	Min	Max	Med	Min	Max	Med	Min	Max	Med	Min	Max	Med	Min	Max	Med	Min	Max	Med			
Pattern																								
Channel Beltwidth (ft)										222	503	301	222	503	301	222	515	301	222	503	301			
Radius of Curvature (ft)										78	296	122	85	296	122	69	207	107	69	207	107			
Meander Wavelength (ft)										534	767	596	536	767	596	533	766	595	534	766	595			
Meander Width ratio										4.5	10.1	6	4.6	10.1	6	4.9	11.3	6.6	4.6	10.4	6.2			
Profile																								
Riffle length (ft)										35	170	80	35	145	75	69	173	76	45	145	82			
Riffle slope (ft/ft)										0.004	0.007	0.005	0.006	0.007	0.005	0.004	0.021	0.006	0.003	0.018	0.005			
Pool length (ft)										60	130	85	60	130	85	35	233	79	35	142	116			
Pool spacing (ft)										175	335	255	175	335	255	212	465	223	112	398	222			
Additional Reach Parameters																								
Valley Length (ft)										2190														
Channel Length (ft)																						3500		
Sinuosity																						1.6		
Water Surface Slope (ft/ft)																						0.0055		
BF slope (ft/ft)																						0.0058		
Rosgen Classification																						0.0055		
Habitat Index*																						C4		
Macroinvertebrates*																						NA		
Macroinvertebrates*																						NA		

Table XIIIc. Morphology and Hydraulic Monitoring Summary
East Prong of the Roaring River at Stone Mountain State Park /Project # 364
Reach 4 - 3500 Feet

Parameter	Cross Section 5							Cross Section 6							Cross Section 7						
	Pool							Riffle							Pool						
Dimension	MY1	MY2	MY3	MY4	MY5	MY6	MY7	MY1	MY2	MY3	MY4	MY5	MY6	MY7	MY1	MY2	MY3	MY4	MY5	MY6	MY7
BF Width (ft)	60	54.2	56	54.2	64	54.5	59.8	46.3	43.7	45.2	45.6	45.1	44.7	42.6	64.5	66.5		71.3	79	73.9	67.0
Floodprone Width (ft)																					
BF Cross Sectional Area (ft ²)	183.6	183.9	175.1	180.7	184.6	202.1	200	210.1	207.3	223.1	215.6	210.3	212.1	225	188.6	221.1		201.7	210.1	214.6	202.0
BF Mean Depth (ft)	3.1	3.4	3.1	3.3	2.9	3.7	3.4	4.5	4.7	4.9	4.7	4.7	4.7	5.3	2.9	3.3		2.8	2.7	2.9	3.0
BF Max Depth (ft)	4.8	5.8	5.8	5.8	5.8	6.6	5.3	6	7.4	7.3	7.4	7.4	7.3	8.5	7.5	8.2		7.4	7.3	7.4	6.3
Width/Depth Ratio	19.6	16.0	17.9	16.3	22.2	14.7	17.8	10.2	9.2	9.2	9.6	9.7	9.4	8.1	22.1	20.0		25.2	29.7	25.4	22.3
Entrenchment Ratio	>5.0	>5.0	>5.0	>5.0	>5.0	>5.0	>5.0	>5.0	>5.0	>5.0	>5.0	>5.0	>5.0	>5.0	>5.0	>5.0		>5.0	>5.0	>5.0	>5.0
Wetted Perimeter(ft)	66.1	61.0	62.3	60.9	69.8	61.9	66.6	55.4	53.2	55.1	55.1	54.4	54.2	53.2	70.3	73.1		77.0	84.3	79.7	73.0
Hydraulic radius (ft)	2.8	3.0	2.8	3.0	2.6	3.3	3.0	3.8	3.9	4.1	3.9	3.9	3.9	4.2	2.7	3.0		2.6	2.5	2.7	2.8
Substrate																					
d50 (mm)						48	0.3	19	17	19		8	47	0.2						23	38.0
d84 (mm)						99	19	53	71	106		68	109	13						76	91.0

Note: Missing data not collected or not reported.

IV. Methodology Section

Monitoring methods used are based on US Army Corps of Engineering and NC Division of Water Quality Guides as referenced below.

The taxonomic standard for vegetation used in this report was based on “Manual of the Vascular Flora of the Carolinas”, by Albert E. Radford et al. The vegetation monitoring protocol used for collecting vegetation data was established for this project in 2000 by the Wetland Restoration Program (WRP) and Karen Hall with NCSU.

References:

Radford, Albert E., Harry E. Ahles, and C. Ritchie Bell. 1968. *Manual of the Vascular Flora of the Carolinas*. University of North Carolina Press: Chapel Hill, North Carolina.

Rosgen, D L. (1996) *Applied River Morphology*. Wildland Hydrology Books, Pagosa Springs, CO.

USACOE (2003) *Stream Mitigation Guidelines*. USACOE, USEPA, NCWRC, NCDENR-DWQ

WRP 2000 Stem Counting Protocol

APPENDIX A

Vegetation Data Tables

1. Stem Counts by Plot
2. Vegetation Problem Areas

Exhibit Table 1 -2007 Stem Counts by Plot			
East Prong of the Roaring River at Stone Mountain State Park/Project # 364			
Bare Root Plants Plots	Stems from Planted Bare Roots	Stems from Natural Regeneration	% Herbaceous Cover
<i>Reach 2 (Plot #1)</i>	0	14	>90%
<i>Reach 4 (Plot #2)</i>	4	>150	>90%
<i>Reach 4 (Plot #3)</i>	0	37	>90%
<i>Reach 4 (Plot #4)</i>	0	>300	>90%
Plot Totals	4	>501	>90%
Overall Total Plot Average	1	125	>90%
Overall Project Stems/Acre	40	5060	
Live Stake Plots			
<i>Reach 2</i>	0	13	
<i>Reach 2</i>	4	22	
<i>Reach 2</i>	5	30	
<i>Reach 4</i>	1	6	
<i>Reach 4</i>	0	0	
<i>Reach 4</i>	0	36	
<i>Reach 4</i>	6	2	
<i>Reach 4</i>	0	5	
Live Stake Totals	16	114	
Overall Total Live Stake Plot Average	2	14	
Overall Project Live Stake Stems/Acre	81	577	

Exhibit Table 2 Vegetative Problem Areas			
East Prong of the Roaring River at Stone Mountain State Park/Project # 364			
Feature/Issue	Station #/Range	Probable Cause	Photo #
Invasive/Exotic Populations	Various Locations	Existing or upland seed source	No photo taken

APPENDIX B

Morphology Raw Data

1. Current Condition Plan View
2. Stream Problem Area Table
3. Stream Problem Area Photos
4. Qualitative Visual Stability Assessment Tables
5. Cross section and Pebble Count Plots and Raw Data Tables
6. Longitudinal Plots and Raw Data Tables
7. Slope Calculation Table
8. Pattern Data
9. GPS Coordinates

Exhibit Table B1. Stream Problem Areas
East Prong of the Roaring River at Stone Mountain State Park/Project # 364

Reach 2 and Reach 4

Problem Number	Feature Issue	Station numbers	Suspected Cause
PA 18	Bank Slump on left bank	3+25 to 3+75 R4	Lack of deep rooting vegetation and steep bank slope

2006



2007



PA 18 Looking Downstream STA 3+50 Left Bank Erosion

Table B2a. Visual Morphological Stability Assessment						
East Prong of the Roaring River at Stone Mountain State Park/Project # 364						
Reach 2 - 1500 Feet						
Feature Category	Metric (per As-built and reference baselines)	(# Stable) Number Performing as Intended	Total number per As-built	Total Number / feet in unstable state ¹	% Perform in Stable Condition ²	Feature Perform. Mean or Totals ³
A. Riffles	1. Present? ⁴	5	5	0/0	100	
	2. Armor stable (e.g. no displacement)?	5	5	0/0	100	
	3. Facet grade appears stable?	5	5	0/0	100	
	4. Minimal evidence of embedding/fining?	5	5	0/0	100	
	5. Length appropriate?	5	5	0/0	100	100%
B. Pools	1. Present? (e.g. not subject to severe aggrad. or migrat.) ⁴	5	5	0/0	100	
	2. Sufficiently deep (Max Pool D:Mean Bkf >1.6?)	5	5	0/0	100	
	3. Length appropriate?	5	5	0/0	100	100%
C. Thalweg	1. Upstream of meander bend (run/inflection) centering? ⁵	3	3	0/0	100	
	2. Downstream of meander (glide/inflection) centering? ⁵	3	3	0/0	100	100%
D. Meanders	1. Outer bend in state of limited/controlled erosion?	3	3	0/0	100	
	2. Of those eroding, # w/concomitant point bar formation?	NA	NA	NA	NA	
	3. Apparent Rc within spec?	3	3	NA	100	
	4. Sufficient floodplain access and relief? ⁶	3	3	NA	100	100%
E. Bed General	1. General channel bed aggradation areas (bar formation)	NA	NA	0/0	100	
	2. Channel bed degradation – areas of increasing down-cutting or head cutting?	NA	NA	0/0	100	100%
F. Bank	1. Actively eroding, wasting, or slumping bank	NA	NA	0/0	100	100%
F. Vanes	1. Free of back or arm scour?	10	10	NA	100	
	2. Height appropriate?	10	10	NA	100	
	3. Angle and geometry appear appropriate?	9	10	NA	90	
	4. Free of piping or other structural failures?	9	10	NA	90	95%
G. Wads/Boulders	1. Free of scour?	0	0	0/0	100	
	2. Footing stable?	0	0	0/0	100	100%

*Note: Significant repairs completed in 2006/2007

Footnotes:

The above table should be completed using the visual assessment data form for each project reach/segment

It is recognized that the various metrics within a feature category may not have equal influence on the overall stability of that feature and that this does not incorporate weighting or scoring; however, at this time, EEP requires documentation of the relevant observations for these feature categories.

1 Metrics that are spatial estimates should be entered as: The number of locales over the reach for which the failing condition is observed / followed by the total linear distance (feet) or area for which the failing or unstable condition is observed.

2 In the case of categorical metrics for which a feature count is involved, this is simply calculated as the number of functional features that are in a state of stability as a percentage of the total. In the case of those metrics based on footage or aerial extent it is that amount in a state of failure or instability expressed as a proportion of the total amount of that feature. The resulting proportion is then subtracted from 1 and then multiplied by 100 to give a percentage that represents the proportion of that feature category in a state of apparent stability.

3 The mean of the metrics for a given feature category.

4 Was the feature actually present as compared to the As-built or has the feature been completely obscured (aggraded) or removed (degraded).

5 Is the Thalweg centering up on the channel in between meander bends?

6 Is the meander bend in a state of constriction?

Documents referenced in the construct of the above assessment table

USDA-NRCS (1998) *Stream Visual Assessment Protocol* National Water and Climate Center (Technical Note 99-1)

Rosgen, D.L. (1996) *Applied River Morphology*. Wildland Hydrology Books, Pagosa Springs, CO.

Phankuch, D.J. (1975) Stream reach inventory and channel stability evaluation. USDA Forest Service, R1-75-002. GPO #696-260/200

**Table B1b. Visual Morphological Stability Assessment
East Prong of the Roaring River at Stone Mountain State Park/Project # 364
Reach 4 - 3500 Feet**

Feature Category	Metric (per As-built and reference baselines)	(# Stable) Number Performing as Intended	Total number per As-built	Total Number / feet in unstable state ¹	% Perform in Stable Condition ²	Feature Perform. Mean or Total ³
A. Riffles	1. Present? ⁴	10	9	0/0	100	
	2. Armor stable (e.g. no displacement)?	10	9	0/0	100	
	3. Facet grade appears stable?	10	9	0/0	100	
	4. Minimal evidence of embedding/fining?	8	9	2/60	80	
	5. Length appropriate?	10	9	0/0	100	96%
B. Pools	1. Present? (e.g not subject to severe aggrad. or migrat.?) ⁴	15	15	0/0	100	
	2. Sufficiently deep (Max Pool D:Mean Bkf >1.6?)	15	15	0/0	100	
	3. Length appropriate?	15	15	0/0	100	100%
C. Thalweg	1. Upstream of meander bend (run/inflection) centering? ⁵	7	7	0/0	100	
	2. Downstream of meander (glide/inflection) centering? ⁵	7	7	0/0	100	100%
D. Meanders	1. Outer bend in state of limited/controlled erosion?	7	7	0/0	100	
	2. Of those eroding, # w/concomitant point bar formation?	7	7	NA	100	
	3. Apparent Rc within spec?	7	7	0/0	100	
	4. Sufficient floodplain access and relief? ⁶	7	7	0/0	100	100%
E. Bed General	1. General channel bed aggradation areas (bar formation)	NA	NA	0/0	100	
	2. Channel bed degradation – areas of increasing down-cutting or head cutting?	NA	NA	0/0	100	100%
F. Bank	1. Actively eroding, wasting, or slumping bank	NA	NA	2/70	98	98%
G. Vanes	1. Free of back or arm scour?	15	15	NA	100	
	2. Height appropriate?	13	15	NA	87	
	3. Angle and geometry appear appropriate?	15	15	NA	100	
	4. Free of piping or other structural failures?	15	15	NA	100	97%
H. Wads/ Boulders	1. Free of scour?	2	4	NA	50	
	2. Footing stable?	2	4	NA	50	50%

*Note: Significant repairs completed in 2006/2007

Footnotes:

The above table should be completed using the visual assessment data form for each project reach/segment

It is recognized that the various metrics within a feature category may not have equal influence on the overall stability of that feature and that this does not incorporate weighting or scoring; however, at this time, EEP requires documentation of the relevant observations for these feature categories.

1 Metrics that are spatial estimates should be entered as: The number of locales over the reach for which the failing condition is observed / followed

2 In the case of categorical metrics for which a feature count is involved, this is simply calculated as the number of functional features that are in a state of stability as a percentage of the total. In the case of those metrics based on footage or aerial extent it is that amount in a state of failure or instability expressed as a proportion of the total amount of that feature. The resulting proportion is then subtracted from 1 and then multiplied by 100 to give a percentage that represents the proportion of that feature category in a state of apparent stability.

3 The mean of the metrics for a given feature category.

4 Was the feature actually present as compared to the As-built or has the feature been completely obscured (aggraded) or removed (degraded).

5 Is the Thalweg centering up on the channel in between meander bends?

6 Is the meander bend in a state of constriction?

Documents referenced in the construct of the above assessment table

USDA-NRCS (1998) *Stream Visual Assessment Protocol* National Water and Climate Center (Technical Note 99-1)

Rosgen, D.L. (1996) *Applied River Morphology*. Wildland Hydrology Books, Pagosa Springs, CO.

Phankuch, D.J. (1975) Stream reach inventory and channel stability evaluation. USDA Forest Service, R1-75-002. GPO #696-260/200

Project Name Stone Mountain
 Cross Section Reach 2 Cross-Section 1
 Feature Riffle
 Date 8/1/07
 Crew Price, Roberts


Year 7 - 2007 2007 Survey			Year 6 - 2006 2006 Survey			Year 5 - 2005 2004 Survey			Year 4 - 2004 2004 Survey			Year 3 - 2003 2003 Survey			Year 2 - 2002 2002 Survey			Year 1 - 2001 2001 Survey					
Station	Elev	Notes	Station	Elev	Notes	Station	Elev	Notes	Station	Elev	Notes	Station	Elev	Notes	Station	Elev	Notes	Station	Elev	Notes			
53.8	1311.16	X1LP	53.8	1311.2		53.8	1311.3	Lpin1	53.8	1311.2		53.8	1311.2		53.8	1311.2	LPIN	53.8	1311.0		53.8	1311.0	
60.42	1311.2		71.9	1311.6		54.2	1311.2		54.0	1311.2		53.8	1311.5		57.0	1311.0	GRND	57.0	1311.0		57.0	1311.0	
86.18	1311.74		72.3	1311.6		56.3	1311.0		66.4	1311.3		80.8	1312.0		60.8	1311.2		61.5	1311.0		61.5	1311.0	
89.01	1311.15		81.5	1312.0		63.5	1311.2		74.6	1311.7		89.8	1311.3		67.8	1311.2		66.0	1311.1		66.0	1311.1	
90.38	1310.11		82.7	1311.9		75.2	1311.8		82.9	1311.9		92.8	1309.5		75.8	1311.8		68.0	1311.0		68.0	1311.0	
91.39	1309.19		89.5	1311.2		77.3	1311.7		89.8	1311.1		94.8	1308.0		85.8	1311.9		70.0	1311.2		70.0	1311.2	
92.88	1308.19		89.8	1311.1		83.4	1312.0		92.0	1309.2		95.8	1306.9		88.8	1311.4		75.3	1311.6		75.3	1311.6	
93.57	1307.57		92.3	1309.1		87.8	1311.6	LBKF	94.1	1307.9		96.3	1305.9		89.8	1311.2		79.0	1311.7		79.0	1311.7	
94.33	1306.88		93.6	1308.3		89.0	1311.3		95.5	1306.1		98.0	1305.6		90.3	1311.0		83.5	1311.7		83.5	1311.7	
95.29	1306.35		93.9	1307.8		89.8	1311.2		96.7	1306.0		102.3	1305.6		90.8	1310.3		86.0	1311.6		86.0	1311.6	
95.69	1305.76		95.2	1306.2		92.4	1309.1		101.6	1305.3		107.8	1305.8		91.8	1309.5		87.8	1311.3	LBKF	87.8	1311.3	
96.48	1305.62		95.4	1306.2		94.5	1307.1		105.9	1305.5		114.8	1306.0		92.3	1308.7		90.0	1310.8		90.0	1310.8	
97.77	1305.5		96.0	1305.0		95.1	1305.4		110.5	1305.7		120.8	1305.9		93.8	1307.8		91.7	1309.0		91.7	1309.0	
99.53	1305.42		96.2	1306.1 X1W		95.2	1305.4		113.5	1305.8		126.3	1305.9		94.3	1307.5		93.3	1307.6		93.3	1307.6	
101.7	1305.51		97.4	1305.6		99.7	1305.3		113.6	1305.8		131.8	1305.8		94.8	1306.7		94.3	1306.7		94.3	1306.7	
103.39	1305.55		99.5	1305.3		105.4	1305.4		113.7	1305.9		138.1	1305.9		95.4	1306.3		94.7	1305.9		94.7	1305.9	
107.38	1305.64		99.8	1305.2		107.8	1305.7		123.2	1305.8		142.3	1305.8		97.3	1305.8		95.0	1305.6		95.0	1305.6	
109.53	1305.74		104.5	1305.5		110.2	1305.8		123.2	1305.9		146.8	1306.4		98.8	1305.3		97.4	1305.5		97.4	1305.5	
111.29	1305.86		104.7	1305.5		111.0	1305.6		123.7	1305.8		148.8	1307.6		99.8	1305.1		99.8	1304.8		99.8	1304.8	
113.15	1305.9		107.3	1305.6		119.0	1305.6		129.8	1305.7		149.4	1308.3		102.8	1305.3		103.4	1305.3		103.4	1305.3	
114.7	1305.88		107.5	1305.6		123.1	1305.7		140.5	1305.7		150.1	1309.9		105.8	1305.5		107.7	1305.4		107.7	1305.4	
116.34	1305.86		108.9	1305.7		128.3	1305.6		147.6	1306.4		150.8	1311.1		108.8	1305.6		110.5	1305.4		110.5	1305.4	
116.78	1305.85		110.5	1305.9		132.2	1305.6		148.7	1307.4		151.8	1311.6		111.8	1305.8		112.0	1305.8		112.0	1305.8	
118.41	1305.9		113.8	1305.9		132.8	1305.6		150.8	1310.9		152.8	1312.0		114.8	1305.9		116.0	1305.6		116.0	1305.6	
120.2	1305.96		115.6	1306.0		138.6	1305.7		153.1	1312.0		154.8	1312.2		118.8	1305.8		119.0	1305.5		119.0	1305.5	
122.3	1305.92		122.6	1305.8		142.5	1305.6		156.1	1312.3		158.8	1312.3		123.8	1306.1		122.0	1305.7		122.0	1305.7	
124.05	1305.9		123.0	1305.9		147.1	1306.0		161.1	1312.0		162.9	1312.2		129.8	1306.0		125.2	1305.8		125.2	1305.8	
126.13	1305.86		130.0	1305.8		148.1	1306.2		163.0	1312.1	Rpin1	162.9	1312.1		134.8	1305.9		127.5	1305.6		127.5	1305.6	
128.12	1305.73		130.7	1305.8		148.7	1306.3		163.0	1312.1		163.0	1312.1		138.8	1305.9		132.0	1305.8		132.0	1305.8	
129.45	1305.69		136.3	1305.8		148.9	1307.4		148.9	1307.4		151.7	1311.5		143.8	1305.9		136.6	1305.7		136.6	1305.7	
132.15	1305.67		138.1	1305.7		149.7	1308.4		150.9	1310.6		146.8	1306.2		146.8	1306.2		142.5	1305.6		142.5	1305.6	
134.12	1305.71		142.1	1305.7		150.9	1310.6		151.5	1311.1		147.5	1306.6		148.3	1307.3		146.8	1306.1		146.8	1306.1	
135.79	1305.75		144.3	1305.8		144.8	1305.9		153.8	1311.9		149.3	1307.8		149.3	1307.5		147.6	1306.2		147.6	1306.2	
138.29	1305.71		144.9	1305.9		144.9	1305.9		154.9	1312.0		149.7	1308.2		149.7	1309.4		149.2	1307.5		149.2	1307.5	
141.3	1305.6		145.3	1306.1		145.3	1306.1		157.8	1312.3		149.8	1309.3		151.4	1311.3		151.4	1311.3		151.4	1311.3	
143.84	1305.75		147.1	1306.4		147.1	1306.4		161.6	1312.0		150.3	1310.1		154.0	1311.9		154.0	1311.9		154.0	1311.9	
146.58	1306.19		147.2	1306.1		147.2	1306.1		163.0	1312.1		150.8	1310.9		156.0	1312.0		156.0	1312.0		156.0	1312.0	
147.48	1306.59		147.4	1306.4 X1W		148.85	1307.76		147.4	1306.4 X1W		148.85	1307.76		148.82	1308.81		148.82	1308.81		148.82	1308.81	
148.82	1308.81		148.8	1306.3		148.8	1306.3		148.8	1306.3		148.8	1306.3		148.8	1306.3		148.8	1306.3		148.8	1306.3	
150.93	1310.02		148.1	1306.7		148.1	1306.7		148.1	1306.7		148.1	1306.7		148.1	1306.7		148.1	1306.7		148.1	1306.7	
152.14	1310.95		148.4	1306.8		148.4	1306.8		148.4	1306.8		148.4	1306.8		148.4	1306.8		148.4	1306.8		148.4	1306.8	
153.48	1311.93		148.9	1307.4		148.9	1307.4		148.9	1307.4		148.9	1307.4		148.9	1307.4		148.9	1307.4		148.9	1307.4	
155.62	1312.21		149.9	1308.8		149.9	1308.8		149.9	1308.8		149.9	1308.8		149.9	1308.8		149.9	1308.8		149.9	1308.8	
	Year 7 - 2007	Year 6 - 2006	Year 5 - 2005	Year 4 - 2004	Year 3 - 2003	Year 2 - 2002	Year 1 - 2001	AS-BUILT 2000
Area	309.9	310.1	318.5	307.0	296.5	306.0	319.8	
Width	6.1	6.1	6.1	6.1	6.2	6.2	6.1	
Mean Depth	5.0	5.0	5.2	5.0	4.8	4.9	5.2	
Max Depth	5.8	6.0	5.9	5.9	5.7	6.1	6.4	
W/D	12.4	12.4	12.0	12.2	13.0	12.6	12.0	

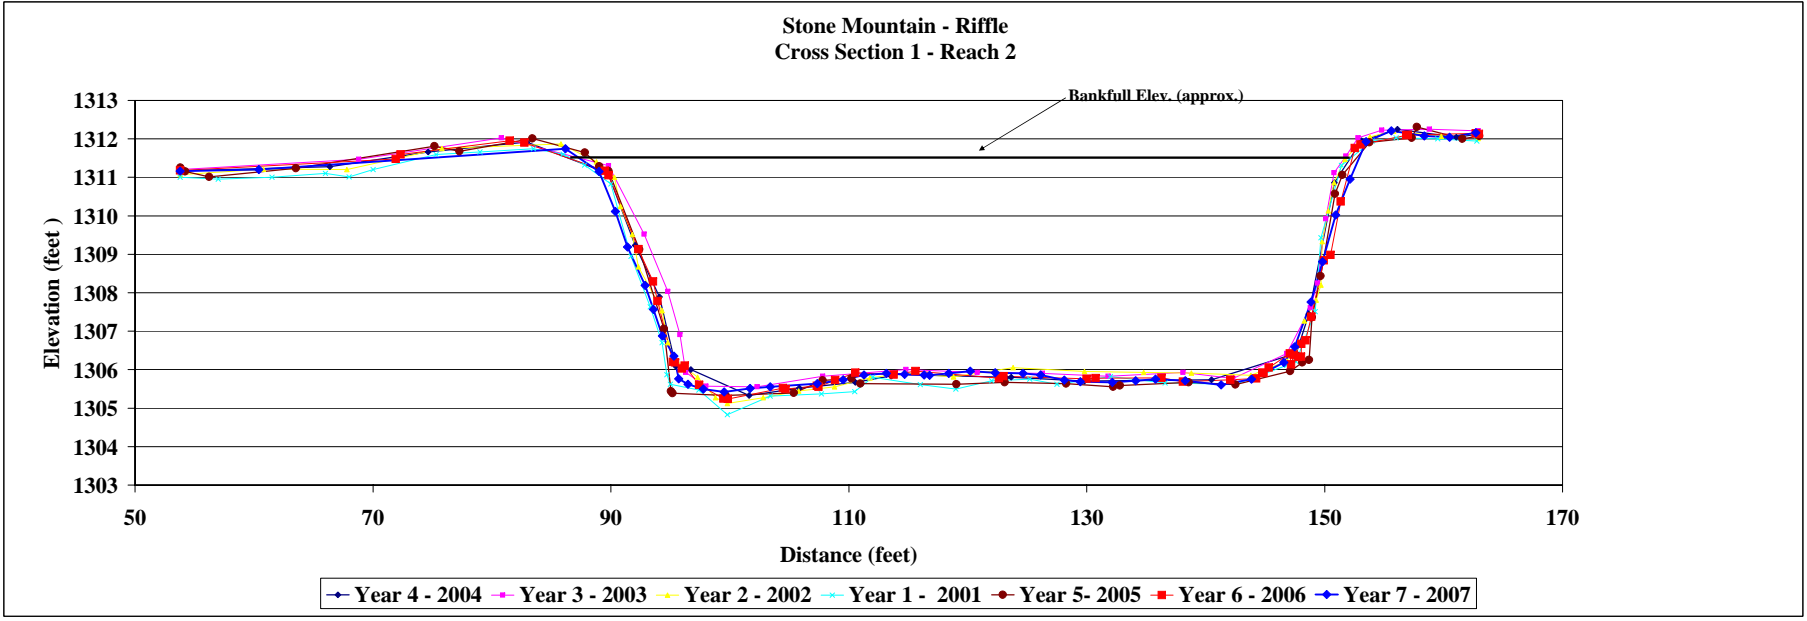Stone Mountain - Riffle
 Cross Section 1 - Reach 2




Project Name Stone Mountain
 Cross Section Reach 2 Cross-Section 2
 Feature Pool
 Date 8/1/07
 Crew Price, Roberts

Year 7 - 2007 2007 Survey			Year 6 - 2006 2006 Survey			Year 5 - 2005 2004 Survey			Year 4 - 2004 2004 Survey			Year 3 - 2003 2003 Survey			Year 2 - 2002 2002 Survey			Year 1 - 2001 2001 Survey			AS-BUILT 2000 AS-BUILT Survey			
Station	Elev	Notes	Station	Elev	Notes	Station	Elev	Notes	Station	Elev	Notes	Station	Elev	Notes	Station	Elev	Notes	Station	Elev	Notes	Station	Elev	Notes	
0	1308.5	X2LP	0	1308.37	X2LP	0.0	1308.5	LPIN	0.0	1308.5	LPIN	0.0	1308.5	LPIN	0.0	1308.5	LPIN	0.0	1308.5	LPIN	0.0	1308.5	LPIN	
1.77	1308.1		4.04	1307.79	X2	14.5	1307.8	1308.0	0.0	1308.2		0.0	1308.2	GRND	0.0	1308.2		3.0	1308.0		3.0	1308.0		
3.81	1307.98		16.53	1308.01	X2	18.0	1308.3	1307.4	14.0	1307.7		18.0	1308.3		3.0	1307.9		5.0	1308.0		5.0	1308.0		
6.07	1308.03		20.5	1307.63	X2	20.7	1307.7	1307.6	17.9	1308.3		23.0	1307.2		7.0	1307.9		7.8	1307.9		7.8	1307.9		
7.77	1307.93		25.8	1306.53	X2	24.5	1306.8	1307.2	21.7	1307.5		27.0	1306.0		12.0	1307.7		11.0	1307.8		11.0	1307.8		
11.74	1307.78		30.35	1305.72	X2	27.3	1306.3	1306.1	26.3	1306.4		32.0	1305.3		15.0	1305.8		13.5	1307.6		13.5	1307.6		
15.33	1308.02		35.59	1305.51	X2	30.7	1305.8	1305.3	30.0	1305.9		36.5	1305.2		16.0	1308.0		18.0	1308.3		18.0	1308.3		LBBF
17.29	1308.32		37.14	1304.56	X2	35.3	1305.6	1305.1	34.9	1305.5		40.3	1304.7		17.0	1308.2		20.3	1307.8		20.3	1307.8		
20.56	1307.8		44.52	1304.01	X2	37.8	1304.5	1304.1	37.6	1304.7		43.6	1304.0	LEW	18.0	1308.4		30.3	1305.2		30.3	1305.2		
23	1307.28		48.91	1303.62	X2	40.7	1304.3	1303.6	46.2	1303.9		45.4	1303.6		20.0	1307.8		36.8	1305.0		36.8	1305.0		
24.19	1306.96		53.47	1303.26	X2	42.2	1304.3	1303.2	52.5	1303.4		49.2	1303.1		22.0	1307.4		46.4	1304.2		46.4	1304.2		
25.79	1306.64		56.81	1302.95	X2	43.4	1304.1	1302.8	60.6	1302.8		53.0	1302.4		24.0	1306.9		53.0	1303.1		53.0	1303.1		
28.21	1306.2		59.57	1302.93	X2	44.8	1303.9	1302.5	63.3	1302.6		56.3	1301.9		26.0	1306.2		56.1	1302.4		56.1	1302.4		
30.55	1305.91		62.67	1302.34	X2	47.4	1303.9	1302.5	66.0	1302.1		60.2	1301.3		28.0	1305.7		59.3	1301.7		59.3	1301.7		
32.73	1305.7		68.57	1301.04	X2	50.5	1303.6	1301.9	68.7	1301.5		62.2	1301.3		30.0	1305.3		62.4	1301.4		62.4	1301.4		
34.83	1305.64		71.43	1301.23	X2	54.5	1303.3	1300.6	70.6	1301.4		65.0	1301.7		31.5	1305.1		64.0	1301.4		64.0	1301.4		
36.26	1305.35		72.9	1301.71	X2	56.3	1303.1	1300.8	72.8	1302.3		68.5	1302.4		34.0	1305.2		65.9	1301.9		65.9	1301.9		
37.71	1304.88		73.33	1301.73	X2	57.8	1303.1	1301.3	73.3	1302.7		70.8	1302.6		37.0	1305.1		68.0	1302.4		68.0	1302.4		
39.24	1304.49		73.6	1302.04	X2	61.3	1303.1	1301.3	73.5	1303.9		72.2	1303.3	REW	39.0	1304.9		70.7	1304.2		70.7	1304.2		
41.32	1304.34		74.28	1304.75	X2	62.0	1303.2	1301.6	73.8	1304.9		72.5	1304.0		42.0	1304.8		72.2	1304.7		72.2	1304.7		
45.55	1303.15		74.73	1304.81	X2	65.0	1301.5	1304.3	75.0	1306.1		73.4	1305.1		43.0	1304.5		73.0	1305.4		73.0	1305.4		RBBF
47.81	1302.64		75.3	1305.73	X2	67.8	1301.2	1304.4	78.0	1307.1		75.0	1305.9		44.5	1304.6		74.2	1305.9		74.2	1305.9		
51.39	1302.12		79.46	1307.11	X2	69.6	1301.2	1305.3	79.2	1307.3		76.4	1306.5		45.5	1304.5		76.2	1306.9		76.2	1306.9		
53.89	1302.19		84.1	1307.06	X2	71.7	1301.3	1306.7	84.0	1307.1		78.0	1306.9		46.5	1304.0		79.8	1307.0		79.8	1307.0		
57.16	1302.26		86.12	1307.32	X2RP	74.1	1301.9	1306.6	84.3	1307.0		84.5	1306.9		48.0	1303.6		81.9	1306.9		81.9	1306.9		
59.55	1302.32		75.0	1304.2	1306.9	81.1	1307.3		86.1	1307.3		87.1	1307.1		49.5	1303.3		85.0	1306.9		85.0	1306.9		
61.91	1302.19		75.5	1305.4	-0.4							51.0	1303.1					87.1	1307.2					
64.24	1301.79		77.0	1306.7	-0.4							53.0	1302.7											
66.5	1301.46		79.9	1307.1	-0.4							55.0	1302.3											
68.59	1301.41		83	1307.1	-0.4							57	1302.1											
70.27	1301.55		84	1307.0	-0.4							58.5	1301.9											
72.14	1301.61		86.9	1307.4	-0.4							59	1301.6											
74.09	1302.3											59.5	1301.6											
74.28	1303.14											61	1301.5											
75.54	1305.23											63	1301.3											
76.17	1306.1											65	1301.5											
77.69	1306.79											67	1301.7											
78.53	1306.98											68	1302.2											
82.84	1307.41											69	1302.7											
84.05	1307.19											70	1303.8											
85.67	1307.34											70.8	1304.1											
86.83	1307.49	X2RP										71	1304.5											
												72	1304.8											
												73	1305.2											
												74	1305.7											
												75	1306.2											
												75	1306.2											
												77	1306.9											
												79	1307.0											
												82	1306.9											
												85	1306.9											
												87.1	1307.4											
												87.1	1307.2											



Photo of Cross-Section 2 - Reach 2 - Looking Downstream @ STA 5-75

	Year 7 - 2007	Year 6 - 2006	Year 5 - 2005	Year 4 - 2004	Year 3 - 2003	Year 2 - 2002	Year 1 - 2001	AS-BUILT 2000
Area	176.0	166.0	166.1	155.6	170.3	158.7	158.4	158.4
Width	51.1	60.3	56.3	53.3	53.4	53.0	53.9	53.9
Mean Depth	3.4	2.8	3.0	2.9	3.2	3.0	2.9	2.9
Max Depth	5.2	5.9	5.8	5.6	5.7	4.6	5.6	5.6
W/D	14.8	21.9	19.1	18.3	16.7	17.7	18.3	18.3

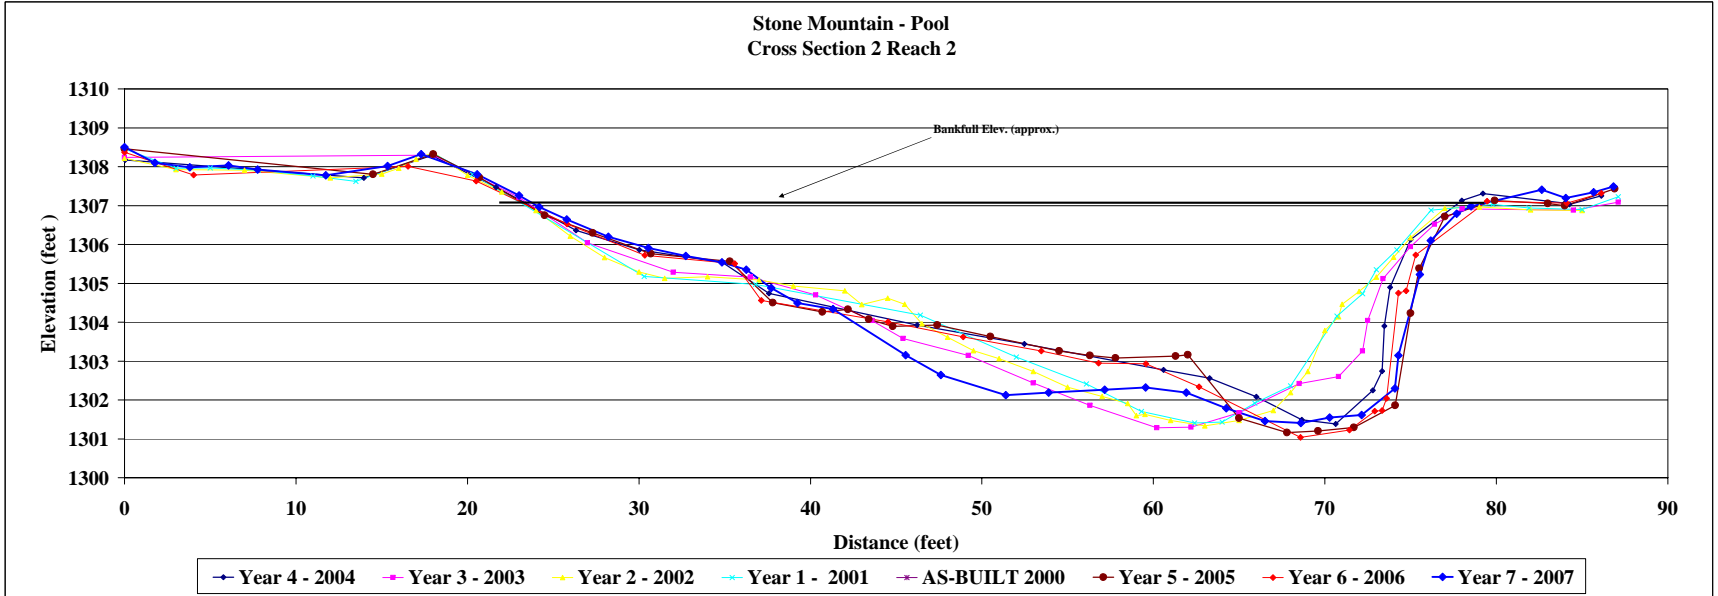

Project Name Stone Mountain
 Cross Section Reach 2 Cross-Section 3
 Feature Riffle
 Date 8/1/07
 Crew Price, Roberts


Year 7 - 2007 2007 Survey			Year 6 - 2006 2006 Survey			Year 5 - 2005 2005 Survey			Year 4 - 2004 2004 Survey			Year 3 - 2003 2003 Survey			Year 2 - 2002 2002 Survey			Year 1 - 2001 2001 Survey			AS-BUILT 2000 AS-BUILT Survey		
Station	Elev	Notes	Station	Elev	Notes	Station	Elev	Notes	Station	Elev	Notes	Station	Elev	Notes	Station	Elev	Notes	Station	Elev	Notes	Station	Elev	Notes
105.7	1308	X1LP	105.7	1307.99	X1LP	105.7	1308.1		105.7	1307.9		105.7	1307.9		105.7	1308.0		105.7	1308.0		105.7	1308.0	
107.46	1307.89		111.21	1306.97	X3	107.2	1307.9	1307.6	105.0	1308.2	Lpin	110.7	1307.2		105.7	1307.9		108.7	1307.6		108.6	1307.5	LBKF
108.87	1307.79		112.75	1306.02	X3	108.3	1307.8	1306.6	105.5	1308.1		115.7	1308.8		107.7	1307.8		110.7	1306.8		115.3	1304.6	
110.85	1307.18		113.97	1305.5	X3	109.5	1307.5	1305.6	108.2	1307.9		114.8	1305.4		109.2	1307.6		112.7	1306.0		118.7	1303.8	
112.15	1306.49		115.35	1303.73	X3	113.1	1306.0	1305.1	110.4	1307.2		115.4	1304.0		109.7	1307.4		114.7	1305.1		124.2	1303.1	
113.47	1306.01		118.91	1301.08	X3	114.6	1305.3	1303.3	112.2	1306.2		117.2	1302.4		110.7	1307.1		115.0	1304.2		127.0	1303.4	
114.49	1305.4		125.51	1303.33	X3	114.8	1303.7	1302.7	114.0	1305.2		121.7	1303.4		111.7	1306.6		118.5	1303.6		132.8	1302.9	
115.27	1303.58		128.6	1303.19	X3	116.2	1303.3	1302.9	115.4	1304.2		125.3	1303.4		112.7	1306.1		121.7	1303.2		136.6	1303.4	
117.43	1303.31		131.71	1302.72	X3	117.6	1303.3	1302.8	115.4	1303.9		127.5	1303.5		113.7	1305.8		124.7	1303.0		142.6	1303.1	
119	1303.2		137.56	1302.45	X3	120.2	1303.3	1302.3	120.0	1303.4		132.2	1303.3		114.7	1305.2		126.7	1303.3		146.9	1303.8	
119.84	1303.01		143.03	1302	X3	123.4	1303.4	1302	125.5	1303.4		137.7	1303.1		115.2	1304.4		132.7	1302.8		153.4	1306.3	
121.15	1302.75		148.93	1302.47	X3	126.7	1303.4	1301.6	132.8	1302.8		142.0	1303.1		115.7	1304.0		134.7	1303.0		188.6	1307.5	RBKF
122.82	1302.42		151.67	1303.65	X3W	129.6	1303.1	1302.1	140.9	1302.1		146.1	1303.1		117.2	1303.5		137.2	1303.5		184.0	1307.4	
123.87	1302.43		153.25	1304.5	X3	131.2	1303.0	1303.2	145.7	1301.8		148.3	1303.4		118.7	1303.3		142.7	1303.2				
126.17	1302.39		154.85	1306.32	X3	133.6	1302.7	1304.1	146.0	1301.7		149.3	1304.0		120.7	1303.3		145.4	1303.6				
128.26	1302.5		156.73	1306.69	X3	134.8	1303.0	1305.9	149.0	1302.3		150.8	1305.5		122.7	1303.3		146.7	1304.3				
130.97	1302.5		159.79	1306.64	X3RP	137.6	1302.7	1306.1	152.9	1303.8		152.7	1306.2		124.7	1303.2		149.7	1305.0				
133.15	1302.56		168.1	1307.66	X3	141.3	1302.2	1306.2	153.0	1306.0		154.7	1305.5		126.7	1303.2		151.7	1305.9				
135.03	1302.67		180.02	1307.48	X3	144.9	1302.0	1307.2	153.1	1306.3		160.0	1306.8		128.7	1303.0		155.7	1306.6				
135.97	1302.55					147.2	1302.0	1307.1	153.2	1306.1		160.0	1306.8		130.7	1303.0		159.9	1306.7				
138.13	1302.64					147.4	1302.0		155.8	1306.5					131.7	1303.0							
140.05	1302.67					149.3	1302.4		156.2	1306.5					133.7	1303.3							
141.3	1302.61		down 0.42 feet			151.0	1303.2		159.1	1306.6	Rpin				136.7	1303.1							
142.74	1302.72					151.8	1303.6		168.4	1307.6					139.7	1303.0							
142.82	1302.78					152.1	1304.0								141.7	1303.0							
142.84	1302.75					152.7	1304.6								144.7	1303.3							
145.24	1302.52					153.2	1305.6								146.7	1303.6							
147.65	1302.48					153.7	1306.3								147.7	1303.9							
149.41	1302.7					154.8	1306.5								147.7	1304.1							
151.22	1303.09					156.4	1306.6								147.9	1304.27							
152.16	1303.08					159.5	1306.7								148.7	1304.62							
152.32	1304.15					168.4	1307.6								149.7	1308.0							
154.28	1306.29														150.7	1306.4							
155.77	1306.44														151.7	1305.7							
156.76	1306.57														152.7	1306.0							
155.84	1306.56														154.7	1306.4							
157.35	1306.68														155.7	1306.4							
158.54	1306.67														157.7	1306.6							
159.94	1306.66	X3RP													159.9	1306.6							



Photo of Cross-Section 3 - Reach 2 - Looking Downstream @ STA 7+00

	Year 7 - 2007	Year 6 - 2006	Year 5 - 2005	Year 4 - 2004	Year 3 - 2003	Year 2 - 2002	Year 1 - 2001	AS-BUILT 2000	Bench - 2004
Area	193.5	195.0	191.7	194.5	169.6	169.5	166.2	165.5	148.1
Width	54.2	60.1	60.1	60.1	58.3	59.7	60.2	60.0	45.4
Mean Depth	3.6	3.2	3.2	3.2	2.9	2.8	2.8	2.8	3.3
Max Depth	5.1	5.5	5.5	5.8	4.5	4.5	4.7	4.6	4.7
W/D	15.2	18.5	18.8	18.6	20.0	21.0	21.8	21.7	13.9

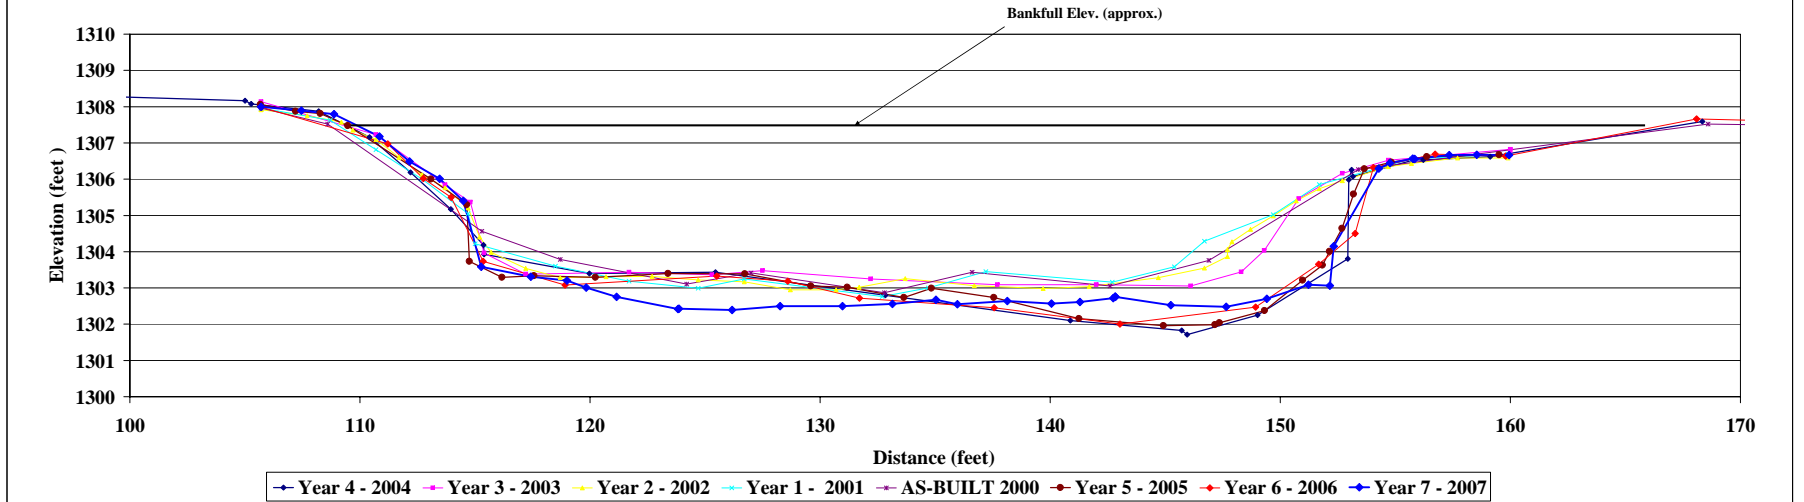Stone Mountain - Riffle
 Cross Section 3 Reach 2




Project Name Stone Mountain
 Cross Section Reach 2 Cross-Section 4
 Feature Riffle
 Date 8/1/07
 Crew Price, Roberts

Year 7 - 2007 2007 Survey			Year 6 - 2006 2006 Survey			Year 5 - 2005 2005 Survey			Year 4 - 2004 2004 Survey			Year 3 - 2003 2003 Survey			Year 2 - 2002 2002 Survey			Year 1 - 2001 2001 Survey			AS-BUILT 2000 AS-BUILT Survey		
Station	Elev	Notes	Station	Elev	Notes	Station	Elev	Notes	Station	Elev	Notes	Station	Elev	Notes	Station	Elev	Notes	Station	Elev	Notes	Station	Elev	Notes
22.23	1303.55	X4LP	22.23	1303.5	X4LP	22.6	1303.6	1303.1	10.6	1303.5		17.7	1303.7		17.7	1304.3		20.0	1303.8		0.0	1303.1	
27.83	1303.03		24.77	1303.5	X4	29.5	1302.8	1303.1	23.0	1303.7	Lpin	24.7	1302.8		20.7	1303.7		22.0	1303.1	LPIN	22.0	1303.6	LBKF
31.09	1302.66		32.02	1302.4	X4	32.3	1302.4	1302.0	24.2	1303.5		28.7	1302.5		22.7	1303.3		25.0	1302.3		24.4	1303.0	
33.14	1301.87		34.66	1300.9	X4	38.6	1300.8	1300.5	30.8	1302.7		32.7	1301.3		24.7	1302.7		28.0	1302.0		33.3	1301.3	
35.49	1300.92		37.91	1300.6	X4	41.5	1300.5	1300.1	31.3	1302.5		34.2	1301.0		26.7	1302.6		32.0	1301.6		38.2	1300.4	
39.21	1300.48		41.32	1300.3	X4	43.6	1300.8	1299.9	34.1	1301.3		37.7	1300.5		29.2	1302.5		34.8	1301.0		44.0	1300.9	
40.87	1298.91		43.75	1300.3	X4	45.3	1300.5	1299.9	36.6	1301.1		48.2	1299.4		30.2	1302.1		38.0	1300.4		46.7	1300.9	
45.33	1298.54		47.16	1299.7	X4	48.1	1300.0	1299.3	40.8	1300.3		54.3	1299.5		31.7	1301.8		47.0	1300.4		47.5	1300.9	
47.5	1298.17		49.63	1299.9	X4	51.1	1300.2	1299.5	43.5	1300.7		56.7	1300.0		34.2	1301.9		52.0	1300.6		52.0	1300.8	
49.21	1298.84		52.6	1299.4	X4	54.0	1299.9	1298.9	49.5	1300.0		62.7	1300.2		35.7	1301.2		55.0	1300.2		55.4	1300.0	
51.67	1298.52		56.35	1299.8	X4	56.7	1299.7	1299.4	53.9	1299.9		67.4	1300.4		38.2	1301.0		59.0	1300.7		58.0	1300.0	
53.49	1299.47		58.93	1300.2	X4	56.9	1299.7	1299.8	60.7	1300.3		69.9	1300.9		40.2	1301.0		63.0	1300.7		60.5	1300.7	
55.35	1299.48		64.5	1299.5	X4	61.4	1299.9	1299.1	67.5	1300.1		72.1	1301.9		42.5	1301.0		68.3	1301.1		61.0	1300.8	
57	1299.54		67.83	1299.7	X4	63.8	1299.7	1299.3	69.1	1300.5		74.2	1303.3		44.7	1300.9		72.0	1302.6		66.0	1300.8	
58.28	1299.58		69.19	1300.5	X4W	67.3	1300.5	1300.1	69.2	1301.1		75.9	1303.9		46.7	1300.6		74.0	1303.6		68.0	1301.2	
60.1	1299.48		72.43	1302.0	X4	69.4	1300.5	1301.6	71.4	1303.5		77.7	1304.3		47.7	1300.3		77.0	1304.5		69.2	1301.7	
61.83	1299.39		75.55	1304.3	X4	69.8	1300.7	1303.9	73.9	1303.9		82.0	1305.1		48.5	1300.5		80.0	1305.3		71.3	1301.7	
64.18	1299.42		78.84	1304.9	X4	72.2	1303.0	1304.4	76.0	1304.4		82.0	1305.1		52.0	1300.3		81.2	1305.3	RPIN	73.4	1301.4	RPIN
65.83	1299.62		78.95	1304.8	X4	75.4	1304.1	1304.4	79.6	1305.2		77.7	1304.3		54.2	1300.4					81.4	1305.3	RPIN
68.36	1300.44		81.5	1305.2	X4RP	75.4	1304.3	1304.8	81.1	1305.3		81.1	1305.3		56.2	1300.4					143.0	1305.0	
70.28	1300.44		84.01	1305.5	X4	81.5	1305.3	1305.1	84.5	1305.3		81.5	1305.3		58.7	1300.3							
72.7	1302.3		85.84	1305.6	X4				84.3	1305.6	Rpin				61.2	1300.5							
73.99	1303.31								91.9	1305.3					62.7	1300.8							
74.93	1303.86														65.7	1300.8							
76.85	1304.12														67.7	1301.0							
77.36	1304.31														68.7	1301.3							
77.39	1304.35														69.7	1301.6							
78.97	1304.91														70.7	1302.3							
80.55	1304.97														71.7	1302.8							
81.7	1305.1	X4RP													73.2	1303.04							
															73.7	1303.36							
															74.7	1303.9							
															75.7	1304.26							
															76.7	1304.39							
															77.7	1304.67							
															78.7	1304.97							
															79.7	1305.22							
															80.7	1305.42							
															82	1305.51							



Photo of Cross-Section 4 - Reach 2 - Looking Downstream @ STA 12+25

	Year 7 - 2007	Year 6 - 2006	Year 5 - 2005	Year 4 - 2004	Year 3 - 2003	Year 2 - 2002	Year 1 - 2001	AS-BUILT 2000
Area	168.5	150.1	135.0	130.6	156.5	124.8	136.3	
Width	53.0	53.2	52.8	52.9	56.5	53.0	54.0	
Mean Depth	3.2	2.8	2.6	2.5	2.8	2.4	2.5	
Max Depth	5.2	4.3	4.0	3.8	4.3	3.4	3.5	
WD	16.7	18.8	20.7	21.4	20.4	22.5	21.4	

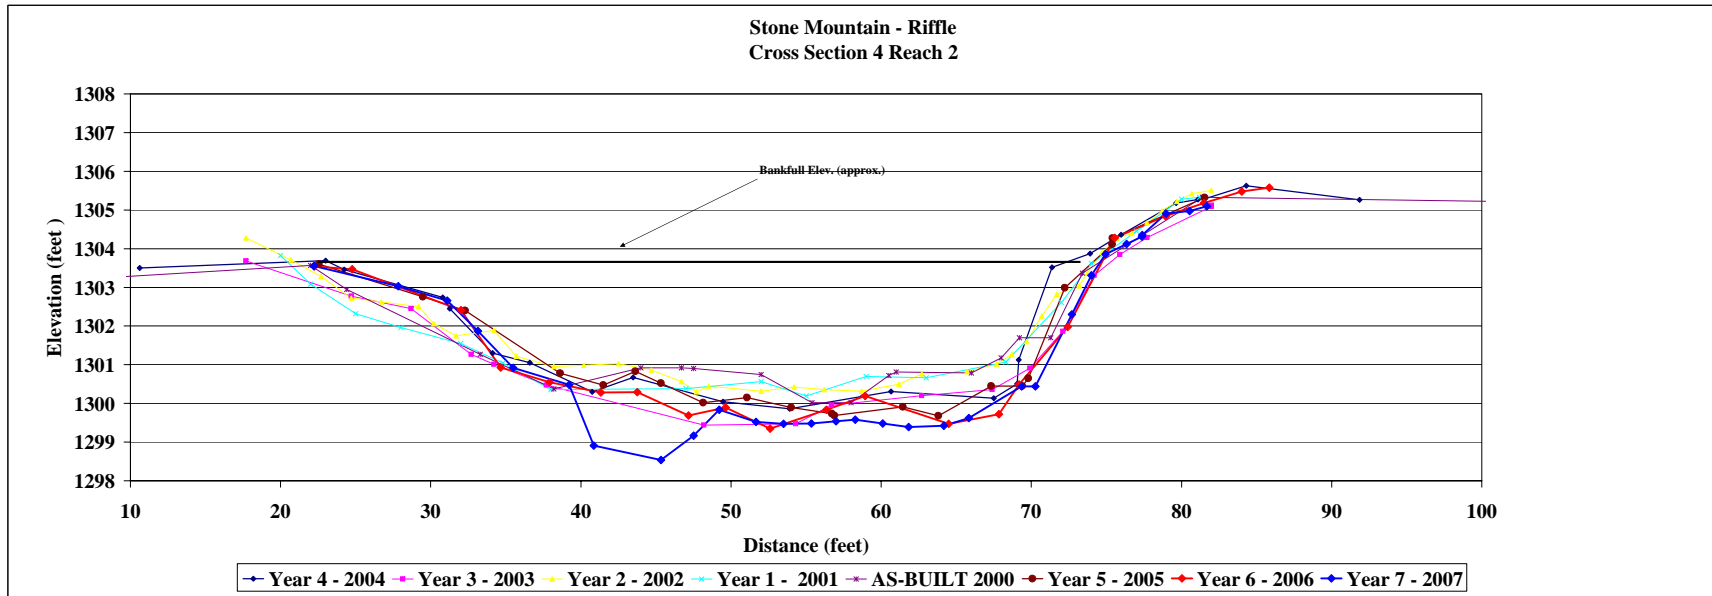


Project Name Stone Mountain
 Cross Section Reach 4 Cross-Section 1
 Feature Riffle
 Date 7/30/07
 Crew Price, Roberts

Year 7 - 2007 2007 Survey			Year 6 - 2006 2006 Survey			Year 5 - 2005 2005 Survey			Year 4 - 2004 2004 Survey			Year 3 - 2003 2003 Survey			Year 2 - 2002 2002 Survey			Year 1 - 2001 2001 Survey			AS-BUILT 2000 AS-BUILT Survey				
Station	Elev	Notes	Station	Elev	Notes	Station	Elev	Notes	Station	Elev	Notes	Station	Elev	Notes	Station	Elev	Notes	Station	Elev	Notes	Station	Elev	Notes		
27	1291.38	XILP	27	1291.4	XILP	27.0	1291.3	Left Pin	27.0	1291.3	Left Pin	27.0	1291.3		27.0	1291.3	LPIN	27.0	1291.3		6.0	1290.2			
27.63	1291.38		33.82	1289.43		28.9	1291.3		31.8	1290.7		30.0	1290.7		31.0	1291.0	LTOB	31.0	1291.0		27.0	1291.3			
28.71	1291.37		34.39	1288.63		29.7	1291.2		33.8	1289.9		33.0	1289.7		34.1	1290.0		33.0	1290.4		32.0	1290.6			
29.82	1291.3		34.8	1285.8		32.0	1290.9		35.2	1289.1		36.0	1288.5		35.0	1289.3		35.0	1289.2		33.0	1289.9	LBKF		
30.86	1291.12		35.37	1285.48	X1W	32.5	1290.7		35.9	1288.2		37.5	1287.3		36.1	1289.3		36.6	1289.0		35.0	1288.0			
31.32	1290.97		36.76	1285.23		33.9	1290.0		36.1	1286.3	Water	38.3	1284.9		39.7	1287.5		38.0	1288.3		38.5	1287.4			
32.24	1290.74		38.68	1285.1		34.9	1289.5		37.0	1285.6		39.0	1284.2		40.0	1285.3	LEW	39.0	1287.6		42.0	1286.0			
33.16	1287.55		38.85	1285.08		35.5	1289.0		38.4	1285.0		40.0	1284.2		42.4	1284.9		40.0	1286.9		49.0	1285.4			
34.27	1286.59		41.36	1285		35.8	1287.8		40.1	1285.0		44.0	1284.4		47.3	1285.1		41.0	1286.3		60.2	1284.8			
35.19	1285.45	X1W	46.86	1285.27		36.2	1285.6		41.9	1284.9	XST	55.0	1284.6		55.8	1285.3		42.0	1285.7		63.2	1285.4			
36.15	1285.14		52.01	1285.34		36.5	1285.3		46.7	1285.0		63.0	1284.8		63.4	1285.3		42.2	1285.2		65.4	1285.4			
37.71	1284.99		54.86	1285.58		37.4	1285.0		50.2	1285.0		72.0	1285.1		68.0	1285.2		42.2	1285.4		65.7	1285.4			
41.75	1284.91		56.64	1285.48		39.8	1285.0		54.4	1285.1		74.0	1286.4		70.6	1285.3		48.0	1285.1		68.5	1285.3			
44.78	1285.11		58.98	1285.36		42.1	1284.9		58.2	1285.4		80.0	1287.8		71.7	1285.6	REWWS	52.0	1285.1		69.0	1284.4			
47.93	1285.33		60.87	1285.24		42.3	1284.9		63.1	1285.1		85.0	1289.4		73.4	1286.1	BAR	57.0	1285.1		78.3	1285.6			
53.17	1285.48		62.25	1285.25		43.5	1284.9		65.1	1285.1		92.3	1289.0		74.4	1286.6		60.0	1285.2		83.4	1287.2	RBKF		
58.25	1285.51		65.63	1284.94		46.2	1285.0		66.9	1285.1					76.2	1286.7		64.0	1285.2		90.0	1289.7			
60.77	1285.66		68.18	1285.42	X1W	48.0	1285.1		69.4	1285.3					78.8	1286.7		68.0	1285.2		105.0	1290.5			
64.2	1285.28		74.31	1288.44		48.2	1285.2		71.4	1285.1					81.0	1286.4		71.0	1285.2		107.0	1288.6			
64.43	1285.28		78.93	1288.93		48.8	1285.2		72.1	1285.4					87.3	1288.3		72.0	1285.4						
67.08	1284.99		84.48	1288.26		51.3	1285.2		73.2	1286.6					89.2	1288.8		75.0	1285.9						
70.34	1285		89.62	1289.68	X1RP	53.0	1285.3		74.0	1287.3					90.0	1289.2	RTOB	79.0	1286.0						
72.17	1285.35	X1W				55.1	1285.4		75.5	1287.6					91.0	1289.5		82.0	1286.4						
72.37	1286.69					58.1	1285.5		77.0	1288.5					86.0	1287.8		86.0	1287.8						
74.78	1288.39					62.1	1285.3		79.4	1288.6					88.0	1288.9		88.0	1288.9						
78.1	1288.63					62.8	1285.3		81.8	1288.3					89.0	1289.4		89.0	1289.4						
82.1	1288.4					64.1	1285.2		85.8	1288.1					90.0	1289.6		90.0	1289.6						
85.62	1288.38					65.2	1285.2		86.9	1288.7															
88.88	1289.5					66.7	1285.0																		
88.93	1289.5					68.6	1285.08																		
89.95	1289.68	X1RP				70.4	1285.06																		
						71.4	1285.01																		
						71.9	1285.21																		
						72.1	1285.83																		
						72.5	1286.55																		
						74.7	1287.26																		
						76.7	1284.42																		
						78.6	1288.58																		
						79.8	1288.66																		
						80.7	1288.6																		
						82.4	1288.36																		
						83.2	1288.35																		
						84.3	1288.07																		
						85.0	1288.09																		
						85.7	1288.3																		
						88.5	1289.12																		
						90.5	1289.64																		
						93.2	1289.78																		



Photo of Cross-Section 1 - Reach 4 - Looking Downstream @ STA 4-50

	Year 7 - 2007	Year 6 - 2006	Year 5 - 2005	Year 4 - 2004	Year 3 - 2003	Year 2 - 2002	Year 1 - 2001	AS-BUILT 2000
Area	198.5	187.3	195.9	196.1	215.8	202.5	206.6	206.3
Width	57.7	62.6	58.3	57.7	59.3	58.2	57.0	57.0
Mean Depth	3.4	3.0	3.4	3.4	3.6	3.5	3.6	3.6
Max Depth	4.9	4.8	4.9	4.9	5.6	4.9	4.7	5.0
W/D	16.8	20.9	17.3	16.9	16.3	16.7	15.7	15.7
Area	Bench 2007	Bench 2006	Bench 2005	Bench 2004				
Width	150.2	137.6	127.0	132.0				
Mean Depth	53.4	55.8	49.5	50.6				
Max Depth	2.8	2.5	2.6	2.6				
W/D	4.0	3.9	3.7	3.7				
	19.0	22.6	19.3	19.4				

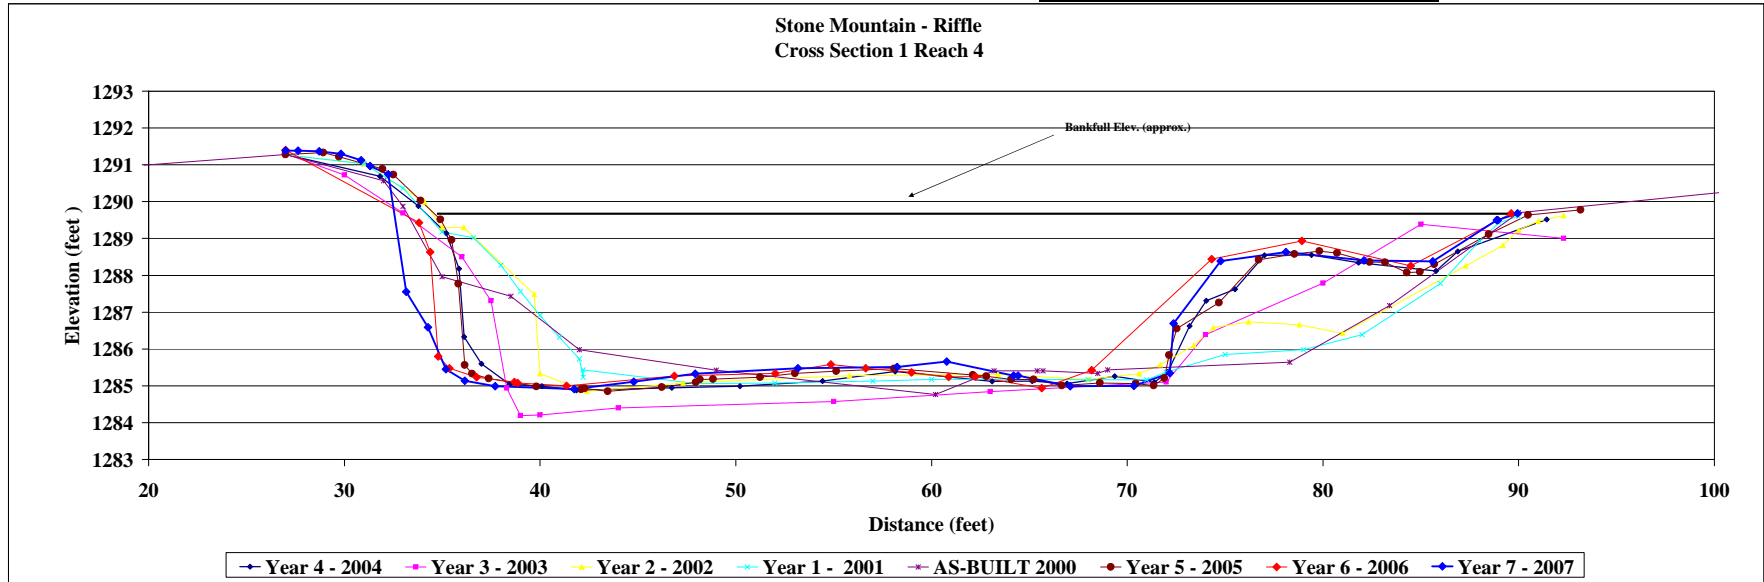

Project Name: Stone Mountain
 Cross Section: Reach 4 Cross-Section 2
 Feature: Pool
 Date: 7/30/07
 Crew: Price, Roberts


Year 7 - 2007 2007 Survey			Year 6 - 2006 2006 Survey			Year 5 - 2005 2005 Survey			Year 4 - 2004 2004 Survey			Year 3 - 2003 2003 Survey			Year 2 - 2002 2002 Survey			Year 1 - 2001 2001 Survey			AS-BUILT 2000 AS-BUILT Survey					
Station	Elev	Notes	Station	Elev	Notes	Station	Elev	Notes	Station	Elev	Notes	Station	Elev	Notes	Station	Elev	Notes	Station	Elev	Notes	Station	Elev	Notes			
6.65	1289.57		5.85	1289.58		16.4	1289.6		8.3	1289.5		19.0	1289.6	Left Pin	19.0	1289.6	Left Pin	19.0	1289.6	Left Pin	0.0	1289.0				
18.74	1289.66	XZLP	18.74	1289.66	XZLP	19.0	1289.5	Left Pin	8.9	1289.7		19.0	1289.5		22.0	1289.0		21.0	1289.3		19.0	1289.1	LBKF			
19.11	1289.52		18.8	1289.63	XZLP	21.4	1289.3		5.2	1289.5		21.0	1289.2		22.8	1287.6		22.0	1289.0		22.1	1288.4				
20.6	1289.4		18.86	1289.65		23.3	1288.4		17.3	1289.5		22.5	1288.3		25.8	1286.6		22.4	1287.9		23.0	1287.0				
21.94	1288.76		20.84	1289.36		24.8	1287.7		19.0	1289.6	Left Pin	30.0	1284.6		27.9	1286.1		24.0	1287.0		25.5	1286.0				
22.63	1288.27		27.49	1286.04		25.4	1287.1		21.0	1289.3		32.0	1283.9		31.0	1285.2		25.0	1286.6		31.0	1283.9				
25.42	1287.45		29.13	1284.47		27.8	1285.9		26.0	1286.8		35.0	1283.8		32.0	1284.6		26.0	1286.1		41.0	1283.5				
26.26	1286.8		29.41	1284.55	X2W	29.1	1284.3		27.9	1285.8		40.0	1283.5		35.0	1283.8		27.0	1285.7		48.0	1283.0				
27.59	1286.08		30.82	1284.02		33.8	1283.9		29.1	1284.7		44.0	1282.9		40.3	1283.6		28.0	1285.4		52.0	1283.3				
28.33	1285.45		40.8	1283.07		36.6	1282.8	Water	29.6	1284.3	Water	50.0	1281.8		43.6	1282.9		30.0	1284.8		52.0	1283.9				
29.01	1283.67		44.54	1282.01		41.7	1282.0		31.7	1283.9		52.0	1282.0		44.8	1282.6		31.0	1284.5		52.6	1285.8				
30.41	1283.65		50.03	1281.72		44.8	1281.6		35.1	1283.3		54.0	1282.2		51.0	1282.6		32.5	1284.3		56.8	1286.7	RBKF			
31.04	1283.5		51.44	1281.7		47.6	1281.5		35.6	1283.0		56.9	1281.7		52.9	1282.7		36.0	1284.0		62.7	1289.6				
32.77	1283.6		53.86	1281.82		49.9	1281.6		40.4	1282.5		59.0	1286.6		53.2	1282.9		42.0	1283.5		67.0	1293.7				
35.43	1283.8		53.87	1281.97		51.7	1281.9		43.6	1282.0		60.5	1288.6		53.2	1284.7		47.0	1282.7		68.6	1293.9				
37.46	1283.69		55.9	1282.3		53.8	1282.5		49.2	1281.5		62.0	1289.6	RBKFL	53.5	1286.2		51.0	1283.0		80.0	1293.9				
38.51	1283.49	X2W	57.69	1283.83		56.1	1282.4		55.2	1281.7		64.5	1291.4		56.5	1287.1		52.4	1283.4		100.0	1293.9				
40.29	1283.11		58.74	1287.58		56.8	1283.6		55.7	1284.0		68.0	1294.3	RTOB	61.1	1289.3	BKF	53.0	1286.3							
41.68	1282.86		61.41	1289.25		57.4	1289.0	Water	56.5	1284.6	Water	58.5	1284.6		62.7	1290.2		55.0	1286.8							
43.45	1282.54		65.19	1291.9		58.6	1287.2		58.2	1286.1		63.0	1289.9		56.0	1287.0		56.0	1287.0							
45.49	1282.23		67.28	1294.35		60.3	1288.7		61.5	1289.7		63.5	1290.5		64.1	1291.3		57.0	1287.3							
47.4	1282.29		68.03	1294.54	X2RP	63.2	1290.3		63.5	1290.5		65.5	1292.8		65.3	1292.7		59.0	1288.6							
49.81	1282.58	X2RP	68.04	1294.38	X2RP	65.3	1292.1		65.5	1292.8		67.0	1294.0		62.0	1289.9		62.0	1289.9							
52.02	1282.91		83.15	1294.48		66.5	1293.9		67.5	1294.2		68.6	1294.4		64.0	1291.3		64.0	1291.3							
53.5	1283.16					68.0	1294.4	Right Pin	79.4	1294.4					67.0	1294.1		67.0	1294.1							
54.3	1283.5					68.2	1294.4		99.7	1294.5					68.4	1294.4		68.4	1294.4							
55.9	1284.3					73.0	1294.4		117.4	1294.0					68.4	1294.4		68.4	1294.4							
57.8	1285.7					78.0	1294.4		127.2	1294.1																
62.1	1289.3								68.0	1294.4	Right Pin															
64.51	1291.99																									
68.06	1294.26	X2RP																								
74.93	1294.55																									



Photo of Cross-Section 2 - Reach 4 - Looking Downstream @ STA 7+65

	Year 7 - 2007	Year 6 - 2006	Year 5 - 2005	Year 4 - 2004	Year 3 - 2003	Year 2 - 2002	Year 1 - 2001	AS-BUILT 2000
Area	208.6	220.3	223.7	224.4	210.6	182.8	179.6	189.6
Width	43.4	42.7	41.3	42.5	41.5	42.1	43.0	43.7
Mean Depth	4.8	5.2	5.4	5.3	5.1	4.3	4.2	4.3
Max Depth	7.3	7.8	8.1	8.1	7.8	6.9	6.8	6.6
W/D	9.0	8.3	7.6	8.1	8.2	9.7	10.3	10.1

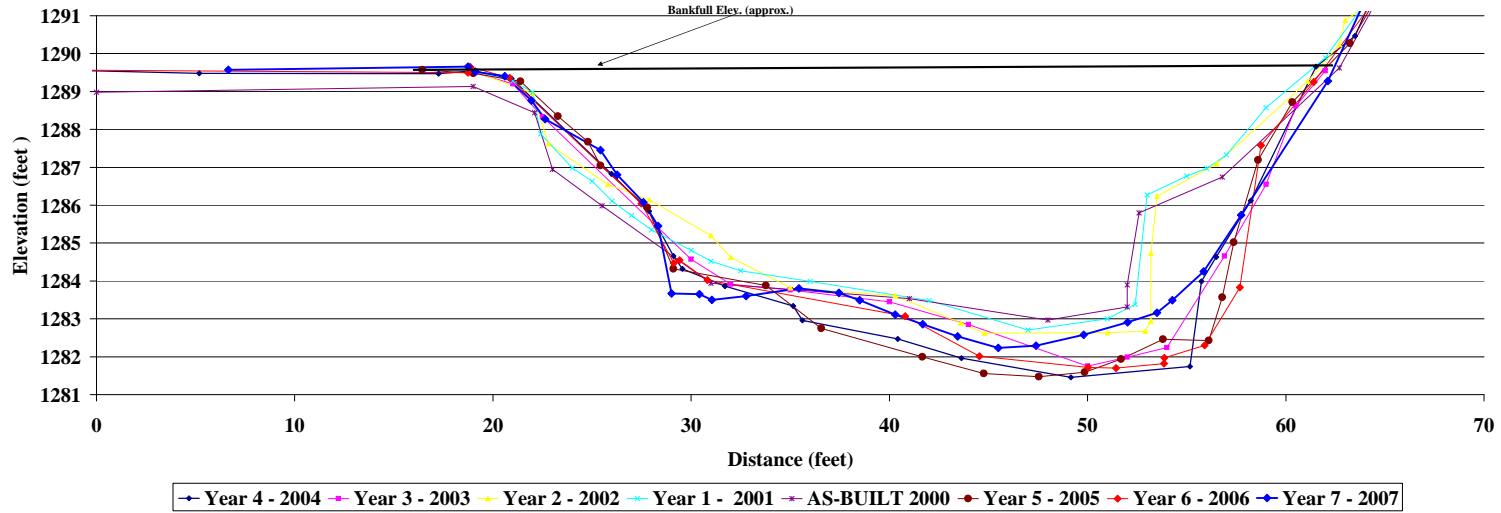Stone Mountain - Pool Cross Section 2 Reach 4



Project Name Stone Mountain
 Cross Section Reach 4 Cross-Section 3
 Feature Pool
 Date 7/30/07
 Crew Price, Roberts


Year 7 - 2007 2007 Survey			Year 6 - 2006 2006 Survey			Year 5 - 2005 2005 Survey			Year 4 - 2004 2004 Survey			Year 3 - 2003 2003 Survey			Year 2 - 2002 2002 Survey			Year 1 - 2001 2001 Survey			AS-BUILT 2000 AS-BUILT Survey					
Station	Elev	Notes	Station	Elev	Notes	Station	Elev	Notes	Station	Elev	Notes	Station	Elev	Notes	Station	Elev	Notes	Station	Elev	Notes	Station	Elev	Notes			
-5.05	1284.4	X3LP	-5.05	1284.63	X3LP	-4.9	1284.4		-4.9	1284.4		5.5	1282.2		8.0	1284.5		-12.5	1284.5		-3.0	1285.0				
-3.24	1283.86	X3	-5.04	1284.48	X3	-3.3	1282.9		3.1	1281.9		10.0	1281.9		2.0	1282.1		-8.5	1283.8		3.5	1282.9	L.BKF			
-1.26	1283.55	X3	3.54	1282.68	X3	5.4	1281.8		17.3	1282.8		11.5	1282.5		7.0	1281.5		-6.5	1283.0		10.0	1281.7				
-0.07	1283.35	X3	11.16	1282.39	X3	11.6	1282.4		24.3	1283.5		19.5	1282.9		17.0	1281.6		-2.5	1282.0		30.8	1281.1				
2.74	1282.74	X3	22.59	1283.53	X3	16.8	1282.9		31.6	1283.0		24.5	1283.2	top bar	31.0	1282.5		1.5	1281.8		47.0	1280.4				
3.91	1282.59	X3	32.24	1283.47	X3	25.8	1283.4		36.0	1282.2		31.5	1282.8		35.4	1281.8		13.5	1282.0		52.0	1278.2				
19	1283.29	X3	36.29	1282.76	X3	35.5	1282.3		37.4	1281.2	Water	36.5	1281.7		36.9	1280.8		26.5	1282.1		62.2	1279.6				
28.28	1283.43	X3	43.49	1280.97	X3	40.6	1280.7		39.3	1280.3		40.5	1280.9		38.0	1280.2		31.5	1281.8		62.8	1279.7				
32.56	1283.05	X3W	45.22	1280.14	X3W	42.7	1280.3		41.0	1280.0		41.0	1280.0	low	42.0	1279.9		36.5	1281.2		65.4	1280.3				
37.28	1282.37	X3	47.16	1279.86	X3	44.1	1280.1		45.0	1280.0		46.5	1279.2		50.0	1277.9		37.1	1281.0		68.3	1280.8				
38.56	1281.75	X3	51.4	1278.84	X3	45.9	1279.7		46.6	1279.4		49.5	1278.8		56.7	1278.0		43.5	1280.5		71.0	1281.0				
41.23	1280.64	X3	53.23	1278.55	X3	47.8	1279.4		54.2	1277.7		51.5	1278.3		61.0	1279.0		45.5	1279.9		80.0	1282.1				
42.91	1280.29	X3	55.29	1277.87	X3	50.7	1278.7		59.6	1278.3		53.5	1277.9		69.4	1280.1		47.5	1279.5		89.0	1286.5	R.BKF			
44.19	1279.97	X3	56.76	1277.86	X3	53.5	1278.4		65.1	1278.8		55.5	1277.7		72.5	1280.9		49.5	1278.3		95.0	1286.5				
45.45	1279.82	X3	58.92	1278.12	X3	54.8	1277.4		68.2	1279.4		57.5	1277.7		73.3	1281.4		51.5	1277.5		97.0	1286.6				
47.46	1279.57	X3	58.93	1278.12	X3	56.1	1277.4		74.6	1280.4	Water	58.5	1277.7		77.3	1282.3		55.5	1277.7							
49.24	1279.4	X3	59.81	1278.09	X3	60.2	1277.8		76.2	1282.5		62.5	1278.2		82.0	1283.0		57.5	1278.1							
51.43	1278.79	X3	62.99	1278.7	X3	62.5	1278.2		82.3	1283.3		66.5	1279.9		89.0	1286.1		60.5	1279.2							
53.66	1277.99	X3	63.56	1278.02	X3	64.5	1278.5		86.5	1285.0		69.5	1279.8		97.0	1286.7	Right Pin	61.0	1279.5							
55.89	1277.66	X3	65.9	1281.18	X3	65.6	1280.7		89.3	1285.9		72.5	1279.7		104.0	1287.0		61.5	1279.6							
56.89	1277.41	X3	67.73	1279.02	X3	66.6	1281.2		96.0	1286.4		74.5	1280.4	new	113.2	1297.8		67.0	1280.8							
58.28	1277.38	X3	71.63	1279.58	X3	69.4	1280.5		107.2	1287.0		77.0	1281.4					68.5	1280.9							
60.15	1277.22	X3W	74.35	1280.2	X3W	69.9	1279.2		114.0	1287.8	Right Pin	79.8	1282.8					70.5	1281.1							
61.6	1277.59	X3	77.6	1281.34	X3	73.4	1279.4		118.5	1288.2		88.7	1286.1					72.0	1281.4							
62.47	1280.3	X3	78.28	1283	X3	74.0	1279.8					94.5	1286.1					75.5	1282.0							
64.98	1279.99	X3	80.96	1284.3	X3	74.0	1280.6					103.5	1286.8					79.5	1282.5							
65.74	1280.21	X3	86.39	1285.87	X3	74.9	1280.9					114.0	1287.8	Right Pin				82.0	1282.7							
68.22	1281.16	X3	93.51	1286.16	X3	75.5	1281.5					114.0	1287.8					85.5	1286.1							
69.88	1279.3	X3LP	100.09	1286.73	X3LP	77.0	1281.4											90.5	1286.7							
71.06	1279.34	X3RP	114.01	1287.96	X3RP	78.0	1282.4											91.0	1286.6							
73.84	1279.69	X3RP	114.13	1287.96	X3RP	79.6	1282.9											94.2	1286.6							
74.49	1279.99					80.1	1283.8		0.0									94.2	1286.6							
75.61	1281.44		left 8.6 feet			83.4	1285.3																			
76.7	1282.05					88.8	1286.2																			
77.6	1282.6					89.7	1286.0																			
81.11	1283.62					95.3	1286.2																			
87.5	1284.97					107.2	1287.1																			
108.98	1287.38					114.0	1287.8																			
114.07	1287.88																									



Photo of Cross-Section 3 - Reach 4 - Looking Downstream @ STA 16+35

	Year 7 - 2007	Year 6 - 2006	Year 5 - 2005	Year 4 - 2004	Year 3 - 2003	Year 2 - 2002	Year 1 - 2001	AS-BUILT 2000
Area	131.2	161.1	161.8	162.2	173.0	181.3	170.0	183.9
Width	52.8	53.8	50.7	58.0	61.3	65.0	66.0	70.0
Mean Depth	2.9	3.0	3.2	2.8	2.8	2.8	2.6	2.6
Max Depth	6.0	5.9	5.5	5.5	5.6	5.4	5.7	5.0
W/D	18.5	18.0	15.9	20.7	21.7	23.3	25.6	26.7

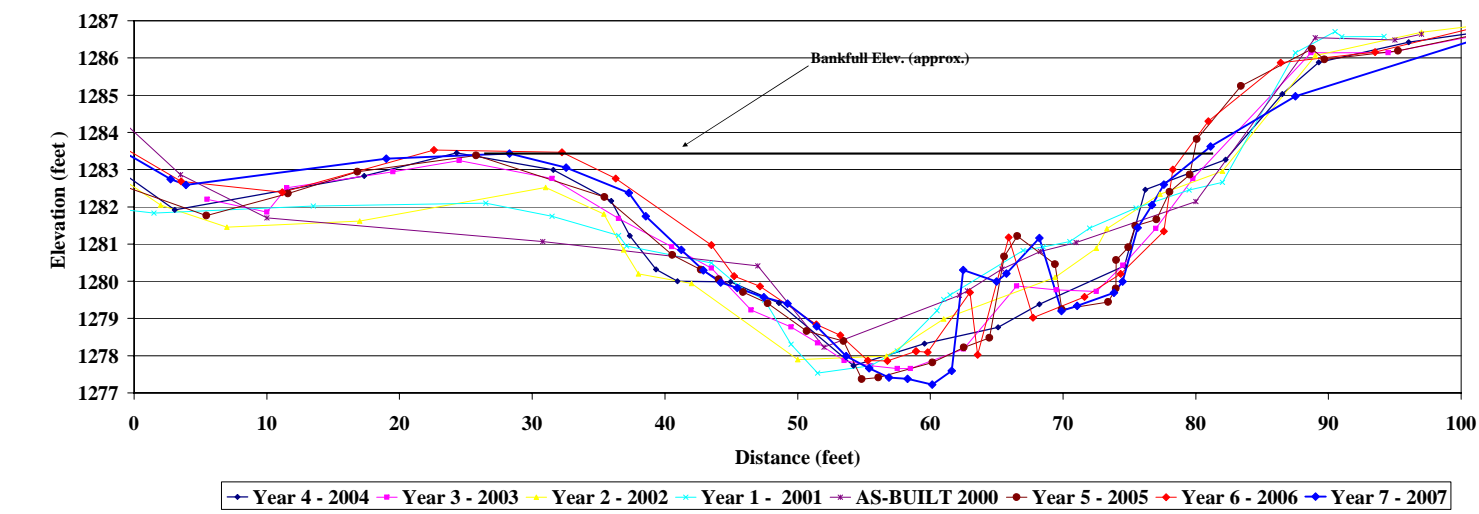Stone Mountain - Pool
 Cross Section 3 Reach 4




Project Name Stone Mountain
 Cross Section Reach 4 Cross-Section 4
 Feature Riffle
 Date 7/30/07
 Crew Price, Roberts

Year 7 - 2007 2007 Survey			Year 6 - 2006 2006 Survey			Year 5 - 2005 2004 Survey			Year 4 - 2004 2004 Survey			Year 3 - 2003 2003 Survey			Year 2 - 2002 2002 Survey			Year 1 - 2001 2001 Survey			AS-BUILT 2000 AS-BUILT Survey			
Station	Elev	Notes	Station	Elev	Notes	Station	Elev	Notes	Station	Elev	Notes	Station	Elev	Notes	Station	Elev	Notes	Station	Elev	Notes	Station	Elev	Notes	
0.1	1285.05	X4LP	0.1	1285.0	X4LP	-0.0	1285.3		-47.0	1287.2		0.0	1284.9	Left Pin	0.0	1284.9	0.0	1284.9	Left Pin					
1.52	1284.63		0.6	1285.0		-1.4	1285.2		-28.9	1287.3		3.0	1283.6		2.9	1283.7	1.0	1284.7						
3.49	1283.64		4.0	1283.5	X4	-0.1	1284.9		-17.6	1285.8		8.0	1283.4		6.4	1283.2	2.0	1284.2						
7.96	1283.62		9.4	1283.5	X4	1.3	1283.0	Left Pin	0.0	1284.9	Left Pin	12.0	1283.1		11.9	1283.1	3.0	1283.6						
12.18	1283.26		16.1	1282.0	X4	3.3	1283.6		0.5	1284.7		20.4	1279.8		15.9	1281.1	3.6	1283.4						
14.33	1282.29		19.8	1280.7	X4	9.1	1283.3		3.7	1283.5		20.7	1279.0		21.0	1279.9	5.0	1283.2						
17.56	1281.95		20.2	1279.6	X4W	10.0	1283.4		11.5	1283.1		23.0	1278.8		25.1	1279.5	11.0	1283.2	LBKF					
19.76	1280.89		20.7	1279.1	X4	11.4	1283.1		14.0	1282.2		27.0	1278.6		30.4	1279.2	12.0	1283.0						
20.89	1279.17		24.1	1278.7	X4	13.4	1282.1		17.5	1281.4		31.5	1278.9		31.7	1279.1	13.0	1282.5						
22.33	1278.86		28.6	1278.3	X4	16.1	1281.5		19.7	1280.1		33.5	1279.1		35.0	1279.1	14.0	1281.8						
25.02	1278.7		38.7	1279.3	X4	17.3	1281.4	Water	20.1	1279.8	Water	36.0	1279.2		44.0	1279.4	15.0	1281.3						
27.5	1278.52		45.2	1279.7	X4W	20.0	1280.1		20.7	1278.9		39.4	1279.3		49.0	1279.5	16.0	1280.8						
30.16	1278.46		49.6	1280.1	X4	21.1	1279.2		24.1	1278.7		42.4	1279.5		51.3	1279.8	17.0	1280.6						
32.01	1278.46		53.2	1280.8	X4	23.3	1278.7		27.0	1278.1		46.0	1279.9		52.3	1280.3	18.0	1280.2						
33.32	1278.38		53.4	1280.9	X4	25.1	1278.4	Thalweg	28.4	1278.3	Thalweg	45.2	1279.8		55.8	1282.4	19.0	1280.0						
35.1	1278.48		53.6	1281.8	X4	27.0	1278.3		32.2	1278.7		50.0	1280.0		58.2	1283.7	22.5	1279.7						
37.01	1278.75		54.9	1282.3	X4	27.6	1278.3		34.6	1279.0		53.5	1280.8		62.0	1284.0	30.0	1279.4						
39.6	1278.89		57.7	1283.7	X4	28.4	1278.2		42.5	1279.4		58.0	1283.7		65.0	1284.0	34.0	1279.3						
41.9	1279.21		64.7	1284.1	X4RP	30.2	1278.5	Water	44.9	1279.7	Water	64.8	1283.9	Right Pin			35.5	1279.2						
43.55	1279.16		30.9	1278.5		30.9	1278.5		52.8	1280.4					39.0	1279.4								
45.89	1279.93		34.2	1279.0	Bankfull	34.2	1279.0	Bankfull	58.0	1283.8	Bankfull				45.5	1279.5								
48.87	1280.2		35.2	1279.2		35.2	1279.2		58.7	1283.8					50.8	1279.6								
52	1280.72		37.4	1279.2	Right Pin	37.4	1279.2	Right Pin	64.4	1283.9	Right Pin				52.0	1280.1								
54.27	1281.39		39.9	1279.2		39.9	1279.2		71.8	1284.7					53.0	1280.8								
56.37	1283		41.5	1279.3		41.5	1279.3								54.0	1281.4								
58.17	1283.83		44.0	1279.5		44.0	1279.5								55.0	1282.0								
60.86	1284.09		45.5	1279.5		45.5	1279.5								56.0	1282.5								
63.49	1284.22		46.5	1279.6		46.5	1279.6								57.0	1283.2	RBKF							
64.78	1284.06	X4RP	47.6	1279.8		47.6	1279.8								58.6	1283.7								
			50.4	1280.0		50.4	1280.0								60.0	1284.0								
			52.0	1279.9		52.0	1279.9								64.9	1283.9								
			53.2	1280.2		53.2	1280.2																	
			54.7	1282.2		54.7	1282.2																	
			57.0	1283.6		57.0	1283.6																	
			59.5	1283.8		59.5	1283.8																	
			60.0	1283.8		60.0	1283.8																	
			62.4	1284.0		62.4	1284.0																	
			64.5	1283.9		64.5	1283.9																	
			66.4	1284.3		66.4	1284.3																	
			70.8	1284.6		70.8	1284.6																	



Photo of Cross-Section 4 - Reach 4 - Looking Downstream @ STA 20-00

	Year 7 - 2007	Year 6 - 2006	Year 5 - 2005	Year 4 - 2004	Year 3 - 2003	Year 2 - 2002	Year 1 - 2001	AS-BUILT 2000
Area	143.9	141.2	147.3	141.4	139.5	140.7	139.5	
Width	44.2	45.5	44.7	41.3	45.5	45.9	45.0	
Mean Depth	3.3	3.1	3.3	3.4	3.1	3.1	3.1	
Max Depth	4.7	4.9	4.9	5.0	4.5	4.0	3.9	
W/D	13.6	14.6	13.6	12.0	14.8	15.0	14.5	

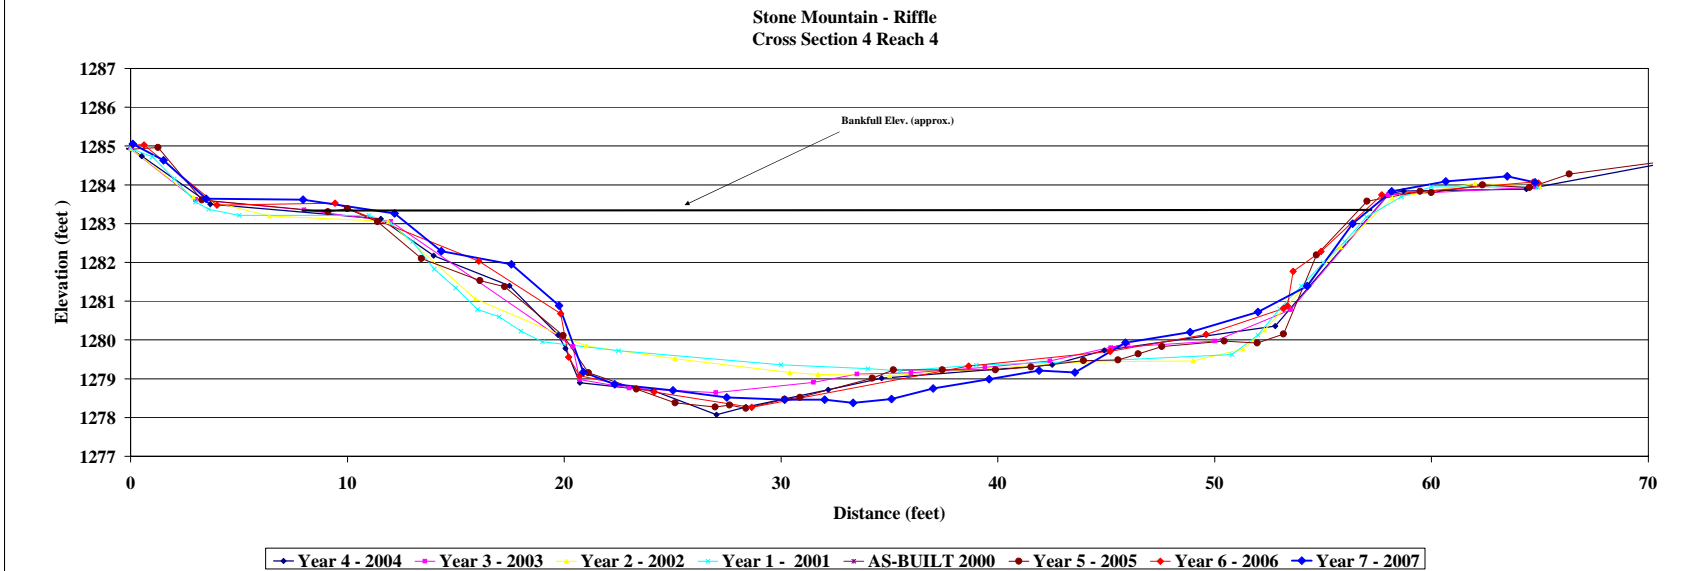

Project Name Stone Mountain
 Cross Section Reach 4 Cross-Section 5
 Feature Pool
 Date 7/30/07
 Crew Price, Roberts


Year 7 - 2007 2007 Survey			Year 6 - 2006 2006 Survey			Year 5 - 2005 2005 Survey			Year 4 - 2004 2004 Survey			Year 3 - 2003 2003 Survey			Year 2 - 2002 2002 Survey			Year 1 - 2001 2001 Survey			AS-BUILT 2000 AS-BUILT Survey					
Station	Elev	Notes	Station	Elev	Notes	Station	Elev	Notes	Station	Elev	Notes	Station	Elev	Notes	Station	Elev	Notes	Station	Elev	Notes	Station	Elev	Notes			
0	1280.96	NCLP	0	1283.45	NCLP04	-11.2	1281.6		-17.8	1280.7		0.0	1281.1		14.0	1279.9		6.0	1281.1							
1.42	1280.91		11.02	1280.21	X5	-1.6	1281.1		-18.3	1281.6		14.0	1279.9		5.0	1280.7		5.0	1280.7							
8.7	1280.15		16.01	1279.76	X5	0.0	1281.1	Left Pin	-7.6	1281.6		22.0	1279.2		6.5	1280.3		6.5	1280.3							
14.65	1279.74		33.16	1278.76	X5	4.9	1280.5		0.0	1281.1	Left Pin	29.0	1279.1		4.0	1280.2		4.0	1280.2							
24.16	1279.16		36.62	1277.72	X5	5.8	1280.4		5.2	1280.7		33.0	1278.5		33.0	1278.5		33.0	1278.5							
27.06	1279.04		39.74	1277.21	X5	12.3	1280.3		5.4	1280.7	Bankfull	36.0	1277.7		13.0	1280.2		13.0	1280.2							
29.06	1279		41.46	1276.89	X5	12.8	1279.9		8.3	1280.4		40.0	1277.4		16.0	1279.9		16.0	1279.9							
30.82	1278.73		46.85	1276.34	X5	18.9	1279.5		17.6	1279.7		44.0	1277.1		19.0	1279.7		19.0	1279.7							
33.53	1278.05		51.94	1276.01	XSW	29.7	1279.0		22.8	1279.2		48.0	1276.8		21.0	1279.3	LBF	21.0	1279.3							
34.73	1277.09		54.97	1275.44	X5	30.1	1279.0		30.6	1279.0		51.5	1276.5		23.0	1278.9		23.0	1278.9							
36.07	1276.77		57.55	1274.11	X5	33.9	1277.6		33.7	1278.5		54.0	1276.3		26.0	1278.6		26.0	1278.6							
36.81	1276.45		60.43	1273.45	X5	36.6	1277.5		37.0	1277.7		58.0	1275.7		29.0	1278.1		29.0	1278.1							
40.35	1275.74		64.83	1272.47	X5	43.2	1276.7		46.2	1276.7		61.0	1275.0		34.8	1277.4		34.8	1277.4							
40.65	1275.76		69.1	1272.99	X5	49.5	1276.2		48.3	1276.6		66.0	1273.9		38.5	1277.0		38.5	1277.0							
44.91	1275.6		76.91	1274.23	X5	52.2	1276.0		54.1	1276.1		70.0	1273.3		42.5	1276.6		42.5	1276.6							
48.33	1275.41		82.61	1275.91	XSW	55.6	1275.6		59.5	1275.4		73.5	1273.4		46.5	1276.3		46.5	1276.3							
51.99	1275.26		84.64	1277.62	X5	59.3	1275.3		61.9	1275.1		76.5	1274.2		49.3	1276.0		49.3	1276.0							
55.42	1275.47		84.65	1276.52	X5	64.0	1274.3		67.4	1273.9		82.4	1276.1		53.0	1275.3		53.0	1275.3							
58.7	1274.77		87.44	1279.37	X5	69.6	1273.9		73.0	1273.4		85.0	1278.3	row	57.0	1275.0		57.0	1275.0							
62.09	1274.15		92.25	1283.04	X5	71.5	1273.3		75.6	1273.7		92.0	1283.0	riob	62.0	1274.7		62.0	1274.7							
64.8	1274.09		92.46	1283.04	X5	73.1	1273.6		78.2	1274.1		100.0	1282.8	upin	66.0	1274.3		66.0	1274.3							
65.21	1274.1		95.03	1283	X5	74.8	1273.7		83.2	1275.5					68.0	1274.3		68.0	1274.3							
67.67	1273.82		100.83	1282.76	XSRP	76.7	1274.2		84.6	1276.3					71.0	1274.4		71.0	1274.4							
71.29	1274.04		102.71	1282.77	X5S	79.6	1275.1		84.8	1277.5					75.0	1275.0		75.0	1275.0							
73.65	1274.25					79.9	1275.4		87.4	1279.2					78.0	1275.9		78.0	1275.9							
75.96	1274.52					81.1	1275.6		92.0	1282.3					82.0	1276.9		82.0	1276.9							
78	1274.97					83.3	1276.3		93.4	1283.0					84.4	1277.4		84.4	1277.4							
80.37	1275.6					85.9	1277.6		100.9	1282.8					85.0	1277.6		85.0	1277.6							
82.47	1276.75					87.0	1279.6		101.2	1282.8	Right Pin				86.0	1279.0	RBFK	86.0	1279.0							
82.97	1276.23					92.1	1283.0		109.6	1283.07					88.0	1280.3		88.0	1280.3							
83.99	1277.58					96.1	1283.0		130.2	1283.14					91.0	1281.7		91.0	1281.7							
87.78	1279.96					100.5	1282.7								93.0	1283.2		93.0	1283.2							
90.51	1281.55					106.1	1283.1								97.0	1282.9		97.0	1282.9							
92.08	1282.79					111.4	1283.0								100.8	1282.8		100.8	1282.8							
93.82	1282.88																									
98.19	1282.72																									
100.32	1282.59	XSRP																								



Photo of Cross-Section 5 - Reach 4 - Looking Downstream @ STA 14+10

	Year 7 - 2007	Year 6 - 2006	Year 5 - 2005	Year 4 - 2004	Year 3 - 2003	Year 2 - 2002	Year 1 - 2001	AS-BUILT 2000
Area	200.4	202.1	184.6	180.7	175.1	183.9	183.6	
Width	59.8	54.5	64.0	54.2	56.0	54.2	60.0	
Mean Depth	3.4	3.7	2.9	3.3	3.1	3.4	3.1	
Max Depth	5.3	6.6	5.8	5.8	5.8	5.8	4.8	
W/D	17.8	14.7	22.2	16.3	17.9	16.0	19.6	

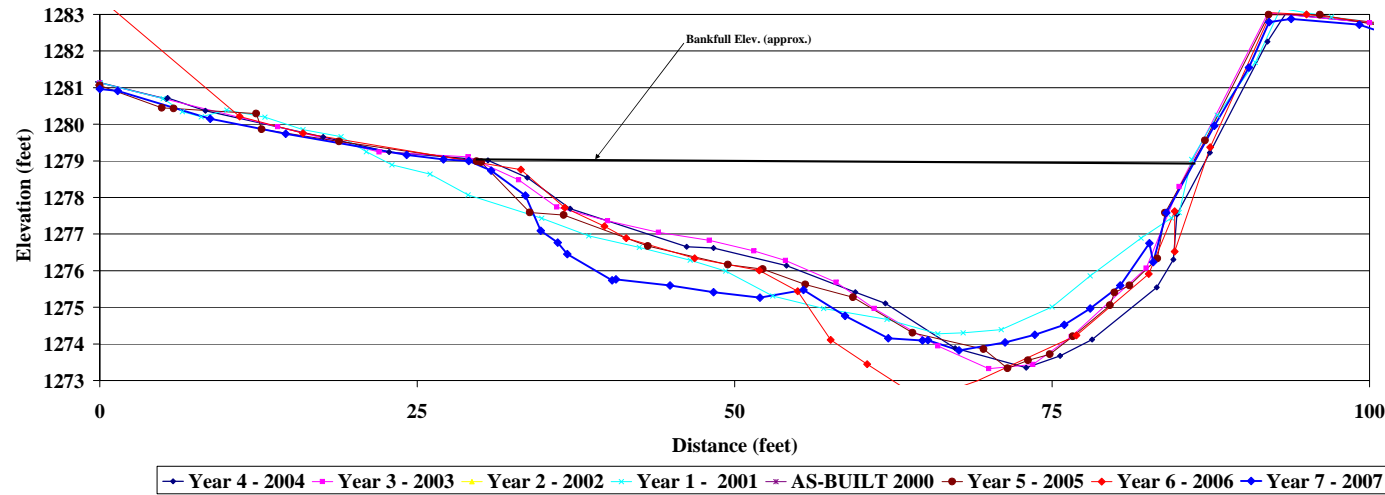Stone Mountain - Pool Cross Section 5 Reach 4




Project Name Stone Mountain
 Cross-Section Reach 4 Cross-Section 6
 Feature Riffle
 Date 7/30/07
 Crew Price Roberts

Year 7 - 2007 2007 Survey			Year 6 - 2006 2006 Survey			Year 5 - 2005 2005 Survey			Year 4 - 2004 2004 Survey			Year 3 - 2003 2003 Survey			Year 2 - 2002 2002 Survey			Year 1 - 2001 2001 Survey			AS-BUILT 2000 AS-BUILT Survey					
Station	Elev	Notes	Station	Elev	Notes	Station	Elev	Notes	Station	Elev	Notes	Station	Elev	Notes	Station	Elev	Notes	Station	Elev	Notes	Station	Elev	Notes			
0	1280.19	X&LP	-24.49	1279.99	s6	-6.6	1279.8		25.3	1280.1		0.0	1280.0	Left Pin	0.0	1280.0	Left Pin	0.0	1280.0	Left Pin	0.0	1280.0	Left Pin	0.0	1280.0	Left Pin
4.08	1280.05		-1	1280.05	X&LP	-4.0	1279.9		4.8	1279.9		5.0	1279.7		9.0	1279.0	LTOP	3.5	1280.0		3.5	1280.0		3.5	1280.0	
5.56	1279.79		0	1279.99	st6p4	0.3	1280.0	Left Pin	0.0	1280.0	Left Pin	8.5	1279.0	lob	10.3	1277.7		8.0	1279.2	LBKF	8.0	1279.2		8.0	1279.2	
8.56	1279.14		0.12	1280.07	st6p	2.1	1280.1		8.5	1278.7		11.5	1275.1		11.9	1275.2		11.0	1275.7		11.0	1275.7		11.0	1275.7	
9.68	1278.25		2.74	1280.14	s6	6.4	1279.6		11.3	1274.6		13.0	1273.0	lew	14.2	1274.0		13.0	1274.2		13.0	1274.2		13.0	1274.2	
10.23	1278.42		2.79	1280.02	s6	7.8	1279.2		12.4	1275.9		13.5	1271.1		14.7	1273.1		15.3	1273.1		15.3	1273.1		15.3	1273.1	
11.3	1274.79		5.07	1279.76	s6	8.9	1279.0		12.7	1271.4		16.5	1270.9		14.7	1270.8	LEW	18.6	1272.8		18.6	1272.8		18.6	1272.8	
11.82	1274		8.12	1279.23	s6	10.0	1277.8		16.7	1270.8		21.0	1271.9		17.7	1271.7		22.2	1272.5		22.2	1272.5		22.2	1272.5	
13.95	1271.76		9.41	1278.39	s6	10.1	1278.3		19.6	1271.6		24.6	1272.2		21.8	1272.1		24.5	1272.3		24.5	1272.3		24.5	1272.3	
14.63	1270.79		11.49	1276.07	s6	10.5	1276.0		23.8	1272.3		30.2	1272.5		27.0	1272.5		28.6	1272.4		28.6	1272.4		28.6	1272.4	
16.09	1270.02		12.1	1274.57	s6	11.3	1274.6		31.1	1272.8		36.0	1272.9		29.6	1272.4		31.2	1272.4		31.2	1272.4		31.2	1272.4	
17.7	1269.75		13.26	1273.57	s6	12.2	1274.3	Water	32.9	1273.0	Water	40.0	1272.7		34.4	1273.0		36.2	1272.5		36.2	1272.5		36.2	1272.5	
19.25	1270.03		13.26	1271.61	s6	12.3	1271.6		37.9	1273.1		41.8	1272.8	rew	38.8	1273.4		39.6	1272.2		39.6	1272.2		39.6	1272.2	
20.11	1270.56		14.72	1271.14	s6	12.7	1273.7		42.0	1273.1		43.0	1273.4		42.4	1273.4		41.6	1272.6		41.6	1272.6		41.6	1272.6	
22.40	1271.81		16.72	1270.89	s6	14.6	1270.9		44.8	1274.2		48.0	1273.0		47.0	1274.2		42.8	1272.9		42.8	1272.9		42.8	1272.9	
24.35	1272.32		18.64	1271.39	s6	15.5	1270.8		48.1	1275.6		53.7	1277.8	rob	54.0	1278.3	RTOP	43.7	1273.5		43.7	1273.5		43.7	1273.5	
27.55	1272.54		22.1	1272.17	s6	15.6	1270.9		50.9	1277.1		60.0	1278.3		58.4	1278.3		46.5	1274.3		46.5	1274.3		46.5	1274.3	
29.8	1272.30		25.13	1272.35	s6	17.3	1271.5	Right Pin	54.1	1278.3	Right Pin	64.0	1278.3		62.0	1278.1		47.3	1274.5		47.3	1274.5		47.3	1274.5	
32.02	1272.86		27.83	1272.51	s6	18.7	1271.6		56.0	1278.2		66.4	1278.1		66.4	1278.2		50.5	1276.5		50.5	1276.5		50.5	1276.5	
32.04	1272.87		29.45	1272.31	s6	21.9	1272.4		62.4	1278.5		66.4	1278.5		66.4	1278.5		54.3	1278.2	BBKF	54.3	1278.2		54.3	1278.2	
34.22	1273.05		30.88	1272.74	st6p	24.3	1272.5		71.9	1278.2							58.0	1278.1		58.0	1278.1		58.0	1278.1		
36.39	1272.79		33.53	1272.94	s6	26.5	1272.5										61.3	1278.4		61.3	1278.4		61.3	1278.4		
38.62	1272.81		36.42	1273.23	s6	28.6	1272.6										65.5	1278.1		65.5	1278.1		65.5	1278.1		
40.85	1273.11		40.24	1272.95	s6	29.7	1272.9										66.4	1278.1		66.4	1278.1		66.4	1278.1		
42.45	1273.56		42.49	1273.51	s6	32.0	1273.1																			
43.72	1273.97		45.32	1274.39	s6	36.7	1273.1																			
44.81	1274.25		48.75	1275.35	s6	38.7	1272.9																			
46.83	1274.95		51.87	1276.87	s6	42.2	1273.3																			
49.17	1275.64		52.98	1278.17	X&RP	42.8	1273.6																			
52.32	1277.42		53.97	1278.21	st6p4	45.4	1274.4																			
53.99	1278.28	st6p	54.1	1278.2	st6p	49.1	1275.9																			
lowered 0.3 feet			57.42	1278.55	s6	53.6	1278.0																			
			72.15	1278.01	s6	54.0	1278.3																			
			59.9	1278.3																						
			69.8	1278.6																						



Photo of Cross-Section 6 - Reach 4 - Looking Downstream @ STA 26-70

	Year 7 - 2007	Year 6 - 2006	Year 5 - 2005	Year 4 - 2004	Year 3 - 2003	Year 2 - 2002	Year 1 - 2001	AS-BUILT 2000
Area	224.5	212.1	210.3	223.1		193.4	210.1	
Width	42.6	44.7	44.7	45.2		36.7	46.3	
Mean Depth	5.3	4.7	4.7	4.9		5.3	4.5	
Max Depth	8.5	7.3	7.4	7.3		7.4	6.0	
W/D	8.1	9.4	9.5	9.2		7.0	10.2	

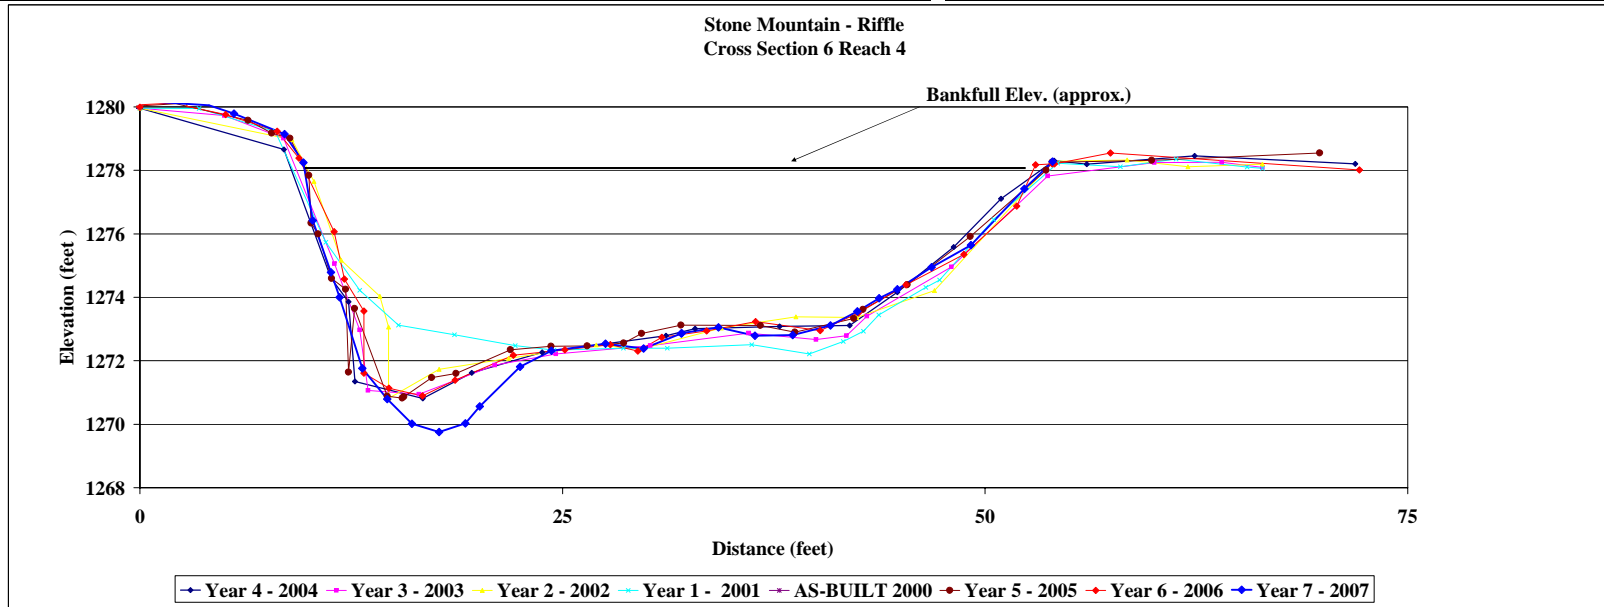

Project Name Stone Mountain
 Cross Section Reach 4 Cross-Section 7
 Feature Pool
 Date 7/30/07
 Crew Price Roberts

*NOTE: The left pin was replaced in 2007 because the original pin was buried during repair work completed that year.


Year 7 - 2007 2007 Survey			Year 6 - 2006 2006 Survey			Year 5 - 2005 2005 Survey			Year 4 - 2004 2004 Survey			Year 3 - 2003 2003 Survey			Year 2 - 2002 2002 Survey			Year 1 - 2001 2001 Survey			AS-BUILT 2000 AS-BUILT Survey																																																																																																																																																																																																																																																																																																																																																																																																																																																																																																																																																																																																																																																																																																																																																																																																																																																																																																																																																																																																																																																																										
Station	Elev	Notes	Station	Elev	Notes	Station	Elev	Notes	Station	Elev	Notes	Station	Elev	Notes	Station	Elev	Notes	Station	Elev	Notes	Station	Elev	Notes																																																																																																																																																																																																																																																																																																																																																																																																																																																																																																																																																																																																																																																																																																																																																																																																																																																																																																																																																																																																																																																																								
0	1273.5	x7p	-17.7	1271.8	x7	-19.4	1274.1		-22.6	1274.3		0.0	1272.5		0.0	1271.1	LBKF							0.35	1273.4		-7.3	1273.2	x7	-11.6	1273.7		-10.5	1273.7		6.0	1272.3		8.0	1272.7								5.98	1273.04		-1.8	1272.7	x7p	-3.0	1273.0		1.4	1272.9		15.0	1272.1		17.0	1272.3								15.93	1272.4		0.2	1272.7	x7	13.7	1272.6		11.3	1272.3		22.0	1271.3		23.7	1271.4								24.79	1271.26		4.4	1272.5	x7	20.5	1271.5		17.6	1272.2	Bankfull	28.0	1270.6		28.4	1270.9								28.9	1270.23		8.9	1272.3	x7	26.9	1271.0		19.3	1272.0		34.0	1270.3		31.0	1270.5								31.54	1269.42		13.1	1272.4	x7	33.0	1270.9		24.0	1271.6		40.7	1269.6		37.7	1269.6								38.33	1268.14		17.9	1271.9	x7	39.9	1269.2		25.1	1271.3		41.4	1269.1	LEW	40.6	1269.4								40.23	1268.97		17.9	1271.9	x7	41.8	1269.2		32.6	1271.0		42.6	1268.4		42.7	1269.1								42.07	1268.73		20.6	1271.8	x7	43.3	1268.9		40.0	1269.8		44.5	1267.9		45.9	1268.1								44.17	1268.62		23.4	1271.4	x7hkf	45.7	1268.3		42.3	1269.1		46.8	1267.1		48.5	1266.9								45.44	1268.31		30.5	1271.1	x7	49.1	1267.9		46.8	1268.3	Water	49.6	1265.9		51.6	1266.4								47.08	1268.07		33.2	1270.4	x7	52.6	1267.1		46.8	1268.3		54.4	1265.0		53.5	1265.7								48.96	1267.74		30.0	1269.7	x7	56.4	1266.0		53.7	1265.8		60.0	1266.3		54.7	1265.9								51.1	1267.39		38.0	1269.7	x7	56.9	1266.0		57.6	1265.8	Max Pool	62.3	1270.6		55.8	1265.9								53.7	1266.97		38.0	1269.7	x7	58.1	1265.9		58.1	1266.0		66.5	1273.1	RTOB	56.7	1266.2								55.41	1266.92		40.5	1269.3	x7	61.7	1267.6		61.7	1267.6		68.0	1273.5		57.8	1267.0								57.25	1266.93		42.6	1268.6	x7w	63.4	1268.1		61.4	1267.6		71.4	1274.0	RPN	59.8	1269.6								59.44	1267.1		45.0	1268.3	x7	65.4	1268.9		63.1	1268.4					62.0	1270.5								60.55	1267.88		45.1	1268.3	x7	65.7	1269.0		64.7	1269.2	Water				63.0	1271.7								61.05	1268.43		45.2	1268.3	x7	66.2	1269.4		66.5	1270.1					64.5	1272.4								62.3	1268.83		48.6	1267.8	x7	66.5	1270.0		66.7	1272.9					67.6	1273.8								64.36	1270.25		48.7	1267.8	x7	66.8	1272.2		66.9	1273.4	Right Pin				69.3	1273.8								65.13	1270.96		52.2	1267.0	x7	67.4	1272.4		71.4	1274.0					71.4	1274.0								66.25	1272.71		52.2	1267.0	x7	68.0	1273.3		68.0	1273.8					74.5	1273.8								67.35	1273.16		54.5	1266.2	x7	68.0	1273.4		68.0	1273.4					79.2	1273.9								70.1	1273.46		56.7	1265.8	x7	71.4	1274.0		83.7	1274.0					83.7	1274.0								71.38	1273.77	x7tp	57.1	1265.9	x7	78.4	1273.7		83.7	1278.9					83.7	1278.9											59.4	1266.6	x7	83.5	1273.8		113.2	1279.0					113.2	1279.0											62.3	1267.8	x7				132.16	1279.55																	63.96	1268.64	x7																						65.59	1269.07	x7																						65.93	1271.77	x7																						66.33	1272.83	x7																						68.17	1273.51	x7																						70.01	1273.72	x7p																						72.78	1273.58	x7																						76.97	1273.46	x7																						79.72	1273.47	x7																						82.31	1273.54	x7																						86.09	1274.93	x7																						91.25	1278.5	x7																						92.65	1278.82	x7																						98.17	1278.79	x7																		
0.35	1273.4		-7.3	1273.2	x7	-11.6	1273.7		-10.5	1273.7		6.0	1272.3		8.0	1272.7								5.98	1273.04		-1.8	1272.7	x7p	-3.0	1273.0		1.4	1272.9		15.0	1272.1		17.0	1272.3								15.93	1272.4		0.2	1272.7	x7	13.7	1272.6		11.3	1272.3		22.0	1271.3		23.7	1271.4								24.79	1271.26		4.4	1272.5	x7	20.5	1271.5		17.6	1272.2	Bankfull	28.0	1270.6		28.4	1270.9								28.9	1270.23		8.9	1272.3	x7	26.9	1271.0		19.3	1272.0		34.0	1270.3		31.0	1270.5								31.54	1269.42		13.1	1272.4	x7	33.0	1270.9		24.0	1271.6		40.7	1269.6		37.7	1269.6								38.33	1268.14		17.9	1271.9	x7	39.9	1269.2		25.1	1271.3		41.4	1269.1	LEW	40.6	1269.4								40.23	1268.97		17.9	1271.9	x7	41.8	1269.2		32.6	1271.0		42.6	1268.4		42.7	1269.1								42.07	1268.73		20.6	1271.8	x7	43.3	1268.9		40.0	1269.8		44.5	1267.9		45.9	1268.1								44.17	1268.62		23.4	1271.4	x7hkf	45.7	1268.3		42.3	1269.1		46.8	1267.1		48.5	1266.9								45.44	1268.31		30.5	1271.1	x7	49.1	1267.9		46.8	1268.3	Water	49.6	1265.9		51.6	1266.4								47.08	1268.07		33.2	1270.4	x7	52.6	1267.1		46.8	1268.3		54.4	1265.0		53.5	1265.7								48.96	1267.74		30.0	1269.7	x7	56.4	1266.0		53.7	1265.8		60.0	1266.3		54.7	1265.9								51.1	1267.39		38.0	1269.7	x7	56.9	1266.0		57.6	1265.8	Max Pool	62.3	1270.6		55.8	1265.9								53.7	1266.97		38.0	1269.7	x7	58.1	1265.9		58.1	1266.0		66.5	1273.1	RTOB	56.7	1266.2								55.41	1266.92		40.5	1269.3	x7	61.7	1267.6		61.7	1267.6		68.0	1273.5		57.8	1267.0								57.25	1266.93		42.6	1268.6	x7w	63.4	1268.1		61.4	1267.6		71.4	1274.0	RPN	59.8	1269.6								59.44	1267.1		45.0	1268.3	x7	65.4	1268.9		63.1	1268.4					62.0	1270.5								60.55	1267.88		45.1	1268.3	x7	65.7	1269.0		64.7	1269.2	Water				63.0	1271.7								61.05	1268.43		45.2	1268.3	x7	66.2	1269.4		66.5	1270.1					64.5	1272.4								62.3	1268.83		48.6	1267.8	x7	66.5	1270.0		66.7	1272.9					67.6	1273.8								64.36	1270.25		48.7	1267.8	x7	66.8	1272.2		66.9	1273.4	Right Pin				69.3	1273.8								65.13	1270.96		52.2	1267.0	x7	67.4	1272.4		71.4	1274.0					71.4	1274.0								66.25	1272.71		52.2	1267.0	x7	68.0	1273.3		68.0	1273.8					74.5	1273.8								67.35	1273.16		54.5	1266.2	x7	68.0	1273.4		68.0	1273.4					79.2	1273.9								70.1	1273.46		56.7	1265.8	x7	71.4	1274.0		83.7	1274.0					83.7	1274.0								71.38	1273.77	x7tp	57.1	1265.9	x7	78.4	1273.7		83.7	1278.9					83.7	1278.9											59.4	1266.6	x7	83.5	1273.8		113.2	1279.0					113.2	1279.0											62.3	1267.8	x7				132.16	1279.55																	63.96	1268.64	x7																						65.59	1269.07	x7																						65.93	1271.77	x7																						66.33	1272.83	x7																						68.17	1273.51	x7																						70.01	1273.72	x7p																						72.78	1273.58	x7																						76.97	1273.46	x7																						79.72	1273.47	x7																						82.31	1273.54	x7																						86.09	1274.93	x7																						91.25	1278.5	x7																						92.65	1278.82	x7																						98.17	1278.79	x7																																										
5.98	1273.04		-1.8	1272.7	x7p	-3.0	1273.0		1.4	1272.9		15.0	1272.1		17.0	1272.3								15.93	1272.4		0.2	1272.7	x7	13.7	1272.6		11.3	1272.3		22.0	1271.3		23.7	1271.4								24.79	1271.26		4.4	1272.5	x7	20.5	1271.5		17.6	1272.2	Bankfull	28.0	1270.6		28.4	1270.9								28.9	1270.23		8.9	1272.3	x7	26.9	1271.0		19.3	1272.0		34.0	1270.3		31.0	1270.5								31.54	1269.42		13.1	1272.4	x7	33.0	1270.9		24.0	1271.6		40.7	1269.6		37.7	1269.6								38.33	1268.14		17.9	1271.9	x7	39.9	1269.2		25.1	1271.3		41.4	1269.1	LEW	40.6	1269.4								40.23	1268.97		17.9	1271.9	x7	41.8	1269.2		32.6	1271.0		42.6	1268.4		42.7	1269.1								42.07	1268.73		20.6	1271.8	x7	43.3	1268.9		40.0	1269.8		44.5	1267.9		45.9	1268.1								44.17	1268.62		23.4	1271.4	x7hkf	45.7	1268.3		42.3	1269.1		46.8	1267.1		48.5	1266.9								45.44	1268.31		30.5	1271.1	x7	49.1	1267.9		46.8	1268.3	Water	49.6	1265.9		51.6	1266.4								47.08	1268.07		33.2	1270.4	x7	52.6	1267.1		46.8	1268.3		54.4	1265.0		53.5	1265.7								48.96	1267.74		30.0	1269.7	x7	56.4	1266.0		53.7	1265.8		60.0	1266.3		54.7	1265.9								51.1	1267.39		38.0	1269.7	x7	56.9	1266.0		57.6	1265.8	Max Pool	62.3	1270.6		55.8	1265.9								53.7	1266.97		38.0	1269.7	x7	58.1	1265.9		58.1	1266.0		66.5	1273.1	RTOB	56.7	1266.2								55.41	1266.92		40.5	1269.3	x7	61.7	1267.6		61.7	1267.6		68.0	1273.5		57.8	1267.0								57.25	1266.93		42.6	1268.6	x7w	63.4	1268.1		61.4	1267.6		71.4	1274.0	RPN	59.8	1269.6								59.44	1267.1		45.0	1268.3	x7	65.4	1268.9		63.1	1268.4					62.0	1270.5								60.55	1267.88		45.1	1268.3	x7	65.7	1269.0		64.7	1269.2	Water				63.0	1271.7								61.05	1268.43		45.2	1268.3	x7	66.2	1269.4		66.5	1270.1					64.5	1272.4								62.3	1268.83		48.6	1267.8	x7	66.5	1270.0		66.7	1272.9					67.6	1273.8								64.36	1270.25		48.7	1267.8	x7	66.8	1272.2		66.9	1273.4	Right Pin				69.3	1273.8								65.13	1270.96		52.2	1267.0	x7	67.4	1272.4		71.4	1274.0					71.4	1274.0								66.25	1272.71		52.2	1267.0	x7	68.0	1273.3		68.0	1273.8					74.5	1273.8								67.35	1273.16		54.5	1266.2	x7	68.0	1273.4		68.0	1273.4					79.2	1273.9								70.1	1273.46		56.7	1265.8	x7	71.4	1274.0		83.7	1274.0					83.7	1274.0								71.38	1273.77	x7tp	57.1	1265.9	x7	78.4	1273.7		83.7	1278.9					83.7	1278.9											59.4	1266.6	x7	83.5	1273.8		113.2	1279.0					113.2	1279.0											62.3	1267.8	x7				132.16	1279.55																	63.96	1268.64	x7																						65.59	1269.07	x7																						65.93	1271.77	x7																						66.33	1272.83	x7																						68.17	1273.51	x7																						70.01	1273.72	x7p																						72.78	1273.58	x7																						76.97	1273.46	x7																						79.72	1273.47	x7																						82.31	1273.54	x7																						86.09	1274.93	x7																						91.25	1278.5	x7																						92.65	1278.82	x7																						98.17	1278.79	x7																																																																		
15.93	1272.4		0.2	1272.7	x7	13.7	1272.6		11.3	1272.3		22.0	1271.3		23.7	1271.4								24.79	1271.26		4.4	1272.5	x7	20.5	1271.5		17.6	1272.2	Bankfull	28.0	1270.6		28.4	1270.9								28.9	1270.23		8.9	1272.3	x7	26.9	1271.0		19.3	1272.0		34.0	1270.3		31.0	1270.5								31.54	1269.42		13.1	1272.4	x7	33.0	1270.9		24.0	1271.6		40.7	1269.6		37.7	1269.6								38.33	1268.14		17.9	1271.9	x7	39.9	1269.2		25.1	1271.3		41.4	1269.1	LEW	40.6	1269.4								40.23	1268.97		17.9	1271.9	x7	41.8	1269.2		32.6	1271.0		42.6	1268.4		42.7	1269.1								42.07	1268.73		20.6	1271.8	x7	43.3	1268.9		40.0	1269.8		44.5	1267.9		45.9	1268.1								44.17	1268.62		23.4	1271.4	x7hkf	45.7	1268.3		42.3	1269.1		46.8	1267.1		48.5	1266.9								45.44	1268.31		30.5	1271.1	x7	49.1	1267.9		46.8	1268.3	Water	49.6	1265.9		51.6	1266.4								47.08	1268.07		33.2	1270.4	x7	52.6	1267.1		46.8	1268.3		54.4	1265.0		53.5	1265.7								48.96	1267.74		30.0	1269.7	x7	56.4	1266.0		53.7	1265.8		60.0	1266.3		54.7	1265.9								51.1	1267.39		38.0	1269.7	x7	56.9	1266.0		57.6	1265.8	Max Pool	62.3	1270.6		55.8	1265.9								53.7	1266.97		38.0	1269.7	x7	58.1	1265.9		58.1	1266.0		66.5	1273.1	RTOB	56.7	1266.2								55.41	1266.92		40.5	1269.3	x7	61.7	1267.6		61.7	1267.6		68.0	1273.5		57.8	1267.0								57.25	1266.93		42.6	1268.6	x7w	63.4	1268.1		61.4	1267.6		71.4	1274.0	RPN	59.8	1269.6								59.44	1267.1		45.0	1268.3	x7	65.4	1268.9		63.1	1268.4					62.0	1270.5								60.55	1267.88		45.1	1268.3	x7	65.7	1269.0		64.7	1269.2	Water				63.0	1271.7								61.05	1268.43		45.2	1268.3	x7	66.2	1269.4		66.5	1270.1					64.5	1272.4								62.3	1268.83		48.6	1267.8	x7	66.5	1270.0		66.7	1272.9					67.6	1273.8								64.36	1270.25		48.7	1267.8	x7	66.8	1272.2		66.9	1273.4	Right Pin				69.3	1273.8								65.13	1270.96		52.2	1267.0	x7	67.4	1272.4		71.4	1274.0					71.4	1274.0								66.25	1272.71		52.2	1267.0	x7	68.0	1273.3		68.0	1273.8					74.5	1273.8								67.35	1273.16		54.5	1266.2	x7	68.0	1273.4		68.0	1273.4					79.2	1273.9								70.1	1273.46		56.7	1265.8	x7	71.4	1274.0		83.7	1274.0					83.7	1274.0								71.38	1273.77	x7tp	57.1	1265.9	x7	78.4	1273.7		83.7	1278.9					83.7	1278.9											59.4	1266.6	x7	83.5	1273.8		113.2	1279.0					113.2	1279.0											62.3	1267.8	x7				132.16	1279.55																	63.96	1268.64	x7																						65.59	1269.07	x7																						65.93	1271.77	x7																						66.33	1272.83	x7																						68.17	1273.51	x7																						70.01	1273.72	x7p																						72.78	1273.58	x7																						76.97	1273.46	x7																						79.72	1273.47	x7																						82.31	1273.54	x7																						86.09	1274.93	x7																						91.25	1278.5	x7																						92.65	1278.82	x7																						98.17	1278.79	x7																																																																																										
24.79	1271.26		4.4	1272.5	x7	20.5	1271.5		17.6	1272.2	Bankfull	28.0	1270.6		28.4	1270.9								28.9	1270.23		8.9	1272.3	x7	26.9	1271.0		19.3	1272.0		34.0	1270.3		31.0	1270.5								31.54	1269.42		13.1	1272.4	x7	33.0	1270.9		24.0	1271.6		40.7	1269.6		37.7	1269.6								38.33	1268.14		17.9	1271.9	x7	39.9	1269.2		25.1	1271.3		41.4	1269.1	LEW	40.6	1269.4								40.23	1268.97		17.9	1271.9	x7	41.8	1269.2		32.6	1271.0		42.6	1268.4		42.7	1269.1								42.07	1268.73		20.6	1271.8	x7	43.3	1268.9		40.0	1269.8		44.5	1267.9		45.9	1268.1								44.17	1268.62		23.4	1271.4	x7hkf	45.7	1268.3		42.3	1269.1		46.8	1267.1		48.5	1266.9								45.44	1268.31		30.5	1271.1	x7	49.1	1267.9		46.8	1268.3	Water	49.6	1265.9		51.6	1266.4								47.08	1268.07		33.2	1270.4	x7	52.6	1267.1		46.8	1268.3		54.4	1265.0		53.5	1265.7								48.96	1267.74		30.0	1269.7	x7	56.4	1266.0		53.7	1265.8		60.0	1266.3		54.7	1265.9								51.1	1267.39		38.0	1269.7	x7	56.9	1266.0		57.6	1265.8	Max Pool	62.3	1270.6		55.8	1265.9								53.7	1266.97		38.0	1269.7	x7	58.1	1265.9		58.1	1266.0		66.5	1273.1	RTOB	56.7	1266.2								55.41	1266.92		40.5	1269.3	x7	61.7	1267.6		61.7	1267.6		68.0	1273.5		57.8	1267.0								57.25	1266.93		42.6	1268.6	x7w	63.4	1268.1		61.4	1267.6		71.4	1274.0	RPN	59.8	1269.6								59.44	1267.1		45.0	1268.3	x7	65.4	1268.9		63.1	1268.4					62.0	1270.5								60.55	1267.88		45.1	1268.3	x7	65.7	1269.0		64.7	1269.2	Water				63.0	1271.7								61.05	1268.43		45.2	1268.3	x7	66.2	1269.4		66.5	1270.1					64.5	1272.4								62.3	1268.83		48.6	1267.8	x7	66.5	1270.0		66.7	1272.9					67.6	1273.8								64.36	1270.25		48.7	1267.8	x7	66.8	1272.2		66.9	1273.4	Right Pin				69.3	1273.8								65.13	1270.96		52.2	1267.0	x7	67.4	1272.4		71.4	1274.0					71.4	1274.0								66.25	1272.71		52.2	1267.0	x7	68.0	1273.3		68.0	1273.8					74.5	1273.8								67.35	1273.16		54.5	1266.2	x7	68.0	1273.4		68.0	1273.4					79.2	1273.9								70.1	1273.46		56.7	1265.8	x7	71.4	1274.0		83.7	1274.0					83.7	1274.0								71.38	1273.77	x7tp	57.1	1265.9	x7	78.4	1273.7		83.7	1278.9					83.7	1278.9											59.4	1266.6	x7	83.5	1273.8		113.2	1279.0					113.2	1279.0											62.3	1267.8	x7				132.16	1279.55																	63.96	1268.64	x7																						65.59	1269.07	x7																						65.93	1271.77	x7																						66.33	1272.83	x7																						68.17	1273.51	x7																						70.01	1273.72	x7p																						72.78	1273.58	x7																						76.97	1273.46	x7																						79.72	1273.47	x7																						82.31	1273.54	x7																						86.09	1274.93	x7																						91.25	1278.5	x7																						92.65	1278.82	x7																						98.17	1278.79	x7																																																																																																																		
28.9	1270.23		8.9	1272.3	x7	26.9	1271.0		19.3	1272.0		34.0	1270.3		31.0	1270.5								31.54	1269.42		13.1	1272.4	x7	33.0	1270.9		24.0	1271.6		40.7	1269.6		37.7	1269.6								38.33	1268.14		17.9	1271.9	x7	39.9	1269.2		25.1	1271.3		41.4	1269.1	LEW	40.6	1269.4								40.23	1268.97		17.9	1271.9	x7	41.8	1269.2		32.6	1271.0		42.6	1268.4		42.7	1269.1								42.07	1268.73		20.6	1271.8	x7	43.3	1268.9		40.0	1269.8		44.5	1267.9		45.9	1268.1								44.17	1268.62		23.4	1271.4	x7hkf	45.7	1268.3		42.3	1269.1		46.8	1267.1		48.5	1266.9								45.44	1268.31		30.5	1271.1	x7	49.1	1267.9		46.8	1268.3	Water	49.6	1265.9		51.6	1266.4								47.08	1268.07		33.2	1270.4	x7	52.6	1267.1		46.8	1268.3		54.4	1265.0		53.5	1265.7								48.96	1267.74		30.0	1269.7	x7	56.4	1266.0		53.7	1265.8		60.0	1266.3		54.7	1265.9								51.1	1267.39		38.0	1269.7	x7	56.9	1266.0		57.6	1265.8	Max Pool	62.3	1270.6		55.8	1265.9								53.7	1266.97		38.0	1269.7	x7	58.1	1265.9		58.1	1266.0		66.5	1273.1	RTOB	56.7	1266.2								55.41	1266.92		40.5	1269.3	x7	61.7	1267.6		61.7	1267.6		68.0	1273.5		57.8	1267.0								57.25	1266.93		42.6	1268.6	x7w	63.4	1268.1		61.4	1267.6		71.4	1274.0	RPN	59.8	1269.6								59.44	1267.1		45.0	1268.3	x7	65.4	1268.9		63.1	1268.4					62.0	1270.5								60.55	1267.88		45.1	1268.3	x7	65.7	1269.0		64.7	1269.2	Water				63.0	1271.7								61.05	1268.43		45.2	1268.3	x7	66.2	1269.4		66.5	1270.1					64.5	1272.4								62.3	1268.83		48.6	1267.8	x7	66.5	1270.0		66.7	1272.9					67.6	1273.8								64.36	1270.25		48.7	1267.8	x7	66.8	1272.2		66.9	1273.4	Right Pin				69.3	1273.8								65.13	1270.96		52.2	1267.0	x7	67.4	1272.4		71.4	1274.0					71.4	1274.0								66.25	1272.71		52.2	1267.0	x7	68.0	1273.3		68.0	1273.8					74.5	1273.8								67.35	1273.16		54.5	1266.2	x7	68.0	1273.4		68.0	1273.4					79.2	1273.9								70.1	1273.46		56.7	1265.8	x7	71.4	1274.0		83.7	1274.0					83.7	1274.0								71.38	1273.77	x7tp	57.1	1265.9	x7	78.4	1273.7		83.7	1278.9					83.7	1278.9											59.4	1266.6	x7	83.5	1273.8		113.2	1279.0					113.2	1279.0											62.3	1267.8	x7				132.16	1279.55																	63.96	1268.64	x7																						65.59	1269.07	x7																						65.93	1271.77	x7																						66.33	1272.83	x7																						68.17	1273.51	x7																						70.01	1273.72	x7p																						72.78	1273.58	x7																						76.97	1273.46	x7																						79.72	1273.47	x7																						82.31	1273.54	x7																						86.09	1274.93	x7																						91.25	1278.5	x7																						92.65	1278.82	x7																						98.17	1278.79	x7																																																																																																																																										
31.54	1269.42		13.1	1272.4	x7	33.0	1270.9		24.0	1271.6		40.7	1269.6		37.7	1269.6								38.33	1268.14		17.9	1271.9	x7	39.9	1269.2		25.1	1271.3		41.4	1269.1	LEW	40.6	1269.4								40.23	1268.97		17.9	1271.9	x7	41.8	1269.2		32.6	1271.0		42.6	1268.4		42.7	1269.1								42.07	1268.73		20.6	1271.8	x7	43.3	1268.9		40.0	1269.8		44.5	1267.9		45.9	1268.1								44.17	1268.62		23.4	1271.4	x7hkf	45.7	1268.3		42.3	1269.1		46.8	1267.1		48.5	1266.9								45.44	1268.31		30.5	1271.1	x7	49.1	1267.9		46.8	1268.3	Water	49.6	1265.9		51.6	1266.4								47.08	1268.07		33.2	1270.4	x7	52.6	1267.1		46.8	1268.3		54.4	1265.0		53.5	1265.7								48.96	1267.74		30.0	1269.7	x7	56.4	1266.0		53.7	1265.8		60.0	1266.3		54.7	1265.9								51.1	1267.39		38.0	1269.7	x7	56.9	1266.0		57.6	1265.8	Max Pool	62.3	1270.6		55.8	1265.9								53.7	1266.97		38.0	1269.7	x7	58.1	1265.9		58.1	1266.0		66.5	1273.1	RTOB	56.7	1266.2								55.41	1266.92		40.5	1269.3	x7	61.7	1267.6		61.7	1267.6		68.0	1273.5		57.8	1267.0								57.25	1266.93		42.6	1268.6	x7w	63.4	1268.1		61.4	1267.6		71.4	1274.0	RPN	59.8	1269.6								59.44	1267.1		45.0	1268.3	x7	65.4	1268.9		63.1	1268.4					62.0	1270.5								60.55	1267.88		45.1	1268.3	x7	65.7	1269.0		64.7	1269.2	Water				63.0	1271.7								61.05	1268.43		45.2	1268.3	x7	66.2	1269.4		66.5	1270.1					64.5	1272.4								62.3	1268.83		48.6	1267.8	x7	66.5	1270.0		66.7	1272.9					67.6	1273.8								64.36	1270.25		48.7	1267.8	x7	66.8	1272.2		66.9	1273.4	Right Pin				69.3	1273.8								65.13	1270.96		52.2	1267.0	x7	67.4	1272.4		71.4	1274.0					71.4	1274.0								66.25	1272.71		52.2	1267.0	x7	68.0	1273.3		68.0	1273.8					74.5	1273.8								67.35	1273.16		54.5	1266.2	x7	68.0	1273.4		68.0	1273.4					79.2	1273.9								70.1	1273.46		56.7	1265.8	x7	71.4	1274.0		83.7	1274.0					83.7	1274.0								71.38	1273.77	x7tp	57.1	1265.9	x7	78.4	1273.7		83.7	1278.9					83.7	1278.9											59.4	1266.6	x7	83.5	1273.8		113.2	1279.0					113.2	1279.0											62.3	1267.8	x7				132.16	1279.55																	63.96	1268.64	x7																						65.59	1269.07	x7																						65.93	1271.77	x7																						66.33	1272.83	x7																						68.17	1273.51	x7																						70.01	1273.72	x7p																						72.78	1273.58	x7																						76.97	1273.46	x7																						79.72	1273.47	x7																						82.31	1273.54	x7																						86.09	1274.93	x7																						91.25	1278.5	x7																						92.65	1278.82	x7																						98.17	1278.79	x7																																																																																																																																																																		
38.33	1268.14		17.9	1271.9	x7	39.9	1269.2		25.1	1271.3		41.4	1269.1	LEW	40.6	1269.4								40.23	1268.97		17.9	1271.9	x7	41.8	1269.2		32.6	1271.0		42.6	1268.4		42.7	1269.1								42.07	1268.73		20.6	1271.8	x7	43.3	1268.9		40.0	1269.8		44.5	1267.9		45.9	1268.1								44.17	1268.62		23.4	1271.4	x7hkf	45.7	1268.3		42.3	1269.1		46.8	1267.1		48.5	1266.9								45.44	1268.31		30.5	1271.1	x7	49.1	1267.9		46.8	1268.3	Water	49.6	1265.9		51.6	1266.4								47.08	1268.07		33.2	1270.4	x7	52.6	1267.1		46.8	1268.3		54.4	1265.0		53.5	1265.7								48.96	1267.74		30.0	1269.7	x7	56.4	1266.0		53.7	1265.8		60.0	1266.3		54.7	1265.9								51.1	1267.39		38.0	1269.7	x7	56.9	1266.0		57.6	1265.8	Max Pool	62.3	1270.6		55.8	1265.9								53.7	1266.97		38.0	1269.7	x7	58.1	1265.9		58.1	1266.0		66.5	1273.1	RTOB	56.7	1266.2								55.41	1266.92		40.5	1269.3	x7	61.7	1267.6		61.7	1267.6		68.0	1273.5		57.8	1267.0								57.25	1266.93		42.6	1268.6	x7w	63.4	1268.1		61.4	1267.6		71.4	1274.0	RPN	59.8	1269.6								59.44	1267.1		45.0	1268.3	x7	65.4	1268.9		63.1	1268.4					62.0	1270.5								60.55	1267.88		45.1	1268.3	x7	65.7	1269.0		64.7	1269.2	Water				63.0	1271.7								61.05	1268.43		45.2	1268.3	x7	66.2	1269.4		66.5	1270.1					64.5	1272.4								62.3	1268.83		48.6	1267.8	x7	66.5	1270.0		66.7	1272.9					67.6	1273.8								64.36	1270.25		48.7	1267.8	x7	66.8	1272.2		66.9	1273.4	Right Pin				69.3	1273.8								65.13	1270.96		52.2	1267.0	x7	67.4	1272.4		71.4	1274.0					71.4	1274.0								66.25	1272.71		52.2	1267.0	x7	68.0	1273.3		68.0	1273.8					74.5	1273.8								67.35	1273.16		54.5	1266.2	x7	68.0	1273.4		68.0	1273.4					79.2	1273.9								70.1	1273.46		56.7	1265.8	x7	71.4	1274.0		83.7	1274.0					83.7	1274.0								71.38	1273.77	x7tp	57.1	1265.9	x7	78.4	1273.7		83.7	1278.9					83.7	1278.9											59.4	1266.6	x7	83.5	1273.8		113.2	1279.0					113.2	1279.0											62.3	1267.8	x7				132.16	1279.55																	63.96	1268.64	x7																						65.59	1269.07	x7																						65.93	1271.77	x7																						66.33	1272.83	x7																						68.17	1273.51	x7																						70.01	1273.72	x7p																						72.78	1273.58	x7																						76.97	1273.46	x7																						79.72	1273.47	x7																						82.31	1273.54	x7																						86.09	1274.93	x7																						91.25	1278.5	x7																						92.65	1278.82	x7																						98.17	1278.79	x7																																																																																																																																																																																										
40.23	1268.97		17.9	1271.9	x7	41.8	1269.2		32.6	1271.0		42.6	1268.4		42.7	1269.1								42.07	1268.73		20.6	1271.8	x7	43.3	1268.9		40.0	1269.8		44.5	1267.9		45.9	1268.1								44.17	1268.62		23.4	1271.4	x7hkf	45.7	1268.3		42.3	1269.1		46.8	1267.1		48.5	1266.9								45.44	1268.31		30.5	1271.1	x7	49.1	1267.9		46.8	1268.3	Water	49.6	1265.9		51.6	1266.4								47.08	1268.07		33.2	1270.4	x7	52.6	1267.1		46.8	1268.3		54.4	1265.0		53.5	1265.7								48.96	1267.74		30.0	1269.7	x7	56.4	1266.0		53.7	1265.8		60.0	1266.3		54.7	1265.9								51.1	1267.39		38.0	1269.7	x7	56.9	1266.0		57.6	1265.8	Max Pool	62.3	1270.6		55.8	1265.9								53.7	1266.97		38.0	1269.7	x7	58.1	1265.9		58.1	1266.0		66.5	1273.1	RTOB	56.7	1266.2								55.41	1266.92		40.5	1269.3	x7	61.7	1267.6		61.7	1267.6		68.0	1273.5		57.8	1267.0								57.25	1266.93		42.6	1268.6	x7w	63.4	1268.1		61.4	1267.6		71.4	1274.0	RPN	59.8	1269.6								59.44	1267.1		45.0	1268.3	x7	65.4	1268.9		63.1	1268.4					62.0	1270.5								60.55	1267.88		45.1	1268.3	x7	65.7	1269.0		64.7	1269.2	Water				63.0	1271.7								61.05	1268.43		45.2	1268.3	x7	66.2	1269.4		66.5	1270.1					64.5	1272.4								62.3	1268.83		48.6	1267.8	x7	66.5	1270.0		66.7	1272.9					67.6	1273.8								64.36	1270.25		48.7	1267.8	x7	66.8	1272.2		66.9	1273.4	Right Pin				69.3	1273.8								65.13	1270.96		52.2	1267.0	x7	67.4	1272.4		71.4	1274.0					71.4	1274.0								66.25	1272.71		52.2	1267.0	x7	68.0	1273.3		68.0	1273.8					74.5	1273.8								67.35	1273.16		54.5	1266.2	x7	68.0	1273.4		68.0	1273.4					79.2	1273.9								70.1	1273.46		56.7	1265.8	x7	71.4	1274.0		83.7	1274.0					83.7	1274.0								71.38	1273.77	x7tp	57.1	1265.9	x7	78.4	1273.7		83.7	1278.9					83.7	1278.9											59.4	1266.6	x7	83.5	1273.8		113.2	1279.0					113.2	1279.0											62.3	1267.8	x7				132.16	1279.55																	63.96	1268.64	x7																						65.59	1269.07	x7																						65.93	1271.77	x7																						66.33	1272.83	x7																						68.17	1273.51	x7																						70.01	1273.72	x7p																						72.78	1273.58	x7																						76.97	1273.46	x7																						79.72	1273.47	x7																						82.31	1273.54	x7																						86.09	1274.93	x7																						91.25	1278.5	x7																						92.65	1278.82	x7																						98.17	1278.79	x7																																																																																																																																																																																																																		
42.07	1268.73		20.6	1271.8	x7	43.3	1268.9		40.0	1269.8		44.5	1267.9		45.9	1268.1								44.17	1268.62		23.4	1271.4	x7hkf	45.7	1268.3		42.3	1269.1		46.8	1267.1		48.5	1266.9								45.44	1268.31		30.5	1271.1	x7	49.1	1267.9		46.8	1268.3	Water	49.6	1265.9		51.6	1266.4								47.08	1268.07		33.2	1270.4	x7	52.6	1267.1		46.8	1268.3		54.4	1265.0		53.5	1265.7								48.96	1267.74		30.0	1269.7	x7	56.4	1266.0		53.7	1265.8		60.0	1266.3		54.7	1265.9								51.1	1267.39		38.0	1269.7	x7	56.9	1266.0		57.6	1265.8	Max Pool	62.3	1270.6		55.8	1265.9								53.7	1266.97		38.0	1269.7	x7	58.1	1265.9		58.1	1266.0		66.5	1273.1	RTOB	56.7	1266.2								55.41	1266.92		40.5	1269.3	x7	61.7	1267.6		61.7	1267.6		68.0	1273.5		57.8	1267.0								57.25	1266.93		42.6	1268.6	x7w	63.4	1268.1		61.4	1267.6		71.4	1274.0	RPN	59.8	1269.6								59.44	1267.1		45.0	1268.3	x7	65.4	1268.9		63.1	1268.4					62.0	1270.5								60.55	1267.88		45.1	1268.3	x7	65.7	1269.0		64.7	1269.2	Water				63.0	1271.7								61.05	1268.43		45.2	1268.3	x7	66.2	1269.4		66.5	1270.1					64.5	1272.4								62.3	1268.83		48.6	1267.8	x7	66.5	1270.0		66.7	1272.9					67.6	1273.8								64.36	1270.25		48.7	1267.8	x7	66.8	1272.2		66.9	1273.4	Right Pin				69.3	1273.8								65.13	1270.96		52.2	1267.0	x7	67.4	1272.4		71.4	1274.0					71.4	1274.0								66.25	1272.71		52.2	1267.0	x7	68.0	1273.3		68.0	1273.8					74.5	1273.8								67.35	1273.16		54.5	1266.2	x7	68.0	1273.4		68.0	1273.4					79.2	1273.9								70.1	1273.46		56.7	1265.8	x7	71.4	1274.0		83.7	1274.0					83.7	1274.0								71.38	1273.77	x7tp	57.1	1265.9	x7	78.4	1273.7		83.7	1278.9					83.7	1278.9											59.4	1266.6	x7	83.5	1273.8		113.2	1279.0					113.2	1279.0											62.3	1267.8	x7				132.16	1279.55																	63.96	1268.64	x7																						65.59	1269.07	x7																						65.93	1271.77	x7																						66.33	1272.83	x7																						68.17	1273.51	x7																						70.01	1273.72	x7p																						72.78	1273.58	x7																						76.97	1273.46	x7																						79.72	1273.47	x7																						82.31	1273.54	x7																						86.09	1274.93	x7																						91.25	1278.5	x7																						92.65	1278.82	x7																						98.17	1278.79	x7																																																																																																																																																																																																																																										
44.17	1268.62		23.4	1271.4	x7hkf	45.7	1268.3		42.3	1269.1		46.8	1267.1		48.5	1266.9								45.44	1268.31		30.5	1271.1	x7	49.1	1267.9		46.8	1268.3	Water	49.6	1265.9		51.6	1266.4								47.08	1268.07		33.2	1270.4	x7	52.6	1267.1		46.8	1268.3		54.4	1265.0		53.5	1265.7								48.96	1267.74		30.0	1269.7	x7	56.4	1266.0		53.7	1265.8		60.0	1266.3		54.7	1265.9								51.1	1267.39		38.0	1269.7	x7	56.9	1266.0		57.6	1265.8	Max Pool	62.3	1270.6		55.8	1265.9								53.7	1266.97		38.0	1269.7	x7	58.1	1265.9		58.1	1266.0		66.5	1273.1	RTOB	56.7	1266.2								55.41	1266.92		40.5	1269.3	x7	61.7	1267.6		61.7	1267.6		68.0	1273.5		57.8	1267.0								57.25	1266.93		42.6	1268.6	x7w	63.4	1268.1		61.4	1267.6		71.4	1274.0	RPN	59.8	1269.6								59.44	1267.1		45.0	1268.3	x7	65.4	1268.9		63.1	1268.4					62.0	1270.5								60.55	1267.88		45.1	1268.3	x7	65.7	1269.0		64.7	1269.2	Water				63.0	1271.7								61.05	1268.43		45.2	1268.3	x7	66.2	1269.4		66.5	1270.1					64.5	1272.4								62.3	1268.83		48.6	1267.8	x7	66.5	1270.0		66.7	1272.9					67.6	1273.8								64.36	1270.25		48.7	1267.8	x7	66.8	1272.2		66.9	1273.4	Right Pin				69.3	1273.8								65.13	1270.96		52.2	1267.0	x7	67.4	1272.4		71.4	1274.0					71.4	1274.0								66.25	1272.71		52.2	1267.0	x7	68.0	1273.3		68.0	1273.8					74.5	1273.8								67.35	1273.16		54.5	1266.2	x7	68.0	1273.4		68.0	1273.4					79.2	1273.9								70.1	1273.46		56.7	1265.8	x7	71.4	1274.0		83.7	1274.0					83.7	1274.0								71.38	1273.77	x7tp	57.1	1265.9	x7	78.4	1273.7		83.7	1278.9					83.7	1278.9											59.4	1266.6	x7	83.5	1273.8		113.2	1279.0					113.2	1279.0											62.3	1267.8	x7				132.16	1279.55																	63.96	1268.64	x7																						65.59	1269.07	x7																						65.93	1271.77	x7																						66.33	1272.83	x7																						68.17	1273.51	x7																						70.01	1273.72	x7p																						72.78	1273.58	x7																						76.97	1273.46	x7																						79.72	1273.47	x7																						82.31	1273.54	x7																						86.09	1274.93	x7																						91.25	1278.5	x7																						92.65	1278.82	x7																						98.17	1278.79	x7																																																																																																																																																																																																																																																																		
45.44	1268.31		30.5	1271.1	x7	49.1	1267.9		46.8	1268.3	Water	49.6	1265.9		51.6	1266.4								47.08	1268.07		33.2	1270.4	x7	52.6	1267.1		46.8	1268.3		54.4	1265.0		53.5	1265.7								48.96	1267.74		30.0	1269.7	x7	56.4	1266.0		53.7	1265.8		60.0	1266.3		54.7	1265.9								51.1	1267.39		38.0	1269.7	x7	56.9	1266.0		57.6	1265.8	Max Pool	62.3	1270.6		55.8	1265.9								53.7	1266.97		38.0	1269.7	x7	58.1	1265.9		58.1	1266.0		66.5	1273.1	RTOB	56.7	1266.2								55.41	1266.92		40.5	1269.3	x7	61.7	1267.6		61.7	1267.6		68.0	1273.5		57.8	1267.0								57.25	1266.93		42.6	1268.6	x7w	63.4	1268.1		61.4	1267.6		71.4	1274.0	RPN	59.8	1269.6								59.44	1267.1		45.0	1268.3	x7	65.4	1268.9		63.1	1268.4					62.0	1270.5								60.55	1267.88		45.1	1268.3	x7	65.7	1269.0		64.7	1269.2	Water				63.0	1271.7								61.05	1268.43		45.2	1268.3	x7	66.2	1269.4		66.5	1270.1					64.5	1272.4								62.3	1268.83		48.6	1267.8	x7	66.5	1270.0		66.7	1272.9					67.6	1273.8								64.36	1270.25		48.7	1267.8	x7	66.8	1272.2		66.9	1273.4	Right Pin				69.3	1273.8								65.13	1270.96		52.2	1267.0	x7	67.4	1272.4		71.4	1274.0					71.4	1274.0								66.25	1272.71		52.2	1267.0	x7	68.0	1273.3		68.0	1273.8					74.5	1273.8								67.35	1273.16		54.5	1266.2	x7	68.0	1273.4		68.0	1273.4					79.2	1273.9								70.1	1273.46		56.7	1265.8	x7	71.4	1274.0		83.7	1274.0					83.7	1274.0								71.38	1273.77	x7tp	57.1	1265.9	x7	78.4	1273.7		83.7	1278.9					83.7	1278.9											59.4	1266.6	x7	83.5	1273.8		113.2	1279.0					113.2	1279.0											62.3	1267.8	x7				132.16	1279.55																	63.96	1268.64	x7																						65.59	1269.07	x7																						65.93	1271.77	x7																						66.33	1272.83	x7																						68.17	1273.51	x7																						70.01	1273.72	x7p																						72.78	1273.58	x7																						76.97	1273.46	x7																						79.72	1273.47	x7																						82.31	1273.54	x7																						86.09	1274.93	x7																						91.25	1278.5	x7																						92.65	1278.82	x7																						98.17	1278.79	x7																																																																																																																																																																																																																																																																																										
47.08	1268.07		33.2	1270.4	x7	52.6	1267.1		46.8	1268.3		54.4	1265.0		53.5	1265.7								48.96	1267.74		30.0	1269.7	x7	56.4	1266.0		53.7	1265.8		60.0	1266.3		54.7	1265.9								51.1	1267.39		38.0	1269.7	x7	56.9	1266.0		57.6	1265.8	Max Pool	62.3	1270.6		55.8	1265.9								53.7	1266.97		38.0	1269.7	x7	58.1	1265.9		58.1	1266.0		66.5	1273.1	RTOB	56.7	1266.2								55.41	1266.92		40.5	1269.3	x7	61.7	1267.6		61.7	1267.6		68.0	1273.5		57.8	1267.0								57.25	1266.93		42.6	1268.6	x7w	63.4	1268.1		61.4	1267.6		71.4	1274.0	RPN	59.8	1269.6								59.44	1267.1		45.0	1268.3	x7	65.4	1268.9		63.1	1268.4					62.0	1270.5								60.55	1267.88		45.1	1268.3	x7	65.7	1269.0		64.7	1269.2	Water				63.0	1271.7								61.05	1268.43		45.2	1268.3	x7	66.2	1269.4		66.5	1270.1					64.5	1272.4								62.3	1268.83		48.6	1267.8	x7	66.5	1270.0		66.7	1272.9					67.6	1273.8								64.36	1270.25		48.7	1267.8	x7	66.8	1272.2		66.9	1273.4	Right Pin				69.3	1273.8								65.13	1270.96		52.2	1267.0	x7	67.4	1272.4		71.4	1274.0					71.4	1274.0								66.25	1272.71		52.2	1267.0	x7	68.0	1273.3		68.0	1273.8					74.5	1273.8								67.35	1273.16		54.5	1266.2	x7	68.0	1273.4		68.0	1273.4					79.2	1273.9								70.1	1273.46		56.7	1265.8	x7	71.4	1274.0		83.7	1274.0					83.7	1274.0								71.38	1273.77	x7tp	57.1	1265.9	x7	78.4	1273.7		83.7	1278.9					83.7	1278.9											59.4	1266.6	x7	83.5	1273.8		113.2	1279.0					113.2	1279.0											62.3	1267.8	x7				132.16	1279.55																	63.96	1268.64	x7																						65.59	1269.07	x7																						65.93	1271.77	x7																						66.33	1272.83	x7																						68.17	1273.51	x7																						70.01	1273.72	x7p																						72.78	1273.58	x7																						76.97	1273.46	x7																						79.72	1273.47	x7																						82.31	1273.54	x7																						86.09	1274.93	x7																						91.25	1278.5	x7																						92.65	1278.82	x7																						98.17	1278.79	x7																																																																																																																																																																																																																																																																																																																		
48.96	1267.74		30.0	1269.7	x7	56.4	1266.0		53.7	1265.8		60.0	1266.3		54.7	1265.9								51.1	1267.39		38.0	1269.7	x7	56.9	1266.0		57.6	1265.8	Max Pool	62.3	1270.6		55.8	1265.9								53.7	1266.97		38.0	1269.7	x7	58.1	1265.9		58.1	1266.0		66.5	1273.1	RTOB	56.7	1266.2								55.41	1266.92		40.5	1269.3	x7	61.7	1267.6		61.7	1267.6		68.0	1273.5		57.8	1267.0								57.25	1266.93		42.6	1268.6	x7w	63.4	1268.1		61.4	1267.6		71.4	1274.0	RPN	59.8	1269.6								59.44	1267.1		45.0	1268.3	x7	65.4	1268.9		63.1	1268.4					62.0	1270.5								60.55	1267.88		45.1	1268.3	x7	65.7	1269.0		64.7	1269.2	Water				63.0	1271.7								61.05	1268.43		45.2	1268.3	x7	66.2	1269.4		66.5	1270.1					64.5	1272.4								62.3	1268.83		48.6	1267.8	x7	66.5	1270.0		66.7	1272.9					67.6	1273.8								64.36	1270.25		48.7	1267.8	x7	66.8	1272.2		66.9	1273.4	Right Pin				69.3	1273.8								65.13	1270.96		52.2	1267.0	x7	67.4	1272.4		71.4	1274.0					71.4	1274.0								66.25	1272.71		52.2	1267.0	x7	68.0	1273.3		68.0	1273.8					74.5	1273.8								67.35	1273.16		54.5	1266.2	x7	68.0	1273.4		68.0	1273.4					79.2	1273.9								70.1	1273.46		56.7	1265.8	x7	71.4	1274.0		83.7	1274.0					83.7	1274.0								71.38	1273.77	x7tp	57.1	1265.9	x7	78.4	1273.7		83.7	1278.9					83.7	1278.9											59.4	1266.6	x7	83.5	1273.8		113.2	1279.0					113.2	1279.0											62.3	1267.8	x7				132.16	1279.55																	63.96	1268.64	x7																						65.59	1269.07	x7																						65.93	1271.77	x7																						66.33	1272.83	x7																						68.17	1273.51	x7																						70.01	1273.72	x7p																						72.78	1273.58	x7																						76.97	1273.46	x7																						79.72	1273.47	x7																						82.31	1273.54	x7																						86.09	1274.93	x7																						91.25	1278.5	x7																						92.65	1278.82	x7																						98.17	1278.79	x7																																																																																																																																																																																																																																																																																																																																										
51.1	1267.39		38.0	1269.7	x7	56.9	1266.0		57.6	1265.8	Max Pool	62.3	1270.6		55.8	1265.9								53.7	1266.97		38.0	1269.7	x7	58.1	1265.9		58.1	1266.0		66.5	1273.1	RTOB	56.7	1266.2								55.41	1266.92		40.5	1269.3	x7	61.7	1267.6		61.7	1267.6		68.0	1273.5		57.8	1267.0								57.25	1266.93		42.6	1268.6	x7w	63.4	1268.1		61.4	1267.6		71.4	1274.0	RPN	59.8	1269.6								59.44	1267.1		45.0	1268.3	x7	65.4	1268.9		63.1	1268.4					62.0	1270.5								60.55	1267.88		45.1	1268.3	x7	65.7	1269.0		64.7	1269.2	Water				63.0	1271.7								61.05	1268.43		45.2	1268.3	x7	66.2	1269.4		66.5	1270.1					64.5	1272.4								62.3	1268.83		48.6	1267.8	x7	66.5	1270.0		66.7	1272.9					67.6	1273.8								64.36	1270.25		48.7	1267.8	x7	66.8	1272.2		66.9	1273.4	Right Pin				69.3	1273.8								65.13	1270.96		52.2	1267.0	x7	67.4	1272.4		71.4	1274.0					71.4	1274.0								66.25	1272.71		52.2	1267.0	x7	68.0	1273.3		68.0	1273.8					74.5	1273.8								67.35	1273.16		54.5	1266.2	x7	68.0	1273.4		68.0	1273.4					79.2	1273.9								70.1	1273.46		56.7	1265.8	x7	71.4	1274.0		83.7	1274.0					83.7	1274.0								71.38	1273.77	x7tp	57.1	1265.9	x7	78.4	1273.7		83.7	1278.9					83.7	1278.9											59.4	1266.6	x7	83.5	1273.8		113.2	1279.0					113.2	1279.0											62.3	1267.8	x7				132.16	1279.55																	63.96	1268.64	x7																						65.59	1269.07	x7																						65.93	1271.77	x7																						66.33	1272.83	x7																						68.17	1273.51	x7																						70.01	1273.72	x7p																						72.78	1273.58	x7																						76.97	1273.46	x7																						79.72	1273.47	x7																						82.31	1273.54	x7																						86.09	1274.93	x7																						91.25	1278.5	x7																						92.65	1278.82	x7																						98.17	1278.79	x7																																																																																																																																																																																																																																																																																																																																																																		
53.7	1266.97		38.0	1269.7	x7	58.1	1265.9		58.1	1266.0		66.5	1273.1	RTOB	56.7	1266.2								55.41	1266.92		40.5	1269.3	x7	61.7	1267.6		61.7	1267.6		68.0	1273.5		57.8	1267.0								57.25	1266.93		42.6	1268.6	x7w	63.4	1268.1		61.4	1267.6		71.4	1274.0	RPN	59.8	1269.6								59.44	1267.1		45.0	1268.3	x7	65.4	1268.9		63.1	1268.4					62.0	1270.5								60.55	1267.88		45.1	1268.3	x7	65.7	1269.0		64.7	1269.2	Water				63.0	1271.7								61.05	1268.43		45.2	1268.3	x7	66.2	1269.4		66.5	1270.1					64.5	1272.4								62.3	1268.83		48.6	1267.8	x7	66.5	1270.0		66.7	1272.9					67.6	1273.8								64.36	1270.25		48.7	1267.8	x7	66.8	1272.2		66.9	1273.4	Right Pin				69.3	1273.8								65.13	1270.96		52.2	1267.0	x7	67.4	1272.4		71.4	1274.0					71.4	1274.0								66.25	1272.71		52.2	1267.0	x7	68.0	1273.3		68.0	1273.8					74.5	1273.8								67.35	1273.16		54.5	1266.2	x7	68.0	1273.4		68.0	1273.4					79.2	1273.9								70.1	1273.46		56.7	1265.8	x7	71.4	1274.0		83.7	1274.0					83.7	1274.0								71.38	1273.77	x7tp	57.1	1265.9	x7	78.4	1273.7		83.7	1278.9					83.7	1278.9											59.4	1266.6	x7	83.5	1273.8		113.2	1279.0					113.2	1279.0											62.3	1267.8	x7				132.16	1279.55																	63.96	1268.64	x7																						65.59	1269.07	x7																						65.93	1271.77	x7																						66.33	1272.83	x7																						68.17	1273.51	x7																						70.01	1273.72	x7p																						72.78	1273.58	x7																						76.97	1273.46	x7																						79.72	1273.47	x7																						82.31	1273.54	x7																						86.09	1274.93	x7																						91.25	1278.5	x7																						92.65	1278.82	x7																						98.17	1278.79	x7																																																																																																																																																																																																																																																																																																																																																																																										
55.41	1266.92		40.5	1269.3	x7	61.7	1267.6		61.7	1267.6		68.0	1273.5		57.8	1267.0								57.25	1266.93		42.6	1268.6	x7w	63.4	1268.1		61.4	1267.6		71.4	1274.0	RPN	59.8	1269.6								59.44	1267.1		45.0	1268.3	x7	65.4	1268.9		63.1	1268.4					62.0	1270.5								60.55	1267.88		45.1	1268.3	x7	65.7	1269.0		64.7	1269.2	Water				63.0	1271.7								61.05	1268.43		45.2	1268.3	x7	66.2	1269.4		66.5	1270.1					64.5	1272.4								62.3	1268.83		48.6	1267.8	x7	66.5	1270.0		66.7	1272.9					67.6	1273.8								64.36	1270.25		48.7	1267.8	x7	66.8	1272.2		66.9	1273.4	Right Pin				69.3	1273.8								65.13	1270.96		52.2	1267.0	x7	67.4	1272.4		71.4	1274.0					71.4	1274.0								66.25	1272.71		52.2	1267.0	x7	68.0	1273.3		68.0	1273.8					74.5	1273.8								67.35	1273.16		54.5	1266.2	x7	68.0	1273.4		68.0	1273.4					79.2	1273.9								70.1	1273.46		56.7	1265.8	x7	71.4	1274.0		83.7	1274.0					83.7	1274.0								71.38	1273.77	x7tp	57.1	1265.9	x7	78.4	1273.7		83.7	1278.9					83.7	1278.9											59.4	1266.6	x7	83.5	1273.8		113.2	1279.0					113.2	1279.0											62.3	1267.8	x7				132.16	1279.55																	63.96	1268.64	x7																						65.59	1269.07	x7																						65.93	1271.77	x7																						66.33	1272.83	x7																						68.17	1273.51	x7																						70.01	1273.72	x7p																						72.78	1273.58	x7																						76.97	1273.46	x7																						79.72	1273.47	x7																						82.31	1273.54	x7																						86.09	1274.93	x7																						91.25	1278.5	x7																						92.65	1278.82	x7																						98.17	1278.79	x7																																																																																																																																																																																																																																																																																																																																																																																																																		
57.25	1266.93		42.6	1268.6	x7w	63.4	1268.1		61.4	1267.6		71.4	1274.0	RPN	59.8	1269.6								59.44	1267.1		45.0	1268.3	x7	65.4	1268.9		63.1	1268.4					62.0	1270.5								60.55	1267.88		45.1	1268.3	x7	65.7	1269.0		64.7	1269.2	Water				63.0	1271.7								61.05	1268.43		45.2	1268.3	x7	66.2	1269.4		66.5	1270.1					64.5	1272.4								62.3	1268.83		48.6	1267.8	x7	66.5	1270.0		66.7	1272.9					67.6	1273.8								64.36	1270.25		48.7	1267.8	x7	66.8	1272.2		66.9	1273.4	Right Pin				69.3	1273.8								65.13	1270.96		52.2	1267.0	x7	67.4	1272.4		71.4	1274.0					71.4	1274.0								66.25	1272.71		52.2	1267.0	x7	68.0	1273.3		68.0	1273.8					74.5	1273.8								67.35	1273.16		54.5	1266.2	x7	68.0	1273.4		68.0	1273.4					79.2	1273.9								70.1	1273.46		56.7	1265.8	x7	71.4	1274.0		83.7	1274.0					83.7	1274.0								71.38	1273.77	x7tp	57.1	1265.9	x7	78.4	1273.7		83.7	1278.9					83.7	1278.9											59.4	1266.6	x7	83.5	1273.8		113.2	1279.0					113.2	1279.0											62.3	1267.8	x7				132.16	1279.55																	63.96	1268.64	x7																						65.59	1269.07	x7																						65.93	1271.77	x7																						66.33	1272.83	x7																						68.17	1273.51	x7																						70.01	1273.72	x7p																						72.78	1273.58	x7																						76.97	1273.46	x7																						79.72	1273.47	x7																						82.31	1273.54	x7																						86.09	1274.93	x7																						91.25	1278.5	x7																						92.65	1278.82	x7																						98.17	1278.79	x7																																																																																																																																																																																																																																																																																																																																																																																																																																										
59.44	1267.1		45.0	1268.3	x7	65.4	1268.9		63.1	1268.4					62.0	1270.5								60.55	1267.88		45.1	1268.3	x7	65.7	1269.0		64.7	1269.2	Water				63.0	1271.7								61.05	1268.43		45.2	1268.3	x7	66.2	1269.4		66.5	1270.1					64.5	1272.4								62.3	1268.83		48.6	1267.8	x7	66.5	1270.0		66.7	1272.9					67.6	1273.8								64.36	1270.25		48.7	1267.8	x7	66.8	1272.2		66.9	1273.4	Right Pin				69.3	1273.8								65.13	1270.96		52.2	1267.0	x7	67.4	1272.4		71.4	1274.0					71.4	1274.0								66.25	1272.71		52.2	1267.0	x7	68.0	1273.3		68.0	1273.8					74.5	1273.8								67.35	1273.16		54.5	1266.2	x7	68.0	1273.4		68.0	1273.4					79.2	1273.9								70.1	1273.46		56.7	1265.8	x7	71.4	1274.0		83.7	1274.0					83.7	1274.0								71.38	1273.77	x7tp	57.1	1265.9	x7	78.4	1273.7		83.7	1278.9					83.7	1278.9											59.4	1266.6	x7	83.5	1273.8		113.2	1279.0					113.2	1279.0											62.3	1267.8	x7				132.16	1279.55																	63.96	1268.64	x7																						65.59	1269.07	x7																						65.93	1271.77	x7																						66.33	1272.83	x7																						68.17	1273.51	x7																						70.01	1273.72	x7p																						72.78	1273.58	x7																						76.97	1273.46	x7																						79.72	1273.47	x7																						82.31	1273.54	x7																						86.09	1274.93	x7																						91.25	1278.5	x7																						92.65	1278.82	x7																						98.17	1278.79	x7																																																																																																																																																																																																																																																																																																																																																																																																																																																																		
60.55	1267.88		45.1	1268.3	x7	65.7	1269.0		64.7	1269.2	Water				63.0	1271.7								61.05	1268.43		45.2	1268.3	x7	66.2	1269.4		66.5	1270.1					64.5	1272.4								62.3	1268.83		48.6	1267.8	x7	66.5	1270.0		66.7	1272.9					67.6	1273.8								64.36	1270.25		48.7	1267.8	x7	66.8	1272.2		66.9	1273.4	Right Pin				69.3	1273.8								65.13	1270.96		52.2	1267.0	x7	67.4	1272.4		71.4	1274.0					71.4	1274.0								66.25	1272.71		52.2	1267.0	x7	68.0	1273.3		68.0	1273.8					74.5	1273.8								67.35	1273.16		54.5	1266.2	x7	68.0	1273.4		68.0	1273.4					79.2	1273.9								70.1	1273.46		56.7	1265.8	x7	71.4	1274.0		83.7	1274.0					83.7	1274.0								71.38	1273.77	x7tp	57.1	1265.9	x7	78.4	1273.7		83.7	1278.9					83.7	1278.9											59.4	1266.6	x7	83.5	1273.8		113.2	1279.0					113.2	1279.0											62.3	1267.8	x7				132.16	1279.55																	63.96	1268.64	x7																						65.59	1269.07	x7																						65.93	1271.77	x7																						66.33	1272.83	x7																						68.17	1273.51	x7																						70.01	1273.72	x7p																						72.78	1273.58	x7																						76.97	1273.46	x7																						79.72	1273.47	x7																						82.31	1273.54	x7																						86.09	1274.93	x7																						91.25	1278.5	x7																						92.65	1278.82	x7																						98.17	1278.79	x7																																																																																																																																																																																																																																																																																																																																																																																																																																																																																										
61.05	1268.43		45.2	1268.3	x7	66.2	1269.4		66.5	1270.1					64.5	1272.4								62.3	1268.83		48.6	1267.8	x7	66.5	1270.0		66.7	1272.9					67.6	1273.8								64.36	1270.25		48.7	1267.8	x7	66.8	1272.2		66.9	1273.4	Right Pin				69.3	1273.8								65.13	1270.96		52.2	1267.0	x7	67.4	1272.4		71.4	1274.0					71.4	1274.0								66.25	1272.71		52.2	1267.0	x7	68.0	1273.3		68.0	1273.8					74.5	1273.8								67.35	1273.16		54.5	1266.2	x7	68.0	1273.4		68.0	1273.4					79.2	1273.9								70.1	1273.46		56.7	1265.8	x7	71.4	1274.0		83.7	1274.0					83.7	1274.0								71.38	1273.77	x7tp	57.1	1265.9	x7	78.4	1273.7		83.7	1278.9					83.7	1278.9											59.4	1266.6	x7	83.5	1273.8		113.2	1279.0					113.2	1279.0											62.3	1267.8	x7				132.16	1279.55																	63.96	1268.64	x7																						65.59	1269.07	x7																						65.93	1271.77	x7																						66.33	1272.83	x7																						68.17	1273.51	x7																						70.01	1273.72	x7p																						72.78	1273.58	x7																						76.97	1273.46	x7																						79.72	1273.47	x7																						82.31	1273.54	x7																						86.09	1274.93	x7																						91.25	1278.5	x7																						92.65	1278.82	x7																						98.17	1278.79	x7																																																																																																																																																																																																																																																																																																																																																																																																																																																																																																																		
62.3	1268.83		48.6	1267.8	x7	66.5	1270.0		66.7	1272.9					67.6	1273.8								64.36	1270.25		48.7	1267.8	x7	66.8	1272.2		66.9	1273.4	Right Pin				69.3	1273.8								65.13	1270.96		52.2	1267.0	x7	67.4	1272.4		71.4	1274.0					71.4	1274.0								66.25	1272.71		52.2	1267.0	x7	68.0	1273.3		68.0	1273.8					74.5	1273.8								67.35	1273.16		54.5	1266.2	x7	68.0	1273.4		68.0	1273.4					79.2	1273.9								70.1	1273.46		56.7	1265.8	x7	71.4	1274.0		83.7	1274.0					83.7	1274.0								71.38	1273.77	x7tp	57.1	1265.9	x7	78.4	1273.7		83.7	1278.9					83.7	1278.9											59.4	1266.6	x7	83.5	1273.8		113.2	1279.0					113.2	1279.0											62.3	1267.8	x7				132.16	1279.55																	63.96	1268.64	x7																						65.59	1269.07	x7																						65.93	1271.77	x7																						66.33	1272.83	x7																						68.17	1273.51	x7																						70.01	1273.72	x7p																						72.78	1273.58	x7																						76.97	1273.46	x7																						79.72	1273.47	x7																						82.31	1273.54	x7																						86.09	1274.93	x7																						91.25	1278.5	x7																						92.65	1278.82	x7																						98.17	1278.79	x7																																																																																																																																																																																																																																																																																																																																																																																																																																																																																																																																										
64.36	1270.25		48.7	1267.8	x7	66.8	1272.2		66.9	1273.4	Right Pin				69.3	1273.8								65.13	1270.96		52.2	1267.0	x7	67.4	1272.4		71.4	1274.0					71.4	1274.0								66.25	1272.71		52.2	1267.0	x7	68.0	1273.3		68.0	1273.8					74.5	1273.8								67.35	1273.16		54.5	1266.2	x7	68.0	1273.4		68.0	1273.4					79.2	1273.9								70.1	1273.46		56.7	1265.8	x7	71.4	1274.0		83.7	1274.0					83.7	1274.0								71.38	1273.77	x7tp	57.1	1265.9	x7	78.4	1273.7		83.7	1278.9					83.7	1278.9											59.4	1266.6	x7	83.5	1273.8		113.2	1279.0					113.2	1279.0											62.3	1267.8	x7				132.16	1279.55																	63.96	1268.64	x7																						65.59	1269.07	x7																						65.93	1271.77	x7																						66.33	1272.83	x7																						68.17	1273.51	x7																						70.01	1273.72	x7p																						72.78	1273.58	x7																						76.97	1273.46	x7																						79.72	1273.47	x7																						82.31	1273.54	x7																						86.09	1274.93	x7																						91.25	1278.5	x7																						92.65	1278.82	x7																						98.17	1278.79	x7																																																																																																																																																																																																																																																																																																																																																																																																																																																																																																																																																																		
65.13	1270.96		52.2	1267.0	x7	67.4	1272.4		71.4	1274.0					71.4	1274.0								66.25	1272.71		52.2	1267.0	x7	68.0	1273.3		68.0	1273.8					74.5	1273.8								67.35	1273.16		54.5	1266.2	x7	68.0	1273.4		68.0	1273.4					79.2	1273.9								70.1	1273.46		56.7	1265.8	x7	71.4	1274.0		83.7	1274.0					83.7	1274.0								71.38	1273.77	x7tp	57.1	1265.9	x7	78.4	1273.7		83.7	1278.9					83.7	1278.9											59.4	1266.6	x7	83.5	1273.8		113.2	1279.0					113.2	1279.0											62.3	1267.8	x7				132.16	1279.55																	63.96	1268.64	x7																						65.59	1269.07	x7																						65.93	1271.77	x7																						66.33	1272.83	x7																						68.17	1273.51	x7																						70.01	1273.72	x7p																						72.78	1273.58	x7																						76.97	1273.46	x7																						79.72	1273.47	x7																						82.31	1273.54	x7																						86.09	1274.93	x7																						91.25	1278.5	x7																						92.65	1278.82	x7																						98.17	1278.79	x7																																																																																																																																																																																																																																																																																																																																																																																																																																																																																																																																																																																										
66.25	1272.71		52.2	1267.0	x7	68.0	1273.3		68.0	1273.8					74.5	1273.8								67.35	1273.16		54.5	1266.2	x7	68.0	1273.4		68.0	1273.4					79.2	1273.9								70.1	1273.46		56.7	1265.8	x7	71.4	1274.0		83.7	1274.0					83.7	1274.0								71.38	1273.77	x7tp	57.1	1265.9	x7	78.4	1273.7		83.7	1278.9					83.7	1278.9											59.4	1266.6	x7	83.5	1273.8		113.2	1279.0					113.2	1279.0											62.3	1267.8	x7				132.16	1279.55																	63.96	1268.64	x7																						65.59	1269.07	x7																						65.93	1271.77	x7																						66.33	1272.83	x7																						68.17	1273.51	x7																						70.01	1273.72	x7p																						72.78	1273.58	x7																						76.97	1273.46	x7																						79.72	1273.47	x7																						82.31	1273.54	x7																						86.09	1274.93	x7																						91.25	1278.5	x7																						92.65	1278.82	x7																						98.17	1278.79	x7																																																																																																																																																																																																																																																																																																																																																																																																																																																																																																																																																																																																																		
67.35	1273.16		54.5	1266.2	x7	68.0	1273.4		68.0	1273.4					79.2	1273.9								70.1	1273.46		56.7	1265.8	x7	71.4	1274.0		83.7	1274.0					83.7	1274.0								71.38	1273.77	x7tp	57.1	1265.9	x7	78.4	1273.7		83.7	1278.9					83.7	1278.9											59.4	1266.6	x7	83.5	1273.8		113.2	1279.0					113.2	1279.0											62.3	1267.8	x7				132.16	1279.55																	63.96	1268.64	x7																						65.59	1269.07	x7																						65.93	1271.77	x7																						66.33	1272.83	x7																						68.17	1273.51	x7																						70.01	1273.72	x7p																						72.78	1273.58	x7																						76.97	1273.46	x7																						79.72	1273.47	x7																						82.31	1273.54	x7																						86.09	1274.93	x7																						91.25	1278.5	x7																						92.65	1278.82	x7																						98.17	1278.79	x7																																																																																																																																																																																																																																																																																																																																																																																																																																																																																																																																																																																																																																										
70.1	1273.46		56.7	1265.8	x7	71.4	1274.0		83.7	1274.0					83.7	1274.0								71.38	1273.77	x7tp	57.1	1265.9	x7	78.4	1273.7		83.7	1278.9					83.7	1278.9											59.4	1266.6	x7	83.5	1273.8		113.2	1279.0					113.2	1279.0											62.3	1267.8	x7				132.16	1279.55																	63.96	1268.64	x7																						65.59	1269.07	x7																						65.93	1271.77	x7																						66.33	1272.83	x7																						68.17	1273.51	x7																						70.01	1273.72	x7p																						72.78	1273.58	x7																						76.97	1273.46	x7																						79.72	1273.47	x7																						82.31	1273.54	x7																						86.09	1274.93	x7																						91.25	1278.5	x7																						92.65	1278.82	x7																						98.17	1278.79	x7																																																																																																																																																																																																																																																																																																																																																																																																																																																																																																																																																																																																																																																																		
71.38	1273.77	x7tp	57.1	1265.9	x7	78.4	1273.7		83.7	1278.9					83.7	1278.9											59.4	1266.6	x7	83.5	1273.8		113.2	1279.0					113.2	1279.0											62.3	1267.8	x7				132.16	1279.55																	63.96	1268.64	x7																						65.59	1269.07	x7																						65.93	1271.77	x7																						66.33	1272.83	x7																						68.17	1273.51	x7																						70.01	1273.72	x7p																						72.78	1273.58	x7																						76.97	1273.46	x7																						79.72	1273.47	x7																						82.31	1273.54	x7																						86.09	1274.93	x7																						91.25	1278.5	x7																						92.65	1278.82	x7																						98.17	1278.79	x7																																																																																																																																																																																																																																																																																																																																																																																																																																																																																																																																																																																																																																																																																										
			59.4	1266.6	x7	83.5	1273.8		113.2	1279.0					113.2	1279.0											62.3	1267.8	x7				132.16	1279.55																	63.96	1268.64	x7																						65.59	1269.07	x7																						65.93	1271.77	x7																						66.33	1272.83	x7																						68.17	1273.51	x7																						70.01	1273.72	x7p																						72.78	1273.58	x7																						76.97	1273.46	x7																						79.72	1273.47	x7																						82.31	1273.54	x7																						86.09	1274.93	x7																						91.25	1278.5	x7																						92.65	1278.82	x7																						98.17	1278.79	x7																																																																																																																																																																																																																																																																																																																																																																																																																																																																																																																																																																																																																																																																																																																		
			62.3	1267.8	x7				132.16	1279.55																	63.96	1268.64	x7																						65.59	1269.07	x7																						65.93	1271.77	x7																						66.33	1272.83	x7																						68.17	1273.51	x7																						70.01	1273.72	x7p																						72.78	1273.58	x7																						76.97	1273.46	x7																						79.72	1273.47	x7																						82.31	1273.54	x7																						86.09	1274.93	x7																						91.25	1278.5	x7																						92.65	1278.82	x7																						98.17	1278.79	x7																																																																																																																																																																																																																																																																																																																																																																																																																																																																																																																																																																																																																																																																																																																																										
			63.96	1268.64	x7																						65.59	1269.07	x7																						65.93	1271.77	x7																						66.33	1272.83	x7																						68.17	1273.51	x7																						70.01	1273.72	x7p																						72.78	1273.58	x7																						76.97	1273.46	x7																						79.72	1273.47	x7																						82.31	1273.54	x7																						86.09	1274.93	x7																						91.25	1278.5	x7																						92.65	1278.82	x7																						98.17	1278.79	x7																																																																																																																																																																																																																																																																																																																																																																																																																																																																																																																																																																																																																																																																																																																																																																		
			65.59	1269.07	x7																						65.93	1271.77	x7																						66.33	1272.83	x7																						68.17	1273.51	x7																						70.01	1273.72	x7p																						72.78	1273.58	x7																						76.97	1273.46	x7																						79.72	1273.47	x7																						82.31	1273.54	x7																						86.09	1274.93	x7																						91.25	1278.5	x7																						92.65	1278.82	x7																						98.17	1278.79	x7																																																																																																																																																																																																																																																																																																																																																																																																																																																																																																																																																																																																																																																																																																																																																																																										
			65.93	1271.77	x7																						66.33	1272.83	x7																						68.17	1273.51	x7																						70.01	1273.72	x7p																						72.78	1273.58	x7																						76.97	1273.46	x7																						79.72	1273.47	x7																						82.31	1273.54	x7																						86.09	1274.93	x7																						91.25	1278.5	x7																						92.65	1278.82	x7																						98.17	1278.79	x7																																																																																																																																																																																																																																																																																																																																																																																																																																																																																																																																																																																																																																																																																																																																																																																																																		
			66.33	1272.83	x7																						68.17	1273.51	x7																						70.01	1273.72	x7p																						72.78	1273.58	x7																						76.97	1273.46	x7																						79.72	1273.47	x7																						82.31	1273.54	x7																						86.09	1274.93	x7																						91.25	1278.5	x7																						92.65	1278.82	x7																						98.17	1278.79	x7																																																																																																																																																																																																																																																																																																																																																																																																																																																																																																																																																																																																																																																																																																																																																																																																																																										
			68.17	1273.51	x7																						70.01	1273.72	x7p																						72.78	1273.58	x7																						76.97	1273.46	x7																						79.72	1273.47	x7																						82.31	1273.54	x7																						86.09	1274.93	x7																						91.25	1278.5	x7																						92.65	1278.82	x7																						98.17	1278.79	x7																																																																																																																																																																																																																																																																																																																																																																																																																																																																																																																																																																																																																																																																																																																																																																																																																																																																		
			70.01	1273.72	x7p																						72.78	1273.58	x7																						76.97	1273.46	x7																						79.72	1273.47	x7																						82.31	1273.54	x7																						86.09	1274.93	x7																						91.25	1278.5	x7																						92.65	1278.82	x7																						98.17	1278.79	x7																																																																																																																																																																																																																																																																																																																																																																																																																																																																																																																																																																																																																																																																																																																																																																																																																																																																																										
			72.78	1273.58	x7																						76.97	1273.46	x7																						79.72	1273.47	x7																						82.31	1273.54	x7																						86.09	1274.93	x7																						91.25	1278.5	x7																						92.65	1278.82	x7																						98.17	1278.79	x7																																																																																																																																																																																																																																																																																																																																																																																																																																																																																																																																																																																																																																																																																																																																																																																																																																																																																																																		
			76.97	1273.46	x7																						79.72	1273.47	x7																						82.31	1273.54	x7																						86.09	1274.93	x7																						91.25	1278.5	x7																						92.65	1278.82	x7																						98.17	1278.79	x7																																																																																																																																																																																																																																																																																																																																																																																																																																																																																																																																																																																																																																																																																																																																																																																																																																																																																																																																										
			79.72	1273.47	x7																						82.31	1273.54	x7																						86.09	1274.93	x7																						91.25	1278.5	x7																						92.65	1278.82	x7																						98.17	1278.79	x7																																																																																																																																																																																																																																																																																																																																																																																																																																																																																																																																																																																																																																																																																																																																																																																																																																																																																																																																																																		
			82.31	1273.54	x7																						86.09	1274.93	x7																						91.25	1278.5	x7																						92.65	1278.82	x7																						98.17	1278.79	x7																																																																																																																																																																																																																																																																																																																																																																																																																																																																																																																																																																																																																																																																																																																																																																																																																																																																																																																																																																																										
			86.09	1274.93	x7																						91.25	1278.5	x7																						92.65	1278.82	x7																						98.17	1278.79	x7																																																																																																																																																																																																																																																																																																																																																																																																																																																																																																																																																																																																																																																																																																																																																																																																																																																																																																																																																																																																																		
			91.25	1278.5	x7																						92.65	1278.82	x7																						98.17	1278.79	x7																																																																																																																																																																																																																																																																																																																																																																																																																																																																																																																																																																																																																																																																																																																																																																																																																																																																																																																																																																																																																																										
			92.65	1278.82	x7																						98.17	1278.79	x7																																																																																																																																																																																																																																																																																																																																																																																																																																																																																																																																																																																																																																																																																																																																																																																																																																																																																																																																																																																																																																																																		
			98.17	1278.79	x7																																																																																																																																																																																																																																																																																																																																																																																																																																																																																																																																																																																																																																																																																																																																																																																																																																																																																																																																																																																																																																																																																										



Photo of Cross-Section 7 - Reach 4 - Looking Downstream @ STA 32+70

Area	Year 7 - 2007	Year 6 - 2006	Year 5 - 2005	Year 4 - 2004	Year 3 - 2003	Year 2 - 2002	Year 1 - 2001	AS-BUILT 2000
Width	201.7	214.6	210.1	201.7		221.1	188.6	
Mean Depth	67.0	73.9	79.0	71.3		66.5	64.5	
Max Depth	3.0	2.7	2.7	2.8		3.1	2.6	
W/D	6.3	7.4	7.3	7.4		8.2	7.5	
	22.3	25.4	25.4	25.5		23.4	27.4	

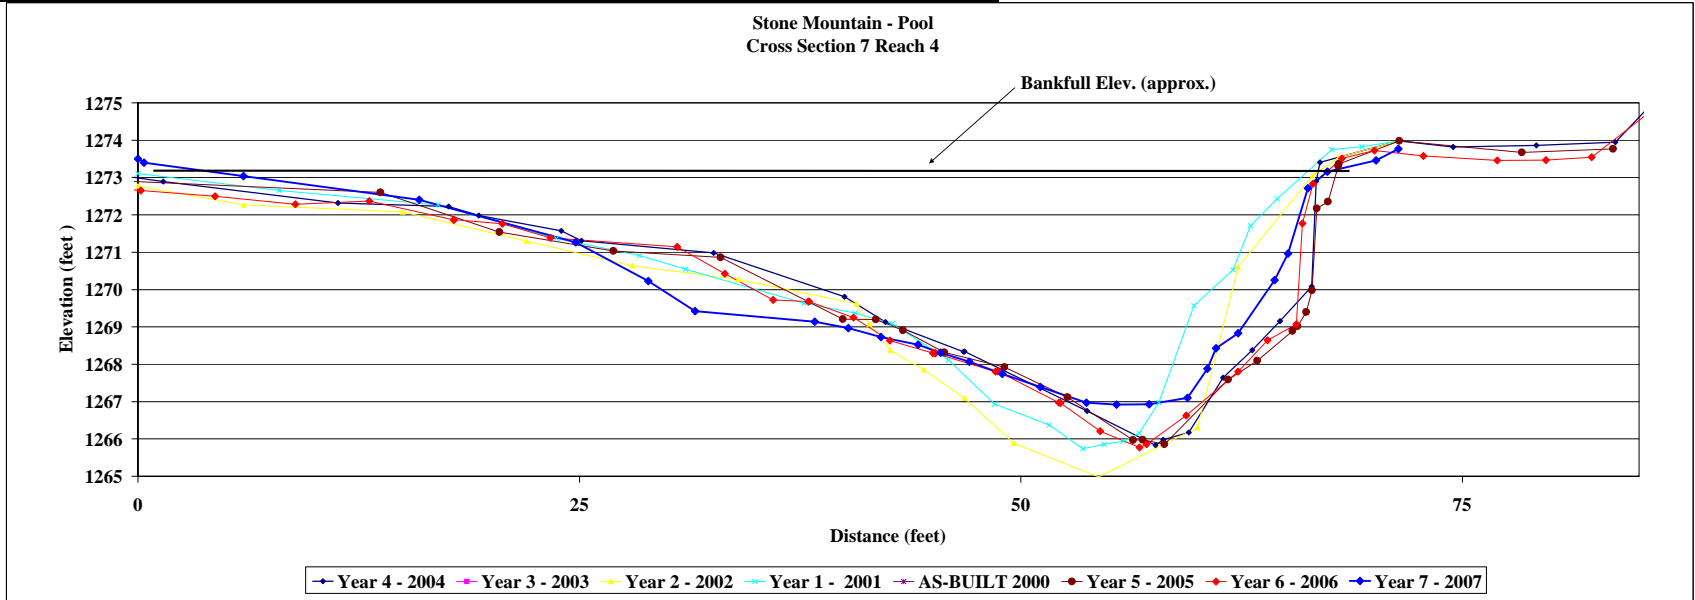
Stone Mountain - Pool
 Cross Section 7 Reach 4



Project Name Stone Mountain Reach 2
 Cross Section #1
 Feature Riffle
 Date 8/1/07
 Crew Roberts, Price, George

Description	Material	Size (mm)	As-Built -2000			Year 4 -2004			Year 5 -2005			Year 6 -2006			Year 7 -2007					
			Riffle - Bed	%	Cum %	Riffle - Bank	Riffle - Bed	%	Cum %	Riffle - Bank	Riffle - Bed	%	Cum %	Riffle - Bank	Riffle - Bed	%	Cum %			
Silt/Clay	silty clay	0.063	1	100.0%	100.0%	0	0.00	0.0	0	0.00	0.0%	0.0%	0	0	0.0%	0.0%	0	0	0.0%	0.0%
	very fine sand	0.062	0	0.0%	100.0%	3	0.03	0.0	9	0.09	13.6%	13.6%	4	0	4.0%	4.0%	6	3	9.0%	13.0%
	fine sand	0.125	0	0.0%	100.0%	12	0.15	0.2	0	0.00	13.6%	13.6%	4	1	5.0%	9.0%	0	0	0.0%	13.0%
	medium sand	0.25	0	0.0%	100.0%	0	0.00	0.2	1	2	4.5%	18.2%	2	2	4.0%	13.0%	0	0	0.0%	13.0%
	course sand	0.50	0	0.0%	100.0%	0	0.00	0.2	0	1	1.5%	19.7%	0	0	0.0%	13.0%	0	0	0.0%	13.0%
Gravel	very course sand	1.0	0	0.0%	100.0%	0	0.00	0.2	0	0	0.0%	19.7%	0	9	9.0%	22.0%	0	6	6.0%	19.0%
	very fine gravel	2.0	0	0.0%	100.0%	0	0.00	0.3	1	1.5%	21.2%	0	1	1.0%	23.0%	0	0	0.0%	19.0%	
	fine gravel	4.0	0	0.0%	100.0%	0	0.00	0.3	5	0.05	27.3%	0	3	3.0%	26.0%	0	2	2.0%	31.0%	
	medium gravel	5.7	0	0.0%	100.0%	0	0.00	0.3	2	0.02	31.8%	0	2	2.0%	28.0%	0	5	5.0%	26.0%	
	course gravel	8.0	0	0.0%	100.0%	0	0.00	0.4	0	4	6.1%	37.9%	0	6	6.0%	34.0%	0	9	9.0%	35.0%
Cobble	medium gravel	11.3	0	0.0%	100.0%	0	0.00	0.4	0	7	10.6%	48.5%	0	6	6.0%	40.0%	0	3	3.0%	38.0%
	course gravel	16.0	0	0.0%	100.0%	0	0.00	0.4	0	3	4.5%	53.0%	0	5	5.0%	45.0%	0	3	3.0%	41.0%
	course gravel	22.6	0	0.0%	100.0%	0	0.00	0.4	0	7	10.6%	63.6%	0	6	6.0%	51.0%	0	5	5.0%	46.0%
	very course gravel	32	0	0.0%	100.0%	8	0.08	0.5	0	0	0.0%	72.7%	0	6	6.0%	57.0%	0	4	4.0%	50.0%
	very course gravel	45	0	0.0%	100.0%	0	0.00	0.5	2	0.02	75.8%	0	9	9.0%	66.0%	0	4	4.0%	54.0%	
Boulder	small cobble	64	0	0.0%	100.0%	0	0.00	0.6	0	7	10.6%	86.4%	0	8	8.0%	74.0%	0	11	11.0%	65.0%
	medium cobble	90	0	0.0%	100.0%	0	0.00	0.7	4	6.1%	92.4%	0	4	4.0%	78.0%	0	15	15.0%	79.0%	
	large cobble	128	0	0.0%	100.0%	0	0.00	0.9	0	4	6.1%	98.5%	0	8	8.0%	86.0%	0	15	15.0%	93.0%
	very large cobble	180	0	0.0%	100.0%	0	0.00	1.0	0	1	1.5%	100.0%	0	10	10.0%	96.0%	0	5	5.0%	98.0%
	small boulder	256	0	0.0%	100.0%	0	0.00	1.0	0	0	0.0%	100.0%	0	2	2.0%	98.0%	0	2	2.0%	100.0%
Bedrock	small boulder	362	0	0.0%	100.0%	0	0.00	1.0	0	0	0.0%	100.0%	0	0	0.0%	100.0%	0	0	0.0%	100.0%
	medium boulder	512	0	0.0%	100.0%	0	0.00	1.0	0	0	0.0%	100.0%	0	0	0.0%	100.0%	0	0	0.0%	100.0%
	large boulder	1024	0	0.0%	100.0%	0	0.00	1.0	0	0	0.0%	100.0%	0	0	0.0%	100.0%	0	0	0.0%	100.0%
	very large boulder	2049	0	0.0%	100.0%	0	0.00	1.0	0	0	0.0%	100.0%	0	0	0.0%	100.0%	0	0	0.0%	100.0%
TOTAL / % of whole count		1	100.0%		15	85	100.0%		10	56	100.0%		10	90	100.0%		10	90	100.0%	


	#16	#35	#60	#84	#98
Year 4 -2004	11.1	8.31	15.51	145.00	209.56
Year 5 -2005	0.70	8.31	15.51	71.99	128.11
Year 6 -2006	1.00	10.32	24.67	102.22	211.60
Year 7 -2007	1.11	9.32	15.50	157.00	119.60

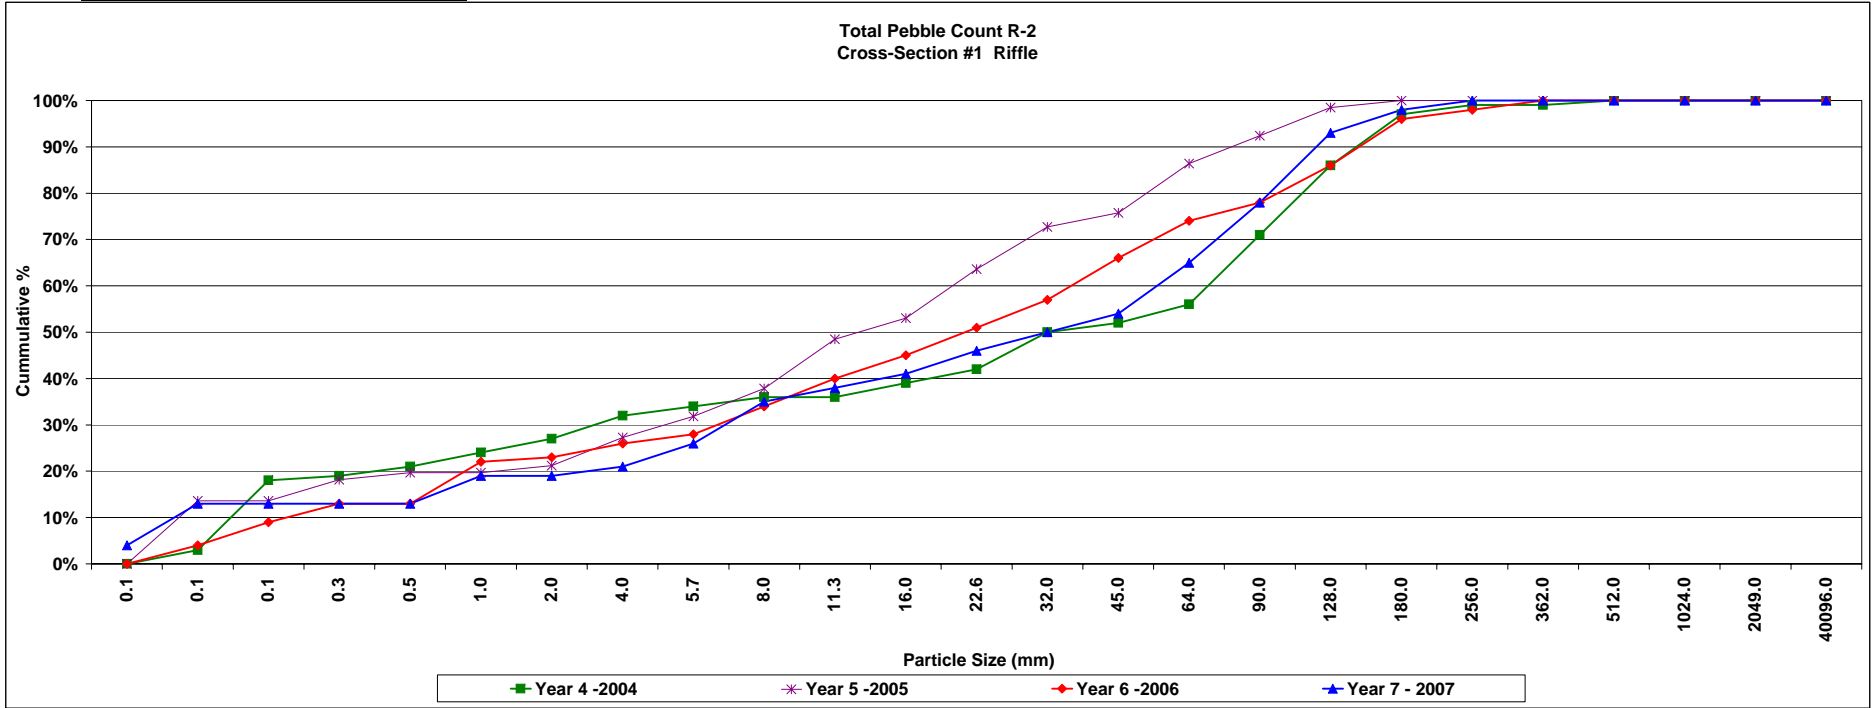

Project Name Stone Mountain Reach 2
 Cross Section #2
 Feature Pool
 Date 7/31/07
 Crew Robert, Price, George

Description	Material	As-Built - 2000			Year 4 - 2004			Year 6 - 2006			Year 7 - 2007					
		Star (mm)	Pool - Bed	%	Pool - Bank	%	Pool - Bank	%	Pool - Bank	%	Pool - Bank	%				
Sand	very fine sand	0.062	1	100.0%	0	0	0.1%	9.1%	1	0	0.0%	0	0	0.0%	9.0%	
	fine sand	0.125	0	0.0%	100.0%	10	0	10.1%	19.2%	1	0	1.0%	0	0	0.0%	9.0%
	medium sand	0.25	0	0.0%	100.0%	10	2	12.1%	31.3%	0	0	0.0%	0	0	0.0%	9.0%
	course sand	0.50	0	0.0%	100.0%	0	1	11.1%	42.4%	2	2	3.8%	1	0	1.0%	10.0%
	very course sand	1.0	0	0.0%	100.0%	0	2	2.0%	44.4%	2	10	11.5%	0	0	0.0%	10.0%
Gravel	very fine gravel	2.0	0	0.0%	100.0%	0	6	6.1%	69.7%	2	0	0.0%	0	0	0.0%	15.0%
	fine gravel	4.0	0	0.0%	100.0%	0	5	5.1%	74.7%	0	0	0.0%	0	1	1.0%	16.0%
	medium gravel	8.0	0	0.0%	100.0%	0	1	1.0%	75.8%	0	4	3.8%	0	2	2.0%	18.0%
	course gravel	11.3	0	0.0%	100.0%	0	0	0.0%	75.8%	0	2	1.9%	0	4	4.0%	22.0%
	very course gravel	16.0	0	0.0%	100.0%	0	1	1.0%	76.8%	1	2	2.9%	0	7	7.0%	34.0%
Cobble	very course gravel	22.6	0	0.0%	100.0%	0	1	1.0%	77.8%	2	4	3.8%	0	8	8.0%	42.0%
	course gravel	32	0	0.0%	100.0%	0	4	4.0%	81.8%	2	10	11.5%	0	9	9.0%	51.0%
	very course gravel	45	0	0.0%	100.0%	0	5	5.1%	86.9%	0	4	3.8%	0	11	11.0%	62.0%
	small cobble	64	0	0.0%	100.0%	0	4	4.0%	90.9%	2	4	3.8%	0	13	13.0%	75.0%
	medium cobble	90	0	0.0%	100.0%	0	5	5.1%	96.0%	1	5	5.8%	0	13	13.0%	88.0%
Boulder	large cobble	128	0	0.0%	100.0%	0	4	4.0%	100.0%	0	0	0.0%	0	8	8.0%	96.0%
	very large cobble	180	0	0.0%	100.0%	0	0	0.0%	100.0%	0	0	0.0%	0	2	2.0%	98.0%
	small boulder	256	0	0.0%	100.0%	0	0	0.0%	100.0%	0	0	0.0%	0	1	1.0%	99.0%
	medium boulder	362	0	0.0%	100.0%	0	0	0.0%	100.0%	0	0	0.0%	0	1	1.0%	100.0%
	large boulder	512	0	0.0%	100.0%	0	0	0.0%	100.0%	0	0	0.0%	0	0	0.0%	100.0%
Bedrock	very large boulder	1024	0	0.0%	100.0%	0	0	0.0%	100.0%	0	0	0.0%	0	0	0.0%	100.0%
	bedrock	2049	0	0.0%	100.0%	0	0	0.0%	100.0%	0	0	0.0%	0	0	0.0%	100.0%
TOTAL / % of whole count			1	100.0%	39	60	100.0%		32	72	100.0%		90	100.0%		


	#16	#35	#50	#84	#95
Year 4 - 2004	0.32	1.60	3.54	99.82	292.84
Year 6 - 2006	1.48	3.20	5.92	75.80	162.53
Year 7 - 2007	4.85	20.20	37.20	90.43	148.38

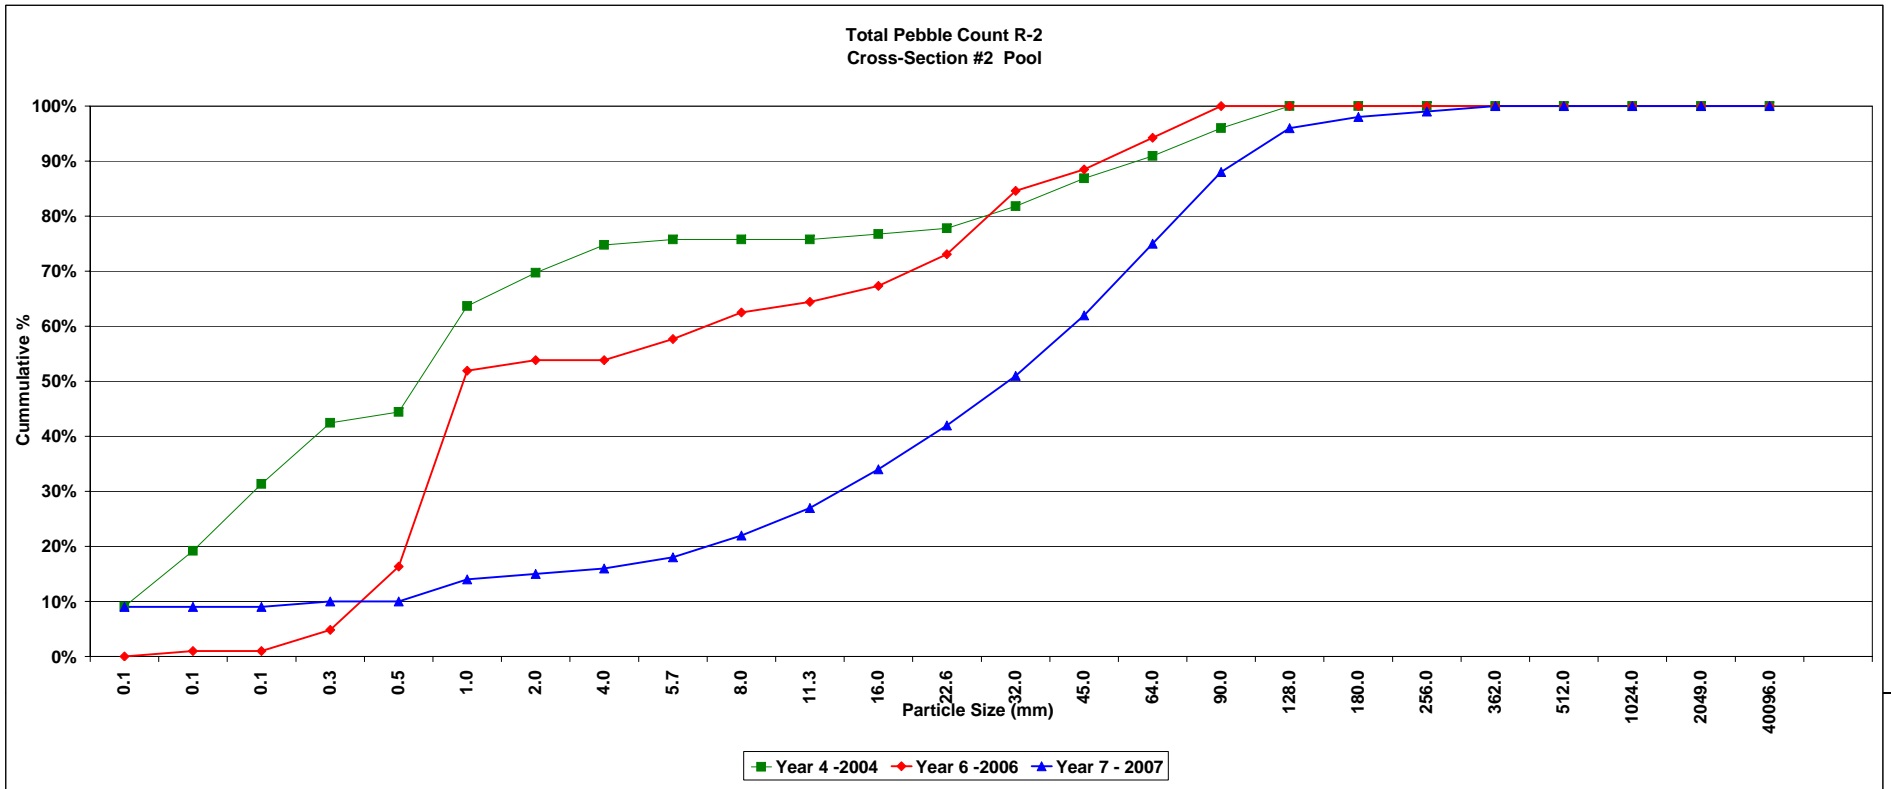

Project Name Stone Mountain Reach 2
 Cross Section #3
 Feature Riffle
 Date 8/1/07
 Crew Roberts, Price, George

Description	Material	Size (mm)	As-Built -2000				Year 1 -2001				Year 2 -2002				Year 3 -2003				Year 4 -2004				Year 5 -2005				Year 6 -2006				Year 7 -2007			
			Riffle - Bed	%	Cum %		Riffle	%	Cum %		Riffle	%	Cum %		Riffle	%	Cum %		Riffle - Bank	Riffle - Bed	%	Cum %	Riffle - Bank	Riffle - Bed	%	Cum %	- Bank	- Bed	%	Cum %	Riffle - Bank	Riffle - Bed	%	Cum %
Silt/Clay	silty/clay	0.061	30	30.0%	30.0%	0	0.0%	0.0%	0	0.0%	0.0%	5	5.0%	5.0%	8	8.1%	8.1%	0	0	0.0%	0.0%	0	0	0.0%	0.0%	0	0	0.0%	0.0%	5	5.0%	5.0%		
	very fine sand	0.062	2	2.0%	32.0%	4	4.0%	4.0%	9	9.0%	9.0%	0	0.0%	9.0%	9	9.1%	17.2%	4	0	0.0%	4.9%	11	2	2.8%	2.8%	0	0	0.0%	2.8%	0	0.0%	5.0%		
	fine sand	0.125	2	2.0%	34.0%	7	7.0%	11.0%	6	6.0%	15.0%	3	3.0%	8.0%	4	2	6.1%	21.2%	0	0	0.0%	4.9%	0	0	0.0%	2.8%	1	0	1.0%	6.0%				
	medium sand	0.25	2	2.0%	36.0%	4	4.0%	15.0%	9	9.0%	24.0%	10	10.0%	18.0%	0	3	3.0%	26.3%	2	1	3.7%	8.6%	2	0	1.9%	4.7%	1	0	1.0%	7.0%				
	course sand	0.50	5	5.0%	41.0%	2	2.0%	17.0%	0	0.0%	17.0%	0	0.0%	18.0%	0	1	1.0%	22.3%	0	3	3.7%	12.3%	2	5	6.6%	11.3%	0	0	0.0%	12.0%				
Gravel	very coarse gravel	1.0	2	2.0%	43.0%	0	0.0%	17.0%	1	1.0%	25.0%	0	0.0%	18.0%	0	1	1.0%	28.3%	0	0	0.0%	12.3%	16	20	34.0%	45.3%	3	7	10.0%	17.0%				
	very fine gravel	2.0	4	4.0%	47.0%	3	3.0%	20.0%	3	3.0%	28.0%	2	2.0%	20.0%	0	1	1.0%	29.3%	0	6	7.4%	19.8%	2	2	3.8%	49.1%	0	10	10.0%	27.0%				
	fine gravel	4.0	6	6.0%	53.0%	5	5.0%	25.0%	2	2.0%	30.0%	5	5.0%	25.0%	0	9	9.1%	38.4%	0	2	2.5%	22.2%	0	1	0.9%	50.0%	0	3	3.0%	30.0%				
	fine gravel	5.7	5	5.0%	58.0%	7	7.0%	32.0%	6	6.0%	36.0%	2	2.0%	27.0%	0	4	4.0%	42.4%	2	1	3.7%	25.9%	0	0	0.0%	50.0%	0	4	4.0%	34.0%				
	medium gravel	8.0	8	8.0%	66.0%	7	7.0%	39.0%	5	5.0%	41.0%	9	9.0%	36.0%	0	1	1.0%	43.4%	1	4	6.2%	32.1%	1	2	2.8%	52.8%	0	4	4.0%	38.0%				
	medium gravel	11.3	6	6.0%	72.0%	5	5.0%	44.0%	7	7.0%	48.0%	5	5.0%	41.0%	0	2	2.0%	45.5%	0	2	2.5%	34.6%	0	2	1.9%	54.7%	0	8	8.0%	46.0%				
	course gravel	16.0	6	6.0%	78.0%	7	7.0%	51.0%	3	3.0%	51.0%	9	9.0%	50.0%	0	4	4.0%	49.5%	0	4	4.9%	39.5%	1	9	9.4%	64.2%	0	8	8.0%	54.0%				
	course gravel	22.6	6	6.0%	84.0%	8	8.0%	59.0%	7	7.0%	67.0%	8	8.0%	58.0%	0	5	5.1%	54.5%	1	15	19.8%	59.3%	2	2	3.8%	67.9%	0	5	5.0%	59.0%				
	very coarse gravel	32	8	8.0%	92.0%	10	10.0%	69.0%	7	7.0%	65.0%	6	6.0%	64.0%	0	12	12.1%	66.7%	1	12	16.0%	75.3%	2	10	11.3%	79.2%	0	5	5.0%	64.0%				
	very coarse gravel	45	5	5.0%	97.0%	16	16.0%	85.0%	14	14.0%	79.0%	9	9.0%	73.0%	0	6	6.1%	72.7%	1	9	12.3%	87.7%	0	11	10.4%	89.6%	0	8	8.0%	72.0%				
Cobble	small cobble	64	2	2.0%	99.0%	7	7.0%	92.0%	7	7.0%	86.0%	11	11.0%	84.0%	0	9	9.1%	81.8%	0	6	7.4%	95.1%	2	2	3.8%	93.8%	0	8	8.0%	80.0%				
	medium cobble	90	1	1.0%	100.0%	5	5.0%	97.0%	11	11.0%	97.0%	12	12.0%	96.0%	0	12	12.1%	93.9%	0	4	4.9%	100.0%	1	2	2.8%	96.2%	0	12	12.0%	92.0%				
	large cobble	128	0	0.0%	100.0%	3	3.0%	100.0%	2	2.0%	99.0%	1	1.0%	97.0%	0	2	2.0%	96.0%	0	0	0.0%	100.0%	0	0	0.0%	96.2%	0	5	5.0%	97.0%				
	very large cobble	180	0	0.0%	100.0%	0	0.0%	100.0%	1	1.0%	100.0%	2	2.0%	99.0%	0	1	1.0%	97.0%	0	0	0.0%	100.0%	0	3	2.8%	99.1%	0	3	3.0%	100.0%				
	small boulder	256	0	0.0%	100.0%	0	0.0%	100.0%	0	0.0%	100.0%	1	1.0%	100.0%	0	3	3.0%	100.0%	0	0	0.0%	100.0%	0	1	0.9%	100.0%	0	0	0.0%	100.0%				
Boulder	small boulder	362	0	0.0%	100.0%	0	0.0%	100.0%	0	0.0%	100.0%	0	0.0%	100.0%	0	0	0.0%	100.0%	0	0	0.0%	100.0%	0	0	0.0%	100.0%	0	0	0.0%	100.0%				
	medium boulder	512	0	0.0%	100.0%	0	0.0%	100.0%	0	0.0%	100.0%	0	0.0%	100.0%	0	0	0.0%	100.0%	0	0	0.0%	100.0%	0	0	0.0%	100.0%	0	0	0.0%	100.0%				
	large boulder	1024	0	0.0%	100.0%	0	0.0%	100.0%	0	0.0%	100.0%	0	0.0%	100.0%	0	0	0.0%	100.0%	0	0	0.0%	100.0%	0	0	0.0%	100.0%	0	0	0.0%	100.0%				
	very large boulder	2049	0	0.0%	100.0%	0	0.0%	100.0%	0	0.0%	100.0%	0	0.0%	100.0%	0	0	0.0%	100.0%	0	0	0.0%	100.0%	0	0	0.0%	100.0%	0	0	0.0%	100.0%				
Bedrock	bedrock	40096	0	0.0%	100.0%	0	0.0%	100.0%	0	0.0%	100.0%	0	0.0%	100.0%	0	0	0.0%	100.0%	0	0	0.0%	100.0%	0	0	0.0%	100.0%	0	0	0.0%	100.0%				
	TOTAL / %of whole count		100	100.0%		100	100.0%		100	100.0%		100	100.0%		100	100.0%		21	78	100.0%		12	69	100.0%		32	74	100.0%		10	90	100.0%		


	d16	d35	d50	d84	d95
As-Built -2000	0.00	0.28	3.93	27.30	48.10
Year 1 -2001	0.66	3.66	18.40	65.40	98.20
Year 2 -2002	0.21	6.52	17.42	70.57	103.18
Year 3 -2003	0.34	9.34	18.30	77.60	106.33
Year 4 -2004	0.09	4.16	20.00	82.78	123.82
Year 5 -2005	2.24	14.14	23.55	49.76	76.81
Year 6 -2006	0.85	1.77	11.70	45.83	95.11
Year 7 -2007	1.43	7.55	16.48	87.67	126.00

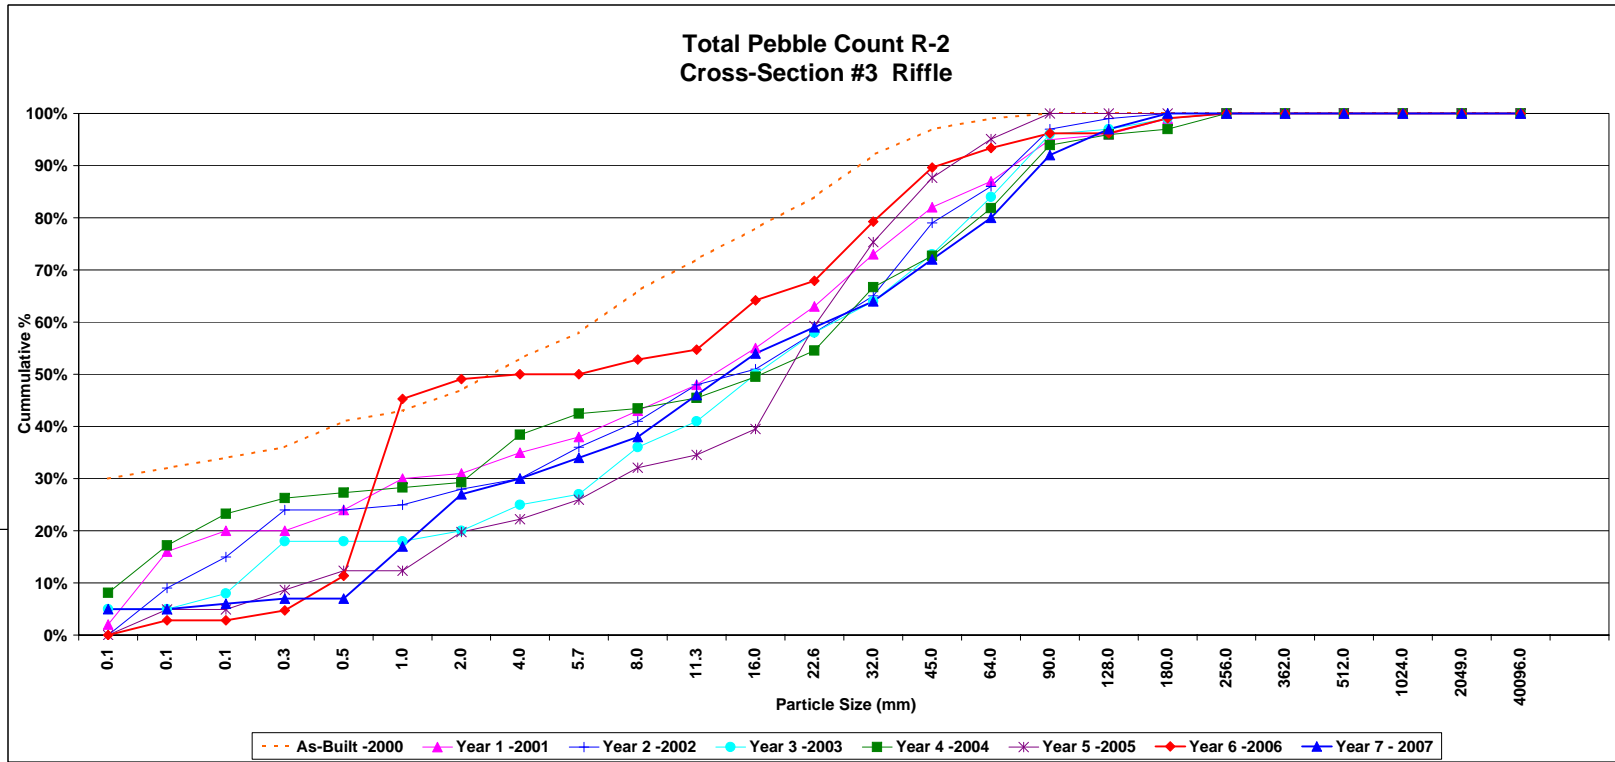

Project Name Stone Mountain Reach 2
 Cross Section #4
 Feature Riffle
 Date 8/1/07
 Crew Roberts, Price, George

Description	Material	Size (mm)	As-Built - 2000			Year 1 - 2001			Year 3 - 2003			Year 4 - 2004			Year 5 - 2005			Year 6 - 2006			Year 7 - 2007			
			Riffle - Bed	%	Cum %	Riffle - Bed	%	Cum %	Riffle - Bed	%	Cum %	Riffle - Bank	Riffle - Bed	%	Cum %	Riffle - Bank	Riffle - Bed	%	Cum %	Riffle - Bank	Riffle - Bed	%	Cum %	
Sand	silica	0.062	14	32.0%	32.0%	2	2.0%	2.0%	0	0.0%	0.0%	5	5.0%	5.0%	0	0.0%	0.0%	4	4.0%	4.0%	14	4.0%	17.1%	
	very fine sand	0.062	14	14.0%	46.0%	14	14.0%	16.0%	0	0.0%	0.0%	5	5.0%	11.0%	0	0.0%	11.5%	6	6.1%	11.1%	2	2.0%	31.0%	
	fine sand	0.125	2	2.0%	48.0%	4	4.0%	20.0%	3	3.0%	3.0%	10	10.0%	15.8%	1	1.3%	12.8%	0	0.0%	11.1%	4	4.0%	34.8%	
	medium sand	0.25	3	3.0%	51.0%	0	0.0%	20.0%	29	29.0%	32.0%	1	1.0%	16.8%	3	3.1%	17.9%	2	2.0%	4.0%	13.2%	2	2.0%	25.7%
	course sand	0.50	2	2.0%	53.0%	4	4.0%	34.0%	4	4.0%	36.0%	1	1.0%	17.8%	0	0.0%	17.8%	6	6.1%	21.2%	0	0.0%	25.7%	
Gravel	very course sand	1.0	1	1.0%	54.0%	6	6.0%	30.0%	0	0.0%	36.0%	0	0.0%	18.8%	0	0.0%	21.8%	4	4.0%	15.2%	36.4%	0	0.0%	27.6%
	very fine gravel	2.0	0	0.0%	54.0%	1	1.0%	31.0%	1	1.0%	37.0%	0	0.0%	20.8%	0	0.0%	21.8%	0	0.0%	15.2%	36.4%	0	0.0%	30.5%
	fine gravel	4.0	1	1.0%	55.0%	4	4.0%	35.0%	1	1.0%	36.0%	0	0.0%	25.7%	0	0.0%	26.4%	0	0.0%	16.4%	36.4%	0	0.0%	32.4%
	medium gravel	5.7	2	2.0%	57.0%	3	3.0%	38.0%	0	0.0%	38.0%	0	0.0%	26.7%	0	0.0%	26.7%	0	0.0%	16.4%	36.4%	0	0.0%	34.3%
	course gravel	8.0	1	1.0%	58.0%	5	5.0%	43.0%	3	3.0%	41.0%	0	0.0%	26.7%	0	0.0%	26.7%	0	0.0%	16.4%	36.4%	0	0.0%	42.9%
	very course gravel	11.3	6	6.0%	64.0%	5	5.0%	48.0%	8	8.0%	49.0%	0	0.0%	31.7%	0	0.0%	31.7%	8	8.0%	14.9%	44.9%	0	0.0%	57.1%
	small cobble	16.0	8	8.0%	72.0%	7	7.0%	55.0%	6	6.0%	55.0%	1	1.0%	25.6%	0	0.0%	10.3%	8	8.0%	15.1%	53.5%	0	0.0%	67.6%
	medium cobble	22.6	7	7.0%	79.0%	8	8.0%	63.0%	8	8.0%	63.0%	1	1.0%	40.6%	0	0.0%	12.8%	8	8.0%	15.1%	53.5%	0	0.0%	77.1%
	large cobble	32	5	5.0%	84.0%	10	10.0%	73.0%	7	7.0%	70.0%	0	0.0%	11.9%	0	0.0%	11.5%	9	9.0%	16.2%	79.8%	0	0.0%	84.8%
	very large cobble	45	4	4.0%	88.0%	9	9.0%	82.0%	11	11.0%	81.0%	0	0.0%	12.9%	0	0.0%	12.9%	4	4.0%	16.2%	85.9%	0	0.0%	89.5%
Boulder	small boulder	64	2	2.0%	90.0%	5	5.0%	87.0%	4	4.0%	85.0%	0	0.0%	16.8%	0	0.0%	16.8%	0	0.0%	16.4%	85.9%	0	0.0%	93.3%
	medium boulder	90	4	4.0%	94.0%	8	8.0%	95.0%	5	5.0%	90.0%	0	0.0%	13.9%	0	0.0%	13.9%	0	0.0%	16.4%	85.9%	0	0.0%	95.2%
	large boulder	128	1	1.0%	95.0%	1	1.0%	96.0%	3	3.0%	93.0%	0	0.0%	5.0%	0	0.0%	5.0%	0	0.0%	16.4%	85.9%	0	0.0%	97.1%
	very large boulder	180	1	1.0%	96.0%	3	3.0%	99.0%	2	2.0%	95.0%	0	0.0%	10.0%	0	0.0%	10.0%	0	0.0%	16.4%	85.9%	0	0.0%	98.1%
	bedrock	256	4	4.0%	100.0%	1	1.0%	100.0%	1	1.0%	96.0%	0	0.0%	10.0%	1	1.3%	100.0%	0	0.0%	16.4%	85.9%	0	0.0%	99.0%
Bedrock	small bedrock	362	0	0.0%	100.0%	0	0.0%	100.0%	4	4.0%	100.0%	0	0.0%	10.0%	0	0.0%	10.0%	0	0.0%	16.4%	85.9%	0	0.0%	99.0%
	medium bedrock	512	0	0.0%	100.0%	0	0.0%	100.0%	0	0.0%	100.0%	0	0.0%	10.0%	0	0.0%	10.0%	0	0.0%	16.4%	85.9%	0	0.0%	100.0%
	large bedrock	1024	0	0.0%	100.0%	0	0.0%	100.0%	0	0.0%	100.0%	0	0.0%	10.0%	0	0.0%	10.0%	0	0.0%	16.4%	85.9%	0	0.0%	100.0%
	very large bedrock	2049	0	0.0%	100.0%	0	0.0%	100.0%	0	0.0%	100.0%	0	0.0%	10.0%	0	0.0%	10.0%	0	0.0%	16.4%	85.9%	0	0.0%	100.0%
TOTAL / %of whole count			100	100.0%	100	100.0%	100	100.0%	0	0.0%	100.0%	20	100.0%	41	100.0%	11	67	100.0%	23	76	100.0%	20	85	100.0%


	d16	d35	d50	d84	d95
As-Built - 2000	0.00	0.07	0.31	28.50	154.00
Year 1 - 2001	0.09	4.85	15.26	62.50	109.00
Year 3 - 2003	0.27	0.66	14.59	71.37	218.00
Year 4 - 2004	0.22	18.38	36.17	81.53	108.88
Year 5 - 2005	0.30	9.80	16.48	82.88	93.80
Year 6 - 2006	0.43	1.43	10.83	49.59	109.75
Year 7 - 2007	0.00	7.08	11.65	37.38	105.00

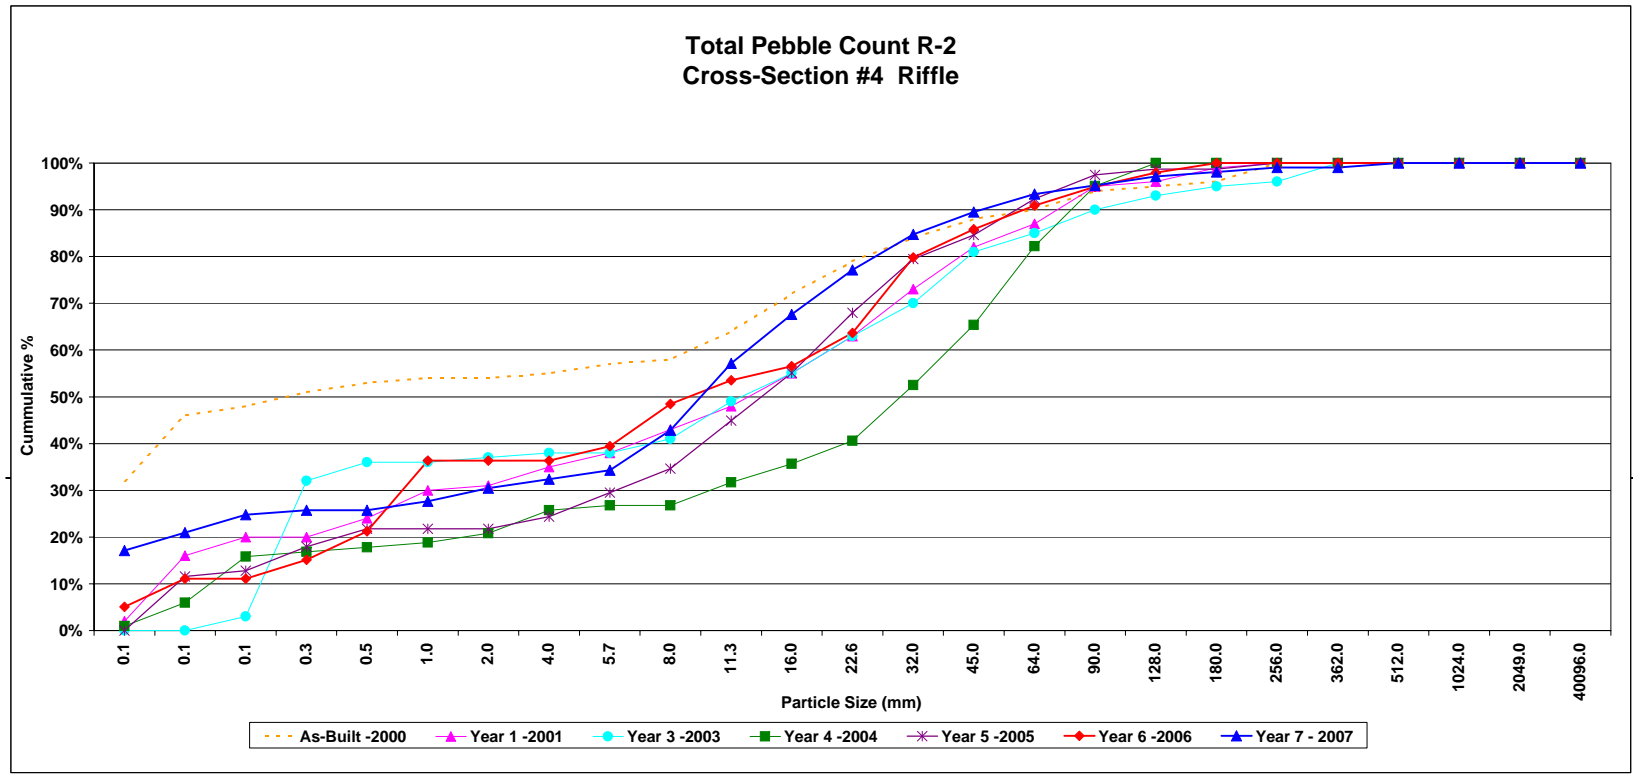

Project Name Stone Mountain Reach 4
 Cross Section #1
 Feature Riffle
 Date 7/31/07
 Crew Roberts, Price, George

Description	Material	Size (mm)	As-Built -2000				Year 5 -2005				Year 6 -2006				Year 7 -2007			
			Riffle - Bed	%	Cum %	Riffle - Bank	Riffle - Bed	%	Cum %	- Bank	- Bed	%	Cum %	Riffle - Bank	Riffle - Bed	%	Cum %	
Sand	all clay	0.061	1	100.0%	0	0	0.0%	0.0%	0	0	0.0%	0.0%	0	0	0.0%	0.0%		
	very fine sand	0.062	0	0.0%	100.0%	0	0	0.0%	9	9.8%	9.8%	0	0	0.0%	2	3.0%		
	fine sand	0.125	0	0.0%	100.0%	0	0	0.0%	0	0.0%	9.8%	0	0	0.0%	0	16.0%		
	medium sand	0.25	0	0.0%	100.0%	3	1	4.3%	14.1%	0	2	1.8%	1.8%	0	0.0%			
	coarse sand	0.50	0	0.0%	100.0%	4	5	9.8%	23.9%	0	0	0.0%	1.8%	0	1.0%			
	very coarse sand	1.0	0	0.0%	100.0%	0	1	1.1%	25.0%	0	6	5.3%	7.1%	0	7.0%			
	very fine gravel	2.0	0	0.0%	100.0%	0	1	1.1%	26.1%	0	0	0.0%	7.1%	0	0.0%			
	fine gravel	4.0	0	0.0%	100.0%	1	6	7.0%	33.7%	0	3	2.7%	9.7%	0	0.0%			
	fine gravel	5.7	0	0.0%	100.0%	0	0	0.0%	33.7%	0	5	4.4%	14.2%	0	2.0%			
	medium gravel	8.0	0	0.0%	100.0%	0	0	0.0%	40.2%	0	6	5.3%	19.5%	0	3.0%			
Gravel	medium gravel	11.3	0	0.0%	100.0%	0	9	9.8%	50.0%	0	8	7.3%	26.7%	0	4.0%			
	coarse gravel	16.0	0	0.0%	100.0%	0	7	7.6%	57.6%	1	10	9.7%	36.3%	0	3.0%			
	coarse gravel	22.6	0	0.0%	100.0%	0	8	8.7%	66.3%	6	10	14.2%	50.4%	0	5.0%			
	very coarse gravel	32	0	0.0%	100.0%	0	11	12.0%	78.2%	8	10	12.0%	66.4%	0	3.0%			
	very coarse gravel	45	0	0.0%	100.0%	0	12	13.0%	91.3%	10	10	17.7%	84.1%	0	6.0%			
	small cobble	64	0	0.0%	100.0%	0	6	6.5%	97.8%	2	10	10.0%	94.7%	0	10.0%			
	medium cobble	90	0	0.0%	100.0%	0	2	2.2%	100.0%	0	5	4.4%	99.1%	0	20.0%			
	large cobble	128	0	0.0%	100.0%	0	0	0.0%	100.0%	0	1	0.9%	100.0%	0	11.0%			
	very large cobble	180	0	0.0%	100.0%	0	0	0.0%	100.0%	0	0	0.0%	100.0%	0	7.0%			
	Boulder	small boulder	256	0	0.0%	100.0%	0	0	0.0%	100.0%	0	0	0.0%	100.0%	0	2.0%		
small boulder		362	0	0.0%	100.0%	0	0	0.0%	100.0%	0	0	0.0%	100.0%	0	0.0%			
medium boulder		512	0	0.0%	100.0%	0	0	0.0%	100.0%	0	0	0.0%	100.0%	0	0.0%			
large boulder		1024	0	0.0%	100.0%	0	0	0.0%	100.0%	0	0	0.0%	100.0%	0	0.0%			
very large boulder		2049	0	0.0%	100.0%	0	0	0.0%	100.0%	0	0	0.0%	100.0%	0	0.0%			
Bedrock	bedrock	4096	0	0.0%	100.0%	0	0	0.0%	100.0%	0	0	0.0%	100.0%	0	0.0%			
	TOTAL / %of whole count		1	100.0%		17	75	100.0%		27	86	100.0%		10	100.0%			


	d16	d35	d50	d84	d95
Year 5 -2005	0.4	7.4	11.7	45.4	62.2
Year 6 -2006	7.8	18.6	27.1	54.4	70.2
Year 7 -2007	0.26	17.42	54.50	125.36	190.07

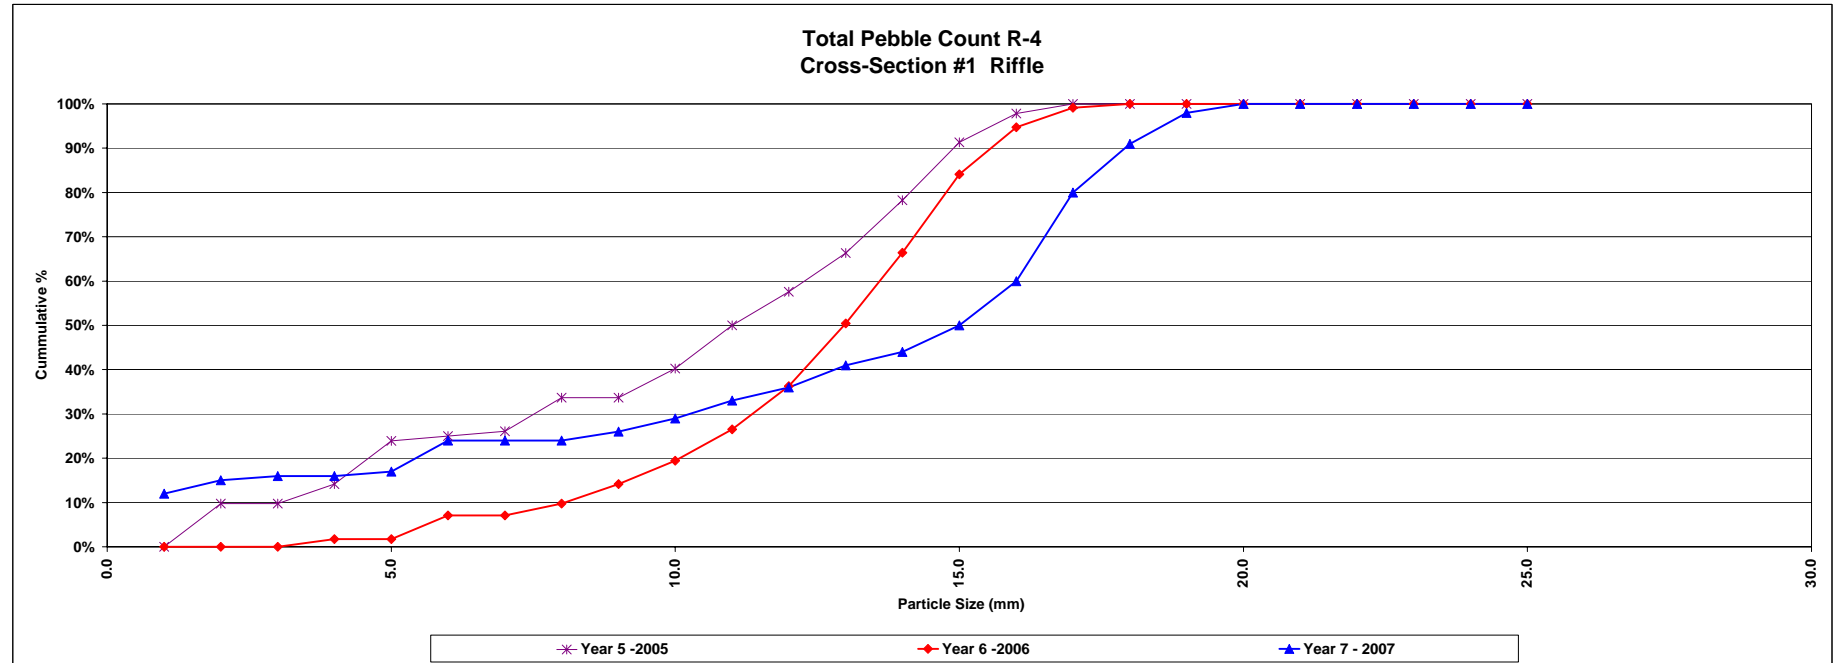

Project Name	Stone Mountain Reach 4
Cross Section	#4
Feature	Riffle
Date	7/31/07
Crew	Roberts, Price, George

Description	As-Built -2000				Year 1-2001				Year 3-2003				Year 4-2004				Year 5-2005				Year 6-2006				Year 7-2007			
	Material	Size (mm)	Riffle - Bed	%	Cum %	Riffle - Bed	%	Cum %	Riffle - Bank	Riffle - Bed	%	Cum %	Riffle - Bank	Riffle - Bed	%	Cum %	Riffle - Bank	Riffle - Bed	%	Cum %	Riffle - Bank	Riffle - Bed	%	Cum %	Riffle - Bank	Riffle - Bed	%	Cum %
Sand	silt/clay	0.061	32	32.0%	32.0%	2	2.0%	2.0%	0	0.0%	0.0%	1	1.0%	1.0%	0	0.0%	0	0.0%	0.0%	0	0	0.0%	0.0%	5	5.0%	5.0%	5.0%	5.0%
	very fine sand	0.062	14	14.0%	46.0%	14	14.0%	16.0%	0	0.0%	0.0%	5	5.0%	5.0%	10	6	19.5%	19.5%	0	0	0.0%	0.0%	10	1	12.2%	17.8%	17.8%	
	fine sand	0.125	2	2.0%	48.0%	4	4.0%	20.0%	3	3.0%	3.0%	10	0	9.9%	15.8%	0	0	0.0%	19.5%	0	0	0.0%	0.0%	0	2	2.2%	20.0%	
	medium sand	0.25	3	3.0%	51.0%	0	0.0%	20.0%	29	29.0%	32.0%	1	0	1.0%	16.8%	2	0	2.4%	22.0%	0	4	3.5%	3.5%	0	4	4.4%	24.4%	
	course sand	0.50	2	2.0%	53.0%	4	4.0%	24.0%	4	4.0%	36.0%	1	0	1.0%	17.8%	2	7	11.0%	32.9%	0	2	1.7%	5.2%	0	6	6.2%	31.1%	
	very course sand	1.0	1	1.0%	54.0%	6	6.0%	30.0%	0	0.0%	36.0%	0	1	1.0%	18.8%	0	0	0.0%	32.9%	0	6	5.2%	10.4%	0	5	5.6%	36.7%	
	very fine gravel	2.0	0	0.0%	54.0%	1	1.0%	31.0%	1	1.0%	37.0%	0	2	2.0%	20.8%	0	0	0.0%	32.9%	0	0	0.0%	10.4%	0	2	2.2%	38.9%	
	fine gravel	4.0	1	1.0%	55.0%	4	4.0%	35.0%	1	1.0%	38.0%	0	5	5.0%	25.7%	1	6	8.5%	41.5%	0	0	0.0%	10.4%	0	0	0.0%	38.9%	
	medium gravel	5.7	2	2.0%	57.0%	3	3.0%	38.0%	0	0.0%	38.0%	0	1	1.0%	26.7%	0	3	3.7%	45.1%	0	2	1.7%	12.2%	0	1	1.1%	40.0%	
	course gravel	8.0	1	1.0%	58.0%	5	5.0%	43.0%	3	3.0%	41.0%	0	0	0.0%	26.7%	0	3	3.7%	48.8%	0	6	5.2%	17.4%	0	0	0.0%	40.0%	
Gravel	medium gravel	11.3	6	6.0%	64.0%	5	5.0%	48.0%	8	8.0%	49.0%	0	5	5.0%	31.7%	0	3	3.7%	52.4%	0	8	7.0%	24.3%	0	0	0.0%	40.0%	
	large gravel	16.0	8	8.0%	72.0%	7	7.0%	55.0%	6	6.0%	55.0%	1	3	4.0%	35.0%	0	4	4.9%	57.3%	0	9	7.8%	32.2%	0	0	0.0%	40.0%	
	course gravel	22.6	7	7.0%	79.0%	8	8.0%	63.0%	8	8.0%	63.0%	1	4	5.0%	40.0%	0	3	3.7%	61.0%	7	10	14.8%	47.0%	0	5	5.6%	45.6%	
	very course gravel	28	5	5.0%	84.0%	10	10.0%	73.0%	7	7.0%	70.0%	0	12	13.9%	52.5%	0	8	9.8%	70.7%	10	10	17.4%	64.3%	0	5	5.6%	51.1%	
	very large gravel	45	4	4.0%	88.0%	9	9.0%	82.0%	11	11.0%	81.0%	0	13	12.9%	65.3%	0	10	12.2%	82.9%	6	10	13.9%	78.3%	0	10	11.1%	62.2%	
	small cobble	64	2	2.0%	90.0%	5	5.0%	87.0%	4	4.0%	85.0%	0	17	16.8%	82.2%	0	9	11.0%	93.9%	7	10	14.8%	93.0%	0	14	15.0%	77.8%	
	medium cobble	90	4	4.0%	94.0%	8	8.0%	95.0%	5	5.0%	90.0%	0	13	12.9%	95.0%	0	3	3.7%	97.0%	0	4	3.5%	96.5%	0	12	13.2%	91.1%	
	large cobble	128	1	1.0%	95.0%	1	1.0%	95.0%	3	3.0%	95.0%	0	5	5.0%	100.0%	0	1	1.2%	98.8%	0	4	3.5%	100.0%	0	5	5.7%	97.8%	
	very large cobble	180	1	1.0%	96.0%	3	3.0%	99.0%	2	2.0%	95.0%	0	0	0.0%	100.0%	0	1	1.2%	100.0%	0	0	0.0%	100.0%	0	2	2.2%	100.0%	
	small boulder	256	4	4.0%	100.0%	1	1.0%	100.0%	1	1.0%	96.0%	0	0	0.0%	100.0%	0	0	0.0%	100.0%	0	0	0.0%	100.0%	0	0	0.0%	100.0%	
Boulder	small boulder	362	0	0.0%	100.0%	0	0.0%	100.0%	4	4.0%	100.0%	0	0	0.0%	100.0%	0	0	0.0%	100.0%	0	0	0.0%	100.0%	0	0	0.0%	100.0%	
	medium boulder	512	0	0.0%	100.0%	0	0.0%	100.0%	0	0.0%	100.0%	0	0	0.0%	100.0%	0	0	0.0%	100.0%	0	0	0.0%	100.0%	0	0	0.0%	100.0%	
	large boulder	1024	0	0.0%	100.0%	0	0.0%	100.0%	0	0.0%	100.0%	0	0	0.0%	100.0%	0	0	0.0%	100.0%	0	0	0.0%	100.0%	0	0	0.0%	100.0%	
Bedrock	very large boulder	2049	0	0.0%	100.0%	0	0.0%	100.0%	0	0.0%	100.0%	0	0	0.0%	100.0%	0	0	0.0%	100.0%	0	0	0.0%	100.0%	0	0	0.0%	100.0%	
	bedrock	40096	0	0.0%	100.0%	0	0.0%	100.0%	0	0.0%	100.0%	0	0	0.0%	100.0%	0	0	0.0%	100.0%	0	0	0.0%	100.0%	0	0	0.0%	100.0%	
TOTAL / % of whole count			100	100.0%		100	100.0%		100	100.0%		20	81	100.0%		15	67	100.0%		30	85	100.0%		15	75	100.0%		


	d16	d38	d50	d84	d95
As-Built -2000	0.0	0.1	0.1	38.5	154.0
Year 1-2001	0.1	4.9	15.3	81.5	109.0
Year 3-2003	0.1	0.7	14.4	71.4	314.0
Year 4-2004	0.1	18.4	36.2	81.5	108.0
Year 5-2005	0.1	3.4	11.0	56.7	36.8
Year 6-2006	8.9	20.8	28.1	63.2	95.0
Year 7-2007	0.1	1.2	36.3	20.4	122.3

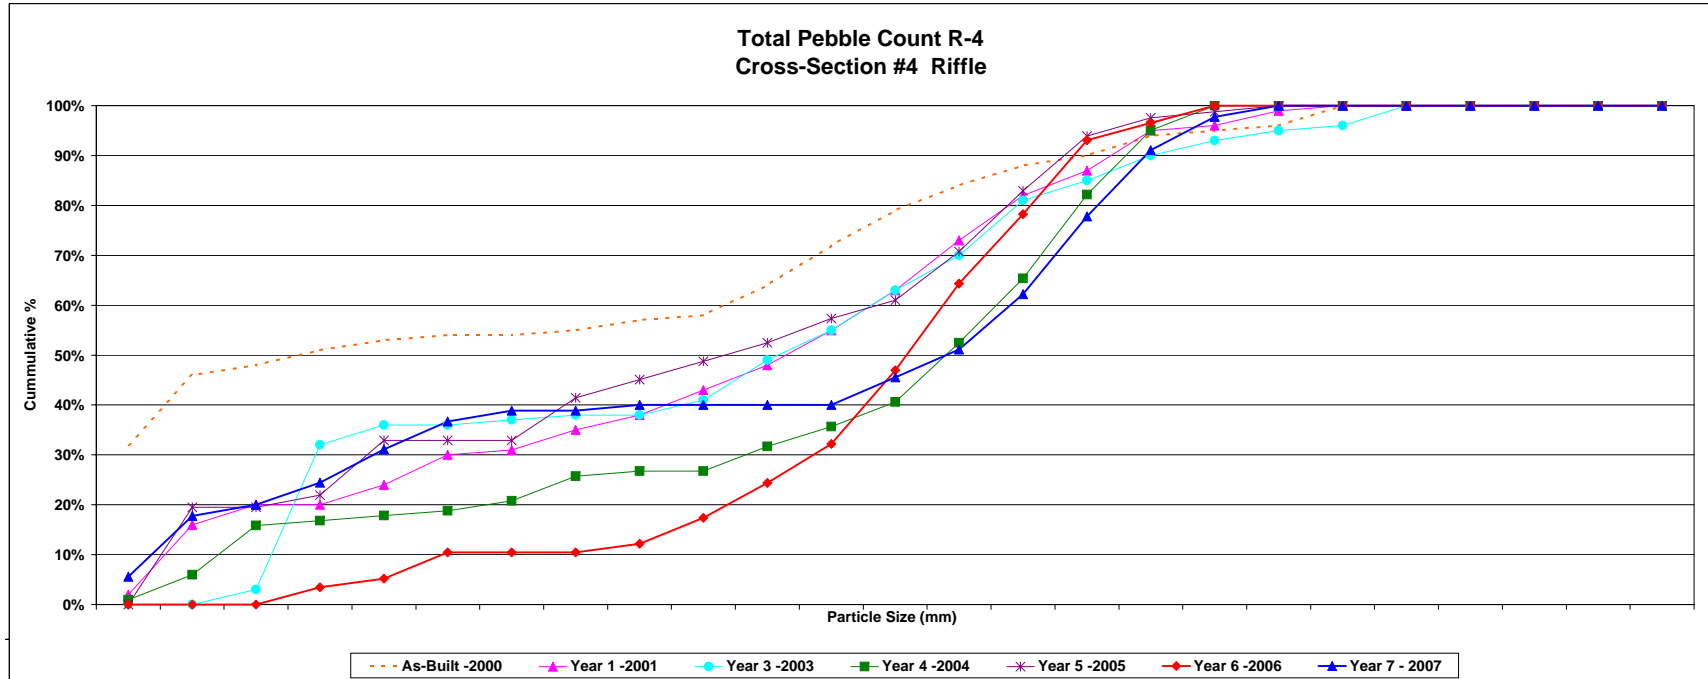

Project Name	Stone Mountain Reach 4
Cross Section	#6
Feature	Riffle
Date	7/31/07
Crew	Roberts, Price, George

Description	Material	Size (mm)	As-Built -2000		Year 1 -2001		Year 2 -2002		Year 3 -2003		Year 5 -2005		Year 6 -2006		Year 7 -2007	
			Riffle - Bed	%	Riffle - Bed	%	Riffle - Bed	%	Riffle - Bed	%	Riffle - Bank	%	Riffle - Bank	%	Riffle - Bank	%
Sand	silts/clay	0.061	50	30.0%	0	0.0%	0	0.0%	5	5.0%	1	0.0%	0	0.0%	25	40.0%
	very fine sand	0.062	2	2.0%	4	4.0%	9	9.0%	0	0.0%	7	0.0%	0	0.0%	2	2.0%
	fine sand	0.125	2	2.0%	7	7.0%	6	6.0%	3	3.0%	0	0.0%	0	0.0%	13	11.0%
	medium sand	0.25	2	2.0%	4	4.0%	9	9.0%	10	10.0%	5	6.0%	1	1.0%	7	7.0%
	course sand	0.50	5	5.0%	2	2.0%	0	0.0%	24.0%	24.0%	2	2.0%	2	2.0%	5	5.0%
Gravel	very coarse sand	1.0	2	2.0%	0	0.0%	1	1.0%	0	0.0%	0	0.0%	0	0.0%	7	7.0%
	very fine gravel	2.0	4	4.0%	3	3.0%	3	3.0%	28.0%	28.0%	1	1.0%	0	0.0%	0	0.0%
	fine gravel	4.0	6	6.0%	5	5.0%	2	2.0%	30.0%	30.0%	5	5.0%	3	3.0%	0	0.0%
	medium gravel	5.7	5	5.0%	7	7.0%	6	6.0%	26.0%	26.0%	6	6.0%	0	0.0%	0	0.0%
	coarse gravel	8.0	8	8.0%	7	7.0%	5	5.0%	41.0%	41.0%	9	9.0%	5	5.0%	1	1.0%
	very coarse gravel	11.3	6	6.0%	5	5.0%	7	7.0%	48.0%	48.0%	5	5.0%	1	1.0%	0	0.0%
	course gravel	16.0	6	6.0%	7	7.0%	3	3.0%	51.0%	51.0%	9	9.0%	1	1.0%	2	2.0%
	coarse gravel	22.6	6	6.0%	8	8.0%	7	7.0%	58.0%	58.0%	8	8.0%	2	2.0%	5	5.0%
	very coarse gravel	32	8	8.0%	10	10.0%	7	7.0%	65.0%	65.0%	9	9.0%	9	9.0%	12.0%	12.0%
	very coarse gravel	45	5	5.0%	16	16.0%	14	14.0%	79.0%	79.0%	9	9.0%	9	9.0%	11.0%	11.0%
Cobble	small cobble	64	2	2.0%	7	7.0%	7	7.0%	86.0%	86.0%	11	11.0%	4	4.0%	3	3.0%
	medium cobble	90	1	1.0%	5	5.0%	11	11.0%	97.0%	97.0%	12	12.0%	3	3.0%	6	6.0%
	large cobble	128	0	0.0%	3	3.0%	2	2.0%	99.0%	99.0%	1	1.0%	2	2.0%	1	1.0%
	very large cobble	180	0	0.0%	0	0.0%	1	1.0%	100.0%	100.0%	2	2.0%	5	5.0%	0	0.0%
Boulder	small boulder	256	0	0.0%	0	0.0%	0	0.0%	100.0%	100.0%	2	2.0%	1	1.0%	0	0.0%
	medium boulder	362	0	0.0%	0	0.0%	0	0.0%	100.0%	100.0%	1	1.0%	0	0.0%	1	1.0%
	large boulder	512	0	0.0%	0	0.0%	0	0.0%	100.0%	100.0%	0	0.0%	0	0.0%	0	0.0%
	very large boulder	1024	0	0.0%	0	0.0%	0	0.0%	100.0%	100.0%	0	0.0%	0	0.0%	0	0.0%
Bedrock	bedrock	2049	0	0.0%	0	0.0%	0	0.0%	100.0%	100.0%	0	0.0%	0	0.0%	0	0.0%
	bedrock	40096	0	0.0%	0	0.0%	0	0.0%	100.0%	100.0%	0	0.0%	0	0.0%	0	0.0%
TOTAL / % of whole count			100	100.0%	100	100.0%	100	100.0%	100	100.0%	15	64	100.0%	25	75	100.0%


	d16	d38	d50	d84	d95
As-Built -2000	0.0	0.1	0.3	2.1	48.1
Year 1 -2001	0.6	8.1	18.5	53.5	98.2
Year 2 -2002	0.3	6.5	17.4	70.6	103.2
Year 3 -2003	0.1	0.2	0.2	106.3	196.3
Year 5 -2005	0.3	2.5	8.2	37.8	250.3
Year 6 -2006	8.7	29.3	46.5	109.0	196.7
Year 7 -2007	0.6	0.6	0.2	13.1	100.0

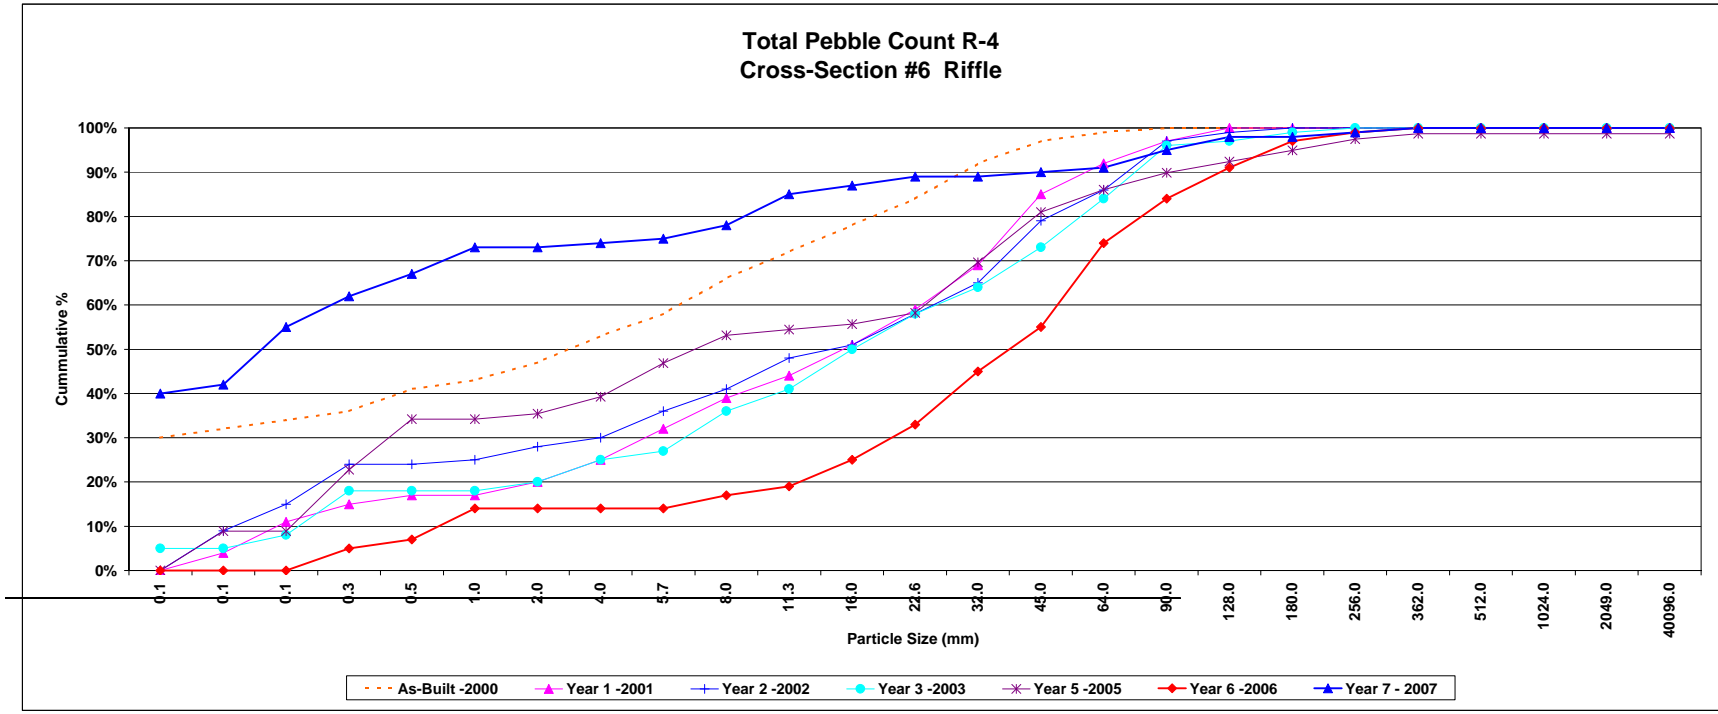

Project Name	Stone Mountain Reach 4
Cross Section	#2
Feature	Pool
Date	7/31/07
Crew	Roberts, Price, George

Description	Material	Size (mm)	Year 6 -2006				Year 7 -2007			
			Pool - Bank	Pool - Bed	%	Cum %	Riffle - Bank	Riffle - Bed	%	Cum %
Silt/Clay	silts/clay	0.061	0	3	3.0%	3.0%	8	3	11.0%	11.0%
	very fine sand	0.062	0	4	4.0%	7.0%	2	2	4.0%	15.0%
	fine sand	0.125	3	10	13.0%	20.0%	2	2	2.0%	17.0%
	medium sand	0.25	7	10	17.0%	37.0%	0	0	0.0%	17.0%
	coarse sand	0.50	0	3	3.0%	40.0%	0	2	2.0%	19.0%
	very coarse sand	1.0	0	2	2.0%	42.0%	0	8	8.0%	27.0%
	very fine gravel	2.0	0	2	2.0%	44.0%	0	1	1.0%	28.0%
	fine gravel	4.0	0	0	0.0%	44.0%	0	3	3.0%	31.0%
	fine gravel	5.7	0	1	1.0%	45.0%	0	4	4.0%	35.0%
	medium gravel	8.0	0	2	2.0%	47.0%	0	5	5.0%	40.0%
Gravel	medium gravel	11.3	0	3	3.0%	50.0%	0	5	5.0%	45.0%
	coarse gravel	16.0	0	7	7.0%	57.0%	0	7	7.0%	52.0%
	coarse gravel	22.6	0	8	8.0%	65.0%	0	7	7.0%	59.0%
	very coarse gravel	32	0	10	10.0%	75.0%	0	7	7.0%	66.0%
	very coarse gravel	45	0	7	7.0%	82.0%	0	11	11.0%	77.0%
	small cobble	64	0	7	7.0%	89.0%	0	1	1.0%	78.0%
	medium cobble	90	0	8	8.0%	97.0%	0	13	13.0%	91.0%
	large cobble	128	0	1	1.0%	98.0%	0	5	5.0%	96.0%
	very large cobble	180	0	2	2.0%	100.0%	0	3	3.0%	99.0%
	small boulder	256	0	0	0.0%	100.0%	0	1	1.0%	100.0%
Boulder	small boulder	362	0	0	0.0%	100.0%	0	0	0.0%	100.0%
	medium boulder	512	0	0	0.0%	100.0%	0	0	0.0%	100.0%
	large boulder	1024	0	0	0.0%	100.0%	0	0	0.0%	100.0%
Bedrock	very large boulder	2049	0	0	0.0%	100.0%	0	0	0.0%	100.0%
	bedrock	40096	0	0	0.0%	100.0%	0	0	0.0%	100.0%
TOTAL / %of whole count			10	90	100.0%		90	100.0%		


	#16	#35	#50	#84	#95
Year 6-2006	0.15	0.35	13.65	60.93	101.00
Year 7-2007	0.15	0.35	12.60	51.77	143.00

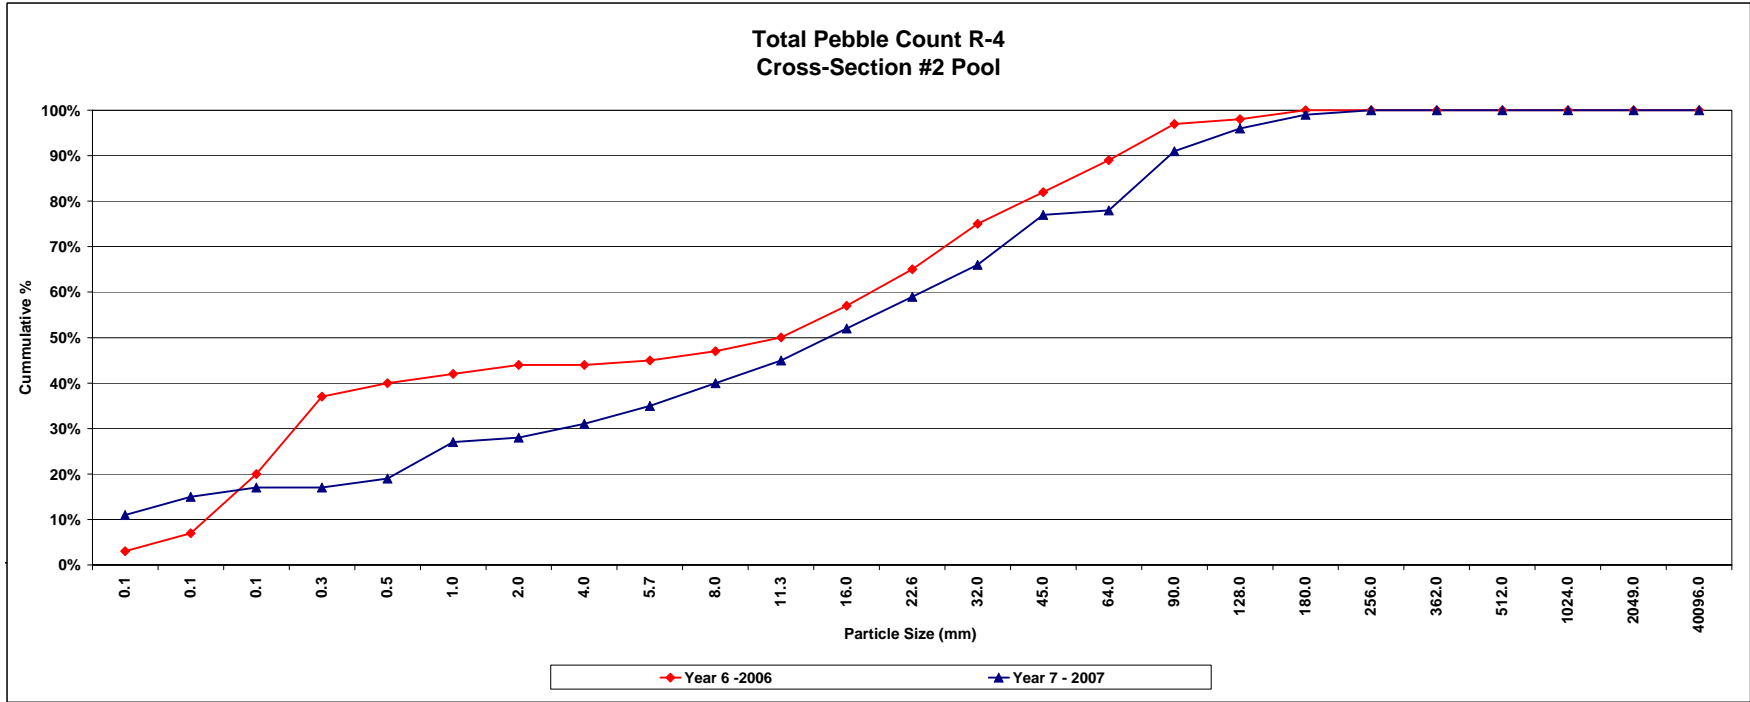

Project Name	Stone Mountain Reach 4
Cross Section	#3
Feature	Pool
Date	7/31/07
Crew	Roberts, Price, George

Description	Material	Size (mm)	Year 6 -2006				Year 7 -2007			
			Pool - Bank	Pool - Bed	%	Cum %	Pool - Bank	Pool - Bed	%	Cum %
Silt/Clay	silt/clay	0.051	0	0	0.0%	0.0%	0	0	0.0%	0.0%
Sand	very fine sand	0.062	0	0	0.0%	0.0%	3	0	3.3%	3.3%
	fine sand	0.125	10	10	18.2%	18.2%	1	0	1.1%	4.4%
	medium sand	0.25	10	20	27.3%	45.5%	4	0	4.4%	8.9%
	coarse sand	0.50	0	13	11.8%	57.3%	0	0	0.0%	8.9%
	very coarse sand	1.0	0	8	7.3%	64.6%	2	8	11.1%	20.0%
Gravel	very fine gravel	2.0	0	1	0.9%	65.5%	0	3	3.3%	23.3%
	fine gravel	4.0	0	6	5.5%	70.9%	0	6	6.7%	30.0%
	medium gravel	5.7	0	7	6.4%	77.3%	0	6	6.7%	36.7%
	coarse gravel	8.0	0	11	10.0%	87.3%	0	12	13.3%	50.0%
	very coarse gravel	11.3	0	7	6.4%	93.6%	0	5	5.6%	55.6%
	small cobble	16.0	0	0	0.0%	93.6%	0	8	8.9%	64.4%
	medium cobble	22.6	0	1	0.9%	94.5%	0	11	12.2%	75.7%
	large cobble	32	0	2	1.8%	96.4%	0	7	7.8%	84.4%
Cobble	very coarse gravel	45	0	2	1.8%	98.2%	0	7	7.8%	92.2%
	small boulder	64	0	0	0.0%	98.2%	0	4	4.4%	96.7%
	medium boulder	90	0	1	0.9%	99.1%	0	1	1.1%	97.8%
	large boulder	128	0	0	0.0%	99.1%	0	2	2.2%	100.0%
Boulder	very large boulder	180	0	1	0.9%	100.0%	0	0	0.0%	100.0%
	small boulder	256	0	0	0.0%	100.0%	0	0	0.0%	100.0%
	medium boulder	362	0	0	0.0%	100.0%	0	0	0.0%	100.0%
	large boulder	512	0	0	0.0%	100.0%	0	0	0.0%	100.0%
	very large boulder	1024	0	0	0.0%	100.0%	0	0	0.0%	100.0%
Bedrock	bedrock	2049	0	0	0.0%	100.0%	0	0	0.0%	100.0%
	bedrock	40096	0	0	0.0%	100.0%	0	0	0.0%	100.0%
TOTAL / %of whole count			20	90	100.0%		10	90	100.0%	


	#16	#35	#50	#84	#95
Year 6-2006	0.2	0.1	0.3	0.7	0.4
Year 7-2007	1.2	0.4	0.7	3.7	0.4

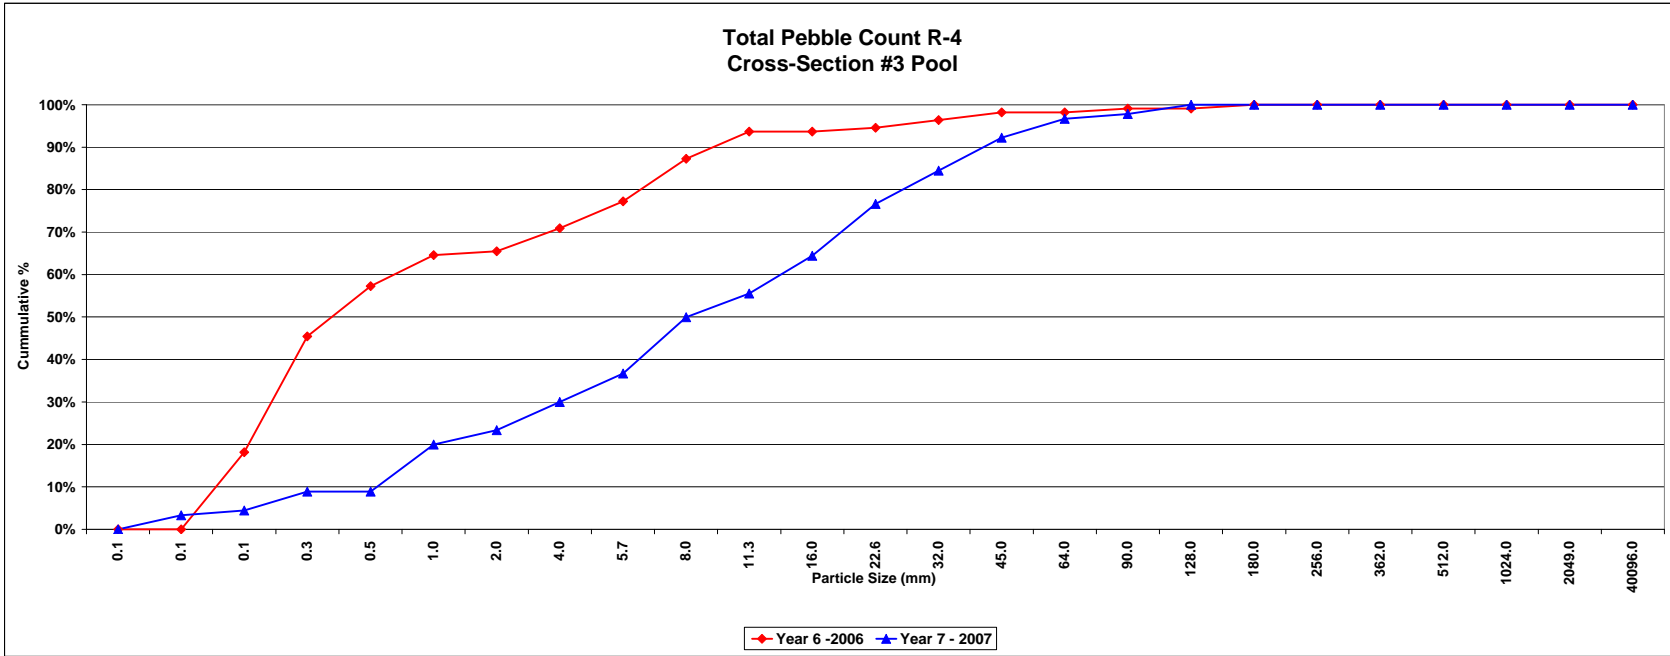

Project Name	Stone Mountain Reach 4
Cross Section	#5
Feature	Pool
Date	7/31/07
Crew	Roberts, Price, George

Description	Material	Size (mm)	Year 6 -2006				Year 7 -2007			
			Pool - Bank	Pool - Bed	%	Cum %	Pool - Bank	Pool - Bed	%	Cum %
Sand	silt/clay	0.001	0	0	0.0%	0.0%	15	15	30.0%	30.0%
	very fine sand	0.062	0	0	0.0%	0.0%	0	9	9.0%	39.0%
	fine sand	0.125	0	0	0.0%	0.0%	0	7	7.0%	46.0%
	medium sand	0.25	0	1	1.0%	1.0%	0	7	7.0%	53.0%
	course sand	0.50	1	1	2.0%	3.0%	0	0	0.0%	53.0%
	very course sand	1.0	0	3	3.0%	6.0%	0	1	1.0%	54.0%
Gravel	very fine gravel	2.0	0	0	0.0%	6.0%	0	5	5.0%	59.0%
	fine gravel	4.0	0	0	0.0%	6.0%	0	3	3.0%	62.0%
	fine gravel	5.7	0	0	0.0%	6.0%	0	5	5.0%	67.0%
	medium gravel	8.0	0	5	5.0%	11.0%	0	7	7.0%	74.0%
	medium gravel	11.3	2	5	7.0%	18.0%	0	2	2.0%	76.0%
	course gravel	16.0	0	2	2.0%	20.0%	0	8	8.0%	84.0%
	course gravel	22.6	1	7	8.0%	28.0%	0	8	8.0%	92.0%
	very course gravel	32	2	11	13.0%	41.0%	0	3	3.0%	95.0%
Cobble	very course gravel	45	2	14	16.0%	57.0%	0	2	2.0%	97.0%
	small cobble	64	3	15	18.0%	75.0%	0	2	2.0%	99.0%
	medium cobble	90	3	10	13.0%	88.0%	0	0	0.0%	99.0%
	large cobble	125	1	9	10.0%	98.0%	0	1	1.0%	100.0%
	very large cobble	180	0	2	2.0%	100.0%	0	0	0.0%	100.0%
Boulder	small boulder	256	0	0	0.0%	100.0%	0	0	0.0%	100.0%
	small boulder	362	0	0	0.0%	100.0%	0	0	0.0%	100.0%
	medium boulder	512	0	0	0.0%	100.0%	0	0	0.0%	100.0%
	large boulder	1024	0	0	0.0%	100.0%	0	0	0.0%	100.0%
	very large boulder	2049	0	0	0.0%	100.0%	0	0	0.0%	100.0%
Bedrock	bedrock	40096	0	0	0.0%	100.0%	0	0	0.0%	100.0%
TOTAL / %of whole count			15	85	100.0%		15	85	100.0%	


	#16	#35	#50	#84	#95
Year 4 -2006	175	333	475	792	1483
Year 7 -2007	101	31	33	123	353

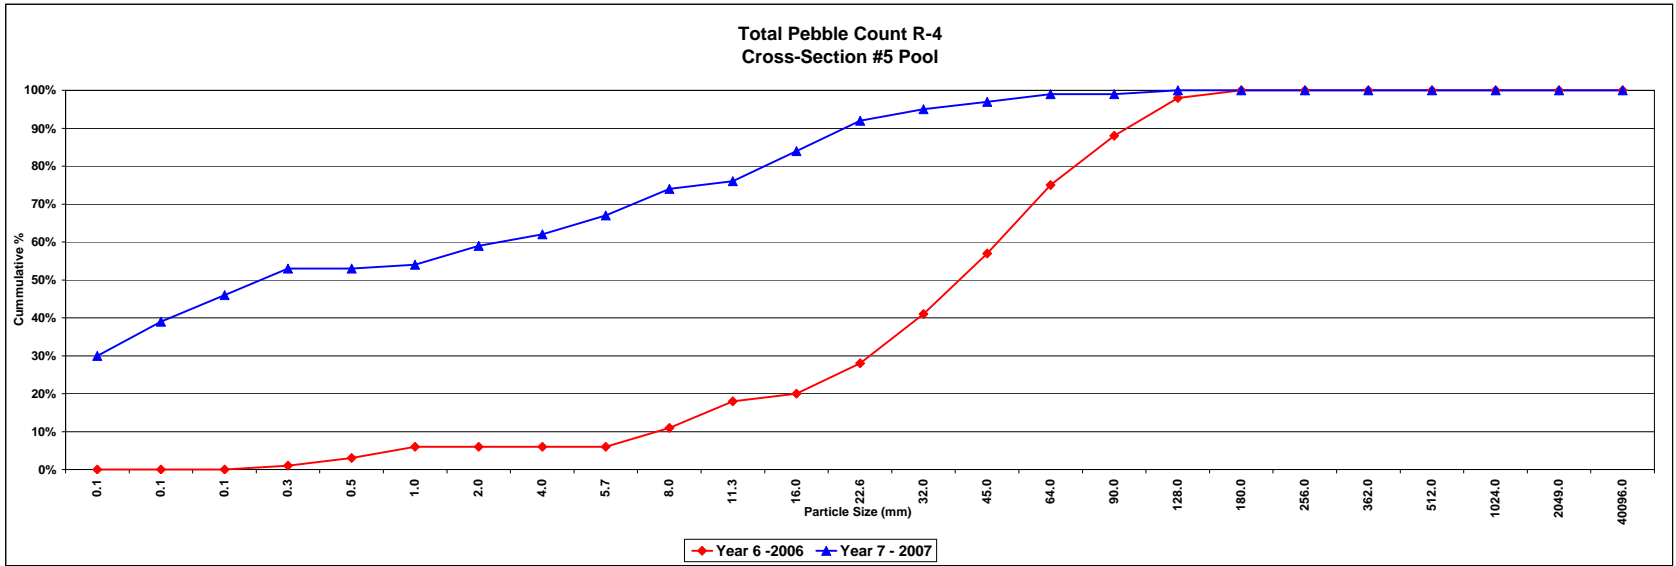


Project Name	Stone Mountain Reach 4
Cross Section	#7
Feature	Pool
Date	7/31/07
Crew	Roberts, Price, George

Description Sub/Clay	Material	Size (mm)	Year 6 -2006			Year 7 -2007				
			Pool - Bank	Pool - Bed	%	Cum %	Pool - Bank	Pool - Bed	%	Cum %
Sand	silt/clay	0.061	1	0	0.8%	0.8%	0	0	0.0%	0.0%
	very fine sand	0.062	0	0	0.0%	0.8%	1	0	1.0%	1.0%
	fine sand	0.125	0	9	7.2%	8.0%	0	0	0.0%	1.0%
	medium sand	0.25	3	9	9.6%	17.6%	0	0	0.0%	1.0%
	coarse sand	0.50	3	4	5.6%	23.2%	4	0	4.0%	5.0%
	very coarse sand	1.0	3	8	8.8%	32.0%	2	0	2.0%	7.0%
Gravel	very fine gravel	2.0	0	1	0.8%	32.8%	3	0	3.0%	10.0%
	fine gravel	4.0	0	1	0.8%	33.6%	0	0	0.0%	10.0%
	medium gravel	5.7	0	2	1.6%	35.2%	0	0	0.0%	10.0%
	coarse gravel	8.0	0	1	0.8%	36.0%	0	3	3.0%	13.0%
	medium gravel	11.3	2	1	2.4%	38.4%	0	3	3.0%	16.0%
	coarse gravel	16.0	2	7	7.2%	45.6%	0	8	8.0%	24.0%
	coarse gravel	22.6	0	1	2.2%	47.8%	0	11	11.0%	35.0%
	very coarse gravel	32	3	14	13.6%	62.4%	0	16	16.0%	51.0%
	very coarse gravel	45	3	10	10.4%	72.8%	0	16	16.0%	67.0%
	very coarse gravel	64	2	13	12.0%	84.8%	0	13	13.0%	80.0%
Cobble	small cobble	90	2	3	4.0%	88.8%	0	9	9.0%	89.0%
	large cobble	125	0	4	3.2%	92.0%	0	5	5.0%	94.0%
	very large cobble	180	0	2	1.6%	93.6%	0	3	3.0%	97.0%
	small boulder	256	1	4	4.0%	97.6%	0	1	1.0%	98.0%
Boulder	small boulder	362	0	0	0.0%	97.6%	0	1	1.0%	99.0%
	medium boulder	512	0	1	0.8%	98.4%	0	1	1.0%	100.0%
	large boulder	1024	0	0	0.0%	98.4%	0	0	0.0%	100.0%
	very large boulder	2049	0	0	0.0%	98.4%	0	0	0.0%	100.0%
Bedrock	bedrock	40006	0	2	1.6%	100.0%	0	0	0.0%	100.0%
	TOTAL / %of whole count		25	100	100.0%		10	90	100.0%	

	#16	#35	#50	#84	#95
Year 6-2006	0.1	6.6	28.1	75.1	249.9
Year 7-2007	13.0	23.1	31.6	91.1	176.0

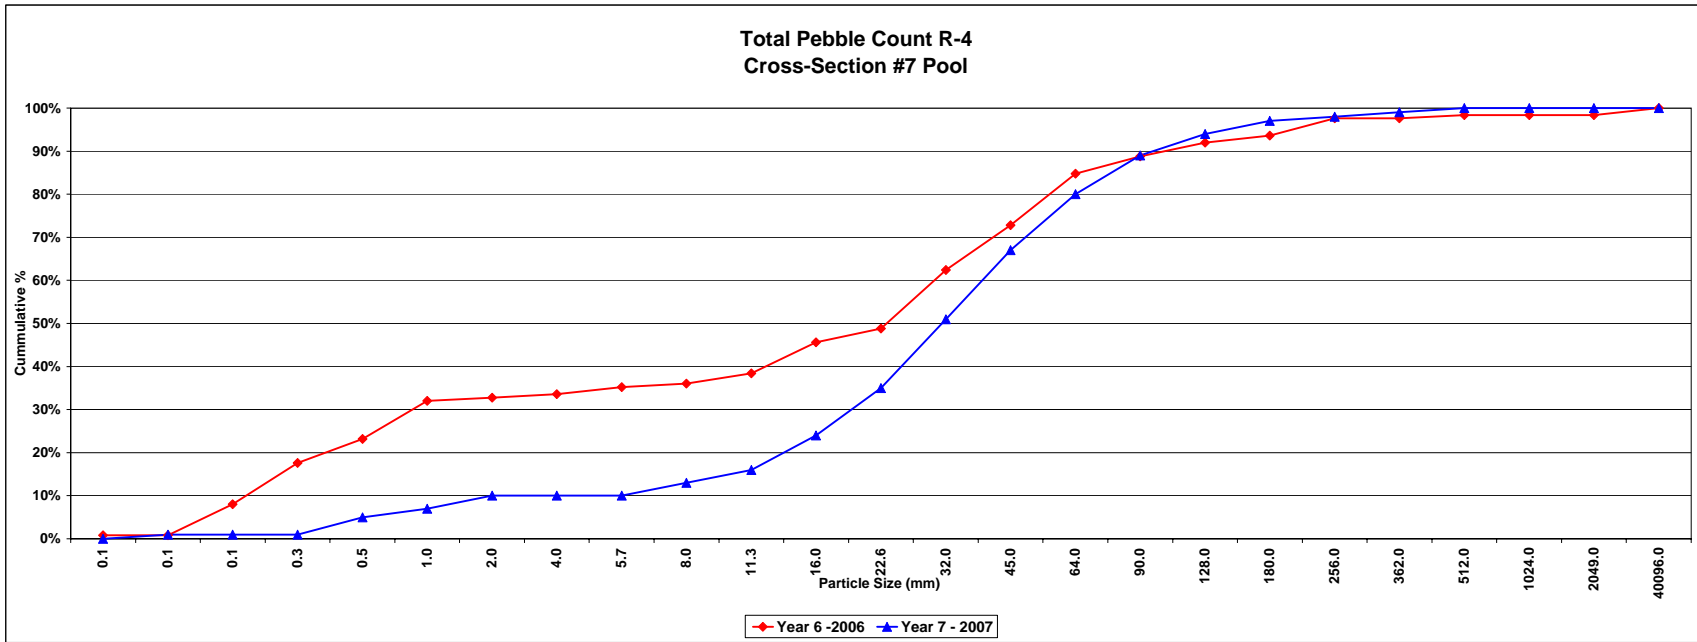

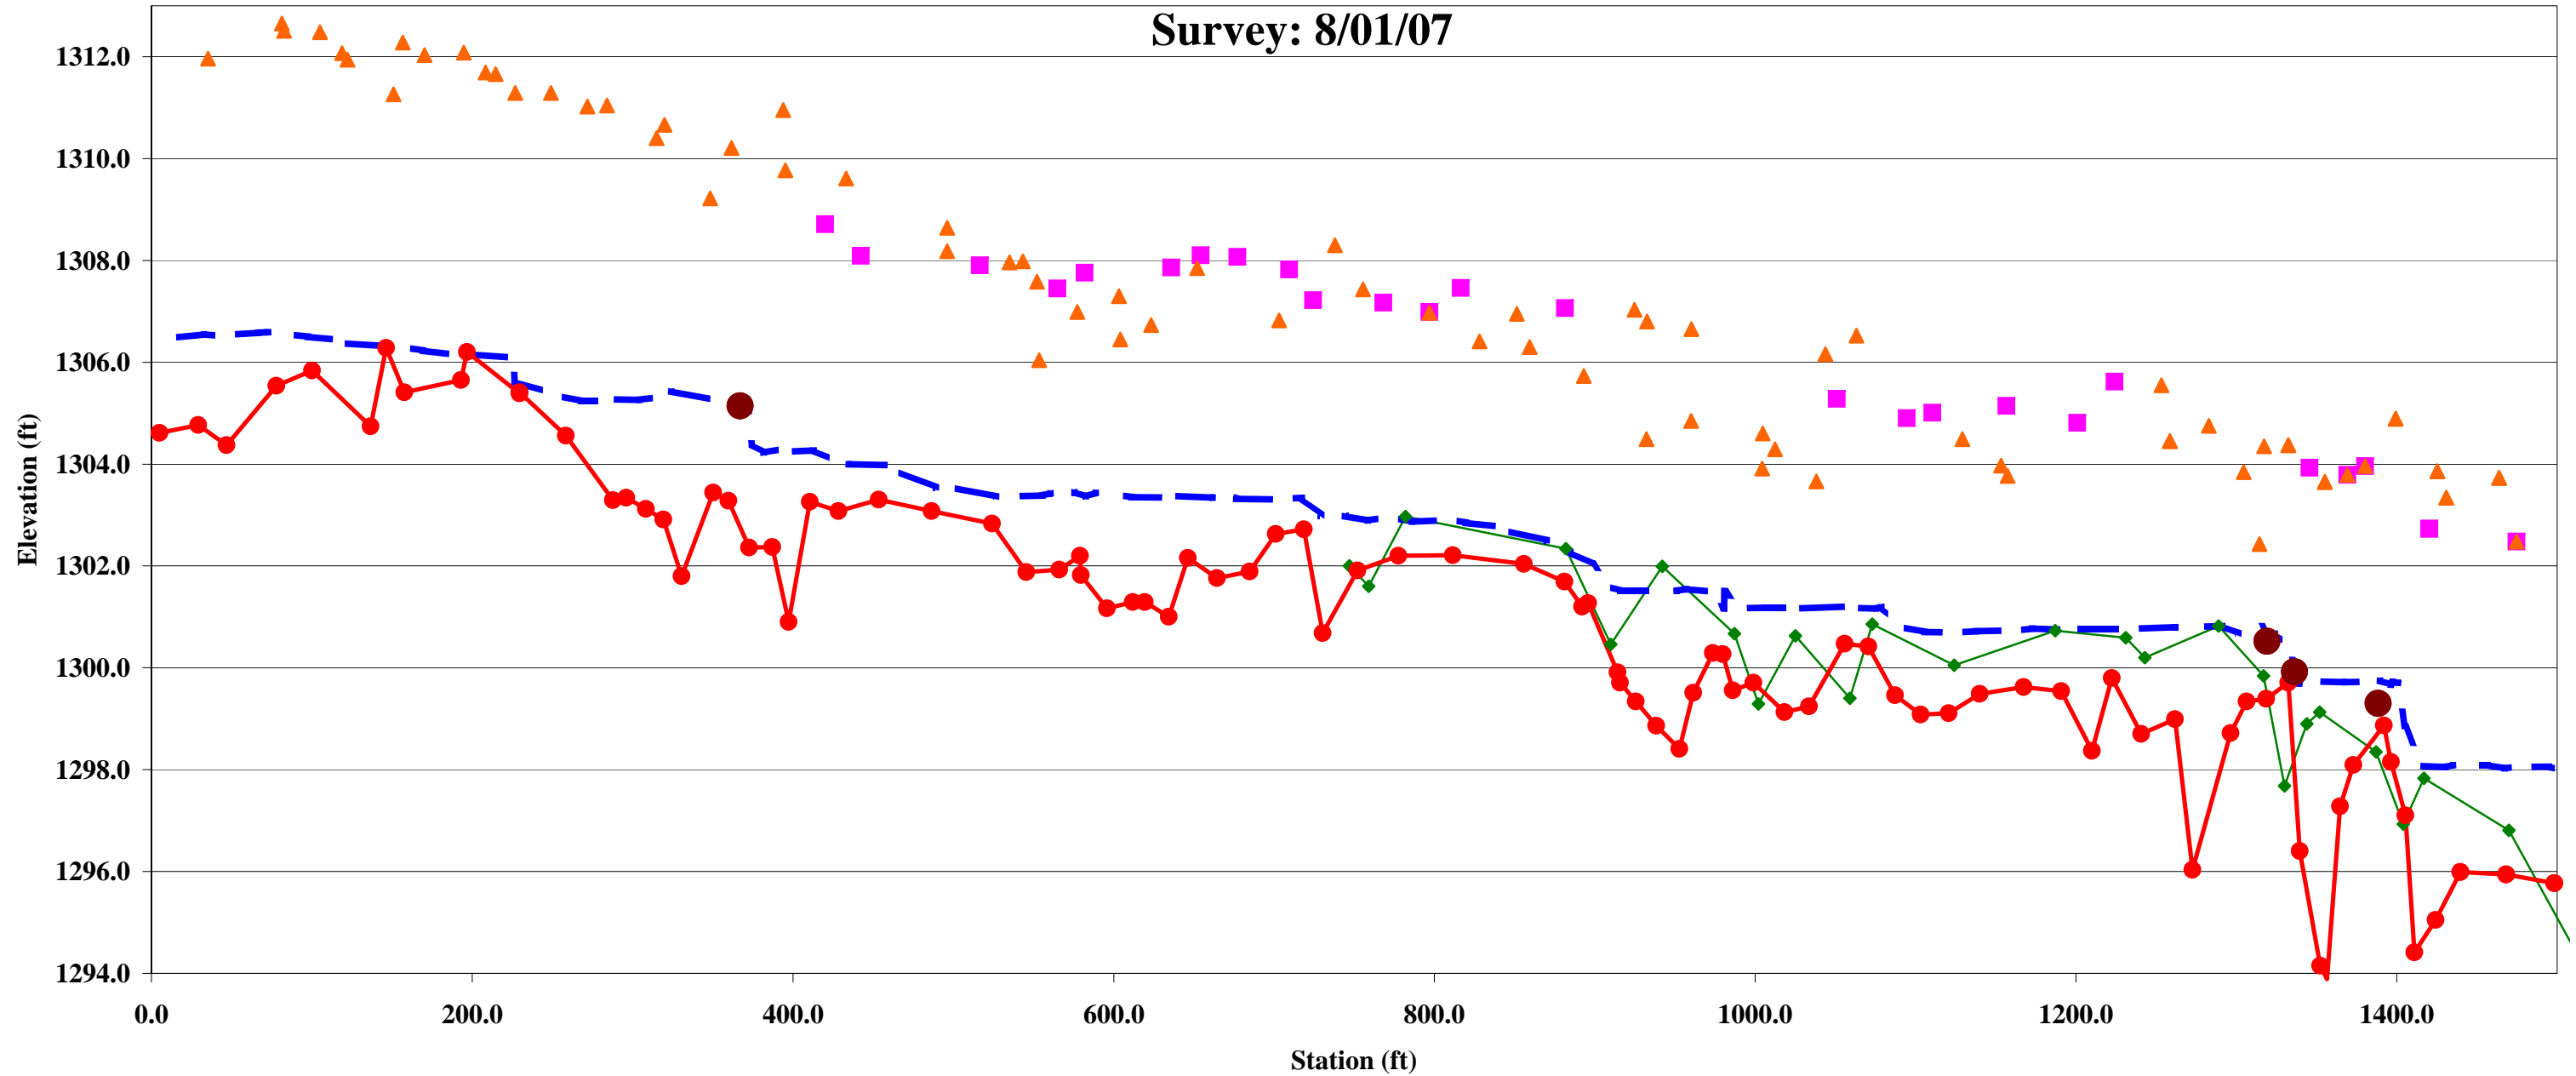Stone Mountain Longitudinal Profile
Reach 2 - 2007
Survey: 8/01/07



2007 Survey Data Stone Mountain- Reach 2


Point	Station	Elevation	Description
8019	5.07	1304.61	T
8023	29.2	1304.77	T
8025	46.86	1304.37	T
8026	77.87	1305.54	T
8028	100.16	1305.84	HRSTART
8032	136.67	1304.74	T
8037	146.34	1306.28	T
8034	157.79	1305.41	T
8036	193.06	1305.65	T
8038	196.85	1306.2	T
8042	229.51	1305.39	T
8039	229.65	1305.41	T
8045	258.4	1304.56	T
8049	287.84	1303.29	T
8098	296.12	1303.34	T
8099	308.42	1303.12	T
8105	319.25	1302.91	T
8109	330.65	1301.8	T
8114	350.35	1303.44	T
8121	359.84	1303.28	T
8124	372.77	1302.36	T
8129	387.09	1302.37	T
8131	397.4	1300.9	T
8134	410.63	1303.26	T
8136	428.38	1303.08	T
8139	453.55	1303.3	T
8142	486.39	1303.08	T
8144	524.12	1302.83	T
8147	545.58	1301.88	T
8149	566.15	1301.93	T
8194	578.97	1302.2	T
8151	579.53	1301.82	T
8201	595.9	1301.17	T
8203	611.94	1301.29	T
8206	619.37	1301.29	T
8208	634.36	1301	T
8210	646.32	1302.16	T
8213	664.46	1301.76	T
8215	684.8	1301.89	T
8216	701.18	1302.63	T
8219	718.67	1302.72	T
8222	730.27	1300.68	T
8225	752	1301.91	T
8228	777.5	1302.2	T
8231	811.55	1302.21	T
8234	855.72	1302.04	T
8236	881.16	1301.69	T
8239	892.19	1301.12	T
8352	895.83	1301.27	T
8243	914.23	1299.91	T
8353	915.7	1299.71	T
8354	925.52	1299.34	T
8355	938.38	1298.86	T
8356	952.71	1298.41	T
8357	961.37	1299.51	T
8358	973.7	1300.29	T
8359	979.68	1300.27	T
8364	986.09	1299.56	T
8365	998.89	1299.71	T
8366	1018.27	1299.13	T
8367	1033.49	1299.24	T
8368	1055.89	1300.47	T
8369	1070.52	1300.42	T
8374	1087.19	1299.46	T
8375	1103.18	1299.08	T
8376	1120.74	1299.11	T
8377	1140.03	1299.49	T
8378	1167.33	1299.62	T
8379	1190.76	1299.54	T
8380	1210.05	1298.37	T
8433	1222.4	1299.8	T
8436	1240.64	1298.7	T
8438	1261.75	1298.99	T
8440	1272.72	1296.03	T
8443	1296.38	1298.72	T
8446	1306.35	1299.34	T
8448	1318.67	1299.39	T
8457	1332.48	1299.71	T
8463	1339.5	1296.4	T
8505	1352.22	1294.15	T
8506	1356.49	1293.89	T
8507	1364.6	1297.28	T
8513	1373.01	1298.09	T
8514	1391.94	1298.87	T
8515	1396.35	1298.15	T
8518	1405.37	1297.1	T
8522	1410.96	1294.41	T
8523	1424.26	1295.05	T
8527	1439.79	1295.99	T
8442	1439.79	1295.99	T
8577	1468.3	1295.94	T
8533	1468.3	1295.94	T
8580	1498.31	1295.77	T
8536	1498.31	1295.77	T

Point	Station	Elevation	Description
8017	17.43	1306.49	W
8027	33.02	1306.55	W
8020	40.1	1306.52	W
8029	67.01	1306.58	W
8022	72.83	1306.59	W
8031	97.57	1306.5	W
8033	116.11	1306.44	W
8030	117.84	1306.38	W
8035	158.76	1306.29	W
8040	169.45	1306.23	W
8043	189.7	1306.14	W
8041	197.04	1306.16	W
8044	225.9	1306.09	W
8048	226.53	1305.62	W
8047	257.64	1305.32	W
8102	267.72	1305.24	W
8104	276.29	1305.24	W
8106	289.63	1305.27	W
8110	304.14	1305.26	W
8107	313.69	1305.31	W
8108	324.14	1305.43	W
8118	354.03	1305.24	W
8115	362.4	1305.16	W
8126	371.3	1305.27	W
8122	374.5	1304.39	W
8125	381.79	1304.22	W
8130	393.21	1304.3	W
8133	400.93	1304.25	W
8135	412.94	1304.27	W
8132	430.05	1304.02	W
8138	434.84	1304	W
8140	461.49	1303.98	W
8137	464.46	1303.87	W
8143	489.15	1303.54	W
8141	501.12	1303.53	W
8146	526.69	1303.36	W
8145	555.53	1303.38	W
8150	560.66	1303.43	W
8202	565.55	1303.38	W
8148	575.66	1303.45	W
8152	582.61	1303.36	W
8198	588.94	1303.44	W
8204	611.28	1303.35	W
8207	636.99	1303.34	W
8205	638.36	1303.37	W
8211	661.77	1303.34	W
8214	673.12	1303.39	W
8218	676.54	1303.32	W
8217	698.87	1303.31	W
8221	717.41	1303.34	W
8220	729.38	1302.99	W
8224	744.2	1302.98	W
8223	758.42	1302.89	W
8227	771.23	1302.96	W
8226	786.05	1302.87	W
8230	812.07	1302.9	W
8229	819.6	1302.85	W
8233	842.42	1302.76	W
8232	844.99	1302.69	W
8235	870.04	1302.5	W
8237	884.83	1302.27	W
8240	898.23	1302.04	W
8242	909.13	1301.59	W
8382	916.3	1301.51	W
8384	951.02	1301.51	W
8383	956.75	1301.55	W
8385	974.97	1301.49	W
8386	980.67	1301.17	W
8387	980.81	1301.5	W
8388	989.71	1301.17	W
8390	1005.57	1301.18	W
8389	1020.82	1301.18	W
8392	1026.76	1301.16	W
8391	1054.89	1301.2	W
8395	1057.23	1301.18	W
8397	1075.35	1301.16	W
8398	1078.67	1301.2	W
8393	1091.93	1300.8	W
8400	1105.78	1300.7	W
8394	1122.77	1300.69	W
8401	1137.71	1300.72	W
8403	1166.42	1300.74	W
8396	1172.69	1300.77	W
8435	1197.8	1300.74	W
8399	1203.06	1300.76	W
8434	1233.02	1300.76	W
8439	1261.9	1300.8	W
8441	1291.38	1300.82	W
8458	1301.38	1300.67	W
8445	1315.78	1300.81	W
8462	1319.91	1300.65	W
8465	1324.13	1300.67	W
8453	1332.52	1300.45	W
8466	1339.07	1299.69	W
8455	1340.33	1299.8	W
8459	1352.86	1299.73	W
8461	1367.38	1299.72	W

Point	Station	Elevation	Description
8500	1379.54	1299.73	W
8500	1389.64	1299.75	W
8464	1396.03	1299.67	W
8496	1397.54	1299.72	W
8498	1400.79	1299.7	W
8502	1405.1	1298.85	W
8504	1415.78	1298.07	W
8508	1430.34	1298.05	W
8511	1435.14	1298.09	W
8510	1456.33	1298.09	W
8516	1467.44	1298.02	W
8512	1470.85	1298.05	W
8519	1494.88	1298.06	W
8517	1496.58	1298.03	W

Point	Station	Elevation	Description
8200	553.53	1306.04	TOB
8486	1004.34	1303.91	TOB
8491	1012.33	1304.29	TOB
8481	1038.08	1303.66	TOB
8475	1157.31	1303.77	TOB
8470	1314.45	1302.43	TOB
8190	0.91	1313.74	TOB
8188	35.33	1311.96	TOB
8186	81.27	1312.65	TOB
8187	82.73	1312.51	TOB
8184	105.15	1312.48	TOB
8183	118.91	1312.07	TOB
8182	122.27	1311.94	TOB
8180	151.01	1311.26	TOB
8181	156.7	1312.28	TOB
8178	170.24	1312.03	TOB
8177	194.76	1312.08	TOB
8179	208.3	1311.89	TOB
8175	214.66	1311.66	TOB
8174	226.89	1311.29	TOB
8173	249.14	1311.29	TOB
8171	271.79	1311.02	TOB
8176	284.11	1311.04	TOB
8172	315.03	1310.4	TOB
8169	319.98	1310.66	TOB
8167	348.44	1309.22	TOB
8170	361.61	1310.21	TOB
8168	393.92	1310.95	TOB
8166	395.25	1309.77	TOB
8164	433.13	1309.61	TOB
8163	496.22	1308.18	TOB
8193	496.23	1308.64	TOB
8159	535.06	1307.96	TOB
8197	543.44	1307.98	TOB
8156	552.24	1307.58	TOB
8154	577.31	1306.99	TOB
8306	603.3	1307.3	TOB
8307	604.22	1306.45	TOB
8304	623.32	1306.73	TOB
8301	651.95	1307.85	TOB
8257	703.12	1306.82	TOB
8258	737.9	1308.3	TOB
8255	755.42	1307.43	TOB
8252	796.82	1306.97	TOB
8249	828.17	1306.41	TOB
8251	851.41	1306.95	TOB
8247	859.41	1306.3	TOB
8246	893.18	1305.73	TOB
8245	924.67	1307.03	TOB
8489	932.15	1304.49	TOB
8494	932.58	1306.8	TOB
8488	960.02	1304.85	TOB
8493	960.17	1306.65	TOB
8485	1004.62	1304.6	TOB
8480	1043.68	1306.16	TOB
8479	1063.11	1306.52	TOB
8477	1129.12	1304.49	TOB
8484	1153.23	1303.97	TOB
8471	1253.26	1305.55	TOB
8616	1258.63	1304.45	TOB
8572	1258.63	1304.45	TOB
8469	1282.83	1304.75	TOB
8472	1304.55	1303.84	TOB
8468	1317.32	1304.35	TOB
8613	1332.34	1304.37	TOB
8569	1332.34	1304.37	TOB
8614	1355.19	1303.85	TOB
8570	1355.19	1303.85	TOB
8567	1369.31	1303.79	TOB
8612	1380.26	1303.96	TOB
8610	1399.27	1304.89	TOB
8566	1399.27	1304.89	TOB
8607	1425.32	1303.86	TOB
8563	1425.32		

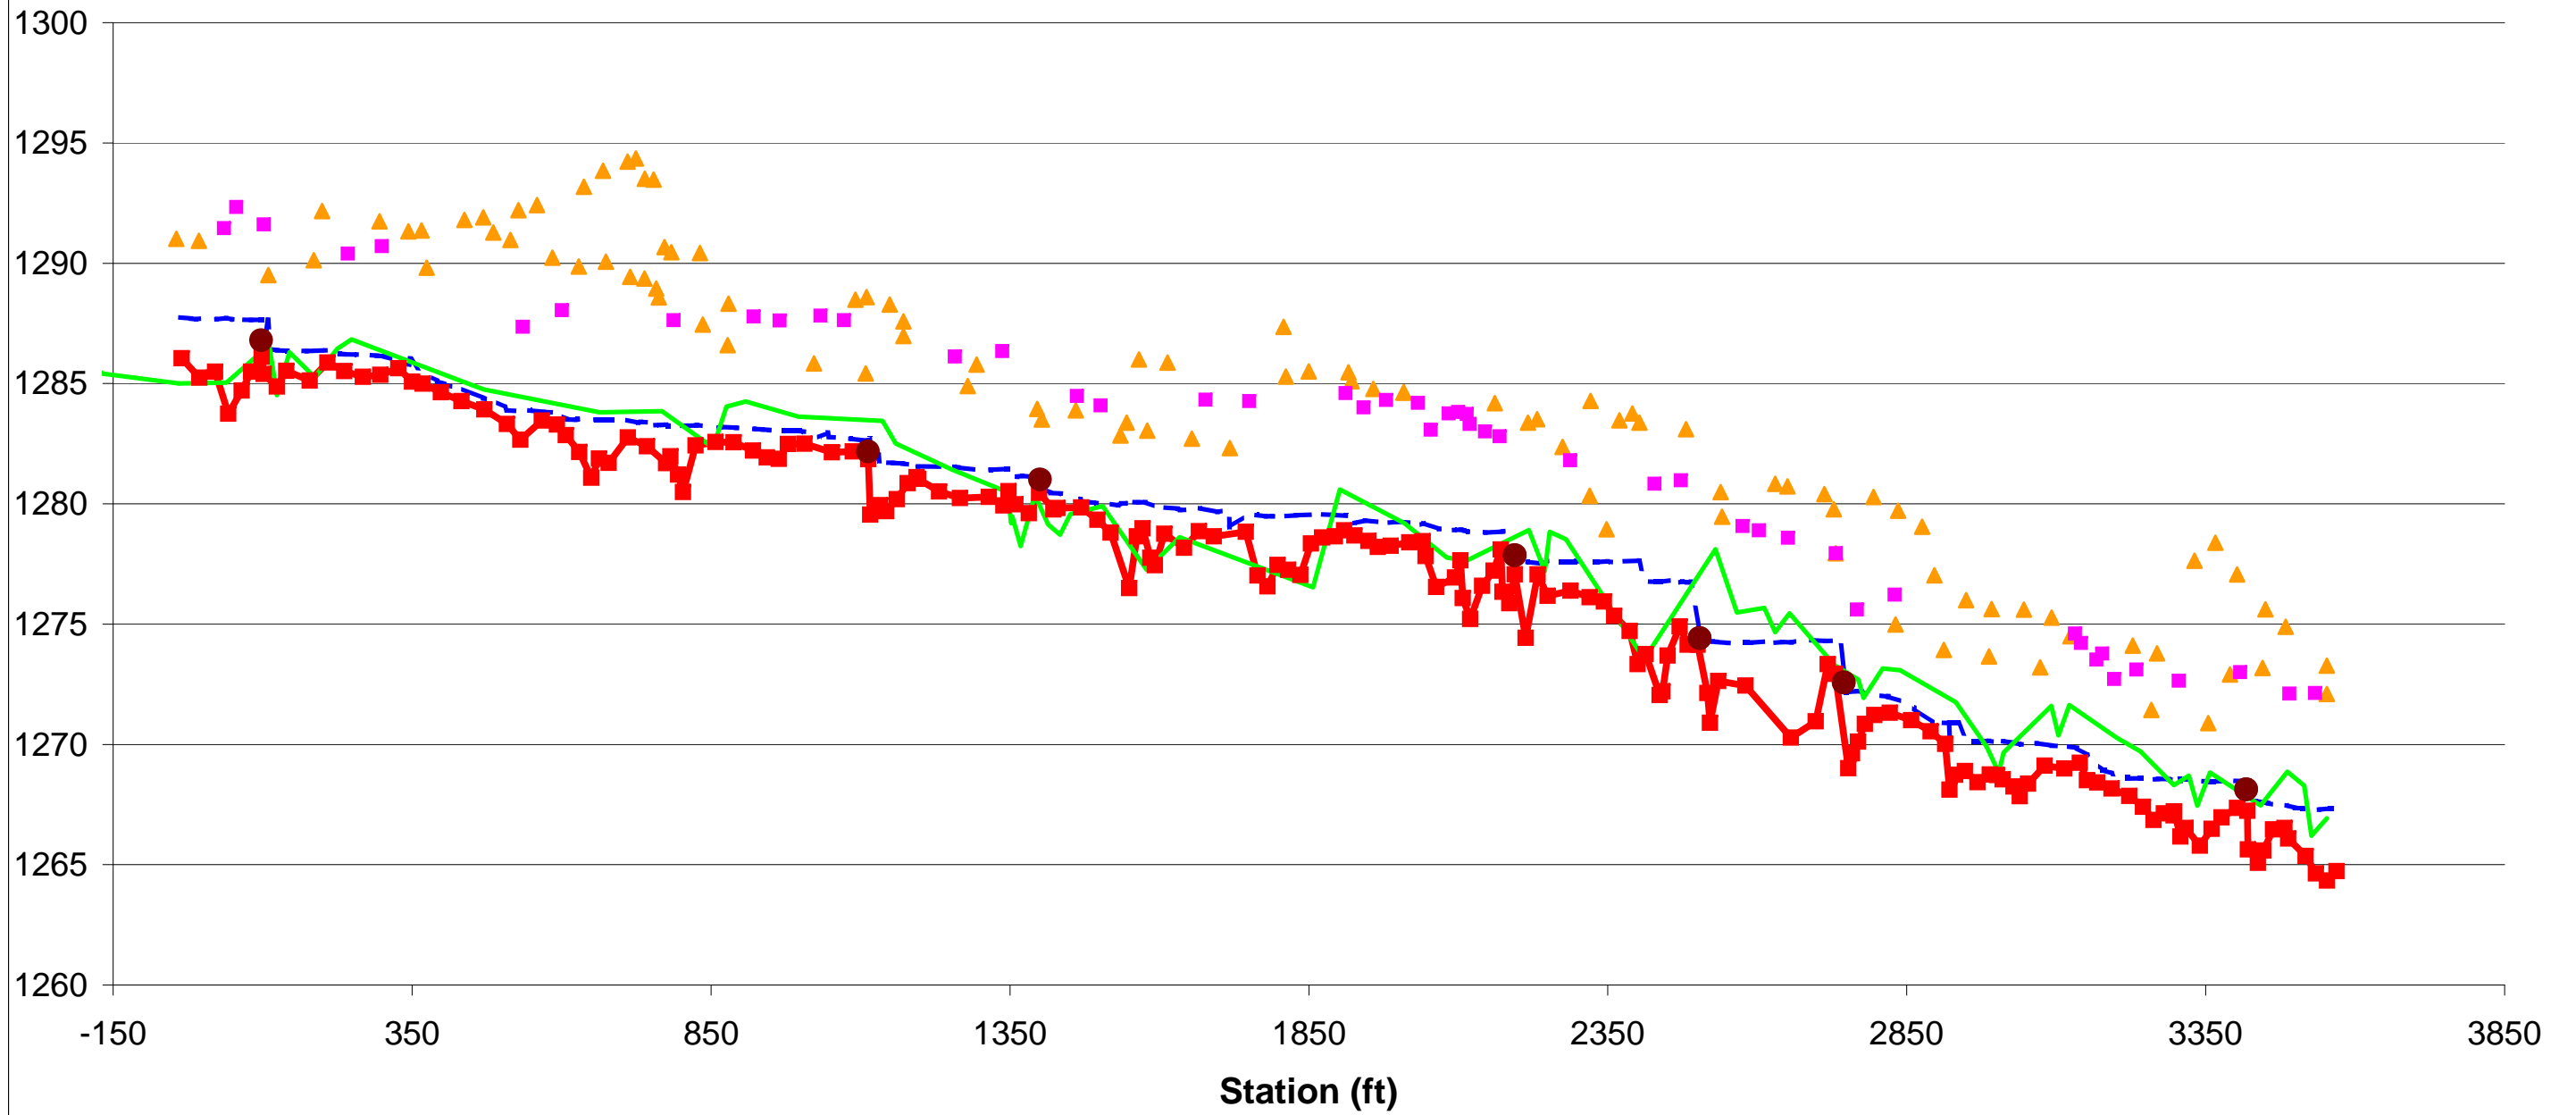2007 Stone Mountain Long Profile - Reach 4
Survey: 7/30/07 - 8/1/07



2007 Thalweg 2007 Water 2007 TOB 2007 Bankfull 2000 As Built Thalweg 2007 Cross Vanes

Project Name	East Prong of the Roaring River @ Stone Mountain
Task	Channel Pattern Measurements
Date	8/1/07
Crew	Roberts, Price

Reach 2 2007		
Radius of Curvature	Meander Wavelength	Channel Beltwidth
157	557	163
144	586	177
145	588	333
144	557	163
157	588	333
145	586	177

Reach 4 2007		
Radius of Curvature	Meander Wavelength	Channel Beltwidth
140	766	503
207	534	222
75	595	326
124	712	275
69	547	225
107		368
96		
69	534	222
207	766	503
107	595	301

min
max
median

GPS Coordinates

Stone Mountain State Park

Description	NAD 1983 State Plane North Carolina		UTM	
	Northing	Easting	EASTING	NORTHING
Reach 2				
PA#1	965572.8919	1391855.313	13211584.84	1620998.99
PA#2 PA#3 PA#4	965284.6839	1391886.104	13211298.24	1621042.24
PA#6 PA#7	965117.995	1392209.266	13211145.71	1621372.32
PA#10	965003.4988	1392190.438	13211030.51	1621358.47
PA#8 PA#9 PA#11	964988.7876	1392132.395	13211013.29	1621301.12
PA#13 PA#14	964797.1319	1392007.416	13210816.40	1621184.56
PA#15	964822.4968	1391949.209	13210839.22	1621125.31
PA#16	964746.2009	1391957.234	13210763.35	1621136.64
Reach 4				
PA#18	962791.0201	1390158.116	13208732.05	1619423.92
PA#19	962447.6132	1390010.445	13208382.56	1619291.27
PA#20	962324.6846	1390298.863	13208272.25	1619584.74
PA#21	962110.3553	1390608.684	13208071.54	1619903.56
PA#22 PA#23	962122.6055	1390785.892	13208091.46	1620080.07
PA#24 PA#25	962064.4962	1390836.616	13208035.60	1620133.26
PA#26 PA#27	961805.3008	1390903.761	13207779.56	1620211.58
PA#28	961846.9449	1390974.611	13207824.24	1620280.56
PA#29	961825.1658	1391006.65	13207803.87	1620313.51
PA#30	961870.1744	1391090.513	13207852.47	1620395.34
PA#31	961675.1076	1391395.54	13207670.80	1620708.54
PA#32	961617.9719	1391387.763	13207613.38	1620703.24
PA#33	961578.2225	1391358.143	13207572.38	1620675.37
PA#34	961483.8307	1391202.214	13207471.33	1620523.68
PA#36	961347.6247	1391207.992	13207335.50	1620535.35

Reach - Field number	Location	Northern	Easting
R2	X1LP	965688.6900	1391798.7100
	X1RP	965604.8168	1391728.8033
	X2LP	965295.1823	1391863.1564
	X2RP	965343.1217	1391934.6939
	X3LP	965278.9577	1392000.3779
	X3RP	965231.1556	1391975.0301
	X4LP	964880.2011	1392120.0650
	X4RP	964907.3310	1392067.3695
R4	X1LP	962.776.1743	1390145.2360
	X1RP	962834.9718	1390122.9670
	X2LP	962613.7084	1389917.1320
	X2RP	962614.9065	1389887.7780
	X3LP	961968.5762	1390302.5390
	X3RP	961954.3593	1390301.1240
	X4LP	962126.5572	1390656.2580
	X4RP	962064.4786	1390672.3770
	X5LP	961877.0900	1390922.9100
	X5RP	961805.3300	1390851.9900
	X6LP	961860.5515	1391152.8720
	X6RP	961809.4108	1391135.8120
	X7LP	961429.6593	1391254.9960
	X7RP	961441.0453	1391184.4540