

RECORD DRAWINGS FOR



SUCK CREEK

STREAM RESTORATION PROJECT

RICHARDSON FARMS

MOORE COUNTY, NORTH CAROLINA
PROJECT ID NO. 000530501

ECOSYSTEM ENHANCEMENT PROGRAM
NCDENR

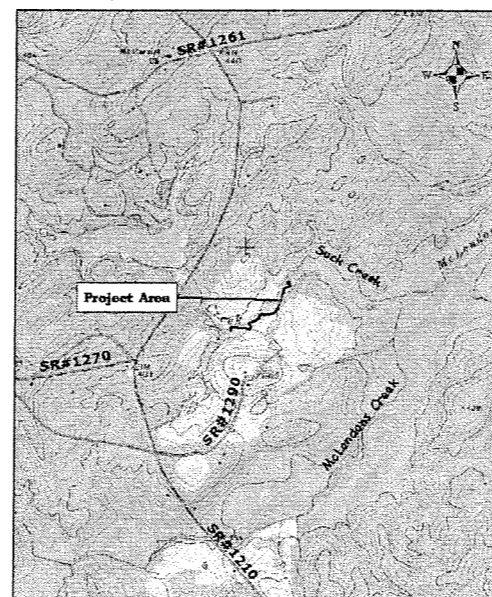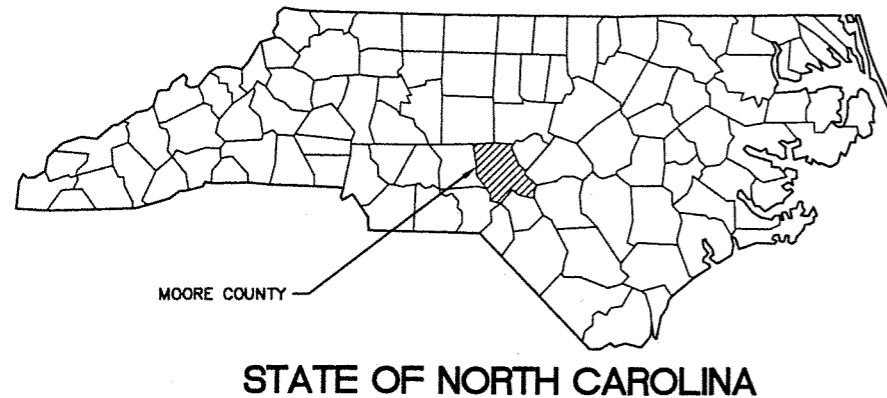

LOCATION MAP

INDEX OF SHEETS

SHEET NO.	DESCRIPTION
1	COVER SHEET
2	STREAM MORPHOLOGY AND SEDIMENT TRANSPORT DATA
3	TYPICAL SECTIONS
4-5	STREAM DETAILS
6	VEGETATION NOTES AND DETAILS
7-10	RECORD DRAWINGS

SURVEY PREPARED BY:

ROGER MORGAN, PLS DATED 12-20-01
REGISTRATION NUMBER L-3847



201 100 AVENUE, NE
ATLANTA, GA 30329
(404) 252-8811

Atlanta, GA
Charlotte, NC
Columbus, GA
Fayetteville, NC
Raleigh, NC
Wilmington, NC

FILE: H:\PN\011795008\DWG\RECORD-DWGS\AB-COVER.DWG

REV. NO.	REVISION	DATE	DRAWN BY	CHECKED BY

This document, together with the concepts and designs presented herein, as an instrument of service, is intended only for the specific purpose and client for which it was prepared. Reuse of and improper reliance on this document without written authorization and adaptation by Kimley-Horn and Associates, Inc. shall be without liability to Kimley-Horn and Associates, Inc.
Copyright Kimley-Horn and Associates, Inc., 2001

PREPARED IN THE OFFICE OF:



Kimley-Horn
and Associates, Inc.


P.O. BOX 33068 - RALEIGH, NORTH CAROLINA 27636-3068
PHONE: (919) 877-2000 FAX: (919) 877-2050

CLIENT:

ECOSYSTEM ENHANCEMENT PROGRAM
NCDENR

TITLE:

COVER SHEET

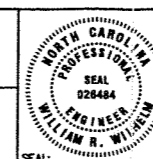

DATE: 6-05-03
HORIZONTAL SCALE: NTS
VERTICAL SCALE: NA
DRAWN BY: SES
DESIGNED BY: SES/AK/WW
CHECKED BY: WW

PROJECT:


SUCK CREEK
MOORE COUNTY

ATTACHED REFERENCE FILES


JOB NUMBER: 011795008

SHEET NUMBER: 1 of 10

PAVEMENT SAMPLE

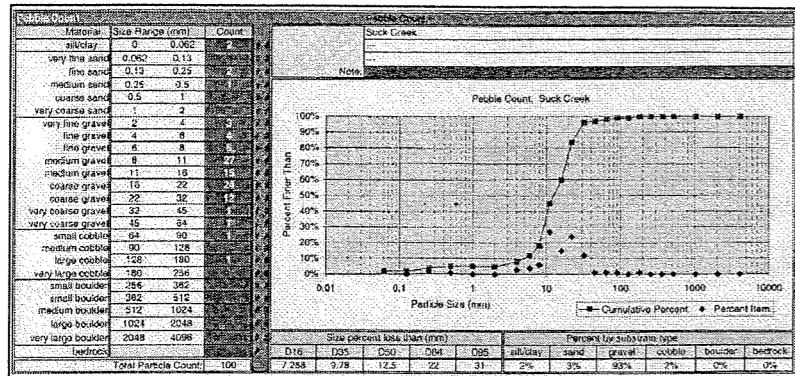

SUB-PAVEMENT SAMPLE

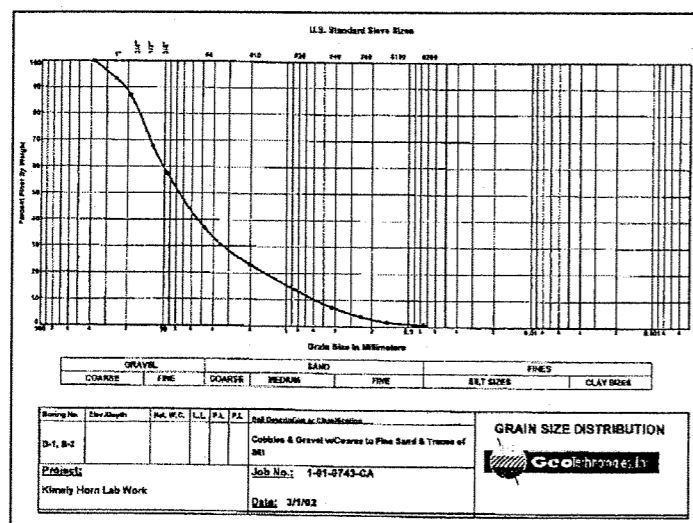

SEDIMENT TRANSPORT CALCULATIONS

Critical Dimensionless Shear Stress:

$$\tau_{ci} = 0.0834(d_i/d_{50})^{-0.872}$$

Value	Variable	Definition
10.3	d_i (mm)	D50 Bed Material (D50 from riffle pebble count)
7.5	d_{50} (mm)	Bar Sample D50 or Sub-pavement D50
0.063	τ_{ci}	Critical Dimensionless Shear Stress

Bankfull Mean Depth Required for Entrainment of Largest Particle in Bar Sample:

$$d_r = (\tau_{ci} * 1.65 * D_i) / S_e$$

Value	Variable	Definition
0.063	τ_{ci}	Critical Dimensionless Shear Stress
0.098	D_i (feet)	Largest particle from bar sample
0.005	S_e (ft/ft)	Existing Bankfull Water Surface Slope
2.045	d_r (ft)	Bankfull Mean Depth Required
1.4	d_o (ft)	Existing Bankfull Mean Depth (from riffle cross section)

Circle: Stable ($d_o/d_r=1$) Aggrading ($d_o/d_r < 1$) Degrading ($d_o/d_r > 1$)

MORPHOLOGY CHARACTERISTICS

Restoration Site: Suck Creek
USGS Station: N/A
Reference Reach: Reference Reach I: Richland Creek, Reference Reach II: Suck Creek Upstream of Project Area

VARIABLES	EXISTING CHANNEL*	PROPOSED CHANNEL	REFERENCE REACH I CHANNEL	REFERENCE REACH II CHANNEL**	REGIONAL CURVES RURAL PIEDMONT***
1. Stream Type (Rosgen)	G4 → F4	C4	C4	B4	C4
2. Drainage Area (sq. mile)	4.8	4.8	1.0	4.8	4.8
3. Bankfull Width (W_{bf})	Mean: 13.9 Range: 12.3 - 15.8	Mean: 20.0 Range: 15 - 20	Mean: 16.5 Range: 16.2 - 16.7	Mean: 17.0 Range: 15 - 20	Mean: 23.5 Range: -
4. Bankfull Mean depth (d_{bf})	Mean: 1.1 Range: 1.0 - 1.4	Mean: 1.5 Range: 1.2 - 1.8	Mean: 0.9 Range: 0.9 - 0.9	Mean: 1.3 Range: 1.2 - 1.8	Mean: 2.5 Range: -
5. Width/Depth Ratio (W_{bf}/d_{bf})	Mean: 12.6 Range: 8.8 - 15.8	Mean: 13.3 Range: 8.3 - 16.7	Mean: 17.8 Range: 17.5 - 18.0	Mean: 13.1 Range: 8.3 - 16.7	Mean: 9.4 Range: -
6. Bankfull cross-sectional Area (A_{bf})	Mean: 16.5 Range: 12.8 - 22.8	Mean: 29.5 Range: 18 - 36	Mean: 15.2 Range: 15.0 - 15.2	Mean: 22.1 Range: 18 - 36	Mean: 63.0 Range: -
7. Bankfull Mean Velocity (V_{bf})	Mean: 4.5 Range: 3.32-5.73	Mean: 4.34 Range: 4.33-4.35	Mean: 5.4 Range: 5.05-5.81	Mean: 6.3 Range: 5.68-6.82	Mean: 4.4 Range: -
8. Bankfull Discharge, cfs (Q_{bf})	Mean: - Range: -	Mean: - Range: -	Mean: 82.5 Range: 75.8-88.3	Mean: - Range: -	Mean: 279.6 Range: -
9. Bankfull Maximum Depth (d_{bmax})	Mean: 1.6 Range: 1.3 - 1.5	Mean: 2.2 Range: 1.8-2.9	Mean: 1.5 Range: 1.4 - 1.5	Mean: 2.0 Range: 1.9 - 2.1	Mean: - Range: -
10. Max d_{bf}/d_{bmax} ratio	Mean: 1.4 Range: 1.3 - 1.5	Mean: 1.5 Range: 1.1 - 1.8	Mean: 1.6 Range: 1.1 - 1.6	Mean: - Range: -	Mean: - Range: -
11. Low Bank Height to max d_{bf} ratio	Mean: 1.8 Range: 1.1 - 2.3	Mean: 1.0 Range: 1.0 - 1.2	Mean: 1.0 Range: -	Mean: - Range: -	Mean: - Range: -
12. Width of Flood Prone Area (W_{fp})	Mean: 19.3 Range: 18.0 - 21.0	Mean: 64.0 Range: 60-66	Mean: 51.7 Range: 50 - 53.3	Mean: - Range: -	Mean: - Range: -
13. Entrenchment Ratio (W_{fp}/W_{bf})	Mean: 1.4 Range: 1.3 - 1.4	Mean: 3.2 Range: 3.0 - 3.3	Mean: 3.2 Range: 3.0 - 3.3	Mean: 1.5 Range: 1.3 - 1.6	Mean: 5.3 Range: 2.7-31.65
14. Meander Length (L_m)	Mean: 99.5 Range: 75 - 129	Mean: 180.0 Range: 112-280	Mean: 92.0 Range: 90 - 94	Mean: - Range: -	Mean: - Range: -
15. Ratio of Meander Length to Bankfull Width (L_m/W_{bf})	Mean: 7.2 Range: 4.7 - 10.5	Mean: 9.0 Range: 5.6 - 14.0	Mean: 5.6 Range: -	Mean: - Range: -	Mean: - Range: 9-14
16. Radius of Curvature (R_c)	Mean: 38.0 Range: 24.4 - 52.0	Mean: 50.0 Range: 24-60	Mean: 19.0 Range: 14 - 26	Mean: - Range: -	Mean: - Range: -
17. Ratio of Radius of Curvature to Bankfull Width (R_c/W_{bf})	Mean: 2.7 Range: 1.5 - 4.2	Mean: 2.5 Range: 1.2 - 3.0	Mean: 1.2 Range: 0.87 - 1.59	Mean: - Range: -	Mean: - Range: 2.5-3
18. Belt Width (W_{bt})	Mean: 25.0 Range: 15 - 35	Mean: 80.0 Range: 30-100	Mean: 31.0 Range: 25 - 40	Mean: - Range: -	Mean: - Range: -
19. Meander Width Ratio (W_{bt}/W_{bf})	Mean: 1.8 Range: 1.1 - 2.5	Mean: 4.0 Range: 1.52 - 2.0	Mean: 1.9 Range: 1.52 - 2.43	Mean: - Range: -	Mean: - Range: -
20. Sinuosity (k) (Stream Length / Valley Length)	1.2	Mean: 1.33 Range: 1.0 - 1.6	1.2	Mean: - Range: -	Mean: 1.9 Range: 1.43-2.8
21. Valley Slope (S_{valley}) (ft/ft)	0.0040	0.0040	0.0136	Mean: - Range: -	Mean: - Range: -
22. Average Stream Slope (S_{avg}) = (S_{valley}/k)	0.0030	Mean: 0.003 Range: 0.0025 - 0.04	0.0133	Mean: 0.0180 Range: -	Mean: 0.005 Range: 0.0011-0.184
23. Riffle Slope (S_{rif})	Mean: 0.0106 Range: 0 - 1.6	Mean: 0.0050 Range: 0.0045 - 0.096	Mean: 0.03 Range: 0.014 - 0.41	Mean: - Range: -	Mean: - Range: -
24. Ratio of Riffle Slope to Avg Slope (S_{rif}/S_{avg})	Mean: 3.5 Range: 0.3-5	Mean: 2.0 Range: 1.8 - 3.2	Mean: 2.4 Range: -	Mean: - Range: -	Mean: - Range: 1.5-2
25. Pool Slope (S_{pool})	Mean: 0.0020 Range: 0.0003-0.003	Mean: 0.0006 Range: 0.00009 - 0.0012	Mean: 0.0005 Range: 0 - .0014	Mean: - Range: -	Mean: - Range: -
26. Ratio of Pool Slope to Avg Slope (S_{pool}/S_{avg})	Mean: 0.7 Range: 0.1-1	Mean: 0.200 Range: .036-4	Mean: 0.0338 Range: -	Mean: - Range: -	Mean: - Range: 2-3
27. Maximum Pool Depth (d_{pool})	Mean: 1.7 Range: 1.3 - 1.9	Mean: 4.5 Range: 3.9 - 6.3	Mean: 2.5 Range: -	Mean: - Range: -	Mean: - Range: -
28. Ratio of Pool Depth to Avg Depth (d_{pool}/d_{avg})	Mean: 1.5 Range: 0.9 - 1.9	Mean: 3.0 Range: 2.6-4.2	Mean: 2.8 Range: -	Mean: - Range: -	Mean: 3.0 Range: 2.5-3.5
29. Pool Width (W_{pool})	Mean: 11.8 Range: 9.4 - 15.6	Mean: 26.0 Range: 14-34	Mean: 11.1 Range: -	Mean: - Range: -	Mean: - Range: -
30. Ratio of Pool Width to Bankfull Width (W_{pool}/W_{bf})	Mean: 0.8 Range: 0.6 - 1.3	Mean: 1.3 Range: 0.7 - 1.7	Mean: 0.7 Range: -	Mean: - Range: -	Mean: 1.5 Range: 1.3-1.7
31. Ratio of Pool Area to Bankfull Area (A_{pool}/A_{bf})	Mean: 0.8 Range: 0.8 - 0.8	Mean: 1.2 Range: -	Mean: 1.3 Range: -	Mean: - Range: -	Mean: - Range: -
32. Pool to Pool Spacing ($p-p$)	Mean: 95.9 Range: 37 - 246	Mean: 100.0 Range: 60-140	Mean: 76.3 Range: 37.3 - 95.8	Mean: - Range: -	Mean: - Range: -
33. Ratio of Pool to Pool Spacing to Bankfull Width ($p-p/W_{bf}$)	Mean: 6.9 Range: 2.3 - 20	Mean: 5.0 Range: 3.0 - 7.0	Mean: 4.6 Range: 2.26 - 5.82	Mean: - Range: -	Mean: - Range: 5-7

Note: * Existing channel severely impacted by cattle. Bankfull field indicators not clear.
** Reference Reach II is a stable section of Suck Creek, upstream of project area.
*** Regional Curve data incorporated with Rosgen Reference data.

FILE: H:\PN\011795008\DWG\RECORD-DWG\LAB-MORPH.DWG

REV. NO.: REVISION DATE: DRAWN BY: CHECKED BY:

This document, together with the concepts and designs presented herein, is intended only for the specific purpose and client for which it was prepared. Reuse of any improper reliance on this document without written authorization and adaptation by Kimley-Horn and Associates, Inc. shall be without liability to Kimley-Horn and Associates, Inc. Copyright Kimley-Horn and Associates, Inc., 2001

PREPARED IN THE OFFICE OF:

Kimley-Horn and Associates, Inc.
P.O. BOX 33068 - RALEIGH, NORTH CAROLINA 27636-0068
PHONE: (919) 677-2000 FAX: (919) 677-2050

CLIENT: ECOSYSTEM ENHANCEMENT PROGRAM NCDENR


TITLE: STREAM MORPHOLOGY AND SEDIMENT TRANSPORT DATA

PROJECT: SUCK CREEK MOORE COUNTY

DATE: 6-05-03
PERCENTAGE COMPLETE: NA
SCALE: NA
DRAWN BY: SES
CHECKED BY: SES/AK/WW
DESIGNED BY: SES/AK/WW


ATTACHED REFERENCE FILES: [None]

JOB NUMBER: 011795008 SHEET NUMBER: 2 of 10

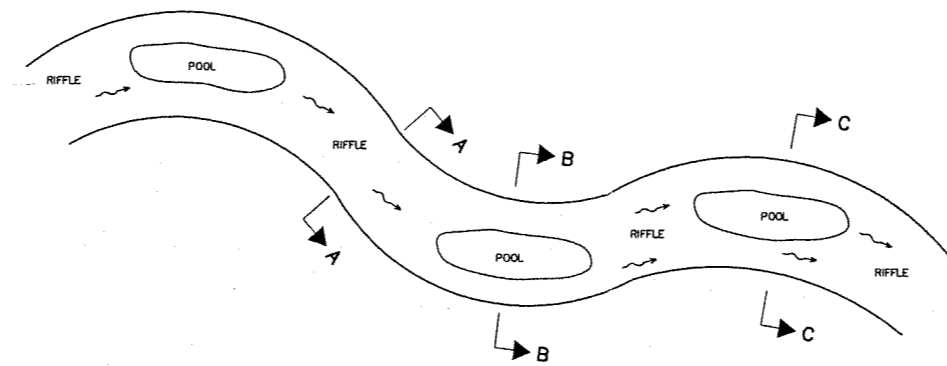

TYPICAL PLAN VIEW SCHEMATIC


NTS

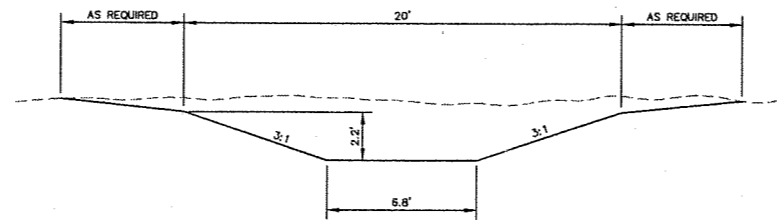

RIFFLE SECTION A-A

NOTES:

TYPICAL SECTIONS ARE PROVIDED TO GIVE THE GENERAL DIMENSIONS OF THE CHANNEL. FINAL GRADING WILL GIVE THE CHANNEL A MORE "NATURAL" APPEARANCE AND ALLOW A SMOOTH TRANSITION FROM EXISTING CHANNEL TO NEW CHANNEL.

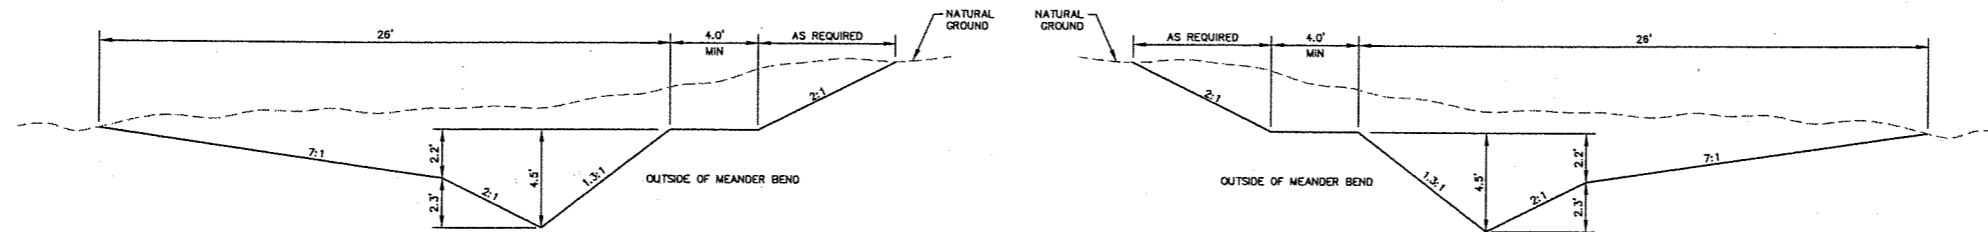

POOL SECTION B-B

POOL SECTION C-C

RESTORED BANKFULL CHANNEL TYPICAL SECTIONS

FILE: H:\PN\011795008\DWG\RECORD-DWGS\AB-TYPICALS.DWG

REV. NO.	REVISION	DATE	DRAWN BY	CHECKED BY


This document, together with the concepts and designs presented herein, is intended only for the specific purpose and client for which it was prepared. Reuse of and improper reliance on this document without written authorization and adaptation by Kimley-Horn and Associates, Inc. shall be without liability to Kimley-Horn and Associates, Inc.
Copyright Kimley-Horn and Associates, Inc., 2001

PREPARED IN THE OFFICE OF:

Kimley-Horn and Associates, Inc.
P.O. BOX 33068 - RALEIGH, NORTH CAROLINA 27636-3068
PHONE: (919) 677-2000 FAX: (919) 677-2050

CLIENT:
**ECOSYSTEM ENHANCEMENT PROGRAM
NCDENR**

TITLE:
TYPICAL SECTIONS

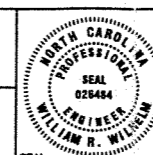










DATE: 6-05-03
PROFESSIONAL SCALE: NTS
PROJECT: **SUCK CREEK
MOORE COUNTY**

DESIGNED BY: SES/AK/WW
CHECKED BY: WW

ATTACHED REFERENCE FILES:

JOB NUMBER: 011795008

SHEET NUMBER: 3 of 10

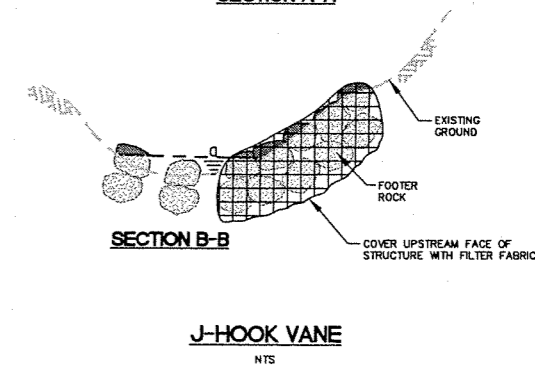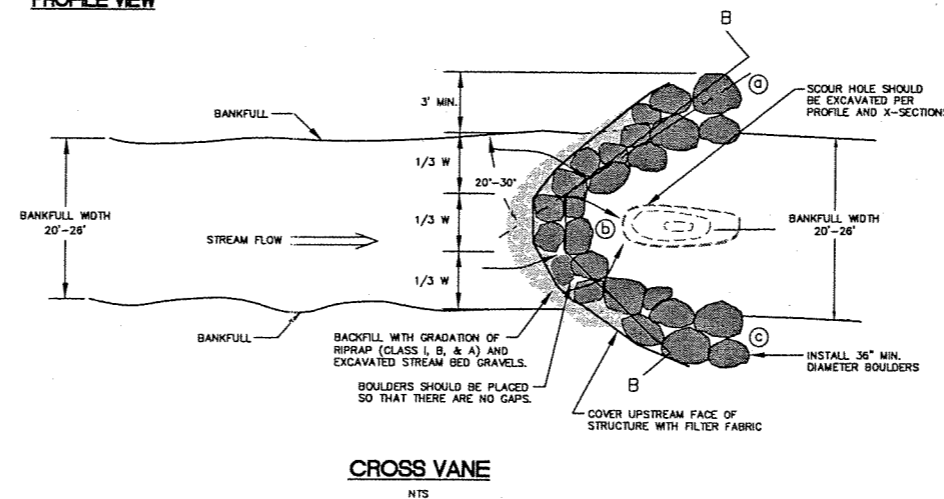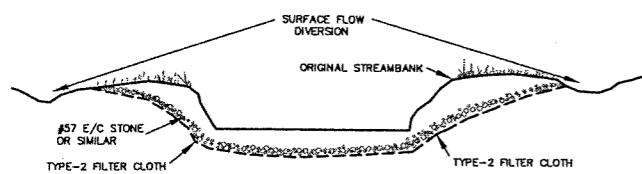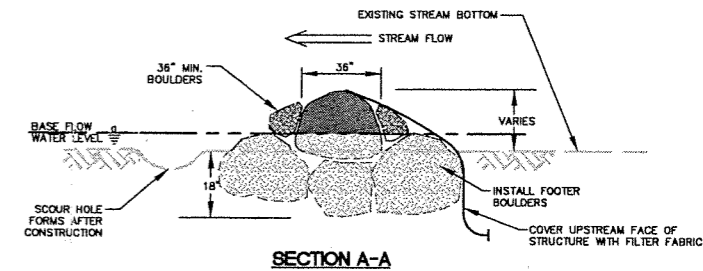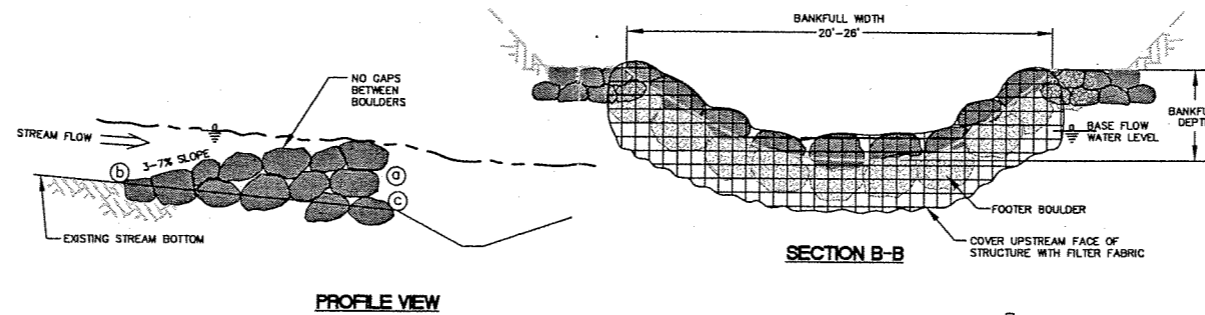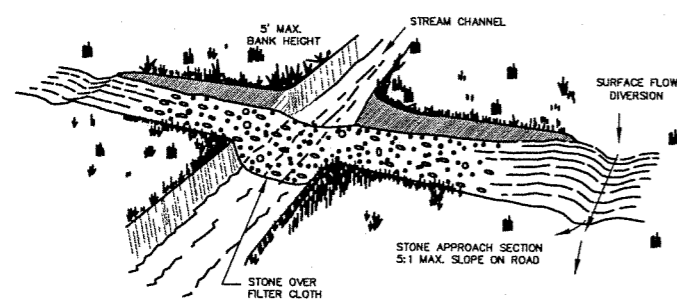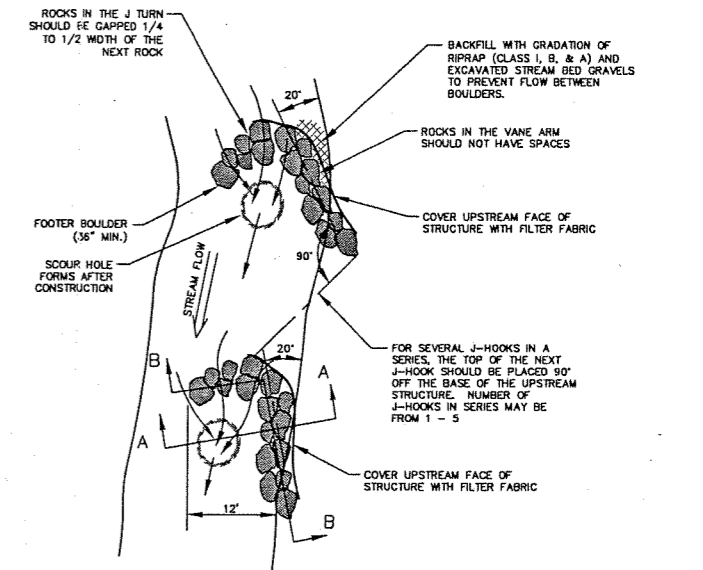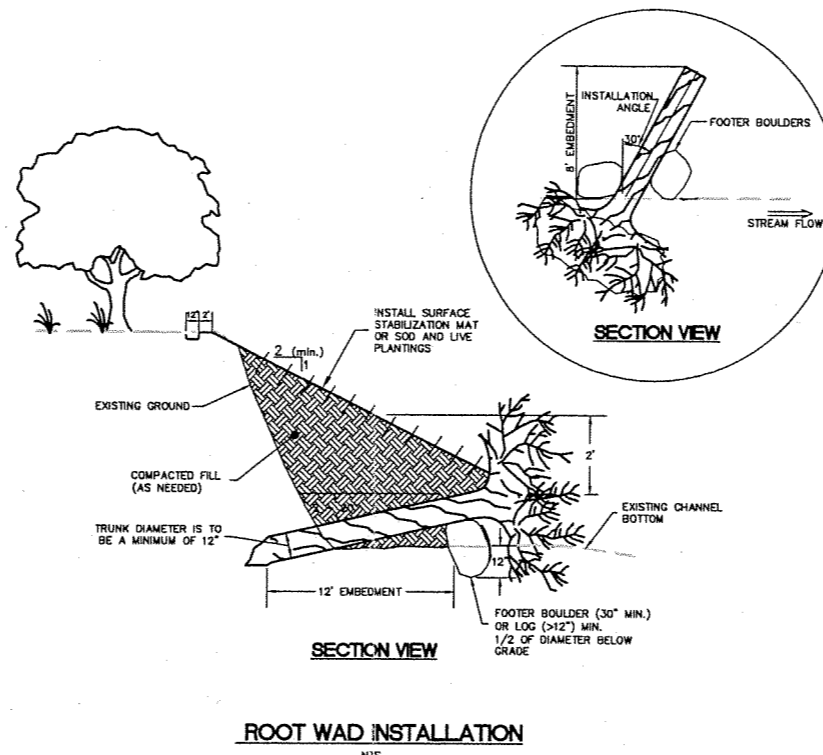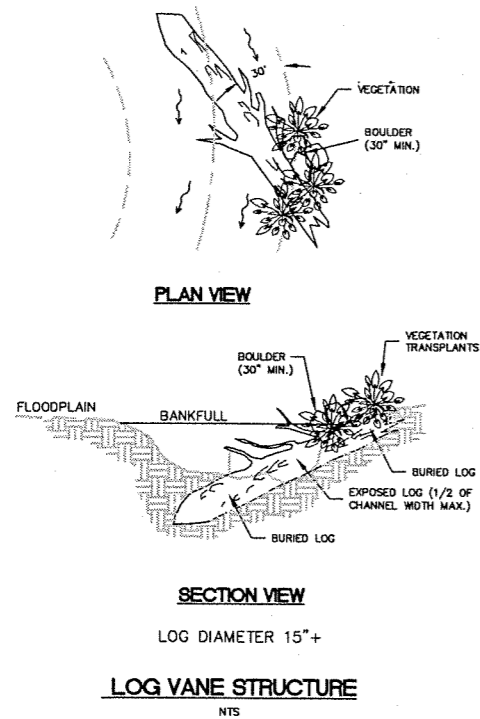

* CONSTRUCTION AND MAINTENANCE PER SECTION 6.70 OF NCDENR EROSION AND SEDIMENT CONTROL PLANNING AND DESIGN MANUAL.

STREAM CROSSING/FORD
NTS

FILE: H:\PN\011795008\DWG\RECORD-DWGS\AB-DETAILS.DWG

REV. NO.	REVISION	DATE	DRAWN BY	CHECKED BY
1	REVISED PER DWQ COMMENTS (DEC. 19, 2001) PER NCDENR LAND QUALITY COMMENTS			

This document, together with the concepts and designs presented herein, as an instrument of service, is intended only for the specific purpose and client for which it was prepared. Reuse of and improper reliance on this document without written authorization and adoption by Kimley-Horn and Associates, Inc. shall be without liability to Kimley-Horn and Associates, Inc. Copyright Kimley-Horn and Associates, Inc., 2001

PREPARED IN THE OFFICE OF:

Kimley-Horn and Associates, Inc.
P.O. BOX 33068 - RALEIGH, NORTH CAROLINA 27636-3068
PHONE: (919) 877-2000 FAX: (919) 877-2050

CLIENT: **ECOSYSTEM ENHANCEMENT PROGRAM**
NCDENR

TITLE: **DETAILS**


DATE: 6-05-03
REVISION: NTS
SCALE: NTS
DRAWN BY: SES
DESIGNED BY: SES/AK/WW
CHECKED BY: WW

PROJECT: **SUCK CREEK**
MOORE COUNTY



ATTACHED REFERENCE FILES

JOB NUMBER: 011795008

SHEET NUMBER: 4 of 10

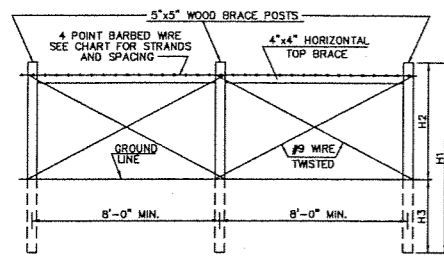


LINE BRACES
(MAXIMUM SPACING 330')

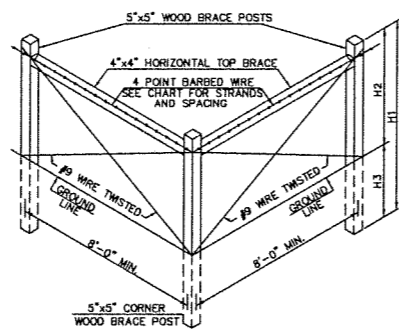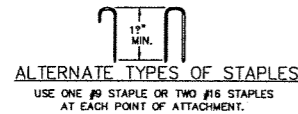


CORNER BRACE
USE WHEN CORNER ANGLE IS 15° OR GREATER

BARBED WIRE FENCE CHART		5	
NUMBER OF BARBED WIRE STRANDS		5	
STRAND SPACING		A	3"
		B	12"
		C	8"
BRACE POSTS	LENGTH	H1	8'-0"
	EXPOSED	H2	4'-11"
	EMBEDMENT	H3	3'-1"
LINE POSTS	LENGTH	H4	7'-6"
	EXPOSED	H5	4'-11"
	EMBEDMENT	H6	2'-7"
HORIZONTAL BRACE		8'-0"	

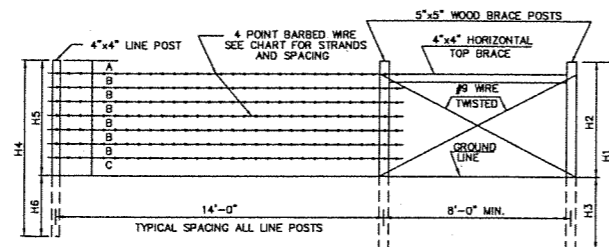


END OR GATE BRACES

BARBED WIRE FENCE WITH WOOD POSTS
NTS

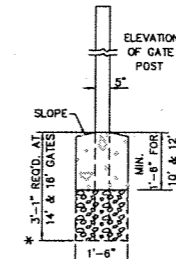

DETAIL OF GATE POST ANCHOR

USE CLASS "B" CONCRETE AT GATE POSTS OR WHERE REQUIRED BY SOIL CONDITIONS. CONCRETE MAY ALSO BE USED IN LIEU OF SETTING POSTS TO THEIR MAXIMUM DEPTH.

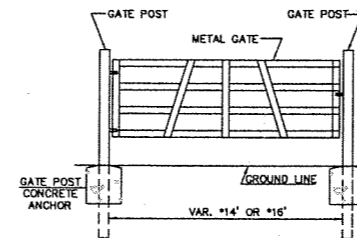

CATTLE GATE

GENERAL NOTES:

ALL POSTS AND BRACES MAY BE EITHER ROUND OR SQUARE AT THE OPTION OF THE CONTRACTOR, PROVIDED THE SAME TYPE IS USED THROUGHOUT THE PROJECT. DIMENSIONS SHOWN ARE THE DIAMETER OF ROUND OR EDGE DIMENSIONS OF SQUARE POSTS AND BRACES.

ERECT LINE BRACES BETWEEN END, CORNER OR GATE POSTS. PLACE LINE BRACES AT INTERVALS NOT EXCEEDING 330' AND AT THE END OF THE BARBED WIRE ROLL.

THE 330' INTERVAL MAY BE REDUCED BY THE ENGINEER ON CURVES WHERE THE DEGREE OF CURVATURE IS GREATER THAN 3 DEGREES.


NOTCH BRACE POSTS 1" MINIMUM FOR HORIZONTAL BRACES. PLACE TWO GALVANIZED 12d OR THREE GALVANIZED 10d NAILS AT EACH END OF ALL BRACES.

PLACE THE BRACE WIRE AROUND THE POST. DRAW ALL BRACE WIRE TAUT BY TWISTING BETWEEN EACH POST.

INSTALL THE FENCE FACING THE PROPERTY OWNER EXCEPT THAT ON HORIZONTAL CURVES GREATER THAN THREE DEGREES (3°) INSTALL THE FENCE TO PULL AGAINST ALL POSTS. SEE NCDOT STD. 866.02 FOR FENCING AT DITCH CROSSINGS, BREAKS IN GRADES AND R/W BREAKS.


USE LATCH DEVICE APPROVED BY THE ENGINEER. HINGE ASSEMBLY AS SHOWN IS SUGGESTED. SUBSTITUTION MAY BE SUBJECT TO APPROVAL BY THE ENGINEER. USE 1" DIAMETER GALVANIZED STEEL PIPE FOR GATE FRAME EXCEPT AS SHOWN HERE.

ANY COMBINATION OF GATE AND FENCE TYPE MEETING THE APPROVAL OF THE ENGINEER IS ACCEPTABLE AND IS NOT LIMITED TO THE EXAMPLES SHOWN HEREON.

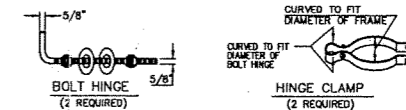

HINGE ASSEMBLY

BARBED WIRE FENCE WITH WOOD POSTS
NTS

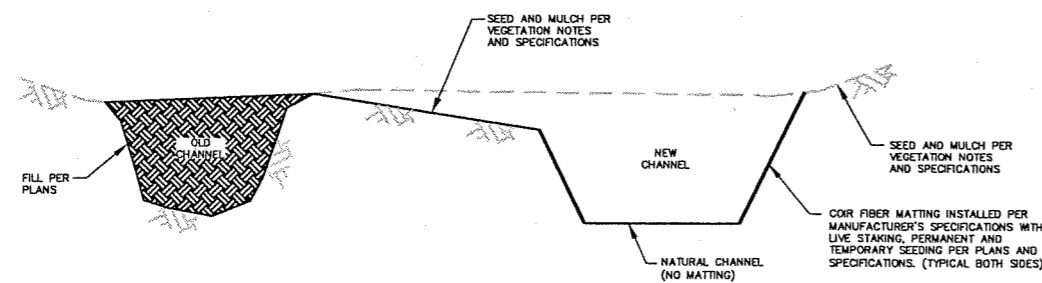

MATTING INSTALLATION GUIDE
NTS

FILE: H:\PN\011795008\DWG\RECORD-DWGS\AB-DETAILS.DWG


REVISED PER DWQ COMMENTS (DEC. 19, 2001)				
REV. NO.	REVISION	DATE	DRAWN BY	CHECKED BY

This document, together with the concepts and designs presented herein, is intended only for the specific purpose and client for which it was prepared. Reuse of and improper reliance on this document without written authorization and adaptation by Kimley-Horn and Associates, Inc. shall be without liability to Kimley-Horn and Associates, Inc.
Copyright Kimley-Horn and Associates, Inc., 2001

PREPARED IN THE OFFICE OF:

Kimley-Horn and Associates, Inc.
P.O. BOX 33068 - RALEIGH, NORTH CAROLINA 27638-3068
PHONE: (919) 677-2000 FAX: (919) 677-2050

CLIENT: ECOSYSTEM ENHANCEMENT PROGRAM
NCDENR
TITLE: DETAILS

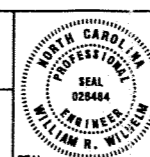

DATE: 6-05-03
PROJECT: SUCK CREEK MOORE COUNTY
SHEET NUMBER: 5 of 10

BUFFER ZONES

Riparian Buffer- Planted easement area with bare root vegetation. Little or no maintenance except for hazard reduction to diseased or dying trees and shrubs.

Grass Filter Strip- Areas adjacent to fence to be maintained in herbaceous cover.

BARE ROOT VEGETATION:

1. General: In order to establish vegetation in restoration areas, such as bankfull benches and slopes, bare root and herbaceous vegetation will be planted as shown on the plans or required in the Special Conditions.

2. Materials:

- a) Initial vegetation material will be provided by the contractor. The contractor is responsible for correctly installing and maintaining vegetation material.
- b) Vegetation material will consist of bare root trees and/or shrubs. Vegetation to be installed in areas shown on the plan labeled "Riparian Buffer" includes, but is not limited to the following:

RIPARIAN BUFFER TREES/SHRUBS

Trees¹

- Celtis laevigata* (sugarberry)
- Diospyros virginiana* (persimmon)
- Fraxinus pennsylvanica* (green ash)
- Nyssa sylvatica* (blackgum)
- Platanus occidentalis* (sycamore)
- Quercus phellos* (willow oak)
- Salix nigra* (black willow)

Shrubs¹

- Amelanchier arborea* (serviceberry)
- Aronia arbutifolia* (red chokeberry)
- Astima triloba* (common pawpaw)
- Calycanthus floridus* (sweet-shrub)
- Cephalanthus occidentalis* (buttonbush)
- Cornus amomum* (silky dogwood)
- Corylus americana* (hazel-nut)
- Lindera benzoin* (spicebush)

3. Composition:

The composition of the riparian buffer trees/shrubs will be 70% trees and 30% shrubs from list above of riparian buffer trees/shrubs. At least seven different tree species with no more than 25% and not less than 5% of any one species. At least eight different shrub species with no more than 25% and not less than 5% of any one species.

4. Preparation:

- a) Planting shall take place in winter (December - March). Immediately following delivery to the project site, all plants with bare roots, if not promptly planted, shall be heeled-in in constantly moist soil or sawdust in an acceptable manner corresponding to generally accepted horticultural practices.
- b) While plants with bare roots are being transported to and from heeling-in beds, or are being distributed in planting beds, or are awaiting planting after distribution, the contractor shall protect the plants from drying out by means of wet canvas, burlap, or straw, or by other means acceptable to Engineer/Project Manager and appropriate to weather conditions and the length of time the roots will remain out of the

5. Installation:

- a) Soil in the area of shrub and tree plantings shall be loosened to a depth of at least 5 inches. This is necessary only on compacted soil.
- b) Bare root vegetation may be planted in hole made by a mattock, dibble, planting bar, or other means approved by Engineer/Project Manager. Rootstock shall be planted in a vertical position with the root collar approximately 1/2 inch below the soil surface. The planting trench or hole shall be deep and wide enough to permit the roots to spread out and down without J-rooting. The plant stem shall remain upright.
- c) Soil shall be replaced around the transplanted vegetation and tamped around the shrub or tree firmly to eliminate air pockets.
- d) The space guidelines of rooted shrubs and trees will be 10 feet between rows on 6-foot centers within rows.

SHRUB AND TREE TRANSPLANTS

1. General:

Vegetation to be transplanted will be identified by the Engineer/Project Manager. Shrub and trees less than 3 inches in diameter shall be salvaged onsite in areas designated for construction, access areas, and other sites that will necessarily be disturbed.

2. Installation:

- a) Transplanted vegetation shall carefully be excavated with rootballs and surrounding soil remaining intact. Care shall be given not to rip limbs or bark from the shrub and tree transplants. Vegetation should be transplanted immediately, if possible. Otherwise, transplanted vegetation shall be carefully transported to designated stockpile areas and heeled-in in constantly moist soil or sawdust in an acceptable manner appropriate to weather or seasonal conditions. The solidity of the plants shall be carefully preserved.
- b) Installation of shrub and tree transplants shall be located in designated areas along the stream bank above bankfull elevation or in floodplain restoration areas as directed by Engineer/Project Manager. Soil in the area of vegetation transplants shall be loosened to a depth of at least 1 foot. This is only necessary on compacted soil. Transplants shall be replanted to the same depth as they were originally growing. The planting trench or hole shall be deep and wide enough to permit the roots to spread out and down without J-rooting. The plant stem shall remain upright.
- c) Soil shall be replaced around the transplanted vegetation and tamped around the shrub or tree firmly to eliminate air pockets.
- d) Spacing of vegetation transplants will be determined onsite by the Engineer/Project Manager.

PERMANENT SEEDING SPECIFICATIONS

Permanent seeding will be used in combination with woody plantings on the up-slope side of the riparian area and down to the bankfull elevation. Permanent seeding will occur in conjunction with temporary seeding where applicable. This mixture will also be used in any terrestrial (areas not inundated) riparian area that has been disturbed by construction, is designated as wetland and/or riparian enhancement, or as directed by Engineer/Project Manager. This mixture shall be planted in late fall in combination with the temporary seeding operation and woody plant installations. Seeding should be done evenly over the area using a mechanical or hand seeder. A drag should be used to cover the seed with no more than 1/2 inch of soils. Where a drag cannot safely be utilized, the seed should be covered by hand raking.

Seedbed Preparation

On sites where equipment can be operated safely, the seedbed shall be adequately loosened. Disking may be needed in areas where soil is compacted. Steep banks may require roughening, either by hand scarifying or by equipment, depending on site conditions. Engineer/Project Manager will determine condition needs onsite. If seeding is done immediately following construction, seedbed preparation may not be required except on compacted, polished or freshly cut areas. If permanent seeding is performed in conjunction with temporary seeding, seedbed preparation only needs to be executed once.

Seeding

A riparian seed mix at the rate of 1/4 lb per 1,000 sq ft or 10 lbs per acre shall be used for seeding. The following table lists herbaceous, permanent seed mixture labeled "riparian seed mix"

Common Name	Scientific Name	%
Rice Cut Grass	<i>Leersia oryzoides</i>	5
Soft Rush	<i>Juncus effusus</i>	10
Deertongue	<i>Panicum clandestinum</i>	20
Switchgrass	<i>Panicum virgatum</i>	50
Ironweed	<i>Vernonia noveboracensis</i>	5
Swamp Sunflower	<i>Helianthus angustifolius</i>	5
Joe Pye Weed	<i>Eupatorium fistulosum</i>	5

GRASS FILTER STRIP

Seeds:

- Panicum virgatum* (switchgrass)
- Tripsacum dactyloides* (Eastern gama grass)
- Andropogon gerardii* (big blue stem)
- Sorghastrum nutans* (Indian grass)

Apply 10 lbs/acre using same seed bed preparation and seeding methods as the permanent seed mix. Use three of the four species with no more than 40% of any one of the three selected species.

LIVE STAKES

Live stakes are to be installed on exposed stream banks to bankfull elevation of the designed stream. The stakes are to be installed at a density of 2 to 4 live stakes per square yard. The species to be used for live staking are listed in the following Species List. The Supervising Engineer reserves the right to reject any "stakes" that do not meet the above mentioned criteria. The Contractor shall replace rejected work at no additional cost to the owner.

Live stakes are to be dormant (cut fall or winter), and either gathered locally or purchased from a commercial supplier.

Collection/Preparation


- Stakes must be freshly cut with side branches removed, but with bark in tact (ensure that the bark is not stripped during the cutting, preparation, or installation of the stake).
- Cuttings are to be collected using a saw (not an ax).
- One end must be cut at an angle for insertion into the soil, and the other must be cut square for tamping.
- Cuttings must be kept fresh and moist prior to installation.
- Cuttings must be prepared from 0.5 to 2-inch diameter stock and approximately 2 to 3 feet in length.

Installation

- Install stakes the same day they are prepared.
 - Start the installation nearest to the stream and work up the bank/floodplain.
 - Cuttings must be installed right side up with the buds pointing upward.
 - Cuttings should be tamped into the ground at right angles to the slope and angled downstream.
 - They are to be tamped into the ground for approximately 4/5 of their length.
 - Cuttings that split or become "mushroomed" must be replaced.
 - Stakes are to be spaced at such that there are 2 to 4 stakes per square yard.
- Stakes should be installed in a random configuration to prevent gullies and promote a more natural effect in the re-vegetated area.

Species List and Composition

Live Stakes	Percent Composition
<i>Cornus amomum</i> (silky dogwood)	25
<i>Populus deltoides</i> (cottonwood)	0-25
<i>Salix nigra</i> (black willow)	50
<i>Sambucus canadensis</i> (elder berry)	0-25
<i>Viburnum dentatum</i> (arrow wood)	0-25

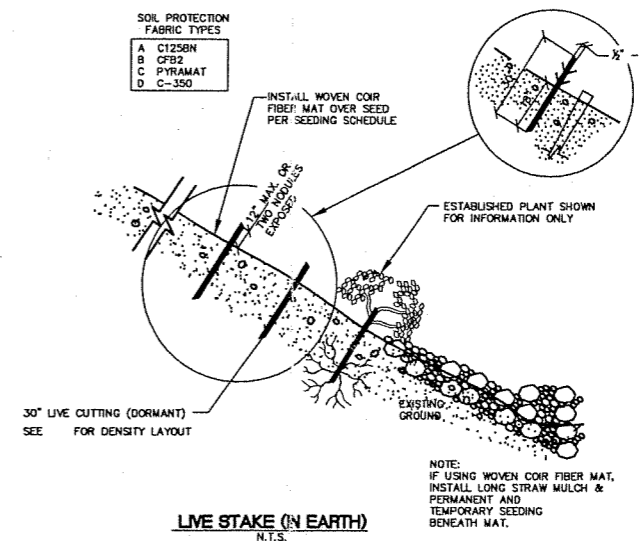

LIVE STAKE (IN EARTH)
N.T.S.

TEMPORARY SEEDING FOR LATE WINTER AND EARLY SPRING

Seeding mixture	Species	Rate (lb/acre)
	Rye (<i>Secale cereale</i>)	120

Soil amendments
Follow recommendations of soil tests or apply 2,000 lb/acre ground agricultural limestone and 700 lb/acre 13-10-10 fertilizer.

Mulch
Apply 4,000 lb/acre straw. Anchor straw by netting, or a mulch anchoring tool. A disk with blades set nearly straight can be used as a mulch anchoring tool.

Maintenance
Referitize if growth is not fully adequate. Reseed, referitize and mulch immediately following erosion or other damage.

Note: Ground cover shall be established on exposed slopes within 30 working days following completion of any phase of grading.

1. Recommended Native Plant Species for Stream Restoration in North Carolina, Karen Hall, NC Stream Restoration Institute NCSU January 2001

FILE: H:\PN\011795008\DWG\RECORD-DWGS\AB-VEG-DET.DWG


REV. NO.	REVISION	DATE	DRAWN BY	CHECKED BY



Kimley-Horn and Associates, Inc.

P.O. BOX 33068 - RALEIGH, NORTH CAROLINA 27636-3068
PHONE: (919) 677-2000 FAX: (919) 677-2050

CLIENT: ECOSYSTEM ENHANCEMENT PROGRAM NCDENR
TITLE: VEGETATION NOTES AND DETAILS

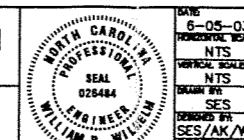

DATE: 6-05-03
PROJECT: SUCK CREEK MOORE COUNTY






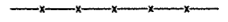
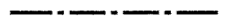


SUCK CREEK MOORE COUNTY

This document, together with the concepts and designs presented herein, as an instrument of service, is intended only for the specific purpose and client for which it was prepared. Reuse of and improper reliance on this document without written authorization and adoption by Kimley-Horn and Associates, Inc. shall be without liability to Kimley-Horn and Associates, Inc. Copyright Kimley-Horn and Associates, Inc., 2001

NORTH BASED ON DESIGN PLANS BY
 KIMLEY-HORN AND ASSOCIATES, INC.
 ENTITLED "SUCK CREEK - MOORE COUNTY"

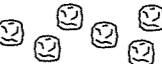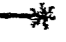

LEGEND


-  BOULDER CLUSTER
-  ROOT WAD
-  BOULDER
-  ROCK CROSS VANE
-  LOG VANE
-  FENCE
-  SUCK CREEK
-  EDGE OF WATER
-  J-HOOK VANE

Original survey
 issued and sealed by
 ROGER D. MORGAN, PLS
 N.C. Registration No. L-3847
 JUNE 2, 2003
 This media should not be
 considered a certified
 document.



231 18th AVENUE, NE
 HICKORY, NC 28601
 (828) 327-9911

Ashville, NC Columbia, SC
 Atlanta, GA Hickory, NC
 Charlotte, NC Raleigh, NC
 Wilmington, NC

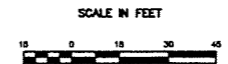

FILE: H:\PN\011795008\DWG\RECORD-DWGS\AB-20506V02-B.DWG

REV. No.	REVISION	DAYSTAMP	DATE	DRAWN BY	CHECKED BY

This document, together with the concepts and designs presented herein, as an instrument of service, is intended only for the specific purpose and client for which it was prepared. Reuse and improper reliance on this document without written authorization and adaptation by Kimley-Horn and Associates, Inc. shall be without liability to Kimley-Horn and Associates, Inc.
 Copyright Kimley-Horn and Associates, Inc., 2001

PREPARED IN THE OFFICE OF:




**Kimley-Horn
 and Associates, Inc.**

P.O. BOX 33068 - RALEIGH, NORTH CAROLINA 27636-3068
 PHONE: (919) 877-2000 FAX: (919) 877-2057

CLIENT:
**ECOSYSTEM ENHANCEMENT PROGRAM
 NCDENR**

TITLE:
RECORD DRAWING




DATE: 6-04-03
 HORIZONTAL SCALE: 30
 VERTICAL SCALE: NTS
 DRAWN BY: SES
 DESIGNED BY: WJM
 CHECKED BY: JME/SWB

PROJECT:
**SUCK CREEK
 MOORE COUNTY**


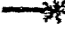



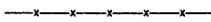



ATTACHED REFERENCE FILES: JOB NUMBER: 011795008 SHEET NUMBER: 7 of 10

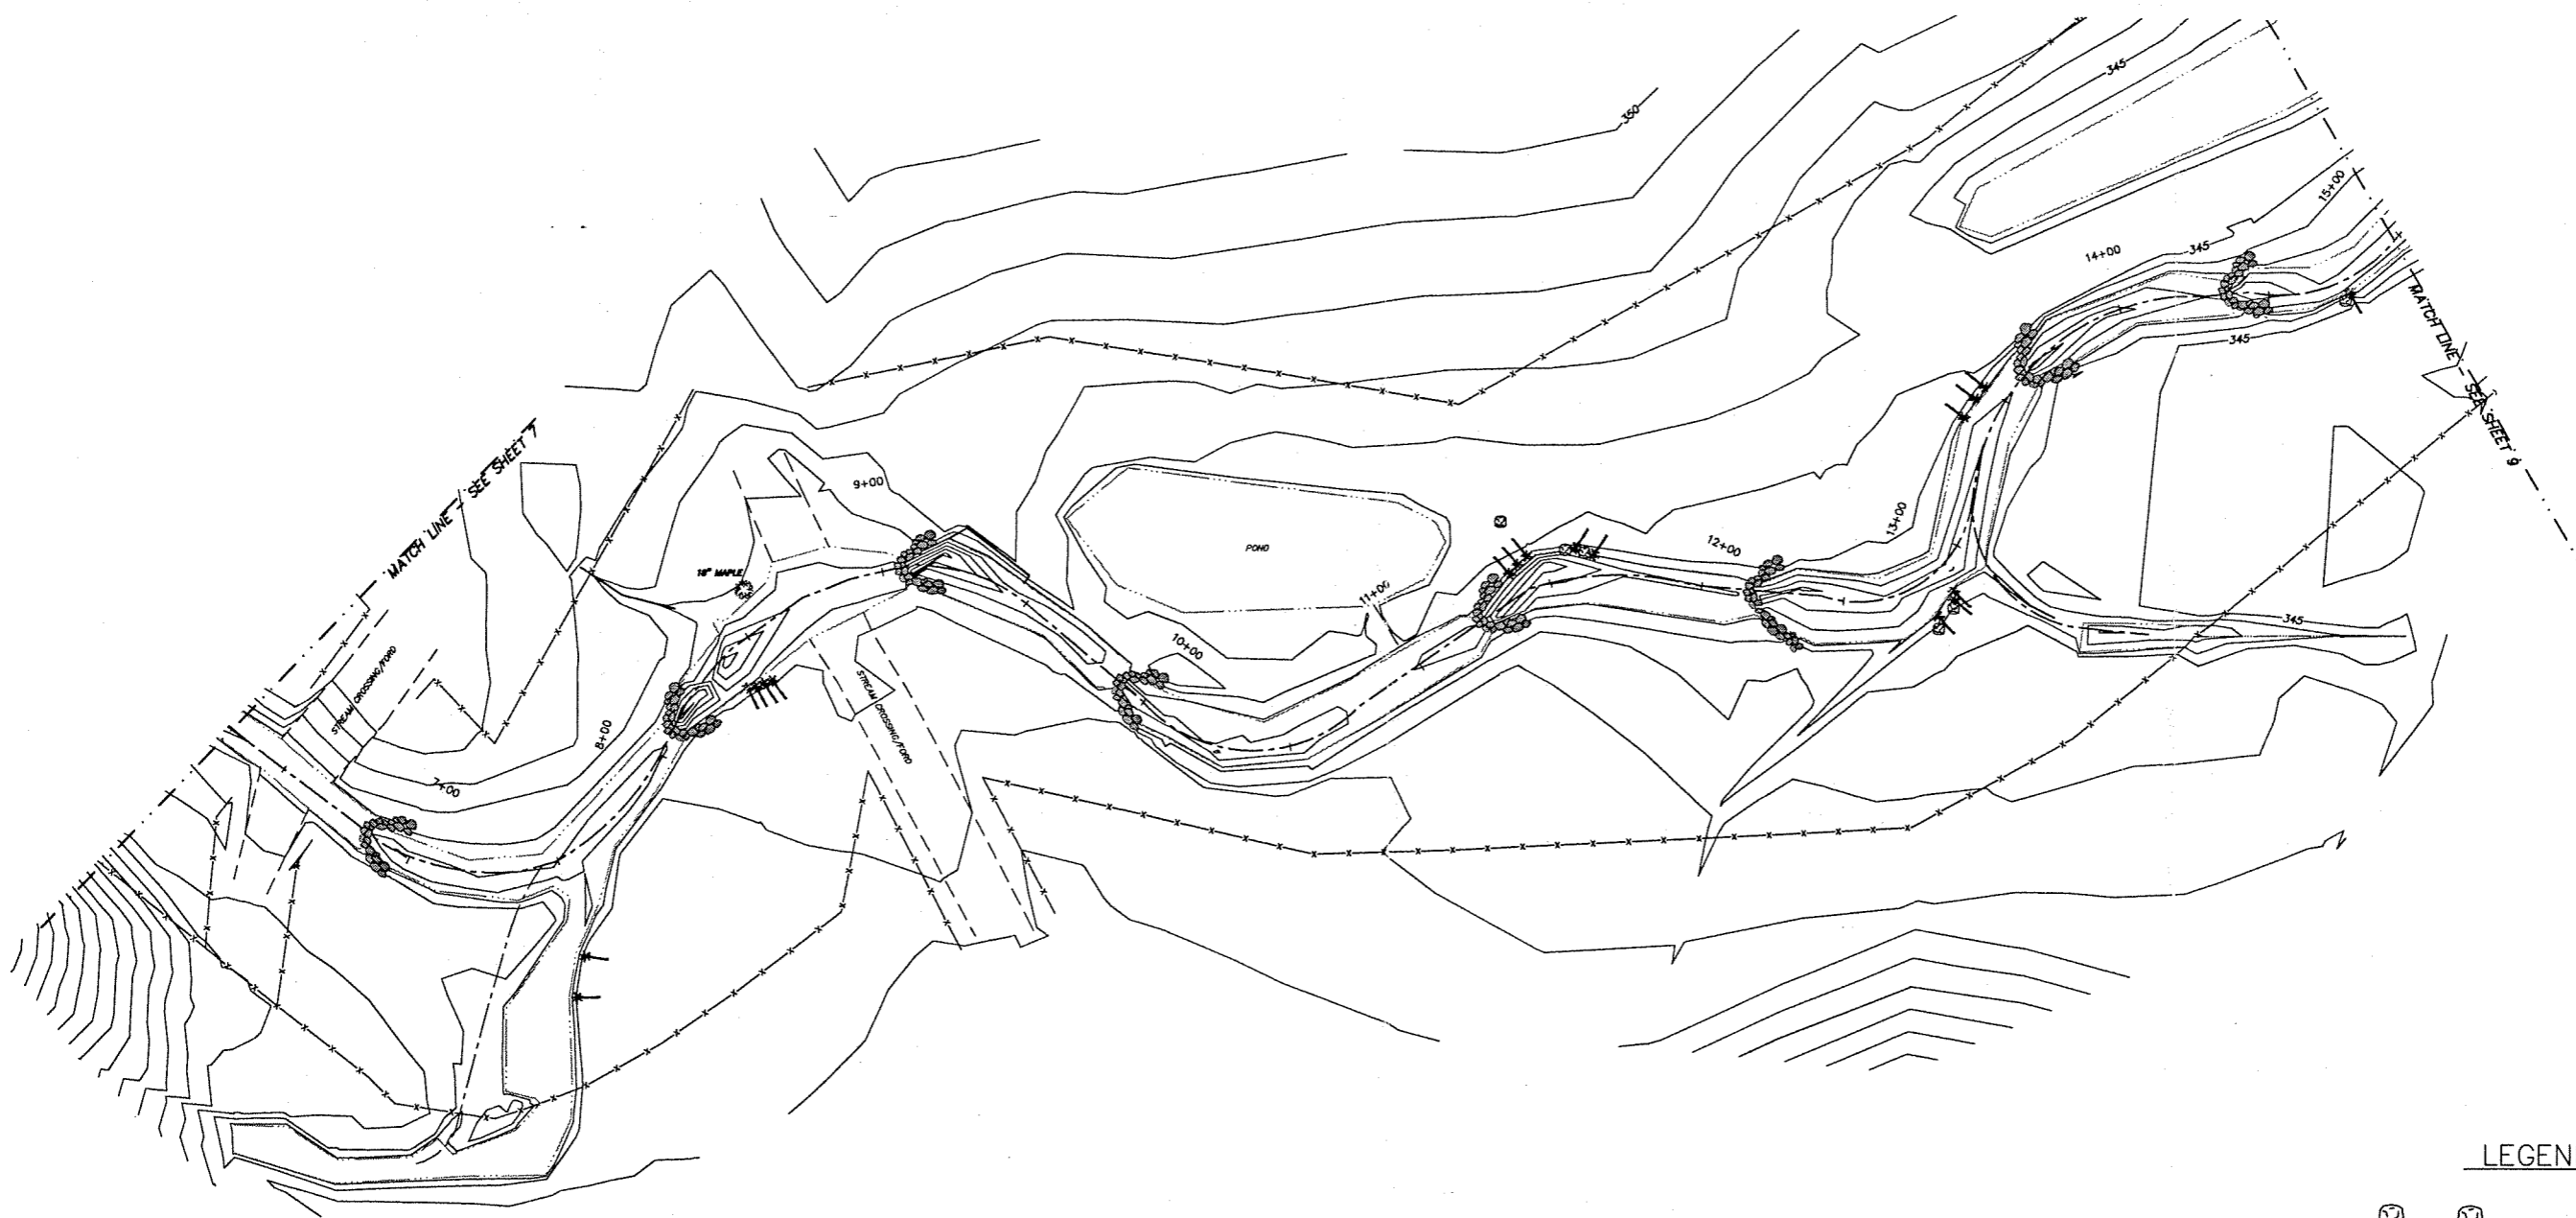T:\pn\011795008\as_built\AB-20506V02-B.dwg, 6/30/2004 2:32:47 PM

NORTH BASED ON DESIGN PLANS BY
 KIMLEY-HORN AND ASSOCIATES, INC.
 ENTITLED "SUCK CREEK - MOORE COUNTY"
 AND DATED 9-12-02




LEGEND

-  BOULDER CLUSTER
-  ROOT WAD
-  BOULDER
-  ROCK CROSS VANE
-  LOG VANE
-  FENCE
-  SUCK CREEK
-  EDGE OF WATER
-  J-HOOK VANE

Original survey
 issued and sealed by
 ROGER D. MORGAN, PLS
 N.C. Registration No. L-3847
 JUNE 2, 2003
 This media should not be
 considered a certified
 document.



231 18th AVENUE, NE
 HICKORY, NC 28601
 (828) 327-8911
 Asheville, NC Columbia, SC
 Atlanta, GA Hickory, NC
 Charlotte, NC Raleigh, NC
 Wilmington, NC

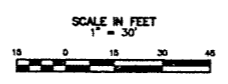

FILE: H:\PN\011795008\DWG\RECORD-DWGS\SC-20506V02-B.DWG

REV. NO.	REVISION	DATE	DRAWN BY	CHECKED BY

H:\PN\011795008\DWG\record-dwgs\AB-020506V02-B

PREPARED IN THE OFFICE OF:




**Kimley-Horn
 and Associates, Inc.**

P.O. BOX 33068 - RALEIGH, NORTH CAROLINA 27636-3068
 PHONE: (919) 677-2000 FAX: (919) 677-2050

CLIENT:
**ECOSYSTEM ENHANCEMENT PROGRAM
 NCDENR**

TITLE:
RECORD DRAWING

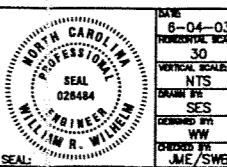


DATE: 6-04-03
 HORIZONTAL SCALE: 30
 VERTICAL SCALE: NTS
 DRAWN BY: SES
 CHECKED BY: WW
 DESIGNED BY: JME/SWB

PROJECT:
**SUCK CREEK
 MOORE COUNTY**

ATTACHED REFERENCE FILES: JOB NUMBER: 011795008 SHEET NUMBER: 8 of 10


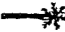



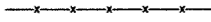
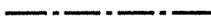


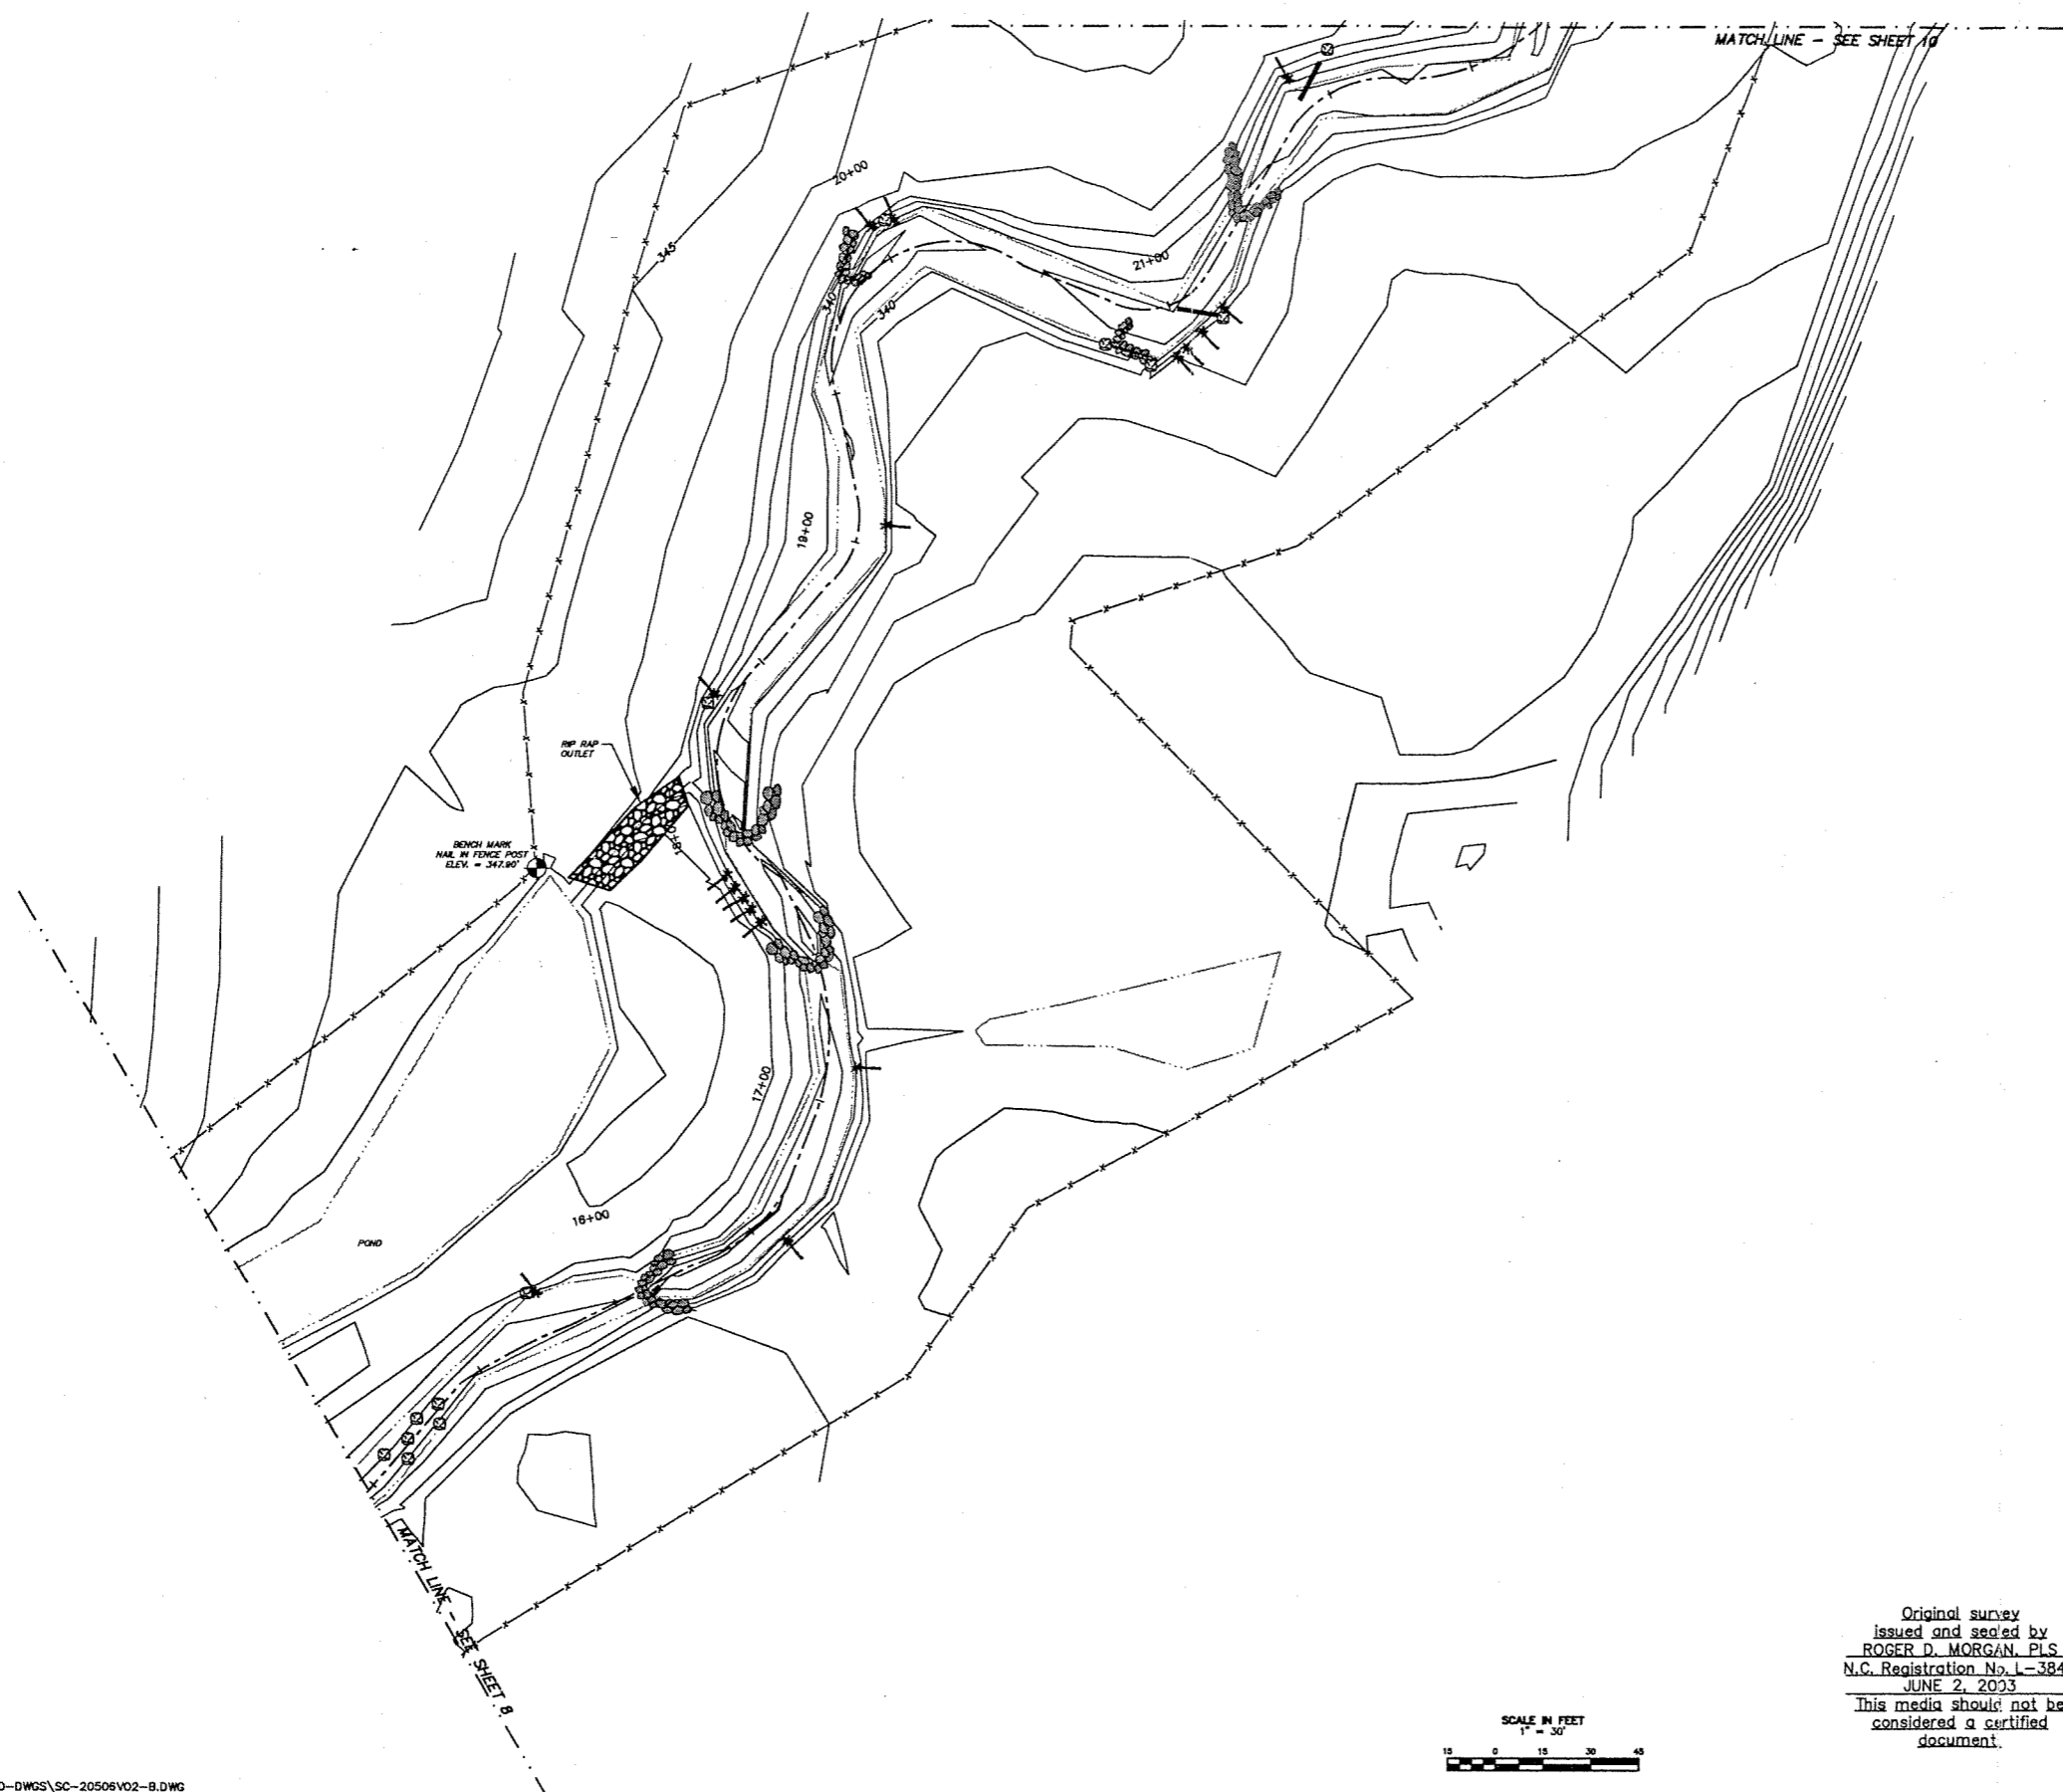T:\pn\011795008\as_built\AB-20506V02-B.dwg, 6/30/2004 2:52:18 PM


T:\pn\011795008\as_built\AB-20506V02-B.dwg, 6/30/2004 2:52:35 PM



NORTH BASED ON DESIGN PLANS BY
KIMLEY-HORN AND ASSOCIATES, INC.
ENTITLED "SUCK CREEK - MOORE COUNTY"
AND DATED 9-12-02

LEGEND

-  BOULDER CLUSTER
-  ROOT WAD
-  BOULDER
-  ROCK CROSS VANE
-  LOG VANE
-  FENCE
-  SUCK CREEK
-  EDGE OF WATER
-  J-HOOK VANE

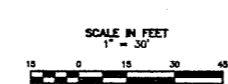

Original survey
issued and sealed by
ROGER D. MORGAN, PLS
N.C. Registration No. L-3847
JUNE 2, 2003
This media should not be
considered a certified
document.

WK DICKSON
Engineers • Planners • Surveyors
Landscape Architects

231 18th AVENUE, NE
HICKORY, NC 28601
(828) 327-8911

Asheville, NC
Atlanta, GA
Charlotte, NC

Columbia, SC
Hickory, NC
Raleigh, NC
Wilmington, NC

FILE: H:\PN\011795008\DWG\RECORD-DWGS\SC-20506V02-B.DWG

REV. No.	REVISION	H:\PN\011795008\DWG\record-dwgs\AB-20506V02-B	DATE	DRAWN BY	CHECKED BY

This document, together with the concepts and designs presented herein, as an instrument of service, is intended only for the specific purpose and client for which it was prepared. Reuse of and improper reliance on this document without written authorization and adoption by Kimley-Horn and Associates, Inc. shall be without liability to Kimley-Horn and Associates, Inc.
Copyright Kimley-Horn and Associates, Inc. 2001

PREPARED IN THE OFFICE OF:




Kimley-Horn and Associates, Inc.

P.O. BOX 33068 - RALEIGH, NORTH CAROLINA 27636-3068
PHONE: (919) 677-2000 FAX: (919) 677-2050

CLIENT:
**ECOSYSTEM ENHANCEMENT PROGRAM
NCDENR**

TITLE:
RECORD DRAWING



DATE: 6-04-03
HORIZONTAL SCALE: 30
VERTICAL SCALE: NTS
DRAWN BY: SES
CHECKED BY: WW
DESIGNED BY: JME/SWB


PROJECT:
**SUCK CREEK
MOORE COUNTY**

ATTACHED REFERENCE FILES


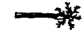





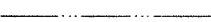

JOB NUMBER: 011795008

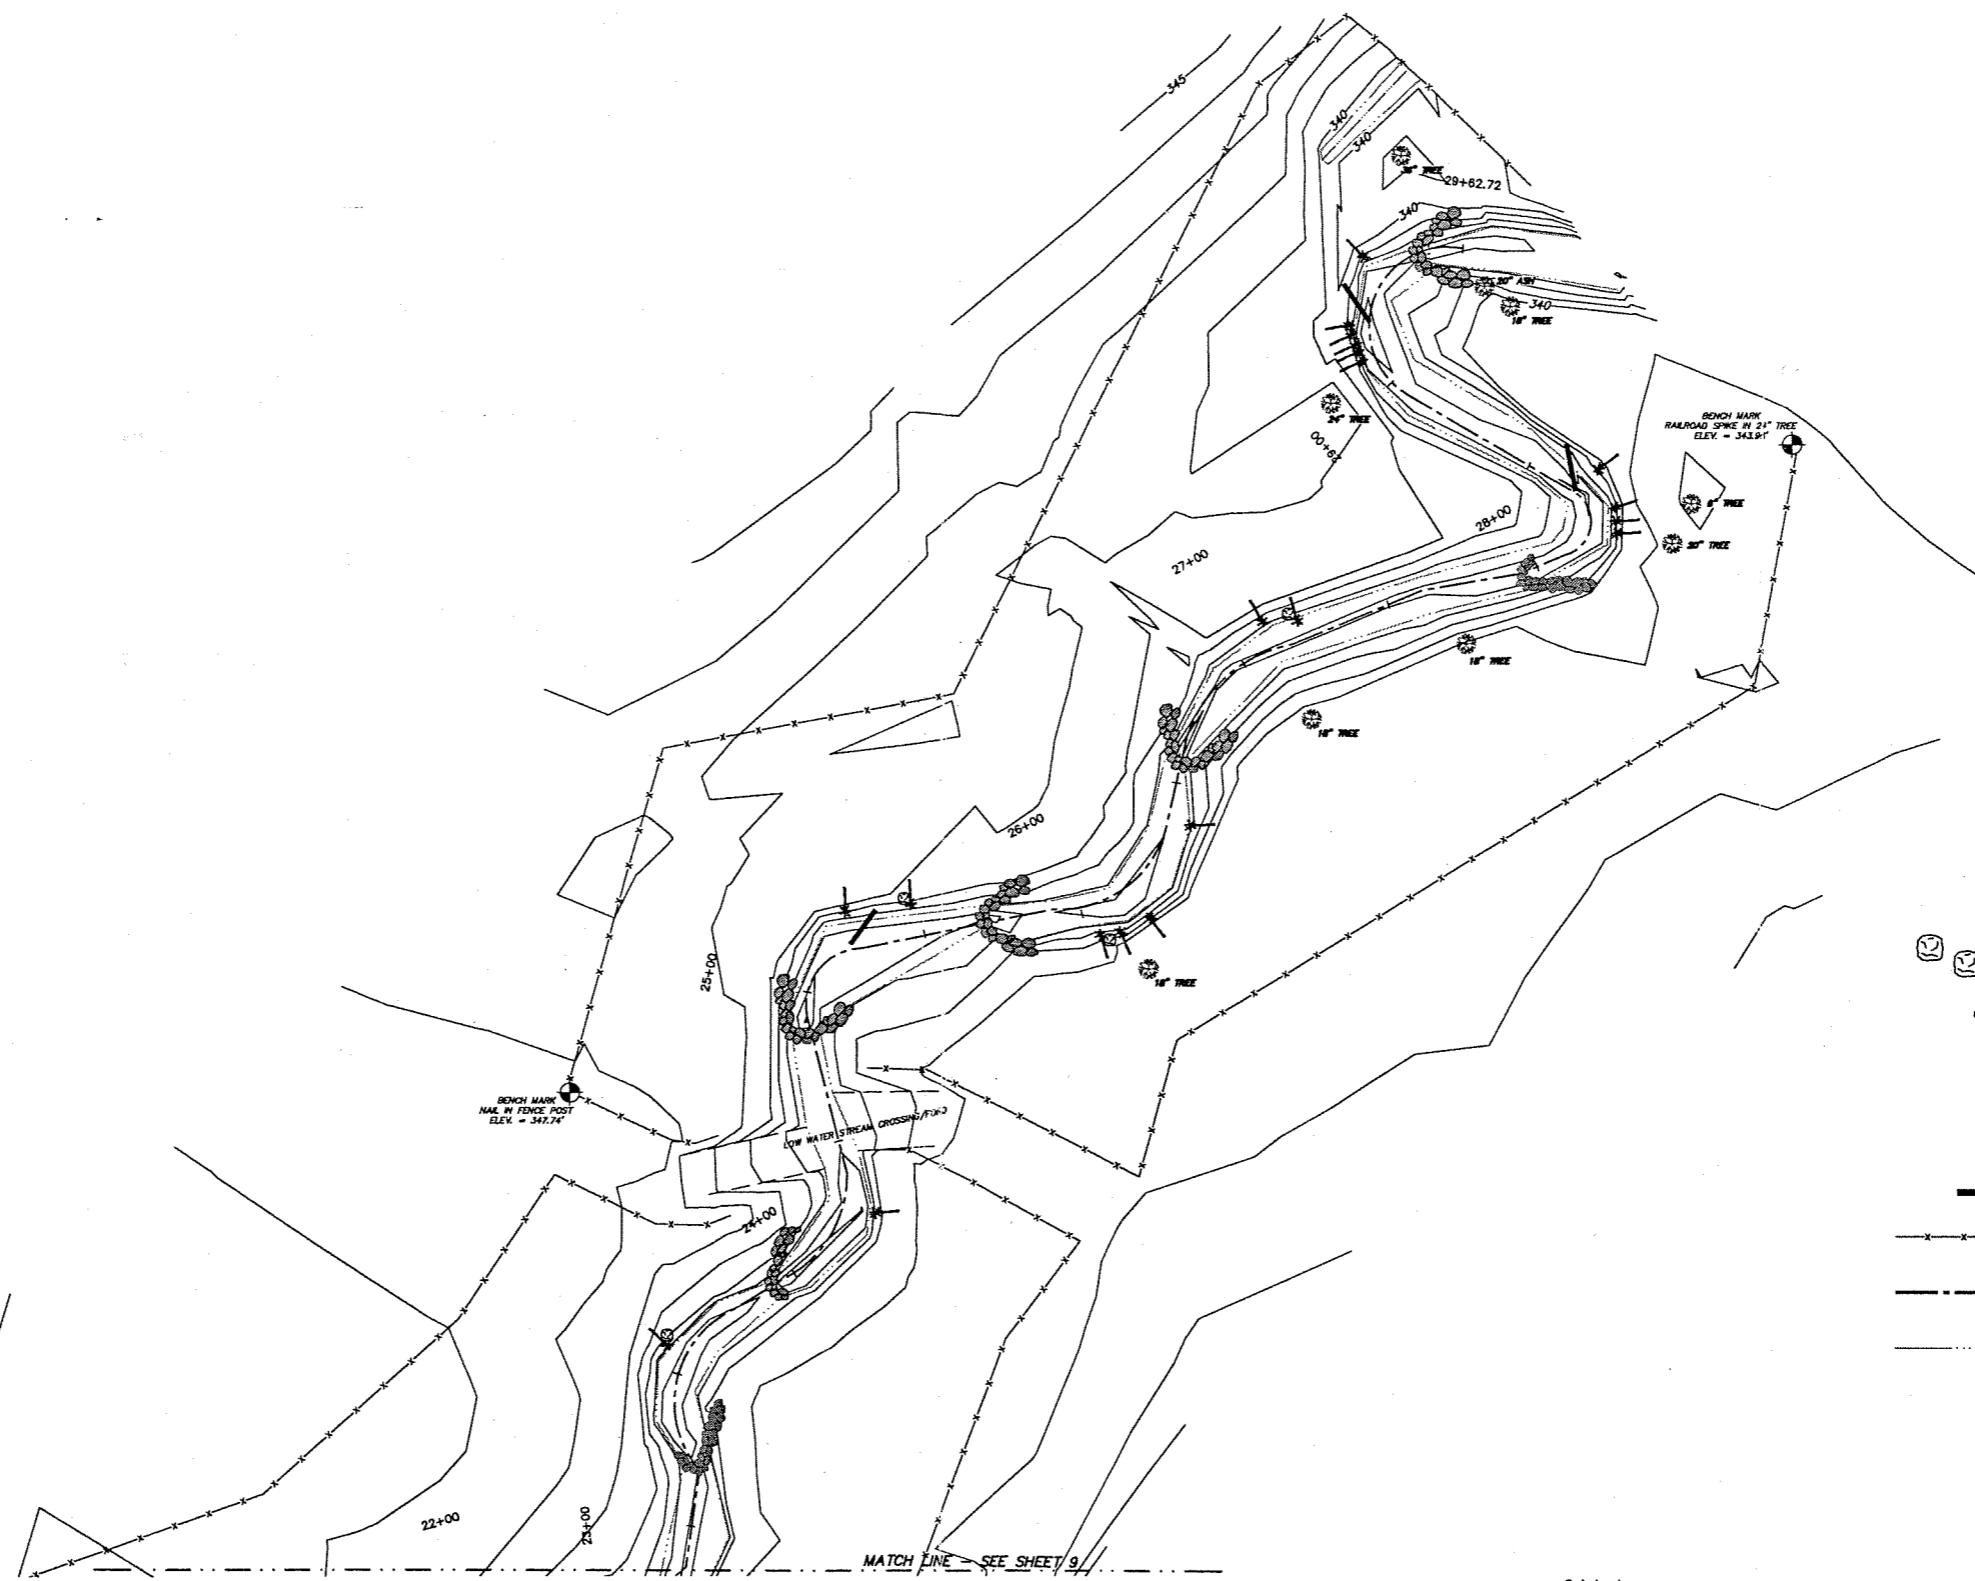SHEET NUMBER: 9 OF 10


NORTH BASED ON DESIGN PLANS BY
 KIMLEY-HORN AND ASSOCIATES, INC.
 ENTITLED "SUCK CREEK - MOORE COUNTY"
 AND DATED 9-12-02



LEGEND

-  BOULDER CLUSTER
-  ROOT WAD
-  BOULDER
-  ROCK CROSS VANE
-  LOG VANE
-  FENCE
-  SUCK CREEK
-  EDGE OF WATER
-  J-HOOK VANE

Original survey
 issued and sealed by
 ROGER D. MORGAN, PLS
 N.C. Registration No. L-3847
 JUNE 2, 2003
 This media should not be
 considered a certified
 document.

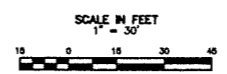

231 18th AVENUE, NE
 HICKORY, NC 28501
 (828) 327-9911
 Asheville, NC Columbia, SC
 Atlanta, GA Hickory, NC
 Charlotte, NC Raleigh, NC
 Wilmington, NC

FILE: H:\PN\011795008\DWG\RECORD-DWGS\SC-20506V02-B.DWG


REV. NO.	REVISION	DATE	DRAWN BY	CHECKED BY
H:\PN\011795008\DWG\record-dwgs\AB-20506V02-B				

This document, together with the concepts and designs presented herein, as an instrument of service, is intended only for the specific purpose and client for which it was prepared. Reuse of and improper reliance on this document without written authorization and adaptation by Kimley-Horn and Associates, Inc. shall be without liability to Kimley-Horn and Associates, Inc.
 Copyright Kimley-Horn and Associates, Inc., 2001

PREPARED IN THE OFFICE OF:

Kimley-Horn and Associates, Inc.
 P.O. BOX 33068 - RALEIGH, NORTH CAROLINA 27638-3068
 PHONE: (919) 677-2000 FAX: (919) 677-2050

CLIENT:
ECOSYSTEM ENHANCEMENT PROGRAM
 NCDENR
 TITLE:
RECORD DRAWING

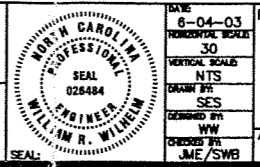

DATE: 6-04-03
 HORIZONTAL SCALE: 30
 VERTICAL SCALE: NTS
 DRAWN BY: SES
 DESIGNED BY: WW
 CHECKED BY: JME/SWB

PROJECT:
SUCK CREEK
MOORE COUNTY

ATTACHED REFERENCE FILES:
 JOB NUMBER: 011795008 SHEET NUMBER: 10 of 10

T:\pn\011795008\as_built\AB-20506V02-B.dwg, 6/30/2004 2:52:49 PM