

AS-BUILT MITIGATION PLAN
THREE MILE CREEK RESTORATION SITE
AVERY COUNTY, NORTH CAROLINA
(Contract #16-D06125-A)

FULL DELIVERY PROJECT
TO PROVIDE STREAM AND WETLAND MITIGATION
IN THE FRENCH BROAD RIVER BASIN
CATALOGING UNIT 06010108



Prepared for:

NORTH CAROLINA DEPARTMENT OF ENVIRONMENT AND NATURAL RESOURCES
RALEIGH, NORTH CAROLINA


Prepared by:



Natural Resources
Restoration & Conservation

Restoration Systems, LLC
1101 Haynes Street, Suite 211
Raleigh, North Carolina 27604

And

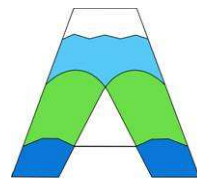

Axiom Environmental, Inc.

Axiom Environmental, Inc.
20 Enterprise Street, Suite 7
Raleigh, North Carolina 27606

April 2009

**THREE MILE CREEK RESTORATION SITE
AS-BUILT MITIGATION PLAN
AVERY COUNTY**

EXECUTIVE SUMMARY

Restoration Systems, L.L.C. (Restoration Systems) has completed restoration of streams and wetlands at the Three Mile Creek Restoration Site (hereafter referred to as the “Site”) to assist the North Carolina Ecosystem Enhancement Program (NCEEP) in fulfilling stream and wetland mitigation goals. The Site, located in southwestern Avery County approximately 5.2 miles northeast of Spruce Pine, North Carolina, provides the minimum of 8021 stream mitigation units and 2.3 riparian wetland mitigation units as outlined in the October 2006 Technical Proposal. The Site is located in United States Geological Survey (USGS) Hydrologic Unit and Targeted Local Watershed 06010108010020 (North Carolina Division of Water Quality Subbasin 04-03-06) of the French Broad River Basin.

A Detailed Stream and Wetland Restoration Plan was completed for the Site in September 2007. The plan outlined methods to complete stream and wetland restoration activities at the Site. A 26.68-acre conservation easement was placed on the Site to incorporate all restoration activities. The Site contains Three Mile Creek, 12 unnamed tributaries to Three Mile Creek, Fork Creek, and associated floodplains. Prior to construction, the project was characterized by agricultural land utilized for Christmas tree and ornamental landscape nursery plant production, timber harvest, and livestock grazing. Agricultural practices including the maintenance and removal of riparian vegetation and relocation, dredging, and straightening of onsite streams resulted in degraded water quality, unstable channel characteristics (stream entrenchment, erosion, and bank collapse), and reduced storage capacity and floodwater attenuation. In addition, hydric soils were disturbed due to regular plowing and vegetation maintenance, hoof shear from livestock, and the removal of groundwater hydrology inputs from the rerouting and straightening of Site tributaries.

Restoration of Site streams and wetlands will result in positive benefits for water quality and biological diversity in the Three Mile Creek watershed. Targeted mitigation efforts focused on improving water quality, enhancing flood attenuation, and restoring aquatic and riparian habitat and were accomplished by:

1. Removing nonpoint and point sources of pollution associated with agricultural practices including a) cessation of broadcasting fertilizer, pesticides, and other agricultural chemicals into and adjacent to the Site and b) provide a forested riparian buffer to treat surface runoff.
2. Reducing sedimentation within onsite and downstream receiving waters by a) reducing bank erosion associated with vegetation maintenance and plowing adjacent to Site streams and wetlands and b) planting a forested riparian buffer adjacent to Site streams and wetlands.
3. Reestablishing stream stability and the capacity to transport watershed flows and sediment loads by restoring a stable dimension, pattern, and profile supported by natural in-stream habitat and grade/bank stabilization structures.
4. Promoting floodwater attenuation by a) reconnecting bankfull stream flows to the abandoned floodplain terrace; b) restoring secondary, dredged, straightened, and entrenched tributaries, thereby reducing floodwater velocities within smaller catchment basins; c) restoration of depressional floodplain wetlands and floodwater storage capacity within the Site, and d) revegetating Site floodplains to increase frictional resistance on floodwaters.

5. Improving aquatic habitat with bed variability and the use of in-stream structures upstream of a reach identified by the North Carolina Wildlife Resources Commission as supporting naturally reproducing rainbow trout populations.
6. Providing a terrestrial wildlife corridor and refuge in an area that is developed for agricultural production.

As constructed, the Site restored historic stream and wetland functions, which existed onsite prior to channel straightening and dredging, agricultural impacts, and vegetation removal. Stream construction of meandering, C-/E-type stream channel resulted in 6057 linear feet of stream restoration, 618 linear feet of stream enhancement (Level I), 875 linear feet of stream enhancement (Level II), 6421 linear feet of stream preservation, 2.5 acres of riverine wetland restoration, and 2.3 acres of riverine wetland enhancement. The total amount of mitigation implemented at the Site is 8103 SMUs and 3.7 riverine WMUs.

TABLE OF CONTENTS

EXECUTIVE SUMMARY	i
1.0 INTRODUCTION	1
1.2 Project Goals and Objectives	1
1.3 Project Structure, Restoration Type, and Approach.....	2
1.4 Project History	4
2.0 RESTORATION ACTIVITIES.....	5
2.1 Stream Restoration.....	5
3.1.1 Belt-width Preparation and Grading.....	5
3.1.2 Floodplain Bench Excavation	6
3.1.3 Channel Excavation.....	6
3.1.4 Channel Backfilling.....	6
3.1.5 Marsh Treatment Areas	6
3.1.6 In-Stream Structures.....	6
3.1.7 Forded Channel Crossing.....	8
3.2 Stream Enhancement (Level I and II)	8
3.3 Stream Preservation	8
3.4 Wetland Restoration and Enhancement.....	8
3.2.1 Reestablishment of Historic Groundwater Elevations.....	8
3.2.2 Excavation and Grading of Elevated Spoil and Sediment Embankments	9
3.2.3 Hydrophytic Vegetation.....	9
4.0 PLANT COMMUNITY RESTORATION	9
5.0 MONITORING PLAN.....	10
5.1 Stream	10
5.2 Hydrology.....	11
5.3 Vegetation.....	11
6.0 SUCCESS CRITERIA.....	11
6.1 Stream Success Criteria.....	11
6.2 Hydrologic Success Criteria	16
6.2 Vegetation Success Criteria.....	16
7.0 MONITORING REPORT SUBMITTAL.....	17
8.0 CONTINGENCY	17
9.0 REFERENCES	19

TABLES

Table 1. Site Restoration Structures and Objectives	2
Table 2. Project Activity and Reporting History.....	4
Table 3. Project Contacts Table	4
Table 4. Project Background Table	5
Table 5. Planted Tree Species	10
Table 6. Baseline Morphology and Hydraulic Summary	12
Table 7A-C. Baseline Morphology and Hydraulic Monitoring Summary	13-15
Table 8. Characteristic Tree Species	16

APPENDICES

- Appendix A. Figures and As-built Construction Sheets
- Appendix B. Preconstruction and Construction Photographs
- Appendix C. As-built Cross-section and Longitudinal Profile Plots

FIGURES and SHEETS

Figure 1. Site Location	Appendix A
Figure 2. Preconstruction Conditions	Appendix A
Figures 3A-3B. Typical Structure Details	Appendix A
Figure 4. Planting Plan	Appendix A
Sheets 1-23. As-built Survey	Appendix A

**THREE MILE CREEK RESTORATION SITE
AS-BUILT MITIGATION PLAN
AVERY COUNTY**

1.0 INTRODUCTION

1.1 Location and Setting

Restoration Systems, L.L.C. (Restoration Systems) has completed restoration of streams and wetlands at the Three Mile Creek Restoration Site (hereafter referred to as the “Site”) to assist the North Carolina Ecosystem Enhancement Program (NCEEP) in fulfilling stream and wetland mitigation goals. The Site, located in southwestern Avery County approximately 5.2 miles northeast of Spruce Pine, North Carolina, provides the minimum of 8021 stream mitigation units and 2.3 riparian wetland mitigation units as outlined in the October 2006 Technical Proposal (Figure 1, Appendix A). The Site is located in United States Geological Survey (USGS) Hydrologic Unit and Targeted Local Watershed 06010108010020 (North Carolina Division of Water Quality Subbasin 04-03-06) of the French Broad River Basin.

Directions to the Site:

- From Asheville or Raleigh, take I-40 to Marion; take NC 226 north through Linville Falls; go left on NC 194; site is ~4.5 miles on left
- Or, From Asheville take 19/23 North to 19E through Spruce Pine to NC 194
- Take a right on NC 194 and travel approximately 1.5 miles
- The Site is on the right
- Latitude, Longitude of Site: 35.9827°N, 81.9843°W (NAD83/WGS84)

1.2 Project Goals and Objectives

A Detailed Stream and Wetland Restoration Plan was completed for the Site in September 2007. The plan outlined methods to complete stream and wetland restoration activities at the Site. A 26.68-acre conservation easement was placed on the Site to incorporate all restoration activities. The Site contains 4.8 acres of hydric soil, Three Mile Creek, 12 unnamed tributaries (UTs) to Three Mile Creek, Fork Creek, and adjacent floodplains, which represent the primary hydrologic features of the Site. The drainage basin size is approximately 5.1 square miles at the Site outfall. The Site watershed is dominated by forest, agricultural land, and sparse industrial/residential development; less than five percent of the upstream watershed is composed of impervious surface.

Prior to construction, the project was characterized by agricultural land utilized for Christmas tree and ornamental landscape nursery plant production, timber harvest, and livestock grazing (Figure 2, Appendix A). Agricultural practices including the maintenance and removal of riparian vegetation and relocation, dredging, and straightening of onsite streams resulted in degraded water quality, unstable channel characteristics (stream entrenchment, erosion, and bank collapse), and reduced storage capacity and floodwater attenuation. In addition, hydric soils were disturbed due to regular plowing and vegetation maintenance, hoof shear from livestock, and the removal of groundwater hydrology inputs from the rerouting and straightening of Site tributaries.

The following objectives were proposed to provide mitigation credit requested under the EEP Request For Proposal (RFP) #16-D06125 dated June 27, 2006.

- Restore aquatic wetland, and riparian habitat within the upper portions of the Three Mile Creek watershed.
- Restore geomorphic stability to the subject stream reaches.
- Restore approximately ten acres of Piedmont/Mountain Bottomland and Piedmont/Low Mountain Alluvial Forests

Restoration of Site streams and wetlands will result in positive benefits for water quality and biological diversity in the Three Mile Creek watershed. Targeted mitigation efforts at the Site were accomplished by:

1. Removing nonpoint and point sources of pollution associated with agricultural practices including a) cessation of broadcasting fertilizer, pesticides, and other agricultural chemicals into and adjacent to the Site and b) provide a forested riparian buffer to treat surface runoff.
2. Reducing sedimentation within onsite and downstream receiving waters by a) reducing bank erosion associated with vegetation maintenance and plowing adjacent to Site streams and wetlands and b) planting a forested riparian buffer adjacent to Site streams and wetlands.
3. Reestablishing stream stability and the capacity to transport watershed flows and sediment loads by restoring a stable dimension, pattern, and profile supported by natural in-stream habitat and grade/bank stabilization structures.
4. Promoting floodwater attenuation by a) reconnecting bankfull stream flows to the abandoned floodplain terrace; b) restoring secondary, dredged, straightened, and entrenched tributaries, thereby reducing floodwater velocities within smaller catchment basins; c) restoration of depressional floodplain wetlands and floodwater storage capacity within the Site, and d) revegetating Site floodplains to increase frictional resistance on floodwaters.
5. Improving aquatic habitat with bed variability and the use of in-stream structures upstream of a reach identified by the North Carolina Wildlife Resources Commission as supporting naturally reproducing rainbow trout populations.
6. Providing a terrestrial wildlife corridor and refuge in an area that is developed for agricultural production.

1.3 Project Structure, Restoration Type, and Approach

As constructed, the Site restored historic stream and wetland functions, which existed onsite prior to channel straightening and dredging, agricultural impacts, and vegetation removal. Stream construction of meandering, C-/E-type stream channel resulted in 6057 linear feet of stream restoration, 618 linear feet of stream enhancement (Level I), 875 linear feet of stream enhancement (Level II), 6421 linear feet of stream preservation, 2.5 acres of riverine wetland restoration, and 2.3 acres of riverine wetland enhancement (Table 1).

Table 1. Site Restoration Structures and Objectives

Restoration Segment/ Reach ID*	Station Range	Mitigation Type	Priority Approach	Existing Linear Footage/ Acreage	Designed Linear Footage/ Acreage**	Comment
Three Mile Creek	1+25-37+30	Restoration	1	3552	3495	Restoration of a straightened channel on new location.
	37+30-42+15	Enhancement I	2	485	485	Restoration of dimension and profile in place.
Fork Creek	0+00-1+58	Enhancement II	NA	158	158	Removal of invasive species and supplemental planting.
Tributary 1	0+00-3+84	Restoration	1	172	384	Restoration of a straightened channel on new location.

Table 1. Site Restoration Structures and Objectives (continued)

Restoration Segment/ Reach ID*	Station Range	Mitigation Type	Priority Approach	Existing Linear Footage/ Acreage	Designed Linear Footage/ Acreage**	Comment
Tributary 2	0+00-1+33	Enhancement I	2	133	133	Restoration of dimension and profile in place.
	NA	Enhancement II	NA	351	351	Removal of invasive species and supplemental planting.
Tributary 3	0+00-3+40	Restoration	1	252	340	Restoration of a ditched and disturbed channel on new location.
	NA	Preservation	NA	1808	1808	Preservation of existing reach
Tributary 4	0+00-2+28	Restoration	1	136	198	Restoration of a ditched and disturbed channel on new location.
	NA	Enhancement II	NA	366	366	Removal of invasive species and supplemental planting.
Tributary 5	0+00-2+44	Restoration	1	150	214	Restoration of a ditched and disturbed channel on new location.
	NA	Preservation	NA	931	931	Preservation of stable, forested stream reaches.
Tributary 6a	0+00-2+44	Restoration	1	124	214	Restoration of a ditched and disturbed channel on new location.
	NA	Preservation	NA	681	681	Preservation of stable, forested stream reaches.
Tributary 7	0+00-2+75	Restoration	1	146	245	Restoration of a ditched and disturbed channel on new location.
Tributary 8	0+00-3+43	Restoration	1	519	343	Restoration of a ditched and disturbed channel on new location.
	242	Restoration	1	242	242	Filling a ditched springhead systems and braiding restoration channel.
Tributary 9	0+00-0+43	NA	NA	0	43	Tie spring head to design channel.
Tributary 11a	0+00-0+92	Restoration	1	72	92	Restoration of a ditched and disturbed channel on new location.
	228	Restoration	1	228	228	Braiding surface flow of restoration channel.
	NA	Preservation	NA	49	49	Preservation of stable, forested stream reaches.
Tributary 11b	0+00-0+62	Restoration	1	51	62	Restoration of a ditched and disturbed channel on new location.
Preservation Tributaries	NA	Preservation	NA	2952	2952	Preservation of stable, forested stream reaches.
Riparian/ Riverine Wetlands	--	Restoration	--	--	2.5	Reconstructing site tributaries, filling ditched channels and ditches, rehydrating floodplain soils, and planting with native forest vegetation.
	--	Enhancement	--	--	2.3	Planting with native forest vegetation.

* Locations of each tributary and restoration type are depicted on Sheets 1-23 in Appendix A (As-built Survey)

** Constructed linear footage excludes crossings or areas outside of easement; therefore, is slightly shorter than stationing depicts.

Priority Approach 1 – Convert incised stream to stable stream at historic floodplain elevation.

Priority Approach 2 – Convert incised stream to stable stream and reestablish floodplain at present location.

1.4 Project History

Completed project activities, reporting history, completion dates, project contacts, and background information are summarized in Tables 2-4.

Table 2. Project Activity and Reporting History

Activity or Report	Data Collection Completion	Actual Completion or Delivery
Restoration Plan	August 2007	September 2007
Construction Completion	NA	January 2009
Site Planting	NA	February 2009
Mitigation Plan/As-builts	March 2009	April 2009

Table 3. Project Contacts Table

Full Delivery Provider	Restoration Systems 1101 Haynes Street, Suite 211 Raleigh, North Carolina 27604 George Howard and John Preyer (919) 755-9490
Designer	Axiom Environmental, Inc. 20 Enterprise Street, Suite 7 Raleigh, NC 27607 Grant Lewis (919) 215-1693
Construction Contractor	Land Mechanics Designs, Inc. 126 Circle G Lane Willow Spring, North Carolina 27592 Lloyd Glover (919) 422-3392
Planting Contractor	Carolina Silvics 908 Indian Trail Road Edenton, North Carolina 27932 Dwight McKinney (919) 523-4375
Surveying Contractor	K2 Design Group, PA 5758 US Highway 70 East Goldsboro, North Carolina 27534 John Rudolph (919) 751-0075

Table 4. Project Background Table

Project County	Avery County, North Carolina
Drainage Area	Three Mile Creek: 5.1 square miles Fork Creek: 1.8 square miles Tributaries: 0.02-0.2 square mile
Drainage impervious cover estimate (%)	< 1
Stream Order	Three Mile Creek: Second and Third Fork Creek: Second Tributaries: First and Second
Physiographic Region	Blue Ridge
Ecoregion	Southern Crystalline Ridges and Mountains
Rosgen Classification of As-built	E-/C-type
Dominant Soil Types	Chandler, Cullowhee, Nikwasi, Micaville, Saunook, Thunder
Reference Site ID	Stone Mountain and Cranberry Creek
USGS HUC	06010108010020
NCDWQ Subbasin	04-03-06
NCDWQ Classification	WS-IV Tr (Stream Index # 7-2-25-(0.7))
Any portion of any project segment 303d listed?	No
Any portion of any project segment upstream of a 303d listed segment?	Yes, the receiving water of the North Toe River (Stream Index Number 7-2-[27.7]b) is listed for impaired biological integrity and turbidity
Reasons for 303d listing or stressor	Not Applicable
% of project easement fenced	+/- 8%

2.0 RESTORATION ACTIVITIES

Primary activities proposed at the Site include 1) stream restoration, 2) stream enhancement (level I and level II), 3) stream preservation, 4) wetland restoration, 5) wetland enhancement, 6) soil scarification, and 7) plant community restoration. Restoration plans constructed 6057 linear feet of stream restoration, 618 linear feet of stream enhancement (Level I), 875 linear feet of stream enhancement (Level II), 6421 linear feet of stream preservation, 2.5 acres of riverine wetland restoration, and 2.3 acres of riverine wetland enhancement. In total, the Site provides 8103 SMUs and 3.7 riverine WMUs (Sheets 1-23, Appendix A).

2.1 Stream Restoration

Portions of Three Mile Creek and eleven of the tributaries are located within a floodplain suitable for design channel excavation on new location. The streams were constructed on new location and the old dredged, straightened, and rerouted channels were abandoned and backfilled. Primary activities designed to restore the channels on new location included 1) belt-width preparation and grading, 2) floodplain bench excavation, 3) channel excavation, 4) installation of channel plugs, 5) backfilling of the abandoned channel, and 6) installation of in-stream structures.

3.1.1 Belt-width Preparation and Grading

The belt-width was prepared and graded; material excavated during grading was stockpiled immediately adjacent to channel segments to be abandoned and backfilled. These segments were backfilled after stream diversion was completed. After preparation of the corridor, the design channel and updated profile survey was developed and the location of each meander wavelength plotted and staked along the profile.

3.1.2 Floodplain Bench Excavation

A bankfull, floodplain bench was created to 1) remove eroding material and collapsing banks, 2) promote overbank flooding during bankfull flood events, 3) reduce the erosive potential of flood waters, and 4) increase the width of the active floodplain. Bankfull benches were created by excavating the adjacent floodplain to bankfull elevations or filling eroded/abandoned channel areas with suitable material. After excavation, or filling of the bench, a relatively level floodplain surface was stabilized with suitable erosion control measures. Planting of the bench with native floodplain vegetation occurred to reduce erosion of bench sediments, reduce flow velocities in flood waters, filter pollutants, and provide wildlife habitat.

3.1.3 Channel Excavation

The channel was constructed within the range of values depicted in the September 2007 Detailed Restoration Plan for the Site.

The stream banks and local belt-width area of constructed channels were planted with shrub and herbaceous vegetation. Deposition of shrub and woody debris into and/or overhanging the constructed channel was encouraged.

Particular attention was directed toward providing vegetative cover and root growth along the outer bends of each stream meander. Live willow stake revetments, available root mats, and/or biodegradable, erosion-control matting were embedded into the break-in-slope to promote more rapid development of an overhanging bank.

3.1.4 Channel Backfilling

After impermeable plugs were installed, the abandoned channels were backfilled. Backfilling was performed primarily by pushing stockpiled materials into the channel. The channels were filled to the extent that onsite material was available and compacted to maximize microtopographic variability, including ruts, ephemeral pools, and hummocks in the vicinity of the backfilled channel.

Borrow material was generated through excavation of groundwater storage depressions throughout the Site landscape. The primary purpose of these depressions was to provide suitable, low permeability material for ditch plugs and backfilling, to increase water storage potential within the wetland restoration area, and to increase potential for biological diversity within the complex.

3.1.5 Marsh Treatment Areas

Shallow wetland marsh treatment areas were excavated in the floodplain to intercept surface waters draining through agricultural areas prior to discharging into the mainstem Three Mile Creek channel. Marsh treatment areas are depicted on Sheets 2-7 (Appendix A) and consisted of shallow depressions that will provide treatment and attenuation of initial stormwater pulses. The outfall of each treatment area was constructed of hydrologically stable rip-rap or other suitable material to protect against headcut migration into the constructed depression and/or upstream stream reaches. It is expected that the treatment areas will fill with sediment and organic matter over time.

3.1.6 In-Stream Structures

In-stream structures were used within the Site for bank stabilization, grade control, and habitat improvement. This included the installation of 2 J-hook vanes, 4 log vanes, 10 rock cross-vanes, and 8 step-pool structures (Sheets 11-15, Appendix A).

J-hook Vanes/Log Vanes

J-hook vanes and log vanes were used to direct high velocity flows during bankfull events towards the center of the channel. J-hook vanes were constructed of boulders approximately 24 inches in minimum width. J-hook vane construction was initiated by imbedding footer rocks into the stream bed for stability to prevent undercutting of the structure. Header rocks were then placed atop the footer rocks at the design elevation. Footer and header rocks create an arm that slopes from the center of the channel upward at approximately 7 to 10 degrees, tying in at the bankfull floodplain elevation. Once the header and footer stones were in place, filter fabric was buried into a trench excavated around the upstream side of the J-hook vane arm. The filter fabric was then draped over the header rocks to force water over the vane. The upstream side of the structure was backfilled with suitable material to the elevation of the header stones.

Log vanes were constructed utilizing large tree trunks harvested from the Site. The tree stems harvested for log cross-vane arms were long enough to be imbedded into the stream channel and extend several feet into the floodplain. Logs create an arm that slopes from the center of the channel upward at approximately 5 to 7 degrees, tying in at the bankfull floodplain elevation. Logs extend from each stream bank at an angle of 20 to 30 degrees. A trench was dug into the stream channel that was deep enough for the head of the log to be at or below the channel invert. The trench was then extended into the floodplain and the log was set into the trench such that the log arm was below the floodplain elevation. Once the vane was in place, filter fabric was toed into a trench on the upstream side of the vane and draped over the structure to force water over the vane. The upstream side of the structure was then backfilled with suitable material.

Rock Cross-vanes

Rock cross-vanes were installed in the channel to 1) sustain bank stability, 2) direct high velocity flows during bankfull events toward the center of the channel, 3) maintain average pool depths throughout the reach, 4) preserve water surface elevations and reconnect bankfull stream flows with the adjacent floodplains, and 5) modify energy distributions through increases in channel roughness and local energy slopes during peak flows.

Rock cross-vanes were constructed of boulders approximately 24 inches in minimum width. Rock cross-vane construction was initiated by imbedding footer rocks into the stream bed for stability to prevent undercutting of the structure. Header rocks were then placed atop the footer rocks at the design elevation. Footer and header rocks create an arm that slopes from the center of the channel upward at approximately 7 to 10 degrees, tying in at the bankfull floodplain elevation. The cross-vane arms at both banks were tied into the bank with a sill to eliminate the possibility of water diverting around the structure. Once the header and footer stones were in place, filter fabric was buried into a trench excavated around the upstream side of the vane arms. The filter fabric was then draped over the header rocks to force water over the vane. The upstream side of the structure was backfilled with suitable material to the elevation of the header stones.

Step-Pool Structures

Step-pool structures were constructed to 1) sustain bank stability, 2) direct high velocity flows during bankfull events toward the center of the channel, 3) preserve water surface elevations and reconnect bankfull stream flows with the adjacent floodplains, and 4) modify energy distributions in steeper stream reaches through increases in channel roughness and local energy slopes during peak flows. Step-pool structures were installed at the infall of restoration reaches of Tributaries 3, 4, and 11A, and the outfall of Tributaries 2, 6A, 7, 8, and 11B to the Main Channel to lower hydrology to the elevation of the tributary or Main Channel, respectively. Step-pool structures were constructed of boulders approximately 24 inches in

minimum width. These structures were constructed similar to a series of rock cross-vanes as described above.

3.1.7 Forded Channel Crossing

Landowner constraints necessitated the installation of two channel fords to allow access to portions of the property isolated by the conservation easement and stream restoration activities. The location of the channel fords are depicted on Sheets 11-15 (Appendix A). The fords were constructed of hydraulically stable rip-rap or suitable rock and are large enough to handle the weight of anticipated vehicular traffic. Approach grades to the fords were at an approximate 15:1 slope and constructed of hard, scour-resistant crushed rock or other permeable material, which is free of fines. The bed elevations of the fords are equal the floodplain elevation above and below the ford to reduce the risk of headcutting.

3.2 Stream Enhancement (Level I and II)

Stream enhancement (Level I and II) on the upper reaches of Tributaries 2 and 4, the lower reach of Three Mile Creek, and Fork Creek entailed the cessation of current land management practices and planting riparian buffers with native forest vegetation. Enhancement Level I also entailed dimension and profile adjustments along with the installation of instream habitat structures. Bank stabilization measures including the use of root/biodegradable erosion control matting, live staking, and bank sloping were implemented where necessary to prevent further bank erosion/degradation. Particular attention was directed toward providing vegetative cover and root growth along the outer bends of each stream meander. Riparian buffers extend a minimum of 30 feet from the top of stream banks to facilitate stream recovery and prevent further degradation of Site streams. In addition, water quality functions and aquatic and wildlife habitat associated with stable riparian corridors/streams will be improved.

3.3 Stream Preservation

The forested/upstream reach of Tributaries 3, 5, 6, and 11 were preserved as part of this project. Based on preliminary analysis and field investigations, these reaches are relatively stable due to a lack of human-induced impacts and a well-developed riparian buffer. These areas will be protected in perpetuity through the establishment of a conservation easement including a minimum 30-foot forested buffer adjacent to each bank of the stream.

3.4 Wetland Restoration and Enhancement

Wetland restoration activities focused on 1) the reestablishment of historic water table elevations, 2) excavation and grading of elevated spoil and sediment embankments, 3) reestablishment of hydrophytic vegetation, and 4) reconstruction of stream corridors.

3.2.1 Reestablishment of Historic Groundwater Elevations

Preconstruction Tributaries 1 and 8 depths averaged 3-5 feet, while the constructed Tributaries 1 and 8 average approximately 0.7-1 foot. Hydric soils adjacent to the incised channels were drained due to lowering of the groundwater tables and a lateral drainage effect from existing stream reaches. Historic flow patterns were restored across the floodplain and channel inverts were reestablished to rehydrate soils adjacent to Site streams. In addition, preconstruction drainage ditches within the Site effectively removed wetland hydrology within the restoration area; these ditches were filled to rehydrate hydric soils. Filling of these ditches and restoring Site tributaries resulted in the restoration of jurisdictional hydrology to riverine wetlands.

3.2.2 Excavation and Grading of Elevated Spoil and Sediment Embankments

Spoil/sediment deposition adjacent to the preconstruction channels and area ditches were removed. Spoil materials were used to fill of onsite ditches, which represented a critical element of onsite wetland restoration.

3.2.3 Hydrophytic Vegetation

Onsite wetland areas endured significant disturbance from land use activities prior to construction such as land clearing and other anthropogenic maintenance. Wetland areas were revegetated with native vegetation typical of wetland communities in the region. Emphasis focused on developing a diverse plant assemblage. Plant Community Restoration is discussed in more detail in Section 4.0.

4.0 PLANT COMMUNITY RESTORATION

The Site was planted with native tree species in January 2009. Onsite observations, reference forest, and pertinent community descriptions from *Classification of the Natural Communities of North Carolina* (Schafale and Weakley 1990) were used to develop the primary plant community association promoted during restoration efforts. Before plant community restoration was implemented, the entire Site was scarified. Scarification was performed as linear bands directed perpendicular to the land slope. Subsequently, community restoration was initiated on scarified surfaces. The Site was planted with species characteristic of Piedmont/Mountain Bottomland Forest within wetland areas, and a Piedmont/Low Mountain Alluvial Forest within the remainder of the Site. Fourteen tree species were planted at the Site; they are as shown in Table 5 (also in Figure 4, Appendix A).

Bare-root seedlings of canopy and understory tree species were planted within the Site at a density of approximately 2790 stems per acre within the stream-side assemblage and a density of approximately 660 stems per acre within the Piedmont/Mountain Bottomland Forest and Piedmont/Low Mountain Alluvial Forest communities. Bare-root seedlings were hand planted to minimize wetland soil disturbance. A total of 19,600 diagnostic tree and shrub seedlings were planted in support of Site restoration.

Table 5. Planted Tree Species

Vegetation Association	Piedmont/Mountain Bottomland Forest		Piedmont/Low Mountain Alluvial Forest		Stream-side Assemblage		TOTAL
	5.4		4.0		4.8		
Area (acres)							14.2
Species	Number planted*	% of total	Number planted*	% of total	Number planted**	% of total	Number planted
Swamp chestnut oak (<i>Quercus michauxii</i>)	600	17	--	--	--	--	600
Cherrybark oak (<i>Quercus pagoda</i>)	900	25	--	--	--	--	900
Sycamore (<i>Platanus occidentalis</i>)	500	14	300	12	--	--	600
Hackberry (<i>Celtis laevigata</i>)	600	17	--	--	--	--	600
Green ash (<i>Fraxinus pennsylvanica</i>)	400	11	600	22	--	--	1000
Pawpaw (<i>Asimina triloba</i>)	300	8	300	12	--	--	600
Northern red oak (<i>Quercus rubra</i>)	--	--	400	15	--	--	400
White oak (<i>Quercus alba</i>)	--	--	400	15	--	--	400
Black cherry (<i>Prunus serotina</i>)	--	--	300	12	--	--	300
Red bud (<i>Cercis canadensis</i>)	--	--	--	--	2000	15	2000
Persimmon (<i>Diospyros virginiana</i>)	--	--	300	12	2300	17	2600
Silky dogwood (<i>Cornus amomum</i>)	300	8	--	--	3900	29	4200
Buttonbush (<i>Cephalanthus occidentalis</i>)	--	--	--	--	2600	19.5	2600
Elderberry (<i>Sambucus canadensis</i>)	--	--	--	--	2600	19.5	2600
TOTAL	3600	100	2600	100	13,400	100	19,600

5.0 MONITORING PLAN

The Three Mile Stream and Wetland Restoration Site monitoring plan will entail analysis of the stream channel, hydrology, and vegetation. Monitoring of restoration efforts will be performed for a minimum of 5 years or until success criteria are fulfilled. Locations of stream cross-sections and vegetation monitoring plots are depicted in Sheets 11-15 (Appendix A).

5.1 Stream

After completion of Site construction, one 3000-linear foot reach of Three Mile Creek was monitored for geomorphic activity along the restored channel. In addition, 11 stream cross-sections were established and permanently monumented within the monitoring reach.

Annual fall monitoring will include development of channel cross-sections on riffles and pools, pebble counts, and a water surface profile of the channel. The data will be presented in graphic and tabular format. Data to be presented will include 1) cross-sectional area, 2) bankfull width, 3) average depth, 4) maximum depth, 5) width-to-depth ratio, 6) water surface slope, and 7) stream substrate composition. A photographic record that will include preconstruction and post-construction pictures has been initiated (Appendix B).

Baseline/as-built measurements, performed in November 2008, emulated the proposed channel morphology; data are included in Tables 6 and 7A to 7C, and cross-section and longitudinal profile plots can be found in Appendix C.

5.2 Hydrology

After hydrological modifications were completed at the Site, four continuously recording, surficial monitoring gauges were installed in accordance with specifications in *Installing Monitoring Wells/Piezometers in Wetlands* (NCWRP 1993). Monitoring gauges were set to a depth of approximately 24 inches below the soil surface. Screened portions of each gauge were surrounded by filter fabric, buried in screened well sand, and sealed with a bentonite cap to prevent siltation and surface flow infiltration during floods.

Three groundwater gauges were installed in wetland restoration and enhancement areas to provide representative coverage of the Site. One additional gauge was placed in a reference wetland area. Hydrological sampling will be performed in restoration and reference areas during the growing season at daily intervals necessary to satisfy the hydrology success criteria within each physiographic landscape area (USEPA 1990).

5.3 Vegetation

Following Site planting, eight (10-meter by 10-meter) vegetation monitoring plots were established within the Site. During the first year, vegetation will receive a cursory, visual evaluation on a periodic basis to ascertain the degree of overtopping of planted elements by nuisance species. Subsequently, quantitative sampling of vegetation will be performed each year using the *CVS-EEP Protocol for Recording Vegetation Level 1-2 Plot Sampling Only* (Version 4.0) (Lee et al. 2006) in September of the first monitoring year and between June 1 and September 30 for each subsequent year until the vegetation success criteria are achieved.

A photographic record of plant growth will be included in each annual monitoring report.

6.0 SUCCESS CRITERIA

6.1 Stream Success Criteria

Success criteria for stream restoration will include 1) successful classification of the reach as a functioning stream system (Rosgen 1996) and 2) channel variables indicative of a stable stream system. Annual monitoring will continue until success criteria are met and no less than two bankfull events have occurred, as determined by in situ crest gauge, otherwise monitoring will continue until the second bankfull event has occurred.

Visual assessment of in-stream structures will be conducted to determine if failure has occurred. Failure of a structure may be indicated by collapse of the structure, undermining of the structure, abandonment of the channel around the structure, and/or stream flow beneath the structure.

**Table 6. Baseline Morphology and Hydraulic Summary
Threemile Creek**

Parameter	USGS Gage Data			Pre-Existing Condition			Project Reference Stream			Design			As-built		
	Min	Max	Med	Min	Max	Med	Min	Max	Med	Min	Max	Med	Min	Max	Med
BF Width (ft)	17.4	23	20.7	27.2	33	30.1	21	29	25	23.1	27.8	26.1			
Floodprone Width (ft)	USGS gage data is unavailable for this project														
BF Cross Sectional Area (ft ²)	32	250	100			100	50	350	250						250
BF Mean Depth (ft)	1.5	2.8	2.2	1.4	1.7	1.6	1.5	2.1	1.8	1.8	2.2	2.1			53.1
BF Max Depth (ft)	1.9	3.3	2.8	2.2	2.6	2.4	2	2.7	2.3	2.2	2.7	2.5			2.1
Width/Depth Ratio	6.6	14.5	10	16.1	23.8	20	12	16	14	12	15	12			2.5
Entrenchment Ratio	1.5	8	6.5	3	3.7	3.4	2.2	7.4	4.4	9	11	10			
Bank Height Ratio	1.9	2.5	1.8	1	1.6	1.3	1	1.3	1.1			1			
Wetted Perimeter(ft)			===			===						28			
Hydraulic radius (ft)			===			===						2			
Pattern															
Channel Beltwidth (ft)	No pattern of riffles and pools due to straightening activities			40	55	46.8	27	76	47	27	76	47	27	76	47
Radius of Curvature (ft)				62.4	312.1	94.5	45	252	52	45	252	52	45	252	52
Meander Wavelength (ft)				101.7	273.2	199.4	136	252	200	136	252	200	136	252	200
Meander Width ratio				1.3	1.8	1.6	1.2	3	2	1.2	3	2	1.2	3	2
Profile															
Riffle length (ft)	No pattern of riffles and pools due to straightening activities					===			===			17	111	51	
Riffle slope (ft/ft)				0.26%	1.83%	1.18%	1.94%	2.91%	2.43%	0.43%	4.80%	1.54%			
Pool length (ft)						===			===			26	78	46	
Pool spacing (ft)				65.2	166.7	104.3	67	176	115	76	176	126			
Substrate															
d50 (mm)			===			===			===						===
d84 (mm)			===			===			===						===
Additional Reach Parameters															
Valley Length (ft)			===			===			===						4057
Channel Length (ft)			===			===			===						3528
Sinuosity		1.1				1.2			1.15						1.15
Water Surface Slope (ft/ft)		1.03%				1.21%			0.97%						0.98%
BF slope (ft/ft)			===			===			===						===
Rosgen Classification		C/E4				Cb3			Ce4						C/E 3/4

6.2 Hydrologic Success Criteria

Target hydrological characteristics include saturation or inundation for 5 to 12.5 percent of the growing season, during average climatic conditions. During growing seasons with atypical climatic conditions, groundwater gauges in reference wetlands may dictate threshold hydrology success criteria (75 percent of reference). These areas are expected to support hydrophytic vegetation. If wetland parameters are marginal as indicated by vegetation and/or hydrology monitoring, a jurisdictional determination will be performed.

6.2 Vegetation Success Criteria

Success criteria have been established to verify that the vegetation component supports community elements necessary for forest development. Success criteria are dependent upon the density and growth of characteristic forest species. Additional success criteria are dependent upon density and growth of "Characteristic Tree Species." Characteristic Tree Species include planted species, species identified through inventory of a reference (relatively undisturbed) forest community used to orient the planting plan, and appropriate Schafale and Weakley (1990) community descriptions. All species planted and identified in the reference forest will be utilized to define "Characteristic Tree Species" as termed in the success criteria (Table 8).

Table 8. Characteristic Tree Species

Planted Species	Reference Species
Pawpaw (<i>Asimina triloba</i>)	Red maple (<i>Acer rubrum</i>)
Sugarberry (<i>Celtis laevigata</i>)	Ironwood (<i>Carpinus caroliniana</i>)
Redbud (<i>Cercis canadensis</i>)	Dogwood (<i>Cornus florida</i>)
Buttonbush (<i>Cephalanthus occidentalis</i>)	Strawberry bush (<i>Euonymus americana</i>)
Silky dogwood (<i>Cornus amomum</i>)	Spice bush (<i>Lindera benzoin</i>)
Persimmon (<i>Diospyros virginiana</i>)	Tulip poplar (<i>Liriodendron tulipifera</i>)
Green ash (<i>Fraxinus pennsylvanica</i>)	Sycamore (<i>Platanus occidentalis</i>)
Sycamore (<i>Platanus occidentalis</i>)	White pine (<i>Pinus strobes</i>)
Black cherry (<i>Prunus serotina</i>)	Black cherry (<i>Prunus serotina</i>)
White oak (<i>Quercus alba</i>)	White oak (<i>Quercus alba</i>)
Swamp chestnut oak (<i>Quercus michauxii</i>)	Red oak (<i>Quercus</i> sp.)
Cherrybark oak (<i>Quercus pagoda</i>)	Rhododendron (<i>Rhododendron</i> sp.)
Northern red oak (<i>Quercus rubra</i>)	Wild azalea (<i>Rhododendron periclymenoides</i>)
Elderberry (<i>Sambucus canadensis</i>)	Black locust (<i>Robinia pseudoacacia</i>)
	Hemlock (<i>Tsuga</i> sp.)

An average density of 320 stems per acre of Characteristic Tree Species must be surviving at the end of the third monitoring year. Subsequently, 290 Characteristic Tree Species per acre must be surviving at the end of year 4 and 260 Characteristic Tree Species per acre at the end of year 5.

If vegetation success criteria are not achieved, based on average density calculations from combined plots over the entire restoration area, supplemental planting may be performed with tree species approved by

regulatory agencies. Supplemental planting will be performed as needed until achievement of vegetation success criteria.

7.0 MONITORING REPORT SUBMITTAL

An Annual Stream and Wetland Monitoring Report will be prepared at the end of each monitoring year (growing season). The monitoring report will depict the sample plot and quadrant locations and include photographs which illustrate Site conditions. Data compilation and analyses will be presented including graphic and tabular format, where practicable.

8.0 CONTINGENCY

In the event that success criteria are not fulfilled, a mechanism for contingency will be implemented.

Stream

In the event that stream success criteria are not fulfilled, a mechanism for contingency will be implemented. Stream contingency may include, but may not be limited to 1) structure installation; 2) repair of dimension, pattern, and/or profile variables; and 3) bank stabilization. The method of contingency is expected to be dependent upon stream variables that are not in compliance with success criteria. Primary concerns, which may jeopardize stream success include 1) headcut migration through the Site, and/or 2) bank erosion.

Headcut Migration Through the Site

In the event that a headcut occurs within the Site (identified visually or through onsite measurements [i.e. bank-height ratios exceeding 1.4]), provisions for impeding headcut migration and repairing damage caused by the headcut will be implemented. Headcut migration may be impeded through the installation of in-stream grade control structures (rip-rap sill and/or log cross-vane weir) and/or restoring stream geometry variables until channel stability is achieved. Channel repairs to stream geometry may include channel backfill with coarse material and stabilizing the material with erosion control matting, vegetative transplants, and/or willow stakes.

Bank Erosion

In the event that severe bank erosion occurs at the Site resulting in elevated width-to-depth ratios, contingency measures to reduce bank erosion and width-to-depth ratio will be implemented. Bank erosion contingency measures may include the installation of cross-vane weirs and/or other bank stabilization measures. If the resultant bank erosion induces shoot cutoffs or channel abandonment, a channel may be excavated which will reduce shear stress to stable values.

Hydrology

Hydrological contingency will require consultation with hydrologists and regulatory agencies if wetland hydrology enhancement is not achieved. Floodplain surface modifications, including construction of ephemeral pools, represent a likely mechanism to increase the floodplain area in support of jurisdictional wetlands. Recommendations for contingency to establish wetland hydrology will be implemented and monitored until Hydrology Success Criteria are achieved.

Vegetation



If vegetation success criteria are not achieved based on average density calculations from combined plots over the entire restoration area, supplemental planting may be performed with tree species approved by regulatory agencies. Supplemental planting will be performed as needed until achievement of vegetation success criteria.

9.0 REFERENCES

- Lee, M.T., R.K. Peet, S.D. Roberts, and T.R. Wentworth. 2006. CVS-EEP Protocol for Recording Vegetation. Version 4.0. North Carolina Department of Environment and Natural Resources, Ecosystem Enhancement Program. Raleigh, North Carolina.
- North Carolina Wetlands Restoration Program (NCWRP). 1993. Installing Monitoring Wells/Piezometers in Wetlands (WRP Technical Note HY-IA-3.1). North Carolina Department of Environment, Health, and Natural Resources, Raleigh, North Carolina
- Rosgen D. 1996. Applied River Morphology. Wildland Hydrology. Pagosa Springs, Colorado.
- Schafale, M.P. and A.S. Weakley. 1990. Classification of the Natural Communities of North Carolina: Third Approximation. North Carolina Natural Heritage Program, Division of Parks and Recreation, North Carolina Department of Environment, Health, and Natural Resources. Raleigh, North Carolina.
- United States Environmental Protection Agency (USEPA). 1990. Mitigation Site Type Classification (MiST). USEPA Workshop, August 13-15, 1989. USEPA Region IV and Hardwood Research Cooperative, NCSU, Raleigh, North Carolina.

Appendix A.
Figures and As-built Construction Sheets

Directions to the Site from Spruce Pine, North Carolina
 -> Travel North on NC Route 19E for ~ 5 miles
 -> Turn Right on NC Route 194 and Travel ~1.5 miles
 -> Site is on Right
 -> Latitude, Longitude : 35.9827°N, 81.9843°W (NAD83/WGS84)

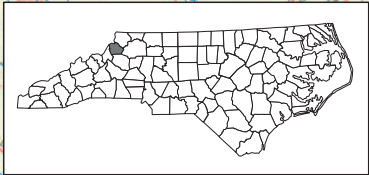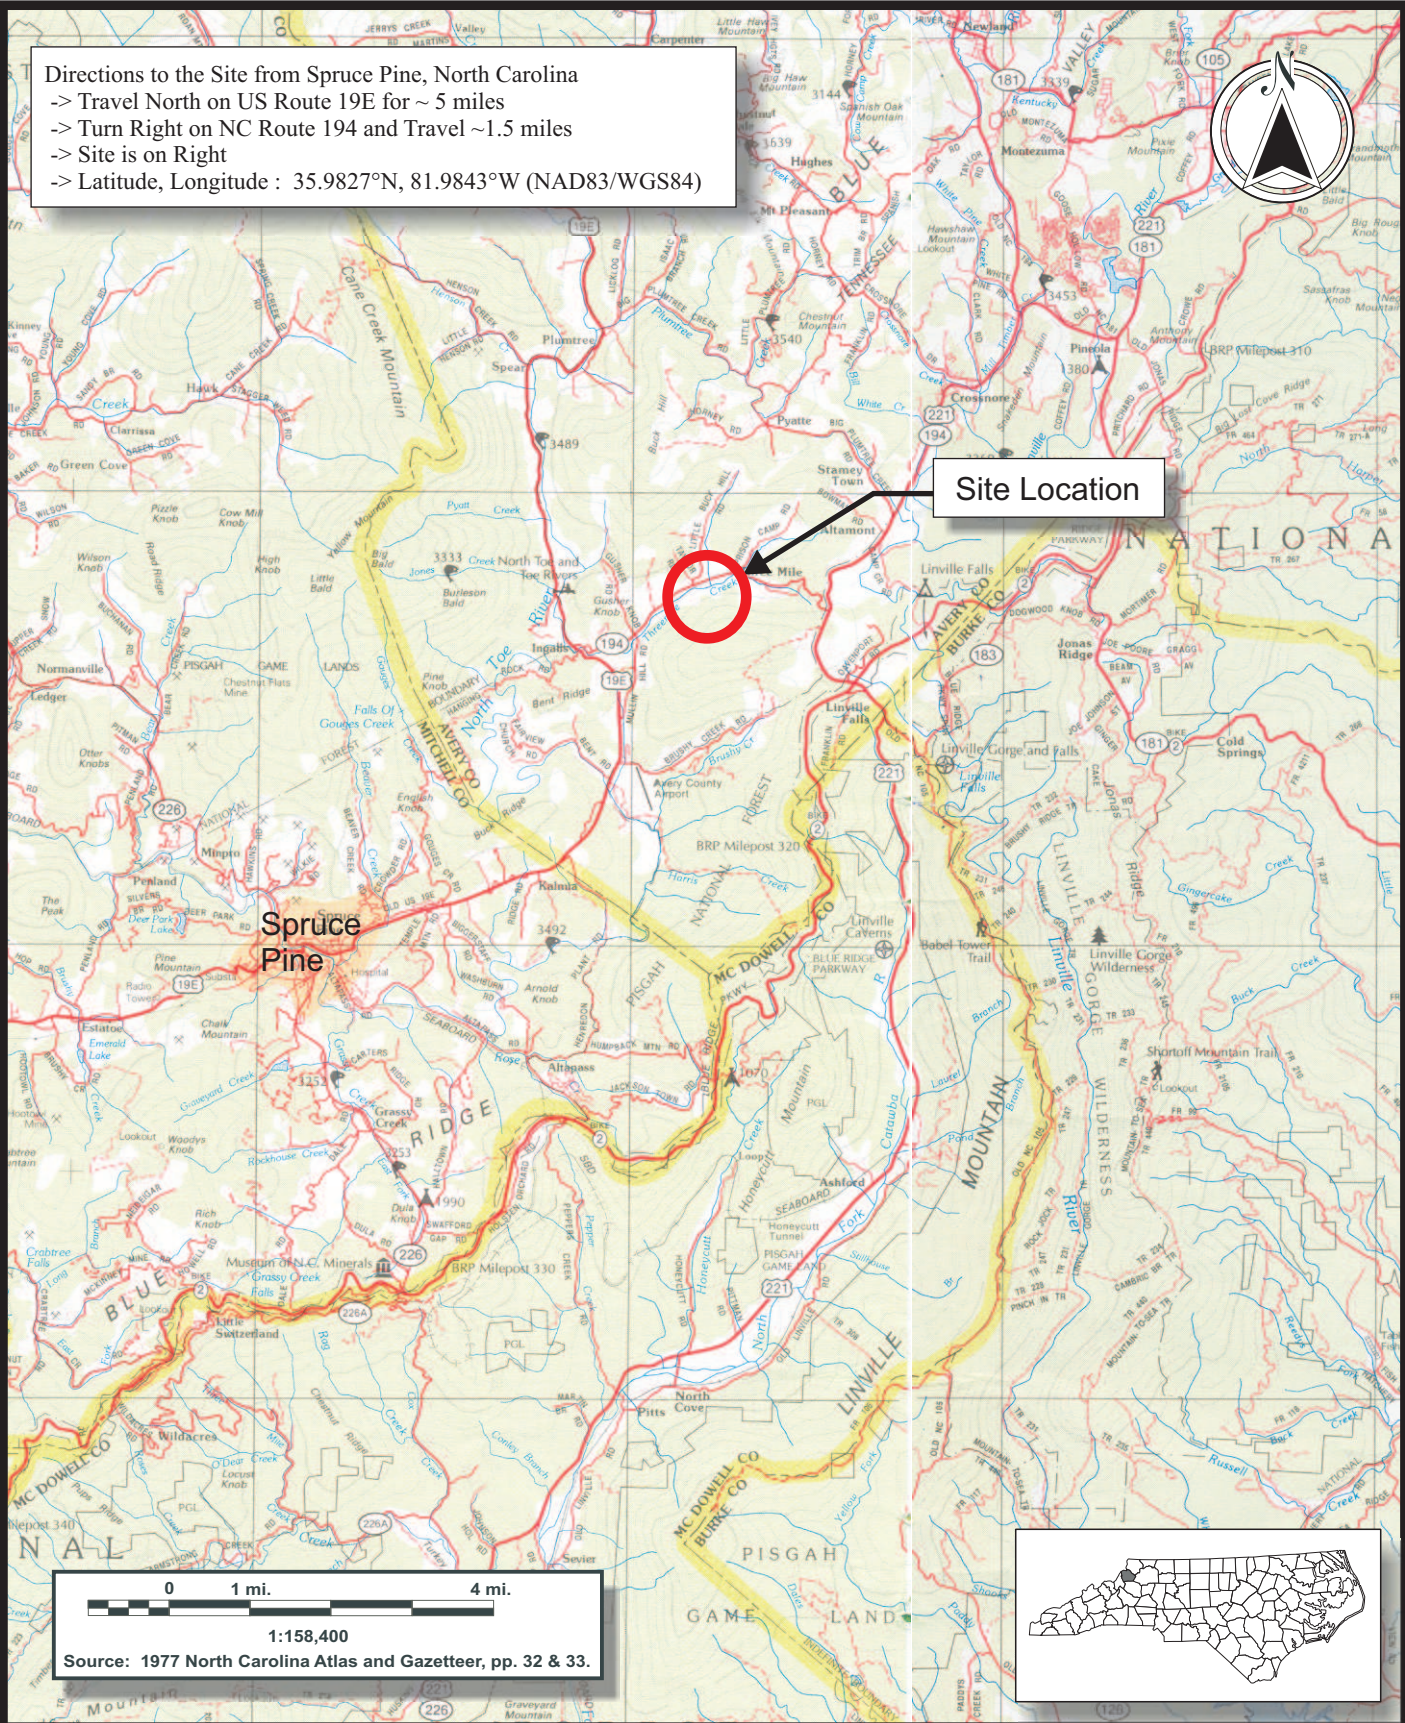


2126 Rowland Pond Dr
 Willow Spring, NC 27592
 (919) 215-1693
 (919) 341-3839 fax

SITE LOCATION
THREE MILE CREEK RESTORATION SITE
 Avery County, North Carolina

Dwn. by:	CLF
Ckd by:	WGL
Date:	Nov 2008
Project:	07-004


FIGURE
1

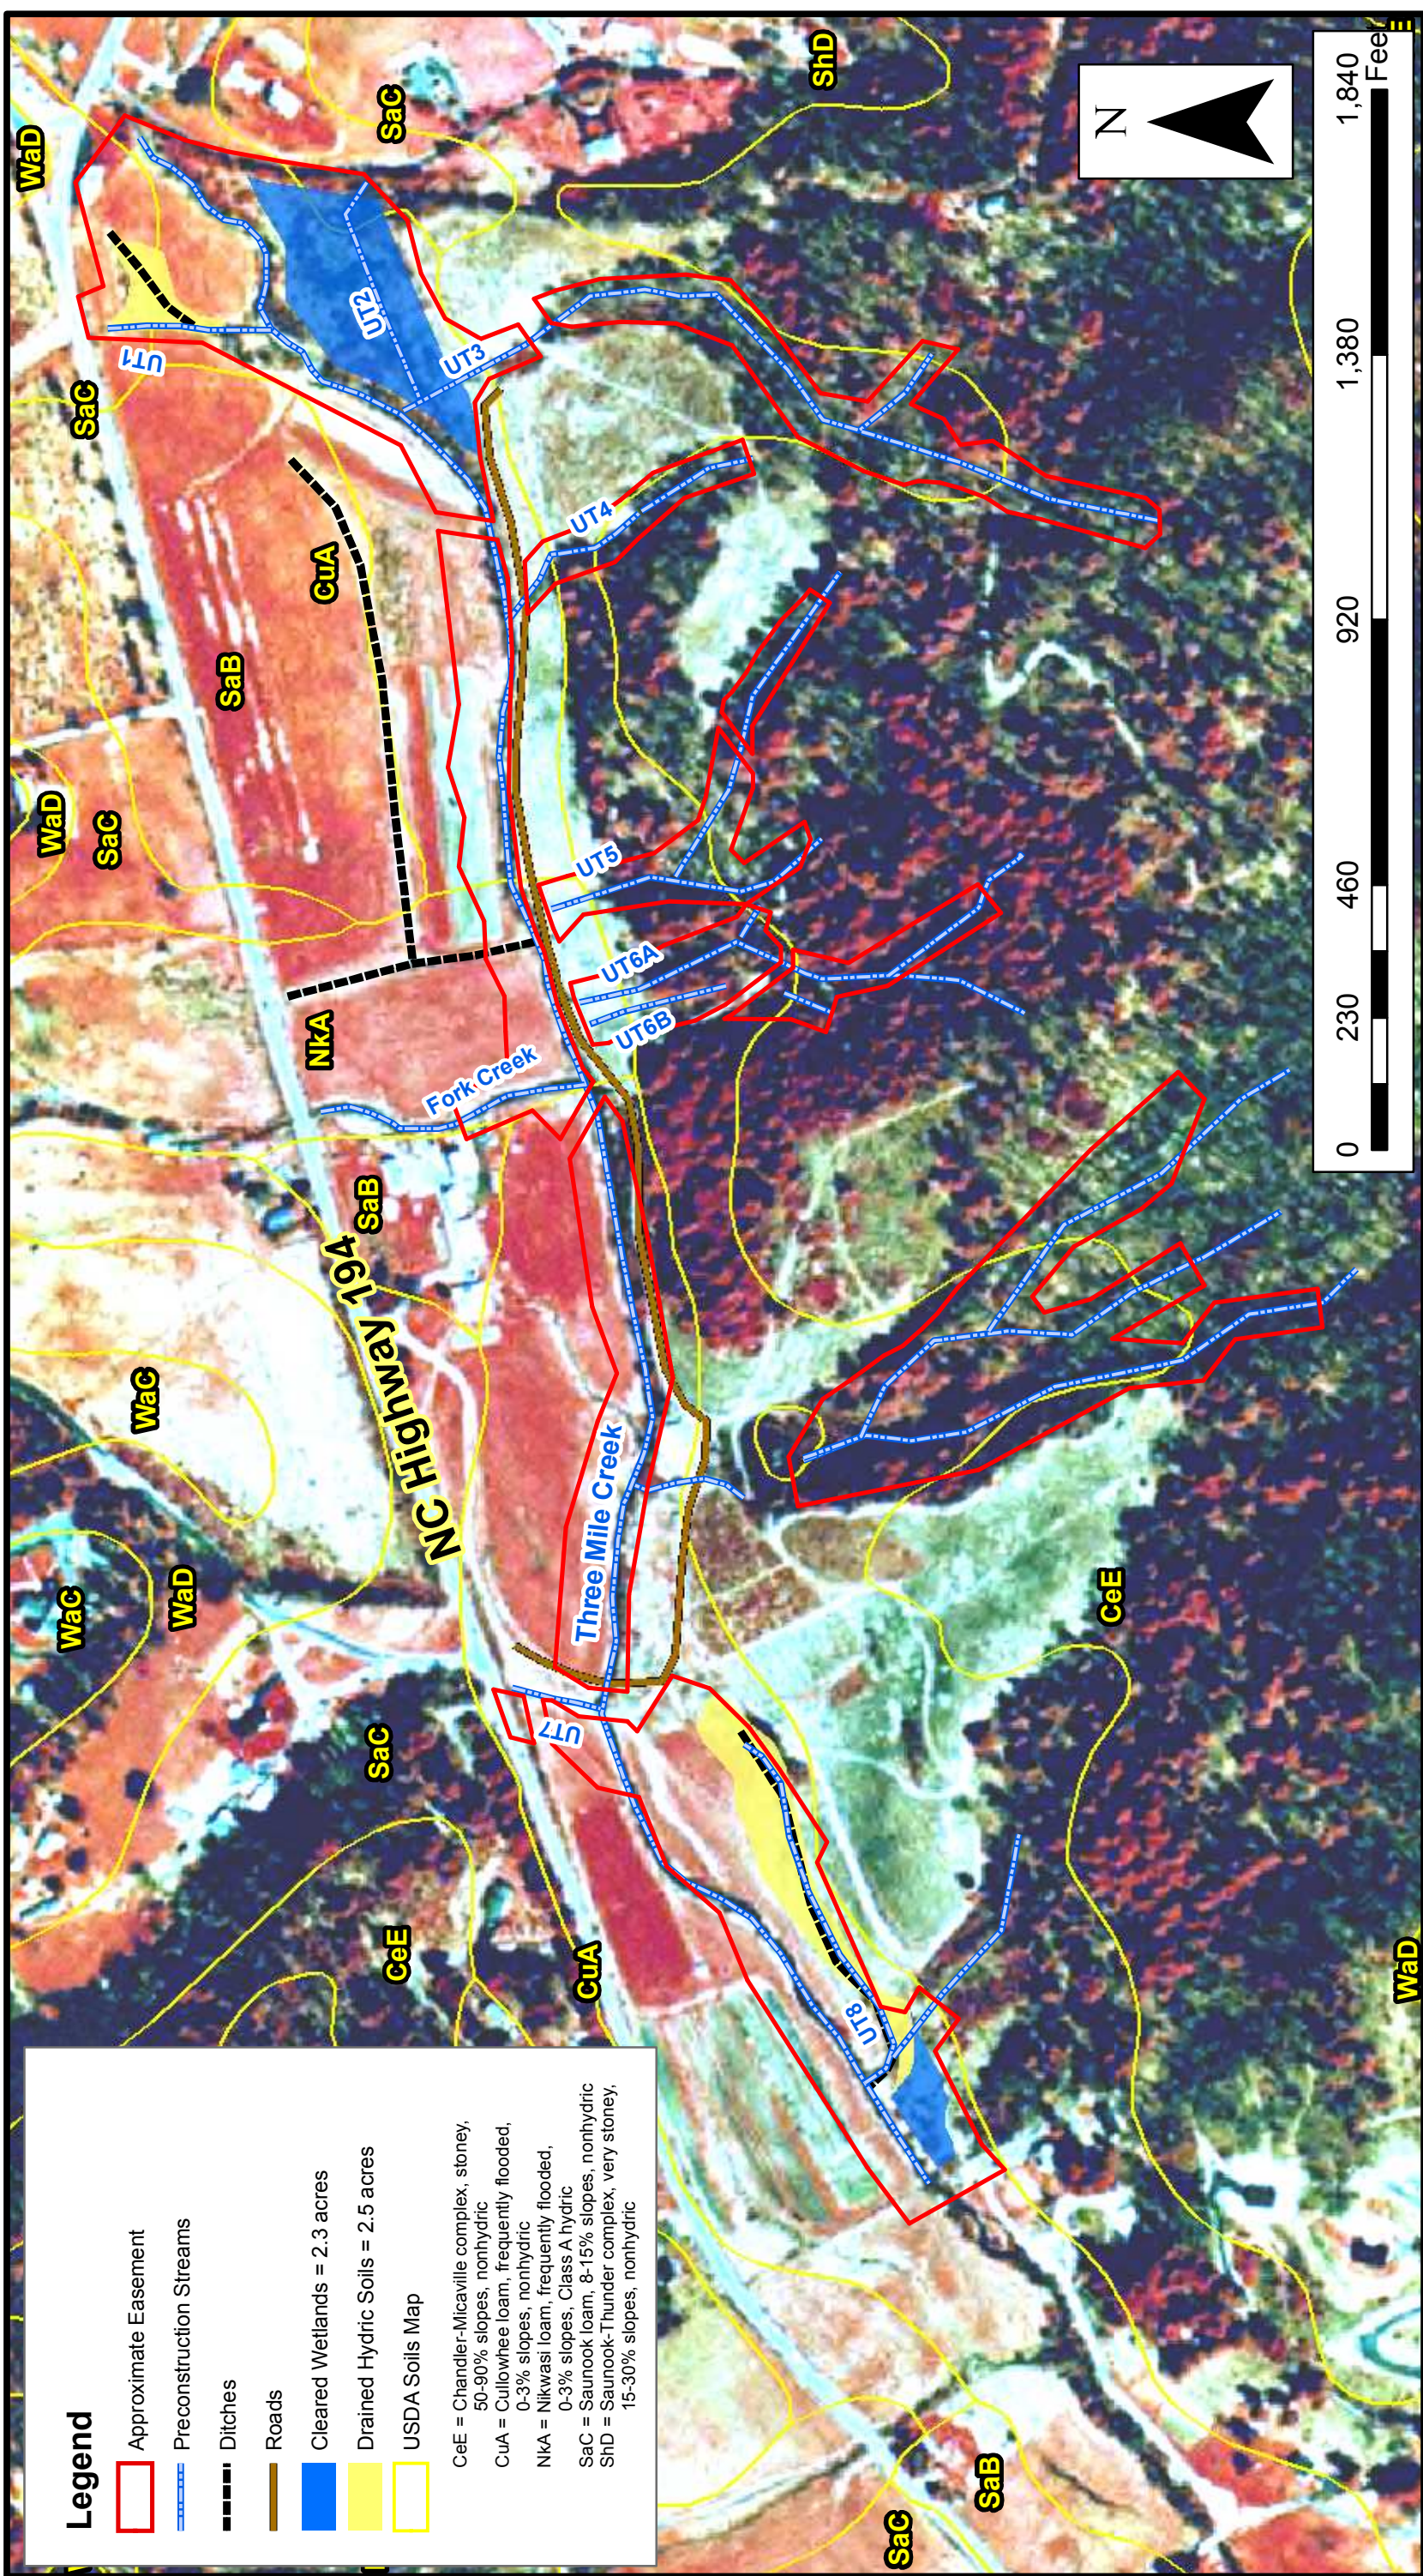


Legend

- Approximate Easement
 - Preconstruction Streams
 - Ditches
 - Roads
 - Cleared Wetlands = 2.3 acres
 - Drained Hydric Soils = 2.5 acres
 - USDA Soils Map
- CeE = Chandler-Micaville complex, stony, 50-90% slopes, nonhydric
 CuA = Cullowhee loam, frequently flooded, 0-3% slopes, nonhydric
 NkA = Nikwasi loam, frequently flooded, 0-3% slopes, Class A hydric
 SaC = Saunook loam, 8-15% slopes, nonhydric
 ShD = Saunook-Thunder complex, very stoney, 15-30% slopes, nonhydric

PRECONSTRUCTION CONDITIONS
THREE MILE CREEK RESTORATION SITE
 Avery County, North Carolina

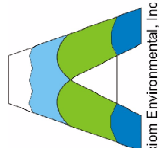
 2126 Rowland Pond Dr.
 Willow Spring, NC 27592
 (919) 215-1693
 (919) 341-3839 (fax)

Dwn. By:	CLF	FIGURE
Date:	Nov 2008	2
Project:	07-004	

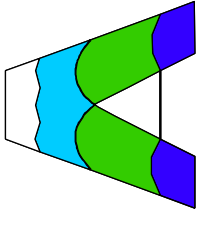

Axiom Environmental, Inc.



NOTES/REVISIONS

Project:
**Threemile Creek
 Restoration
 Site**
**Avery County
 North Carolina**



Title:
**TYPICAL
 STRUCTURE
 DETAILS**

Scale: NO SCALE
 Date: July 2007
 Project No.: 07-004
 FIGURE NO.
3A

- NOTES:
1. EXPOSED VANE OCCUPIES 1/3 OF THE BANKFULL WIDTH OF THE CHANNEL.
 2. SUPPORT PILINGS SHALL BE PENCIL SHARPENED, UNTREATED, PEELED, A MINIMUM OF 4 INCHES IN TOP DIAMETER, AND 8 FEET LONG.
 3. LOGS SHALL CONSIST OF NATIVE HARDWOOD SPECIES, RELATIVELY STRAIGHT WITH A MINIMUM DIAMETER OF 15 INCHES AND APPROXIMATELY 35 FEET IN LENGTH.
 4. USE FILTER FABRIC TO SEAL GAPS BETWEEN LOGS.

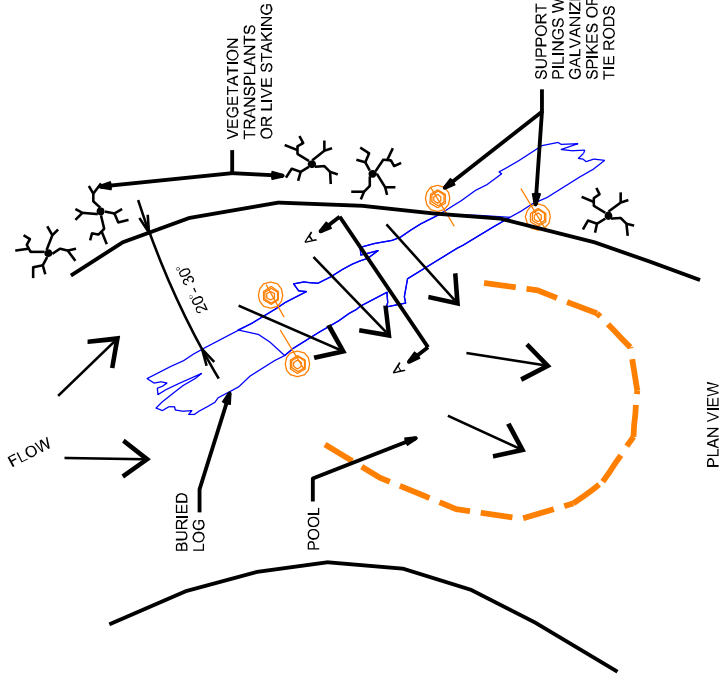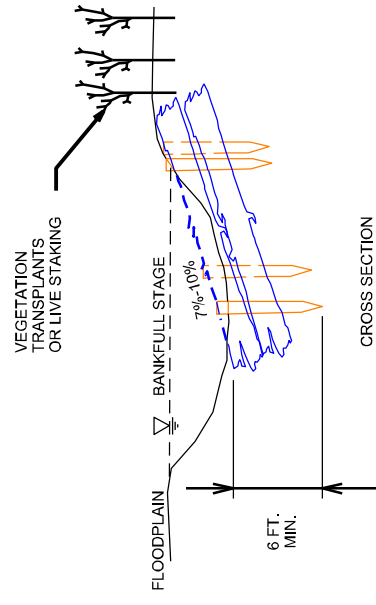


TYPICAL LOG VANE

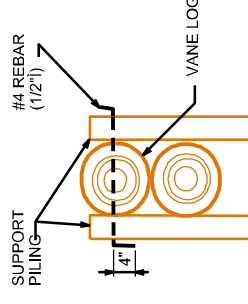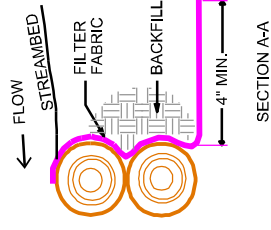

- CLOSE-UP OF SUPPORT PILING
- SUPPORT PILING SHOULD BE CUT SLIGHTLY BELOW THE TOP LOG
 - AFTER PLACING LOGS, DRIVE REBAR THROUGH LOGS AND BEND ENDS.
 - REBAR MAY BE REPLACED WITH LAG BOLT WITH APPROVAL OF THE ENGINEER.

NOTE: HEADER AND FOOTER STONES ARE LARGE, ANGULAR BOULDERS MEASURING A MINIMUM OF 32" ALONG THE SHORTEST DIMENSION.

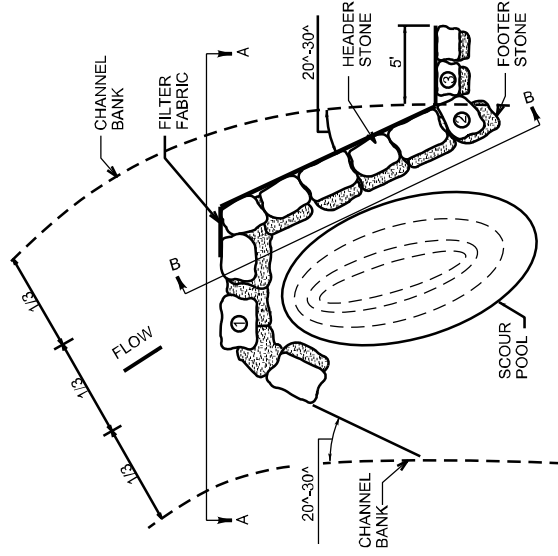


PLAN VIEW


TYPICAL J-HOOK VANE

REACH	ARM LENGTH (FT.)	CHANNEL DEPTH (FT.)
MAIN CHANNEL	20.0	2.1 - 2.5
FORK CREEK	15.0	1.8
TRIBUTARIES	8.0	0.4 - 0.8

PROFILE B-B

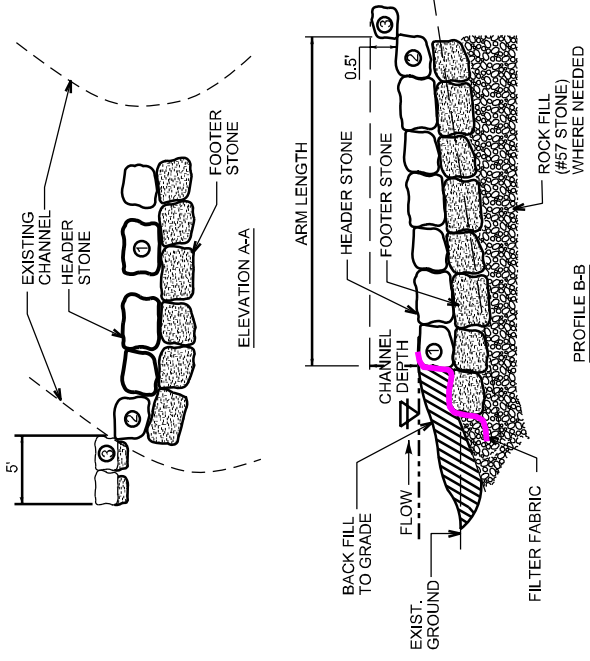


NOTE: HEADER AND FOOTER STONES ARE LARGE, ANGULAR BOULDERS MEASURING A MINIMUM OF 32" ALONG THE SHORTEST DIMENSION.

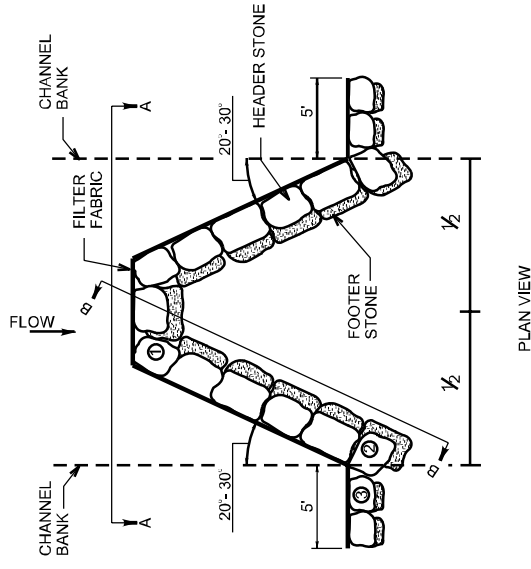


PLAN VIEW

TYPICAL CROSS-VANE

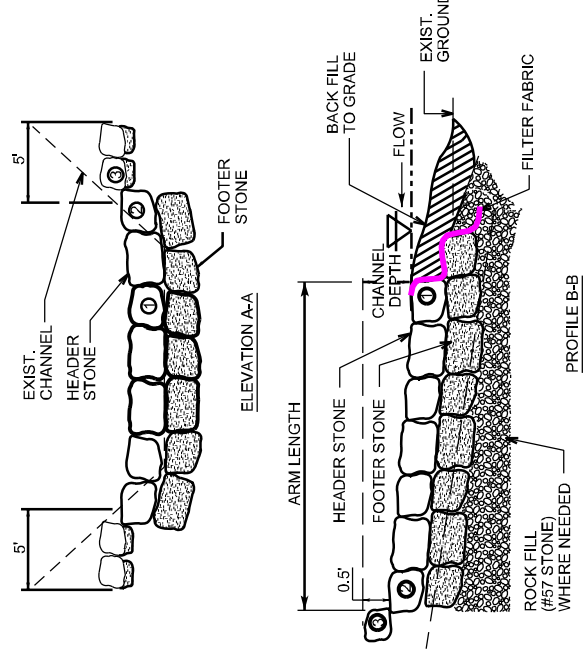

PROFILE B-B

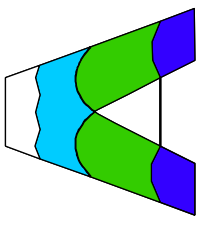

Axiom Environmental, Inc.


NOTES/REVISIONS

Project:
**Threemile Creek
 Restoration
 Site**
**Avery County
 North Carolina**




Title:
**TYPICAL
 STRUCTURE
 DETAILS**

Scale: NO SCALE
 Date: July 2007
 Project No.: 07-004
 FIGURE NO.
3B


FILL SCOULL HOLE TO MINIMUM DEPTH
 6 INCHES CLASS 1 STONE
 ON TOP OF FILTER FABRIC

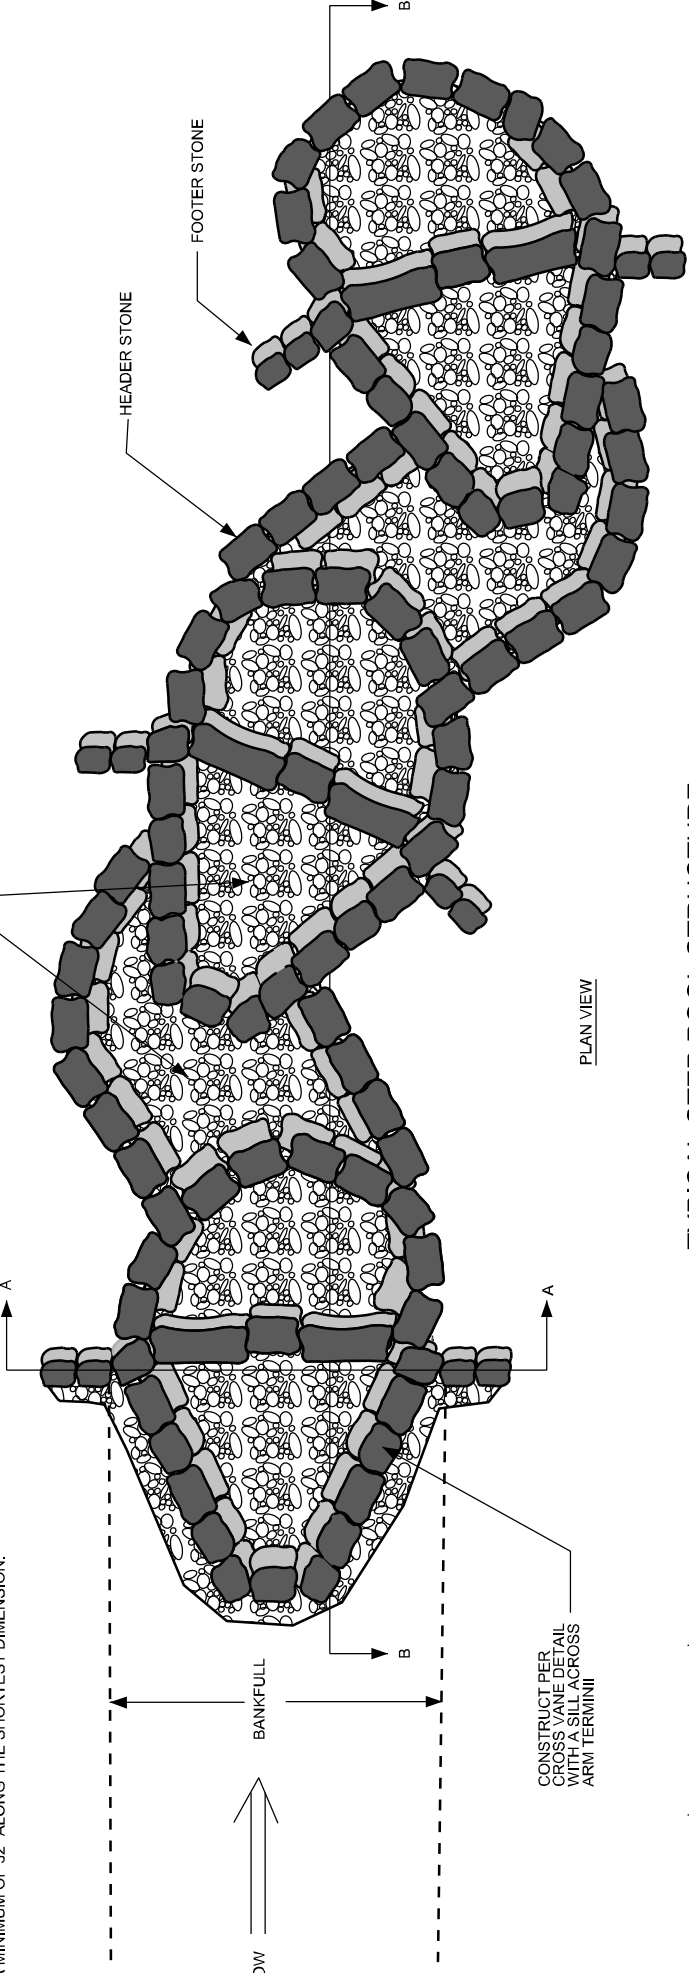


TYPICAL STEP POOL STRUCTURE

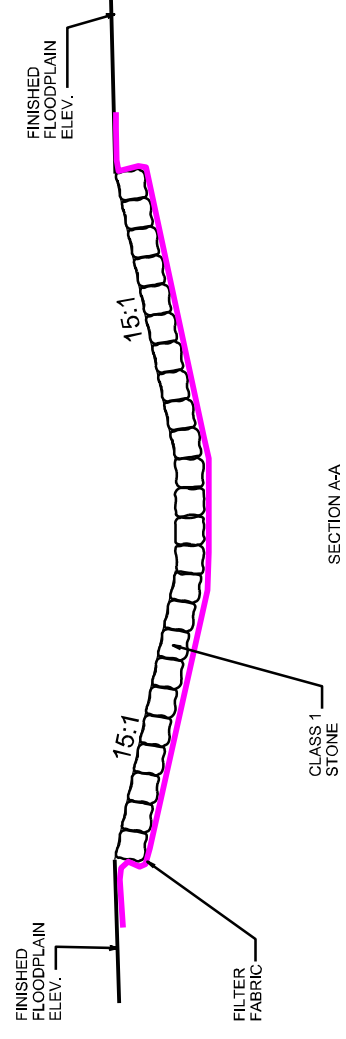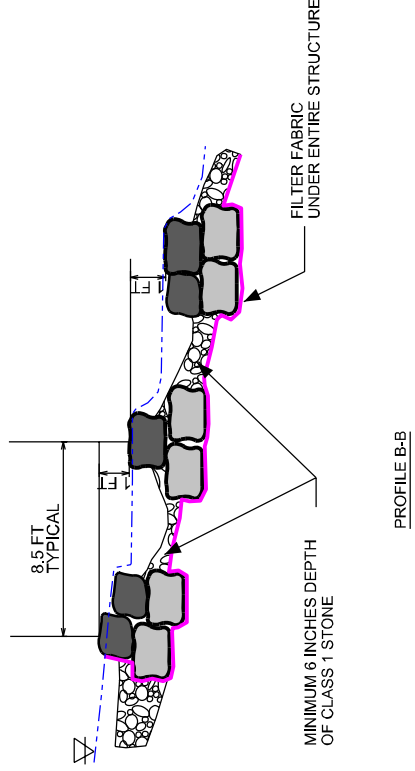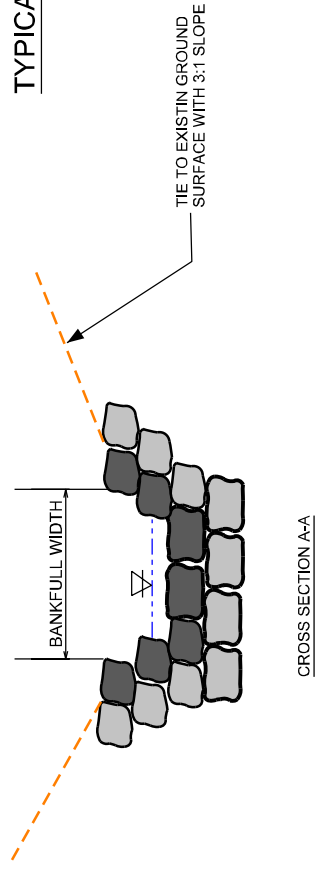

- NOTES:
- KEEP FORD CROSS FALL WITHIN 1-2% OF STREAM GRADIENT.
 - FILL VOIDS BETWEEN CLASS 1 STONE WITH AGGREGATE BASE COURSE CLASS A TO CREATE DRIVEABLE SURFACE.

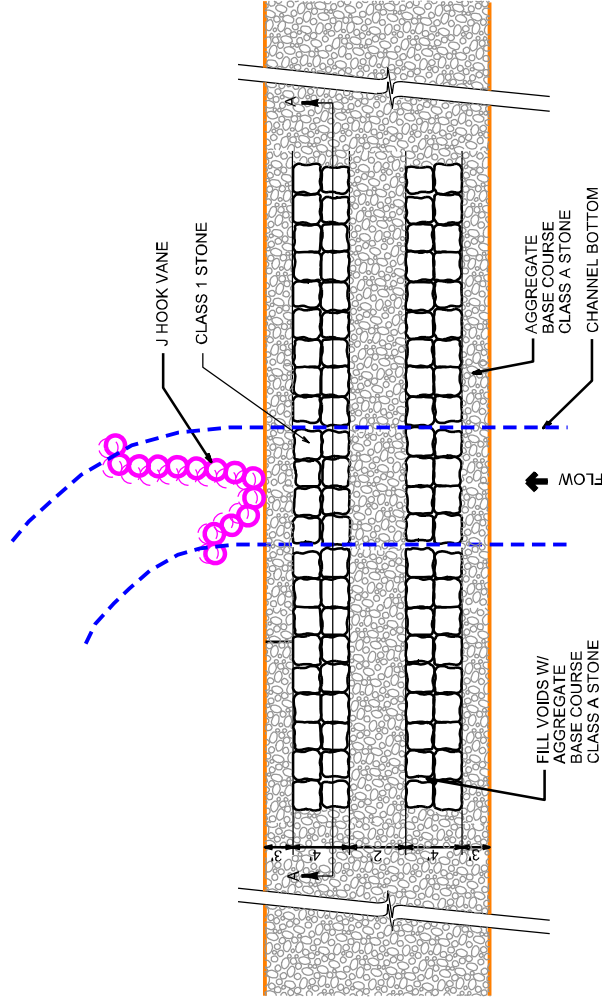

PERMANENT CHANNEL FORD DETAIL

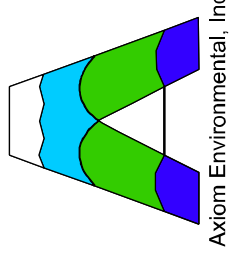

Axiom Environmental, Inc.

NOTES/REVISIONS

Project:
**Threemile Creek
 Restoration
 Site**
**Avery County
 North Carolina**

Title:
**Planting
 Plan**

Scale:
1 in = 300 ft
 Date: **Mar 2009**
 Project No.: **07-004**



FIGURE NO.
4

Legend


	Easement Boundary	26.7 acres
	Stream Side Assemblage (15 feet each side of channel)	4.8 acres
	Piedmont Mountain Bottomland Hardwood Forest (Wetland Areas)	5.4 acres
	Piedmont Low Mountain Alluvial Forest	4.0 acres

Vegetation Association	Piedmont/Mountain Bottomland Forest		Piedmont/Low Mountain Alluvial Forest		Stream-side Assemblage		TOTAL
	Area (acres)	5.4	4.0	4.8	14.2		
Species	Number planted*	% of total	Number planted*	% of total	Number planted**	% of total	Number planted
Swamp chestnut oak (<i>Quercus michauxii</i>)	600	17	--	--	--	--	600
Cherrybark oak (<i>Quercus pagoda</i>)	900	25	--	--	--	--	900
Sycamore (<i>Platanus occidentalis</i>)	500	14	300	12	--	--	600
Hackberry (<i>Celtis laevigata</i>)	600	17	--	--	--	--	600
Green ash (<i>Fraxinus pennsylvanica</i>)	400	11	600	22	--	--	1000
Pawpaw (<i>Asimina triloba</i>)	300	8	300	12	--	--	600
Northern red oak (<i>Quercus rubra</i>)	--	--	400	15	--	--	400
White oak (<i>Quercus alba</i>)	--	--	400	15	--	--	400
Black cherry (<i>Prunus serotina</i>)	--	--	300	12	--	--	300
Red bud (<i>Cercis canadensis</i>)	--	--	--	--	2000	15	2000
Persimmon (<i>Diospyros virginiana</i>)	--	--	300	12	2300	17	2600
Silky dogwood (<i>Cornus amomum</i>)	300	8	--	--	3900	29	4200
Buttombush (<i>Cephalanthus occidentalis</i>)	--	--	--	--	2600	19.5	2600
Elderberry (<i>Sambucus canadensis</i>)	--	--	--	--	2600	19.5	2600
TOTAL	3673	100	2720	100	13,056	100	19,449

* Planted at a density of 660 stems/acre.
 ** Planted at a density of 2,790 stems/acre.

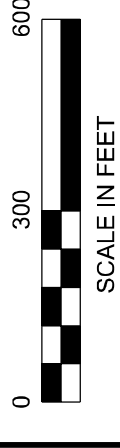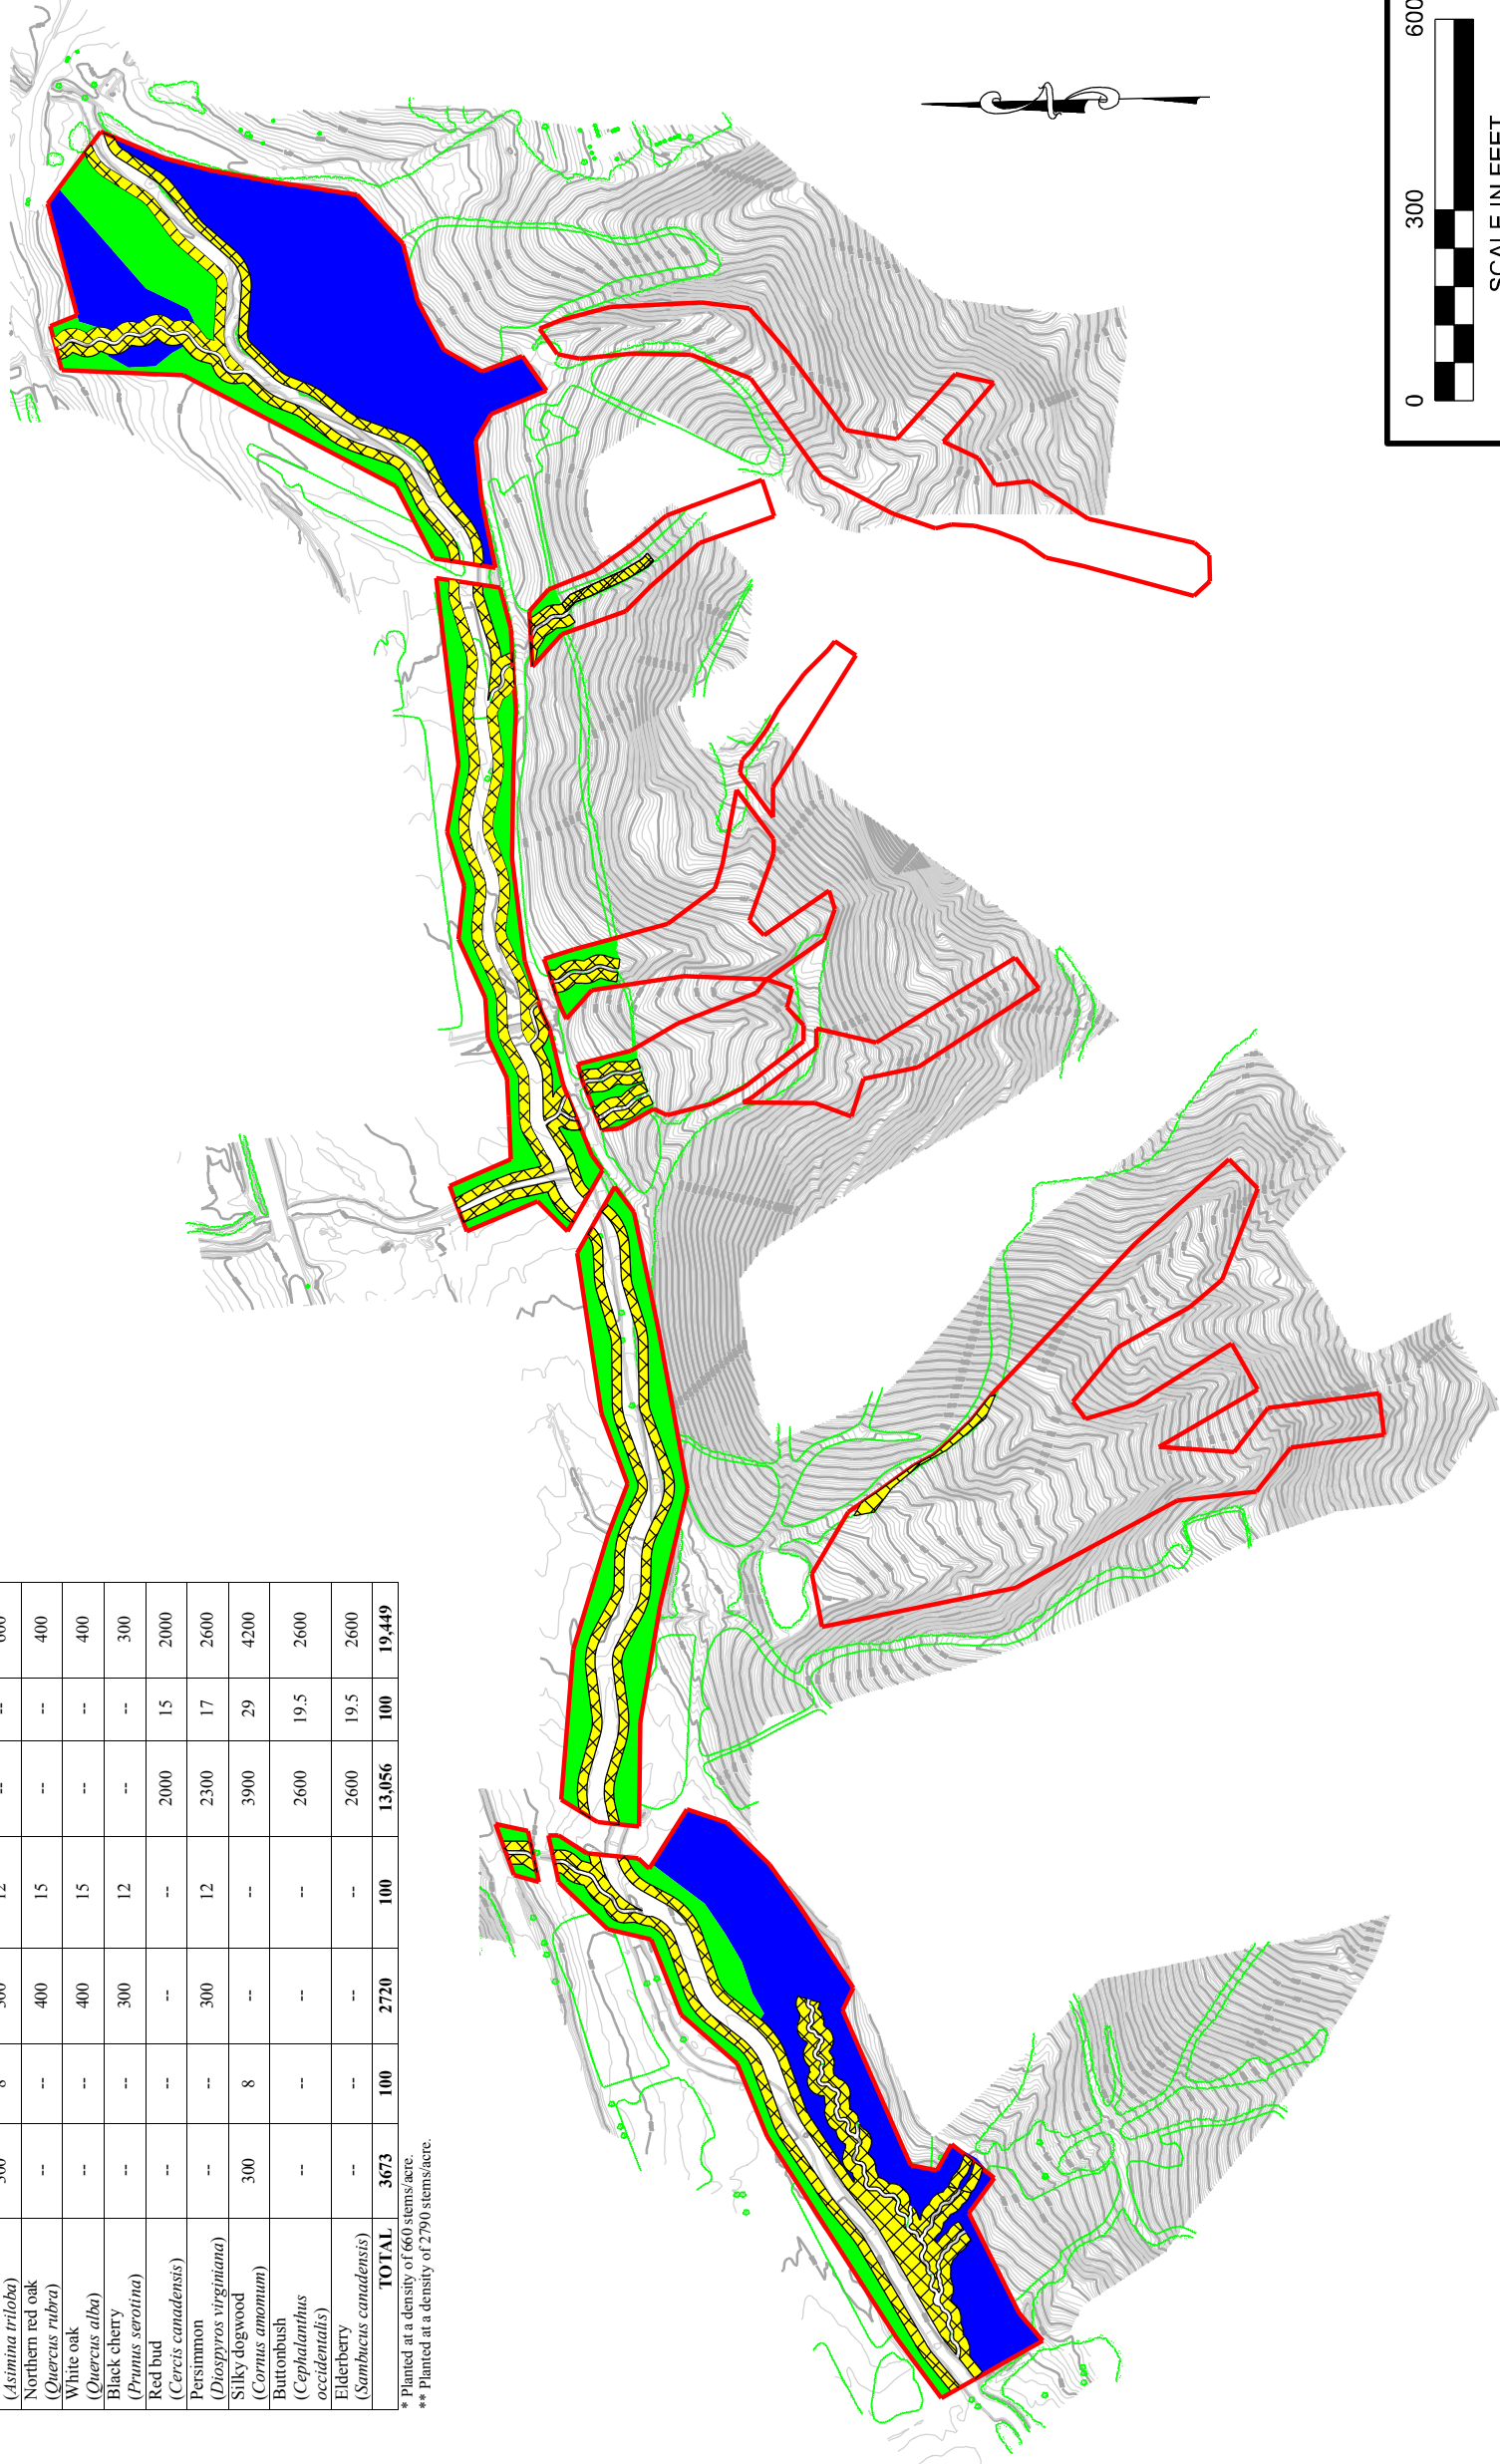

SCALE IN FEET

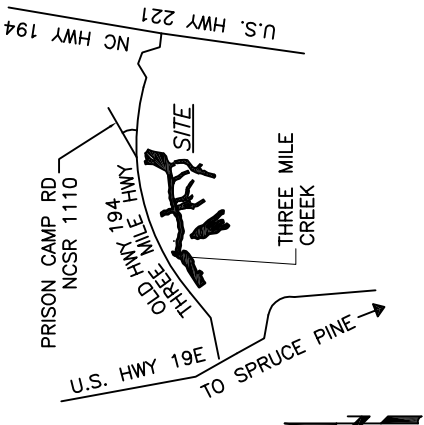

VICINITY MAP (NTS)

DEED REFERENCE(S):
 BEING A PORTION OF THE PROPERTY RECORDED IN D.B. 95, PG. 1728 OF THE AVERY COUNTY REGISTRY.

NC DOT R/W INFORMATION:
 R/W WIDTH OBTAINED FROM NCDOT R/W OFFICE OF AVERY COUNTY ON 07/10/07. PH. (336) 667-9111

FOR FURTHER REFERENCES, SEE M.B. 1, PG. 53 RECORDED IN AVERY COUNTY REGISTRY.

POSSIBLE WATER RIGHT DEED REFERENCE(S):
 NOT FIELD LOCATABLE, RECORDED IN D.B. 1560, PG. 761 OF THE AVERY COUNTY REGISTRY.

A PORTION OF THE AREA REPRESENTED BY THIS PLAT IS LOCATED IN A FLOOD HAZARD BOUNDARY ACCORDING TO FEMA MAP NUMBER(S) 37101B1200J ZONE(S): AE DATED: PRELIMINARY JUNE 22, 2007.

A PORTION OF THE AREA REPRESENTED BY THIS PLAT IS LOCATED IN A FLOOD HAZARD BOUNDARY ACCORDING TO FEMA MAP NUMBER(S) 370010 0100 B ZONE(S): A, DATED: SEPT. 28, 1990.

CONSERVATION EASEMENT IS 26.68 ACRES± EXCLUDING THREE MILE ROAD R/W AND EXCLUDING ALL ACCESS EASEMENTS IN THE EXCEPTION OF ACCESS EASEMENT 1 WHICH IS INCLUDED. ALL ACREAGE CALCULATED BY COMPUTER.

N.C.S.R. 1110
 PRISON CAMP ROAD
 (60' R/W - PAVED - PUBLIC)

THREE MILE ROAD
 OLD HIGHWAY 194
 (40' R/W - PAVED - PUBLIC)

N.C.S.R. 1109
 LITTLE BUCK HILL ROAD
 (60' R/W - PAVED - PUBLIC)

ACCESS EASEMENT 11
 NEW 30' WIDE ACCESS EASEMENT

START RESTORATION TRIB. 7
 STA 00+00 TO STA 02+75

END RESTORATION ENHANCEMENT I
 MAIN CHANNEL
 STA 37+30

SPRY
 D.B. 95, PG. 1728

ACCESS EASEMENT 9
 NEW 10' WIDE ACCESS EASEMENT (5' ON EACH SIDE OF CENTER LINE OF SOIL ROAD)

START RESTORATION TRIB. 8
 STA 00+00 TO STA 03+43

START RESTORATION TRIB. 9
 STA 00+00 TO STA 00+43

START RESTORATION TRIB. 11A
 STA 00+00 TO STA 00+92

START RESTORATION TRIB. 11B
 STA 00+00 TO STA 00+62

JAMES D. MAIN
 D.B. 396, PG. 1731

MANGANELLO
 D.B. 345, PG. 1990

EXISTING 30' CAROLINA POWER AND LIGHT (15' ON EACH SIDE OF POWER LINE)
 D.B. 127, PG. 1278

LEDFORD
 D.B. 386, PG. 2449
 LOTS 56-69
 M.B. 1, PG. 53

END RESTORATION ENHANCEMENT I
 MAIN CHANNEL
 STA 42+15

SPRY
 D.B. 95, PG. 1728

START RESTORATION TRIB. 5
 STA 00+00 TO STA 02+44

RESTORATION TRIB. 1
 STA 00+00

ACCESS EASEMENT 2
 NEW 30' WIDE ACCESS EASEMENT

ACCESS EASEMENT 4
 NEW 30' WIDE ACCESS EASEMENT

ACCESS EASEMENT 3
 NEW 30' WIDE ACCESS EASEMENT

ACCESS EASEMENT 10
 NEW 50' WIDE ACCESS EASEMENT

ACCESS EASEMENT 8
 NEW 30' WIDE ACCESS EASEMENT

ACCESS EASEMENT 6
 NEW 30' WIDE ACCESS EASEMENT

ACCESS EASEMENT 7
 NEW 20' WIDE ACCESS EASEMENT

ACCESS EASEMENT 5
 NEW 20' WIDE ACCESS EASEMENT

ACCESS EASEMENT 4
 NEW 30' WIDE ACCESS EASEMENT

ACCESS EASEMENT 3
 NEW 30' WIDE ACCESS EASEMENT

ACCESS EASEMENT 2
 NEW 30' WIDE ACCESS EASEMENT

ACCESS EASEMENT 1
 NEW 30' WIDE ACCESS EASEMENT

ACCESS EASEMENT 1
 NEW 30' WIDE ACCESS EASEMENT

- LEGEND:**
- Existing Iron Stake
 - Existing Iron Pipe
 - Non Monumented Corner
 - Existing Concrete Monument
 - Right-Of-Way
 - Deed Book
 - Page
 - North Carolina Secondary Road
 - Edge Of Pavement
 - Iron Stake Set (No. 5 Rebar with Plastic Cap Inscribed with "BOUNDARY MARKER") unless Otherwise Noted. Driven Flush with Grade Unless Otherwise Noted
 - Pump Pipe Set (3" O.D.)
 - 2" Above Grade
 - Iron Stake Set (No. 5 Rebar)
 - Non-Monumented Corner
 - Tributary
 - Conservation Easement
 - Spring

- EIS - Existing Iron Stake
- EIP - Existing Iron Pipe
- NMC - Non Monumented Corner
- ECM - Existing Concrete Monument
- R/W - Right-Of-Way
- D.B. - Deed Book
- PG. - Page
- NCSR - North Carolina Secondary Road
- EOP - Edge Of Pavement
- - Iron Stake Set (No. 5 Rebar with Plastic Cap Inscribed with "BOUNDARY MARKER") unless Otherwise Noted. Driven Flush with Grade Unless Otherwise Noted
- PPS - Pump Pipe Set (3" O.D.)
- ISS - Iron Stake Set (No. 5 Rebar)
- - Non-Monumented Corner
- Trib. - Tributary
- C/E - Conservation Easement
- ~ - Spring

GENERAL NOTES:

- 1) NOTE: NO ABSTRACT TITLE, NOR TITLE COMMITMENT, NOR RESULTS OF TITLE SEARCH WERE FURNISHED TO THE SURVEYOR. ALL DOCUMENTS OF RECORD REVIEWED ARE NOTED HEREON (SEE REFERENCES). THERE MAY EXIST OTHER DOCUMENTS OF RECORD THAT MAY AFFECT THIS SURVEYED PARCEL.
- 2) COORDINATES SHOWN ARE BASED ON NC STATE PLANE COORDINATES 1983.
- 3) ACCESS EASEMENTS SHOWN ARE FOR THE USE OF RESTORATION SYSTEMS, LLC & THE SPRY FAMILY.
- 4) SPRINGS SHOWN (☼) ARE THE BEGINNINGS OF THE UNNAMED TRIBUTARIES FLOWING TOWARD THREE MILE CREEK.
- 5) THIS PLAT SHOWS THE CONSTRUCTED CENTERLINE OF THE NEW CHANNEL AS FIELD LOCATED JANUARY, 2009.
- 6) ALL DISTANCES SHOWN ARE HORIZONTAL GROUND DISTANCES UNLESS OTHERWISE NOTED.
- 7) FOR COMPLETE BOUNDARY INFORMATION SEE PLAT RECORDED IN M.B. 40, PG.S 217-220 BY K2 DESIGN GROUP, P.A.
- 8) ALL WETLAND RESTORATION AND ENHANCEMENT AREAS WERE OBTAINED AND IDENTIFIED BY AXIOM ENVIRONMENTAL, INC.

SHEET 1 OF 23

AS-BUILT SURVEY

FOR


RESTORATION SYSTEMS, LLC

THREE MILE CREEK SITE




Natural Resources
 Restoration & Conservation

TOE RIVER TOWNSHIP AVERY COUNTY NORTH CAROLINA

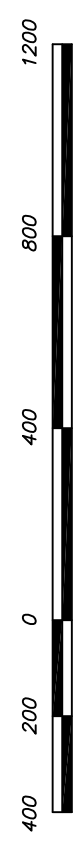

GRAPHIC SCALE 1" = 400'

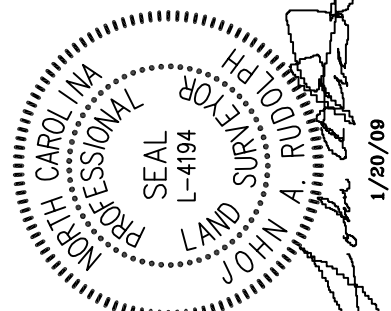

1/20/09

5688 U.S. Hwy. 70 East
 Goldsboro, NC 27534
 Tel.: (919) 751-0075
 Fax: (919) 778-9087
 k2design@suddenlink.net



DRAWN BY: FGR
 DATE: 1/20/09
 DWG. NO.: RSS922AB 08
 SURVEYED BY: J.A.R.

SEVERAL ACCESS EASEMENTS	
COURSES FROM "A" TO "B"	
LINE	LENGTH
L26	51.05'
L27	59.64'
L28	31.13'
L29	31.98'
L30	39.46'
L31	31.54'
L32	30.48'
L33	30.19'
L34	30.00'
L35	31.43'
L36	32.75'
L37	36.92'

LINE DATA ALONG CONSERVATION EASEMENT "D"		
LINE	LENGTH	BEARING
L99	46.16'	S48°22'18"E
L100	77.57'	S21°25'42"E
L101	71.65'	S35°42'08"E
L108	106.15'	N20°02'43"W
L109	69.26'	N47°27'57"W
L110	87.73'	N86°45'18"E

LINE DATA ALONG CONSERVATION EASEMENT "E"		
LINE	LENGTH	BEARING
L111	49.97'	S17°42'49"E
L112	151.78'	S15°01'29"E
L125	145.86'	N08°41'24"W
L126	60.94'	N48°05'41"W
L127	24.03'	N65°15'37"E
L128	77.25'	N71°21'22"E

LINE DATA ALONG CONSERVATION EASEMENT "A"		
LINE	LENGTH	BEARING
L1	109.98'	S22°18'24"W
L2	75.28'	S14°50'24"W
L3	93.14'	S10°34'24"W
L4	138.71'	S08°39'08"W
L5	106.64'	S46°48'00"W
L6	93.07'	S75°46'54"W
L7	86.88'	S62°03'58"W
L8	69.09'	S29°02'03"W
L9	67.60'	S20°51'12"E
L10A	31.45'	S54°55'57"W
L10B	34.96'	S54°55'57"W
L11	94.86'	N23°19'36"W
L12	47.23'	N58°46'04"W
L13	93.82'	S84°11'44"W
L14	109.46'	S78°19'34"W
L15	98.61'	N08°35'57"E
L16	128.02'	N62°17'37"E
L17	376.30'	N27°33'43"E
L18	191.98'	N02°26'44"E
L19A	34.89'	N75°17'27"E
L19B	37.13'	N75°17'27"E
L20	45.97'	S21°53'17"E
L21	160.71'	N75°04'37"E
L22	20.53'	N75°04'37"E
L23	29.57'	S53°43'36"E
L24	43.58'	S53°43'36"E
L25	67.63'	S53°43'36"E


LINE DATA ALONG CONSERVATION EASEMENT "C"		
LINE	LENGTH	BEARING
L38	67.07'	S74°41'56"W
L39	71.83'	S86°45'18"W
L40	57.91'	S86°45'18"W
L41	93.19'	N87°39'29"W
L42	138.37'	N89°15'49"W
L43	163.76'	S82°59'41"W
L44	84.24'	S71°21'22"W
L45	29.00'	S65°15'37"W
L46	64.69'	S76°03'22"W
L47	28.40'	S76°03'22"W
L48	76.32'	S68°01'49"W
L49	40.86'	S68°01'49"W

LINE DATA ALONG CONSERVATION EASEMENT "B"		
LINE	LENGTH	BEARING
L19A	34.89'	N75°17'27"E
L19B	37.13'	N75°17'27"E
L20	45.97'	S21°53'17"E
L21	160.71'	N75°04'37"E
L22	20.53'	N75°04'37"E
L23	29.57'	S53°43'36"E
L24	43.58'	S53°43'36"E
L25	67.63'	S53°43'36"E


LINE DATA ALONG CONSERVATION EASEMENT "C"		
LINE	LENGTH	BEARING
L50	28.11'	S53°10'28"W
L51	111.32'	N60°29'26"W
L52	67.06'	N45°24'38"E
L53	121.24'	N23°13'33"W
L54A	37.21'	N69°24'09"E
L54B	38.86'	N69°24'09"E
L55	104.99'	S23°37'46"E
L56	68.33'	N86°58'13"E
L57	59.43'	N87°47'44"E
L58	69.98'	N63°50'03"E
L59	64.04'	N86°55'51"E
L60	101.71'	N65°25'53"E
L61	83.87'	S83°44'27"E
L62	88.85'	N72°01'00"E
L63	107.77'	S80°13'49"E
L64	295.88'	N83°07'19"E
L65	101.38'	S08°35'57"W

LINE DATA ALONG CONSERVATION EASEMENT "C"		
LINE	LENGTH	BEARING
L59	64.04'	N86°55'51"E
L60	101.71'	N65°25'53"E
L61	83.87'	S83°44'27"E
L62	88.85'	N72°01'00"E
L63	107.77'	S80°13'49"E
L64	295.88'	N83°07'19"E
L65	101.38'	S08°35'57"W





LINE DATA ALONG CONSERVATION EASEMENT "A"		
LINE	LENGTH	BEARING
L1	109.98'	S22°18'24"W
L2	75.28'	S14°50'24"W
L3	93.14'	S10°34'24"W
L4	138.71'	S08°39'08"W
L5	106.64'	S46°48'00"W
L6	93.07'	S75°46'54"W
L7	86.88'	S62°03'58"W
L8	69.09'	S29°02'03"W
L9	67.60'	S20°51'12"E
L10A	31.45'	S54°55'57"W
L10B	34.96'	S54°55'57"W
L11	94.86'	N23°19'36"W
L12	47.23'	N58°46'04"W
L13	93.82'	S84°11'44"W
L14	109.46'	S78°19'34"W
L15	98.61'	N08°35'57"E
L16	128.02'	N62°17'37"E
L17	376.30'	N27°33'43"E
L18	191.98'	N02°26'44"E
L19A	34.89'	N75°17'27"E
L19B	37.13'	N75°17'27"E
L20	45.97'	S21°53'17"E
L21	160.71'	N75°04'37"E
L22	20.53'	N75°04'37"E
L23	29.57'	S53°43'36"E
L24	43.58'	S53°43'36"E
L25	67.63'	S53°43'36"E

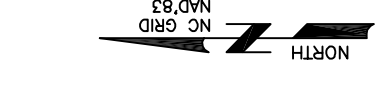

- LEGEND**
- J HOOK VANE
 - STEP POOL
 - DROP STRUCTURE
 - CROSS-SECTION
 - LOG VANE
 - FORD CROSSING
 - ROCK CROSS-VANE
 - MONITORING WELL
 - MODIFIED FROM DESIGN
 - VEGETATIVE PLOT AREA
 - MONITORING REACH
 - ACCESS EASEMENT
 - STONE STRUCTURE
 - MARSH TREATMENT AREA BMP
 - WETLAND ENHANCEMENT
 - WETLAND RESTORATION

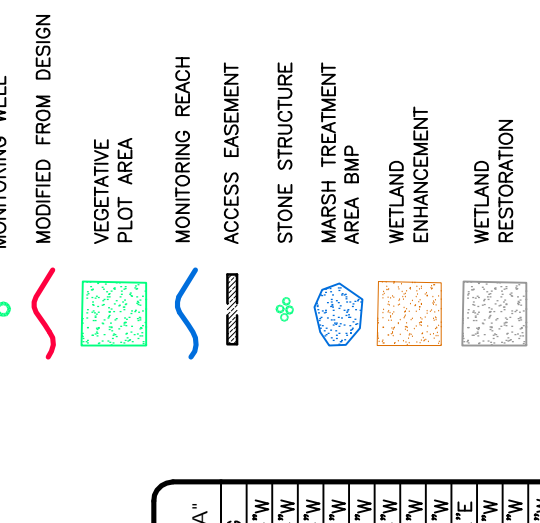

SHEET 2 OF 23
 AS-BUILT SURVEY
 FOR
RESTORATION SYSTEMS, LLC
 THREE MILE CREEK SITE
 NORTH CAROLINA
 AVERY COUNTY
 TOE RIVER TOWNSHIP

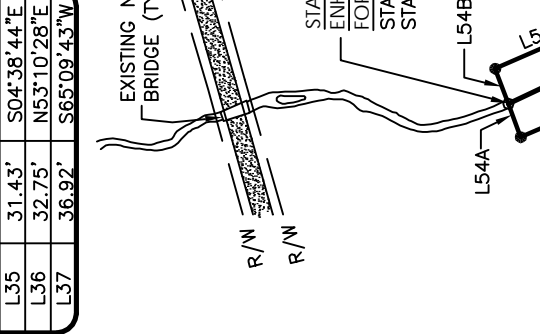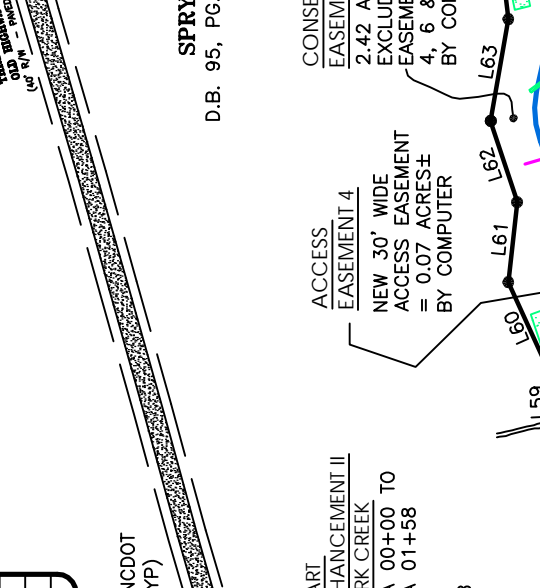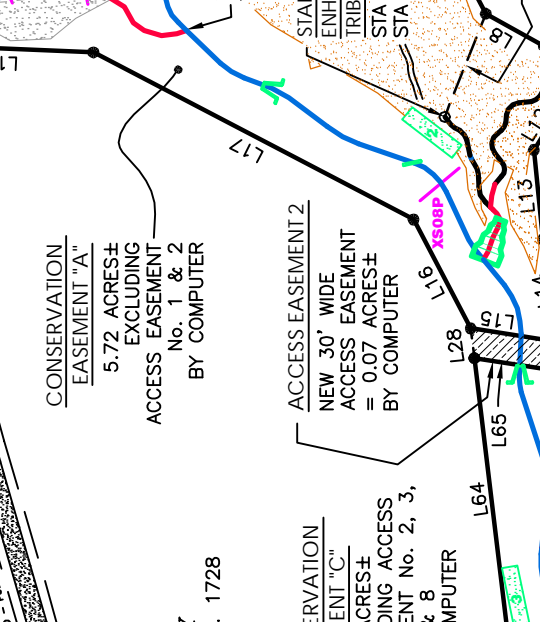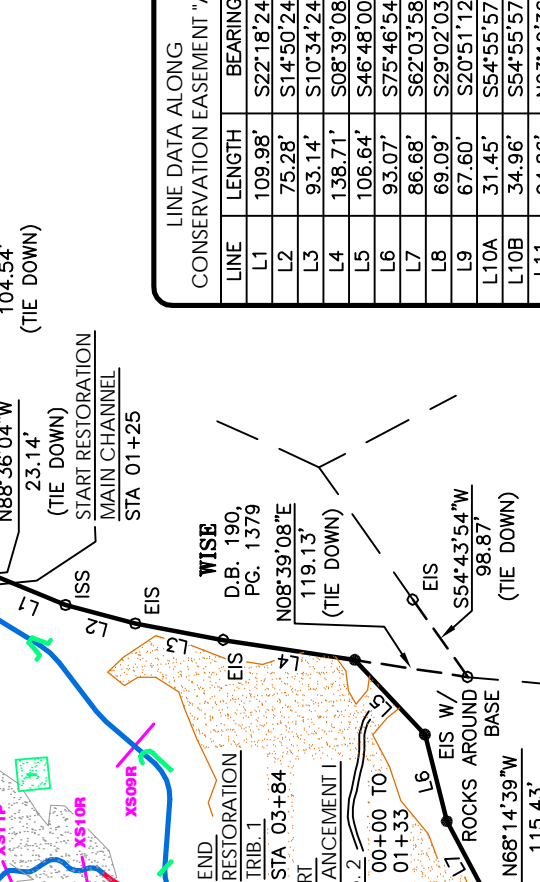

LEGEND:

- Existing Iron Stake
- Existing Iron Pipe
- Non Monumented Corner
- Existing Concrete Monument
- Right-Of-Way
- Deed Book
- Page
- North Carolina Secondary Road
- Edge Of Pavement
- Iron Stake Set (No. 5 Rebar with Plastic Cap Inscribed with "BOUNDARY MARKER" unless Otherwise Noted)
- PPS - Pump Pipe Set (3" O.D.)
- ISS - Iron Stake Set (No. 5 Rebar)
- - Non-Monumented Corner
- Trib. - Tributary
- C/E - Conservation Easement

LEGEND:


- Existing Iron Stake
- Existing Iron Pipe
- Non Monumented Corner
- Existing Concrete Monument
- Right-Of-Way
- Deed Book
- Page
- North Carolina Secondary Road
- Edge Of Pavement
- Iron Stake Set (No. 5 Rebar with Plastic Cap Inscribed with "BOUNDARY MARKER" unless Otherwise Noted)
- PPS - Pump Pipe Set (3" O.D.)
- ISS - Iron Stake Set (No. 5 Rebar)
- - Non-Monumented Corner
- Trib. - Tributary
- C/E - Conservation Easement

LEGEND:

- Existing Iron Stake
- Existing Iron Pipe
- Non Monumented Corner
- Existing Concrete Monument
- Right-Of-Way
- Deed Book
- Page
- North Carolina Secondary Road
- Edge Of Pavement
- Iron Stake Set (No. 5 Rebar with Plastic Cap Inscribed with "BOUNDARY MARKER" unless Otherwise Noted)
- PPS - Pump Pipe Set (3" O.D.)
- ISS - Iron Stake Set (No. 5 Rebar)
- - Non-Monumented Corner
- Trib. - Tributary
- C/E - Conservation Easement

LEGEND:

- Existing Iron Stake
- Existing Iron Pipe
- Non Monumented Corner
- Existing Concrete Monument
- Right-Of-Way
- Deed Book
- Page
- North Carolina Secondary Road
- Edge Of Pavement
- Iron Stake Set (No. 5 Rebar with Plastic Cap Inscribed with "BOUNDARY MARKER" unless Otherwise Noted)
- PPS - Pump Pipe Set (3" O.D.)
- ISS - Iron Stake Set (No. 5 Rebar)
- - Non-Monumented Corner
- Trib. - Tributary
- C/E - Conservation Easement

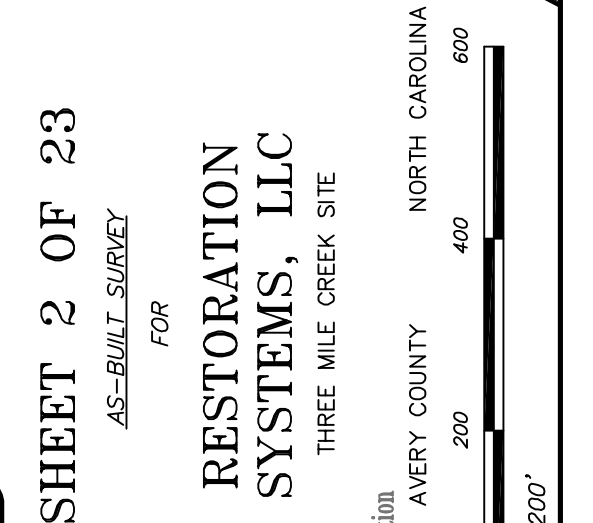


RESTORATION SYSTEMS, LLC
 Natural Resources
 Restoration & Conservation
 THREE MILE CREEK SITE
 NORTH CAROLINA
 AVERY COUNTY
 TOE RIVER TOWNSHIP

RESTORATION SYSTEMS, LLC
 Natural Resources
 Restoration & Conservation
 THREE MILE CREEK SITE
 NORTH CAROLINA
 AVERY COUNTY
 TOE RIVER TOWNSHIP

RESTORATION SYSTEMS, LLC
 Natural Resources
 Restoration & Conservation
 THREE MILE CREEK SITE
 NORTH CAROLINA
 AVERY COUNTY
 TOE RIVER TOWNSHIP

RESTORATION SYSTEMS, LLC
 Natural Resources
 Restoration & Conservation
 THREE MILE CREEK SITE
 NORTH CAROLINA
 AVERY COUNTY
 TOE RIVER TOWNSHIP

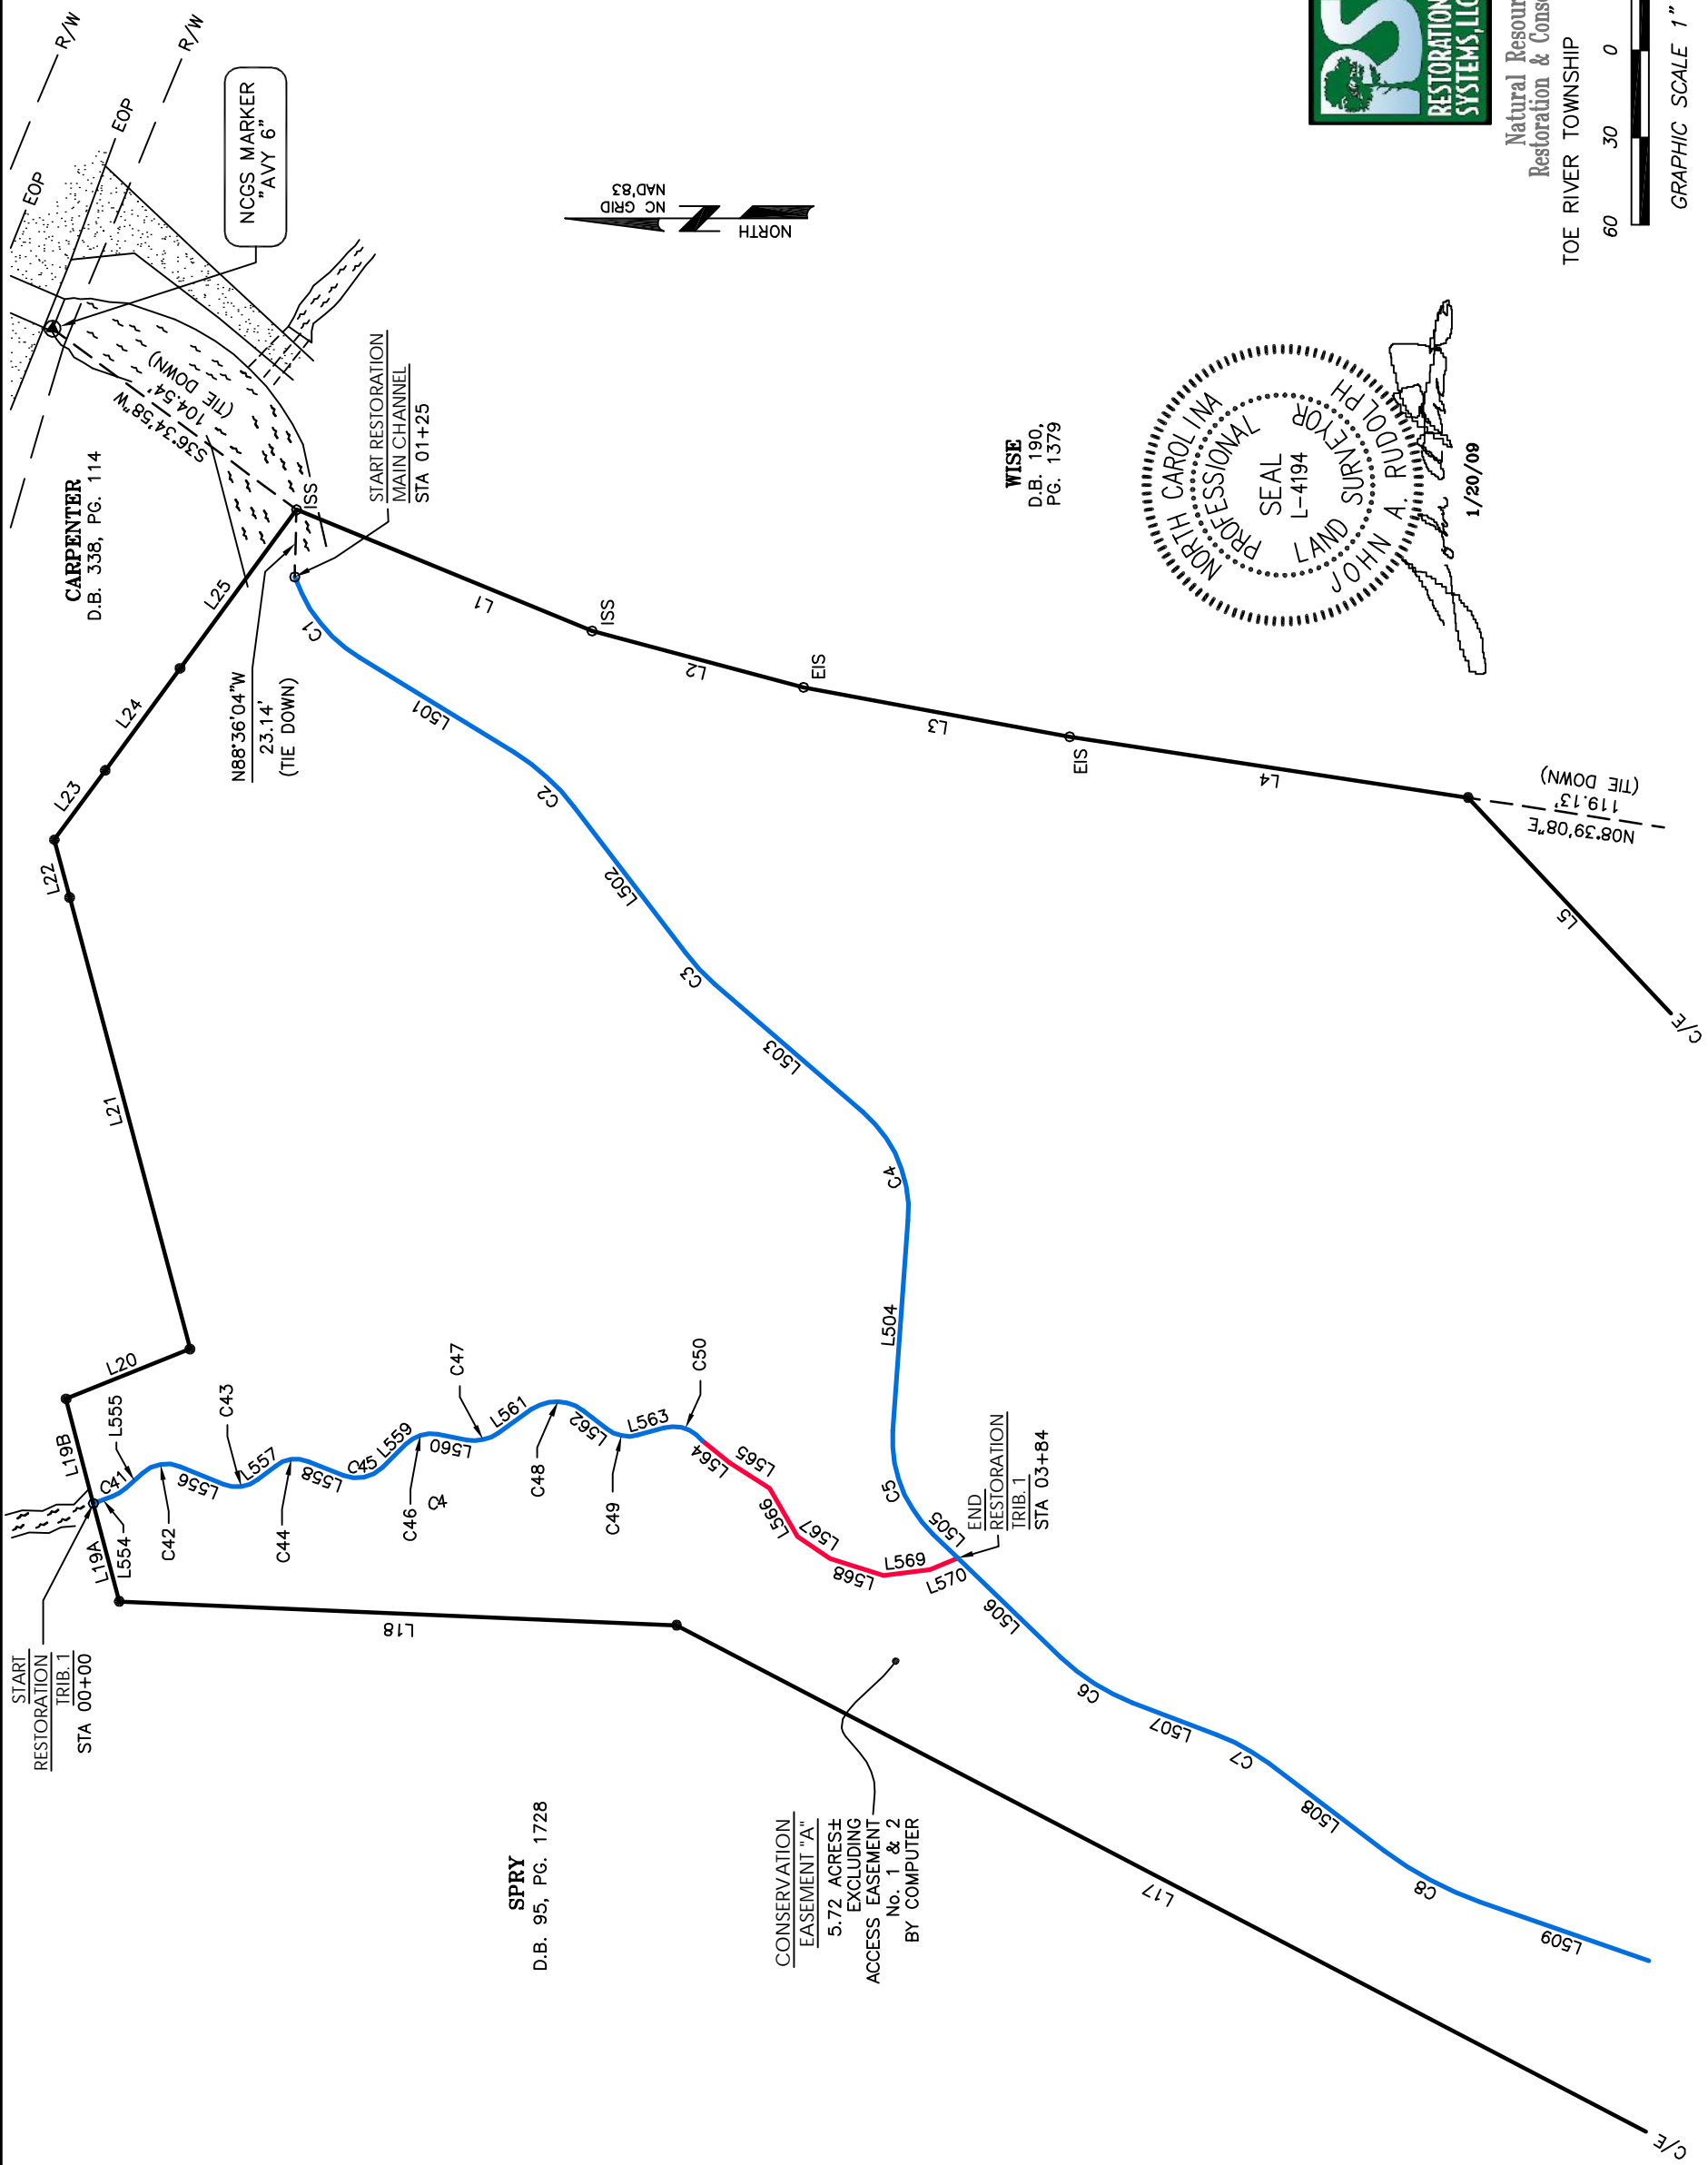

LEGEND:

- EIS — Existing Iron Stake
- EIP — Existing Iron Pipe
- NMC — Non-Monumented Corner
- ECM — Existing Concrete Monument
- R/W — Right-Of-Way
- D.B. — Deed Book
- PG. — Page
- NCSR — North Carolina Secondary Road
- EOP — Edge Of Pavement
- — Iron Stake Set (No. 5 Rebar with Plastic Cap Inscribed with "BOUNDARY MARKER") unless Otherwise Noted. Driven Flush with Grade Unless Otherwise Noted
- PPS — Pump Pipe Set (3" O.D.) 2' Above Grade
- ISS — Iron Stake Set (No. 5 Rebar)
- O — Non-Monumented Corner
- Trib. — Tributary
- C/E — Conservation Easement
- ~ — Spring
- — MONITORING REACH
- — MODIFIED FROM DESIGN



SHEET 4 OF 23

AS-BUILT SURVEY

FOR


RESTORATION SYSTEMS, LLC

THREE MILE CREEK SITE




Natural Resources
Restoration & Conservation

TOE RIVER TOWNSHIP AVERY COUNTY NORTH CAROLINA

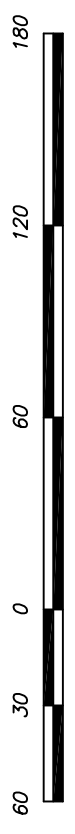

GRAPHIC SCALE 1" = 60'

WISE
D.B. 190,
PG. 1379

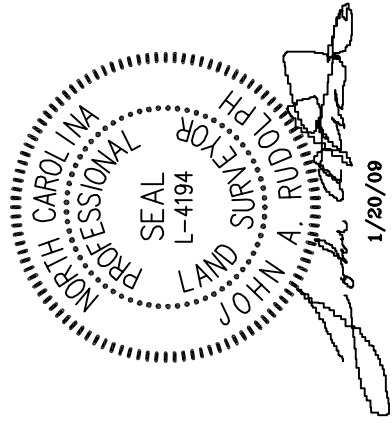

LEGEND:

- EIS - Existing Iron Stake
- EIP - Existing Iron Pipe
- NMC - Non Monumented Corner
- ECM - Existing Concrete Monument
- R/W - Right-Of-Way
- D.B. - Deed Book
- PG. - Page
- NCSR - North Carolina Secondary Road
- EOP - Edge Of Pavement
- - Iron Stake Set (No. 5 Rebar with Plastic Cap Inscribed with "BOUNDARY MARKER") unless Otherwise Noted. Driven Flush with Grade Unless Otherwise Noted
- PPS - Pump Pipe Set (3" O.D.)
- ISS - Iron Stake Set (No. 5 Rebar)
- O - Non-Monumented Corner
- Trib. - Tributary
- C/E - Conservation Easement
- ~ - Spring
- - MONITORING REACH
- - MODIFIED FROM DESIGN
- - MARSH TREATMENT AREA BMP

CONSERVATION EASEMENT "C"
2.42 ACRES±
EXCLUDING ACCESS EASEMENT No. 2, 3, 4, 6 & 8
BY COMPUTER

SPRY
D.B. 95, PG. 1728

CONSERVATION EASEMENT "A"
5.72 ACRES±
EXCLUDING ACCESS EASEMENT No. 1 & 2
BY COMPUTER

ACCESS EASEMENT 2
NEW 30' WIDE
ACCESS EASEMENT
= 0.07 ACRES±
BY COMPUTER

ACCESS EASEMENT 3
NEW 30' WIDE ACCESS
EASEMENT = 0.05
ACRES± BY COMPUTER

CONSERVATION EASEMENT "D"
0.68 ACRES±
EXCLUDING ACCESS EASEMENT No. 3
BY COMPUTER

START RESTORATION
TRIB. 4
STA 00+00 TO
STA 02+28

START RESTORATION
TRIB. 3
STA 00+00 TO
STA 03+40

NC GRID COORDINATE
N=825,907.7987'
E=1,119,084.8745'

SPRY
D.B. 95, PG. 1728

Natural Resources
Restoration & Conservation



RESTORATION SYSTEMS, LLC

THREE MILE CREEK SITE

TOE RIVER TOWNSHIP AVERY COUNTY NORTH CAROLINA



GRAPHIC SCALE 1" = 60'

SHEET 5 OF 23

AS-BUILT SURVEY


FOR



1/20/09

CONSERVATION EASEMENT "B"
2.41 ACRES±
EXCLUDING ACCESS EASEMENT No. 1
BY COMPUTER

ACCESS EASEMENT 1
0.06 ACRES±
BY COMPUTER

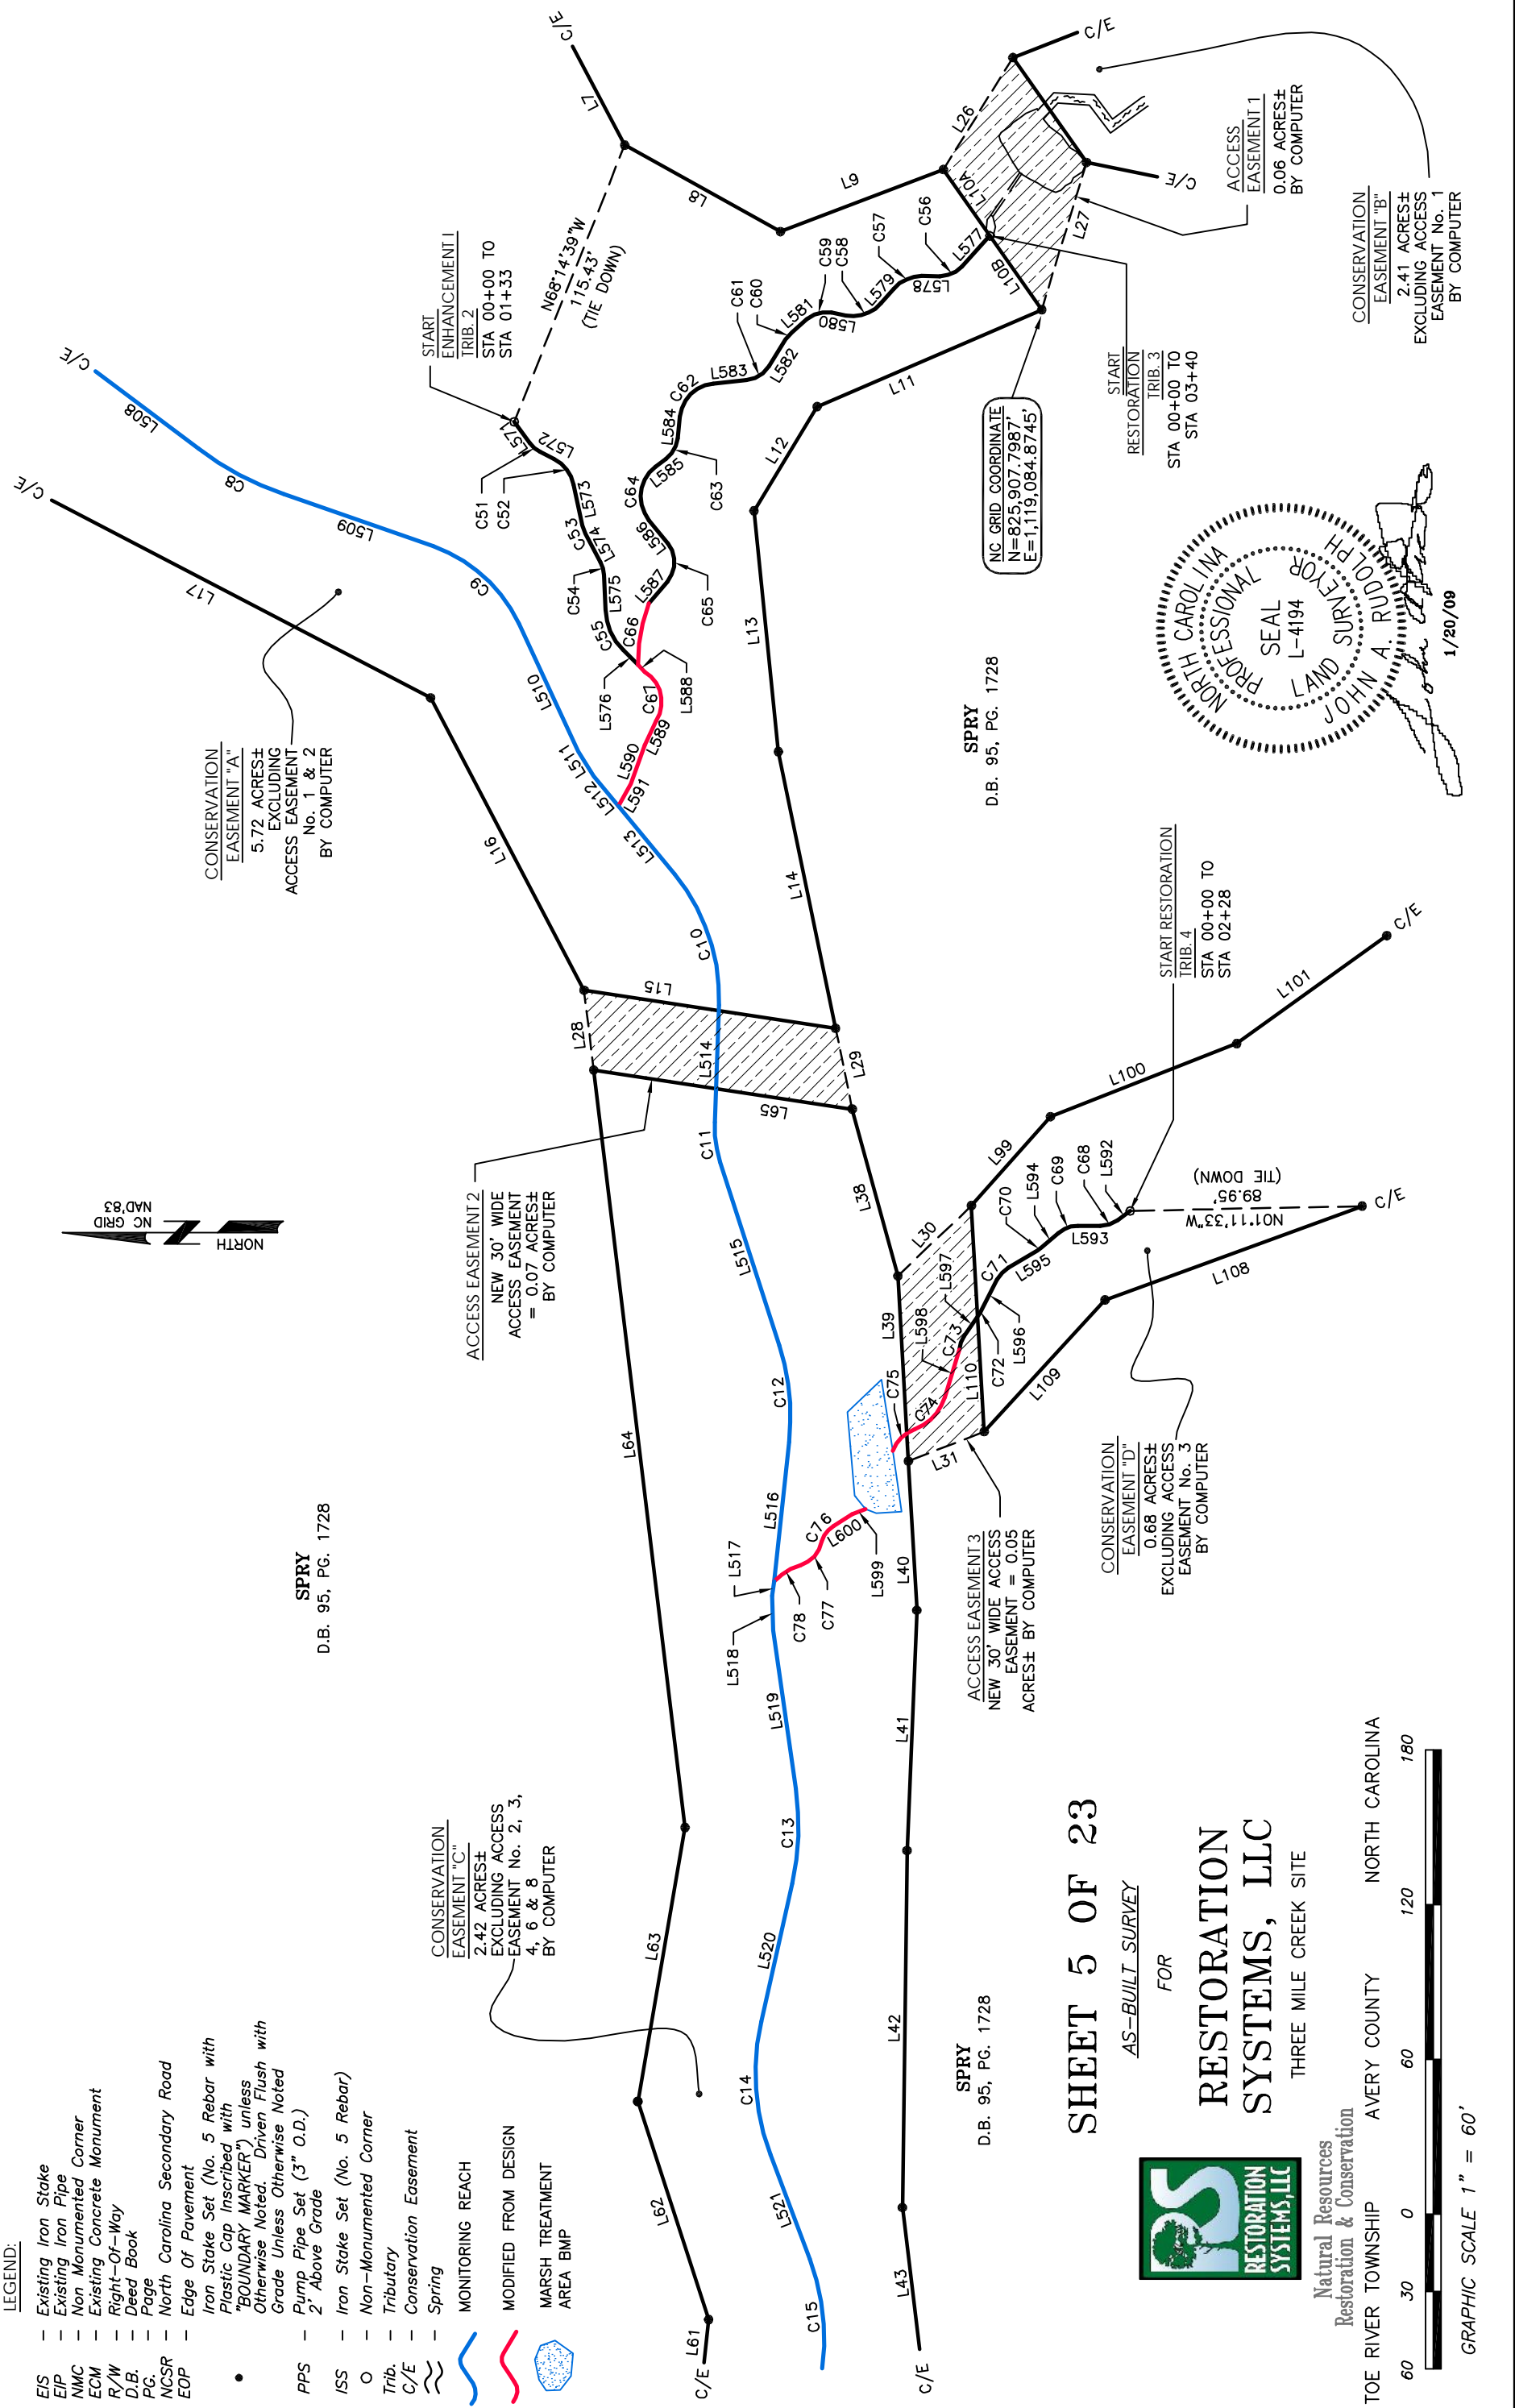

LEGEND:

- EIS - Existing Iron Stake
- EIP - Existing Iron Pipe
- NMC - Non-Monumented Corner
- ECM - Existing Concrete Monument
- R/W - Right-Of-Way
- D.B. - Deed Book
- PG. - Page
- NCGR - North Carolina Secondary Road
- EOP - Edge Of Pavement
- - Iron Stake Set (No. 5 Rebar with Plastic Cap Inscribed with "BOUNDARY MARKER") unless Otherwise Noted. Driven Flush with Grade Unless Otherwise Noted
- PFS - Pump Pipe Set (3" O.D.)
- ISS - Iron Stake Set (No. 5 Rebar)
- O - Non-Monumented Corner
- Trib. - Tributary
- C/E - Conservation Easement
- ~ - Spring
- - MONITORING REACH
- - MODIFIED FROM DESIGN
- - MARSH TREATMENT AREA BMP

ACCESS EASEMENT 8
NEW 30' WIDE ACCESS
EASEMENT = 0.08
ACRES± BY COMPUTER

ACCESS EASEMENT 6
NEW 30' WIDE ACCESS
EASEMENT = 0.07
ACRES± BY COMPUTER

ACCESS
EASEMENT 4
NEW 30' WIDE
ACCESS EASEMENT
= 0.07 ACRES±
BY COMPUTER

CONSERVATION
EASEMENT "E"
1.14 ACRES±
EXCLUDING ACCESS
EASEMENT No. 4 &
5 BY COMPUTER


CONSERVATION EASEMENT "I"
2.42 ACRES± EXCLUDING
ACCESS EASEMENT No. 8,
9 & 10 BY COMPUTER

CONSERVATION EASEMENT "G"
0.96 ACRES± EXCLUDING ACCESS
EASEMENT No. 6 & 7 BY
COMPUTER

START RESTORATION IRIB. 6A
STA. 00+00 TO
STA. 02+44

START RESTORATION
IRIB. 5
STA. 00+00 TO
STA. 02+44

START
ENHANCEMENT II
FORK CREEK
STA. 00+00 TO
STA. 01+58

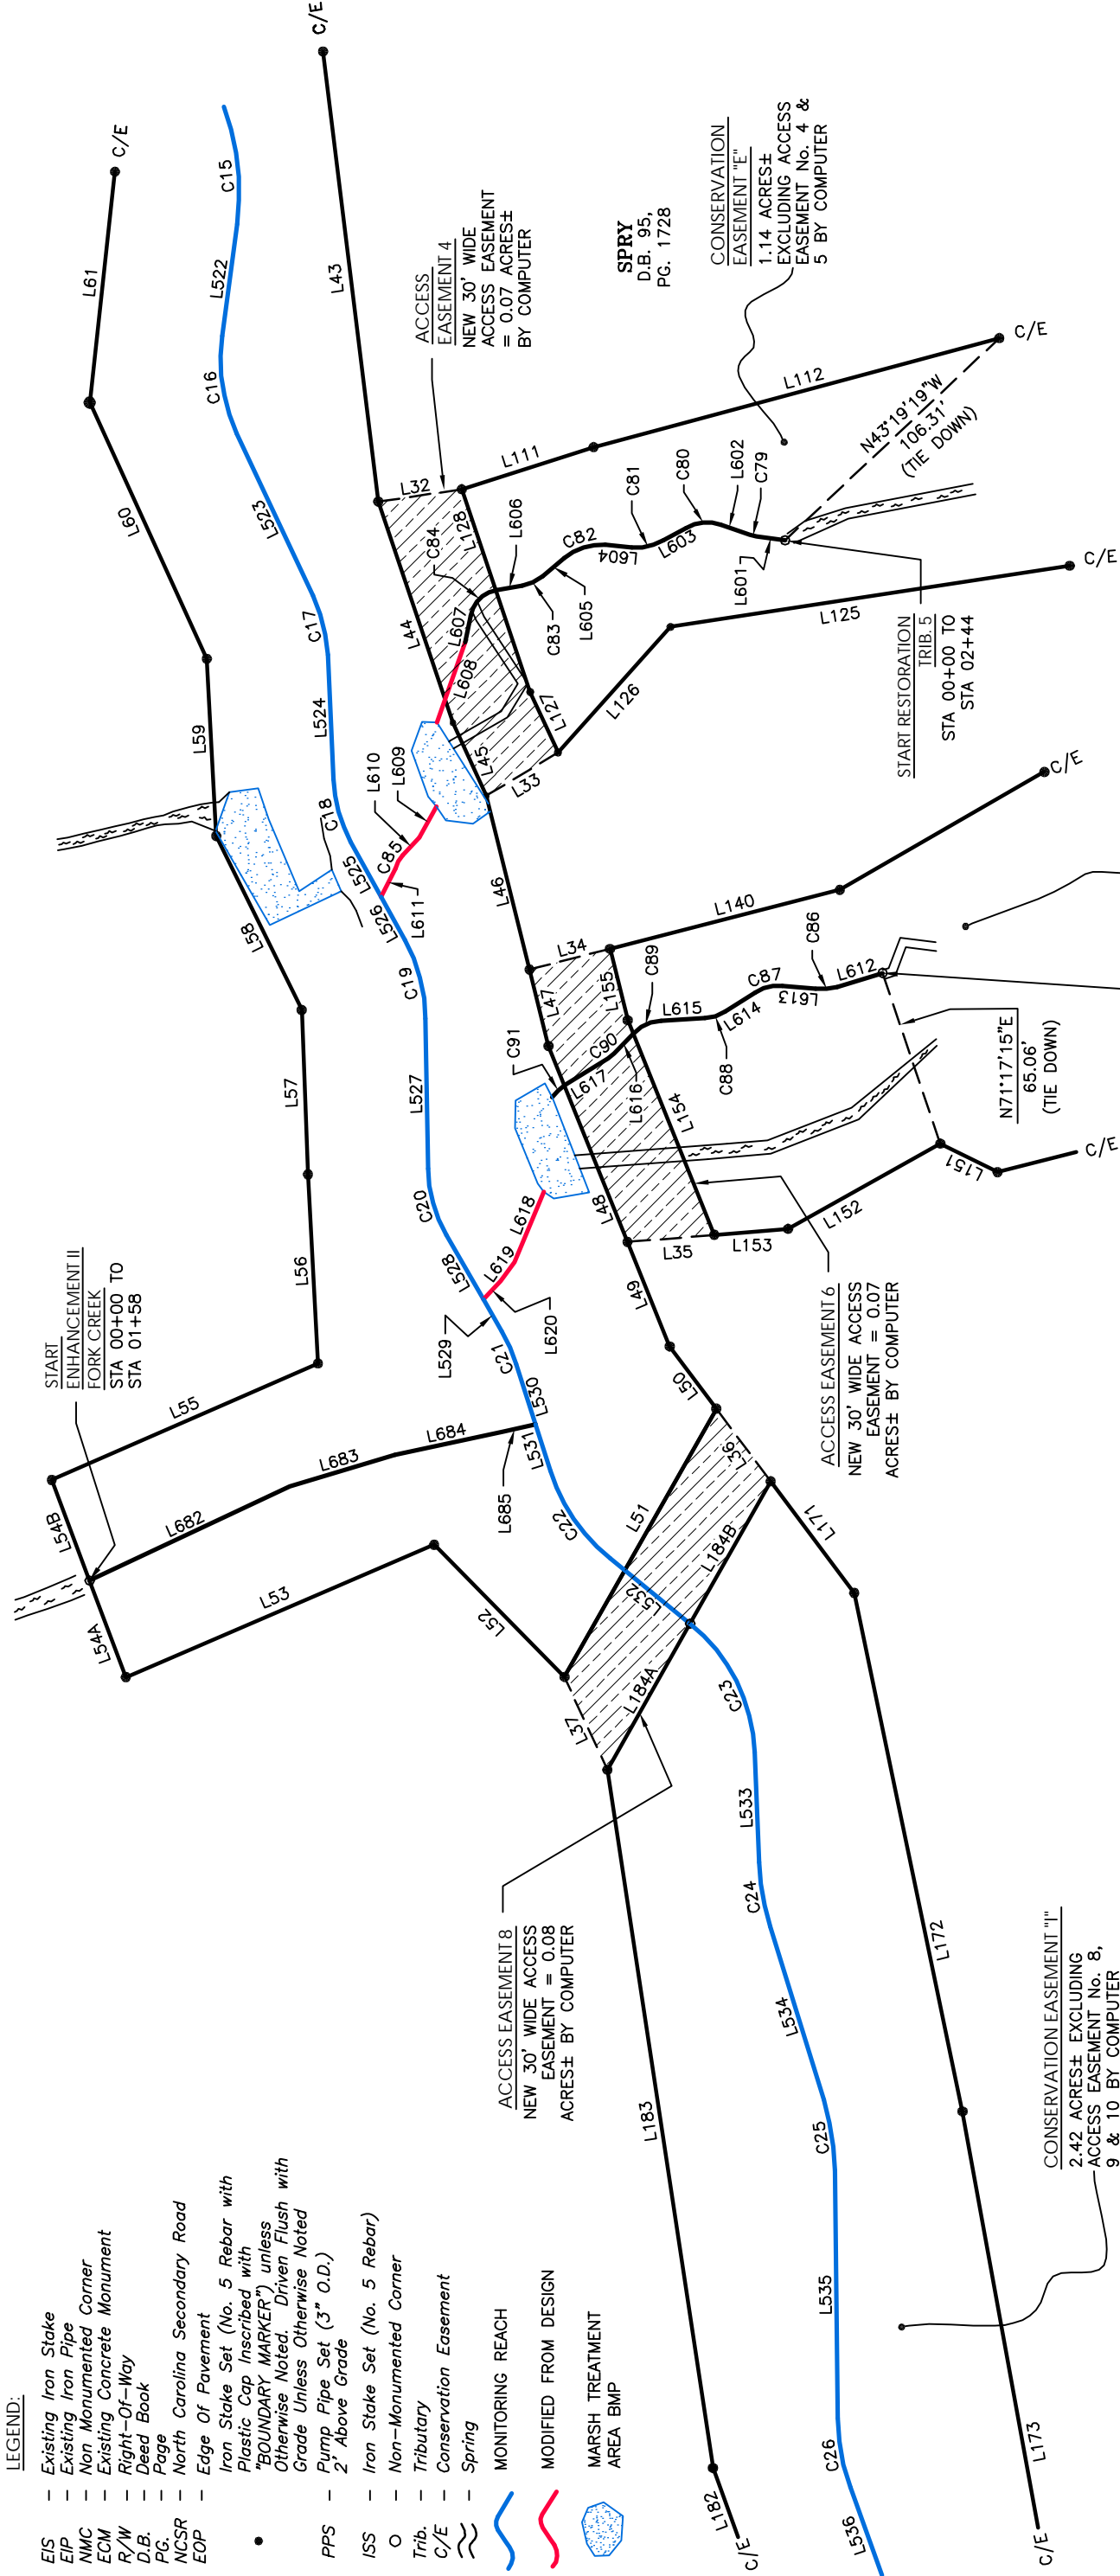

SHEET 6 OF 23

AS-BUILT SURVEY




Natural Resources
Restoration & Conservation


FOR
**RESTORATION
SYSTEMS, LLC**

THREE MILE CREEK SITE

TOE RIVER TOWNSHIP AVERY COUNTY NORTH CAROLINA

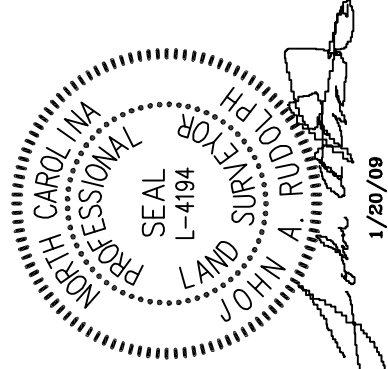

1/20/09

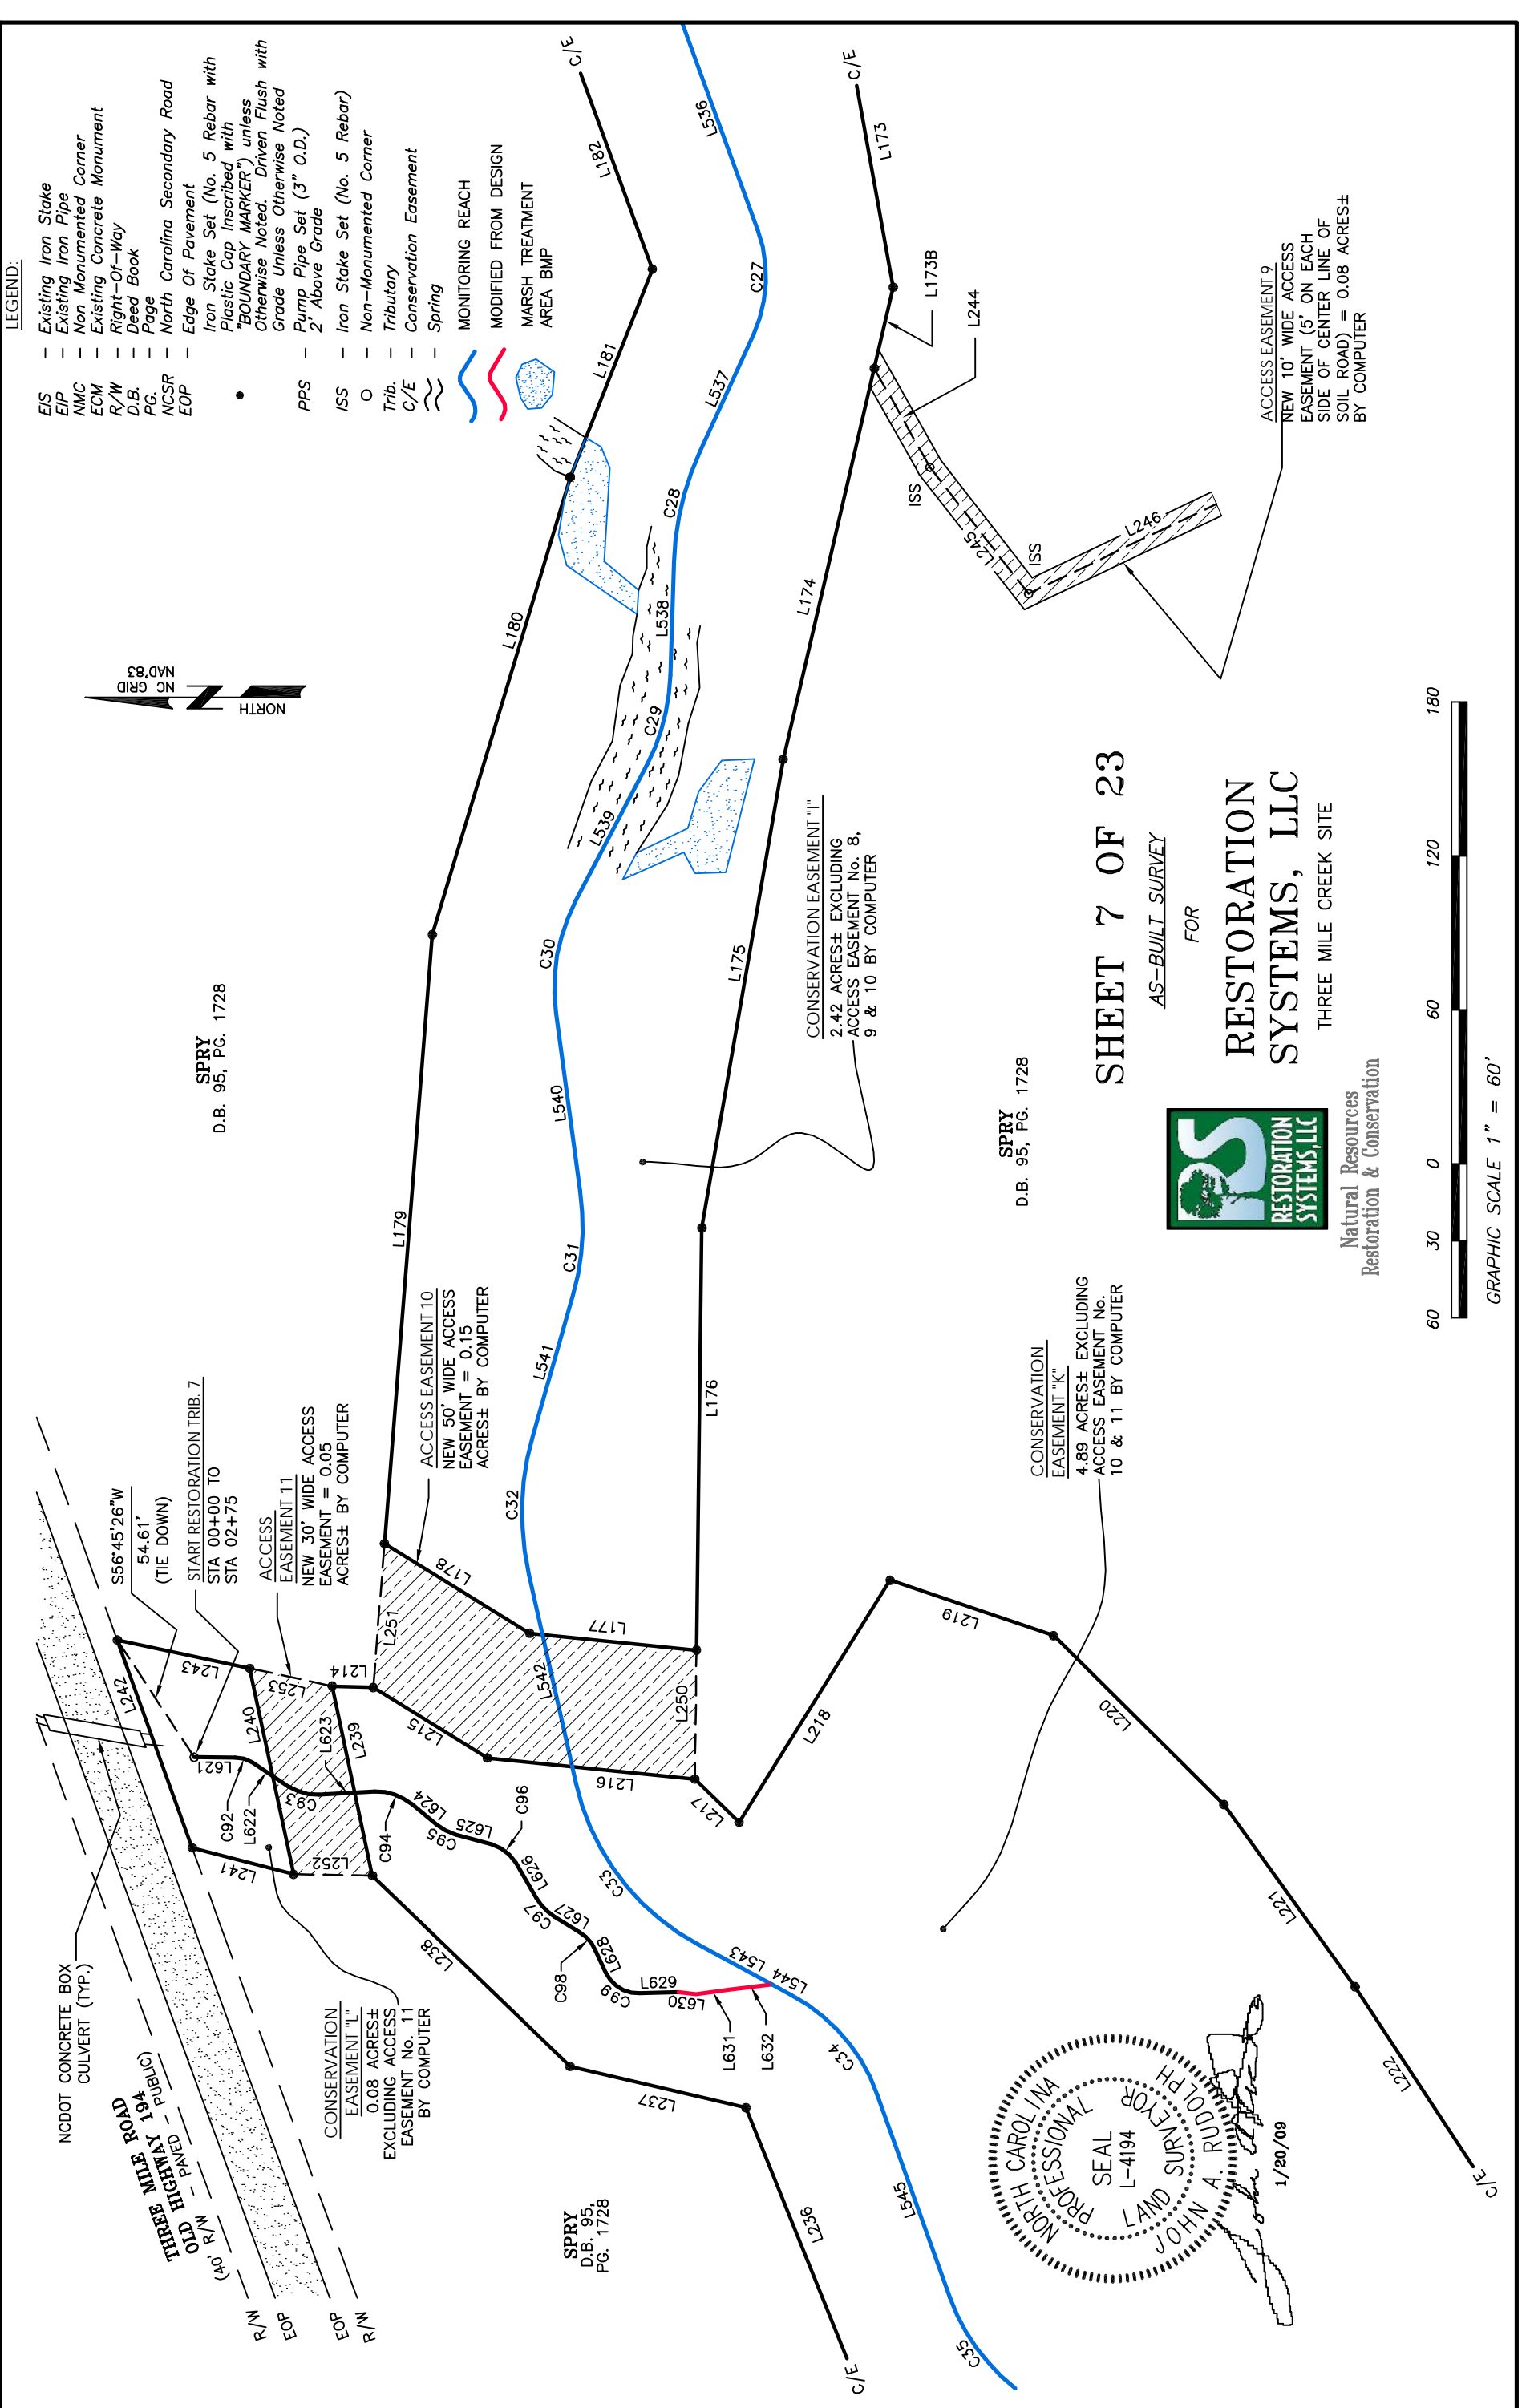

LEGEND:

- E/S — Existing Iron Stake
- EIP — Existing Iron Pipe
- NMC — Non Monumented Corner
- ECM — Existing Concrete Monument
- R/W — Right-Of-Way
- D.B. — Deed Book
- PG. — Page
- NCSR — North Carolina Secondary Road
- EOP — Edge Of Pavement
- — Iron Stake Set (No. 5 Rebar with Plastic Cap Inscribed with "BOUNDARY MARKER") unless Otherwise Noted. Driven Flush with Grade Unless Otherwise Noted
- PPS — Pump Pipe Set (3" O.D.)
- ISS — Iron Stake Set (No. 5 Rebar)
- O — Non-Monumented Corner
- Trib. — Tributary
- C/E — Conservation Easement
- ~ — Spring
- — MONITORING REACH
- — MODIFIED FROM DESIGN
- — MARSH TREATMENT AREA BMP



SPRY
D.B. 95, PG. 1728

SPRY
D.B. 95, PG. 1728


SHEET 7 OF 23

AS-BUILT SURVEY

FOR
RESTORATION SYSTEMS, LLC
THREE MILE CREEK SITE



Natural Resources
Restoration & Conservation

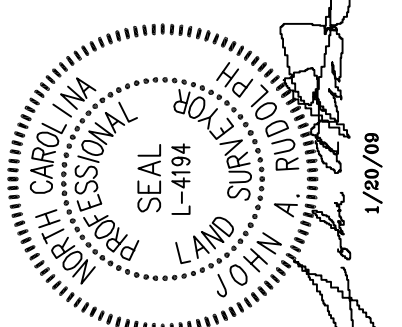

60 30 0 60 120 180
GRAPHIC SCALE 1" = 60'

CONSERVATION EASEMENT "I"
2.42 ACRES± EXCLUDING
ACCESS EASEMENT No. 8,
9 & 10 BY COMPUTER

CONSERVATION
EASEMENT "K"
4.89 ACRES± EXCLUDING
ACCESS EASEMENT No.
10 & 11 BY COMPUTER

CONSERVATION
EASEMENT "L"
0.08 ACRES±
EXCLUDING ACCESS
EASEMENT No. 11
BY COMPUTER

ACCESS EASEMENT 10
NEW 50' WIDE ACCESS
EASEMENT = 0.15
ACRES± BY COMPUTER

ACCESS
EASEMENT 11
NEW 30' WIDE ACCESS
EASEMENT = 0.05
ACRES± BY COMPUTER

START RESTORATION TRIB. 7
STA 00+00 TO
STA 02+75

THREE MILE ROAD
149 (40' R/W)
NCDOT CONCRETE BOX
CULVERT (TYP.)

ACCESS EASEMENT 9
NEW 10' WIDE ACCESS
EASEMENT (5' ON EACH
SIDE OF CENTER LINE OF
SOIL ROAD) = 0.08 ACRES±
BY COMPUTER

LEGEND:

- EIS - Existing Iron Stake
- EIP - Existing Iron Pipe
- NMC - Non Monumented Corner
- ECM - Existing Concrete Monument
- R/W - Right-Of-Way
- D.B. - Deed Book
- PG. - Page
- NCSR - North Carolina Secondary Road
- EOP - Edge Of Pavement
- - Iron Stake Set (No. 5 Rebar with Plastic Cap Inscribed with "BOUNDARY MARKER") unless Otherwise Noted. Driven Flush with Grade Unless Otherwise Noted
- PPS - Pump Pipe Set (3" O.D.)
- ISS - Iron Stake Set (No. 5 Rebar)
- O - Non-Monumented Corner
- Trib. - Tributary
- C/E - Conservation Easement
- ~ - Spring
- ~ - MONITORING REACH
- ~ - MODIFIED FROM DESIGN



CONSERVATION EASEMENT "K"
 4.89 ACRES± EXCLUDING ACCESS EASEMENT NO. 10 & 11 BY COMPUTER



END RESTORATION START ENHANCEMENT I MAIN CHANNEL
 STA 37+30

SPRY
 D.B. 95,
 PG. 1728

EXISTING 30' CAROLINA POWER AND LIGHT (15' ON EACH SIDE OF POWER LINE) D.B. 127, PG. 1278

LEDFORD
 D.B. 386, PG. 2449
LOTS 56-69
 M.B. 1, PG. 53

JAMES D. MAIN
 D.B. 386,
 PG. 2449

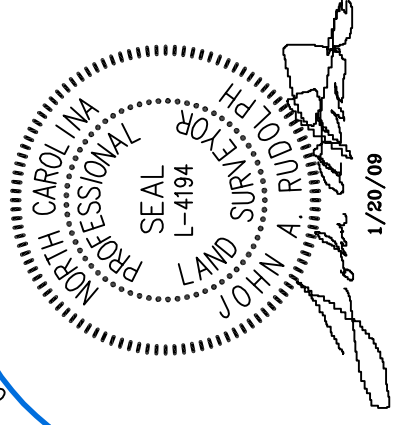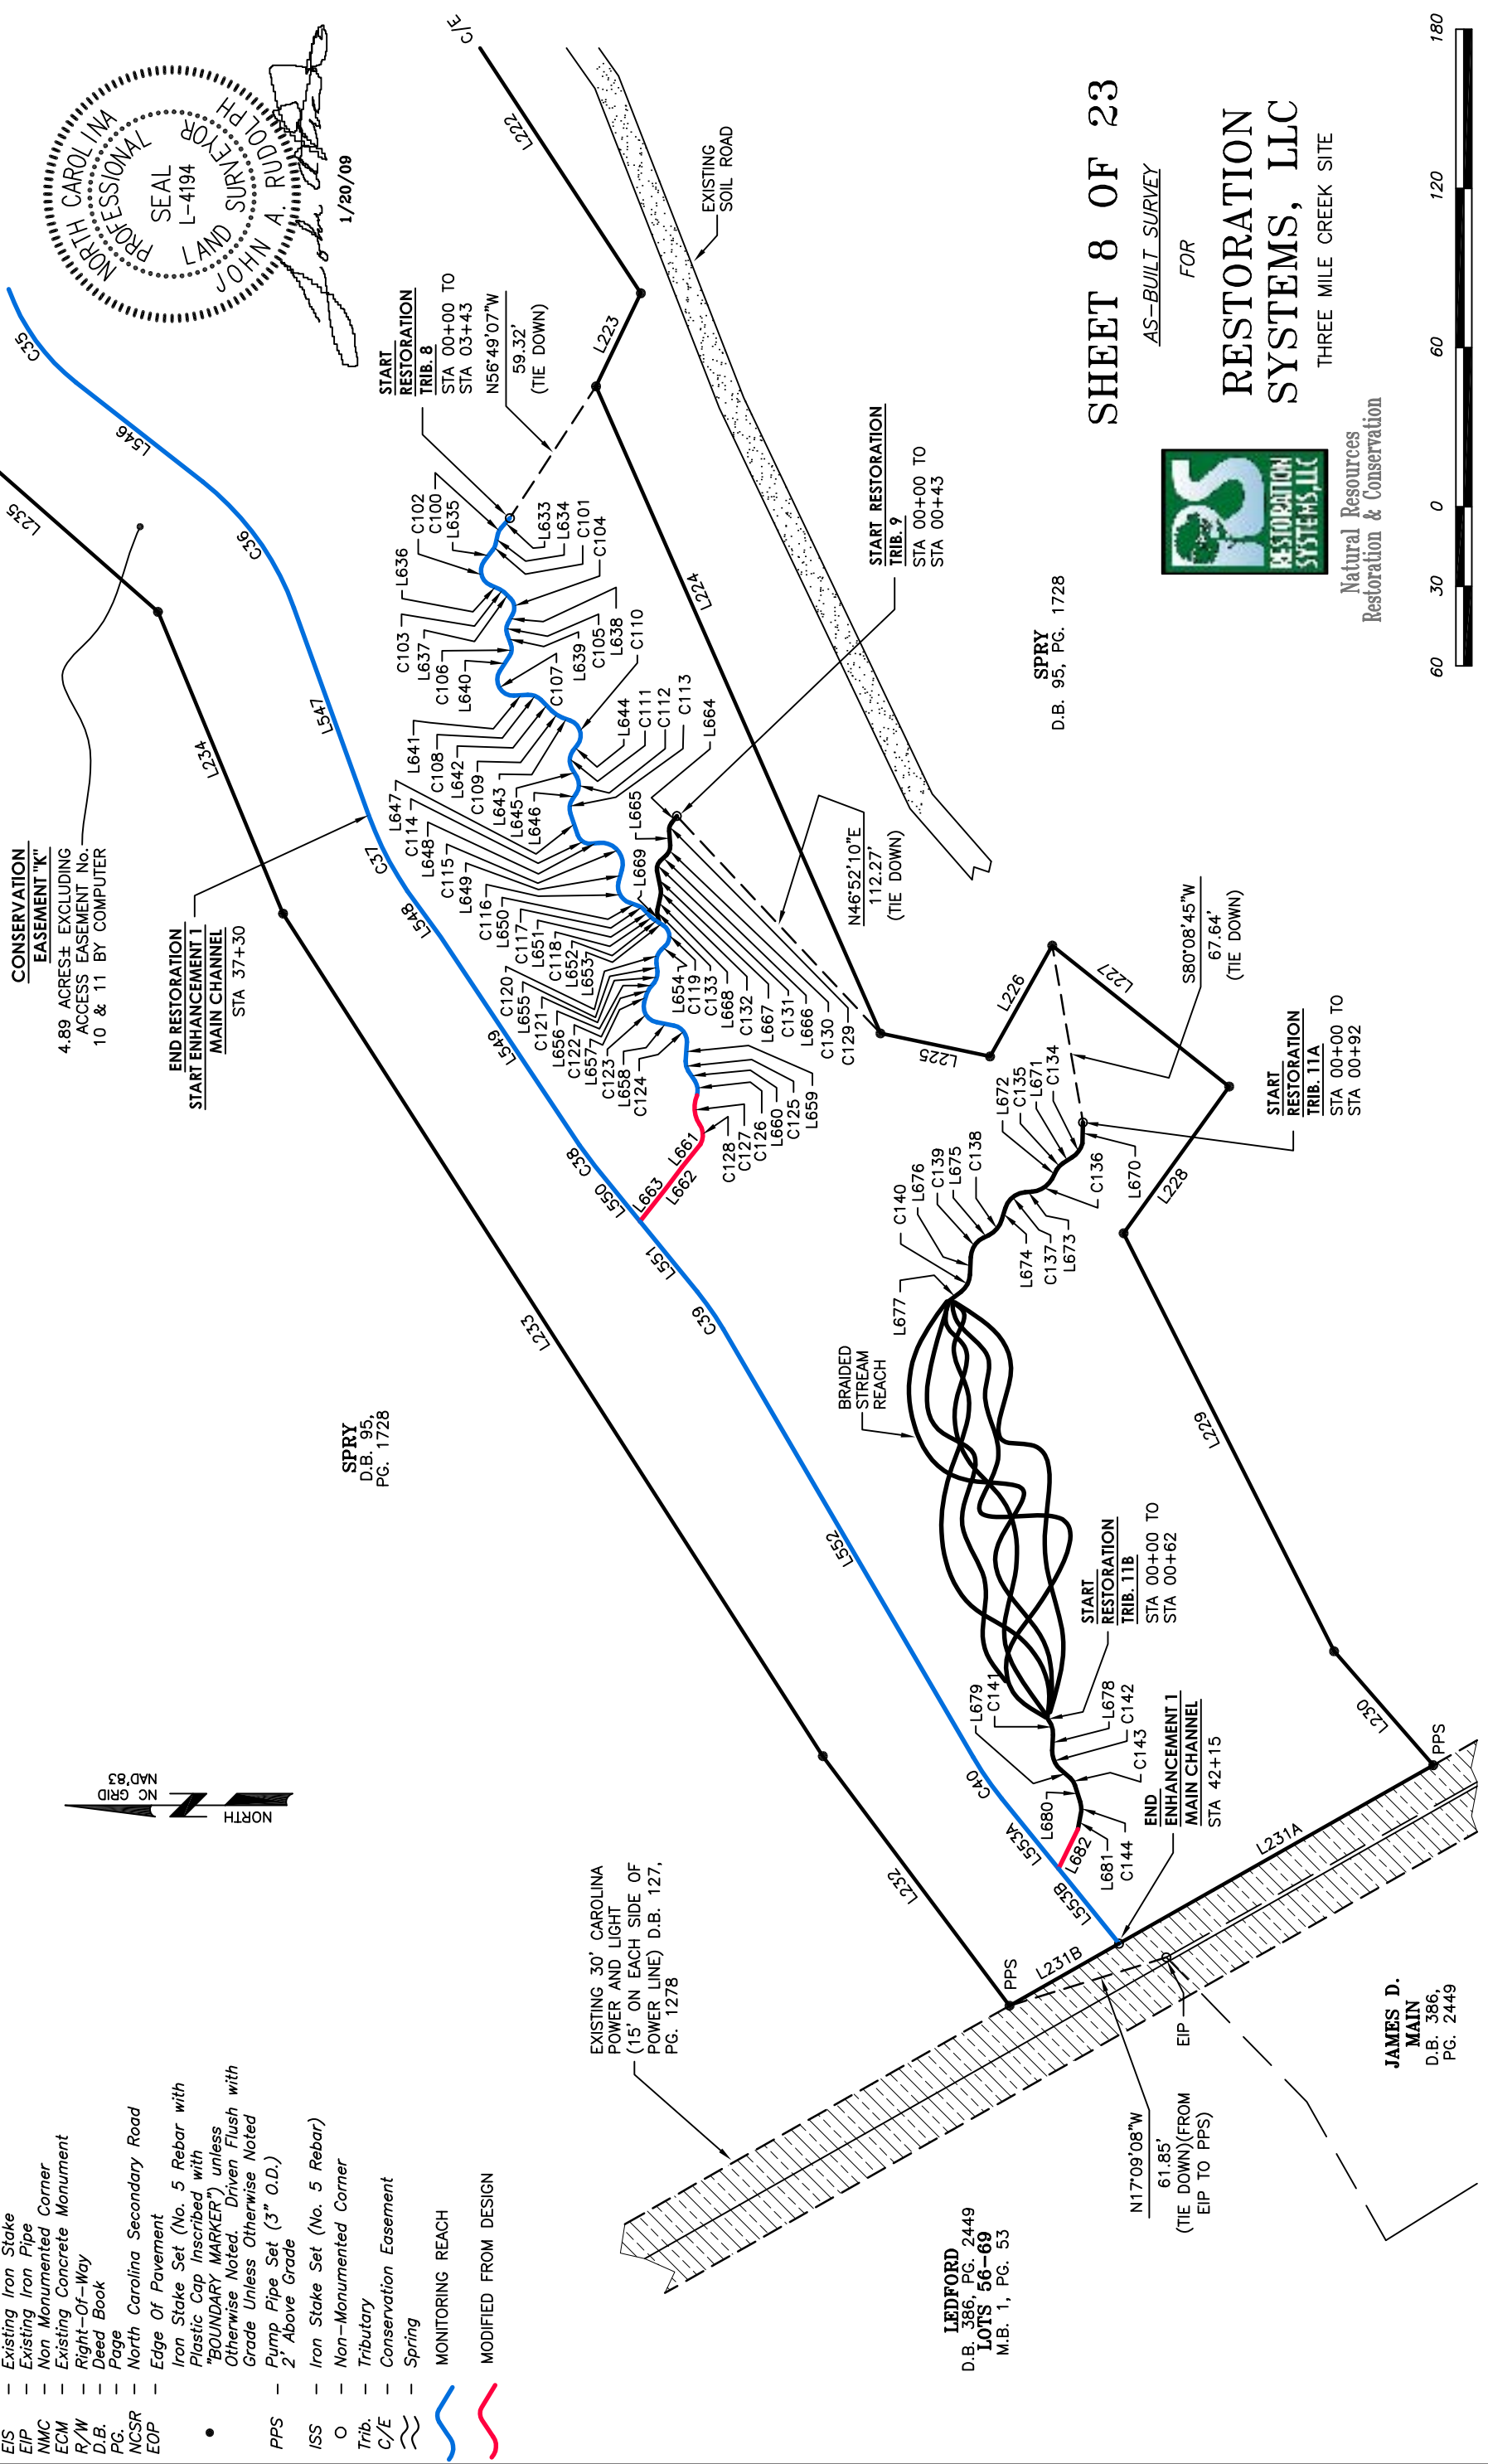

SHEET 8 OF 23

AS-BUILT SURVEY

FOR



RESTORATION SYSTEMS, LLC

THREE MILE CREEK SITE

Natural Resources
 Restoration & Conservation

SPRY
 D.B. 95, PG. 1728



GRAPHIC SCALE 1" = 60'

LINE DATA ALONG MAIN CHANNEL			
LINE	LENGTH	BEARING	
L501	62.39'	S31°30'05"W	
L502	63.31'	S52°38'31"W	
L503	67.29'	S40°48'41"W	
L504	72.39'	N85°52'49"W	
L505	11.89'	S43°53'11"W	
L506	49.24'	S43°53'11"W	
L507	30.86'	S20°42'48"W	
L508	49.94'	S37°01'07"W	
L509	61.33'	S19°12'06"W	
L510	54.62'	S65°00'22"W	
L511	11.40'	S57°43'43"W	
L512	14.98'	S50°27'05"W	
L513	34.14'	S50°27'05"W	
L514	45.31'	N87°52'55"W	
L515	74.76'	S72°09'18"W	
L516	54.37'	N83°48'23"W	
L517	5.62'	N83°48'23"W	
L518	13.42'	S88°59'20"W	
L519	61.89'	S81°47'02"W	
L520	54.93'	N77°22'02"W	
L521	43.15'	S69°17'48"W	
L522	40.83'	N82°20'03"W	
L523	64.77'	S64°56'04"W	
L524	45.04'	S87°28'17"W	
L525	22.63'	S61°11'15"W	
L526	17.74'	S61°11'15"W	
L527	54.21'	S89°02'55"W	
L528	26.68'	S60°05'01"W	
L529	13.43'	S60°05'01"W	
L530	22.99'	S72°20'00"W	
L531	17.49'	S72°20'00"W	
L532	37.24'	S39°02'05"W	
L533	39.83'	S87°44'45"W	
L534	65.51'	S72°45'52"W	
L535	89.17'	S89°21'24"W	
L536	95.27'	S70°00'49"W	
L537	49.84'	N65°23'01"W	
L538	44.25'	N88°11'46"W	
L539	60.15'	N62°21'39"W	
L540	70.25'	S82°15'37"W	
L541	56.89'	N74°03'20"W	
L542	83.61'	S77°20'00"W	
L543	32.71'	S28°18'57"W	
L544	8.72'	S28°18'57"W	
L545	84.16'	S70°16'44"W	
L546	60.77'	S38°05'13"W	
L547	83.10'	S70°08'58"W	
L548	21.38'	S54°02'31"W	
L549	94.30'	S56°17'51"W	
L550	26.85'	S50°51'15"W	
L551	34.25'	S50°51'15"W	
L552	186.75'	S59°42'41"W	
L553A	33.99'	S51°02'39"W	
L553B	36.30'	S51°02'39"W	

CURVE DATA ALONG MAIN CHANNEL				
CURVE	DELTA	RADIUS	CH. BRG.	CH. DIST.
C1	39°22'48"	53.00	S51°11'29"W	35.71
C2	21°08'26"	75.00	S42°04'18"W	27.52
C3	11°49'50"	72.50	S46°43'36"W	14.94
C4	53°18'30"	45.00	S67°27'56"W	40.37
C5	50°14'00"	45.00	S69°00'11"W	38.20
C6	23°10'23"	72.50	S32°18'00"W	29.12
C7	16°18'19"	72.50	S28°51'57"W	20.56
C8	17°49'01"	121.00	S28°06'36"W	37.48
C9	45°48'16"	57.50	S42°06'14"W	44.75
C10	41°40'00"	75.50	S71°17'05"W	53.70
C11	19°57'46"	45.00	S82°08'12"W	15.60
C12	24°02'19"	90.00	S84°10'28"W	37.48
C13	20°50'56"	102.00	N87°47'30"W	36.91
C14	33°20'10"	90.00	S85°57'53"W	51.63
C15	28°22'10"	87.00	S83°28'52"W	42.64
C16	32°43'54"	63.00	S81°18'01"W	35.50
C17	21°28'44"	59.00	S75°40'26"W	21.99
C18	26°17'03"	51.50	S74°19'46"W	23.42
C19	27°51'40"	61.00	S75°07'05"W	29.37
C20	28°57'54"	50.00	S74°33'58"W	25.01
C21	12°14'59"	60.00	S66°12'30"W	12.80
C22	33°17'55"	67.00	S65°41'03"W	38.39
C23	48°42'40"	63.00	S63°23'25"W	51.96
C24	14°58'53"	90.00	S80°15'18"W	23.47
C25	16°35'33"	90.00	S81°03'38"W	25.97
C26	19°20'35"	76.00	S79°41'07"W	25.54
C27	44°36'09"	54.00	N87°41'06"W	40.98
C28	22°44'44"	112.00	N76°47'23"W	44.30
C29	25°50'06"	80.00	N75°16'42"W	35.77
C30	35°22'44"	72.50	N80°03'01"W	44.06
C31	23°41'04"	99.00	N85°53'52"W	40.63
C32	28°36'40"	109.00	N88°21'40"W	53.87
C33	49°01'03"	95.00	S52°49'28"W	78.82
C34	41°57'47"	71.50	S49°17'50"W	51.20
C35	32°11'31"	78.00	S54°10'58"W	43.25
C36	32°03'46"	106.00	S54°07'05"W	58.55
C37	14°16'07"	129.50	S63°00'54"W	32.17
C38	5°01'36"	111.00	S53°22'03"W	9.73
C39	8°51'26"	111.00	S55°16'58"W	17.14
C40	8°40'02"	125.50	S55°22'40"W	18.97

LINE DATA ALONG TRIBUTARY 2			
LINE	LENGTH	BEARING	
L571	10.19'	S53°47'00"W	
L572	6.05'	S27°06'47"W	
L573	16.27'	S78°18'20"W	
L574	12.37'	S61°28'44"W	
L575	13.40'	S87°47'27"W	
L576	8.07'	S45°00'27"W	

LINE DATA ALONG TRIBUTARY 3			
LINE	LENGTH	BEARING	
L577	16.14'	N47°23'11"W	
L578	6.97'	N00°07'15"E	
L579	7.69'	N48°19'47"W	
L580	5.75'	N10°24'41"E	
L581	7.75'	N40°34'39"W	
L582	12.41'	N57°58'16"W	
L583	12.91'	N05°44'02"W	
L584	8.48'	N83°48'19"W	
L585	5.04'	N36°59'36"W	
L586	11.56'	S50°53'45"W	
L587	10.93'	N50°09'54"W	
L588	3.87'	S45°00'27"W	
L589	10.42'	N65°16'18"W	
L590	15.99'	N70°10'41"W	
L591	9.80'	N60°41'16"W	

LINE DATA ALONG TRIBUTARY 4			
LINE	LENGTH	BEARING	
L592	6.10'	N35°51'47"W	
L593	8.69'	N00°07'04"W	
L594	8.75'	N40°31'21"W	
L595	13.12'	N30°56'24"W	
L596	13.20'	N62°38'21"W	
L597	10.82'	N55°50'45"W	
L598	19.21'	N73°12'18"W	
L599	5.61'	N21°51'48"W	
L600	8.44'	N33°03'19"W	

CURVE DATA ALONG TRIBUTARY 4				
CURVE	DELTA	RADIUS	CH. BRG.	CH. DIST.
C68	35°44'44"	11.50	N17°59'25"W	7.06
C69	40°24'17"	11.50	N20°19'12"W	7.94
C70	9°34'57"	11.50	N35°43'52"W	1.92
C71	31°41'57"	11.50	N46°47'22"W	6.28
C72	6°47'35"	11.50	N59°14'33"W	1.36
C73	28°08'11"	11.50	N69°54'51"W	5.59
C74	52°11'59"	19.28	N47°06'19"W	16.96
C75	45°10'17"	15.68	N43°35'28"W	12.04
C76	38°30'16"	11.50	N52°18'28"W	7.58
C77	61°57'41"	11.97	N48°02'33"W	12.33
C78	28°36'56"	24.16	N31°22'11"W	11.94

LINE DATA ALONG TRIBUTARY 5			
LINE	LENGTH	BEARING	
L592	6.10'	N35°51'47"W	
L593	8.69'	N00°07'04"W	
L594	8.75'	N40°31'21"W	
L595	13.12'	N30°56'24"W	
L596	13.20'	N62°38'21"W	
L597	10.82'	N55°50'45"W	
L598	19.21'	N73°12'18"W	
L599	5.61'	N21°51'48"W	
L600	8.44'	N33°03'19"W	
L601	10.57'	N03°06'59"E	
L602	10.98'	N19°14'00"E	
L603	9.36'	N29°08'56"W	
L604	9.62'	N05°05'50"E	
L605	10.30'	N40°17'54"W	
L606	9.38'	N09°43'45"W	
L607	9.74'	N78°50'48"W	
L608	30.83'	N70°33'35"W	
L609	12.93'	N61°19'35"W	
L610	8.66'	N46°41'12"W	
L611	11.44'	N62°59'25"W	


CURVE DATA ALONG TRIBUTARY 5				
CURVE	DELTA	RADIUS	CH. BRG.	CH. DIST.
C69	40°24'17"	11.50	N20°19'12"W	7.94
C71	31°41'57"	11.50	N46°47'22"W	6.28
C73	28°08'11"	11.50	N69°54'51"W	5.59
C74	52°11'59"	19.28	N47°06'19"W	16.96
C75	45°10'17"	15.68	N43°35'28"W	12.04
C76	38°30'16"	11.50	N52°18'28"W	7.58
C77	61°57'41"	11.97	N48°02'33"W	12.33
C78	28°36'56"	24.16	N31°22'11"W	11.94
C79	11°47'01"	11.50	N13°20'30"E	2.36
C80	48°22'56"	15.50	N04°57'28"W	12.70
C81	34°14'45"	20.00	N12°01'33"W	11.78
C82	45°23'43"	20.00	N17°36'02"W	15.43
C83	30°34'09"	15.50	N25°00'49"W	8.17
C84	69°07'04"	11.50	N44°17'16"W	13.05
C85	27°33'54"	11.50	N60°28'09"W	5.48

LINE DATA ALONG TRIBUTARY 6A			
LINE	LENGTH	BEARING	
L612	17.25'	N16°46'24"W	
L613	12.11'	N05°22'11"E	
L614	12.87'	N32°32'34"W	
L615	15.70'	N03°18'09"W	
L616	9.71'	N46°24'26"W	
L617	18.16'	N31°44'00"W	
L618	27.54'	N67°12'15"W	
L619	8.43'	N54°04'16"W	
L620	9.07'	N46°49'33"W	

CURVE DATA ALONG TRIBUTARY 6A				
CURVE	DELTA	RADIUS	CH. BRG.	CH. DIST.
C86	22°08'35"	20.00	N05°42'07"W	7.68
C87	37°54'45"	15.50	N13°35'12"W	10.07
C88	29°14'25"	15.50	N17°55'21"W	7.82
C89	43°06'17"	15.50	N24°51'17"W	11.39
C90	14°40'25"	11.50	N39°04'13"W	2.94
C91	23°51'36"	15.50	N43°39'48"W	6.41

CURVE DATA ALONG TRIBUTARY 1				
CURVE	DELTA	RADIUS	CH. BRG.	CH. DIST.
C41	22°09'30"	14.50	S31°02'52"E	5.57
C42	64°18'58"	12.50	S09°58'08"E	13.31
C43	59°36'18"	12.00	S07°36'48"E	11.93
C44	58°56'11"	11.50	S07°56'51"E	11.31
C45	66°17'31"	12.50	S11°37'31"E	13.67
C46	55°28'32"	12.50	S17°02'01"E	11.64
C47	45°57'59"	14.00	S12°16'44"E	10.93
C48	73°27'31"	15.00	S01°28'02"W	17.94
C49	53°45'26"	12.50	S11°19'04"W	11.30
C50	67°38'19"	12.50	S18°15'31"W	13.91

LINE DATA ALONG TRIBUTARY 1			
LINE	LENGTH	BEARING	
L554	6.82'	S19°58'07"E	
L555	7.63'	S42°07'37"E	
L556	15.94'	S22°11'21"W	
L557	7.65'	S37°24'57"E	
L558	13.14'	S21°31'14"W	
L559	11.27'	S44°46'17"E	
L560	10.16'	S10°42'15"W	
L561	14.12'	S35°15'44"E	
L562	9.90'	S38°11'47"W	
L563	9.12'	S15°33'39"E	
L564	12.07'	S39°06'38"W	
L565	16.37'	S32°13'46"W	
L566	19.09'	S60°16'58"W	
L567	13.53'	S34°21'40"W	
L568	19.38'	S17°29'25"W	
L569	16.09'	S07°23'14"E	
L570	10.32'	S21°57'20"E	

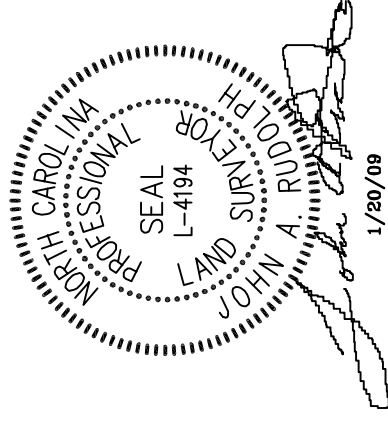

SHEET 9 OF 23

AS-BUILT SURVEY
FOR

RESTORATION SYSTEMS, LLC

THREE MILE CREEK SITE



Natural Resources
Restoration & Conservation

LINE DATA ALONG TRIBUTARY 7		
LINE	LENGTH	BEARING
L621	16.06'	S00°11'53"W
L622	16.80'	S33°14'47"W
L623	21.80'	S02°51'19"E
L624	12.51'	S39°56'38"W
L625	14.78'	S15°13'20"W
L626	16.04'	S59°49'36"W
L627	11.02'	S31°20'38"W
L628	9.52'	S64°59'50"W
L629	15.06'	S02°07'43"E
L630	7.03'	S06°56'02"W
L631	13.27'	S07°23'33"E
L632	16.47'	S07°14'29"E

CURVE DATA ALONG TRIBUTARY 7					
CURVE	DELTA	RADIUS	CH.	BRG.	CH. DIST.
C92	33°02'54"	12.00	S16°43'20"W		6.83
C93	36°06'07"	20.00	S15°11'44"W		12.39
C94	42°47'57"	21.00	S18°32'39"W		15.32
C95	24°43'17"	19.00	S27°34'59"W		8.13
C96	44°36'16"	15.50	S37°31'28"W		11.76
C97	28°28'58"	20.50	S45°35'07"W		10.09
C98	33°39'12"	17.00	S48°10'14"W		9.84
C99	67°07'32"	14.00	S31°26'03"W		15.48

LINE DATA ALONG TRIBUTARY 8		
LINE	LENGTH	BEARING
L633	4.83'	N47°51'29"W
L634	4.05'	N76°30'47"W
L635	5.14'	N52°08'39"W
L636	3.66'	S22°58'08"W
L637	3.35'	S44°50'30"W
L638	3.78'	N61°09'47"W
L639	3.99'	S69°17'01"W
L640	6.79'	N57°01'27"W
L641	5.21'	S03°17'56"E
L642	5.80'	S45°26'37"W
L643	3.23'	S20°10'53"W
L644	2.75'	N52°48'36"W
L645	3.61'	S69°41'00"W
L646	2.55'	N55°29'39"W
L647	8.45'	S71°12'42"W
L648	2.91'	S06°00'15"E
L649	4.92'	N75°07'24"W
L650	3.18'	S18°36'39"W
L651	3.11'	S48°08'59"W
L652	2.70'	S32°29'34"W
L653	1.71'	S32°29'34"W
L654	1.79'	N42°06'41"W
L655	3.15'	S82°55'25"W
L656	2.78'	N50°57'47"W
L657	3.45'	N72°56'28"W
L658	6.64'	S10°39'16"W
L659	7.21'	N86°42'52"W
L660	4.48'	S56°38'30"W
L661	11.16'	S51°09'16"E
L662	9.54'	N52°51'42"W
L663	16.16'	N51°48'53"W

CURVE DATA ALONG TRIBUTARY 8					
CURVE	DELTA	RADIUS	CH.	BRG.	CH. DIST.
C100	29°14'42"	5.50	N61°53'26"W		2.78
C101	24°22'07"	5.50	N64°19'43"W		2.32
C102	104°53'13"	6.00	S75°24'44"W		9.51
C103	21°52'22"	5.50	S33°54'19"W		2.09
C104	73°59'43"	5.00	S81°50'22"W		6.02
C105	49°33'13"	5.00	N85°56'23"W		4.19
C106	53°41'32"	5.00	N83°52'13"W		4.52
C107	72°16'29"	6.00	S59°50'18"W		10.71
C108	48°44'33"	6.50	S21°04'21"W		5.36
C109	25°15'44"	10.50	S32°48'45"W		4.59
C110	107°00'31"	6.00	S73°41'08"W		9.65
C111	67°30'24"	6.00	N86°33'48"W		6.67
C112	64°49'21"	6.00	N87°54'20"W		6.43
C113	53°17'39"	6.00	N82°08'28"W		5.38
C114	77°12'57"	5.00	S32°36'14"W		6.24
C115	110°52'51"	8.00	S49°26'10"W		73.18
C116	86°15'57"	6.50	S61°44'37"W		8.89
C117	29°32'20"	6.00	S33°22'49"W		3.06
C118	15°39'25"	6.00	S40°19'17"W		1.63
C119	105°23'45"	5.00	S85°11'27"W		7.95
C120	54°57'54"	6.00	N69°35'38"W		5.54
C121	46°06'48"	5.50	N74°01'11"W		4.31
C122	21°58'42"	5.50	N61°57'07"W		2.10
C123	96°24'16"	6.00	S58°51'24"W		8.95
C124	82°37'52"	6.00	S51°58'12"W		7.92
C125	36°38'39"	6.00	S74°57'49"W		3.77
C126	50°50'35"	6.50	S82°03'47"W		5.58
C127	57°00'39"	11.34	S84°46'59"W		10.82
C128	62°39'52"	7.34	S87°36'35"W		7.64

LINE DATA ALONG TRIBUTARY 9		
LINE	LENGTH	BEARING
L664	3.33'	N52°51'46"W
L665	5.36'	S85°42'18"W
L666	3.26'	N43°22'56"W
L667	6.94'	S79°06'03"W
L668	5.14'	N77°21'34"W
L669	3.08'	S76°36'38"W


LINE DATA ALONG TRIBUTARY 11A		
LINE	LENGTH	BEARING
L670	7.90'	N88°32'31"W
L671	4.11'	N32°41'45"W
L672	3.77'	N61°48'24"W
L673	2.50'	N04°13'07"W
L674	4.31'	N73°47'31"W
L675	2.32'	N26°11'24"W
L676	6.63'	N87°36'08"W
L677	6.07'	N37°19'44"W

CURVE DATA ALONG TRIBUTARY 11A					
CURVE	DELTA	RADIUS	CH.	BRG.	CH. DIST.
C134	40°51'05"	9.50	N53°07'17"W		6.63
C135	29°06'39"	6.50	N47°15'04"W		3.27
C136	57°35'17"	9.50	N33°00'45"W		9.15
C137	69°34'24"	8.50	N39°00'19"W		9.70
C138	47°36'06"	9.50	N49°59'27"W		7.67
C139	61°24'44"	8.50	N56°53'46"W		8.68
C140	50°16'24"	8.50	N62°27'56"W		7.22

LINE DATA ALONG TRIBUTARY 11B		
LINE	LENGTH	BEARING
L678	5.80'	N87°19'15"W
L679	4.87'	S40°45'38"W
L680	6.57'	S72°48'25"W
L681	5.53'	N79°42'36"W
L682	16.58'	N63°38'20"W

CURVE DATA ALONG TRIBUTARY 11B					
CURVE	DELTA	RADIUS	CH.	BRG.	CH. DIST.
C141	39°05'38"	9.00	S73°07'57"W		6.02
C142	51°55'07"	9.00	S66°43'12"W		7.88
C143	32°02'47"	6.00	S56°47'02"W		3.31
C144	31°07'18"	9.00	S88°22'05"W		4.83

LINE DATA ALONG FORK CREEK		
LINE	LENGTH	BEARING
L682	79.95'	S25°12'56"E
L683	39.61'	S16°40'03"E
L684	40.14'	S12°02'33"E
L685	11.84'	S12°23'42"E

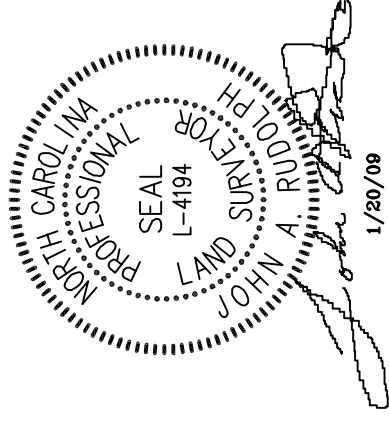

1/20/09

SHEET 10 OF 23

AS-BUILT SURVEY


FOR

RESTORATION
SYSTEMS, LLC

THREE MILE CREEK SITE



Natural Resources
Restoration & Conservation

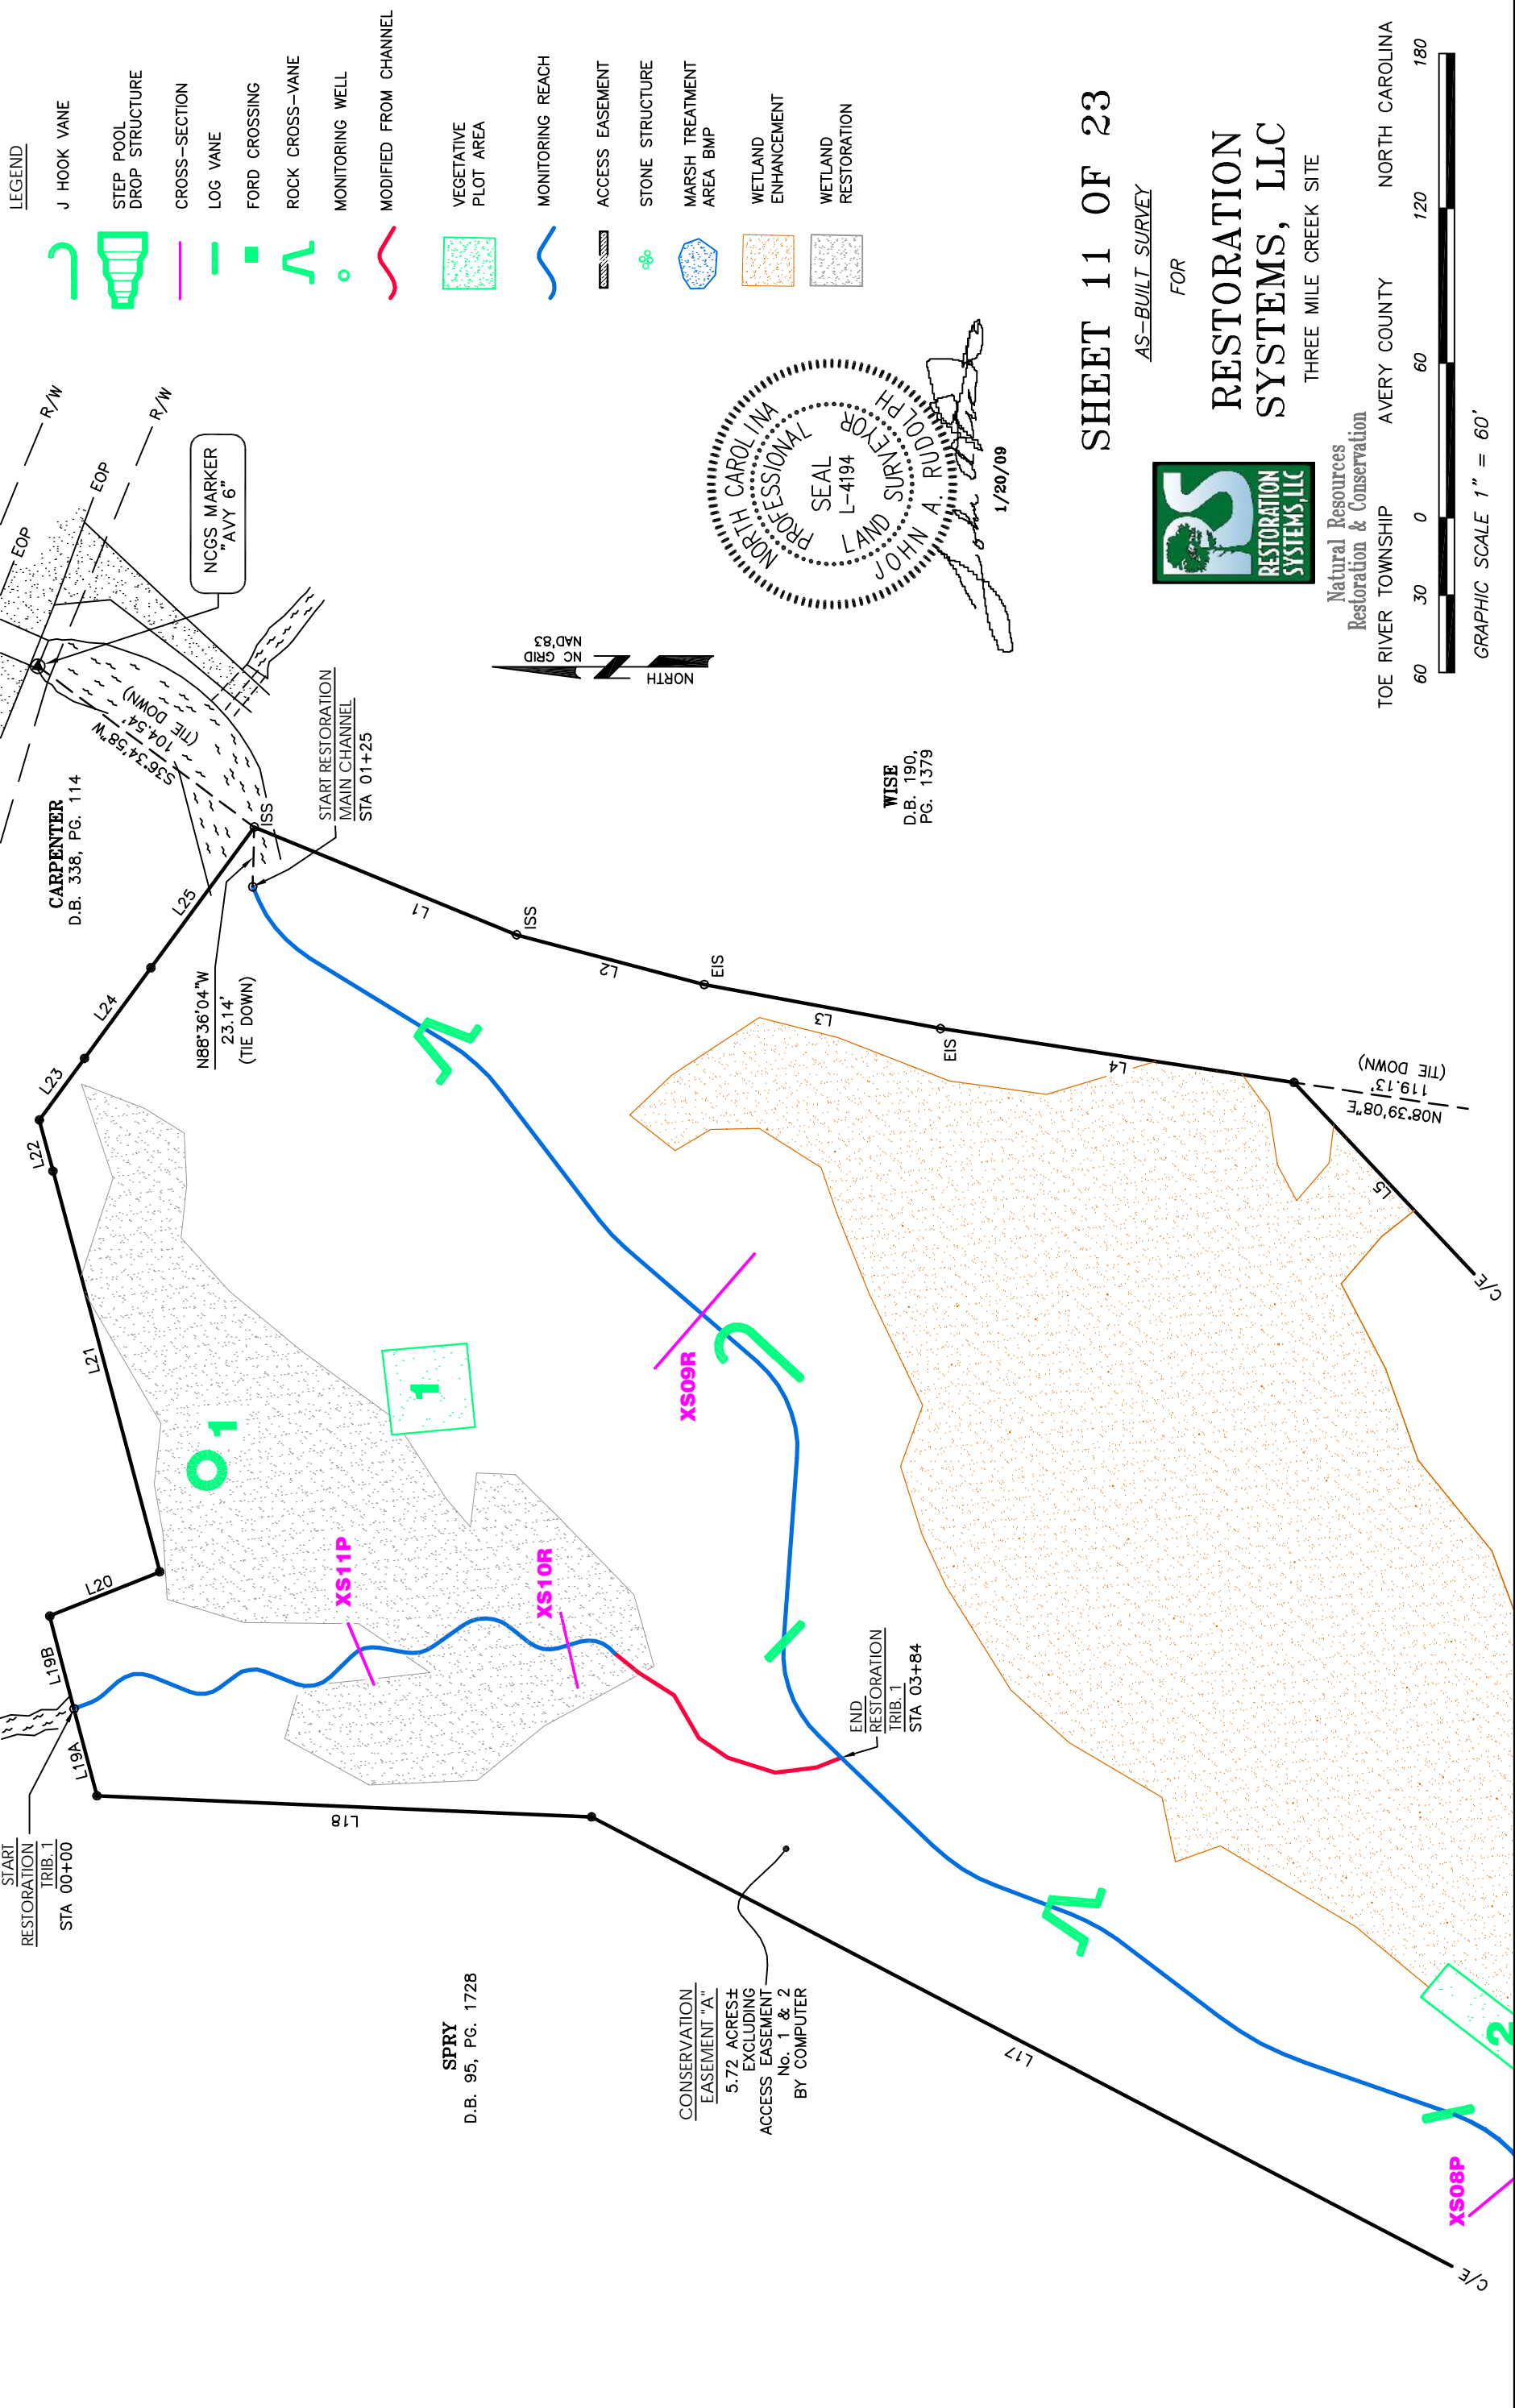

LEGEND

- J HOOK VANE
- STEP POOL DROP STRUCTURE
- CROSS-SECTION
- LOG VANE
- FORD CROSSING
- ROCK CROSS-VANE
- MONITORING WELL
- MODIFIED FROM CHANNEL
- VEGETATIVE PLOT AREA
- MONITORING REACH
- ACCESS EASEMENT
- STONE STRUCTURE
- MARSH TREATMENT AREA BMP
- WETLAND ENHANCEMENT
- WETLAND RESTORATION

SHEET 11 OF 23

AS-BUILT SURVEY




RESTORATION SYSTEMS, LLC


THREE MILE CREEK SITE

Natural Resources
Restoration & Conservation

TOE RIVER TOWNSHIP AVERY COUNTY NORTH CAROLINA

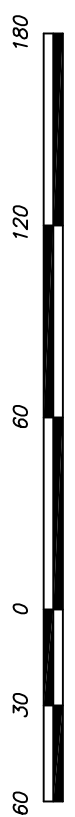

GRAPHIC SCALE 1" = 60'

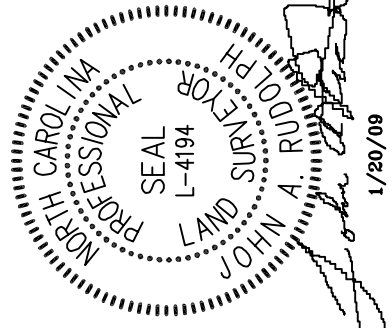

WISE
D.B. 190,
PG. 1379



START RESTORATION TRIB. 1 STA 00+00

CARPENTER D.B. 356, PG. 114

N88°36'04"W
23.14'
(TIE DOWN)

START RESTORATION MAIN CHANNEL STA 01+25
















END RESTORATION TRIB. 1 STA 03+84

N08°39'08"E
119.13'
(TIE DOWN)

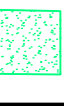SPRY
D.B. 95, PG. 1728

CONSERVATION EASEMENT "A"
5.72 ACRES±
EXCLUDING ACCESS EASEMENT No. 1 & 2
BY COMPUTER

LEGEND


-  J HOOK VANE
-  STEP POOL DROP STRUCTURE
-  CROSS-SECTION
-  LOG VANE
-  FORD CROSSING
-  ROCK CROSS-VANE
-  MONITORING WELL
-  MODIFIED FROM DESIGN
-  VEGETATIVE PLOT AREA
-  MONITORING REACH
-  ACCESS EASEMENT
-  STONE STRUCTURE
-  MARSH TREATMENT AREA BMP
-  WETLAND ENHANCEMENT
-  WETLAND RESTORATION

CONSERVATION EASEMENT "C" 2.42 ACRES± EXCLUDING ACCESS EASEMENT No. 2, 3, 4, 6 & 8 BY COMPUTER


ACCESS EASEMENT 2 NEW 30' WIDE ACCESS EASEMENT = 0.07 ACRES± BY COMPUTER

CONSERVATION EASEMENT "A" 5.72 ACRES± EXCLUDING ACCESS EASEMENT No. 1 & 2 BY COMPUTER

SPRY D.B. 95, PG. 1728

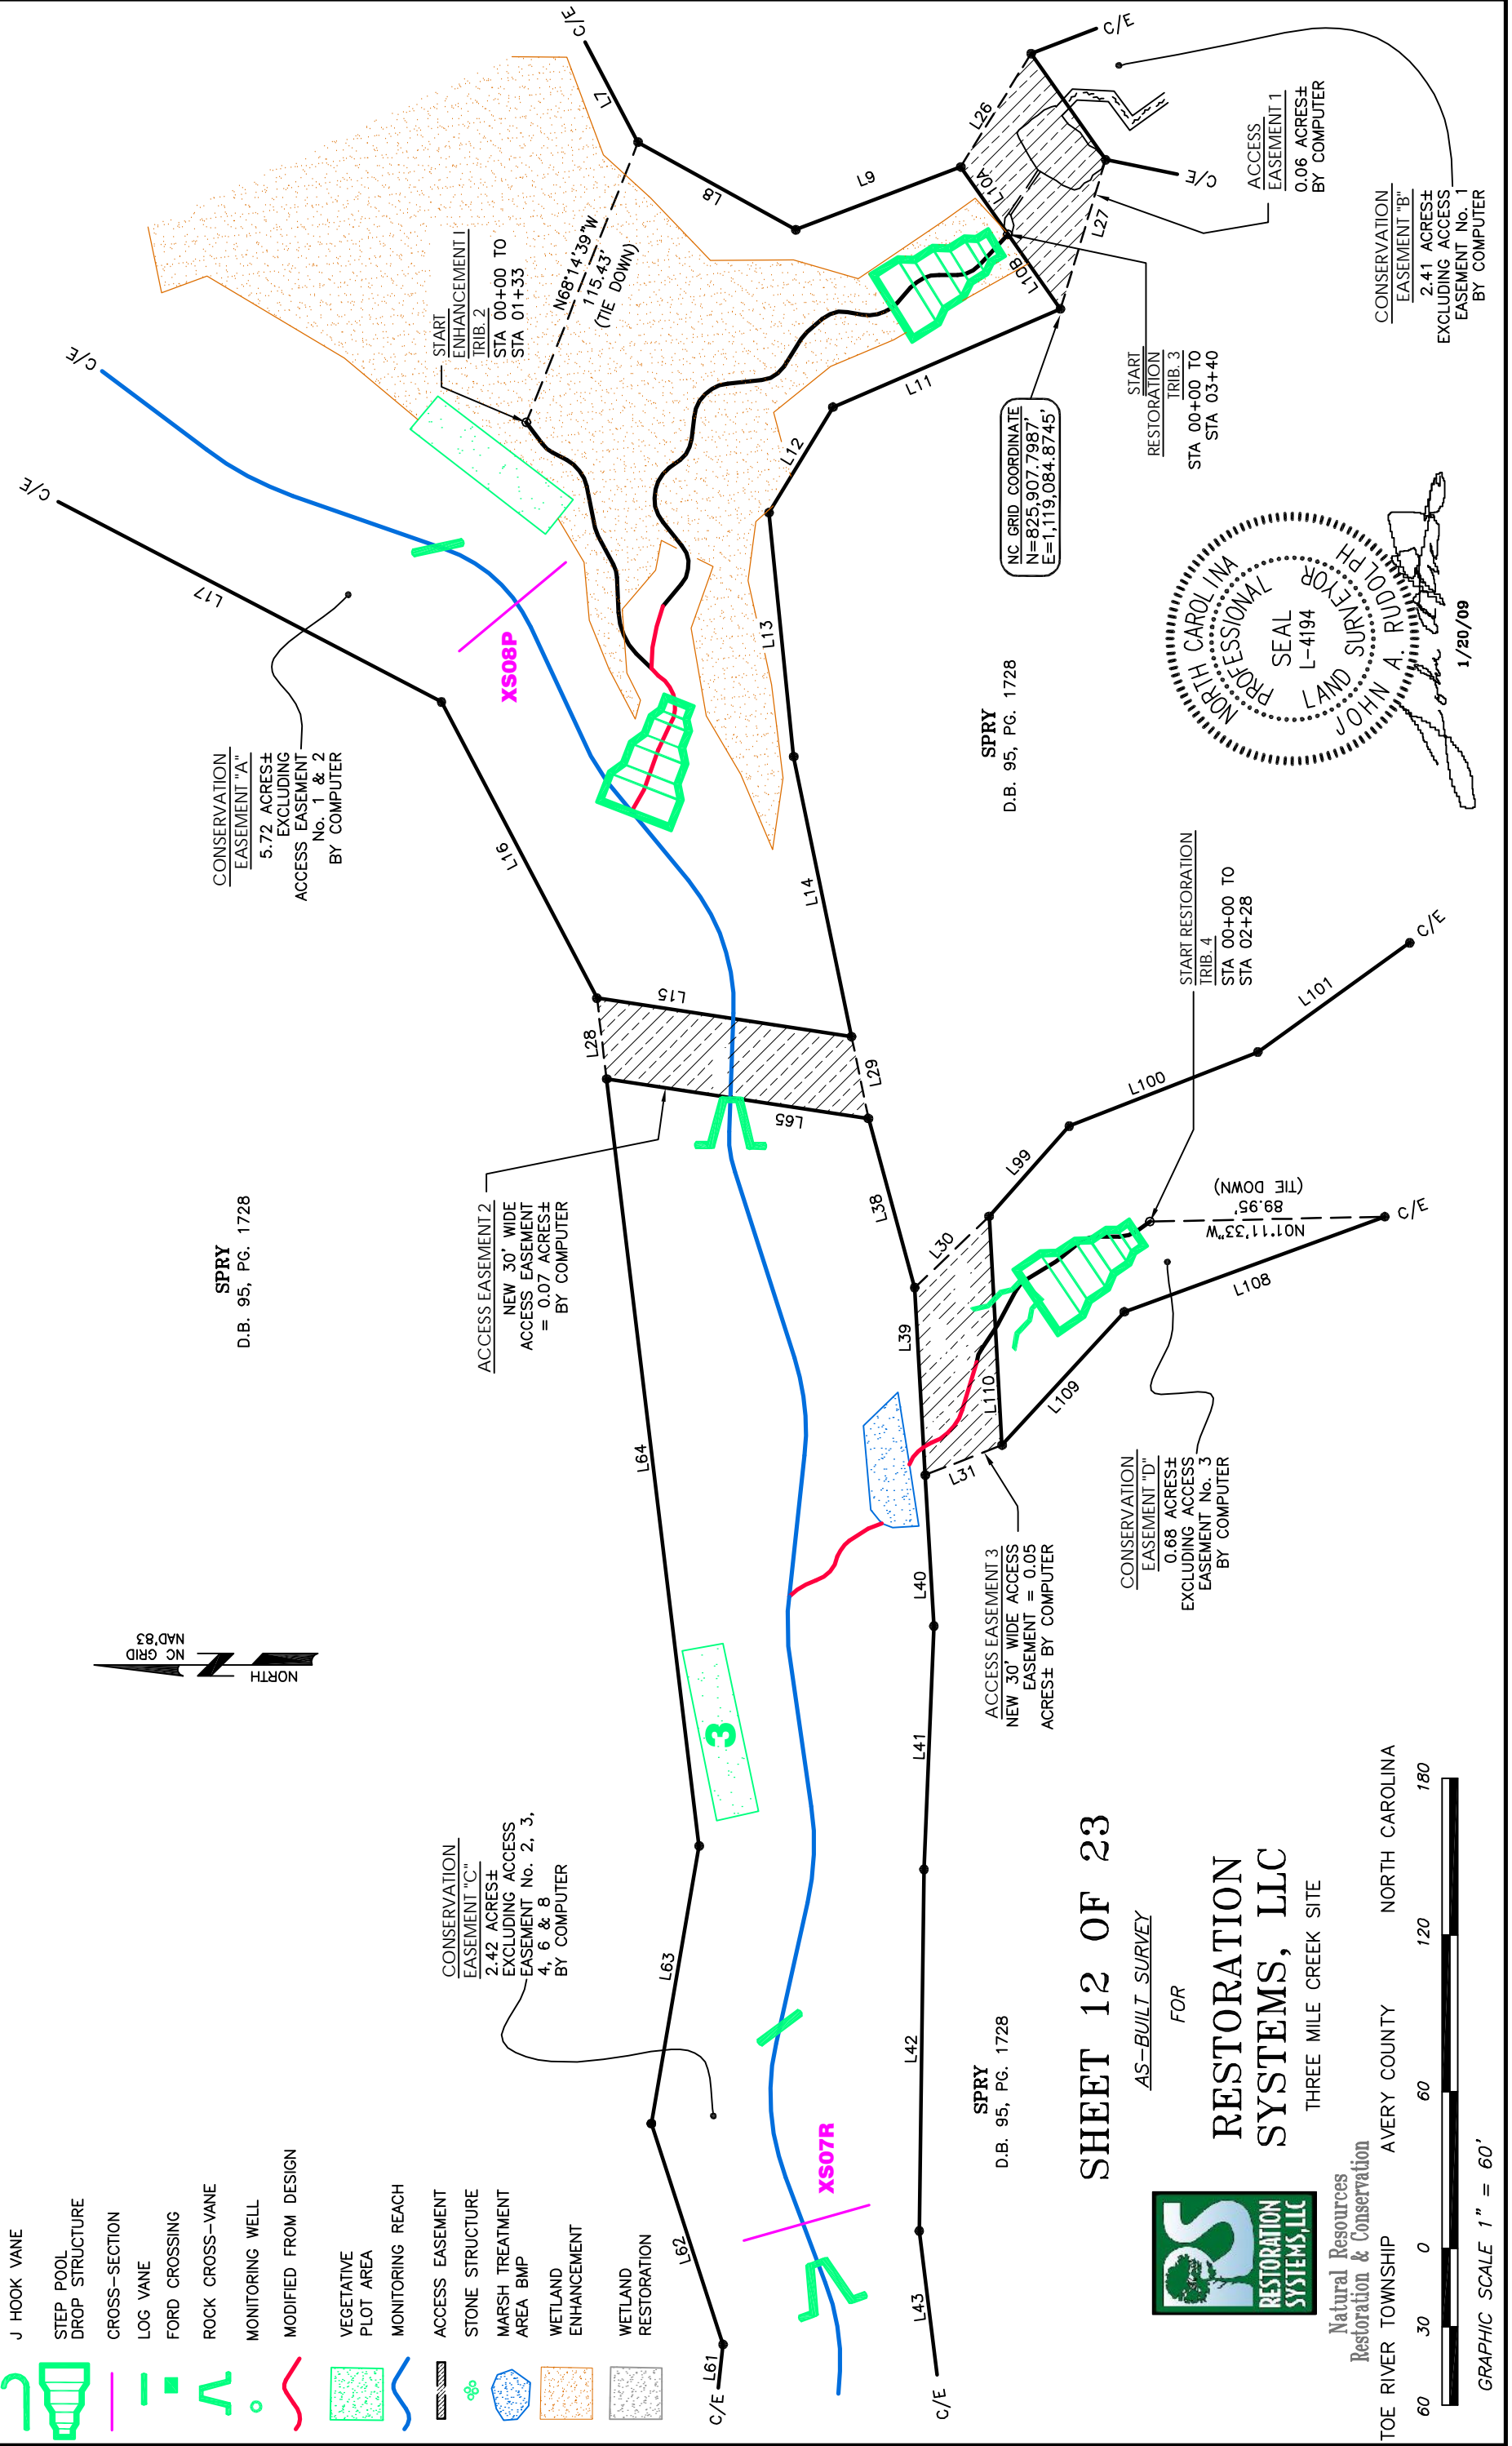

NC GRID COORDINATE
N=825,907.7987
E=1,119,084.8745

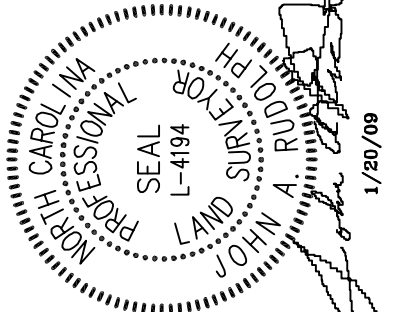

SHEET 12 OF 23

AS-BUILT SURVEY


FOR
RESTORATION SYSTEMS, LLC
THREE MILE CREEK SITE

Natural Resources
Restoration & Conservation

TOE RIVER TOWNSHIP AVERY COUNTY NORTH CAROLINA

GRAPHIC SCALE 1" = 60'

- LEGEND**
- J HOOK VANE
 - STEP POOL DROP STRUCTURE
 - CROSS-SECTION
 - LOG VANE
 - FORD CROSSING
 - ROCK CROSS-VANE
 - MONITORING WELL
 - MODIFIED FROM DESIGN
 - VEGETATIVE PLOT AREA
 - MONITORING REACH
 - ACCESS EASEMENT
 - STONE STRUCTURE
 - MARSH TREATMENT AREA BMP
 - WETLAND ENHANCEMENT
 - WETLAND RESTORATION

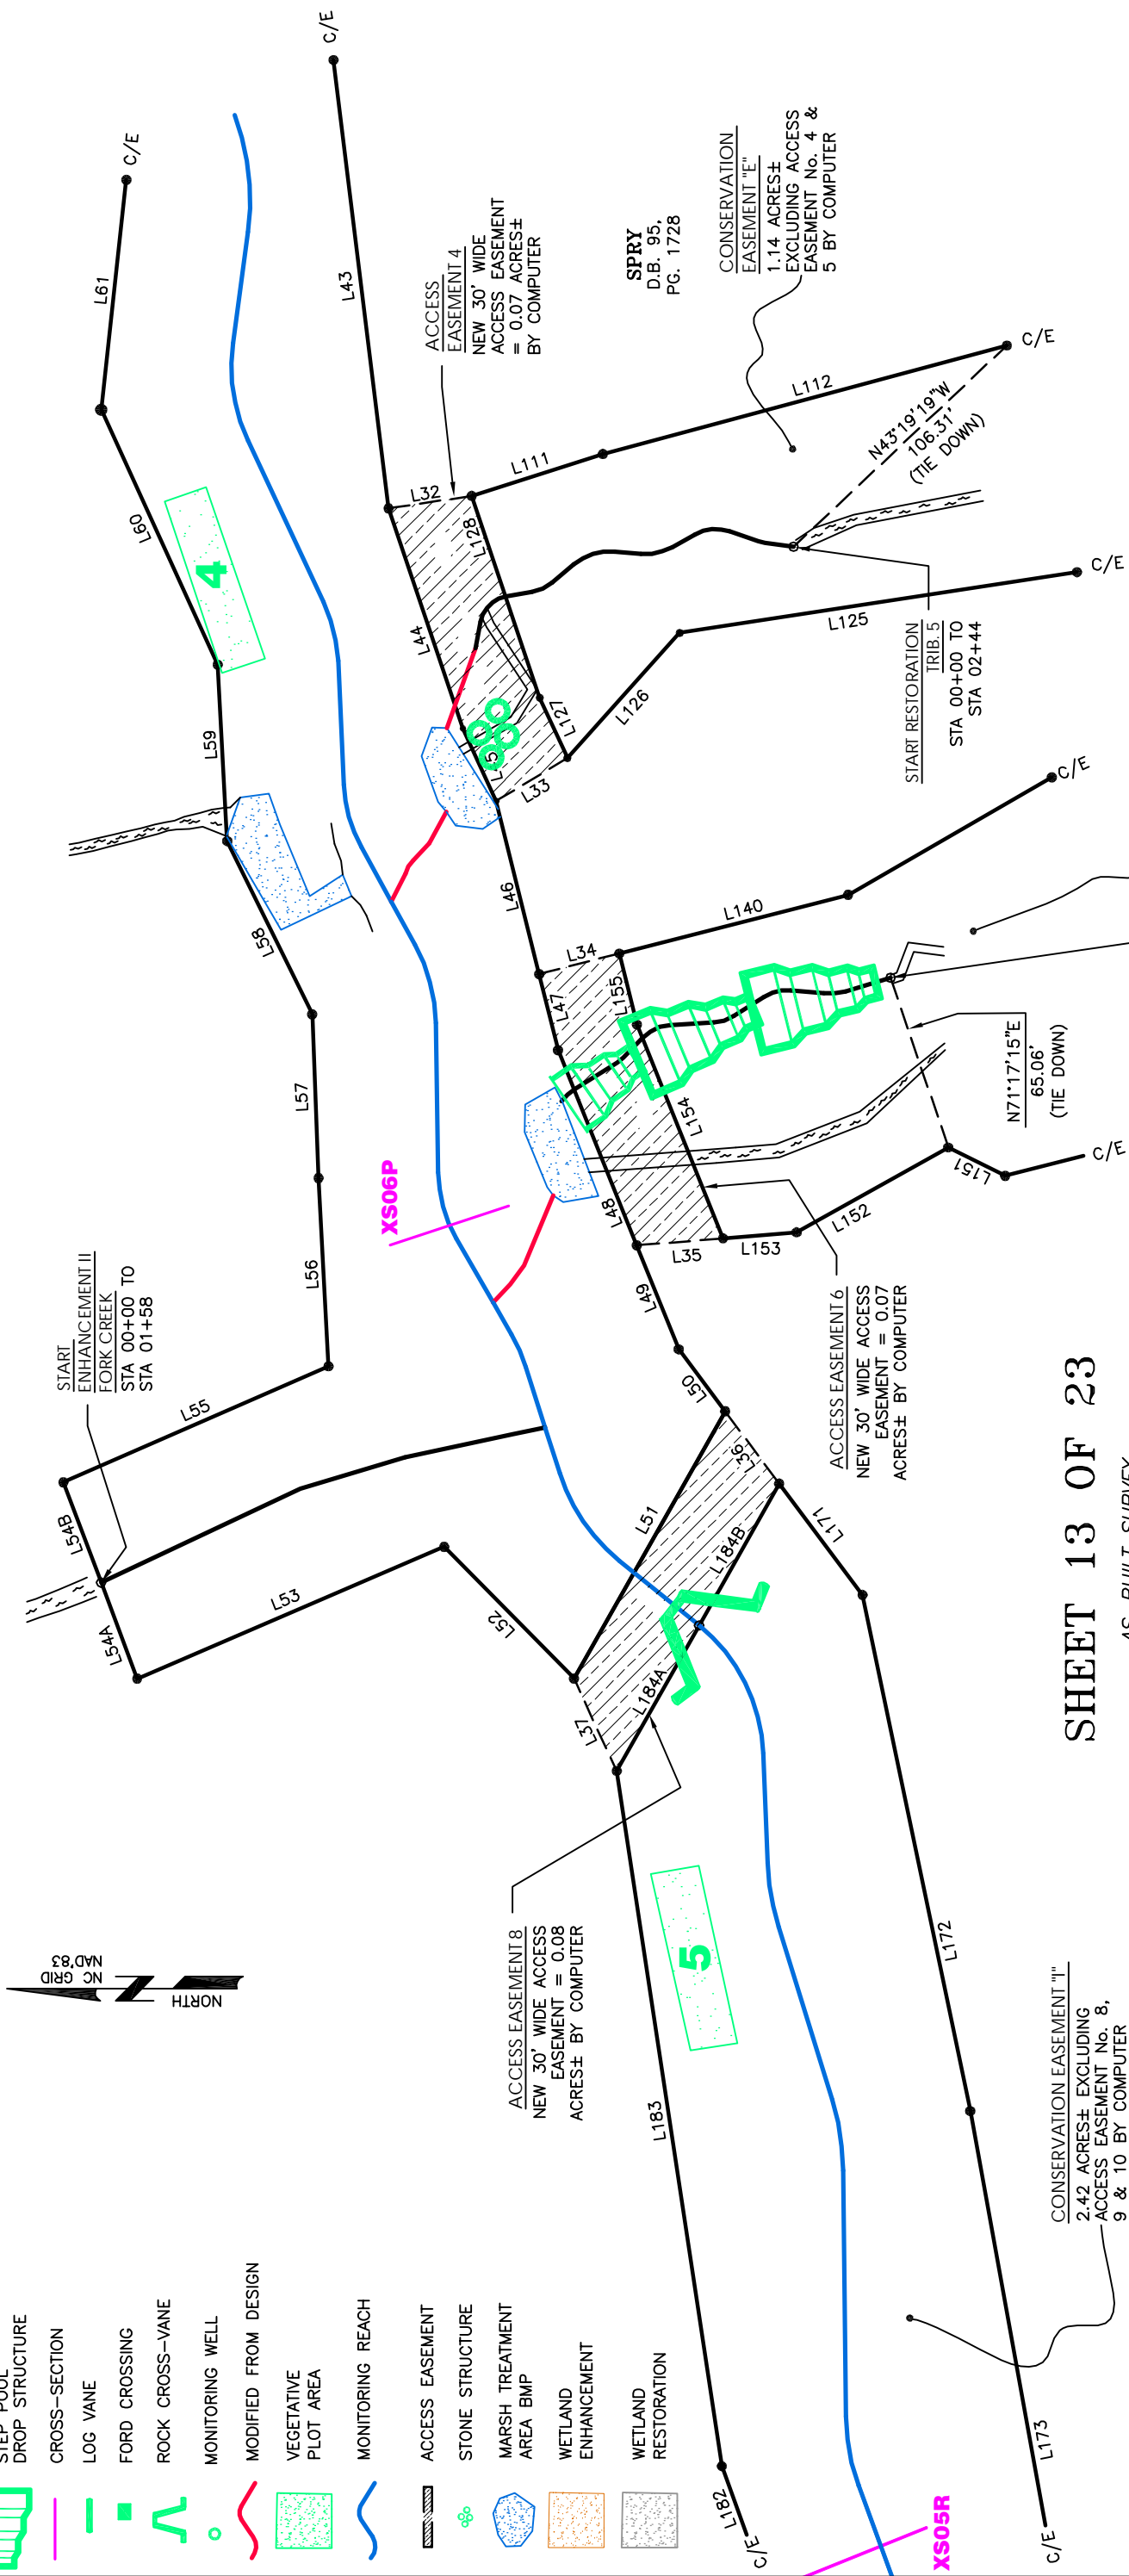

Natural Resources
Restoration & Conservation

FOR
RESTORATION SYSTEMS, LLC

THREE MILE CREEK SITE


TOE RIVER TOWNSHIP AVERY COUNTY NORTH CAROLINA



GRAPHIC SCALE 1" = 60'

SHEET 13 OF 23

AS-BUILT SURVEY

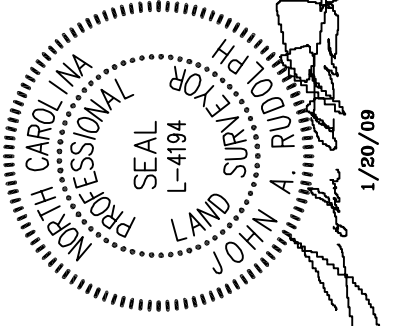

SPRY
D.B. 95,
PG. 1728

CONSERVATION EASEMENT "E"
1.14 ACRES± EXCLUDING ACCESS EASEMENT No. 4 & 5 BY COMPUTER

ACCESS EASEMENT 4
NEW 30' WIDE ACCESS EASEMENT = 0.07 ACRES± BY COMPUTER

START RESTORATION TRIB. 5
STA 00+00 TO STA 02+44

CONSERVATION EASEMENT "G"
0.96 ACRES± EXCLUDING ACCESS EASEMENT No. 6 & 7 BY COMPUTER

START RESTORATION TRIB. 6A
STA 00+00 TO STA 02+44

ACCESS EASEMENT 6
NEW 30' WIDE ACCESS EASEMENT = 0.07 ACRES± BY COMPUTER

CONSERVATION EASEMENT "I"
2.42 ACRES± EXCLUDING ACCESS EASEMENT No. 8, 9 & 10 BY COMPUTER


START ENHANCEMENT II
FORK CREEK
STA 00+00 TO STA 01+58

N71°17'15"E
65.06'
(TIE DOWN)

N43°19'19"W
106.31'
(TIE DOWN)

LEGEND

- J HOOK VANE
- STEP POOL
- DROP STRUCTURE
- CROSS-SECTION
- LOG VANE
- FORD CROSSING
- ROCK CROSS-VANE
- MONITORING WELL
- MODIFIED CHANNEL
- VEGETATIVE PLOT AREA
- MONITORING REACH
- ACCESS EASEMENT
- STONE STRUCTURE
- MARSH TREATMENT AREA
- WETLAND ENHANCEMENT
- WETLAND RESTORATION

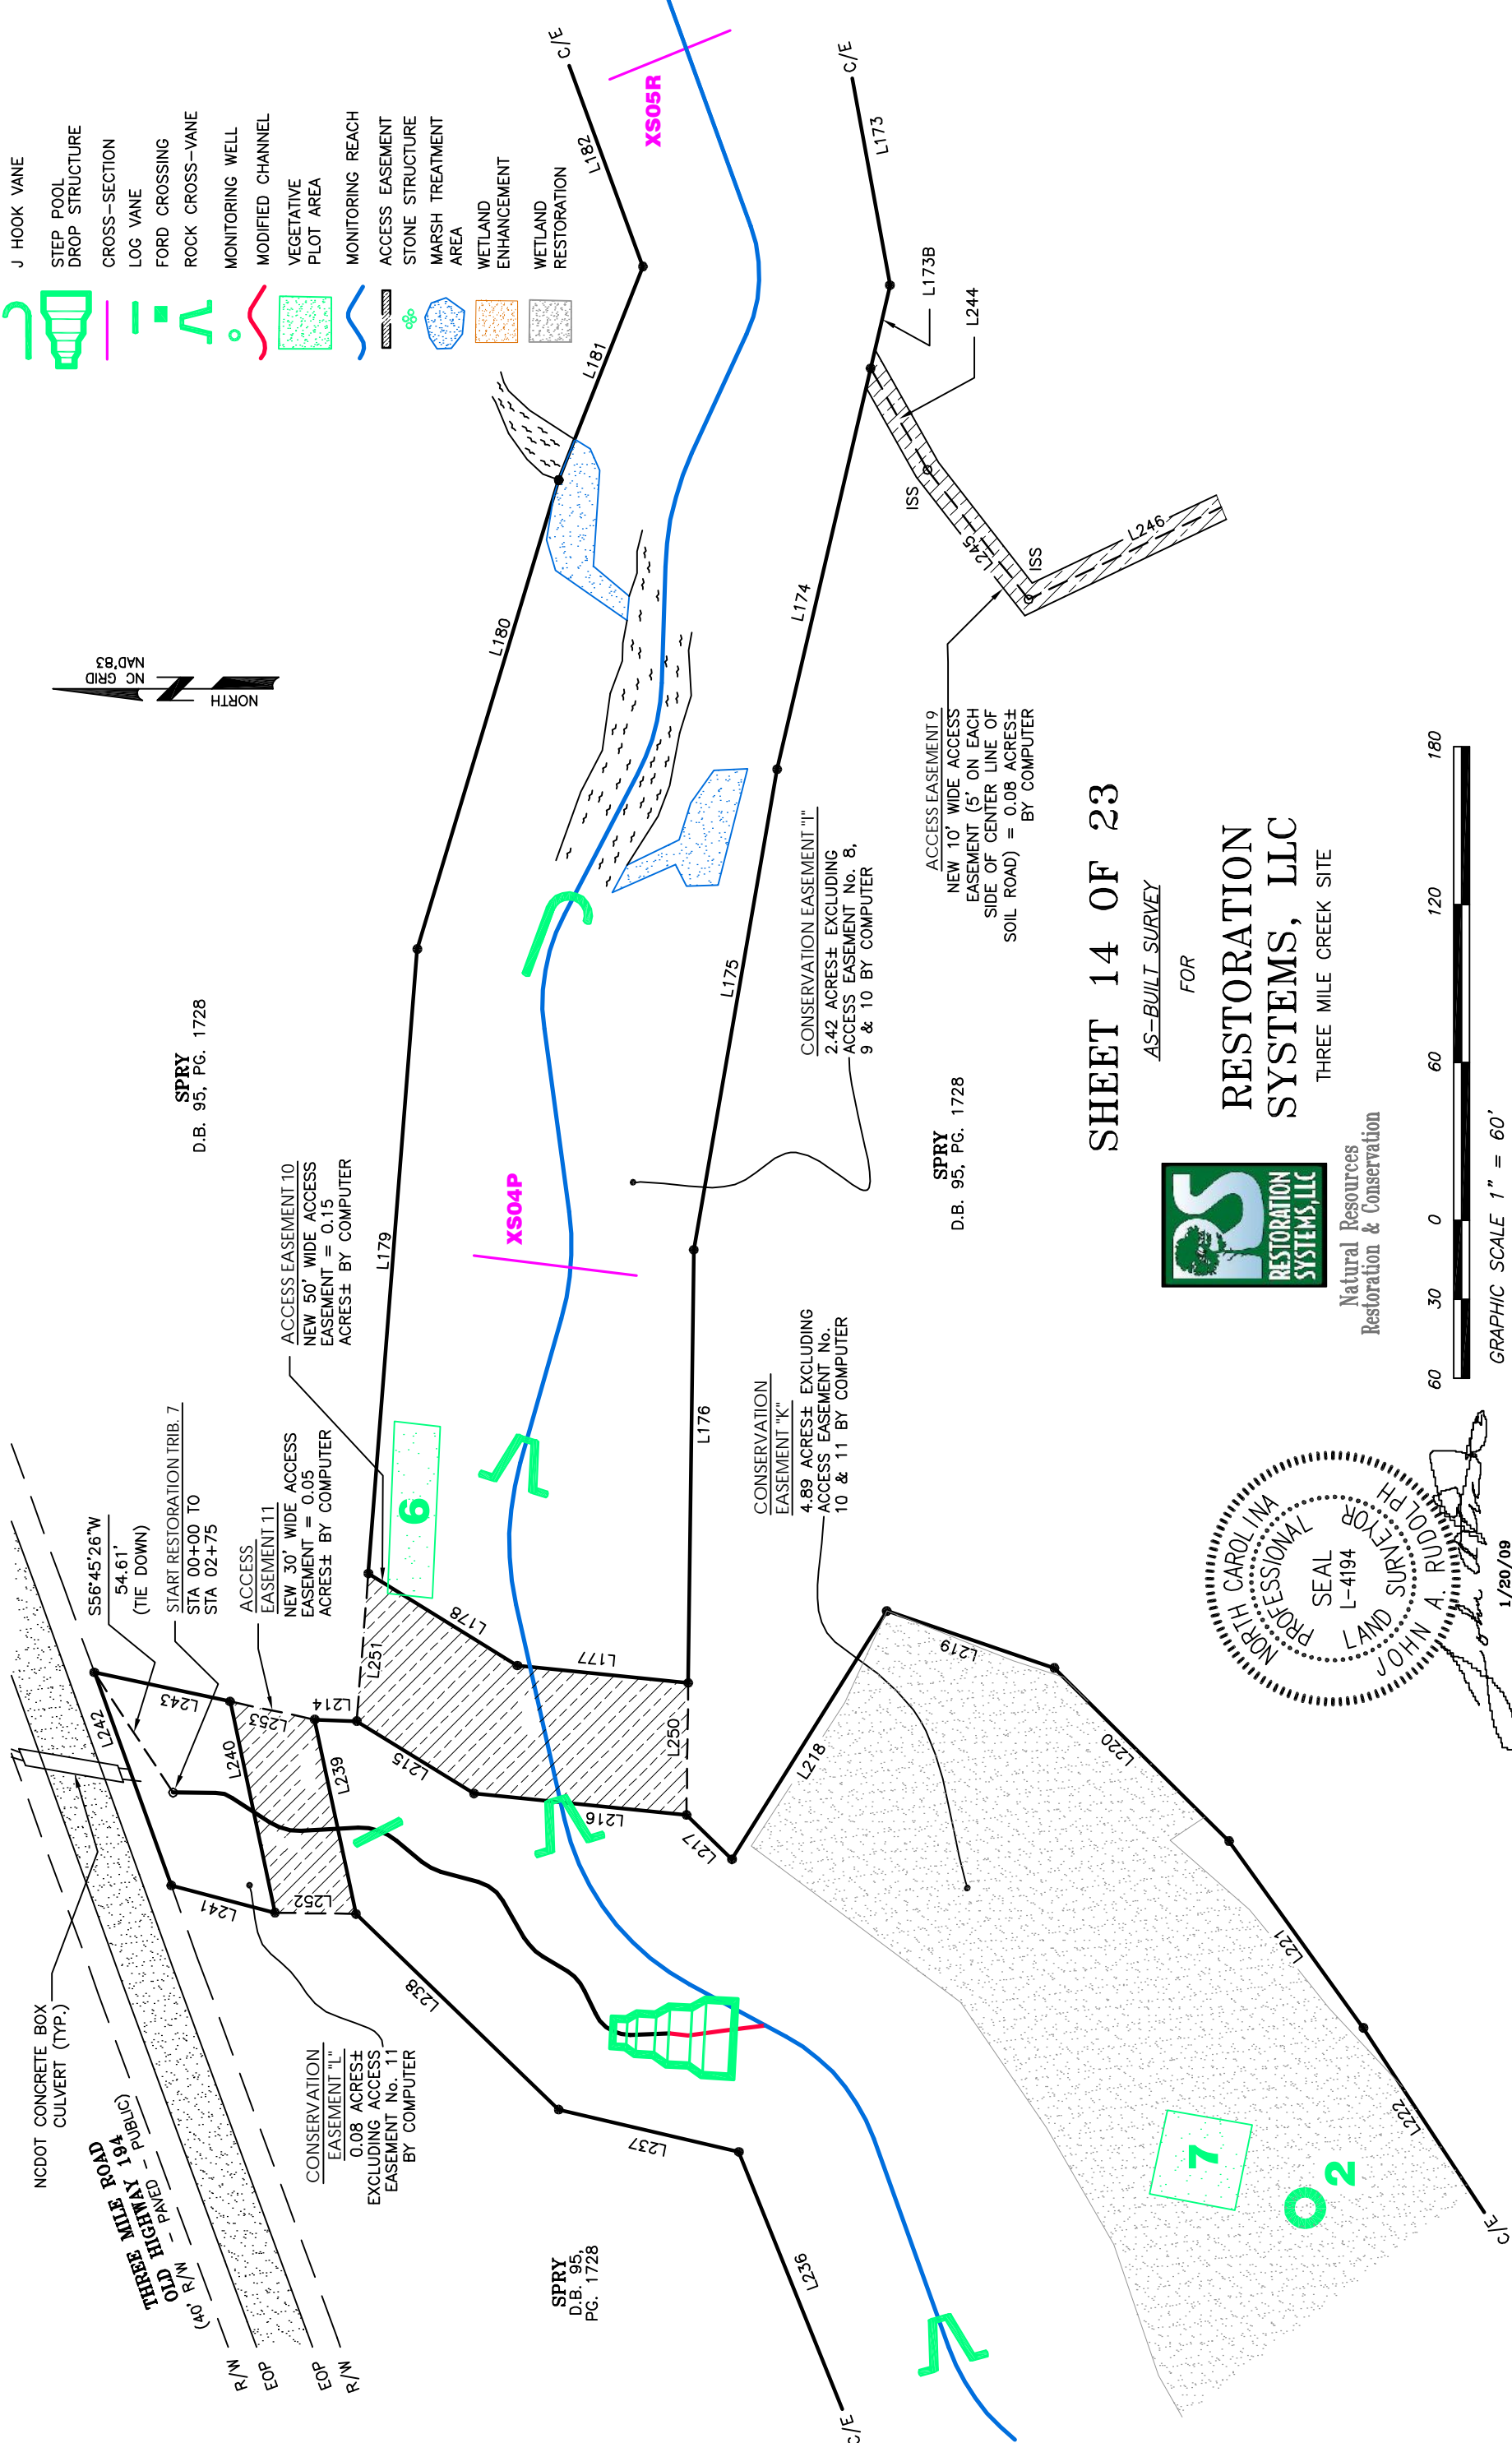

SPRY
D.B. 95, PG. 1728

ACCESS EASEMENT 10
NEW 50' WIDE ACCESS
EASEMENT = 0.15
ACRES± BY COMPUTER

ACCESS EASEMENT 11
NEW 30' WIDE ACCESS
EASEMENT = 0.05
ACRES± BY COMPUTER

CONSERVATION EASEMENT "I"
0.08 ACRES±
EXCLUDING ACCESS
EASEMENT No. 11
BY COMPUTER

SPRY
D.B. 95,
PG. 1728

CONSERVATION EASEMENT "K"
4.89 ACRES± EXCLUDING
ACCESS EASEMENT No.
10 & 11 BY COMPUTER

CONSERVATION EASEMENT "I"
2.42 ACRES± EXCLUDING
ACCESS EASEMENT No. 8,
9 & 10 BY COMPUTER

ACCESS EASEMENT 9
NEW 10' WIDE ACCESS
EASEMENT (5' ON EACH
SIDE OF CENTER LINE OF
SOIL ROAD) = 0.08 ACRES±
BY COMPUTER

SPRY
D.B. 95, PG. 1728

7

2

XS04P

XS05R

SHEET 14 OF 23

AS-BUILT SURVEY


FOR

RESTORATION SYSTEMS, LLC

THREE MILE CREEK SITE



Natural Resources
Restoration & Conservation

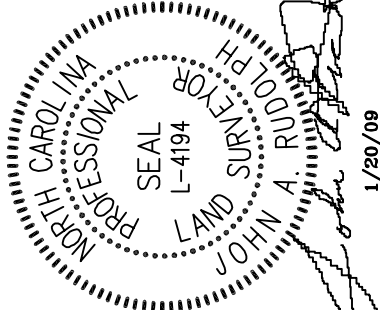
















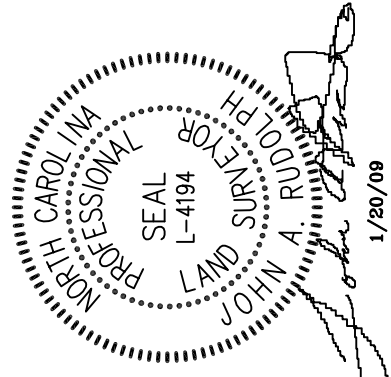
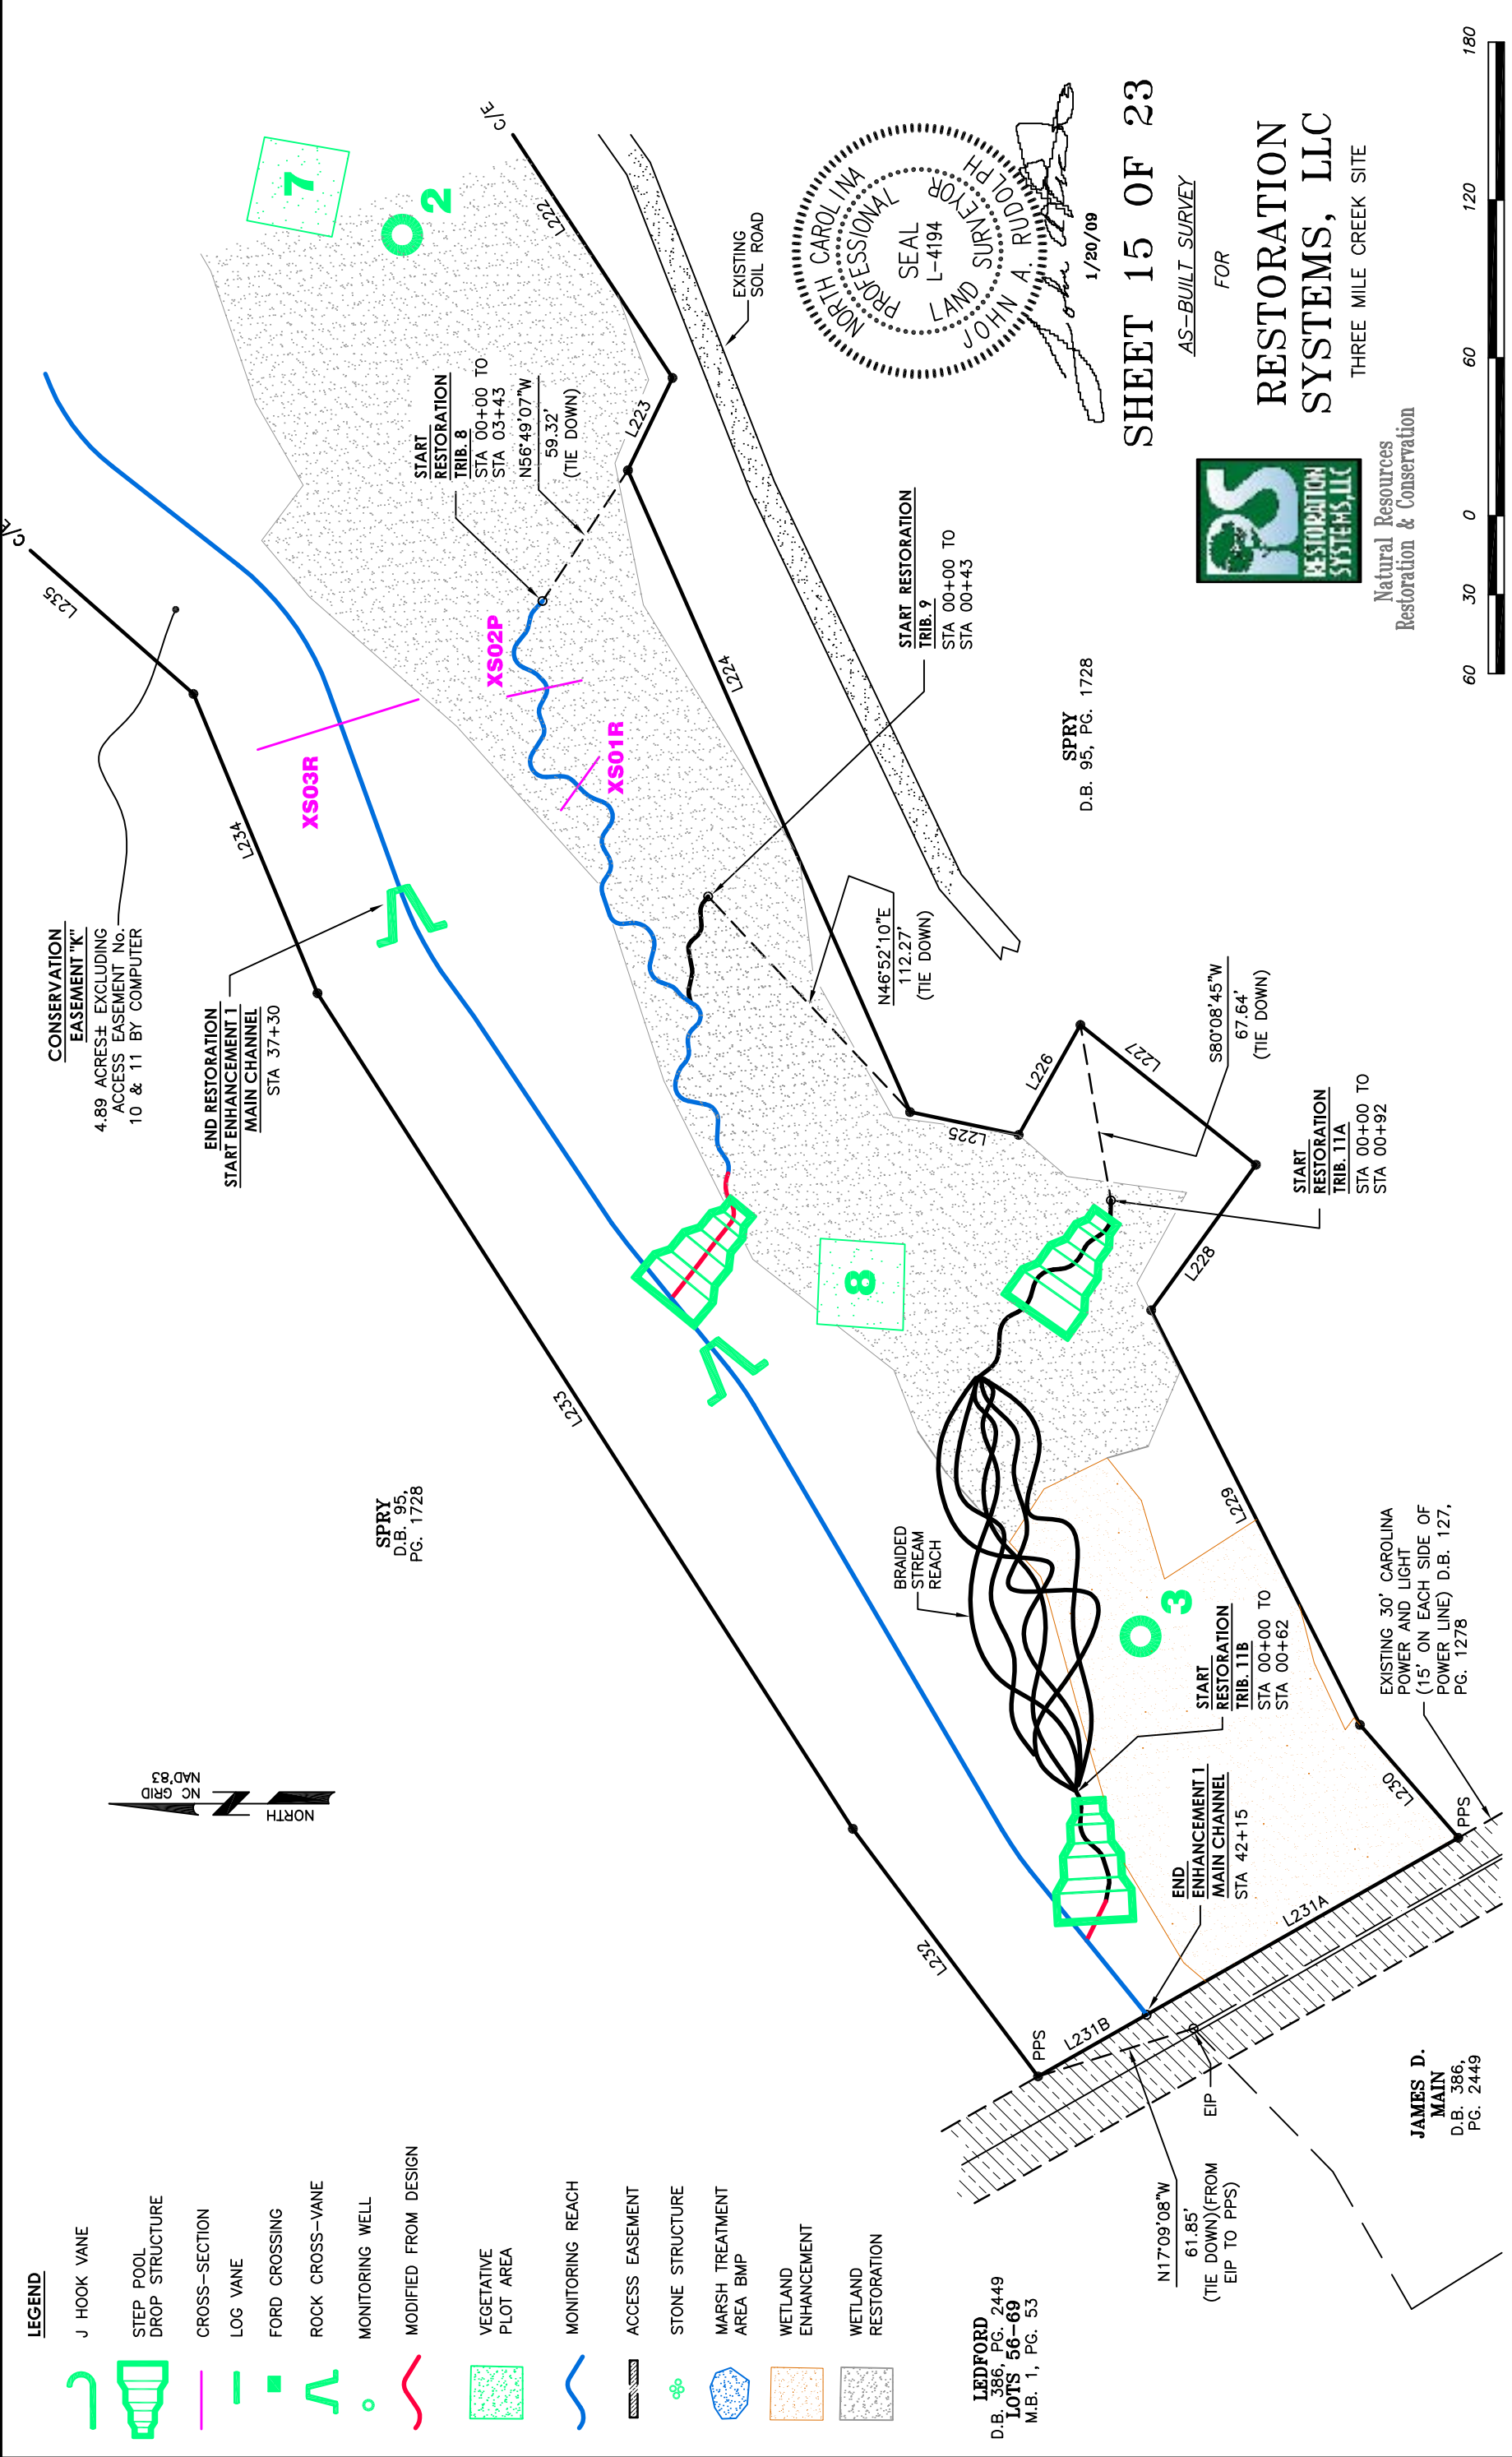
1/20/09



GRAPHIC SCALE 1" = 60'

LEGEND

-  J HOOK VANE
-  STEP POOL DROP STRUCTURE
-  CROSS-SECTION
-  LOG VANE
-  FORD CROSSING
-  ROCK CROSS-VANE
-  MONITORING WELL
-  MODIFIED FROM DESIGN
-  VEGETATIVE PLOT AREA
-  MONITORING REACH
-  ACCESS EASEMENT
-  STONE STRUCTURE
-  MARSH TREATMENT AREA BMP
-  WETLAND ENHANCEMENT
-  WETLAND RESTORATION



SHEET 15 OF 23

AS-BUILT SURVEY

FOR

RESTORATION SYSTEMS, LLC

THREE MILE CREEK SITE



Natural Resources
Restoration & Conservation

SPRY
D.B. 95, PG. 1728

SPRY
D.B. 95,
PG. 1728

LEDFORD
D.B. 386, PG. 2449
LOTS 56-69
M.B. 1, PG. 53

JAMES D. MAIN
D.B. 386,
PG. 2449



SHEET 16 OF 23

AS-BUILT SURVEY


FOR

RESTORATION SYSTEMS, LLC

THREE MILE CREEK SITE




Natural Resources
Restoration & Conservation

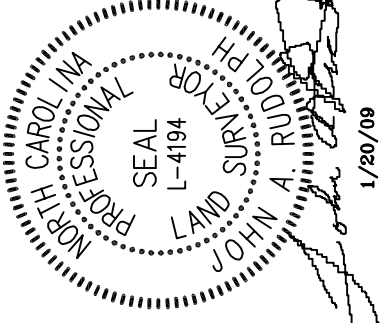


1/20/09


NOTE:
TBM IS NATURAL GROUND AT
BOTTOM OF METAL STAKE(S)
LOCATED AT THE BEGINNING
AND END OF EACH
CROSS-SECTION (ASSUMED
ELEVATION)

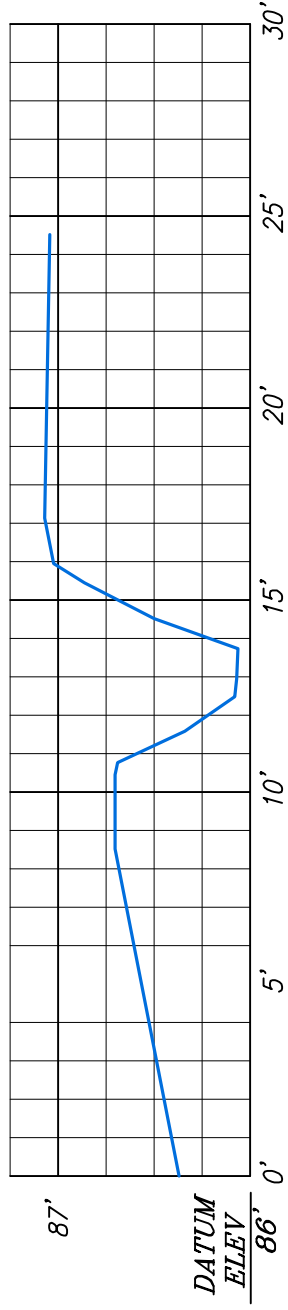


CROSS-SECTION 1R
(EAST BANK TO WEST BANK)
SCALE: 1" = 5' HORZ./1" = 1' VERT.

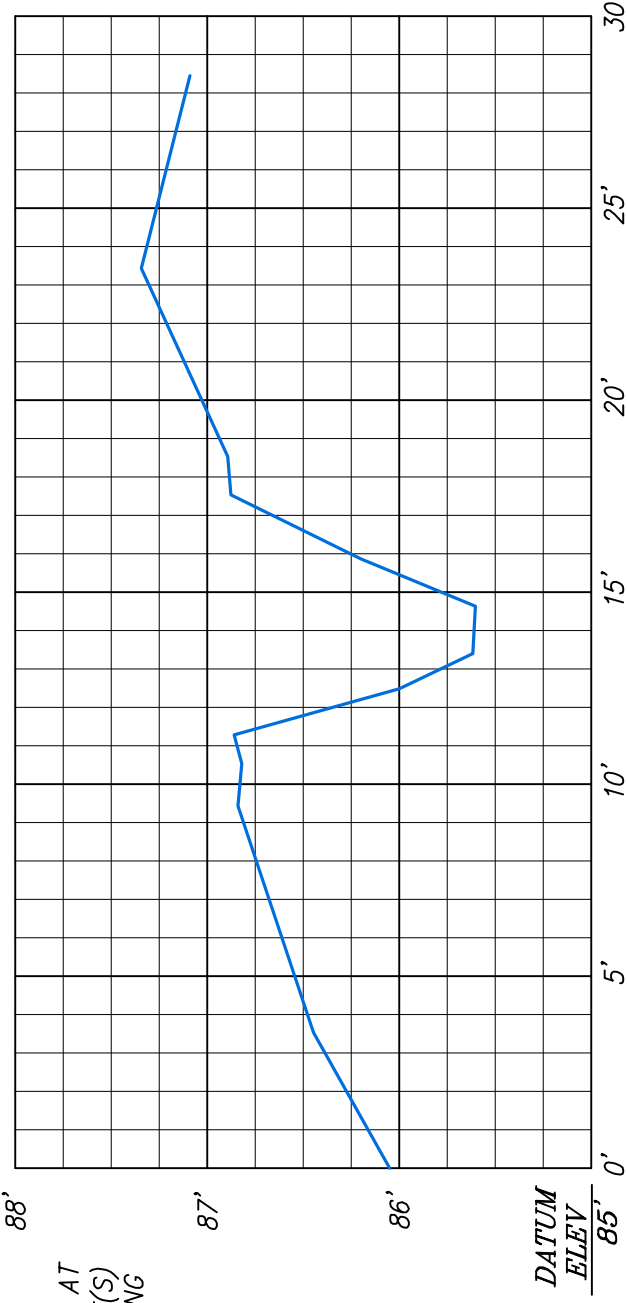


CROSS-SECTION 2P
(EAST BANK TO WEST BANK)
SCALE: 1" = 5' HORZ./1" = 1' VERT.

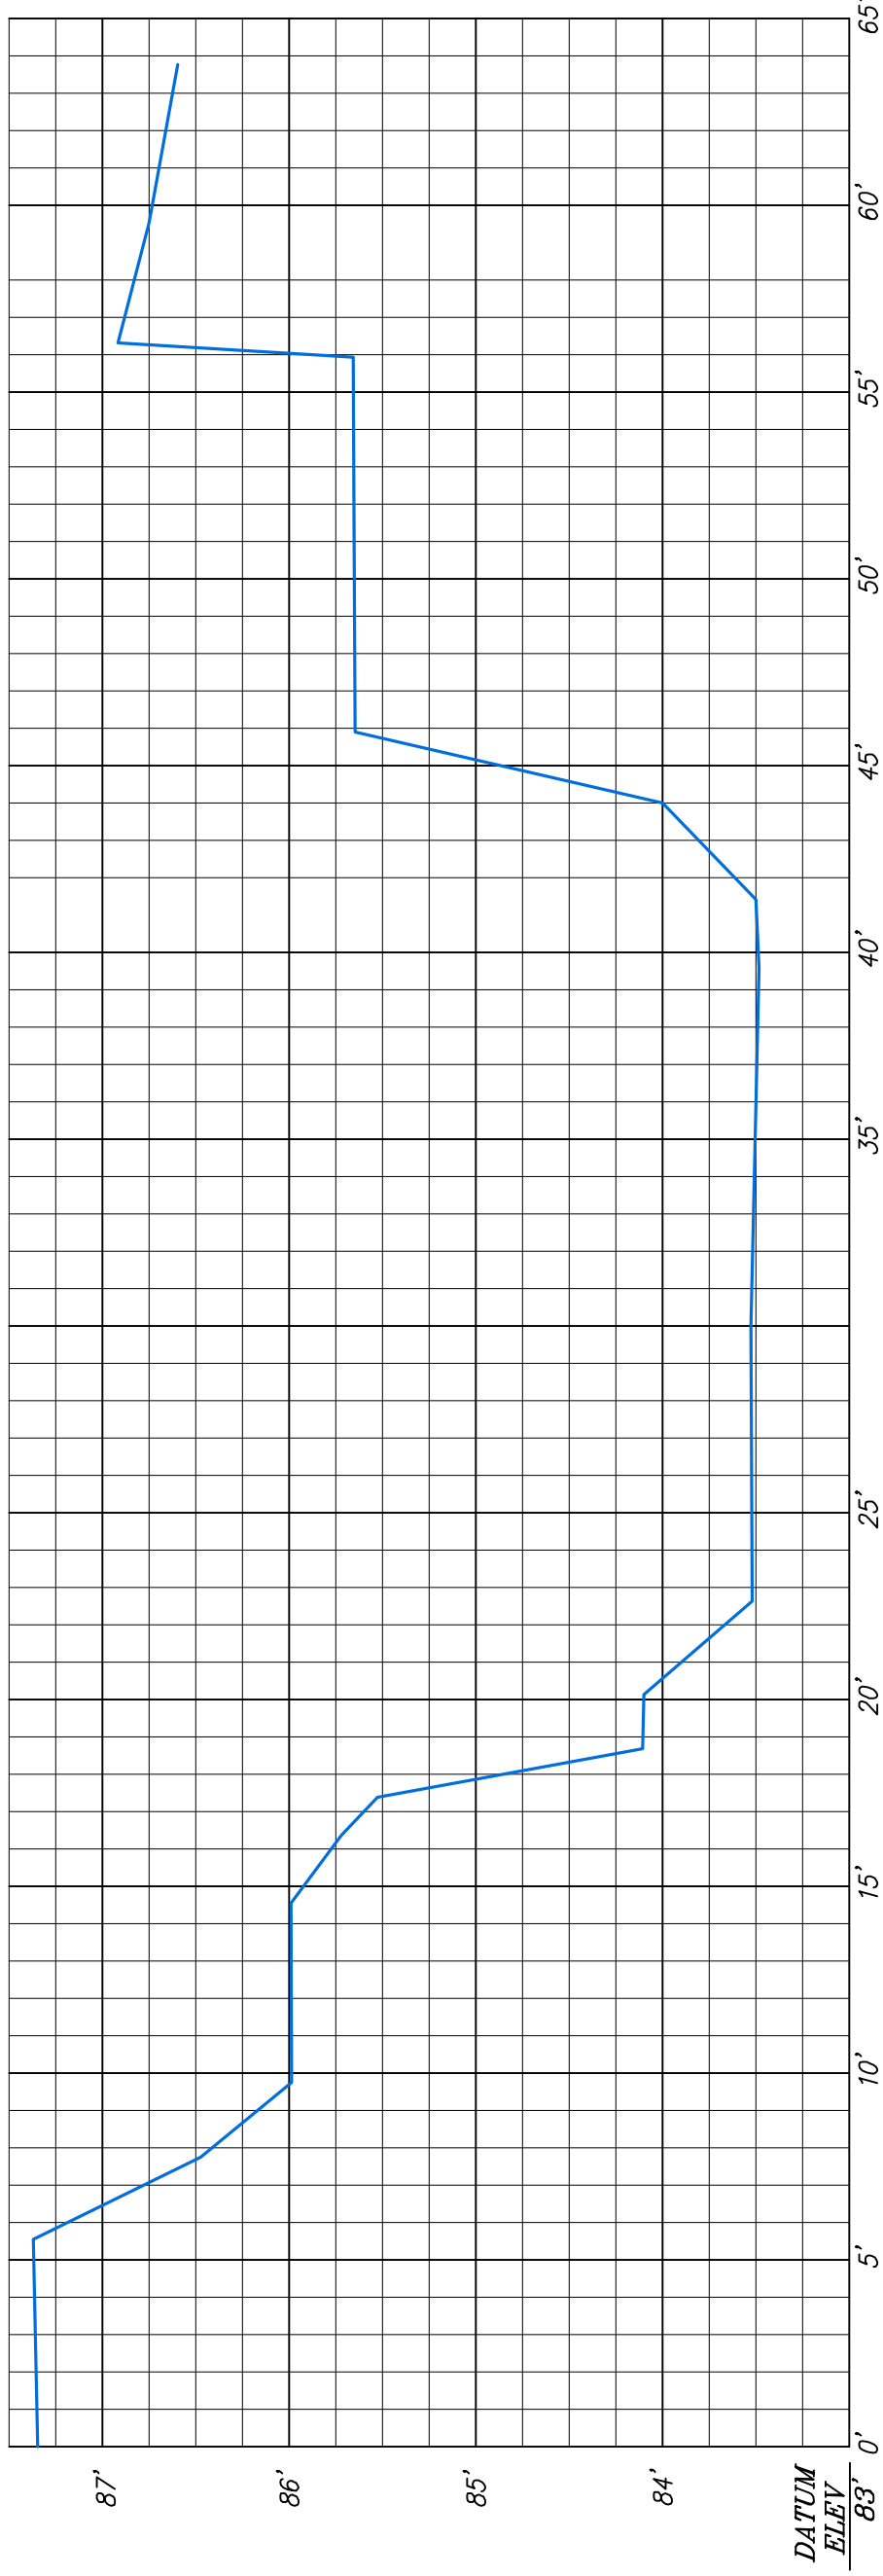

CROSS-SECTION 3R
(EAST BANK TO WEST BANK)
SCALE: 1" = 5' HORZ./1" = 1' VERT.

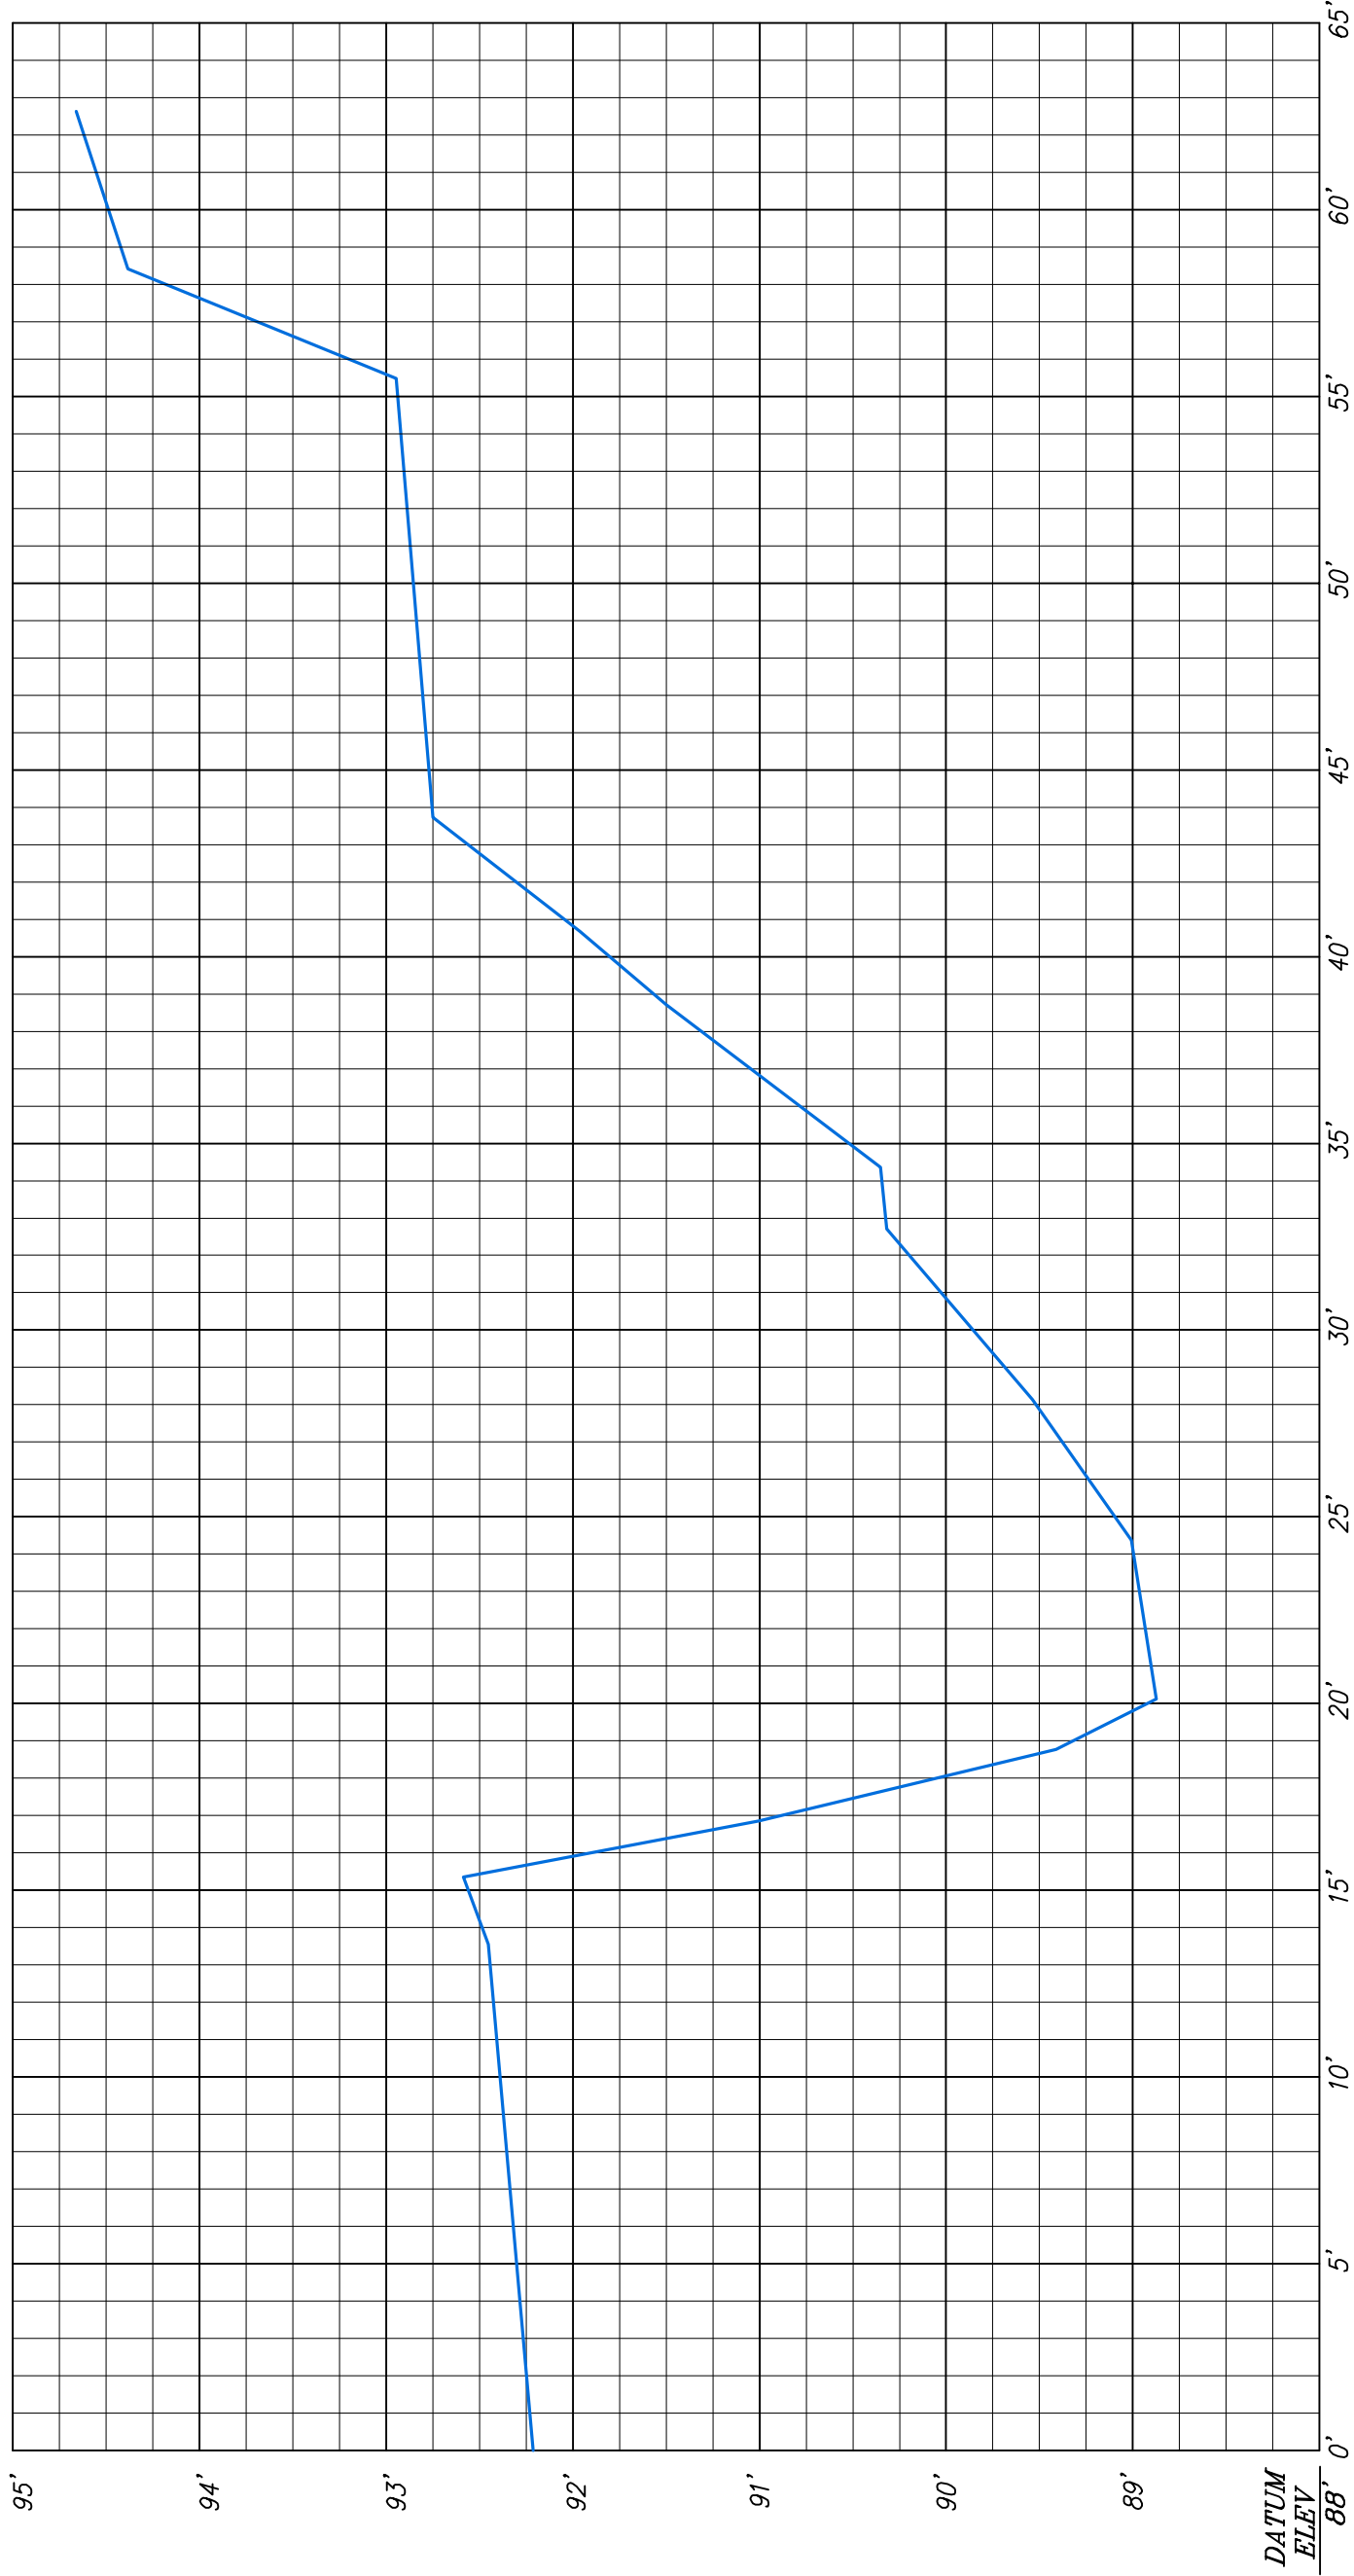

CROSS-SECTION 4P
 (EAST BANK TO WEST BANK)
 SCALE: 1"=5' HORZ./1"=1' VERT.

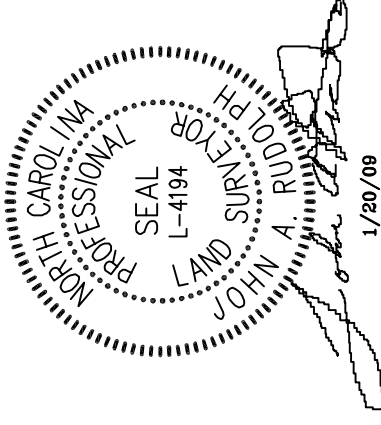


NOTE:
 TBM IS NATURAL GROUND AT
 BOTTOM OF METAL STAKE(S)
 LOCATED AT THE BEGINNING
 AND END OF EACH
 CROSS-SECTION (ASSUMED
 ELEVATION)

SHEET 17 OF 23

AS-BUILT SURVEY
 FOR
**RESTORATION
 SYSTEMS, LLC**
 THREE MILE CREEK SITE
 Natural Resources
 Restoration & Conservation



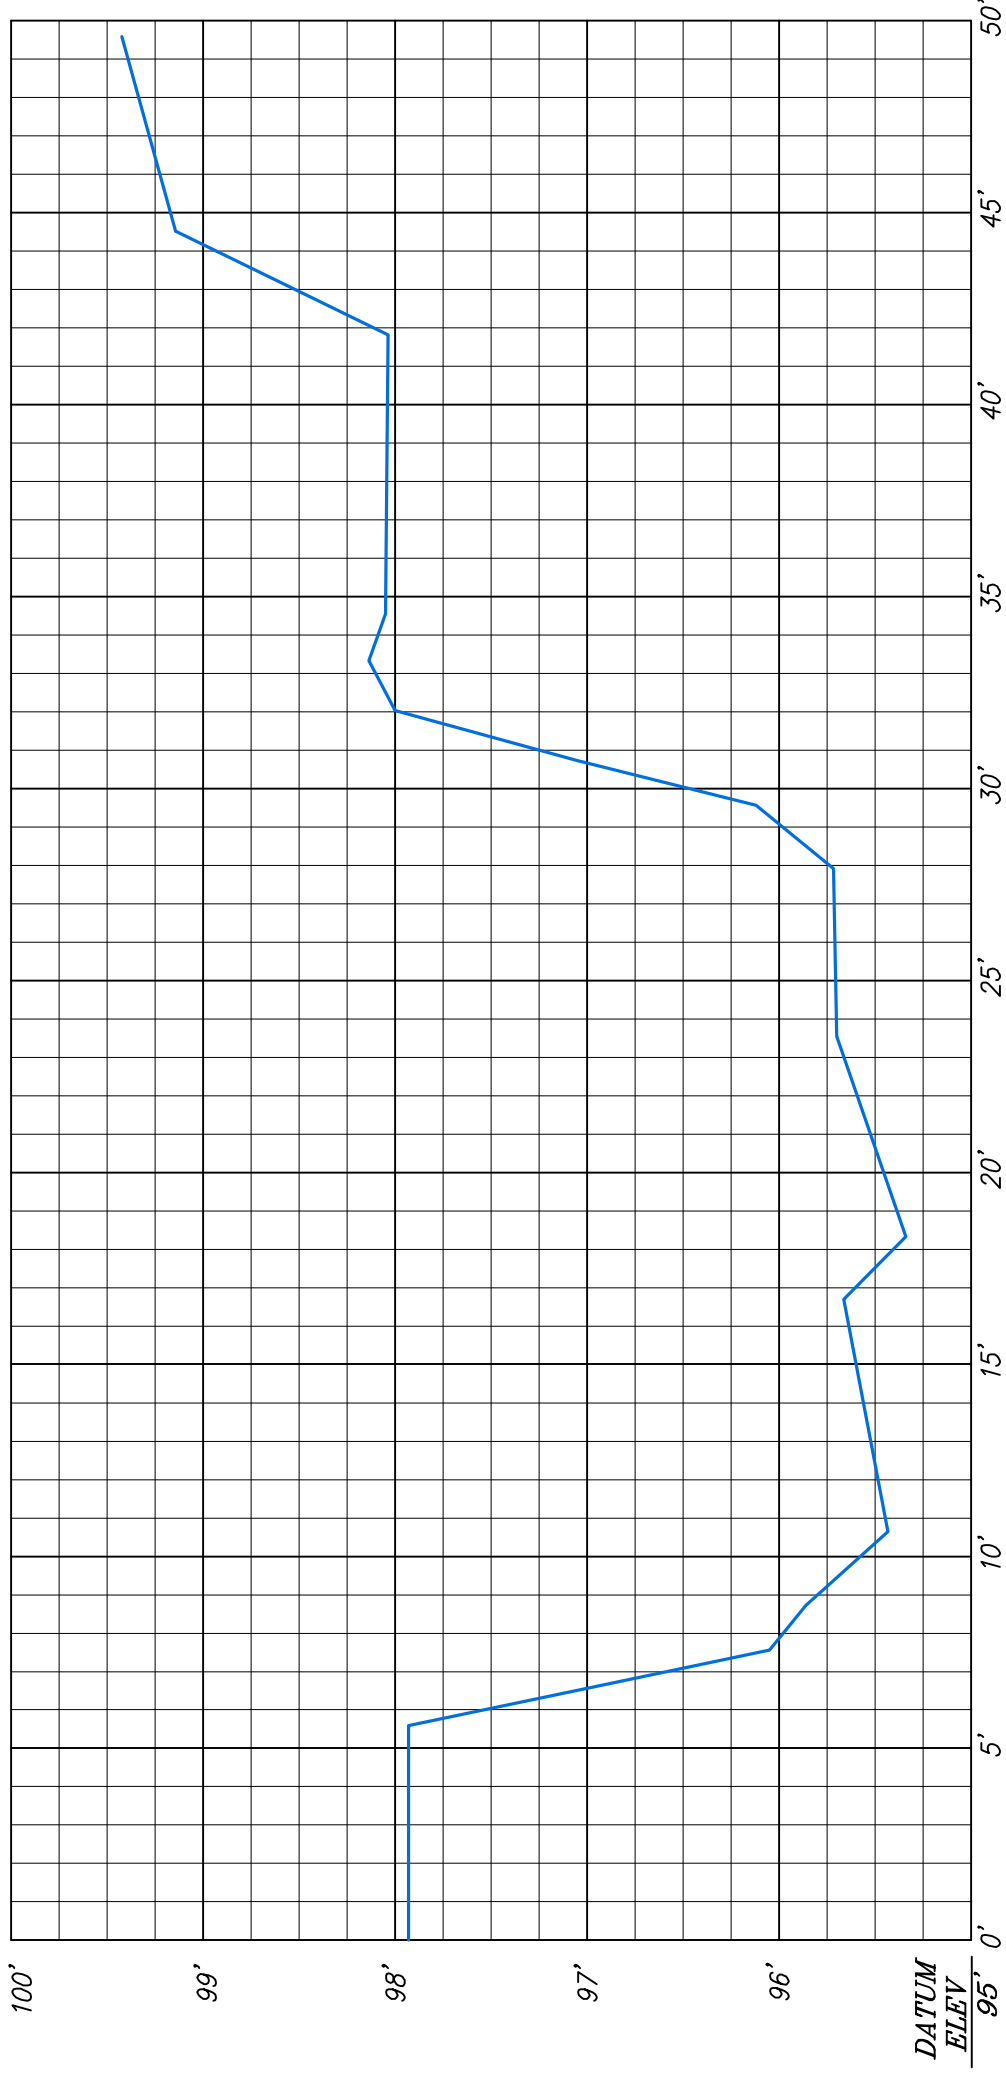

CROSS-SECTION 5R
(EAST BANK TO WEST BANK)
SCALE: 1"=5' HORIZ./1"=1' VERT.

NOTE:
TBM IS NATURAL GROUND AT
BOTTOM OF METAL STAKE(S)
LOCATED AT THE BEGINNING
AND END OF EACH
CROSS-SECTION (ASSUMED
ELEVATION)

PROFESSIONAL SEAL
L-4194
LAND SURVEYOR
JOHN A. RUDOLPH
John A. Rudolph
1/20/09

SHEET 18 OF 23

AS-BUILT SURVEY

FOR

RESTORATION
SYSTEMS, LLC




THREE MILE CREEK SITE



Natural Resources
Restoration & Conservation

NOTE:

TBM IS NATURAL GROUND AT
BOTTOM OF METAL STAKE(S)
LOCATED AT THE BEGINNING
AND END OF EACH
CROSS-SECTION (ASSUMED
ELEVATION)

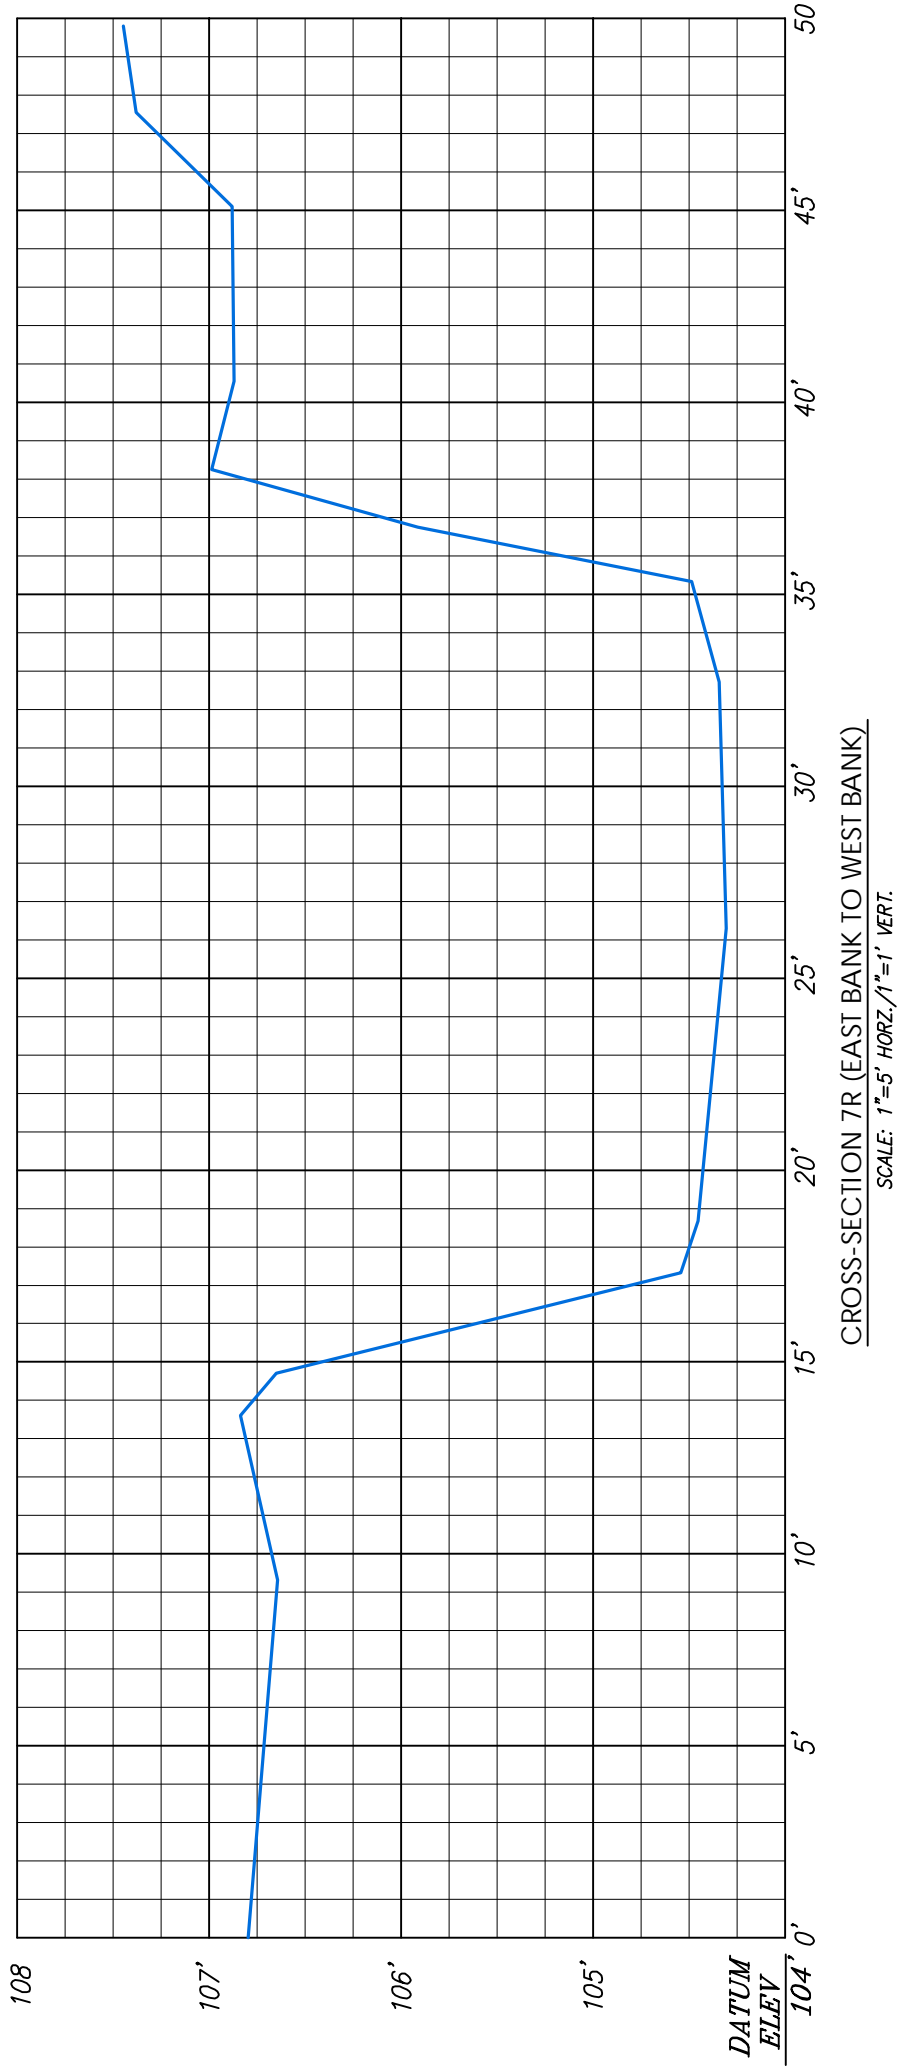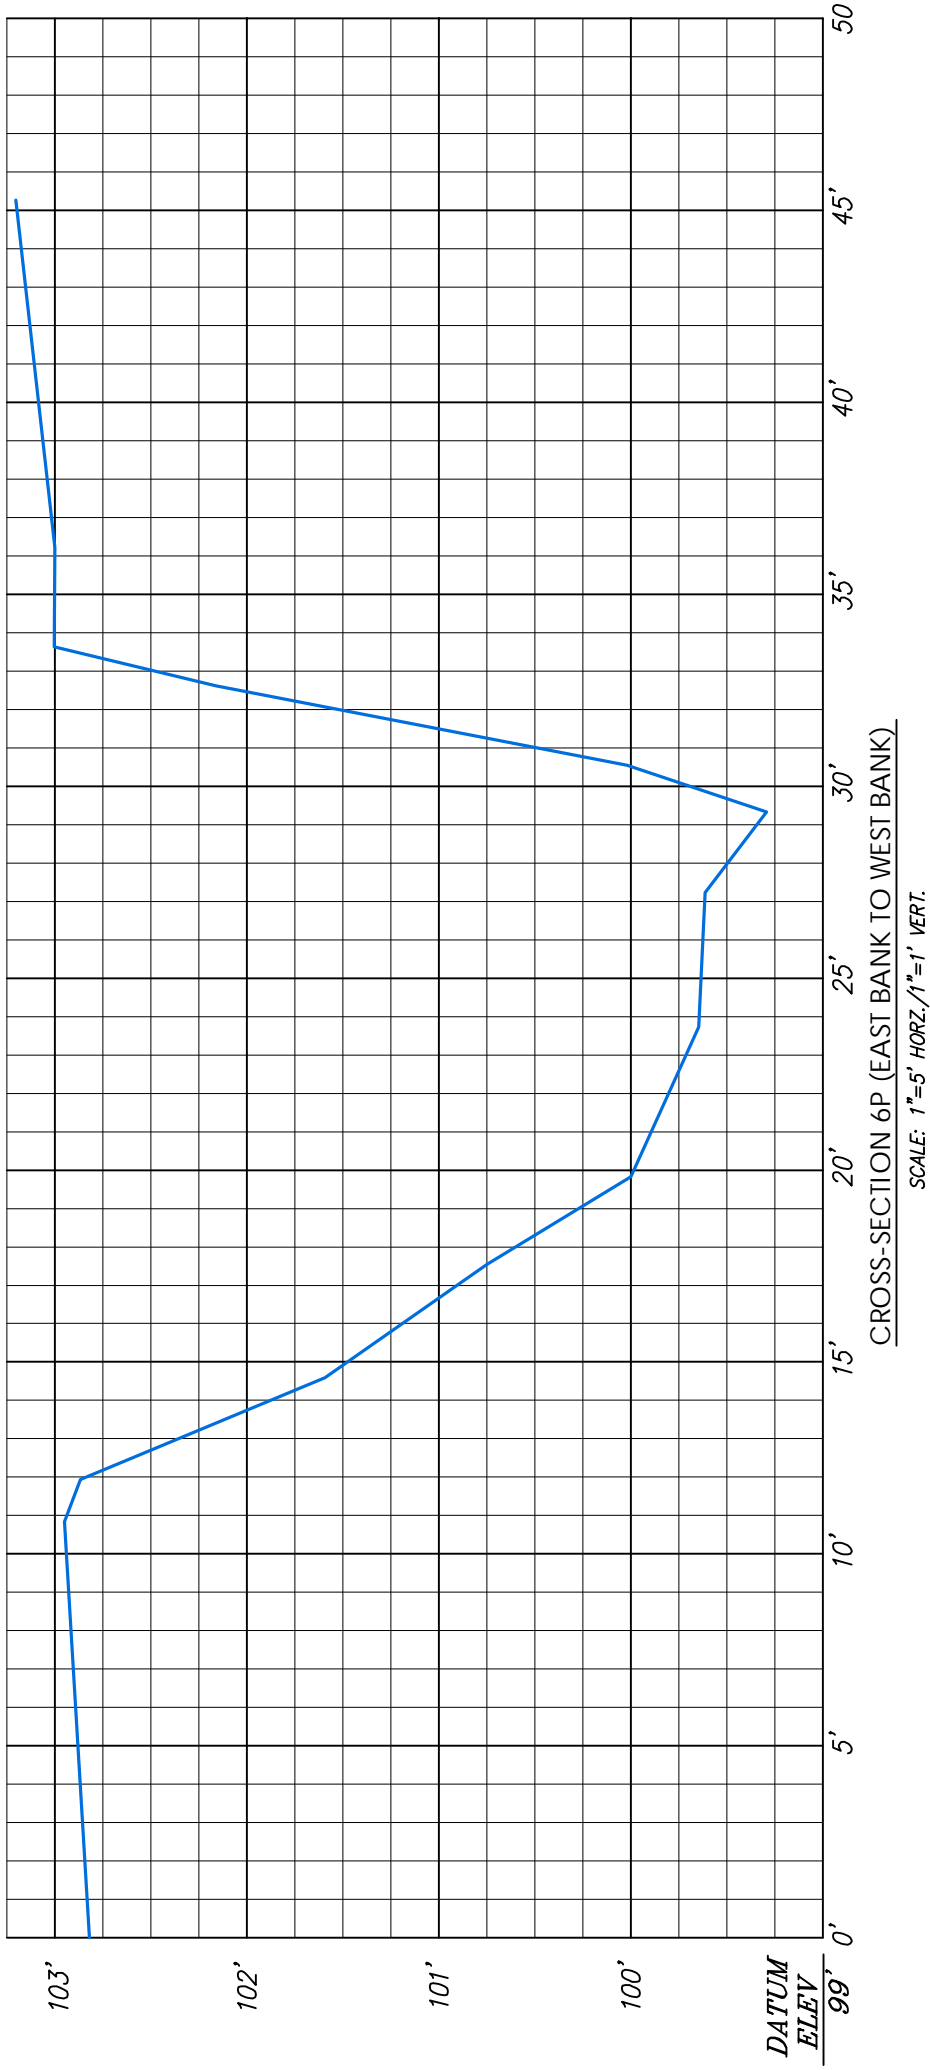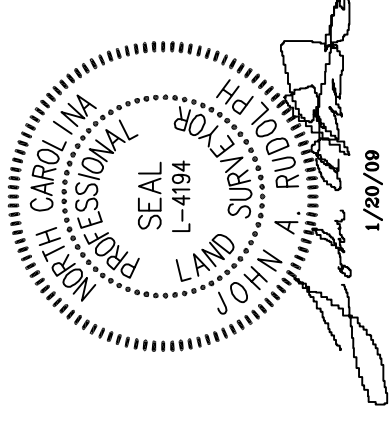

SHEET 19 OF 23

AS-BUILT SURVEY


FOR

RESTORATION
SYSTEMS, LLC

THREE MILE CREEK SITE




Natural Resources
Restoration & Conservation

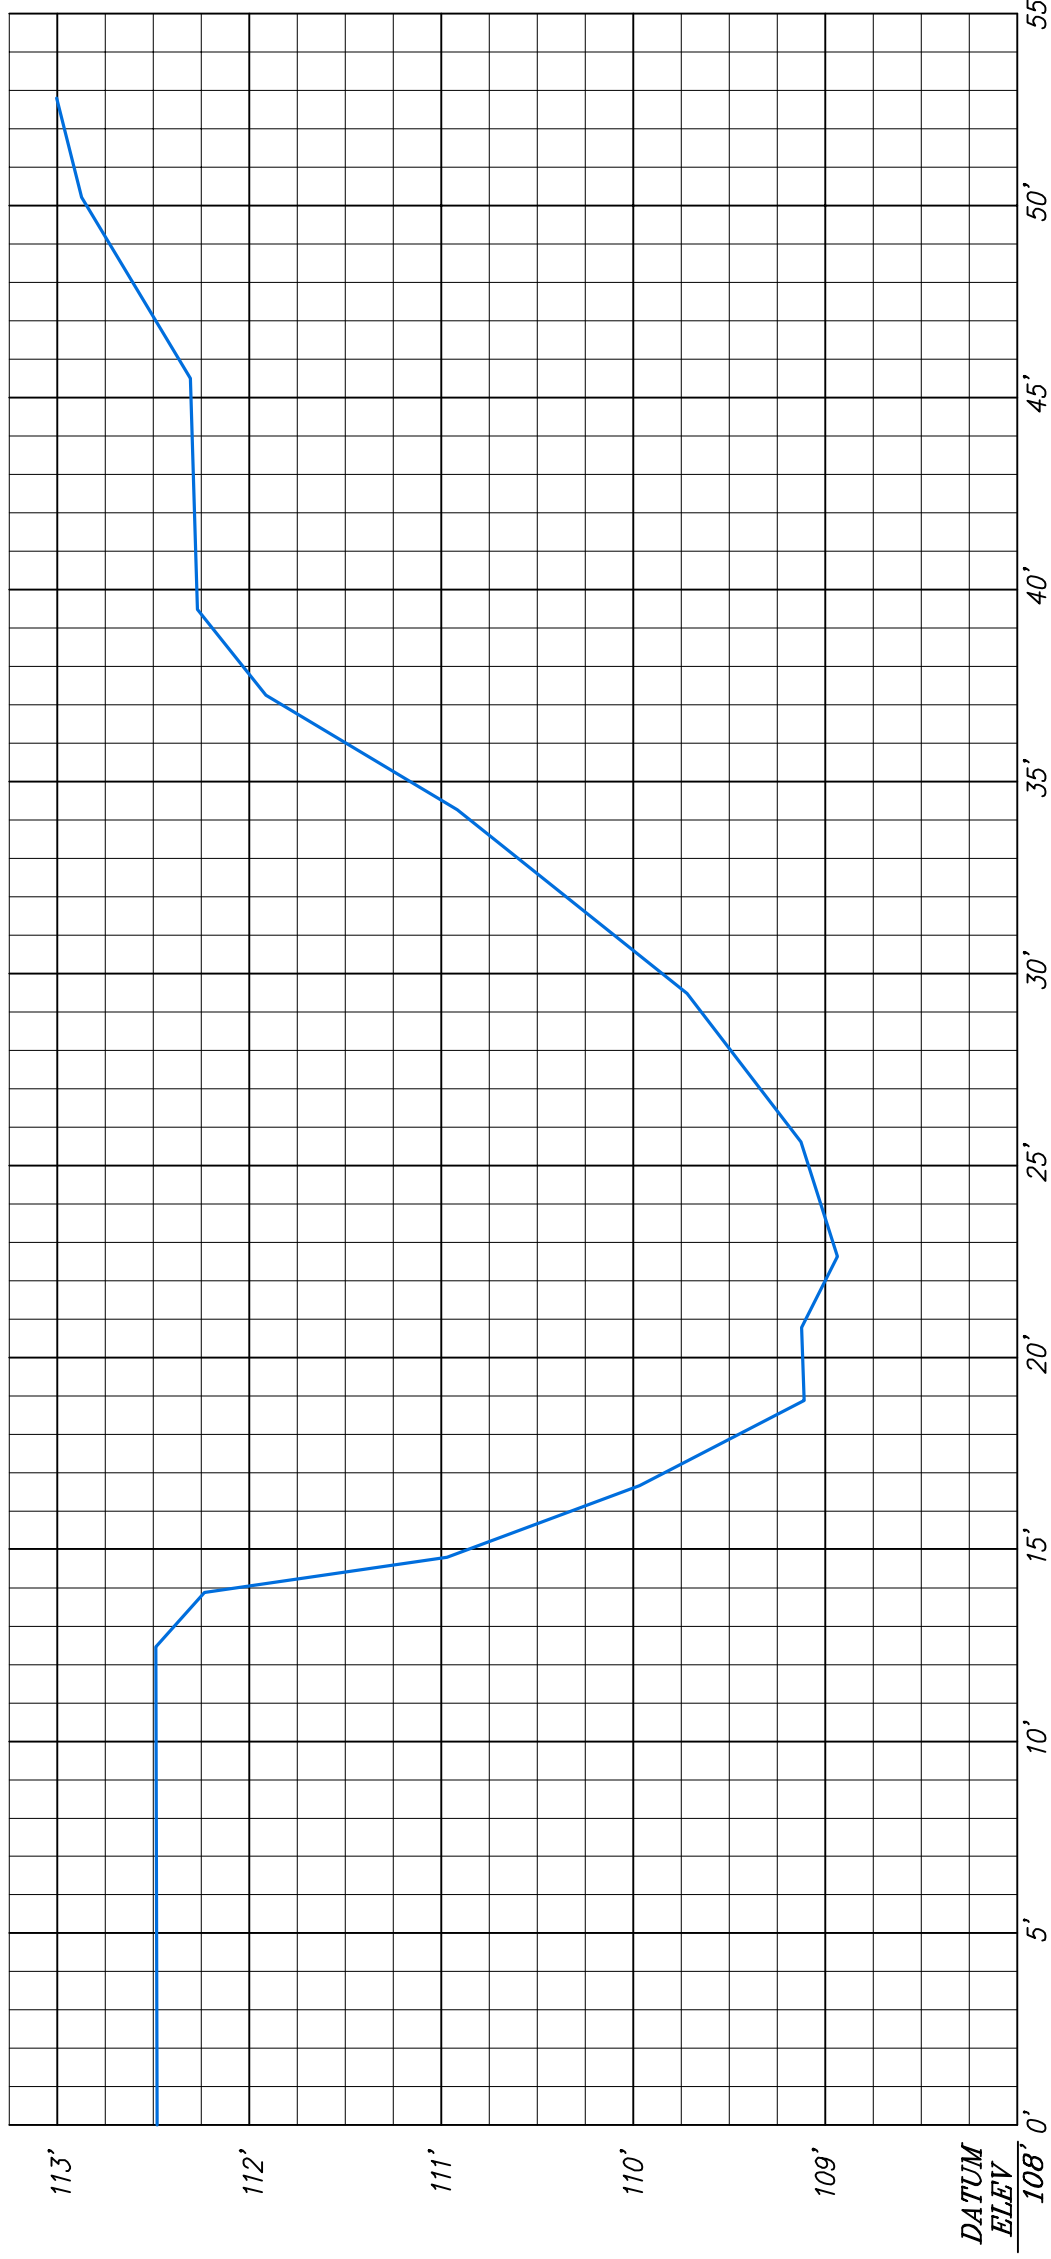

CROSS-SECTION 8P
 (EAST BANK TO WEST BANK)
 SCALE: 1"=5' HORIZ./1"=1' VERT.

NOTE:

TBM IS NATURAL GROUND AT
 BOTTOM OF METAL STAKE(S)
 LOCATED AT THE BEGINNING
 AND END OF EACH
 CROSS-SECTION (ASSUMED
 ELEVATION)

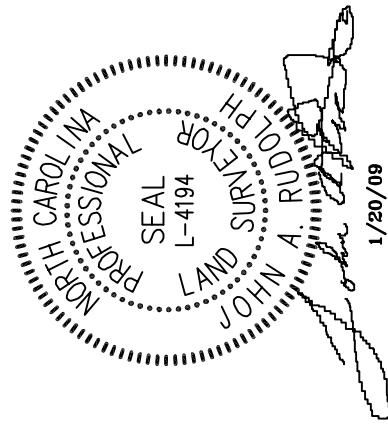

SHEET 20 OF 23

AS-BUILT SURVEY


FOR

RESTORATION
 SYSTEMS, LLC


THREE MILE CREEK SITE



Natural Resources
 Restoration & Conservation

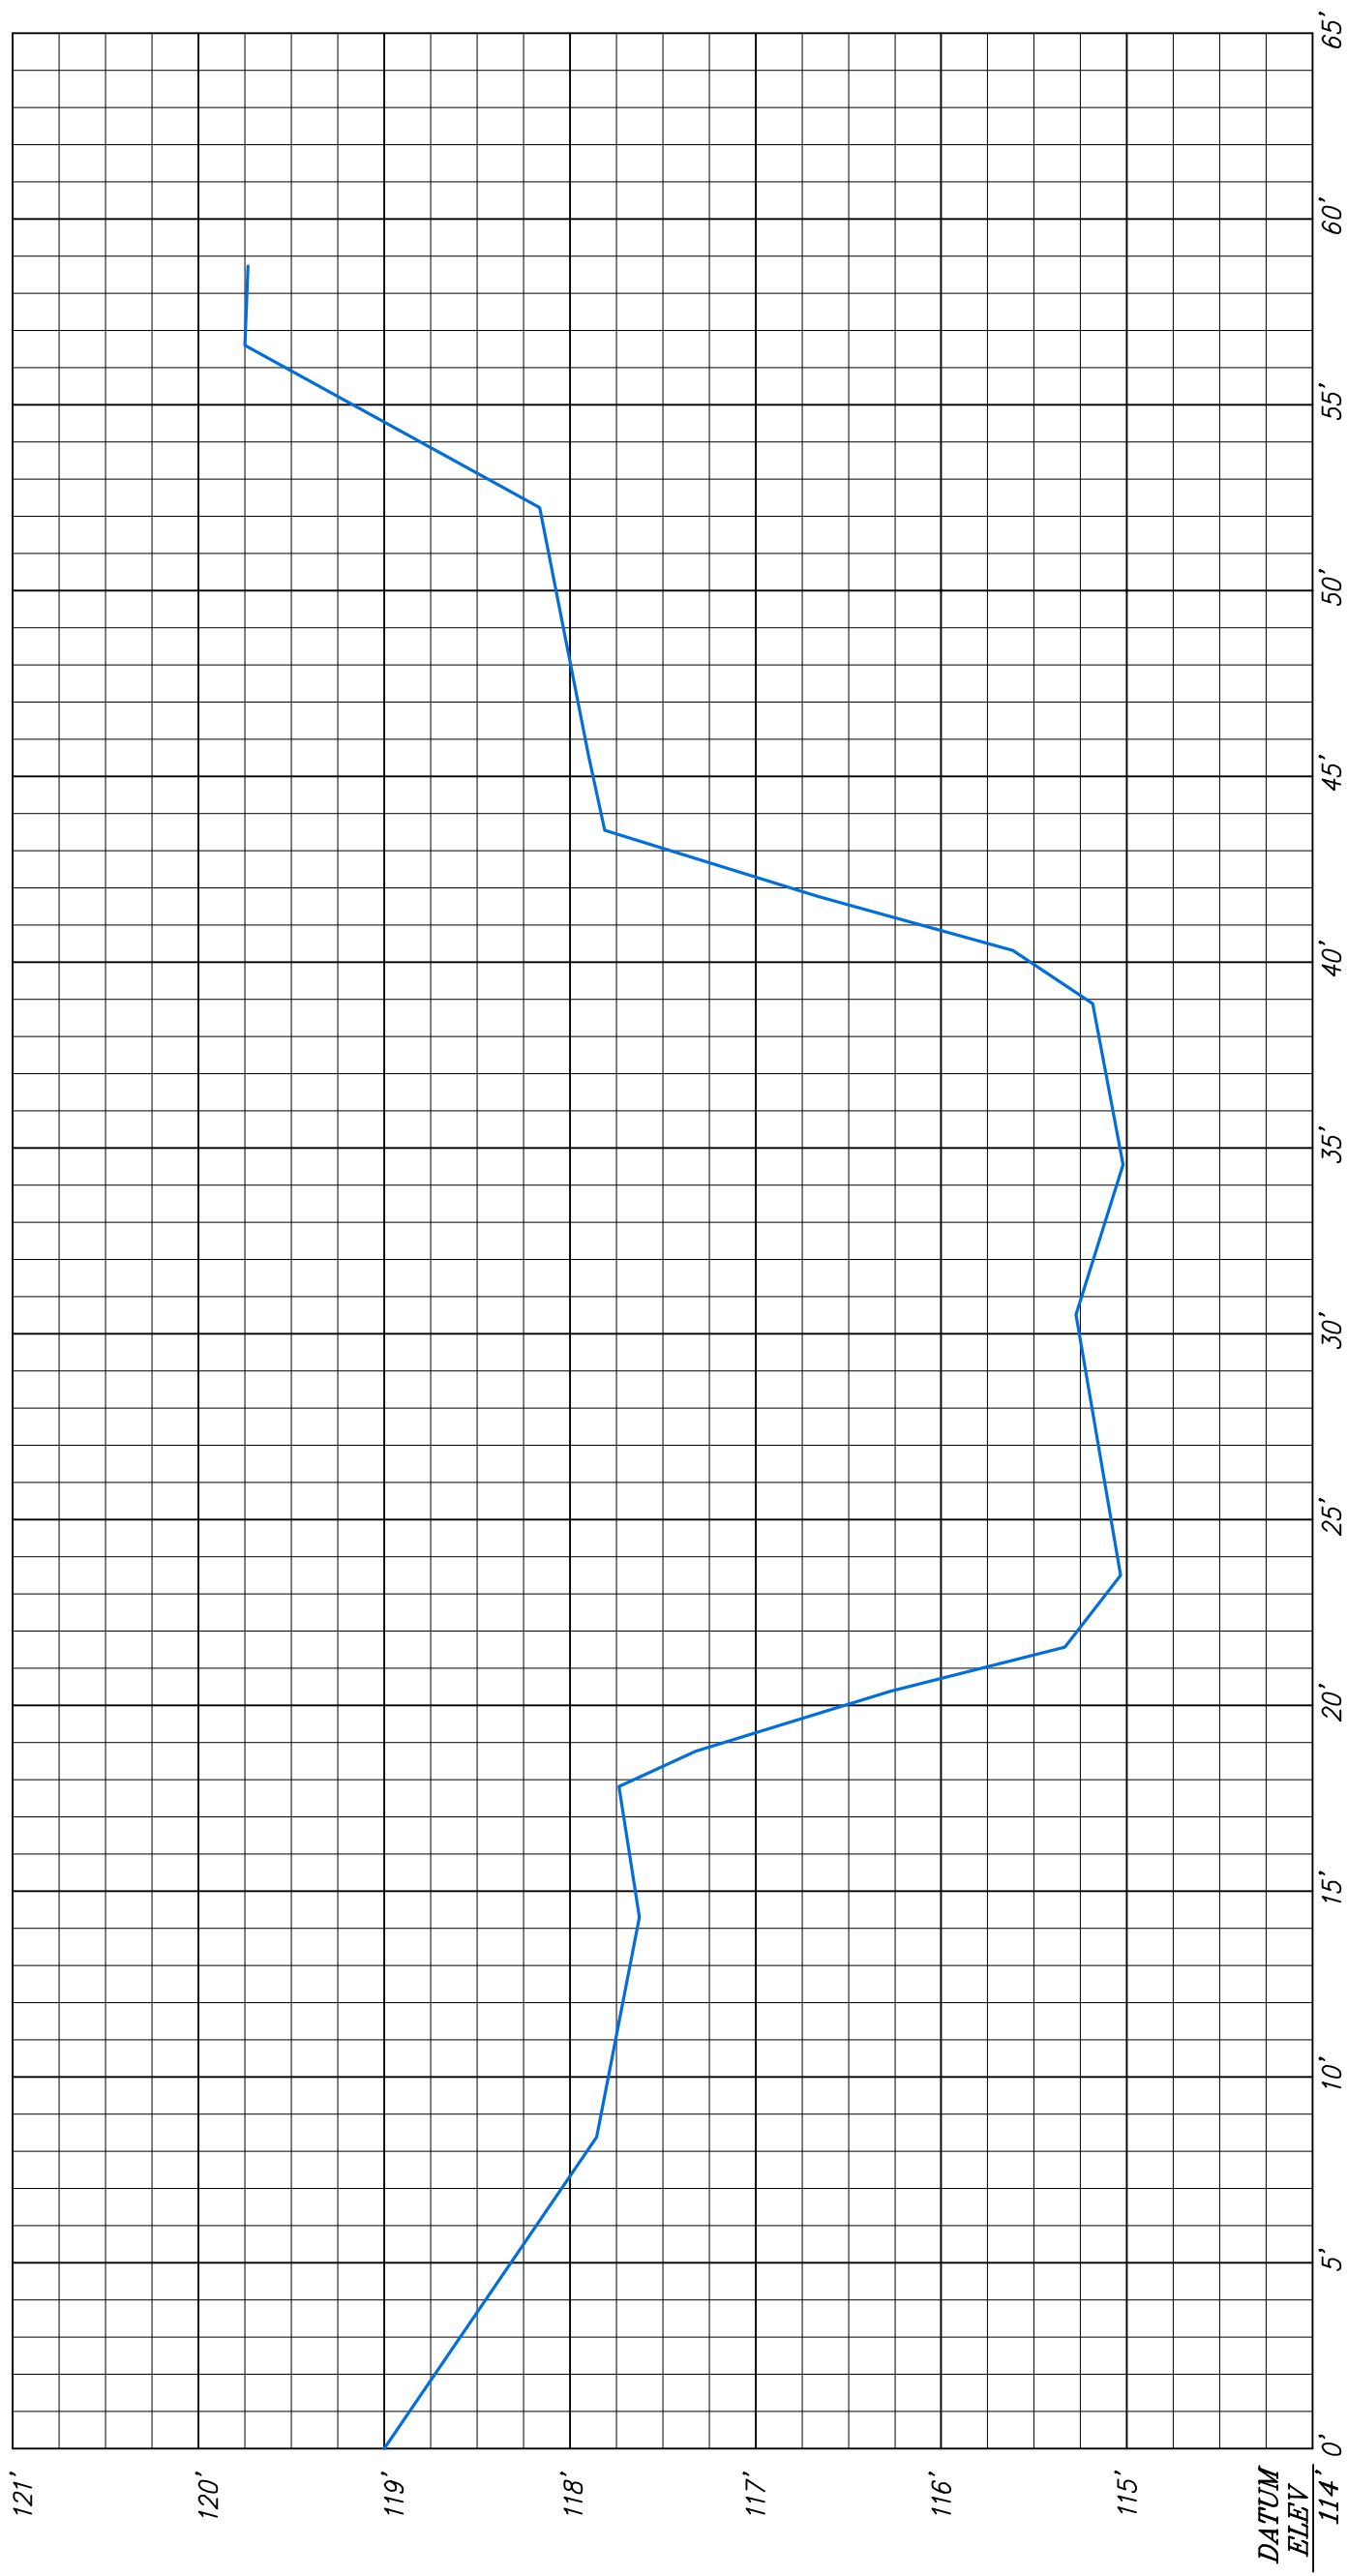

CROSS-SECTION 9R
 (EAST BANK TO WEST BANK)
 SCALE: 1"=5' HORZ./1"=1' VERT.

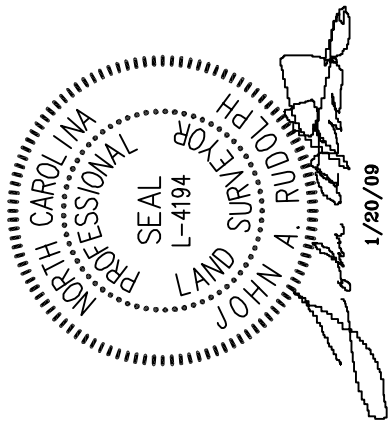

NOTE:
 TBM IS NATURAL GROUND AT
 BOTTOM OF METAL STAKE(S)
 LOCATED AT THE BEGINNING
 AND END OF EACH
 CROSS-SECTION (ASSUMED
 ELEVATION)

SHEET 21 OF 23

AS-BUILT SURVEY


FOR

RESTORATION
 SYSTEMS, LLC


THREE MILE CREEK SITE



Natural Resources
 Restoration & Conservation

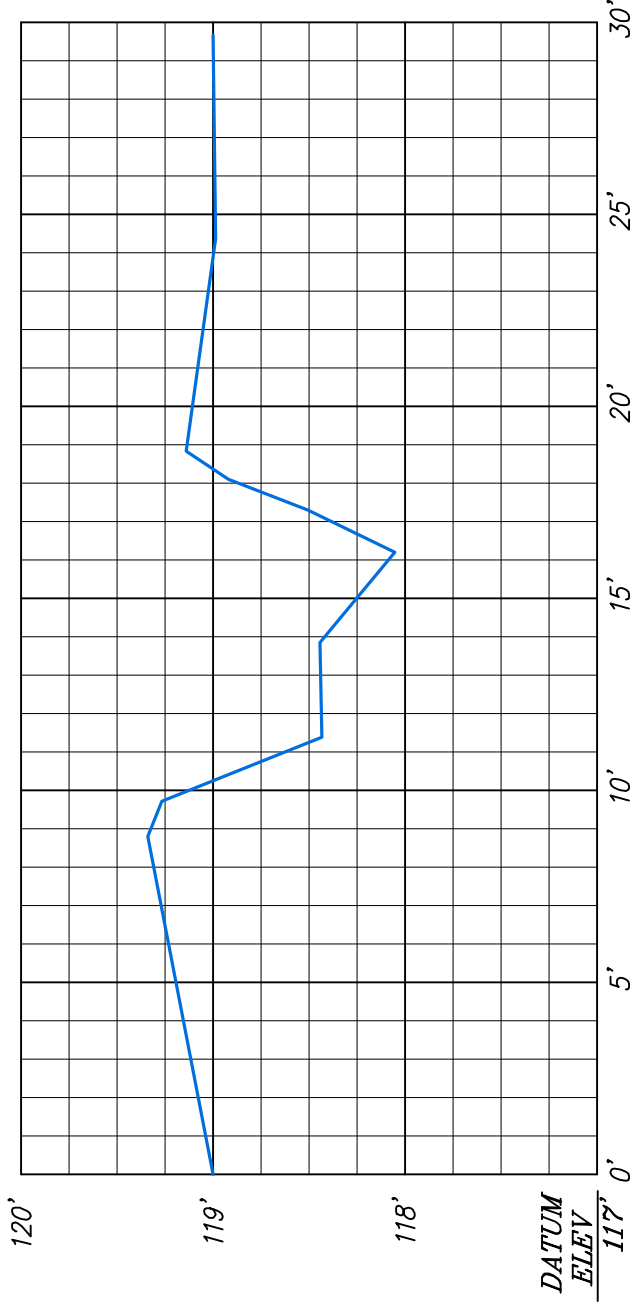


CROSS-SECTION 10R
(EAST BANK TO WEST BANK)
SCALE: 1"=5' HORZ./1"=1' VERT.

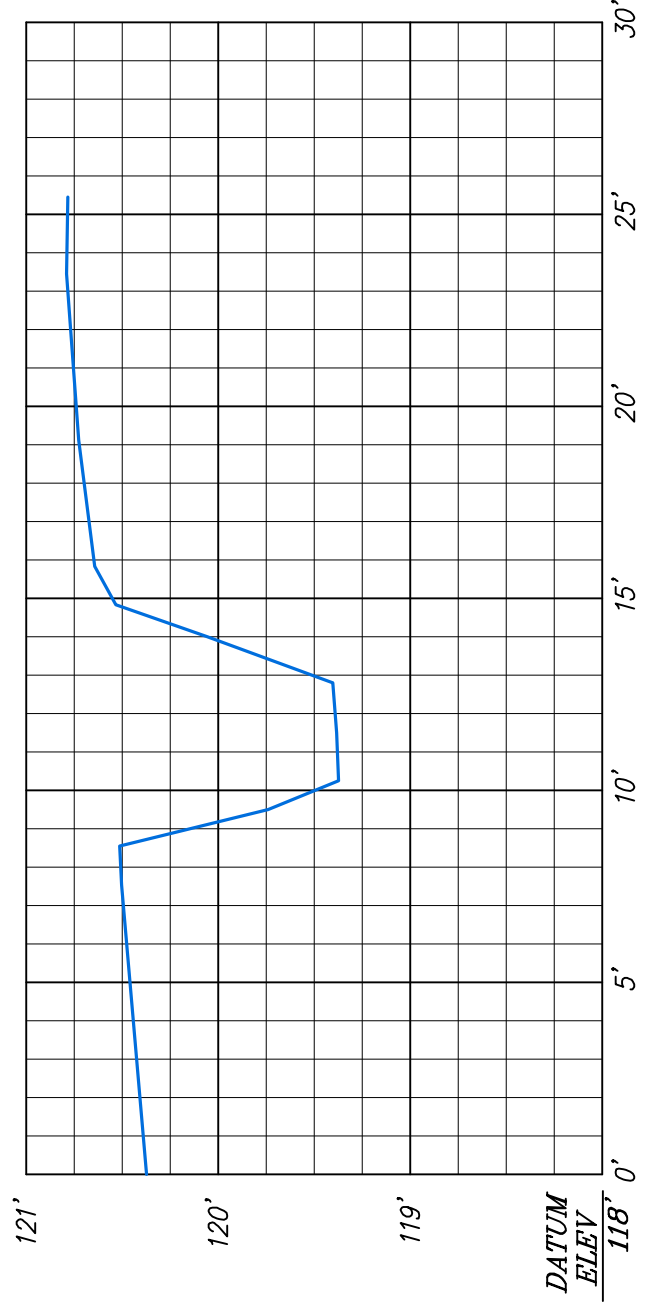

CROSS-SECTION 11P
(EAST BANK TO WEST BANK)
SCALE: 1"=5' HORZ./1"=1' VERT.

NOTE:
TBM IS NATURAL GROUND AT
BOTTOM OF METAL STAKE(S)
LOCATED AT THE BEGINNING
AND END OF EACH
CROSS-SECTION (ASSUMED
ELEVATION)

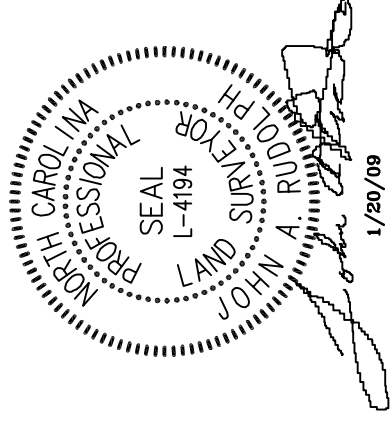

SHEET 22 OF 23

AS-BUILT SURVEY


FOR

RESTORATION
SYSTEMS, LLC

THREE MILE CREEK SITE



Natural Resources
Restoration & Conservation

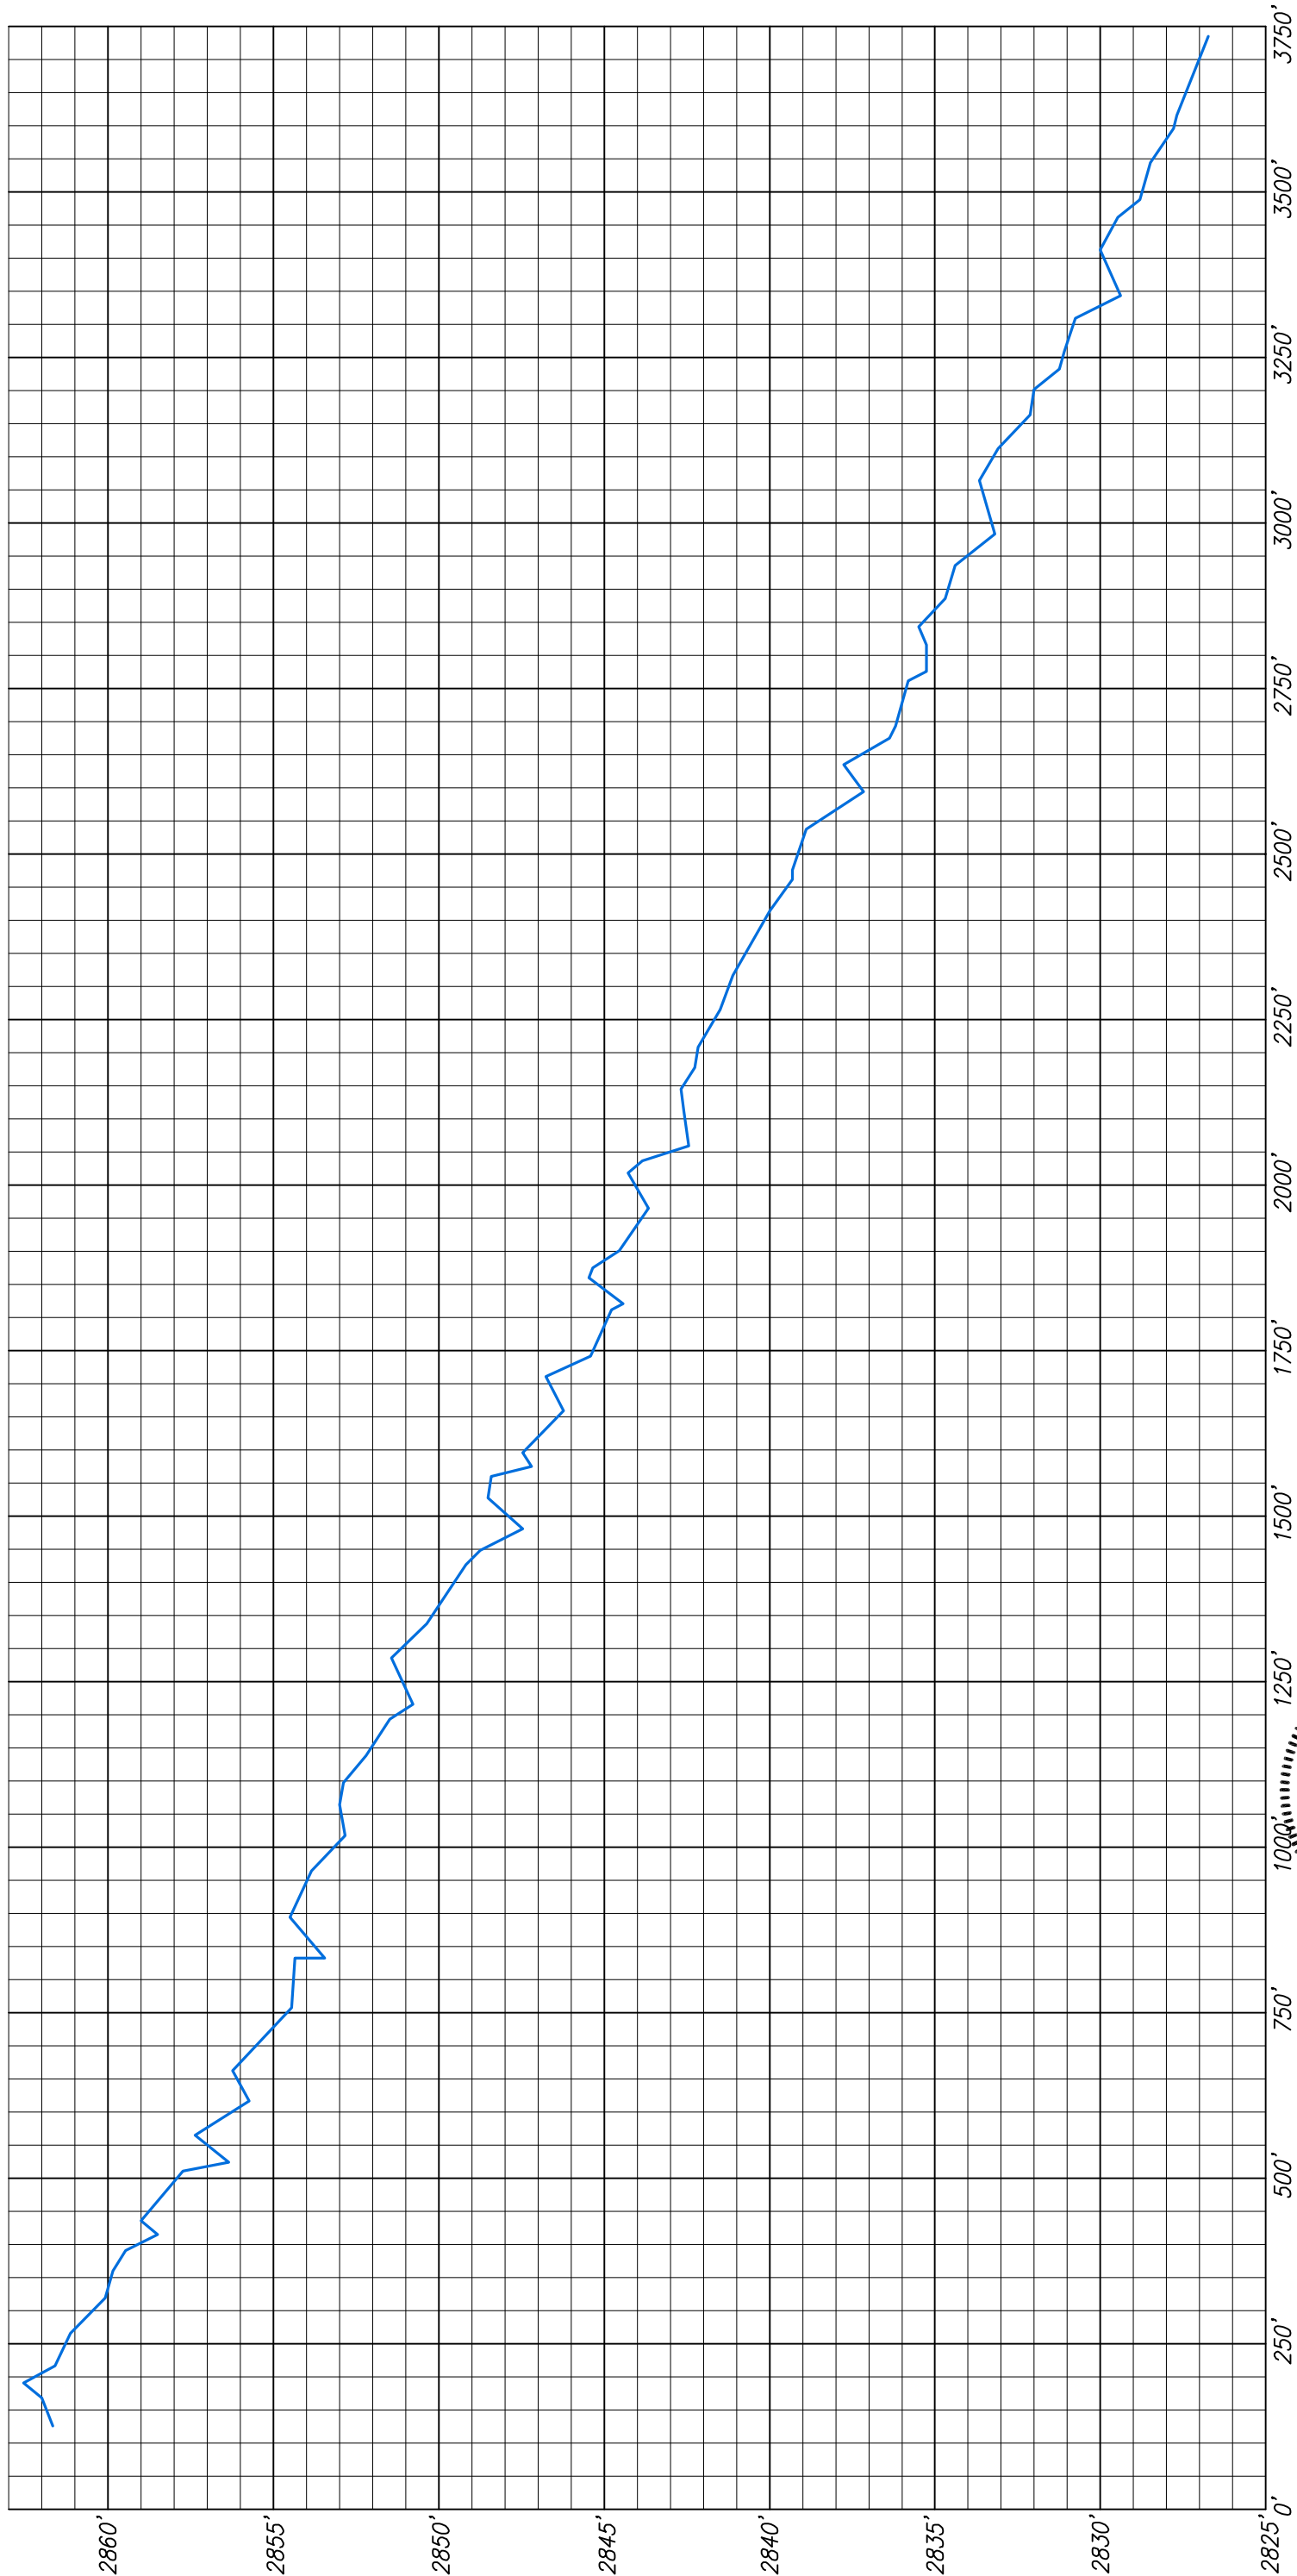

NOTE:
 ALL ELEVATIONS SHOWN ARE REFERENCED TO NAVD 1988. BENCHMARK USED: NCGS MARKER "MORRISON" WITH AN ELEVATION OF 2,679.26' NAVD 88. (THIS SHEET ONLY).

MAIN CHANNEL CENTERLINE PROFILE
 SCALE: 1"=250' HORZ./1"=5' VERT.

SHEET 23 OF 23

AS-BUILT SURVEY


FOR

RESTORATION SYSTEMS, LLC

THREE MILE CREEK SITE



Natural Resources
 Restoration & Conservation

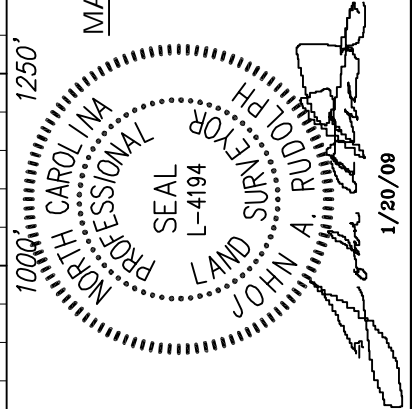

1/20/09

**Appendix B.
Preconstruction and
Construction Photographs**

**Three Mile Creek Preconstruction Conditions
Taken March 2007**



**Three Mile Creek During Construction
Taken June 2008**




Appendix C.
As-built Cross-section and Longitudinal Profile Plots

River Basin:	French Broad
Watershed:	Threemile Creek
XS ID	XS - 2, Pool
Drainage Area (sq mi):	0.05
Date:	11/6/2008
Field Crew:	Lewis, St. Clair

Station	Elevation
0.00	263.19
3.47	263.51
9.43	263.96
10.56	263.95
11.25	263.97
12.48	263.12
13.30	262.72
14.64	262.71
15.89	263.33
17.51	263.97
18.54	263.98
23.36	264.47
28.70	264.21

SUMMARY DATA		
Bankfull Elevation:		264.0
Bankfull Cross-Sectional Area:		4.8
Bankfull Width:		6.3
Flood Prone Area Elevation:		-
Flood Prone Width:		-
Max Depth at Bankfull:		1.3
Mean Depth at Bankfull:		0.8
W / D Ratio:		-
Entrenchment Ratio:		-
Bank Height Ratio:		-

Stream Type	E
--------------------	---

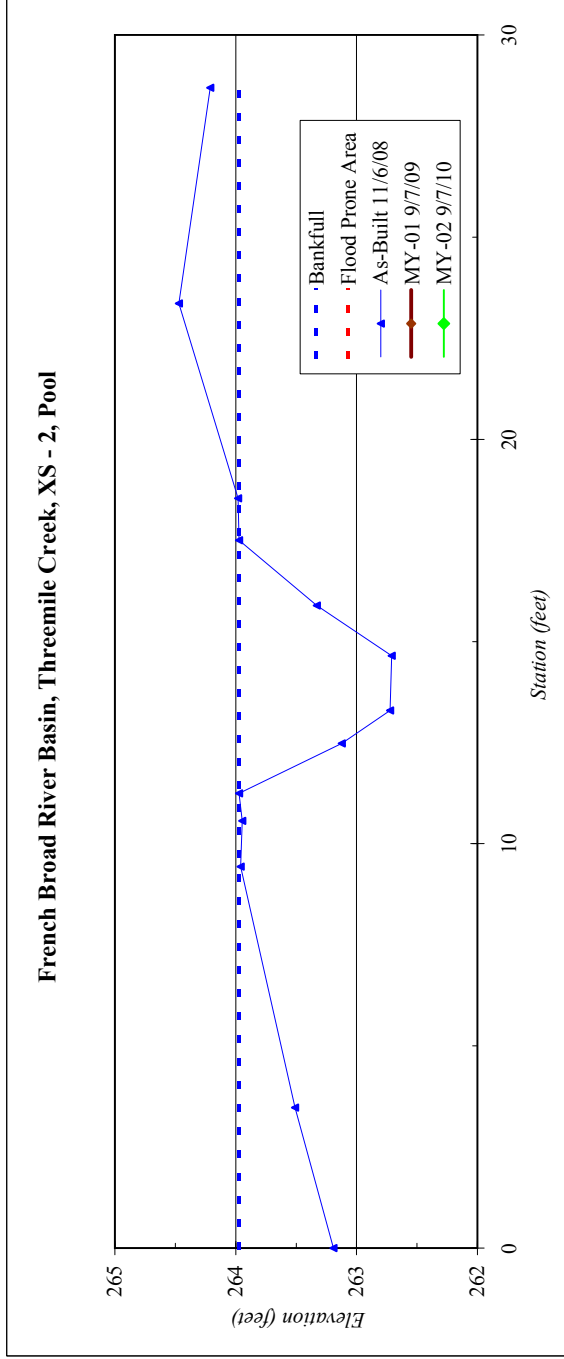


River Basin:	French Broad
Watershed:	Threemile Creek
XS ID	XS - 3, Riffle
Drainage Area (sq mi):	4.7
Date:	11/6/2008
Field Crew:	Lewis, St.Clair

Station	Elevation
0.00	264.45
5.62	264.46
7.74	263.59
9.71	263.06
14.57	263.08
16.31	262.81
17.33	262.66
19.03	261.26
19.23	261.24
20.58	260.68
23.13	260.69
30.48	260.59
40.01	260.62
41.78	261.14
44.5	262.8
46.5	262.8
52.8	262.8
56.5	264.0
57.0	263.9
60.1	263.7
64.5	263.7

SUMMARY DATA	
Bankfull Elevation:	262.8
Bankfull Cross-Sectional Area:	51.1
Bankfull Width:	27.8
Flood Prone Area Elevation:	265.0
Flood Prone Width:	>65
Max Depth at Bankfull:	2.2
Mean Depth at Bankfull:	1.8
W / D Ratio:	15.2
Entrenchment Ratio:	>5
Bank Height Ratio:	1.0

Stream Type E/C

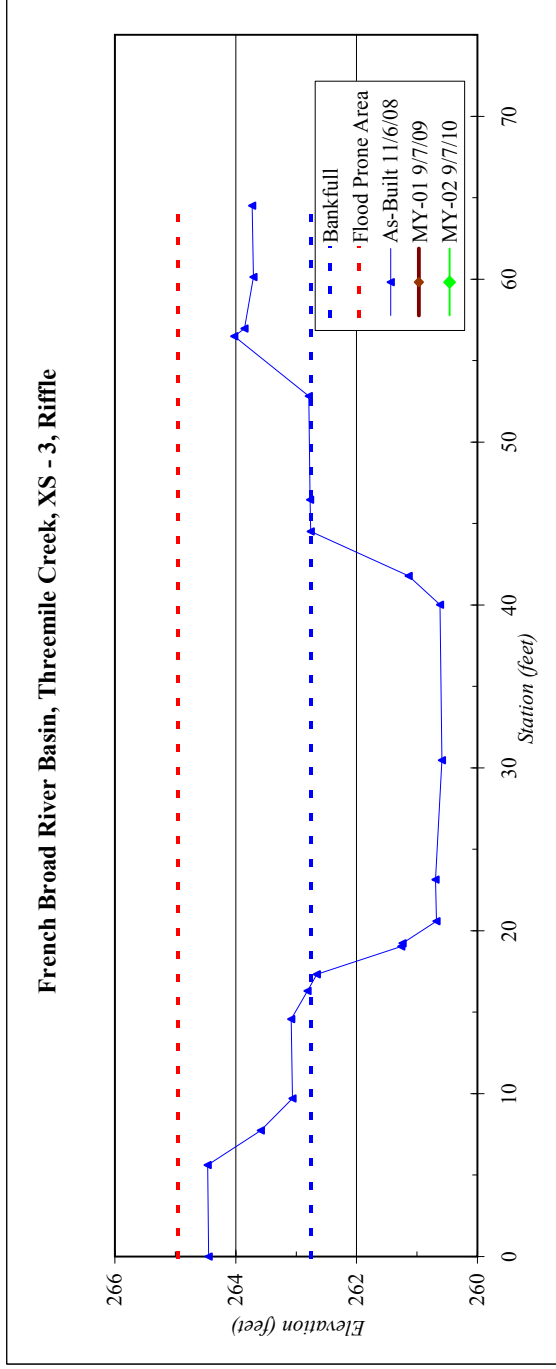


River Basin:	French Broad
Watershed:	Threemile Creek
XS ID	XS - 4, Pool
Drainage Area (sq mi):	4.7
Date:	11/6/2008
Field Crew:	Lewis, St.Clair

Station	Elevation
0.0	269.3
13.6	269.5
15.3	269.7
17.0	268.1
18.8	266.5
20.1	266.0
24.4	266.2
28.1	266.7
32.7	267.4
34.4	267.5
38.8	268.6
40.8	269.1
43.9	269.9
51.6	270.0
55.5	270.06
58.4	271.49
62.7	271.79

SUMMARY DATA	
Bankfull Elevation:	269.7
Bankfull Cross-Sectional Area:	63.4
Bankfull Width:	27.9
Flood Prone Area Elevation:	-
Flood Prone Width:	-
Max Depth at Bankfull:	2.3
Mean Depth at Bankfull:	3.7
W / D Ratio:	-
Entrenchment Ratio:	-
Bank Height Ratio:	-

Stream Type **E**

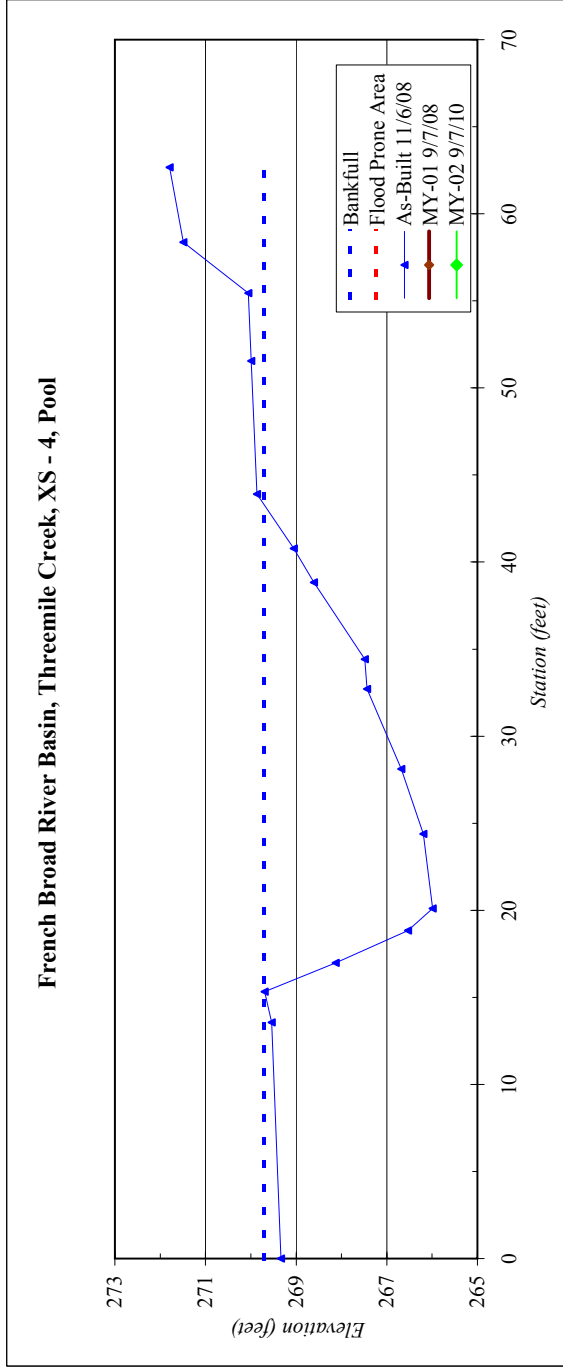


River Basin:	French Broad
Watershed:	Threemile Creek
XS ID	XS - 5, Riffle
Drainage Area (sq mi):	4.7
Date:	11/6/2008
Field Crew:	Lewis, St.Clair

Station	Elevation
0.0	275.1
5.6	275.1
6.8	274.0
7.5	273.2
8.8	273.0
10.7	272.5
16.8	272.8
18.4	272.4
23.5	272.8
28.0	272.8
29.6	273.2
30.8	274.2
32.0	275.1
33.4	275.3
34.6	275.2
42.0	275.2
44.6	276.3
49.6	276.5

SUMMARY DATA	
Bankfull Elevation:	275.1
Bankfull Cross-Sectional Area:	55.0
Bankfull Width:	21.6
Flood Prone Area Elevation:	277.7
Flood Prone Width:	>65
Max Depth at Bankfull:	2.6
Mean Depth at Bankfull:	2.1
W / D Ratio:	12.6
Entrenchment Ratio:	>5
Bank Height Ratio:	1.0

Stream Type: E/C

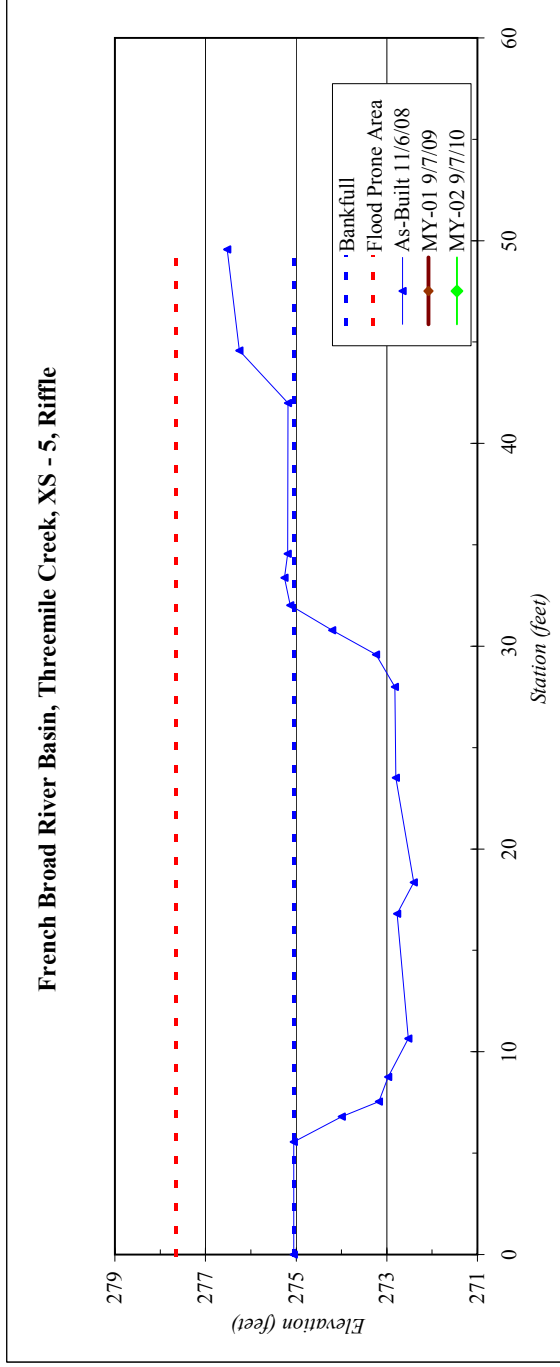


River Basin:	French Broad
Watershed:	Threemile Creek
XS ID	XS - 6, Pool
Drainage Area (sq mi):	4.7
Date:	11/6/2008
Field Crew:	Lewis, St.Clair

Station	Elevation
0.0	279.9
10.9	280.1
12.0	279.9
14.7	278.7
17.5	277.9
19.9	277.1
23.8	276.8
27.2	276.7
29.4	276.4
30.7	277.2
32.7	279.3
33.7	280.1
36.2	280.1
45.4	280.3

SUMMARY DATA		
Bankfull Elevation:		280.0
Bankfull Cross-Sectional Area:		49.9
Bankfull Width:		21.6
Flood Prone Area Elevation:		-
Flood Prone Width:		-
Max Depth at Bankfull:		2.3
Mean Depth at Bankfull:		3.7
W / D Ratio:		-
Entrenchment Ratio:		-
Bank Height Ratio:		-

Stream Type	E/C
--------------------	-----

French Broad River Basin, Threemile Creek, XS - 6, Pool

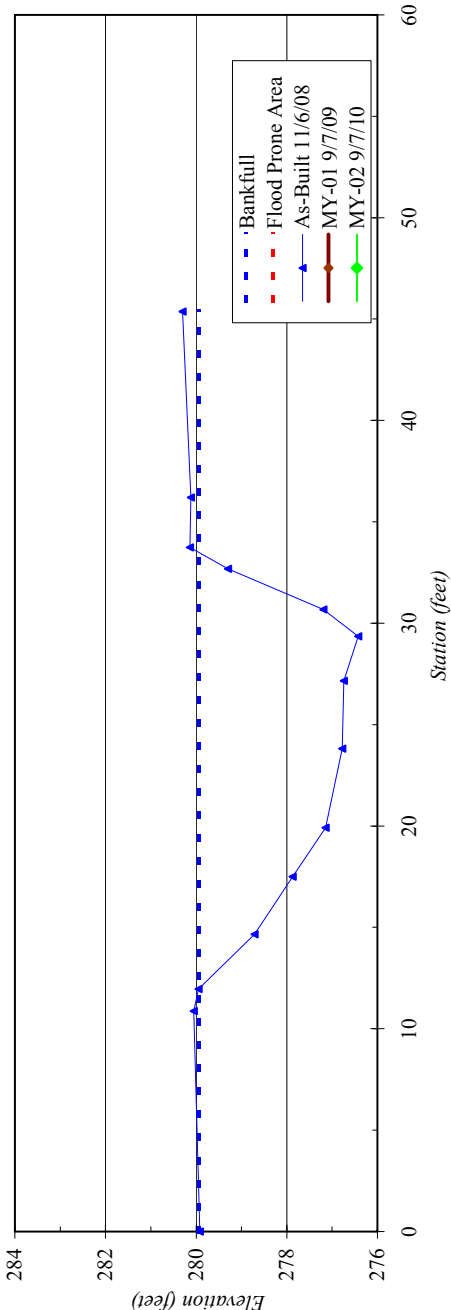


River Basin:	French Broad
Watershed:	Threemile Creek
XS ID	XS - 7, Riffle
Drainage Area (sq mi):	4.7
Date:	11/6/2008
Field Crew:	Lewis, St.Clair

Station	Elevation
0.0	283.9
9.3	283.8
13.6	283.9
14.8	283.8
17.2	281.7
18.8	281.5
26.2	281.4
32.8	281.5
35.3	281.6
36.8	283.0
38.2	284.1
40.5	284.0
45.2	284.0
47.5	284.5
49.9	284.6

SUMMARY DATA	
Bankfull Elevation:	283.8
Bankfull Cross-Sectional Area:	46.5
Bankfull Width:	23.1
Flood Prone Area Elevation:	286.2
Flood Prone Width:	>65
Max Depth at Bankfull:	2.4
Mean Depth at Bankfull:	2.0
W / D Ratio:	11.5
Entrenchment Ratio:	>5
Bank Height Ratio:	1.0

Stream Type: E/C

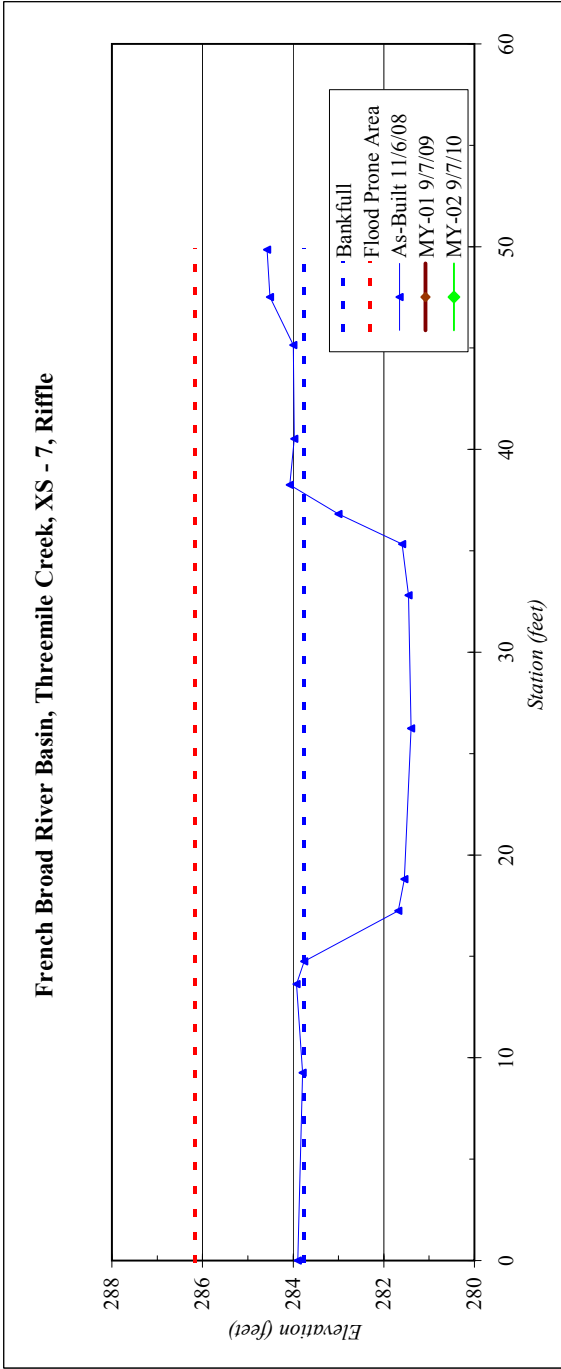


River Basin:	French Broad
Watershed:	Threemile Creek
XS ID	XS - 8, Pool
Drainage Area (sq mi):	4.7
Date:	11/6/2008
Field Crew:	Lewis, St.Clair

Station	Elevation
0.0	289.6
12.4	289.6
14.0	289.6
14.9	289.3
16.7	288.0
17.6	287.1
19.0	286.2
21.0	286.3
22.9	286.0
25.7	286.3
29.6	286.8
34.4	288.0
37.4	289.0
39.6	289.4
45.7	289.4
50.4	290.0
53.1	290.1

SUMMARY DATA	
Bankfull Elevation:	289.4
Bankfull Cross-Sectional Area:	52.1
Bankfull Width:	25.7
Flood Prone Area Elevation:	-
Flood Prone Width:	-
Max Depth at Bankfull:	3.4
Mean Depth at Bankfull:	2.0
W / D Ratio:	-
Entrenchment Ratio:	-
Bank Height Ratio:	-

Stream Type: E/C

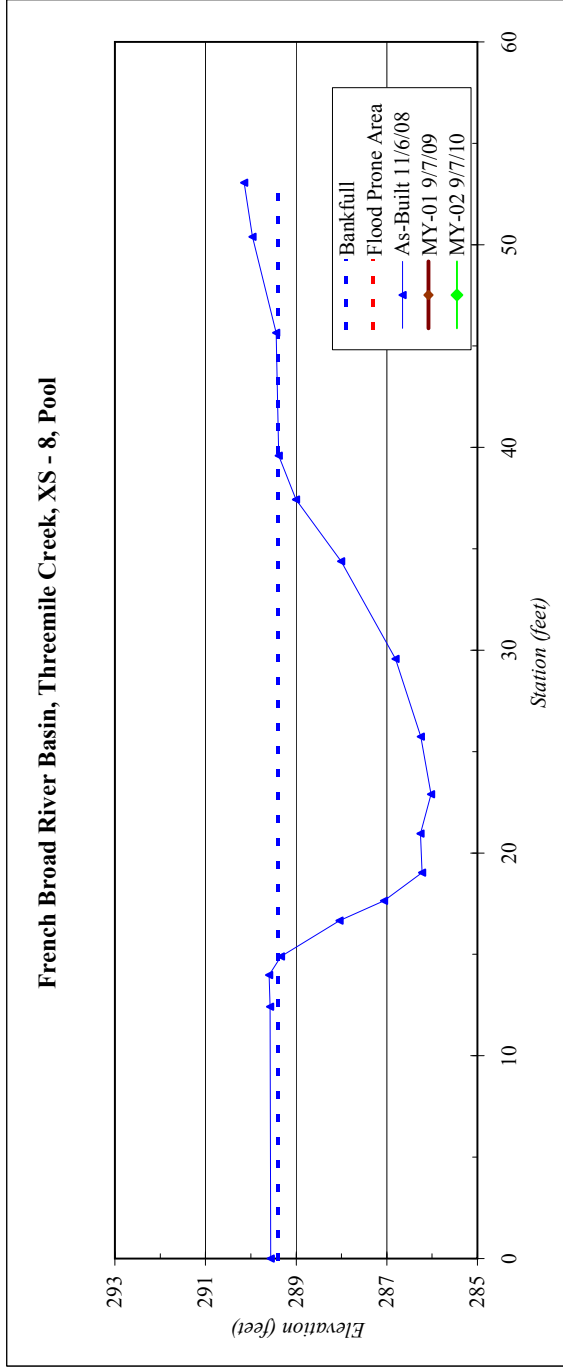


River Basin:	French Broad
Watershed:	Threemile Creek
XS ID	XS - 9, Riffle
Drainage Area (sq mi):	4.7
Date:	11/6/2008
Field Crew:	Lewis, St.Clair

Station	Elevation
0.0	296.1
8.4	295.0
14.3	294.8
17.9	294.9
18.8	294.5
20.4	293.4
21.6	292.5
23.5	292.2
30.4	292.4
34.5	292.2
38.9	292.3
40.3	292.7
41.9	293.8
43.7	294.9
45.7	295.0
52.3	295.3
56.8	296.9
58.9	296.8

SUMMARY DATA		
Bankfull Elevation:		294.9
Bankfull Cross-Sectional Area:		55.3
Bankfull Width:		25.7
Flood Prone Area Elevation:		297.6
Flood Prone Width:		>65
Max Depth at Bankfull:		2.7
Mean Depth at Bankfull:		2.2
W/D Ratio:		11.9
Entrenchment Ratio:		>5
Bank Height Ratio:		1.0

Stream Type: E/C

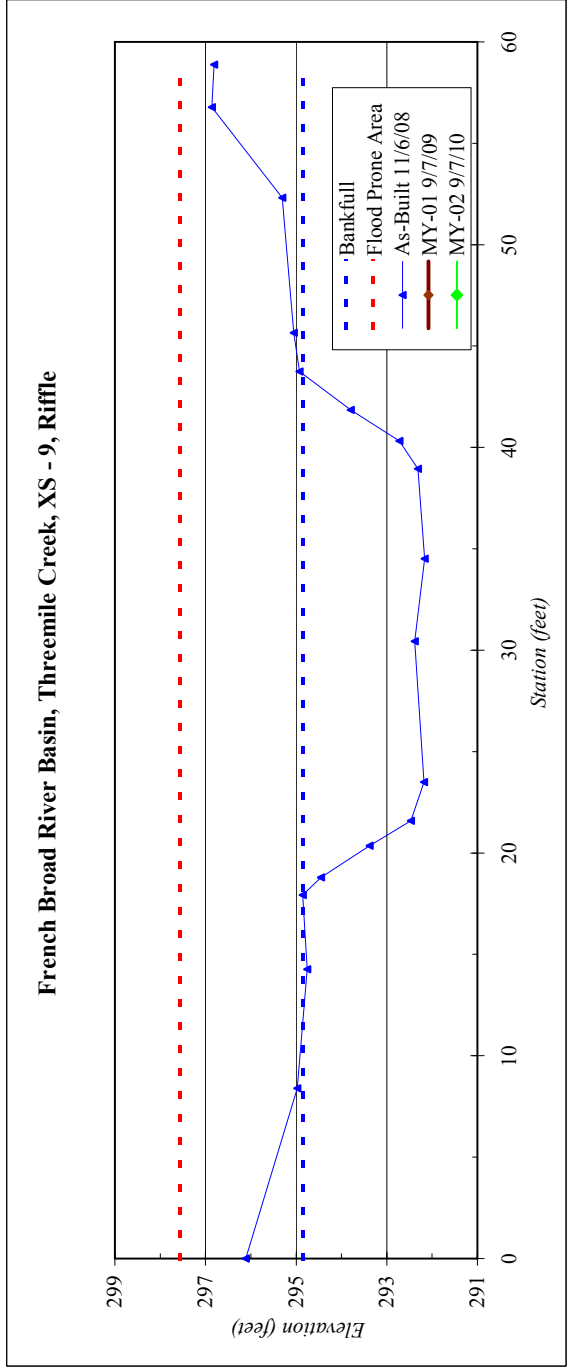


River Basin:	French Broad
Watershed:	Threemile Creek
XS ID	XS - 10, Riffle
Drainage Area (sq mi):	0.05
Date:	11/6/2008
Field Crew:	Lewis, St.Clair

Station	Elevation
0.0	296.1
8.8	296.4
9.8	296.2
11.3	295.5
14.0	295.5
16.1	295.2
17.3	295.6
18.1	296.0
18.9	296.3
24.4	296.1
29.8	296.1

SUMMARY DATA	
Bankfull Elevation:	296.3
Bankfull Cross-Sectional Area:	6.1
Bankfull Width:	9.5
Flood Prone Area Elevation:	297.4
Flood Prone Width:	>35
Max Depth at Bankfull:	1.1
Mean Depth at Bankfull:	0.6
W / D Ratio:	14.8
Entrenchment Ratio:	>5
Bank Height Ratio:	1.0

Stream Type: E/C

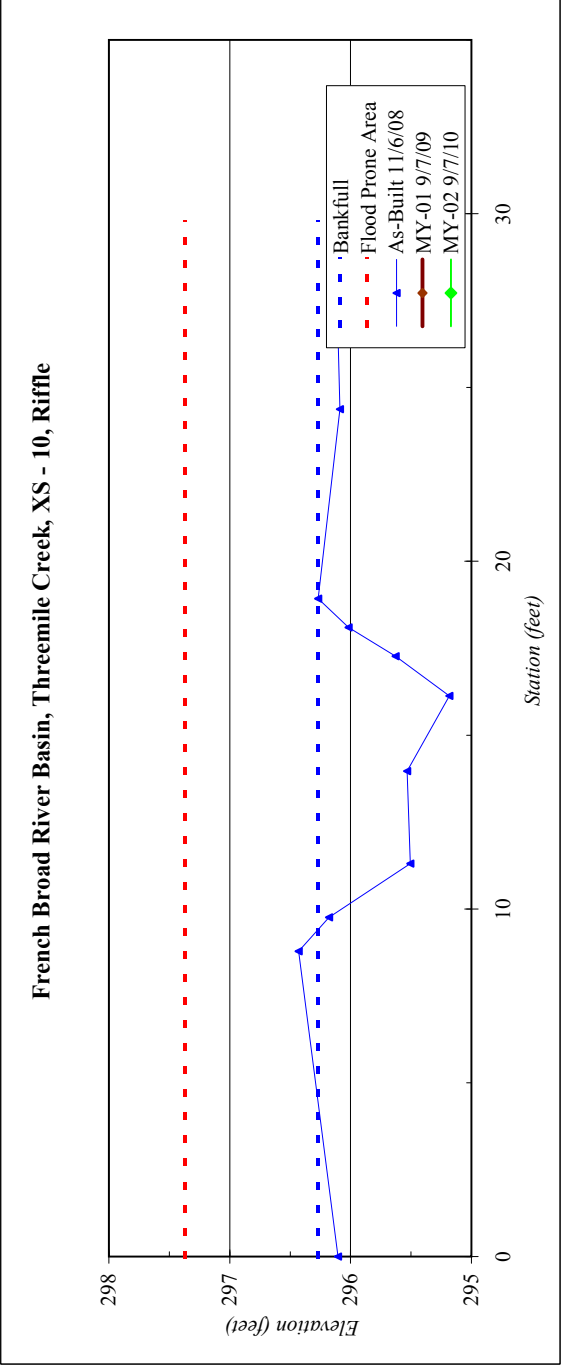


River Basin:	French Broad
Watershed:	Threemile Creek
XS ID	XS - 11, Pool
Drainage Area (sq mi):	0.05
Date:	11/6/2008
Field Crew:	Lewis, St.Clair

Station	Elevation
0.0	297.5
7.5	297.6
8.5	297.7
9.5	296.8
10.3	296.5
11.5	296.5
12.9	296.5
14.0	297.2
15.0	297.7
16.0	297.8
19.2	297.8
23.5	297.9
25.5	297.9


SUMMARY DATA		
Bankfull Elevation:		297.7
Bankfull Cross-Sectional Area:		5.3
Bankfull Width:		6.4
Flood Prone Area Elevation:		-
Flood Prone Width:		-
Max Depth at Bankfull:		1.2
Mean Depth at Bankfull:		0.8
W / D Ratio:		-
Entrenchment Ratio:		-
Bank Height Ratio:		-

Stream Type: E/C

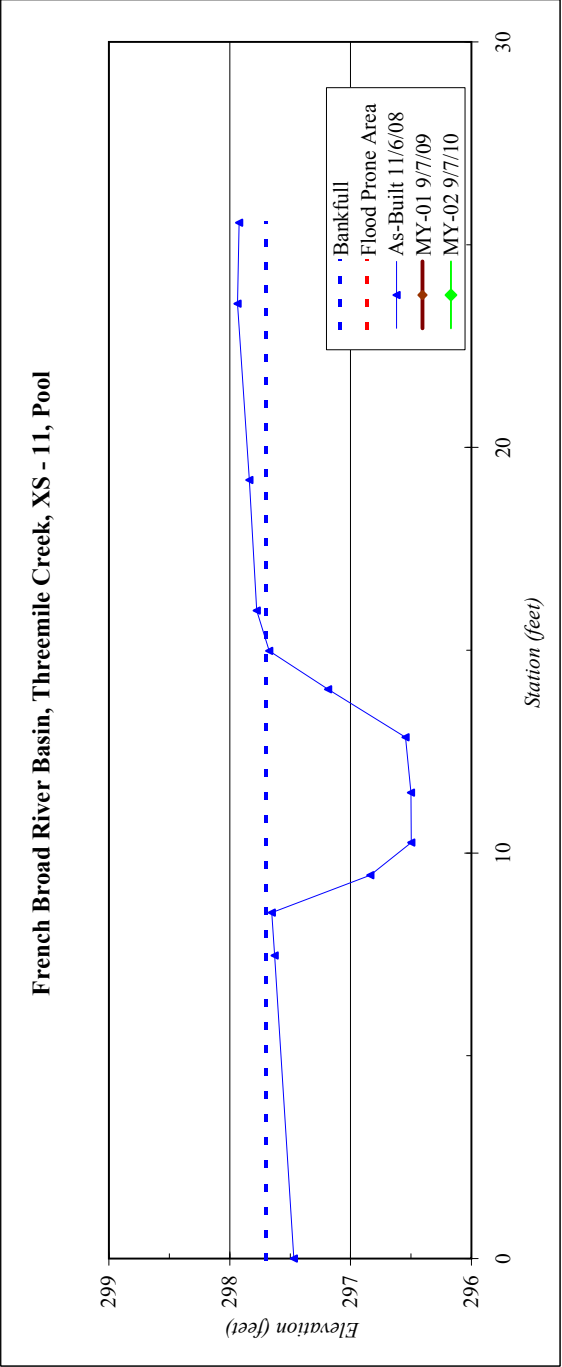


Project Name		Threemile Creek - As-built (2008) Profile											
Reach		all											
Feature		Profile											
Date	10/21/08												
Crew	Lewis, St. Clair												
Station	2008			2009			2010			2011			
	As-built Survey	Water Elevation	Bed Elevation	Year 1 Monitoring / Survey	Water Elevation	Bed Elevation	Year 2 Monitoring / Survey	Water Elevation	Bed Elevation	Year 3 Monitoring / Survey	Water Elevation	Bed Elevation	
0+0	82.3	82.6											
37.1	82.8	83.2											
95.1	83.4	83.9											
98.8	83.2	83.9											
107.4	83.2	83.9											
111.0	84.1	84.1											
120.0	83.4	84.1											
138.8	83.4	84.3											
144.7	83.7	84.3											
197.0	84.7	85.1											
226.7	84.1	85.1											
236.5	83.3	85.2											
250.9	82.1	85.2											
253.2	85.2	85.2											
281.5	85.4	85.9											
325.5	86.0	86.4											
346.6	85.2	85.4											
370.6	85.7	86.4											
384.2	85.7	86.3											
420.6	86.8	87.0											
438.2	86.1	87.2											
448.3	86.2	87.2											
457.1	86.8	87.2											
484.0	87.2	87.6											
494.7	86.5	87.6											
513.8	85.6	87.6											
517.6	87.9	88.2											
543.8	87.7	88.3											

As-built	2008	2009	2010
Avg. Water Surface Slope	0.0098		
Riffle Length	51.0		
Avg. Riffle Slope	0.0154		
Pool Length	46.0		
Pool to Pool Spacing	110.0		

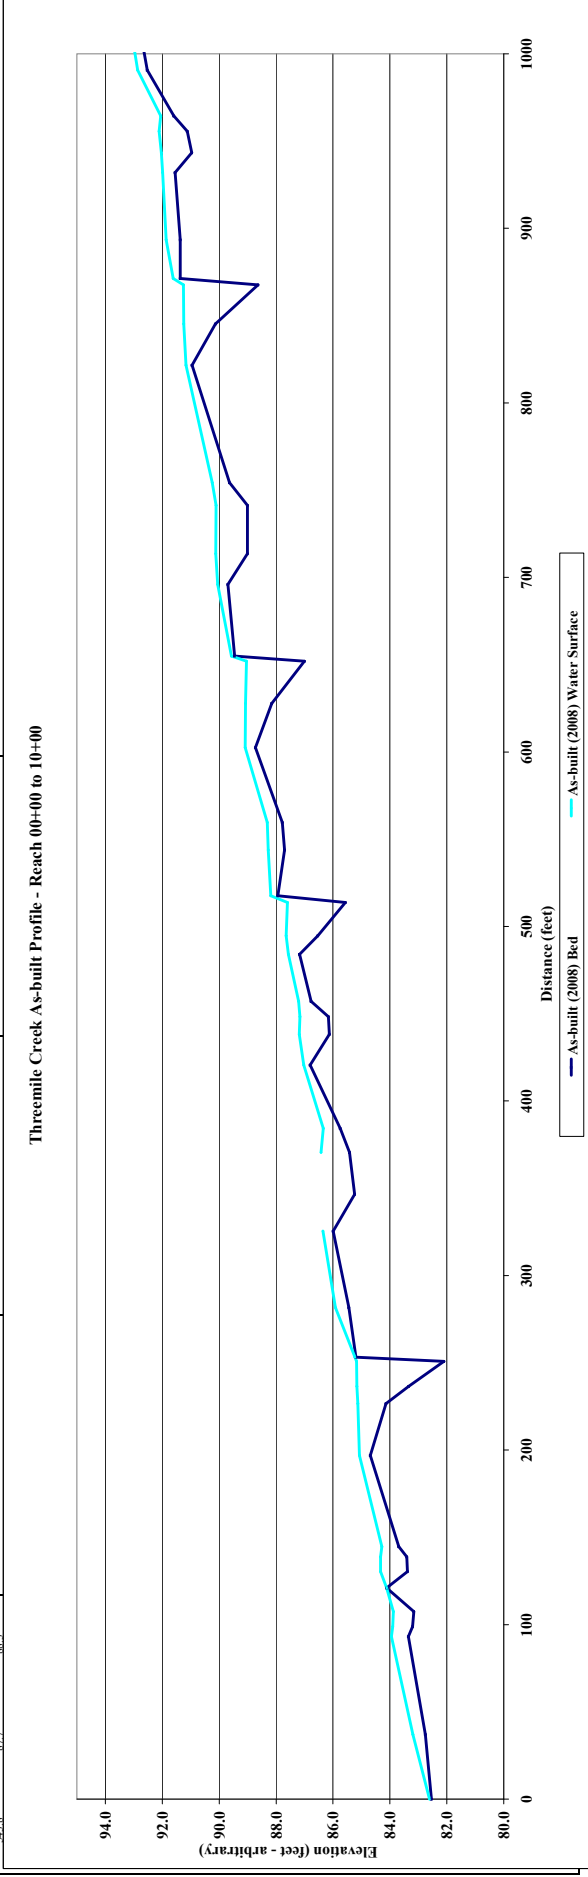

Project Name: Threemile Creek - As-built (2008) Profile									
Reach: all									
Profile									
Feature: 102108									
Date: Lewis, S, Clar									
Crew:									
Station	2008		2009		2010		2011		
	As-built Survey	Water Elevation	Year 1 Monitoring / Survey	Water Elevation	Year 2 Monitoring / Survey	Water Elevation	Year 3 Monitoring / Survey	Water Elevation	
	Bed Elevation		Bed Elevation		Bed Elevation		Bed Elevation		
0+0	82.5								
37.1	82.8	82.6							
93.1	83.4	83.2							
98.8	83.2	83.9							
107.4	83.2	83.9							
110.0	84.1	84.1							
120.4	83.4	84.3							
138.8	83.4	84.3							
144.7	83.7	84.3							
197.0	84.7	85.1							
226.7	84.1	85.1							
236.5	83.3	85.2							
250.9	82.1	85.2							
253.2	85.2	85.2							
281.5	85.4	85.9							
325.5	86.0	86.4							
346.6	85.2								
370.6	85.4	86.4							
384.2	85.7	86.3							
420.6	86.8	87.0							
438.2	86.1	87.2							
448.3	86.2	87.2							
457.1	86.8	87.2							
484.0	87.2	87.6							
494.7	86.5	87.6							
513.8	85.6	87.6							
517.6	87.9	88.2							
543.8	87.7	88.3							


	As-built	2008	2009	2010
Avg. Water Surface Slope	0.0098			
Riffle Length	51.0			
Avg. Riffle Slope	0.0154			
Pool Length	46.0			
Avg. Pool Slope	110.0			

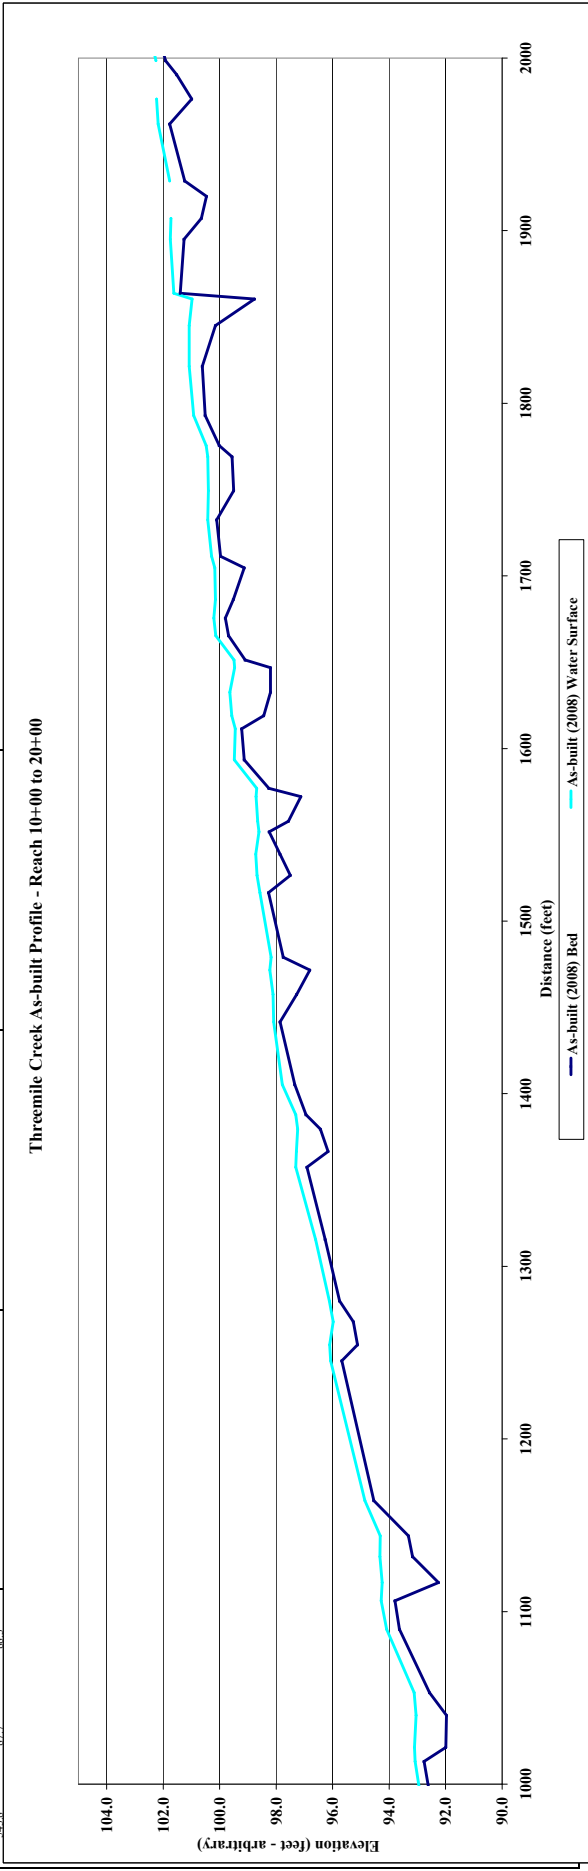

Project Name: Threemile Creek - As-built (2008) Profile									
Reach: all									
Profile									
Feature: 102108									
Date: Lewis, S, Clar									
Crew:									
Station	2008		2009		2010		2011		
	As-built Survey	Water Elevation	Year 1 Monitoring / Survey	Water Elevation	Year 2 Monitoring / Survey	Water Elevation	Year 3 Monitoring / Survey	Water Elevation	
0+0	82.5	82.6							
37.1	82.8	82.2							
93.1	83.4	83.9							
98.8	83.2	83.9							
107.4	83.2	83.9							
110.0	84.1	84.1							
120.4	83.4	84.3							
138.8	83.4	84.3							
144.7	83.7	84.3							
197.0	84.7	85.1							
226.7	84.1	85.1							
236.5	83.3	85.2							
250.9	82.1	85.2							
253.2	85.2	85.2							
281.5	85.4	85.9							
325.5	86.0	86.4							
346.6	85.2	85.2							
370.6	85.4	86.4							
384.2	85.7	86.3							
420.6	86.8	87.0							
438.2	86.1	87.2							
448.3	86.2	87.2							
457.1	86.8	87.2							
484.0	87.2	87.6							
494.7	86.5	87.6							
513.8	85.6	87.6							
517.6	87.9	88.2							
543.8	87.7	88.3							

	As-built	2008	2009	2010
Avg. Water Surface Slope	0.0098			
Riffle Length	51.0			
Avg. Riffle Slope	0.0154			
Pool Length	46.0			
Avg. Pool Slope	110.0			

Threemile Creek As-built Profile - Reach 20+00 to 30+00

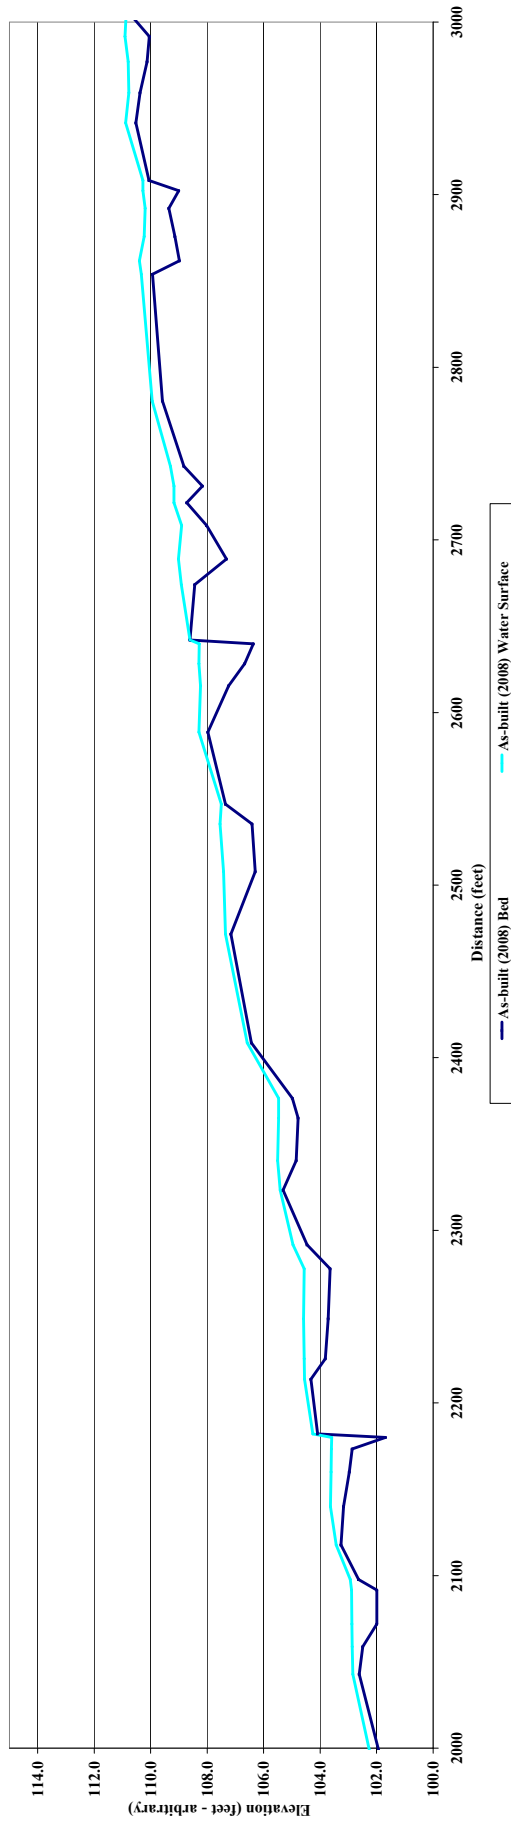

Project Name: Threemile Creek - As-built (2008) Profile												
Reach: all												
Profile												
Feature: 10/21/08												
Date: Lewis, S, Clar												
Crew:												
Station	2008			2009			2010			2011		
	As-built Survey	Water Elevation		Year 1 Monitoring /Survey	Water Elevation		Year 2 Monitoring /Survey	Water Elevation		Year 3 Monitoring /Survey	Water Elevation	
	Bed Elevation		Station	Bed Elevation	Water Elevation	Station	Bed Elevation	Water Elevation	Station	Bed Elevation	Water Elevation	Station
0+0	82.3	82.6										
37.1	82.8	83.2										
93.1	83.4	83.9										
98.8	83.2	83.9										
107.4	83.2	83.9										
110.4	84.1	84.1										
120.4	83.4	84.3										
138.8	83.4	84.3										
144.7	83.7	84.3										
197.0	84.7	85.1										
226.7	84.1	85.1										
236.5	83.3	85.2										
250.9	82.1	85.2										
253.2	85.2	85.2										
281.5	85.4	85.9										
325.5	86.0	86.4										
346.6	85.2	85.4										
370.6	85.4	86.4										
384.2	85.7	86.3										
420.6	86.8	87.0										
438.2	86.1	87.2										
448.3	86.2	87.2										
457.1	86.8	87.2										
484.0	87.2	87.6										
494.7	86.5	87.6										
513.8	85.6	87.6										
517.6	87.9	88.2										
543.8	87.7	88.3										

	As-built	2008	2009	2010
Avg. Water Surface Slope	0.0098			
Riffle Length	51.0			
Avg. Riffle Slope	0.0154			
Pool Length	46.0			
Avg. Pool Slope	110.0			

Threemile Creek As-built Profile - Reach 30+00 to 36+00

