

**YEAR 2 of 5 Monitoring Report  
Tributaries of Wicker Branch Stream Restoration  
Union County, North Carolina  
DMS Project Number: 95022  
Contract No: 003982  
USACE Action Id No: SAW 2013-01680**

**Yadkin River  
03040105**



**Prepared for:**

**NC Department of Environmental Quality  
Division of Mitigation Services  
1652 Mail Service Center  
Raleigh, NC 27699-1652**

**Data Collection Period October 2015  
Submitted: January 2017**

**YEAR 2 of 5 Monitoring Report**  
**Tributaries of Wicker Branch Stream Restoration**  
**Union County, North Carolina**  
**DMS Project Number: 95022**  
**Contract No: 003982**  
**USACE Action Id No: SAW 2013-01680**

**Yadkin River**  
**03040105**

**Prepared for:**

**NC Department of Environmental Quality**  
**Division of Mitigation Services**  
**1652 Mail Service Center**  
**Raleigh, NC 27699-1652**

**Prepared by:**

**AECOM**

**701 Corporate Center Drive, Suite 475**  
**Raleigh, NC 27607**  
**Phone: 919-854-6200**  
**Fax: 919-854-6259**

**January 2017**

**Table of Contents**

1.0 PROJECT SUMMARY ..... 1

2.0 METHODOLOGY ..... 2

    2.1 VEGETATION ..... 3

    2.2 STREAM ASSESSMENT ..... 3

    2.3 VISUAL ASSESSMENT ..... 3

    2.4 DIGITAL PHOTOS ..... 3

3.0 REFERENCES ..... 3

## **APPENDICIES**

### Appendix A – Background Tables

Figure 1: Vicinity Map

Figure 2: Stream Assets Map

Table 1: Project Components and Mitigation Credits

Table 2: Project Activity and Reporting History

Table 3: Project Contacts

Table 4: Project Baseline Information and Attribute

### Appendix B – Visual Assessment Data

Figure 3: Current Condition Plan View

Table 5: Visual Stream Morphology Stability Assessment

Table 6: Vegetation Condition Assessment

Photos: Stream Stations

Photos: Vegetation Plots

### Appendix C – Vegetation Plot Data

Table 7: Vegetation Plot Counts and Densities

### Appendix D – Stream Geomorphology Data

Cross-Sections

Longitudinal Profiles

Pebble Counts

Table 8: Baseline Stream Data Summary

Table 9a: Cross-Section Morphology Data

Table 9b: Stream Reach Morphology Data

### Appendix E – Hydrologic Data

Table 10: Verification of Bankfull Events

## 1.0 PROJECT SUMMARY

The Tributaries of Wicker Branch Stream Restoration Project is located in Union County, North Carolina in the Yadkin River Basin, (HUC 03040105081010), and within a North Carolina Department of Environment and Natural Resources (NCDENR) Division of Mitigation Services (DMS) Targeted Local Watershed (TLW). It is also located within the watershed of Lanes Creek, a 303d-listed stream and Water Supply Watershed.

The project site consists of four headwater stream channels that flow through agricultural land and prior to restoration efforts were devoid of riparian vegetation. Past and present agricultural use of the land had severely impacted and degraded the channels. The project goals address stressors identified in the TLW and include the following:

- Improved water quality in Wicker Branch.
- Improve aquatic habitat in the tributary channels.
- Provide aesthetic value, wildlife habitat, and bank stability through the creation of a riparian zone.
- Create a contiguous wildlife corridor, with connection of some isolated adjacent natural habitats to larger downstream forested tracts.
- Provide shading and biomass input to the stream and mast for wildlife when vegetation is mature.

These objectives were achieved through restoring, enhancing, and preserving 4020 feet of perennial and intermittent stream channel. The riparian areas were also planted with native vegetation to improve habitat and protect water quality. The project reaches consist of Tributary 1A (Priority 1 Restoration), Tributary 1B (Enhancement Level II including invasive species control), Tributary 2 (Preservation), Tributary 3 (Enhancement Levels I and II), and Tributary 4 (Enhancement Level II)(See **Table 1** in **Appendix A** and **Figure 2** in **Appendix A**).

Project success will be determined by monitoring channel stability and vegetation within the easement. Success criteria have been outlined in the 2013 Mitigation Plan and include a stable dimension, pattern, and profile documented through the surveying of cross-sections and longitudinal profiles. Vegetation monitoring plots will have a minimum of 260 stems per acre after 5 years.

Project design was completed in December 2013 and the project constructed in September and October 2014. Planting was complete in March 2015 (See **Table 2** in **Appendix A**). Tributary 1A was constructed as designed. Several log sills were not installed on Tributary 3. These primarily were sills that were to be placed on the upper reach between the wetland areas the channel to help maintain stability. This area had developed significant vegetation following the establishment of the Conservation Easement and had already stabilized. Therefore, the log sills were determined to be unnecessary.

In late November shortly after completion of the construction there was a significant bankfull flow event. While the channel held up well during the flow event, there were several locations where scouring occurred on the floodplain of Tributary 1A and 3. Due to the wet spring, repairs were not performed until June. Soil was removed from the adjacent slopes to rebuild the floodplains. The floodplains were regraded to eliminate the low points that allowed for

concentration of flows. Small berms perpendicular to the channel were placed periodically in the floodplain to disrupt flows and direct flows back into the channel. Following the grading activities, the disturbed areas were reseeded with both a temporary and a permanent seed mix, and covered with straw. These areas were shown as Vegetation Problem Areas in the Y1 Monitoring Report. The areas were replanted with woody stems in March 2016 and appear to have stabilized. These areas are no longer considered Vegetation Problem Areas.

A log sill that had been installed at a headcut at the lower end of Tributary 1B was also rebuilt. During the high flow events a scour hole had formed upstream of the sill. The sill was rebuilt and larger stone was placed both in the plunge pool below the sill as well as above the sill. The coir matting was reinstalled and the disturbed areas were reseeded.

Herbaceous vegetation is well established though out the easement. The vegetation monitoring plots show an average density of 442 stems per acre down from baseline planting of 684 stems per acre but still well above the 320 stems per acre at end of year 3 and 260 stems per acre at year 5. Two plots do not meet the vegetation success criteria. Plot 6 is at 202 stems per acre and plot 10 is at 242 stems per acre. A number of volunteer woody stems were observed this year. Volunteer species included persimmon, oaks, sweetgum, pine, willows, elderberry, and red bud.

Chinese privet (*Ligustrum sinense*) is present in the buffer along Tributary 1B. An extensive removal effort occurred during construction in 2014 but stems remain. A second treatment occurred in the spring of 2016 but it was not very effective and it will need to be retreated. These areas will be addressed again more vigorously during spring and summer of 2017.

The stream channels appear to be stable with no areas of bank erosion observed. Flows were observed in all channels during a site visit on March 16, 2016. Tributary 1A and 1B were dry during a site visit on June 22, 2016 (Tributaries 3 and 4 had flow) and all the channels were dry during the monitoring visit on September 14, and 15. Installation of a gauge to measure flows in Tributary 1A was unsuccessful. A trail camera has been installed at the lower end of Tributary 1A on a trial basis to see if it is effective in documenting stream flows.

The adjacent fields were planted in soybeans in 2016. Additional signage was installed in the spring of 2016 to address encroachments along the edges of the field. There is still some encroachment into the easements at the equipment crossings and AECOM will continue to work with the landowner and the current farmer to address these encroachments. The areas of encroachment are shown on **Figure 3 in Appendix B**.

## **2.0 METHODOLOGY**

Vegetation survival, channel stability, and wetland hydrology were monitored on the project site. Post restoration monitoring will occur for a minimum of five years or until success criteria are met.

## **2.1 VEGETATION**

Eleven vegetation plots were established and assess for the baseline vegetation monitoring. The Carolina Vegetative Survey-EEP Protocol Level 2 methodology was used to sample vegetation on October 14 and 15, 2015 (Lee et al. 2006, <http://cvs.bio.unc.edu/methods.htm>).

## **2.2 STREAM ASSESSMENT**

Twelve permanent monitoring cross-sections have been established on the site as follows:

- Tributary 1A (1,390 feet) – 4 riffle and 3 pool cross-sections
- Tributary 3 (640 feet) – 2 riffle and 1 pool cross-sections
- Tributary 4 (631 feet) – 2 riffle cross-sections

Wolman pebble counts were conducted on each cross-section. Particle sizes less than 2.0 millimeters (mm) were determined by touch using the following guidelines:

- Silt – Smooth feeling (not gritty)
- Fine sand – Slightly gritty texture
- Coarse sand – Very gritty texture

Multiple parameters were located including top of bank, thalweg, and water surface. Pool and riffle features were called out to calculate feature slopes and lengths. The survey was performed with a survey grade GPS (Trimble TCS3 with an R8 Model 3 GNSS receiver).

## **2.3 VISUAL ASSESSMENT**

A visual assessment of the stream was performed to assess the bank (lateral stability), bed (vertical stability), the easement boundary, and site vegetation.

## **2.4 DIGITAL PHOTOS**

Digital photos of each of the vegetation plots and each cross-section were also taken as seen in **Appendix B**.

## **3.0 REFERENCES**

Lee, M.T., R.K. Peet, S.D. Roberts, T.R. Wentworth. 2006. *CVS-EEP Protocol for RecordingVegetation Version 4.0*.

## **APPENDIX A – General Figures and Tables**

Figure 1: Vicinity Map

Figure 2: Stream Assets Map


Table 1: Project Components and Mitigation Credits

Table 2: Project Activity and Reporting History

Table 3: Project Contacts

Table 4: Project Baseline Information and Attribute





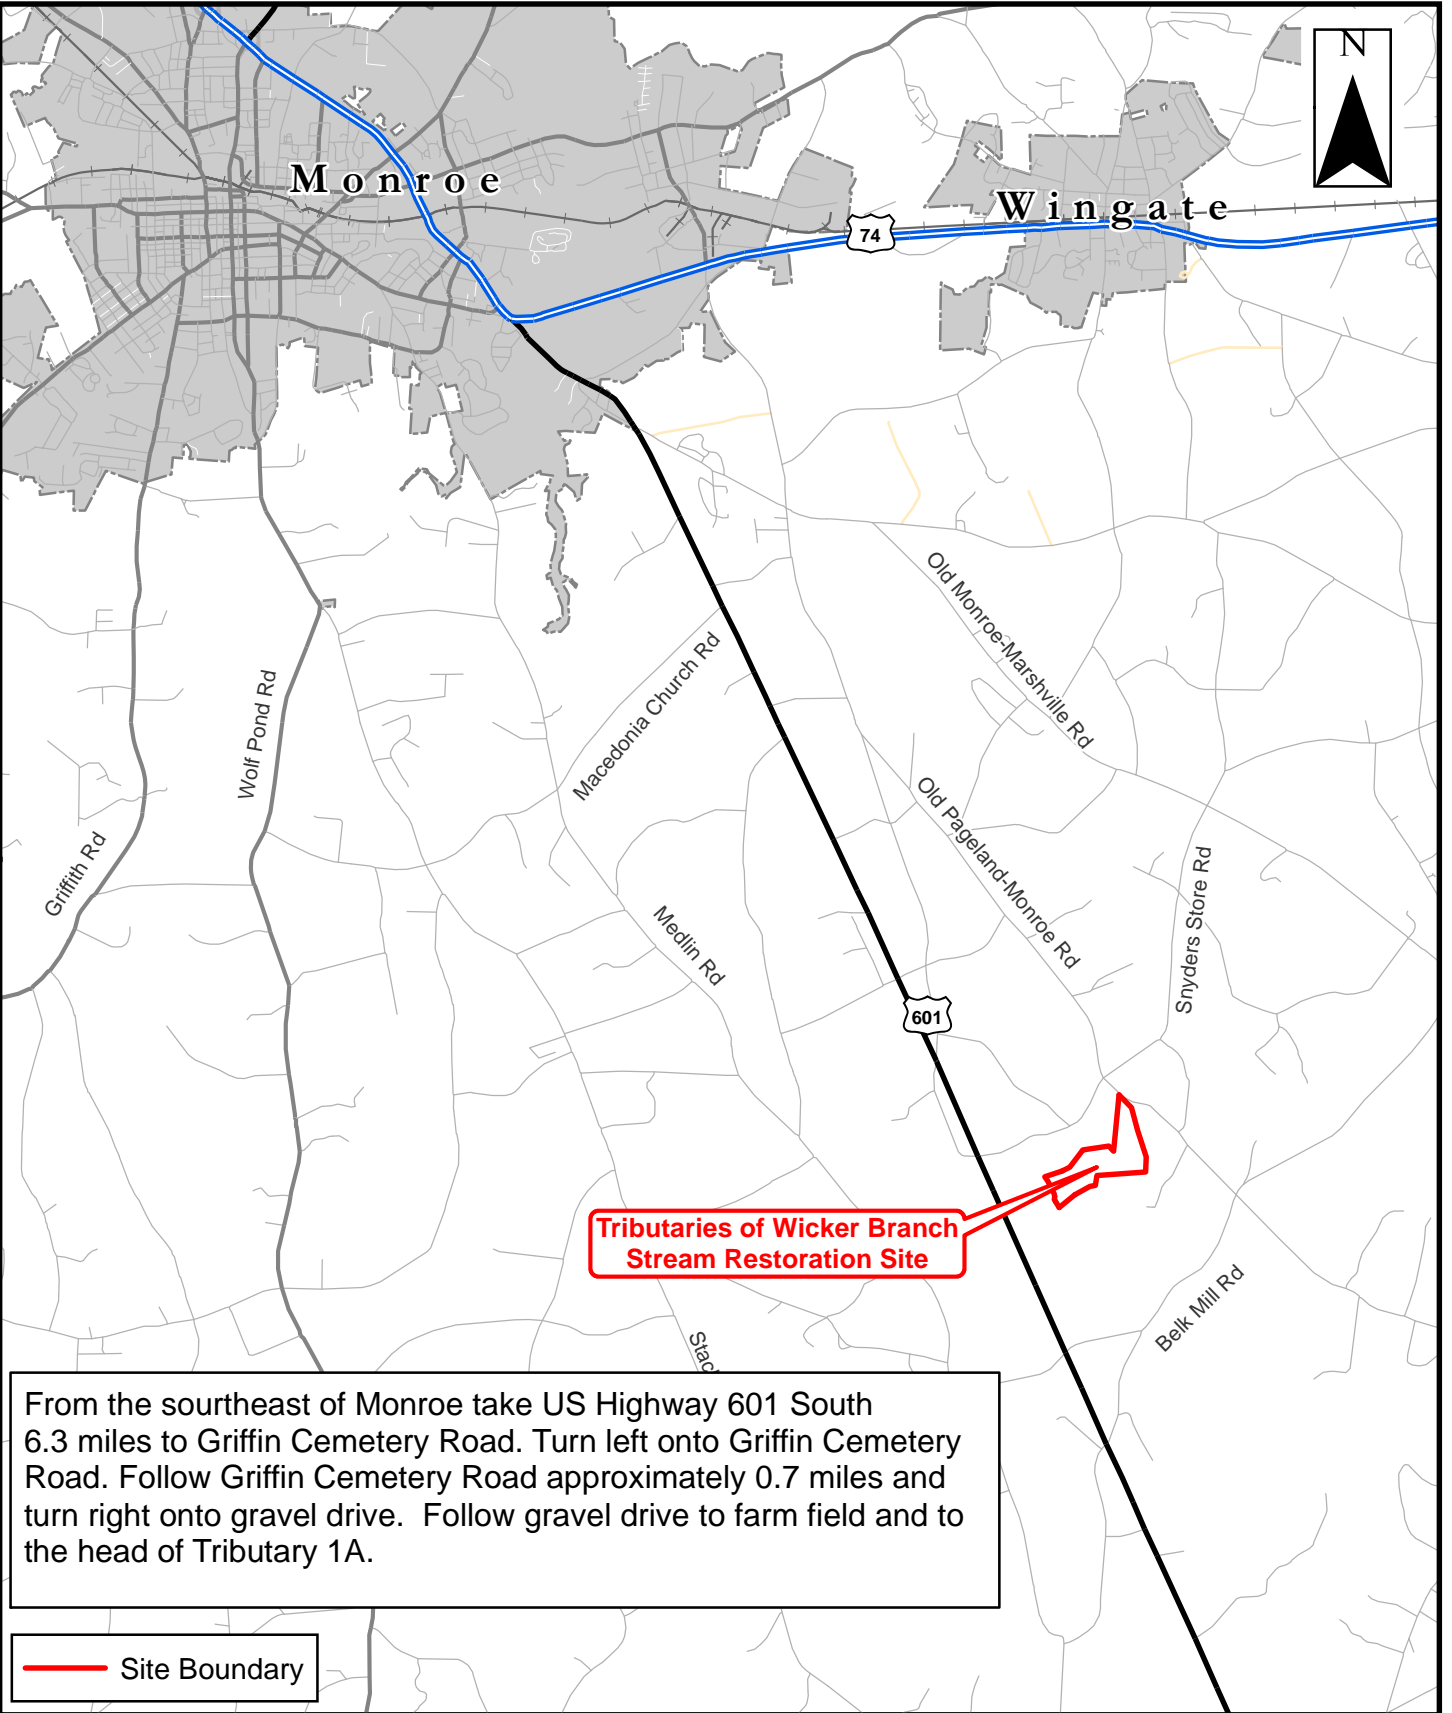


**Tributaries of Wicker Branch  
Stream Restoration Site**




From the southeast of Monroe take US Highway 601 South 6.3 miles to Griffin Cemetery Road. Turn left onto Griffin Cemetery Road. Follow Griffin Cemetery Road approximately 0.7 miles and turn right onto gravel drive. Follow gravel drive to farm field and to the head of Tributary 1A.

— Site Boundary

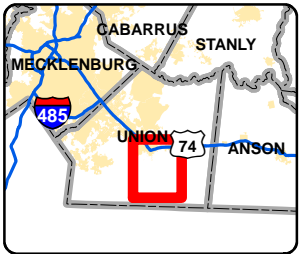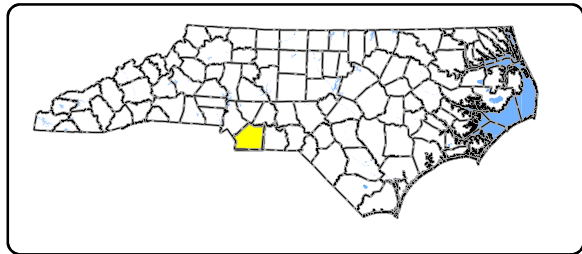


**1. Vicinity Map**  
Tributaries of Wicker Branch  
Stream Restoration Site (DMS No. 95022)  
Union County, NC

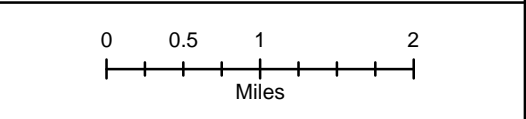

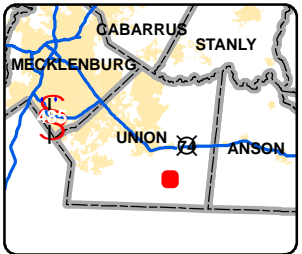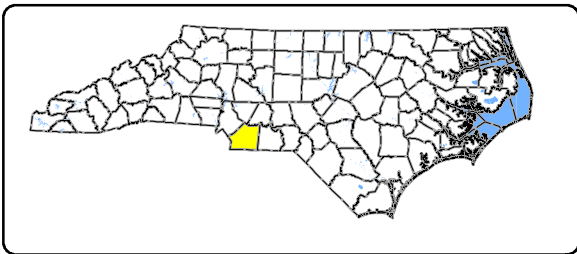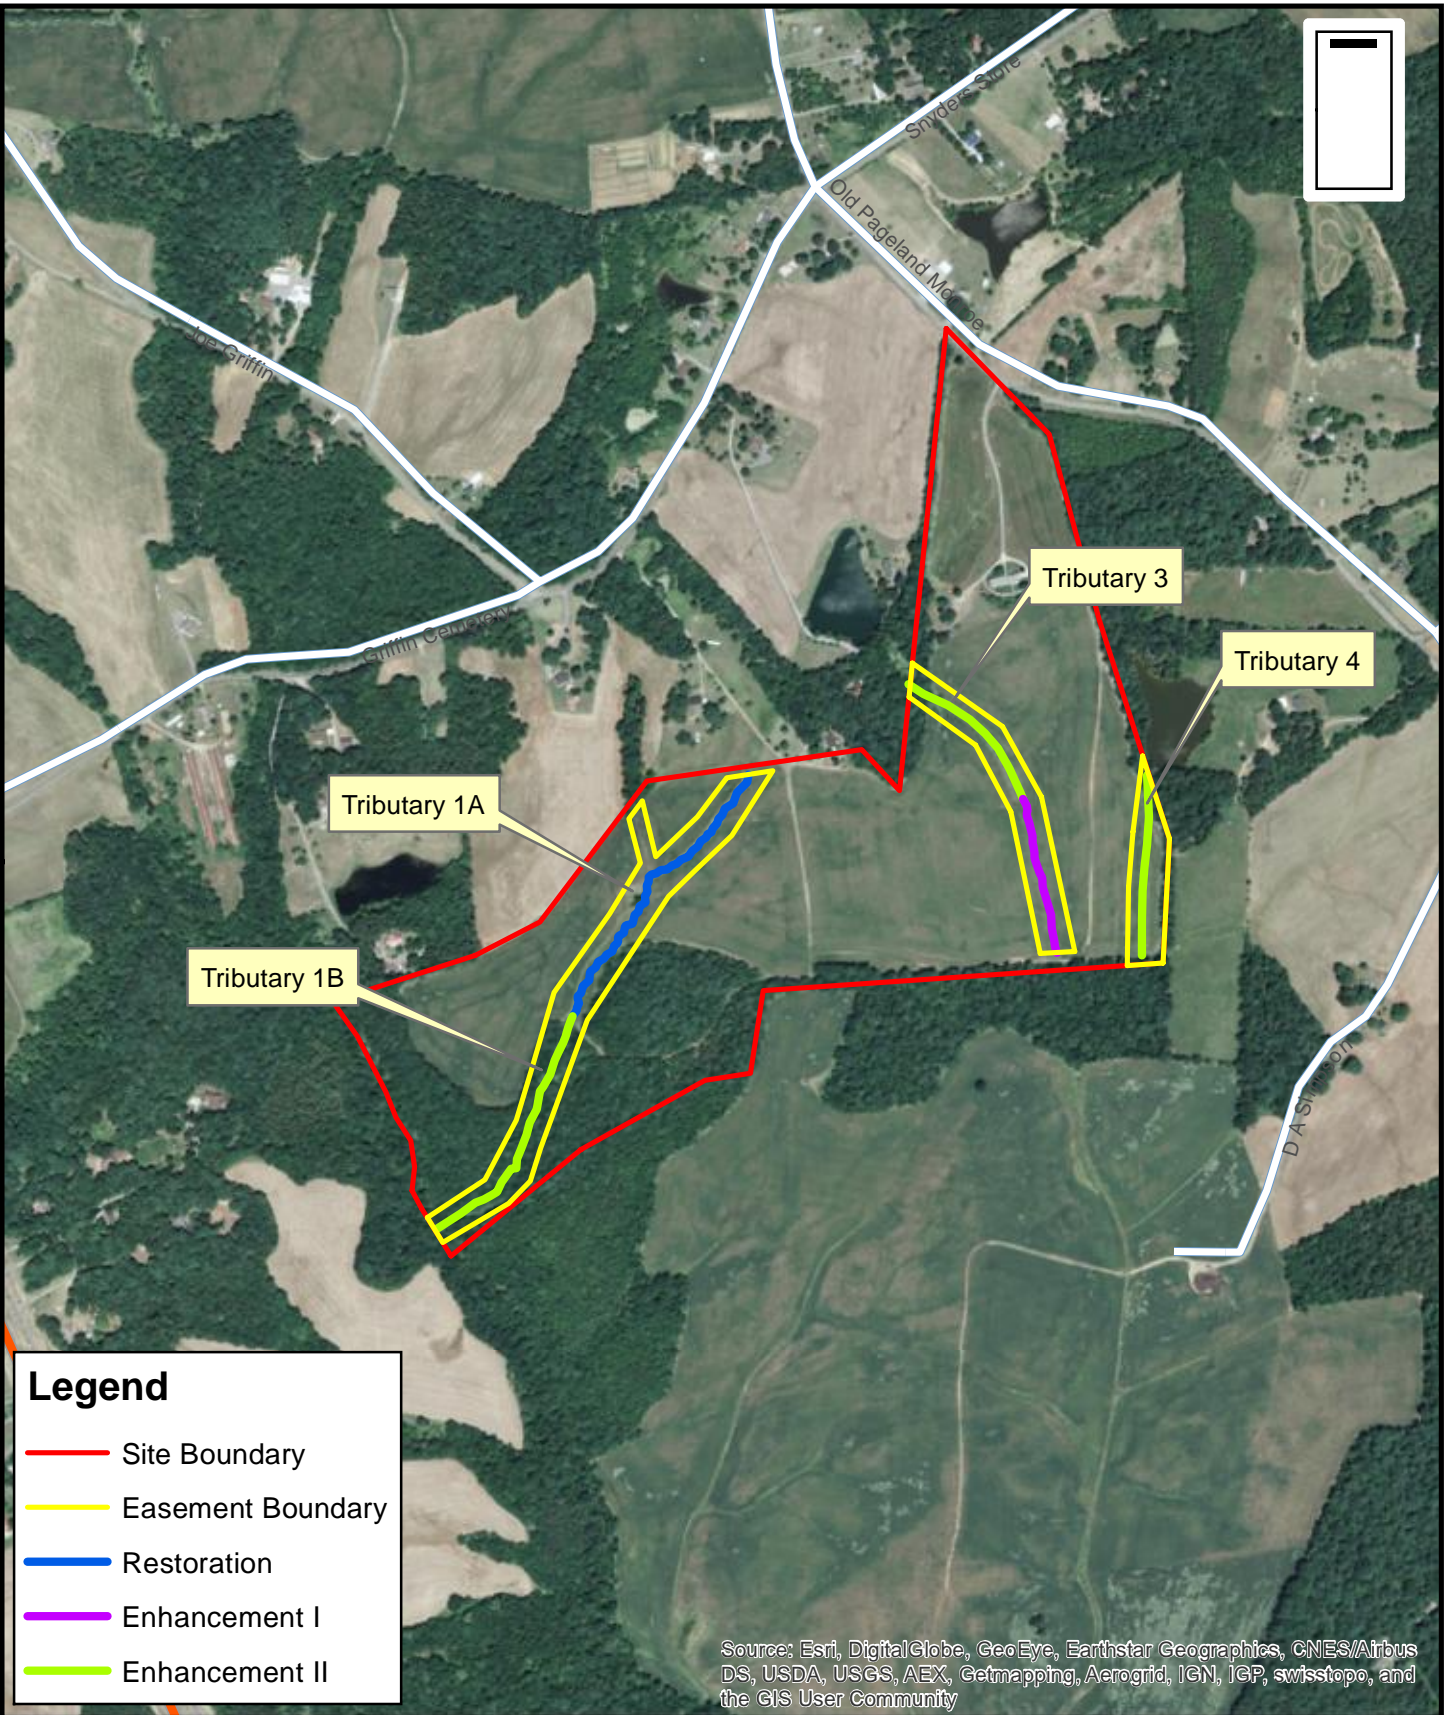

**2. Stream Assets Map**  
 Tributaries of Wicker Branch  
 Stream Restoration Site (DMS No. 95022)  
 Union County, NC

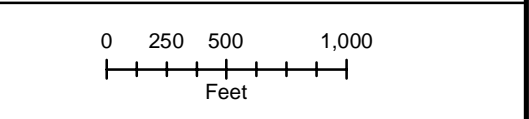



**Table 2. Project Activity and Reporting History  
Tributaries of Wicker Branch Stream Restoration/ DMS No. 95022**

<b>Activity or Report</b>	<b>Data Collection Complete</b>	<b>Completion or Delivery</b>
Restoration Plan	Dec-13	Dec-13
Final Design – Construction Plans	Mar-14	Mar-14
Construction	Nov-14	Nov-14
Permanent seed applied to entire site	Nov-14	Nov-14
Plantings for entire site	Mar-15	Mar-15
Mitigation Plan (Year 0 Monitoring – baseline)	May-15	Jan-16
Year 1 Monitoring	Oct-15	Mar-16
Year 2 Monitoring	Oct-16	Dec-16
Year 3 Monitoring		
Year 4 Monitoring		
Year 5 Monitoring		

**Table 3. Project Contact Table**  
**Tributaries of Wicker Branch Stream Restoration/ DMS No. 95022**

<p><b>Owner</b></p> <p>NCDENR - Division of Mitigation Services</p>	<p>Harry Tsomides  NCDENR - Division of Mitigation Services  5 Ravenscroft Drive, Suite 102  Asheville, NC 28801</p> <p>(828) 545-7057</p>
<p><b>Designer</b></p> <p>AECOM of North Carolina, Inc.</p>	<p>Ron Johnson, Project Manager  701 Corporate Center Drive, Suite 475  Raleigh, NC 27607</p> <p>(919) 854-6210</p>
<p><b>Landowner</b></p> <p>Richard Simpson</p>	<p>3308 Old Pageland Monroe Rd.  Monroe, NC 28112</p> <p>704-506-5184</p>
<p><b>Construction Contractor</b></p>	<p>Riverworks  6105 Chapel Hill Road  Raleigh, NC 27607</p>
<p><b>Planting Contractor</b></p>	<p>Efird's Landscaping  42759 Greenview Drive  Albemarle, NC 38001</p> <p>(704) 985-6559</p>
<p><b>Seeding Contractor</b></p>	<p>Riverworks</p>
<p><b>Monitoring Performer</b></p> <p>AECOM of North Carolina, Inc.</p>	<p>701 Corporate Center Drive, Suite 475  Raleigh, NC 27607</p> <p>919-760-4000</p>

**Table 4. Project Baseline Information and Attributes  
Tributaries of Wicker Branch Stream Restoration/ DMS No. 95022**

<b>Project Information</b>					
Project Name	Tributaries of Wicker Branch				
Project County	Union				
Project Area (acres)	15.49				
Project Coordinates (lat/long)	34.8946849, -80.4472082				
<b>Project Watershed Summary</b>					
Physiographic Province	Carolina Slate Belt - Piedmont				
Project River Basin	Yadkin-Pee Dee				
USGS HUC for Project	3040105081010				
NCDWQ Sub-basin for Project	3/7/2014				
Project Drainage Area (acres)	173				
Project Drainage Area Percentage of Impervious Area	2% to 3%				
CGIA Land Use Classification	Cultivated/Managed Herbaceous Cover				
<b>Reach Summary Information (Pre-restoration)</b>					
Parameters	Trib 1A	Trib 1B	Trib 2	Trib 3	Trib 4
Length of Reach (feet)	1293	1095	330	1184	631
Valley Classification	Type II	Type II	Type II	Type II	Type II
Drainage area (acres)	71.5	94.5	17.6	32.7	29.8
NCDWQ Stream ID Score	38.5	38.5	27	43	31.5
NCDWQ Water Quality Classification	WS-V	WS-V	WS-V	WS-V	WS-V
Morphological Description	B4c, G4c, F4	C4/F4	N/A	F/B6c/F6	N/A*
Evolutionary Trend	G→F→C	N/A	N/A	G→F→C	N/A
Underlying Mapped Soils	Cid channery silt loam	Chewacla silt loam	Cid channery silt loam, Badin channery silt loam	Cid channery silt loam	Cid channery silt loam, Goldston-Badin complex
Drainage Class	Moderately well drained/ somewhat poorly drained	Somewhat poorly drained	Moderately well drained/ somewhat poorly drained, well drained	Moderately well drained/ somewhat poorly drained	Somewhat poorly drained to excessively drained
Soil Hydric Status	No	Yes	No	No	No
Slope	1.30%	1.00%	1.70%	1.40%	1.00%
FEMA Classification	Zone X	Zone X	Zone X	Zone X	Zone X
Native Vegetation	None	Mesic Mixed Hardwoods	None	None	None
Percent Composition of Exotic Invasive Vegetation	0	50 % Understory	0	0	0
<b>Regulatory Considerations</b>					
Regulation	Applicable				Resolved
Waters of the US – Section 404	Yes				Yes
Waters of the US – Section 401	Yes				Yes
Endangered Species Act	Yes				Yes
Historic Preservation Act	No				N/A
CZMA/CAMA	No				N/A
FEMA Floodplain Compliance	No				N/A
Essential Fisheries Habitat	No				N/A

## **APPENDIX B – VISUAL ASSESSMENT DATA**


Figure 3: Current Condition Plan View

Table 5: Visual Stream Morphology Stability Assessment

Table 6: Vegetation Condition Assessment

Photos: Stream Stations

Photos: Vegetation Plots

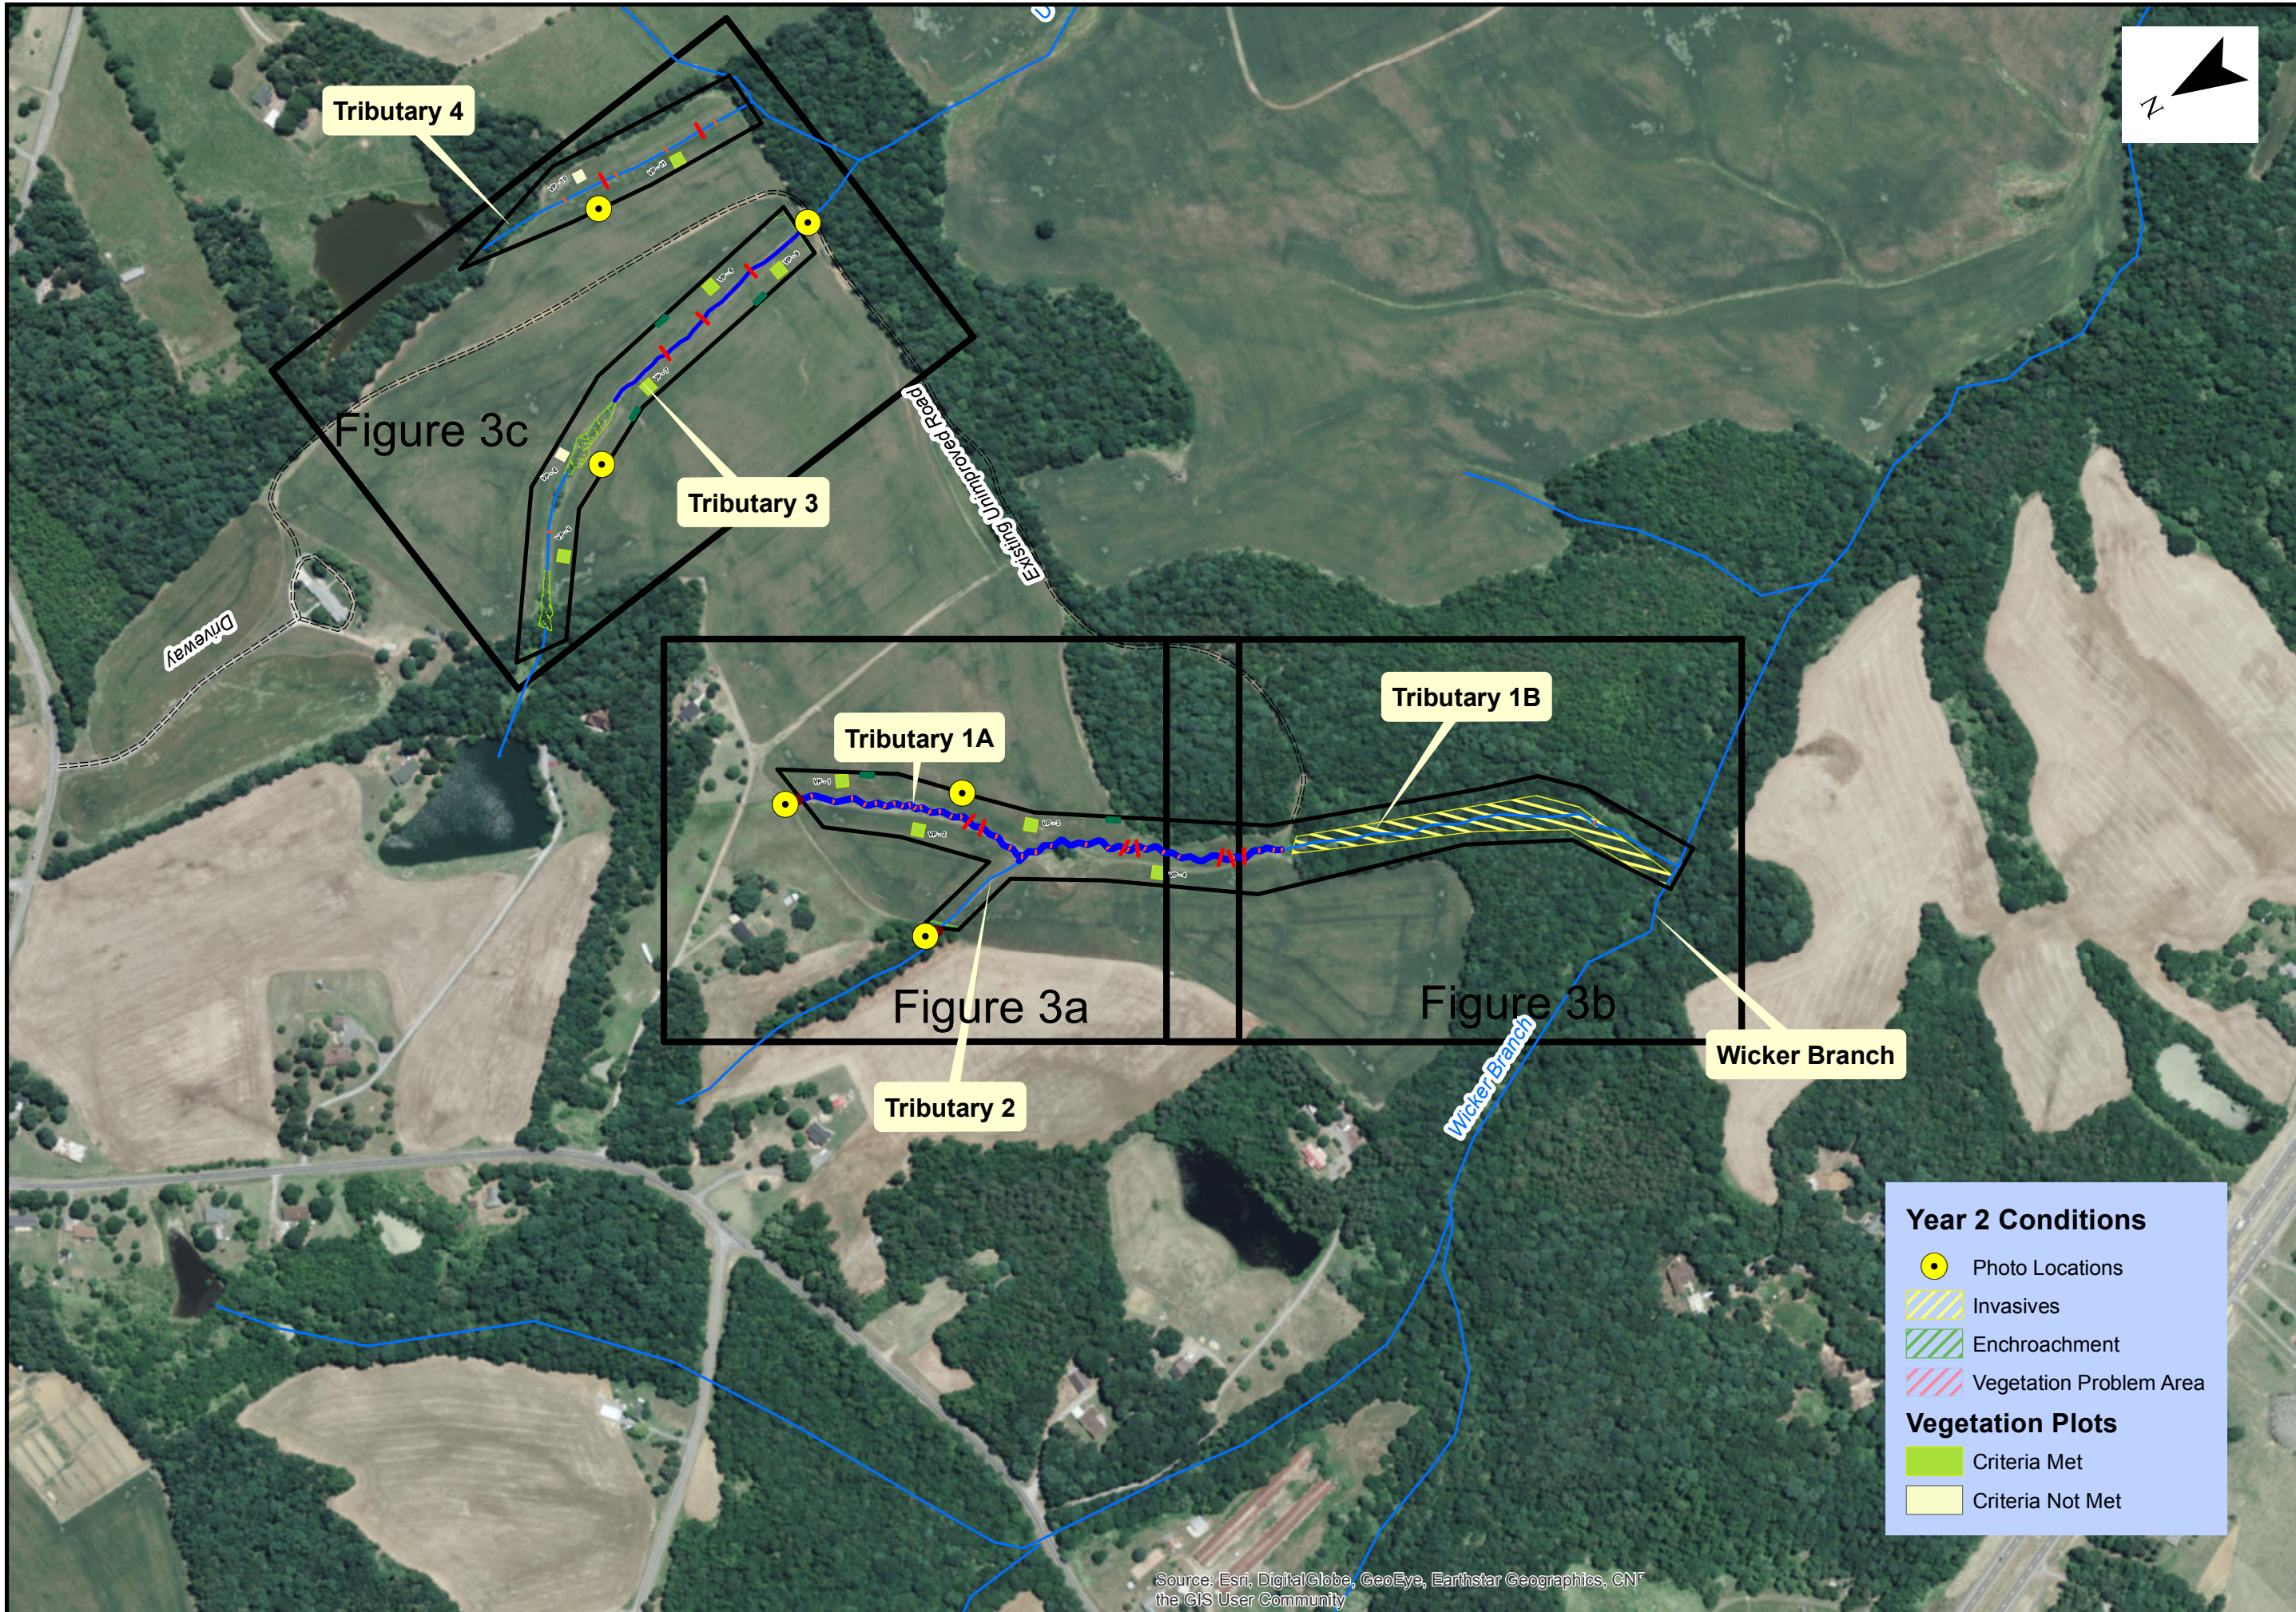

**Year 2 Conditions**

- Photo Locations
- Invasives
- Encroachment
- Vegetation Problem Area

**Vegetation Plots**

- Criteria Met
- Criteria Not Met

**Legend**

- Cross Sections
- Equipment Crossing
- Log Sill
- Level Spreader
- Stream
- Existing Wetlands
- Easement Boundary



0 50 100  
Scale in Feet

**Existing Condition Plan View**  
 Tributaries of Wicker Branch Stream Restoration  
 Union County, NC  
 DMS Project No. 95022

**FIGURE 3**


Source: Esri, DigitalGlobe, GeoEye, Earthstar Geographics, CNF the GIS User Community



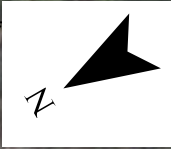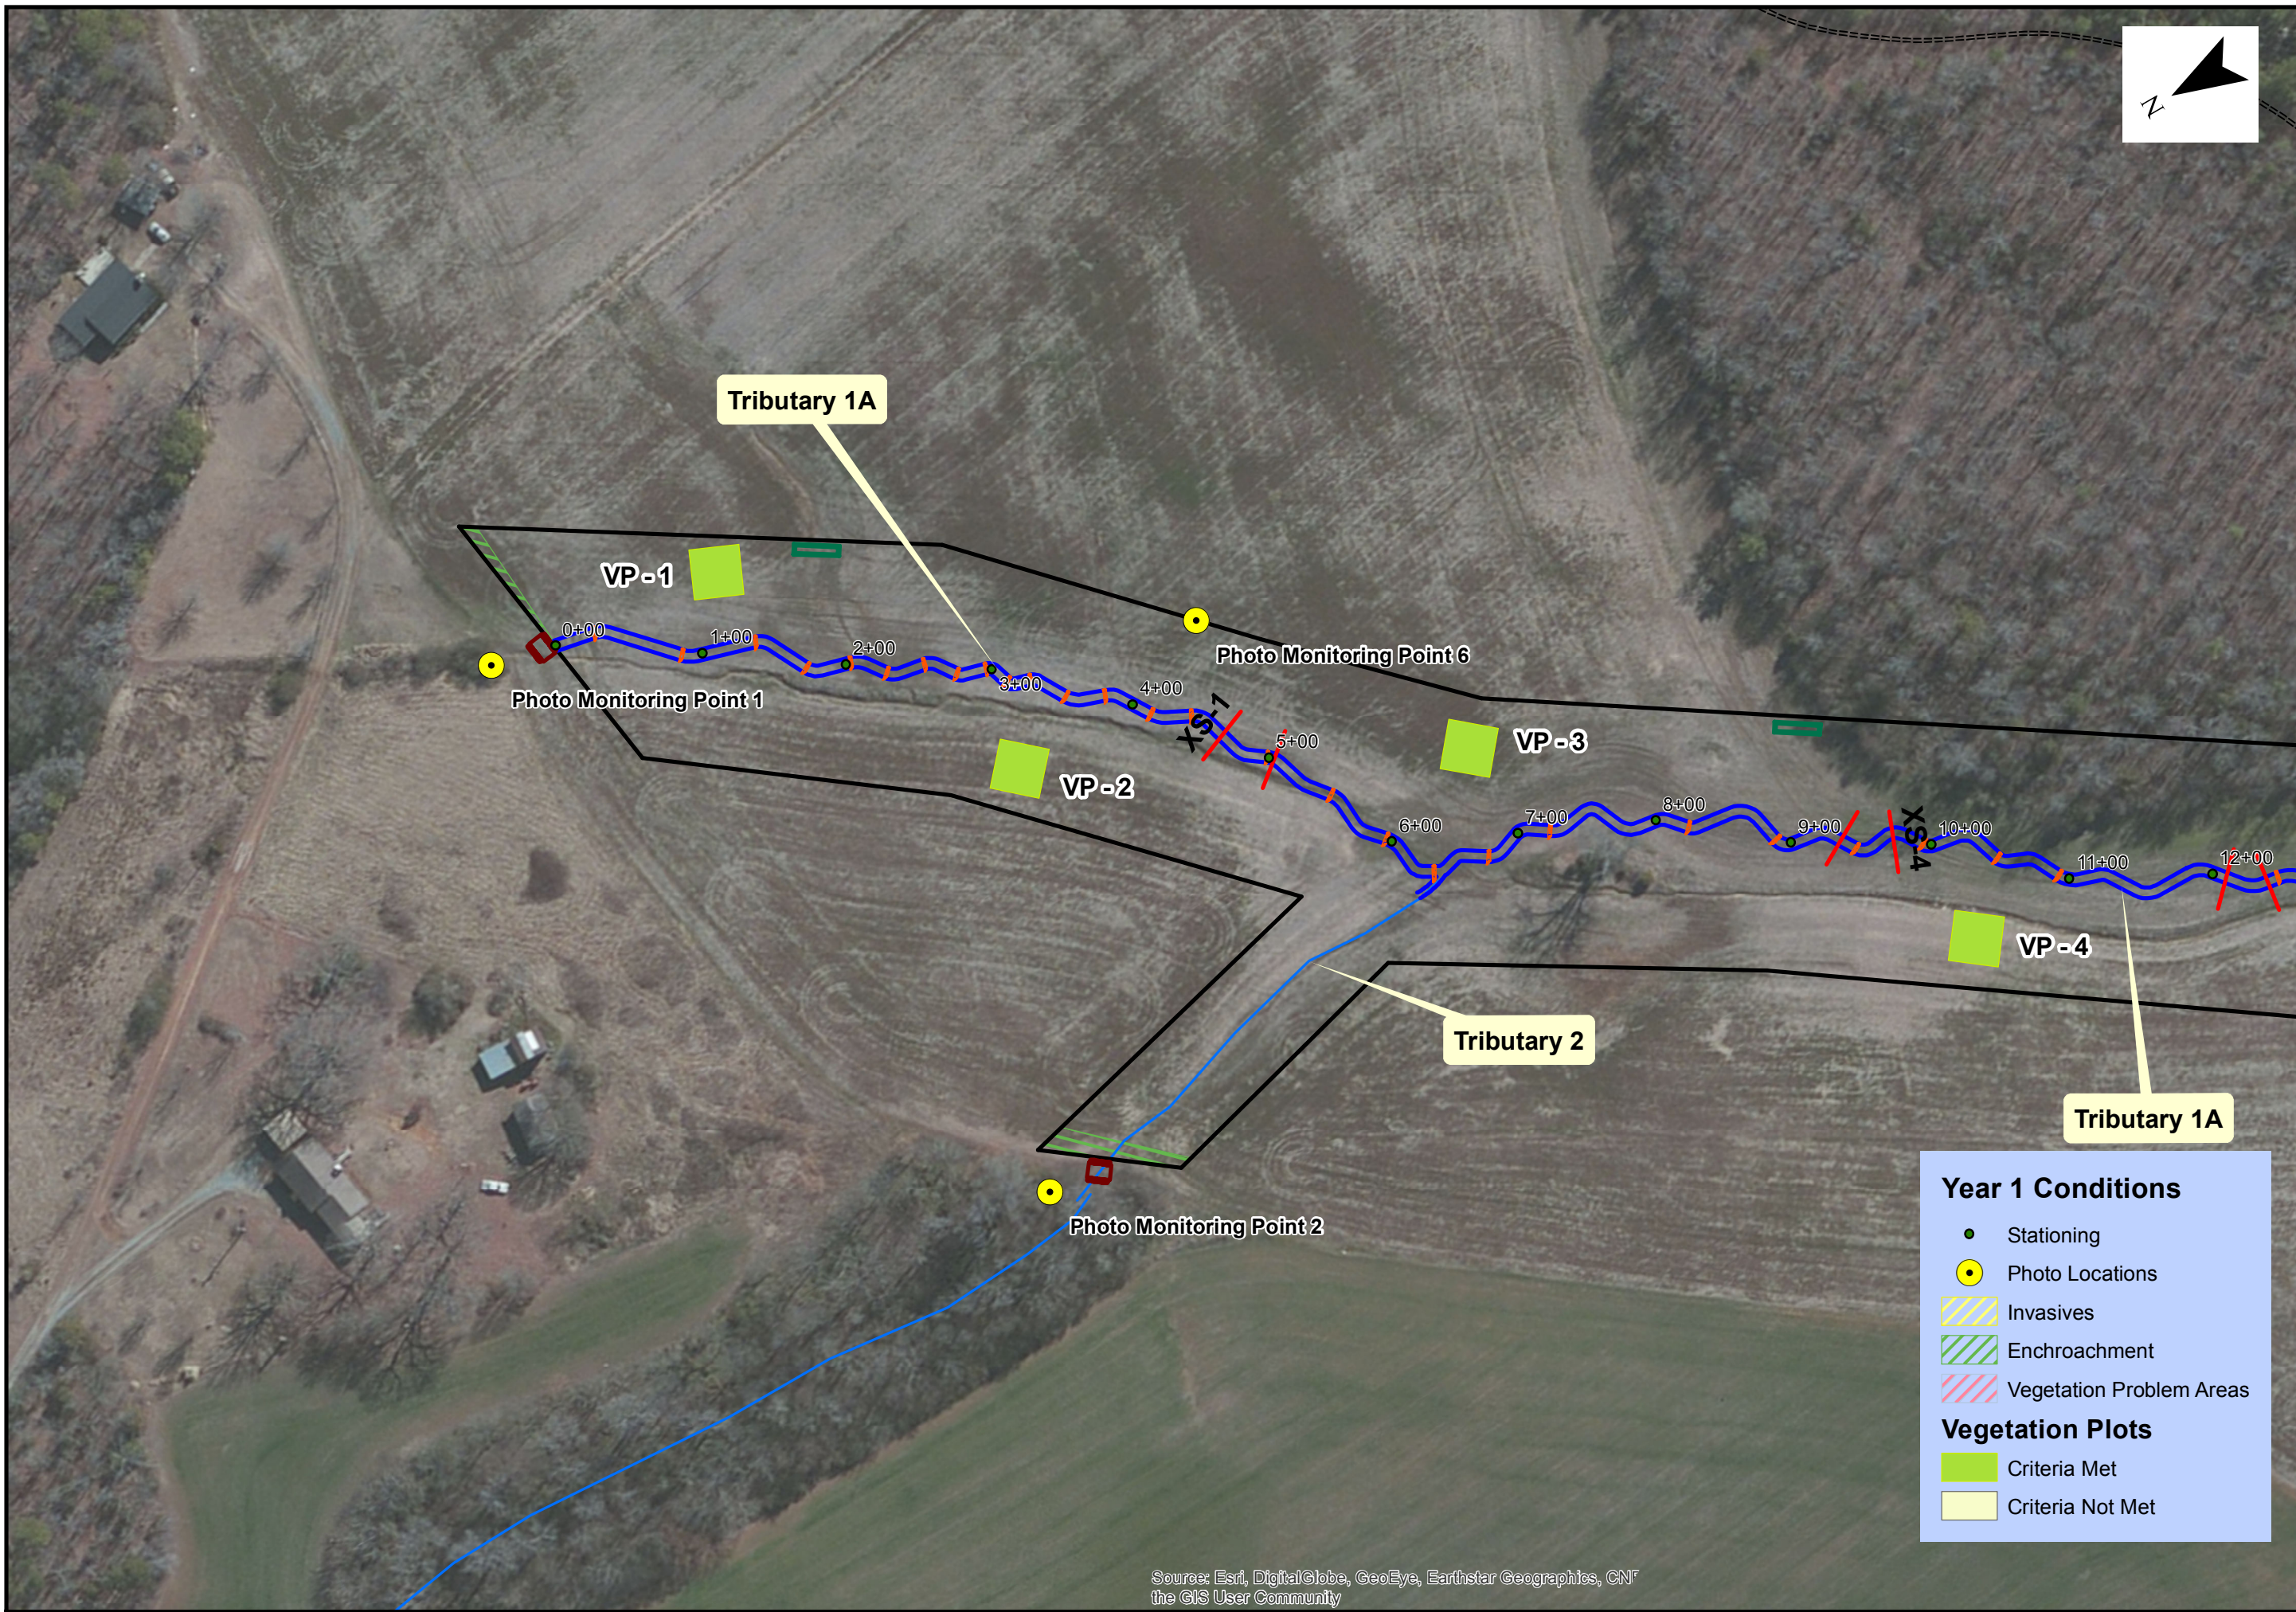

**Legend**

- Cross Sections
- Equipment Crossing
- Log Sill
- Level Spreader
- Stream
- Easement Boundary
- Existing Wetlands
- Culvert
- Unimproved Road

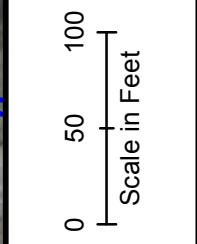

**Year 1 Conditions**

- Stationing
- Photo Locations
- Invasives
- Enchroachment
- Vegetation Problem Areas



**Vegetation Plots**

- Criteria Met
- Criteria Not Met

**Existing Condition Plan View**  
 Tributaries of Wicker Branch Stream Restoration  
 Union County, NC  
 DMS Project No. 95022

**FIGURE 3a**

Source: Esri, DigitalGlobe, GeoEye, Earthstar Geographics, CNR the GIS User Community

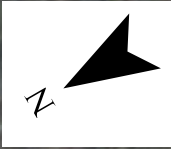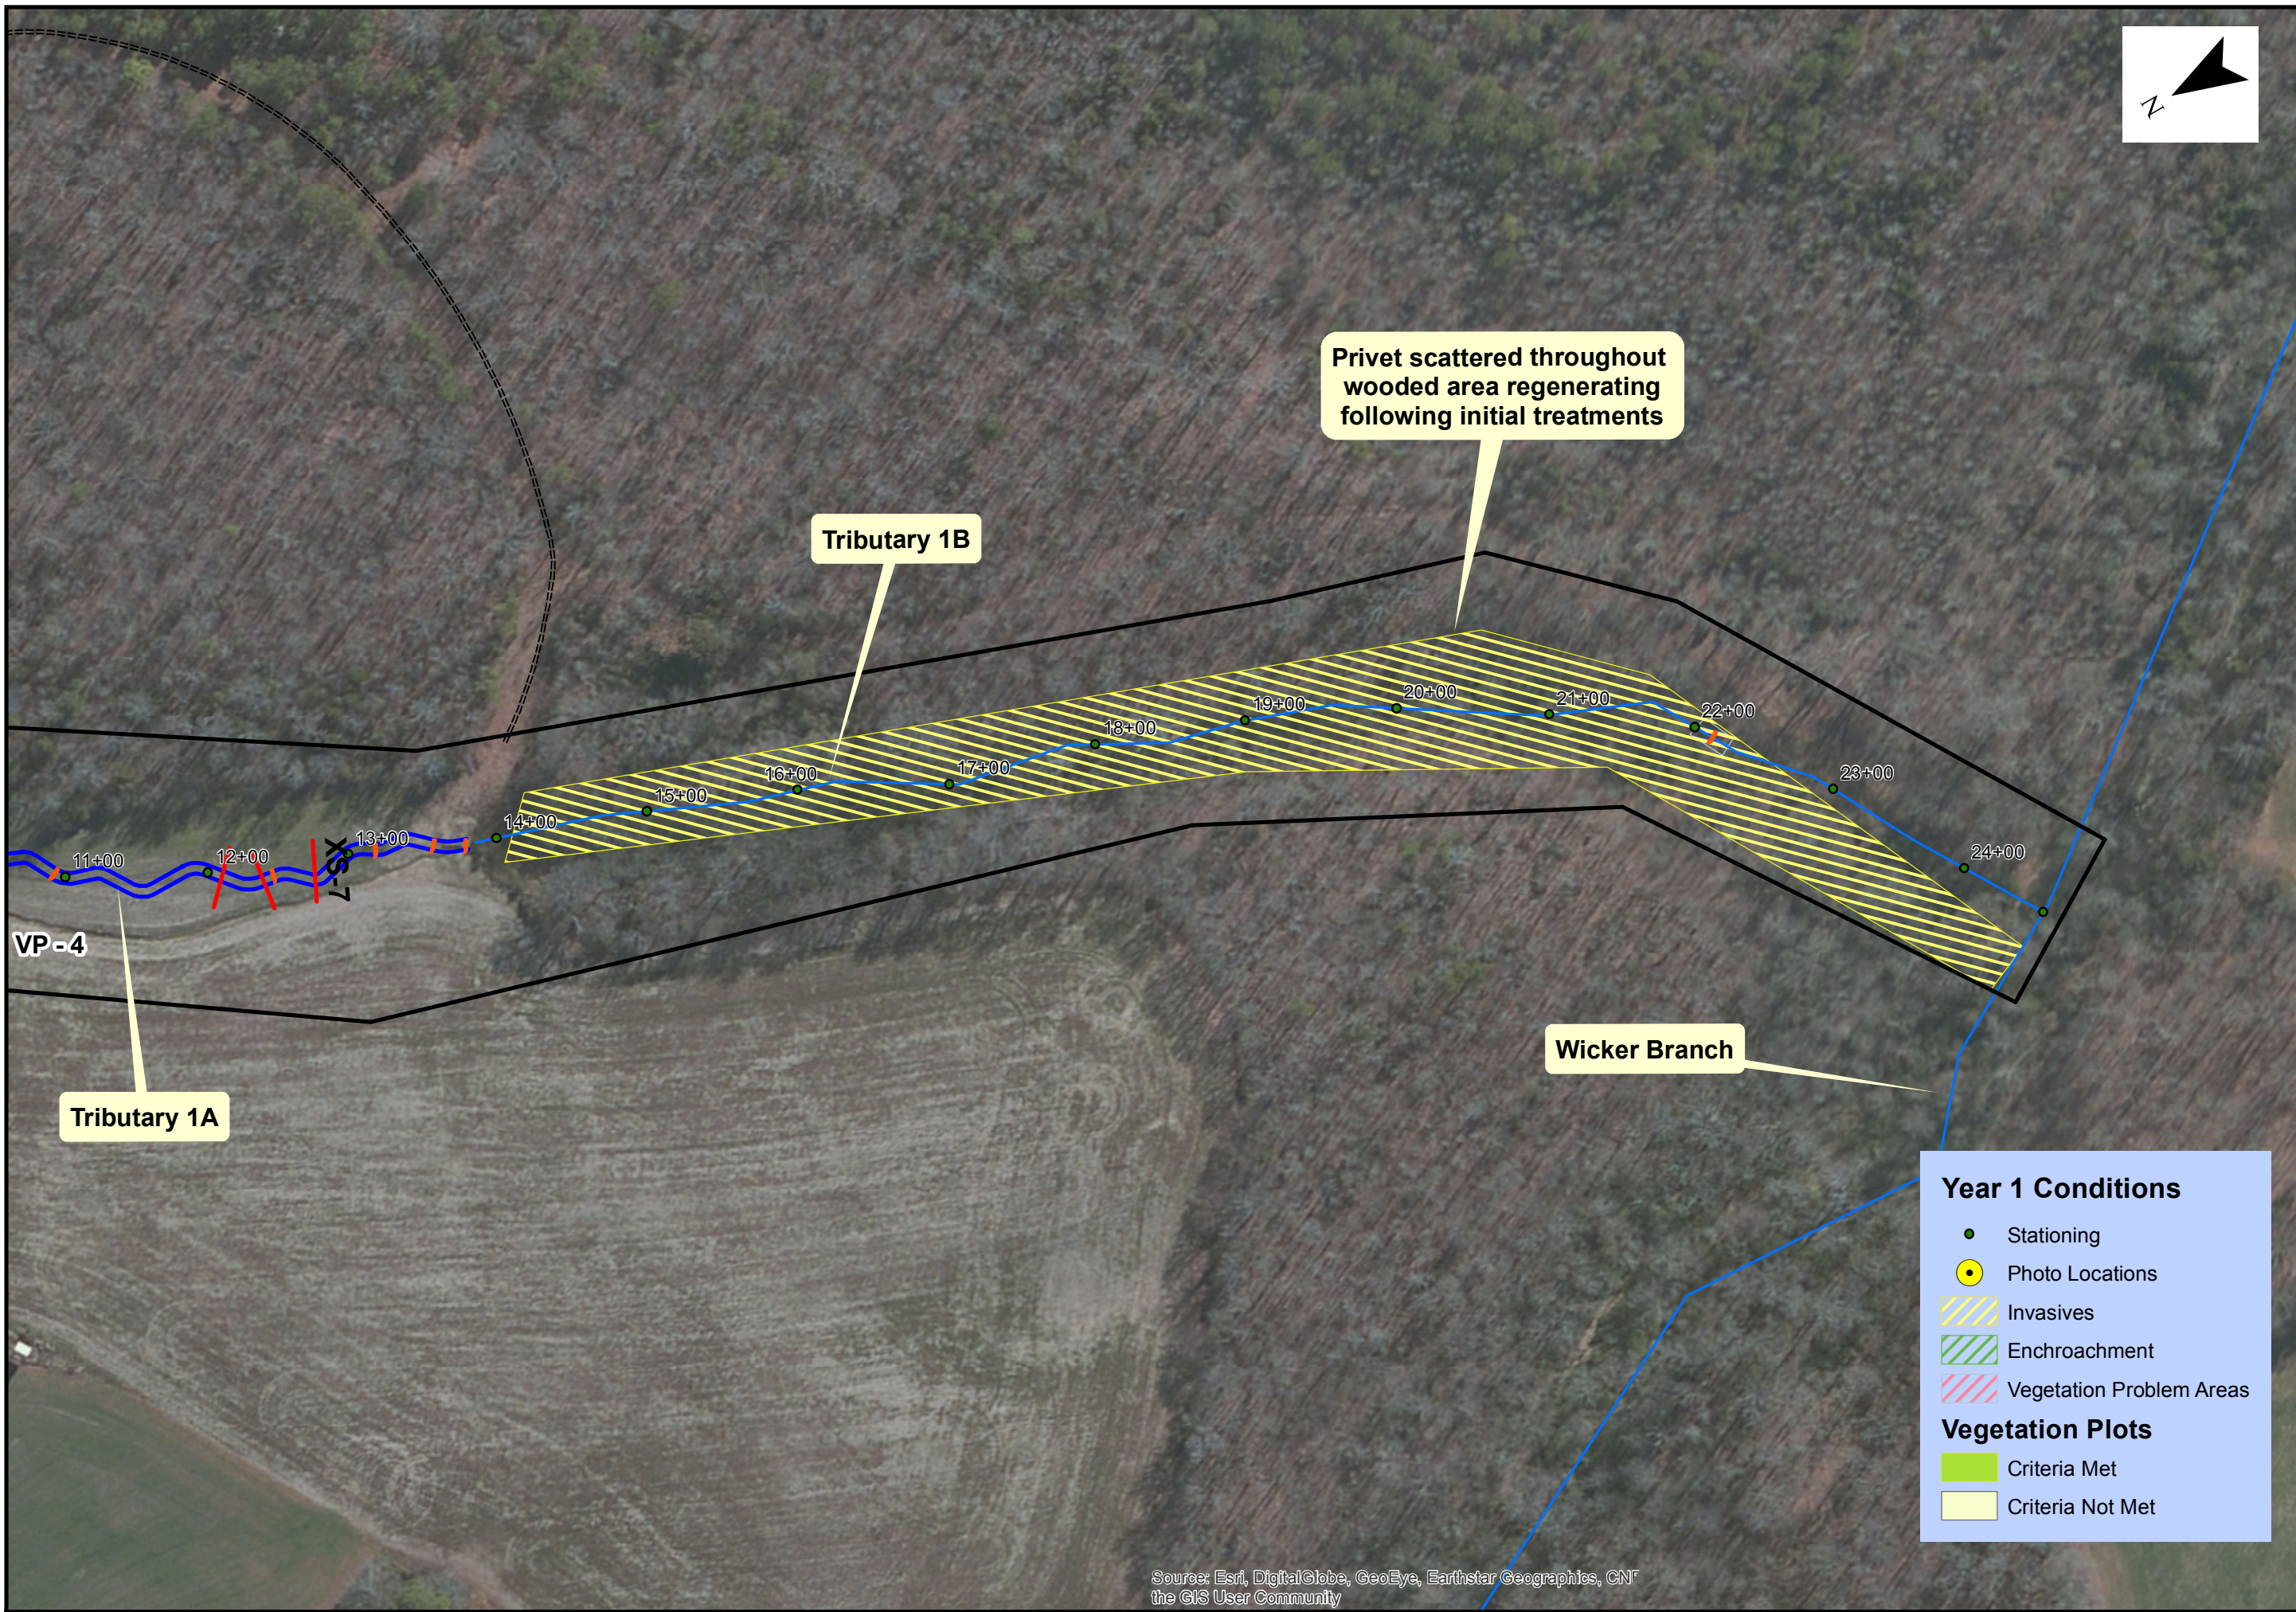

Privet scattered throughout wooded area regenerating following initial treatments

Tributary 1B

Wicker Branch

Tributary 1A

VP-4

XS-7

**Year 1 Conditions**

- Stationing
- Photo Locations
- ▨ Invasives
- ▨ Enchroachment
- ▨ Vegetation Problem Areas

**Vegetation Plots**

- Criteria Met
- Criteria Not Met

**Legend**


- Cross Sections
- Equipment Crossing
- Log Sill
- Level Spreader
- Stream
- Easement Boundary
- ▨ Existing Wetlands
- Culvert
- Unimproved Road

0 50 100  
Scale in Feet

**Existing Condition Plan View**  
 Tributaries of Wicker Branch Stream Restoration  
 Union County, NC  
 DMS Project No. 95022

**FIGURE 3b**

Source: Esri, DigitalGlobe, GeoEye, Earthstar Geographics, CNR the GIS User Community

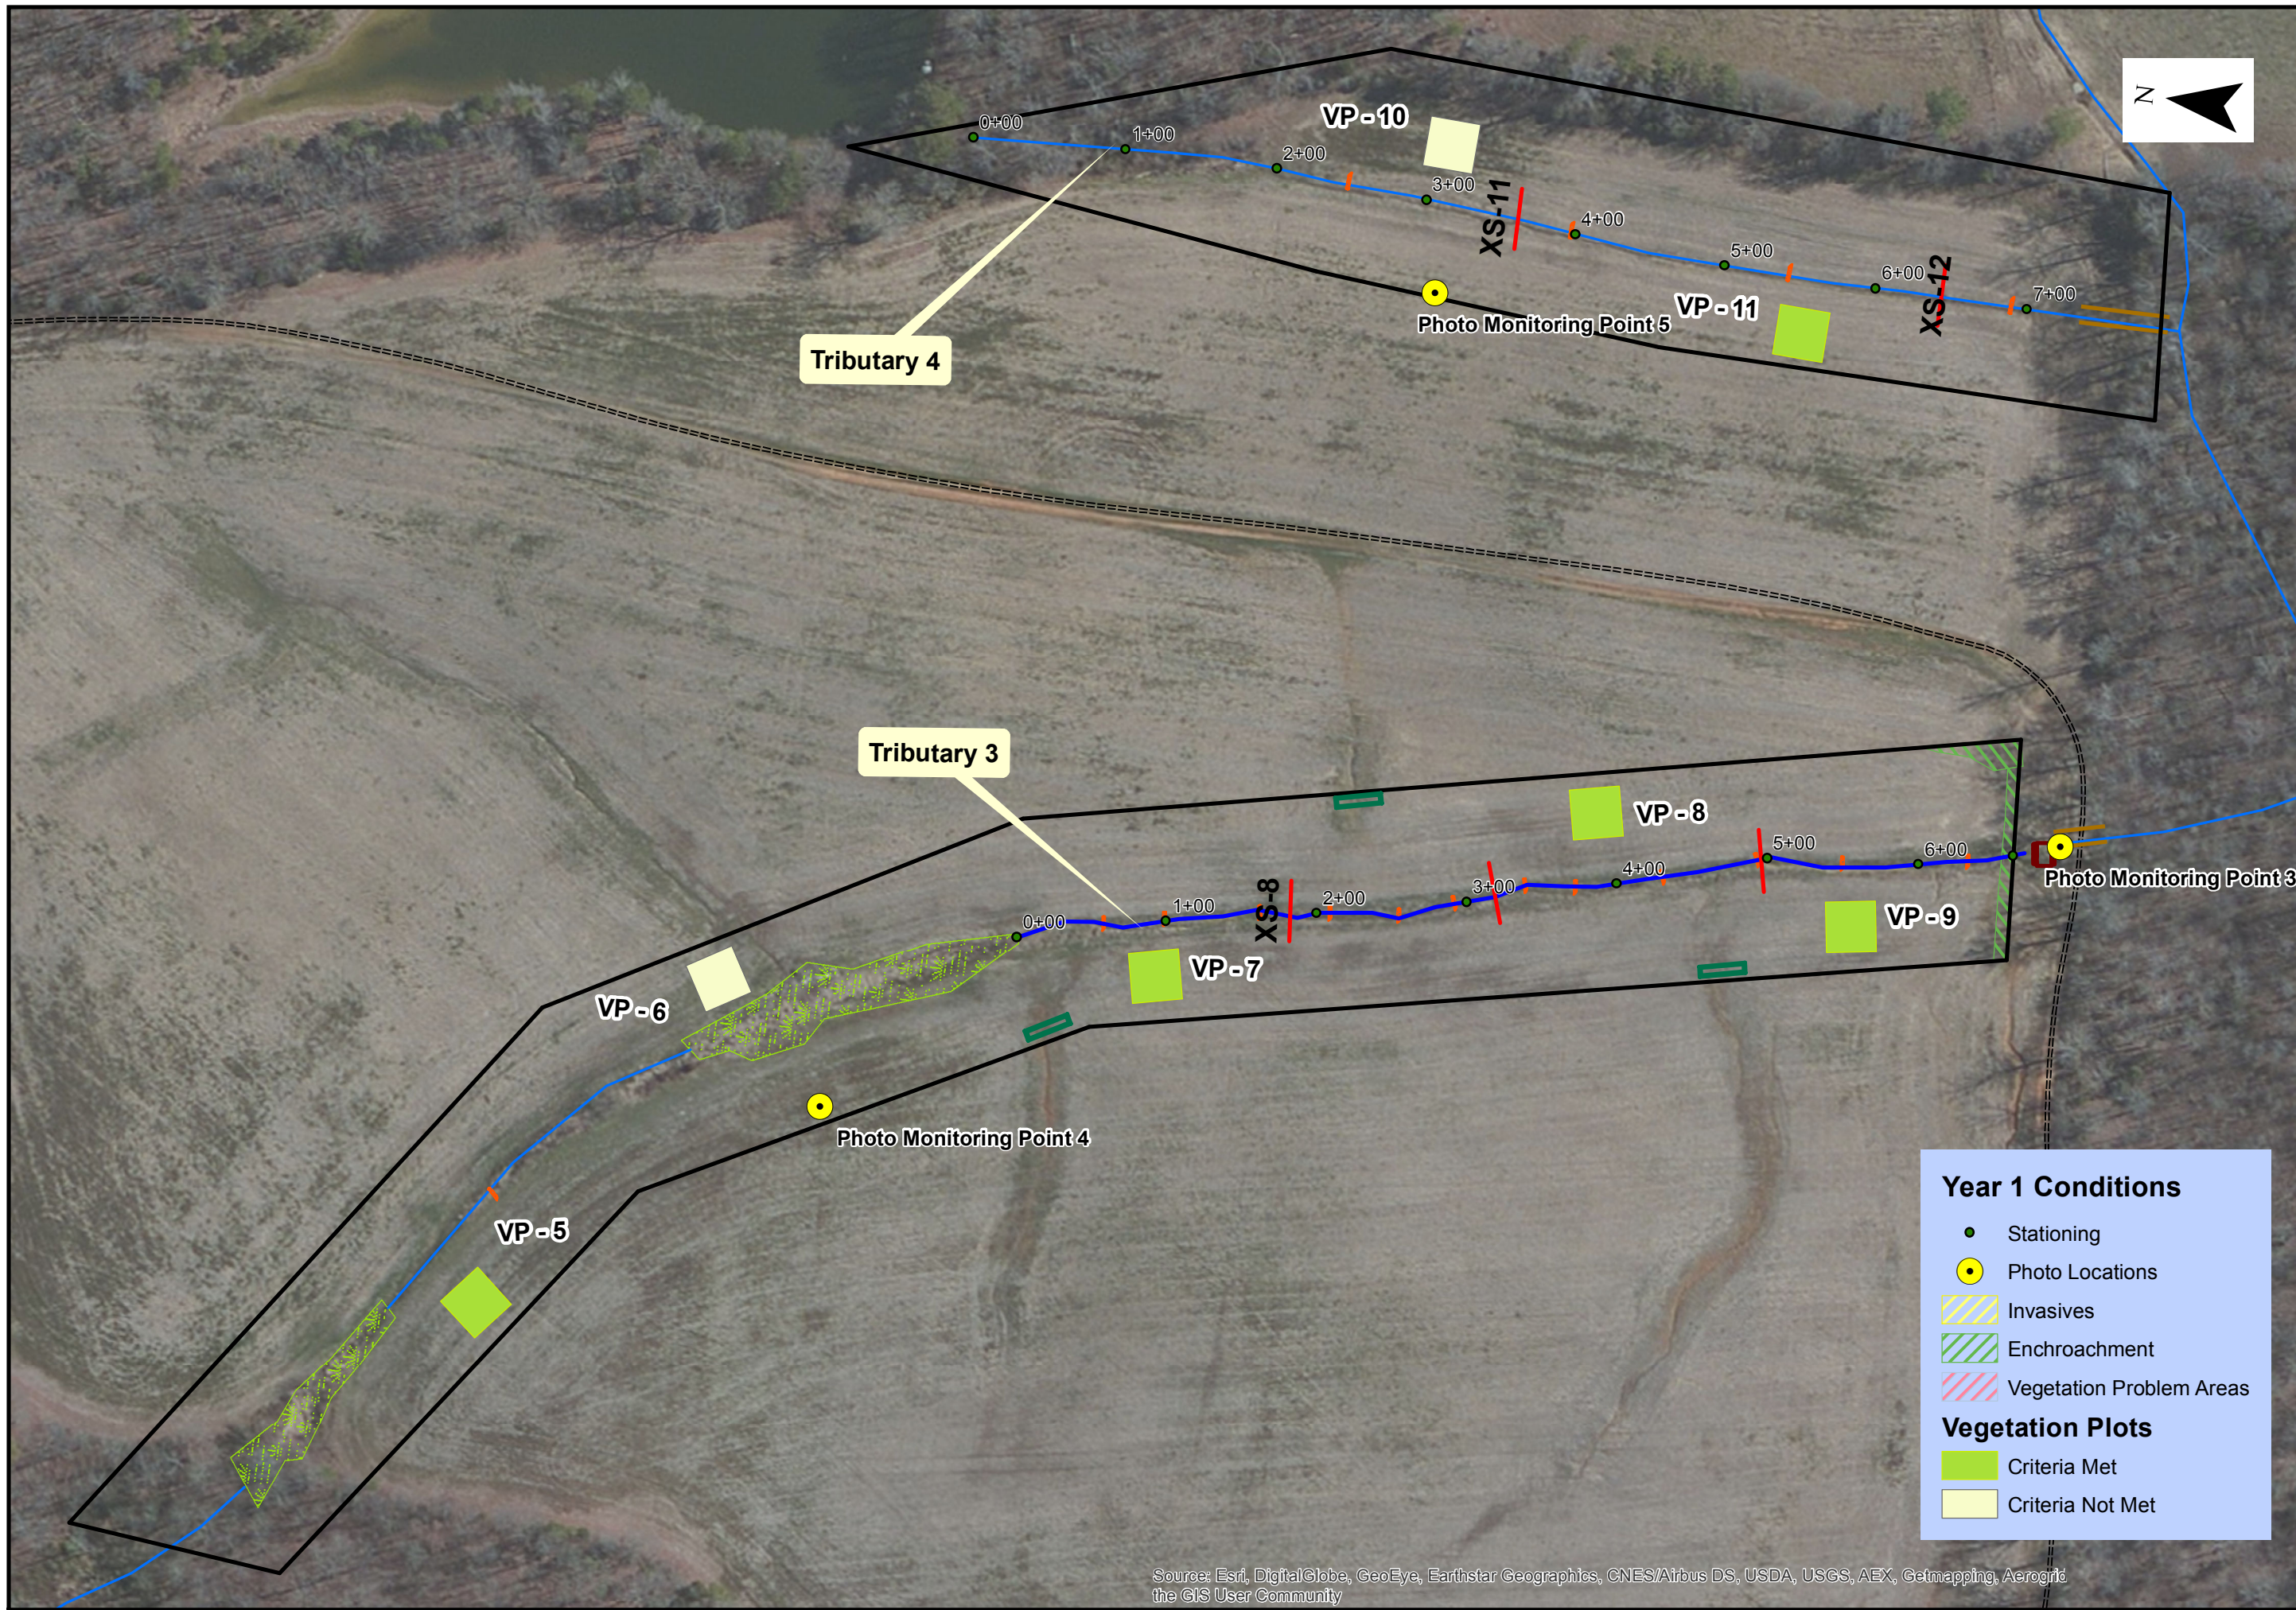

- Legend**
- Cross Sections
  - Equipment Crossing
  - Log Sill
  - Level Spreader
  - Stream
  - Easement Boundary
  - Existing Wetlands
  - Culvert
  - Unimproved Road



**Year 1 Conditions**

- Stationing
- Photo Locations
- Invasives
- Encroachment
- Vegetation Problem Areas

**Vegetation Plots**

- Criteria Met
- Criteria Not Met

**Existing Condition Plan View**  
 Tributaries of Wicker Branch Stream Restoration  
 Union County, NC  
 DMS Project No. 95022

Source: Esri, DigitalGlobe, GeoEye, Earthstar Geographics, CNES/Airbus DS, USDA, USGS, AEX, Getmapping, Aerogrid, the GIS User Community

**Table 5. Visual Stream Morphology Stability Assessment  
Tributaries of Wicker Branch Stream Restoration/ DMS No. 95022**

Reach ID		Tributary 1								
Assessed Length		2485								
Major Channel Category	Channel Sub-Category	Metric	Number Stable, Performing as Intended	Total Number in As-built	Number of Unstable Segments	Amount of Unstable Footage	% Stable, Performing as Intended	Number with Stabilizing Woody Vegetation	Footage with Stabilizing Woody Vegetation	Adjusted % for Stabilizing Woody Vegetation
1. Bed	1. Vertical Stability (Riffle and Run units)	1. <u>Aggradation</u> - Bar formation/growth sufficient to significantly deflect flow laterally (not to include point bars)			1	10	100%			
		2. <u>Degradation</u> - Evidence of downcutting			0	0	100%			
	2. Riffle Condition	1. <u>Texture/Substrate</u> - Riffle maintains coarser substrate	49	50			98%			
	3. Meander Pool Condition	1. <u>Depth</u> Sufficient (Max Pool Depth : Mean Bankfull Depth $\geq$ 1.6)	49	49			100%			
		2. <u>Length</u> appropriate (>30% of centerline distance between tail of upstream riffle and head of downstream riffle)	49	49			100%			
	4. Thalweg Position	1. Thalweg centering at upstream of meander bend (Run)	50	50			100%			
2. Thalweg centering at downstream of meander (Glide)		50	50			100%				
<b>Totals</b>										
2. Bank	1. Scoured/Eroding	Bank lacking vegetative cover resulting simply from poor growth and/or scour and erosion			0	0	100%	0	0	100%
	2. Undercut	Banks undercut/overhanging to the extent that mass wasting appears likely. Does <u>NOT</u> include undercuts that are modest, appear sustainable and are providing habitat.			0	0	100%	0	0	100%
	3. Mass Wasting	Bank slumping, calving, or collapse			0	0	100%	0	0	100%
<b>Totals</b>										
3. Engineered Structures	1. Overall Integrity	Structures physically intact with no dislodged boulders or logs.	32	33			97%			
	2. Grade Control	Grade control structures exhibiting maintenance of grade across the sill.	33	33			100%			
	2a. Piping	Structures lacking any substantial flow underneath sills or arms.	33	33			100%			
	3. Bank Protection	Bank erosion within the structures extent of influence does <u>not</u> exceed 15%. (See guidance for this table in EEP monitoring guidance document)	33	33			100%			
	4. Habitat	Pool forming structures maintaining - Max Pool Depth : Mean Bankfull Depth ratio $\geq$ 1.6 Rootwads/logs providing some cover at base-flow.	33	33			100%			

**Table 5. Visual Stream Morphology Stability Assessment  
Tributaries of Wicker Branch Stream Restoration/ DMS No. 95022**

Reach ID		Tributary 3										
Assessed Length		904										
Major Channel Category	Channel Sub-Category	Metric	Number Stable, Performing as Intended	Total Number in As-built	Number of Unstable Segments	Amount of Unstable Footage	% Stable, Performing as Intended	Number with Stabilizing Woody Vegetation	Footage with Stabilizing Woody Vegetation	Adjusted % for Stabilizing Woody Vegetation		
1. Bed	1. Vertical Stability (Riffle and Run units)	1. <u>Aggradation</u> - Bar formation/growth sufficient to significantly deflect flow laterally (not to include point bars)	12	12	0	0	100%	0	0	100%		
		2. <u>Degradation</u> - Evidence of downcutting					100%					
	2. Riffle Condition	1. <u>Texture/Substrate</u> - Riffle maintains coarser substrate					12				12	100%
	3. Meander Pool Condition	1. <u>Depth</u> Sufficient (Max Pool Depth : Mean Bankfull Depth $\geq$ 1.6)					12				12	100%
		2. <u>Length</u> appropriate (>30% of centerline distance between tail of upstream riffle and head of downstream riffle)					12				12	100%
	4. Thalweg Position	1. Thalweg centering at upstream of meander bend (Run)					12				12	100%
		2. Thalweg centering at downstream of meander (Glide)					12				12	100%
	<b>Totals</b>											
2. Bank	1. Scoured/Eroding	Bank lacking vegetative cover resulting simply from poor growth and/or scour and erosion	0	0	0	0	100%	0	0	100%		
	2. Undercut	Banks undercut/overhanging to the extent that mass wasting appears likely. Does <b>NOT</b> include undercuts that are modest, appear sustainable and are providing habitat.					100%					
	3. Mass Wasting	Bank slumping, calving, or collapse					100%					
<b>Totals</b>												
3. Engineered Structures	1. Overall Integrity	Structures physically intact with no dislodged boulders or logs.	13	13	0	0	100%	0	0	100%		
	2. Grade Control	Grade control structures exhibiting maintenance of grade across the sill.	13	13			100%					
	2a. Piping	Structures lacking any substantial flow underneath sills or arms.	13	13			100%					
	3. Bank Protection	Bank erosion within the structures extent of influence does <u>not</u> exceed 15%. (See guidance for this table in EEP monitoring guidance document)	13	13			100%					
	4. Habitat	Pool forming structures maintaining - Max Pool Depth : Mean Bankfull Depth ratio $\geq$ 1.6 Rootwads/logs providing some cover at base-flow.	13	13			100%					

**Table 5. Visual Stream Morphology Stability Assessment  
Tributaries of Wicker Branch Stream Restoration/ DMS No. 95022**

Reach ID		Tributary 4												
Assessed Length		630												
Major Channel Category	Channel Sub-Category	Metric	Number Stable, Performing as Intended	Total Number in As-built	Number of Unstable Segments	Amount of Unstable Footage	% Stable, Performing as Intended	Number with Stabilizing Woody Vegetation	Footage with Stabilizing Woody Vegetation	Adjusted % for Stabilizing Woody Vegetation				
1. Bed	1. Vertical Stability (Riffle and Run units)	1. <u>Aggradation</u> - Bar formation/growth sufficient to significantly deflect flow laterally (not to include point bars)	4	4	0	0	100%							
		2. <u>Degradation</u> - Evidence of downcutting					100%							
	2. Riffle Condition	1. <u>Texture/Substrate</u> - Riffle maintains coarser substrate					4				4	0	0	100%
	3. Meander Pool Condition	1. <u>Depth</u> Sufficient (Max Pool Depth : Mean Bankfull Depth $\geq$ 1.6)					4				4	0	0	100%
		2. <u>Length</u> appropriate (>30% of centerline distance between tail of upstream riffle and head of downstream riffle)					4				4	0	0	100%
	4. Thalweg Position	1. Thalweg centering at upstream of meander bend (Run)					4				4	0	0	100%
		2. Thalweg centering at downstream of meander (Glide)					4				4	0	0	100%
	<b>Totals</b>													
2. Bank	1. Scoured/Eroding	Bank lacking vegetative cover resulting simply from poor growth and/or scour and erosion	4	4	0	0	100%	0	0	100%				
	2. Undercut	Banks undercut/overhanging to the extent that mass wasting appears likely. Does <b>NOT</b> include undercuts that are modest, appear sustainable and are providing habitat.					100%							
	3. Mass Wasting	Bank slumping, calving, or collapse					100%							
<b>Totals</b>														
3. Engineered Structures	1. Overall Integrity	Structures physically intact with no dislodged boulders or logs.	4	4	0	0	100%							
	2. Grade Control	Grade control structures exhibiting maintenance of grade across the sill.	4	4			100%							
	2a. Piping	Structures lacking any substantial flow underneath sills or arms.	4	4			100%							
	3. Bank Protection	Bank erosion within the structures extent of influence does <u>not</u> exceed 15%. (See guidance for this table in EEP monitoring guidance document)	4	4			100%							
	4. Habitat	Pool forming structures maintaining - Max Pool Depth : Mean Bankfull Depth ratio $\geq$ 1.6 Rootwads/logs providing some cover at base-flow.	4	4			100%							

**Table 6. Vegetation Condition Assessment  
Tributaries of Wicker Branch Stream Restoration/ DMS No. 95022**

Planted Acreage		11.57				
Vegetation Category	Definitions	Mapping Threshold	CCPV Depiction	Number of Polygons	Combined Acreage	% of Planted Area
1. Bare Areas	Very limited cover of both woody and herbaceous material.	0.1 acres	Beige dot pattern	0	0.00	0.0%
2. Low Stem Density Areas	Woody stem densities clearly below target levels based on MY3, 4, or 5 stem count criteria.	0.1 acres	Red Hatch	0	0.00	0.0%
<b>Total</b>				0	0.00	0.0%
3. Areas of Poor Growth Rates or Vigor	Areas with woody stems of a size class that are obviously small given the monitoring year.	0.25 acres	N/A	0	0.00	0.0%
<b>Cumulative Total</b>				0	0.00	0.0%

**Easement Acreage<sup>2</sup>**                      **15.49**

Vegetation Category	Definitions	Mapping Threshold	CCPV Depiction	Number of Polygons	Combined Acreage	% of Easement Acreage
4. Invasive Areas of Concern <sup>4</sup>	Presence of Chinese privet.	1000 SF	Yellow Hatch	4	1.00	6.5%
5. Easement Encroachment Areas <sup>3</sup>	Areas or points (if too small to render as polygons at map scale).	none	Green Hatch	3	0.08	0.5%

<sup>1</sup> = Enter the planted acreage within the easement. This number is calculated as the easement acreage minus any existing mature tree stands that were not subject to supplemental planting of the understory, the channel acreage, crossings or any other elements not directly planted as part of the project effort.

<sup>2</sup> = The acreage within the easement boundaries.

<sup>3</sup> = Encroachment may occur within or outside of planted areas and will therefore be calculated against the overall easement acreage. In the event a polygon is cataloged into items 1, 2 or 3 in the table and is the result of encroachment, the associated acreage should be tallied in the relevant item (i.e., item 1, 2 or 3) as well as a parallel tally in item 5.

<sup>4</sup> = Invasives may occur in or out of planted areas, but still within the easement and will therefore be calculated against the overall easement acreage. Invasives of concern/interest are listed below. The list of high concern species are those with the potential to directly outcompete native, young, woody stems in the short-term (e.g. monitoring period or shortly thereafter) or affect the community structure for existing, more established tree/shrub stands over timeframes that are slightly longer (e.g. 1-2 decades). The low/moderate concern group are those species that generally do not have this capacity over the timeframes discussed and therefore are not expected to be mapped with regularity, but can be mapped, if in the judgement of the observer their coverage, density or distribution is suppressing the viability, density, or growth of planted woody stems. Decisions as to whether remediation will be needed are based on the integration of risk factors by EEP such as species present, their coverage, distribution relative to native biomass, and the practicality of treatment. For example, even modest amounts of Kudzu or Japanese Knotweed early in the projects history will warrant control, but potentially large coverages of Microstegium in the herb layer will not likely trigger control because of the limited capacities to impact tree/shrub layers within the timeframes discussed and the potential impacts of treating extensive amounts of ground cover. Those species with the "watch list" designator in gray shade are of interest as well, but have yet to be observed across the state with any frequency. Those in *red italics* are of particular interest given their extreme risk/threat level for mapping as points where isolated specimens are found, particularly early in a projects monitoring history. However, areas of discreet, dense patches will of course be mapped as polygons. The symbology scheme below was one that was found to be helpful for symbolizing invasives polygons, particularly for situations where the condition for an area is somewhere between isolated specimens and dense, discreet patches. In any case, the point or polygon/area feature can be symbolized to describe things like high or low concern and species can be listed as a map inset, in legend items if the number of species are limited or in the narrative section of the executive summary.



Vegetation Monitoring Plot 1 – 9/15/16



Vegetation Monitoring Plot 4 – 9/15/16



Vegetation Monitoring Plot 2 – 9/15/16



Vegetation Monitoring Plot 5 – 9/15/16



Vegetation Monitoring Plot 3 – 9/15/16



Vegetation Monitoring Plot 6 – 9/15/16





Vegetation Monitoring Plot 7 – 9/15/16



Vegetation Monitoring Plot 10 – 9/15/16



Vegetation Monitoring Plot 8 – 9/15/16



Vegetation Monitoring Plot 11 – 9/15/16



Vegetation Monitoring Plot 9 – 9/15/16



Cross Section 1 (looking upstream) – 9/15/16



Cross Section 4 (looking upstream) – 9/15/16



Cross Section 2 (looking upstream) – 9/15/16



Cross Section 5 (looking upstream) – 9/15/16



Cross Section 3 (looking upstream) – 9/15/16



Cross Section 6 (looking upstream) – 9/15/16



Cross Section 7 (looking upstream) – 9/15/16



Cross Section 10 (looking upstream) – 9/15/16



Cross Section 8 (looking upstream) – 9/15/16



Cross Section 11 (looking upstream) – 9/15/16



Cross Section 9 (looking upstream) – 9/15/16



Cross Section 12 (looking upstream) – 9/15/16



Photo Monitoring Point 1 – 10/16/15



Photo Monitoring Point 2 – 10/16/15



Photo Monitoring Point 3 – 10/16/15



Photo Monitoring Point 4 – 10/16/15



Photo Monitoring Point 5 – 10/16/15



Photo Monitoring Point 6 – 10/16/15

## **APPENDIX C: VEGETATION PLOT DATA**

Table 7: Vegetation Plot Counts and Densities

**Table 7. Vegetation Plot Stem Count Summary**  
DMS Project Code 95022. Project Name: Tributaries of Wicker Branch

Scientific Name	Common Name	Species Type	Current Plot Data (MY2 2016)																					
			95022-01-0001			95022-01-0002			95022-01-0003			95022-01-0004			95022-01-0005			95022-01-0006			95022-01-0007			
			PnoLS	P-all	T	PnoLS	P-all	T	PnoLS	P-all	T	PnoLS	P-all	T	PnoLS	P-all	T	PnoLS	P-all	T	PnoLS	P-all	T	
Acer negundo	boxelder	Tree						1			2													
Cercis canadensis	eastern redbud	Tree	1	1	1	2	2	2	3	3	3	4	4	4	2	2	3				3	3	5	
Cornus amomum	silky dogwood	Shrub	4	4	5							1	1	1	3	3	3							
Diospyros virginiana	common persimmon	Tree	1	1	2	1	1	1	1	1	1													
Liquidambar styraciflua	sweetgum	Tree			1			1									6						1	
Liriodendron tulipifera	tuliptree	Tree	1	1	1	3	3	3				2	2	3	4	4	4					1	1	1
Pinus taeda	loblolly pine	Tree			1						1													
Platanus occidentalis	American sycamore	Tree									1													
Quercus	oak	Tree																						
Quercus alba	white oak	Tree	3	3	3	2	2	2	2	2	3	2	2	2	4	4	4	5	5	5	6	6	6	
Quercus falcata	southern red oak	Tree	4	4	5	1	1	2						1	1	1								
Rhus copallinum	flameleaf sumac	shrub																						
Rhus glabra	smooth sumac	shrub																						
Robinia pseudoacacia	black locust	Tree	1	1	1	1	1	2			1										4	4	5	
Salix nigra	black willow	Tree											1	4										
Sambucus canadensis	Common Elderberry	Shrub	5	5	5	3	3	4	3	3	3	1	1	2										
Ulmus alata	winged elm	Tree									1													
Unknown		Shrub or Tree																						
Stem count			20	20	25	13	13	18	9	9	16	10	11	19	14	14	21	5	5	5	14	14	18	
size (ares)			1			1			1			1			1			1			1			
size (ACRES)			0.02			0.02			0.02			0.02			0.02			0.02			0.02			
Species count			8	8	10	7	7	9	4	4	9	5	6	8	5	5	6	1	1	1	4	4	5	
Stems per ACRE			809.4	809.4	1012	526.1	526.1	728.4	364.2	364.2	647.5	404.7	445.2	768.9	566.6	566.6	849.8	202.3	202.3	202.3	566.6	566.6	728.4	

Scientific Name	Common Name	Species Type	Current Plot Data (MY2 2016)												Annual Means														
			95022-01-0008			95022-01-0009			95022-01-0010			95022-01-0011			MY2 (2016)			MY1 (2015)			MY0 (2015)								
			PnoLS	P-all	T	PnoLS	P-all	T	PnoLS	P-all	T	PnoLS	P-all	T	PnoLS	P-all	T	PnoLS	P-all	T	PnoLS	P-all	T						
Acer negundo	boxelder	Tree																					3						
Cercis canadensis	eastern redbud	Tree	1	1	1	3	3	3	2	2	2	1	1	1	22	22	25	21	21	21	26	26	26						
Cornus amomum	silky dogwood	Shrub										1	1	1	9	9	10	18	18	18	21	21	21						
Diospyros virginiana	common persimmon	Tree	4	4	4									2	7	7	10	6	6	6	7	7	7						
Liquidambar styraciflua	sweetgum	Tree									2			2			13												
Liriodendron tulipifera	tuliptree	Tree				3	3	3				1	1	2	15	15	17	16	16	16	38	38	38						
Pinus taeda	loblolly pine	Tree															2												
Platanus occidentalis	American sycamore	Tree															1												
Quercus	oak	Tree																1	1	1	2	2	2						
Quercus alba	white oak	Tree	4	4	4	3	3	3	1	1	1	2	2	2	34	34	35	26	26	26	41	41	41						
Quercus falcata	southern red oak	Tree	1	1	1										7	7	9	10	10	10	20	20	20						
Rhus copallinum	flameleaf sumac	shrub															1												
Rhus glabra	smooth sumac	shrub						1									1												
Robinia pseudoacacia	black locust	Tree				1	1	1	1	1	2				8	8	14	7	7	7	9	9	9						
Salix nigra	black willow	Tree														1	4		1	1		1	1						
Sambucus canadensis	Common Elderberry	Shrub	1	1	1				2	2	2	2	2	3	17	17	20	15	15	15	21	21	21						
Ulmus alata	winged elm	Tree												1		2													
Unknown		Shrub or Tree										1	1	1	1	1	1	1	1	1	1	1	1						
Stem count			11	11	11	10	10	11	6	6	9	8	8	15	120	121	168	121	122	122	186	187	187						
size (ares)			1			1			1			1			11			11			11								
size (ACRES)			0.02			0.02			0.02			0.02			0.27			0.27			0.27								
Species count			5	5	5	4	4	5	4	4	5	6	6	9	9	10	17	10	11	11	10	11	11						
Stems per ACRE			445.2	445.2	445.2	404.7	404.7	445.2	242.8	242.8	364.2	323.7	323.7	607	441.5	445.2	618.1	445.2	448.8	448.8	684.3	688	688						

**Color for Density**  
Exceeds requirements by 10%  
Exceeds requirements, but by less than 10%  
Fails to meet requirements, by less than 10%  
Fails to meet requirements by more than 10%

## **APPENDIX D: STREAM GEOMORPHOLOGY DATA**

Cross-Sections

Longitudinal Profiles

Pebble Counts

Table 8: Baseline Stream Data Summary

Table 9a: Cross-Section Morphology Data

Table 9b: Stream Reach Morphology Data

## Cross-section Plot Exhibit

River Basin	Yadkin-Pee Dee
Watershed	Wicker Branch
X-Sec ID	XS-1, Sta. 4+65
Feature	Riffle
Drainage Area (sq mi)	0.15
Date	9/15/2016
Field Crew	Steven Pires, Chris Inscore


Station	Elevation	
0	578.8	LTPIN
0.05	578.2	LBPIN
6.13	577.49	GR
12.97	577.48	GR
18.41	577.58	TOB
18.82	577.28	TOE
20.13	577.17	TW
21.31	577.23	TOE
22.42	577.71	TOB
29.34	577.58	GR
35.13	577.72	GR
39.9	577.98	RBPIN
40	578.59	RTPIN

### Summary Data

Bankfull Elevation	577.67
Bankfull Width (ft)	3.07
Floodprone Width (ft)	50
Bankfull Mean Depth (ft)	0.42
Bankfull Max Depth (ft)	0.5
Bankfull Cross Sectional Area (ft <sup>2</sup> )	1.28
Bankfull Width/Depth Ratio	7.31
Bankfull Entrenchment Ratio	16.29
Bankfull Bank Height Ratio	1



Photo: Cross-section 1 looking upstream

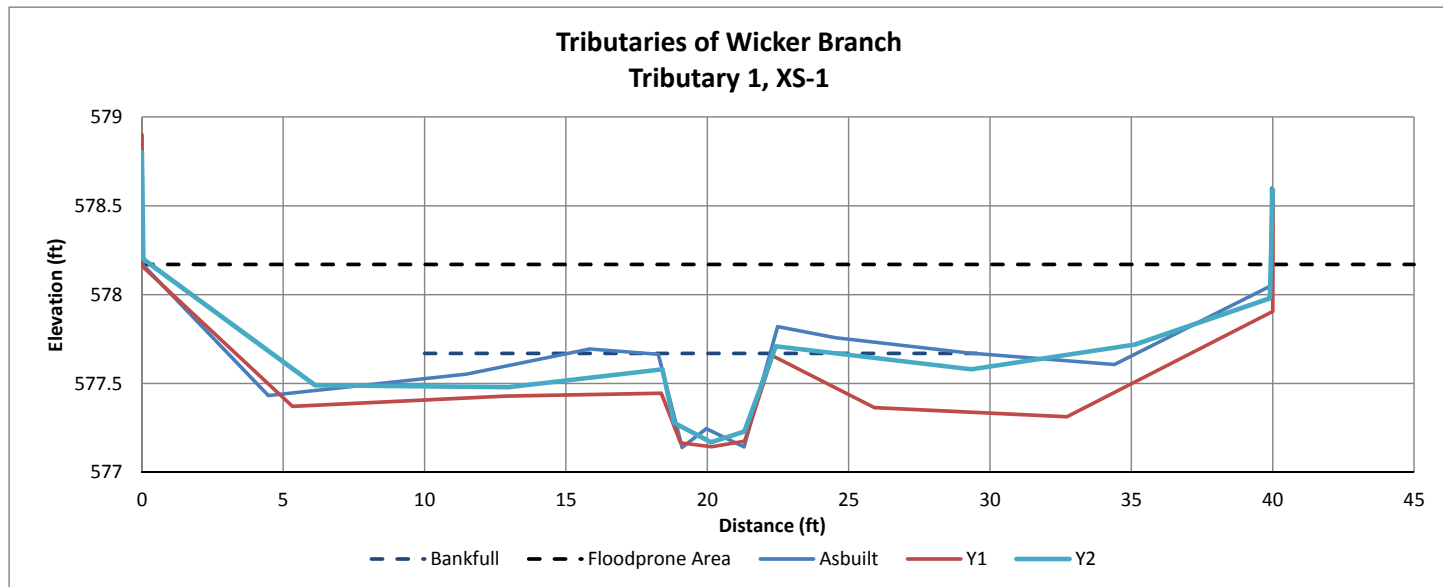



## Cross-section Plot Exhibit

River Basin	Yadkin-Pee Dee
Watershed	Wicker Branch
X-Sec ID	XS-2, Sta. 5+05
Feature	Pool
Drainage Area (sq mi)	0.15
Date	9/15/2016
Field Crew	Steven Pires, Chris Inscore


Station	Elevation	
0	578.56	LTPIN
0	577.90	LBPIN
4.37	577.18	GR
10.69	577.08	GR
17.72	577.03	TOB
19.7	575.54	TOE
20.24	575.40	TW
21.19	575.69	TOE
23.06	576.71	TOB
29.4	576.99	GR
35.68	576.90	GR
39.96	577.27	RBPIN
40.02	578.08	RTPIN

### Summary Data

Bankfull Elevation	576.78
Bankfull Width (ft)	5.85
Floodprone Width (ft)	50
Bankfull Mean Depth (ft)	0.69
Bankfull Max Depth (ft)	1.38
Bankfull Cross Sectional Area (ft <sup>2</sup> )	4.03
Bankfull Width/Depth Ratio	8.5
Bankfull Entrenchment Ratio	8.5
Bankfull Bank Height Ratio	1



Photo: Cross-section 2 looking upstream

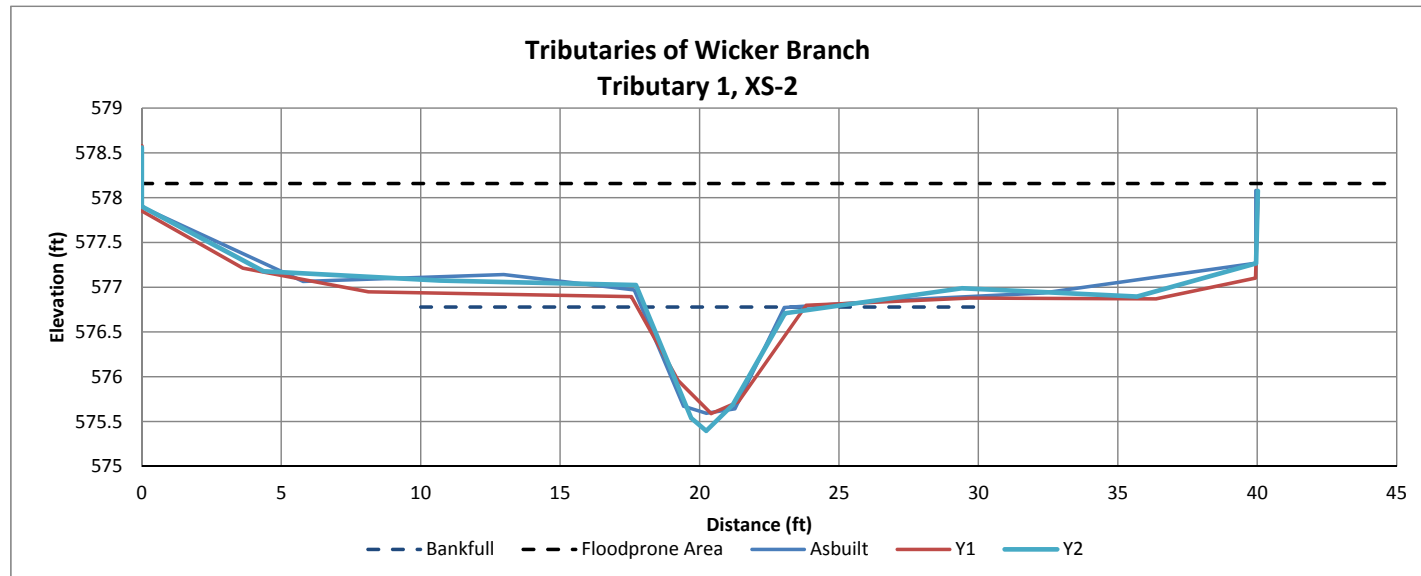

## Cross-section Plot Exhibit


<b>River Basin</b>	Yadkin-Pee Dee
<b>Watershed</b>	Wicker Branch
<b>X-Sec ID</b>	XS-3, Sta. 9+34
<b>Feature</b>	Riffle
<b>Drainage Area (sq mi)</b>	0.15
<b>Date</b>	9/15/2016
<b>Field Crew</b>	Steven Pires, Chris Inscore



Photo: Cross-section 3 looking upstream

Station	Elevation	
0	572.51	LTPIN
0.1	571.84	LBPIN
3.79	571.62	GR
8.56	570.94	GR
13.11	571.45	GR
16.99	571.62	TOB
19.08	570.83	TOE
19.79	570.60	TW
20.92	570.76	TOE
22.09	571.61	TOB
29.01	571.34	GR
36.37	571.50	GR
39.79	571.72	RBPIN
39.81	572.27	RTPIN

Summary Data	
Bankfull Elevation	571.82
Bankfull Width (ft)	5.08
Floodprone Width (ft)	50
Bankfull Mean Depth (ft)	0.8
Bankfull Max Depth (ft)	1.22
Bankfull Cross Sectional Area (ft <sup>2</sup> )	4.06
Bankfull Width/Depth Ratio	6.4
Bankfull Entrenchment Ratio	9.8
Bankfull Bank Height Ratio	0.9

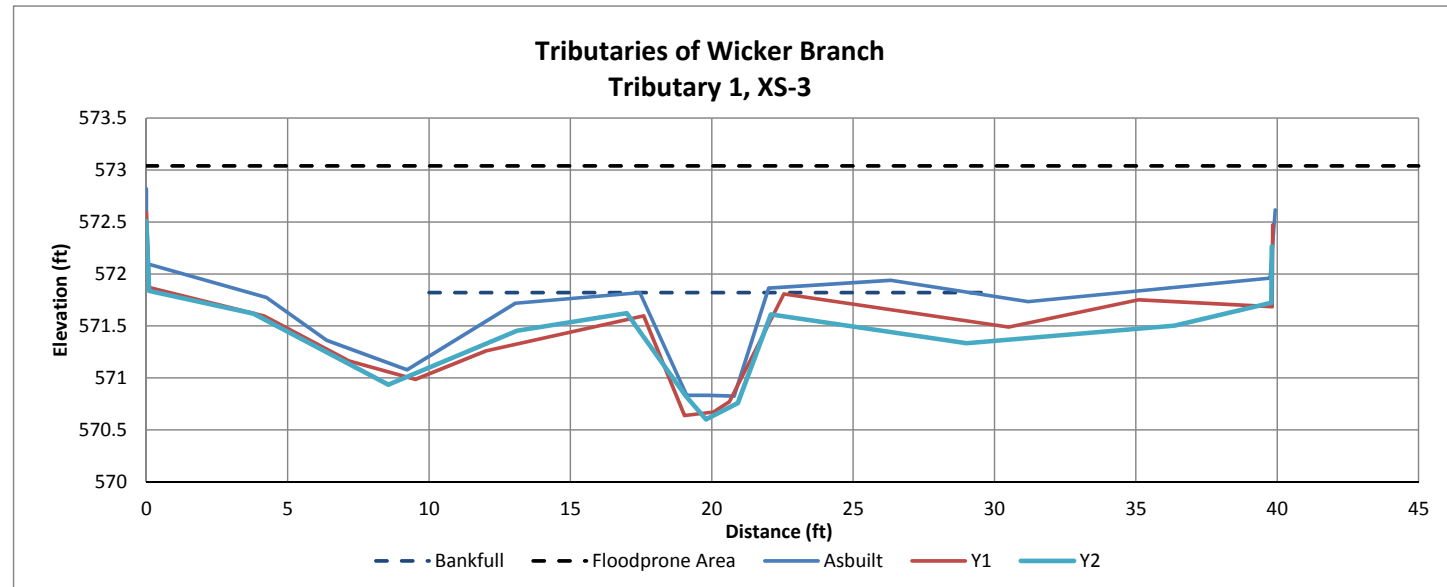

### Cross-section Plot Exhibit


River Basin	Yadkin-Pee Dee
Watershed	Wicker Branch
X-Sec ID	XS-4, Sta. 9+72
Feature	Pool
Drainage Area (sq mi)	0.15
Date	9/15/2016
Field Crew	Steven Pires, Chris Inscore



Photo: Cross-section 4 looking upstream

Station	Elevation	
0.13	572.19	LTPIN
0.19	571.69	LBPIN
9.41	571.03	GR
12.93	571.05	TOB
14.98	569.80	TOE
15.56	569.73	TW
16.54	569.96	TOE
18.49	571.21	TOB
25.79	570.99	GR
33.88	570.97	GR
39.87	571.45	RBPIN
40.02	572.08	RTPIN

Summary Data	
Bankfull Elevation	571.23
Bankfull Width (ft)	6.2
Floodprone Width (ft)	50
Bankfull Mean Depth (ft)	0.83
Bankfull Max Depth (ft)	1.5
Bankfull Cross Sectional Area (ft <sup>2</sup> )	5.17
Bankfull Width/Depth Ratio	7.4
Bankfull Entrenchment Ratio	8.1
Bankfull Bank Height Ratio	1

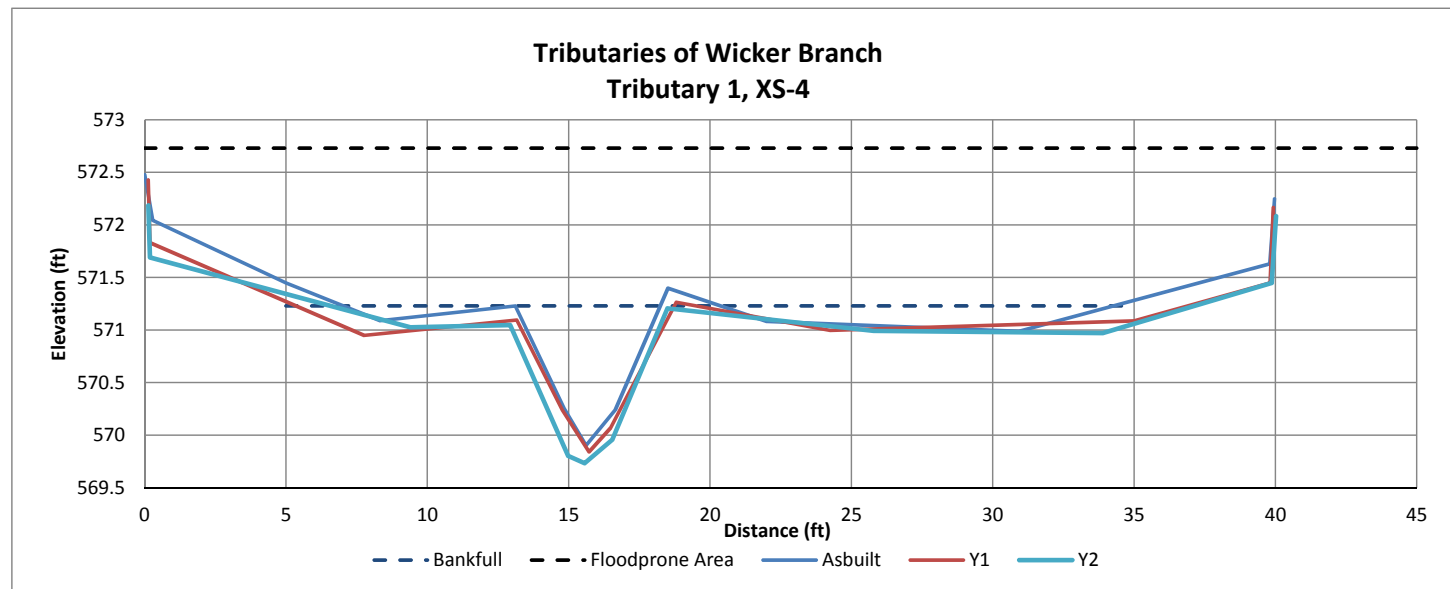

## Cross-section Plot Exhibit

River Basin	Yadkin-Pee Dee
Watershed	Wicker Branch
X-Sec ID	XS-5, Sta. 12+10
Feature	Riffle
Drainage Area (sq mi)	0.15
Date	9/15/2016
Field Crew	Steven Pires, Chris Inscore

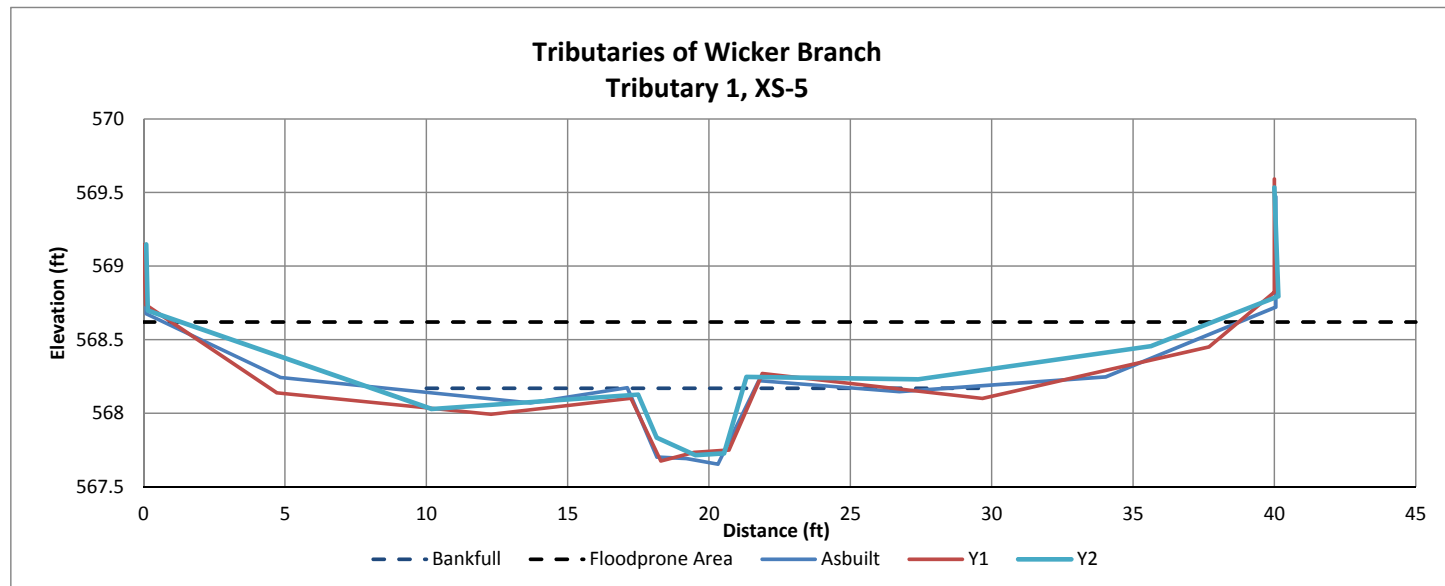


Photo: Cross-section 5 looking upstream

Station	Elevation	
0.09	569.15	LTPIN
0.15	568.70	LBPIN
10.19	568.03	GR
17.49	568.13	TOB
18.15	567.84	TOE
19.52	567.72	TW
20.53	567.73	TOE
21.32	568.25	TOB
27.38	568.23	GR
35.64	568.46	GR
40.14	568.80	RBPIN
40	569.53	RTPIN

### Summary Data

Bankfull Elevation	568.17
Bankfull Width (ft)	3.8
Floodprone Width (ft)	50
Bankfull Mean Depth (ft)	0.3
Bankfull Max Depth (ft)	0.45
Bankfull Cross Sectional Area (ft <sup>2</sup> )	1.3
Bankfull Width/Depth Ratio	11.5
Bankfull Entrenchment Ratio	13.2
Bankfull Bank Height Ratio	1



## Cross-section Plot Exhibit

<b>River Basin</b>	Yadkin-Pee Dee
<b>Watershed</b>	Wicker Branch
<b>X-Sec ID</b>	XS-6, Sta. 12+37
<b>Feature</b>	Riffle
<b>Drainage Area (sq mi)</b>	0.15
<b>Date</b>	9/15/2016
<b>Field Crew</b>	Steven Pires, Chris Inscore

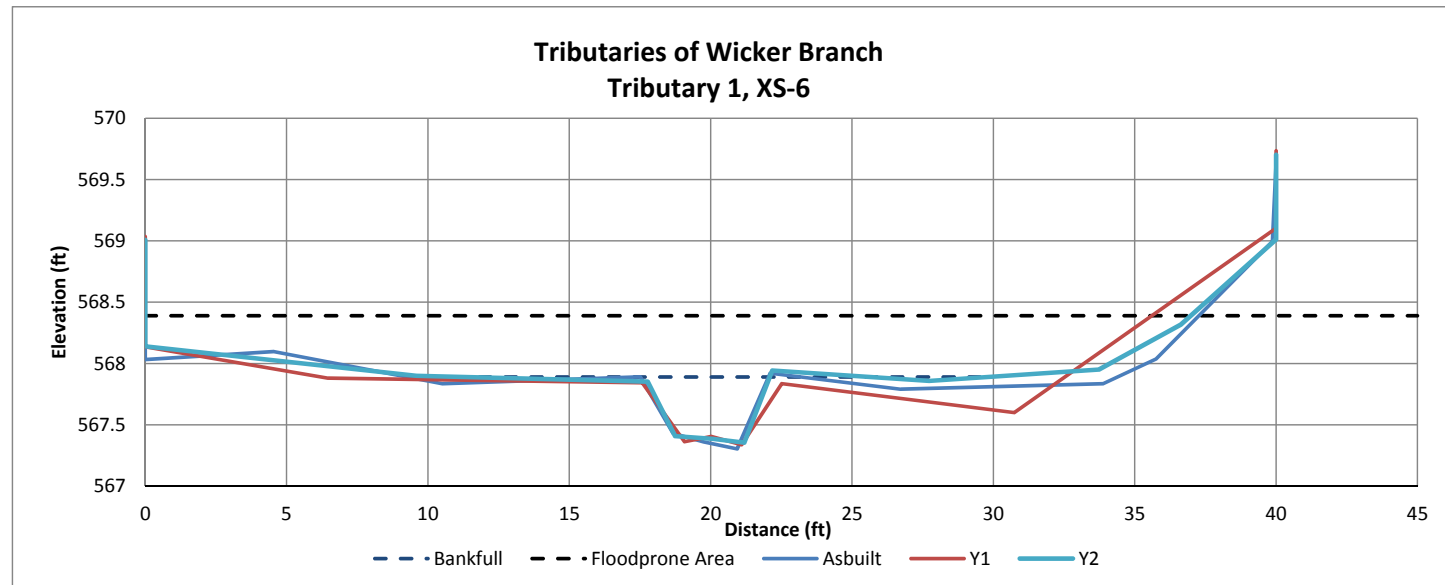


Photo: Cross-section 6 looking upstream

Station	Elevation	
0	569.01	LTPIN
0	568.14	LBPIN
9.59	567.90	GR
17.77	567.85	TOB
18.74	567.41	TOE
20.07	567.39	TW
21.19	567.36	TOE
22.18	567.94	TOB
27.73	567.86	GR
33.73	567.95	GR
36.63	568.32	GR
40	569.01	RBPIN
40	569.70	RTPIN

### Summary Data

Bankfull Elevation	567.89
Bankfull Width (ft)	4.37
Floodprone Width (ft)	50
Bankfull Mean Depth (ft)	0.4
Bankfull Max Depth (ft)	0.5
Bankfull Cross Sectional Area (ft <sup>2</sup> )	1.73
Bankfull Width/Depth Ratio	10.97
Bankfull Entrenchment Ratio	11.4
Bankfull Bank Height Ratio	1



## Cross-section Plot Exhibit

<b>River Basin</b>	Yadkin-Pee Dee
<b>Watershed</b>	Wicker Branch
<b>X-Sec ID</b>	XS-7, Sta. 12+72
<b>Feature</b>	Pool
<b>Drainage Area (sq mi)</b>	0.15
<b>Date</b>	9/15/2016
<b>Field Crew</b>	Steven Pires, Chris Inscore


Station	Elevation	
0.00	568.81	LTPIN
0.00	567.90	LPIN
10.21	567.28	GR
24.15	567.42	TOB
26.04	566.57	TOE
26.90	566.50	TW
28.27	566.61	TOE
30.36	567.33	TOB
35.17	567.43	GR
39.86	568.40	RPIN
39.85	569.15	RTPIN

### Summary Data

Bankfull Elevation	567.42
Bankfull Width (ft)	9.94
Floodprone Width (ft)	40
Bankfull Mean Depth (ft)	0.4
Bankfull Max Depth (ft)	0.97
Bankfull Cross Sectional Area (ft <sup>2</sup> )	3.98
Bankfull Width/Depth Ratio	24.8
Bankfull Entrenchment Ratio	4.02
Bankfull Bank Height Ratio	1



Photo: Cross-section 7 looking upstream

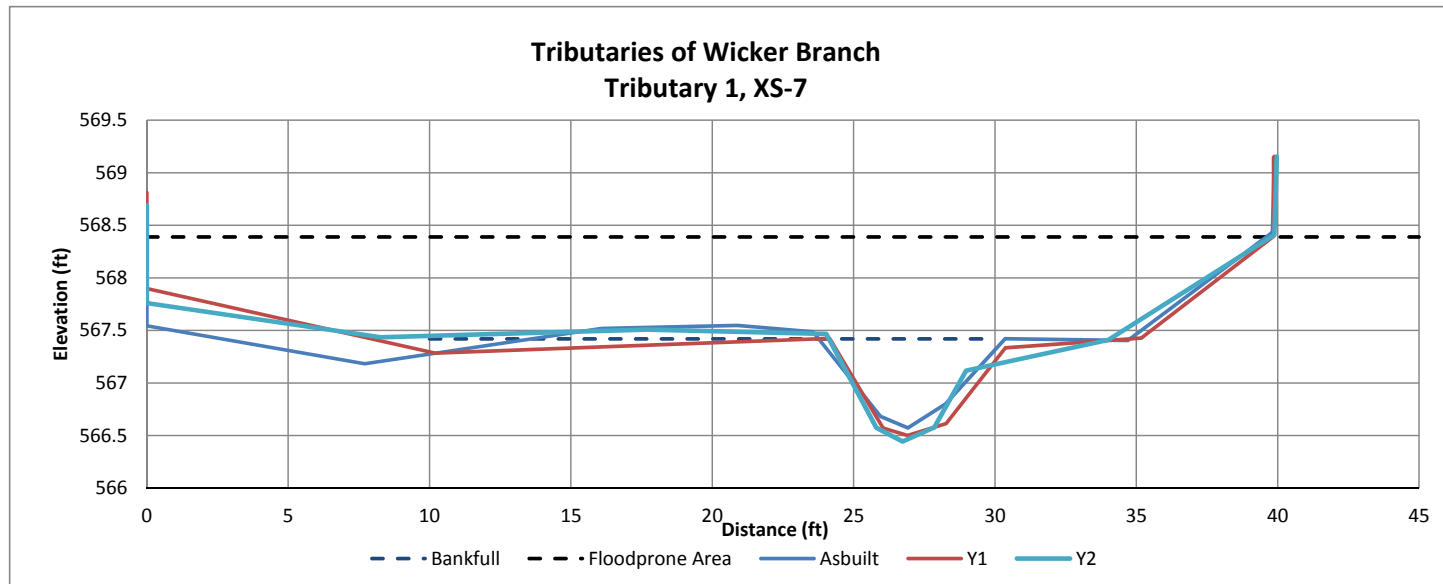

## Cross-section Plot Exhibit

<b>River Basin</b>	Yadkin-Pee Dee
<b>Watershed</b>	Wicker Branch
<b>X-Sec ID</b>	XS-8, Sta. 1+83
<b>Feature</b>	Riffle
<b>Drainage Area (sq mi)</b>	0.05
<b>Date</b>	9/15/2016
<b>Field Crew</b>	Steven Pires, Chris Inscore


Station	Elevation	
0	575.57	LTPIN
0	574.93	LBPIN
6.99	574.64	GR
13.38	574.40	GR
18.44	574.42	LTOB
20.29	573.91	LTOE
20.9	573.83	TW
21.52	573.95	RTOE
22.77	574.44	RTOB
29.43	574.47	GR
36.89	574.47	GR
40	574.86	RBPIN
40	575.54	RTPIN

### Summary Data

Bankfull Elevation	574.41
Bankfull Width (ft)	4.2
Floodprone Width (ft)	40
Bankfull Mean Depth (ft)	0.33
Bankfull Max Depth (ft)	0.6
Bankfull Cross Sectional Area (ft <sup>2</sup> )	1.38
Bankfull Width/Depth Ratio	12.8
Bankfull Entrenchment Ratio	9.48
Bankfull Bank Height Ratio	1



Photo: Cross-section 8 looking downstream

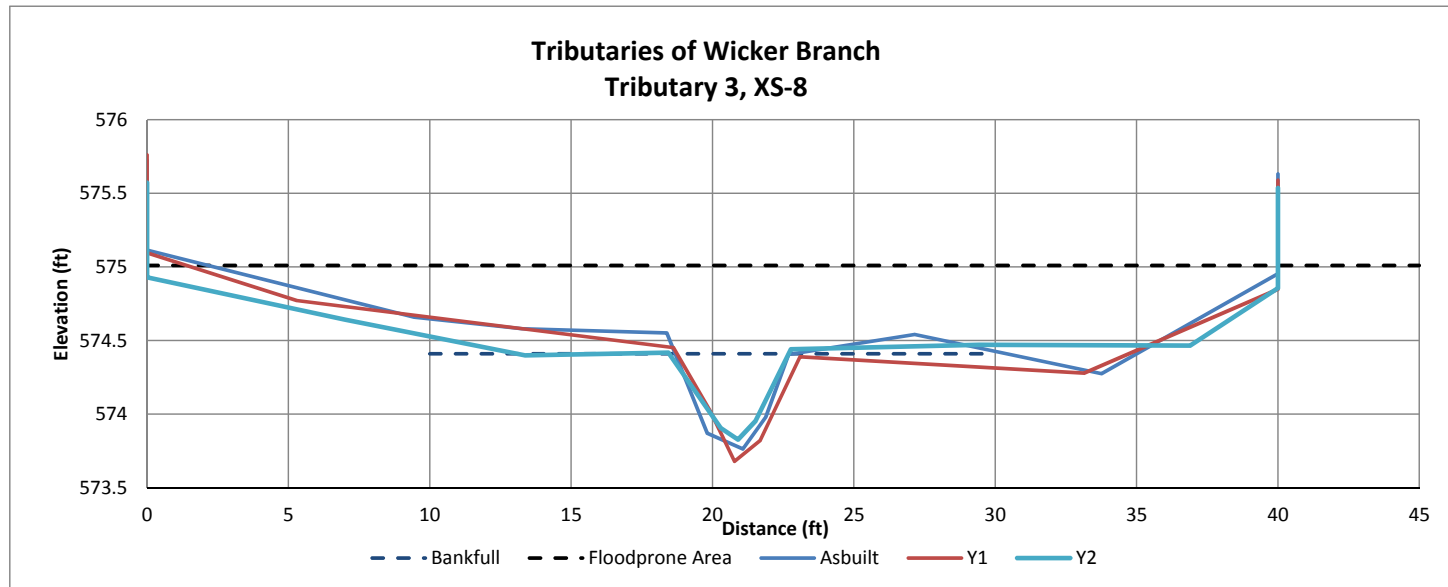

## Cross-section Plot Exhibit

<b>River Basin</b>	Yadkin-Pee Dee
<b>Watershed</b>	Wicker Branch
<b>X-Sec ID</b>	XS-9, Sta 3+19
<b>Feature</b>	Riffle
<b>Drainage Area (sq mi)</b>	0.05
<b>Date</b>	9/15/2016
<b>Field Crew</b>	Steven Pires, Chris Inscore


Station	Elevation	
0	573.70	LTPIN
0	573.55	LBPIN
4.23	573.04	GR
12.55	572.70	GR
19.15	572.62	LTOB
20.02	572.22	LTOE
20.84	572.09	TW
21.68	572.20	RTOE
22.86	572.74	RTOB
28.01	572.68	GR
31.64	572.60	GR
33.83	572.65	GR
39.99	573.87	RBPIN
40	574.55	RBPIN

### Summary Data

Bankfull Elevation	572.58
Bankfull Width (ft)	3.3
Floodprone Width (ft)	32
Bankfull Mean Depth (ft)	0.31
Bankfull Max Depth (ft)	0.49
Bankfull Cross Sectional Area (ft <sup>2</sup> )	1.01
Bankfull Width/Depth Ratio	10.6
Bankfull Entrenchment Ratio	9.77
Bankfull Bank Height Ratio	1



Photo: Cross-section 9 looking upstream

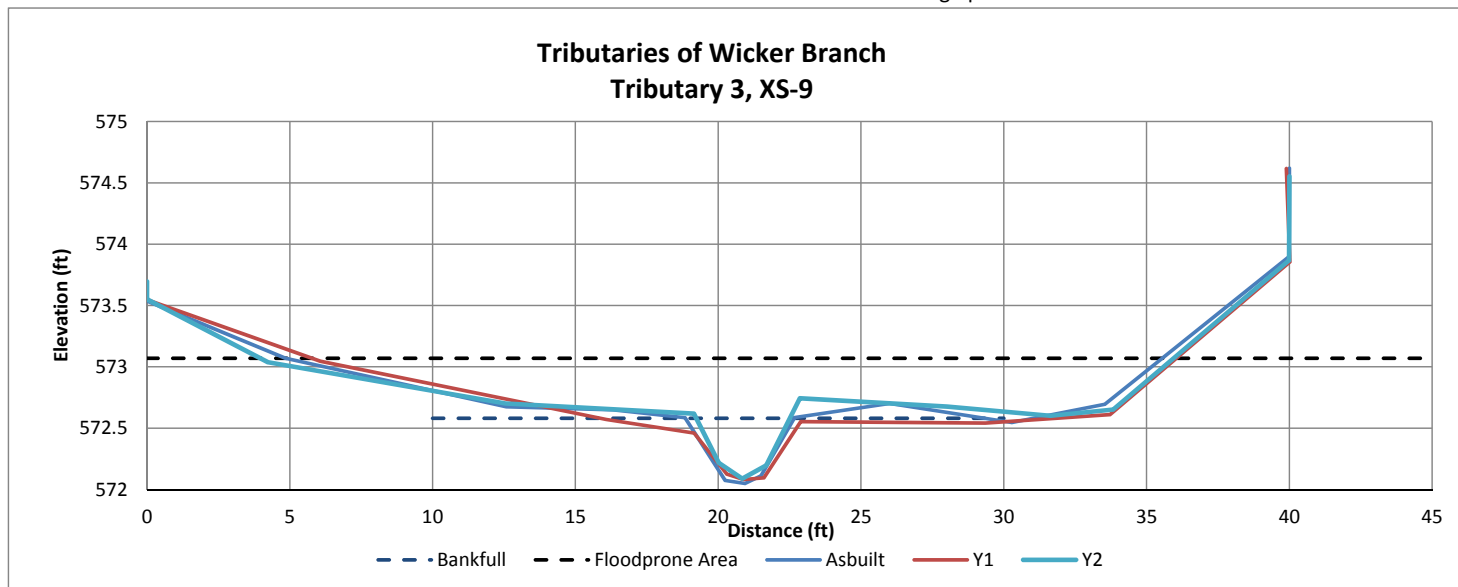



## Cross-section Plot Exhibit

<b>River Basin</b>	Yadkin-Pee Dee
<b>Watershed</b>	Wicker Branch
<b>X-Sec ID</b>	XS-10, Sta. 4+95
<b>Feature</b>	Pool
<b>Drainage Area (sq mi)</b>	0.05
<b>Date</b>	9/15/2016
<b>Field Crew</b>	Steven Pires, Chris Inscore


Station	Elevation	
0	574.53	LTPIN
0	573.87	LBPIN
10.8	570.78	GR
15.75	570.61	TOB
17.21	569.69	LTOE
18.81	569.53	TW
20	569.57	RTOE
22.25	570.69	RTOB
29.05	570.57	GR
36.58	571.49	GR
40.64	572.17	RBPIN
40.78	572.78	RTPIN

### Summary Data

Bankfull Elevation	570.76
Bankfull Width (ft)	6.61
Floodprone Width (ft)	33
Bankfull Mean Depth (ft)	0.84
Bankfull Max Depth (ft)	1.22
Bankfull Cross Sectional Area (ft <sup>2</sup> )	5.53
Bankfull Width/Depth Ratio	7.87
Bankfull Entrenchment Ratio	4.96
Bankfull Bank Height Ratio	1



Photo: Cross-section 10 looking upstream

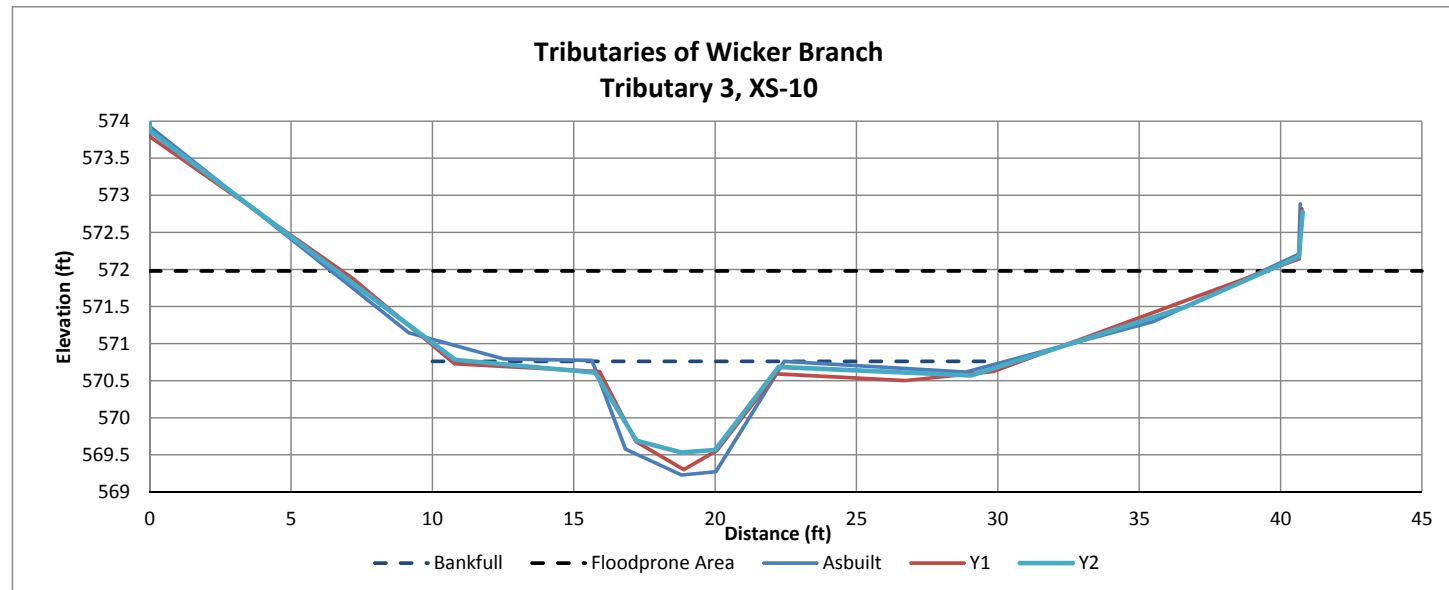

## Cross-section Plot Exhibit

<b>River Basin</b>	Yadkin-Pee Dee
<b>Watershed</b>	Wicker Branch
<b>X-Sec ID</b>	XS-11, Sta. 3+61
<b>Feature</b>	Riffle
<b>Drainage Area (sq mi)</b>	0.05
<b>Date</b>	9/15/2016
<b>Field Crew</b>	Steven Pires, Chris Inscore

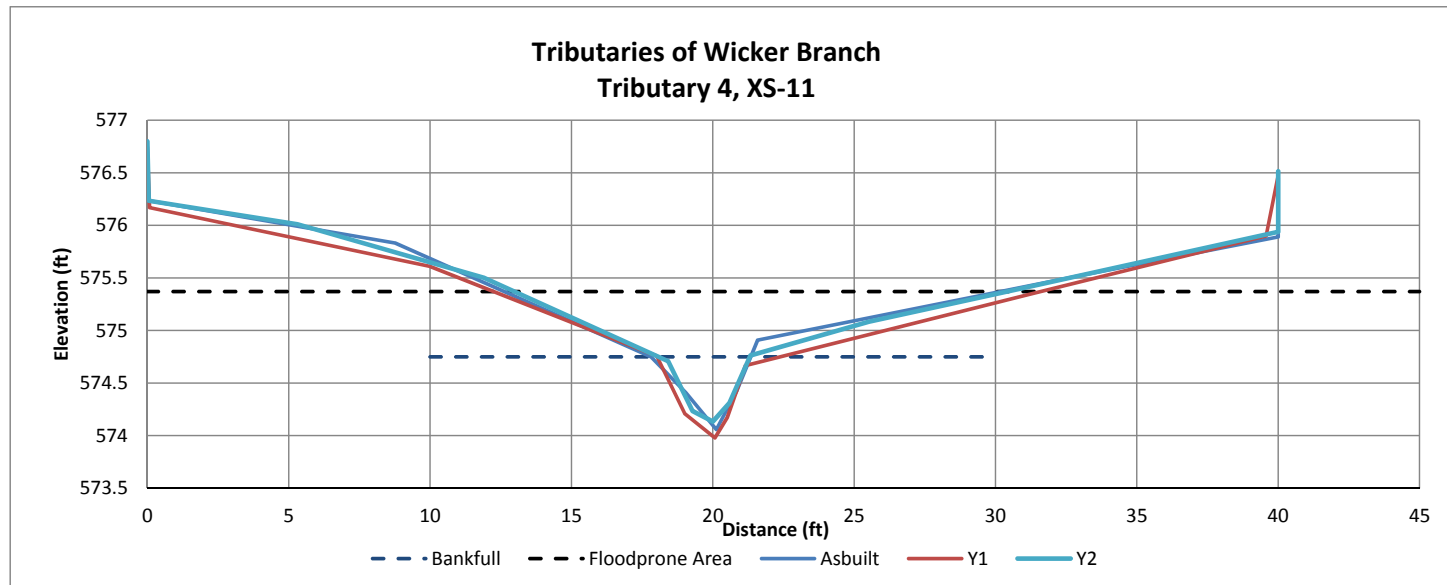


Photo: Cross-section 11 looking upstream

Station	Elevation	
0	576.80	LTPIN
0.05	576.24	LBPIN
5.31	576.01	GR
11.91	575.50	GR
18.42	574.71	LTOB
19.28	574.24	LTOE
20	574.13	TW
20.58	574.31	RTOE
21.33	574.76	RTOB
25.52	575.08	GR
31.31	575.42	GR
40	575.94	RBPIN
40	576.52	RTOP

### Summary Data

Bankfull Elevation	574.75
Bankfull Width (ft)	3.22
Floodprone Width (ft)	18
Bankfull Mean Depth (ft)	0.35
Bankfull Max Depth (ft)	0.62
Bankfull Cross Sectional Area (ft <sup>2</sup> )	1.12
Bankfull Width/Depth Ratio	9.2
Bankfull Entrenchment Ratio	5.42
Bankfull Bank Height Ratio	1



## Cross-section Plot Exhibit

<b>River Basin</b>	Yadkin-Pee Dee
<b>Watershed</b>	Wicker Branch
<b>X-Sec ID</b>	XS-12, Sta. 6+42
<b>Feature</b>	Riffle
<b>Drainage Area (sq mi)</b>	0.05
<b>Date</b>	9/15/2016
<b>Field Crew</b>	Steven Pires, Chris Inscore


Station	Elevation
0.00	573.27 RTPIN
0.00	572.68 RBPIN
3.74	572.72 GR
10.65	572.63 GR
17.29	572.39 RTOB
19.18	571.90 RTOE
20.18	571.70 TW
20.92	571.74 LTOE
21.98	572.18 LTOB
27.40	572.67 GR
34.54	573.29 GR
39.94	573.95 LBPIN
40.00	574.53 LTPIN

### Summary Data


Bankfull Elevation	572.2
Bankfull Width (ft)	4.18
Floodprone Width (ft)	24
Bankfull Mean Depth (ft)	0.28
Bankfull Max Depth (ft)	0.5
Bankfull Cross Sectional Area (ft <sup>2</sup> )	1.19
Bankfull Width/Depth Ratio	14.93
Bankfull Entrenchment Ratio	5.83
Bankfull Bank Height Ratio	1




Photo: Cross-section 12 looking upstream

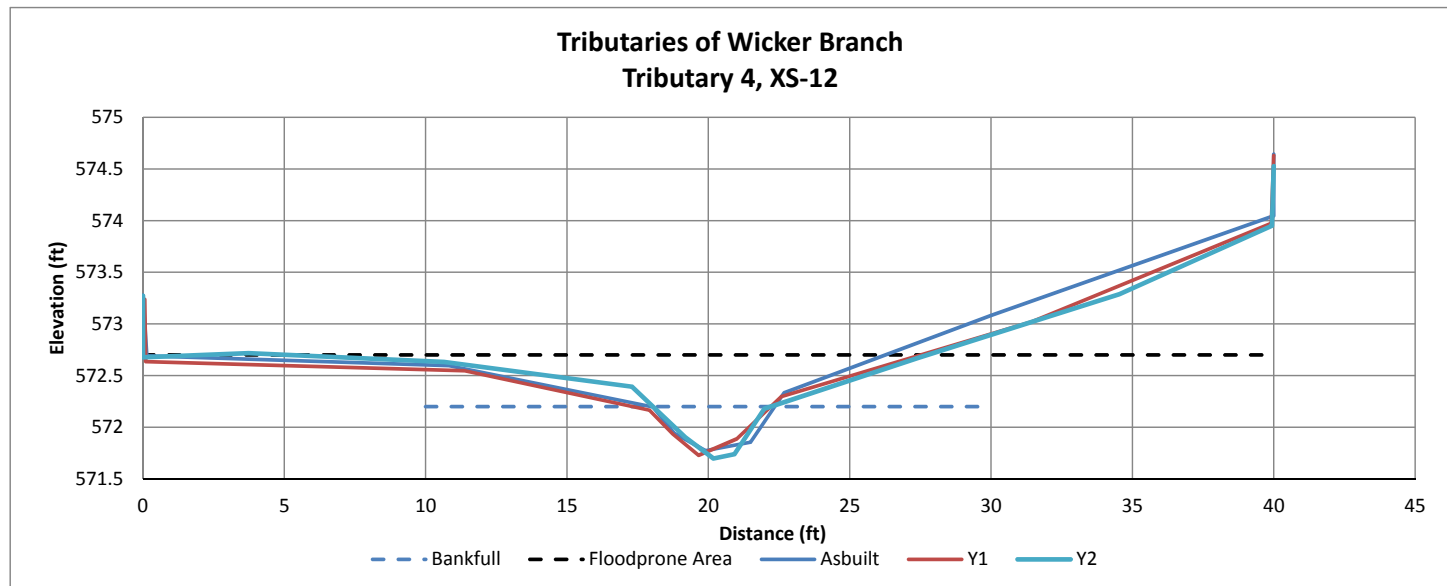


Tributaries of Wicker Branch - Tributary 1A Longitudinal Profile

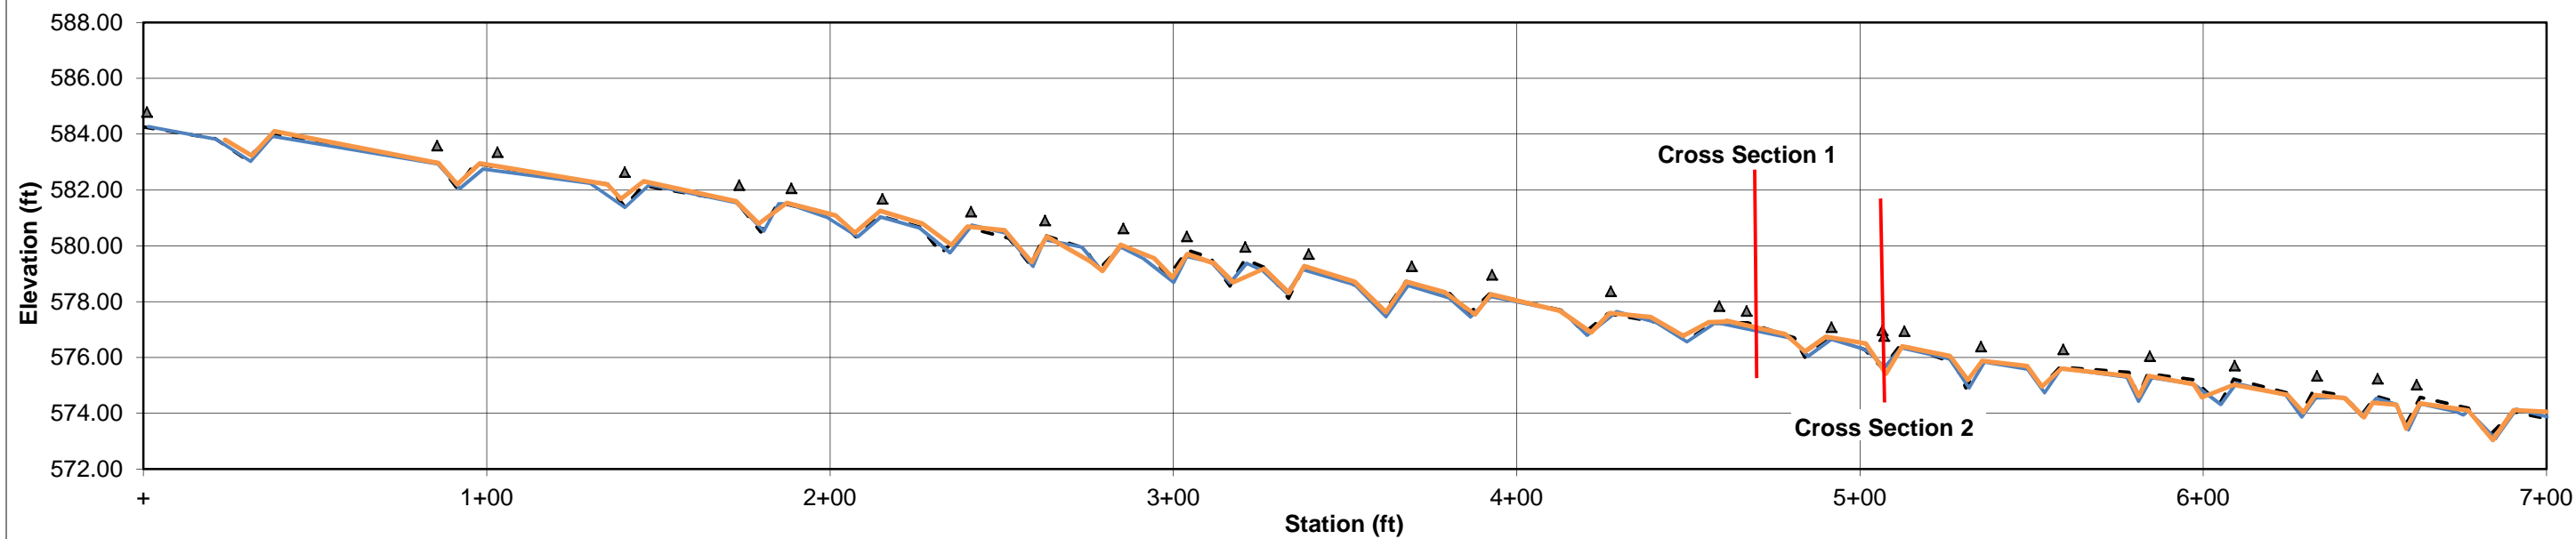


Tributaries of Wicker Branch - Tributary 1A Longitudinal Profile

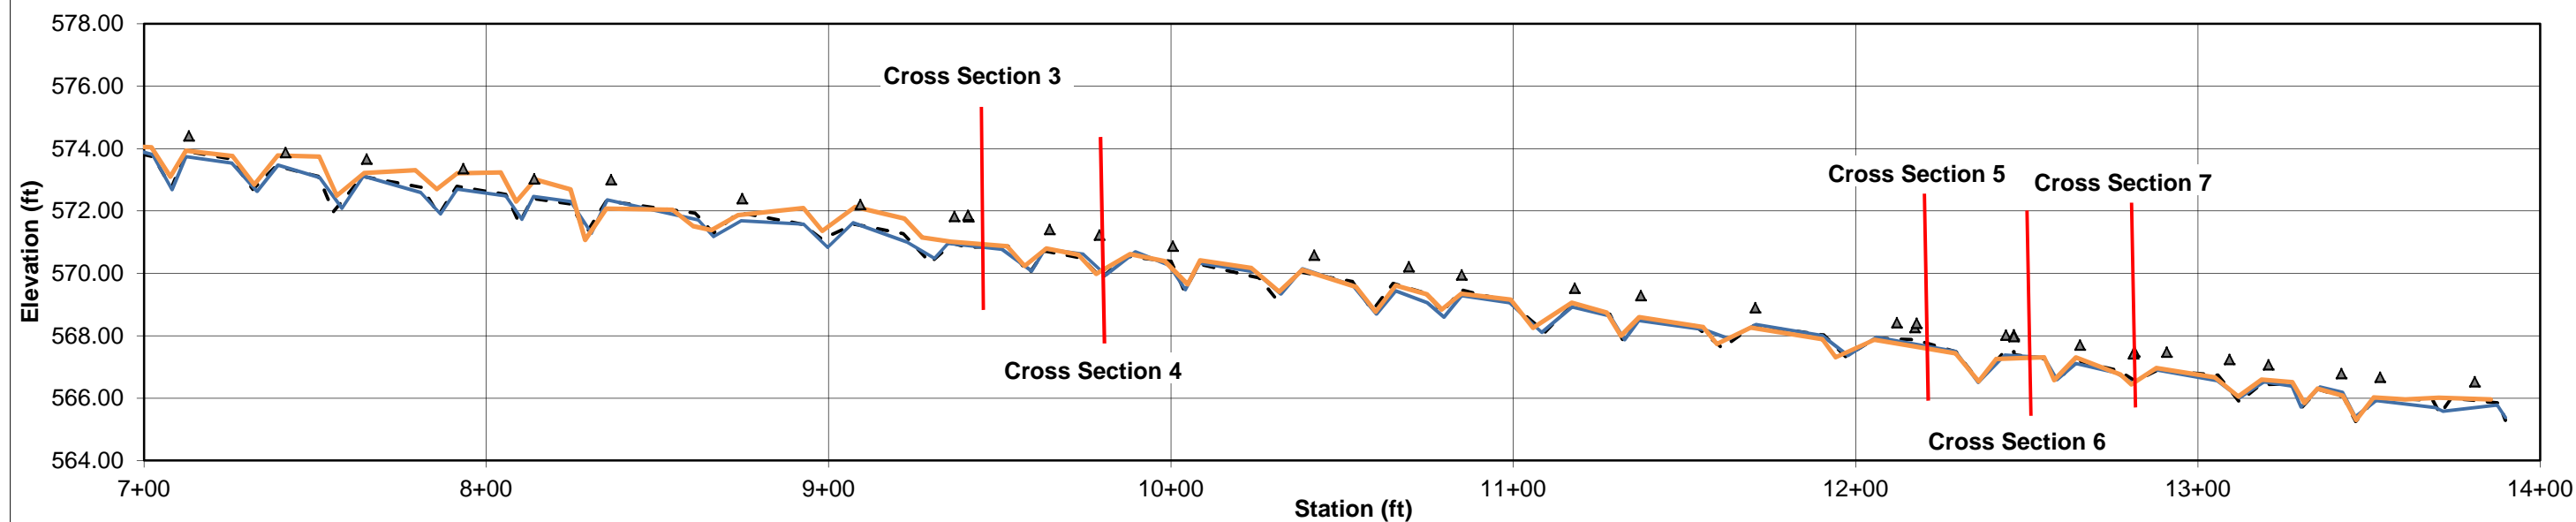

Tributaries of Wicker Branch - Tributary 3 Longitudinal Profile

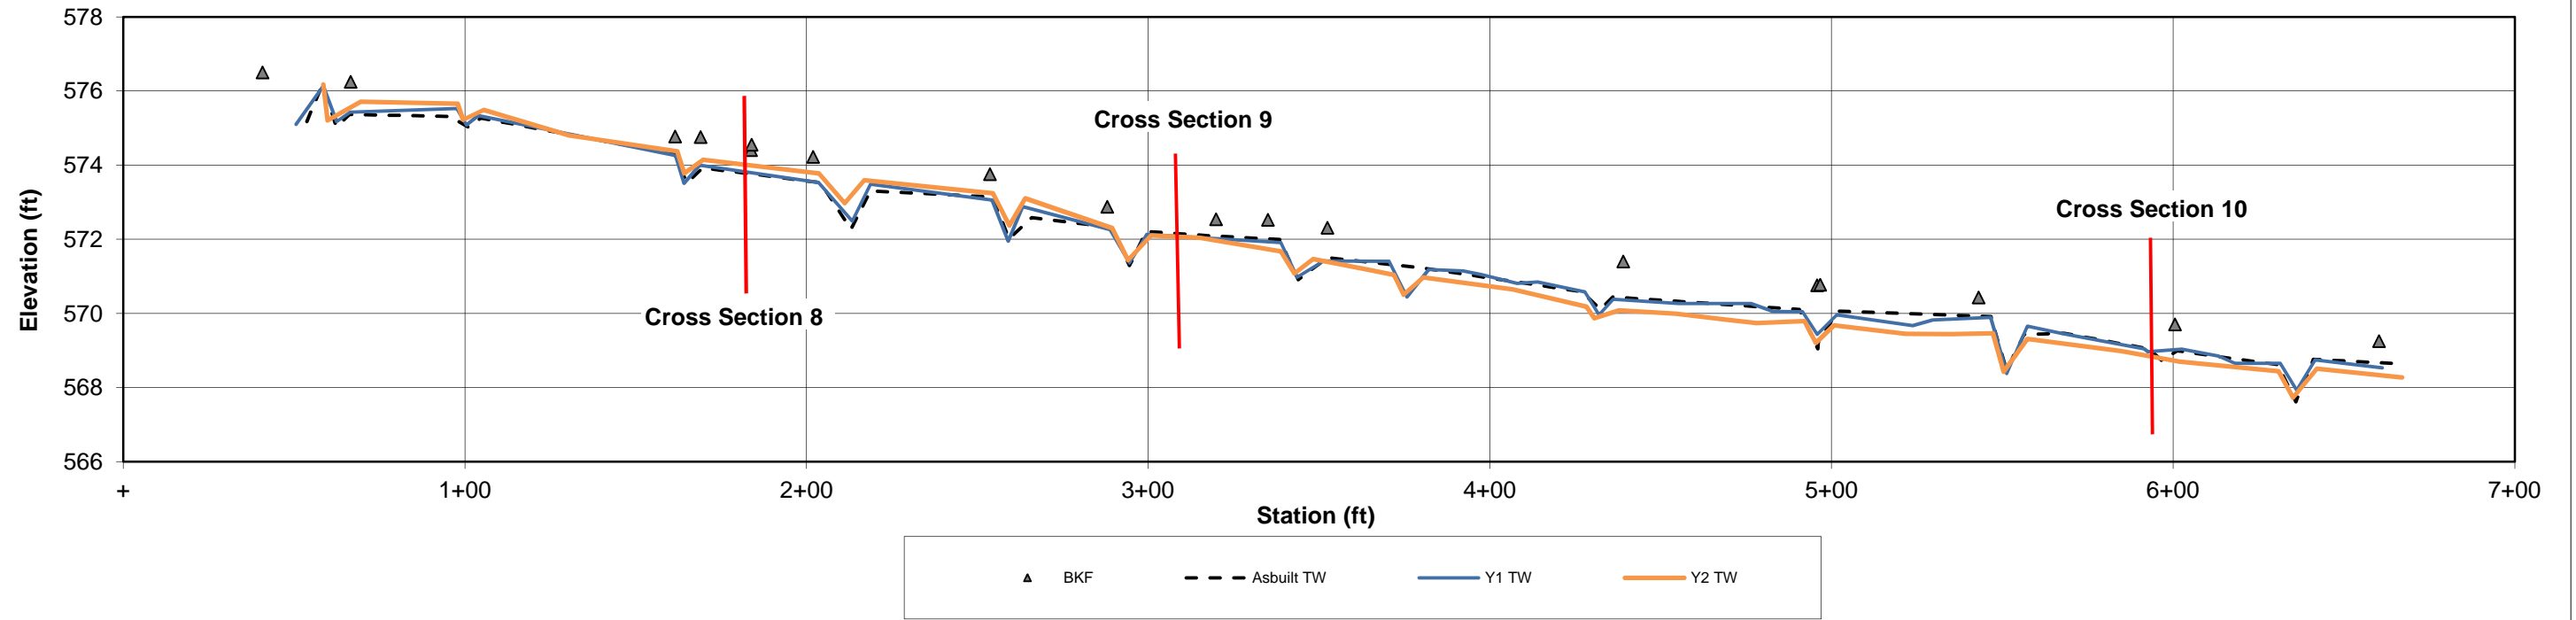

Tributaries of Wicker Branch - Tributary 4 Longitudinal Profile


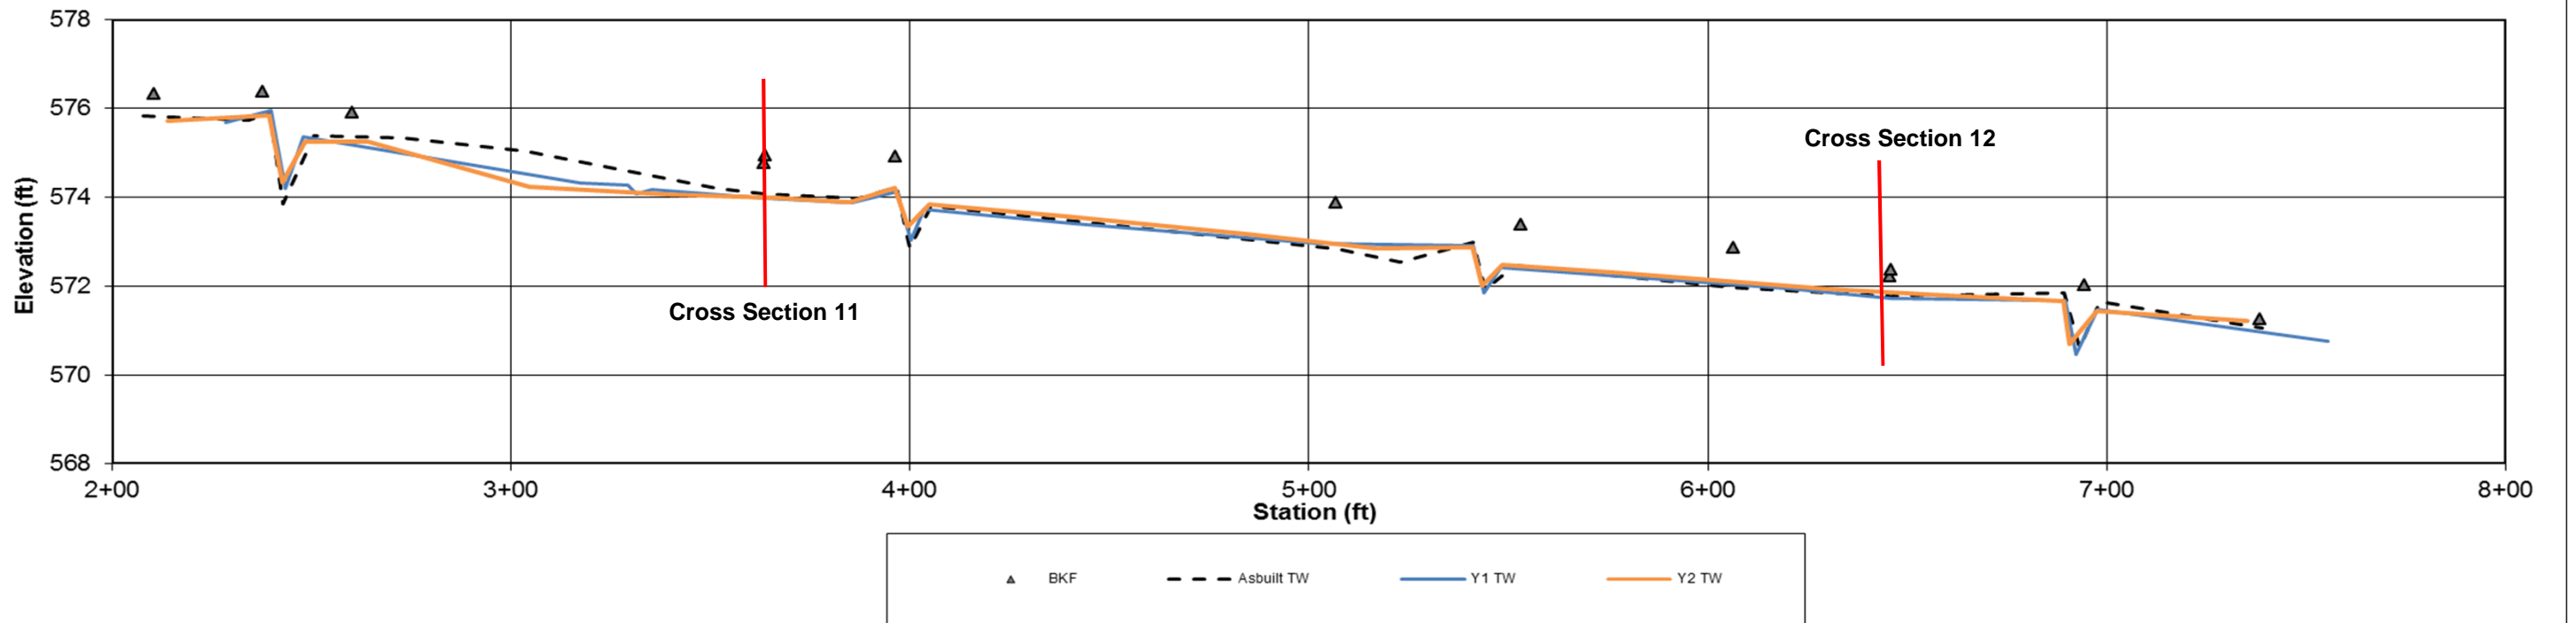


## Cross - Section Pebble Count

Project Name : Tributaries of Wickers Branch  
 Cross Section: 1  
 Feature: Riffle

Description	Particle	Millimeter	Total #	Item %	Cum %
S/C	Silt/Clay	< 0.062	3	6%	6%
S A N D	Very Fine	.062 - .125	0	0%	6%
	Fine	.125 - .25	0	0%	6%
	Medium	.25 - .50	0	0%	6%
	Coarse	.50 - 1.0	0	0%	6%
S	Very Coarse	1.0 - 2.0	0	0%	6%
G R A V E L S	Very Fine	2.0 - 4.0	0	0%	6%
	Fine	4.0 - 5.7	0	0%	6%
	Fine	5.7 - 8.0	0	0%	6%
	Medium	8.0 - 11.3	1	2%	8%
	Medium	11.3 - 16.0	4	8%	16%
	Coarse	16.0 - 22.6	5	10%	26%
	Coarse	22.6 - 32.0	13	26%	52%
	Very Coarse	32.0 - 45.0	13	26%	78%
	Very Coarse	45.0 - 64.0	7	14%	92%
C O B L	Small	64 - 90	4	8%	100%
	Small	90 - 128	0	0%	100%
	Large	128 - 180	0	0%	100%
L	Large	180 - 256	0	0%	100%
B L	Small	256 - 362	0	0%	100%
	Small	362 - 512	0	0%	100%
D R	Medium	512 - 1024	0	0%	100%
	Lrg- Very Lrg	1024 - 2048	0	0%	100%
BDRK	Bedrock		0	0%	100%
<b>Totals</b>			<b>50</b>	<b>100%</b>	

Summary Data	
D50	31
D84	53
D95	74

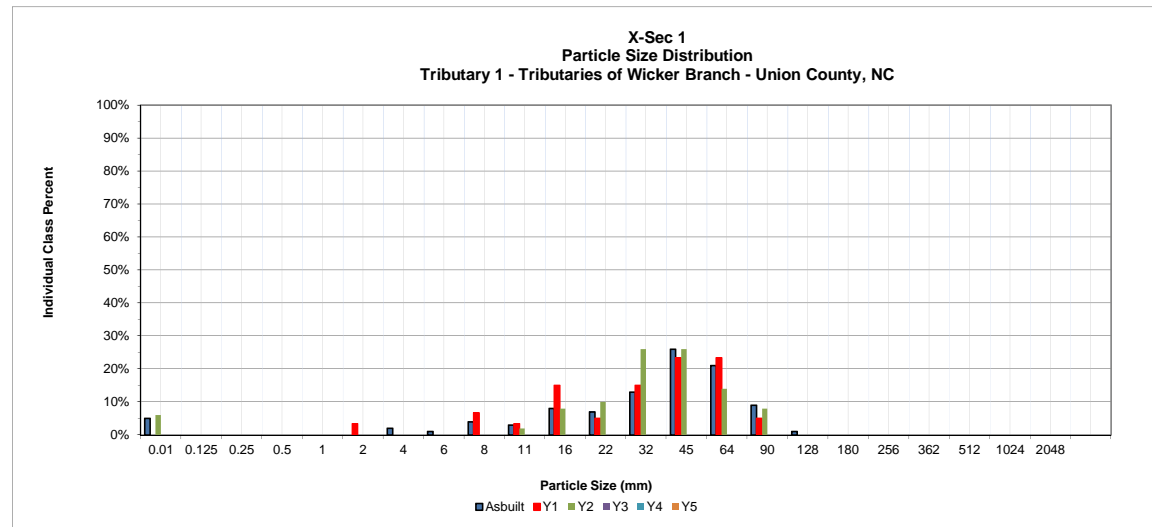
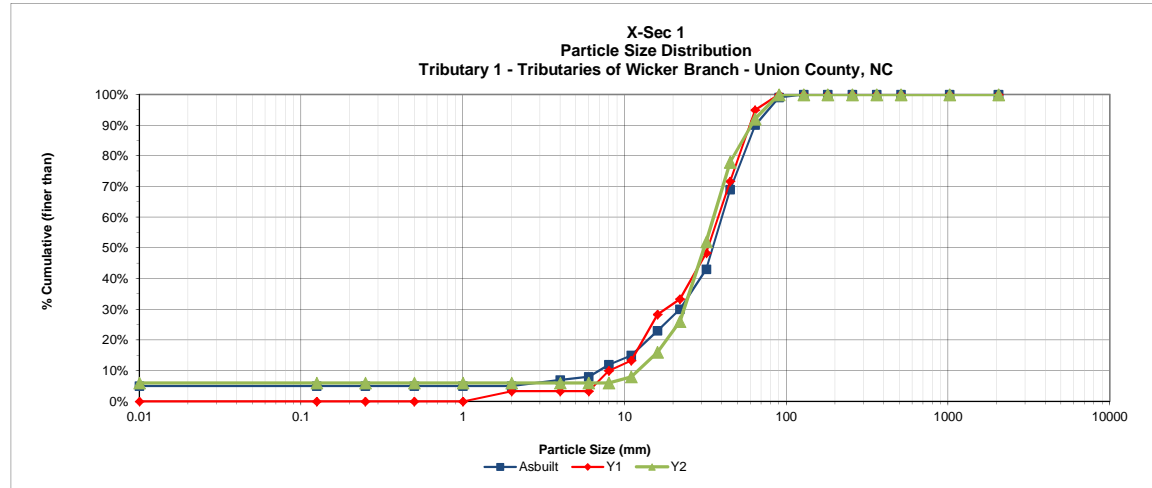


## Cross - Section Pebble Count

Project Name : Tributaries of Wickers Branch  
 Cross Section: 2  
 Feature: Pool

Description	Particle	Millimeter	Total #	Item %	Cum %
S/C	Silt/Clay	< 0.062	14	28%	28%
S	Very Fine	.062 - .125	0	0%	28%
	Fine	.125 - .25	0	0%	28%
N	Medium	.25 - .50	0	0%	28%
D	Coarse	.50 - 1.0	18	36%	64%
S	Very Coarse	1.0 - 2.0	0	0%	64%
G	Very Fine	2.0 - 4.0	0	0%	64%
	Fine	4.0 - 5.7	0	0%	64%
R	Fine	5.7 - 8.0	0	0%	64%
A	Medium	8.0 - 11.3	0	0%	64%
V	Medium	11.3 - 16.0	3	6%	70%
E	Coarse	16.0 - 22.6	3	6%	76%
L	Coarse	22.6 - 32.0	2	4%	80%
S	Very Coarse	32.0 - 45.0	6	12%	92%
C	Very Coarse	45.0 - 64.0	1	2%	94%
	Small	64 - 90	2	4%	98%
O	Small	90 - 128	1	2%	100%
B	Large	128 - 180	0	0%	100%
L	Large	180 - 256	0	0%	100%
B	Small	256 - 362	0	0%	100%
L	Small	362 - 512	0	0%	100%
D	Medium	512 - 1024	0	0%	100%
R	Lrg- Very Lrg	1024 - 2048	0	0%	100%
BDRK	Bedrock		0	0%	100%
<b>Totals</b>			<b>50</b>	<b>100%</b>	

Summary Data	
D50	0.81
D84	36
D95	70

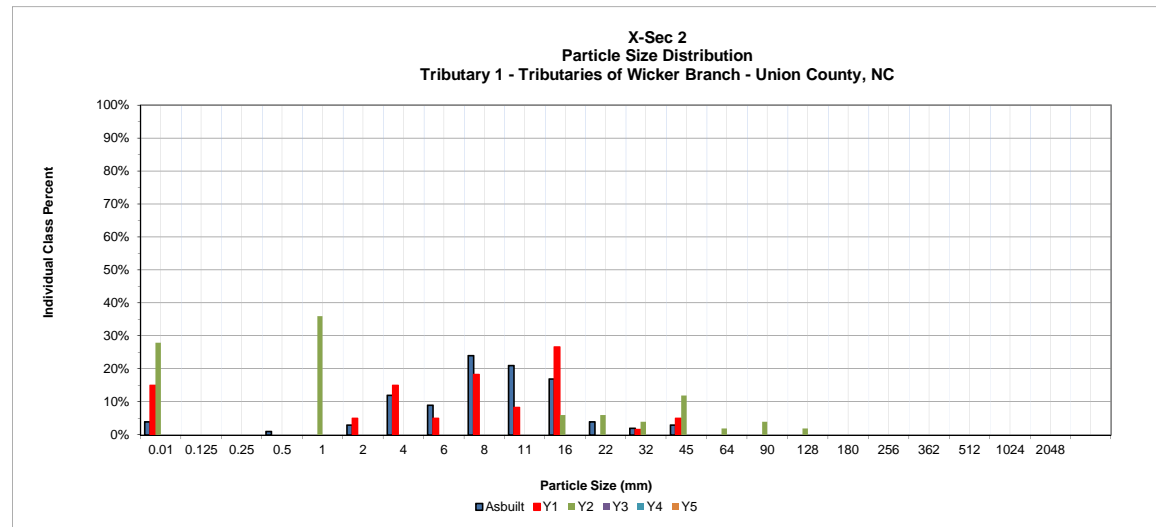
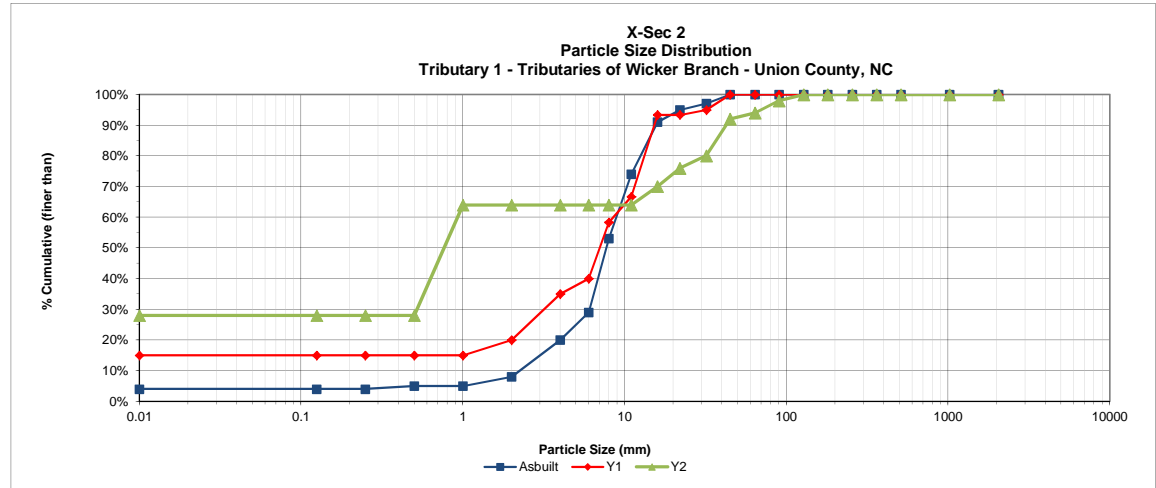


## Cross - Section Pebble Count

Project Name : Tributaries of Wickers Branch  
 Cross Section: 3  
 Feature: Riffle

Description	Particle	Millimeter	Total #	Item %	Cum %
S/C	Silt/Clay	< 0.062	2	3%	3%
S A N D	Very Fine	.062 - .125	0	0%	3%
	Fine	.125 - .25	0	0%	3%
	Medium	.25 - .50	0	0%	3%
	Coarse	.50 - 1.0	0	0%	3%
S	Very Coarse	1.0 - 2.0	1	2%	5%
G R A V E L S	Very Fine	2.0 - 4.0	2	3%	8%
	Fine	4.0 - 5.7	3	5%	13%
	Fine	5.7 - 8.0	6	10%	23%
	Medium	8.0 - 11.3	3	5%	28%
	Medium	11.3 - 16.0	6	10%	38%
	Coarse	16.0 - 22.6	6	10%	48%
	Coarse	22.6 - 32.0	1	2%	50%
	Very Coarse	32.0 - 45.0	6	10%	60%
C O B B L E S	Very Coarse	45.0 - 64.0	6	10%	70%
	Small	64 - 90	13	22%	92%
B L O C K S	Small	90 - 128	3	5%	97%
	Large	128 - 180	2	3%	100%
B L O C K S	Large	180 - 256	0	0%	100%
	Small	256 - 362	0	0%	100%
L A R G E B L O C K S	Small	362 - 512	0	0%	100%
	Medium	512 - 1024	0	0%	100%
R O U N D B L O C K S	Lrg- Very Lrg	1024 - 2048	0	0%	100%
	Bedrock		0	0%	100%
<b>Totals</b>			<b>60</b>	<b>100%</b>	

Summary Data	
D50	73
D84	124
D95	167

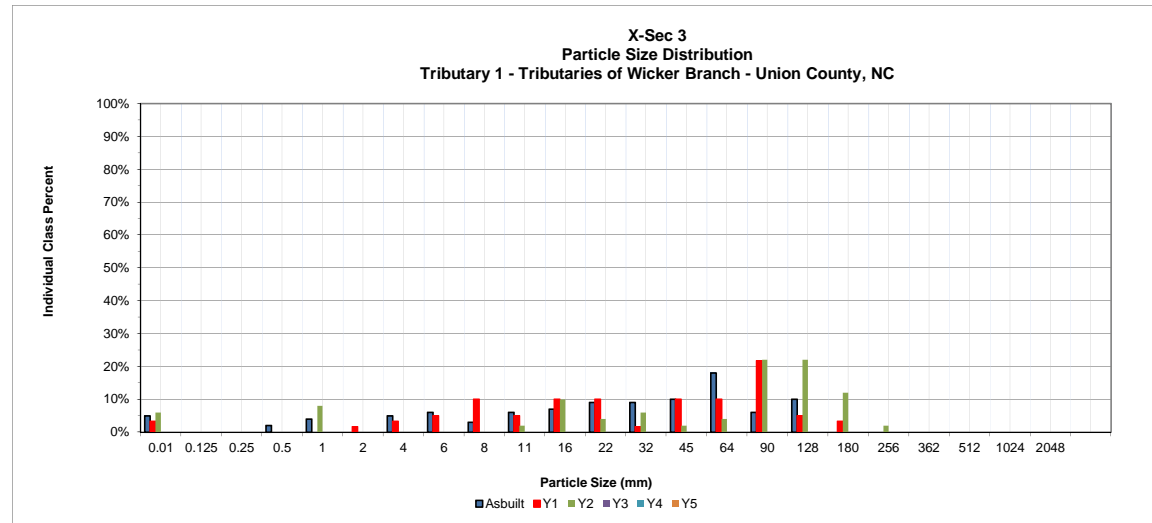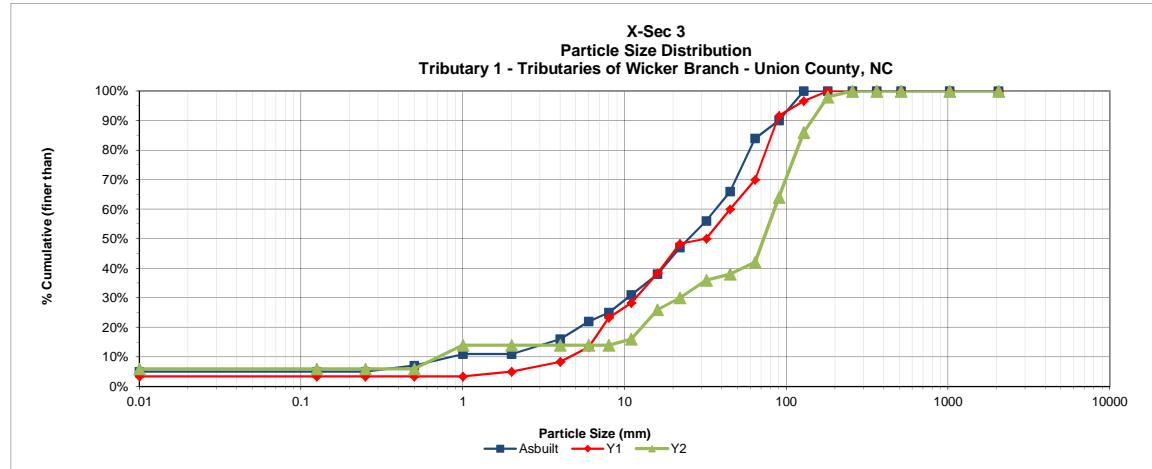





## Cross - Section Pebble Count

Project Name : Tributaries of Wickers Branch  
 Cross Section: 4  
 Feature: Pool

Description	Particle	Millimeter	Total #	Item %	Cum %
S/C	Silt/Clay	< 0.062	33	65%	65%
S	Very Fine	.062 - .125	0	0%	65%
	Fine	.125 - .25	0	0%	65%
N	Medium	.25 - .50	0	0%	65%
	Coarse	.50 - 1.0	8	16%	80%
S	Very Coarse	1.0 - 2.0	0	0%	80%
G	Very Fine	2.0 - 4.0	0	0%	80%
	Fine	4.0 - 5.7	0	0%	80%
R	Fine	5.7 - 8.0	0	0%	80%
A	Medium	8.0 - 11.3	1	2%	82%
V	Medium	11.3 - 16.0	1	2%	84%
E	Coarse	16.0 - 22.6	2	4%	88%
	Coarse	22.6 - 32.0	2	4%	92%
S	Very Coarse	32.0 - 45.0	2	4%	96%
	Very Coarse	45.0 - 64.0	1	2%	98%
C	Small	64 - 90	1	2%	100%
	Small	90 - 128	0	0%	100%
B	Large	128 - 180	0	0%	100%
	Large	180 - 256	0	0%	100%
B	Small	256 - 362	0	0%	100%
L	Small	362 - 512	0	0%	100%
D	Medium	512 - 1024	0	0%	100%
R	Lrg- Very Lrg	1024 - 2048	0	0%	100%
BDRK	Bedrock		0	0%	100%
<b>Totals</b>			<b>51</b>	<b>100%</b>	

Summary Data	
D50	0.05
D84	15
D95	41

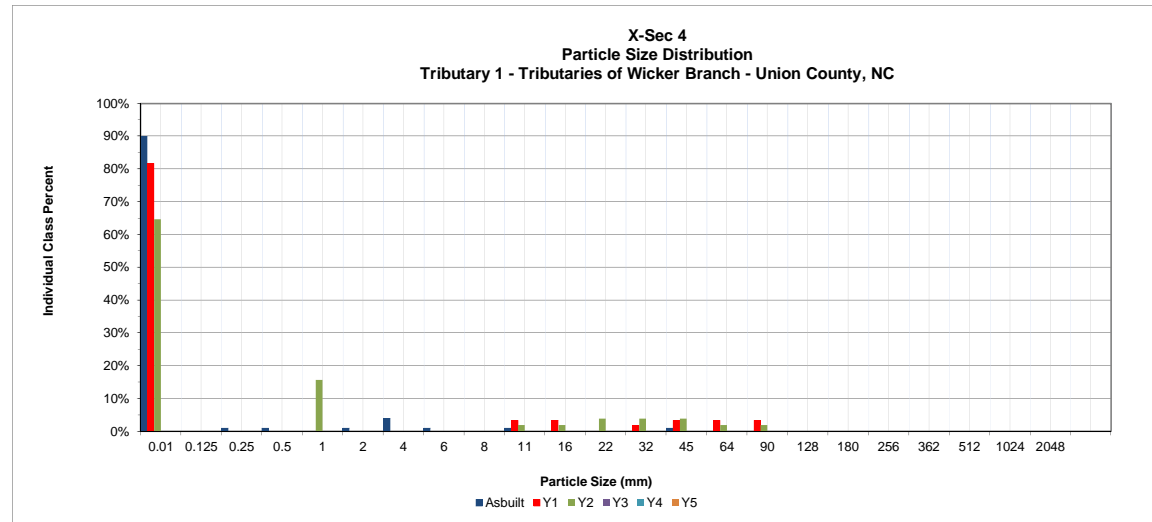
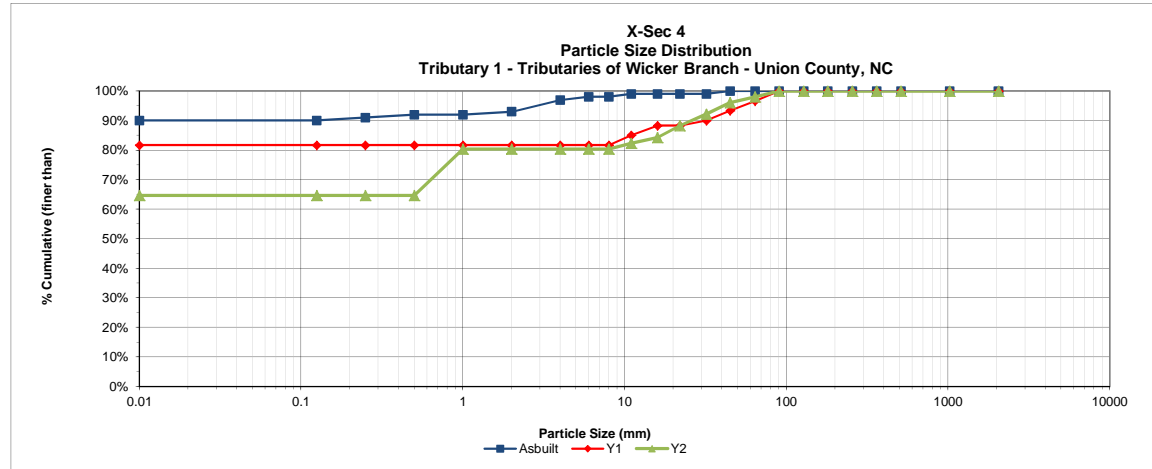


## Cross - Section Pebble Count

Project Name : Tributaries of Wickers Branch  
 Cross Section: 5  
 Feature: Riffle

Description	Particle	Millimeter	Total #	Item %	Cum %
S/C	Silt/Clay	< 0.062	1	2%	2%
S	Very Fine	.062 - .125	0	0%	2%
	Fine	.125 - .25	0	0%	2%
N	Medium	.25 - .50	4	8%	10%
D	Coarse	.50 - 1.0	4	8%	18%
S	Very Coarse	1.0 - 2.0	1	2%	20%
G	Very Fine	2.0 - 4.0	0	0%	20%
	Fine	4.0 - 5.7	0	0%	20%
R	Fine	5.7 - 8.0	0	0%	20%
A	Medium	8.0 - 11.3	0	0%	20%
V	Medium	11.3 - 16.0	0	0%	20%
E	Coarse	16.0 - 22.6	0	0%	20%
L	Coarse	22.6 - 32.0	7	14%	34%
S	Very Coarse	32.0 - 45.0	8	16%	50%
C	Very Coarse	45.0 - 64.0	18	36%	86%
	Small	64 - 90	4	8%	94%
O	Small	90 - 128	3	6%	100%
B	Large	128 - 180	0	0%	100%
L	Large	180 - 256	0	0%	100%
B	Small	256 - 362	0	0%	100%
L	Small	362 - 512	0	0%	100%
D	Medium	512 - 1024	0	0%	100%
R	Lrg- Very Lrg	1024 - 2048	0	0%	100%
BDRK	Bedrock		0	0%	100%
<b>Totals</b>			<b>50</b>	<b>100%</b>	

Summary Data	
D50	45
D84	63
D95	96

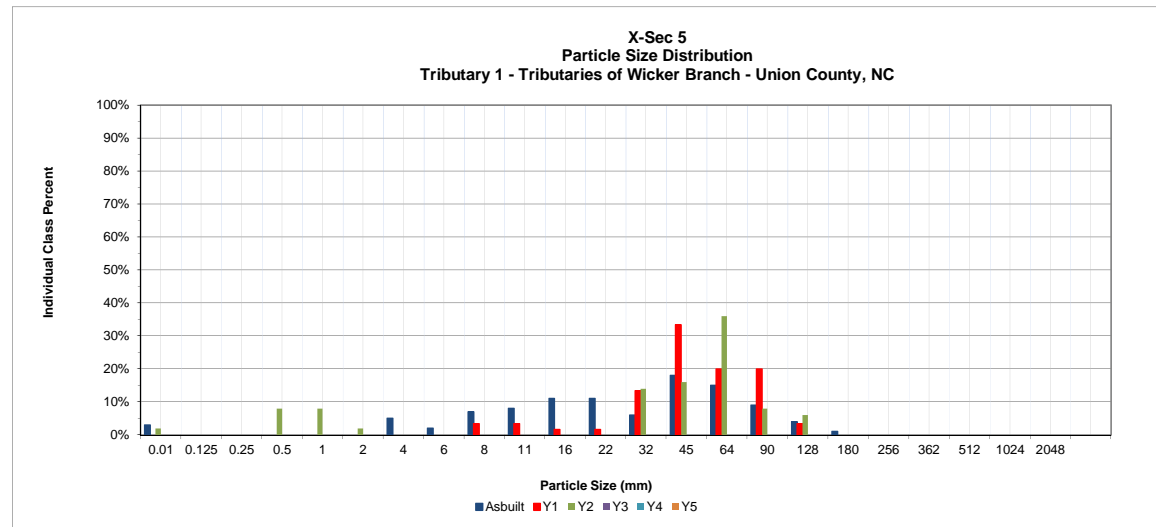
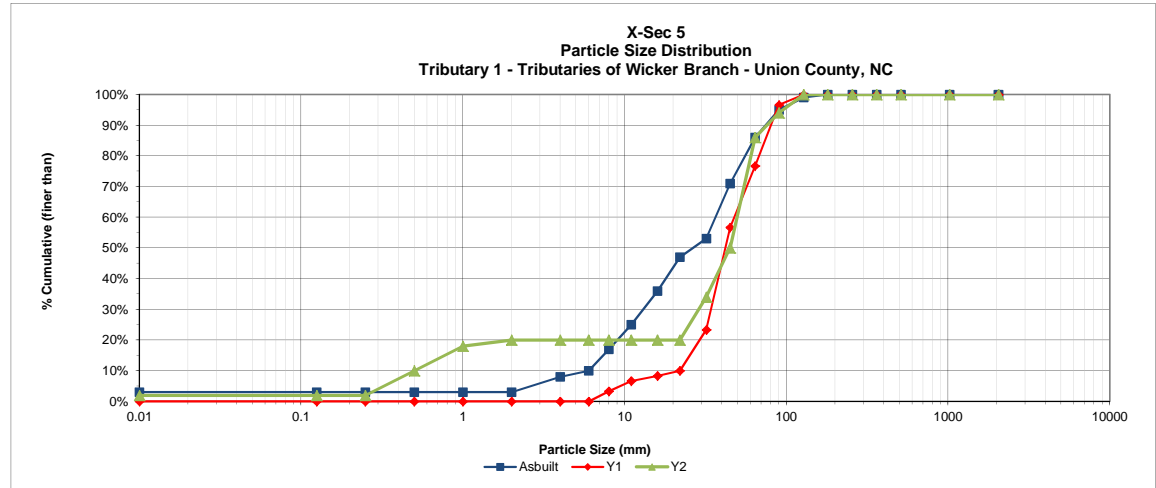


## Cross - Section Pebble Count

Project Name : Tributaries of Wickers Branch  
 Cross Section: 6  
 Feature: Riffle

Description	Particle	Millimeter	Total #	Item %	Cum %
S/C	Silt/Clay	< 0.062	4	8%	8%
S	Very Fine	.062 - .125	0	0%	8%
	Fine	.125 - .25	3	6%	14%
N	Medium	.25 - .50	0	0%	14%
D	Coarse	.50 - 1.0	3	6%	20%
S	Very Coarse	1.0 - 2.0	0	0%	20%
G	Very Fine	2.0 - 4.0	2	4%	24%
	Fine	4.0 - 5.7	0	0%	24%
R	Fine	5.7 - 8.0	0	0%	24%
A	Medium	8.0 - 11.3	0	0%	24%
V	Medium	11.3 - 16.0	0	0%	24%
E	Coarse	16.0 - 22.6	0	0%	24%
L	Coarse	22.6 - 32.0	2	4%	28%
S	Very Coarse	32.0 - 45.0	15	30%	58%
C	Very Coarse	45.0 - 64.0	13	26%	84%
	Small	64 - 90	7	14%	98%
O	Small	90 - 128	1	2%	100%
B	Large	128 - 180	0	0%	100%
L	Large	180 - 256	0	0%	100%
B	Small	256 - 362	0	0%	100%
L	Small	362 - 512	0	0%	100%
D	Medium	512 - 1024	0	0%	100%
R	Lrg- Very Lrg	1024 - 2048	0	0%	100%
BDRK	Bedrock		0	0%	100%
<b>Totals</b>			<b>50</b>	<b>100%</b>	

Summary Data	
D50	41
D84	64
D95	84

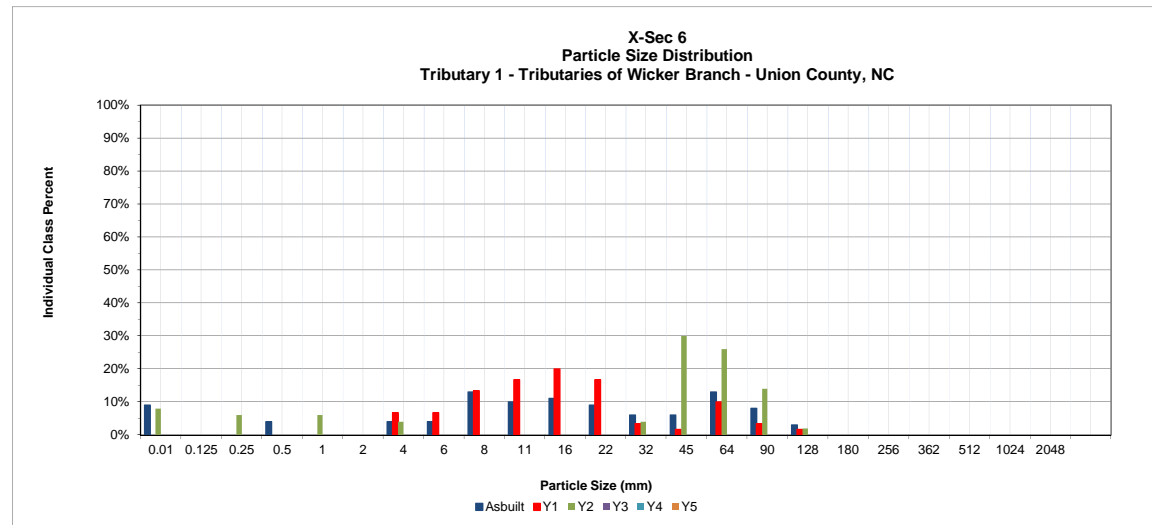
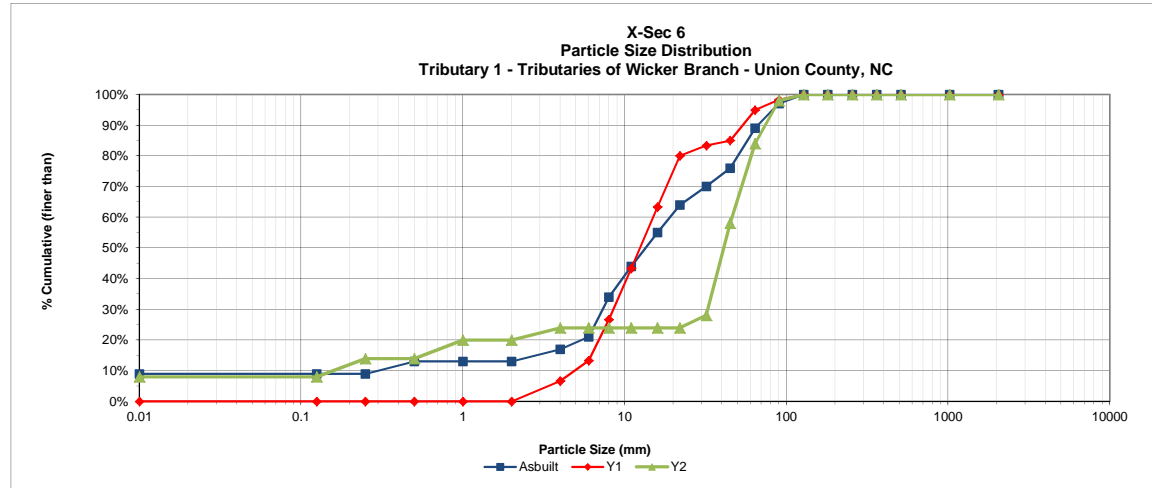


## Cross - Section Pebble Count

Project Name : Tributaries of Wickers Branch  
 Cross Section: 7  
 Feature: Pool

Description	Particle	Millimeter	Total #	Item %	Cum %
S/C	Silt/Clay	< 0.062	16	32%	32%
S	Very Fine	.062 - .125	0	0%	32%
	Fine	.125 - .25	5	10%	42%
N	Medium	.25 - .50	1	2%	44%
D	Coarse	.50 - 1.0	5	10%	54%
S	Very Coarse	1.0 - 2.0	0	0%	54%
G	Very Fine	2.0 - 4.0	5	10%	64%
	Fine	4.0 - 5.7	0	0%	64%
R	Fine	5.7 - 8.0	0	0%	64%
A	Medium	8.0 - 11.3	0	0%	64%
V	Medium	11.3 - 16.0	2	4%	68%
E	Coarse	16.0 - 22.6	6	12%	80%
L	Coarse	22.6 - 32.0	5	10%	90%
S	Very Coarse	32.0 - 45.0	4	8%	98%
	Very Coarse	45.0 - 64.0	0	0%	98%
C	Small	64 - 90	1	2%	100%
	Small	90 - 128	0	0%	100%
B	Large	128 - 180	0	0%	100%
L	Large	180 - 256	0	0%	100%
B	Small	256 - 362	0	0%	100%
	Small	362 - 512	0	0%	100%
D	Medium	512 - 1024	0	0%	100%
R	Lrg- Very Lrg	1024 - 2048	0	0%	100%
BDRK	Bedrock		0	0%	100%
<b>Totals</b>			<b>50</b>	<b>100%</b>	

Summary Data	
D50	0.8
D84	26
D95	40

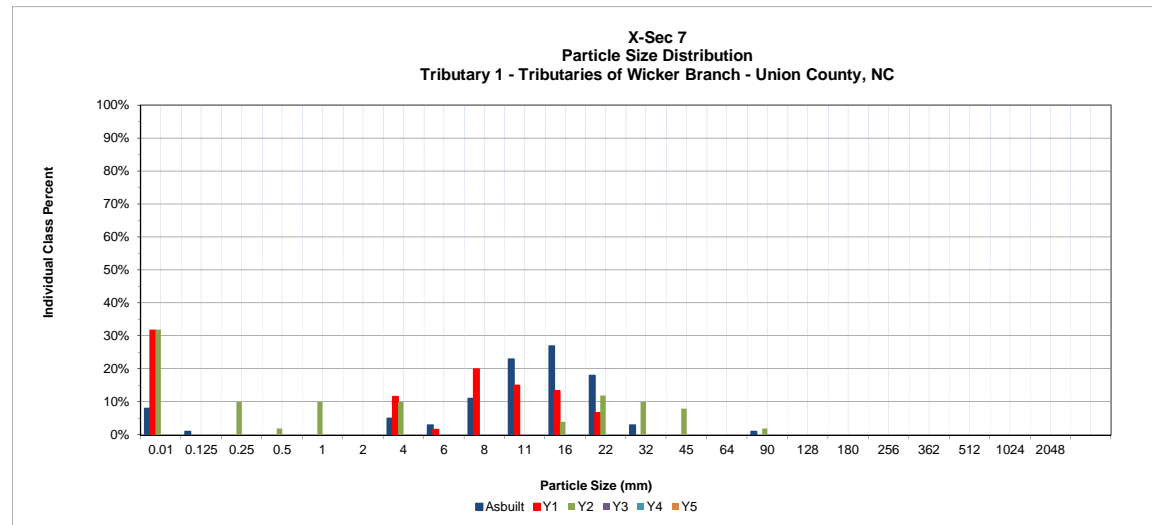
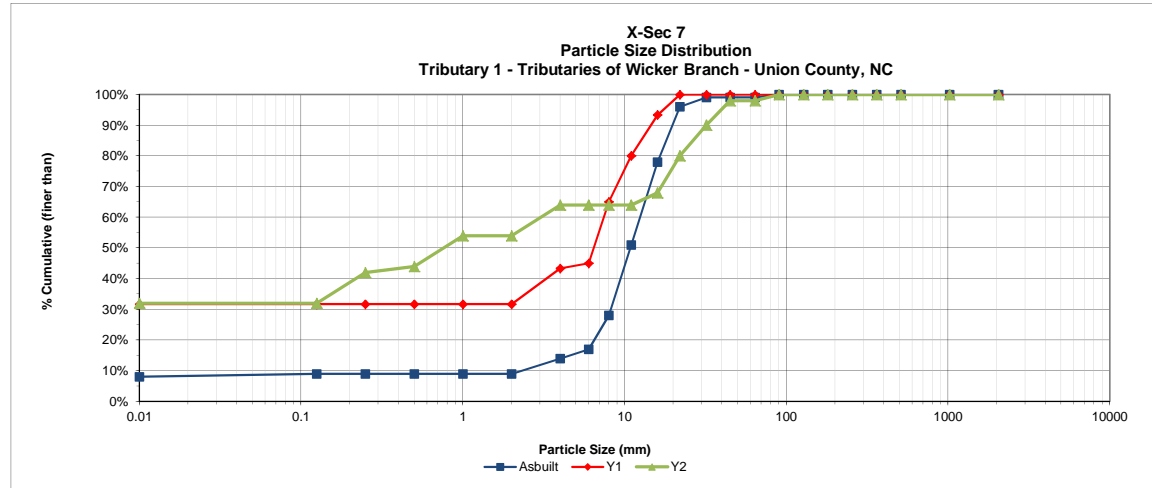


## Cross - Section Pebble Count

Project Name : Tributaries of Wickers Branch  
 Cross Section: 8  
 Feature: Riffle

Description	Particle	Millimeter	Total #	Item %	Cum %
S/C	Silt/Clay	< 0.062	48	96%	96%
S	Very Fine	.062 - .125	0	0%	96%
	Fine	.125 - .25	1	2%	98%
N	Medium	.25 - .50	0	0%	98%
D	Coarse	.50 - 1.0	0	0%	98%
S	Very Coarse	1.0 - 2.0	0	0%	98%
G	Very Fine	2.0 - 4.0	1	2%	100%
	Fine	4.0 - 5.7	0	0%	100%
R	Fine	5.7 - 8.0	0	0%	100%
A	Medium	8.0 - 11.3	0	0%	100%
V	Medium	11.3 - 16.0	0	0%	100%
E	Coarse	16.0 - 22.6	0	0%	100%
L	Coarse	22.6 - 32.0	0	0%	100%
S	Very Coarse	32.0 - 45.0	0	0%	100%
C	Very Coarse	45.0 - 64.0	0	0%	100%
	Small	64 - 90	0	0%	100%
O	Small	90 - 128	0	0%	100%
B	Large	128 - 180	0	0%	100%
L	Large	180 - 256	0	0%	100%
B	Small	256 - 362	0	0%	100%
L	Small	362 - 512	0	0%	100%
D	Medium	512 - 1024	0	0%	100%
R	Lrg- Very Lrg	1024 - 2048	0	0%	100%
BDRK	Bedrock		0	0%	100%
<b>Totals</b>			<b>50</b>	<b>100%</b>	

Summary Data	
D50	0.03
D84	0.05
D95	0.06

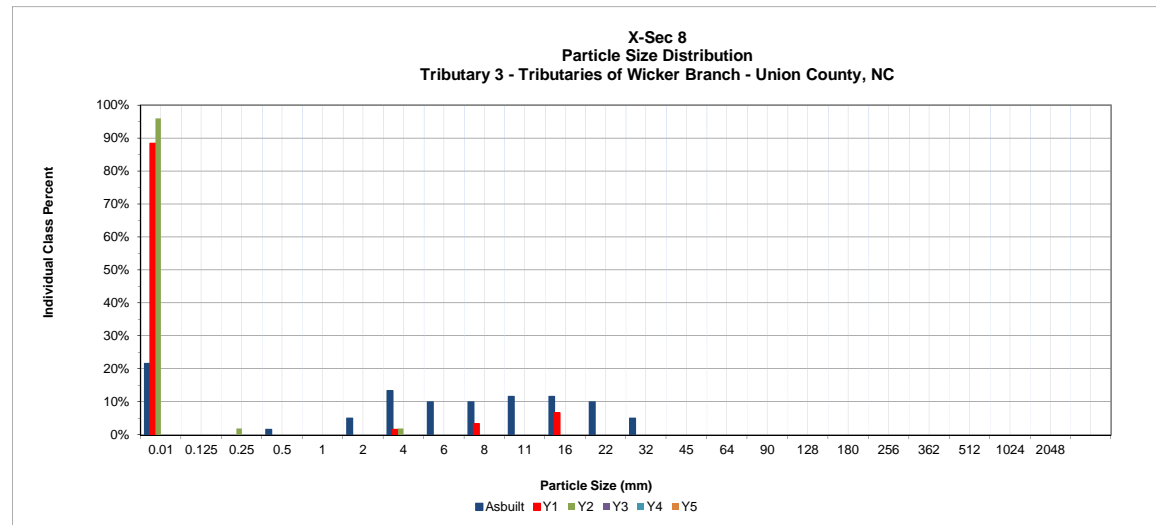
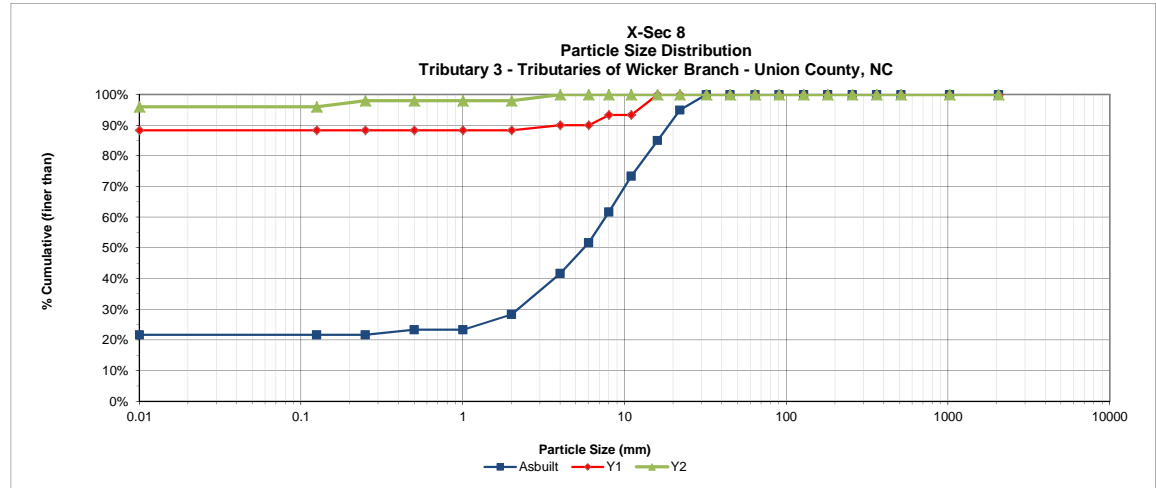


## Cross - Section Pebble Count

Project Name : Tributaries of Wickers Branch  
 Cross Section: 9  
 Feature: Riffle

Description	Particle	Millimeter	Total #	Item %	Cum %
S/C	Silt/Clay	< 0.062	40	78%	78%
S A N D	Very Fine	.062 - .125	0	0%	78%
	Fine	.125 - .25	0	0%	78%
	Medium	.25 - .50	0	0%	78%
	Coarse	.50 - 1.0	0	0%	78%
S	Very Coarse	1.0 - 2.0	1	2%	80%
G R A V E L S	Very Fine	2.0 - 4.0	0	0%	80%
	Fine	4.0 - 5.7	0	0%	80%
	Fine	5.7 - 8.0	0	0%	80%
	Medium	8.0 - 11.3	0	0%	80%
	Medium	11.3 - 16.0	0	0%	80%
	Coarse	16.0 - 22.6	0	0%	80%
	Coarse	22.6 - 32.0	1	2%	82%
	Very Coarse	32.0 - 45.0	3	6%	88%
	Very Coarse	45.0 - 64.0	5	10%	98%
C O B L	Small	64 - 90	1	2%	100%
	Small	90 - 128	0	0%	100%
	Large	128 - 180	0	0%	100%
L	Large	180 - 256	0	0%	100%
B L	Small	256 - 362	0	0%	100%
	Small	362 - 512	0	0%	100%
D R	Medium	512 - 1024	0	0%	100%
	Lrg- Very Lrg	1024 - 2048	0	0%	100%
BDRK	Bedrock		0	0%	100%
<b>Totals</b>			<b>51</b>	<b>100%</b>	

Summary Data	
D50	0.04
D84	36
D95	58

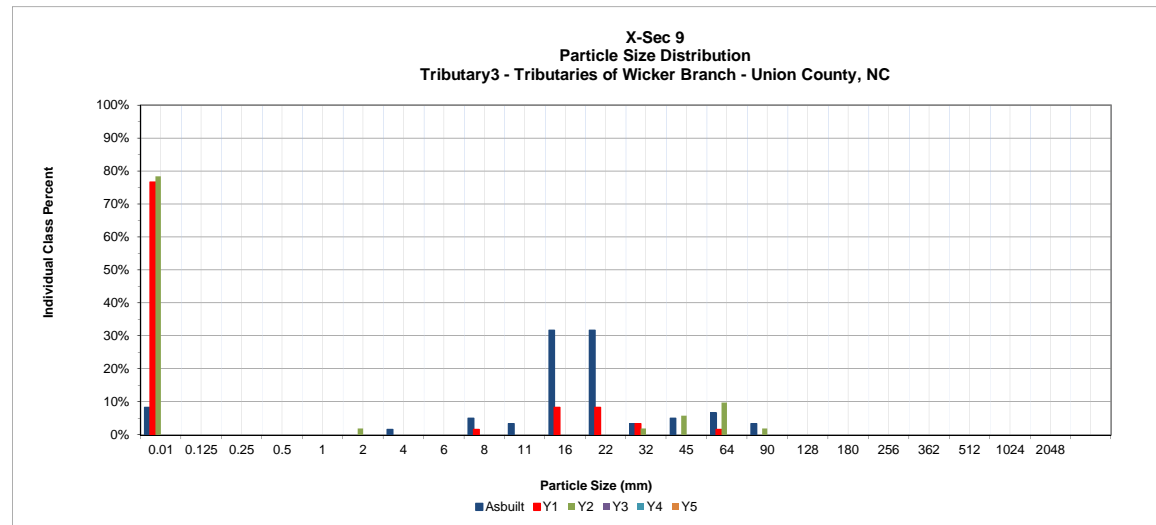
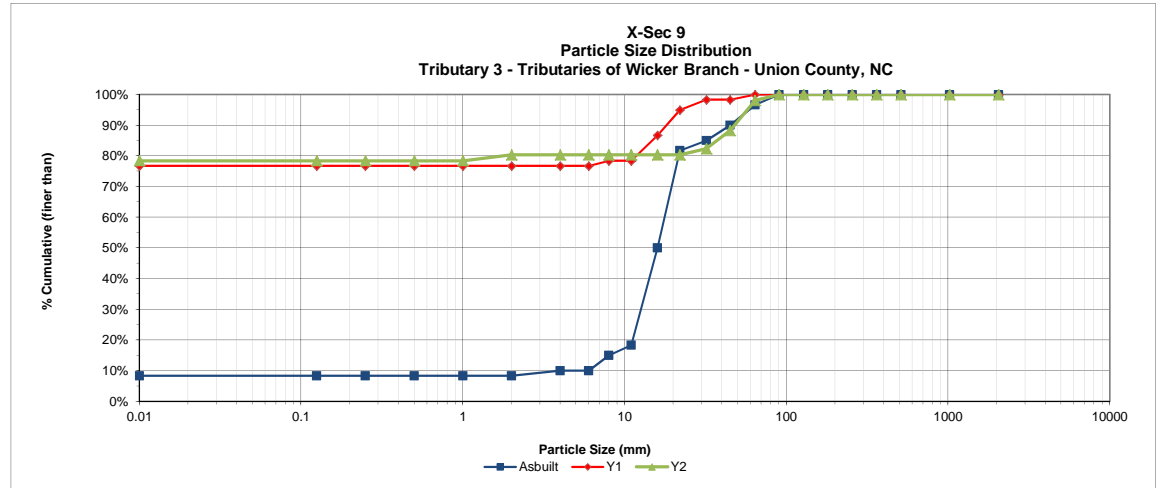


## Cross - Section Pebble Count

Project Name : Tributaries of Wickers Branch  
 Cross Section: 10  
 Feature: Pool

Description	Particle	Millimeter	Total #	Item %	Cum %
S/C	Silt/Clay	< 0.062	50	100%	100%
S	Very Fine	.062 - .125	0	0%	100%
	Fine	.125 - .25	0	0%	100%
N	Medium	.25 - .50	0	0%	100%
D	Coarse	.50 - 1.0	0	0%	100%
S	Very Coarse	1.0 - 2.0	0	0%	100%
G	Very Fine	2.0 - 4.0	0	0%	100%
	Fine	4.0 - 5.7	0	0%	100%
R	Fine	5.7 - 8.0	0	0%	100%
A	Medium	8.0 - 11.3	0	0%	100%
V	Medium	11.3 - 16.0	0	0%	100%
E	Coarse	16.0 - 22.6	0	0%	100%
L	Coarse	22.6 - 32.0	0	0%	100%
S	Very Coarse	32.0 - 45.0	0	0%	100%
C	Very Coarse	45.0 - 64.0	0	0%	100%
	Small	64 - 90	0	0%	100%
O	Small	90 - 128	0	0%	100%
B	Large	128 - 180	0	0%	100%
L	Large	180 - 256	0	0%	100%
B	Small	256 - 362	0	0%	100%
	Small	362 - 512	0	0%	100%
D	Medium	512 - 1024	0	0%	100%
R	Lrg- Very Lrg	1024 - 2048	0	0%	100%
BDRK	Bedrock		0	0%	100%
<b>Totals</b>			<b>50</b>	<b>100%</b>	

Summary Data	
D50	0.03
D84	0.05
D95	0.06

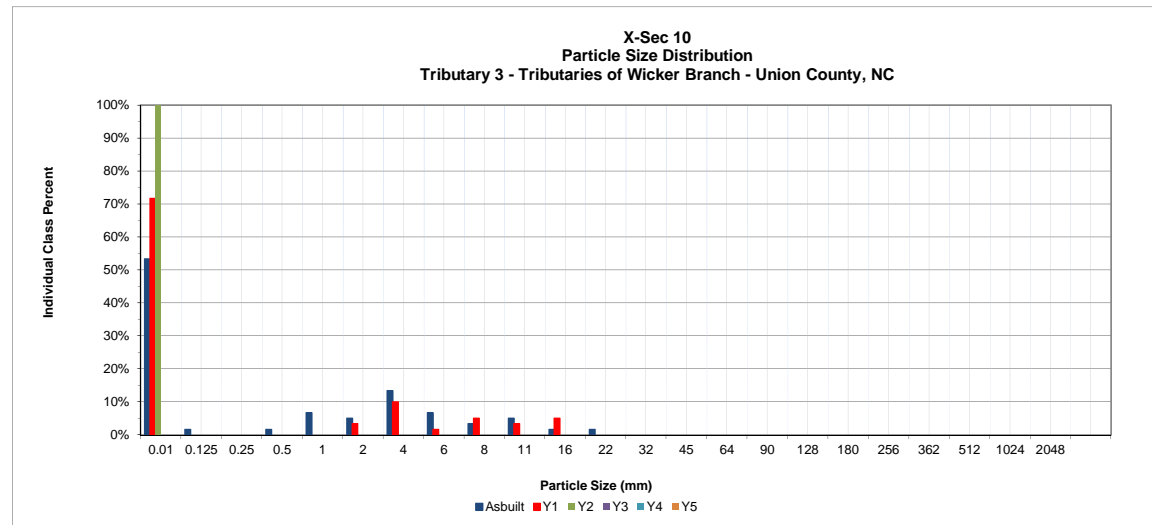
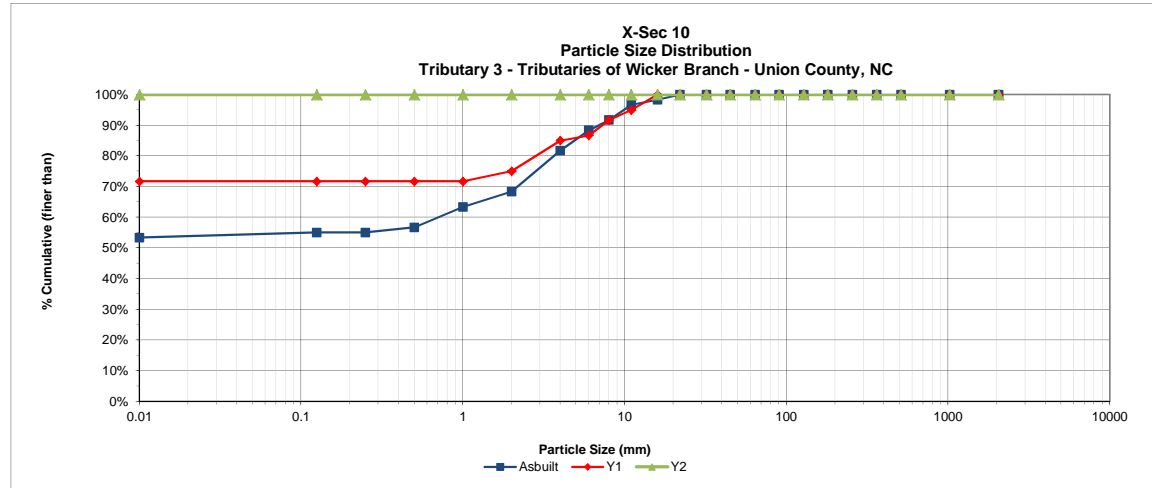


## Cross - Section Pebble Count

Project Name : Tributaries of Wickers Branch  
 Cross Section: 11  
 Feature: Riffle

Description	Particle	Millimeter	Total #	Item %	Cum %
S/C	Silt/Clay	< 0.062	50	100%	100%
S	Very Fine	.062 - .125	0	0%	100%
	Fine	.125 - .25	0	0%	100%
N	Medium	.25 - .50	0	0%	100%
D	Coarse	.50 - 1.0	0	0%	100%
S	Very Coarse	1.0 - 2.0	0	0%	100%
G	Very Fine	2.0 - 4.0	0	0%	100%
	Fine	4.0 - 5.7	0	0%	100%
R	Fine	5.7 - 8.0	0	0%	100%
A	Medium	8.0 - 11.3	0	0%	100%
V	Medium	11.3 - 16.0	0	0%	100%
E	Coarse	16.0 - 22.6	0	0%	100%
L	Coarse	22.6 - 32.0	0	0%	100%
S	Very Coarse	32.0 - 45.0	0	0%	100%
	Very Coarse	45.0 - 64.0	0	0%	100%
C	Small	64 - 90	0	0%	100%
	Small	90 - 128	0	0%	100%
B	Large	128 - 180	0	0%	100%
L	Large	180 - 256	0	0%	100%
B	Small	256 - 362	0	0%	100%
	Small	362 - 512	0	0%	100%
D	Medium	512 - 1024	0	0%	100%
R	Lrg- Very Lrg	1024 - 2048	0	0%	100%
BDRK	Bedrock		0	0%	100%
<b>Totals</b>			<b>50</b>	<b>100%</b>	

Summary Data	
D50	0.03
D84	0.05
D95	0.06

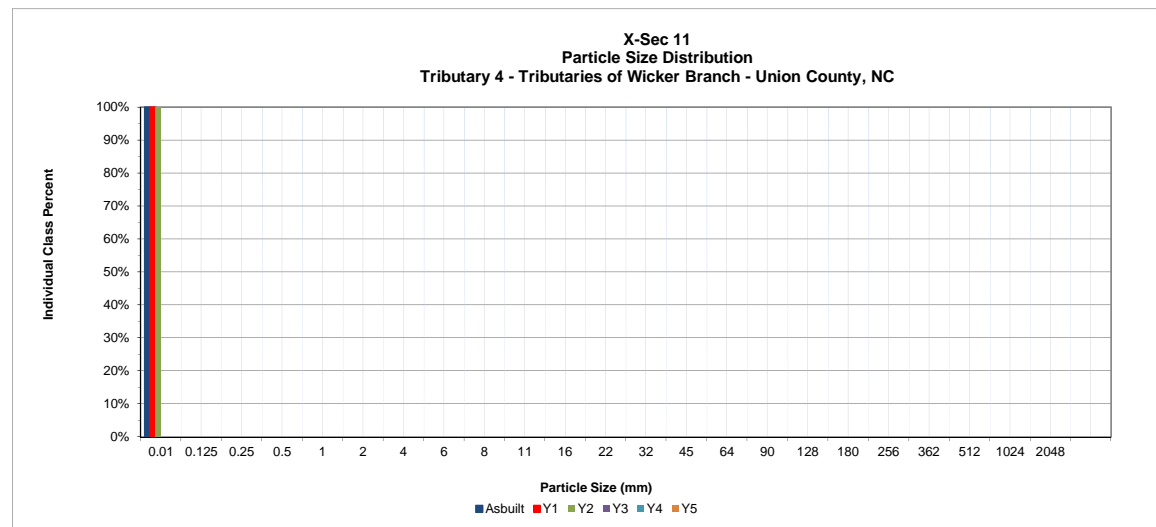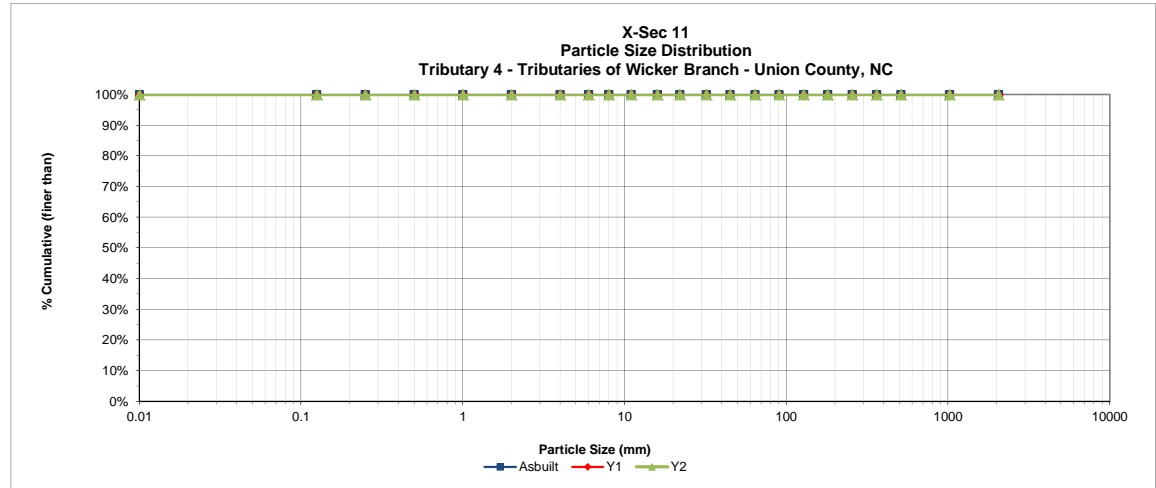





## Cross - Section Pebble Count

Project Name : Tributaries of Wickers Branch  
 Cross Section: 12  
 Feature: Riffle

Description	Particle	Millimeter	Total #	Item %	Cum %
S/C	Silt/Clay	< 0.062	46	92%	92%
S	Very Fine	.062 - .125	0	0%	92%
	Fine	.125 - .25	0	0%	92%
N	Medium	.25 - .50	0	0%	92%
	Coarse	.50 - 1.0	1	2%	94%
S	Very Coarse	1.0 - 2.0	0	0%	94%
G	Very Fine	2.0 - 4.0	1	2%	96%
	Fine	4.0 - 5.7	0	0%	96%
R	Fine	5.7 - 8.0	0	0%	96%
	Medium	8.0 - 11.3	0	0%	96%
V	Medium	11.3 - 16.0	0	0%	96%
	Coarse	16.0 - 22.6	1	2%	98%
L	Coarse	22.6 - 32.0	1	2%	100%
	Very Coarse	32.0 - 45.0	0	0%	100%
S	Very Coarse	45.0 - 64.0	0	0%	100%
C	Small	64 - 90	0	0%	100%
	Small	90 - 128	0	0%	100%
B	Large	128 - 180	0	0%	100%
	Large	180 - 256	0	0%	100%
B	Small	256 - 362	0	0%	100%
	Small	362 - 512	0	0%	100%
D	Medium	512 - 1024	0	0%	100%
	Lrg- Very Lrg	1024 - 2048	0	0%	100%
BDRK	Bedrock		0	0%	100%
<b>Totals</b>			<b>50</b>	<b>100%</b>	

Summary Data	
D50	0.03
D84	0.06
D95	3

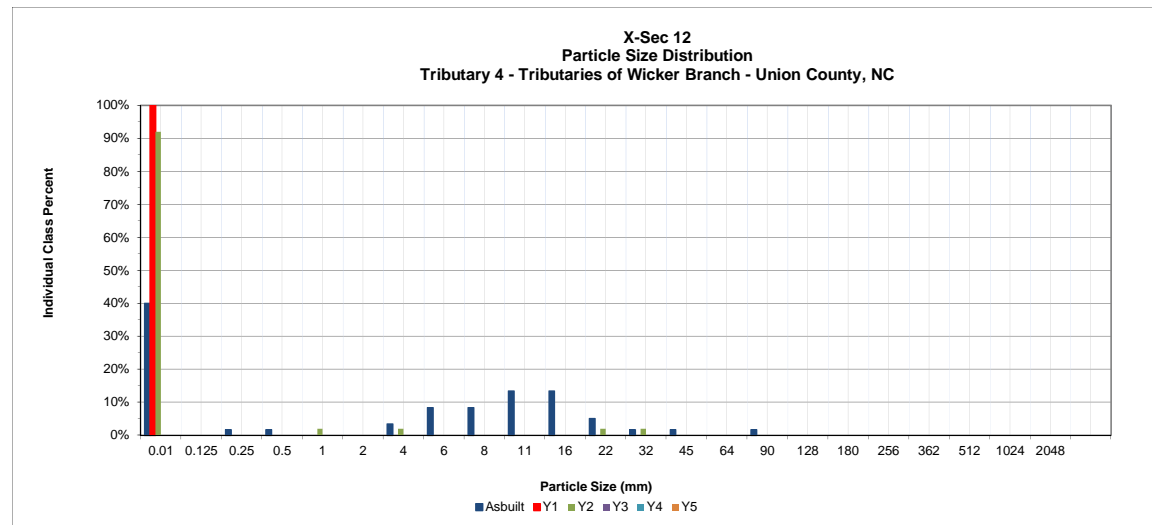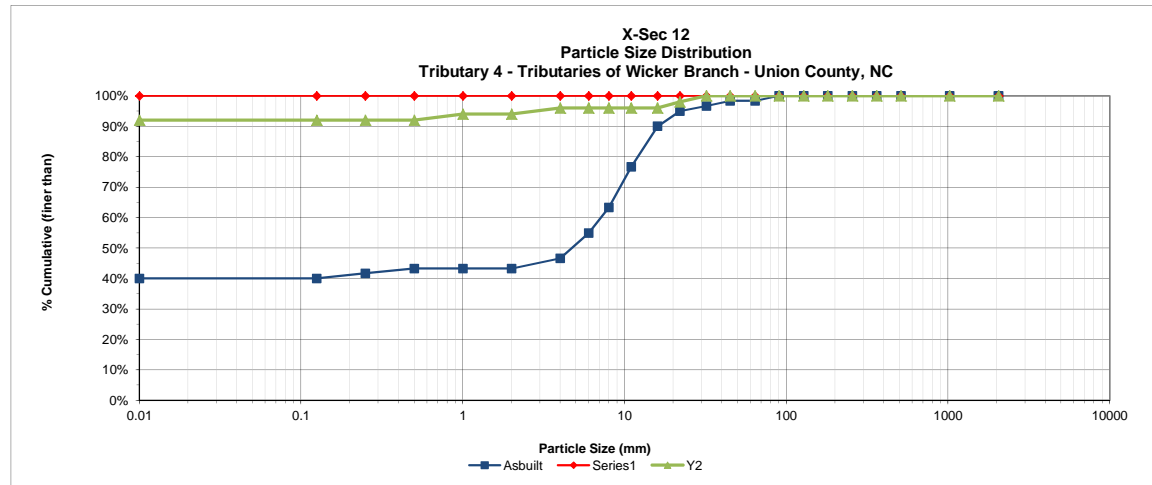

**Table 8. Baseline Stream Data Summary**  
**Tributaries of Wicker Branch Stream Restoration/ DMS No. 95022**

Parameter	Existing Trib 1A to Wickers Branch			Reference Reach- Spencer Creek			Reference Reach UT4 Rockwell Pastures			Proposed Trib 1 to Wickers Branch			As-built Baseline (Tributary 1A)			
	G4/B4c			C4			C4			E4						
Stream Type	0.14			0.5			0.11			0.1						
Drainage Area (sq mi)																
Dimension	Min	Max	Avg	Min	Max	Avg	Min	Max	Avg	Min	Max	Avg	Min	Max	Avg	n
BF Width (ft)	3.27	3.90	<b>3.58</b>			<b>12.30</b>			<b>7.30</b>			<b>4.00</b>	3.93	4.93	<b>4.43</b>	4
BF Cross Sectional Area (ft <sup>2</sup> )	1.52	1.99	<b>1.74</b>			<b>10.80</b>			<b>4.20</b>			<b>1.50</b>	1.62	2.80	<b>1.94</b>	4
BF Mean Depth (ft)	0.43	0.61	<b>0.50</b>			<b>0.88</b>			<b>0.60</b>			<b>0.38</b>	0.30	0.61	<b>0.41</b>	4
BF Max Depth (ft)	0.54	1.10	<b>0.76</b>			<b>1.80</b>			<b>1.10</b>			<b>0.50</b>	0.42	0.69	<b>0.53</b>	4
Width/Depth Ratio	5.36	8.48	<b>7.37</b>			<b>13.98</b>			<b>12.60</b>			<b>10.52</b>	7.49	14.94	<b>11.56</b>	4
Entrenchment Ratio	1.54	1.88	<b>1.70</b>			<b>&gt;2.20</b>			<b>2.70</b>			<b>&gt;2.20</b>	7.16	10.18	<b>8.63</b>	4
Wetted Perimeter (ft)	3.94	4.31	<b>4.17</b>			<b>14.13</b>			<b>5.77</b>			<b>4.76</b>	4.31	5.09	<b>4.73</b>	4
Hydraulic radius (ft)	0.39	0.47	<b>0.43</b>			<b>0.76</b>			<b>0.76</b>			<b>0.32</b>	0.29	0.55	<b>0.38</b>	4
Bank Height Ratio	2.21	2.41	<b>2.32</b>			<b>1.10</b>			<b>1.00</b>			<b>1.00</b>	1.00	1.00	<b>1.00</b>	4
Pool Area/Riffle Area			<b>N/A</b>			<b>1.17</b>			<b>1.00</b>			<b>5.70</b>			<b>1.98</b>	
Max riffle depth/mean riffle depth	1.08	1.22	<b>1.52</b>			<b>2.05</b>			<b>1.90</b>			<b>1.32</b>			<b>1.29</b>	
Max pool depth/mean riffle depth	1.22	2.3	<b>1.76</b>			<b>2.38</b>			<b>2.5</b>			<b>6.50</b>			<b>2.76</b>	
<b>Pattern</b>																
Channel Beltwidth (ft)	7	10	<b>9</b>	24	52	<b>38</b>	3.20	5.70	<b>4.40</b>	15	30	<b>23</b>	18	25	<b>22</b>	
Radius of Curvature (ft)	6	8	<b>7</b>	5	22	<b>13</b>	5	13	<b>9</b>	5	30	<b>18</b>	6	20	<b>12</b>	
Meander Wavelength	27	497	<b>181</b>	54	196	<b>125</b>	10.00	17.00	<b>13.60</b>	30	110	<b>70</b>	34	106	<b>50</b>	
Meander Width ratio	1.98	2.79	<b>2.39</b>	1.95	4.23	<b>3.09</b>	0.40	0.80	<b>0.60</b>	1.80	4.50	<b>3.15</b>			<b>5.0</b>	
Meander Length ratio	7.64	138.78	<b>50.53</b>	4.39	15.93	<b>10.16</b>	1.40	2.30	<b>1.90</b>	7.50	27.50	<b>17.50</b>			<b>11.20</b>	
Radius of Curvature/Riffle Width (ft)	1.68	2.23	<b>1.96</b>	0.44	4.23	<b>1.05</b>	0.70	1.70	<b>1.20</b>	1.00	4.20	<b>2.60</b>	1.35	4.06	<b>2.71</b>	
Pool Length/Riffle Width	3.91	7.65	<b>5.53</b>	0.76	1.94	<b>1.45</b>			<b>N/A</b>	1.05	3.75	<b>2.40</b>			<b>2.50</b>	
Pool to Pool Spacing/ Riffle Width	5.50	26.26	<b>13.08</b>	1.06	3.78	<b>1.97</b>	2.40	3.30	<b>2.90</b>	3.50	14.75	<b>9.13</b>	2.93	13.77	<b>6.00</b>	
Riffle Length/Riffle Width	1.90	20.75	<b>8.13</b>	0.30	1.84	<b>1.07</b>			<b>N/A</b>	2.45	11.00	<b>6.73</b>	1.85	10.61	<b>3.54</b>	
<b>Profile</b>																
Pool length (ft)	14.0	27.4	<b>19.8</b>	9.3	23.9	<b>17.8</b>			<b>N/A</b>	4.2	15.0	<b>9.8</b>	4.9	17.8	<b>11.3</b>	49
Pool spacing (ft)	19.7	94.0	<b>46.8</b>	13.0	46.5	<b>24.2</b>	17.6	24.1	<b>20.8</b>	14.0	59.0	<b>26.5</b>	13.0	61.0	<b>26.6</b>	48
Riffle length (ft)	6.8	74.3	<b>29.1</b>	3.7	22.6	<b>13.1</b>			<b>N/A</b>	9.8	44.0	<b>26.9</b>	8.2	47.0	<b>15.7</b>	50
Riffle slope (ft/ft)	0.014	0.027	<b>0.02</b>	0.020	0.036	<b>0.026</b>	0.006	0.049	<b>0.028</b>	0.018	0.029	<b>0.02</b>	0.01	0.48	<b>0.03</b>	50
Pool slope (ft/ft)	0.006	0.017	<b>0.012</b>	0.000	0.005	<b>0.003</b>	0.008	0.014	<b>0.010</b>	0.018	0.029	<b>0.024</b>	0.010	0.001	<b>0.005</b>	48
Run slope (ft/ft)	0.009	0.025	<b>0.018</b>	0.028	0.059	<b>0.041</b>			<b>N/A</b>			<b>N/A*</b>			<b>N/A*</b>	
Glide slope (ft/ft)	0.006	0.016	<b>0.01</b>	0.000	0.012	<b>0.003</b>			<b>N/A</b>			<b>N/A*</b>			<b>N/A*</b>	
Riffle Slope/Avg. Water Surface Slope	1.09	2.11	<b>1.56</b>	1.52	2.73	<b>1.97</b>	0.40	3.20	<b>1.80</b>	1.29	2.09	<b>1.69</b>			<b>2.36</b>	
Run slope/Avg. Water Surface Slope	0.73	1.95	<b>1.41</b>	2.12	4.47	<b>3.11</b>			<b>N/A</b>			<b>N/A*</b>			<b>N/A*</b>	
Pool Slope/Avg. Water Surface Slope	0.47	1.33	<b>0.94</b>	0.00	0.38	<b>0.23</b>	0.50	0.90	<b>0.60</b>	1.29	2.09	<b>1.69</b>			<b>0.39</b>	
Glide Slope/Avg. Water Surface Slope	0.50	1.25	<b>0.78</b>	0.00	0.91	<b>0.23</b>			<b>N/A</b>			<b>N/A*</b>			<b>N/A*</b>	
<b>Substrate</b>																
d50 (mm)	2.5	23.32	<b>10.09</b>			<b>8.6</b>			<b>12.70</b>				13.8	35.5	<b>25.6</b>	4
d84 (mm)	10.38	44.3	<b>25.7</b>			<b>77.00</b>			<b>38.00</b>	123			37	88	<b>65.3</b>	4
<b>Additional Reach Parameters</b>																
Valley Length (ft)			<b>1285</b>			<b>235</b>			<b>N/A</b>			<b>1284</b>			<b>1285</b>	
Channel Length (ft)			<b>1293</b>			<b>266</b>			<b>N/A</b>			<b>1395</b>			<b>1390</b>	
Valley Slope (ft/ft)	0.0113	0.0138	<b>0.0132</b>			<b>0.0139</b>			<b>0.0173</b>			<b>0.0132</b>			<b>0.0129</b>	
Water Surface Slope (ft/ft)	0.0080	0.0177	<b>0.0128</b>			<b>0.0132</b>			<b>0.0156</b>			<b>0.0139</b>			<b>0.0127</b>	
Sinuosity			<b>1</b>			<b>1.1</b>			<b>1.05</b>			<b>1.1</b>			<b>1.1</b>	

\* Runs and Glides are too short to obtain meaningful measurements

**Table 8. Baseline Stream Data Summary**  
**Tributaries of Wicker Branch Stream Restoration/ DMS No. 95022**

Parameter	Existing Trib 3 to Wickers Branch			Existing Trib 4 to Wickers Branch			Reference Reach- Spencer Creek			Reference Reach UT4 Rockwell Pastures			Proposed Trib 3 & 4 to Wickers Branch*			As-built Baseline (Tributary 3)				As-built Baseline (Tributary 4)			
	B6c			E6**			C4			C4			C4										
Stream Type	0.05			0.05			0.5			0.11			0.05										
Drainage Area (sq mi)																							
Dimension	Min	Max	Avg	Min	Max	Avg	Min	Max	Avg	Min	Max	Avg	Min	Max	Avg	Min	Max	Avg	n	Min	Max	Avg	n
BF Width (ft)	2.55	2.66	<b>2.61</b>	2.90	3.66	<b>3.28</b>			<b>12.30</b>			<b>7.30</b>			<b>3.60</b>	3.58	6.74	<b>4.70</b>	3	3.53	4.29	3.91	2
BF Cross Sectional Area (ft <sup>2</sup> )	0.40	0.63	<b>0.52</b>	0.83	1.13	<b>0.98</b>			<b>10.80</b>			<b>4.20</b>			<b>1.08</b>	1.16	6.98	<b>3.2</b>	3	1.21	1.23	<b>1.22</b>	2
BF Mean Depth (ft)	0.15	0.25	<b>0.20</b>	0.23	0.39	<b>0.31</b>			<b>0.88</b>			<b>0.60</b>			<b>0.30</b>	0.32	1.04	<b>0.59</b>	3	0.29	0.34	<b>0.32</b>	2
BF Max Depth (ft)	0.38	0.45	<b>0.42</b>	0.38	0.65	<b>0.52</b>			<b>1.80</b>			<b>1.10</b>			<b>0.60</b>	0.49	1.53	<b>0.89</b>	3	0.43	0.69	<b>0.56</b>	2
Width/Depth Ratio	10.20	17.73	<b>13.97</b>	7.44	15.91	<b>11.68</b>			<b>13.98</b>			<b>12.60</b>			<b>12.00</b>	6.48	11.19	<b>9.15</b>	3	10.38	14.79	<b>12.59</b>	2
Entrenchment Ratio	1.36	1.88	<b>1.62</b>	2.46	4.84	<b>3.65</b>			<b>&gt;2.20</b>			<b>2.70</b>			<b>&gt;2.20</b>	5.12	8.60	<b>7.20</b>	3	4.26	5.50	<b>4.88</b>	2
Wetted Perimeter (ft)	2.83	2.84	<b>2.84</b>	3.26	3.77	<b>3.52</b>			<b>14.13</b>			<b>5.77</b>			<b>4.20</b>	3.59	6.80	<b>5.20</b>	2	3.81	4.42	<b>4.12</b>	2
Hydraulic radius (ft)	0.14	0.22	<b>0.18</b>	0.22	0.35	<b>0.29</b>			<b>0.76</b>			<b>0.76</b>			<b>0.26</b>	0.24	0.72	<b>0.48</b>	2	0.28	0.32	<b>0.3</b>	2
Bank Height Ratio	2.24	3.32	<b>2.78</b>	1.00	1.60	<b>1.30</b>			<b>1.10</b>			<b>1.00</b>			<b>1.00</b>			<b>1.00</b>				<b>1.00</b>	
Pool Area/Riffle Area			<b>N/A</b>			<b>N/A</b>			<b>1.17</b>			<b>1.00</b>			<b>8.00</b>			<b>0.52</b>				<b>N/A</b>	
Max riffle depth/mean riffle depth	1.9	2.25	<b>2.08</b>			<b>1.68</b>			<b>2.05</b>			<b>1.90</b>			<b>2.00</b>			<b>1.51</b>				<b>1.78</b>	
Max pool depth/mean riffle depth	2.15	3.4	<b>2.78</b>	1.13	1.97	<b>1.55</b>			<b>2.38</b>			<b>2.5</b>			<b>8.30</b>			<b>2.64</b>				<b>N/A</b>	
<b>Pattern</b>																							
Channel Beltwidth (ft)	5	9	<b>7</b>			<b>N/A</b>	24	52	<b>38</b>	3.20	5.70	<b>4.40</b>			<b>N/A*</b>			<b>N/A***</b>				<b>N/A***</b>	
Radius of Curvature (ft)	2	8	<b>5</b>			<b>N/A</b>	5	22	<b>13</b>	5	13	<b>9</b>			<b>N/A*</b>			<b>N/A***</b>				<b>N/A***</b>	
Meander Wavelength	109	312	<b>189</b>			<b>N/A</b>	54	196	<b>125</b>	10.00	17.00	<b>13.60</b>			<b>N/A*</b>			<b>N/A***</b>				<b>N/A***</b>	
Meander Width ratio	2.00	3.31	<b>2.65</b>			<b>N/A</b>	1.95	4.23	<b>3.09</b>	0.40	0.80	<b>0.60</b>			<b>N/A*</b>			<b>N/A***</b>				<b>N/A***</b>	
Meander Length ratio	41.68	119.38	<b>72.24</b>			<b>N/A</b>	4.39	15.93	<b>10.16</b>	1.40	2.30	<b>1.90</b>			<b>N/A*</b>			<b>N/A***</b>				<b>N/A***</b>	
Radius of Curvature/Riffle Width (ft)	0.69	3.07	<b>1.88</b>			<b>N/A</b>	0.44	4.23	<b>1.05</b>	0.70	1.70	<b>1.20</b>			<b>N/A*</b>			<b>N/A***</b>				<b>N/A***</b>	
Pool Length/Riffle Width	6.79	14.39	<b>9.13</b>	3.60	10.09	<b>6.22</b>	0.76	1.94	<b>1.45</b>			<b>N/A</b>	1.11	1.67	<b>N/A*</b>			<b>2.19</b>				<b>2.38</b>	
Pool to Pool Spacing/ Riffle Width	14.80	34.66	<b>24.86</b>	5.46	15.70	<b>9.91</b>	1.06	3.78	<b>1.97</b>	2.40	3.30	<b>2.90</b>	5.56	16.11	<b>10.83</b>			<b>11</b>				<b>37</b>	
Riffle Length/Riffle Width	2.72	8.58	<b>5.40</b>	5.46	11.16	<b>8.45</b>	0.30	1.84	<b>1.07</b>			<b>N/A</b>	4.44	14.44	<b>9.44</b>			<b>8.64</b>				<b>35.29</b>	
<b>Profile</b>																							
Pool length (ft)	17.7	37.6	<b>23.8</b>	11.8	33.1	<b>20.4</b>	9.3	23.9	<b>17.8</b>			<b>N/A</b>	4.0	6.0	<b>5.0</b>	7.7	17.7	<b>10.3</b>	11	7.6	11.2	<b>9.3</b>	4
Pool spacing (ft)	38.6	90.5	<b>64.9</b>	17.9	51.5	<b>32.5</b>	13.0	46.5	<b>24.2</b>	17.6	24.1	<b>20.8</b>	20.0	58.0	<b>45.3</b>	34.7	88	<b>52</b>	10	140	150	<b>145</b>	4
Riffle length (ft)	7.1	22.4	<b>14.1</b>	17.9	36.62	<b>27.7</b>	3.7	22.6	<b>13.1</b>			<b>N/A</b>	16.0	52.0	<b>34.0</b>	22.2	74.9	<b>40.6</b>	10	133	145	<b>138</b>	3
Riffle slope (ft/ft)	0.011	0.027	<b>0.019</b>	0.008	0.014	<b>0.0095</b>	0.020	0.036	<b>0.026</b>	0.006	0.049	<b>0.028</b>	0.018	0.029	<b>0.02</b>	0.0048	0.0179	<b>0.0115</b>	10	0.007	0.014	<b>0.009</b>	3
Pool slope (ft/ft)	0.012	0.013	<b>0.011</b>	0.008	0.009	<b>0.0085</b>	0.000	0.005	<b>0.003</b>	0.008	0.014	<b>0.010</b>	0.018	0.029	<b>0.024</b>	0.0001	0.0048	<b>0.0025</b>	10	0.0001	0.0012	<b>0.0007</b>	4
Run slope (ft/ft)	0.013	0.034	<b>0.023</b>	0.008	0.030	<b>0.0125</b>	0.028	0.059	<b>0.041</b>			<b>N/A</b>			<b>N/A</b>			<b>N/A****</b>				<b>N/A****</b>	
Glide slope (ft/ft)	0.008	0.020	<b>0.012</b>	0.0050	0.0460	<b>0.015</b>	0.000	0.012	<b>0.003</b>			<b>N/A</b>			<b>N/A</b>			<b>N/A****</b>				<b>N/A****</b>	
Riffle Slope/Avg. Water Surface Slope	0.79	1.93	<b>1.36</b>	0.89	1.56	<b>1.06</b>	1.52	2.73	<b>1.97</b>	0.40	3.20	<b>1.80</b>	1.29	2.09	<b>1.69</b>			<b>0.97</b>				<b>0.95</b>	
Run slope/Avg. Water Surface Slope	0.93	2.43	<b>1.64</b>	0.87	3.33	<b>1.39</b>	2.12	4.47	<b>3.11</b>			<b>N/A</b>			<b>N/A</b>			<b>N/A****</b>				<b>N/A****</b>	
Pool Slope/Avg. Water Surface Slope	0.86	0.93	<b>0.79</b>	0.89	0.97	<b>0.94</b>	0.00	0.38	<b>0.23</b>	0.50	0.90	<b>0.60</b>	1.29	2.09	<b>1.69</b>			<b>0.21</b>				<b>0.07</b>	
Glide Slope/Avg. Water Surface Slope	0.57	1.43	<b>0.86</b>	0.56	5.11	<b>1.67</b>	0.00	0.91	<b>0.23</b>			<b>N/A</b>			<b>N/A</b>			<b>N/A****</b>				<b>N/A****</b>	
<b>Substrate</b>																							
d50 (mm)			<b>0.04</b>			<b>0.04</b>			<b>8.6</b>			<b>12.70</b>				0.06	16	<b>7.1</b>	3	0.03	4.7	<b>2.4</b>	2
d84 (mm)			<b>0.06</b>			<b>6.16</b>			<b>77.00</b>			<b>38.00</b>			<b>108</b>	5	29	<b>17</b>	3	0.05	14	<b>7</b>	2
<b>Additional Reach Parameters</b>																							
Valley Length (ft)			<b>1184</b>			<b>629</b>			<b>235</b>			<b>N/A</b>			<b>1284</b>			<b>1184</b>				<b>629</b>	
Channel Length (ft)			<b>1184</b>			<b>631</b>			<b>266</b>			<b>N/A</b>			<b>1395</b>			<b>1184</b>				<b>631</b>	
Valley Slope (ft/ft)	0.0116	0.0164	<b>0.0135</b>	0.0087	0.0122	<b>0.0095</b>			<b>0.0139</b>			<b>0.0173</b>			<b>0.0132</b>			<b>0.0119</b>				<b>0.0097</b>	
Water Surface Slope (ft/ft)	0.0100	0.0176	<b>0.0140</b>	0.0090	0.0090	<b>0.0090</b>			<b>0.0132</b>			<b>0.0156</b>			<b>0.0139</b>			<b>0.0119</b>				<b>0.0095</b>	
Sinuosity			<b>1</b>			<b>1</b>			<b>1.1</b>			<b>1.05</b>			<b>1.1</b>			<b>1.0</b>				<b>1.0</b>	

\* Tributary 3 and 4 - The Pattern of the channel was not altered. Tributary 4 only minimal work consisting of altering dimension was performed.

\*\* Tributary modified/channelized in past so application of classification of natural channels may not be applicable

\*\*\*Note on Tributaries 3 and 4 Pattern Data. These two tributaries are relatively straight channels. Beltwidth, radius of curvature, and other measurements are not applicable.

\*\*\*\* Runs and glides are too short to obtain meaningful measurements

**Table 9a. Morphology and Hydraulic Monitoring Summary (Dimensional Parameters – Cross Sections)**

**Tributaries of Wicker Branch Stream Restoration/ DMS No. 95022**

	Cross Section 1 (Riffle)							Cross Section 2 (Pool)							Cross Section 3 (Riffle)							Cross Section 4 (Pool)							Cross Section 5 (Riffle)						
	Base	MY1	MY2	MY3	MY4	MY5	MY+	Base	MY1	MY2	MY3	MY4	MY5	MY+	Base	MY1	MY2	MY3	MY4	MY5	MY+	Base	MY1	MY2	MY3	MY4	MY5	MY+	Base	MY1	MY2	MY3	MY4	MY5	MY+
<b>Based on fixed baseline bankfull elevation</b>																																			
Bankfull Width (ft)	3.97	3.93	3.07					5.13	6.09	5.85					4.51	4.57	5.08					5.14	5.31	6.2					4.76	4.27	3.8				
Floodprone Width (ft)	50	50	50					50	50	50					50	50	50					50	50	50					50	50	50				
Bankfull Mean Depth (ft)	0.38	0.41	0.42					0.78	0.7	0.69					0.68	0.61	0.8					0.72	0.68	0.83					0.32	0.3	0.3				
Bankfull Max Depth (ft)	0.53	0.51	0.5					1.19	1.21	1.38					1	0.69	1.22					1.33	1.26	1.5					0.79	0.42	0.45				
Bankfull Cross Sectional Area (ft <sup>2</sup> )	1.51	1.62	1.28					3.98	4.27	4.03					3.08	2.8	4.06					3.72	3.59	5.17					1.54	1.7	1.3				
Bankfull Width/Depth Ratio	10.45	9.59	7.31					6.58	8.7	8.5					6.63	7.49	6.4					7.14	7.81	7.4					14.87	14.23	11.5				
Bankfull Entrenchment Ratio	10.06	10.18	16.29					7.79	6.57	8.5					11.1	8.72	9.8					9.7	7.49	8.1					10.5	8.44	13.2				
Bankfull Bank Height Ratio	1	1	1					1	1	1					1	1	0.9					1	1	1					1	1	1				
<b>Based on current/developing bankfull feature</b>																																			
Bankfull Width (ft)																																			
Floodprone Width (ft)																																			
Bankfull Mean Depth (ft)																																			
Bankfull Max Depth (ft)																																			
Bankfull Cross Sectional Area (ft <sup>2</sup> )																																			
Bankfull Width/Depth Ratio																																			
Bankfull Entrenchment Ratio																																			
Bankfull Bank Height Ratio																																			
Cross Sectional Area between end pins (ft <sup>2</sup> )																																			
d50 (mm)	35.5	32.9	31.2					7.7	6.9	0.8					25.7	32	73					0.03	0.04	0.05					27.3	42.4	45				
	Cross Section 6 (Riffle)							Cross Section 7 (Pool)							Cross Section							Cross Section													
	Base	MY1	MY2	MY3	MY4	MY5	MY+	Base	MY1	MY2	MY3	MY4	MY5	MY+	Base	MY1	MY2	MY3	MY4	MY5	MY+	Base	MY1	MY2	MY3	MY4	MY5	MY+	Base	MY1	MY2	MY3	MY4	MY5	MY+
<b>Based on fixed baseline bankfull elevation</b>																																			
Bankfull Width (ft)	4.39	4.93	4.37					6.59	6.21	9.94																									
Floodprone Width (ft)	50	50	50					40	40	40																									
Bankfull Mean Depth (ft)	0.39	0.33	0.4					0.49	0.59	0.4																									
Bankfull Max Depth (ft)	0.58	0.5	0.5					0.85	0.92	0.97																									
Bankfull Cross Sectional Area (ft <sup>2</sup> )	1.72	1.64	1.73					3.21	3.69	3.98																									
Bankfull Width/Depth Ratio	11.26	14.94	10.97					13.45	10.53	24.8																									
Bankfull Entrenchment Ratio	11.4	7.16	11.4					6.1	6.37	4.02																									
Bankfull Bank Height Ratio	1	1	1					1	1	1																									
<b>Based on current/developing bankfull feature</b>																																			
Bankfull Width (ft)																																			
Floodprone Width (ft)																																			
Bankfull Mean Depth (ft)																																			
Bankfull Max Depth (ft)																																			
Bankfull Cross Sectional Area (ft <sup>2</sup> )																																			
Bankfull Width/Depth Ratio																																			
Bankfull Entrenchment Ratio																																			
Bankfull Bank Height Ratio																																			
Cross Sectional Area between end pins (ft <sup>2</sup> )																																			
d50 (mm)	13.8	12.9	41					11.2	6.3	0.8																									

**Table 9a. Morphology and Hydraulic Monitoring Summary (Dimensional Parameters – Cross Sections)**

**Tributaries of Wicker Branch Stream Restoration/ DMS No. 95022**

	Cross Section 8 (Pool)							Cross Section 9 (Riffle)							Cross Section 10 (Riffle)							
	Base	MY1	MY2	MY3	MY4	MY5	MY+	Base	MY1	MY2	MY3	MY4	MY5	MY+	Base	MY1	MY2	MY3	MY4	MY5	MY+	
<b>Based on fixed baseline bankfull elevation</b>																						
Bankfull Width (ft)	4	4.3	4.2					3.58	3.48	3.3					6.74	6.19	6.61					
Floodprone Width (ft)	32	32	40					31	31	32					35	35	33					
Bankfull Mean Depth (ft)	0.41	0.38	0.33					0.32	0.24	0.31					1.04	0.79	0.84					
Bankfull Max Depth (ft)	0.65	0.71	0.6					0.49	0.38	0.49					1.53	1.29	1.22					
Bankfull Cross Sectional Area (ft <sup>2</sup> )	1.66	1.65	1.38					1.16	0.85	1.01					6.98	4.87	5.53					
Bankfull Width/Depth Ratio	9.78	11.32	12.8					11.19	14.5	10.6					6.48	7.84	7.87					
Bankfull Entrenchment Ratio	7.9	9.31	9.48					8.6	6.89	9.77					5.12	5.1	4.96					
Bankfull Bank Height Ratio	1	1	1					1	1	1					1	1	1					
<b>Based on current/developing bankfull feature</b>																						
Bankfull Width (ft)																						
Floodprone Width (ft)																						
Bankfull Mean Depth (ft)																						
Bankfull Max Depth (ft)																						
Bankfull Cross Sectional Area (ft <sup>2</sup> )																						
Bankfull Width/Depth Ratio																						
Bankfull Entrenchment Ratio																						
Bankfull Bank Height Ratio																						
Cross Sectional Area between end pins (ft <sup>2</sup> )																						
d50 (mm)	5.42	0.04	0.03					16	0.04	0.04					0.06	0.04	0.03					
	Cross Section 11 (Riffle)							Cross Section 12 (Riffle)							Cross Section							
	Base	MY1	MY2	MY3	MY4	MY5	MY+	Base	MY1	MY2	MY3	MY4	MY5	MY+	Base	MY1	MY2	MY3	MY4	MY5	MY+	
<b>Based on fixed baseline bankfull elevation</b>																						
Bankfull Width (ft)	3.53	2.98	3.22					4.29	4.17	4.18												
Floodprone Width (ft)	19.5	19.5	18					18.3	18.3	24												
Bankfull Mean Depth (ft)	0.34	0.41	0.35					0.29	0.25	0.28												
Bankfull Max Depth (ft)	0.69	0.69	0.62					0.43	0.44	0.5												
Bankfull Cross Sectional Area (ft <sup>2</sup> )	1.21	1.22	1.12					1.23	1.05	1.19												
Bankfull Width/Depth Ratio	10.38	7.27	9.2					14.79	16.68	14.93												
Bankfull Entrenchment Ratio	5.5	6.39	5.42					4.26	5.4	5.83												
Bankfull Bank Height Ratio	1	1	1					1	1	1												
<b>Based on current/developing bankfull feature</b>																						
Bankfull Width (ft)																						
Floodprone Width (ft)																						
Bankfull Mean Depth (ft)																						
Bankfull Max Depth (ft)																						
Bankfull Cross Sectional Area (ft <sup>2</sup> )																						
Bankfull Width/Depth Ratio																						
Bankfull Entrenchment Ratio																						
Bankfull Bank Height Ratio																						
Cross Sectional Area between end pins (ft <sup>2</sup> )																						
d50 (mm)	0.03	0.03	0.03					4.7	0.03	0.03												



**Table 9b. Stream Reach Data Summary**  
**Tributaries of Wicker Branch Stream Restoration/ DMS No. 95022**

Parameter	MY 0			MY 1			MY 2			MY 3			MY 4			MY 5		
	Trib 3			Trib 3			Trib 3			Trib 3			Trib 3			Trib 3		
Dimension and Substrate - Riffle	Min	Max	Avg	Min	Max	Avg	Min	Max	Avg	Min	Max	Avg	Min	Max	Avg	Min	Max	Avg
Bankfull Width (ft)	3.58	6.74	4.77	3.48	6.19	4.66	3.30	6.61	4.70									
Floodprone Width (ft)	31.00	35.00	32.67	31	35	32.70	32	40	35									
Bankfull Mean Depth (ft)	0.32	1.04	0.59	0.24	0.79	0.47	0.31	0.84	0.49									
<sup>1</sup> Bankfull Max Depth (ft)	0.49	1.53	0.89	0.38	1.29	0.79	0.49	1.22	0.77									
Bankfull Cross Sectional Area (ft <sup>2</sup> )	1.16	6.98	3.27	0.85	4.87	2.45	1.01	5.53	2.64									
Width/Depth Ratio	6.48	11.19	9.15	7.84	14.5	11.22	7.87	12.80	10.42									
Entrenchment Ratio	5.12	8.60	7.21	5.1	9.31	7.10	4.96	9.77	8.07									
<sup>1</sup> Bank Height Ratio			1			1			1									
Profile																		
Riffle Length (ft)	22.2	74.9	40.6	22.2	74.9	40.6	24	73	43									
Riffle Slope (ft/ft)	0.0048	0.0179	0.0115	0.0048	0.019	0.013	0.0048	0.0179	0.0115									
Pool Length (ft)	7.7	17.7	10.3	7.6	17.8	10.4	6	12	9.4									
Pool Max depth (ft)	1.01	1.97	1.56	1	1.95	1.52	0.9	1.7	1.3									
Pool Spacing (ft)	34.7	88	52	34.8	88.1	52	31	84	52									
Pattern																		
Channel Beltwidth (ft)	N/A*	N/A*	N/A*	N/A*	N/A*	N/A*	N/A*	N/A*	N/A*									
Radius of Curvature (ft)	N/A*	N/A*	N/A*	N/A*	N/A*	N/A*	N/A*	N/A*	N/A*									
Rc/Bankfull width (ft/ft)	N/A*	N/A*	N/A*	N/A*	N/A*	N/A*	N/A*	N/A*	N/A*									
Meander Wavelength (ft)	N/A*	N/A*	N/A*	N/A*	N/A*	N/A*	N/A*	N/A*	N/A*									
Meander Width Ratio	N/A*	N/A*	N/A*	N/A*	N/A*	N/A*	N/A*	N/A*	N/A*									
Transport parameters																		
Reach Shear Stress (competency) lb/ft <sup>2</sup>																		
Max part size (mm) mobilized at bankfull																		
Stream Power (transport capacity) W/m <sup>2</sup>																		
Additional Reach Parameters																		
Rosgen Classification		C4			C4			C4										
Bankfull Velocity (fps)																		
Bankfull Discharge (cfs)																		
Valley length (ft)		1184			1184			1184										
Channel Thalweg length (ft)		1184			1184			1184										
Sinuosity (ft)		1.0			1.0			1.0										
Water Surface Slope (Channel) (ft/ft)		0.0119			0.0119			0.0119										
BF slope (ft/ft)		0.0119			0.0119			0.0119										
<sup>3</sup> Bankfull Floodplain Area (acres)																		
<sup>4</sup> Proportion over wide (%)																		
Channel Stability or Habitat Metric																		
Biological or Other																		

\*Note on Tributary 3 Pattern Data. This tributary is a relatively straight channel. Beltwidth, radius of curvature, and other pattern measurements does not provide meaningful information

**Table 9b. Stream Reach Data Summary**  
**Tributaries of Wicker Branch Stream Restoration/ DMS No. 95022**

Parameter	MY 0			MY 1			MY 2			MY 3			MY 4			MY 5		
	Trib 4			Trib 4			Trib 4			Trib 4			Trib 4			Trib 4		
Dimension and Substrate - Riffle	Min	Max	Avg	Min	Max	Avg	Min	Max	Avg	Min	Max	Avg	Min	Max	Avg	Min	Max	Avg
Bankfull Width (ft)	3.53	4.29	3.91	2.98	4.17	3.57	3.57	4.17	2.98									
Floodprone Width (ft)	18.30	19.50	18.90	18.3	19.5	18.9	18.9	19.5	18.3									
Bankfull Mean Depth (ft)	0.29	0.34	0.32	0.25	0.41	0.33	0.33	0.41	0.25									
<sup>1</sup> Bankfull Max Depth (ft)	0.43	0.69	0.56	0.44	0.69	0.56	0.56	0.69	0.44									
Bankfull Cross Sectional Area (ft <sup>2</sup> )	1.21	1.23	1.22	1.05	1.22	1.13	1.13	1.22	1.05									
Width/Depth Ratio	10.38	14.79	12.59	7.27	16.68	11.97	11.97	16.68	7.27									
Entrenchment Ratio	4.26	5.50	4.88	5.4	6.39	5.89	5.89	6.39	5.40									
<sup>1</sup> Bank Height Ratio			1			1			1									
Profile																		
Riffle Length (ft)	133	145	138	130	145	136	140	160	148									
Riffle Slope (ft/ft)	0.007	0.014	0.009	0.006	0.014	0.009	0.006	0.014	0.009									
Pool Length (ft)	7.6	11.2	9.3	7.4	11.1	9.2	7.1	13	10.6									
Pool Max depth (ft)	1.39	2.35	1.78	1.37	2.35	1.77	1.18	1.79	1.46									
Pool Spacing (ft)	140	150	145	140	150	145	140	150	145									
Pattern																		
Channel Beltwidth (ft)	N/A*	N/A*	N/A*	N/A*	N/A*	N/A*	N/A*	N/A*	N/A*									
Radius of Curvature (ft)	N/A*	N/A*	N/A*	N/A*	N/A*	N/A*	N/A*	N/A*	N/A*									
Rc/Bankfull width (ft/ft)	N/A*	N/A*	N/A*	N/A*	N/A*	N/A*	N/A*	N/A*	N/A*									
Meander Wavelength (ft)	N/A*	N/A*	N/A*	N/A*	N/A*	N/A*	N/A*	N/A*	N/A*									
Meander Width Ratio	N/A*	N/A*	N/A*	N/A*	N/A*	N/A*	N/A*	N/A*	N/A*									
Transport parameters																		
Reach Shear Stress (competency) lb/ft <sup>2</sup>																		
Max part size (mm) mobilized at bankfull																		
Stream Power (transport capacity) W/m <sup>2</sup>																		
Additional Reach Parameters																		
Rosgen Classification		N/A			N/A			N/A										
Bankfull Velocity (fps)																		
Bankfull Discharge (cfs)																		
Valley length (ft)		631			631			631										
Channel Thalweg length (ft)		631			631			631										
Sinuosity (ft)		1.0			1.0			1.0										
Water Surface Slope (Channel) (ft/ft)		0.00972			0.00972			0.00972										
BF slope (ft/ft)		0.0095			0.0095			0.0095										
<sup>3</sup> Bankfull Floodplain Area (acres)																		
<sup>4</sup> Proportion over wide (%)																		
Channel Stability or Habitat Metric																		
Biological or Other																		

\*Note on Tributary 4 Pattern Data. This tributary is a relatively straight channel. Beltwidth, radius of curvature, and other pattern measurements does not provide meaningful information



## **APPENDIX E: HYDROLOGIC DATA**

Table 10 – Verification of Bankfull Events

**Table 10. Documentation of Geomorphologically Significant Flow Events  
Tributaries of Wicker Branch Stream Restoration/ DMS No. 95022**

Date of Observation	Date of occurrence	Method	Greater Than $Q_{gs}=Q_2^{*0.66}$ Stage	Greater than $Q_{bkf}$ Stage?	Notes
12/3/2014	11/23/2014	Photo on-site wrack line		Yes	See photo below

