


A-9WM

PROJECT: 6.939004T

STATE OF NORTH CAROLINA
 DIVISION OF HIGHWAYS
GRAHAM COUNTY

STATE	STATE PROJECT REFERENCE NO.	SHEET NO.	TOTAL SHEETS
N.C.	A-9WM	1A	21
STATE PROJ. NO.	F.A. PROJ. NO.	DESCRIPTION	
6.931003		PE	
6.939004T		CONST.	

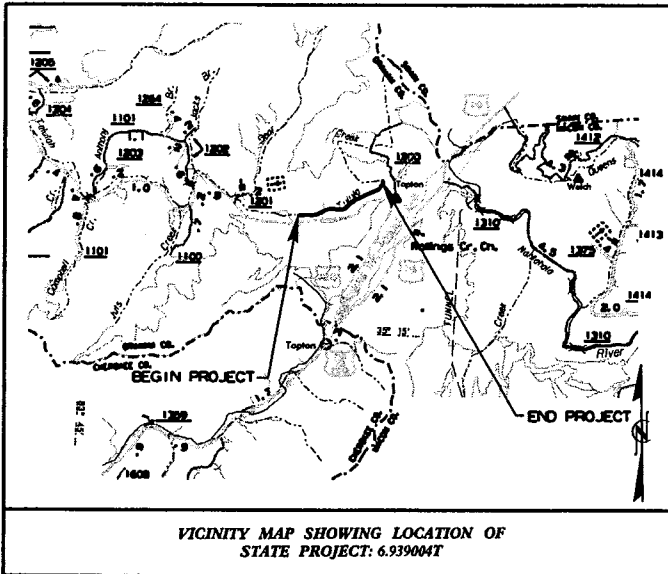


LOCATION: TULULA CREEK WETLAND MITIGATION SITE, NORTH OF US 129
 WEST OF TOPTON, EAST OF SR 1201
AS-BUILT PLANS


-L- STA. 10+00.00 BEGIN STATE PROJECT 6.939004T

INDEX OF SHEETS

SHEET NO.	SHEET
1A	TITLE SHEET
1B	CONVENTIONAL SYMBOLS
2A THRU 2D	MISCELLANEOUS DETAILS
4 THRU 11	PLAN SHEETS
12 THRU 14	PROFILE SHEETS
X-1 THRU X-4	CROSS SECTION SHEETS

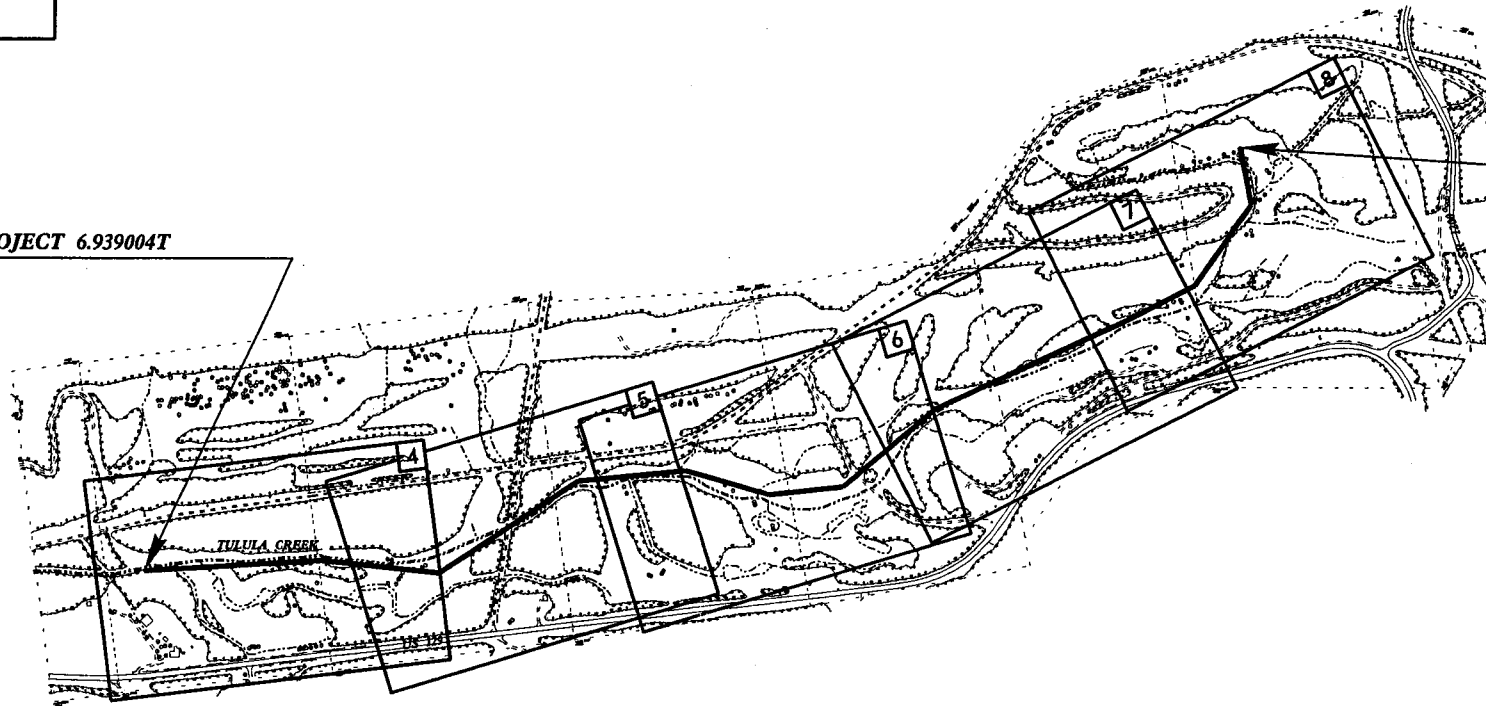

NCDOT CONTACT: MR. RANDY GRIFFIN, P.E., PROJECT DEVELOPMENT & ENVIRONMENTAL ANALYSIS BRANCH

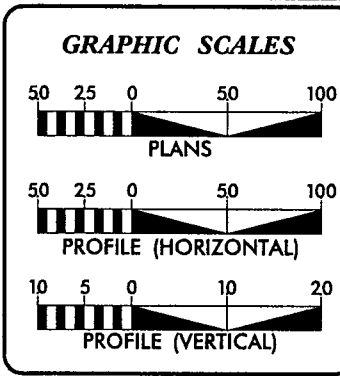

DESIGN DATA

PROJECT LENGTH

RESTORED STREAM LENGTH =	8,639 FEET
PRESERVED STREAM LENGTH =	1,248 FEET
WETLAND RESTORATION =	102 ACRES

Prepared For The North Carolina Department of Transportation
 In the Office of:
 HSM

1305 NAVAHO DR., SUITE 303
 RALEIGH, NC 27609
 (919)878-5250

1995 STANDARD SPECIFICATIONS

RIGHT OF WAY DATE:	H.R. CURRIN, P.E. PROJECT ENGINEER
LETTING DATE:	S.G. GINN, P.E. PROJECT DESIGN ENGINEER
JULY 20, 1999	

HYDRAULICS ENGINEER

SIGNATURE: _____ P.E.

DIVISION OF HIGHWAYS
STATE OF NORTH CAROLINA


P.E.

DEPARTMENT OF TRANSPORTATION
FEDERAL HIGHWAY ADMINISTRATION


APPROVED FOR DIVISION ADMINISTRATOR _____ DATE _____

5/14/99


PROJECT REFERENCE NO.	SHEET NO.
A-9WM	2B
RAW SHEET NO.	
ROADWAY DESIGN ENGINEER	HYDRAULICS ENGINEER
AS-BUILT PLANS	

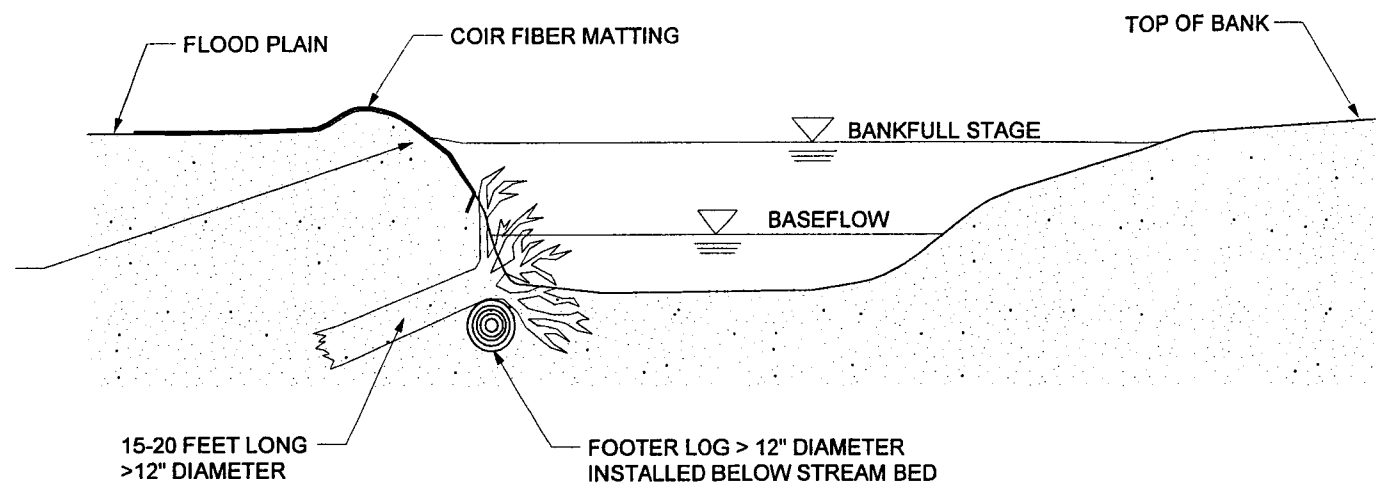

CROSS SECTION VIEW

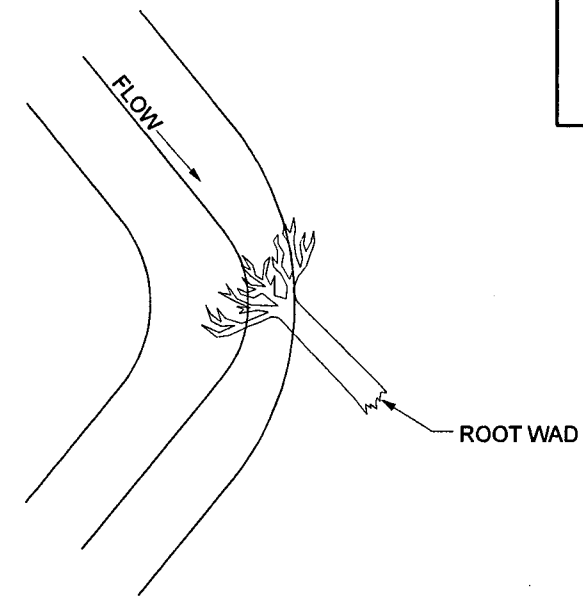

PLAN VIEW DRIVE POINT METHOD

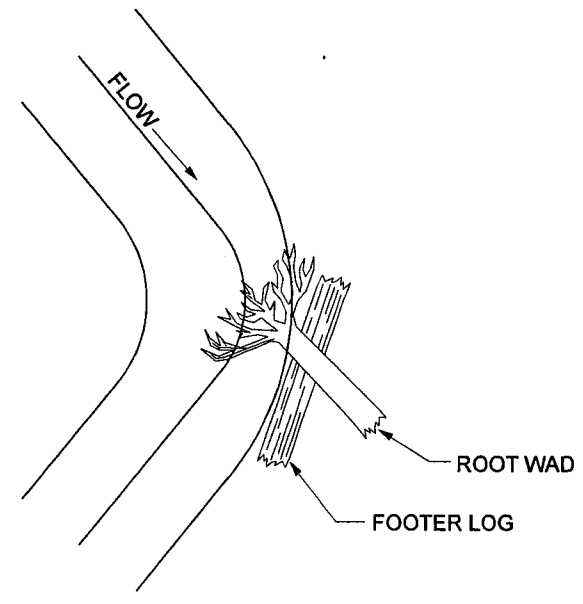

PLAN VIEW TRENCHING METHOD

NOTE:

DRIVE POINT METHOD:

SHARPEN THE END OF THE LOG WITH A CHAINSAW BEFORE "DRIVING" IT INTO THE BANK. ORIENT ROOT WADS UPSTREAM SO THAT THE STREAM FLOW MEETS THE ROOT WAD AT A 90-DEGREE ANGLE, DEFLECTING THE WATER AWAY FROM THE BANK. A TRANSPLANT OR BOULDER SHOULD BE PLACED ON THE DOWNSTREAM SIDE OF THE ROOT WAD IF A BACK EDDY IS FORMED BY THE ROOT WAD. THE BOULDER SHALL BE APPROXIMATELY 4' X 3' X 2'.



TRENCHING METHOD:

IF THE ROOT WAD CANNOT BE DRIVEN INTO THE BANK OR THE BANK NEEDS TO BE RECONSTRUCTED, THE TRENCHING METHOD SHOULD BE USED. THIS METHOD REQUIRES THAT A TRENCH BE EXCAVATED FOR THE LOG PORTION OF THE ROOT WAD. IN THIS CASE, A FOOTER LOG SHOULD BE INSTALLED UNDERNEATH THE ROOT WAD IN A TRENCH EXCAVATED PARALLEL TO THE BANK AND WELL BELOW THE STREAMBED. ONE-THIRD OF THE ROOT WAD SHOULD REMAIN BELOW NORMAL BASE FLOW CONDITIONS.

ROOT WAD
(NOT TO SCALE)

SYTIME*****

PROJECT REFERENCE NO. A-9WM	SHEET NO. 20
RW SHEET NO.	
ROADWAY DESIGN ENGINEER	HYDRAULICS ENGINEER
AS-BUILT PLANS	

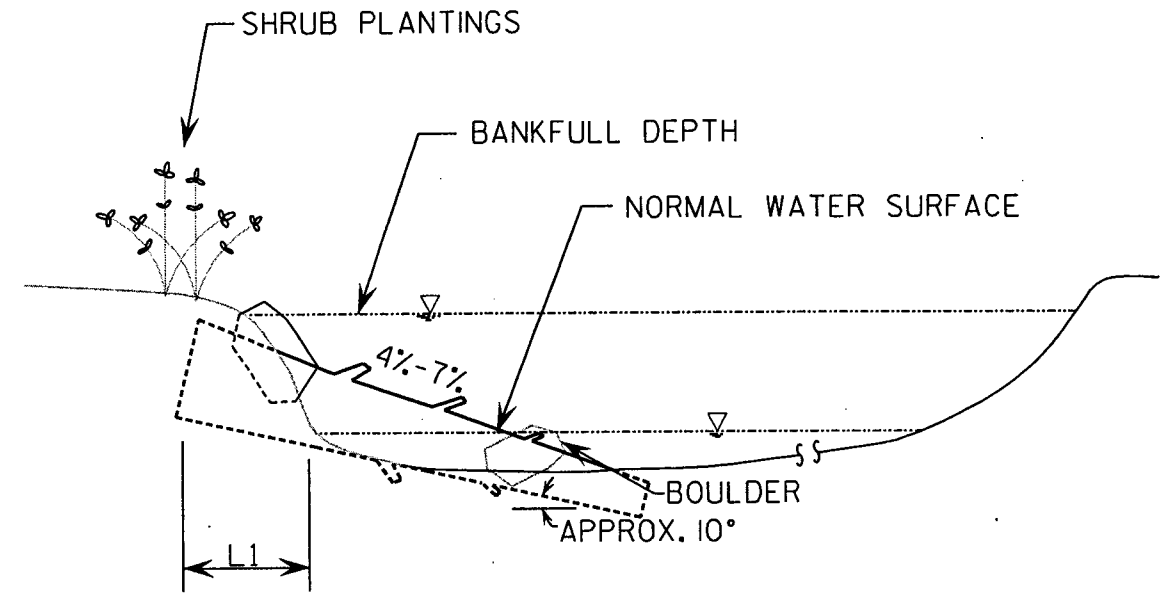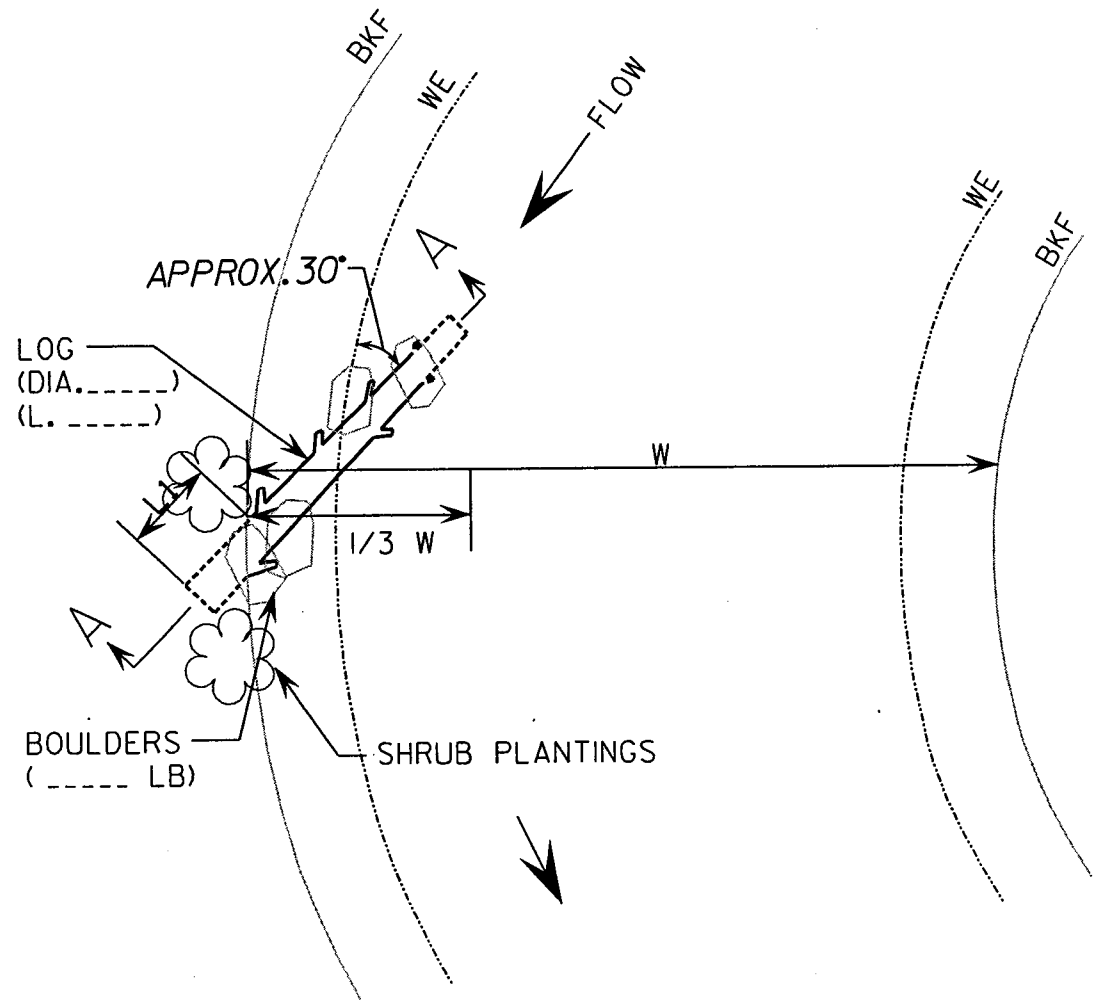

SECTION A-A

LOG VANE

(NOT TO SCALE)

5/14/99
SYSTEMS
DCON
US
ENR


PLANTING DETAILS

SEEDLING / LINER BAREROOT PLANTING DETAIL


HEALING IN

1. Locate a healing-in site in a shady, well protected area.


2. Excavate a flat bottom trench 12" deep and provide drainage.

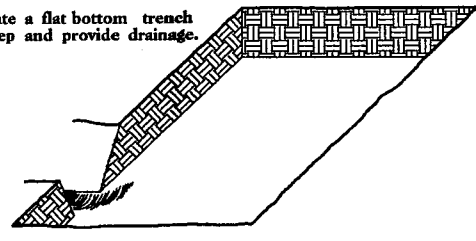


3. Backfill the trench with 2" well rotted sawdust. Place a 2" layer of well rotted sawdust at a sloping angle at one end of the trench.

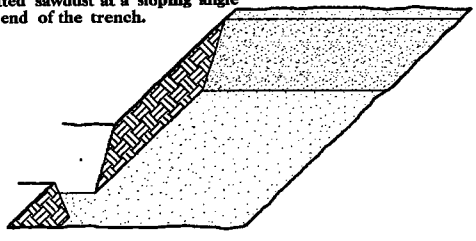

4. Place a single layer of plants against the sloping end so that the root collar is at ground level.

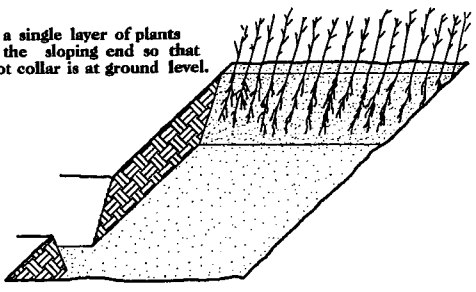


5. Place a 2" layer of well rotted sawdust over the roots maintaining a sloping angle.

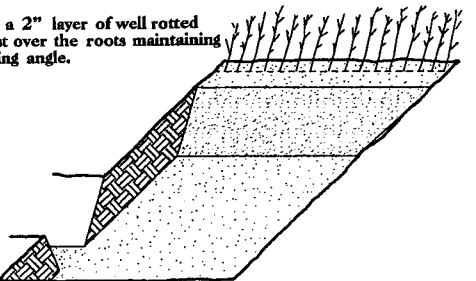


6. Repeat layers of plants and sawdust as necessary and water thoroughly.

DIBBLE PLANTING METHOD USING THE KBC PLANTING BAR

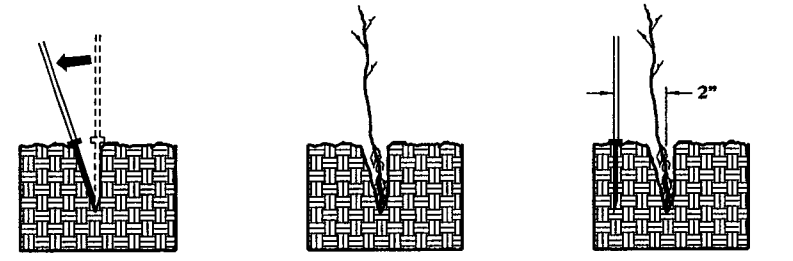

1. Insert planting bar as shown and pull handle toward planter.
2. Remove planting bar and place seedling at correct depth.
3. Insert planting bar 2" toward planter from seedling.

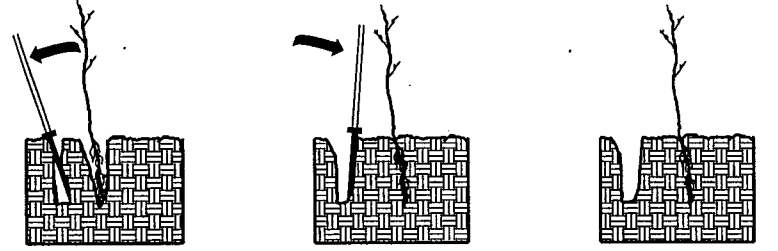

4. Pull handle of bar toward planter, firming soil at bottom.
5. Push handle forward firming soil at top.
6. Leave compaction hole open. Water thoroughly.

PLANTING NOTES:

PLANTING BAG
During planting, seedlings shall be kept in a moist canvas bag or similar container to prevent the root systems from drying.



KBC PLANTING BAR
Planting bar shall have a blade with a triangular cross section, and shall be 12" long, 4" wide and 1" thick at center.



ROOT PRUNING
All seedlings shall be root pruned, if necessary, so that no roots extend more than 10 inches (10") below the root collar.

WETLAND REFORESTATION

TREE REFORESTATION SHALL BE PLANTED 6' TO 10' ON CENTER, RANDOM SPACING, AVERAGING 8' ON CENTER, APPROXIMATELY 680 PLANTS PER ACRE.

MIXTURE, TYPE, SIZE, AND FURNISH SHALL CONFORM TO THE FOLLOWING:

HARDWOOD TREE PLANTING TYPE I (13.9 AC.)

Black Cherry	<i>Prunus serotina</i>	12" - 18", SEEDLING BR
Black Gum	<i>Nyssa sylvatica</i>	12" - 18", SEEDLING BR
Northern Red Oak	<i>Quercus rubra</i>	12" - 18", SEEDLING BR
Scarlet Oak	<i>Quercus coccinea</i>	12" - 18", SEEDLING BR
White Oak	<i>Quercus alba</i>	12" - 18", SEEDLING BR
Yellow Poplar	<i>Liriodendron tulipifera</i>	12" - 18", SEEDLING BR

HARDWOOD TREE PLANTING TYPE II (4.3 AC.)

Black Cherry	<i>Prunus serotina</i>	12" - 18", SEEDLING BR
Black Gum	<i>Nyssa sylvatica</i>	12" - 18", SEEDLING BR
Northern Red Oak	<i>Quercus rubra</i>	12" - 18", SEEDLING BR
Red Maple	<i>Acer rubrum</i>	12" - 18", SEEDLING BR
River Birch	<i>Betula nigra</i>	12" - 18", SEEDLING BR
White Oak	<i>Quercus alba</i>	12" - 18", SEEDLING BR
Yellow Poplar	<i>Liriodendron tulipifera</i>	12" - 18", SEEDLING BR

SHRUB PLANTING (1.1 Ac.)

Buttonbush	<i>Cephalanthus occidentalis</i>	12" - 18", SEEDLING BR
Hazel Alder	<i>Alnus serrulata</i>	12" - 18", SEEDLING BR
Roughleaf Dogwood	<i>Cornus drummondii</i>	12" - 18", SEEDLING BR

STREAM AREA (19.4 Ac.)

Black Gum	<i>Nyssa sylvatica</i>	12" - 18", SEEDLING BR
Northern Red Oak	<i>Quercus rubra</i>	12" - 18", SEEDLING BR
River Birch	<i>Betula nigra</i>	12" - 18", SEEDLING BR
Yellow Poplar	<i>Liriodendron tulipifera</i>	12" - 18", SEEDLING BR
White Oak	<i>Quercus alba</i>	12" - 18", SEEDLING BR

SEE PLAN SHEETS FOR AREAS TO BE PLANTED

WETLAND REFORESTATION


DETAIL SHEET

N.C.D.O.T. - ROADSIDE ENVIRONMENTAL UNIT

050191

REVISIONS

A-9WM		4
R/W SHEET NO.		
		HYDRAULICS ENGINEER
AS-BUILT PLANS		

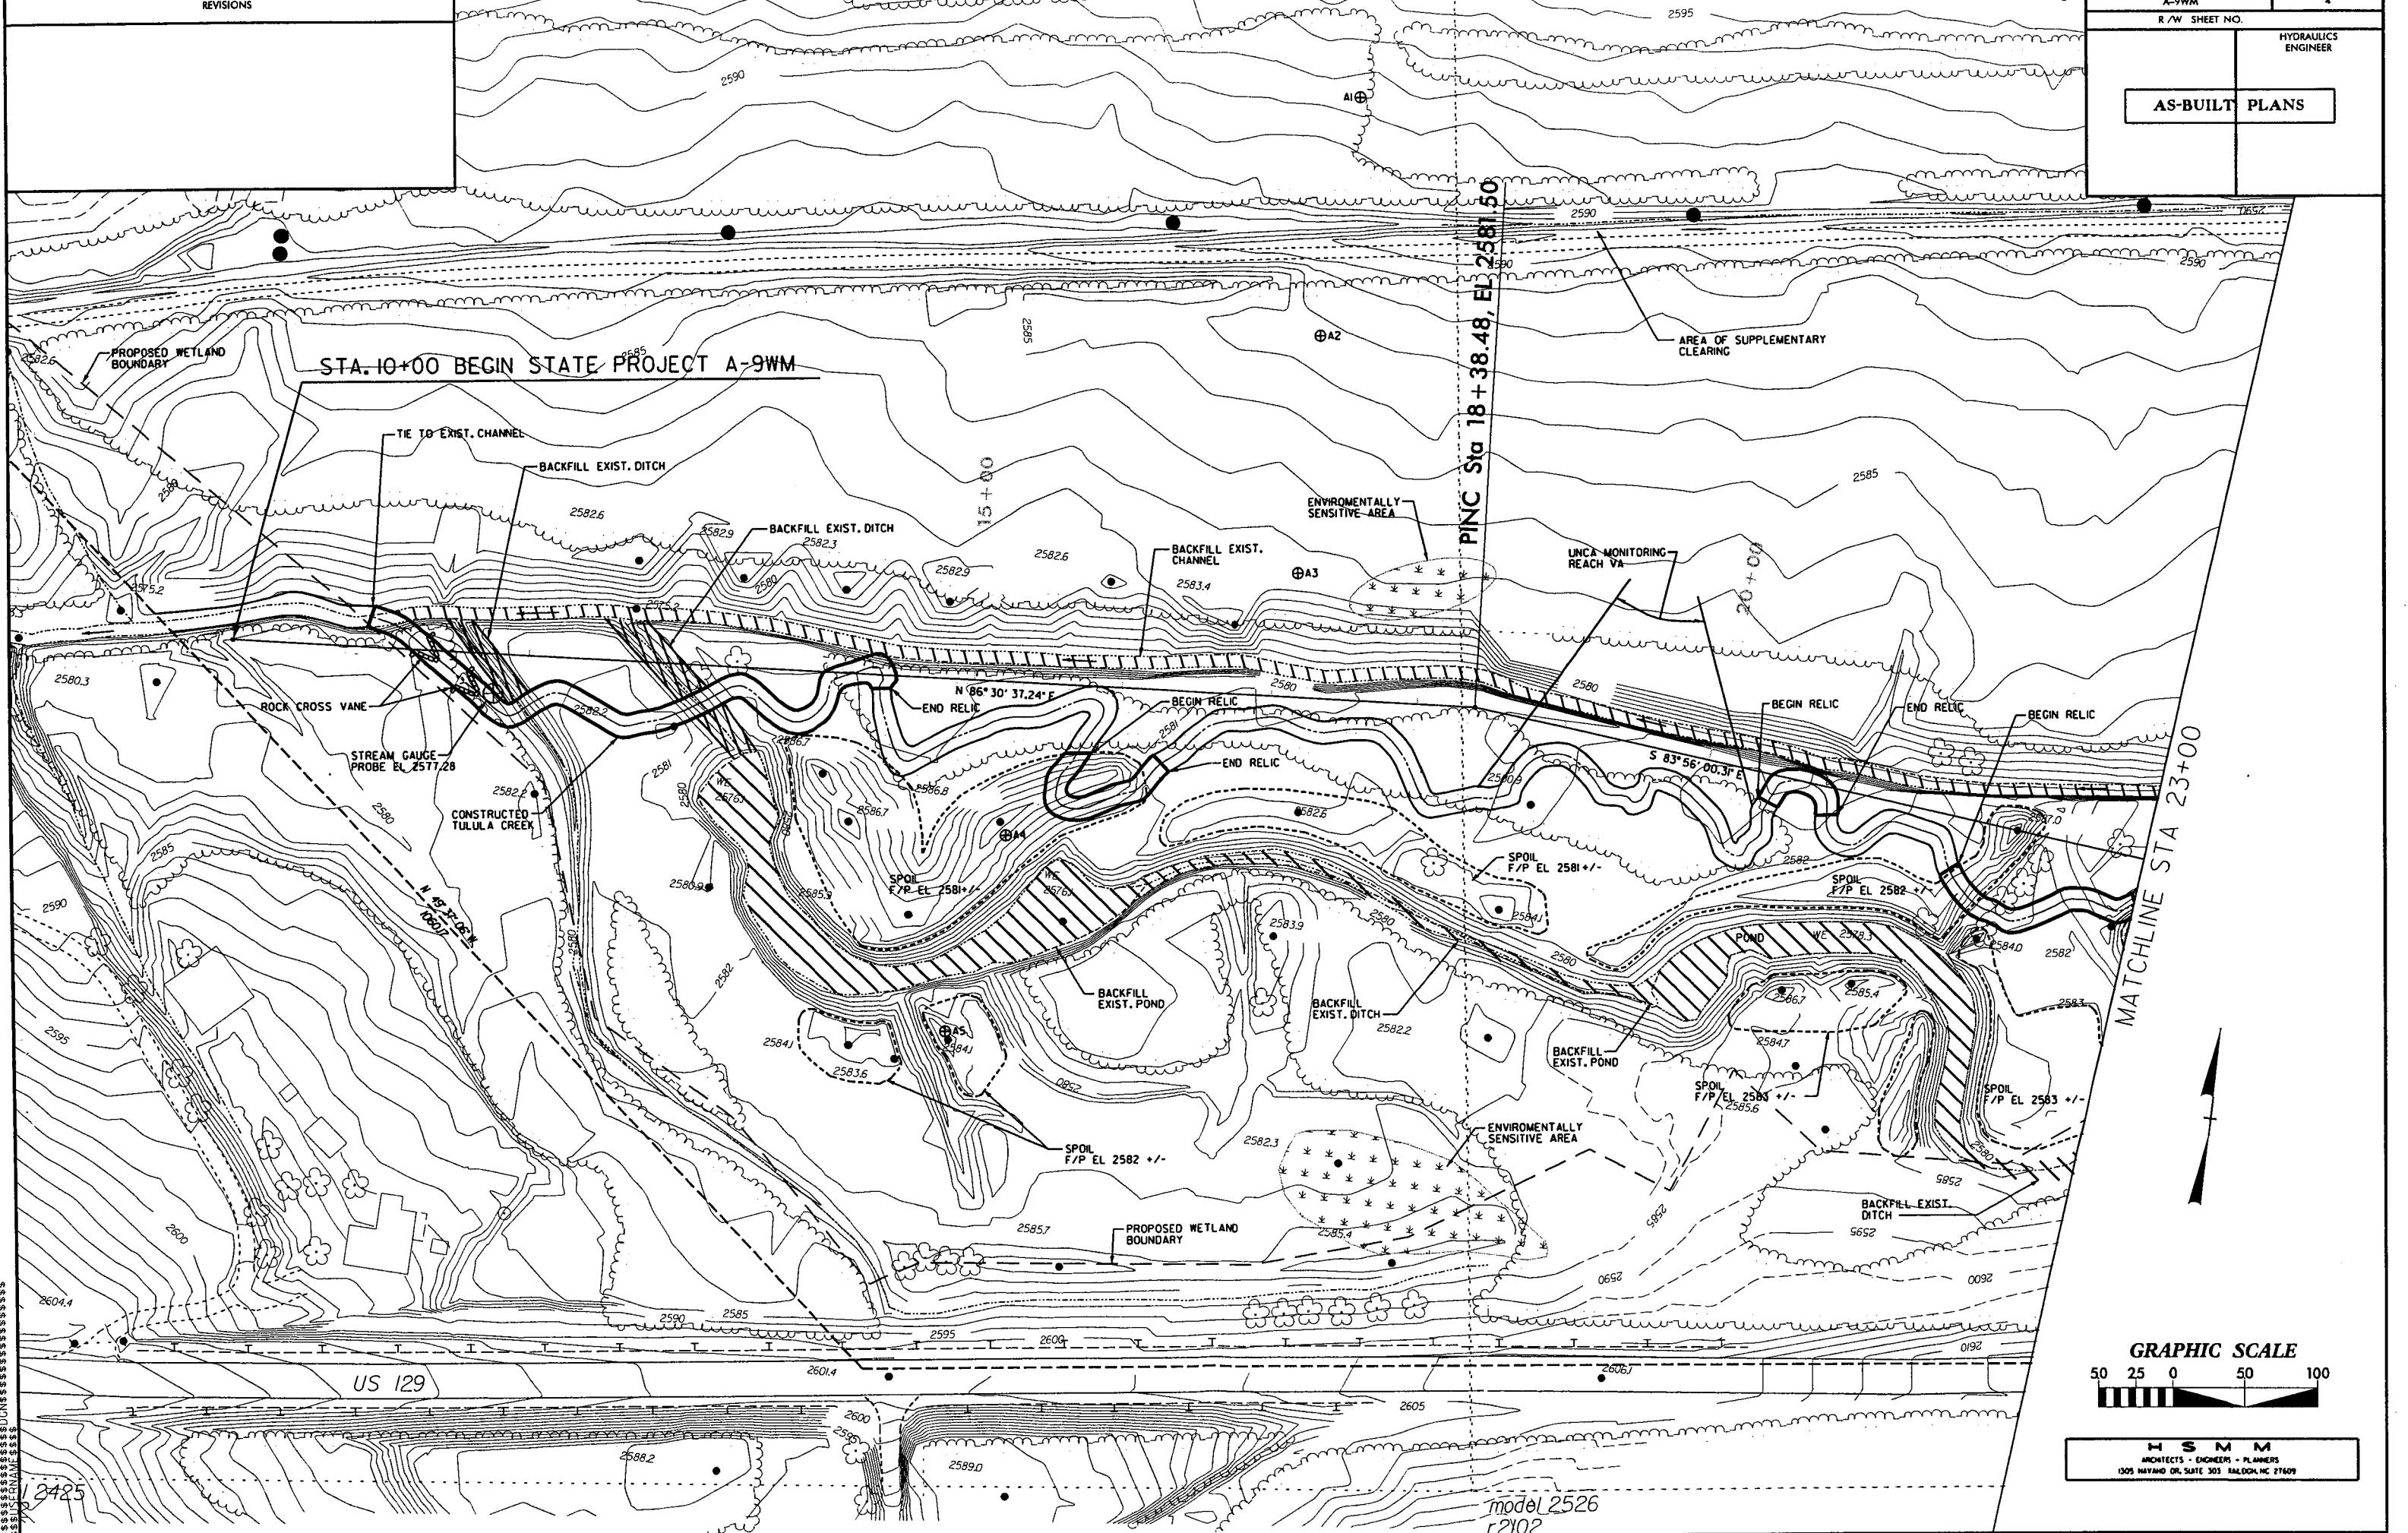


SYSTEMS CONNECTION



8425

model 2526
r2102

H S M M
 ARCHITECTS - ENGINEERS - PLANNERS
 1305 MAYANO DR. SUITE 303 RALPH, NC 27609

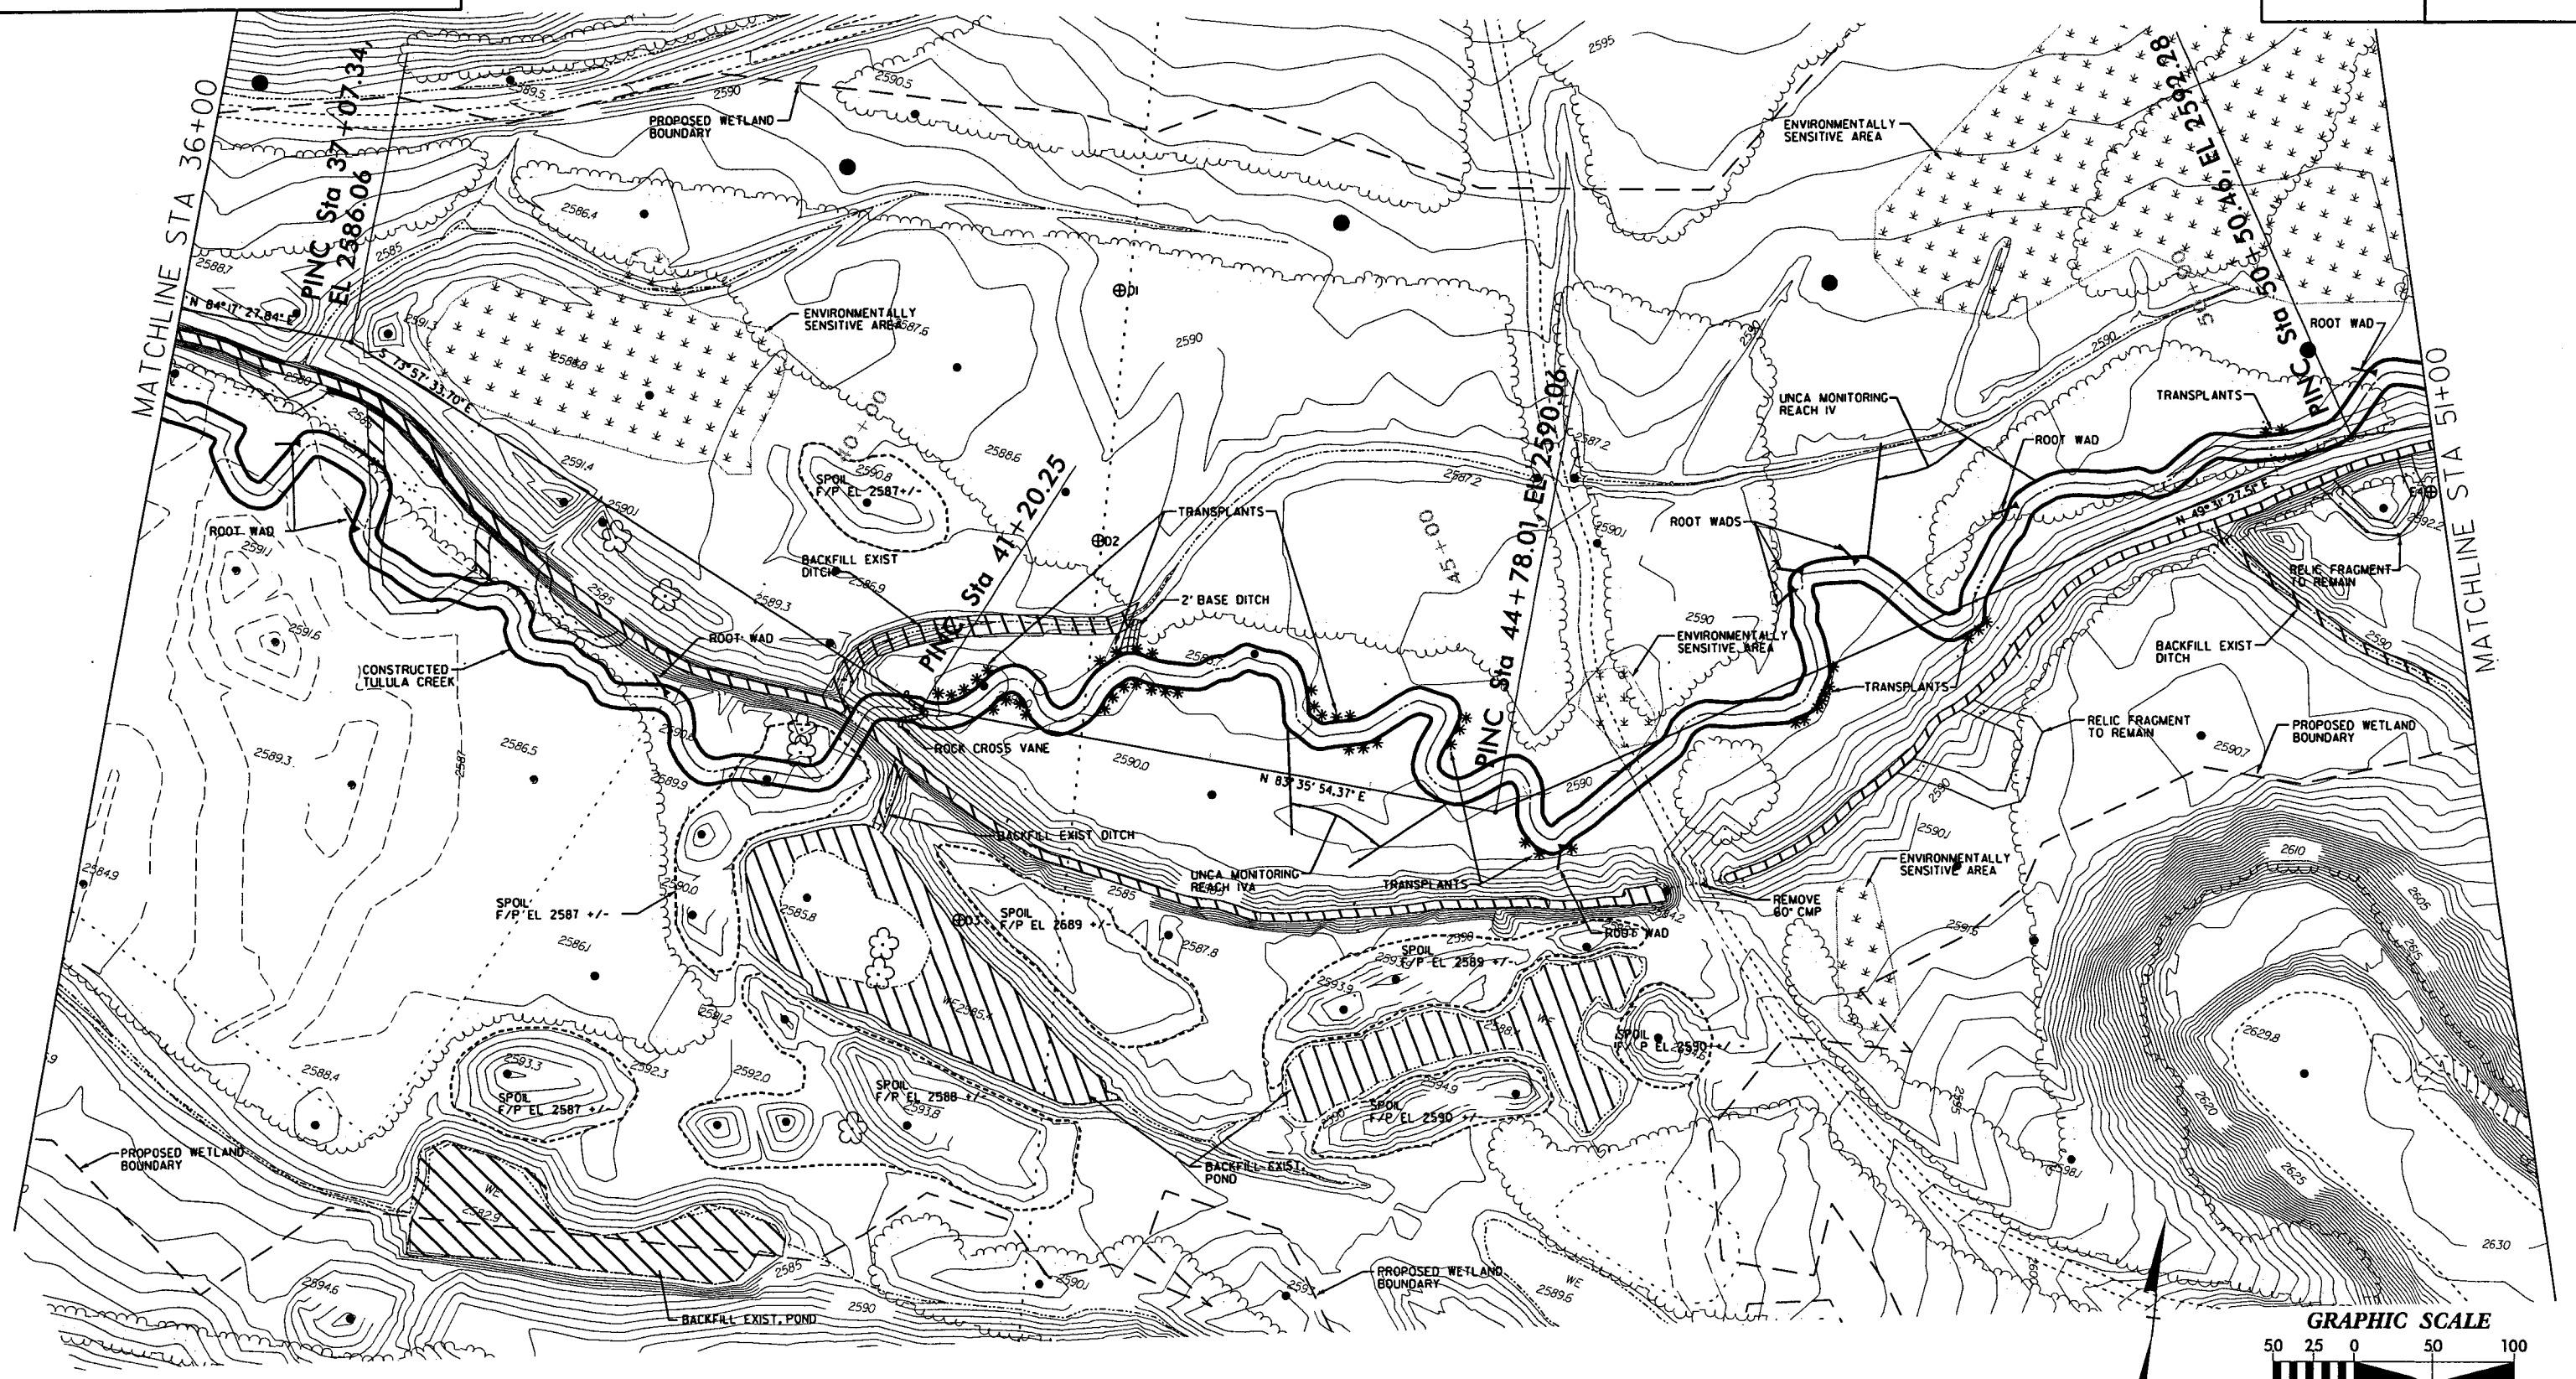

DATE: 11/11/11
 TIME: 10:00 AM
 BY: J. W. HARRIS
 CHECKED: J. W. HARRIS
 APPROVED: J. W. HARRIS

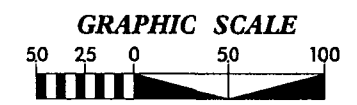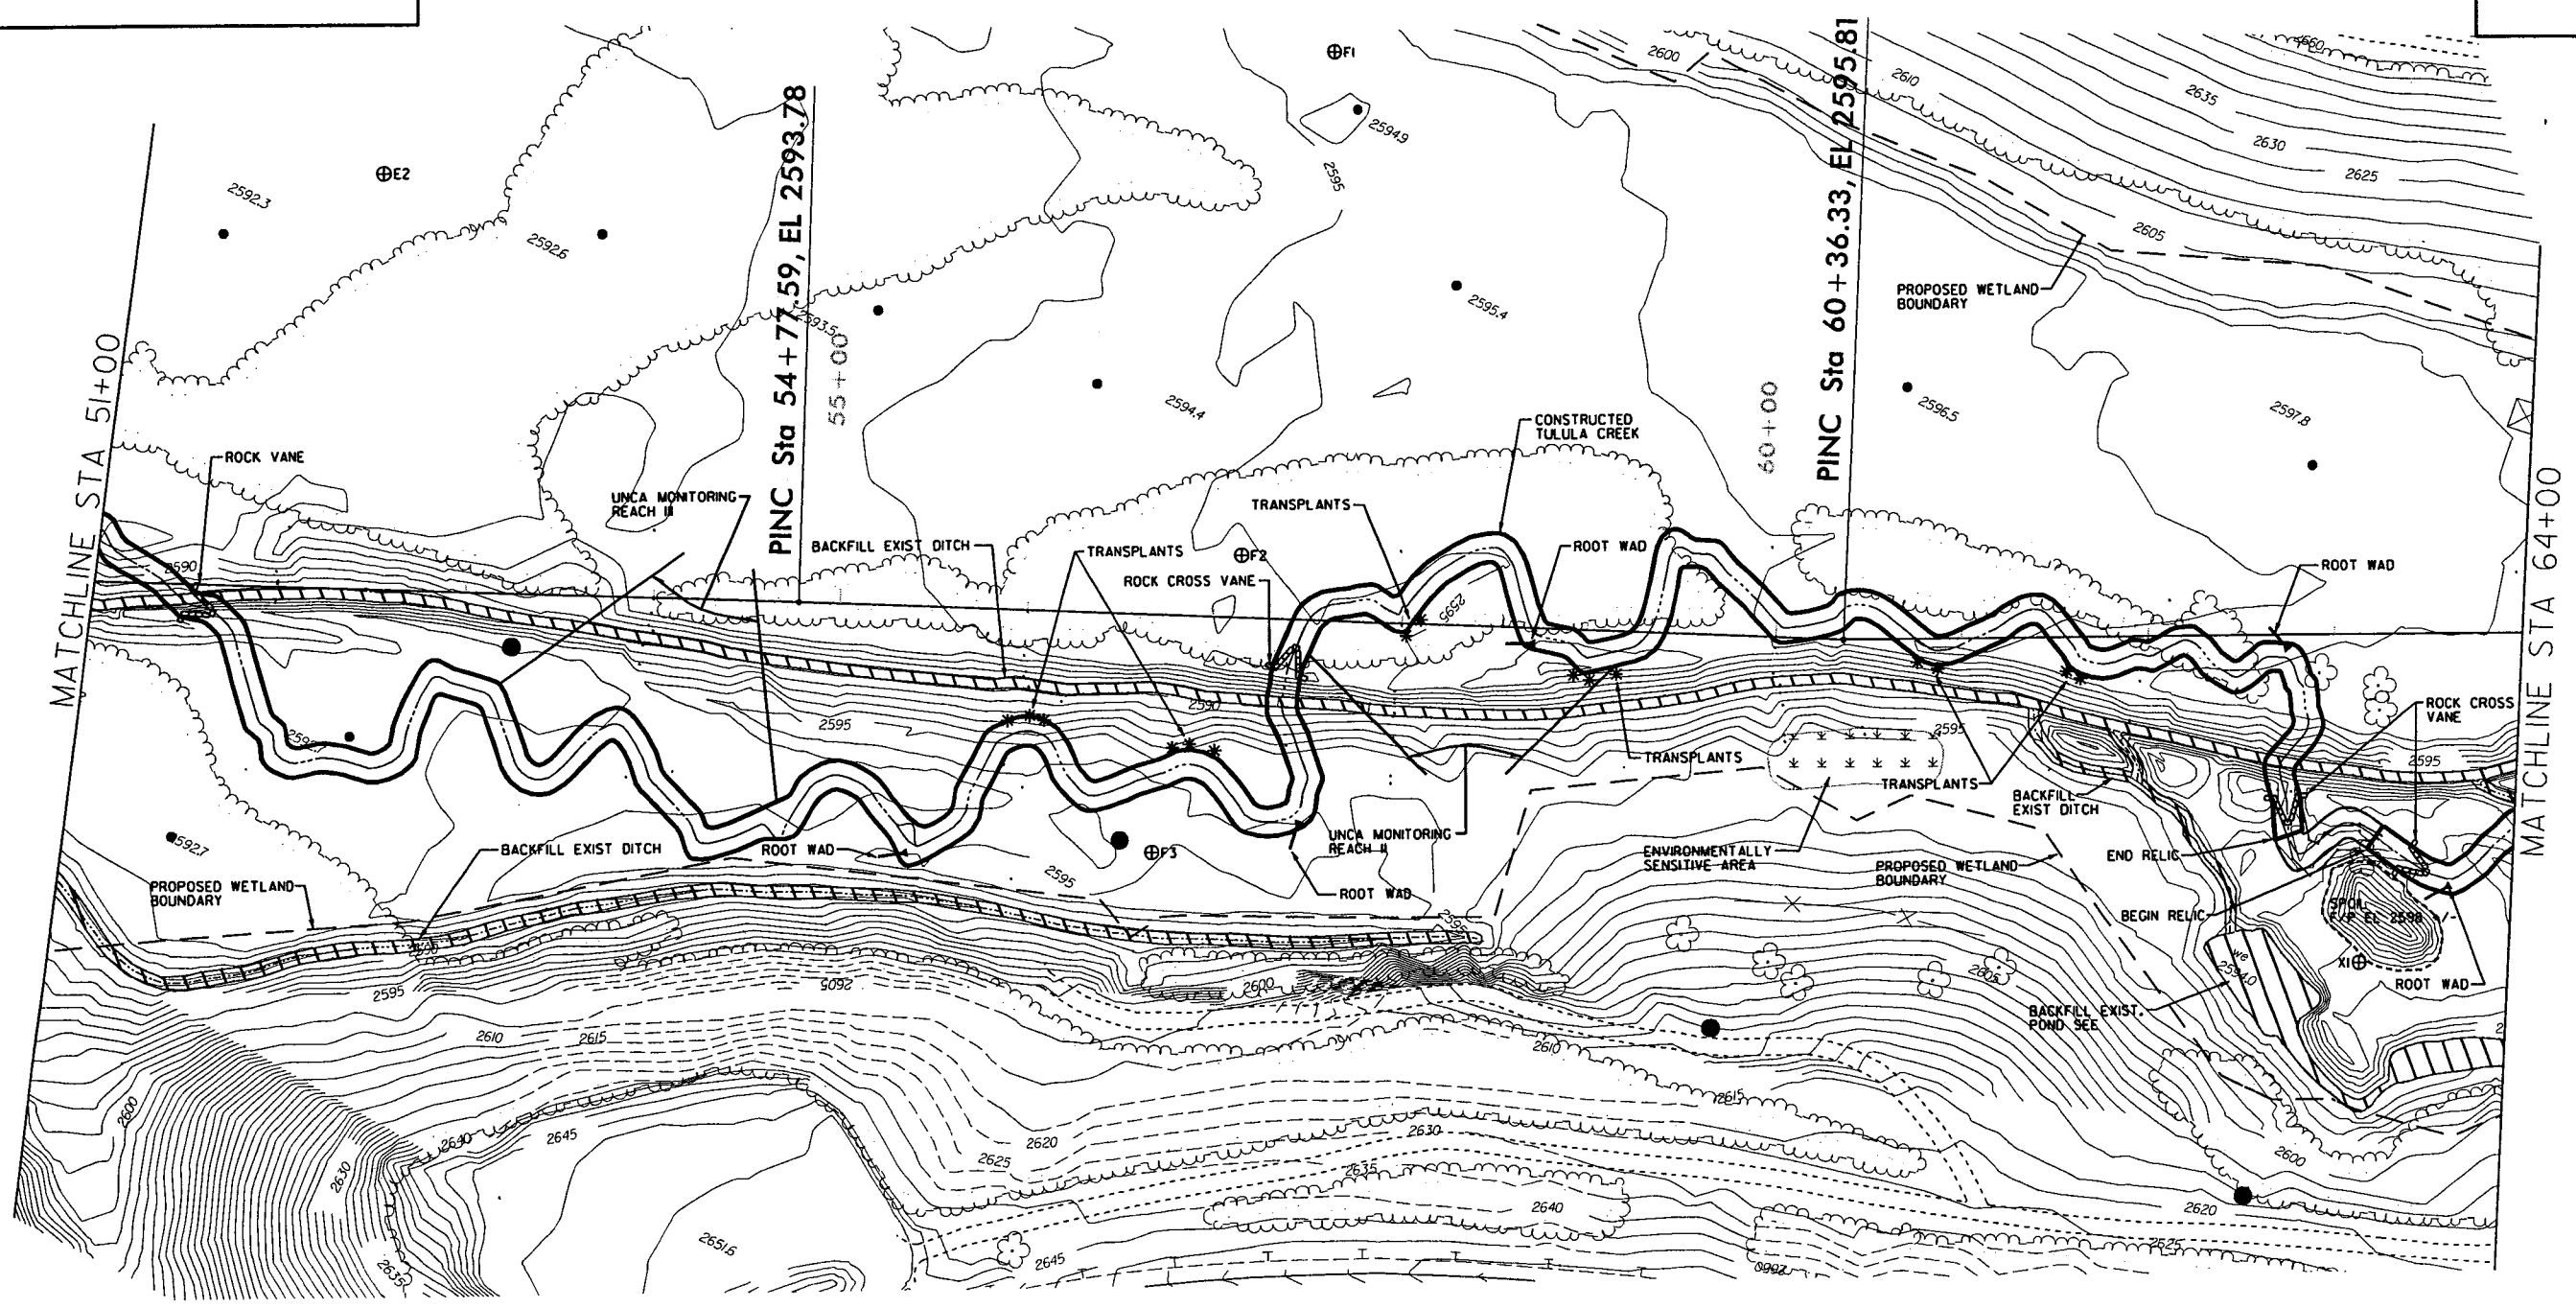



05015
 1
 2
 3

STA. 71+57.72
END STATE PROJECT A-9WM

STA. 10+00
BEGIN STATE PROJECT A-9WM



LEGEND


-  CONSTRUCTED TULULA CREEK
-  GROUNDWATER MONITORING GAUGE

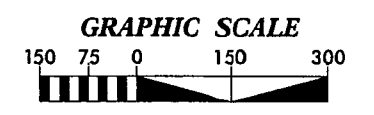

GROUNDWATER GAUGE LOCATIONS

STA. 71+57.72
END STATE PROJECT A-9WM


STA. 10+00
BEGIN STATE PROJECT A-9WM

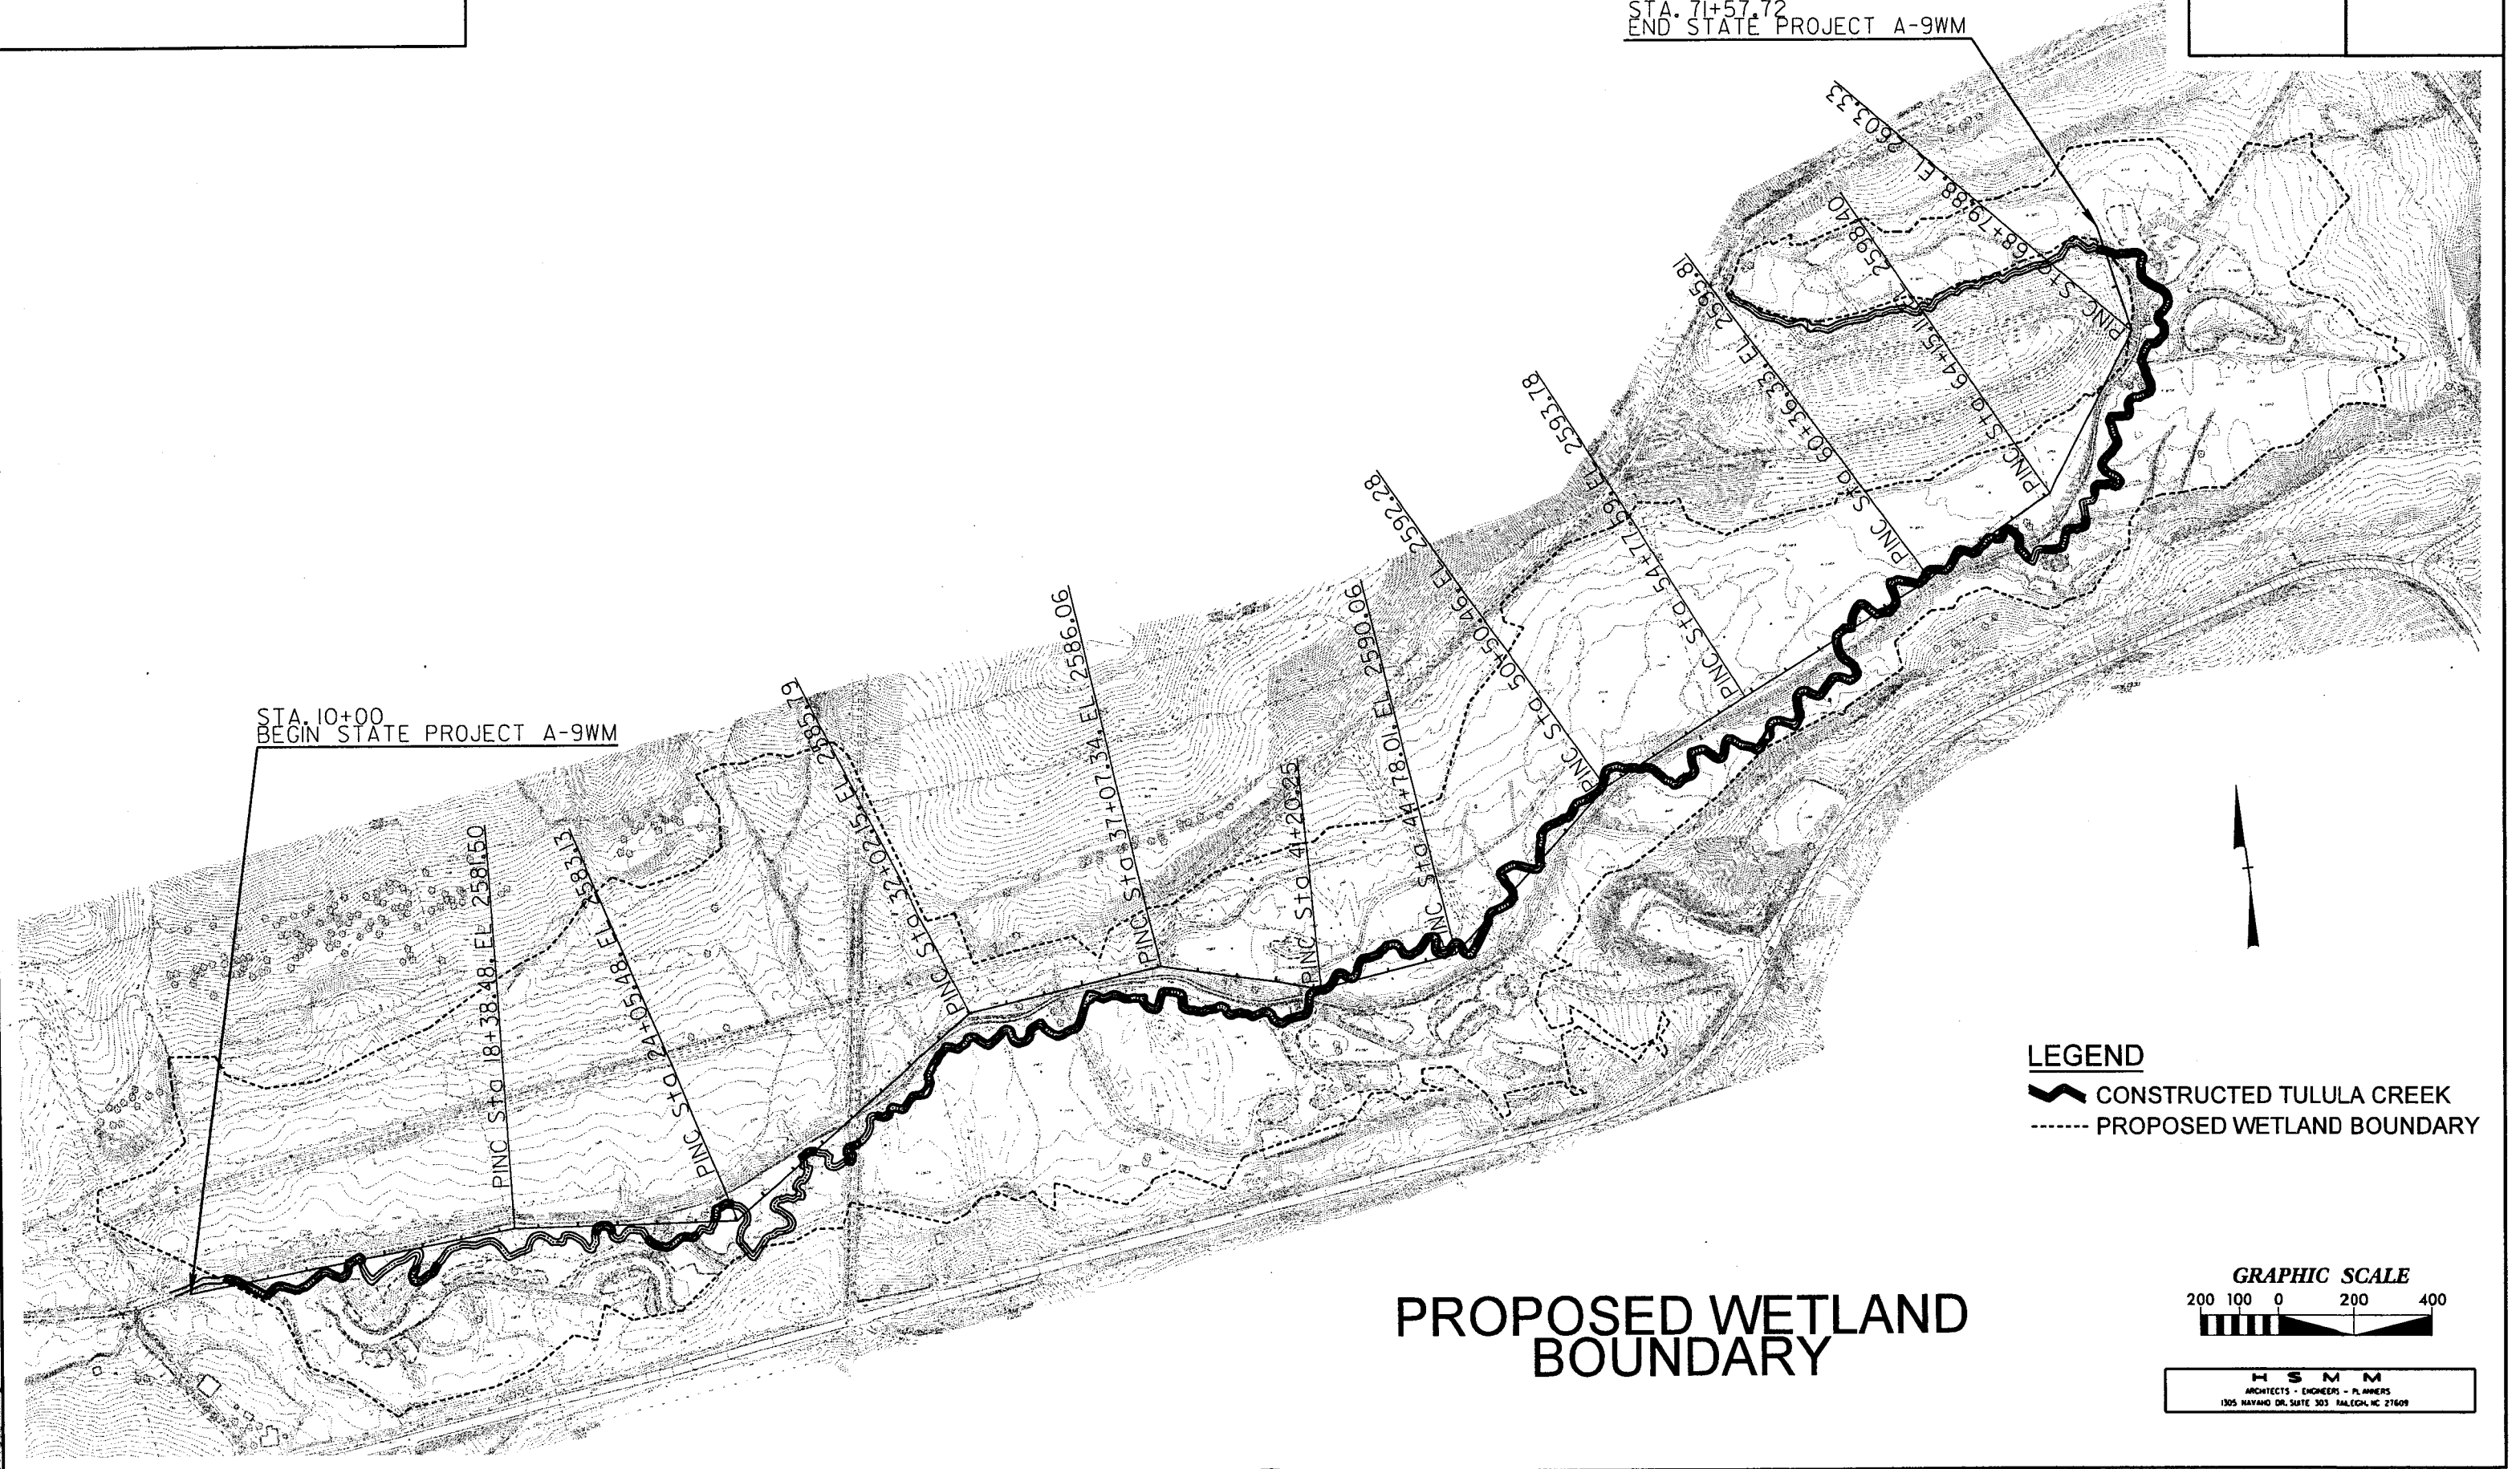

LEGEND

- CONSTRUCTED TULULA CREEK
- PROPOSED WETLAND BOUNDARY

GRAPHIC SCALE

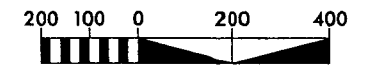


PROPOSED WETLAND BOUNDARY

H S M M
 ARCHITECTS - ENGINEERS - PLANNERS
 1305 HAYWARD DR. SUITE 303 RALEIGH, NC 27609





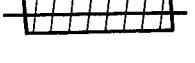


05019

STA. 71+57.72
END STATE PROJECT A-9WM

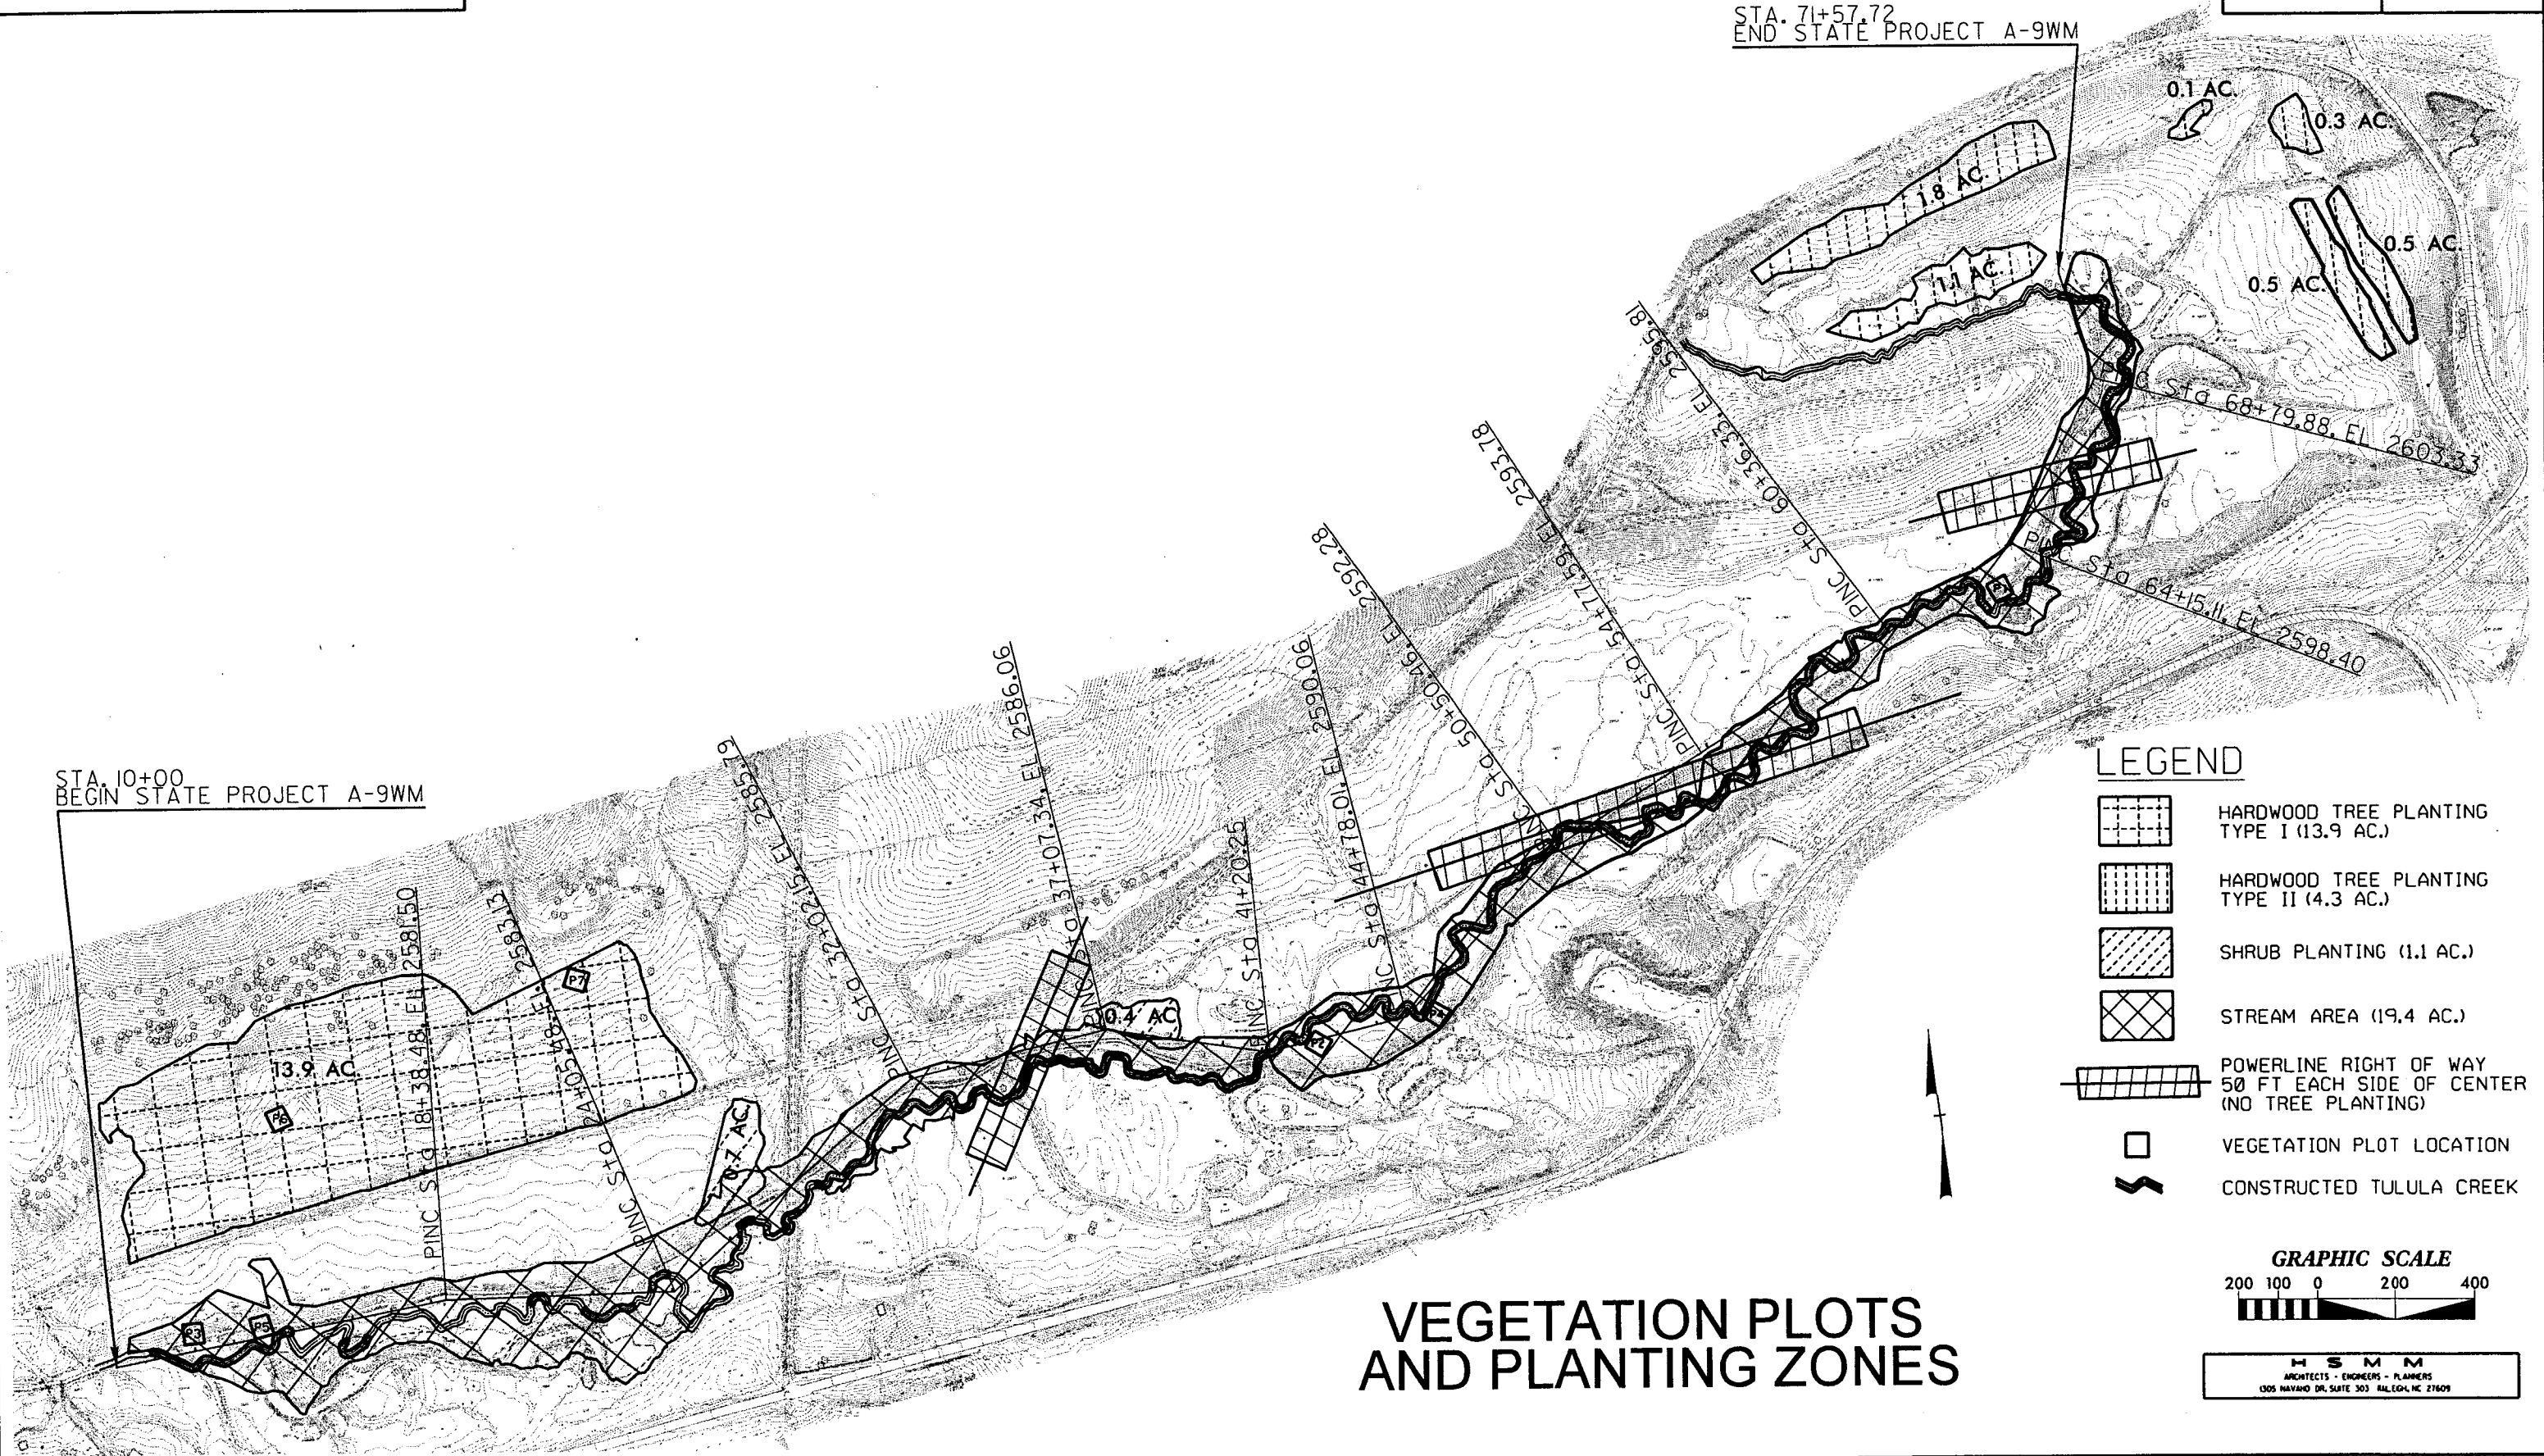
STA. 10+00
BEGIN STATE PROJECT A-9WM

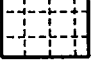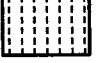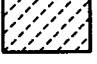

LEGEND



-  HARDWOOD TREE PLANTING TYPE I (13.9 AC.)
-  HARDWOOD TREE PLANTING TYPE II (4.3 AC.)
-  SHRUB PLANTING (1.1 AC.)
-  STREAM AREA (19.4 AC.)
-  POWERLINE RIGHT OF WAY 50 FT EACH SIDE OF CENTER (NO TREE PLANTING)
-  VEGETATION PLOT LOCATION
-  CONSTRUCTED TULULA CREEK

GRAPHIC SCALE

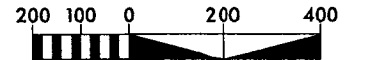

VEGETATION PLOTS AND PLANTING ZONES

5/28/99

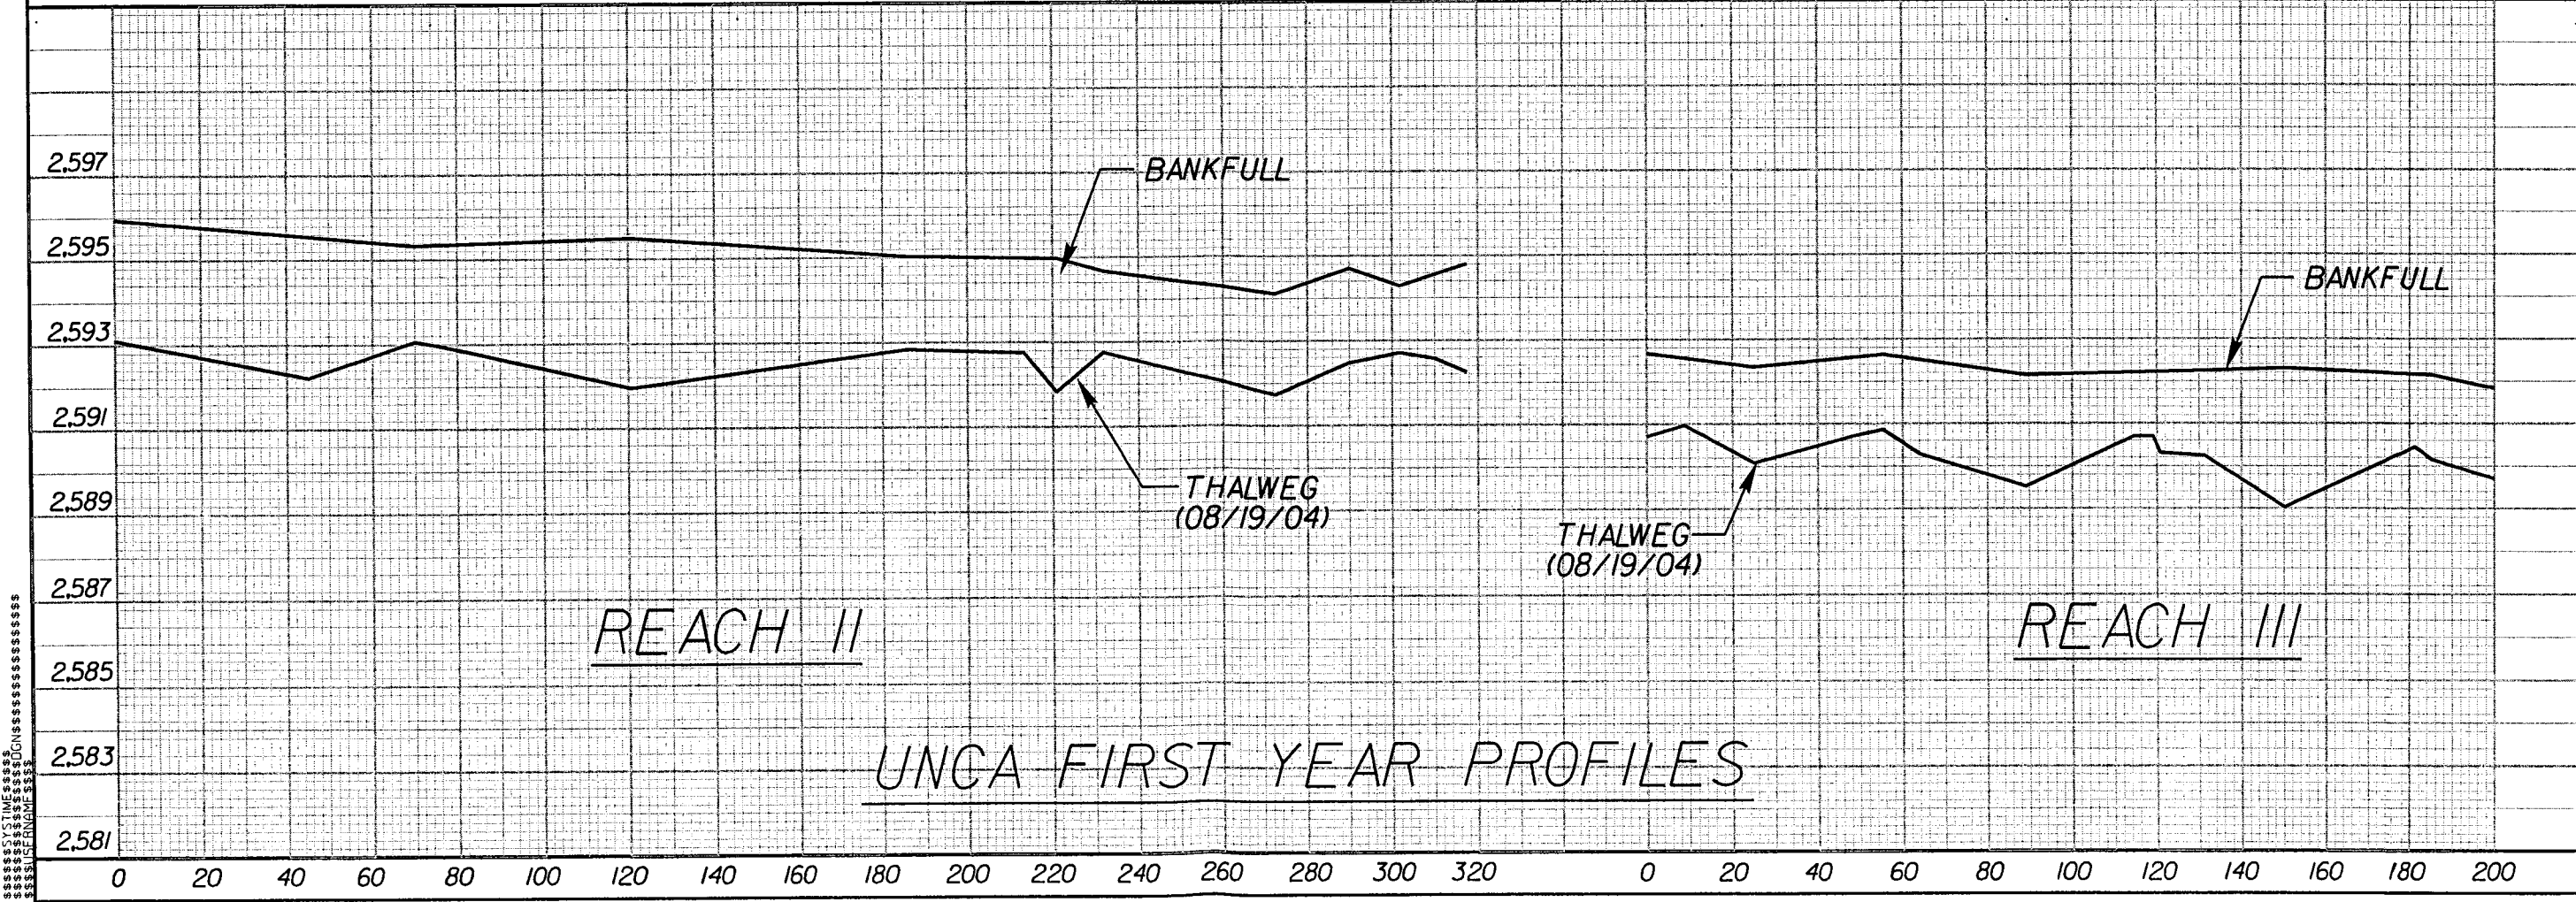
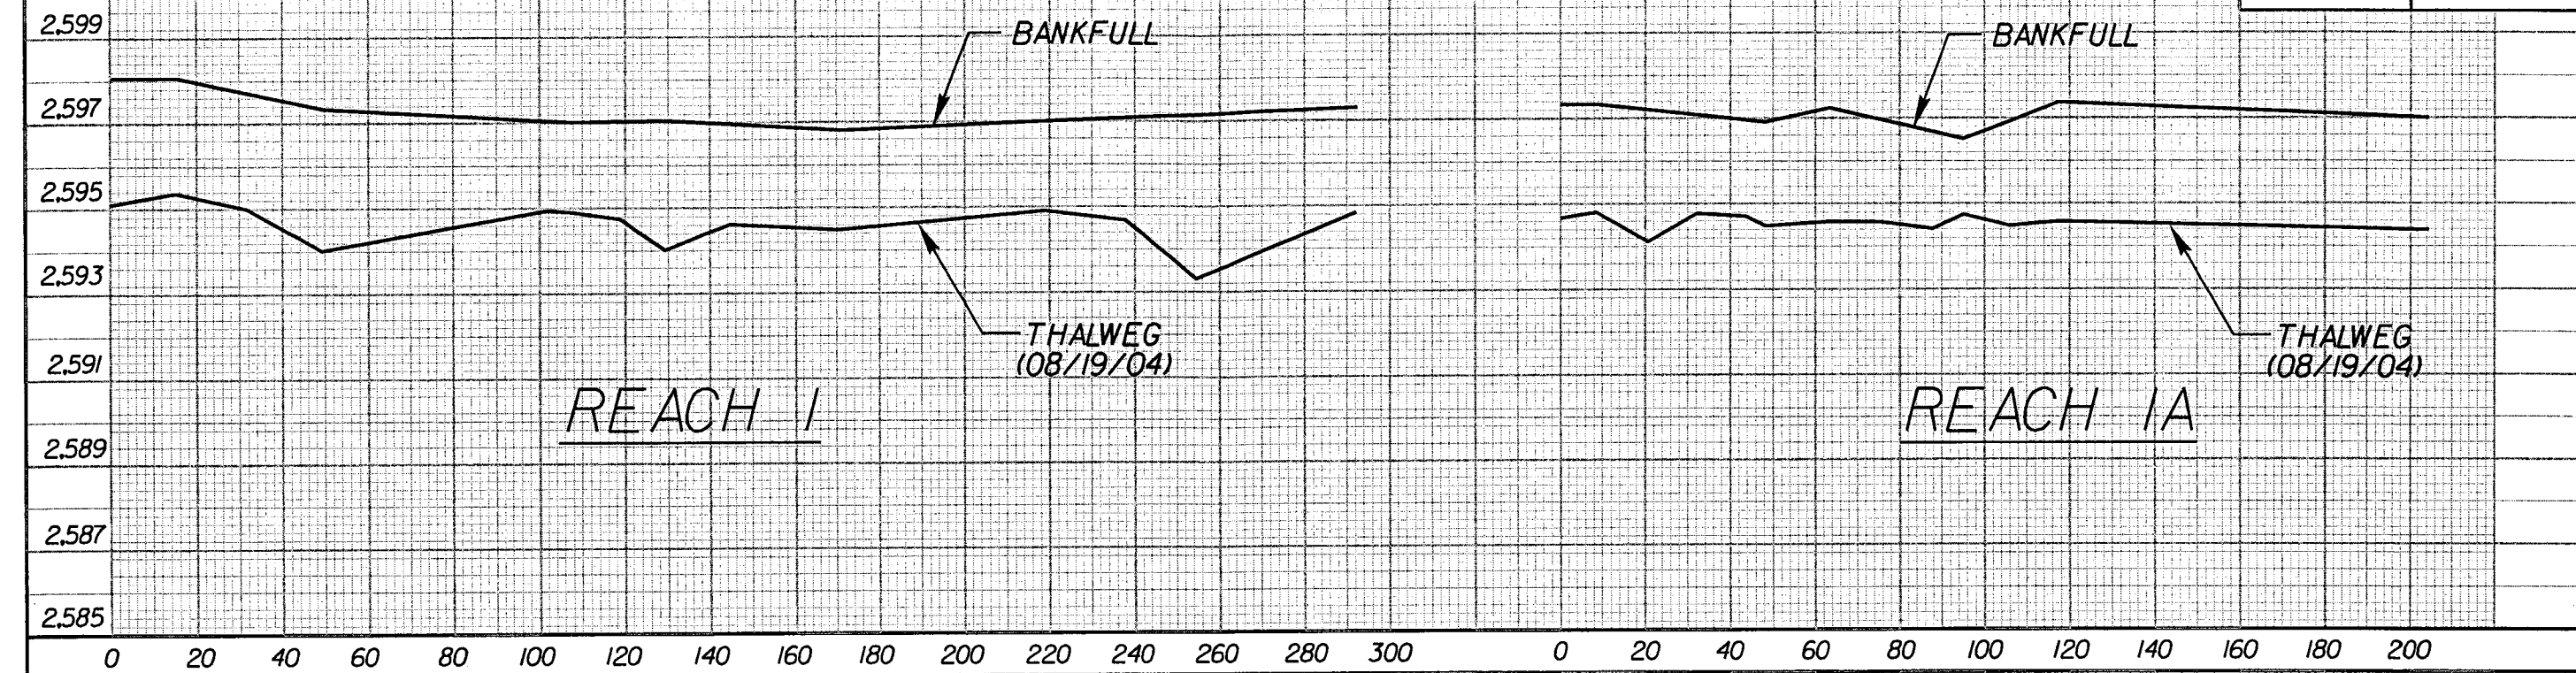


UNCA FIRST YEAR PROFILES

SYSTEMS
DESIGN
ENGINEER









5/28/99

PROJECT REFERENCE NO. A-9WM	SHEET NO. 13
ROADWAY DESIGN ENGINEER	HYDRAULICS ENGINEER
AS-BUILT	PLANS

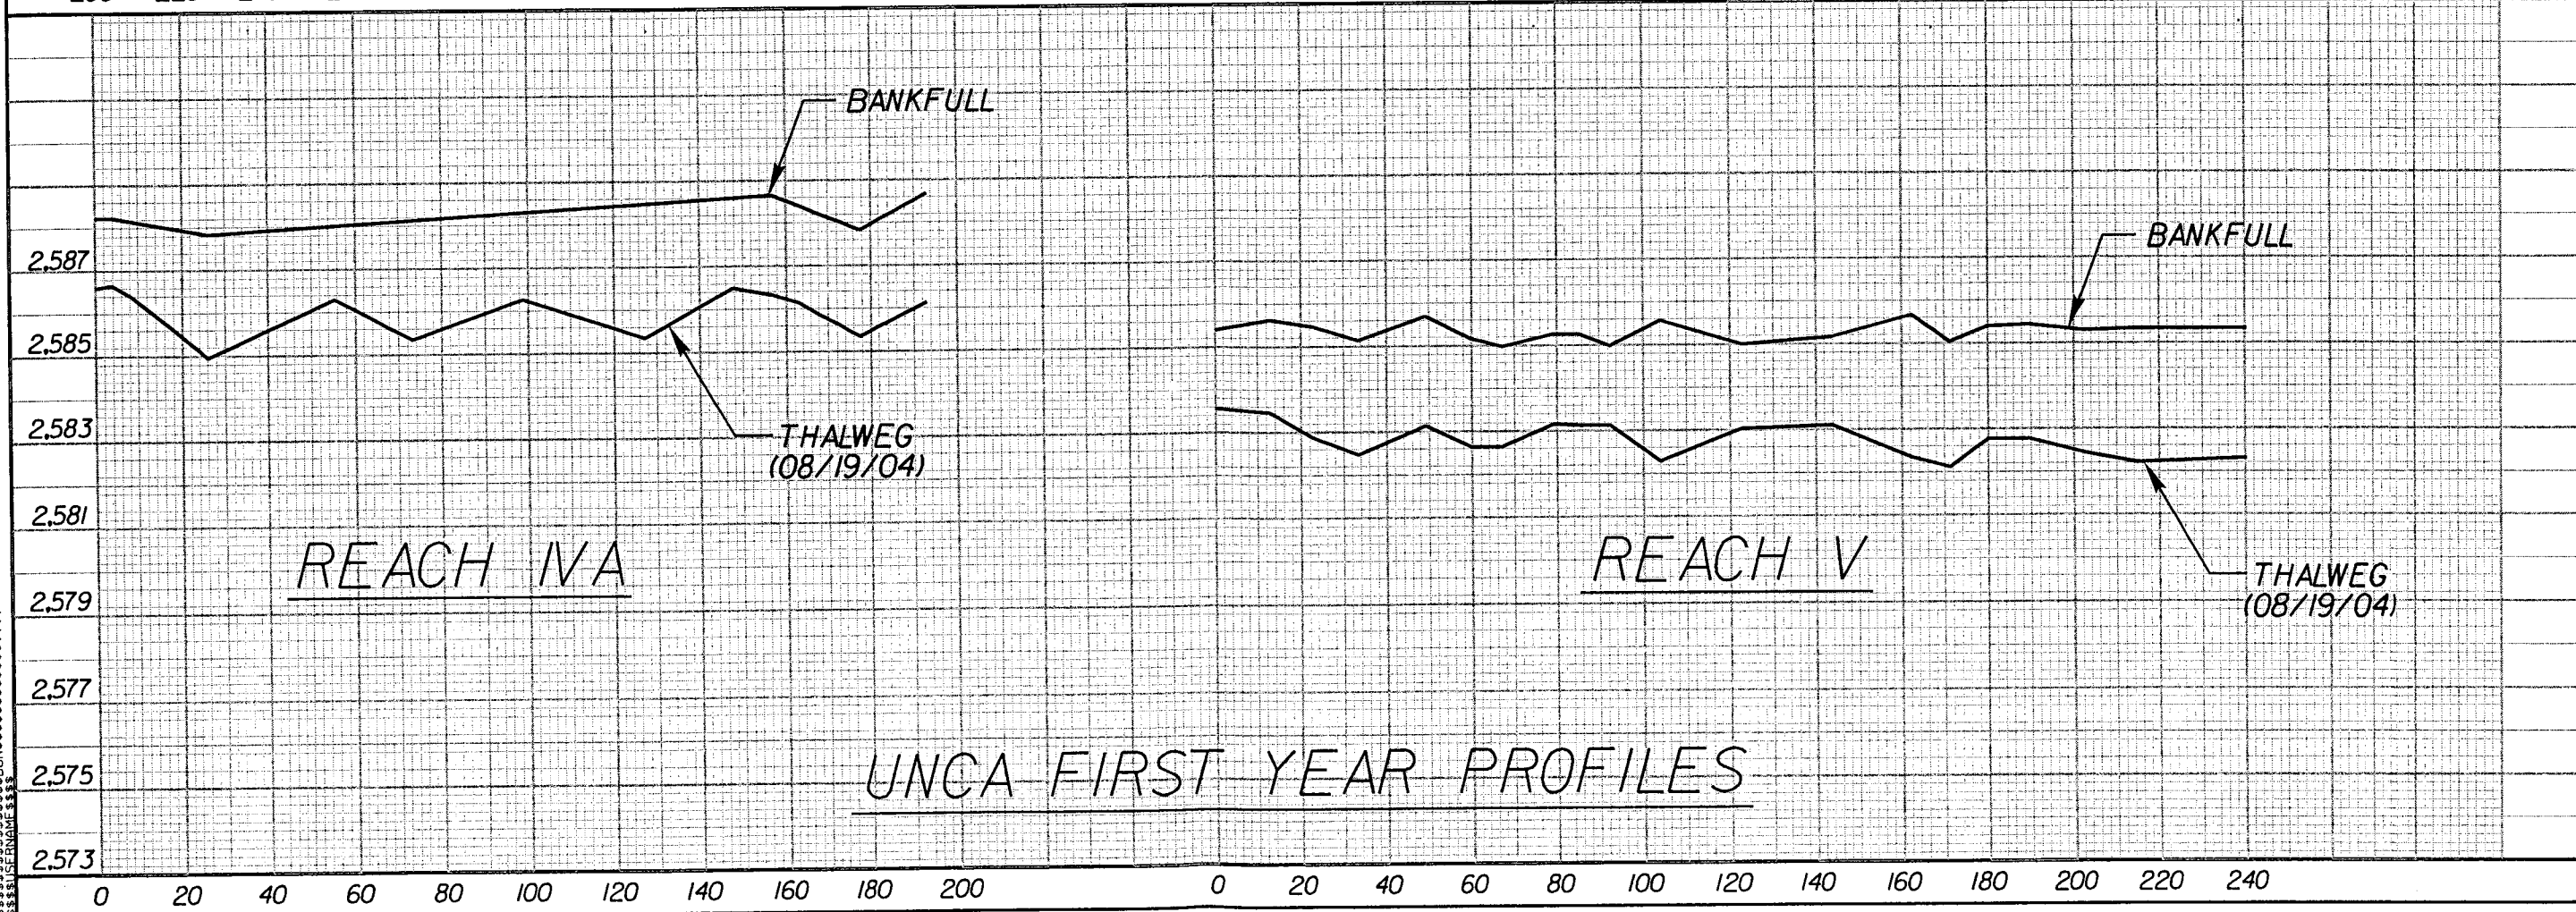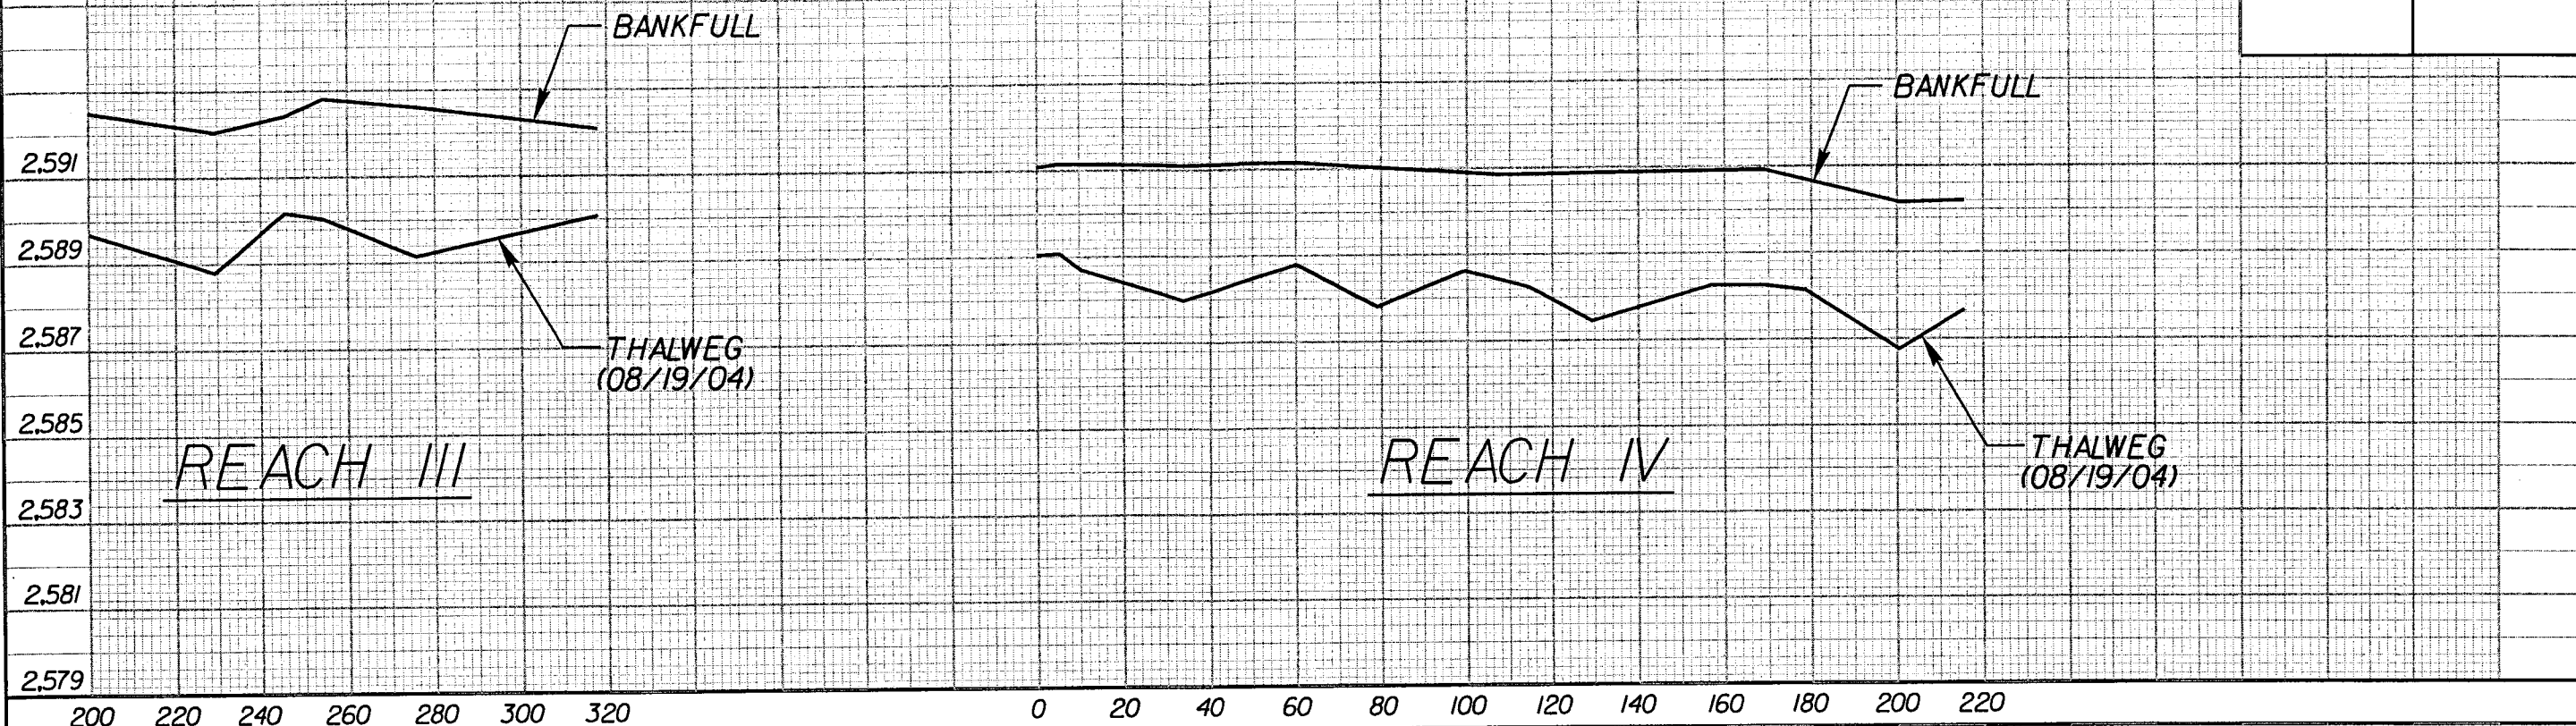

\$\$\$\$\$SYTIME\$\$\$\$\$
\$\$\$\$\$DESIGN\$\$\$\$\$
\$\$\$\$\$DATE\$\$\$\$\$

02/03/98

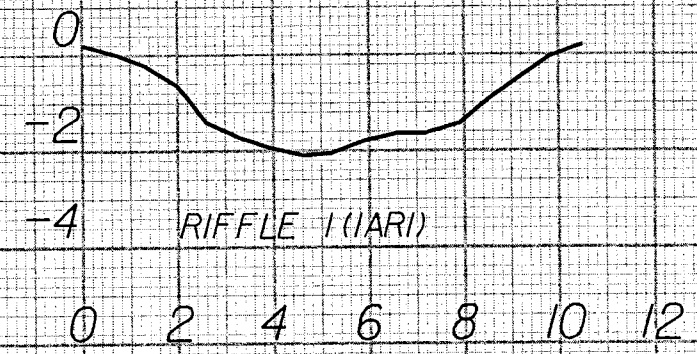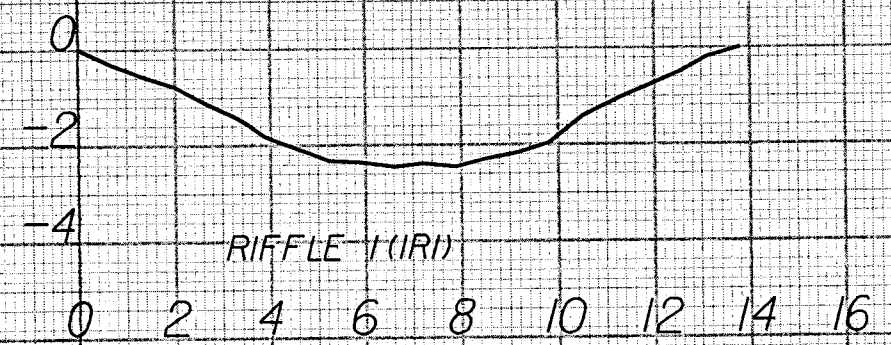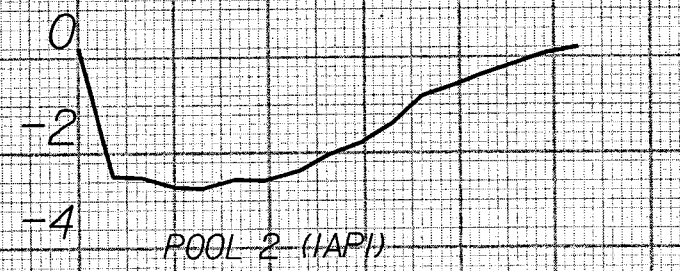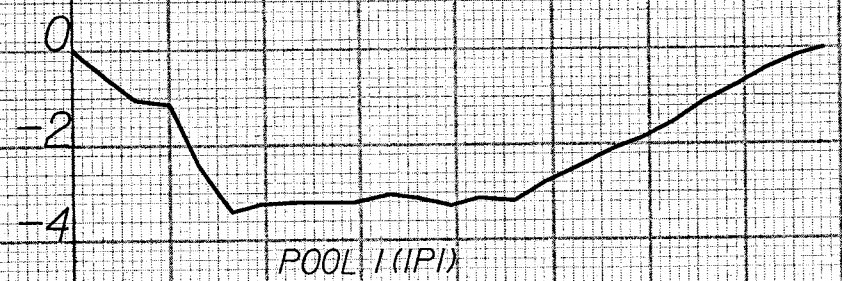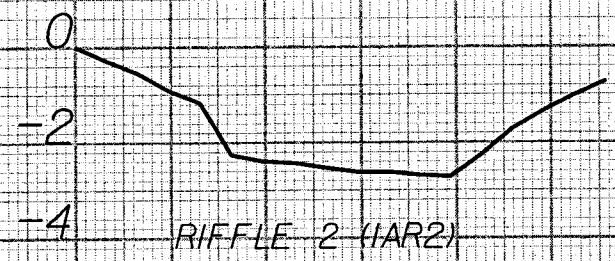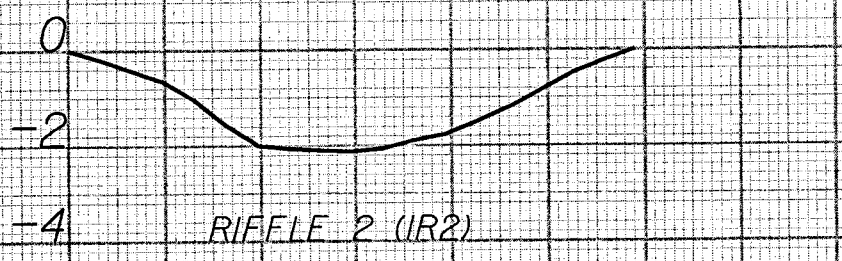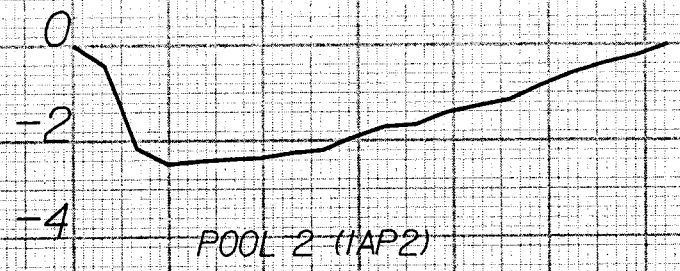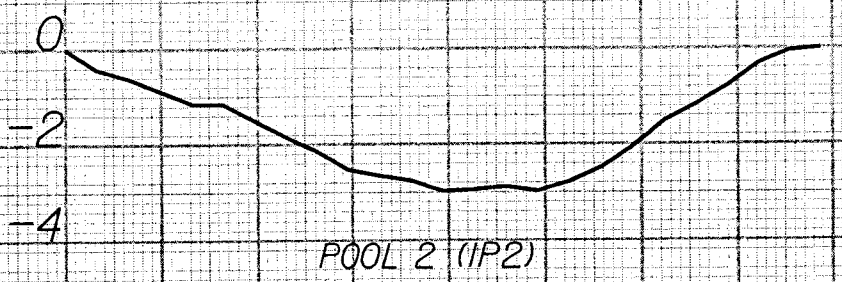




REACH I

REACH IA

UNCA FIRST YEAR CROSS SECTIONS





SYSTEMS DESIGN SERVICES

02/03/98

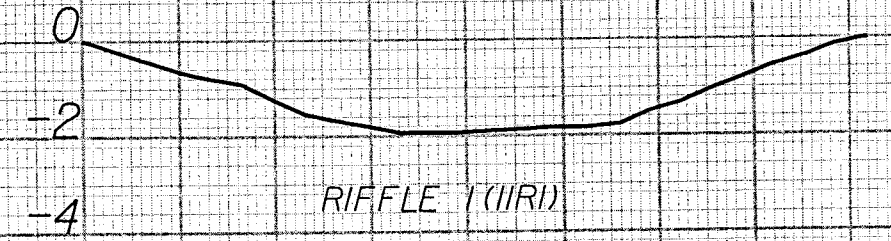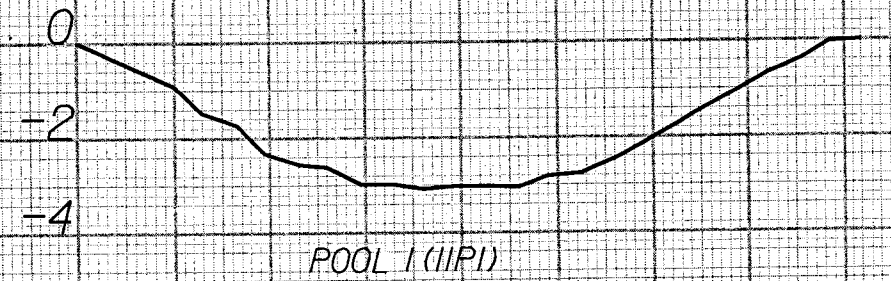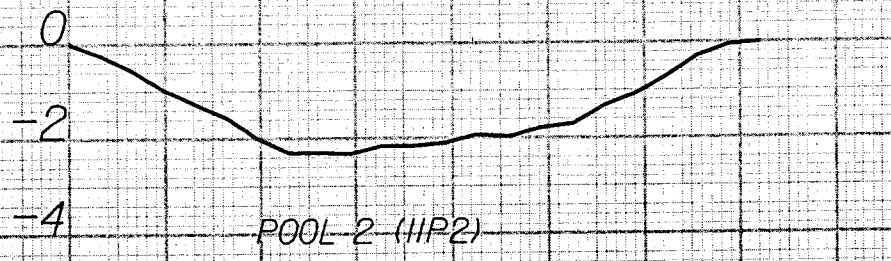

0 2 4 6 8 10 12 14 16

REACH II

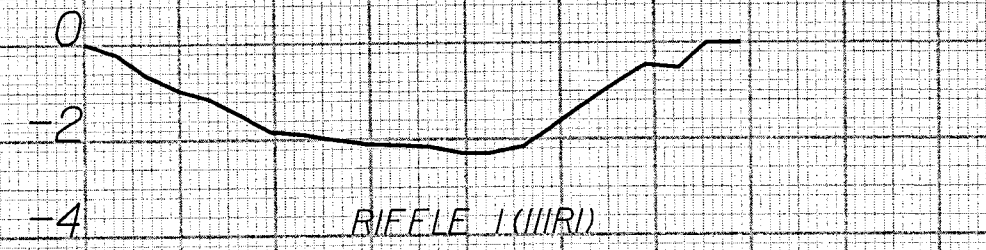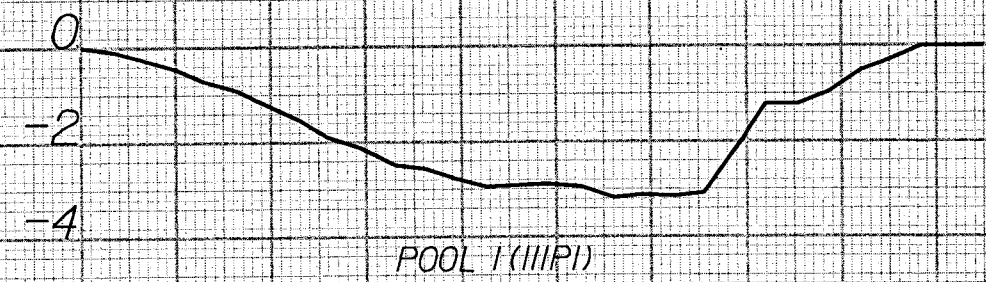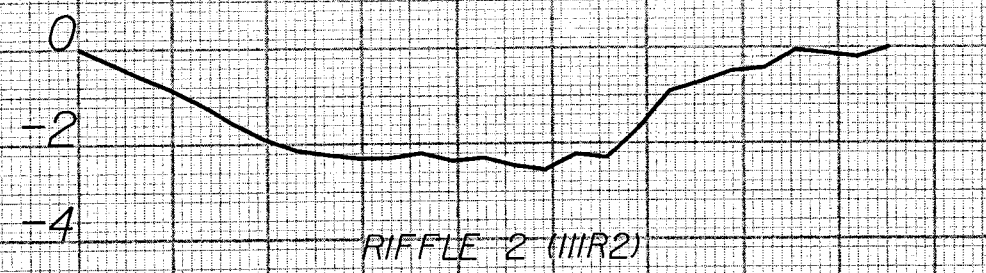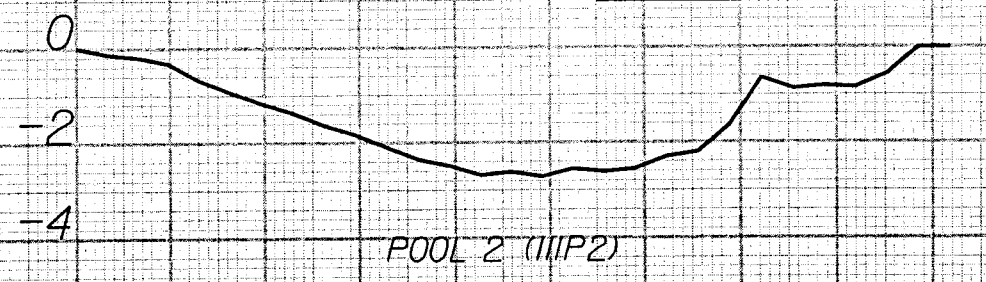

0 2 4 6 8 10 12 14 16 18

REACH III

UNCA FIRST YEAR CROSS SECTIONS

SYNOPSIS OF DATA SOURCES

