

PROJECT: 167680 UT to MAGNESS CREEK

**NORTH CAROLINA
DIVISION OF MITIGATION SERVICES**

CLEVELAND COUNTY

STATE	BAKER PROJECT REFERENCE NO.	SHEET NO.	TOTAL SHEETS
NC	167680	1	18




VICINITY MAP

INDEX OF SHEETS


1.....	TITLE SHEET
1-A.....	STREAM CONVENTIONAL SYMBOLS GENERAL NOTES STANDARD SPECIFICATIONS VEGETATION SELECTION
1-B.....	NCDOT CONVENTIONAL SYMBOLS
2-2F.....	DETAILS
3-10.....	PLAN AND PROFILE VIEW

LOCATION: FROM LAWNDALE, TAKE NC-182 1.9 MILES EAST TO FALL STREET ON LEFT, GO .28 MILES TO SELKIRK ROAD ON LEFT, TRAVEL .87 MILES SOUTH AND SITE IS EAST OF SELKIRK ROAD AT CULVERT.

TYPE OF WORK: RECORD DRAWINGS

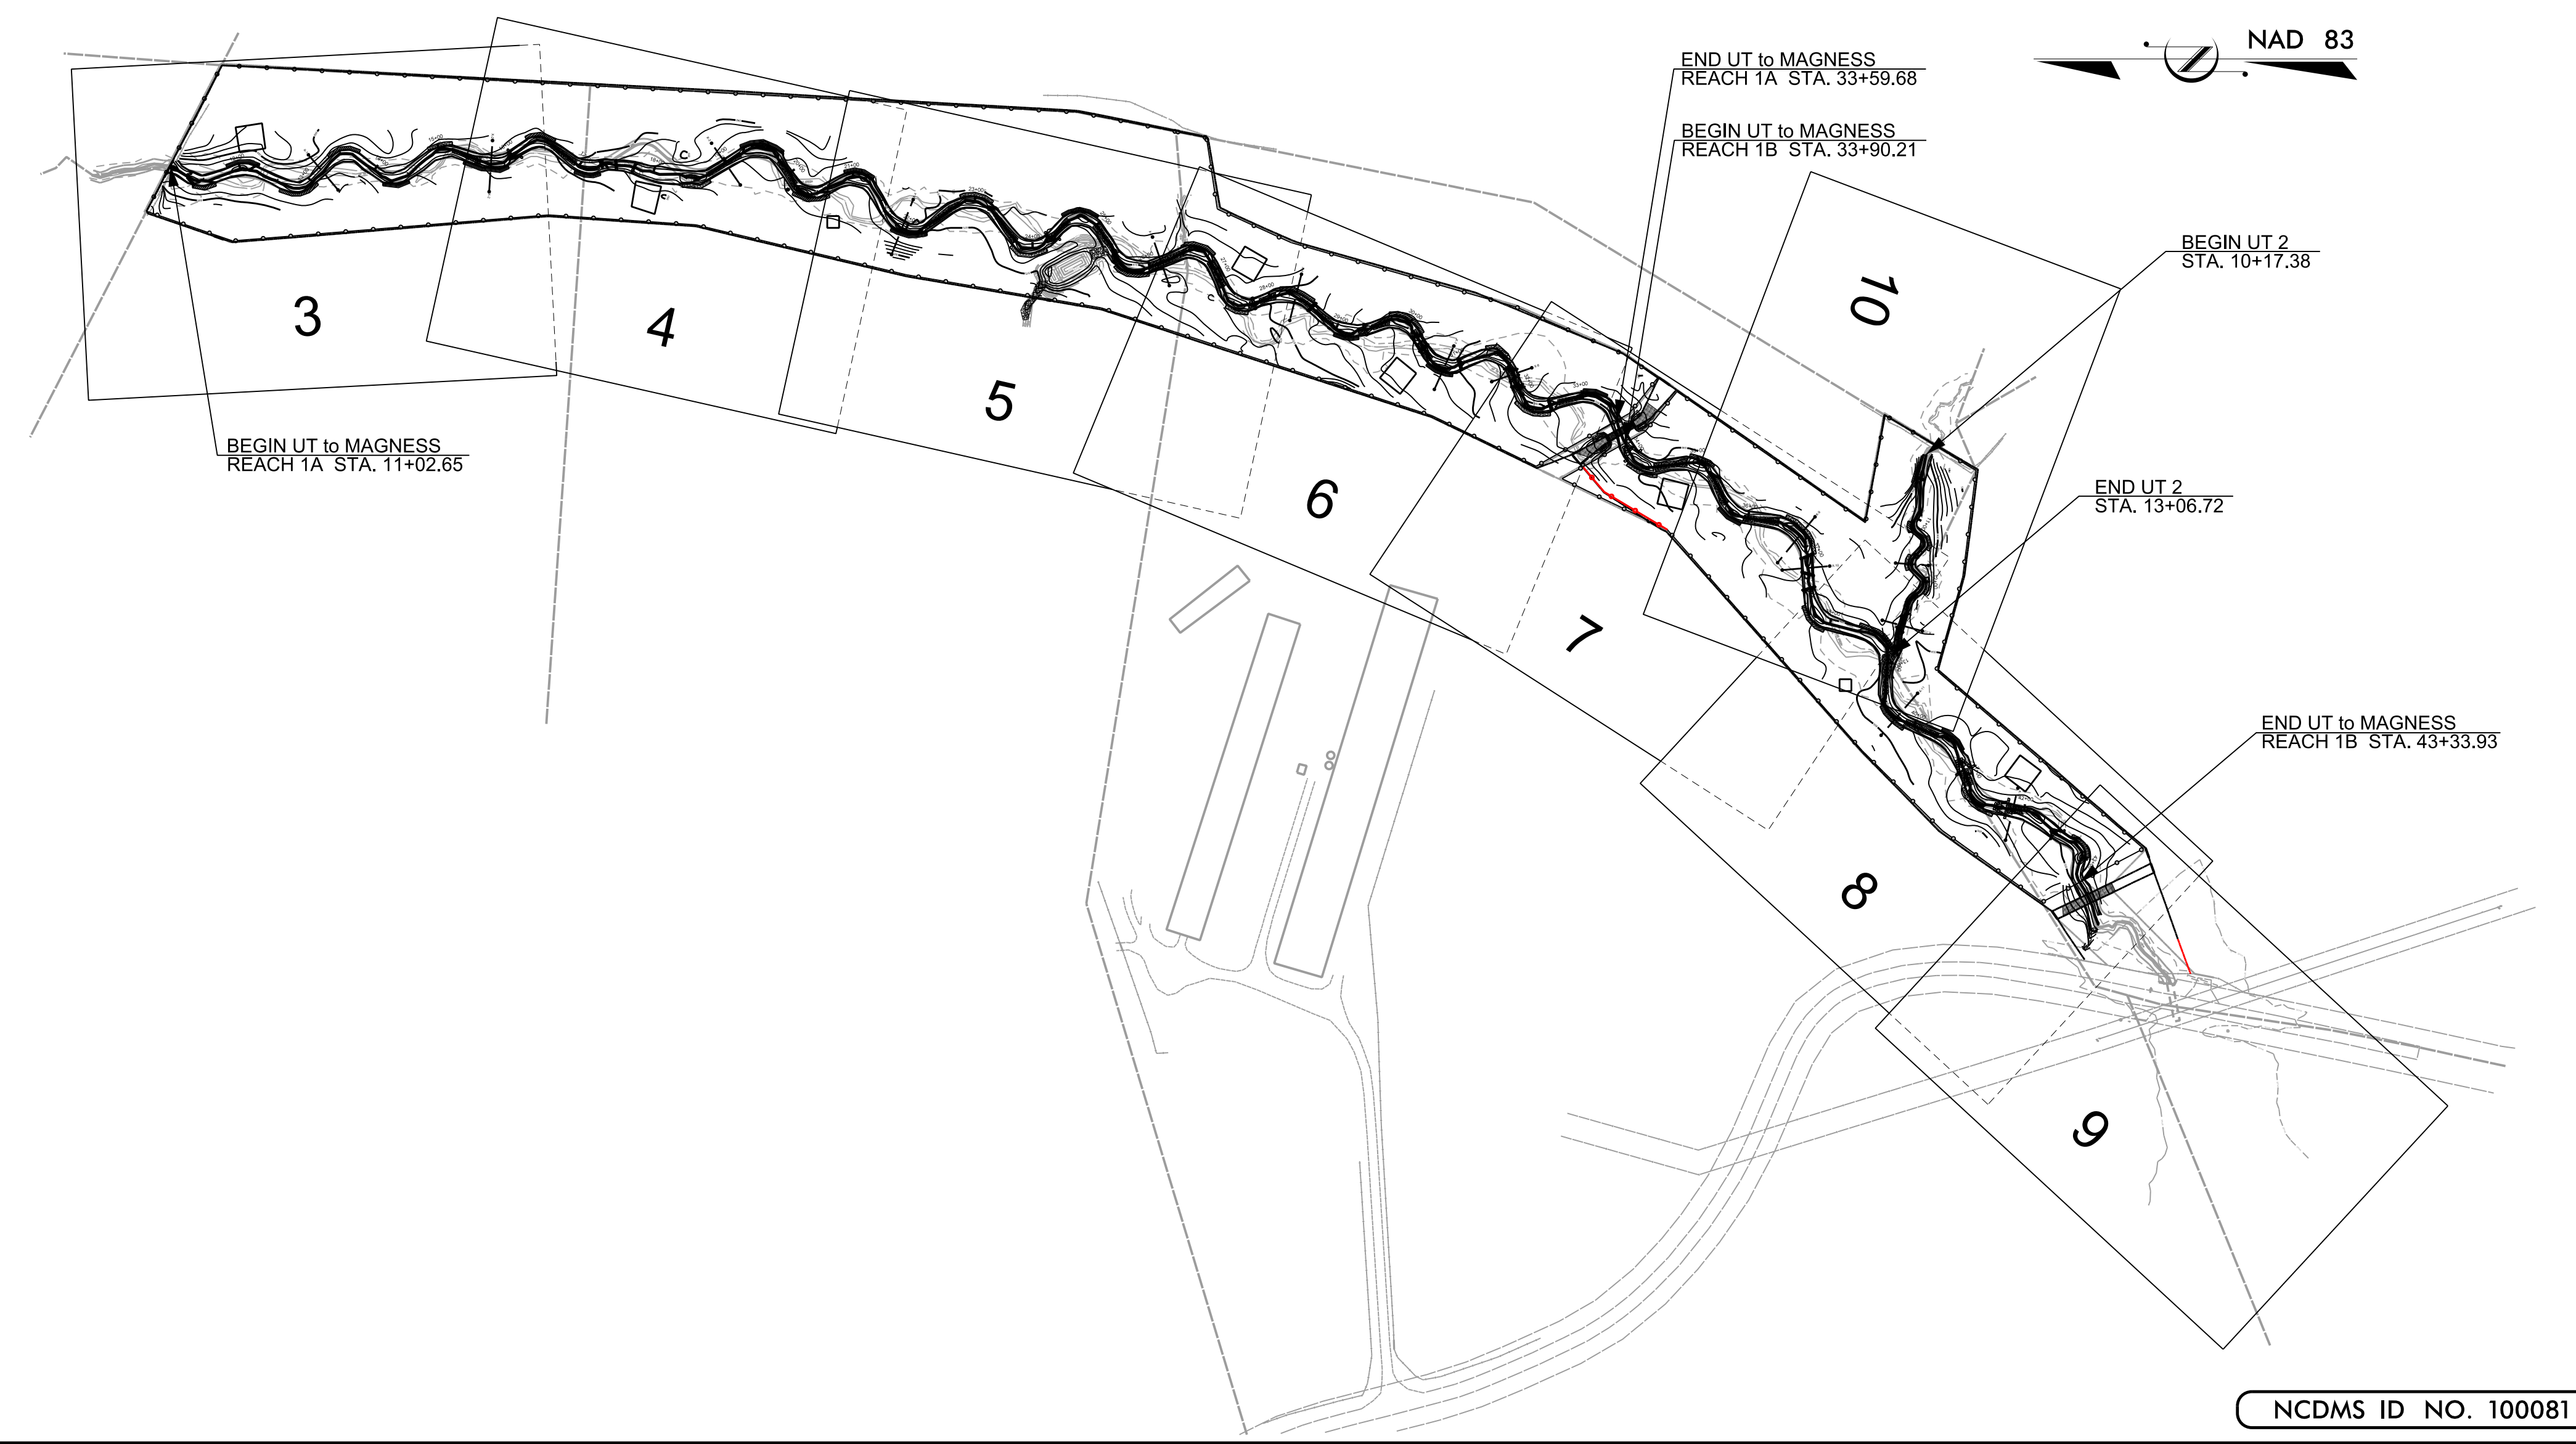

NCDMS ID NO. 100081

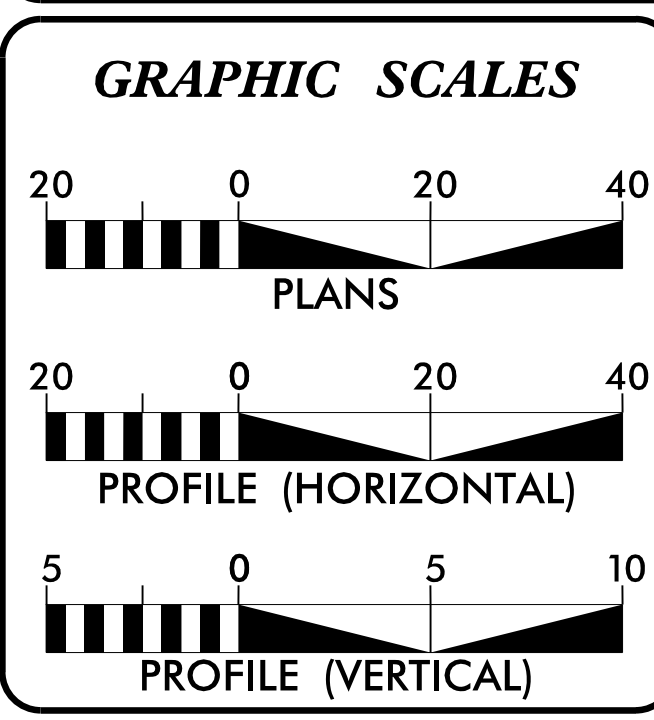

AS-BUILT MITIGATION SUMMARY

STREAM:	STREAM RESTORATION (Ft.)	STREAM ENHANCEMENT I (Ft.)	RATIO	CREDIT
1A	2,257.03	0	1:1	2,257.03
1B	943.72	0	1:1	943.72
UT2	0	289.34	1.5:1	192.89
TOTAL STREAM CREDITS				3,393.64

WETLAND:	APPROACH	AREA (Ac.)	RATIO	CREDIT
	RESTORATION BY RE-ESTABLISHMENT	1.817	1:1	1.817
	RESTORATION BY REHABILITATION	0.035	1.5:1	0.023
TOTAL WETLAND CREDITS				1.840

PREPARED FOR THE OFFICE OF:

NCDEQ – NC DMS
217 WEST JONES STREET, SUITE 3000A
RALEIGH, NC 27603

CONTACT: PAUL WIESNER
PROJECT MANAGER

Michael Baker International

Michael Baker Engineering Inc.
8000 Regency Parkway, Suite 600
Cary, NORTH CAROLINA 27518
Phone: 919.463.5488
Fax: 919.463.5490
License #: F-1084

LETTING DATE: _____

KATHLEEN M. MCKEITHAN, PE
PROJECT ENGINEER

PROJECT ENGINEER

6/12/2023

DocuSigned by:
Kathleen M. McKeithan
SIGNATURE: _____ P.E.

2/26/2023

STREAM CONVENTIONAL SYMBOLS SUPERCEDES SHEET 1-B

ROCK J-HOOK GRADE CONTROL ROCK J-HOOK ROCK VANE OUTLET PROTECTION ROCK CROSS VANE ROCK DOUBLE DROP ROCK CROSS VANE SINGLE WING DEFLECTOR DOUBLE WING DEFLECTOR TEMPORARY SILT CHECK ROOT WAD LOG J-HOOK GRADE CONTROL LOG J-HOOK LOG VANE LOG STEP LOG CROSS VANE LOG AND ROCK STEP POOL BOULDER STEP CONSTRUCTED RIFFLE BOULDER CLUSTER ROCK STEP POOL	JURISDICTIONAL WETLAND BOUNDARY SAFETY FENCE TAPE FENCE 100 YEAR FLOOD PLAIN CONSERVATION EASEMENT EXISTING MAJOR CONTOUR EXISTING MINOR CONTOUR LIMITS OF DISTURBANCE PROPERTY LINE FOOT BRIDGE TEMPORARY STREAM CROSSING PERMANENT STREAM CROSSING CHANNEL PLUG CHANNEL FILL BRUSH TOE WITH MATTING AND DOUBLE LIVE STAKES GEOLIFT WITH BRUSH TOE GEOLIFT WITH LIVE BRUSH, LOGS, AND ROOT WADS NON-CREDITED JURISDICTIONAL WETLANDS WETLAND RE-ESTABLISHMENT WETLAND ENHANCEMENT	TRANSPLANTED VEGETATION TREE REMOVAL TREE PROTECTION MONITORING WELL RAIN GAUGE CREST GAUGE IN STREAM FLOW GAUGE
--	---	--

**NOTE: ALL ITEMS ABOVE MAY NOT BE USED ON THIS PROJECT

STANDARD SPECIFICATIONS

NORTH CAROLINA EROSION AND SEDIMENT CONTROL PLANNING AND DESIGN MANUAL MARCH 2009 (REV 2013)

- 6.06 TEMPORARY GRAVEL CONSTRUCTION ENTRANCE
- 6.24 RIPARIAN AREA SEEDING
- 6.60 TEMPORARY SEDIMENT TRAP
- 6.62 TEMPORARY SILT FENCE
- 6.63 TEMPORARY ROCK DAM
- 6.70 TEMPORARY STREAM CROSSING

PROJECT REFERENCE NO. 167680	SHEET NO. 1-A
PROJECT ENGINEER	
APPROVED BY:	
6/12/2023	
DATE:	
Michael Baker International	
<small>Michael Baker Engineering Inc. 8000 Regency Parkway, Suite 500 Cary, NORTH CAROLINA 27518 Phone: 919.463.5488 Fax: 919.463.5490 License #: F-1084</small>	
NCDMS ID NO. 100081	

GENERAL NOTES

1. THE CONTRACTOR IS REQUIRED TO INSTALL IN-STREAM STRUCTURES USING A TRACK HOE WITH A HYDRAULIC THUMB OF SUFFICIENT SIZE TO PLACE BOULDERS (4'x3'x2'), LOGS AND ROOTWADS.
2. WORK IS BEING PERFORMED AS AN ENVIRONMENTAL RESTORATION PLAN. THE CONTRACTOR SHOULD MAKE ALL REASONABLE EFFORTS TO REDUCE SEDIMENT LOSS AND MINIMIZE DISTURBANCE OF THE SITE WHILE PERFORMING THE CONSTRUCTION WORK.
3. CONSTRUCTION IS SCHEDULED FOR THE SUMMER OF 2021.
4. CONTRACTOR SHOULD CALL NORTH CAROLINA "ONE-CALL" BEFORE EXCAVATION STARTS. (1-800-632-4949)
5. BOULDER SIZES FOR IN-STREAM STRUCTURES SHALL BE A MINIMUM OF 4'x3'x2' AND CAN BE CHANGED PER DIRECTION OF THE ENGINEER.
6. ALL ON-SITE ALLUVIUM SHALL BE HARVESTED AND STOCKPILED PRIOR TO FILLING ABANDONED CHANNELS.
7. TOPSOIL SHALL BE EXCAVATED TO A DEPTH OF 8" AND STOCKPILED SEPARATELY FROM UNDERCUT SOIL. 6" OF TOPSOIL SHALL BE PLACED ON ALL BANKFULL BENCHES AND AS DIRECTED BY THE ENGINEER.
8. ALL DISTURBED EMBANKMENTS SHALL BE MATTED WITH COIR FIBER MATTING OR AS DIRECTED BY THE ENGINEER.
9. ALL STREAM BANKS SHALL BE LIVE STAKED.
10. UNLESS THE ALIGNMENT IS BEING ALTERED, THE EXISTING CHANNEL DIMENSIONS ARE TO REMAIN UNLESS OTHERWISE NOTED.
11. CONTRACTOR WILL ENSURE THAT FENCING IS INSTALLED ON OR OUTSIDE THE CONSERVATION EASEMENT AS SHOWN ON THE PLANS BUT NO MORE THAN 1' OUTSIDE.
12. WHERE PROPOSED FENCE CROSSES EXISTING STREAMS, THE CONTRACTOR SHALL UTILIZE A SECTION OF BREAK AWAY FENCE, A FLOOD GATE, OR ELECTRIFIED CHAINS AS DIRECTED BY THE ENGINEER.

VEGETATION SELECTION

Proposed Bare-Root and Live Stake Species			
UT to Magness Creek Mitigation Project - NCDMS Project No. 100081			
Botanical Name	Common Name	% Planted by Species	Wetland Tolerance
All Buffer Plantings at 680 stems/acre using 8' X 8' spacing			
General Riparian Zone – Overstory/Canopy Species			
<i>Liriodendron tulipifera</i>	Tulip Poplar	15%	FACU
<i>Betula nigra</i>	River Birch	15%	FACW
<i>Platanus occidentalis</i>	Sycamore	15%	FACW
<i>Quercus phellos</i>	Willow Oak	10%	FAC
<i>Celtis laevigata</i>	Sugarberry	10%	FACW
<i>Quercus nigra</i>	Water Oak	5%	FAC
<i>Fraxinus pennsylvanica</i>	Green Ash	5%	FACW
<i>Diospyros virginiana</i>	Persimmon	5%	FAC
<i>Ulmus americana</i>	American Elm	5%	FACW
General Riparian Zone – Understory/Shrub Species			
<i>Carpinus caroliniana</i>	American Hornbeam	5% 7.5%	FAC
<i>Lindera benzoin</i>	Spicebush	2.5%	FAC
<i>Asimina triloba</i>	Pawpaw	2.5% 5%	FAC
<i>Magnolia tripetala</i>	Umbrella Tree	2.5%	FACU
<i>Halesia carolina</i>	Carolina Silverbell	2.5%	FAC

REDLINED SPECIES UNAVAILABLE

Wetland Zone – Overstory/Canopy Species			
<i>Betula nigra</i>	River Birch	15%	FACW
<i>Platanus occidentalis</i>	Sycamore	15%	FACW
<i>Quercus michauxii</i>	Swamp Chestnut Oak	15%	FACW
<i>Quercus palustris</i>	Pin Oak	10%	FACW
<i>Quercus phellos</i>	Willow Oak	10%	FAC
<i>Nyssa sylvatica</i>	Blackgum	5%	FAC
<i>Acer negundo</i>	Box Elder	5%	FAC
<i>Fraxinus pennsylvanica</i>	Green Ash	5%	FACW
<i>Ulmus americana</i>	American Elm	5%	FACW
Wetland Zone – Understory/Shrub Species			
<i>Alnus serrulata</i>	Tag Alder	5%	OBL
<i>Ilex verticillata</i>	Winterberry	2.5%	FACW
<i>Cephalanthus occidentalis</i>	Buttonbush	2.5%	OBL
<i>Cornus amomum</i>	Silky Dogwood	2.5%	FACW
<i>Aronia arbutifolia</i>	Red Chokeberry	2.5%	FACW
Streambank Live Stake Plantings			
<i>Salix sericea</i>	Silky Willow	25%	OBL
<i>Sambucus canadensis</i>	Elderberry	20%	FACW
<i>Cephalanthus occidentalis</i>	Buttonbush	10%	OBL
<i>Cornus amomum</i>	Silky Dogwood	20%	FACW
<i>Salix nigra</i>	Black Willow	25%	OBL

Proposed Permanent Seed Mixture				
UT to Magness Creek Mitigation Project – NCDMS Project No. 100081				
Botanical Name	Common Name	% Planted by Species	Density (lbs/ac)	Wetland Tolerance
<i>Agrostis perennans</i>	Autumn Bentgrass	10%	1.5	FACW
<i>Elymus virginicus</i>	Virginia Wildrye	15%	2.25	FACW
<i>Panicum virgatum</i>	Switchgrass	15%	2.25	FAC
<i>Tripsacum dactyloides</i>	Eastern Gamma Grass	5%	0.75	FACW
<i>Polygonum pennsylvanicum</i>	Pennsylvania Smartweed	5%	0.75	FACW
<i>Schizachyrium scoparium</i>	Little Blue Stem	5%	0.75	FACU
<i>Juncus effusus</i>	Soft Rush	5%	0.75	FACW
<i>Bidens frondosa (or aristosa)</i>	Beggars Tick	5%	0.75	FACW
<i>Coreopsis lanceolata</i>	Lance-Leaved Tick Seed	10%	1.5	FACU
<i>Dichanthelium clandestinum</i>	Tioga Deer Tongue	10%	1.5	FAC
<i>Andropogon gerardii</i>	Big Blue Stem	5%	0.75	FAC
<i>Sorghastrum nutans</i>	Indian Grass	5%	0.75	FACU
<i>Monarda punctata</i>	Spotted Beebalm	5%	0.75	FACU
Total		100%	15	

Note: Final species selection may change due to refinement of site conditions or to availability at the time of planting. If species substitution is required, the planting Contractor will submit a revised planting list to Baker for approval prior to the procurement of plant stock.

6/6/2023 10:00:00 AM C:\Users\mcb\OneDrive\Documents\167680\UT to Magness Cr\Design\As-Built\Plans\167680_ASB_PSH_01A.dgn

DocuSigned by:
Kathleen M. McKeithan
APPROVED BY:
6/12/2023
DATE:

STATE OF NORTH CAROLINA
DIVISION OF HIGHWAYS

CONVENTIONAL SYMBOLS

*S.U.E = SUBSURFACE UTILITY ENGINEER

BOUNDARIES AND PROPERTY:

State Line	-----
County Line	-----
Township Line	-----
City Line	-----
Reservation Line	-----
Property Line	-----
Existing Iron Pin	○ EP
Property Corner	-----
Property Monument	□ ECM
Parcel/Sequence Number	②③
Existing Fence Line	-x-x-x-
Proposed Woven Wire Fence	○
Proposed Chain Link Fence	□
Proposed Barbed Wire Fence	◇
Existing Wetland Boundary	-WLB-
Proposed Wetland Boundary	-WLB-
Existing Endangered Animal Boundary	-EAB-
Existing Endangered Plant Boundary	-EPB-

BUILDINGS AND OTHER CULTURE:

Gas Pump Vent or U/G Tank Cap	○
Sign	○ S
Well	○ W
Small Mine	⋈
Foundation	□
Area Outline	□
Cemetery	↑
Building	□
School	□
Church	□
Dam	▬

HYDROLOGY:

Stream or Body of Water	-----
Hydro, Pool or Reservoir	□
Jurisdictional Stream	-JS-
Buffer Zone 1	-BZ 1-
Buffer Zone 2	-BZ 2-
Flow Arrow	←
Disappearing Stream	-----
Spring	○
Wetland	▬
Proposed Lateral, Tail, Head Ditch	▬
False Sump	▽

RAILROADS:

Standard Gauge	-----
RR Signal Milepost	○ MILEPOST 35
Switch	□ SWITCH
RR Abandoned	-----
RR Dismantled	-----

RIGHT OF WAY:

Baseline Control Point	◆
Existing Right of Way Marker	△
Existing Right of Way Line	-----
Proposed Right of Way Line	-----
Proposed Right of Way Line with Iron Pin and Cap Marker	○ R W
Proposed Right of Way Line with Concrete or Granite Marker	△ R W
Existing Control of Access	○ C A
Proposed Control of Access	○ C A
Existing Easement Line	-E-
Proposed Temporary Construction Easement	-E-
Proposed Temporary Drainage Easement	-TDE-
Proposed Permanent Drainage Easement	-PDE-
Proposed Permanent Utility Easement	-PUE-
Proposed Temporary Utility Easement	-TUE-
Proposed Permanent Easement with Iron Pin and Cap Marker	◆

ROADS AND RELATED FEATURES:

Existing Edge of Pavement	-----
Existing Curb	-----
Proposed Slope Stakes Cut	-C-
Proposed Slope Stakes Fill	-F-
Proposed Wheel Chair Ramp	WCR
Existing Metal Guardrail	-----
Proposed Guardrail	-----
Existing Cable Guiderail	-----
Proposed Cable Guiderail	-----
Equality Symbol	⊕
Pavement Removal	▨

VEGETATION:

Single Tree	○
Single Shrub	○
Hedge	-----
Woods Line	-----
Orchard	-----
Vineyard	▨ Vineyard

EXISTING STRUCTURES:

MAJOR:	
Bridge, Tunnel or Box Culvert	CONC
Bridge Wing Wall, Head Wall and End Wall	CONC WW
MINOR:	
Head and End Wall	CONC HW
Pipe Culvert	-----
Footbridge	-----
Drainage Box: Catch Basin, DI or JB	□ CB
Paved Ditch Gutter	-----
Storm Sewer Manhole	○ S
Storm Sewer	-S-

UTILITIES:

POWER:	
Existing Power Pole	●
Proposed Power Pole	○
Existing Joint Use Pole	●
Proposed Joint Use Pole	○
Power Manhole	○ P
Power Line Tower	□
Power Transformer	▨
U/G Power Cable Hand Hole	□ H
H-Frame Pole	●
Recorded U/G Power Line	-P-
Designated U/G Power Line (S.U.E.*)	-P-

TELEPHONE:

Existing Telephone Pole	●
Proposed Telephone Pole	○
Telephone Manhole	○ T
Telephone Booth	□
Telephone Pedestal	□
Telephone Cell Tower	□
U/G Telephone Cable Hand Hole	□ H
Recorded U/G Telephone Cable	-T-
Designated U/G Telephone Cable (S.U.E.*)	-T-
Recorded U/G Telephone Conduit	-TC-
Designated U/G Telephone Conduit (S.U.E.*)	-TC-
Recorded U/G Fiber Optics Cable	-T FO-
Designated U/G Fiber Optics Cable (S.U.E.*)	-T FO-

WATER:

Water Manhole	○ W
Water Meter	○
Water Valve	⊗
Water Hydrant	⊕
Recorded U/G Water Line	-W-
Designated U/G Water Line (S.U.E.*)	-W-
Above Ground Water Line	-A/G Water-

TV:

TV Satellite Dish	⋈
TV Pedestal	□
TV Tower	⊗
U/G TV Cable Hand Hole	□ H
Recorded U/G TV Cable	-TV-
Designated U/G TV Cable (S.U.E.*)	-TV-
Recorded U/G Fiber Optic Cable	-TV FO-
Designated U/G Fiber Optic Cable (S.U.E.*)	-TV FO-

GAS:

Gas Valve	◇
Gas Meter	⊕
Recorded U/G Gas Line	-G-
Designated U/G Gas Line (S.U.E.*)	-G-
Above Ground Gas Line	-A/G Gas-





SANITARY SEWER:

Sanitary Sewer Manhole	⊕
Sanitary Sewer Cleanout	⊕
U/G Sanitary Sewer Line	-SS-
Above Ground Sanitary Sewer	-A/G Sanitary Sewer-
Recorded SS Forced Main Line	-FSS-
Designated SS Forced Main Line (S.U.E.*)	-FSS-

MISCELLANEOUS:

Utility Pole	●
Utility Pole with Base	□
Utility Located Object	○
Utility Traffic Signal Box	□
Utility Unknown U/G Line	-TUTL-
U/G Tank; Water, Gas, Oil	□
A/G Tank; Water, Gas, Oil	□
U/G Test Hole (S.U.E.*)	⊕
Abandoned According to Utility Records	AATUR
End of Information	E.O.I.

TYPICAL RIFFLE, POOL, AND BANKFULL BENCH CROSS SECTIONS

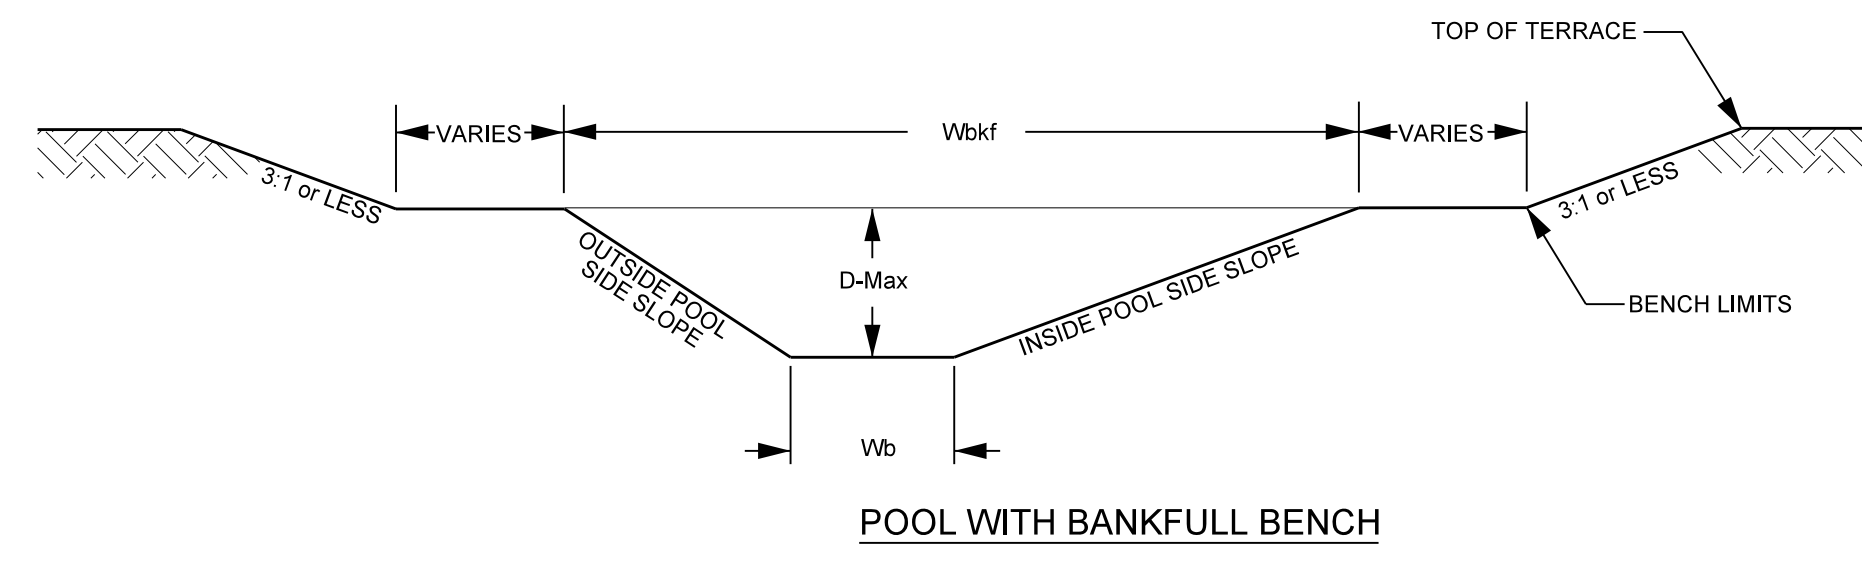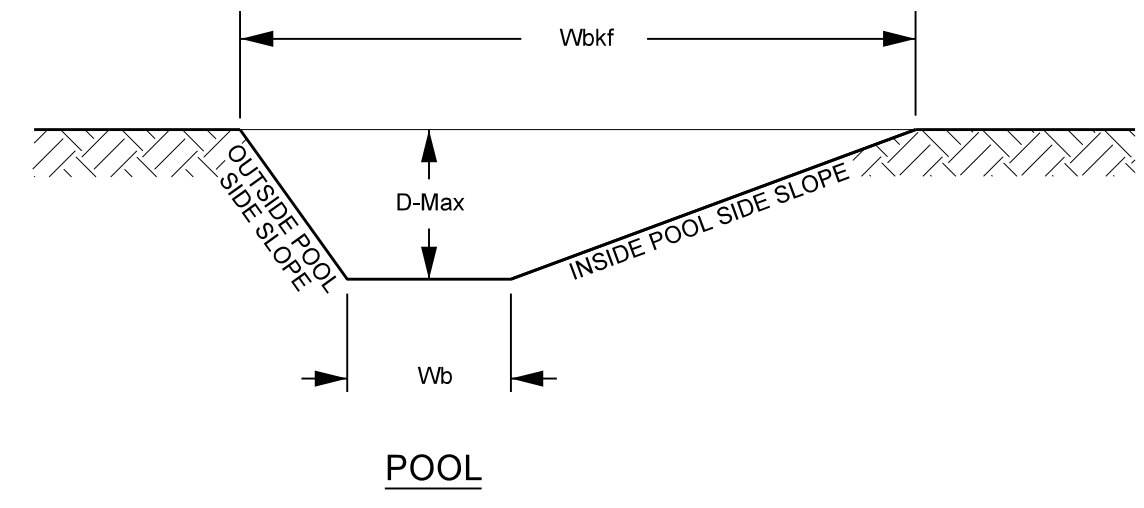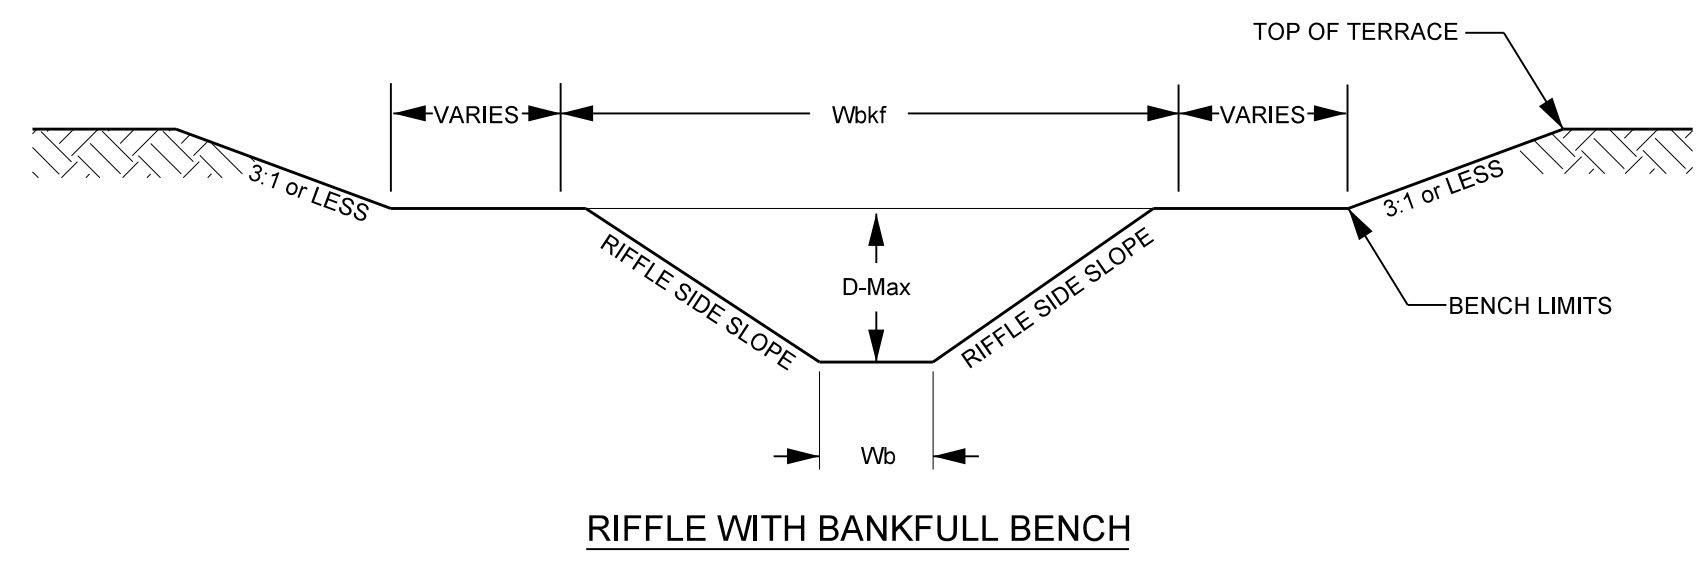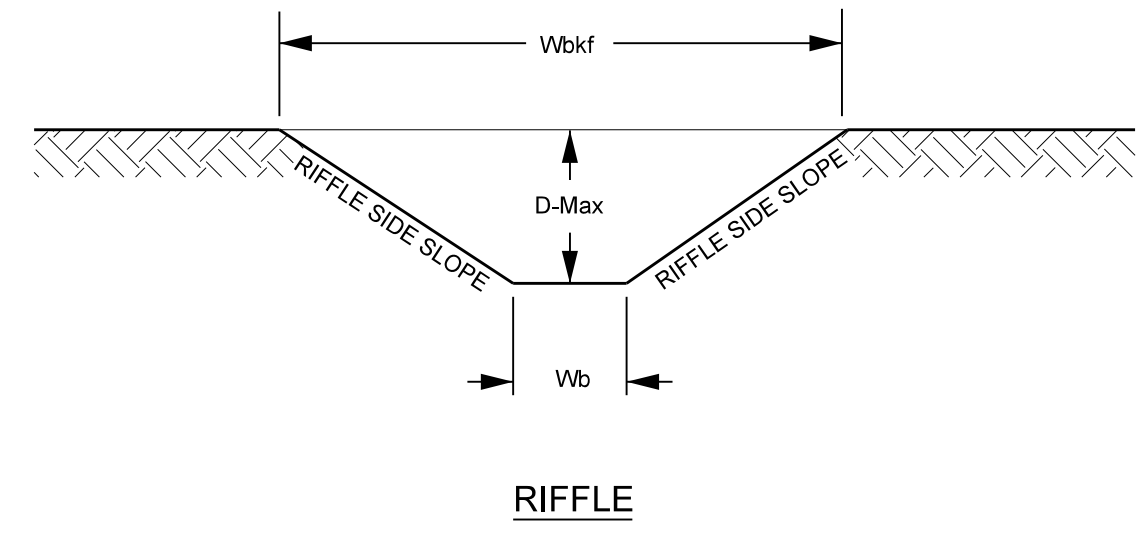

UT to MAGNESS REACH 1A		UT to MAGNESS REACH 1B		UT2	
RIFFLE	POOL	RIFFLE	POOL	RIFFLE	POOL
11+02.17 to 33+53.65	33+79.06 to 43+06.86				
12.5	18.0	14.5	20.0	6.3	8.0
0.9	1.4	1.0	1.8	0.5	0.9
1.2	2.5	1.3	3.0	0.6	1.3
14.2	13.1	15.2	11.3	12.5	9.1
11.0	24.7	13.8	35.3	2.7	7.0
8.3	1.8	10.0	3.5	4.2	2.8
2.0	N/A	2.0	N/A	2.0	N/A
N/A	4.0	N/A	4.0	N/A	2.0
N/A	1.5	N/A	1.5	N/A	2.0

WIDTH OF BANKFULL (Wb_{kf})
 AVERAGE DEPTH
 MAXIMUM DEPTH (D_{max})
 WIDTH TO DEPTH RATIO (b_{kf} W/D)
 BANKFULL AREA (A_{b_{kf}})
 BOTTOM WIDTH (W_b)
 RIFFLE SIDE SLOPE (X:1)
 INSIDE POOL SIDE SLOPE
 OUTSIDE POOL SIDE SLOPE

PROJECT REFERENCE NO. 167680 SHEET NO. 2

PROJECT ENGINEER

DocuSigned by:
Kathleen M. McKeithan
 3426840E4181473

APPROVED BY:


6/12/2023

DATE:

Michael Baker International Michael Baker Engineering Inc.
 8000 Regency Parkway, Suite 600
 Cary, NORTH CAROLINA 27518
 Phone: 919.463.5486
 Fax: 919.463.5490
 License #: F-1084


NCDMS ID NO. 10081

TYPICAL STRUCTURE PLACEMENT

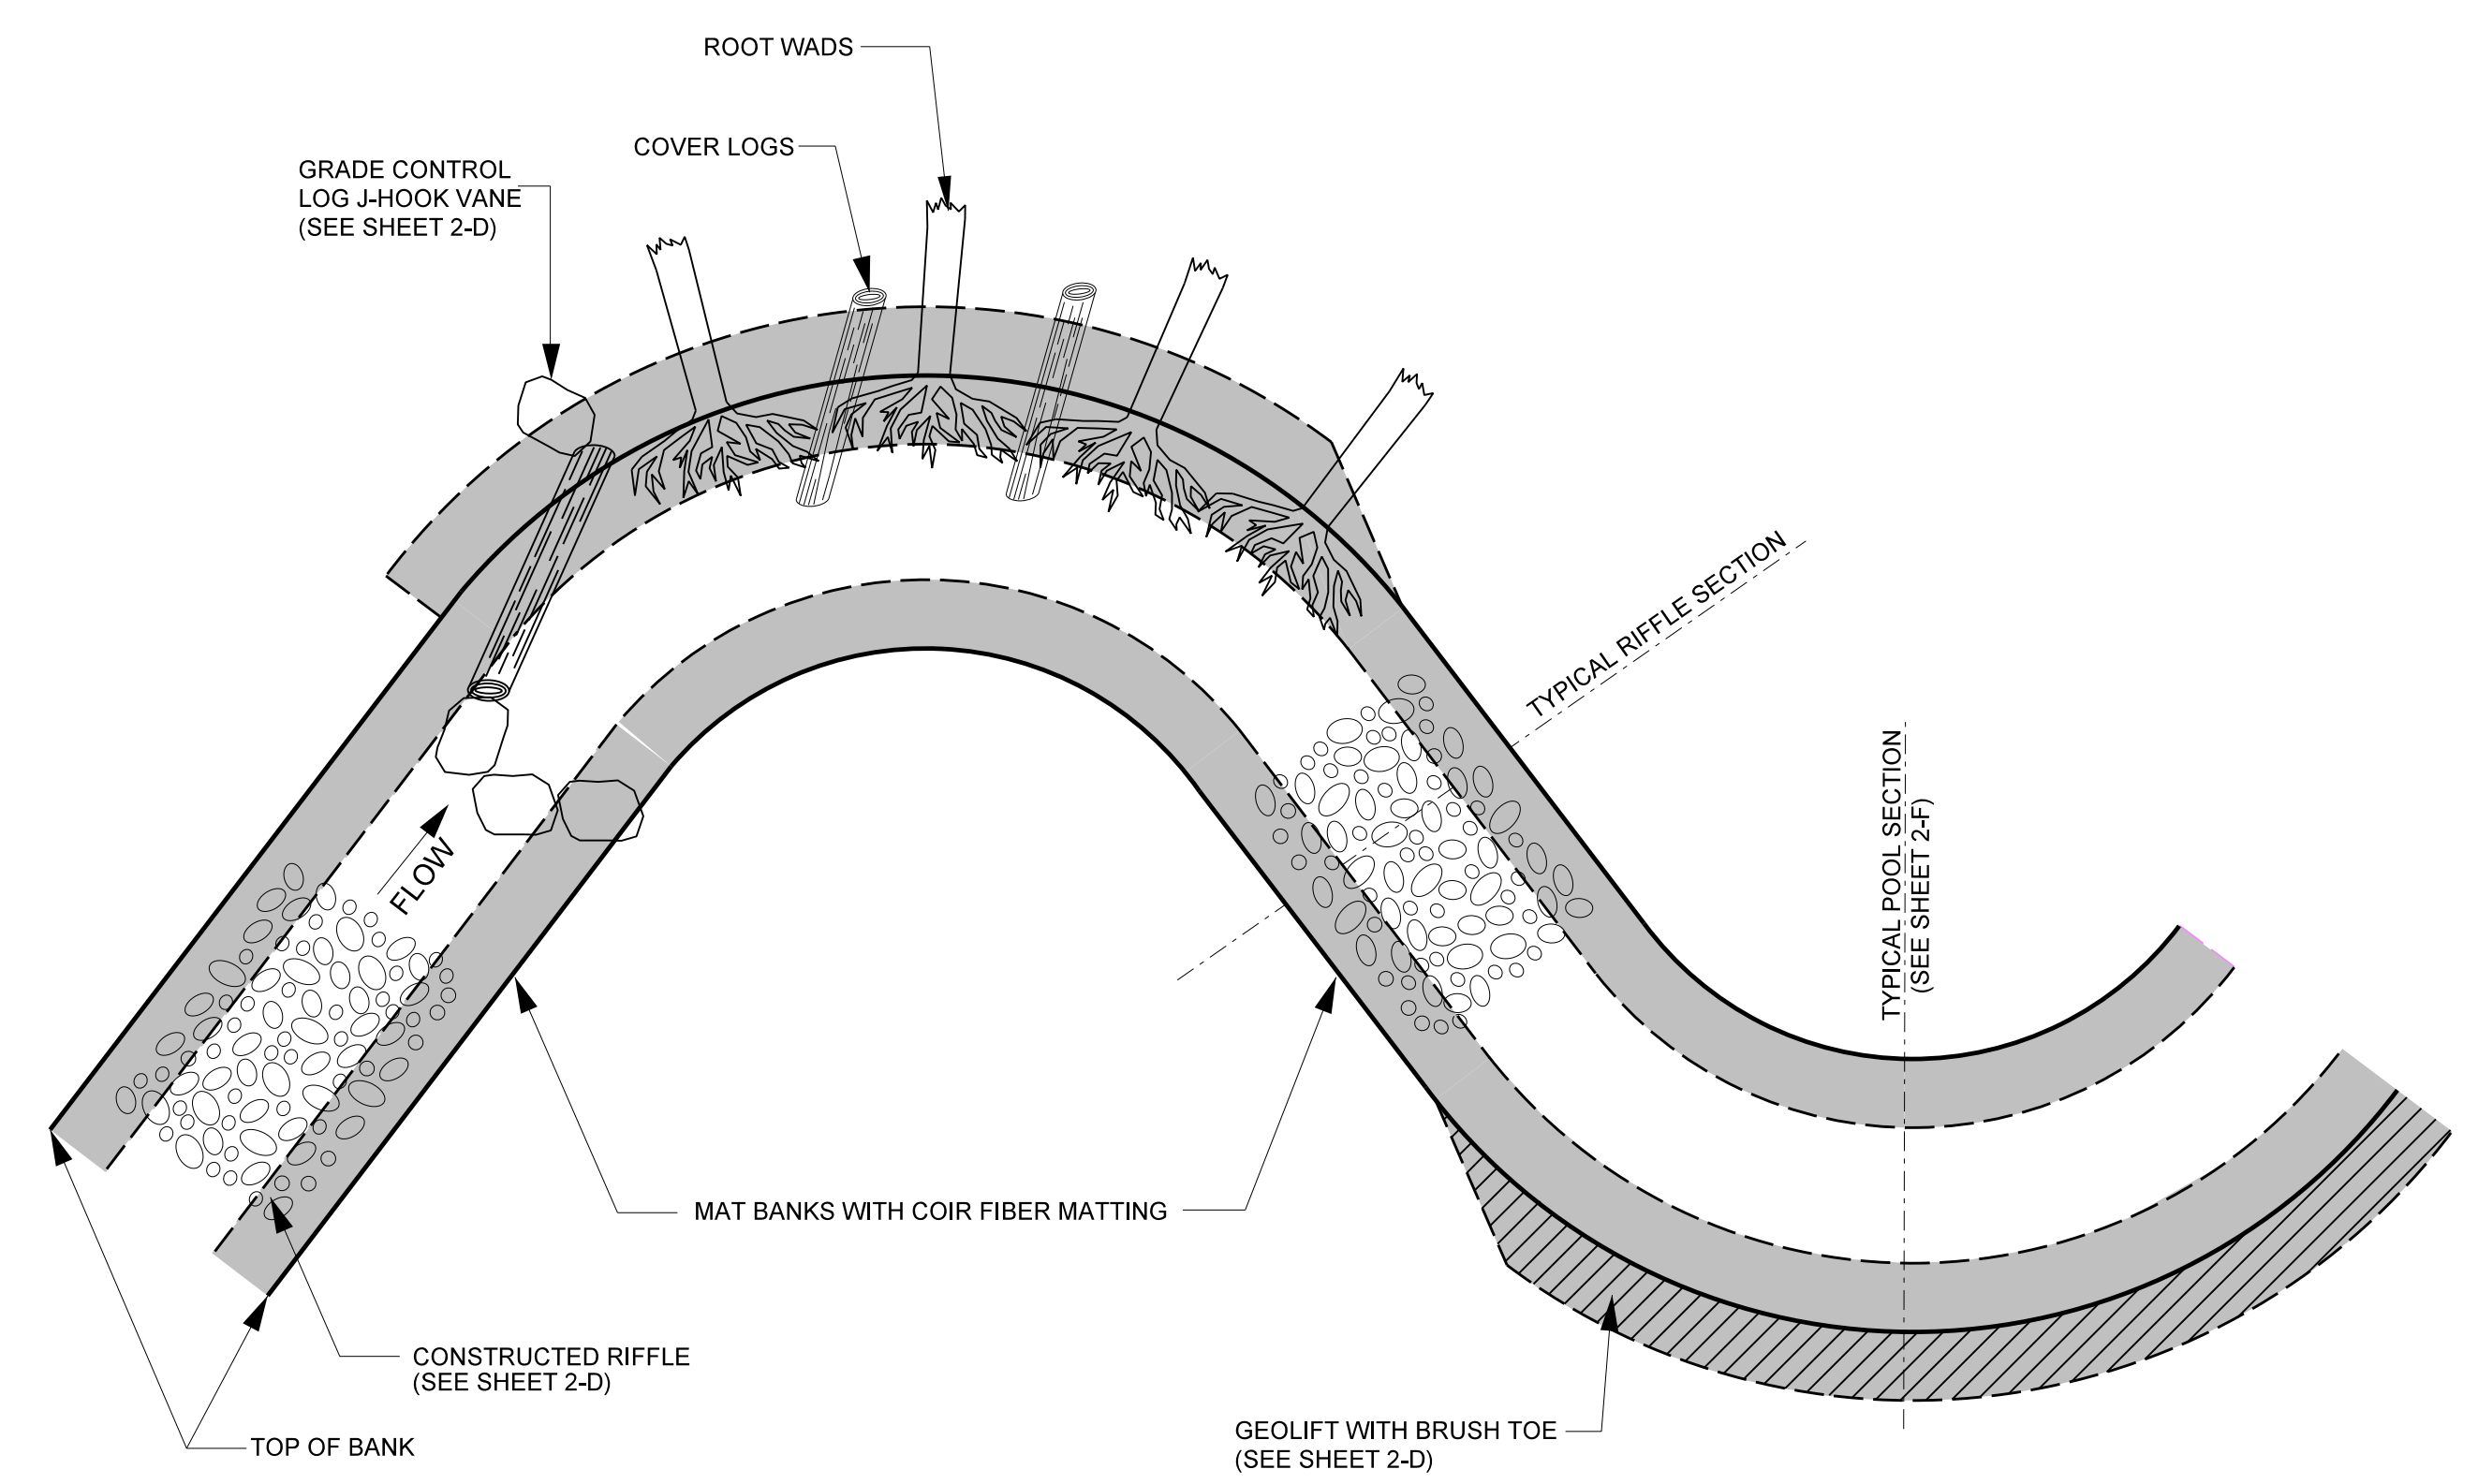




- STRUCTURE NOTES:**
- GENERALLY CONSTRUCTED RIFFLES, ROOT WADS, LOG VANES AND COIR FIBER MATTING WILL BE INSTALLED IN THE LOCATION AND SEQUENCE AS SHOWN.
 - ANY CHANGES TO NUMBER OR LOCATION OF STRUCTURES DURING CONSTRUCTION MUST BE APPROVED BY THE DESIGN ENGINEER.
 - COIR FIBER MATTING TO BE INSTALLED ON ALL RESTORED STREAMBANKS, FLOODPLAIN BENCHING, AND TERRACE SLOPES AS DESCRIBED IN THE TECHNICAL SPECIFICATIONS.
 - ROOTWADS MAY BE REPLACED WITH GEOLIFT.

ROCK CROSS VANE

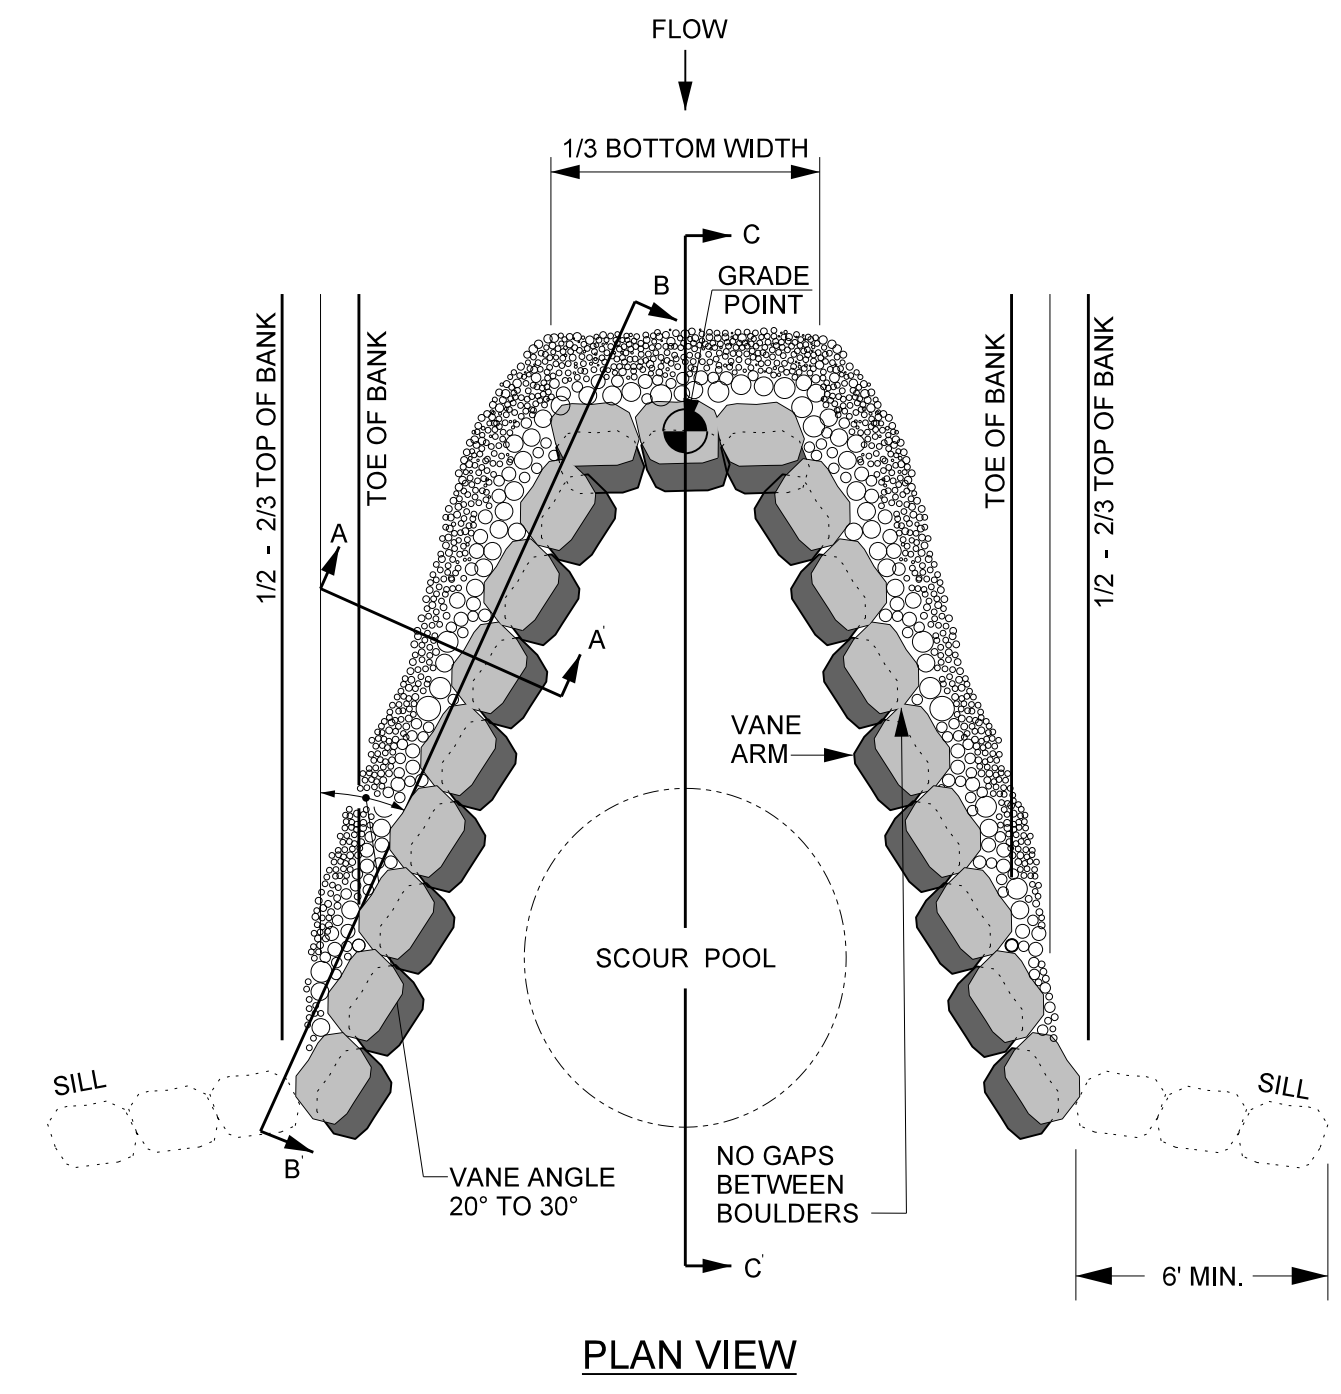


REACH	VANE LENGTH	BOULDER SIZE
REACH 1A	11.3'	2'x3'x4' #57 STONE
REACH 1B	14.0'	2'x3'x4' #57 STONE
UT2	N/A	N/A

- NOTES FOR ALL VANE STRUCTURES:**
- INSTALL FILTER FABRIC FOR DRAINAGE BEGINNING AT THE MIDDLE OF THE HEADER ROCKS AND EXTEND DOWNWARD TO THE DEPTH OF THE BOTTOM FOOTER ROCK, AND THEN UPSTREAM TO A MINIMUM OF SIX FEET.
 - DIG A TRENCH BELOW THE BED FOR FOOTER ROCKS AND PLACE FILL ON UPSTREAM SIDE OF VANE ARM, BETWEEN THE ARM AND STREAMBANK.
 - CONSTRUCT ANGLE AND SLOPE SPECIFICATIONS AS SHOWN.
 - BACKFILL VANE ARMS AND INVERT WITH A WELL GRADED MIX OF CLASS B, A, AND #57 STONE.
 - ON-SITE ALLUVIUM SHALL BE INCORPORATED INTO THE STONE BACKFILL WHERE AVAILABLE.
 - BOULDER SILL MUST BE A MINIMUM OF 6'.
 - BOULDERS FOR REACH 1A AND REACH 1B MUST BE AT LEAST 2'x3'x4'; WHILE BOULDERS FOR UT2 SHOULD BE 1'x2'x3'.

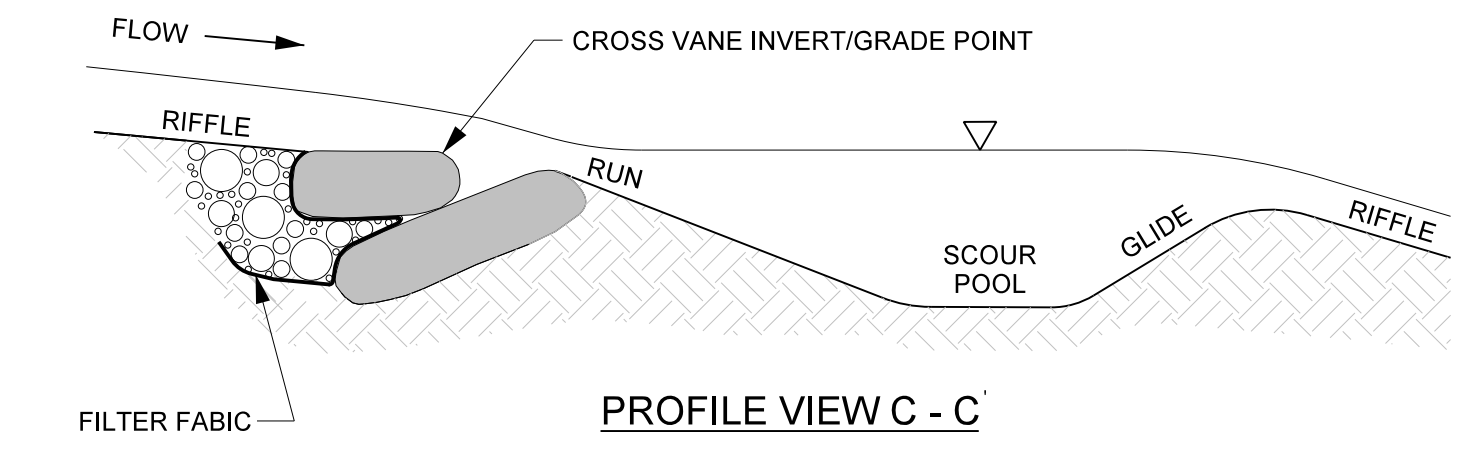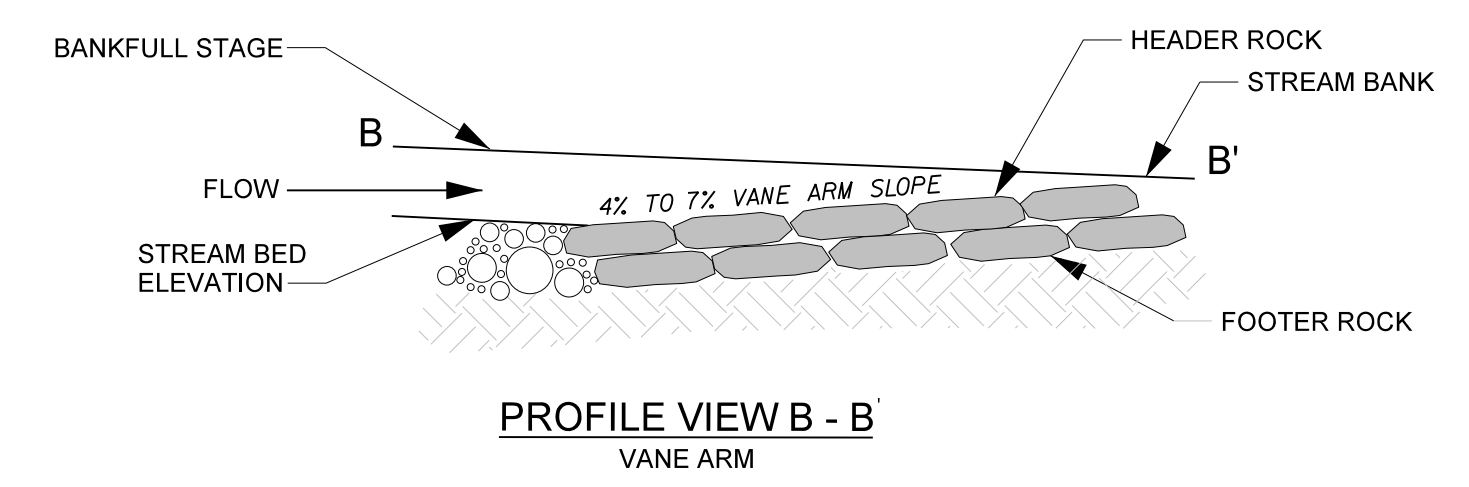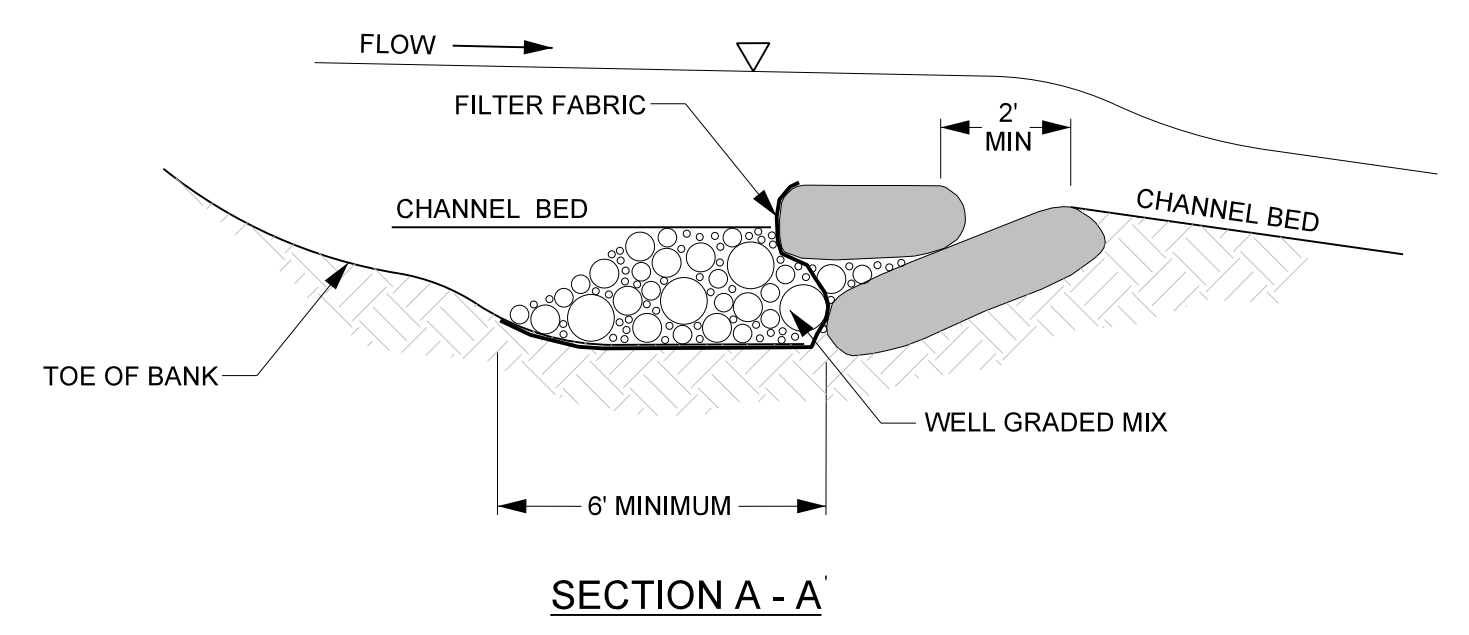


2/26/2023


OUTLET PROTECTION

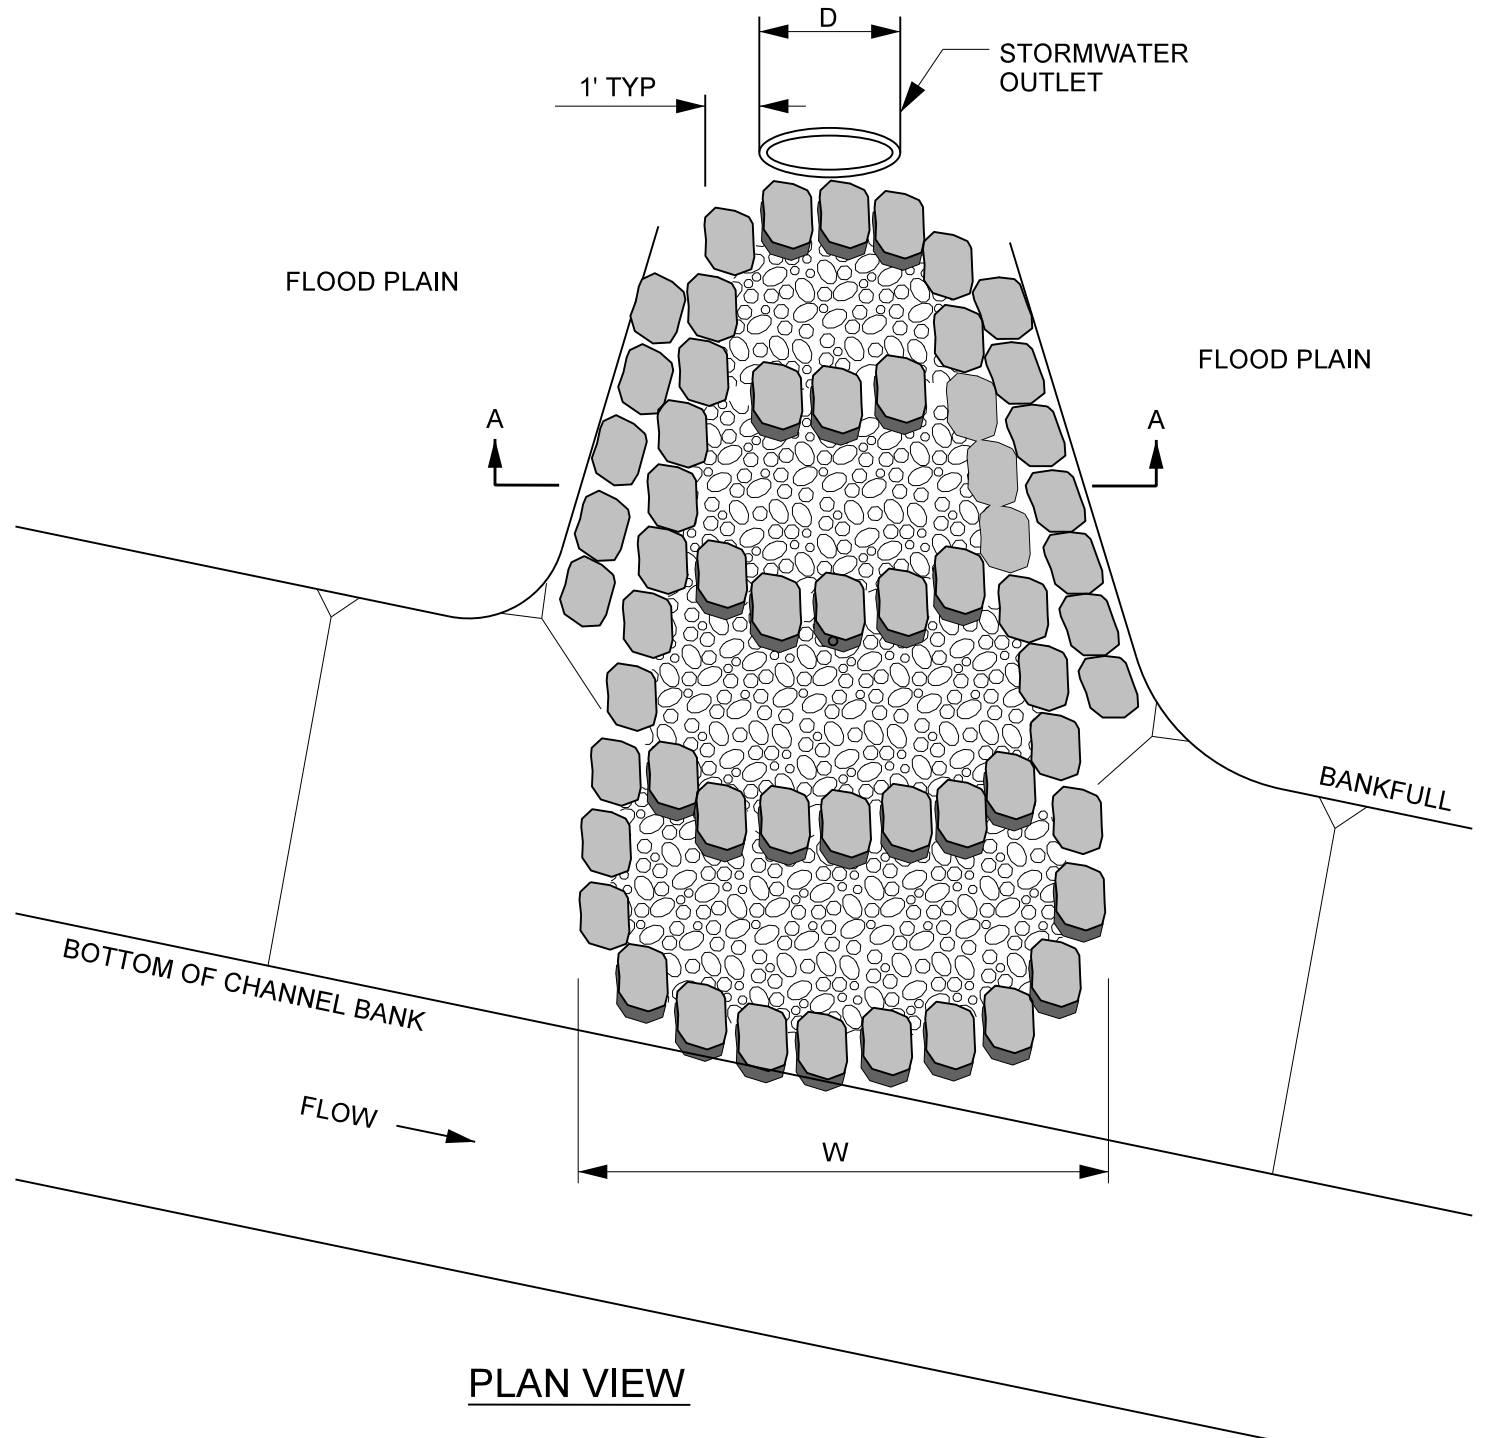

PLAN VIEW

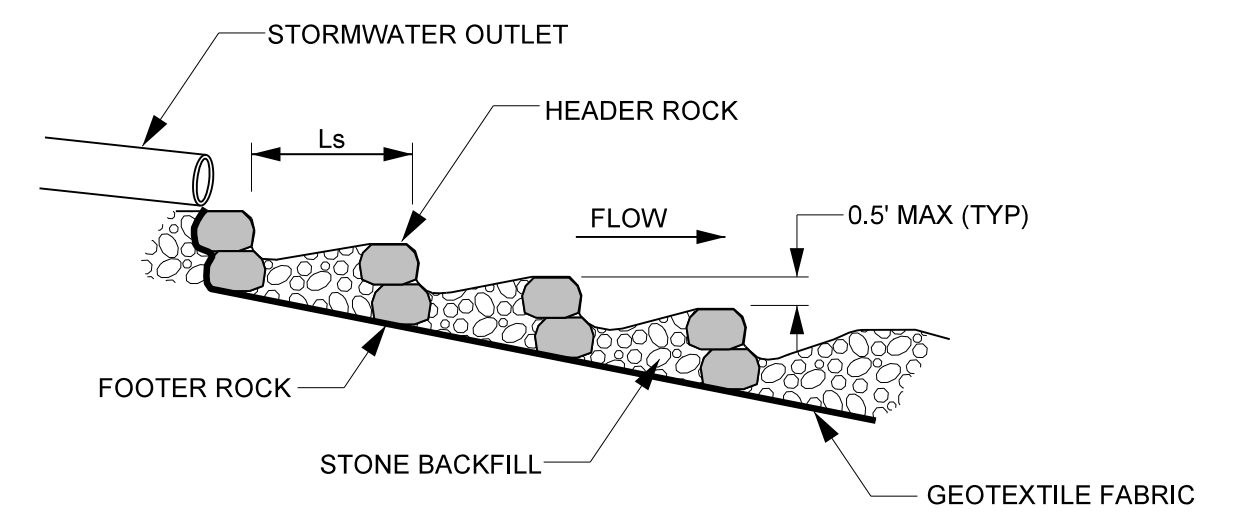


PROFILE VIEW

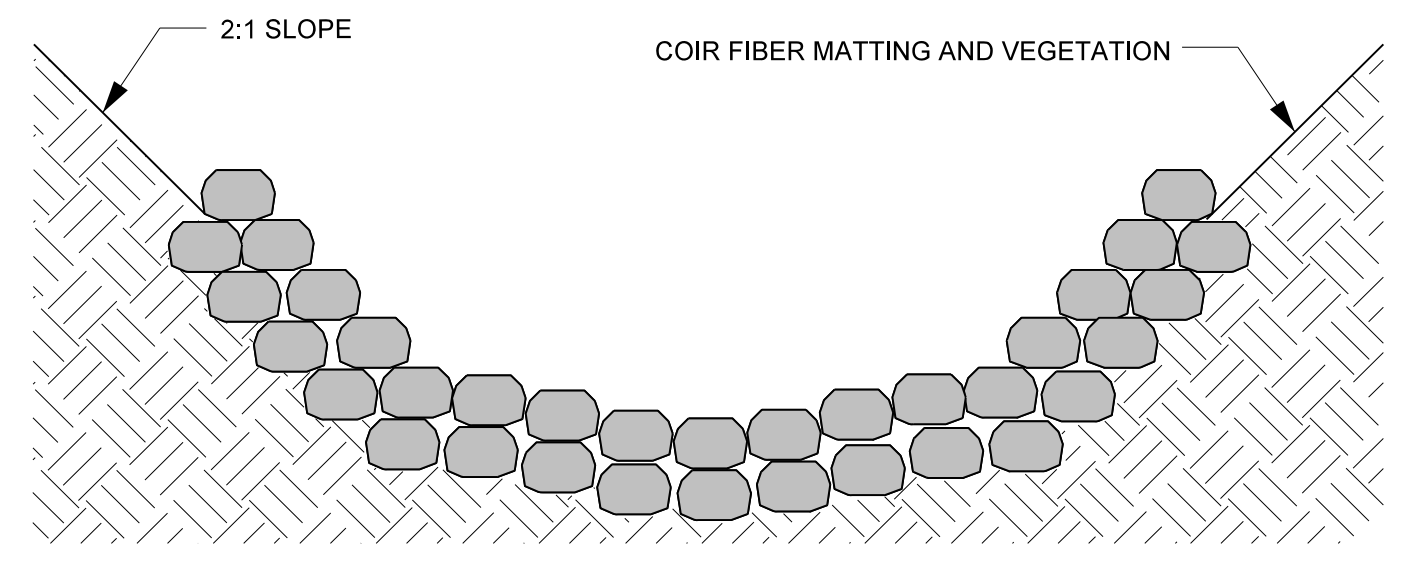

CROSS SECTION A - A

ROCK VANE

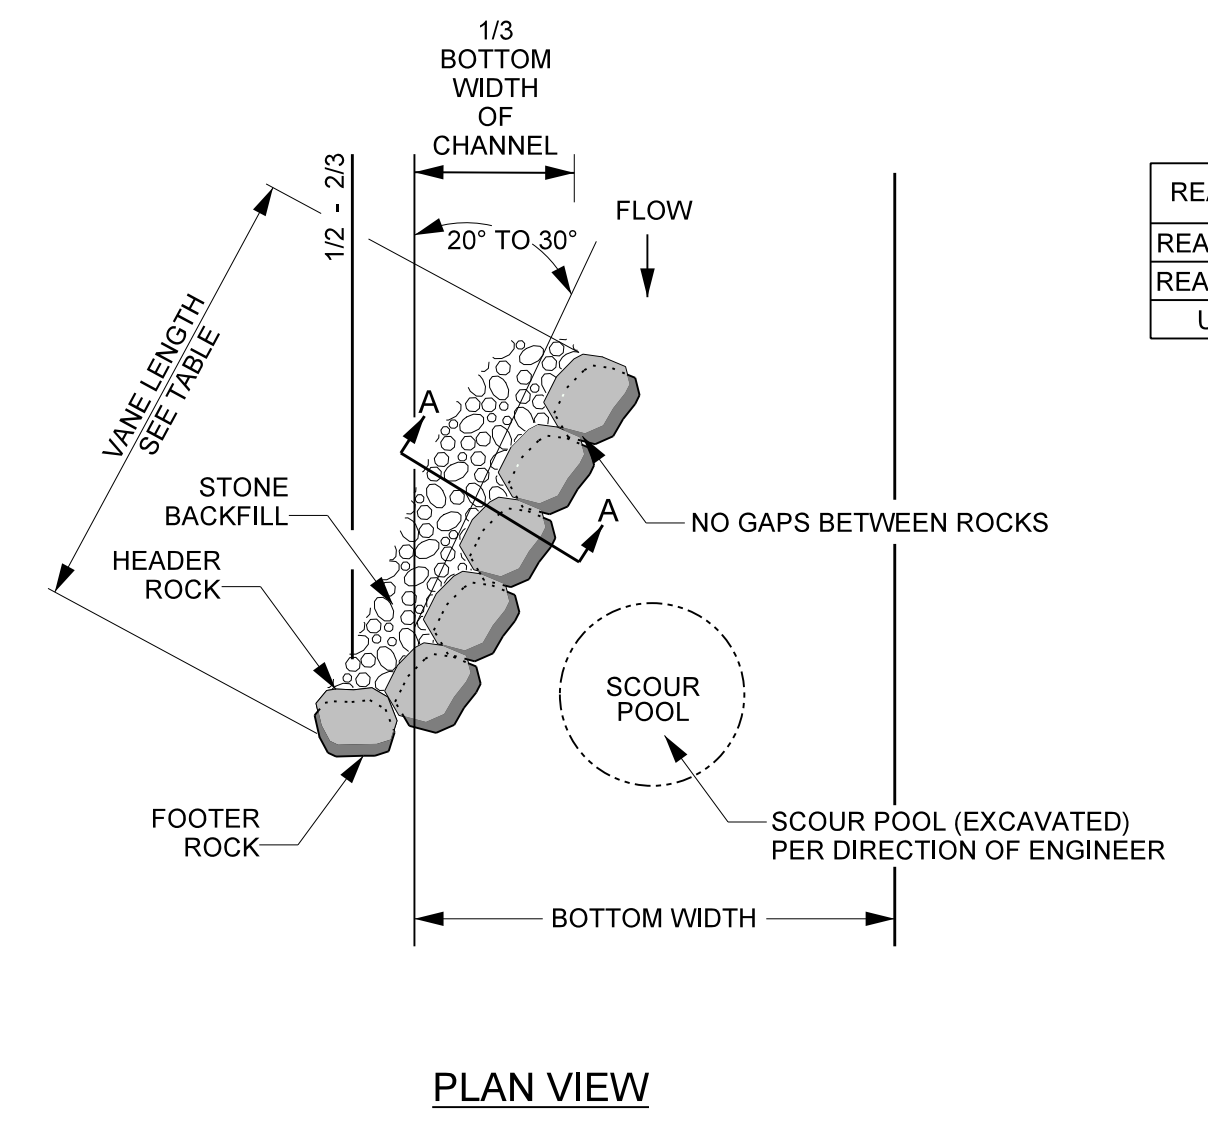


PLAN VIEW


REACH	VANE LENGTH	BOULDER SIZE
REACH 1A	11.3'	2'x3'x4'
REACH 1B	14.0'	2'x3'x4'
UT2	N/A	N/A

NOTES FOR ALL VANE STRUCTURES:

1. DIG A TRENCH BELOW THE BED FOR FOOTER ROCKS.
2. START AT BANK AND PLACE FOOTER ROCKS FIRST AND THEN HEADER (TOP) ROCK.
3. CONTINUE WITH STRUCTURE, FOLLOWING ANGLE AND SLOPE SPECIFICATIONS.
4. AN EXTRA ROCK CAN BE PLACED IN SCOUR POOL FOR HABITAT IMPROVEMENT.
5. USE HAND PLACED STONE TO FILL GAPS ON UPSTREAM SIDE OF HEADER AND FOOTER ROCKS.
6. INSTALL GEOTEXTILE FABRIC BEGINNING AT THE TOP OF THE HEADER ROCKS AND EXTEND DOWNWARD TO THE DEPTH OF THE BOTTOM FOOTER ROCK, AND THEN UPSTREAM TO A MINIMUM OF SIX FEET.
7. AFTER ALL STONE BACKFILL HAS BEEN PLACED, FILL IN THE UPSTREAM SIDE OF THE STRUCTURE WITH WELL GRADED MIX OF CLASS B, CLASS A, & #57 STONE TO THE ELEVATION 2"-4" BELOW THE THE HEADER ROCK. INCORPORATE ON-SITE ALLUVIUM WHERE AVAILABLE. FILL SHOULD BE CONCAVE BEHIND THE VANE ARM TO ALLOW POOLING OF FLOW.
8. START SLOPE AT 2/3 TO 3/4 TIMES THE BANKFULL STAGE.
9. ALL REACHES, BOULDER SIZE 1' x 2' x 3' TO 2' x 2' x 4'.

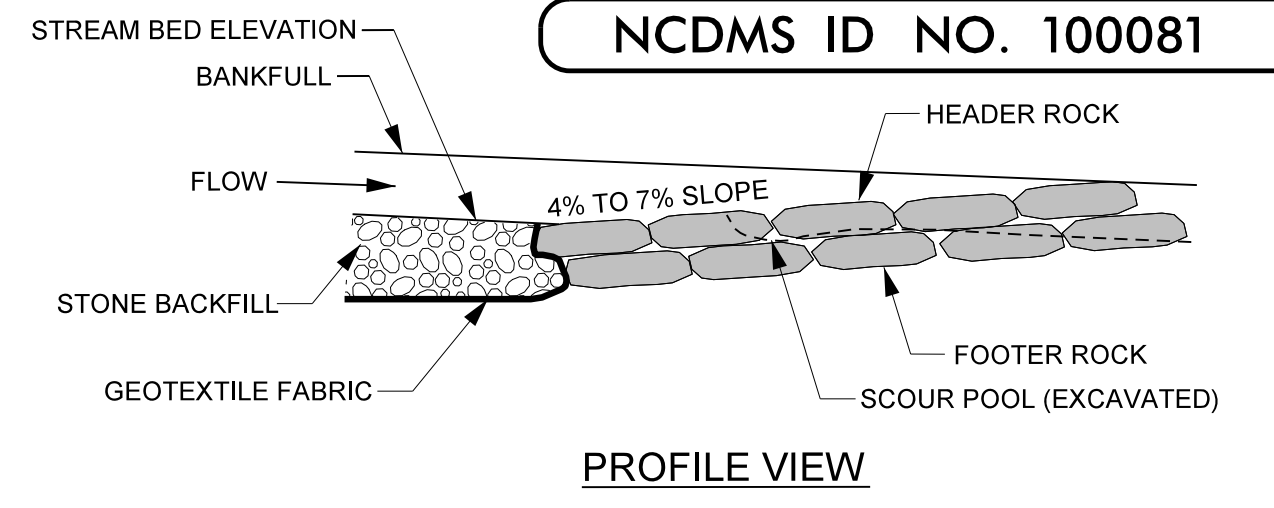


PROFILE VIEW

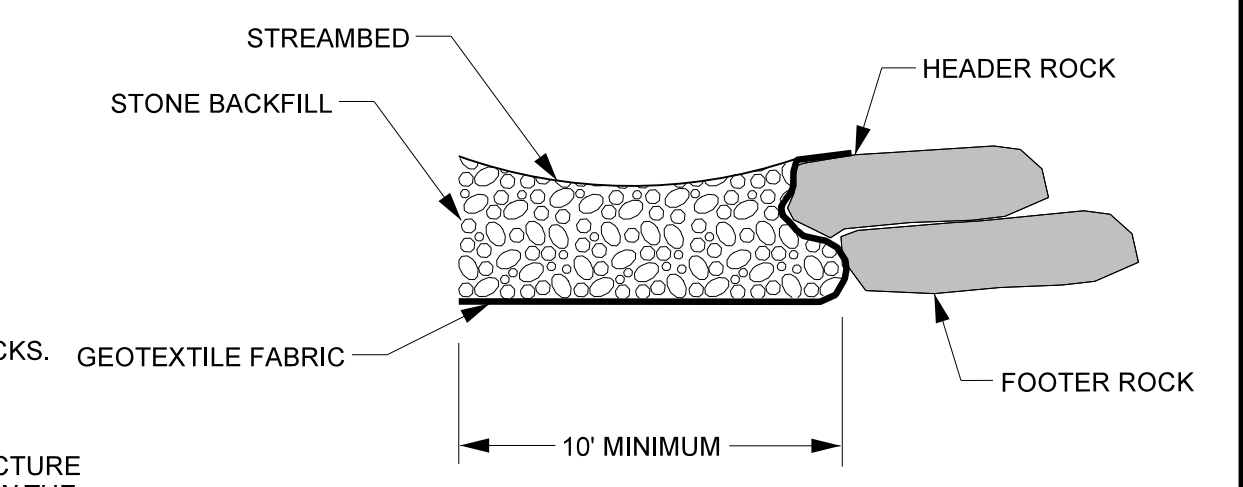


SECTION A - A


GRADE CONTROL ROCK J-HOOK VANE

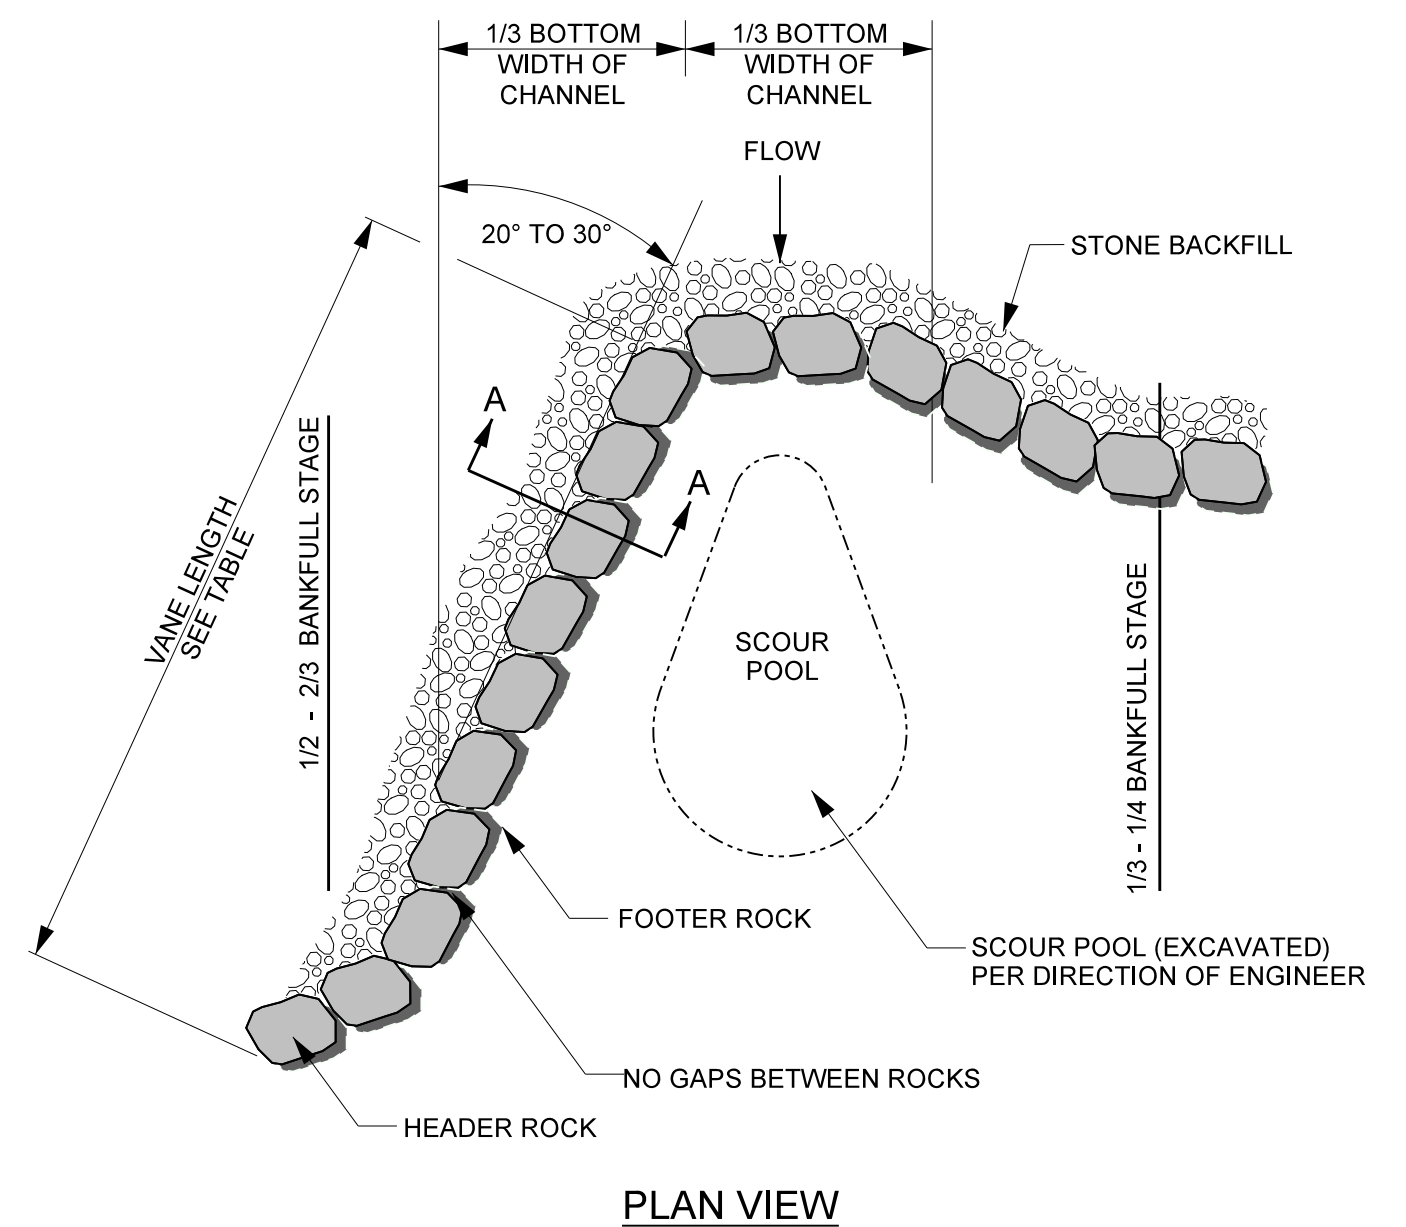

PLAN VIEW

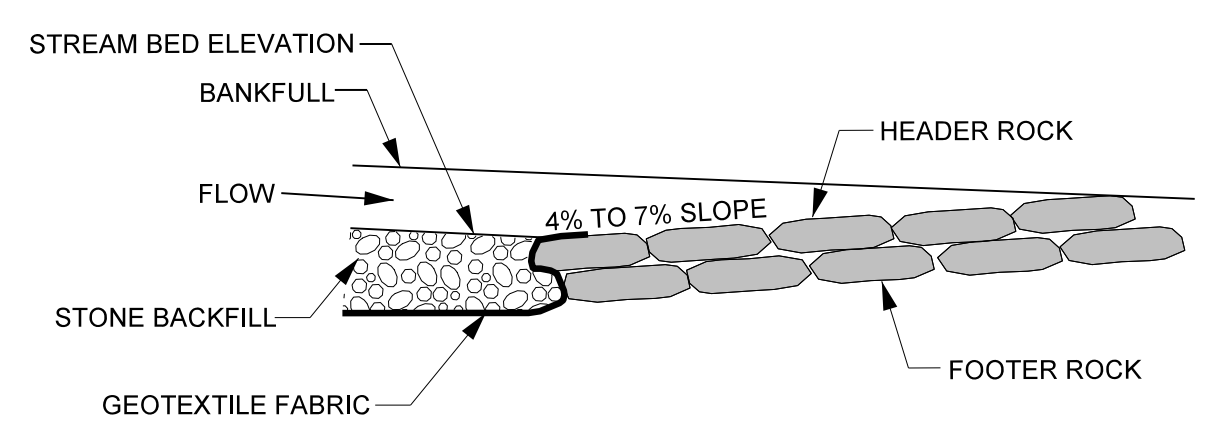

PROFILE VIEW

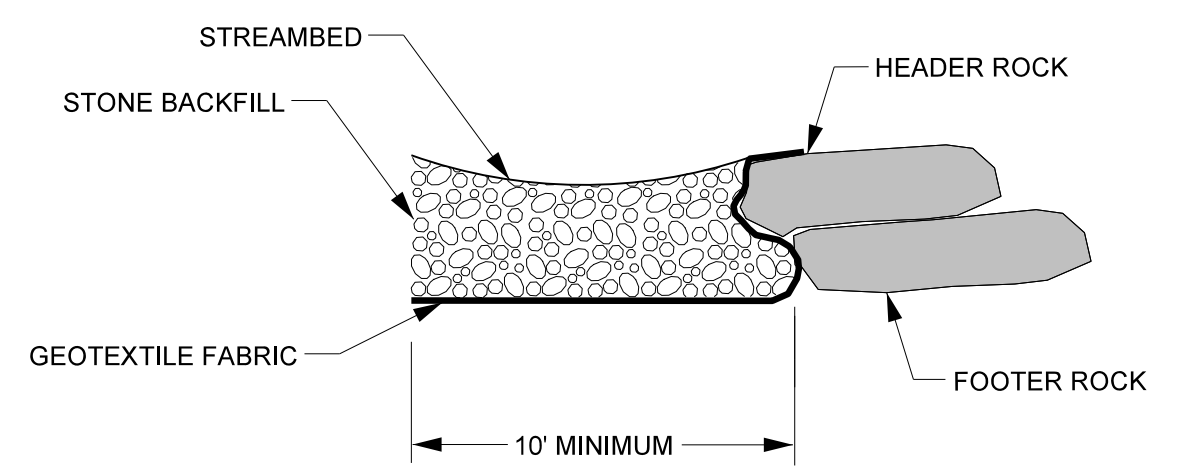


SECTION A - A

REACH	VANE LENGTH	BOULDER SIZE
REACH 1A	11.3'	2'x3'x4'
REACH 1B	14.0'	2'x3'x4'
UT2	N/A	N/A


NOTES FOR ALL VANE STRUCTURES:

1. DIG A TRENCH BELOW THE BED FOR FOOTER ROCKS.
2. START AT BANK AND PLACE FOOTER ROCKS FIRST AND THEN HEADER (TOP) ROCK.
3. CONTINUE WITH STRUCTURE, FOLLOWING ANGLE AND SLOPE SPECIFICATIONS.
4. AN EXTRA ROCK CAN BE PLACED IN SCOUR POOL FOR HABITAT IMPROVEMENT.
5. USE HAND PLACED STONE TO FILL GAPS ON UPSTREAM SIDE OF HEADER AND FOOTER ROCKS.
6. INSTALL GEOTEXTILE FABRIC BEGINNING AT THE TOP OF THE HEADER ROCKS AND EXTEND DOWNWARD TO THE DEPTH OF THE BOTTOM FOOTER ROCK, AND THEN UPSTREAM TO A MINIMUM OF SIX FEET.
7. AFTER ALL STONE BACKFILL HAS BEEN PLACED, FILL IN THE UPSTREAM SIDE OF THE STRUCTURE WITH WELL GRADED MIX OF CLASS B, CLASS A, & #57 STONE TO THE ELEVATION 2"-4" BELOW THE THE HEADER ROCK. INCORPORATE ON-SITE ALLUVIUM WHERE AVAILABLE. FILL SHOULD BE CONCAVE BEHIND THE VANE ARM TO ALLOW POOLING OF FLOW.
8. START SLOPE AT THE BANKFULL ELEVATION.
9. REACH 1A AND 1B, BOULDER SIZE 2' x 3' x 4'.


ROCK J-HOOK VANE

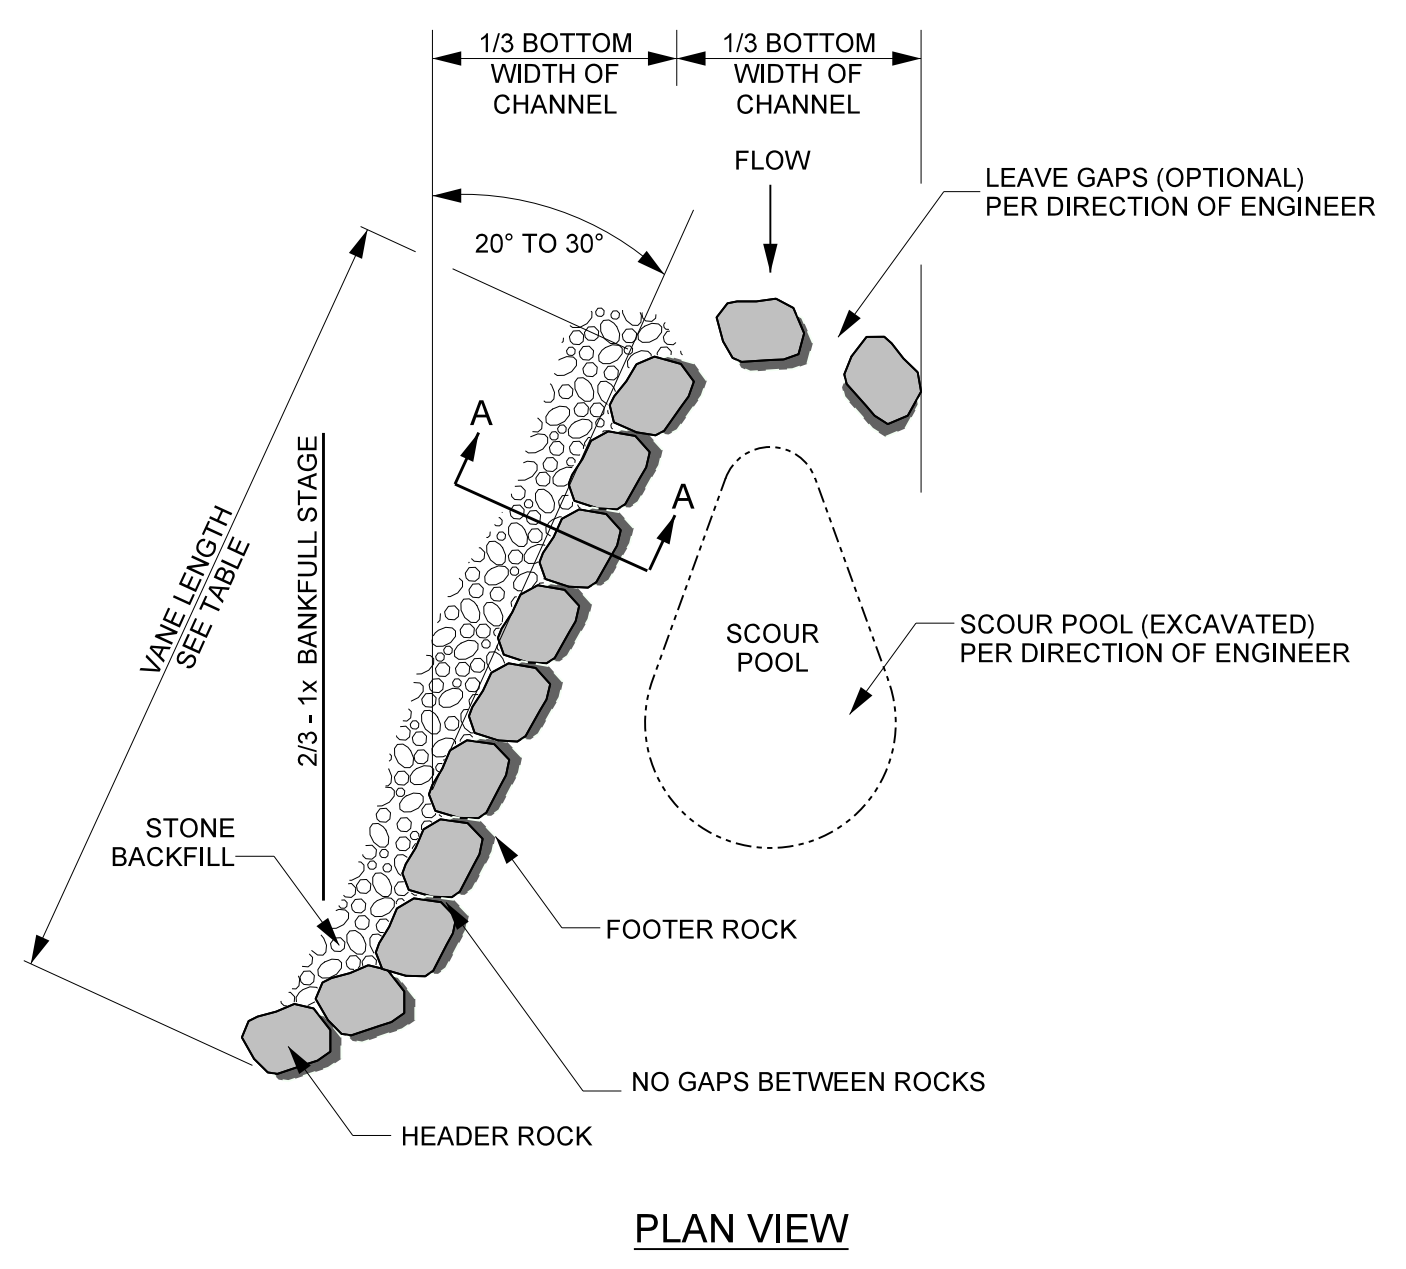

PLAN VIEW

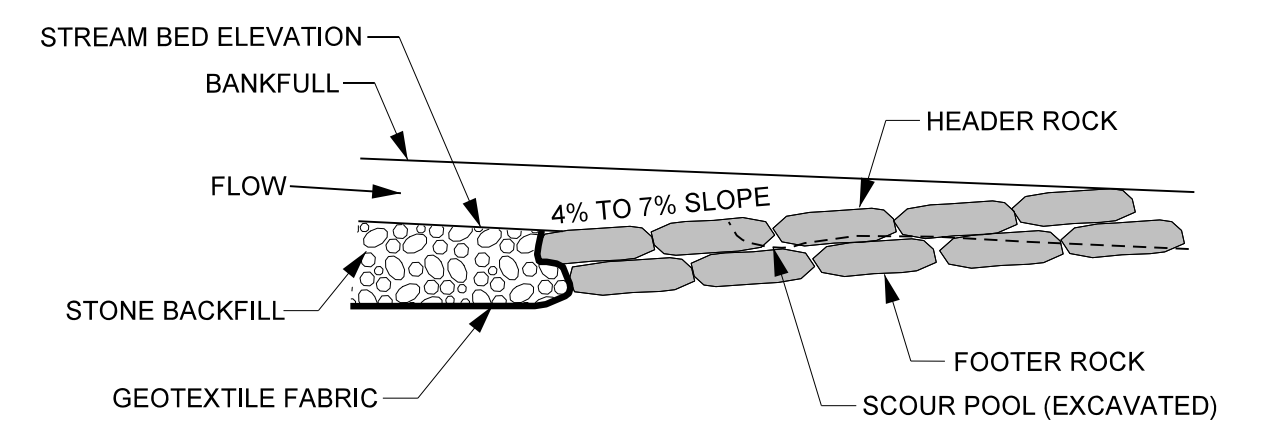

PROFILE VIEW

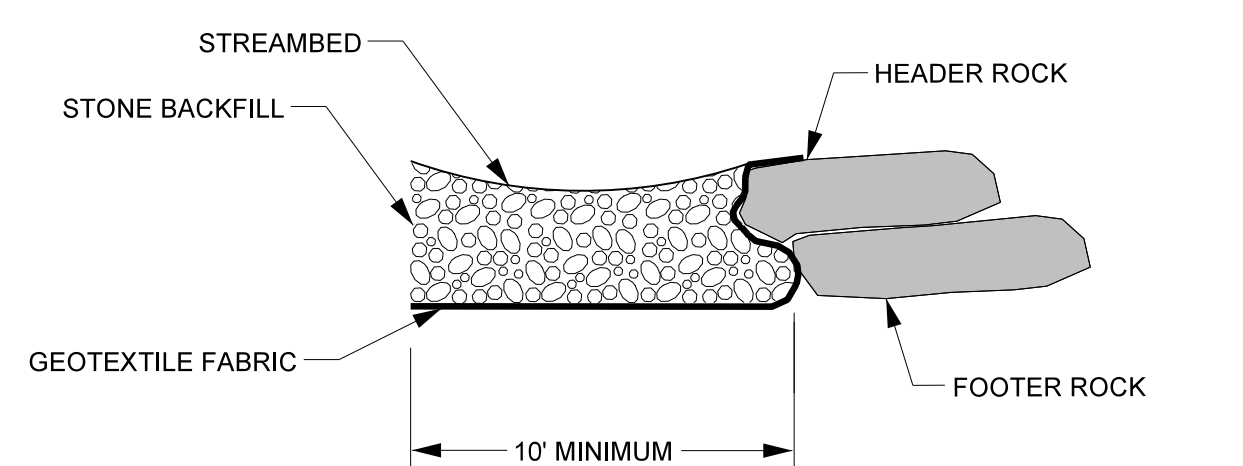

SECTION A - A

REACH	VANE LENGTH	BOULDER SIZE
REACH 1A	11.3'	2'x3'x4'
REACH 1B	14.0'	2'x3'x4'
UT2	N/A	N/A




NOTES FOR ALL VANE STRUCTURES:

1. DIG A TRENCH BELOW THE BED FOR FOOTER ROCKS.
2. START AT BANK AND PLACE FOOTER ROCKS FIRST AND THEN HEADER (TOP) ROCK.
3. CONTINUE WITH STRUCTURE, FOLLOWING ANGLE AND SLOPE SPECIFICATIONS.
4. AN EXTRA ROCK CAN BE PLACED IN SCOUR POOL FOR HABITAT IMPROVEMENT.
5. USE HAND PLACED STONE TO FILL GAPS ON UPSTREAM SIDE OF HEADER AND FOOTER ROCKS.
6. INSTALL GEOTEXTILE FABRIC BEGINNING AT THE TOP OF THE HEADER ROCKS AND EXTEND DOWNWARD TO THE DEPTH OF THE BOTTOM FOOTER ROCK, AND THEN UPSTREAM TO A MINIMUM OF SIX FEET.
7. AFTER ALL STONE BACKFILL HAS BEEN PLACED, FILL IN THE UPSTREAM SIDE OF THE STRUCTURE WITH WELL GRADED MIX OF CLASS B, CLASS A, & #57 STONE TO THE ELEVATION 2"-4" BELOW THE THE HEADER ROCK. INCORPORATE ON-SITE ALLUVIUM WHERE AVAILABLE. FILL SHOULD BE CONCAVE BEHIND THE VANE ARM TO ALLOW POOLING OF FLOW.
8. START SLOPE AT THE BANKFULL ELEVATION.
9. REACH 1A AND 1B, BOULDER SIZE 2' x 3' x 4'.

4/2/2023 M:\Projects\167680\UT to Megness Cr\Design\As-Built\Plans\167680_ASB-PSH_02A.dgn

27/26/2023



LOG AND ROCK STEP / POOL

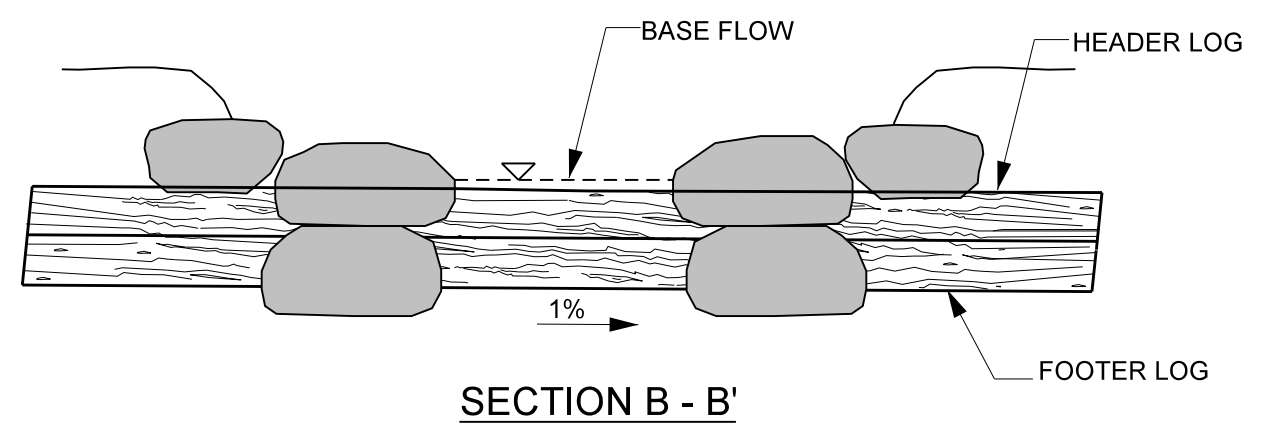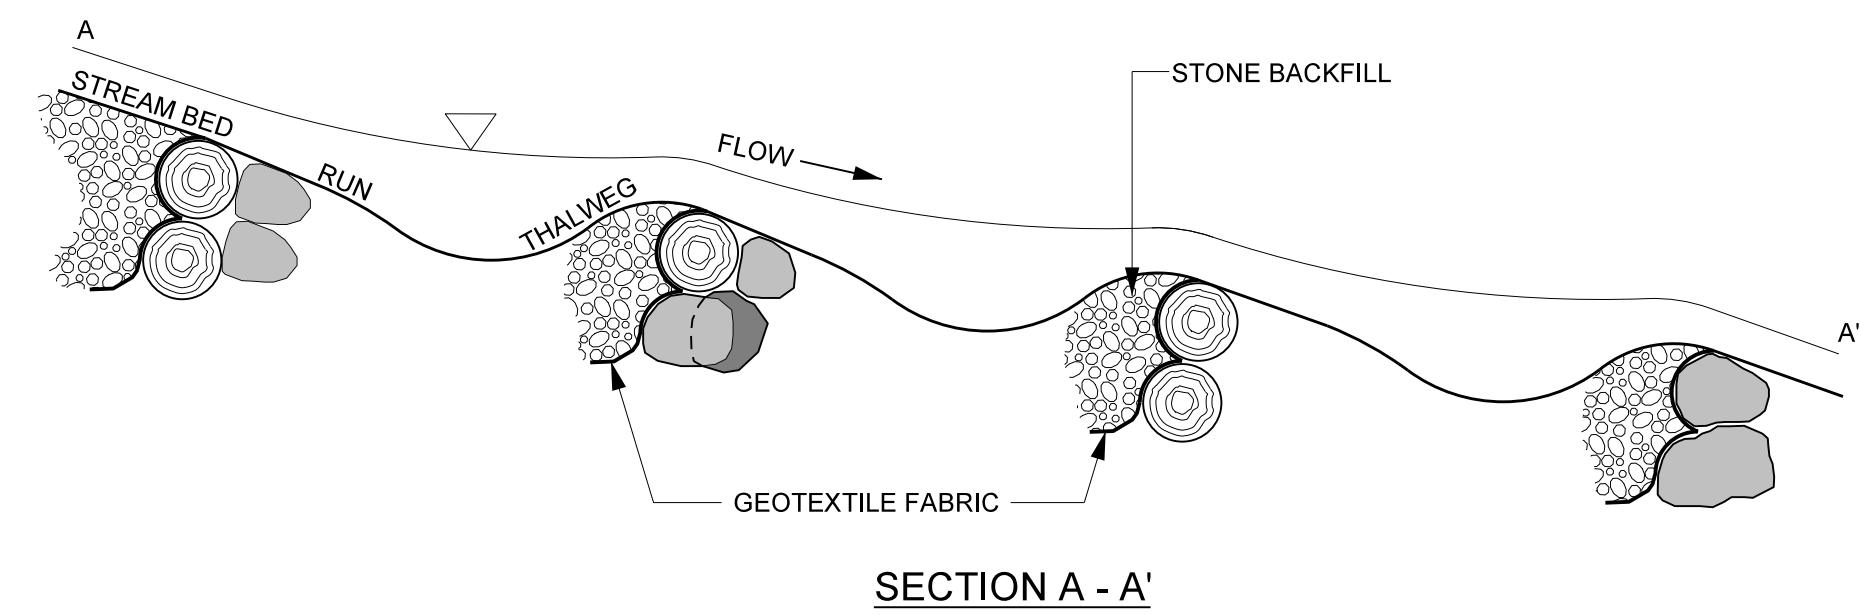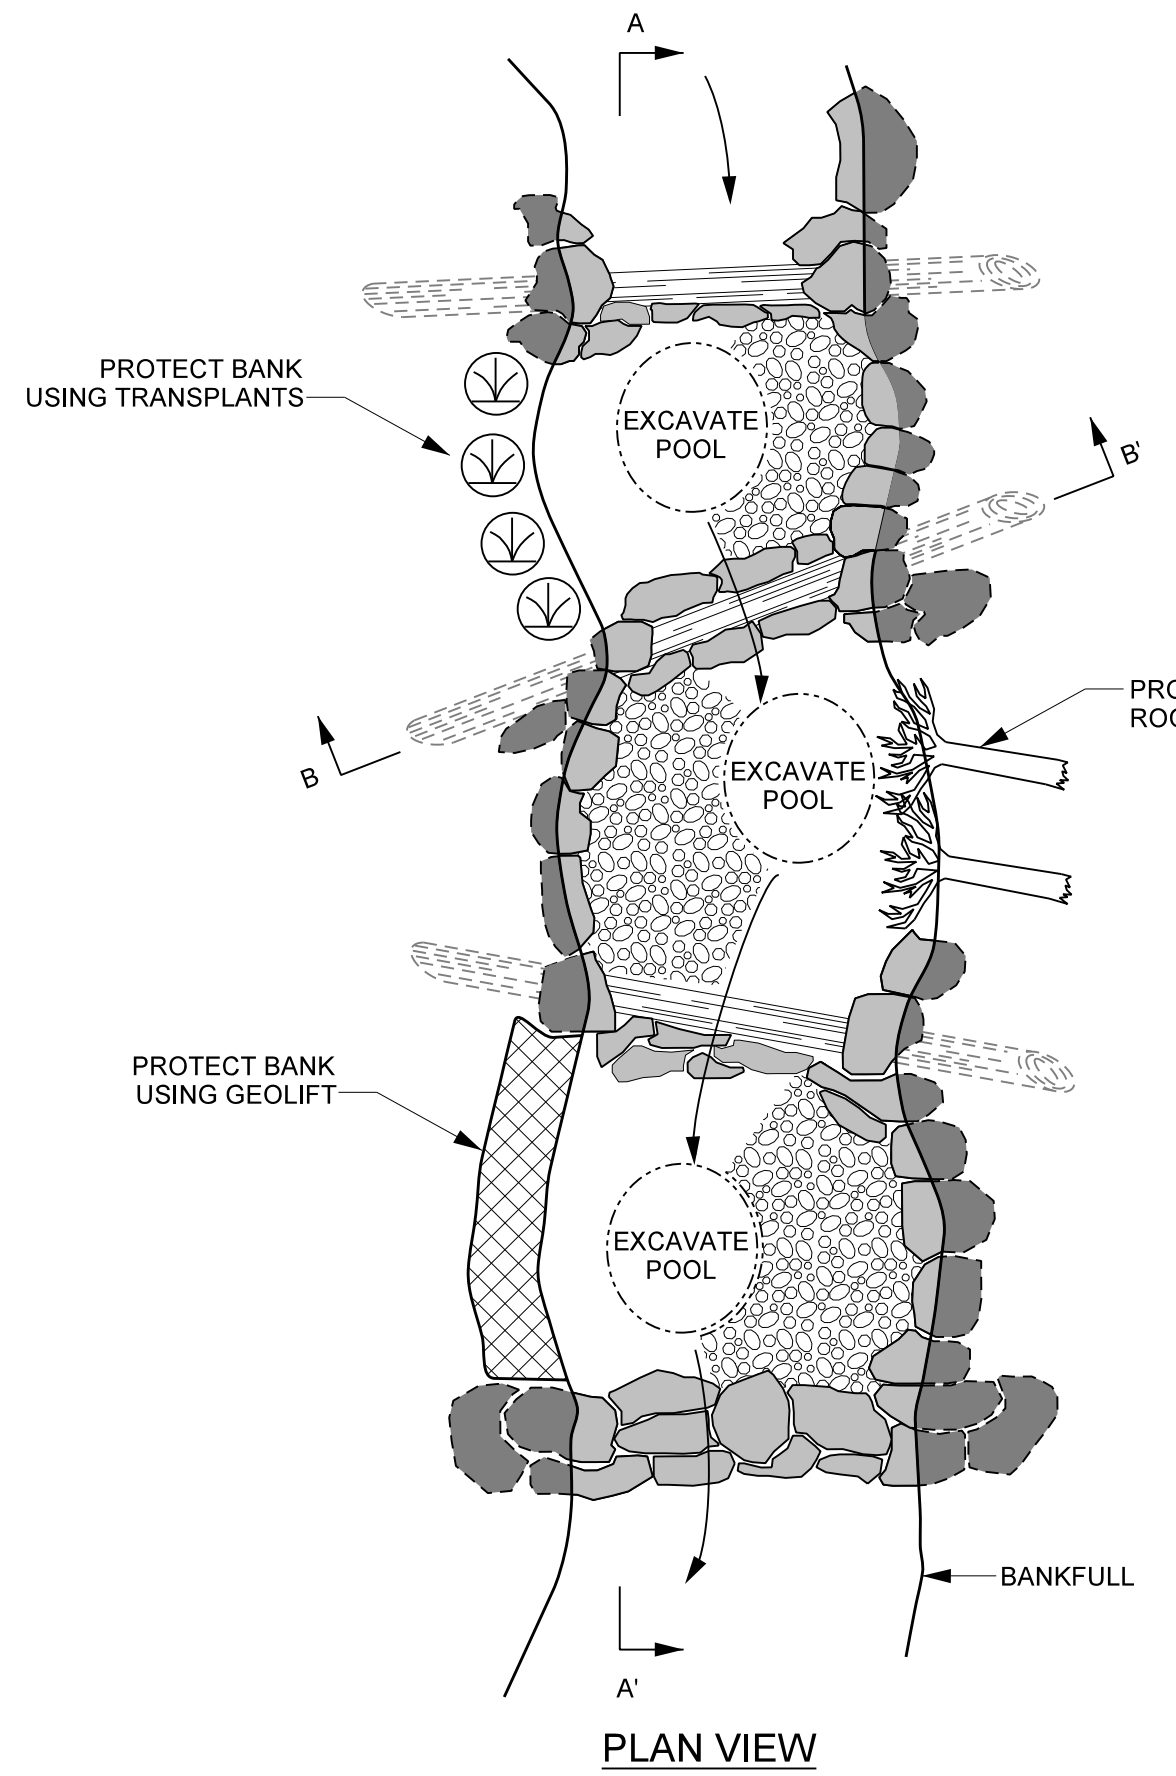

REACH	BOULDER SIZE
REACH 1A	2'x3'x4'
REACH 1B	2'x3'x4'
UT2	1'x2'x3'

- NOTES:**
- LOGS SHOULD BE AT LEAST 10" IN DIAMETER, RELATIVELY STRAIGHT, HARDWOOD, AND RECENTLY HARVESTED AND EXTENDING INTO THE BANK 5' ON EACH SIDE.
 - SOIL SHOULD BE COMPACTED WELL AROUND BURIED PORTIONS OF LOG.
 - GEOTEXTILE FABRIC SHOULD BE NAILED TO THE LOG BELOW THE BACKFILL.
 - BOULDERS SHOULD BE PLACED ON TOP OF HEADER LOG FOR ANCHORING.
 - TRANSPLANTS CAN BE USED INSTEAD OF BOULDERS, PER DIRECTION OF ENGINEER.
 - AFTER ALL STONE BACKFILL HAS BEEN PLACED, FILL IN THE UPSTREAM SIDE OF THE STRUCTURE WITH WELL GRADED MIX OF CLASS B, CLASS A, & #57 STONE TO THE ELEVATION OF THE TOP OF THE HEADER ROCK. INCORPORATE ON-SITE ALLUVIUM WHERE AVAILABLE.




BOULDER STEP

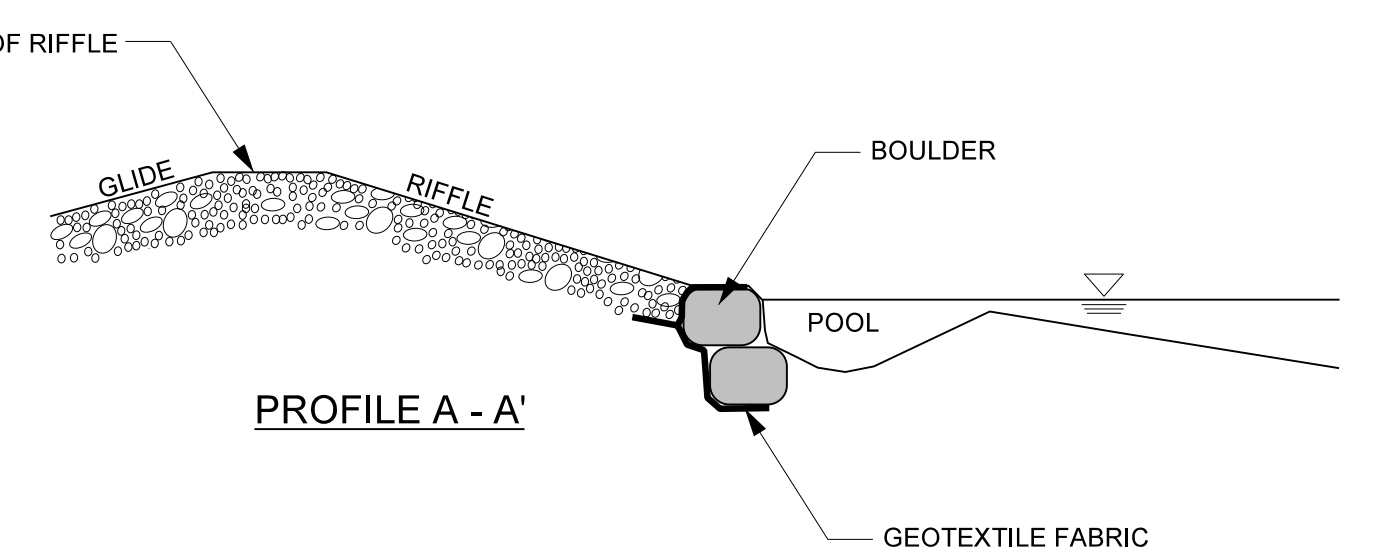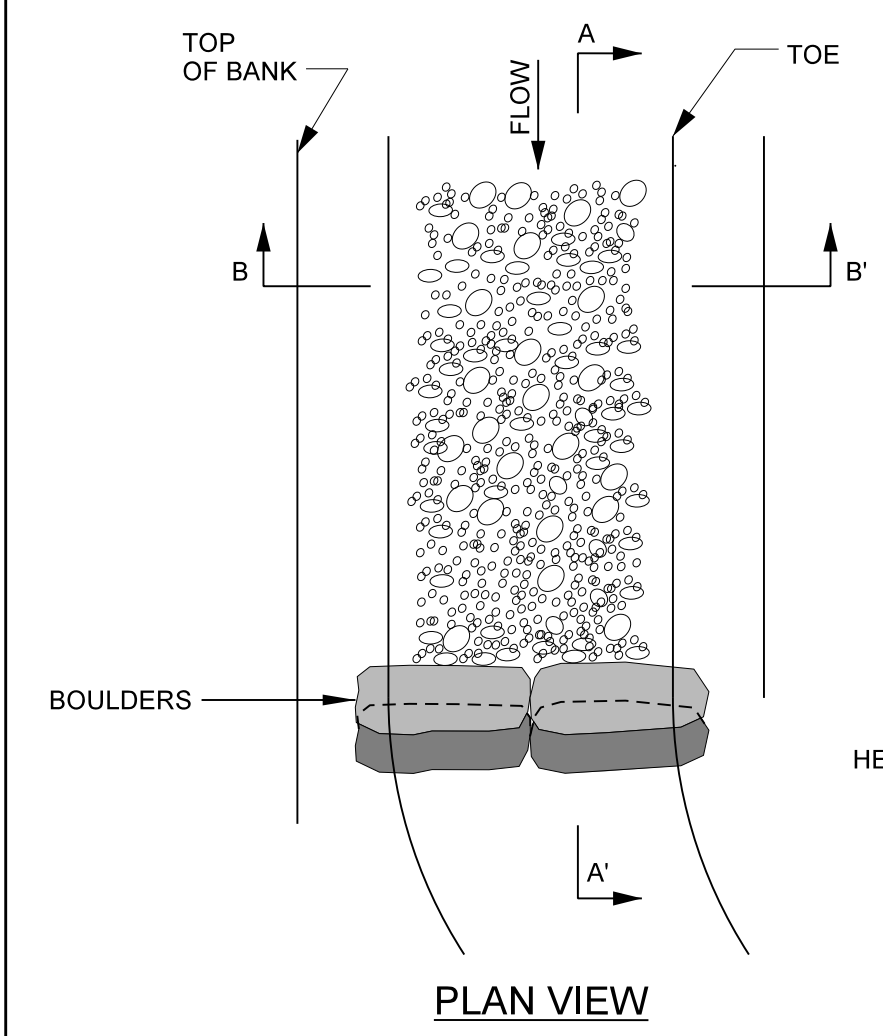

REACH	BOULDER SIZE
REACH 1A	2'x3'x4'
REACH 1B	2'x3'x4'
UT2	1'x2'x3'

- NOTES:**
- FOOTERS SHALL BE INSTALLED SUCH THAT 1/4 TO 1/3 OF THE LENGTH IS DOWNSTREAM OF THE HEADER.
 - SOIL SHALL BE WELL COMPACTED AROUND BURIED PORTION OF FOOTERS WITH THE BUCKET OF EXCAVATOR.
 - INSTALL NON-WOVEN FILTER FABRIC UNDERNEATH FOOTER BOULDERS.
 - UNDERCUT THE RIFFLE ELEVATION 12 INCHES TO ALLOW FOR A LAYER OF STONE.
 - INSTALL EROSION CONTROL MATTING ALONG COMPLETED BANKS SUCH THAT THE EROSION CONTROL MATTING AT THE TOE OF THE BANK EXTENDS DOWN TO THE UNDERCUT ELEVATION.
 - FILL TRENCH WITH GRADED MIX OF CLASS A, CLASS B, AND #57 STONE TO THE BED ELEVATION OF THE CHANNEL.
 - BOULDER STEPS MUST BE EXTENDED TO A MINIMUM OF 2' INTO THE BANK. USE SILL BOULDERS IF NECESSARY.
 - THALWEG AND STEP INVERT WILL BE CONCAVE AND SHAPED PER DIRECTION OF THE DESIGNER.




GRADE CONTROL LOG J-HOOK VANE

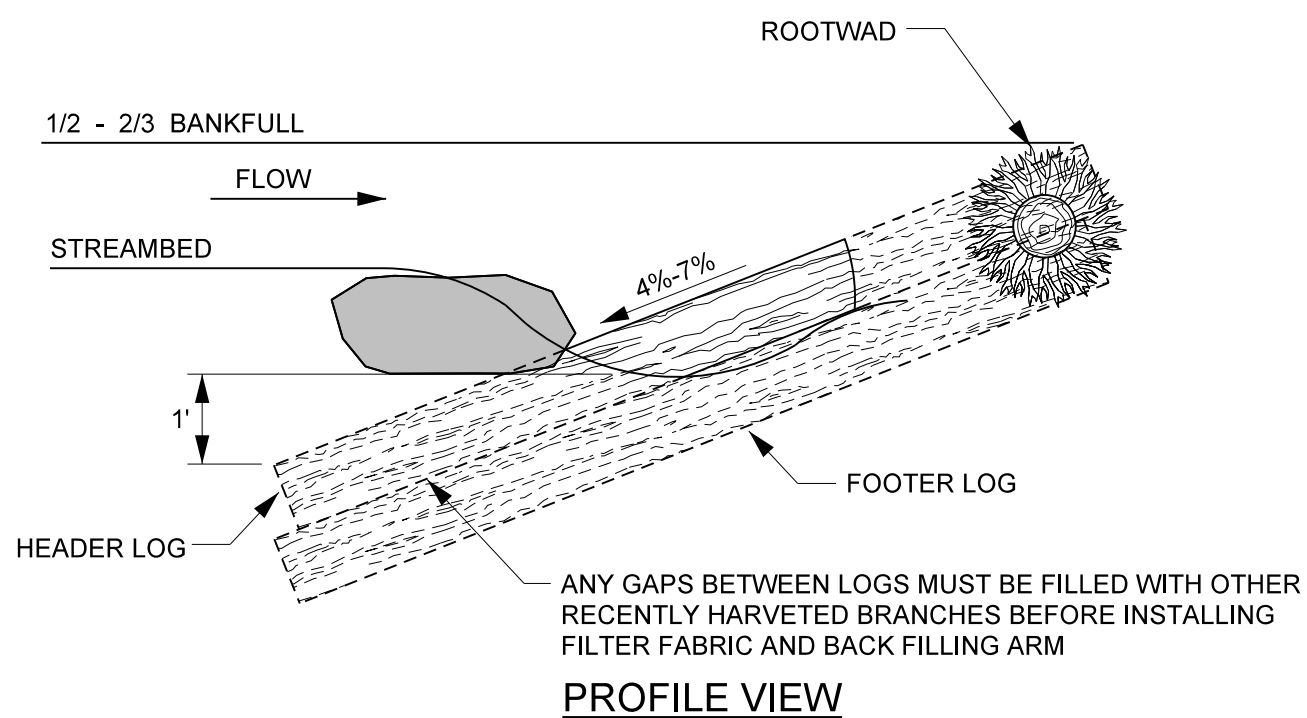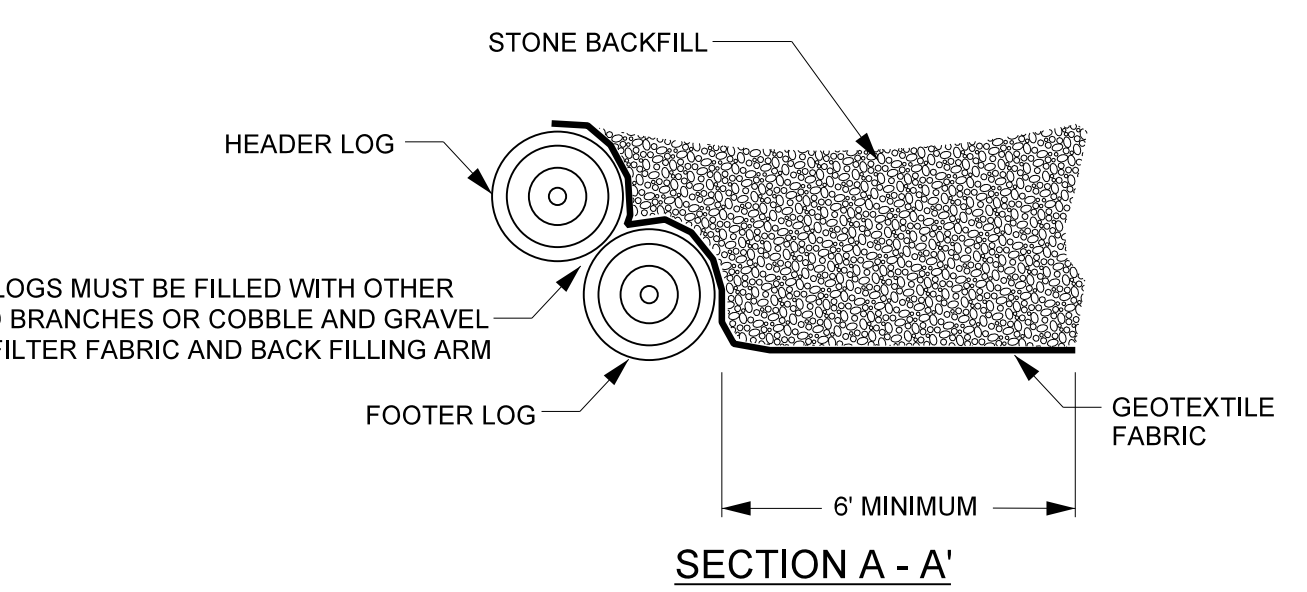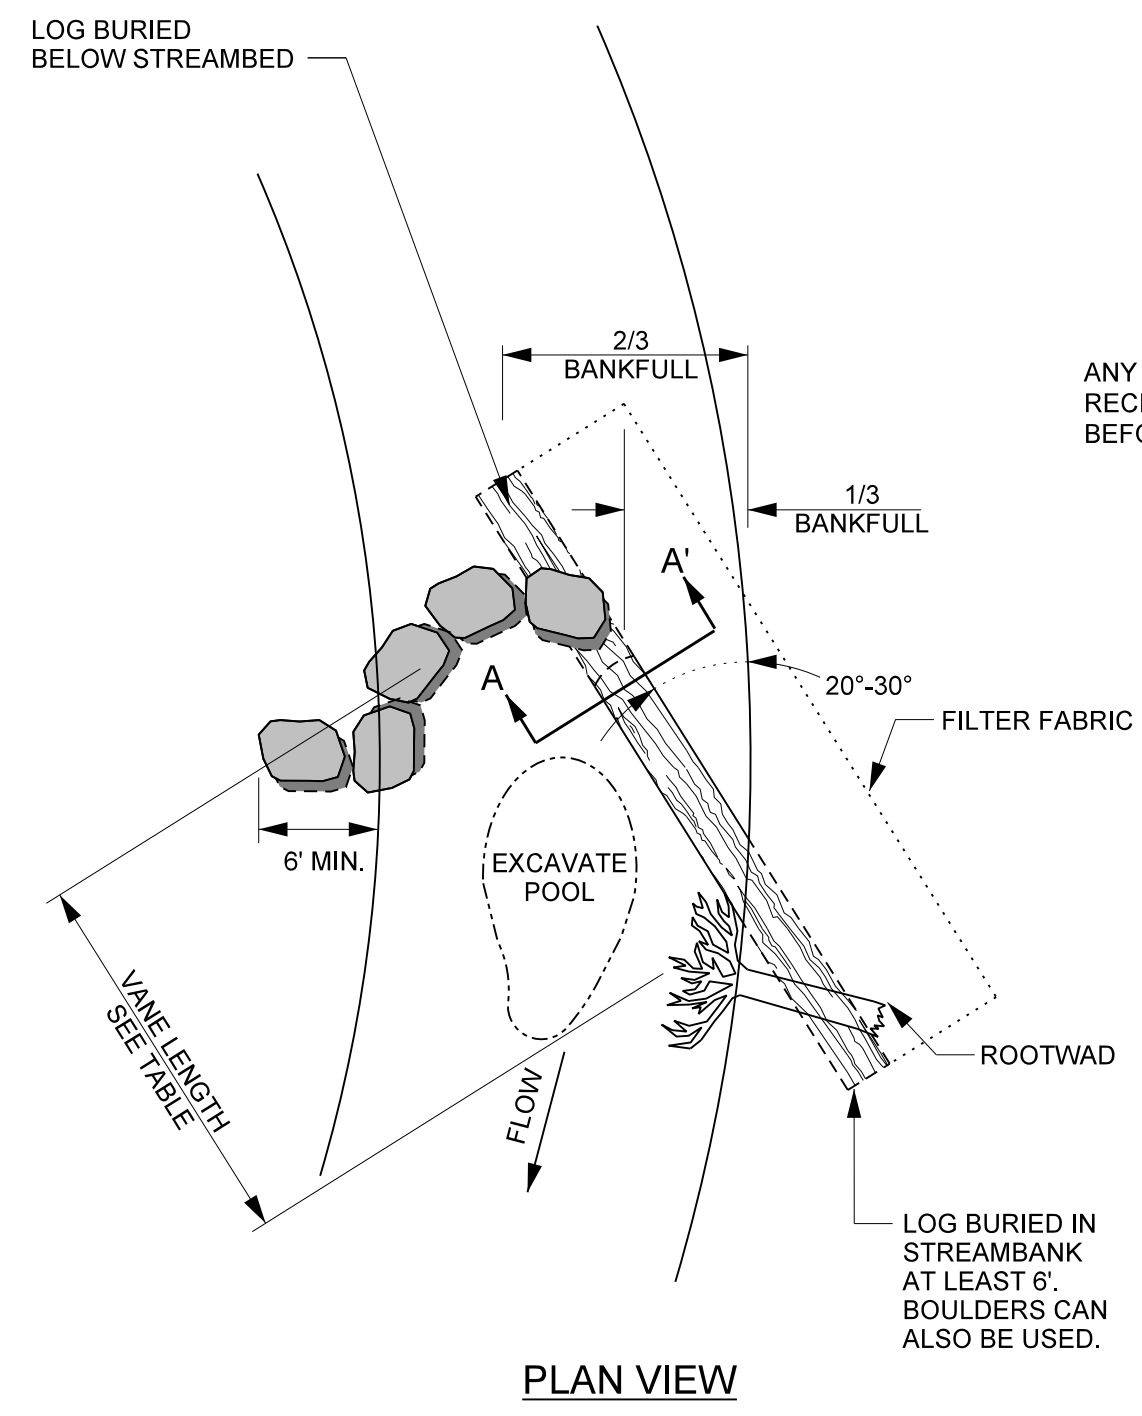

REACH	VANE LENGTH	BOULDER SIZE
REACH 1A	11.3'	2'x3'x4'
REACH 1B	14.0'	2'x3'x4'
UT2	N/A	N/A

- NOTES:**
- LOGS SHOULD BE AT LEAST 10" IN DIAMETER, RELATIVELY STRAIGHT, HARDWOOD, RECENTLY HARVESTED, AND FOOTERED.
 - BOULDERS MUST BE OF SUFFICIENT SIZE TO ANCHOR LOGS.
 - SOIL SHOULD BE COMPACTED WELL AROUND BURIED PORTIONS OF LOG.
 - ROOTWADS SHOULD BE PLACED BENEATH THE HEADER LOG AND PLACED SO THAT IT LOCKS THE HEADER LOG INTO THE BANK. SEE ROOTWAD DETAIL.
 - BOULDERS SHOULD BE PLACED ON TOP OF HEADER LOG FOR ANCHORING.
 - HEADER BOULDERS TO BE PLACED 0.5 TO 0.75 FEET APART.
 - FILTER FABRIC SHOULD BE NAILED TO THE LOG BELOW THE BACKFILL.
 - TRANSPLANTS OR BOULDERS CAN BE USED INSTEAD OF ROOTWADS, PER DIRECTION OF ENGINEER.
 - BOULDER SILL MUST BE A MINIMUM OF 5'.
 - AFTER ALL STONE BACKFILL HAS BEEN PLACED, FILL IN THE UPSTREAM SIDE OF THE STRUCTURE WITH WELL GRADED MIX OF CLASS B, CLASS A, & #57 STONE TO THE ELEVATION OF THE TOP OF THE HEADER ROCK. INCORPORATE ON-SITE ALLUVIUM WHERE AVAILABLE.

LOG VANE

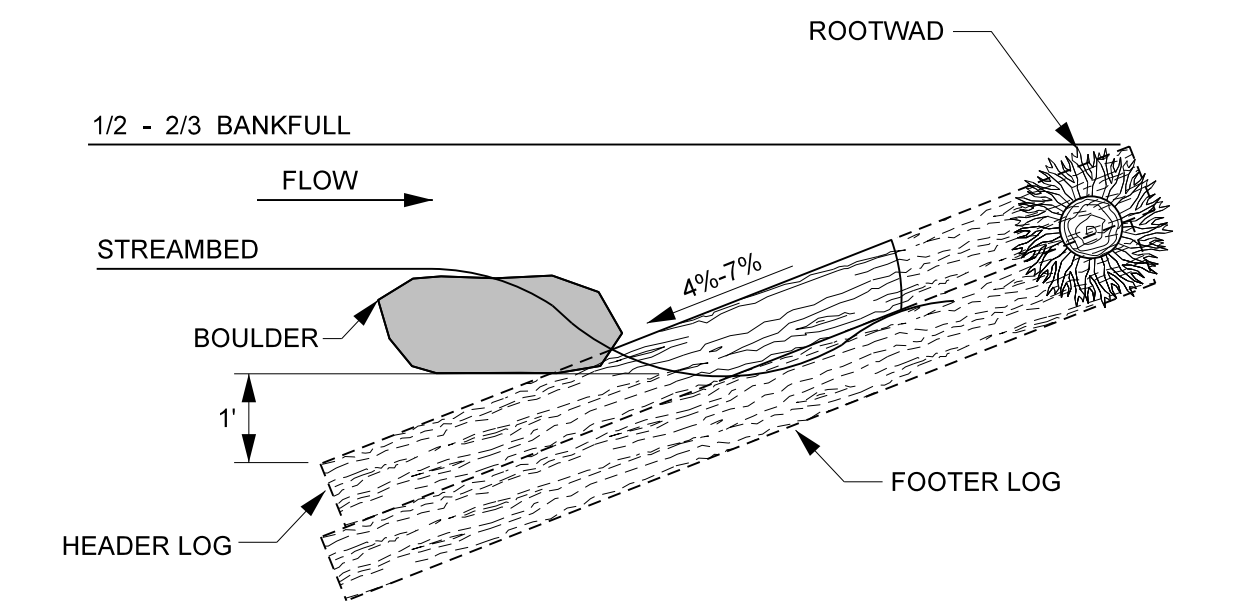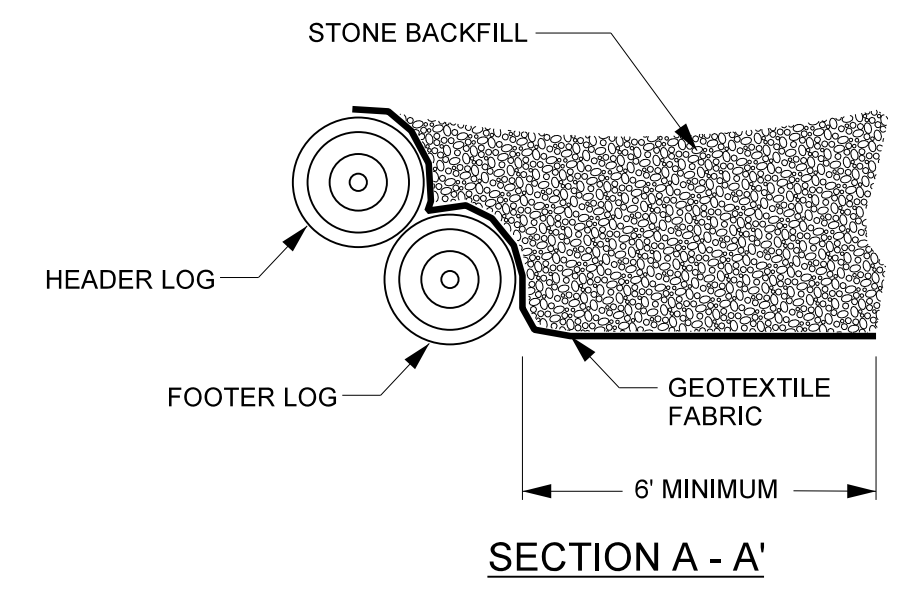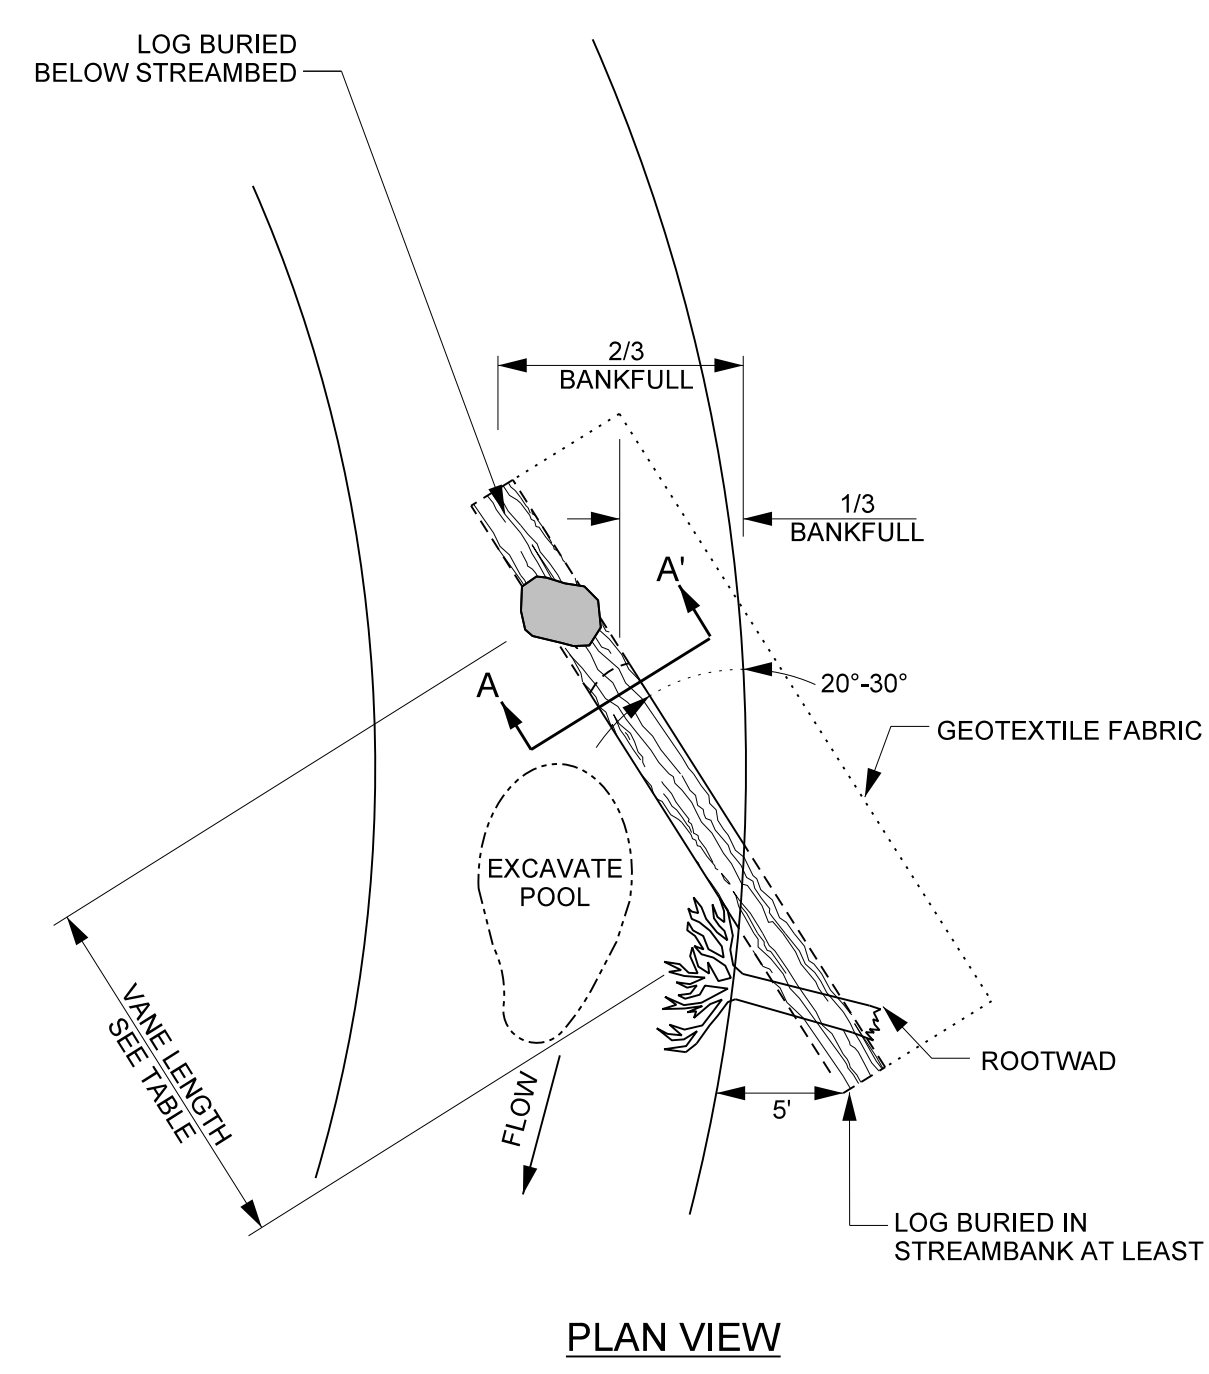

REACH	VANE LENGTH	BOULDER SIZE
REACH 1A	11.3'	2'x3'x4'
REACH 1B	14.0'	2'x3'x4'
UT2	N/A	N/A




- NOTES:**
- LOGS SHOULD BE AT LEAST 10" IN DIAMETER, RELATIVELY STRAIGHT, HARDWOOD, AND RECENTLY HARVESTED.
 - BOULDERS MUST BE OF SUFFICIENT SIZE TO ANCHOR LOGS.
 - SOIL SHOULD BE COMPACTED WELL AROUND BURIED PORTIONS OF LOGS.
 - ROOTWADS SHOULD BE PLACED BENEATH THE HEADER LOG AND PLACED SO THAT IT LOCKS THE HEADER LOG INTO THE BANK. SEE ROOTWAD DETAIL.
 - BOULDER SHOULD BE PLACED ON TOP OF HEADER LOG FOR ANCHORING.
 - GEOTEXTILE FABRIC SHOULD BE NAILED TO THE LOG BELOW THE BACKFILL.
 - TRANSPLANTS CAN BE USED INSTEAD OF ROOTWADS, PER DIRECTION OF ENGINEER.
 - AFTER ALL STONE BACKFILL HAS BEEN PLACED, FILL IN THE UPSTREAM SIDE OF THE STRUCTURE WITH WELL GRADED MIX OF CLASS B, CLASS A, & #57 STONE TO THE ELEVATION OF THE TOP OF THE HEADER ROCK. INCORPORATE ON-SITE ALLUVIUM WHERE AVAILABLE.

PROJECT REFERENCE NO. 167680	SHEET NO. 2B
PROJECT ENGINEER	
DocuSigned by: Kathleen M. McKethan 34268406484273	
APPROVED BY:	
6/12/2023	
DATE:	
Michael Baker International Michael Baker Engineering Inc. 8000 Regency Parkway, Suite 600 Cary, NORTH CAROLINA 27518 Phone: 919.463.5488 Fax: 919.463.5490 License #: F-1084	
NCDMS ID NO. 10081	

4/21/2023
 M:\Projects\167680\UT to Magness Cr\Design\As-Built\Plans\167680_AS-B-PSH_02B.dgn



2/26/2023

LIVE STAKING

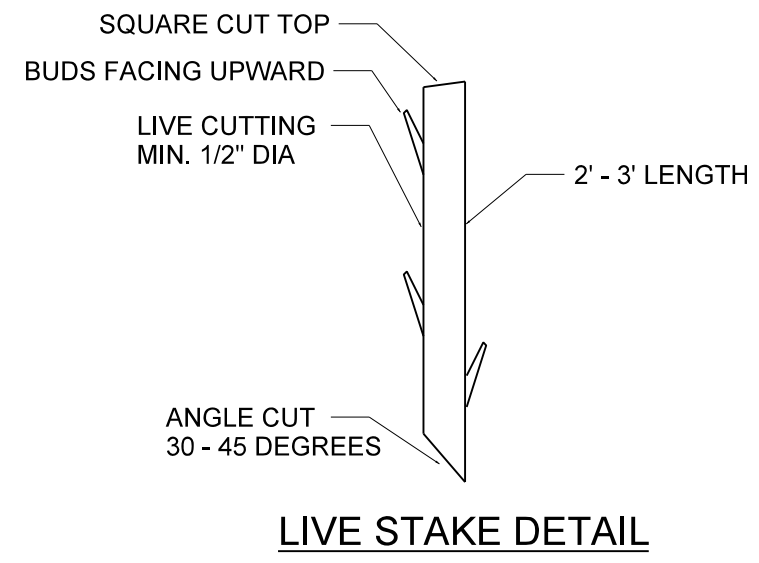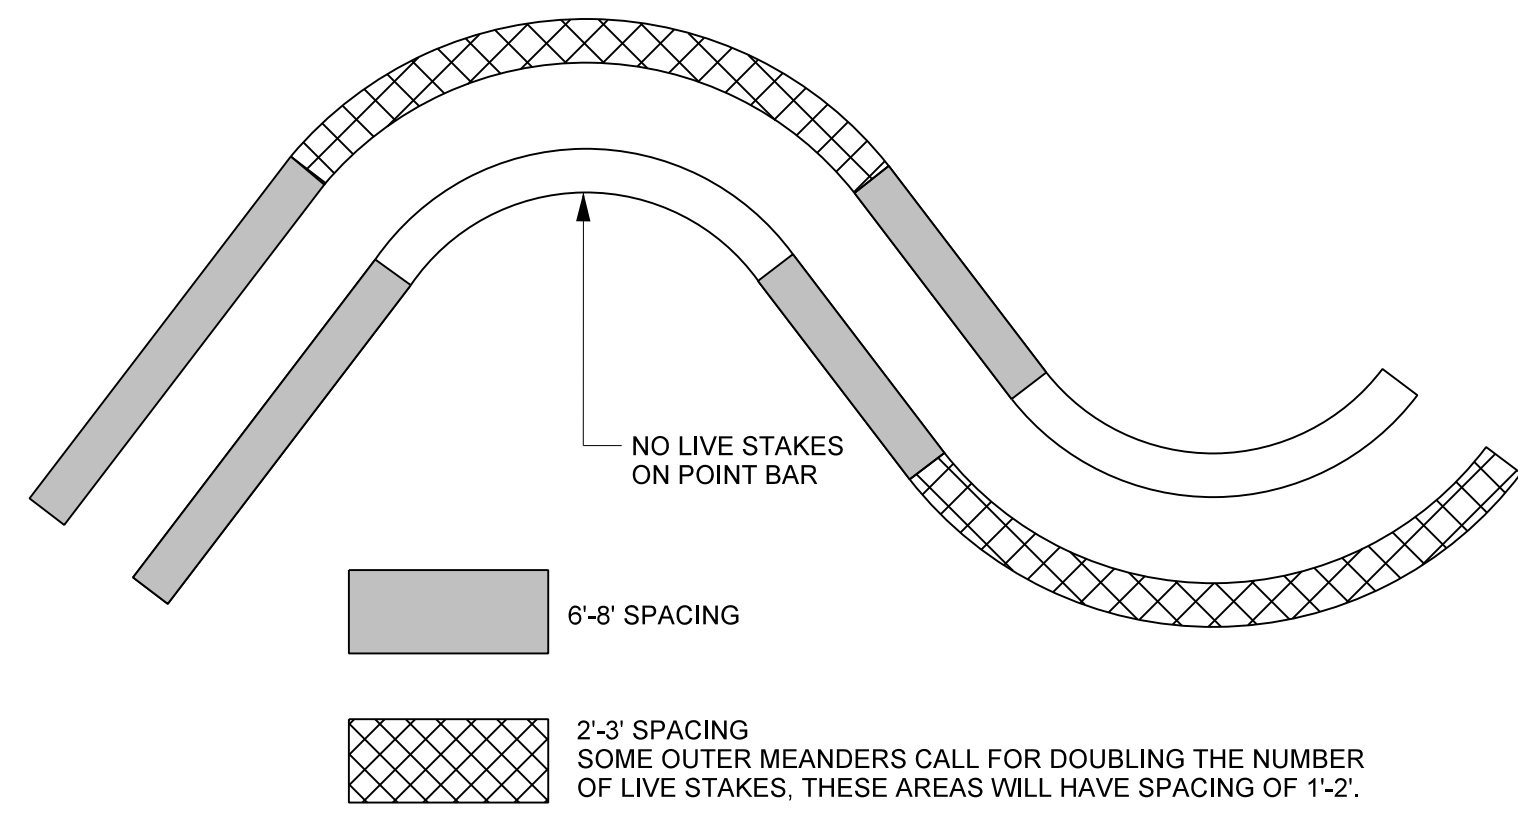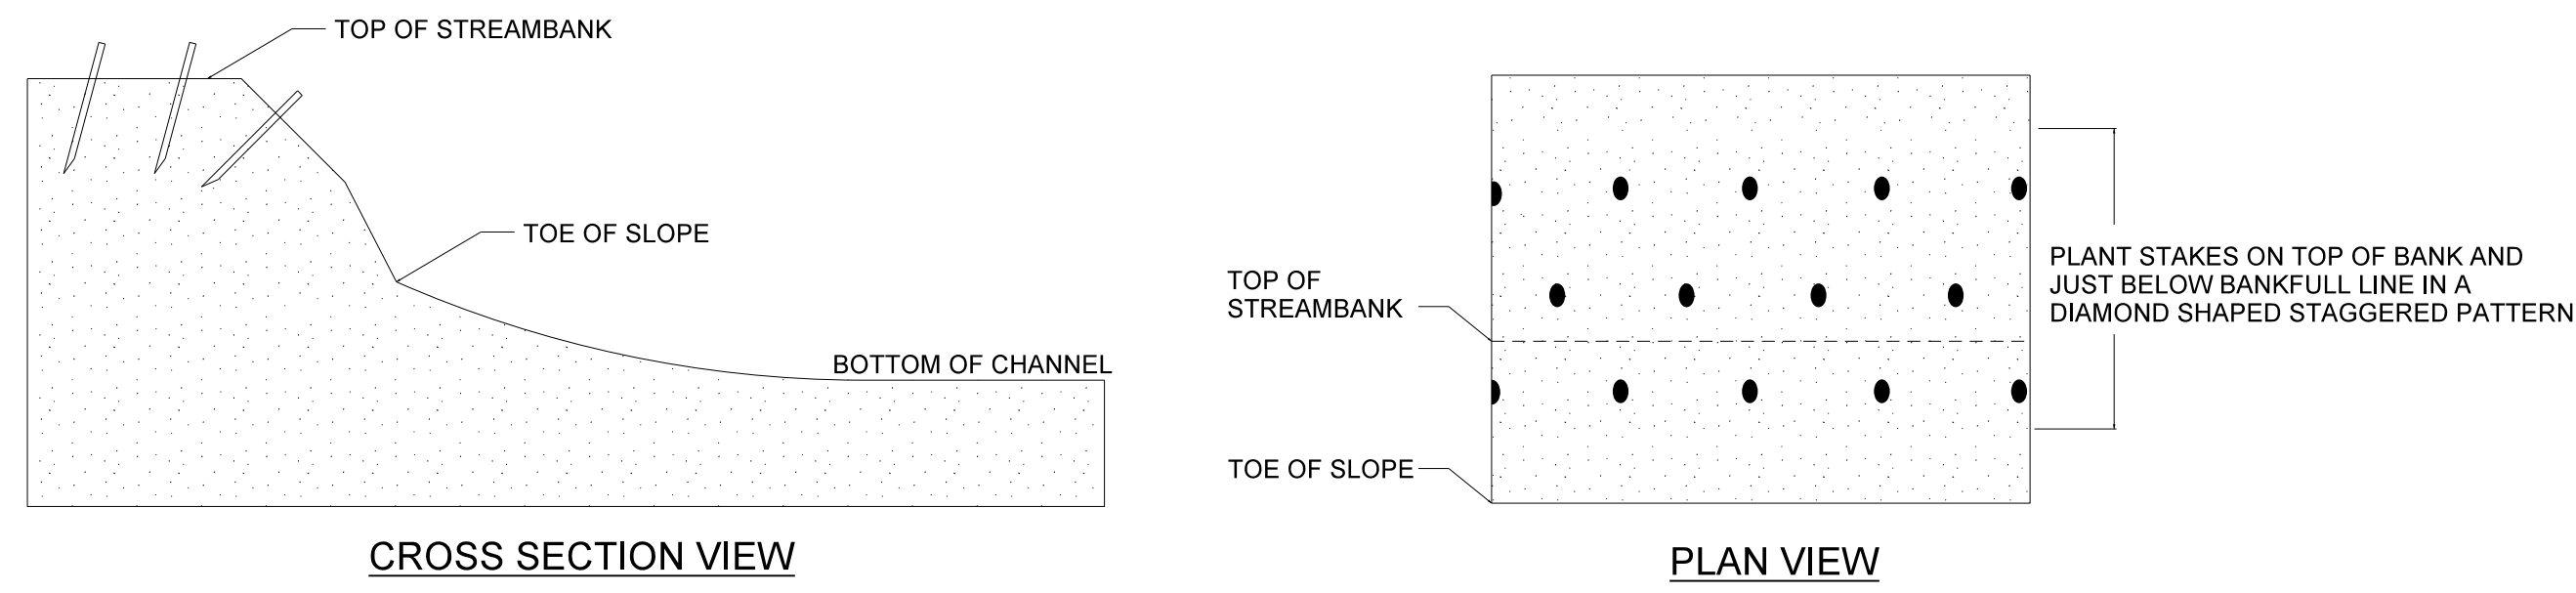

- NOTES:**
1. STAKES SHOULD BE CUT AND INSTALLED ON THE SAME DAY.
 2. DO NOT INSTALL STAKES THAT HAVE BEEN SPLIT.
 3. STAKES MUST BE INSTALLED WITH BUDS POINTING UPWARDS.
 4. STAKES SHOULD BE INSTALLED PERPENDICULAR TO BANK.
 5. STAKES SHOULD BE 1/2 TO 2 INCHES IN DIAMETER AND 2 TO 3 FT LONG.
 6. STAKES SHOULD BE INSTALLED LEAVING 1/5 OF STAKE ABOVE GROUND.
 7. DOUBLE THE LIVE STAKES IN MEANDER BENDS THAT HAVE A BRUSH TOE AND BANKS ARE MATTED.

TRANSPLANTED VEGETATION

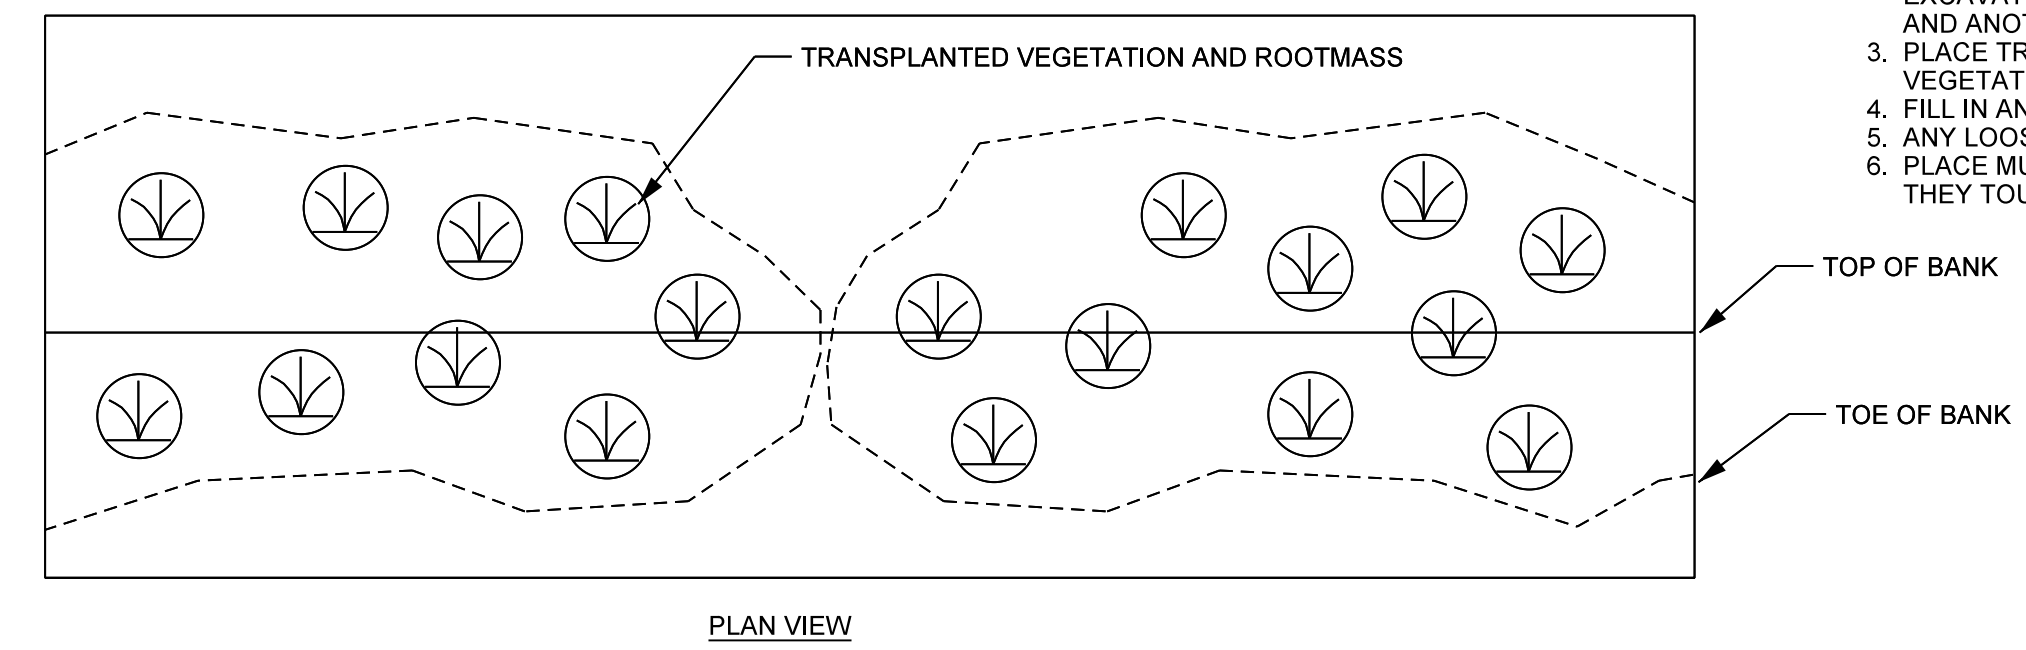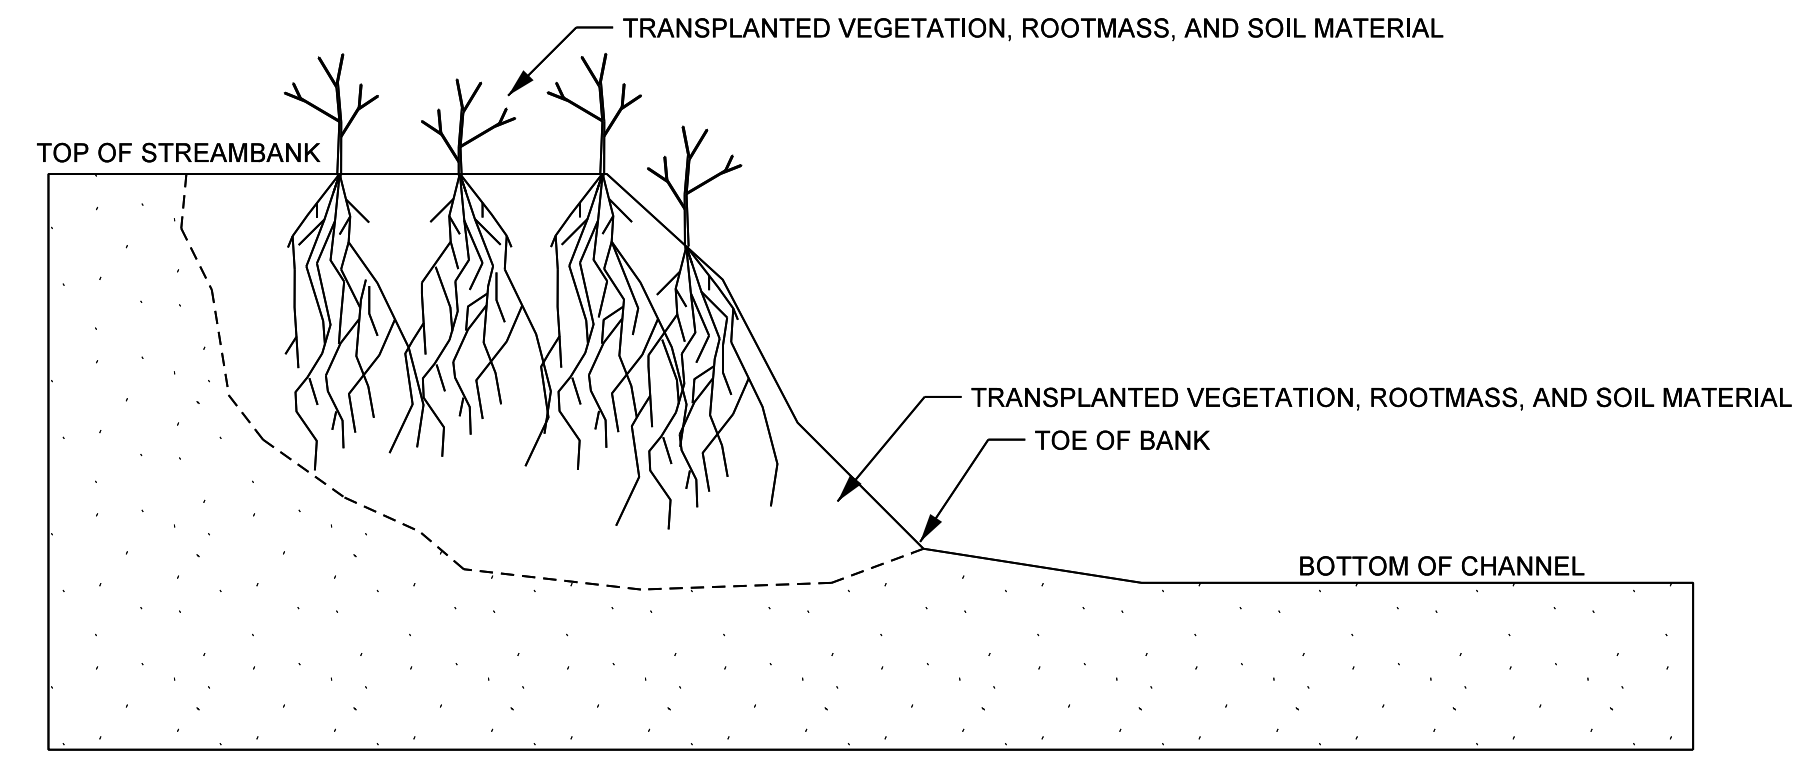


NOTES:


1. EXCAVATE A HOLE IN THE BANK TO BE STABILIZED THAT WILL ACCOMMODATE THE SIZE OF TRANSPLANT TO BE PLACED. BEGIN EXCAVATION AT THE TOE OF THE BANK.
2. EXCAVATE TRANSPLANT USING A FRONT END LOADER. EXCAVATE THE ENTIRE ROOT MASS AND AS MUCH ADDITIONAL SOIL MATERIAL AS POSSIBLE. IF ENTIRE ROOT MASS CAN NOT BE EXCAVATED IN ONE BUCKET LOAD, THE TRANSPLANT IS TOO LARGE AND ANOTHER SHOULD BE SELECTED.
3. PLACE TRANSPLANT IN THE BANK TO BE STABILIZED SO THAT VEGETATION IS ORIENTATED VERTICALLY.
4. FILL IN ANY HOLES AROUND THE TRANSPLANT AND COMPACT.
5. ANY LOOSE SOIL LEFT IN THE STREAM SHOULD BE REMOVED.
6. PLACE MULTIPLE TRANSPLANTS CLOSE TOGETHER SUCH THAT THEY TOUCH.

PROJECT REFERENCE NO. 167680	SHEET NO. 2C
PROJECT ENGINEER	
DocuSigned by: <i>Kathleen M. McKeithan</i> 2476401418474	
APPROVED BY:	
6/12/2023	
DATE:	
Michael Baker International Michael Baker Engineering Inc. 8000 Regency Parkway, Suite 600 Cary, NORTH CAROLINA 27518 Phone: 919.463.5488 Fax: 919.463.5490 License #: F-1084	
NCDMS ID NO. 10081	

PLANTING SPECIFICATIONS

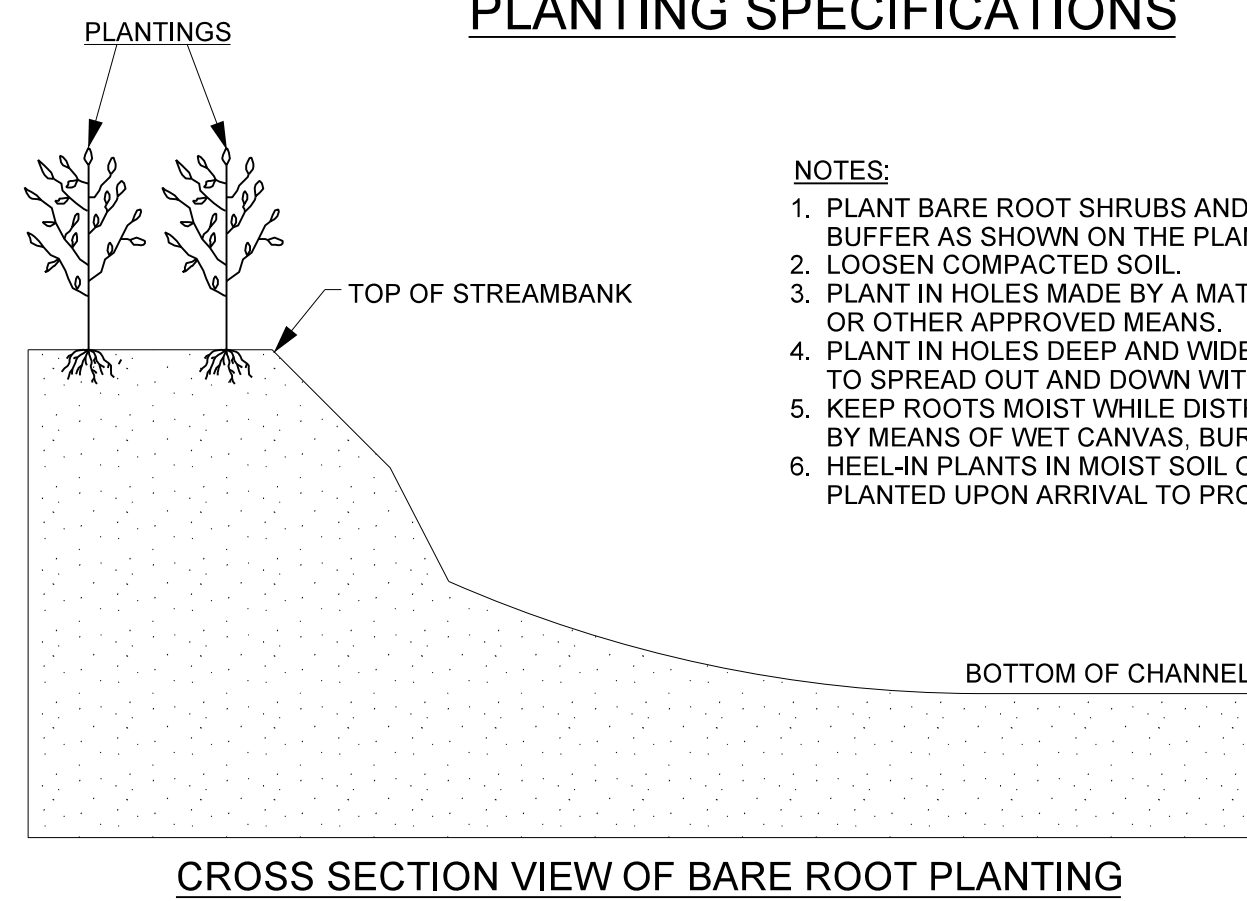


- NOTES:**
1. PLANT BARE ROOT SHRUBS AND TREES TO THE WIDTH OF THE BUFFER AS SHOWN ON THE PLANS.
 2. LOOSEN COMPACTED SOIL.
 3. PLANT IN HOLES MADE BY A MATTOCK, DIBBLE, PLANTING BAR, OR OTHER APPROVED MEANS.
 4. PLANT IN HOLES DEEP AND WIDE ENOUGH TO ALLOW THE ROOTS TO SPREAD OUT AND DOWN WITHOUT J-ROOTING.
 5. KEEP ROOTS MOIST WHILE DISTRIBUTING OR WAITING TO PLANT BY MEANS OF WET CANVAS, BURLAP, OR STRAW.
 6. HEEL-IN PLANTS IN MOIST SOIL OR SAWDUST IF NOT PROMPTLY PLANTED UPON ARRIVAL TO PROJECT SITE.

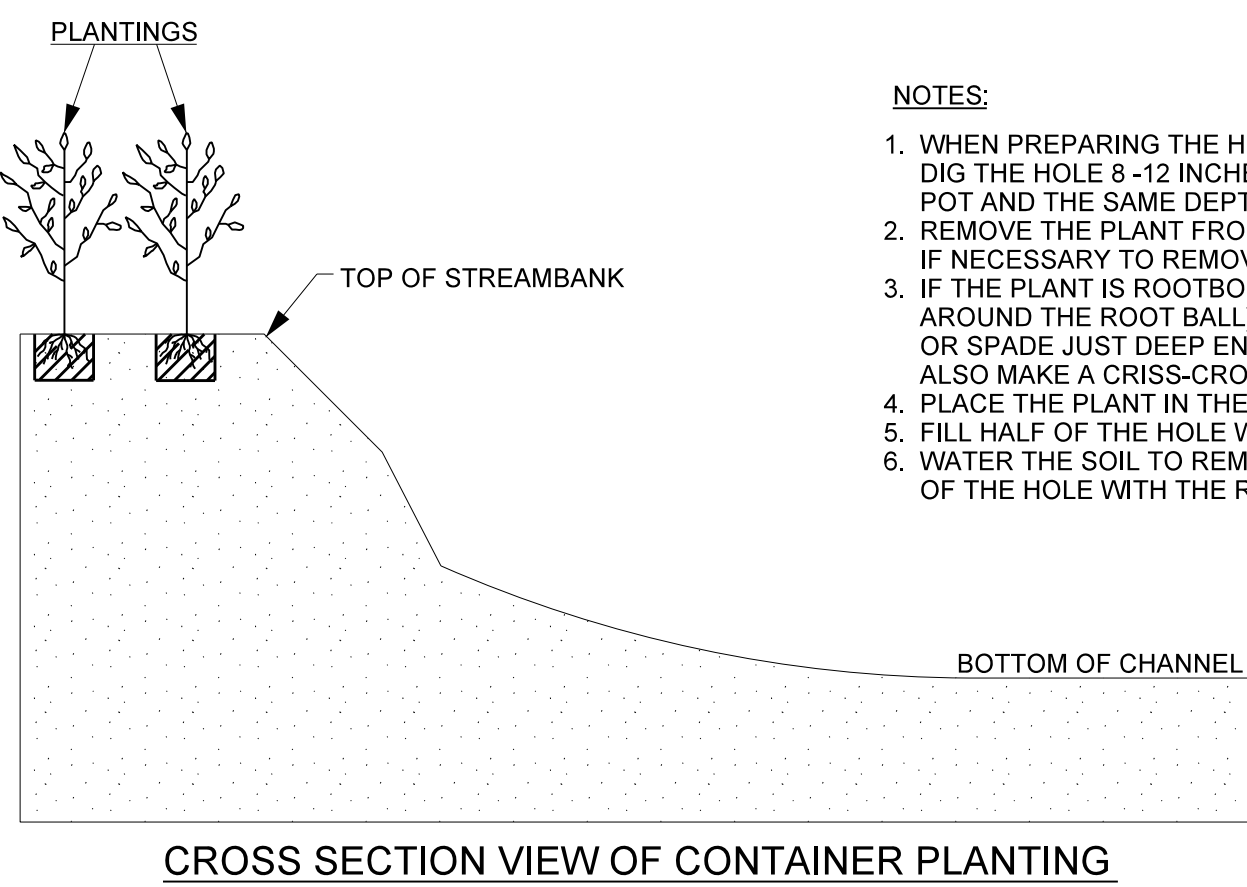


- NOTES:**
1. WHEN PREPARING THE HOLE FOR A POTTED PLANT OR SHRUB DIG THE HOLE 8 - 12 INCHES LARGER THAN THE DIAMETER OF THE POT AND THE SAME DEPTH AS THE POT.
 2. REMOVE THE PLANT FROM THE POT. LAY THE PLANT ON ITS SIDE IF NECESSARY TO REMOVE THE POT.
 3. IF THE PLANT IS ROOTBOUND (ROOTS GROWING IN A SPIRAL AROUND THE ROOT BALL), MAKE VERTICAL CUTS WITH A KNIFE OR SPADE JUST DEEP ENOUGH TO CUT THE NET OF ROOTS. ALSO MAKE A CRISS-CROSS CUT ACROSS THE BOTTOM OF THE BALL.
 4. PLACE THE PLANT IN THE HOLE.
 5. FILL HALF OF THE HOLE WITH SOIL (SAME SOIL REMOVED FOR BACKFILL).
 6. WATER THE SOIL TO REMOVE AIR POCKETS AND FILL THE REST OF THE HOLE WITH THE REMAINING SOIL.


COIR FIBER MATTING

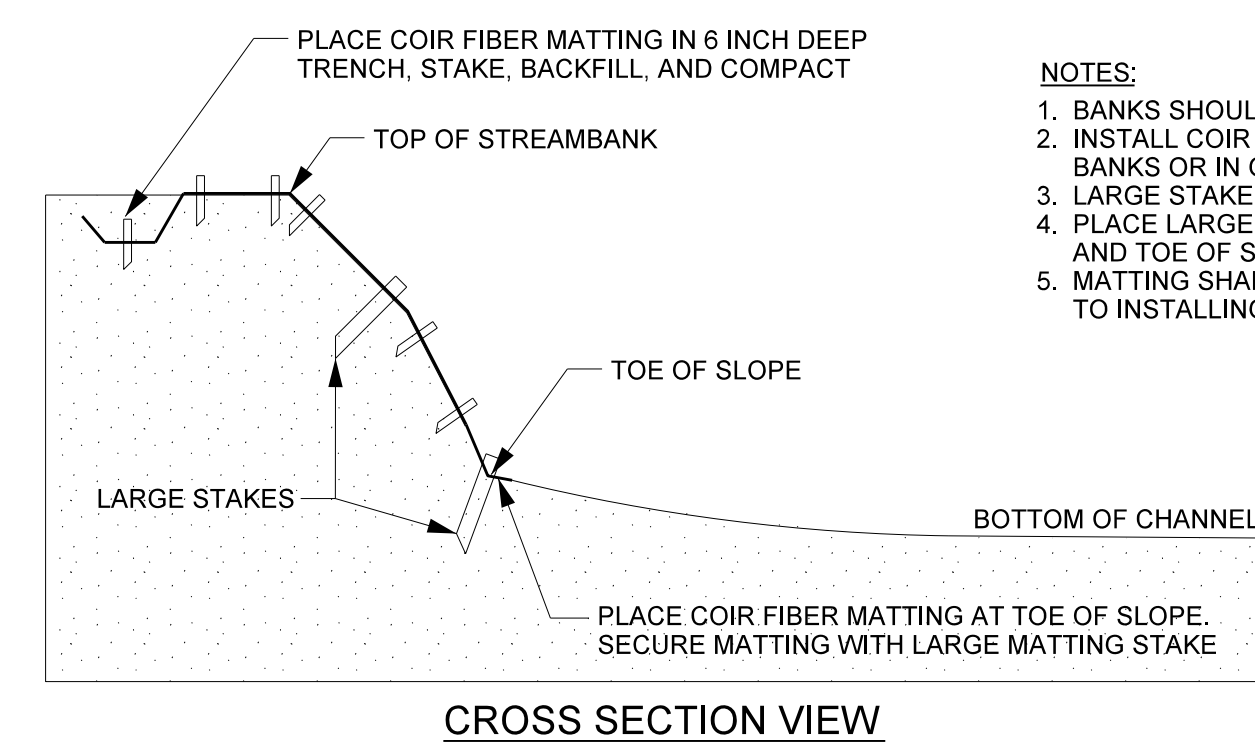

- NOTES:**
1. BANKS SHOULD BE SEEDED PRIOR TO PLACEMENT OF MATTING.
 2. INSTALL COIR FIBER MATTING PER SPECIFICATIONS ALONG STREAM BANKS OR IN OTHERS LOCATIONS SPECIFIED BY ENGINEER.
 3. LARGE STAKES SHOULD NOT BE SPACED FURTHER THAN 36" APART.
 4. PLACE LARGE STAKES ALONG ALL SEAMS, IN THE CENTER OF BANK, AND TOE OF SLOPE.
 5. MATTING SHALL BE PLACED ON BANKS, STAKED, AND TRENCHED PRIOR TO INSTALLING CONSTRUCTED RIFFLE MATERIAL.

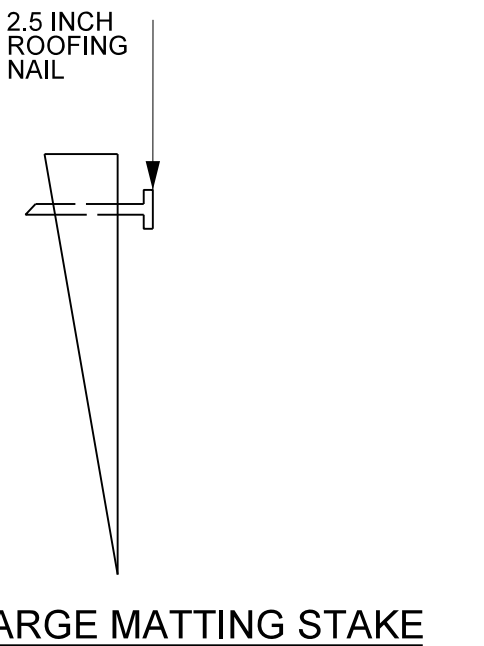

LEG LENGTH	17.00 IN (43.18 CM) (TAPERED TO POINT)
WIDTH	1.5 IN (3.81 CM)
THICKNESS	1.5 IN (3.81 CM)

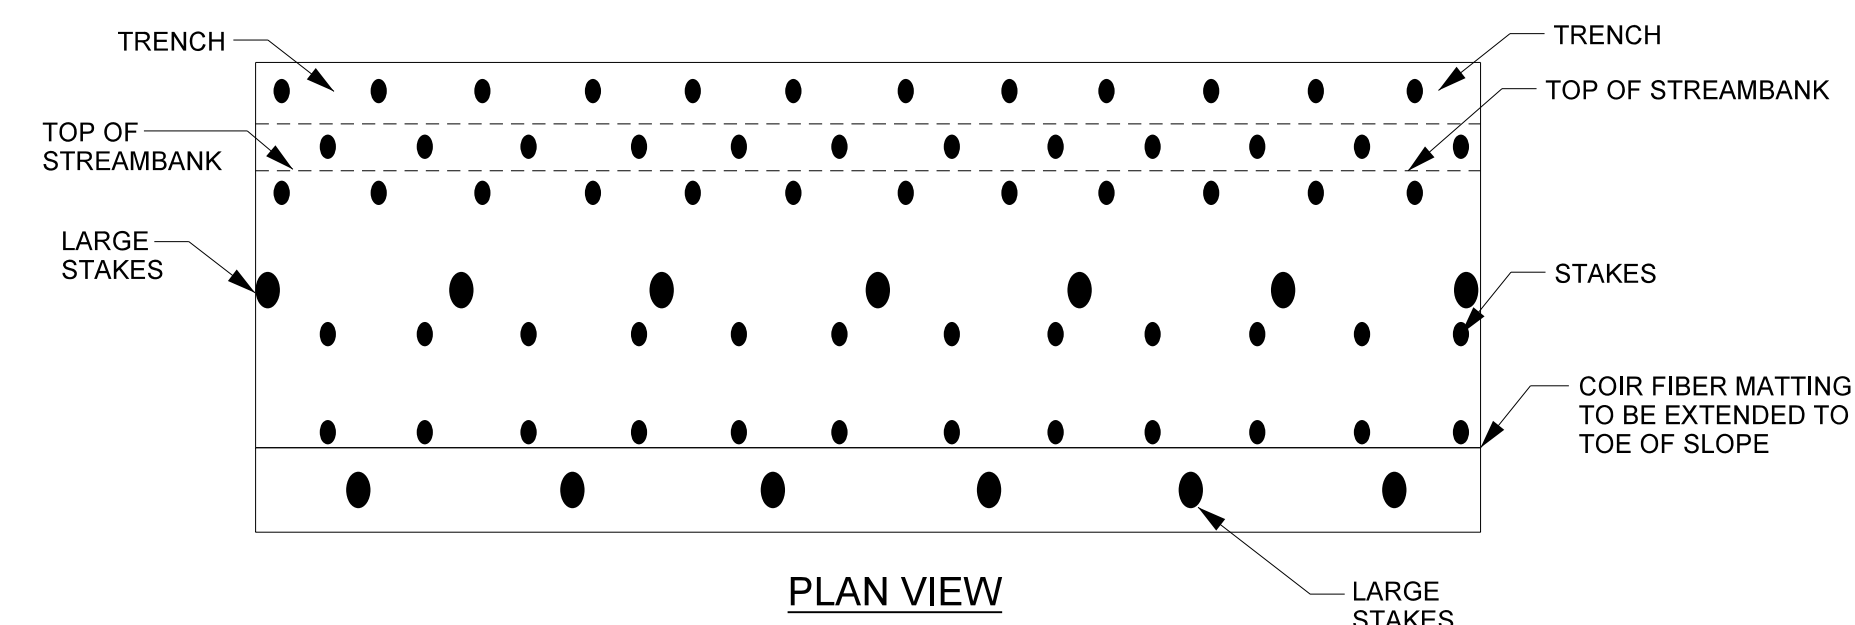


LEG LENGTH	11.00 IN (27.94 CM)
HEAD WIDTH	1.25 IN (3.18 CM)
HEAD THICKNESS	0.40 IN (1.02 CM)
LEG WIDTH	0.60 IN (1.52 CM) (TAPERED TO POINT)
LEG THICKNESS	0.40 IN (1.02 CM)
TOTAL LENGTH	12.00 IN (30.48 CM)


4/21/2023 M:\projects\167680\167680.dgn to Megness Cr:\Design\As-Built\Plans\167680_ASB-PSH_02C.dgn

2/26/2023

GEOLIFT WITH LIVE BRUSH, LOGS AND ROOT WADS


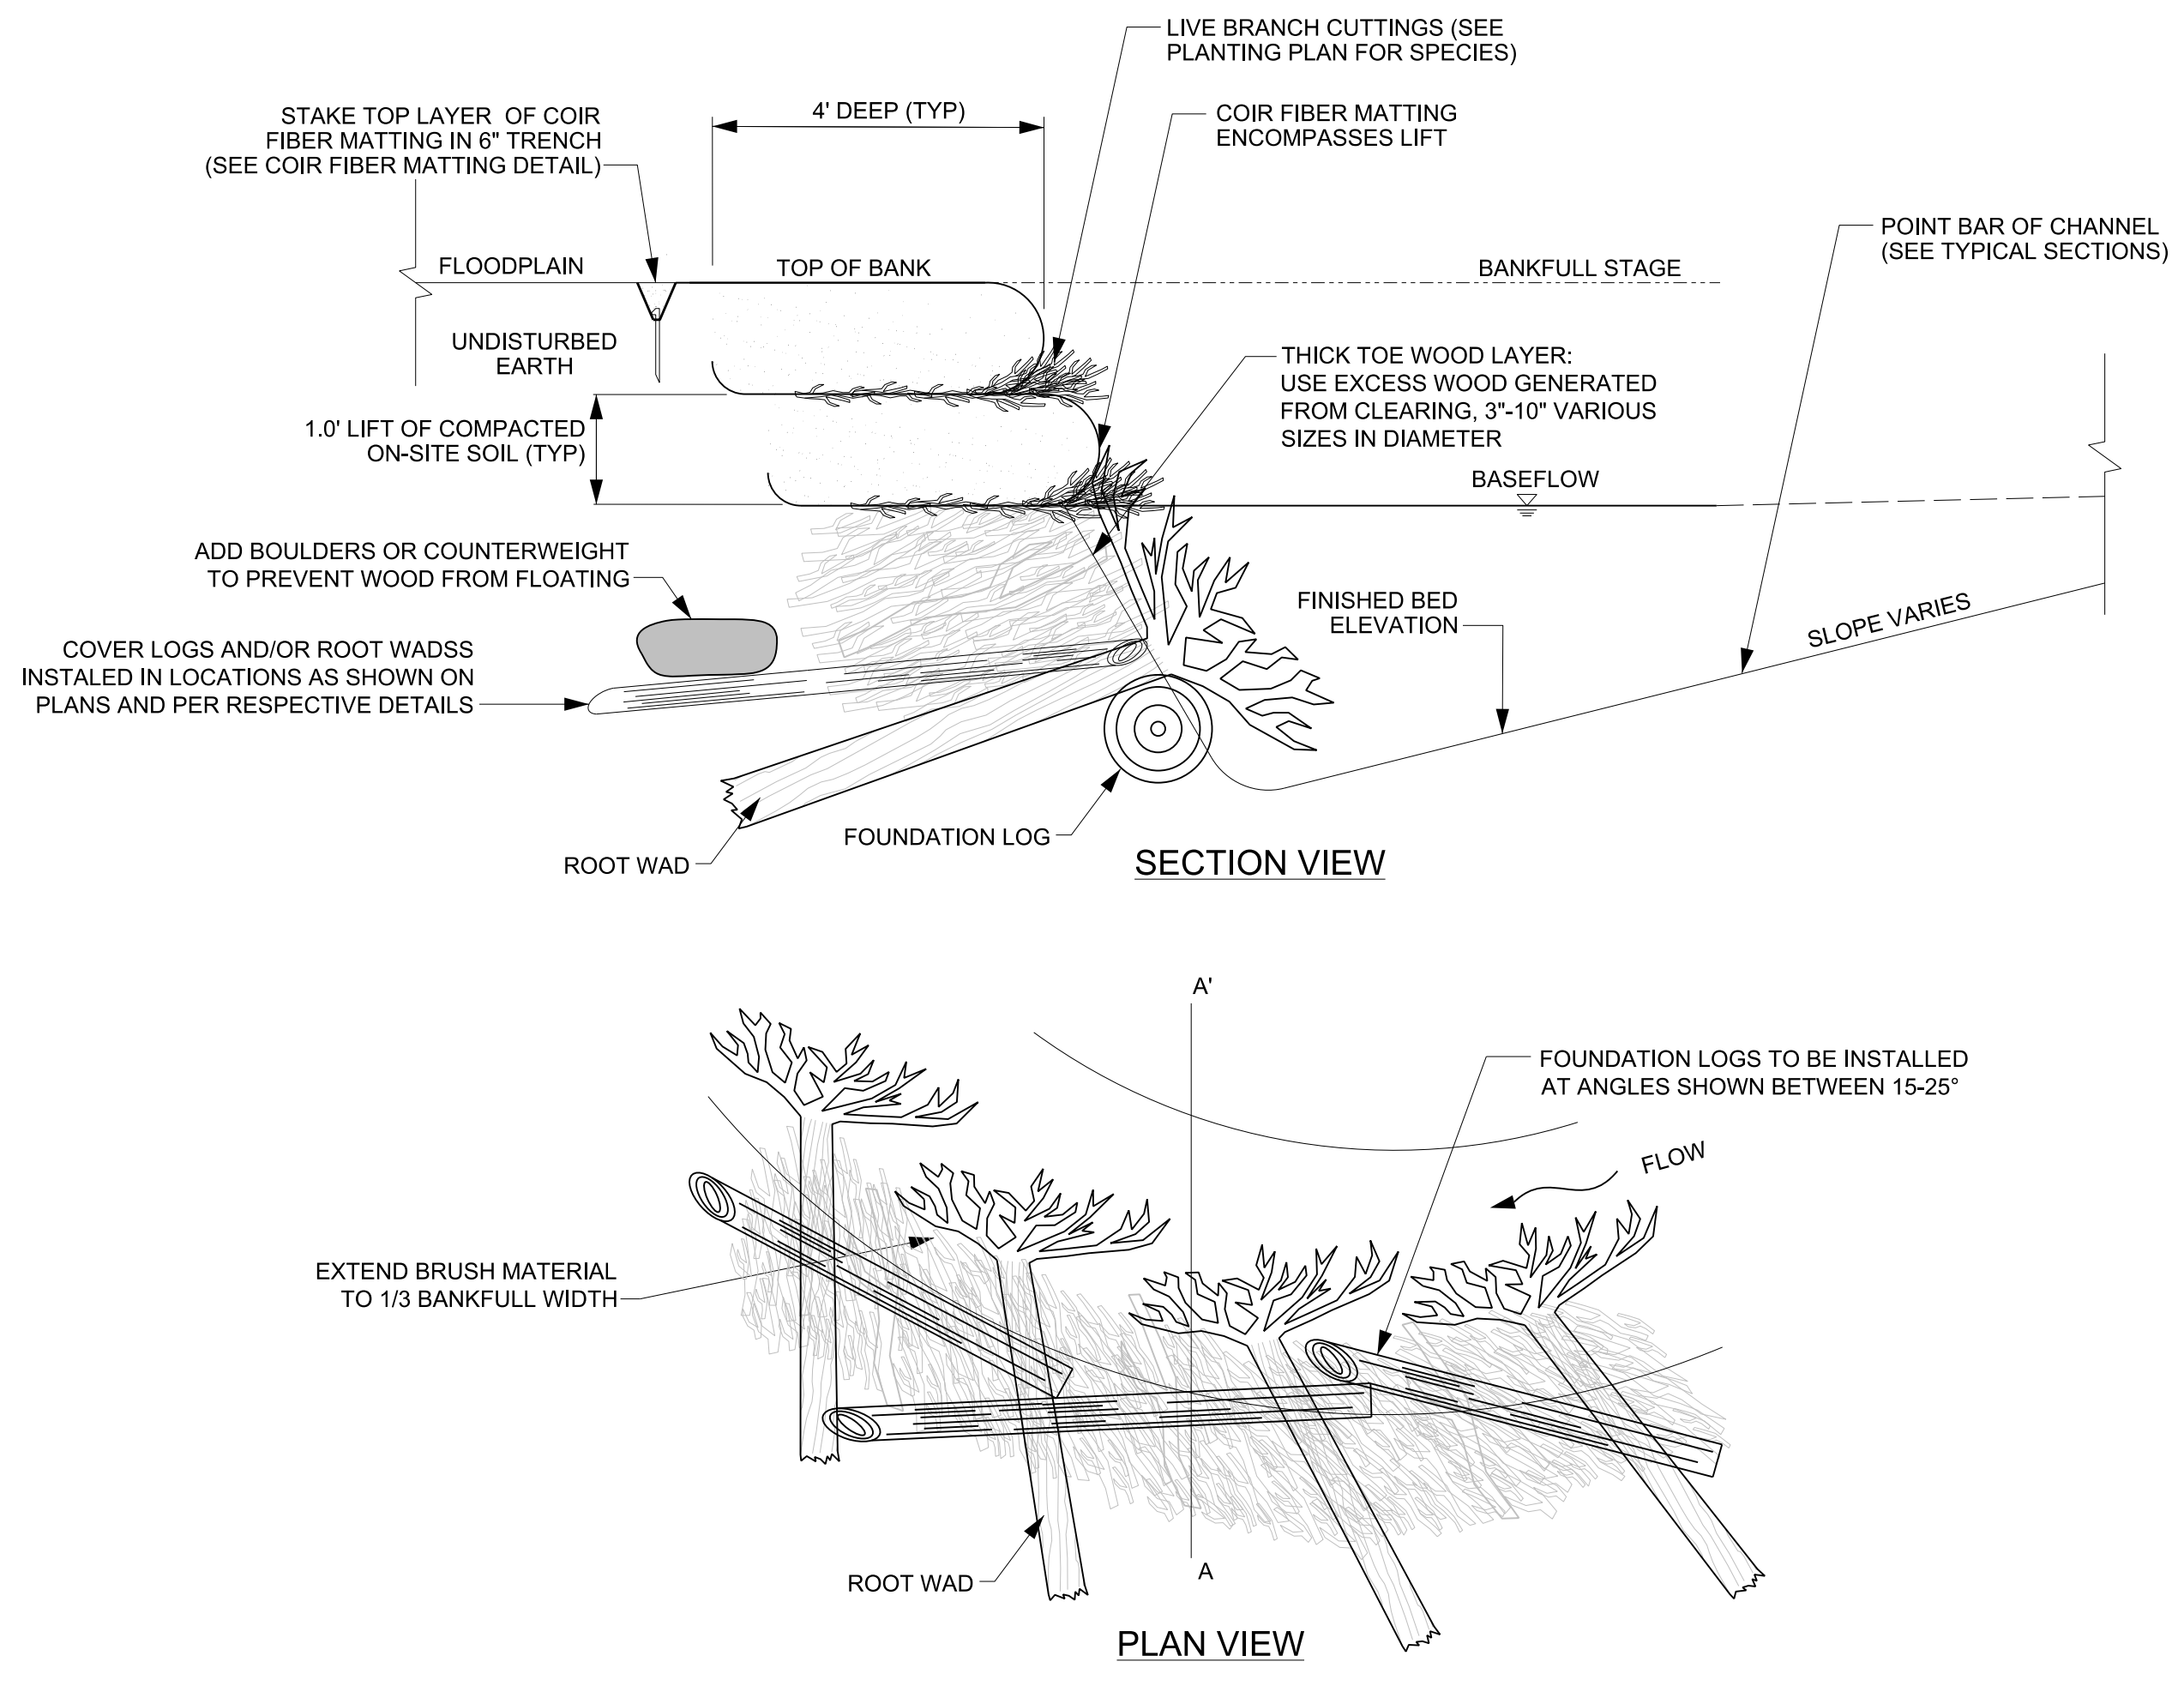


GEOLIFT WITH BRUSH TOE

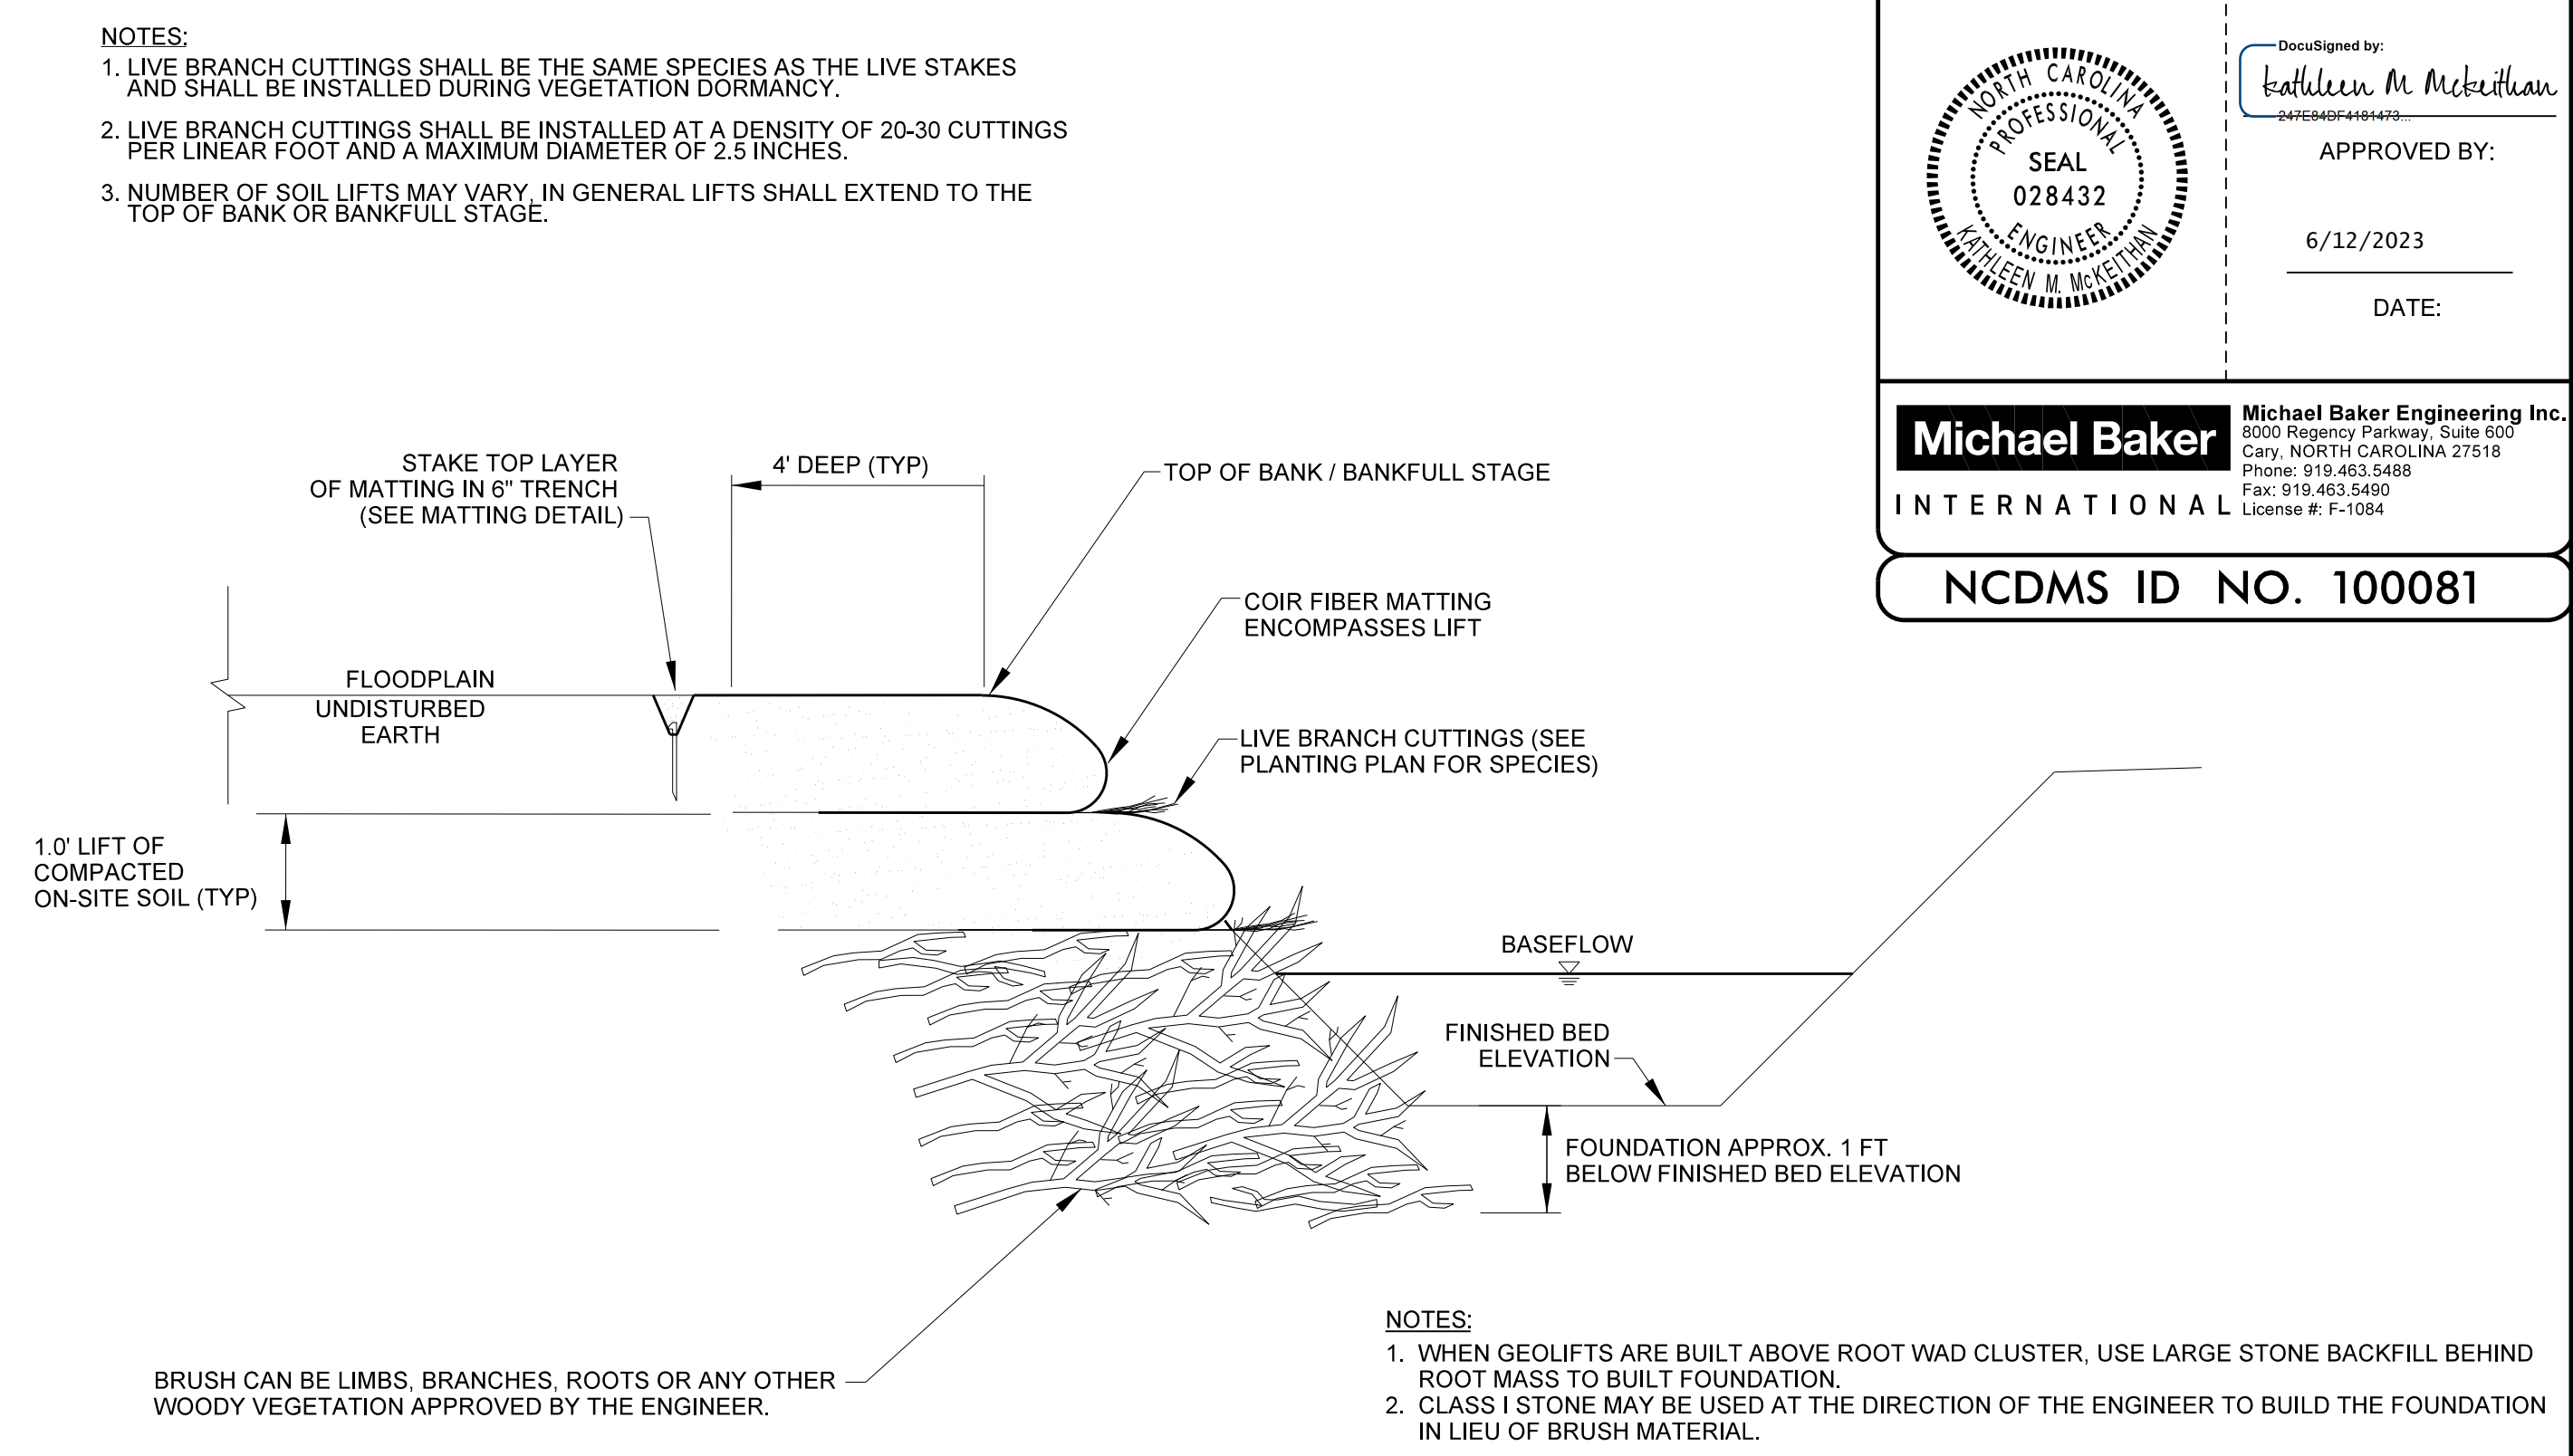

PROJECT REFERENCE NO. 167680	SHEET NO. 2D
PROJECT ENGINEER	
DocuSigned by: Kathleen M. McKeithan APPROVED BY: DATE: 6/12/2023	
Michael Baker International Michael Baker Engineering Inc. 8000 Regency Parkway, Suite 600 Cary, NORTH CAROLINA 27518 Phone: 919.463.5486 Fax: 919.463.5490 License #: F-1084	
NC DMS ID NO. 100081	

FLAT BED RAIL CAR BRIDGE APPLICATION

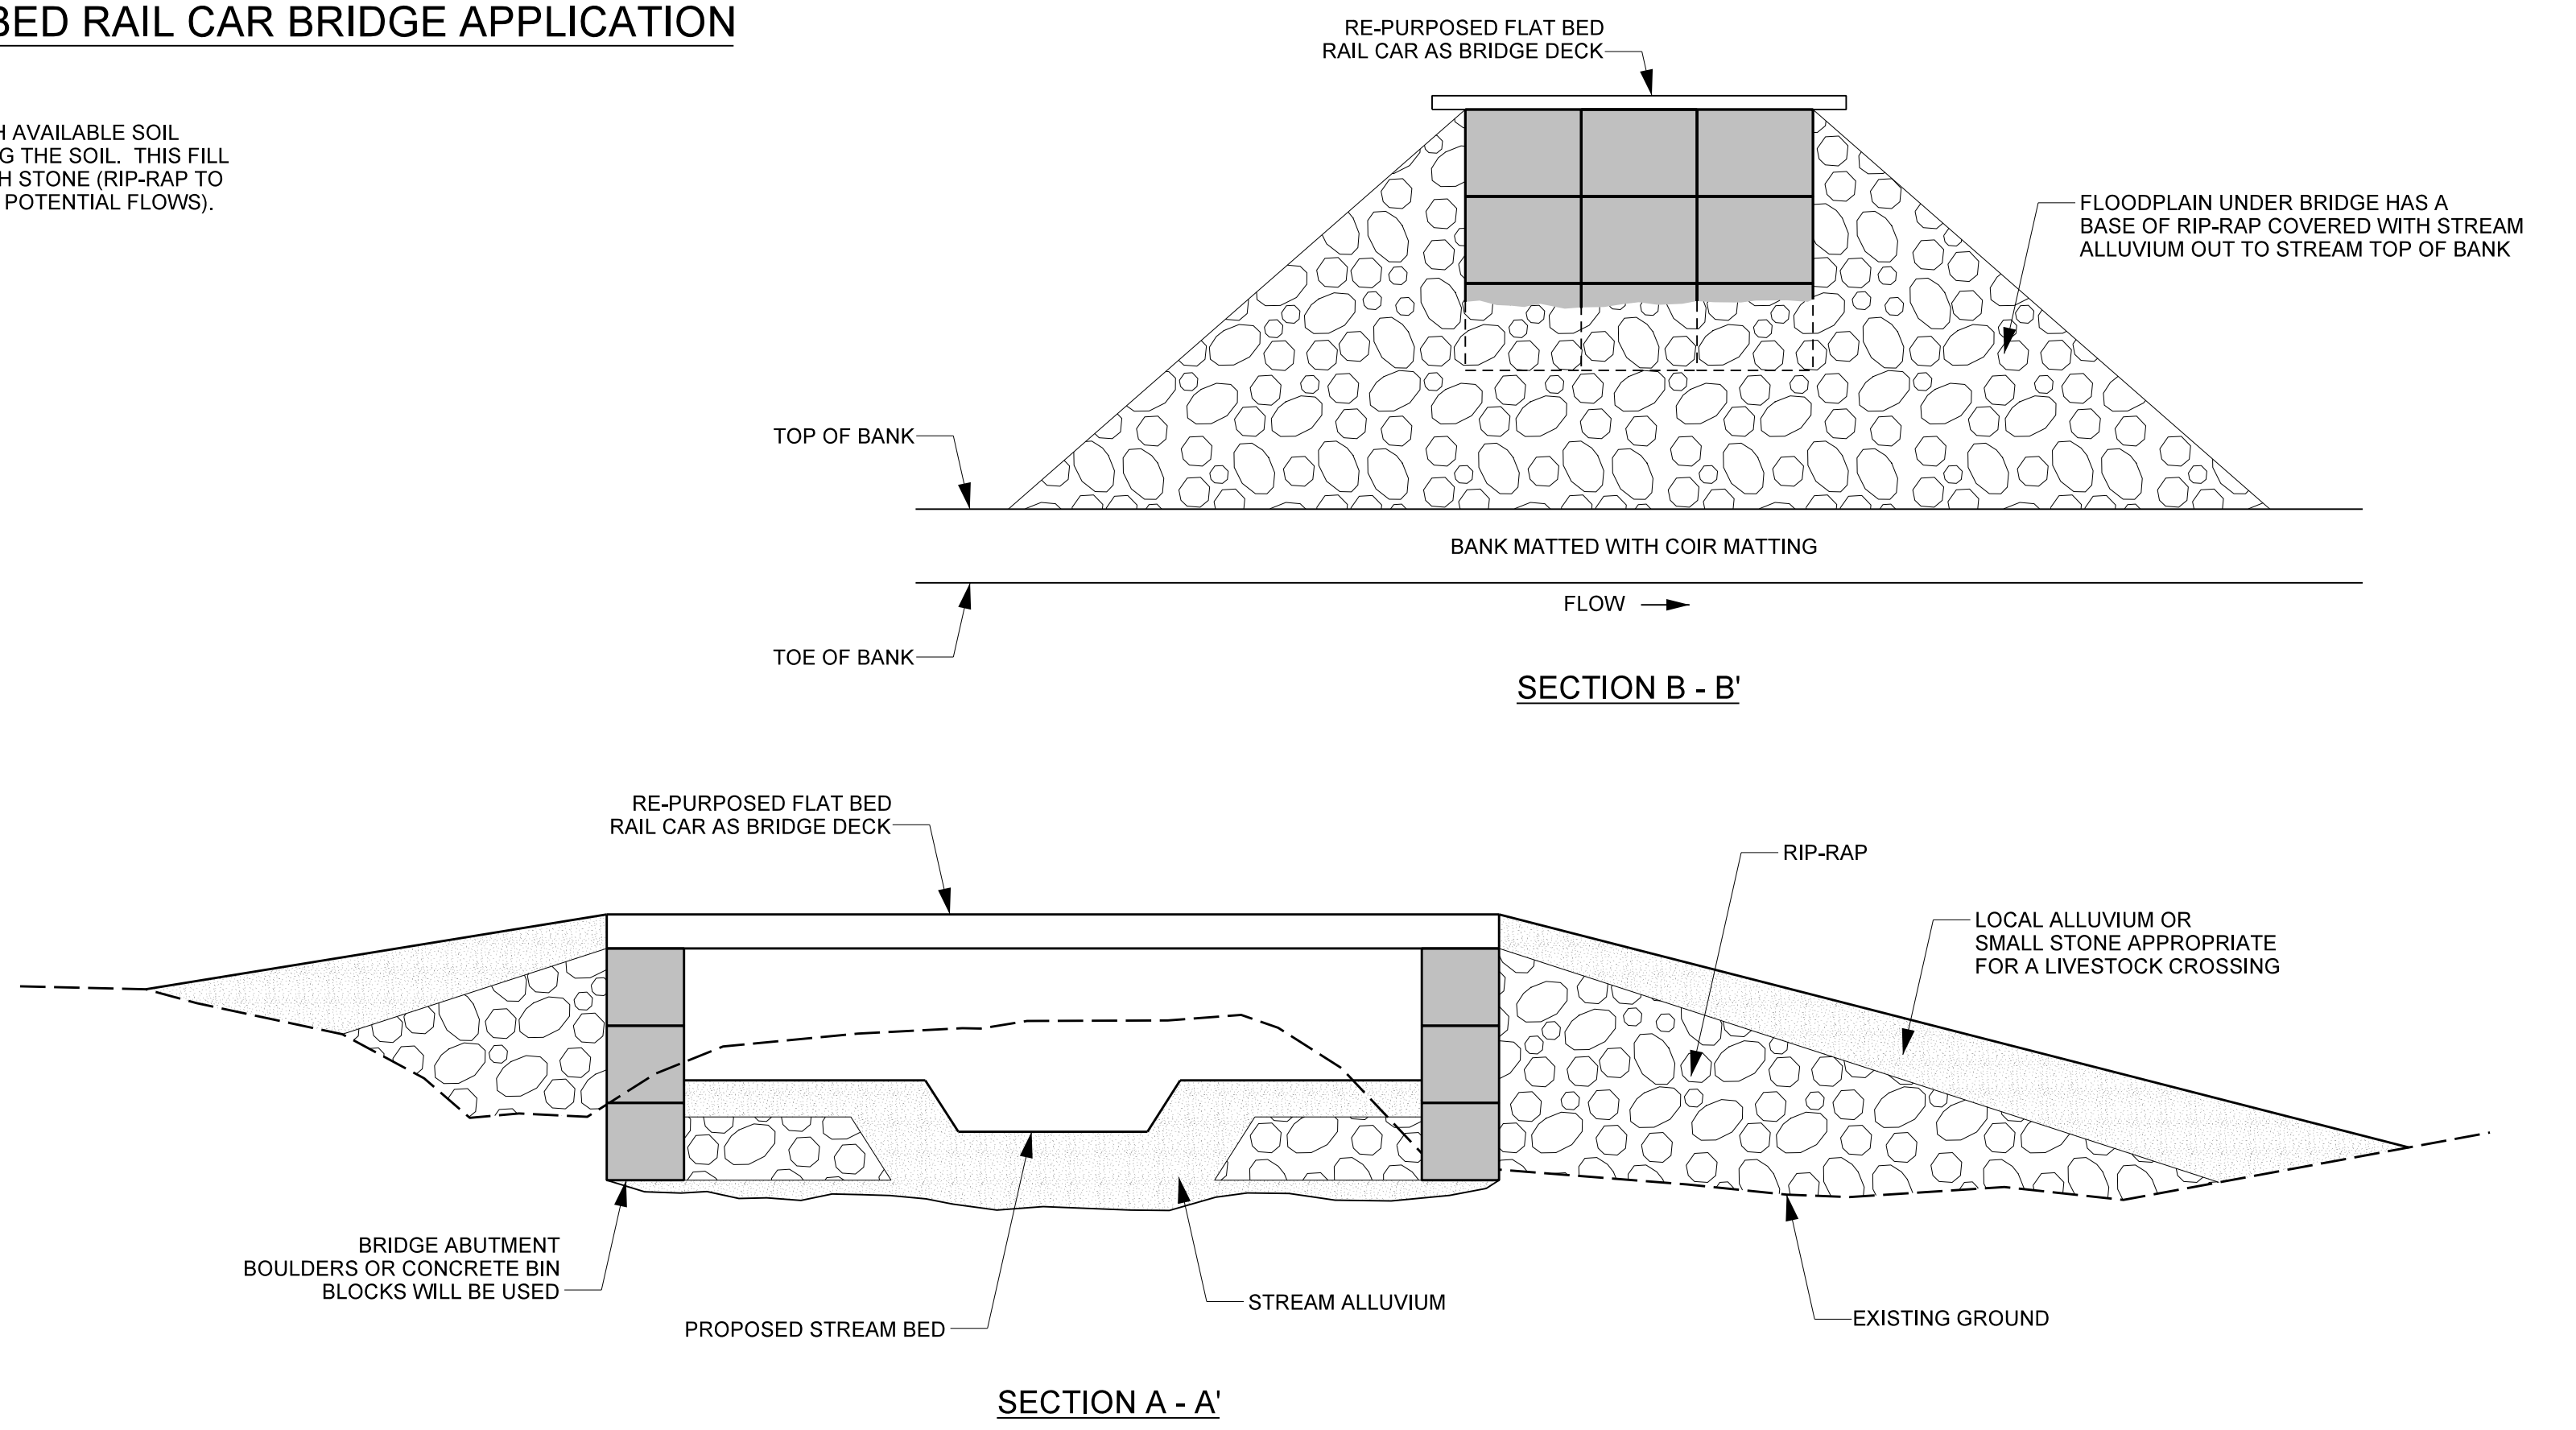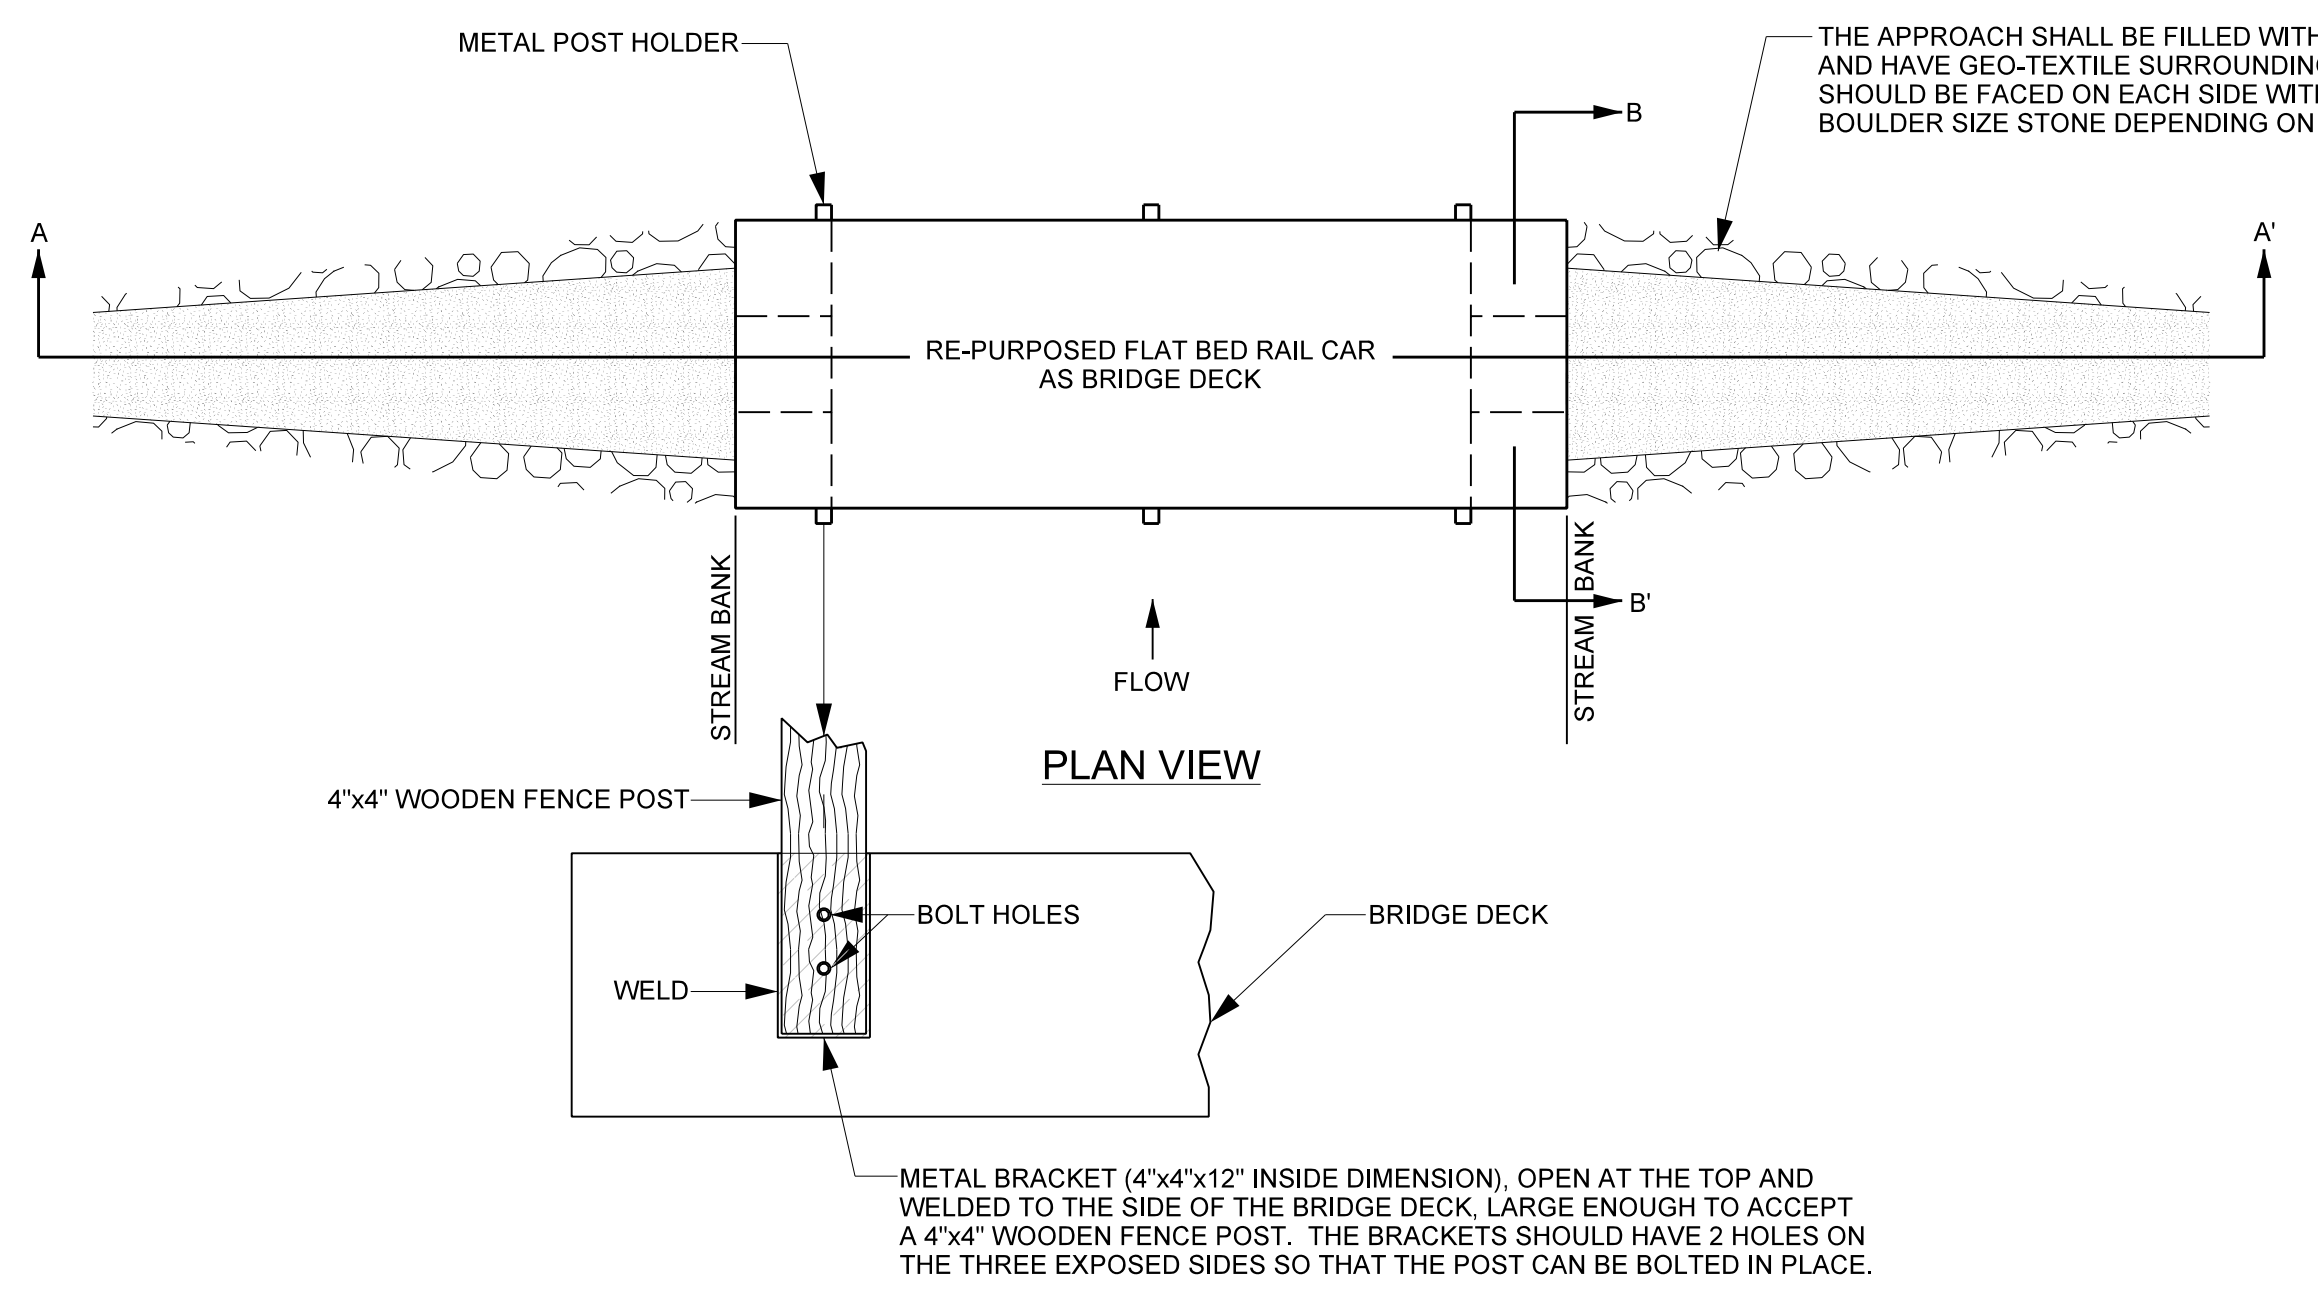


- NOTES:**
- GENERALLY, CONSTRUCTION SHOULD BE FROM THE CENTER OF THE CHANNEL OUT TO THE BRIDGE SUPPORTING STRUCTURE AND APPROACHES.
 - THE STREAM CHANNEL THROUGH THE BRIDGE OPENING SHOULD BE CONSTRUCTED AND THE BANKS MATTED BEFORE THE STONE IS PLACED FOR STABILIZING THE CROSSING OR BLOCKS/BOULDERS ARE PLACED TO SUPPORT THE BRIDGE DECK.
 - ABUTMENTS SHOULD BE CONSTRUCTED FROM THE CONCRETE BIN BLOCKS OR LARGE BOULDERS (ENGINEER APPROVED).
 - BLOCKS OR BOULDERS SHOULD EXTEND BELOW SCOUR DEPTH, FOOTERS SHALL BE AT LEAST 2' BELOW THE EXISTING BED.
 - GEO-TEXTILE FABRIC SHALL BE PLACED BETWEEN SURFACE STONE AND SOIL USED IN THE BRIDGE APPROACHES.
 - BOULDERS AND OTHER STONE SHALL BE BACKFILLED AND COMPACTED. VOID SPACE BETWEEN FABRIC AND STONE SURFACE MATERIAL SHALL BE MINIMIZED.
 - GEO-TEXTILE FABRIC SHOULD BE PLACED BEHIND BOULDERS/STONE, BURIED BELOW STONE DEPTH AND EXTENDED INTO THE BANK.
 - THE CUBE FENCE POST HOLDERS SHOULD BE ATTACHED BY WELDING PRIOR TO PLACING THE DECK IN PLACE.

6/6/2023
 C:\Users\magness\OneDrive\Documents\167680\ASB-PSH-020.dgn
 to Magness Cr\Design\As-Built\Plans\167680_ASB-PSH-020.dgn



2/26/2023

BARB WIRE FIELD FENCE

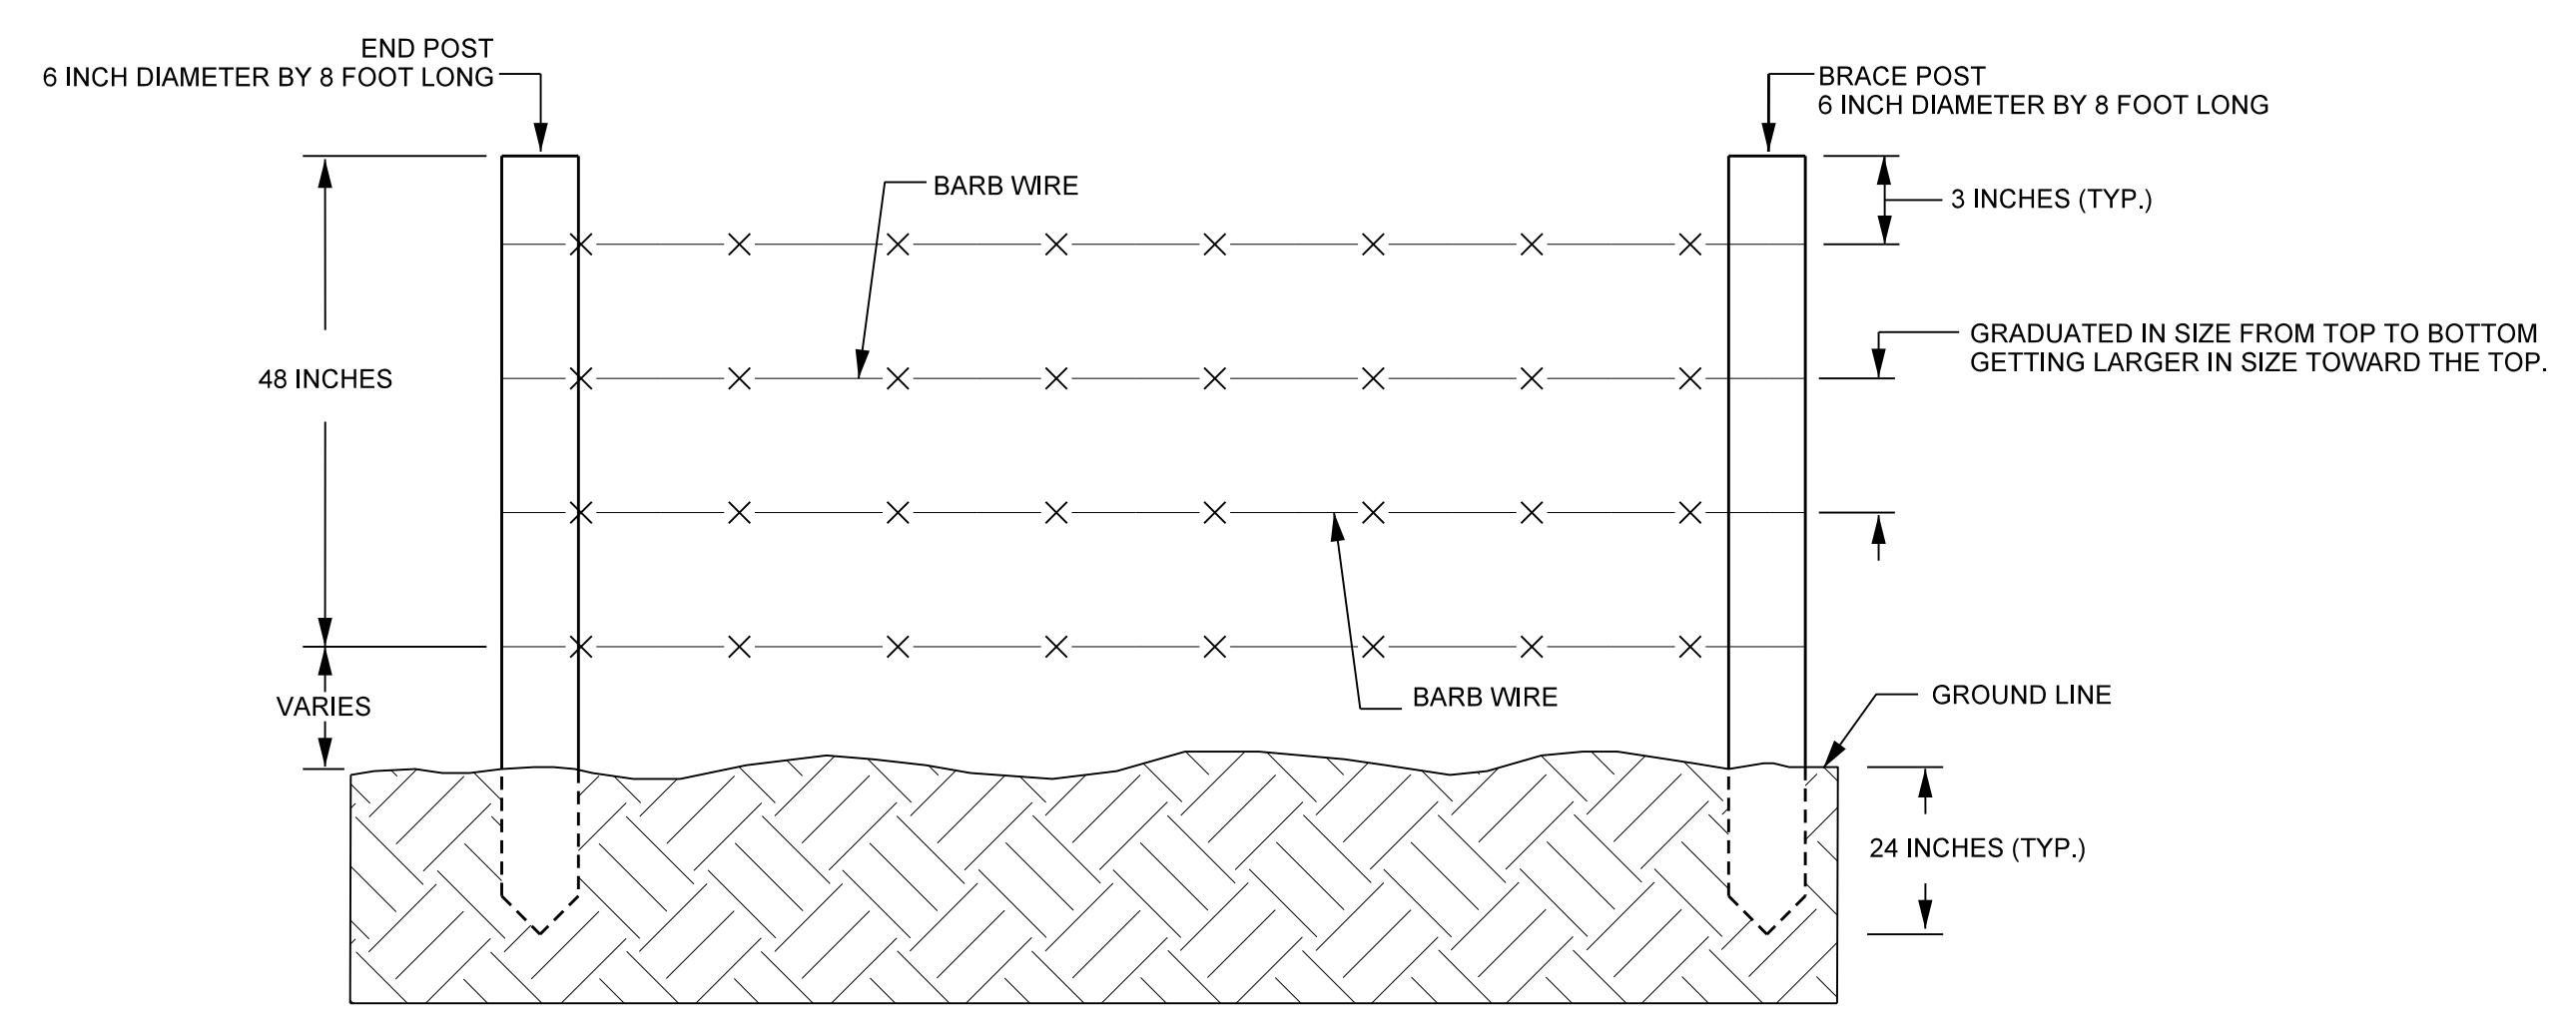


NOTE:
1. END POSTS SHALL BE INSTALLED AT A SPACING OF 10-15 FEET.

CHANNEL PLUG

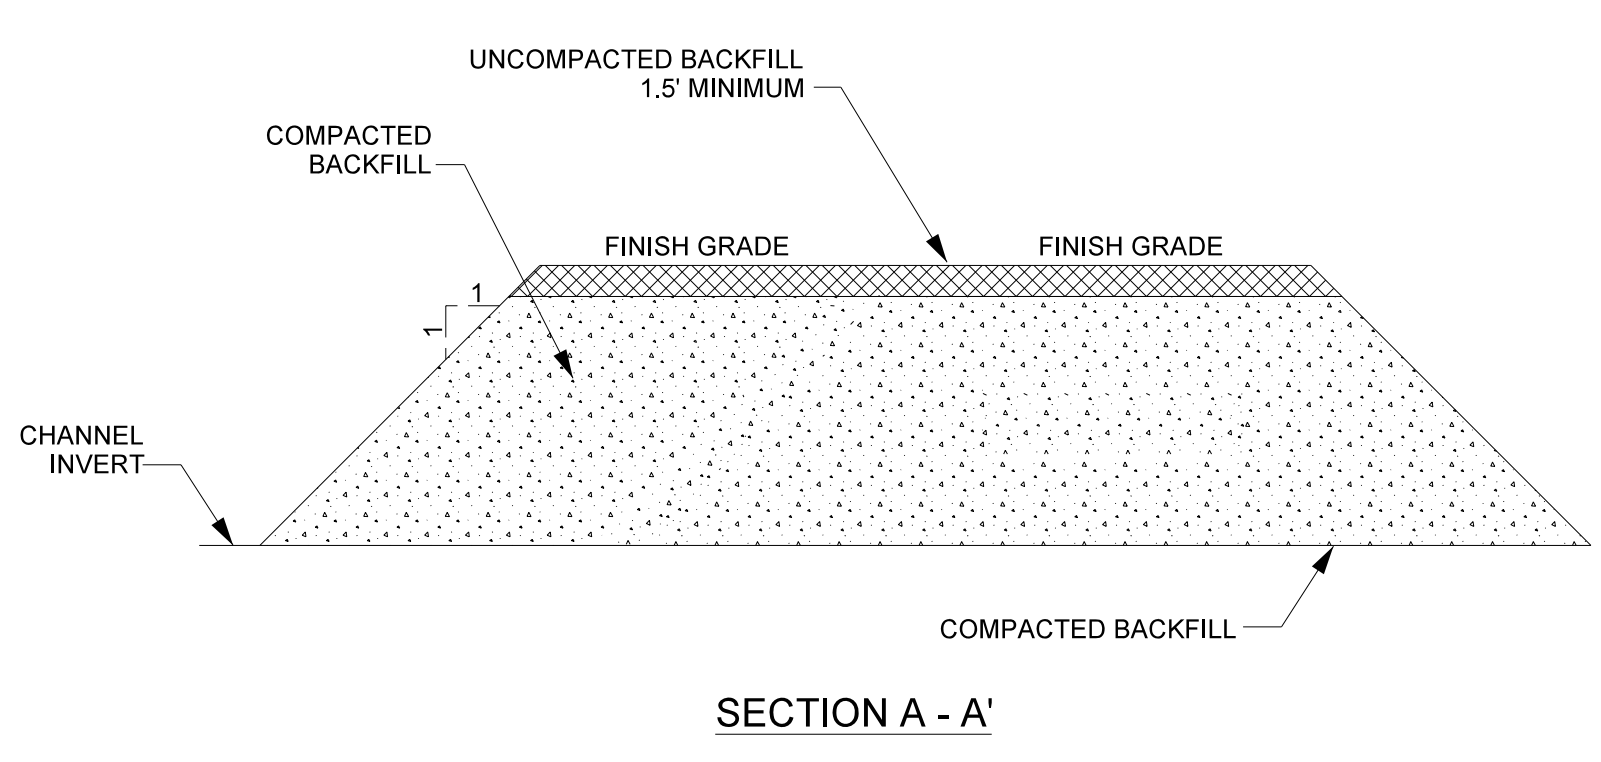
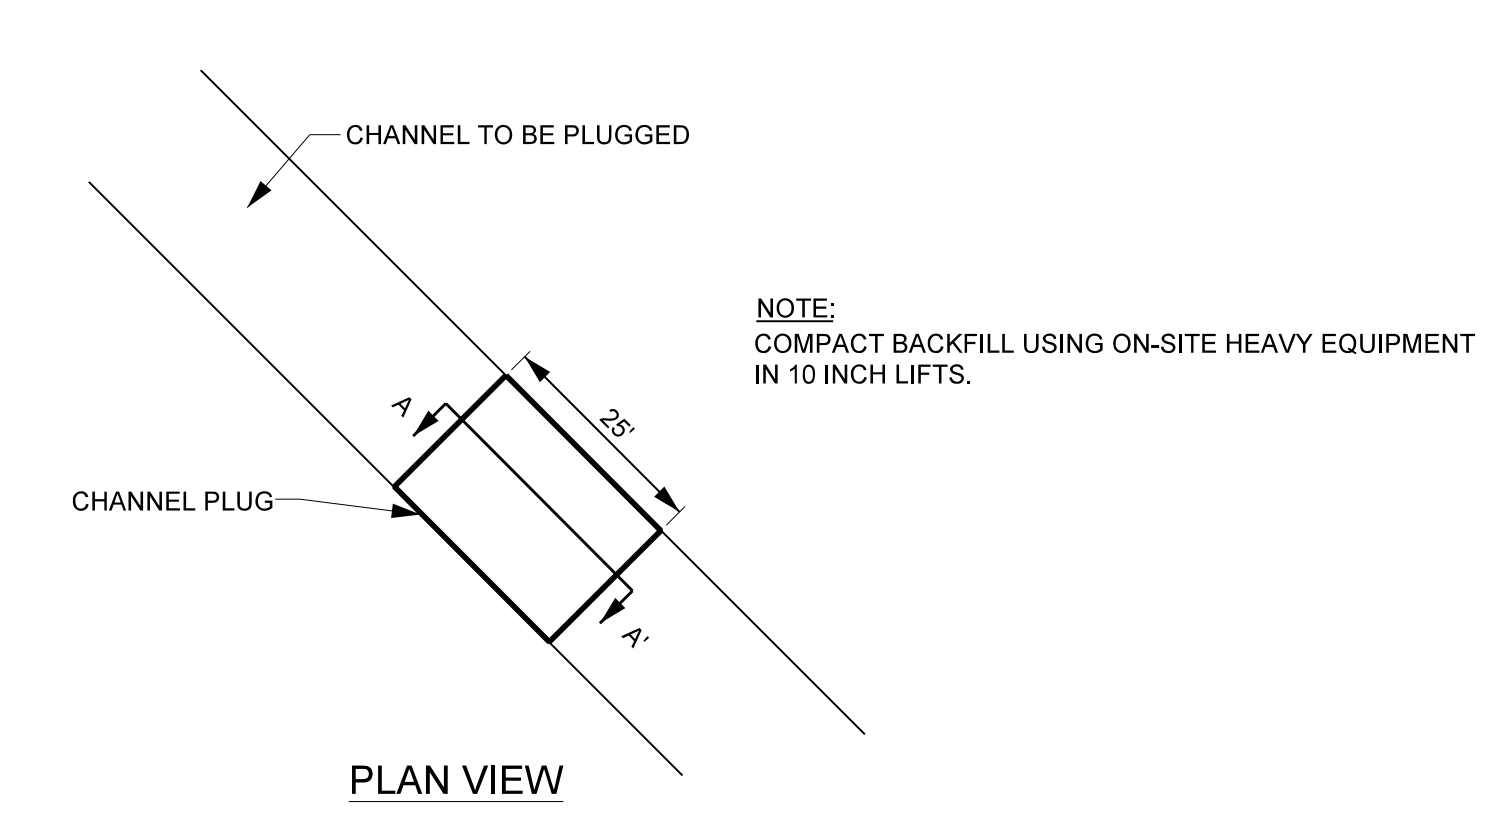


STEEL GATES

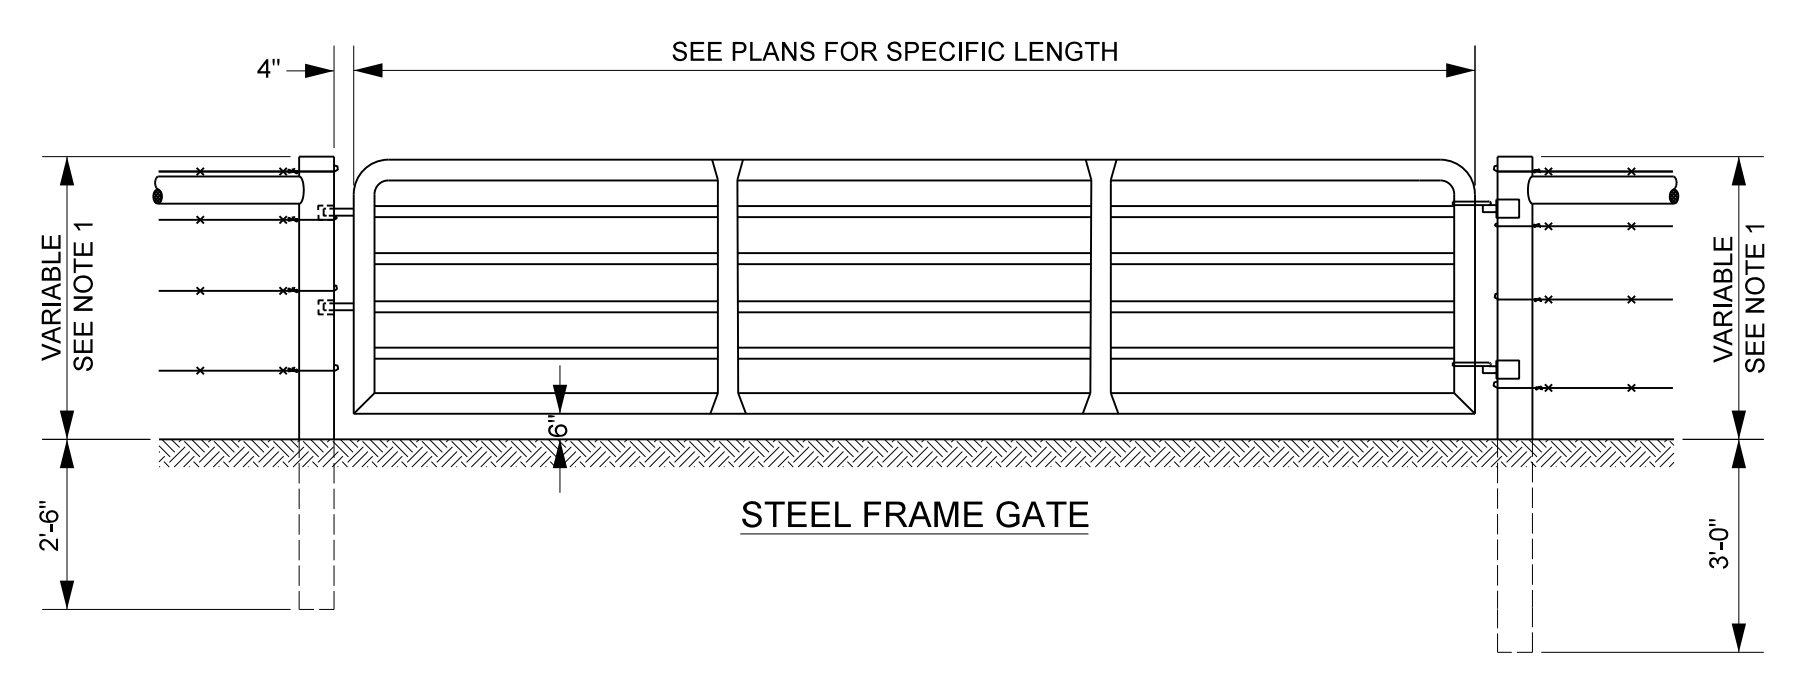


NOTES:
1. POST HEIGHT DIMENSION SHALL BE THE SAME AS REQUIRED FOR THE ADJACENT FENCE.
2. CONSTRUCT AN END OR STRESS PANEL, AS REQUIRED IN THE SPECIFICATION, ON EACH SIDE OF GATE.
3. HINGES AND LOCKS SHALL BE INSTALLED AS SPECIFIED BY GATE MANUFACTURER.

LOG STEP

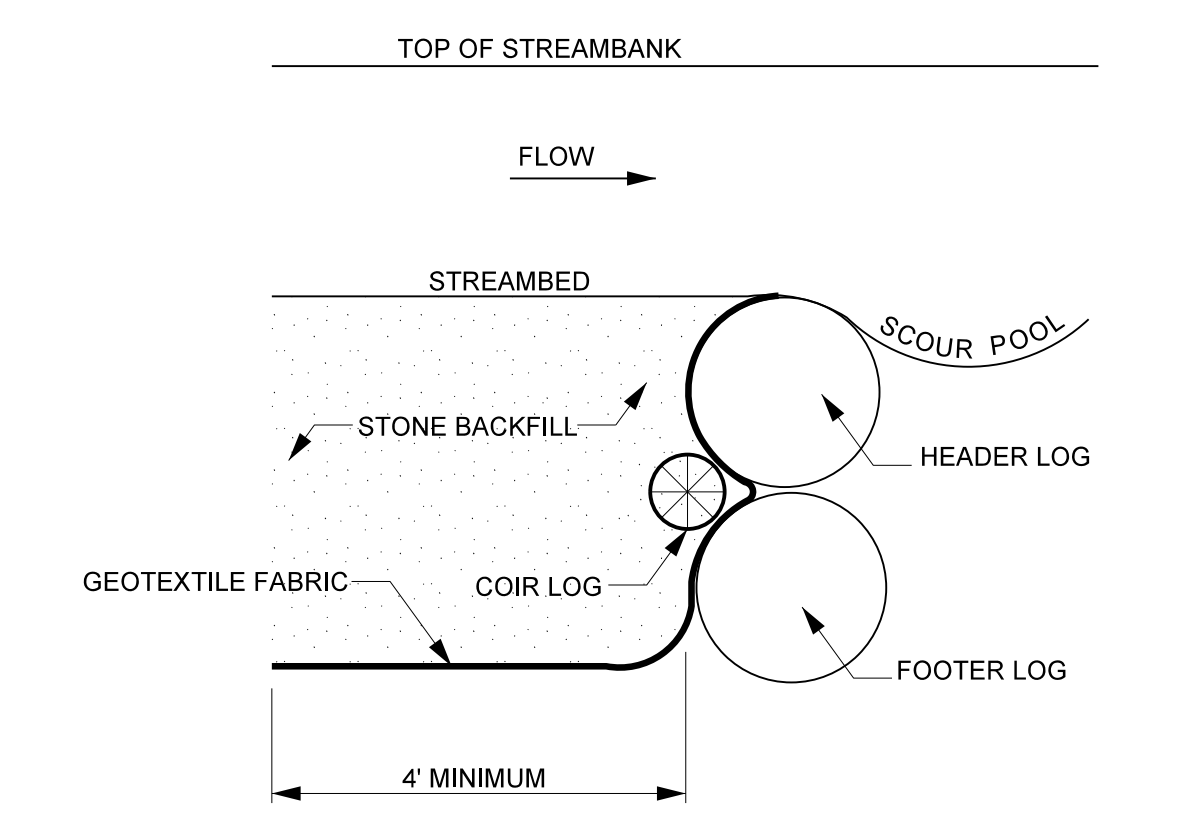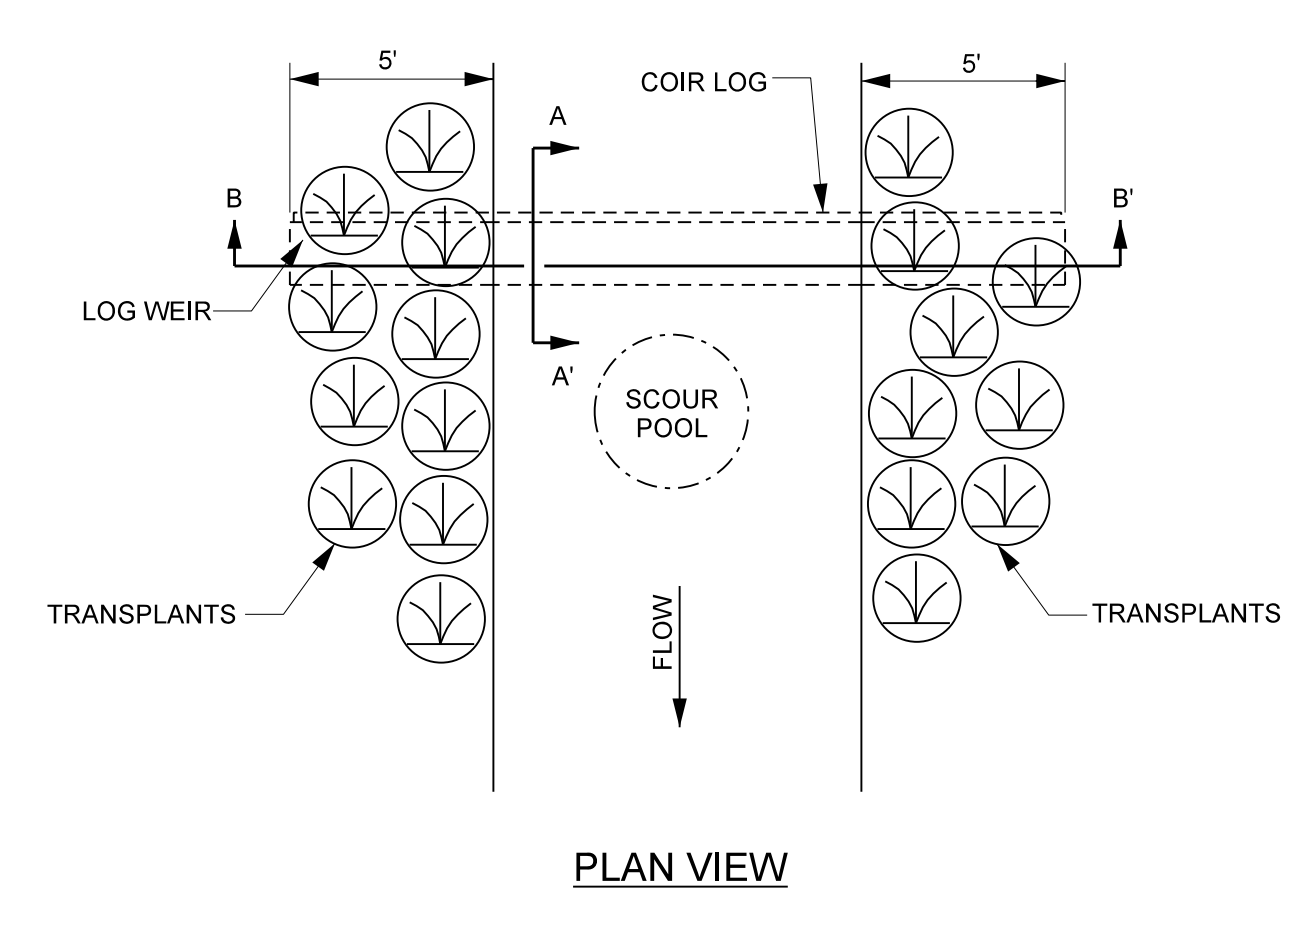


NOTES:
1. LOGS SHOULD BE AT LEAST 10 INCHES IN DIAMETER, RELATIVELY STRAIGHT, HARDWOOD, AND RECENTLY HARVESTED.
2. TOP OF HEADER LOG SHOULD BE SET AT SAME ELEVATION AS THE STREAMBED.
3. DIAMETER OF COIR LOG SHOULD BE APPROXIMATELY 1/2 DIAMETER OF LOGS.
4. USE GEOTEXTILE FABRIC WITH COIR LOGS TO SEAL GAPS BETWEEN LOGS.
5. PLACE TRANSPLANTS ALONG BANKS TO PROTECT AGAINST BANK EROSION.
6. THE HEADER LOG SHOULD BE NOTCHED 2-3 INCHES DEEP IN THE CENTER AND FOR 20-30% OF THE CHANNEL WIDTH.

FORD STREAM CROSSING

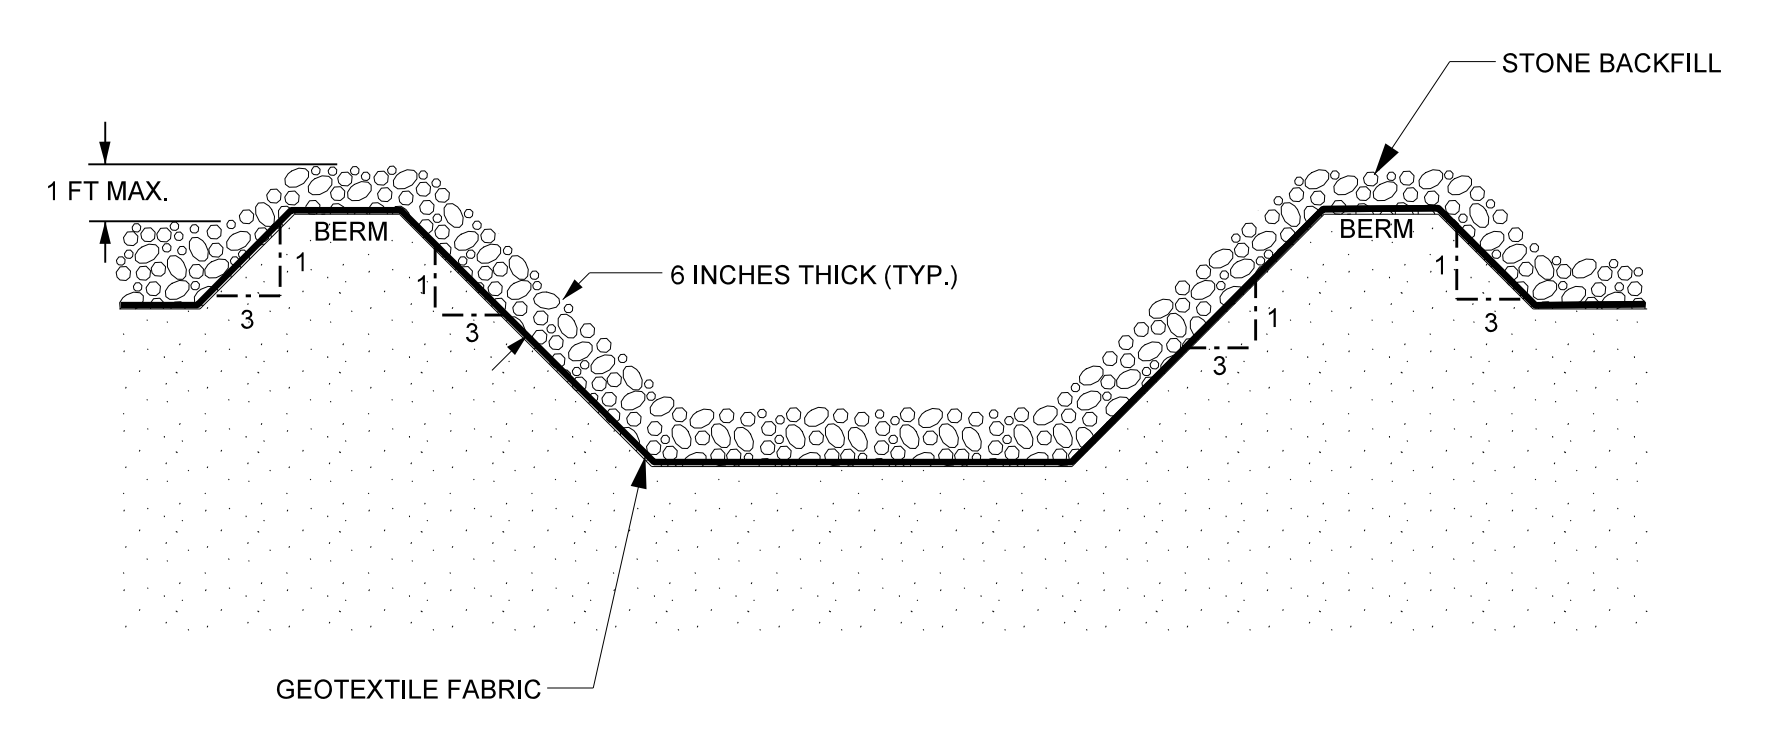

NOTES:
1. CONSTRUCT STREAM CROSSING WHEN FLOW IS LOW.
2. HAVE ALL NECESSARY MATERIALS AND EQUIPMENT ON-SITE BEFORE WORK BEGINS.
3. MINIMIZE CLEARING AND EXCAVATION OF STREAMBANKS. DO NOT EXCAVATE CHANNEL BOTTOM. COMPLETE ONE SIDE BEFORE STARTING ON THE OTHER SIDE.
4. INSTALL STREAM CROSSING AT RIGHT ANGLE TO THE FLOW.
5. GRADE SLOPES TO A 3:1 SLOPE. TRANSPLANT SOD FROM ORIGINAL STREAMBANK ONTO SIDE SLOPES.
6. MAINTAIN CROSSING SO THAT RUNOFF IN THE CONSTRUCTION ROAD DOES NOT ENTER EXISTING CHANNEL.
7. A STABILIZED PAD OF STONE BACKFILL, 6 INCHES THICK, LINED WITH GEOTEXTILE FABRIC SHALL BE USED OVER THE BERM AND ACCESS SLOPES.
8. WIDTH OF THE CROSSING SHALL BE SUFFICIENT TO ACCOMMODATE THE LARGEST VEHICLE CROSSING THE CHANNEL.
9. CONTRACTOR SHALL DETERMINE AN APPROPRIATE RAMP ANGLE ACCORDING TO EQUIPMENT UTILIZED.

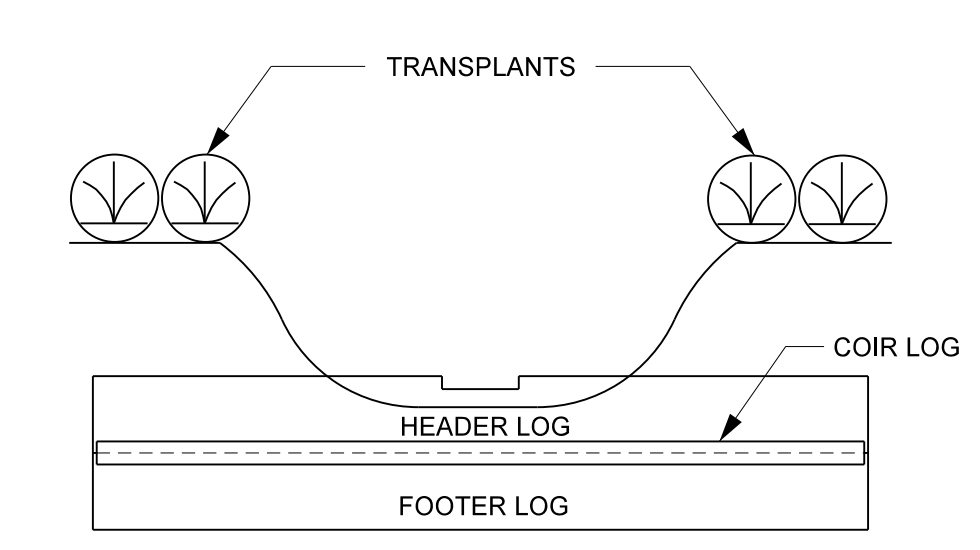


CROSS SECTION VIEW B - B'

4/21/2023 M:\Projects\167680\167680.dgn to Magness Cr:\Design\As-Built\Plans\167680_ASB_PSH_02E.dgn


PROJECT REFERENCE NO. 167680	SHEET NO. 2E
PROJECT ENGINEER	
DocuSigned by: Kathleen M. McKeithan 0282640F4181423	
APPROVED BY:	
6/12/2023	
DATE:	
Michael Baker International Michael Baker Engineering Inc. 8000 Regency Parkway, Suite 600 Cary, NORTH CAROLINA 27518 Phone: 919.463.5486 Fax: 919.463.5490 License #: F-1084	
NCDMS ID NO. 10081	

2/26/2023

CONSTRUCTED RIFFLE

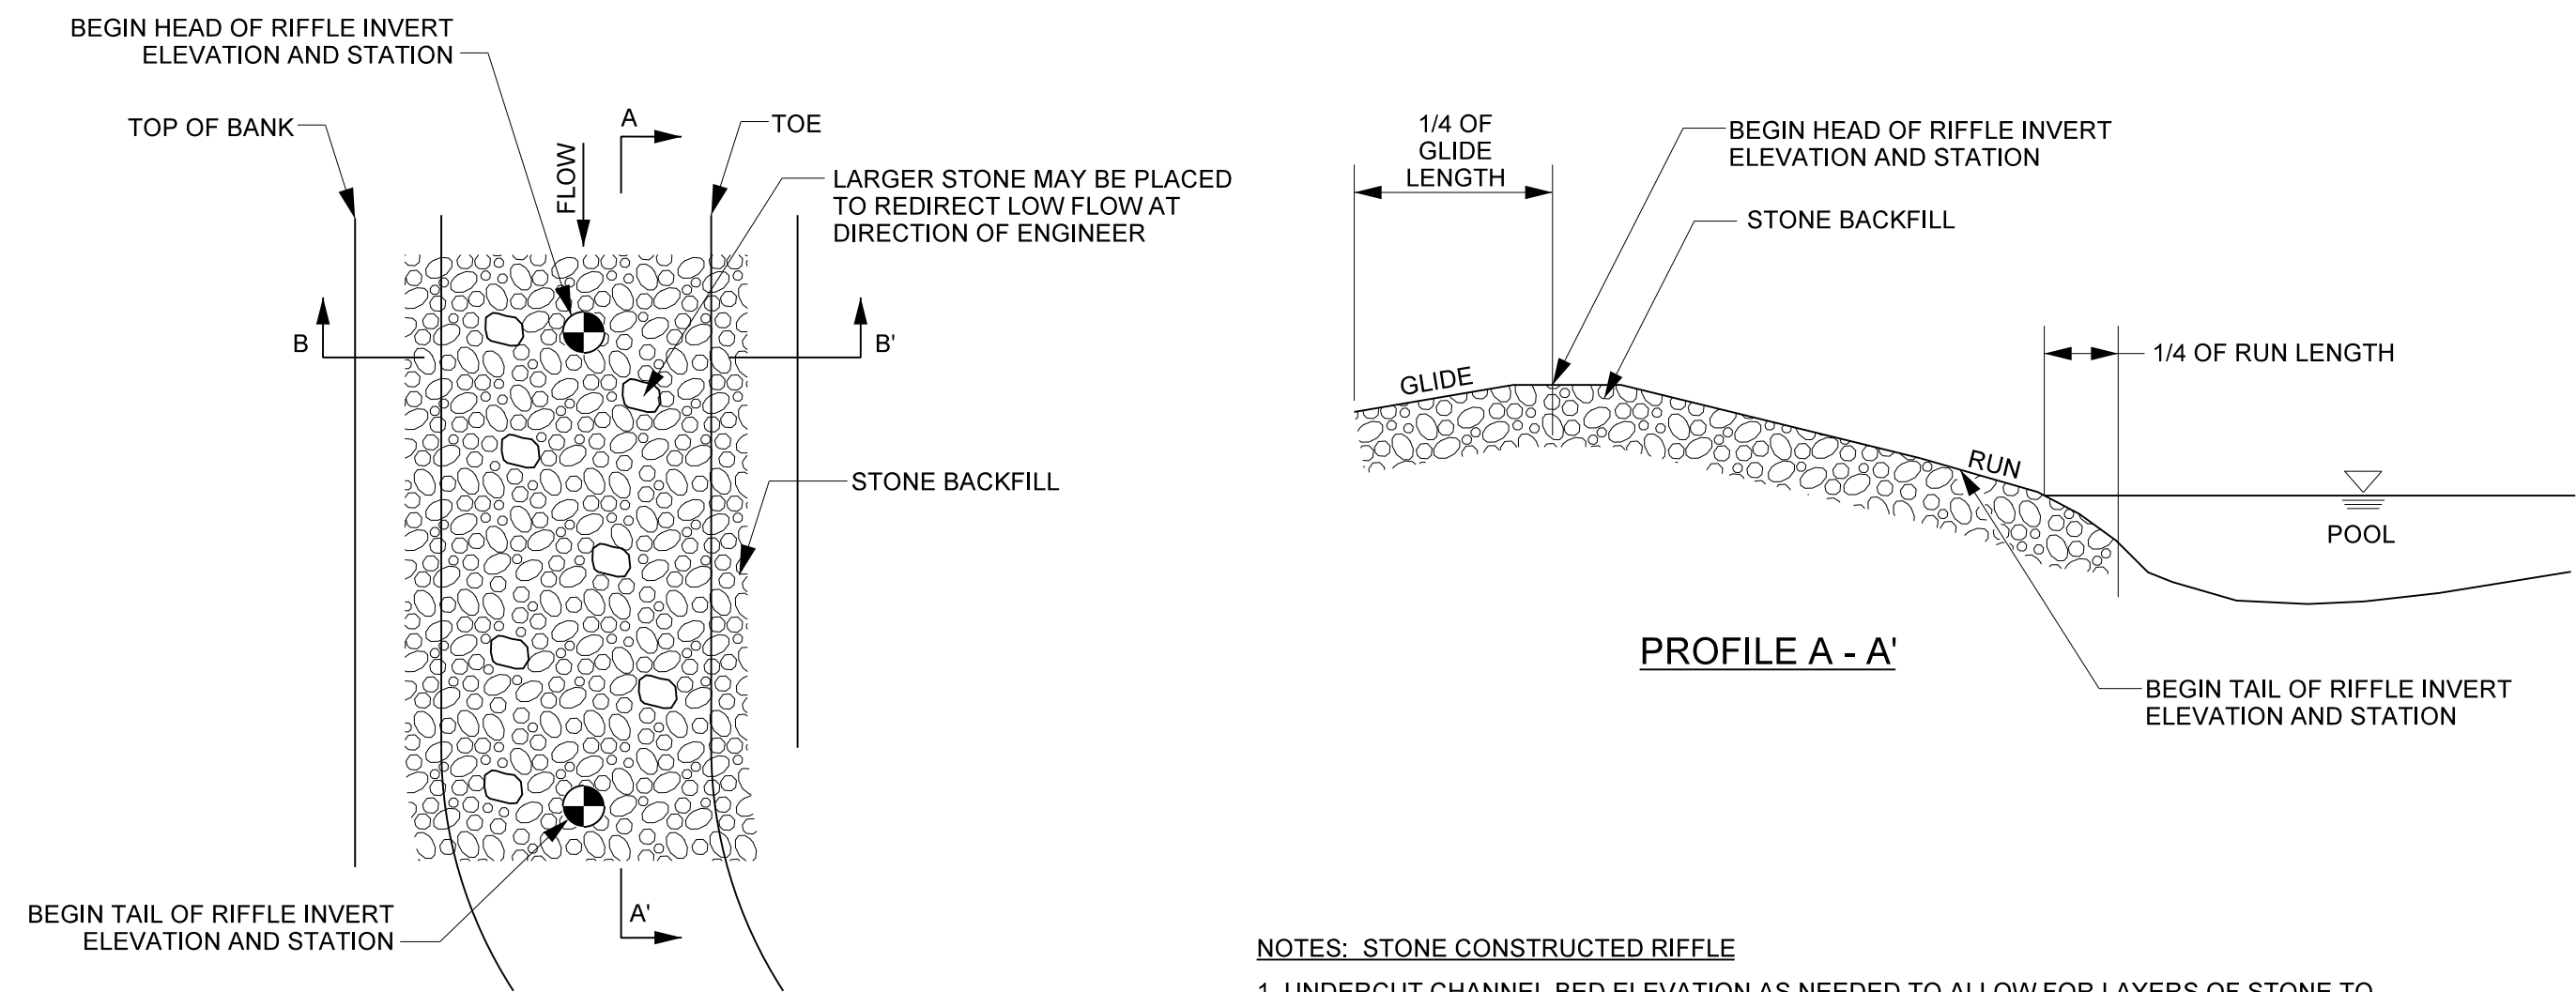

PLAN VIEW

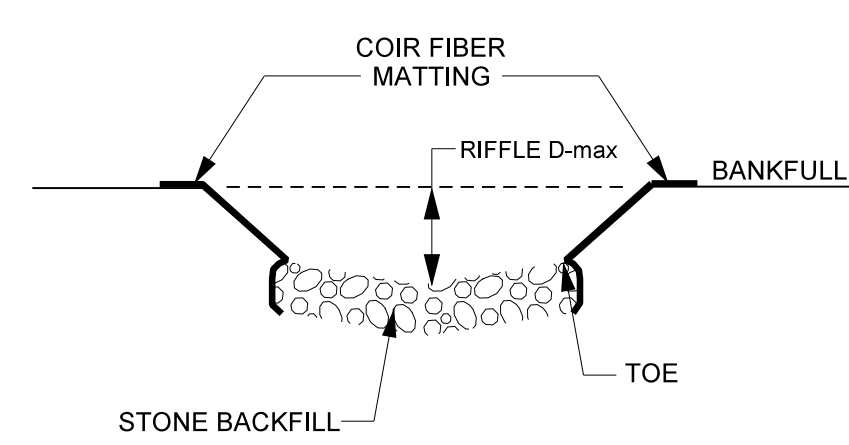


SECTION B - B'


- NOTES: STONE CONSTRUCTED RIFFLE**
1. UNDERCUT CHANNEL BED ELEVATION AS NEEDED TO ALLOW FOR LAYERS OF STONE TO ACHIEVE FINAL GRADE.
 2. INSTALL COIR FIBER MATTING ALONG COMPLETED BANKS SUCH THAT THE EROSION CONTROL MATTING AT THE TOE OF THE BANK EXTENDS DOWN TO THE UNDERCUT ELEVATION.
 3. INSTALL STONE BACKFILL, COMPACTED TO GRADE.
 4. FINAL CHANNEL BED SHAPE SHOULD BE ROUNDED, SMOOTH, AND CONCAVE, WITH THE ELEVATION OF THE BED 0.2 FT DEEPER IN THE CENTER THAN AT THE EDGES.
 5. STONE BACKFILL SHALL CONSIST OF 5% CLASS I, 10% CLASS B, 50% CLASS A, 20% ABC, AND 15% ON-SITE ALLUVIUM.
 6. CONSTRUCTED RIFFLES SHALL BE 12" THICK.
 7. BOULDERS FOR REACH 1A AND 1B MUST BE AT LEAST 2' x 3' x 4'; WHILE BOULDERS FOR UT2 SHOULD BE 1' x 2' x 3'.
 8. SATURATED WOODY DEBRIS THAT IS EXISTING WITHIN THE CHANNEL CAN BE RELOCATED INTO THE NEW RIFFLE AREAS.

- NOTES: NATURAL ALLUVIUM RIFFLE**
1. STOCK PILE NATURAL ALLUVIUM RIFFLE FROM SECTIONS OF CHANNEL THAT ARE BEING ABANDONED AND FILLED.
 2. APPLY NATURAL ALLUVIUM BED MATERIAL IN THOSE RIFFLES WHERE STONE IS NOT INDICATED.
 3. ANY WATER LOGGED WOODY MATERIAL COLLECTED SHOULD BE INSTALLED WITH BED MATERIAL.

ROCK DAM

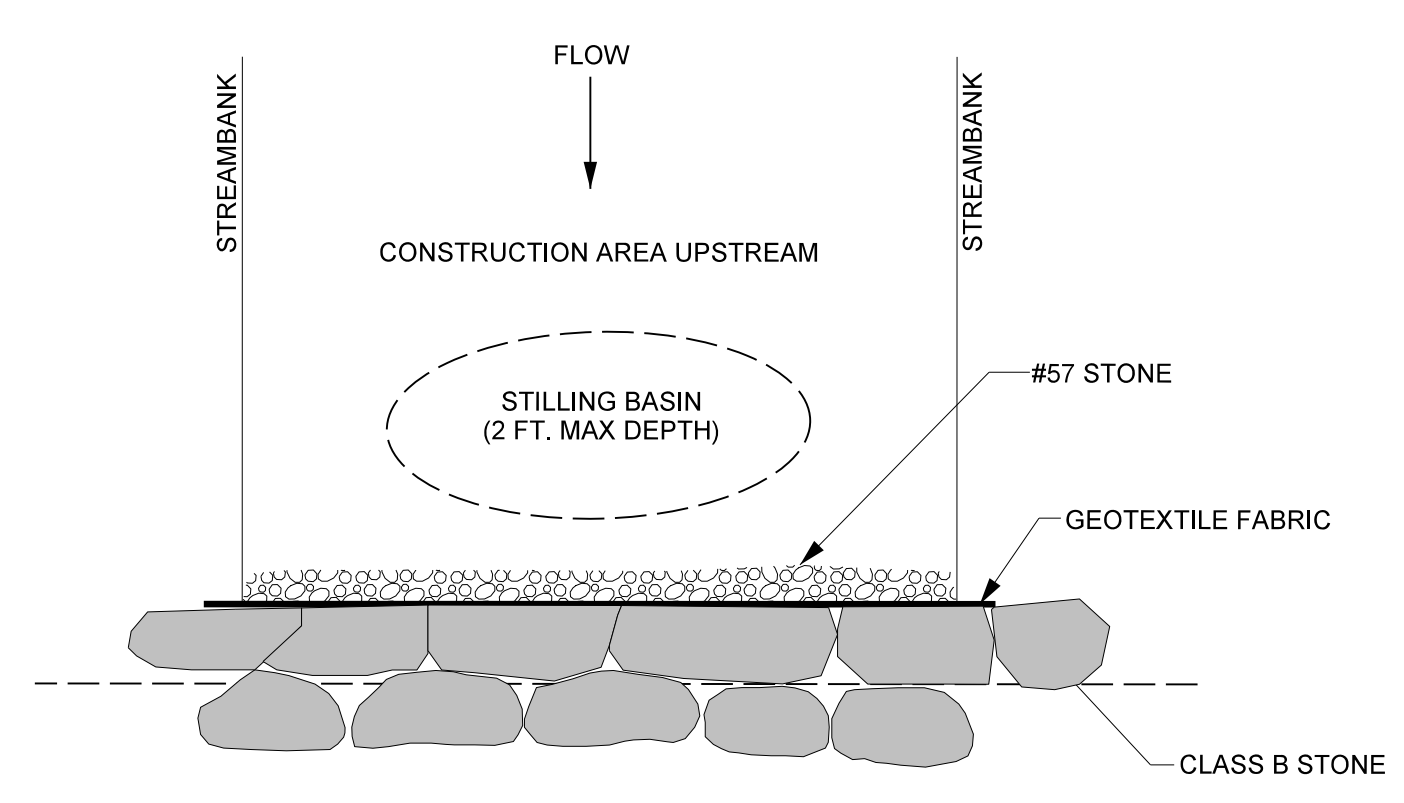

PLAN VIEW

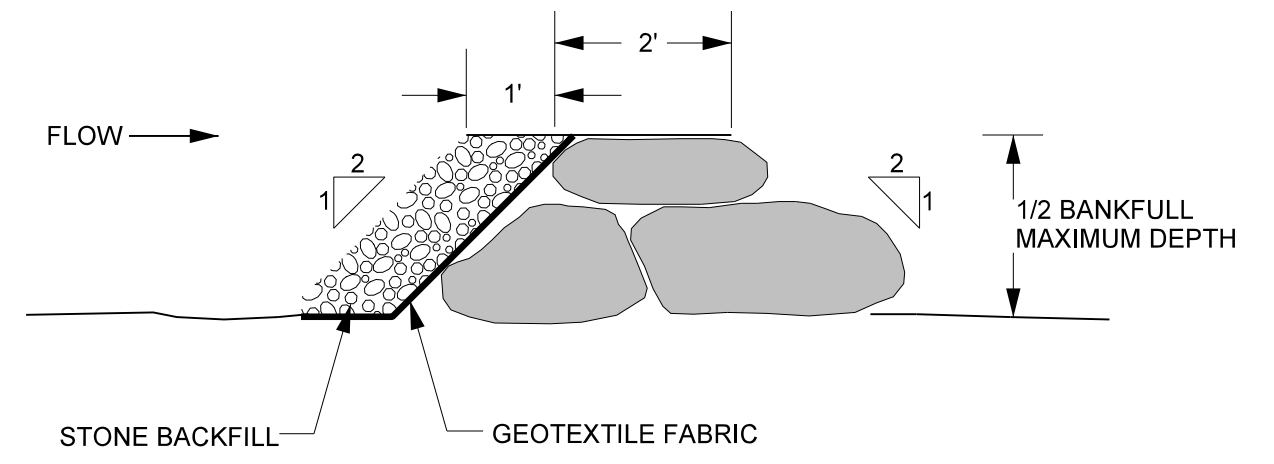


CROSS SECTION

- NOTES:**
1. CLEAN OUT STILLING BASIN OF TRAPPED SEDIMENT PRIOR TO REMOVAL.


PROJECT REFERENCE NO. 167680	SHEET NO. 2F
PROJECT ENGINEER	
APPROVED BY:	
6/12/2023	
DATE:	
Michael Baker International	
Michael Baker Engineering Inc. 8000 Regency Parkway, Suite 600 Cary, NORTH CAROLINA 27518 Phone: 919.463.5488 Fax: 919.463.5490 License #: F-1084	
NCDMS ID NO. 100081	

ROCK DOUBLE DROP CROSS VANE

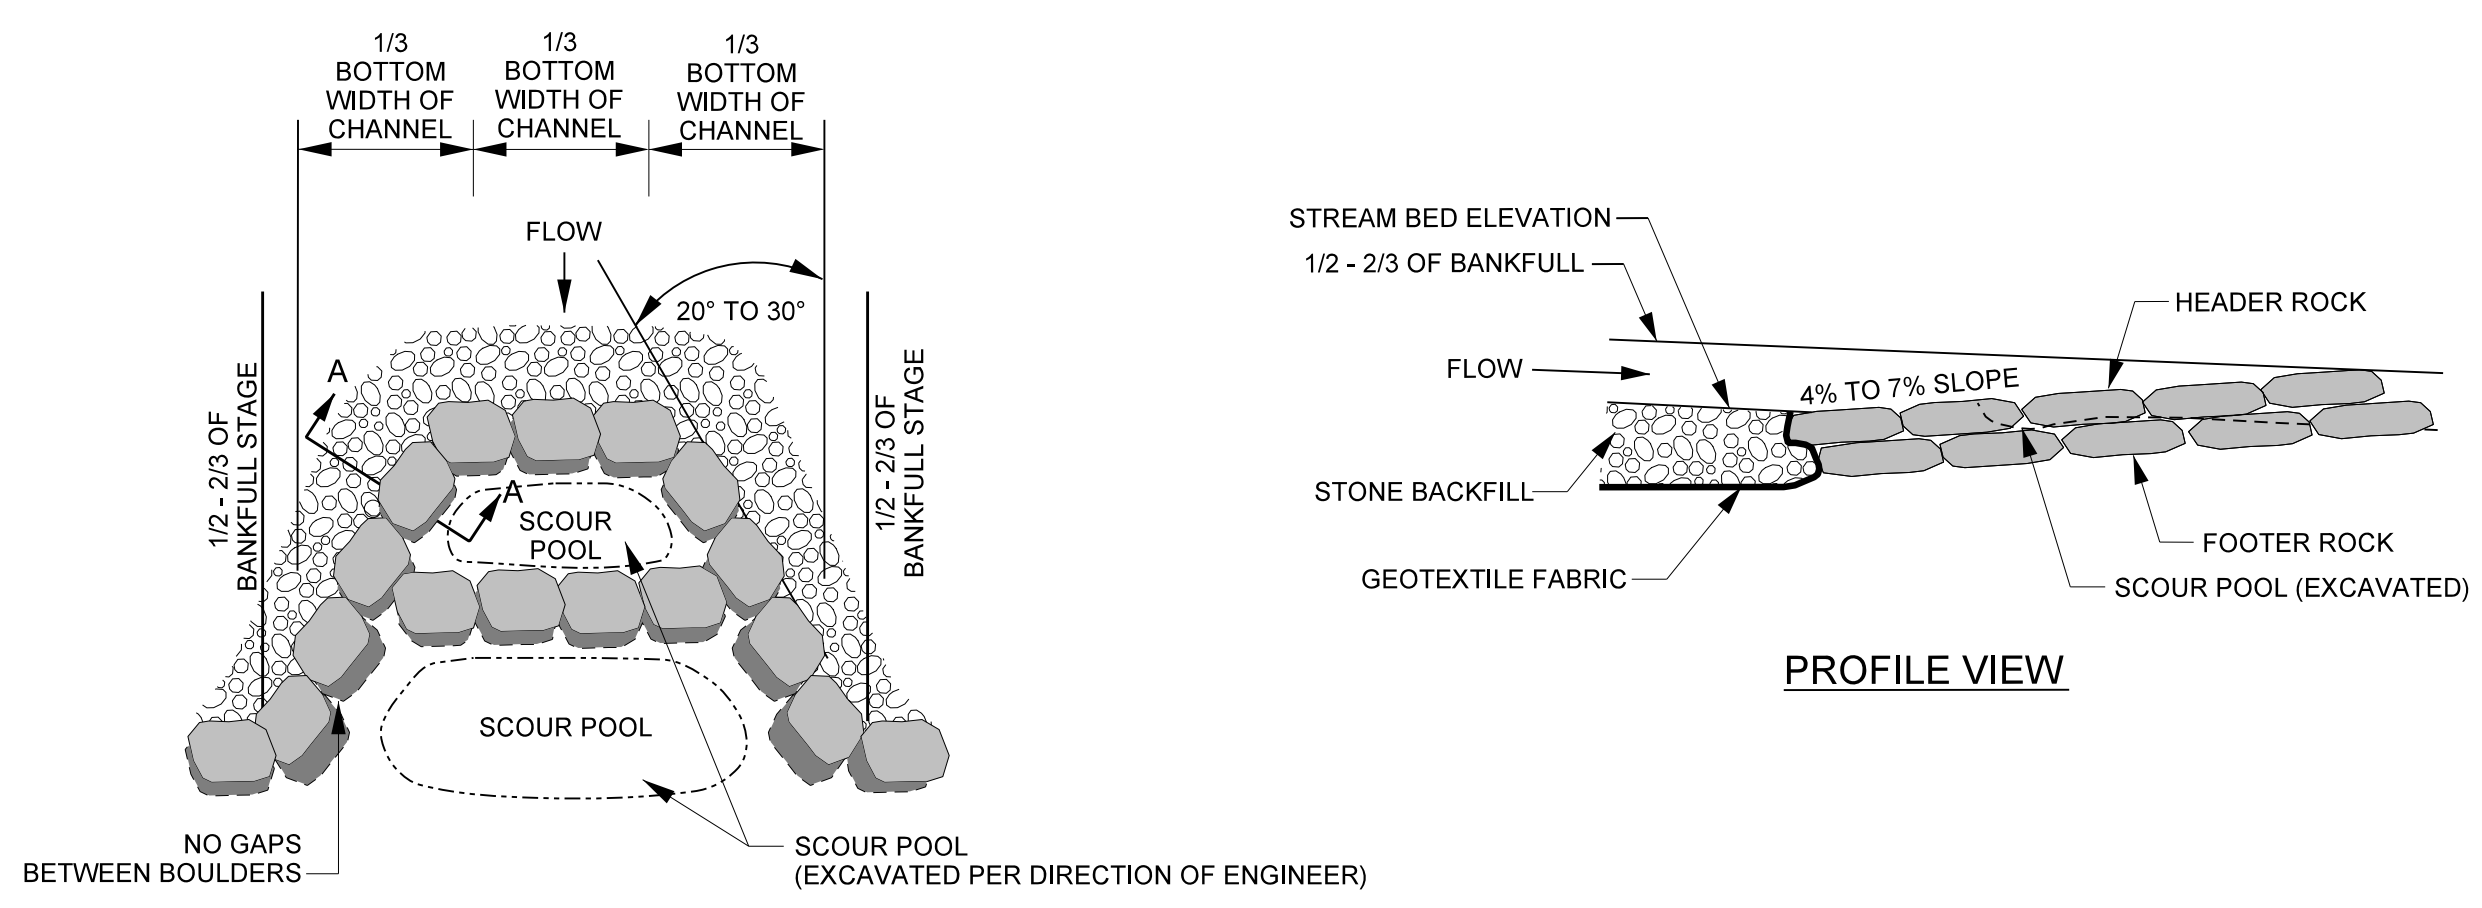

PLAN VIEW


PROFILE VIEW

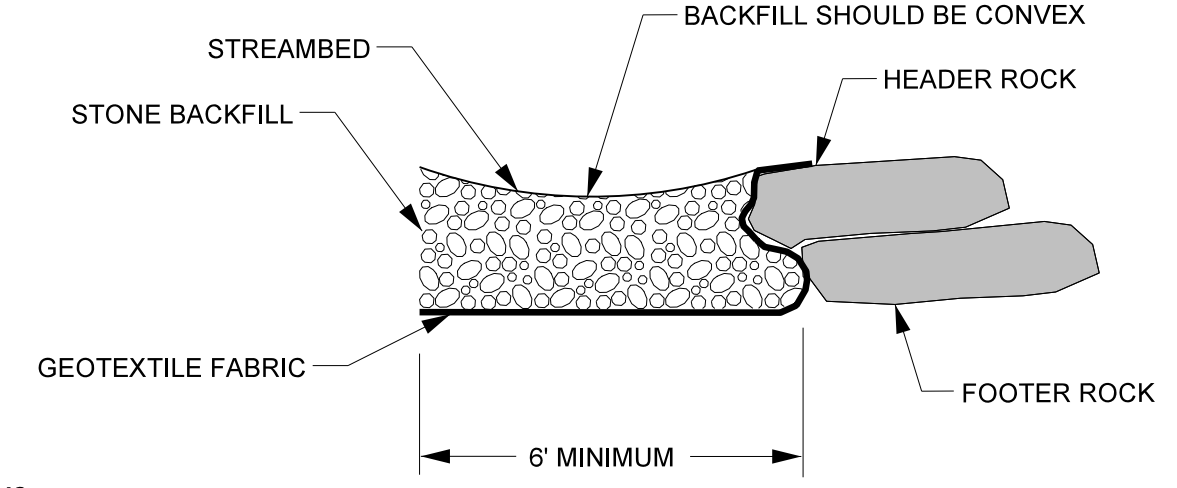


SECTION A - A

- NOTES FOR ALL VANE STRUCTURES:**
1. DIG A TRENCH BELOW THE BED FOR FOOTER ROCKS.
 2. START AT BANK AND PLACE FOOTER ROCKS FIRST AND THEN HEADER (TOP) ROCK.
 3. CONTINUE WITH STRUCTURE, FOLLOWING ANGLE AND SLOPE SPECIFICATIONS.
 4. AN EXTRA ROCK CAN BE PLACED IN SCOUR POOL FOR HABITAT IMPROVEMENT.
 5. USE HAND PLACED STONE TO FILL GAPS ON UPSTREAM SIDE OF HEADER AND FOOTER ROCKS.
 6. INSTALL GEOTEXTILE FABRIC BEGINNING AT THE TOP OF THE HEADER ROCKS AND EXTEND DOWNWARD TO THE DEPTH OF THE BOTTOM FOOTER ROCK, AND THEN UPSTREAM TO A MINIMUM OF SIX FEET.
 7. AFTER ALL STONE BACKFILL HAS BEEN PLACED, FILL IN THE UPSTREAM SIDE OF THE STRUCTURE WITH WELL GRADED MIX OF CLASS B, CLASS A, & #57 STONE TO THE ELEVATION 2'-4" BELOW THE THE HEADER ROCK. INCORPORATE ON-SITE ALLUVIUM WHERE AVAILABLE. FILL SHOULD BE CONCAVE BEHIND THE VANE ARM TO ALLOW POOLING OF FLOW.
 8. START SLOPE AT 3/4 THE BANKFULL ELEVATION.
 9. ALL REACHES, BOULDER SIZE 2' x 2' x 4'.


BOULDER HEADWALL / ENDWALL

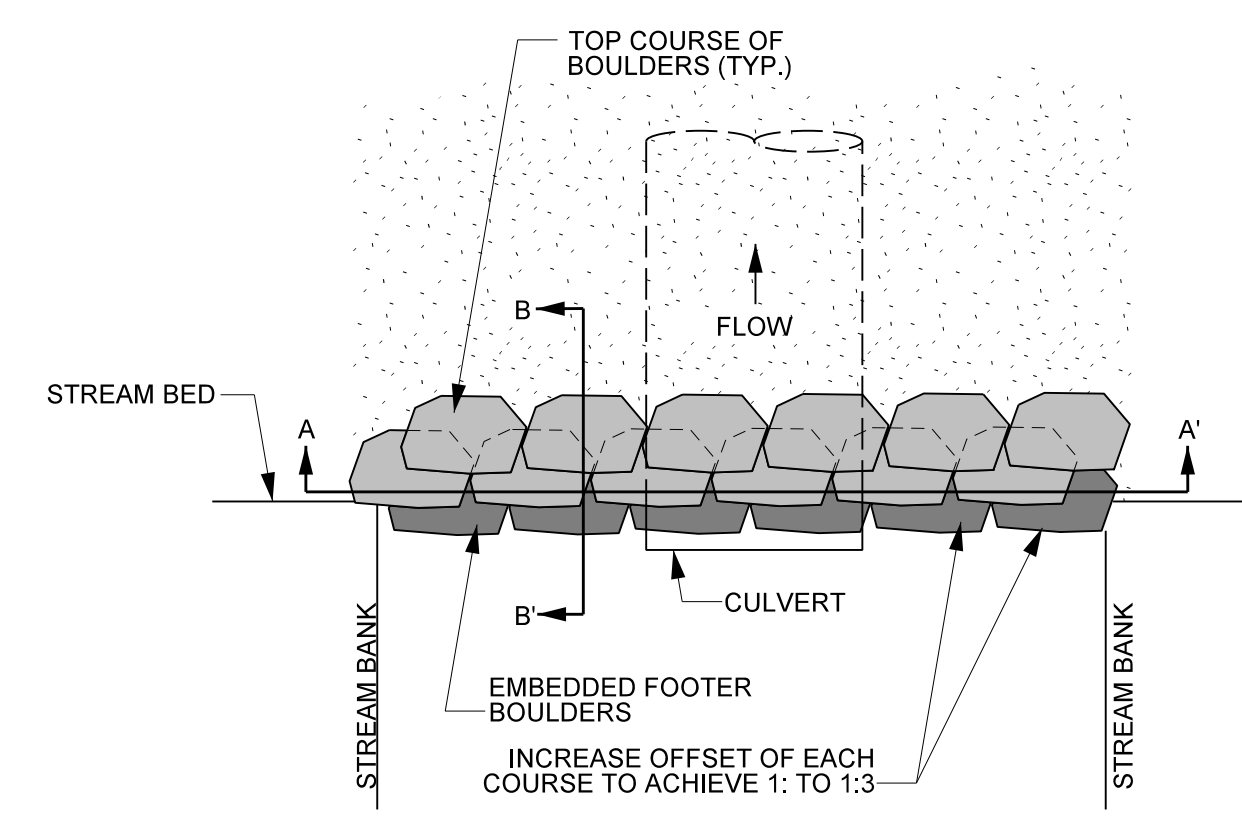

PLAN VIEW

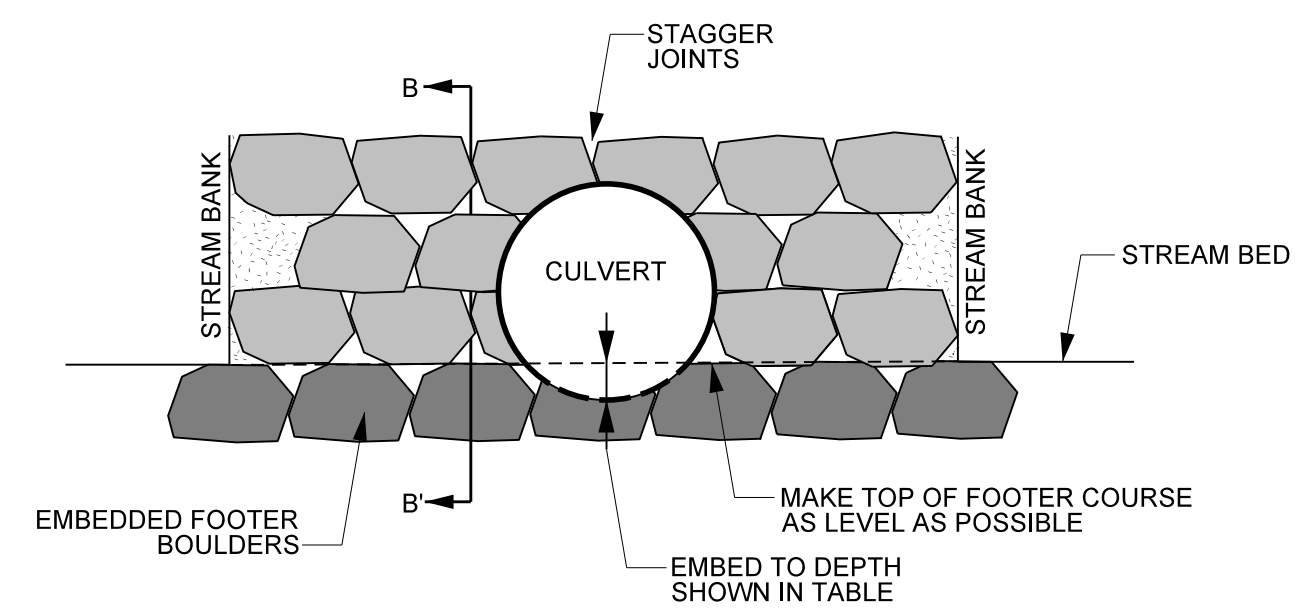

SECTION A - A'

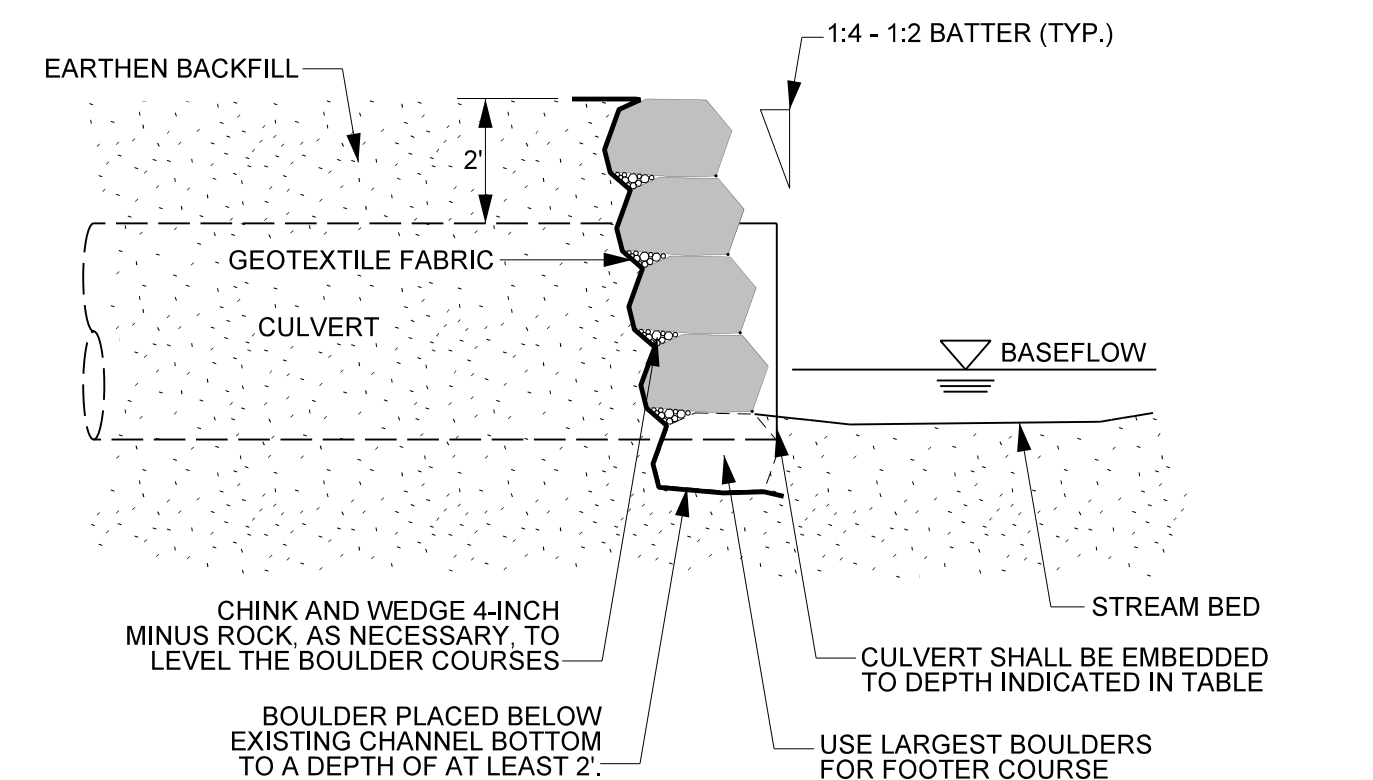


SECTION B - B'

- NOTES:**
1. BOULDERS SHALL BE TOUCHING SO THAT VOID SPACE IS MINIMIZED.
 2. BOULDERS SHOULD EXTEND BELOW SCOUR DEPTH. FOOTER BOULDERS SHALL BE AT LEAST 2' BELOW THE EXISTING BED
 3. GEOTEXTILE MATTING SHOULD BE PLACED BETWEEN BOULDERS AND SOIL.
 4. BOULDERS SHOULD BE BACKFILLED AND COMPACTED. VOID SPACE BETWEEN FABRIC AND BOULDER OR ROCK FILL MATERIAL, SHOULD BE MINIMIZED.
 5. BOULDERS SHOULD NOT BE HIGHER THAN THE TOP OF CROSSING ELEVATION.
 6. FILTER FABRIC SHOULD BE PLACED BEHIND BOULDERS, BURIED BELOW BOULDER DEPTH, AND EXTEND INTO THE BANK.

6/6/2023 C:\Design\As-Built\Plans\167680_ASB_PSH_02F.dgn

2/26/2023

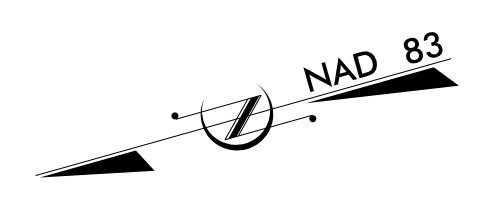


APPARENT GAP BETWEEN THE ROBERT & KAY YARBORO PROPERTIES AND THE PROPERTY OF CEDAR LAKE FARM, LLC AS DESCRIBED IN DB: 1587 PG: 1352 (TRACT 4)

ROBERT E. YARBORO & WIFE
KAY DIXON YARBORO
PIN: 2641-52-8927
DB: 1168 PG: 30 (PARCEL 1, TRACT 10)
24" POPLAR PB: 7 PG: 46 (TRACT 10)

ROBERT E. YARBORO & WIFE
KAY DIXON YARBORO
PIN: 2641-53-8722
DB: 1168 PG: 30 (PARCEL 2)
PB: 7 PG: 46 (TRACT 9)



ROBERT E. YARBORO & WIFE
KAY DIXON YARBORO
PIN: 2641-53-8722
DB: 1168 PG: 30 (PARCEL 2)
PB: 7 PG: 46 (TRACT 9)

ROBERT E. YARBORO & WIFE
KAY DIXON YARBORO
PIN: 2641-52-8927
DB: 1168 PG: 30 (PARCEL 1, TRACT 10)
PB: 7 PG: 46 (TRACT 10)


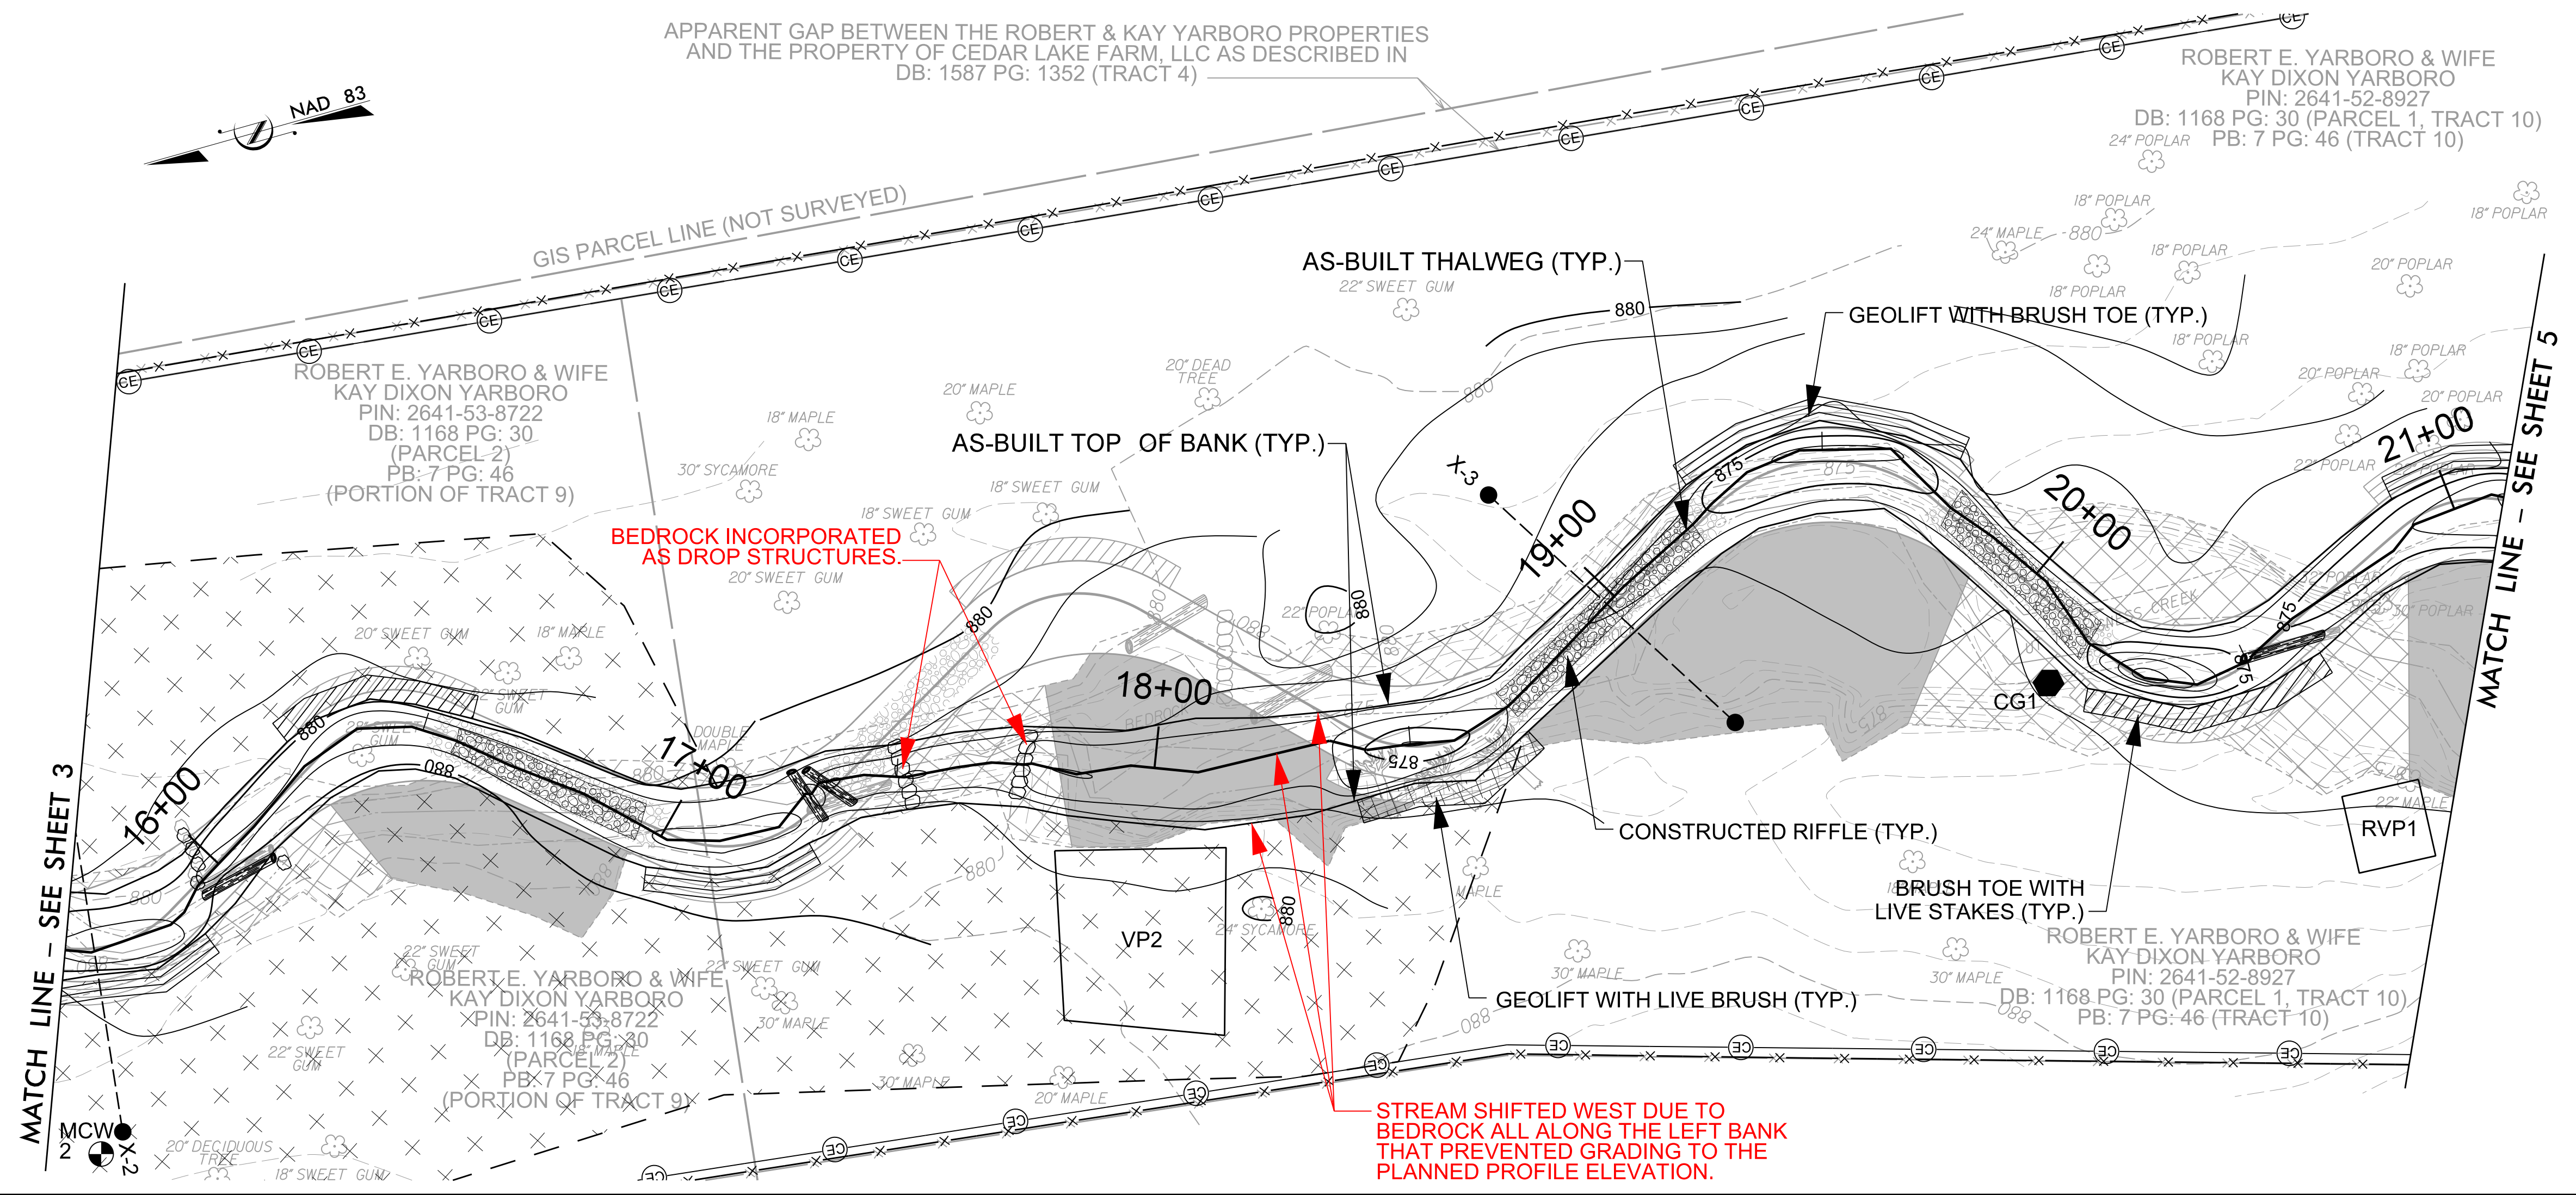

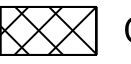


MATCH LINE - SEE SHEET 3


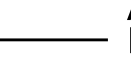

MATCH LINE - SEE SHEET 5

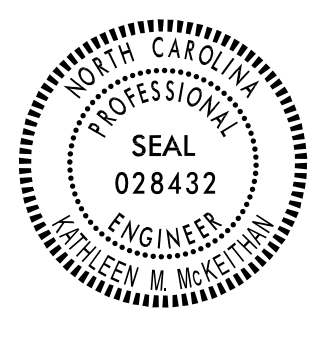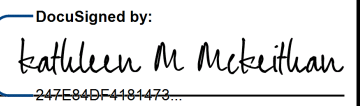BAKER PROJECT REFERENCE NO. 167680	SHEET NO. 4
PROJECT ENGINEER	
	
DocuSigned by:  APPROVED BY: 6/12/2023 DATE:	
Michael Baker International	
NCDMS ID NO. 100081	


AS-BUILT LEGEND

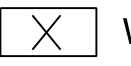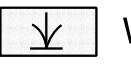-  WETLAND RE-ESTABLISHMENT
-  WETLAND REHABILITATION
-  FILL EXISTING CHANNEL
-  CHANNEL PLUG


AS-BUILT LEGEND

-  PROPOSED DESIGN
-  AS-BUILT SURVEY BY KEE MAPPING & SURVEYING 10/10/22
-  RED LINE VARIATIONS FROM ORIGINAL DESIGN SUBMITTED WITH THE MITIGATION PLAN

UT TO MAGNESS CREEK RECORD DRAWING PLAN & PROFILE VIEW






SCALE (FT)


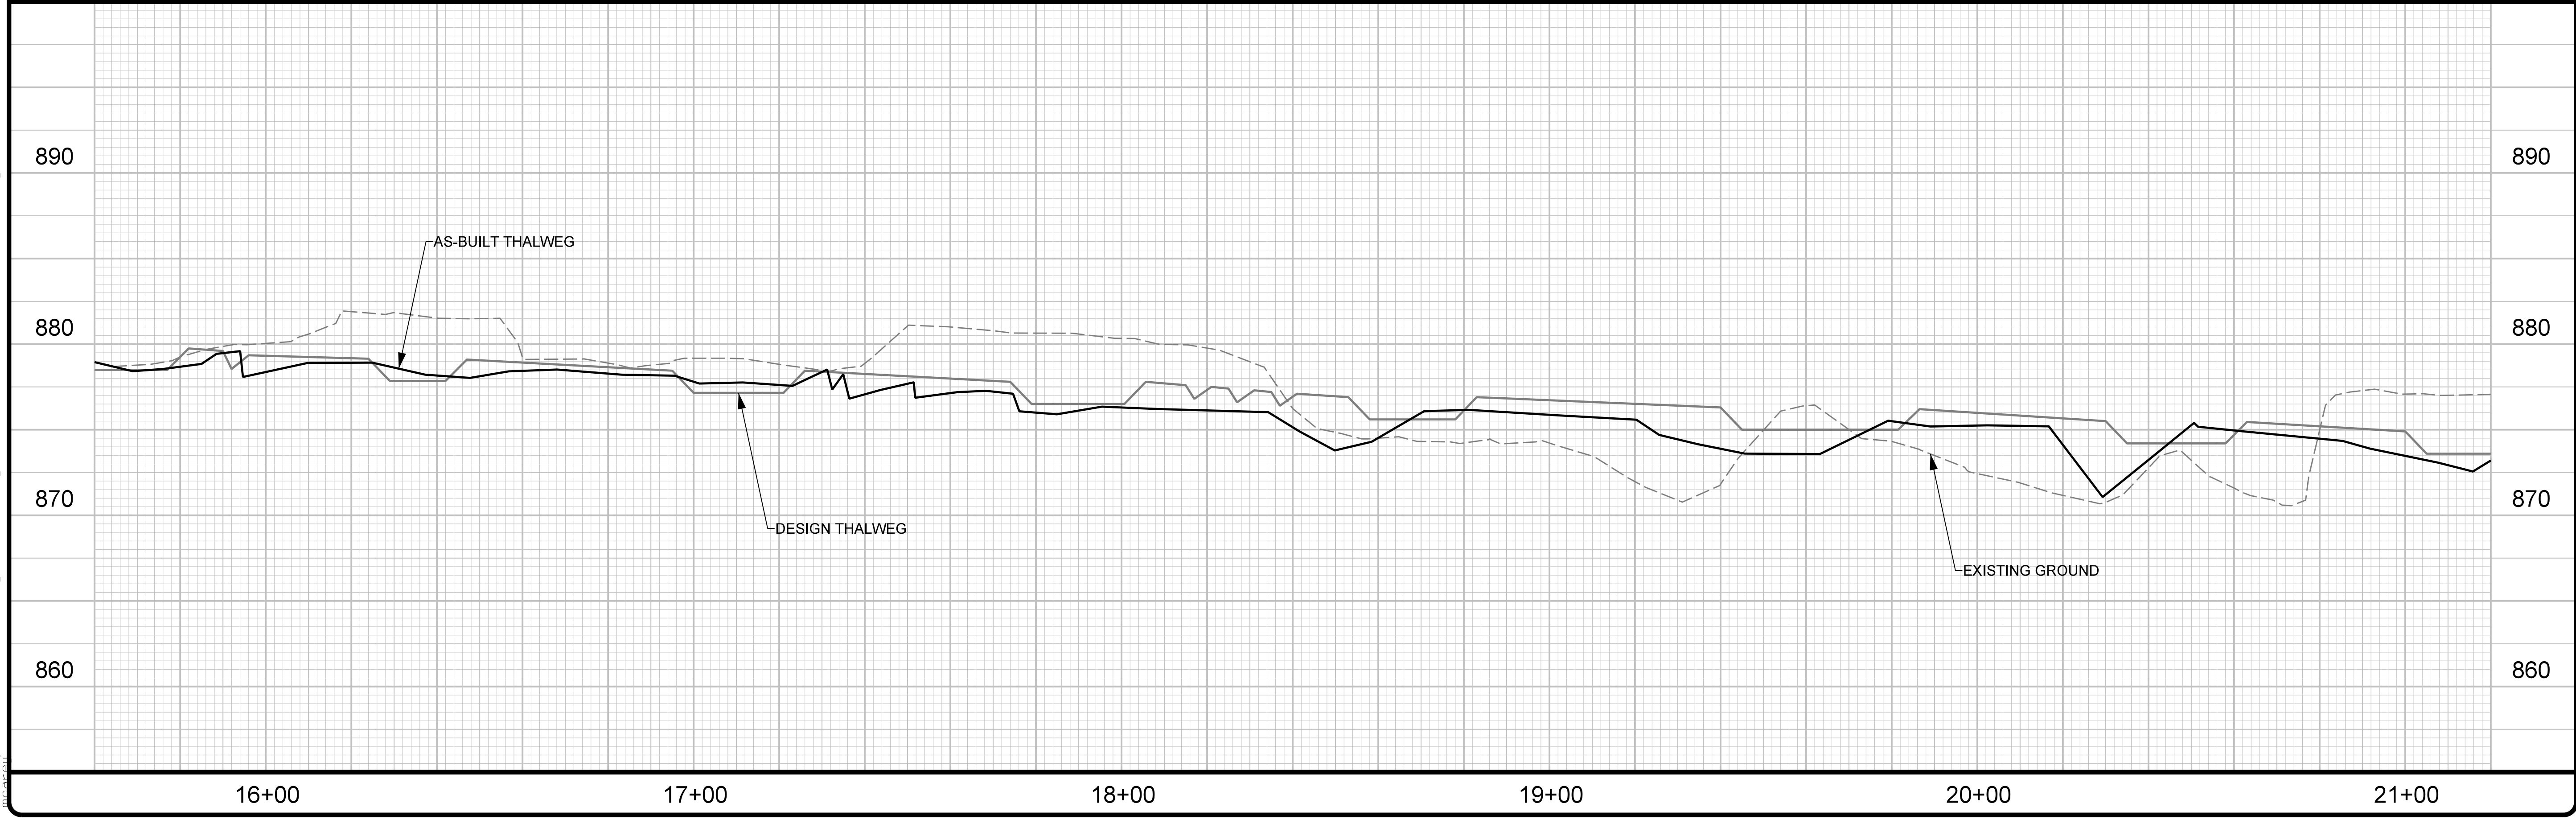





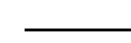

6/12/2023
C:\Users\jts\OneDrive\Documents\167680\UT to Magness Cr.\Design\As-Built\Plans\167680_AS-B-PSH_04.dgn

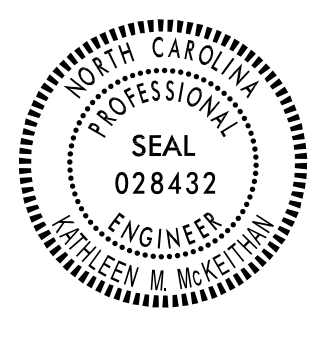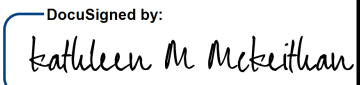2/26/2023

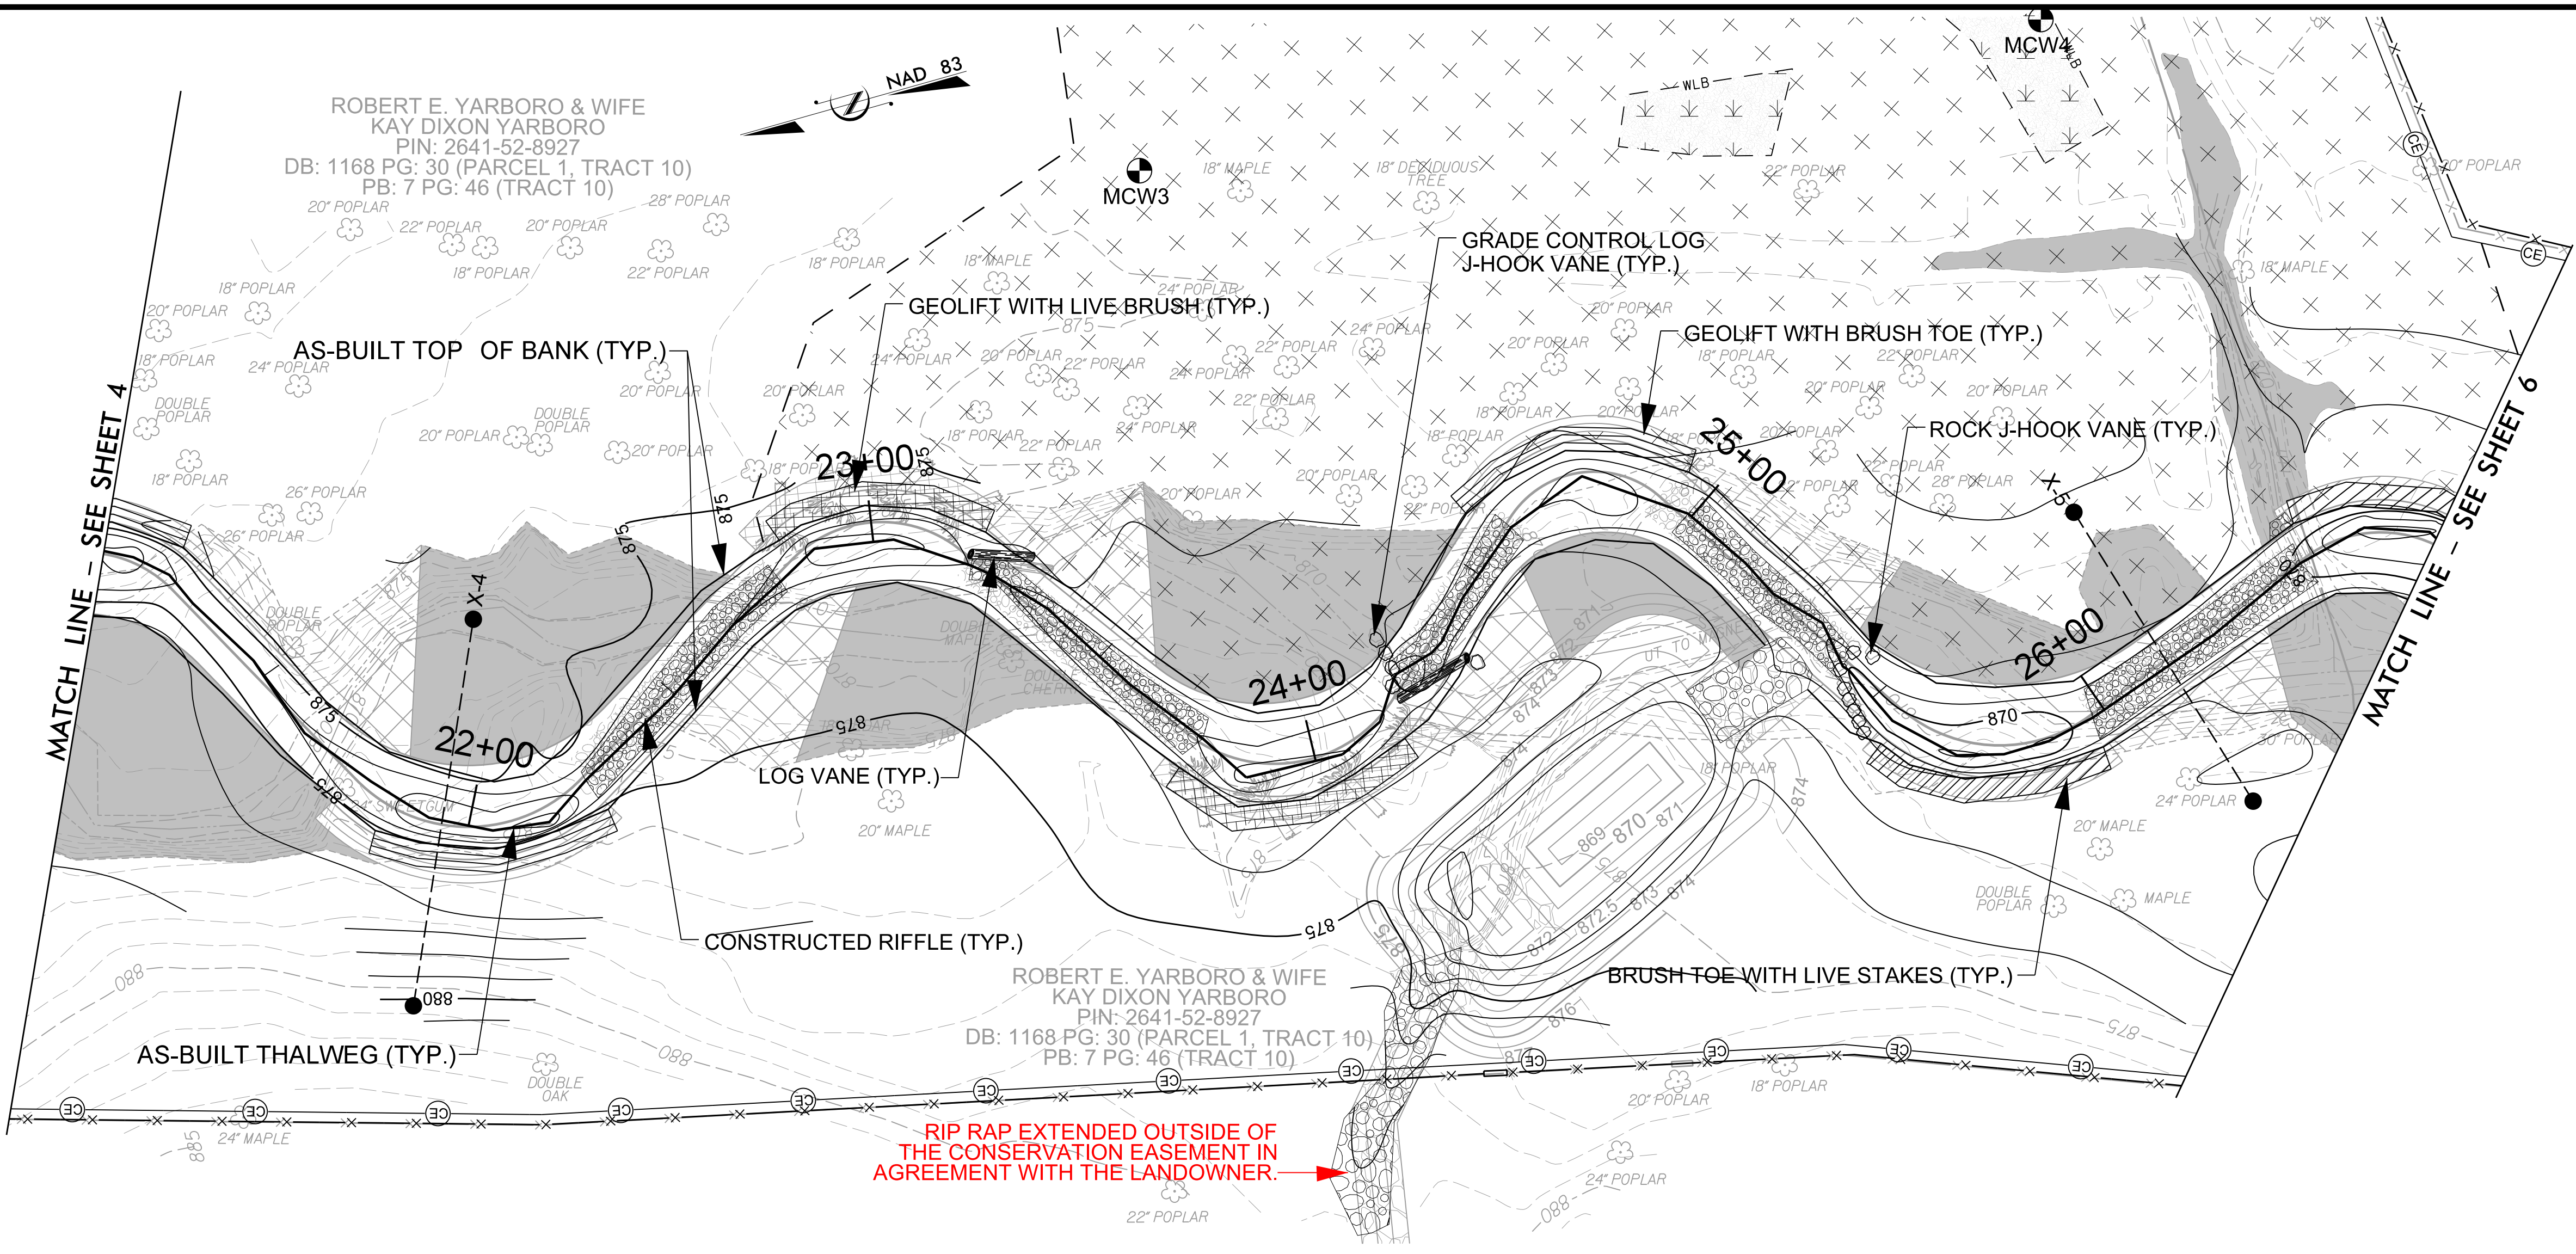
BAKER PROJECT REFERENCE NO. 167680	SHEET NO. 5
PROJECT ENGINEER	
	
DocuSigned by:  APPROVED BY: 6/12/2023 DATE:	
Michael Baker International	
Michael Baker Engineering Inc. 6200 Regency Parkway, Suite 500 Cary, NORTH CAROLINA 27518 Phone: 919.463.5488 Fax: 919.463.5490 License #: F-1084	
NCDMS ID NO. 100081	

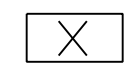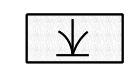

	WETLAND RE-ESTABLISHMENT
	WETLAND REHABILITATION
	FILL EXISTING CHANNEL
	CHANNEL PLUG


AS-BUILT LEGEND	
	PROPOSED DESIGN
	AS-BUILT SURVEY BY KEE MAPPING & SURVEYING 10/10/22
	RED LINE VARIATIONS FROM ORIGINAL DESIGN SUBMITTED WITH THE MITIGATION PLAN

**UT TO MAGNESS CREEK
RECORD DRAWING
PLAN & PROFILE VIEW**




SCALE (FT)


6/6/2023
C:\Users\jca\OneDrive\Documents\167680\UT to Magness Cr.\Design\As-Built\Plans\167680_AS-B-PSH_05.dgn

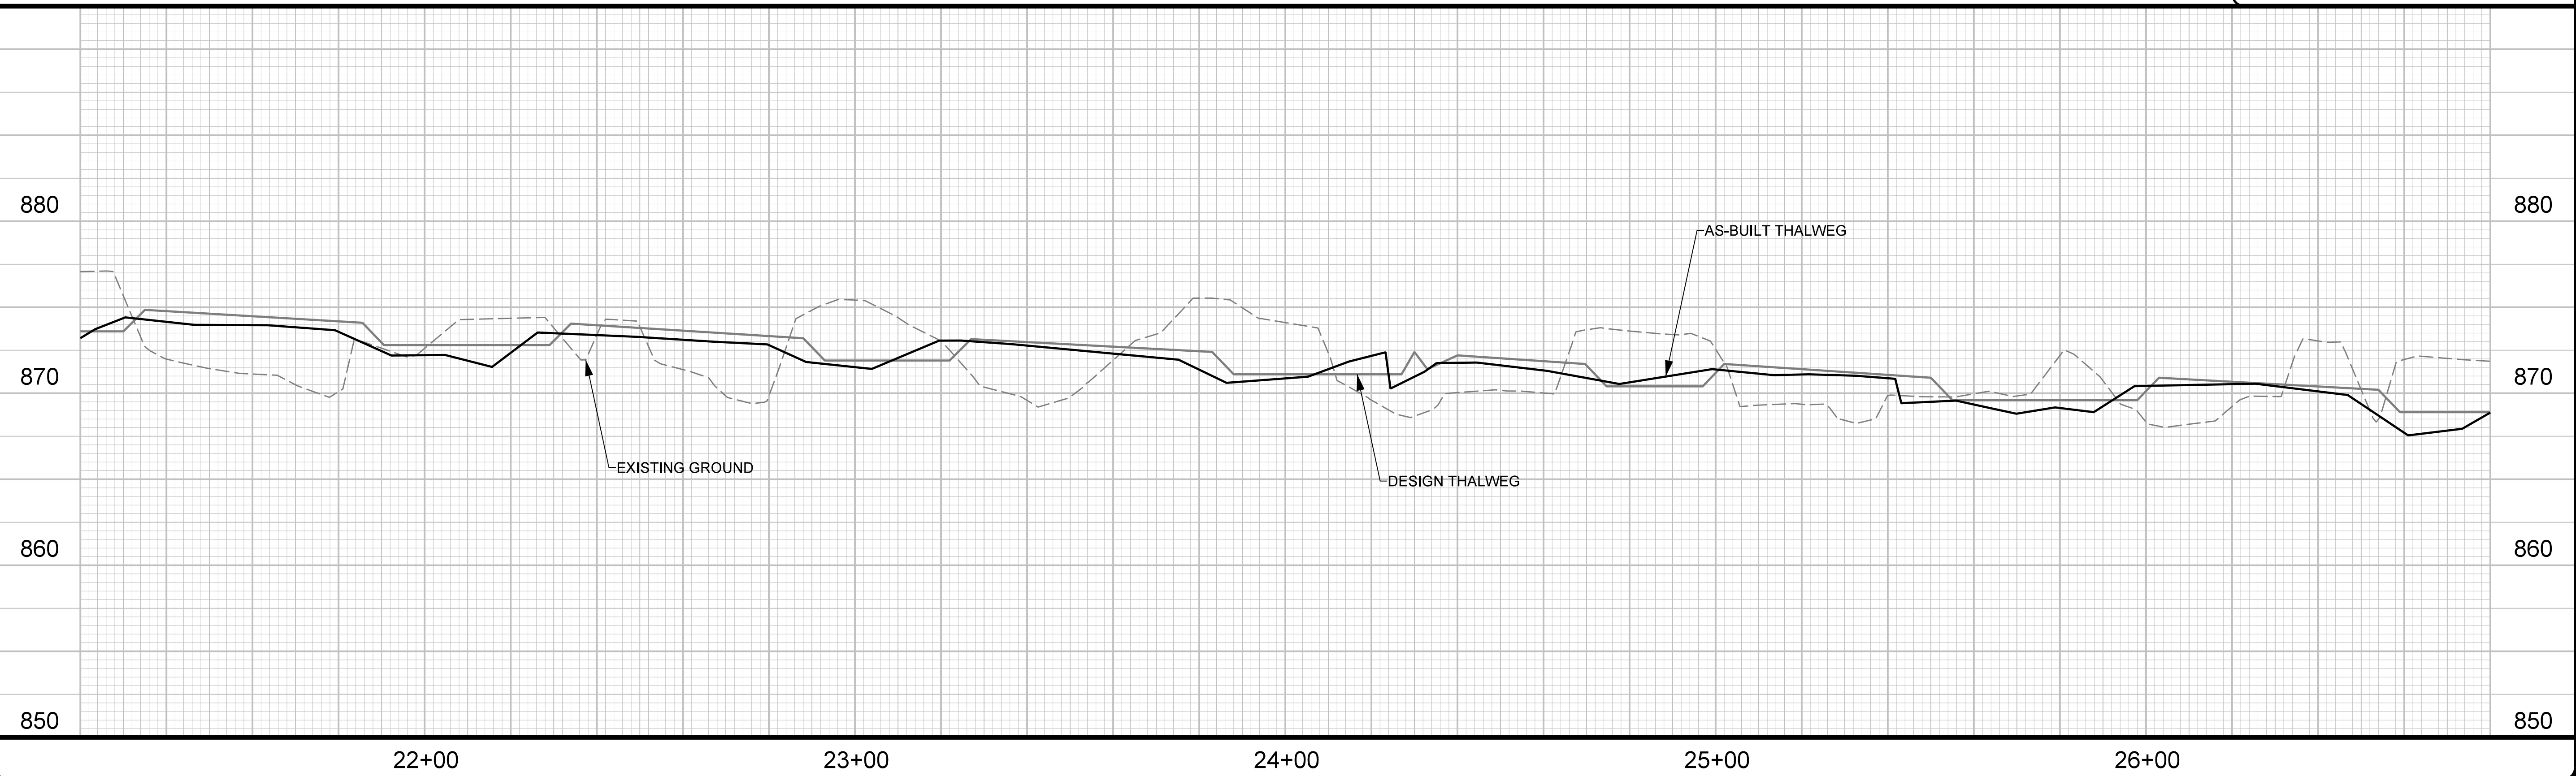

27/26/2023

ROBERT E. YARBORO & WIFE
KAY DIXON YARBORO
PIN: 2641-41-9802
DB: 16-D PG: 143 & DB: 1069 PG: 439
PB: 7 PG: 46 (TRACT 11)


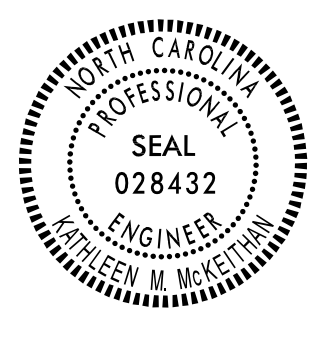

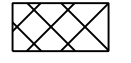
BAKER PROJECT REFERENCE NO. 167680	SHEET NO. 6
PROJECT ENGINEER	
	
DocuSigned by: <i>Kathleen M. McKeithan</i> APPROVED BY: 6/12/2023 DATE:	
Michael Baker International Michael Baker Engineering Inc. 6320 Regency Parkway, Suite 500 Cary, NORTH CAROLINA 27518 Phone: 919.463.5488 Fax: 919.463.5490 License #: F-1084	
NCDMS ID NO. 100081	

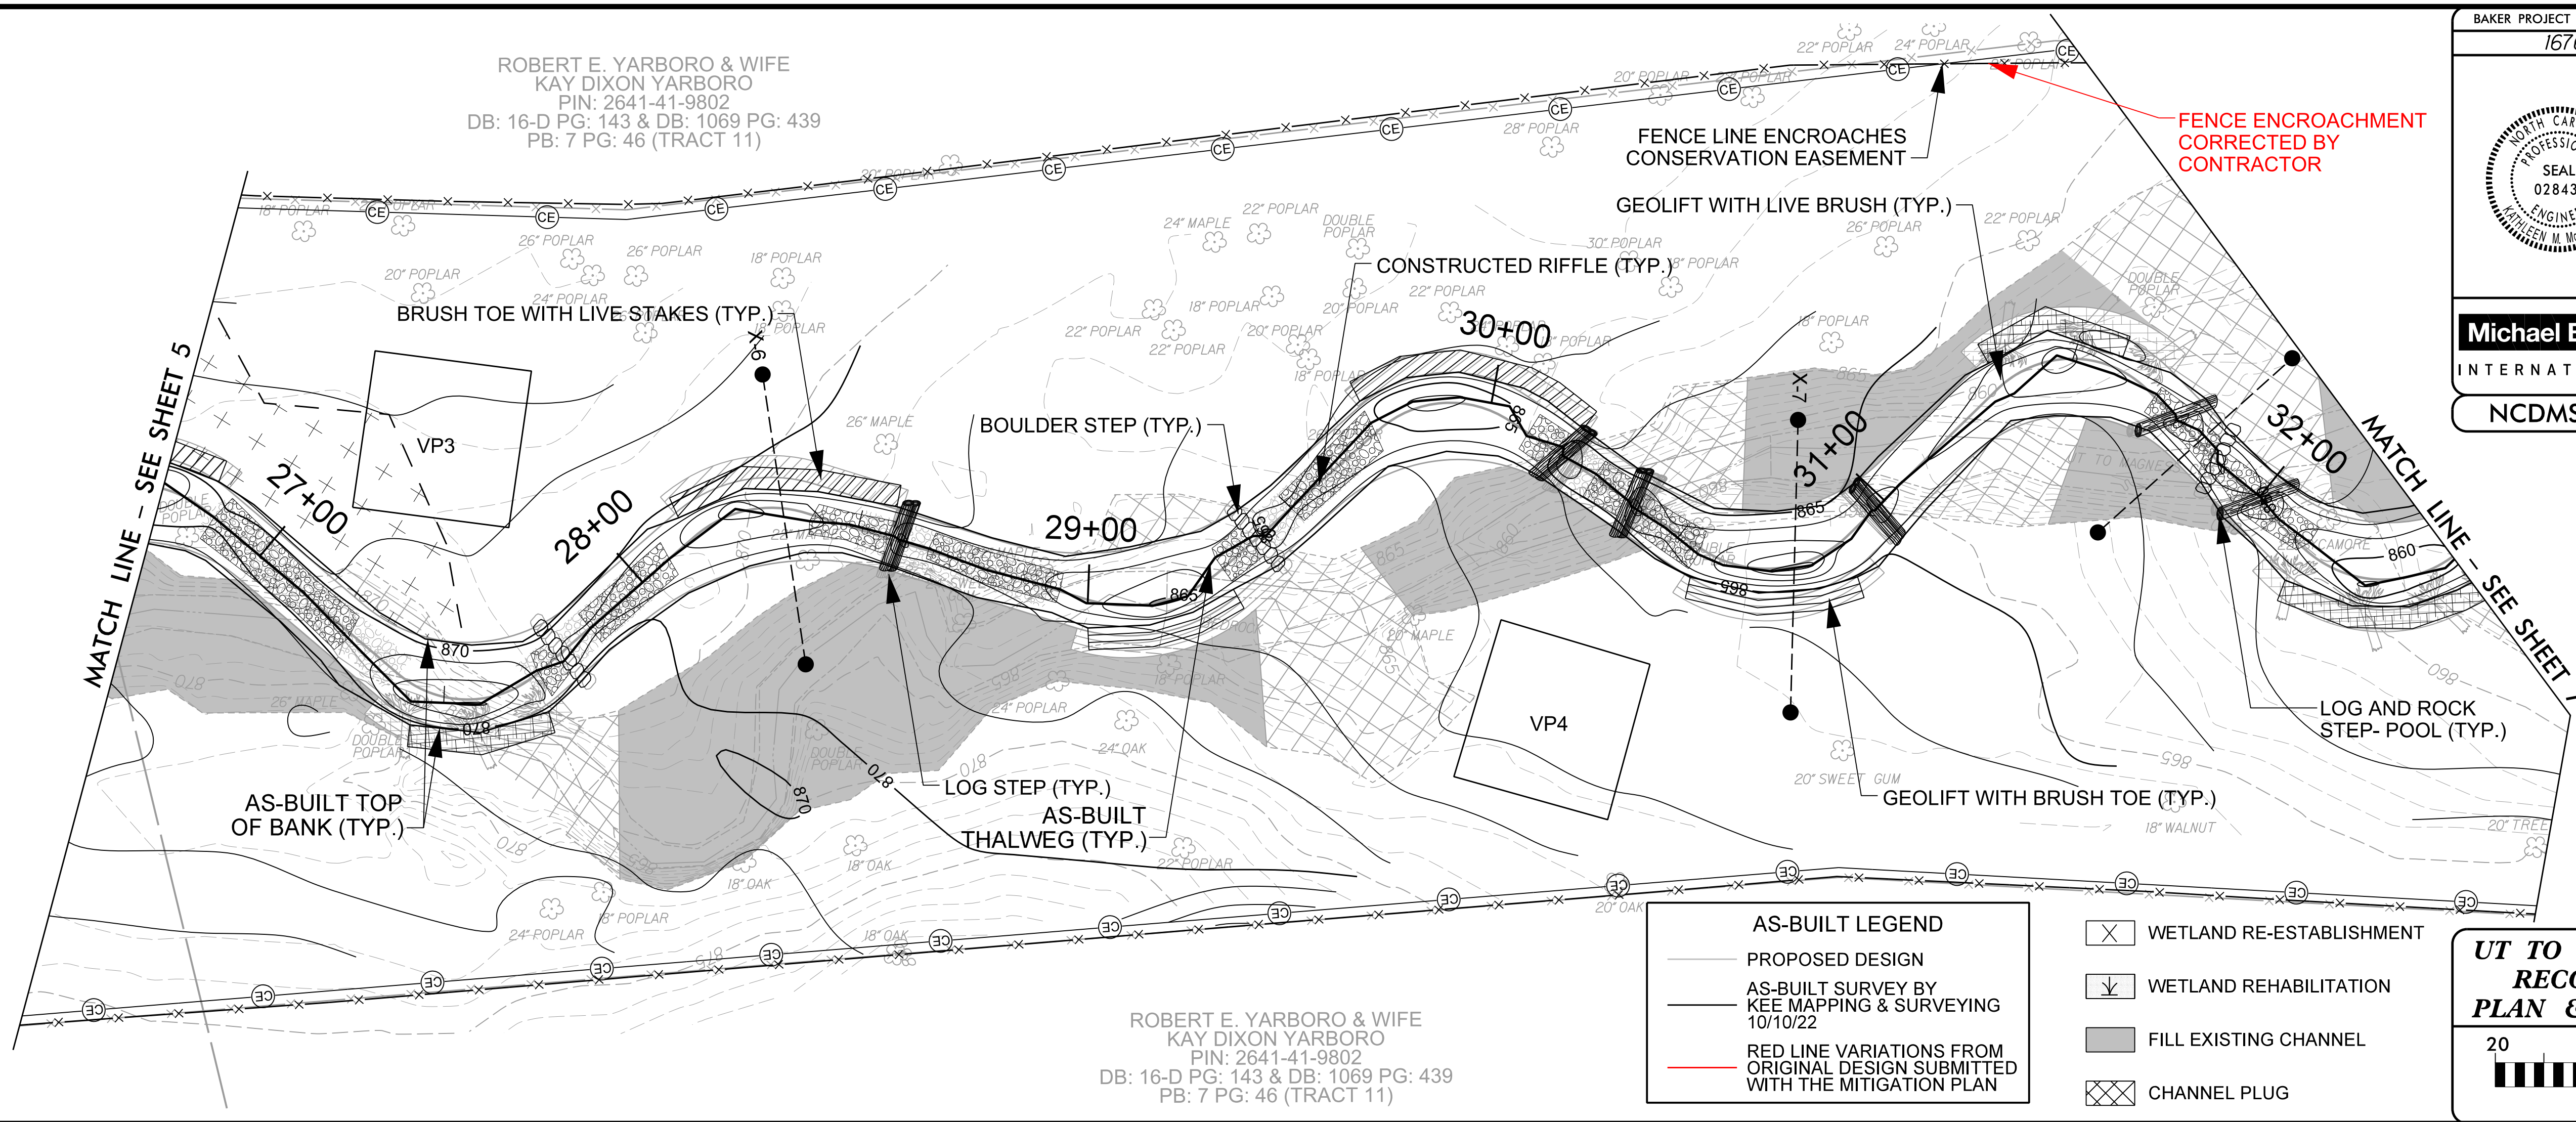


ROBERT E. YARBORO & WIFE
KAY DIXON YARBORO
PIN: 2641-41-9802
DB: 16-D PG: 143 & DB: 1069 PG: 439
PB: 7 PG: 46 (TRACT 11)

AS-BUILT LEGEND



- PROPOSED DESIGN
- AS-BUILT SURVEY BY KEE MAPPING & SURVEYING 10/10/22
- RED LINE VARIATIONS FROM ORIGINAL DESIGN SUBMITTED WITH THE MITIGATION PLAN

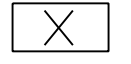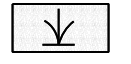-  WETLAND RE-ESTABLISHMENT
-  WETLAND REHABILITATION
-  FILL EXISTING CHANNEL
-  CHANNEL PLUG

**UT TO MAGNESS CREEK
RECORD DRAWING
PLAN & PROFILE VIEW**




SCALE (FT)

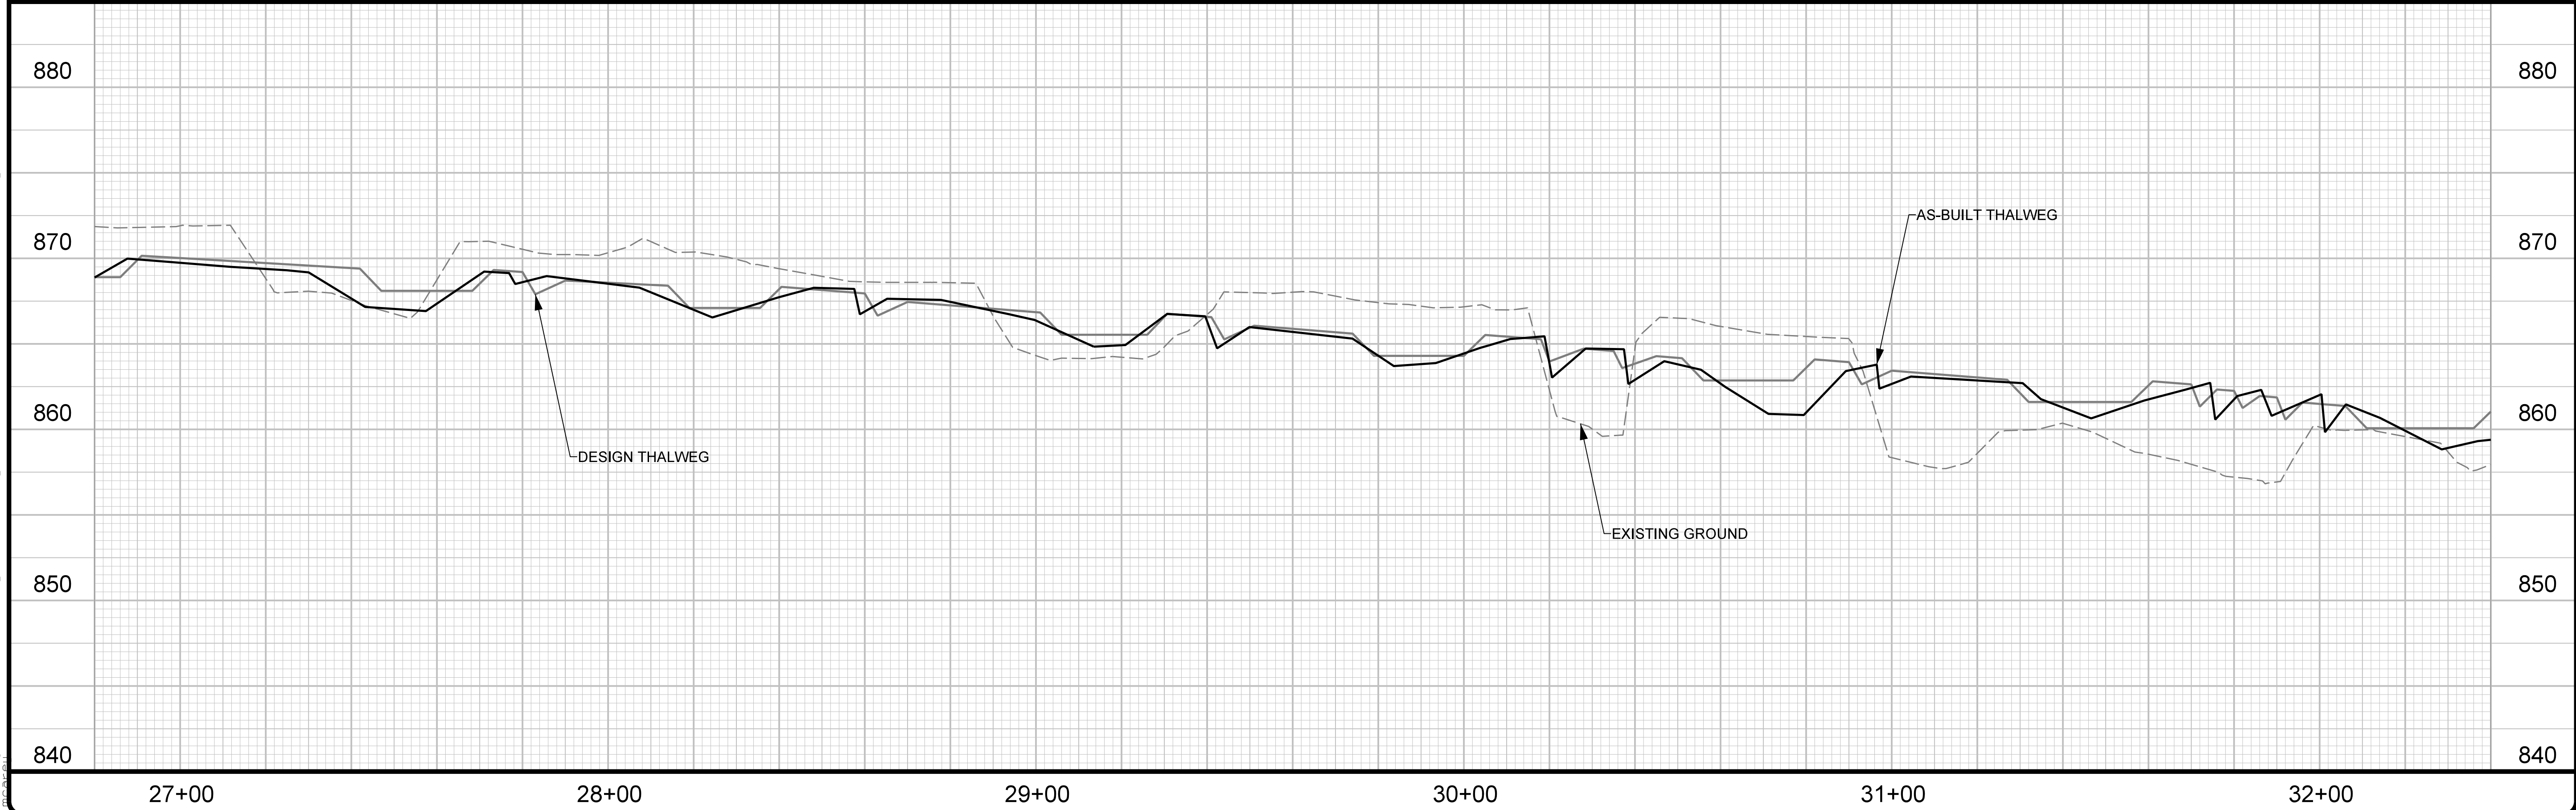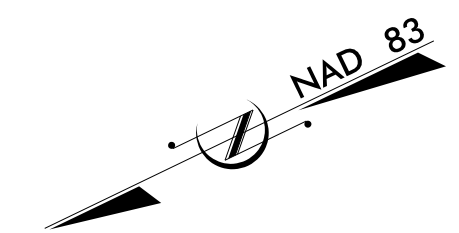


6/6/2023
C:\Users\jts\OneDrive\Projects\167680\UT to Magness Cr\Design\As-Built\Plans\167680_ASB_PSH_06.dgn

2/26/2023

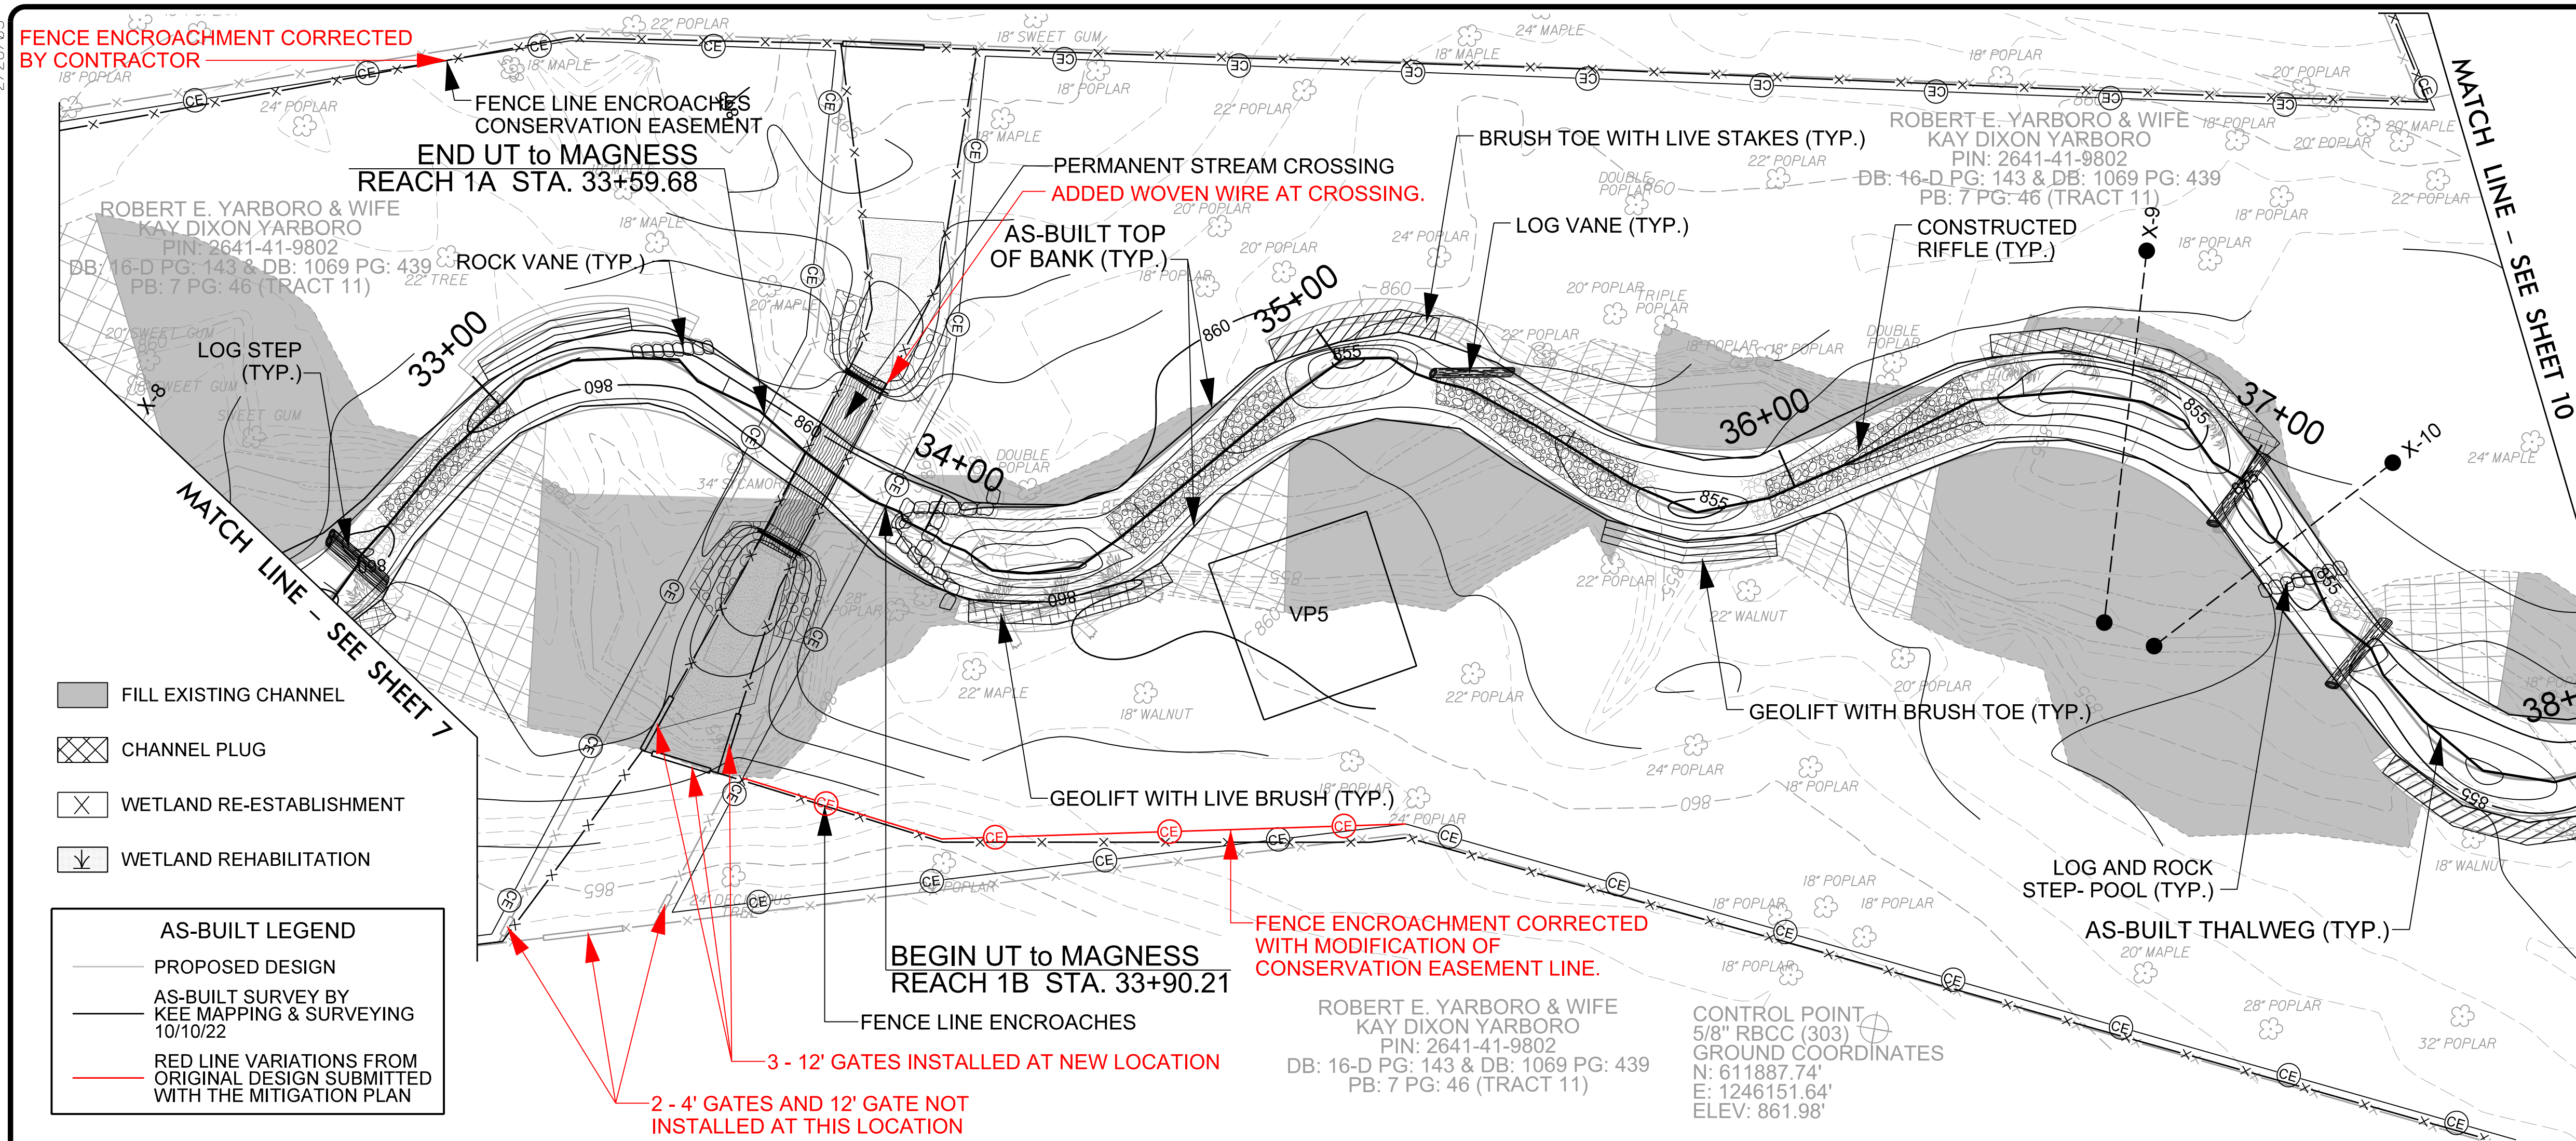


BAKER PROJECT REFERENCE NO. 167680	SHEET NO. 7
PROJECT ENGINEER	
Documented by: Kathleen M. McArthur APPROVED BY: DATE: 6/12/2023	
Michael Baker International Michael Baker Engineering Inc. 6300 Regency Parkway, Suite 500 Cary, NORTH CAROLINA 27518 Phone: 919.463.5488 Fax: 919.463.5490 License #: F-1084	
NCDMS ID NO. 100081	

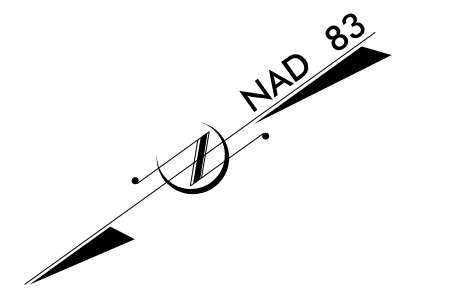


UT TO MAGNESS CREEK
RECORD DRAWING
PLAN & PROFILE VIEW

SCALE (FT)

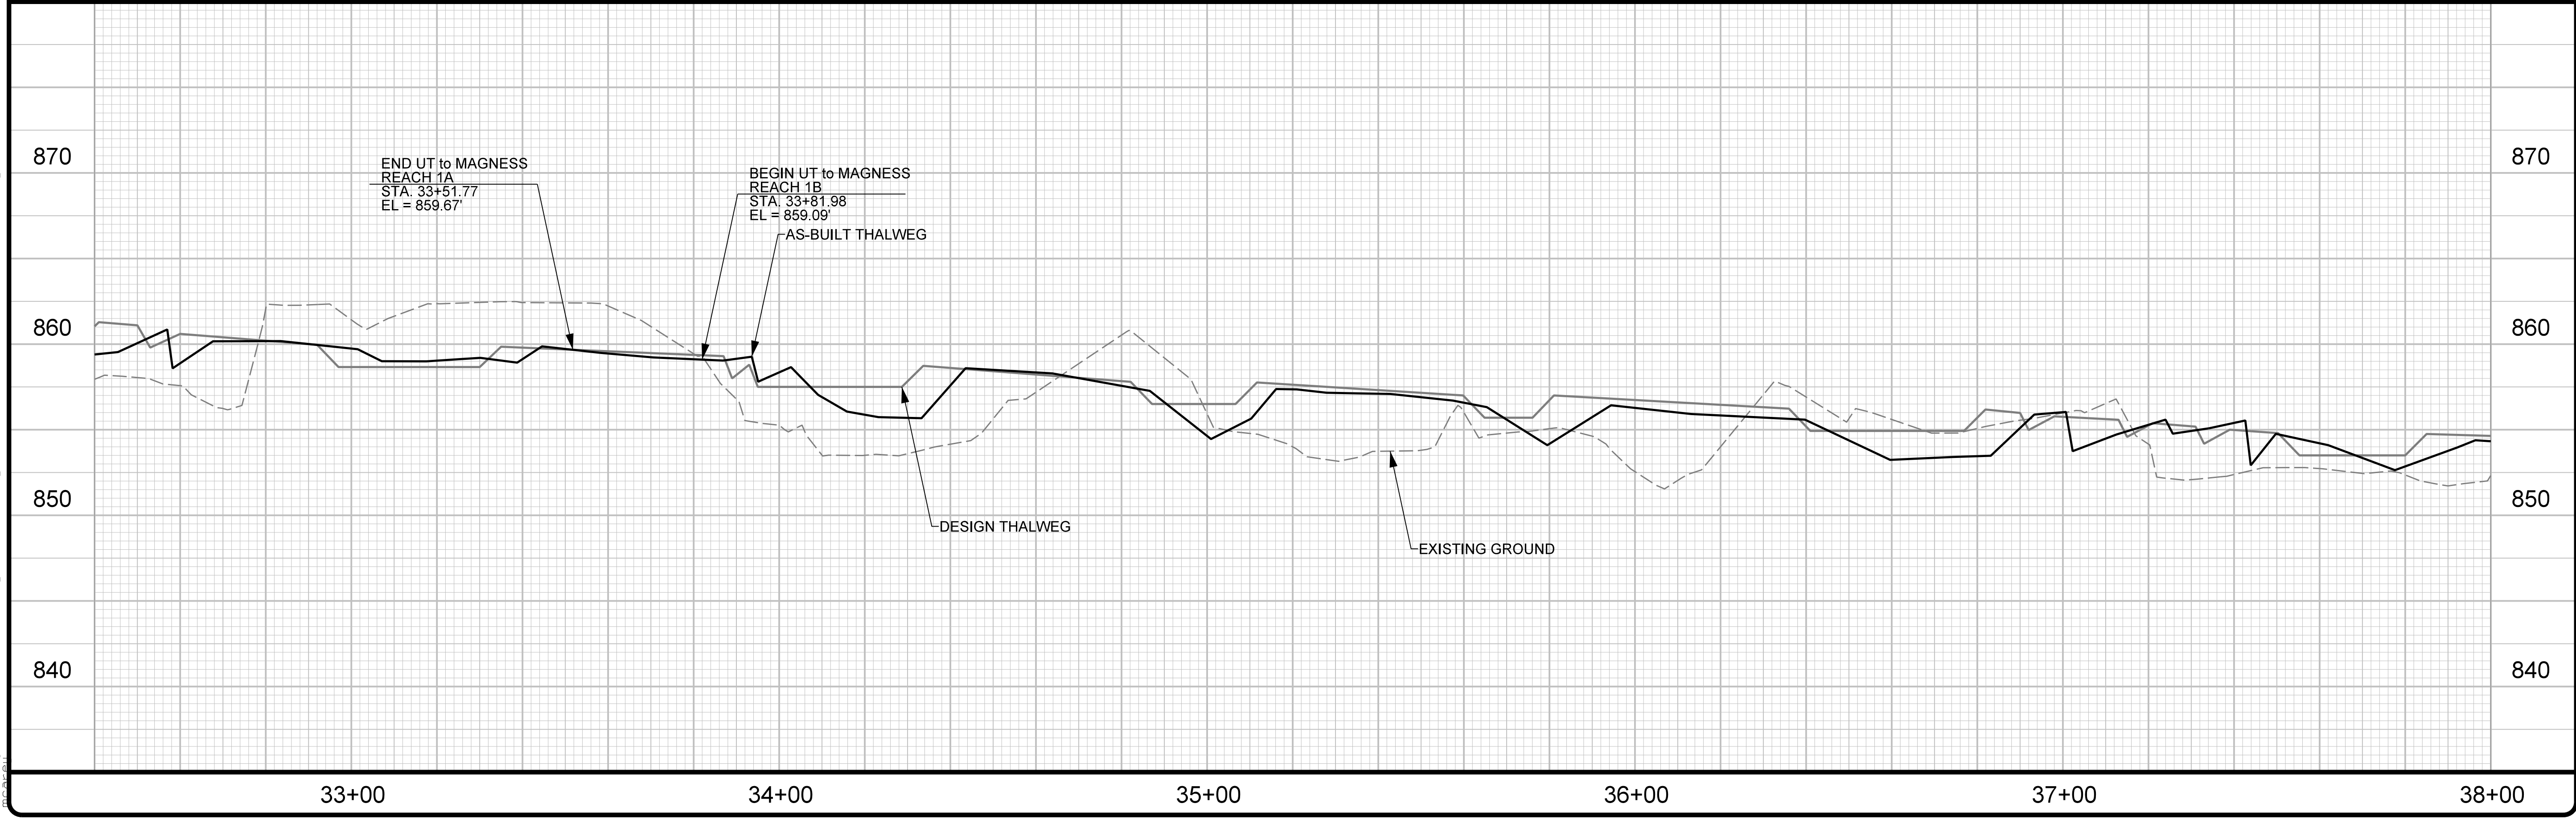

6/6/2023
C:\Users\jts\Documents\Projects\167680\UT to Magness Cr.\Design\As-Built\Plans\167680_ASB-PSH_07.dgn

2/26/2023

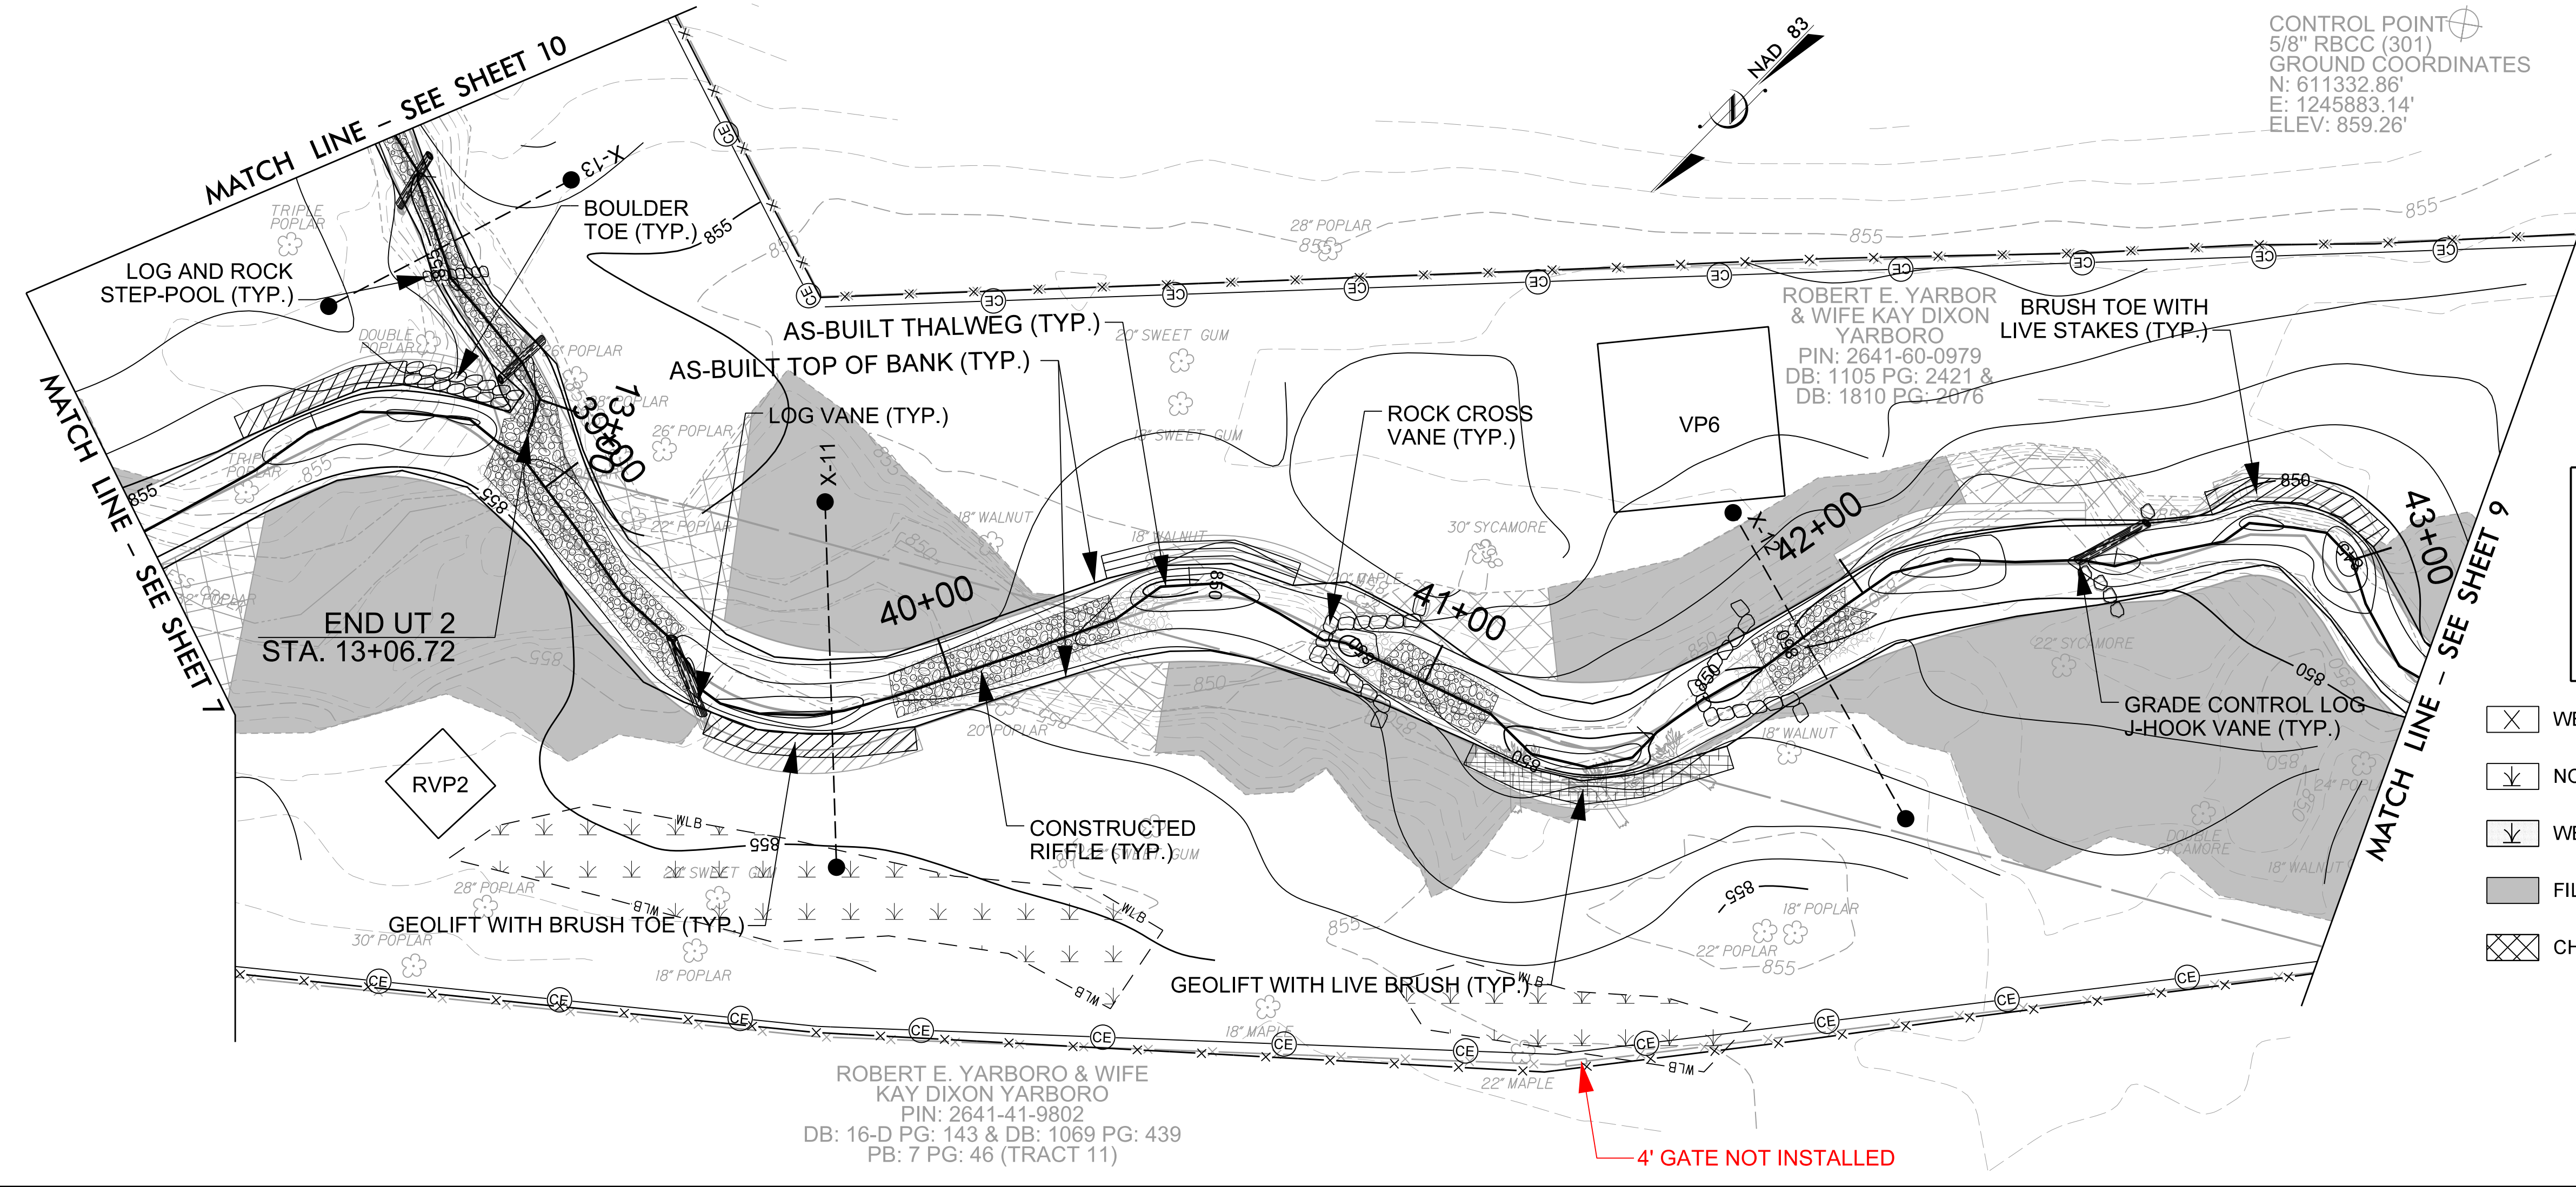

BAKER PROJECT REFERENCE NO. 167680	SHEET NO. 8
PROJECT ENGINEER Kathleen M. McKeithan Professional Seal 028432 APPROVED BY: 6/12/2023 DATE:	

Michael Baker International
Michael Baker Engineering Inc.
3200 Regency Parkway, Suite 500
Cary, NORTH CAROLINA 27518
Phone: 919.463.5488
Fax: 919.463.5490
License #: F-1084

NCDMS ID NO. 100081


AS-BUILT LEGEND

- PROPOSED DESIGN
- AS-BUILT SURVEY BY KEE MAPPING & SURVEYING 10/10/22
- RED LINE VARIATIONS FROM ORIGINAL DESIGN SUBMITTED WITH THE MITIGATION PLAN

- WETLAND RE-ESTABLISHMENT
- NON-CREDITED JURISDICTIONAL WETLANDS
- WETLAND REHABILITATION
- FILL EXISTING CHANNEL
- CHANNEL PLUG


UT TO MAGNESS CREEK RECORD DRAWING PLAN & PROFILE VIEW


SCALE (FT)

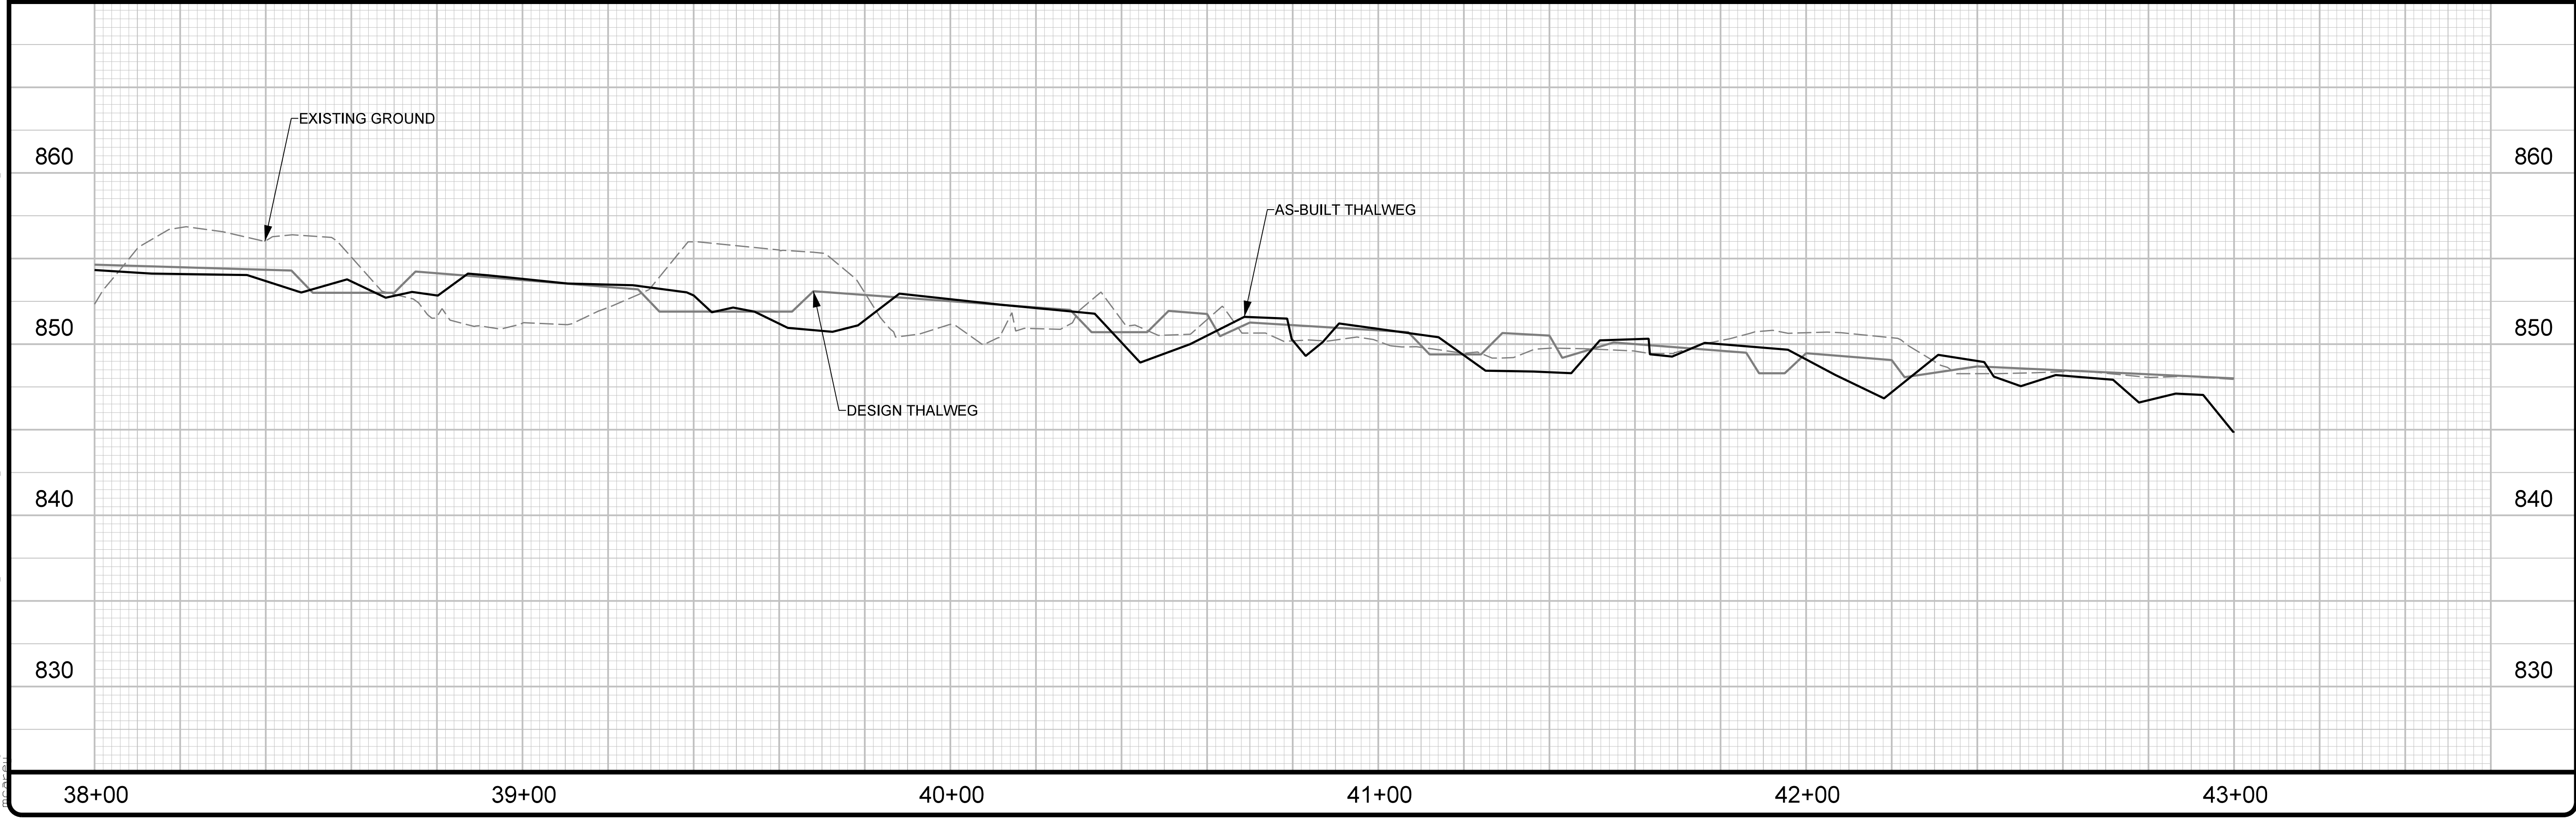

6/6/2023
C:\Users\jts\OneDrive\Documents\Projects\167680\UT to Magness Cr.\Design\As-Built\Plans\167680_ASB-PSH_08.dgn

2/26/2023


BAKER PROJECT REFERENCE NO. 167680	SHEET NO. 9
PROJECT ENGINEER	
	
DocuSigned by: Kathleen M. McKeithan 24752691484433	
APPROVED BY:	
6/12/2023	
DATE:	
Michael Baker International Michael Baker Engineering Inc. 6200 Regency Parkway, Suite 500 Cary, NORTH CAROLINA 27518 Phone: 919.463.5488 Fax: 919.463.5490 License #: F-1084	
NCDMS ID NO. 100081	

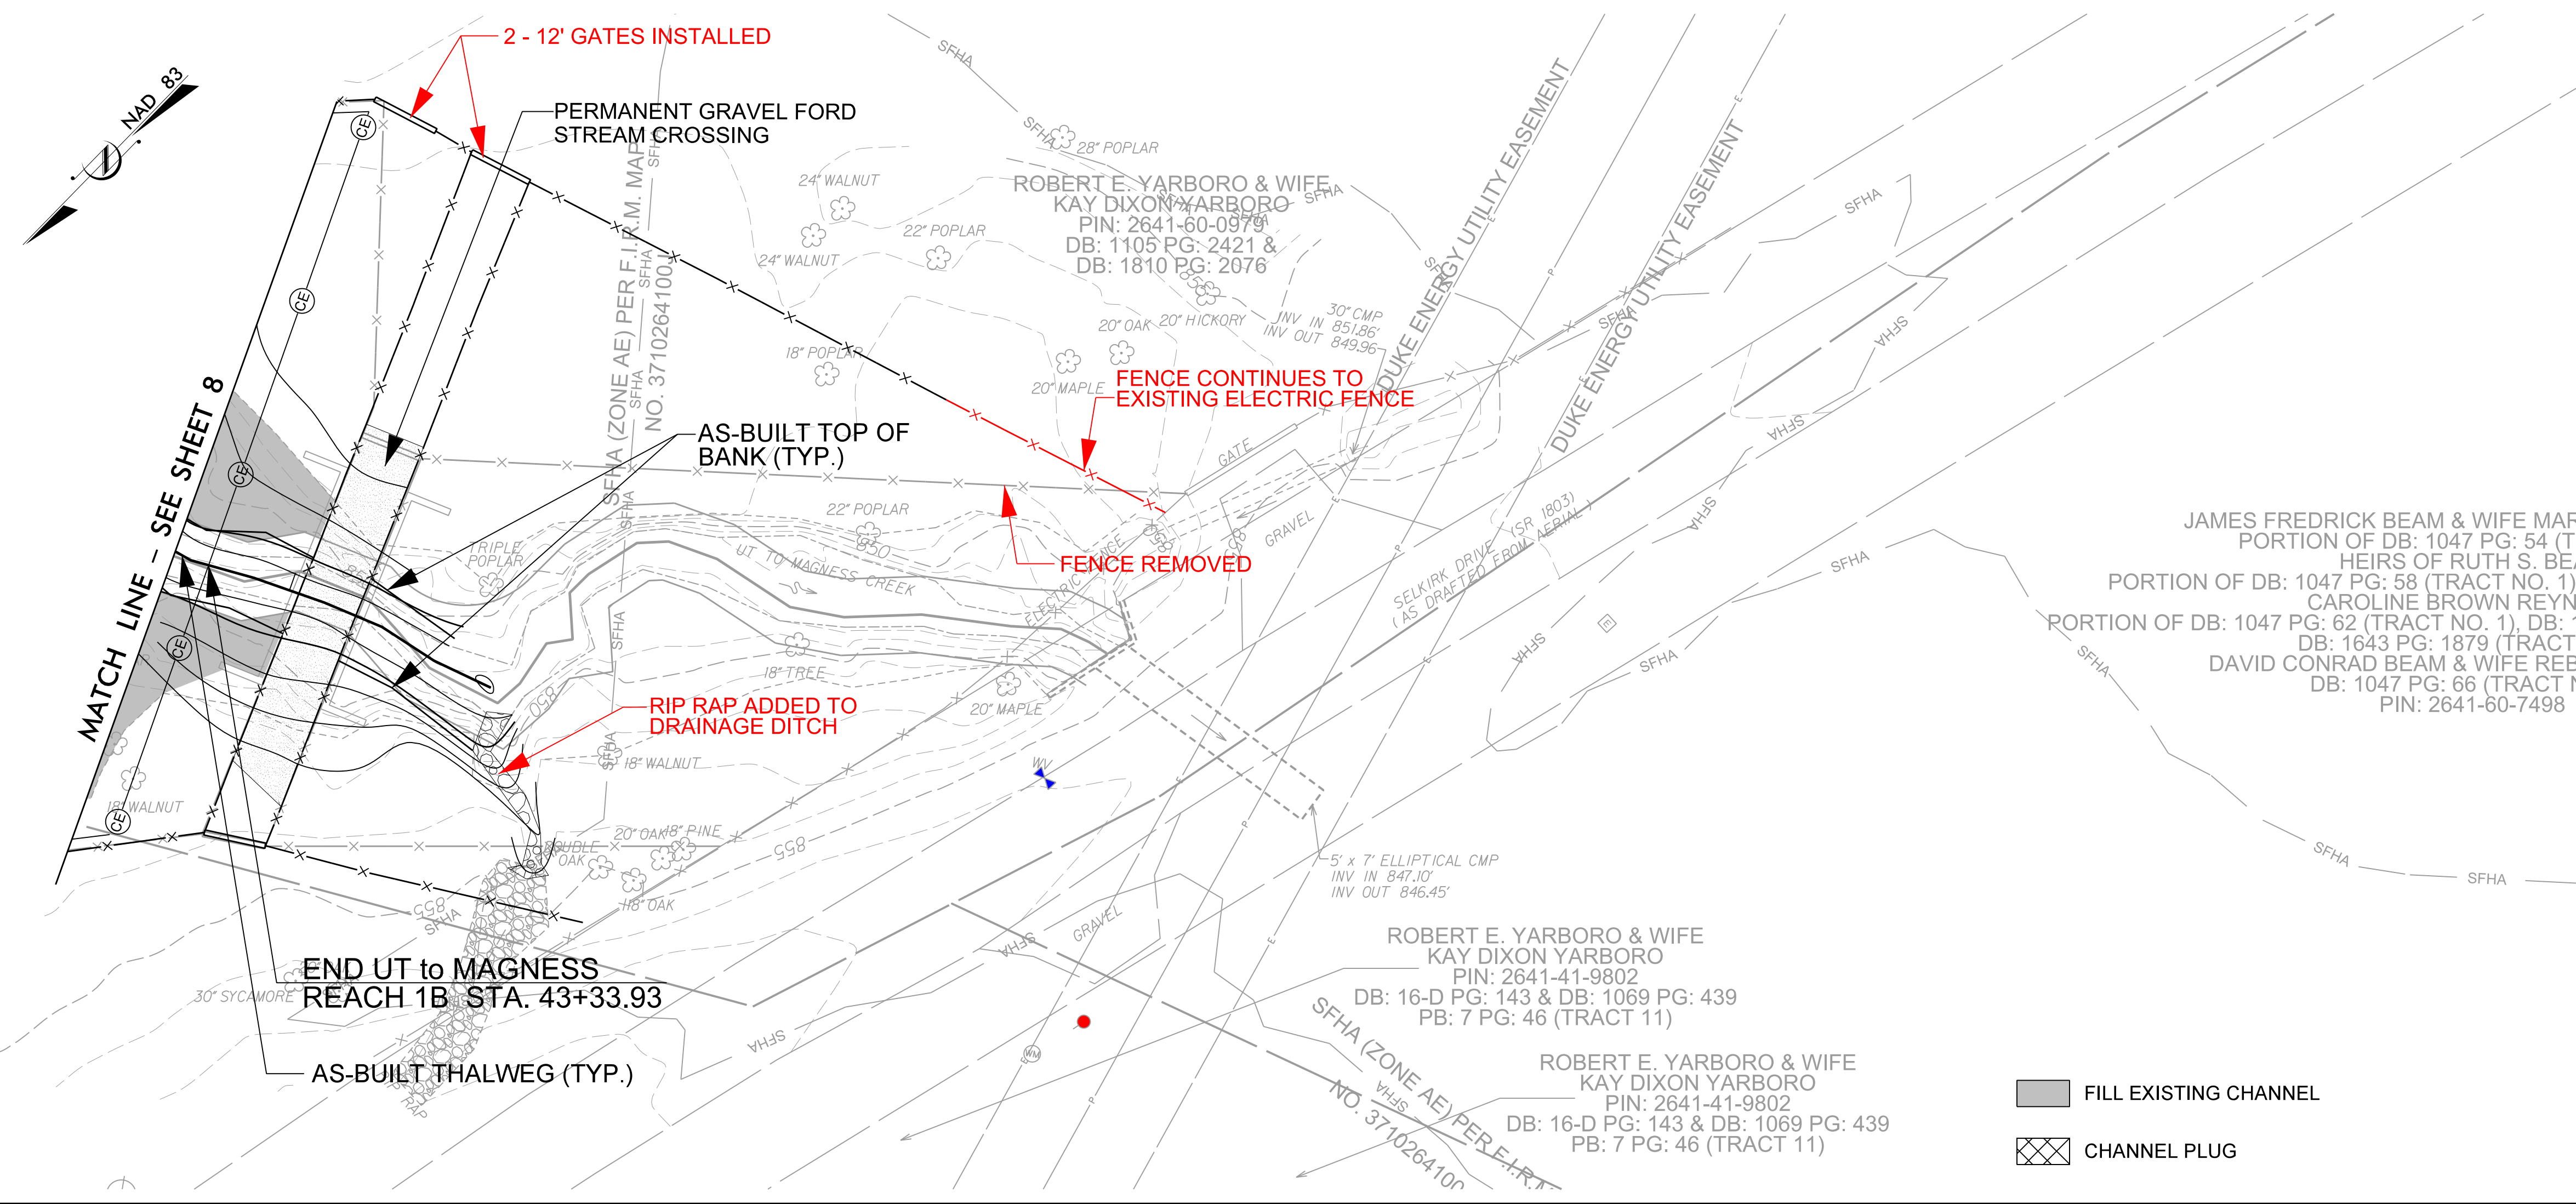


AS-BUILT LEGEND

- PROPOSED DESIGN
- AS-BUILT SURVEY BY KEE MAPPING & SURVEYING 10/10/22
- RED LINE VARIATIONS FROM ORIGINAL DESIGN SUBMITTED WITH THE MITIGATION PLAN

UT to MAGNESS CREEK RECORD DRAWING PLAN & PROFILE VIEW




SCALE (FT)

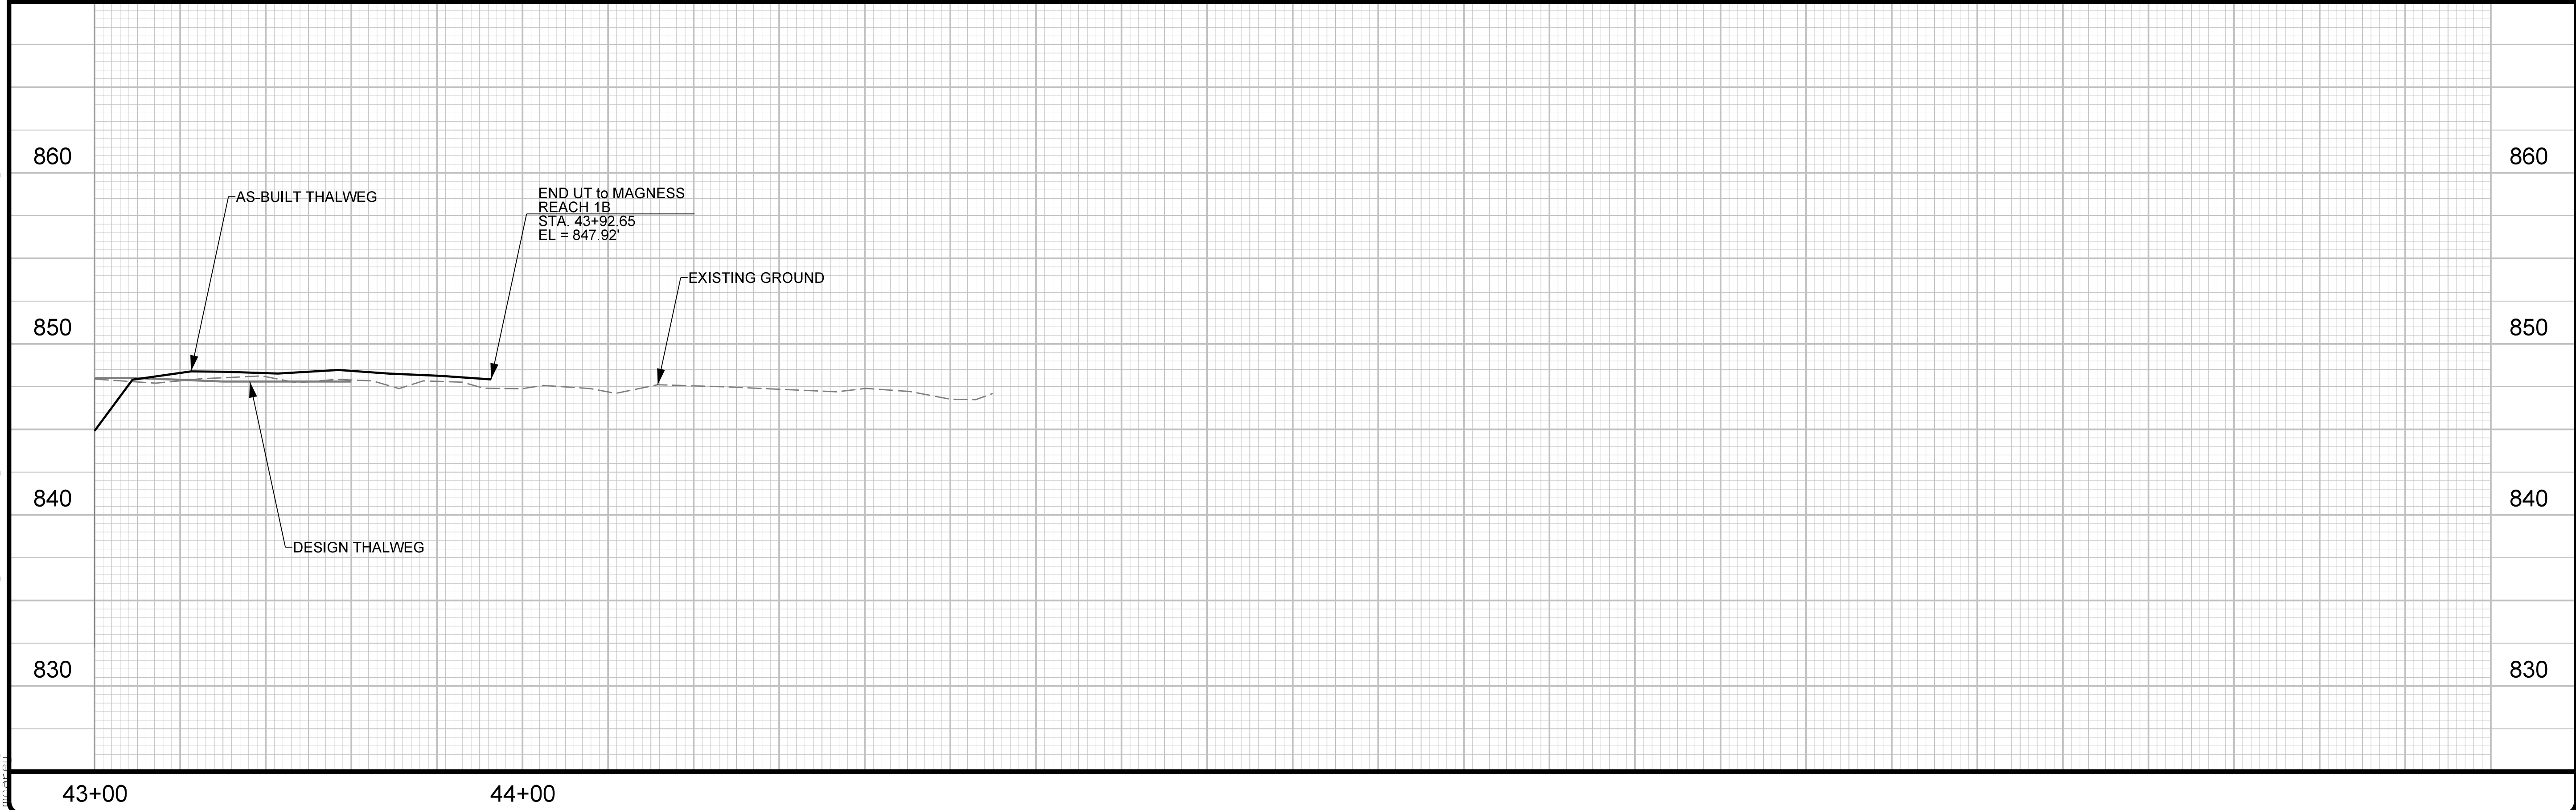

6/6/2023
C:\Users\jts\OneDrive\Documents\167680\UT to Magness Cr\Design\As-Built\Plans\167680_ASB_PSH_09.dgn

2/26/2023

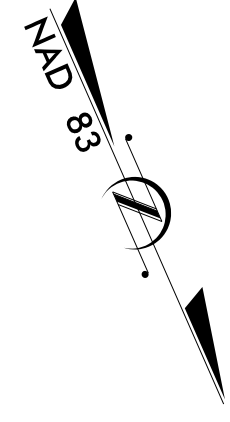



ROY P. SHARPE & WIFE
DRUSILLA D. SHARPE
PIN: 2641-71-0003
DB: 1632 PG: 190

CEDAR LAKE FARM, LLC
PIN: 2641-72-1337
DB: 1587 PG: 1352 (TRACT 4)

ROBERT E. YARBORO & WIFE
KAY DIXON YARBORO
PIN: 2641-60-0979
DB: 1105 PG: 2421 &
DB: 1810 PG: 2076

CONTROL POINT
NCGS MONUMENT (302)
GROUND COORDINATES
N: 611569.06'
E: 1246122.01'
ELEV: 860.26'

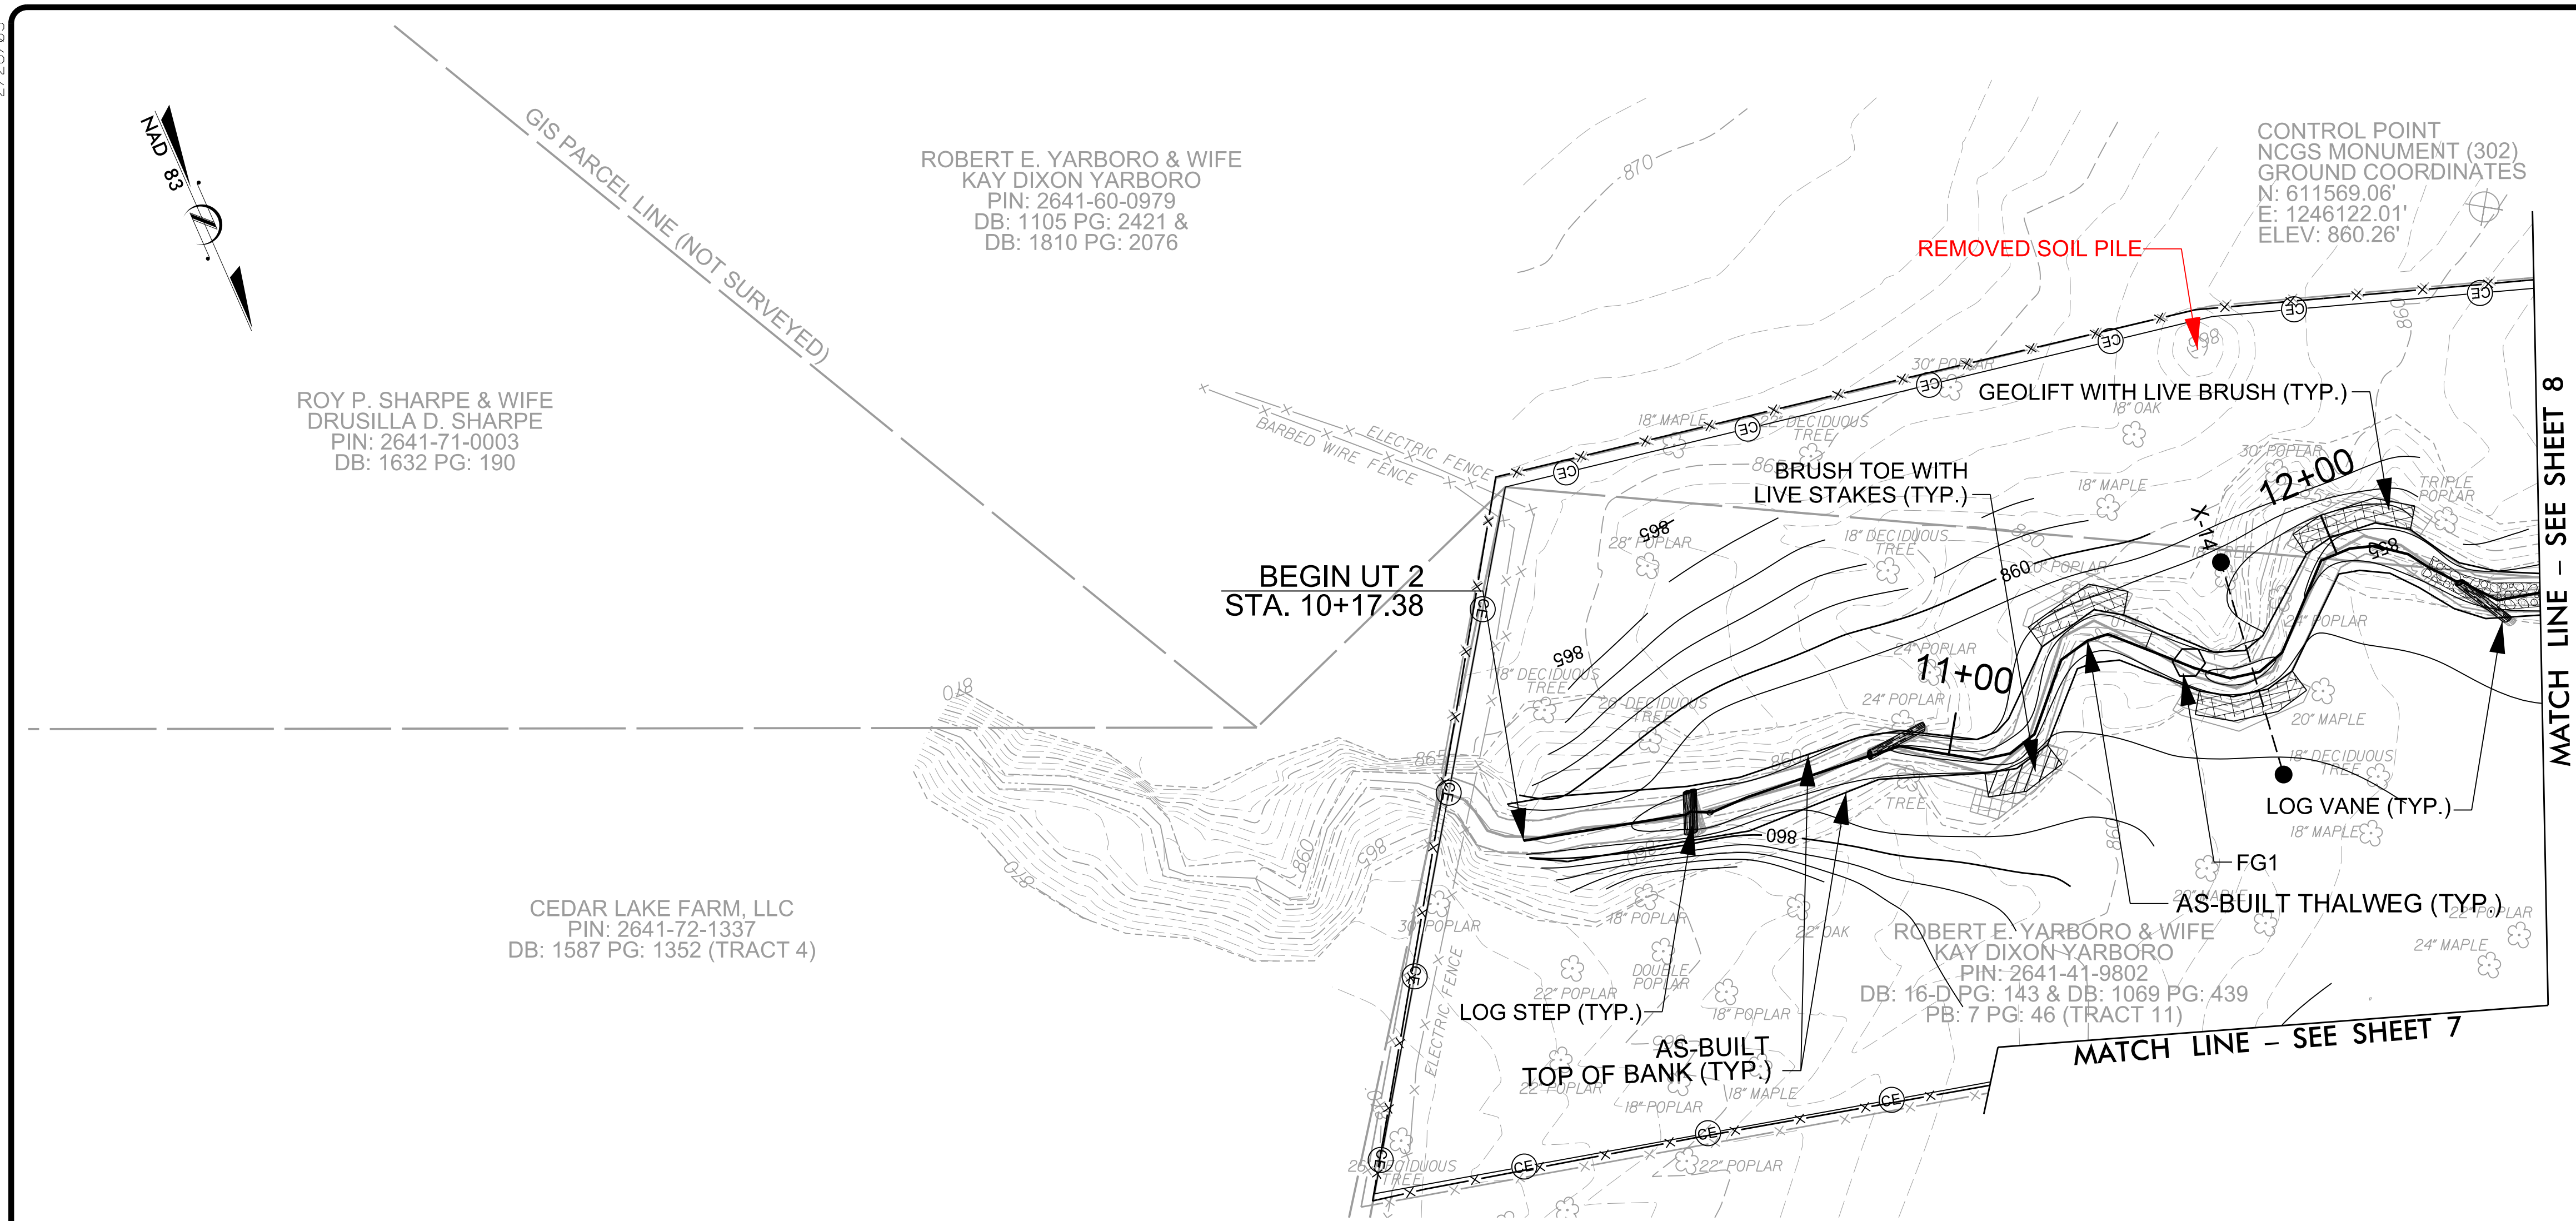

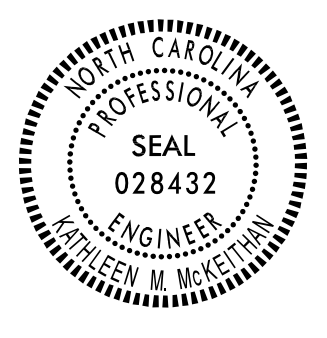
BAKER PROJECT REFERENCE NO. 167680	SHEET NO. 10
PROJECT ENGINEER	
	
DocuSigned by: <i>Kathleen M. McKeithan</i> APPROVED BY:	
DATE: 6/12/2023	
Michael Baker International	
Michael Baker Engineering Inc. 6200 Regency Parkway, Suite 500 Cary, NORTH CAROLINA 27518 Phone: 919.463.5488 Fax: 919.463.5490 License #: F-1084	
NC DMS ID NO. 100081	

AS-BUILT LEGEND


- PROPOSED DESIGN
- AS-BUILT SURVEY BY
KEE MAPPING & SURVEYING
10/10/22
- RED LINE VARIATIONS FROM
ORIGINAL DESIGN SUBMITTED
WITH THE MITIGATION PLAN

- FILL EXISTING CHANNEL
- CHANNEL PLUG

**UT TO MAGNESS CREEK
RECORD DRAWING
PLAN & PROFILE VIEW**



SCALE (FT)

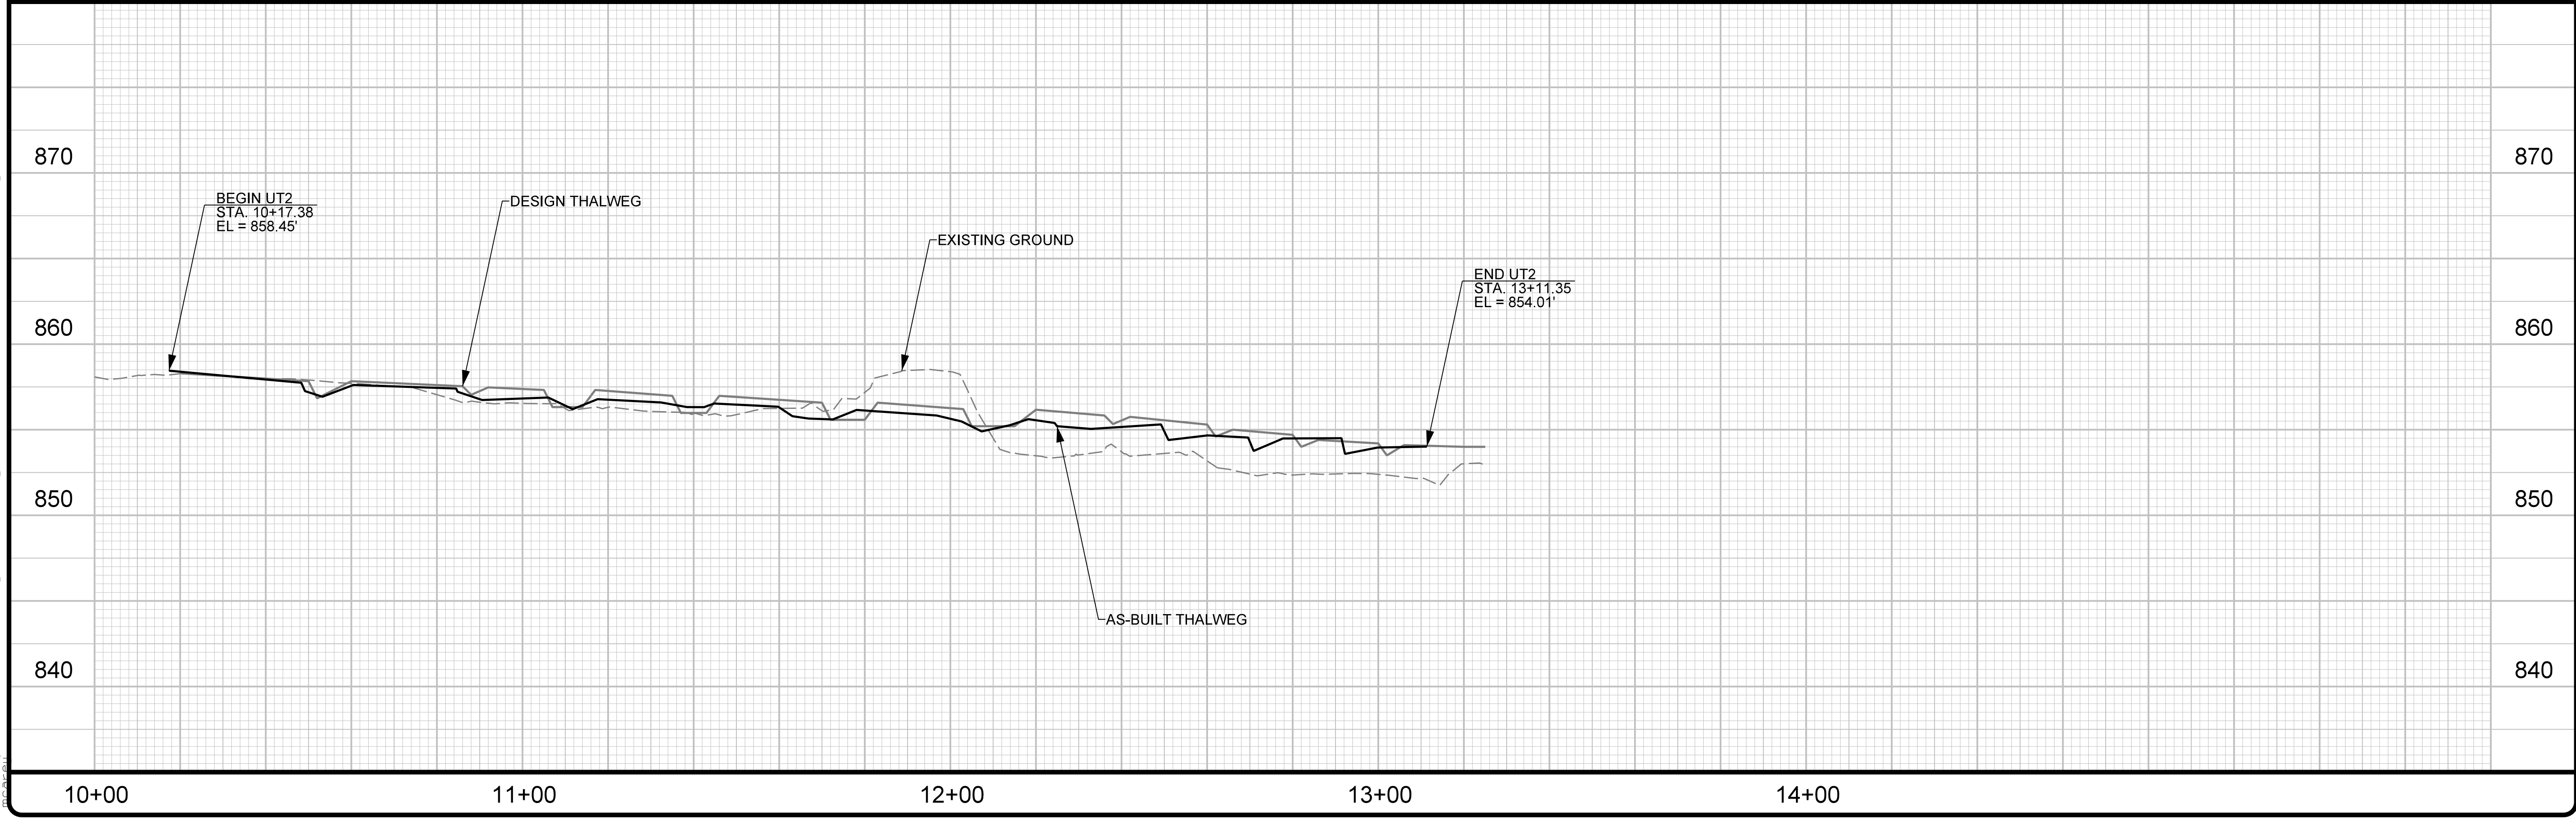

6/6/2023
C:\Users\jts\OneDrive\Documents\Projects\167680\AS-Built\Plans\167680_AS-Built_PSH_10.dgn