

STATE	STATE PROJECT REFERENCE NO.	SHEET NO.	TOTAL SHEETS
N.C.	U-2524WM	1	12
STATE PROJ. NO.	P.A. PROJ. NO.	DESCRIPTION	
34820.4.1		PE	
34820.4.2		R/W	
34820.4.3		CONST.	


STATE OF NORTH CAROLINA
DIVISION OF HIGHWAYS

CHATHAM COUNTY


LOCATION: UT BEAR CREEK NEAR SR 1141
AND SR 1136 (HERB BEAVERS ROAD)

TYPE OF WORK: STREAM MITIGATION

PROJECT: WBS 34820.4.3 U-2524WM

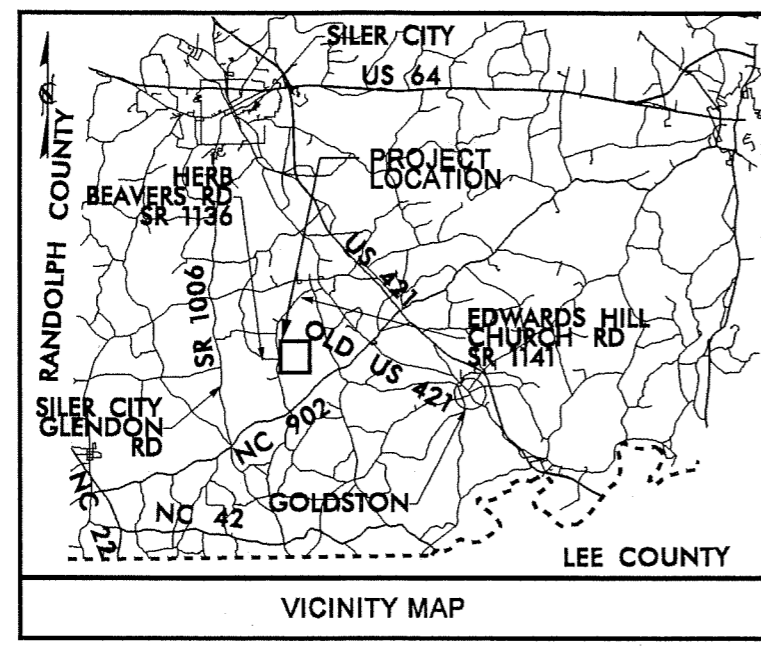


VICINITY MAP
SEE SHEET 1-A FOR INDEX OF SHEETS

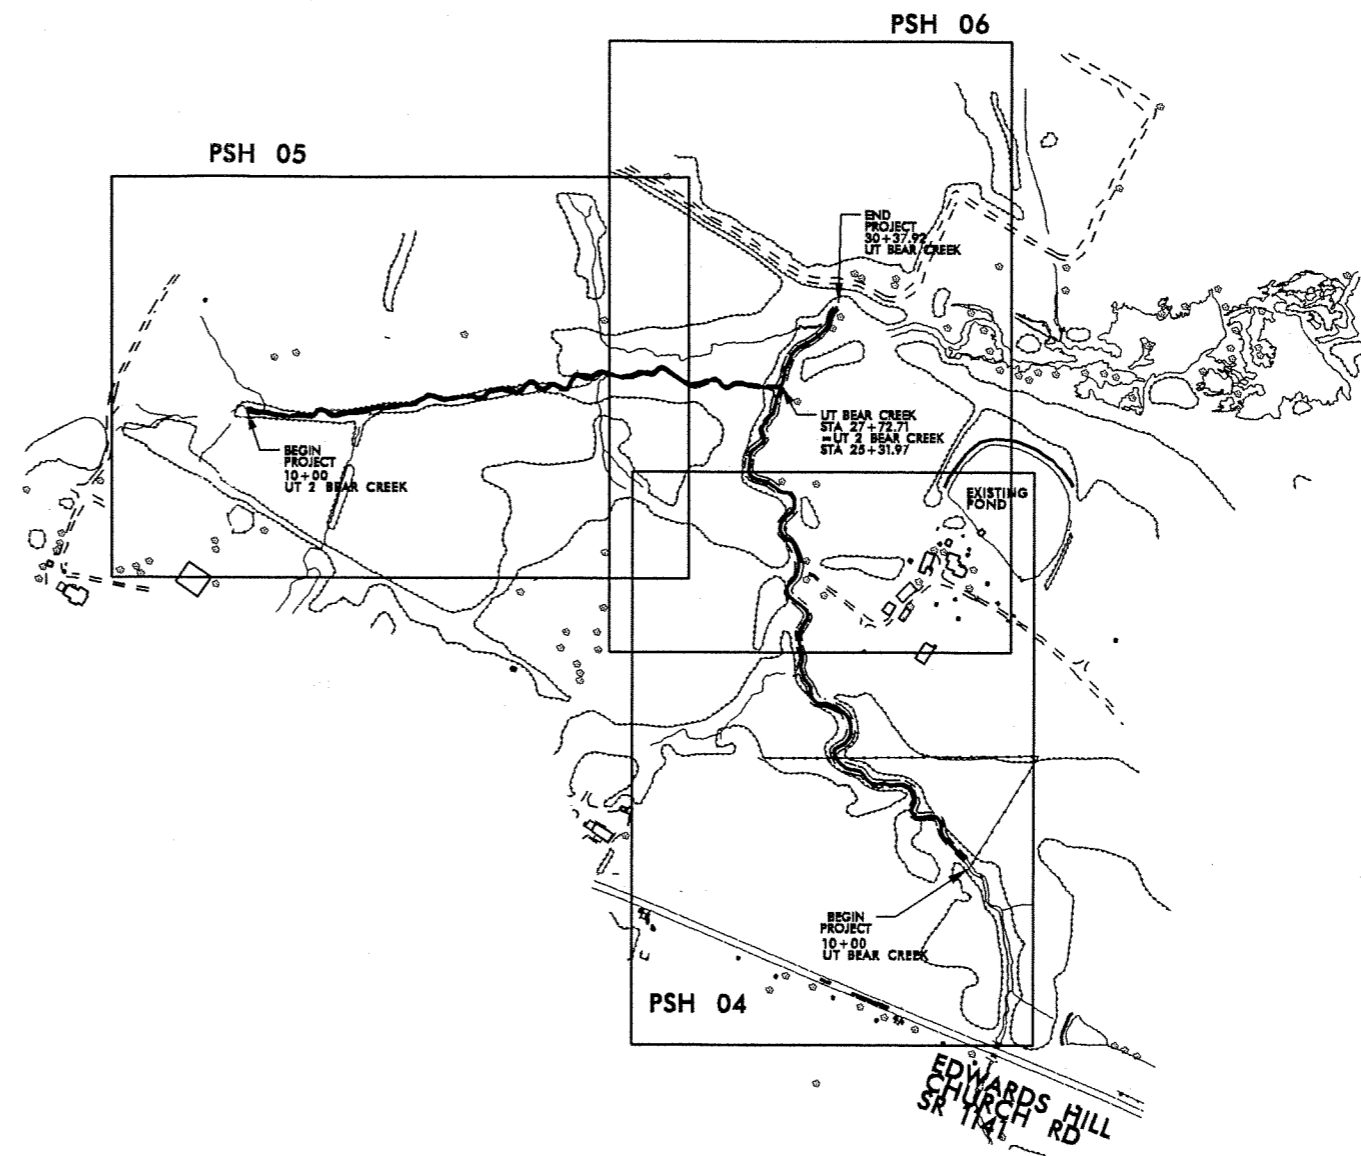

AS BUILT

AS BUILT
2,500 LF Restoration
1,070 LF Enhancement

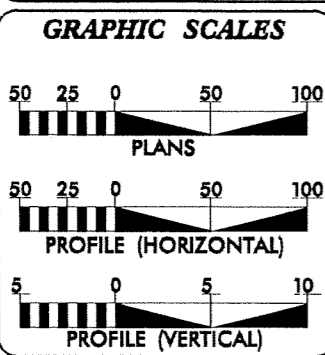

DESIGN DATA		
	UT BEAR CREEK	UT-2
DESIGN STREAM TYPE	C-4C-5	C-4C-5
DESIGN REACH LENGTH	2040	1532
BANKFULL XSEC AREA	34.6	7.2
BANKFULL WIDTH	21.3	9.8
BANKFULL DEPTH	1.7	0.9
W/D RATIO	12.2	10.8





PROJECT LENGTH	
UT BEAR CREEK	
EXISTING STREAM LENGTH	= 1926.7 FEET
PROPOSED DESIGN STREAM LENGTH	= 2017.0 FEET
UT-2	
EXISTING STREAM LENGTH	= 1284.0 FEET
PROPOSED DESIGN STREAM LENGTH	= 1532.0 FEET

NGDOT CONTACTS: BYRON MOORE, PE
PROJECT MANAGERS

PREPARED IN THE OFFICE OF:	
MARCH 29, 2006 LETTING DATE:	<u>W. HENRY WELLS, PE</u> PROJECT ENGINEER

PROJECT ENGINEER
_____ SIGNATURE

TYPICAL RIFFLE AND POOL FOR UT BEAR CREEK AND UT2 BEAR CREEK

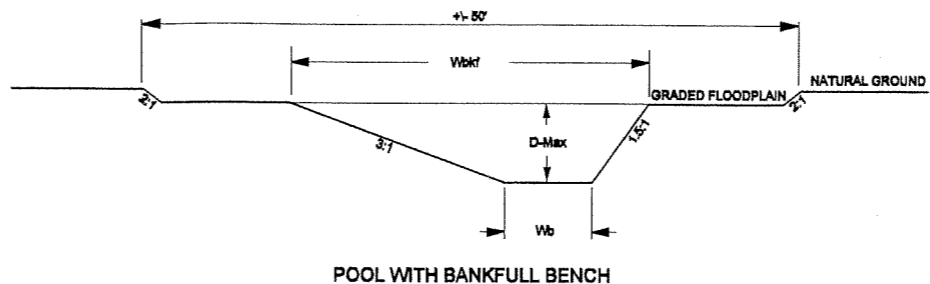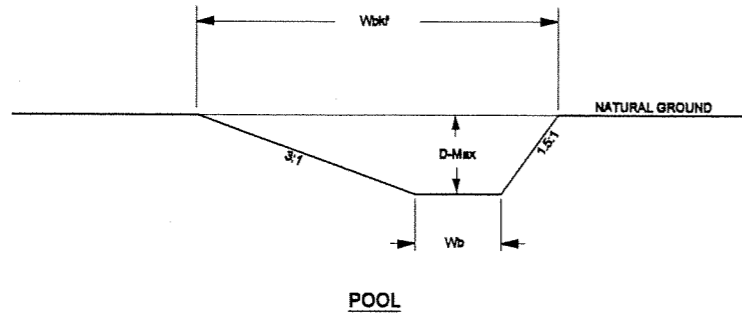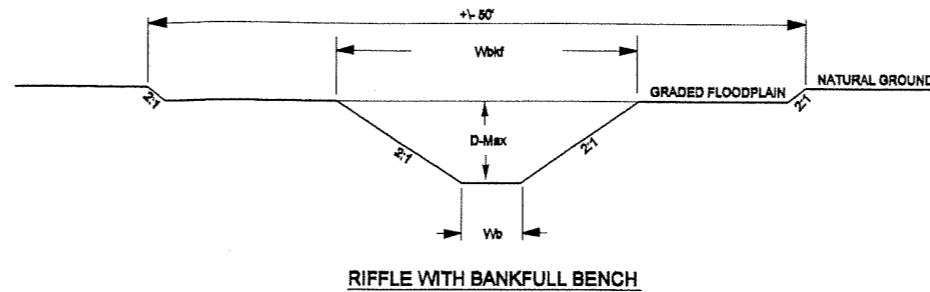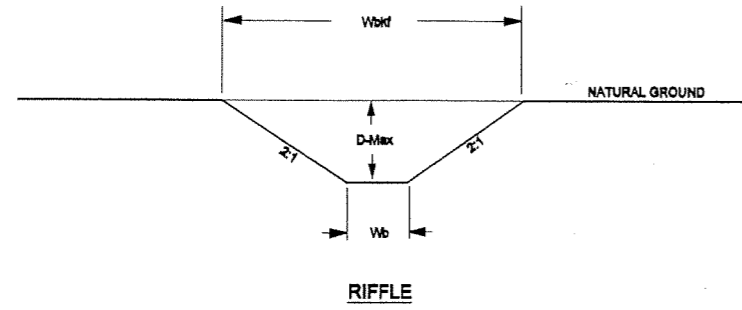


UT BEAR CREEK		UT2 BEAR CREEK	
RIFFLE	POOL	RIFFLE	POOL
21.3'	11-21'	9.8'	8-10'
1.7'	3.0'	0.9'	1.3'
2.0'	3.0'	1.3'	1.4-2.0'
12.8	3.7-7.0	9.0	5-7.1
34.8 ft ²	18.8-43.8 ft ²	7.2 ft ²	3.8-11.0 ft ²
13.3'	0-7.8'	6.2'	0-1.0'

WIDTH OF BANKFULL (Wbkt)
 AVERAGE DEPTH
 MAXIMUM DEPTH (D-Max)
 WIDTH TO DEPTH RATIO (bkt W/D)
 BANKFULL AREA (Abkt)
 BOTTOM WIDTH (Wb)

- NOTES:
 1. DURING CONSTRUCTION CORNERS OF DESIGN CHANNEL WILL BE ROUNDED AND A THALWEG WILL BE SHAPED PER DIRECTION OF ENGINEER.
 2. POOLS SHOWN ABOVE ARE RIGHT POOLS ONLY. REVERSE DIMENSIONS FOR LEFT TYPICAL POOL.

PROJECT REFERENCE NO. R-2237WM SHEET NO. 2
 PROJECT ENGINEER
 APPROVED BY:
 DATE:
 SUNGATE DESIGN GROUP, P.A.
 ENVIRONMENTAL SERVICES, INC.
 AS BUILT

TYPICAL STRUCTURE PLACEMENT

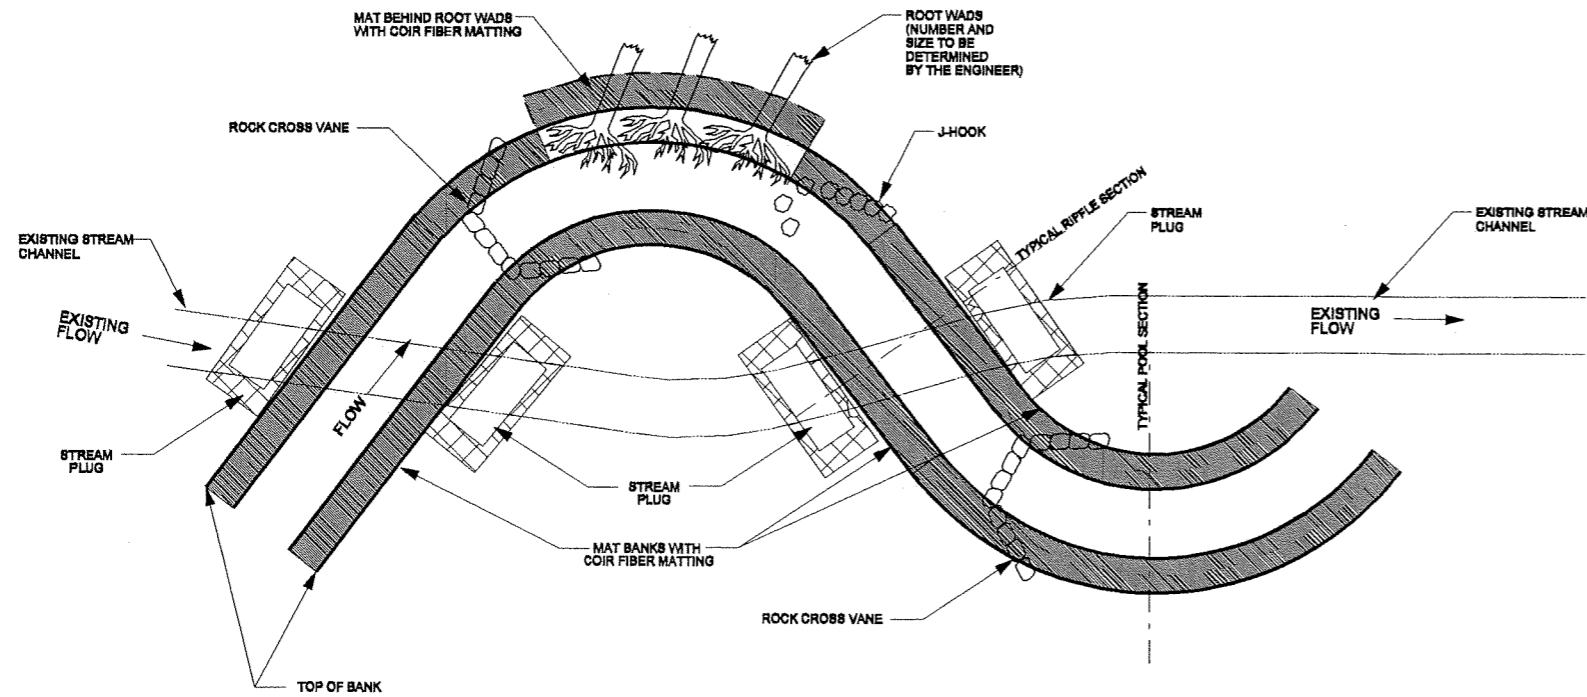


- STRUCTURE NOTES:
 1. GENERALLY STREAM STRUCTURES WILL BE INSTALLED IN THE LOCATION AND SEQUENCE AS SHOWN.
 2. ADDITIONAL STRUCTURES OR CHANGES TO STRUCTURE LOCATIONS MAY BE MADE BY THE ENGINEER DURING CONSTRUCTION.

- NOTES:
 1. COIR FIBER MATTING TO BE INSTALLED ON STREAMBANK AND BEHIND ROOT WADS ON OUTSIDE OF MEANDER BENDS.
 2. IF ROOT WADS DO NOT COVER ENTIRE SLOPE ON OUTSIDE OF MEANDER BENDS, COIR FIBER MATTING IS NEEDED.

STREAM PLUG


SCALE: NTS

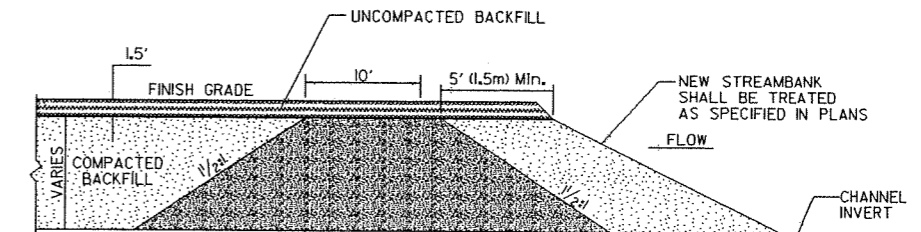

IMPERVIOUS SELECT MATERIAL (SEE PROJECT SPECIAL PROVISIONS)

ROCK CROSS VANE


NOT TO SCALE

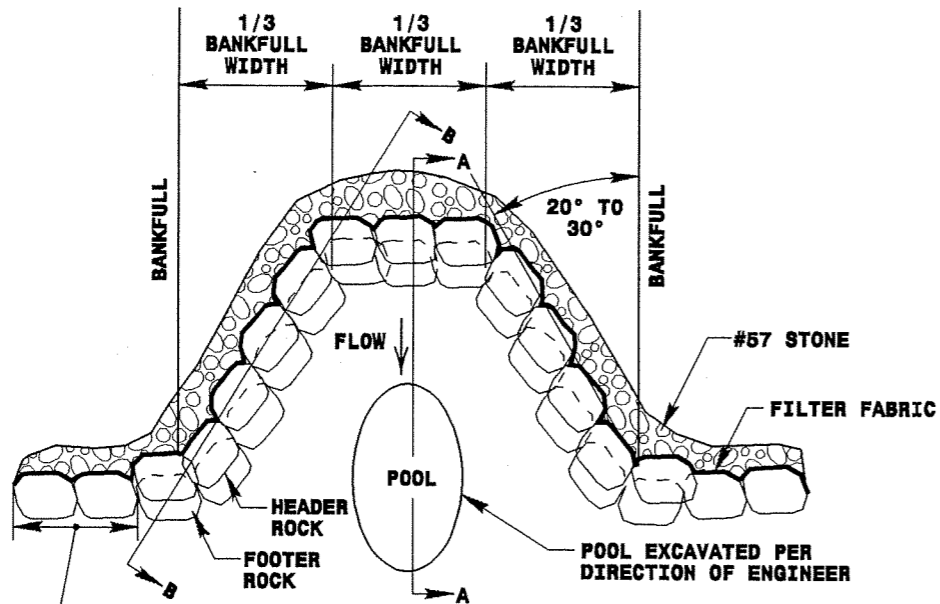

PLAN VIEW


	UT Bear Creek	UT 2
VANE ARM LENGTH	15'-25'	7'-15'
INVERT LENGTH	4.0'-5.0'	2.0'-3.0'
BANKFULL WIDTH	21.0'	10.0'
BOTTOM WIDTH	13.5'	6.0'
SILL LENGTH	5.0'-8.0'	3.0'-5.0'
ARM ANGLE	20° TO 30°	20° TO 30°
ARM SLOPE	4% - 10%	4% - 10%

* DIMENSIONS ARE GENERAL ACTUAL DIMENSIONS DEPENDANT ON SPECIFIC SITE CONDITIONS

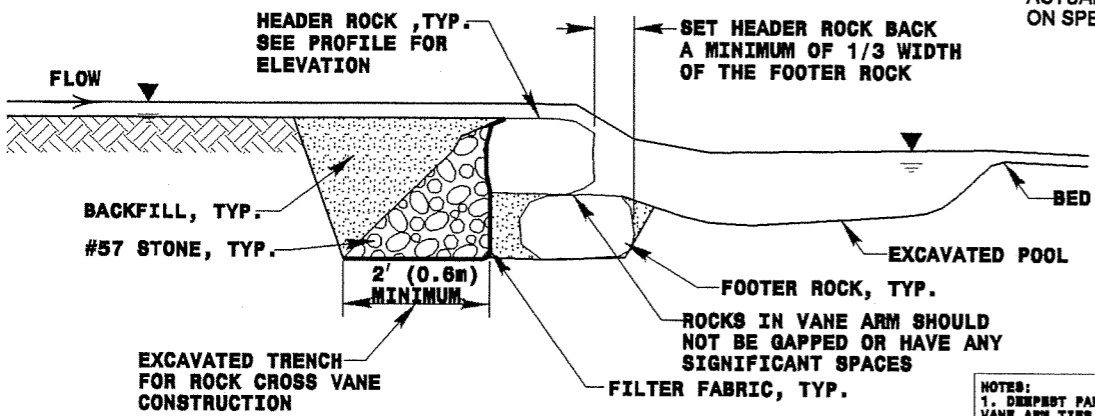


SECTION A-A


- NOTES:
1. DEEPEST PART OF POOL TO BE IN LINE WITH WHERE VANE ARM TIES INTO BANKFULL.
 2. DO NOT EXCAVATE POOL TOO CLOSE TO FOOTER BOULDERS.
 3. CLASS "A" STONE CAN BE USED TO REDUCE VOIDS BETWEEN HEADERS AND FOOTERS.
 4. COMPACT BANKFULL TO EXTENT POSSIBLE OR AT THE DIRECTION OF THE ENGINEER.
 5. POOL DEPTH SHOULD BE 2 TO 3 TIMES BANKFULL DEPTH.
 6. FOOTER AND HEADER ROCKS SHOULD BE NATIVE QUARRIED ROCK OR LOCALLY SHOT ROCK, ANGULAR AND OBLONG WITH MINIMUM DIMENSIONS OF 4.0' X 3.0' X 2.0'.
 7. ROCKS SHOULD FIT WITH MINIMAL SPACES.

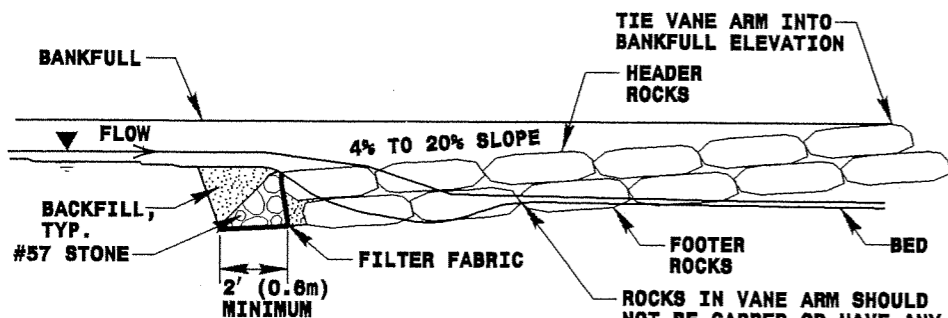


SECTION B-B

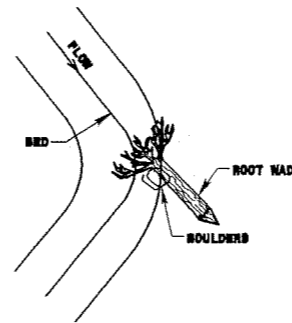

PLAN VIEW
DRIVE POINT METHOD

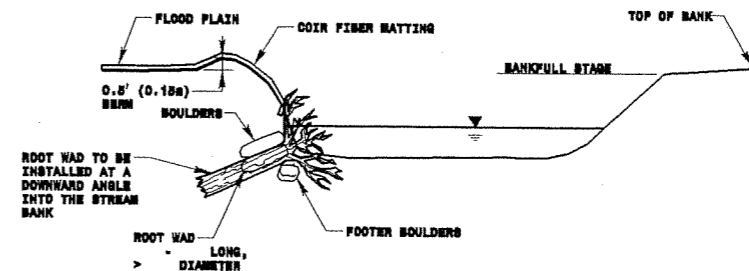

SECTION A-A

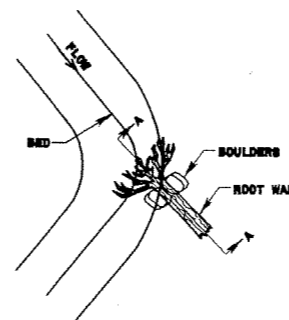

PLAN VIEW
TRENCHING METHOD

NOTES:

ORIENT ROOT WADS SO THAT THE STREAM FLOW MEETS THE ROOT WAD STRAIGHT ON, DEFLECTING THE WATER AWAY FROM THE BANK.

METHODS OF INSTALLATION:

DRIVE POINT METHOD:

SHARPEN THE END OF THE LOG BEFORE "DRIVING" AT A DOWNWARD ANGLE INTO THE BANK. BOULDER SHOULD BE PLACED ON EACH SIDE OF THE ROOT WAD TO PIN IT IN PLACE. THE BOULDERS SHALL BE APPROXIMATELY X X, ONE-THIRD OF THE ROOT WAD SHOULD REMAIN BELOW NORMAL BANK FLOW CONDITIONS.


TRENCHING METHOD:

IF THE ROOT WAD CANNOT BE DRIVEN INTO THE BANK OR THE BANK NEEDS TO BE RECONSTRUCTED, THE TRENCHING METHOD SHOULD BE USED. THIS METHOD REQUIRES THAT A TRENCH BE EXCAVATED FOR THE LOG PORTION OF THE ROOT WAD. IN THIS CASE FOOTER BOULDERS SHOULD BE INSTALLED UNDERNEATH THE ROOT WAD IN A TRENCH EXCAVATED PARALLEL TO THE BANK AND WELL BELOW THE STREAM BED. BOULDERS SHOULD BE PLACED ON EACH SIDE OF THE ROOTWAD TO PIN IT IN PLACE. THE BOULDERS SHOULD BE APPROXIMATELY X X, ONE-THIRD OF THE ROOT WAD SHOULD REMAIN BELOW NORMAL BANK FLOW CONDITIONS.

ROOT WAD DETAIL

"J" HOOK VANE

SCALE: NTS

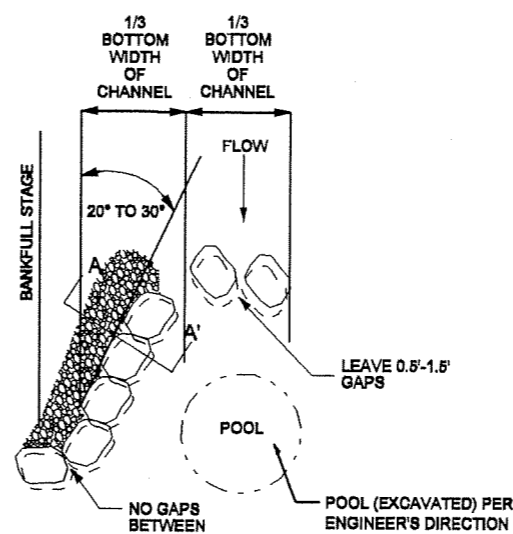


PLAN VIEW


NOTE

FOOTER AND HEADER ROCKS SHOULD BE NATIVE QUARRIED ROCK OR LOCALLY SHOT ROCK, ANGULAR AND OBLONG WITH MINIMUM DIMENSIONS OF 4.0' X 3.0' X 2.0'.

ROCKS SHOULD FIT WITH MINIMAL SPACES

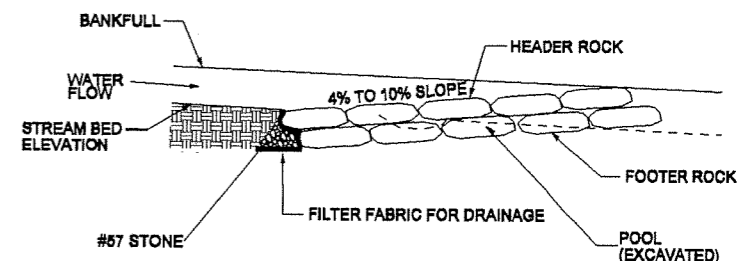

PROFILE VIEW

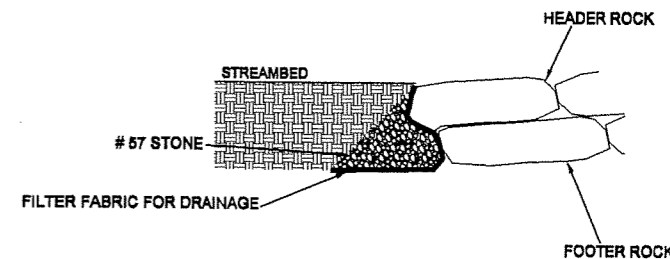

SECTION A-A

PROJECT REFERENCE NO. U-2524VM SHEET NO. 2-A

PROJECT ENGINEER

APPROVED BY:

DATE:


SUNGATE DESIGN GROUP, P.A.
114 NEW YORK AVENUE
SUITE 2000
NEW YORK, NY 10038
(212) 512-1740


ENVIRONMENTAL SERVICES, INC.
100 WEST 17TH AVENUE
SUITE 1000
DENVER, CO 80202
(303) 733-1740

AS BUILT


CATTLE AND EQUIPMENT STREAM CROSSING

AS BUILT


PROJECT REFERENCE NO. U-2524NM	SHEET NO. 2-B
PROJECT ENGINEER	
APPROVED BY:	
DATE:	
	
ENVIRONMENTAL SERVICES, INC. 804 N.W. 10TH ROAD MIAMI, FL 33136	

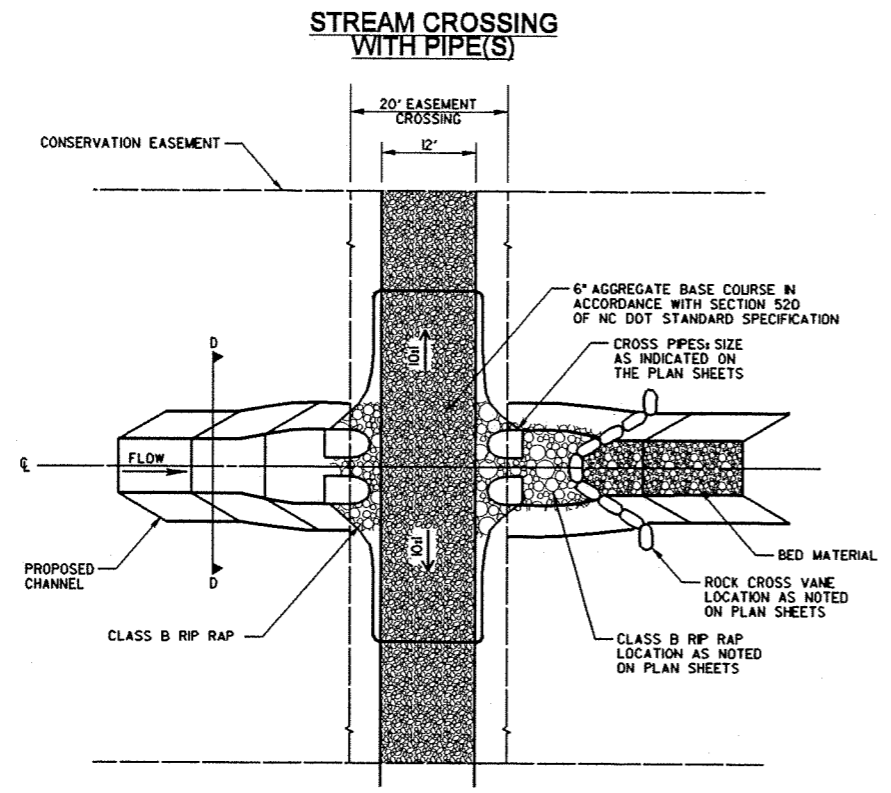


STREAM CROSSING - TYPE I
PLAN VIEW
NOT TO SCALE

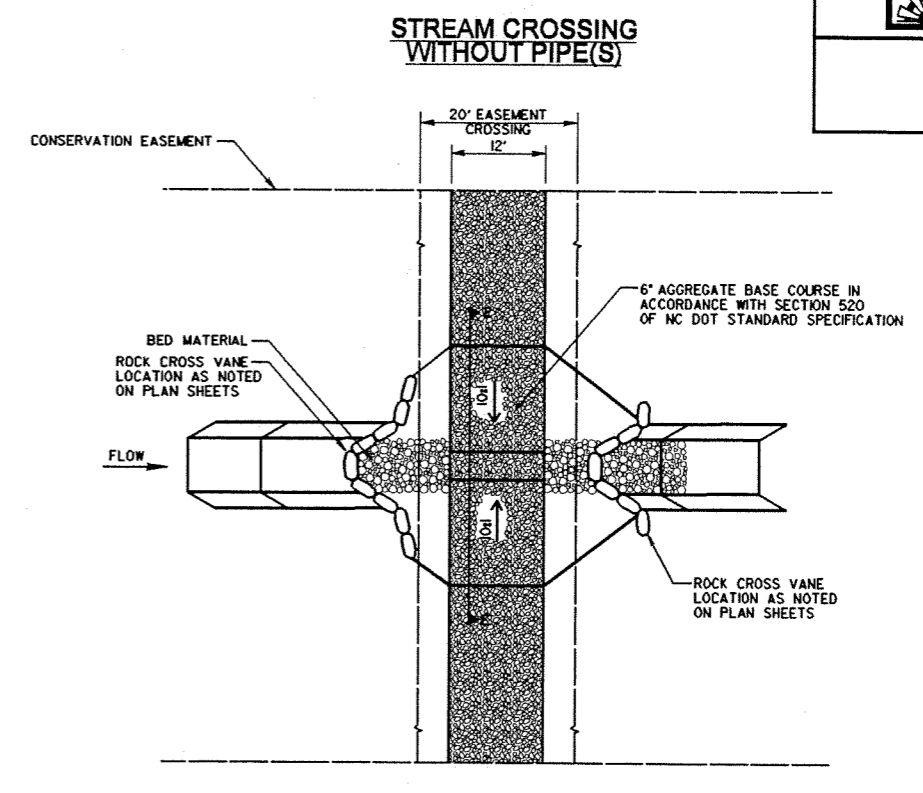


STREAM CROSSING - TYPE II
PLAN VIEW
NOT TO SCALE

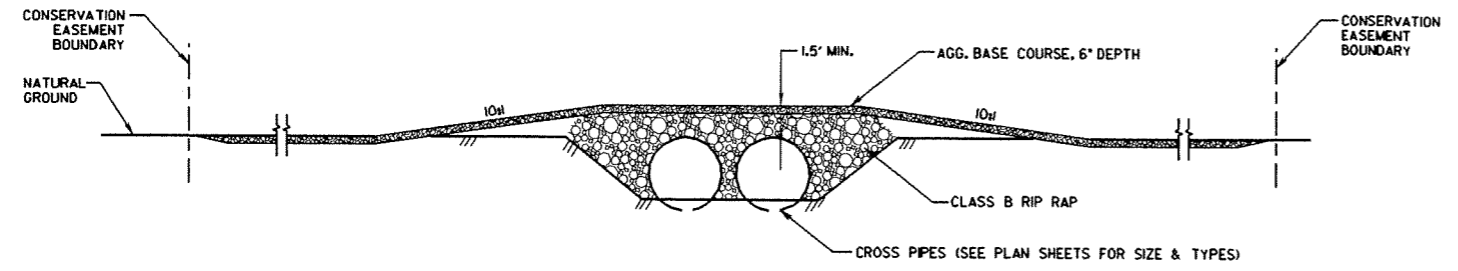




STREAM CROSSING - TYPE I
SECTION D-D
NOT TO SCALE

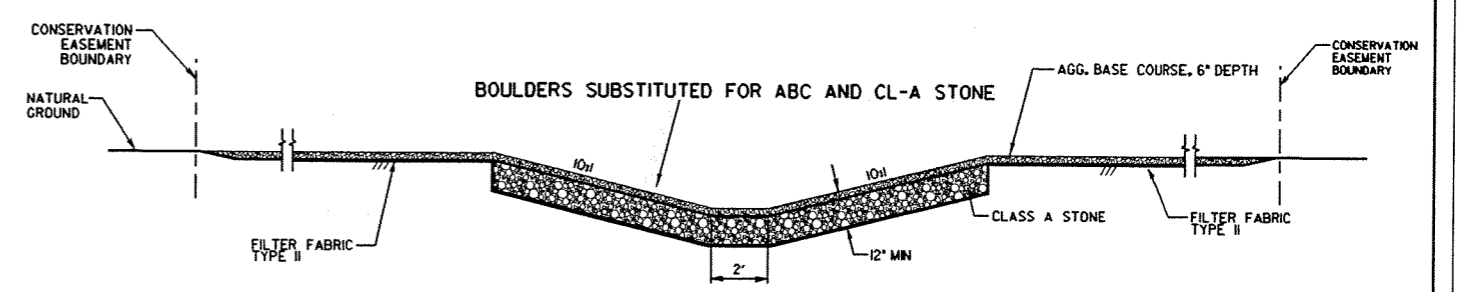

STREAM CROSSING - TYPE II
SECTION E-E
NOT TO SCALE

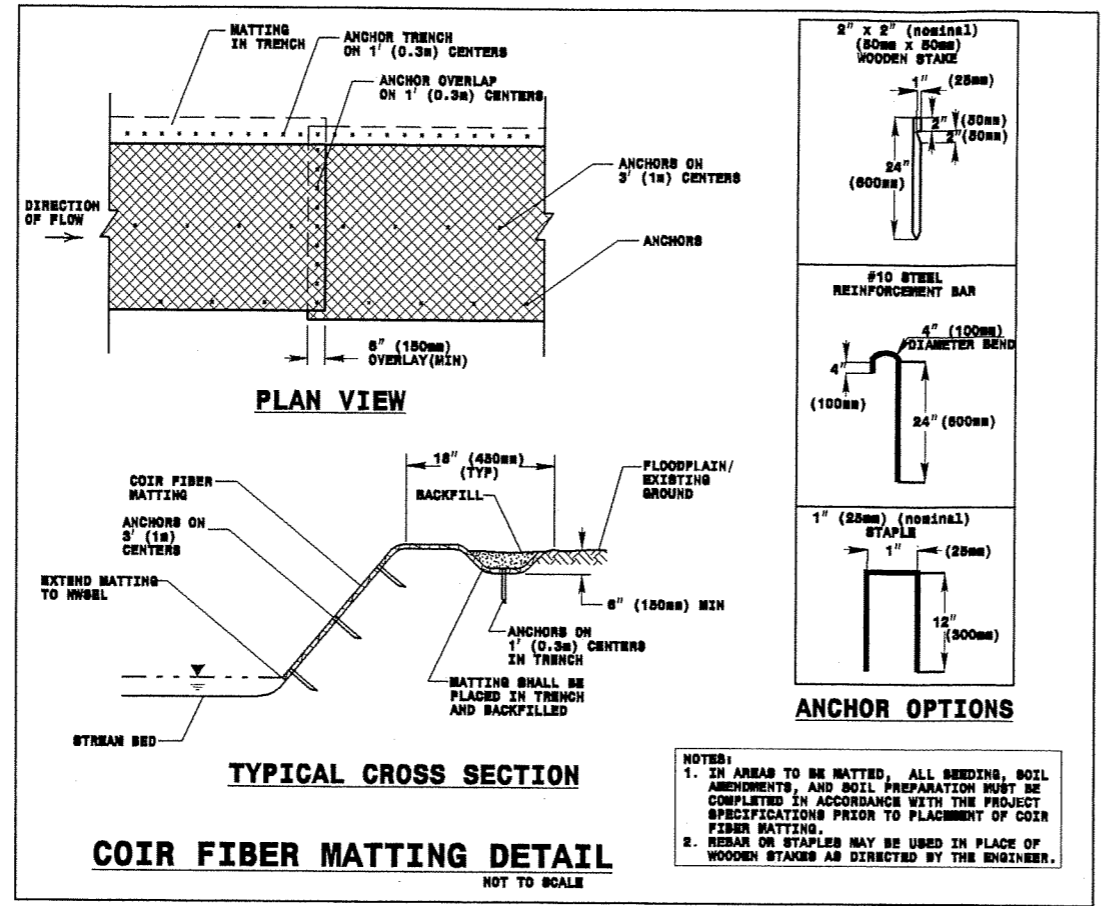


AS BUILT

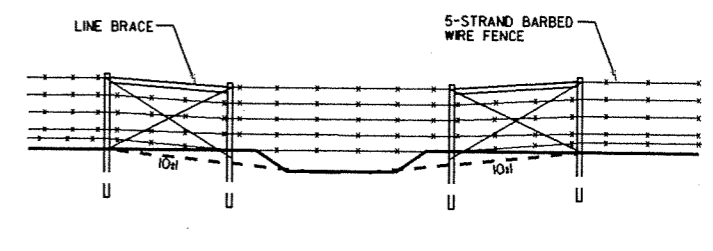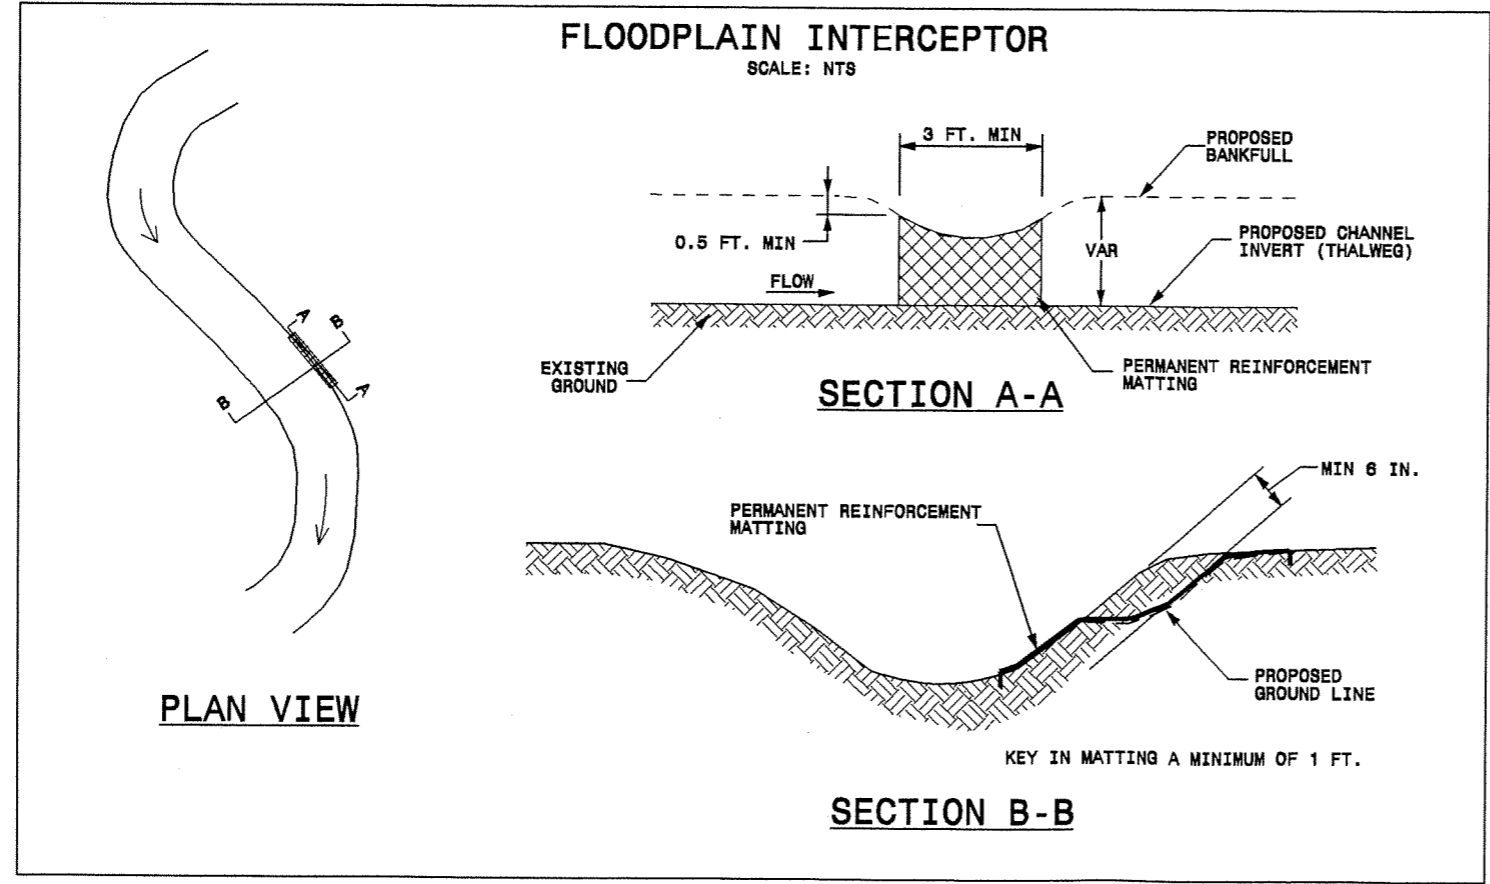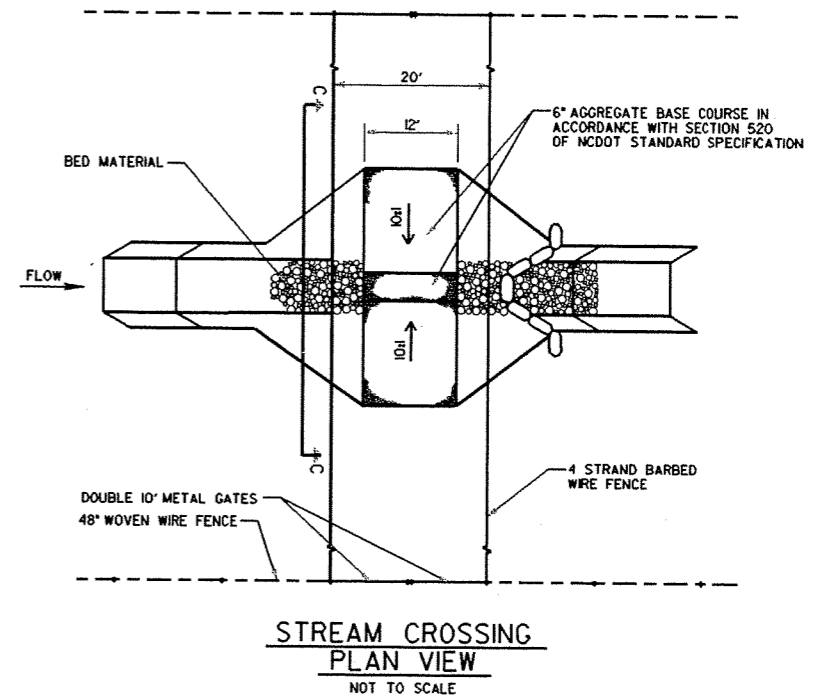

NOTE:
THE TWO LOWEST STRANDS OVER THE CHANNEL SHALL TERMINATE AT ONE OF THE ADJACENT POSTS AND BE SECURED TO THAT POST SUCH THAT FLOATING DEBRIS WOULD DISLODGE THE WIRE WITHOUT DAMAGING THE REMAINING FENCE.


APPROVED BY:
DATE:

ENVIRONMENTAL SERVICES, INC.

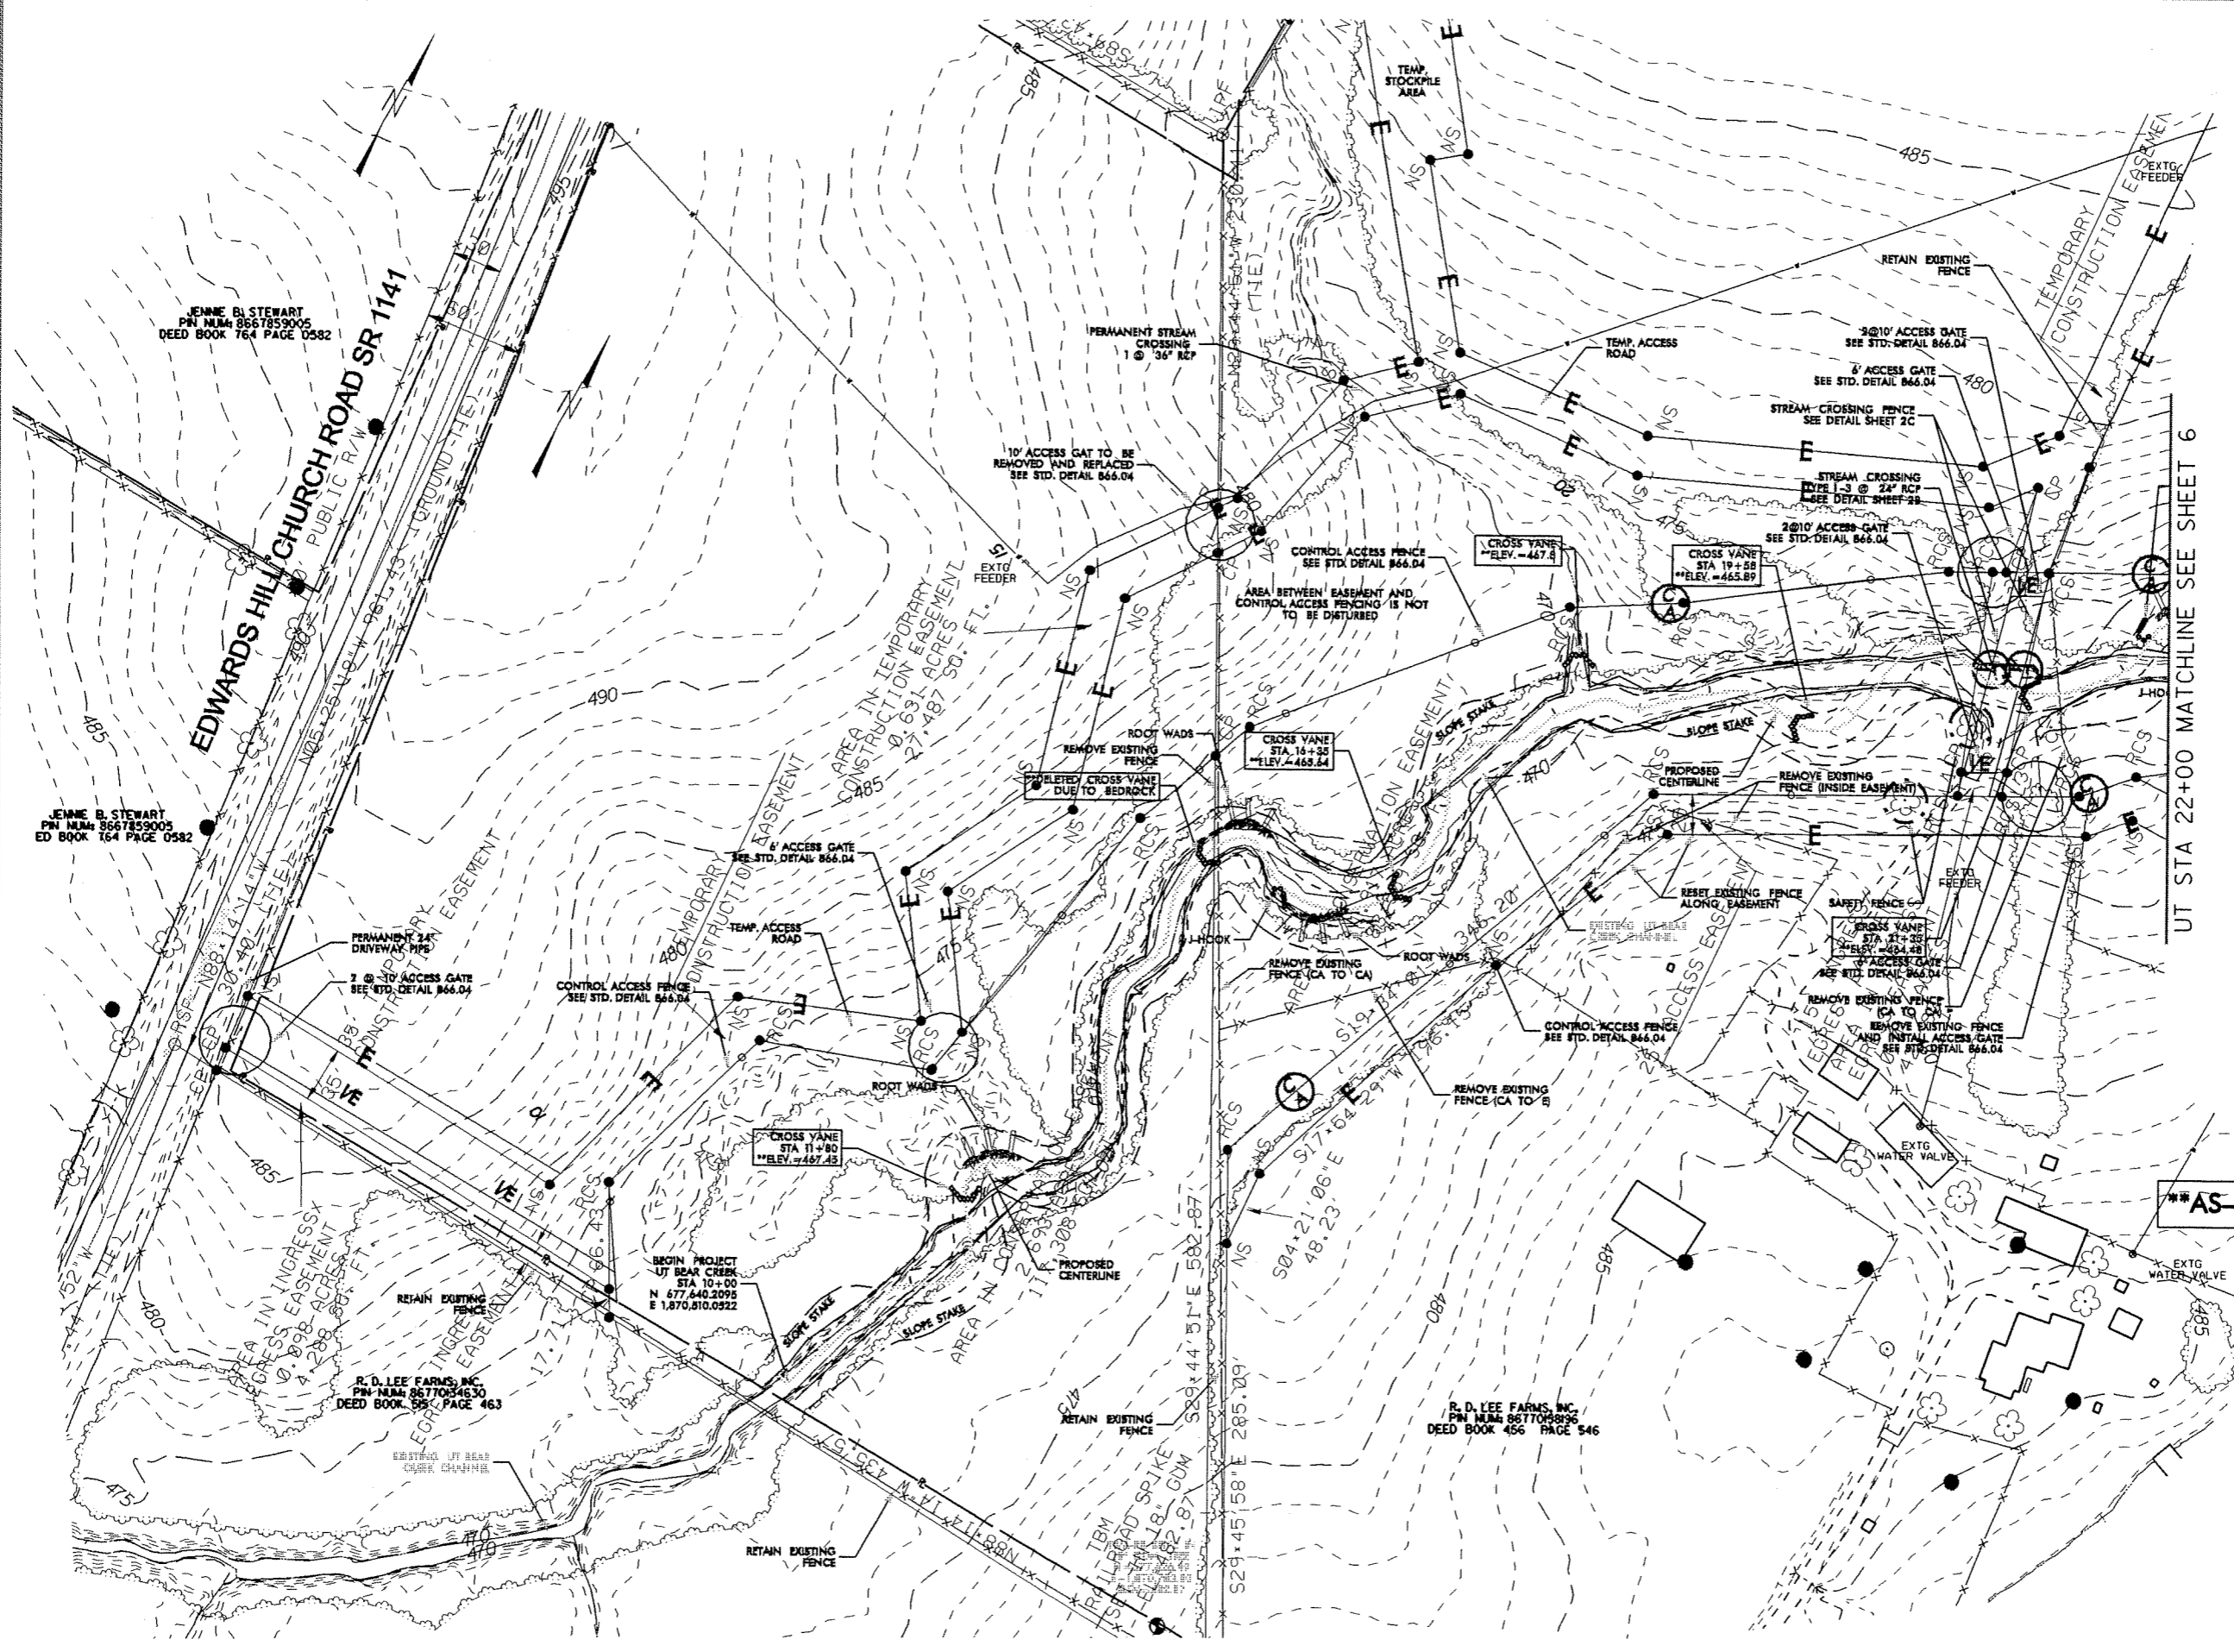

**AS-BUILT

EXISTING CONDITIONS AND PROPOSED STREAM DESIGN

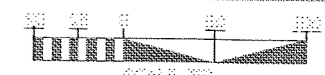


APPROVED BY:

DATE:

ENVIRONMENTAL SERVICES, INC.


CHANNEL WORK DELETED

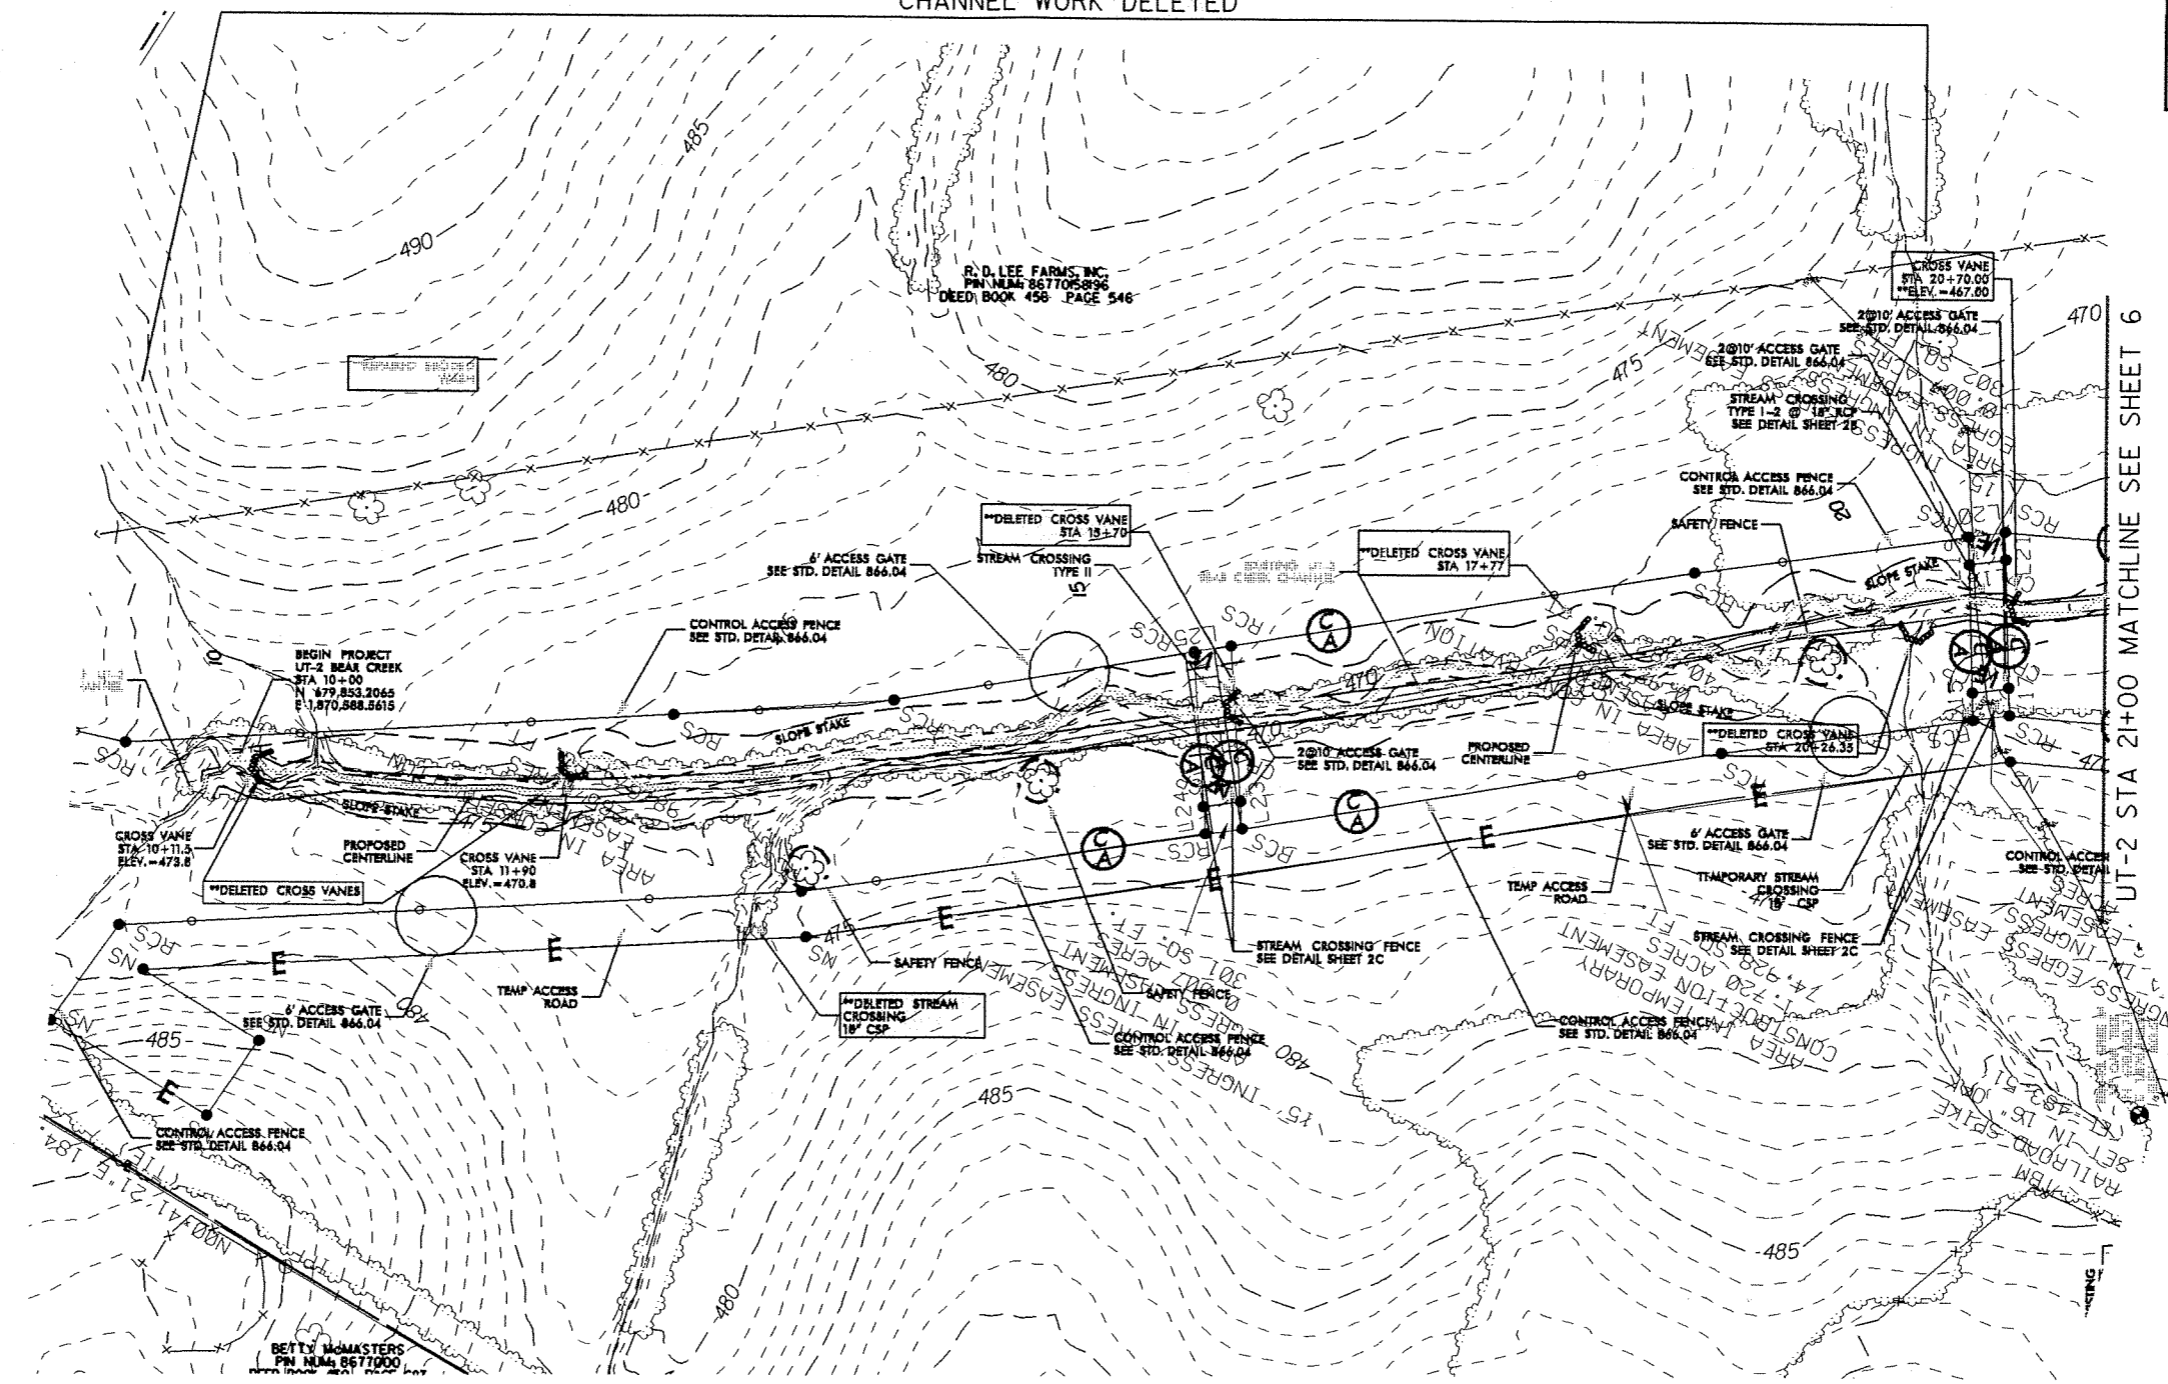


UT-2 STA 21+00 MATCHLINE SEE SHEET 6

****AS-BUILT**

EXISTING CONDITIONS AND PROPOSED STREAM DESIGN

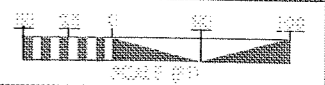


UT-2 STA 21+00 MATCHLINE SEE SHEET 5

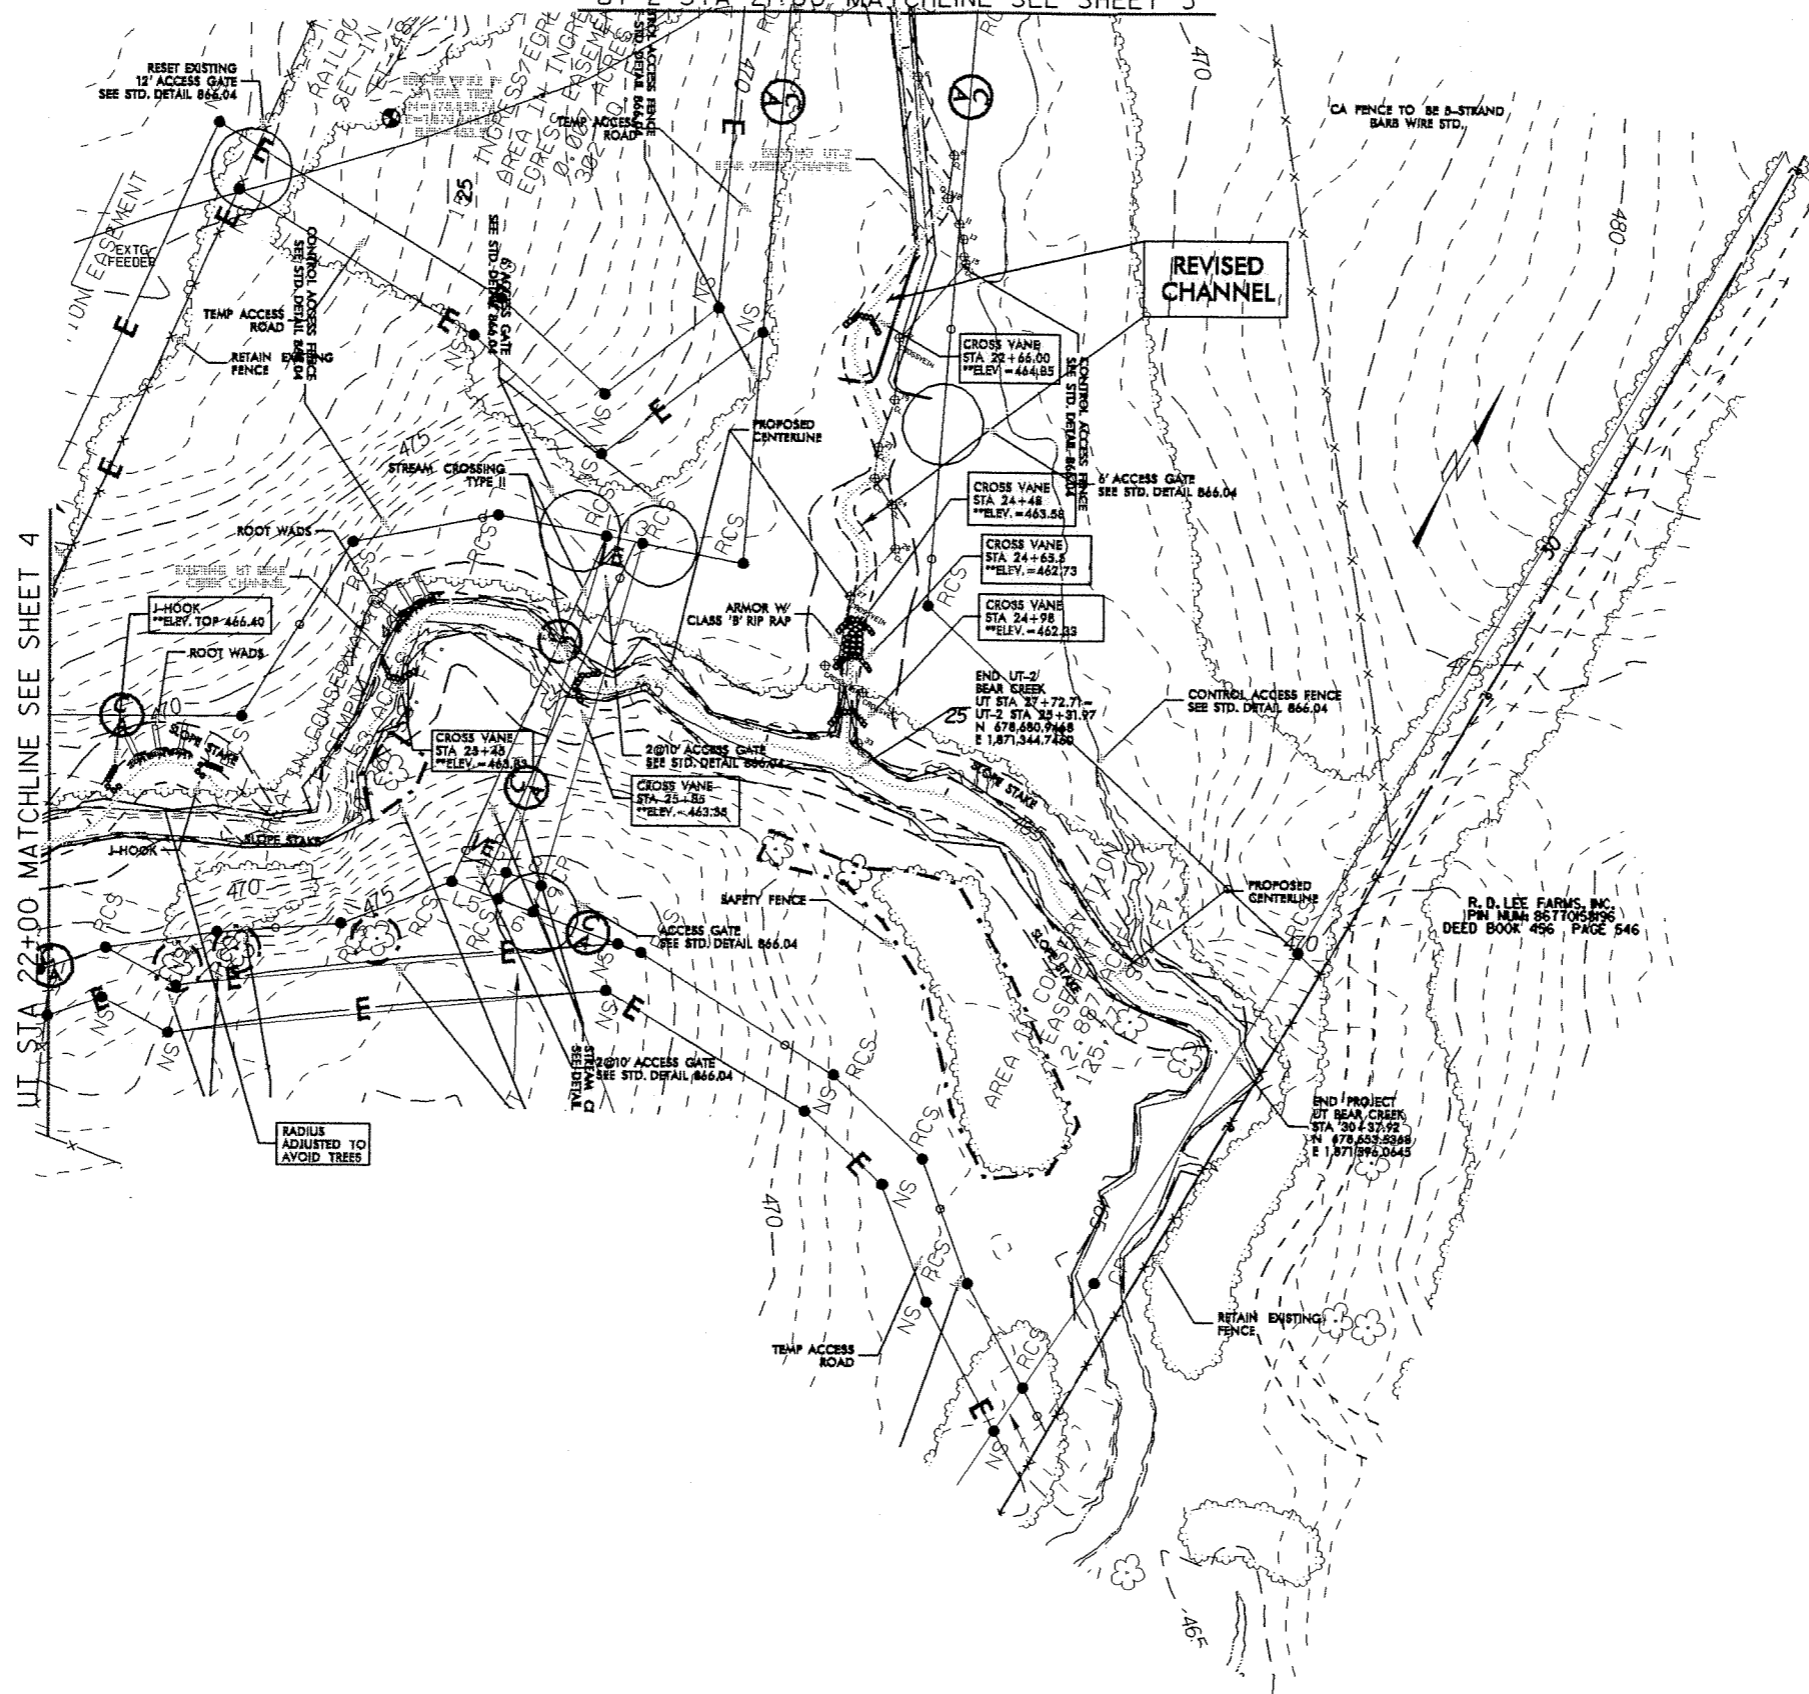



U-2524MM	As B-5
APPROVED BY:	
DATE:	
ENVIRONMENTAL SERVICES, INC.	


AS-BUILT

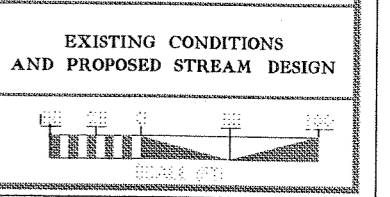



NORTH SIDE OF PROJECT SCREEN PLANTING
SEE REFORESTATION DETAIL SHEET FOR
MIXTURE TYPE

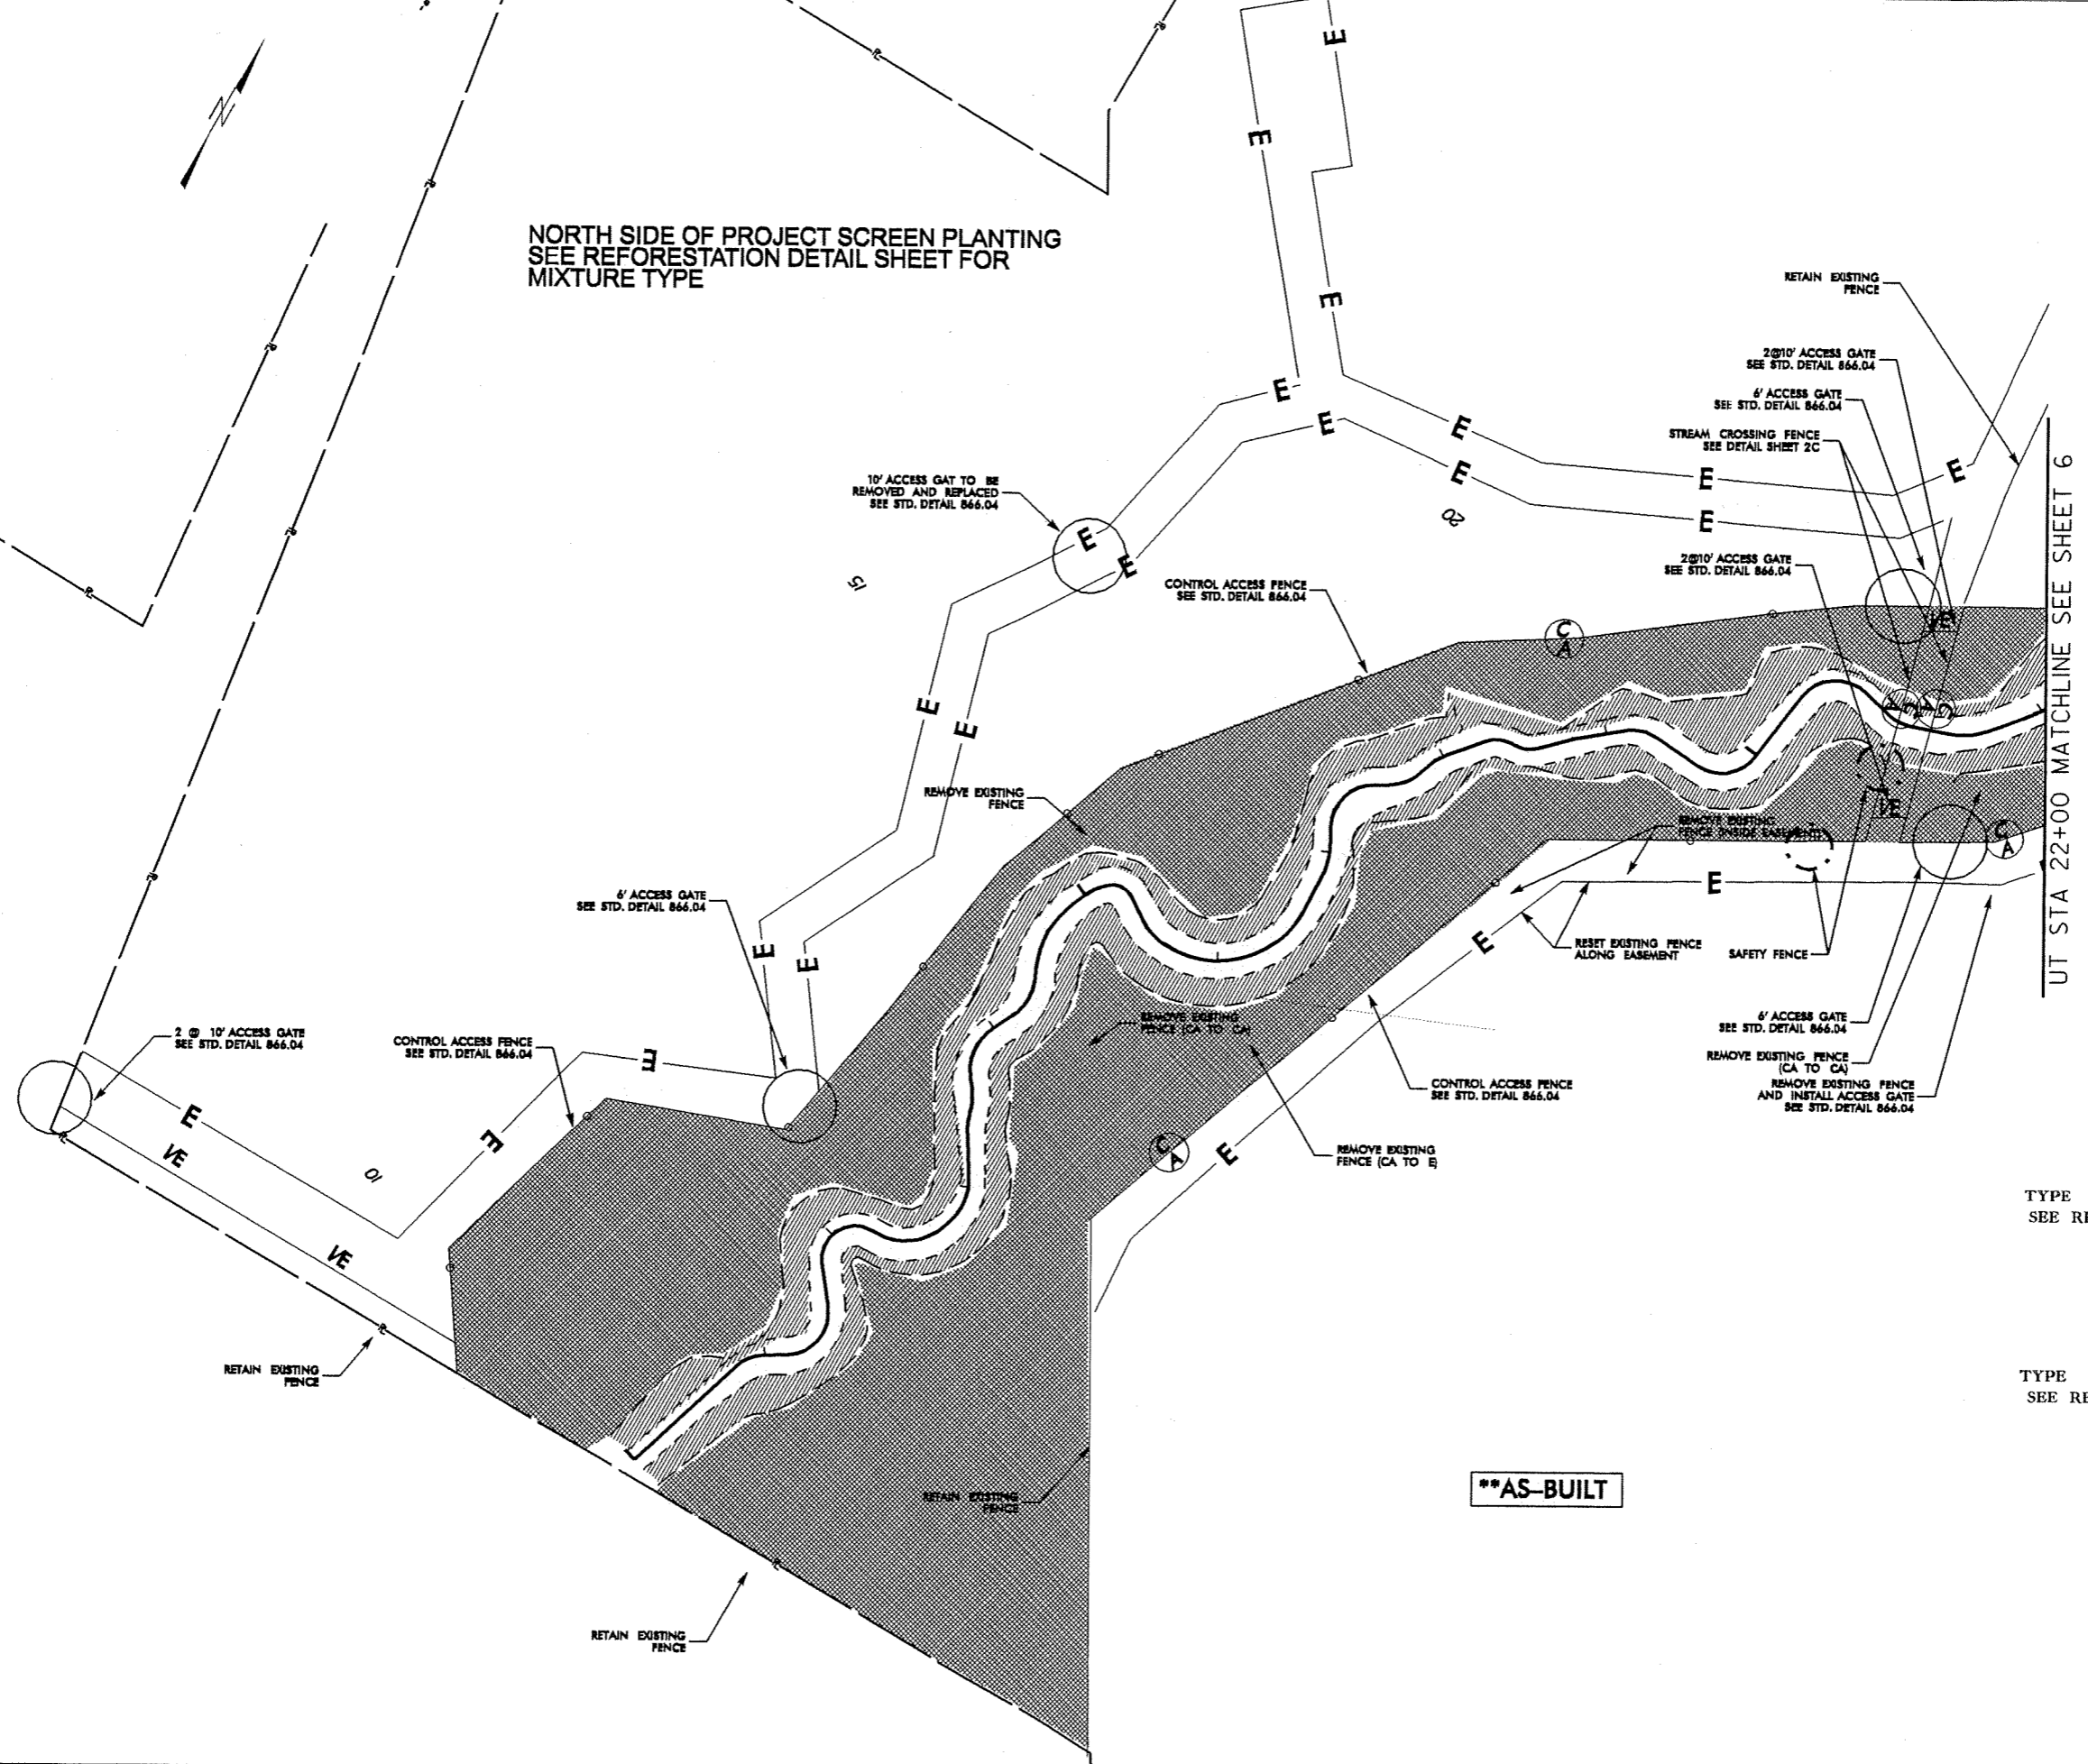


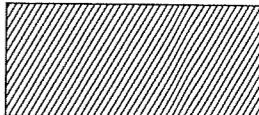
TYPE I STREAMBANK REFORESTATION
SEE REFORESTATION DETAIL SHEET 1

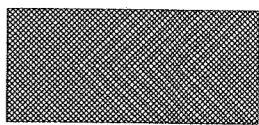

TYPE II STREAMBANK REFORESTATION
SEE REFORESTATION DETAIL SHEET 1

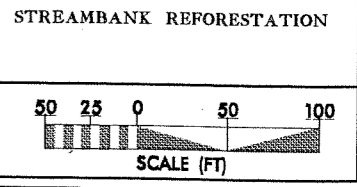


PROJECT REFERENCE NO. U-2524VM	SHEET NO. As B-7
PROJECT ENGINEER	
APPROVED BY:	
DATE:	
	
ENVIRONMENTAL SERVICES, INC. <small>124 NEW HITE ROAD RAYLEIGH, NORTH CAROLINA 27610 (919) 816-1700</small>	

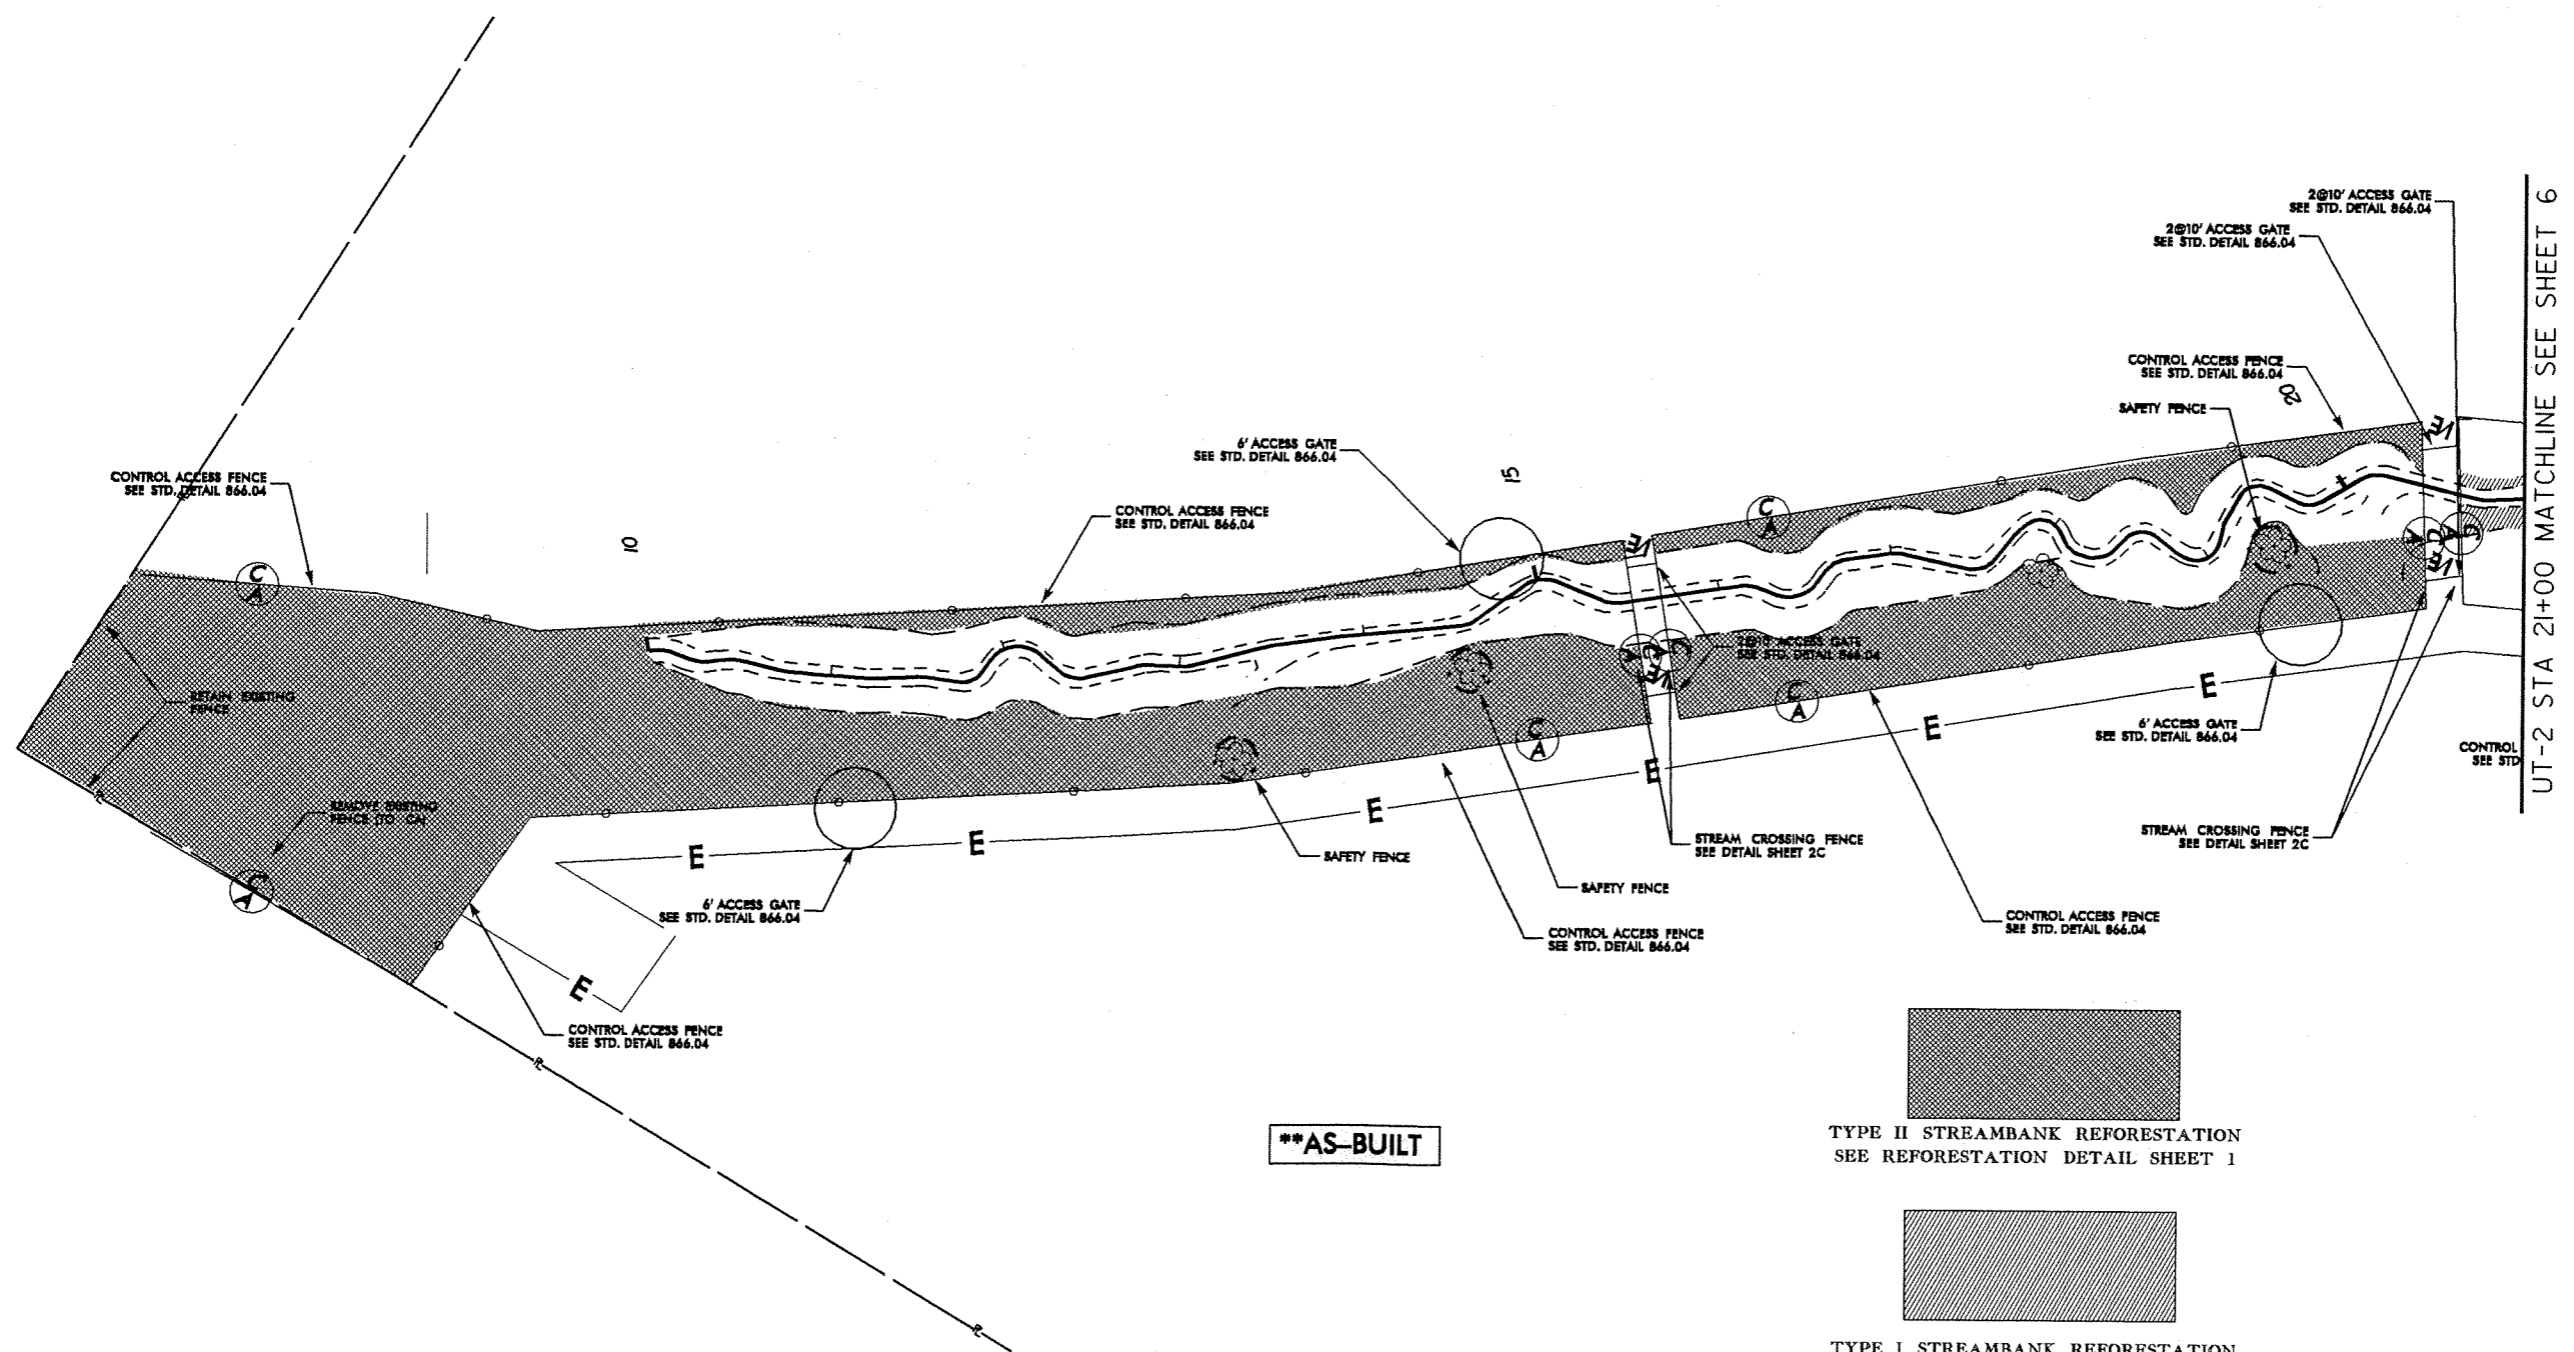



****AS-BUILT**

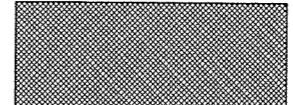
 TYPE II STREAMBANK REFORESTATION
 SEE REFORESTATION DETAIL SHEET 1



 TYPE I STREAMBANK REFORESTATION
 SEE REFORESTATION DETAIL SHEET 1

UT-2 STA 21+00 MATCHLINE SEE SHEET 6

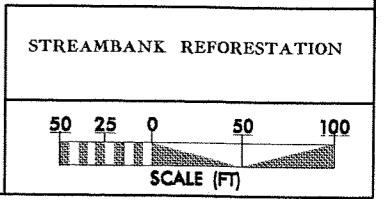



PROJECT REFERENCE NO. <i>U-2524NM</i>	SHEET NO. <i>As B-8</i>
PROJECT ENGINEER	
APPROVED BY:	
DATE:	
	
ENVIRONMENTAL SERVICES, INC. 834 NEW HOPKIN ROAD WILMINGTON, DELAWARE 19810	

UT-2 STA 21+00 MATCHLINE SEE SHEET 5

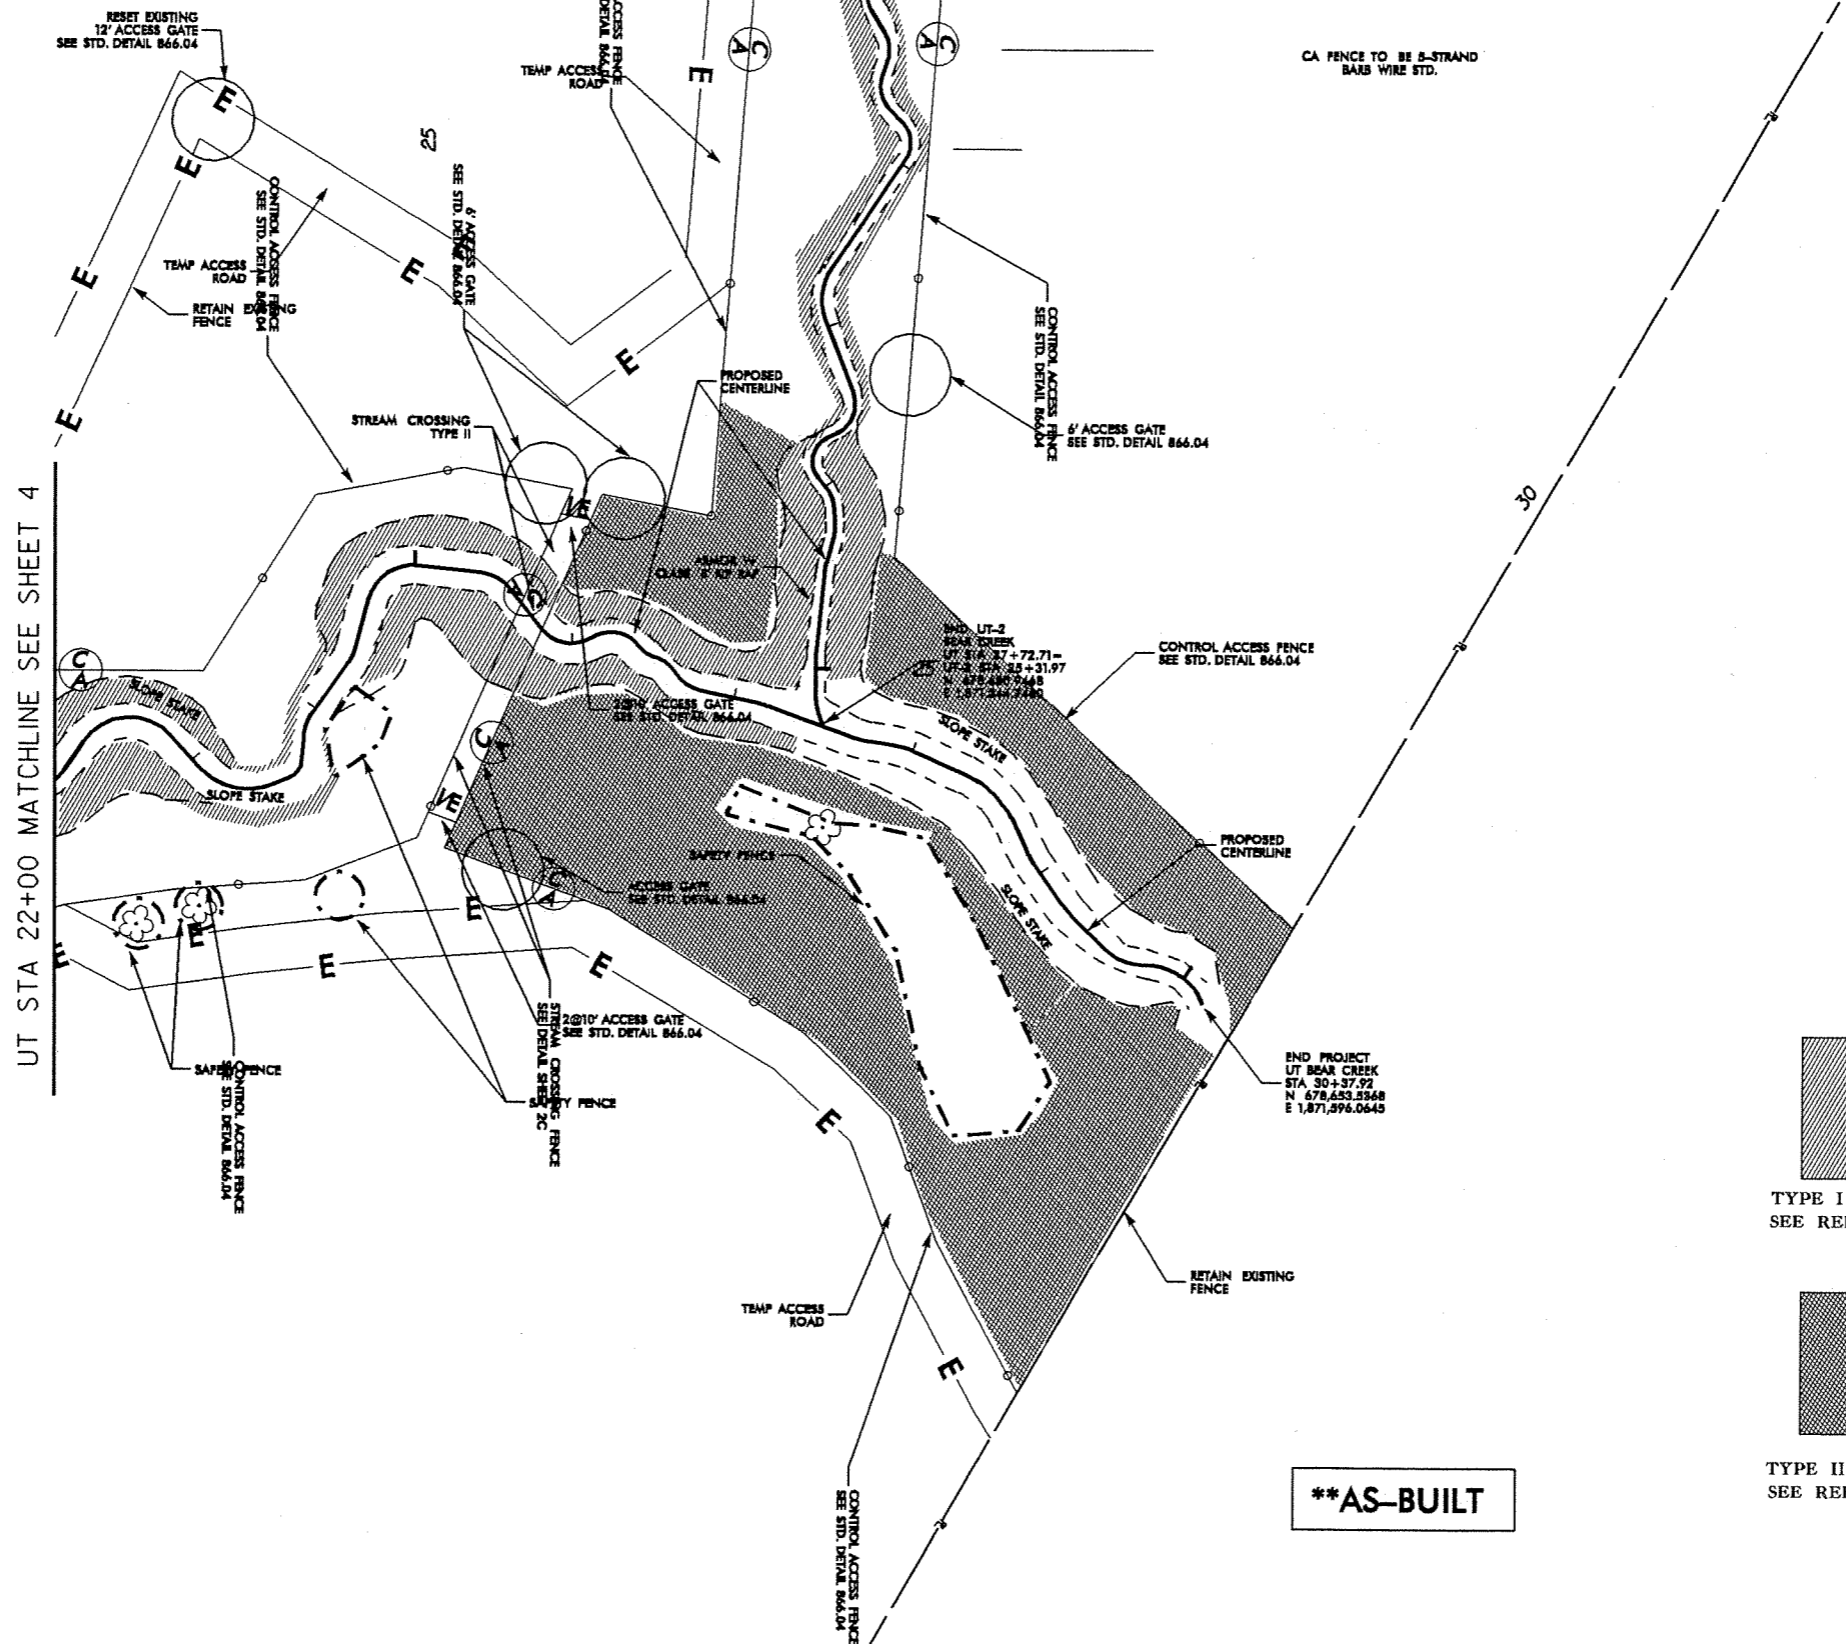


UT STA 22+00 MATCHLINE SEE SHEET 4

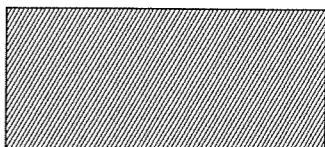
 TYPE I STREAMBANK REFORESTATION
 SEE REFORESTATION DETAIL SHEET 1

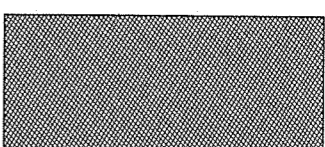
 TYPE II STREAMBANK REFORESTATION
 SEE REFORESTATION DETAIL SHEET 1



****AS-BUILT**

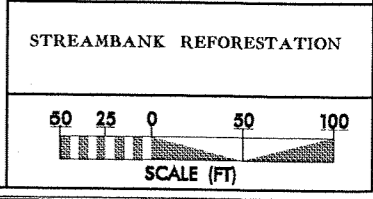


STATE	STATE PROJECT REFERENCE NO.	SHEET NO.	TOTAL SHEETS
N.C.	U-2524WM	RF-1	
STATE PROGRAM	F.A. PROGRAM	DESCRIPTION	
		AS BUILT	

PLANTING DETAILS

LIVE STAKES PLANTING DETAIL

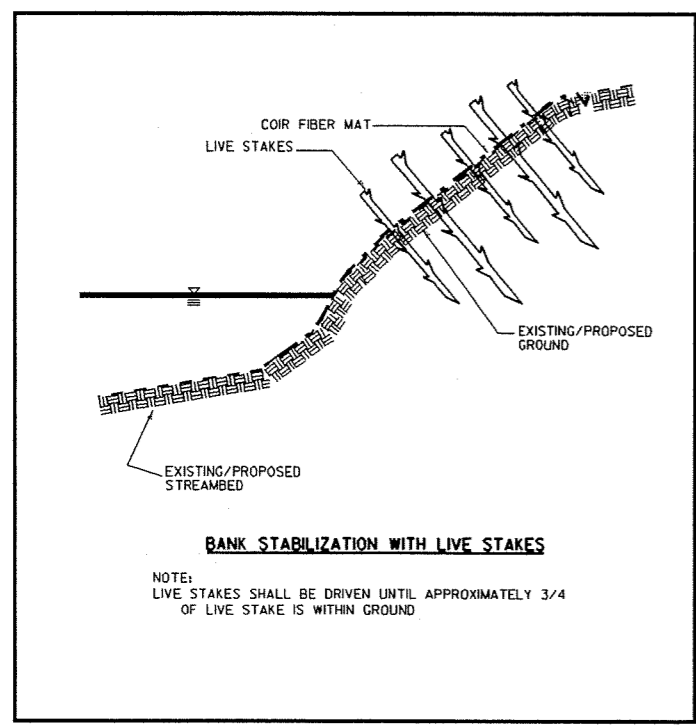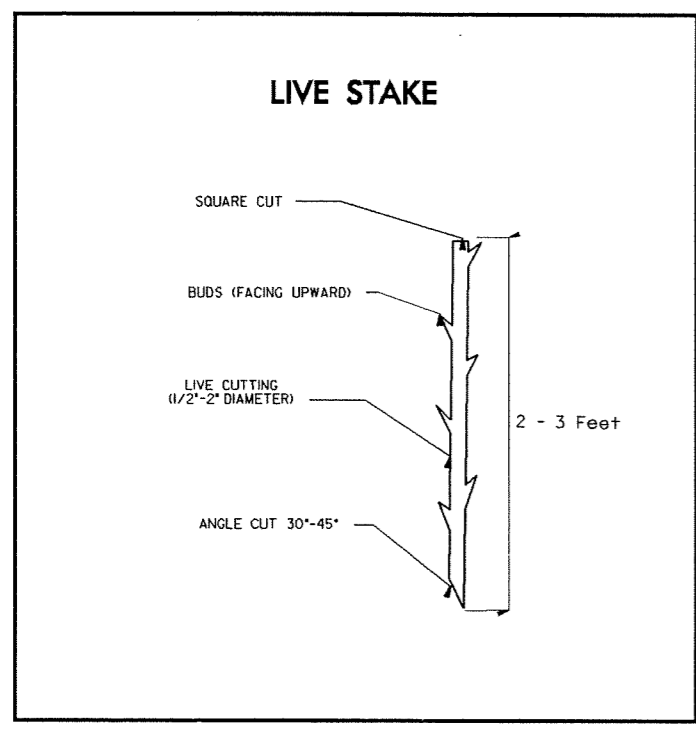

BAREROOT PLANTING DETAIL DIBBLE PLANTING METHOD USING THE KBC PLANTING BAR

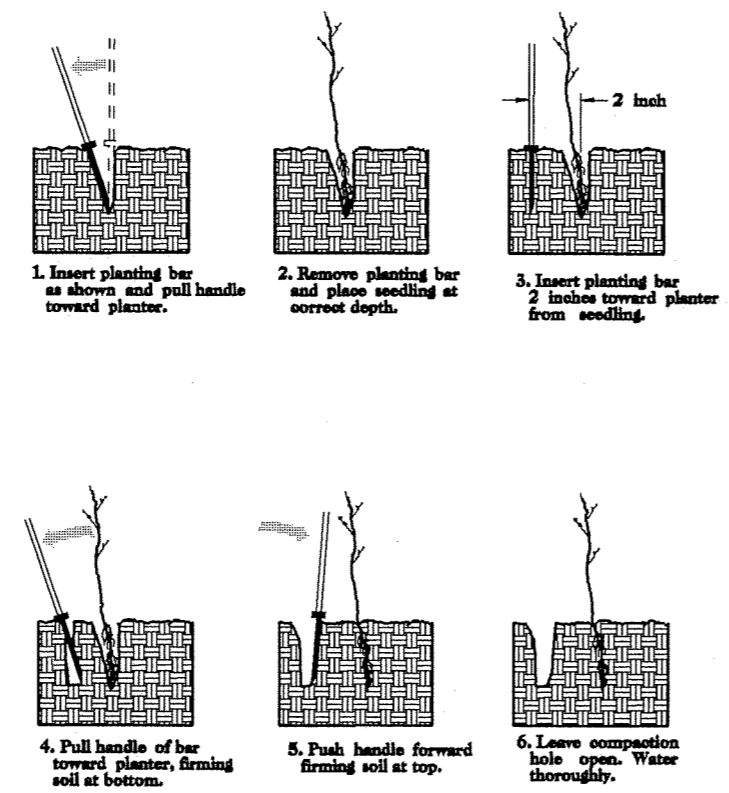

PLANTING NOTES:

PLANTING BAG
During planting, seedlings shall be kept in a moist canvas bag or similar container to prevent the root systems from drying.




KBC PLANTING BAR
Planting bar shall have a blade with a triangular cross section, and shall be 12 inches long, 4 inches wide and 1 inch thick at center.



ROOT PRUNING
All seedlings shall be root pruned, if necessary, so that no roots extend more than 10 inches below the root collar.

- TYPE 1 STREAMBANK REFORESTATION SHALL BE PLANTED 3 FT. TO 5 FT. ON CENTER, RANDOM SPACING, AVERAGING 4 FT. ON CENTER, APPROXIMATELY 2724 PLANTS PER ACRE.
- TYPE 2 STREAMBANK REFORESTATION SHALL BE PLANTED 6 FT. TO 10 FT. ON CENTER, RANDOM SPACING, AVERAGING 8 FT. ON CENTER, APPROXIMATELY 680 PLANTS PER ACRE.

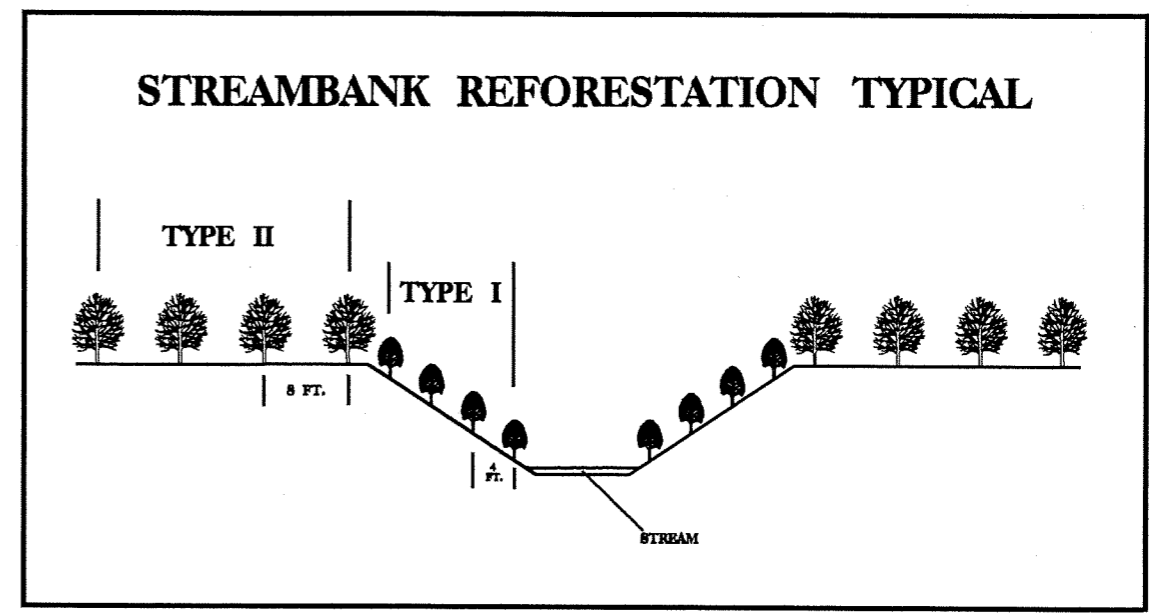

STREAMBANK REFORESTATION

MIXTURE, TYPE, SIZE, AND FURNISH SHALL CONFORM TO THE FOLLOWING:

TYPE 1		
50% SALIX NIGRA	BLACK WILLOW	2 ft - 3 ft LIVE STAKES
50% CORNUS AMOMUM	SILKY DOGWOOD	2 ft - 3 ft LIVE STAKES
TYPE 2		
20% QUERCUS MICHAUXII	SWAMP CHESTNUT OAK	12 in - 18 in BR
20% QUERCUS PHELLOS	WILLOW OAK	12 in - 18 in BR
20% FRAXINUS PENNSYLVANICA	GREEN ASH	12 in - 18 in BR
20% PLATANUS OCCIDENTALIS	SYCAMORE	12 in - 18 in BR
20% NYSSA SYLVATICA	BLACK GUM	12 in - 18 in BR

- SEE PLAN SHEETS FOR AREAS TO BE PLANTED

SCREEN PLANTING SEE PLAN SHEET 4

- 50% PINUS TAEDA
- 50% JUNIPERUS VIRGINIANA
- LOBLOLLY PINE
- RED CEDAR

STREAMBANK REFORESTATION

DETAIL SHEET

N.C.D.O.T. - ROADSIDE ENVIRONMENTAL UNIT